

APPENDIX MR-2017

RECORD DRAWINGS

RMTA BRIDGES Boulevard, 4, 6, 8S, 8N, 9S, 9N, 10S, 10N, 17, 36, 61, 63, 64, 65, 66, 67 & 68


(NOTE: Additional As-built Plans are Available upon Request to the Engineer)

RMTA
System Map





RICHMOND EXPRESSWAY SYSTEM

Scale: 0 1000 2000 3000ft.

48 - Bridge Number
RMTA Facilities Shown in Red

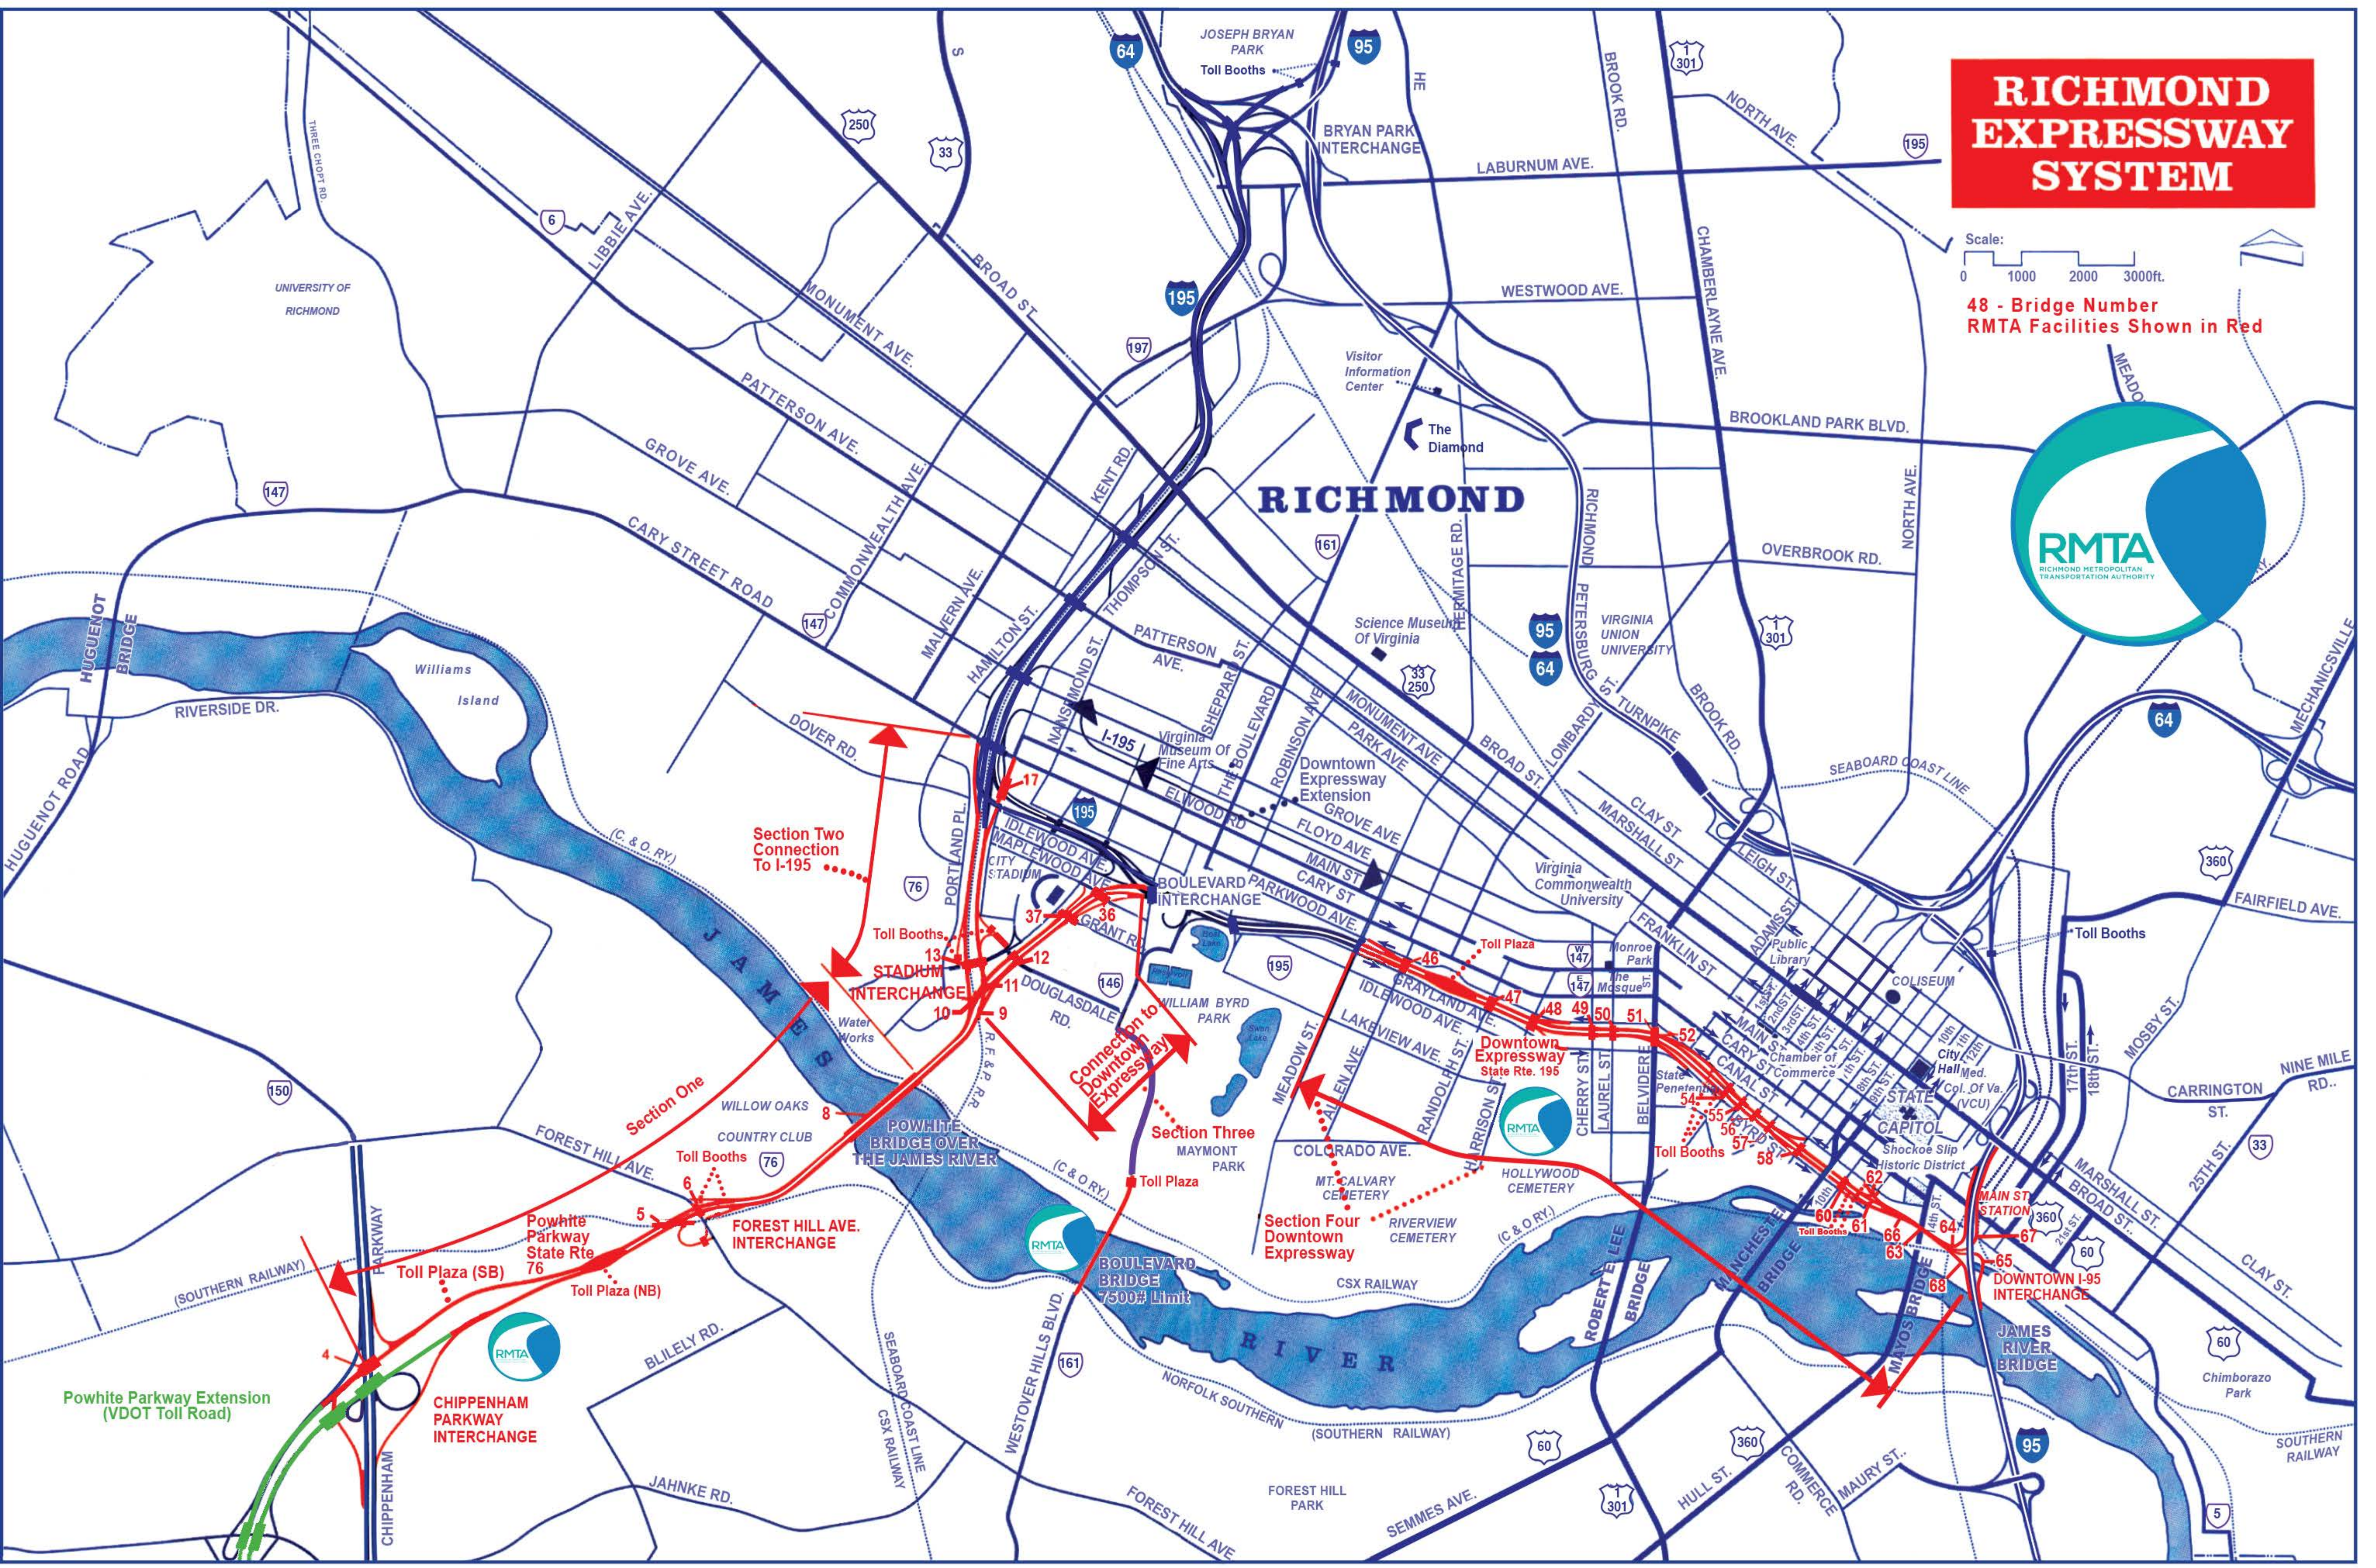

RMATA DTE, I-95 Ramps Pier Location Exhibit

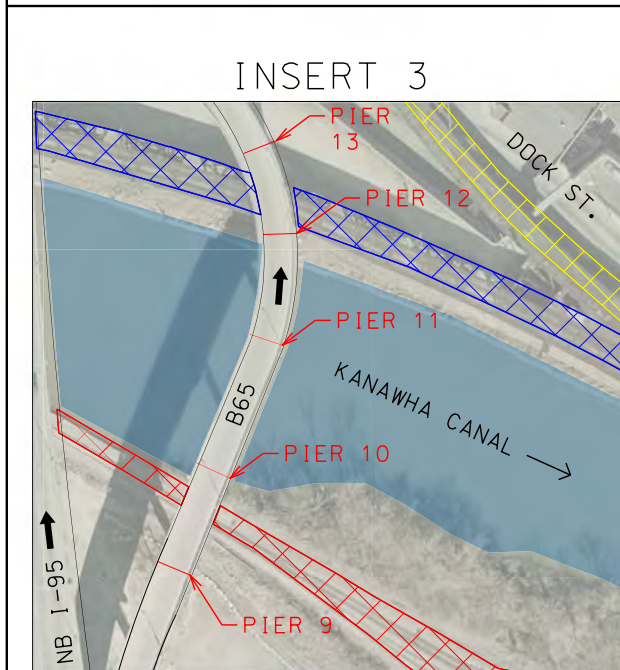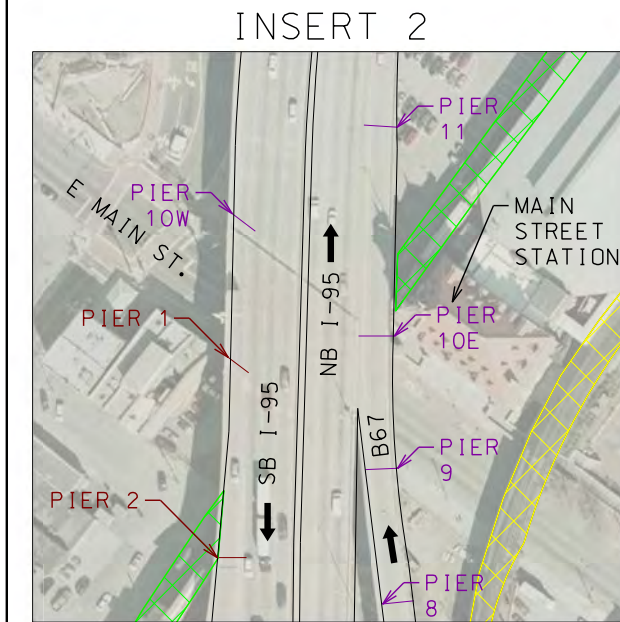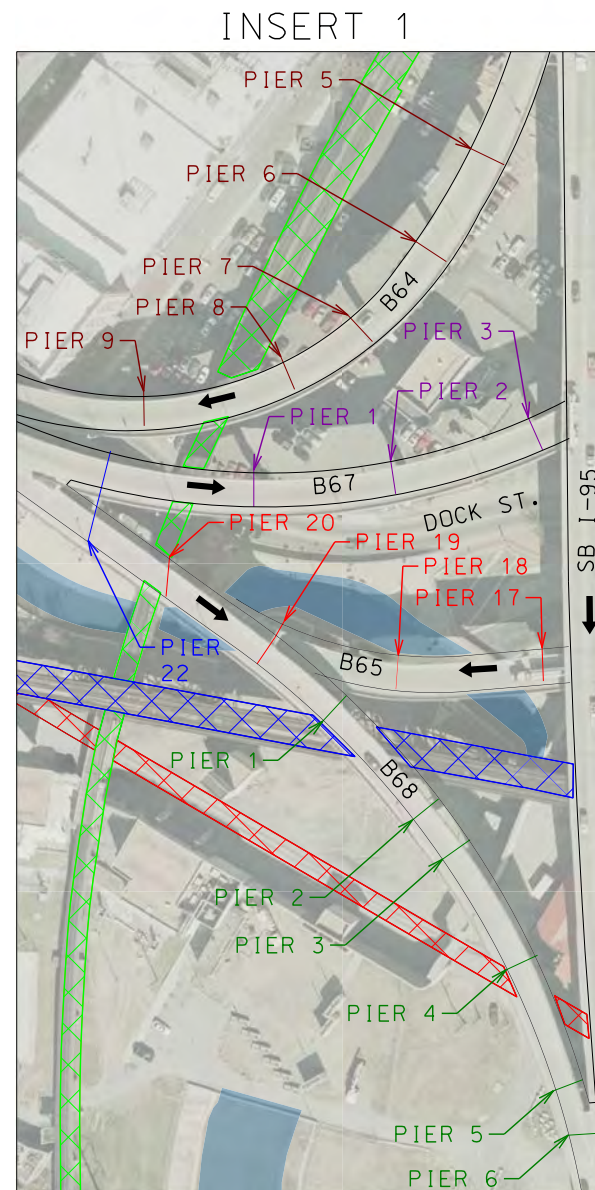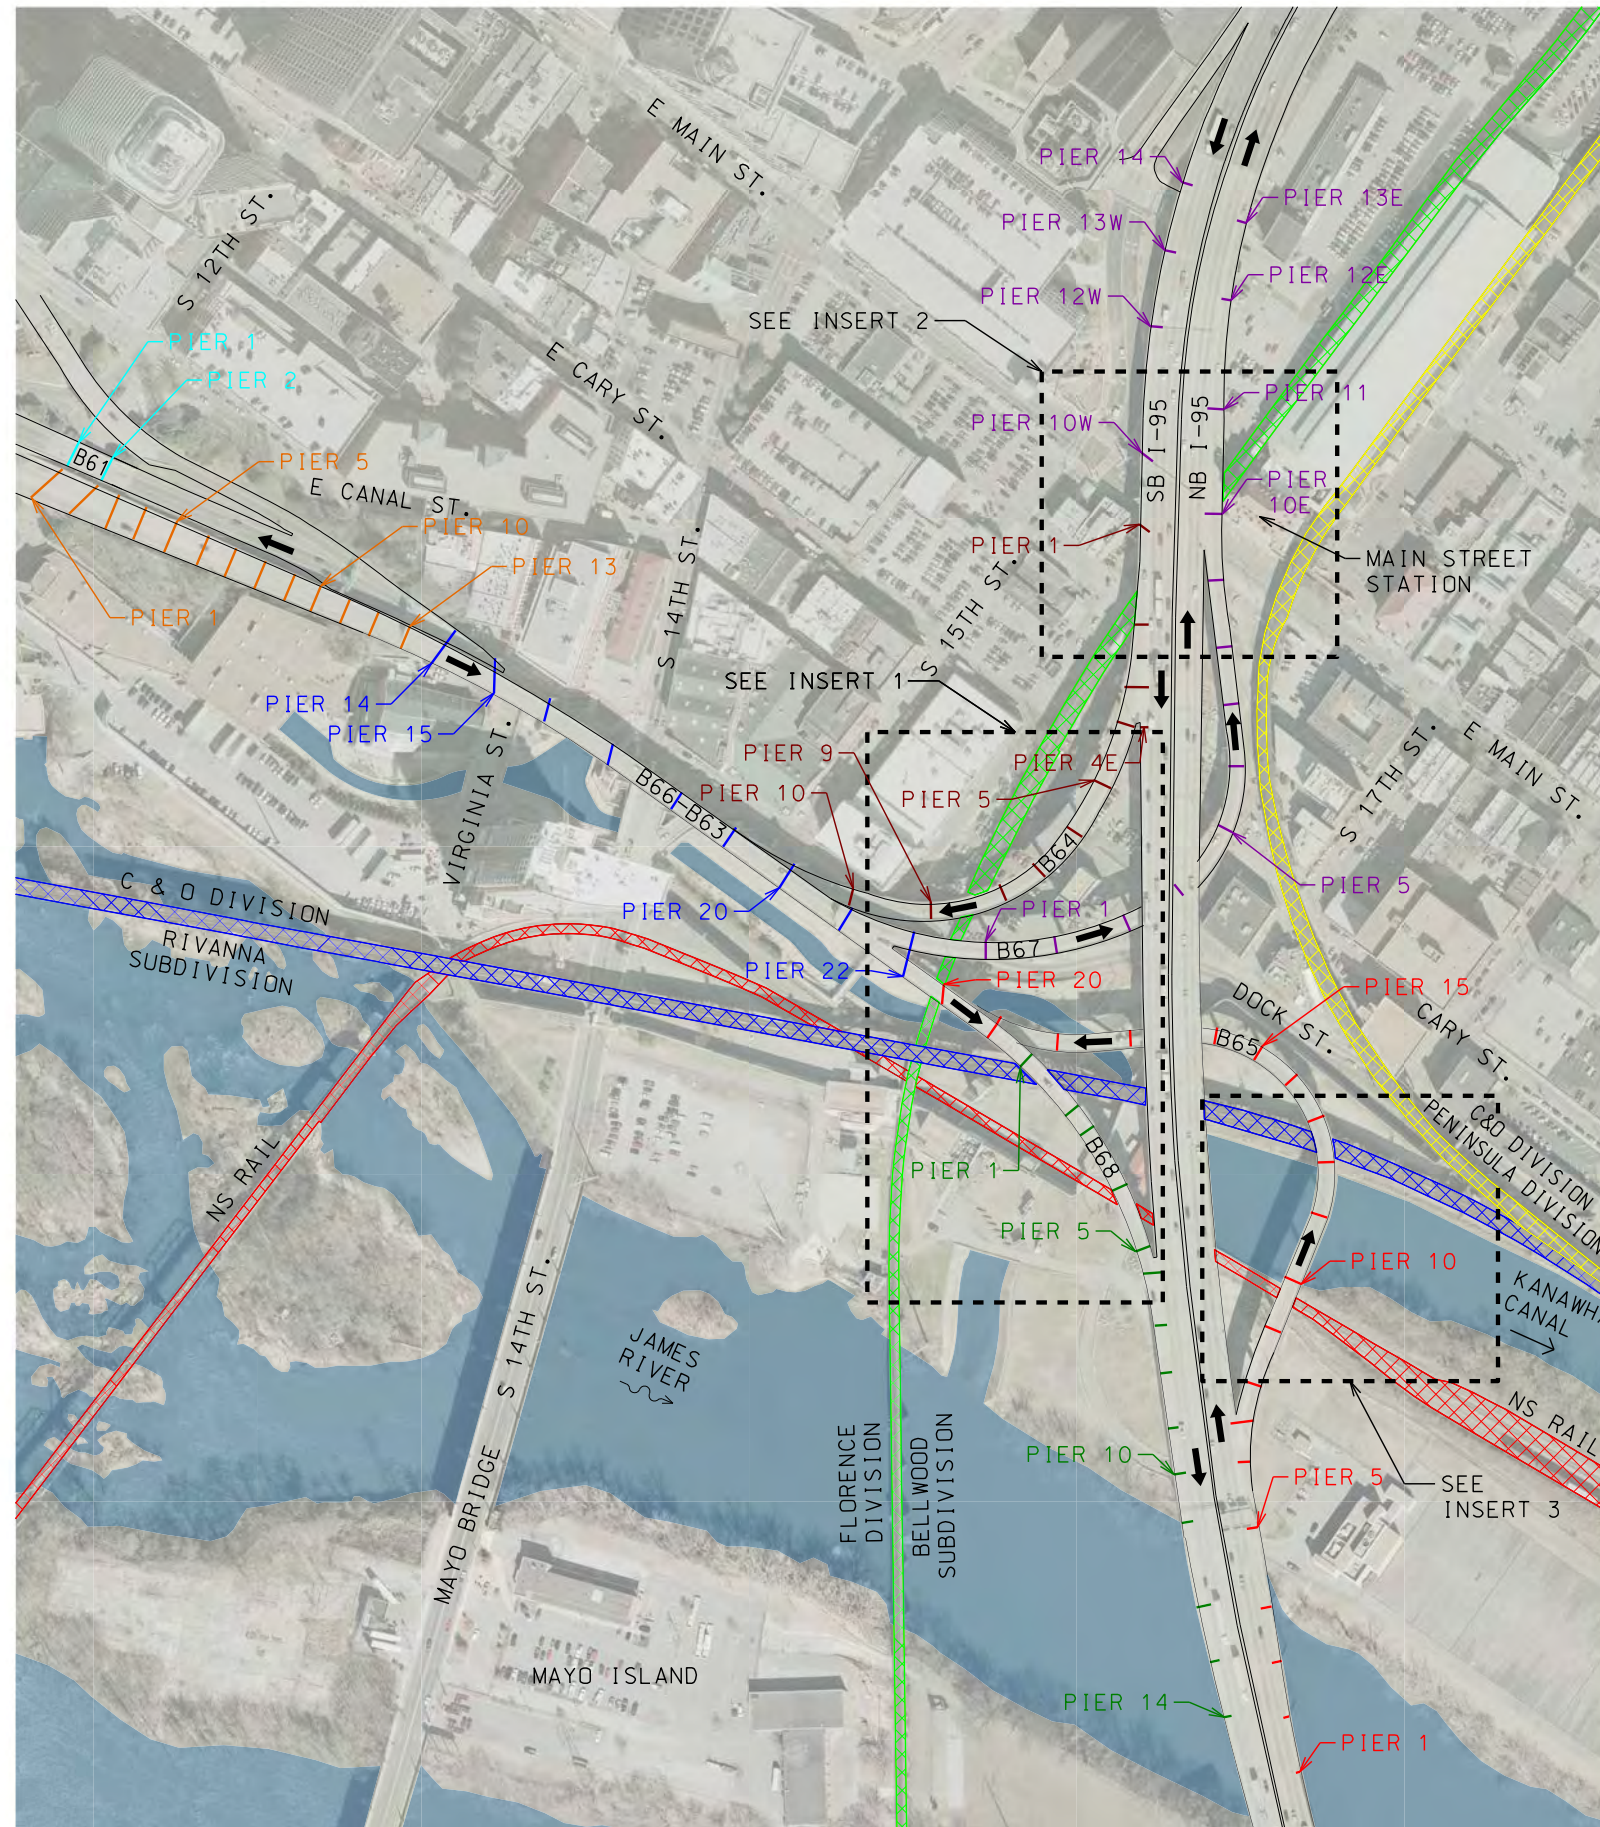

LEGEND:

	BRIDGE 63
	BRIDGE 64
	BRIDGE 65
	BRIDGE 66
	BRIDGE 67
	BRIDGE 68
	N&S RAILROAD
	CSX RAILROAD
	CSX RAILROAD
	CSX RAILROAD

- NOTES:**
- 1) PIER NUMBERS BASED ON AS-BUILT DRAWINGS FROM CONTRACTS C-10 AND C-11.
 - 2) RAILROAD LIMITS AND PIER LOCATIONS BASED ON AERIAL PHOTOGRAPHY.
 - 3) THIS EXHIBIT IS FOR REFERENCE ONLY. REFER TO AS-BUILT DRAWINGS FOR EXACT PIER LOCATIONS.
 - 4) BRIDGE 63 IS ON BOTTOM, BRIDGE 66 IS ON TOP.

RICHMOND METROPOLITAN TRANSPORTATION AUTHORITY

HNTB

I-95 RAMPS PIER LOCATION EXHIBIT

2900 S. QUINCY STREET, SUITE 200
ARLINGTON, VIRGINIA
(703) 824-5100


Scale:	Date:	Contract No.:	Sheet:
N.T.S.	MAY 2015	MR-2015	1 OF 1

Boulevard Bridge

(VA State Rte. 161 – Westover Hills Blvd.)

Record Set Plans

RICHMOND EXPRESSWAY SYSTEM			
SECTION	PROJECT	SHEET NO.	TOTAL SHEETS
C-17B	Boulevard Bridge Rehab	35(1)	

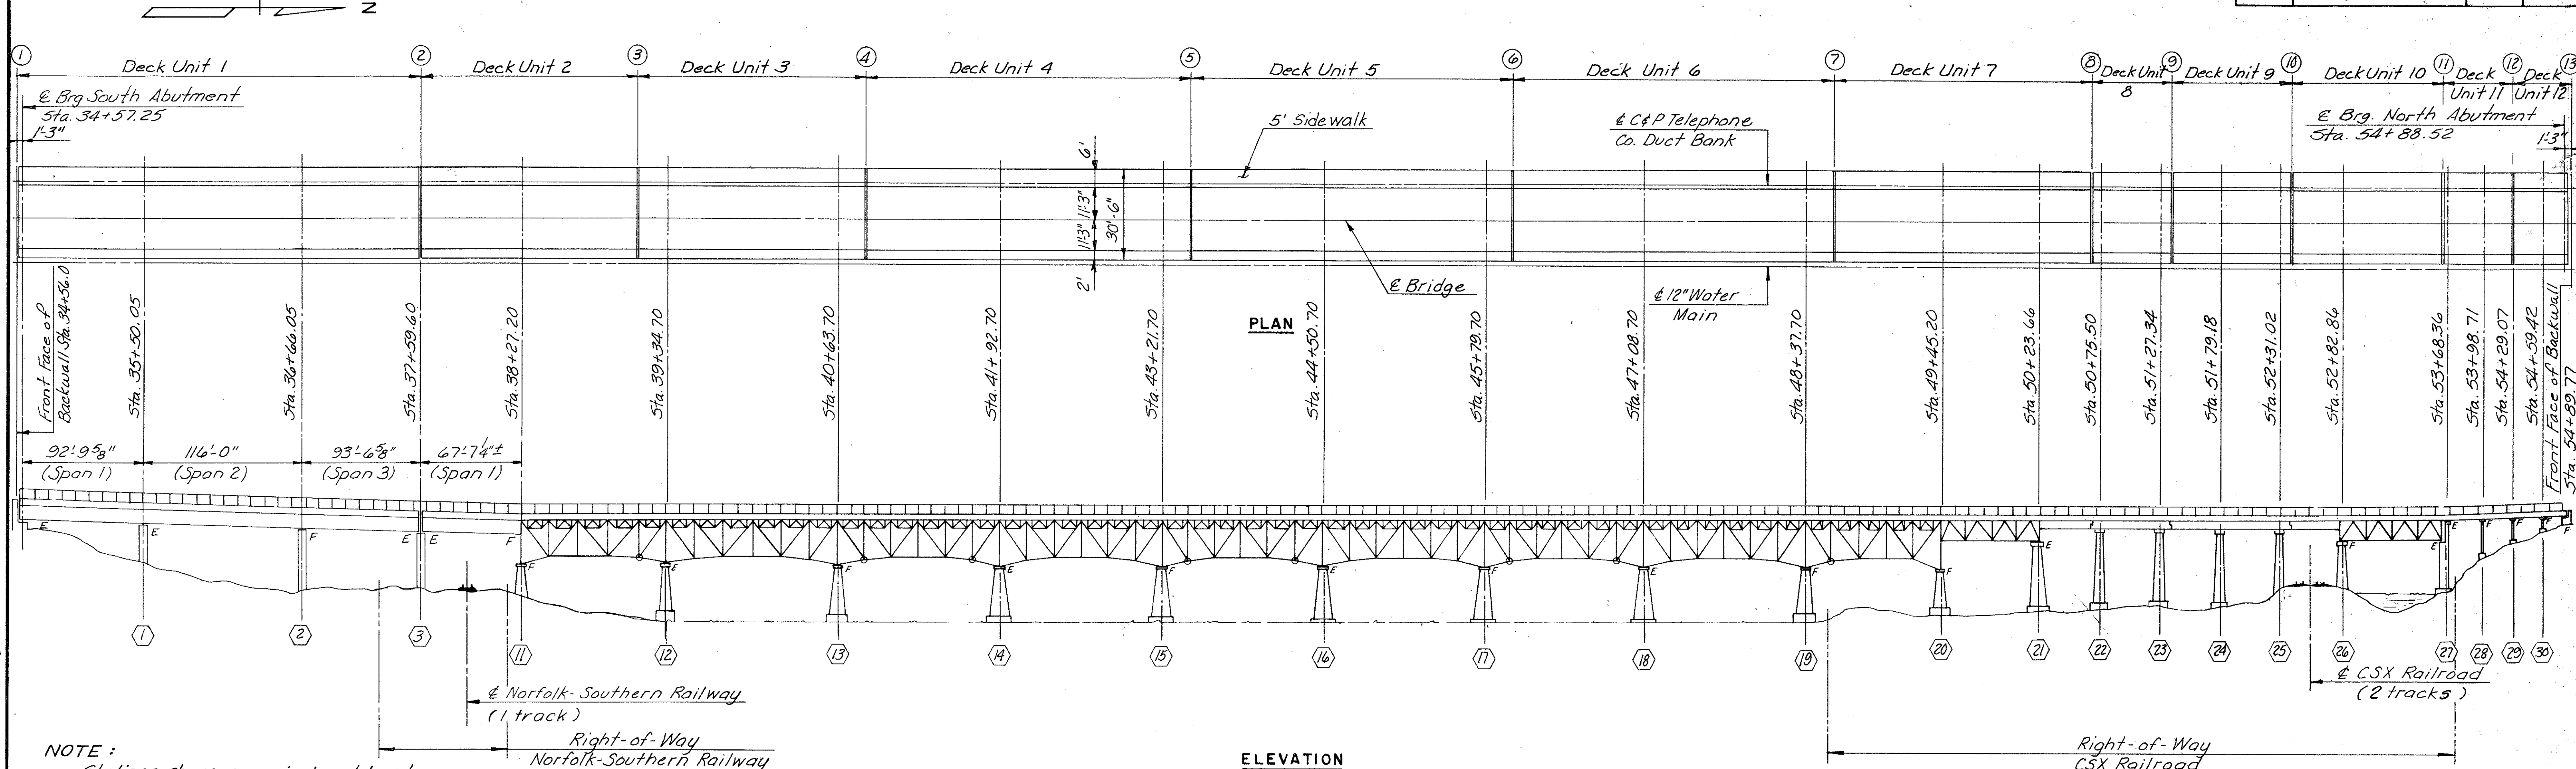

NOTE:
Stations shown approximate and based on surveyed deck joint station. The Contractor is to verify all pertinent dimensions and elevations prior to the fabrication of any structural steel.


ELEVATION

INDEX


- 1 GENERAL PLAN, ELEVATION AND INDEX
- 2 GENERAL NOTES AND QUANTITIES
- 3 GRADING AND SLOPE PROTECTION AT SOUTH ABUTMENT
- 4 NORTH ABUTMENT SLOPE PROTECTION DETAILS
- 5 & 6 SOUTH ABUTMENT DETAILS
- 7 NORTH ABUTMENT DETAILS
- 8 PIER 1
- 9 PIER 2
- 10 PIER 3
- 11-15 GIRDER DETAILS
- 16 TYPICAL CROSS SECTION
- 17 KEY PLAN, LIGHTING LAYOUT PLAN AND CONCRETE PLACEMENT PLAN
- 18-25 DECK UNIT 1 THROUGH 12 REINFORCING PLANS
- 26 SIDEWALK DETAILS (DELETED)
- 27 EXPANSION JOINT DETAILS
- 28 PREFORMED ELASTOMERIC JOINT SEALER DETAILS
- 29 ELASTOMERIC EXPANSION DAM DETAILS
- 30 SIDEWALK RAILING DETAILS
- 31 TRAFFIC RAILING DETAIL
- 32 TELEPHONE CONDUIT SYSTEM
- 33 WATER MAIN INSTALLATION DETAILS
- 34 BRIDGE LIGHTING SYSTEM
- 35 APPROACH SLAB DETAILS
- 36 SOUTH ABUTMENT DRAINAGE APRON REPAIR AND MODIFICATIONS

37 & 38 BAR LIST

LEGEND:
① Joint Number
① Pier Number

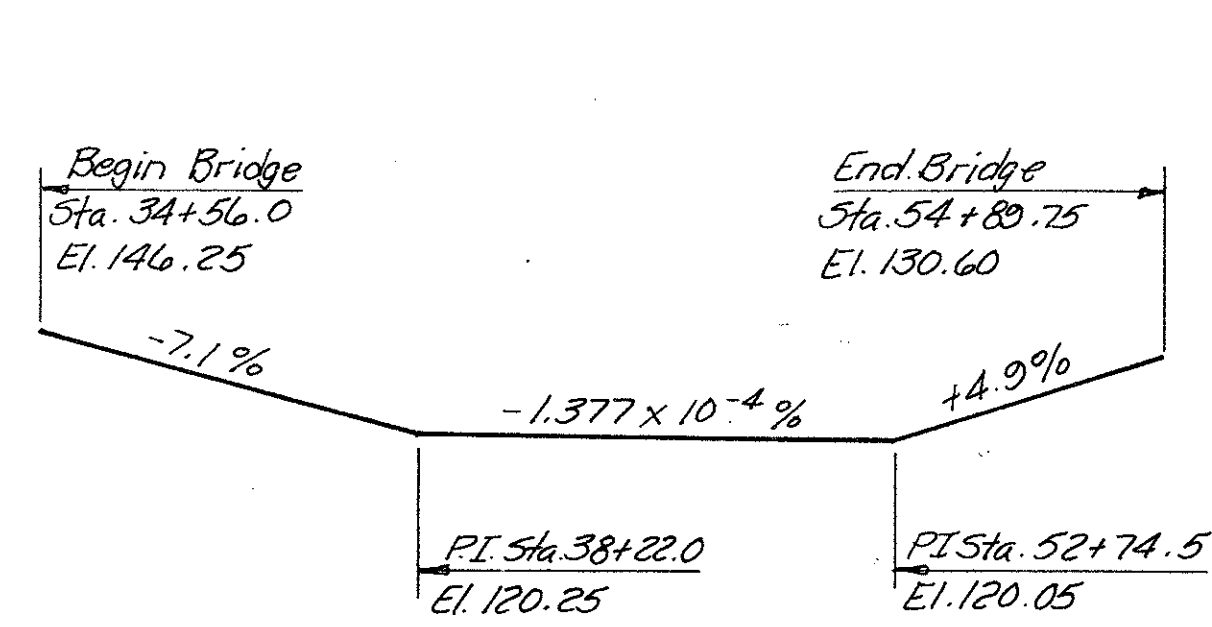


APPROXIMATE EXISTING PROFILE GRADE
Profile grade shown is based on surveyed elevation along the ℓ of the existing bridge. The contractor is to verify all elevations prior to construction.

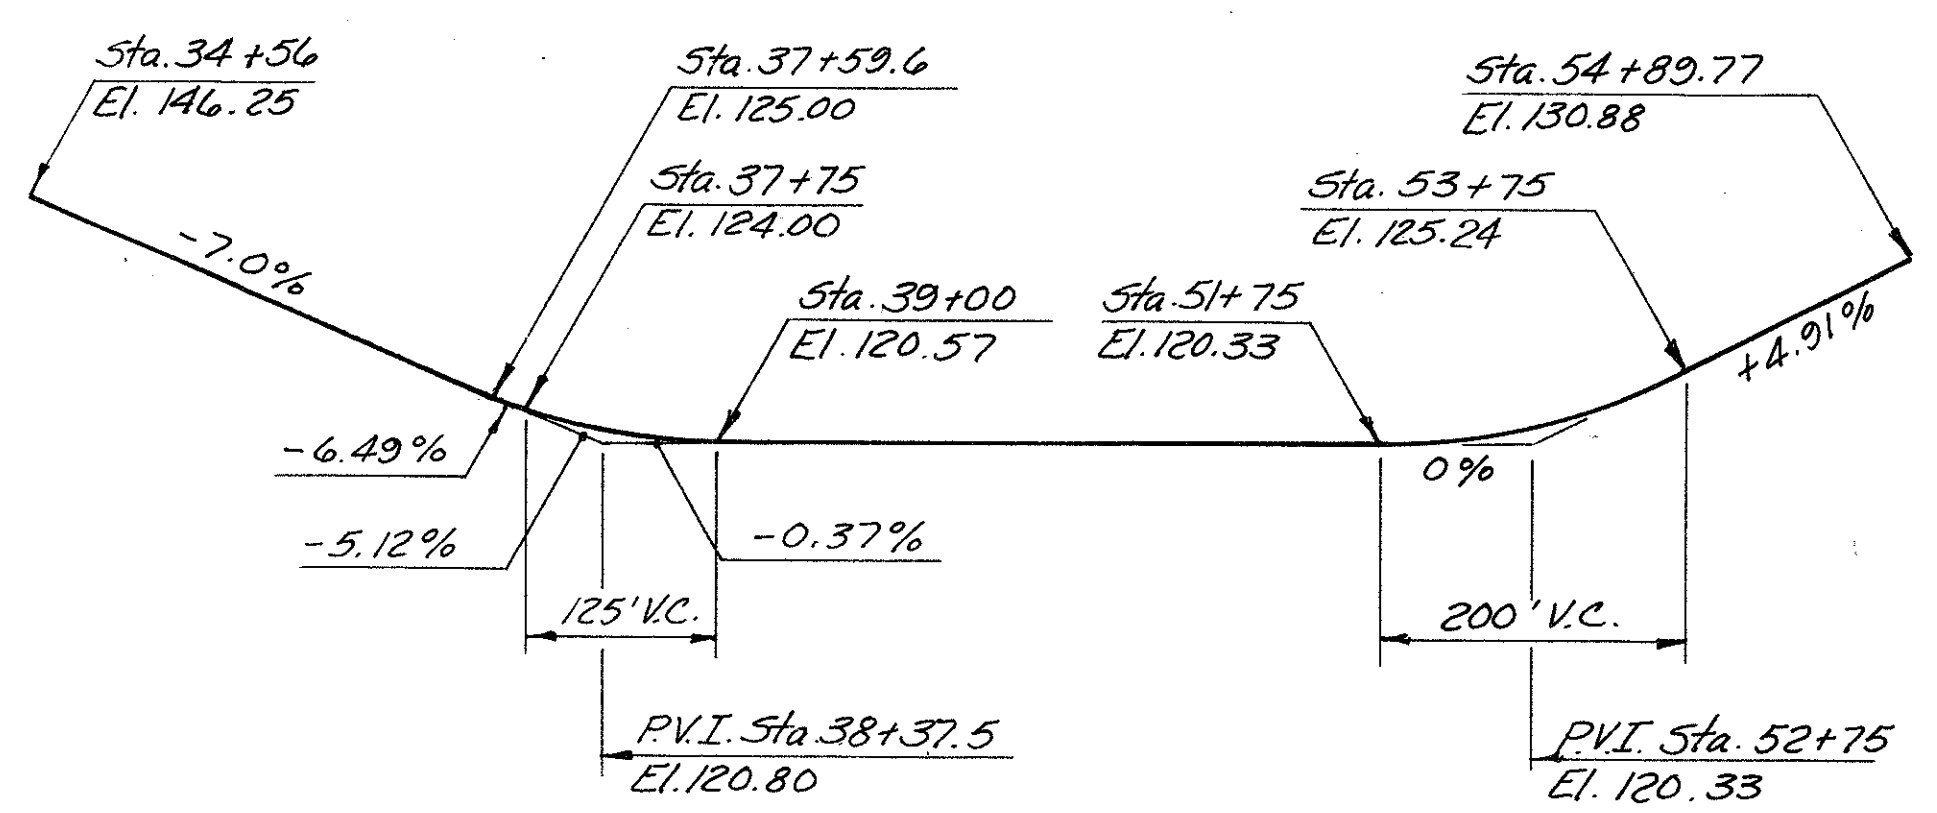

PROPOSED PROFILE GRADE

NOTE:
LOAD RESTRICTIONS ARE CURRENTLY IN EFFECT ON THE EXISTING BRIDGE. CONSTRUCTION EQUIPMENT WEIGHING IN EXCESS OF 8 TONS SHOULD NOT BE PERMITTED ON THE BRIDGE.

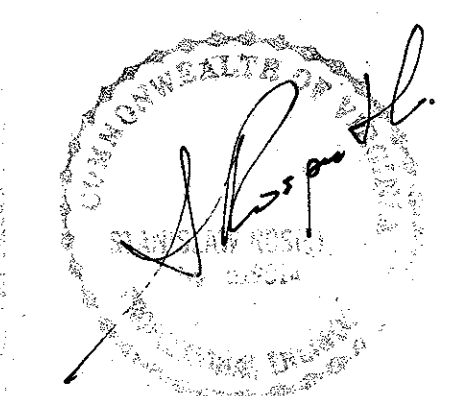

BY	DATE				
MADE	H.H.	2-92			
CHECKED	T.E.M.	3-92			
IN CHARGE			NO.	REVISION	BY DATE

RECORD DRAWING

**RICHMOND METROPOLITAN AUTHORITY
RICHMOND EXPRESSWAY SYSTEM**


**BOULEVARD BRIDGE REHABILITATION
DECK REPLACEMENT**

**GENERAL PLAN, ELEVATIONS
AND INDEX**


SCALE: No. Scale
CONTRACT NO. C-17B
SHEET NO. 1 OF 38

HOWARD, NEEDLES, TAMMEN & BERGENDOFF
General Consultants


RICHMOND EXPRESSWAY SYSTEM			
SECTION	PROJECT	SHEET NO.	TOTAL SHEETS

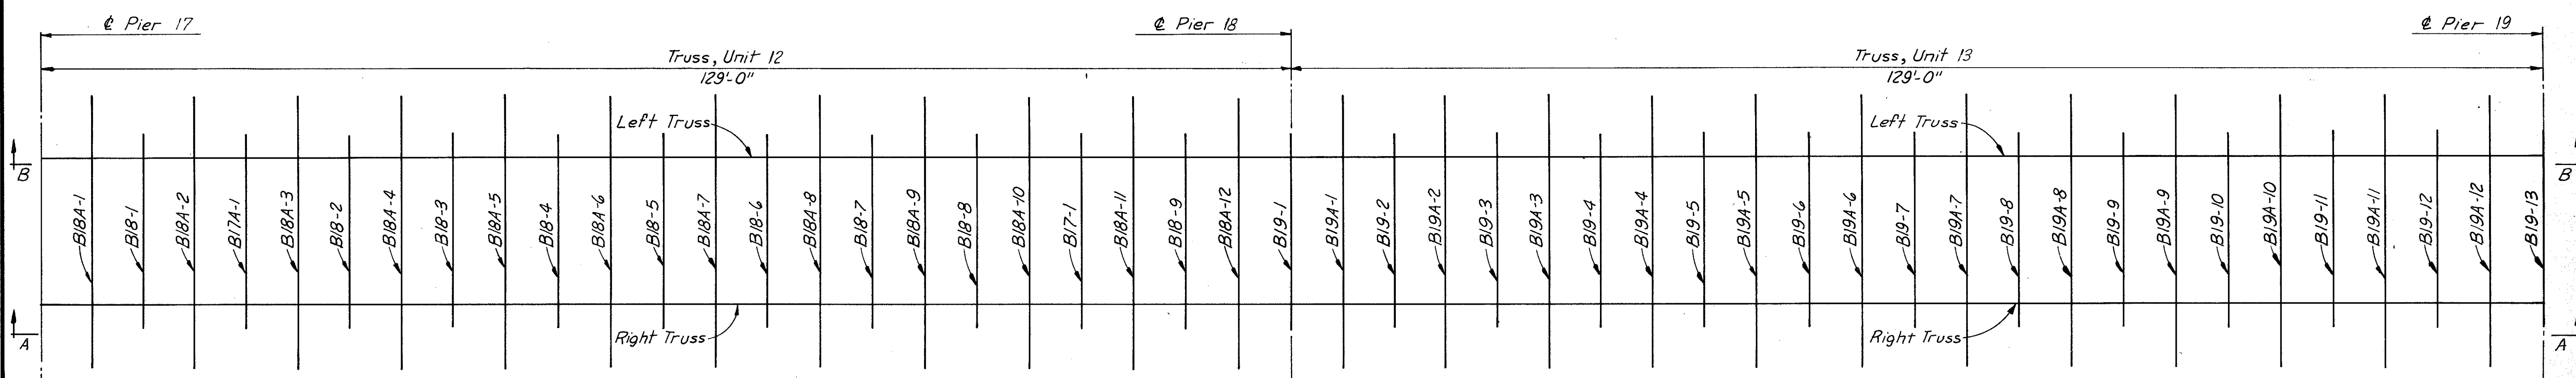


PLAN OF FLOOR BEAMS AND TRUSS

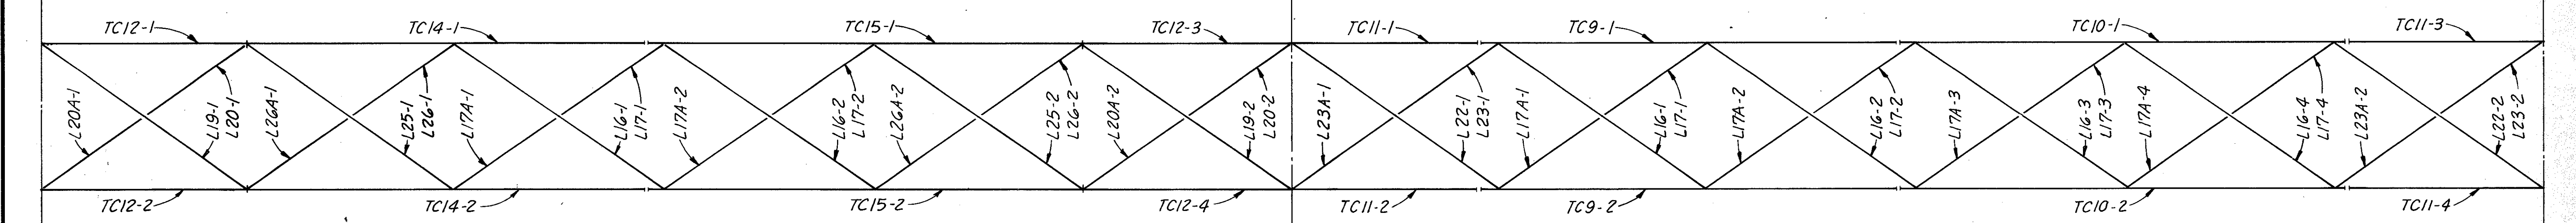

PLAN OF TOP CHORD AND LATERAL BRACING

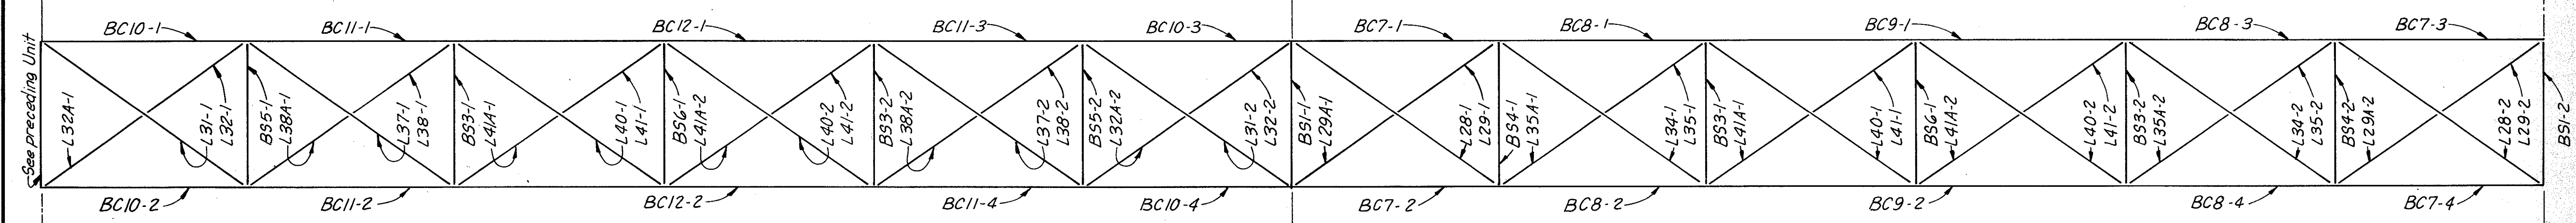

PLAN OF BOTTOM CHORD, DIAPHRAGMS AND LATERAL BRACING

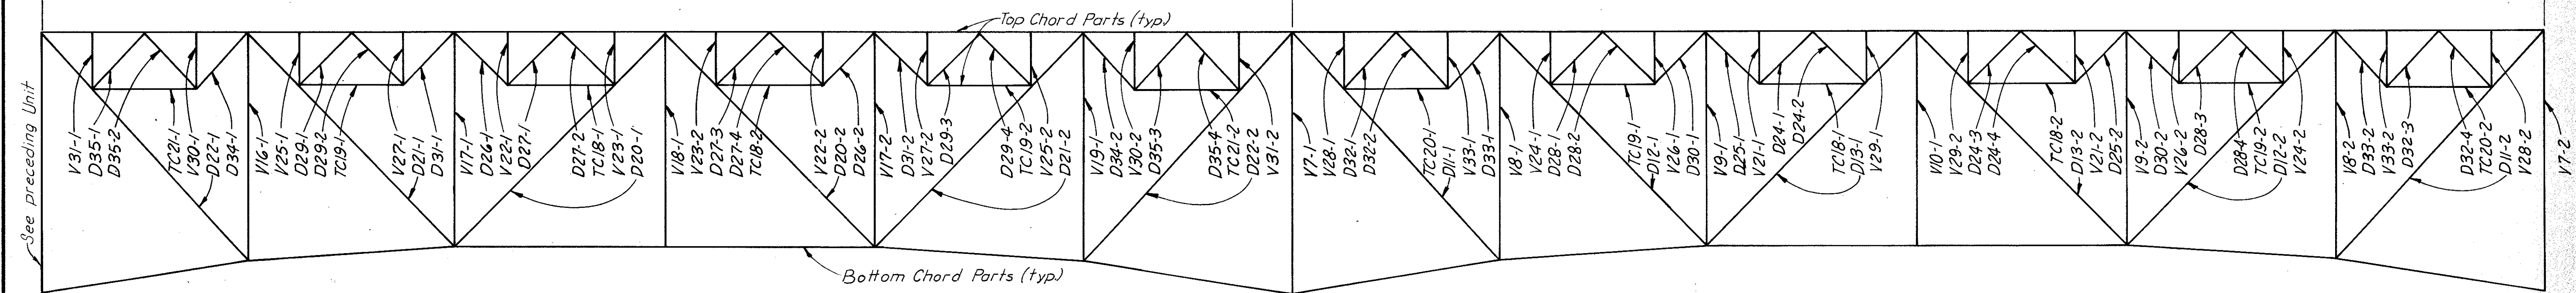

VIEW A-A

Note:
View B-B is similar to View A-A. Parts appearing in the Left Truss (except those shown on the Plans of the Top and Bottom Chords) are indicated, in the table, with an L following the part identification.

Notes:
For Typical Floor Beam Detail, see Layout Units 1 thru 5.
For Typical Diaphragm Details and Elevations, see Layout Unit 14.
For Truss Details see, Typical Truss Detail Sheet.

MADE	BY	DATE			
	T.E.M.	2-72			
CHECKED	H.B.W.	3-72			
IN CHARGE	P.R.V.		NO.	REVISION	BY
					DATE

RICHMOND METROPOLITAN AUTHORITY
RICHMOND EXPRESSWAY SYSTEM

BOULEVARD BRIDGE OVER JAMES RIVER

LAYOUT UNITS 12 & 13


SCALE: No Scale

CONTRACT NO.:


HOWARD, NEEDLES, TAMMEN & BERGENDOFF
General Consultants

SHEET NO. 20 OF


RICHMOND EXPRESSWAY SYSTEM			
SECTION	PROJECT	SHEET NO.	TOTAL SHEETS

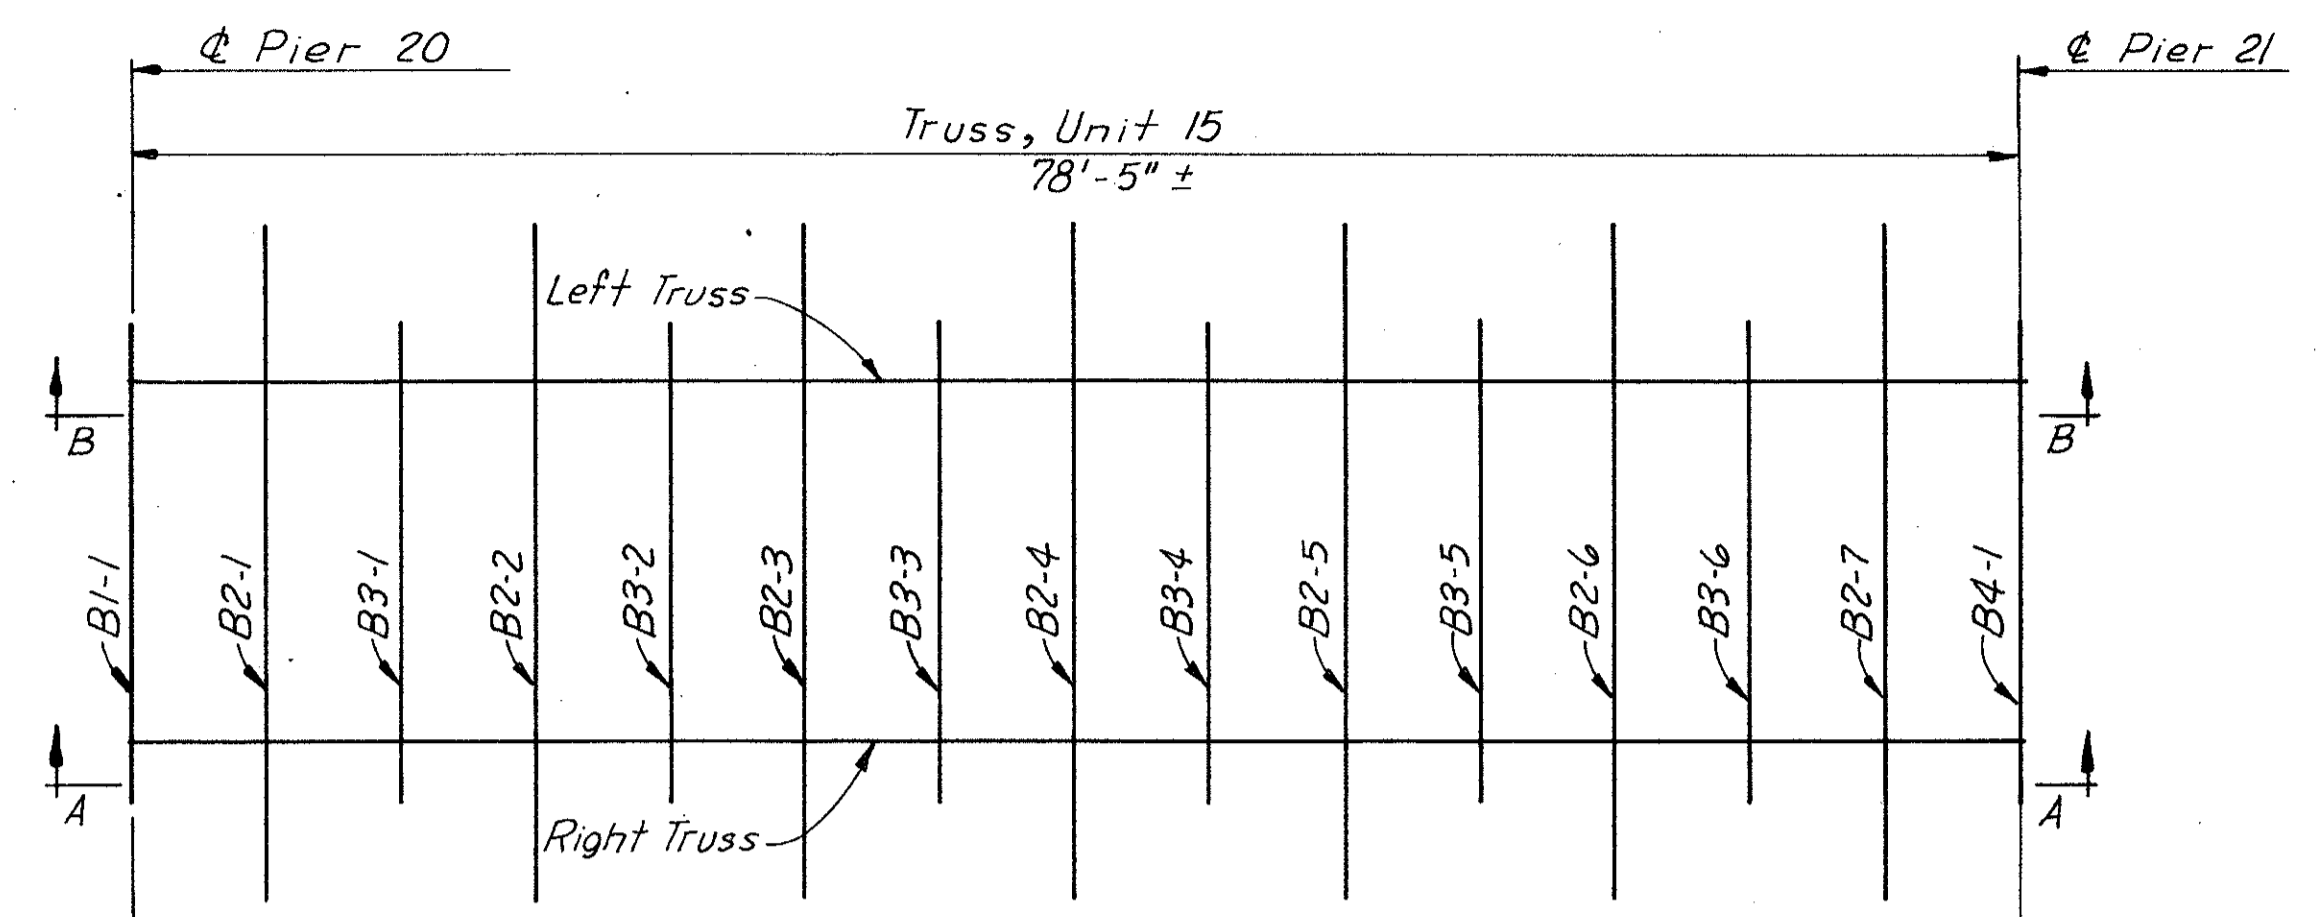


PLAN OF FLOOR BEAMS AND TRUSS

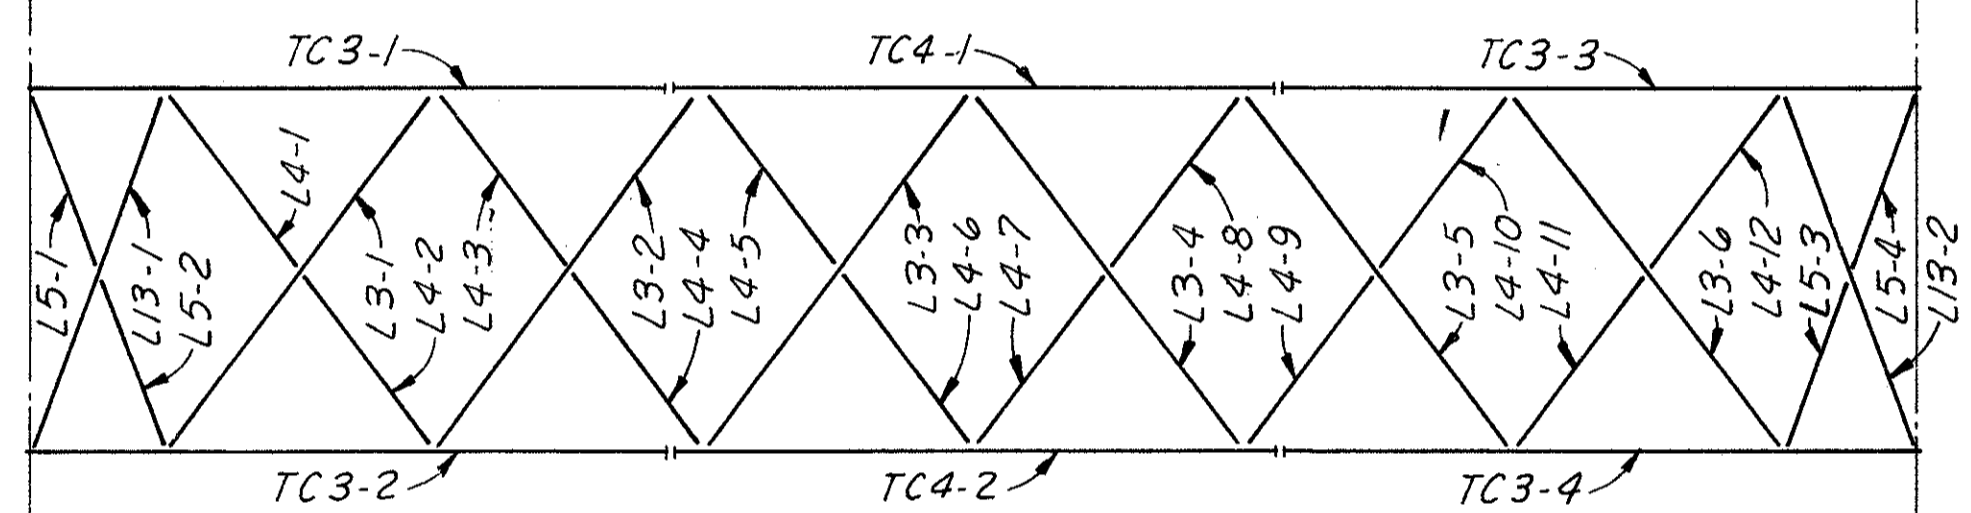


PLAN OF TOP CHORD AND LATERAL BRACING

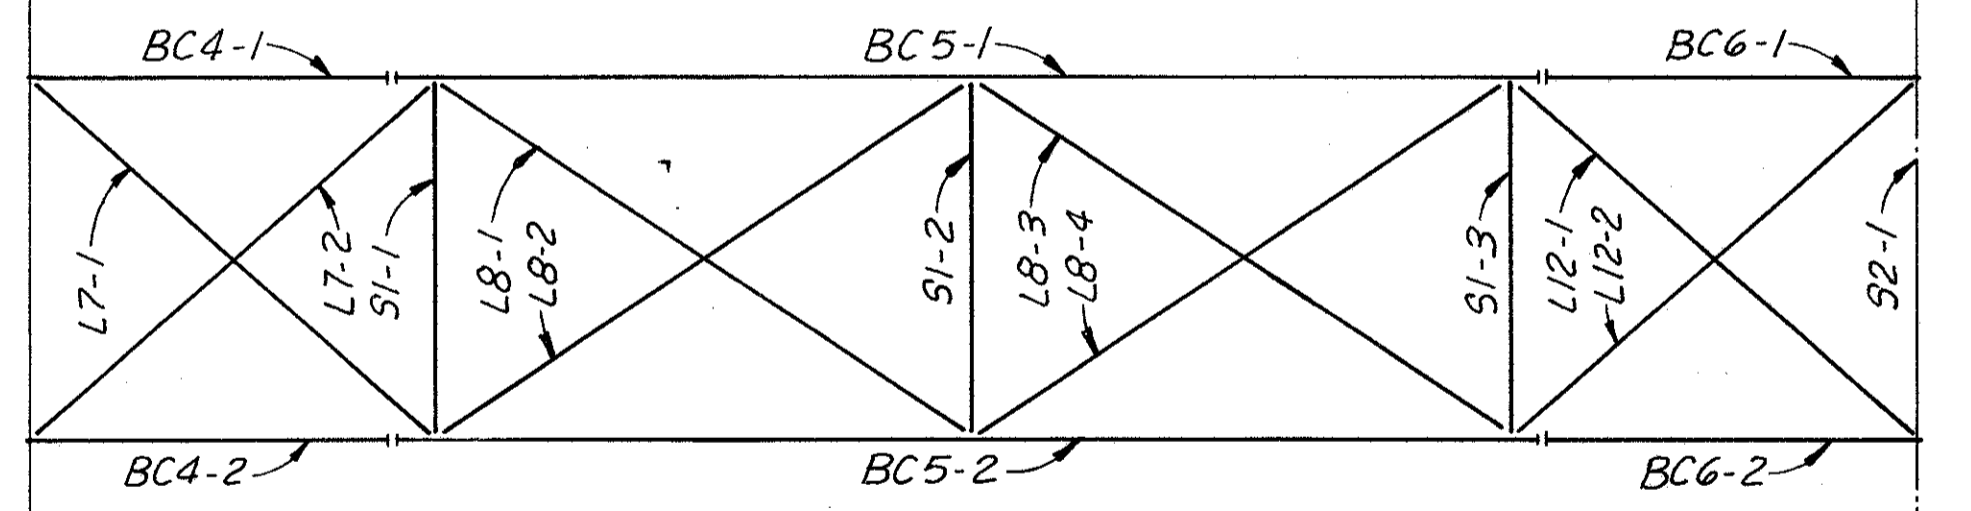


PLAN OF BOTTOM CHORD, DIAPHRAGMS AND LATERAL BRACING

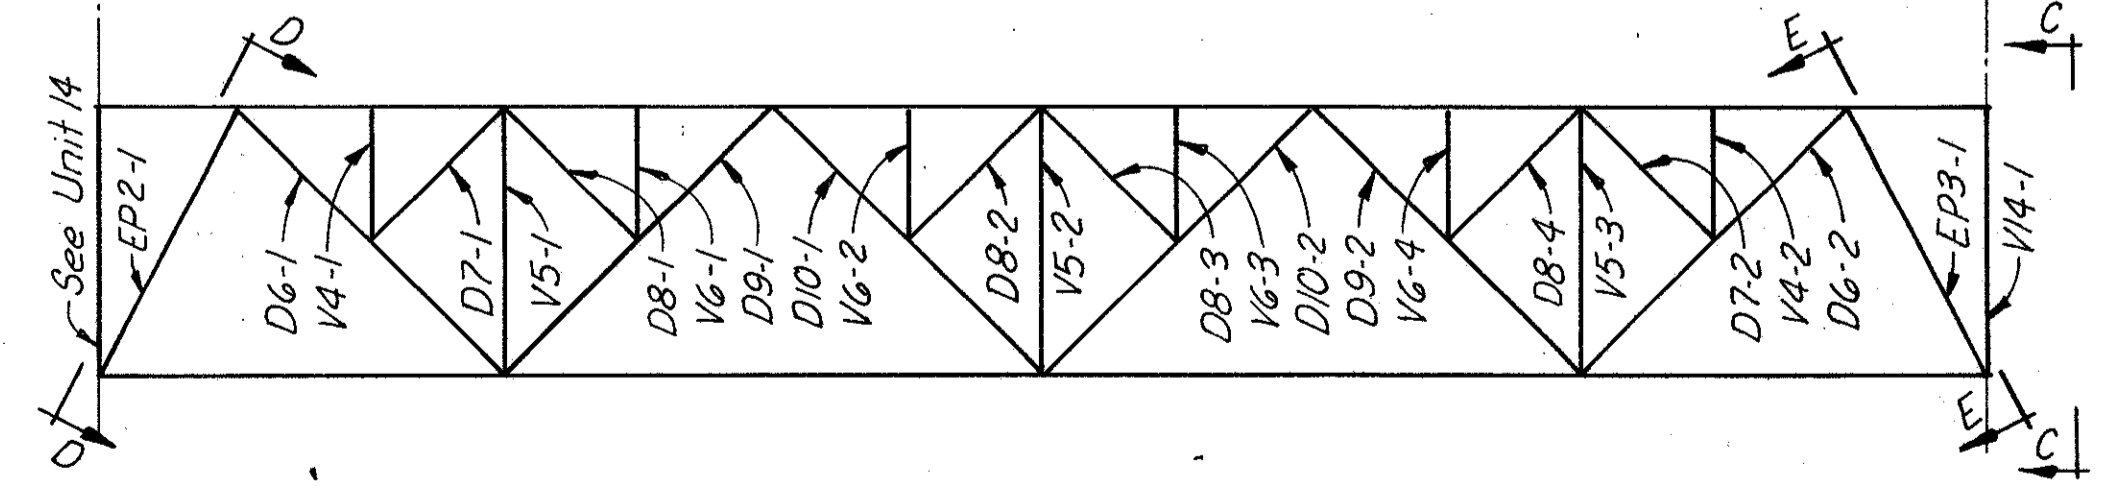


VIEW A-A

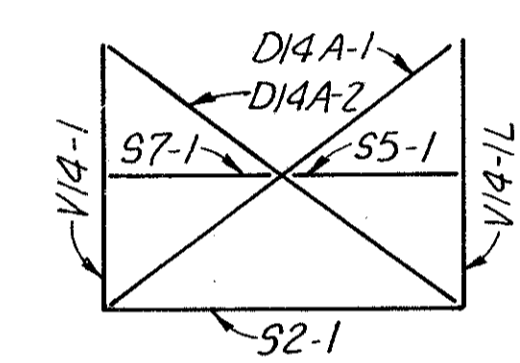


VIEW C-C

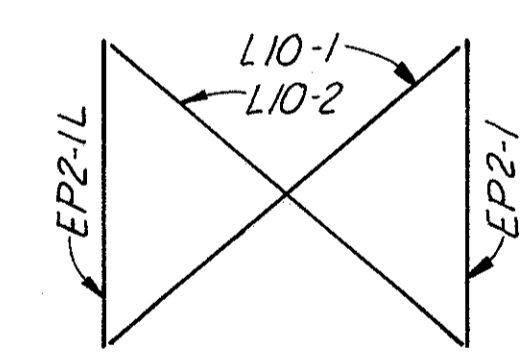

VIEW D-D

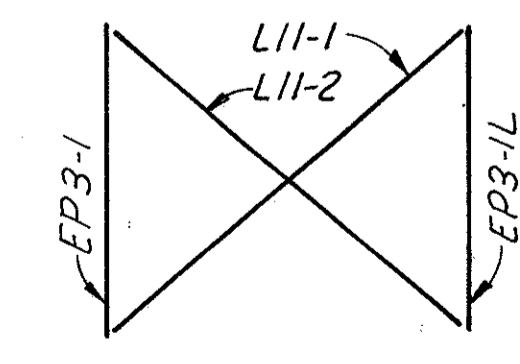

VIEW E-E

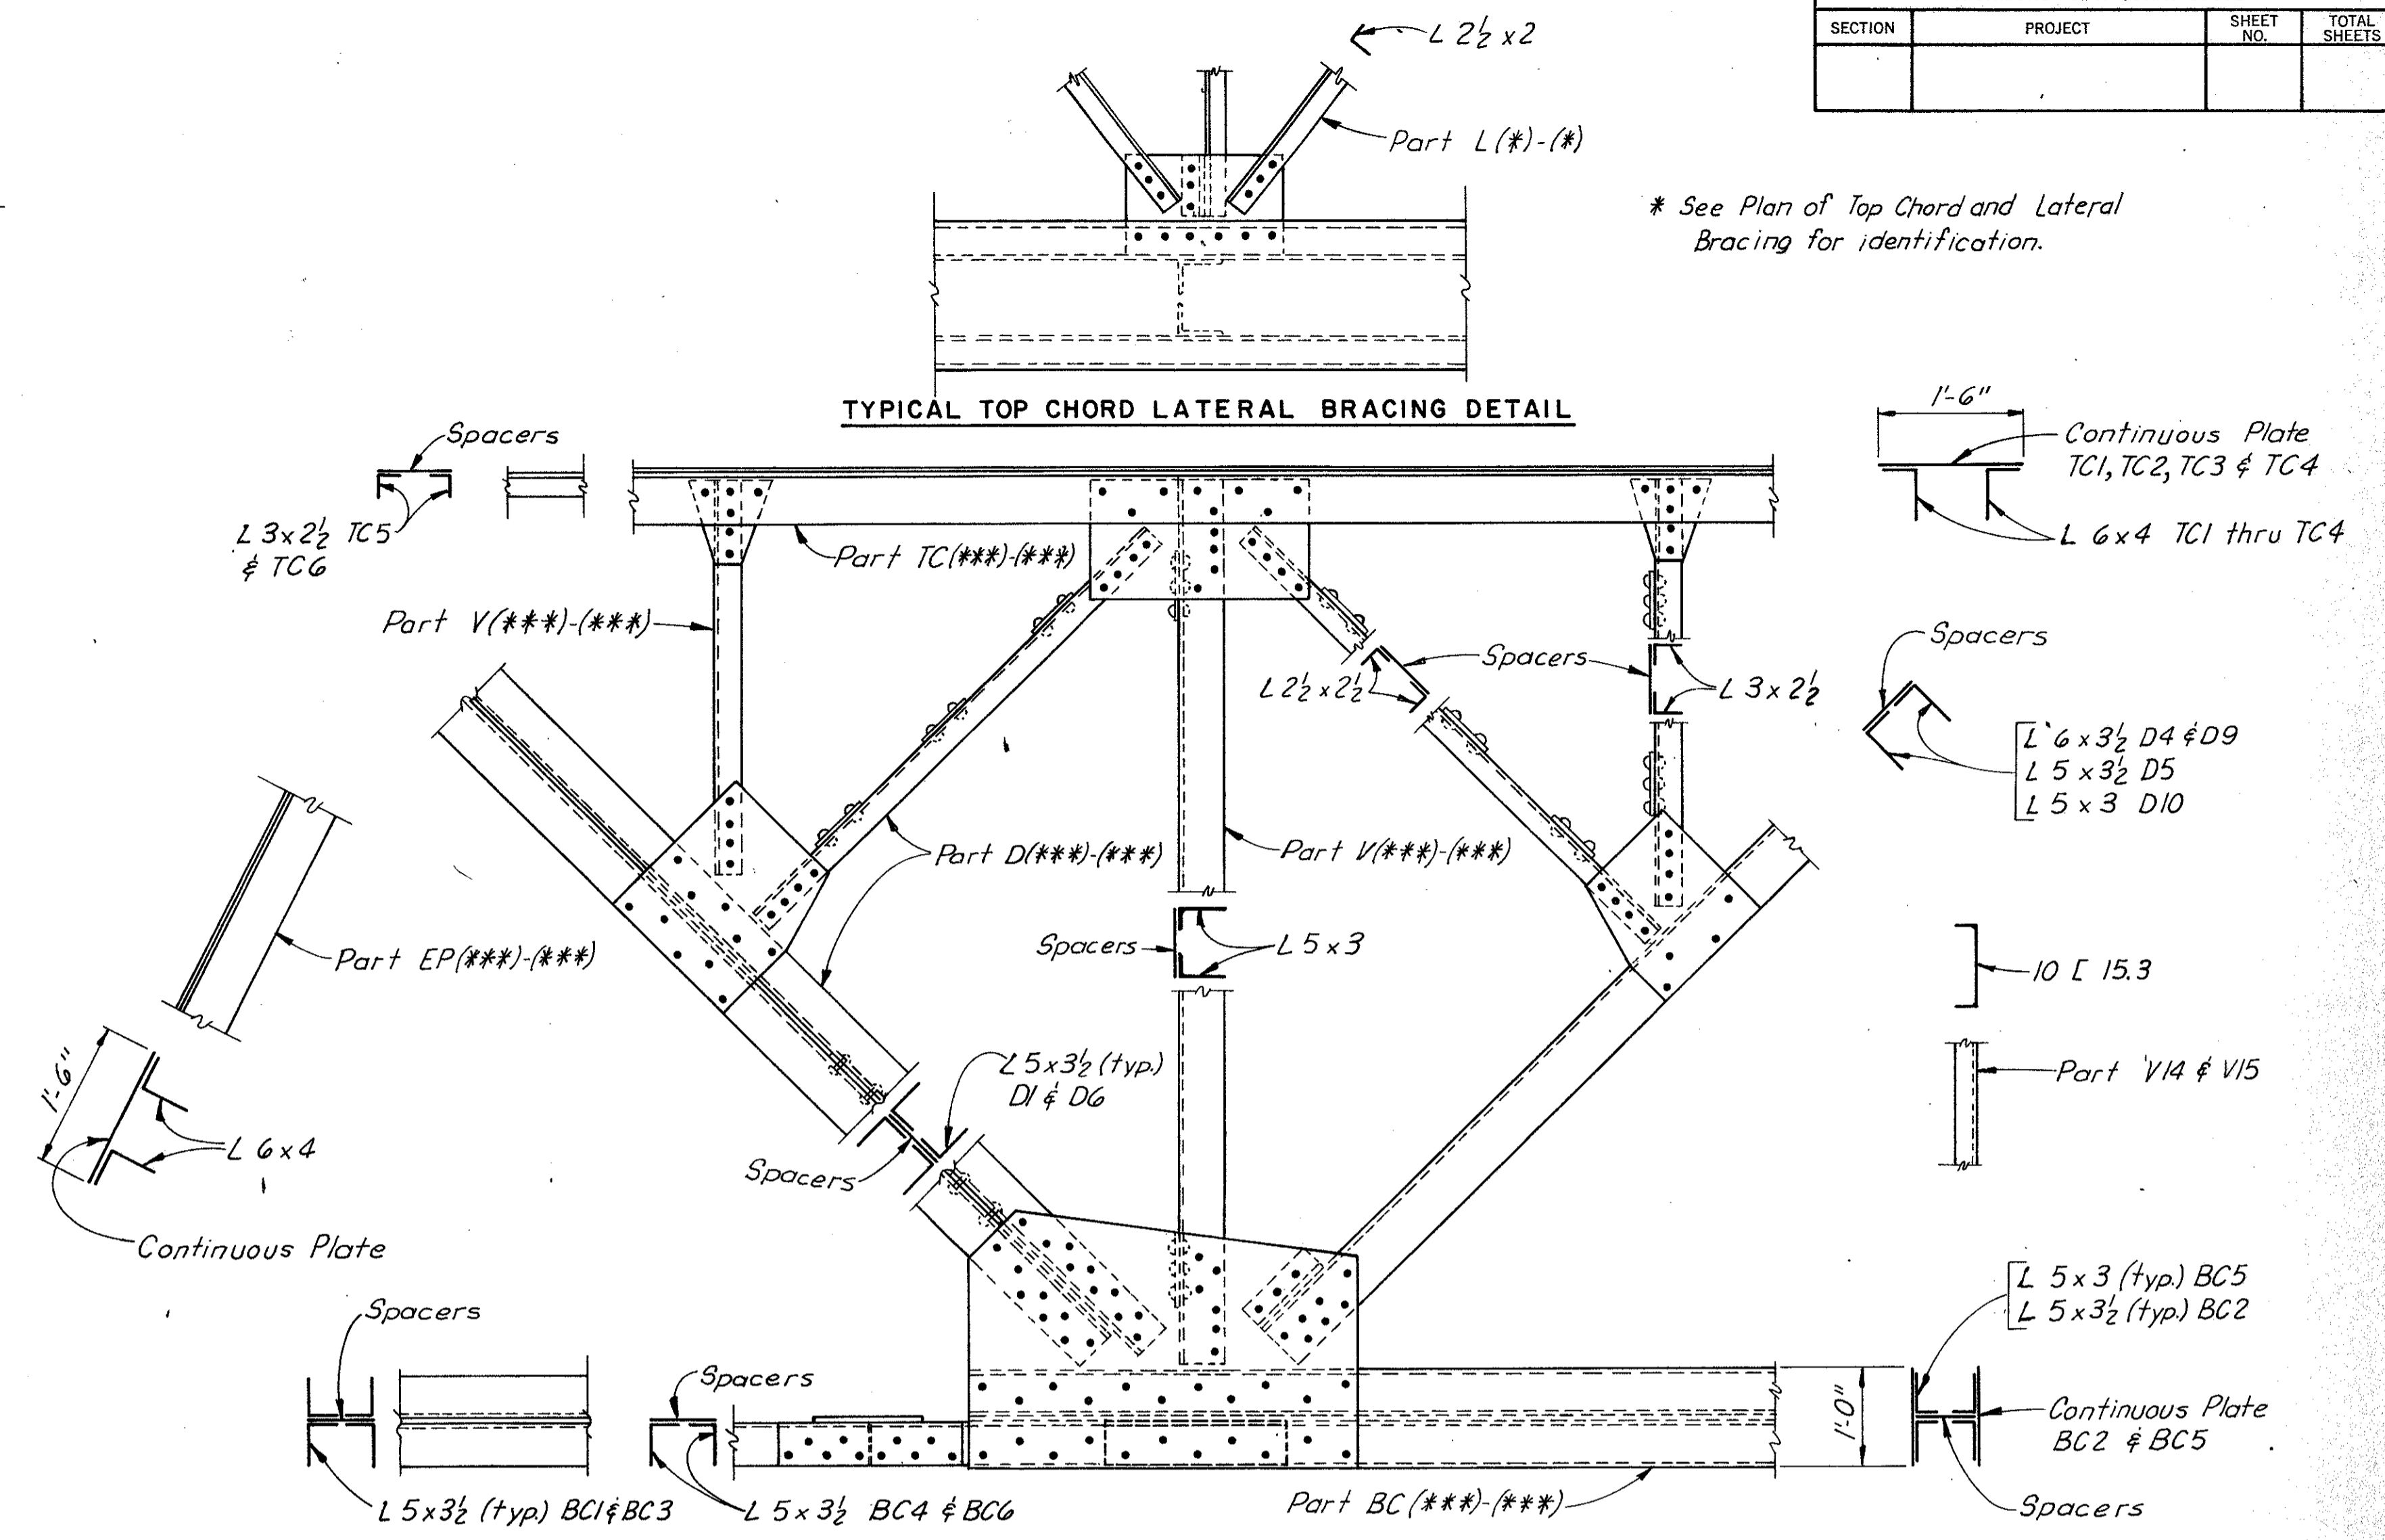

TYPICAL TOP CHORD LATERAL BRACING DETAIL

TYPICAL TRUSS DETAIL UNIT 15 AND 21

TYPICAL BOTTOM CHORD LATERAL BRACING DETAIL

* See Plan of Top Chord and Lateral Bracing for identification.

*** See View A-A for identification.

** See Plan of Bottom Chord, Diaphragms and Lateral Bracing for identification.

Note:
View B-B is similar to View A-A. Parts appearing in the Left Truss (except those shown on the Plans of the Top and Bottom Chords) are indicated, in the table, with an L following the part identification.

Notes:
For Typical Floor Beam Detail, see Layout Units 1 thru 5.
For Typical Diaphragm Details see Layout Units 21 thru 23.

BY	DATE				
MADE	T.E.M.	2-72			
CHECKED	H.B.W.	3-72			
IN CHARGE	P.R.V.				

RICHMOND METROPOLITAN AUTHORITY
RICHMOND EXPRESSWAY SYSTEM

BOULEVARD BRIDGE OVER JAMES RIVER


LAYOUT UNIT 15

SCALE: No Scale

CONTRACT NO. _____

HOWARD, NEEDLES, TAMMEN & BERGENDOFF
General Consultants

SHEET NO. 27 OF _____

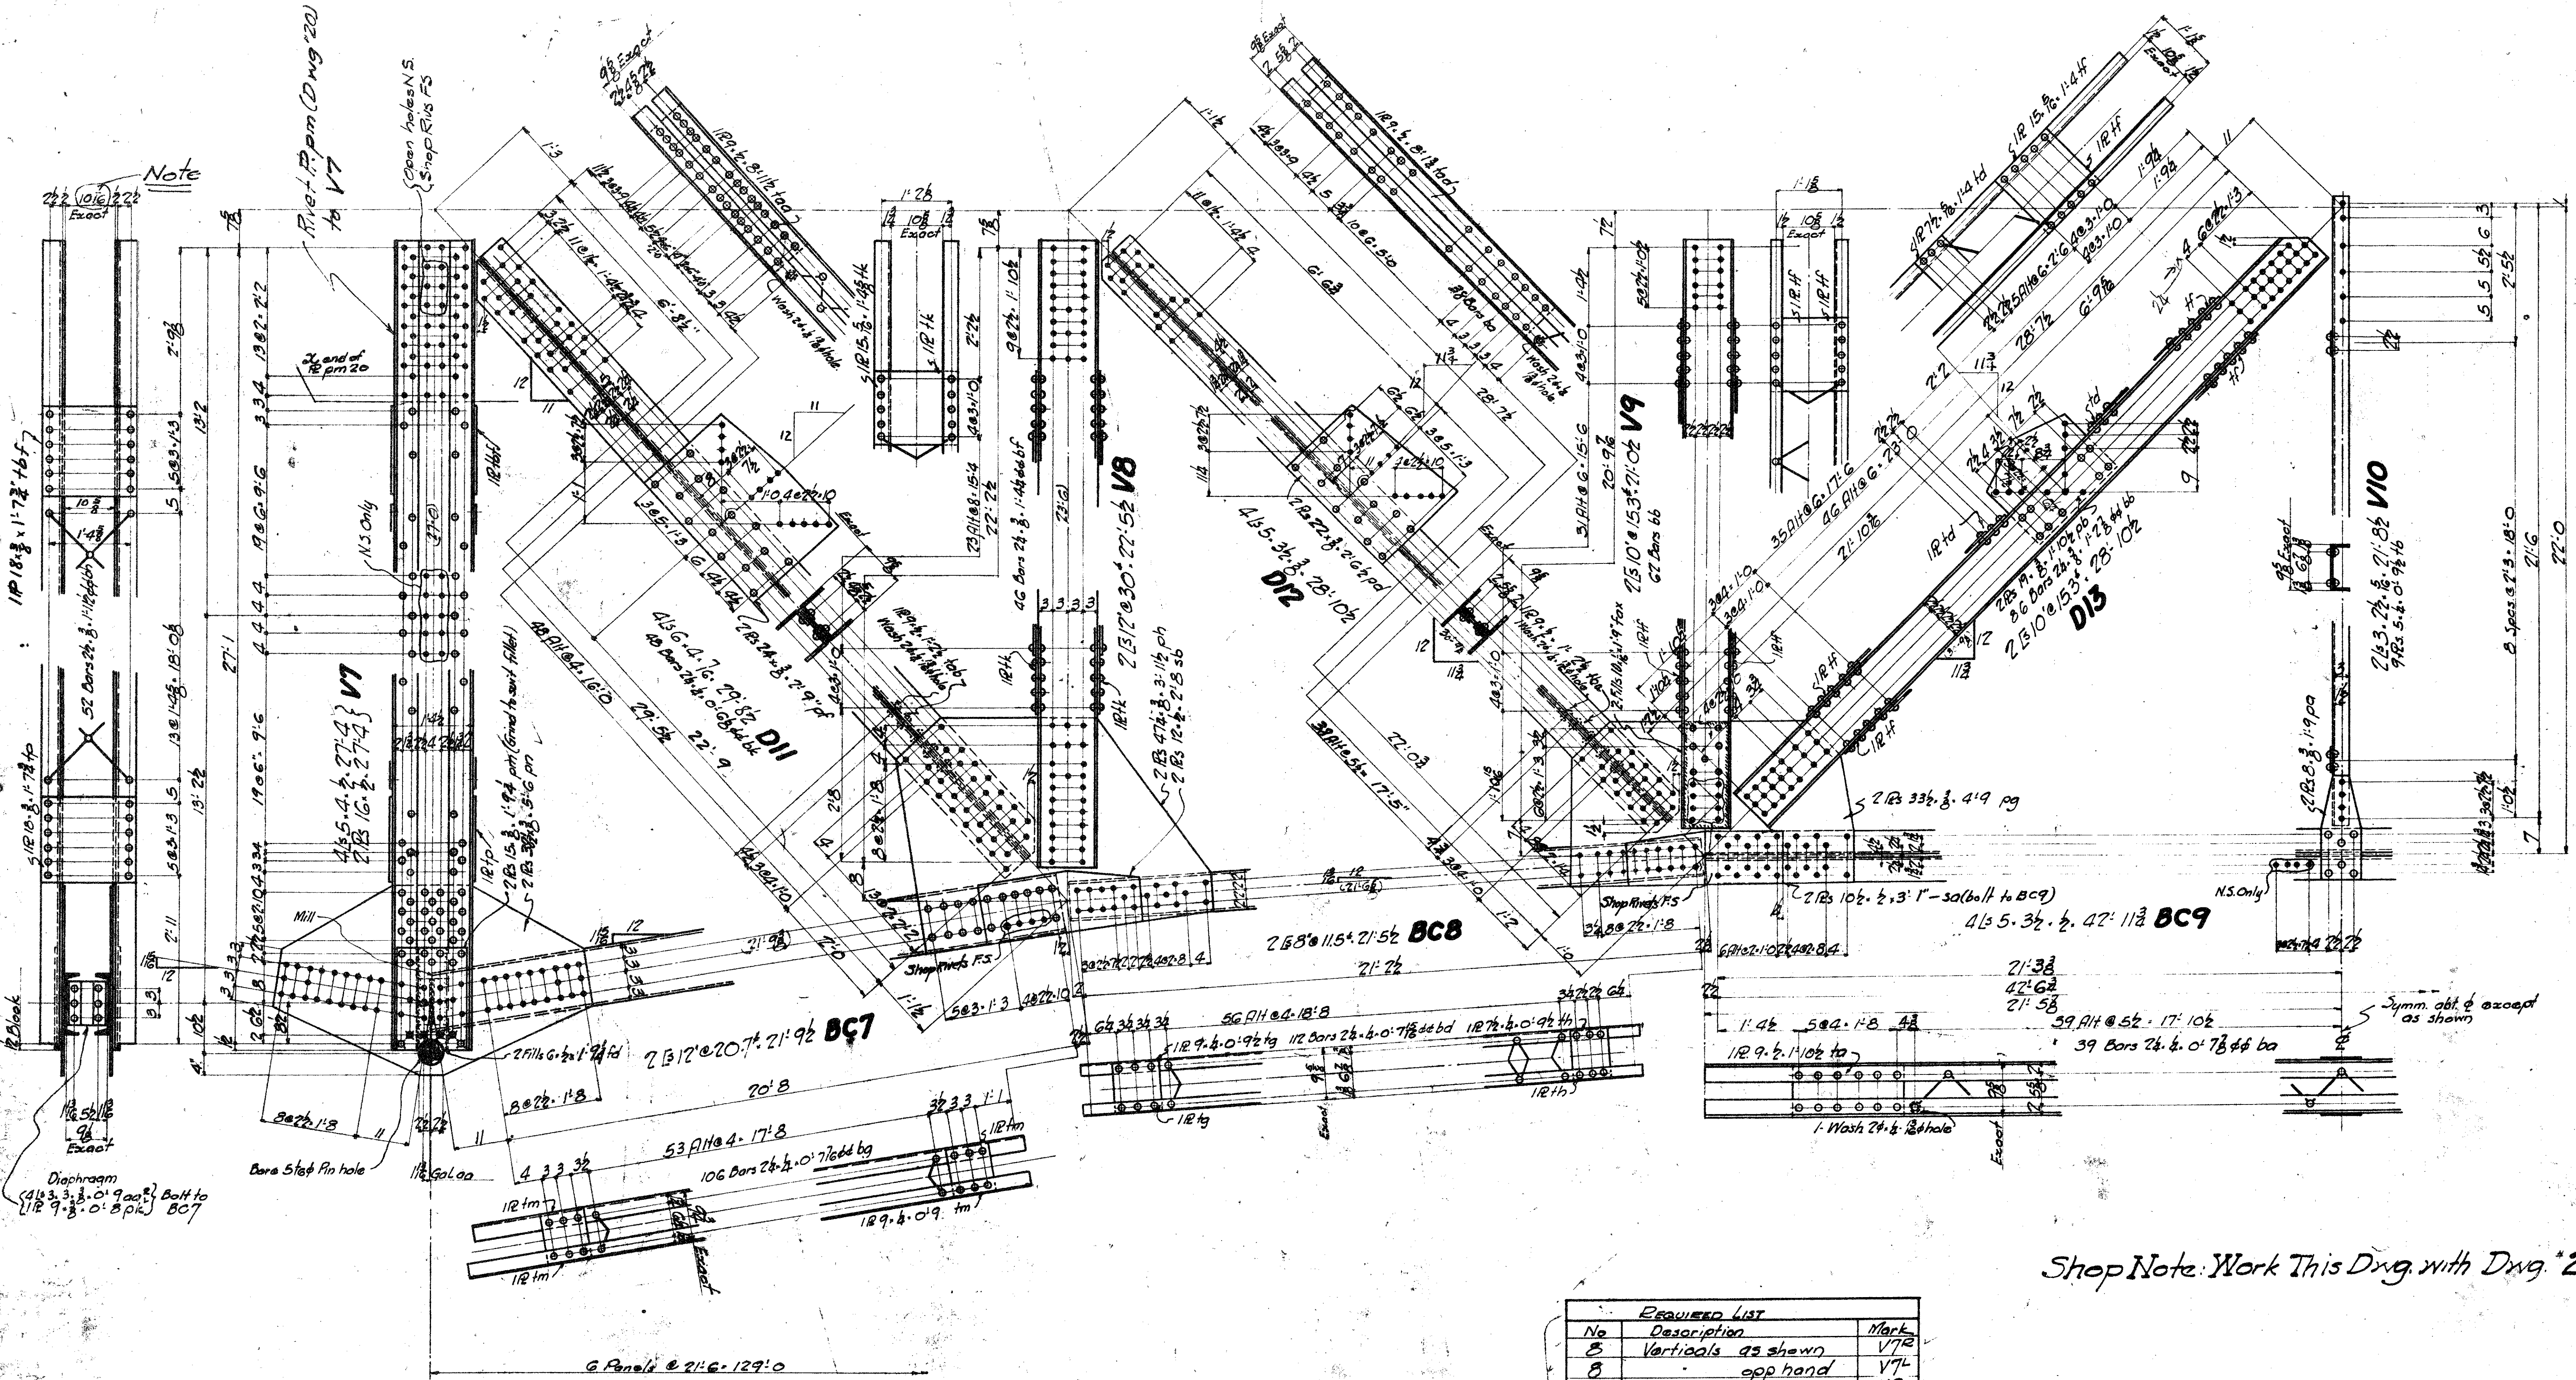

Note

22 (10) 22
Rivet 17pm (Dwg 20)
Shop Note: Work This Dwg. with Dwg. *20

No	Description	Mark
8	Verticals as shown	V7R
8	opp hand	V7L
16		V8
8		V10
16	Diagonals	D11
16		D12
16		D13
8	Bottom Chords as shown	BC7R
8	opp hand	BC7L
8	as shown	BC8R
8	opp hand	BC8L
8	Verticals as shown	V9R
8	opp hand	V9L

GENERAL NOTES:

- Material
- Specifications
- Rivets 3/4"
- Holes 1/8" unless noted
- Reaming
- Shop Paint 1/2 lb Red Lead & Oil
- Field Paint
- Erection
- Field Conn's
- Inspection

Atlantic Bridge Co. Dept. 406


CONTRACT V 5585

Details of *Continous Trusses*

For - Bridge over James River
Location - Richmond, Va.
Owner - Atlantic Bridge Co.

Virginia Bridge and Iron Co.
ROANOKE, VA.

Scale 1/4" = 1'-0"

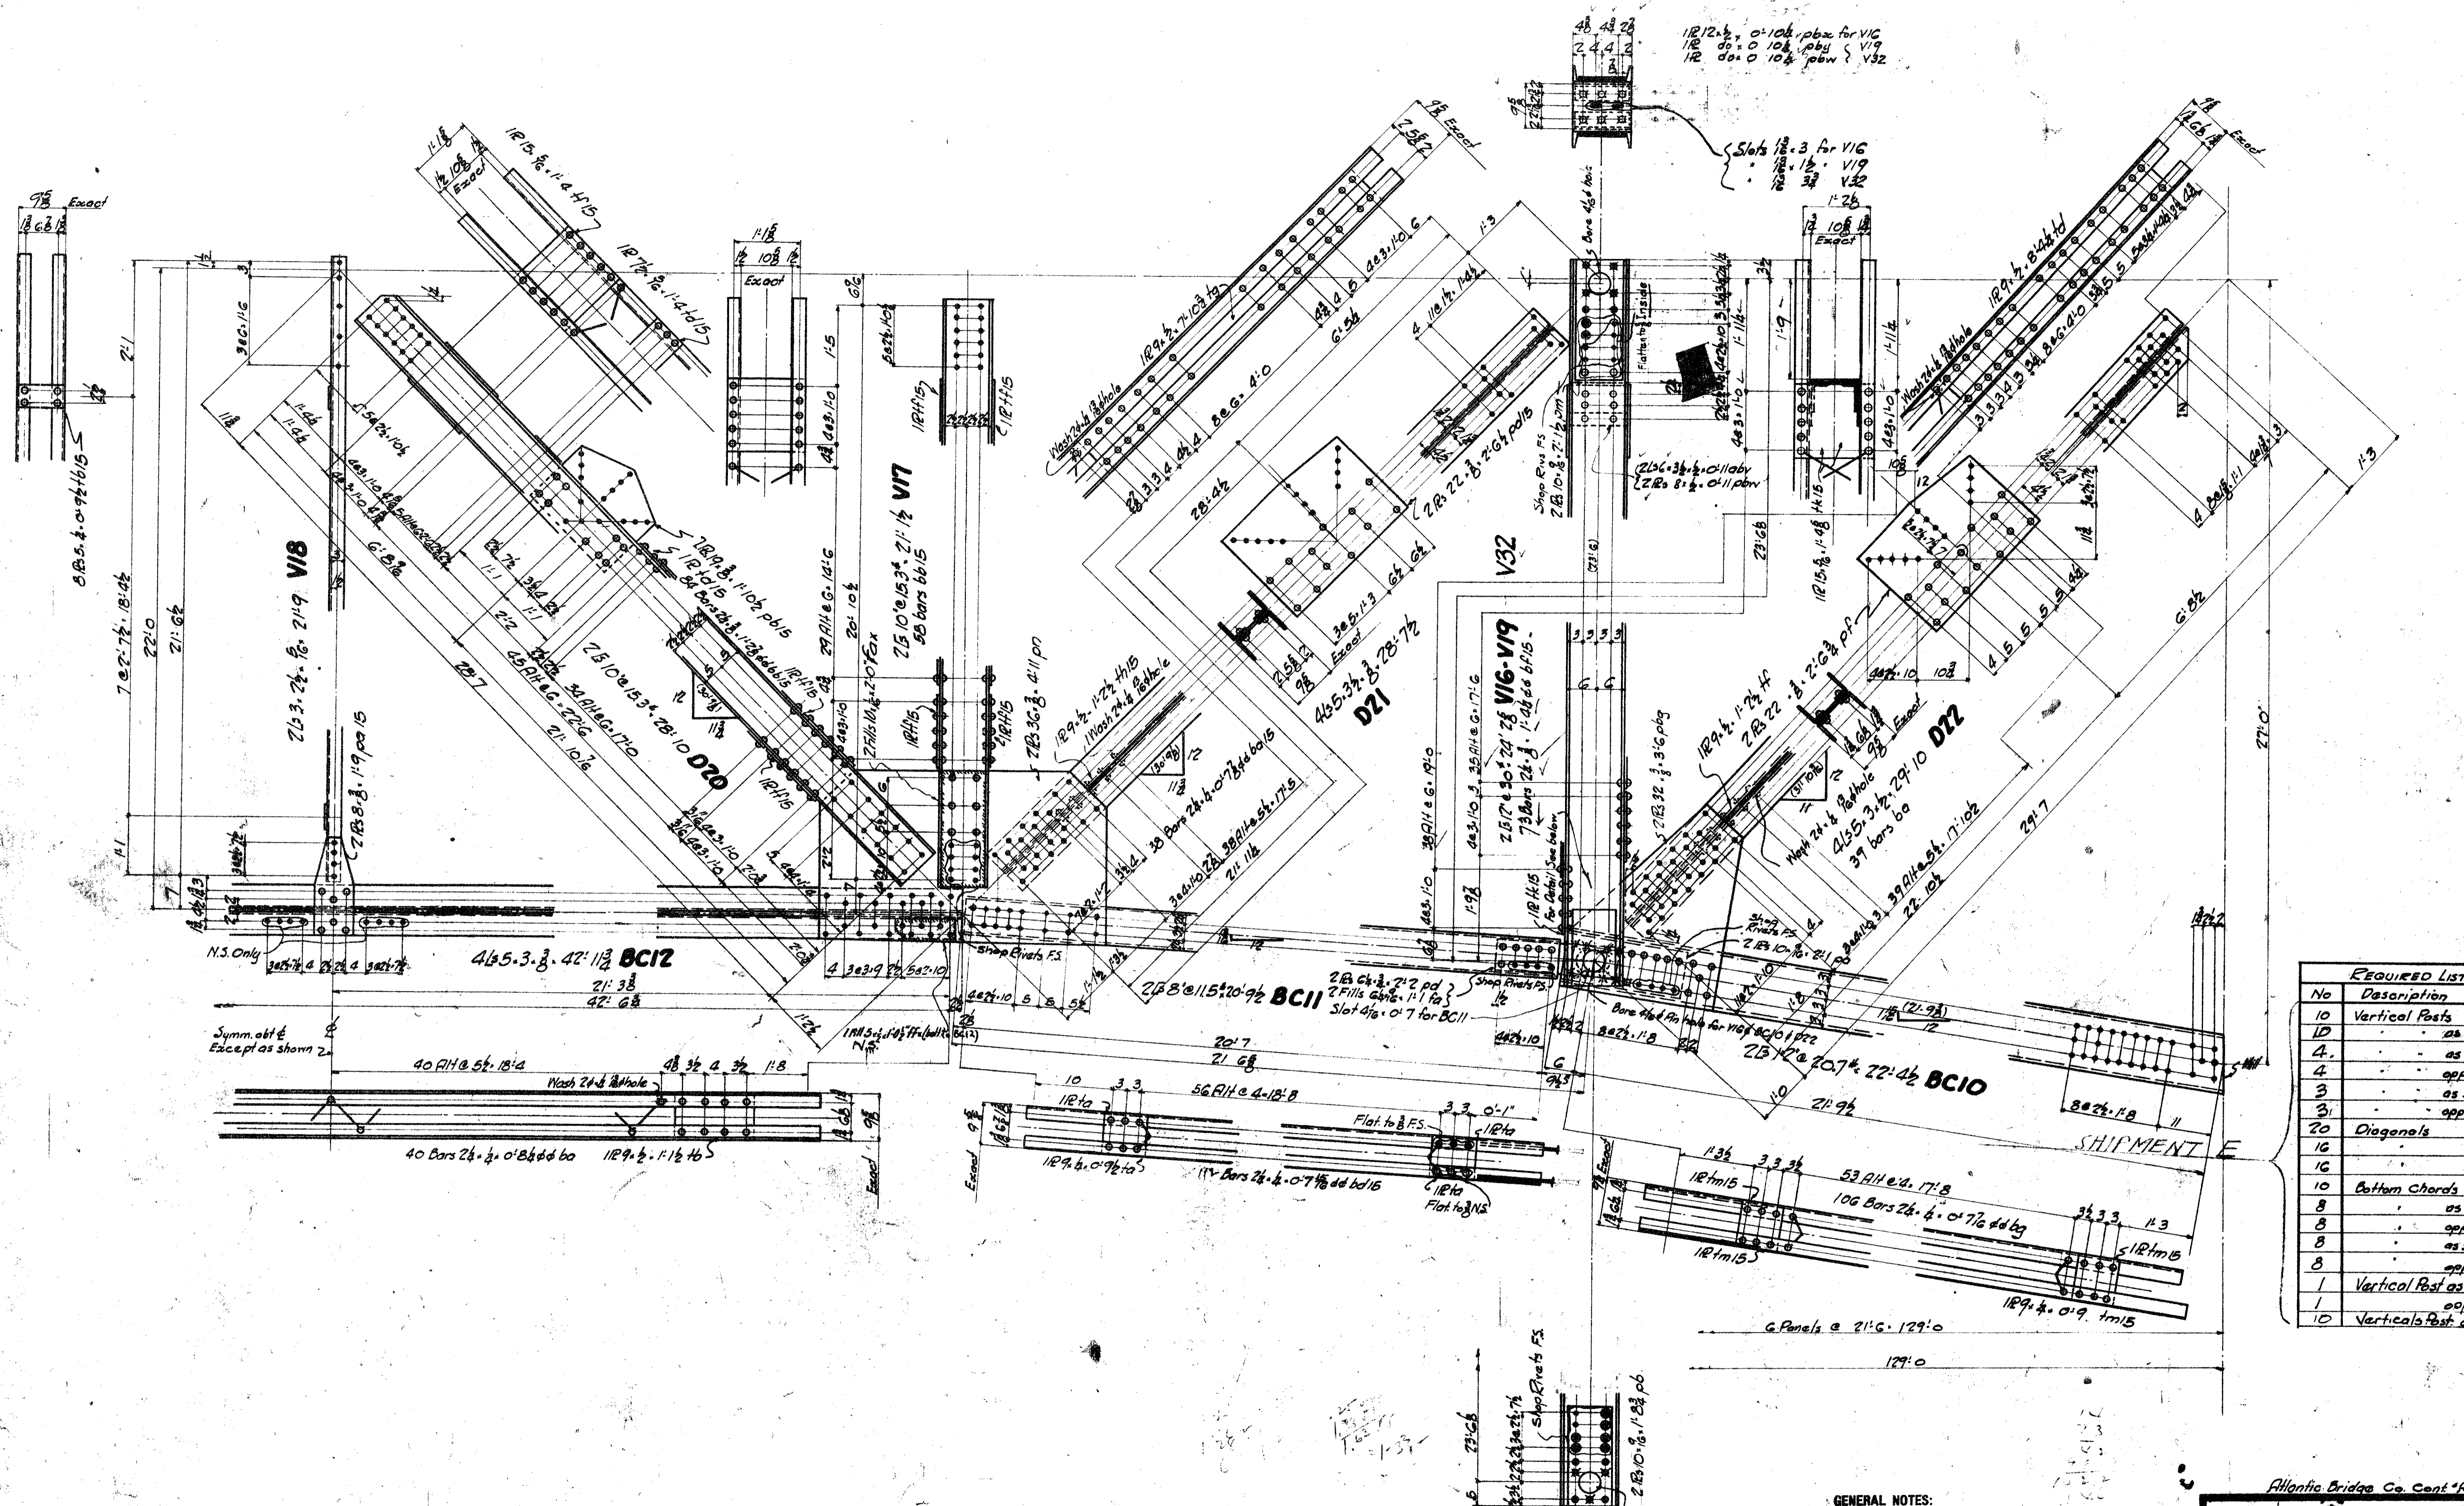

12 1/2 x 3/4 0 104 pbs for V16
 12 3/4 x 3/4 0 104 pbs for V19
 12 3/4 x 3/4 0 104 pbs for V32

Slots 18.3 for V16
 18.12 for V19
 18.37 for V32

N.S. Only
 Symm. abt & Except as shown

Detail About Pin hole for V16-V19-V32

REQUIRED LIST		
No	Description	Mark
10	Vertical Posts	V18
10	"	as shown V17R
4	"	as shown V16R
4	"	app hand V16L
3	"	as shown V19R
3	"	app hand V19L
20	Diagonals	D20
16	"	D21
16	"	D22
10	Bottom Chords	BC12
8	"	as shown BC11R
8	"	app hand BC11L
8	"	as shown BC10R
8	"	app hand BC10L
1	Vertical Post as shown	V32R
1	app hand	V32L
10	Verticals Post app hand	V17L

GENERAL NOTES:
 Material
 Specifications
 Rivets 3/4
 Holes 1/8 unless noted
 Reaming
 Shop Paint / Oil Red Lead / Oil
 Field Paint
 Erection
 Field Conn's
 Inspection

For General Notes See Sheet 1

Atlantic Bridge Co. Cont. #1400


CONTRACT V 5585

Details of Bottom Chord & Web Members for Suspended Trusses
 For Bridge over James River
 Location Richmond, Va.
 Owner Atlantic Bridge Co.

VIRGINIA BRIDGE AND IRON CO.
 ROANOKE, VA.

To be fabricated at Roanoke
 Made by J.M.P.
 In charge of Moore
 Checked by G.I.
 Forged by
 Scale 1/4" = 1' Fl. Sheet No. 16

Material on Shop Bills 45,46,47

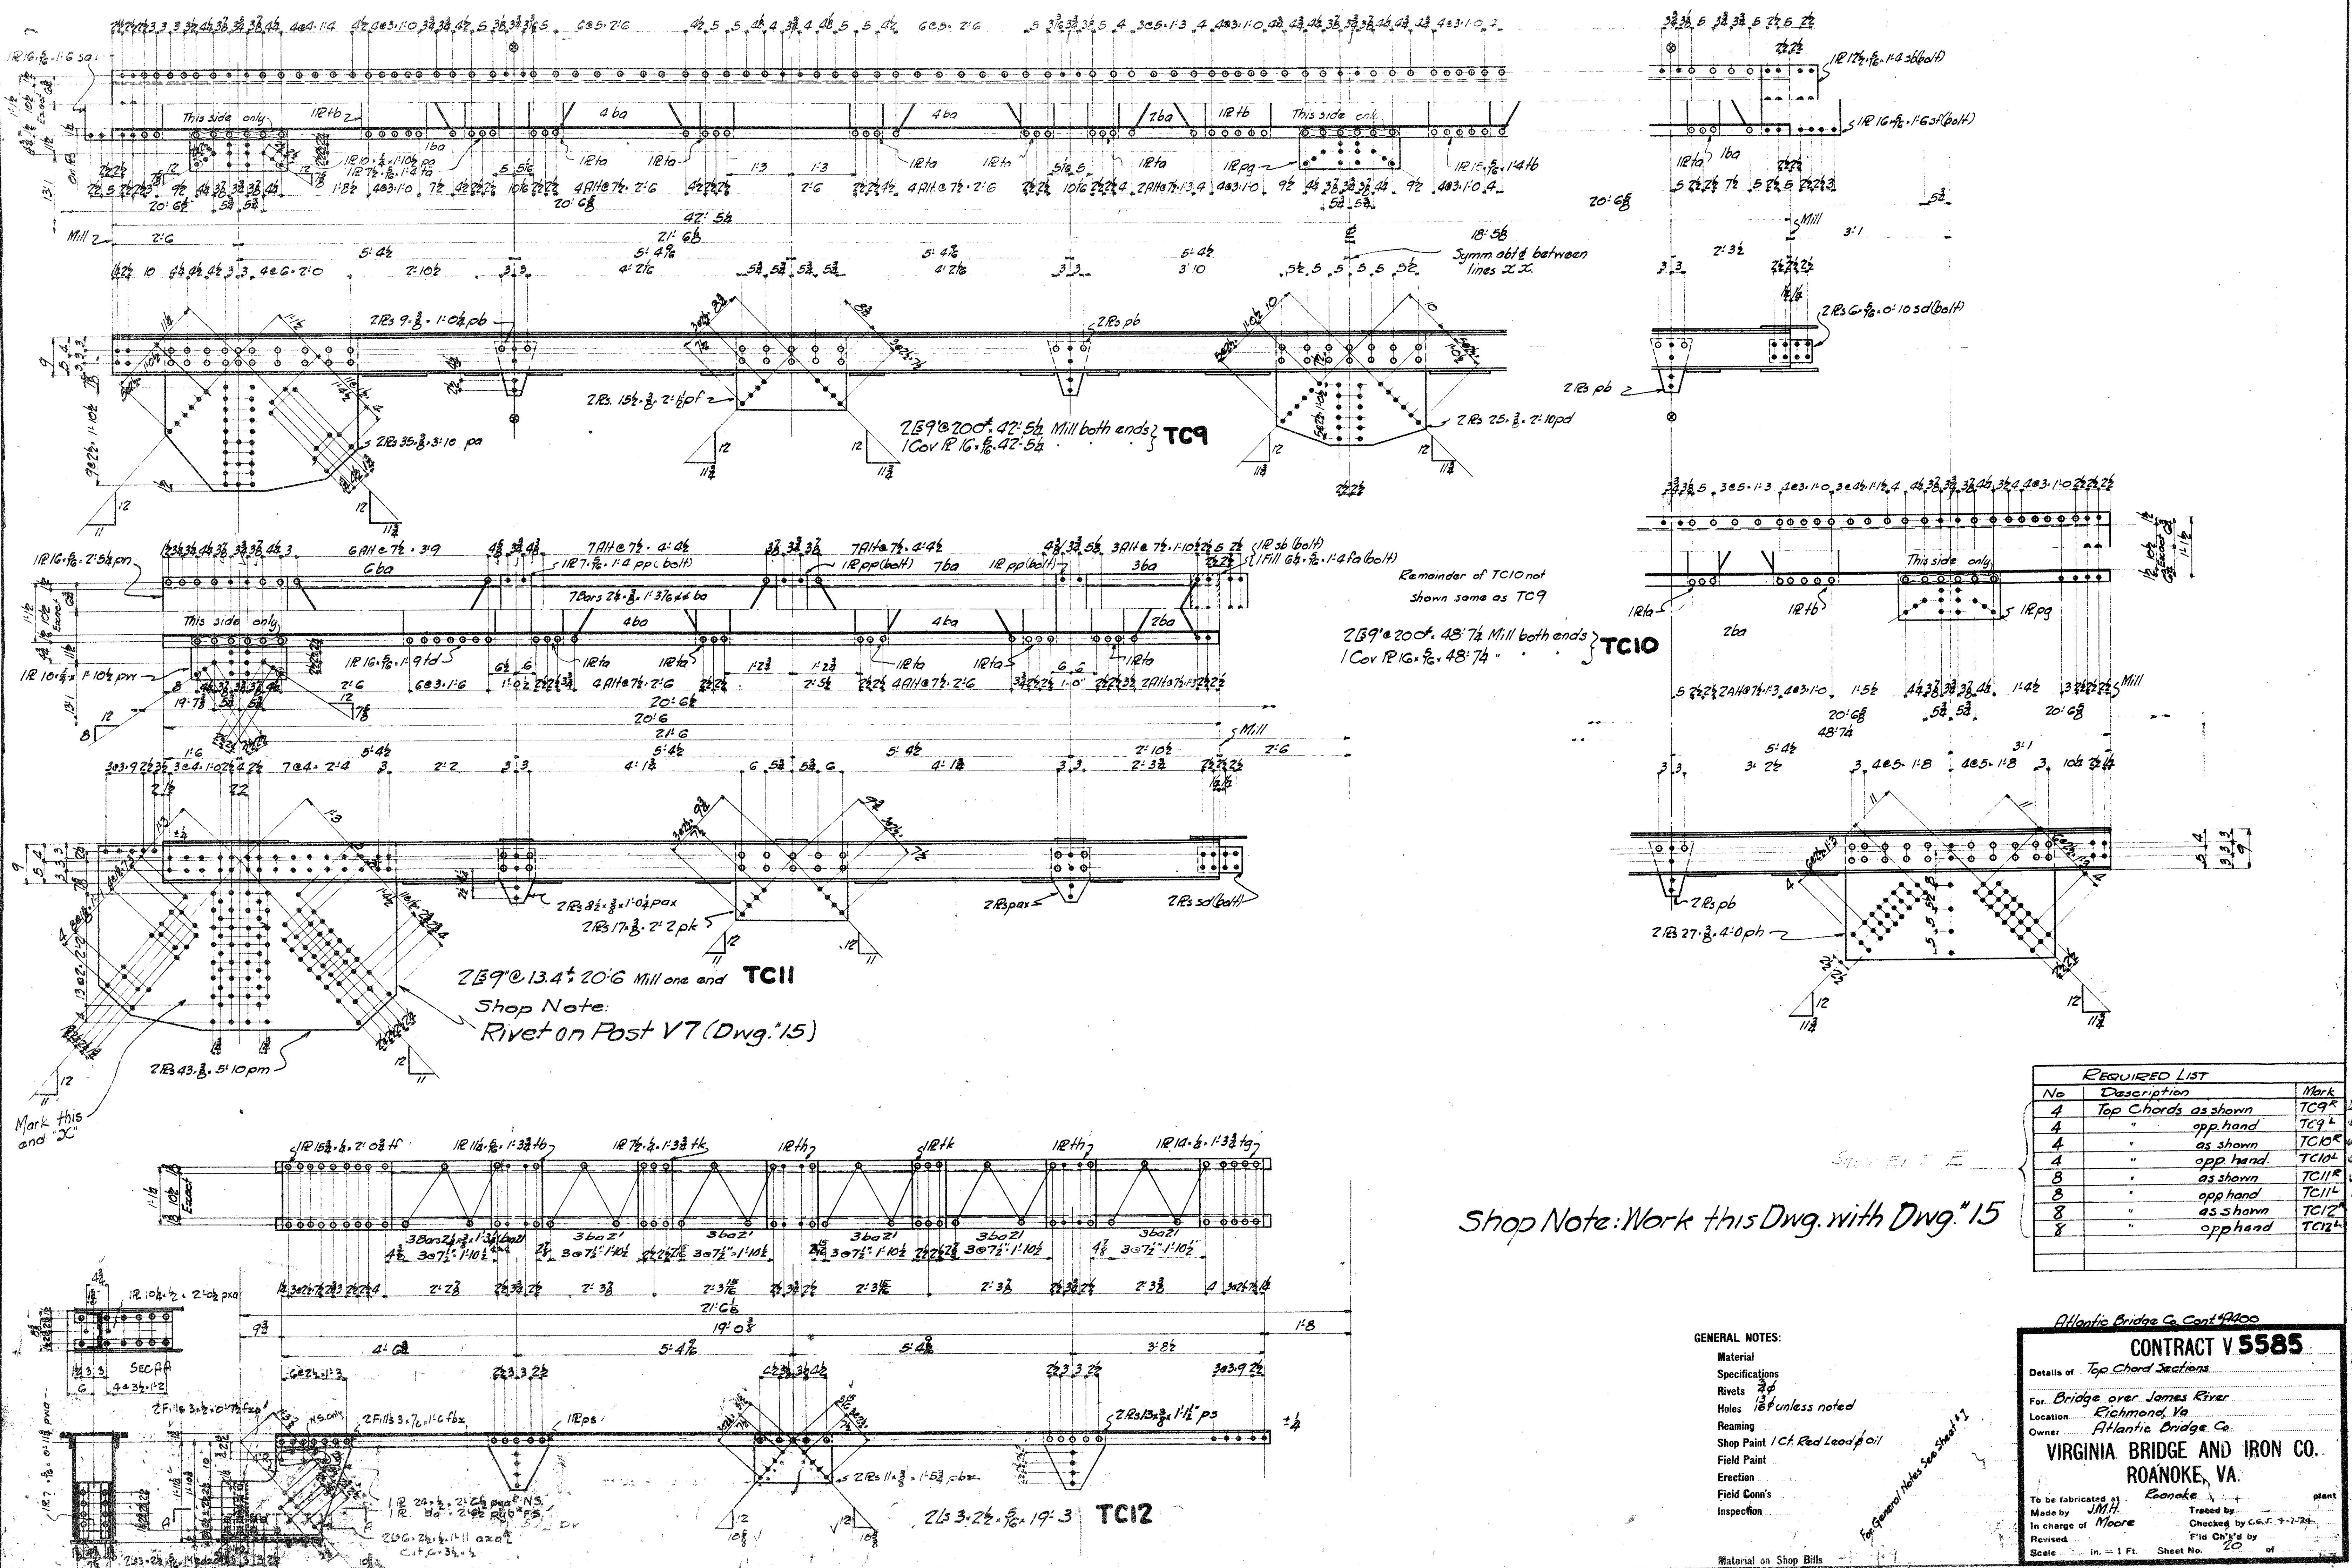

Mark this and '2'

TC11
 269' x 134' x 20' 6\"/>

Shop Note: Work this Dwg. with Dwg. #15

REQUIRED LIST		
No	Description	Mark
4	Top Chords as shown	TC9 ^R
4	" opp hand	TC9 ^L
4	" as shown	TC10 ^R
4	" opp hand	TC10 ^L
8	" as shown	TC11 ^R
8	" opp hand	TC11 ^L
8	" as shown	TC12 ^R
8	" opp hand	TC12 ^L

GENERAL NOTES:

- Material Specifications
- Rivets 3/8"
- Holes 1/8" unless noted
- Reaming
- Shop Paint 1/2" Red Lead paint
- Field Paint
- Erection
- Field Conn's
- Inspection

Atlantic Bridge Co. Cont. 4900










CONTRACT V 5585

Details of Top Chord Sections

For Bridge over James River
 Location Richmond, Va.
 Owner Atlantic Bridge Co.

VIRGINIA BRIDGE AND IRON CO.
 ROANOKE, VA.

To be fabricated at Roanoke plant
 Made by J.M.H. Traced by
 In charge of Moore Checked by C.G.S. 7-7-24
 Revised Field Ch'ed by
 Scale in. = 1 Ft. Sheet No. 20 of

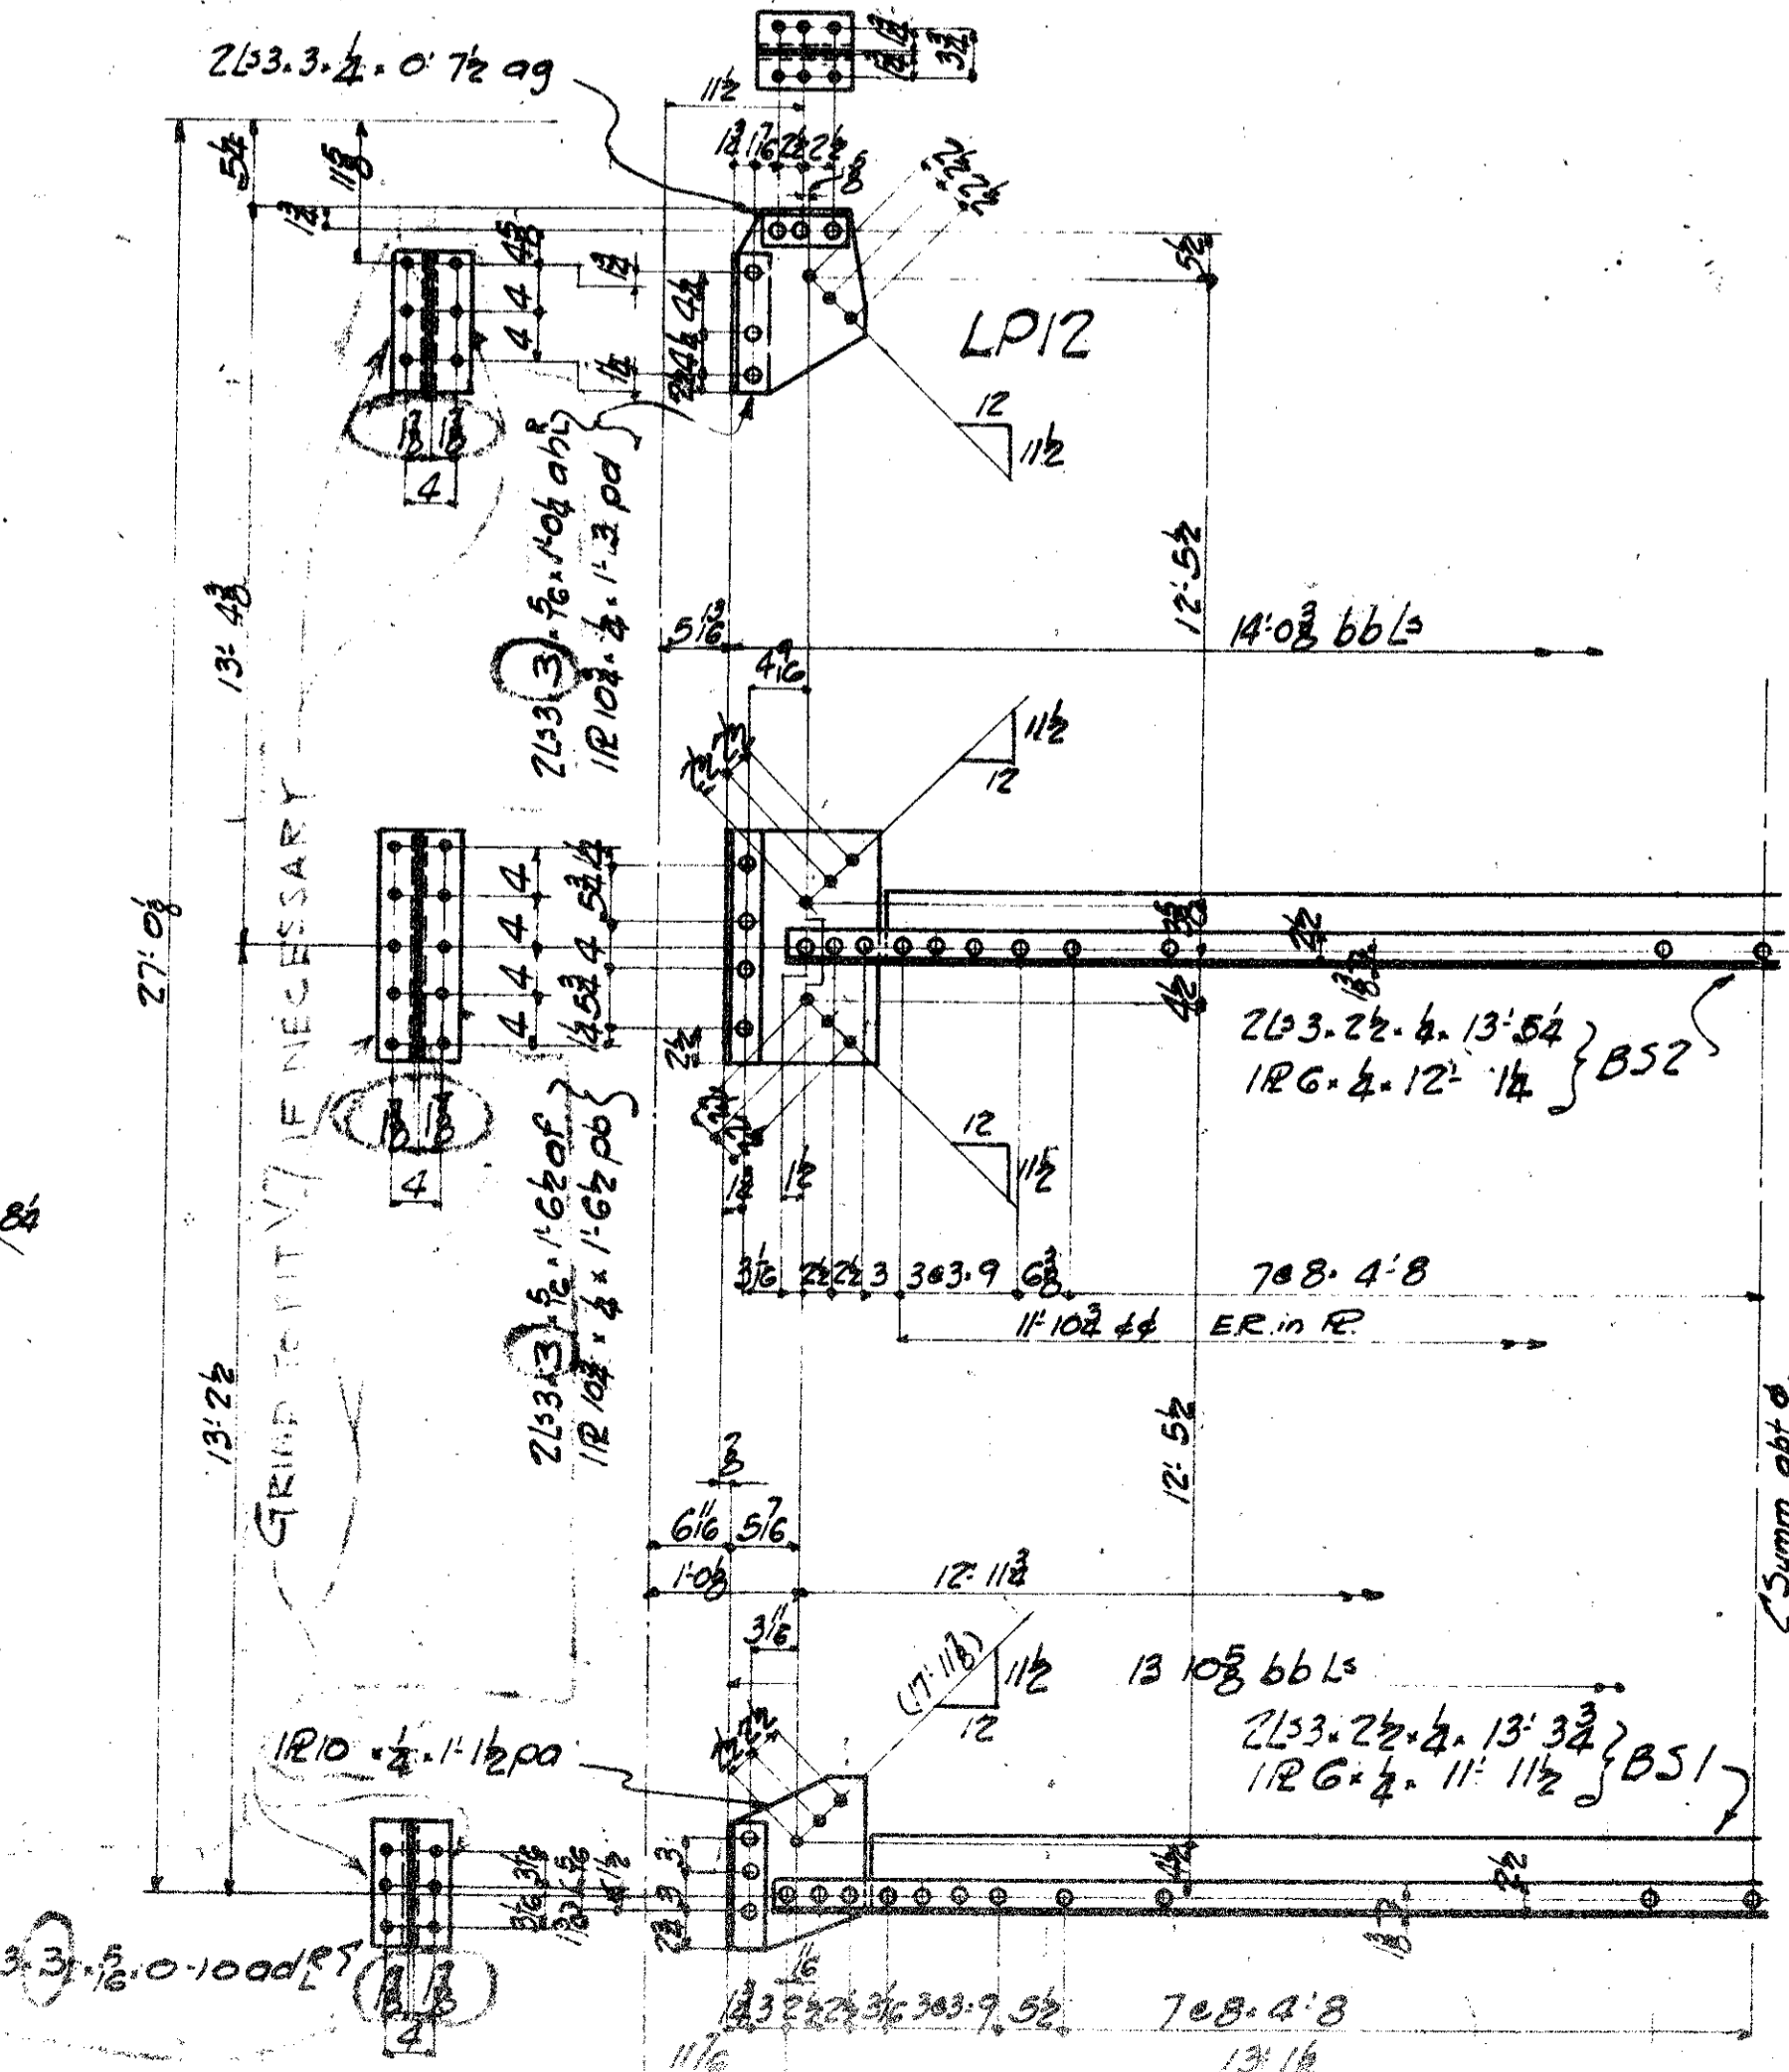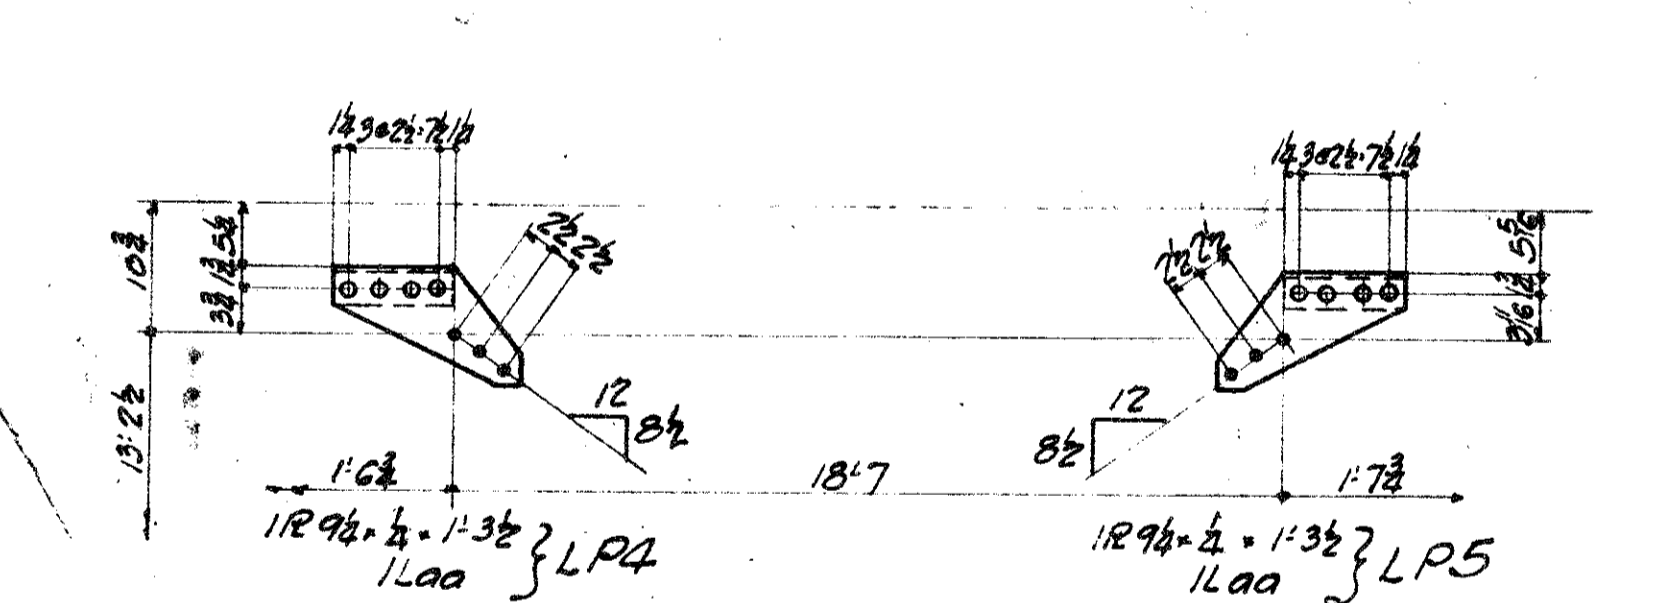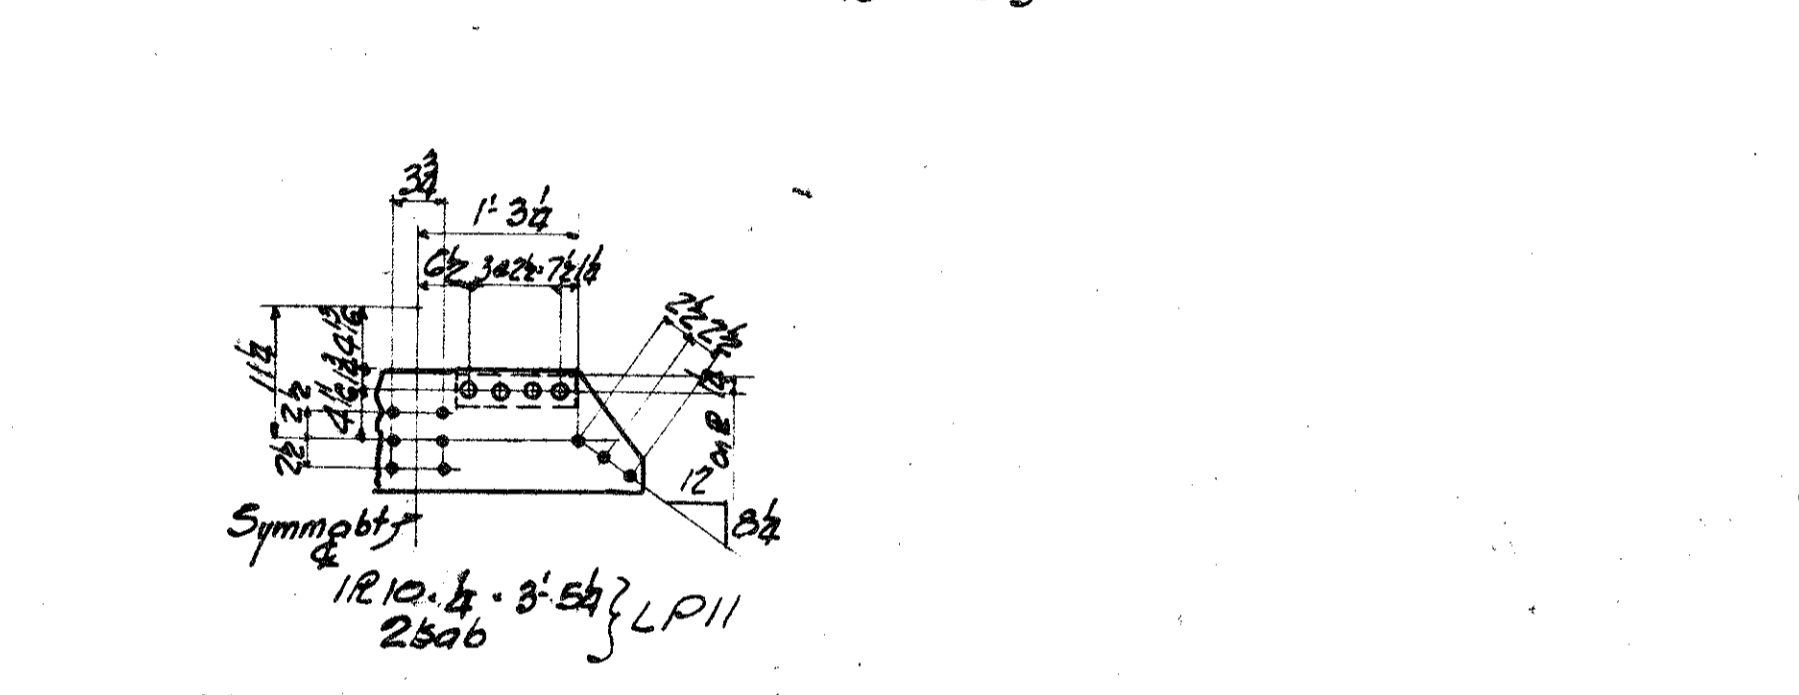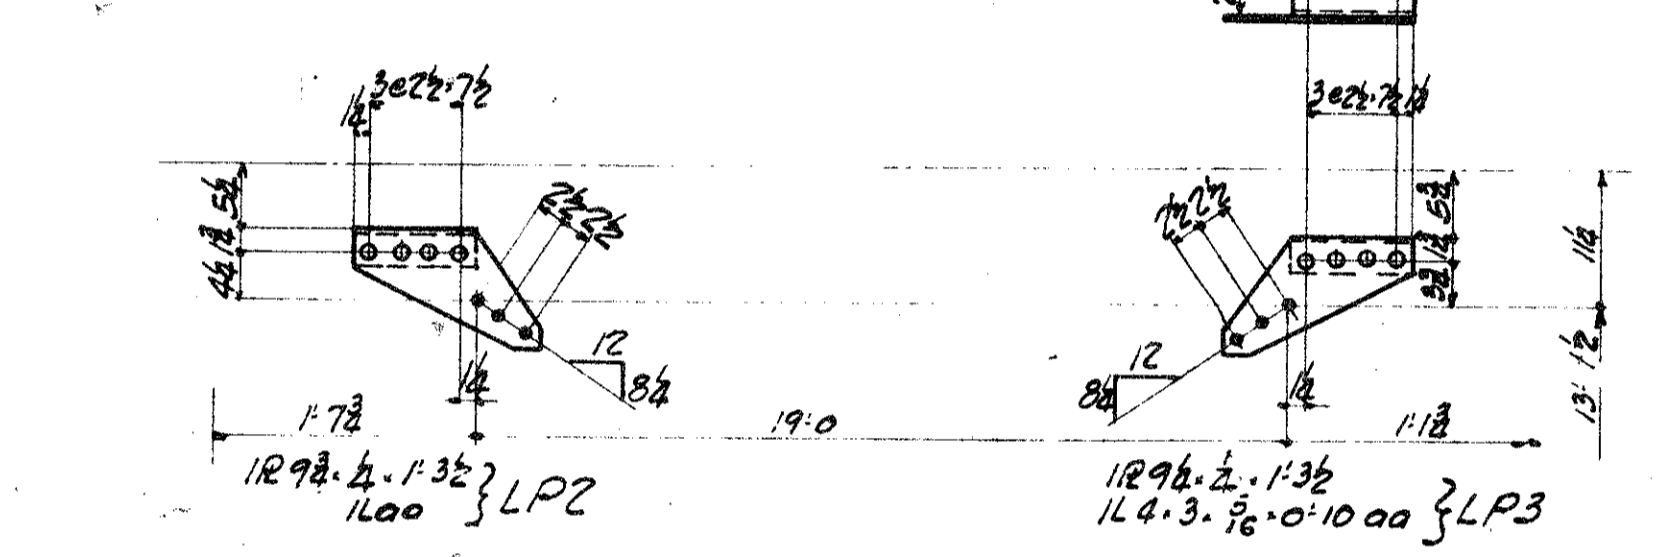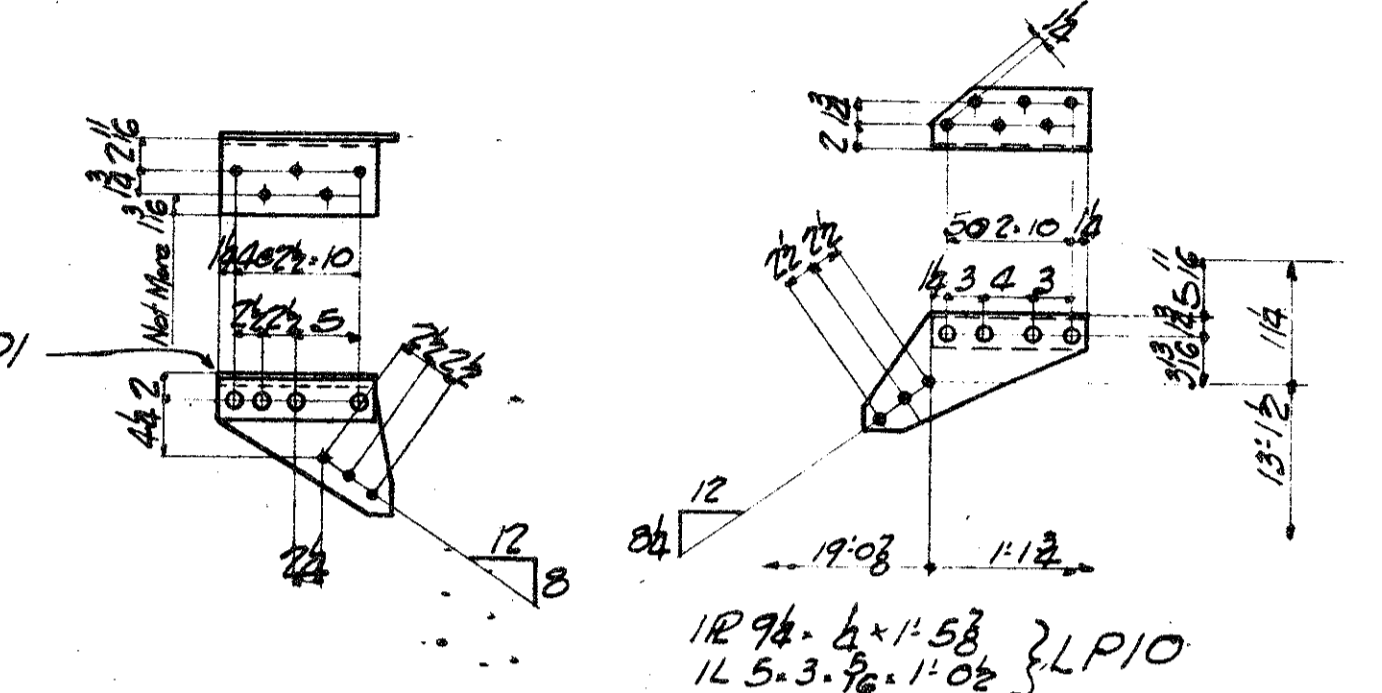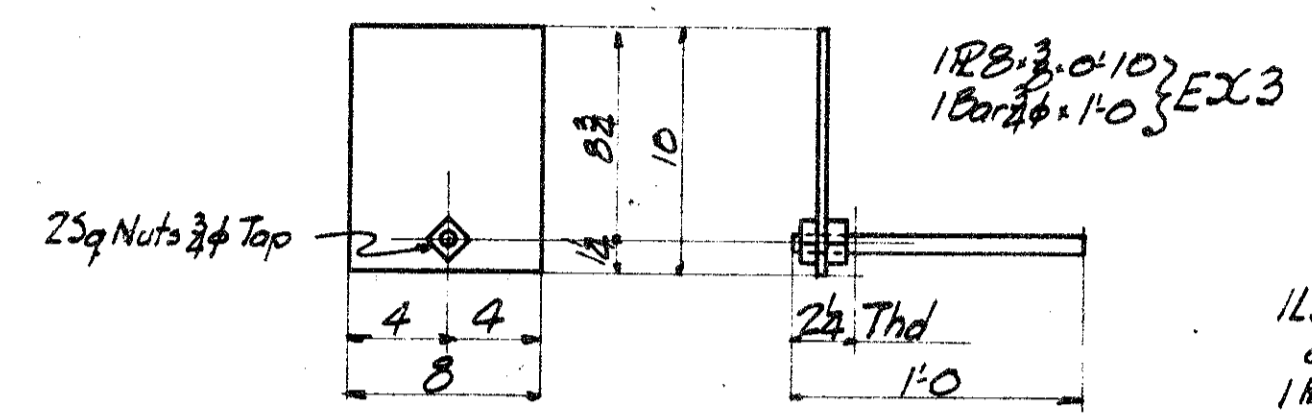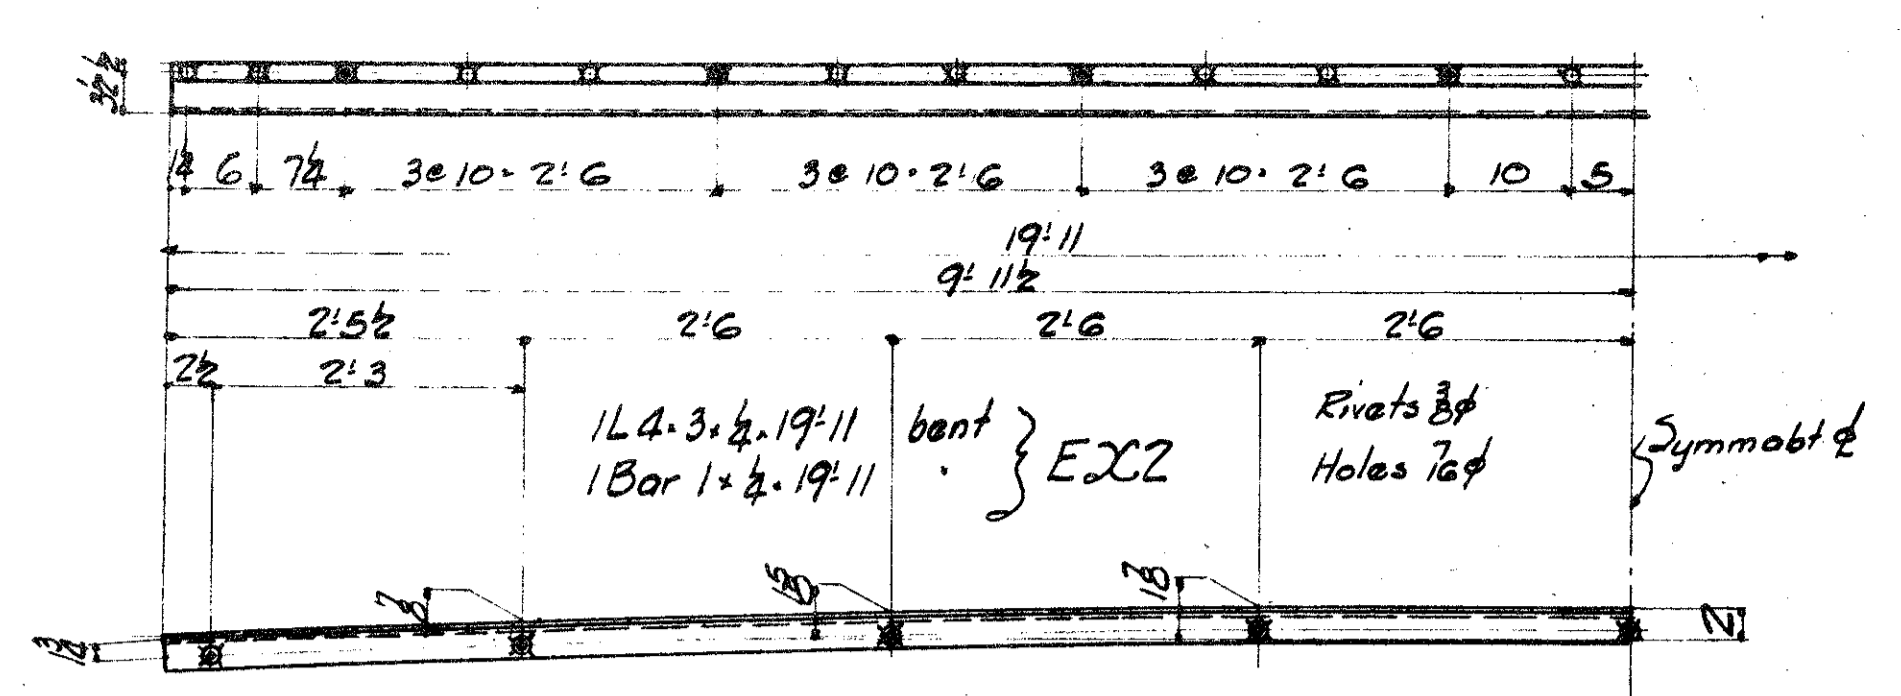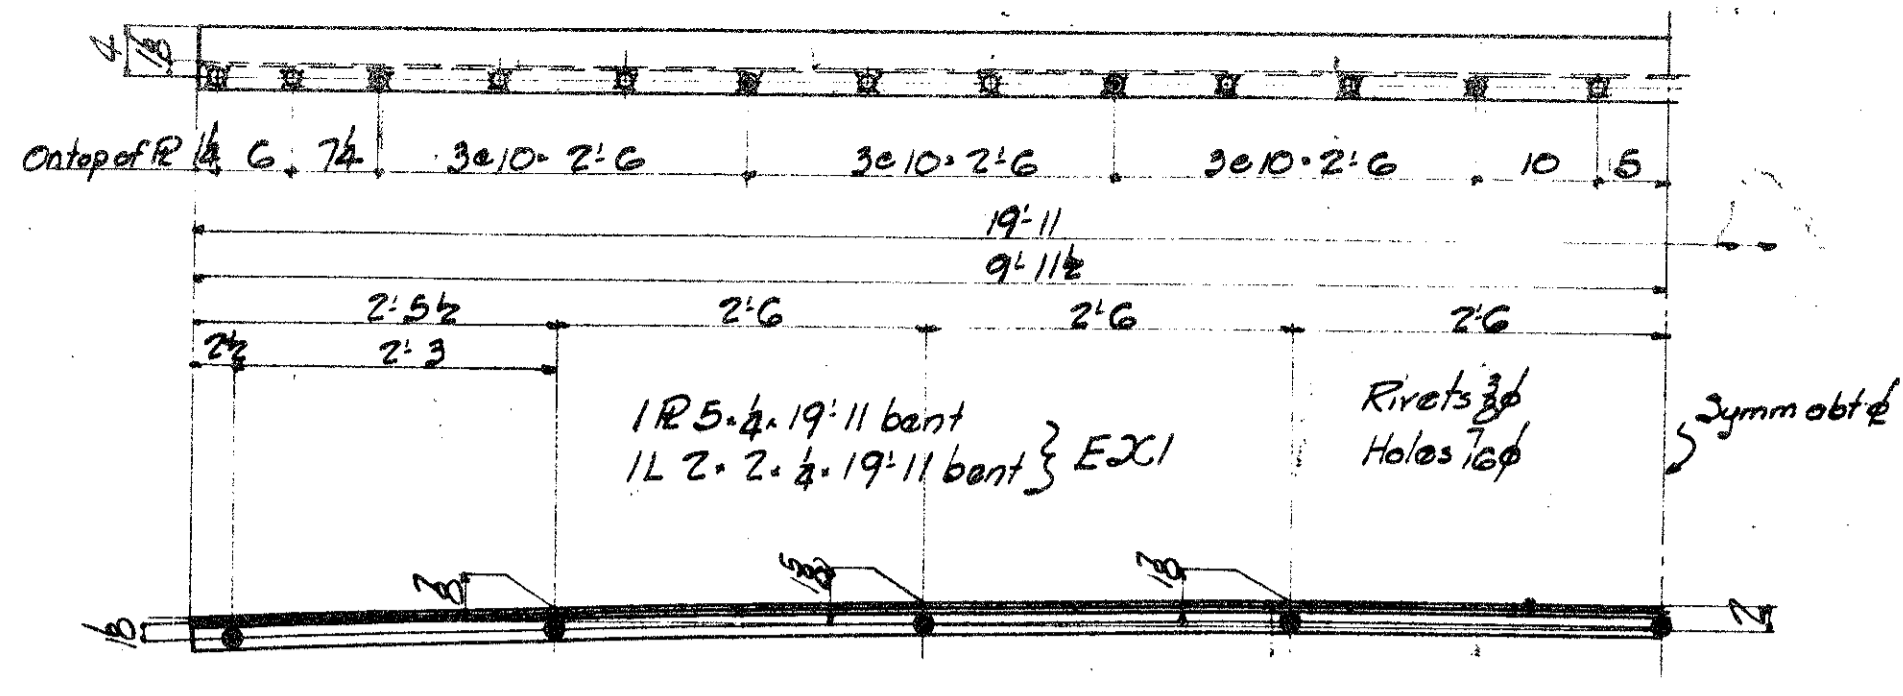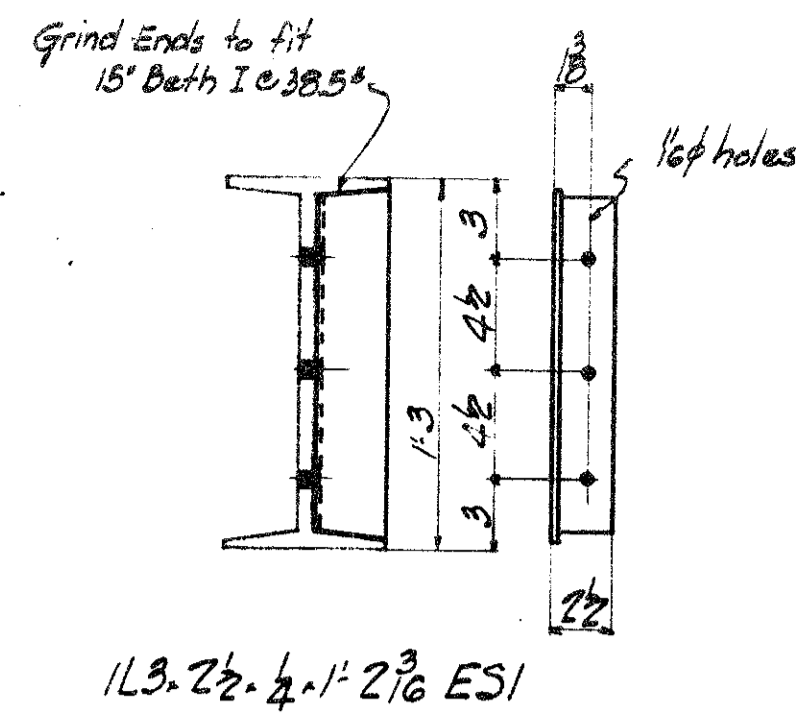

13ar 3-3 x 1-8 1/2 ba for L17-L20-L23-L26
L29-L32-L35-L38-L41-L44


Open holes for L17A-L20A-L23A
L26A-L29A-L32A-L35A-L38A
L41A-L44A, L16, L19, L22
L25, L28, L31, L37, L40, L43

L16	12-2 1/2	12-2 1/2
L19	11-9 1/8	11-9 1/8
L22	12-2 1/2	12-2 1/2
L25	11-8 3/4	11-8 3/4
L28	11-6 1/2	11-6 1/2
L31	11-4 1/2	11-4 1/2
L34	11-10 1/2	11-10 1/2
L37	11-7 1/8	11-7 1/8
L40	11-6 1/2	11-6 1/2
L43	8-11 1/8	8-11 1/8
L16		24-4 1/2
L19		23-6 1/2
L22		24-4 1/2
L25		23-5 1/2
L28		23-1
L31		22-9 1/8
L34		23-8 1/2
L37		23-2 1/2
L40		23-1 1/2
L43		17-11 1/8
L17A+L17		11-10
L20A+L20		11-5 1/2
L23A+L23		11-9 1/2
L26A+L26		11-4 1/2
L29A+L29		11-2 1/2
L32A+L32		11-0 1/2
L35A+L35		11-6 1/2
L38A+L38		11-3 1/2
L41A+L41		11-2 1/2
L44A+L44		8-7 1/2

24-6 1/2 for L16
23-9 1/2 L19
24-6 1/2 L22
23-8 L25
23-3 1/2 L28
22-11 1/2 L31
23-10 1/2 L34
23-5 1/2 L37
23-4 1/2 L40
18-2 1/2 L43
12-0 1/2 L17+L17A
11-7 1/2 L20+L20A
12-0 1/2 L23+L23A
11-7 1/2 L26+L26A
11-5 L29+L29A
11-3 1/2 L32+L32A
11-8 1/2 L35+L35A
11-5 1/2 L38+L38A
11-5 1/2 L41+L41A
8-10 1/2 L44+L44A

REQUIRED LIST		
No	Description	Mark
60	Stiffeners	ES1
6	Expansion Plates	EX1
6	Slides	EX2
24	Plates	EX3
204	Anchors 8" o. cast hd	AB1
8	Lateral Plates as shown	LP1R
8	" app hand	LP1L
8	" as shown	LP2R
8	" app hand	LP2L
8	" as shown	LP3R
8	" app hand	LP3L
8	" as shown	LP4R
8	" app hand	LP4L
8	" as shown	LP5R
8	" app hand	LP5L
16	" as shown	LP6R
16	" app hand	LP6L
10	" as shown	LP7R
10	" app hand	LP7L
8	" as shown	LP8R
8	" app hand	LP8L
2	" as shown	LP9R
2	" app hand	LP9L
18	" as shown	LP10R
18	" app hand	LP10L
18	" as shown	LP11R
18	" app hand	LP11L
8	Bottom Struts	B51
8	Struts	B52
16	Lateral Plates	LP12
26	Laterals	L16
26	"	L17
8	"	L19
8	"	L20
8	"	L22
8	"	L23
10	"	L25
10	"	L28
8	"	L31
8	"	L32
8	"	L34
8	"	L35
10	"	L37
10	"	L38
18	"	L40
18	"	L41
16	"	L43
16	"	L44
9	Struts	B56
26	Laterals	L17A
8	"	L20A
8	"	L23A
10	"	L26A
8	"	L29A
8	"	L32A
8	"	L35A
10	"	L38A
18	"	L41A
16	"	L44A

SHIPMENT E

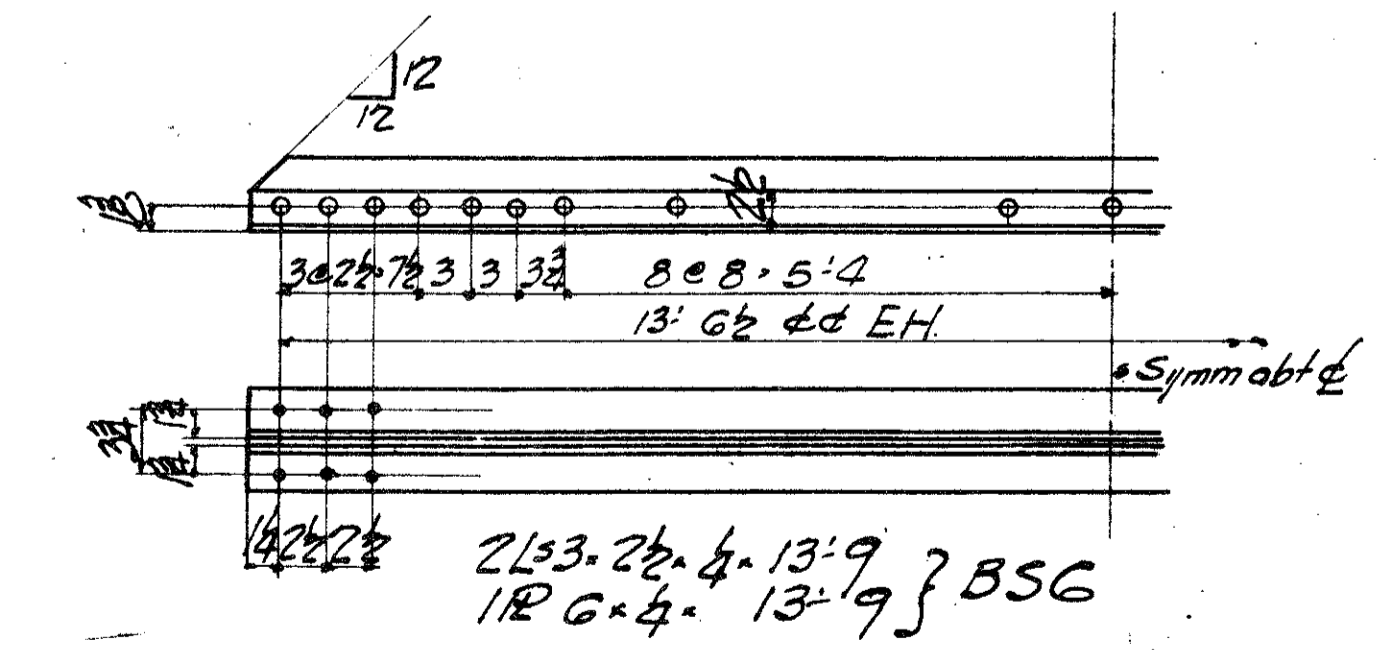

GENERAL NOTES:
Material Specifications
Rivets 3/4" unless noted
Holes 1 3/4"
Reaming
Shop Paint 1/2" Red Lead/Oil
Field Paint
Erection
Field Conn's
Inspection

For General Notes See Sheet 1

Atlantic Bridge Co Cont R400

CONTRACT V 5585

Details of Expansion Plates etc, Laterals and Lateral Plates

For Bridge over James River

Location Richmond, Va

Owner Atlantic Bridge Co

VIRGINIA BRIDGE AND IRON CO.

ROANOKE, VA.

To be fabricated by
Made by JMH
In charge of Moore
Revised
Scale 1" = 1 Ft



Traced by
Checked by
Field Checked by
Inspected by

Bridge 4

(SB Powhite Parkway Over Chippenham Parkway)




Record Set Plans

RICHMOND EXPRESSWAY SYSTEM			
SECTION	PROJECT	SHEET NO.	TOTAL SHEETS
2	POWHITE PARKWAY	118	188

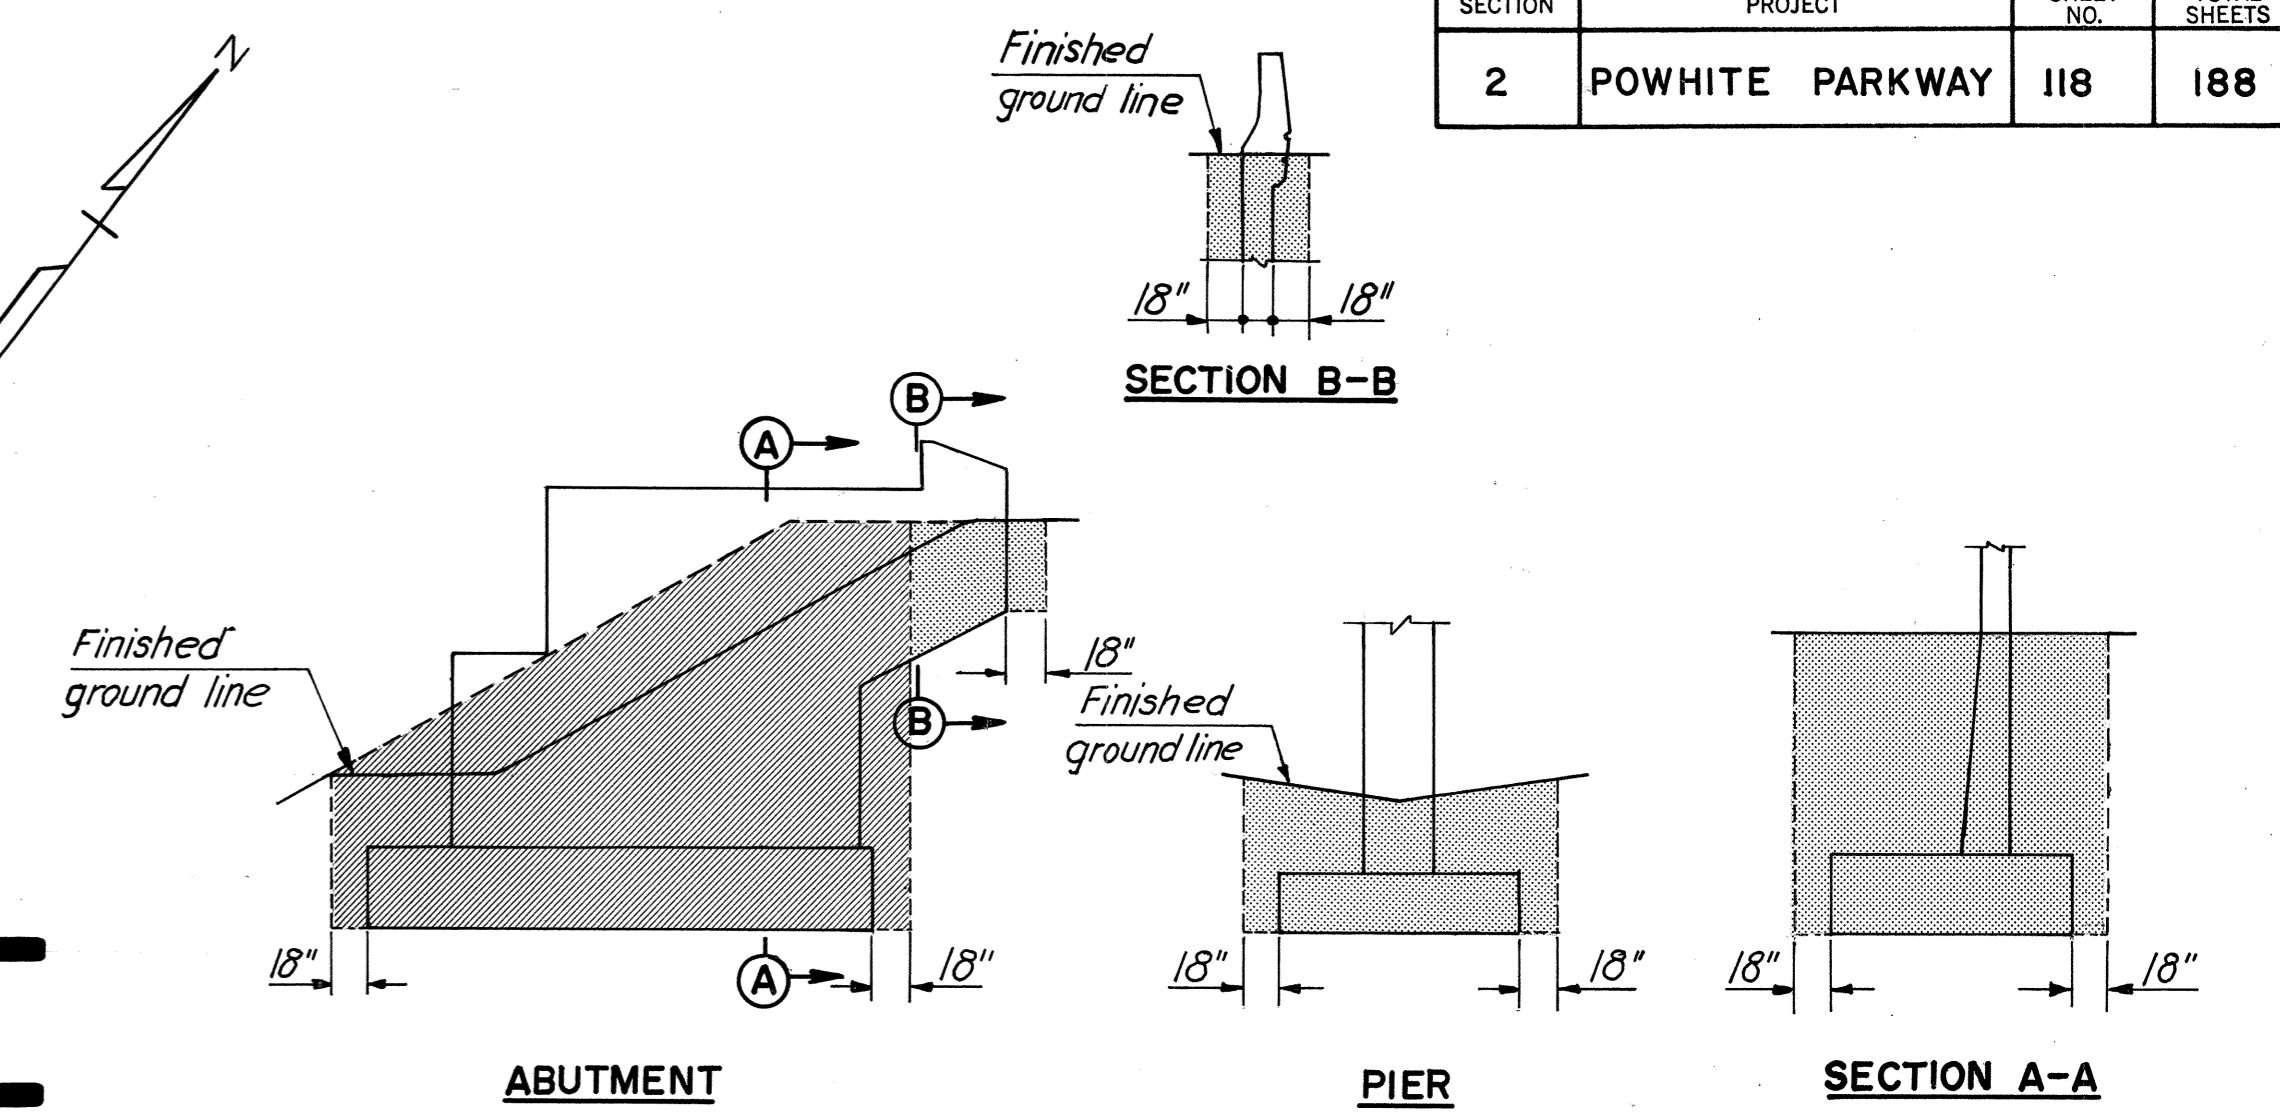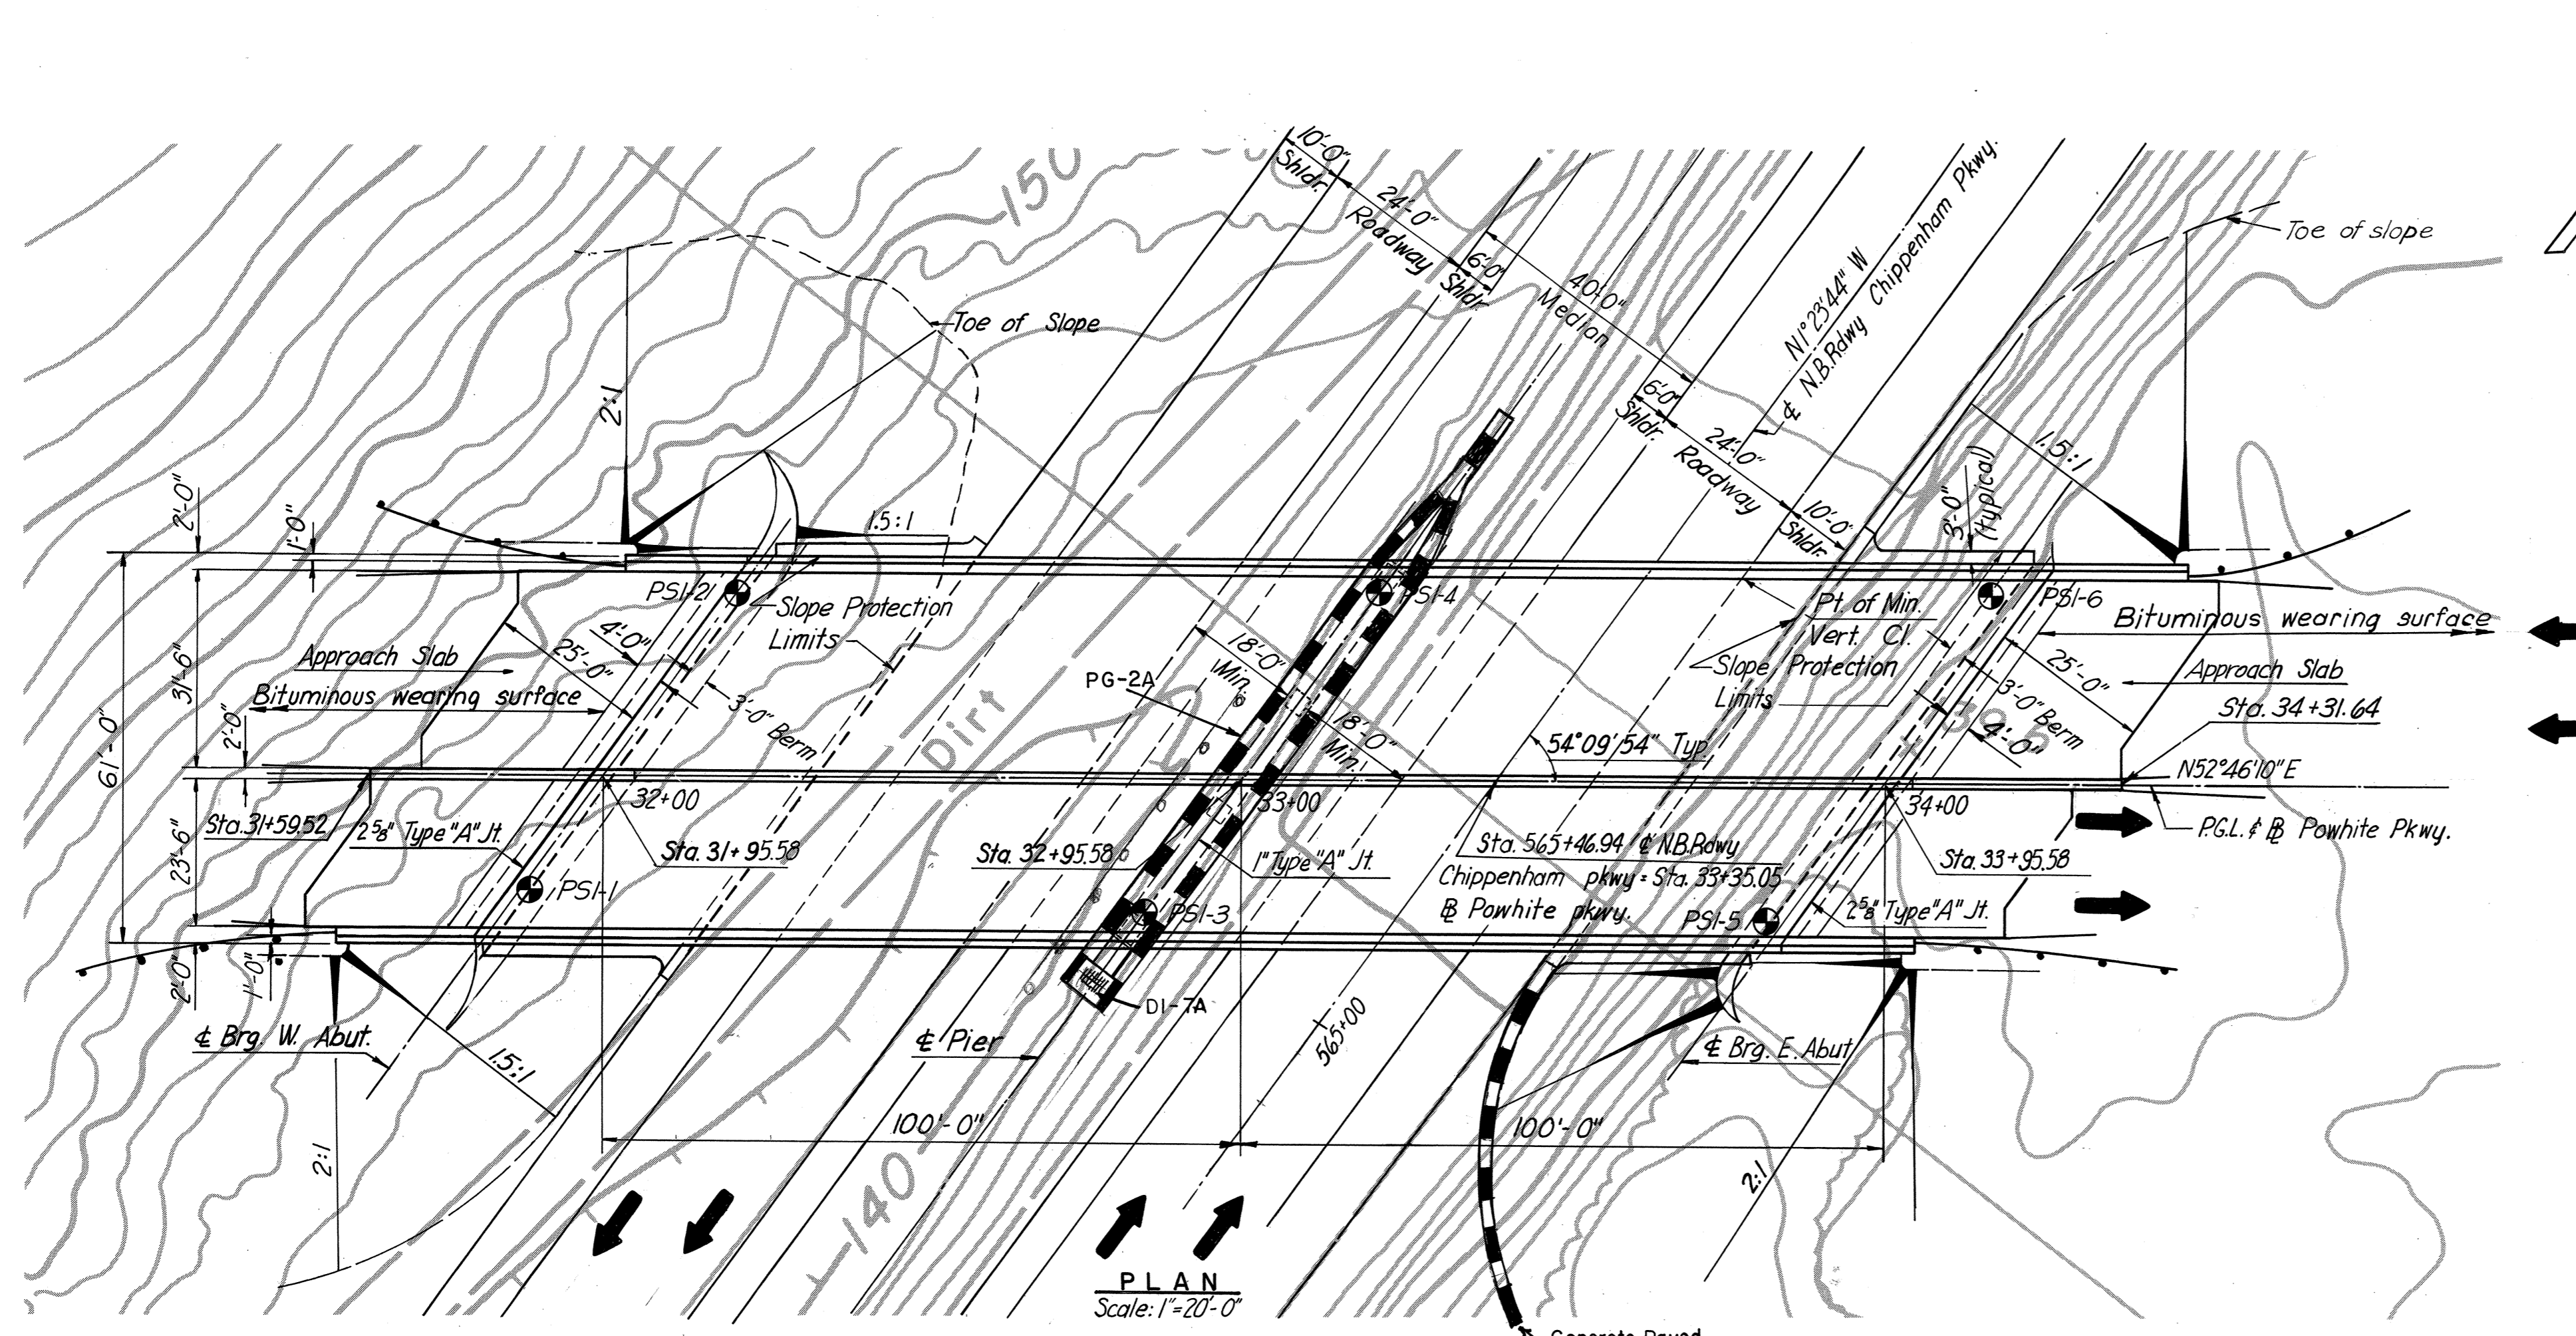

PAYMENT LIMITS FOR STRUCTURE EXCAVATIONS
No Scale

INDEX	
NO.	DESCRIPTION
1.	General Plan and Elevation
2.	General Notes and Quantities
3.	West Abutment
4.	East Abutment
5.	Abutment Details (1)
6.	Abutment Details (2)
7.	Pier Details
8.	Framing Plan
9.	Cross Section
10.	Deck Plans
11.	Joint Details
12.	Approach Slab and Slope Protection
13.	Boring Logs
14.	Boring Logs
S1.	Standard Shoe Details
S2.	Standard Aluminum Rolling Details
S7.	Standard Architectural Details

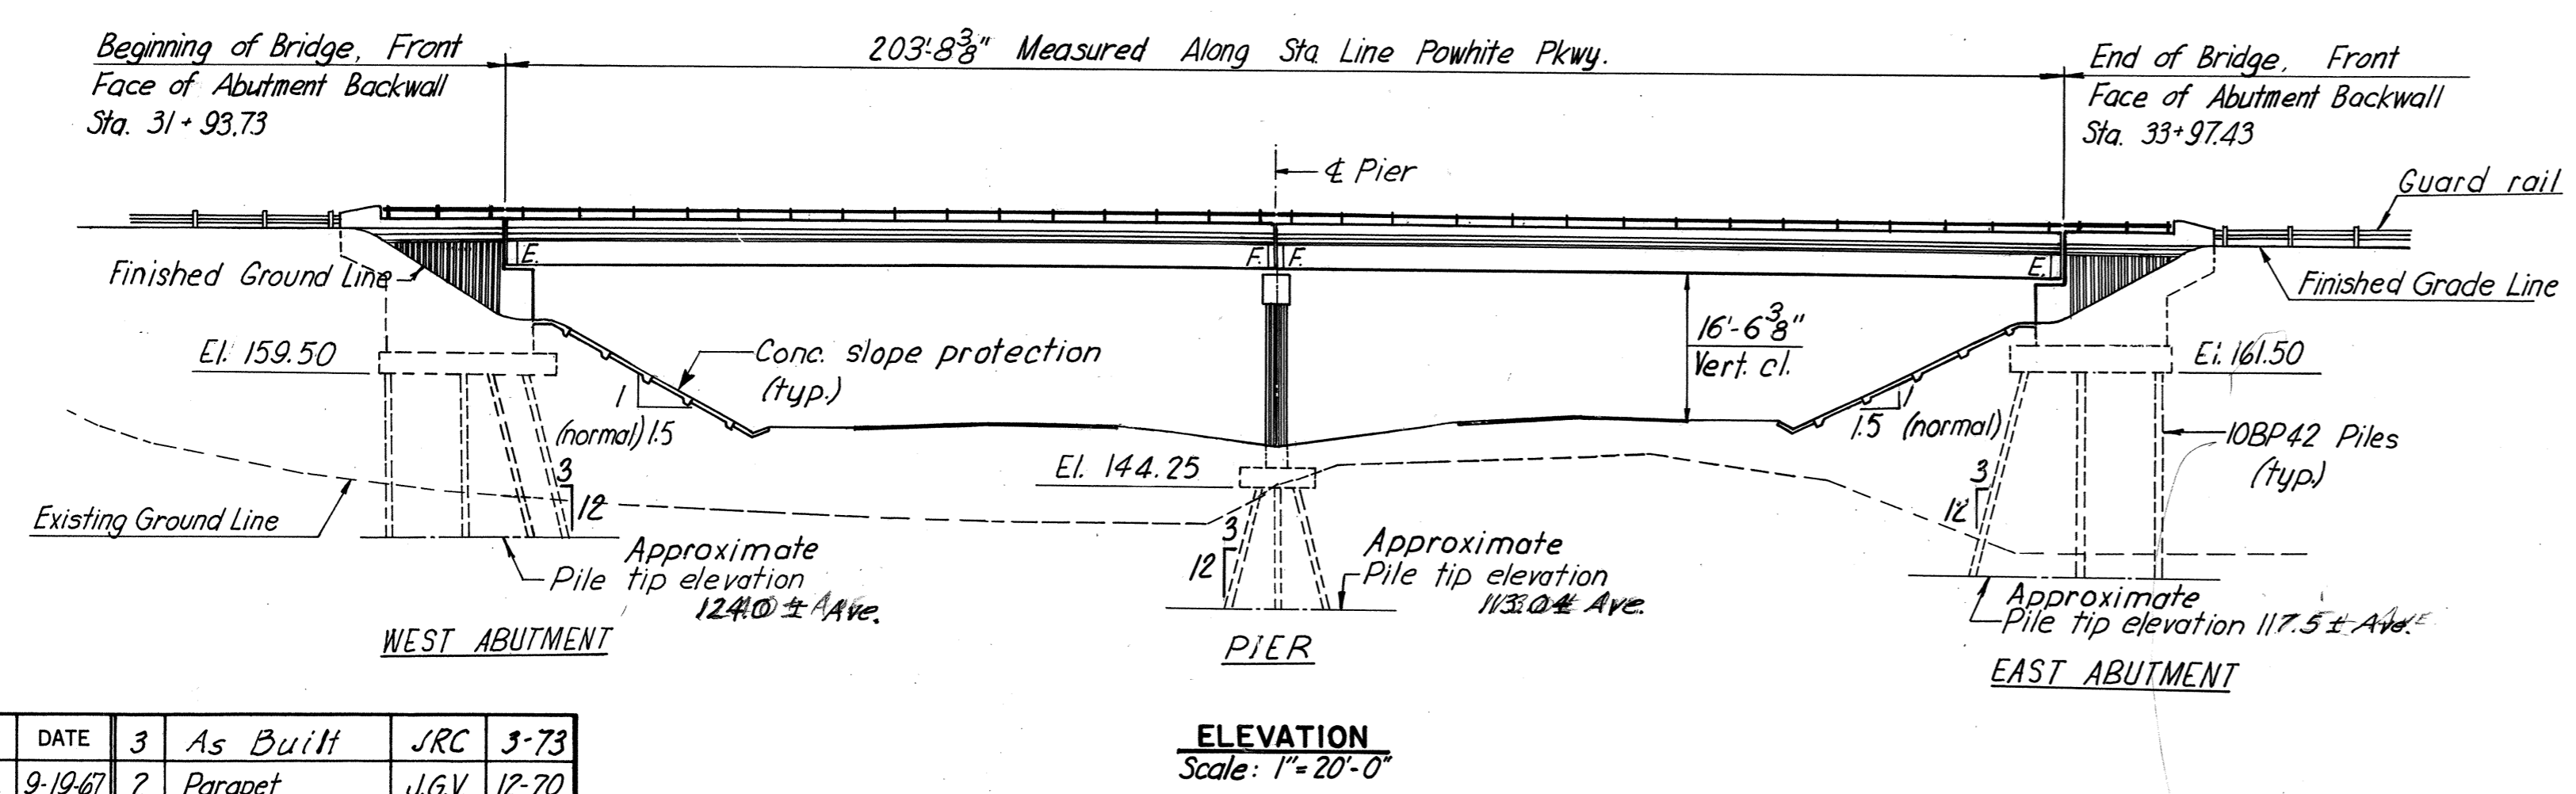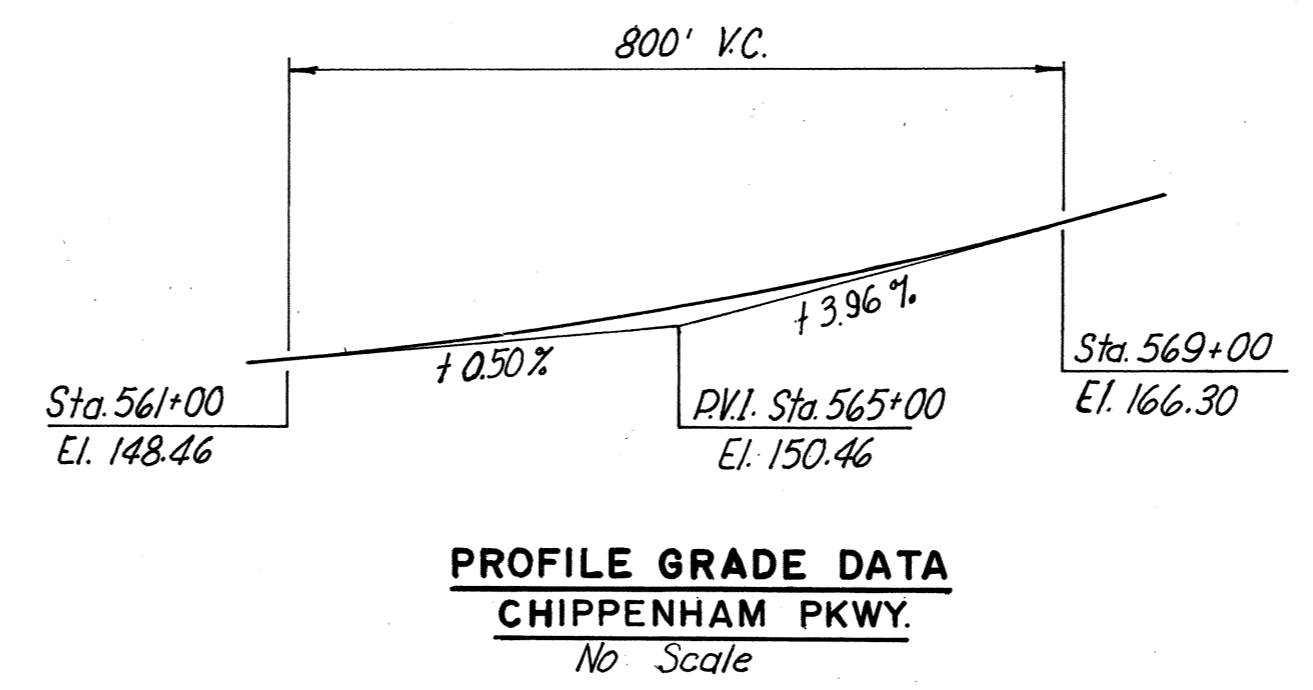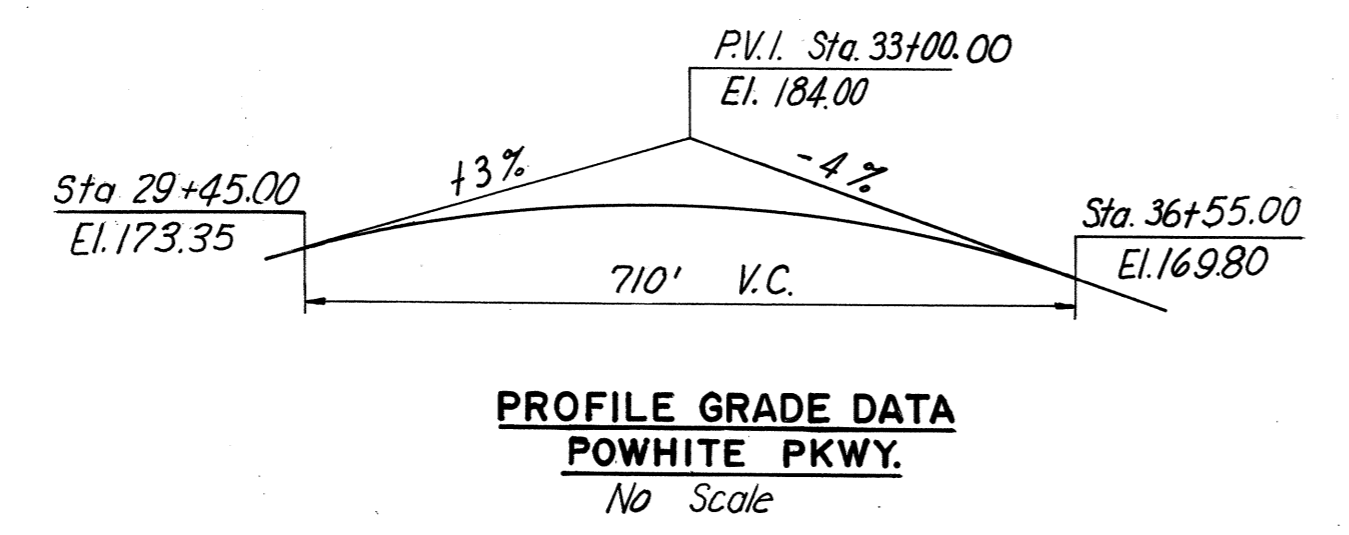

BORINGS: ● Indicates location of 2 1/2\"/>

BENCH MARKS: See Reference Ties and Field Control Data sheet in highway plans.
F-30 (Copper Weld Rod) Elevation 218.82
G-11 (Copper Weld Rod) Elevation 150.10

AS BUILT

**RICHMOND METROPOLITAN AUTHORITY
RICHMOND EXPRESSWAY SYSTEM
POWHITE PARKWAY**

**POWHITE PARKWAY OVER
CHIPPENHAM PARKWAY
BRIDGE B-04**

GENERAL PLAN & ELEVATION

BY	DATE	3	As Built	JRC	5-73	
MADE	TE.M.	9-19-67	2	Parapet	J.G.V.	12-70
CHECKED	DSB	5-27-68	1	Dimension	TE.M.	5-68
IN CHARGE	PRY		NO.	REVISION	BY	DATE

SCALE: **AS SHOWN**


HOWARD, NEEDLES, TAMMEN & BERGENDOFF
consulting engineers
NEW YORK ALEXANDRIA KANSAS CITY

CONTRACT NO. **C-2**


SHEET NO. **1** OF **14**

RICHMOND EXPRESSWAY SYSTEM			
SECTION	PROJECT	SHEET NO.	TOTAL SHEETS
2	POWHITE PARKWAY	120	188


For guardrail attachment
Details see Abutment
Details (2) sheet

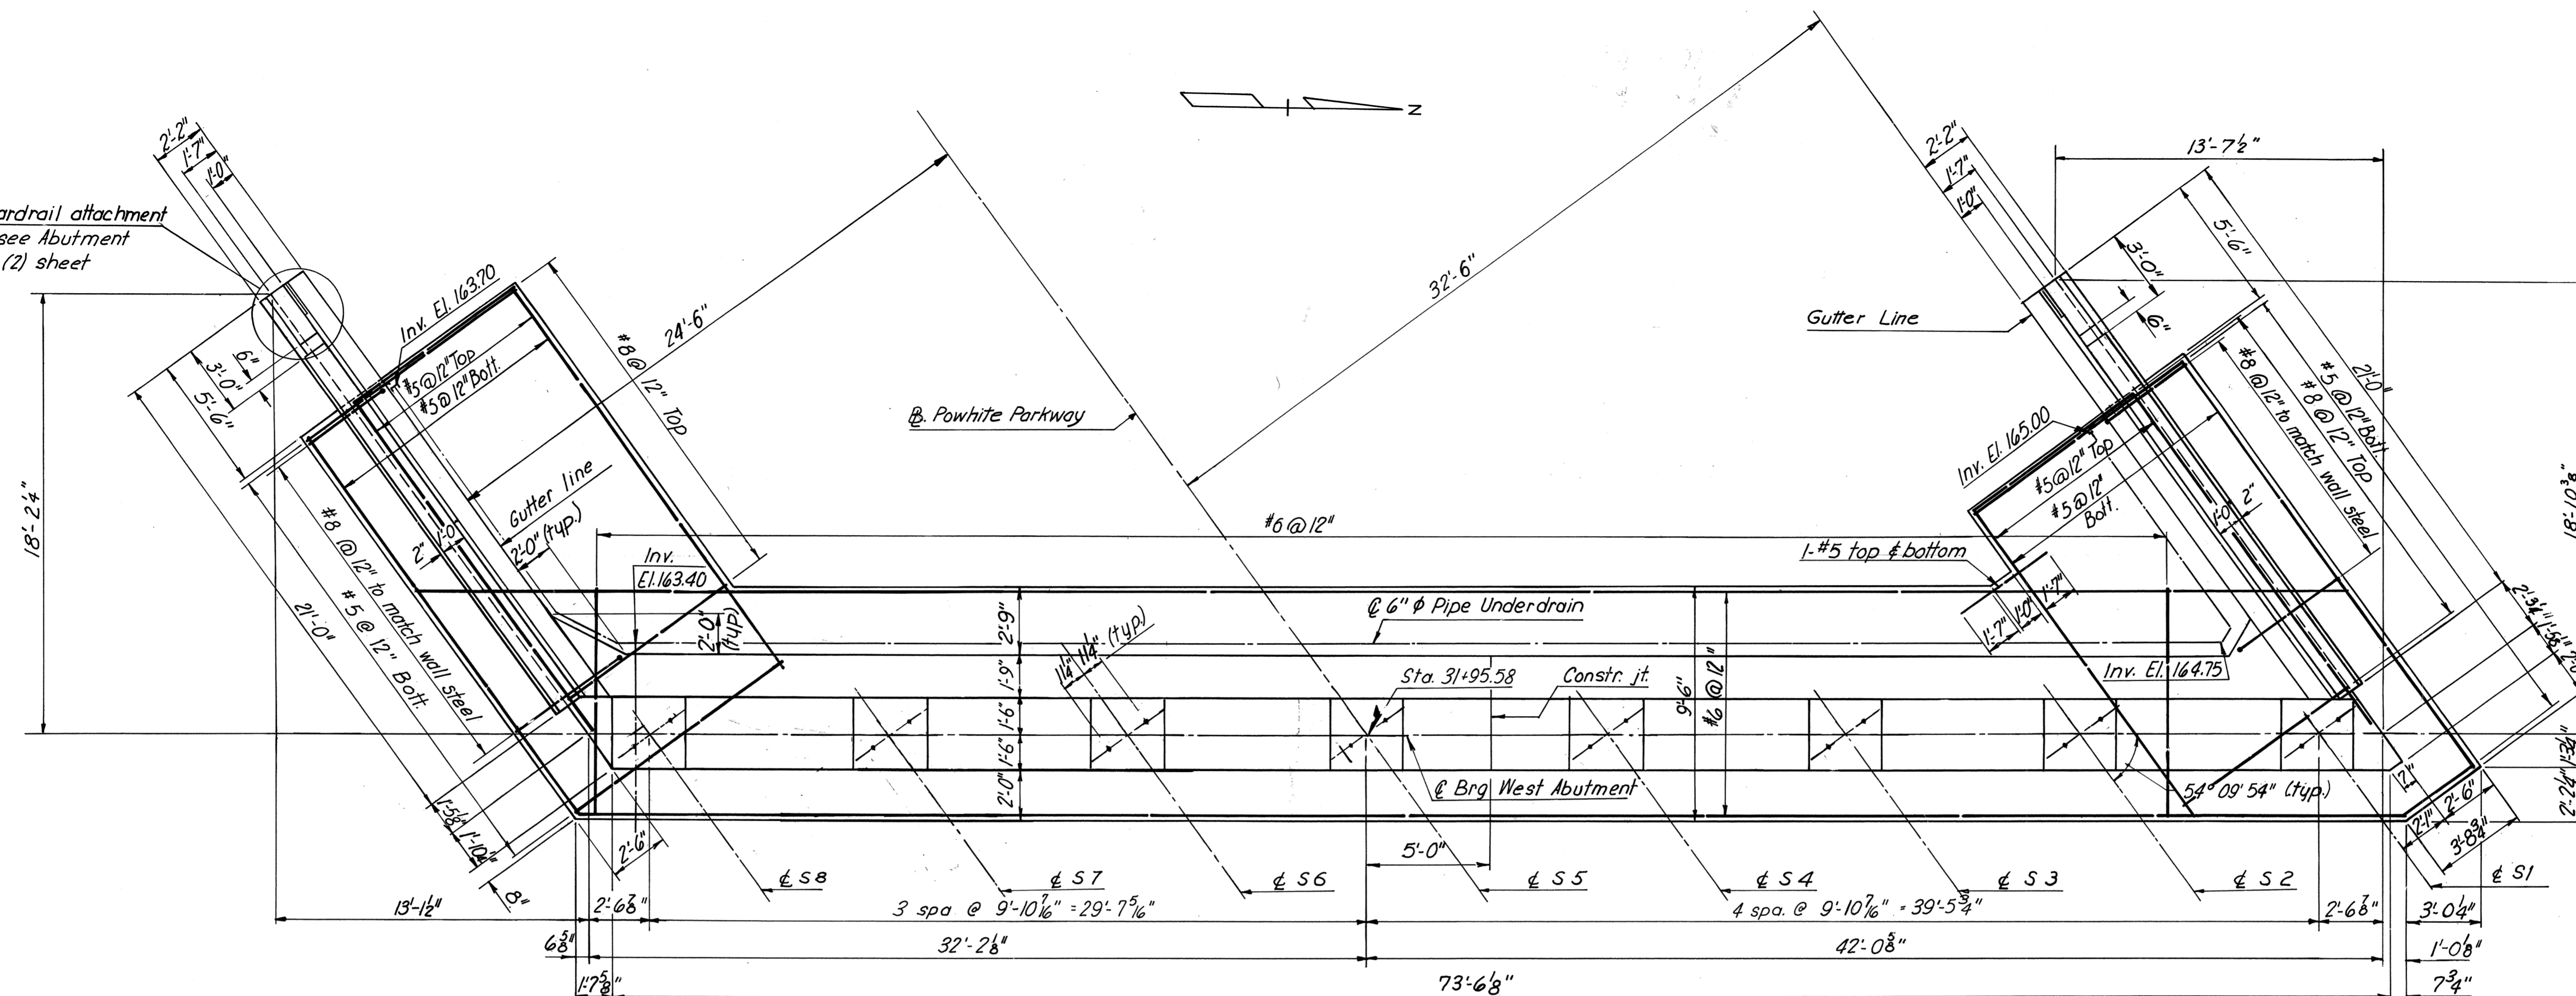


PLAN

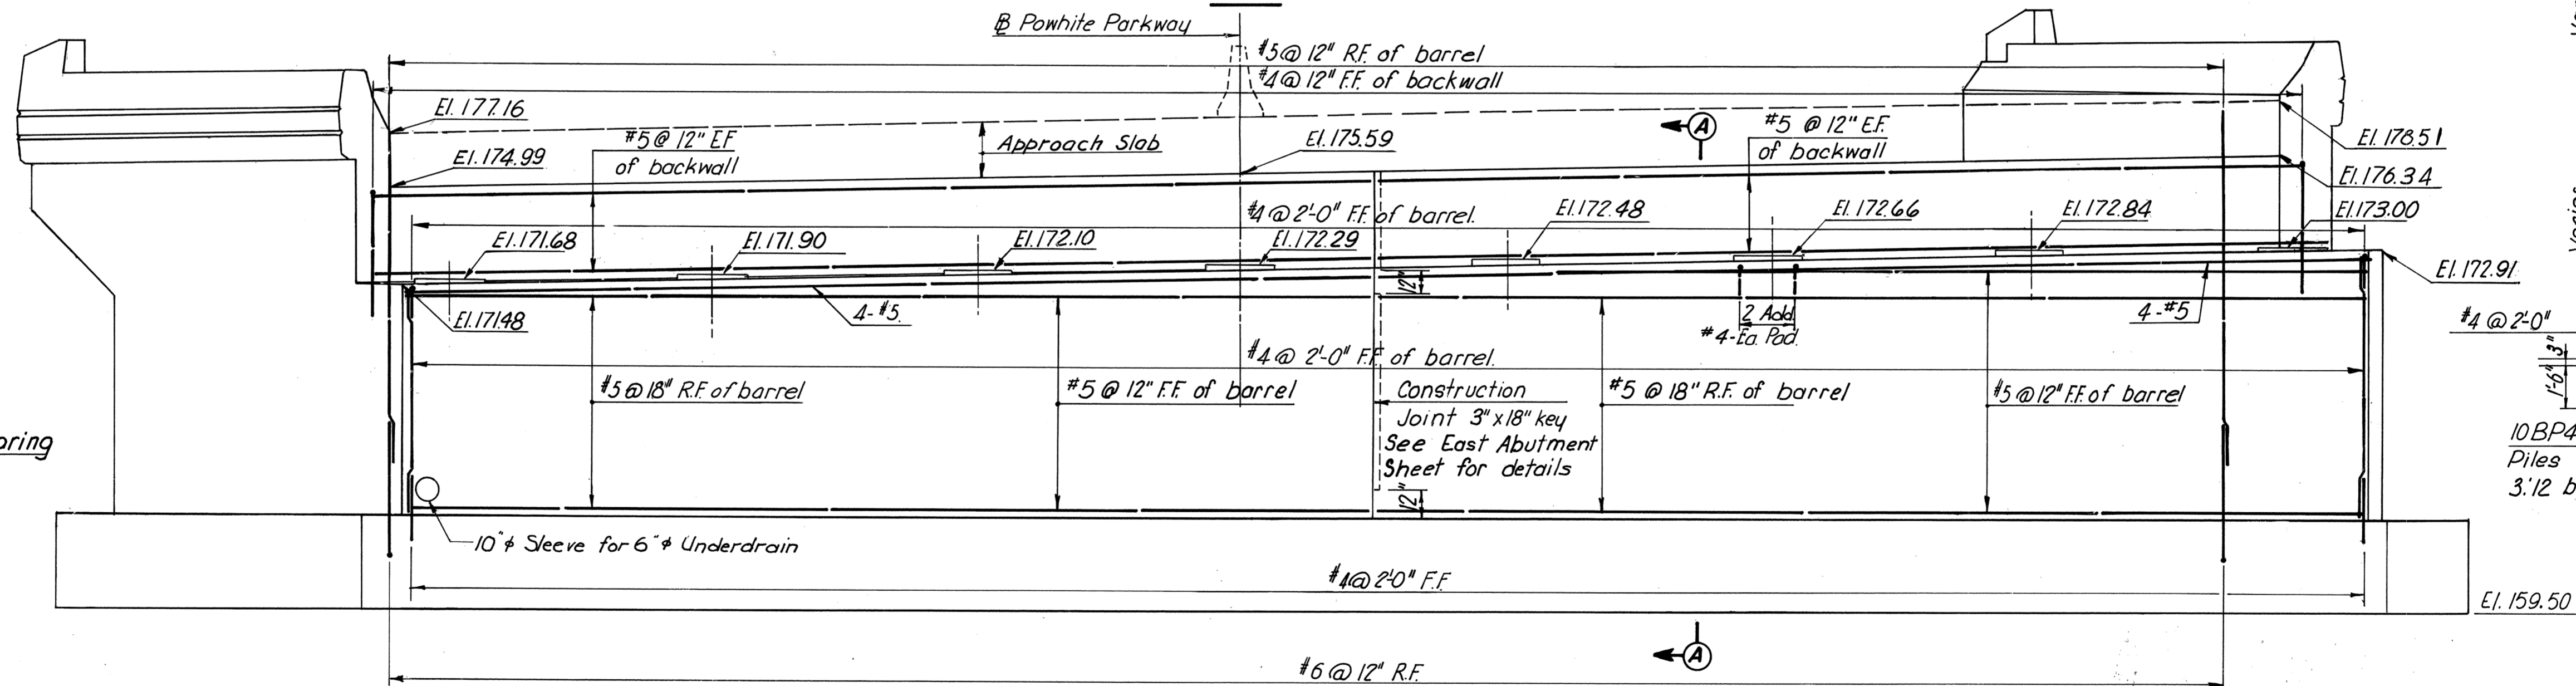

ELEVATION

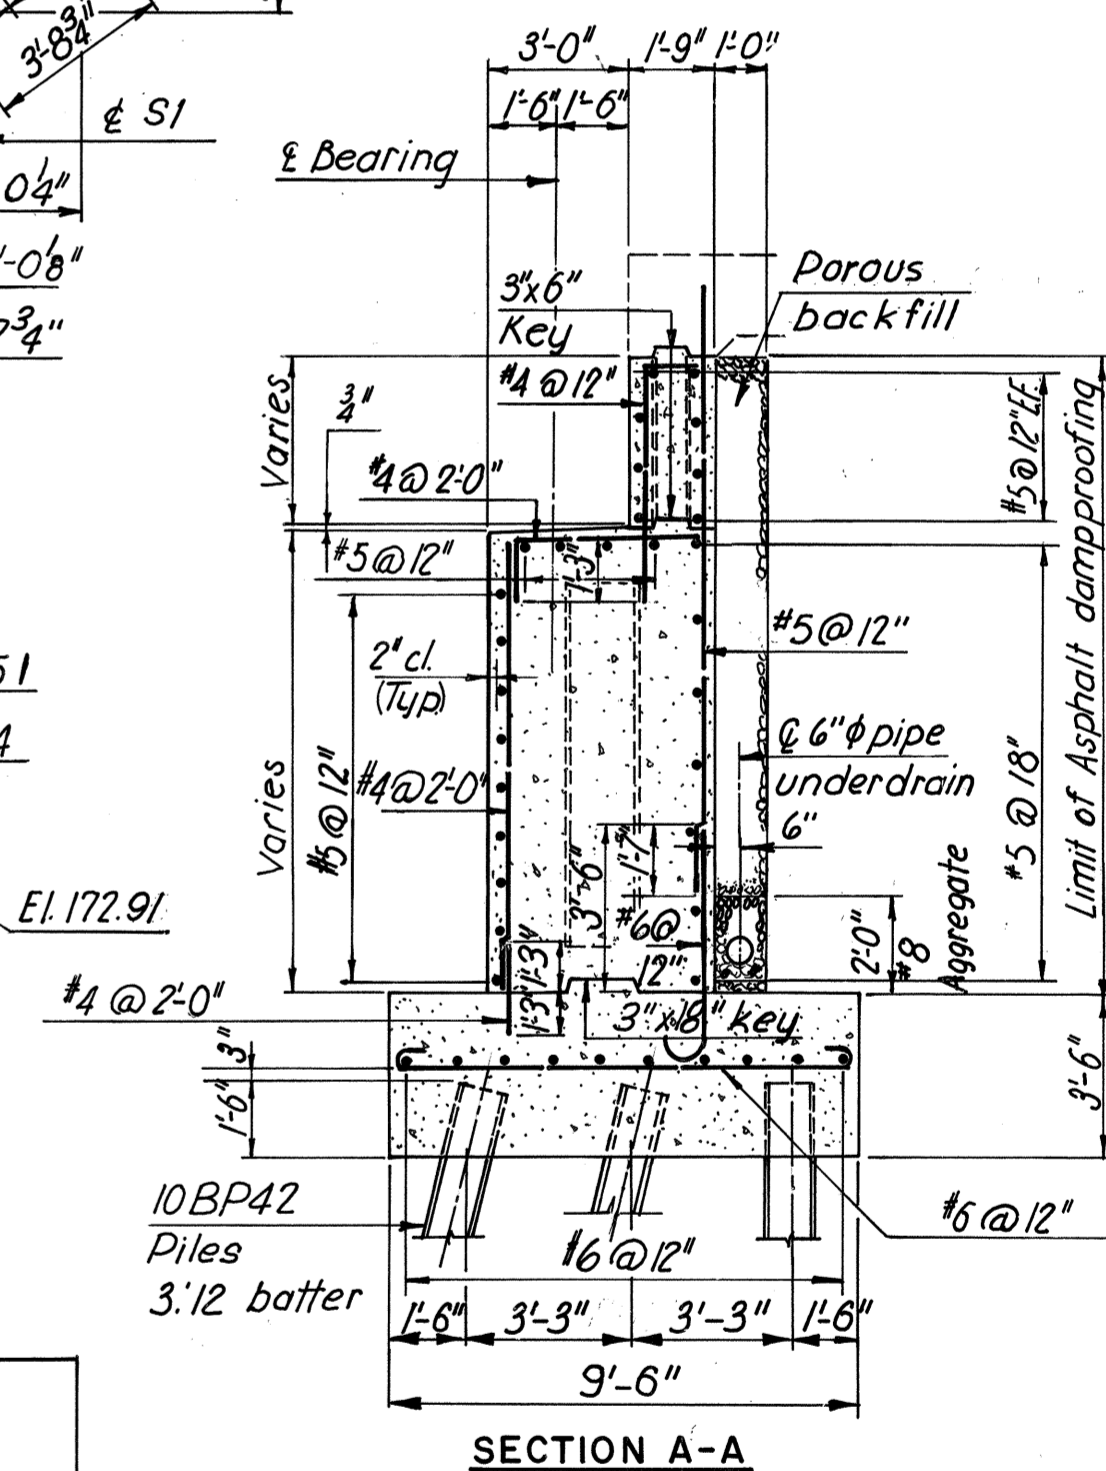

SECTION A-A

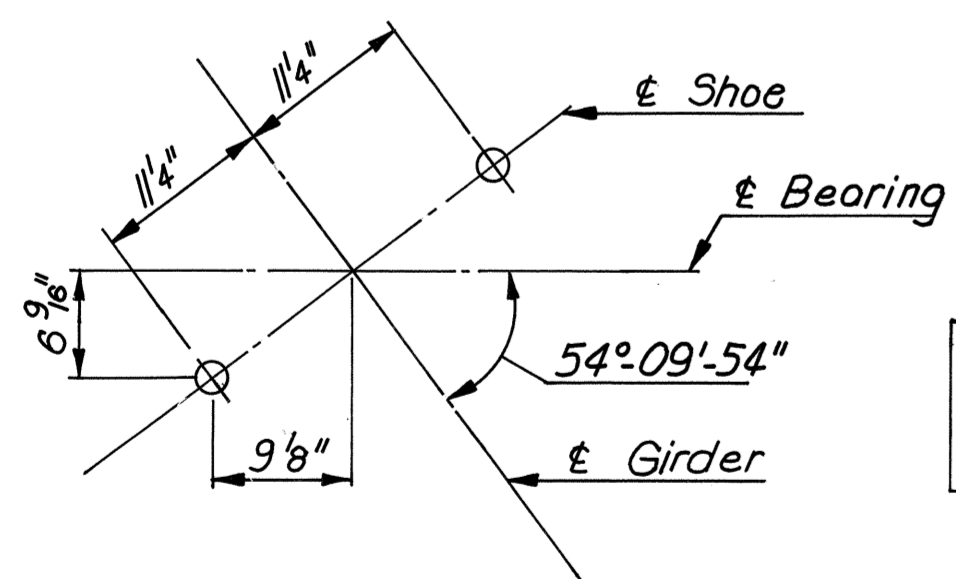

BOLT SETTING PLAN
No Scale

FOUNDATION NOTES:

Footings shall be founded at the elevation shown on the Plans unless otherwise directed by the Engineer due to conditions at the site during construction. In such cases, the Engineer will determine the extent of redesign necessary and will advise the Contractor before construction begins.
All piles shall be 10BP42 Steel Piles (Design Capacity = 45 tons).
For Pile Plan see Abutment Details (2), Sheet No. 6.

NOTES:

For anchor bolts and treatment of pads, see Standard Shoe Details sheet.
For architectural treatment of abutment wingwalls, see Standard Architectural Details sheets.

LEGEND:

F.F. denotes Front Face
R.F. denotes Rear Face
E.F. denotes Each Face


AS BUILT

RICHMOND METROPOLITAN AUTHORITY
RICHMOND EXPRESSWAY SYSTEM
POWHITE PARKWAY
POWHITE PARKWAY OVER
CHIPPENHAM PARKWAY
BRIDGE B-04
WEST ABUTMENT



HOWARD, NEEDLES, TAMMEN & BERGENDOFF
consulting engineers
NEW YORK ALEXANDRIA KANSAS CITY
SCALE: 1/4" = 1'-0"
CONTRACT NO.: 2
SHEET NO. 3 OF 14

MADE	BY	DATE	NO.	REVISION	BY	DATE
	F.S.K.	8/1/47	2	As Built	JRC	3-73
	T.E.M.	10/23/67	1	Parapet	EVR	12-70
	PRY					


RICHMOND EXPRESSWAY SYSTEM			
SECTION	PROJECT	SHEET NO.	TOTAL SHEETS
2	POWHITE PARKWAY	121	188

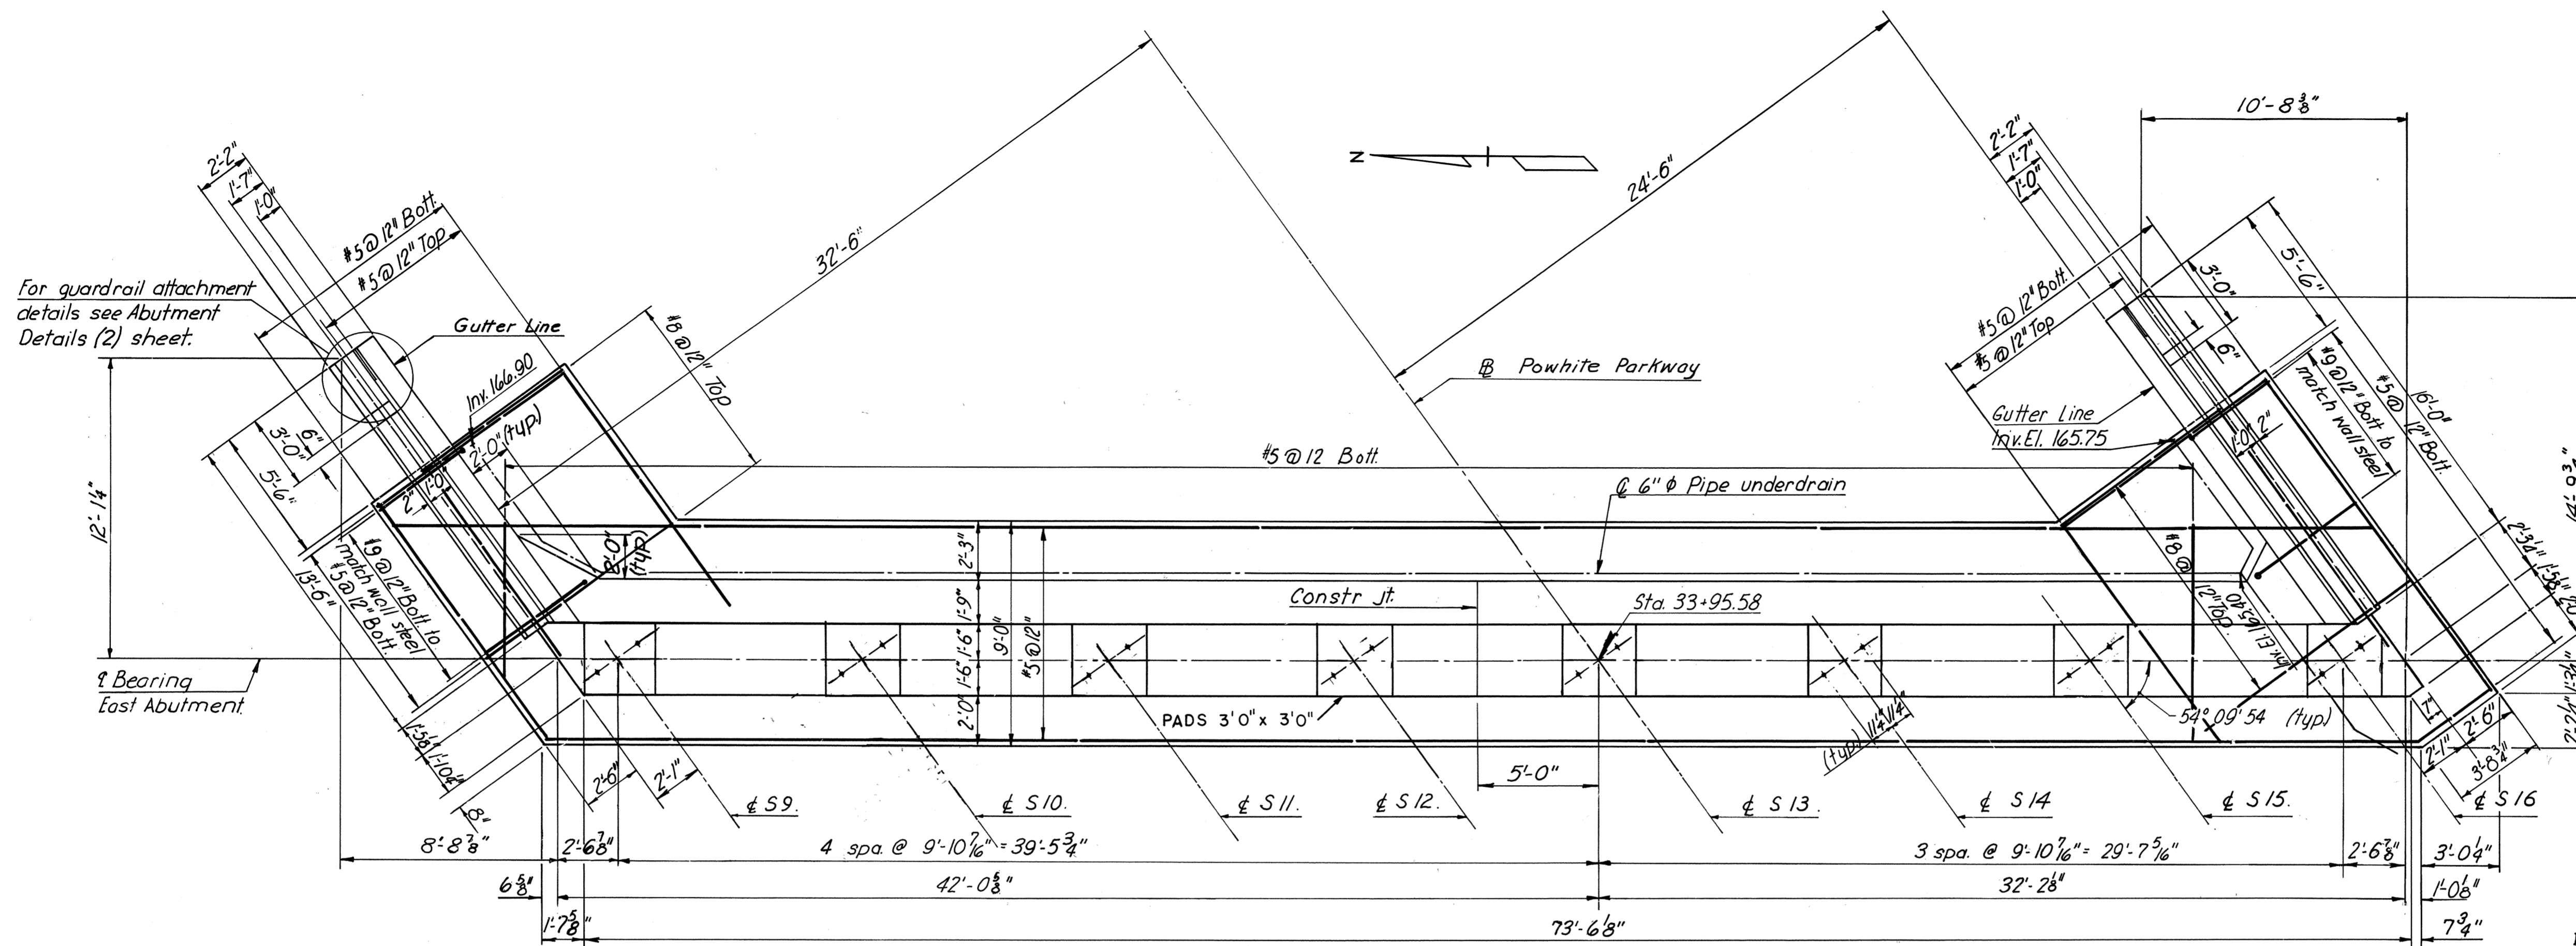

Note:
See Sheet No. 3 for
Bolt Setting Plan.

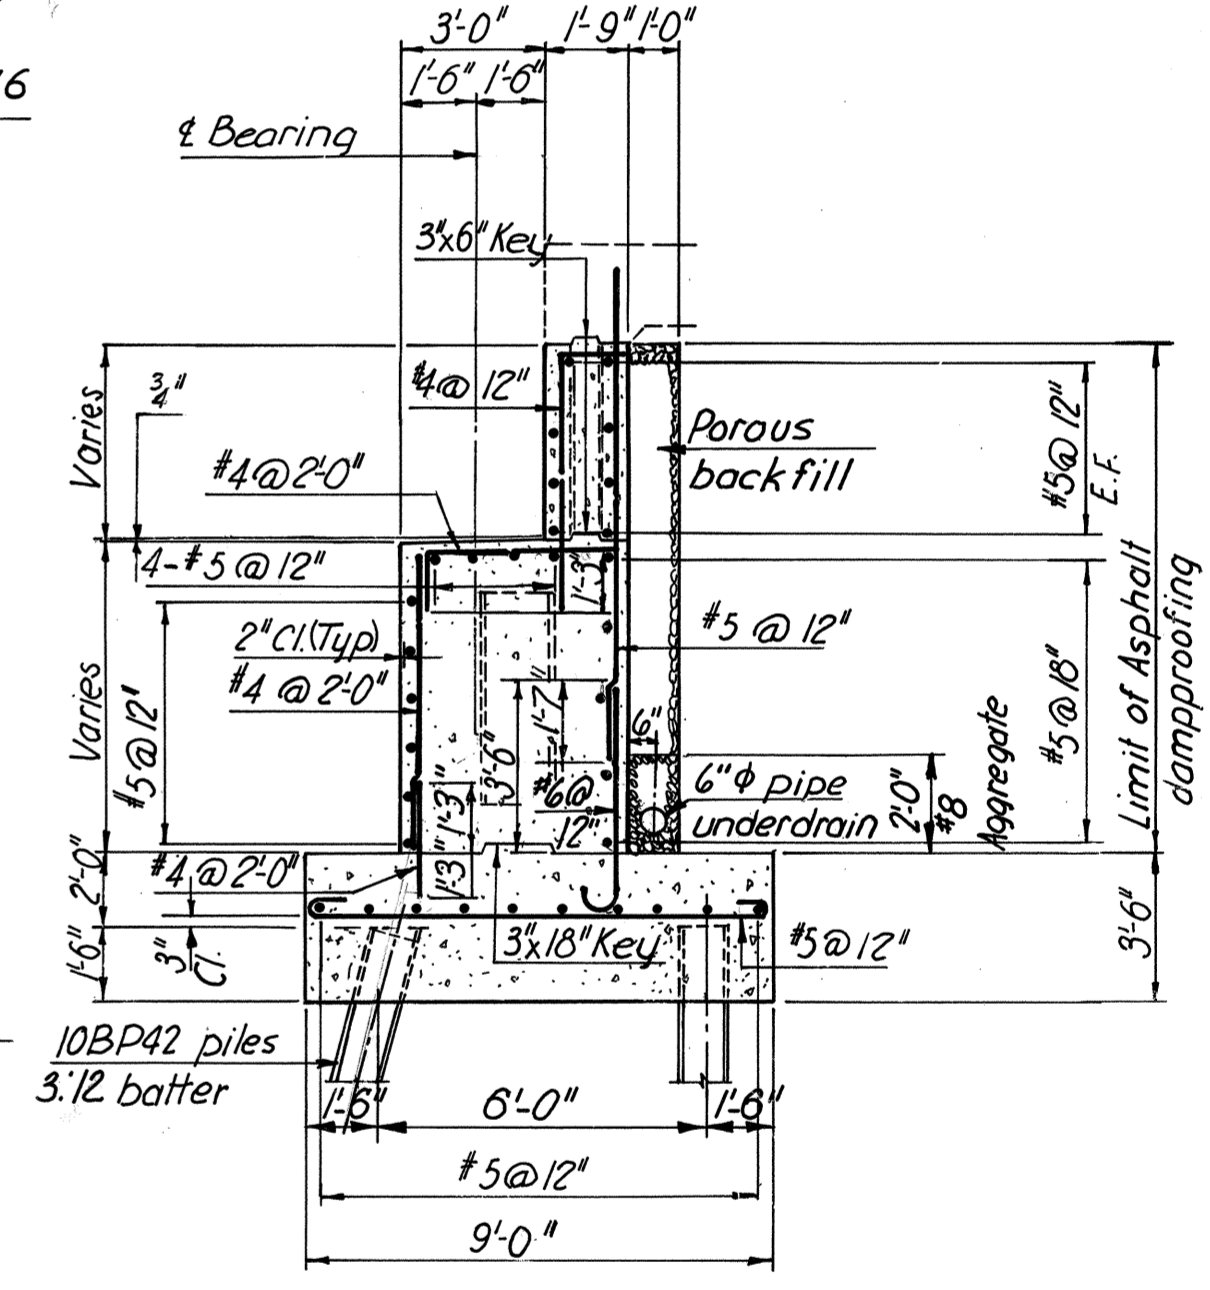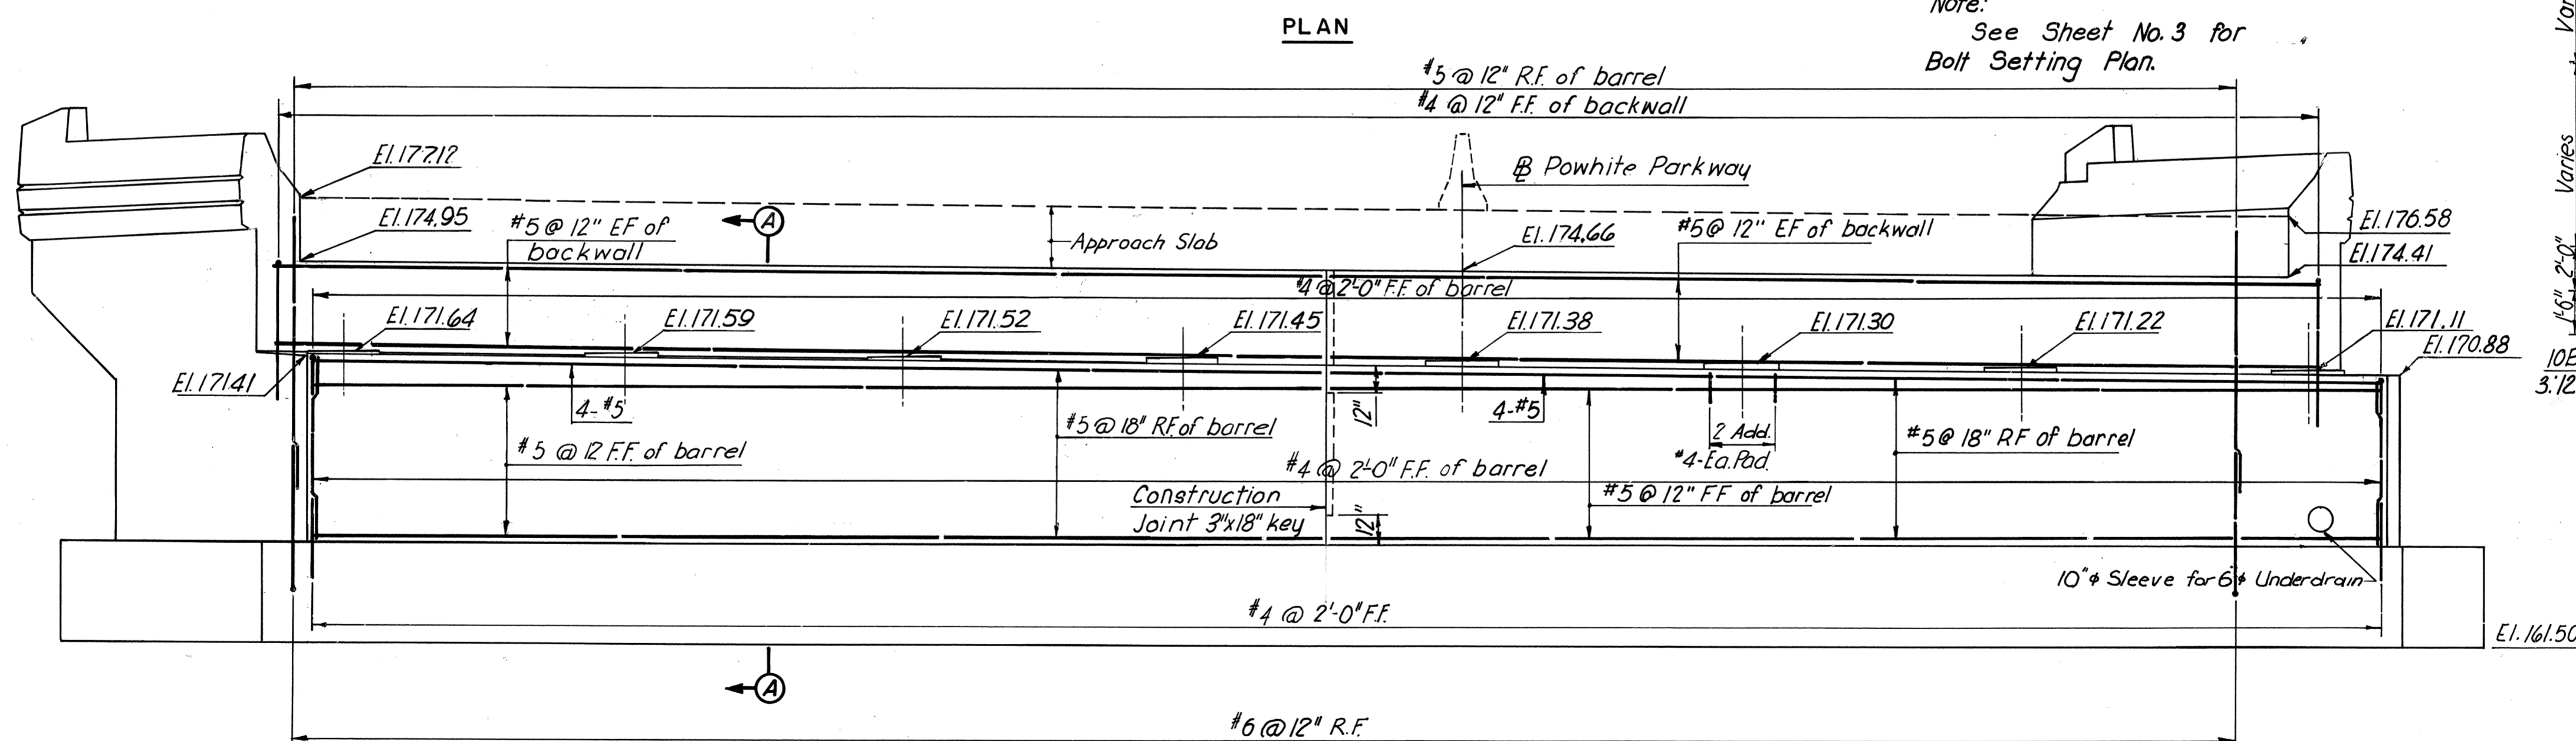

FOUNDATION NOTES:
Footings shall be founded at the elevation shown on the Plans unless otherwise directed by the Engineer due to conditions of the site during construction. In such cases, the Engineer will determine the extent of redesign necessary and will advise the Contractor before construction begins.
All piles shall be 10BP42 Steel Piles (Design Capacity = 45 tons).

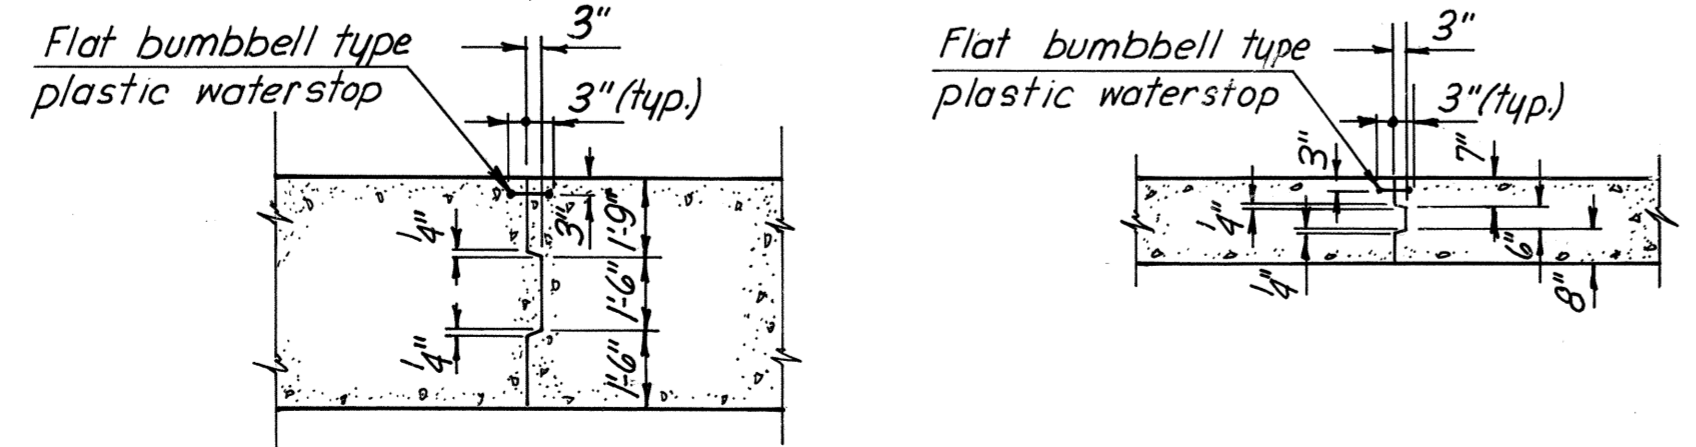

TYPICAL CONSTRUCTION JOINT DETAIL THRU ABUTMENT BARREL
TYPICAL CONSTRUCTION JOINT DETAIL THRU ABUTMENT BACKWALL

NOTES:
For anchor bolts and treatment of pads, see Standard Shoe Details sheet.
For architectural treatment of abutment wingwalls, see Standard Architectural Details sheets.

LEGEND:
F.F. denotes Front Face
R.F. denotes Rear Face
E.F. denotes Each Face

For Pile Plan see Abutment Details, Sheet No. 6.

AS BUILT


BY	DATE	NO.	REVISION	BY	DATE
MADE	7/67	2	As Built	JRC	3-73
CHECKED	10-25-67	1	Parapet	J.G.V.	12-70
IN CHARGE	PRY				

**RICHMOND METROPOLITAN AUTHORITY
RICHMOND EXPRESSWAY SYSTEM
POWHITE PARKWAY
POWHITE PARKWAY OVER
CHIPPENHAM PARKWAY
BRIDGE B-04
EAST ABUTMENT**


HOWARD, NEEDLES, TAMMEN & BERGENDOFF
consulting engineers
NEW YORK ALEXANDRIA KANSAS CITY

SCALE: 1/4" = 1'-0"
CONTRACT NO.: 2
SHEET NO. 4 OF 14

RICHMOND EXPRESSWAY SYSTEM			
SECTION	PROJECT	SHEET NO.	TOTAL SHEETS
2	POWHITE PARKWAY	122	188

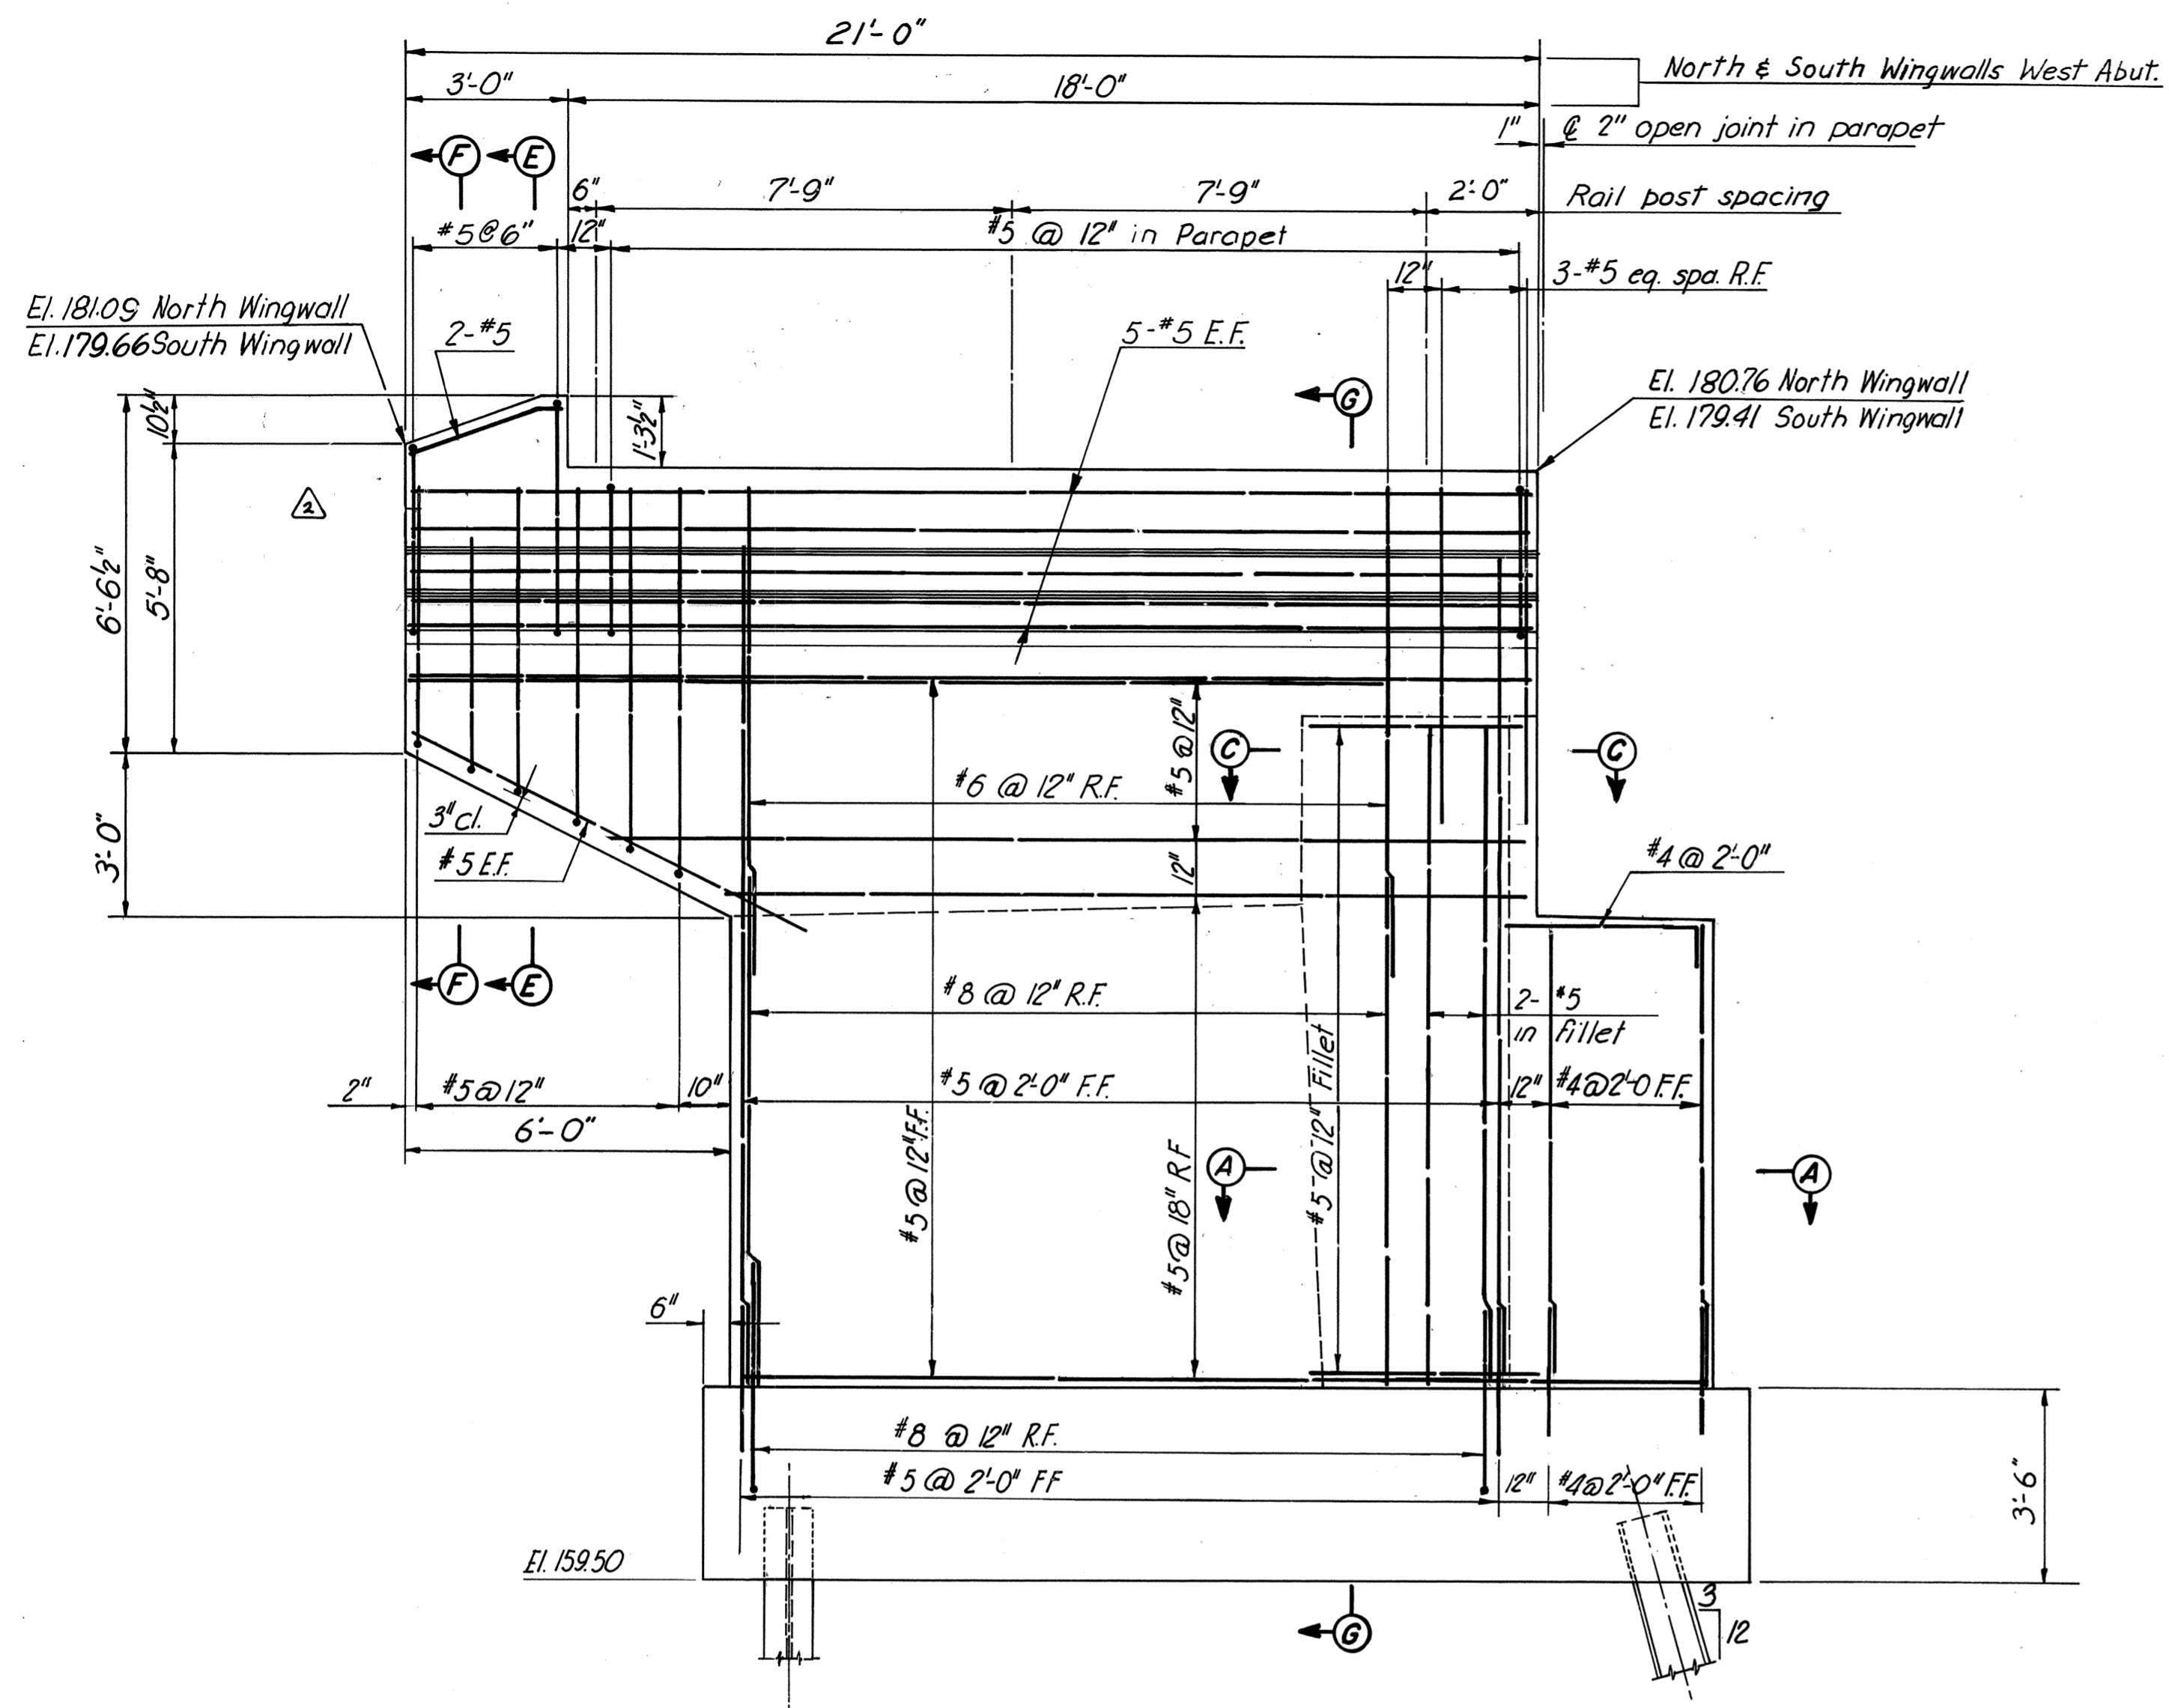

SOUTH WINGWALL WEST ABUTMENT
(North Wingwall similar)

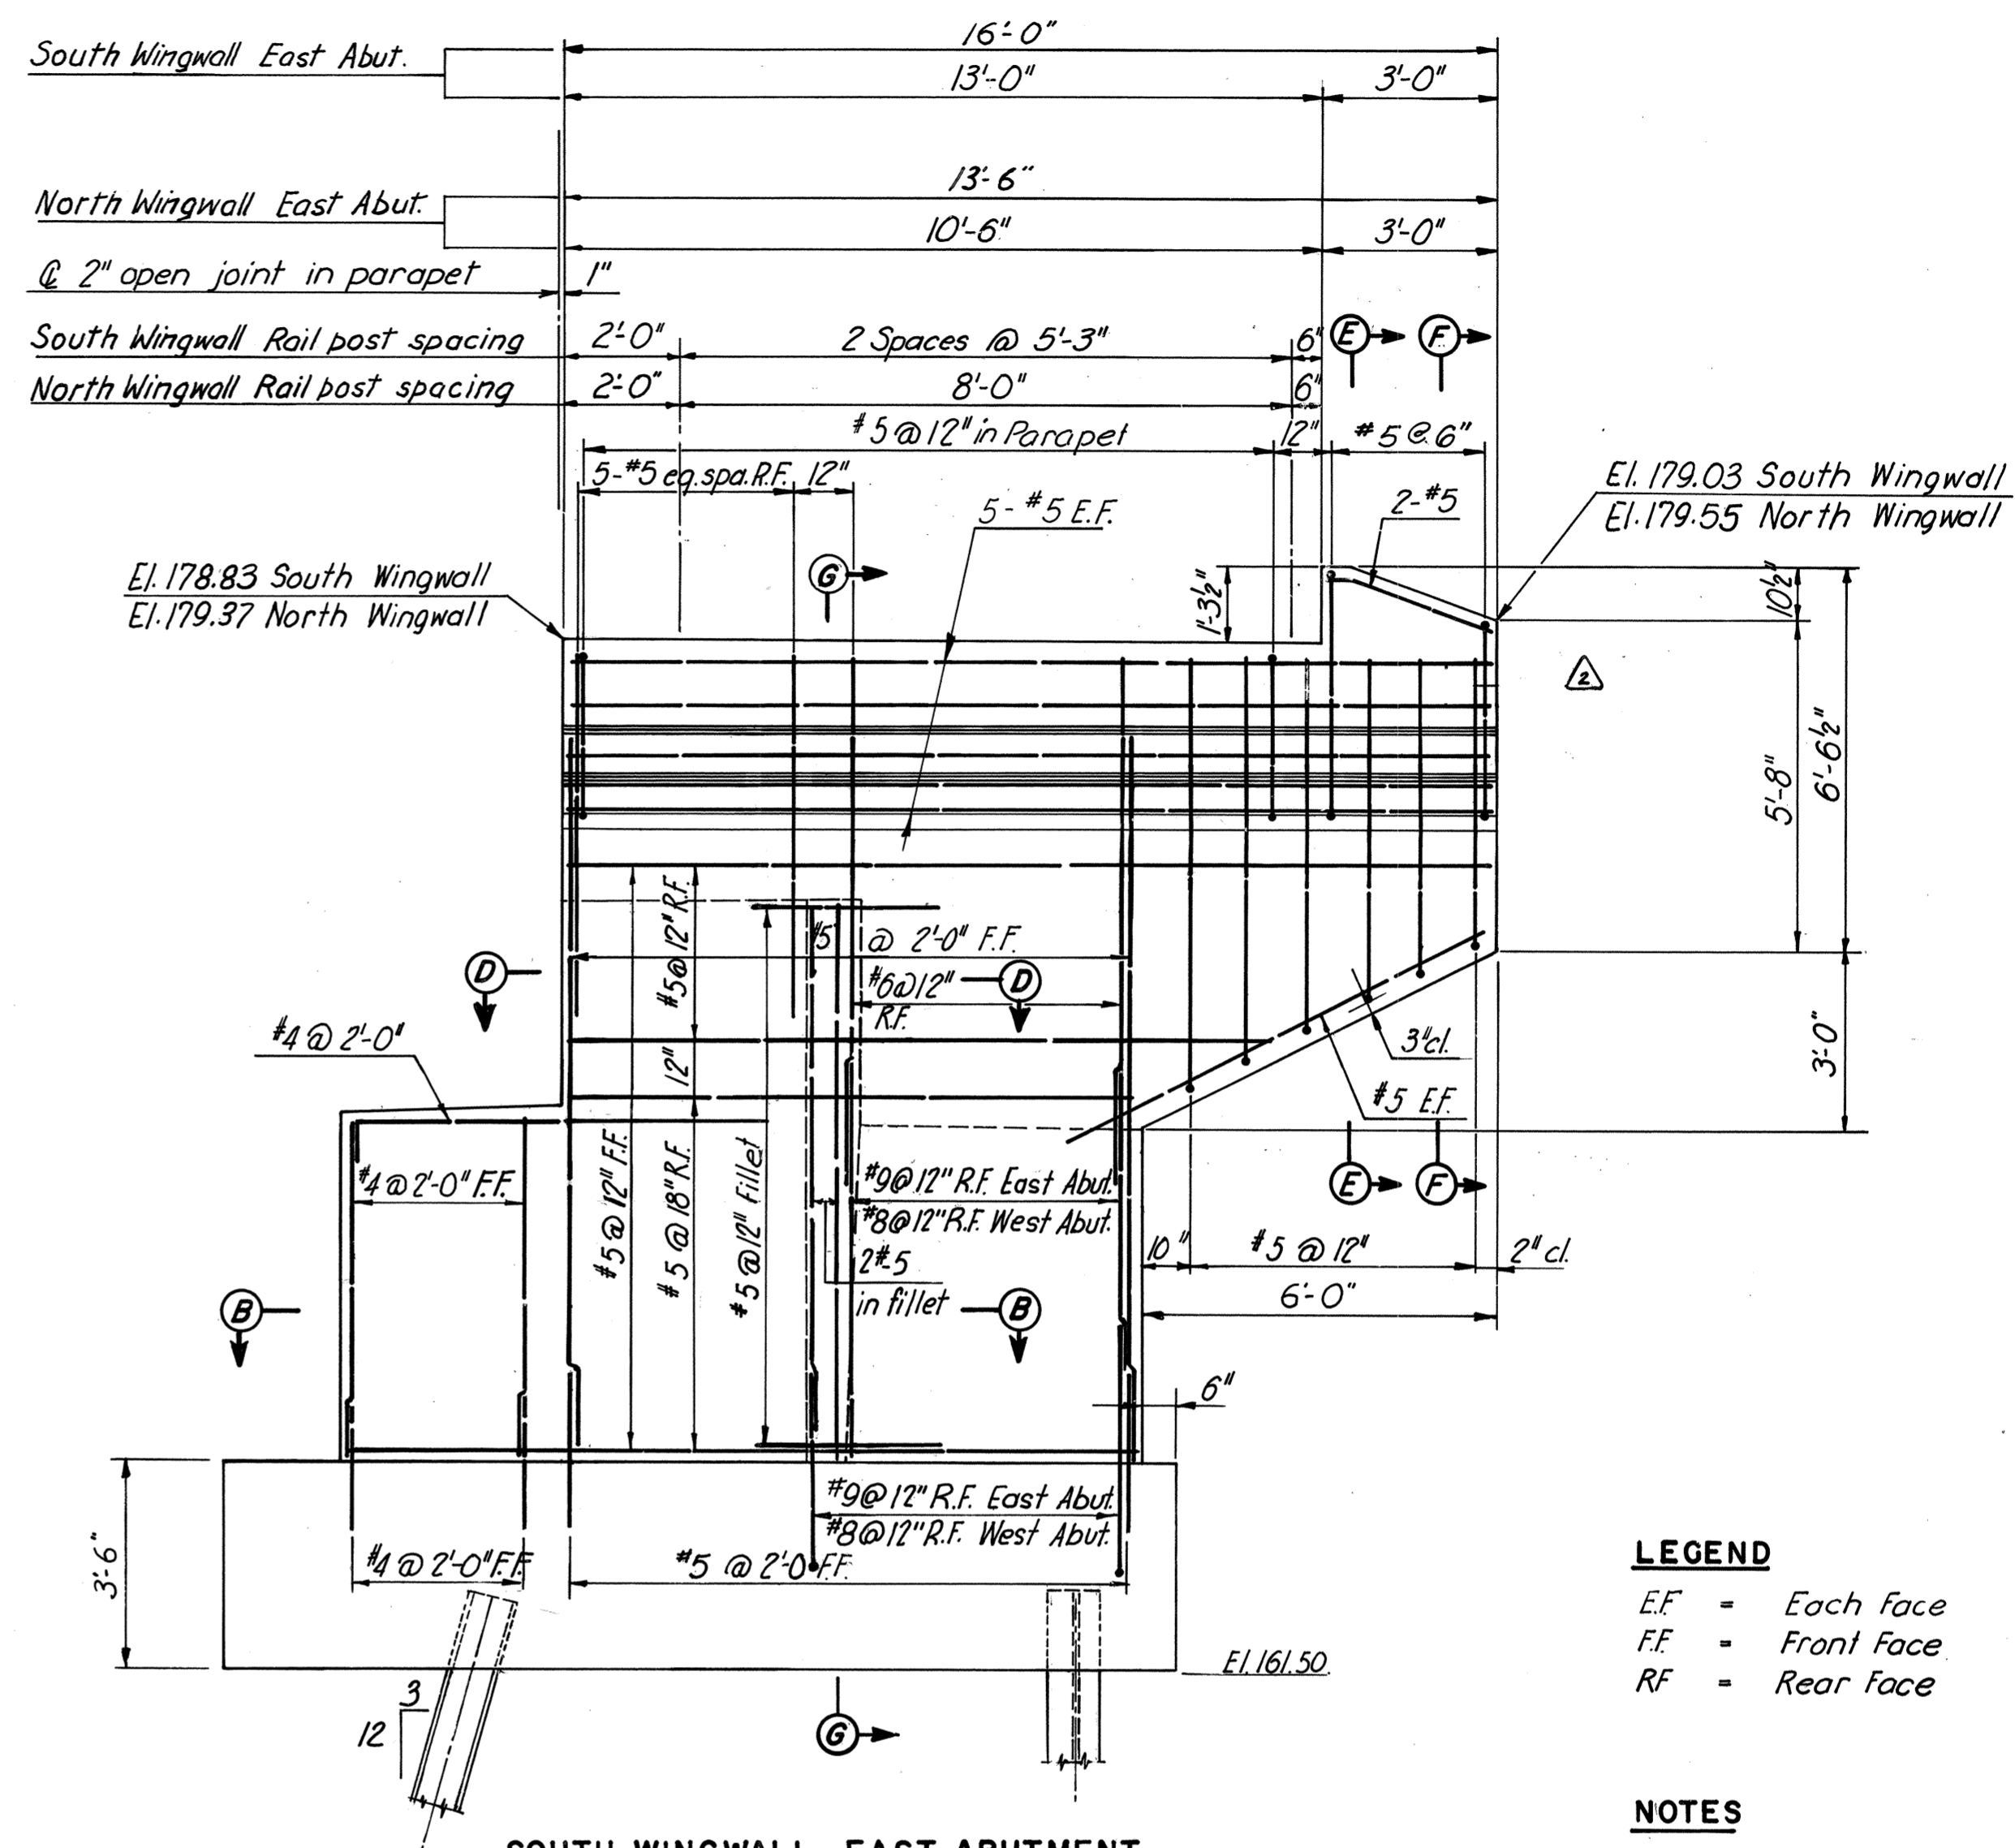


SOUTH WINGWALL EAST ABUTMENT
(North Wingwall similar except where noted)

LEGEND
 EF = Each Face
 FF = Front Face
 RF = Rear Face


NOTES
 For Section E-E, Section F-F and Section G-G see next sheet.
 For Guardrail Attachment Details see Abutment Details (2) sheet.

FOUNDATION NOTES:
 Footings shall be founded at the elevation shown on the Plans unless otherwise directed by the Engineer due to conditions at the site during construction. In such cases, the Engineer will determine the extent of redesign necessary and will advise the Contractor before construction begins.
 All piles shall be 10BP42 Steel Piles (Design Capacity = 45 tons).

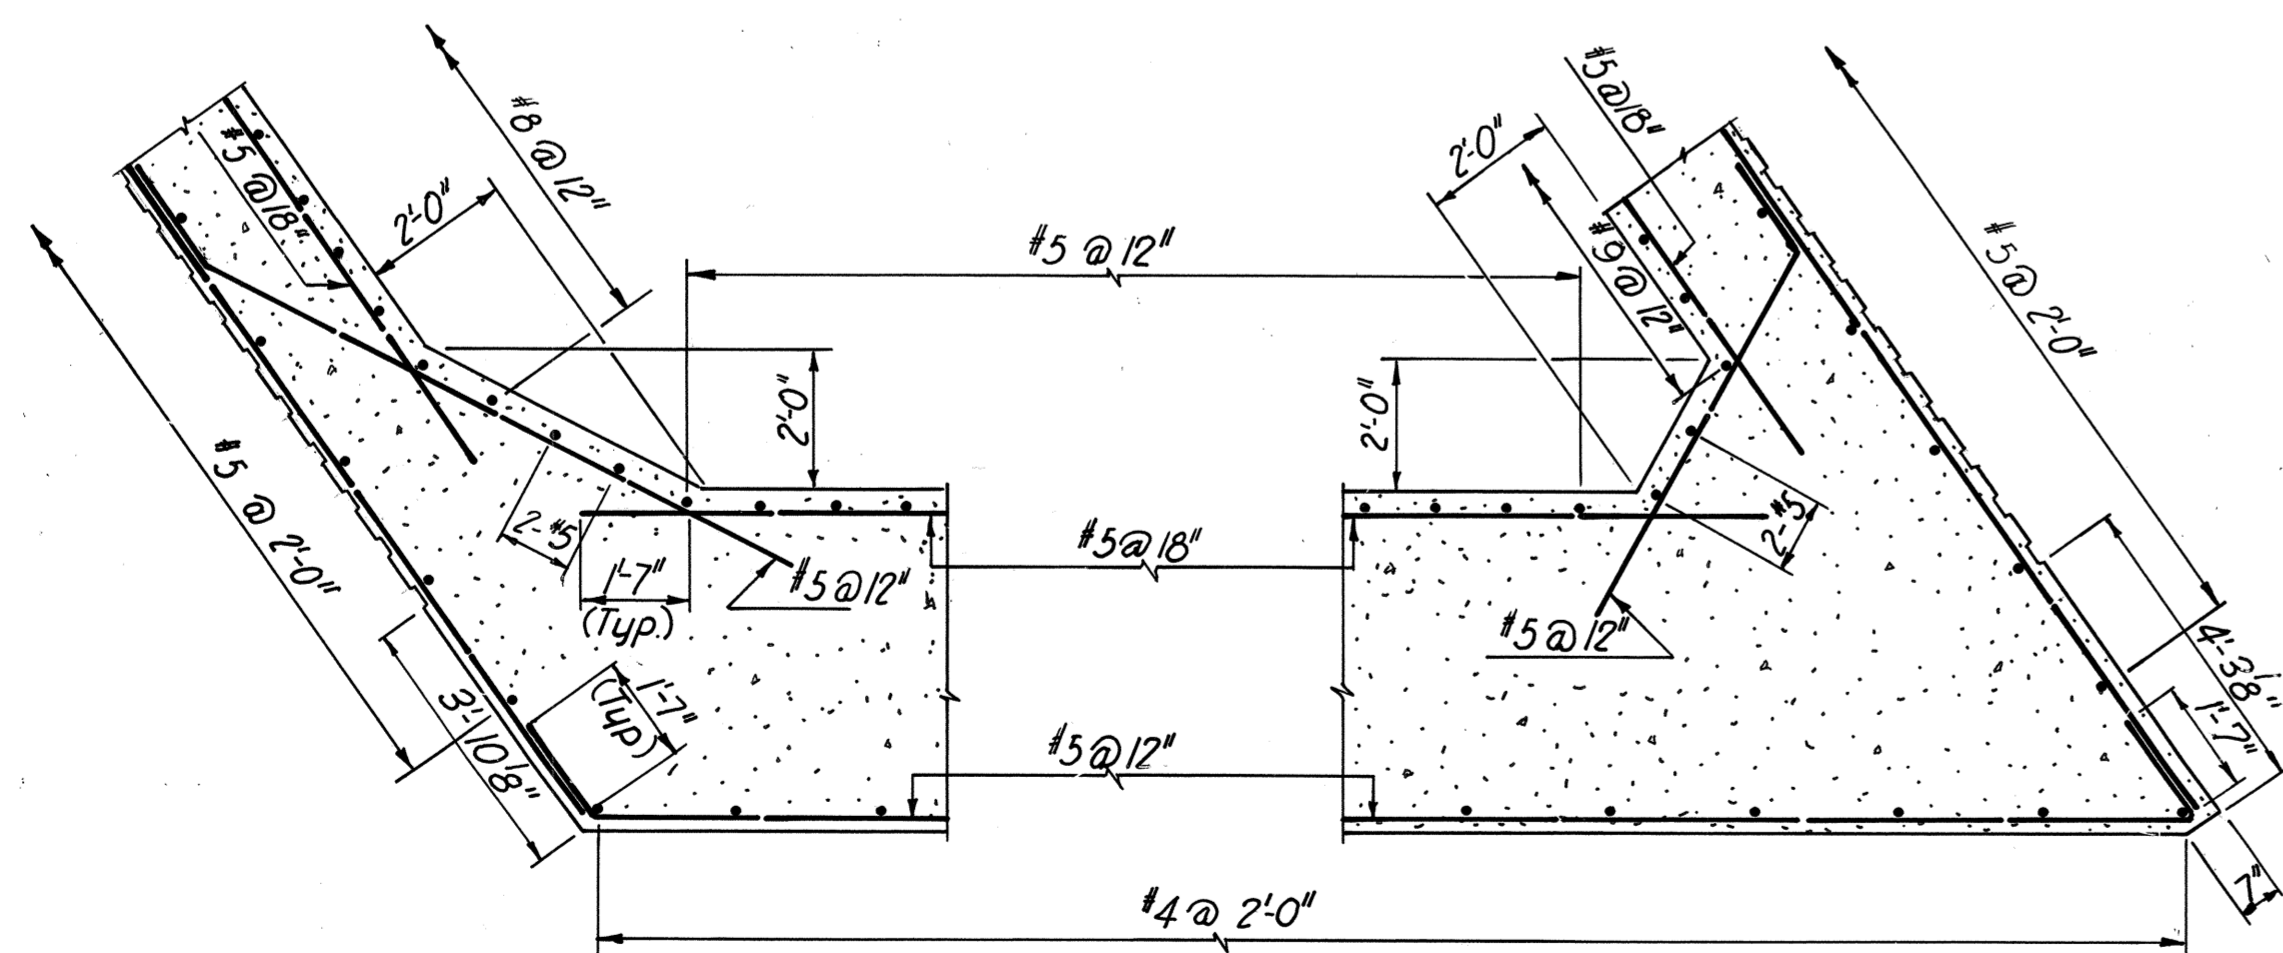

SECTION A-A

SECTION B-B

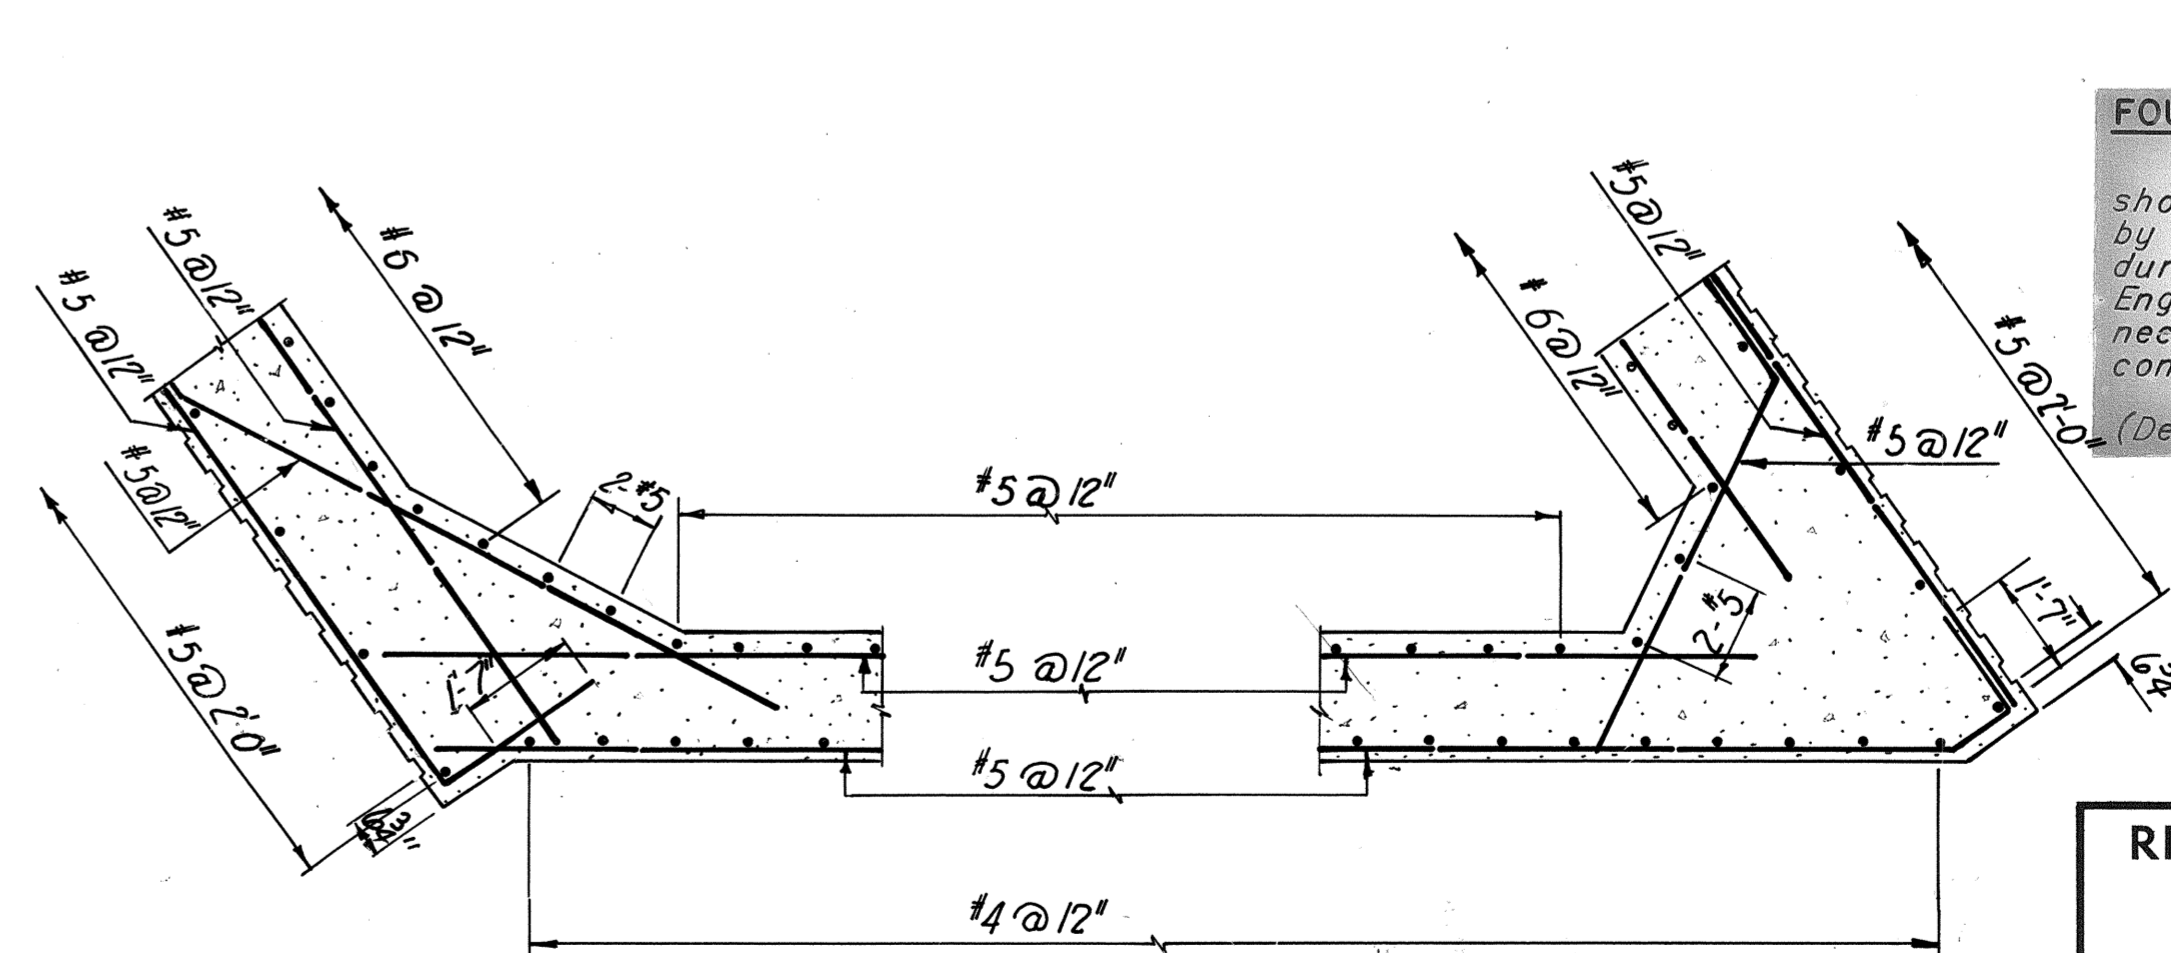

SECTION C-C

SECTION D-D







AS BUILT

RICHMOND METROPOLITAN AUTHORITY
RICHMOND EXPRESSWAY SYSTEM
 POWHITE PARKWAY
 POWHITE PARKWAY OVER
 CHIPPENHAM PARKWAY
 BRIDGE B-04
ABUTMENT DETAILS (1)

HOWARD, NEEDLES, TAMMEN & BERGENDOFF
 consulting engineers
 NEW YORK ALEXANDRIA KANSAS CITY
 SCALE: 3/8" = 1'-0"
 CONTRACT NO.: 2
 SHEET NO. 5 OF 14

BY	DATE	NO.	REVISION	BY	DATE
As Built	JRC	3-73			
MADE	F.S.K. 8/67	1	Reinf. Bars	TEM	8-71
CHECKED	T.E.M. 10-27-67	1	Parapet	J.G.V.	12-70
IN CHARGE	PRY				

RICHMOND EXPRESSWAY SYSTEM			
SECTION	PROJECT	SHEET NO.	TOTAL SHEETS
2	POWHITE PARKWAY	123	188

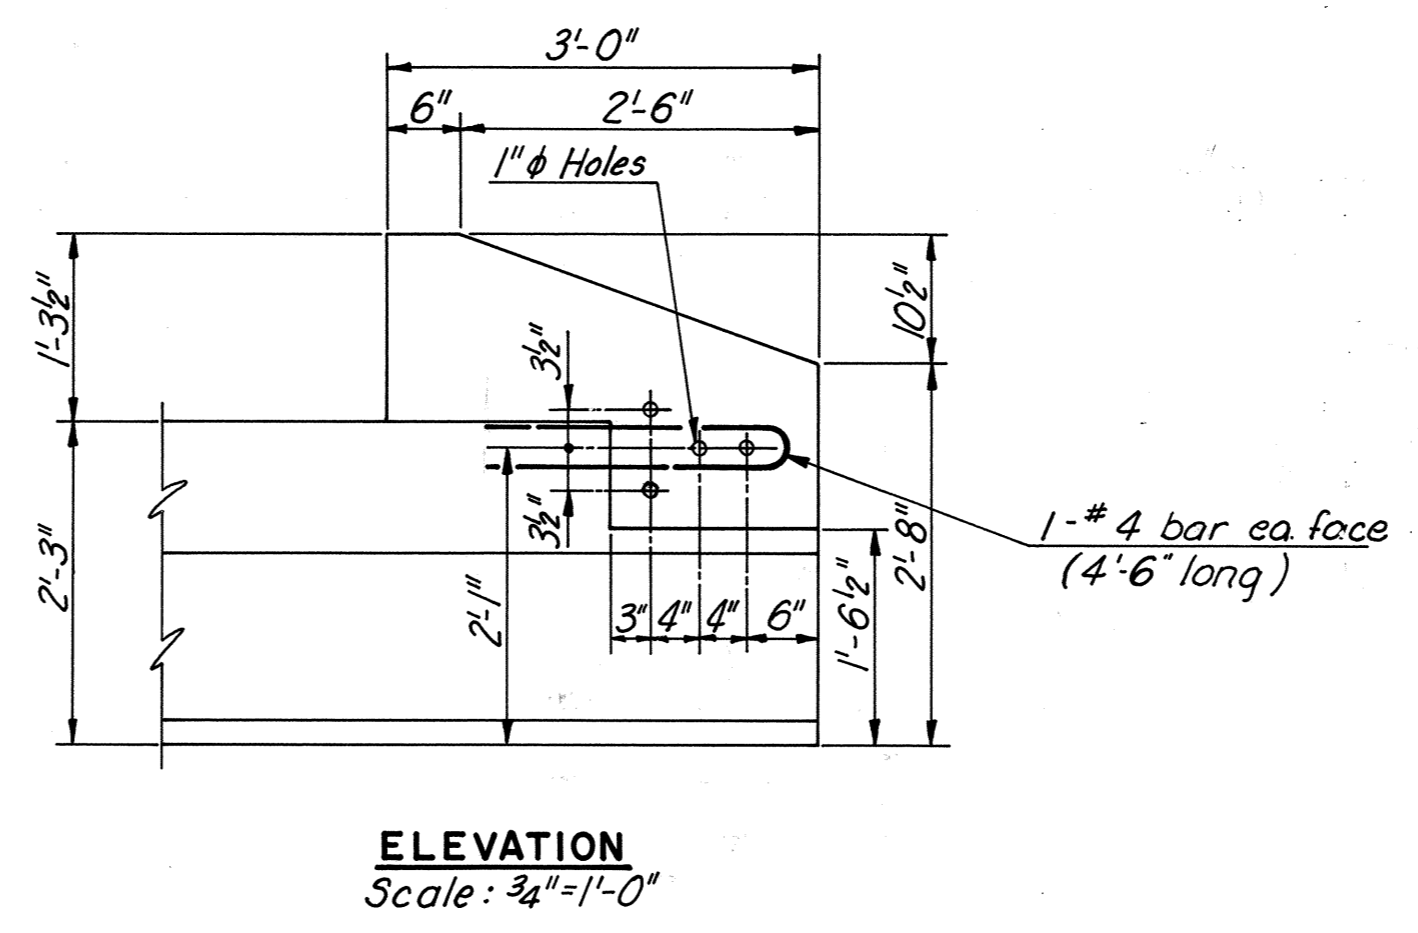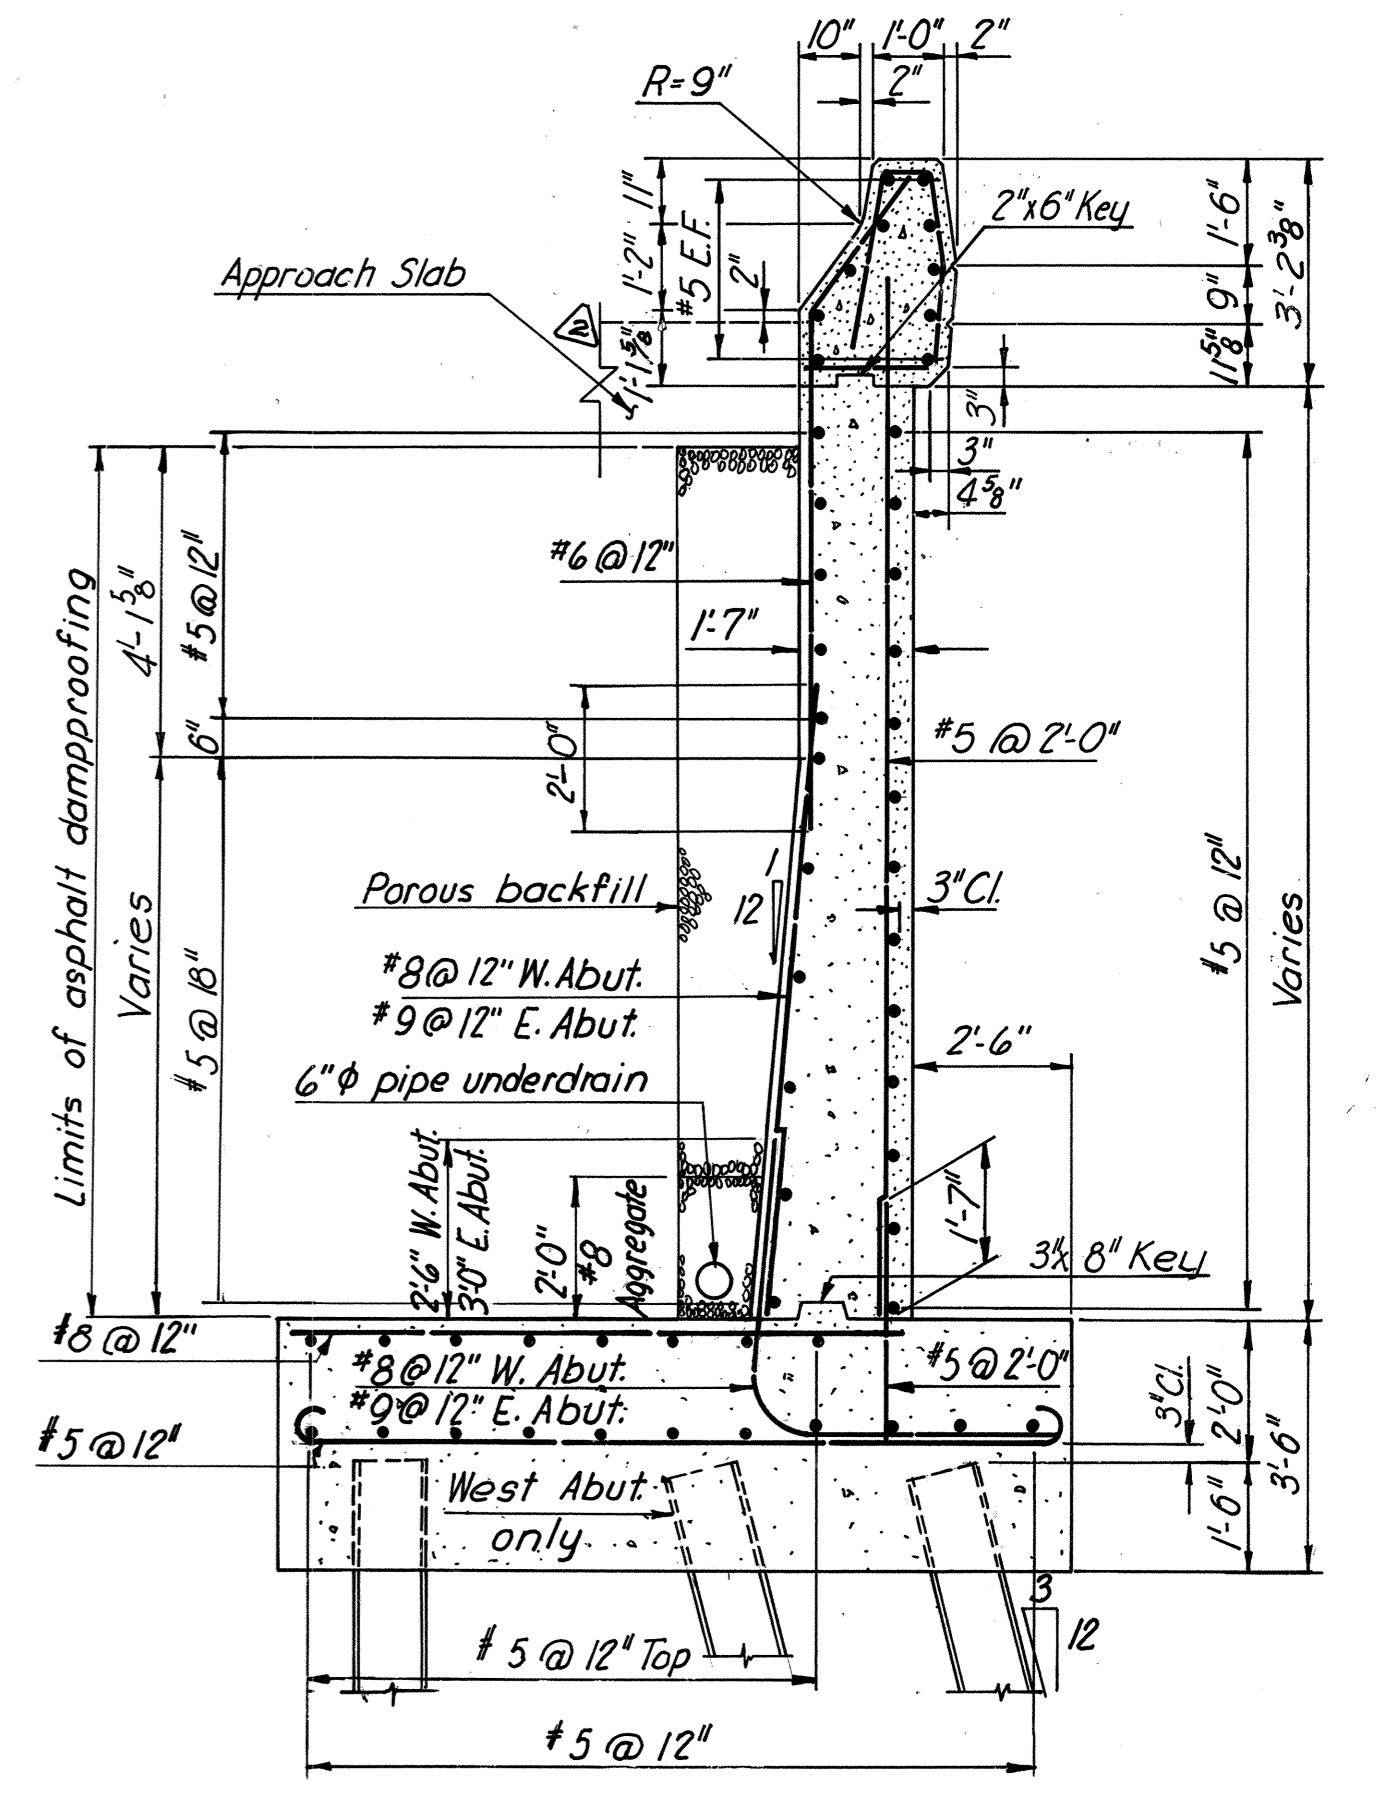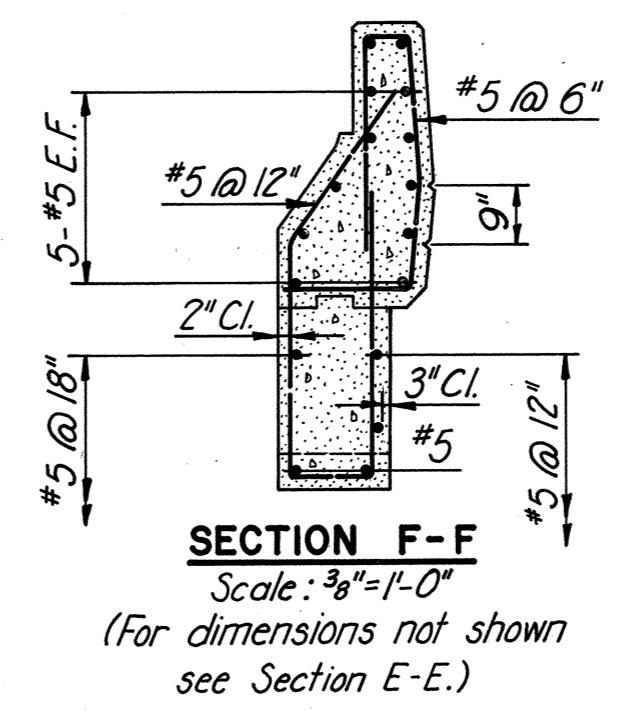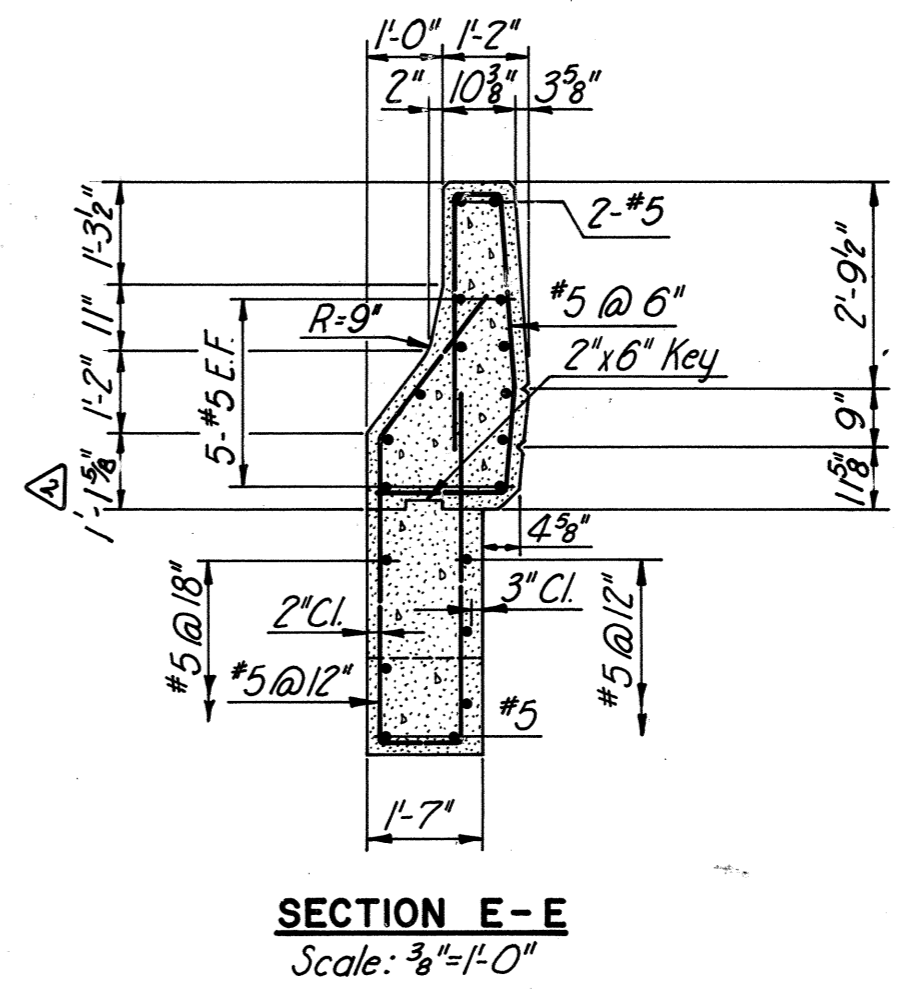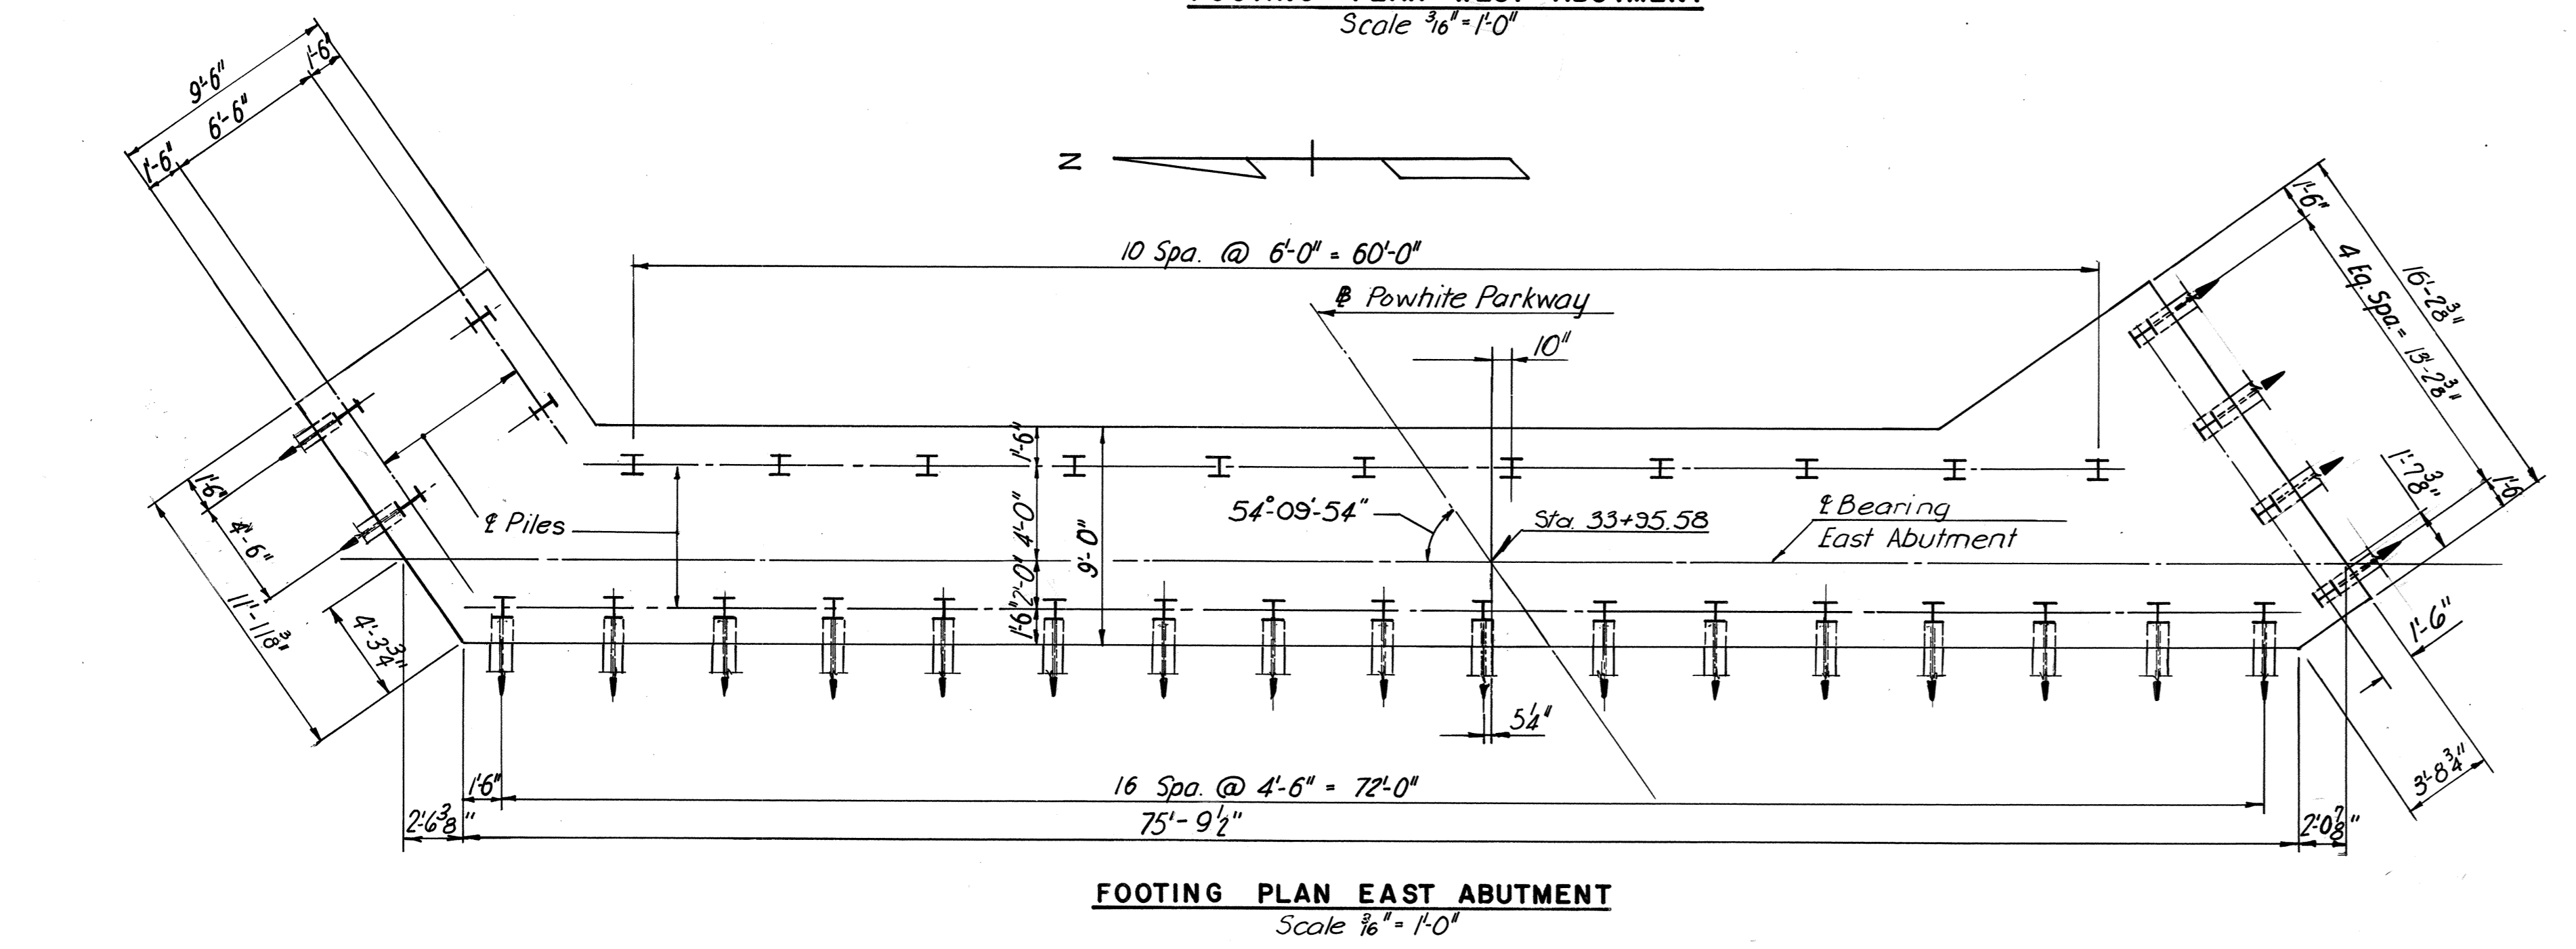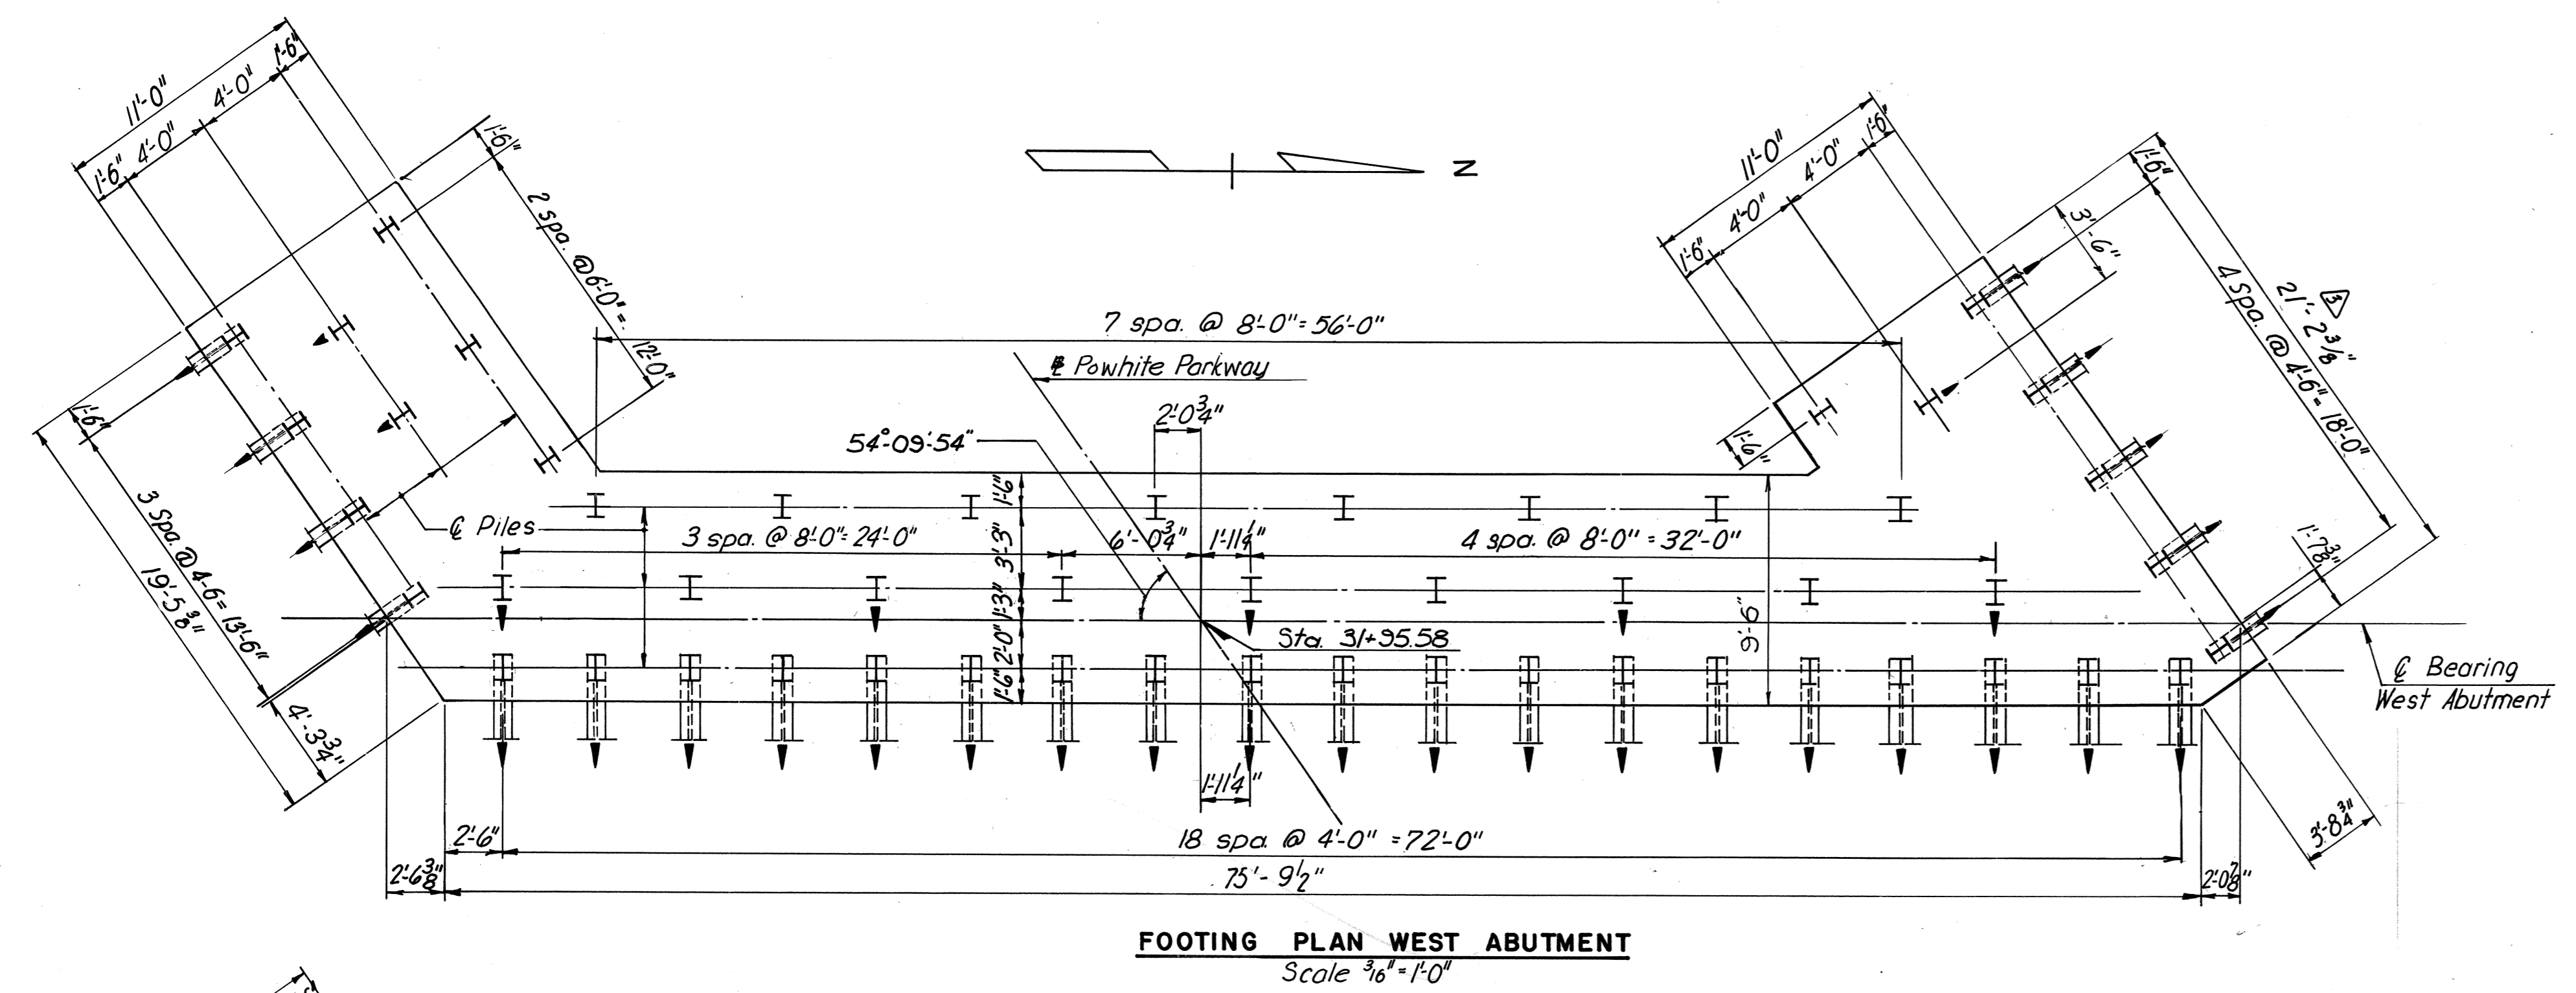

GUARDRAIL ATTACHMENT DETAILS

AS BUILT

Notes:
 Pile dimensions are given at bottom of footing.
 For location of Sections E-E, F-F and G-G see preceding sheet.
 Arrows indicate direction of 3 in 12 batter piles.


FOUNDATION NOTES:
 Footings shall be founded at the elevation shown on the Plans unless otherwise directed by the Engineer due to conditions at the site during construction. In such cases, the Engineer will determine the extent of redesign necessary and will advise the Contractor before construction begins.
 All piles shall be 10BP42 Steel Piles (Design Capacity = 45 tons).

RICHMOND METROPOLITAN AUTHORITY
RICHMOND EXPRESSWAY SYSTEM
POWHITE PARKWAY
 POWHITE PARKWAY OVER
 CHIPPENHAM PARKWAY
 BRIDGE B-04
ABUTMENT DETAILS (2)

HOWARD, NEEDLES, TAMMEN & BERGENDOFF
 consulting engineers
 NEW YORK ALEXANDRIA KANSAS CITY


SCALE: **AS SHOWN**
 CONTRACT NO.: **2**
 SHEET NO. **6** OF **14**

BY	DATE	As Built	JRC	3-73
MADE	EF	10-23-67	Parapet Dim.	TEM 8-71
CHECKED	TEM	11-2-67	1 Parapet	J.G.V 12-70
IN CHARGE	PRY			

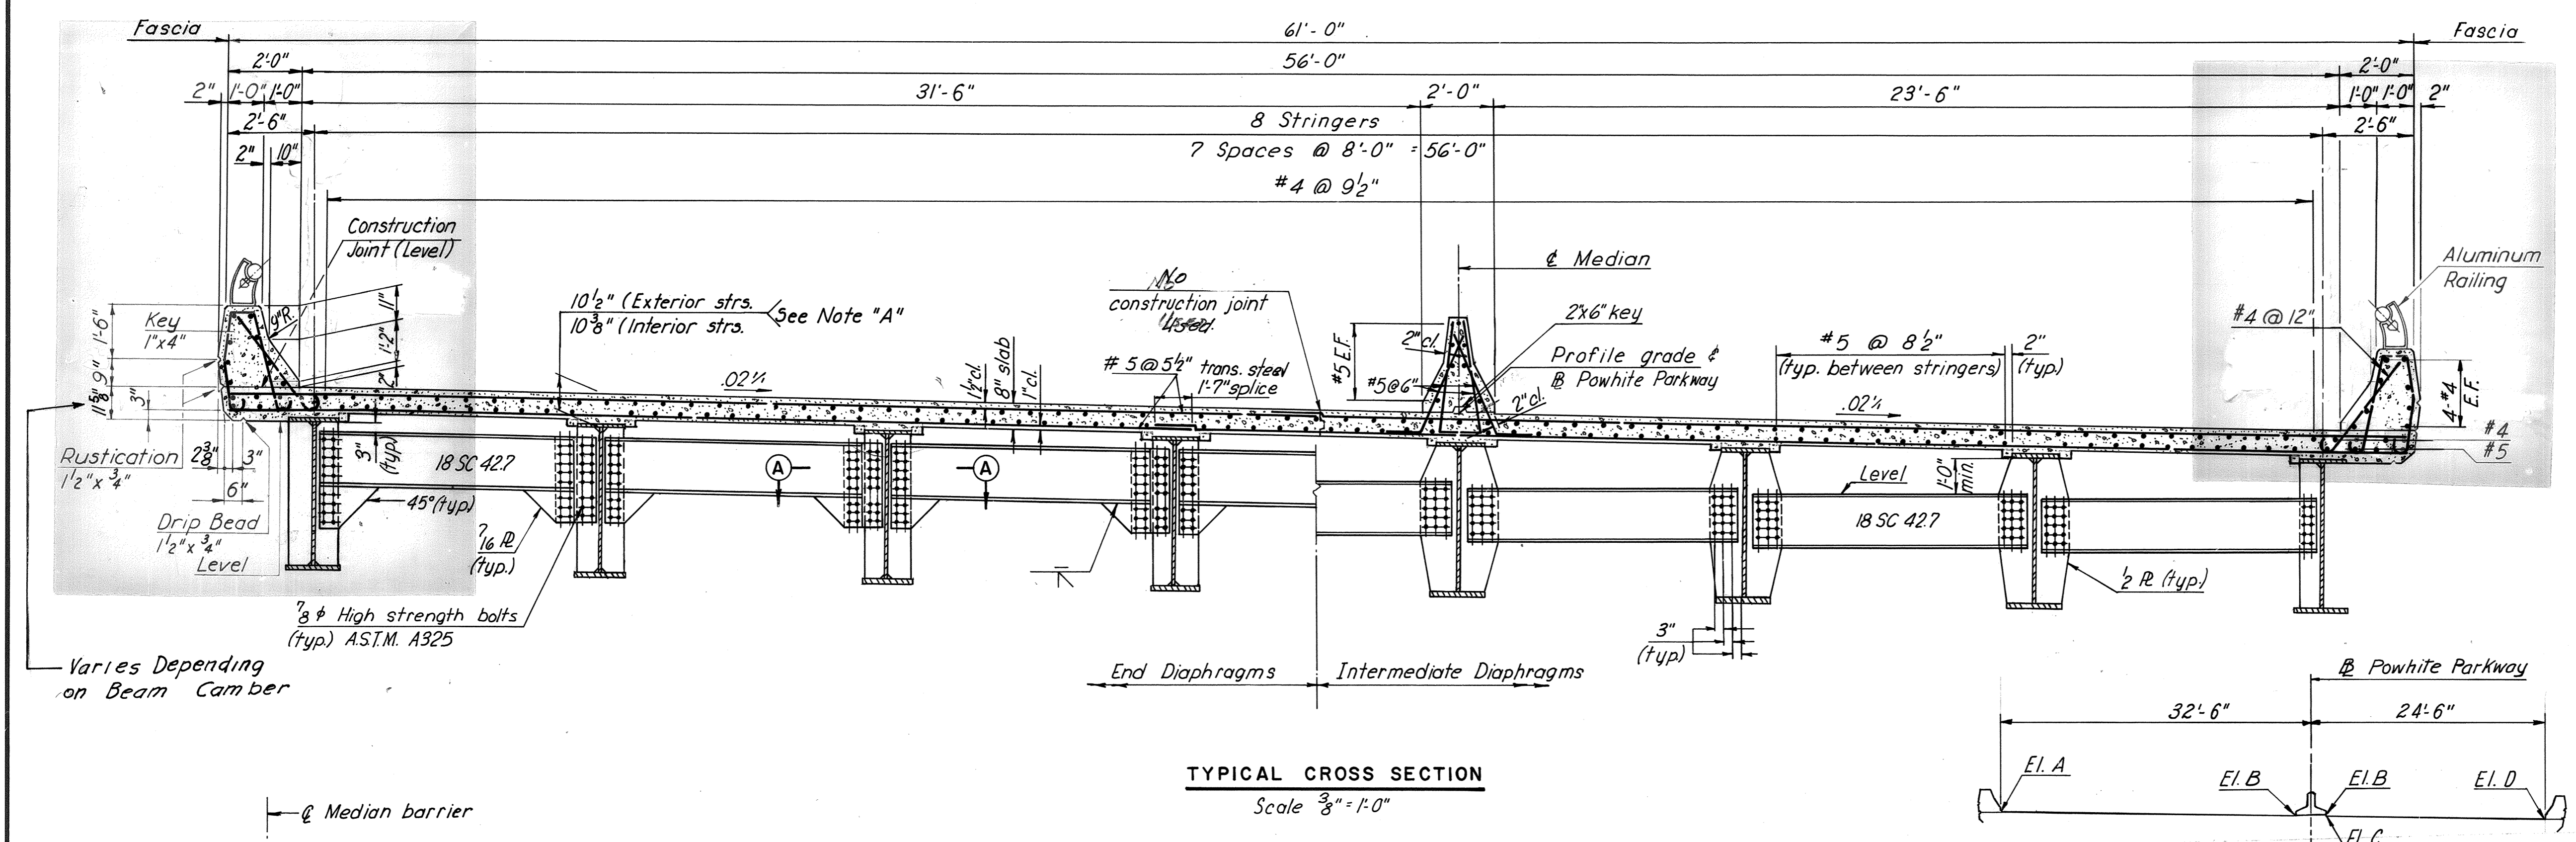


TYPICAL CROSS SECTION
Scale 3/8" = 1'-0"


NOTE "A":
Dimension shown is measured from top of web to top of slab at the intersection of the centerline of stringer and the centerline of bearing. This dimension may be varied between bearings as required to care for variation in camber, except that no portion of the stringer flange may fall within the 8" slab.

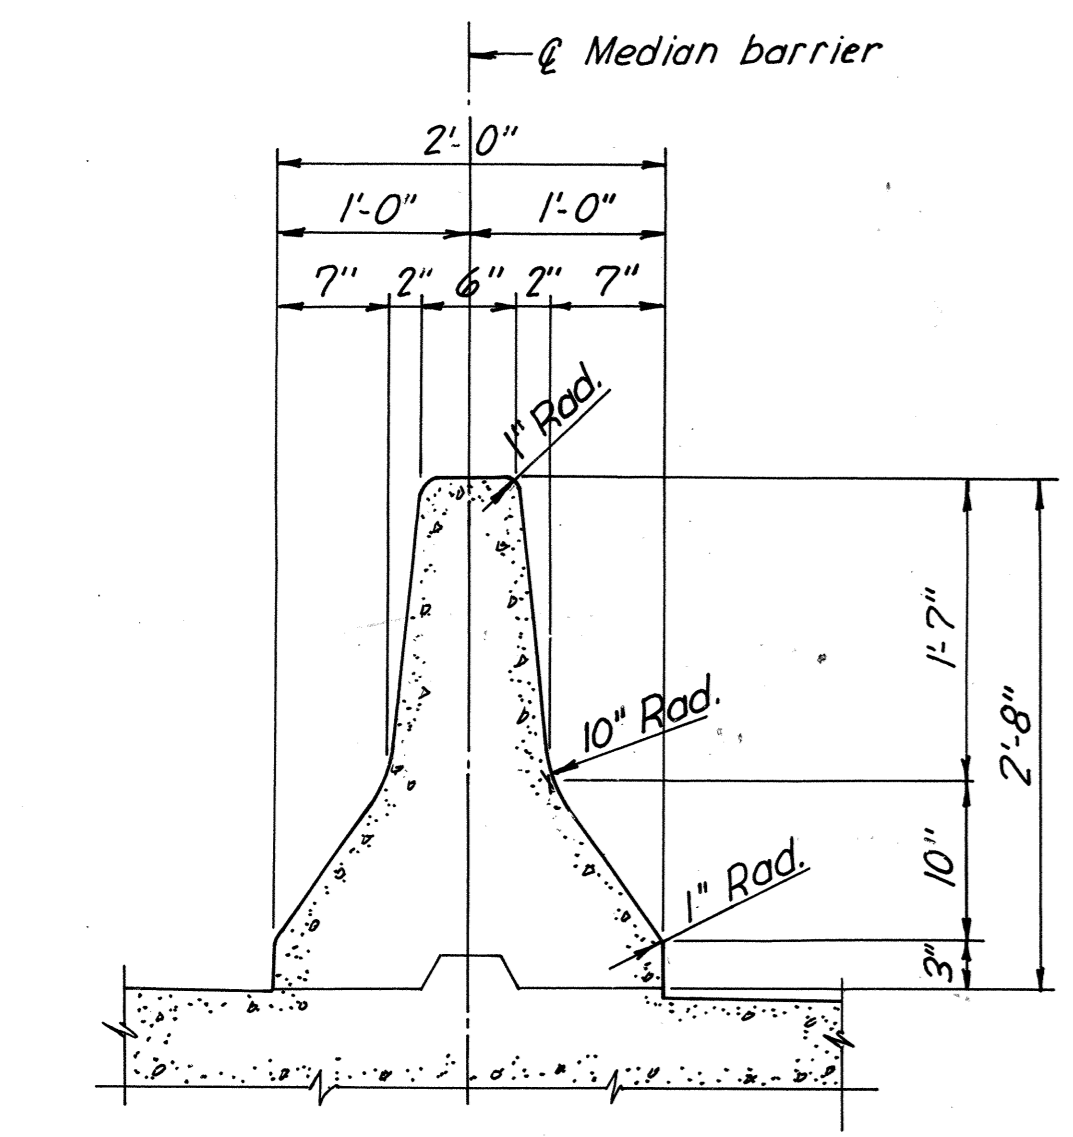


TYPICAL MEDIAN SECTION
Scale 1" = 1'-0"

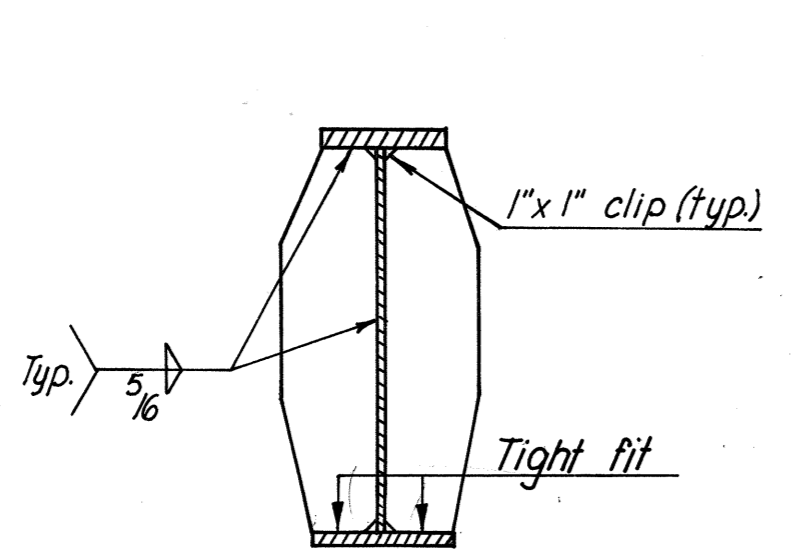

INTERIOR DIAPHRAGM CONNECTION PLATE
Scale 1/2" = 1'-0"

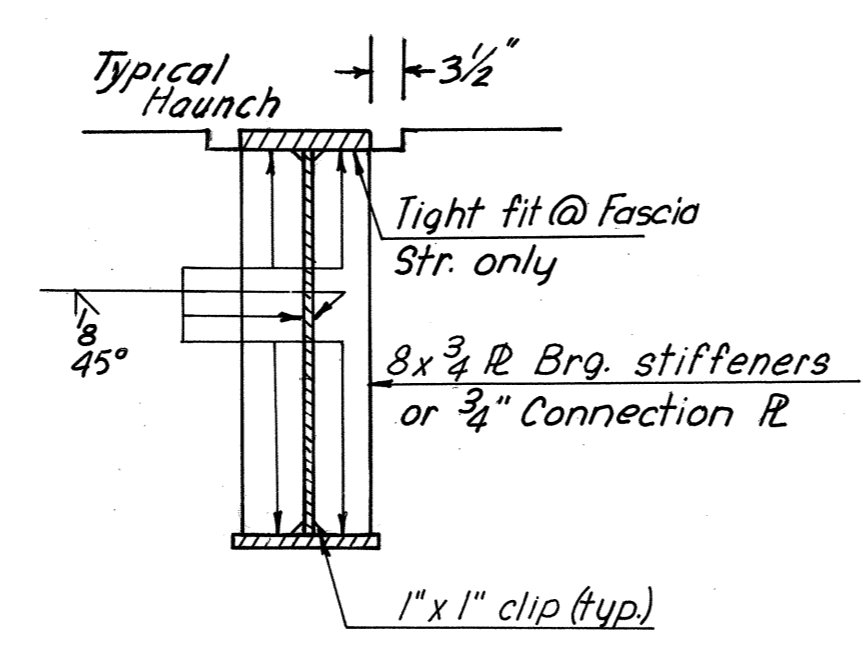


END DIAPHRAGM CONNECTION PLATE AND/OR BEARING STIFFENERS

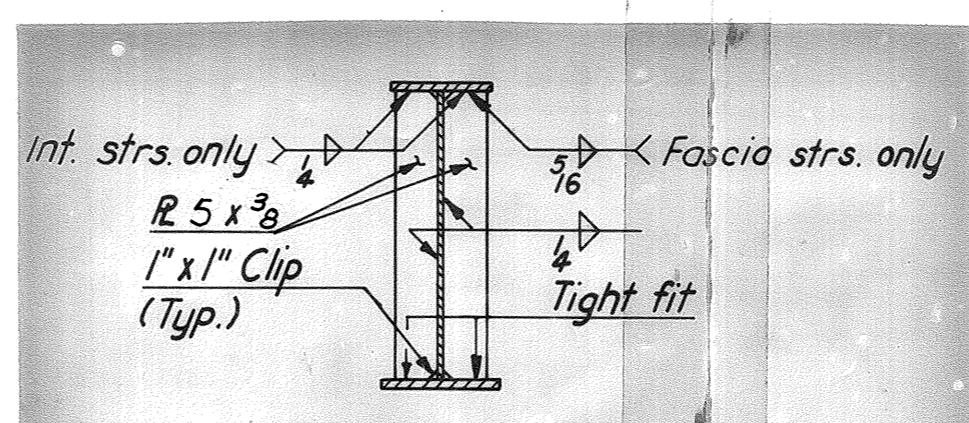

Note: Stiffener shall be welded to compression flange and have a tight fit to the tension flange.

INTERMEDIATE STIFFENER DETAIL

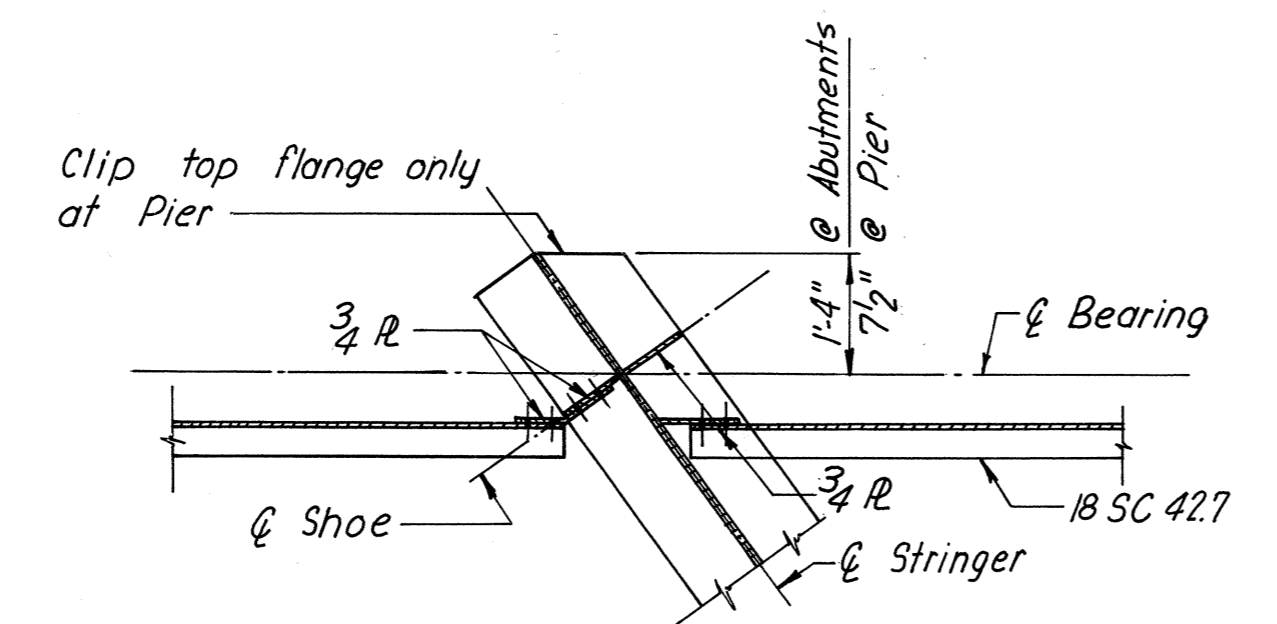

SECTION A-A
Scale 1/2" = 1'-0"

STATION	GUTTER LINE ELEVATION			
	EL. A	EL. B	EL. C	EL. D
31+60.00	178.17	177.54	177.50	177.03
20.00	178.25	177.62	177.58	177.11
76.04				177.16
80.00	178.33	177.70	177.66	177.19
90.00	178.39	177.76	177.72	177.25
93.01			177.73	
94.45		177.78		
32+00.00	178.44	177.81	177.77	177.30
10.00	178.49	177.86	177.82	177.35
17.20	178.51			
20.00	178.52	177.89	177.85	177.38
30.00	178.55	177.92	177.88	177.41
40.00	178.56	177.93	177.89	177.42
50.00	178.56	177.93	177.89	177.42
60.00	178.56	177.93	177.89	177.42
70.00	178.54	177.91	177.87	177.40
77.89				177.39
80.00	178.52	177.89	177.85	177.38
90.00	178.48	177.85	177.81	177.34
94.86			177.79	
96.30		177.83		
33+00.00	178.44	177.81	177.77	177.30
10.00	178.38	177.75	177.71	177.24
19.05	178.33			
20.00	178.32	177.69	177.65	177.18
30.00	178.24	177.61	177.57	177.10
40.00	178.16	177.53	177.49	177.02
50.00	178.06	177.43	177.39	176.92
60.00	177.96	177.33	177.29	176.82
70.00	177.85	177.22	177.18	176.71
79.74				176.58
80.00	177.72	177.09	177.05	176.58
90.00	177.59	176.96	176.92	176.45
96.71			176.83	
98.51		176.85		
34+00.00	177.45	176.82	176.78	176.31
10.00	177.29	176.66	176.62	176.15
20.00	177.13	176.50	176.46	175.99
20.90	177.12			
30.00	176.95	176.32	176.28	175.81

MADE	BY	DATE			
	I.E.M.	9-21-67	2	As Built	JRC 3-73
CHECKED	DEK.	10-67	1	Parapet	EVR 12-70
IN CHARGE	NO.	REVISION	BY	DATE	

AS BUILT

RICHMOND METROPOLITAN AUTHORITY
RICHMOND EXPRESSWAY SYSTEM
POWHITE PARKWAY
POWHITE PARKWAY OVER
CHIPPENHAM PARKWAY
BRIDGE B-04
CROSS SECTION

Bridge 6

(Forest Hill Avenue over Powhite Parkway)

Record Set Plans

RICHMOND EXPRESSWAY SYSTEM			
SECTION	PROJECT	SHEET NO.	TOTAL SHEETS
2	POWHITE PARKWAY	151	188

CURVE DATA: $D = 5^{\circ}00'$
 $R = 1145.92'$

GENERAL NOTES:

ROADWAY: Two 27'-0" Clear roadways. One 5'-0" sidewalk. One 1'-6" curb.
CAPACITY: Dead Load- Includes 15 lbs. per sq. ft. for future wearing surface. Live Loads- HS20-44 loading and B.P.R. modified for military vehicles.
SPECIFICATIONS: GENERAL - Virginia Department of Highways Road and Bridge Specifications, 1970
 DESIGN - A.A.S.H.O. Standard Specifications for Highway Bridges, 1961, modified by Special Design Provisions.
 WELDING - 1969 Standard Specifications for Welded Highway and Railway Bridges of the American Welding Society.

CONTRACT SPECIAL PROVISIONS

Specifications and Contract Special Provisions referred to above are necessary to make these plans complete.

DATUM

CITY OF RICHMOND

TEMPERATURE

The normal temperature referred to on the plan is 68°F. The temperature range for movement is 0°F, to 120°F.

DIMENSIONS:

All dimensions are measured horizontally and vertically unless otherwise noted.

EXCAVATION:

Excavation below subgrade and cut slope template shall be classified as Structure Excavation. All excavation above these limits shall be classified as Regular Excavation and is not included in the Structural Quantities.

FOUNDATIONS:

Footings shall rest on firm material. Foundation material shall be kept dry and special attention is called to Section 401.05 of the General Specifications, and to the Contract Special Provisions, concerning preparation of foundations for footings.

CONCRETE NOTES:

Concrete in superstructure shall be Class A4. All other concrete shall be Class A-3. All exposed edges and corners shall have a 3/4" chamfer or fillet unless otherwise noted. Care in the method of vibration, the use of low-slump concrete, and/or other means shall be employed to prevent downgrade movement of newly placed slab concrete. (When gradient is over 2%)

Finishing concrete surfaces: See the Standard Architectural Detail Sheets and the Contract Special Provisions for types and details.

All reinforcing steel shall conform to A.S.T.M. A615, Grade 40. All reinf. bar dimensions on the detailed drawings are to be to the centers of bars unless otherwise noted. Clear distance between reinforcing steel and face of concrete shall be as noted on the plans. All bar laps shall be 30 diameters of the smaller diameter bar unless otherwise noted.

STEEL NOTES:

Structural steel shall conform to A.S.T.M. Specification A36 except as noted.





All field connections shall be made with high strength bolts. High strength bolts shall be 7/8" diameter unless otherwise noted and shall conform to A.S.T.M. Specification A325.

BENCH MARK:

See Reference Ties and Field Control Data sheet in highway plans.
 F-17 (Copper Weld Rod) Elevation 139.03
 F-18 (Copper Weld Rod) Elevation 141.18

BORINGS:

Indicates location of 2 1/2" φ cased hole boring.

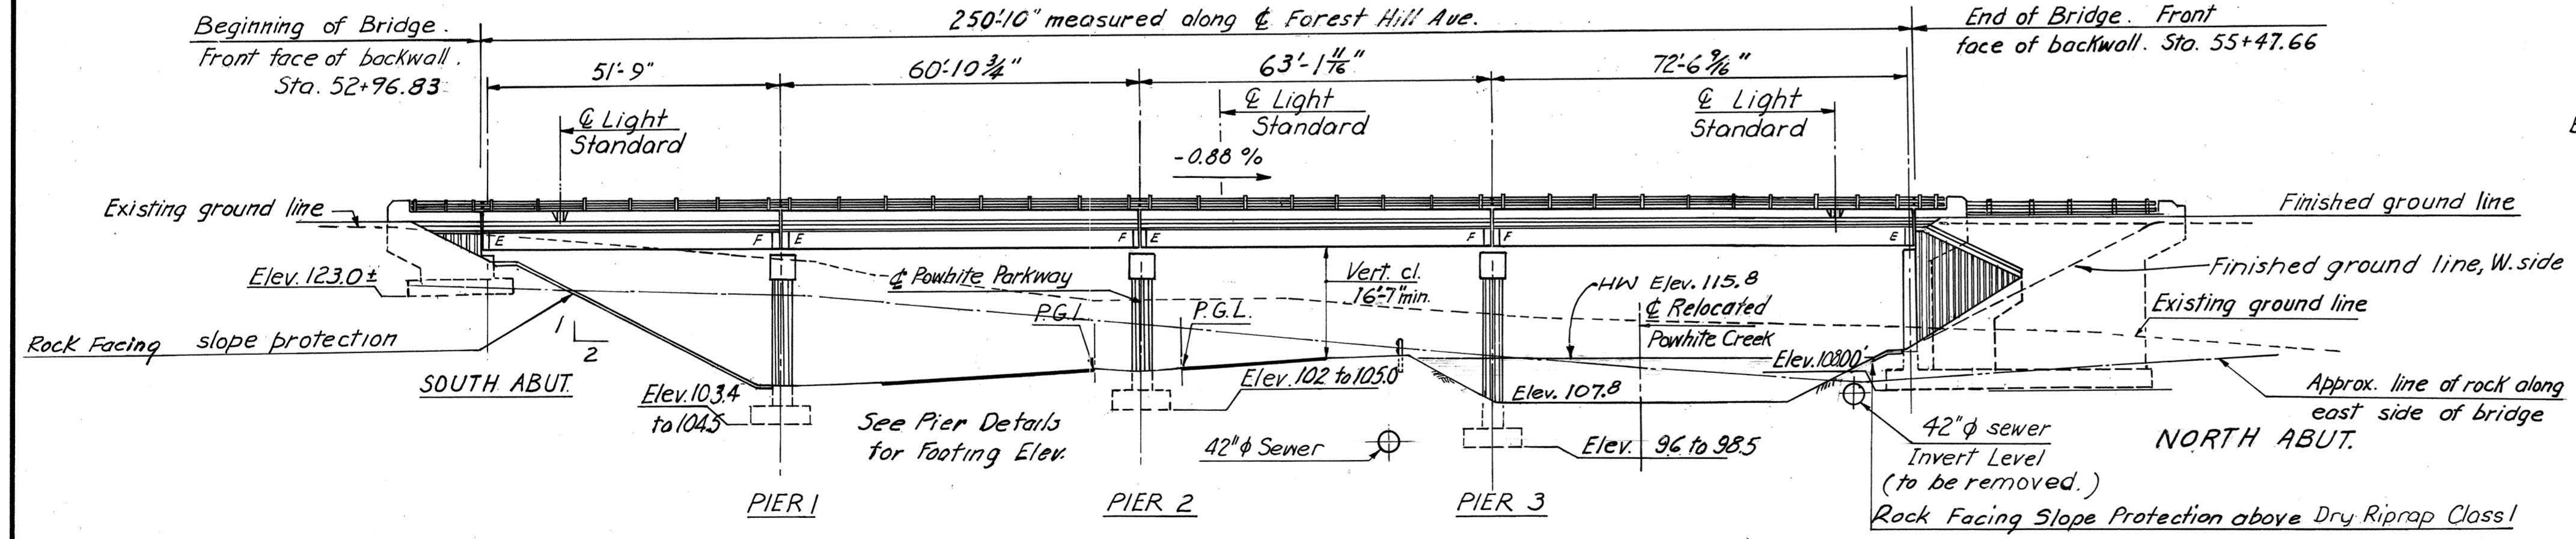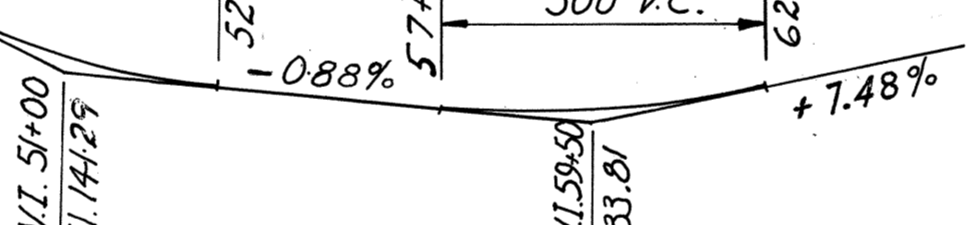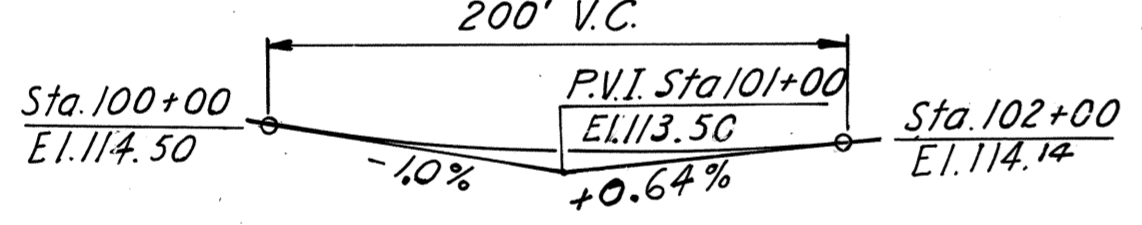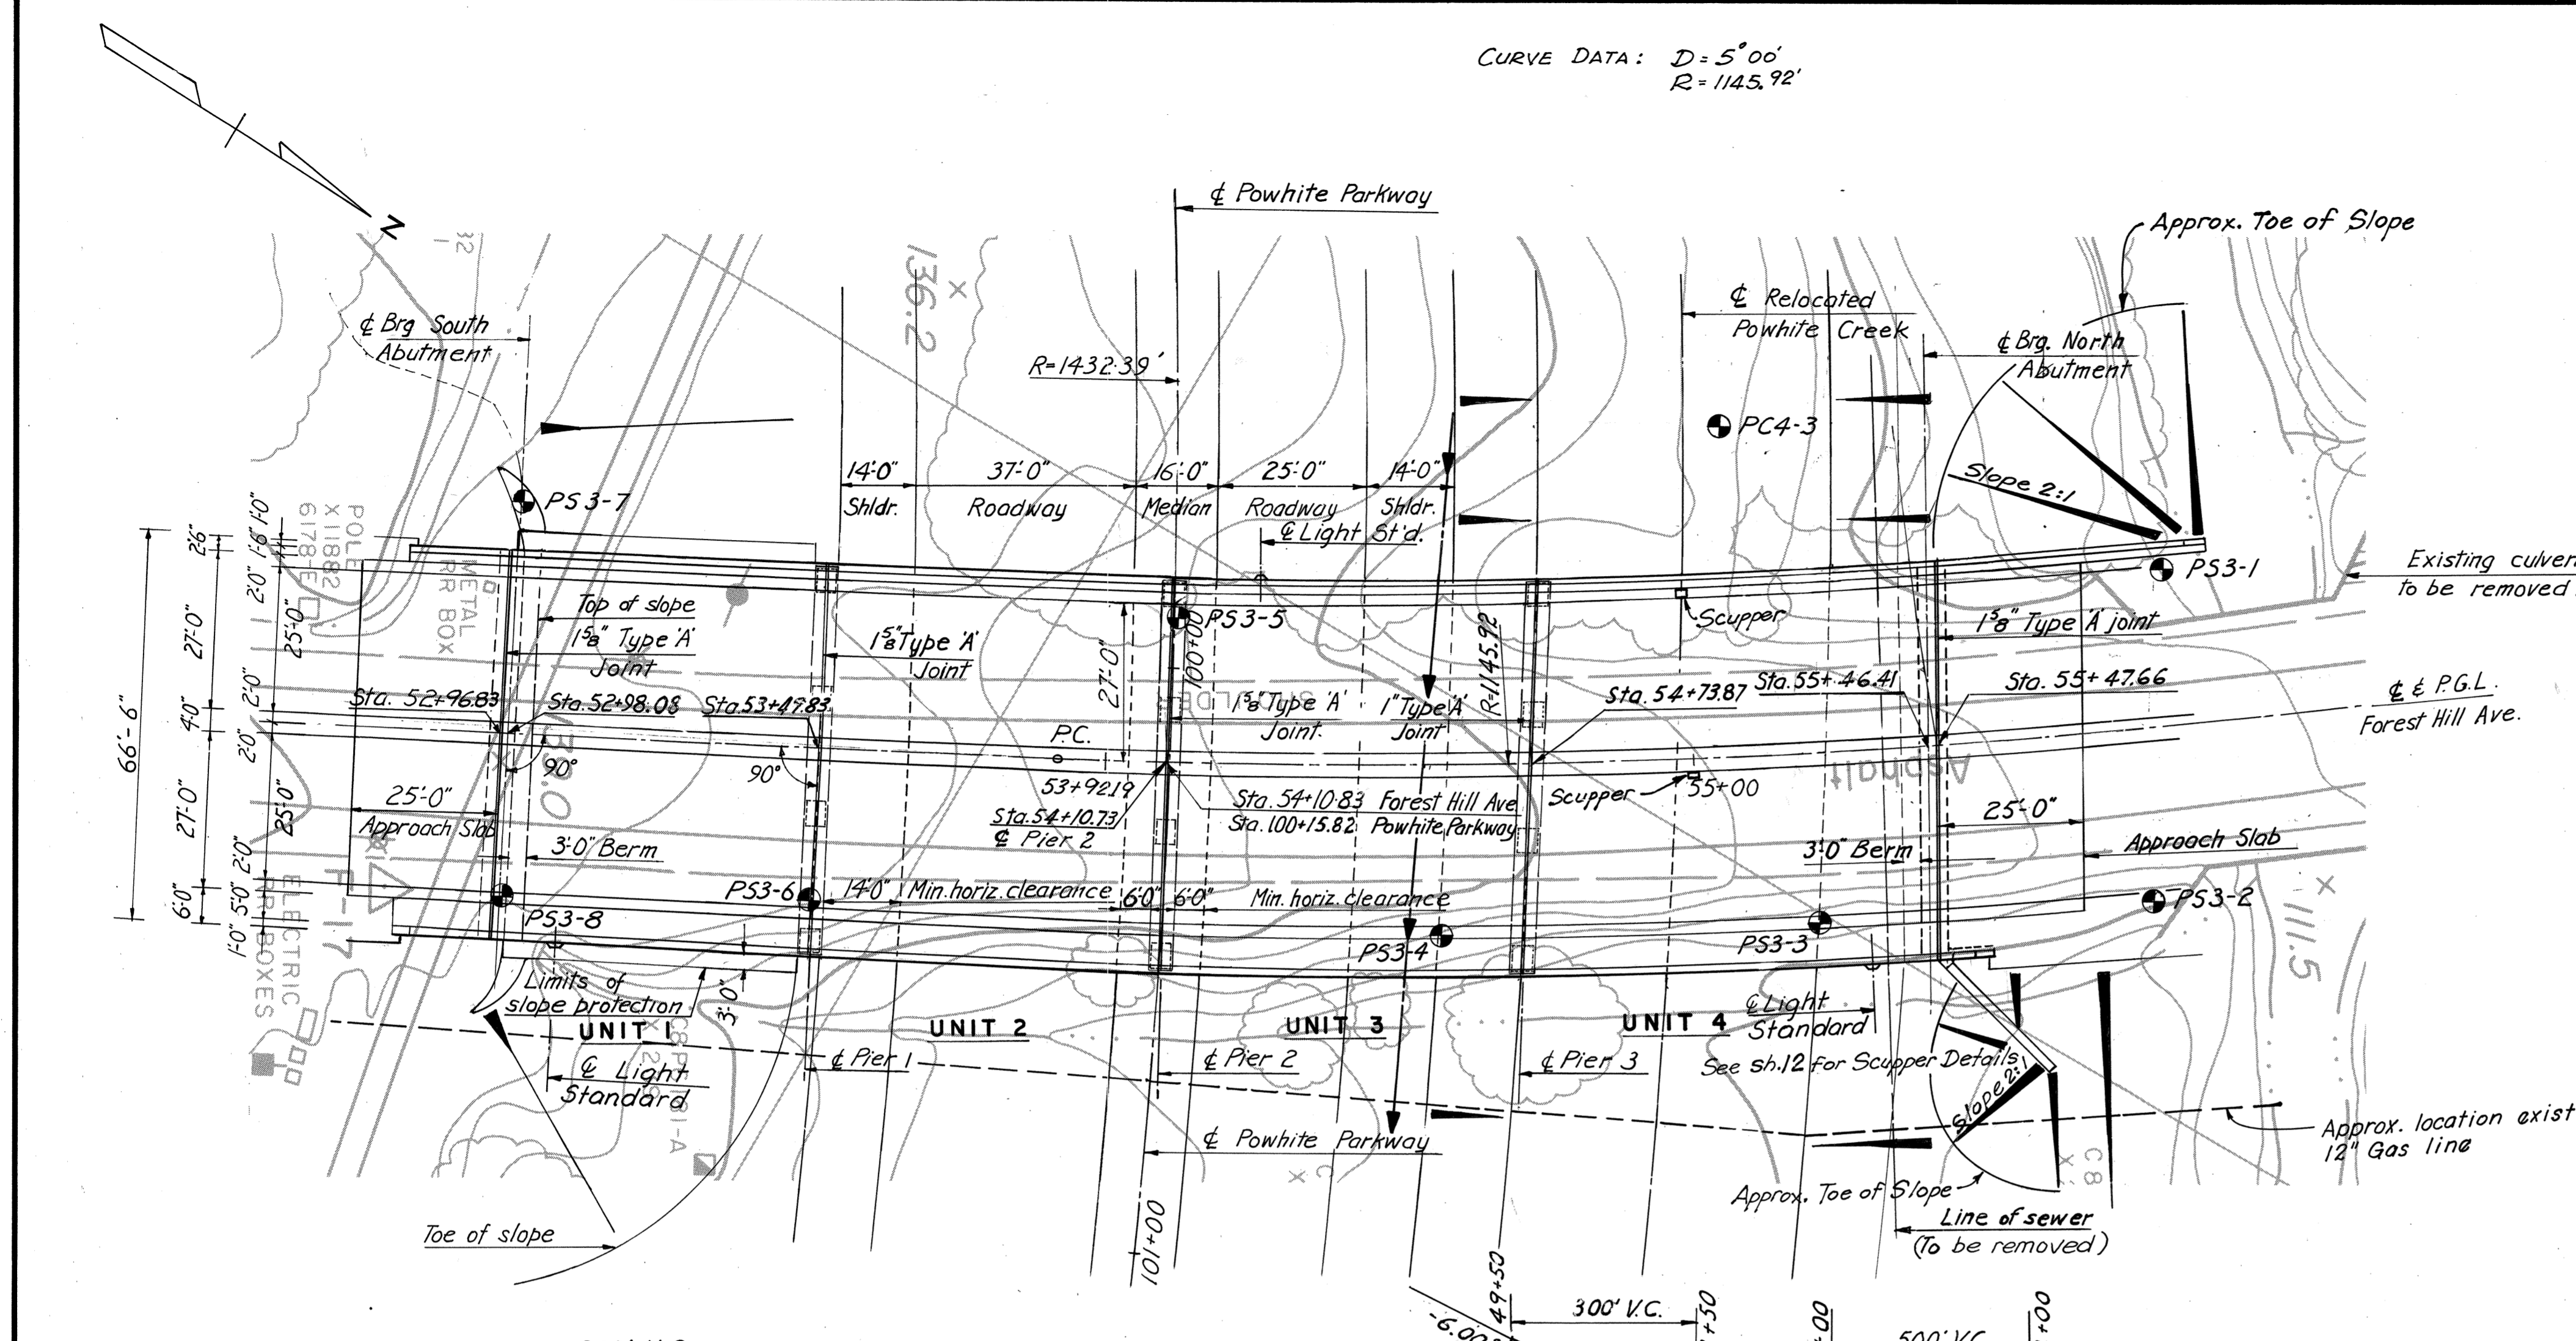

ELEVATION
Scale 1" = 20'-0"

INDEX		
NO.	DESCRIPTION	
1	General Plan and Elevation	10 Typ Transverse Section
2	Quantities and Misc. Details	11 Deck Plans
3	South Abutment Details	12 Scupper Details
4	North Abutment Details	13 Electrical Detail
5	North Abutment Details (1)	14 Joint Details
6	North Abutment Details (2)	15 Conduit Installation Details
7	Pier 1 Details	16 Utility Support Det. At Bridge Abut.
8	Pier 2 & 3 Details	17 Approach Slab and Slope Pro Det.
9	Framing Plan	18 Boring Logs
10	Typ Transverse Section	51 Standard Shoe Details
11	Deck Plans	53 Standard Alum. Rail Det. (2 Rail)
12	Scupper Details	57 Standard Architectural Details
13	Electrical Detail	58 Standard Architectural Details
14	Joint Details	
15	Conduit Installation Details	

BY	DATE			
MADE	JLN	2-68		
CHECKED	THN	2-68	1 As Built	JRC 3-79
IN CHARGE	RHW			
	NO.	REVISION	BY	DATE

AS BUILT


RICHMOND METROPOLITAN AUTHORITY
RICHMOND EXPRESSWAY SYSTEM
 POWHITE PARKWAY

FOREST HILL AVENUE OVER
POWHITE PARKWAY
 BRIDGE B-06
GENERAL PLAN & ELEVATION

HAYES, SEAY, MATTERN & MATTERN
 Associate Engineers
 HOWARD, NEEDLES, TAMMEN & BERGENDOFF
 General Consultants


SCALE: **AS SHOWN**
 CONTRACT NO.: **C-2**
 SHEET NO. **1** OF **18**

RICHMOND EXPRESSWAY SYSTEM			
SECTION	PROJECT	SHEET NO.	TOTAL SHEETS
2	POWHITE PARKWAY	157	188

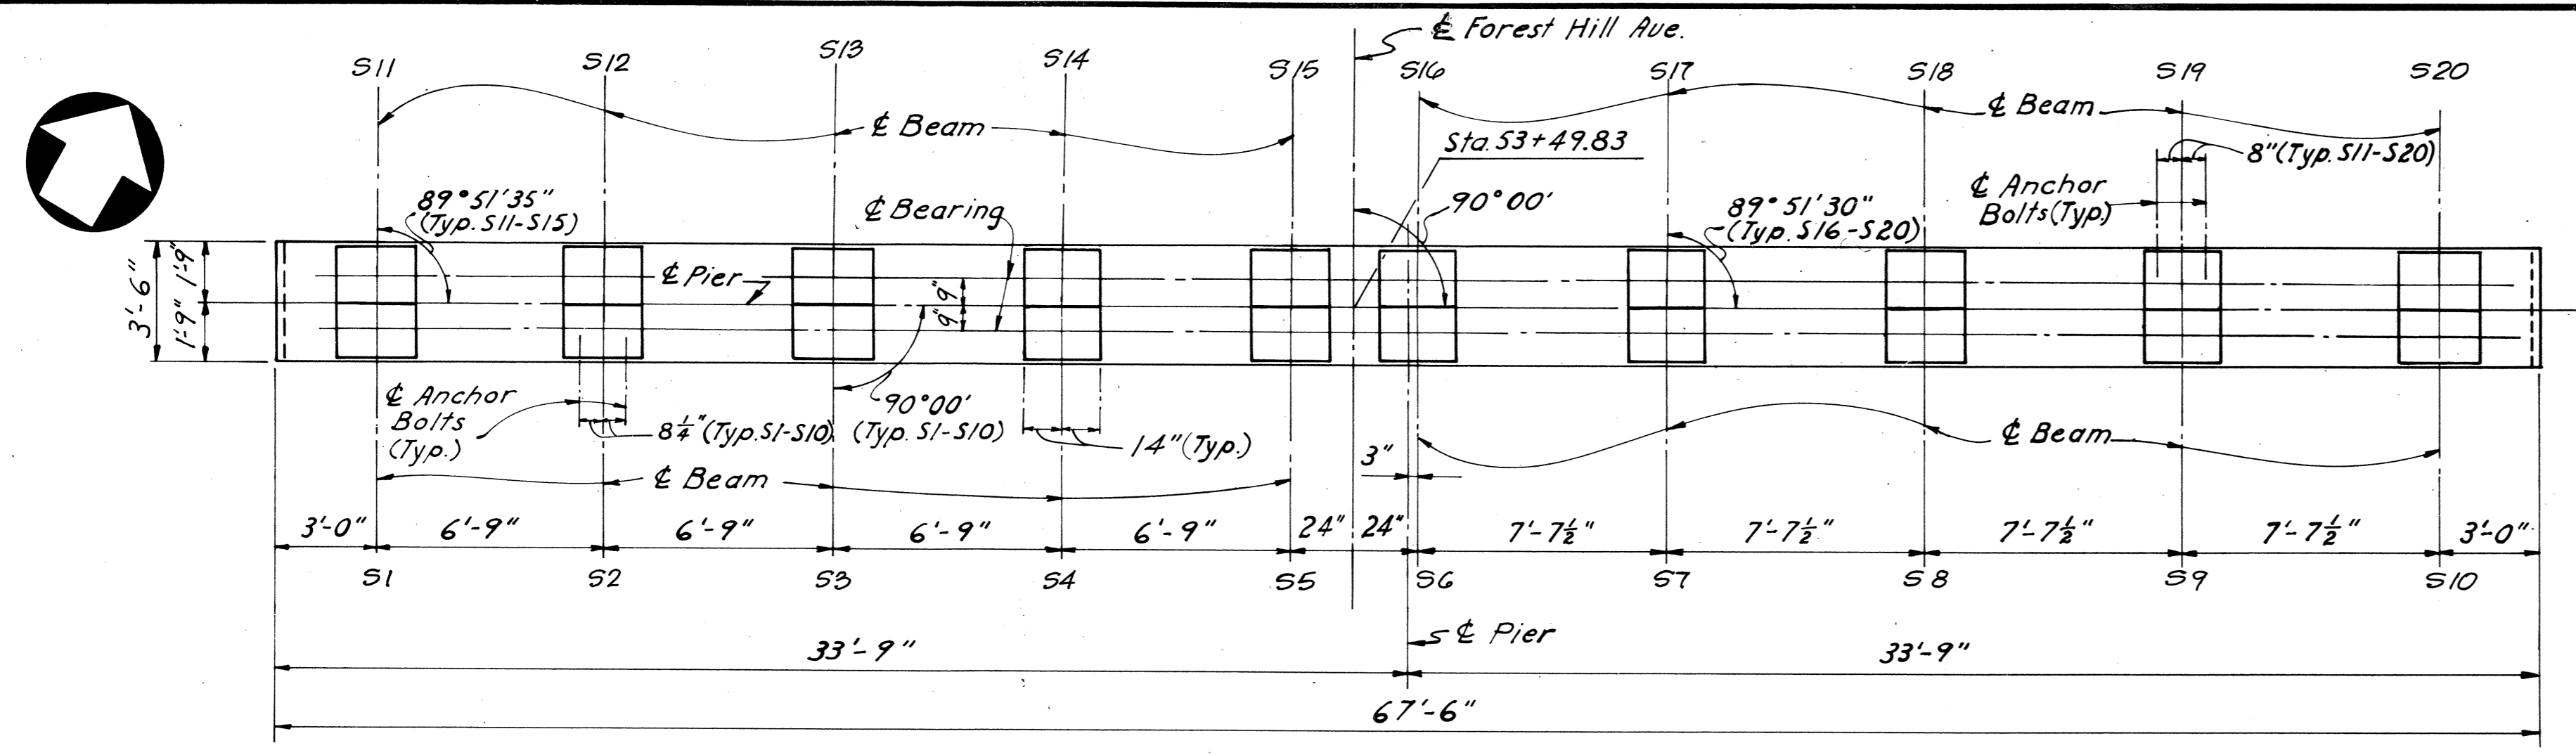


PLAN
Scale: 1/4" = 1'-0"

NOTE: See sh. 2 for Anchor Bolt Setting Diagrams.

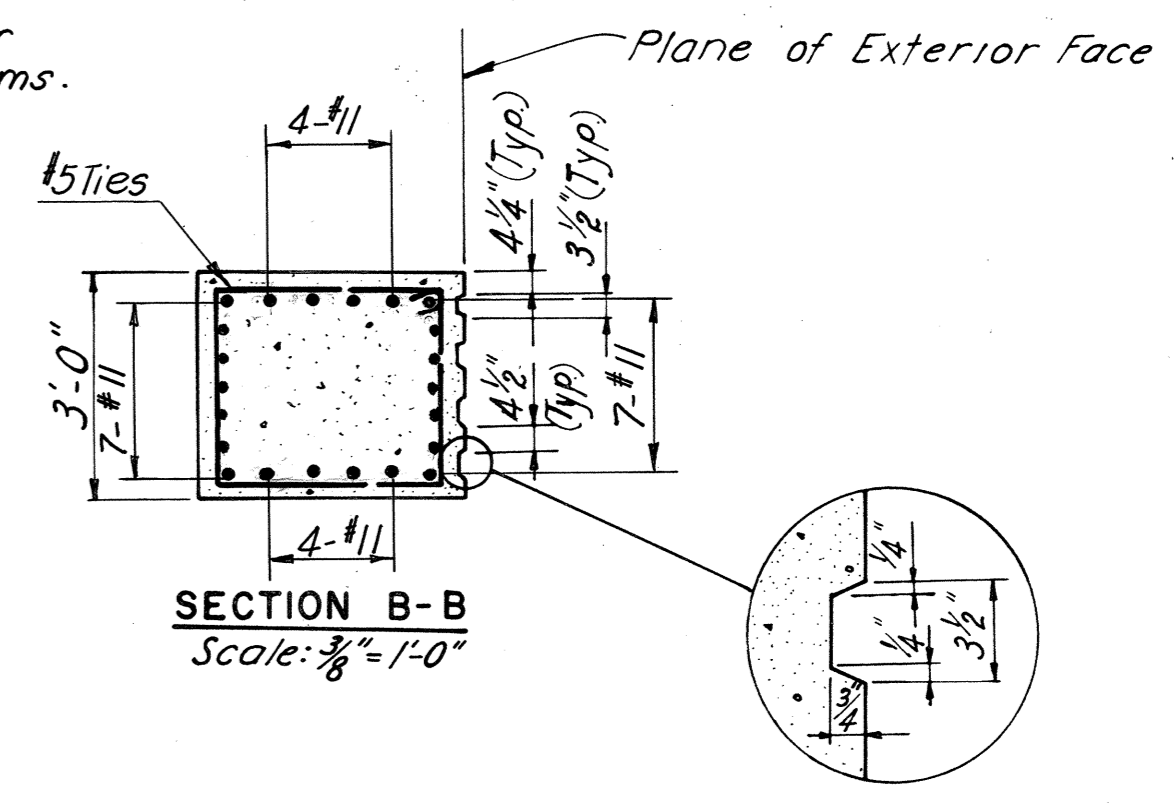


SECTION B-B
Scale: 3/8" = 1'-0"


RUSTICATION DETAILS
No Scale

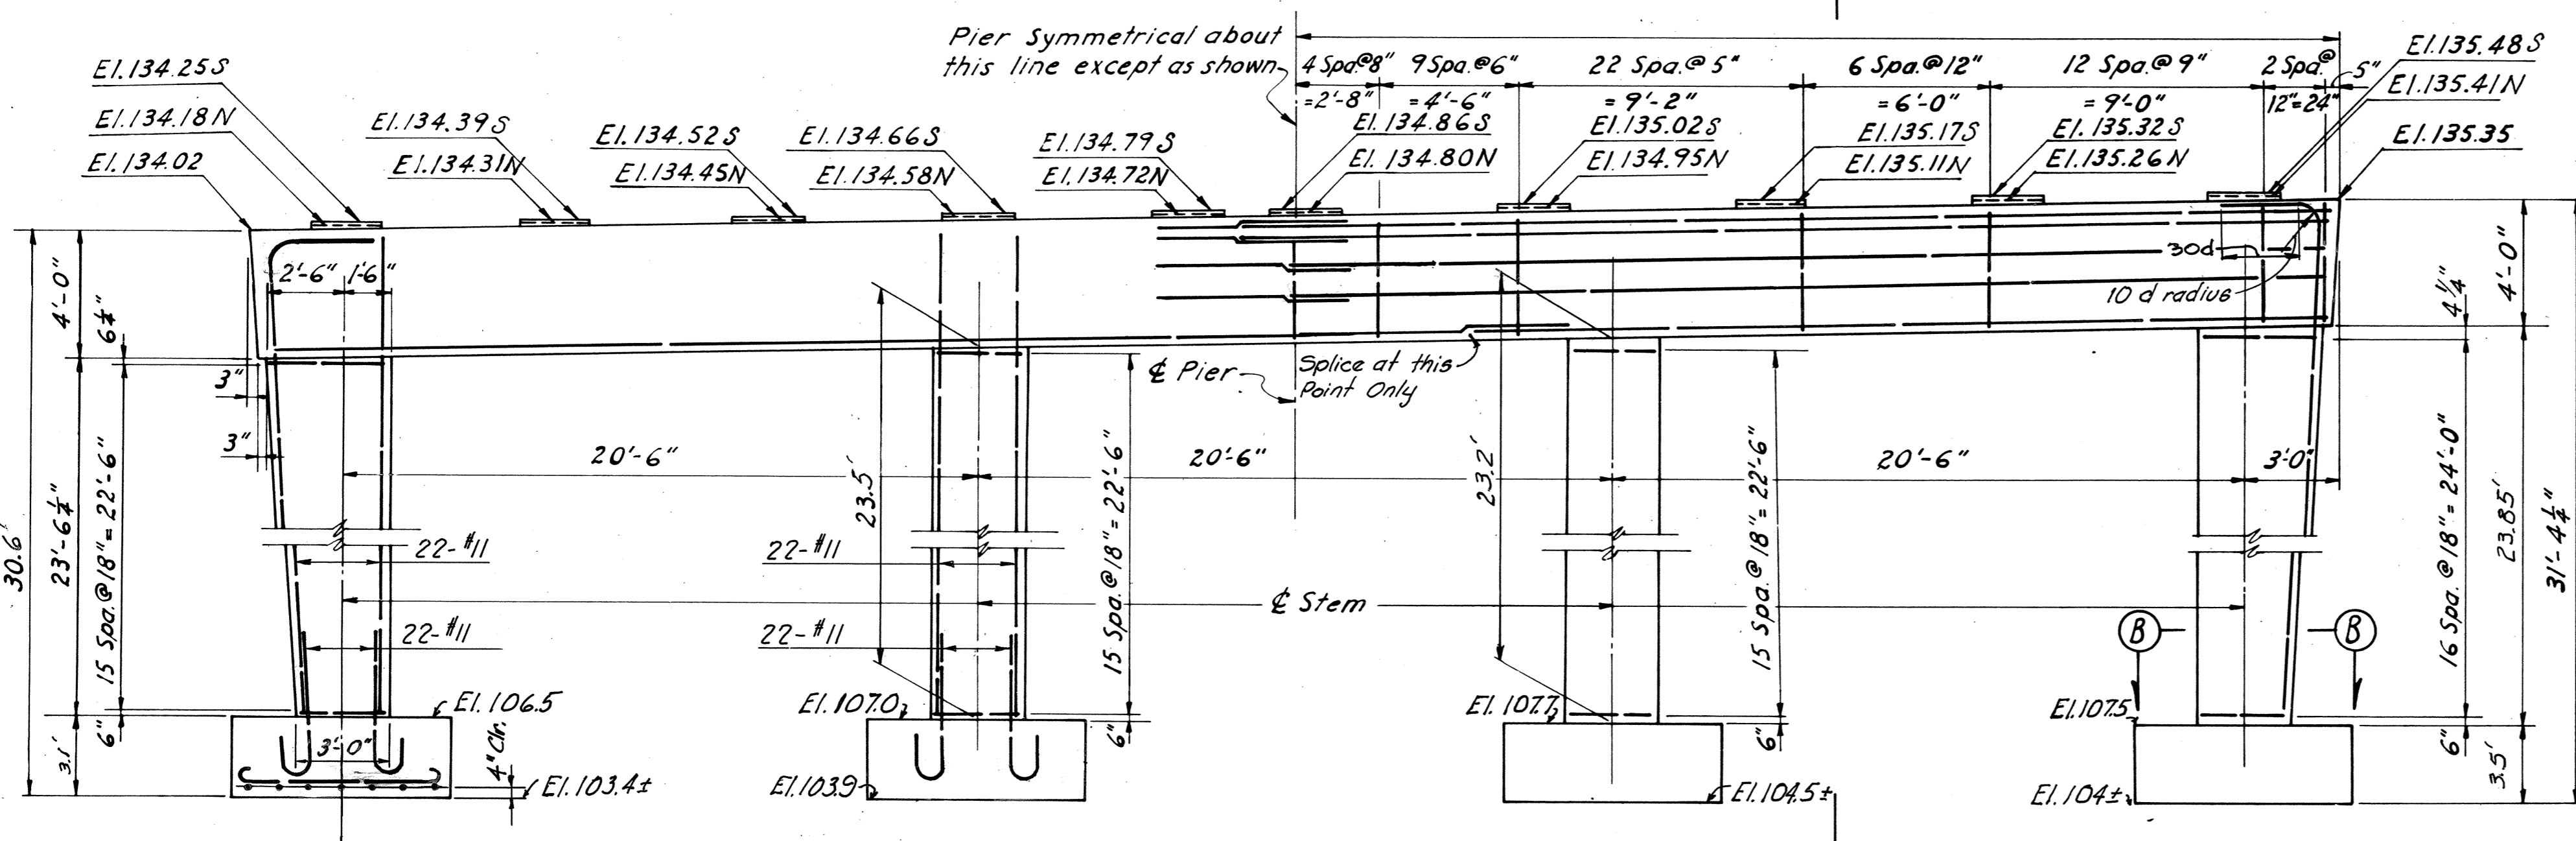

ELEVATION - PIER
Scale: 1/4" = 1'-0"

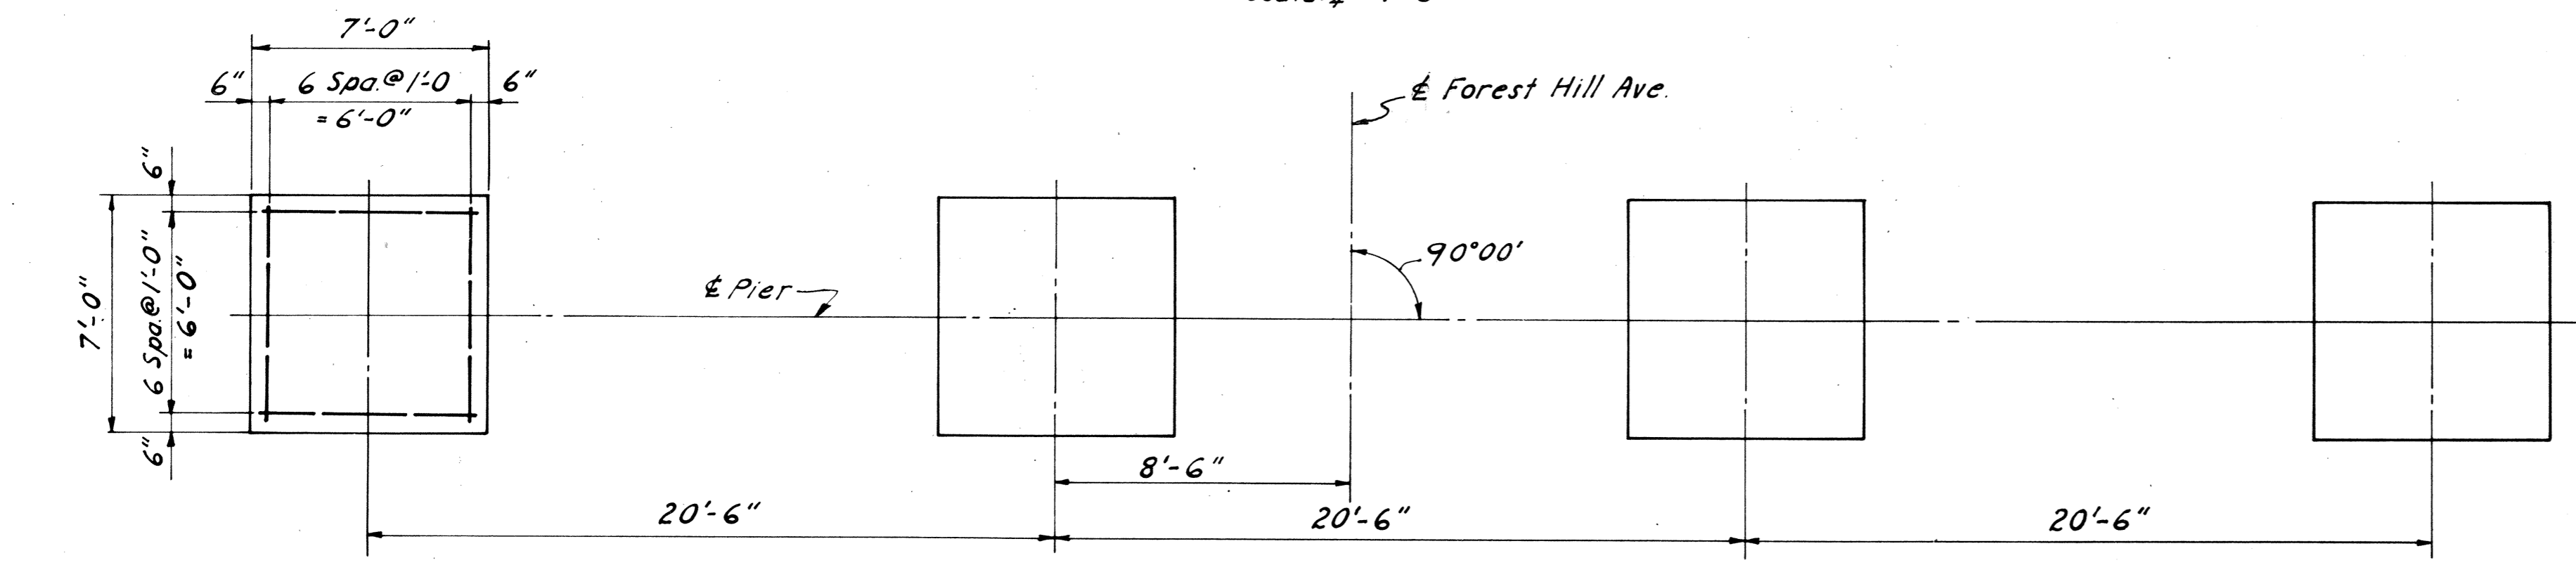

FOOTING PLAN
Scale: 1/4" = 1'-0"

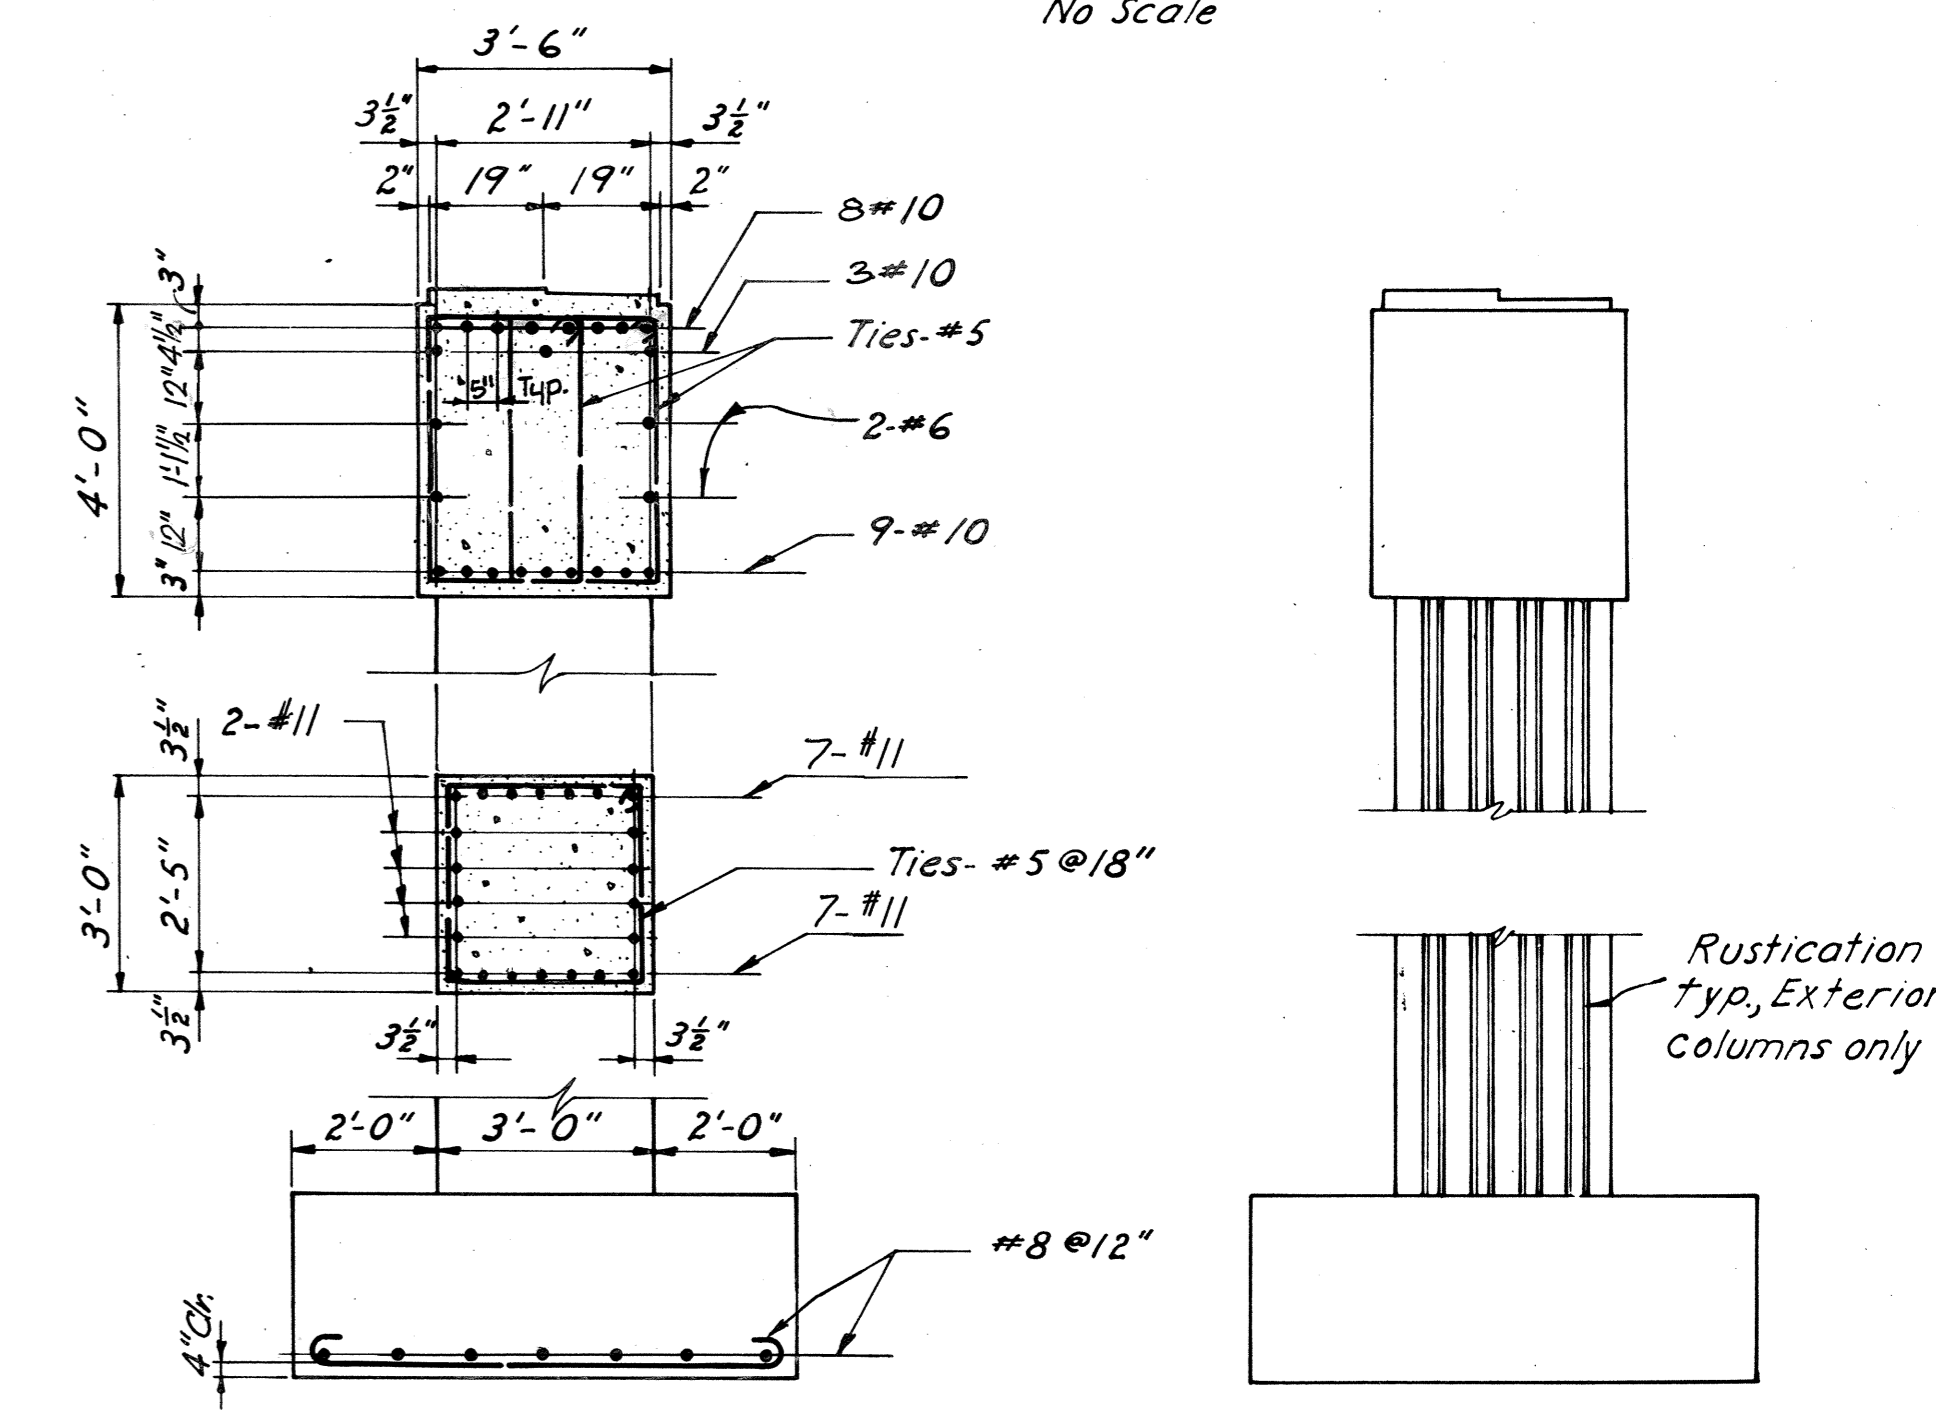

SECTION A-A
Scale: 3/8" = 1'-0"

END ELEVATION
Scale: 3/8" = 1'-0"



NOTE: All pier footing elevations are approximate only and may be varied to suit field conditions as directed by the Engineer. Vertical shaft reinforcing shall not be cut until these elevations are established. Where elevations change more than 2 ft., redesign will be required.

AS BUILT



RICHMOND METROPOLITAN AUTHORITY RICHMOND EXPRESSWAY SYSTEM POWHITE PARKWAY	
FOREST HILL AVENUE OVER POWHITE PARKWAY BRIDGE B-06 PIER I DETAILS	
HAYES, SEAY, MATTERN & MATTERN Associate Engineers	SCALE: AS SHOWN
HOWARD, NEEDLES, TAMMEN & BERGENDOFF General Consultants	CONTRACT NO.: 2 SHEET NO. 7 OF 18

BY	DATE	NO.	REVISION	BY	DATE
MADE	JLN 2-68				
CHECKED	THN 2-68	1	As Built	JRC	3-73
IN CHARGE	RHW				


RICHMOND EXPRESSWAY SYSTEM			
SECTION	PROJECT	SHEET NO.	TOTAL SHEETS
2	POWHITE PARKWAY	158	188

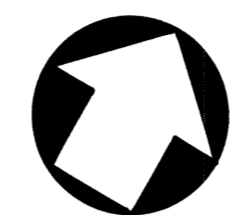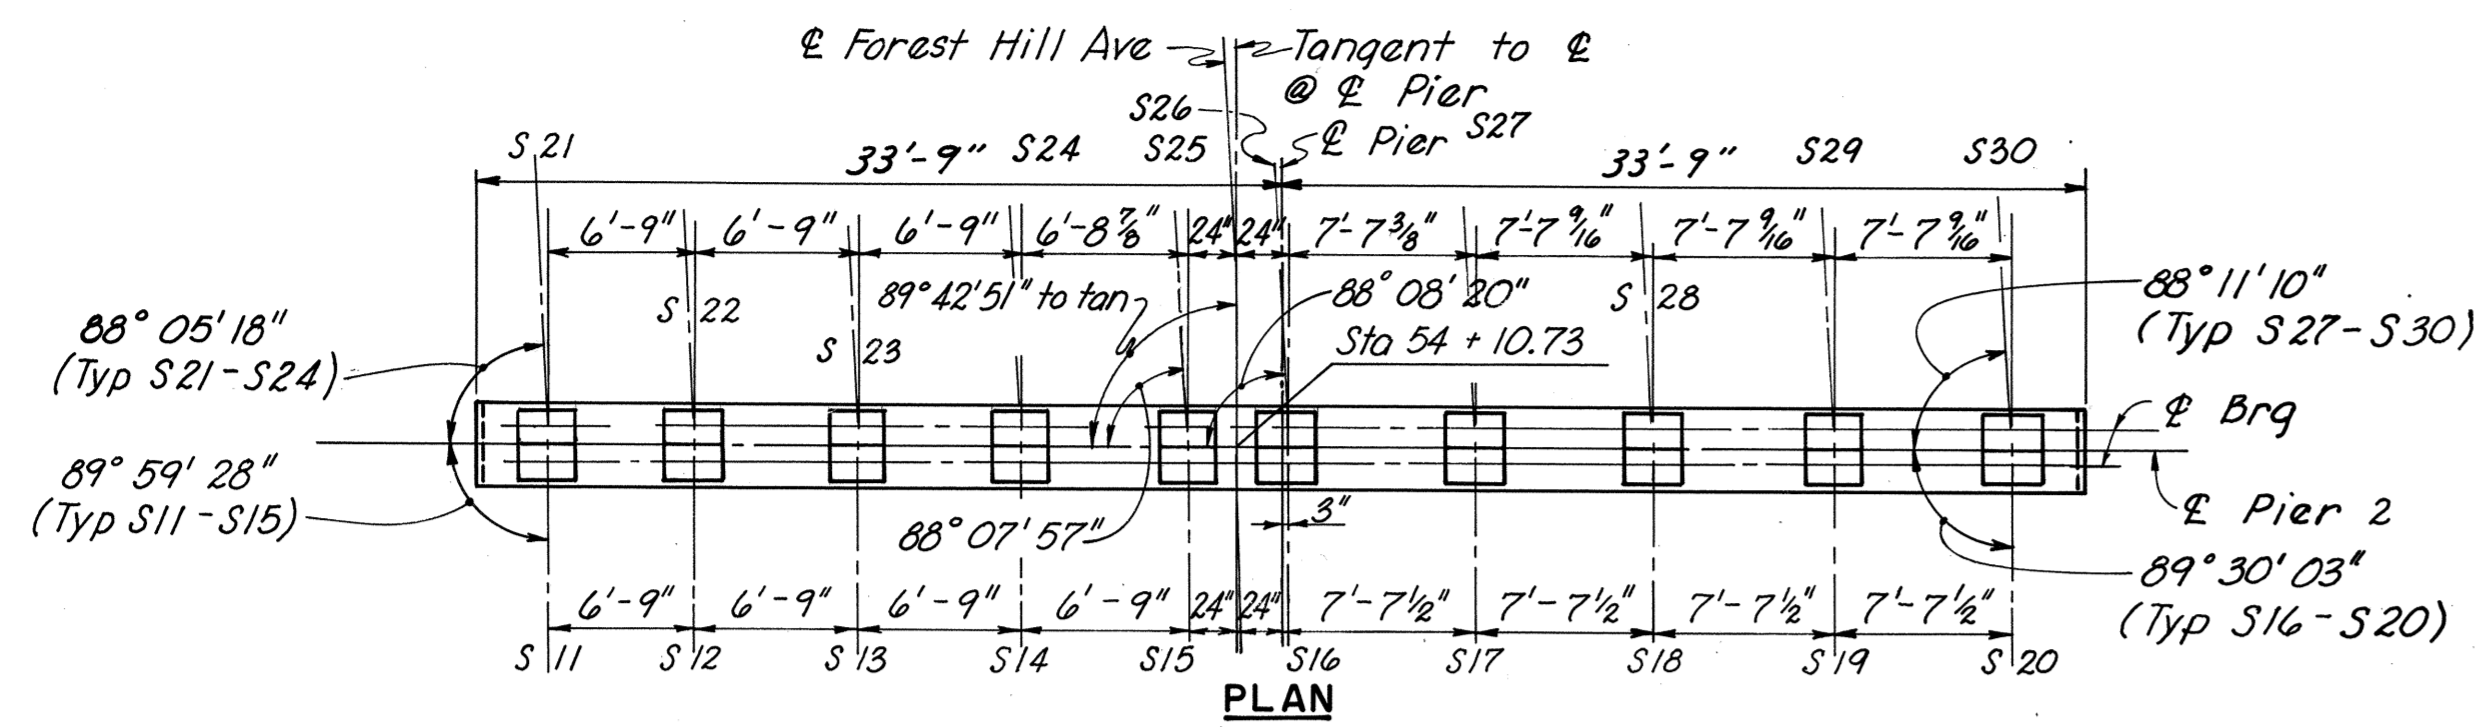


NOTE: See sh. 2 for Anchor Bolt Setting Diagrams.

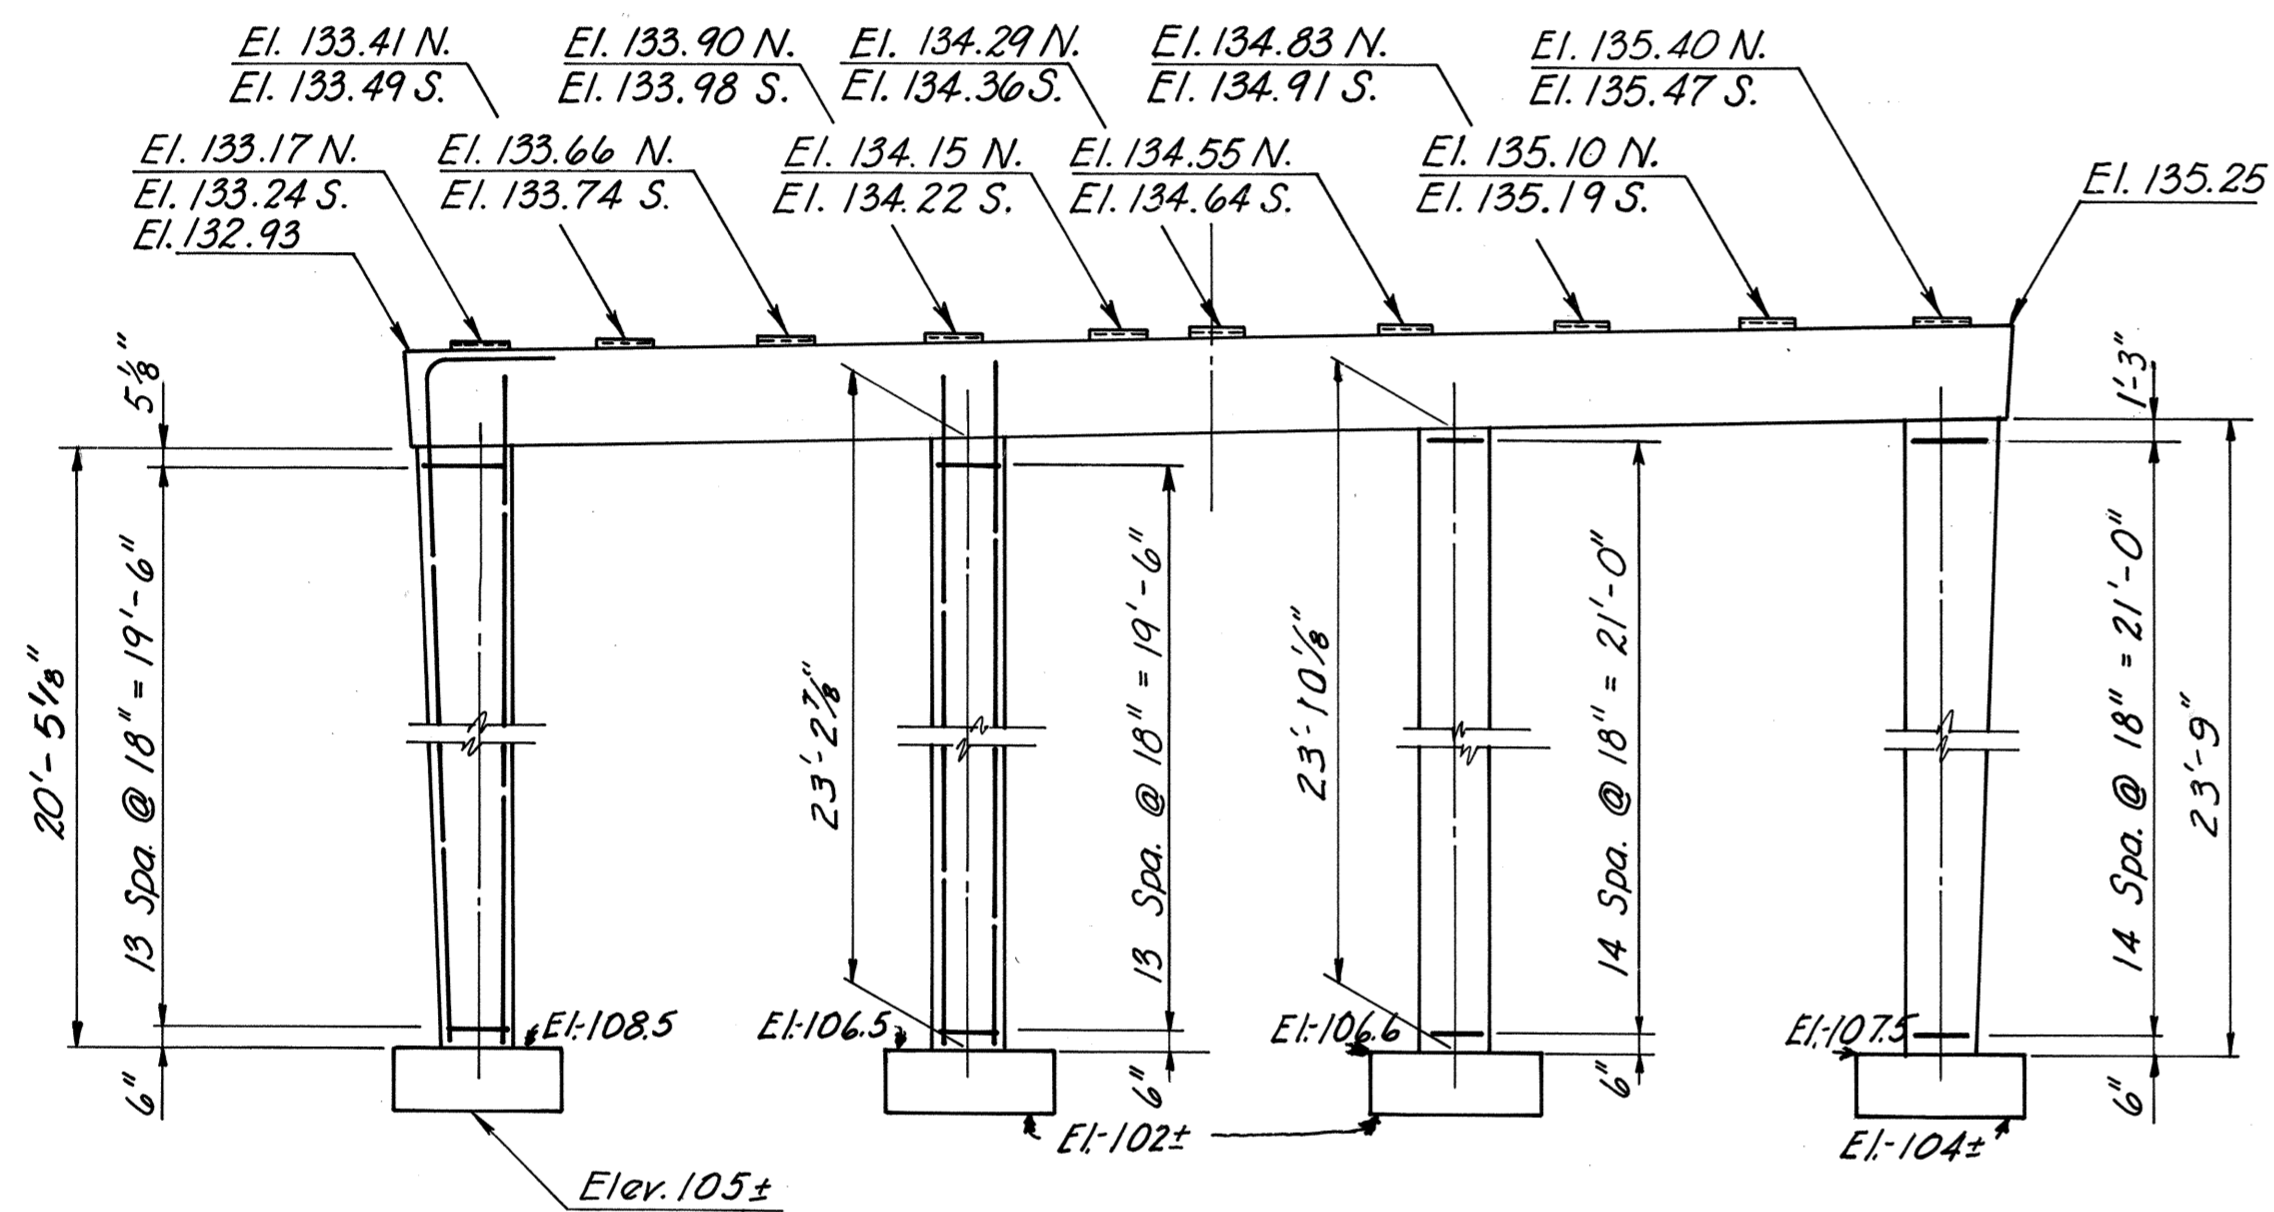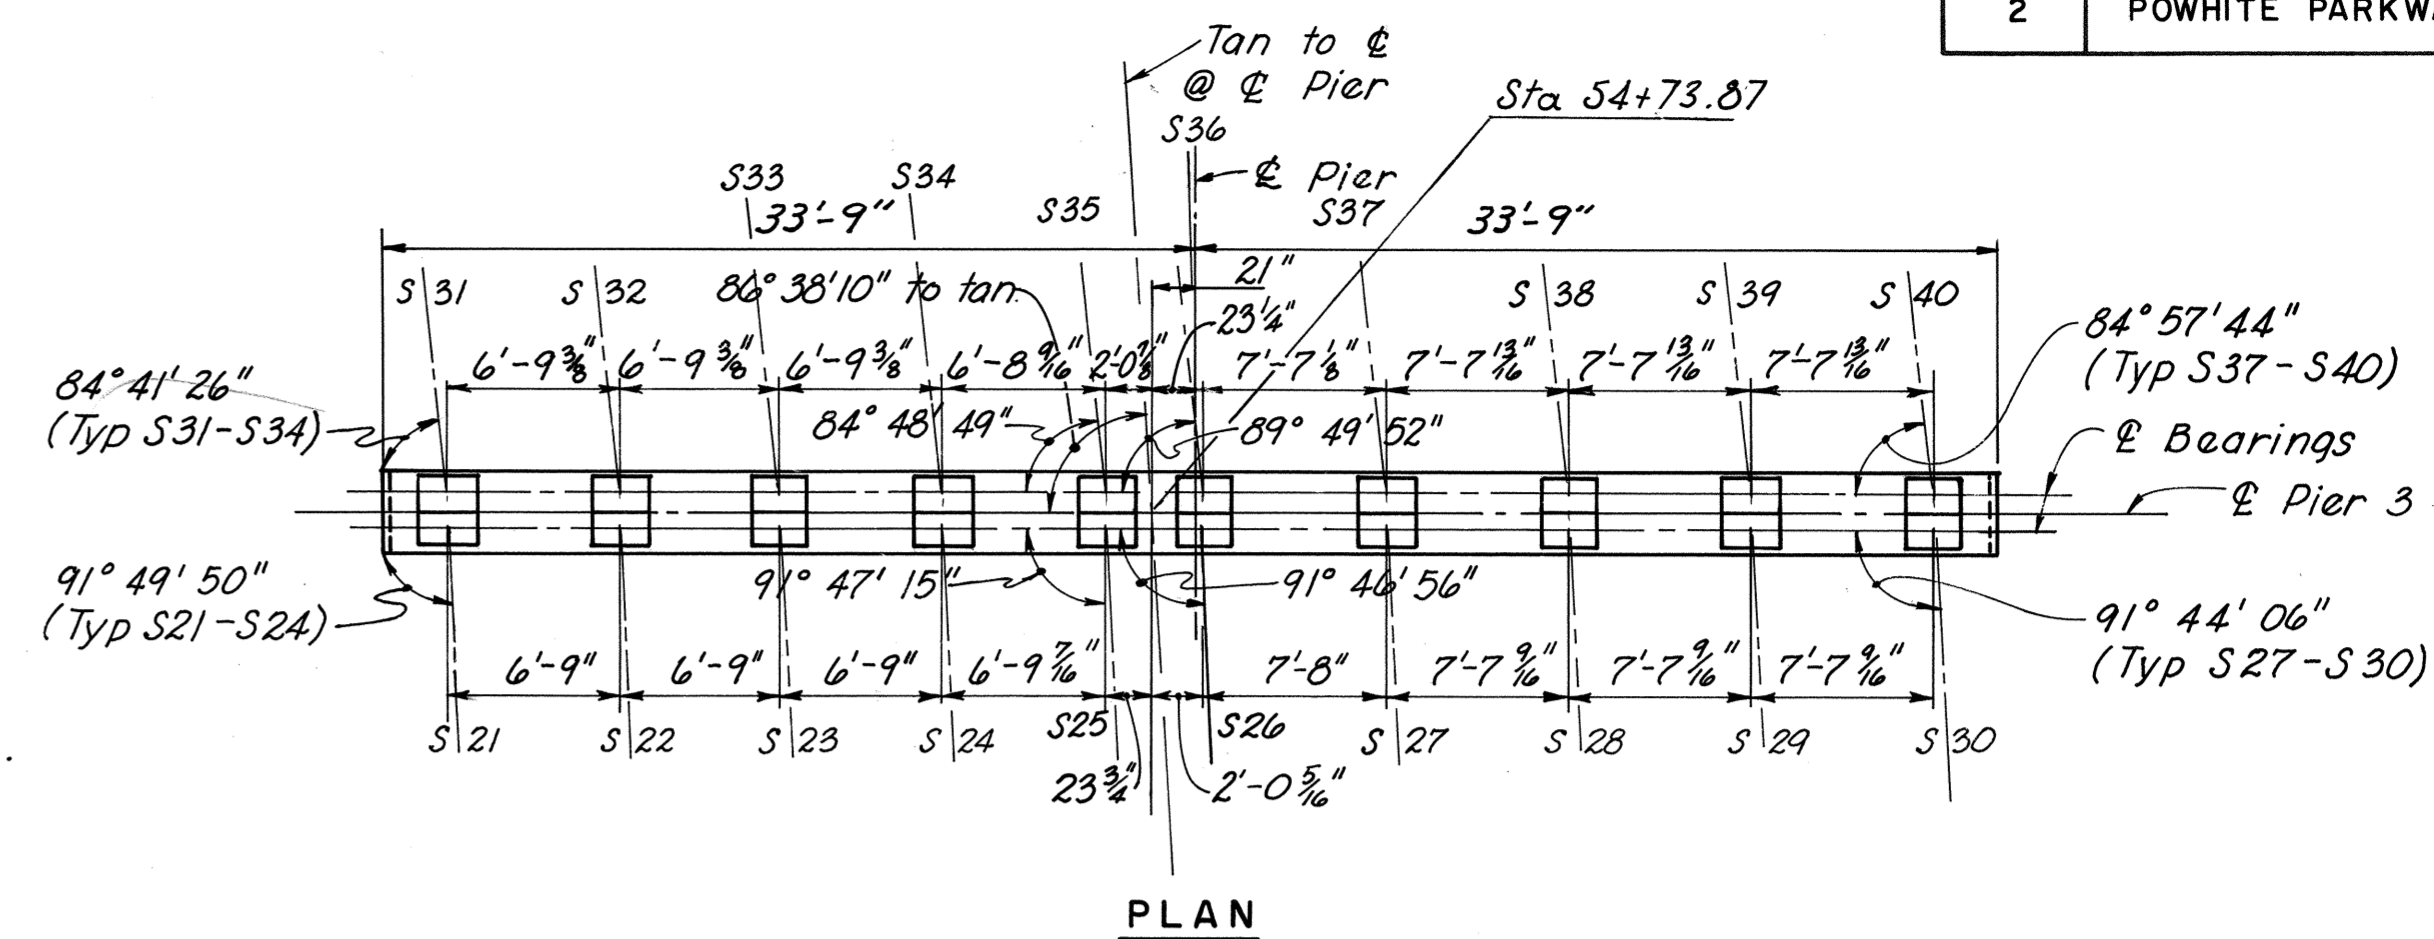


ELEVATION - PIER 2

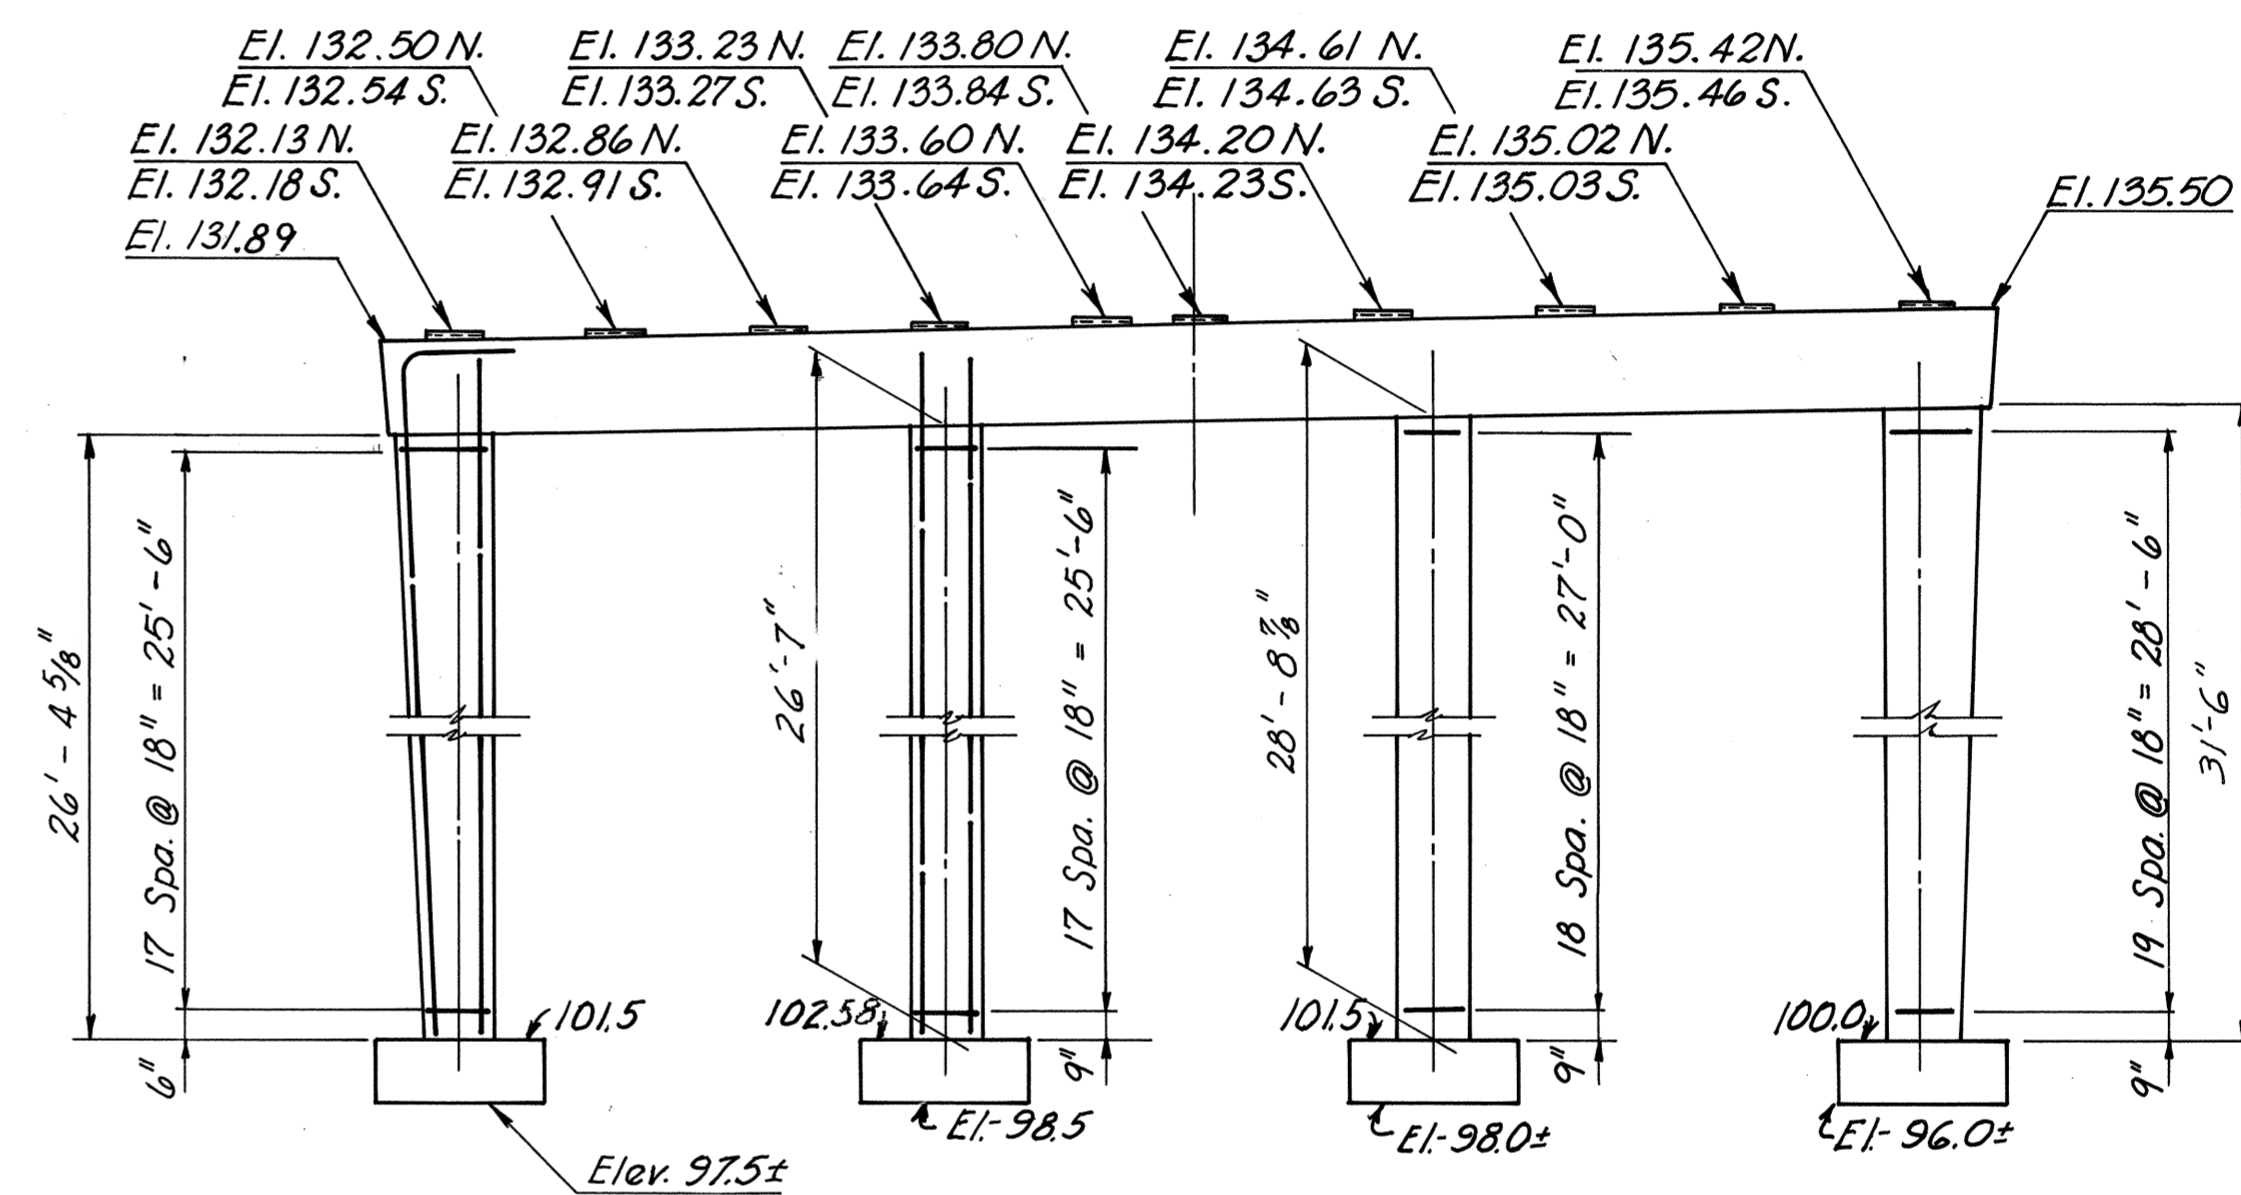

ELEVATION - PIER 3

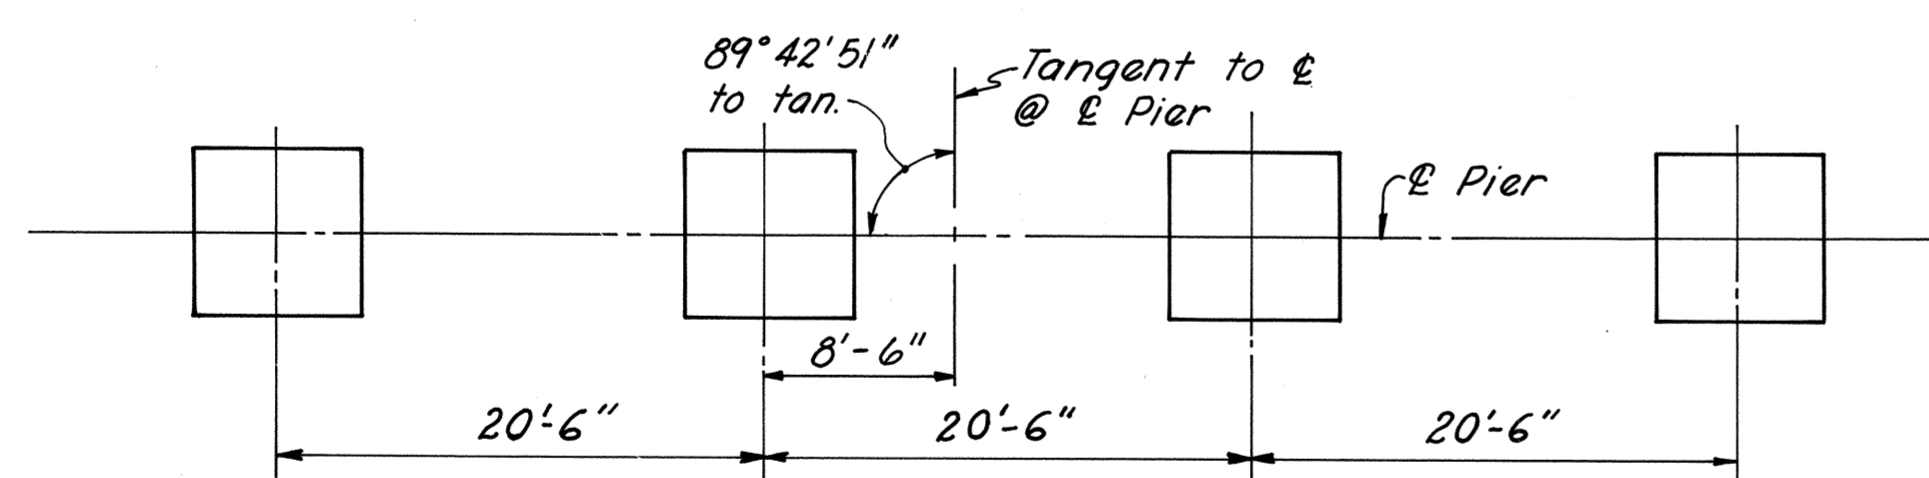

FOOTING PLAN

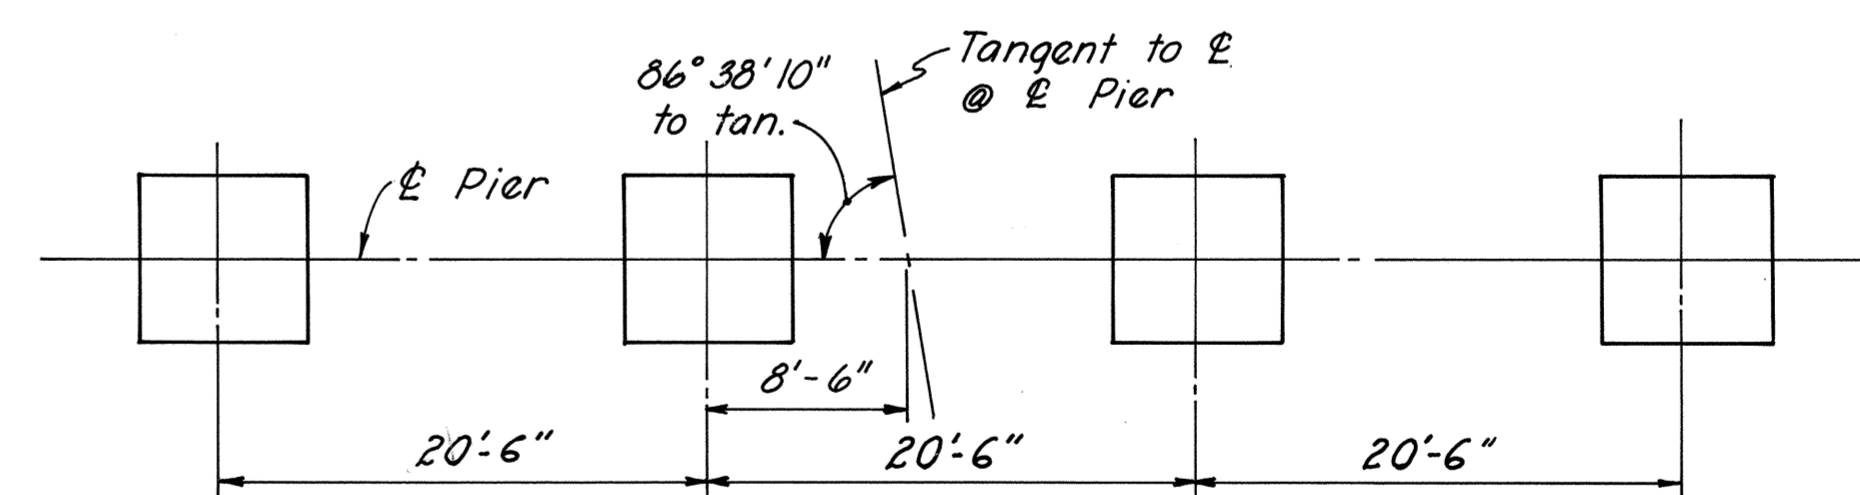

FOOTING PLAN

AS BUILT

RICHMOND METROPOLITAN AUTHORITY RICHMOND EXPRESSWAY SYSTEM POWHITE PARKWAY	
FOREST HILL AVENUE OVER POWHITE PARKWAY BRIDGE B-06	
PIERS 2 & 3 DETAILS	
HAYES, SEAY, MATTERN & MATTERN Associate Engineers	SCALE: 1/8" = 1'-0"
HOWARD, NEEDLES, TAMMEN & BERGENDOFF General Consultants	CONTRACT NO.: 2
	SHEET NO. 8 OF 18

BY	DATE	REVISION	BY	DATE
MADE	JLN 2-68			
CHECKED	THN 2-68	1 As Built	JRC	3-73
IN CHARGE	RHW			

Note: For dimensions, reinforcement and details not shown, see Pier 1, Sheet 7

Bridge 8

(Powhite Parkway “Rte. 76” Over James River, Kanawha Canal and CSX RR)

Record Set Plans

INDEX OF SHEETS

SHEET NO.	TITLE
1	COVER SHEET
2-3	GENERAL PLAN AND ELEVATION
4	BRIDGE LAYOUT, GENERAL NOTES AND ESTIMATE OF QUANTITIES
5	PROFILES AND PAVEMENT ELEVATIONS
6	SOUTH ABUTMENT
7	NORTH ABUTMENT
8	ABUTMENT DETAILS
9	PIER 1
10	PIER 2
11	PIER 3
12	(DELETED) △
13	PIER 4
14	(DELETED) △
15	PIER 5
16	PIER 6
17	PIER 7
18	PIER 8
19	PIER 9
20	PIER 10
21	PIER 11
22	PIER 12
23	PIER 13
24	PIER 14
25	PIER 15
26	PIER 16
27	PIER 17
28	FRAMING PLAN - UNITS 1, 2, 3 AND 4
29	FRAMING PLAN - UNITS 5 THRU 12 △
30	FRAMING PLAN - UNITS 13, 14 AND 15
31	FRAMING PLAN - UNITS 16, 17 AND 18
32-33	STRUCTURAL STEEL DETAILS
34	SHOES
35	JOINT DETAILS
36	DRAINAGE SCUPPERS
37	DECK PLAN - UNITS 1, 2, 3 AND 4
38	DECK PLAN - UNITS 5 THRU 12 △
39	DECK PLAN - UNITS 13, 14 AND 15
40	DECK PLAN - UNITS 16, 17 AND 18
41	DECK DETAILS
42	ALUMINUM RAILING DETAILS
43	(DELETED) △
44	ELECTRICAL DETAILS
45	APPROACH SLABS
46	SLOPE PROTECTION
47-53	BORING LOGS


RICHMOND METROPOLITAN AUTHORITY

PLAN AND PROFILE OF PROPOSED RICHMOND EXPRESSWAY SYSTEM

CHESTERFIELD COUNTY CITY OF RICHMOND

JAMES RIVER BRIDGE

LIMITED ACCESS HIGHWAY			
RICHMOND EXPRESSWAY SYSTEM			
SECTION	PROJECT	SHEET NO.	TOTAL SHEETS
3	JAMES RIVER BRIDGE	1	53

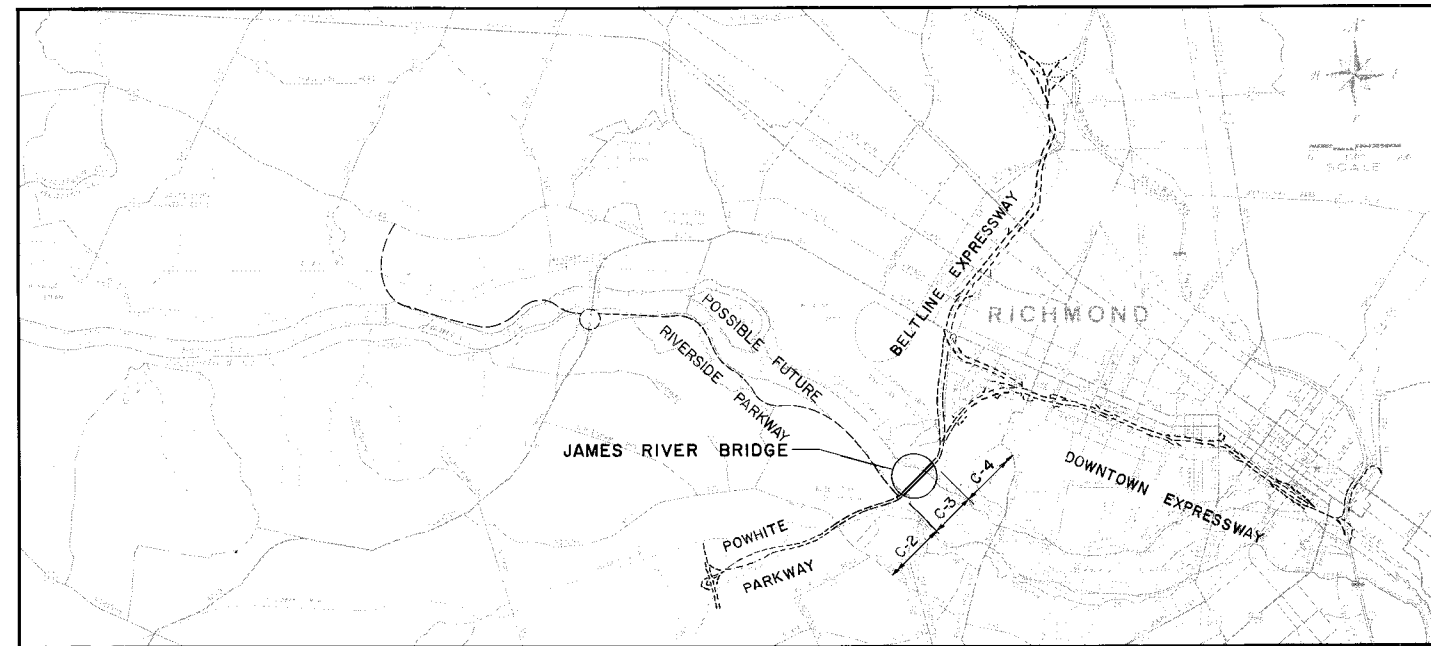

CONTRACT C-3

BRIDGE B-8

CONVENTIONAL SIGNS	
STATE LINE	LEVEE OR EMBANKMENT
COUNTY LINE	BRIDGES
CITY, TOWN OR VILLAGE	CULVERTS
RIGHT OF WAY LINE	DROP INLET
FENCE LINE	TROLLEY POLES
UNFENCED PROPERTY LINE	POWER POLES
FENCED PROPERTY LINE	TELEPHONE OR TELEGRAPH POLES
TRAVELED WAY	MARSH
GUARD RAIL	HEDGE
RETAINING WALL	WOODS
RAILROADS	GROUND ELEVATION
BASE OR SURVEY LINE	GRADE ELEVATION
	POLES WITHIN CONSTRUCTION LIMITS


SUBMITTED BY	
Date	
1-22-71	<i>John P. Fowler</i>
Date	HOWARD, NEEDLES, TAMMEN & BERGENDOFF General Consultant

RECOMMENDED BY	
Date	
1-23-71	<i>Charles A. ...</i>
Date	GENERAL MANAGER, RICHMOND METROPOLITAN AUTHORITY


APPROVED BY	
Date	
1-23-71	<i>Charles A. ...</i>
Date	CHAIRMAN, RICHMOND METROPOLITAN AUTHORITY

Plans Revised			
Sheet No.	Date	Sheet No.	Date
1-6,9-16,28,29	2-20-71		
32-38,41,43,46	2-20-71		
1,2,3,17,37	3-9-71		
38,39,40	3-9-71		
1,4,35,36,44	4-5-71		
21	9-3-71		
23	4-12-72		
45	9-12-72		

RICHMOND EXPRESSWAY SYSTEM			
SECTION	PROJECT	SHEET NO.	TOTAL SHEETS
3	JAMES RIVER BRIDGE	2	53

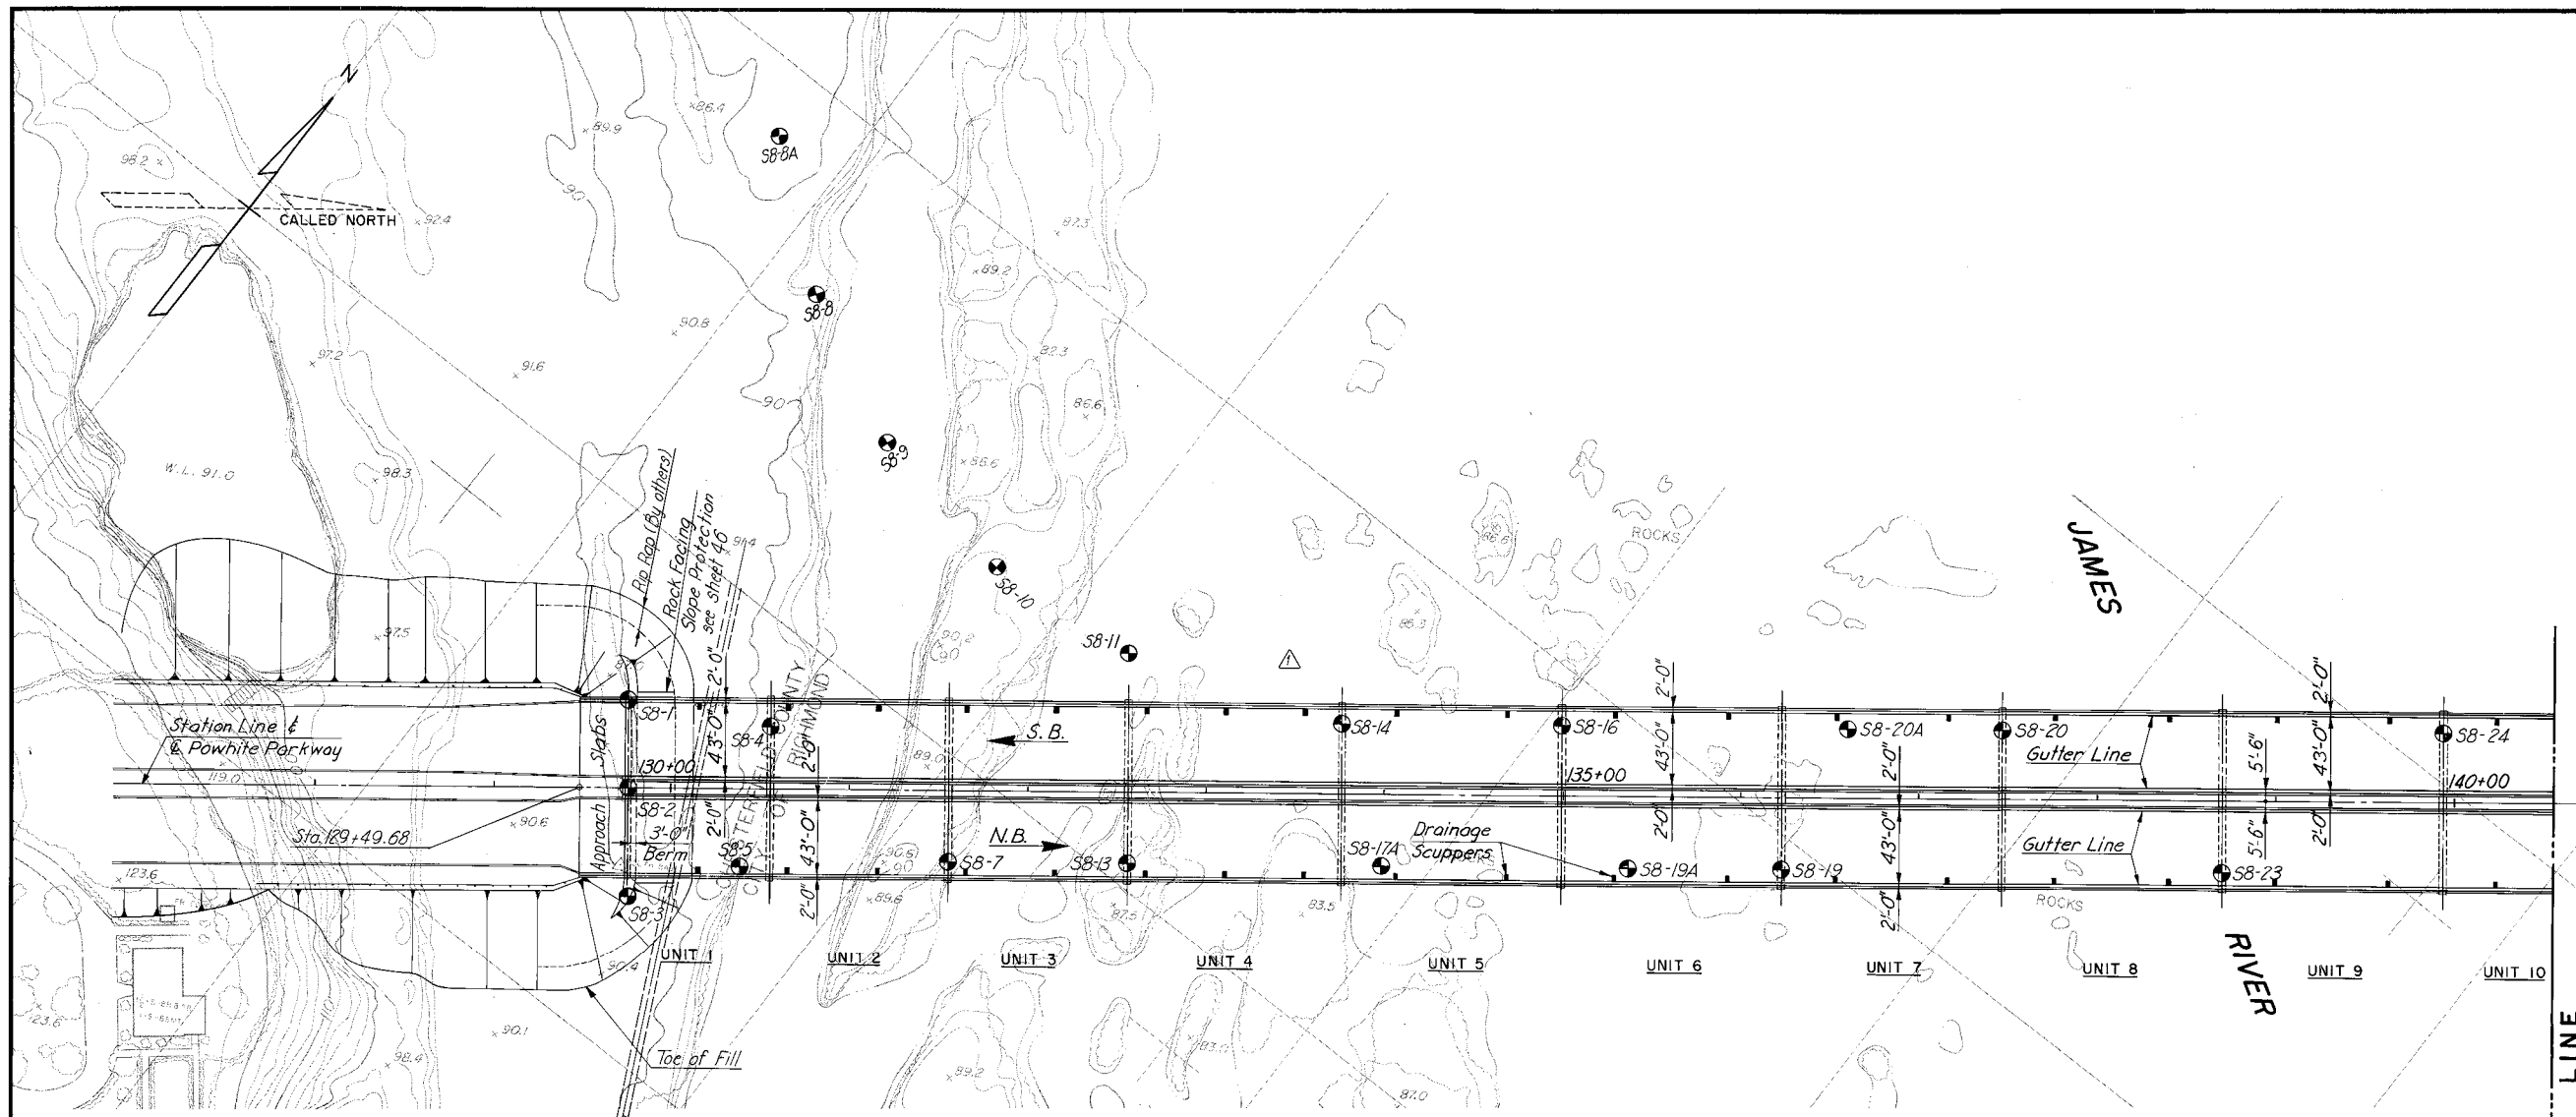

PLAN

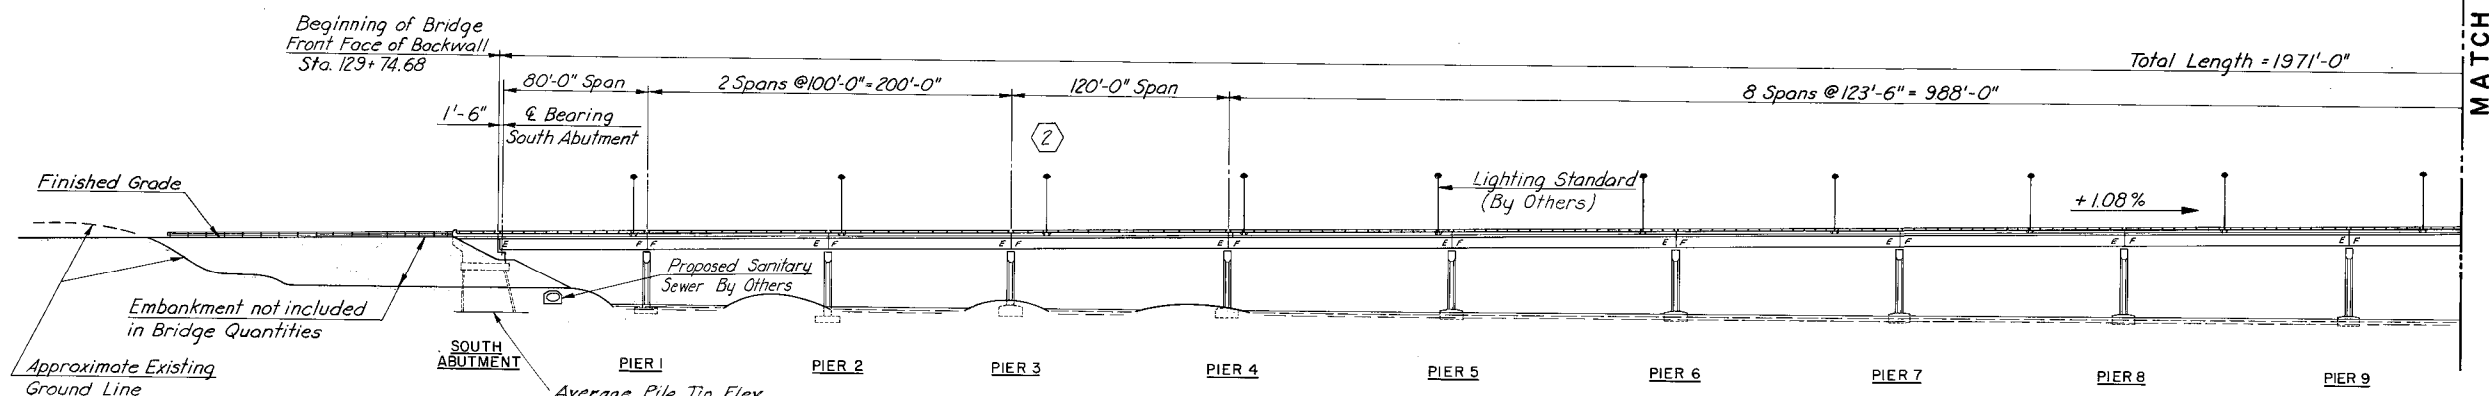

ELEVATION

NOTES:
 For Bridge Layout and General Notes see sheet no. 4.
 For Profiles see sheet no. 5.
 ● Indicates 2 1/2" Cased Hole Boring.

RICHMOND METROPOLITAN AUTHORITY
RICHMOND EXPRESSWAY SYSTEM

JAMES RIVER BRIDGE
GENERAL PLAN AND ELEVATION



HOWARD, NEEDLES, TAMMEN & BERGENDOFF
 consulting engineers
 NEW YORK ALEXANDRIA KANSAS CITY

SCALE: 1" = 50'
 CONTRACT NO.: C-3
 SHEET NO. 2 OF 53

CURVE NO.	CURVE DATA				SUMMARY				
	Δ	D	R	T	L	BACK TANGENT BEARING	FORWARD TANGENT BEARING	BEGIN CURVE	END CURVE
1	8°00'00"	10°00'00.0"	572.96'	40.06'	80.00'	S52°46'10.5"W	S60°46'10.5"W	P.C. 10+00.00	P.C.C. 10+80.00
2	61°13'55.5"	33°22'40.4"	310.00'	183.45'	231.50'	S60°46'10.5"W	N57°59'54.0"W	P.C. 10+80.00	P.C.C. 14+11.30
3	30°20'00"	10°00'00.0"	572.96'	153.52'	300.00'	N57°59'54.0"W	N27°59'54.0"W	P.C.C. 14+11.30	P.T. 17+11.30

BY	DATE	NO.	REVISION	BY	DATE
MADE	HBW 8-67	②	Light Std Location	J.G.V.	3/9/71
CHECKED	FXH 2-68	①	Remove Ramp Taper	H.B.W.	2/20/71
IN CHARGE	FXH				

RICHMOND EXPRESSWAY SYSTEM			
SECTION	PROJECT	SHEET NO.	TOTAL SHEETS
3	JAMES RIVER BRIDGE	3	53

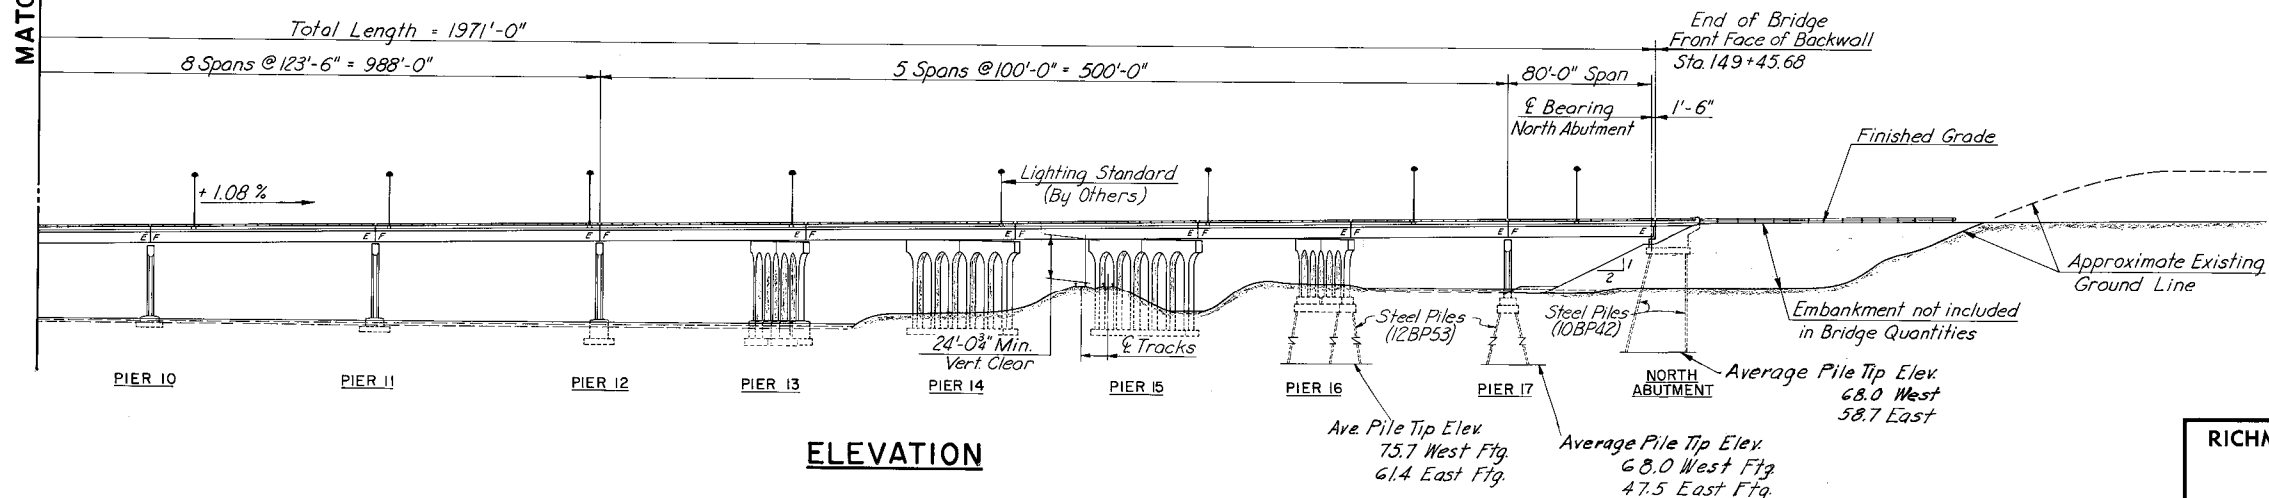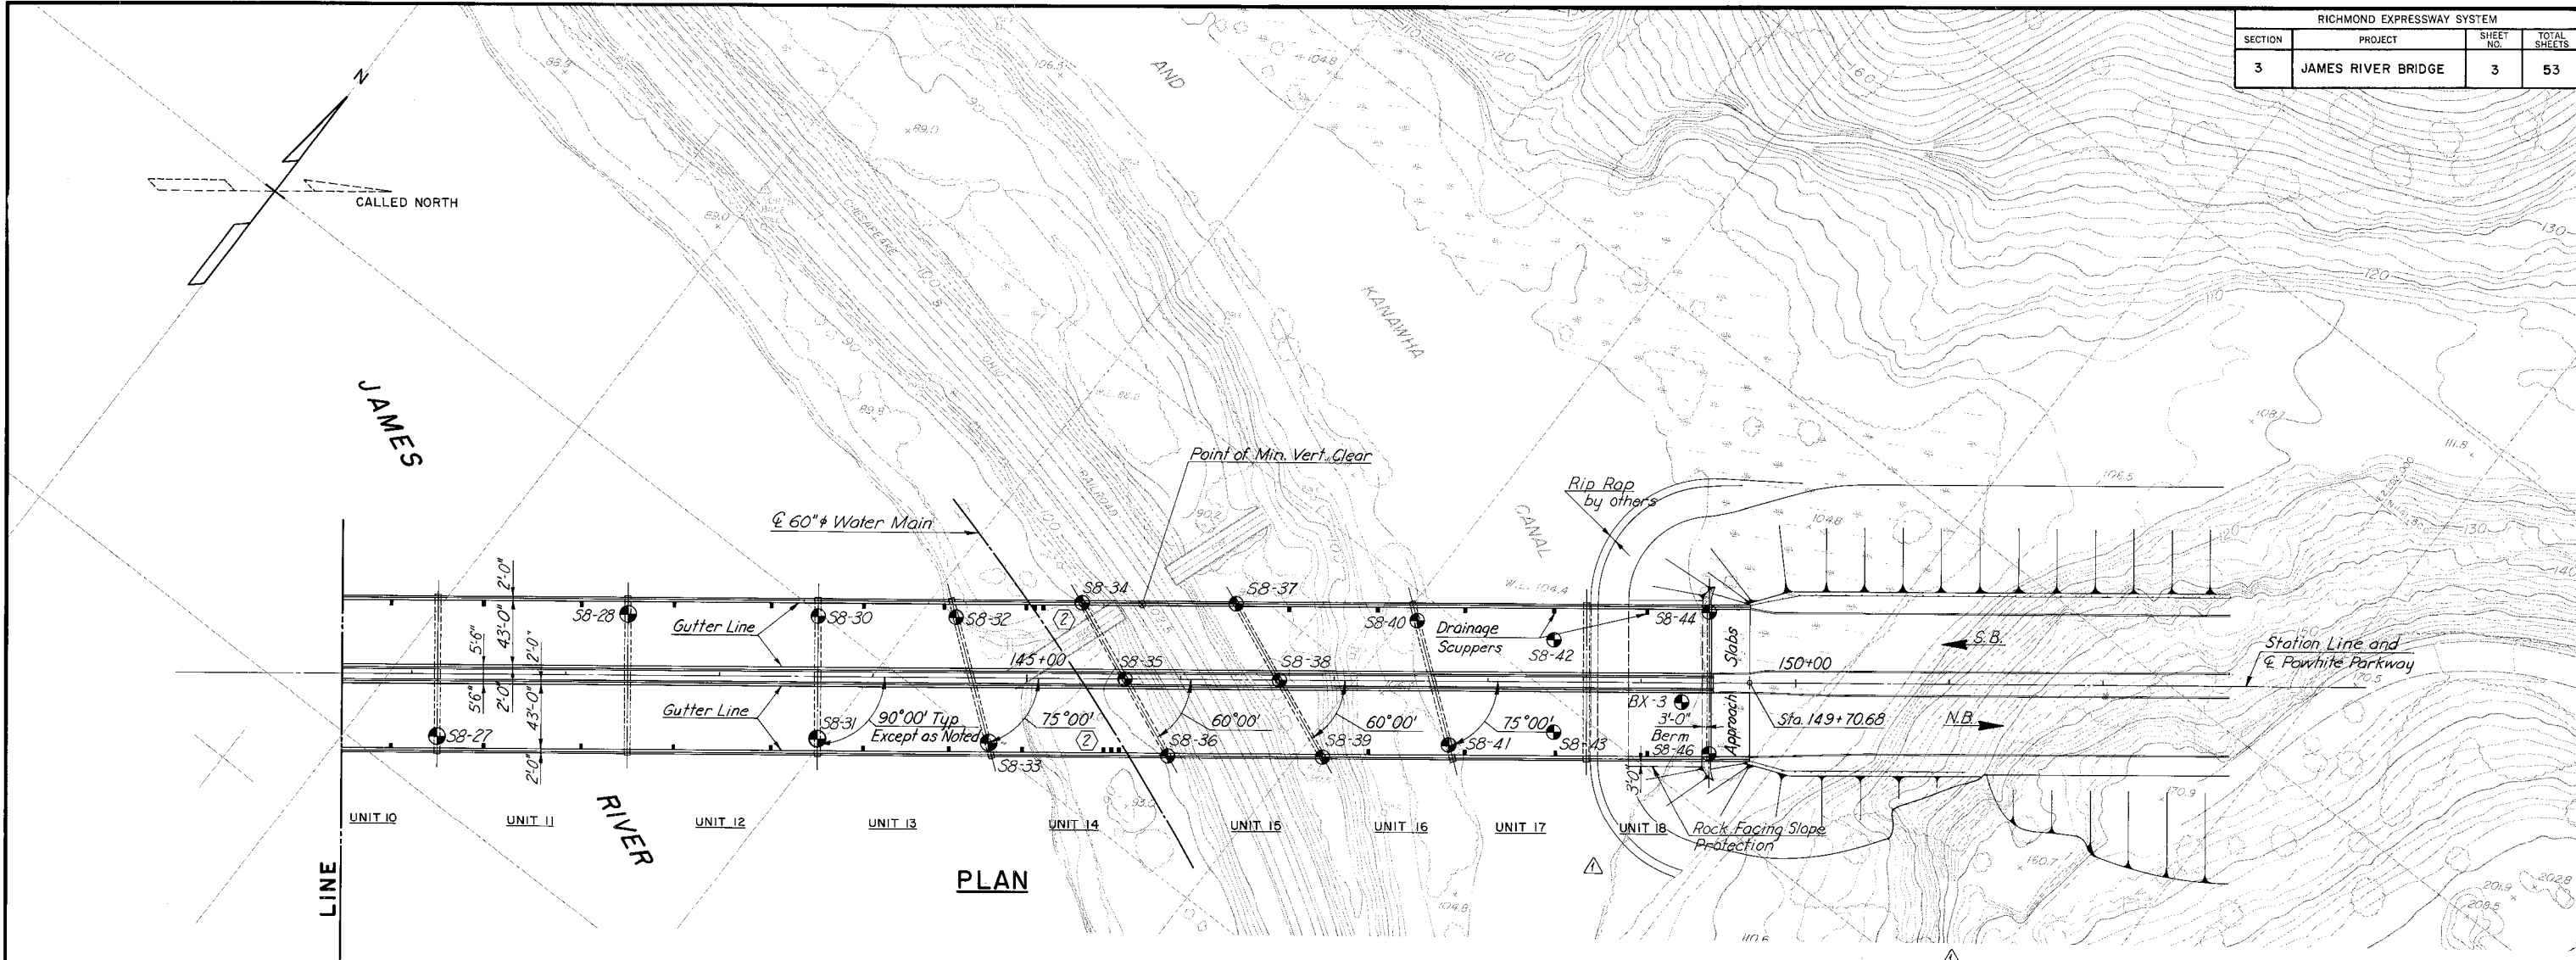

NOTES:
 For Bridge Layout and General Notes see sheet no. 4.
 For Profiles see sheet no. 5.
 Ⓢ Indicates 2" Cased Hole Boring.

AS BUILT

**RICHMOND METROPOLITAN AUTHORITY
 RICHMOND EXPRESSWAY SYSTEM**






**JAMES RIVER BRIDGE
 GENERAL PLAN AND ELEVATION**

BY	DATE	NO.	AS BUILT	JRC	12-72
MADE	HBW	8-67	Ⓢ Scupper Location	J.G.V.	3/9/71
CHECKED	FXH	2-68	Ⓢ Elim. Disposal Area Add Foot Path	E.V.R.	2/20/71
IN CHARGE	FXH				

HOWARD, NEEDLES, TAMMEN & BERGENDOFF
 consulting engineers
 NEW YORK ALEXANDRIA KANSAS CITY

SCALE: 1" = 50'
 CONTRACT NO.: C-3
 SHEET NO. 3 OF 53

RICHMOND EXPRESSWAY SYSTEM			
SECTION	PROJECT	SHEET NO.	TOTAL SHEETS
3	JAMES RIVER BRIDGE	6	53

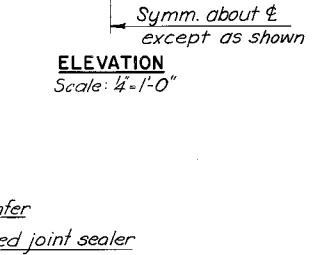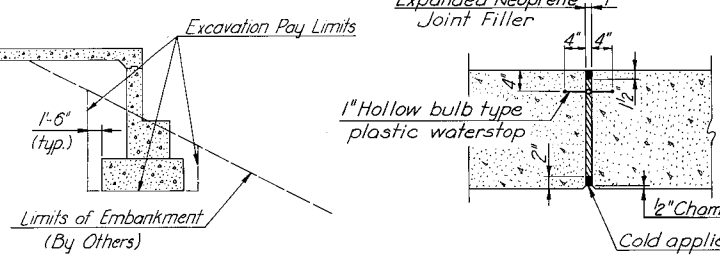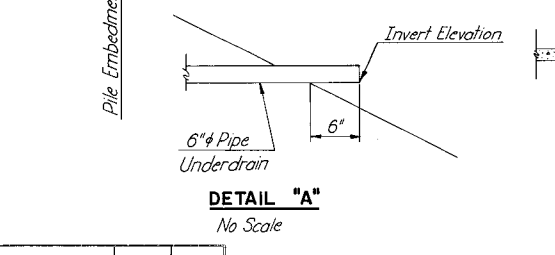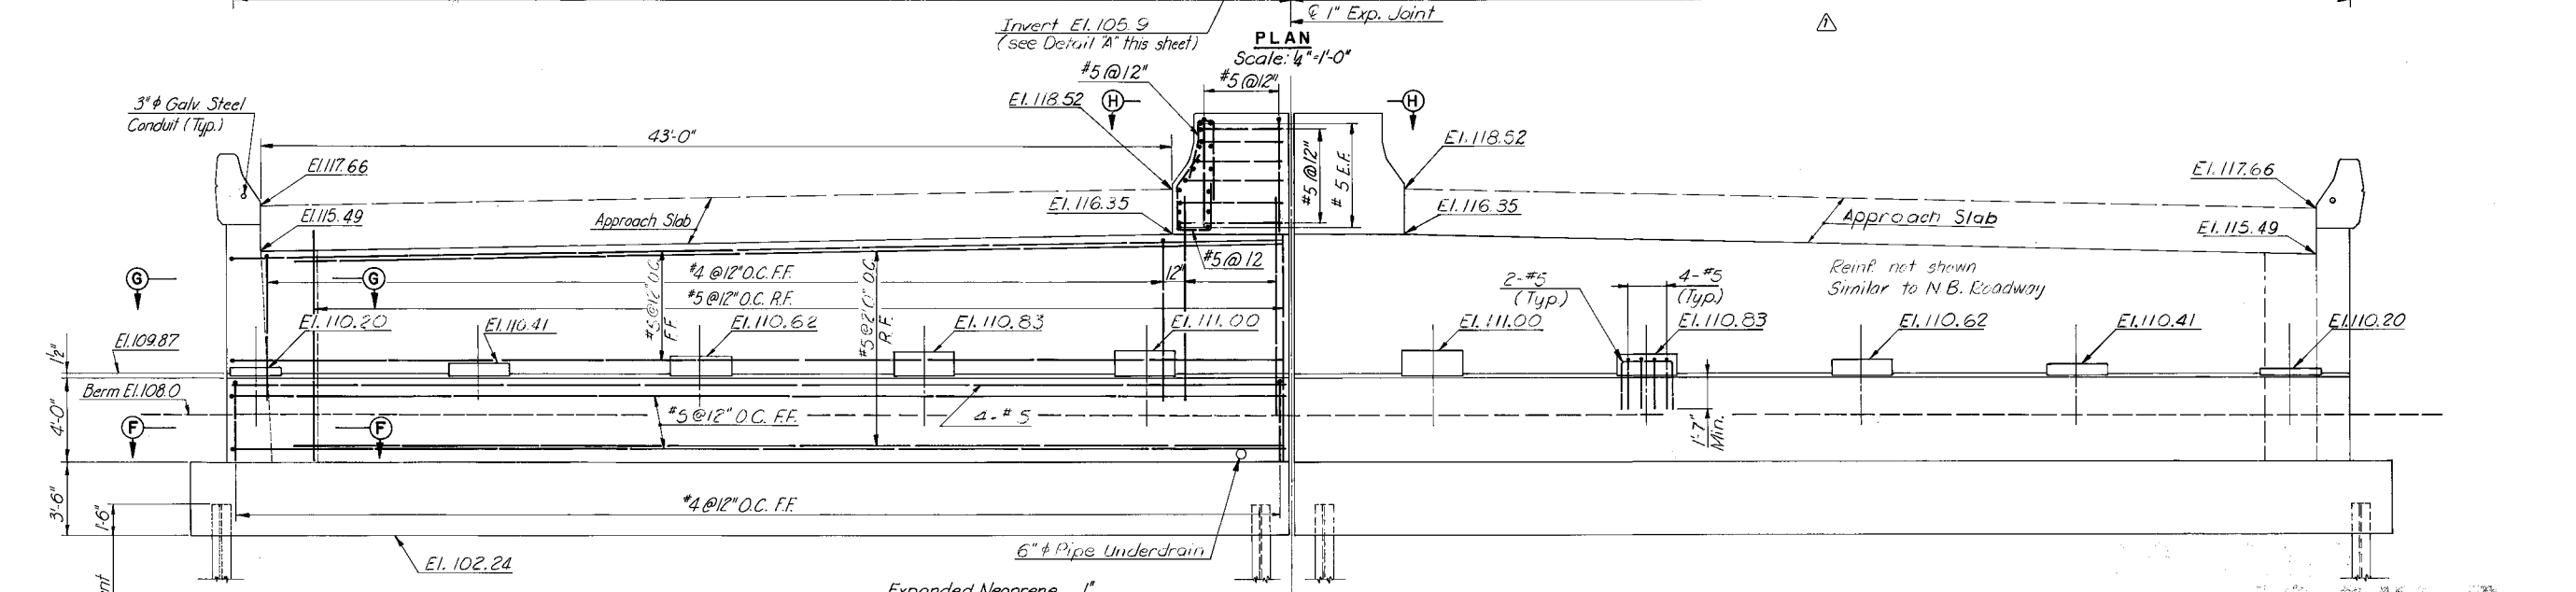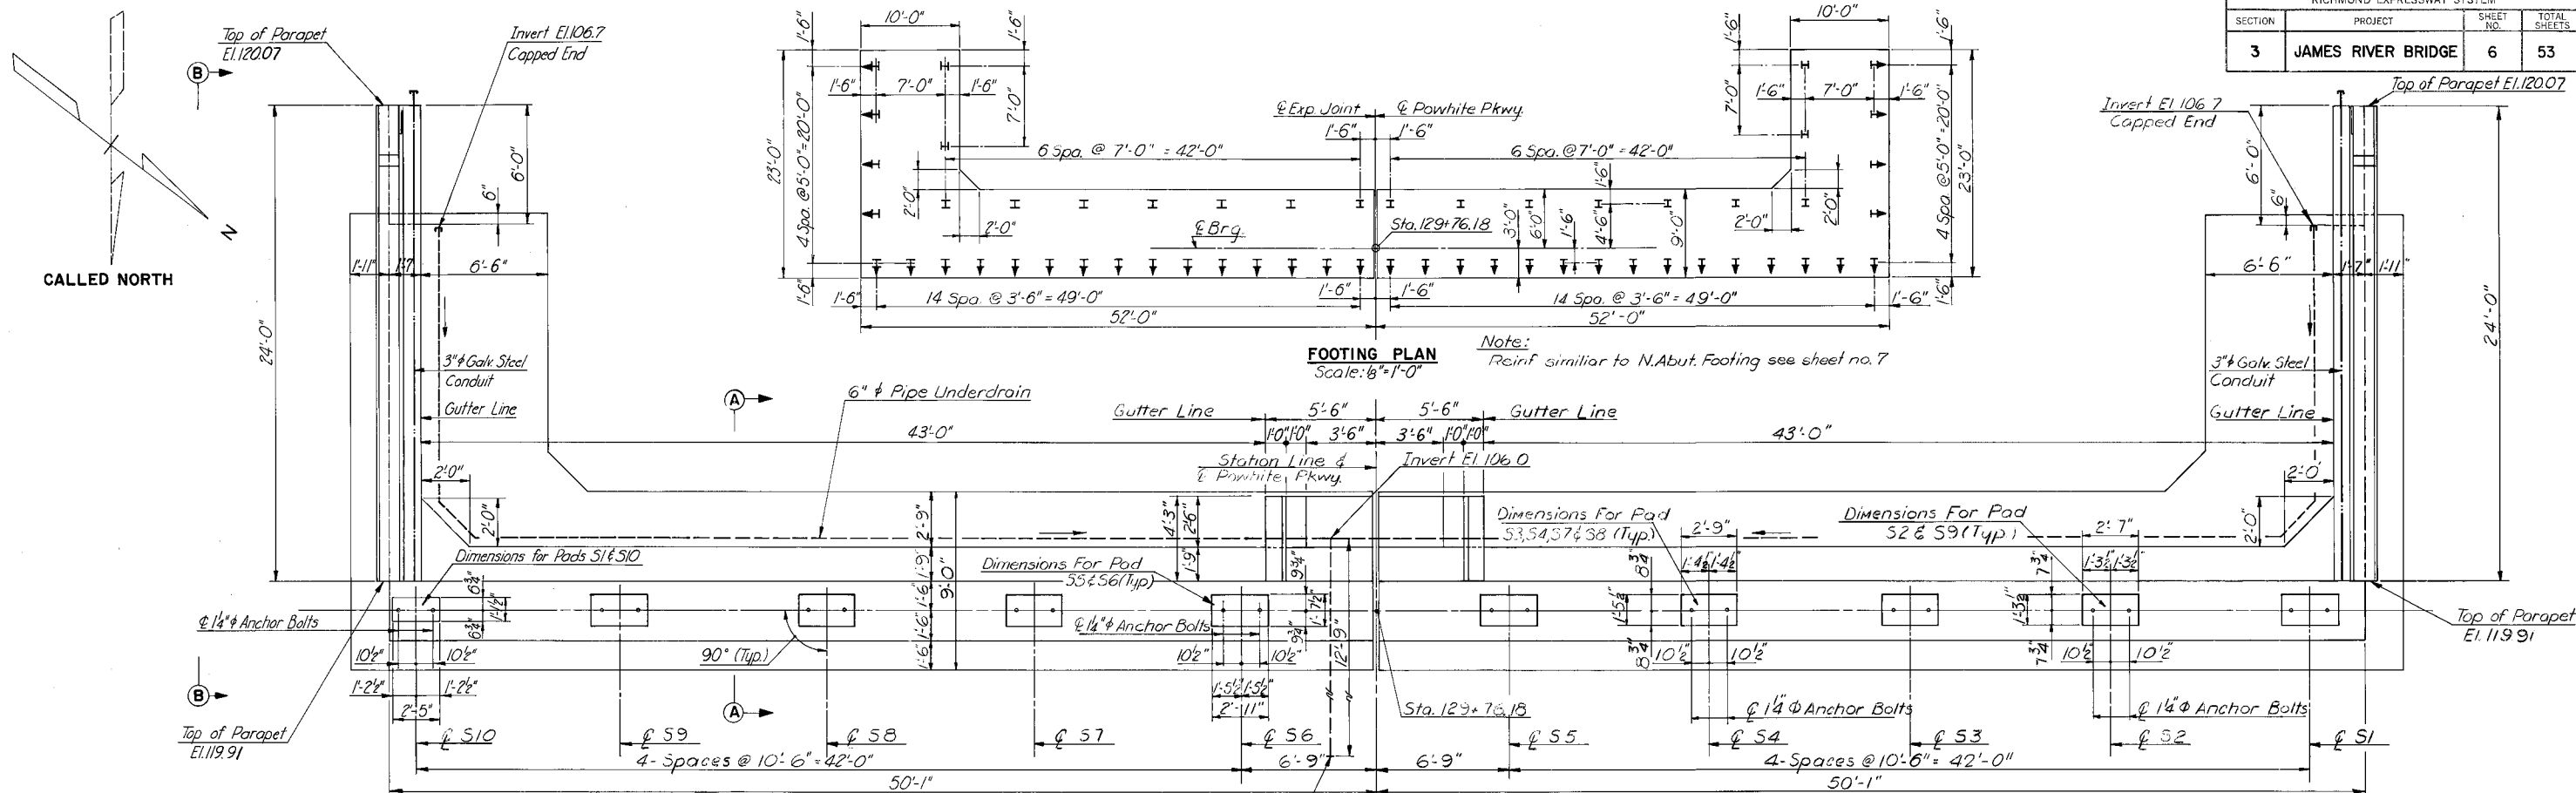

NOTES:
View B-B and Sections G-G & F-F opposite hand for West Wingwall.
For Views B-B & H-H see sheet no. 8
For Sections A-A, F-F & G-G see sheet no. 8
For Pile Details and Pile Notes see sheet no. 7

BY	DATE				
MADE	D.E.K. 7-67	2	AS BUILT	JRC	12-72
CHECKED	H.B.W. 12-67	Δ	Stringer Spa.	H.B.W.	2/20/71
IN CHARGE	F.X.H.	NO.	REVISION	BY	DATE

RICHMOND METROPOLITAN AUTHORITY
RICHMOND EXPRESSWAY SYSTEM



JAMES RIVER BRIDGE
SOUTH ABUTMENT

HOWARD, NEEDLES, TAMMEN & BERGENDOFF
consulting engineers
ALEXANDRIA KANSAS CITY

SCALE: **AS SHOWN**
CONTRACT NO.: **C-3**
SHEET NO. **6** OF **53**


RICHMOND EXPRESSWAY SYSTEM			
SECTION	PROJECT	SHEET NO.	TOTAL SHEETS
3	JAMES RIVER BRIDGE	7	53

CALLED NORTH

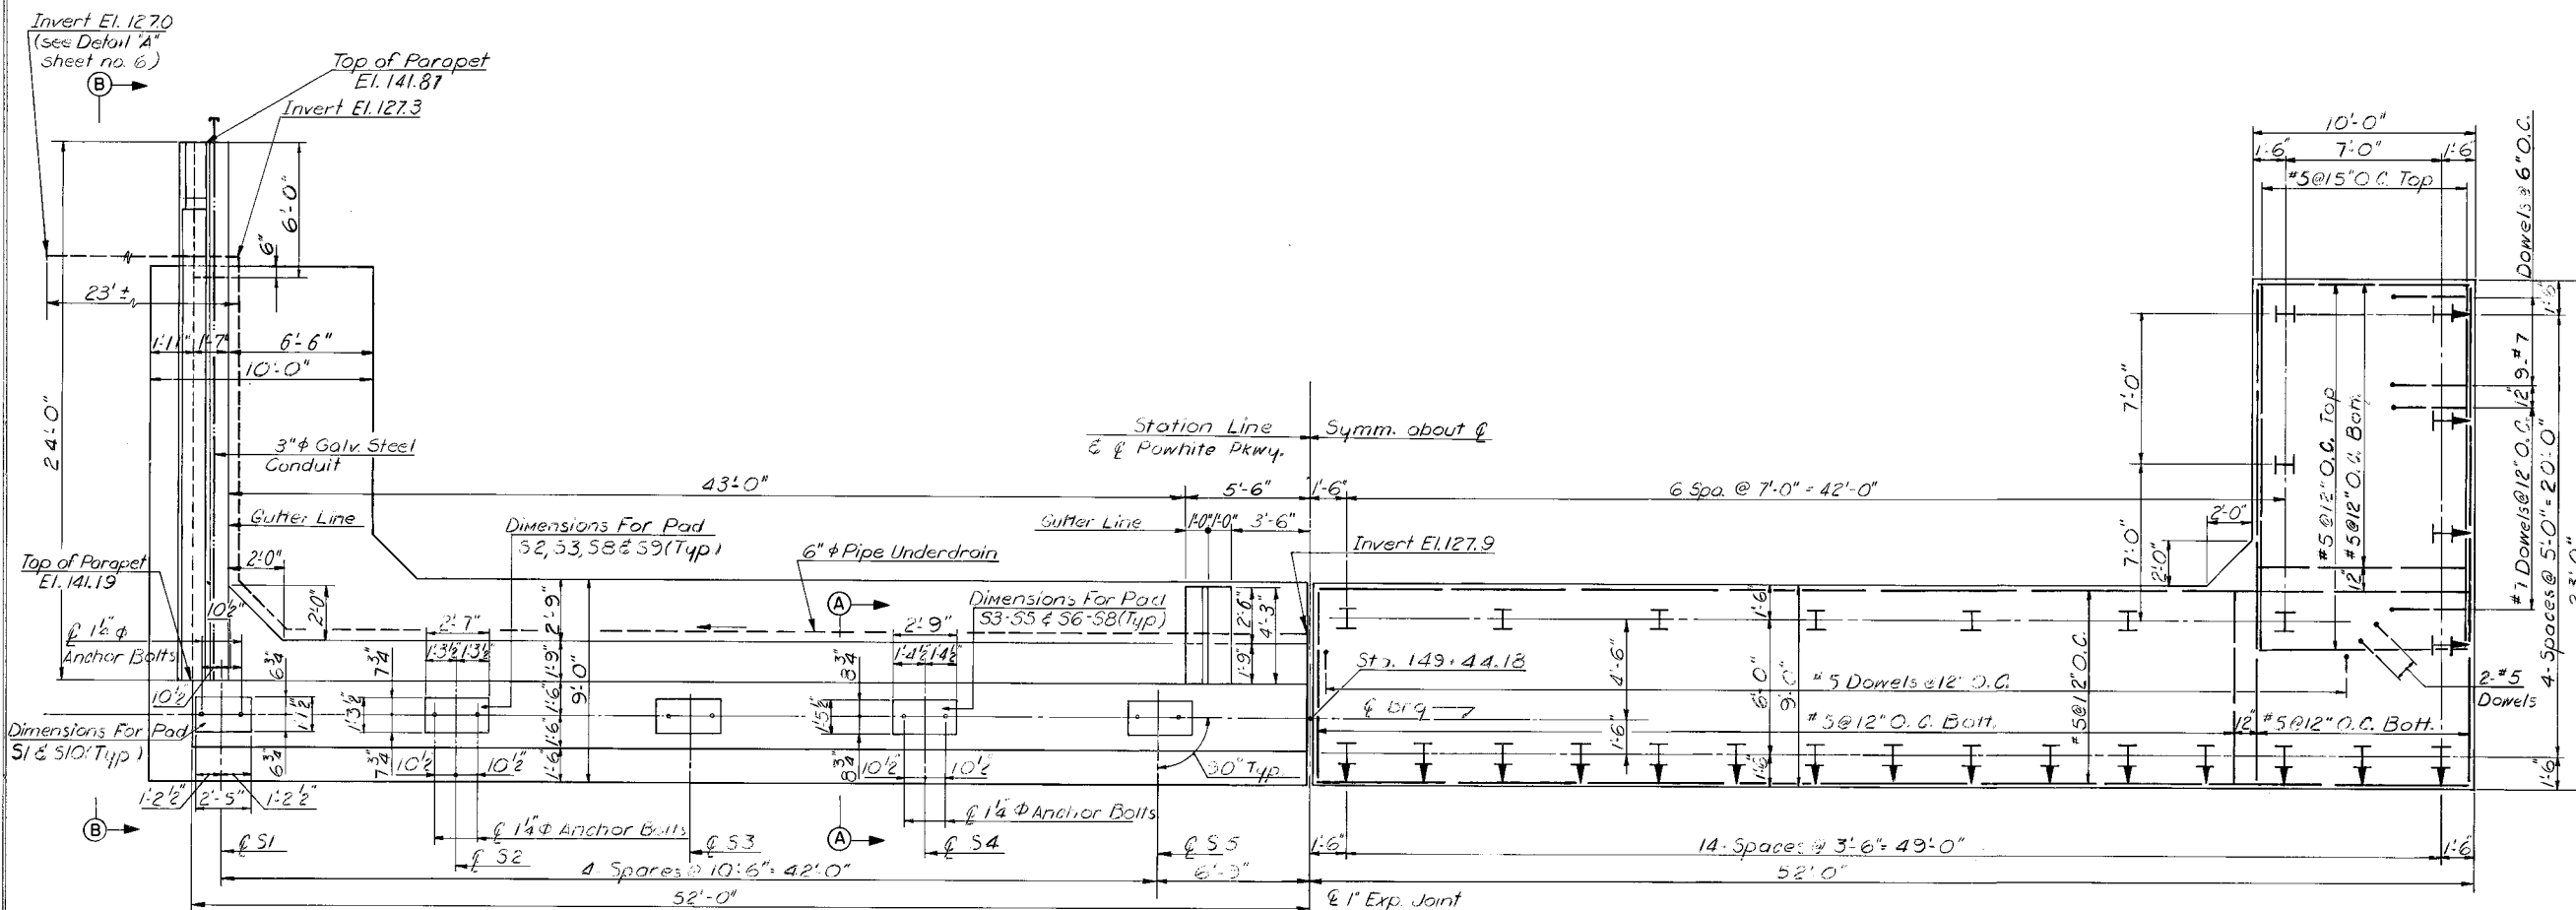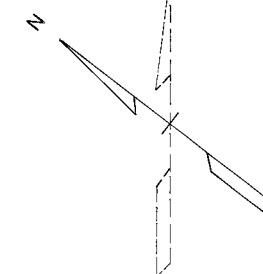


HALF - ABUTMENT PLAN
Scale: 1/4" = 1'-0"

HALF - FOOTING PLAN
Scale: 1/4" = 1'-0"

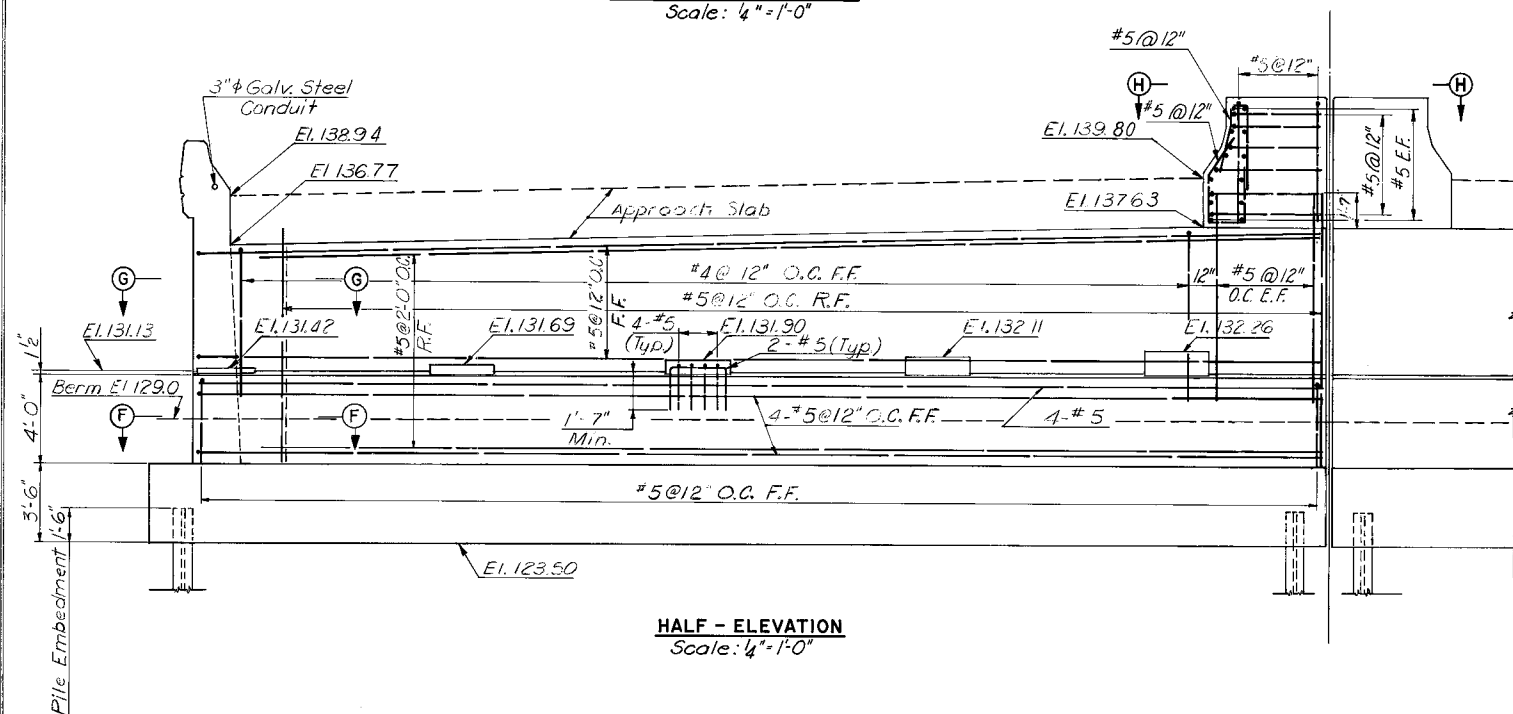

HALF - ELEVATION
Scale: 1/4" = 1'-0"

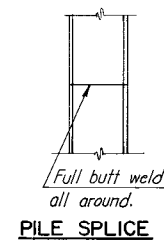

- NOTES:**
- For Views B-B & H-H see sheet no. 8.
 - For Sections A-A, F-F & G-G see sheet no. 8.
 - For Expansion Joint Detail see sheet no. 6.


- PILE NOTES:**
- All piles are 45 ton capacity 10BP42 steel piles.
 - ∇ Indicates piles battered 3:12 in direction of arrow.
 - ⊥ Indicates vertical piles.
 - Jetting of piles not permitted.
 - Estimated pile tip
 - South Abut. - Average Elev. Pile Tip - 75.5 West Fig. - 78.7 East F.
 - North Abut. - Average Elev. Pile Tip - 68.0 West Fig. - 58.7 East F.

BY	DATE				
MADE	D.E.K.	7-67			
CHECKED	H.B.W.	11-67	AS BUILT	JRC	12-72
IN CHARGE	FX.H.		NO. REVISION	BY	DATE





RICHMOND METROPOLITAN AUTHORITY
RICHMOND EXPRESSWAY SYSTEM

JAMES RIVER BRIDGE
NORTH ABUTMENT


HOWARD, NEEDLES, TAMMEN & BERGENDOFF consulting engineers NEW YORK ALEXANDRIA KANSAS CITY	SCALE: AS SHOWN CONTRACT NO.: C-3 SHEET NO. 7 OF 53
---	---

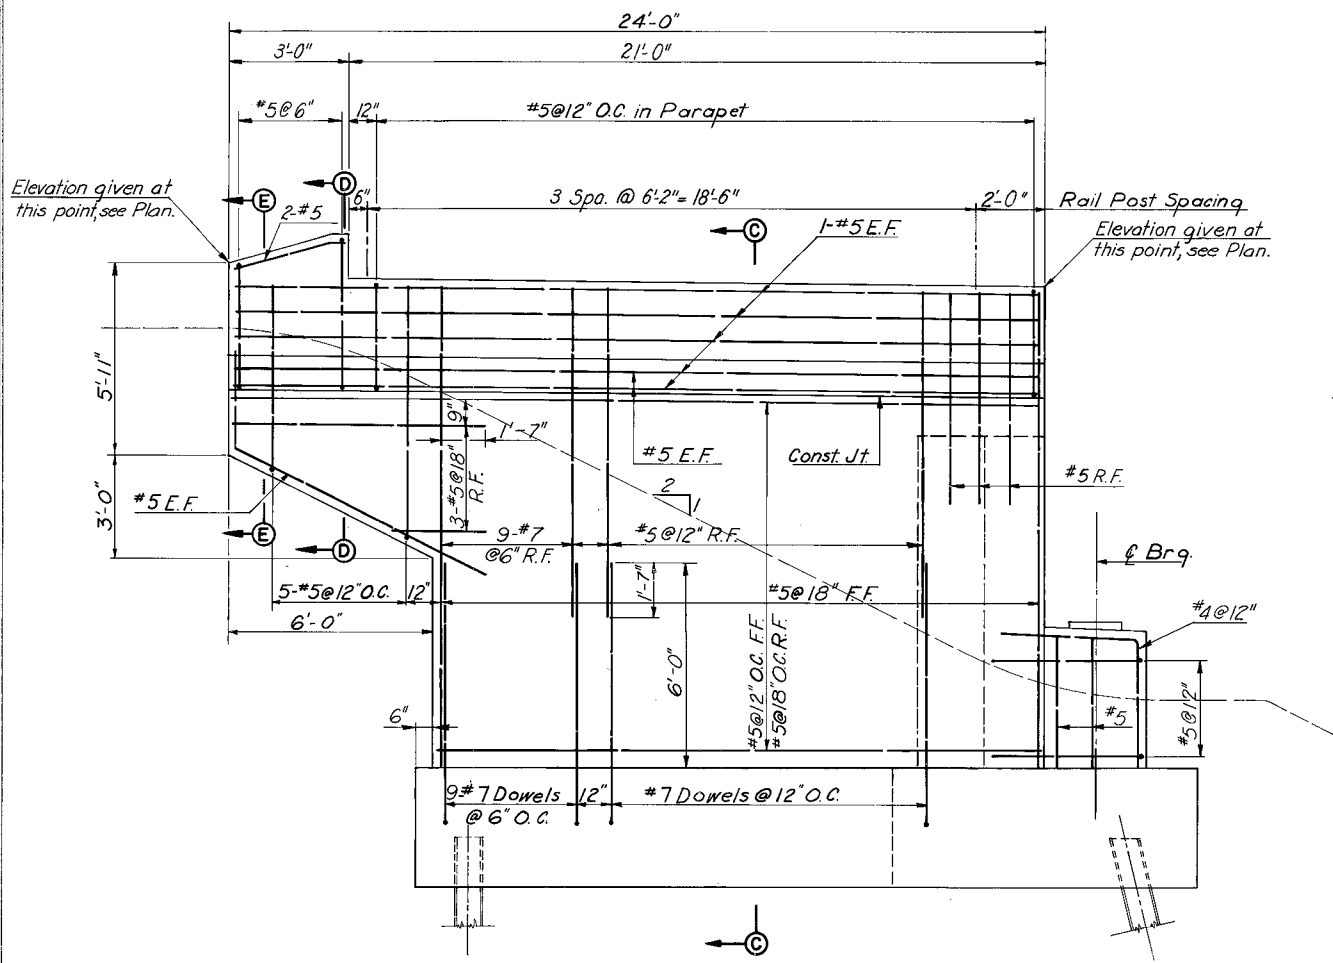



VIEW B-B
Scale: 3/8" = 1'-0"

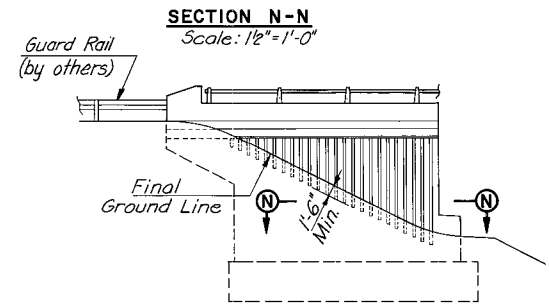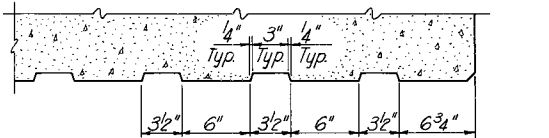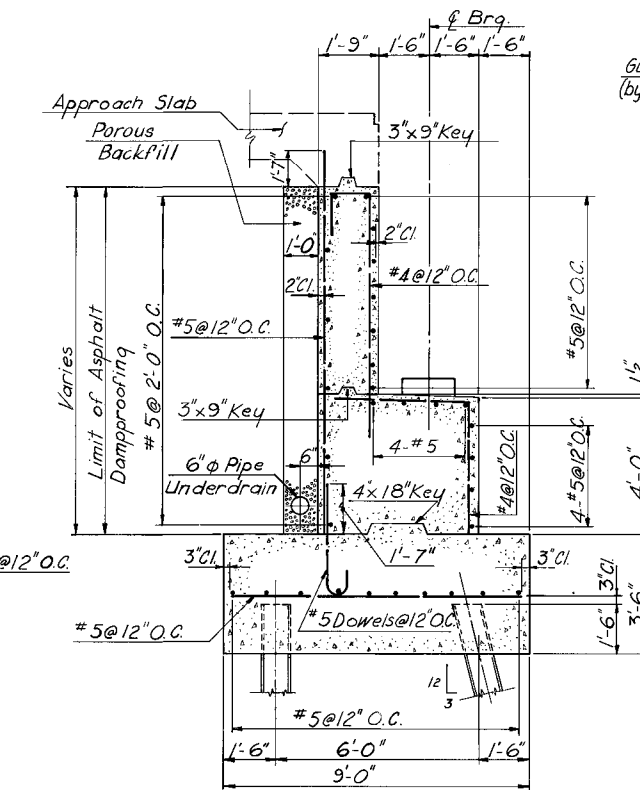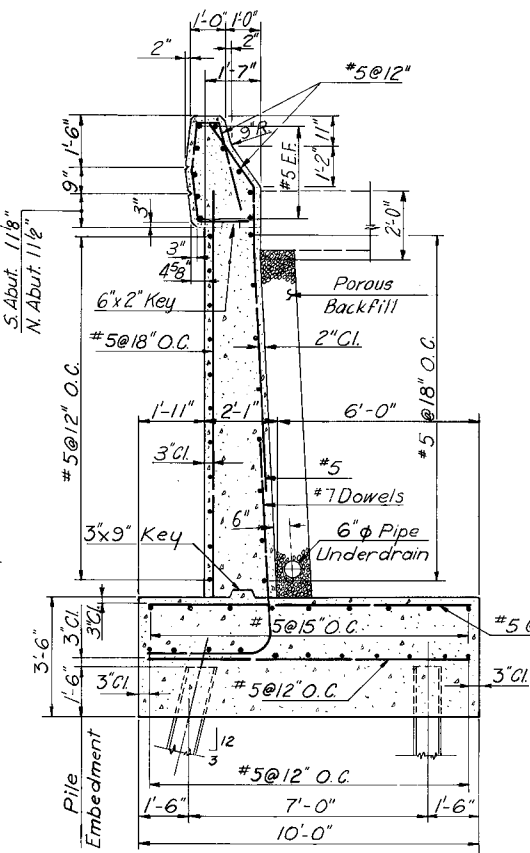


ELEVATION
Scale: 1/2" = 1'-0"
WINGWALL RUSTICATION DETAILS

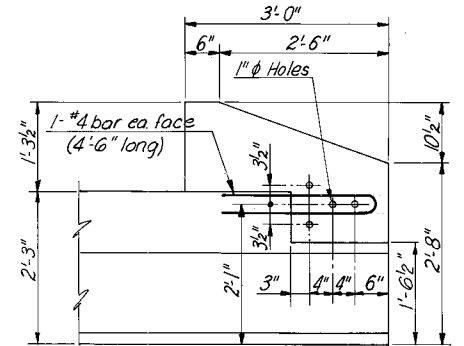


ELEVATION
Scale: 3/4" = 1'-0"

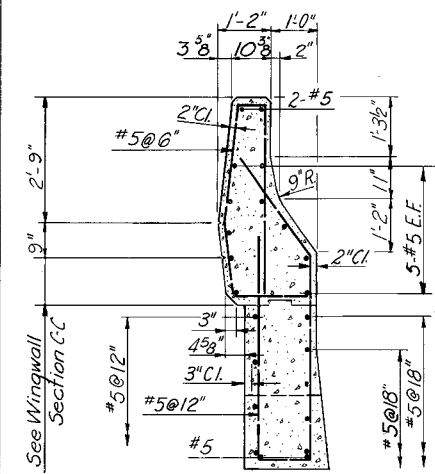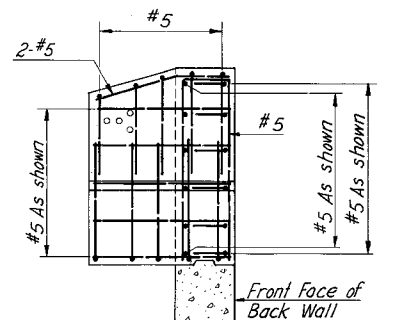


SECTION D-D
Scale: 1/2" = 1'-0"

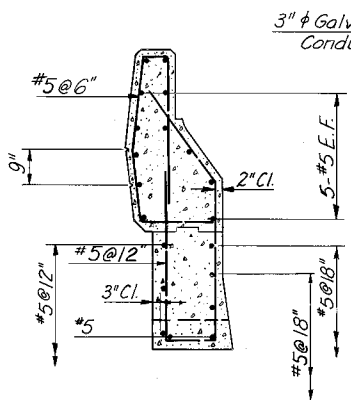


SECTION E-E
Scale: 1/2" = 1'-0"
(For dimensions not shown see Section D-D)

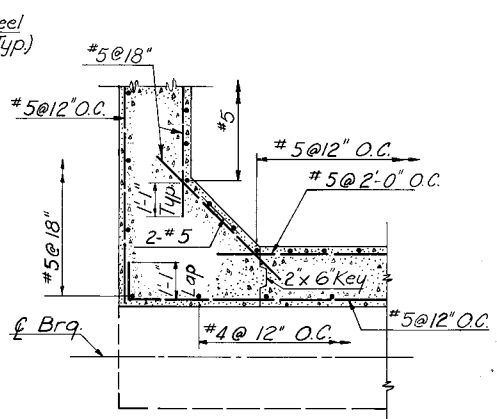

SECTION G-G
Scale: 3/8" = 1'-0"

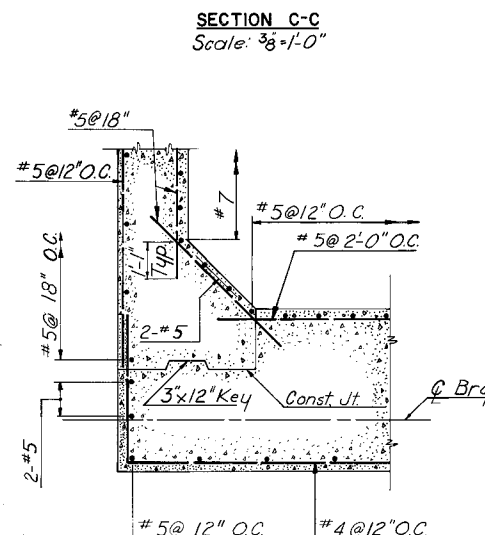

SECTION F-F
Scale: 3/8" = 1'-0"

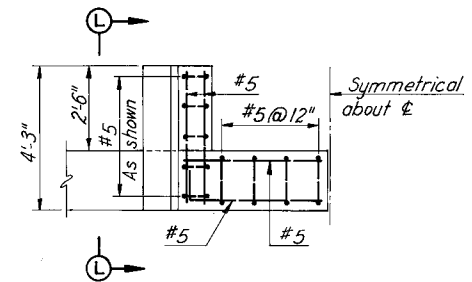


VIEW H-H
Scale: 3/8" = 1'-0"

RICHMOND METROPOLITAN AUTHORITY
RICHMOND EXPRESSWAY SYSTEM

JAMES RIVER BRIDGE
ABUTMENT DETAILS

BY	DATE				
MADE	DE.K.	7-67			
CHECKED	H.B.W.	12-67	AS BUILT	JRC	12-72
IN CHARGE	F.X.H.		NO.	REVISION	BY
					DATE

HOWARD, NEEDLES, TAMMEN & BERGENDOFF consulting engineers NEW YORK ALEXANDRIA KANSAS CITY	SCALE: AS SHOWN CONTRACT NO.: C-3 SHEET NO. 8 OF 53
---	---

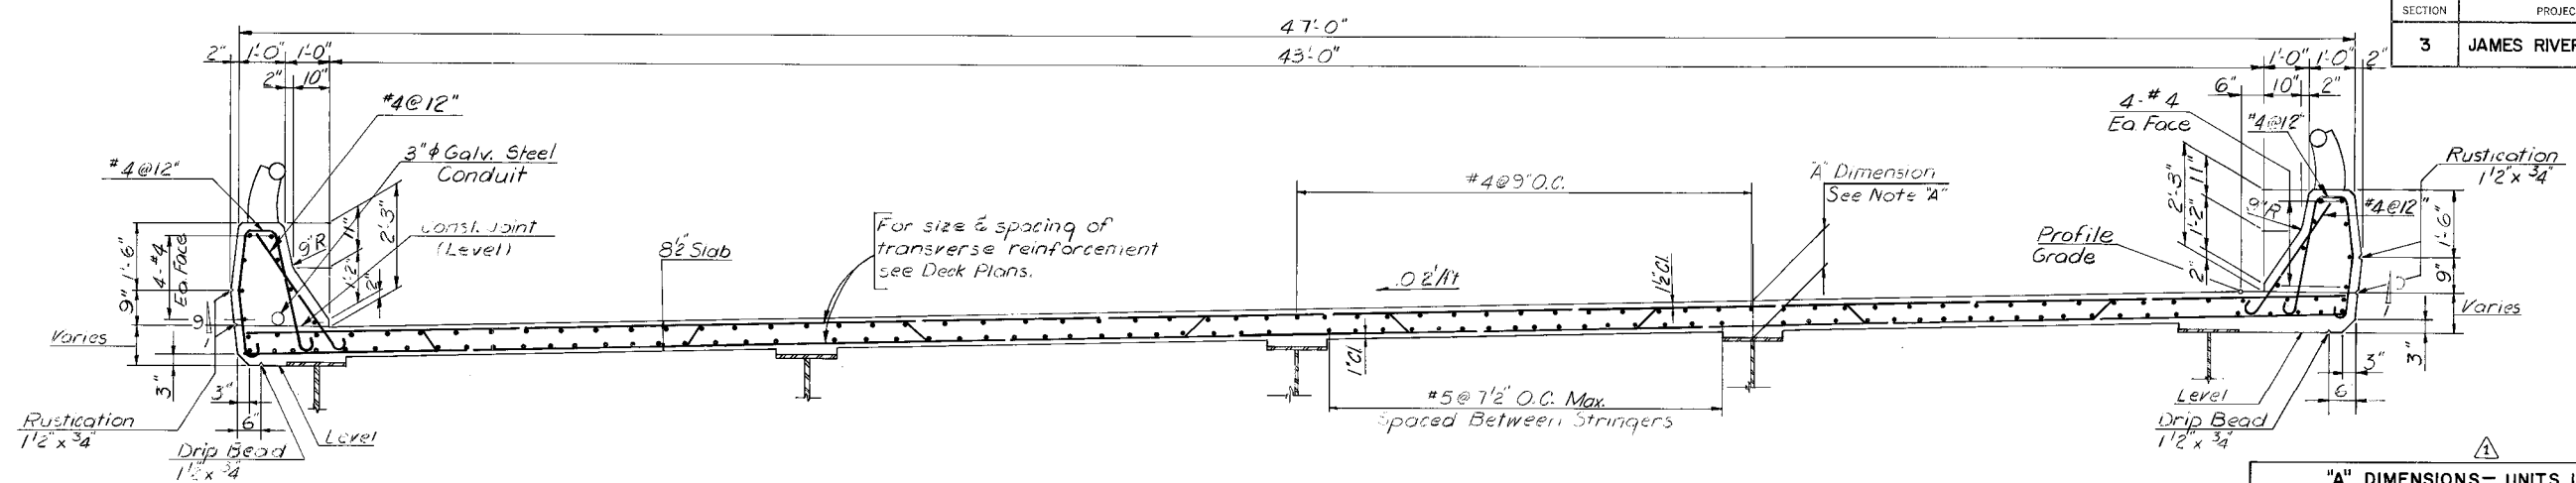


TYPICAL CROSS SECTION S.B. (N.B. OPPOSITE HAND)
SCALE: 1/2" = 1'-0"

"A" DIMENSIONS - UNITS 1 THRU 18			
UNIT 1	UNIT 7		
S5 & S6	10 3/8"	S7A	10 3/8"
S1-S4 & S7-S10	9 3/4"	S2-S4 & S7-S9	10 1/4"
UNIT 2 & 3		S5 & S6	
S5 & S6	10 1/4"	S1 & S10	10 1/2"
S1-S4 & S7-S10	9 3/4"	UNIT 8 THRU 12	
UNIT 4		S2-S4 & S7-S9	10 1/4"
S1 (AT PIER 3)	10"	S5 & S6	10 1/8"
S1 (AT PIER 4)	10 1/8"	S1 & S10	10 1/2"
S2	11"	UNIT 13 & 14	
S3	10"	S1	10 3/4"
S4	10 1/2"	S2, S3, S4 & S7	9 3/4"
S5	9 3/4"	S5 & S6	10 1/4"
S6	10"	S8 & S9	10"
S1-S10	10 1/8"	S10	10 1/2"
UNIT 5		UNIT 15	
S1	10 1/8"	S2-S4 & S7-S9	9 3/4"
S2	9 3/4"	S5 & S6	10 1/4"
S3 & S6	9 3/4"	S1 & S10	10 1/2"
S5 & S6	10 1/8"	UNIT 16 & 17	
S2-S4 & S7-S9	10 1/4"	S1	10 1/2"
S1 & S10	10 1/2"	S2 & S3	10"
UNIT 6		S4, S7, S8 & S9	9 3/4"
S5 & S6	10 1/8"	S5 & S6	10 1/4"
S2-S4 & S7-S9	10 1/4"	S10	10 3/4"
S1 & S10	10 1/2"	UNIT 18	
		S2-S4 & S7-S9	9 3/4"
		S5 & S6	10 3/8"
		S1 & S10	10 3/4"

"A" DIMENSIONS - UNITS 1A THRU 4A			
UNIT 1A	UNIT 4A		
S1, S2 & S3	9 1/2"	S1 (AT PIER 3A)	9 1/2"
S4	10"	S1 (AT PIER 3)	10 1/4"
UNITS 2A & 3A		S2 & S3	9 1/2"
S1, S2 & S3	9 1/2"	S4	10"
S4	9 3/4"		


Note "A"
"A" Dimension is given at the intersection of the \emptyset Stringer and \emptyset Bearing. Dimension shown is measured from top of top flange to construction joint for Fascia Stringers with 1'-3" overhang (see deck plan) and from top of top flange to top of deck for all other stringers. This dimension may vary between bearings due to change in top flange thickness or variation in camber, except that no portion of the stringer flange may fall within the slab.

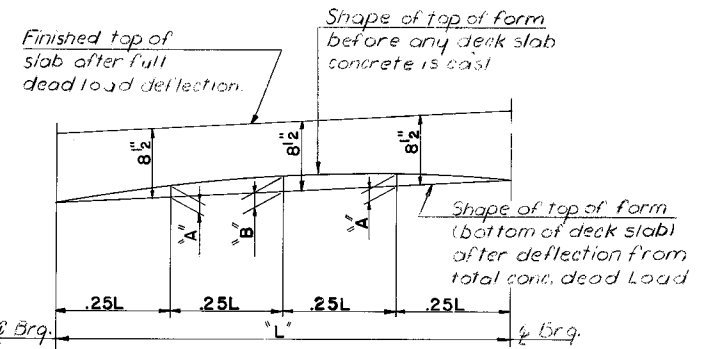

DEAD LOAD DEFLECTION DIAGRAM
NO SCALE


NOTE TO CONTRACTOR

The deflections noted are those anticipated to occur in the stringer upon placement of the total concrete dead load. In practice the stringers, in place, are not likely to have the exact camber to compensate for these deflections during construction. The residual amounts shall be provided for by adjusting forms to vary the thickness of the concrete 1/4" between the bottom of the slab & the top of stringer, without alteration of the slab thickness.

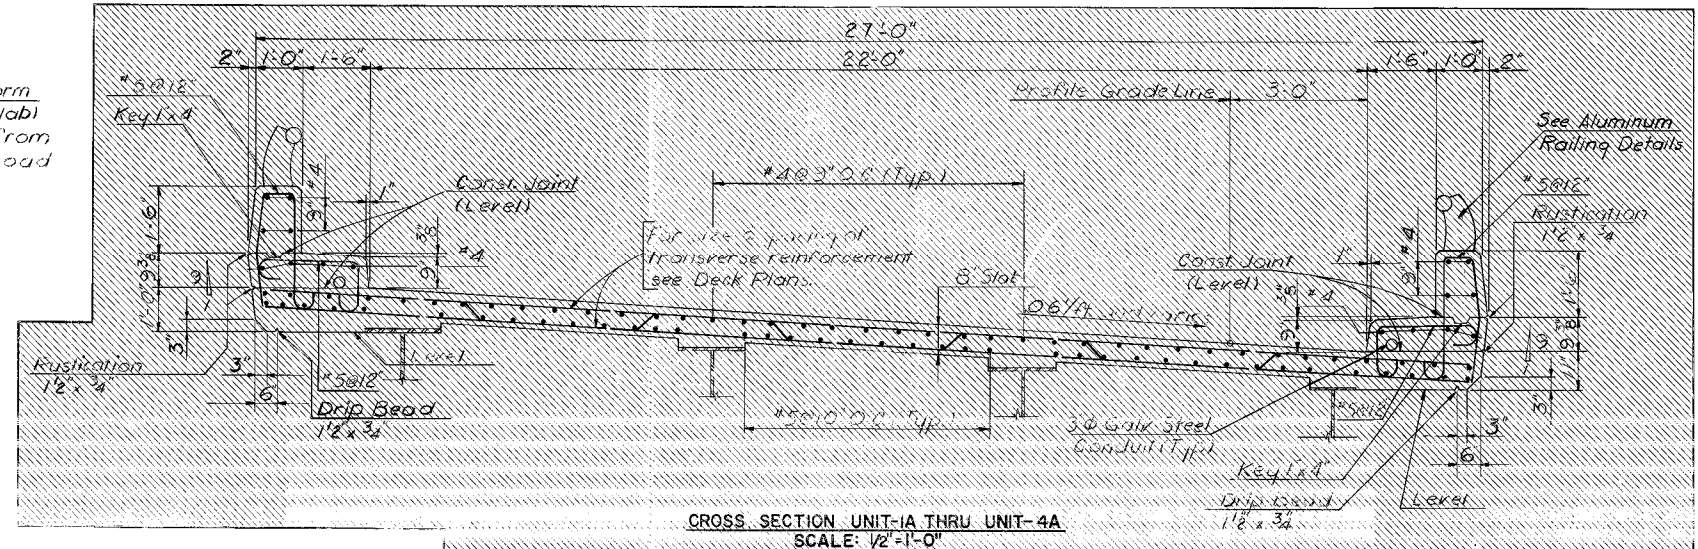


CROSS SECTION UNIT 1A THRU UNIT 4A
SCALE: 1/2" = 1'-0"


DEFLECTION SCHEDULE							
UNIT	STRINGER	A	B	UNIT	STRINGER	A	B
1	SI-S10	5/8"	7/8"	7-12	SI-S10	1 5/8"	2 1/4"
2	SI-S10	1"	1 3/8"	13 & 14	S1	3/4"	1"
	SI-S10	1 1/8"	1 1/2"		S2	7/8"	1 1/8"
3	SI-S10	1"	1 3/8"	16 & 17	S3	1 1/4"	1 3/4"
	SI-S10	1 1/8"	1 1/2"		S4	1"	1 3/8"
4	SI-S10	1 5/8"	2 1/4"	18	S5	1"	1 1/2"
	SI-S10	1 3/8"	2 1/8"		S6	1 1/8"	1 5/8"
	SI-S10	1 1/2"	2 1/8"		S7	1 1/4"	1 5/8"
	SI-S10	1 1/2"	2 1/8"		S8	7/8"	1 1/4"
	SI-S10	1 1/2"	2 1/8"		S9	7/8"	1 1/8"
	SI-S10	1 1/2"	2 1/8"		S10	3/4"	1"
5	SI-S10	1 5/8"	2 1/4"	15	SI-S10	1 1/8"	1 1/2"
6	SI-S10	1 5/8"	2 1/4"				

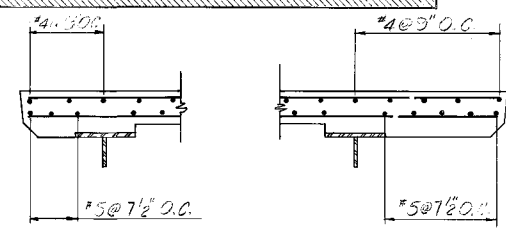

LONGITUDINAL REINFORCEMENT AT FASCIA

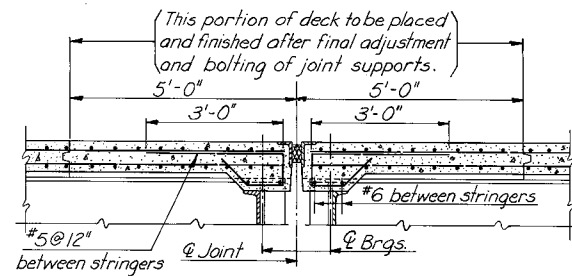

TYPICAL SECTION AT JOINT

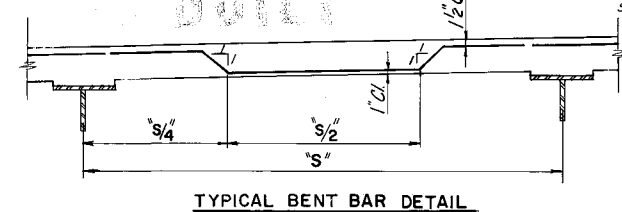

TYPICAL BENT BAR DETAIL

Notes:
For Notes see Sheet No. 37.
All Bar clearances to conc. face are 2" unless noted.

BY	DATE				
MADE	D.E.K.	7-67	2	AS BUILT	JRC 12-72
CHECKED	H.B.W.	9-67	1	X-Sections & Deflections	EB 2/20/71
IN CHARGE	F.X.H.			REVISION	BY DATE

RICHMOND METROPOLITAN AUTHORITY
RICHMOND EXPRESSWAY SYSTEM

JAMES RIVER BRIDGE
DECK DETAILS

HOWARD, NEEDLES, TAMMEN & BERGENDOFF
consulting engineers
NEW YORK ALEXANDRIA KANSAS CITY

SCALE: 1/2" = 1'-0" UNLESS NOTED
CONTRACT NO. C-3
SHEET NO. 41 OF 53

RICHMOND METROPOLITAN AUTHORITY

RICHMOND EXPRESSWAY SYSTEM



PROPOSED WIDENING

JAMES RIVER BRIDGE

LIMITED ACCESS HIGHWAY			
RICHMOND EXPRESSWAY SYSTEM			
SECTION	PROJECT	SHEET NO.	TOTAL SHEETS
13	WIDENING JAMES RIVER BRIDGE	1	106

INDEX OF SHEETS

SHEET NO.	TITLE
1	COVER SHEET
2-3	GENERAL PLAN AND ELEVATION
4	GENERAL NOTES AND ESTIMATED QUANTITIES
5-7	SOUTH ABUTMENT DETAILS
8-10	NORTH ABUTMENT DETAILS
11	FLARED TERMINAL WALL DETAILS
12-28	PIER DETAILS
29	MISCELLANEOUS SUBSTRUCTURE DETAILS
30-44	FRAMING PLANS
45	STEEL DETAILS
46	SHOE DETAILS
47	CAMBER DIAGRAMS AND SCHEDULE
48-49	DECK SLAB ELEVATIONS
50	TYPICAL CROSS SECTION AND PARAPET DETAILS
51-65	DECK PLANS
66-67	LIGHTING STANDARD AND ELECTRICAL DETAILS
68	DEAD LOAD DEFLECTION DIAGRAM AND SCHEDULE
69	JOINT DETAILS
70	DRAIN ASSEMBLY DETAILS
71	ALUMINUM RAILING DETAILS
72-89	BAR LIST
90	BAR BENDS
91	SLOPE PROTECTION
92	APPROACH SLAB DETAILS
93-99	BORING LOGS
100	CONSTRUCTION SEQUENCE AND METHOD
101	MAINTENANCE AND PROTECTION OF TRAFFIC
102	PARTIAL EMBANKMENT PLAN
103	TYPICAL ROADWAY SECTION
104-105	EMBANKMENT CROSS SECTION
106	EROSION CONTROL

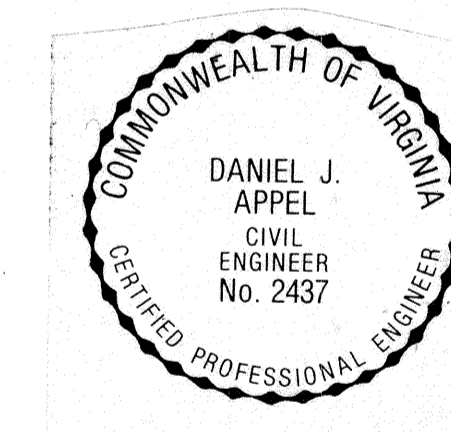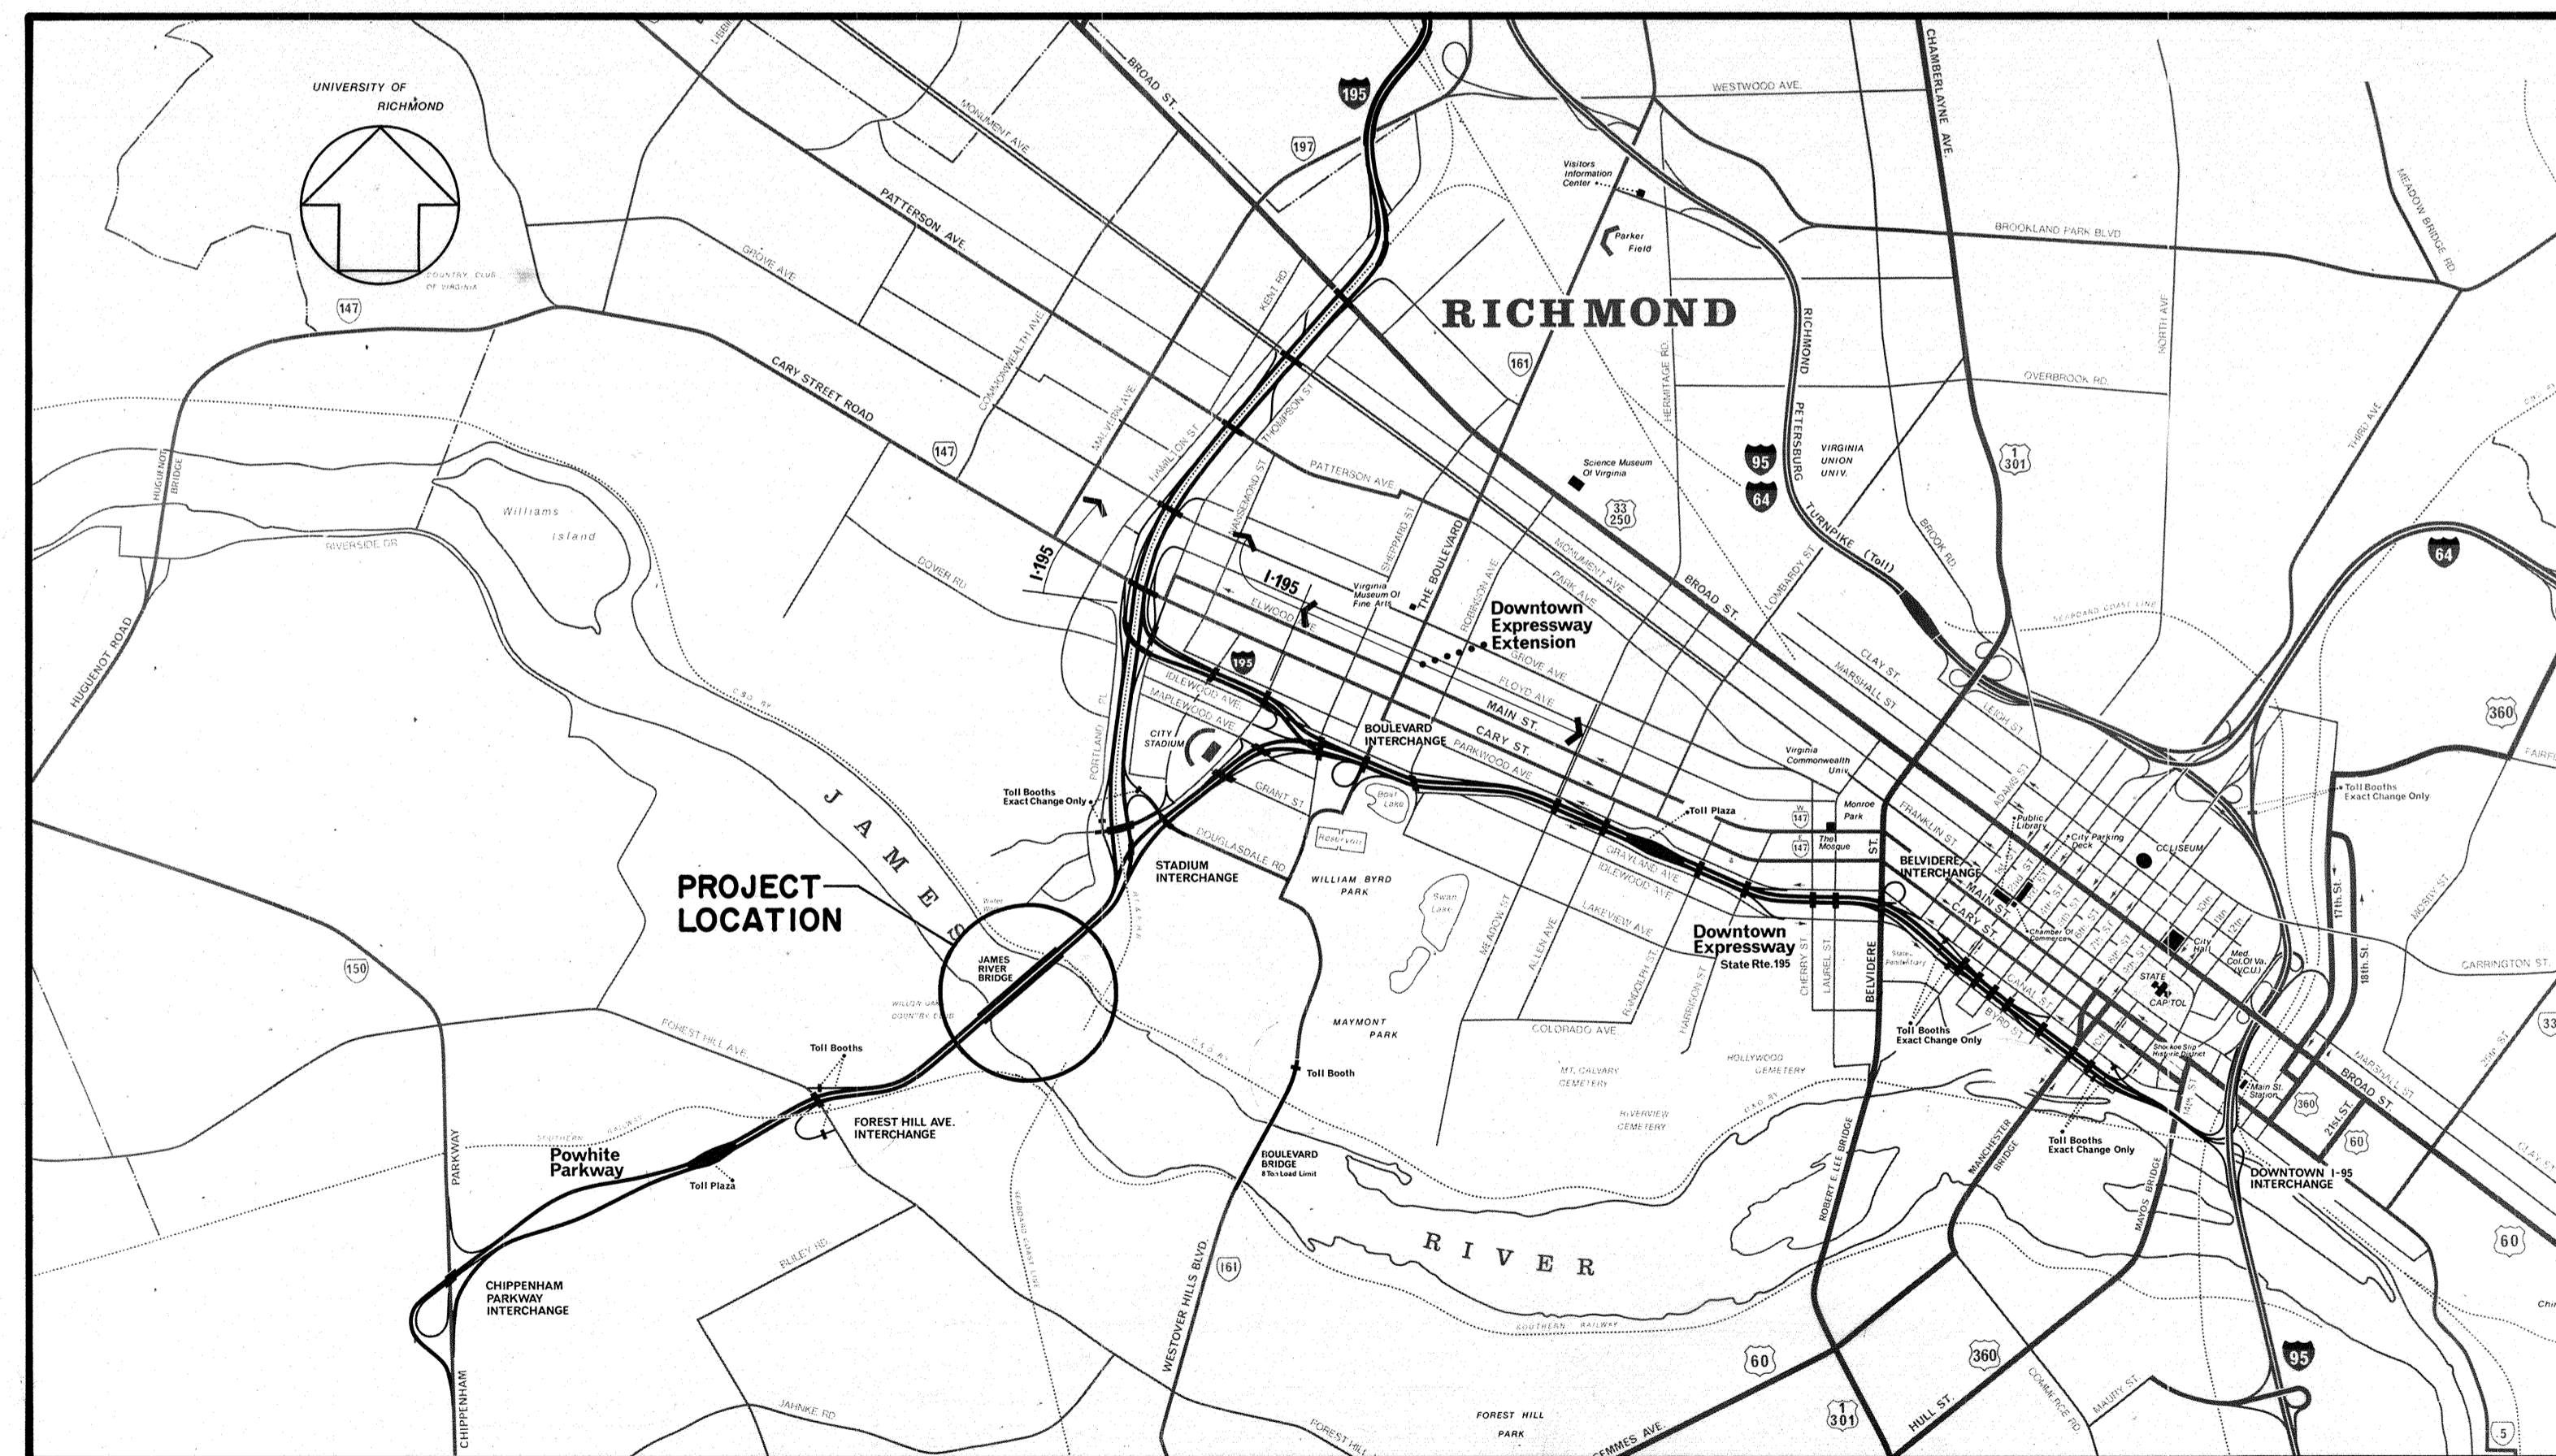

SUBMITTED BY	
Date	
3-16-87	HOWARD, NEEDLES, TAMMEN & BERGENDOFF general consultant

RECOMMENDED BY	
Date	
3-29-87	GENERAL MANAGER, RICHMOND METROPOLITAN AUTHORITY

APPROVED BY	
Date	
3-29-87	CHAIRMAN, RICHMOND METROPOLITAN AUTHORITY

Plans Revised			
Sheet No.	Date	Sheet No.	Date



CONVENTIONAL SIGNS	
STATE LINE	LEVEE OR EMBANKMENT
COUNTY LINE	BRIDGES
CITY, TOWN OR VILLAGE	CULVERTS
RIGHT OF WAY LINE	DROP INLET
FENCE LINE	TROLLEY POLES
UNFENCED PROPERTY LINE	POWER POLES
FENCED PROPERTY LINE	TELEPHONE OR TELEGRAPH POLES
TRAVELED WAY	MARSH
GUARD RAIL	HEDGE
RETAINING WALL	WOODS
RAILROADS	GROUND ELEVATION
BASE OR SURVEY LINE	GRADE ELEVATION
	POLES WITHIN CONSTRUCTION LIMITS

CONTRACT C-13

AS BUILT

DESIGNED BY _____ REVISED BY _____

RICHMOND EXPRESSWAY SYSTEM			
SECTION	PROJECT	SHEET NO.	TOTAL SHEETS
13	WIDENING JAMES RIVER BRIDGE	2	106

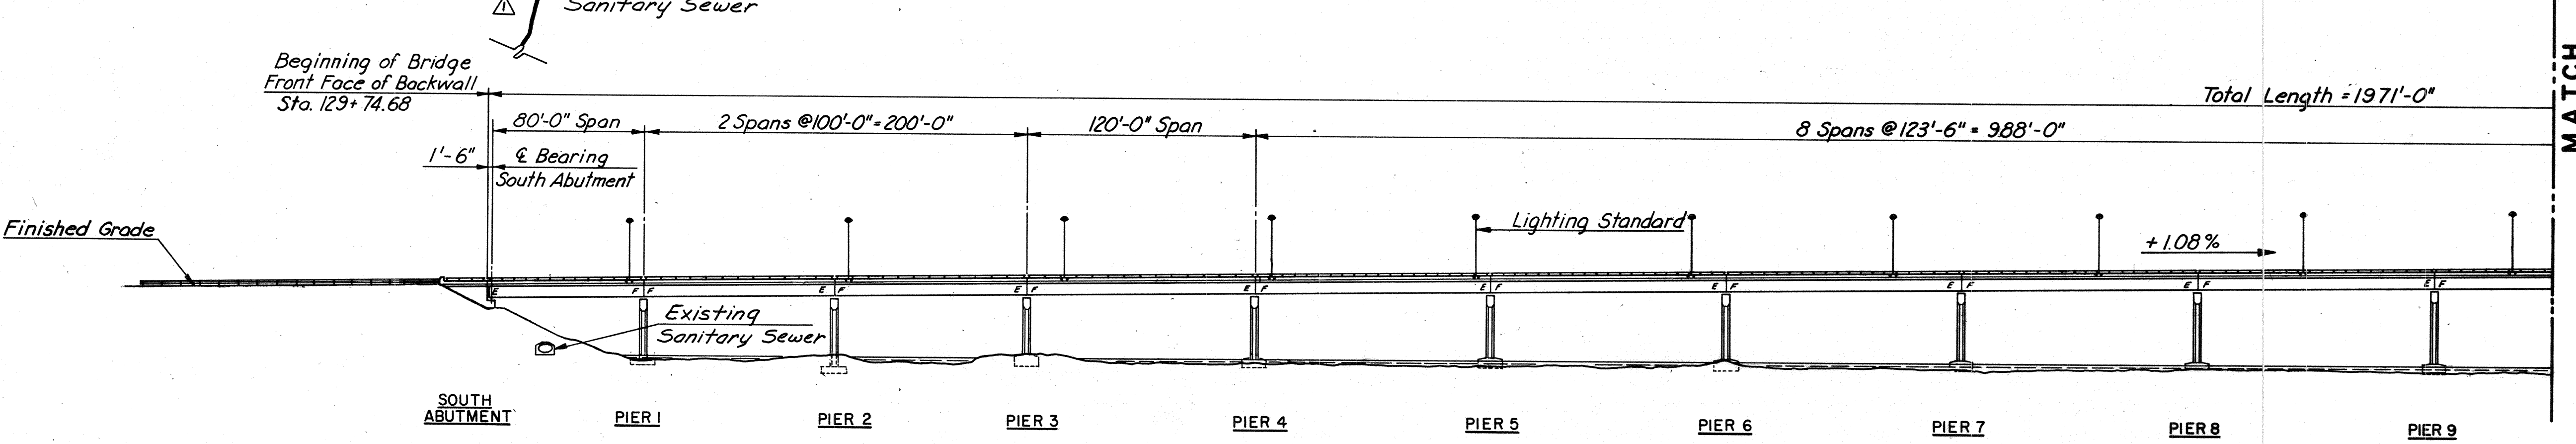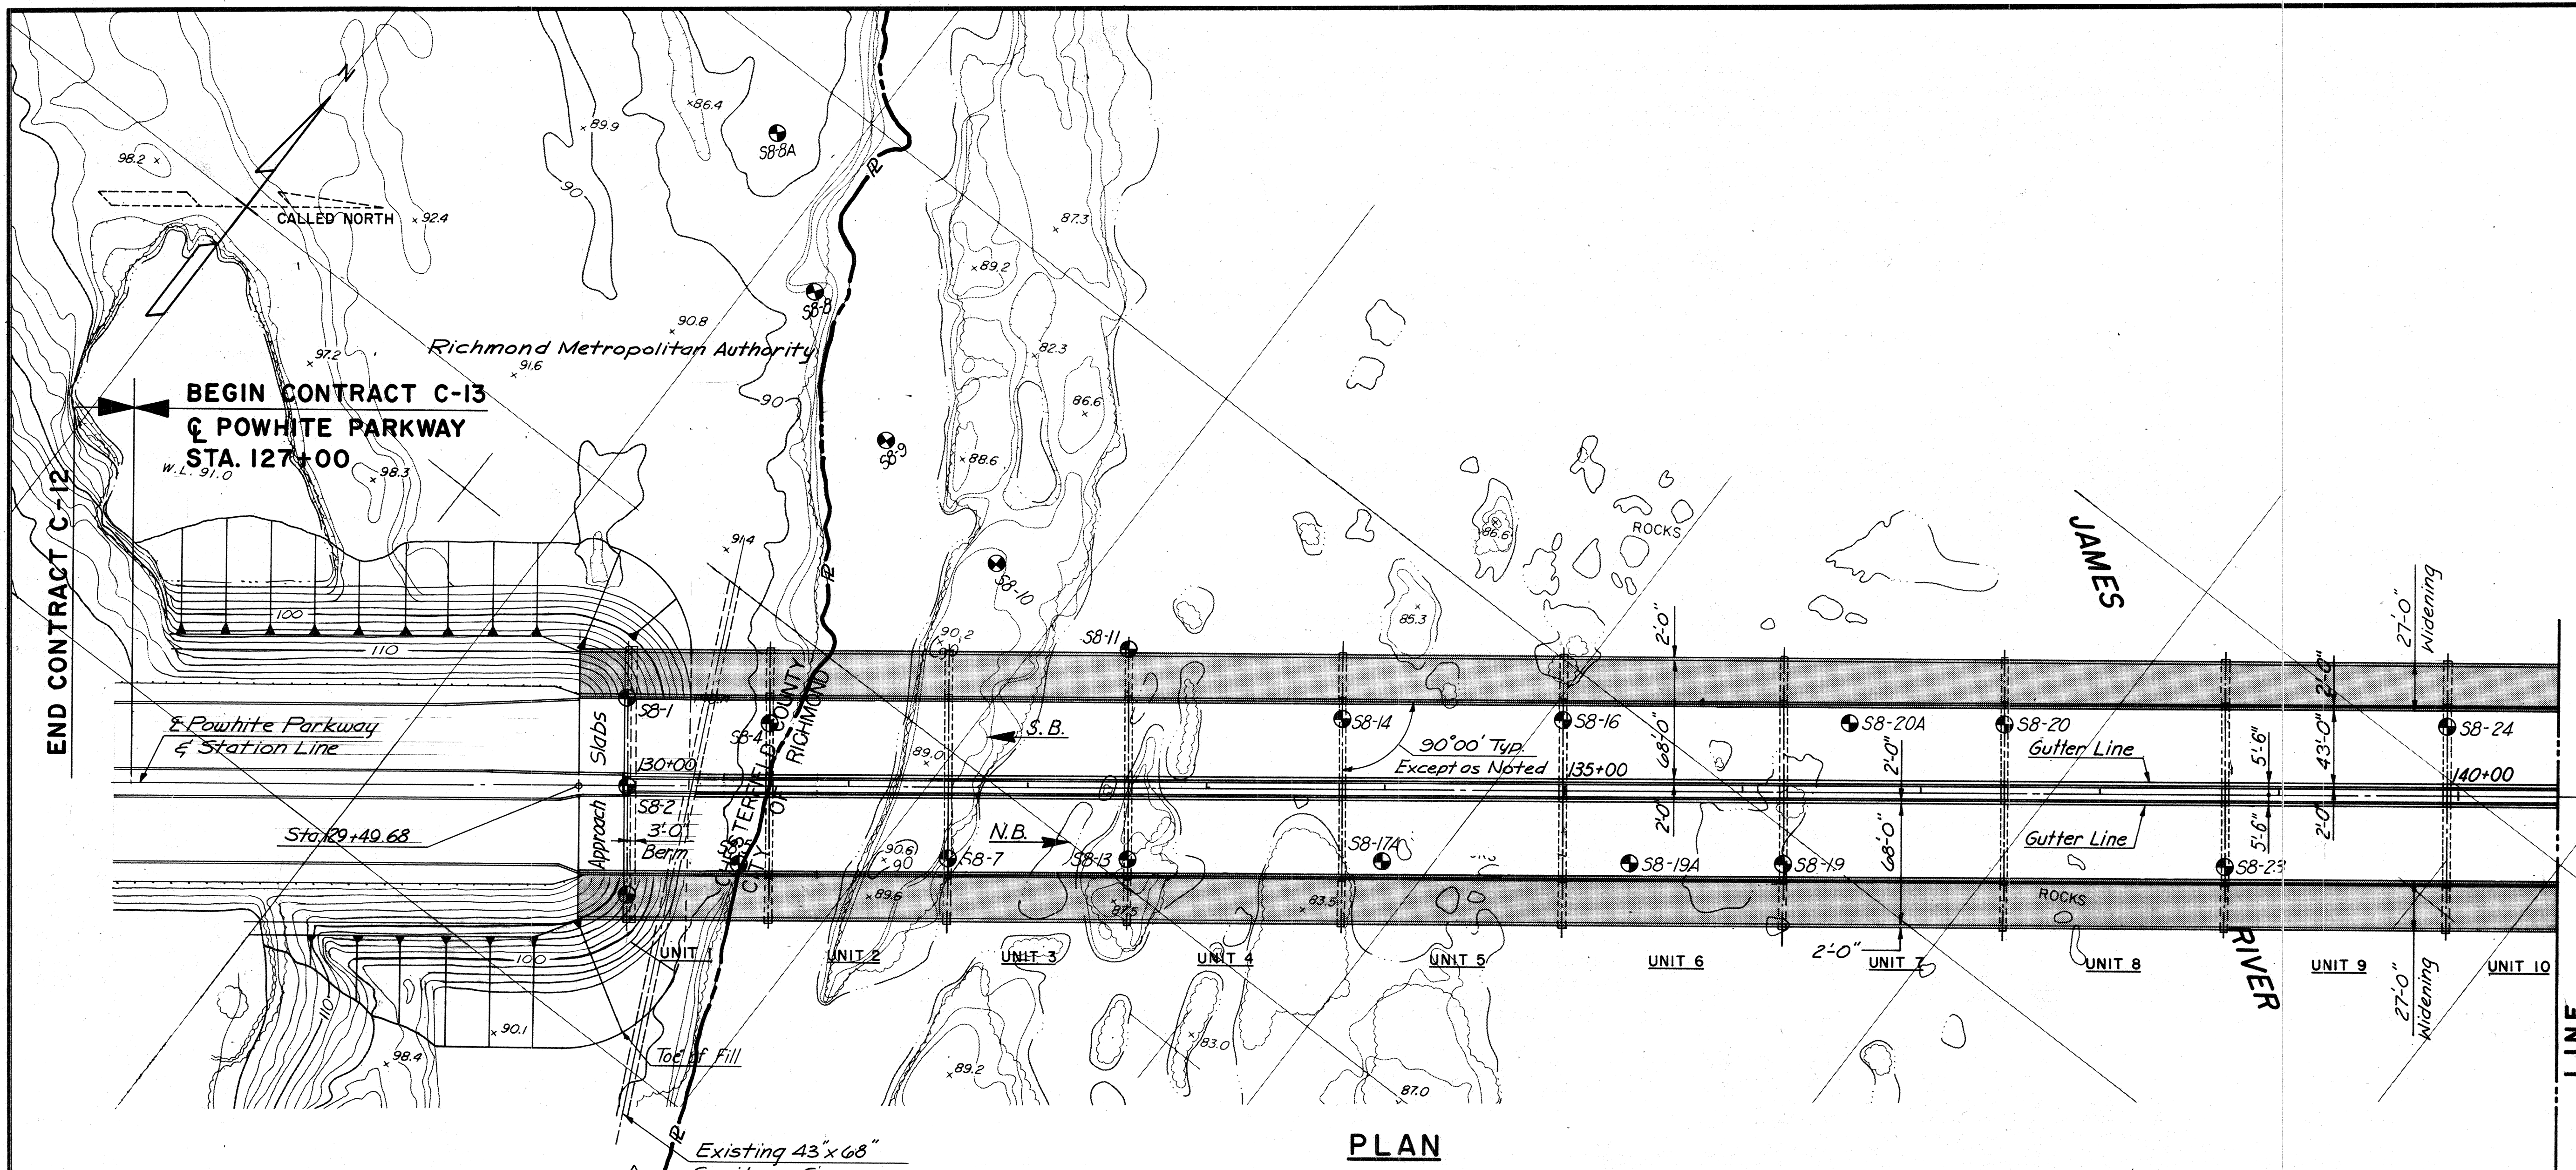

MADE	BY	DATE	NO.	REVISION	BY	DATE
ALC	3-87	As Built	TEM	3-89		
T.F.P.	3-87	Property Line	ALC	4-87		
S.R.						

AS BUILT



**RICHMOND METROPOLITAN AUTHORITY
 RICHMOND EXPRESSWAY SYSTEM**

GENERAL PLAN AND ELEVATION

HOWARD, NEEDLES, TAMMEN & BERGENDOFF
 consulting engineers
 Alexandria, Virginia

SCALE: 1" = 50'
 CONTRACT NO.: C-13
 SHEET NO. 2 OF 106

RICHMOND EXPRESSWAY SYSTEM			
SECTION	PROJECT	SHEET NO.	TOTAL SHEETS
13	WIDENING JAMES RIVER BRIDGE	3	106

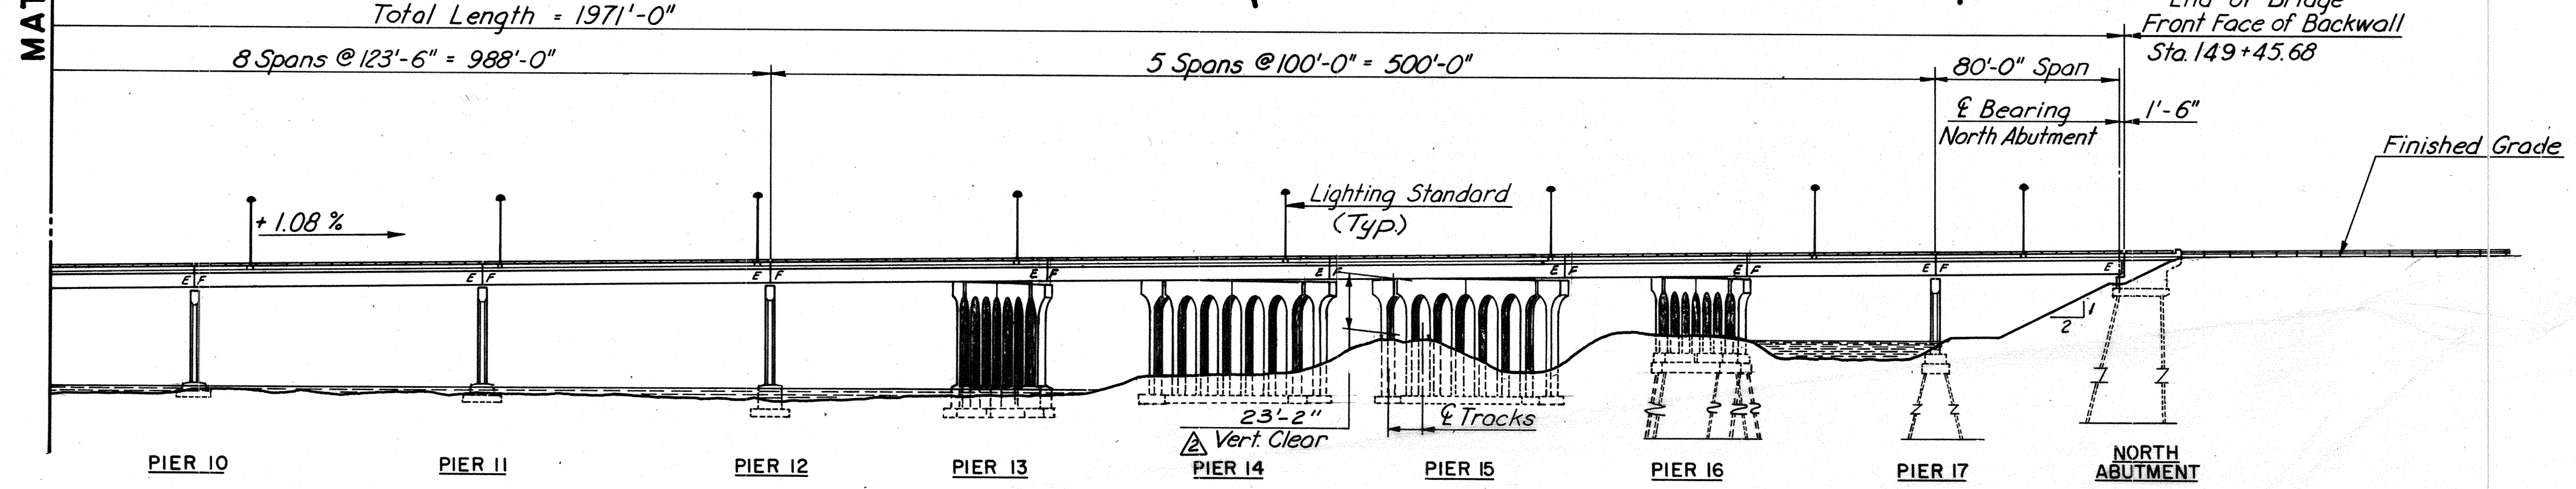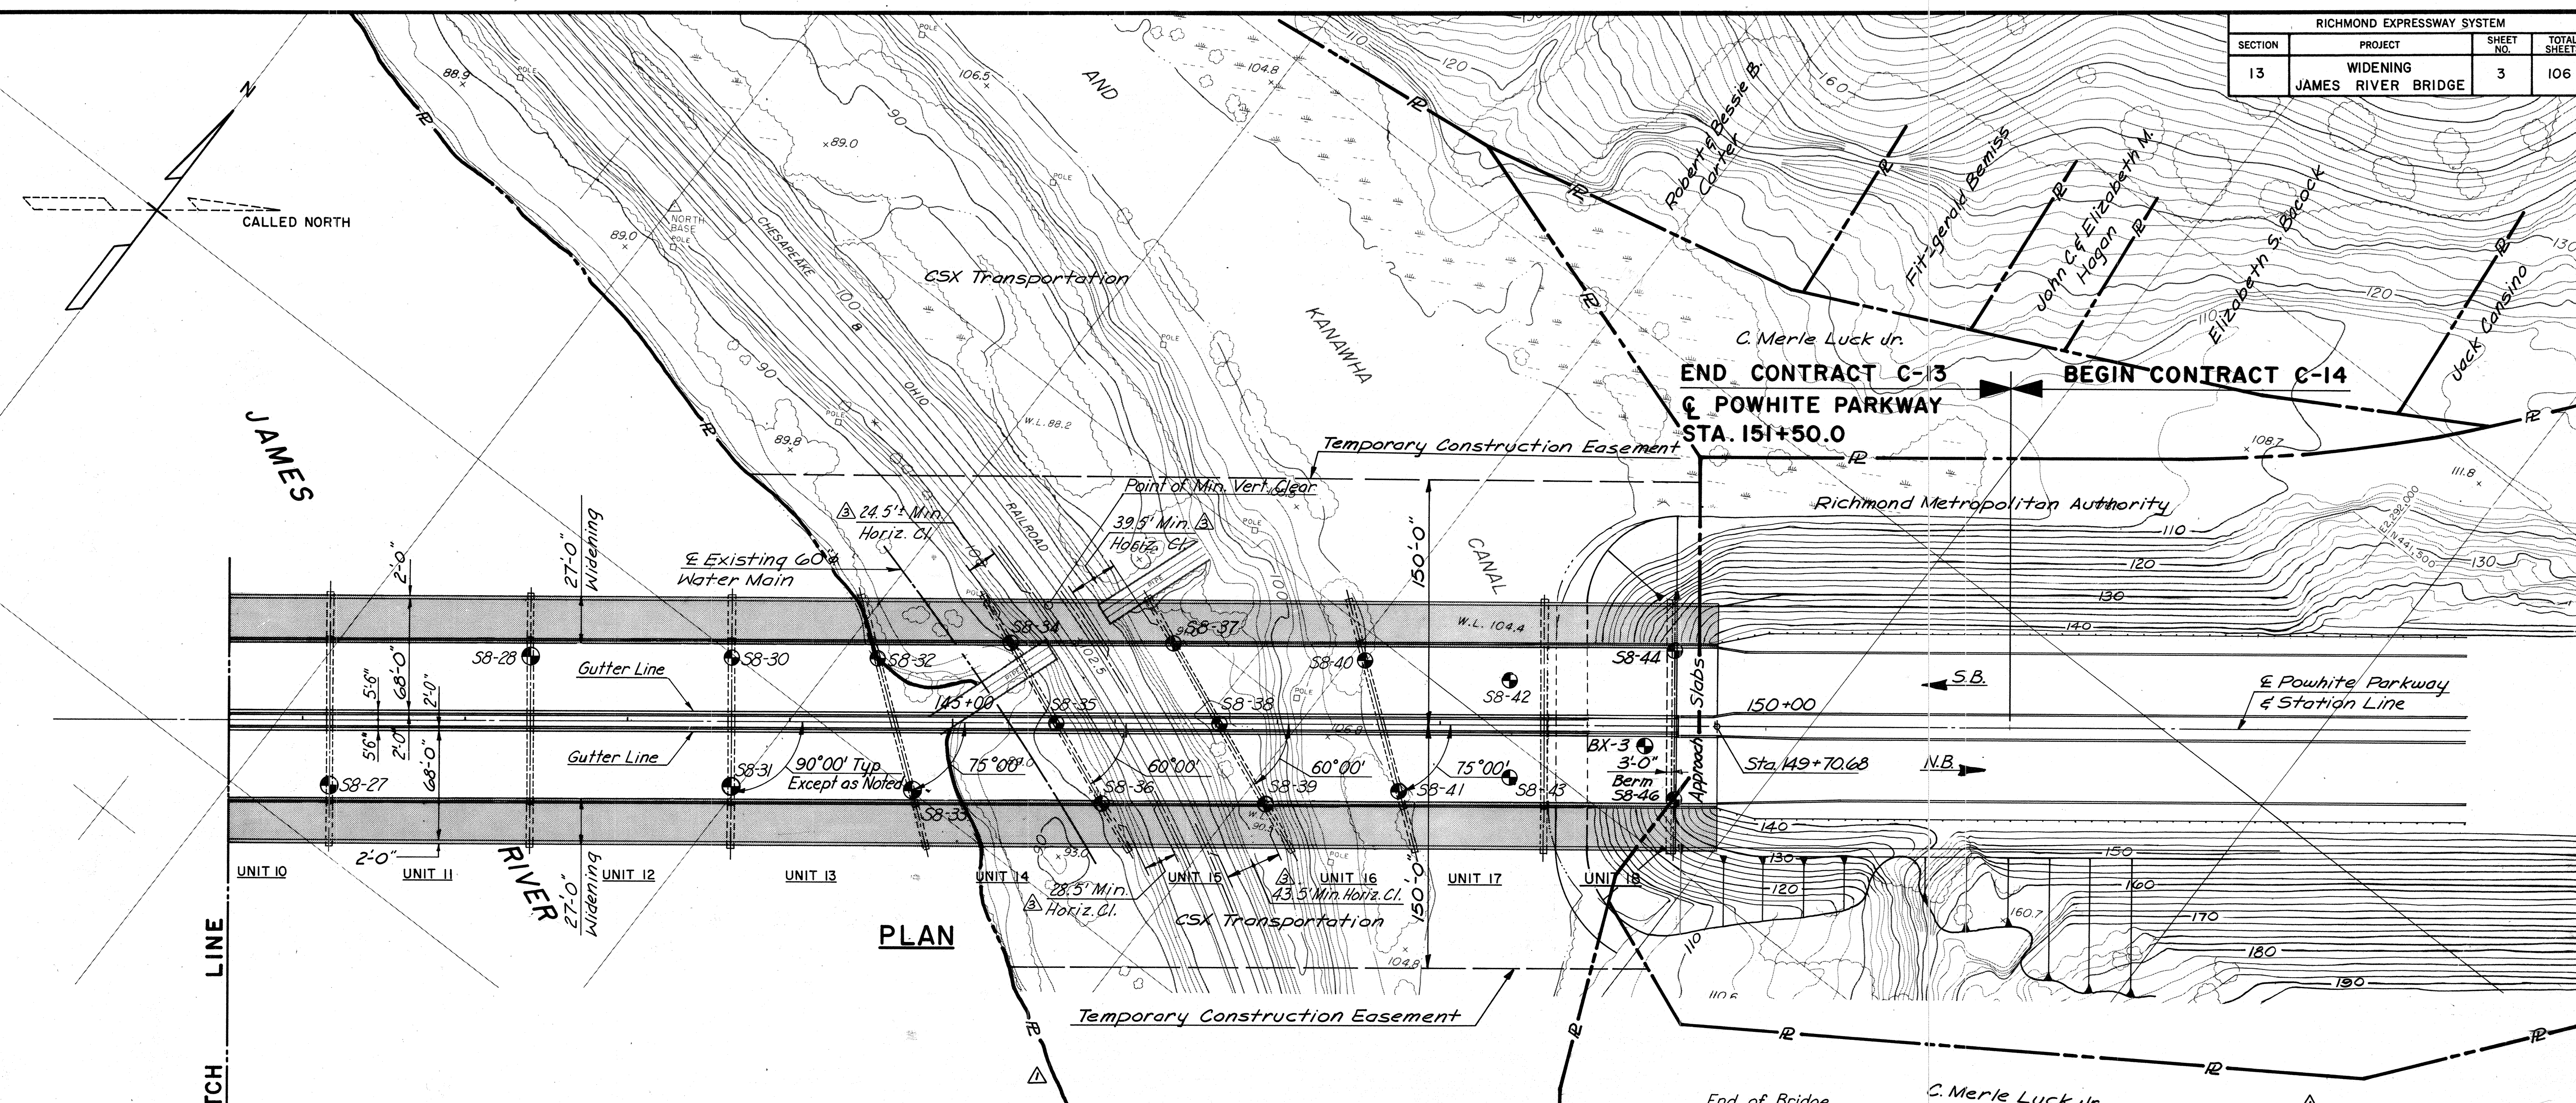

ELEVATION

As Built TEM 3-89				
BY	DATE	REVISION	BY	DATE
ALC.	3-87	Added Horiz. Cl.	EJM	7-87
T.F.P.	3-87	Vert. Clear	ALC	5-87
S.R.		Property Line	ALC	4-87

AS BUILT


**RICHMOND METROPOLITAN AUTHORITY
RICHMOND EXPRESSWAY SYSTEM**

GENERAL PLAN AND ELEVATION

HOWARD, NEEDLES, TAMMEN & BERGENDOFF
consulting engineers
Alexandria, Virginia


SCALE: 1" = 50'
CONTRACT NO.: C-13
SHEET NO. 3 of 106

RICHMOND EXPRESSWAY SYSTEM			
SECTION	PROJECT	SHEET NO.	TOTAL SHEETS
13	WIDENING JAMES RIVER BRIDGE	5	106

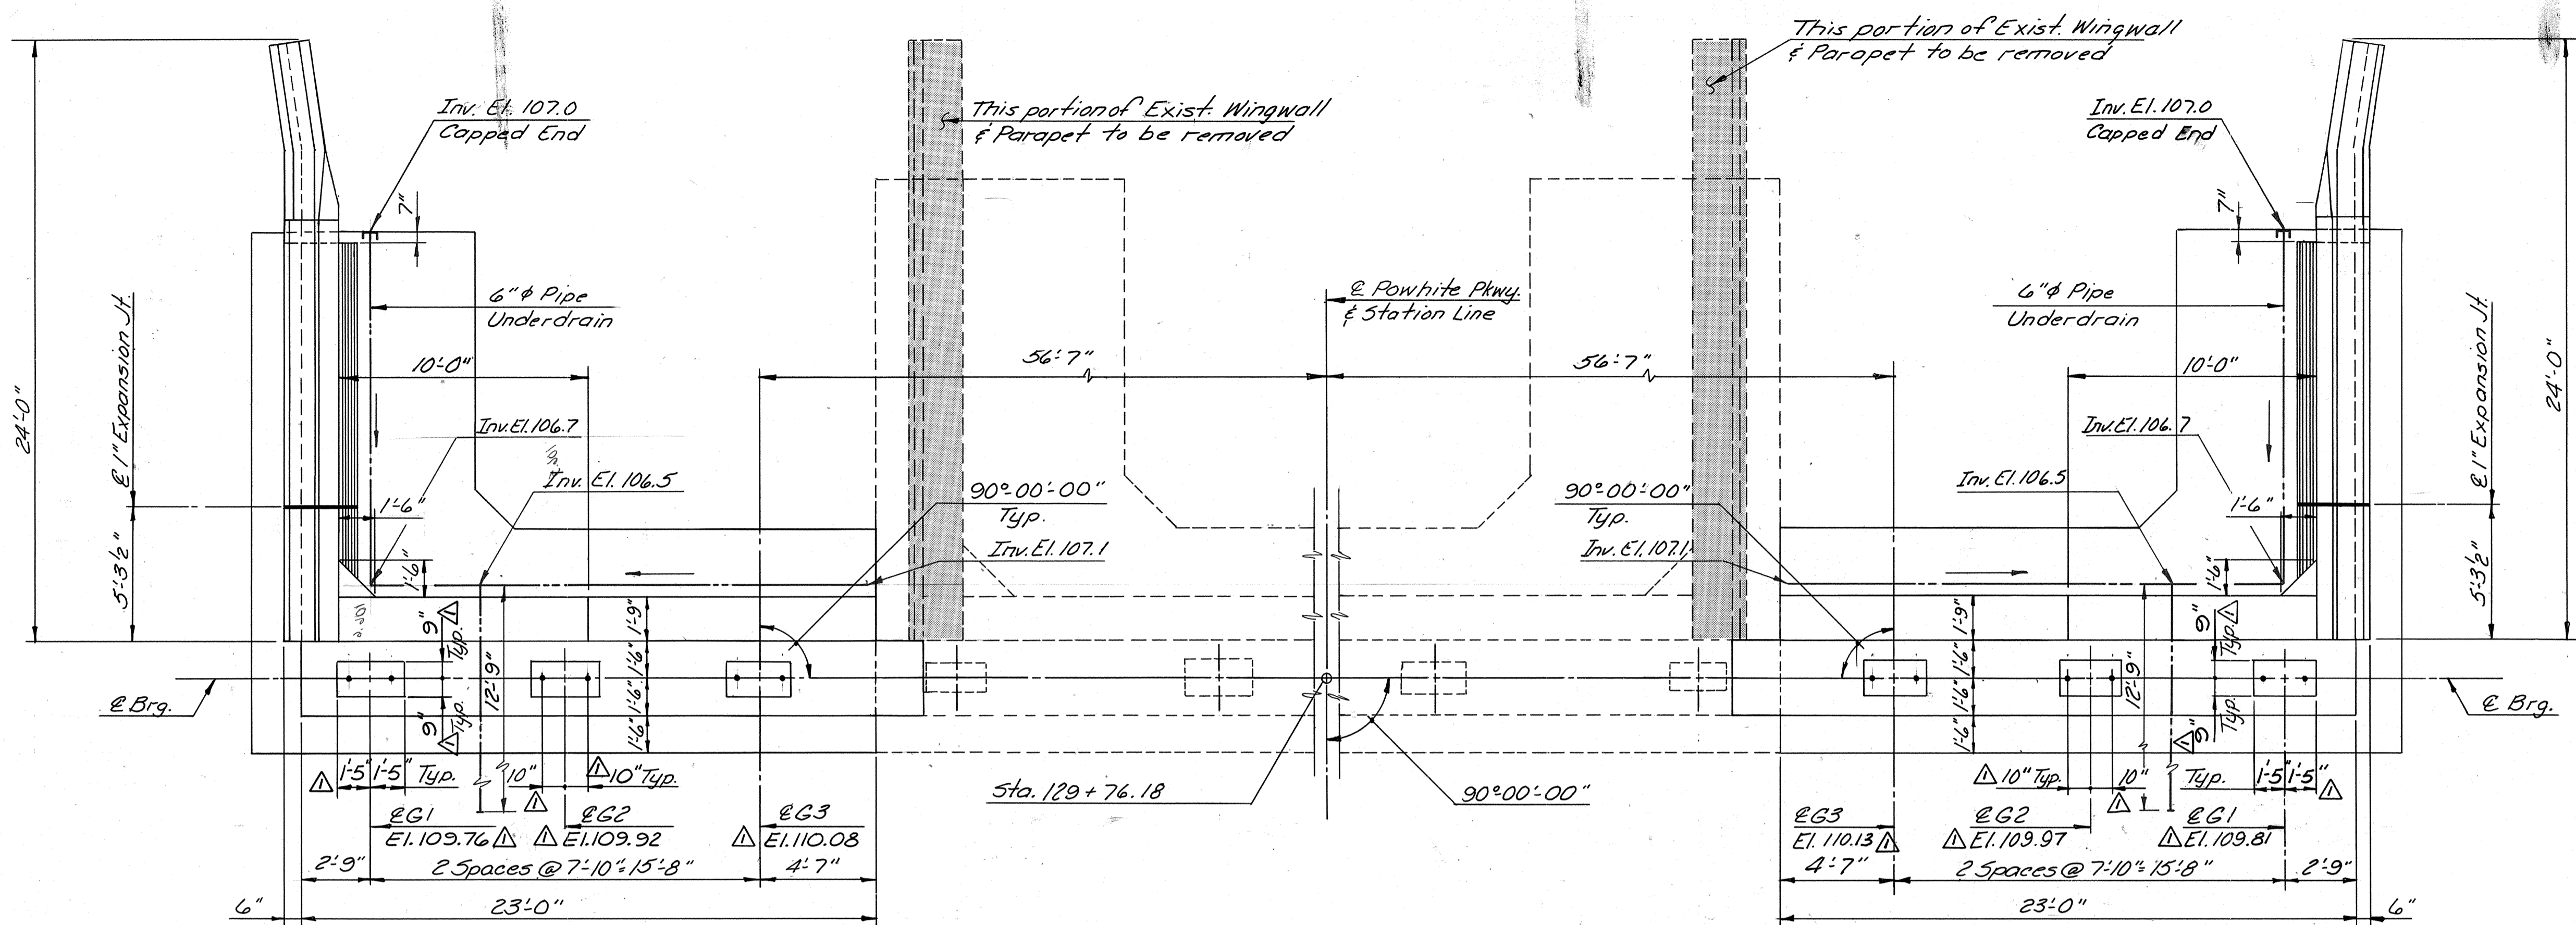

PLAN - NORTHBOUND
Scale: 4"=1'-0"


PLAN - SOUTHBOUND
Scale: 4"=1'-0"

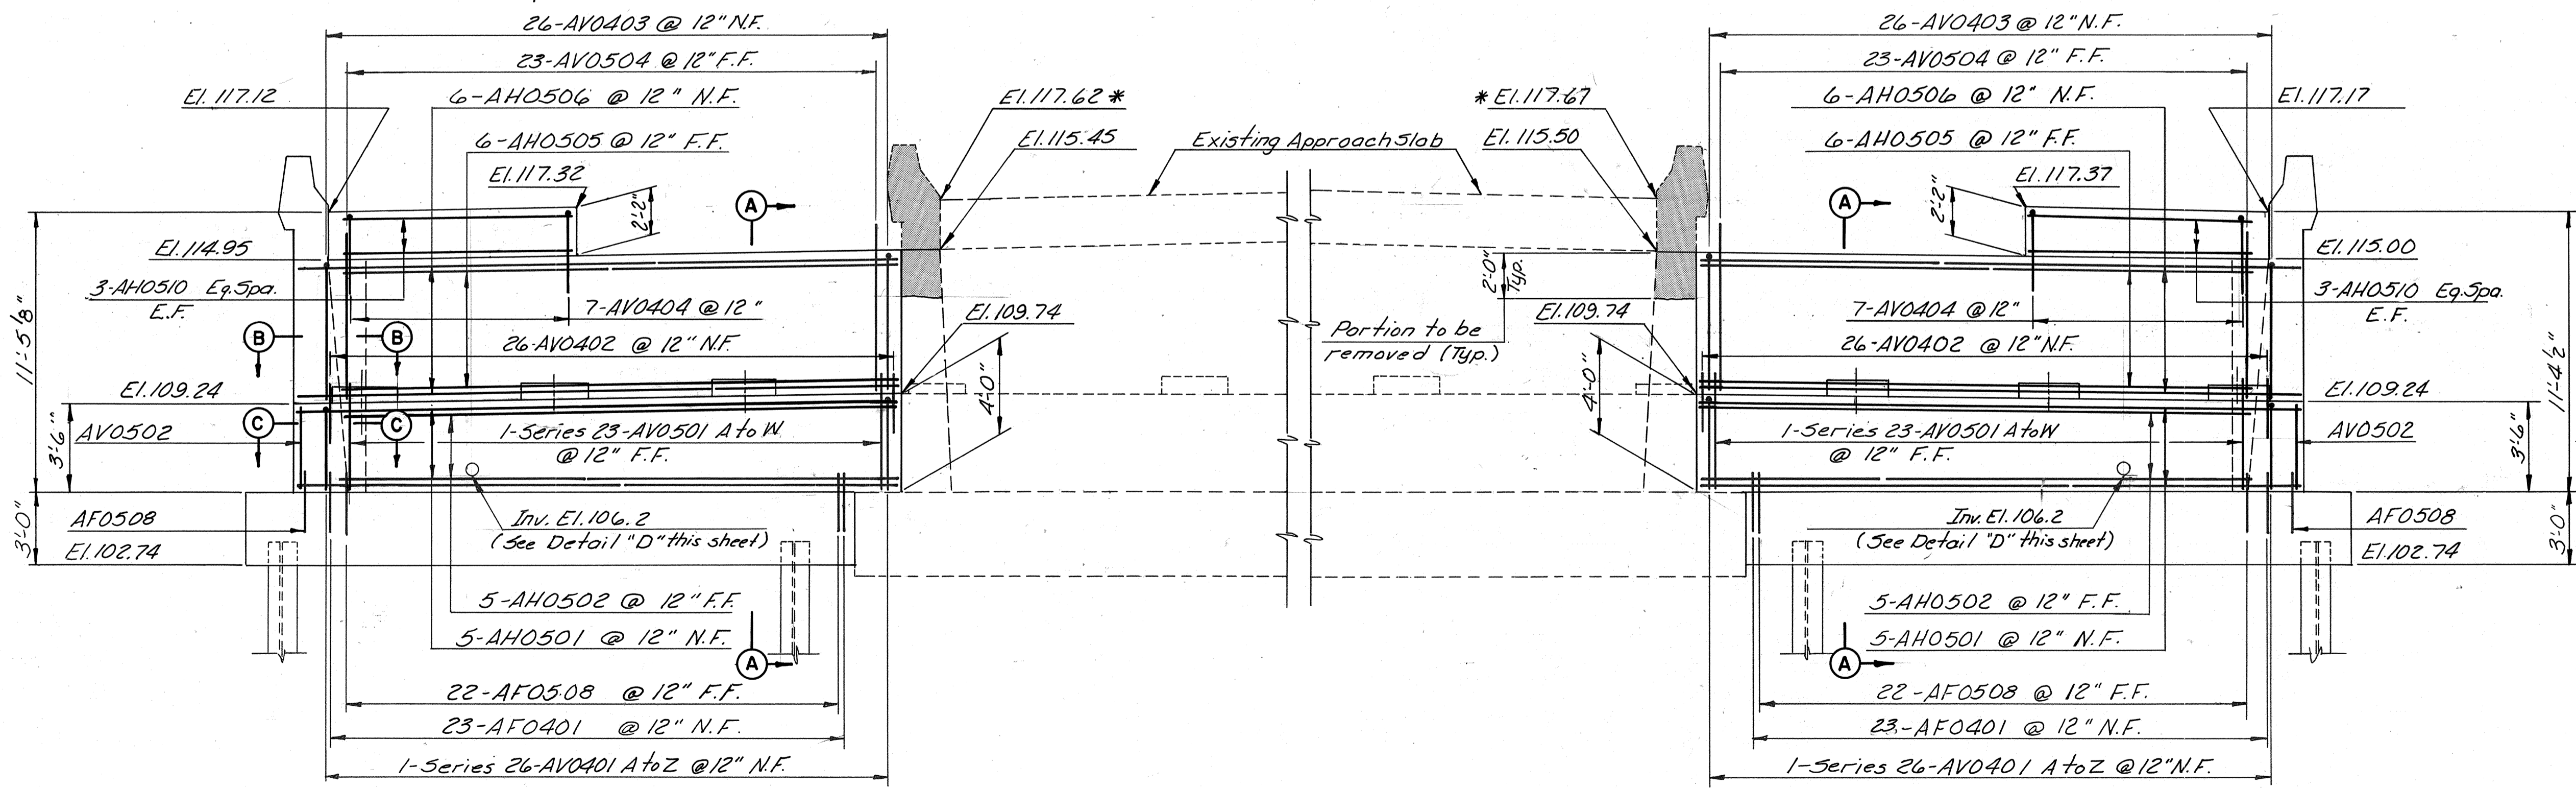

ELEVATION - NORTHBOUND
Scale: 4"=1'-0"


ELEVATION - SOUTHBOUND
Scale: 4"=1'-0"

* Field survey elevations.

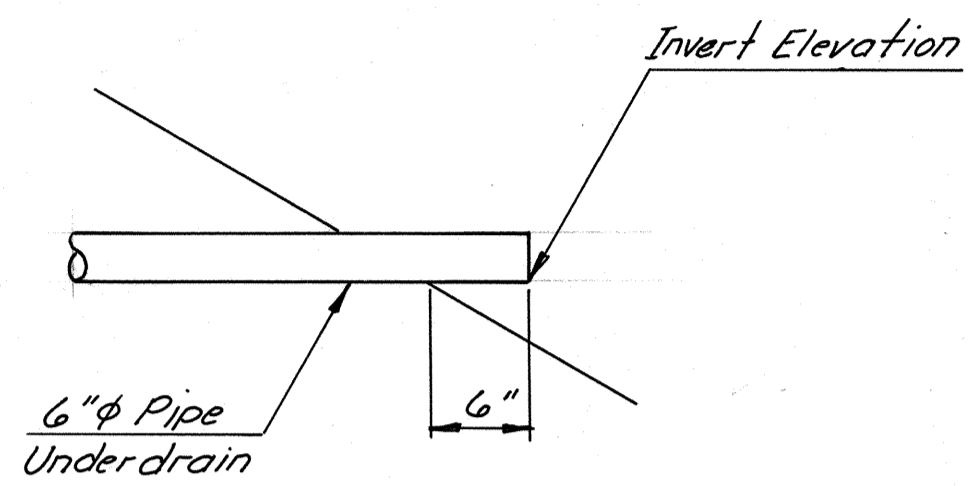

DETAIL "D"
No Scale

LEGEND:
E.F. = Each Face
F.F. = Far Face
N.F. = Near Face

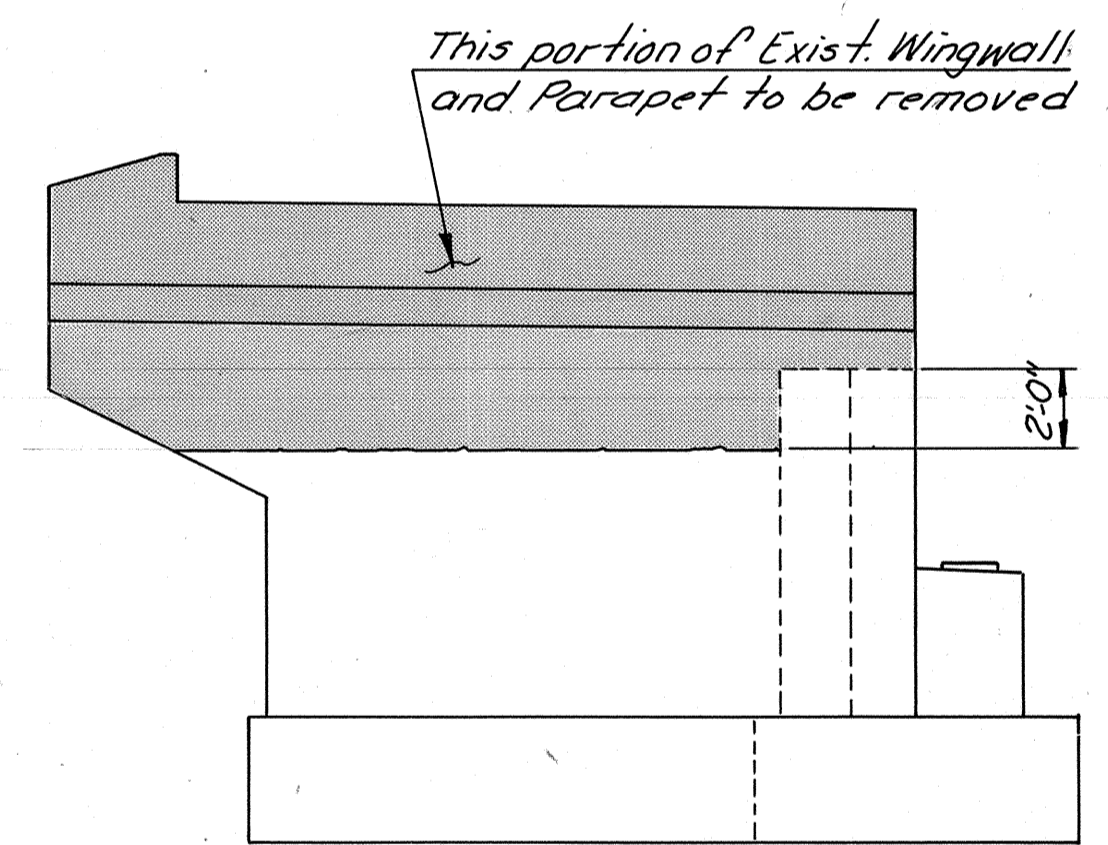

LIMITS OF REMOVAL
No Scale

NOTE:
For Sections A-A, B-B, and C-C see Sheet No. G

BY	DATE	REVISION	BY	DATE
MADE	TAL 1-87	As Built	TEM	3-89
CHECKED	T.F.P. 3-87	Rev Anchor Bolt	ALC	6-87
IN CHARGE	S.R.			

RICHMOND METROPOLITAN AUTHORITY
RICHMOND EXPRESSWAY SYSTEM

SOUTH ABUTMENT PLAN AND ELEVATION



HOWARD, NEEDLES, TAMMEN & BERGENDOFF
consulting engineers
Alexandria, Virginia

SCALE: AS SHOWN
CONTRACT NO.: C-13
SHEET NO. 5 OF 106

AS BUILT




RICHMOND EXPRESSWAY SYSTEM			
SECTION	PROJECT	SHEET NO.	TOTAL SHEETS
13	WIDENING JAMES RIVER BRIDGE	7	106

LEGEND:
 E.F. = Each Face
 F.F. = Far Face
 N.F. = Near Face

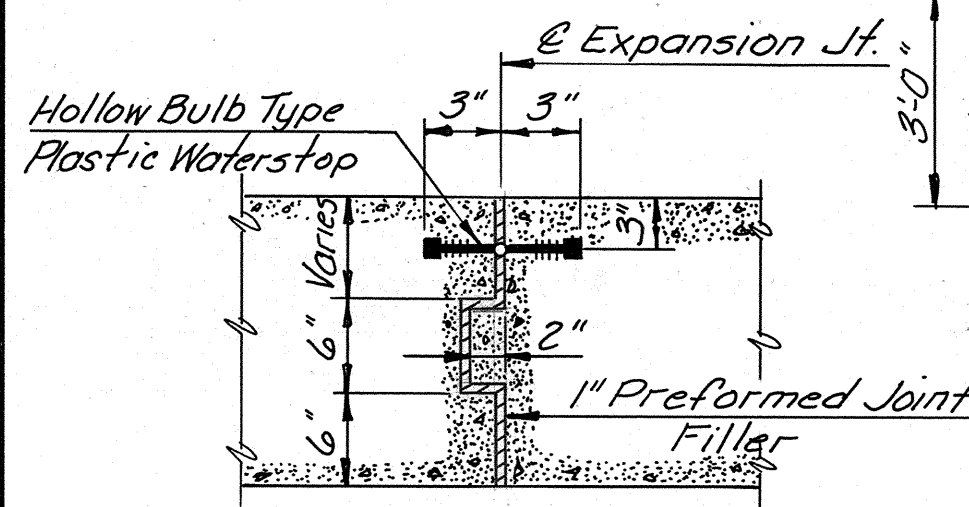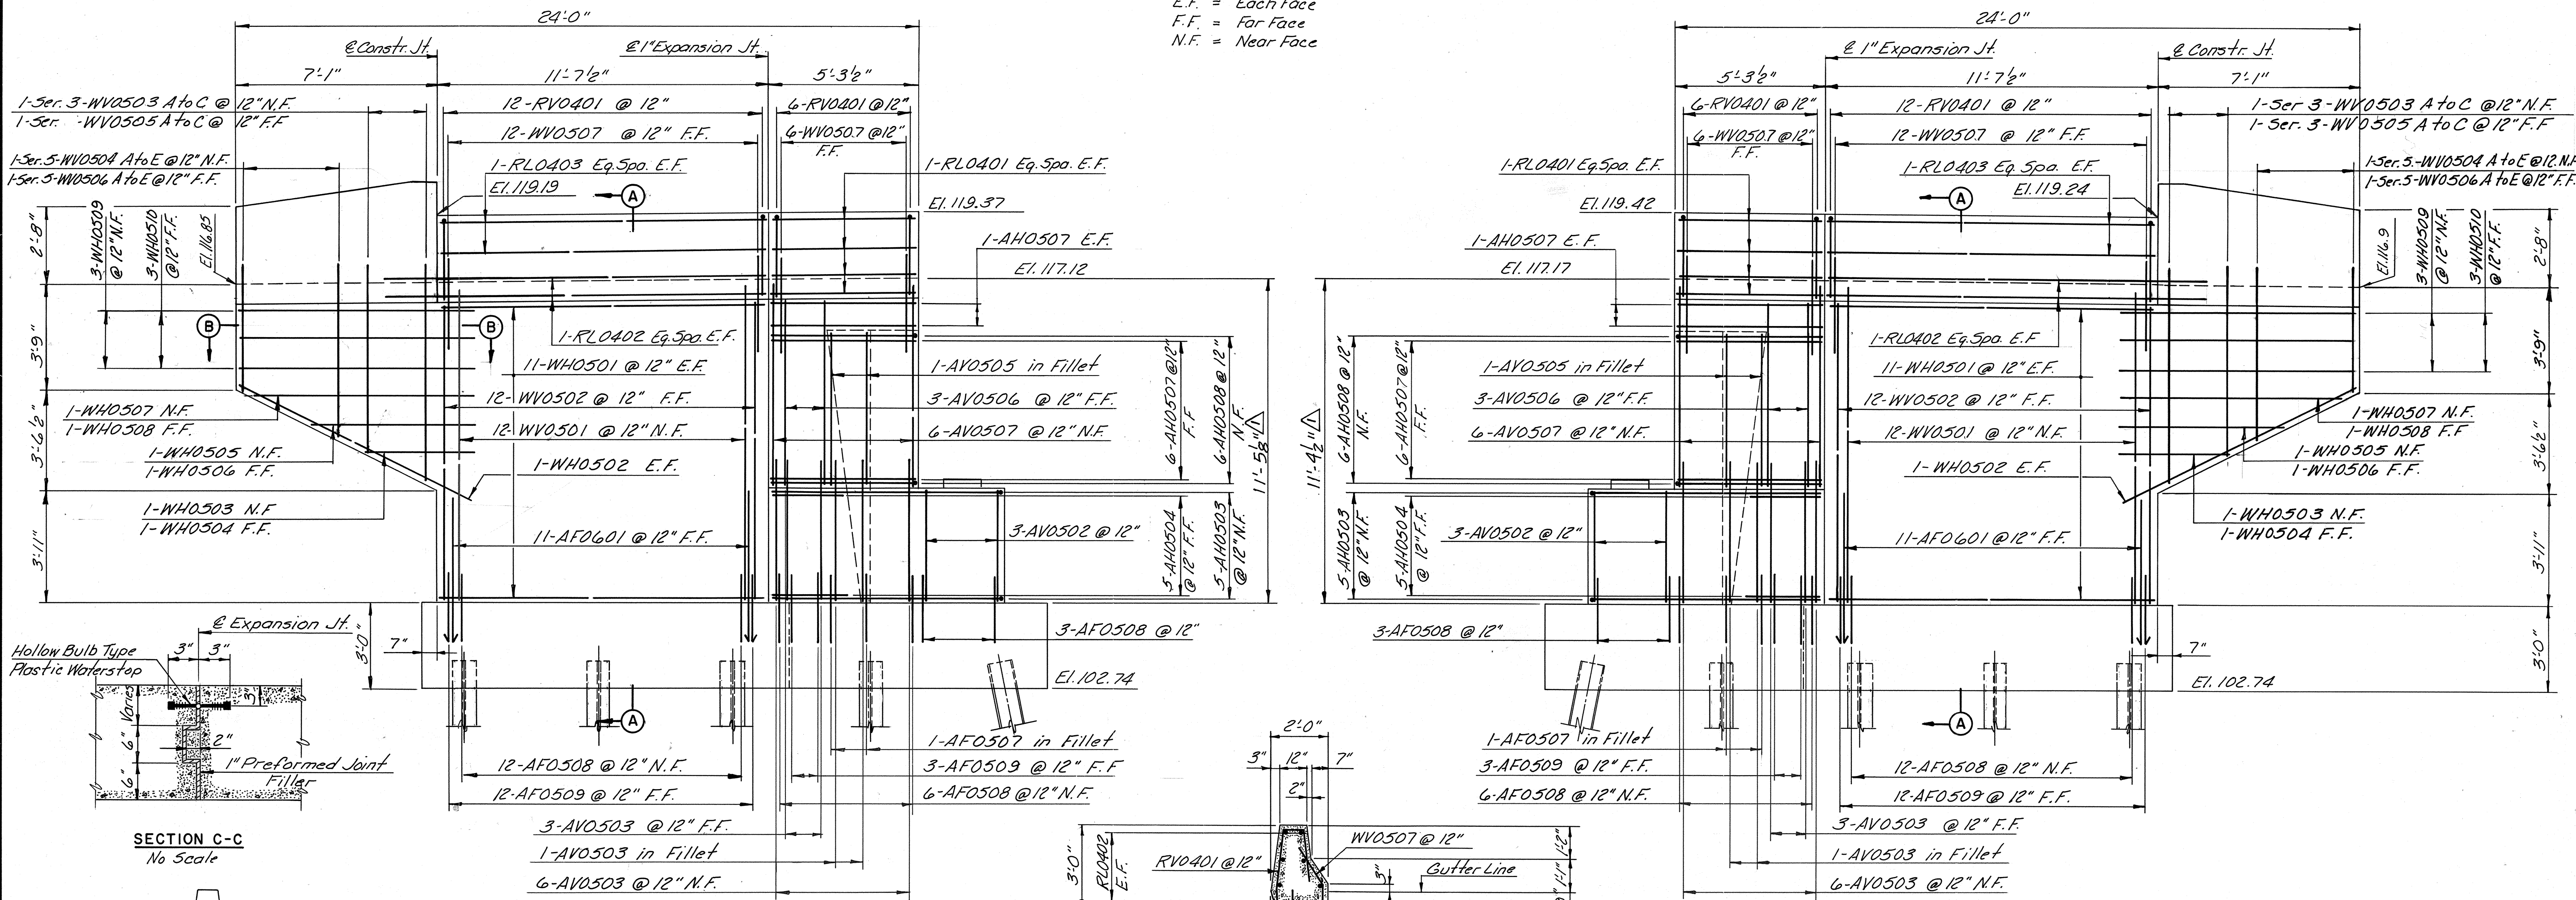

ELEVATION - SOUTHEAST WINGWALL
 Scale: 3/8" = 1'-0"

ELEVATION - SOUTHWEST WINGWALL
 Scale: 3/8" = 1'-0"

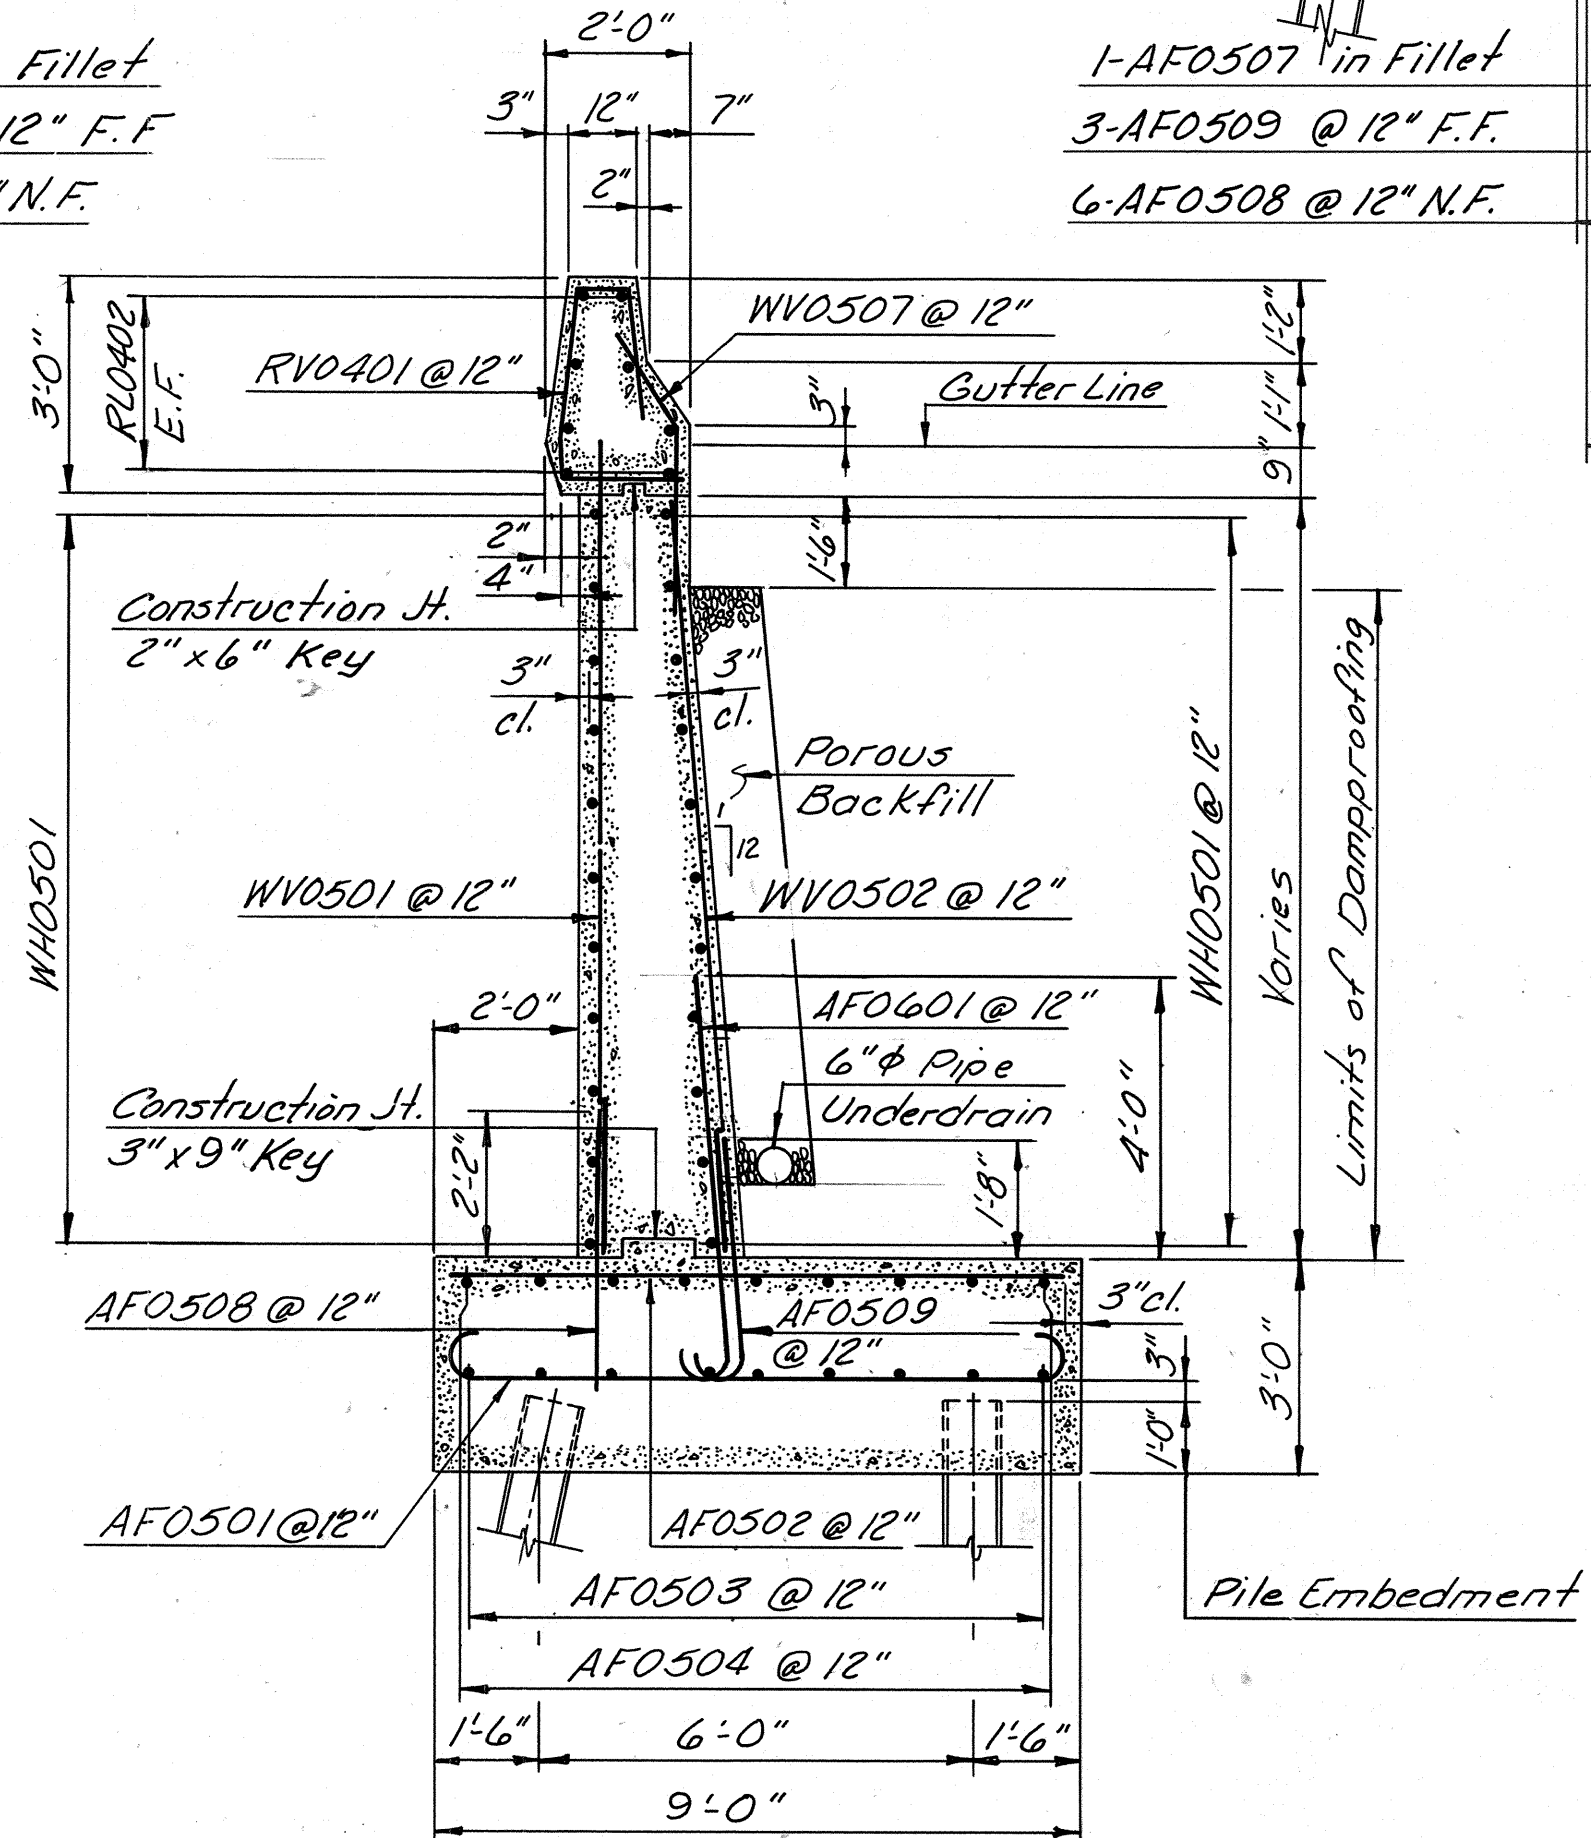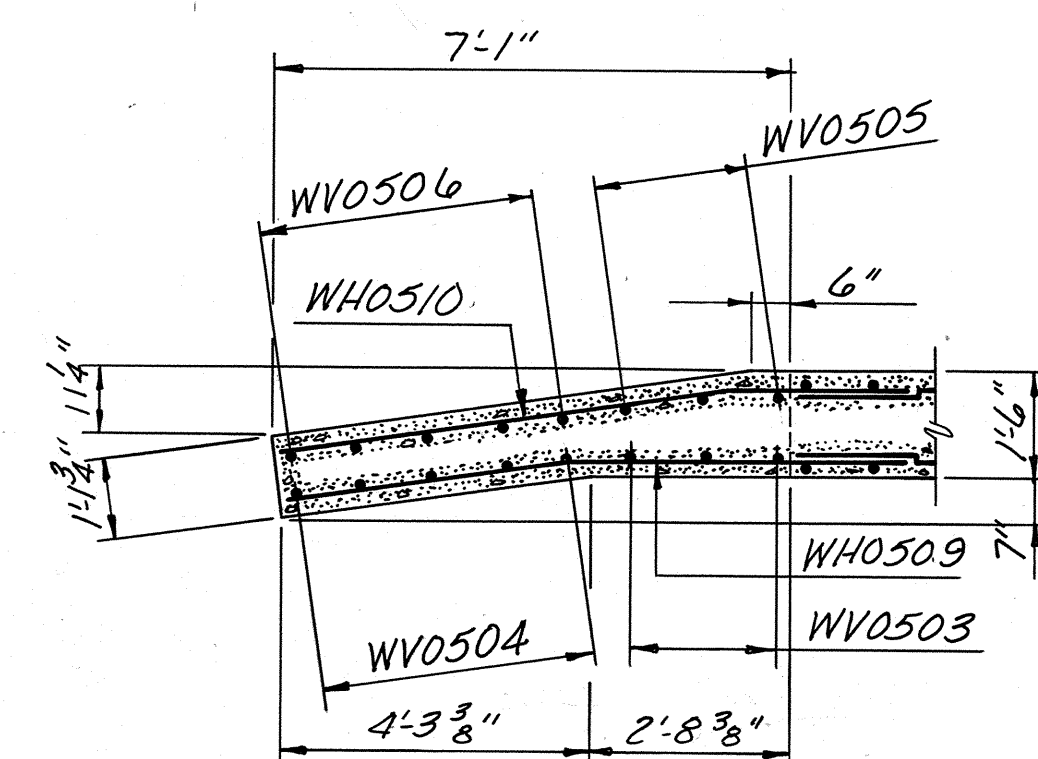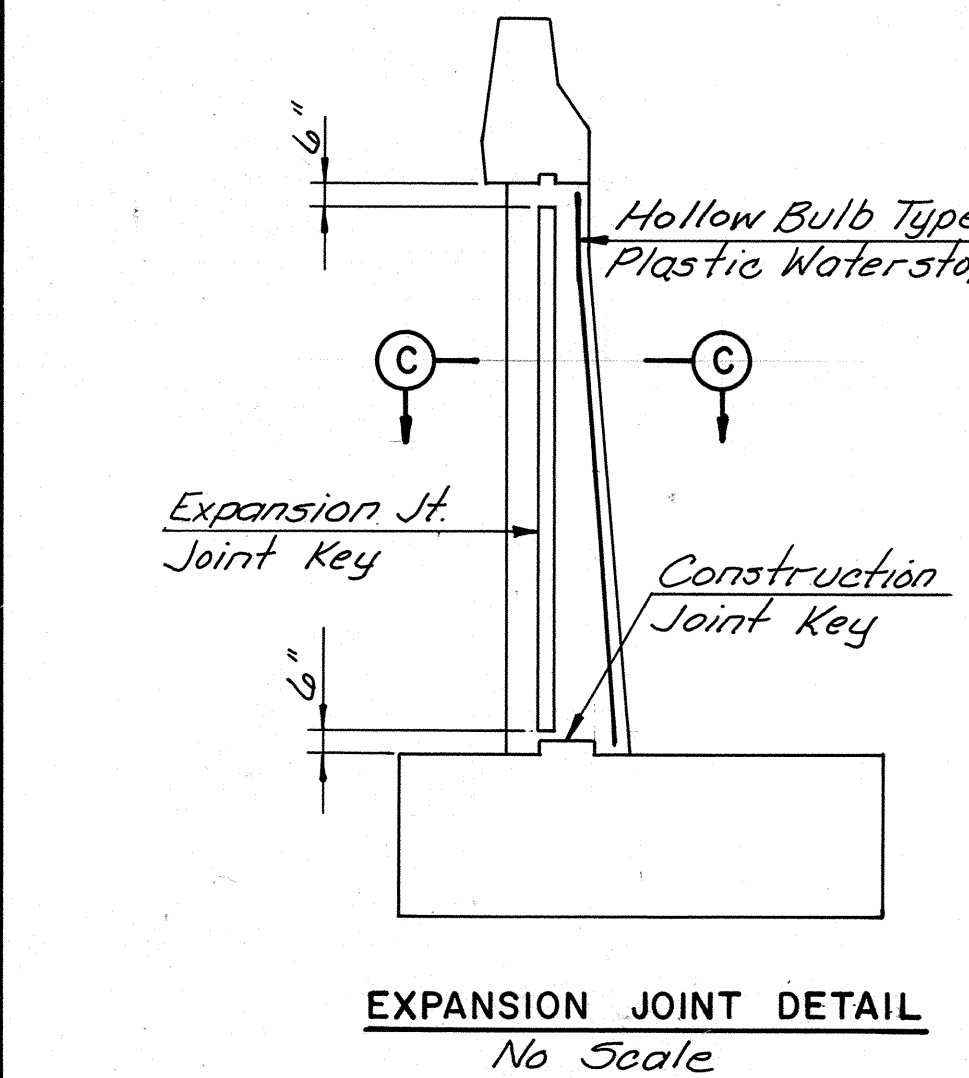

NOTE:
 For wingwall rustication details see Sheet No. 29

RICHMOND METROPOLITAN AUTHORITY
RICHMOND EXPRESSWAY SYSTEM

SOUTH ABUTMENT WINGWALLS


MADE	BY	DATE	NO.	REVISION	BY	DATE
	T.A.L.	2-87				
	T.F.P.	3-87		As Built	TEM	3-89
	S.R.					

AS BUILT


HOWARD, NEEDLES, TAMMEN & BERGENDOFF
 consulting engineers
 Alexandria, Virginia

SCALE: AS SHOWN
 CONTRACT NO: C-13
 SHEET NO. 7 OF 106

RICHMOND EXPRESSWAY SYSTEM			
SECTION	PROJECT	SHEET NO.	TOTAL SHEETS
13	WIDENING JAMES RIVER BRIDGE	8	106

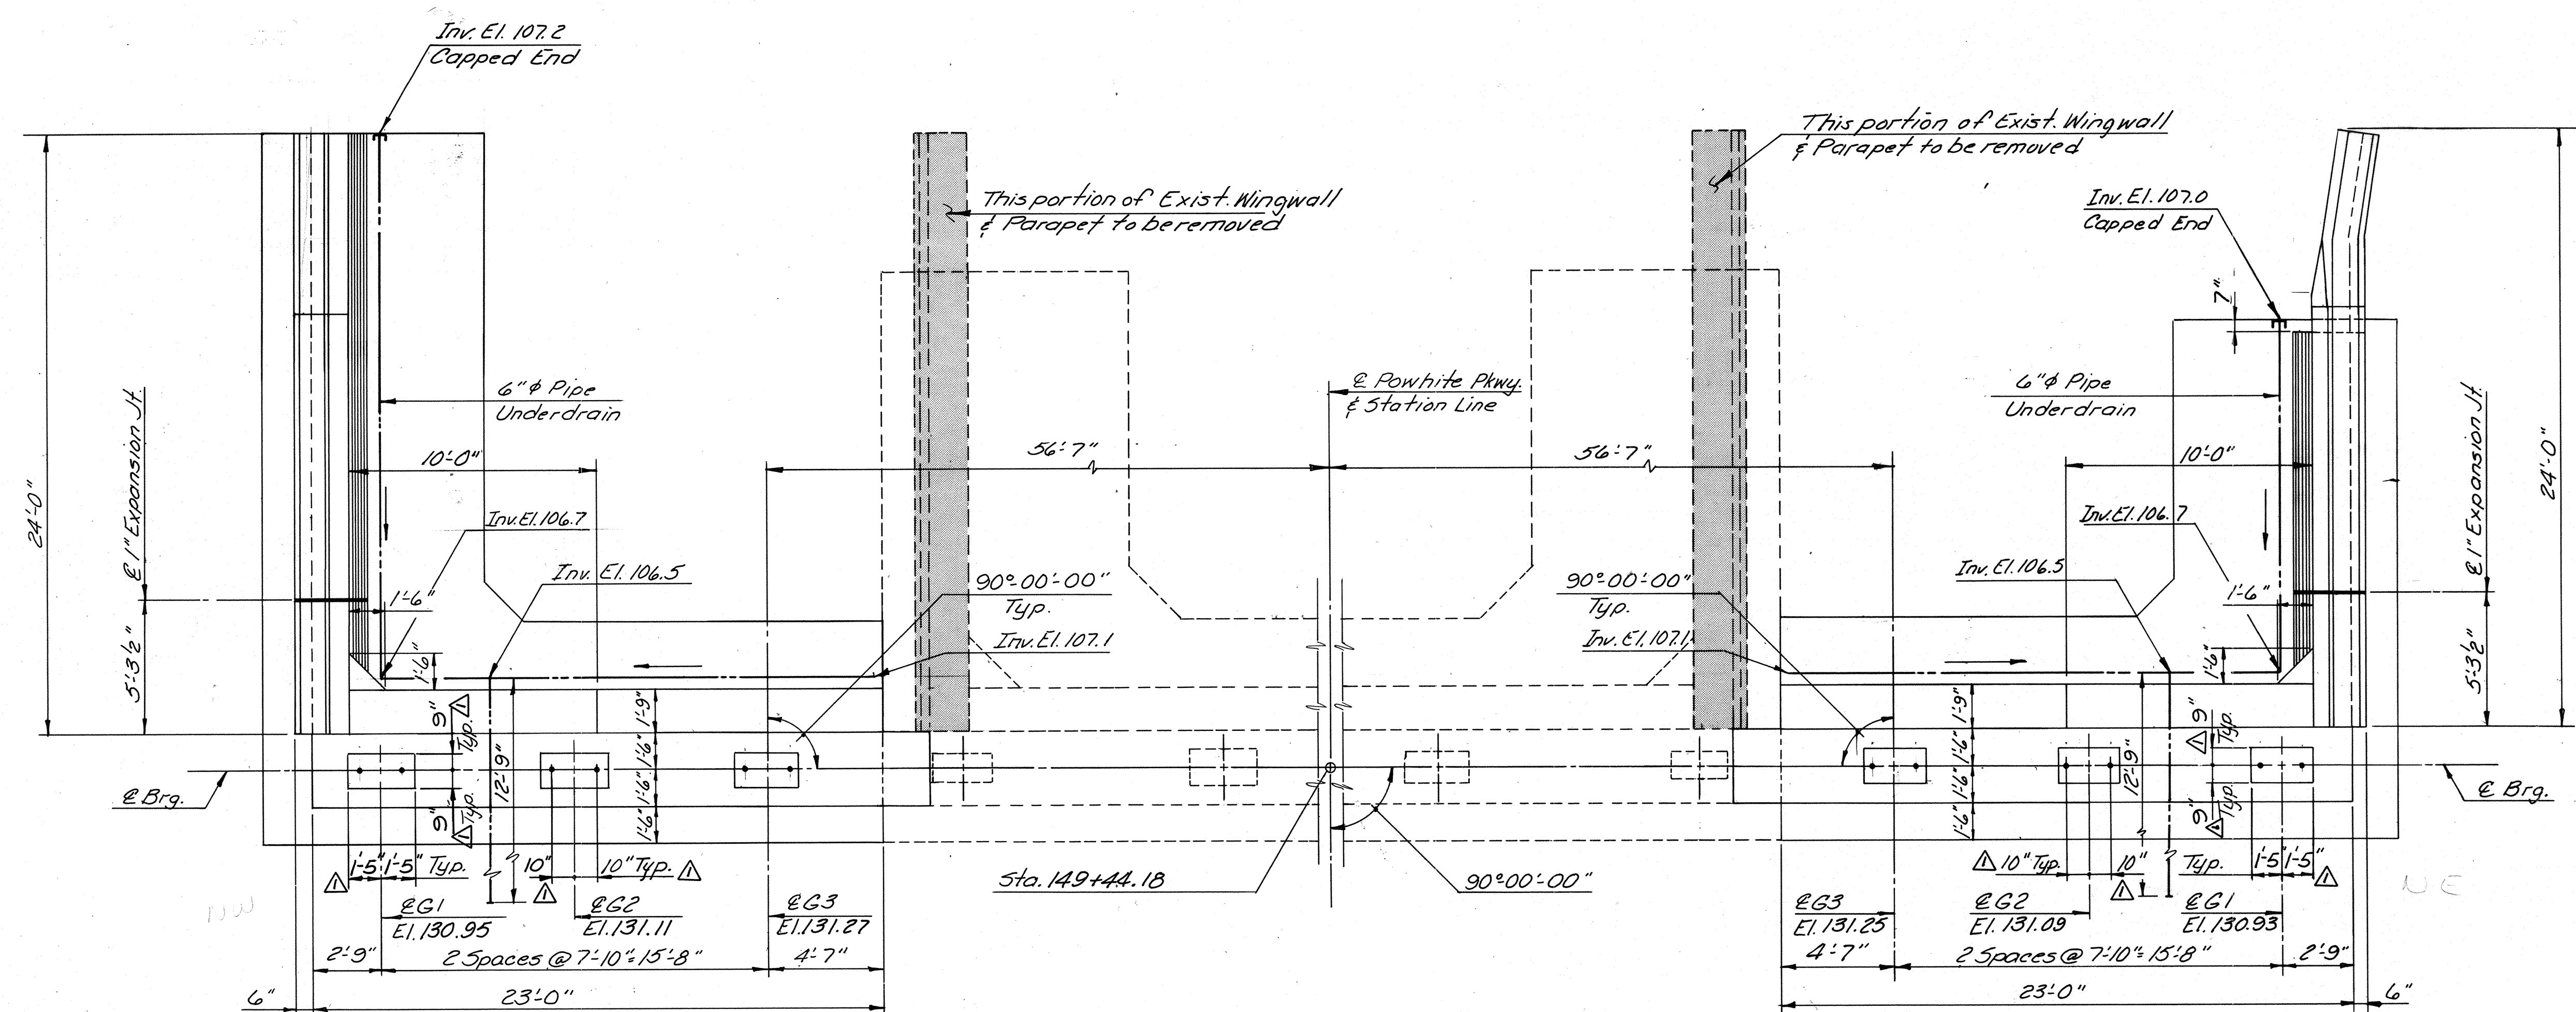


* Field survey elevations.

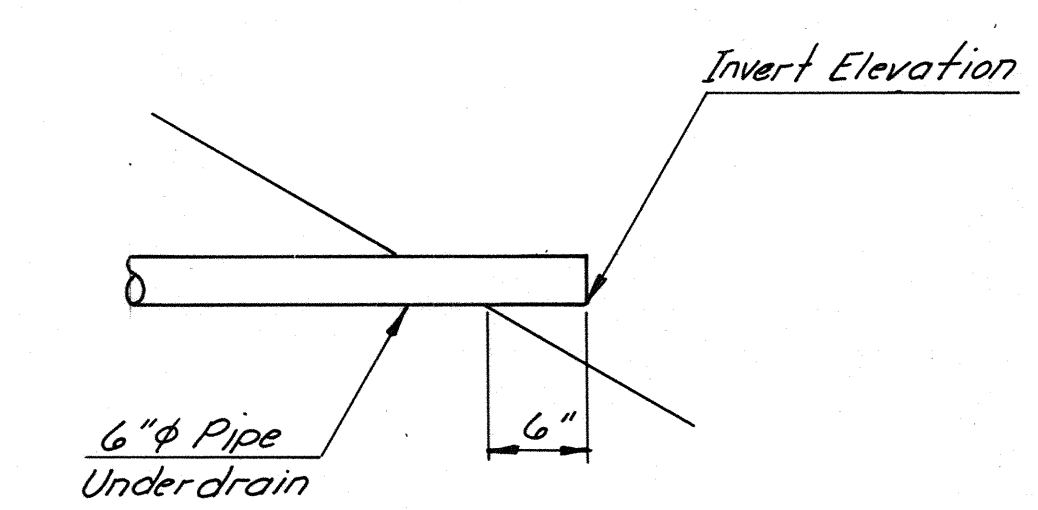


DETAIL "D"
No Scale

LEGEND:
E.F. = Each Face
F.F. = Far Face
N.F. = Near Face

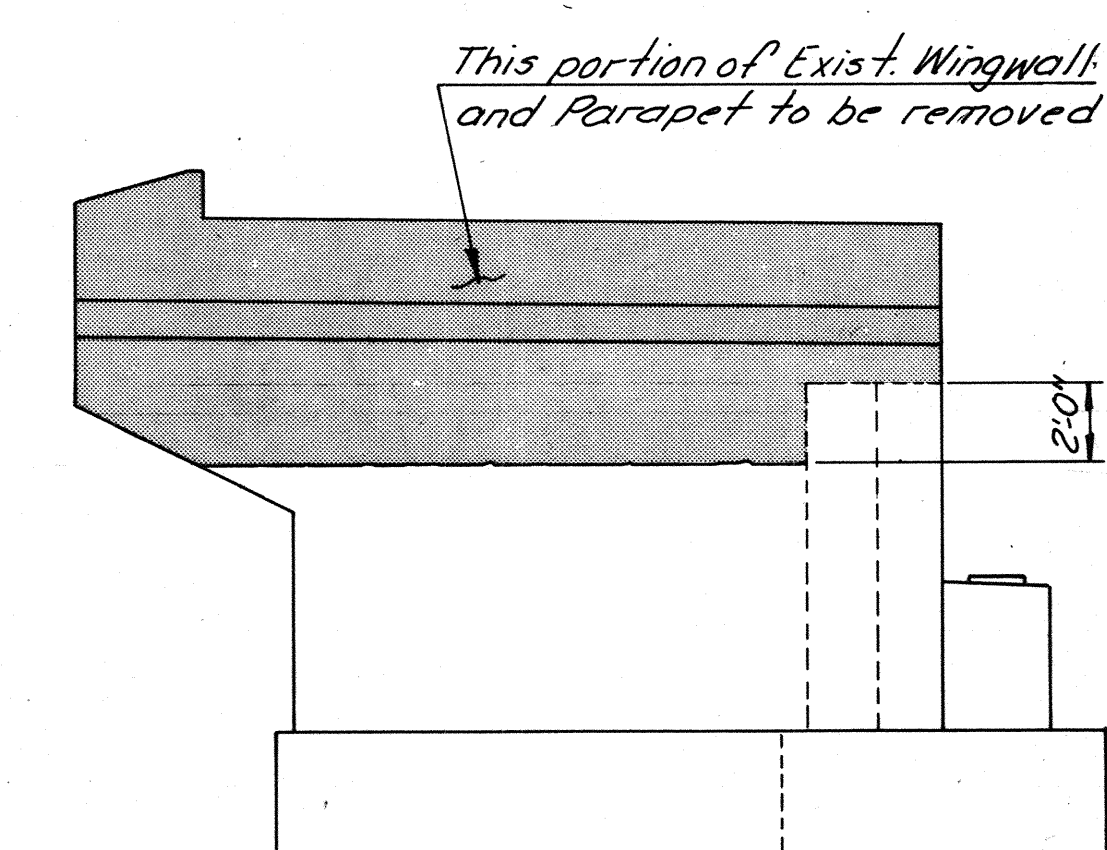


LIMITS OF REMOVAL
No Scale

NOTE:
For Sections A-A, B-B, and C-C
See Sheet No. 9

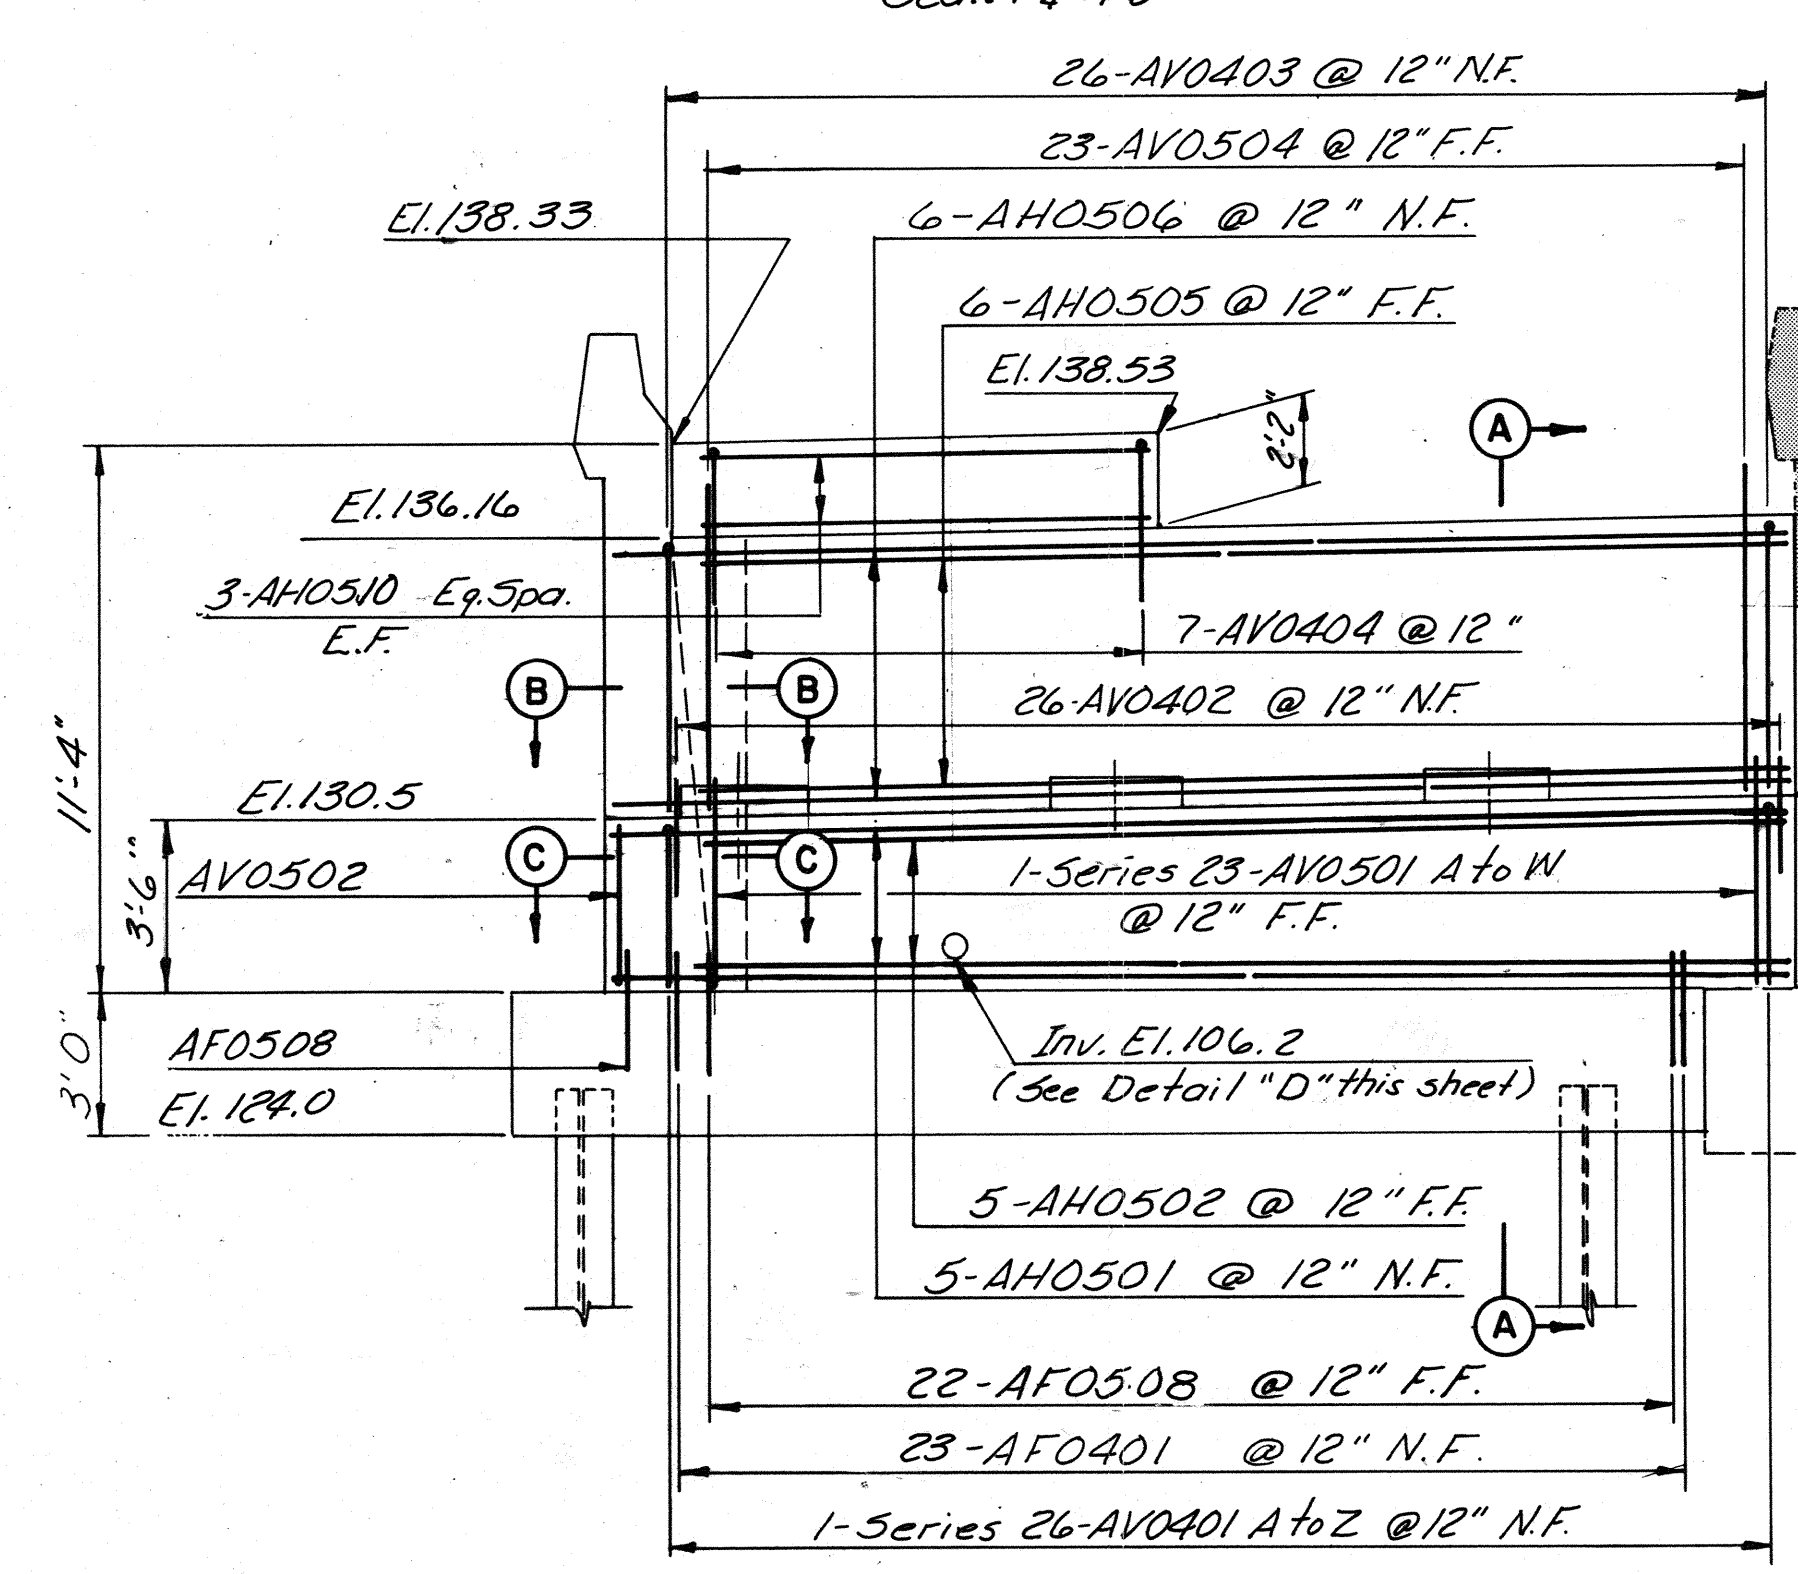

ELEVATION - SOUTHBOUND
Scale: 1/4" = 1'-0"

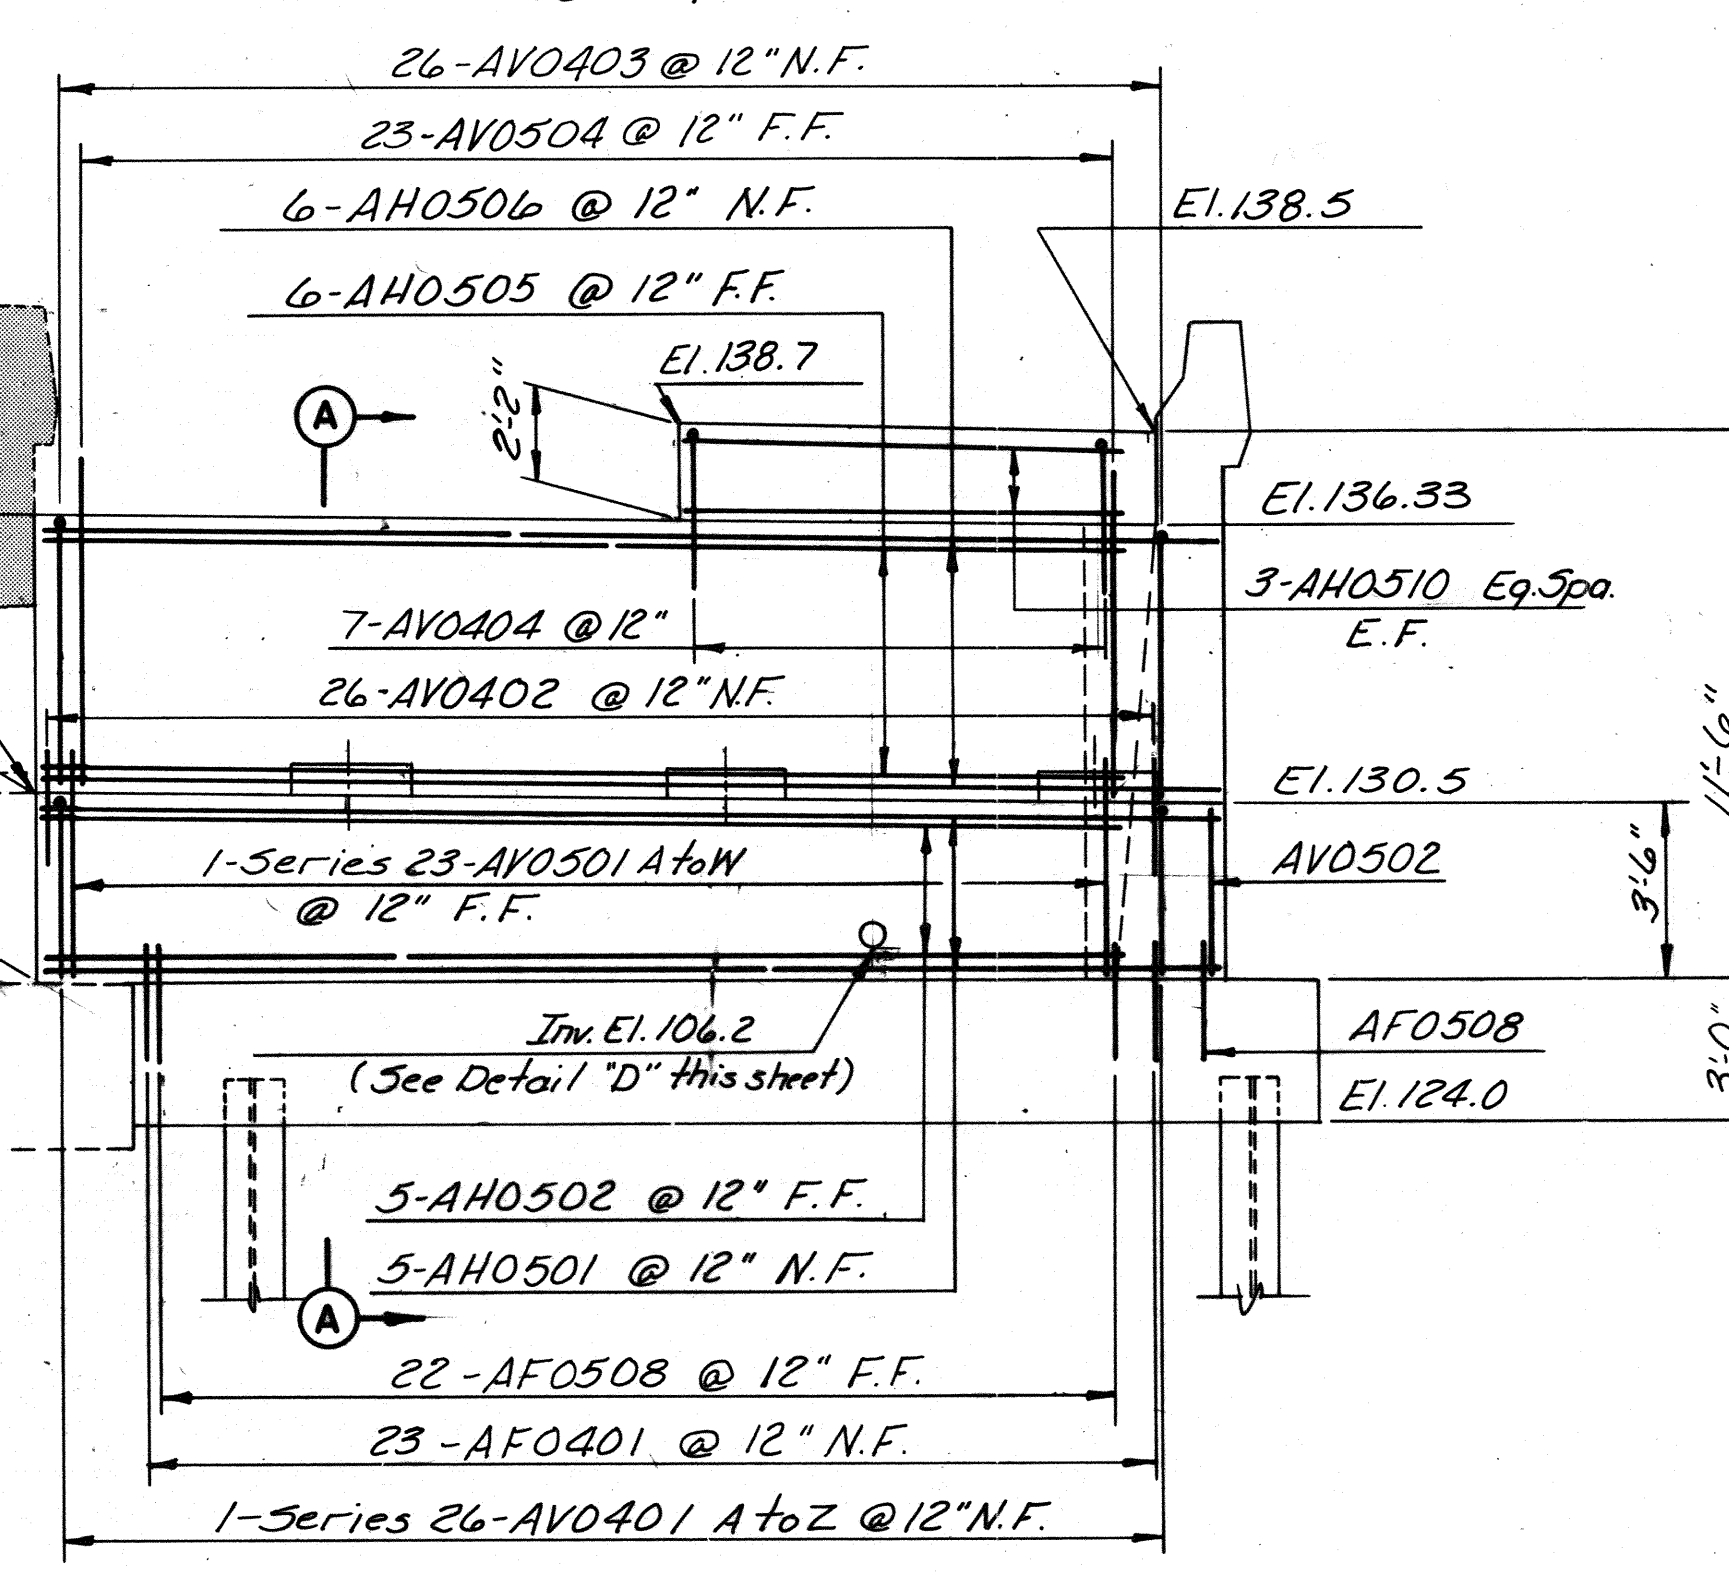

ELEVATION - NORTHBOUND
Scale: 1/4" = 1'-0"

BY	DATE	REVISION	BY	DATE
MADE	TAL 1-87	As Built	TEM	3-89
CHECKED	T.F.P. 3-87	Rev Anchor Bolt	ALC	6-87
IN CHARGE	S.R.			

**RICHMOND METROPOLITAN AUTHORITY
RICHMOND EXPRESSWAY SYSTEM**



**NORTH ABUTMENT PLAN
AND ELEVATION**

SCALE: AS SHOWN
HOWARD, NEEDLES, TAMMEN & BERGENOFF
consulting engineers
Alexandria, Virginia
CONTRACT NO.: C-13
SHEET NO. 8 OF 106

AS BUILT


RICHMOND EXPRESSWAY SYSTEM			
SECTION	PROJECT	SHEET NO.	TOTAL SHEETS
13	WIDENING JAMES RIVER BRIDGE	10	106

LEGEND:
 E.F. = Each Face
 F.F. = Far Face
 N.F. = Near Face

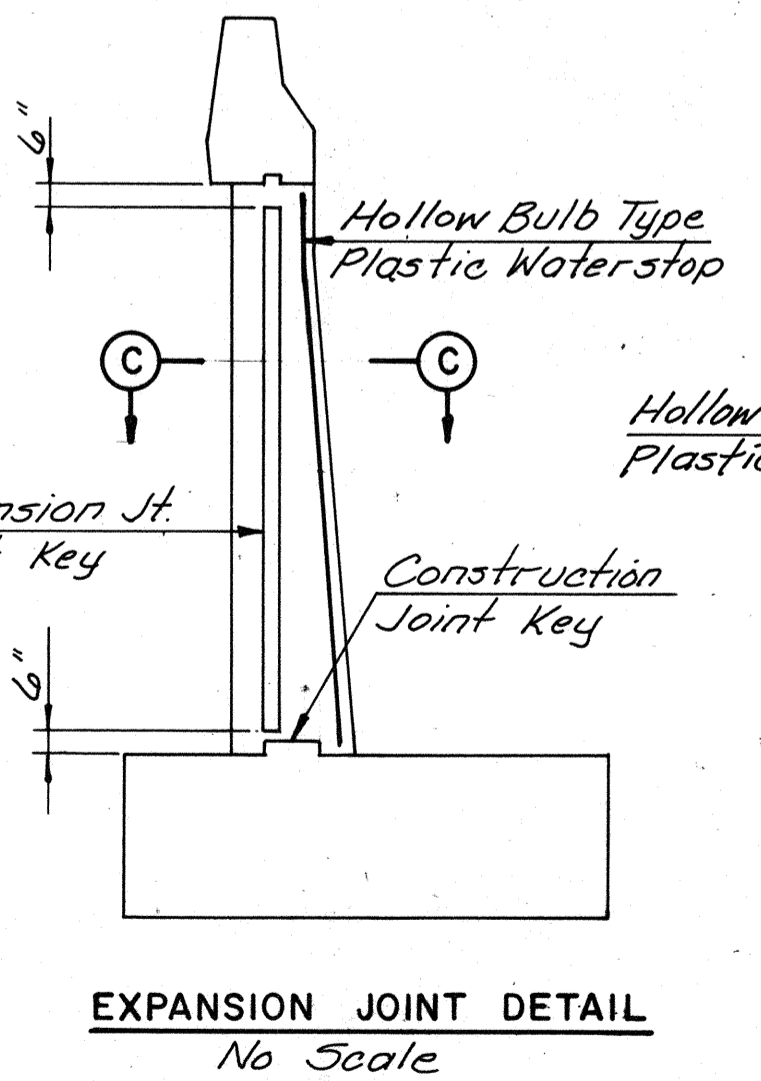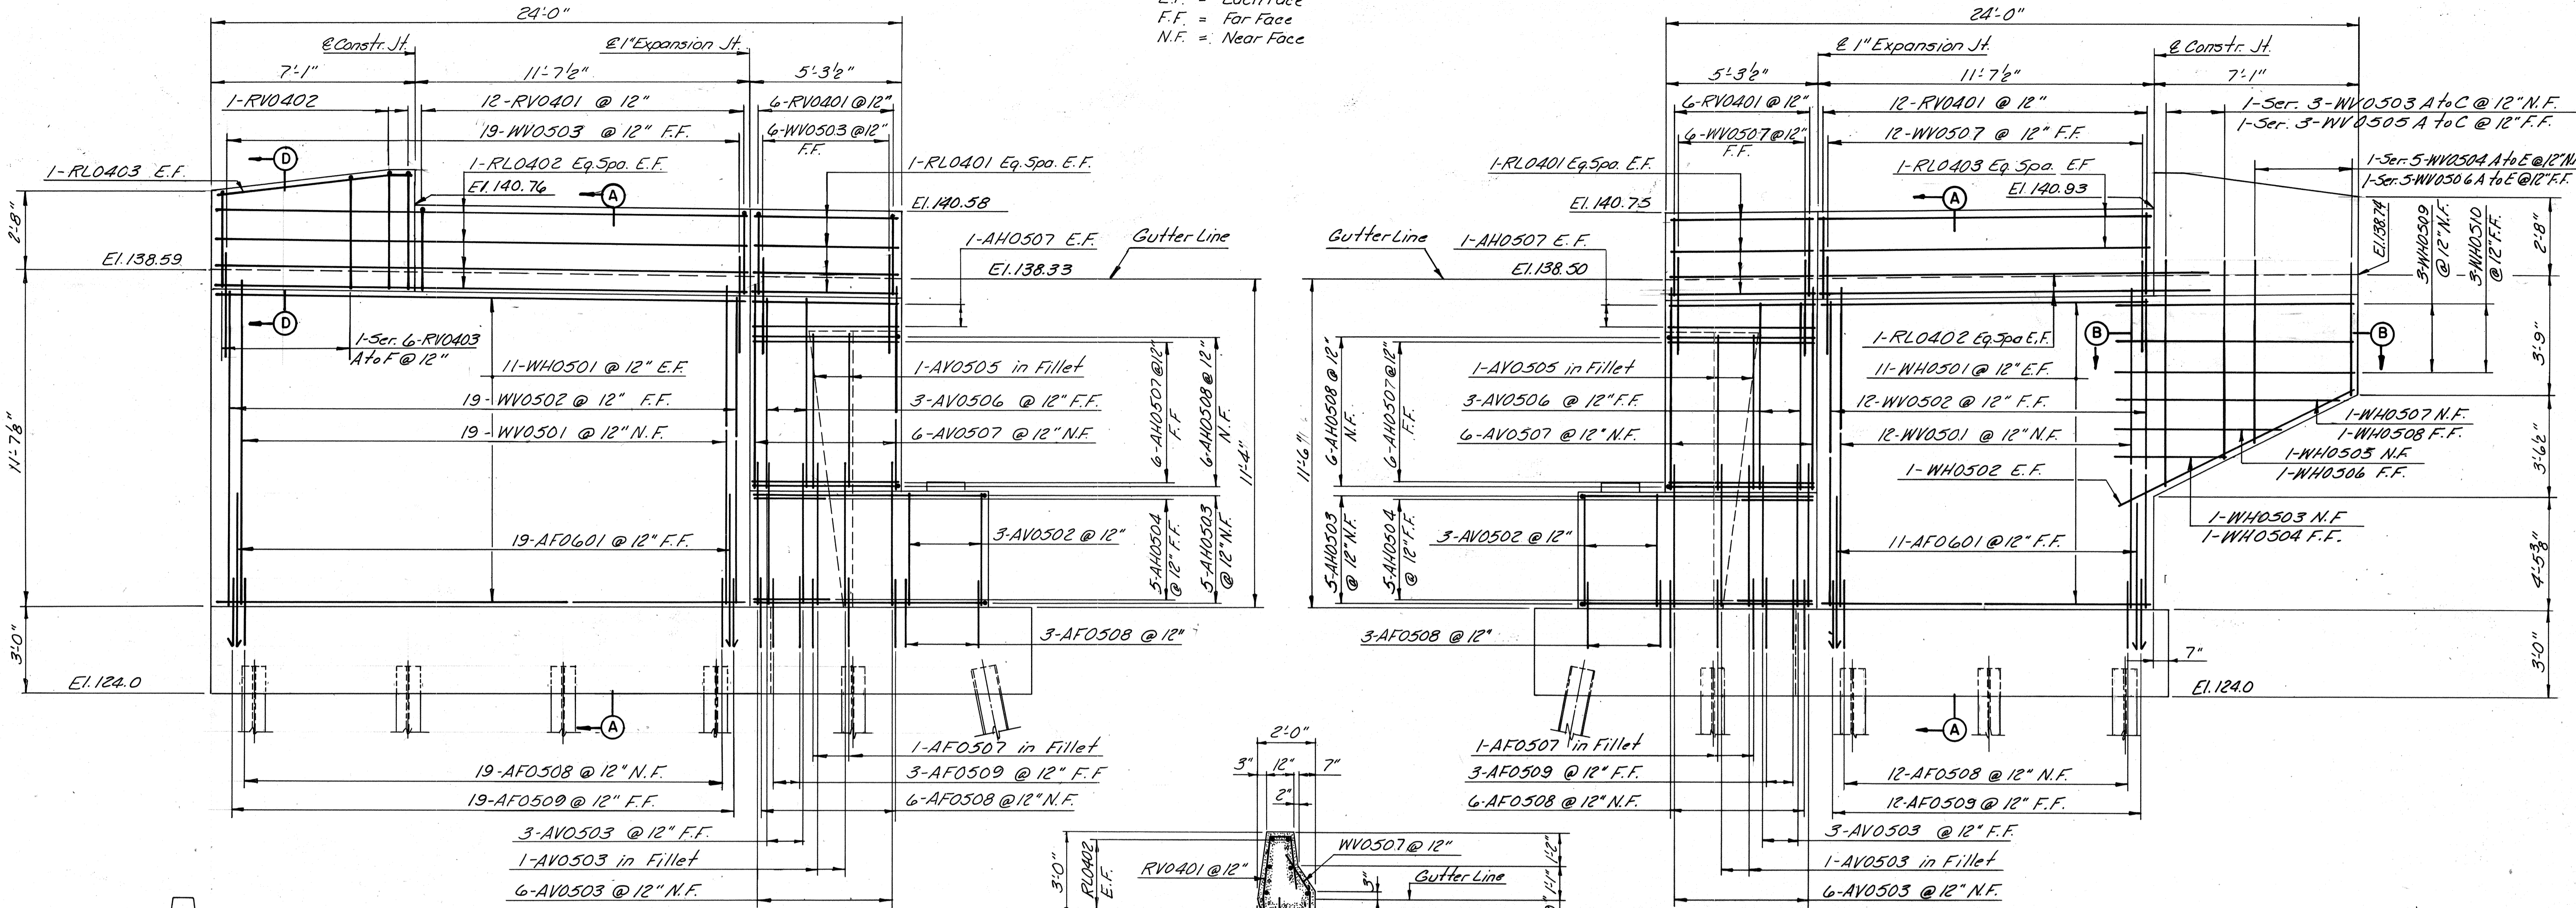


ELEVATION - NORTHWEST WINGWALL
 Scale: 3/8" = 1'-0"


ELEVATION - NORTHEAST WINGWALL
 Scale: 3/8" = 1'-0"

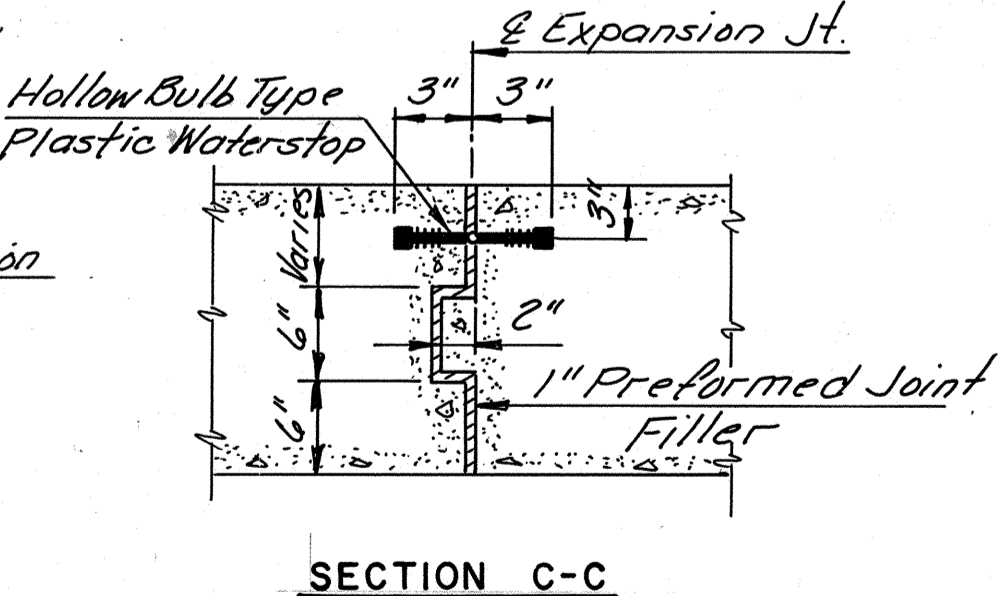


SECTION C-C
 No Scale

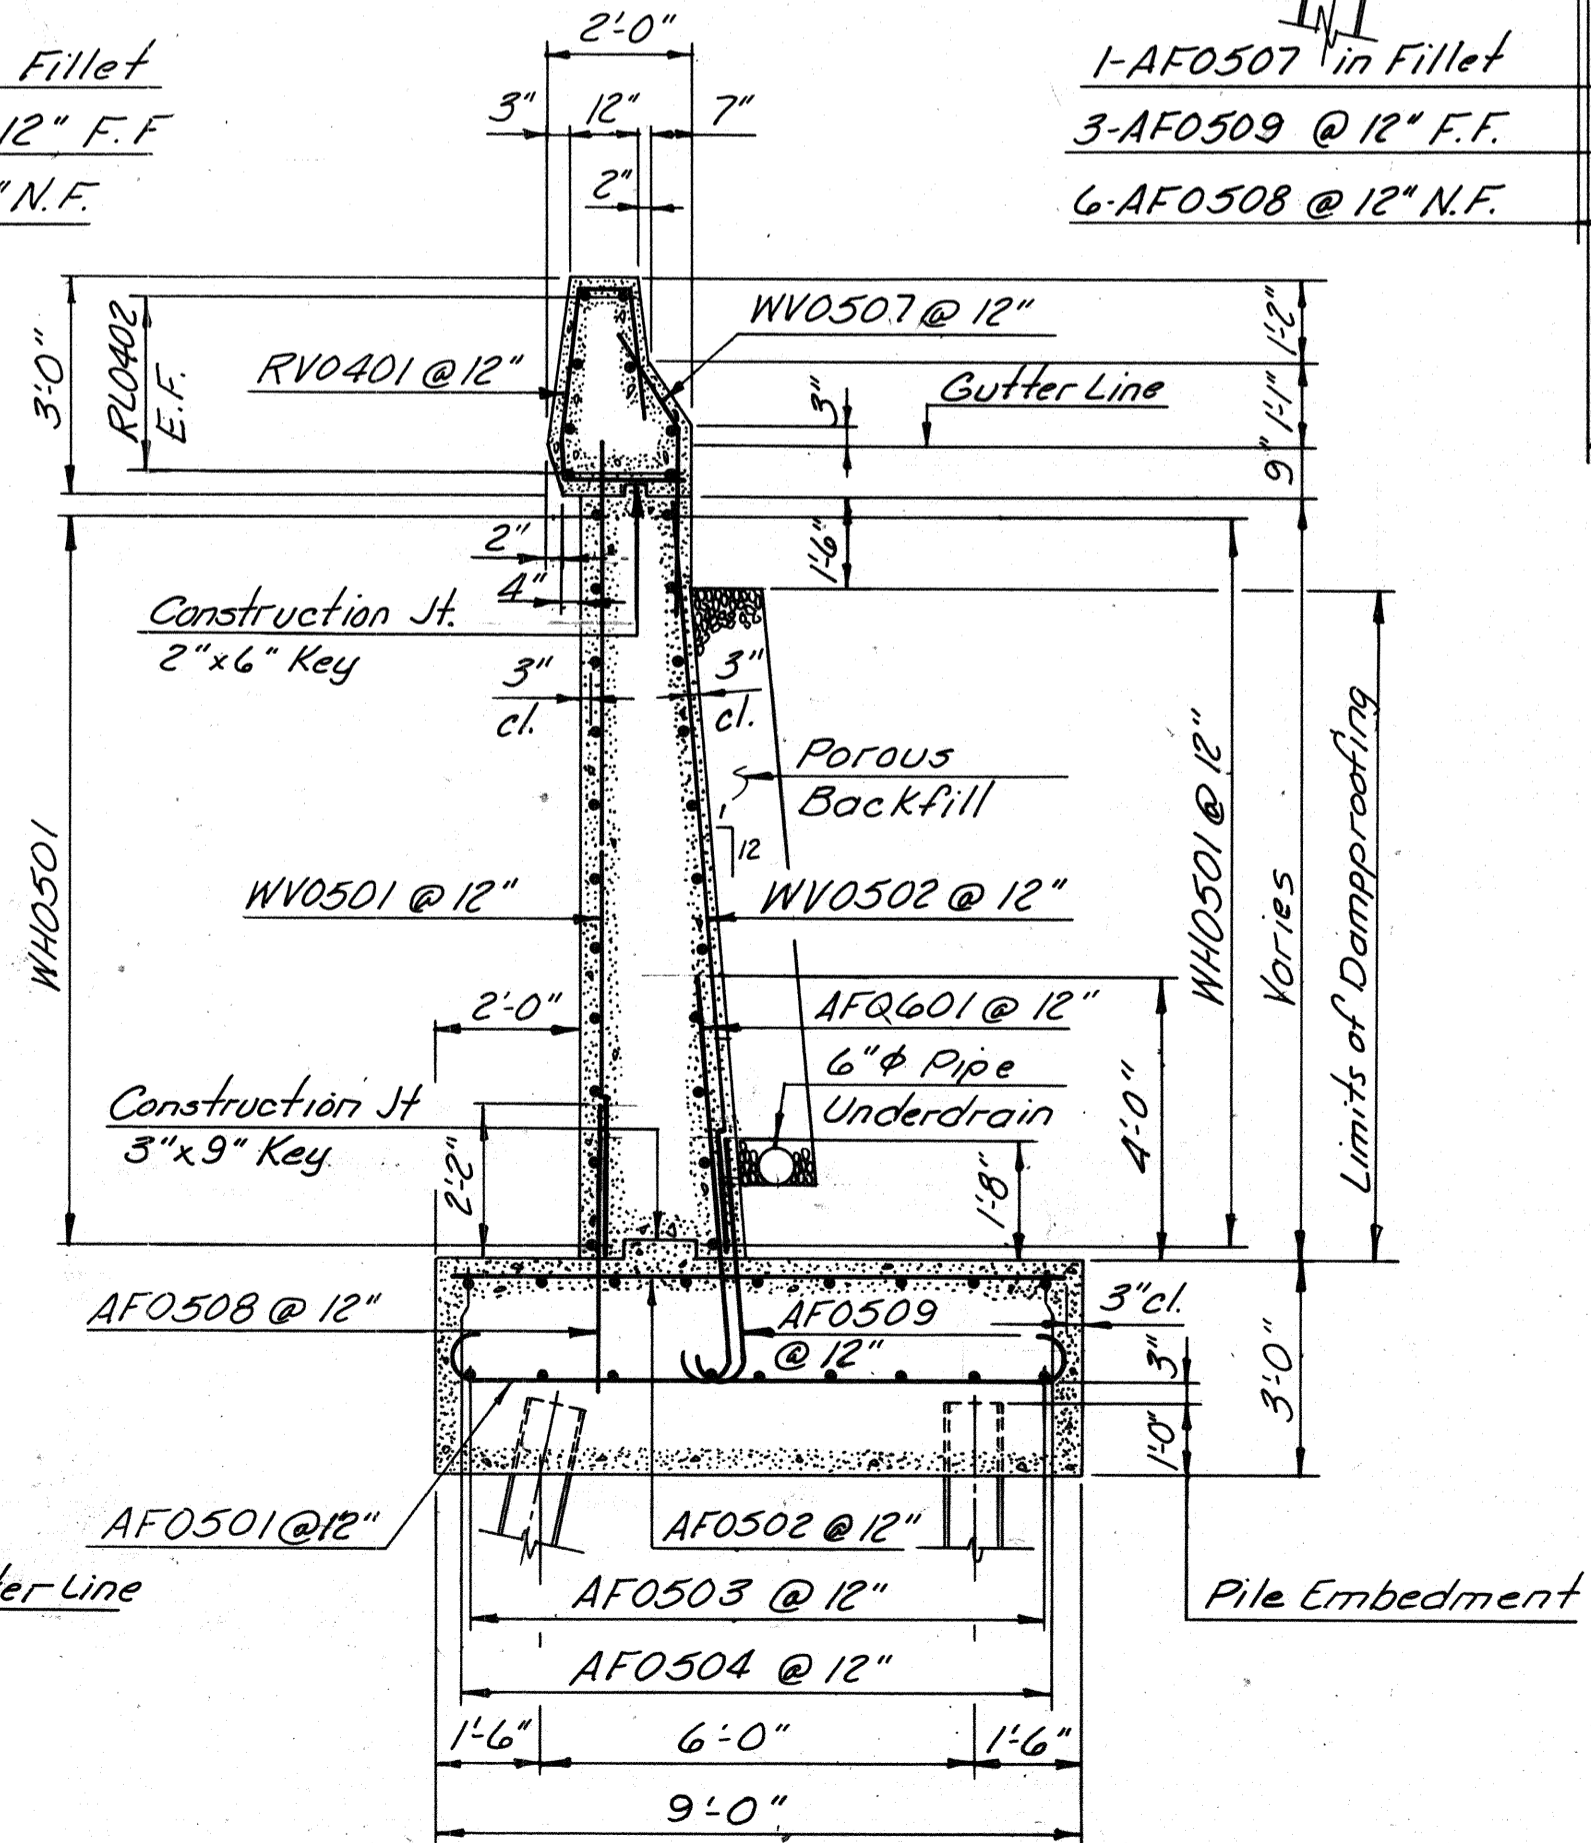

SECTION A-A
 Scale: 3/8" = 1'-0"

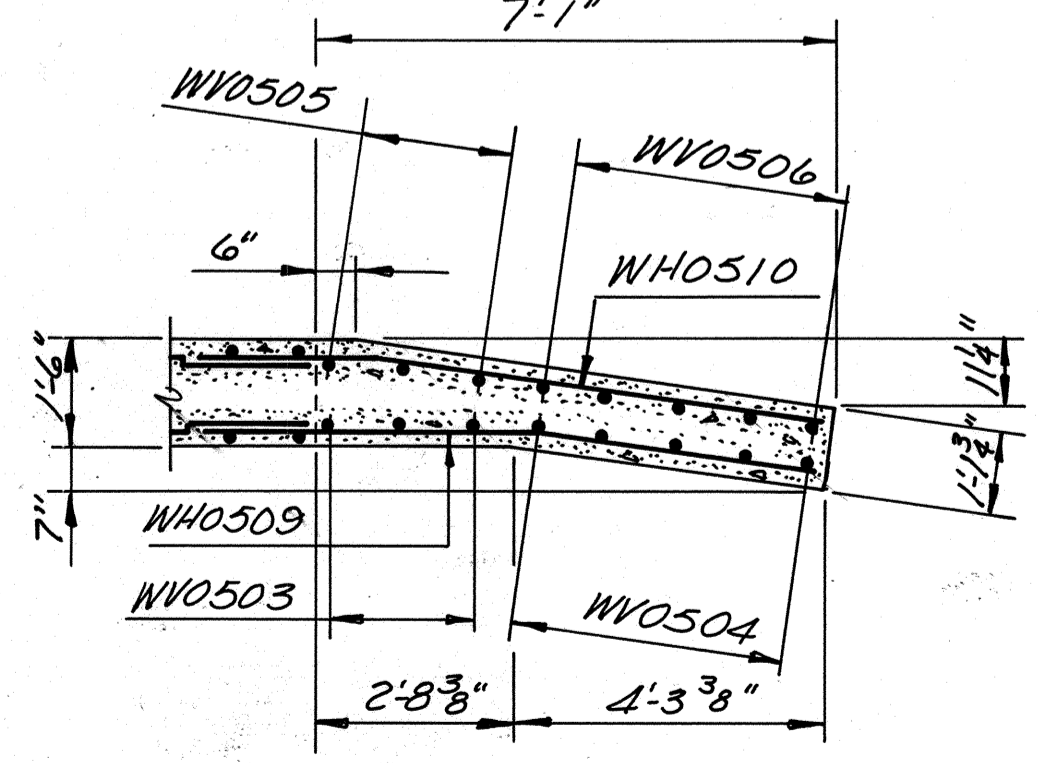

SECTION B-B
 Scale: 3/8" = 1'-0"

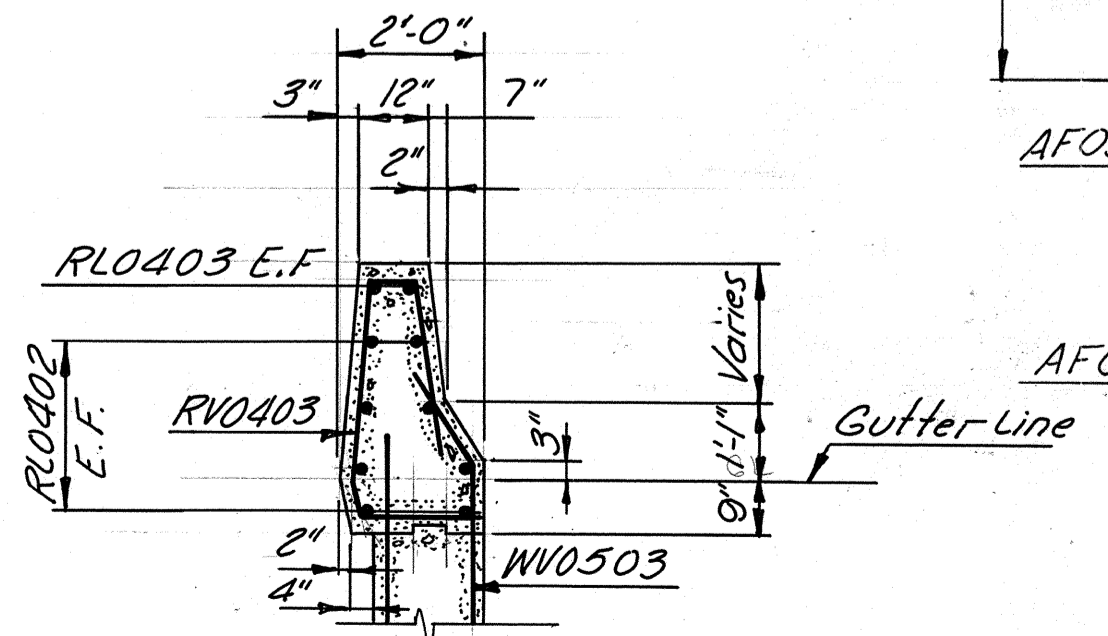

SECTION D-D
 Scale: 3/8" = 1'-0"

NOTE:
 For wingwall rustication details see Sheet No. 29

BY	DATE	REVISION	BY	DATE
MADE	TAL 2-87			
CHECKED	TFR 3-87	As Built	TEM	3-89
IN CHARGE	SR			





RICHMOND METROPOLITAN AUTHORITY
RICHMOND EXPRESSWAY SYSTEM

NORTH ABUTMENT WINGWALLS

HOWARD, NEEDLES, TAMMEN & BERGENDOFF
 consulting engineers
 Alexandria, Virginia


SCALE: AS SHOWN
 CONTRACT NO: C-13
 SHEET NO. 10 of 106

AS BUILT

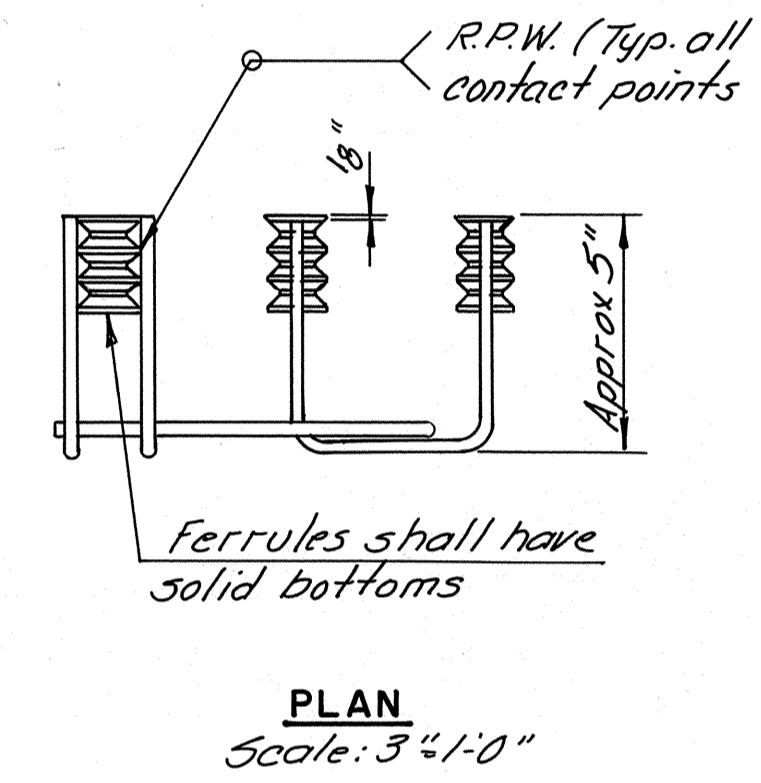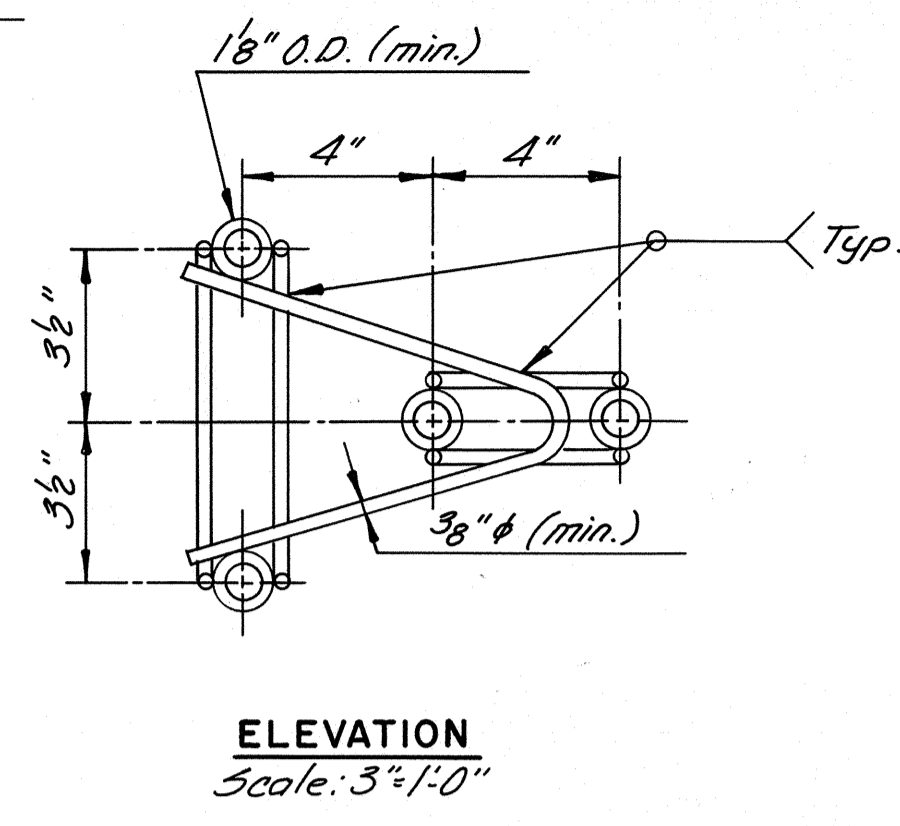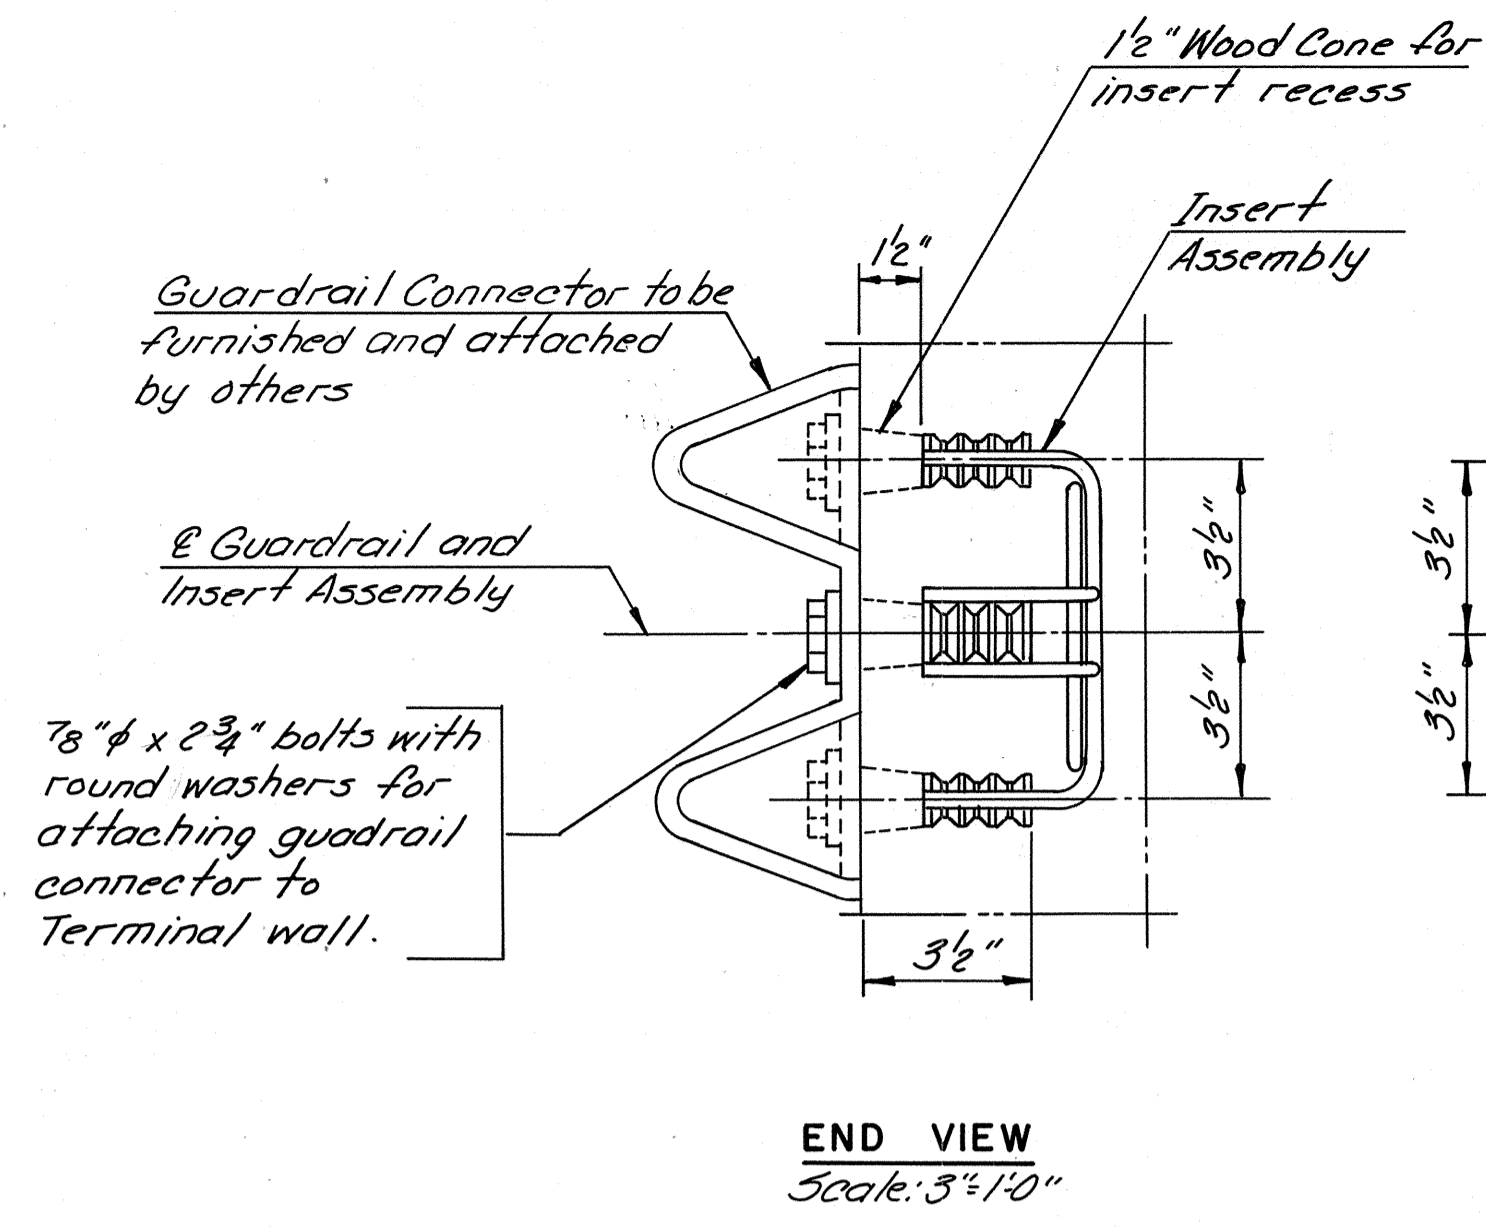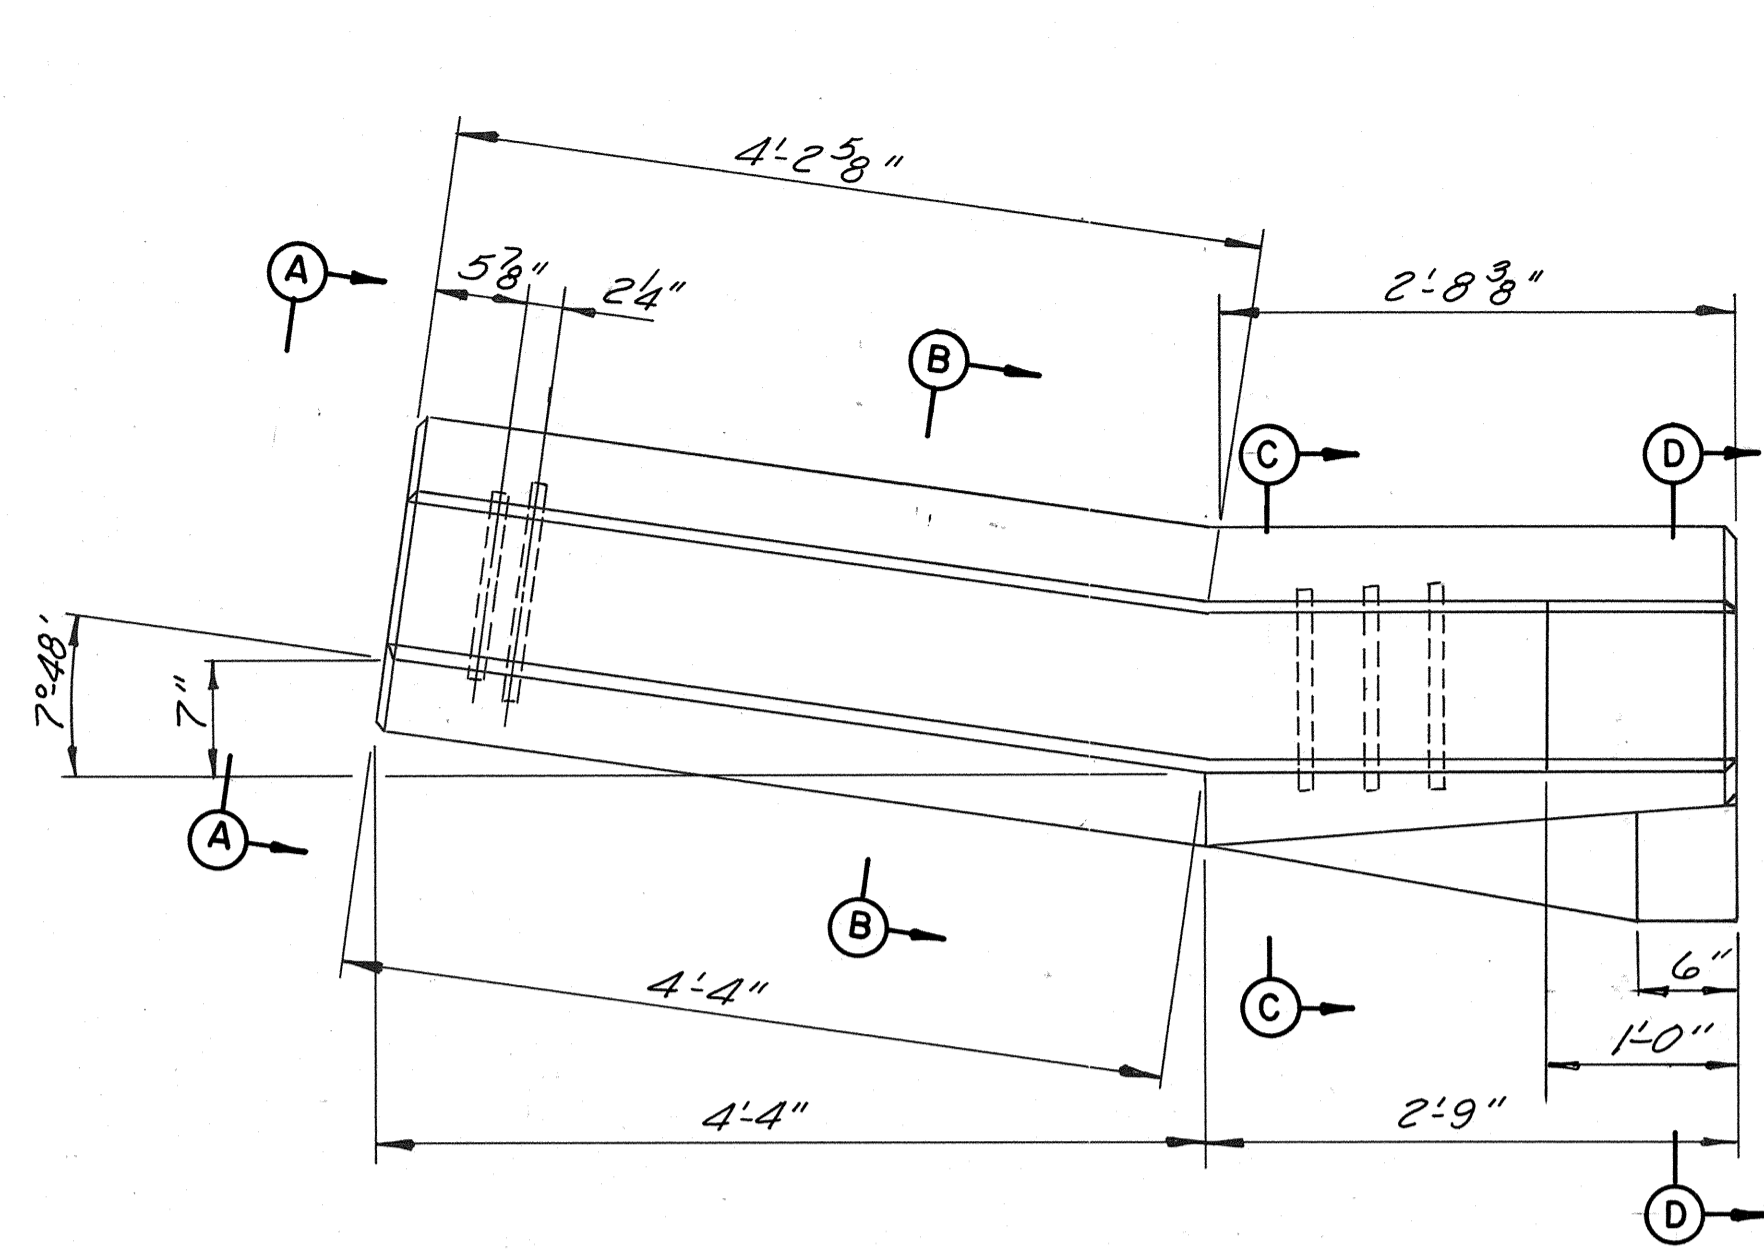





NOTES:
 Alternate Insert Assembly
 The alternate insert assembly may be used in lieu of 1" holes detailed for guardrail attachment.
 Ferrules shall be made from steel meeting the requirements of ASTM A108, Grade 12L14.
 Bolts and washers shall be galvanized.
 At the contractor's option, stainless steel bolts and washers may be used as an alternate for 7/8" x 2 3/4" galvanized bolts and washers. They shall conform to or exceed the mechanical requirements of ASTM A307.
 Wire struts shown in the inserts assembly shall have a minimum tensile strength of 100,000 p.s.i.
 The insert assembly shall be assembled in the shop.
 Bolt threads may be recut as necessary to insure fit.
 The cost of the insert assembly unit consisting of the insert assembly and 4 - 7/8" x 2 3/4" bolts with washers complete in place shall be included in the unit price bid for abutment concrete.

NOTES:
 Each terminal wall shall be cast as one piece.
 For details of wingwall below construction joint, see Abutment Detail sheet.
 Terminal walls are detailed to take guardrail attachment GR-1NS.
 All bevels for concrete on this sheet shall be 3/4".
 Rounded edges with 1" radius may be used in lieu of bevels along top of terminal wall.
 The contractor at his option, may substitute Concrete Class A4 for Concrete Class A3 at no additional cost in accordance with Section 219 of V.D.O.T. specifications.

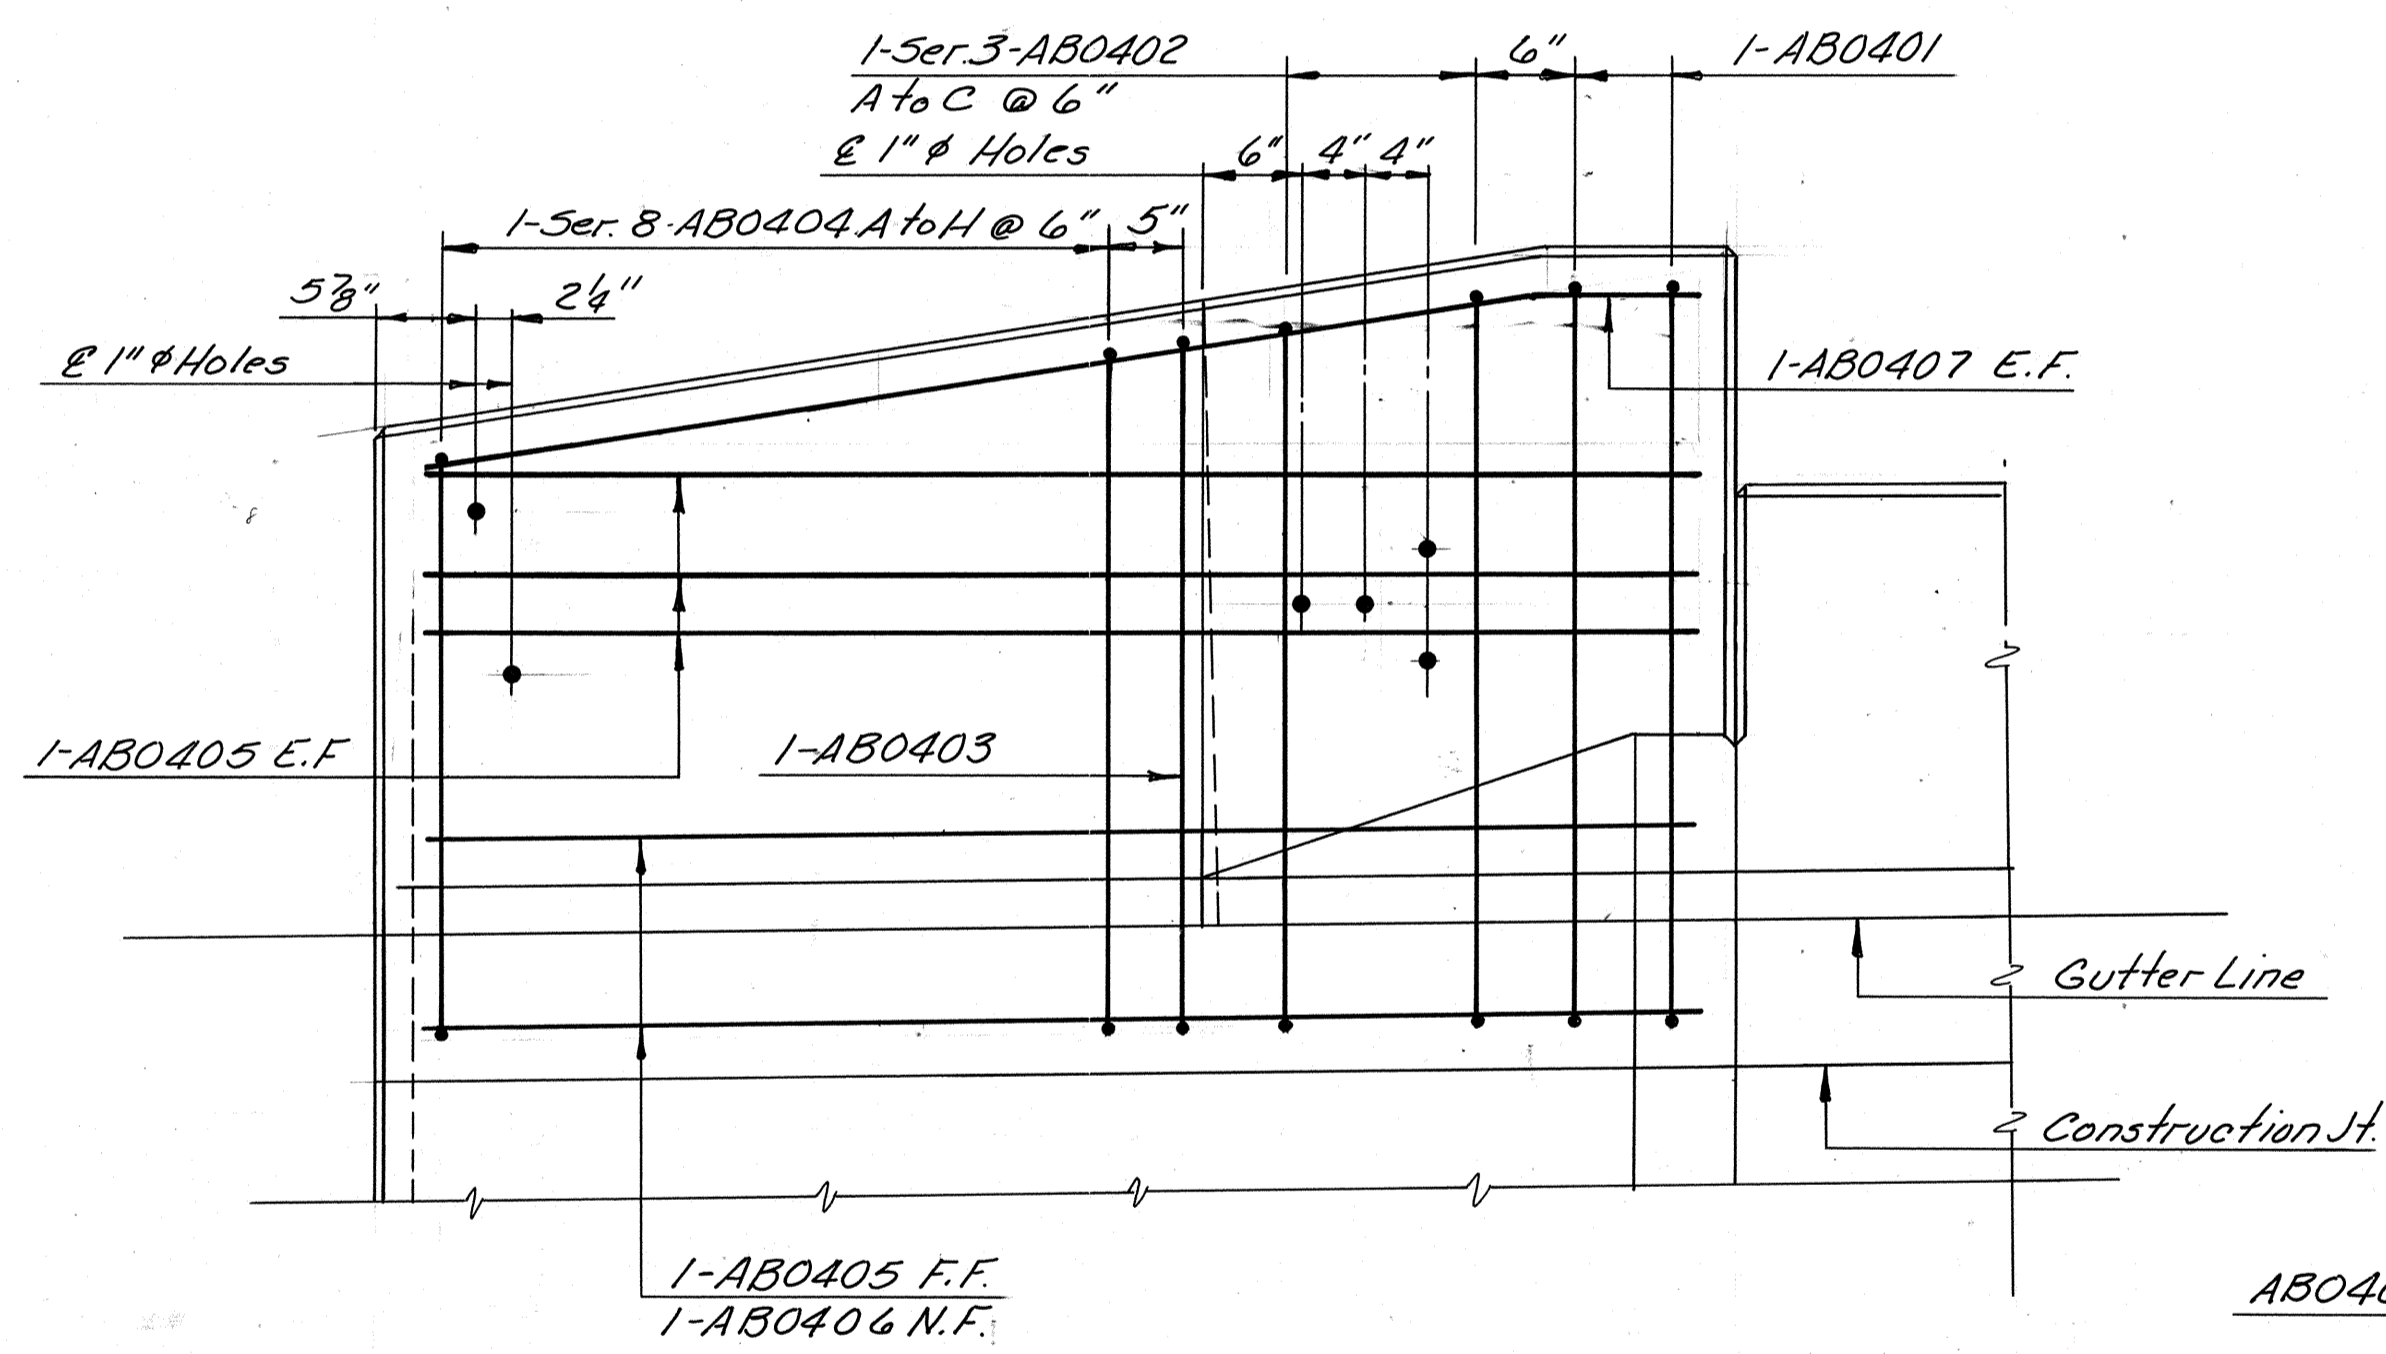

MARK	NO.	LENGTH	TYPE	DIM. A	DIM. B	DIM. C	DIM. D	DIM. E	DIM. F	REMARKS
AB0401	2	8-9	11	2-8	0-64	3-4	0-4	0-1 1/2	1-6 1/2	
AB0402	3	8-8	11	2-8	0-64	3-3	0-4	0-1 1/2	1-5 1/2	1 Each
A to C		8-5	11	2-8	0-64	3-2	0-4	0-1 1/2	1-4 1/2	A to C
AB0403	1	8-2	11	2-5	0-64	3-1	0-4	0-1 1/2	1-2 3/4	
AB0404	8	7-8	11	2-4	0-64	3-0	0-4	0-1 1/2	1-2 3/4	1 Each
A to H		7-5	11	2-3	0-64	2-6	0-4	0-1 1/2	1-2 3/4	A to H
AB0405	8	6-7	6	4-1	2-6	2-5 3/4	0-4 1/2			
AB0406	2	6-9	6	6-4	0-3	0-3	0-1			
AB0407	2	6-9	6	4-0	2-5 1/2	2-5 3/8	0-4			

Bar List is for 1 Terminal Wall, 3 Required

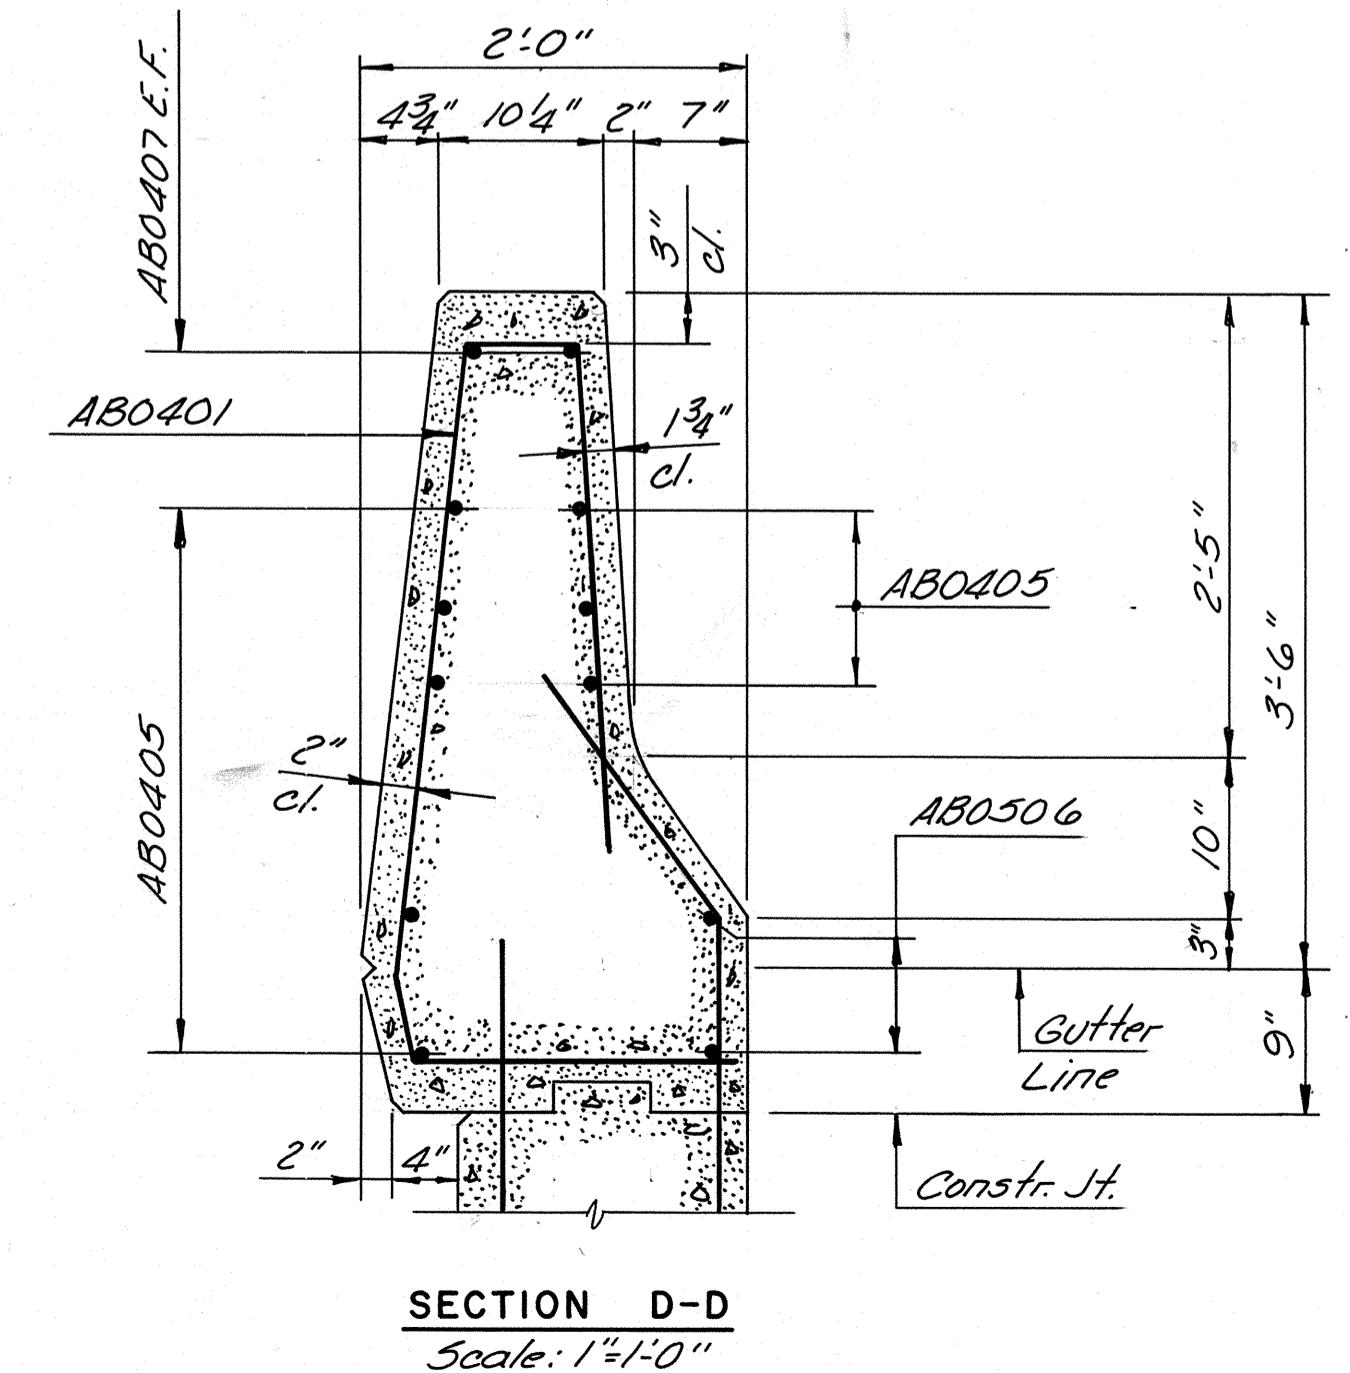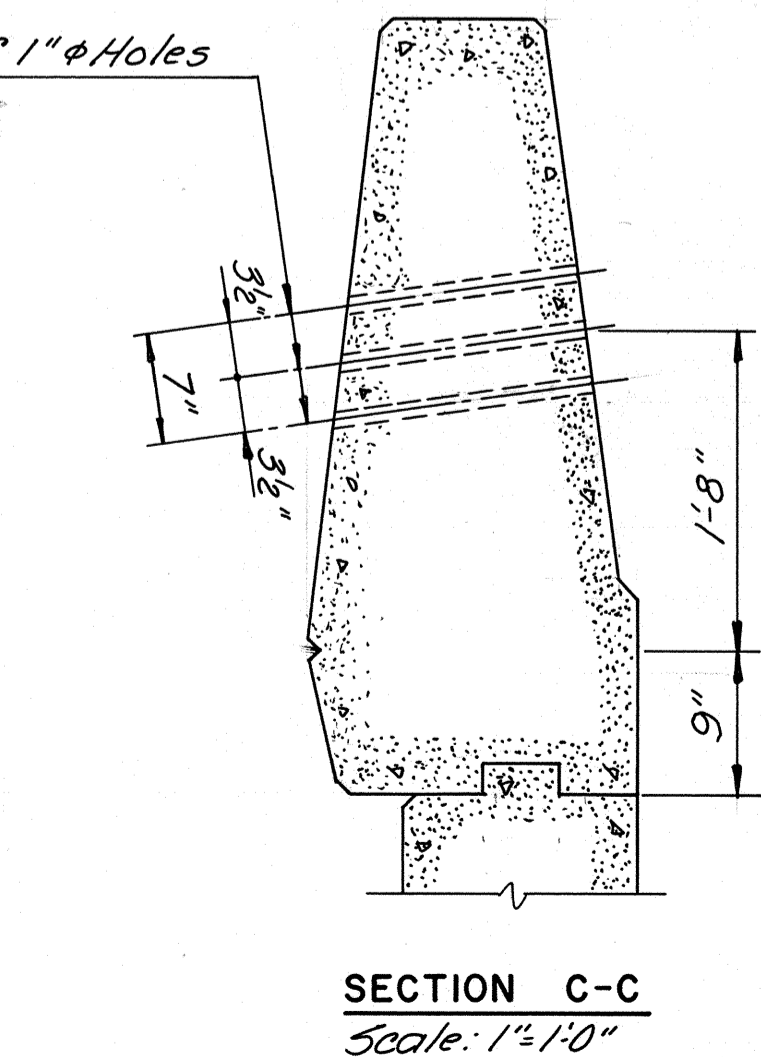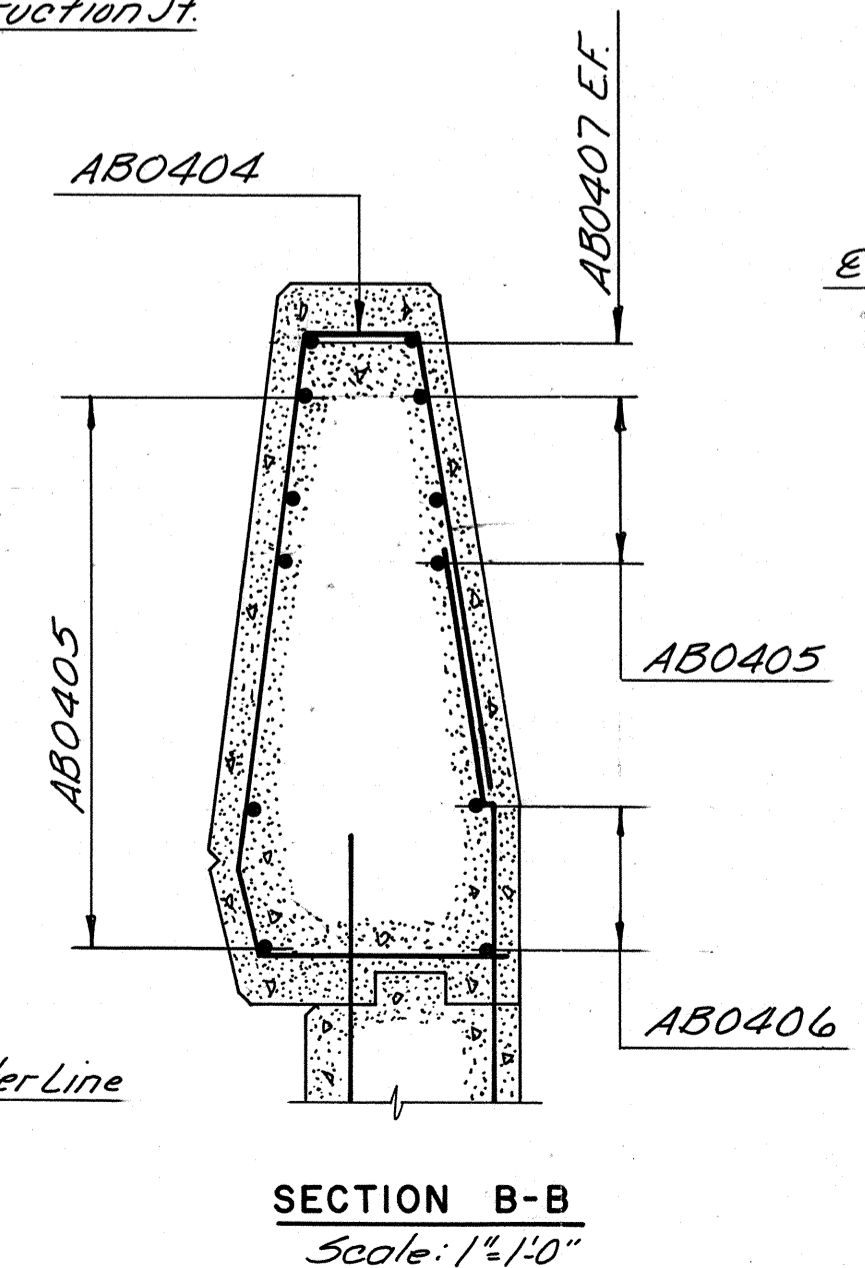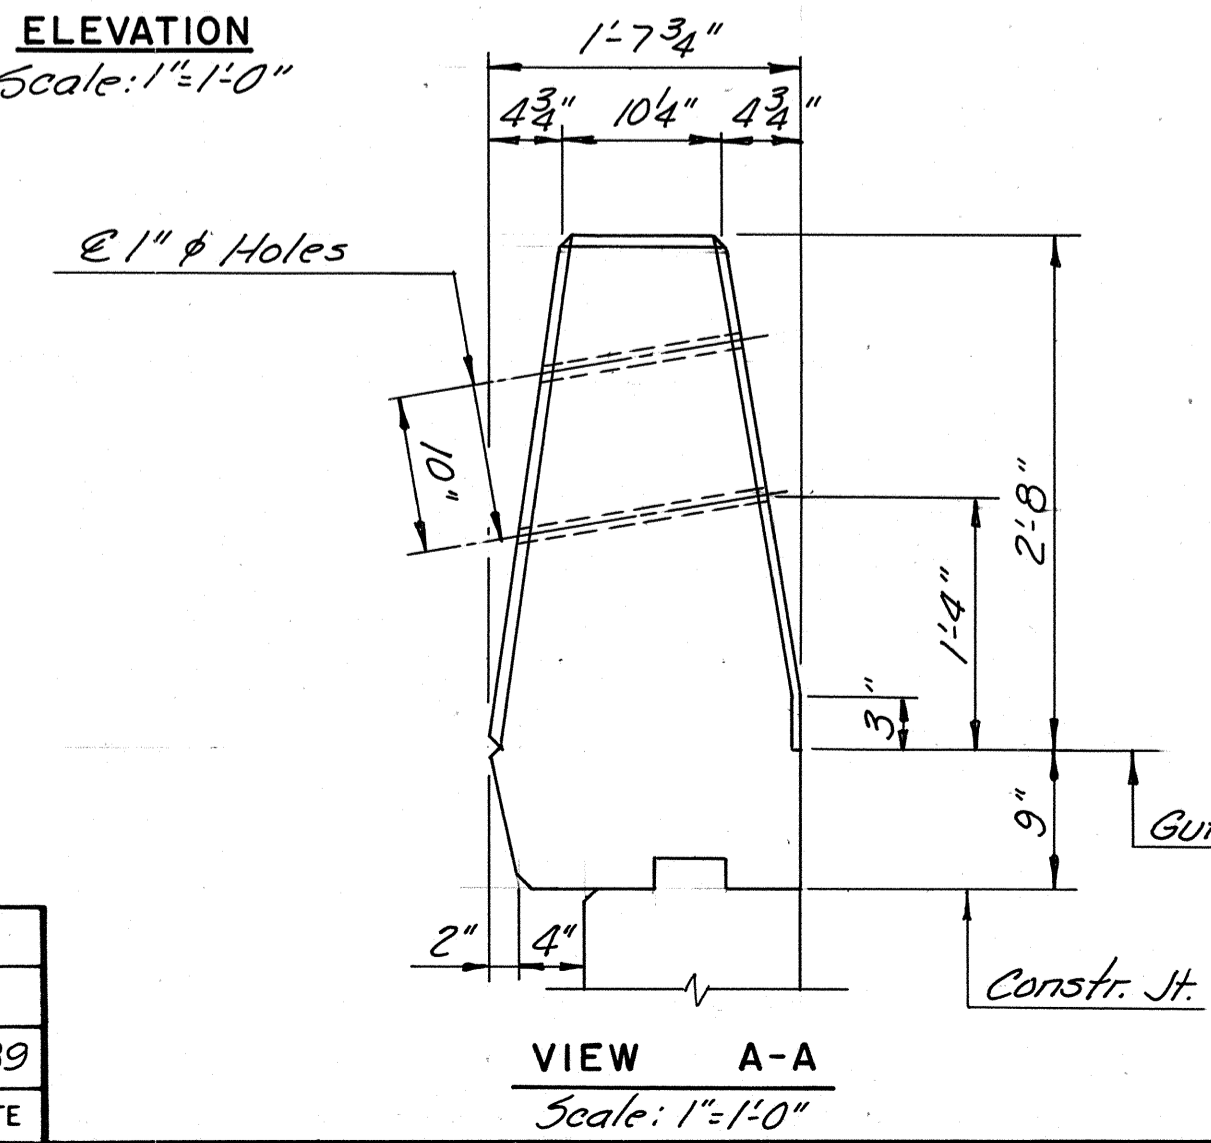

MADE	BY	DATE			
	J.A.L.	3-87			
CHECKED	T.F.P.	3-87	As Built	TEM	3-89
IN CHARGE	S.R.				

RICHMOND METROPOLITAN AUTHORITY
RICHMOND EXPRESSWAY SYSTEM


FLARED TERMINAL WALL
 DETAILS

HOWARD, NEEDLES, TAMMEN & BERGENDOFF
 consulting engineers
 Alexandria, Virginia

SCALE: NO SCALE
 CONTRACT NO.: C-13
 SHEET NO. 11 OF 106

AS BUILT

RICHMOND EXPRESSWAY SYSTEM			
SECTION	PROJECT	SHEET NO.	TOTAL SHEETS
13	WIDENING JAMES RIVER BRIDGE	50	106

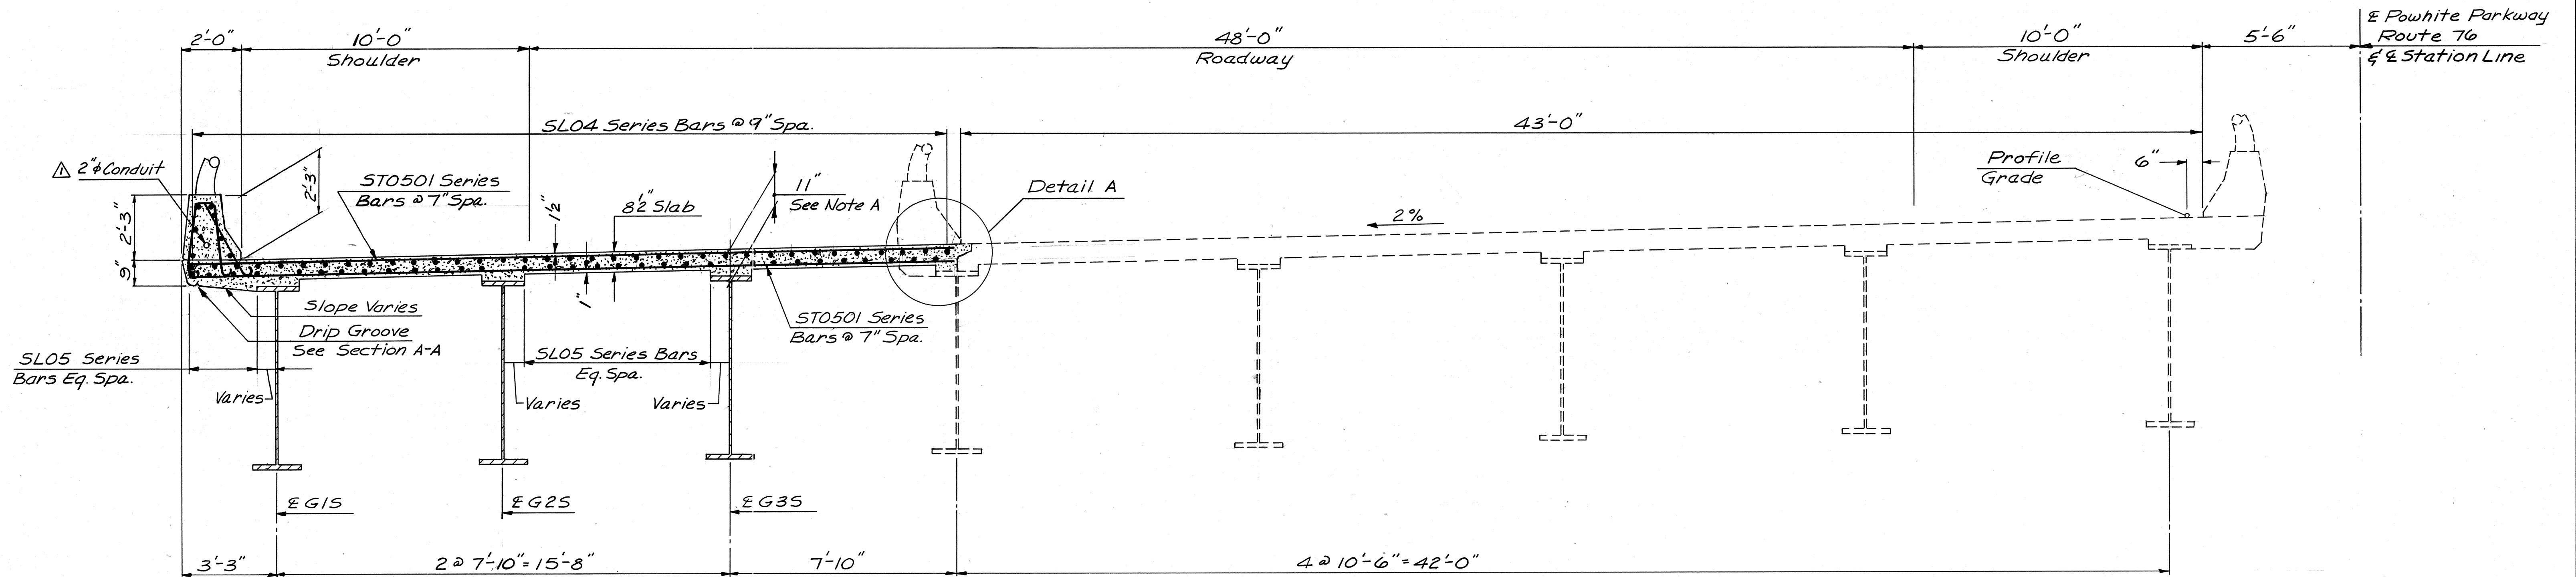

TYPICAL SECTION
(SOUTHBOUND SHOWN)
Scale: 3/8" = 1'-0"

NOTE A:



Dimension shown is measured from top of web to top of slab at the intersection of the centerline of bearing and the centerline of girder. This dimension may be varied between bearings as required to compensate for variations in camber, except that no portion of the girder flange may fall within the slab.

NOTES:



All bevels for concrete on this sheet shall be 3/4". Rounded edges with 1" radius may be used in lieu of bevels along top of parapet. For groove location, see Deck Plan Sheets. Precast Parapet shall not be used on this structure.

Existing No. 5 transverse steel top & bottom to remain in place and be cleaned of any concrete


Coat edge of existing slab with Type EP-4 epoxy immediately preceding placement of new concrete (Typ.)

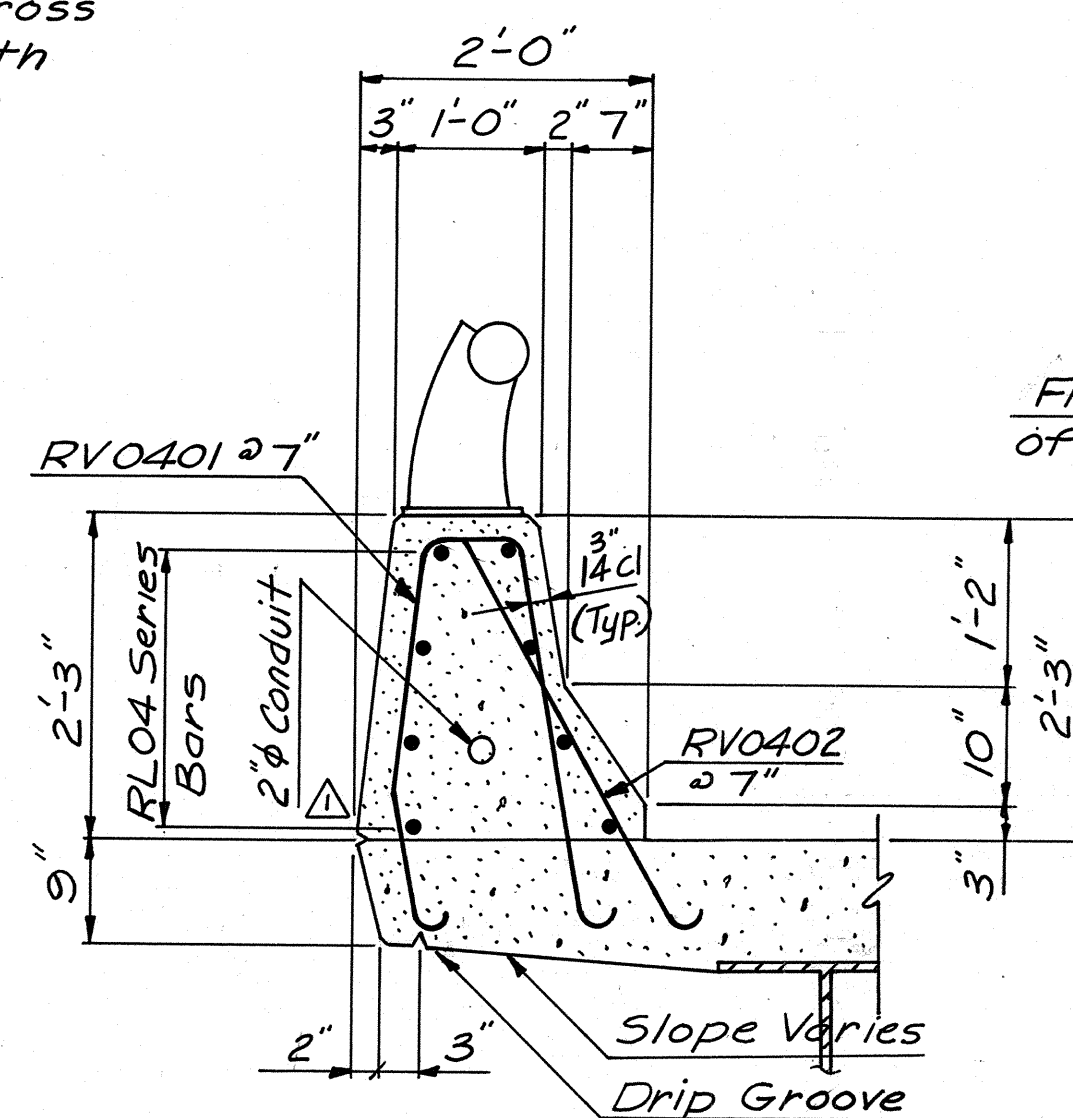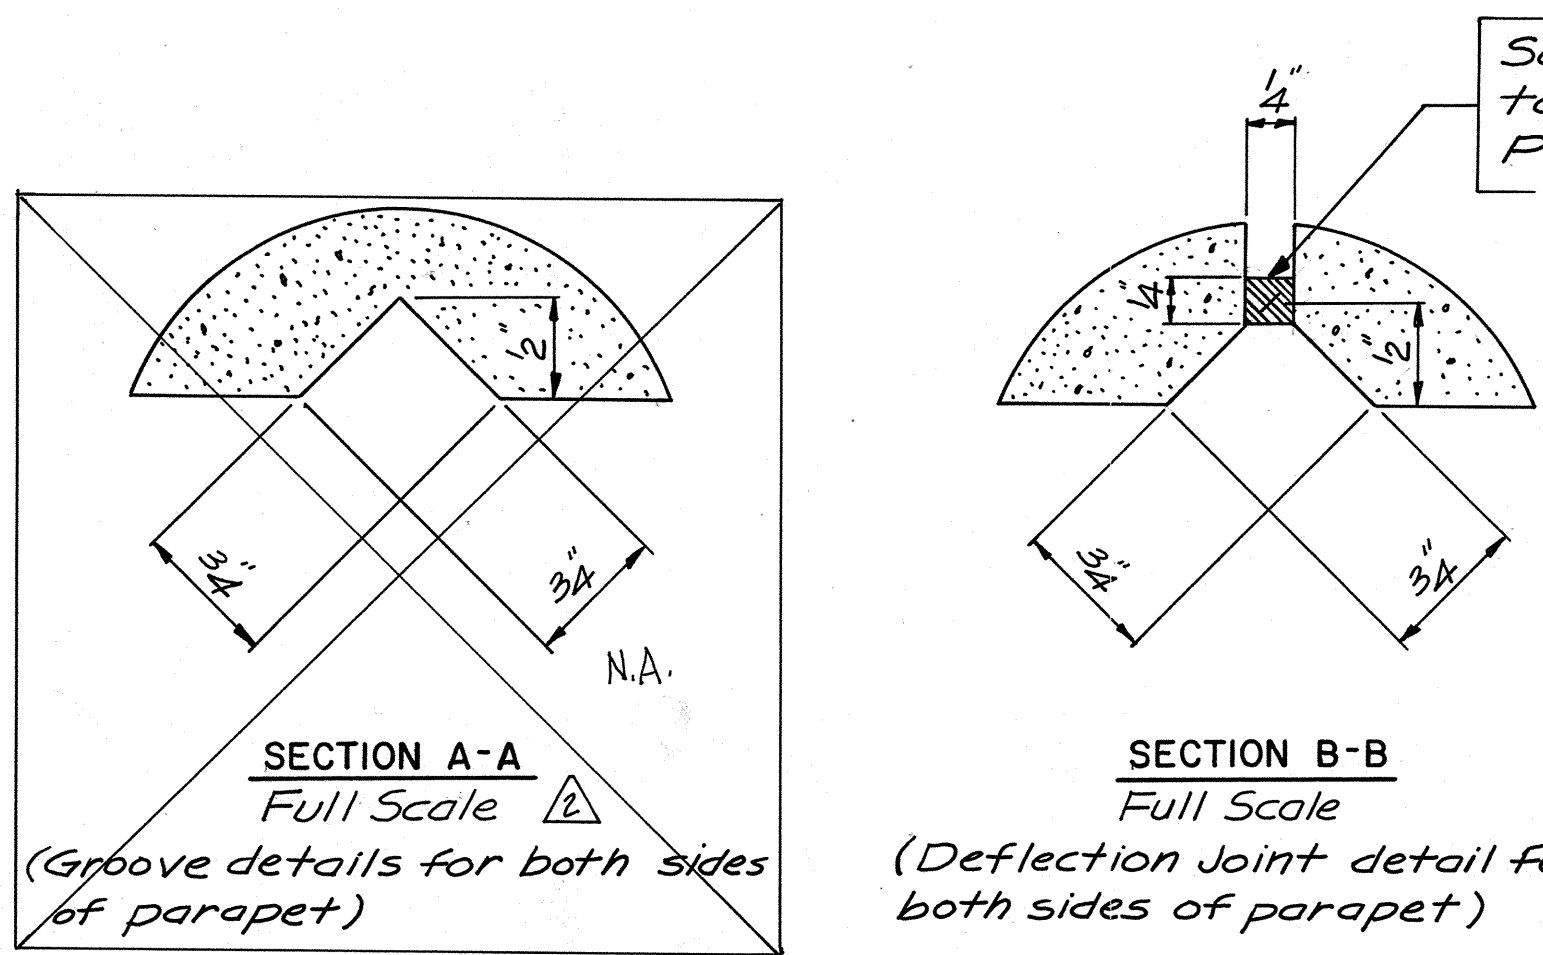

SECTION C-C
Scale: 3/4" = 1'-0"

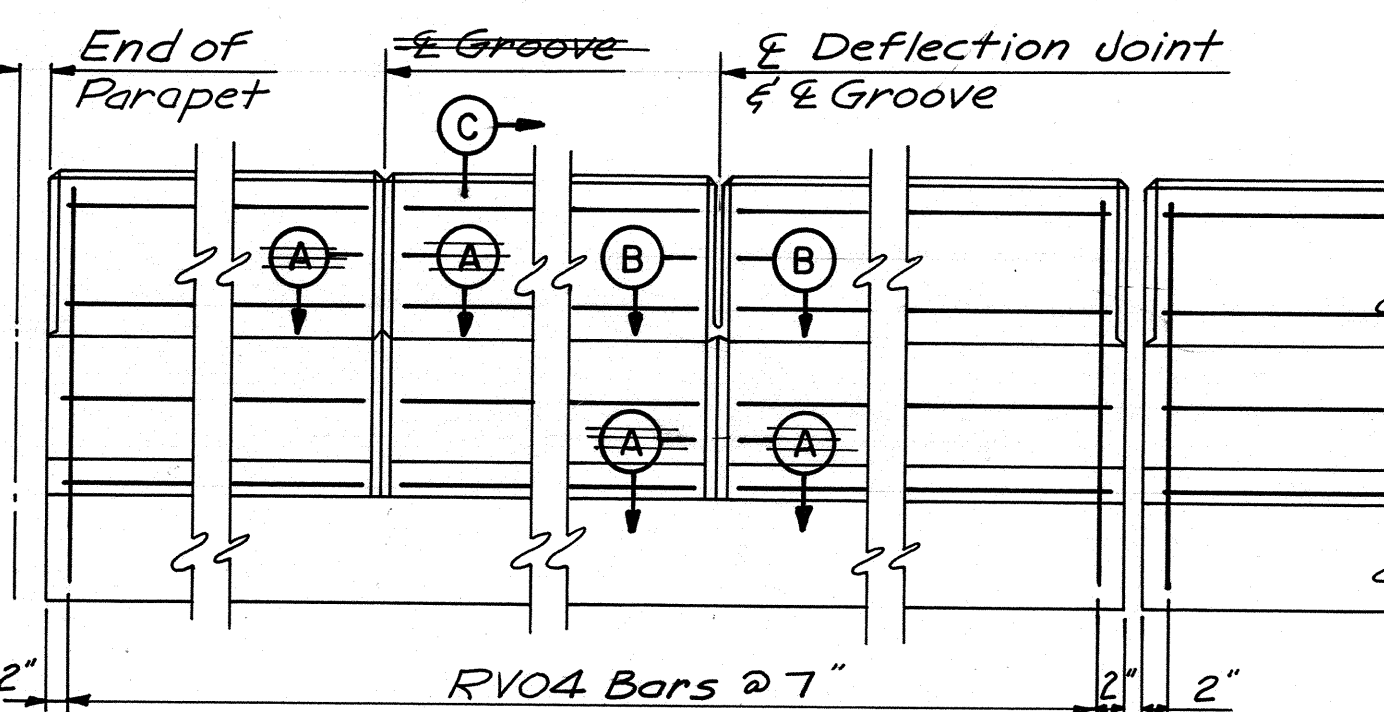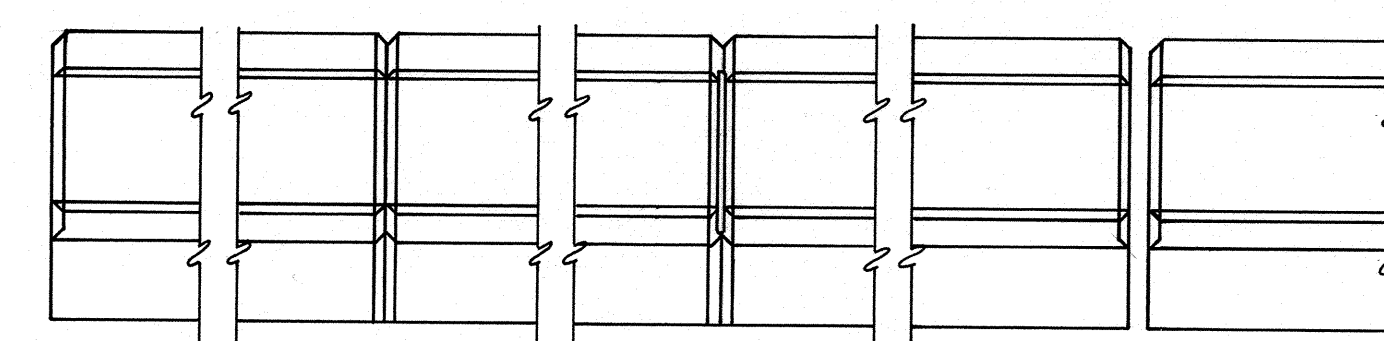

ELEVATION
Scale: 3/4" = 1'-0"

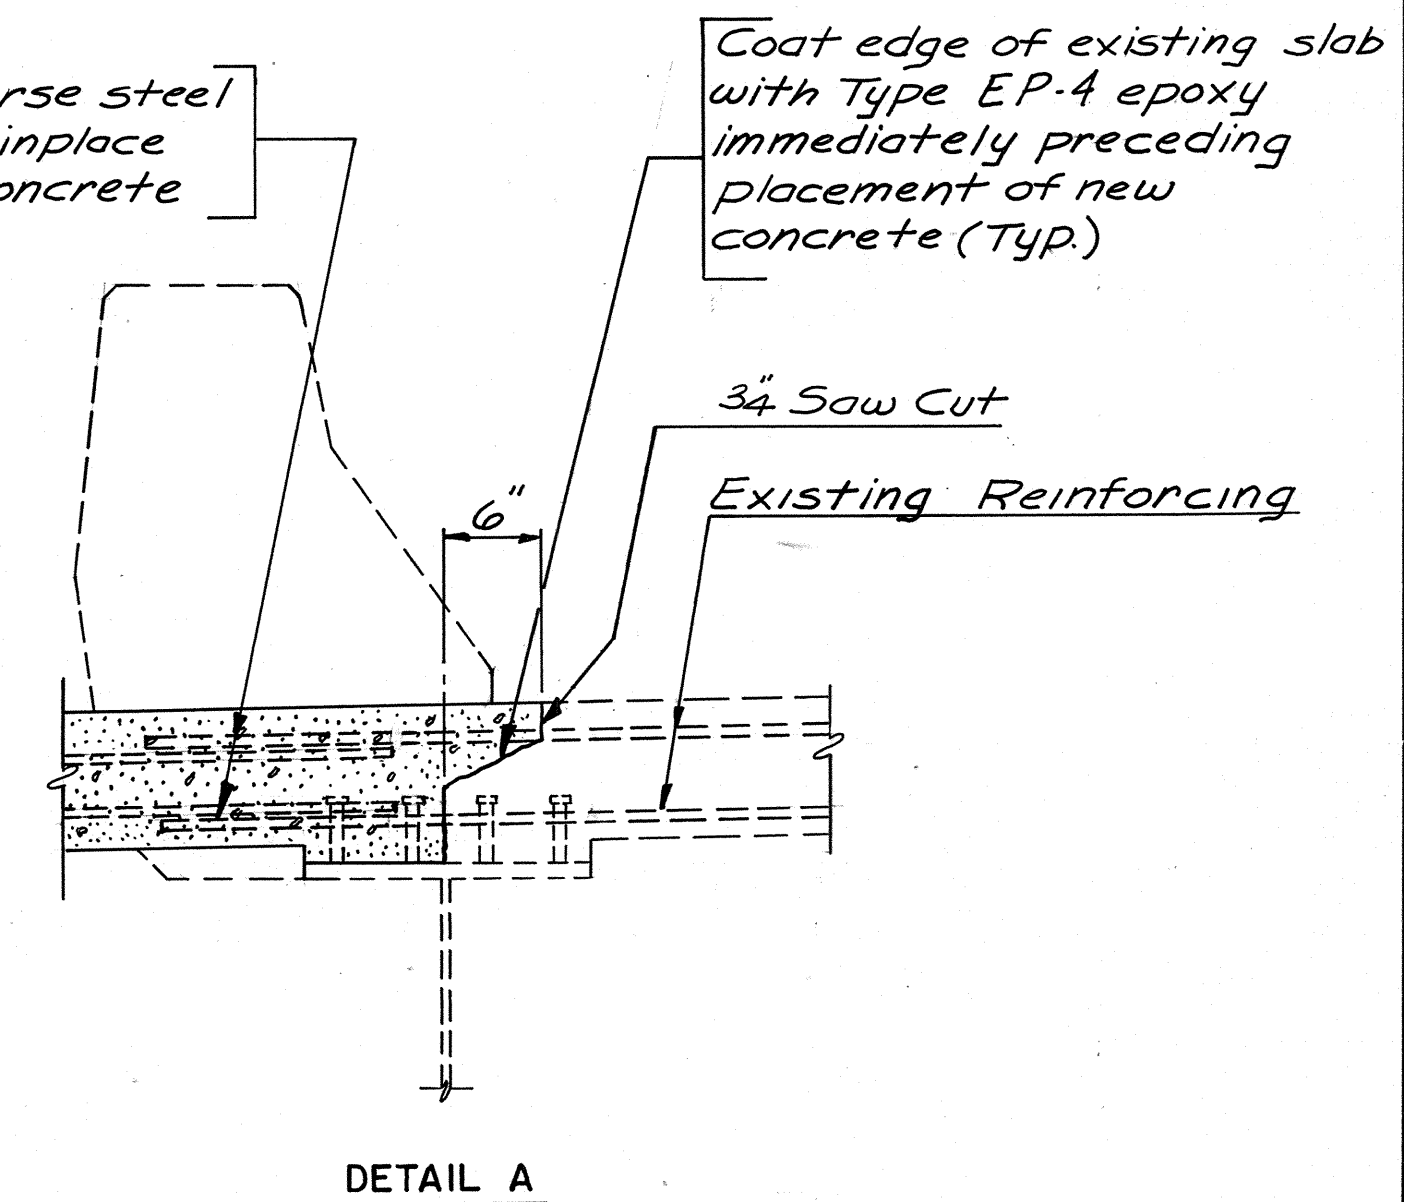

RICHMOND METROPOLITAN AUTHORITY
RICHMOND EXPRESSWAY SYSTEM

TYPICAL CROSS SECTION
AND PARAPET DETAILS

HOWARD, NEEDLES, TAMMEN & BERGENDOFF
consulting engineers
Alexandria, Virginia

SCALE: AS SHOWN
CONTRACT NO.: C-13
SHEET NO. 50 OF 106

BY	DATE	NO.	REVISION	BY	DATE
MADE	ALC 3-87	2	As Built	TEM	3-89
CHECKED	T.F.P. 3-87	1	2" Conduit	ALC	4-87
IN CHARGE	S.R.				

AS BUILT

Bridge 9S & 9N

(Northbound & Southbound CSX RR over Northbound Powhite Parkway “Rte. 76”)

Record Set Plans

RICHMOND EXPRESSWAY SYSTEM			
SECTION	PROJECT	SHEET NO.	TOTAL SHEETS
4	BELTLINE EXPRESSWAY	94	155

GENERAL NOTES

STRUCTURE: Dual structures with one welded steel girder span and one rolled beam at each approach. Distance between girders of 18'-4" with 1'-6" min. clear between structures.

CAPACITY: Live Loads - Cooper E-80 with 50% impact

SPECIFICATIONS: GENERAL: Virginia Department of Highway Road and Bridge Specifications 1970 and Contract Special Specifications. DESIGN: A.R.E.A. 1966 for Steel Railway Bridges, for Fixed Spans not exceeding 400 feet in length. WELDING: 1969 Standard Specifications for Welded Highway and Railway Bridges of the American Welding Society.

CONTRACT SPECIAL PROVISIONS: Specifications and Contract Special Provisions referred to above are necessary to make these plans complete.

DATUM: City of Richmond

TEMPERATURE: The normal temperature referred to on the plan is 68°F. The temperature range for movement is 0°F to 120°F.

DIMENSIONS: All dimensions are measured horizontally and vertically unless otherwise noted.

EXCAVATION: Excavation below subgrade and cut slope template shall be classified as Structure Excavation. All excavation above these limits shall be classified as Regular Excavation and is not included in the Structural Quantities.




FOUNDATION: Piles shall be driven to a minimum length corresponding to the approximate tip elevations shown on the Plans but in no case to less than a penetration affording the required safe bearing capacity noted on the Plans.

CONCRETE NOTES: All concrete shall be Class A3. All exposed edges and corners shall have a 3/4" chamfer or fillet unless otherwise noted. Finishing Concrete Surfaces: See The Standard Architectural Detail sheets and the Contract Special Provisions for Types and details.

All Reinforcing steel shall conform to A.S.T.M. A615, Grade 40. All reinforcing bar dimensions on the detailed drawings are to centers of bars unless otherwise noted. Clear distance between reinforcing steel and face of concrete shall be as noted on the Plans. All bar laps shall be 30 diameters of the smaller bar unless otherwise noted.

STEEL NOTES: Structural steel shall conform to A.S.T.M. Specification A-36 and A-588. All Field Connections shall be made with high strength bolts or rivets. High strength bolts and rivets shall be 1/2" diameter unless otherwise noted and shall conform to A.S.T.M. Specification A-325.

BENCH MARK: A-15 Copperweld rod on bridge on Blue Shingles Road Elev. 204.73.

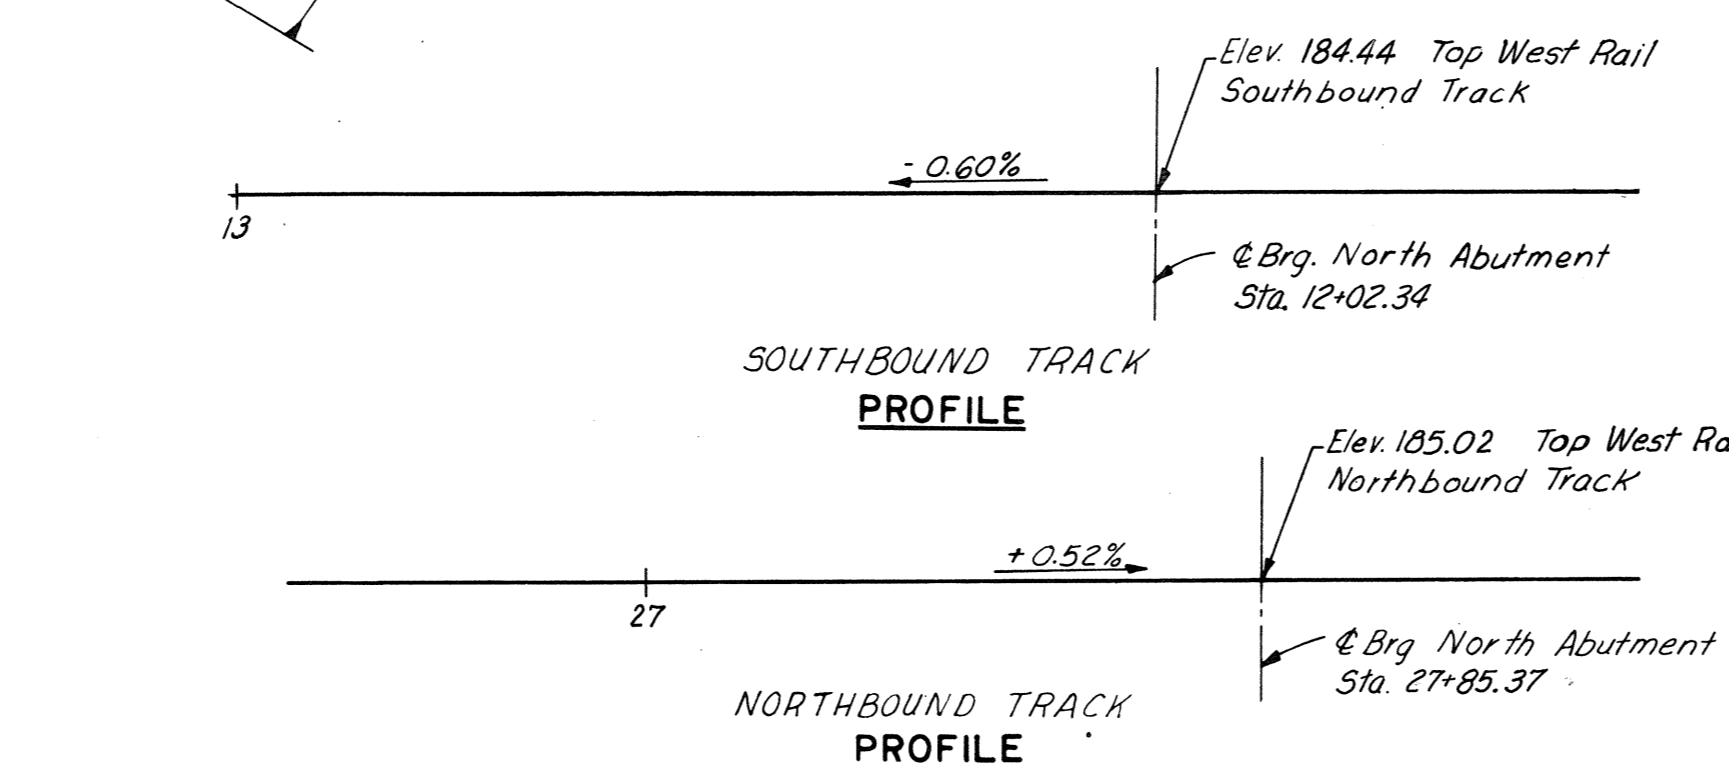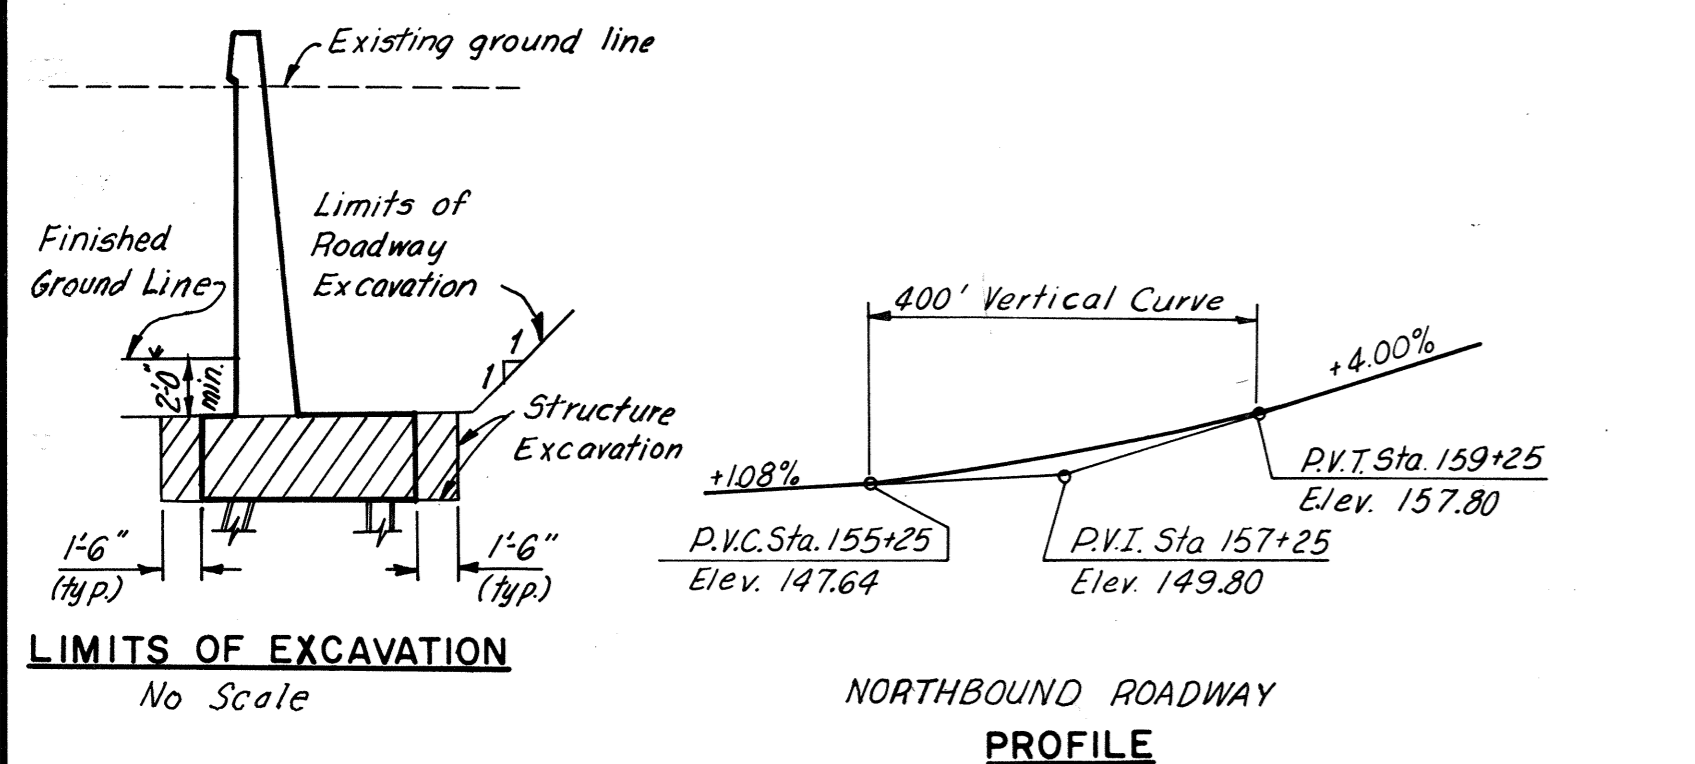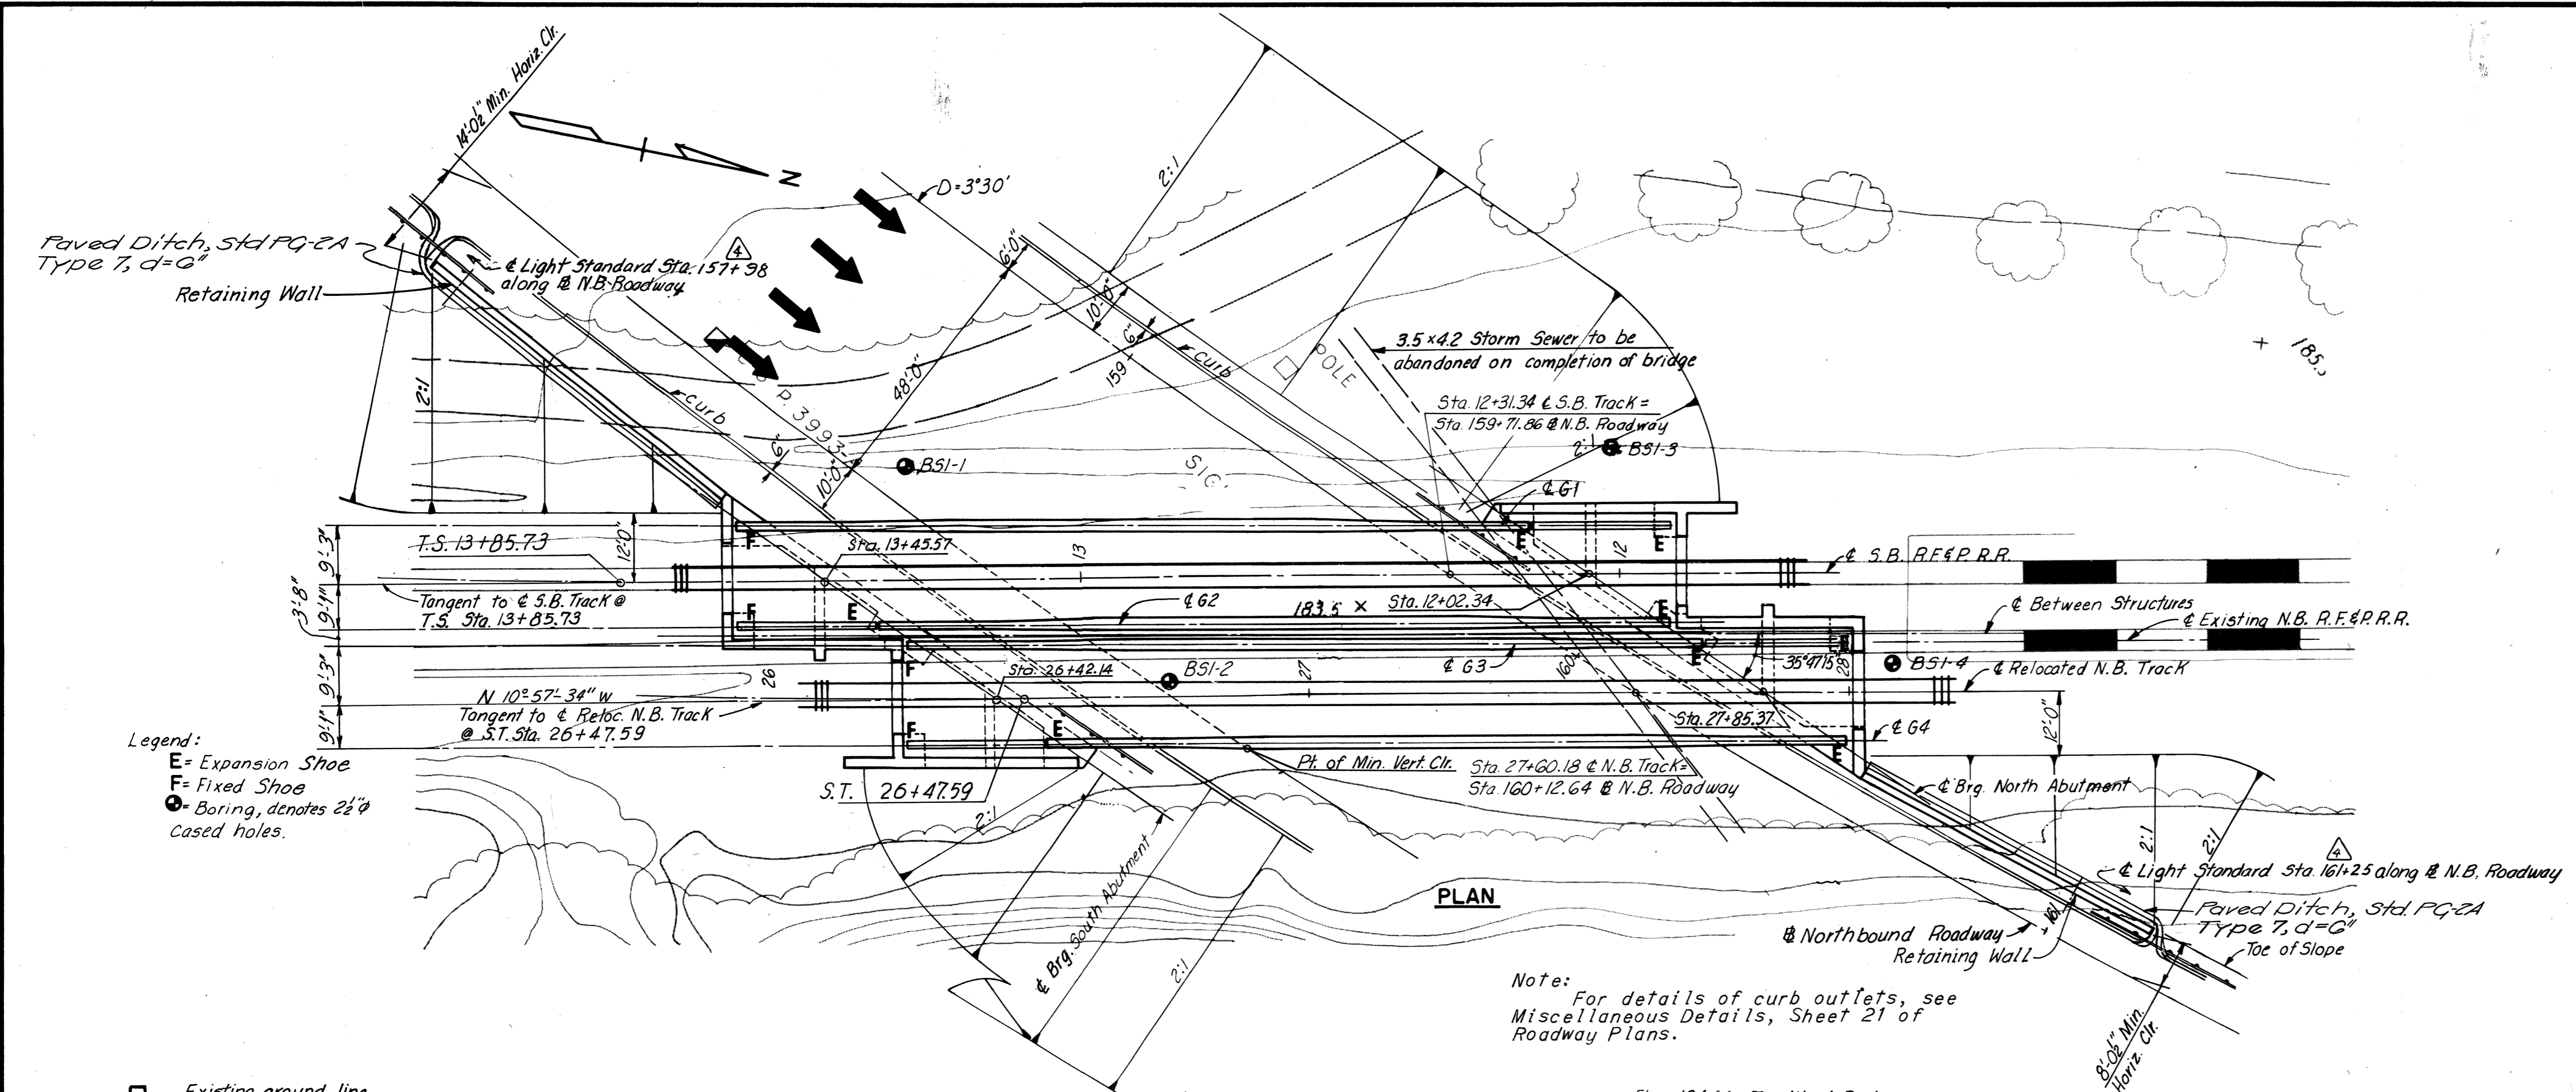

ESTIMATED QUANTITIES


	Struct. Excav. Cu. Yds.	Concrete (a) Cu. Yds.	Reinf. Steel Lbs.	Struct. Steel (Lbs.)		Porous Backfill Cu. Yds.	Under-drain 6" Dia. Pipe Lin. Ft.	Steel piles 10BP42 Lin. Ft.	Steel piles 12BP53 Lin. Ft.	Asphalt damp-proofing Sq. Yds.	1/2" Asphalt Plank Sq. Ft.	1/2" Butyl Rubber Water-proofing Square	Bridge Drainage Metalwork Lbs.
				Mild Carbon	High Strength								
Superstructure				855,568.2	280,976.7						7498	75	
North Abutment	286	538.82	65,027			64	129	1,858.4	2,993.0	183			
South Abutment	298	657.26	76,926			75	136	982.8	2,030.4	207			2,691
TOTAL	584	1,256.08	141,953	855,568.2	280,976.7	139	265	2,841.2	5,029.4	390	7498	75	2,691

(a) Class A3

INDEX

Sheet

GENERAL PLAN AND ELEVATION	1
NORTH ABUTMENT	2
NORTH ABUTMENT RETAINING WALL	3
SOUTH ABUTMENT	4
SOUTH ABUTMENT RETAINING WALL	5
ABUTMENT DETAILS	6
FRAMING PLAN	7
SUPERSTRUCTURE DETAILS	8
SUPERSTRUCTURE DETAILS	9
SHOE DETAILS	10
BORING LOGS	11
BORING LOGS	12
STANDARD ELECTRICAL DETAILS	S6
STANDARD ARCHITECTURAL DETAILS - S8 AND S9	

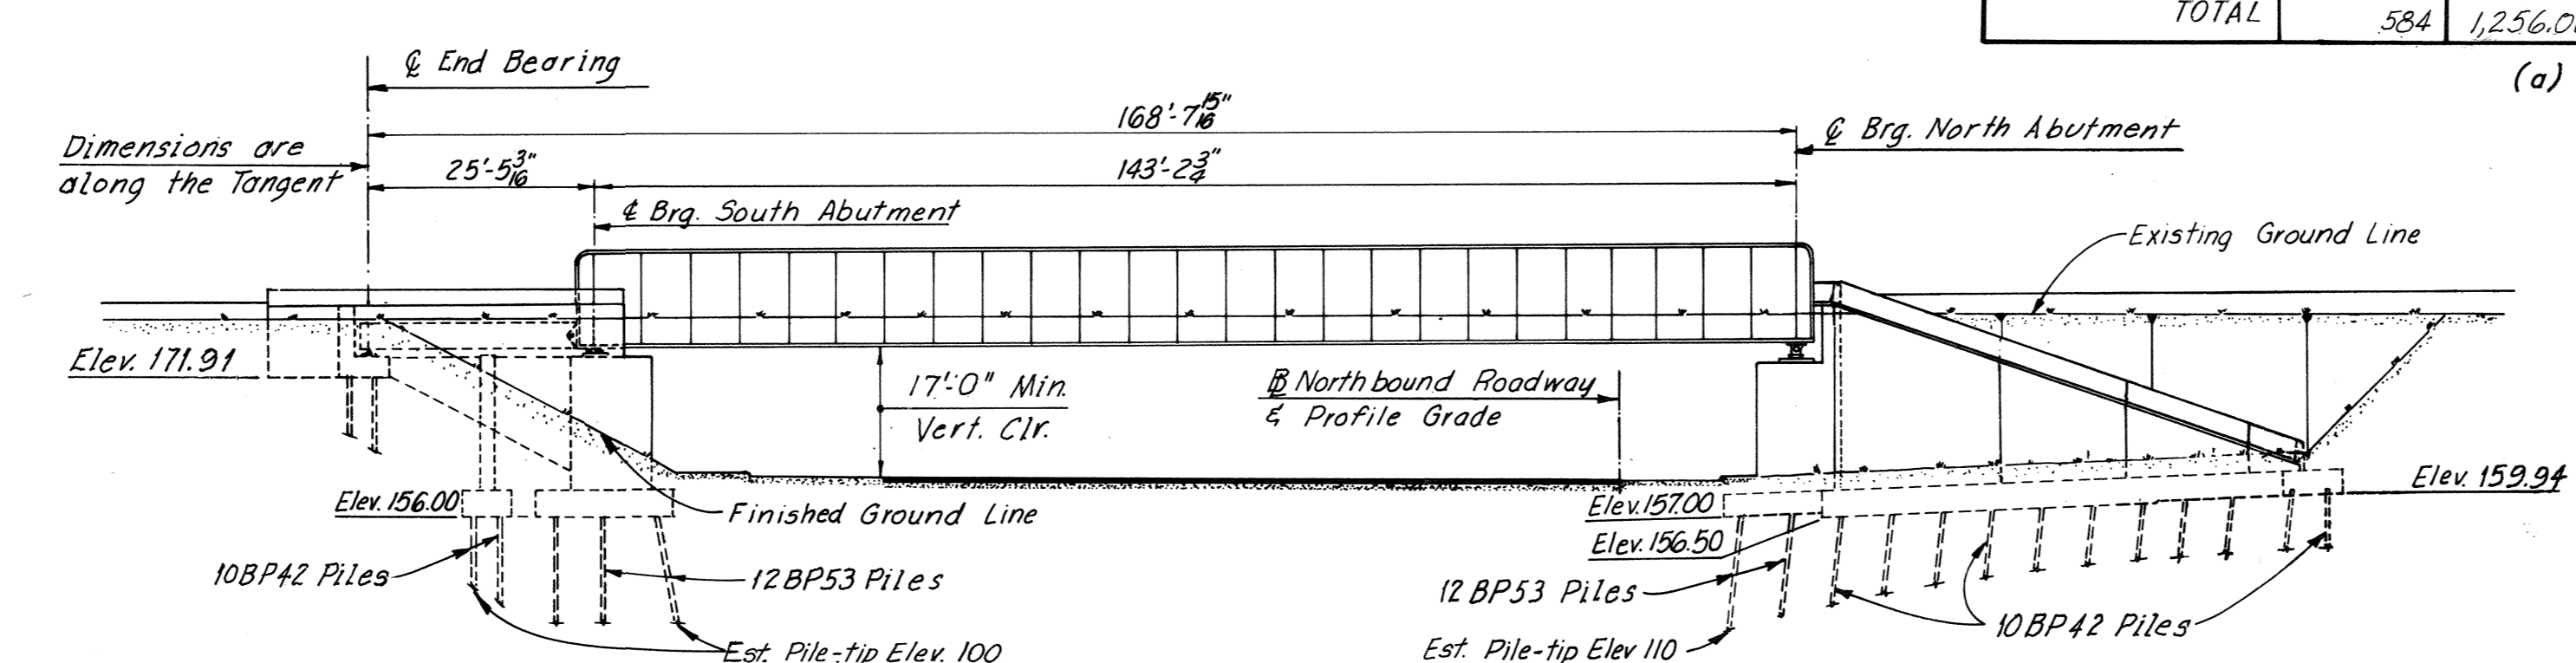

BY	DATE	NO.	REVISION	BY	DATE
As Built	JRC	3-73			
Revise Ltg. Std.	JRC	9-71			
Profile Grade	P.S.	4-12-71			
General	J.G.V.	10-70			
General Checking	AMH	5-13-68			

CURVE DATA

Station	Value	Station	Value	Station	Value
T.S. @ Southbound Track	Sta. 13+85.73	P.I. @ Northbound Roadway	Sta. 156+91.30	C.S. @ Reloc. Northbound Track	Sta. 23+97.59
S.C. @ Southbound Track	Sta. 16+41.73	A @ Northbound Roadway	37°59'54"	S.T. @ Reloc. Northbound Track	Sta. 26+47.59
Ls @ Southbound Track	256.00'	D @ Northbound Roadway	3°30'100"	Ls @ Reloc. Northbound Track	250.00'
Os @ Southbound Track	5'40'149"	T @ Northbound Roadway	563.64'	Os @ Reloc. Northbound Track	4°22'30"
Xc @ Southbound Track	255.75'	L @ Northbound Roadway	1085.66'	Xc @ Reloc. Northbound Track	249.85'
Yc @ Southbound Track	8.45'	R @ Northbound Roadway	1637.02'	Yc @ Reloc. Northbound Track	6.36'
L.T. @ Southbound Track	170.75'			L.T. @ Reloc. Northbound Track	166.72'
S.T. @ Southbound Track	85.41'			S.T. @ Reloc. Northbound Track	83.38'
L.C. @ Southbound Track	255.89'			L.C. @ Reloc. Northbound Track	249.94'






AS BUILT

RICHMOND METROPOLITAN AUTHORITY
RICHMOND EXPRESSWAY SYSTEM
BELTLINE EXPRESSWAY

BRIDGE NO. 9
R.F.&P.R.R. OVER
NORTHBOUND ROADWAY
GENERAL PLAN AND ELEVATION

HOWARD, NEEDLES, TAMMEN & BERGENDOFF consulting engineers
NEW YORK ALEXANDRIA KANSAS CITY

SCALE: 1" = 20' unless noted
CONTRACT NO.: 4
SHEET NO. 1 OF 12

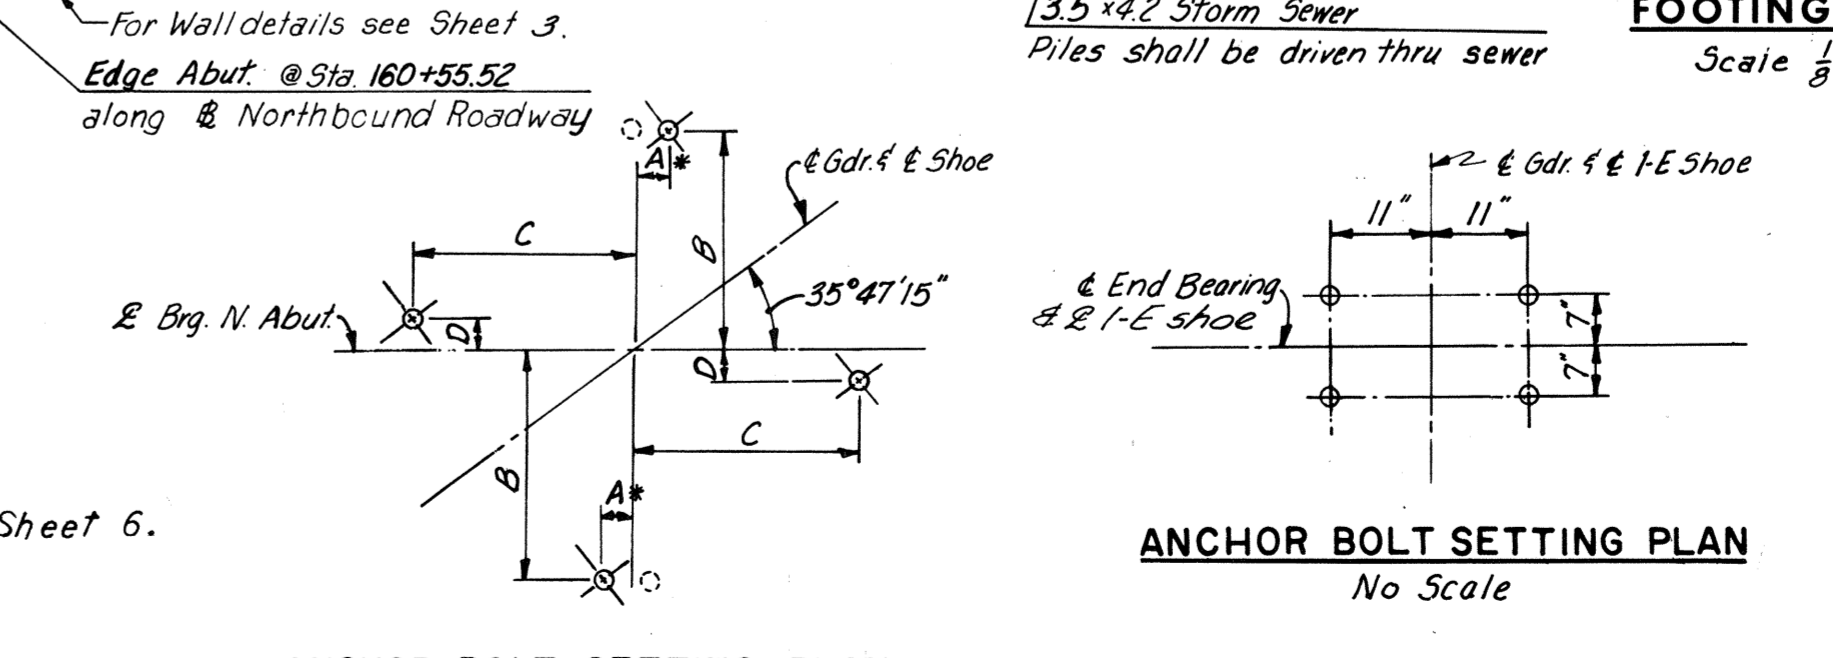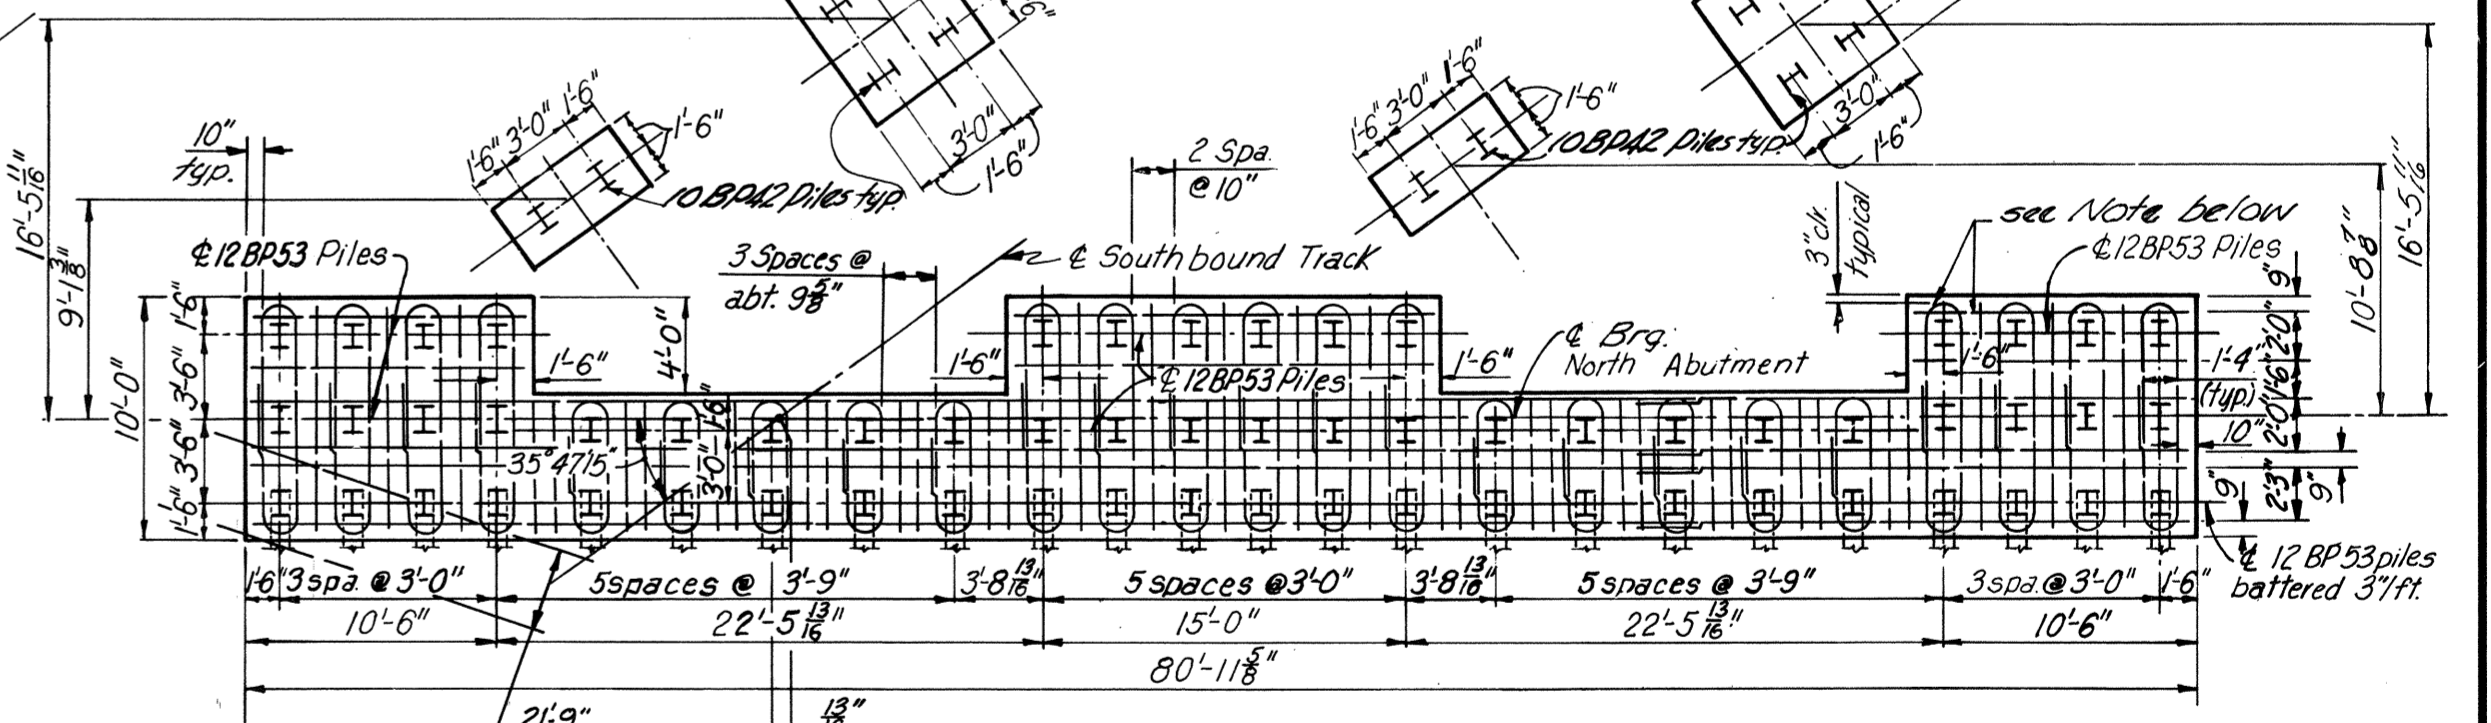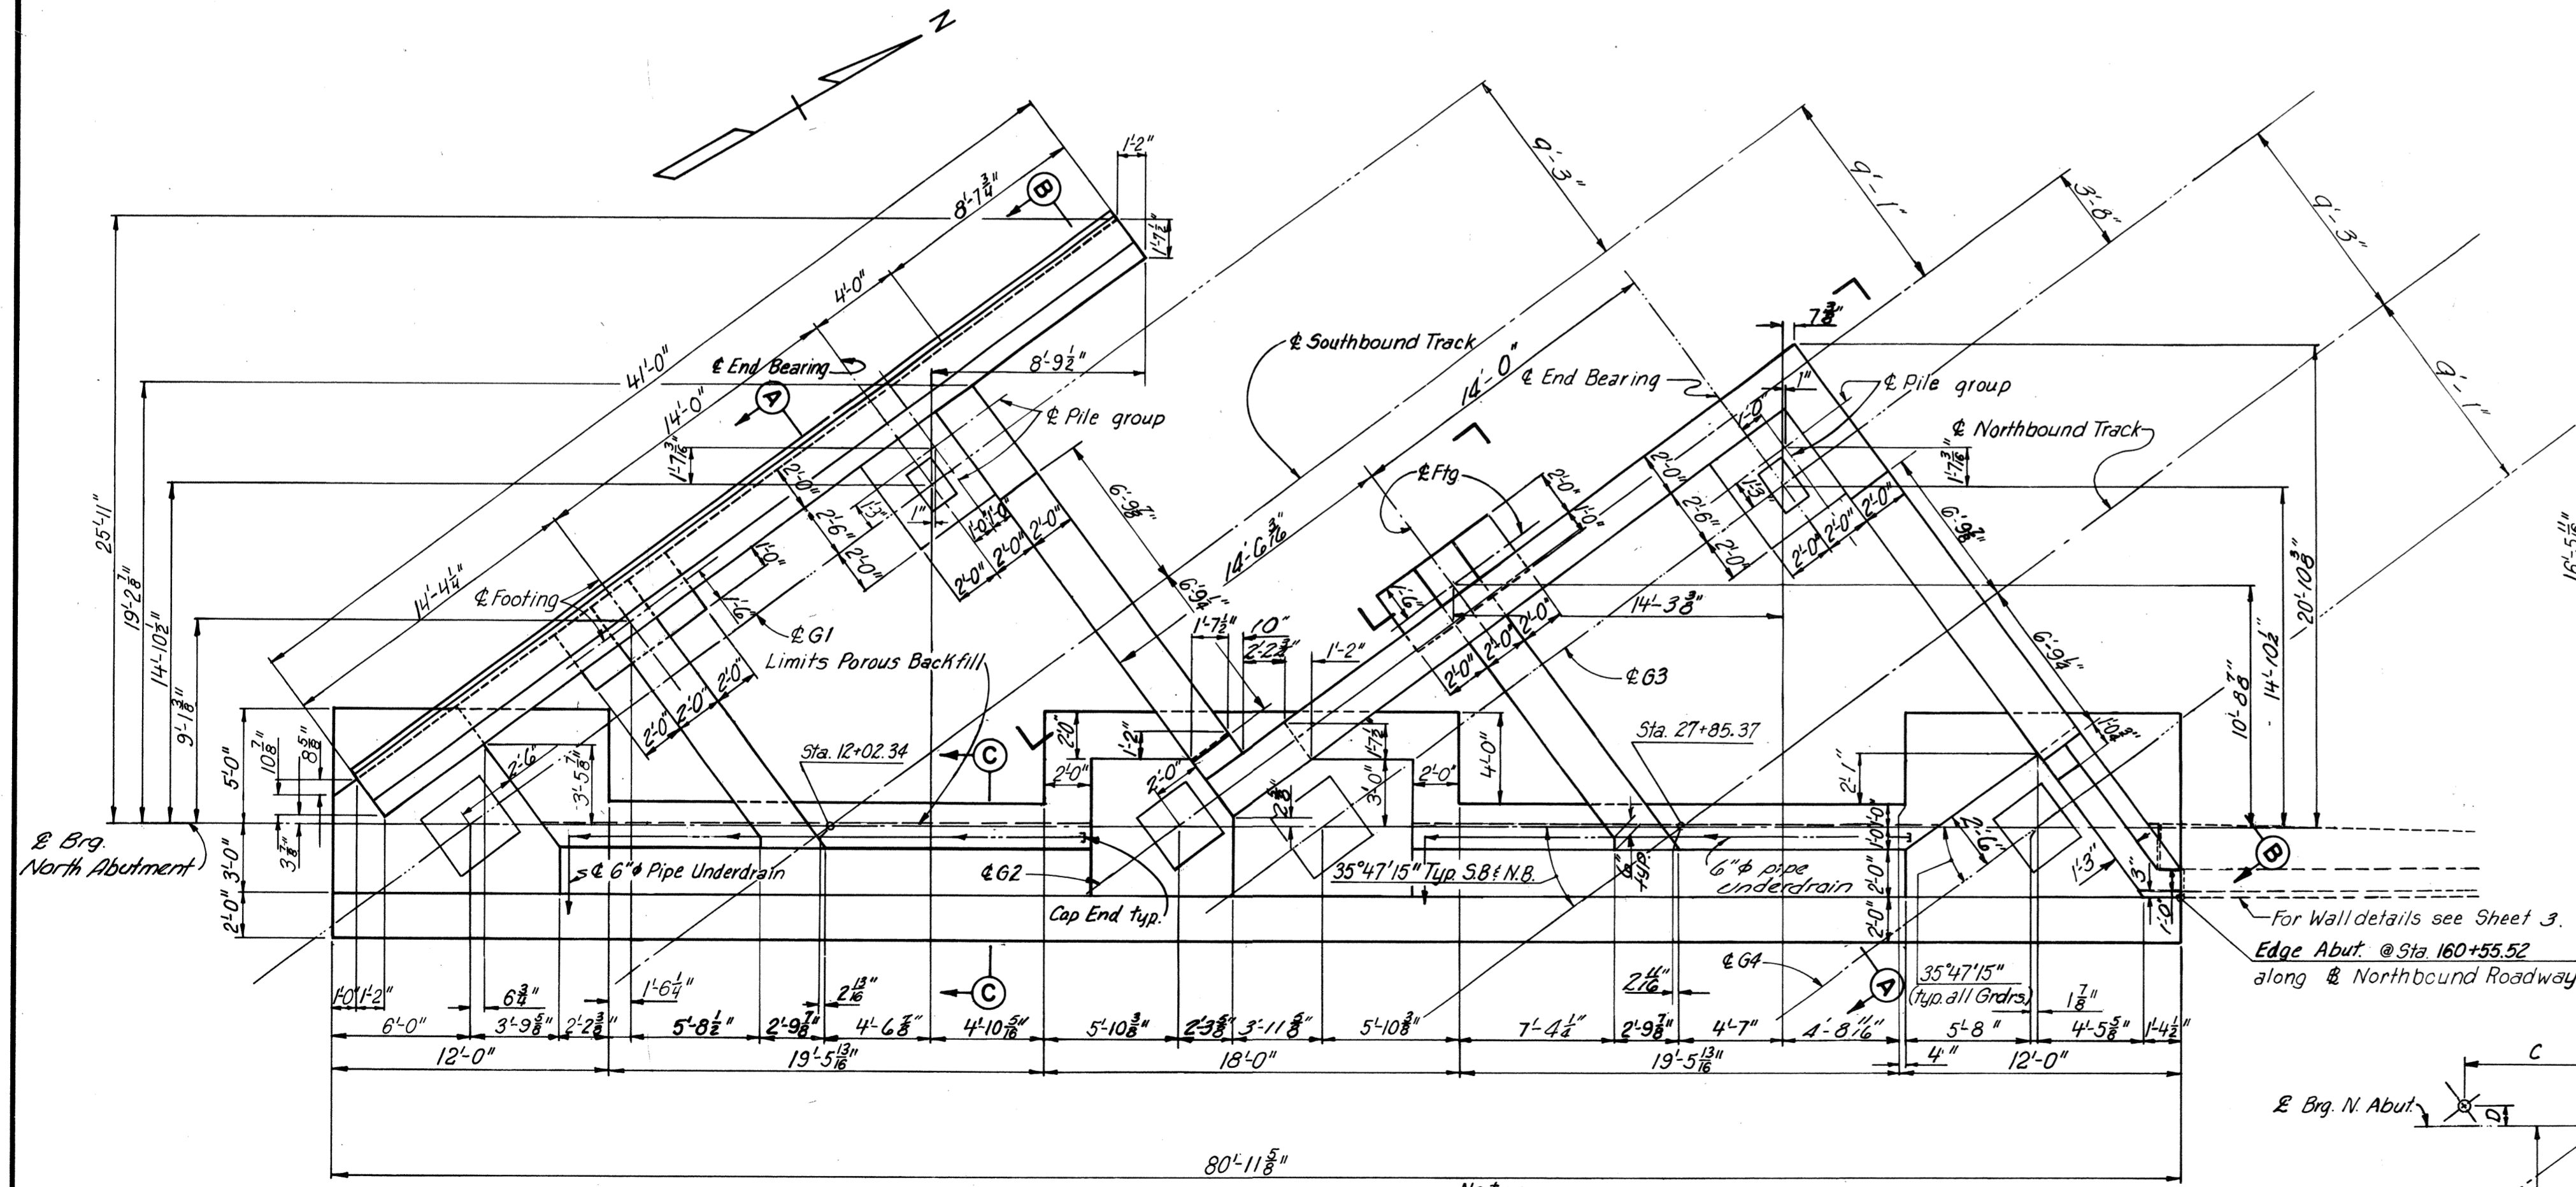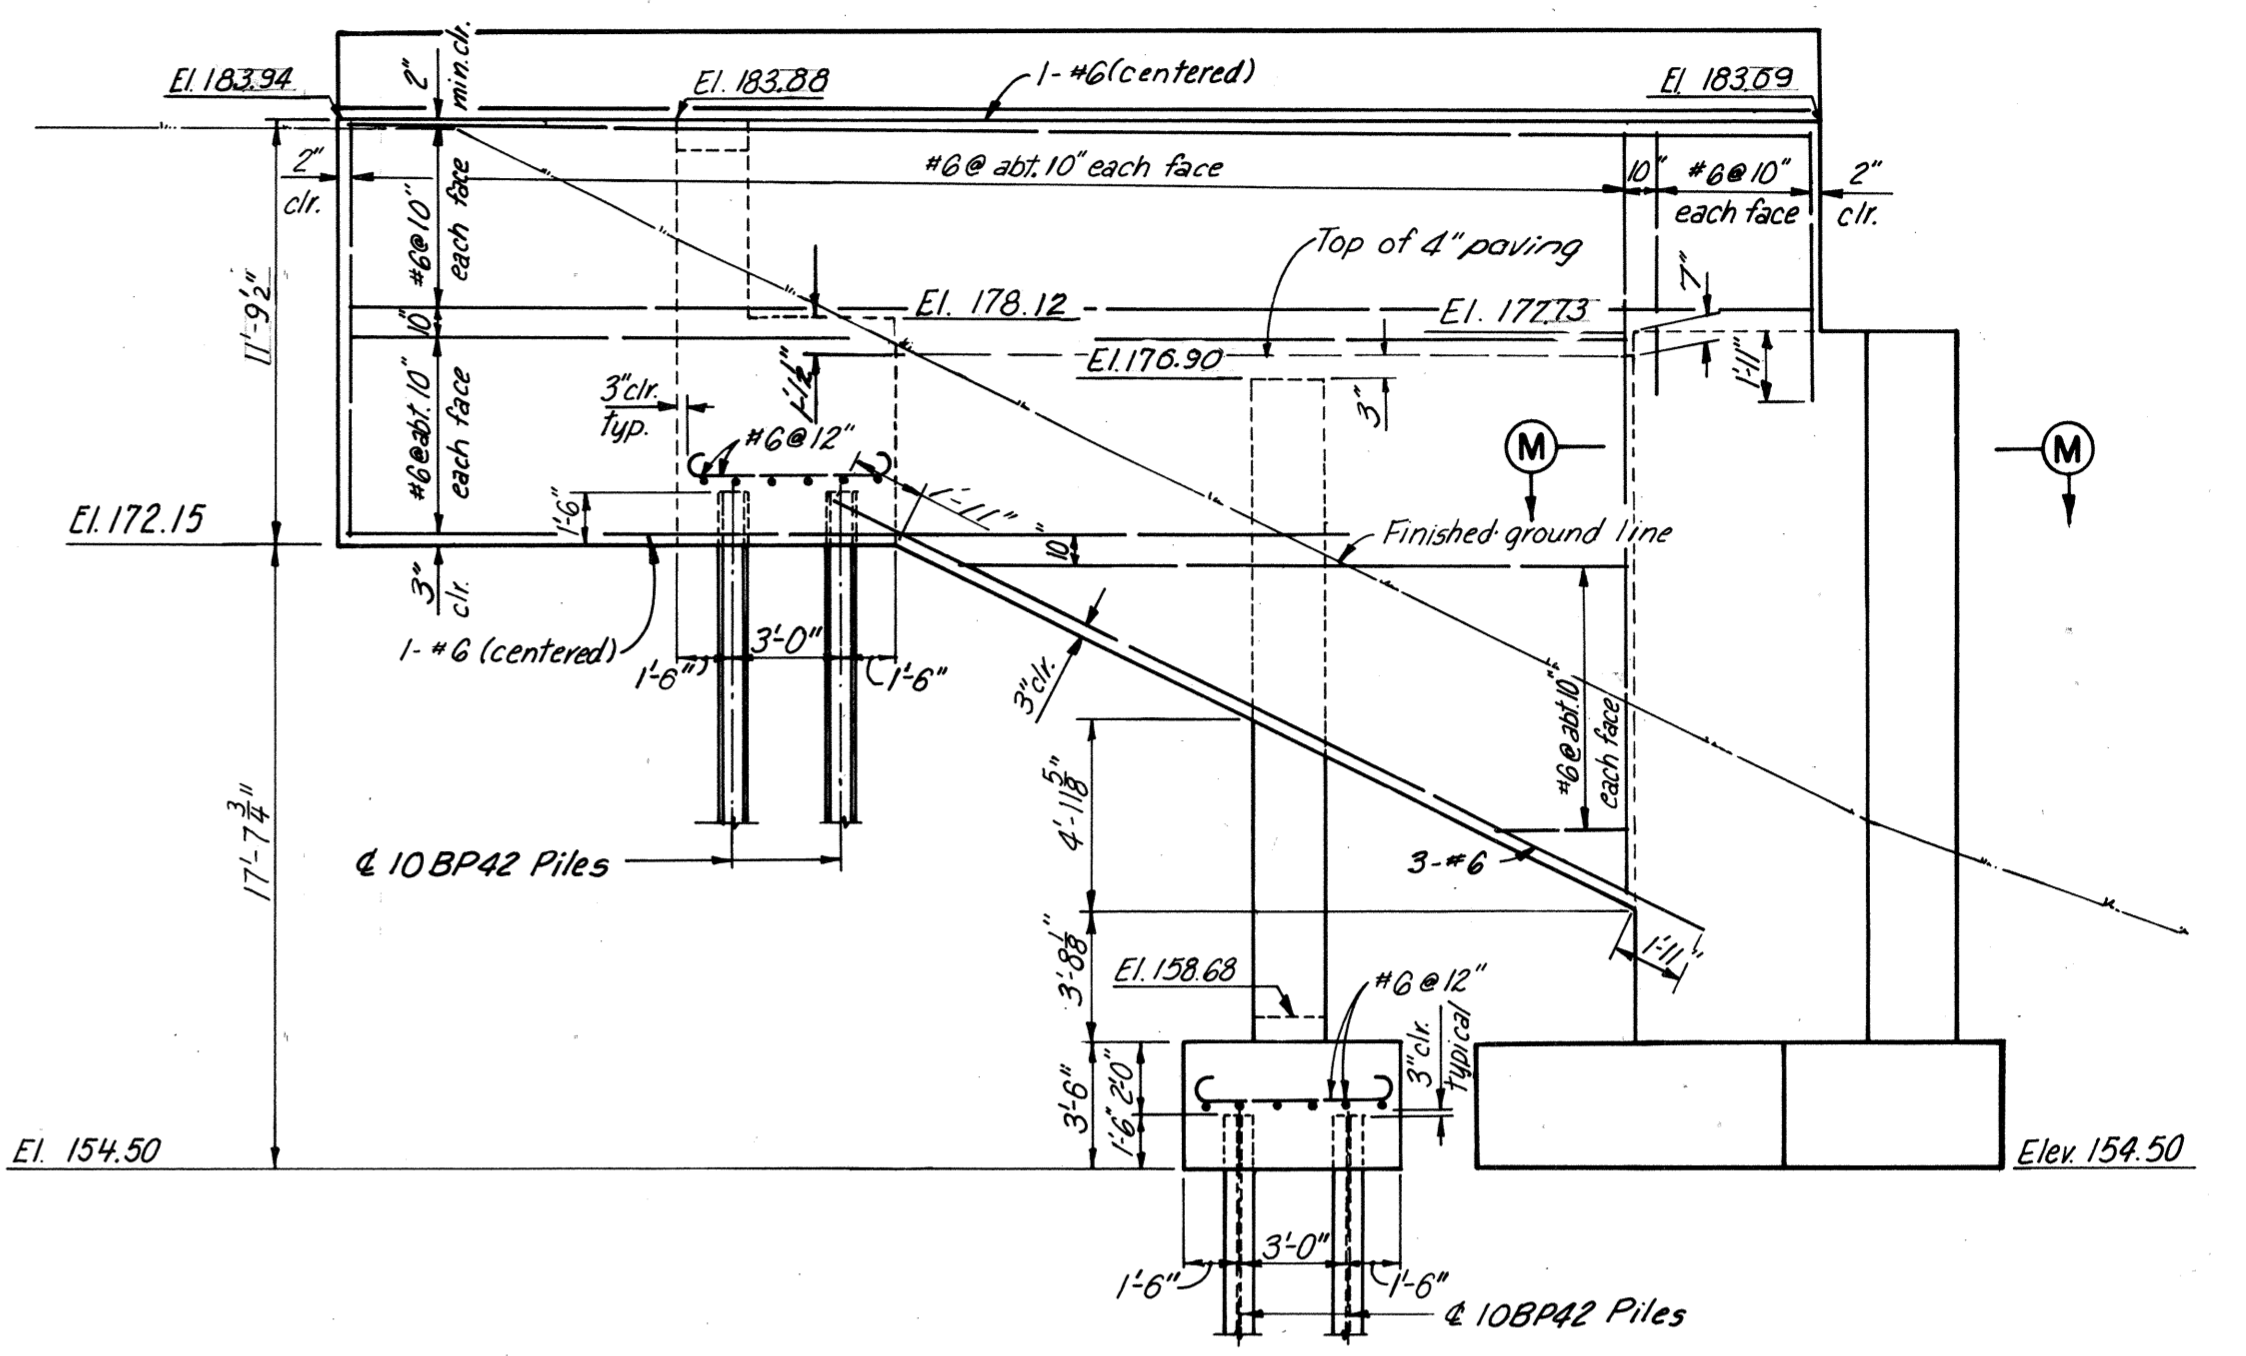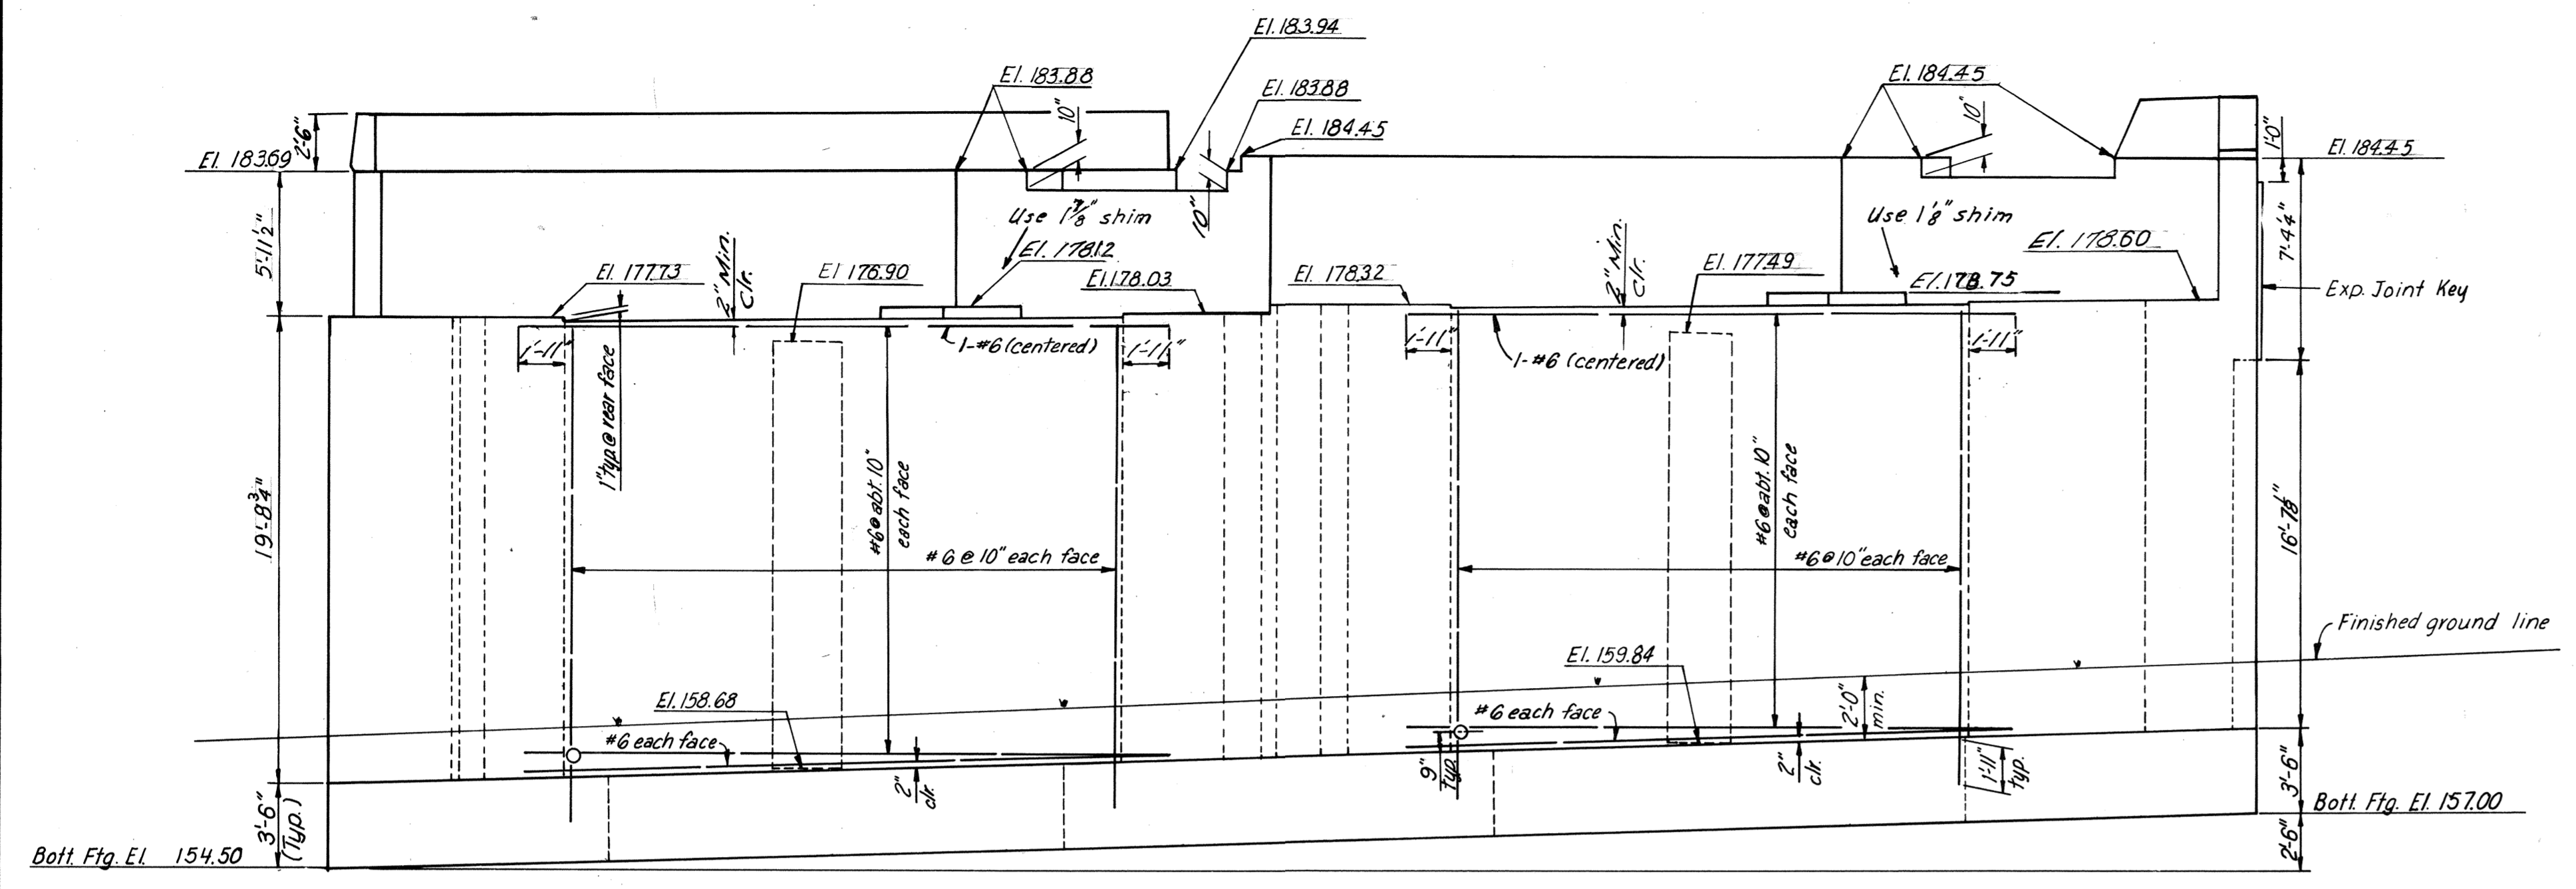

AS BUILT

Note: Stirrups around piles have a radius of 8" for the bends and a lap of 21'-6".
Reinforcing shown is typical for both top and bottom. All footing bars are # 8 bars.

RICHMOND METROPOLITAN AUTHORITY
RICHMOND EXPRESSWAY SYSTEM
BELTLINE EXPRESSWAY
BRIDGE NO. 9
R.F.&P.R.R. OVER
NORTHBOUND ROADWAY
NORTH ABUTMENT

BY	DATE	3	As Built	JRC	3-73
MADE	RLM	2-7-68	2	Profile Grade	P.S. 4-12-71
CHECKED	AMH	5-10-68	1	General Checking	AMH 5-13-68
IN CHARGE	FKD	NO.	REVISION	BY	DATE

Note: 6" Dia. Pipe Underdrain going thru front wall of Abutment, is to connect with tee to Std. UD-1 under N.B. Roadway. See Roadway Plans.


	A	B	C	D
1-EL SHOE	3 3/4"	11-1 1/8"	11-1 1/8"	3 3/4"
2-E SHOE	18"	11-7 1/8"	11-6 1/4"	4 6 3/8"

*Anchor Bolt for 2-E Shoe lies on other side of dimension line as shown by dotted circle. This will also put dimension A on other side of dimension line.

HOWARD, NEEDLES, TAMMEN & BERGENDOFF
consulting engineers
NEW YORK ALEXANDRIA KANSAS CITY

SCALE: As noted
CONTRACT NO. 4
SHEET NO. 2 OF 12





Note: For North Abutment, see Sheet 2.

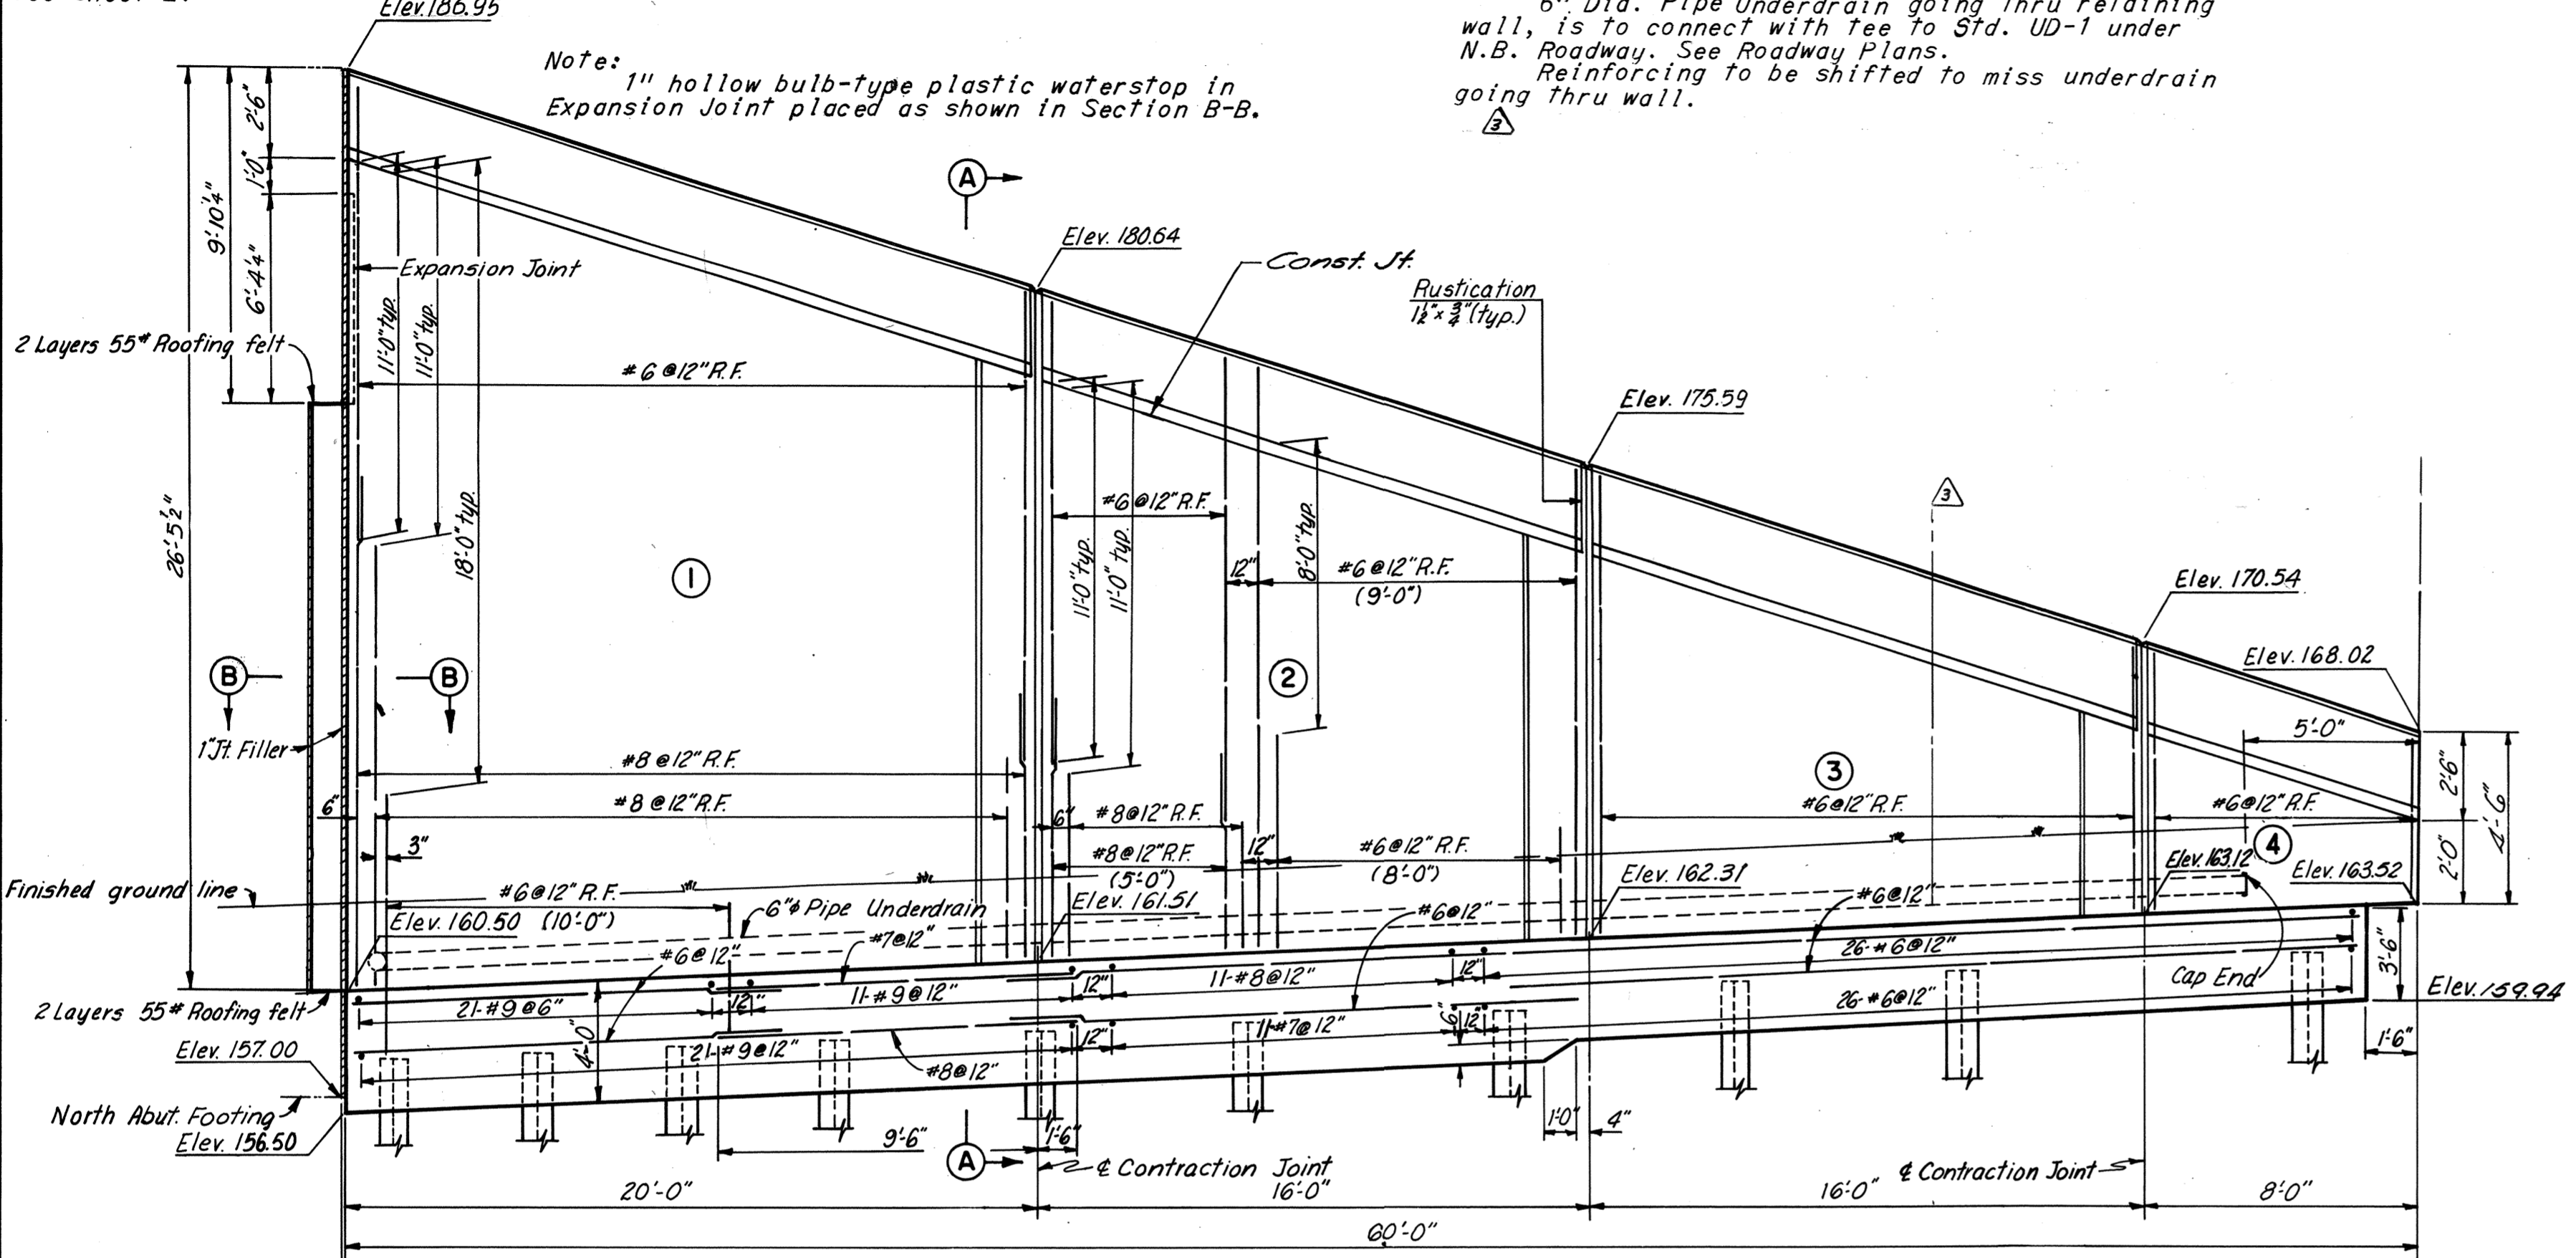

Legend:
R.F. denotes Rear Face.

ELEVATION
Scale: 1/4" = 1'-0"


Note: Longitudinal footing bars have the following splice lengths:
 #6 Bar = 1'-11"
 #8 Bar = 2'-6"
 #9 Bar = 2'-10"
 Dowel bars not shown. See Section A-A for shape and spacing.

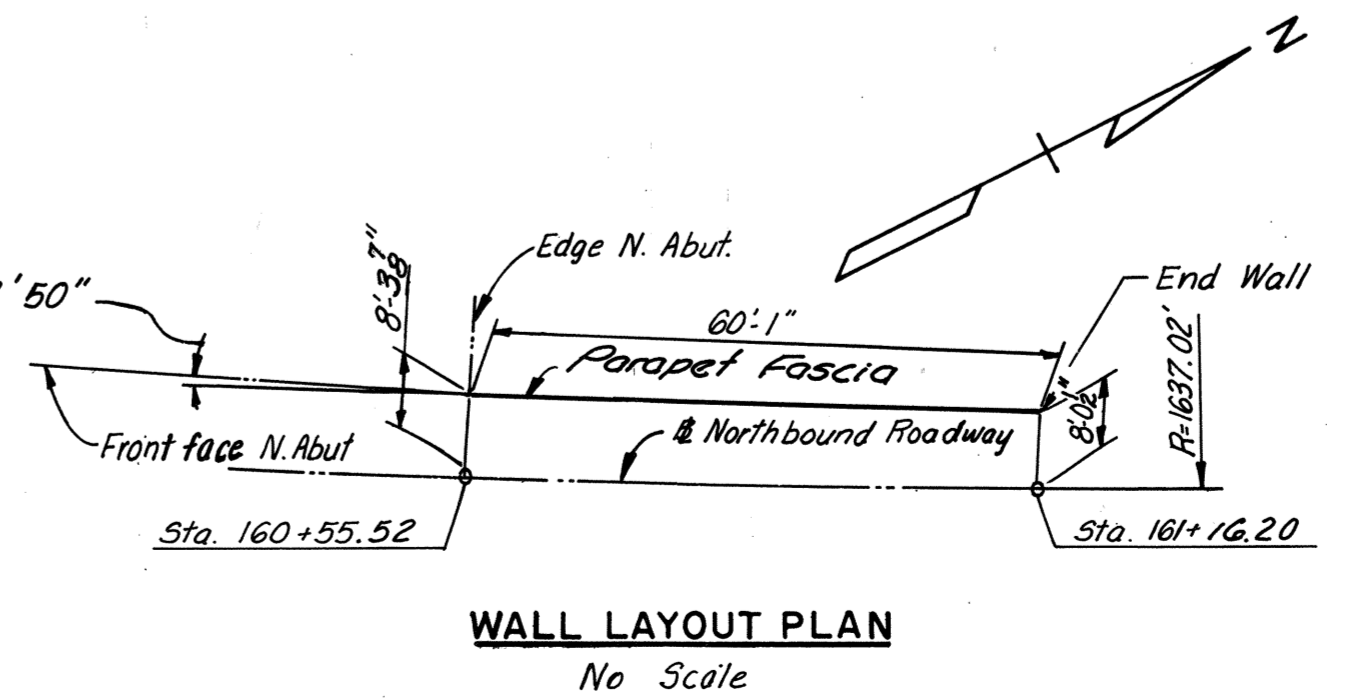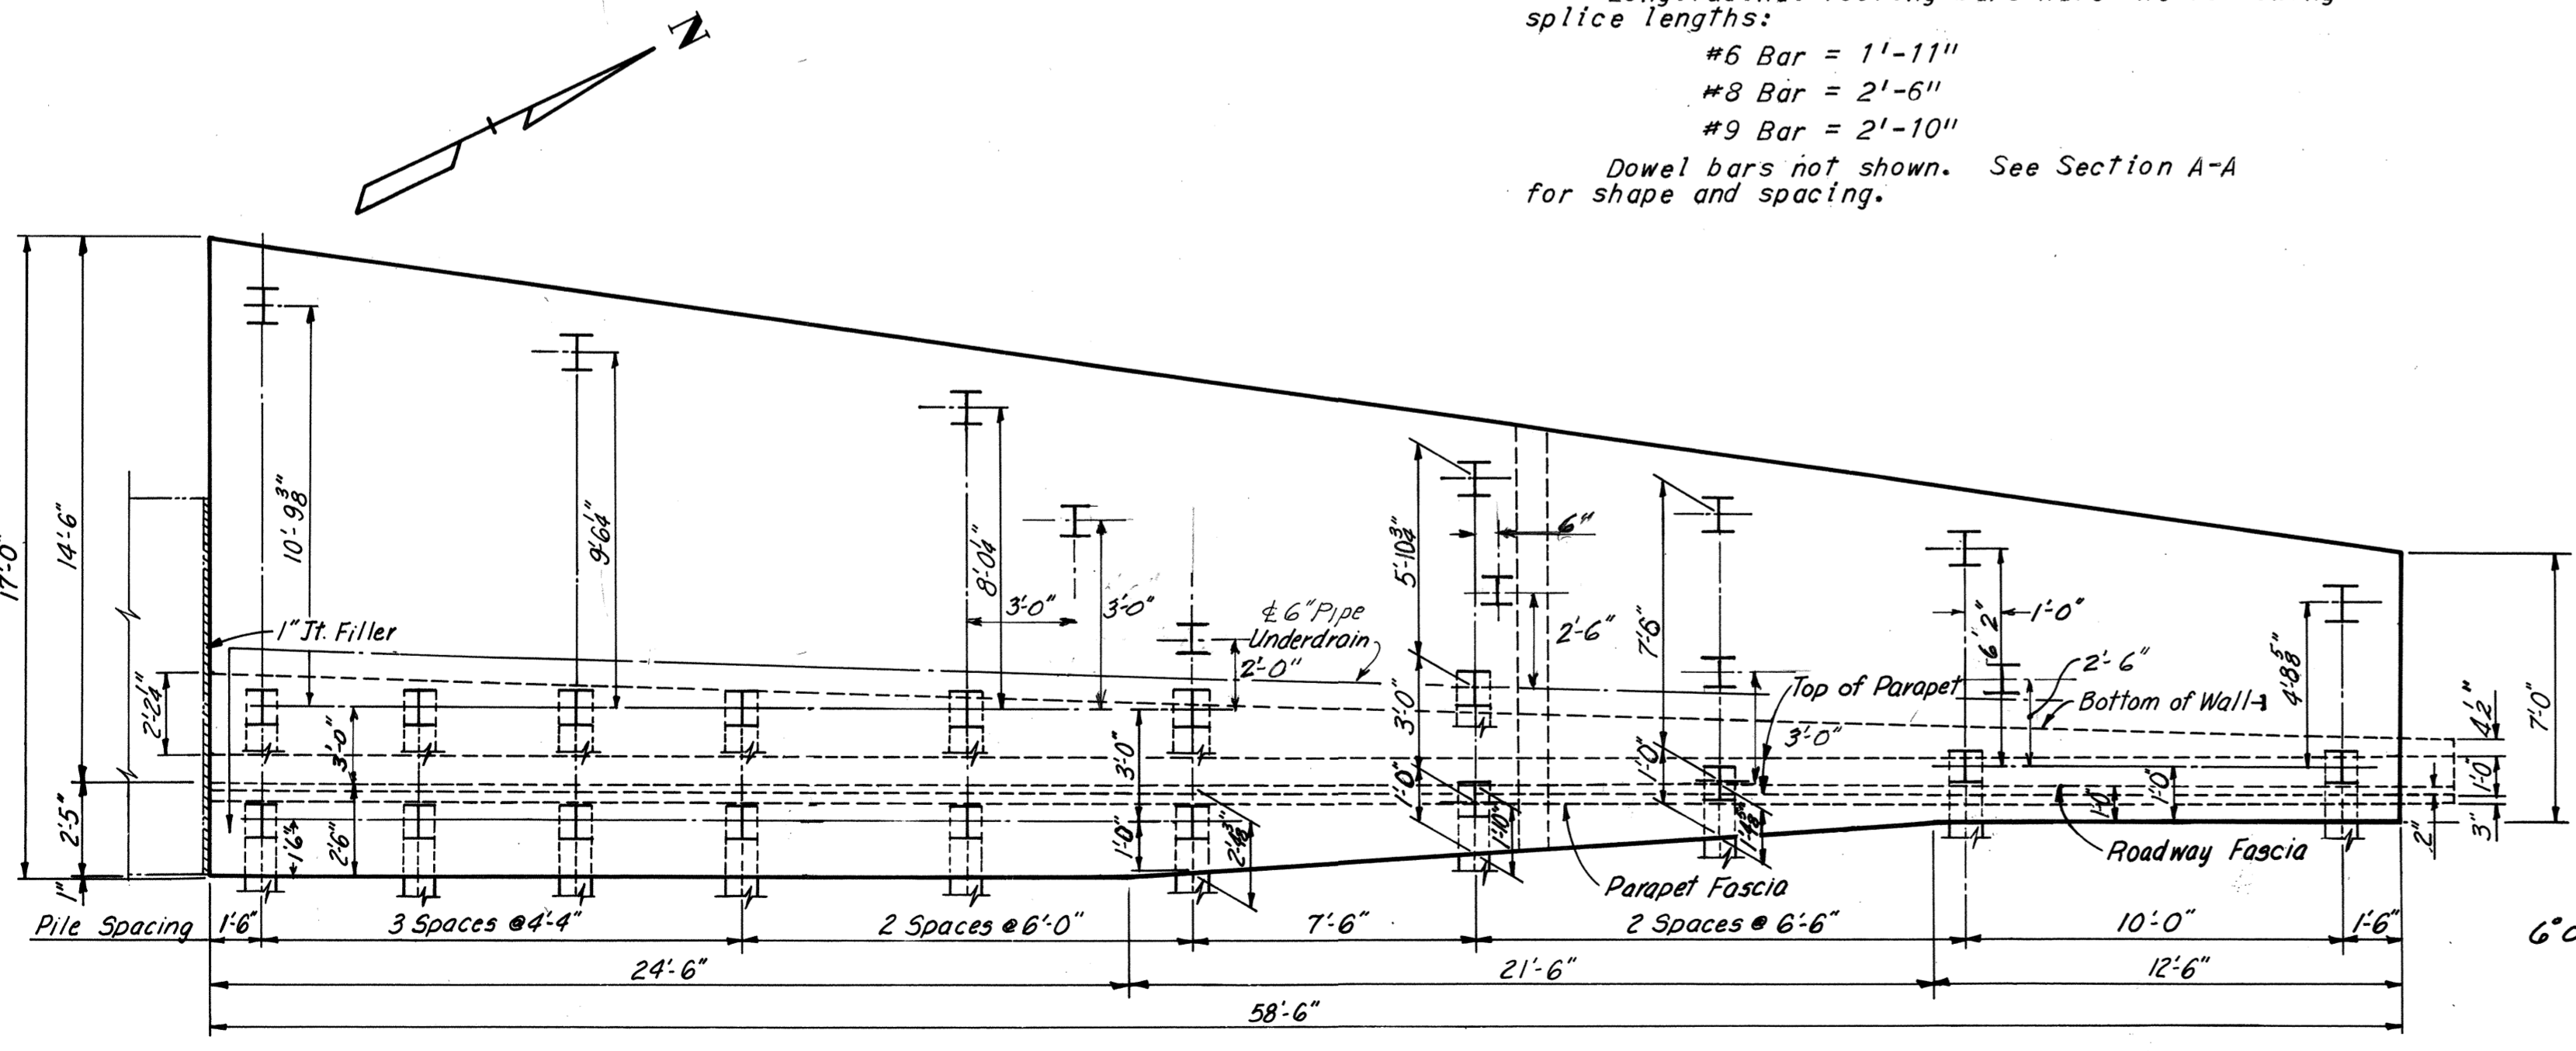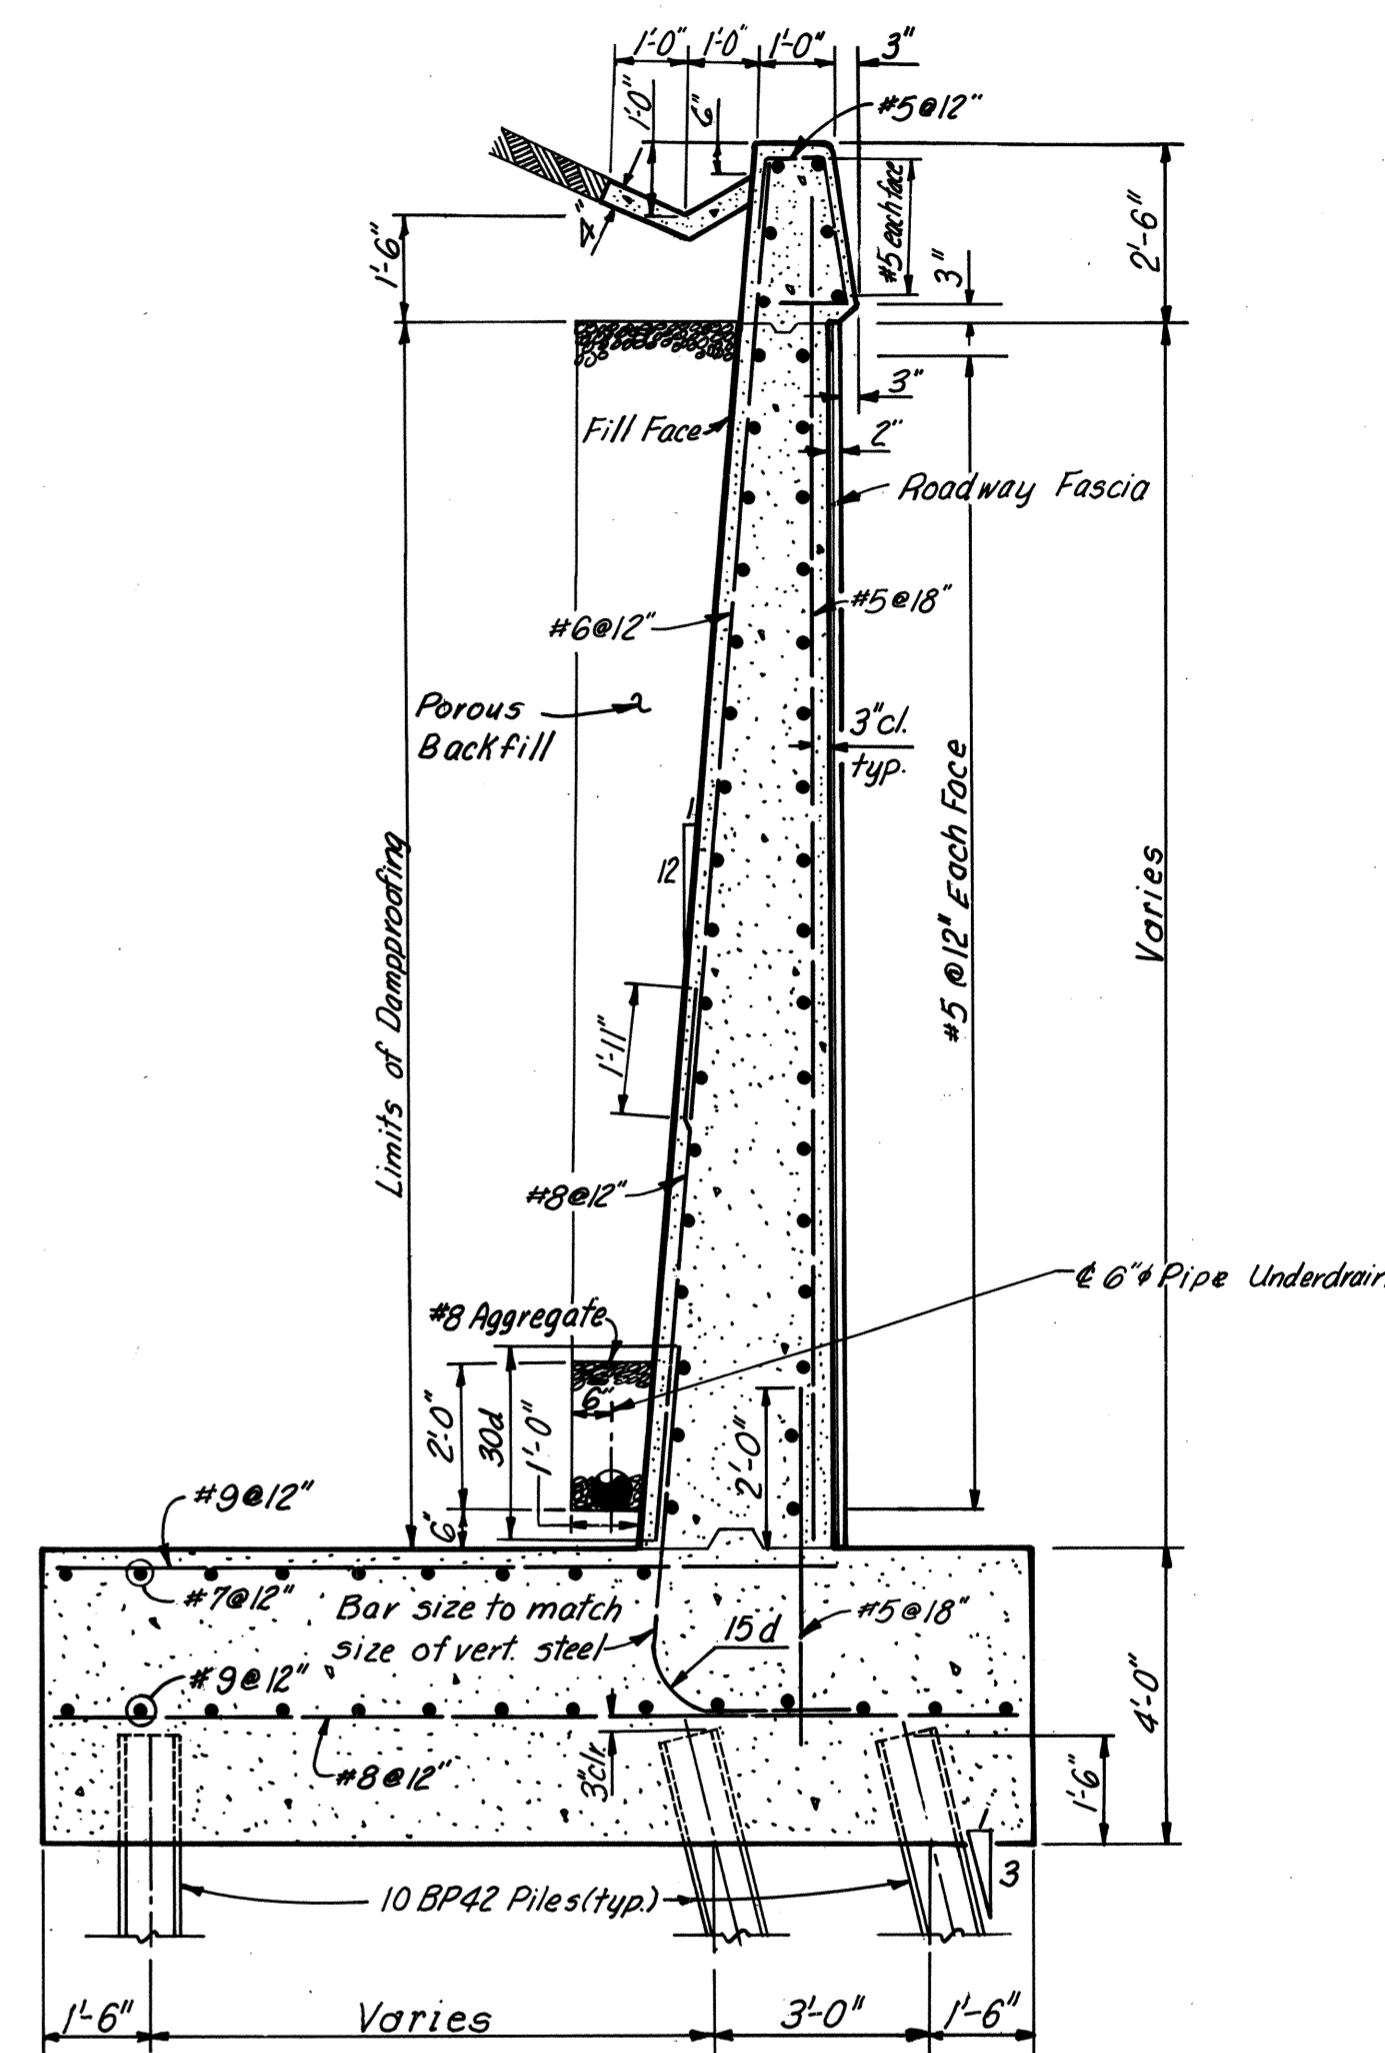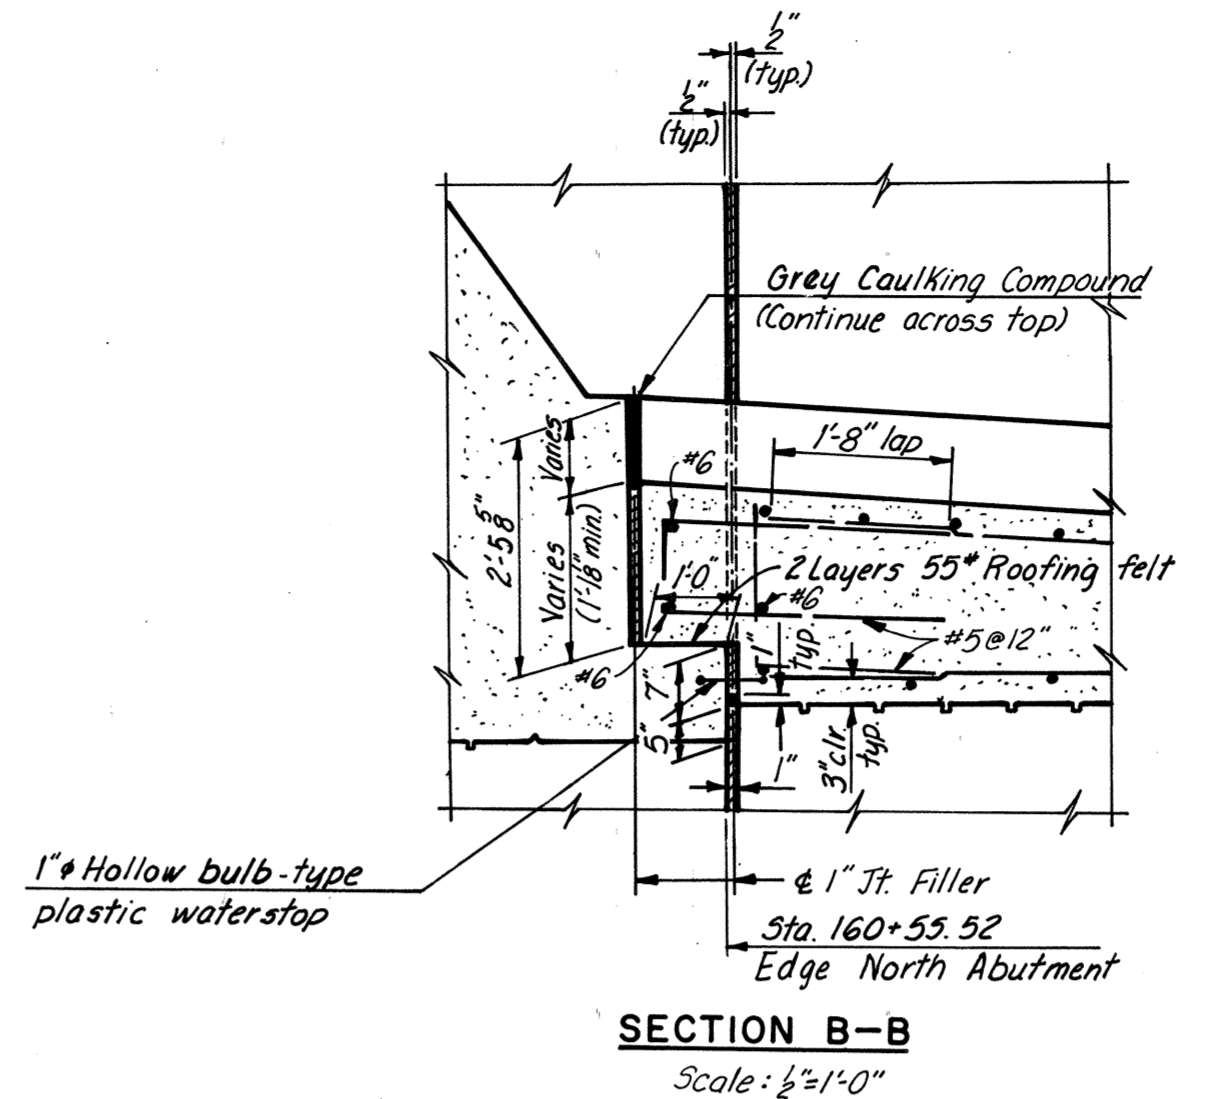


AS BUILT

RICHMOND METROPOLITAN AUTHORITY
 RICHMOND EXPRESSWAY SYSTEM
 BELTLINE EXPRESSWAY
 BRIDGE NO. 9
 R.F.&P.R.R. OVER
 NORTHBOUND ROADWAY
 NORTH ABUTMENT RETAINING WALL


NO.	REVISION	BY	DATE
4	As Built	JRC	3-73
3	Revise Lig. Std.	JRC	9-71
2	Profile Grade	P.S.	4-12-71
1	General Checking	AMH	5-13-68

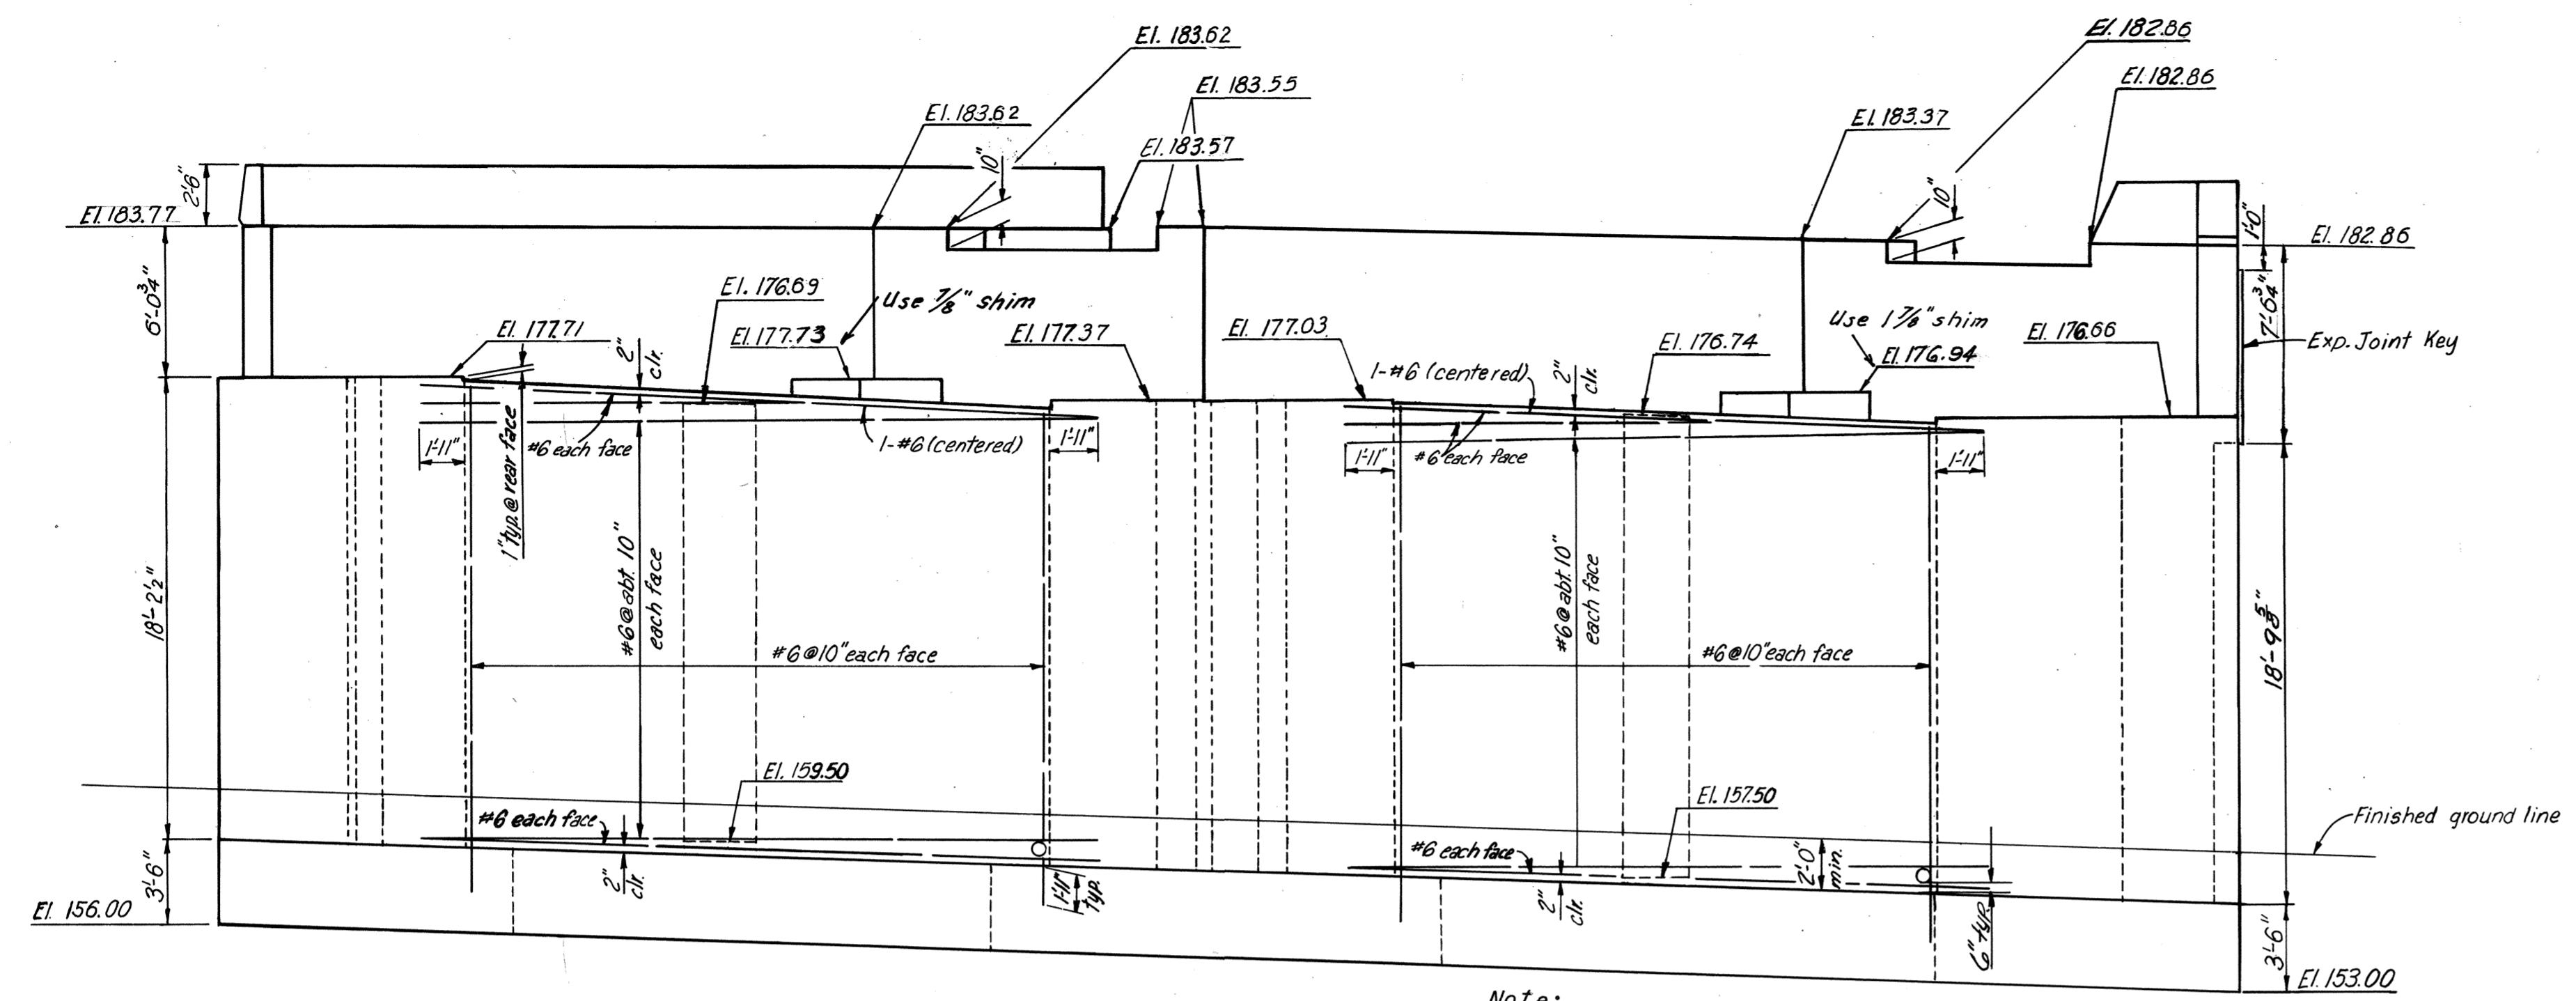


ELEVATION
No Scale

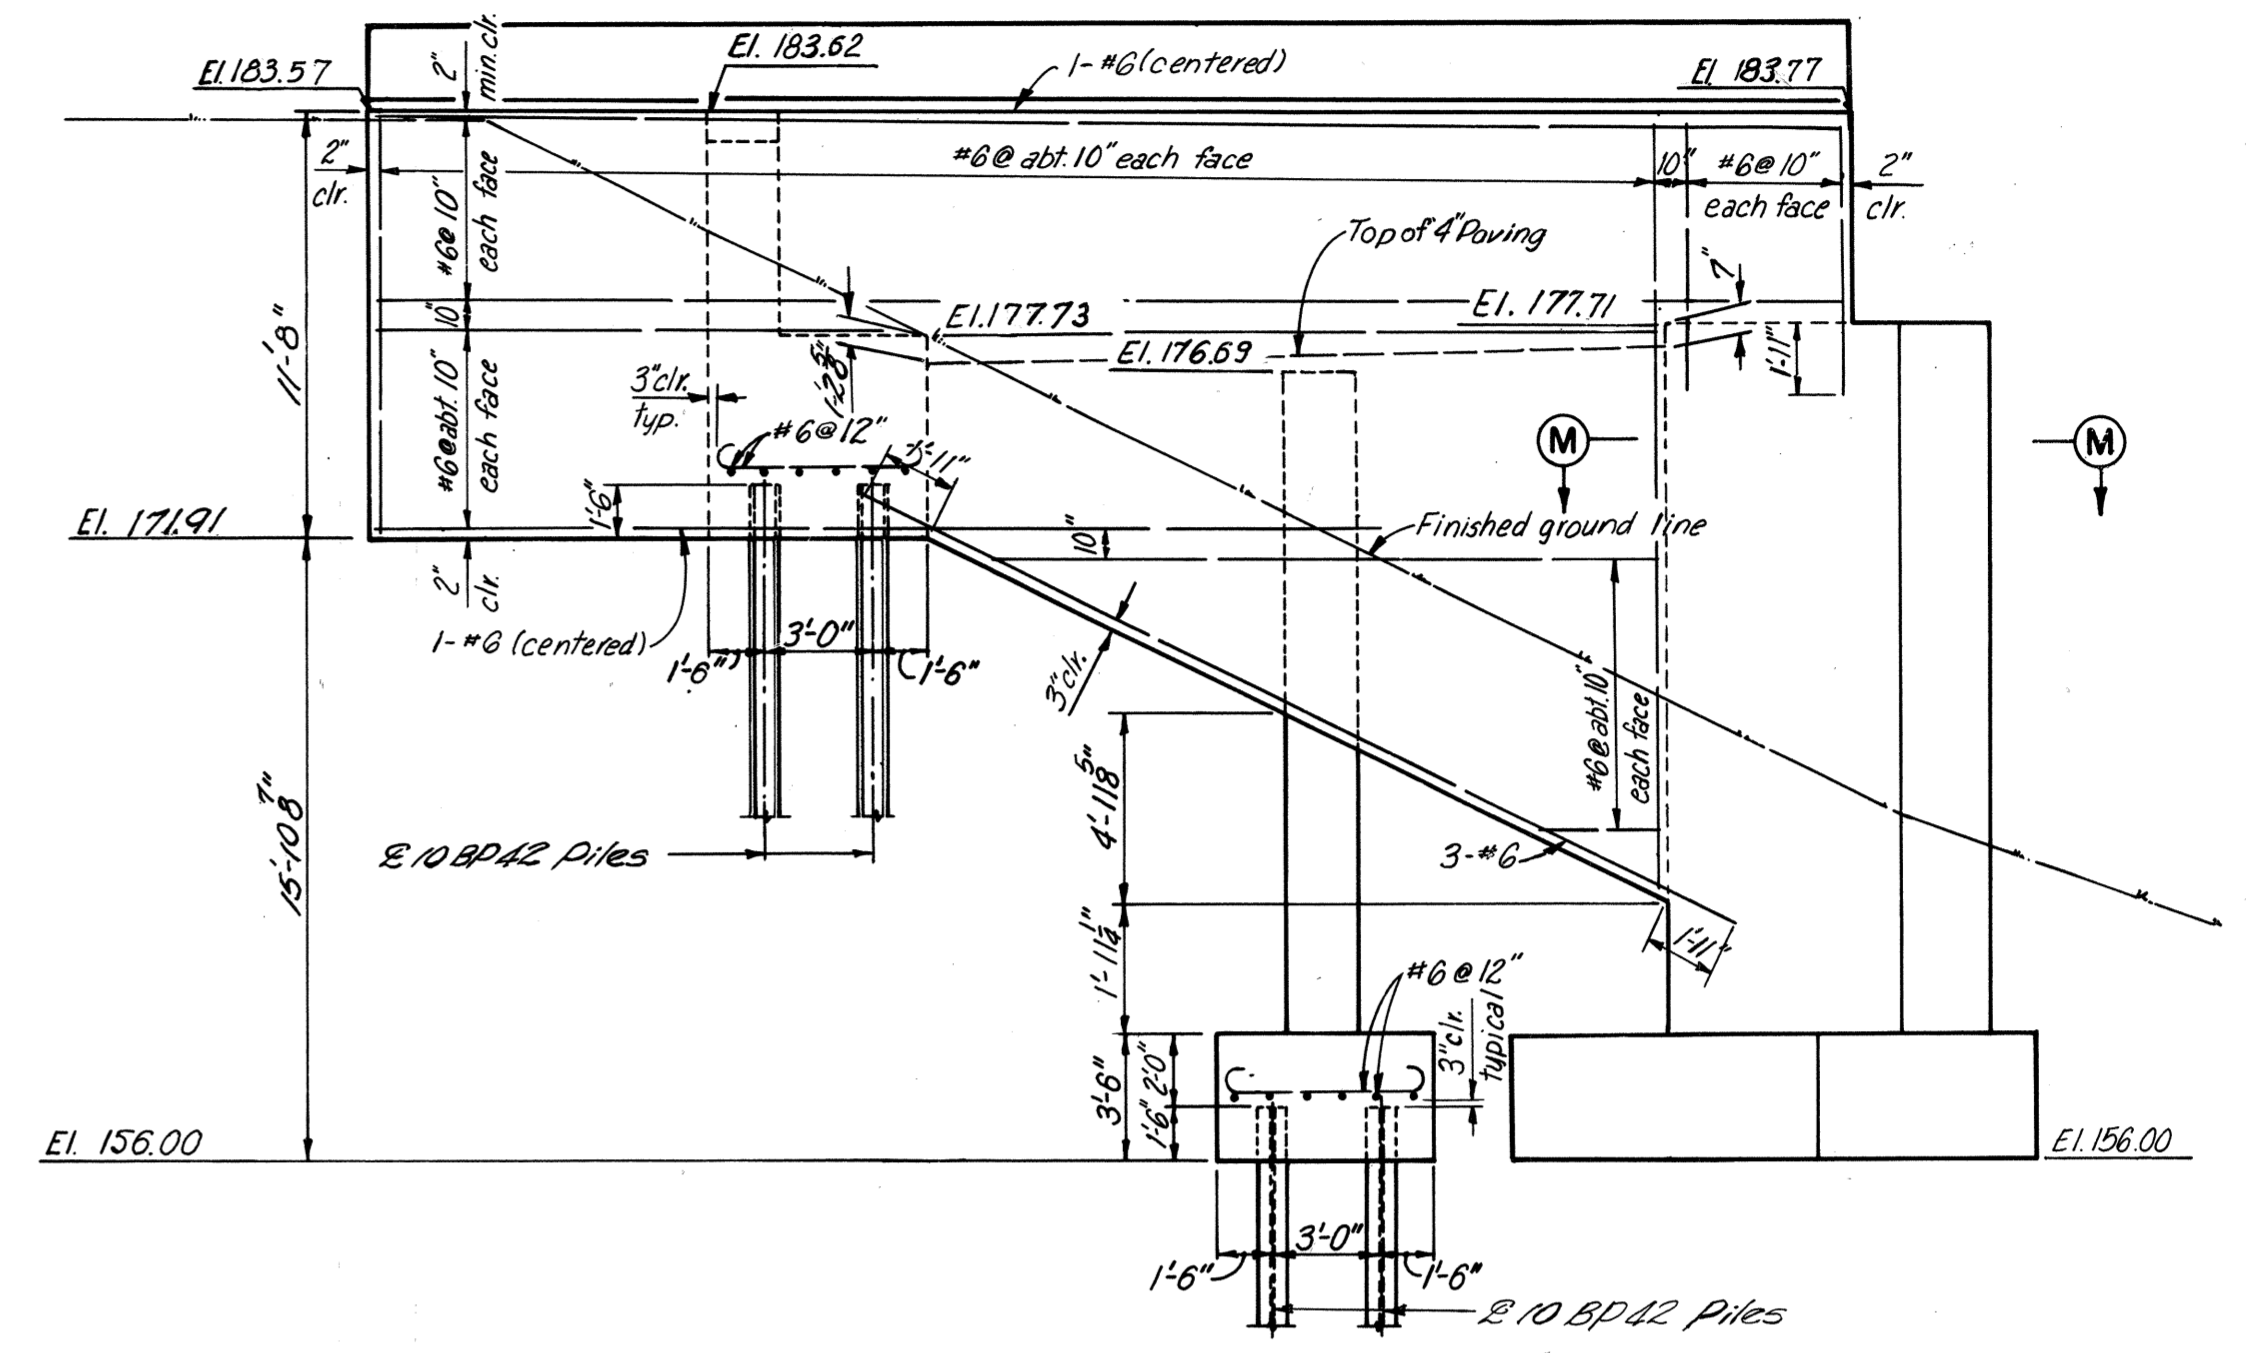

EAST WINGWALL ELEVATION
Scale 3/8" = 1'-0"

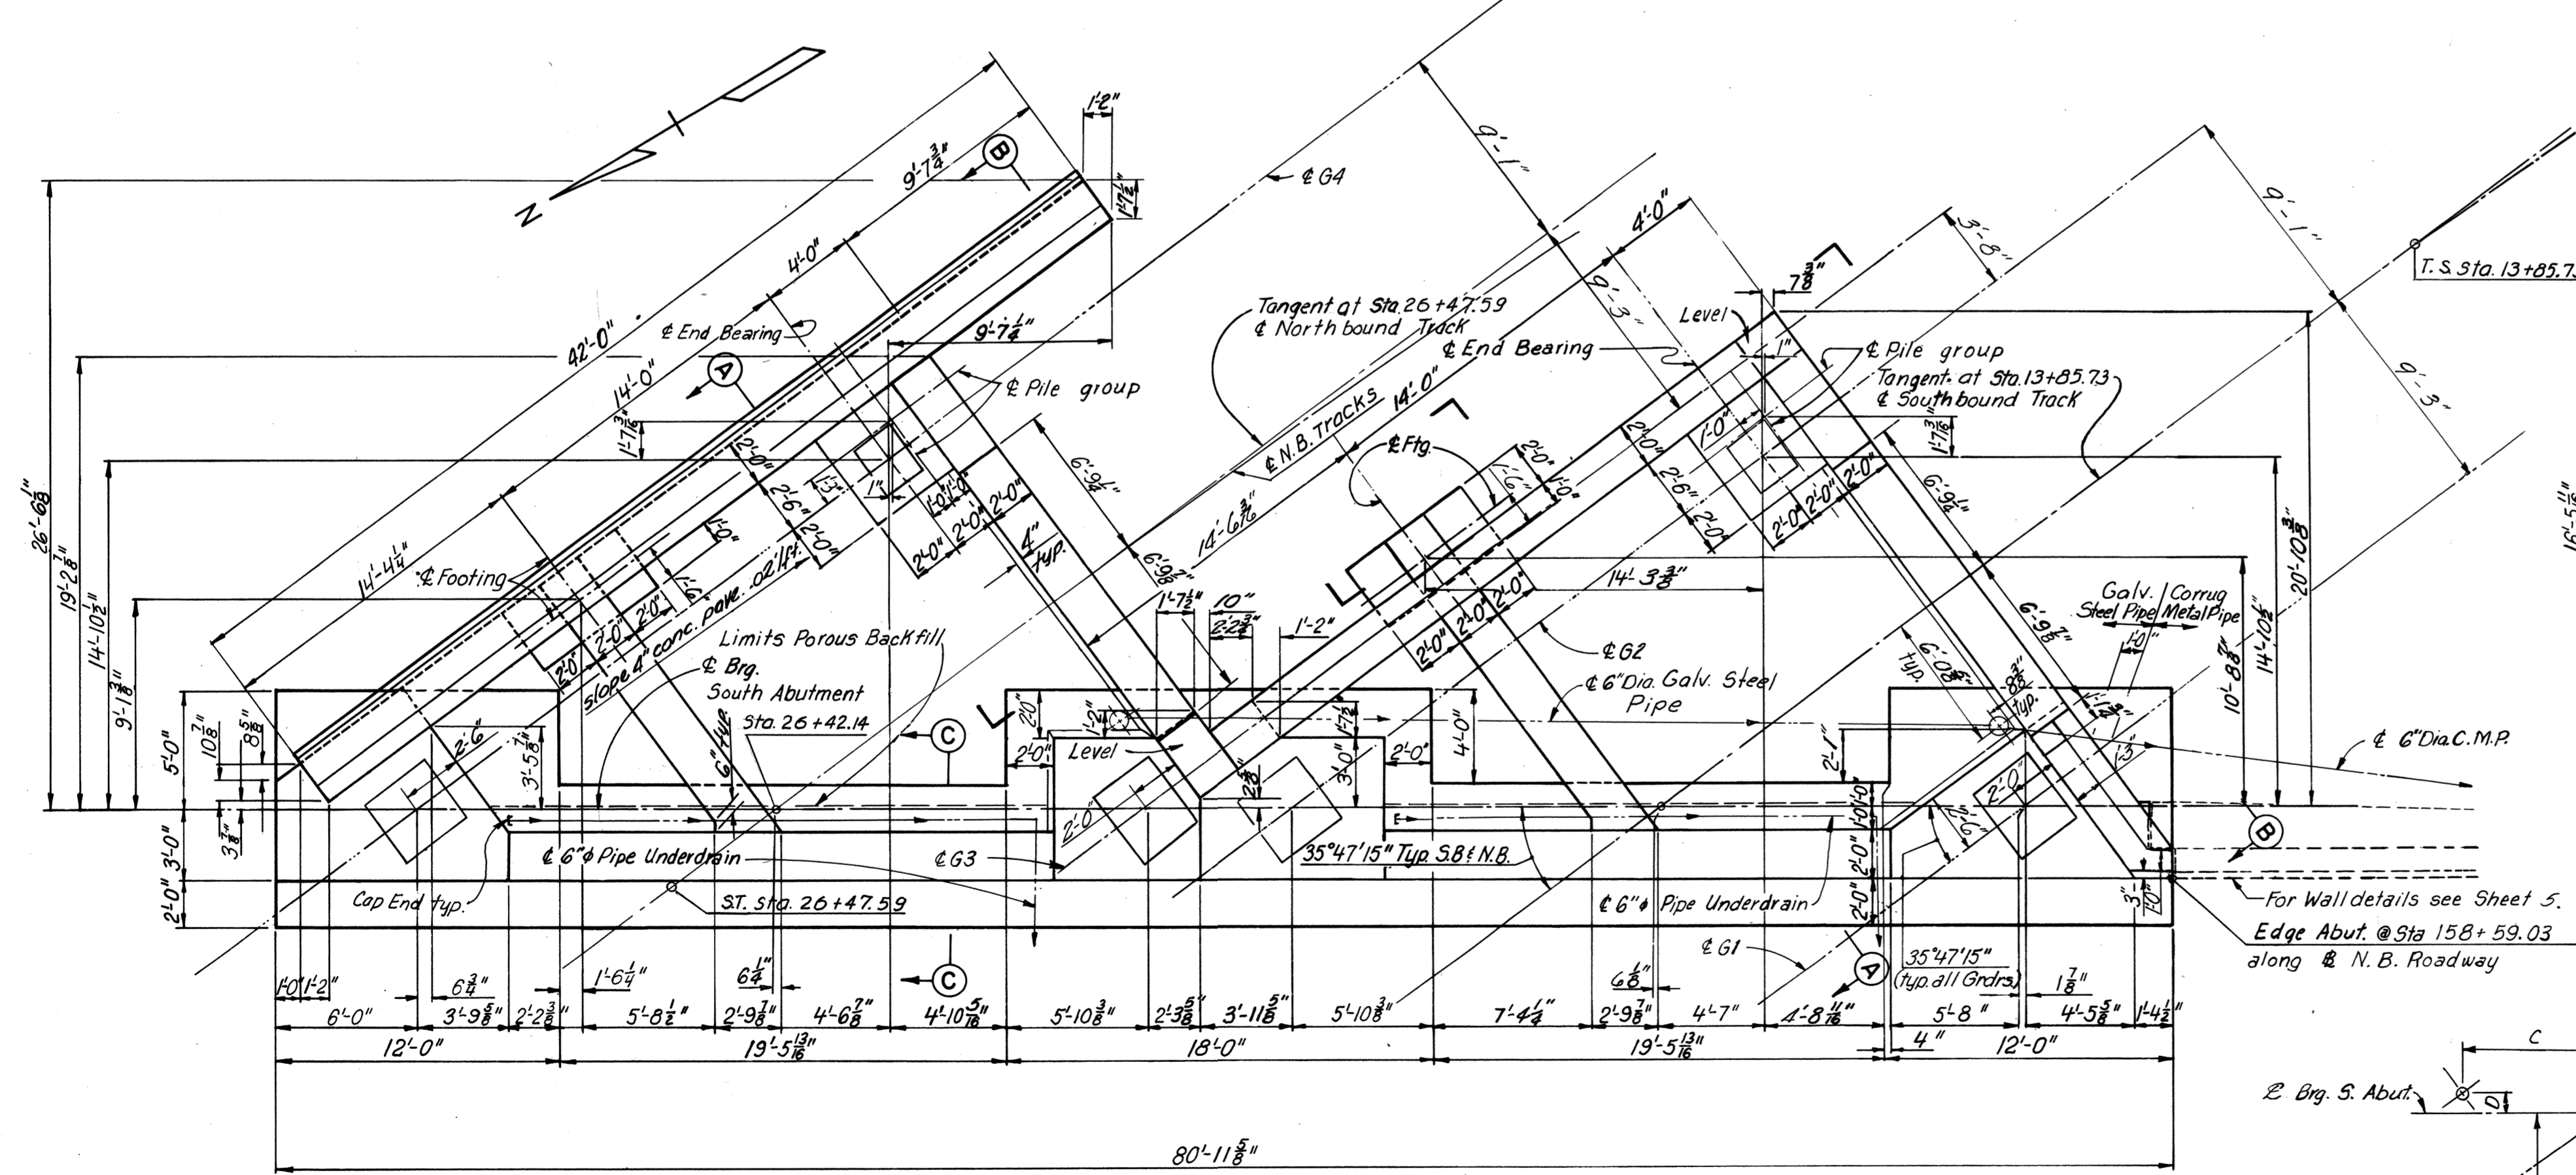

PLAN
Scale 3/16" = 1'-0"

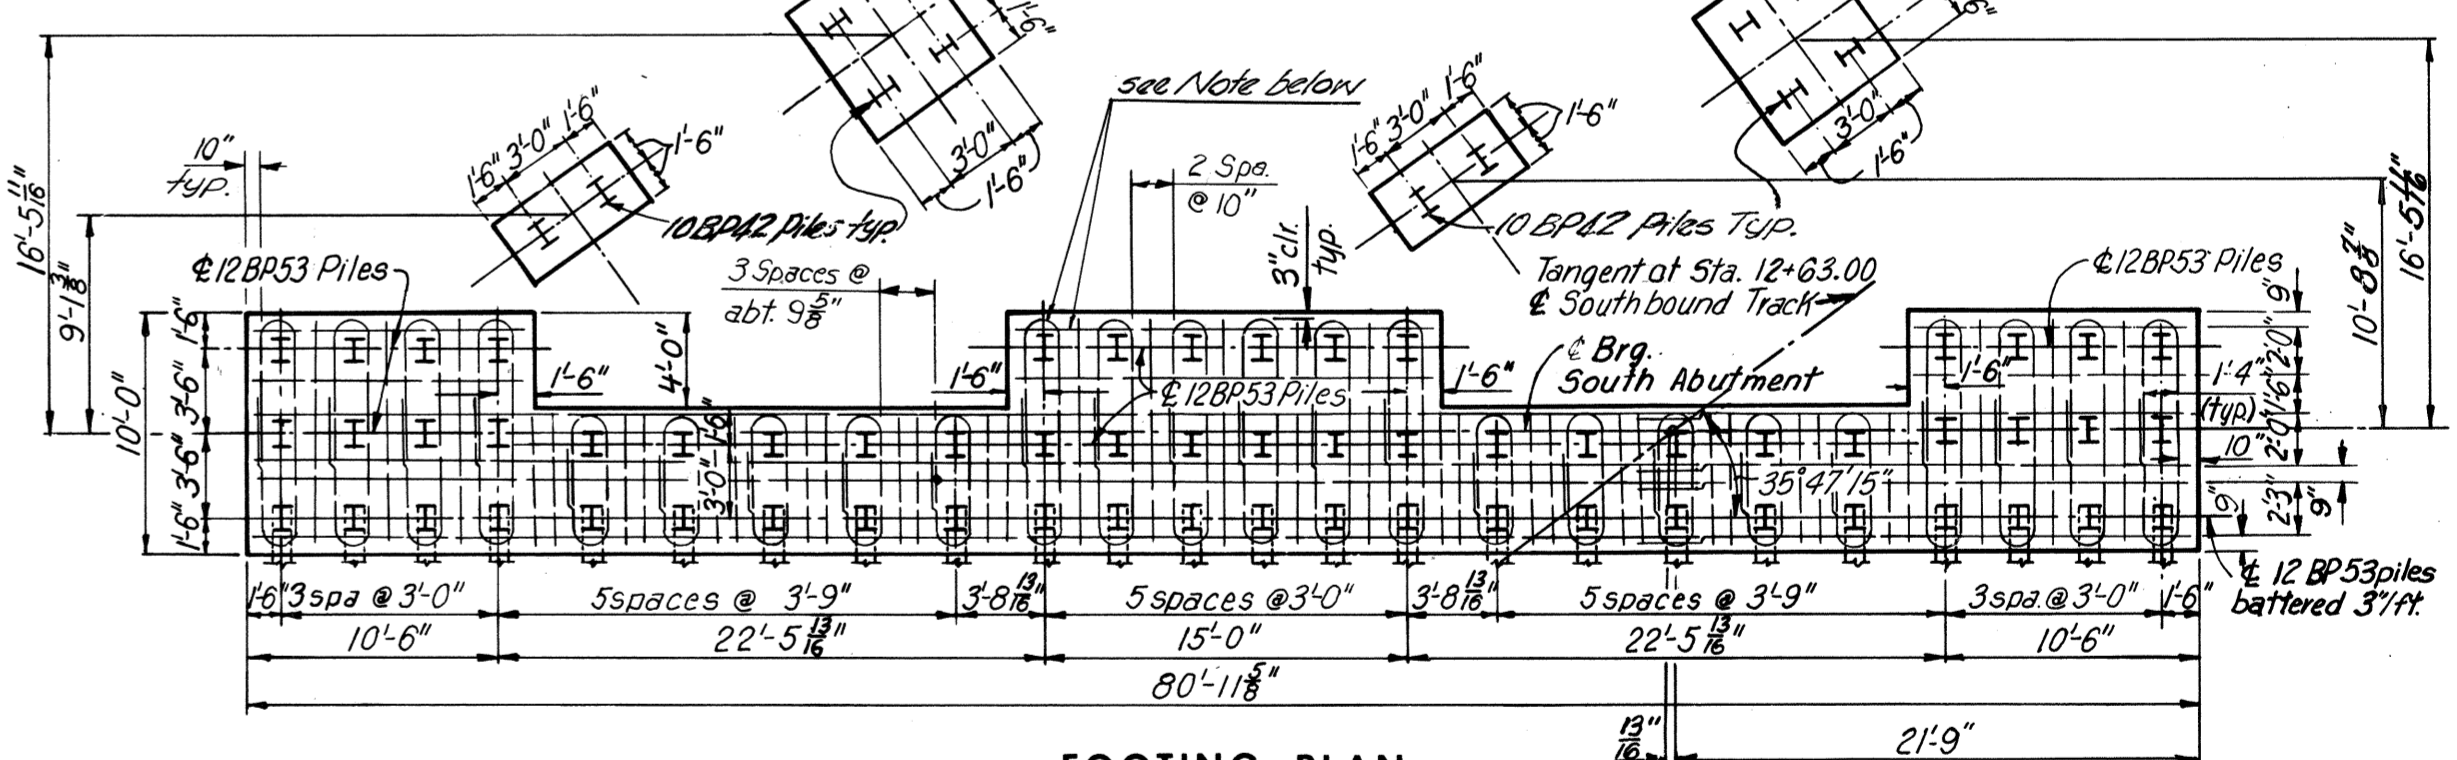

FOOTING PLAN
Scale 1/8" = 1'-0"

AS BUILT

Note: Stirrups around piles have a radius of 8" for the bends and a lap of 2'-6".
Reinforcing shown is typical for both top and bottom. All footing bars are #8 bars.

ANCHOR BOLT SETTING PLAN
No Scale

	A	B	C	D	E	F	G	H
1-EL Shoe	3 3/4"	1-1 1/8"	1-1 1/8"	3 3/4"	—	—	—	—
1-F Shoe	1 3/8"	7 1/8"	1-2 1/8"	1-7 1/8"	5 3/8"	2 3/4"	1-0 1/8"	1-8 3/8"

ANCHOR BOLT SETTING PLAN
No Scale

BY	DATE	3	As Built	JRC	3-73
MADE	RLM	2-21-68	2	Profile Grade	P.S. 4-12-71
CHECKED	AMH	5-9-68	1	General Checking	AMH 5-13-68
IN CHARGE	FKD		NO.	REVISION	BY DATE



Note: 6" Dia. Pipe Underdrain going thru front wall of Abutment, is to connect with tee to Sta. UD-1 under N.B. Roadway. See Roadway Plans.

RICHMOND METROPOLITAN AUTHORITY
RICHMOND EXPRESSWAY SYSTEM
BELTLINE EXPRESSWAY
BRIDGE NO. 9
R.F.&P.R.R. OVER
NORTHBOUND ROADWAY
SOUTH ABUTMENT

HOWARD, NEEDLES, TAMMEN & BERGENDOFF
consulting engineers
NEW YORK ALEXANDRIA KANSAS CITY


SCALE: As noted
CONTRACT NO. 4
SHEET NO. 4 OF 12

RICHMOND EXPRESSWAY SYSTEM			
SECTION	PROJECT	SHEET NO.	TOTAL SHEETS
4	BELTLINE EXP.	98A	155

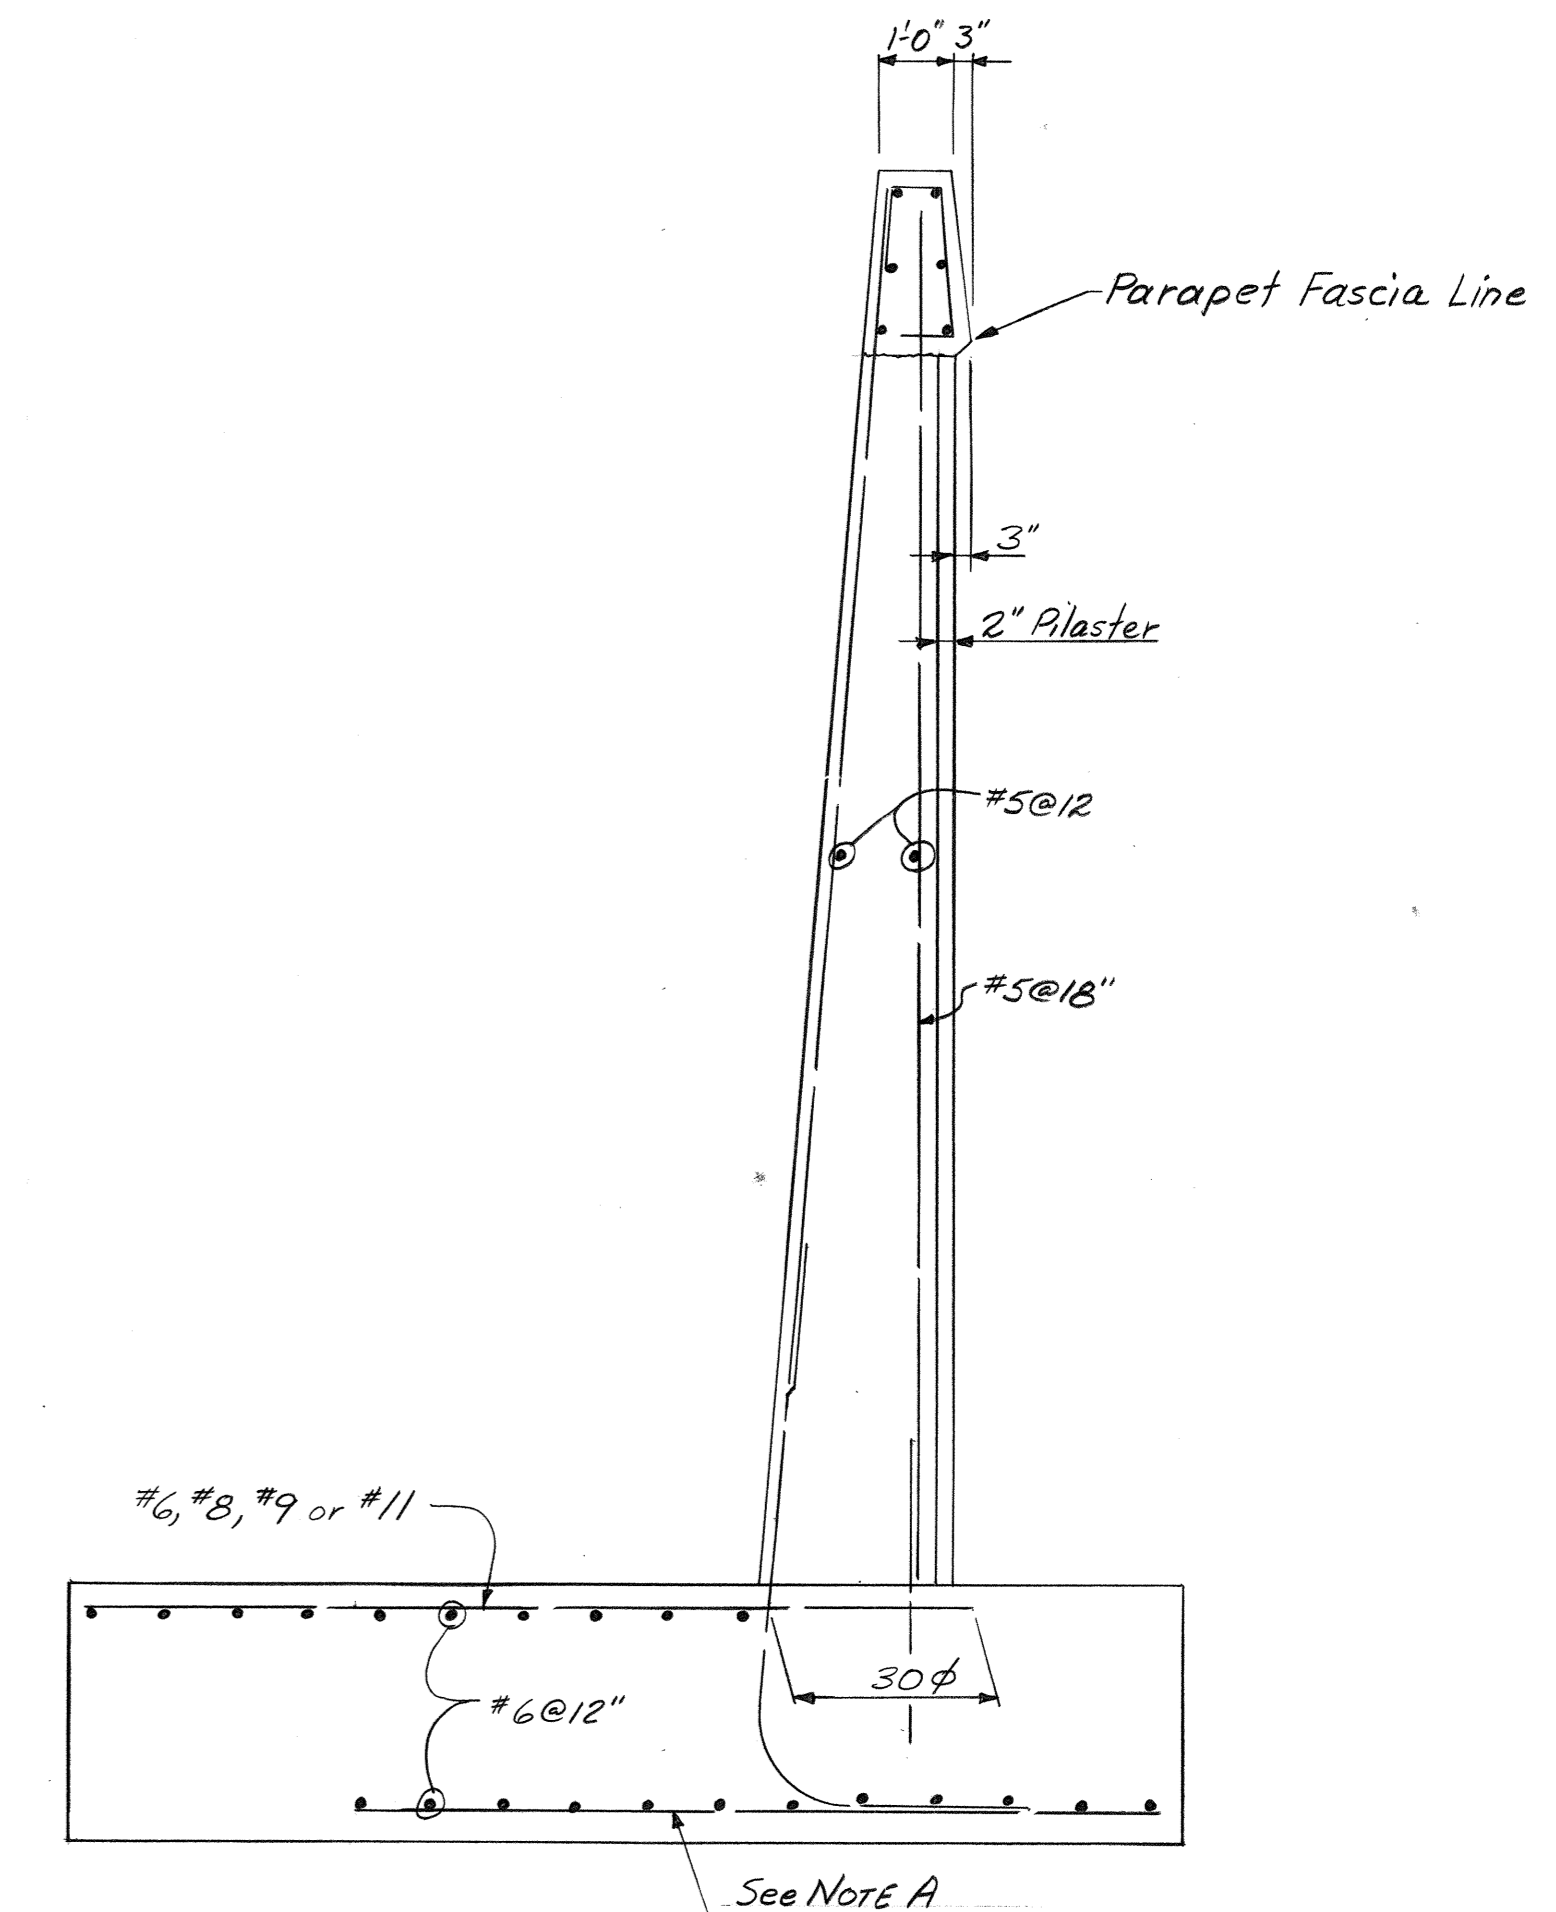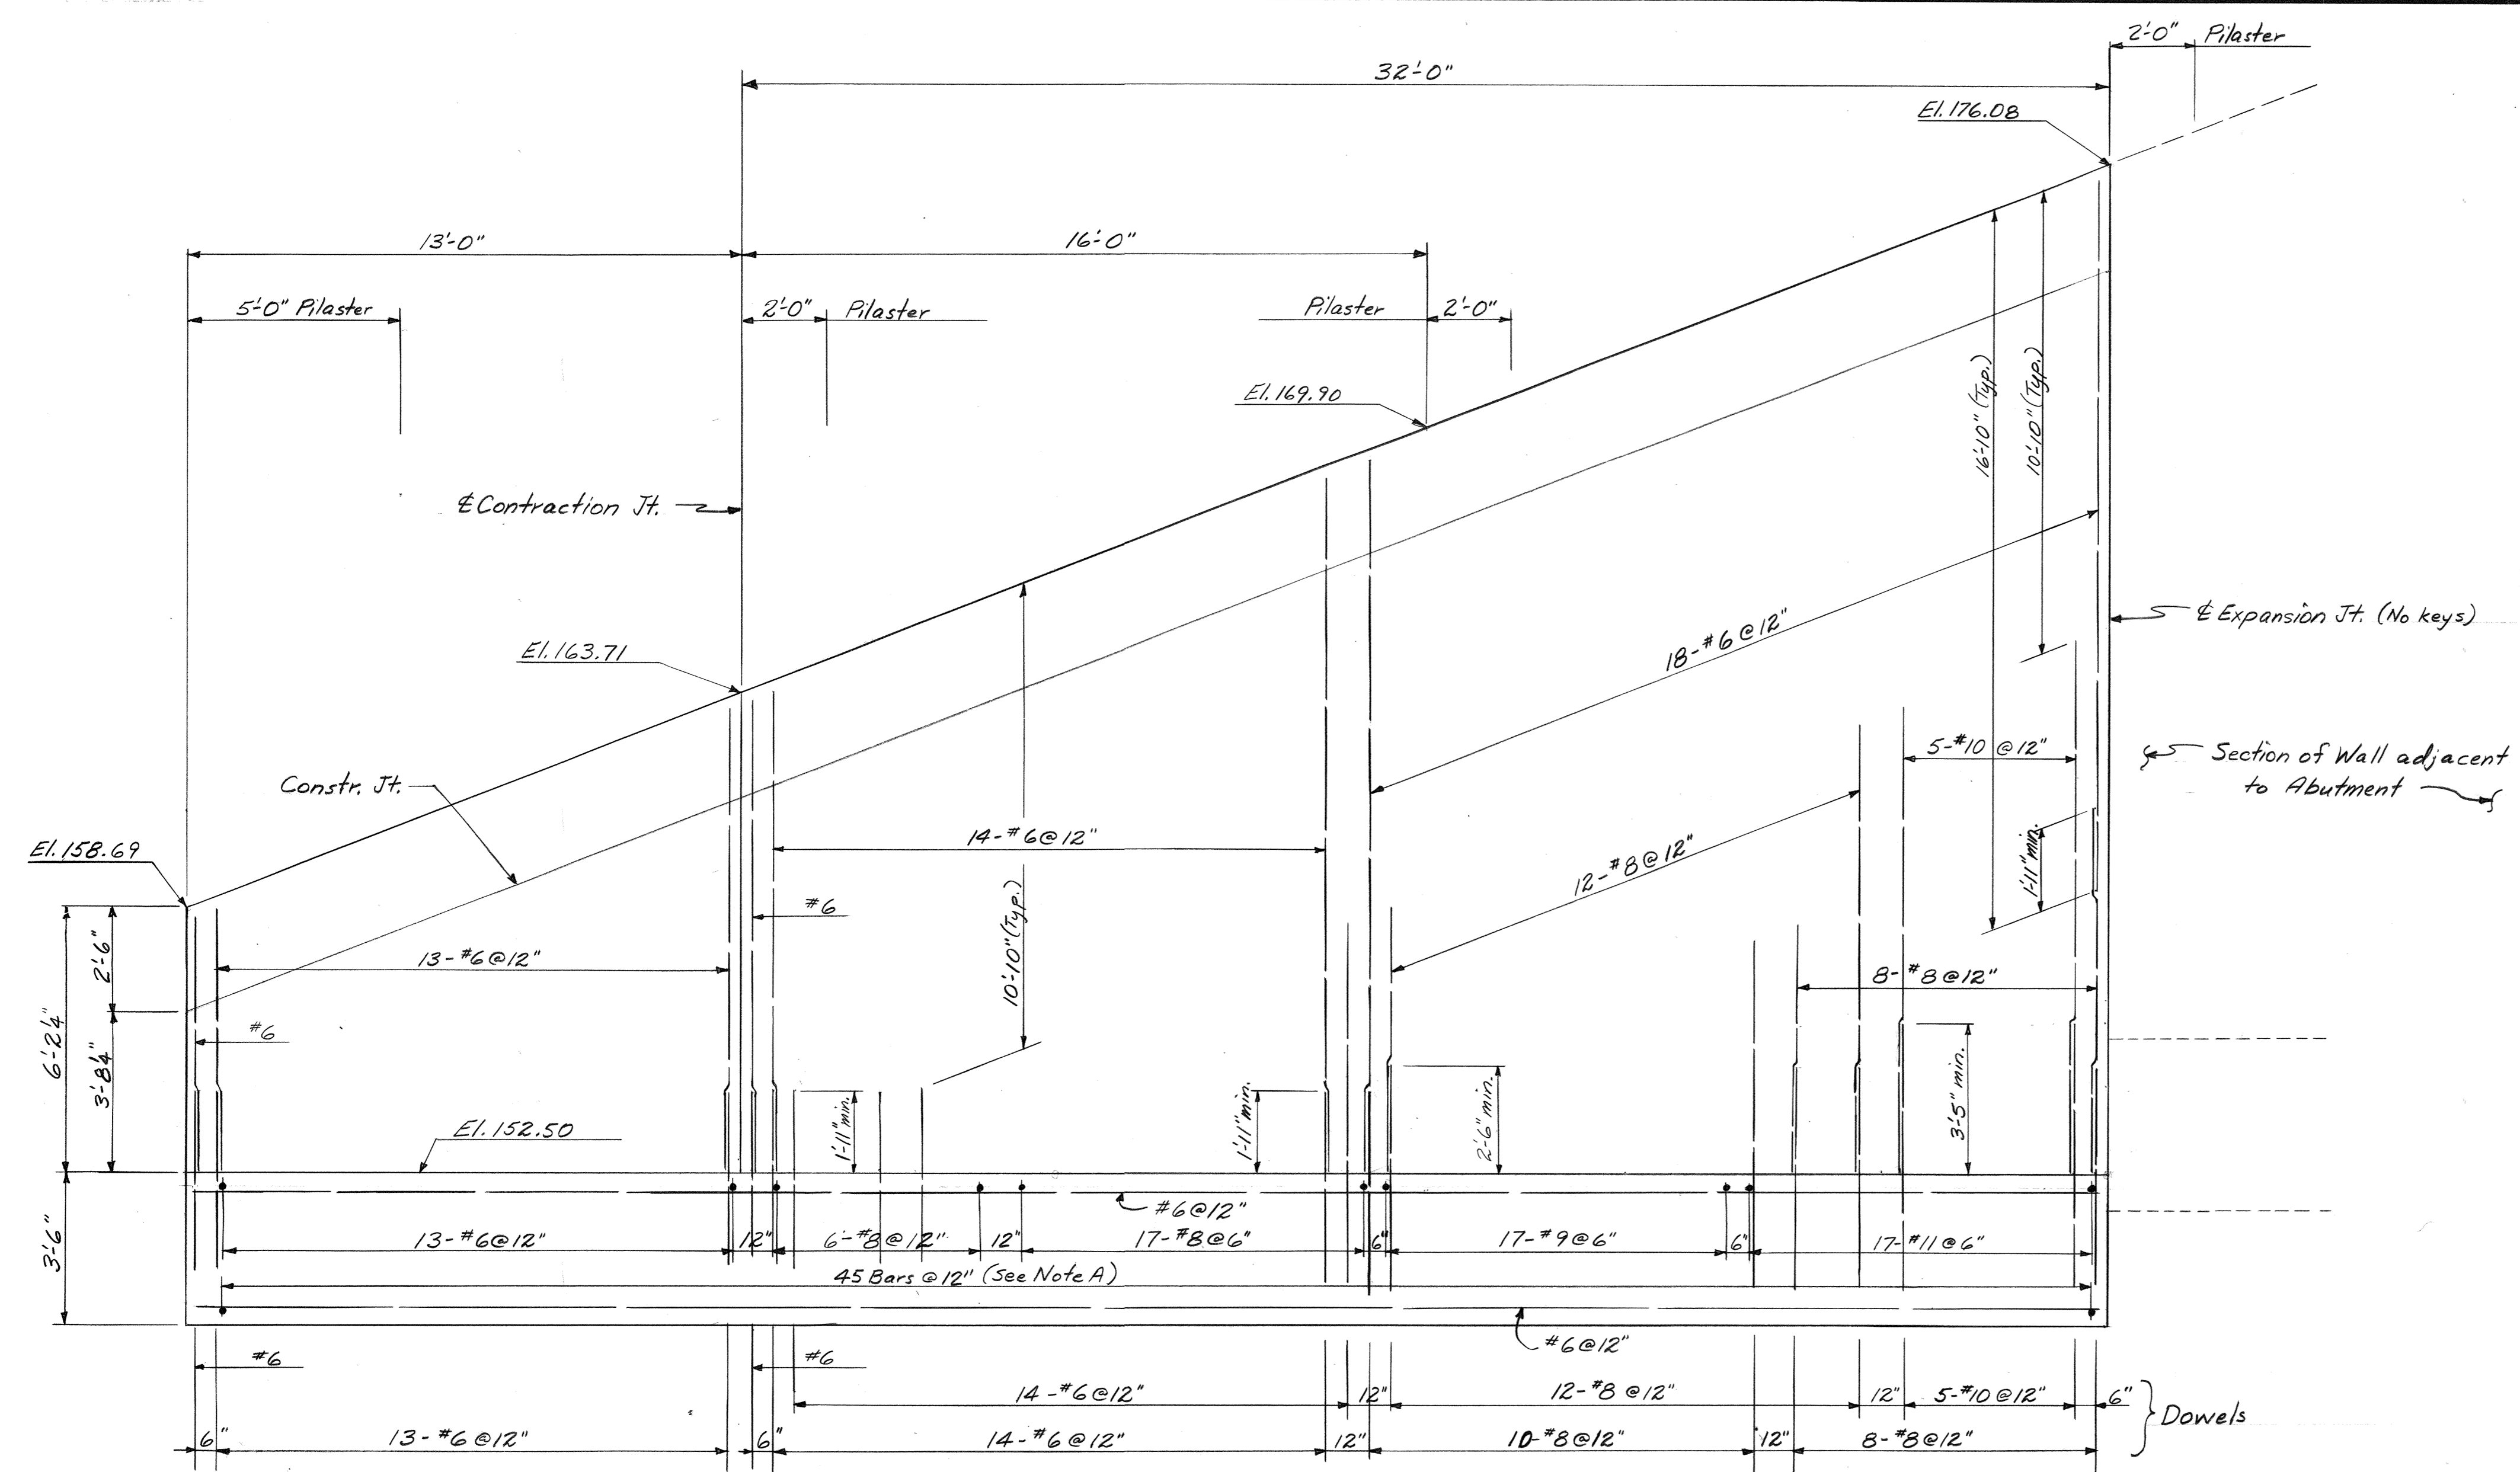

TYPICAL SECTION

ELEVATION
All stem reinforcing and dowels shown for fill face.

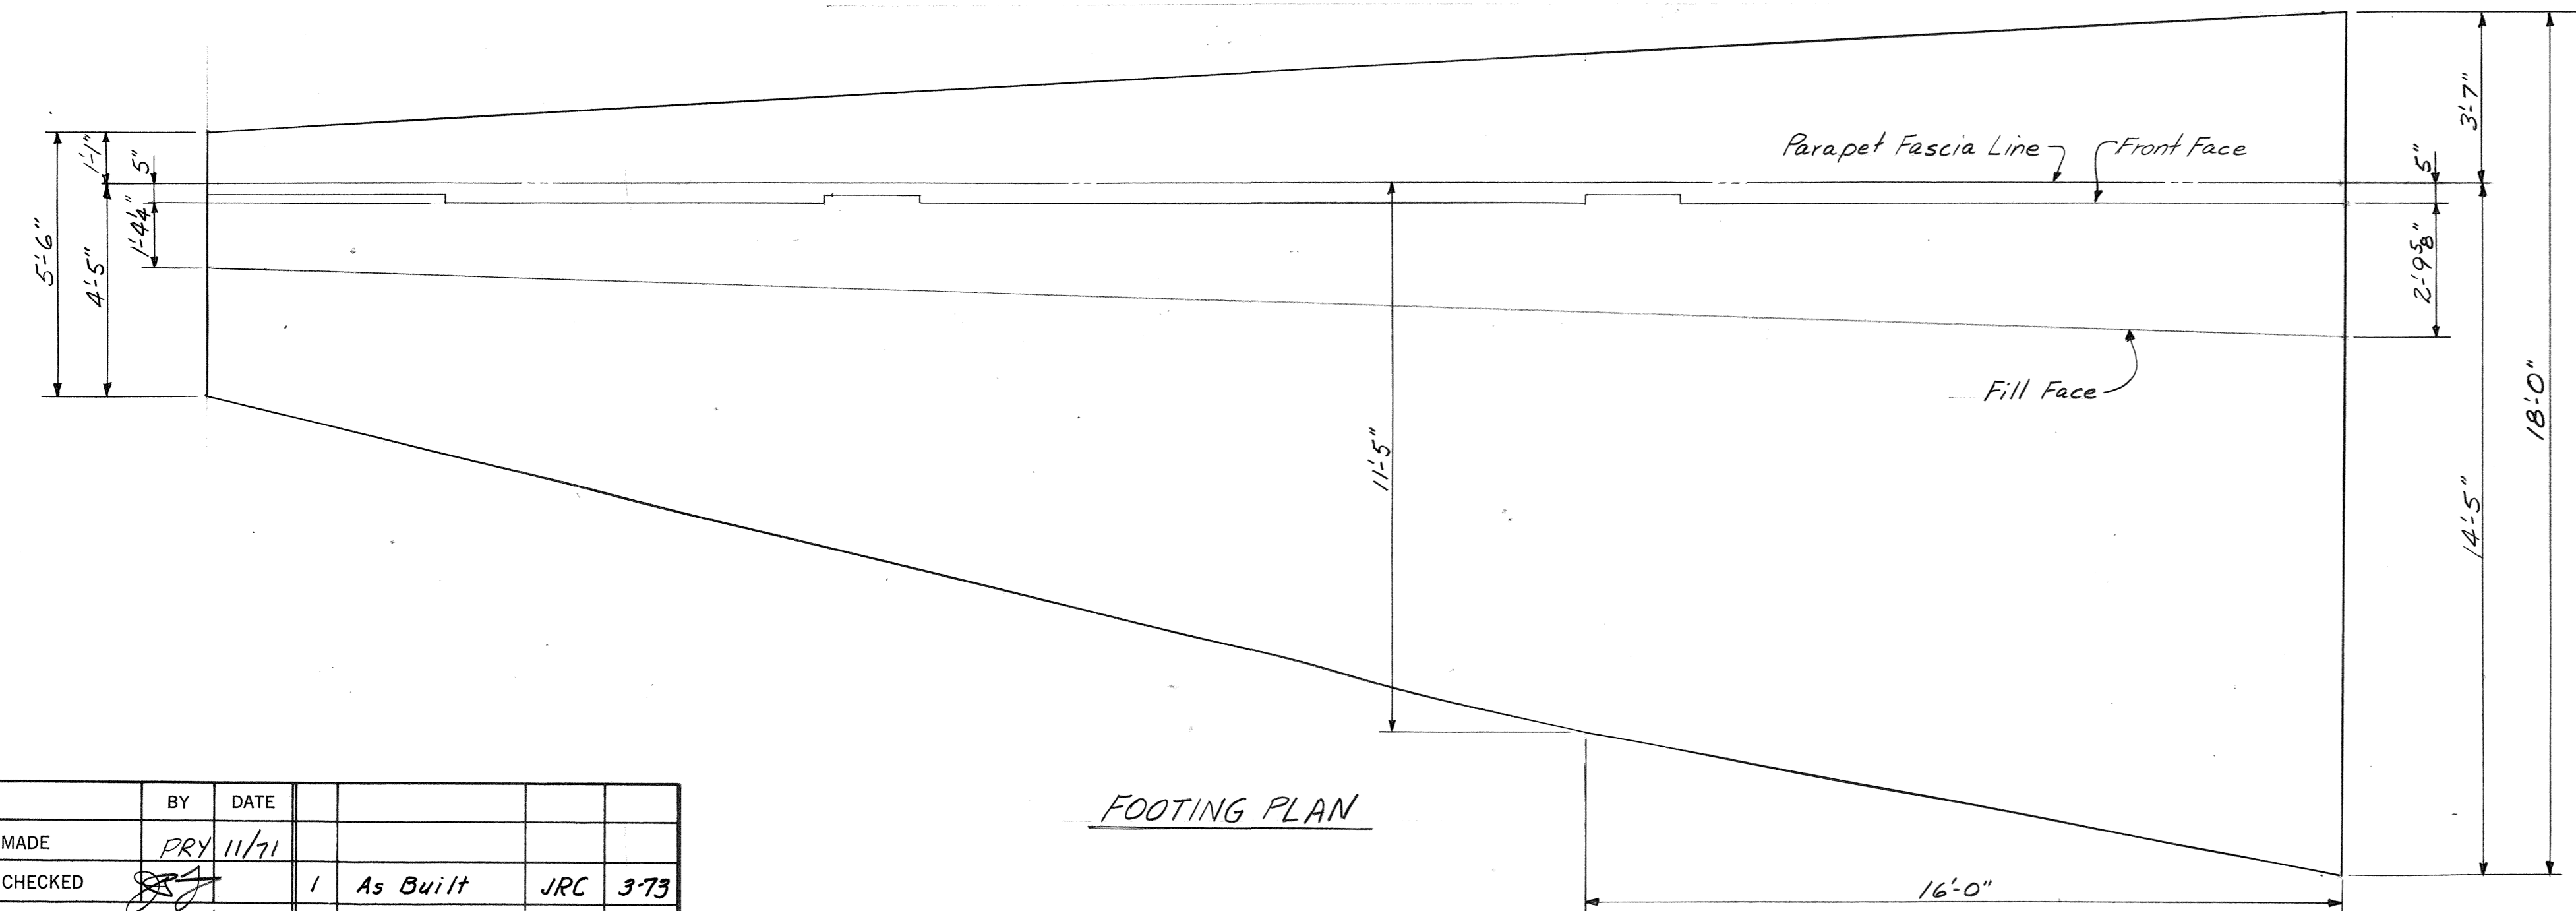

FOOTING PLAN

Note:
Horizontal stem steel, parapet bars and front face vertical bars & dowels are same as original except for increased quantity and/or length due to increased stem height.

NOTE A:
Use original transverse footing steel to the maximum extent possible. Place steel forward into the toe leaving the lower rear of the footing unreinforced if necessary. At the low end of the wall, salvage the longer original #6 top bars for use in the bottom as required.

AS BUILT

RICHMOND METROPOLITAN AUTHORITY
RICHMOND EXPRESSWAY SYSTEM






BRIDGE No. 9
R.F. & P.R.R. OVER NORTHBOUND ROADWAY
REVISED PORTION
SOUTH ABUTMENT RETAINING WALL

HOWARD, NEEDLES, TAMMEN & BERGENDOFF
consulting engineers
NEW YORK ALEXANDRIA KANSAS CITY

SCALE: 3/8" = 1'-0"
CONTRACT NO.: 4
SHEET NO. 5A OF 12



MADE	BY	DATE	NO.	REVISION	BY	DATE
	PRY	11/71				
CHECKED			1	As Built	JRC	3-73
IN CHARGE	PRY					

Note: For detail of connection of 6" Dia. C.M.P. to Concrete V-Gutter, see Detail C.

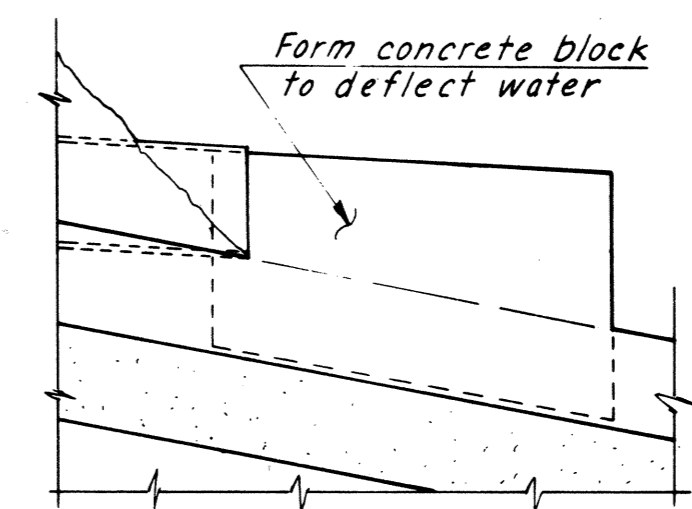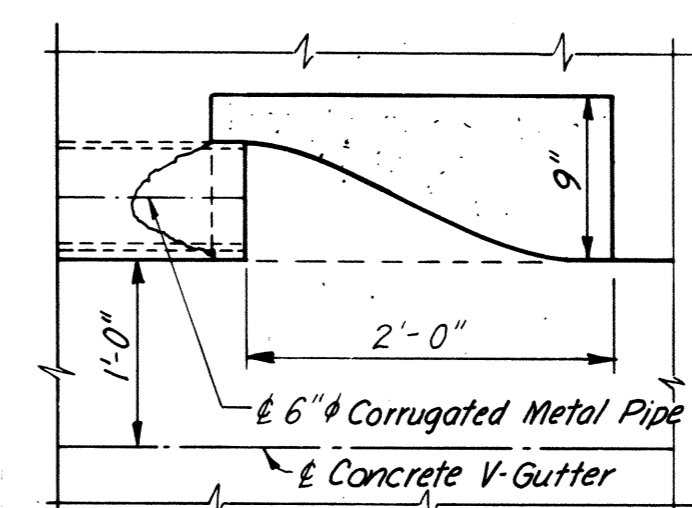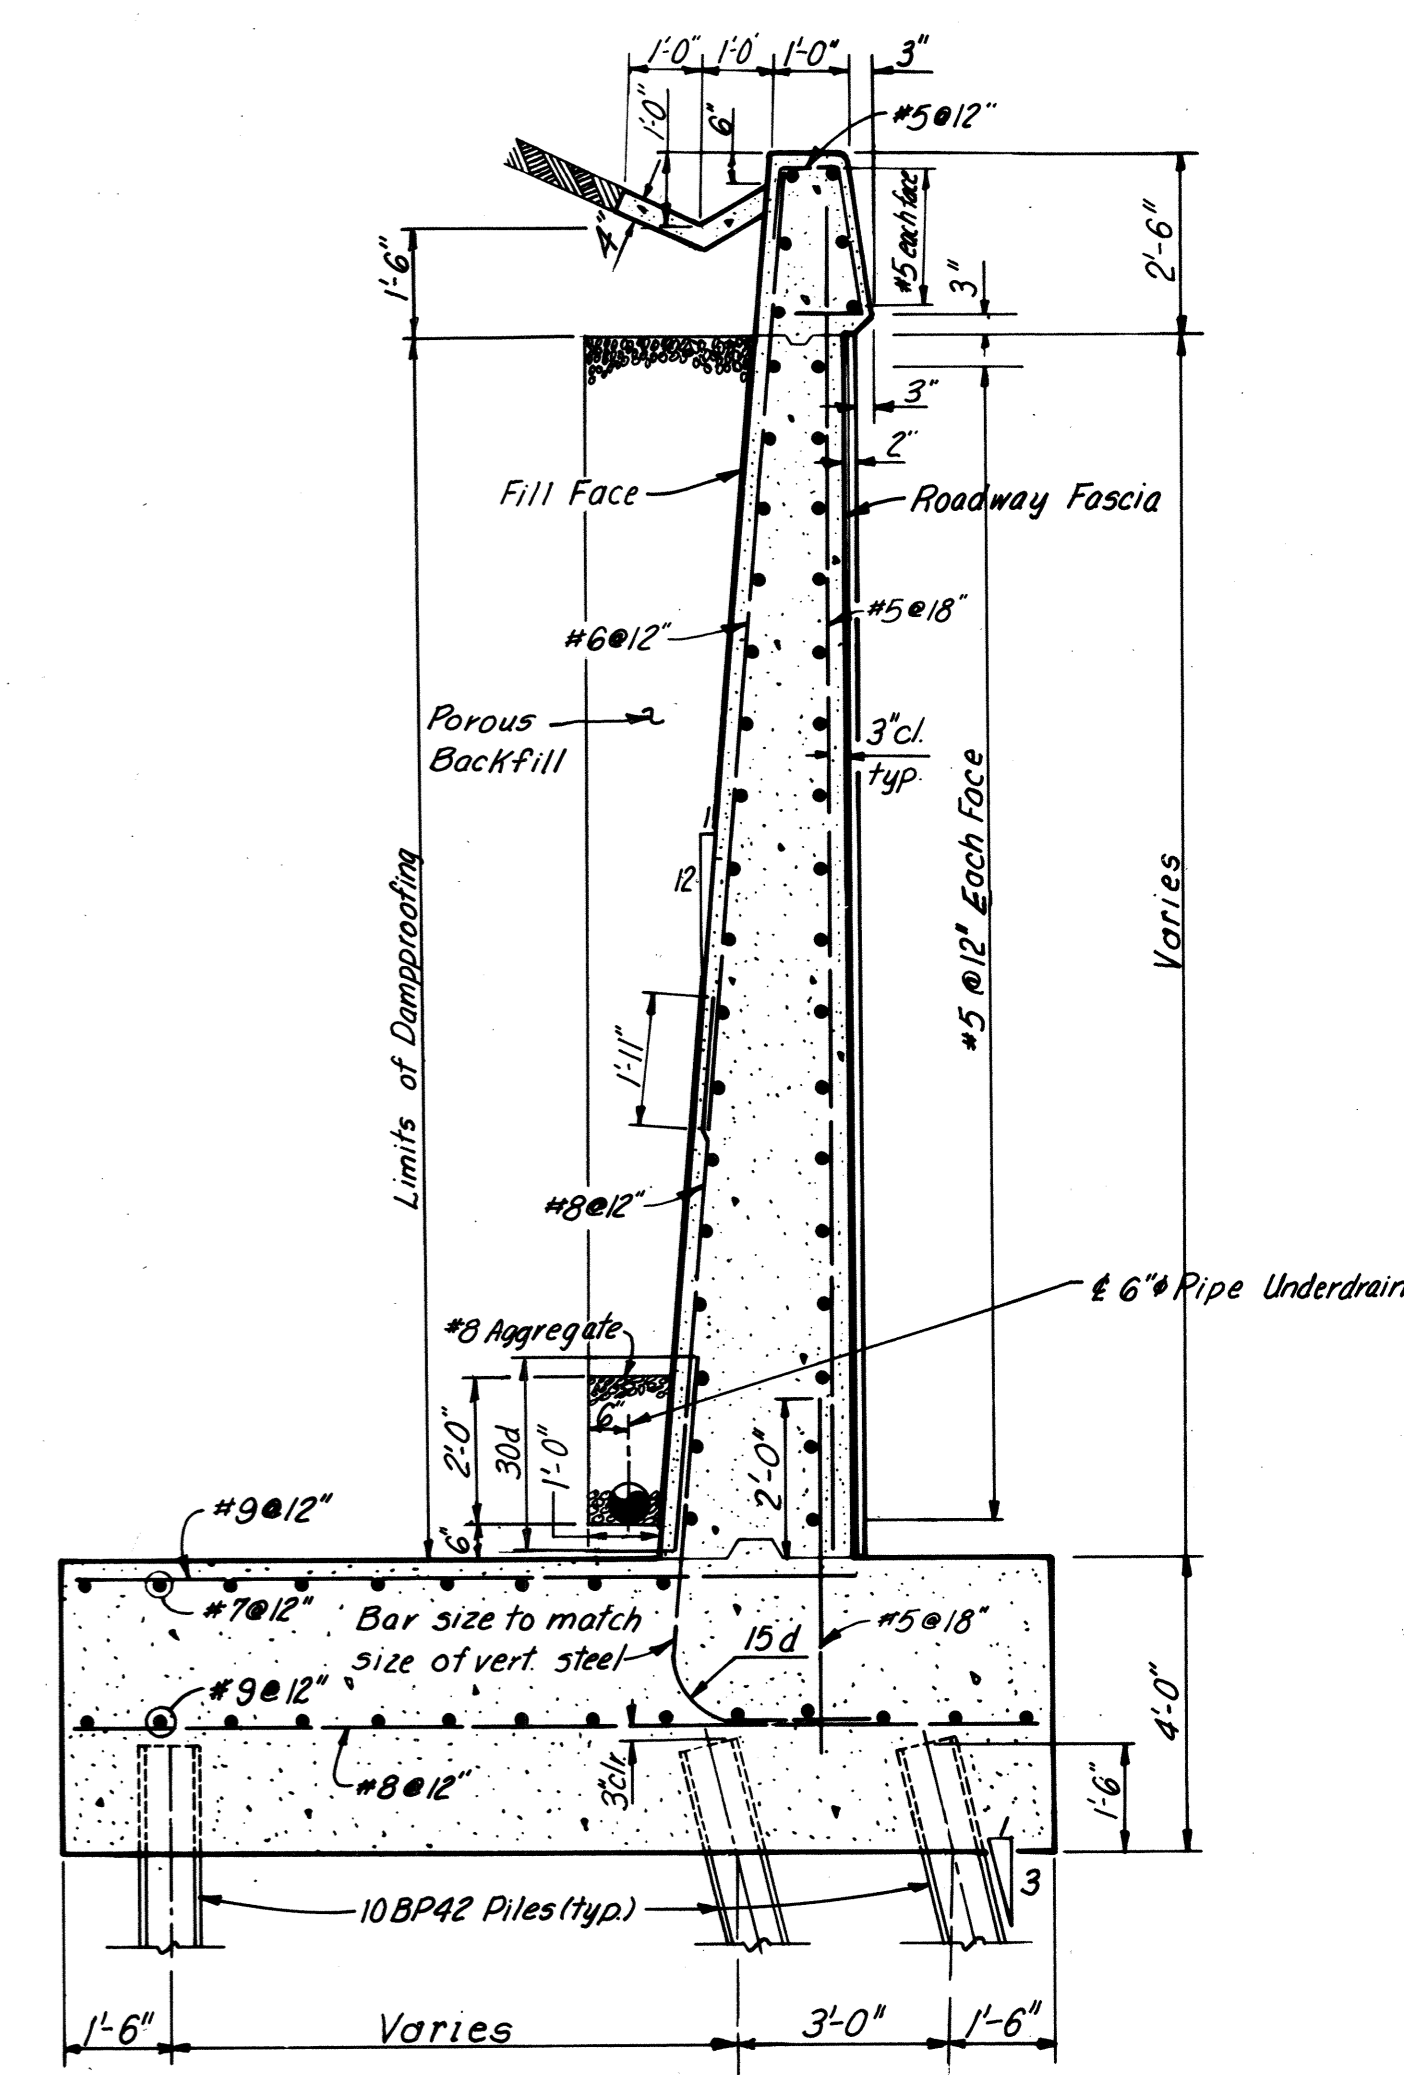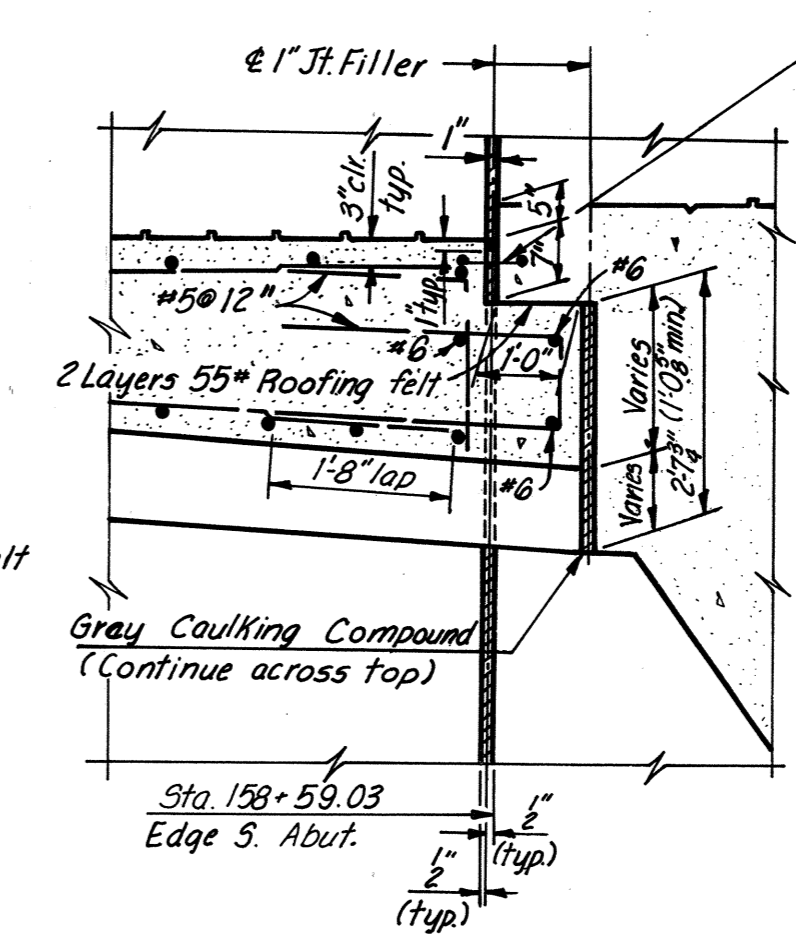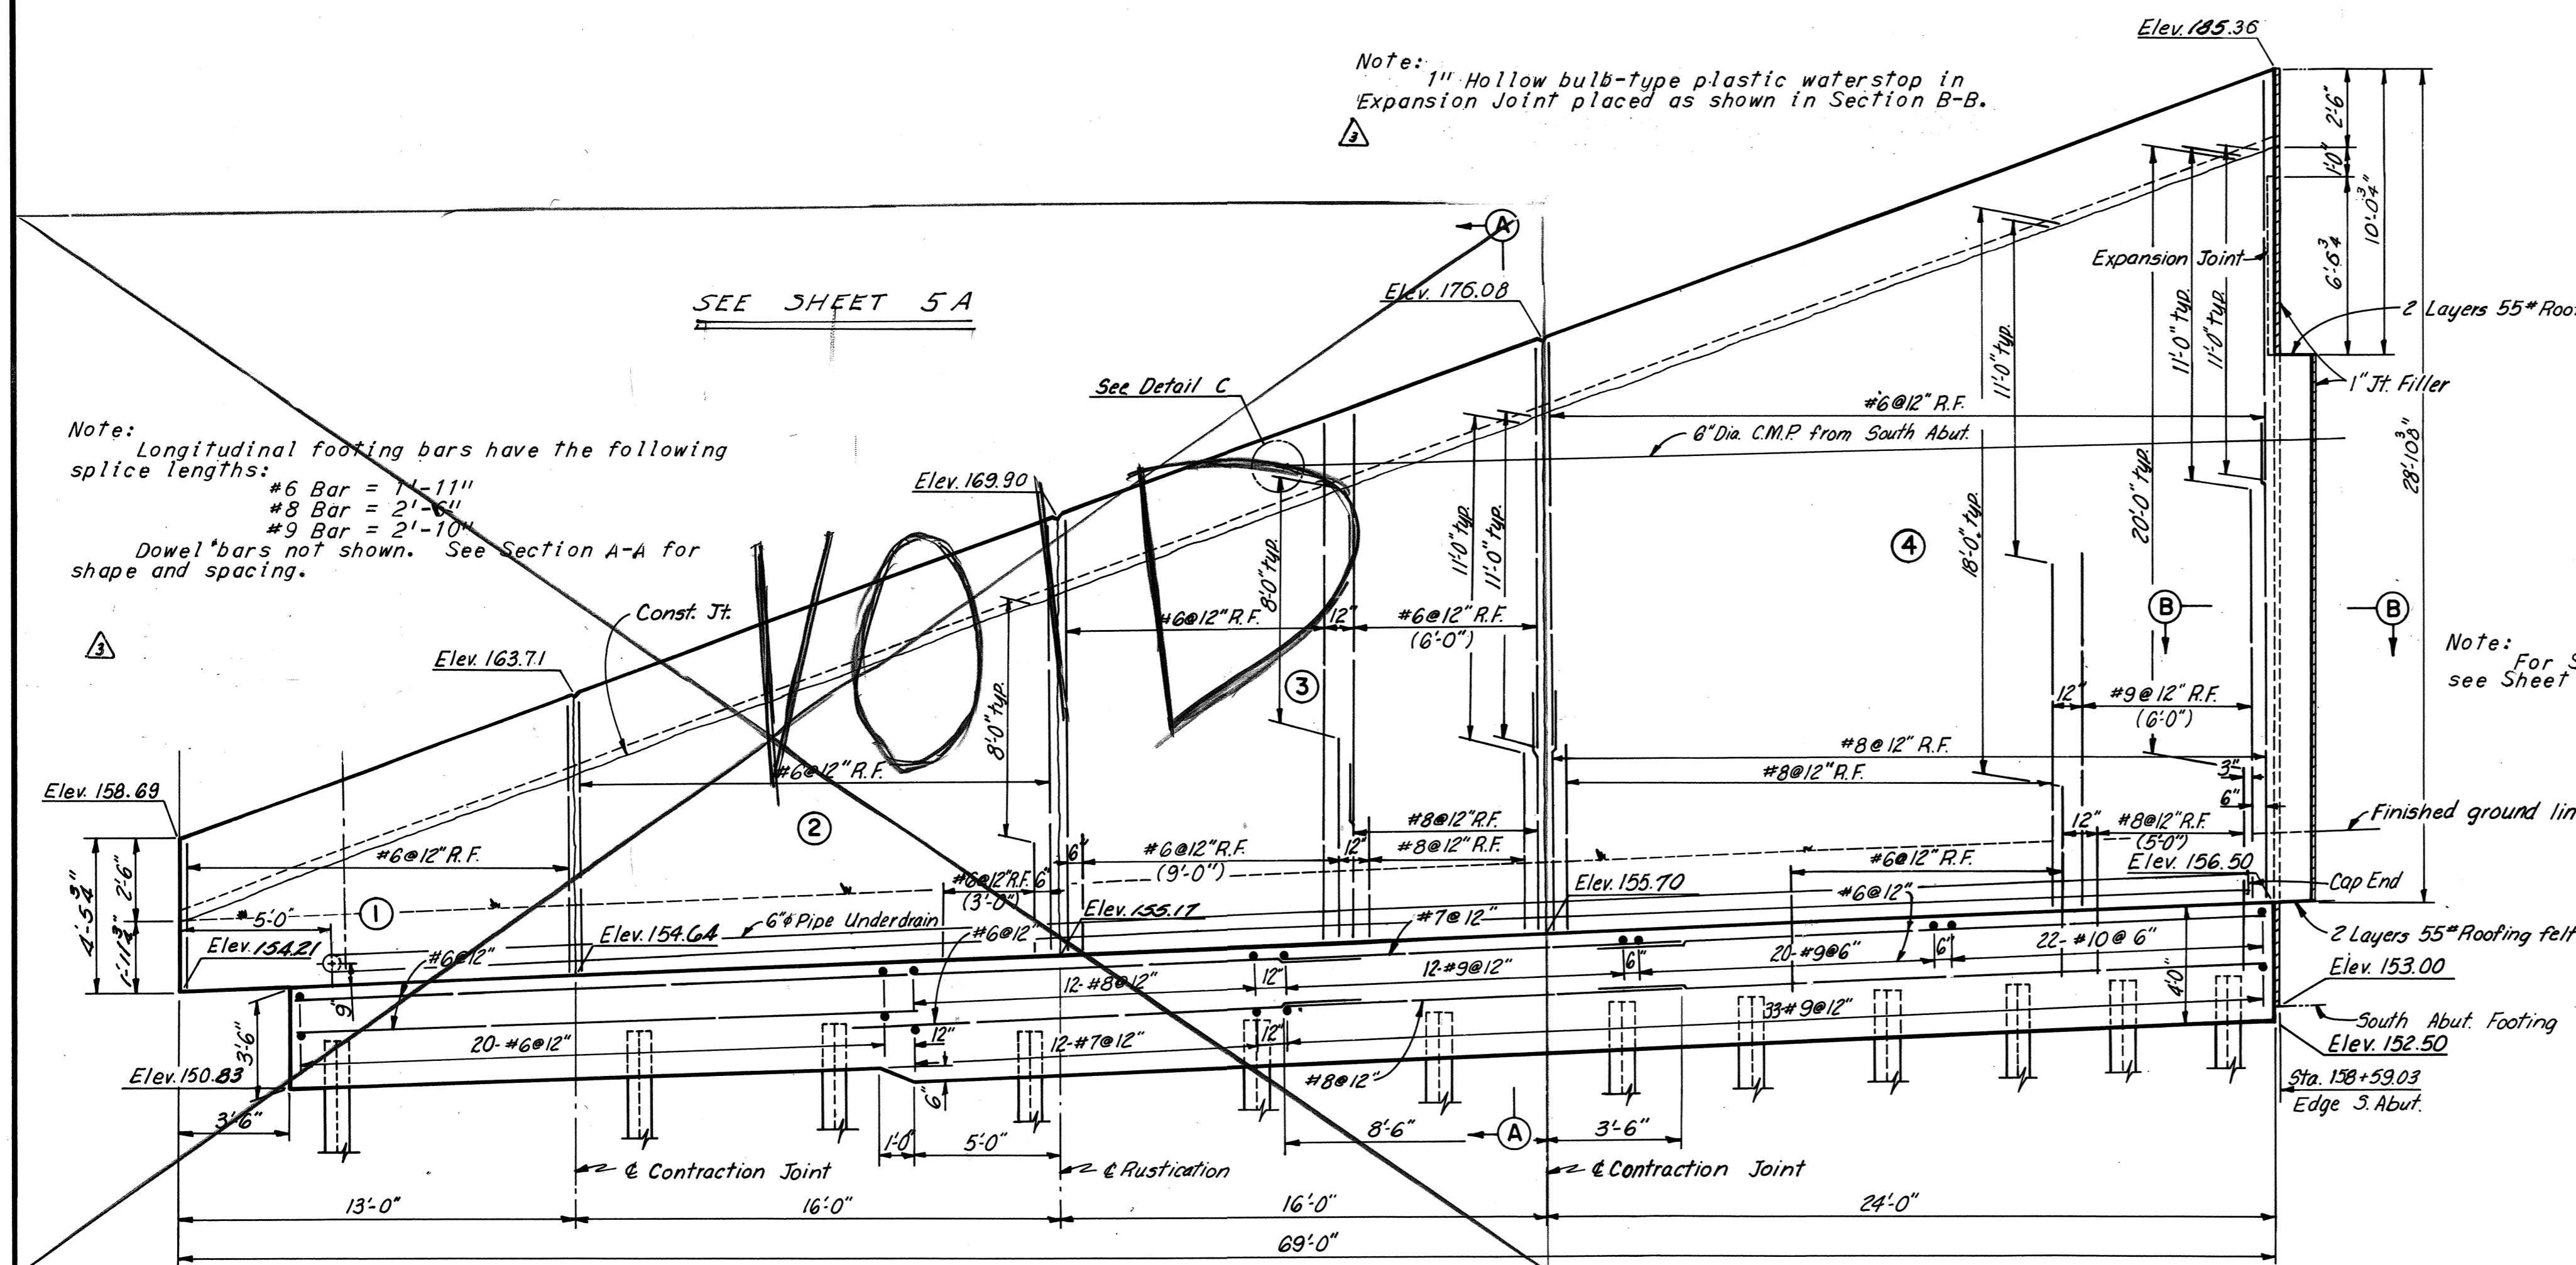

Note: 6" Dia. Pipe Underdrain going thru retaining wall, is to connect with tee to Std. UD-1 under N.B. Roadway. See Roadway Plans. Reinforcing to be shifted to miss underdrain going thru wall.

Legend: R.F. denotes Fill Face.

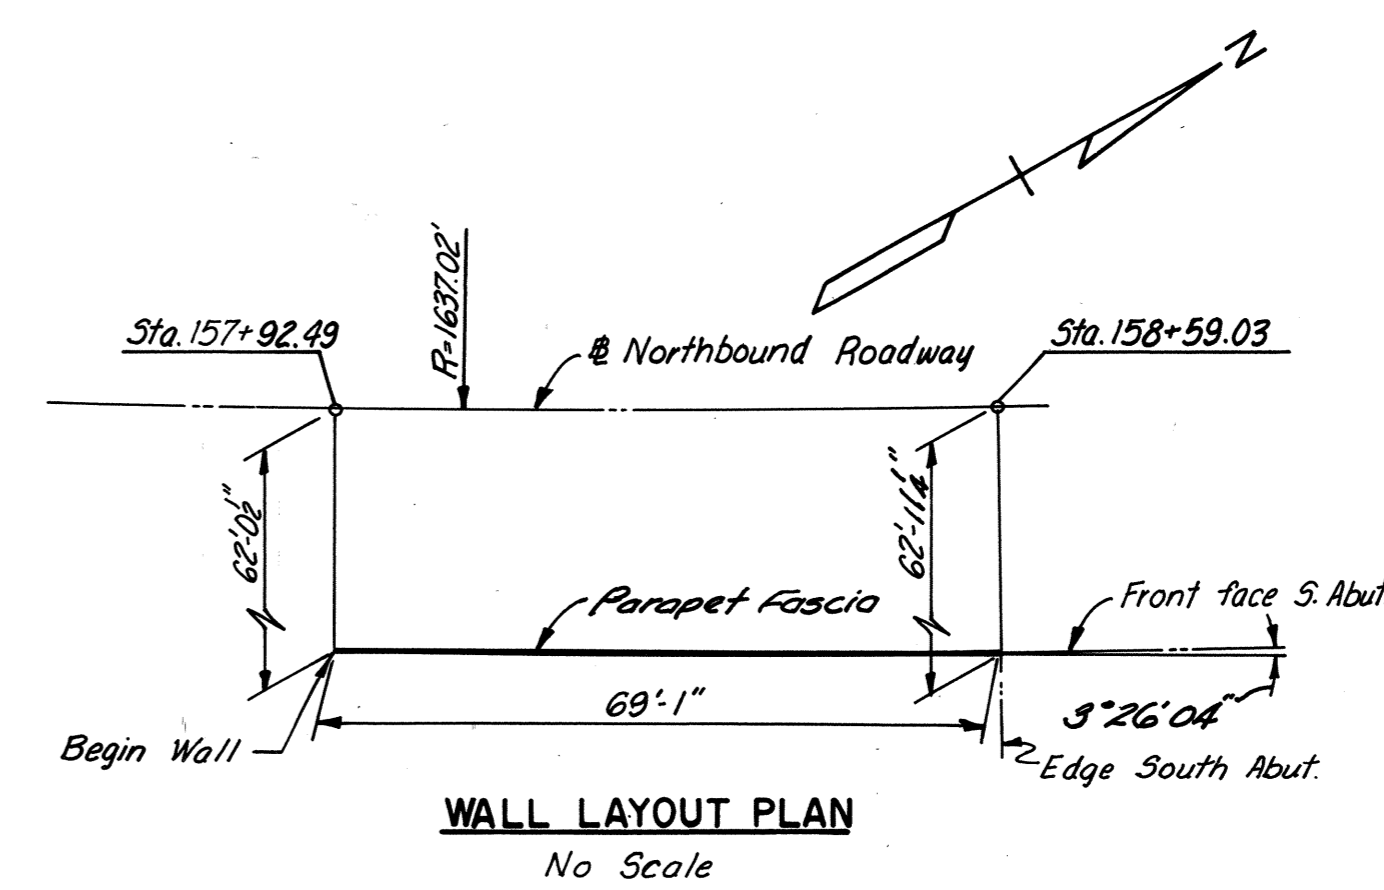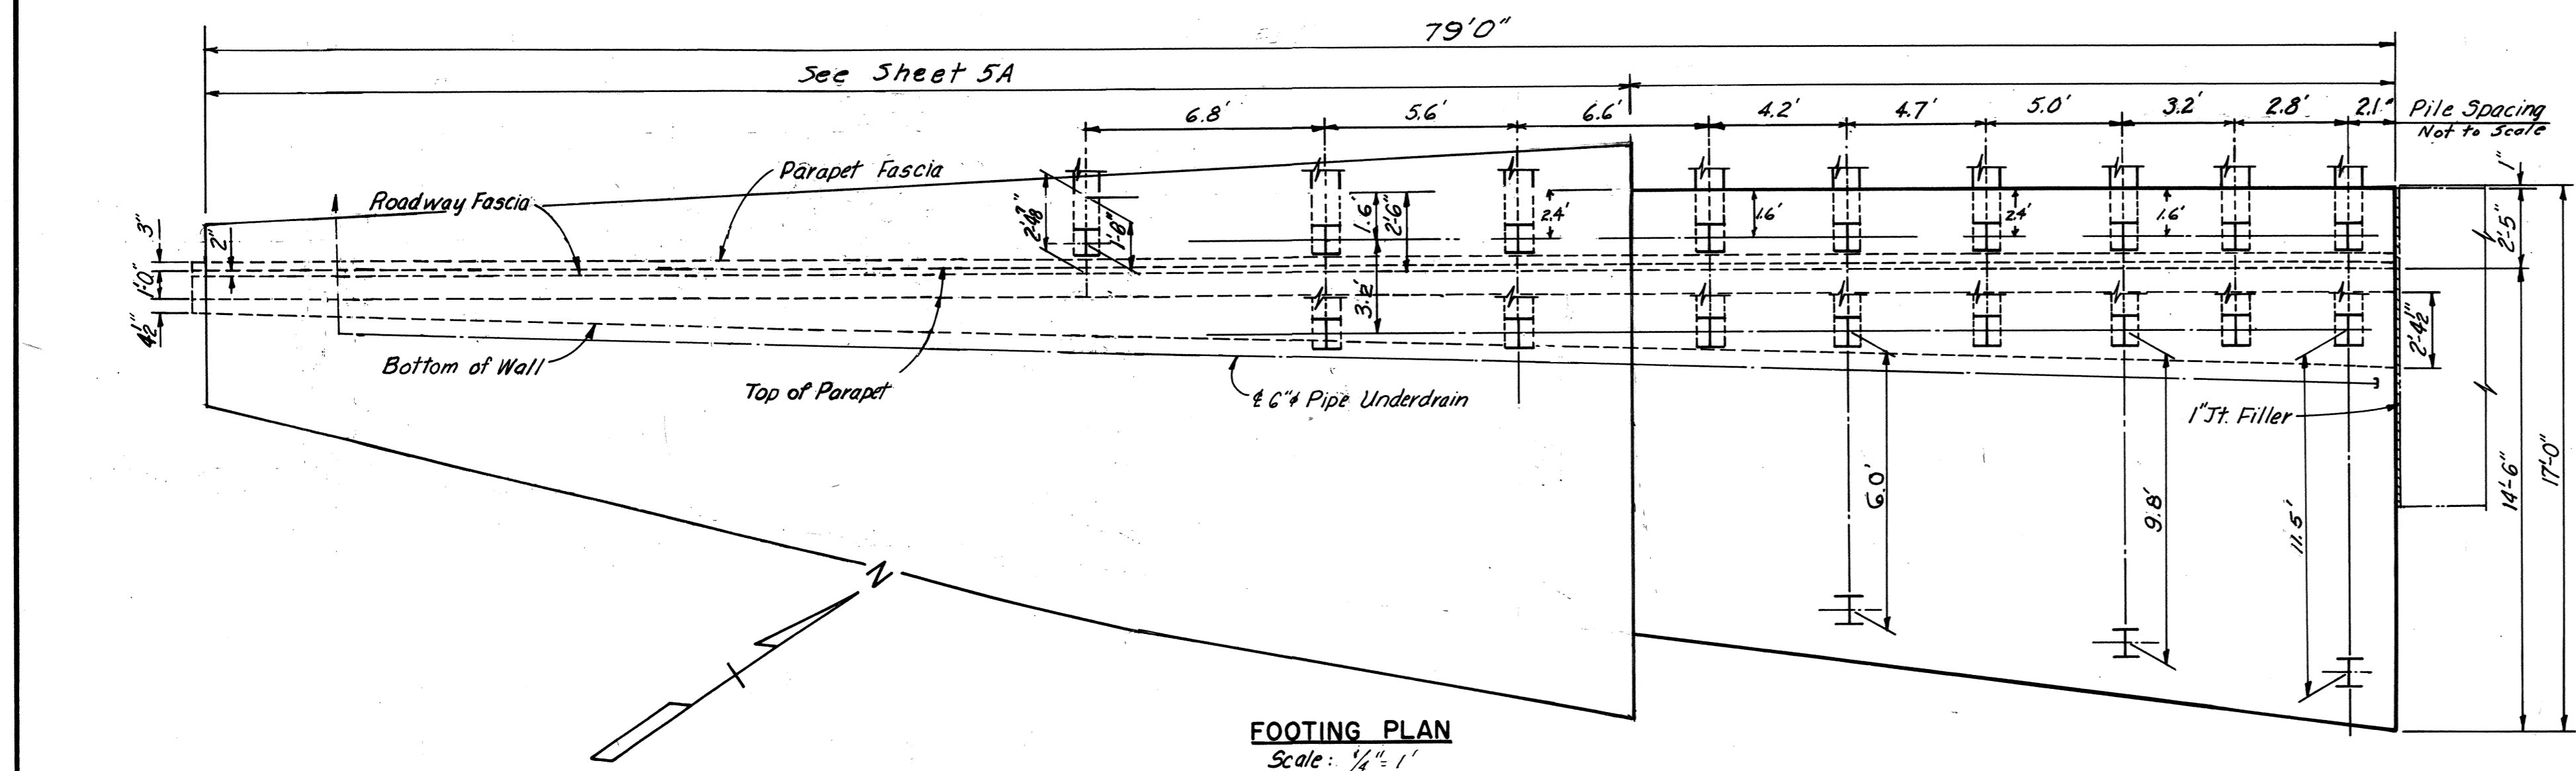

AS BUILT

RICHMOND METROPOLITAN AUTHORITY
RICHMOND EXPRESSWAY SYSTEM
 BELTLINE EXPRESSWAY
 BRIDGE NO. 9
 R.F.&P.R.R. OVER
 NORTHBOUND ROADWAY
SOUTH ABUTMENT RETAINING WALL


HOWARD, NEEDLES, TAMMEN & BERGENDOFF
 consulting engineers
 NEW YORK ALEXANDRIA KANSAS CITY

SCALE: As Noted
 CONTRACT NO.: 4
 SHEET NO. 5 OF 12


4	As Built	JRC	5-73
3	Revised Lt. Std.	JRC	9-71
2	Profile Grade	P.S.	4-12-71
1	General Revision	AMH	5-13-68
NO.	REVISION	BY	DATE
BY	DATE		
MADE	RLM 2-19-68		
CHECKED	AKC 4-2-68		
IN CHARGE	FKD		

RICHMOND EXPRESSWAY SYSTEM			
SECTION	PROJECT	SHEET NO.	TOTAL SHEETS
4	BELTLINE EXPRESSWAY	99	155


Note: For Parapet Details, see Section H-H, Section S-S, and Section Y-Y, on Sheet 2 of Bridge 10 Plans.

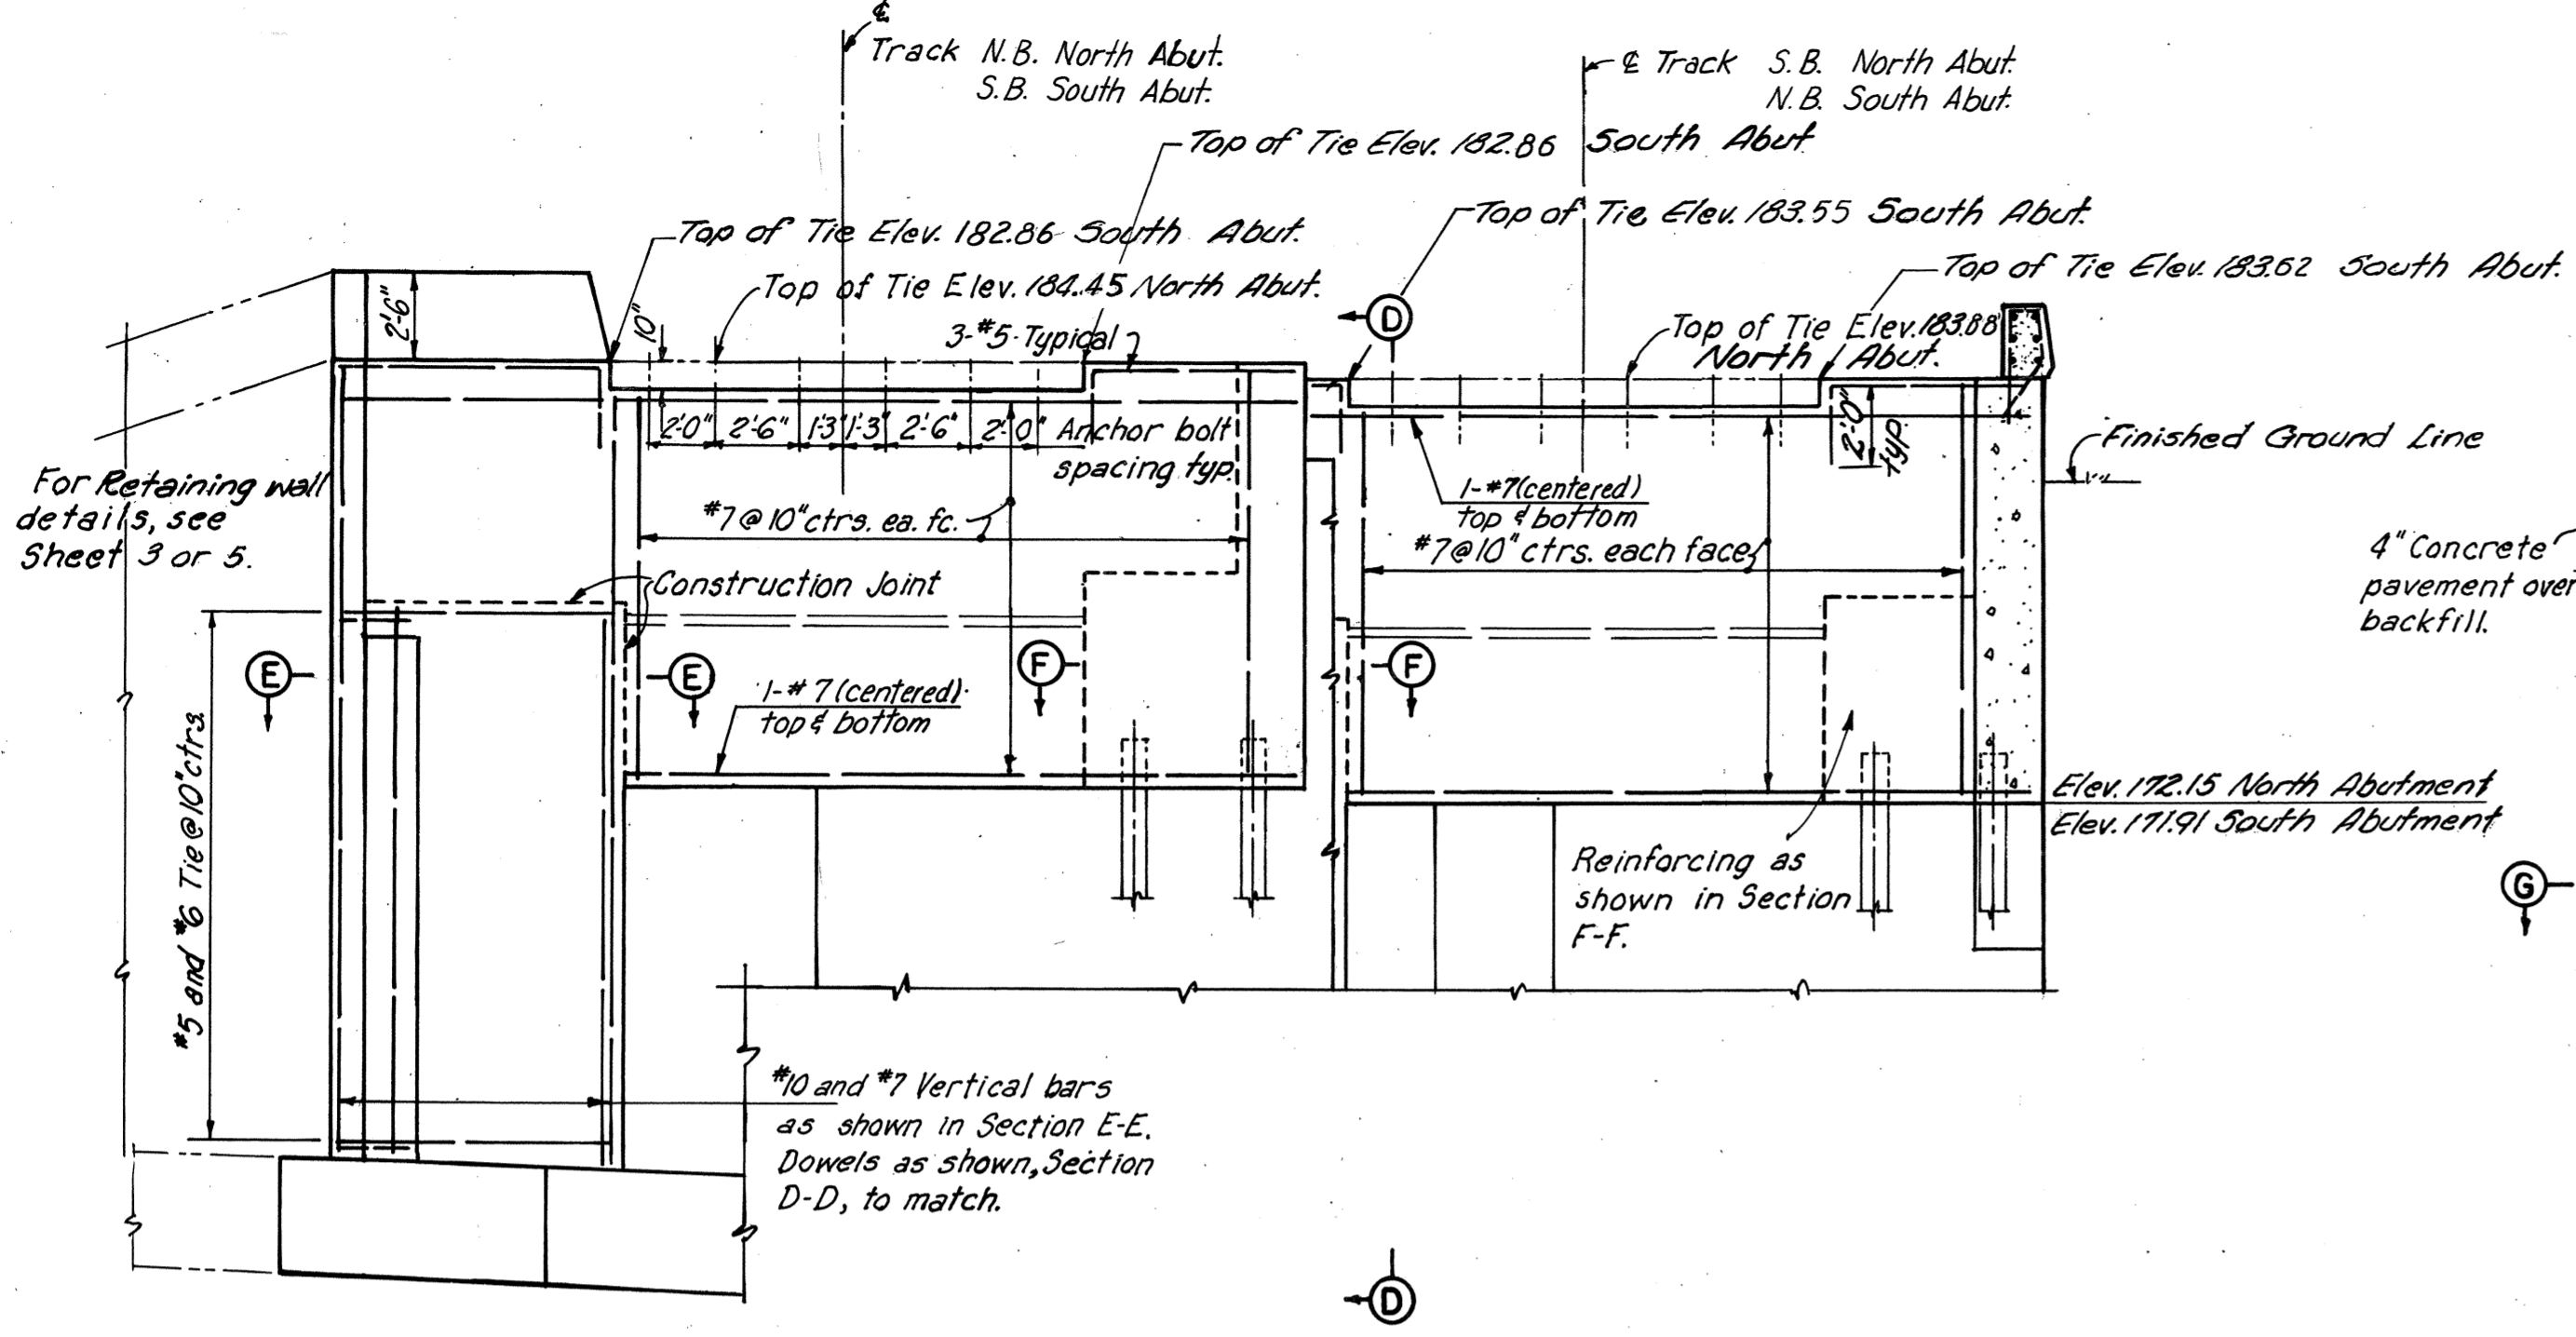

SECTION B-B
Scale: 3/8"=1'-0"
For location, see Sheet 2 or 4.

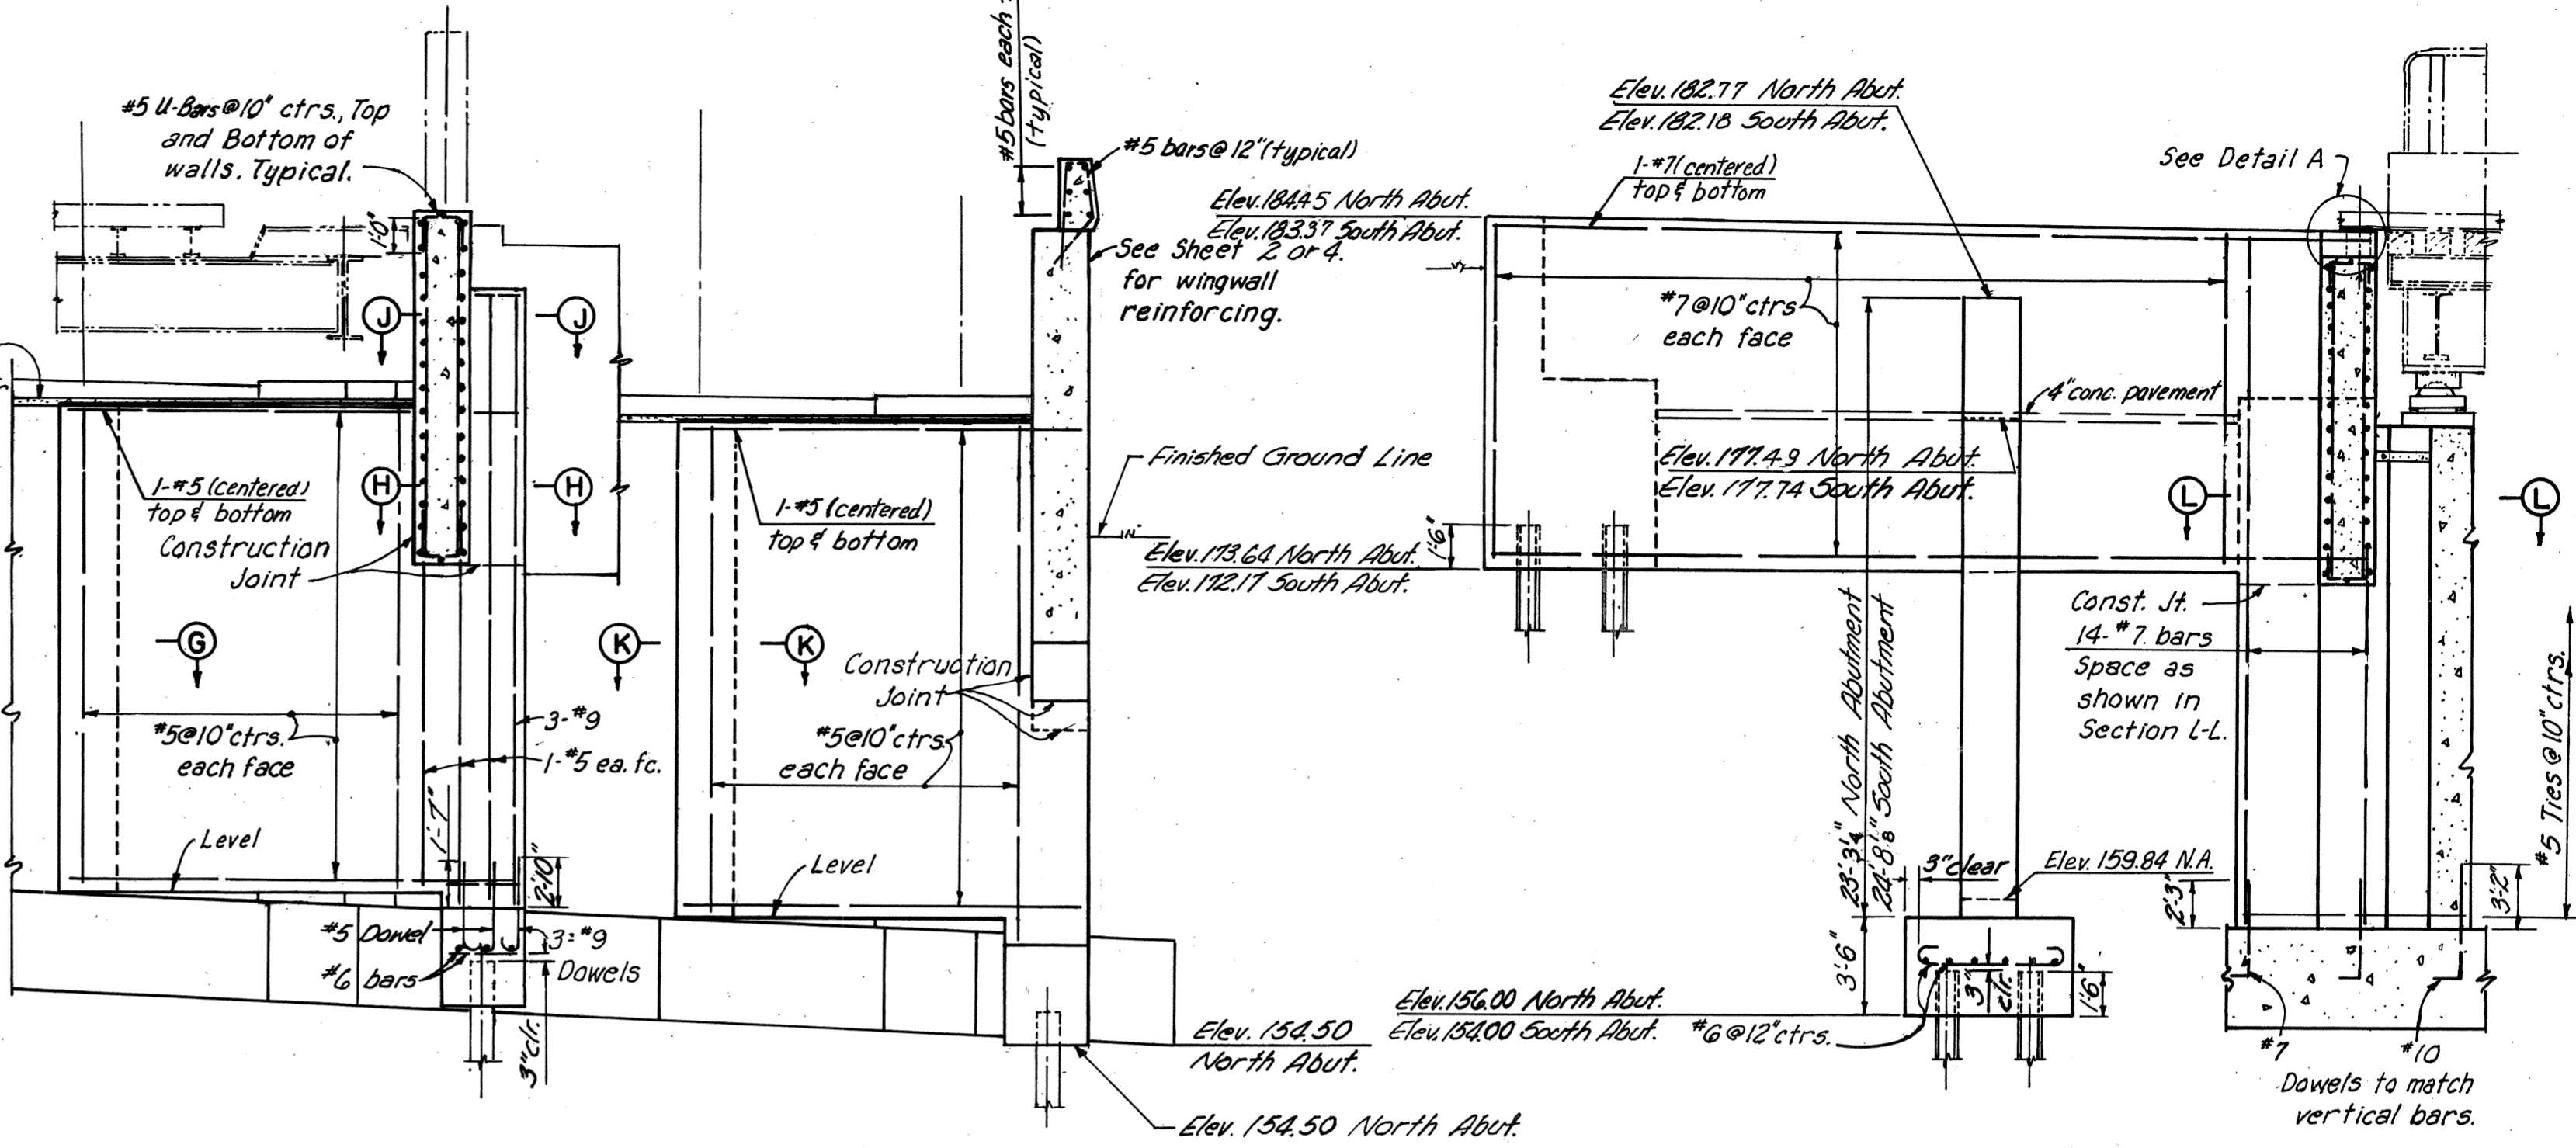


SECTION A-A
Scale: 3/8"=1'-0"
For location, see Sheet 2 or 4.

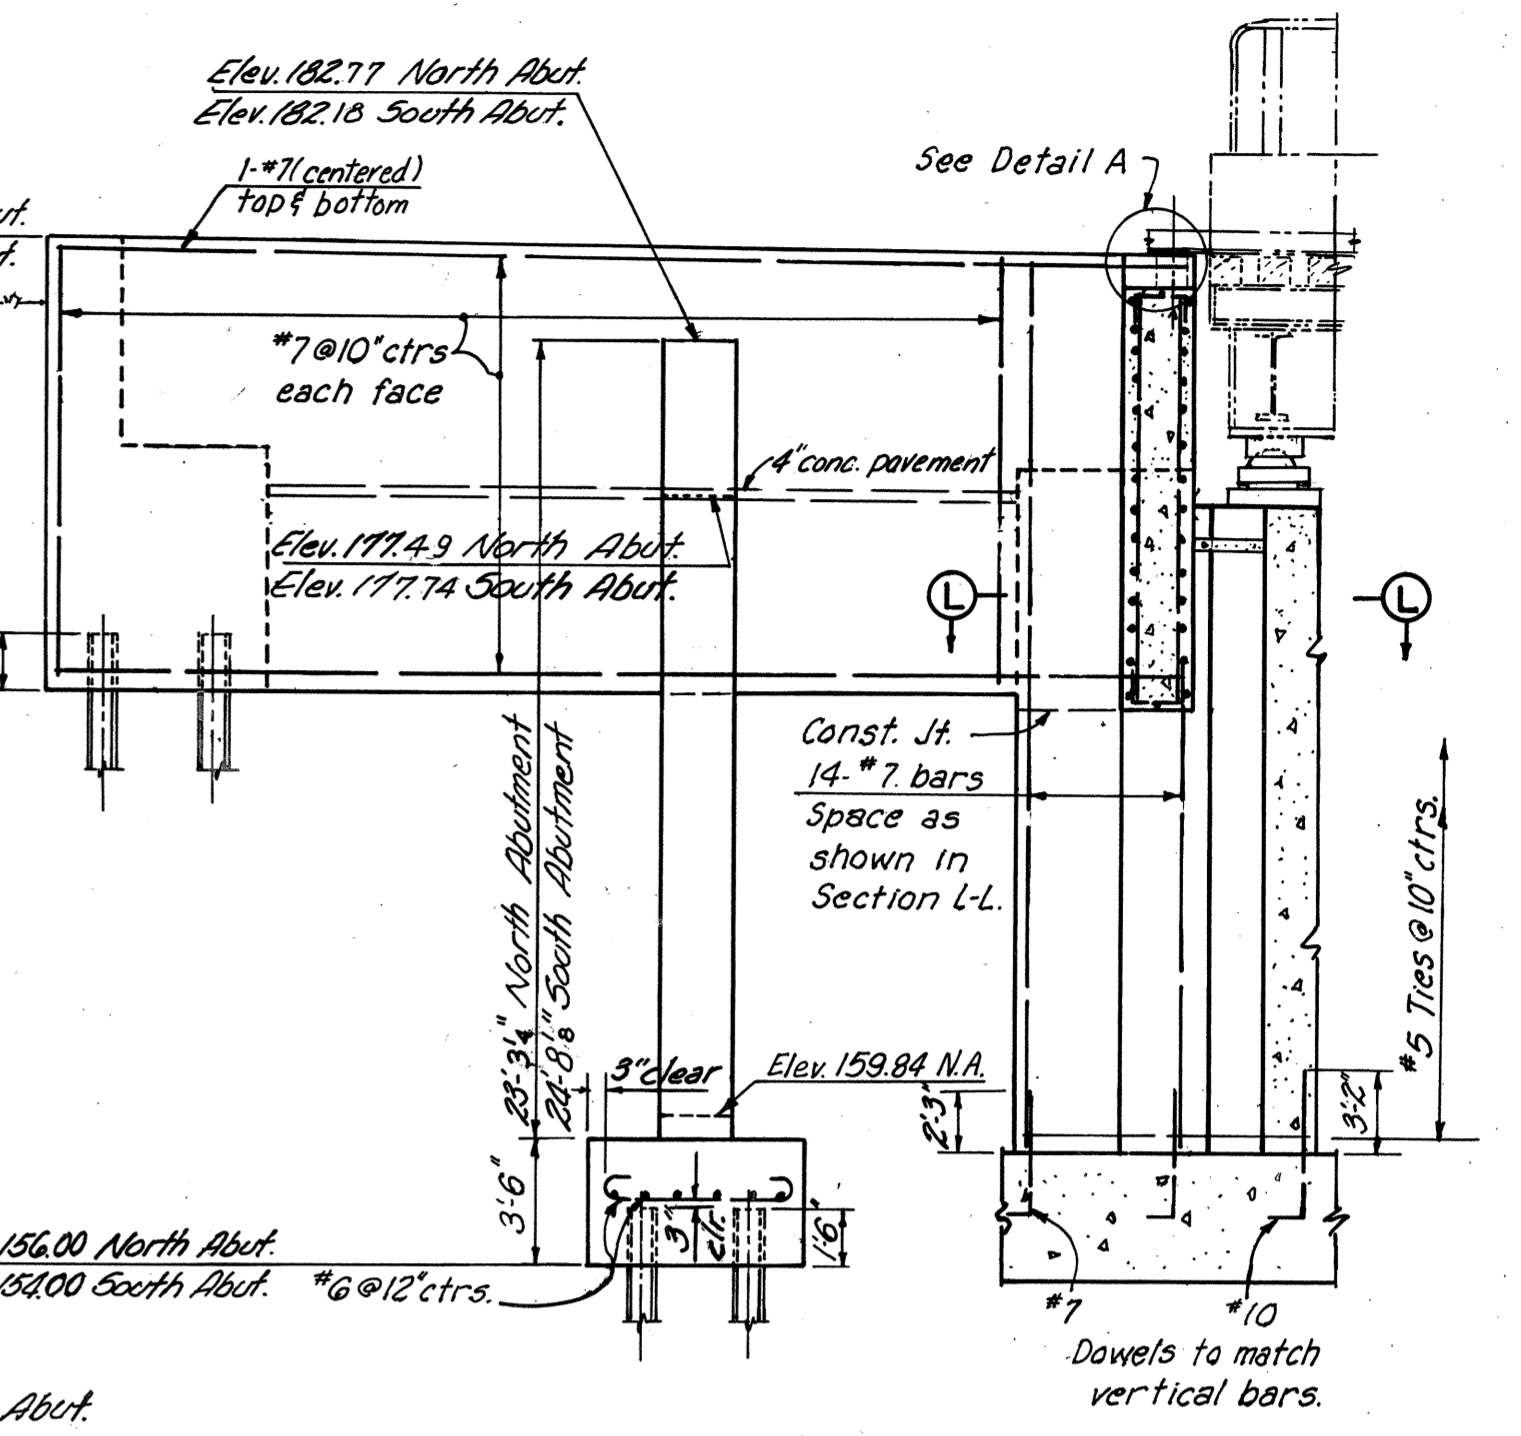


SECTION D-D
Scale: 3/8"=1'-0"


Note: Paving shown within limits of abutment shall be 4" thick, 1/2" preformed joint filler, sealed with a 7" depth of hot applied joint sealer, shall be installed between paving and abutment walls. Preformed joint sealer shall be bituminous type conforming to AASHTO M213. Paving will be paid for as "Concrete, Class A3, Substructures and Walls."

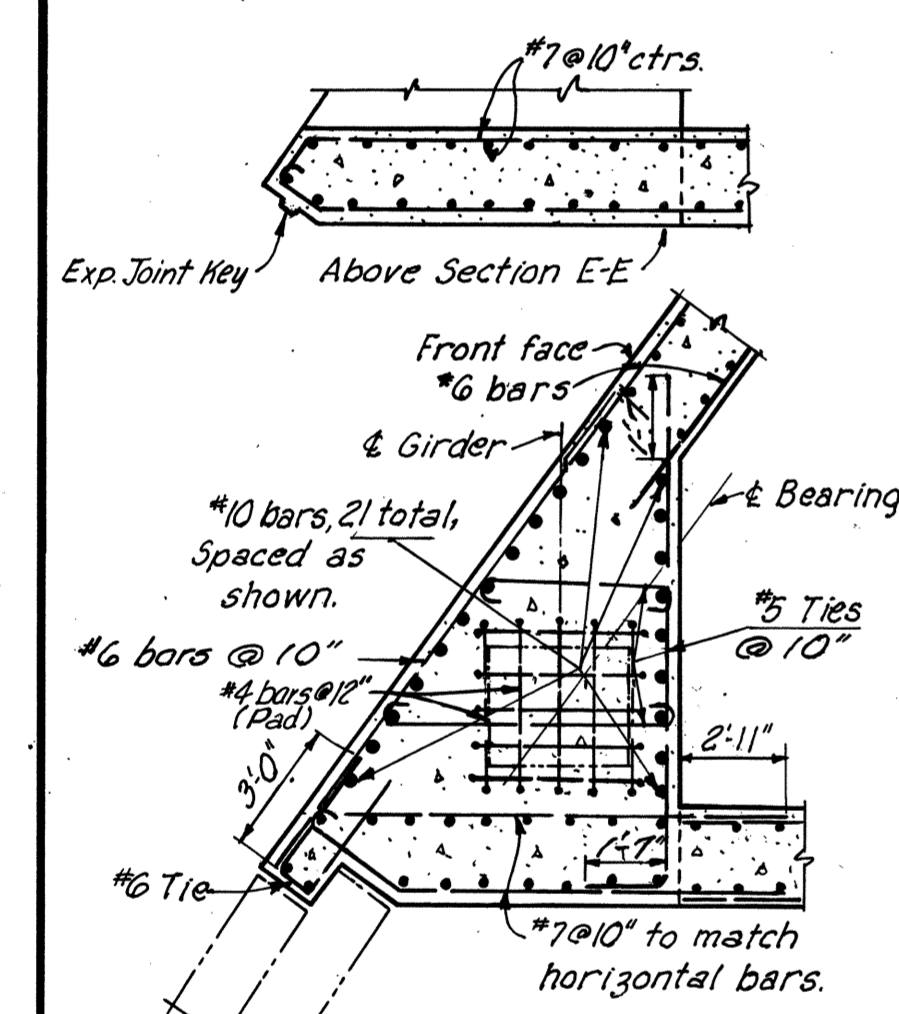


SECTION E-E
Scale: 1/4"=1'-0"

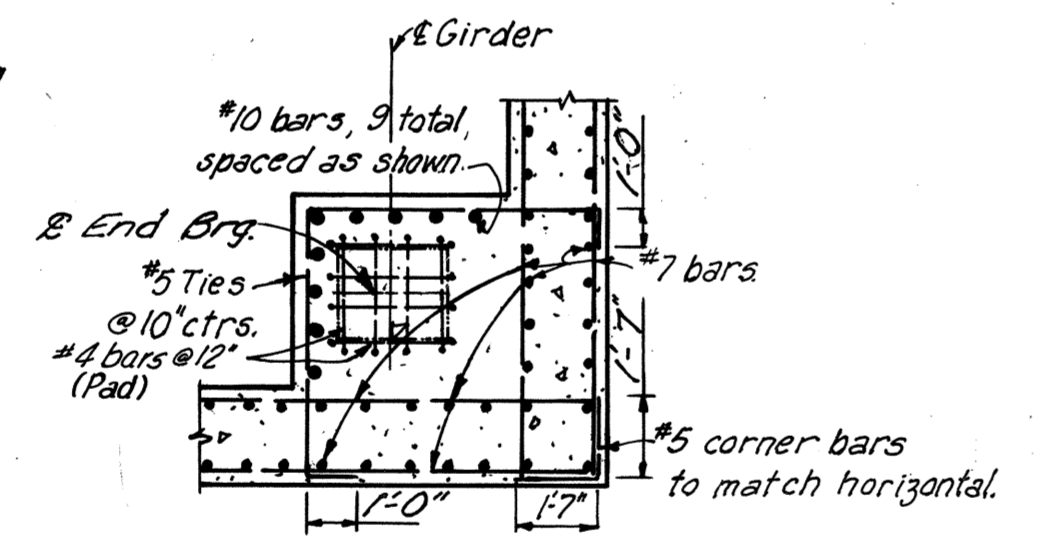


SECTION F-F
Scale: 1/4"=1'-0"

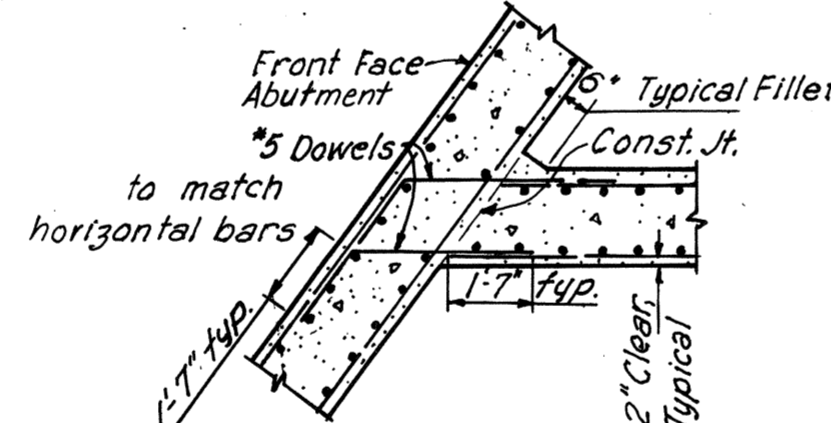


SECTION G-G
Scale: 1/4"=1'-0"

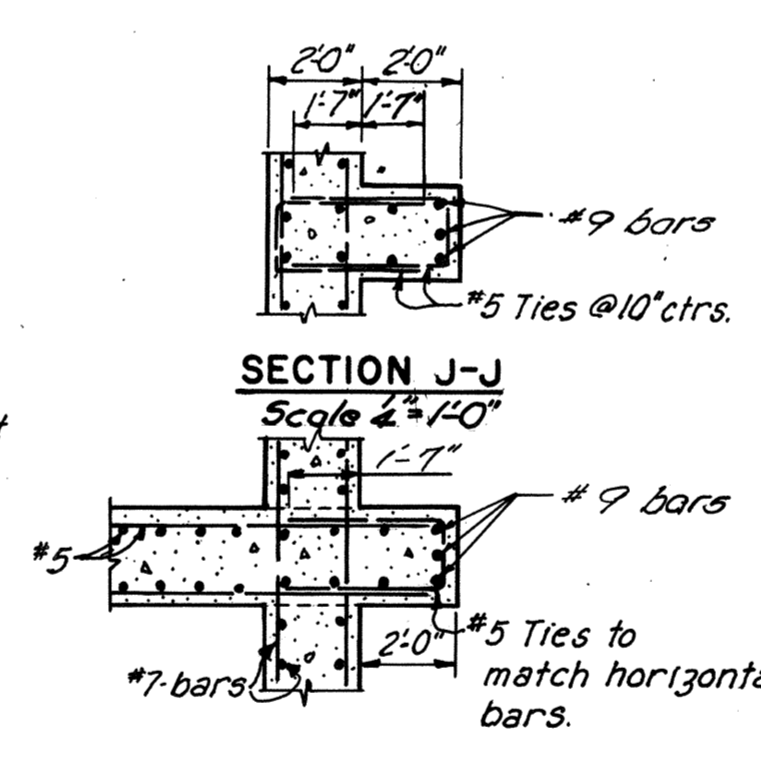


SECTION H-H
Scale: 1/4"=1'-0"

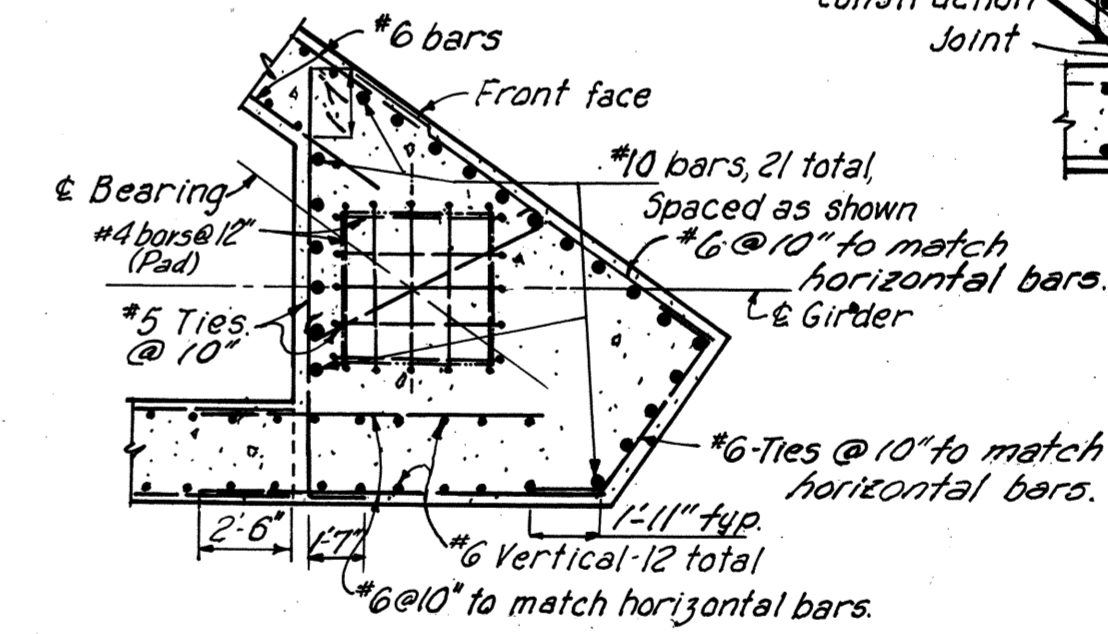


SECTION M-M
Scale: 1/4"=1'-0"
For location, see Sheet 2 or 4.

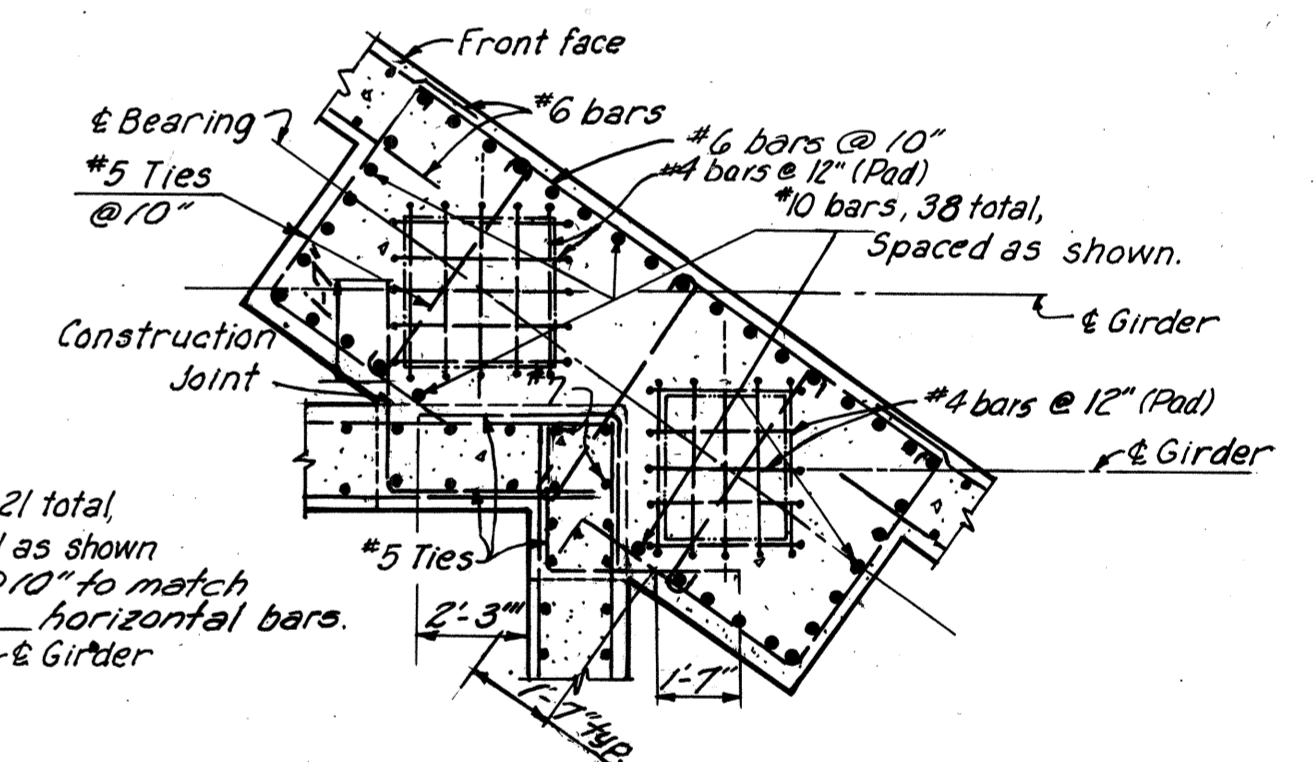

SECTION L-L
Scale: 1/4"=1'-0"

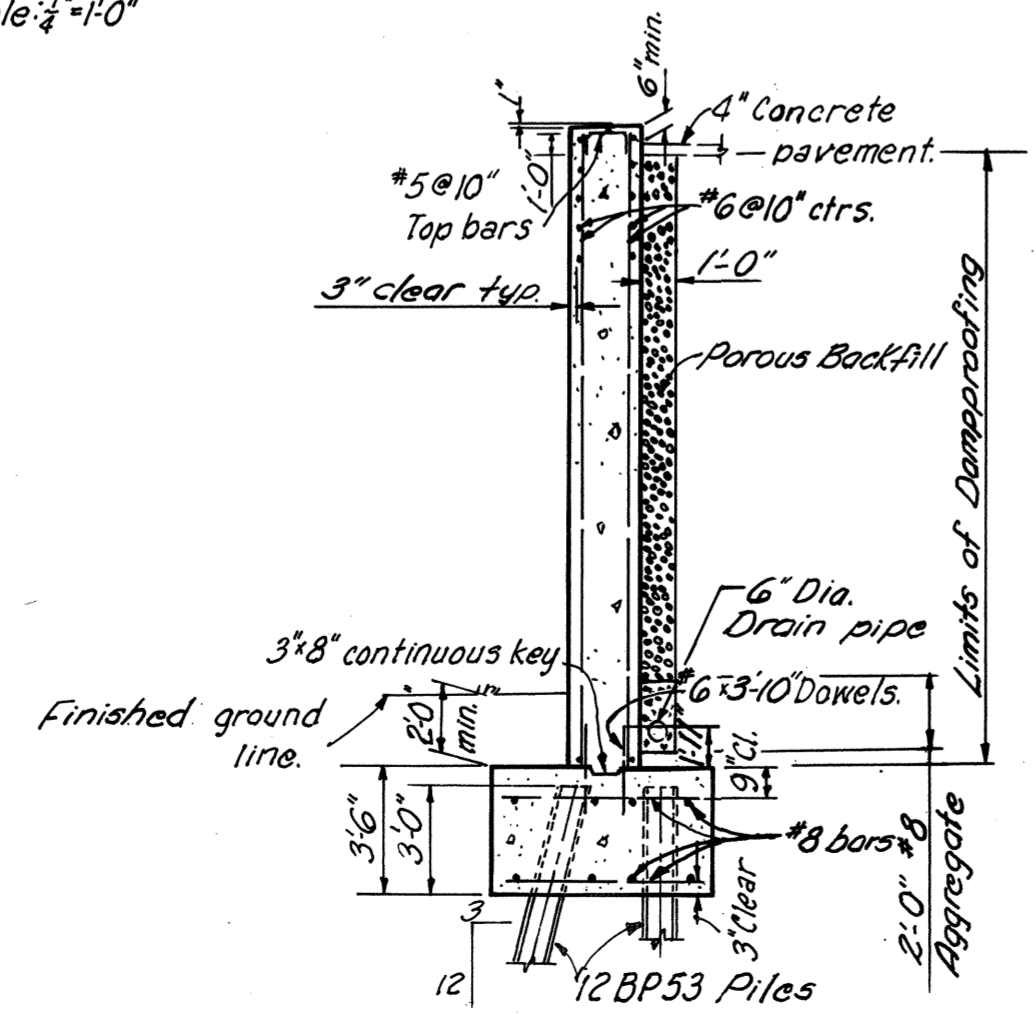

SECTION C-C
Scale: 3/8"=1'-0"
For location, see Sheet 2 or 4.

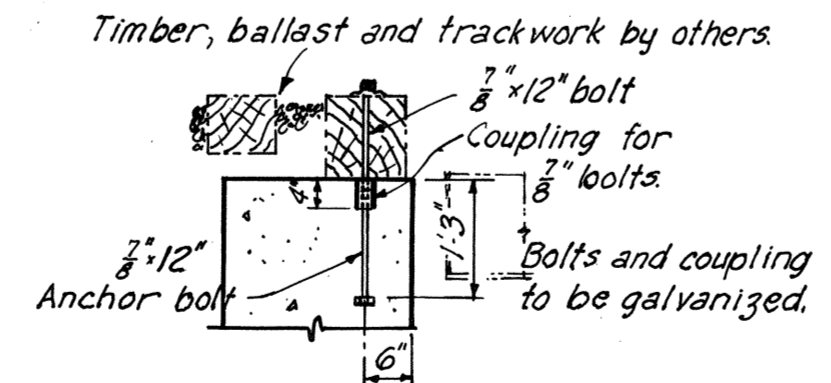

DETAIL A
Scale: 1/2"=1'-0"



Note: Sections shown are for North Abutment, South Abutment similar. #4 Bars @ 12" shown in Sections E-E, F-F, L-L, and M-M, are to be U-shaped bars with 1'-6" legs.

AS BUILT

RICHMOND METROPOLITAN AUTHORITY
RICHMOND EXPRESSWAY SYSTEM
BELTLINE EXPRESSWAY
BRIDGE NO. 9
R.F.&P.R.R. OVER
NORTHBOUND ROADWAY
ABUTMENT DETAILS

BY	DATE	NO.	REVISION	BY	DATE
As Built	JRC	3-73			
Profile Grade	P.S.	4-15-71			
General Checking	AMH	5-13-68			

HOWARD, NEEDLES, TAMMEN & BERGENDOFF consulting engineers NEW YORK ALEXANDRIA KANSAS CITY	SCALE: As Shown CONTRACT NO. 4 SHEET NO. 6 OF 12
---	--


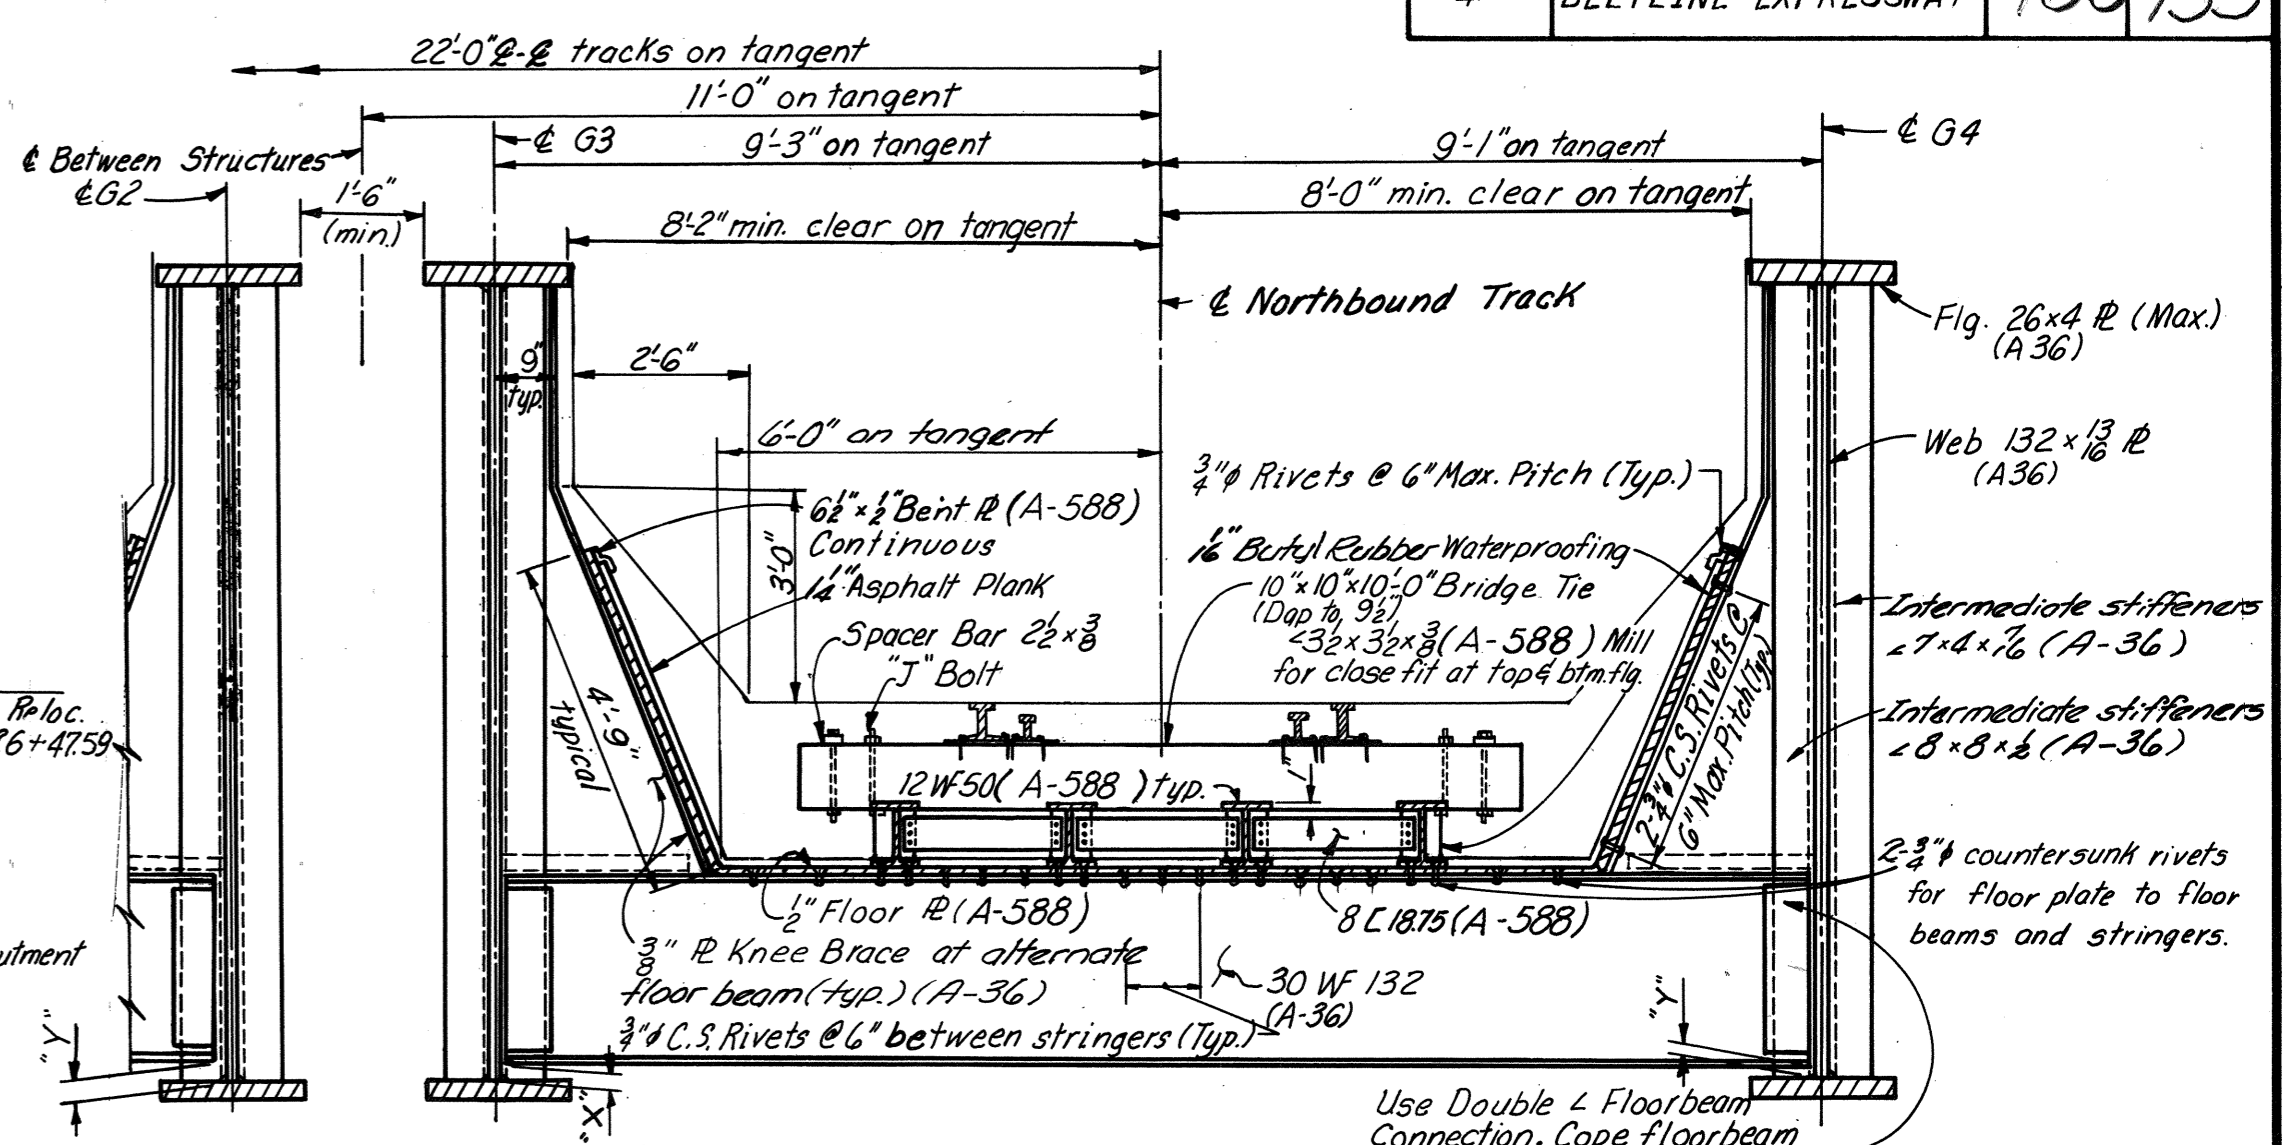
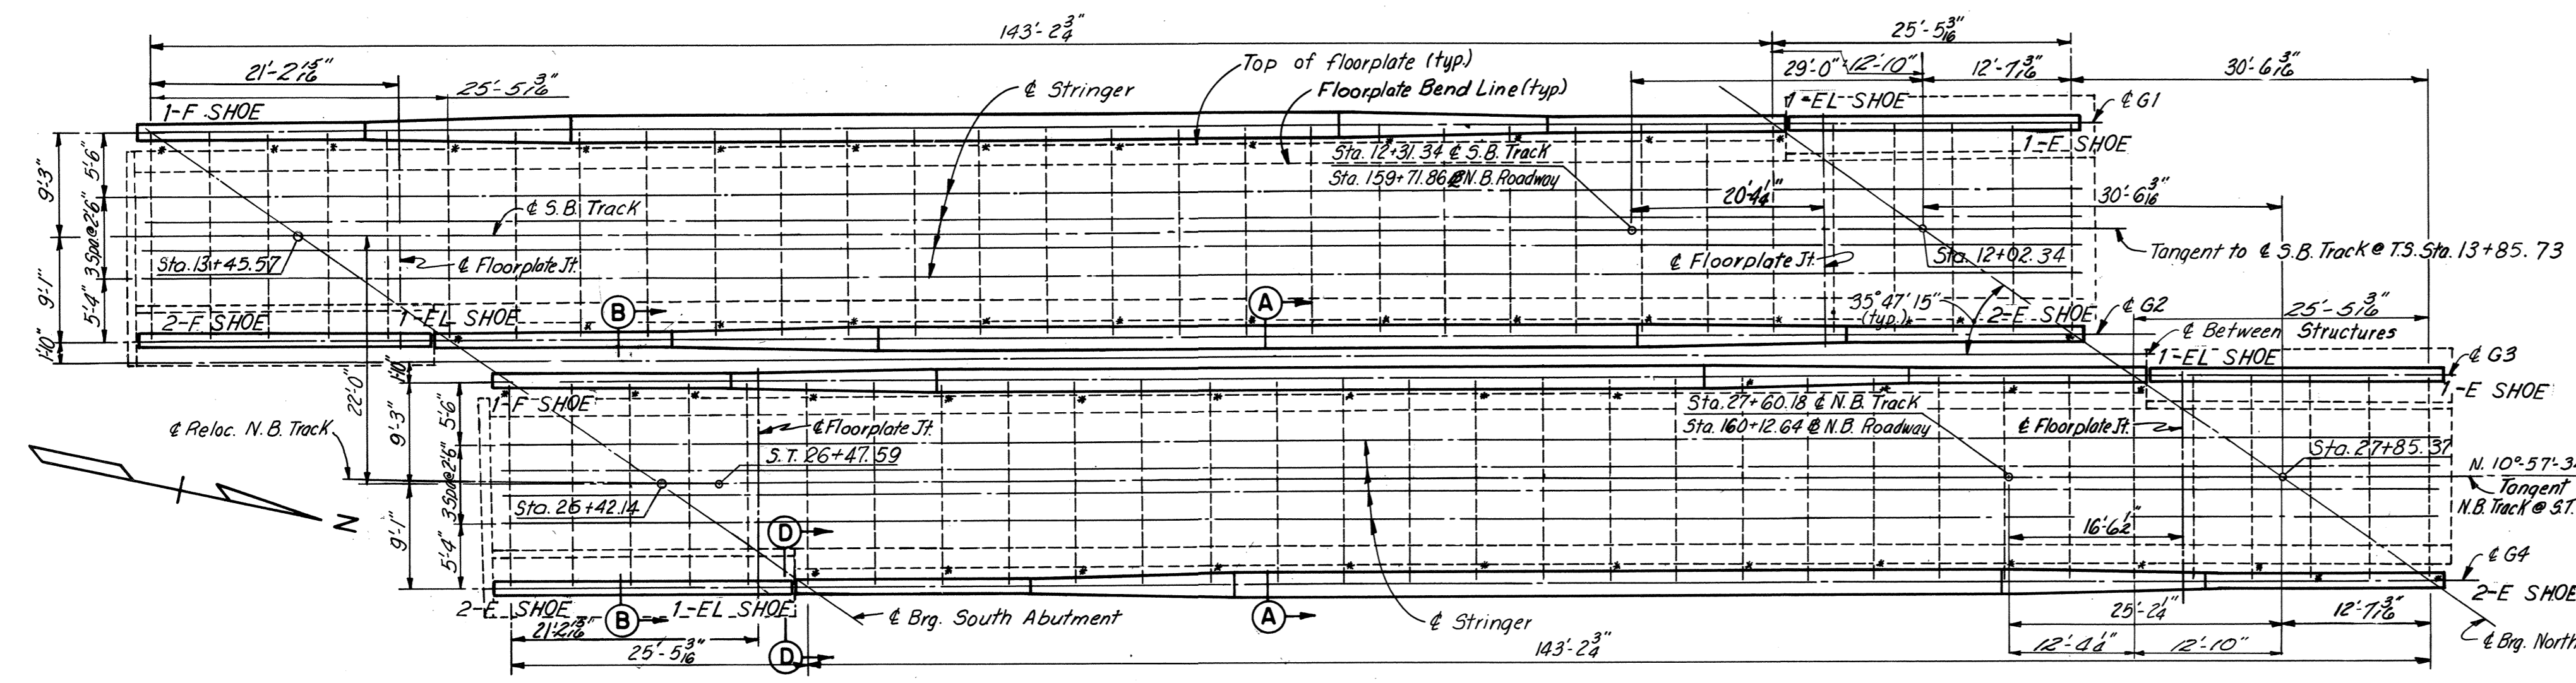


Note: Floorplate connected to stringers by 2 rows of 3/4" Dia. countersunk rivets at 6" maximum pitch.
 All riveted connections shown herein may, at the contractor's option, be replaced by high strength bolt connections.

Note: Ties, track, and fasteners are to be furnished and installed by others.
 Note: Asphalt plank shall be recessed to receive flange of 12 WF 50 stringers.

FLOOR BEAM LOCATION TABLE		
SOUTHBOUND TRACK		
DISTANCE	G1 DIMENSION "X"	G2 DIMENSION "Y"
0	2 3/4"	3"
4'-11 1/2"	2 3/4"	3"
10'-0 1/2"	2 3/4"	3"
15'-1 1/2"	2 3/4"	3"
20'-2 1/2"	2 3/4"	3"
25'-5 3/8"	3"	3"
31'-4 3/8"	3"	3"
37'-2 3/8"	3"	3"
43'-1 3/8"	3"	3"
49'-0 3/8"	3"	3"
54'-10 1/8"	3"	3"
60'-9 1/8"	3"	3"
66'-8 1/8"	3"	3"
72'-6 1/8"	3"	3"
78'-5 3/8"	3"	3"
84'-3 3/8"	3"	3"
90'-2 3/8"	3"	3"
96'-1 3/8"	3"	3"
101'-11 1/8"	3"	3"
107'-10 1/8"	3"	3"
113'-9 1/8"	3"	3"
119'-7 1/8"	3"	3"
125'-6 3/8"	3"	3"
131'-4 3/8"	3"	3"
137'-3 3/8"	3"	3"
143'-2 3/8"	3"	3"
148'-5"	3"	2 3/4"
153'-6"	3"	2 3/4"
158'-7"	3"	2 3/4"
163'-8"	3"	2 3/4"
168'-7 1/8"	3"	2 3/4"

FLOOR BEAM LOCATION TABLE		
NORTHBOUND TRACK		
DISTANCE	G3 DIMENSION "X"	G4 DIMENSION "Y"
0	2 9/16"	3 1/8"
4'-11 1/2"	2 9/16"	3 1/8"
10'-0 1/2"	2 9/16"	3 1/8"
15'-1 1/2"	2 9/16"	3 1/8"
20'-2 1/2"	3"	3 1/8"
25'-5 3/8"	3"	3"
31'-4 3/8"	3"	3"
37'-3"	3"	3"
43'-1 1/2"	3"	3"
49'-0 1/2"	3"	3"
54'-10 1/2"	3"	3"
60'-9 1/2"	3"	3"
66'-8 1/2"	3"	3"
72'-6 1/2"	3"	3"
78'-5 3/8"	3"	3"
84'-4"	3"	3"
90'-2 3/8"	3"	3"
96'-1 3/8"	3"	3"
101'-11 1/8"	3"	3"
107'-10 1/8"	3"	3"
113'-9 1/8"	3"	3"
119'-7 1/8"	3"	3"
125'-6 3/8"	3"	3"
131'-5"	3"	3"
137'-3 3/8"	3"	3"
143'-2 3/8"	3"	3"
148'-5"	3"	2 3/4"
153'-6"	3"	2 3/4"
158'-7"	3"	2 3/4"
163'-8"	3"	2 3/4"
168'-7 1/8"	3"	2 3/4"

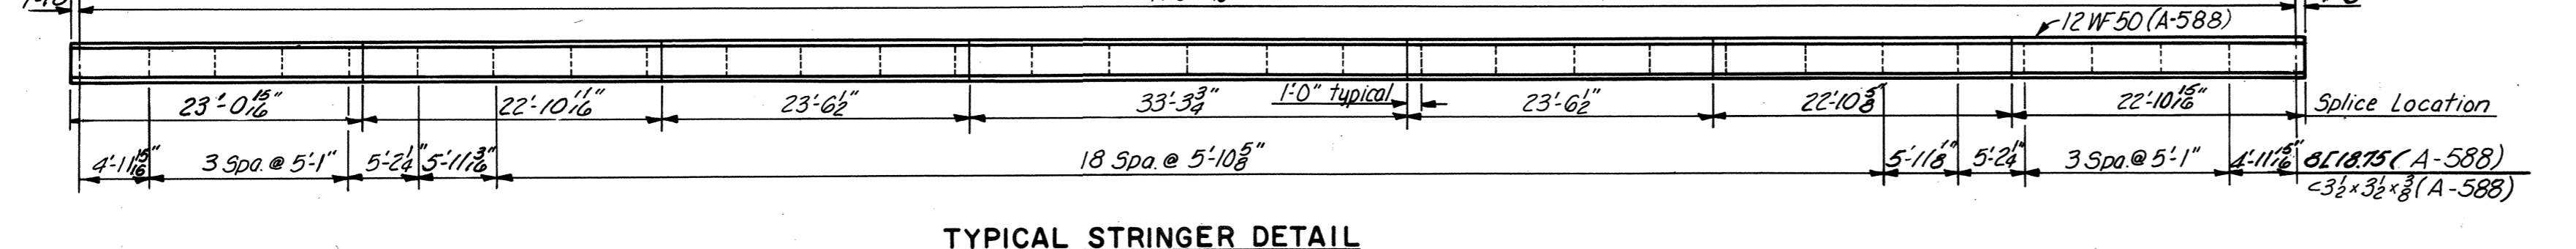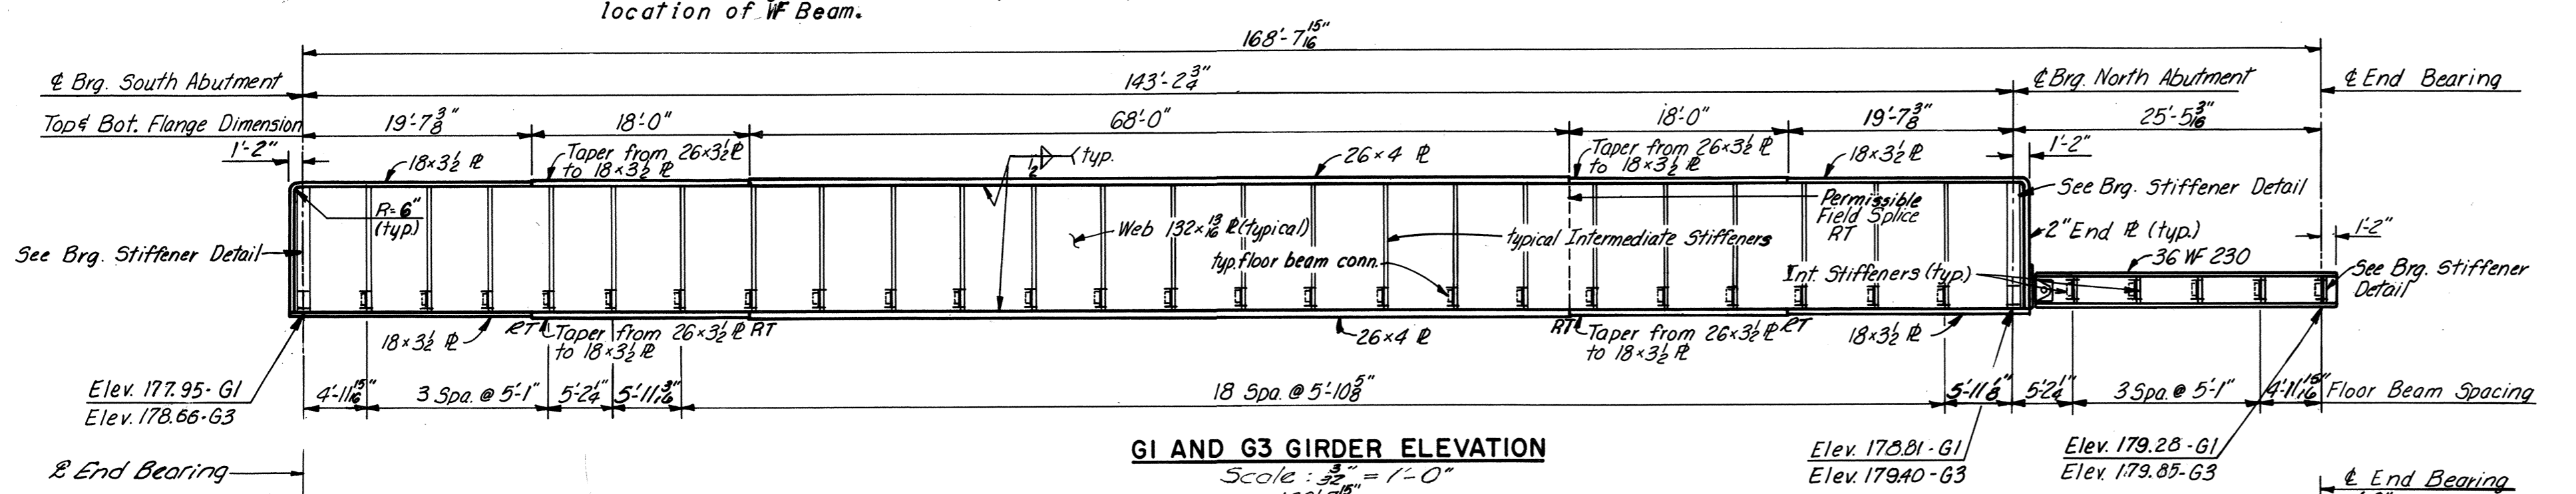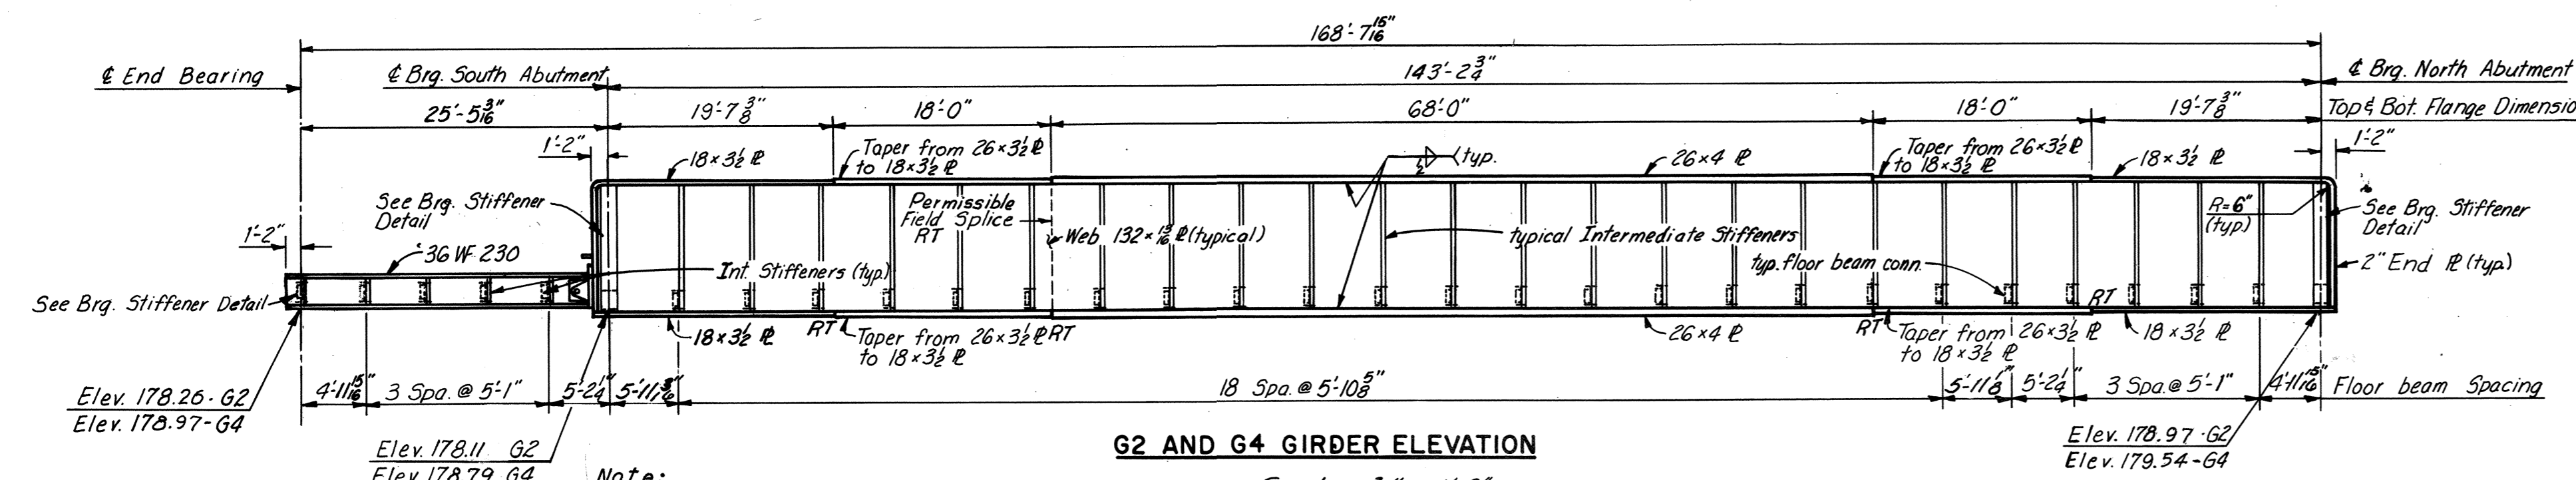

RADIOGRAPHIC INSPECTION NOTE:
 An "RT" shown on elevation views indicates radiographic inspection of adjacent flange and web, flange, or web welds in accordance with the Special Provisions.

Note: Welded Girders are to be cambered to compensate for full anticipated dead load, see Sheet 9.

Notes - Southbound Track:
 Distances shown in Floor Beam Table are measured from north to south, starting at the extreme north floor beam.
 Dimensions "X" and "Y" shown in Floor Beam Table for G1 and G2 are measured from top of bottom flange for Plate Girder section and from bottom of WF Beam section.

Elevations shown on Girder Elevations are at bottom of bottom flange for Plate Girder section and for WF Beam section.

Notes - Northbound Track:
 Distances shown in Floor Beam Table are measured from south to north, starting at the extreme south floor beam.
 Dimensions "X" and "Y" shown in Floor Beam Table for G3 and G4 are measured from top of bottom flange for Plate Girder section and from bottom of WF Beam section.

Elevations shown on Girder Elevations are at bottom of bottom flange for Plate Girder section and for WF section.

Notes:
 For Shoe Details, see Sheet 10.
 For Dead Load Deflections, see Sheet 9.
 For Superstructure Details, see Sheets 8 and 9.
 For Sections B-B, and D-D, see Sheet 9.

Note:
 One butt welded shop splice will be permitted in each 26"x4" flange plate; details of splice shall be similar to that shown for Field Flange Splice, sheet 8. A maximum of 3 web splices including web splice at "Permissible Field Splice", will be permitted; detail of shop web splice shall be similar to that shown for Field Flange Splice, Sheet 8, except that web opening is not required and web splice shall not be located within 2'-0" of a shop flange splice.

BY	DATE	NO.	REVISION	BY	DATE
4	As Built	JRC	3-73		
BY	DATE	NO.	REVISION	BY	DATE
MADE	RLM 12-13-67	2	Profile Grade	ER	4-12-71
CHECKED	JFH 4-9-68	1	General Checking	AMH	5-13-68
IN CHARGE	FKD				

AS BUILT

RICHMOND METROPOLITAN AUTHORITY
RICHMOND EXPRESSWAY SYSTEM
BELTLINE EXPRESSWAY
BRIDGE NO. 9
R.F.&P.R.R. OVER
NORTHBOUND ROADWAY
FRAMING PLAN

HOWARD, NEEDLES, TAMMEN & BERGENDOFF
 consulting engineers
 NEW YORK ALEXANDRIA KANSAS CITY

SCALE: As Noted
 CONTRACT NO. 4
 SHEET NO. 7 OF 12

Bridge 10S & 10N

(Northbound & Southbound CSX RR over Southbound DTE Connector “Rte. 146”)

Record Set Plans

GENERAL NOTES

STRUCTURE: Dual structures with one welded steel girder span and one rolled beam at each approach. Distance between girders of 18'-4" with 1'-6" min. clear between structures.

CAPACITY: Live Loads - Cooper E-80 with 50% impact.

SPECIFICATIONS: GENERAL: Virginia Department of Highway Road and Bridge Specifications 1970 and Contract Special Specifications. DESIGN: A.R.E.A. 1966 for Steel Railway Bridges, for Fixed Spans not exceeding 400 feet in length. WELDING: 1969 Standard Specifications for Welded Highway and Railway Bridges of the American Welding Society.

CONTRACT SPECIAL PROVISIONS: Specifications and Contract Special Provisions referred to above are necessary to make these plans complete.

DATUM: City of Richmond

TEMPERATURE: The normal temperature referred to on the plan is 68°F. The temperature range for movement is 0°F to 120°F.

DIMENSIONS: All dimensions are measured horizontally and vertically unless otherwise noted.

EXCAVATION: Excavation below subgrade and cut slope template shall be classified as Structure Excavation. All excavation above these limits shall be classified as Regular Excavation and is not included in the Structural Quantities.

FOUNDATION: Footings shall rest on firm material. Foundation material shall be kept dry and special attention is called to Section 401.05 of the General Specifications, and to the Contract Special provisions, concerning preparation of foundations for footings.


CONCRETE NOTES: All concrete shall be Class A3. All exposed edges and corners shall have a 3/4" chamfer or fillet unless otherwise noted. Finishing Concrete Surfaces: See the Standard Architectural Detail Sheets and the Contract Special Provisions for types and details.

All reinforcing steel shall conform to A.S.T.M. A615, Grade 40. All reinforcing bar dimensions on the detailed drawings are to centers of bars unless otherwise noted. Clear distance between reinforcing steel and face of concrete shall be as noted on the plans. All bar laps shall be 30 diameters of the smaller bar unless otherwise noted.

STEEL NOTES: Structural steel shall conform to A.S.T.M. Specification A-36 and A-588. All field connections shall be made with high strength bolts or rivets. High strength bolts and rivets shall be 1/2" diameter unless otherwise noted and shall conform to A.S.T.M. Specification A-325.


BENCH MARK: A-15 Copperweld rod on bridge on Blue Shingles Road Elev. 204.73.

FOUNDATION: Piles shall be driven to a minimum length corresponding to the approximate tip elevations shown on the Plans but in no case to less than a penetration affording the required safe bearing capacity noted on the Plans.

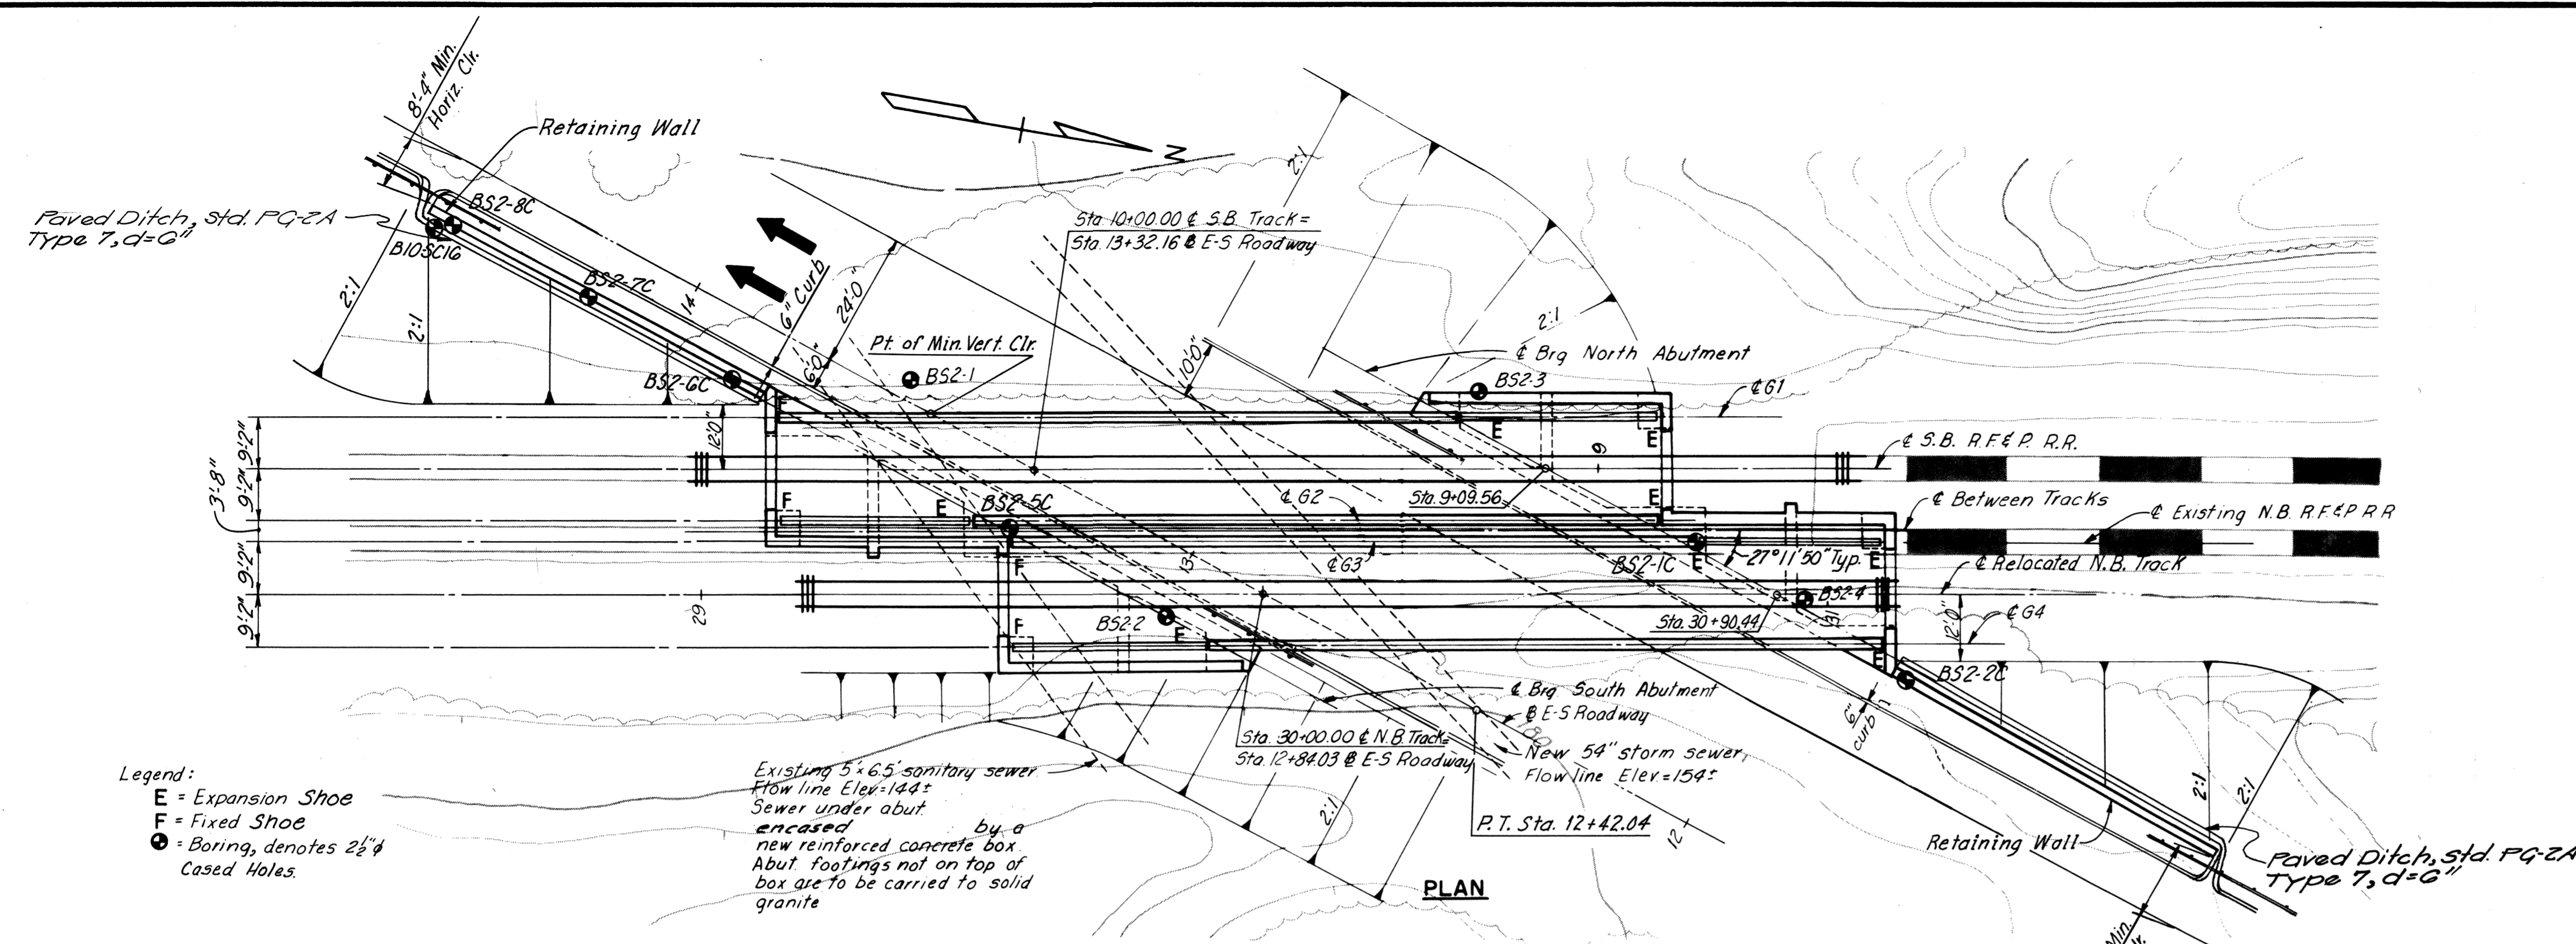

Legend:
 E = Expansion Shoe
 F = Fixed Shoe
 ● = Boring, denotes 2 1/4" Cased Holes.

Note: For details of curb outlets, see Miscellaneous Details, Sheet 21 of Roadway Plans.

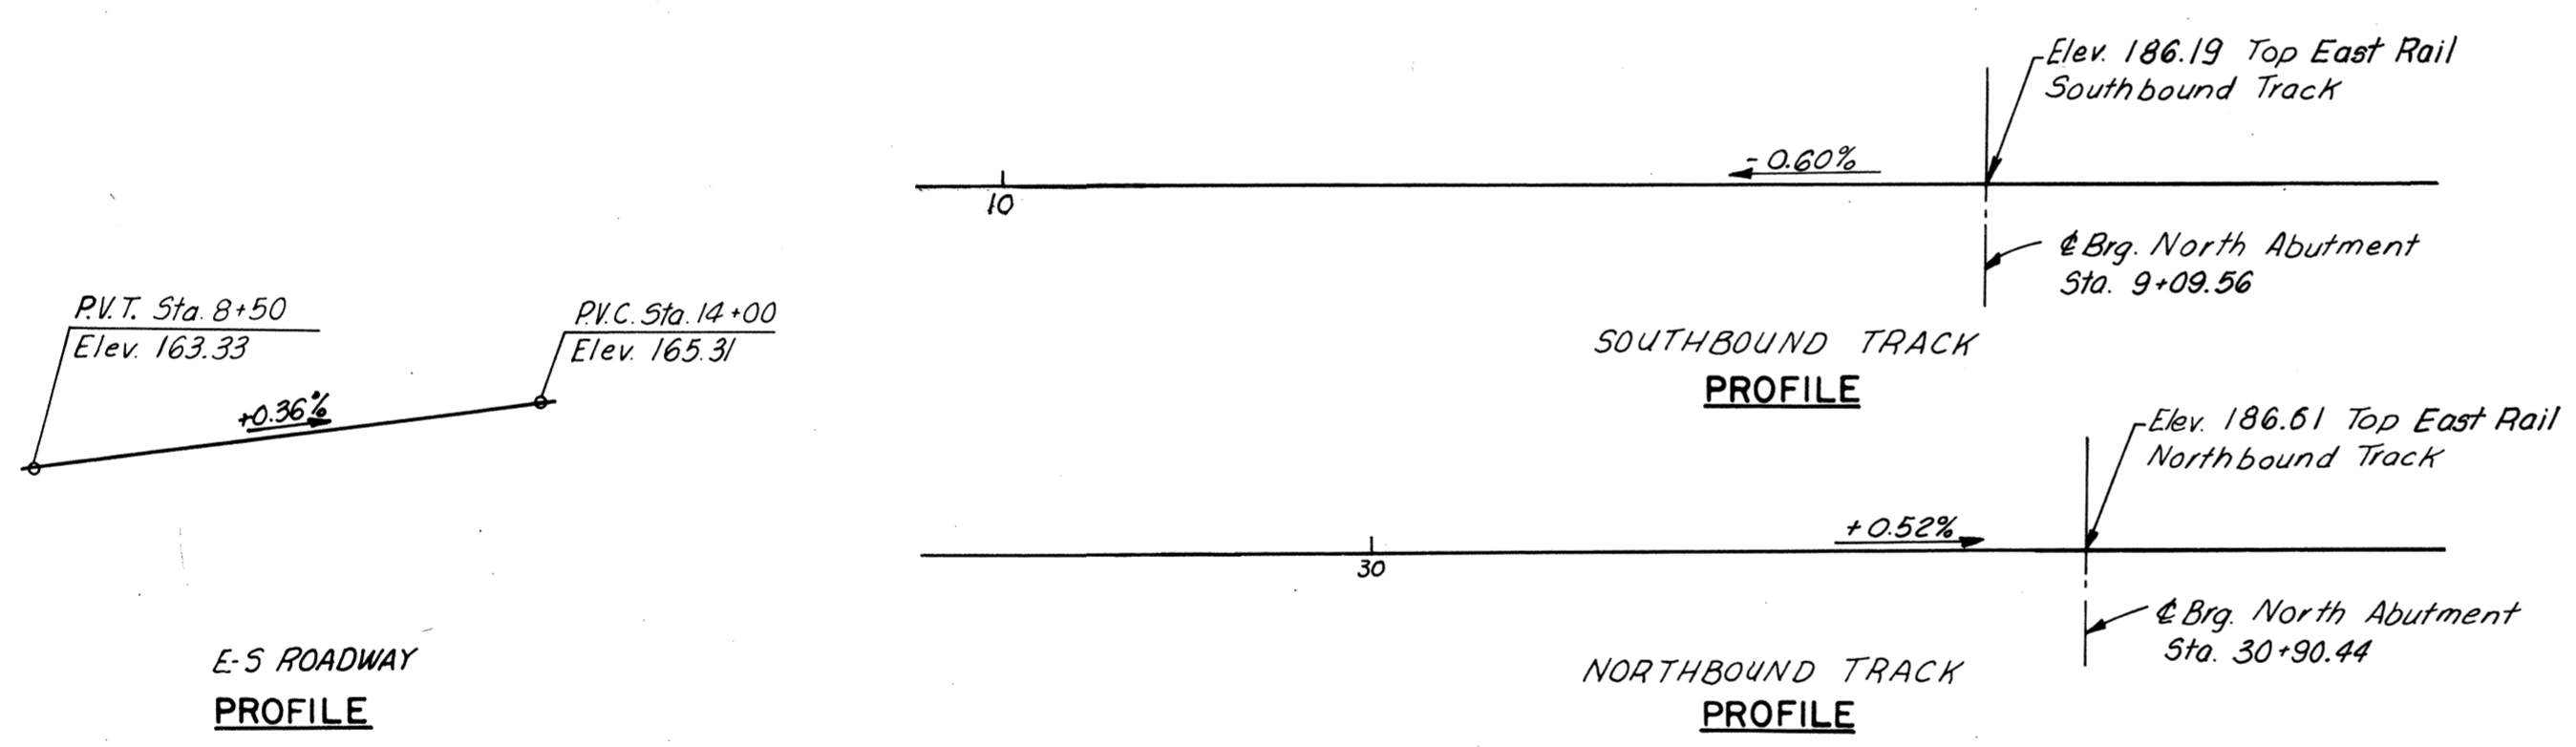


ESTIMATED QUANTITIES

	Struct. Excav. Cu. Yds.	Concrete (a) Cu. Yds.	Reinf. Steel Lbs.	Steel Piles 10HP42 Lin. Ft.	Porous Backfill Cu. Yds.	Under-drain 6" Pipe Lin. Ft.	Struct. Steel (Lbs.)		Asphalt Damp Proofing Sq. Yds.	1/4" Asphalt Plank Sq. Ft.	1/2" Butyl Rubber Waterproofing Square	Bridge Drainage Metalwork Lbs.
							Mild Carbon	High Strength				
Superstructure							674,692.2	251,107.1		6,756	68	
North Abutment	267	656.47	75,346		66	167			242			
South Abutment	1,284	788.15	91,072	794.9	62	163			231			3,080
TOTAL	1,551	1,444.62	166,418	794.9	128	330	674,692.2	251,107.1	473	6,756	68	3,080

INDEX


- Sheet
- GENERAL PLAN AND ELEVATION ----- 1
 - NORTH ABUTMENT ----- 2
 - NORTH ABUTMENT DETAILS ----- 3
 - NORTH ABUTMENT RETAINING WALL ----- 4
 - SOUTH ABUTMENT ----- 5
 - SOUTH ABUTMENT DETAILS ----- 6
 - SOUTH ABUTMENT RETAINING WALL ----- 7
 - FRAMING PLAN ----- 8
 - SUPERSTRUCTURE DETAILS ----- 9
 - SUPERSTRUCTURE DETAILS ----- 10
 - SHOE DETAILS ----- 11
 - BORING LOGS ----- 12
 - STANDARD ARCHITECTURAL DETAILS - S8 AND S9

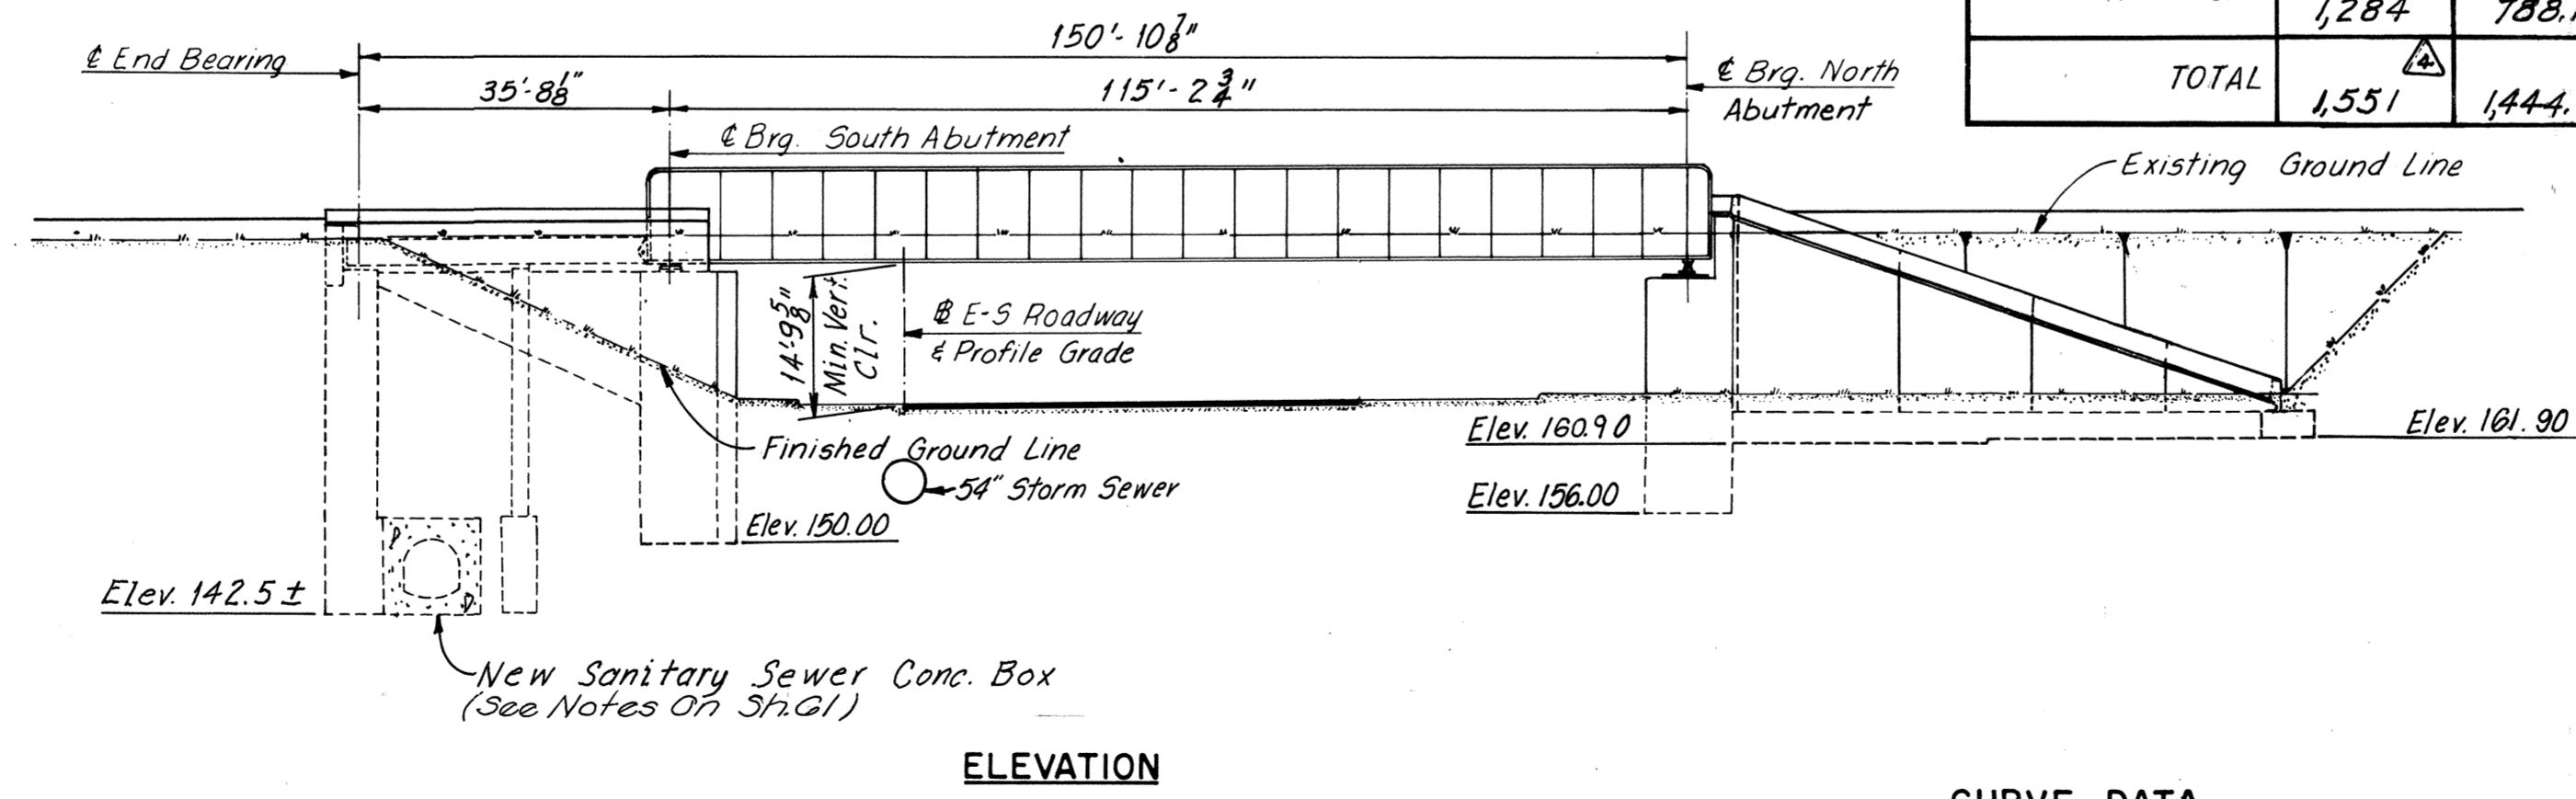

CURVE DATA

@ E-S Roadway
 P.I. = Sta. 6+43.88
 Δ = 37°15'41"
 D = 3°00'00"
 T = 643.88'
 L = 1242.04'
 R = 1909.86'

Note: North Abutment Wingwall Only.

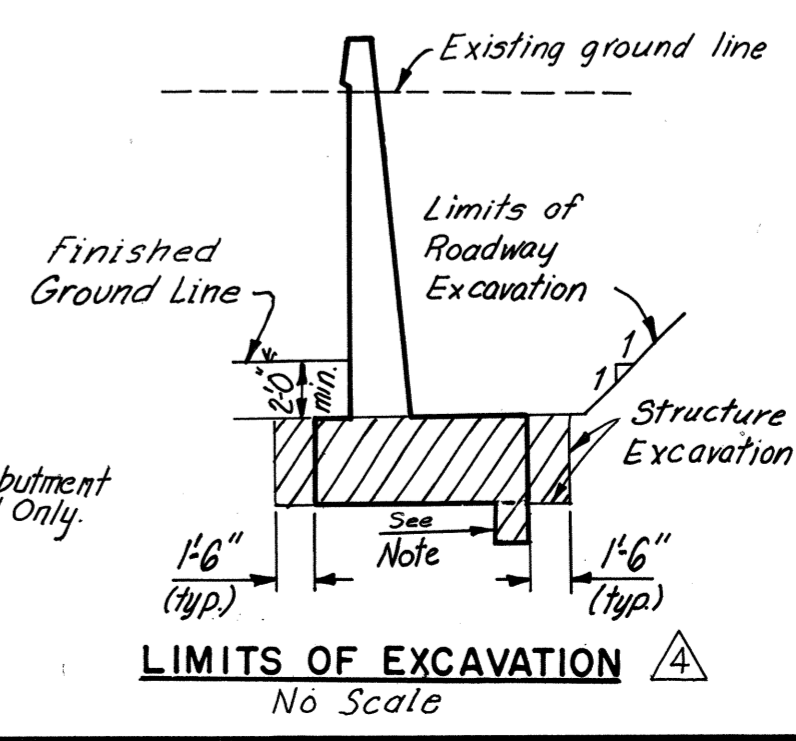

AS BUILT


RICHMOND METROPOLITAN AUTHORITY
 RICHMOND EXPRESSWAY SYSTEM
 BELTLINE EXPRESSWAY
 BRIDGE NO. 10
 R.F.&P.R.R. OVER
 EAST-SOUTH ROADWAY
 GENERAL PLAN AND ELEVATION

HOWARD, NEEDLES, TAMMEN & BERGENDOFF
 consulting engineers
 NEW YORK ALEXANDRIA KANSAS CITY

SCALE: 1"=20' unless noted
 CONTRACT NO.: 4
 SHEET NO. 1 OF 12




MADE	BY	DATE	NO.	REVISION	BY	DATE
	RLM	12-5-67	2	General	J.G.V.	10-70
CHECKED	JEH	4-9-68	1	General Checking	AMH	5-13-68
IN CHARGE	FKD					

RICHMOND EXPRESSWAY SYSTEM			
SECTION	PROJECT	SHEET NO.	TOTAL SHEETS
4	BELTLINE EXPRESSWAY	107	155

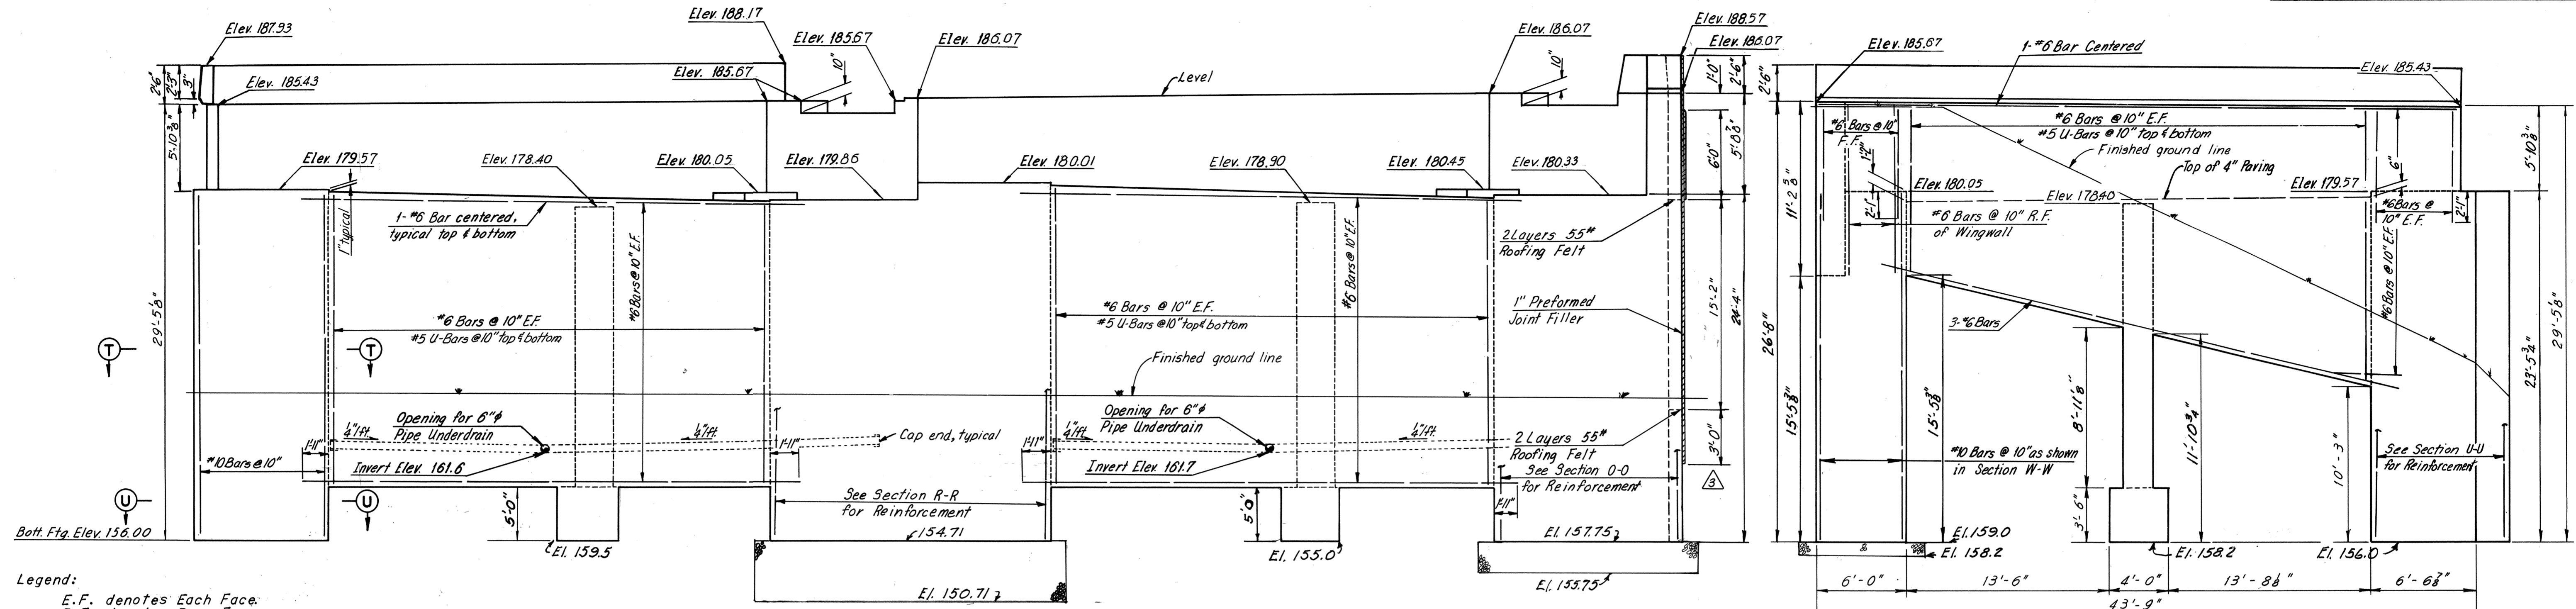

ELEVATION

WEST WINGWALL ELEVATION

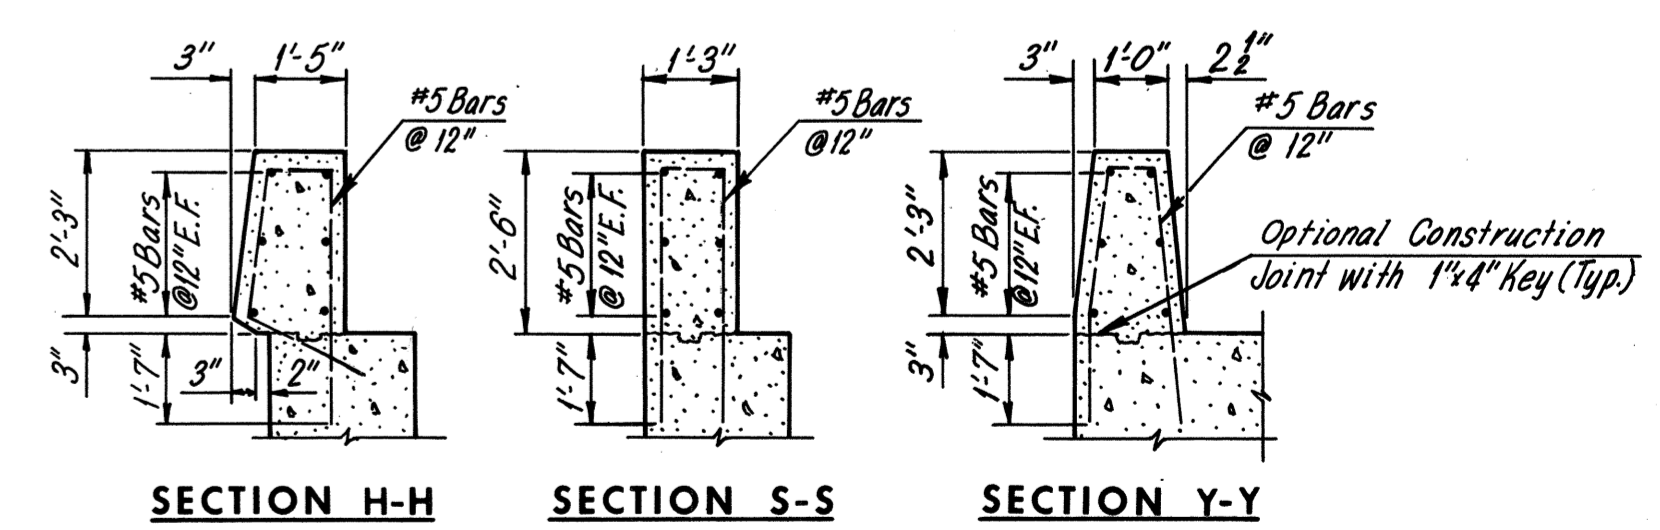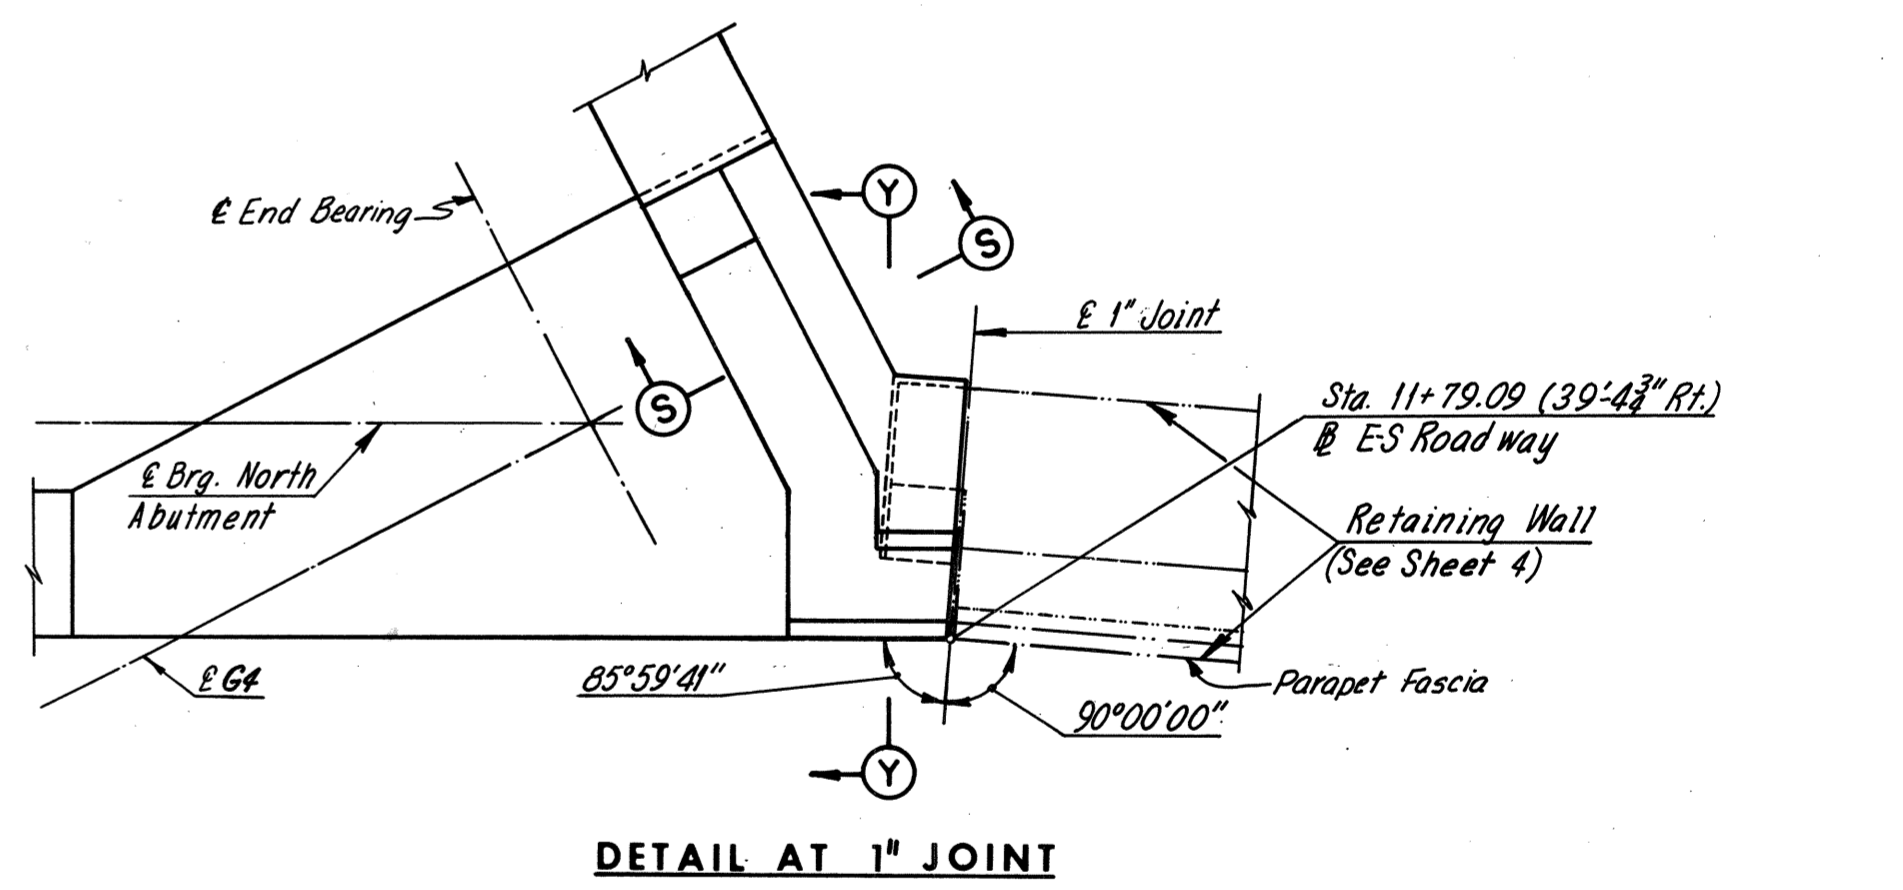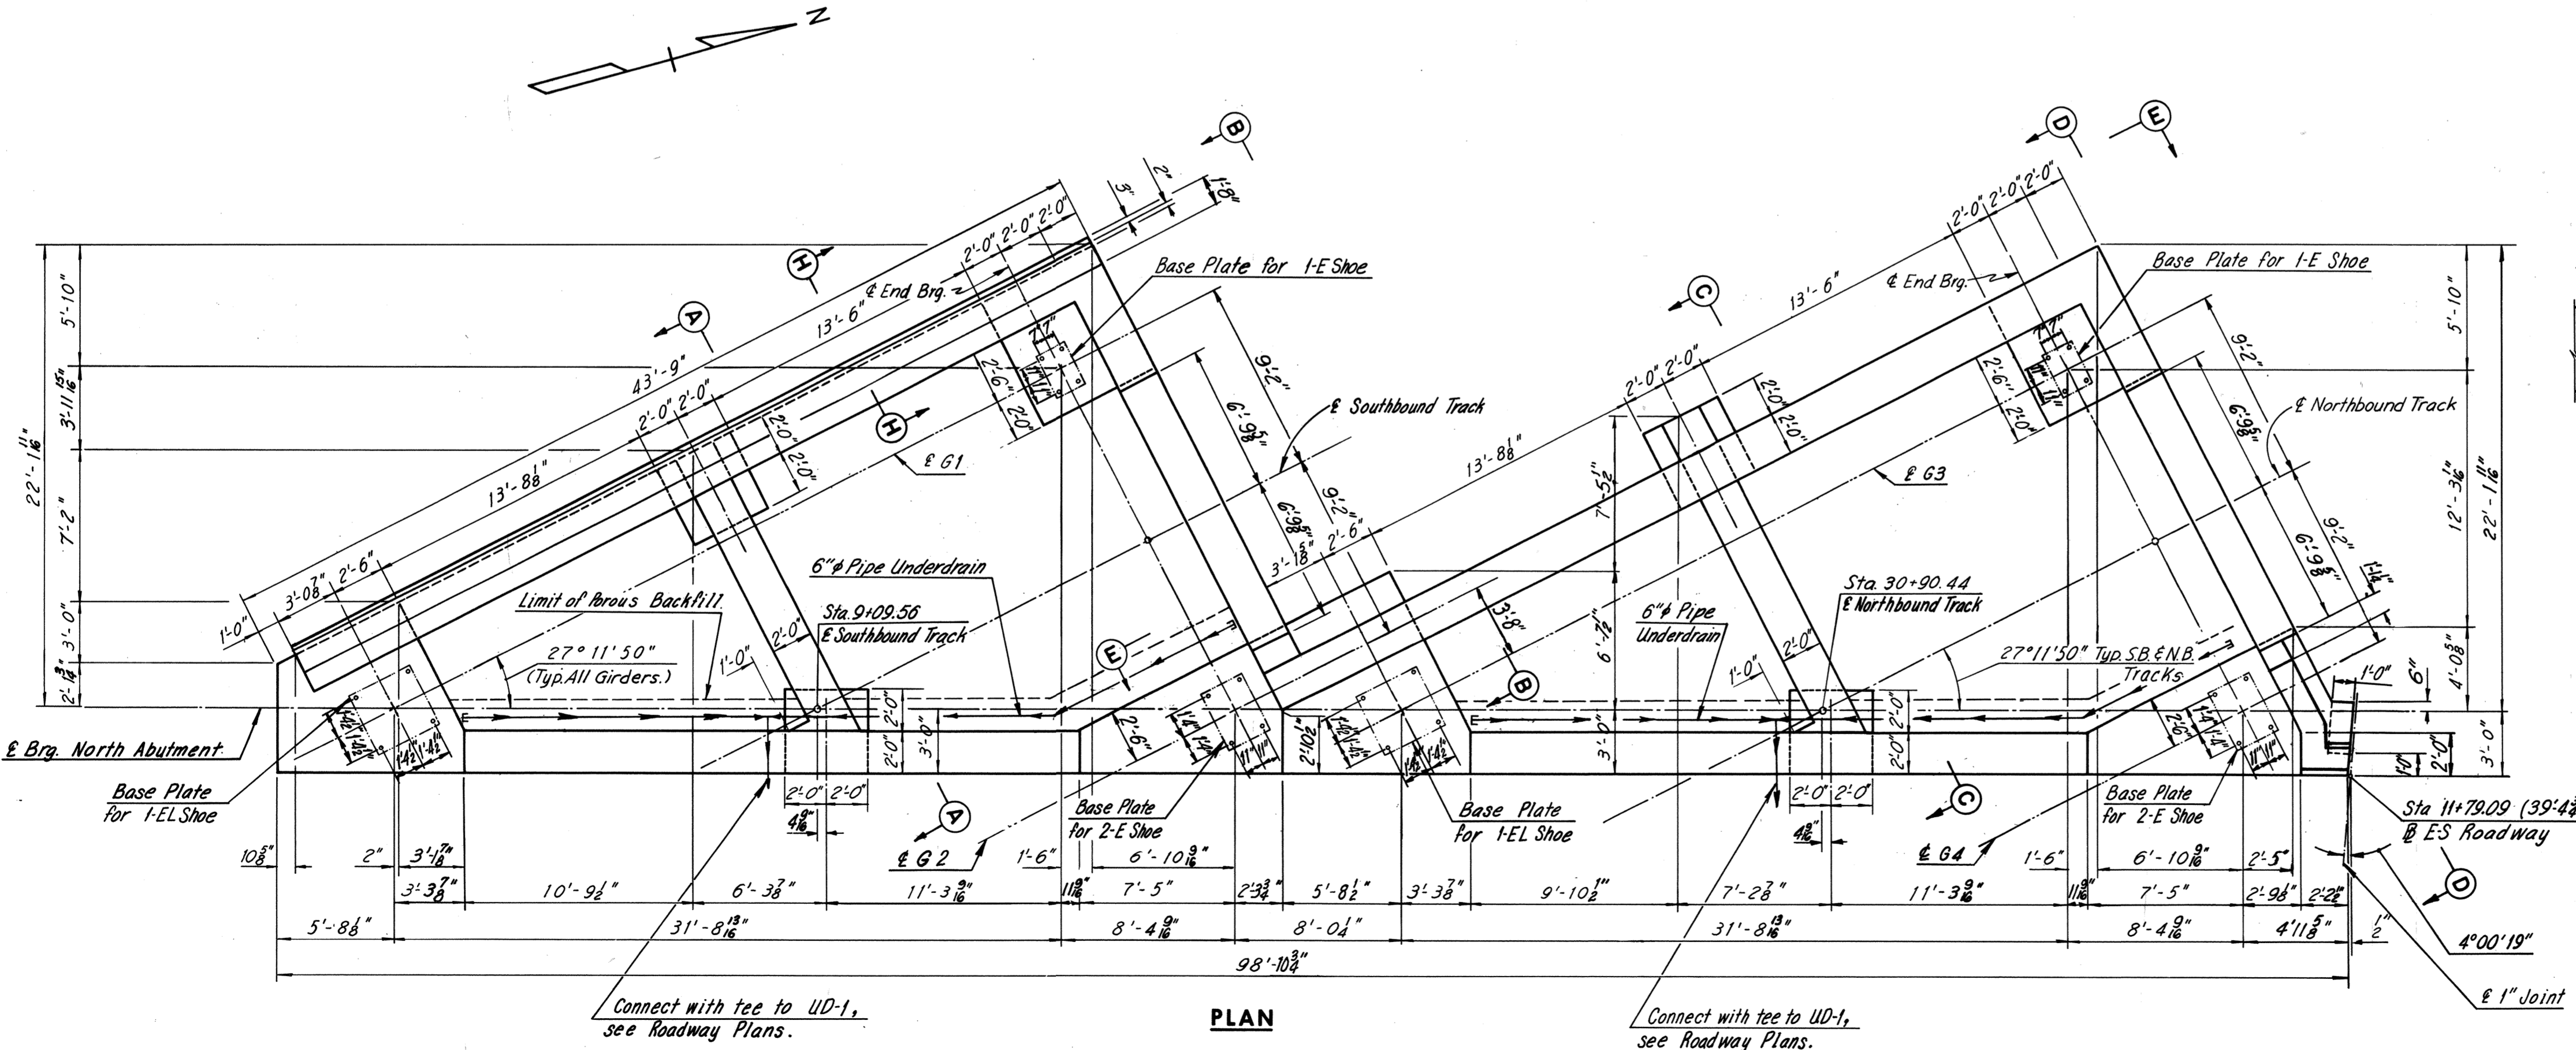

AS BUILT

Note:
 For Sections, see Sheet 3.
 Reinforcing to be shifted to miss underdrain going thru walls.


RICHMOND METROPOLITAN AUTHORITY
RICHMOND EXPRESSWAY SYSTEM
 BELTLINE EXPRESSWAY
 BRIDGE NO. 10
 R.F.&P.R. OVER
 EAST-SOUTH ROADWAY
 NORTH ABUTMENT

HOWARD, NEEDLES, TAMMEN & BERGENDOFF
 consulting engineers
 NEW YORK ALEXANDRIA KANSAS CITY

SCALE: *No Scale*
 CONTRACT NO.: 4
 SHEET NO. 2 OF 12

NO.	REVISION	BY	DATE
4	As Built	JRC	3-73
3	Wall Ftg. Elev.	J.G.V.	2-23-72
2	Profile Grade	P.S.	4-15-71
1	General Checking	AMH	5-17-68



RICHMOND EXPRESSWAY SYSTEM			
SECTION	PROJECT	SHEET NO.	TOTAL SHEETS
4	BELTLINE EXPRESSWAY	108	155

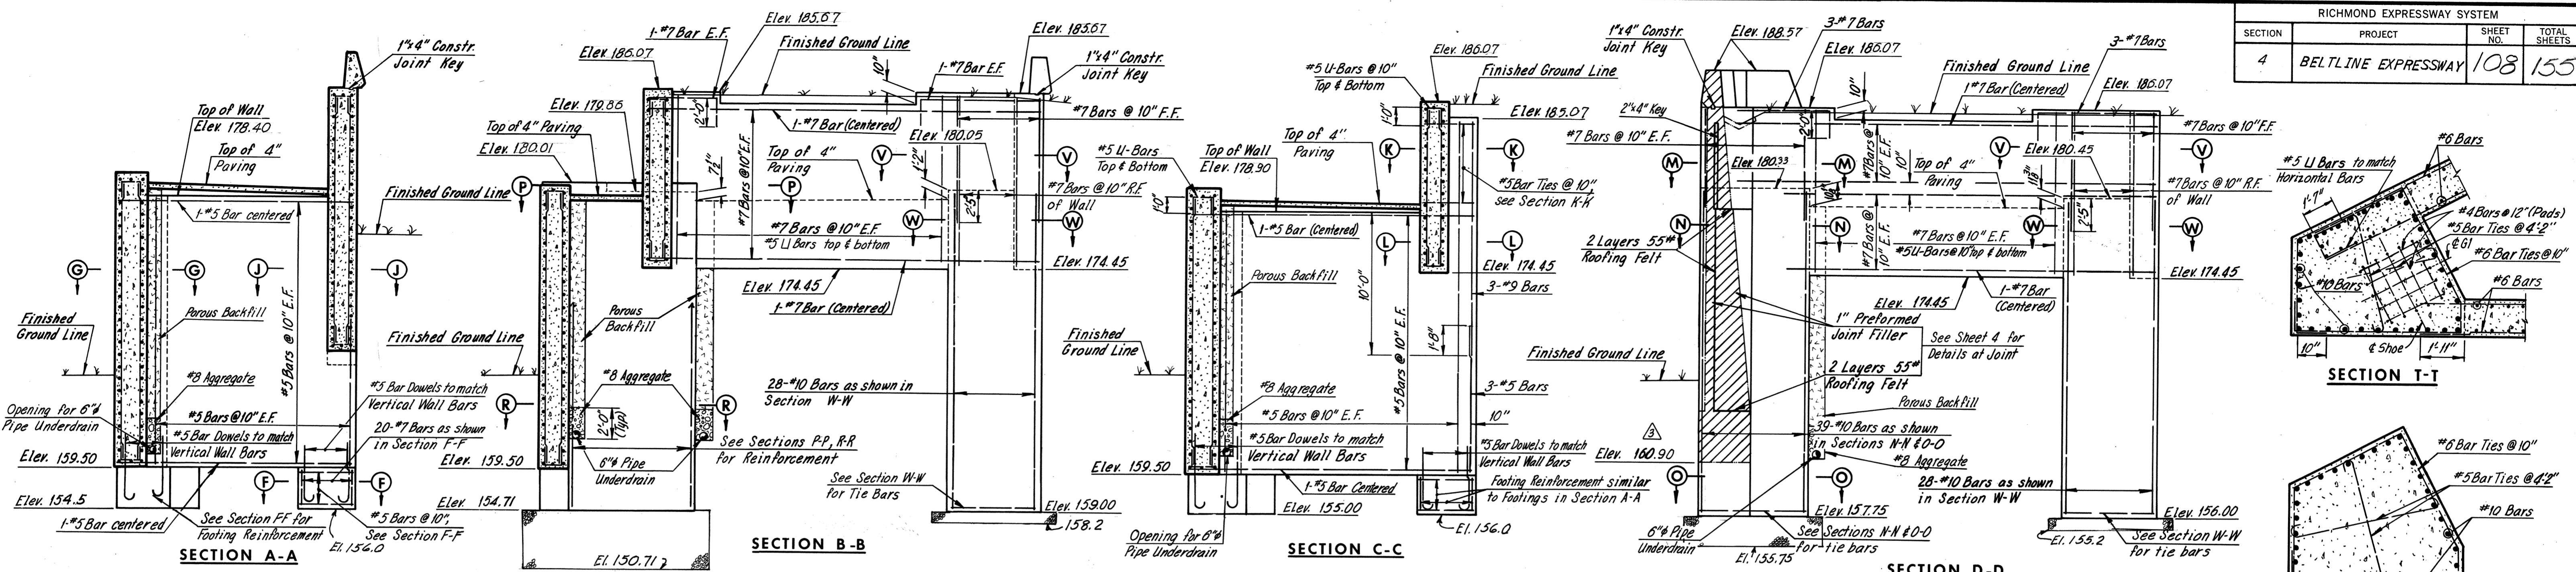


Note: #5 U-Bars to be placed @ 10" ctrs. between footings in Section A-A and Section C-C.

Note: Dampproofing to be applied between wall and porous backfill, from bottom of 4" concrete paving to bottom of wall.


Note: #4 Bars @ 12" shown in Sections M-M, P-P, T-T, and W-W, are to be U-Shaped Bars with 1'-6" legs.

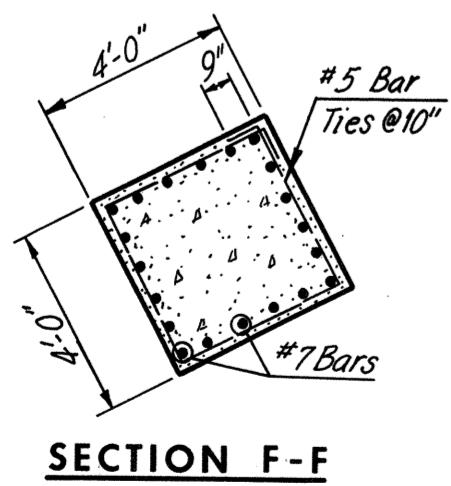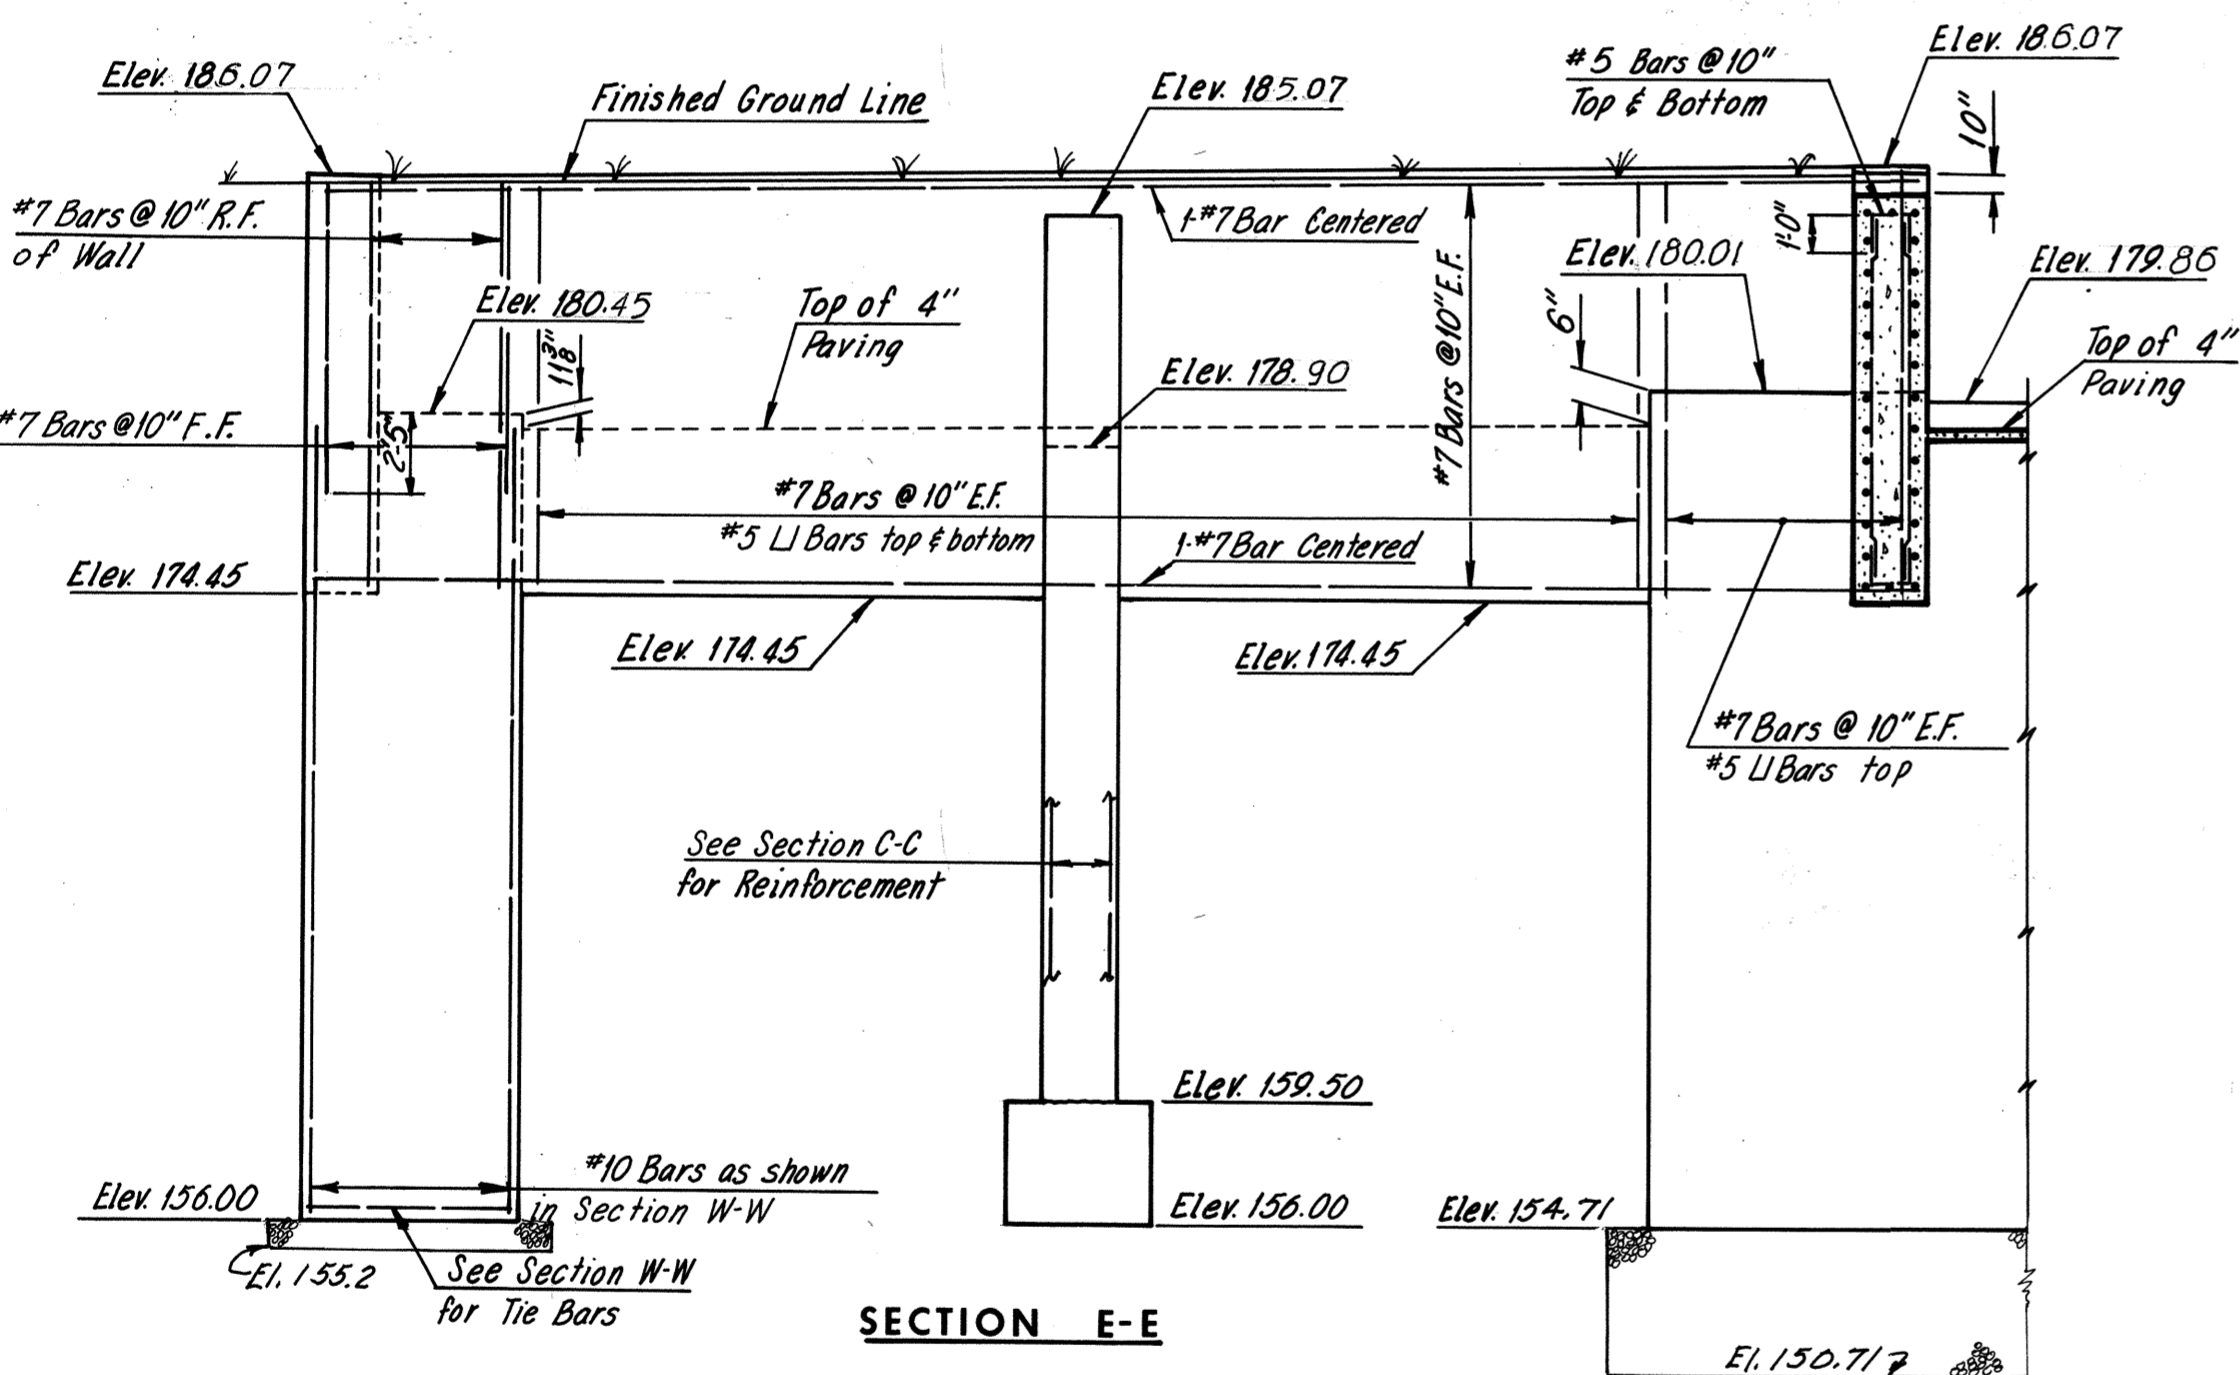


SECTION F-F

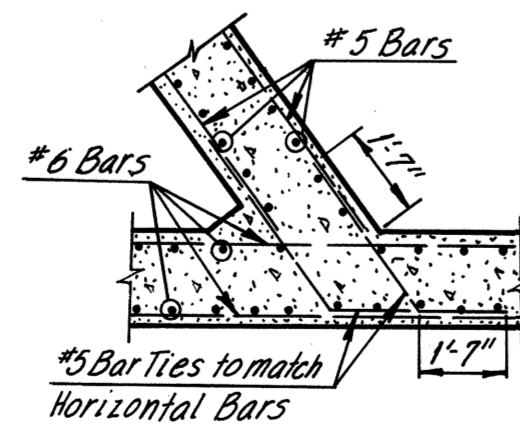


SECTION G-G

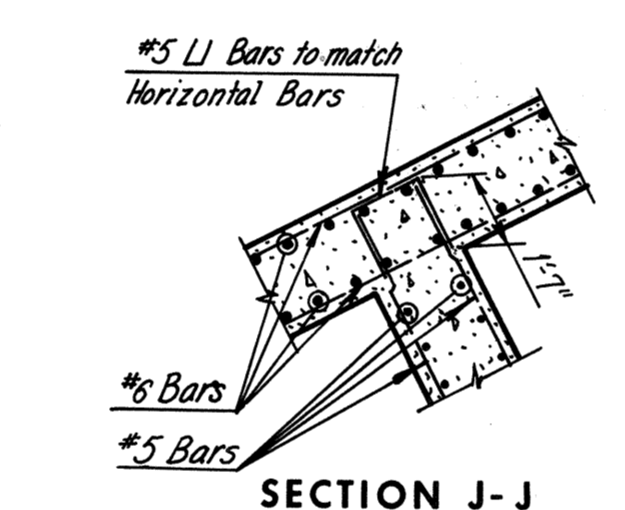


SECTION J-J

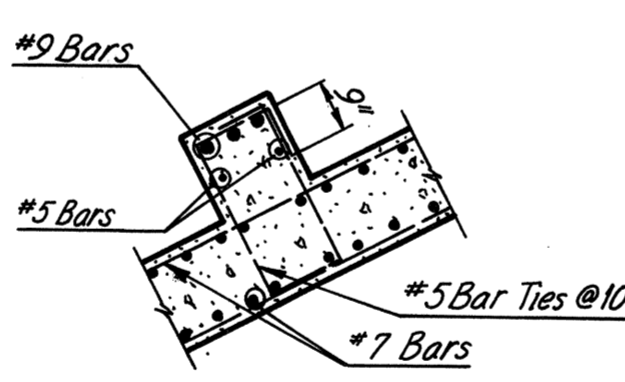


SECTION K-K

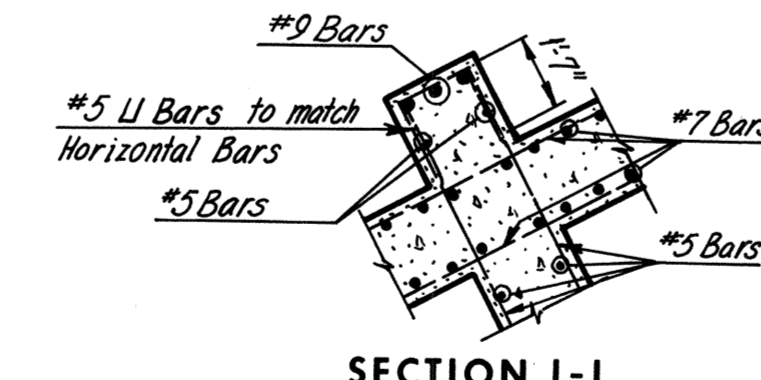


SECTION L-L

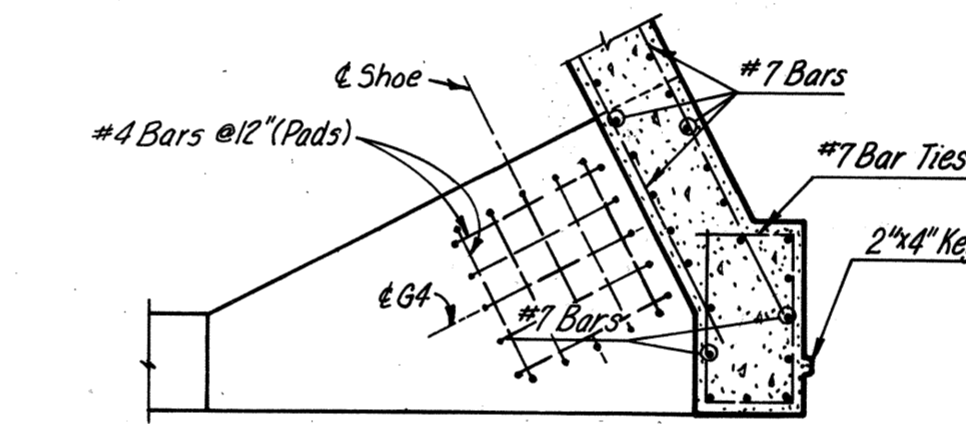


SECTION M-M

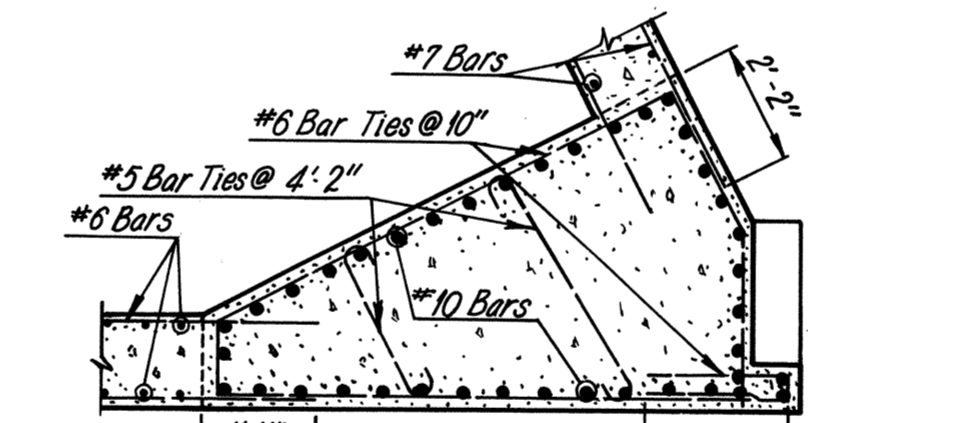


SECTION N-N

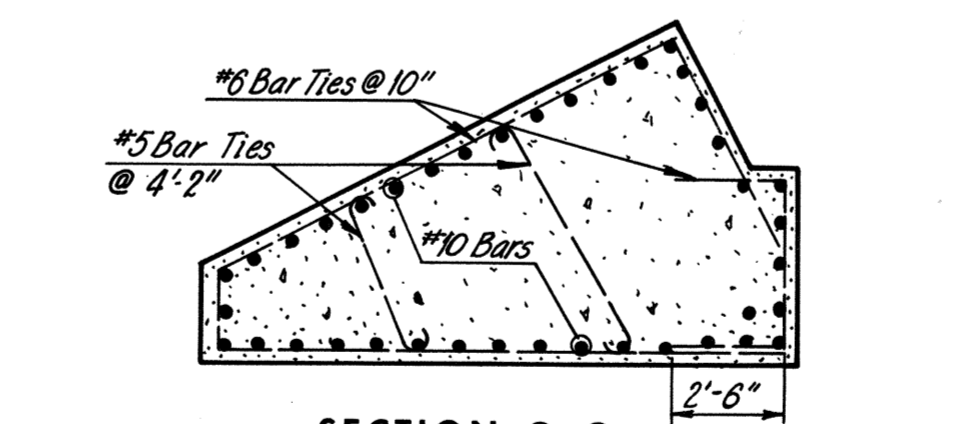


SECTION O-O

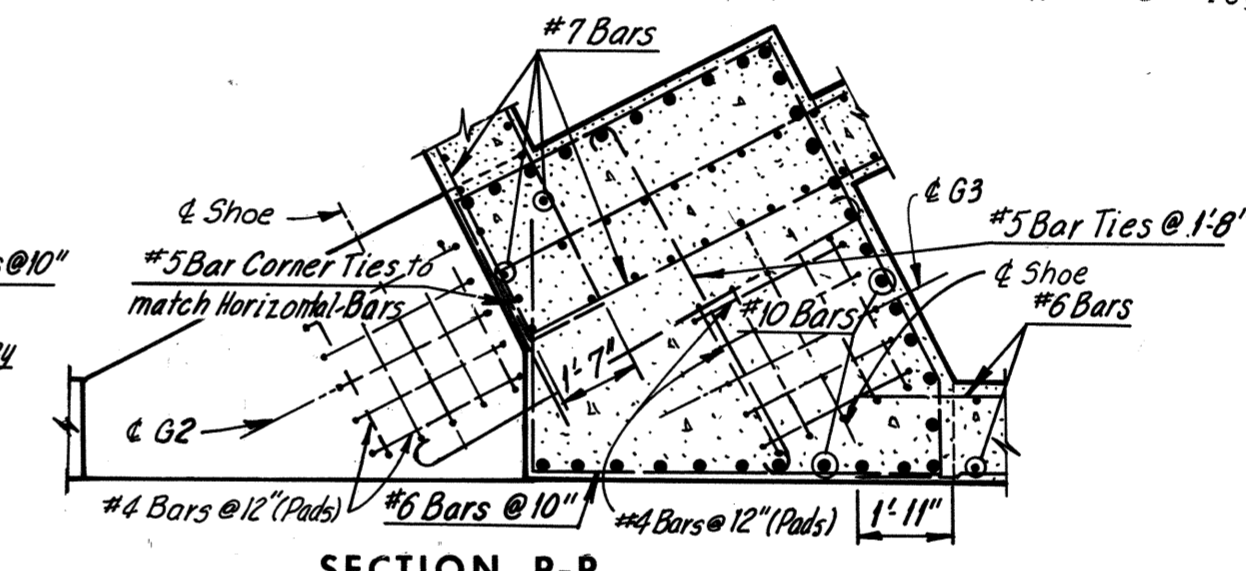


SECTION P-P

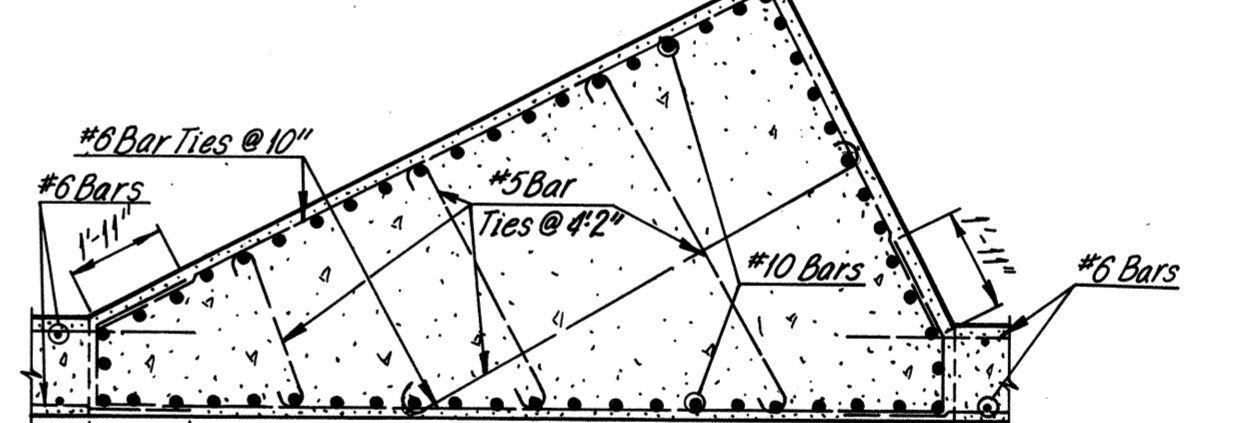


SECTION R-R

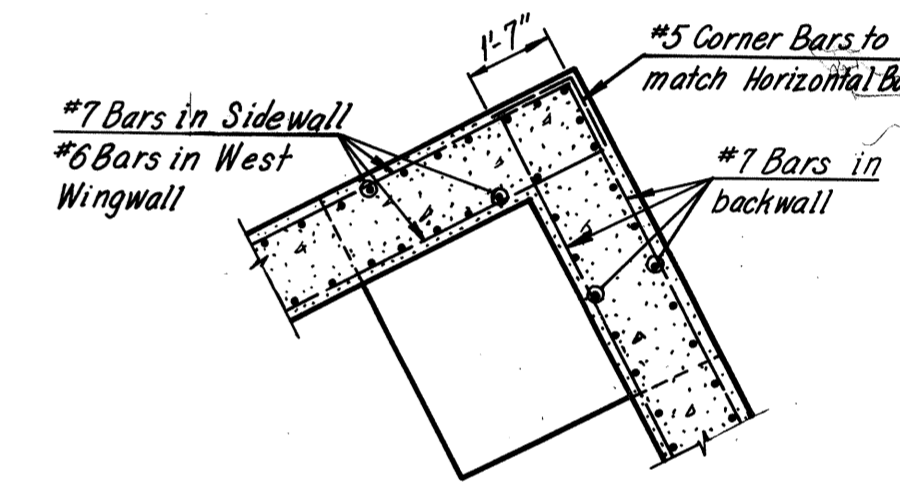

SECTION U-U

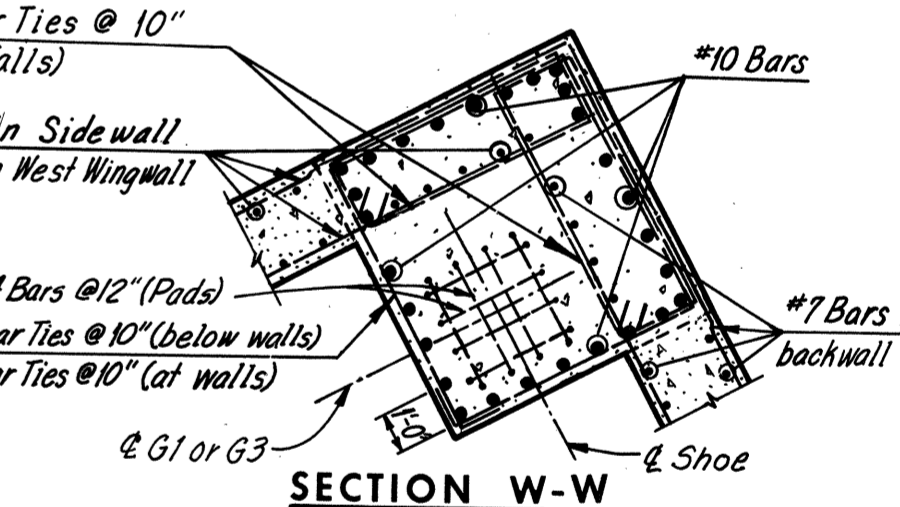

SECTION V-V

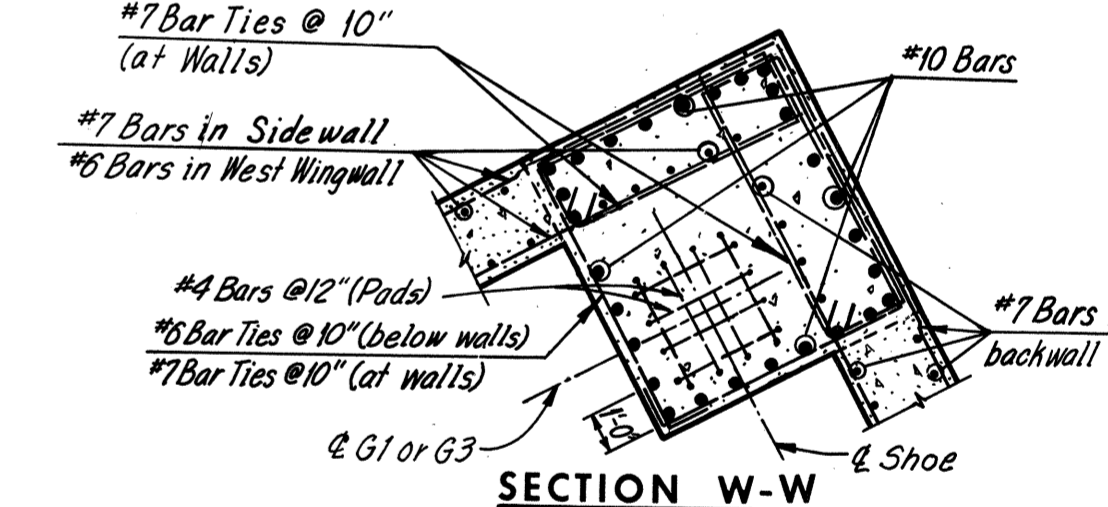

SECTION W-W

Notes:
 Paving shown within limits of abutment shall be 4" thick.
 2" preformed joint filler, sealed with a 1" depth of hot applied joint sealer, shall be installed between paving and abutment walls.
 Preformed joint filler shall be bituminous type conforming to AASHTO M213.
 Paving will be paid for as "Concrete, Class A3, Substructures and Walls."
 For Location of sections A-A, B-B, C-C, D-D, E-E, T-T and U-U, see Sheet 2.

AS BUILT








Legend:
 E.F. denotes Each Face
 F.F. denotes Front Face
 R.F. denotes Rear Face

NO.	REVISION	BY	DATE
1	As Built	JRC	3-73
2	Wall Fig. Elev.	J.G.V.	2-23-72
3	Profile Grade	P.S.	4-15-71
4	General Checking	AMH	5-13-68

RICHMOND METROPOLITAN AUTHORITY
RICHMOND EXPRESSWAY SYSTEM
BELTLINE EXPRESSWAY
BRIDGE NO. 10
R.F.&P.R. OVER
EAST-SOUTH ROADWAY
NORTH ABUTMENT DETAILS

HOWARD, NEEDLES & BERGENDOFF
 consulting engineers
 NEW YORK ALEXANDRIA KANSAS CITY

SCALE: No Scale
 CONTRACT NO: 4
 SHEET NO. 3 OF 12

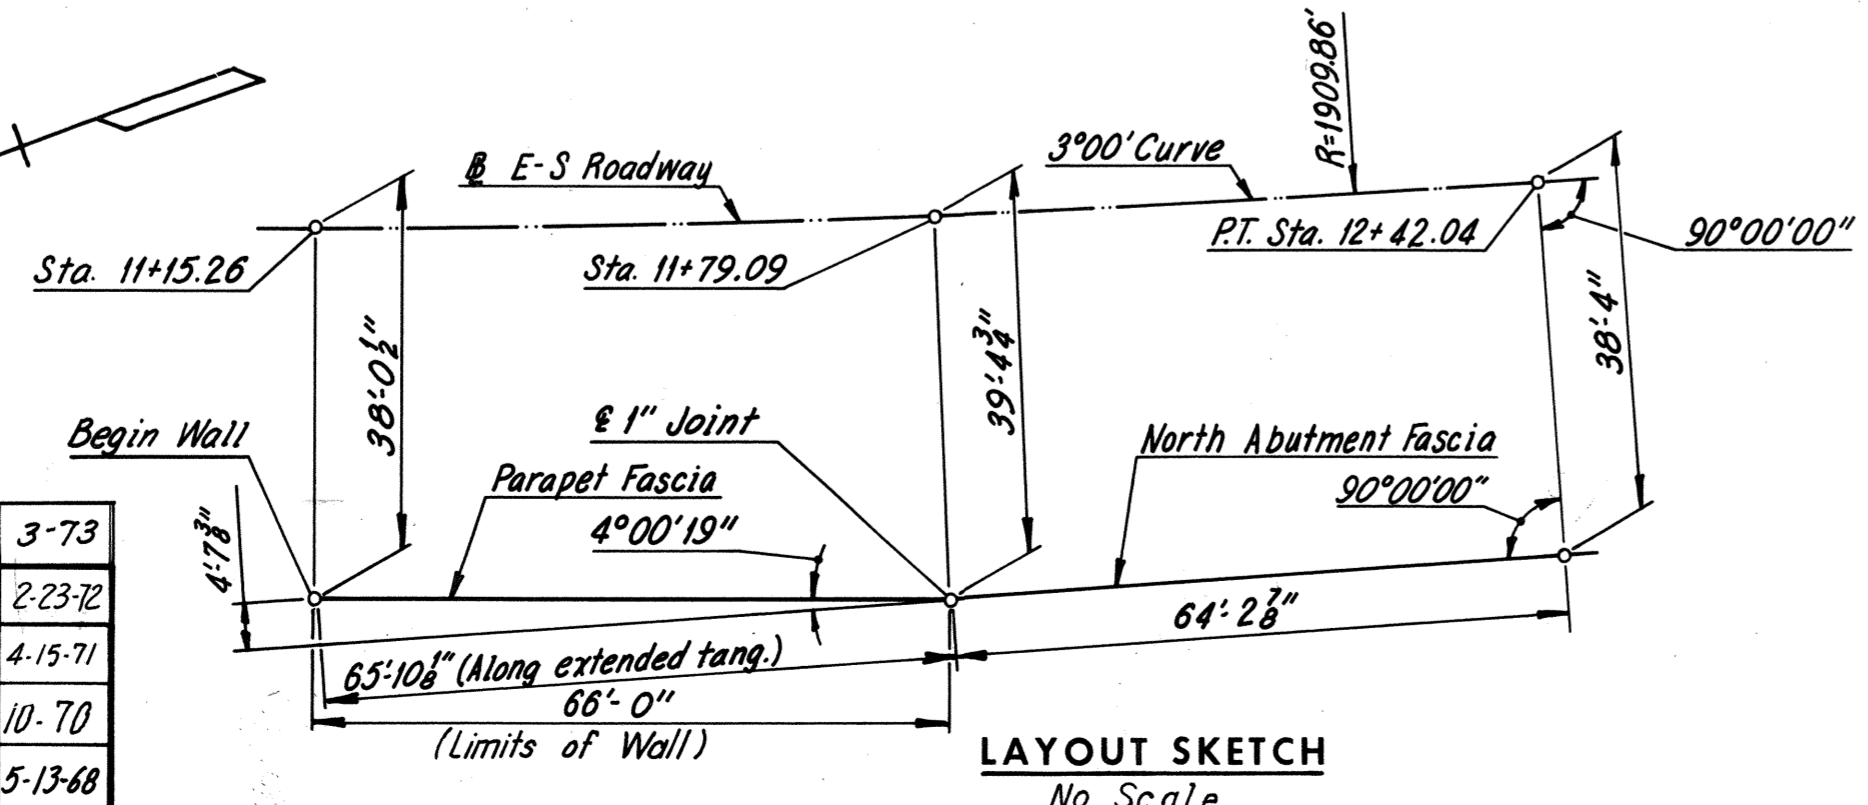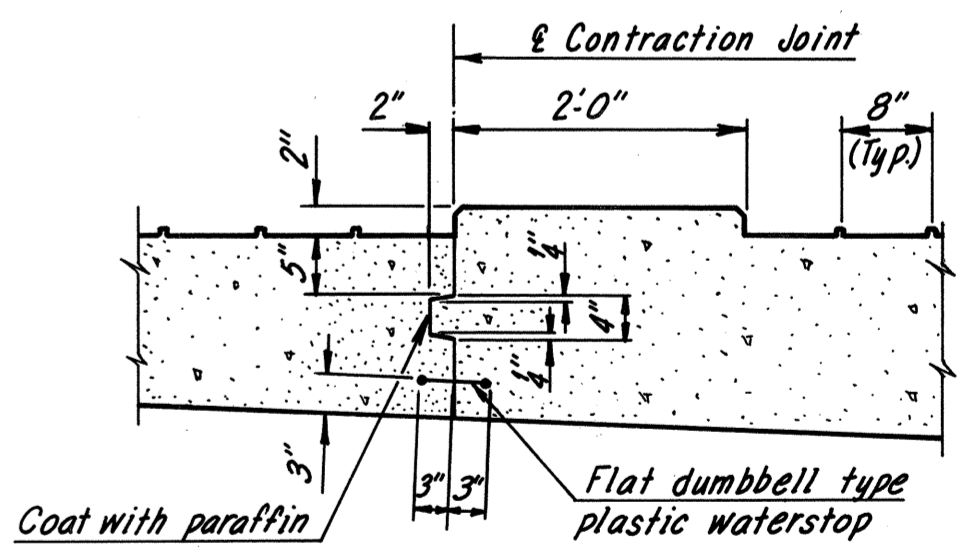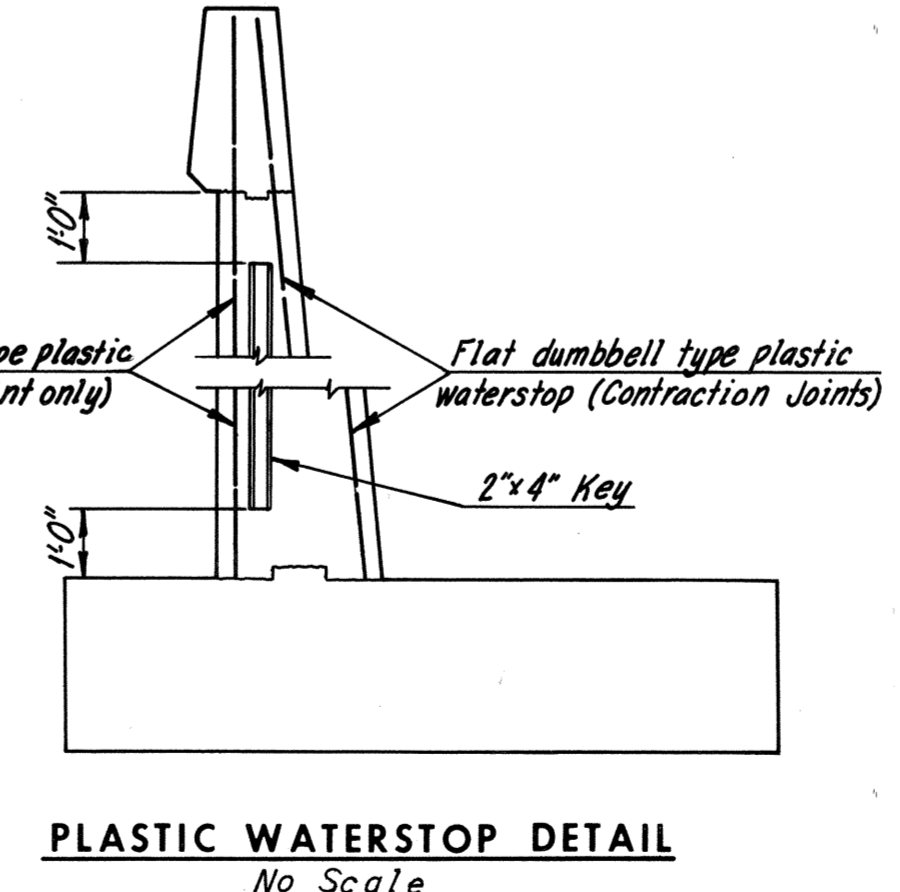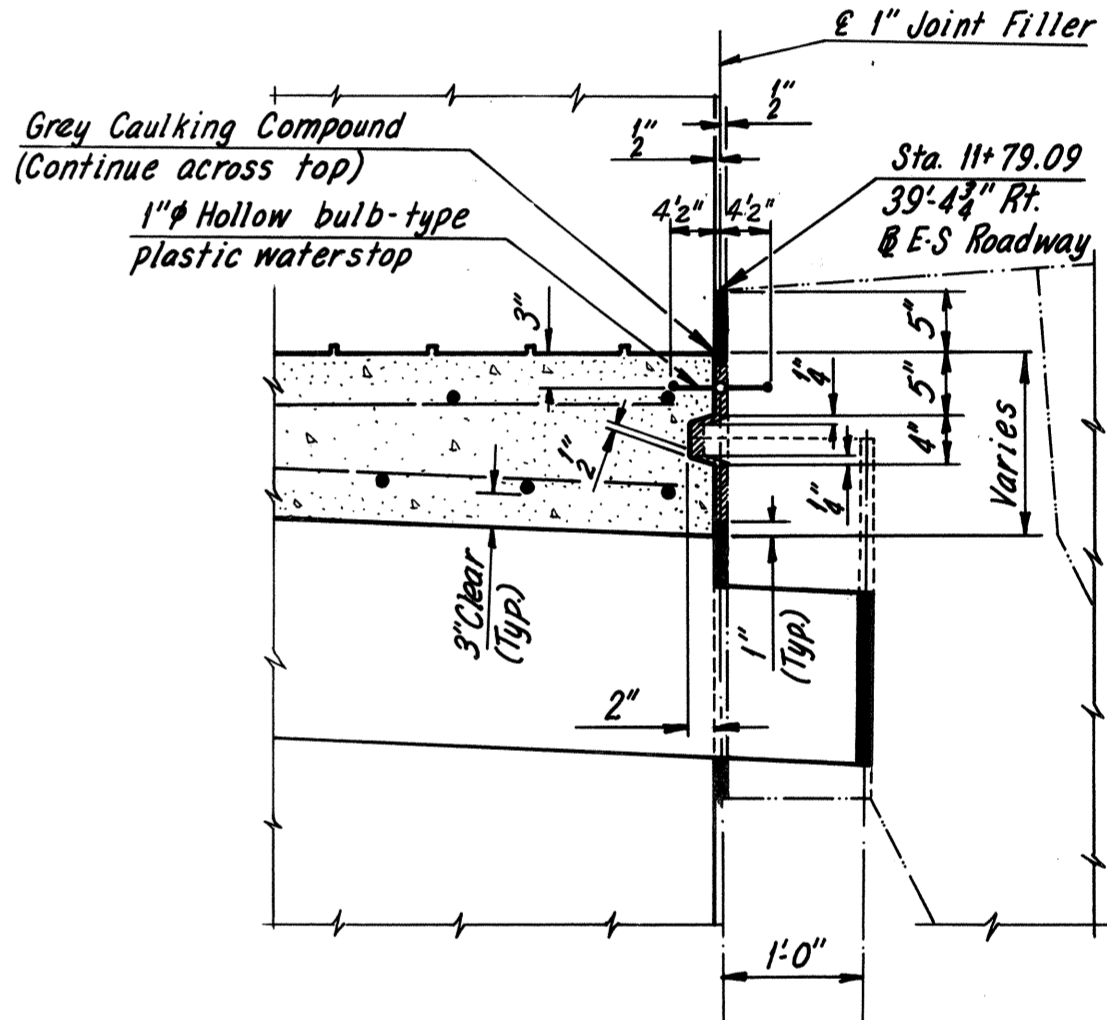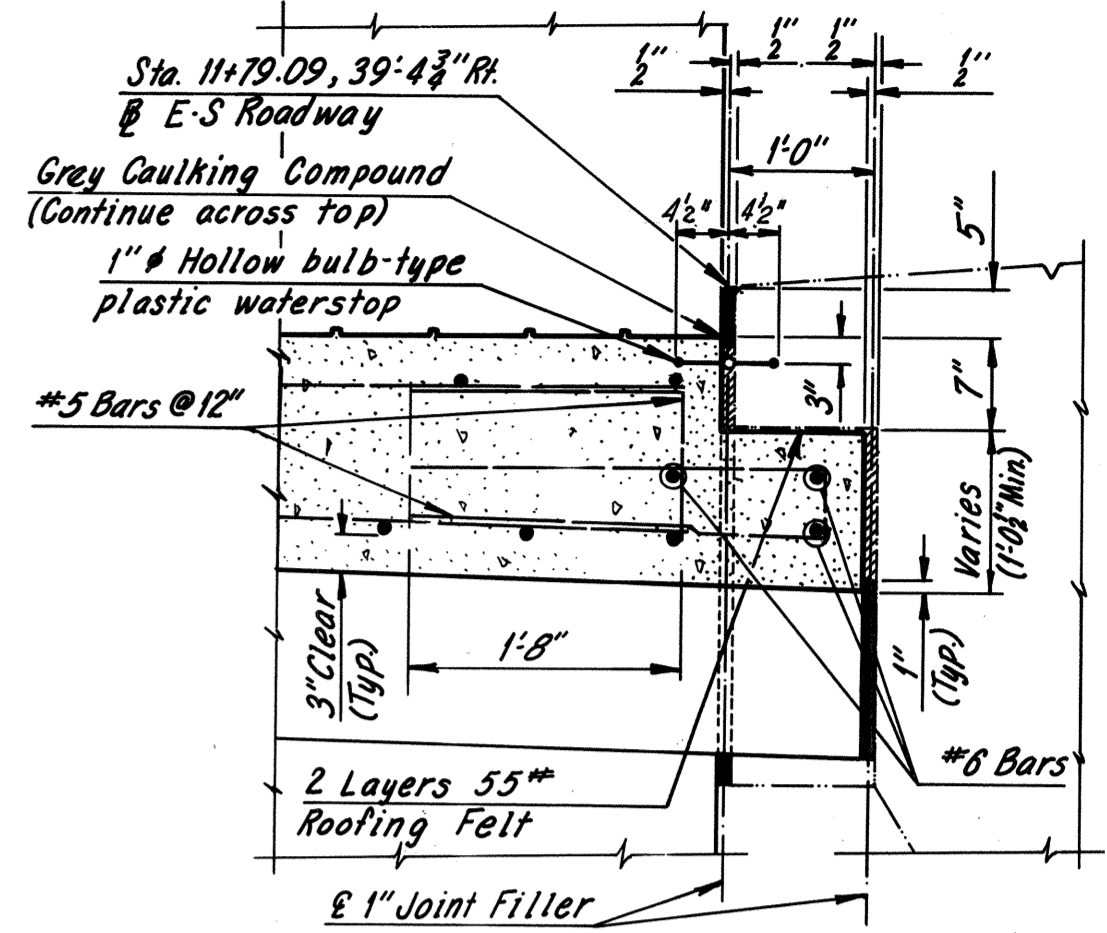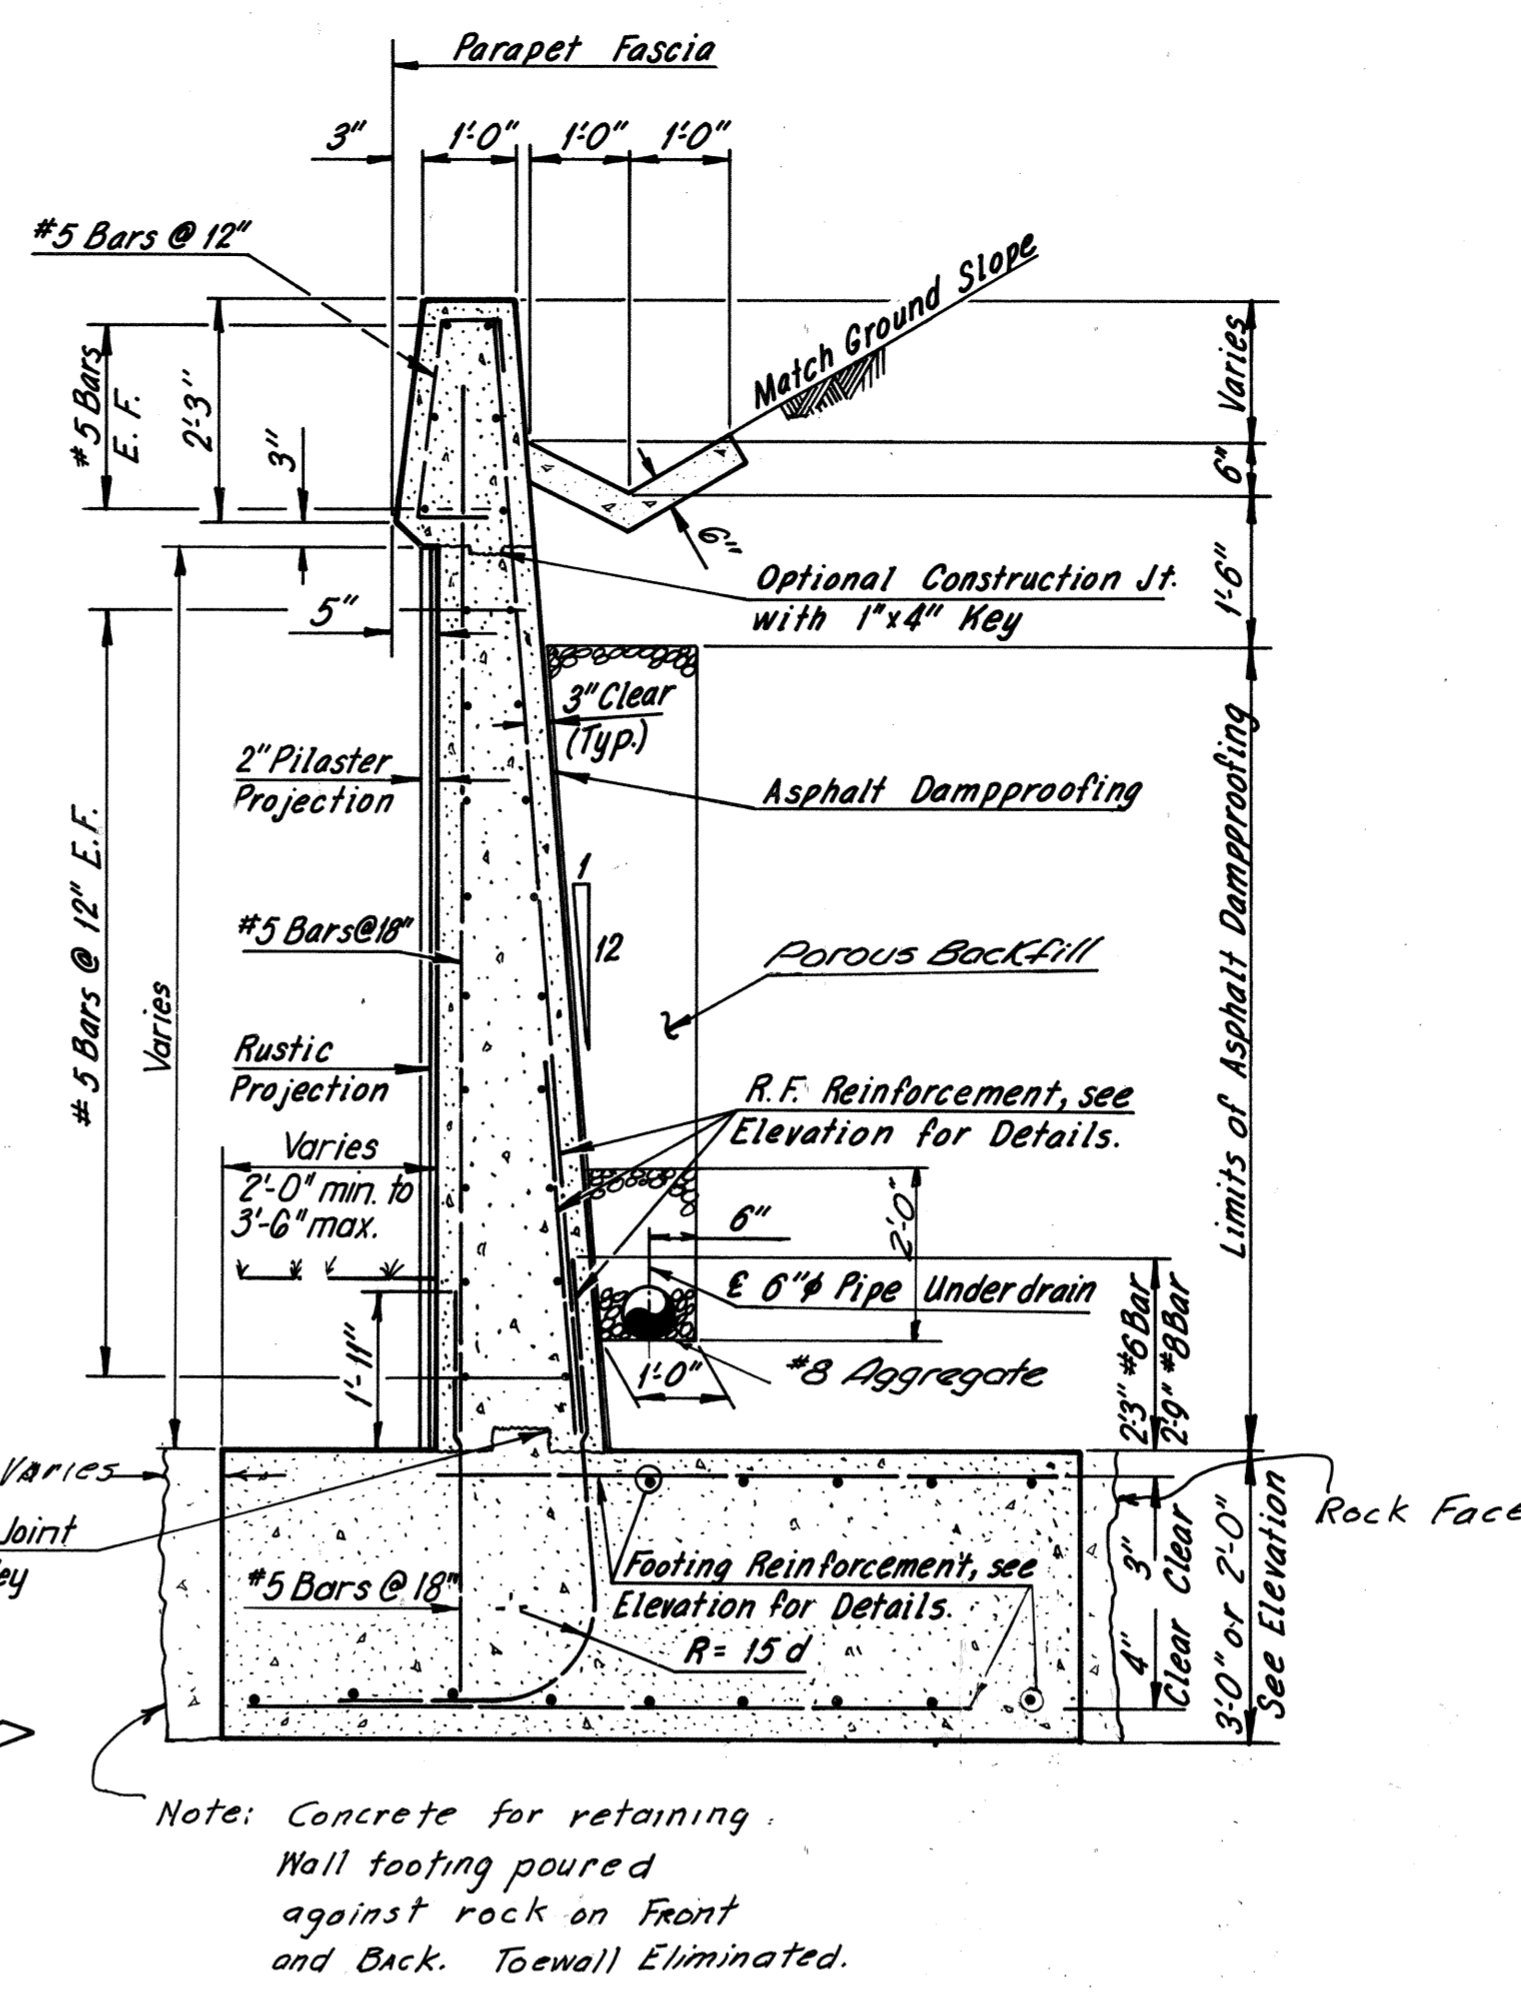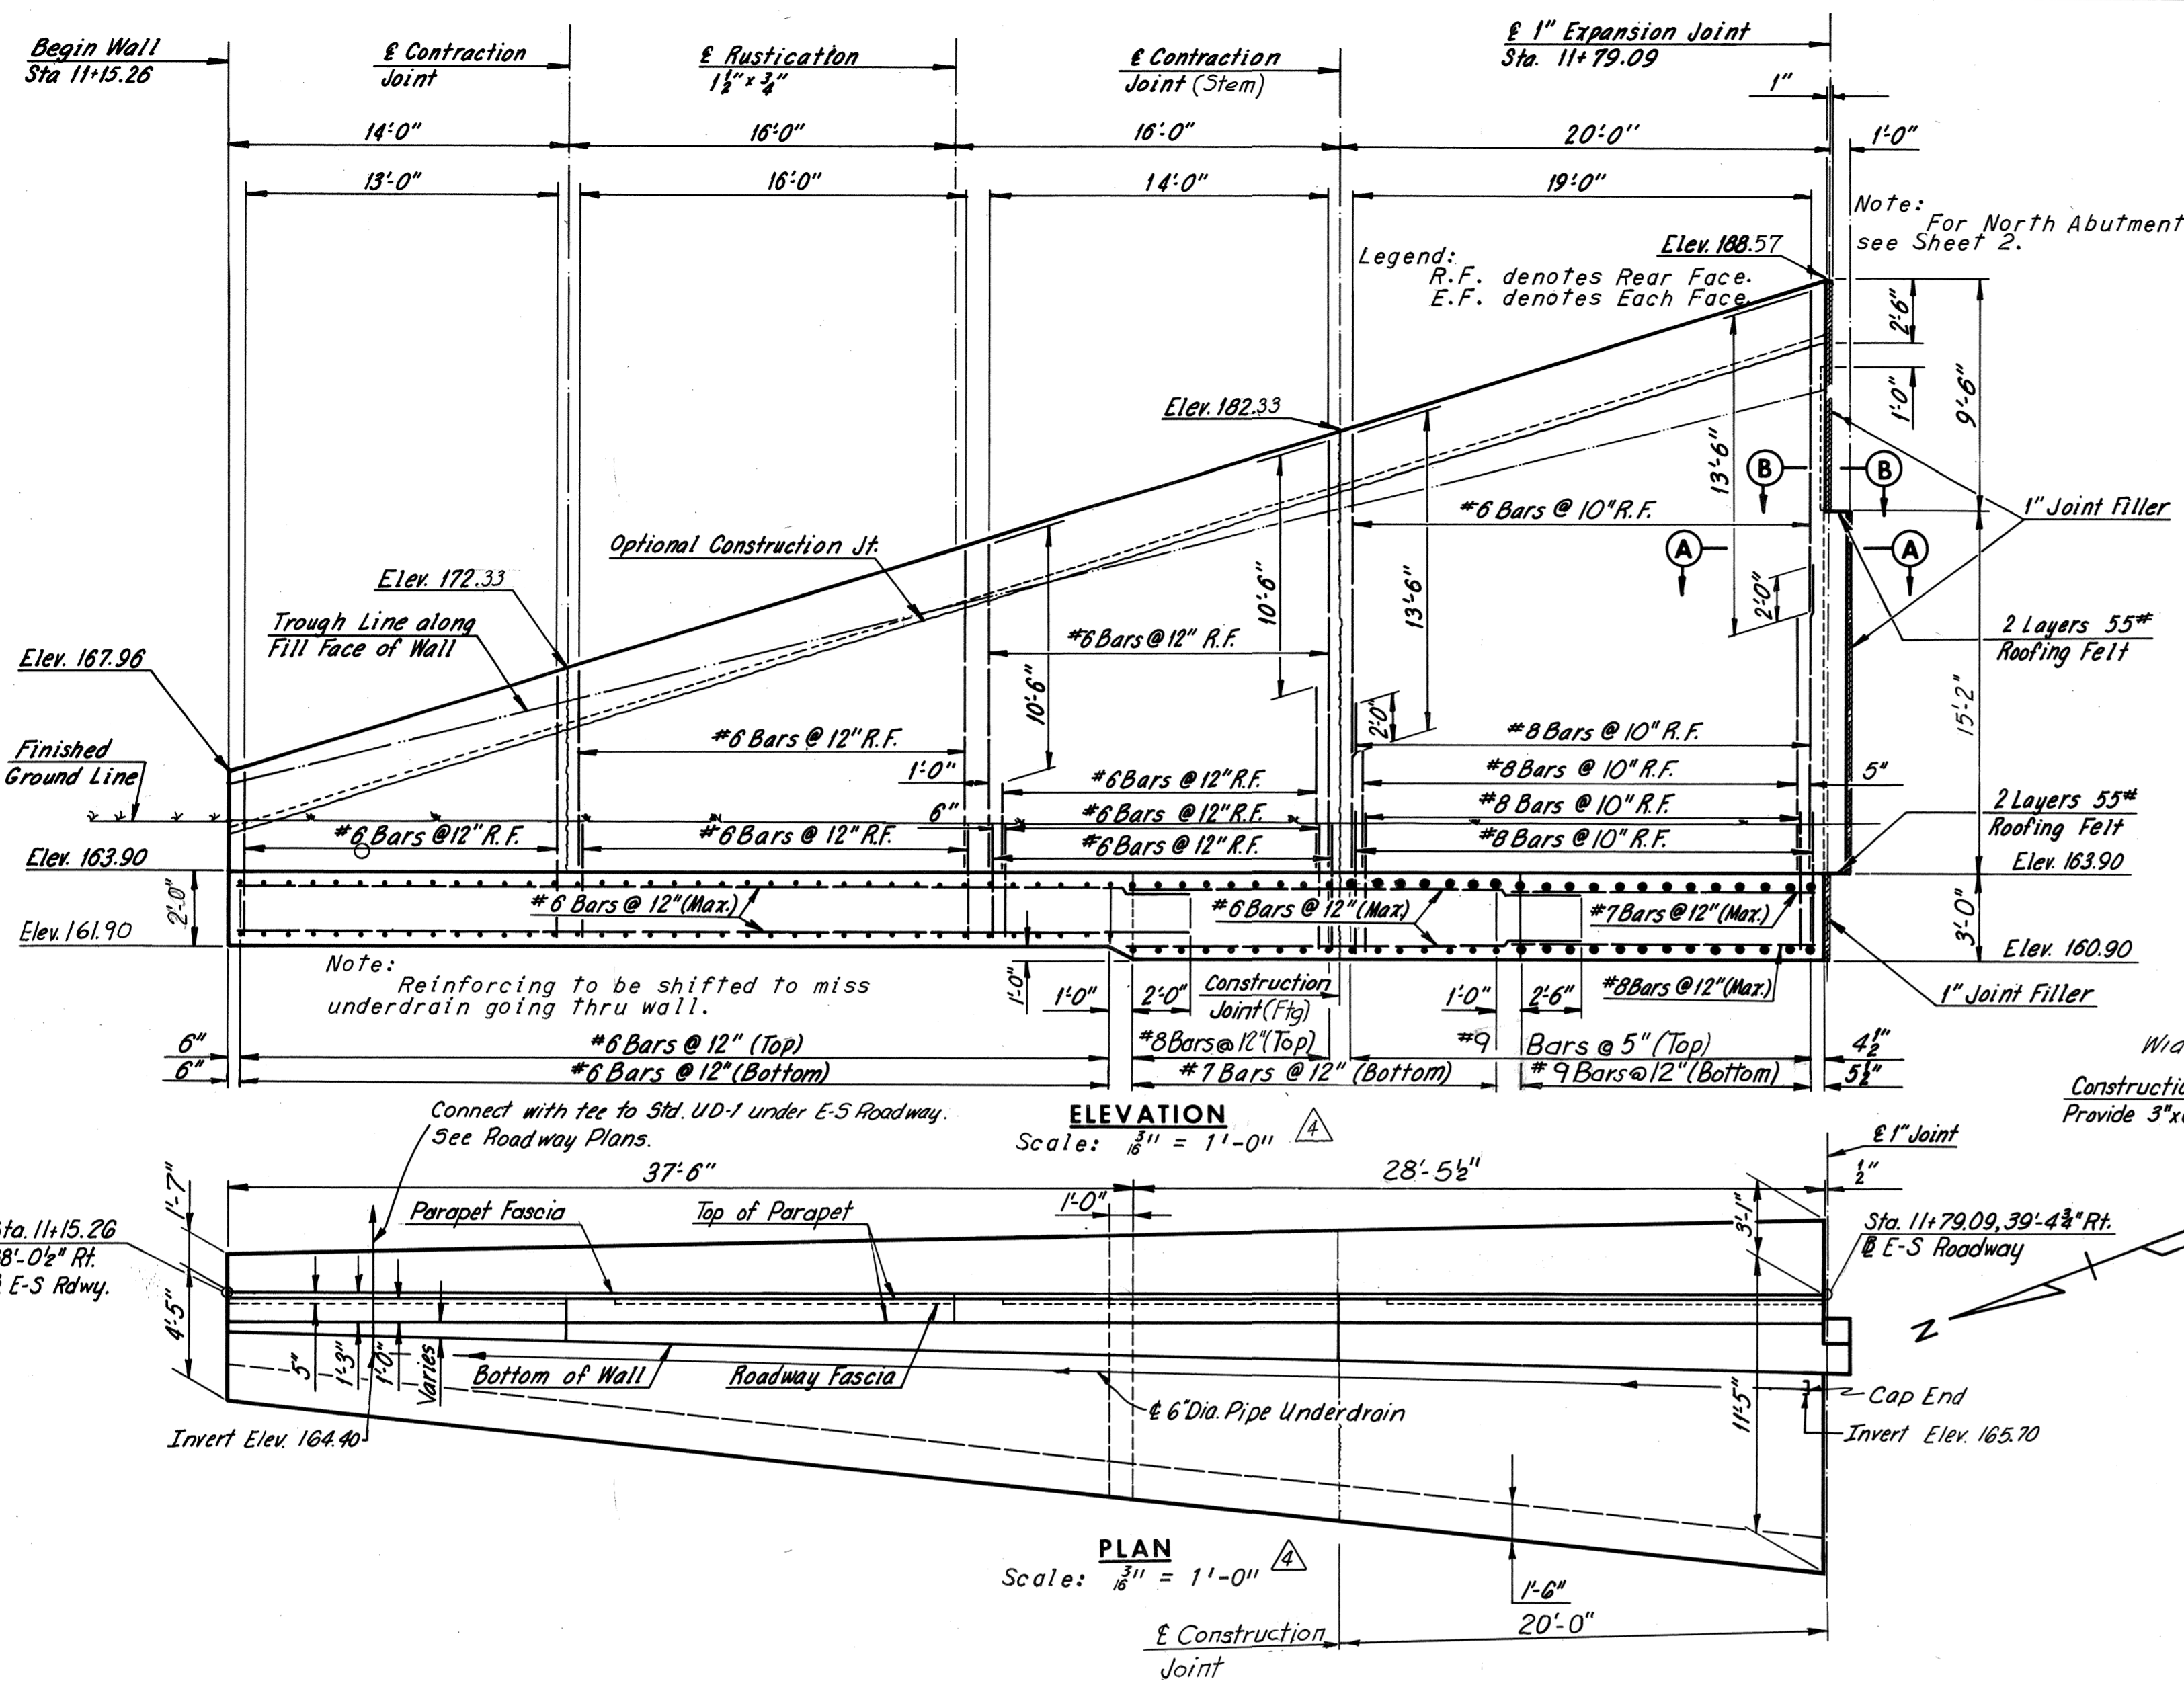

5	As Built	JRC	3-73
4	Footing Revisions	J.G.V.	2-23-72
3	Profile Grade	P.S.	4-15-71
2	General	P.S.	10-70
1	General Revisions	AMH	5-13-68
NO.	REVISION	BY	DATE

AS BUILT





RICHMOND METROPOLITAN AUTHORITY
RICHMOND EXPRESSWAY SYSTEM
BELTLINE EXPRESSWAY

BRIDGE NO. 10
R.F.&P.R.R. OVER
EAST-SOUTH ROADWAY
NORTH ABUTMENT RETAINING WALL

HOWARD, NEEDLES, TAMMEN & BERGENDOFF
consulting engineers
NEW YORK ALEXANDRIA KANSAS CITY

SCALE: *As Noted*
CONTRACT NO.: 4
SHEET NO. 4 OF 12

RICHMOND EXPRESSWAY SYSTEM			
SECTION	PROJECT	SHEET NO.	TOTAL SHEETS
4	BELTLINE EXPRESSWAY	110	155

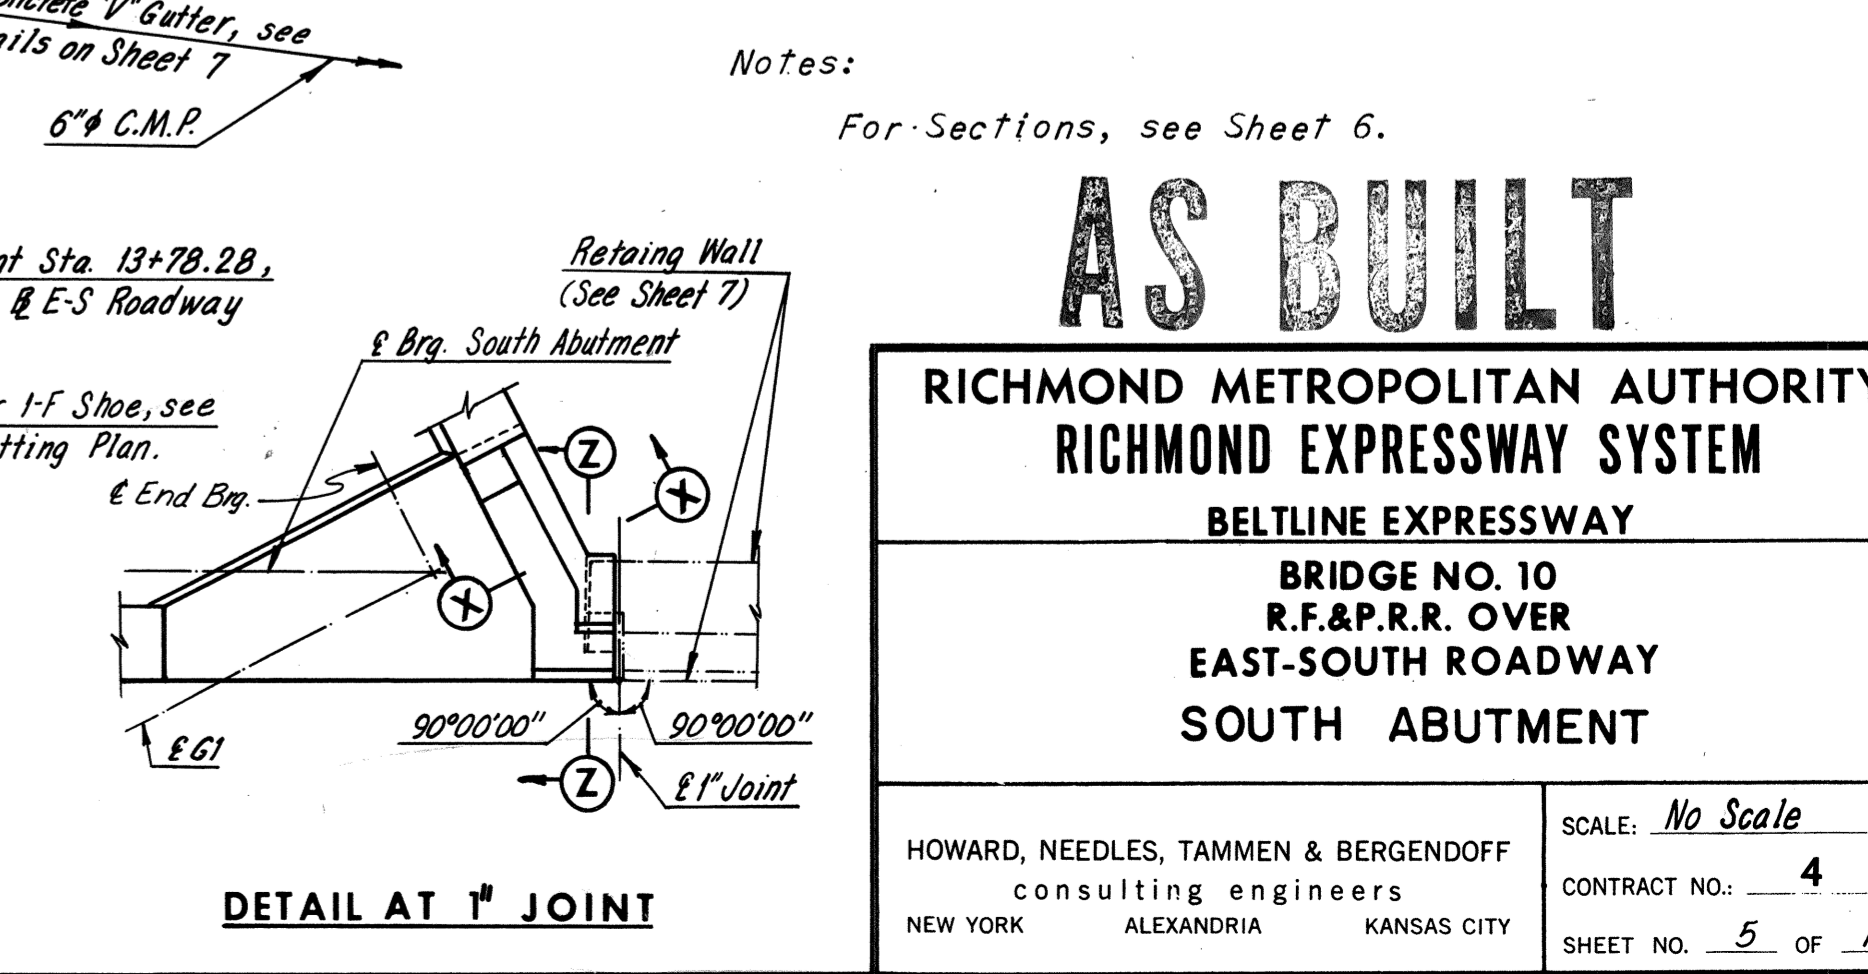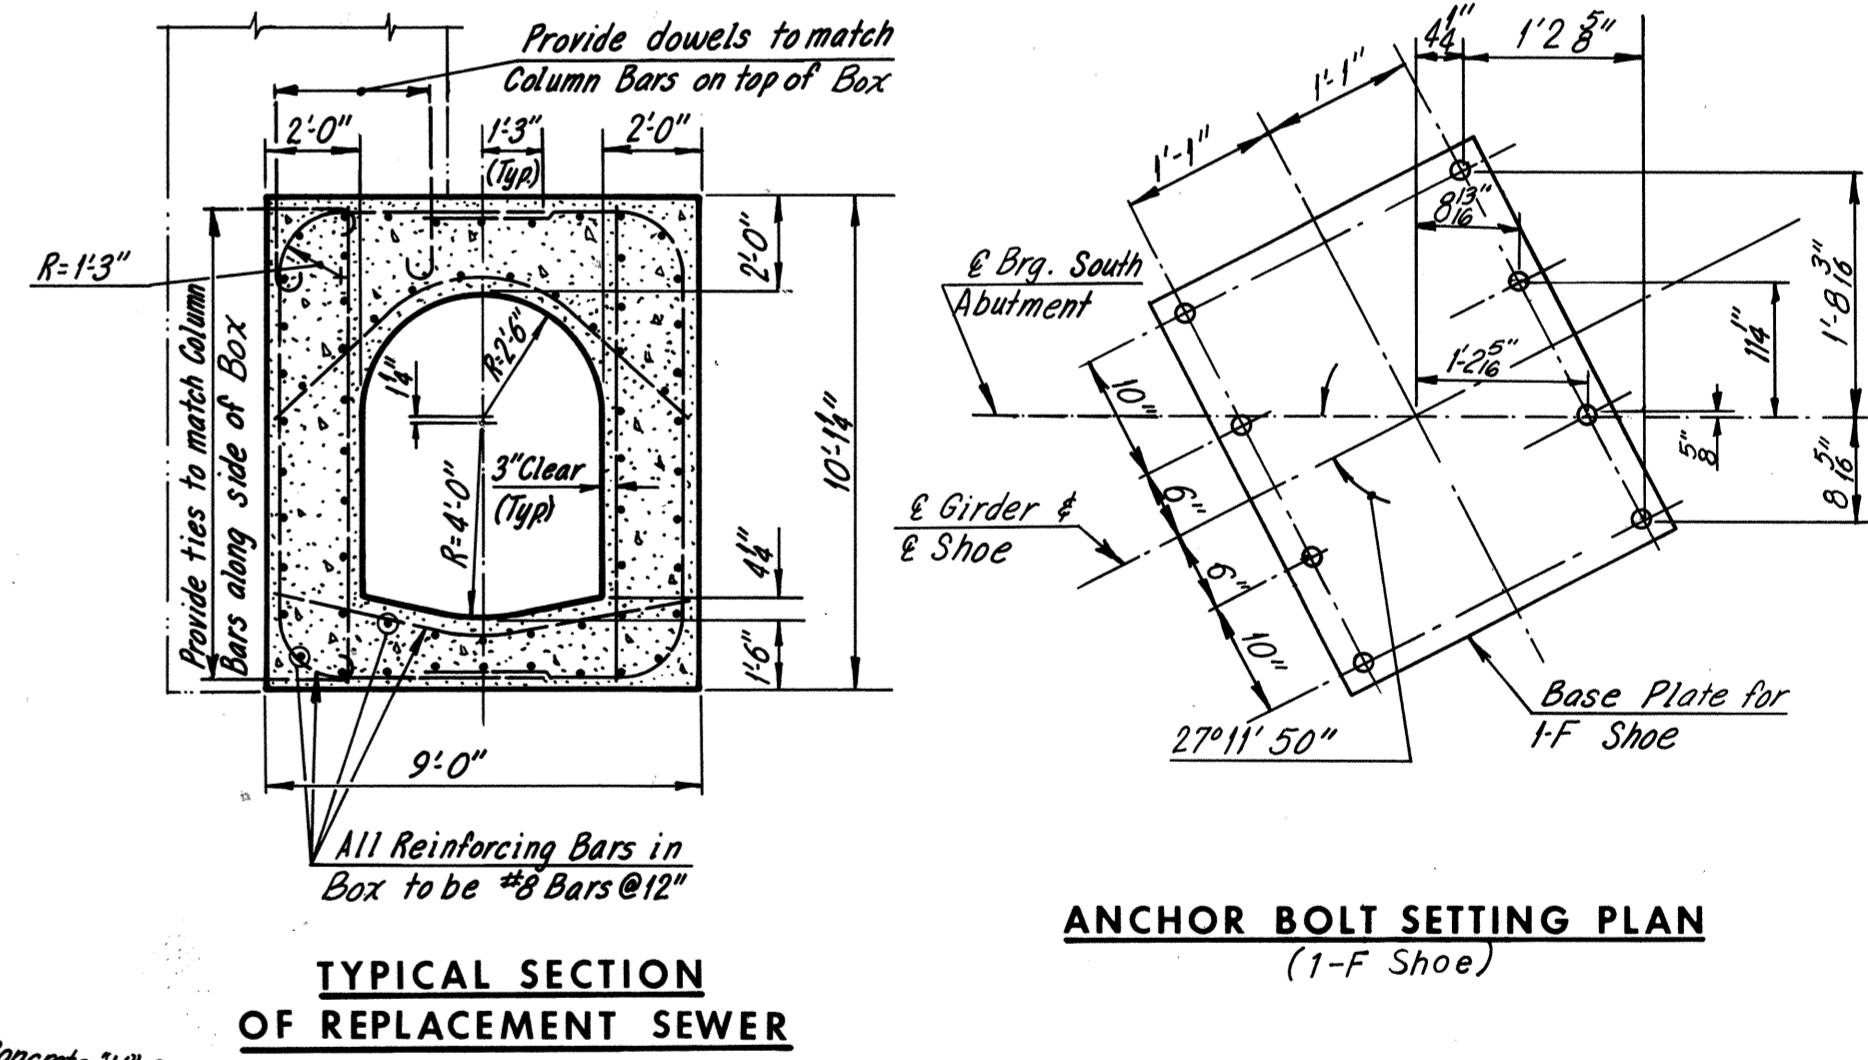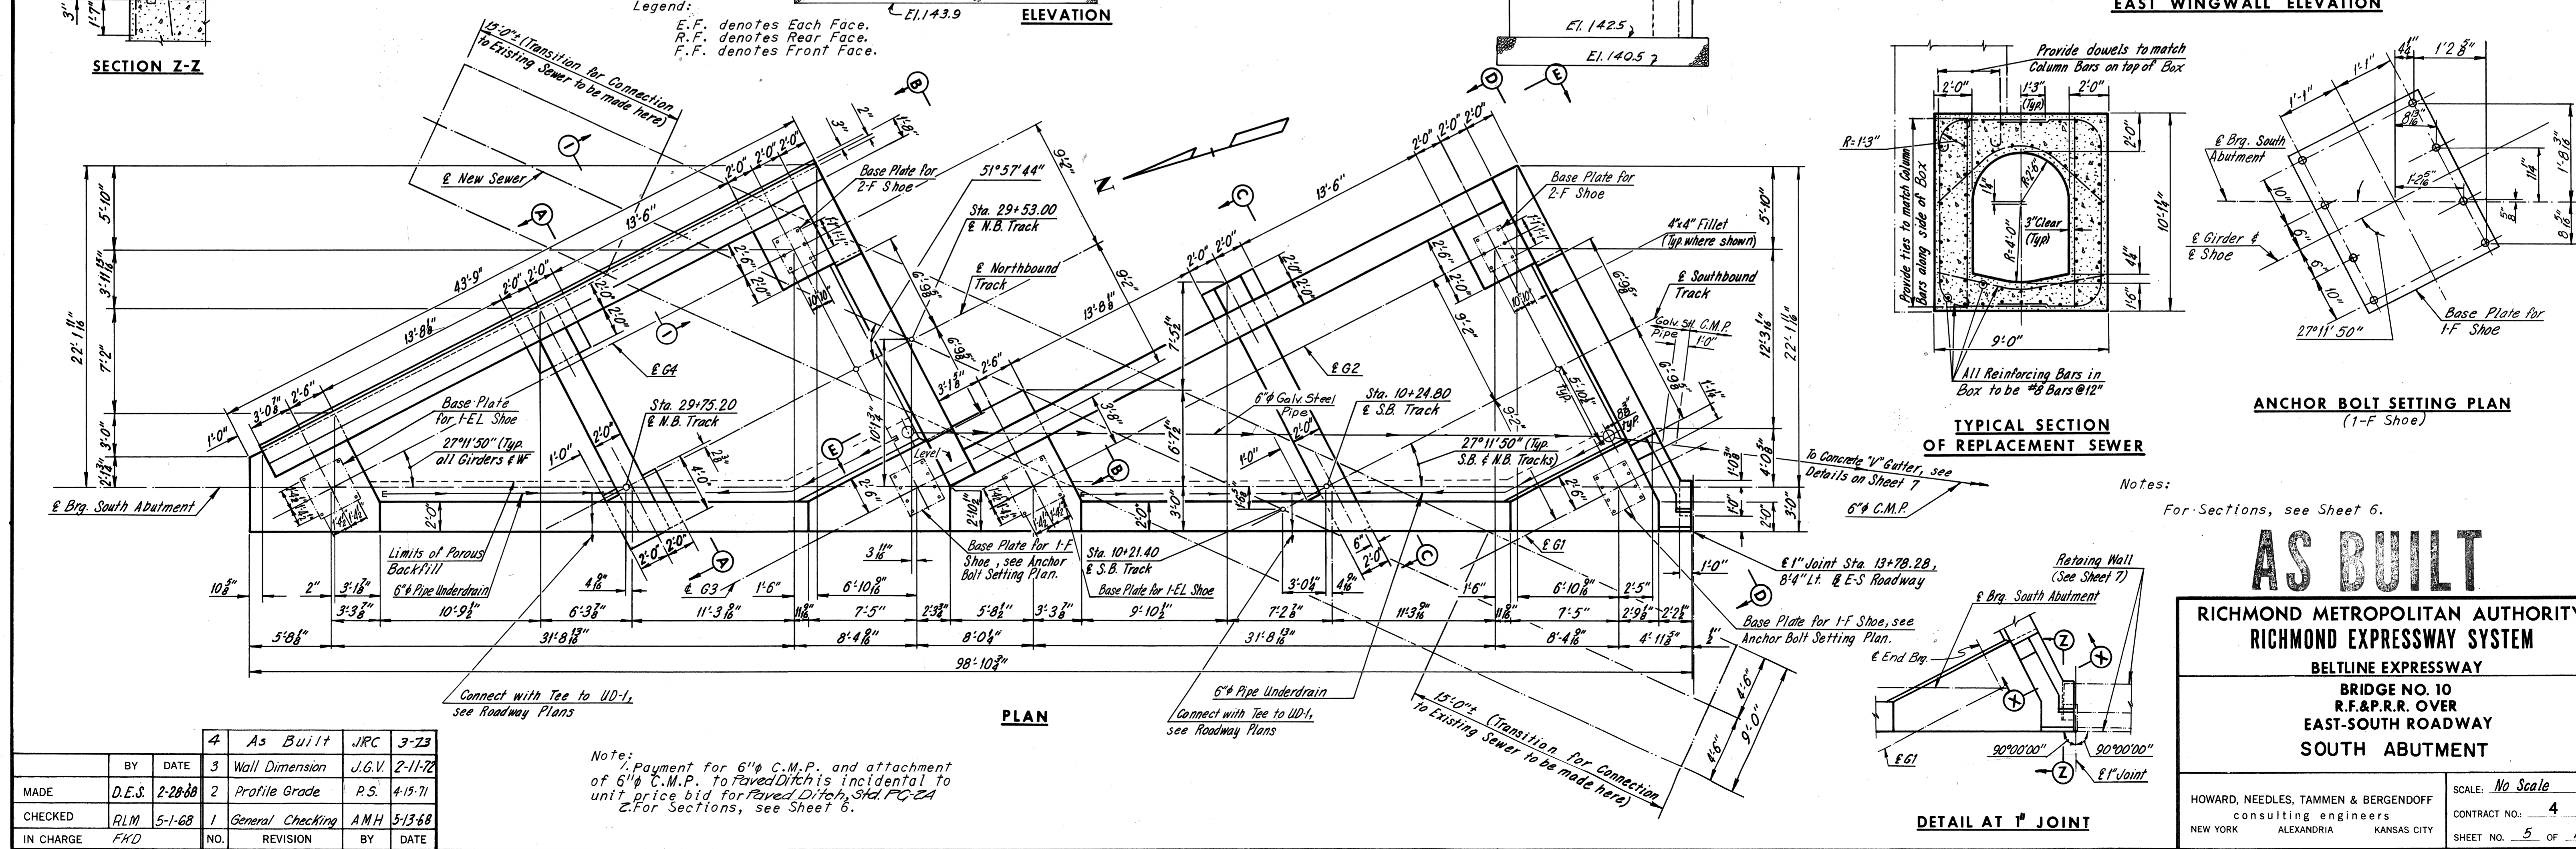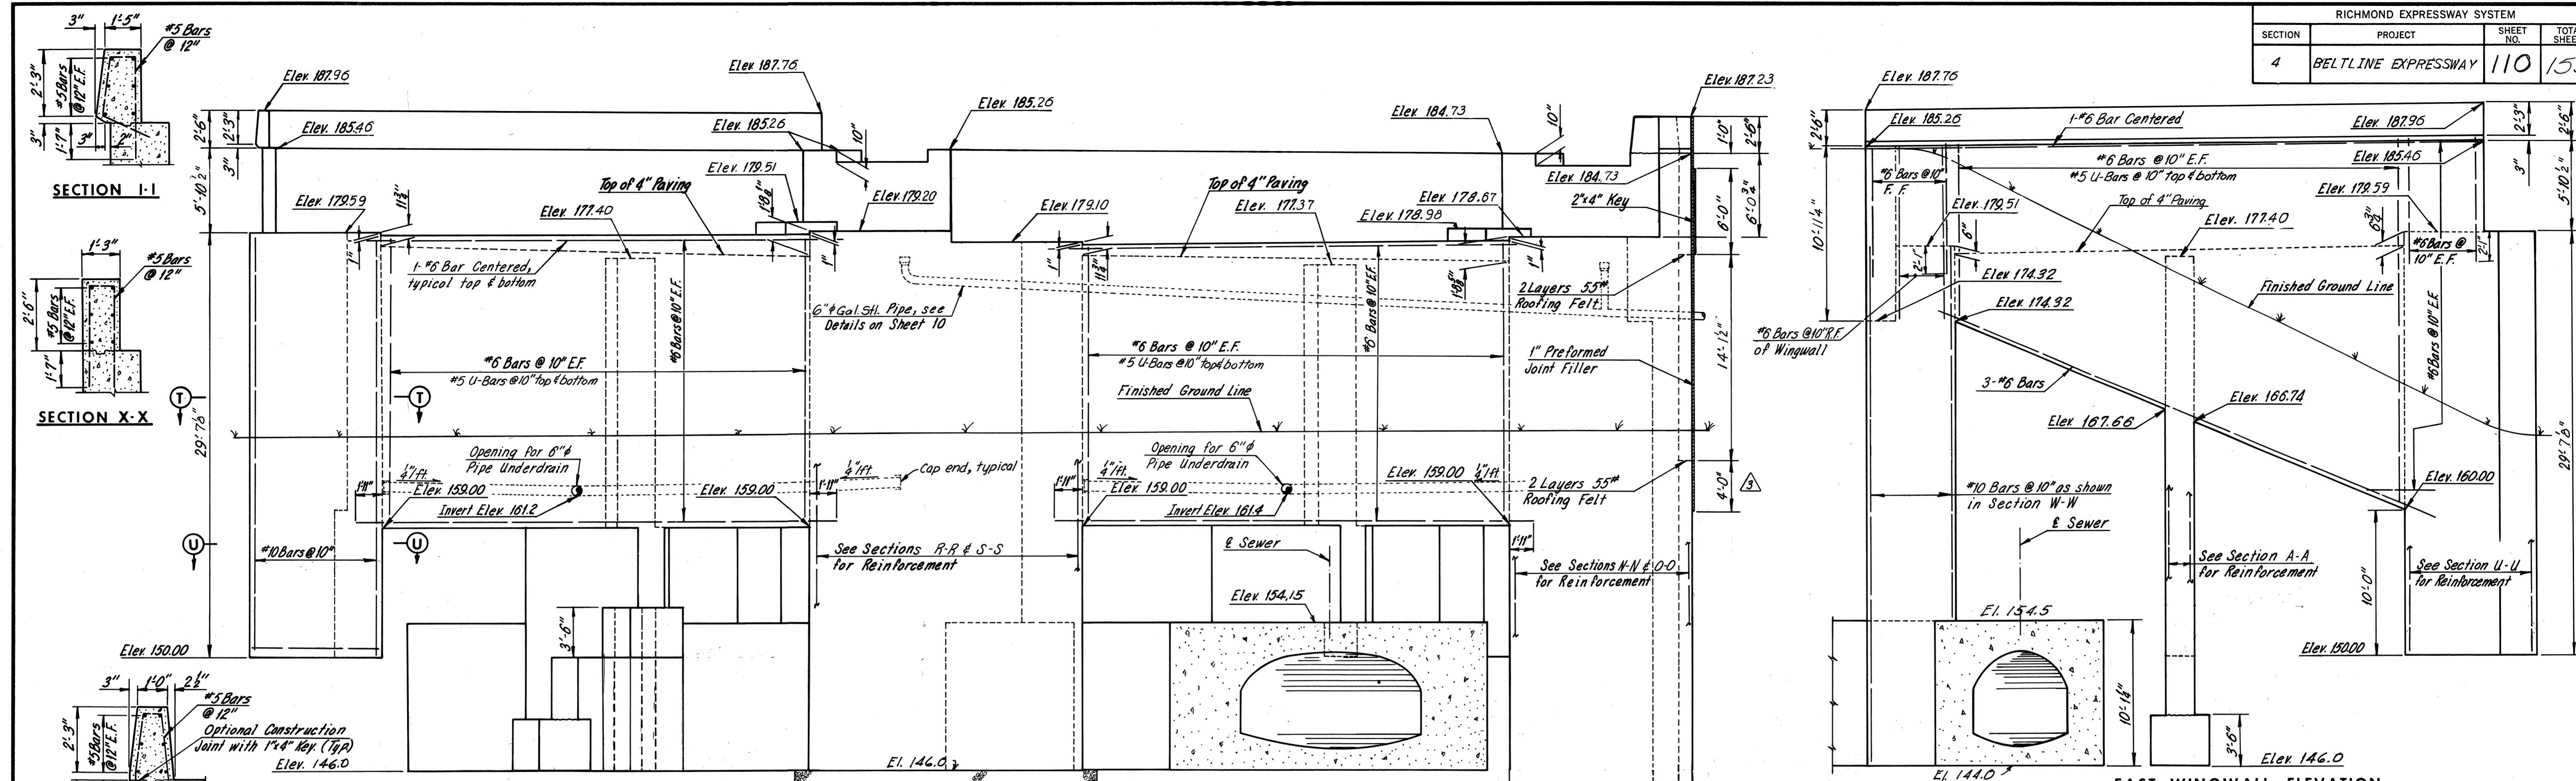

NO.	REVISION	BY	DATE
4	As Built	JRC	3-23
3	Wall Dimension	J.G.V.	2-11-72
2	Profile Grade	P.S.	4-15-71
1	General Checking	AMH	5-13-68

Note:
 1. Payment for 6" C.M.P. and attachment of 6" C.M.P. to paved ditch is incidental to unit price bid for Paved Ditch, Std. PG-2A.
 2. For Sections, see Sheet 6.

AS BUILT


RICHMOND METROPOLITAN AUTHORITY
RICHMOND EXPRESSWAY SYSTEM
BELTLINE EXPRESSWAY
BRIDGE NO. 10
R.F.&P.R.R. OVER
EAST-SOUTH ROADWAY
SOUTH ABUTMENT

HOWARD, NEEDLES, TAMMEN & BERGENDOFF
 consulting engineers
 NEW YORK ALEXANDRIA KANSAS CITY

SCALE: No Scale
 CONTRACT NO. 4
 SHEET NO. 5 OF 12

RICHMOND EXPRESSWAY SYSTEM			
SECTION	PROJECT	SHEET NO.	TOTAL SHEETS
4	BELTLINE EXPRESSWAY	111	155

Legend:
 E.F. denotes Each Face
 F.F. denotes Front Face
 R.F. denotes Rear Face

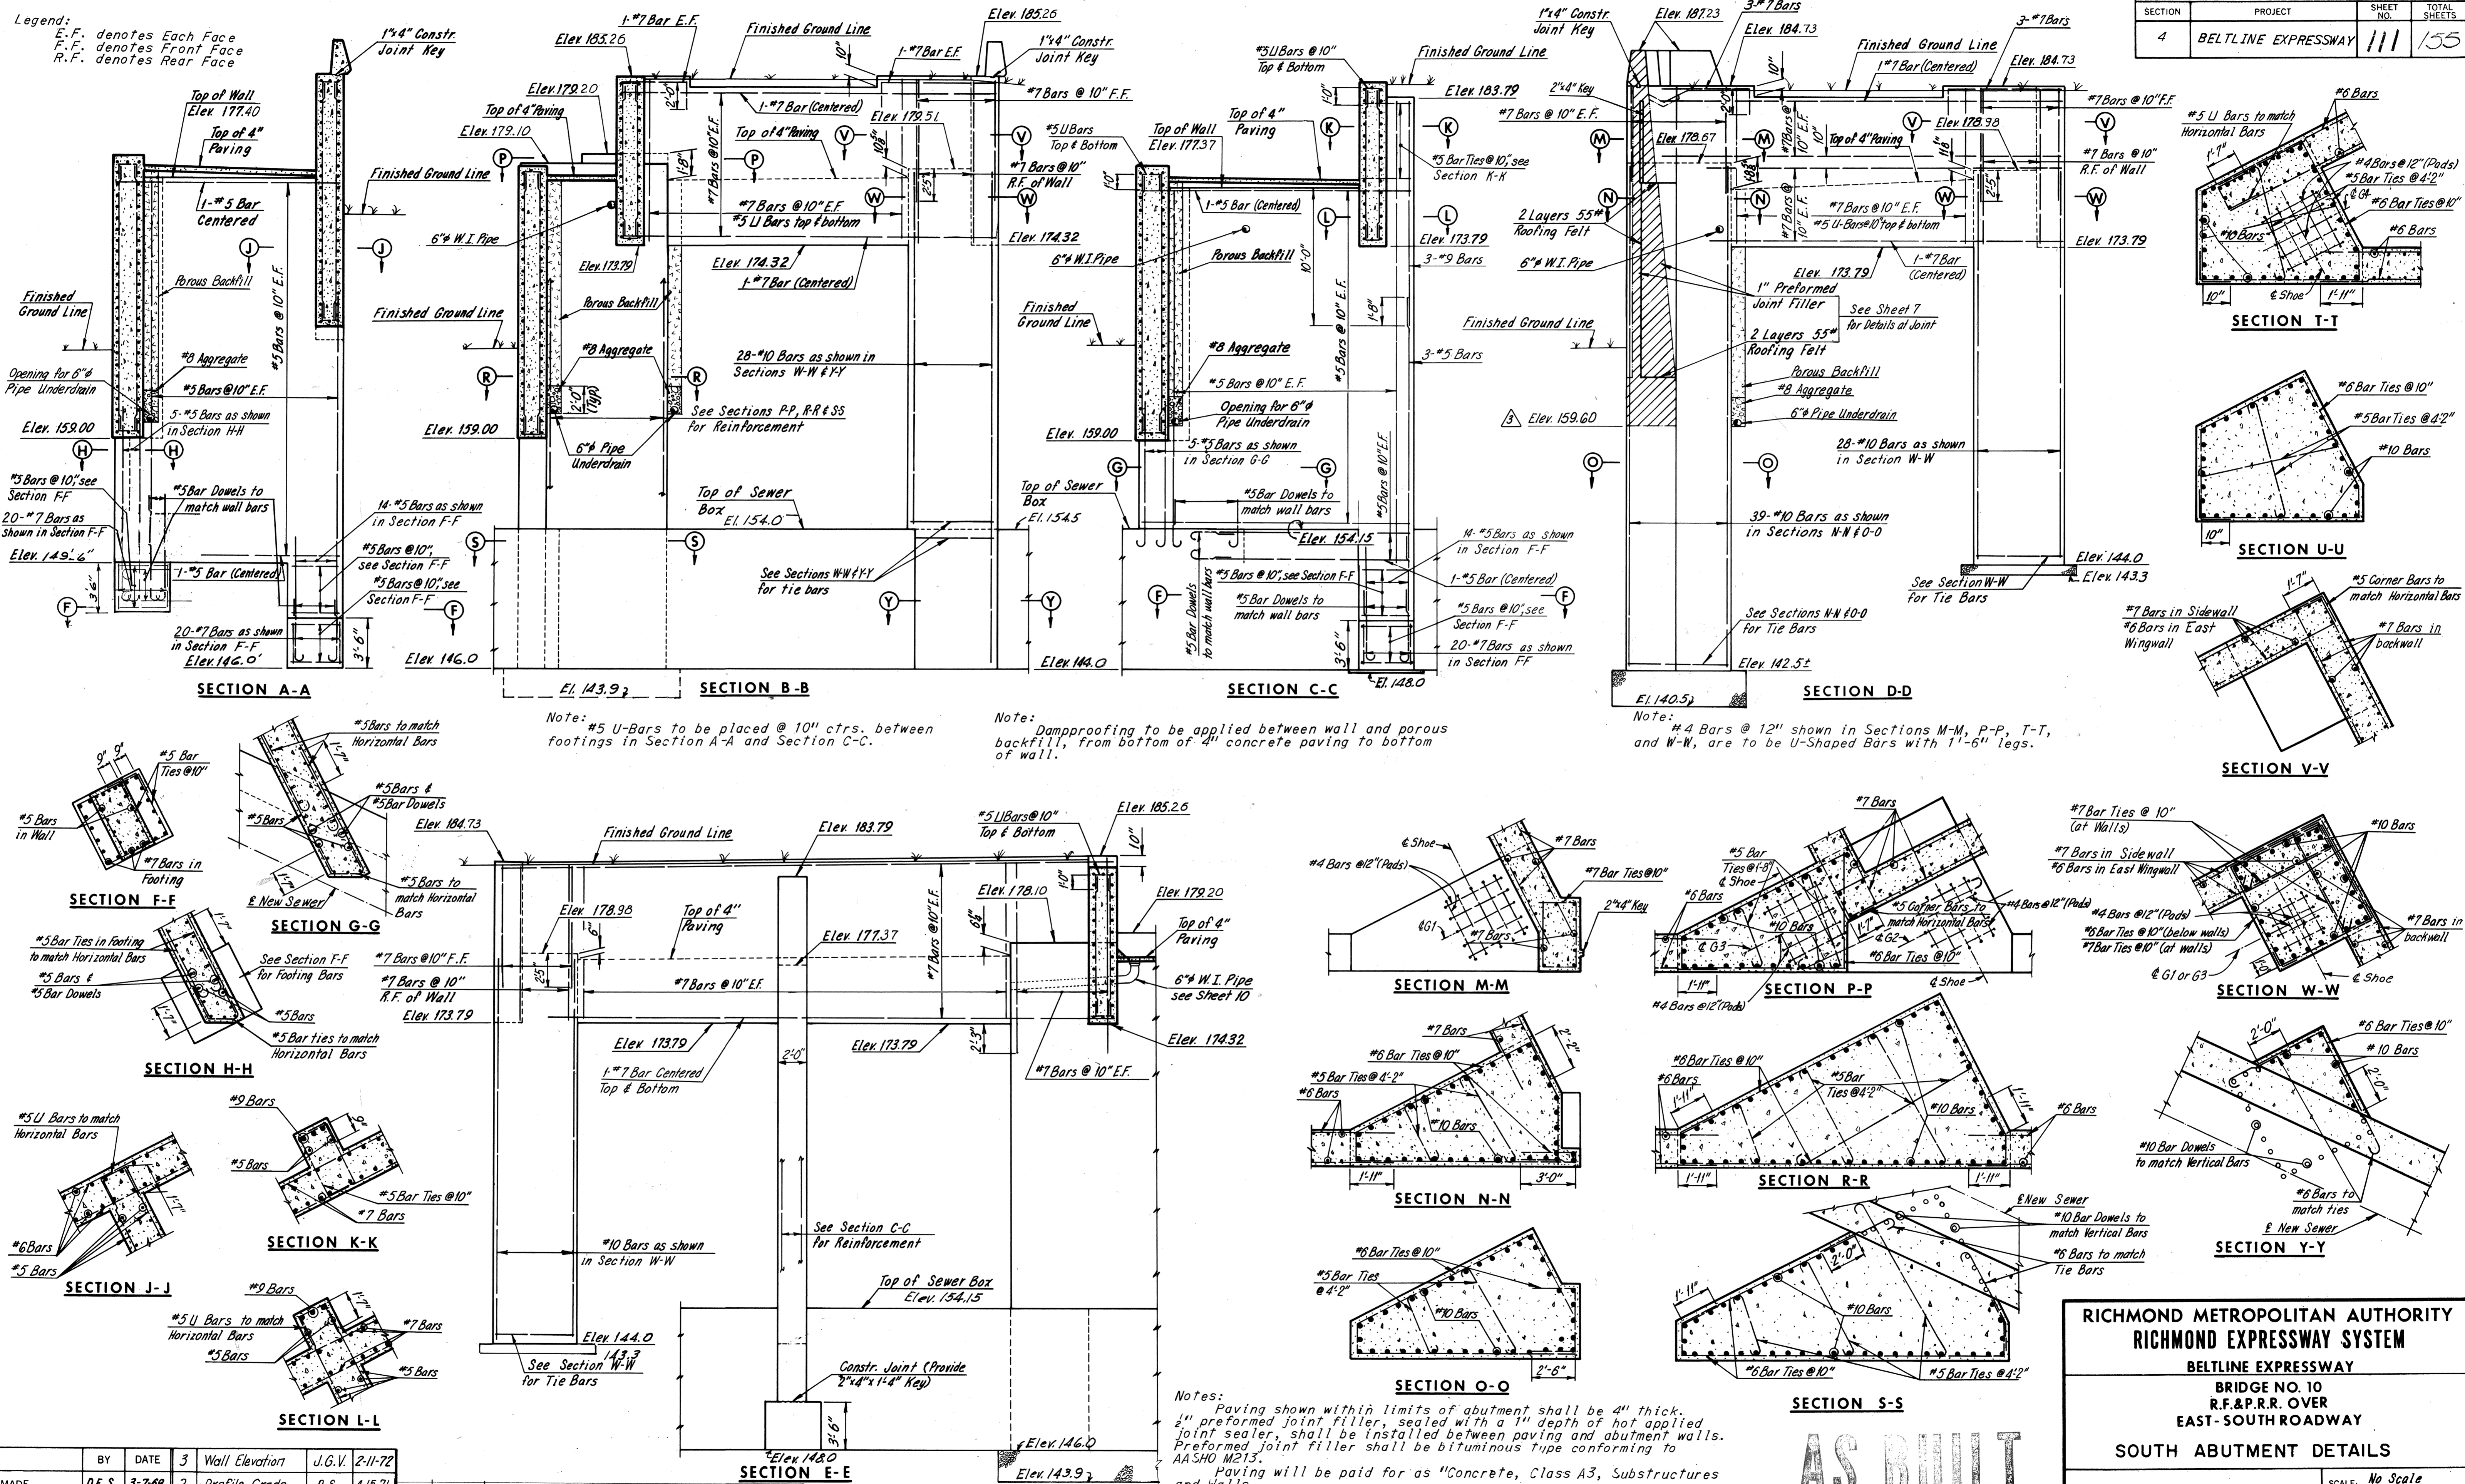

Note: #5 U-Bars to be placed @ 10" ctrs. between wall and porous backfill, from bottom of 4" concrete paving to bottom of wall.

Note: Dampproofing to be applied between wall and porous backfill, from bottom of 4" concrete paving to bottom of wall.

Note: #4 Bars @ 12" shown in Sections M-M, P-P, T-T, and W-W, are to be U-Shaped Bars with 1'-6" legs.

Notes:
 Paving shown within limits of abutment shall be 4" thick. 2" preformed joint filler, sealed with a 1" depth of hot applied joint sealer, shall be installed between paving and abutment walls. Preformed joint filler shall be bituminous tape conforming to AASHTO M213.
 Paving will be paid for as "Concrete, Class A3, Substructures and Walls."
 For Location of sections A-A, B-B, C-C, D-D, E-E, T-T and U-U, see Sheet 5.

AS BUILT

RICHMOND METROPOLITAN AUTHORITY
RICHMOND EXPRESSWAY SYSTEM
BELTLINE EXPRESSWAY
BRIDGE NO. 10
R.F.&P.R. OVER
EAST-SOUTH ROADWAY
SOUTH ABUTMENT DETAILS

HOWARD, NEEDLES, TAMMEN & BERGENDOFF
 consulting engineers
 NEW YORK ALEXANDRIA KANSAS CITY


SCALE: No Scale
 CONTRACT NO.: 4
 SHEET NO.: 6 OF 12

NO.	REVISION	BY	DATE	NO.	DATE	REVISION	BY
3	Wall Elevation	J.G.V.	2-11-72				
2	Profile Grade	P.S.	4-15-71				
1	General Checking	AMH	5-13-68	4	3-73	As Built	J.P.C.

BY DATE 3 Wall Elevation J.G.V. 2-11-72
 MADE D.E.S. 3-7-68 2 Profile Grade P.S. 4-15-71
 CHECKED R.L.M. 5-1-68 1 General Checking AMH 5-13-68 4 3-73 As Built J.P.C.
 IN CHARGE F.K.D. NO. REVISION BY DATE NO. DATE REVISION BY

RICHMOND EXPRESSWAY SYSTEM			
SECTION	PROJECT	SHEET NO.	TOTAL SHEETS
4	BELTLINE EXPRESSWAY	112	155











Note: For detail of connection of 6" Dia. C.M.P. to Concrete V-Gutter, see Detail C.

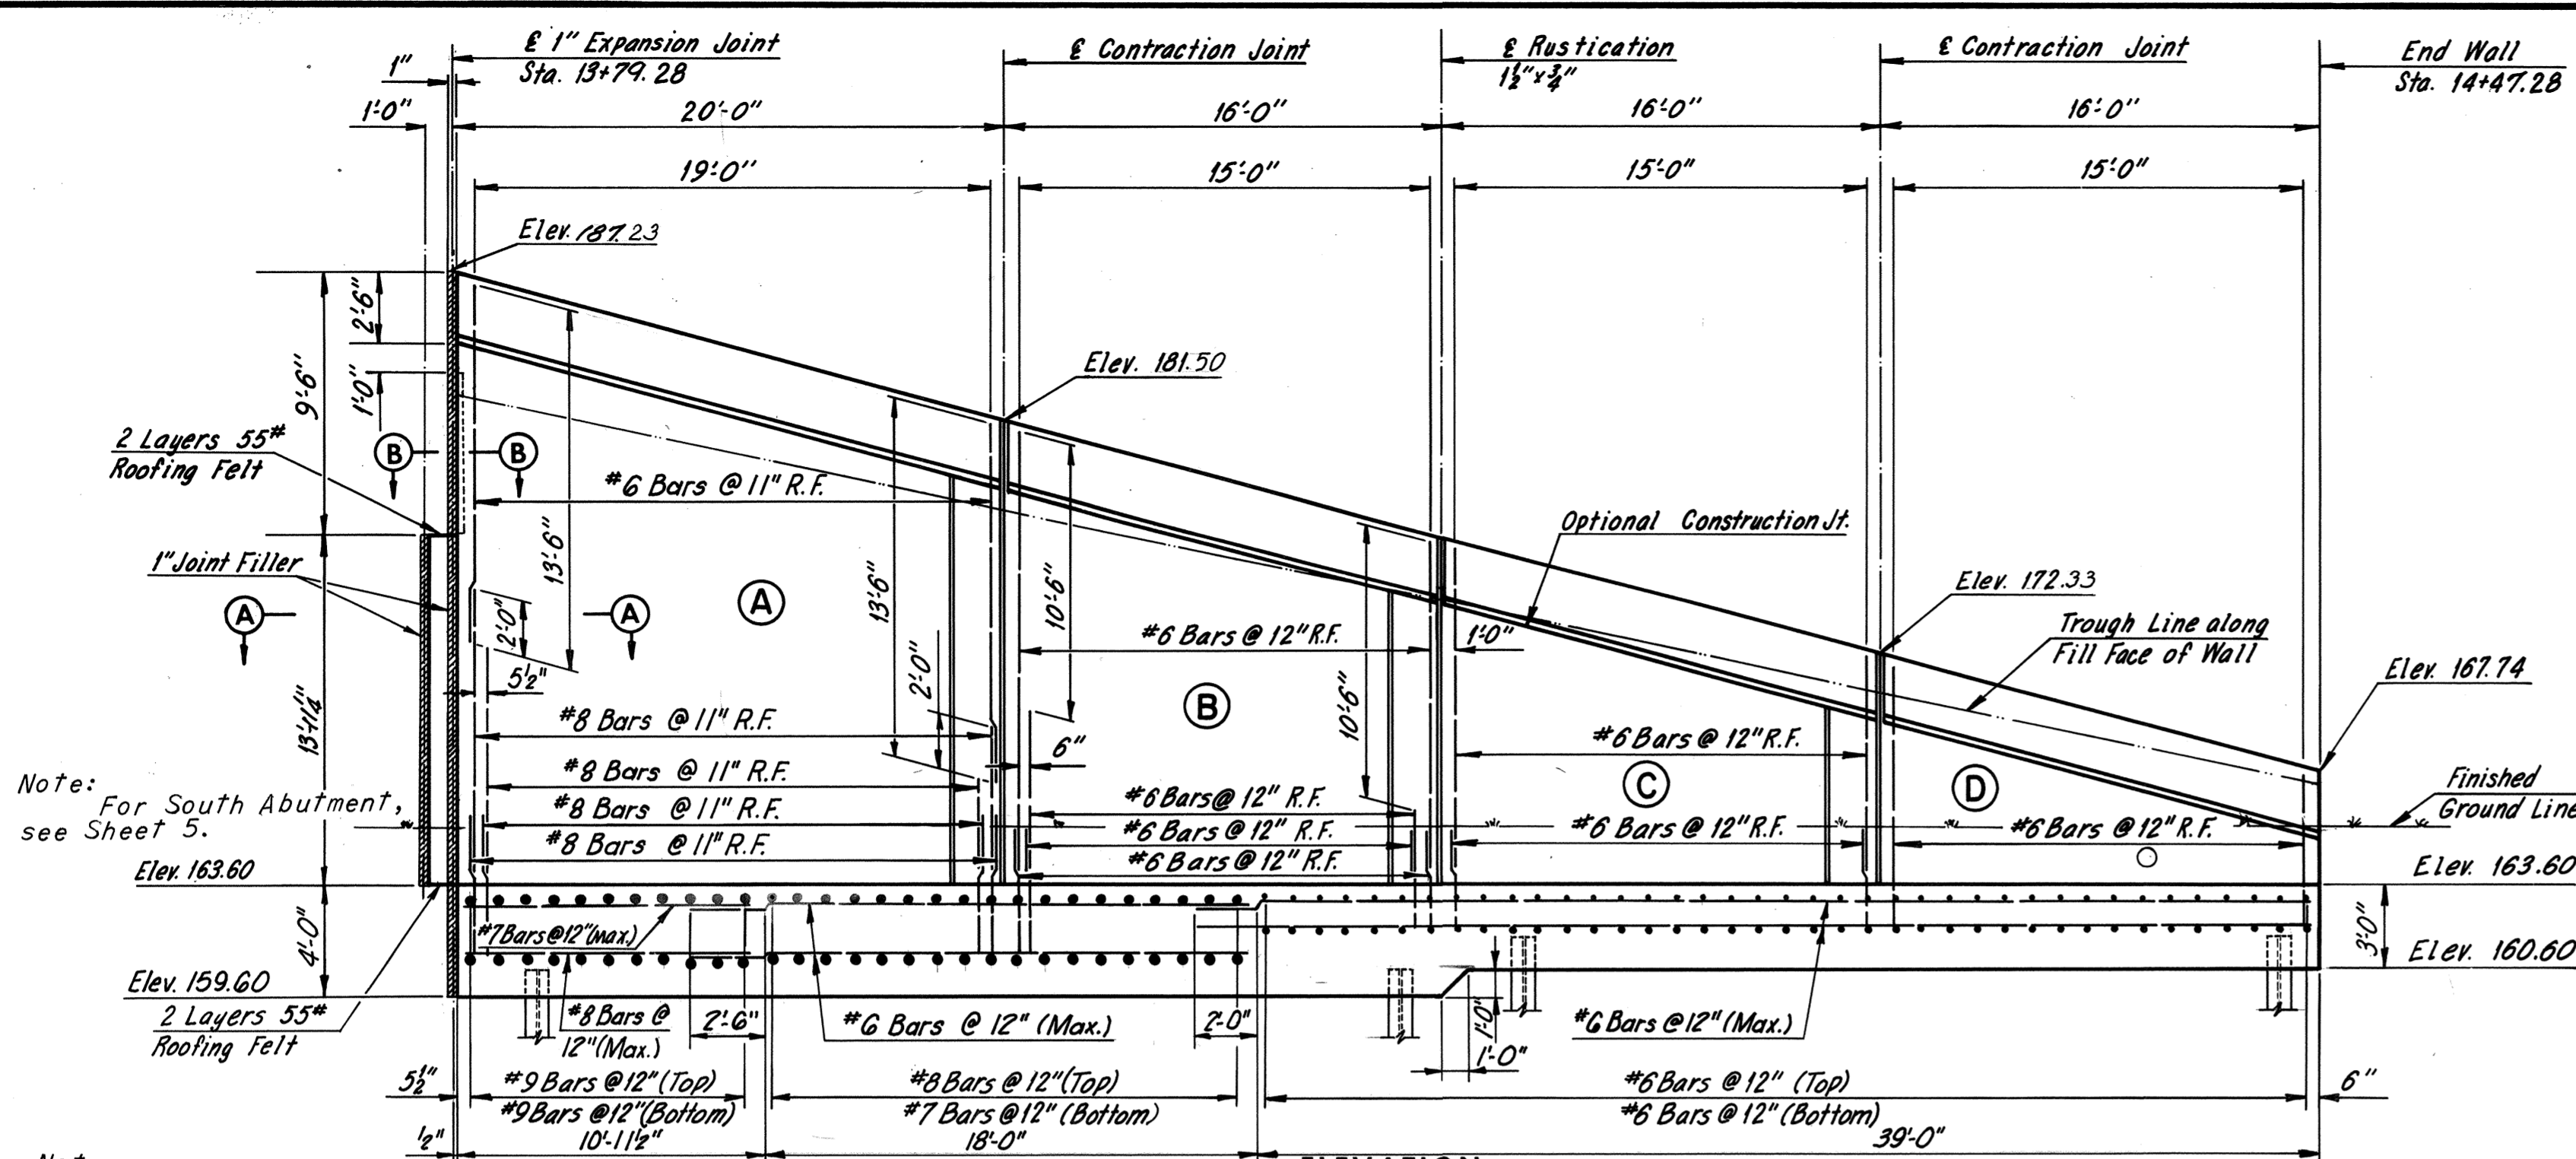

Note: For South Abutment, see Sheet 5.

Note: Reinforcing to be shifted to miss underdrain going thru wall.

Legend: R.F. denotes Rear Face. E.F. denotes Each Face.

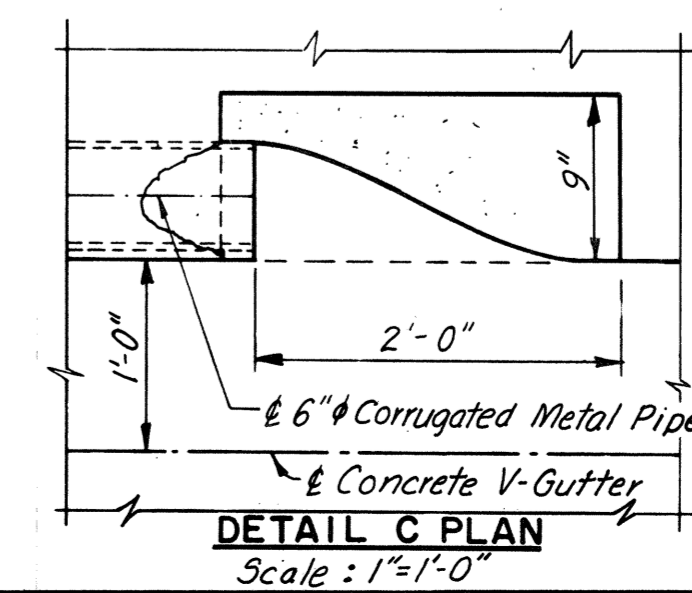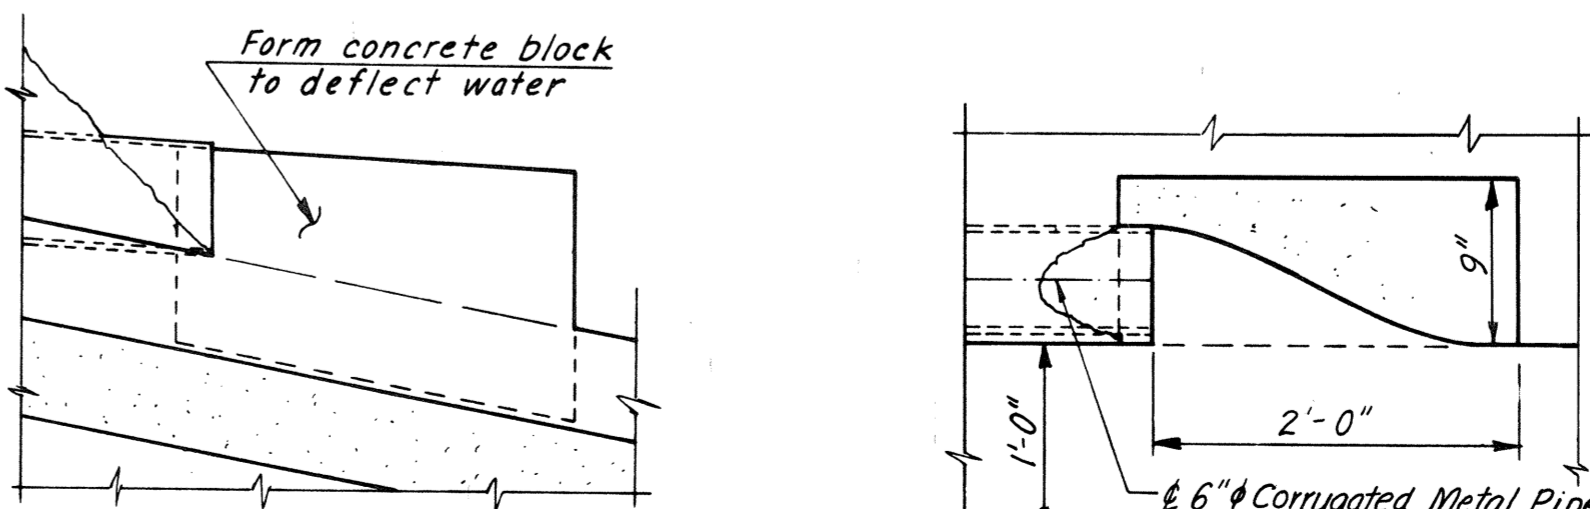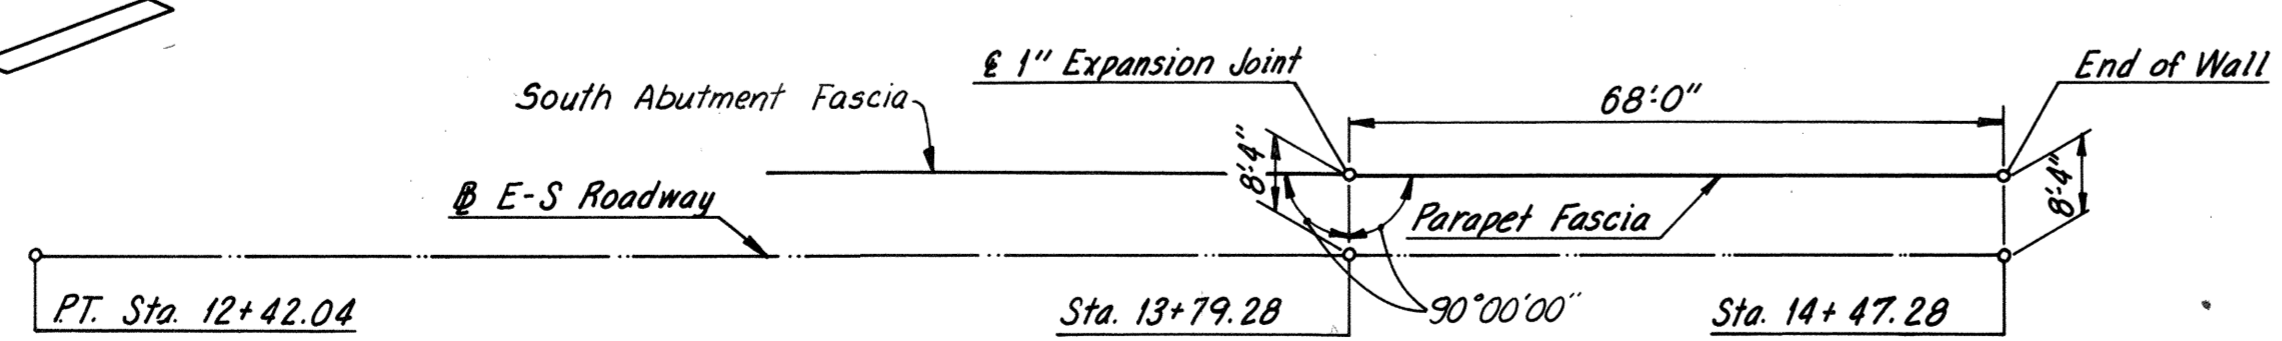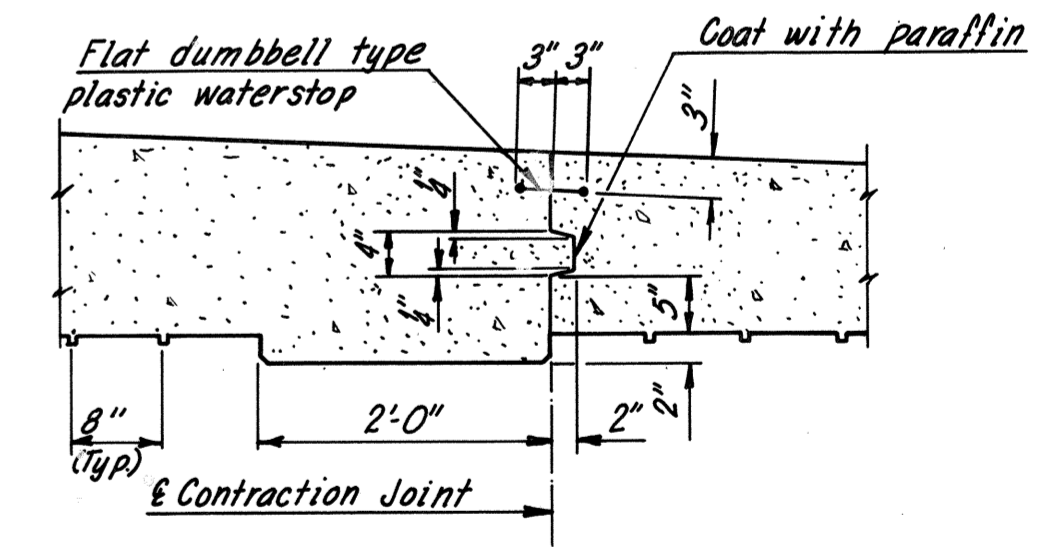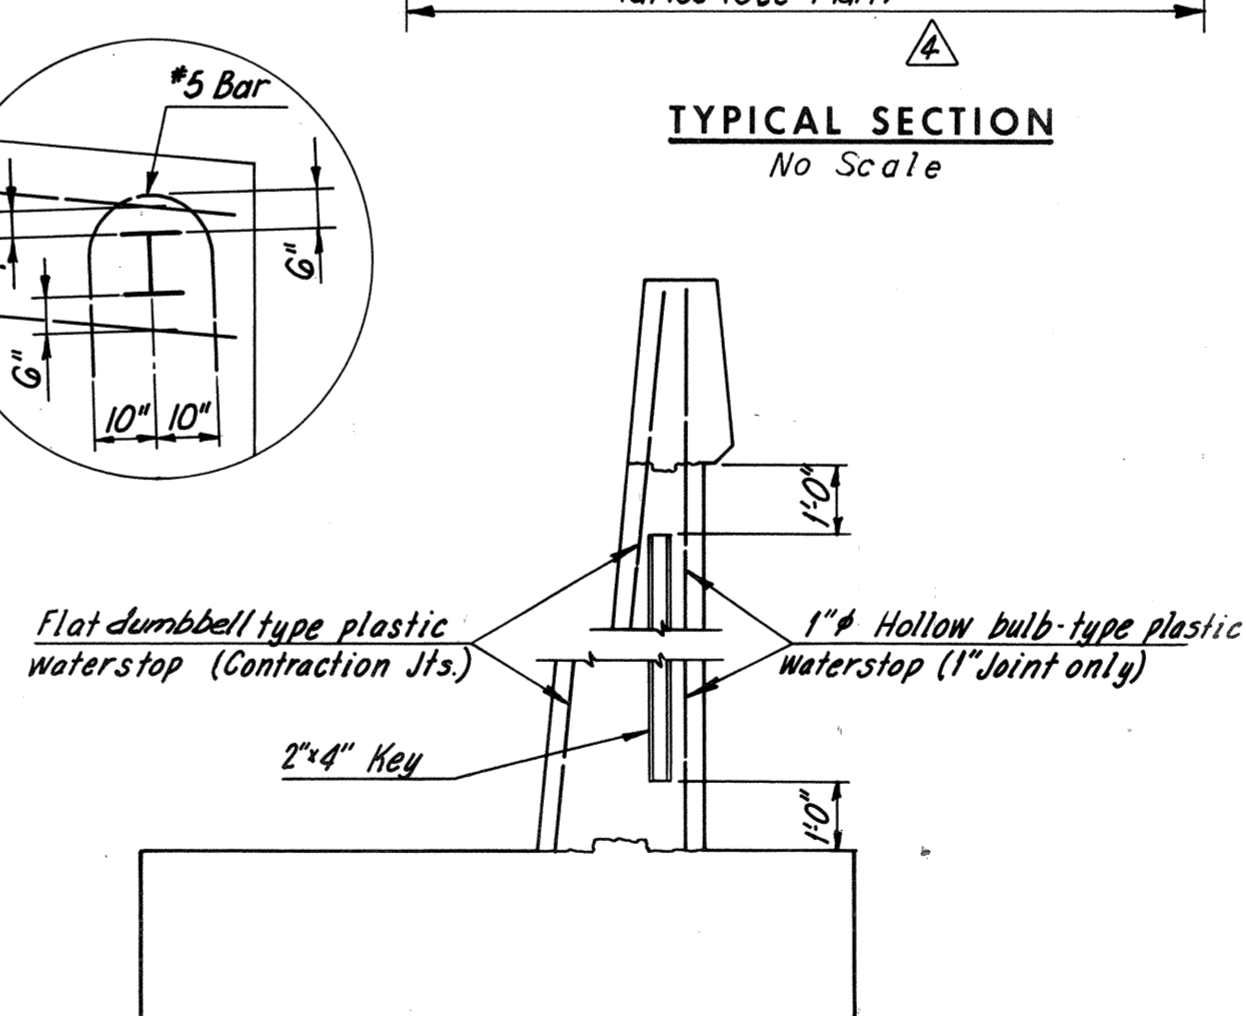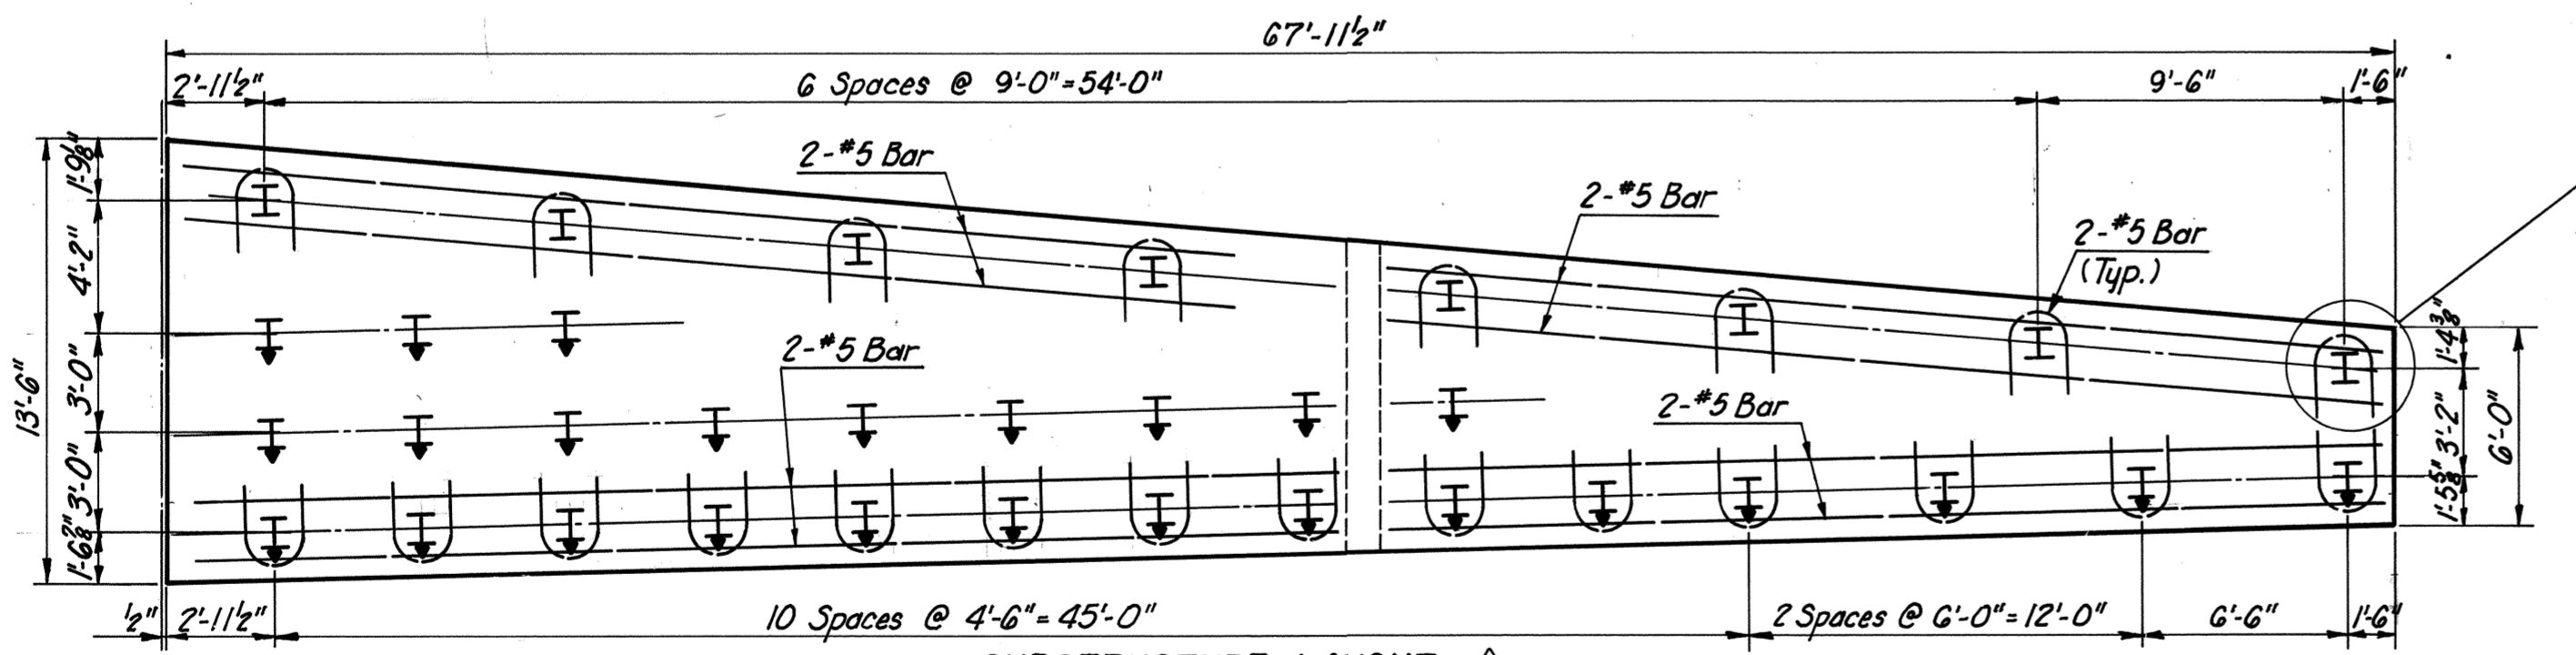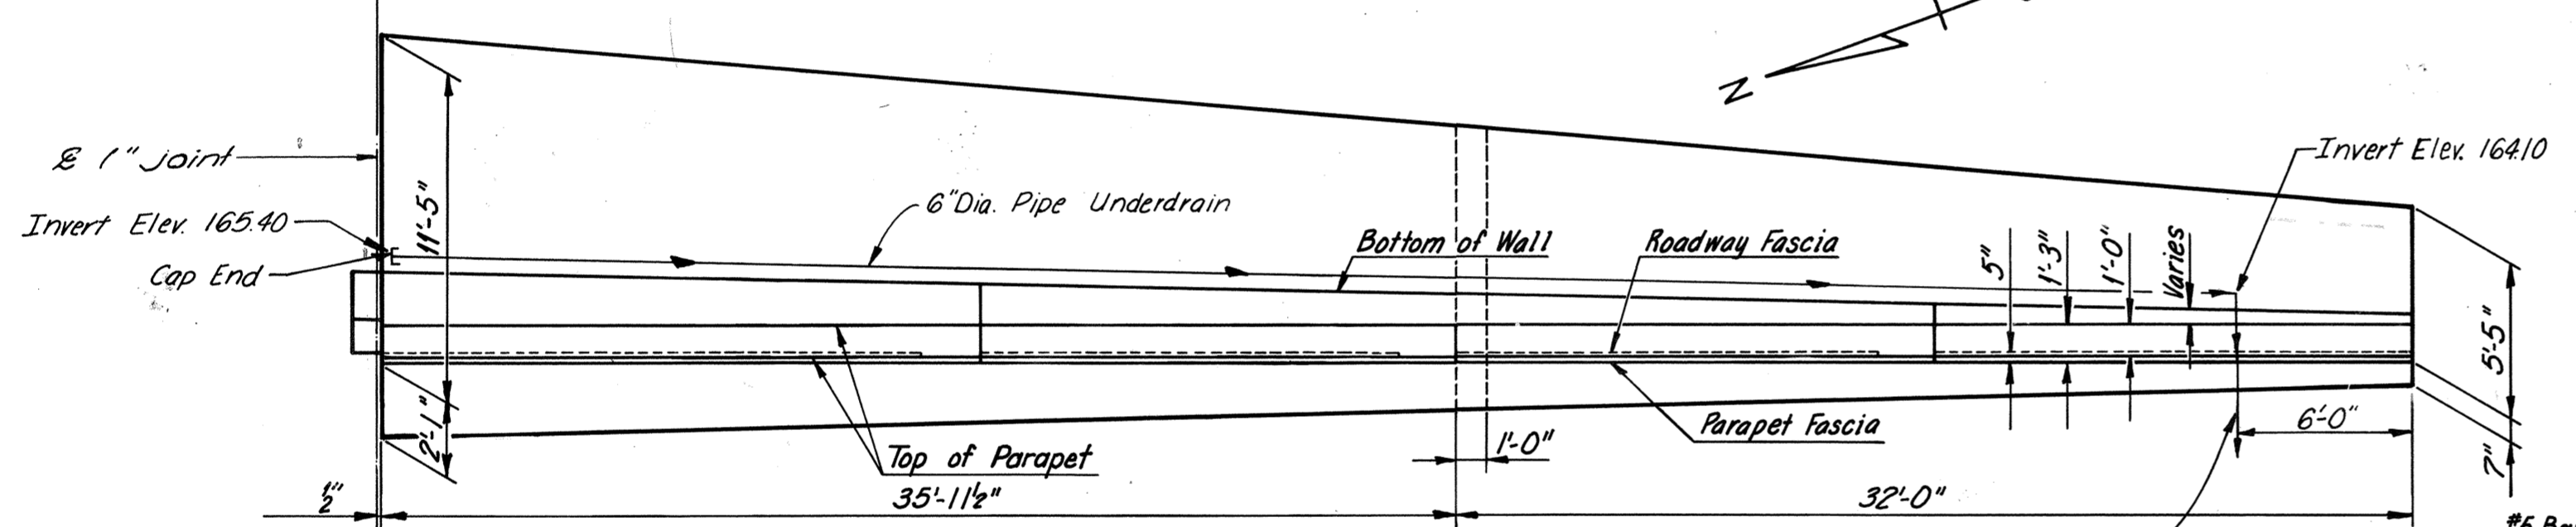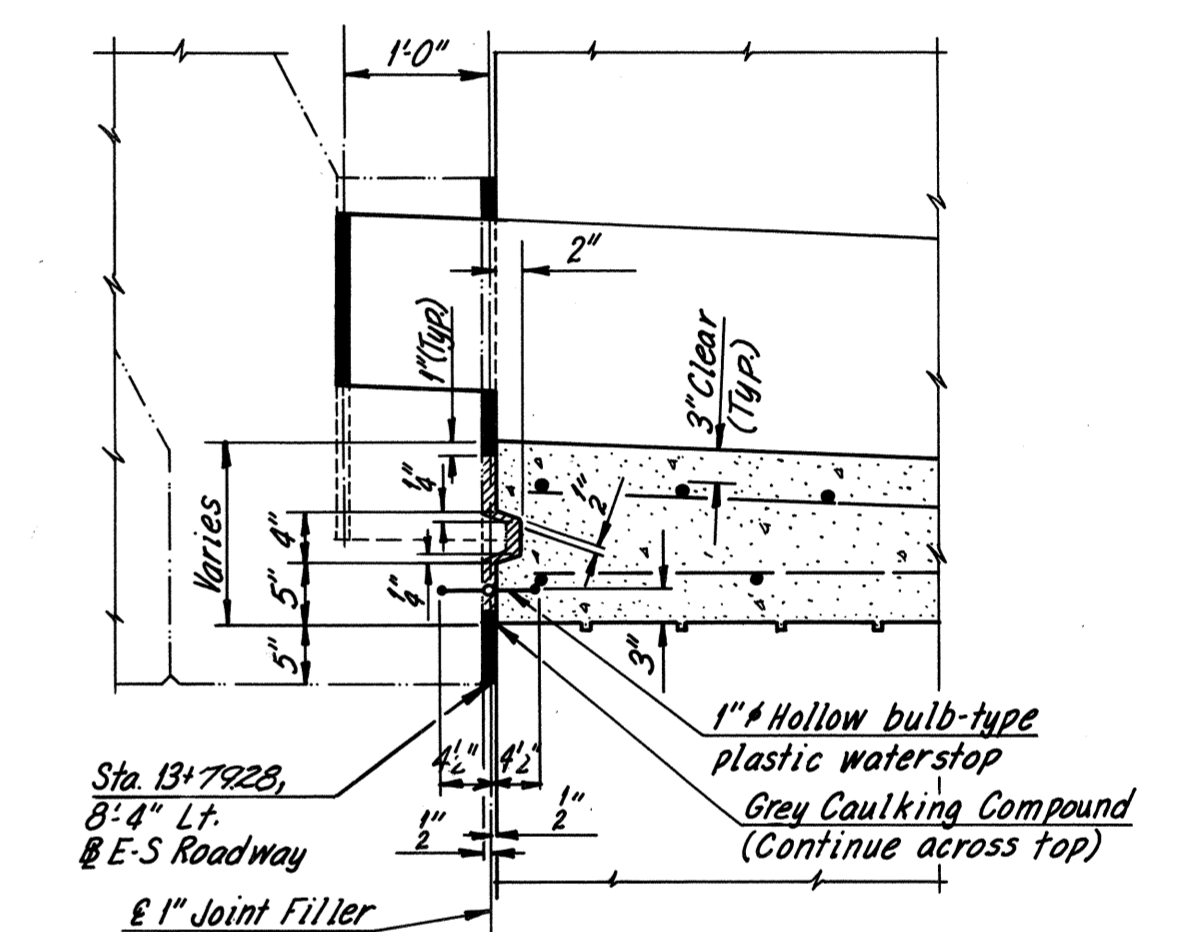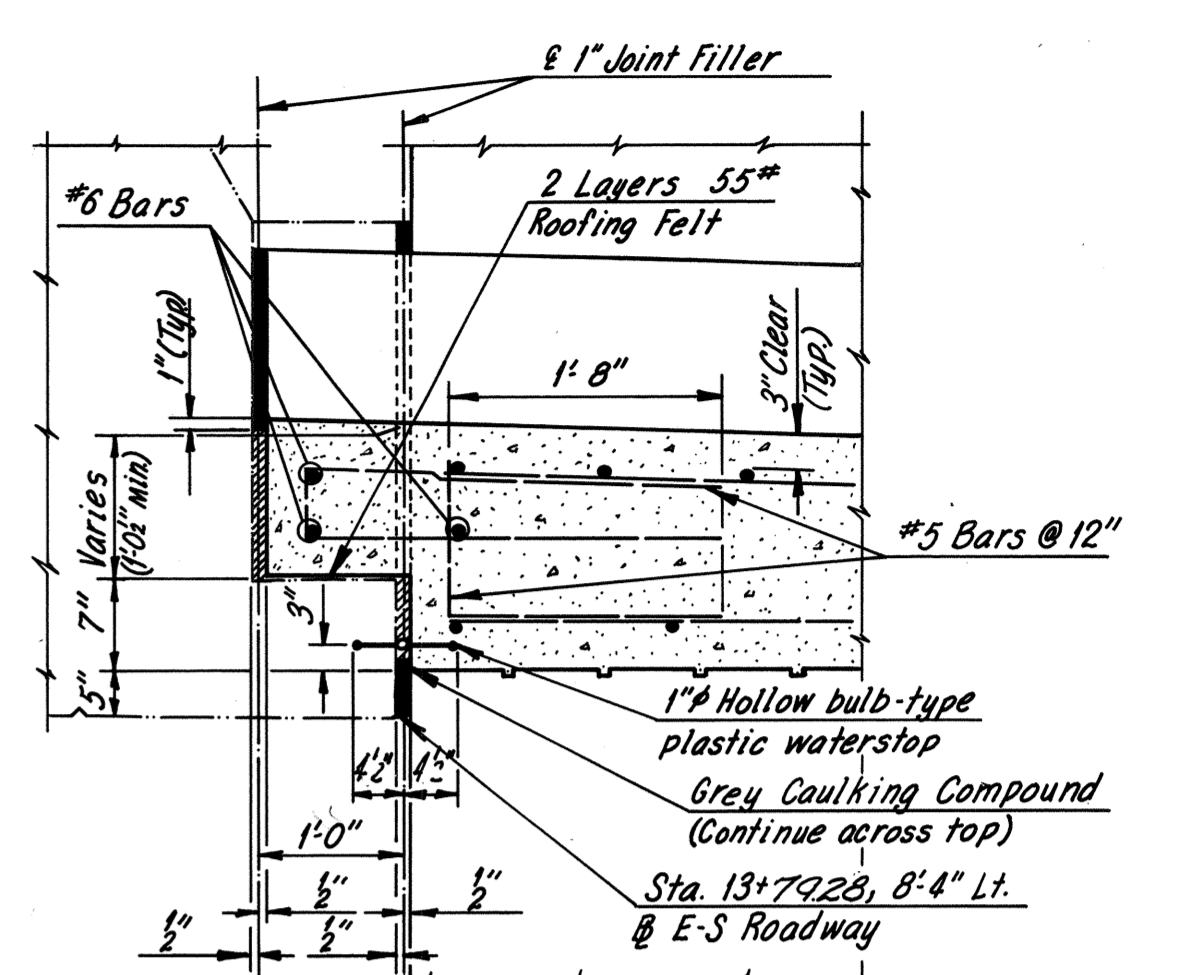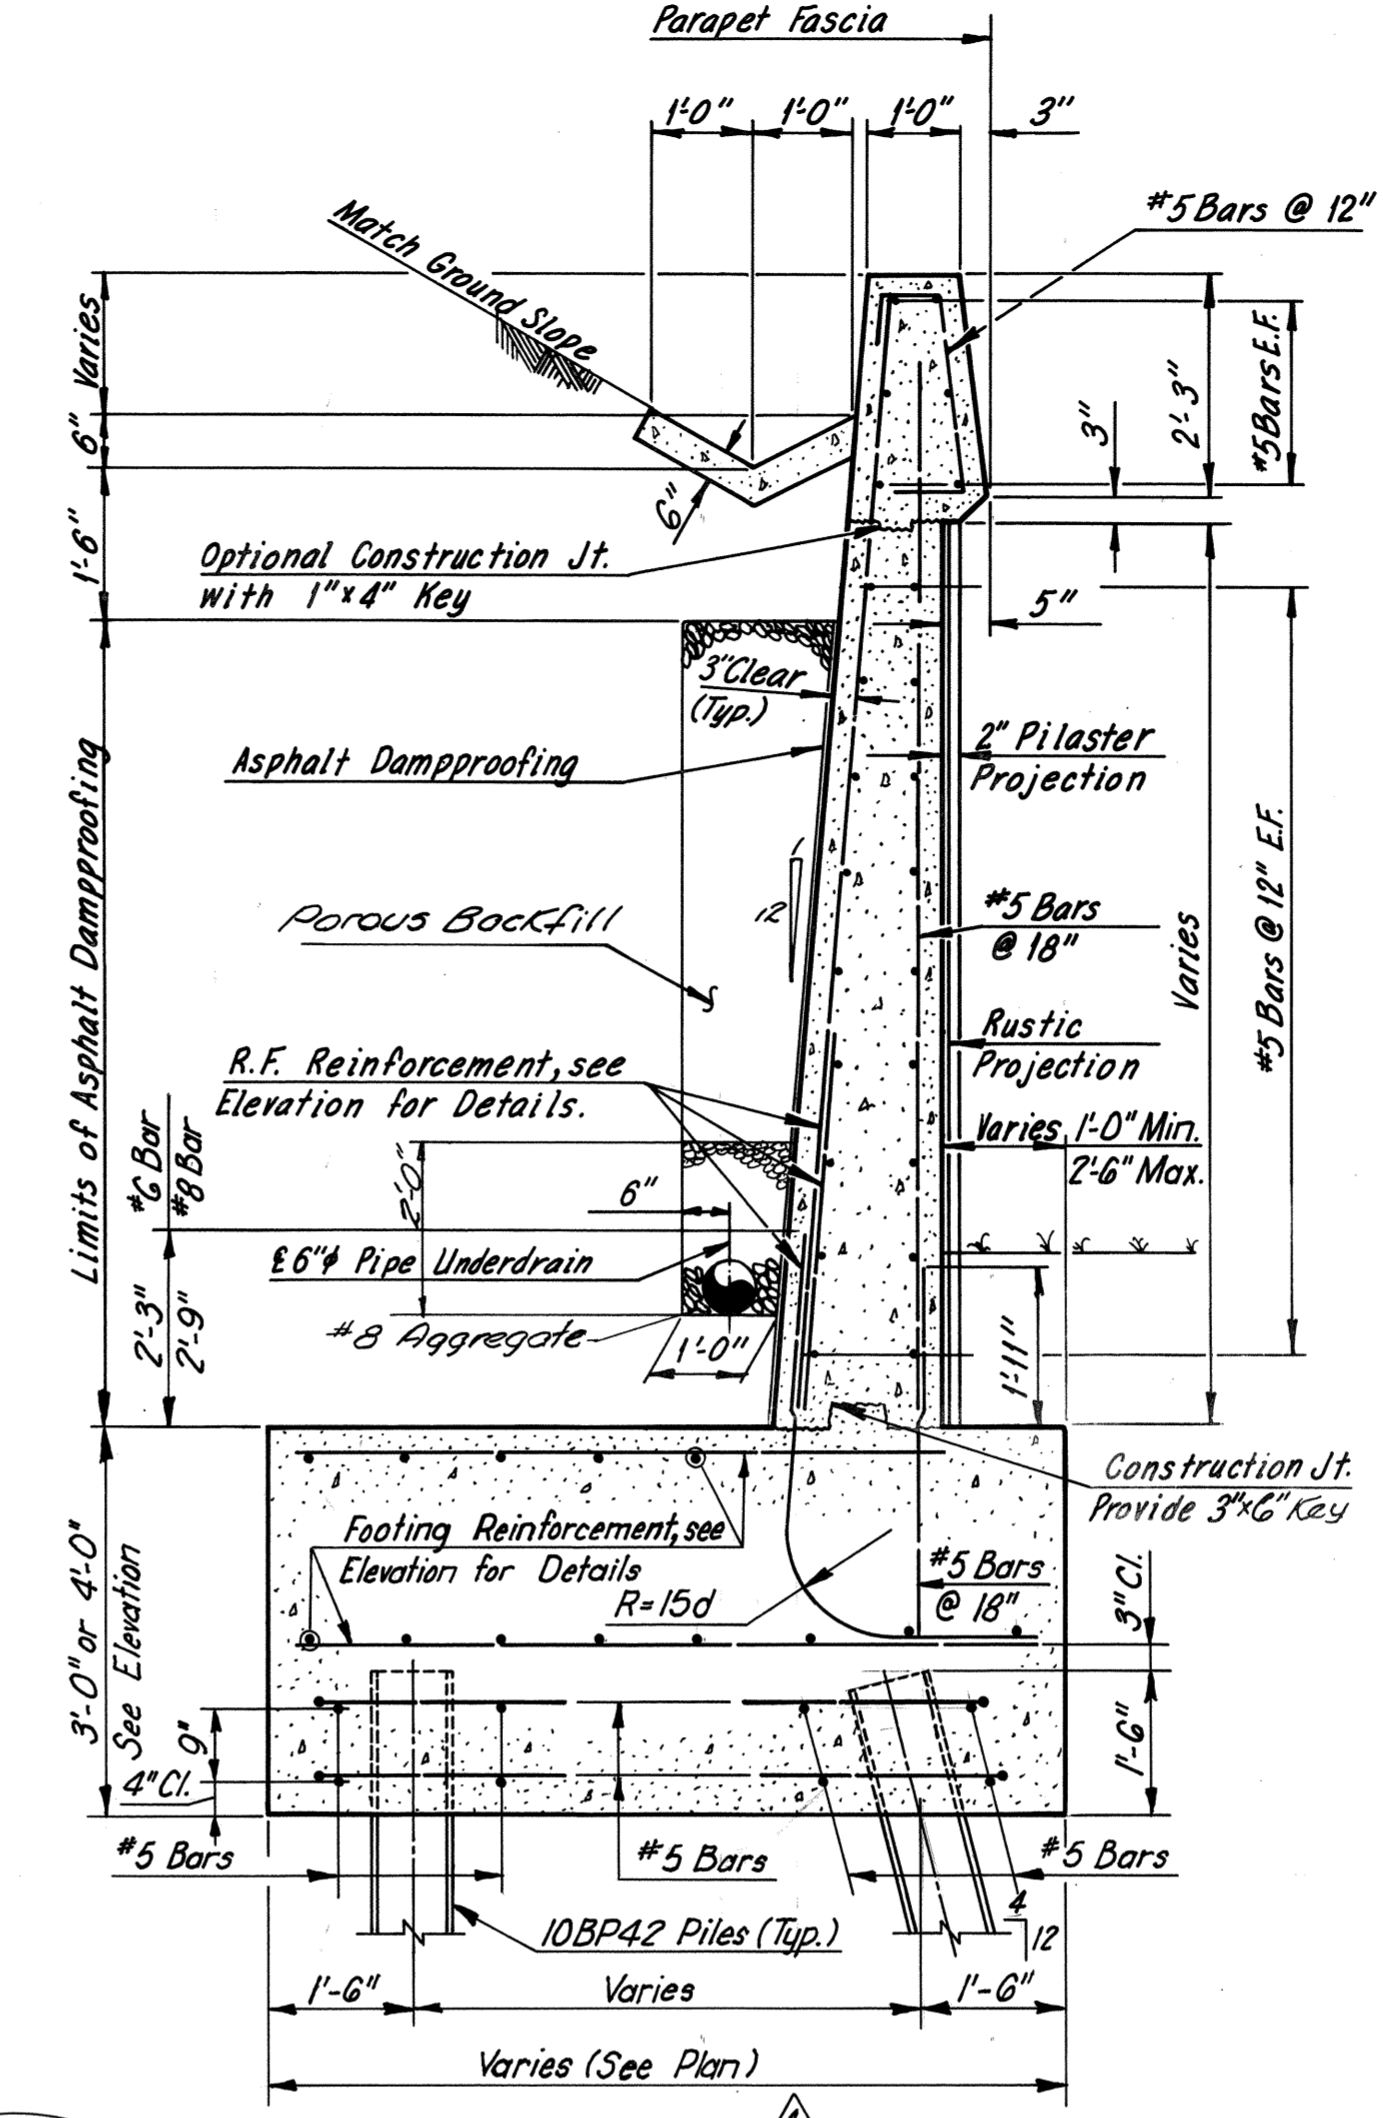

NOTES:
All Piles 10BP42 steel piles (design capacity = 45 tons)
Jetting not permitted.
Number of Piles = 34.

⊥ Denotes 4:12 batter in direction of arrow.
⊥ Denotes vertical pile.



AS BUILT

RICHMOND METROPOLITAN AUTHORITY
RICHMOND EXPRESSWAY SYSTEM
BELTLINE EXPRESSWAY
BRIDGE NO. 10
R.F.&P.R.R. OVER
EAST-SOUTH ROADWAY
SOUTH ABUTMENT RETAINING WALL




HOWARD, NEEDLES, TAMMEN & BERGENDOFF
consulting engineers
NEW YORK ALEXANDRIA KANSAS CITY
SCALE: As Noted
CONTRACT NO. 4
SHEET NO. 7 OF 12

NO.	REVISION	BY	DATE
5	As Built	JRC	3-73
4	Footing Revision	J.G.V.	2-11-72
3	Profile Grade	P.S.	4-15-71
2	General	P.S.	7-70
1	General Revisions	AMH	5-13-68

Note: Asphalt plank shall be recessed to receive flange of 12 WF 50 stringers.

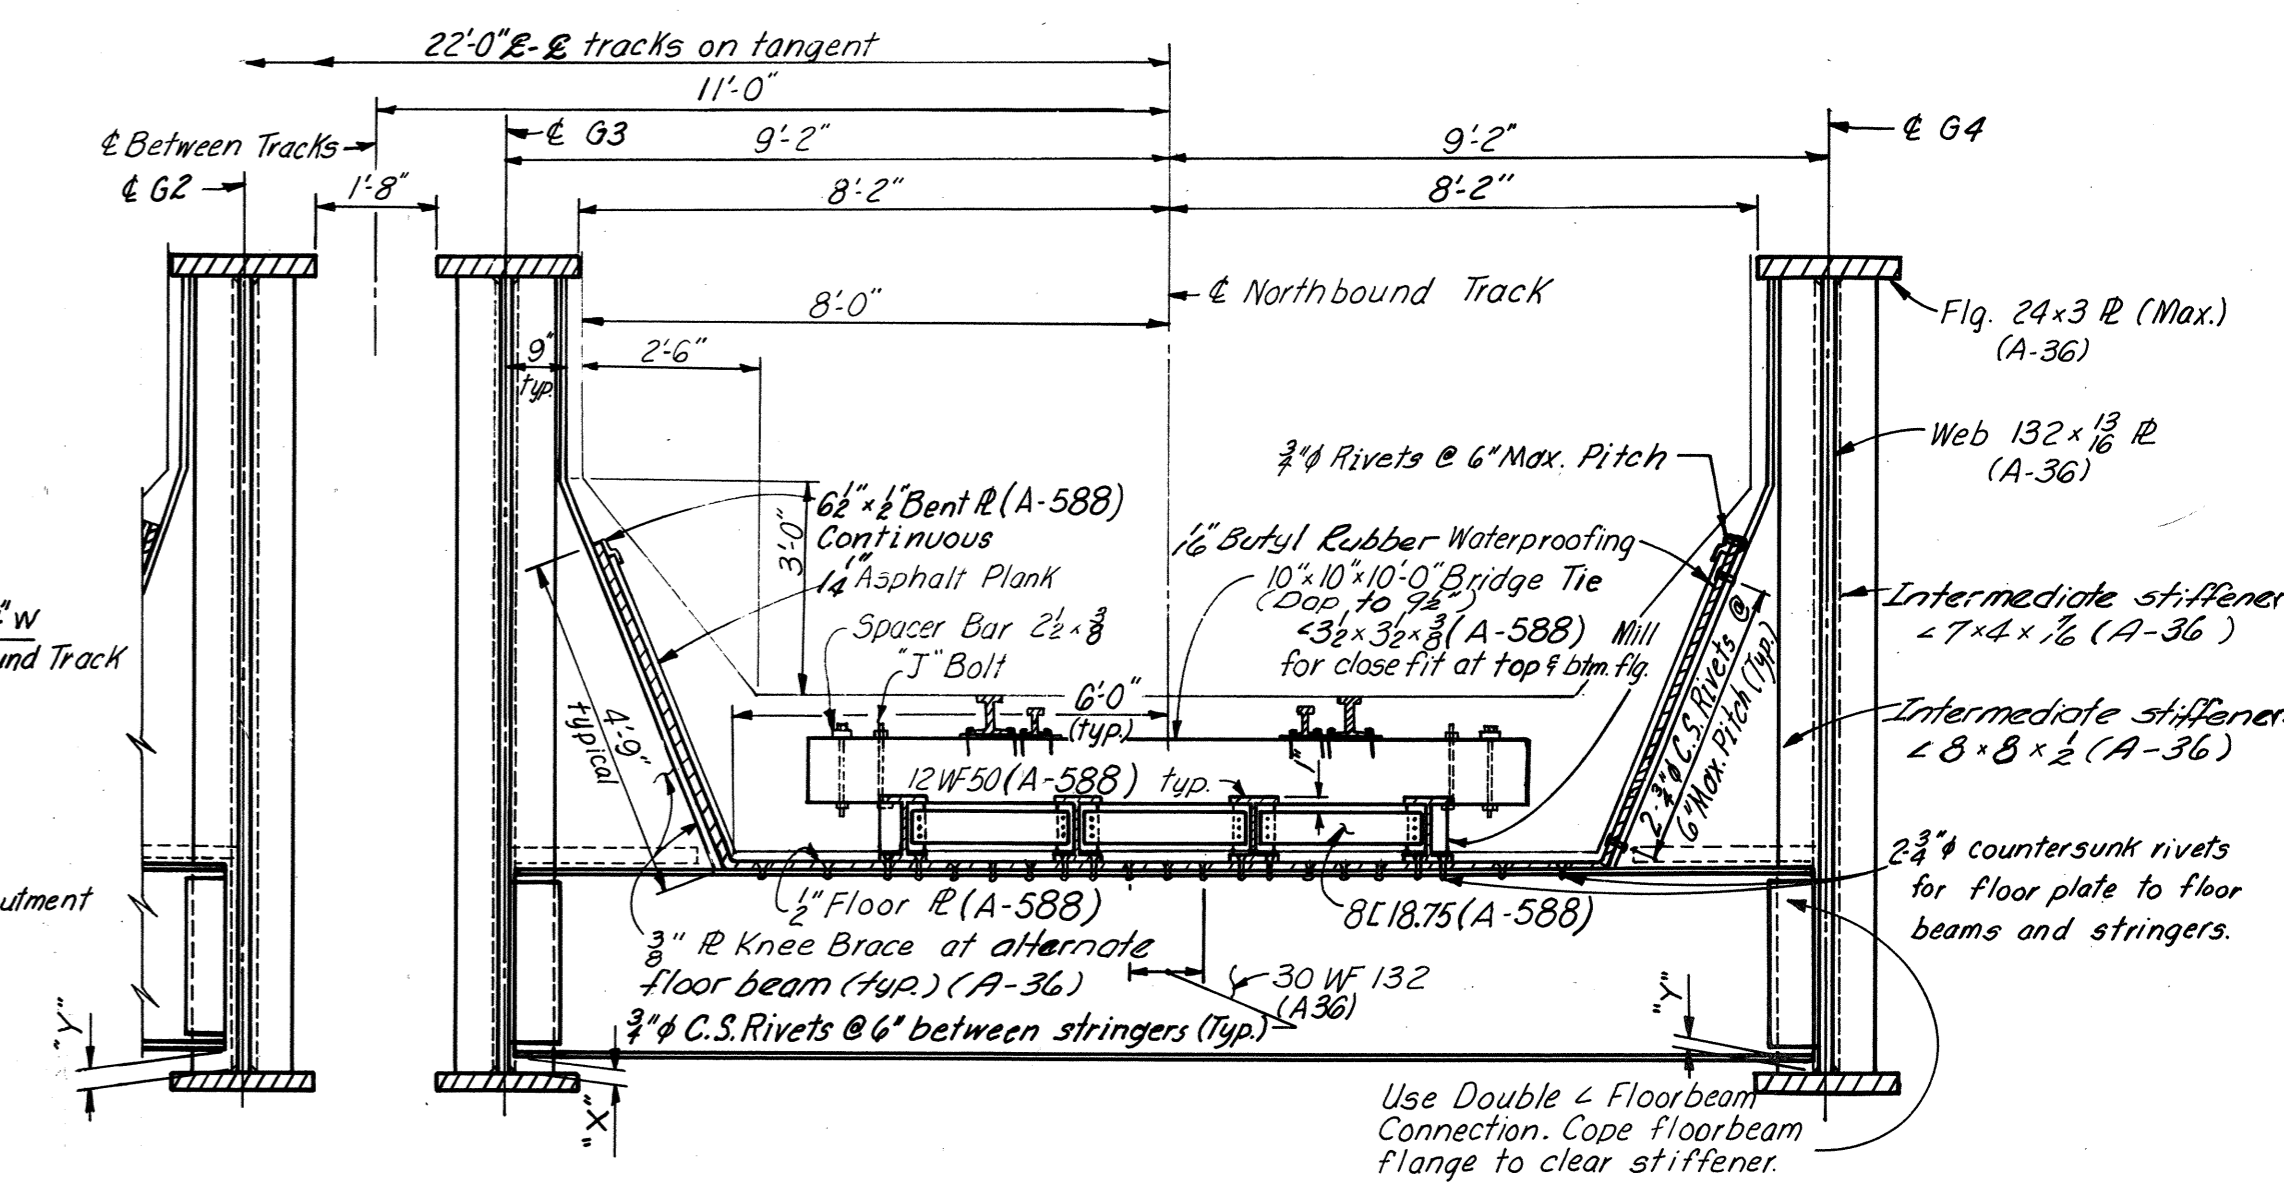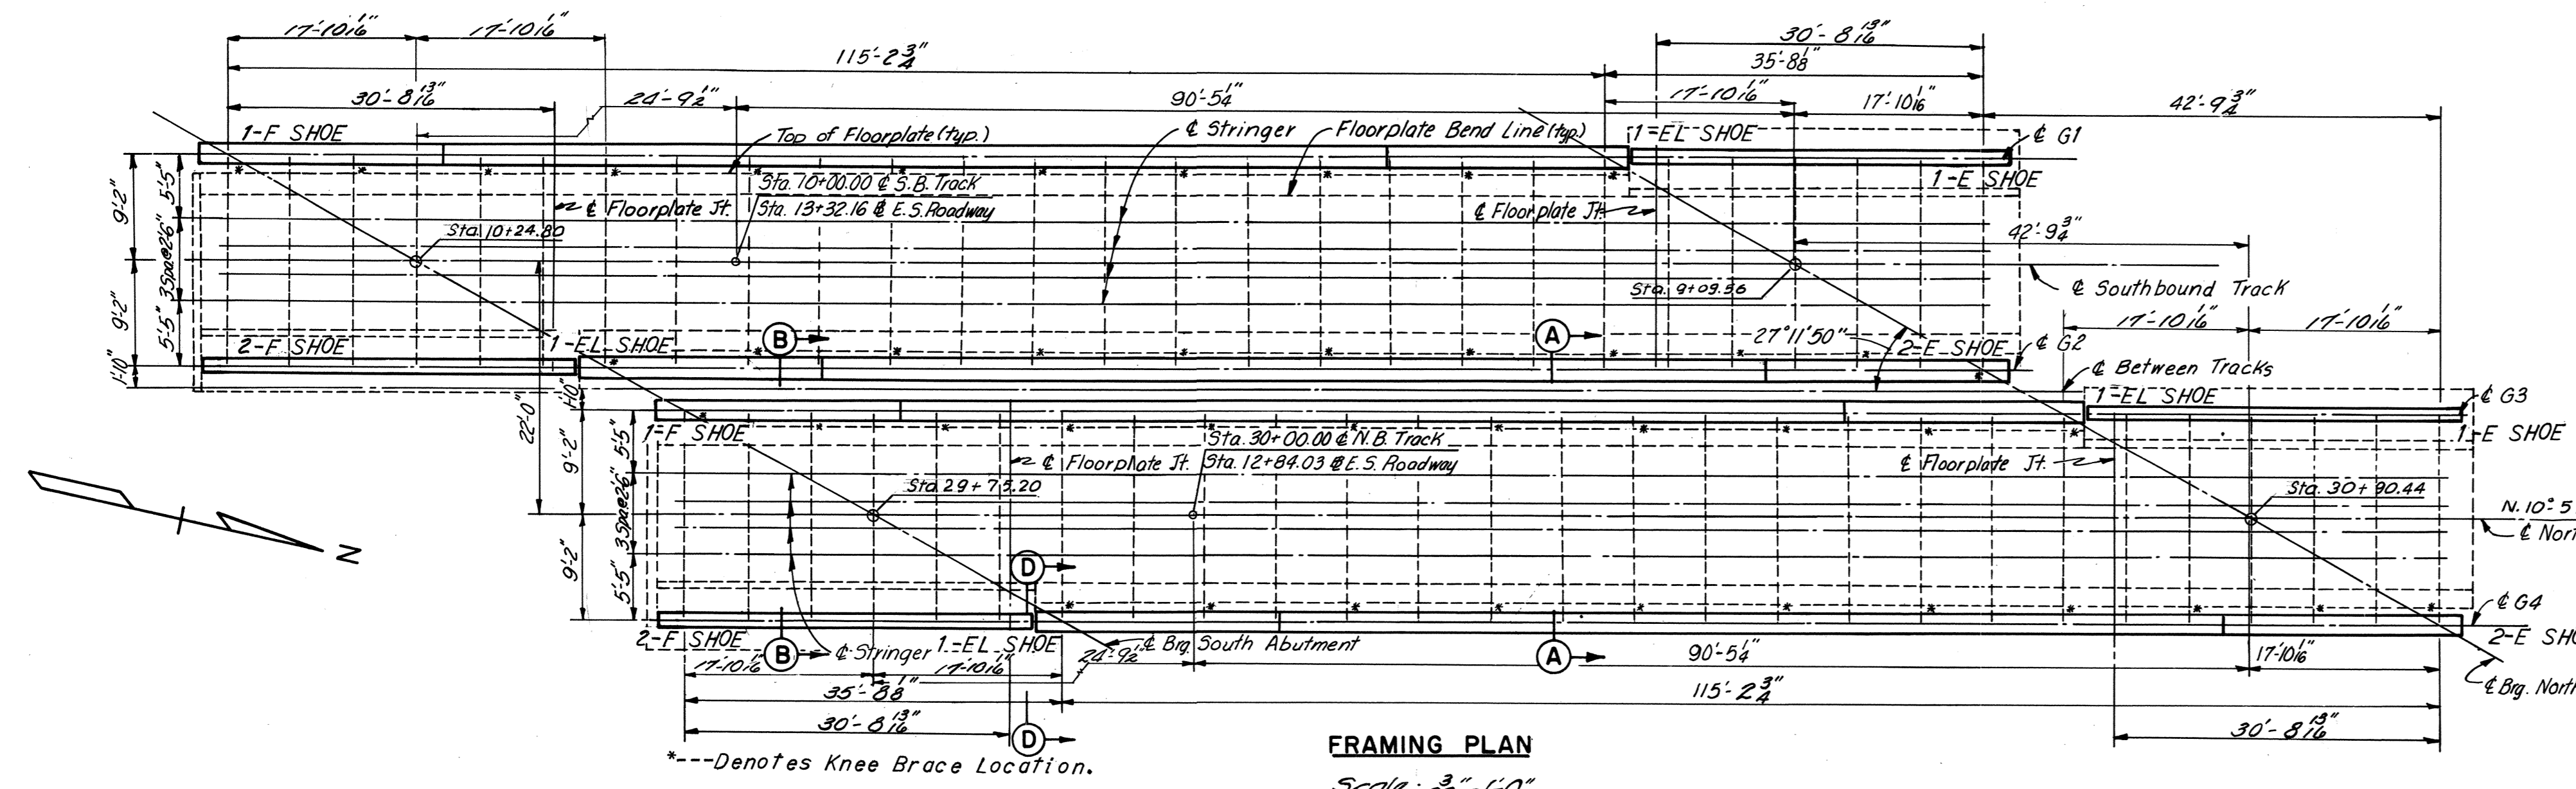

Note: Floorplate connected to stringers by two rows of 3/4" countersunk rivets at 6" maximum pitch.

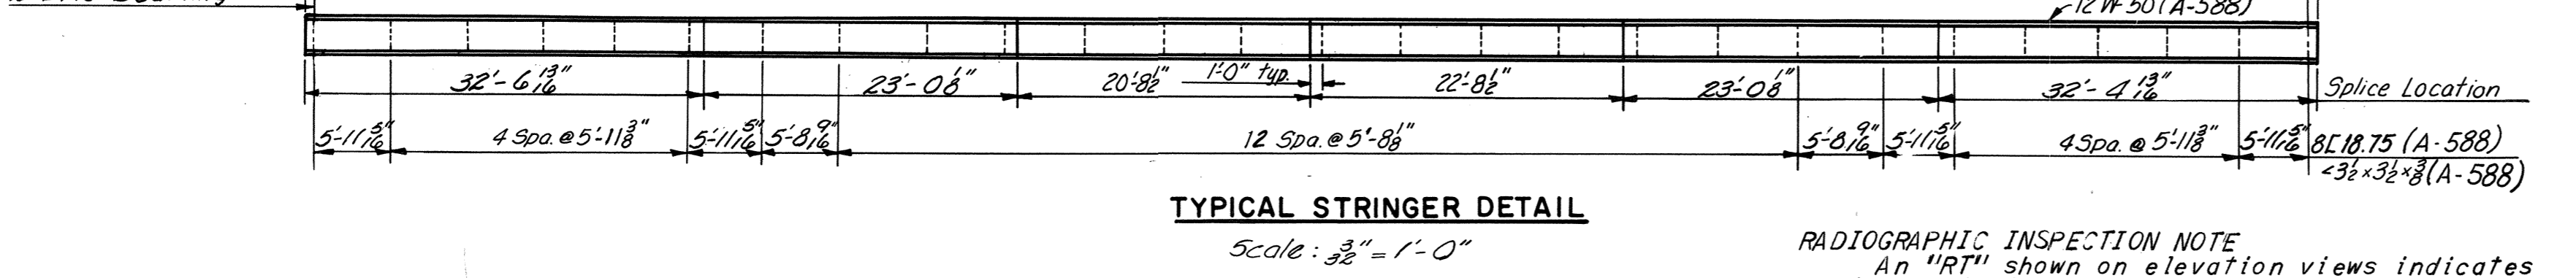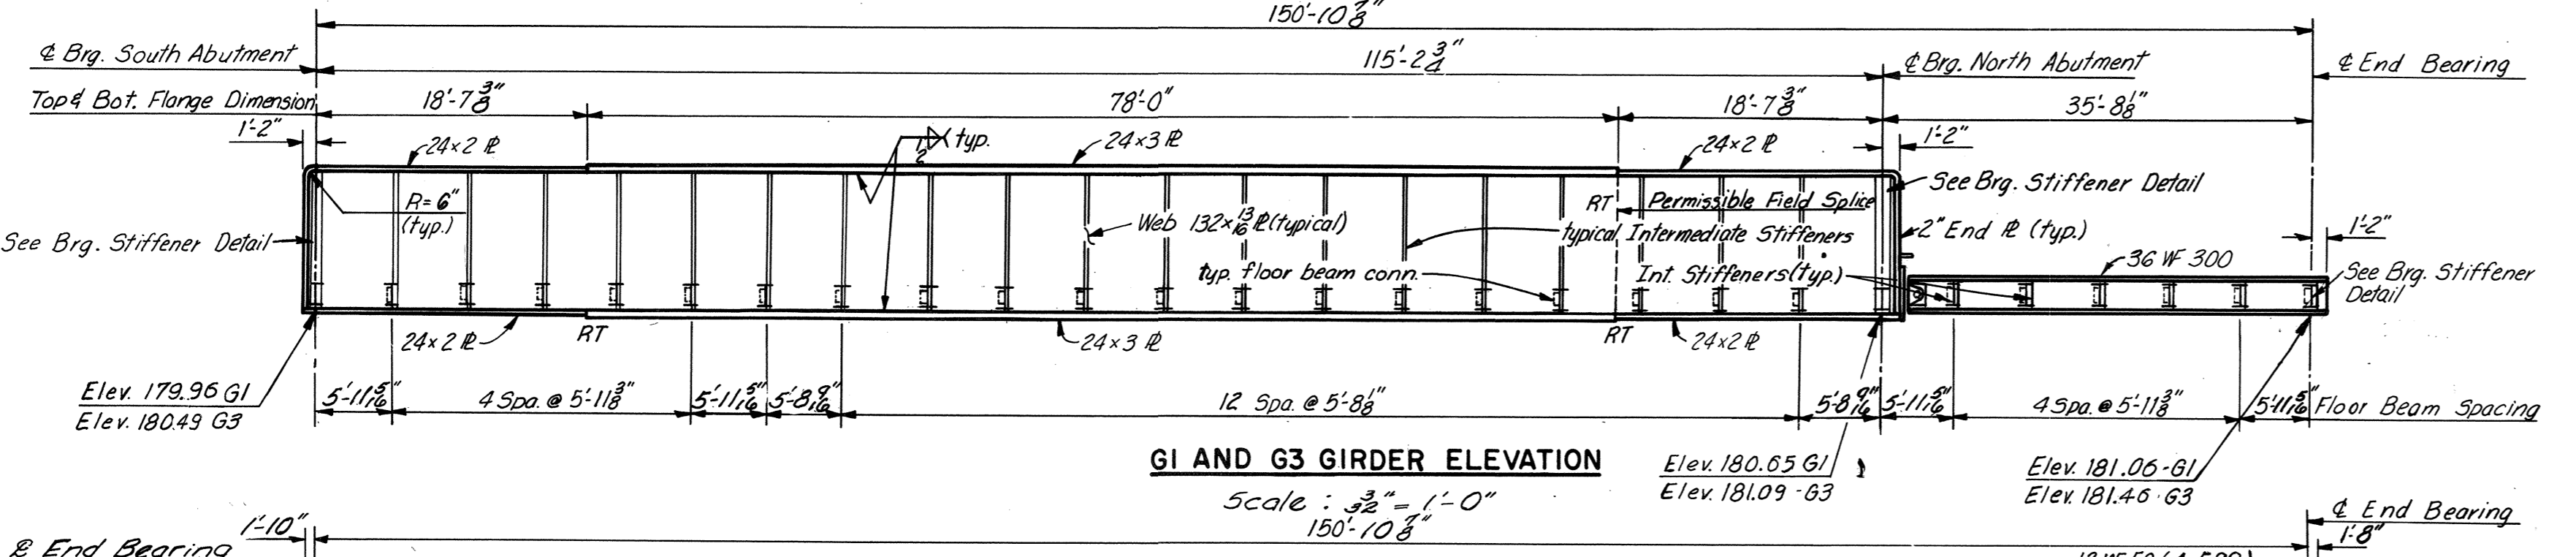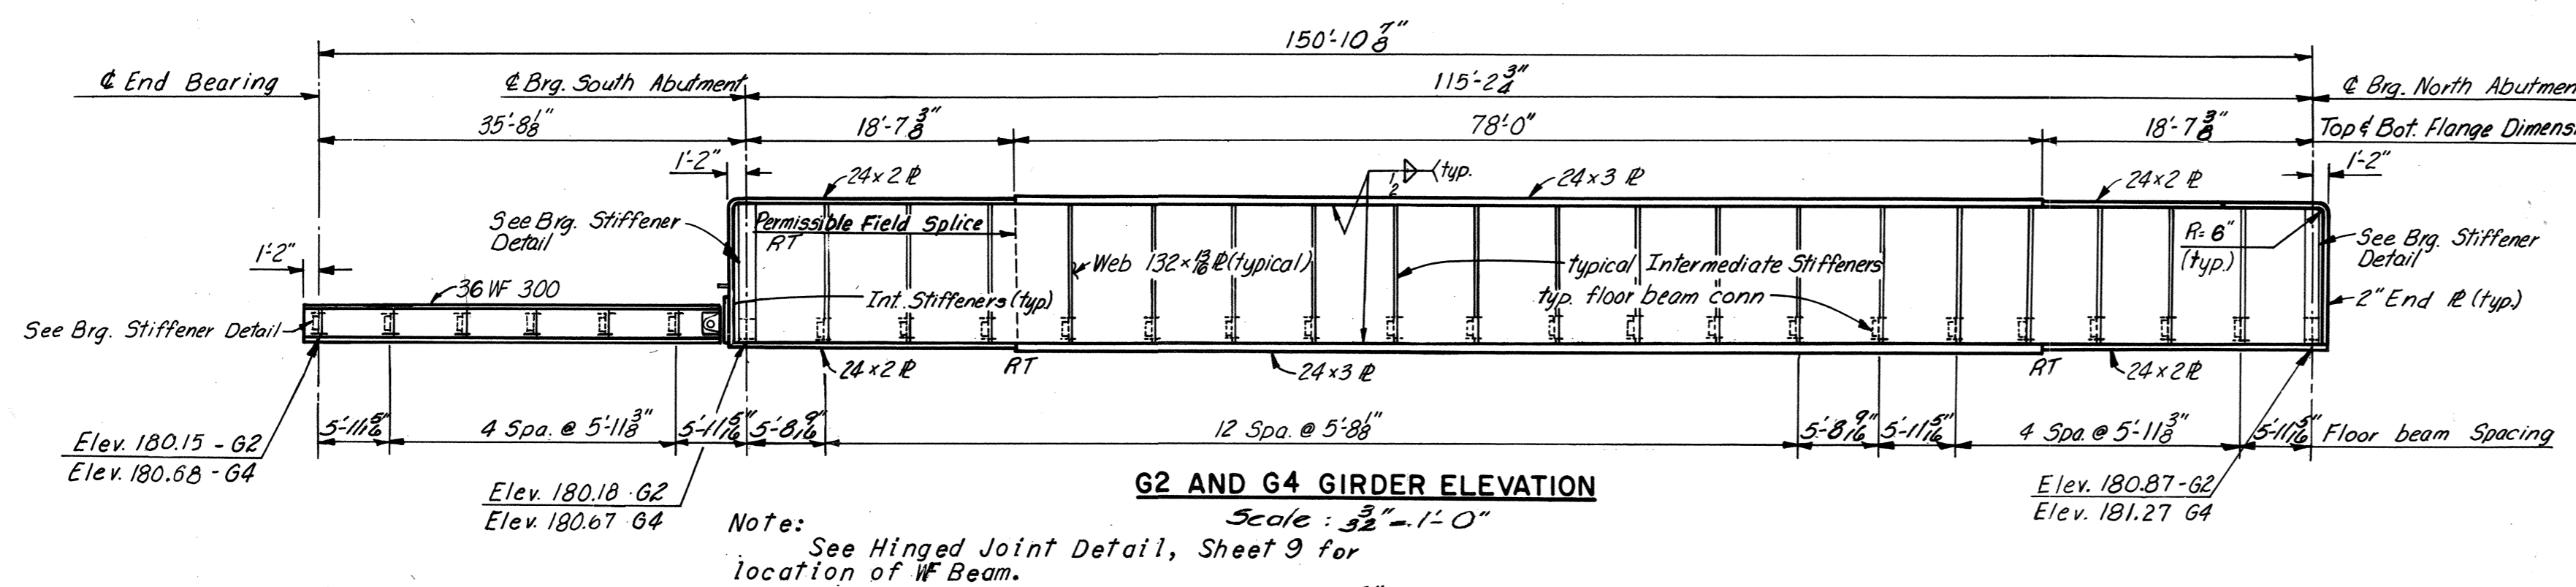

FLOOR BEAM LOCATION TABLE

SOUTHBOUND TRACK

DISTANCE	G1 DIMENSION "X"	G2 DIMENSION "Y"
0	2 3/4"	3"
5'-11 5/8"	2 3/4"	3"
11'-10 1/4"	2 3/4"	3"
17'-10 1/4"	2 3/4"	3"
23'-9 1/4"	2 3/4"	3"
29'-8 1/4"	2 3/4"	3"
35'-8 1/4"	3"	3"
41'-4 1/4"	3"	3"
47'-0 3/4"	3"	3"
52'-8 1/4"	3"	3"
58'-5 1/4"	3"	3"
64'-1 1/4"	3"	3"
69'-9 3/4"	3"	3"
75'-5 1/4"	3"	3"
81'-1 3/4"	3"	3"
86'-9 1/4"	3"	3"
92'-5 1/4"	3"	3"
98'-1 1/4"	3"	3"
103'-10 1/4"	3"	3"
109'-6 3/4"	3"	3"
115'-2 3/4"	3"	3"
121'-2 1/4"	3"	2 3/4"
127'-1 1/4"	3"	2 3/4"
133'-0 3/4"	3"	2 3/4"
139'-0 3/4"	3"	2 3/4"
144'-11 3/4"	3"	2 3/4"
150'-10 3/4"	3"	2 3/4"

FLOOR BEAM LOCATION TABLE

NORTHBOUND TRACK

DISTANCE	G3 DIMENSION "X"	G4 DIMENSION "Y"
0	3"	2 3/4"
5'-11 5/8"	3"	2 3/4"
11'-10 1/4"	3"	2 3/4"
17'-10 1/4"	3"	2 3/4"
23'-9 1/4"	3"	2 3/4"
29'-8 1/4"	3"	2 3/4"
35'-8 1/4"	3"	3"
41'-4 1/4"	3"	3"
47'-0 3/4"	3"	3"
52'-8 1/4"	3"	3"
58'-5 1/4"	3"	3"
64'-1 1/4"	3"	3"
69'-9 3/4"	3"	3"
75'-5 1/4"	3"	3"
81'-1 3/4"	3"	3"
86'-9 1/4"	3"	3"
92'-5 1/4"	3"	3"
98'-1 1/4"	3"	3"
103'-10 1/4"	3"	3"
109'-6 3/4"	3"	3"
115'-2 3/4"	3"	3"
121'-2 1/4"	2 3/4"	3"
127'-1 1/4"	2 3/4"	3"
133'-0 3/4"	2 3/4"	3"
139'-0 3/4"	2 3/4"	3"
144'-11 3/4"	2 3/4"	3"
150'-10 3/4"	2 3/4"	3"

Note: All riveted connections shown hereon may, at the contractors option, be replaced by high strength bolt connections.

RADIOGRAPHIC INSPECTION NOTE
An "RT" shown on elevation views indicates radiographic inspection of adjacent flange and web, flange, or web welds in accordance with the Special Provisions.

Notes - Southbound Track:
Distances shown in Floor Beam Table are measured from north to south, starting at the extreme north floor beam.
Dimensions "X" and "Y" shown in Floor Beam Table for G1 and G2 are measured from top of bottom flange for Plate Girder section and from bottom of WF Beam section.
Elevations shown on Girder Elevations are at bottom of bottom flange for Plate Girder section and for WF Beam section.

Notes - Northbound Track:
Distances shown in Floor Beam Table are measured from south to north, starting at the extreme south floor beam.
Dimensions "X" and "Y" shown in Floor Beam Table for G3 and G4 are measured from top of bottom flange for Plate Girder section and from bottom of WF Beam section.
Elevations shown on Girder Elevations are at bottom of bottom flange for Plate Girder section and for WF Beam section.

Note: One butt welded shop splice will be permitted in each 24" x 3" flange plate; details of splice shall be similar to that shown for Field Flange Splice, sheet 9.A maximum of 2 web splices including web splice at "Permissible Field Splice" will be permitted; detail of shop web splice shall be similar to that shown for Field Flange Splice, sheet 9, except that web opening is not required and web splice shall not be located within 2'-0" of a shop flange splice.

Notes:
For Shoe Details, see Sheet 11.
For Dead Load Deflections, see Sheet 10.
For Superstructure Details, see Sheets 9 and 10.
For Sections B-B, and D-D, see Sheet 10.

BY	DATE	NO.	REVISION	BY	DATE
4	As Built	ARC	3-73		
BY	DATE	NO.	REVISION	BY	DATE
MADE	RLM 12-14-67	2	Addendum 3 Amendment 3 Profile Grade	ER	4-12-71
CHECKED	JEH 4-10-68	1	General Checking	AMH	5-13-68
IN CHARGE	FKD				

AS BUILT

RICHMOND METROPOLITAN AUTHORITY
RICHMOND EXPRESSWAY SYSTEM
BELTLINE EXPRESSWAY
BRIDGE NO. 10
R.F.&P.R.R. OVER
EAST-SOUTH ROADWAY
FRAMING PLAN


HOWARD, NEEDLES, TAMMEN & BERGENDOFF
consulting engineers
NEW YORK ALEXANDRIA KANSAS CITY

SCALE: As Noted
CONTRACT NO.: 4
SHEET NO. 8 OF 12

Bridge 17

(Ramp from NB Powhite Parkway “Rte. 76”/NB I-195 Connector over I-195 to Cary Street and Ramp from Northbound I-195 to Floyd Avenue)

Record Set Plans

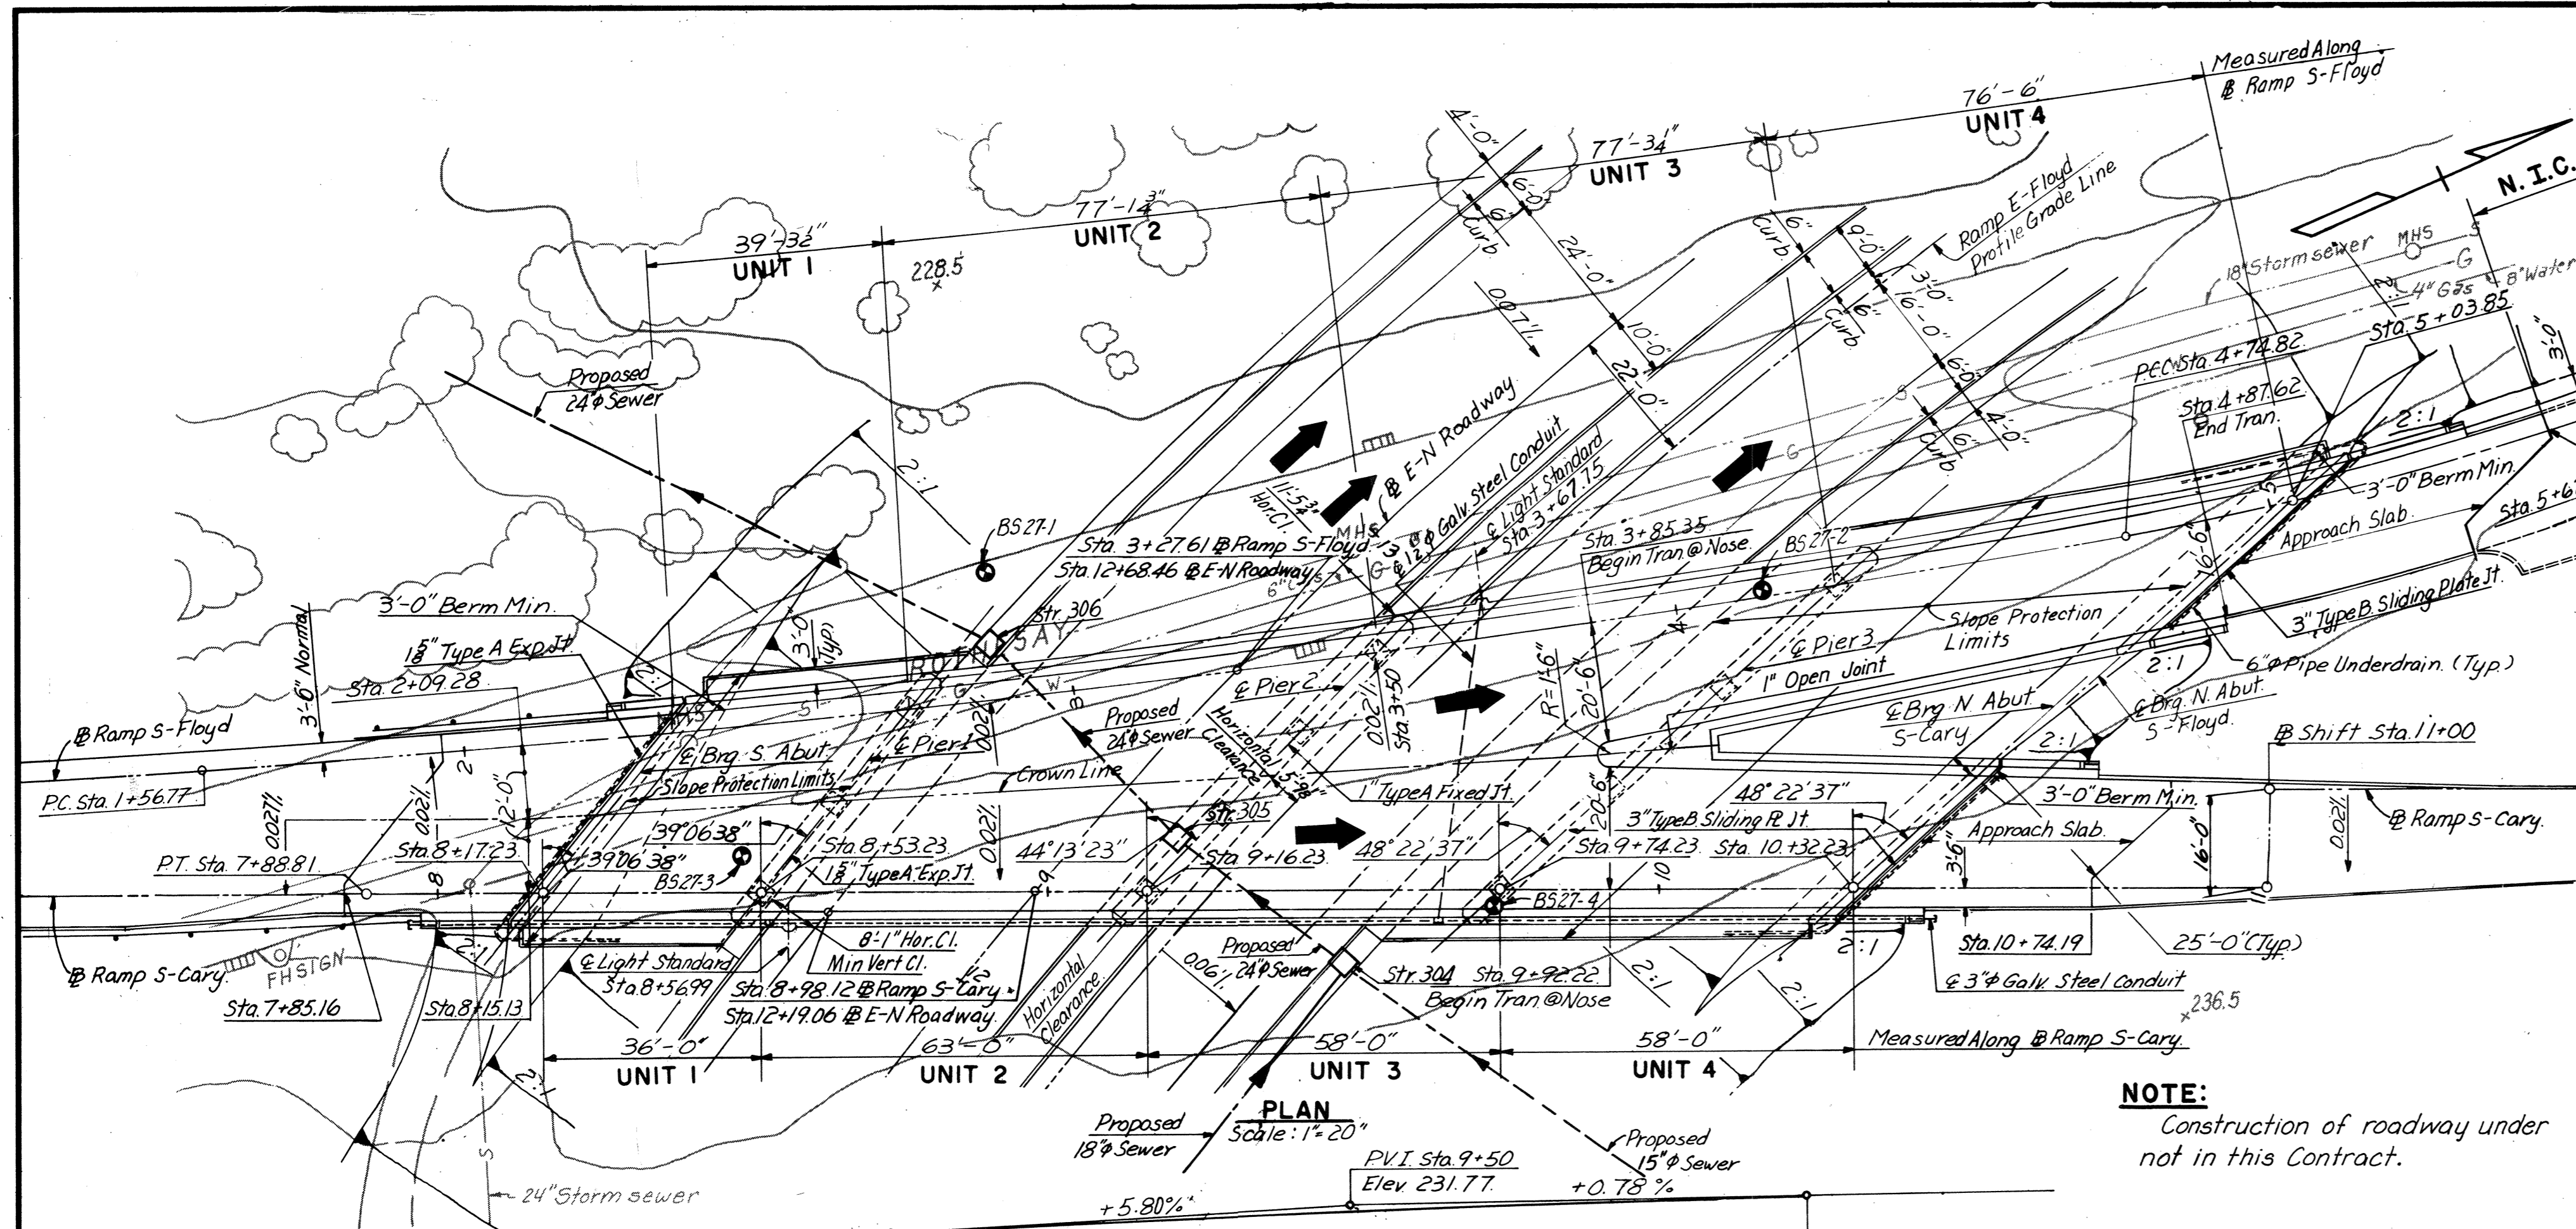

GENERAL NOTES

ROADWAY: Variable width of roadway.

CAPACITY: Dead Load includes 15 lbs. per sq. ft. for future wearing surface.

SPECIFICATIONS:

GENERAL: Virginia Department of Highway Road and Bridge Specifications 1970.
 DESIGN: A.A.S.H.O. Standard Specifications for Highway Bridges 1961, modified by Special Design provisions.
 WELDING: 1969 Standard Specifications for Welded Highway and Railway Bridges of the American Welding Society.

CONTRACT SPECIAL PROVISIONS
 Specifications and Contract Special Provisions referred to above are necessary to make these plans complete.

DATUM: City of Richmond

TEMPERATURE: The normal temperature referred to on the plan is 68°F. The temperature range for movement is 0°F to 120°F.

DIMENSIONS: All dimensions are measured horizontally and vertically unless otherwise noted.

EXCAVATION: Excavation below grade and cut slope template shall be classified as Structure Excavation. All excavation above these limits shall be classified as Regular Excavation and is not included in the Structural Quantities.


FOUNDATIONS: Piles shall be driven to a minimum length corresponding to the approximate tip elevations shown on the Plans but in no case to less than a penetration affording the required safe bearing capacity noted on the Plans.

CONCRETE NOTES: Concrete in superstructure shall be Class A4. All other concrete shall be Class A3. All exposed edges and corners shall have a 3/8" chamfer or fillet unless otherwise noted. Care in the method of vibration, the use of low-slump concrete, and other means shall be employed to prevent downgrade movement of newly placed slab concrete.


STEEL NOTES: All reinforcing steel shall conform to A.S.T.M. A-615, Grade 40. All reinforcing bar dimensions on the detailed drawings are to centers of bars unless otherwise noted. Clear distance between reinforcing steel and face of concrete shall be as noted on the plans. All bar laps shall be 30 diameters of the smaller diameter bar unless otherwise noted.

Structural steel shall conform to A.S.T.M. Specification A36 except as noted. All field connections shall be made with high strength bolts. High strength bolts shall be 3/4" diameter unless otherwise noted and shall conform to A.S.T.M. Specification A-325.

BENCH MARK: A-25 Copperweld rod S. side of Thompson St. and Cary Road. Elev. 236.59.

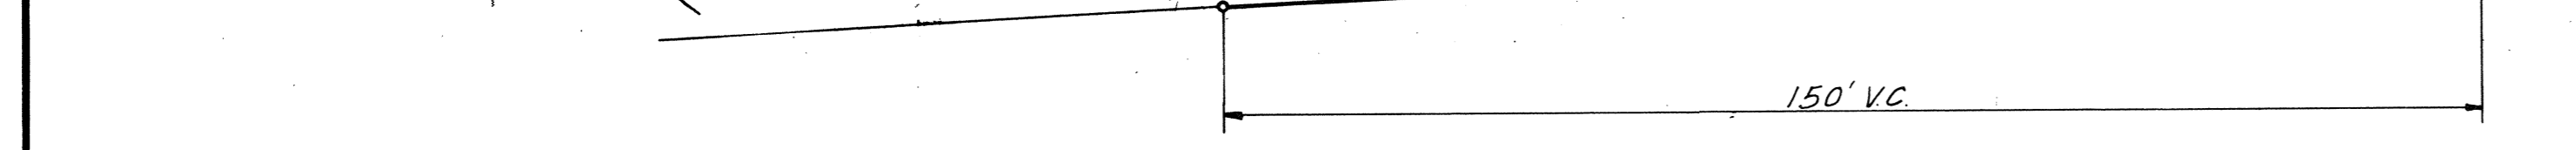


PROFILE GRADE RAMP S-CARY

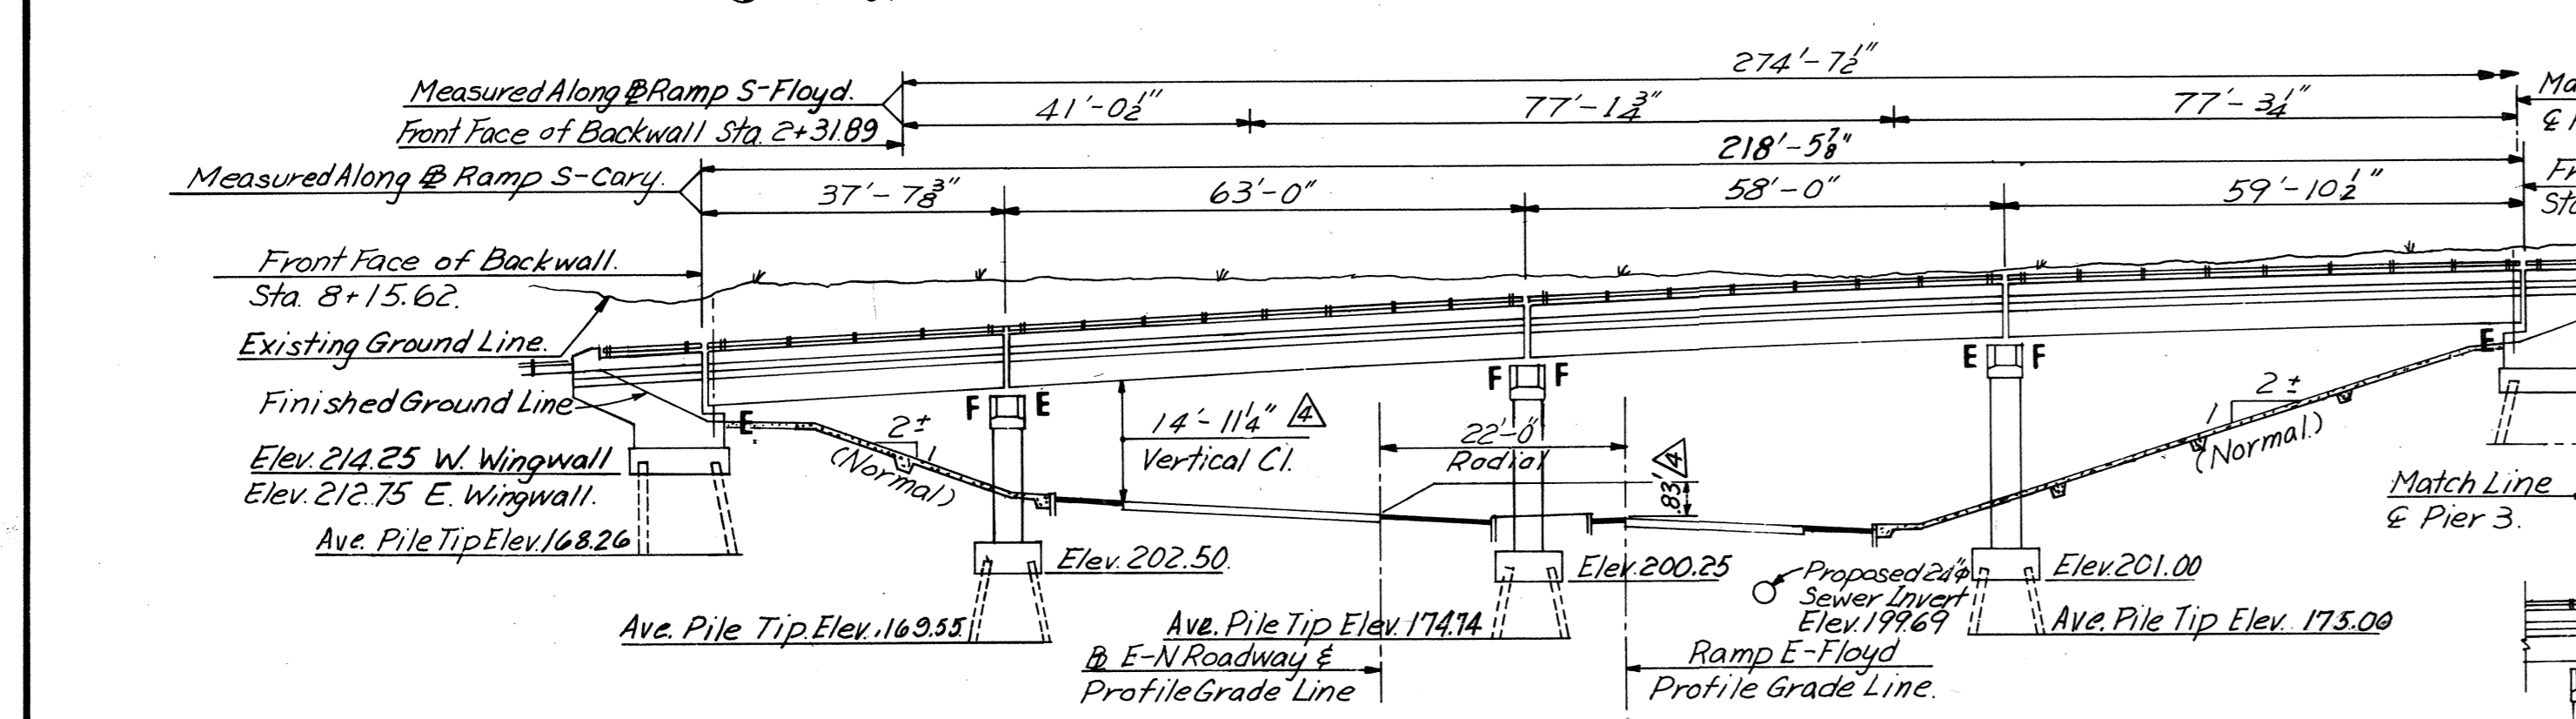

PROFILE GRADE RAMP S-FLOYD

CURVE DATA

RAMP S-CARY		RAMP S-FLOYD	
P.I. = Sta. 3+96.91	Δ = 15°46'34"	P.I. = Sta. 3+15.96	Δ = 6°21'39"
D = 2°00'00"	T = 396.91'	D = 2°00'00"	T = 159.19'
L = 788.81'	R = 2864.79'	D = 7°30'00"	T = 434.42'
		L = 169.24'	R = 790.00'
			R = 763.94'

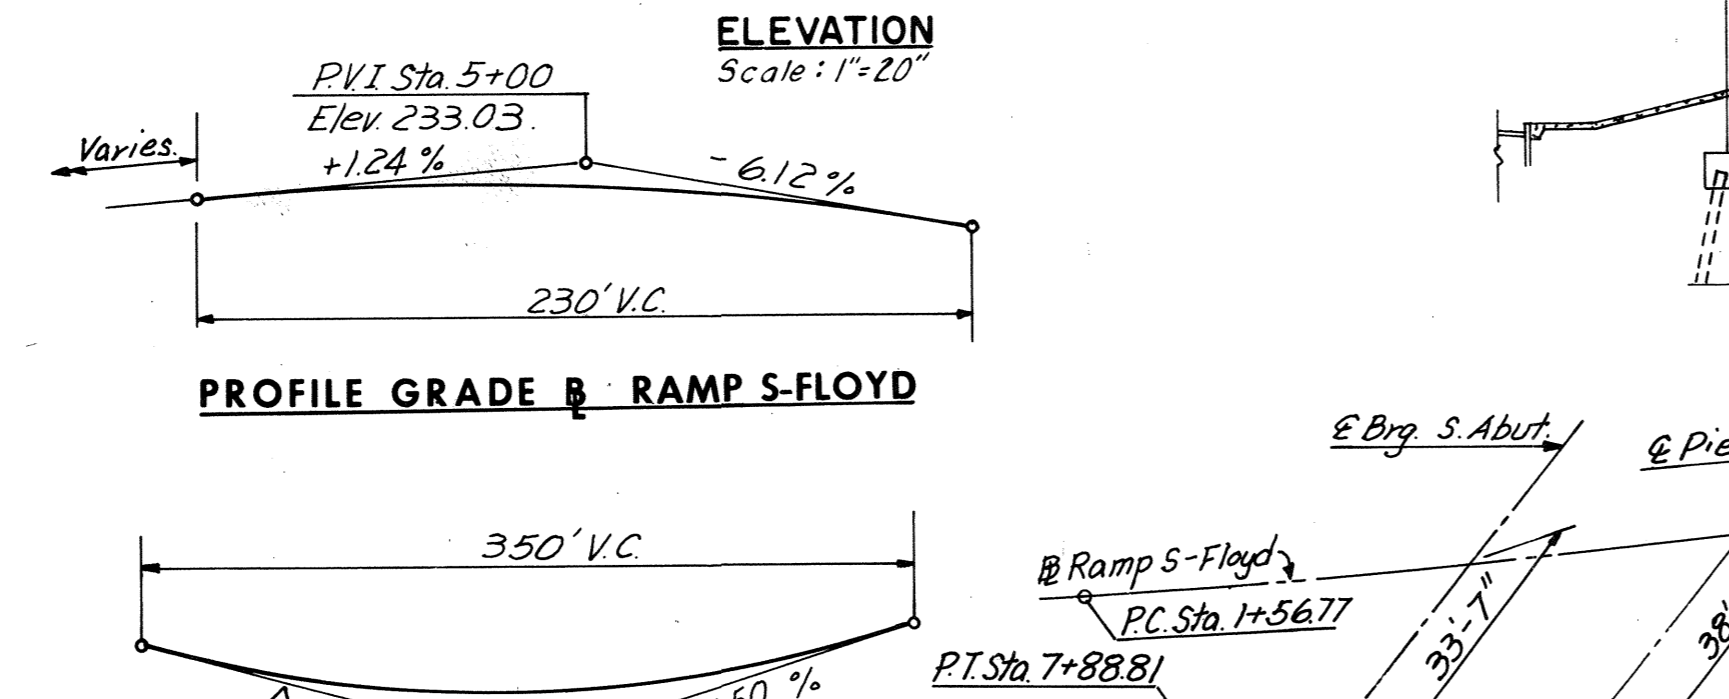


PROFILE GRADE E-N ROADWAY

ESTIMATED QUANTITIES


Str. STL High Strength lbs. A588	Struct. Excav. Cu. Yds.	Concrete (a) Cu. Yds.	Reinf. Steel Lbs.	Str. STL Mild Carbon Lbs.	Aluminum railing (1-Rail) Lin. Ft.	Porous Backfill Cu. Yds.	Under-6" dia. Pipe Lin. Ft.	Con. Slab Sl. Prot. Sq. Yds.	Asphalt damp-proofing Conc. (a) Cu. Yds.	Approach Slab Conc. (a) Cu. Yds.	Steel Piles 10BP42 Lin. Ft.	Parapet Juncif. Box Complete Each	Metal Conduit 3" Dia. Lin. Ft.	Metal Conduit 1 1/2" Dia. Lin. Ft.
11,561.2	-	325.98(b)	94,764	342,021.5	687	-	-	-	-	-	-	2	290	56
	179	87.81	26,326	-	-	7	68	-	31	62.91	654.3	-	-	-
	67	67.39	7,653	-	-	-	-	-	-	-	413.4	-	-	-
	90	99.35	12,167	-	-	-	-	-	-	-	432.1	-	-	-
	156	112.88	15,056	-	-	-	-	-	-	-	493.8	-	-	-
	143	79.26	21,016	-	-	5	56	-	25	52.85	621.7	-	-	-
	180	88.22	29,400	-	-	6	80	-	28	73.48	802.1	-	-	-
	815	325.98(b)	206,382	342,021.5	687	18	204	-	84	189.24	3,417.4	2	290	56
		5,344.91												

Estimated Quantities Notes:
 (a) Class A3, unless noted
 (b) Class A4

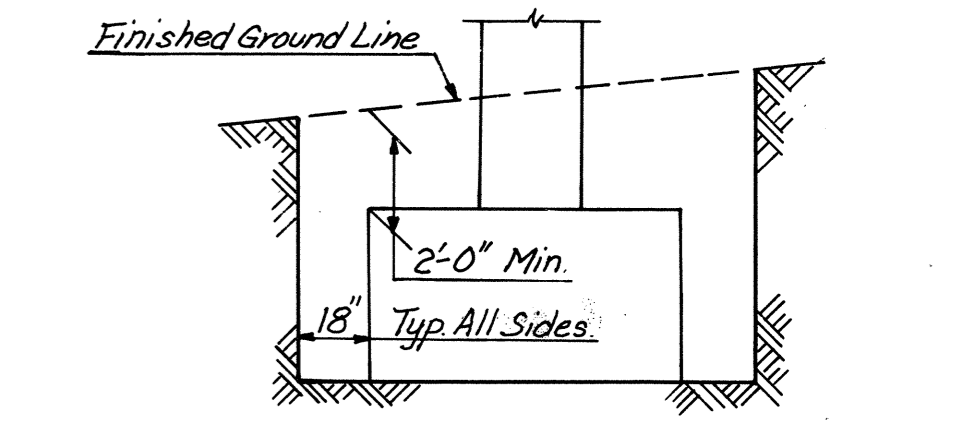

LIMITS OF STRUCTURE EXCAVATION

5	As Built	R.H.	2-5-73	4	Profile Grade - E-N Roadway	L.B.P.	4-70
		BY	DATE	3	Parapet	E.V.R.	12-70
MADE	G.C.C.	1-2-68	2	General	J.G.V.	10-70	
CHECKED	L.J.R.	3-7-68	1	General Revision	A.M.H.	5-13-68	
IN CHARGE	F.K.D.		NO.	REVISION	BY	DATE	

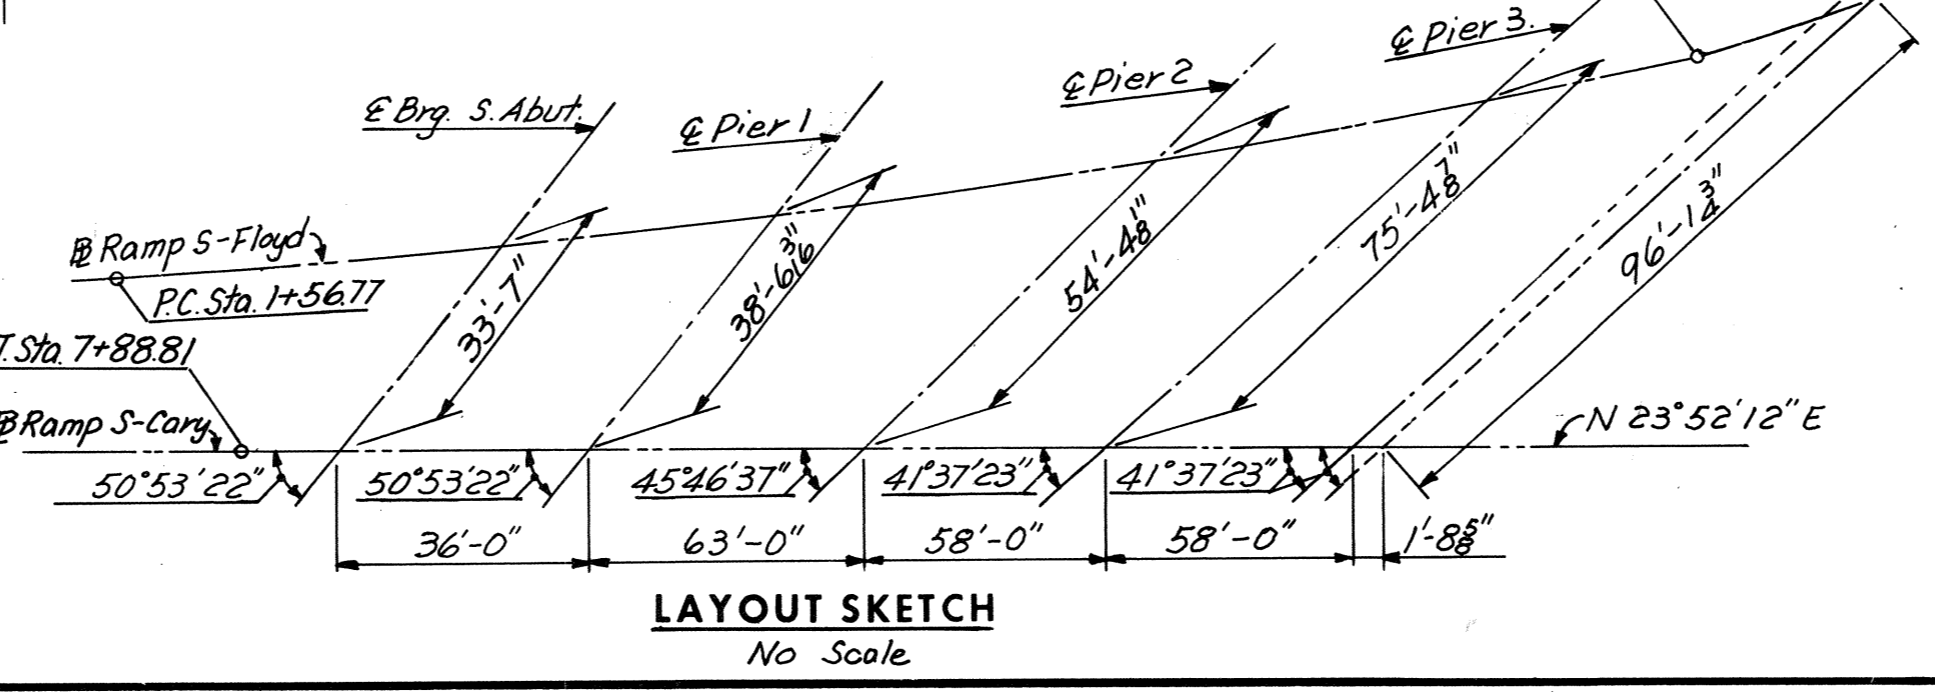

LAYOUT SKETCH
No Scale

AS BUILT


INDEX

GENERAL PLAN AND ELEVATION	Sheet
SOUTH ABUTMENT	1
NORTH ABUTMENT S-CARY	2
NORTH ABUTMENT S-FLOYD	3
ABUTMENT DETAILS	4
PIER 1	5
PIERS 2 AND 3	6
FRAMING PLAN	7
DECK PLAN	8
DECK DETAILS	9
JOINT DETAILS	10
JOINT DETAILS	11
APPROACH SLAB AND SLOPE PROTECTION DETAILS	12
BORING LOGS	13
STANDARD SHOE DETAILS	14
STANDARD ALUMINUM RAILING DETAILS	15
STANDARD ELECTRICAL DETAILS	16
STANDARD ARCHITECTURAL DETAILS	17


RICHMOND METROPOLITAN AUTHORITY
RICHMOND EXPRESSWAY SYSTEM
BELTLINE EXPRESSWAY
BRIDGE NO. 17
RAMP S-CARY OVER
EAST-NORTH ROADWAY
GENERAL PLAN AND ELEVATION

HOWARD, NEEDLES, TAMMEN & BERGENDOFF
 consulting engineers
 NEW YORK ALEXANDRIA KANSAS CITY


SCALE: As noted
 CONTRACT NO. 4
 SHEET NO. 1 OF 14

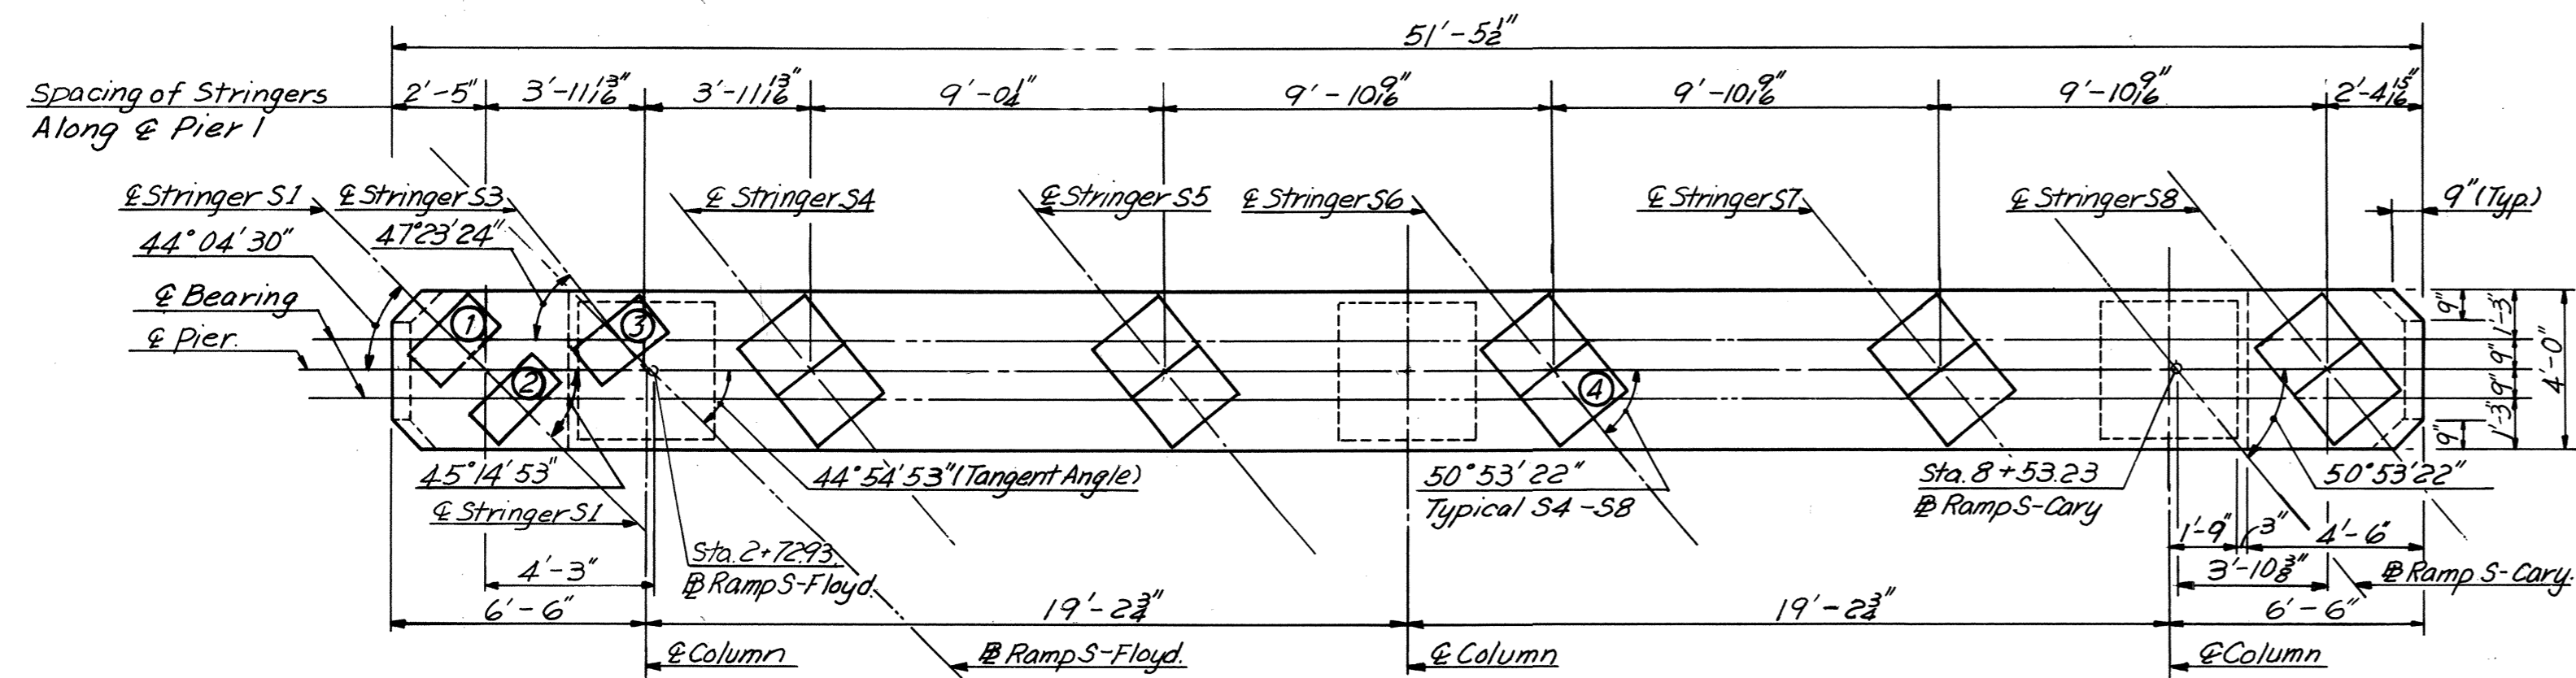

Note: ③ Indicates case of Anchor bolt setting plan, see table.

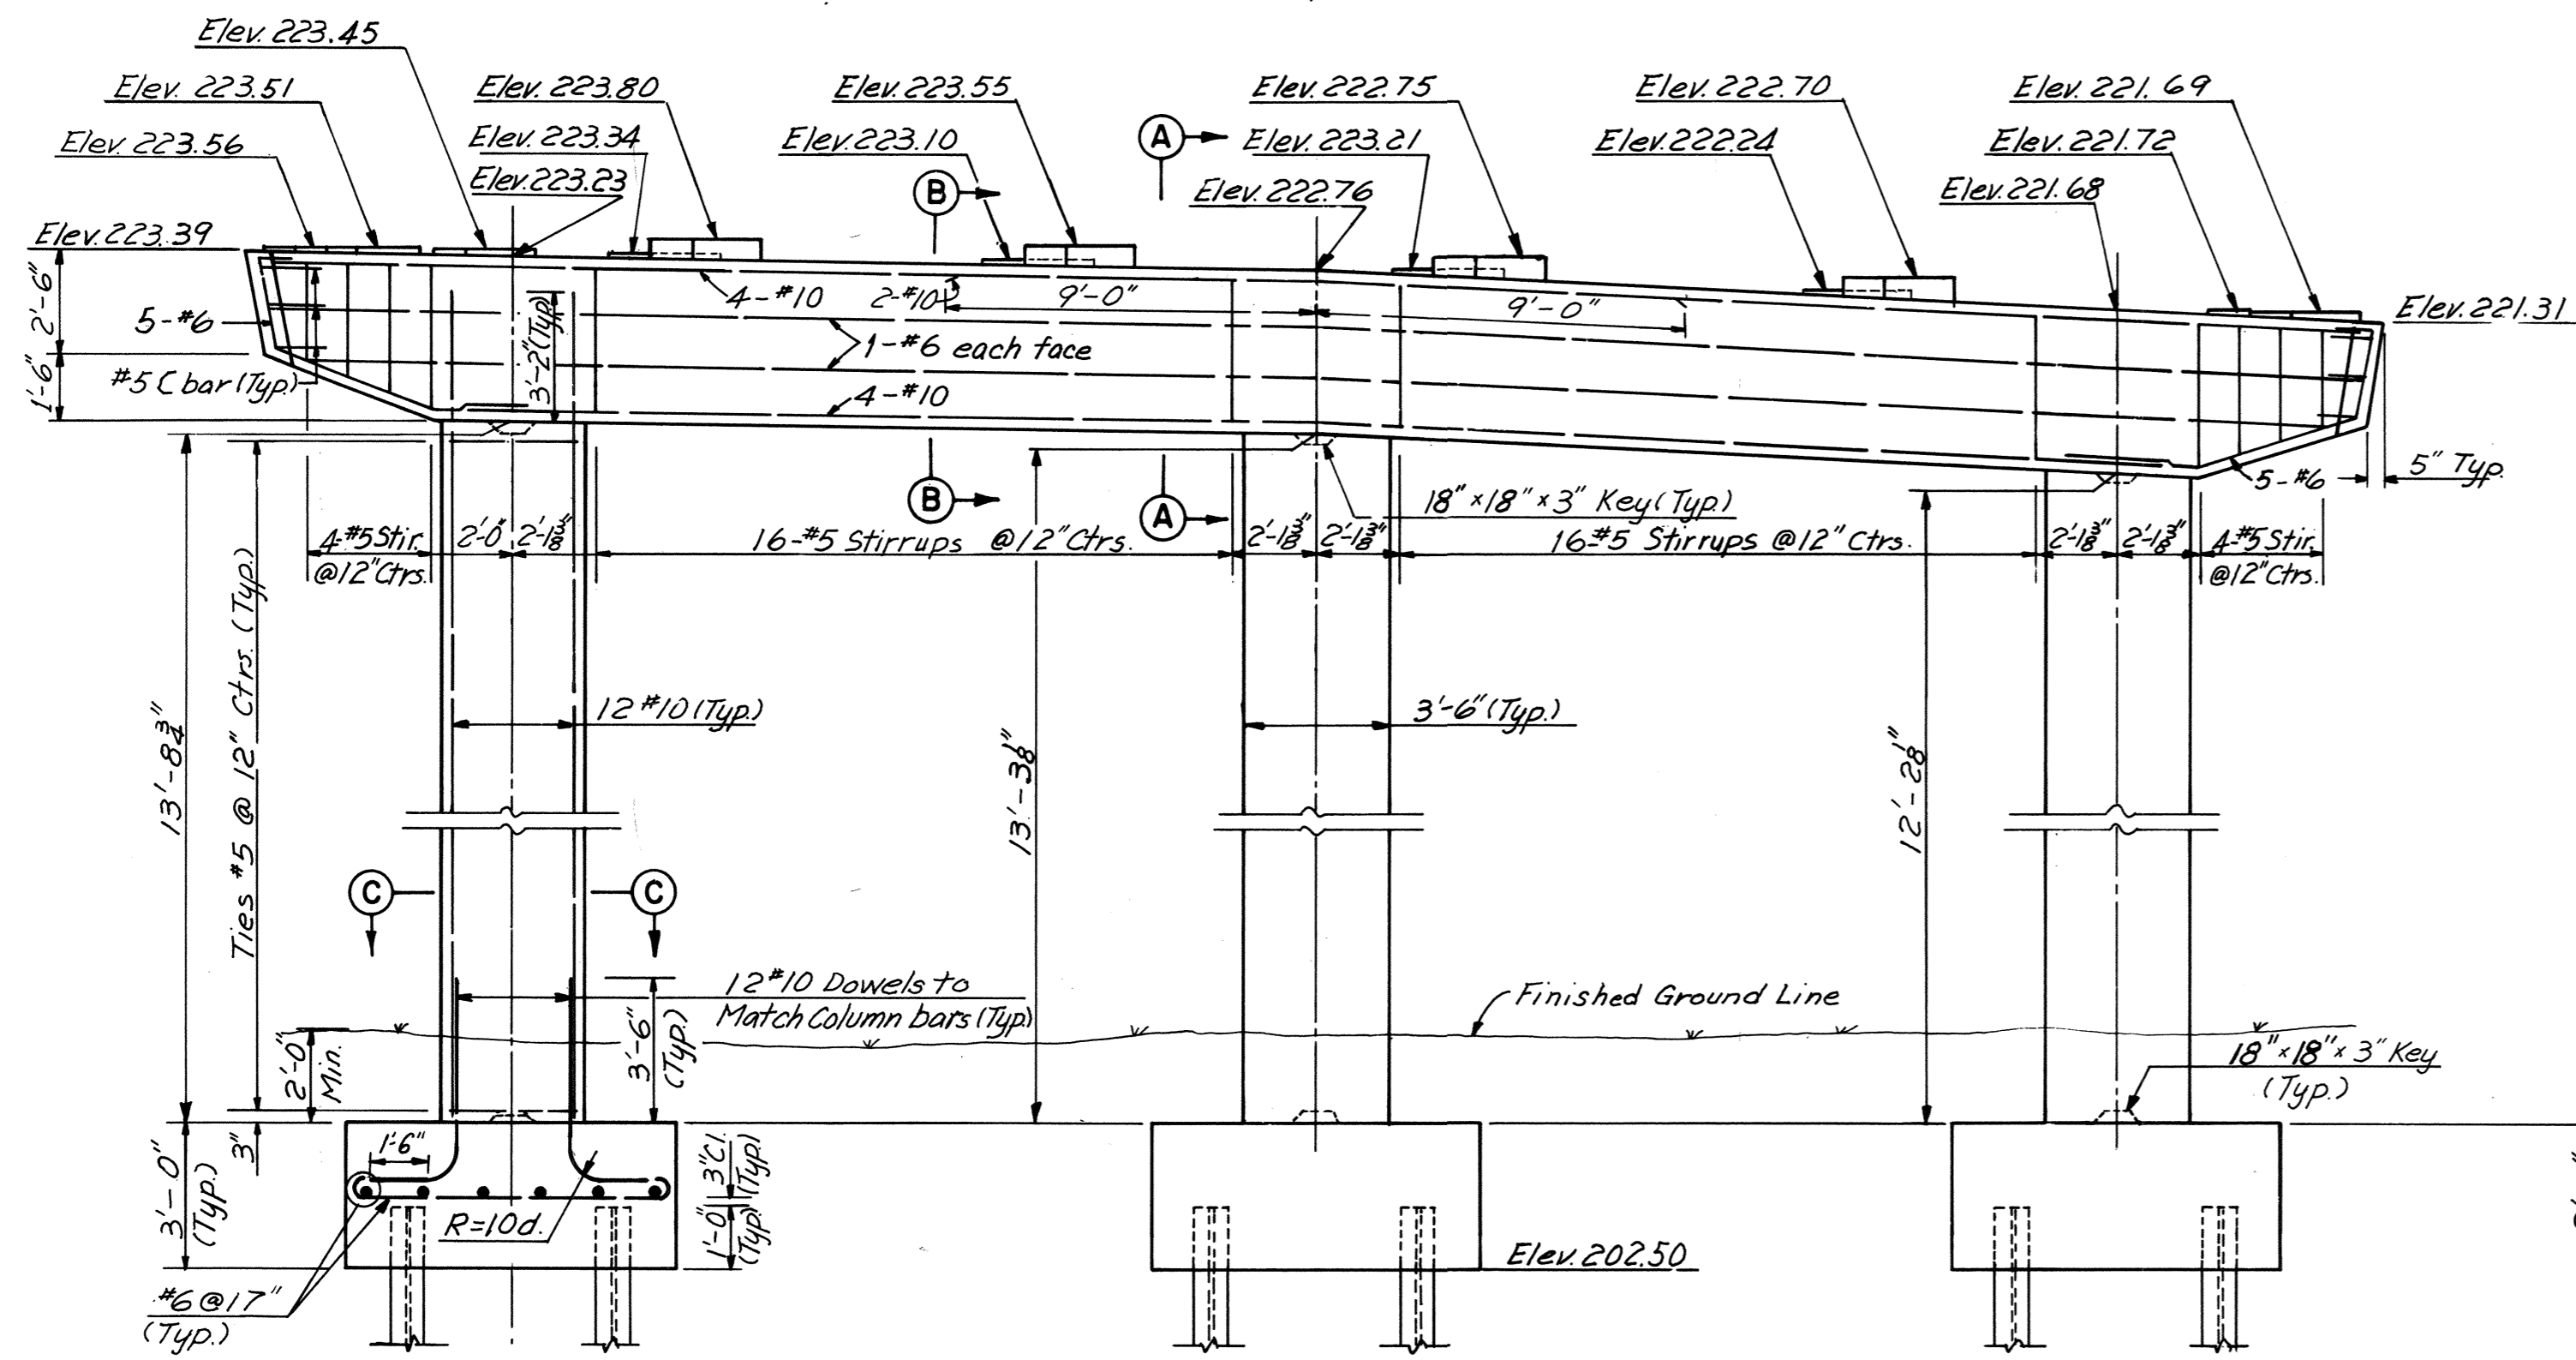


ELEVATION Scale 1/4" = 1'-0"

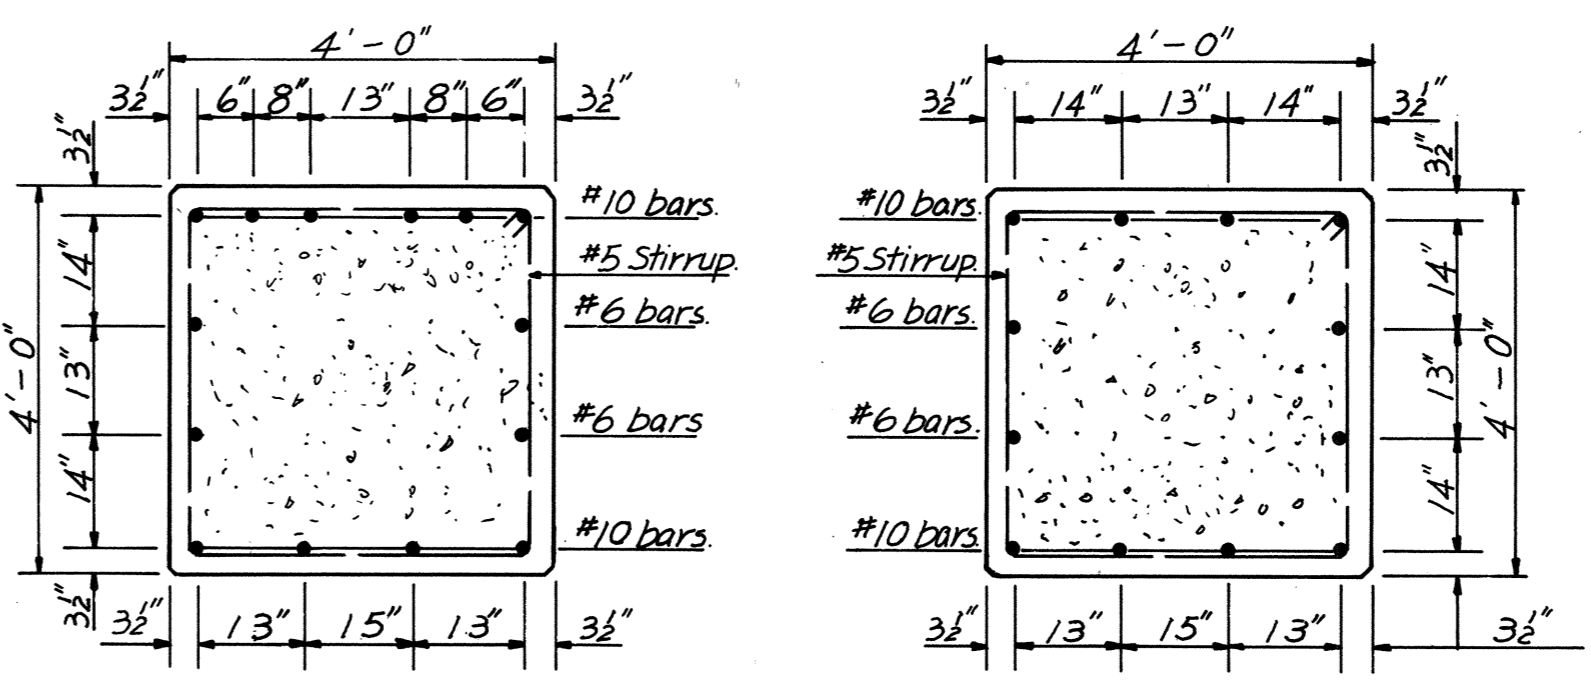

SECTION A-A Scale 1/2" = 1'-0"

SECTION B-B Scale 1/2" = 1'-0"

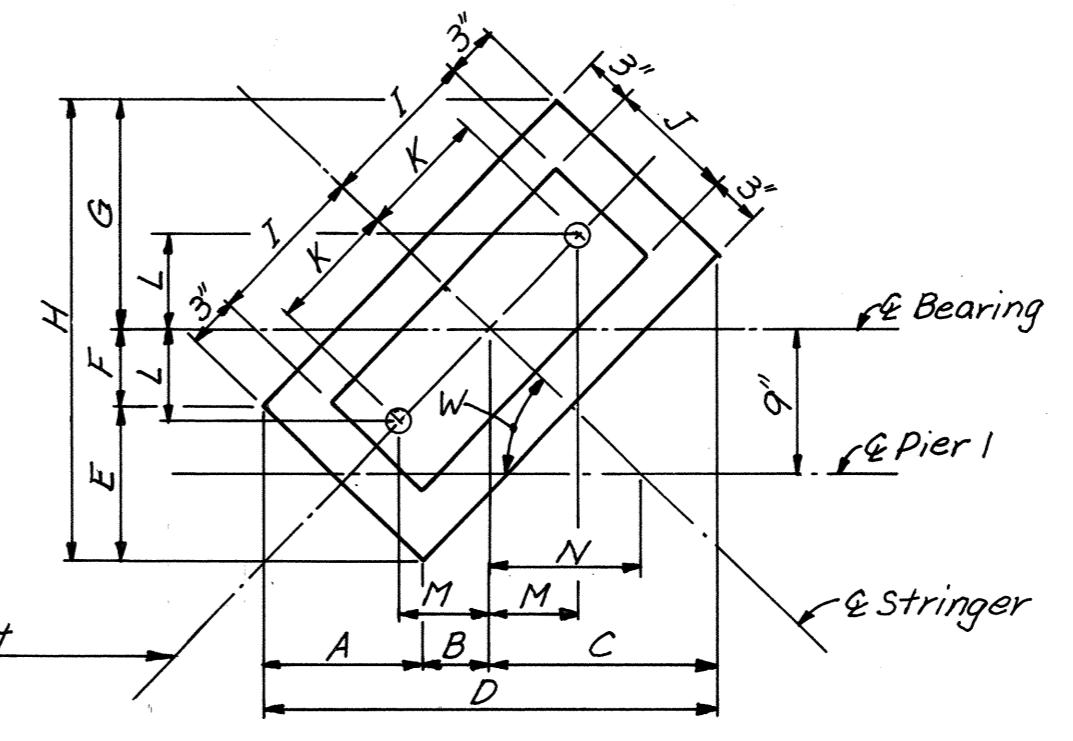



ANCHOR BOLT SETTING PLAN DIMENSIONS																
Case	Angle	W	A	B	C	D	E	F	G	H	I	J	K	L	M	N
1	44°04'30"	10	4 1/4	14 1/4	28 1/2	9 3/4	4 3/8	14 3/8	28 3/8	10 1/4	8	8 1/4	5 1/8	5 3/8	9 3/8	
2	45°14'53"	9 1/2	4 1/8	14 3/8	28 3/8	9 3/8	4 3/8	14 3/8	28 1/2	10 1/2	7 1/2	8	5 3/8	5 1/8	8 1/8	
3	47°23'24"	9 1/2	5	14 1/2	29	10 1/4	3 7/8	14 3/8	28 1/4	10 1/4	8	8 1/4	5 3/8	6 1/8	8 1/4	

(Dimensions are in inches)

Case ①, ② & ③


ANCHOR BOLT SETTING PLAN No Scale

Note: Footing elevations are approximate only and may be varied to suit field conditions as directed by the Engineer. Vertical shaft reinforcing shall not be cut until these elevations are established. Where elevations change more than 2 ft. redesign will be required.

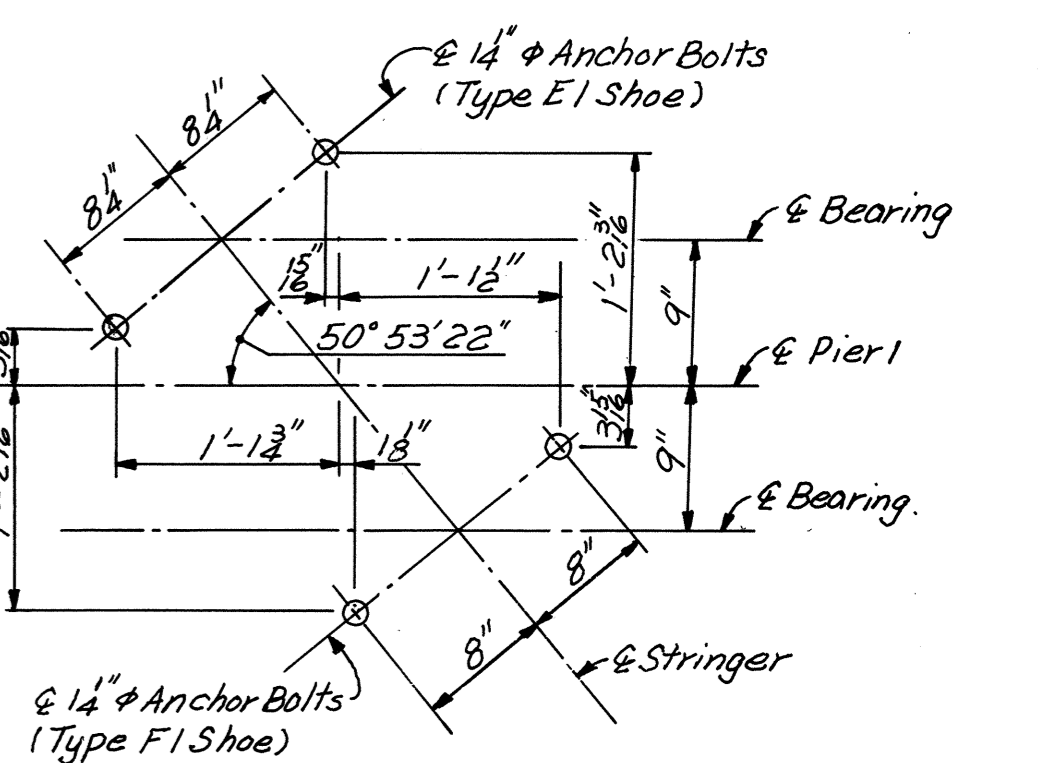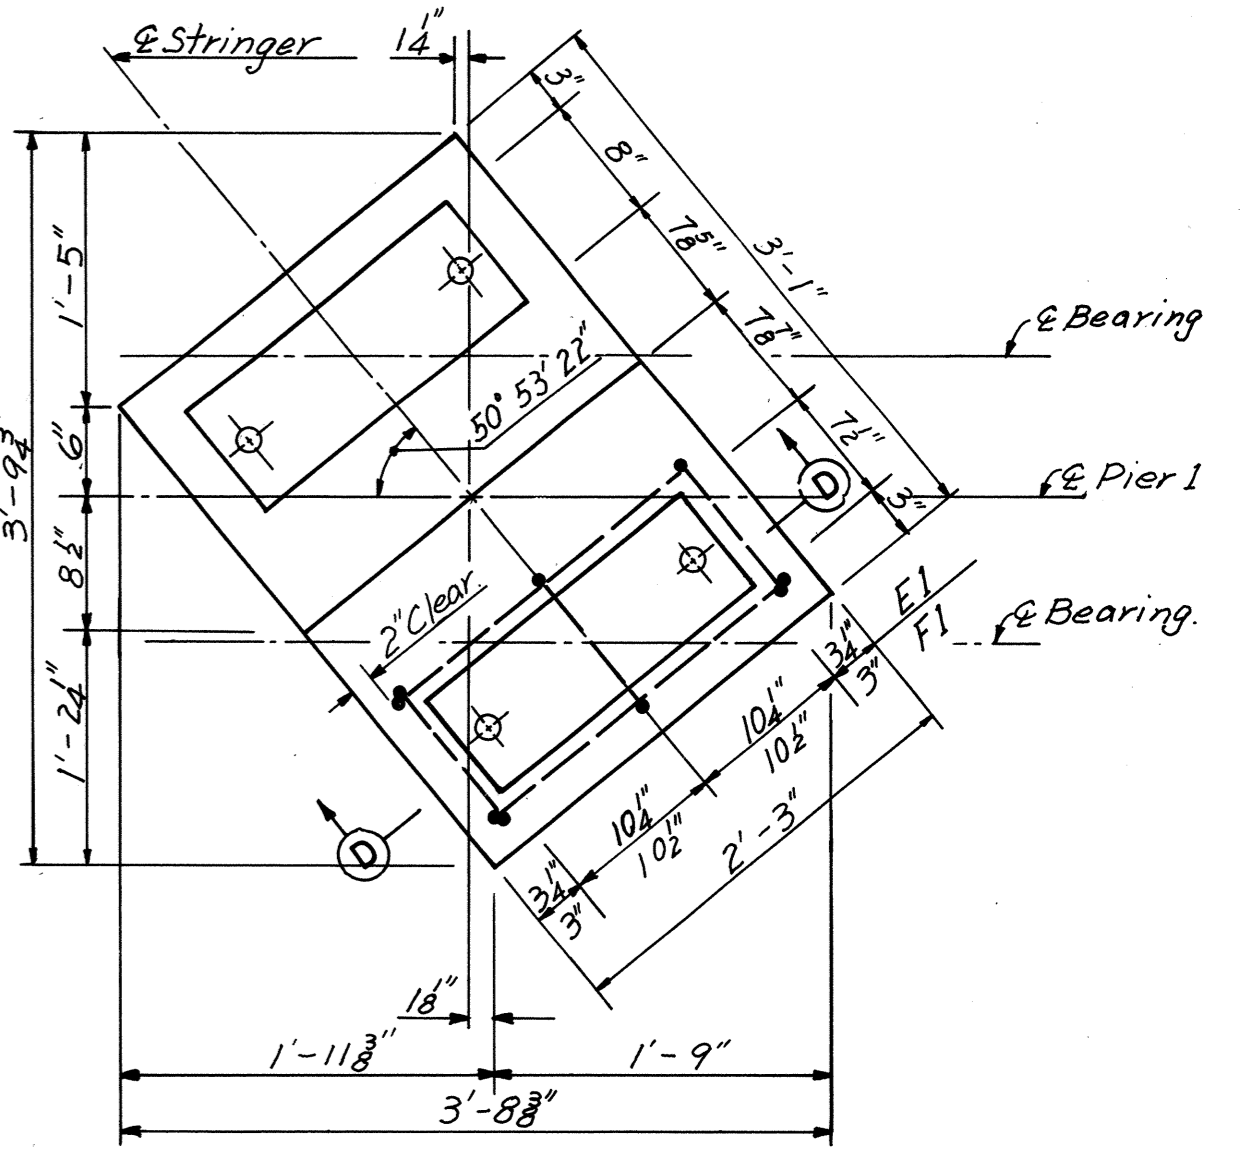


Case ④

No Scale

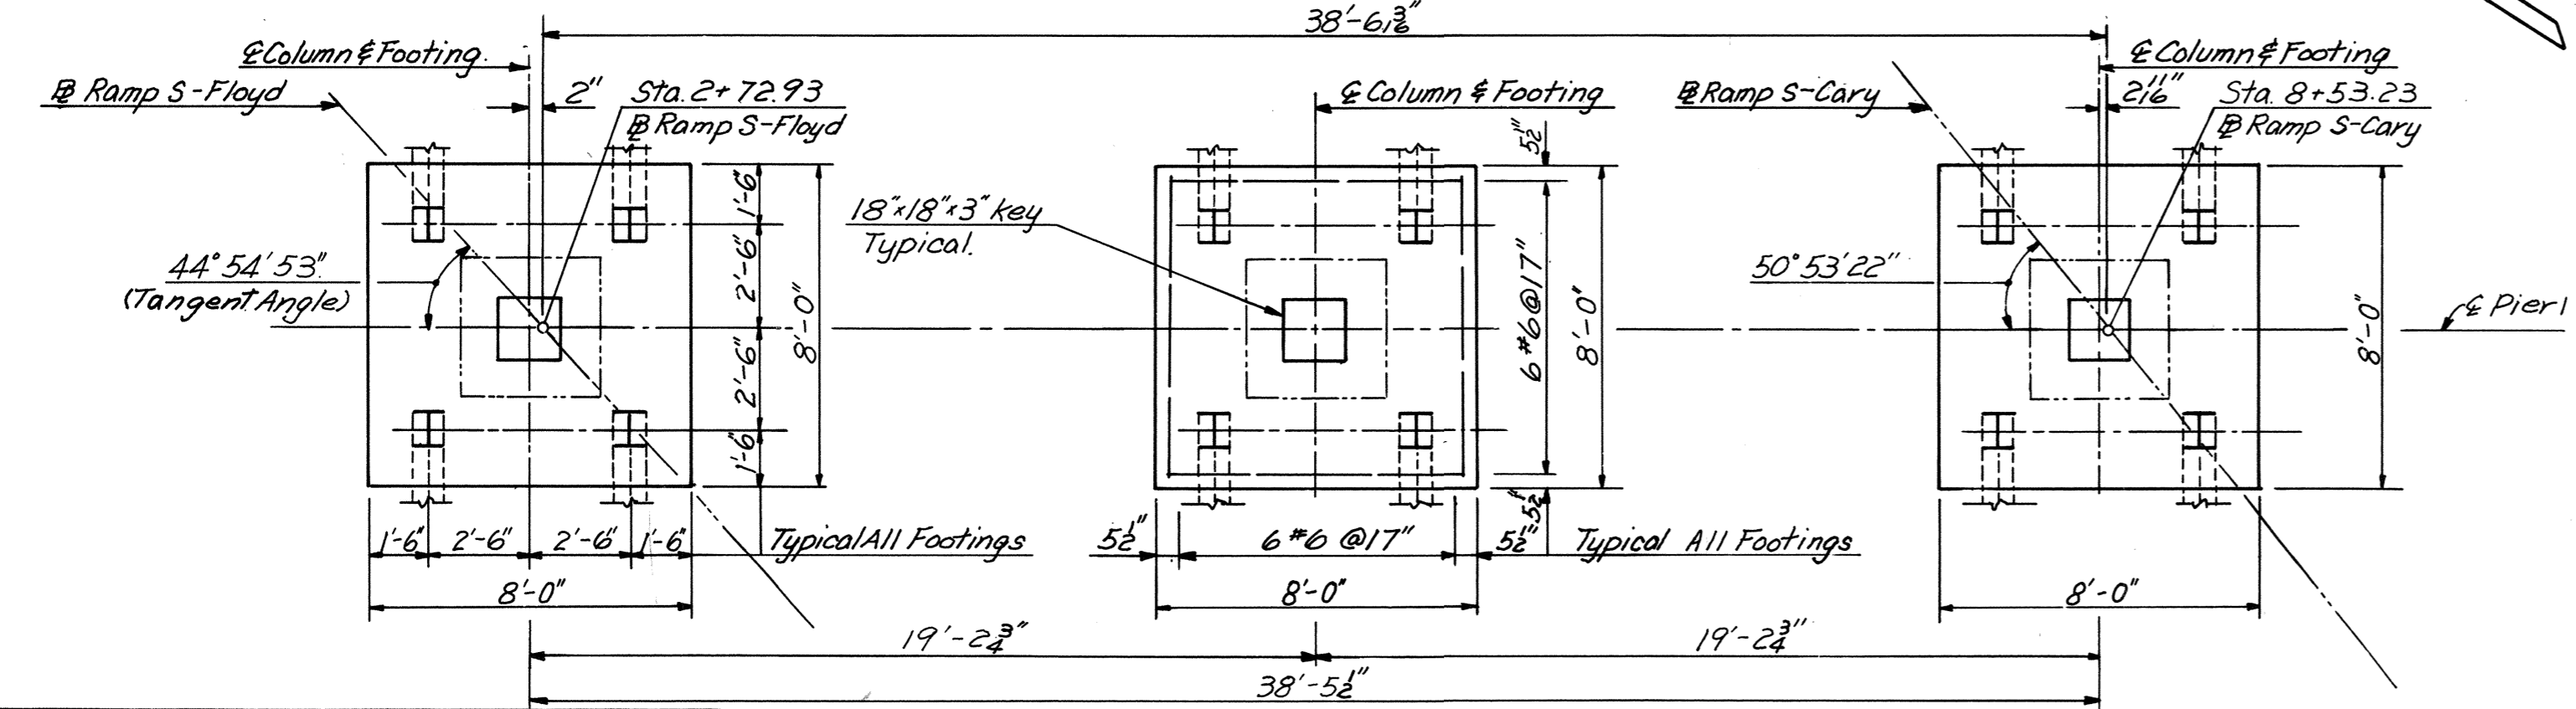


FOOTING PLAN Scale 1/4" = 1'-0"

Note: All piles shall be 10BP42 Steel Piles (Design capacity = 45 tons). Batter all piles 2" per foot where shown. For Standard Shoe details see Sheet S1. For Framing Plan see Sheet 3. For Steel Pile details see Sheet 12.

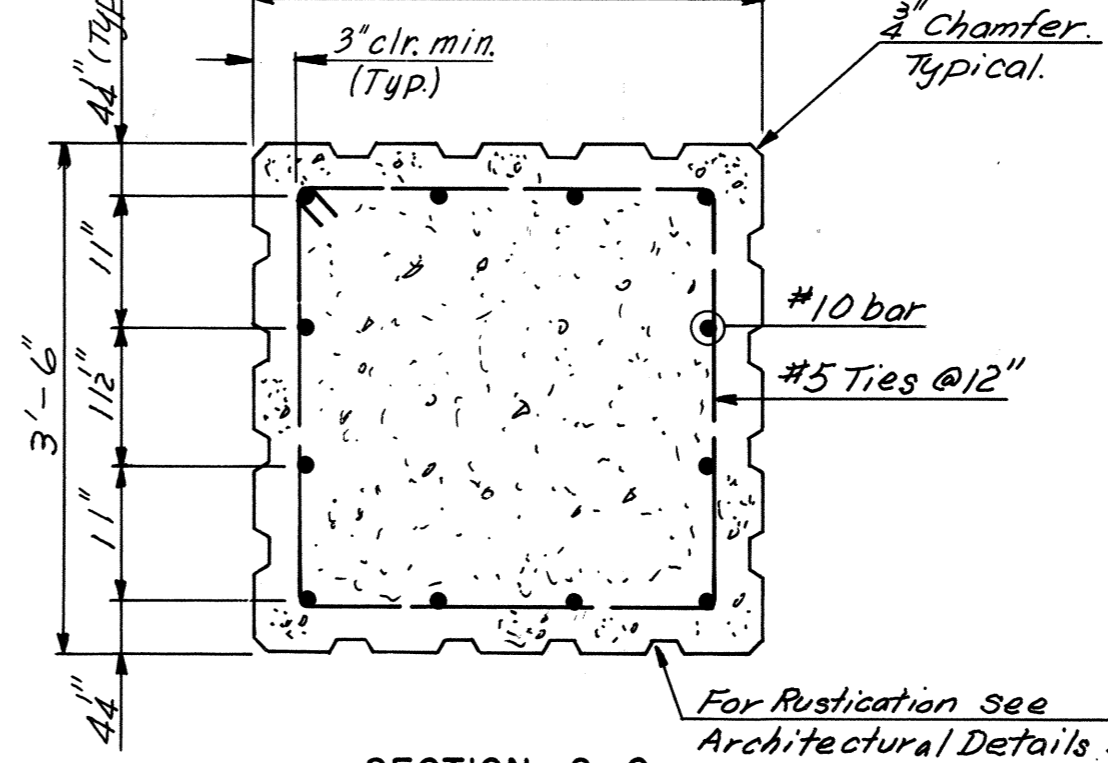

SECTION C-C Scale 3/4" = 1'-0"

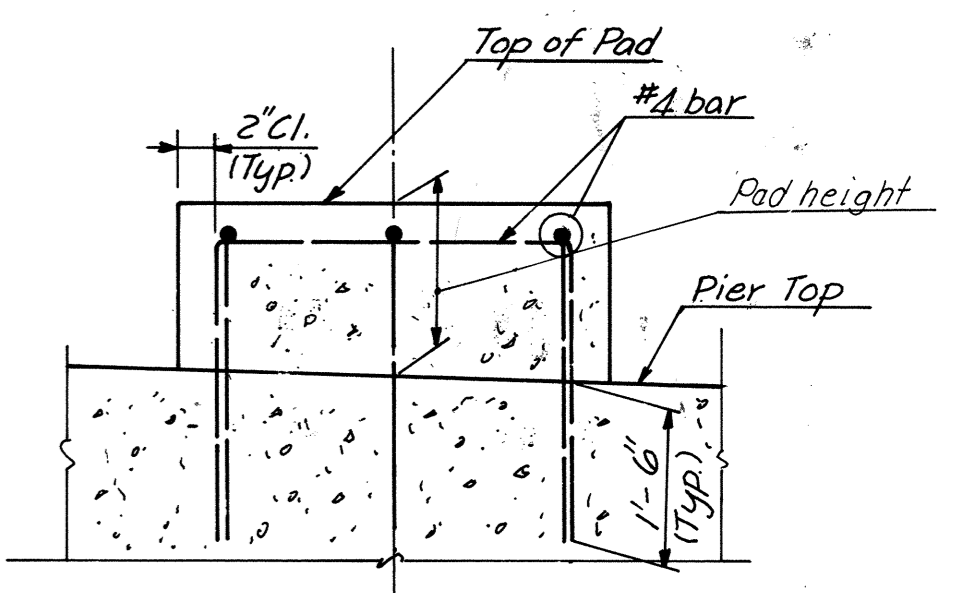

SECTION D-D No Scale

Note: No reinforcing steel required for pad height less than 4".

BY	DATE				
MADE	G.C.C.	11-3-67	2	As Built	R.H. 2-5-73
CHECKED	AMH	3-7-68	1	General Revision	RLM 5-15-68
IN CHARGE	FKD				
NO.	REVISION	BY	DATE		







RICHMOND METROPOLITAN AUTHORITY
RICHMOND EXPRESSWAY SYSTEM
 BELTLINE EXPRESSWAY

BRIDGE NO. 17
RAMP S-CARY OVER
EAST-NORTH ROADWAY
PIER 1

HOWARD, NEEDLES, TAMMEN & BERGENDOFF
 consulting engineers
 NEW YORK ALEXANDRIA KANSAS CITY

SCALE: As noted
 CONTRACT NO.: 4
 SHEET NO. 6 OF 14

AS BUILT

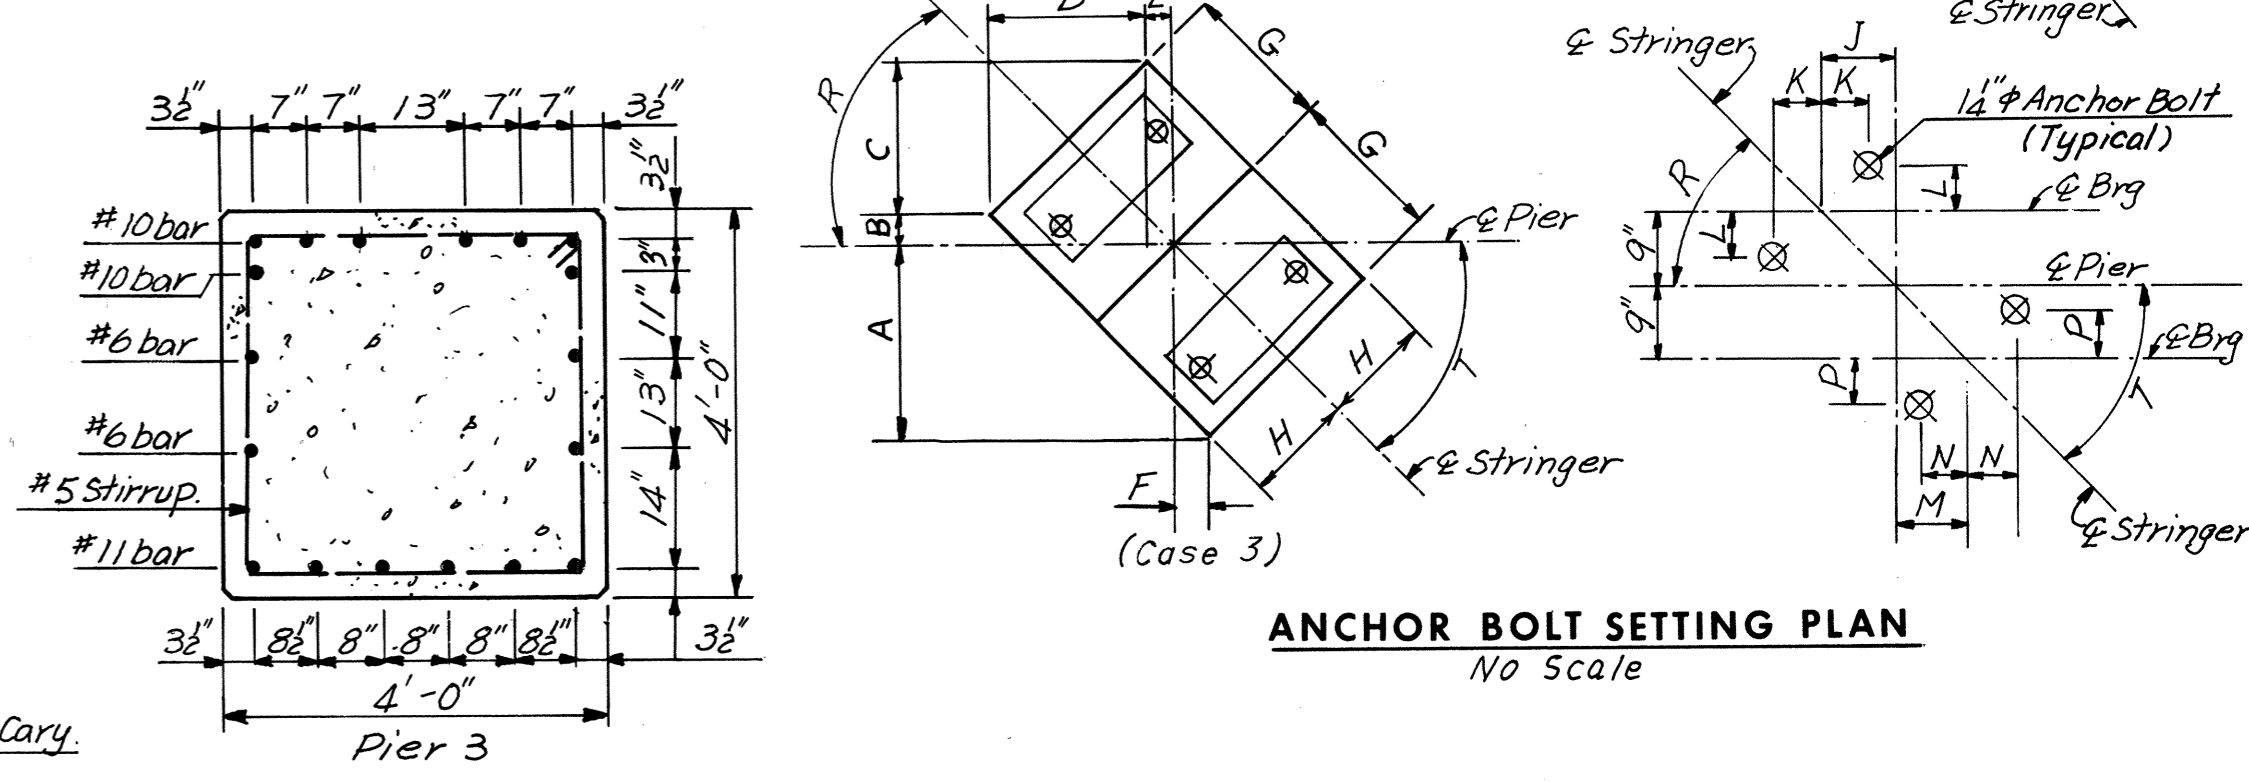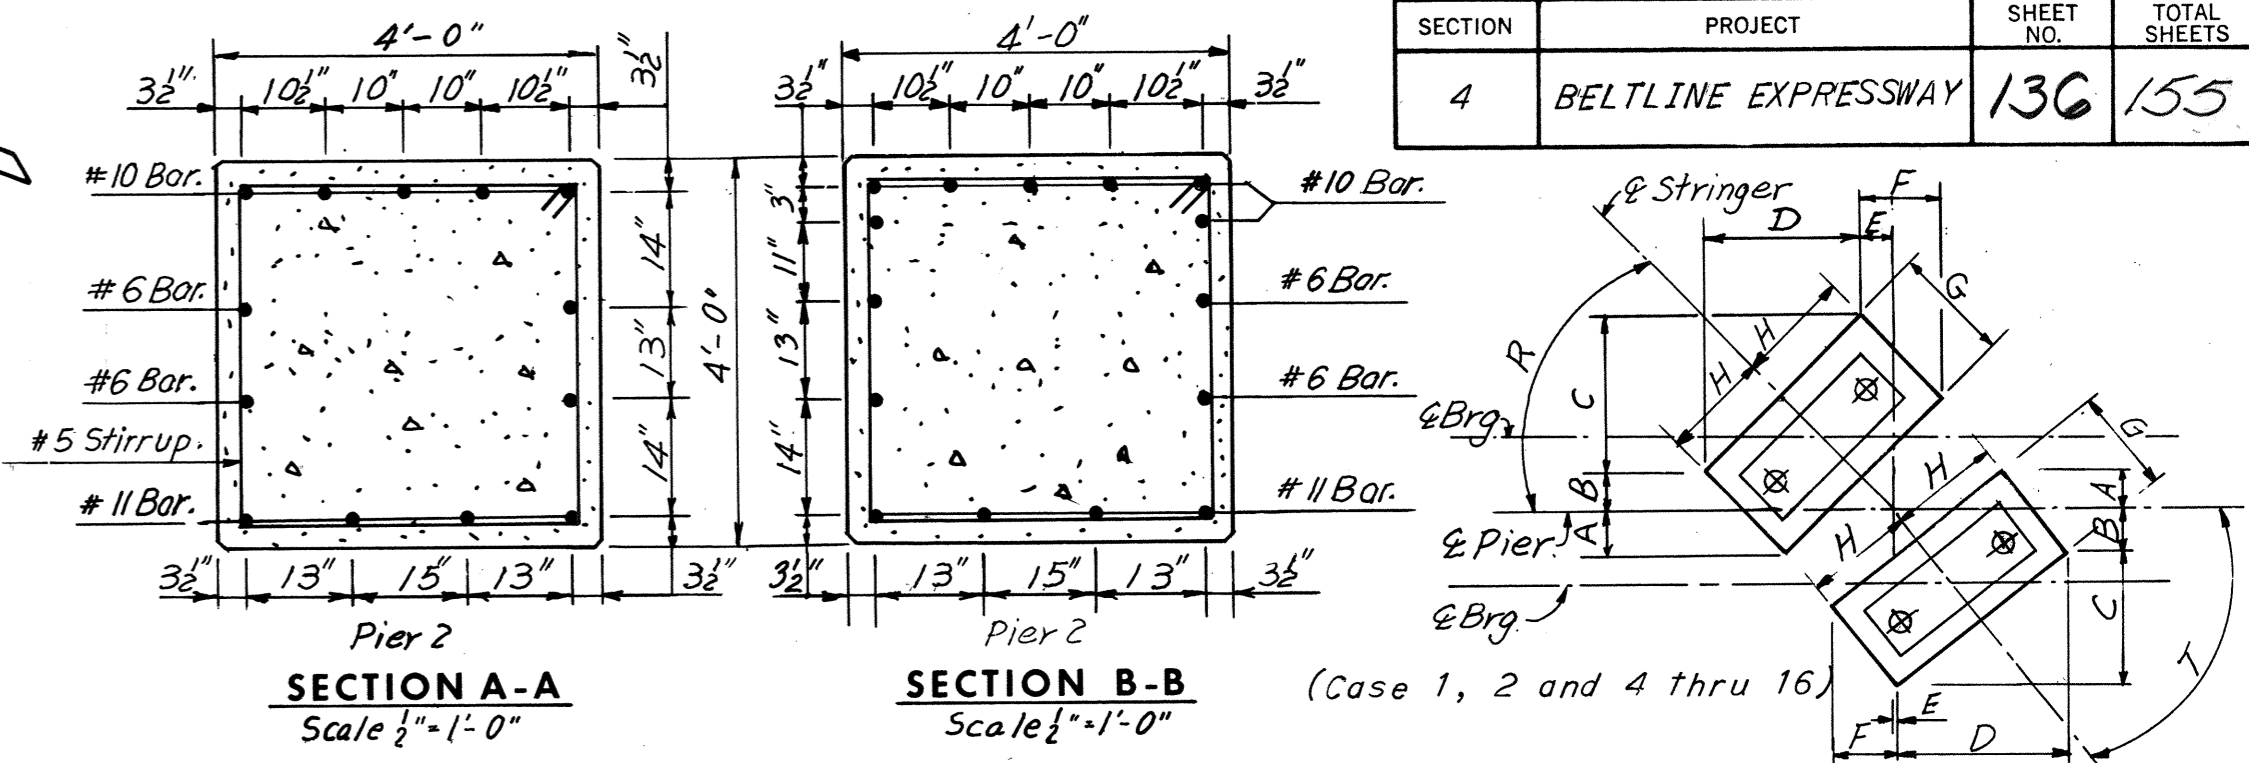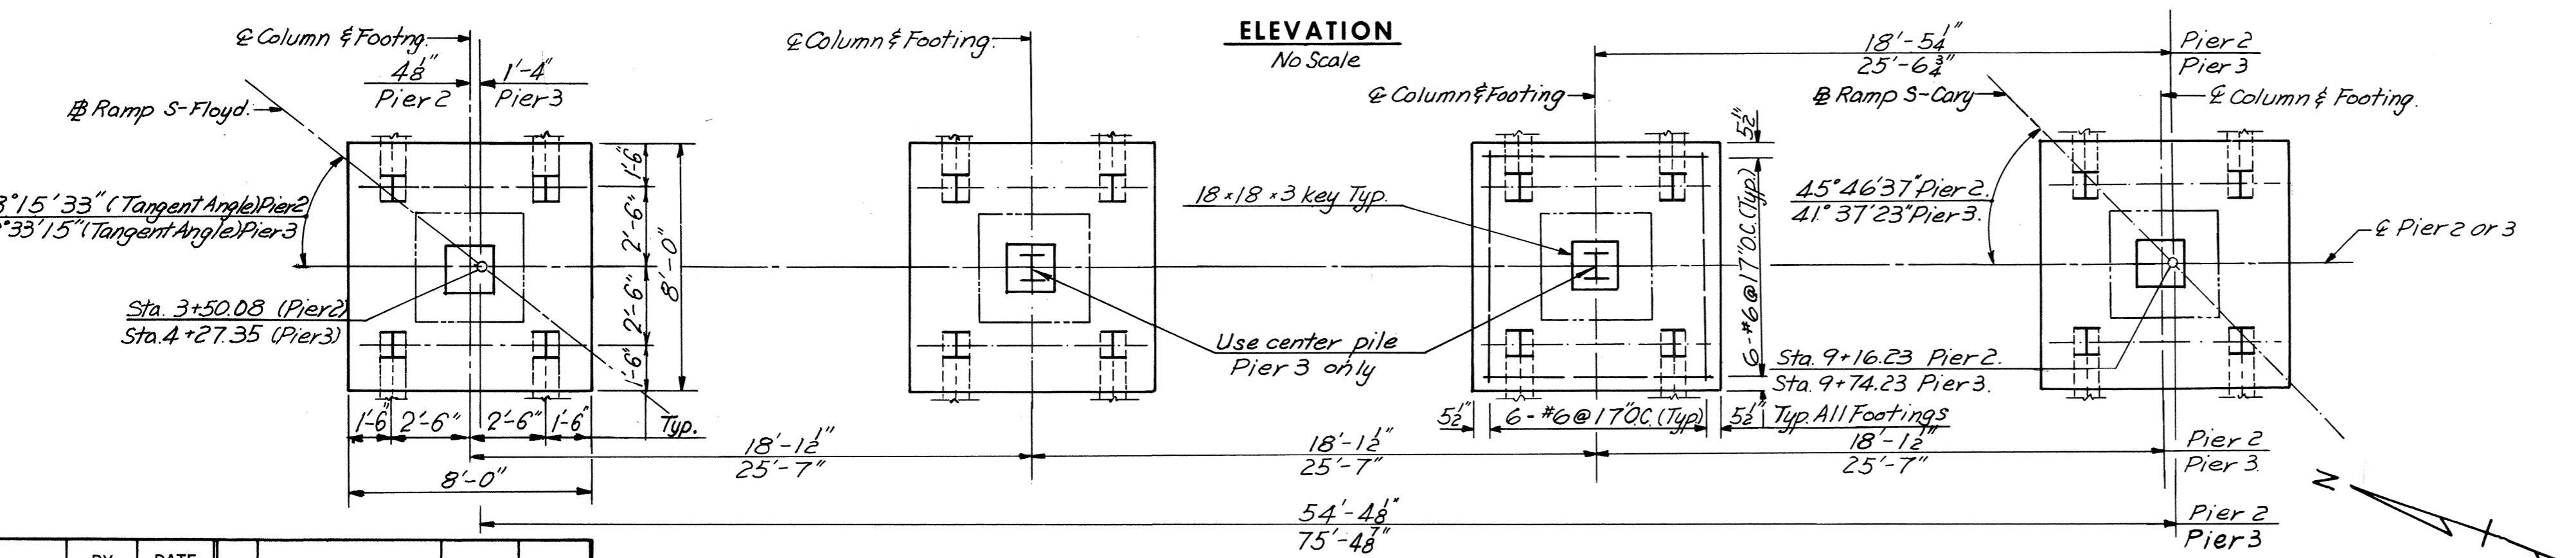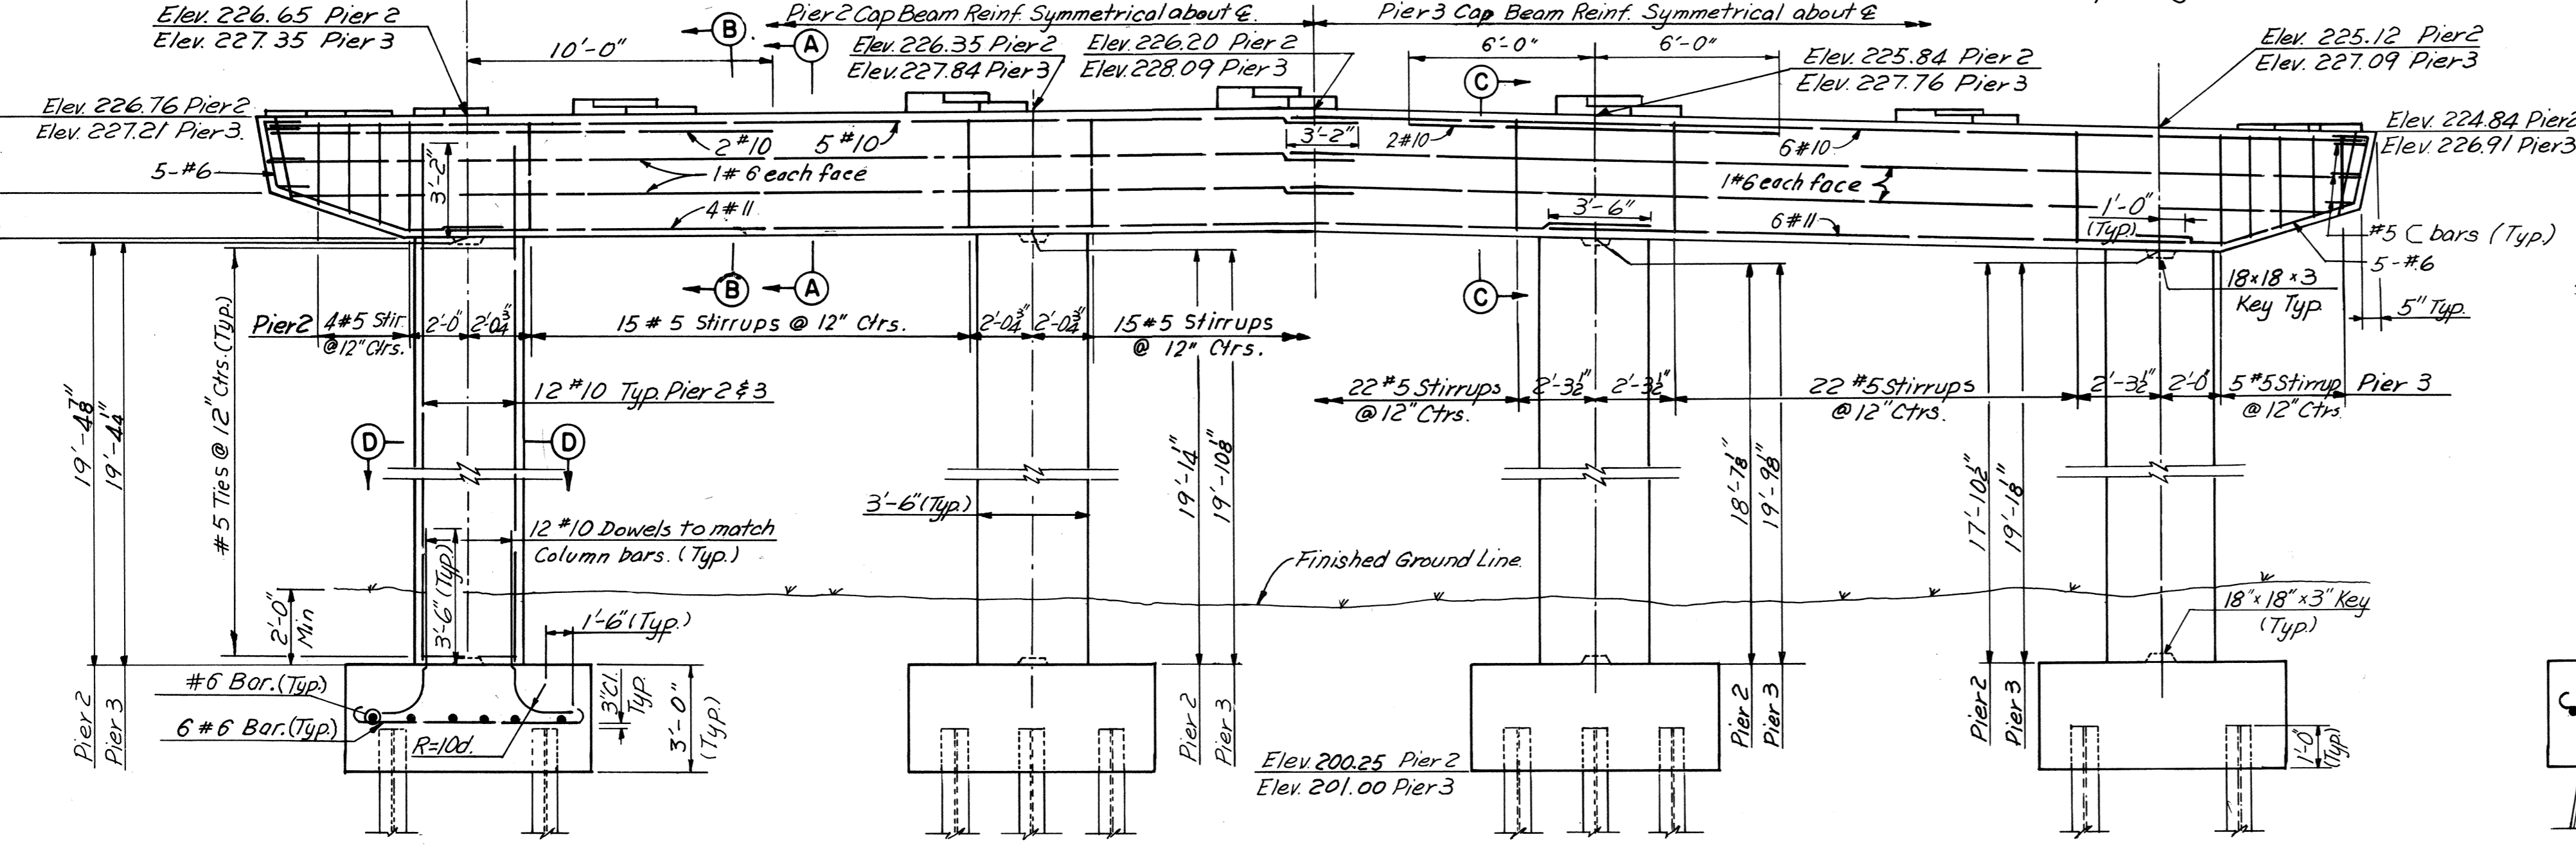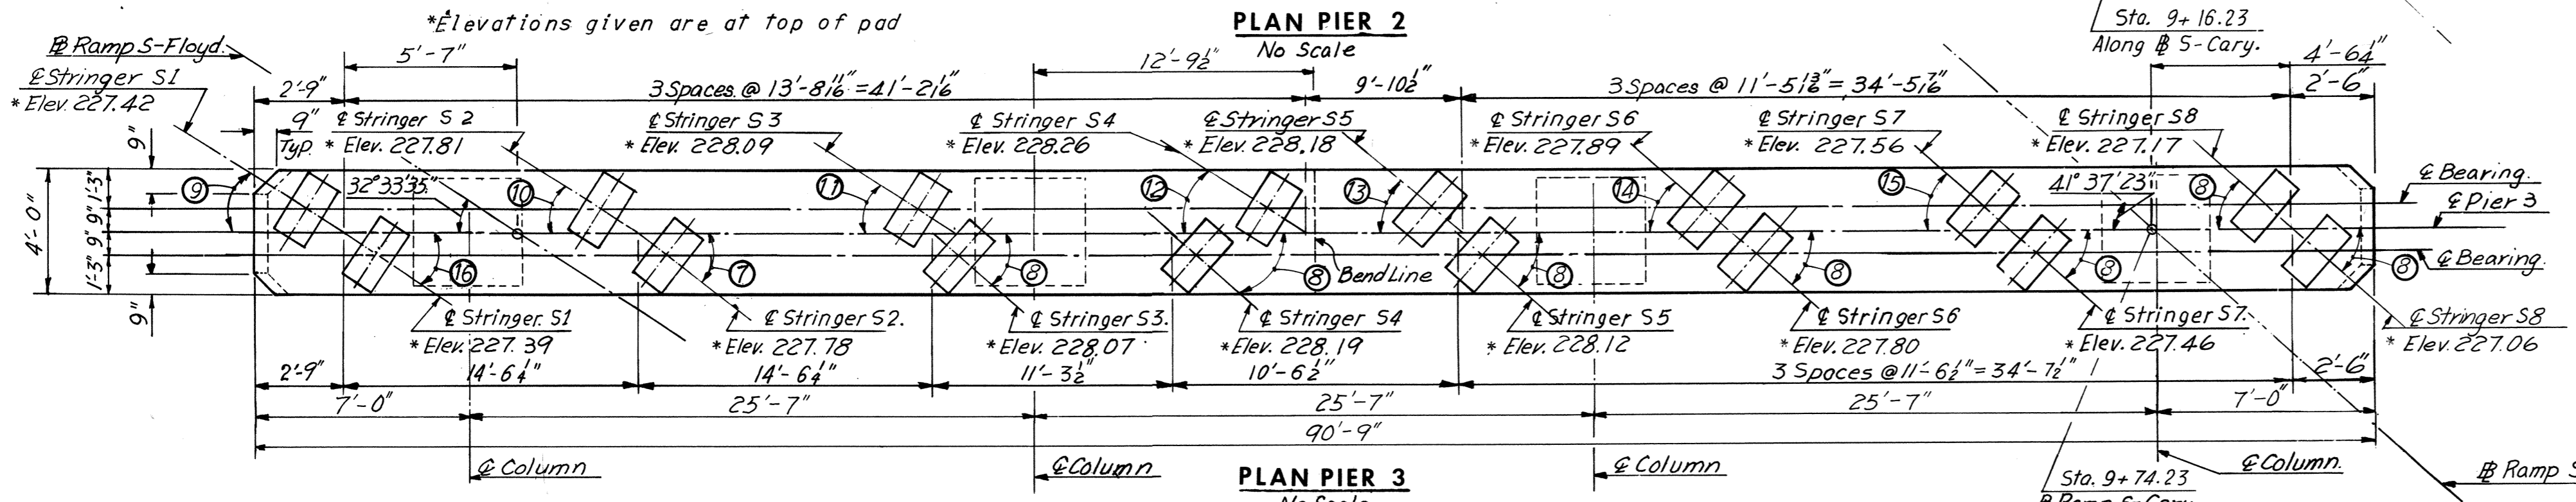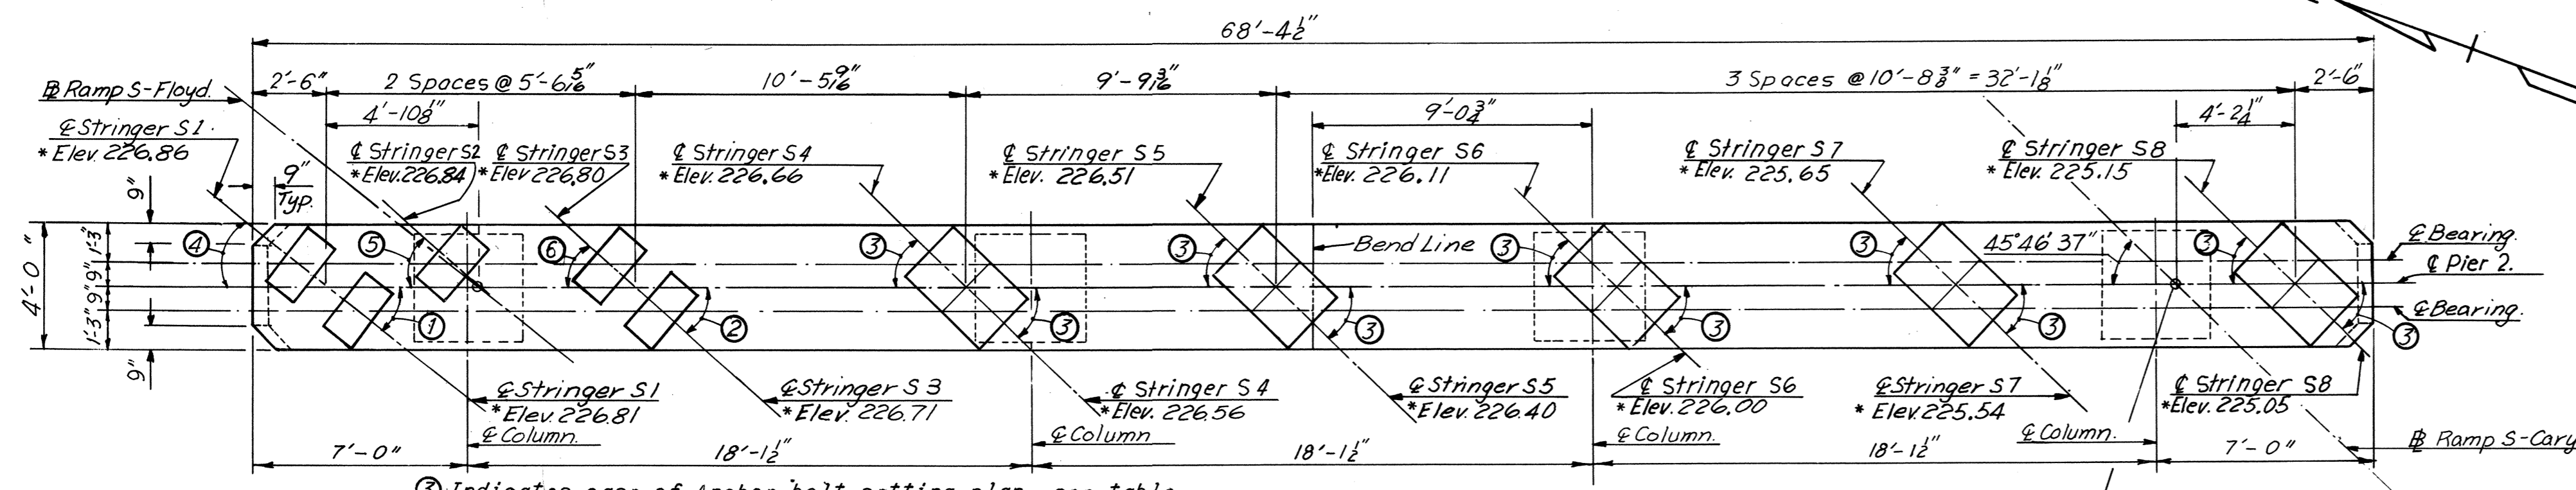


ANCHOR BOLT SETTING PLAN DIMENSIONS																
Case	Angle R	Angle T	A	B	C	D	E	F	G	H	J	K	L	M	N	P
1	-	38°57'45"	5 1/2	2 1/2	21	17	7 1/2	10 1/2	13 1/2	13 1/2	-	-	-	11 1/2	5	6 1/2
2	-	42°16'39"	5 1/2	3 3/8	20	18 1/2	5 1/2	10	13 1/2	13 1/2	-	-	-	9 1/2	5 1/2	5 1/2
3	45°46'37"	45°46'37"	2 1/2	4 1/8	18 1/2	19 1/2	3 1/2	3 1/2	19 1/2	13 1/2	8 1/2	5 1/2	5 1/2	8 1/2	5 1/2	5 1/2
4	37°24'05"	-	5 1/2	2 1/2	21 1/2	16 1/2	8 1/2	10 1/2	13 1/2	13 1/2	11 1/2	4 1/2	6 1/2	-	-	-
5	41°08'52"	-	5 1/2	3 1/2	20 1/2	17 1/2	6 1/2	10 1/2	13 1/2	13 1/2	10 1/2	5 1/2	6 1/2	-	-	-
6	45°46'37"	-	5 1/2	4 1/8	18 1/2	19 1/2	3 1/2	9 1/2	13 1/2	13 1/2	8 1/2	5 1/2	5 1/2	-	-	-
7	-	36°59'38"	5 1/2	2 1/2	21 1/2	16	9 1/2	11 1/2	14	13 1/2	-	-	-	11 1/2	4 1/2	6 1/2
8	41°37'23"	41°37'23"	5 1/2	3 1/2	20 1/2	17 1/2	6 1/2	10 1/2	14	13 1/2	10 1/2	5 1/2	6 1/2	10 1/2	5 1/2	5 1/2
9	30°54'54"	-	6	0 1/2	23 1/2	13 1/2	11 1/2	13 1/2	13 1/2	15	4 1/2	6 1/2	-	-	-	-
10	30°37'47"	-	6	0 1/2	23 1/2	13 1/2	14 1/2	11 1/2	13 1/2	13 1/2	15	4 1/2	6 1/2	-	-	-
11	30°20'58"	-	6	0 1/2	23 1/2	13 1/2	14 1/2	11 1/2	13 1/2	13 1/2	15 1/2	4 1/2	6 1/2	-	-	-
12	30°04'26"	-	6 1/2	0 1/2	23 1/2	13 1/2	14 1/2	11 1/2	13 1/2	13 1/2	15 1/2	4 1/2	6 1/2	-	-	-
13	42°09'102"	-	5 1/2	3 1/2	20	18 1/2	5 1/2	10	13 1/2	13 1/2	9 1/2	5 1/2	5 1/2	-	-	-
14	42°37'53"	-	5 1/2	3 1/2	19 1/2	18 1/2	5 1/2	9 1/2	13 1/2	13 1/2	9 1/2	5 1/2	5 1/2	-	-	-
15	42°07'21"	-	5 1/2	3 1/2	20	18 1/2	5 1/2	10	13 1/2	13 1/2	9 1/2	5 1/2	5 1/2	-	-	-
16	-	33°14'51"	5 1/2	1 1/2	22 1/2	14 1/2	12 1/2	11 1/2	14	13 1/2	-	-	-	13 1/2	4 1/2	6 1/2

(Dimensions are in inches)

Note: Footing elevations are approximate only and may be varied to suit field conditions as directed by the Engineer. Vertical shaft reinforcing shall not be cut until these elevations are established. Where elevations change more than 2 ft. redesign will be required.

AS BUILT

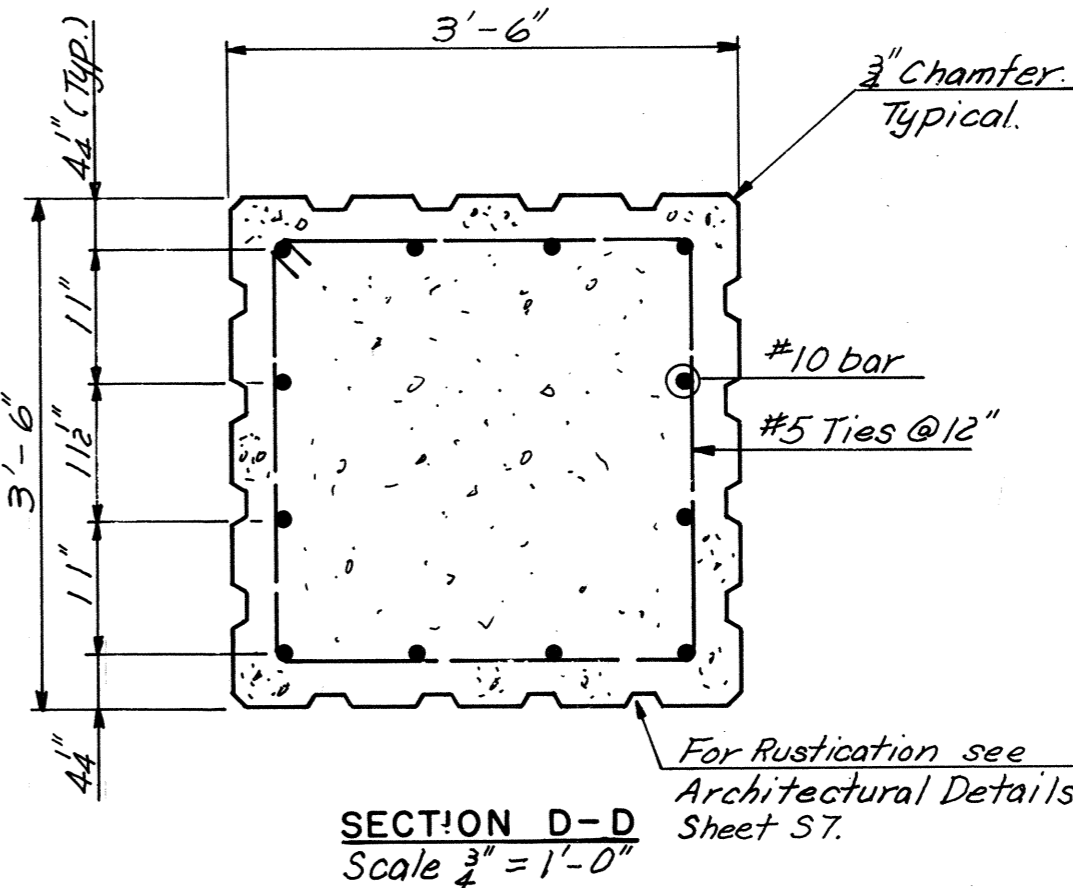

Note: All piles shall be 10BP42 Steel Piles (Design capacity = 45 tons).
Batter all piles 2" per foot where shown.
For Standard shoe details see Sheet S1.
For Framing Plan see Sheet 8.

RICHMOND METROPOLITAN AUTHORITY
RICHMOND EXPRESSWAY SYSTEM
BELTLINE EXPRESSWAY
BRIDGE NO. 17
RAMP S-CARY OVER
EAST-NORTH ROADWAY
PIERS 2 AND 3


BY	DATE				
MADE	M.A.A. G.C.C.	11-1-67			
CHECKED	AMH	3-7-68	1	As Built	R.H. 2-5-78
IN CHARGE	FKD				
NO.	REVISION	BY	DATE		

Bridge 36

(Maplewood Avenue over DTE Connector)

Record Set Plans

RICHMOND EXPRESSWAY SYSTEM			
SECTION	PROJECT	SHEET NO.	TOTAL SHEETS
7	DOWNTOWN EXPRESSWAY	96	

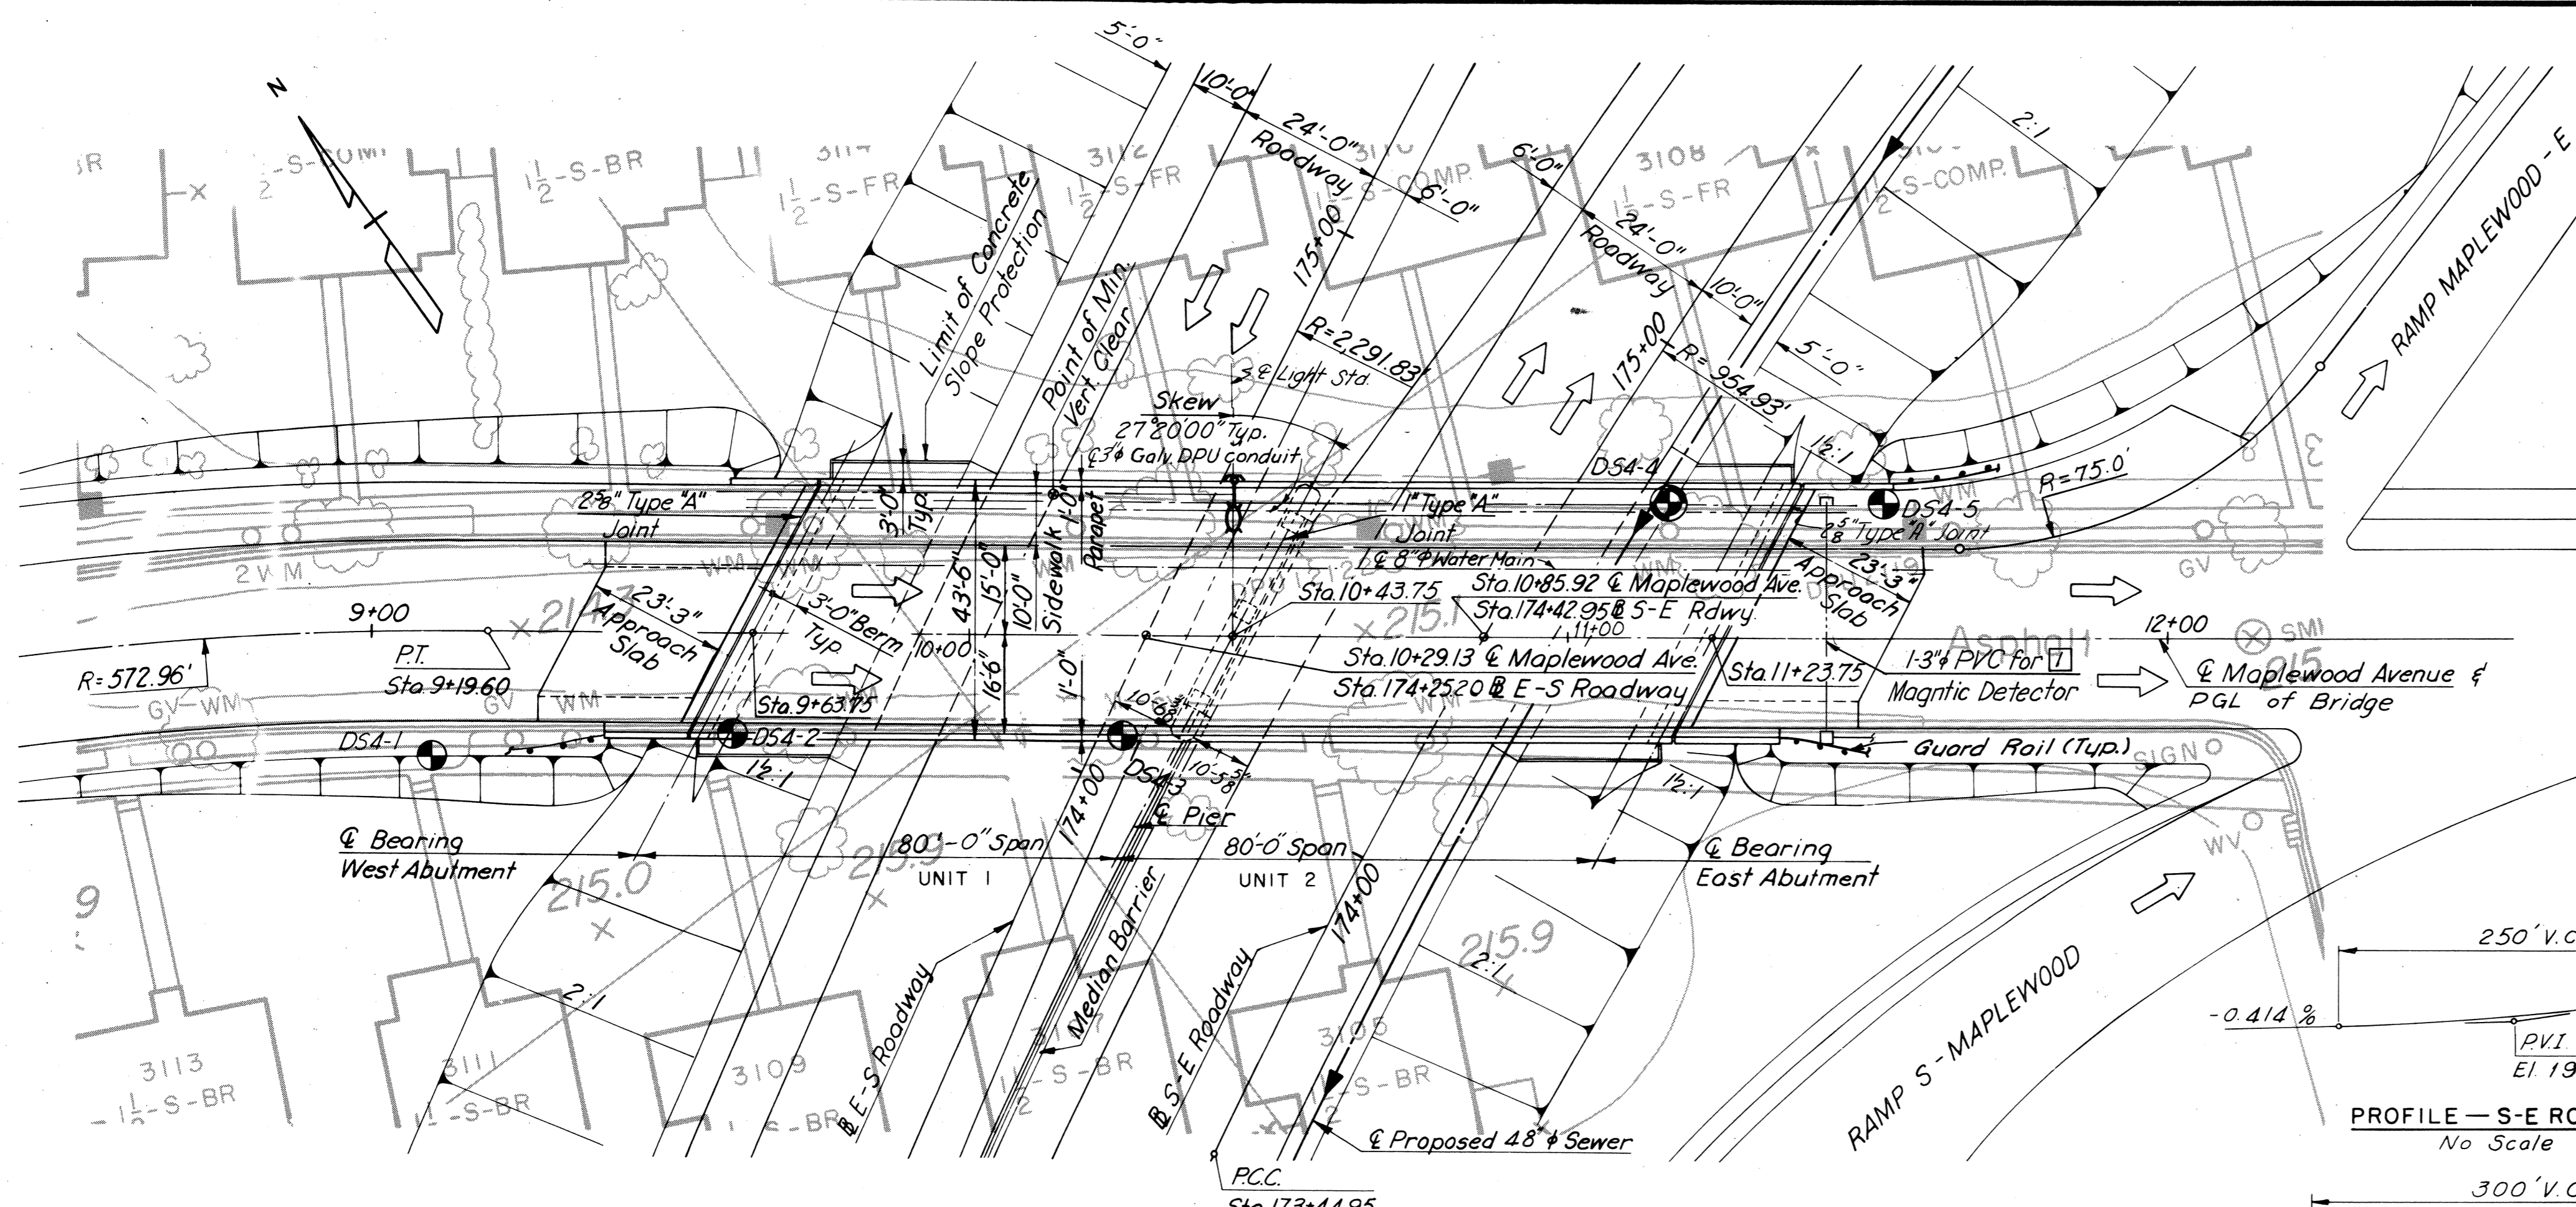

GENERAL NOTES

ROADWAY: 36'-1" Face of rail to edge of sidewalk.

CAPACITY: Dead Load-Includes 15 lbs. per sq. ft. for future wearing surface. Live Loads-HS20-44 loading and B.P.R. modified for military vehicles.

SPECIFICATIONS: GENERAL-Virginia Department of Highway Road and Bridge Specifications, 1970. DESIGN-A.A.S.H.O. Standard Specifications for Highway Bridges, 1969 and 1970-72 Interim Specifications, modified by Special Design Provisions. WELDING: 1972 Structural Welding Code of the American Welding Society.

CONTRACT SPECIAL PROVISIONS
Specifications and Contract Special Provisions referred to above are necessary to make these plans complete.

DATUM: CITY OF RICHMOND

TEMPERATURE: The normal temperature referred to on the plan is 60° F. The temperature range for movement is 0° F. to 120° F.

DIMENSIONS: All dimensions are measured horizontally and vertically unless otherwise noted.

EXCAVATION: Excavation below subgrade and cut slope template shall be classified as Structure Excavation. All excavation above these limits shall be classified as Regular Excavation and is not included in the Structural Quantities.


FOUNDATIONS: Footings shall rest on firm material. Found. mat'l. shall be kept dry & special attn. is called to Sec. 401.05 of the Gen. Specs. & to the Contract Special Prov. concerning preparation of found. for ftgs.

CONCRETE NOTES: Concrete in superstructure shall be Class A4. All other concrete shall be Class A3. All exposed edges and corners shall have a 3/8" chamfer or fillet unless otherwise noted. Care in the method of vibration, the use of low-slump concrete, and/or other means shall be employed to prevent downgrade movement of newly placed slab concrete. (When gradient is over 2%).

Finishing concrete surfaces: See the Standard Architectural Detail Sheets and the Contract Special Provisions for types and details.

STEEL NOTES: Structural steel shall conform to A.S.T.M. Specification A36 except as noted.

BENCH MARK: C-11. Copper Weld Rod, South side of Maplewood Ave. of Belmont Ave. Elev. 215.37.

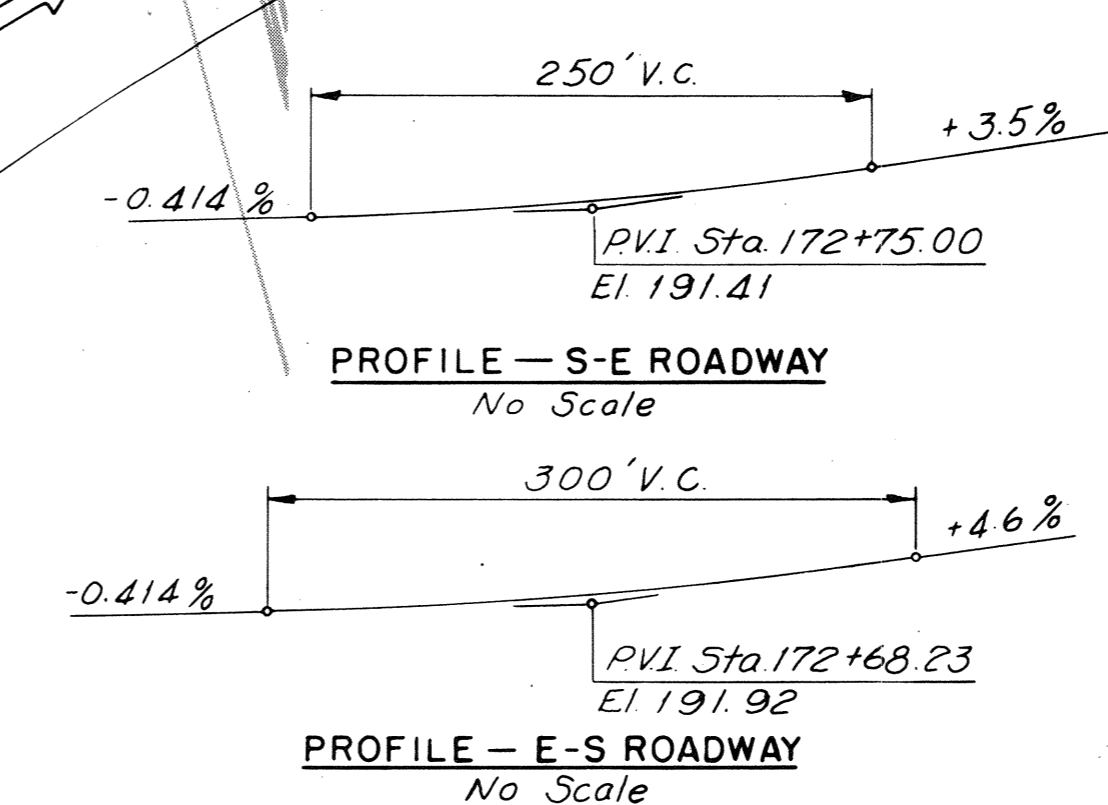

INDEX	
NO.	DESCRIPTION
1	GENERAL PLAN AND ELEVATION
2	WEST ABUTMENT
3	EAST ABUTMENT
4	ABUTMENT DETAILS
5	PIER
6	FRAMING PLAN
7	DECK PLAN AND CROSS SECTION
8	JOINT DETAILS
9	APPROACH SLAB & SLOPE PROTECTION DETAILS
10	BORING LOGS
S1	STANDARD SHOE DETAILS
S3	STANDARD ALUMINUM RAILING DETAILS (2 RAILS)
S4	STANDARD ELECTRICAL DETAILS
S7 TO S9	STANDARD ARCHITECTURAL DETAILS
S11	STANDARD GAS AND WATER MAIN SUPPORT DETAILS
S13	LIMITS OF EXCAVATION AND BACKFILL

Note:
The cost of furnishing and installing 2" φ and 3" φ galvanized steel conduit shall be included in the bid price for the item "Metal Conduit."

	STRUCTURE EXCAVATION	CONCRETE			STRUCTURAL STEEL	ALUMINUM BR. RAILING (2 RAIL) L.F.	POROUS BACKFILL	REINFORCING STEEL	STEEL PILES IOBP 42	CONC. SLAB SLOPE PROT.	ASPHALT DAMPROOFING	UNDERDRAIN 6" PIPE	WATER MAIN 8" φ	METAL CONDUIT	3" φ PVC CONDUIT
		CLASS A4 C.Y.	CLASS A3 C.Y.	CLASS A3 APPR. SLABS C.Y.											
SUPERSTRUCTURE		276.2			270,749	32.7		53,067							
WEST ABUTMENT	218.6		143.0			23	12.3	7,081	864.2	150.2	57	57		213	1,176
EAST ABUTMENT	454.0		215.0			31.4	43	13,320	1,291.4	133.1	107	60			
PIER	131.4		82.7					12,264	480.2						
APPROACH SLABS				86				22,420							
TOTAL	804.0	276.2	440.7	86	270,749	381.4	55.3	108,152	2,635.8	283.3	164	117	213	1,176	34

MADE	BY	DATE	REVISION	BY	DATE
LCC	TCY	1-3-68	2	As Built	9-75
TCY	AGC	3-12-68	1	Add PVC Cond.	1-31-74

AS BUILT



RICHMOND METROPOLITAN AUTHORITY
RICHMOND EXPRESSWAY SYSTEM
DOWNTOWN EXPRESSWAY

BRIDGE NO. 36
MAPLEWOOD AVENUE OVER
DOWNTOWN EXPRESSWAY
GENERAL PLAN AND ELEVATION


HOWARD, NEEDLES, TAMMEN & BERGENDOFF
consulting engineers
NEW YORK ALEXANDRIA KANSAS CITY

SCALE: 1"=20' UNLESS NOTED
CONTRACT NO. 7
SHEET NO. 1 OF 10



RICHMOND EXPRESSWAY SYSTEM			
SECTION	PROJECT	SHEET NO.	TOTAL SHEETS
7	DOWNTOWN EXPRESSWAY	102	

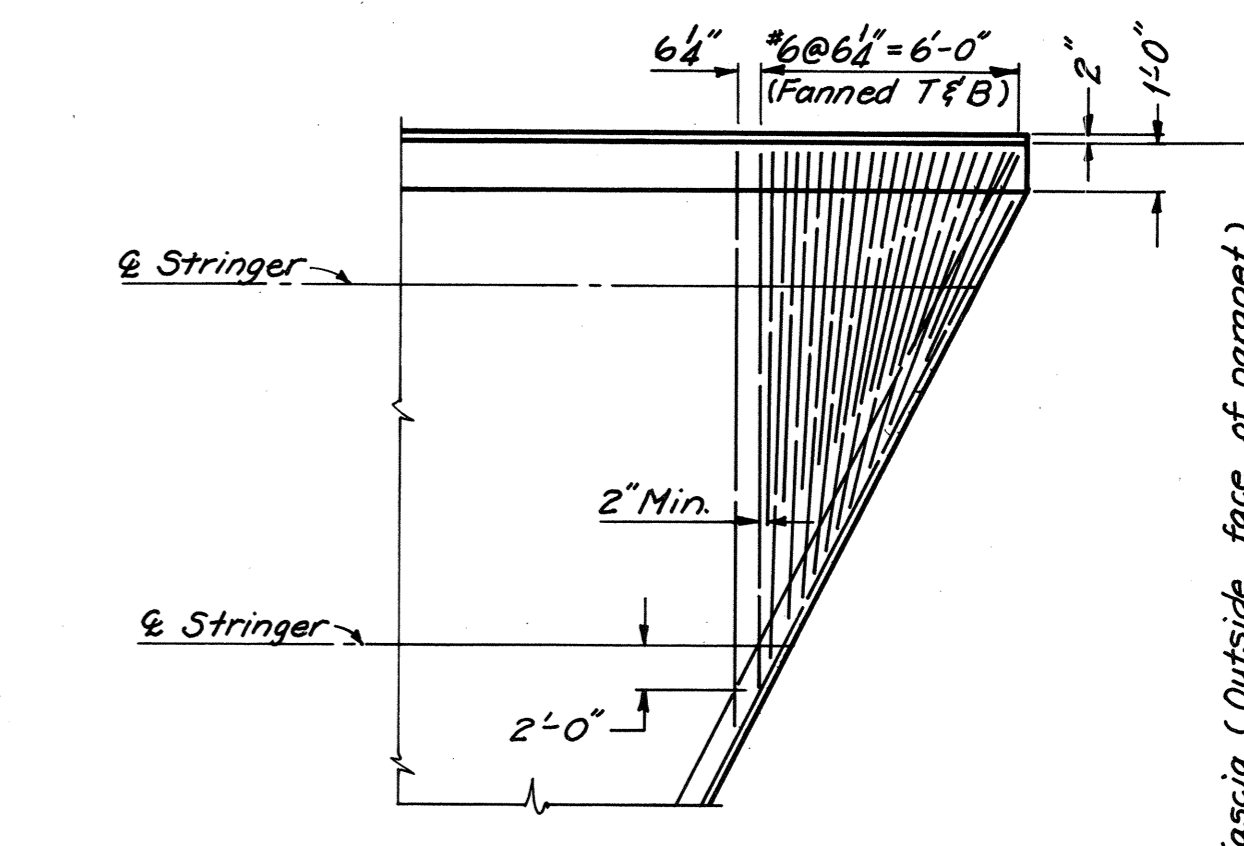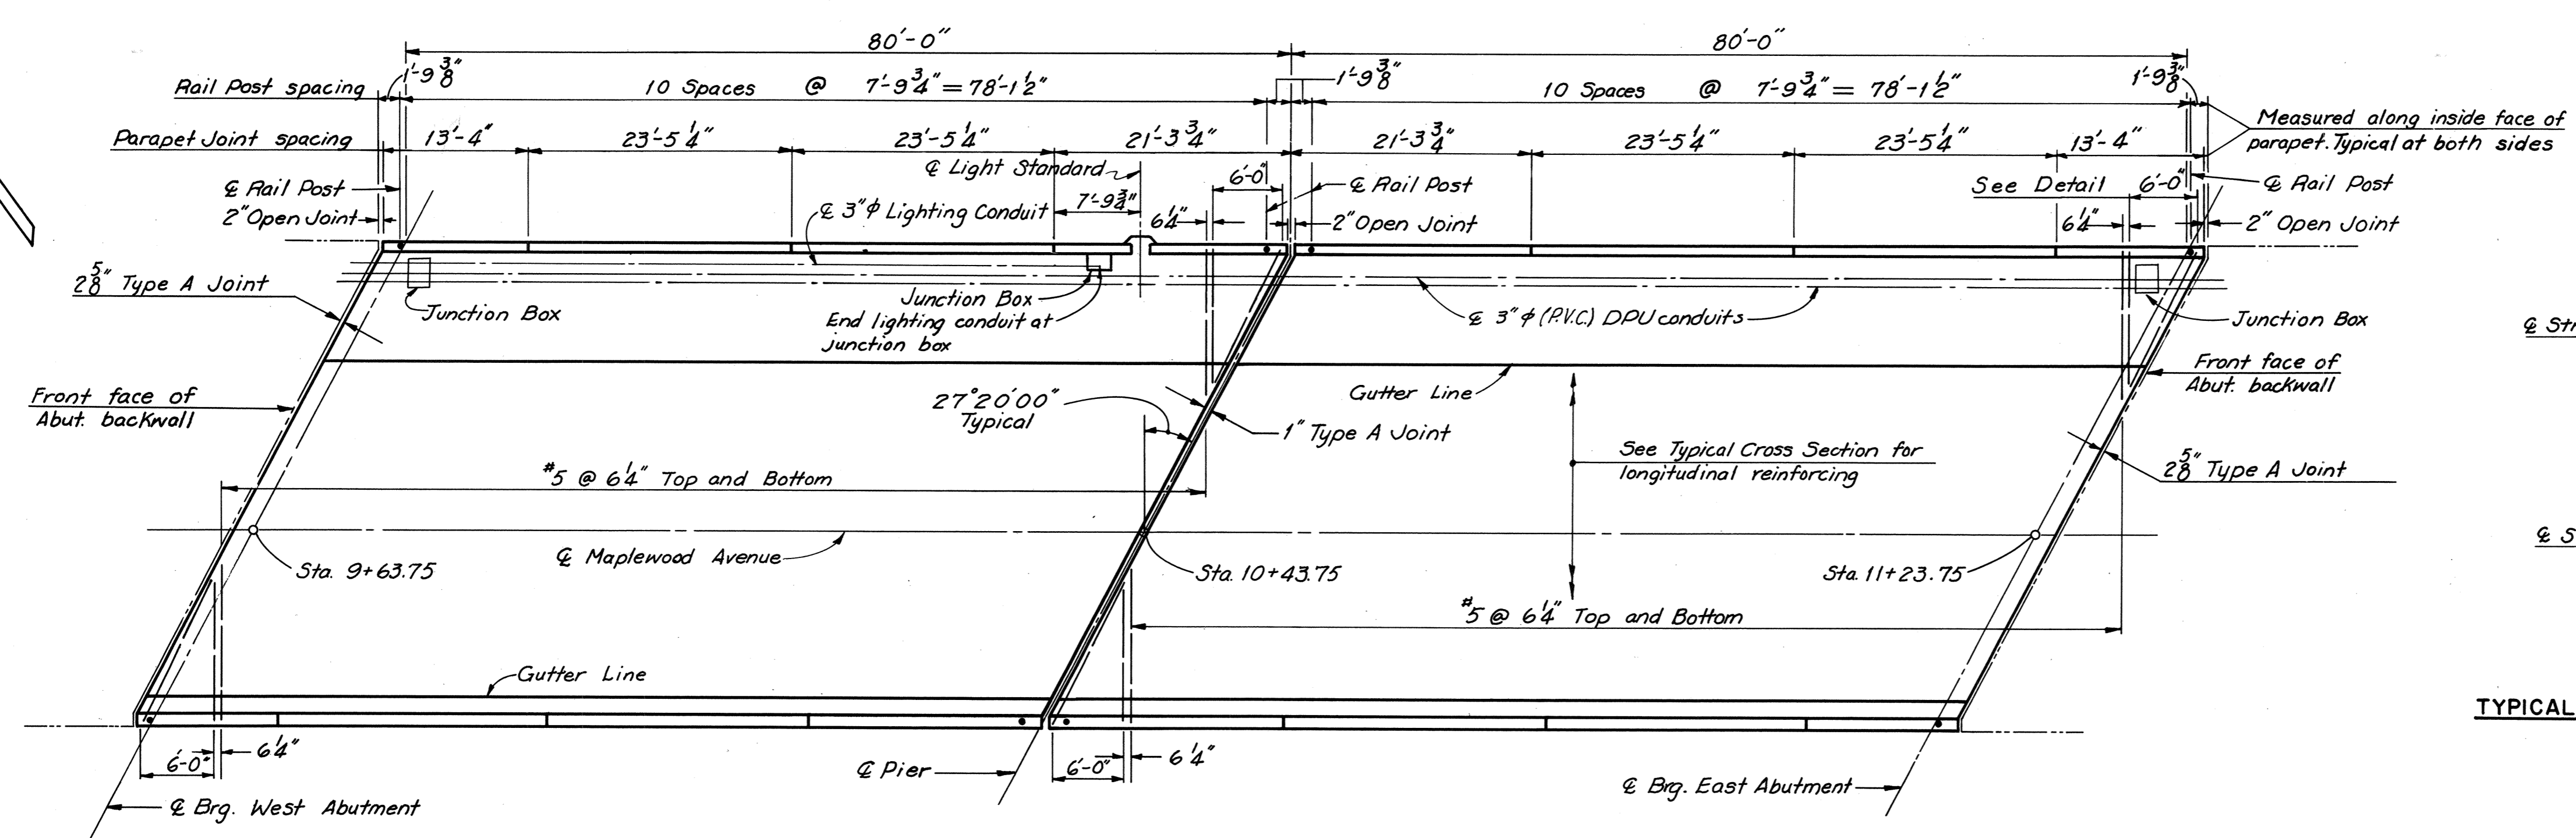

3 Junction Boxes
2 each 2'-0" x 1'-11"
1 each 2'-0" x 1'-1/2"

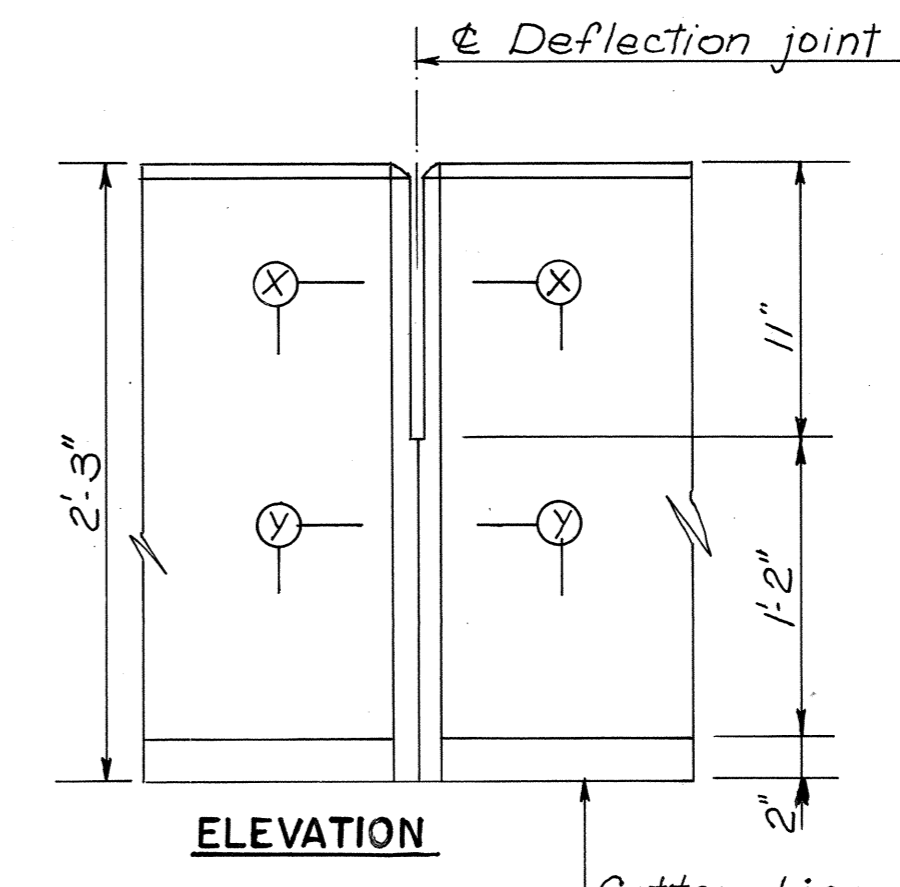

ROADWAY ELEVATIONS			
LOCATION	ELEV. A	ELEV. B	ELEV. C
Front Face W. Abut. BKwall	218.89	218.93	218.47
1/4 Point	219.32	219.41	219.00
1/2 Point	219.62	219.76	219.40
3/4 Point	219.80	219.98	219.67
Center Line Pier	219.86	220.08	219.82
1/4 Point	219.78	220.06	219.84
1/2 Point	219.59	219.91	219.74
3/4 Point	219.27	219.64	219.51
Front Face E. Abut. BKwall	218.82	219.24	219.16

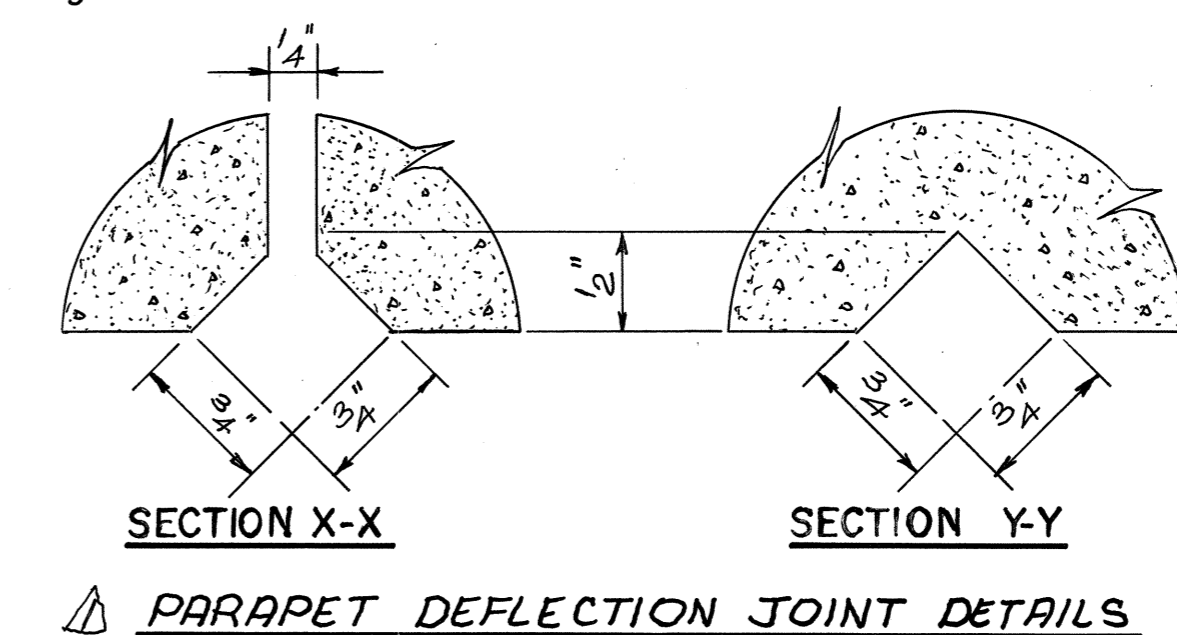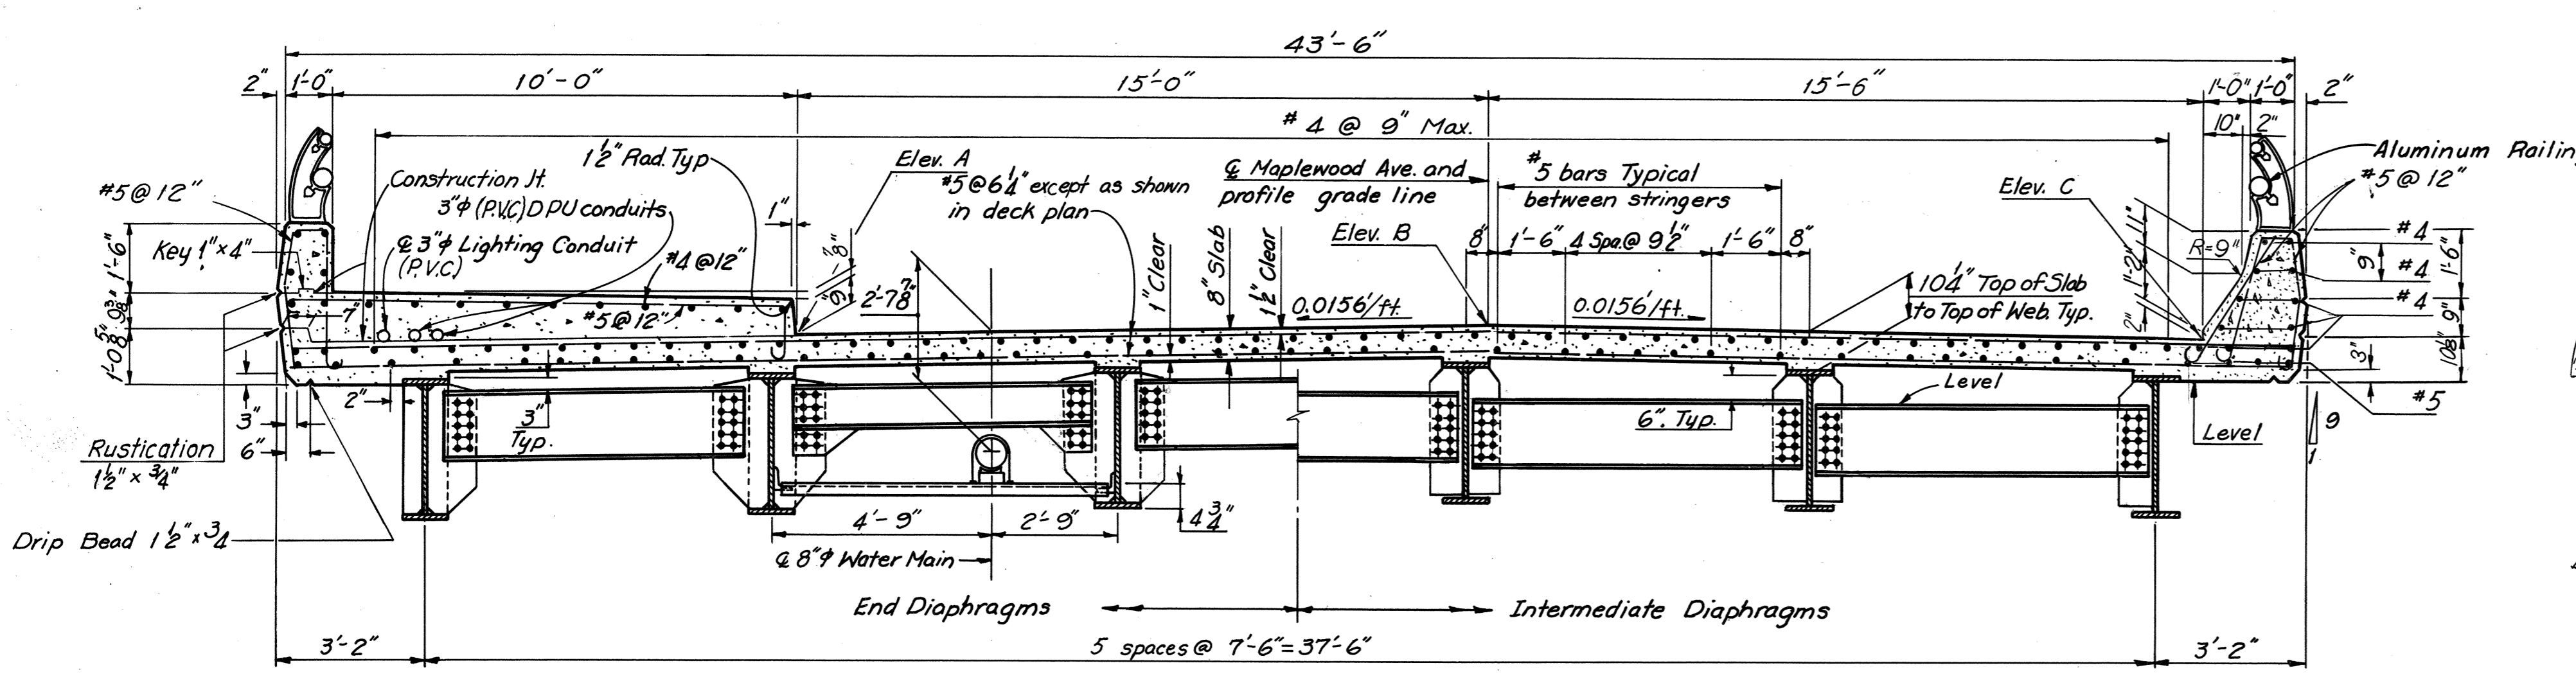

Notes:
Minimum splice length for #4 bar is 1'-3" and #5 bar is 1'-7"
For details of water main support, see Standard Gas and Water Main Support Details Sheet S11.
For Lighting details and DPU conduit details, see Standard Electrical Details (Bridge Carrying City Street) Sheet S4.

BY	DATE	REVISION	BY	DATE
MADE	LCC 11-14-67	2	As Built	TEM 9-75
CHECKED	Q.M. 2-9-68	1	PARAPET JOINT ADDED.	T.E.M. 7-74
IN CHARGE	R. G. C.			

RICHMOND METROPOLITAN AUTHORITY
RICHMOND EXPRESSWAY SYSTEM
DOWNTOWN EXPRESSWAY


BRIDGE NO. 36
MAPLEWOOD AVENUE OVER
DOWNTOWN EXPRESSWAY

DECK PLAN AND CROSS SECTION

HOWARD, NEEDLES, TAMMEN & BERGENDOFF
consulting engineers
NEW YORK ALEXANDRIA KANSAS CITY


SCALE: As Noted
CONTRACT NO.: 7
SHEET NO. 7 OF 10

AS BUILT

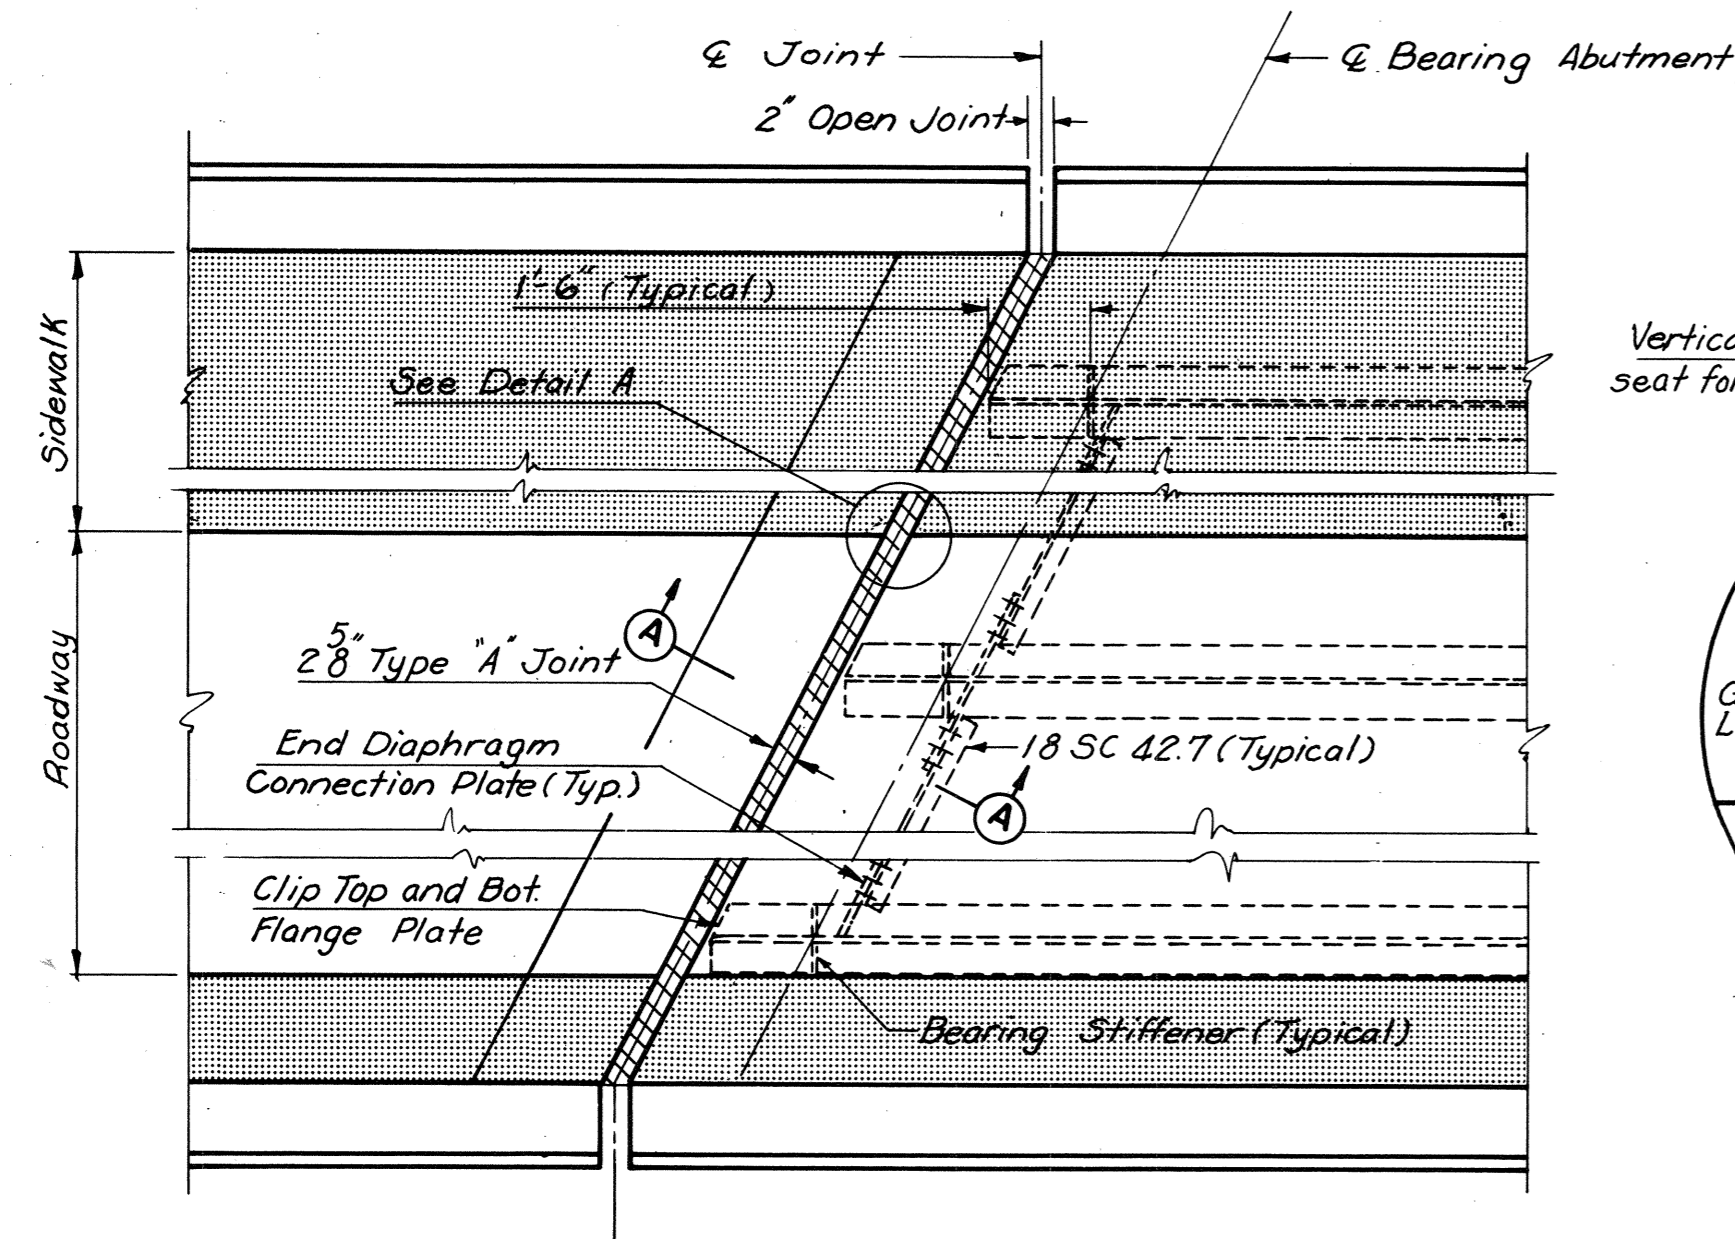


PLAN-JOINT AT WEST ABUTMENT
No Scale


Note: Joint at East Abutment is similar to the one at West Abutment.

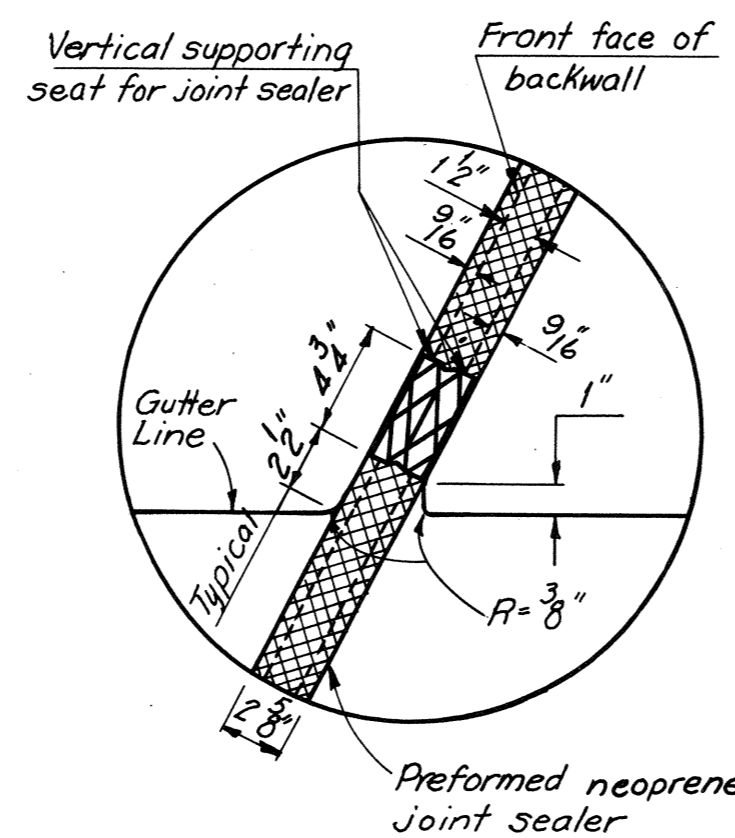


DETAIL "A"
No Scale

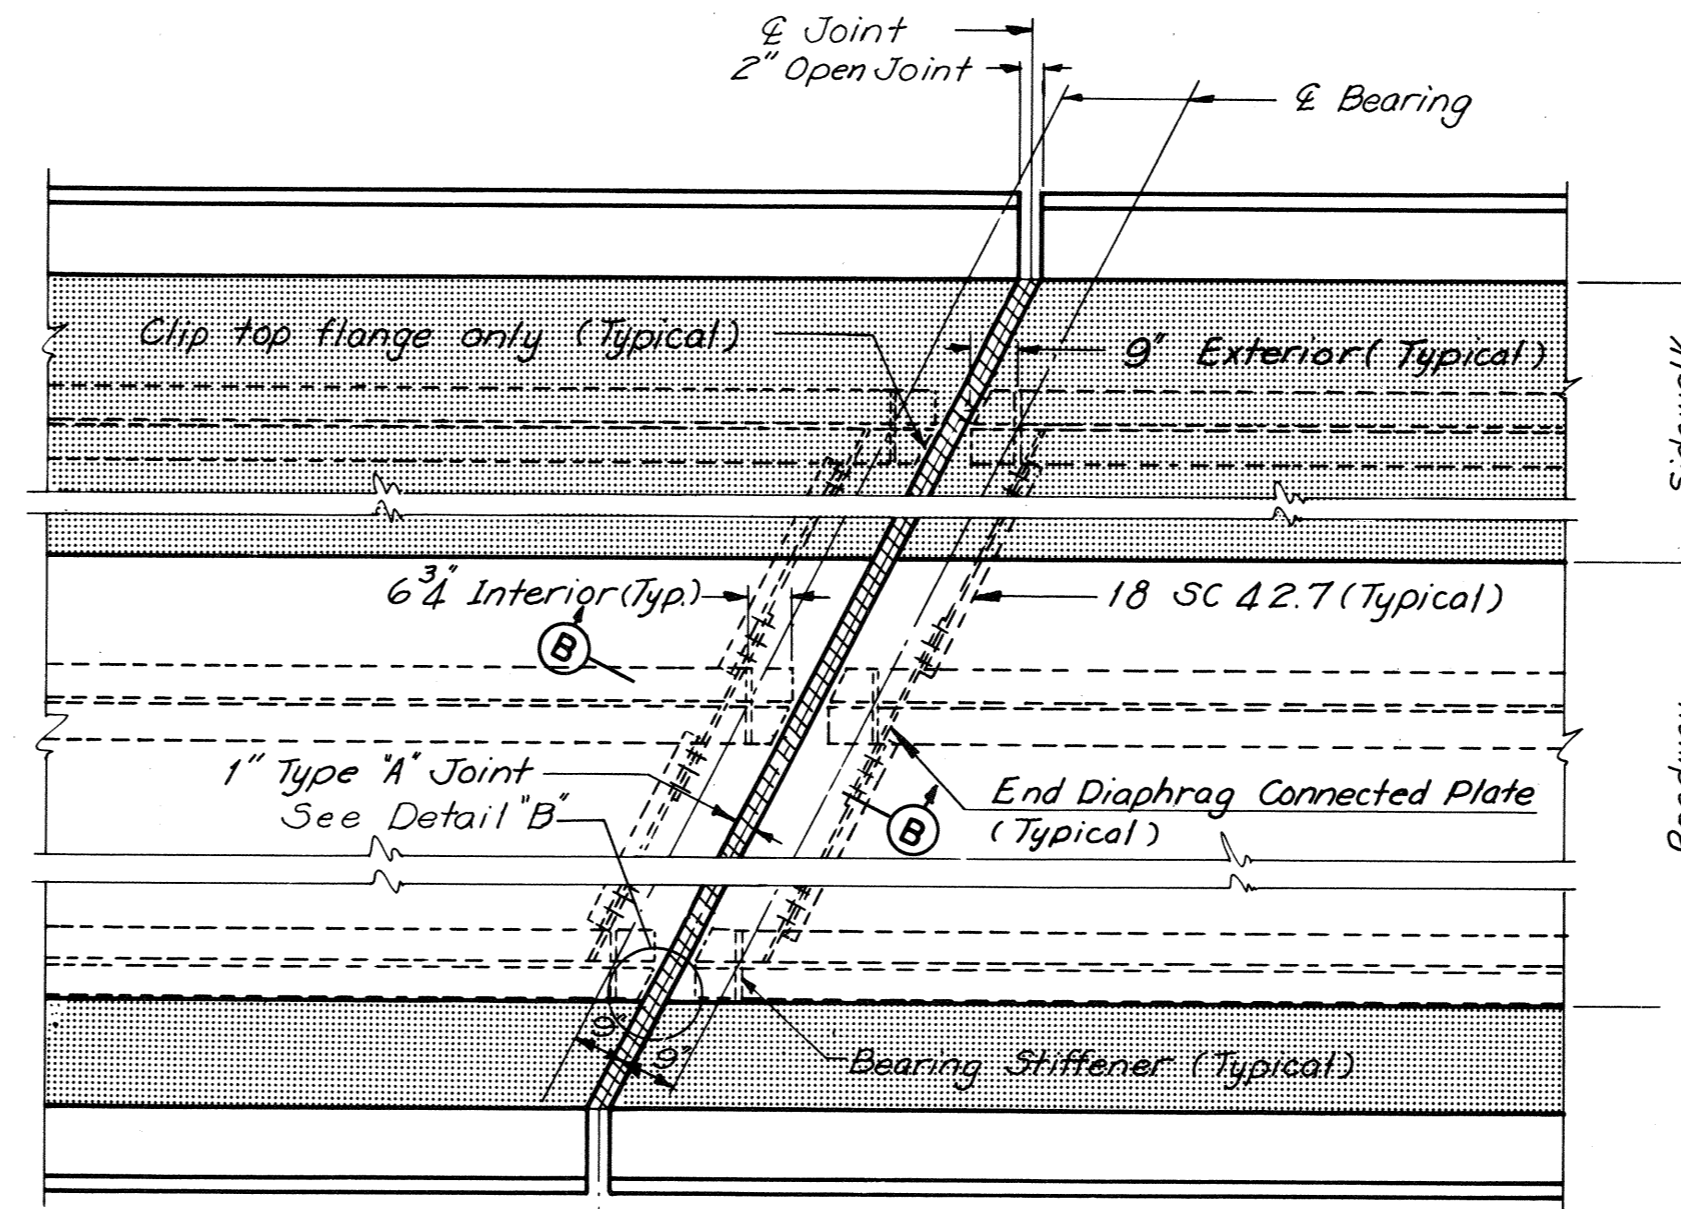


PLAN-JOINT AT PIER
No Scale

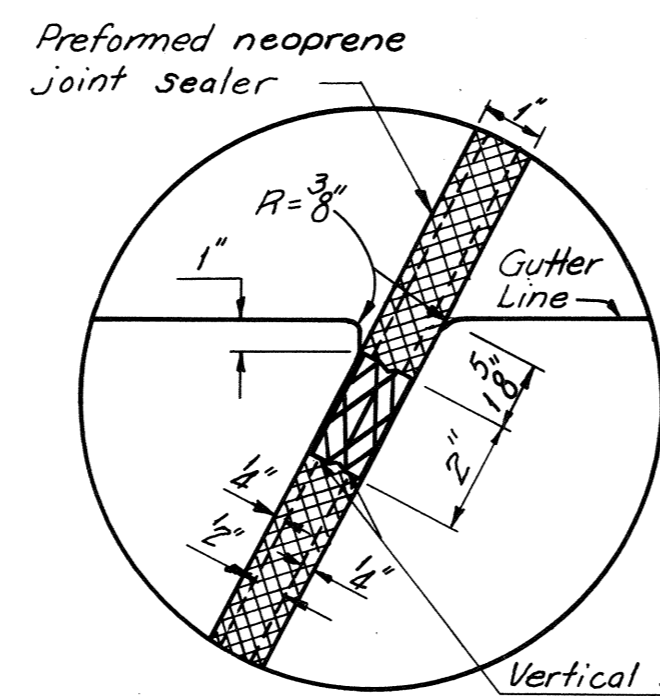

DETAIL "B"
No Scale

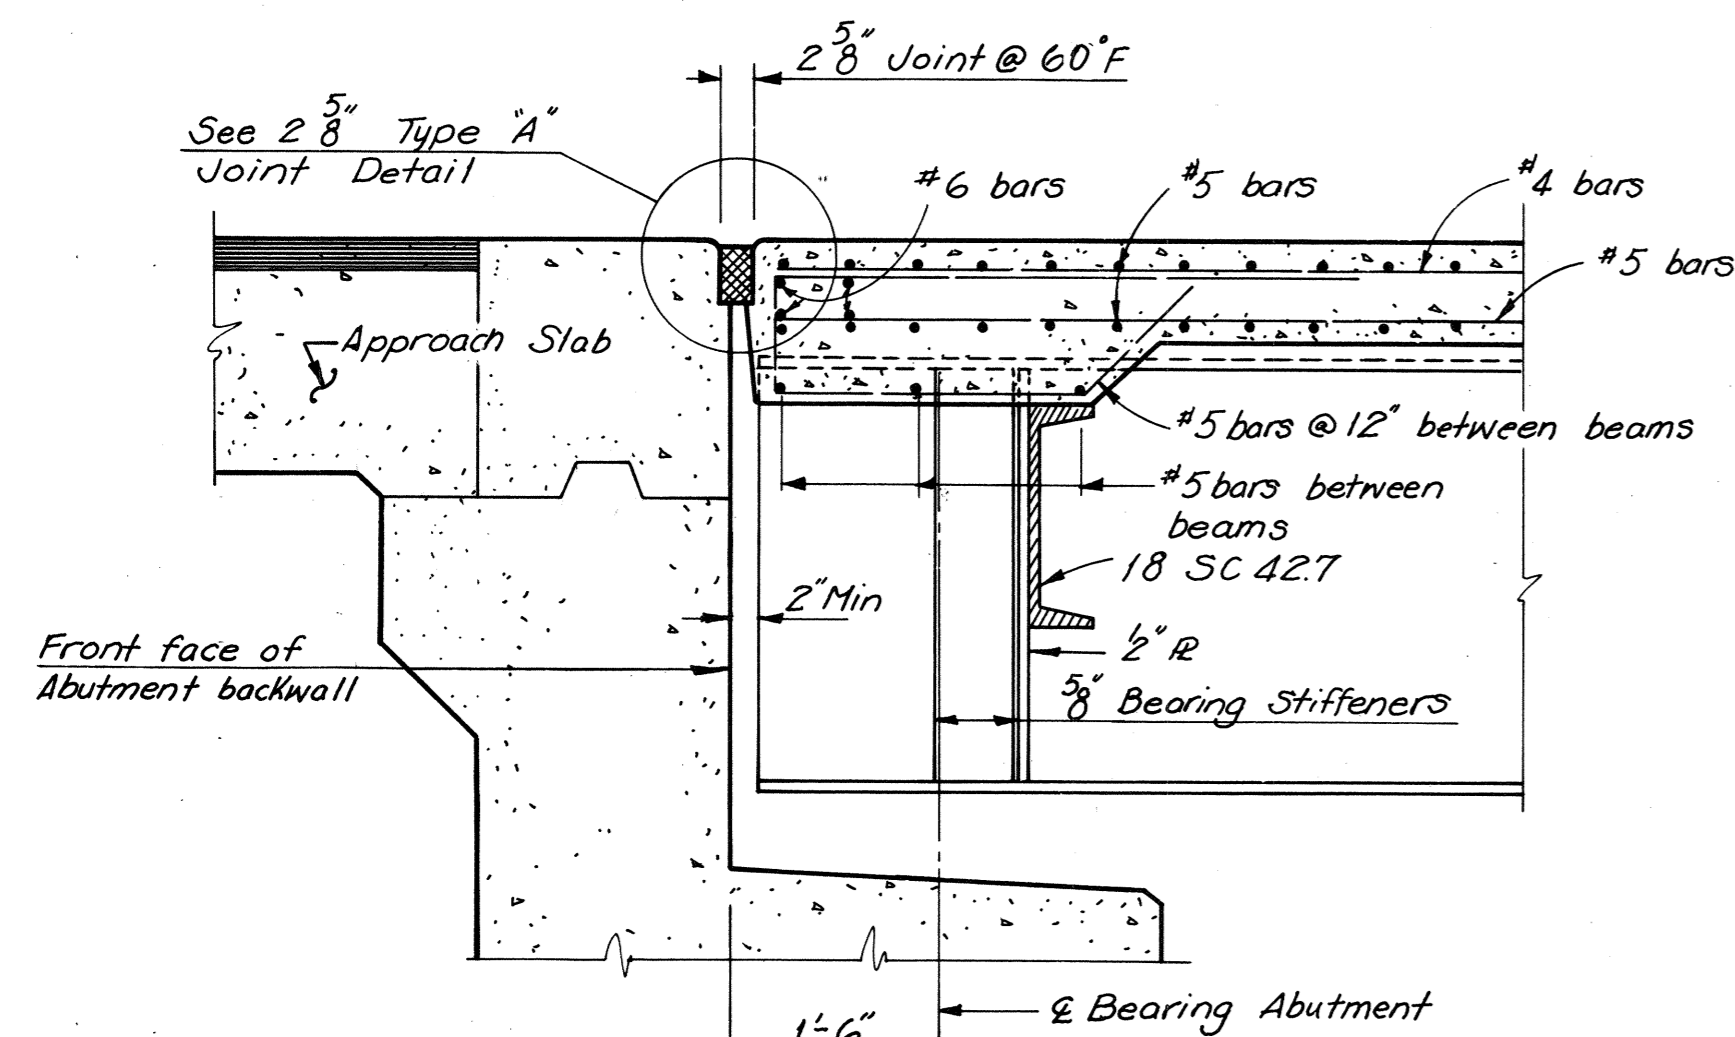


SECTION A-A
Scale: 3/4" = 1'-0"

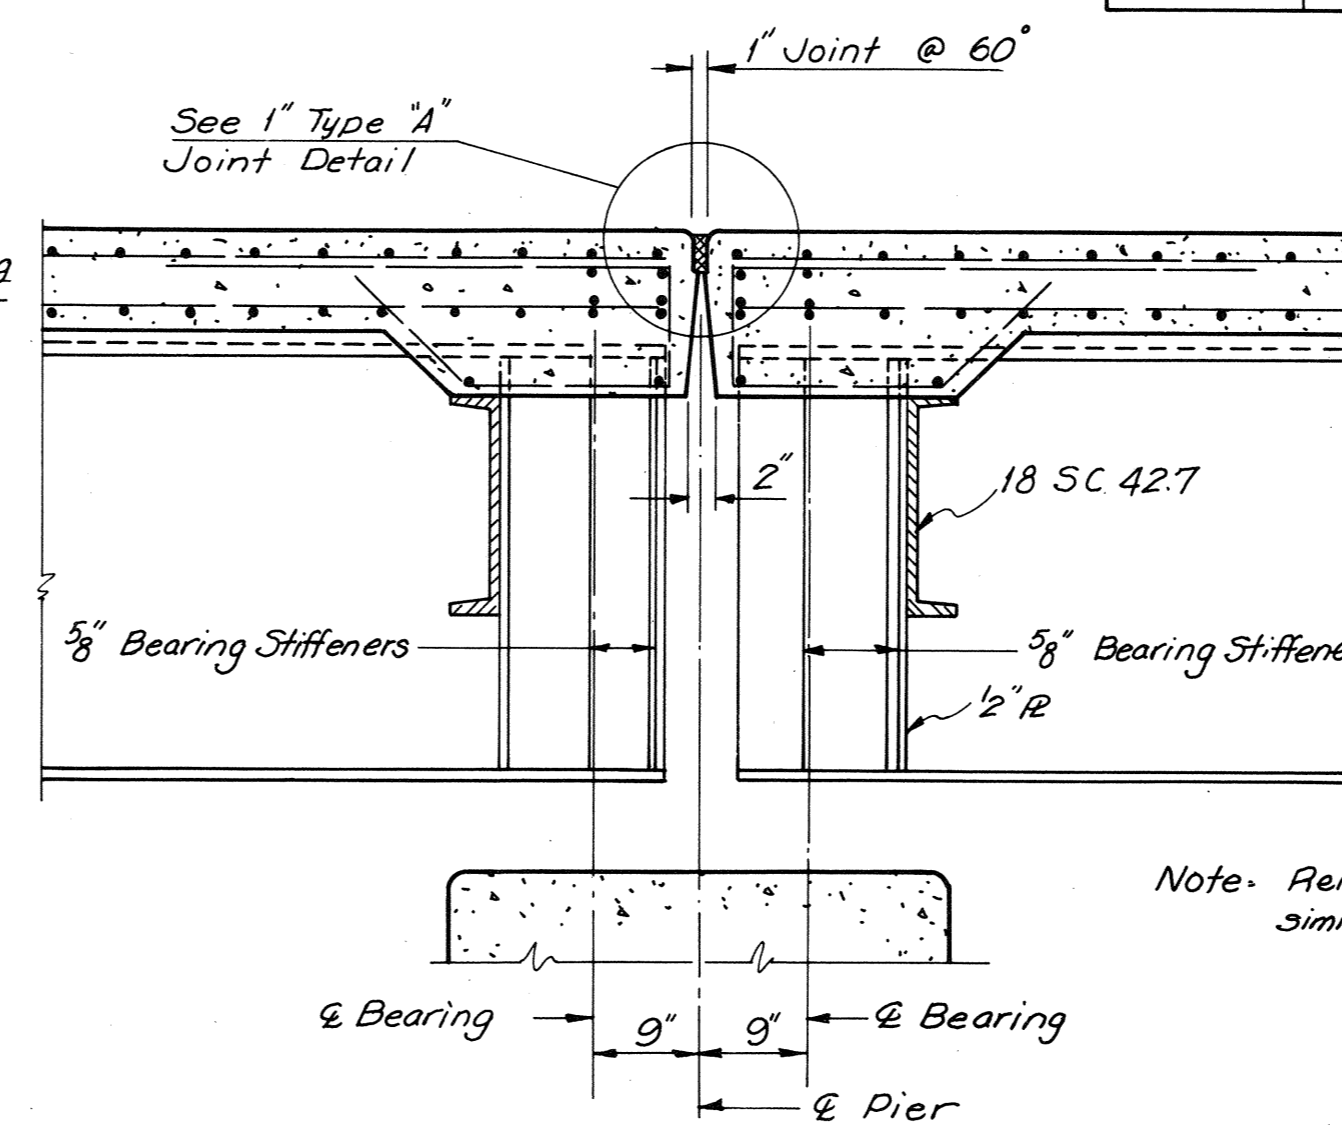


SECTION B-B
Scale: 3/4" = 1'-0"


Note: Reinforcing steels are similar to Section A-A.

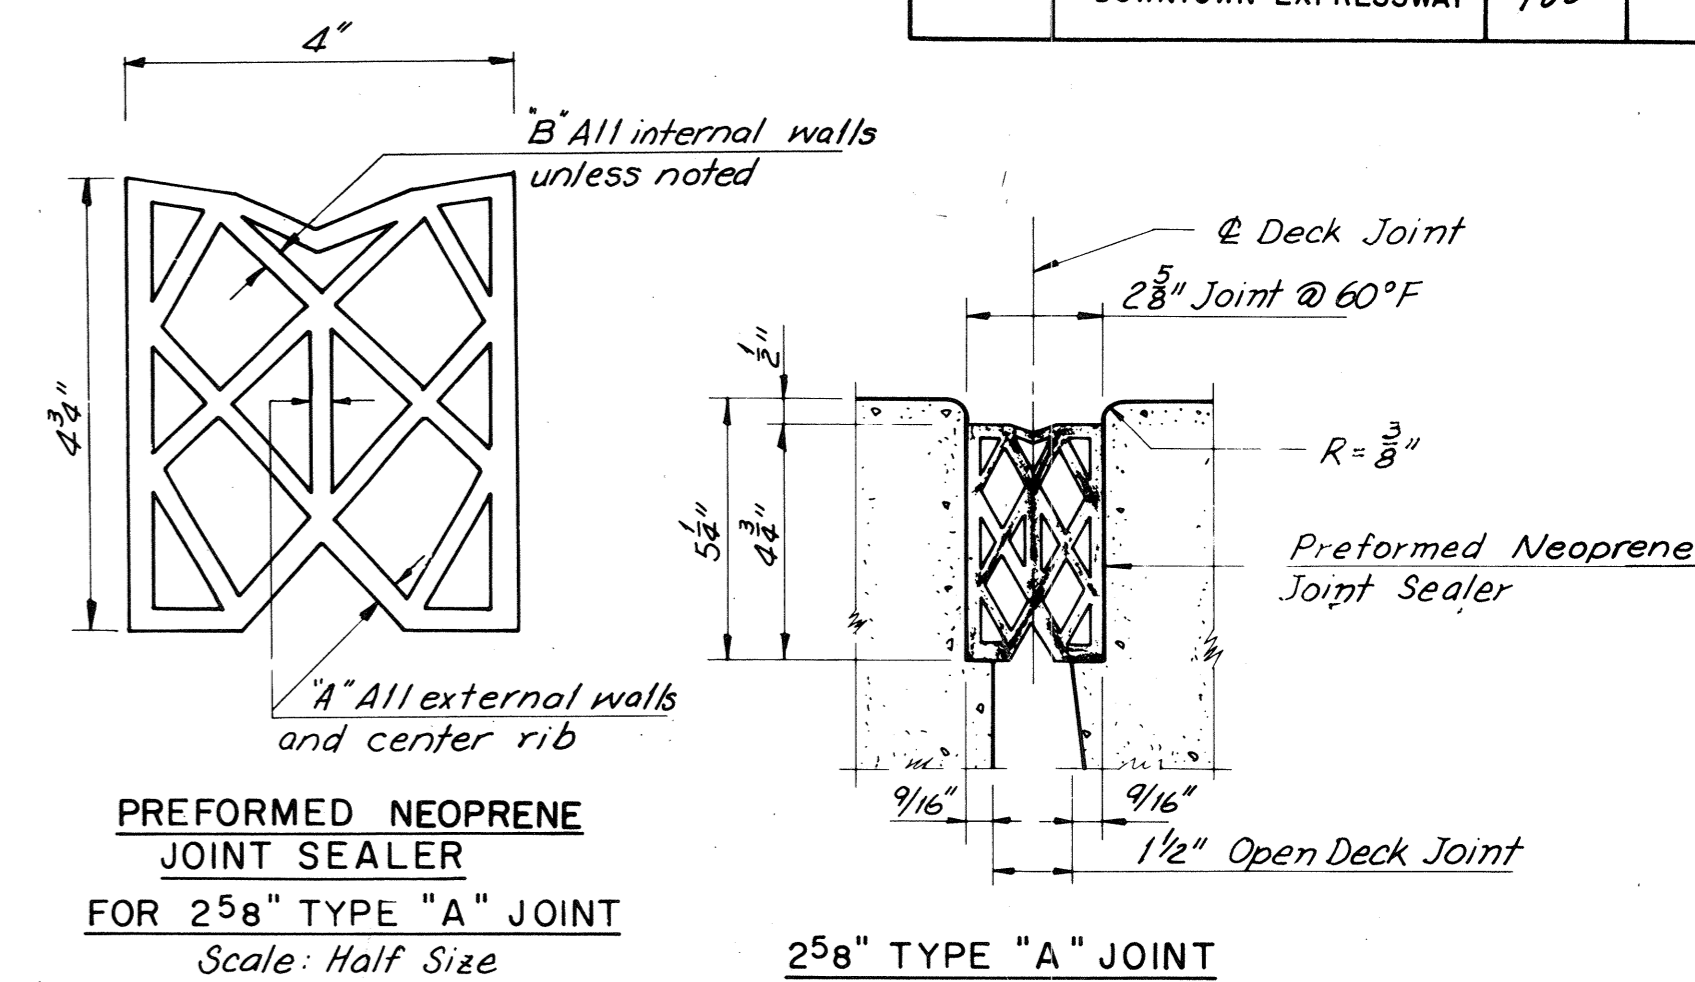


PREFORMED NEOPRENE JOINT SEALER FOR 258" TYPE "A" JOINT
Scale: Half Size

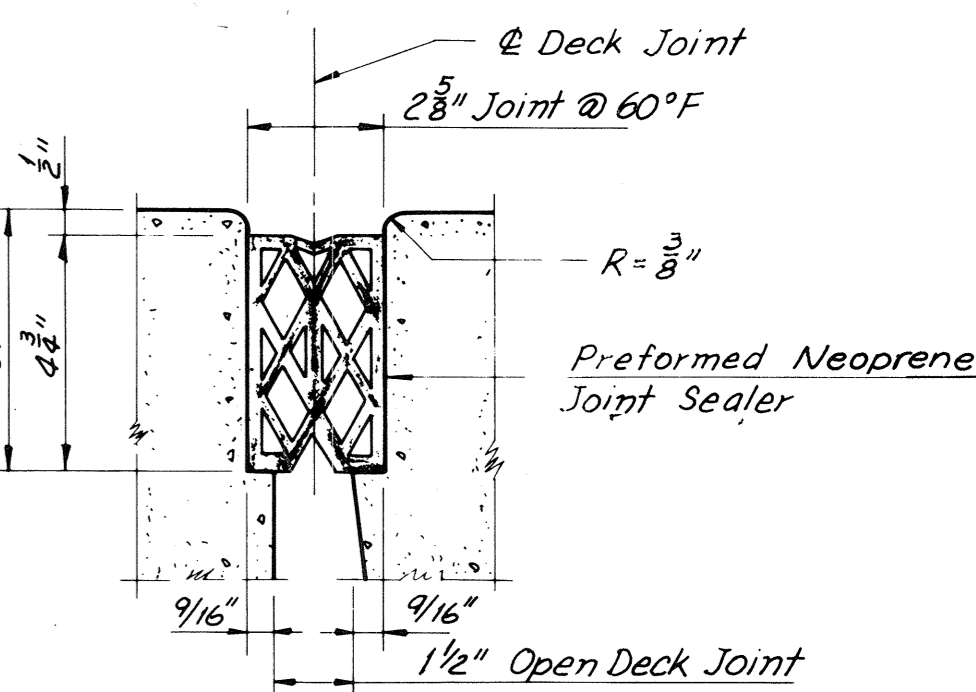

258" TYPE "A" JOINT
Scale: 3" = 1'-0"

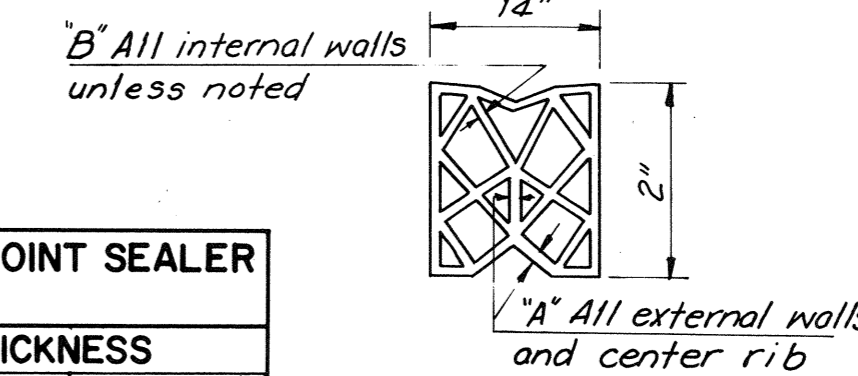


PREFORMED NEOPRENE JOINT SEALER FOR 1" TYPE "A" JOINT
Scale: Half Size

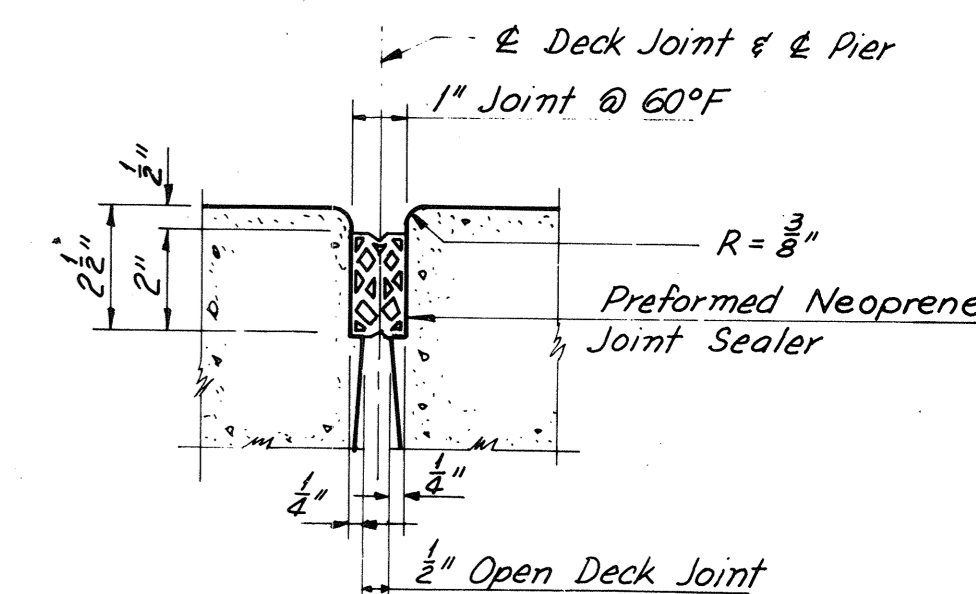

1" TYPE "A" JOINT
Scale: 3" = 1'-0"

PREFORMED NEOPRENE JOINT SEALER TOLERANCES				
WIDTH	HEIGHT	THICKNESS		
		A	B	
1 3/4" + 3/16" - 0"	2" ± 8"	1/8" + 1/32" - 1/64"	3/32" + 1/64" - 3/32"	
4" + 5/16" - 0"	4 3/4" ± 1/4"	1/4" + 3/64" - 1/32"	3/16" + 3/64" - 1/16"	

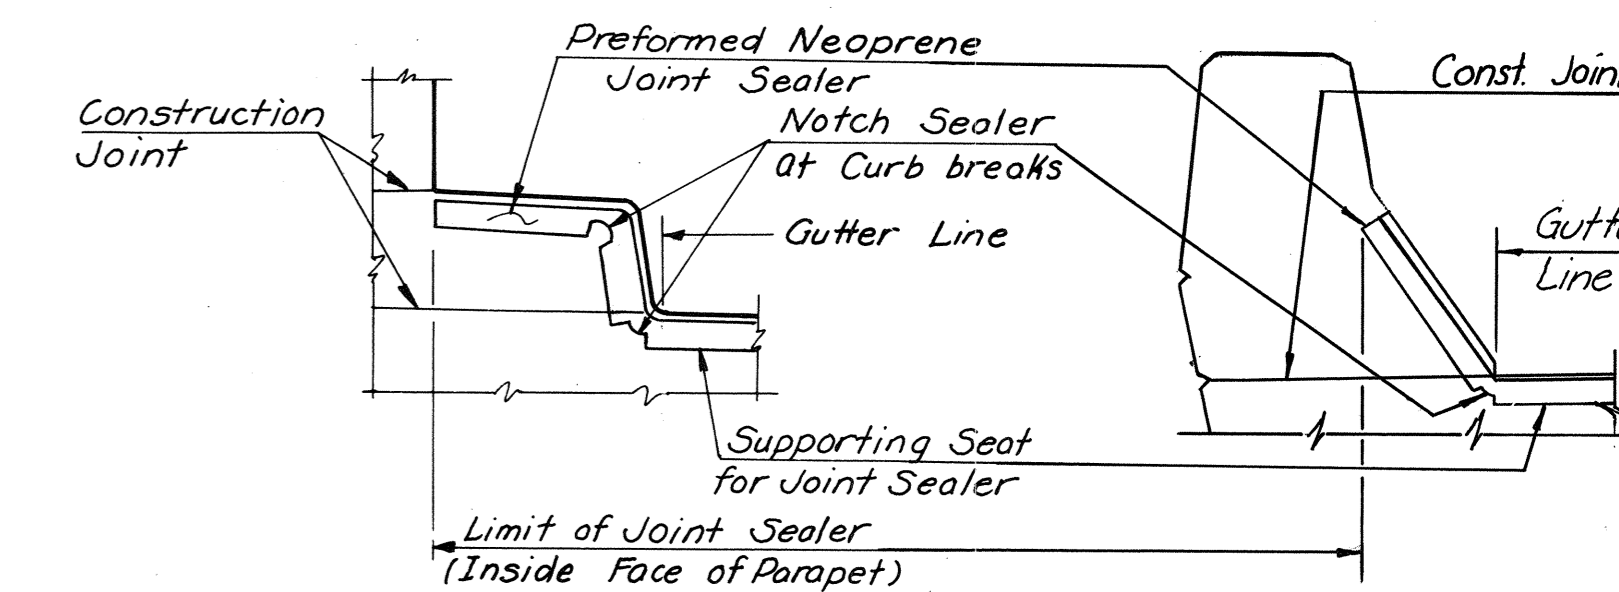

TREATMENT OF TYPE "A" JOINT AT CURB
No Scale

TREATMENT OF TYPE "A" JOINT AT G.M. PARAPET
No Scale

NOTE TO CONTRACTOR

It is absolutely essential that the openings for the preformed neoprene joint sealers be accurately formed and constructed to smooth, straight lines. The size of the opening shall be adjusted to allow for anticipated dead load rotation of the ends of the slab and for the temperature at the time of construction.

AS BUILT

BY	DATE				
MADE	LCC	12-5-67			
CHECKED	A.M.	1-22-68	As Built		
IN CHARGE	R. G. C.				
NO.	REVISION	BY	DATE		

RICHMOND METROPOLITAN AUTHORITY
RICHMOND EXPRESSWAY SYSTEM
DOWNTOWN EXPRESSWAY

BRIDGE NO. 36
MAPLEWOOD AVENUE OVER
DOWNTOWN EXPRESSWAY
JOINT DETAILS


HOWARD, NEEDLES, TAMMEN & BERGENDOFF
consulting engineers
NEW YORK ALEXANDRIA KANSAS CITY
SCALE: As Noted
CONTRACT NO. 7
SHEET NO. 8 OF 10

Bridge 61


(Westbound Downtown Expressway “Rte. 195” over South 12th Street)

Record Set Plans

RICHMOND EXPRESSWAY SYSTEM			
SECTION	PROJECT	SHEET NO.	TOTAL SHEETS
9	DOWNTOWN EXPRESSWAY	221	

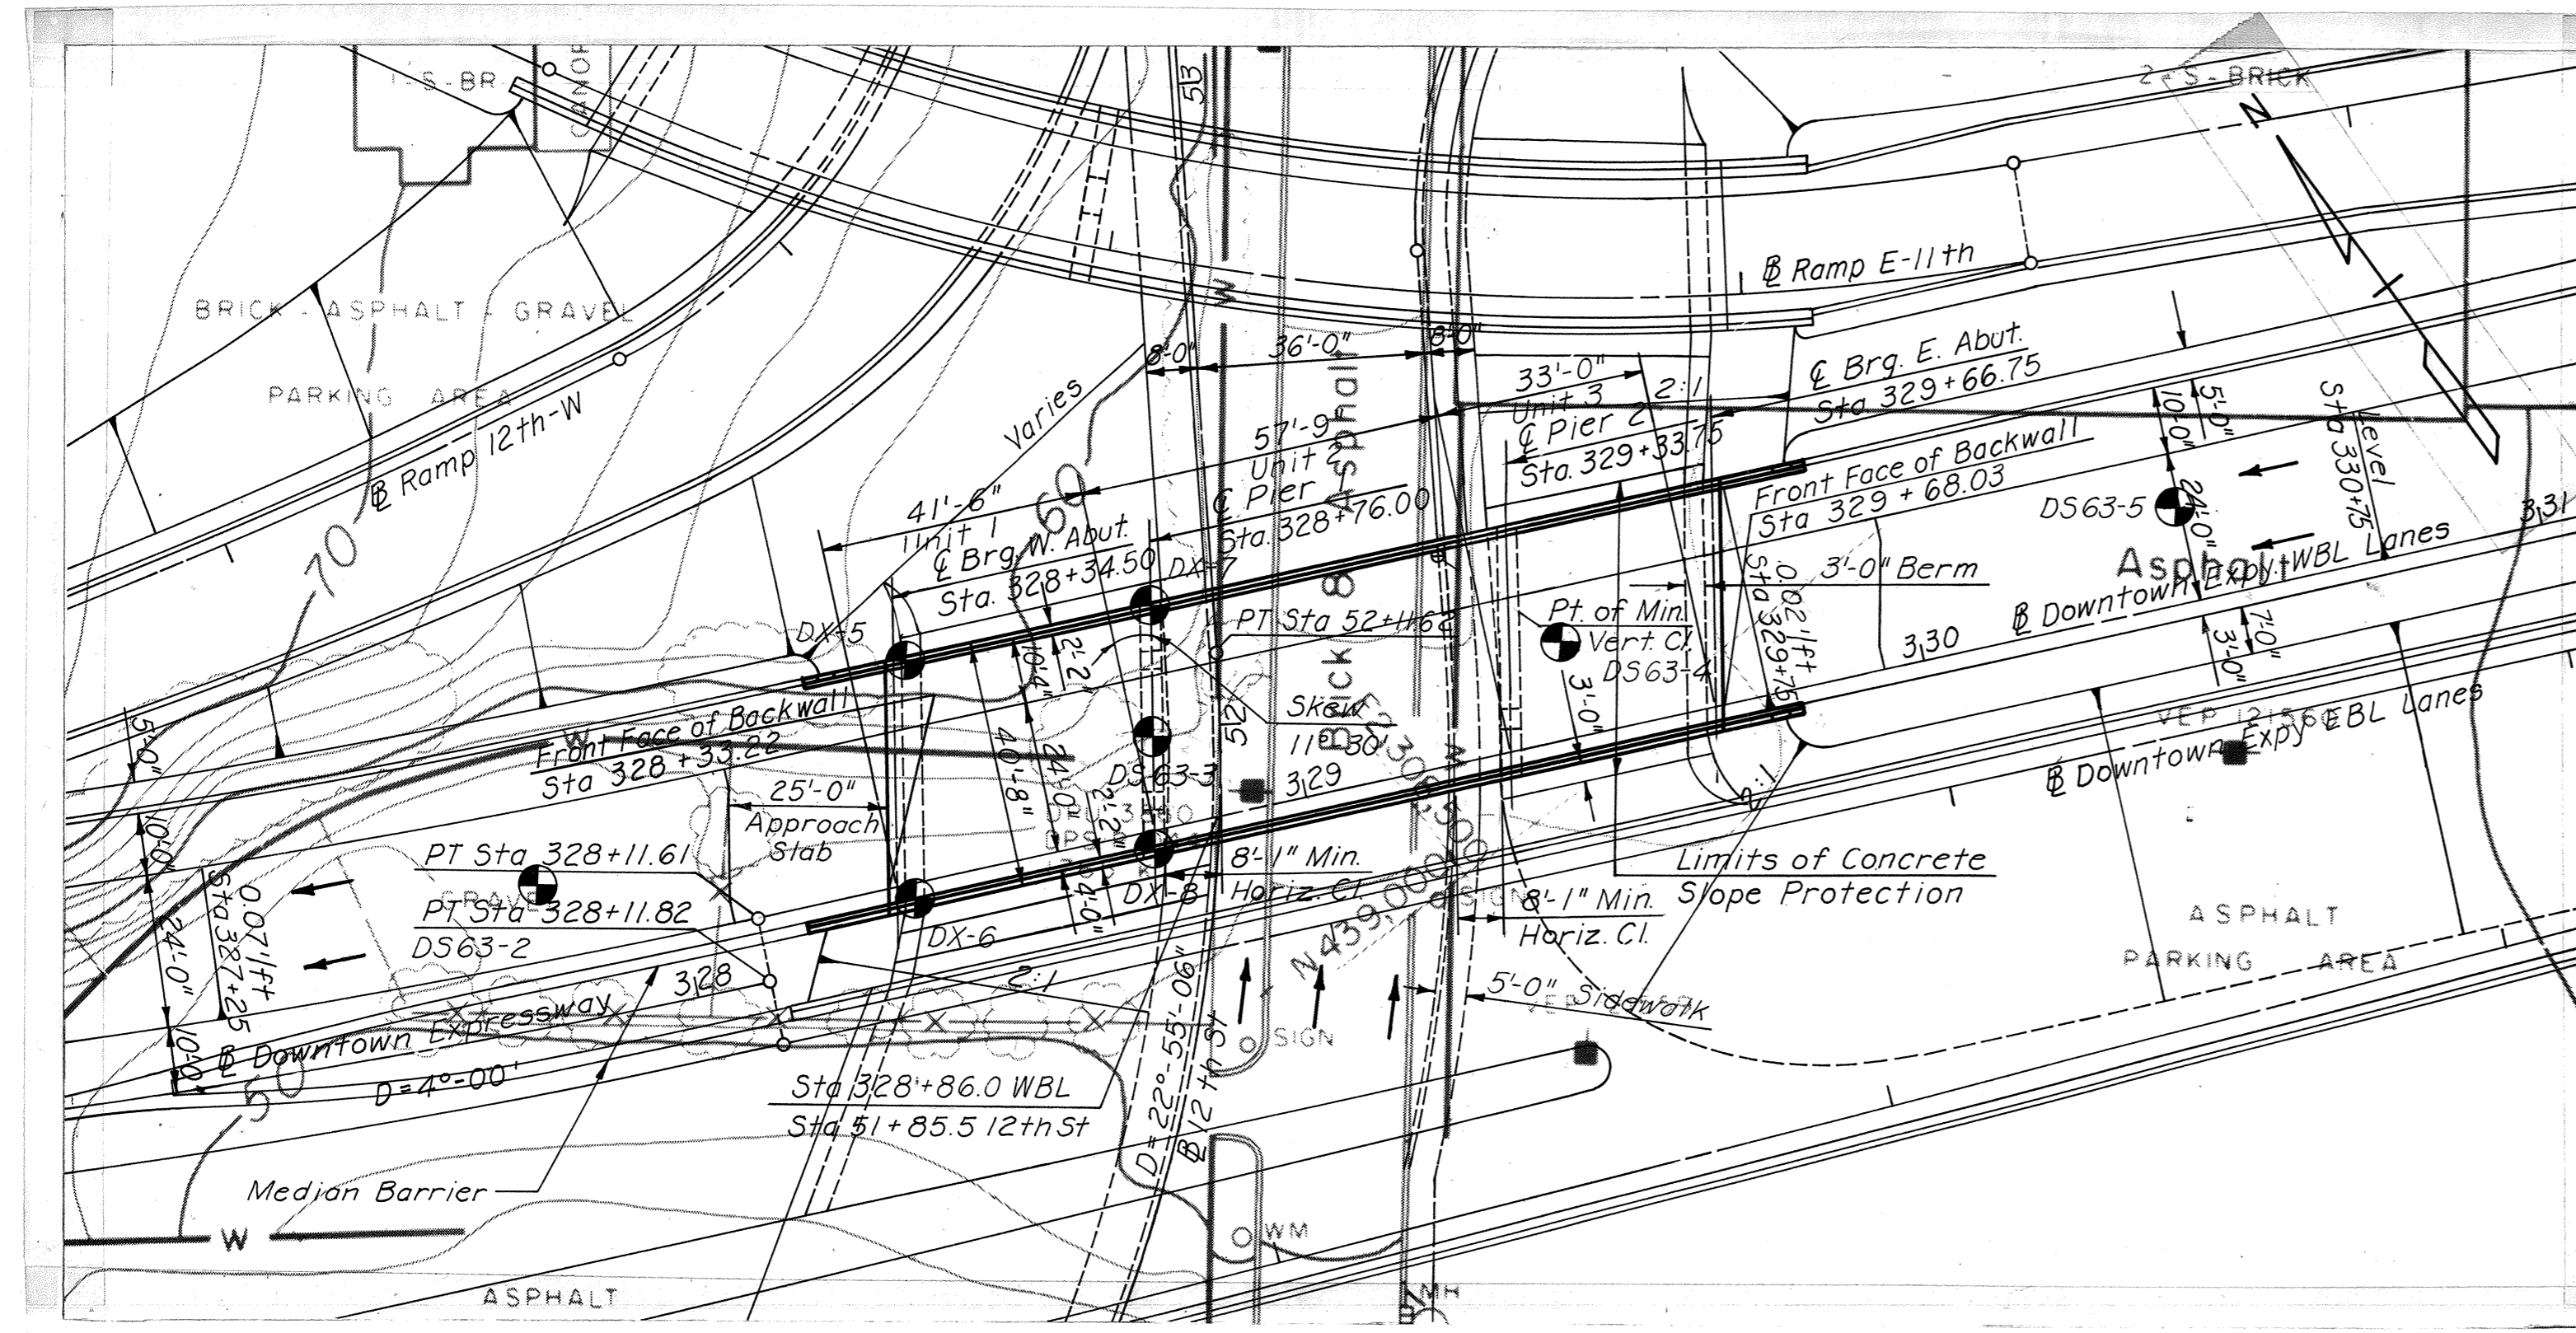

PLAN
Scale: 1" = 25'

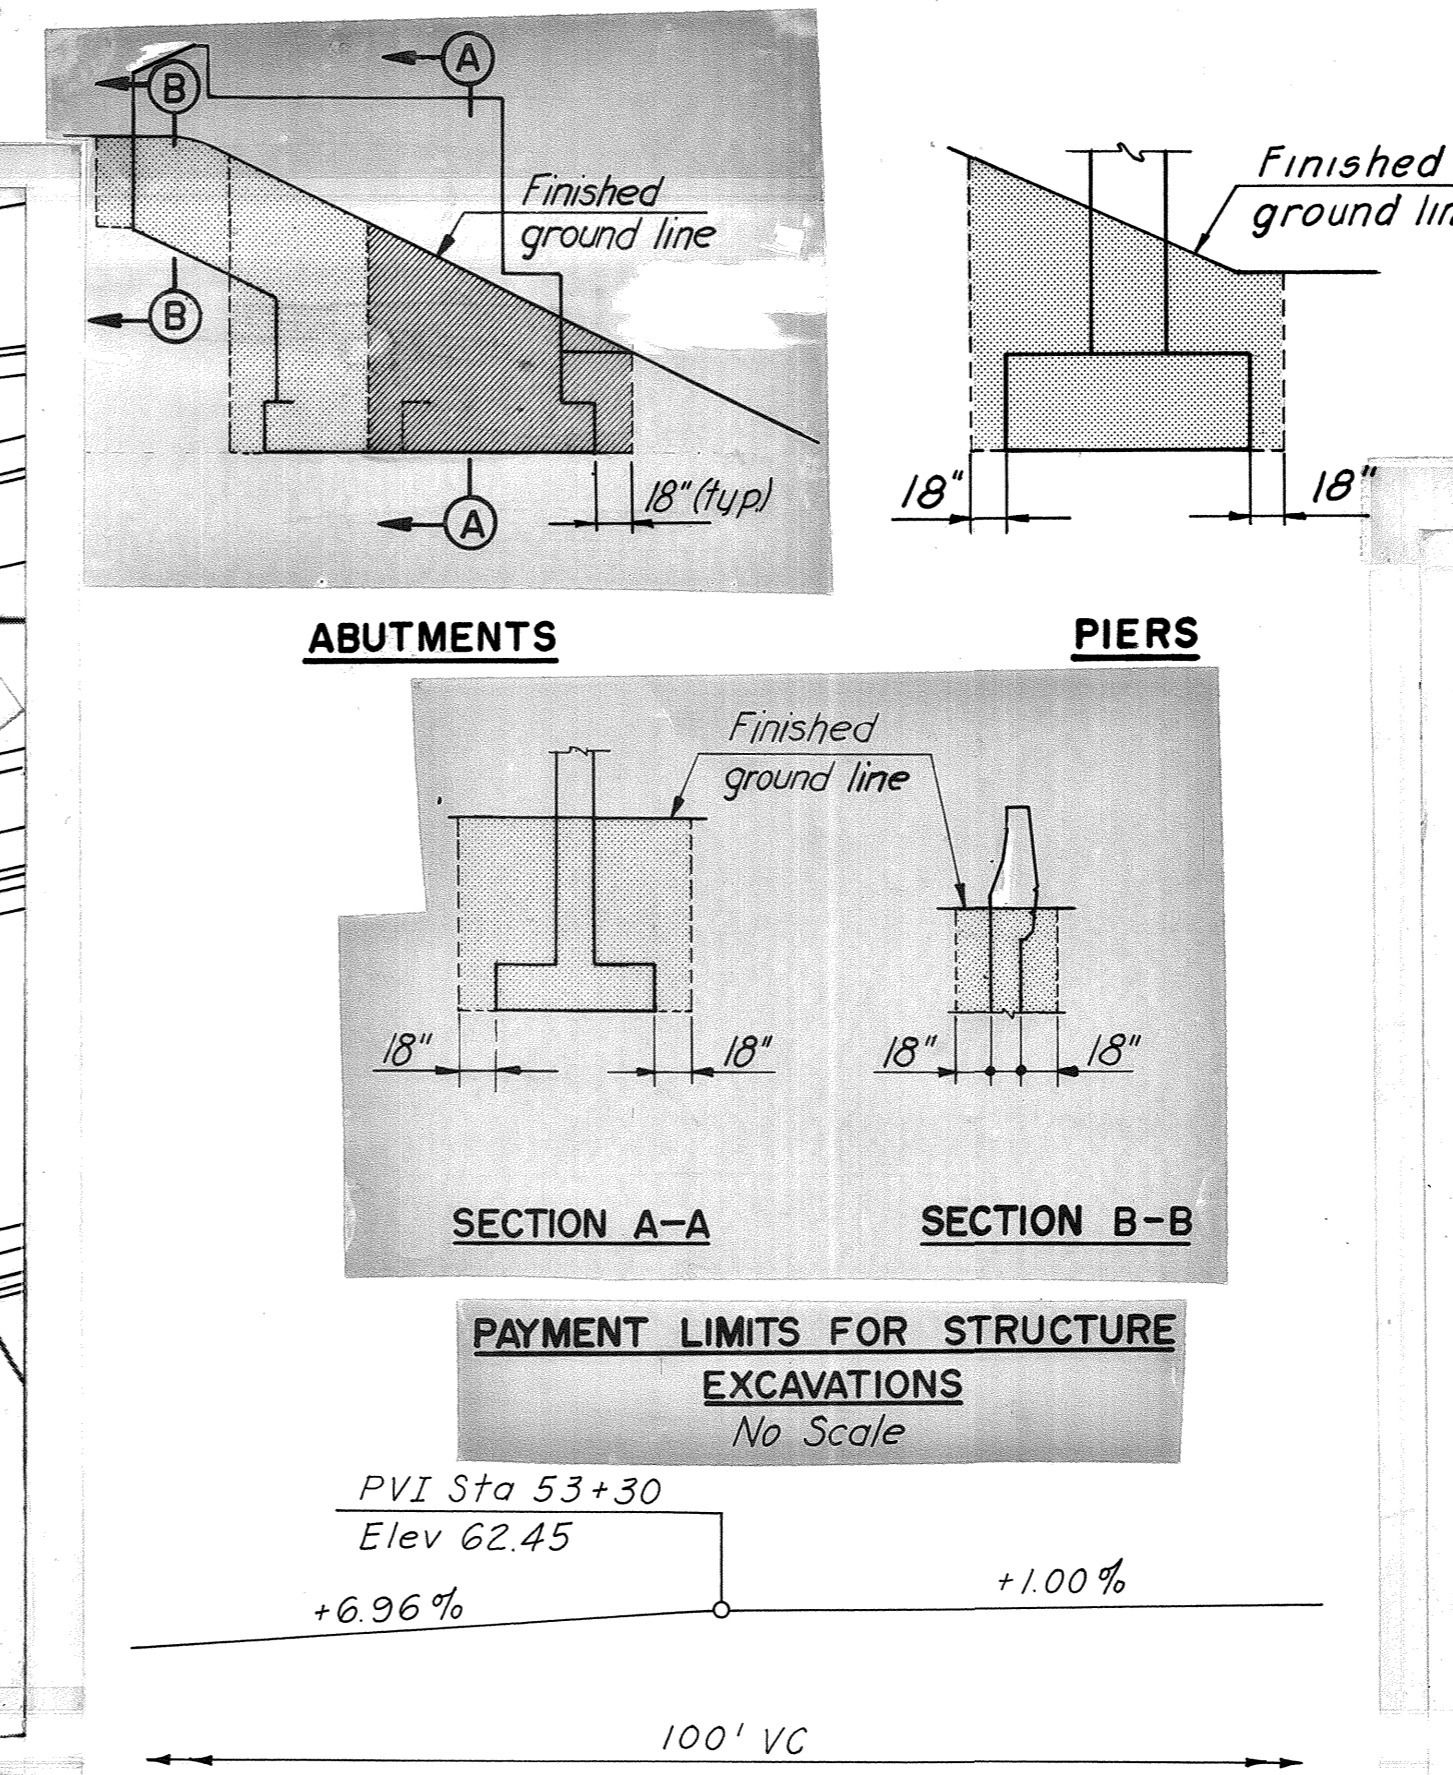

PROFILE GRADE 12TH ST
No Scale

GENERAL NOTES

ROADWAY: One 38'-4" Face to Face of rail.

CAPACITY: Dead Load-Includes 15 lbs. per sq. ft. for future wearing surface. Live Loads-MS20-44 loading and B.P.R. modified for military vehicles.

SPECIFICATIONS: GENERAL-Virginia Department of Highway Road and Bridge Specifications, 1970. DESIGN-A.A.S.H.O. Standard Specifications for Highway Bridges, 1961, modified by Special Design Provisions. WELDING-1969 Standard Specifications for welded Highway and Railway Bridges of The American Welding Society.

CONTRACT SPECIAL PROVISIONS
Specifications and Contract Special Provisions referred to above are necessary to make these plans complete.

DATUM: CITY OF RICHMOND

TEMPERATURE: The normal temperature referred to on the plan is 60°F. The temperature range for movement is 0°F. to 120°F.

DIMENSIONS: All dimensions are measured horizontally and vertically unless otherwise noted.

EXCAVATION: Excavation below subgrade and cut slope template shall be classified as Structure Excavation. All excavation above these limits shall be classified as Regular Excavation and is not included in the Structural Quantities.


FOUNDATIONS: Footings shall rest on firm material. Foundation material shall be kept dry and special attention is called to Section 401.05 of the General Specifications and to the Contract Special Provisions concerning preparation of foundations for footings.

CONCRETE NOTES: Concrete in superstructure shall be Class A4. All other concrete shall be Class A3. All exposed edges and corners shall have a 3/8" chamfer or fillet unless otherwise noted. Care in the method of vibration, the use of low-slump concrete, and or other means shall be employed to prevent downgrade movement of newly placed slab concrete. (When gradient is over 2%).

Finishing concrete surfaces: See the Standard Architectural Detail Sheets and the Contract Special Provisions for types and details.


STEEL NOTES: Structural steel shall conform to A.S.T.M. Specification A36 except as noted.

All field connections shall be made with high strength bolts. High strength bolts shall be 7/8" diameter unless otherwise noted and shall conform to A.S.T.M. Specification A-325.

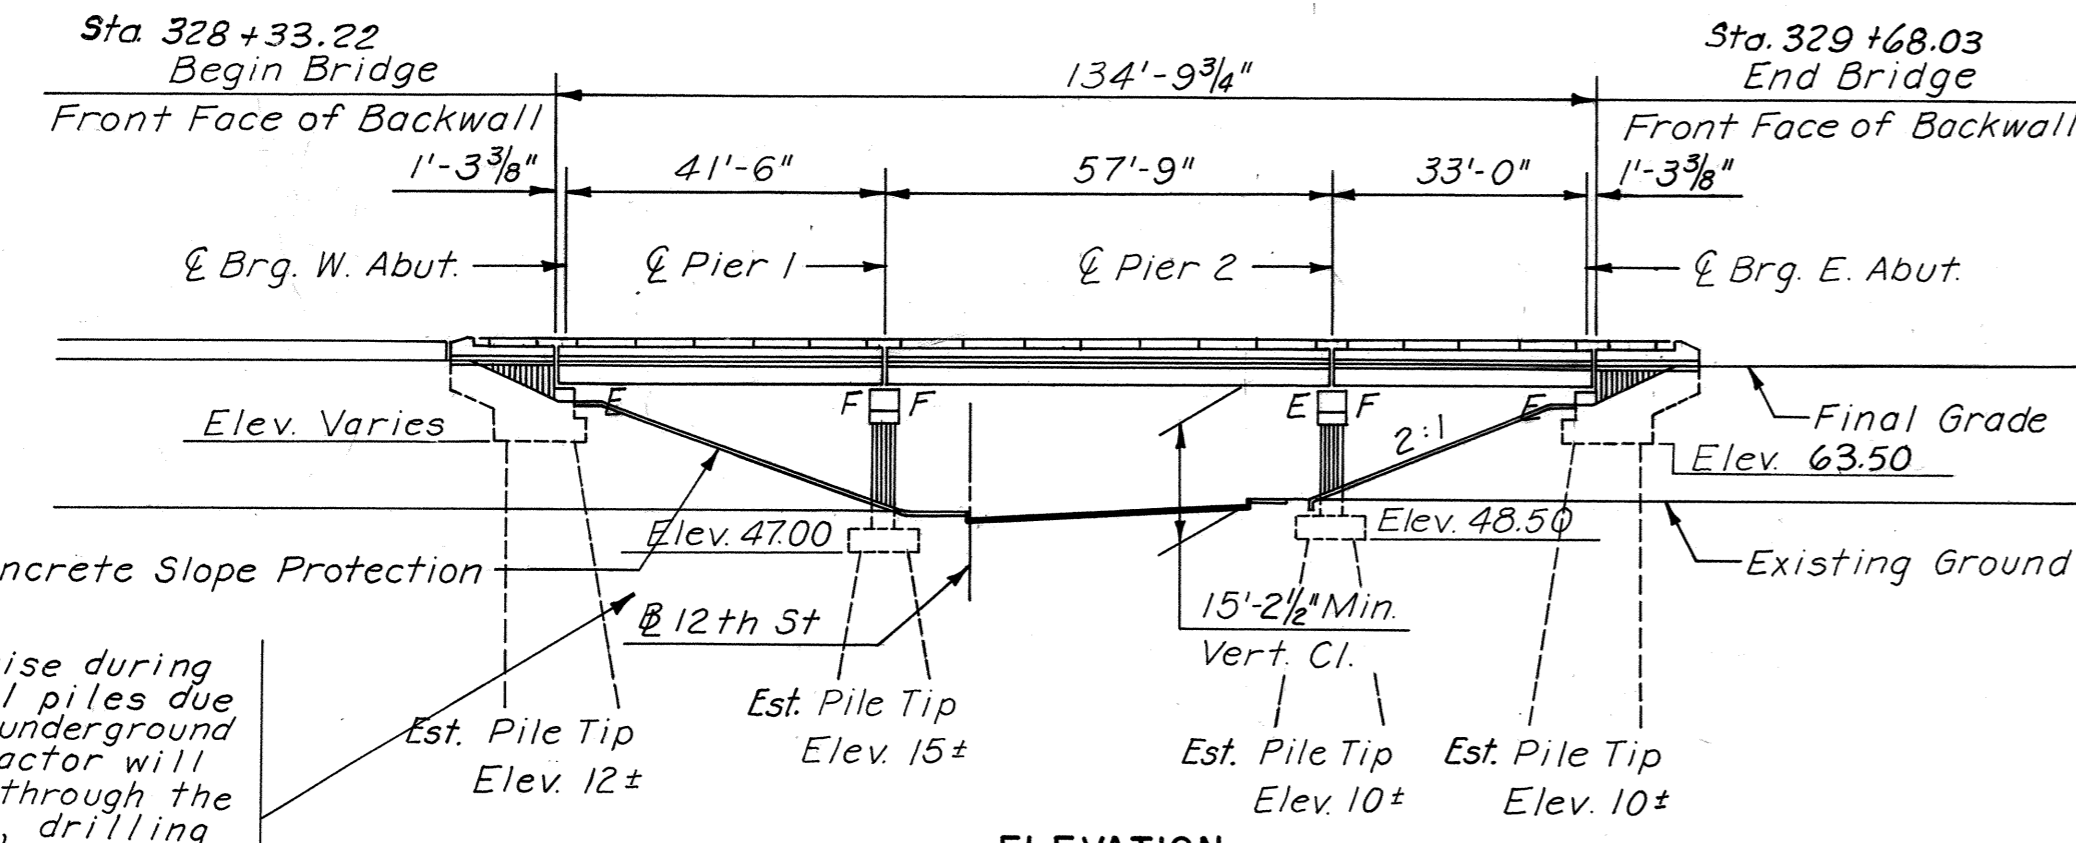

ELEVATION
Scale: 1" = 25'

If difficulties arise during the driving of the steel piles due to the encountering of underground obstructions, the Contractor will be required to advance through the obstruction by spudding, drilling or some other suitable means and then proceed to redrive the pile to approximately the tip elevations given.

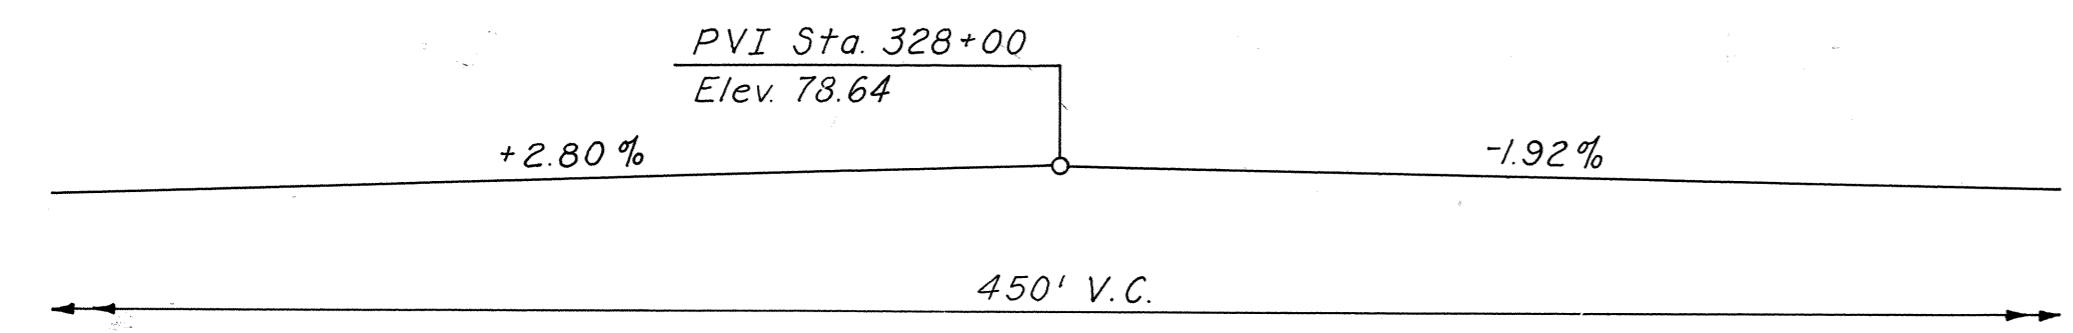

PROFILE DOWNTOWN EXPRESSWAY WESTBOUND LANES
No Scale

INDEX OF SHEETS	
No.	Title
1	General Plan and Elevation
2	West Abutment
3	East Abutment
4	Piers 1 and 2
5	Stringers
6	Slab
7	Joint Details
8	Approach Slab and Slope Protection Details
9&10	Boring Logs
S1	Standard Shoe Details
S2	Standard Aluminum Railing Details (1 Rail)
S5	Standard Electrical Details (Exp. Bridges)
S7	Standard Architectural Details

	FINAL QUANTITIES												
	Structure Excavation	Concrete Class A4	Concrete Class A3 Substruc.	Concrete Class A3 App. Slab	Reinforcing Steel	Structural Steel A-36	Aluminum Br. Railing (1 Rail) L.F.	Porous Backfill	Steel Piles 10BP42	Conc. Slab Slope Prot.	Asphalt Dampproofg	Underdrain 6" Pipe	Metal Conduit 3" L.F.
	C.Y.	C.Y.	C.Y.	C.Y.	Lbs.	Lbs.	L.F.	C.Y.	L.F.	S.Y.	S.Y.	L.F.	3" L.F.
Superstructure		177.6			42,588	114,823	269						135
West Abutment	141		82.57		4,319		24	7	747.8	229.4	20	61	19
East Abutment	141		88.15		4,483		24	7	745.9	203.8	20	61	19
Pier 1	64.27		51.38		5,051				333.0				
Pier 2	56.80		50.24		4,916				362.8				
Approach Slabs				68.08	15,248								
Total	403.07	177.6	272.34	68.08	76,605	114,823	317	14	2,209.5	433.2	40	122	173

BY	DATE	NO.	REVISION	BY	DATE
MADE	JLJ 11-67	2	As Built	TEM	7-77
CHECKED	IDL 1-68	1	Light deleted	T.E.M.	9-74
IN CHARGE	P.R. Yeager				

AS BUILT


RICHMOND METROPOLITAN AUTHORITY
RICHMOND EXPRESSWAY SYSTEM
DOWNTOWN EXPRESSWAY

BRIDGE NO. 61
DOWNTOWN EXPRESSWAY WESTBOUND LANES
OVER 12TH ST
GENERAL PLAN AND ELEVATION

HOWARD, NEEDLES, TAMMEN & BERGENDOFF
consulting engineers
NEW YORK ALEXANDRIA KANSAS CITY


SCALE: As Noted
CONTRACT NO.: 9
SHEET NO. 1 OF 10

RICHMOND EXPRESSWAY SYSTEM			
SECTION	PROJECT	SHEET NO.	TOTAL SHEETS
9	DOWNTOWN EXPRESSWAY	226	


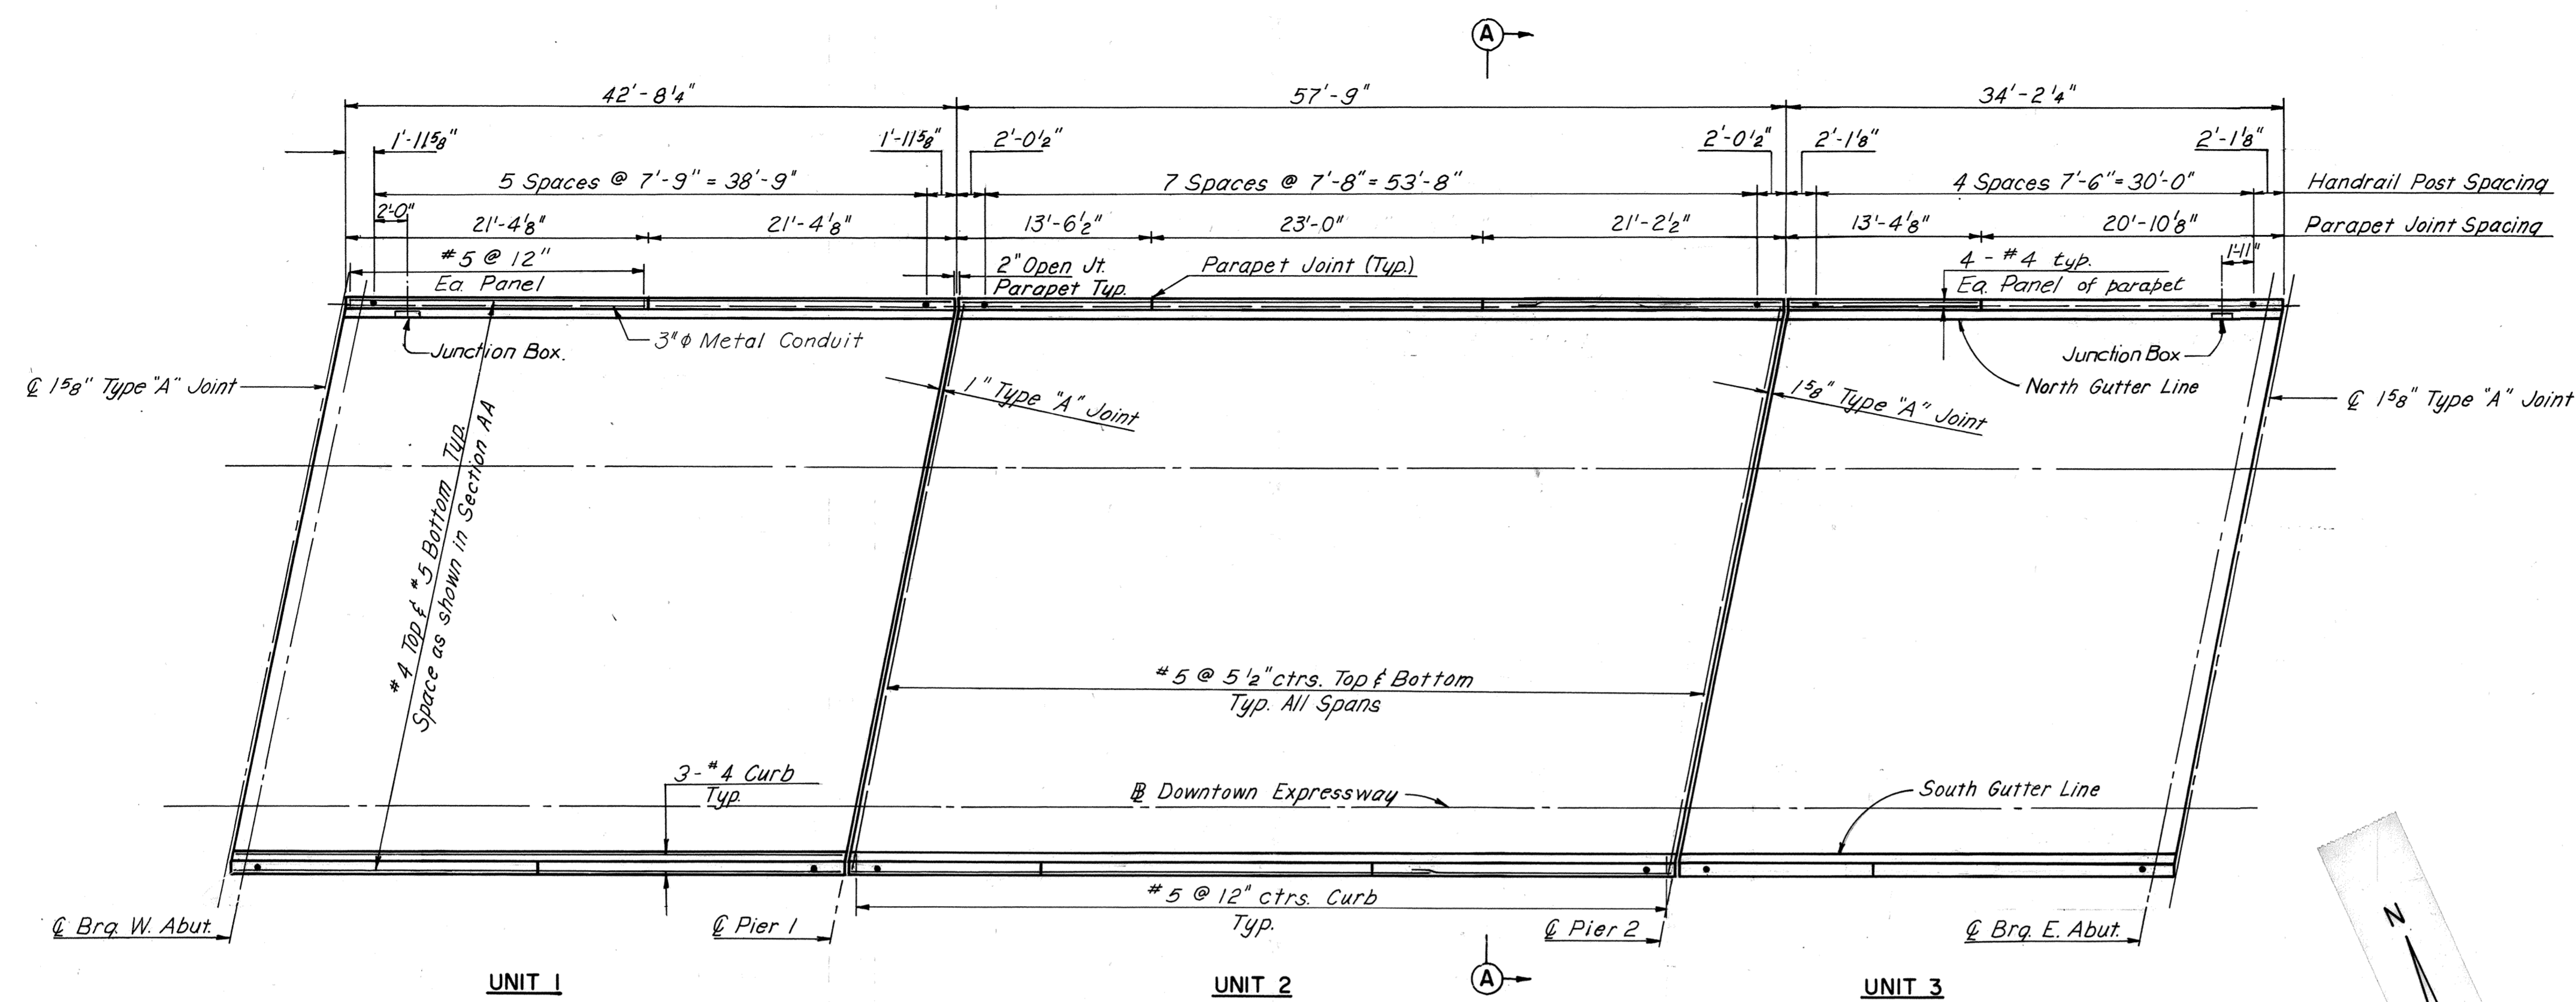


LOCATION	N. GUTTER	BASE LINE	S. GUTTER
∅ Jt. Abut.	74.51	76.07	76.22
1/4 Point	74.58	76.08	76.22
1/2 Point	74.63	76.07	76.20
3/4 Point	74.68	76.05	76.18
∅ Jt. Pier 1	74.71	76.02	76.14
1/4 Point	74.73	75.95	76.07
1/2 Point	74.73	75.87	75.98
3/4 Point	74.71	75.76	75.86
∅ Jt. Pier 2	74.67	75.64	75.73
1/4 Point	74.64	75.55	75.64
1/2 Point	74.59	75.46	75.54
3/4 Point	74.54	75.35	75.43
∅ Jt. Abut.	74.48	75.24	75.32

SLAB PLAN
Scale 1/8" = 1'-0"

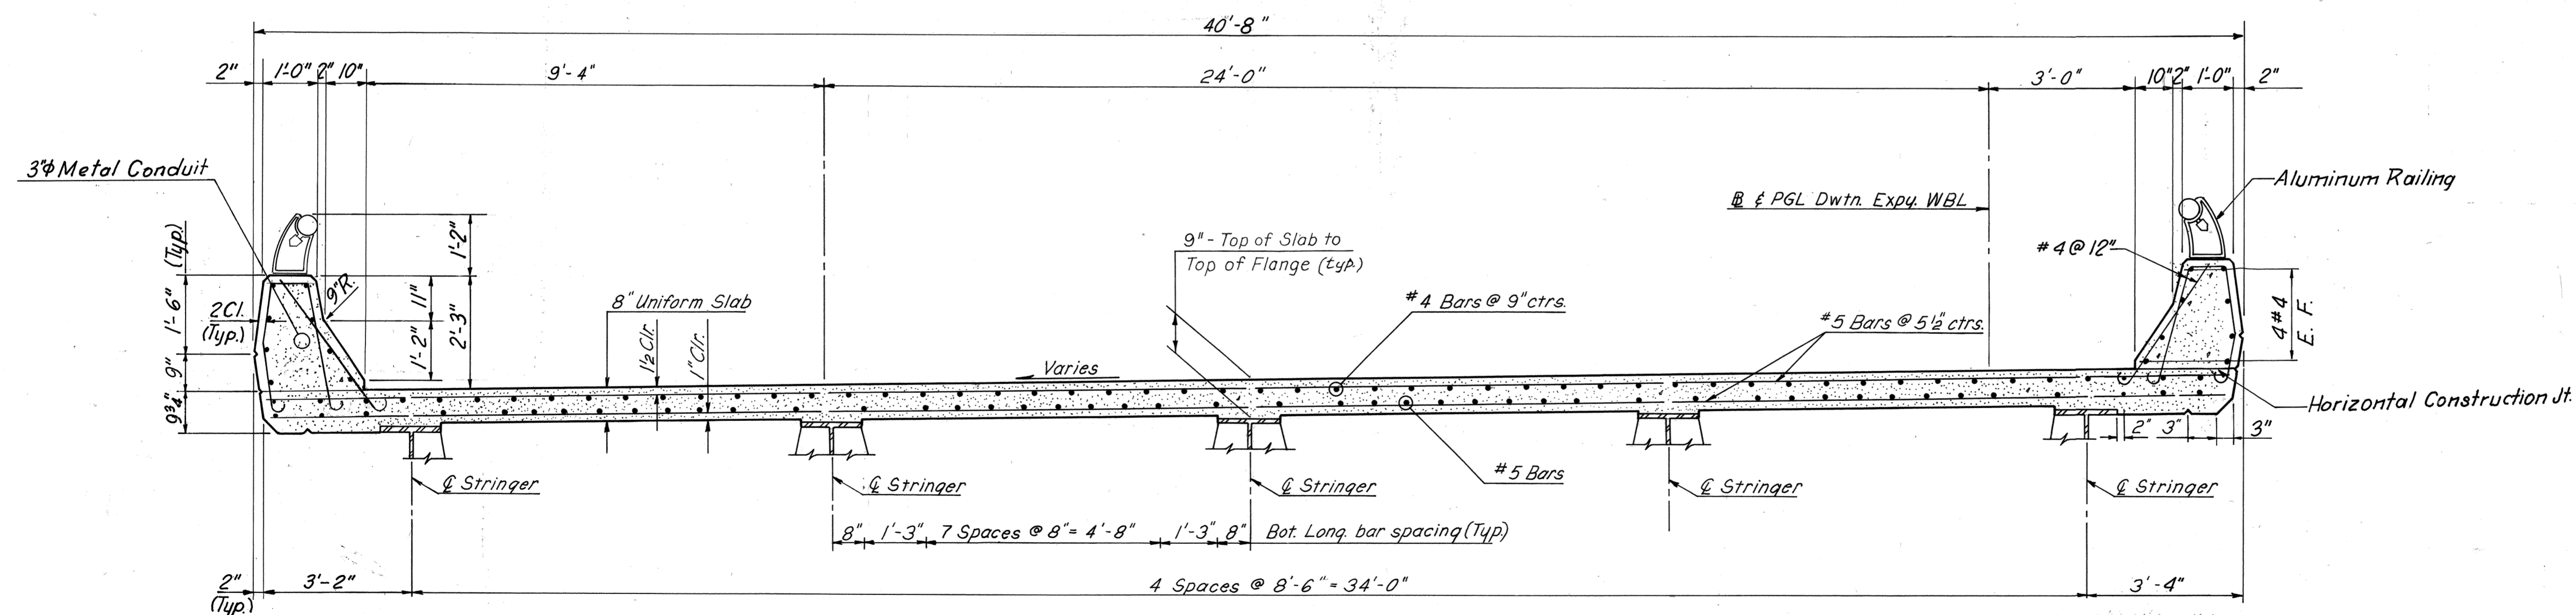

SECTION A A
Scale 1/2" = 1'-0"

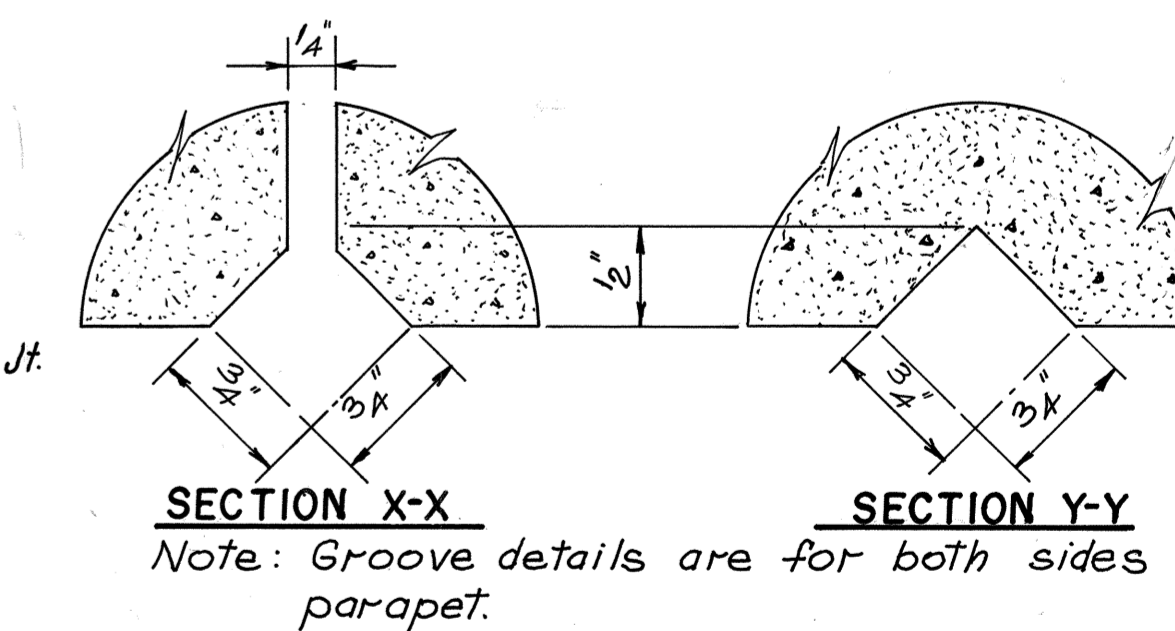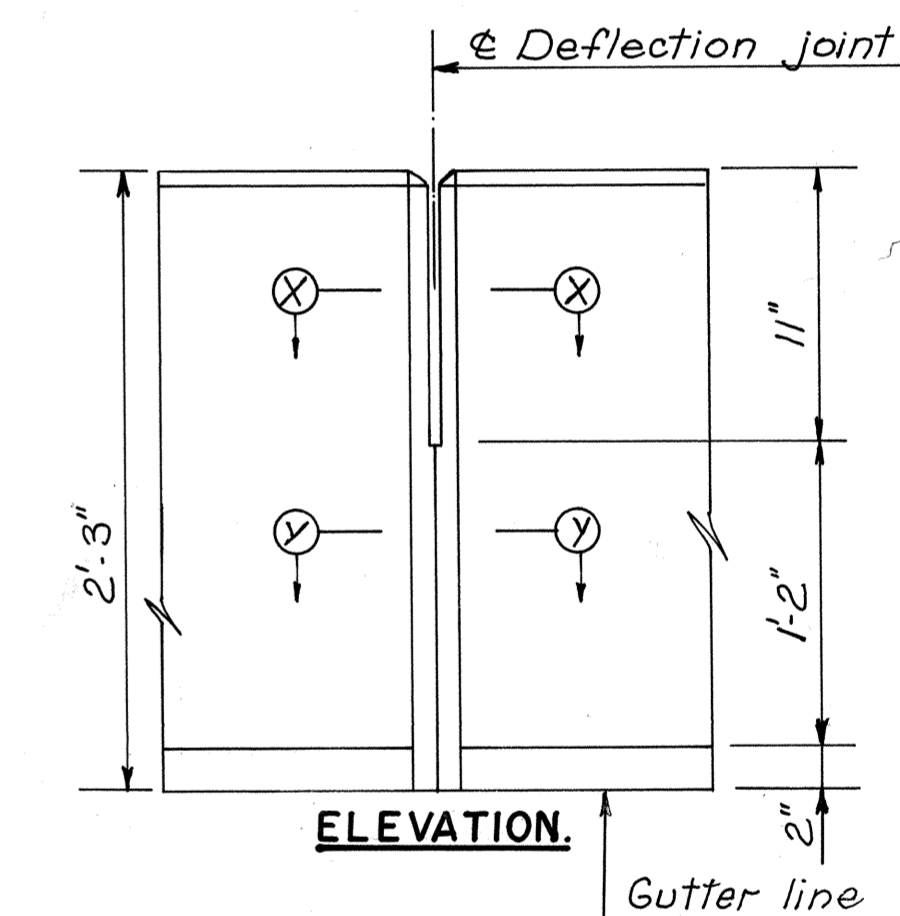

PARAPET DEFLECTION JOINT DETAILS

RICHMOND METROPOLITAN AUTHORITY
RICHMOND EXPRESSWAY SYSTEM
DOWNTOWN EXPRESSWAY

BRIDGE NO. 61
DOWNTOWN EXPRESSWAY WESTBOUND LANES
OVER 12TH ST.


SLAB

HOWARD, NEEDLES, TAMMEN & BERGENDOFF
consulting engineers
NEW YORK ALEXANDRIA KANSAS CITY


SCALE: As Noted
CONTRACT NO.: 9
SHEET NO. 6 OF 10

NO.	REVISION	BY	DATE
3	As Built	TEM	7-77
2	Light deleted Junc. Box's added	TEM	3-74
1	PARAPET JOINT ADDED.	T.E.M.	7-74


AS BUILT

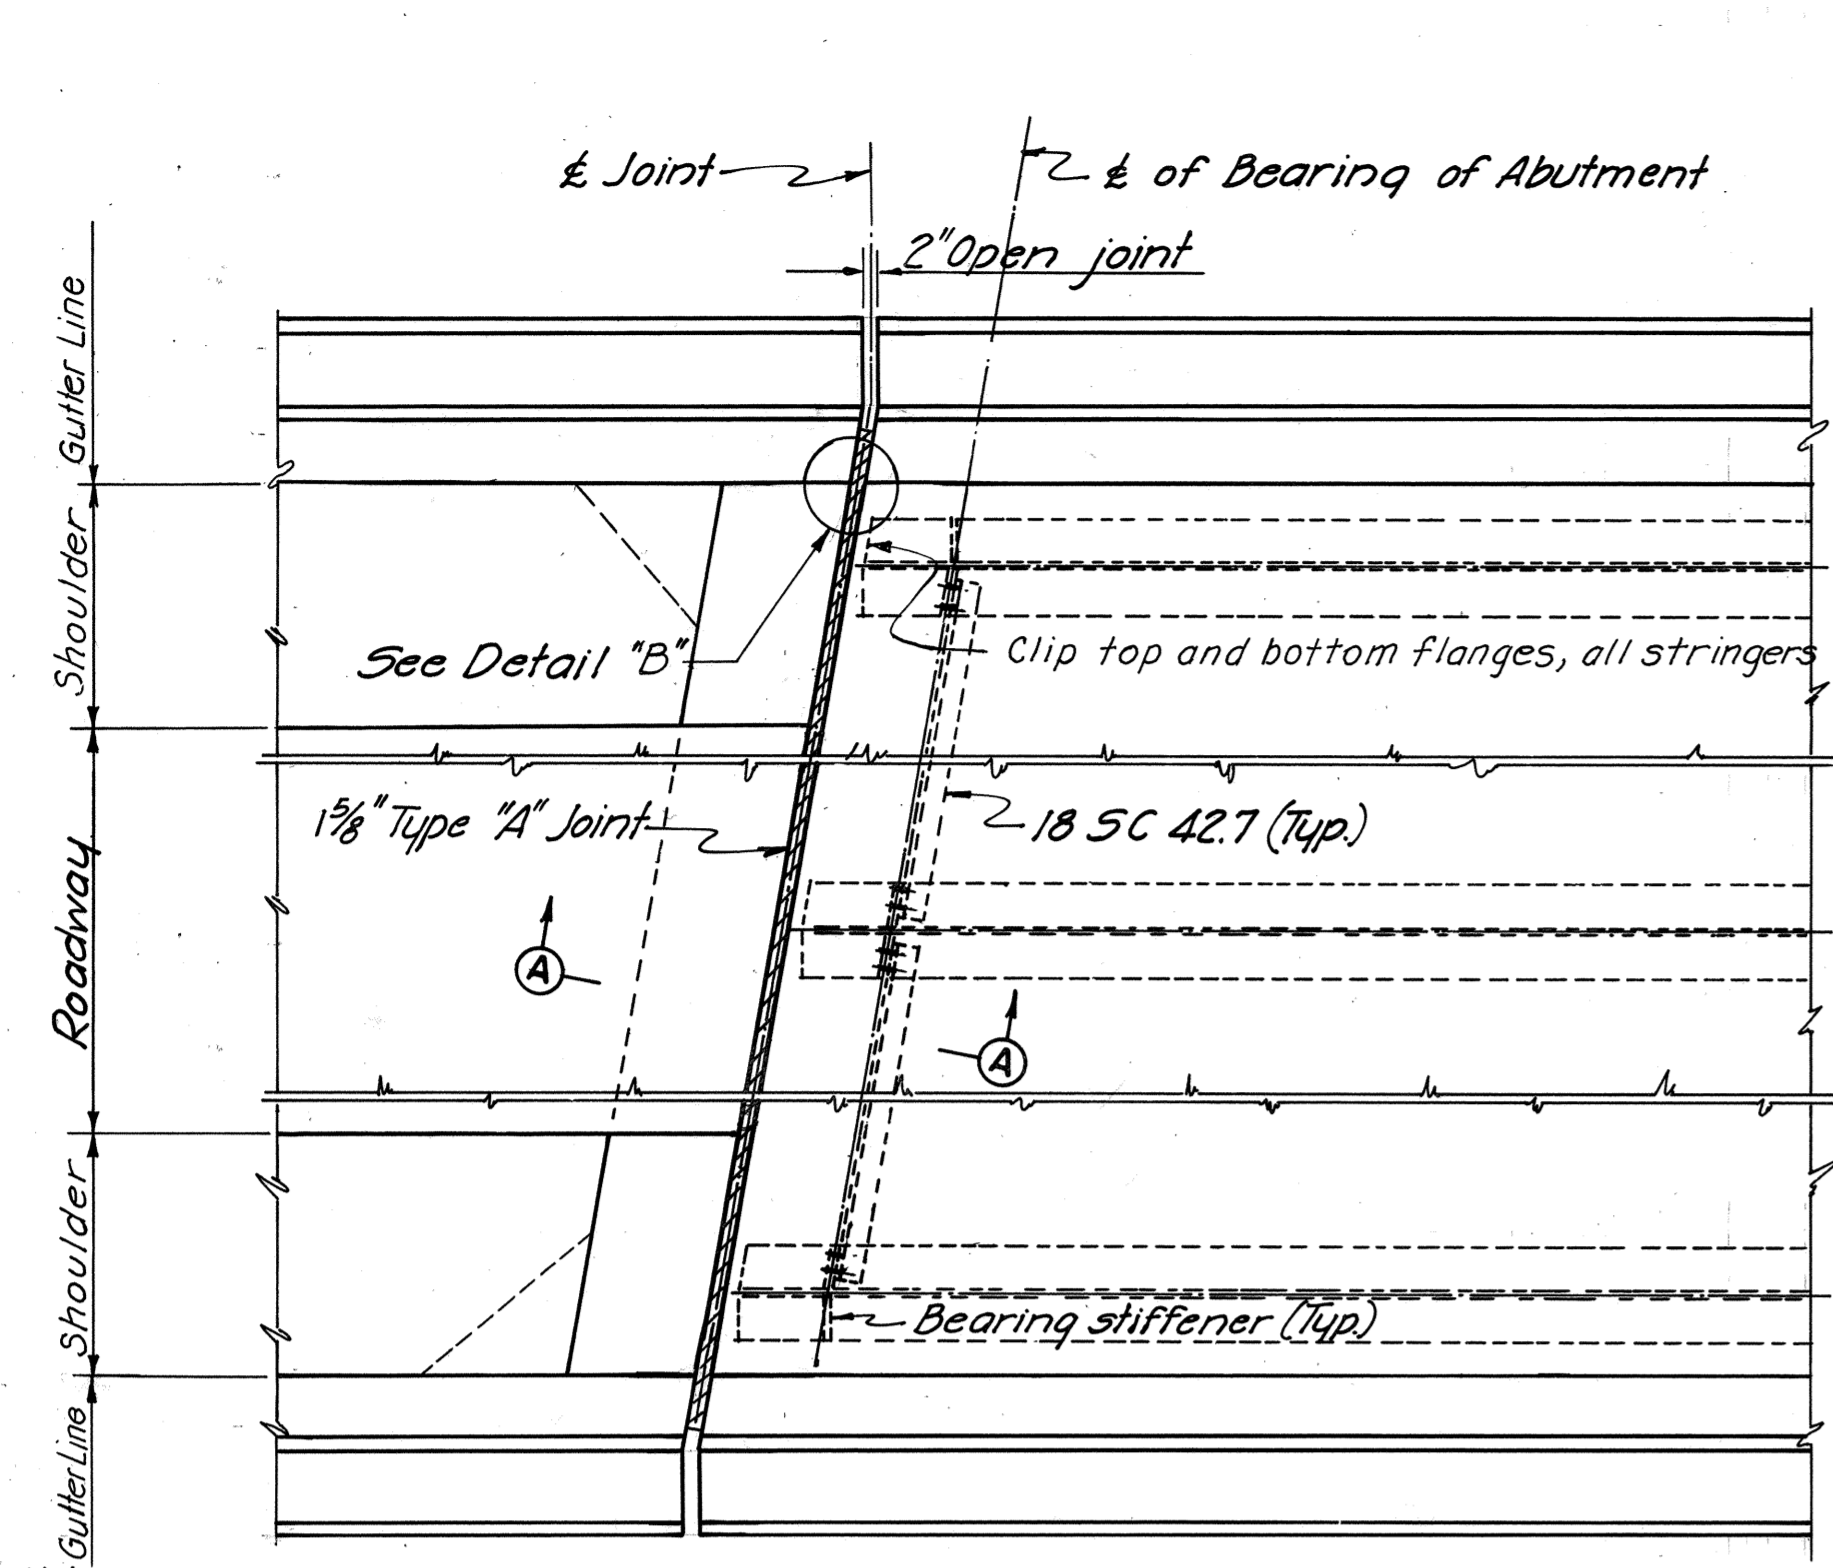


PLAN-JOINT AT WEST ABUTMENT
No Scale

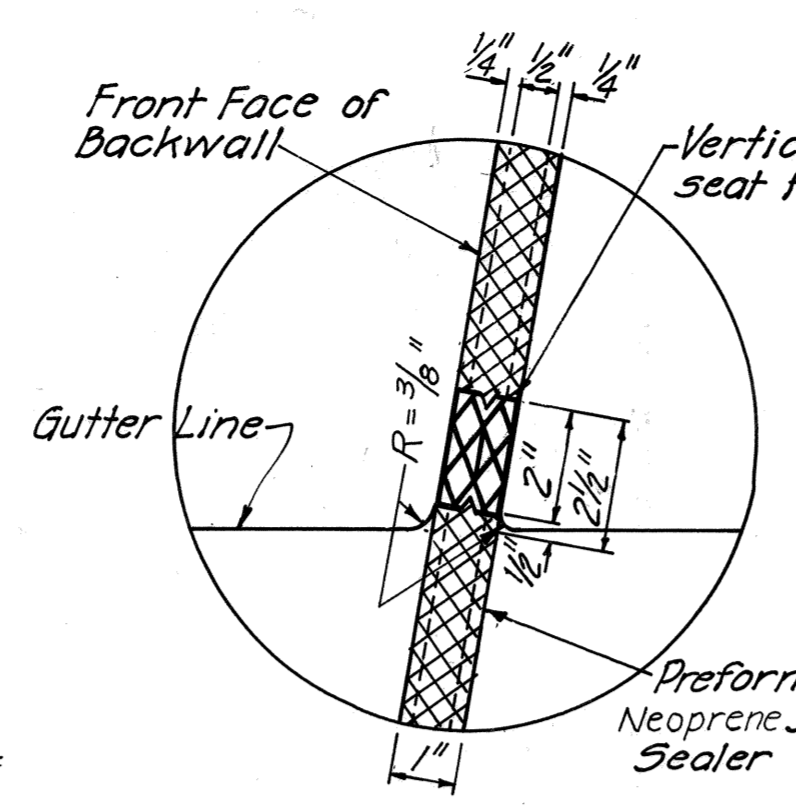


DETAIL "A"
No Scale

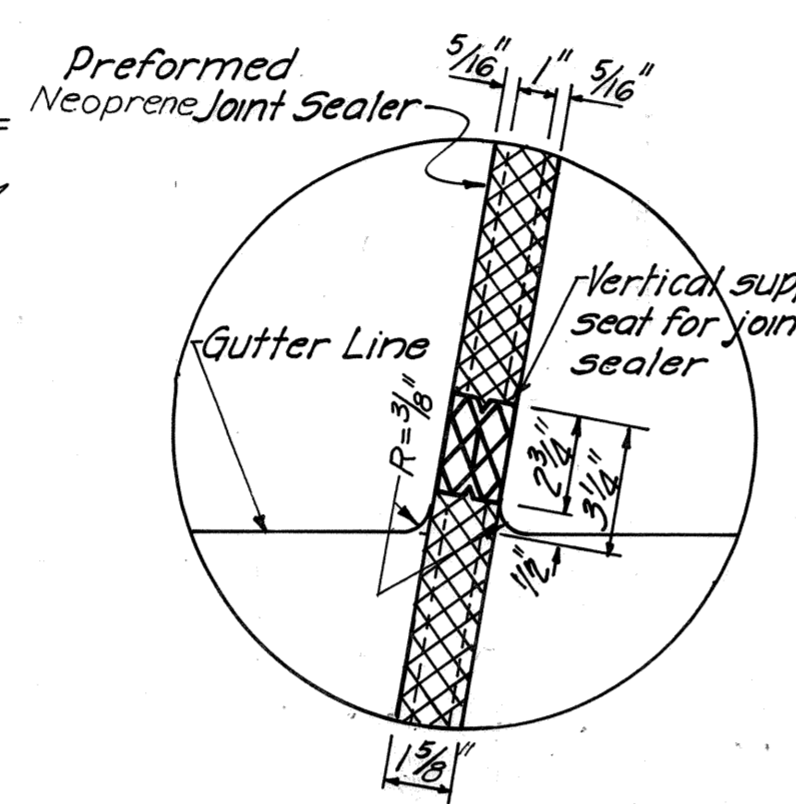

DETAIL "B"
No Scale

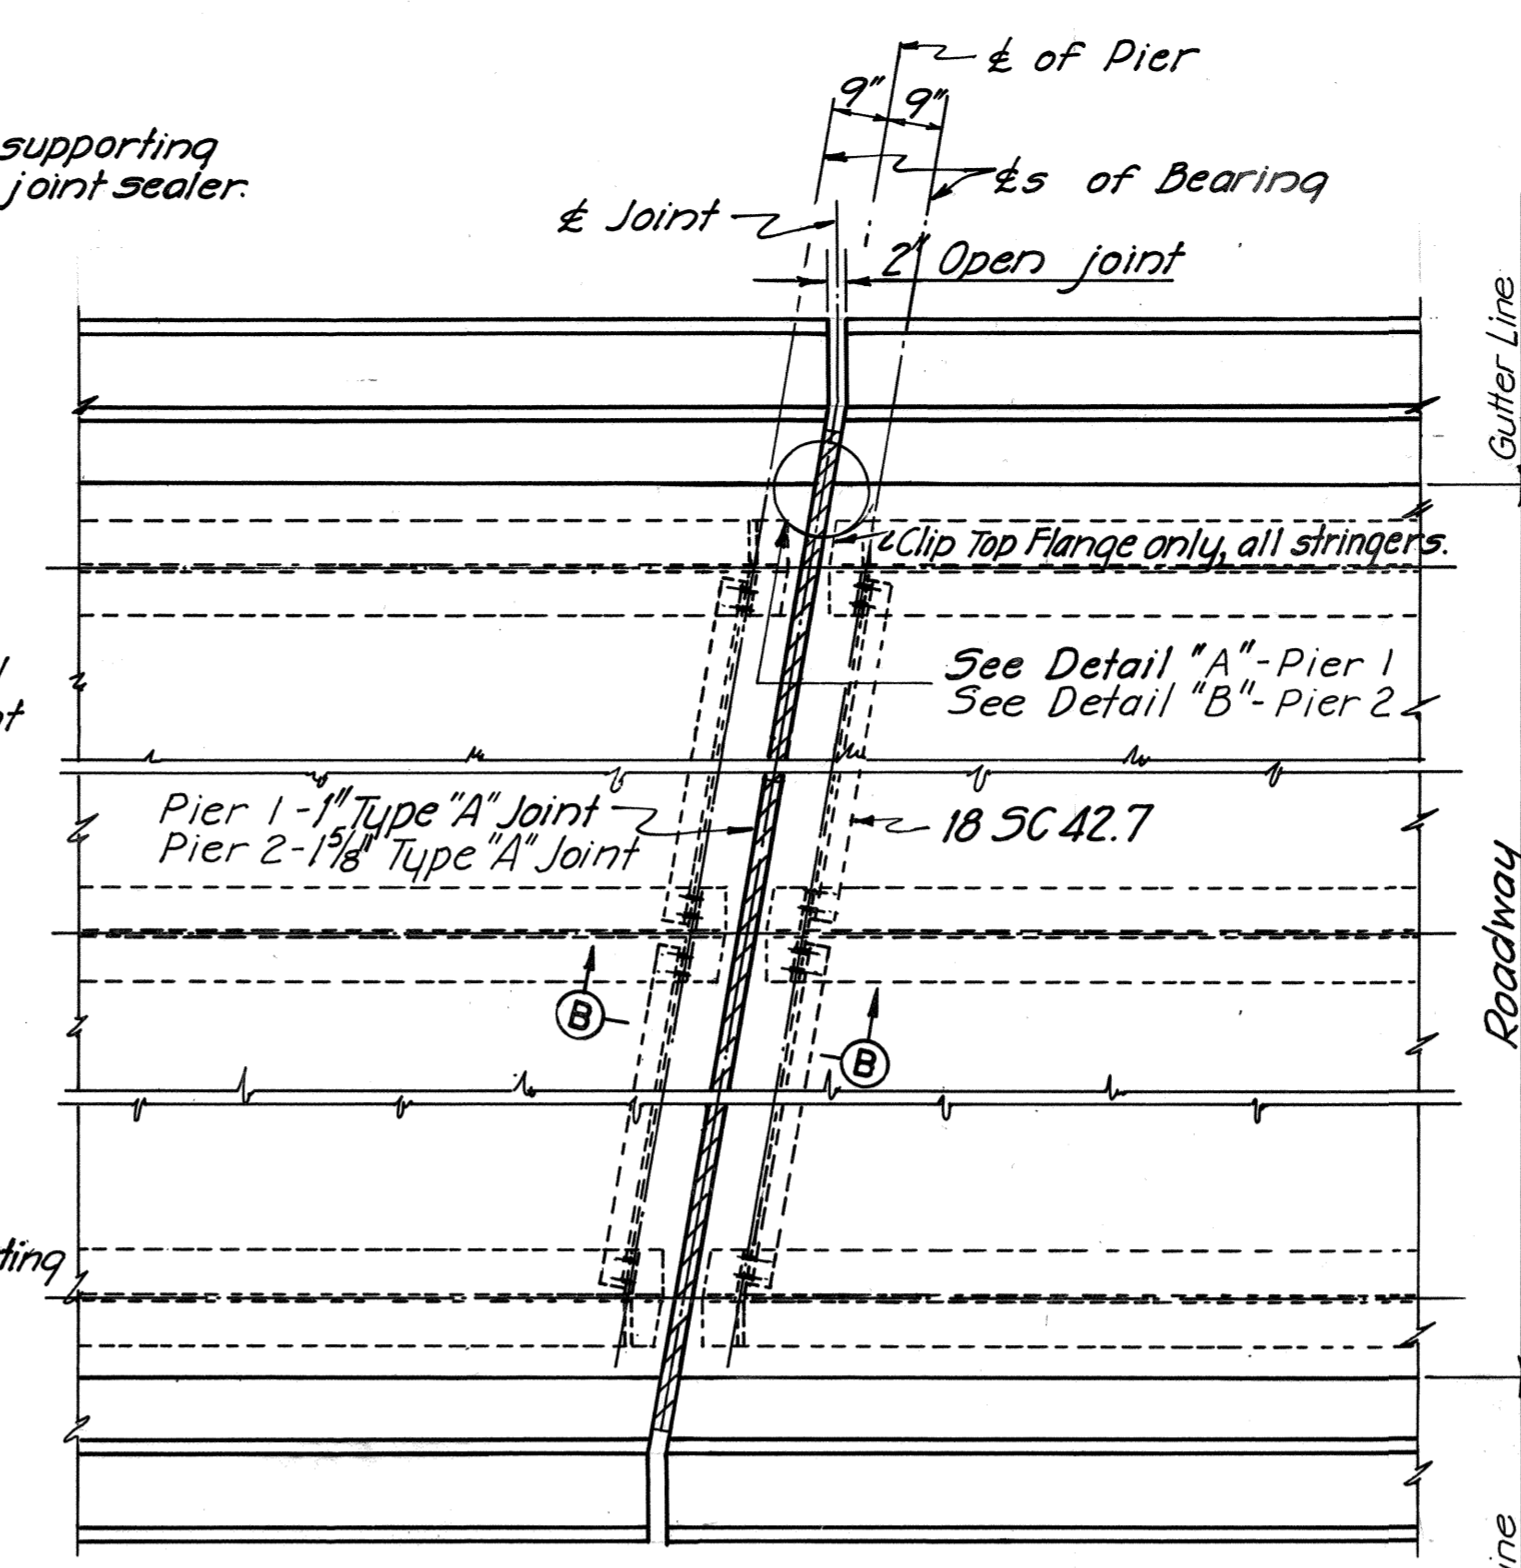


PLAN-JOINT AT PIER
No Scale

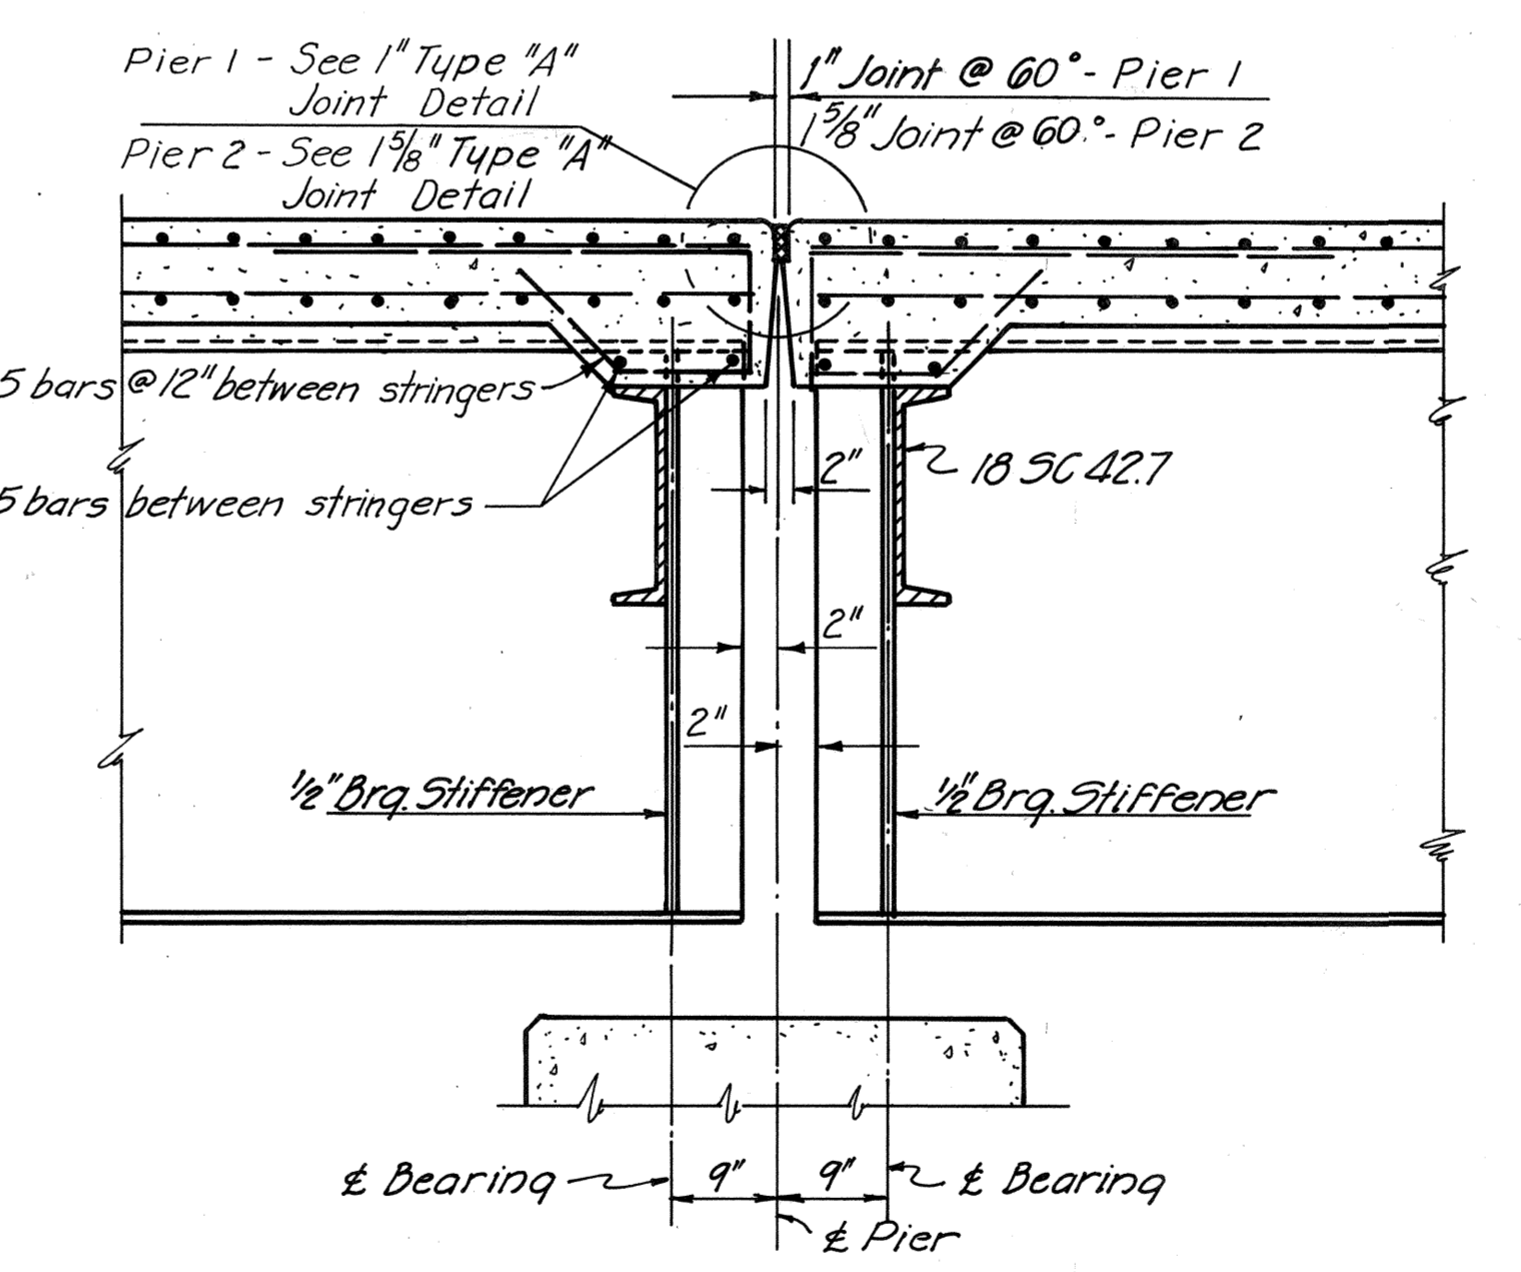


SECTION B-B
Scale: 3/4" = 1'-0"

Note: Joint at East Abutment is similar.

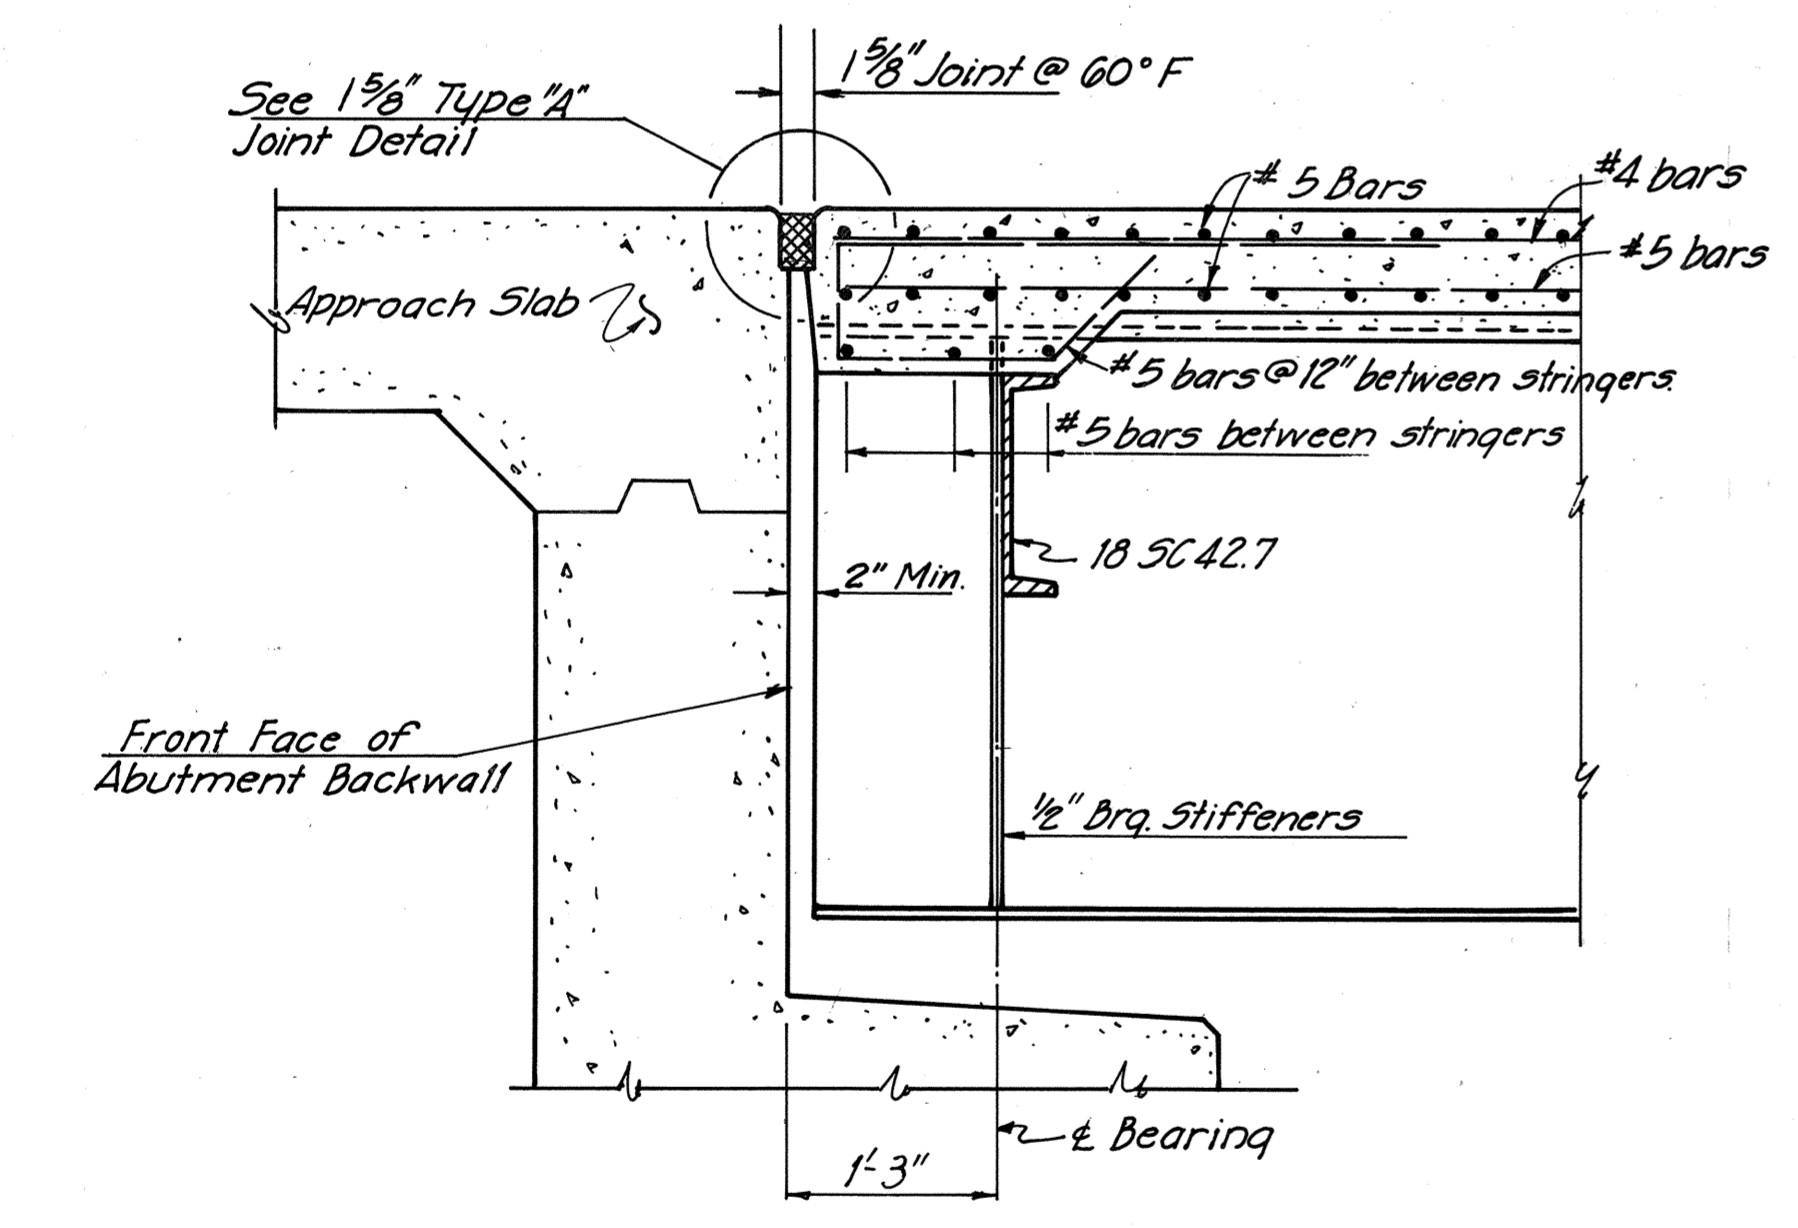


SECTION A-A
Scale: 3/4" = 1'-0"

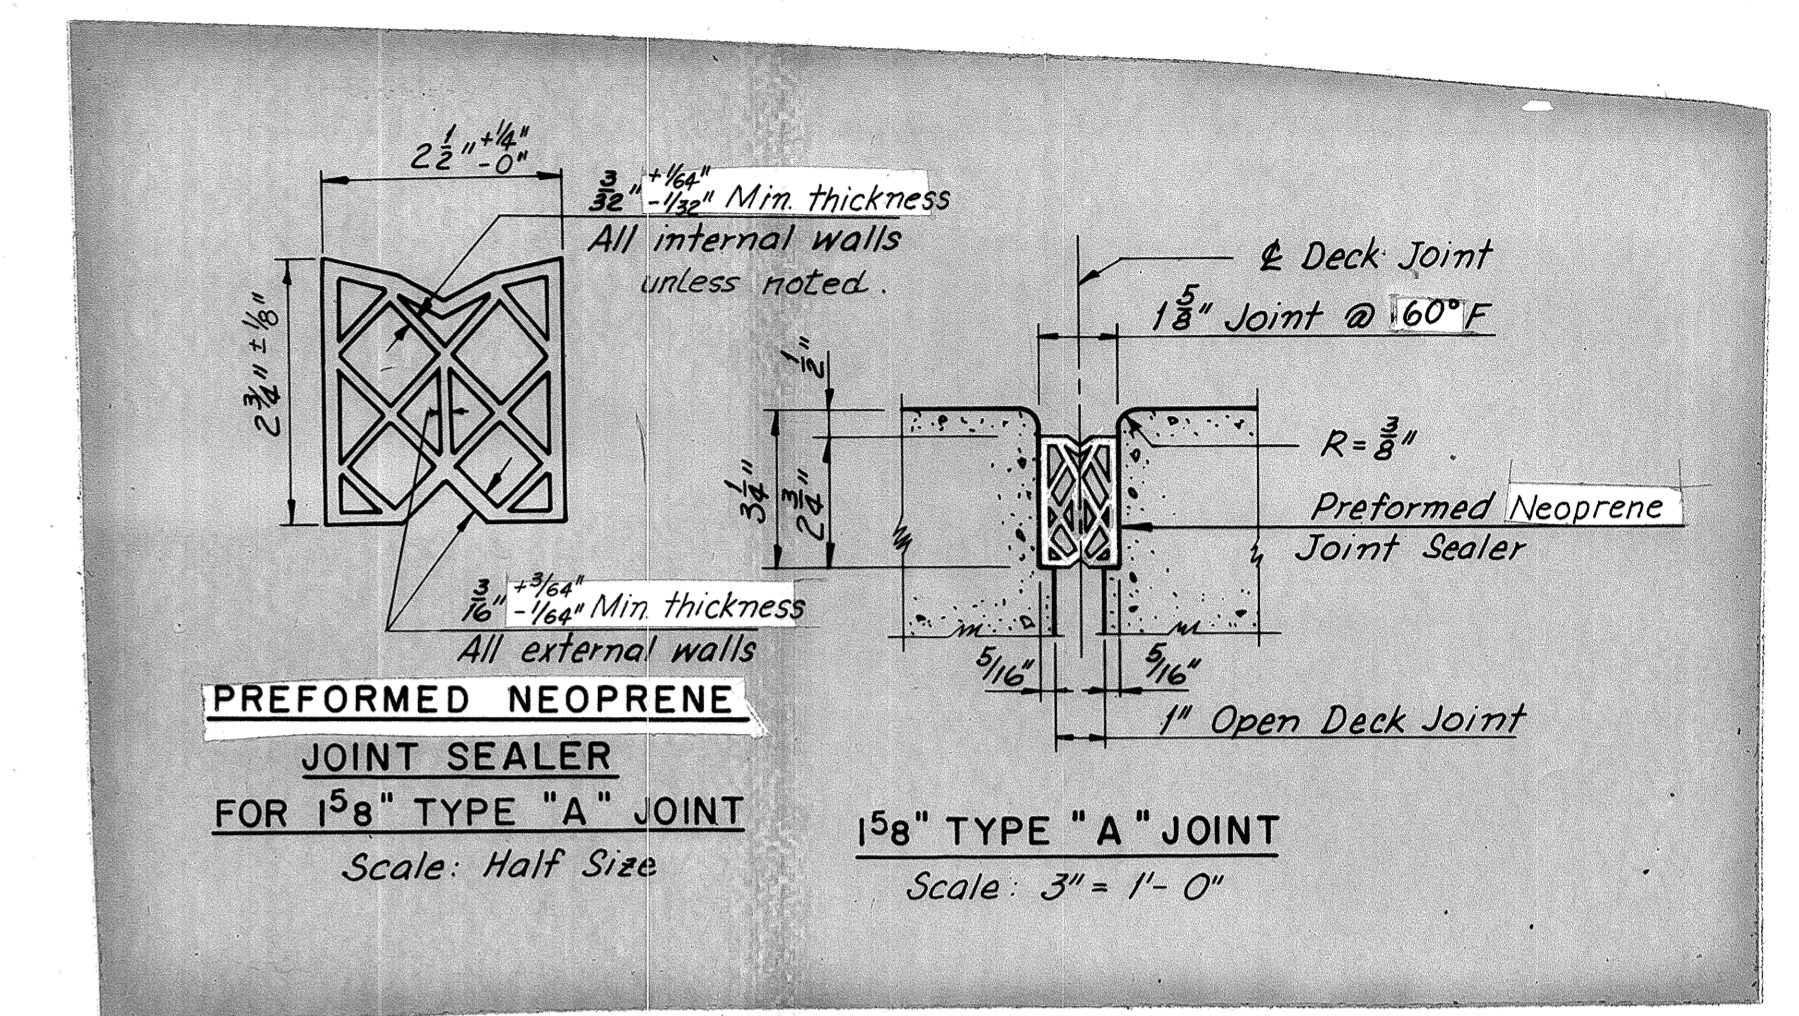


PREFORMED NEOPRENE JOINT SEALER FOR 1 1/2" TYPE "A" JOINT
Scale: Half Size

1 1/2" TYPE "A" JOINT
Scale: 3" = 1'-0"

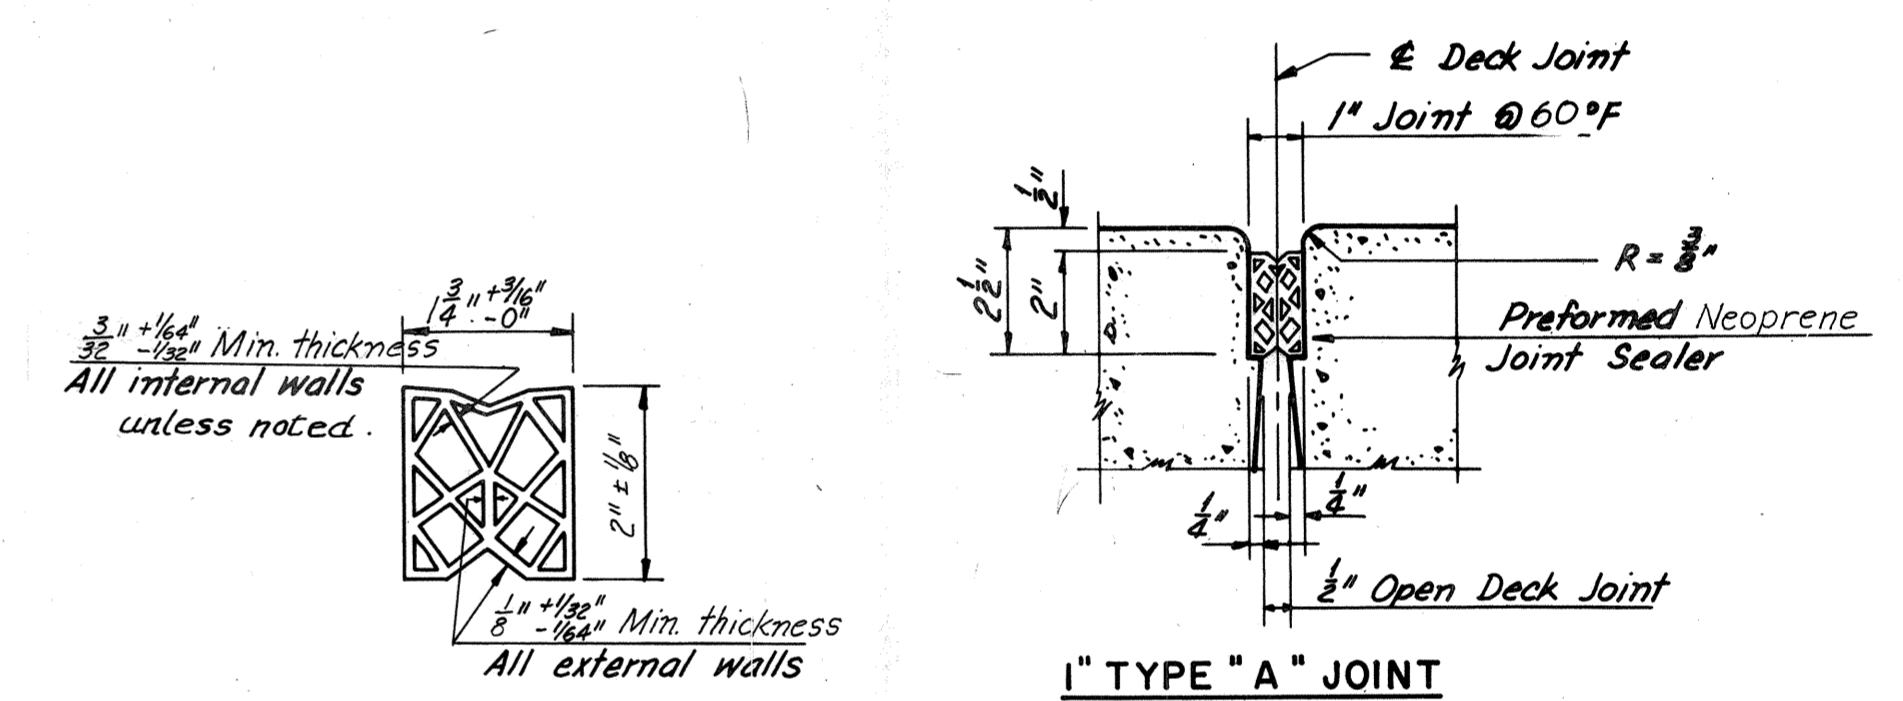

PREFORMED NEOPRENE JOINT SEALER FOR 1" TYPE "A" JOINT
Scale: Half Size

1" TYPE "A" JOINT
Scale: 3" = 1'-0"

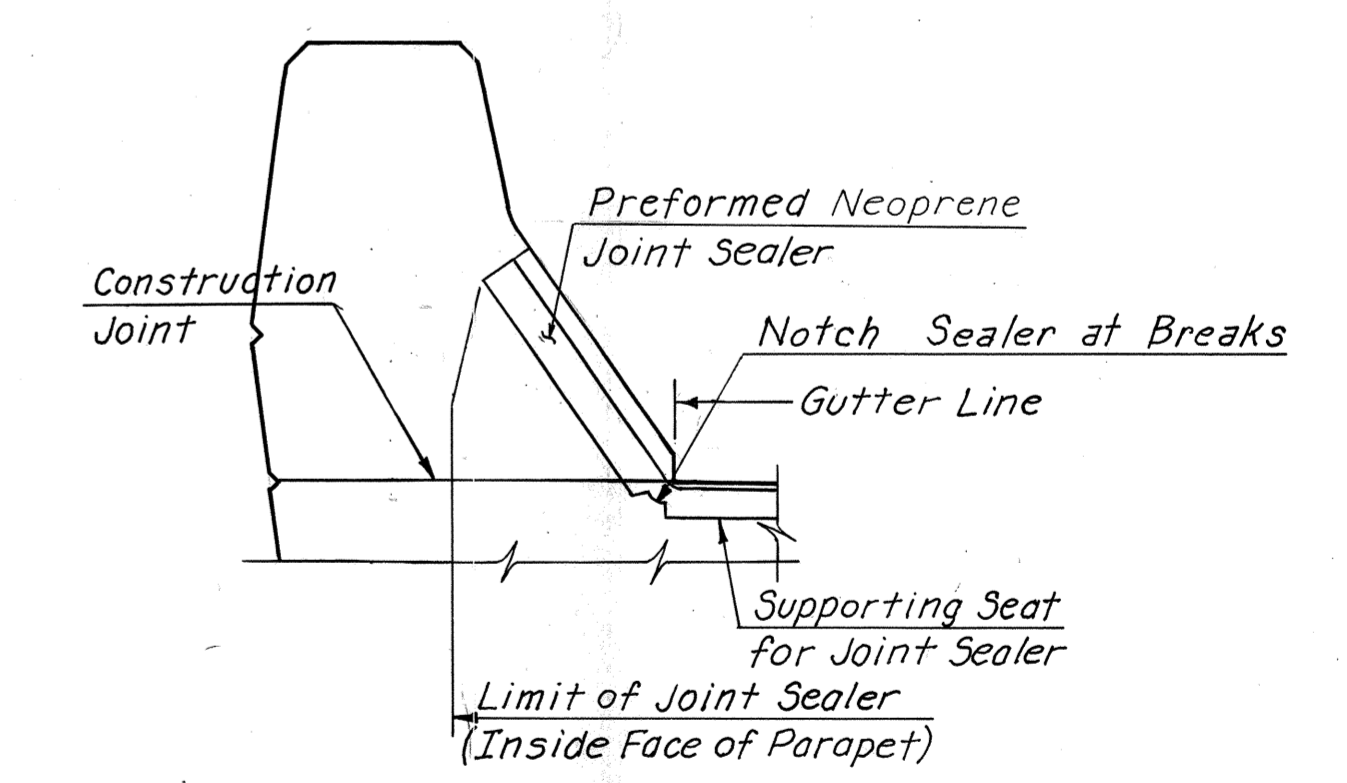

TREATMENT OF TYPE "A" JOINT AT GUTTER LINE
No Scale

NOTE TO CONTRACTOR.
It is absolutely essential that the openings for the preformed neoprene joint sealers be accurately formed and constructed to smooth, straight lines. The size of the opening shall be adjusted to allow for anticipated dead load rotation of the ends of the slab and for the temperature at the time of construction.

BY	DATE				
MADE	JLJ	1-68			
CHECKED	LDL	1-68	1	As Built	TEM 7-77
IN CHARGE	PRY		NO.	REVISION	BY DATE

AS BUILT

RICHMOND METROPOLITAN AUTHORITY
RICHMOND EXPRESSWAY SYSTEM
DOWNTOWN EXPRESSWAY

BRIDGE NO. 61
DOWNTOWN EXPRESSWAY WESTBOUND LANES
OVER 12TH ST.

JOINT DETAILS

HOWARD, NEEDLES, TAMMEN & BERGENDOFF
consulting engineers
NEW YORK ALEXANDRIA KANSAS CITY





SCALE: As Noted
CONTRACT NO.: 9
SHEET NO. 7 OF 10

Bridge 63

(Westbound Downtown Expressway “Rte. 195” over Virginia Street and South 14th Street “US Rte. 360”)

Record Set Plans

RICHMOND EXPRESSWAY SYSTEM			
SECTION	PROJECT	SHEET NO.	TOTAL SHEETS
10	DOWNTOWN EXPRESSWAY	70	265

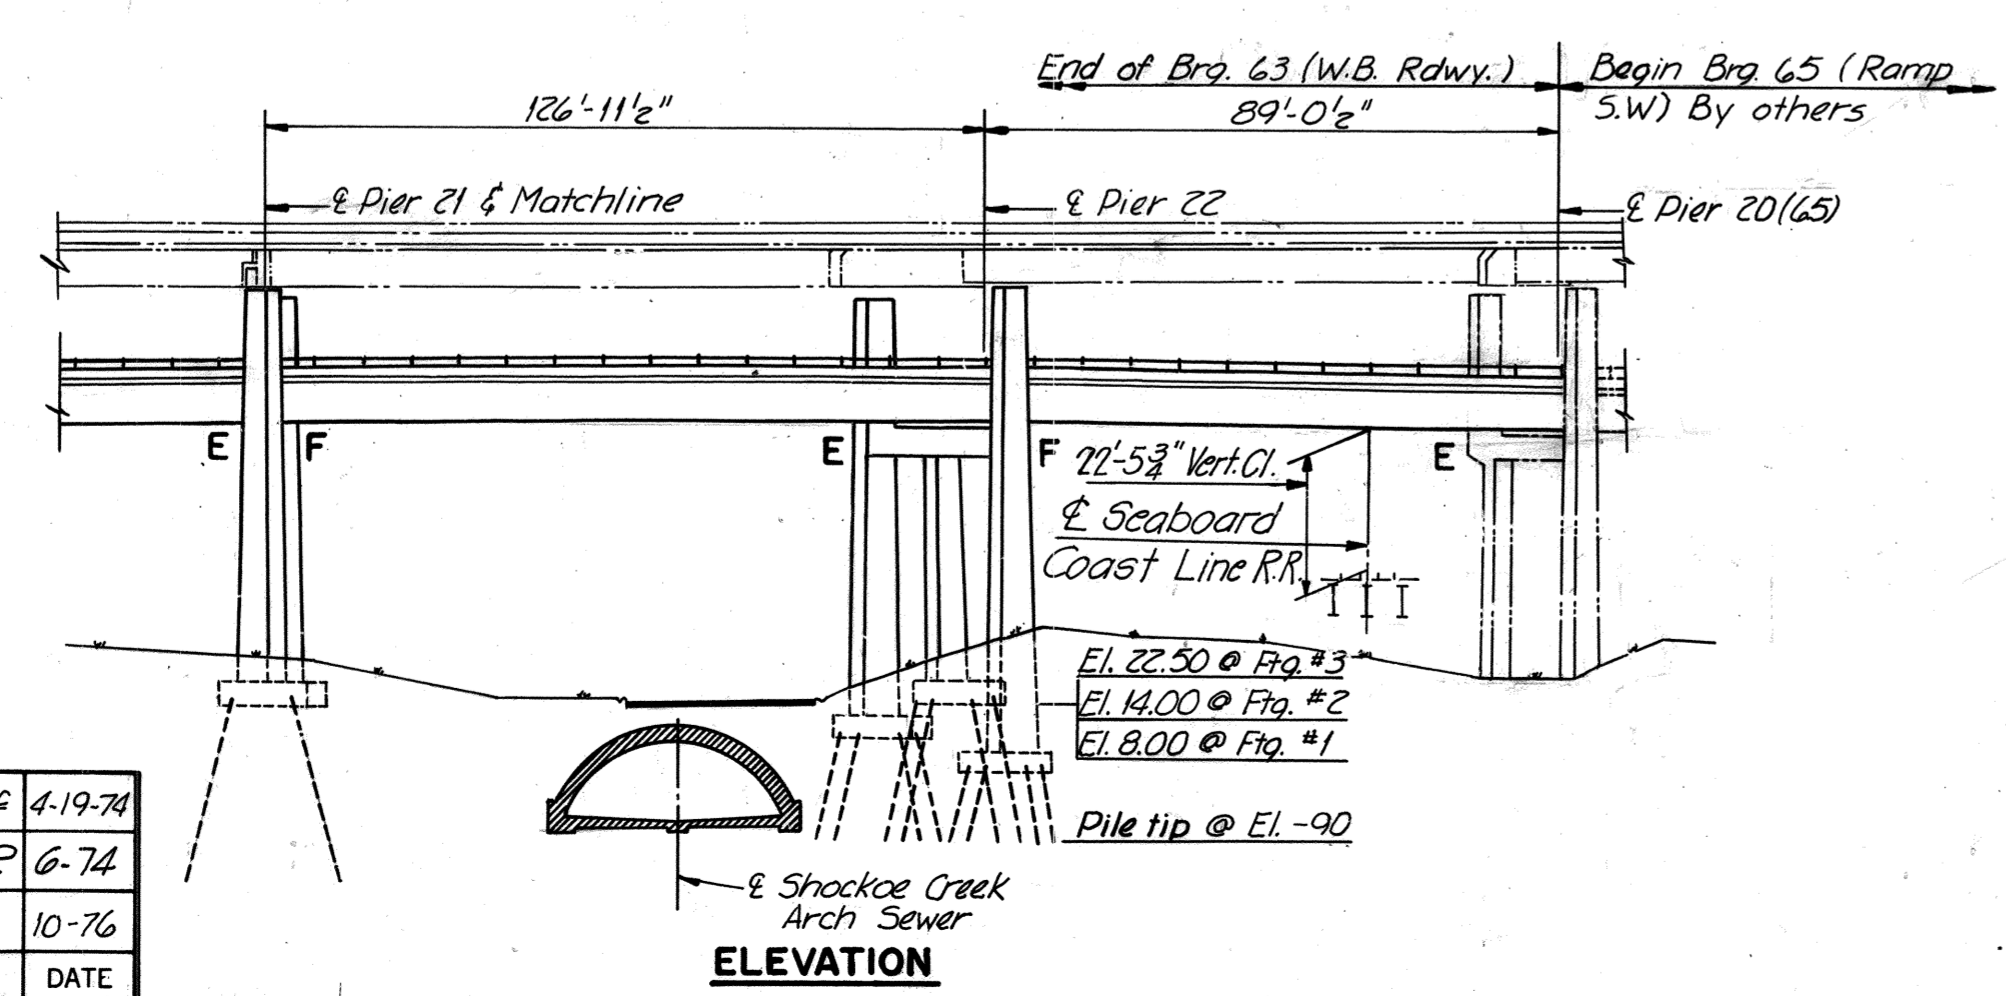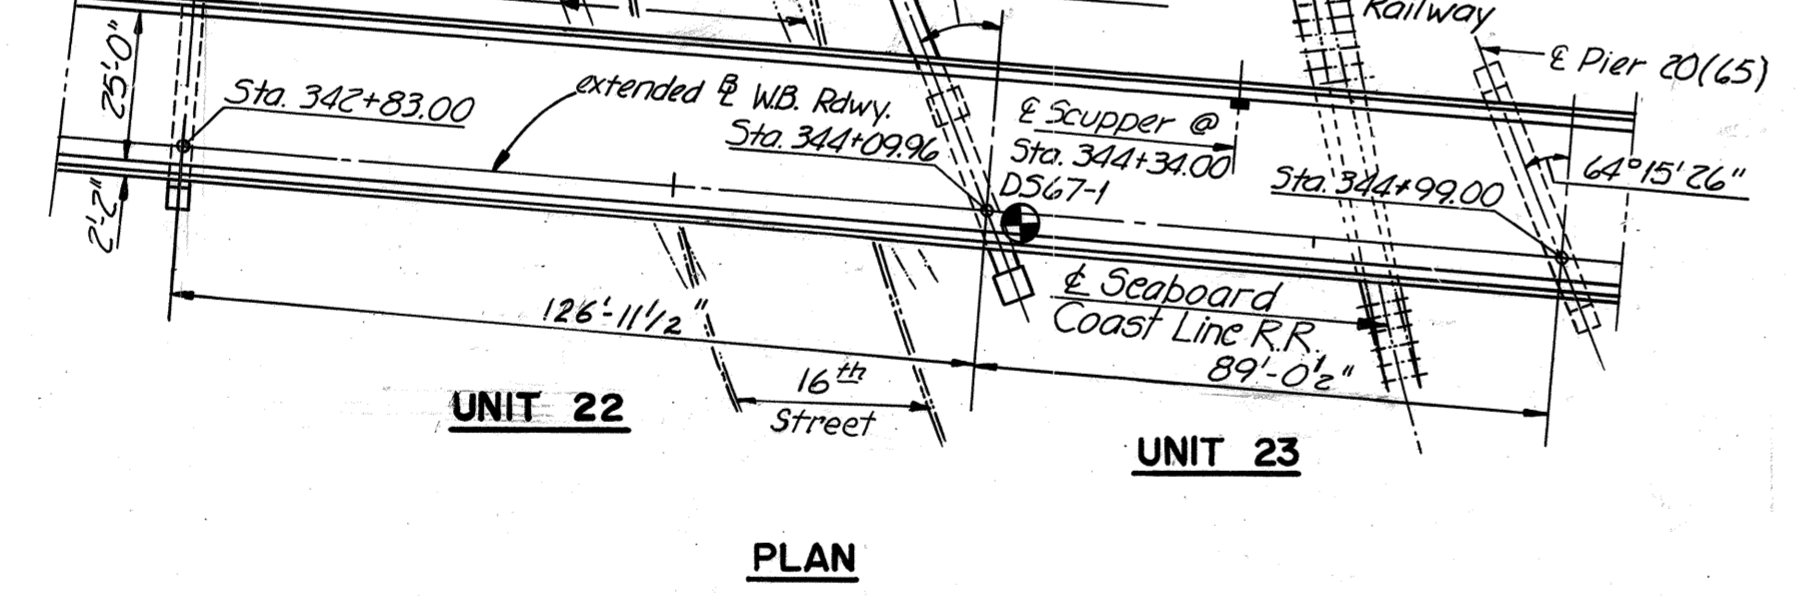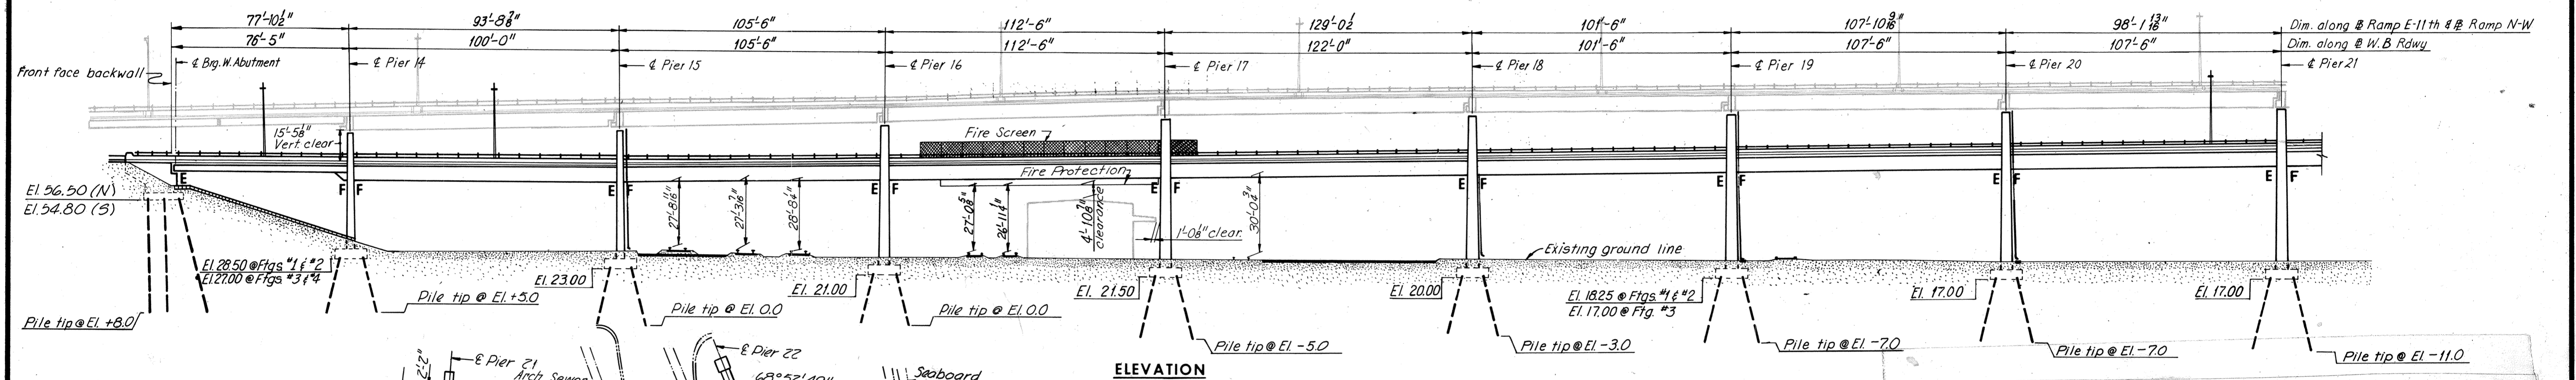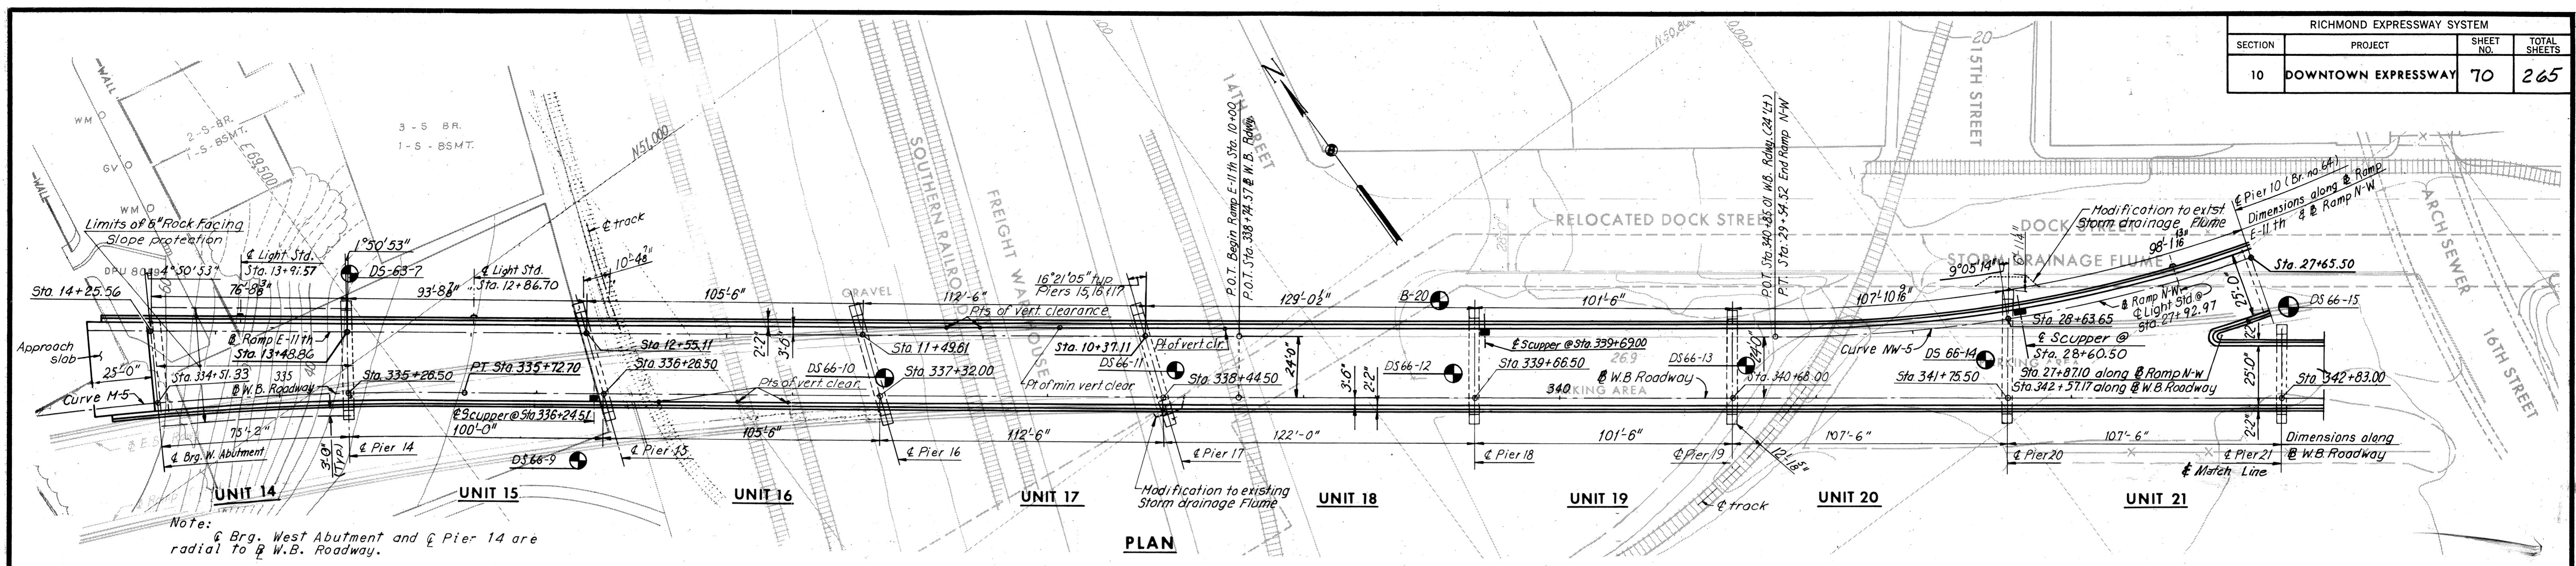

HORIZONTAL CURVE DATA

W.B. Roadway		Ramp N-W	
Curve	M-5	Curve	NW-5
P.I.	Sta. 334+26.15	P.I.	Sta. 28+25.38
Δ	11°45'56"	Δ	26°18'00"
D	4°00'	D	10°00'
T	147.59'	T	133.86'
L	294.14'	L	263.00'
R	1432.40'	R	572.96'

INDEX

GENERAL PLAN AND ELEVATION.	SHEET
QUANTITIES	1
WEST ABUTMENT	2
WEST ABUTMENT DETAILS	3
PIER 14	4
PIER 15	5
PIER 16	6
PIER 17	7
PIER 18 AND 19	8
PIER 20	9
PIER 21	10
PIER 22	11
FRAMING PLAN UNITS 14, 15 AND 16	12
FRAMING PLAN UNITS 17 AND 18	13
FRAMING PLAN UNITS 19, 20 AND 21	14
FRAMING DETAILS UNITS 20 AND 21	15
FRAMING PLAN UNITS 22 AND 23	16
DECK PLAN UNITS 14, 15 AND 16	17
DECK PLAN UNITS 17, 18 AND 19	18
DECK PLAN UNITS 19, 20 AND 21	19
DECK PLAN UNITS 22 AND 23	20
STRUCTURE DETAILS	21
FIRE PROTECTION DETAILS	22
JOINT DETAILS	23
APPROACH SLAB AND SLOPE PROTECTION DETAILS	24
BORING LOGS	25
STANDARD SHEETS	26 THRU 29
	30 THRU 37

Notes:
 For Estimated quantities and General Notes see Sheet 2.
 For Boring Logs see Sheets 26 Thru 29.
 For Layout of Pier 10(64) see Bridge No. 64 (Ramp N-W) Sheet 3.
 ⊙ Indicates boring location.
 Footing numbers (1,2, etc.) on each pier go from North to South.
 For Profile Grade Data see Sheet 2.

BY	DATE	Joint Type & Rail-Road Name Added	PRMS	4-19-74
MADE	Y.C.P.	1-9-69	K.D.P.	6-74
CHECKED	J.D.	3-13-69	TEM	10-76
IN CHARGE	FKD			

AS BUILT


RICHMOND METROPOLITAN AUTHORITY
RICHMOND EXPRESSWAY SYSTEM
DOWNTOWN EXPRESSWAY

BRIDGE NO. 63
WESTBOUND ROADWAY OVER
12TH ST. - R.R. TRACKS AND 16TH ST.
GENERAL PLAN AND ELEVATION

HOWARD, NEEDLES, TAMMEN & BERGENDOFF
 consulting engineers
 NEW YORK ALEXANDRIA KANSAS CITY


SCALE: 1" = 30'
 CONTRACT NO.: 10
 SHEET NO. 1 OF 29

RICHMOND EXPRESSWAY SYSTEM			
SECTION	PROJECT	SHEET NO.	TOTAL SHEETS
10	DOWNTOWN EXPRESSWAY	87	265

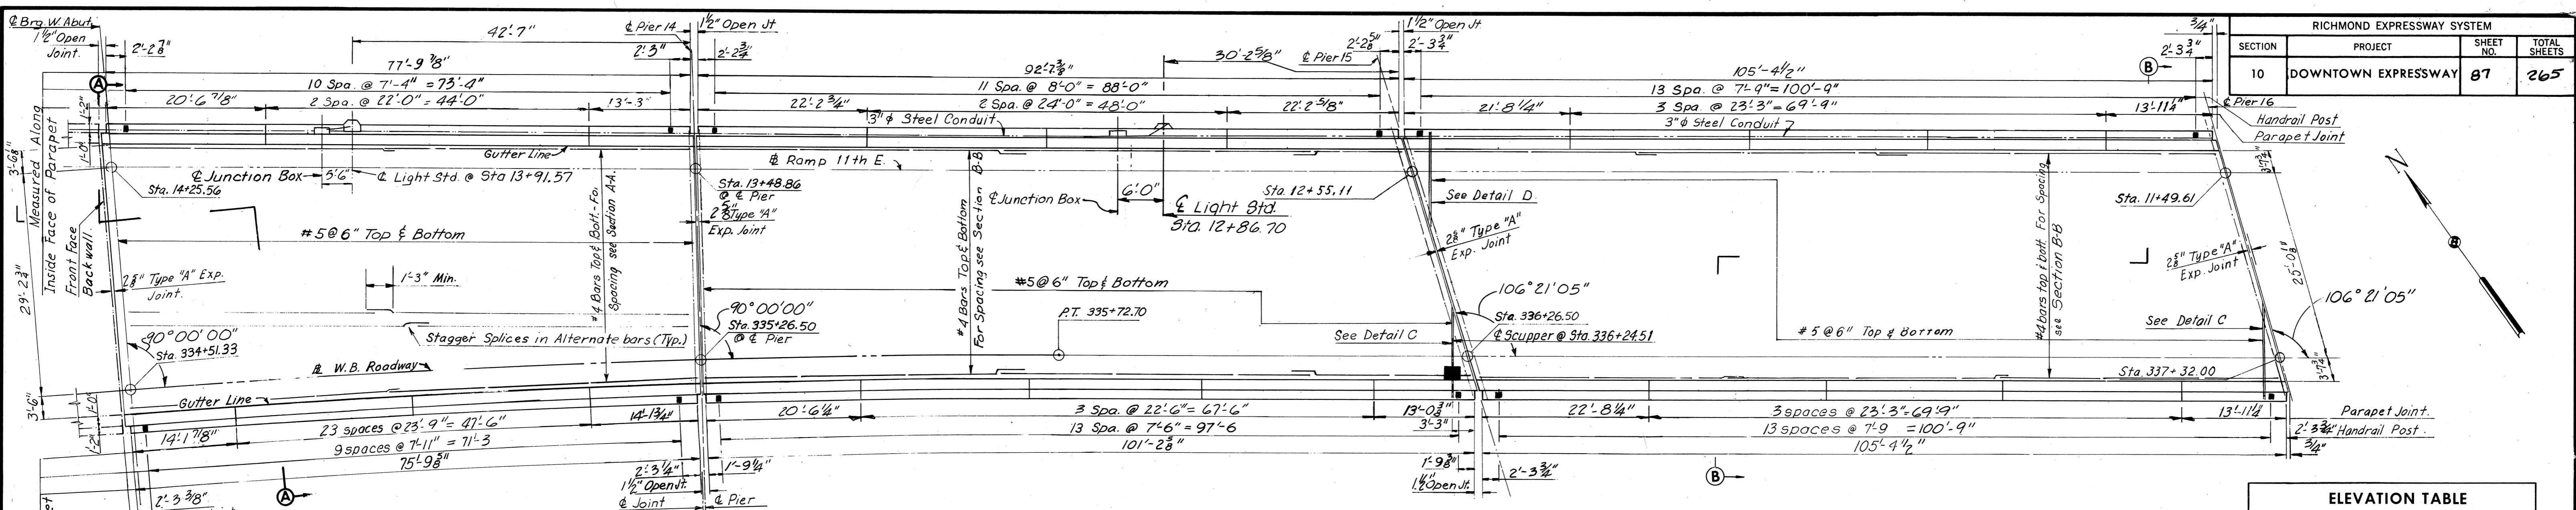


Notes:
 For End Diaphragms at Abutment, see Section A-A this Sheet.
 For End Diaphragms at Pier 14, Units 14 & 15, see Section A-A Sheet 14.
 For End Diaphragms at Pier 15, Units 15 & 16, see Section B-B this Sheet.
 For End Diaphragms at Pier 16, Unit 16, see Section B-B this Sheet.


ELEVATION TABLE			
STATION	ELEV. A	ELEV. B	ELEV. C
334+50.00	68.13	66.16	65.95
+51.50	68.10	66.13	65.92
+60.00	67.89	65.97	65.76
+70.00	67.65	65.78	65.57
+80.00	67.42	65.58	65.37
+90.00	67.17	65.39	65.18
335+00.00	66.92	65.20	64.99
+10.00	66.67	65.02	64.81
+20.00	66.43	64.85	64.65
+26.50	66.28	64.74	64.55
+30.00	66.20	64.69	64.50
+40.00	65.99	64.55	64.37
+50.00	65.78	64.43	64.26
+60.00	65.61	64.32	64.16
+70.00	65.46	64.23	64.07
+80.00	65.32	64.15	64.00
+90.00	65.20	64.09	63.95
336+00.00	65.09	64.04	63.91
+10.00	65.00	64.01	63.88
+18.58	64.93	---	---
+20.00	64.92	63.99	63.87
+26.50	---	63.99	---
+27.38	---	---	63.87
+30.00	64.86	63.99	63.87
+40.00	64.81	64.00	63.90
+50.00	64.78	64.03	63.94
+60.00	64.76	64.07	63.99
+70.00	64.76	64.13	64.05
+80.00	64.78	64.21	64.13
+90.00	64.81	64.30	64.23
337+00.00	64.85	64.40	64.34
+10.00	64.91	64.51	64.46
+20.00	64.97	64.62	64.58
+24.08	64.96	---	---
+30.00	65.00	64.74	64.71
+32.00	---	64.76	---
+32.88	---	---	64.74
+40.00	65.05	64.85	64.83

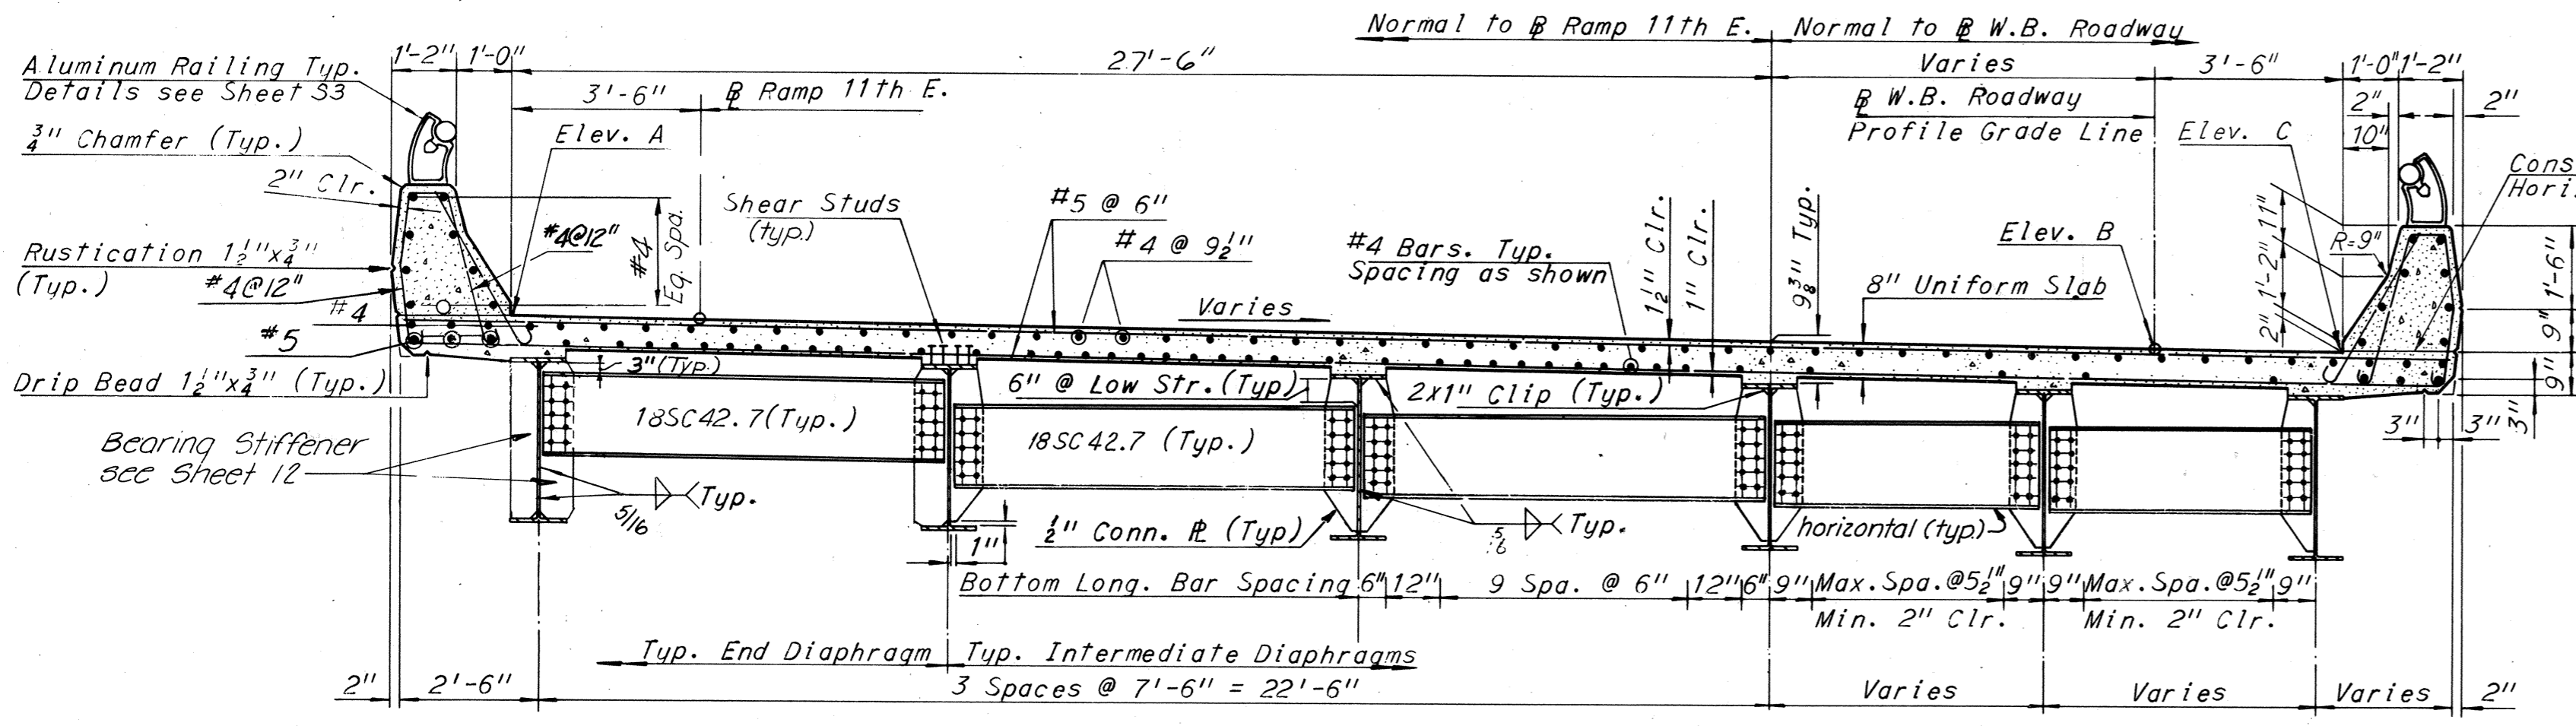


SECTION A-A
 Scale: 3/8" = 1'-0"

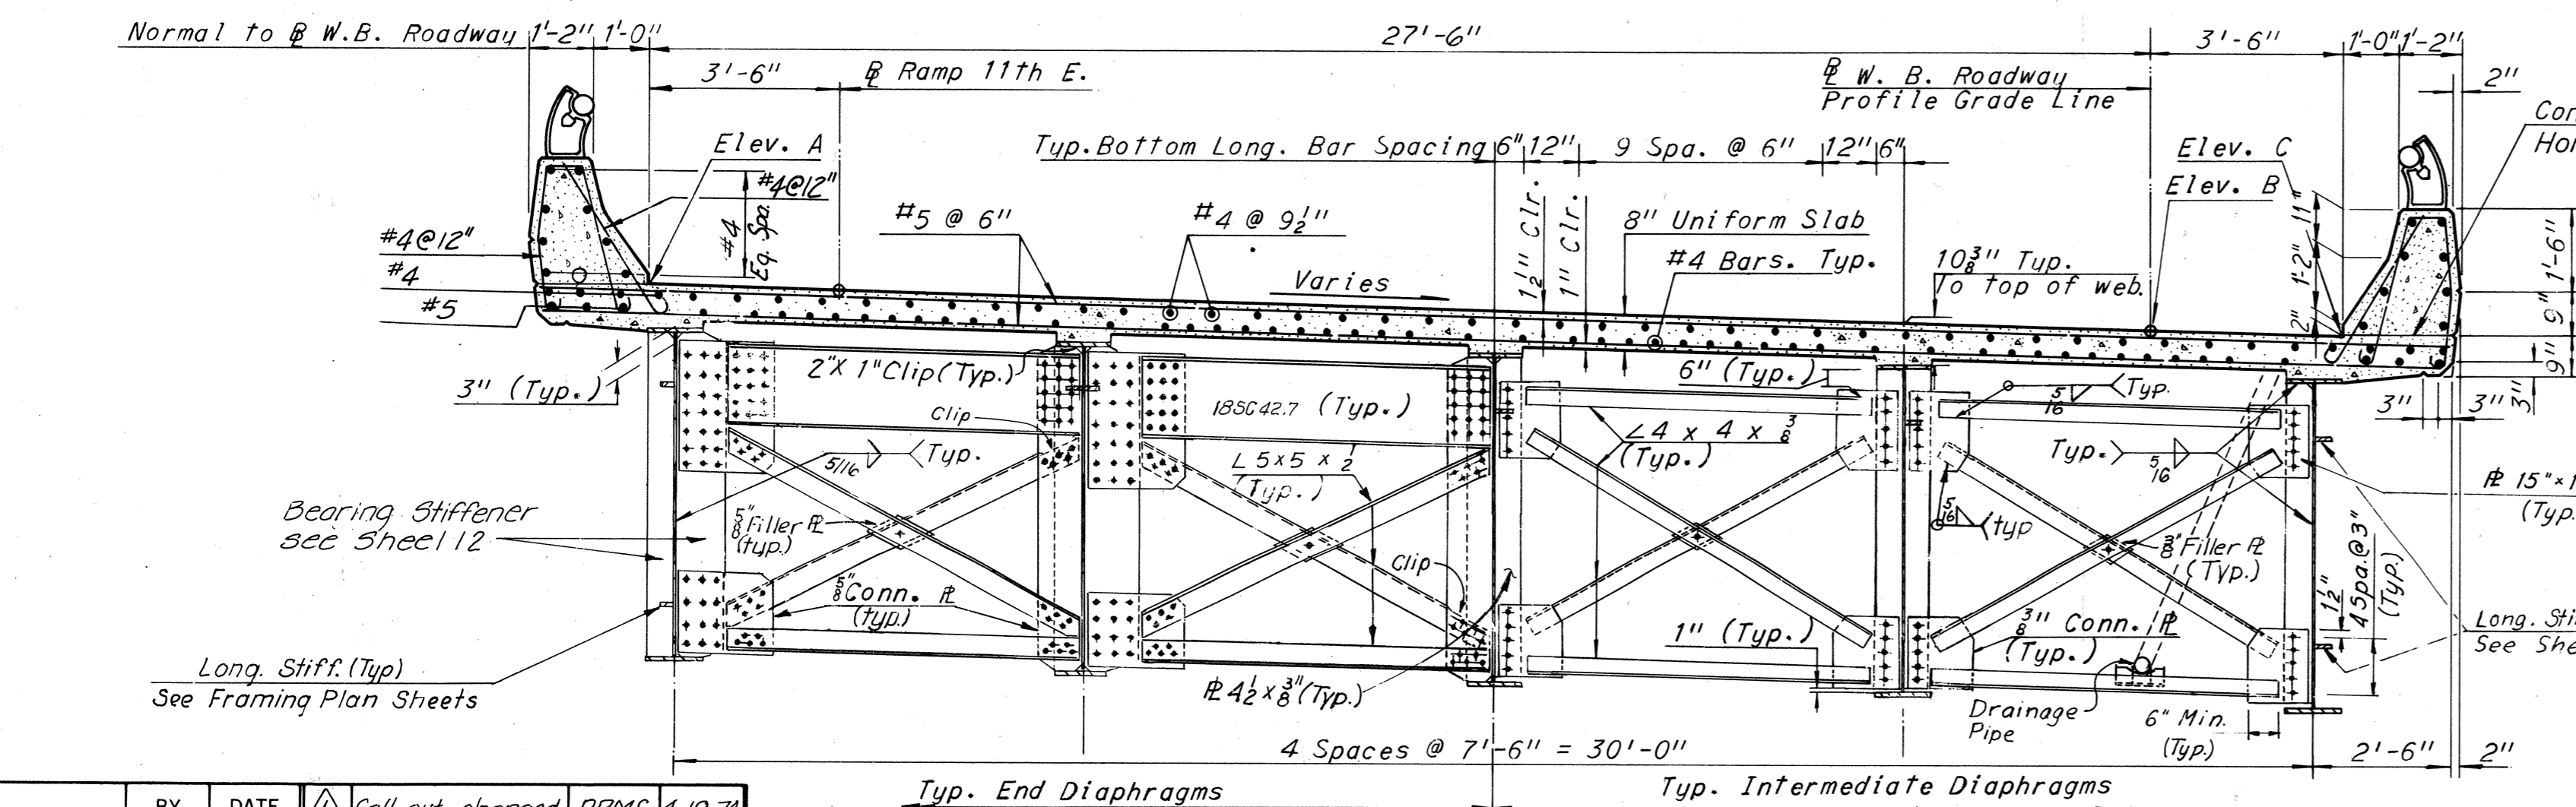

SECTION B-B
 Scale: 3/8" = 1'-0"

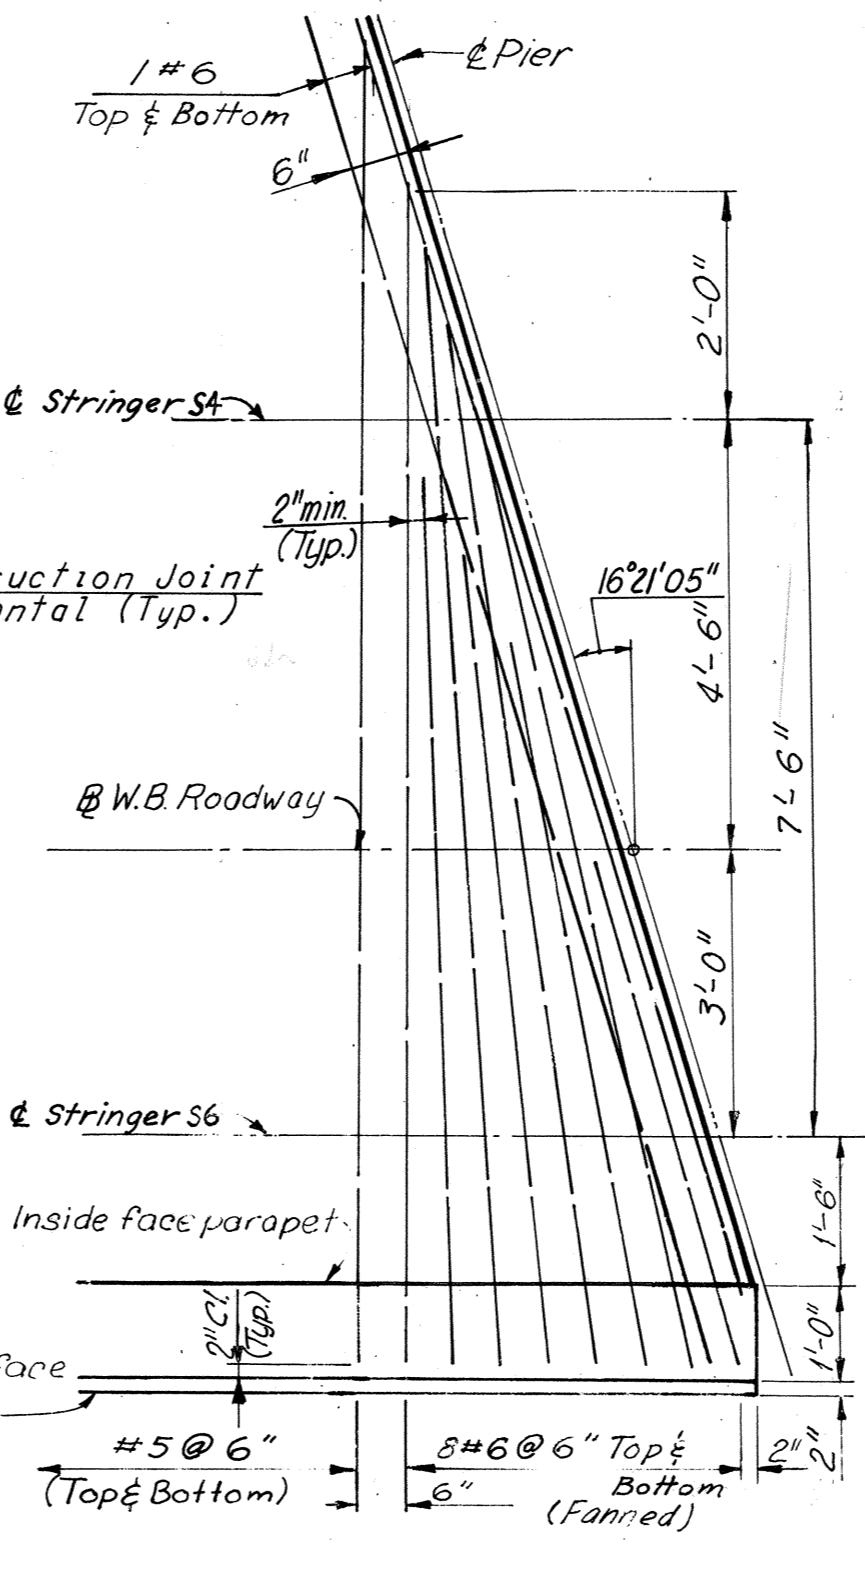

DETAIL C
 Scale: 1" = 2'-0"

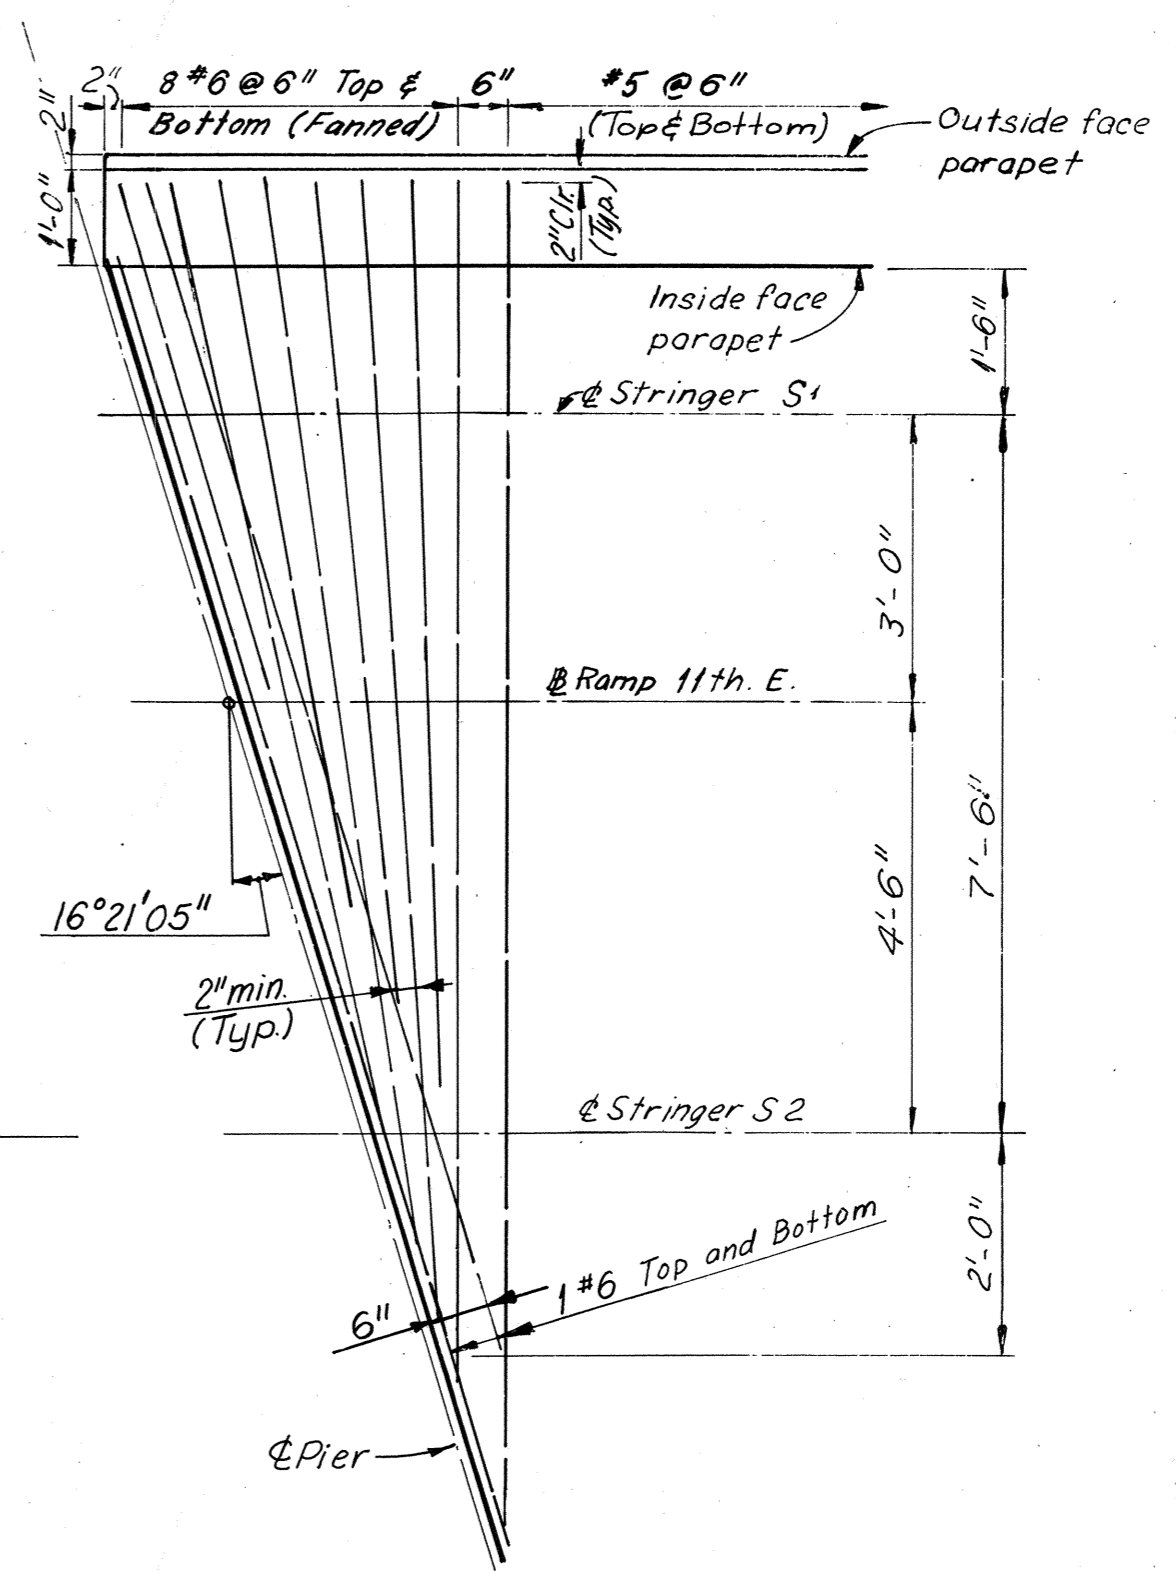

DETAIL D
 Scale: 1" = 2'-0"

Notes:
 For Superstructure quantities, see Sheet 2.
 For Framing plan, see Sheet 13.
 For Joint details, see Sheet 24.
 For Railing details, see Sheet 53.
 For Standard Drainage Details, see Support Type 2 Sheet 55 & 56.

BY	DATE	Call-out changed	PRMS	4-19-78
MADE	SHS	8-2-68	2	As Built
CHECKED	R.C.	10-23-68		
IN CHARGE				
	NO.	REVISION	BY	DATE

RICHMOND METROPOLITAN AUTHORITY
RICHMOND EXPRESSWAY SYSTEM
DOWNTOWN EXPRESSWAY


BRIDGE NO. 63
WESTBOUND ROADWAY OVER
12TH ST. - R.R. TRACKS AND 16TH ST.
DECK PLAN - UNITS 14, 15, AND 16

HOWARD, NEEDLES, TAMMEN & BERGENDOFF
 consulting engineers
 NEW YORK ALEXANDRIA KANSAS CITY

SCALE: _____
 CONTRACT NO. **10**
 SHEET NO. **18** OF **29**





AS BUILT

RICHMOND EXPRESSWAY SYSTEM			
SECTION	PROJECT	SHEET NO.	TOTAL SHEETS
10	DOWNTOWN EXPRESSWAY	88	265

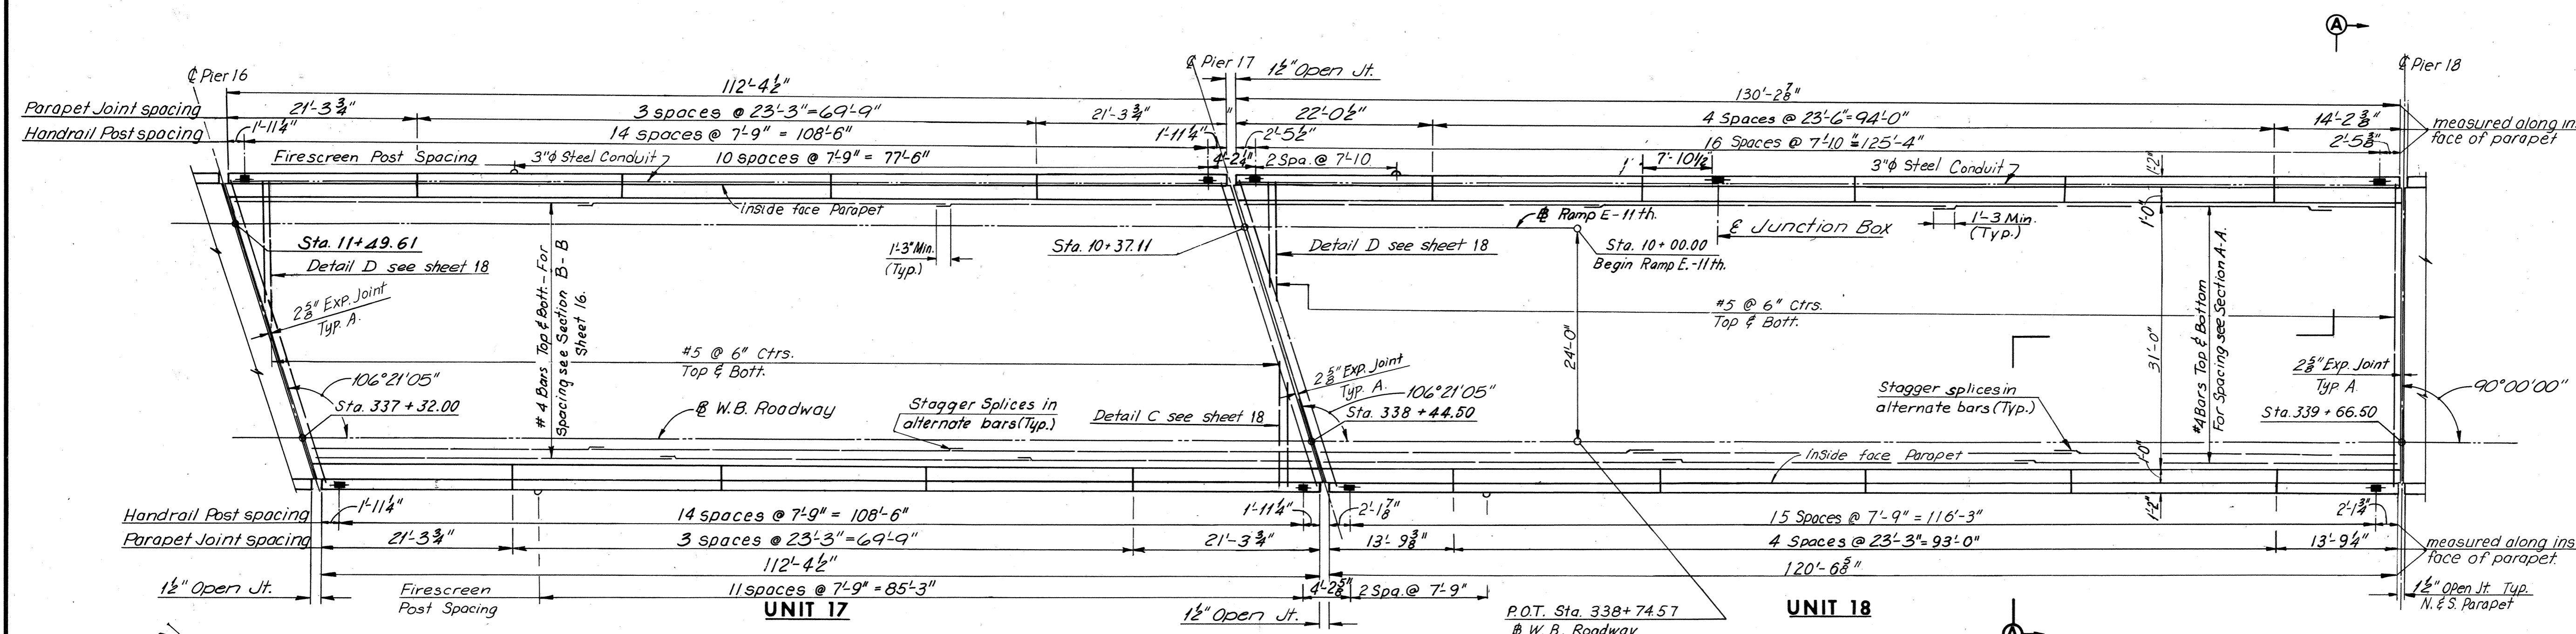


ELEVATION TABLE			
STATION	ELEV. A	ELEV. B	ELEV. C
337+24.08	64.97	—	—
+30.00	65.01	64.74	64.71
+32.00	—	64.76	—
+32.88	—	—	64.75
+40.00	65.05	64.85	64.83
+50.00	65.11	64.96	64.94
+60.00	65.16	65.07	65.06
+70.00	65.22	65.18	65.18
+80.00	65.27	65.30	65.30
+90.00	65.33	65.41	65.42
338+00.00	65.38	65.52	65.54
+10.00	65.44	65.63	65.65
+20.00	65.49	65.74	65.78
+30.00	65.55	65.86	65.90
+40.00	65.61	65.97	66.02
+44.50	—	66.02	—
+50.00	65.66	66.08	66.13
+60.00	65.73	66.19	66.25
+70.00	65.80	66.30	66.37
+80.00	65.89	66.42	66.49
+90.00	65.98	66.53	66.60
339+00.00	66.09	66.64	66.71
+10.00	66.20	66.75	66.82
+20.00	66.31	66.86	66.93
+30.00	66.43	66.98	67.05
+40.00	66.54	67.09	67.16
+50.00	66.65	67.20	67.27
+60.00	66.76	67.31	67.38
+66.50	—	67.39	—

Note: Spacing of posts for fire screen shall match handrail post spacing.

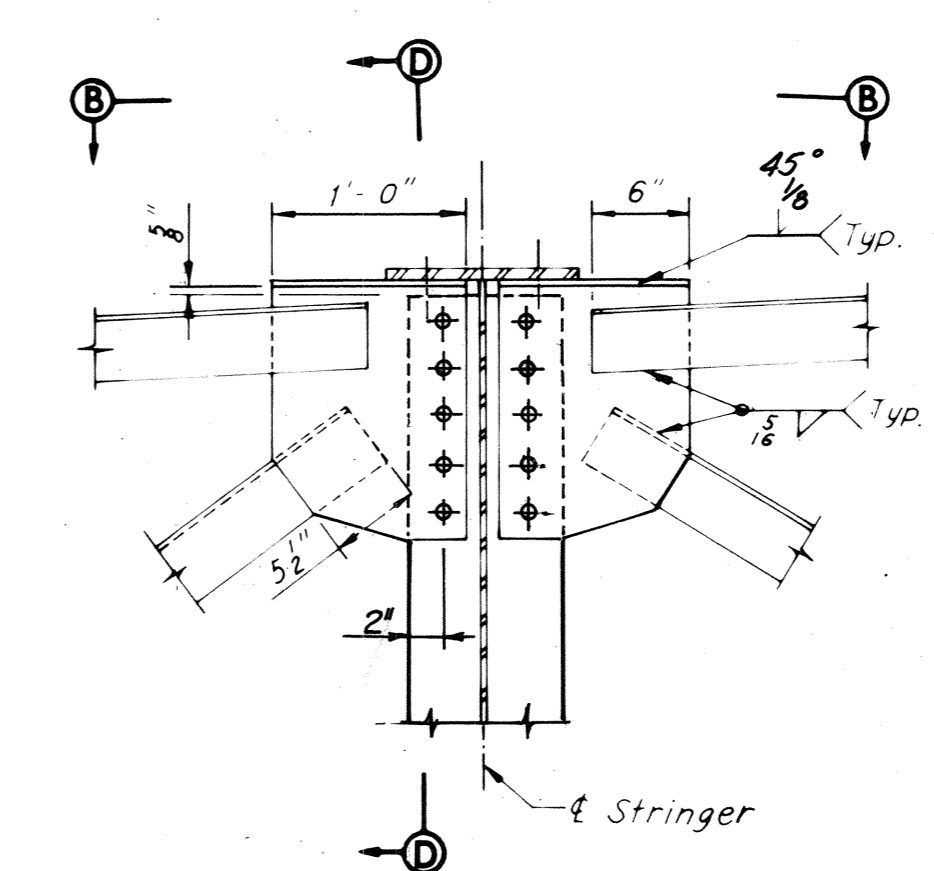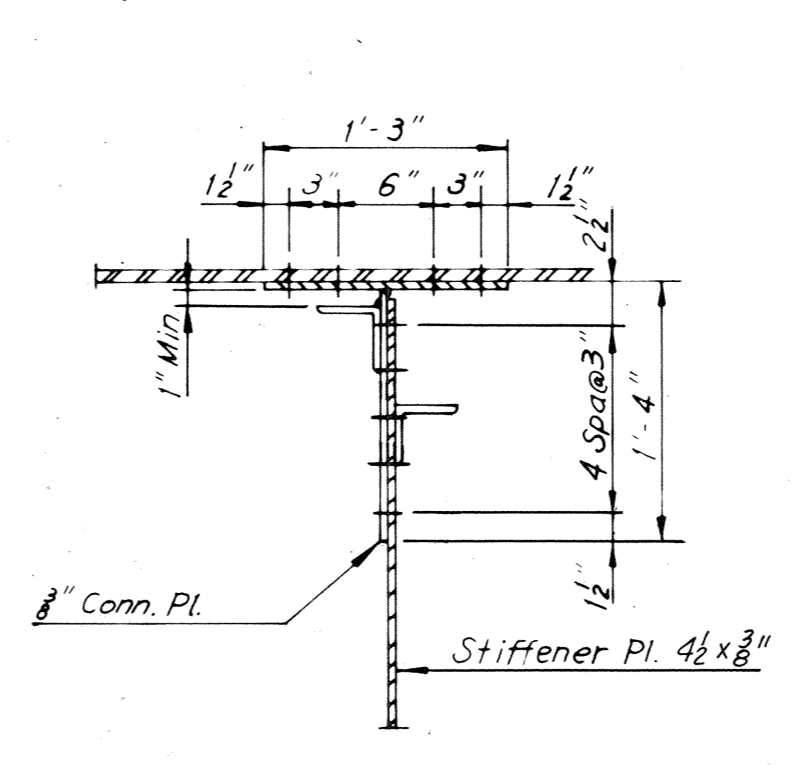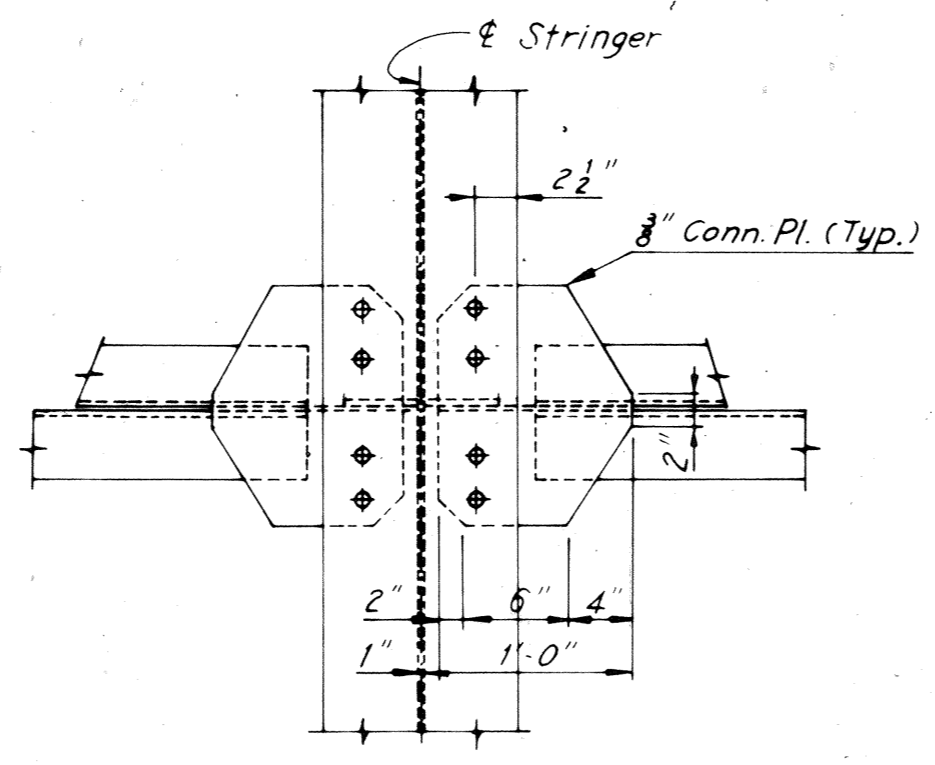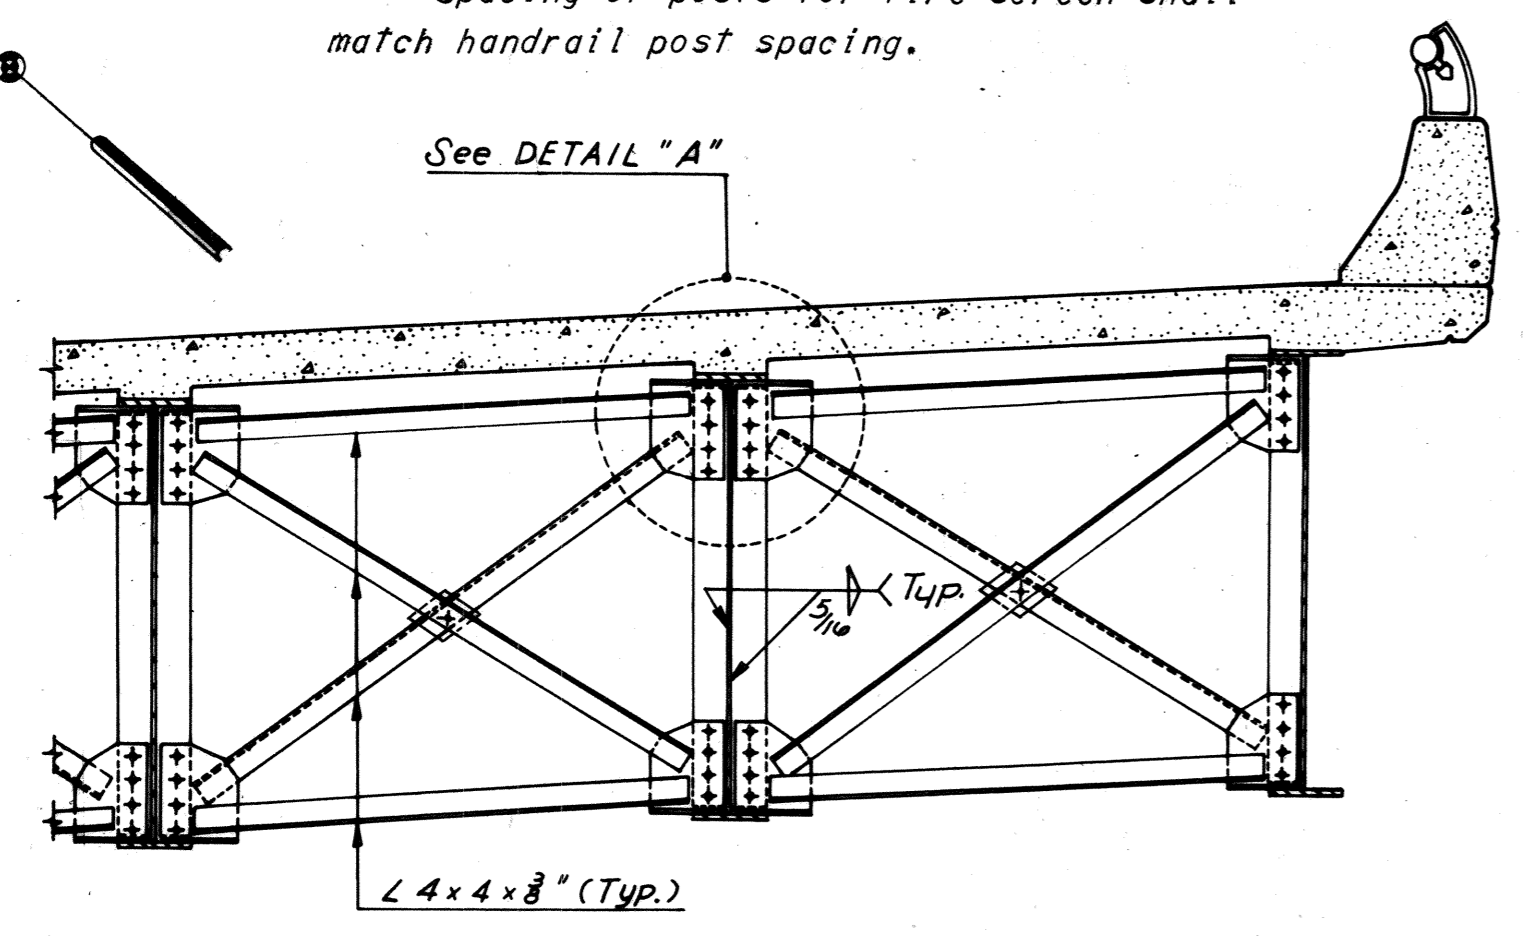

Notes:
 For End Diaphragms at Pier 16, Unit 17, see Section B-B Sheet 18
 For End Diaphragms at Pier 17, Units 17 & 18, see Section B-B Sheet 18
 For End Diaphragms at Pier 18, Unit 18, see Section A-A, this sheet.

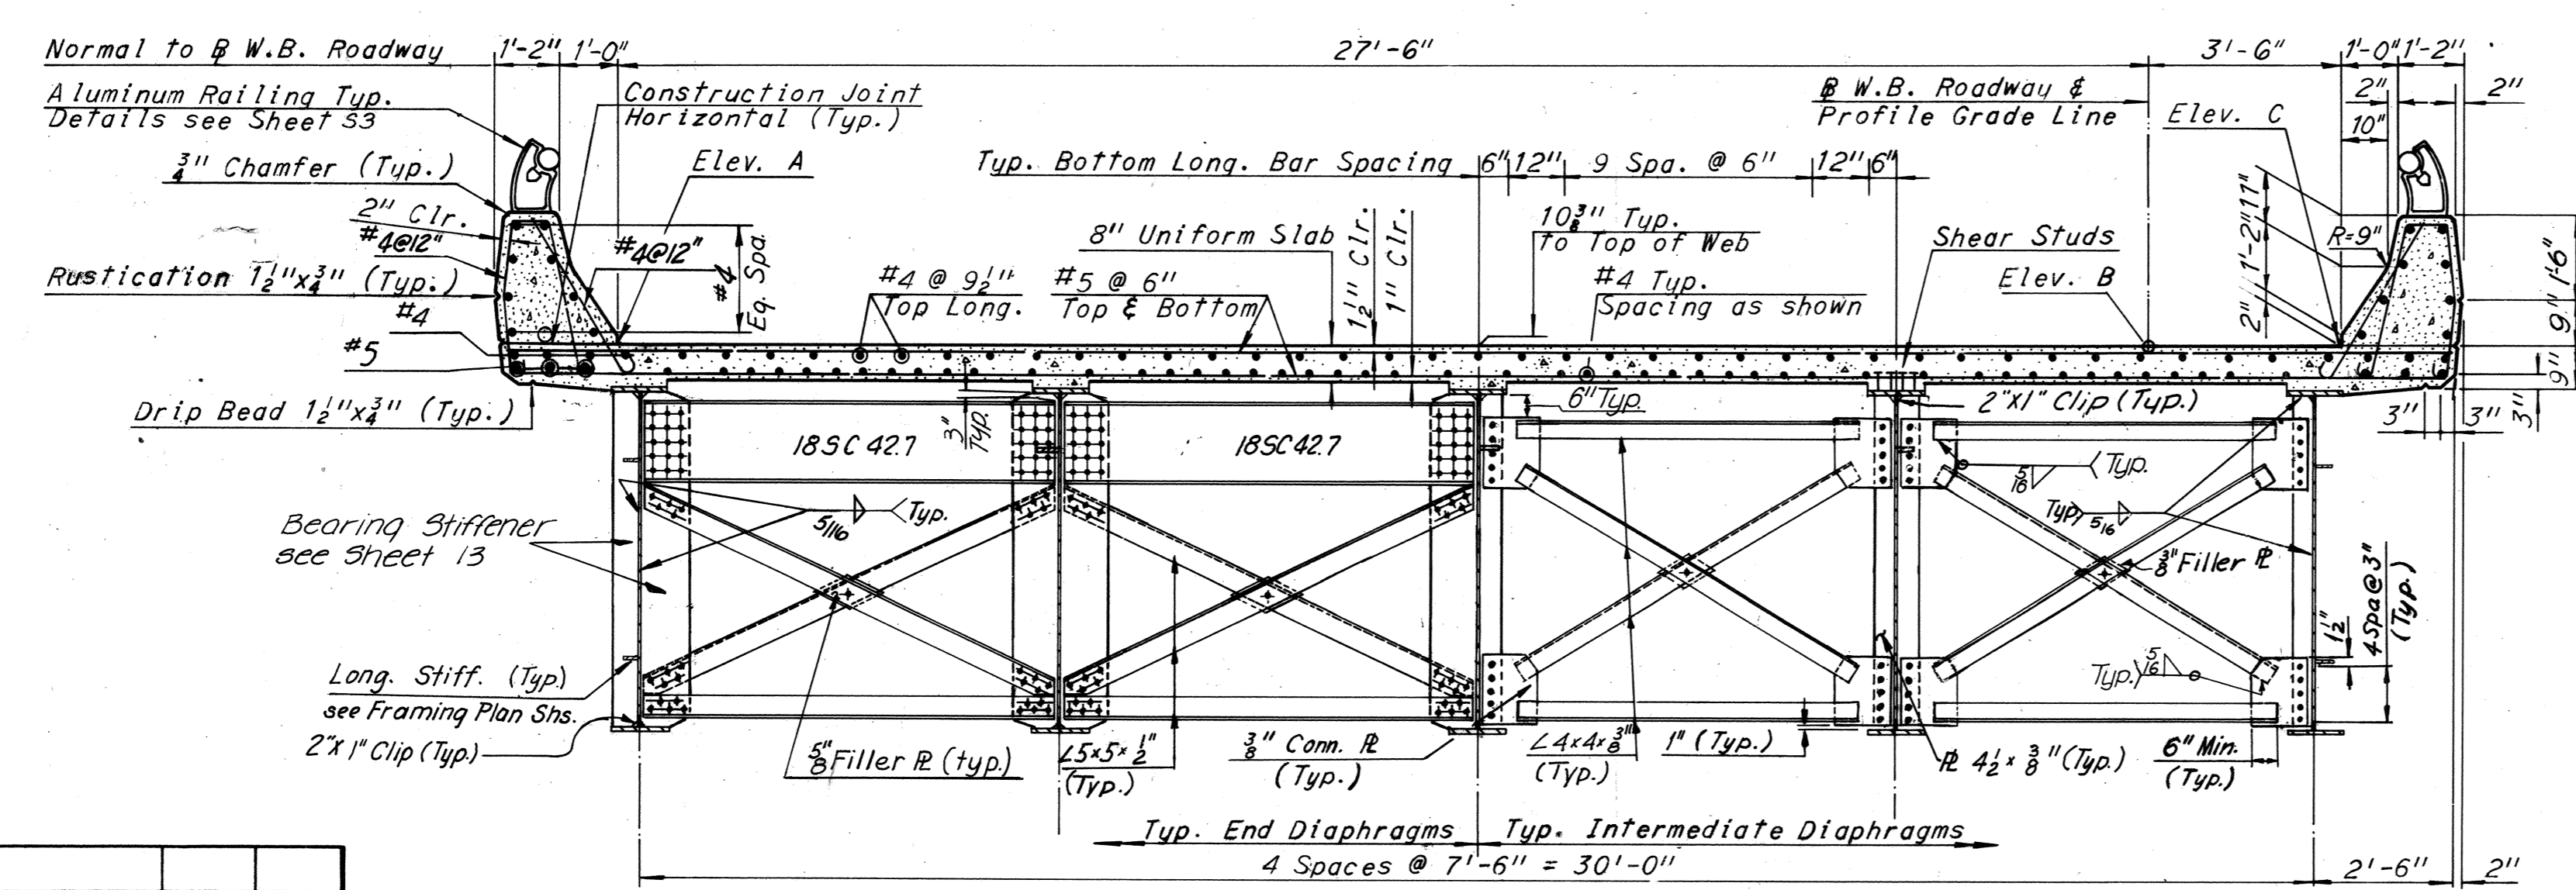

Note: Intermediate Diaphragm Details shown, are for Units 22 and 23 and curved stringers only in Units 20 and 21. Flame Conn. PL as shown above is also to be used in bays where only one of the two stringers is curved. For Units 20 and 21 see sheet 15 for Framing Plan and sheet 20 for Deck Plan. For Units 22 and 23 see Sheet 17 for Framing Plan and Sheet 21 for Deck Plan.

Notes: For Superstructure quantities, see Sheet 2. For Framing plan, see Sheet 14. For Joint details, see Sheet 24. For Railing details, see Sheet 53.

BY	DATE				
MADE	GSH	08-01-68			
CHECKED	SCC	10-21-68	1	As Built	TEM 10-76
IN CHARGE			NO.	REVISION	BY DATE

RICHMOND METROPOLITAN AUTHORITY
RICHMOND EXPRESSWAY SYSTEM
DOWNTOWN EXPRESSWAY

BRIDGE NO. 63
WESTBOUND ROADWAY OVER
12TH ST. - R.R. TRACKS AND 16TH ST.
DECK PLAN UNITS 17 AND 18

SCALE: As Noted
 CONTRACT NO.: 10
 SHEET NO. 19 OF 29


HOWARD, NEEDLES, TAMMEN & BERGENDOFF
 consulting engineers
 NEW YORK ALEXANDRIA KANSAS CITY

AS BUILT


RICHMOND EXPRESSWAY SYSTEM			
SECTION	PROJECT	SHEET NO.	TOTAL SHEETS
10	DOWNTOWN EXPRESSWAY	89	265

Notes:
 For End Diaphragms at Pier 18, Unit 19, see Section A-A, Sheet 19.
 For End Diaphragms at Pier 19, Units 19 & 20, see Section A-A, Sheet 19.
 For End Diaphragms at Pier 20, Units 20 & 21, see Section A-A, Sheet 19.
 and for Detail "C" see Sheet 16.
 For End Diaphragms at Pier 10, Unit 21N and Pier 21, Unit 21S, see Section C-C this Sheet.

Note: Transverse dotted lines in Units 20 and 21 represent interior diaphragm at left end of stringers S5-20, S3-21N and S6-21N.
 For location of diaphragms see Sheet 14.

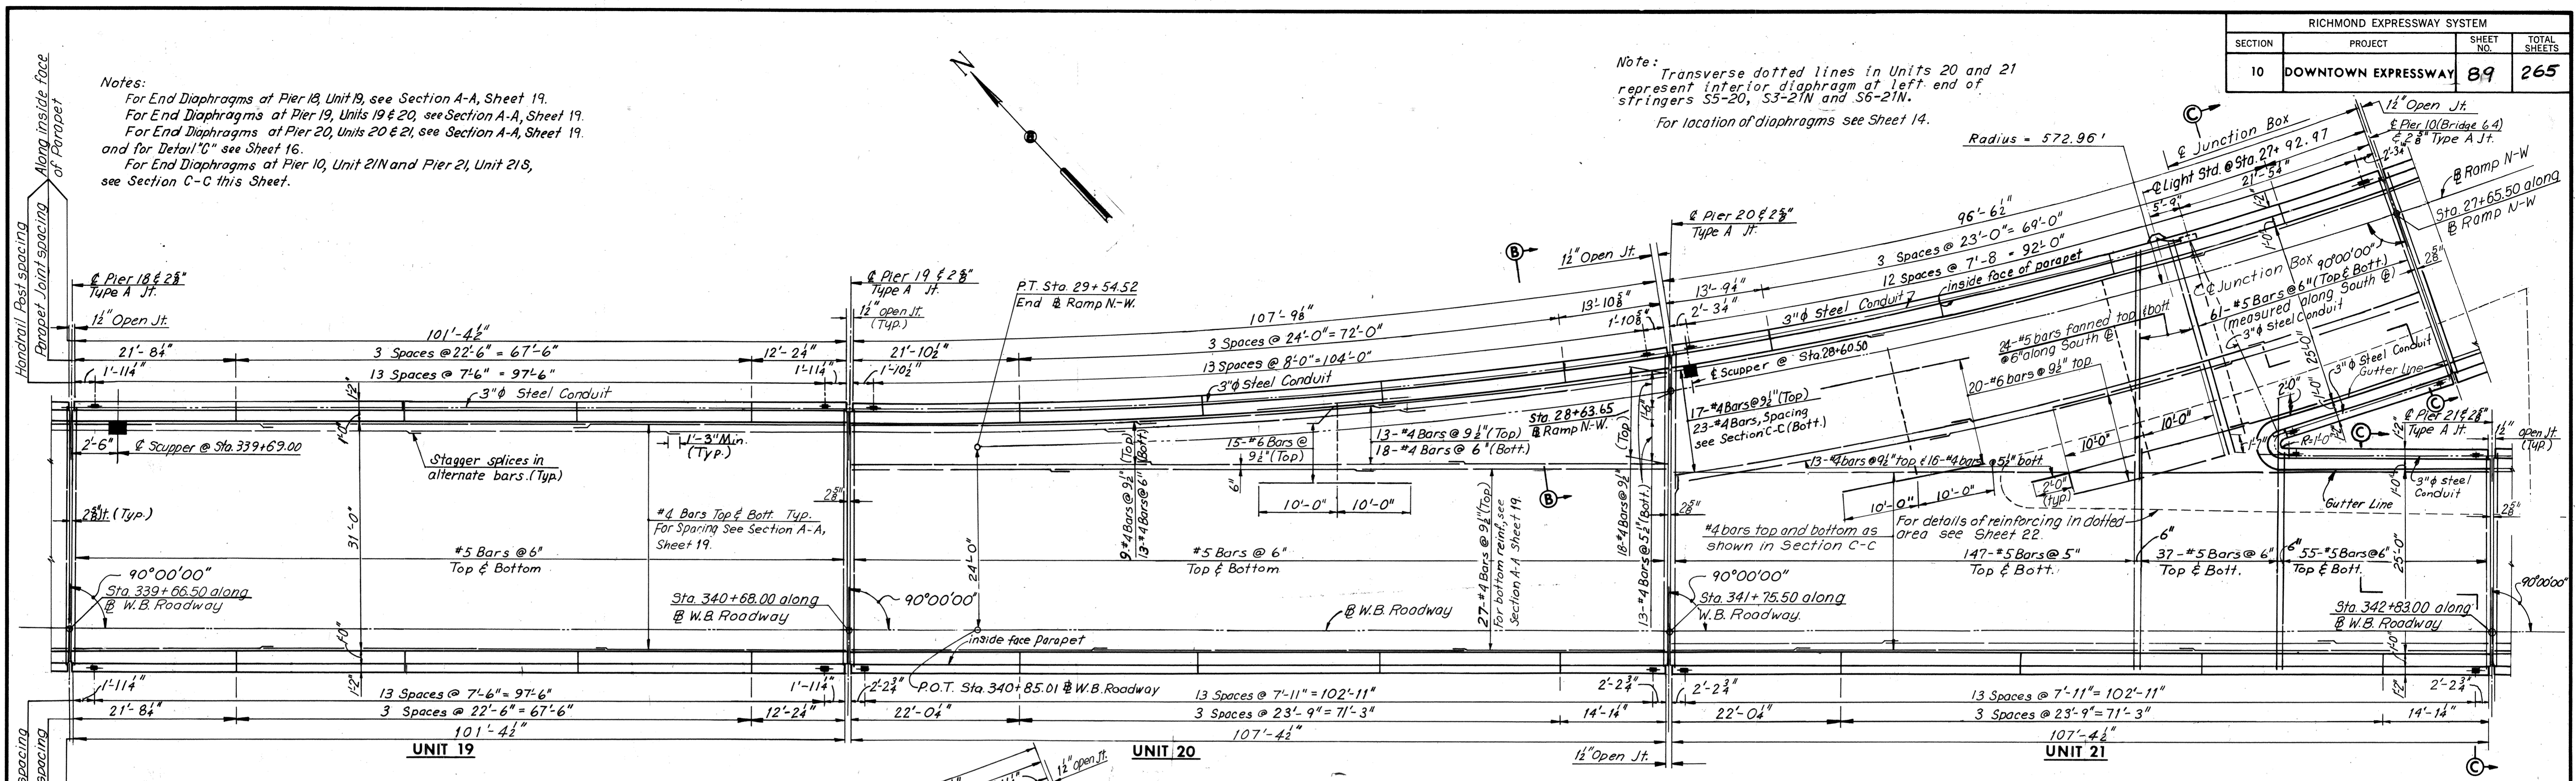

DECK PLAN
Scale 1/4" = 10'-0"

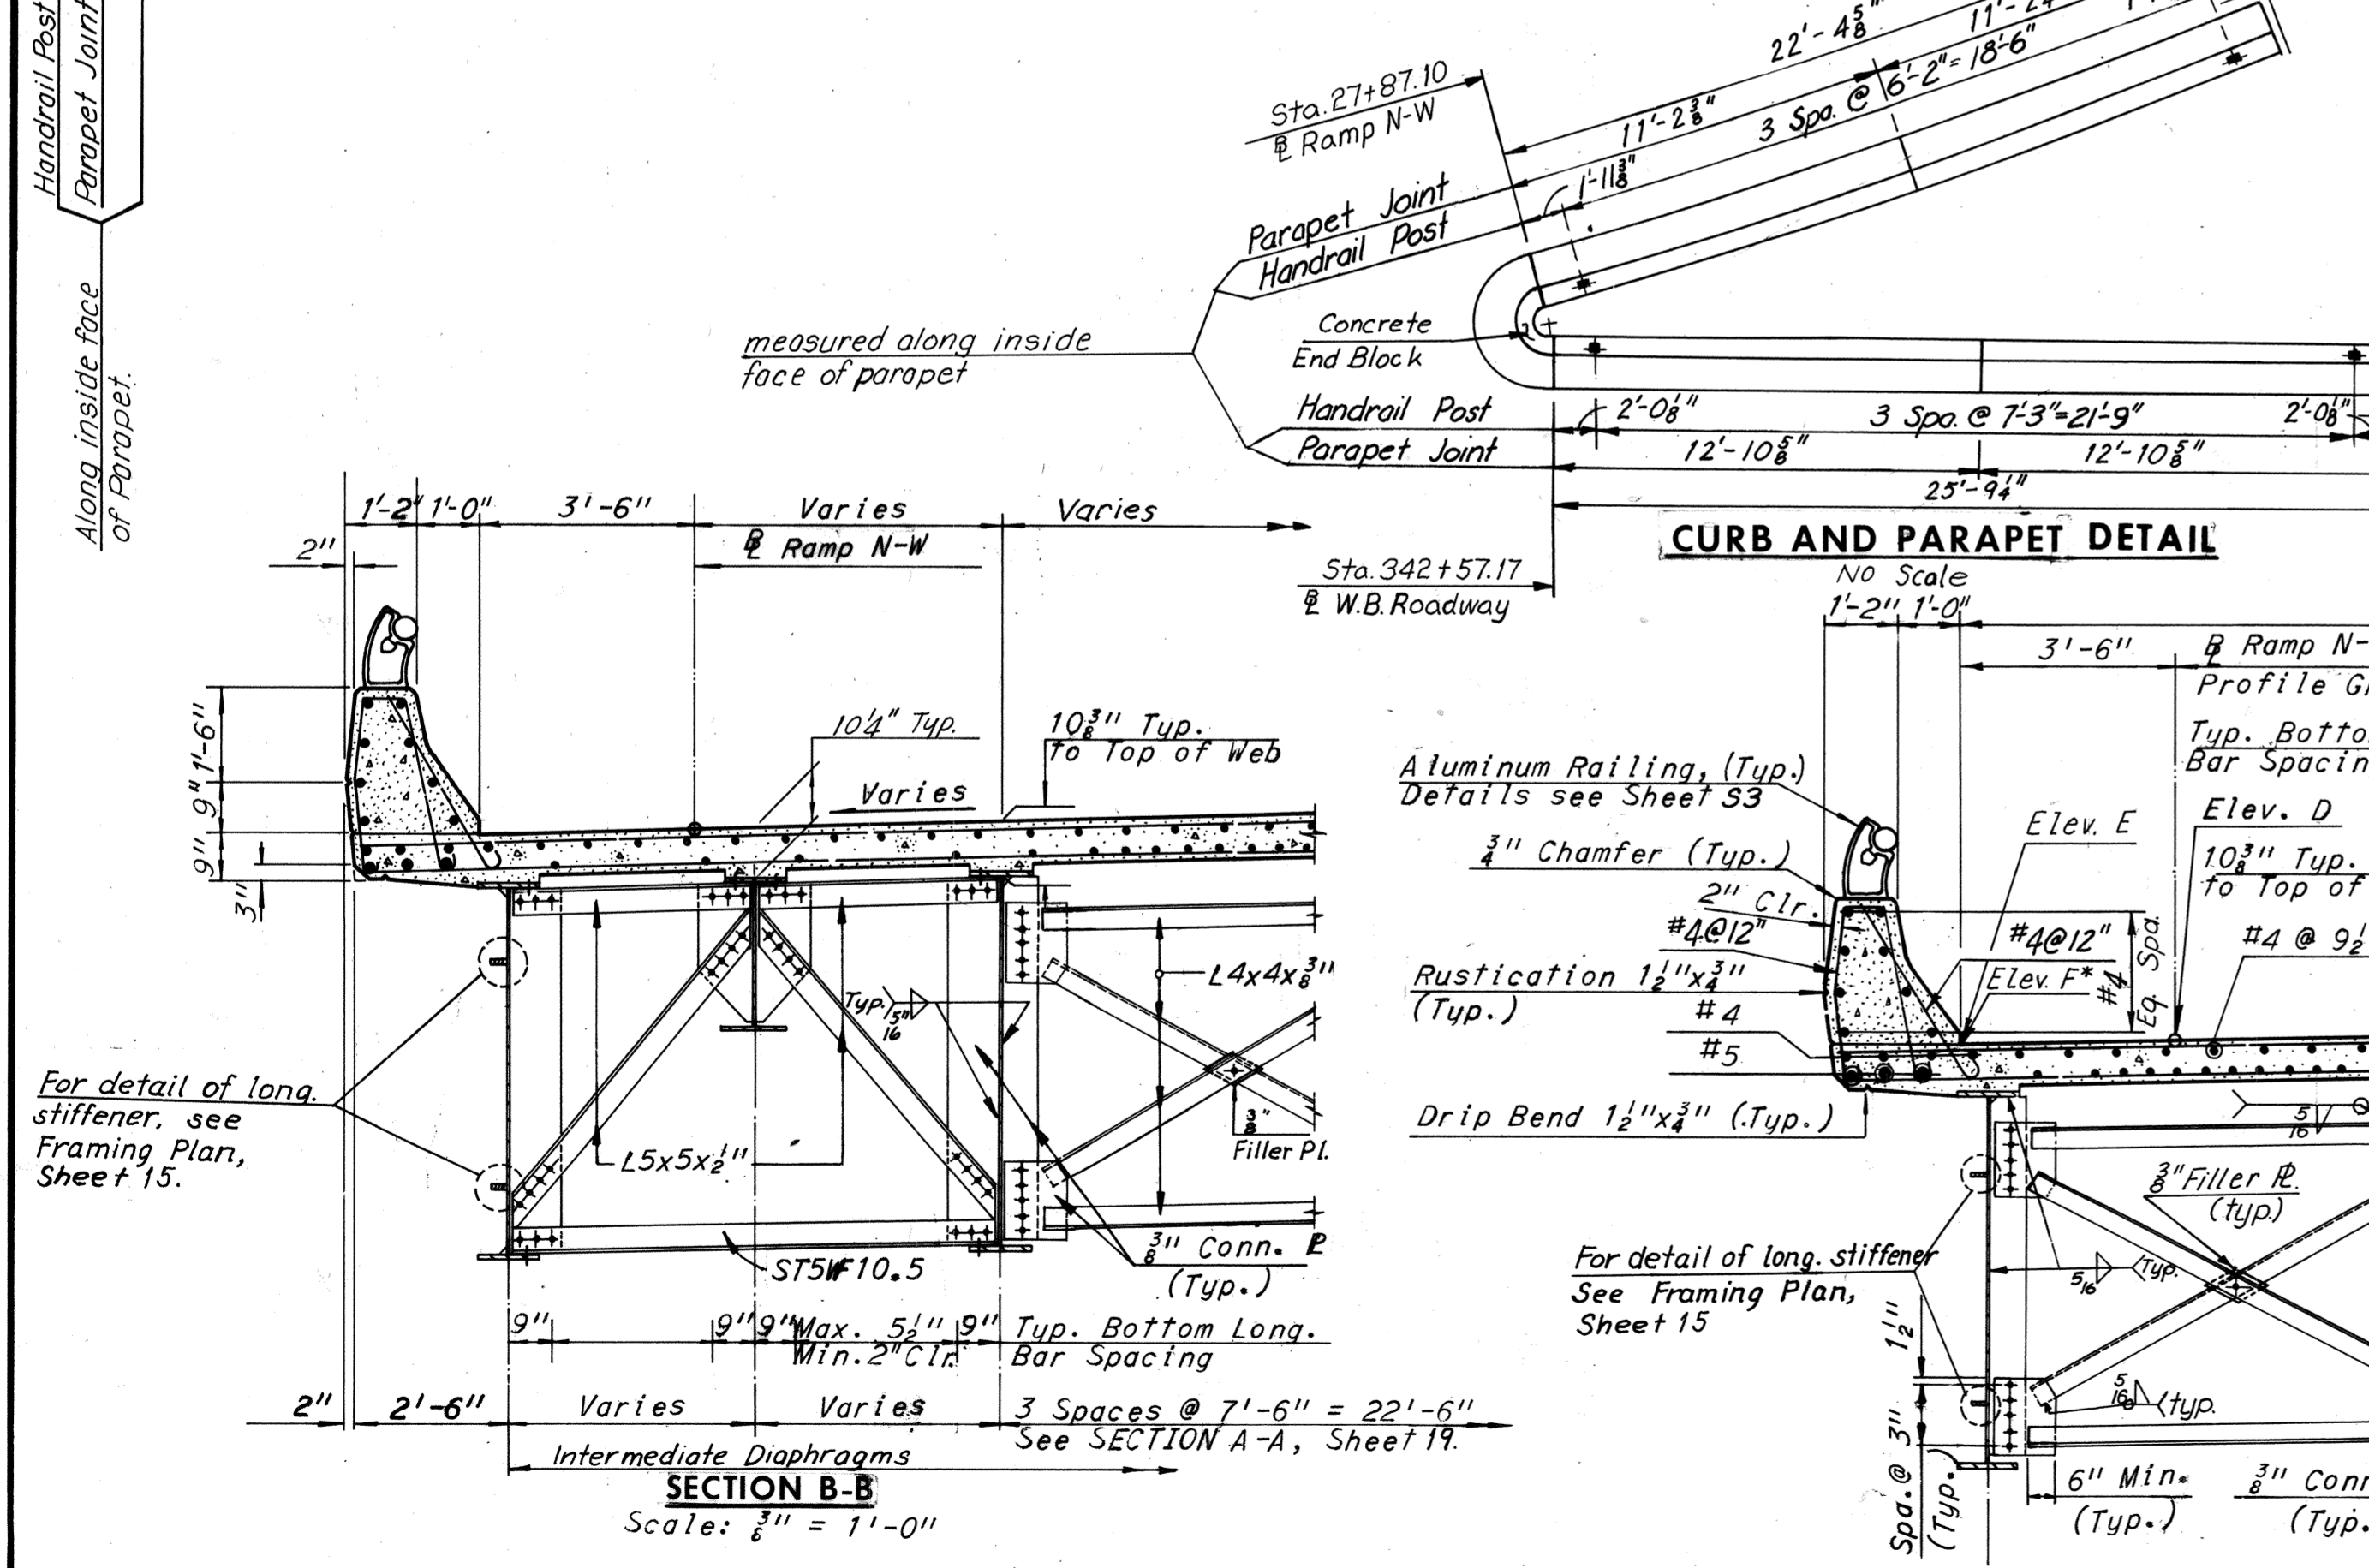


CURB AND PARAPET DETAIL
No Scale

BY	DATE	NO.	REVISION	BY	DATE
MADE	GSH 7-29-68				
CHECKED	KCT 10-18-68	1	As Built	TEM	10-76
IN CHARGE					

Note: Elev. C* are elevations along south gutterline of Ramp N-W from Pier 10 (64) to Sta 27+87.10 @ ctr. of Nose.
 Elev. F* are elevations along north gutterline of W.B. Roadway between Sta. 342+57.17 @ ctr. of Nose and Sta. 342+83.00 @ Pier 21.

Notes:
 For Superstructure quantities, see Sheet 2.
 For Framing plan, see Sheet 15.
 For Joint details, see Sheet 24.
 For Railing details, see Sheet 53.
 For Standard Drainage Details, see Sheet 55 & 56.
 Support Type 2 for Units 19 and 21, see Sheet 19.

Note: Intermediate Diaphragms shown in Section C-C can only be used where stringers are straight. For Intermediate Diaphragm Details for curved stringers, see Sheet 19.

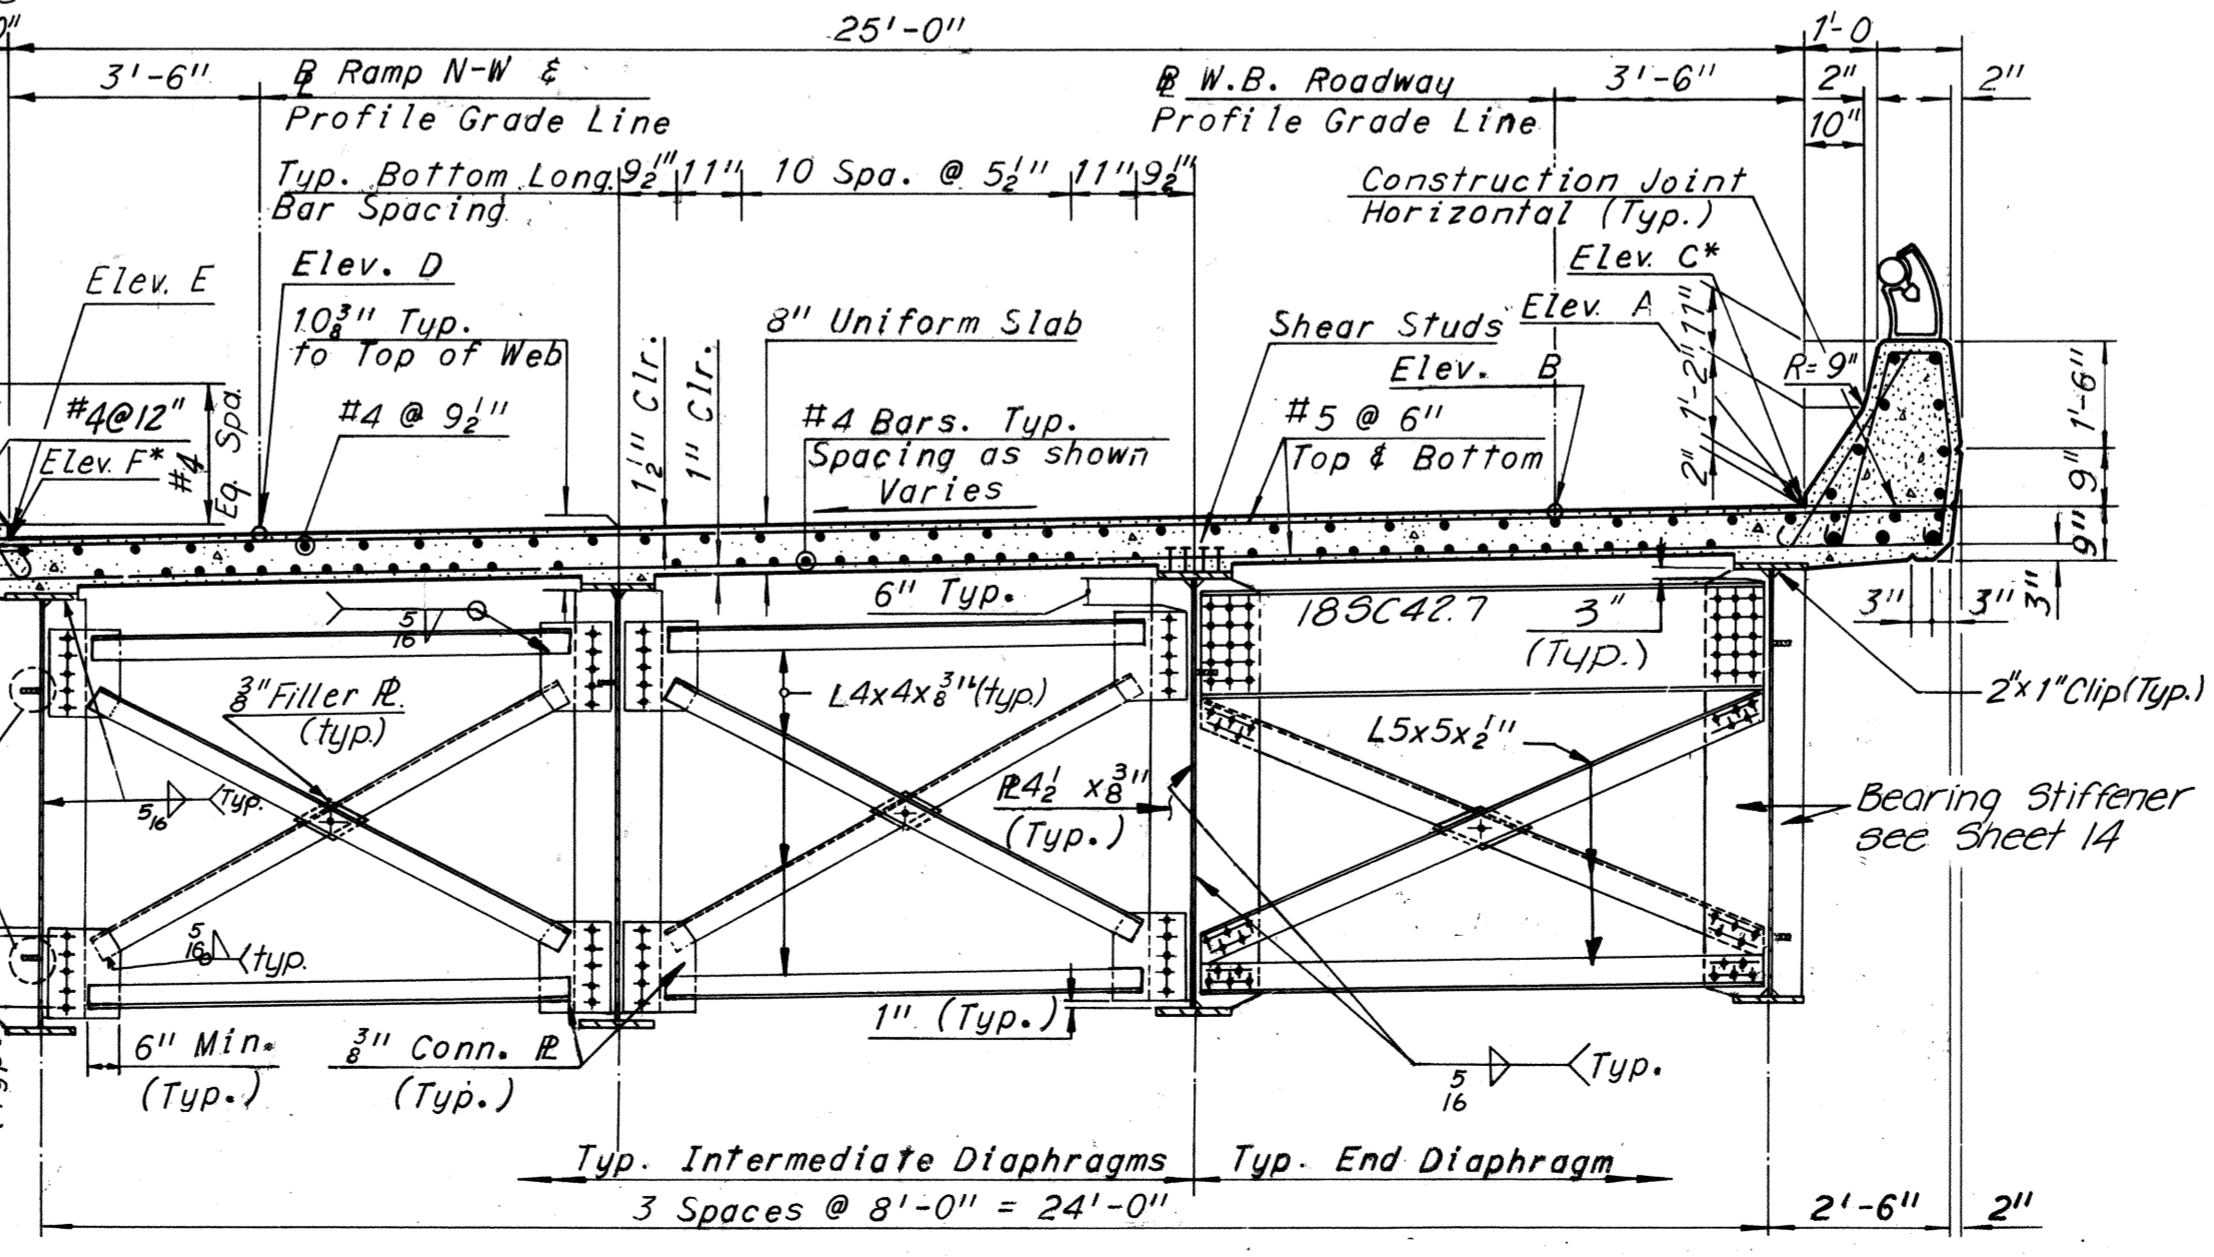

SECTION C-C
Scale: 3/8" = 1'-0"

STATION @ W.B.	ELEVATION TABLE				
	ELEV. A	ELEV. B	ELEV. F	ELEV. D	ELEV. E
339+66.50	67.46	67.39	—	66.91	66.84
+70.00	67.49	67.42	—	66.94	66.87
+80.00	67.61	67.54	—	67.06	66.99
+90.00	67.72	67.65	—	67.17	67.10
340+00.00	67.83	67.76	—	67.28	67.21
+10.00	67.94	67.87	—	67.39	67.32
+20.00	68.05	67.98	—	67.50	67.43
+30.00	68.17	68.10	—	67.62	67.55
+40.00	68.28	68.21	—	67.73	67.66
+50.00	68.39	68.32	—	67.84	67.77
+60.00	68.50	68.43	—	67.95	67.88
+68.00	68.59	68.52	—	68.04	67.97
+70.00	68.61	68.54	—	68.06	67.99
+80.00	68.73	68.66	—	68.18	68.11
+85.01	68.78	68.71	—	68.23	68.16
+90.00	68.84	68.77	—	—	—
341+00.00	68.95	68.88	—	—	—
+10.00	69.06	68.99	—	—	—
+20.00	69.18	69.11	—	—	—
+30.00	69.29	69.22	—	—	—
+40.00	69.40	69.33	—	—	—
+50.00	69.51	69.44	—	—	—
+60.00	69.62	69.55	—	—	—
+70.00	69.73	69.66	—	—	—
+75.50	69.80	69.73	—	—	—
+80.00	69.85	69.78	—	—	—
+90.00	69.96	69.89	—	—	—
342+00.00	70.07	70.00	—	—	—
+10.00	70.18	70.11	—	—	—
+20.00	70.29	70.22	—	—	—
+30.00	70.41	70.34	—	—	—
+40.00	70.52	70.45	—	—	—
+50.00	70.63	70.56	—	—	—
+57.17	70.71	70.64	70.21	—	—
+60.00	70.74	70.67	70.24	—	—
+70.00	70.85	70.78	70.35	—	—
+80.00	70.97	70.90	70.47	—	—
342+83.00	71.00	70.93	70.50	—	—

STATION @ Ramp N-W	ELEVATION TABLE		
	ELEV. D	ELEV. E	ELEV. C
29+54.52	68.23	—	—
+50.00	68.28	68.21	—
+40.00	68.39	68.32	—
+30.00	68.50	68.43	—
+20.00	68.60	68.53	—
+10.00	68.70	68.63	—
29+00.00	68.80	68.73	—
28+90.00	68.89	68.82	—
+80.00	68.98	68.91	—
+70.00	69.07	69.00	—
+63.65	69.12	—	—
+63.17	—	69.05	—
+60.00	69.15	69.08	—
+50.00	69.23	69.16	—
+40.00	69.30	69.23	—
+30.00	69.37	69.30	—
+20.00	69.44	69.37	—
+10.00	69.51	69.44	—
28+00.00	69.57	69.50	—
27+90.00	69.64	69.56	—
27+87.10	69.67	69.58	70.21
+80.00	69.74	69.64	70.34
+70.00	69.81	69.76	70.56
27+65.50	69.94	69.87	70.66







AS BUILT
RICHMOND METROPOLITAN AUTHORITY
RICHMOND EXPRESSWAY SYSTEM
DOWNTOWN EXPRESSWAY

BRIDGE NO. 63
WESTBOUND ROADWAY OVER
12TH ST. - R.R. TRACKS AND 16TH ST.
DECK PLAN - UNITS 19, 20 AND 21

HOWARD, NEEDLES, TAMMEN & BERGENDOFF
 consulting engineers
 NEW YORK ALEXANDRIA KANSAS CITY

SCALE: As Noted
 CONTRACT NO.: 10
 SHEET NO. 20 OF 29

RICHMOND EXPRESSWAY SYSTEM			
SECTION	PROJECT	SHEET NO.	TOTAL SHEETS
10	DOWNTOWN EXPRESSWAY	90	265

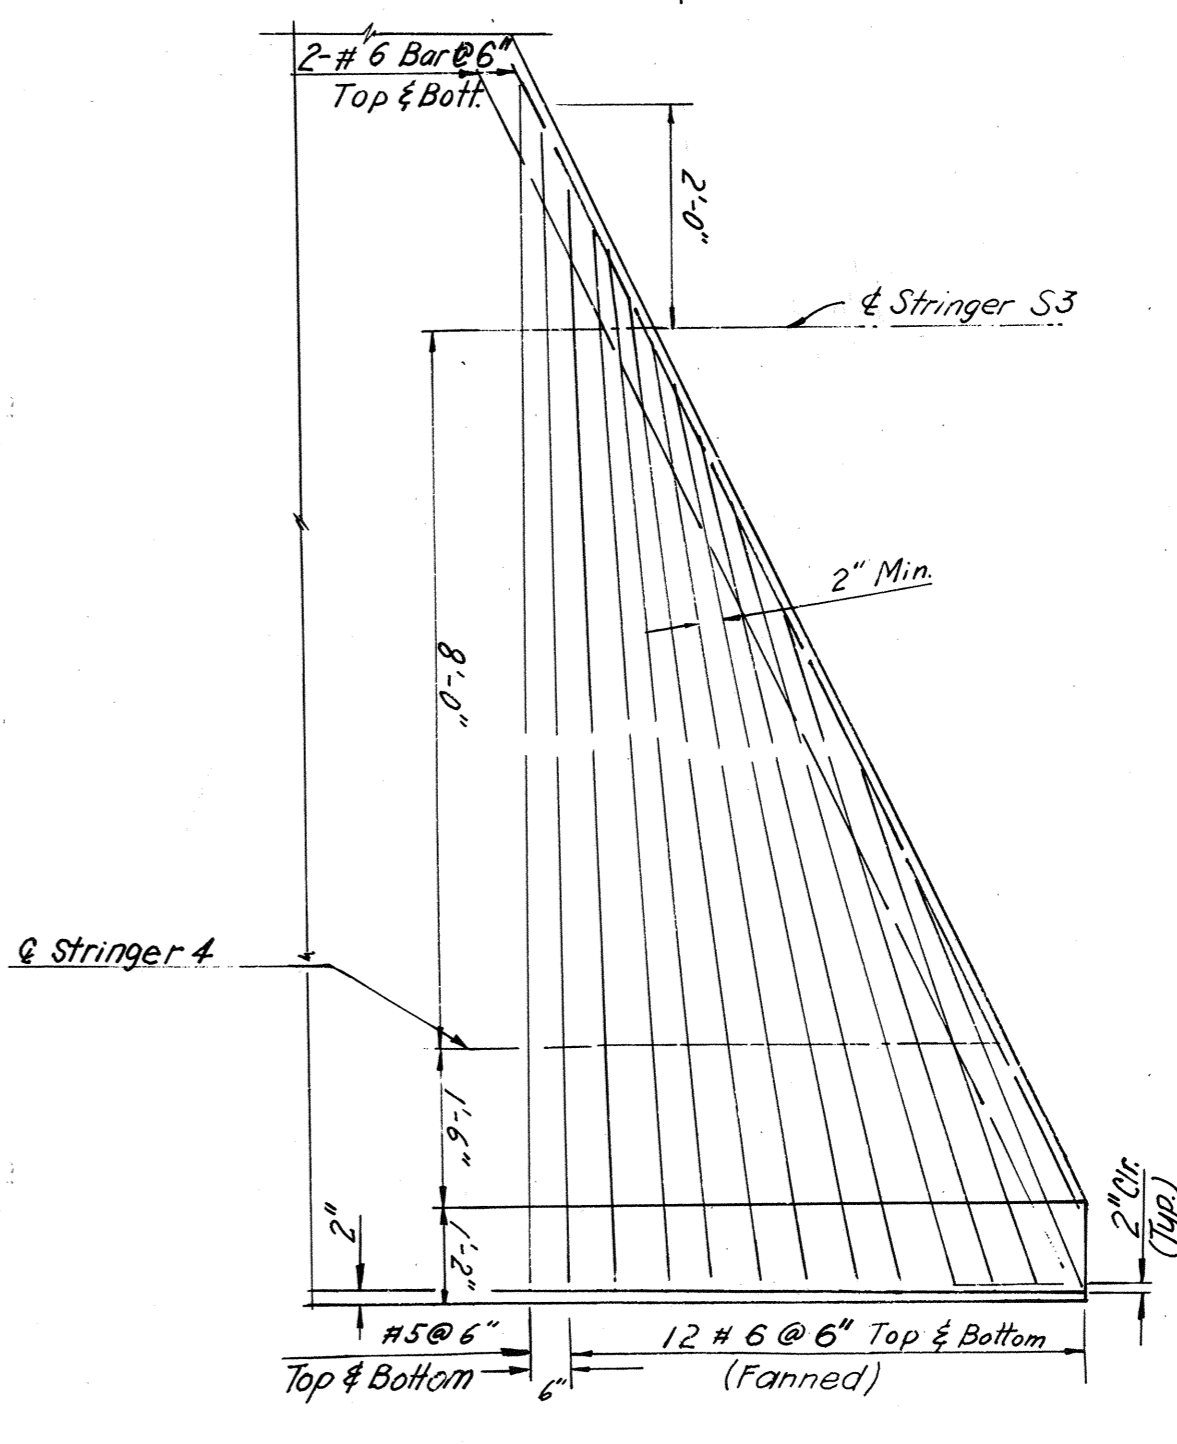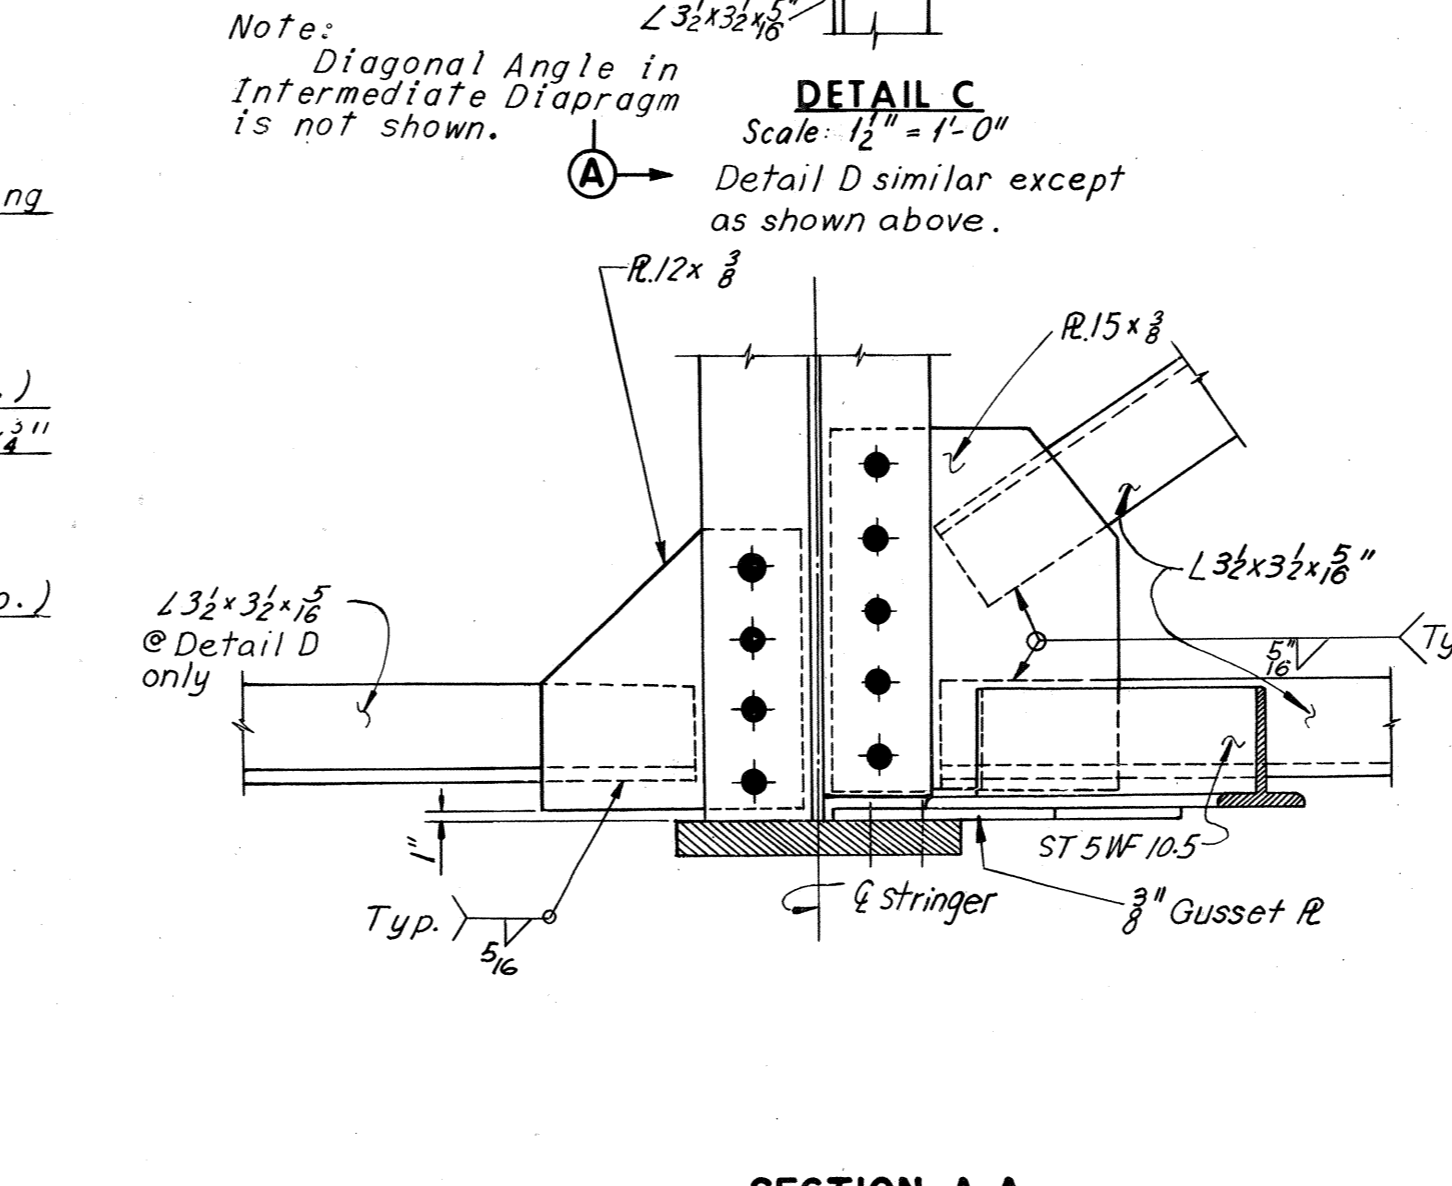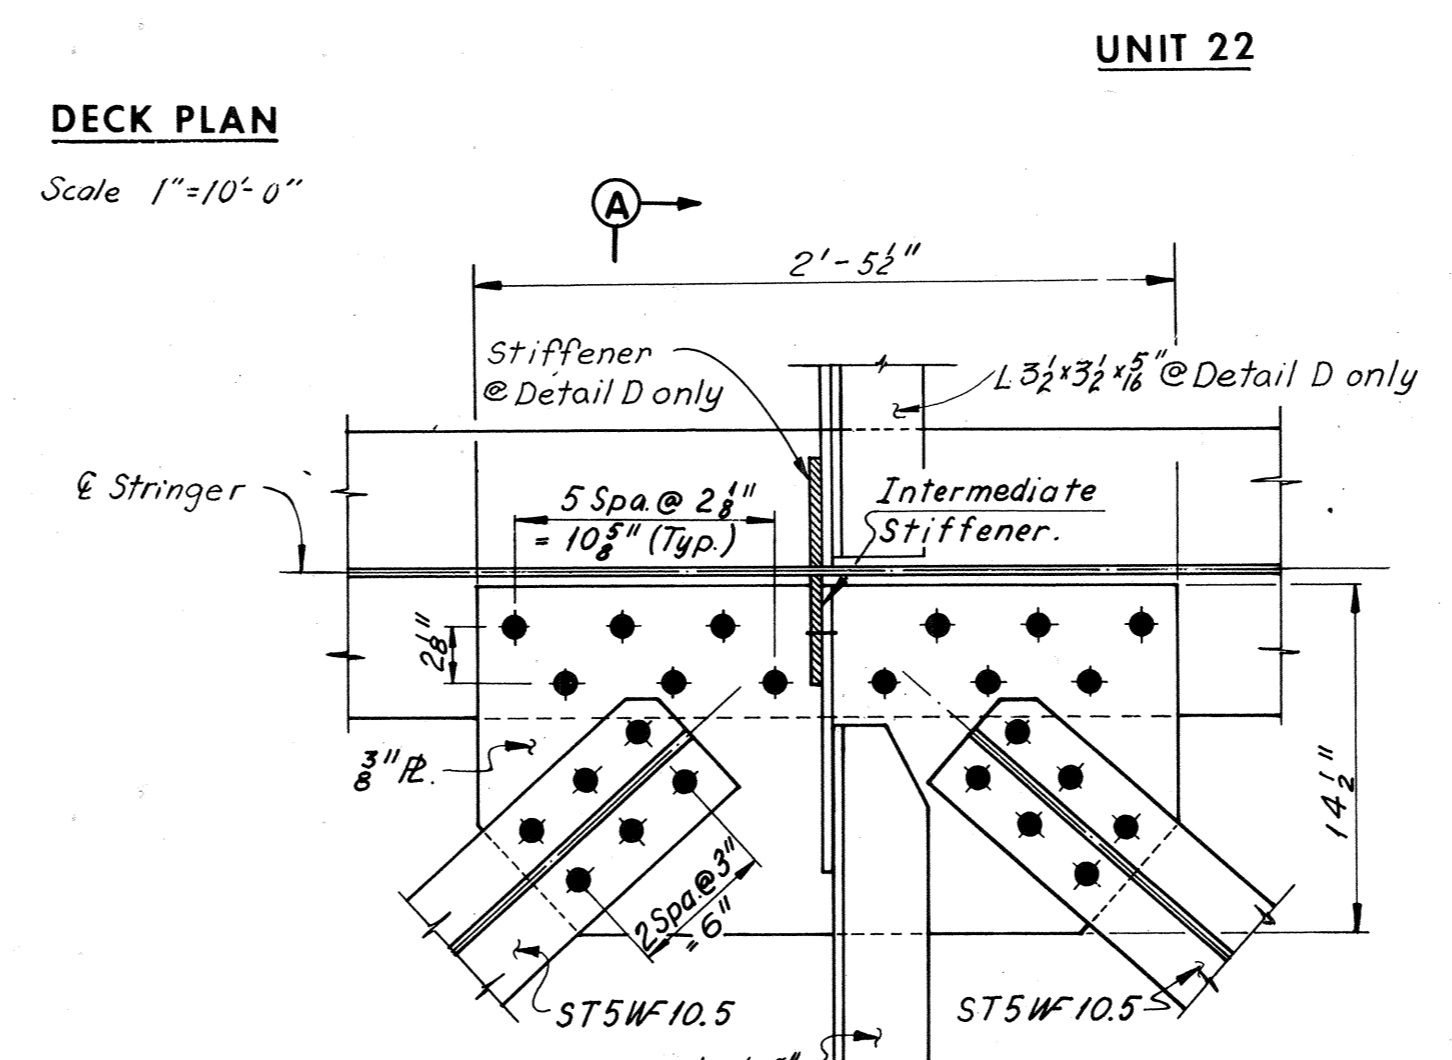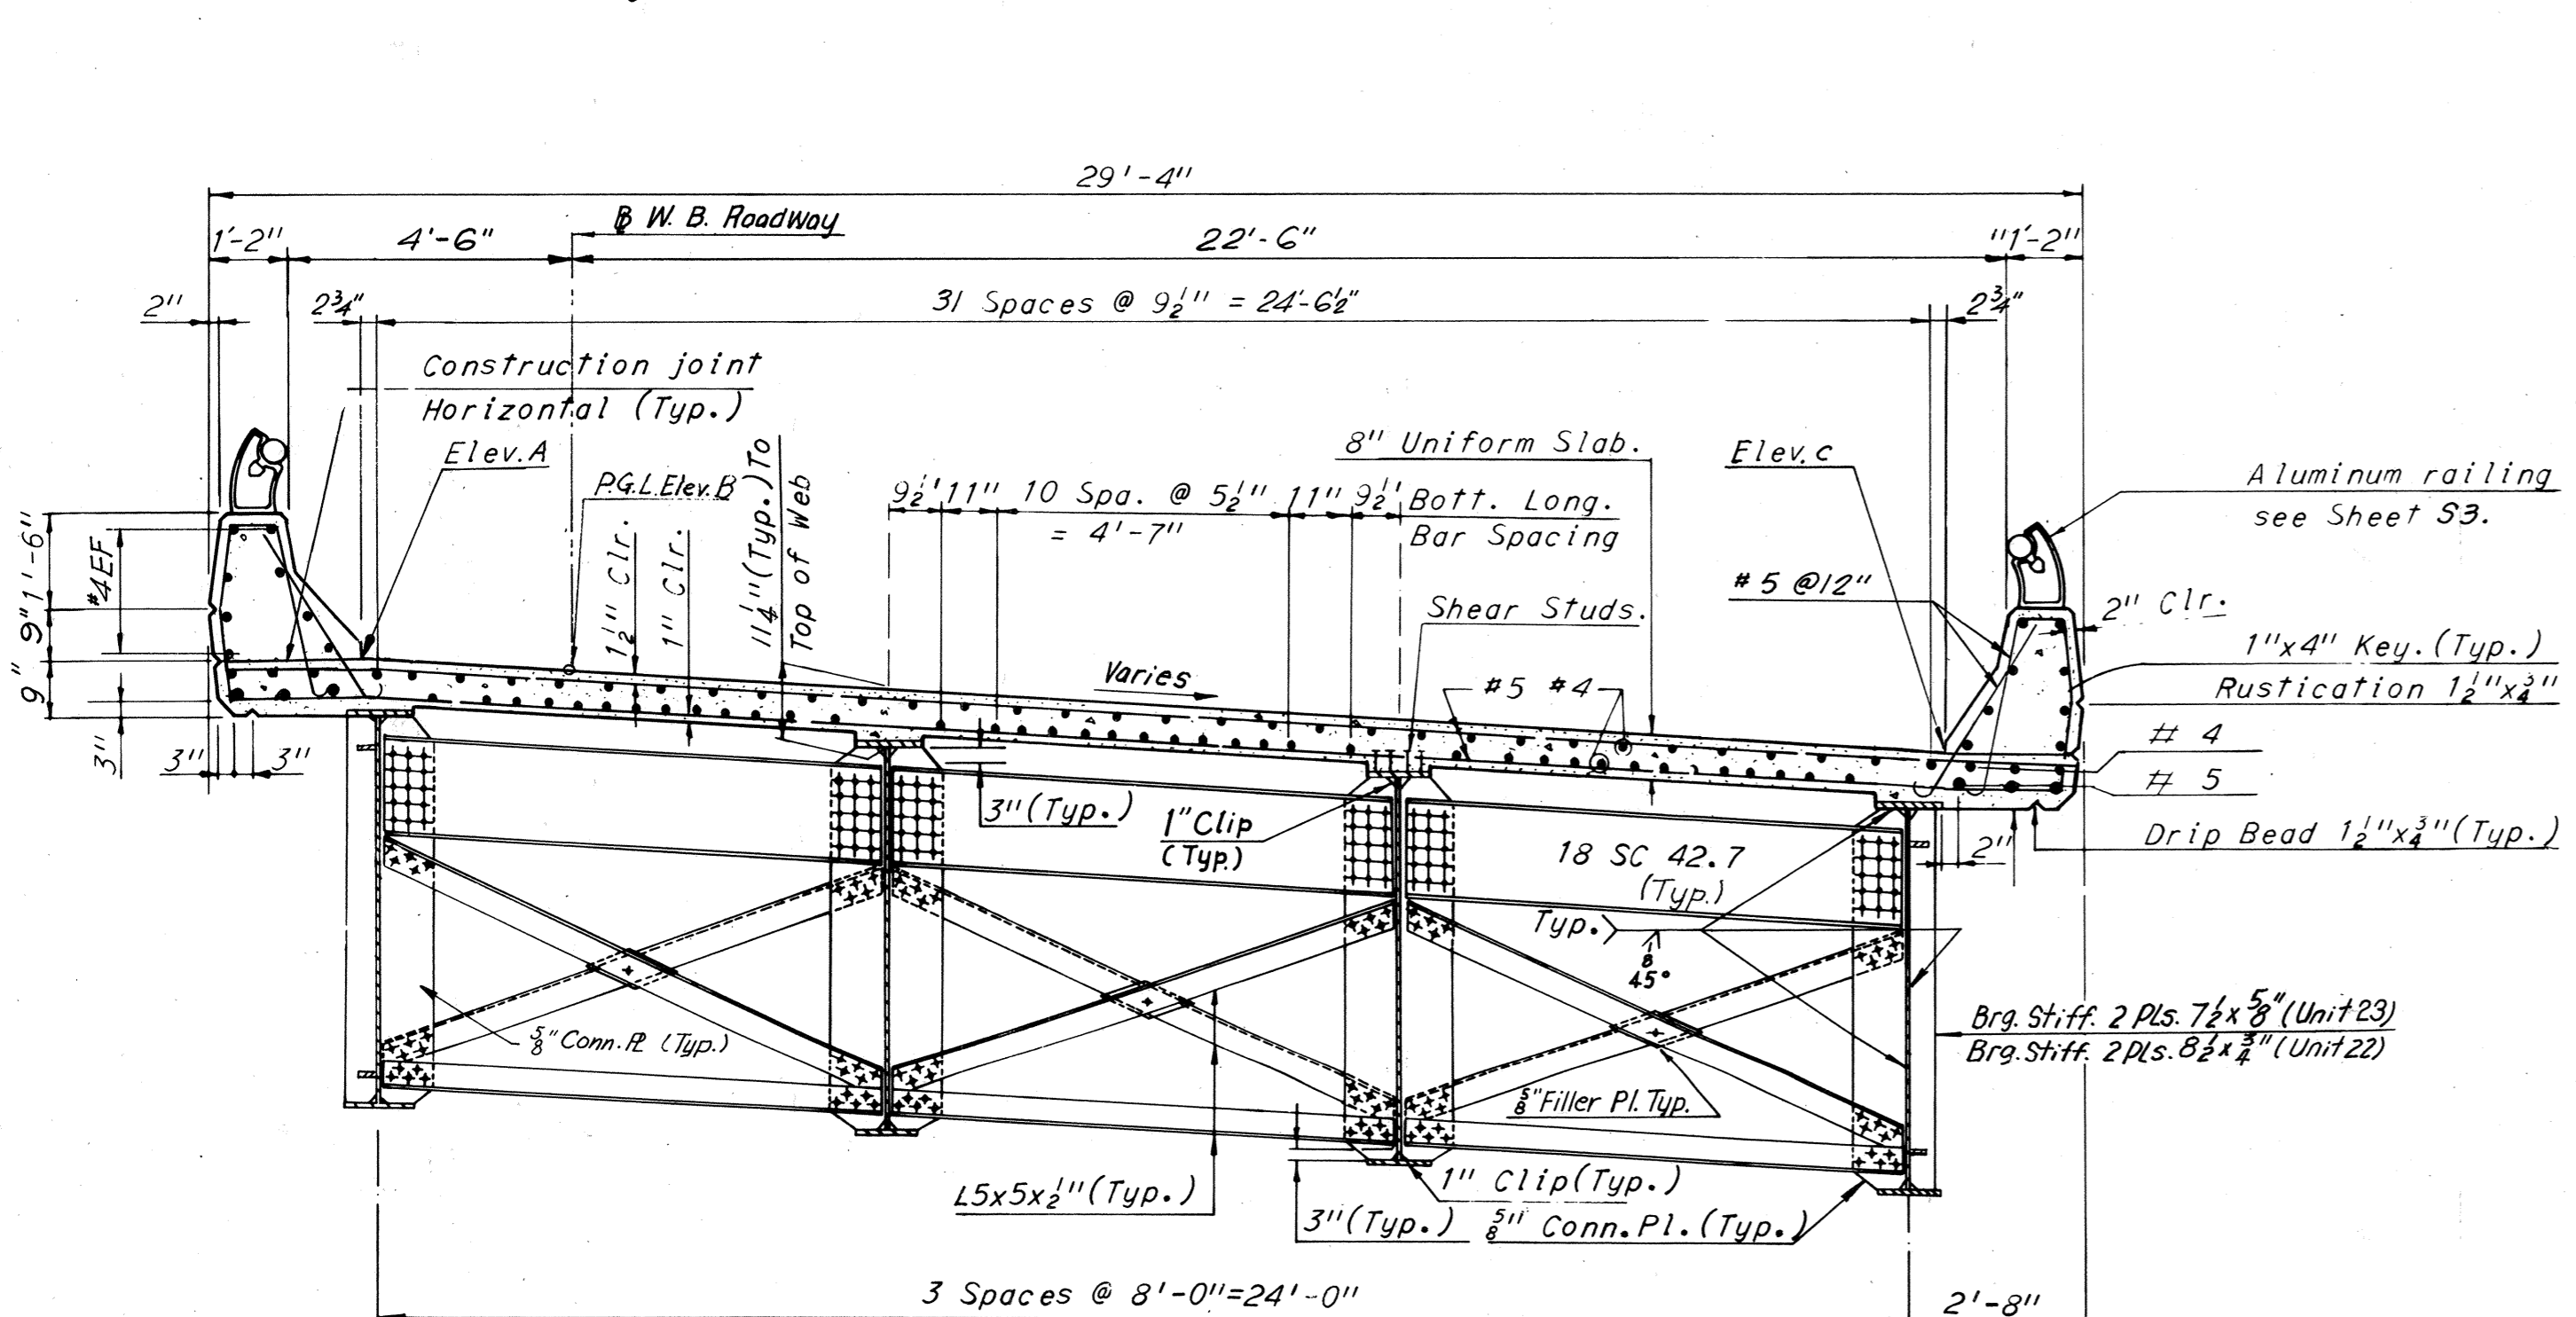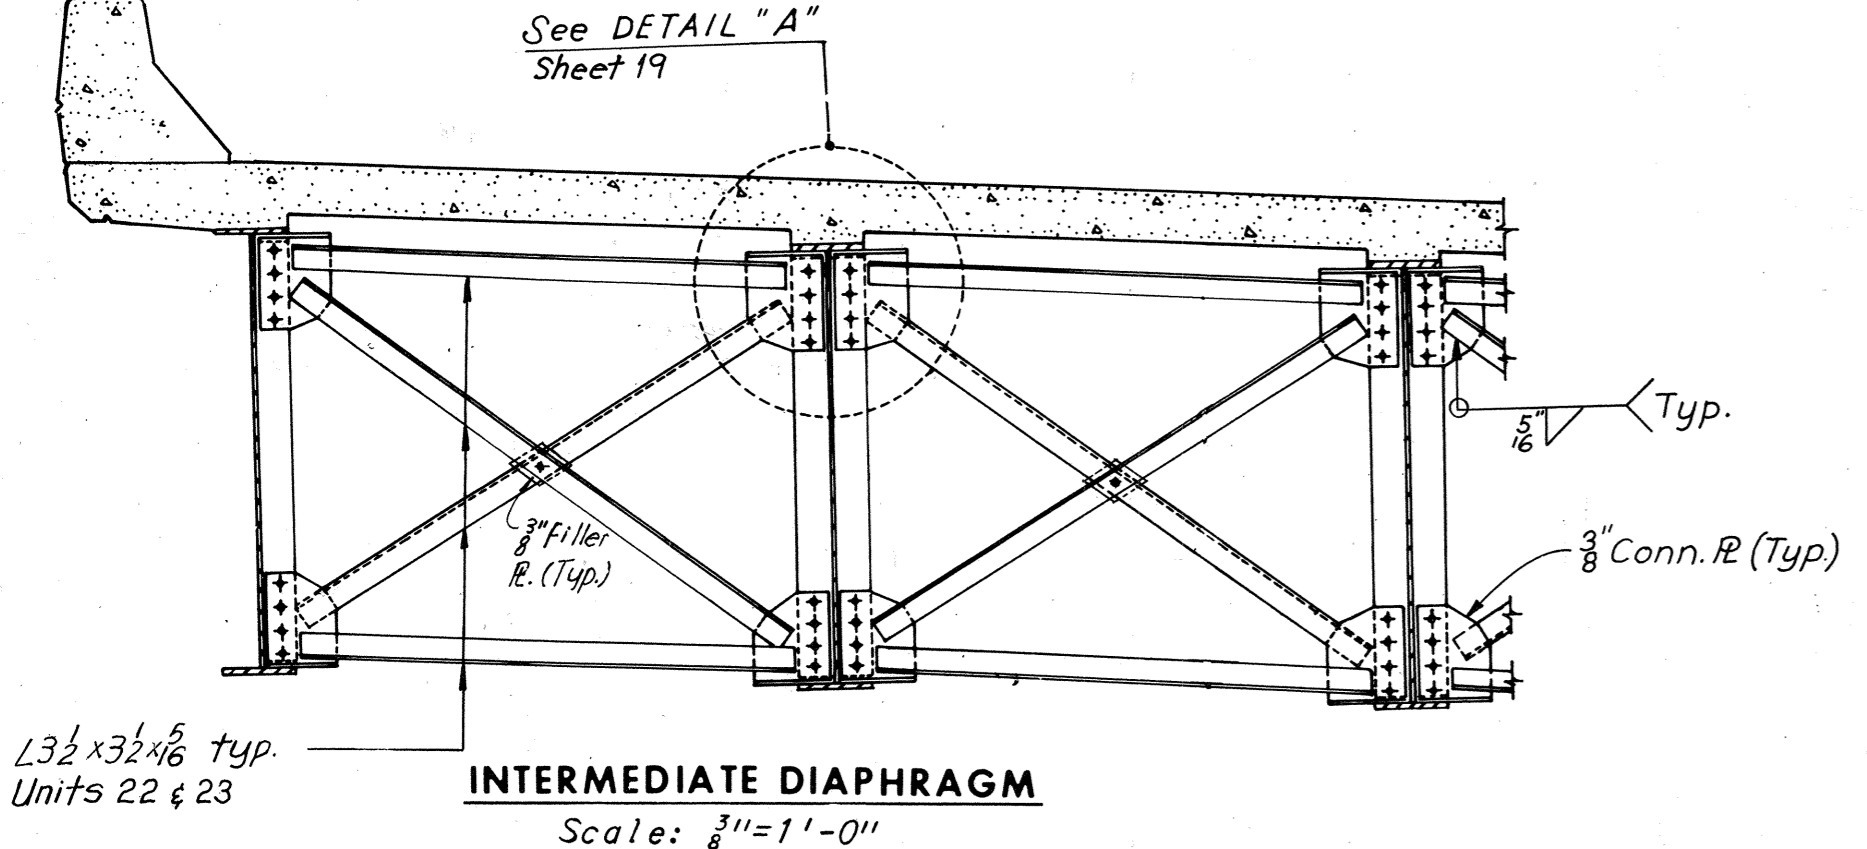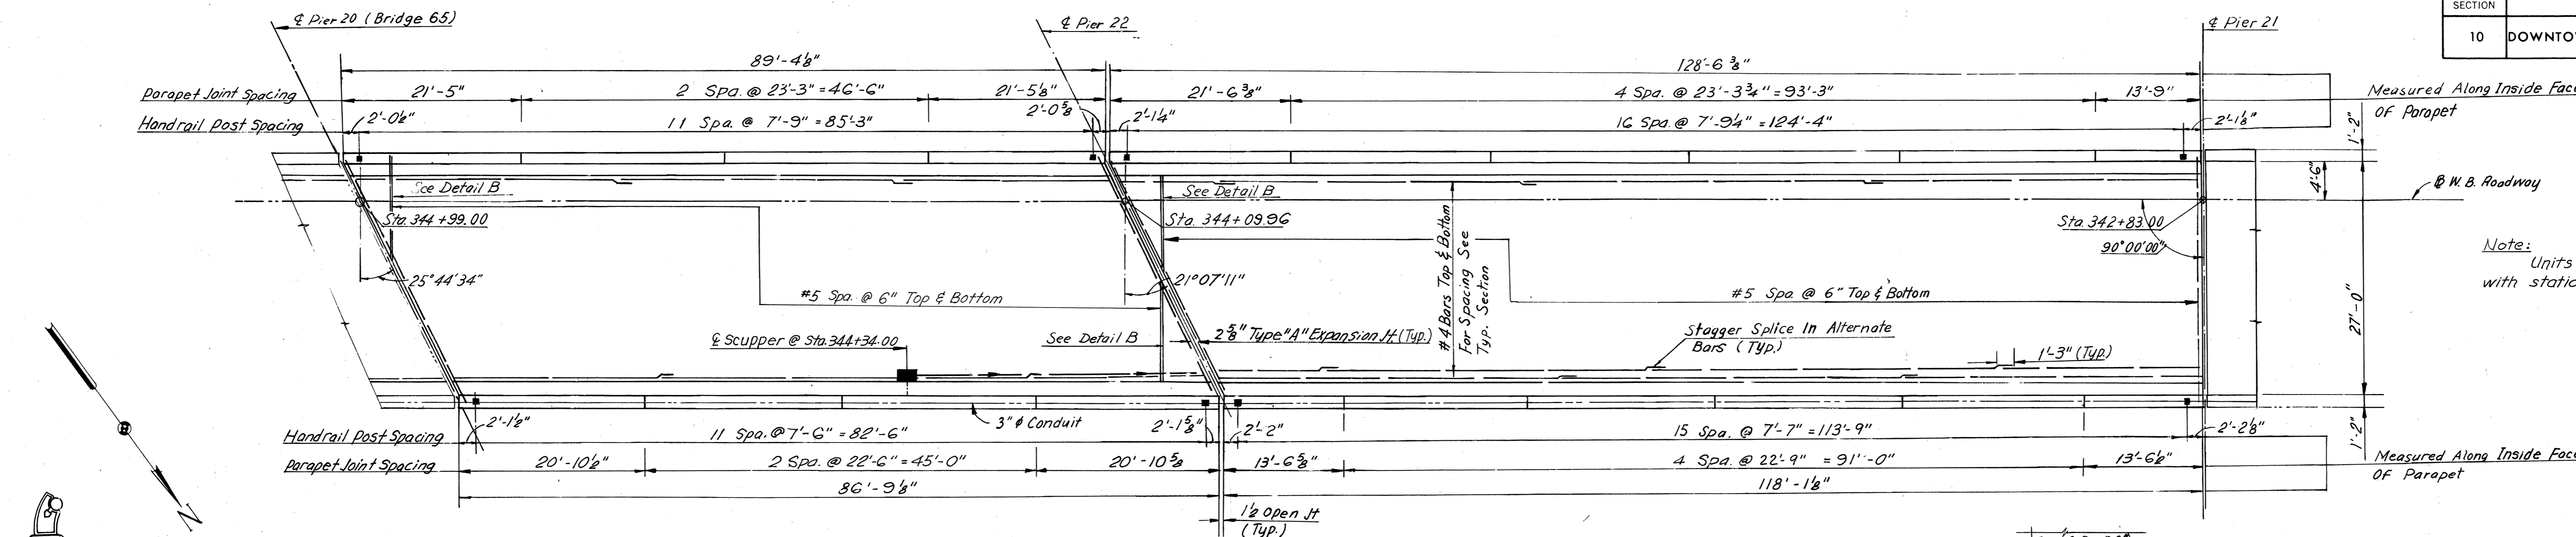

ELEVATION TABLE			
STATION	ELEV. A	ELEV. B	ELEV. C
345+00.69	72.02	—	—
345+00.00	72.02	71.89	71.07
344+99.00	—	71.90	—
344+90.00	72.10	72.97	71.23
344+88.63	—	—	71.25
344+80.00	72.16	72.06	71.40
344+70.00	72.23	72.14	71.55
344+60.00	72.29	72.20	71.68
344+50.00	72.33	72.25	71.81
344+40.00	72.35	72.27	71.83
344+30.00	72.35	72.28	71.85
344+20.00	72.34	72.27	71.84
344+11.31	72.31	—	—
344+10.00	72.30	72.23	71.80
344+09.96	—	72.23	—
344+00.00	72.25	72.18	71.75
344+01.68	—	—	71.76
343+90.00	72.18	72.11	71.68
343+80.00	72.08	72.01	71.58
343+70.00	71.97	71.90	71.47
343+60.00	71.86	71.79	71.36
343+50.00	71.75	71.68	71.25
343+40.00	71.64	71.57	71.14
343+30.00	71.53	71.46	71.03
343+20.00	71.41	71.34	70.91
343+10.00	71.30	71.23	70.80
343+00.00	71.19	71.12	70.69
342+90.00	71.08	71.01	70.58
342+83.00	71.00	70.93	70.50

Note: For Standard Drainage Details for Unit 21 see Support Type 2 Sheet 35 & 36.
Notes: For Framing Plan see Sheet 17. For Joint Details, see Sheet 24. For Quantities see Sheet 2. For Handrail Details, see Sheet 33.

MADE	BY	DATE	NO.	REVISION	BY	DATE
	RC	11-21-68				
	Y.C.P.	1-15-69	1	As Built	TEM	10-70










RICHMOND METROPOLITAN AUTHORITY
RICHMOND EXPRESSWAY SYSTEM
DOWNTOWN EXPRESSWAY

BRIDGE NO. 63
WESTBOUND ROADWAY OVER
12TH ST.-R.R. TRACKS AND 16TH ST.
DECK PLAN UNITS 22 AND 23

HOWARD, NEEDLES, TAMMEN & BERGENDOFF
consulting engineers
NEW YORK ALEXANDRIA KANSAS CITY

SCALE: As Noted
CONTRACT NO.: 10
SHEET 21 OF 29

AS BUILT

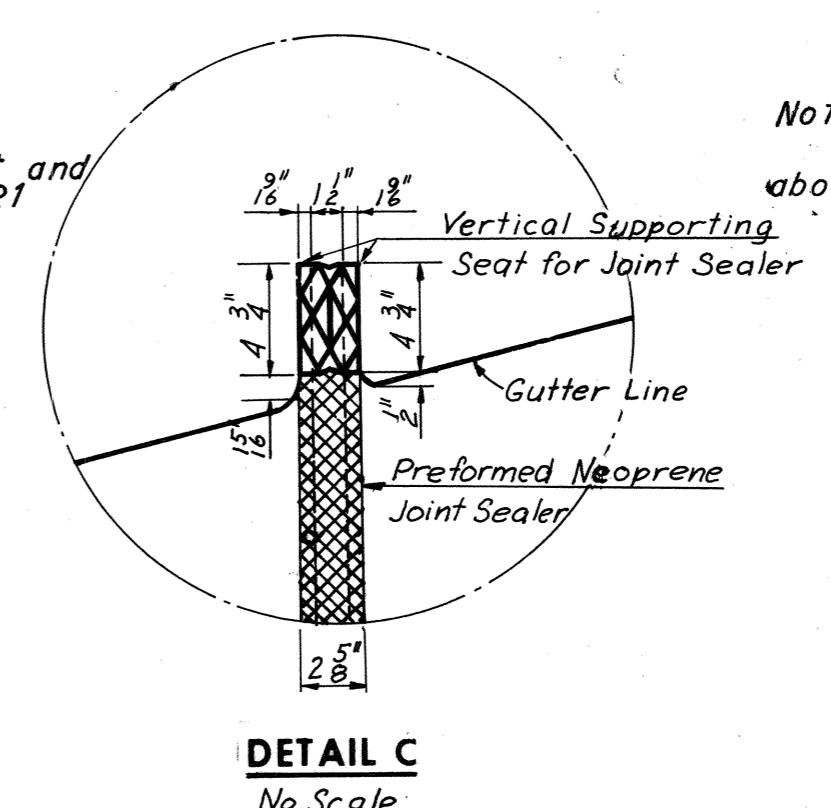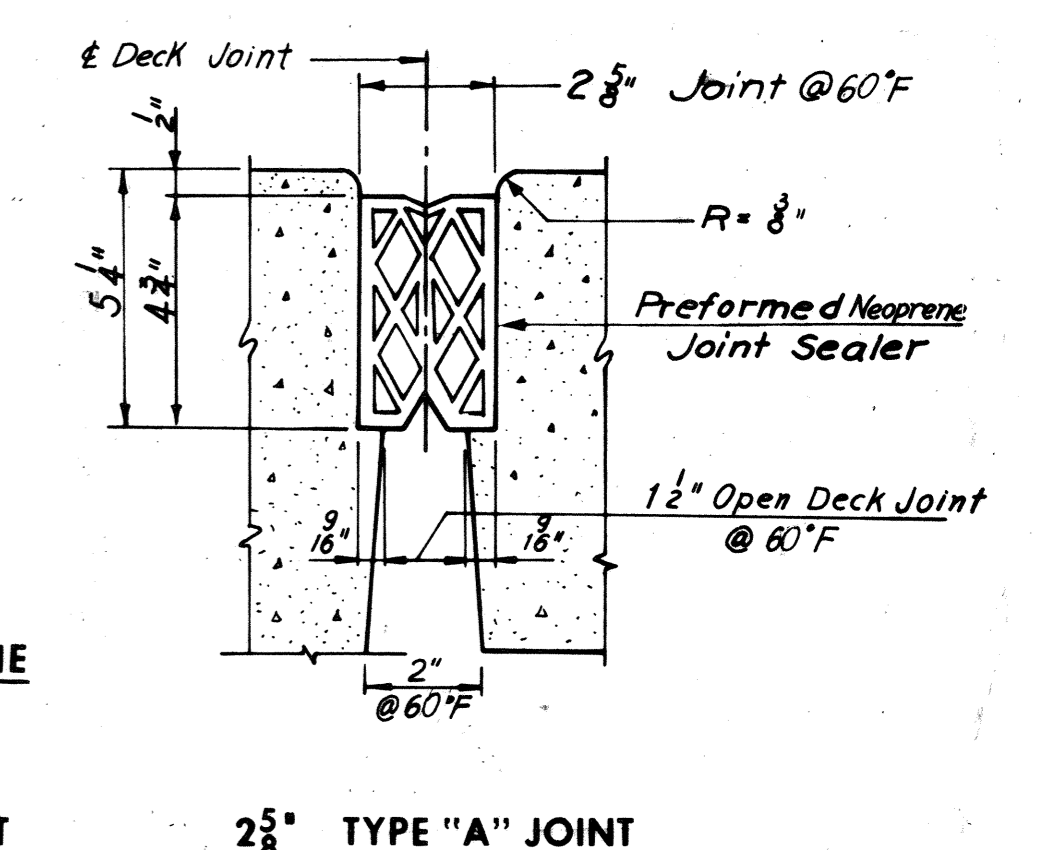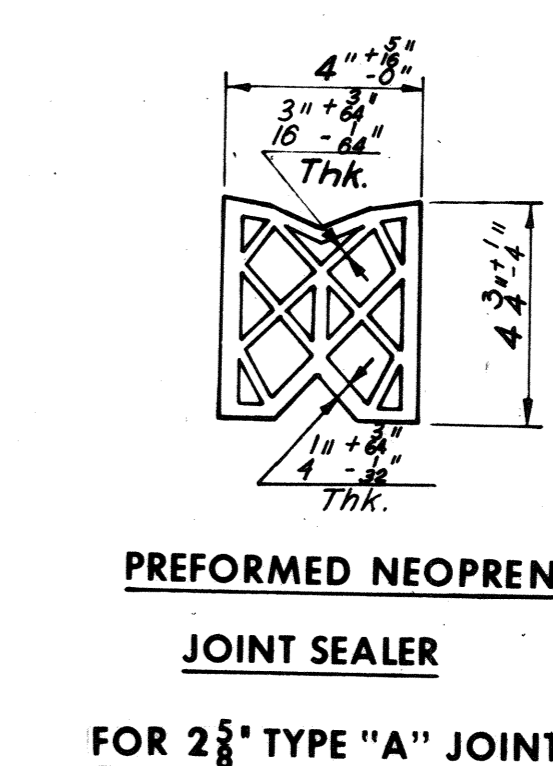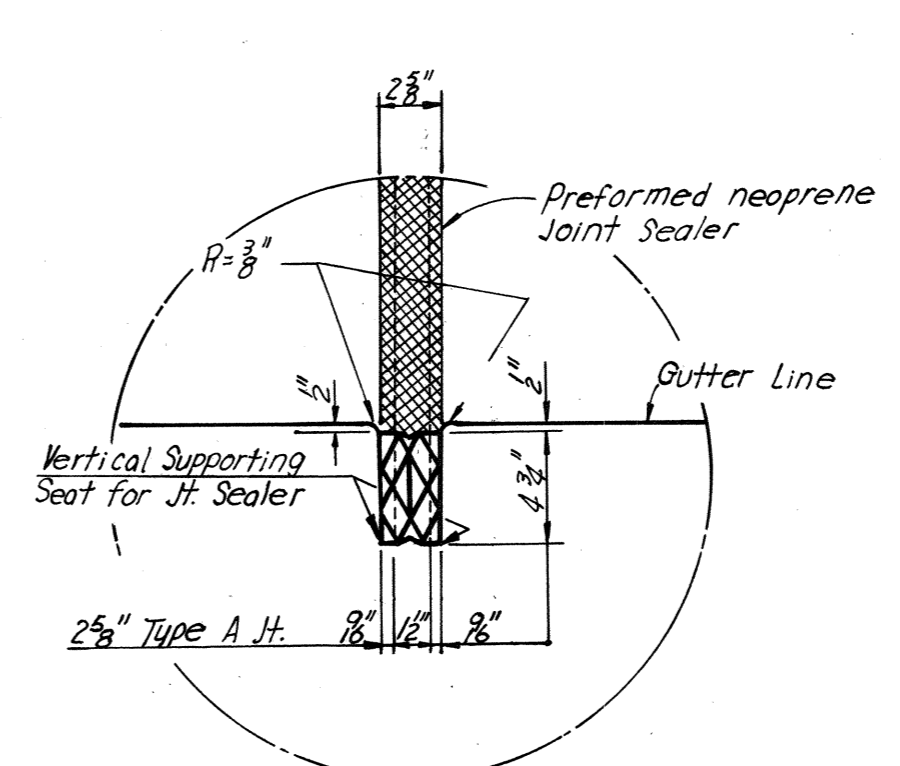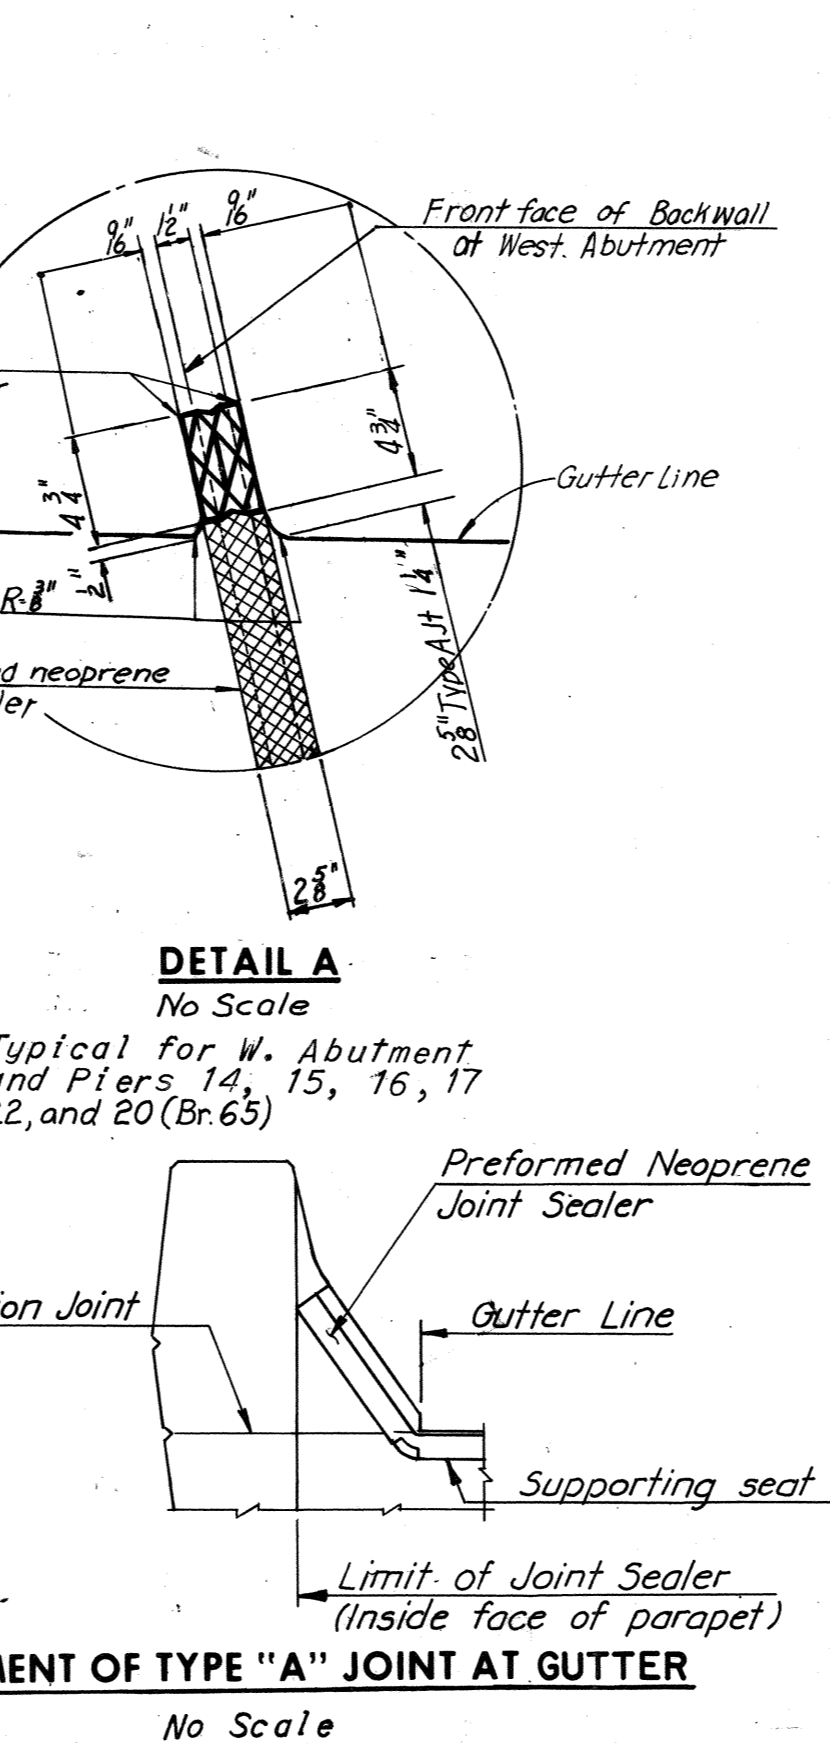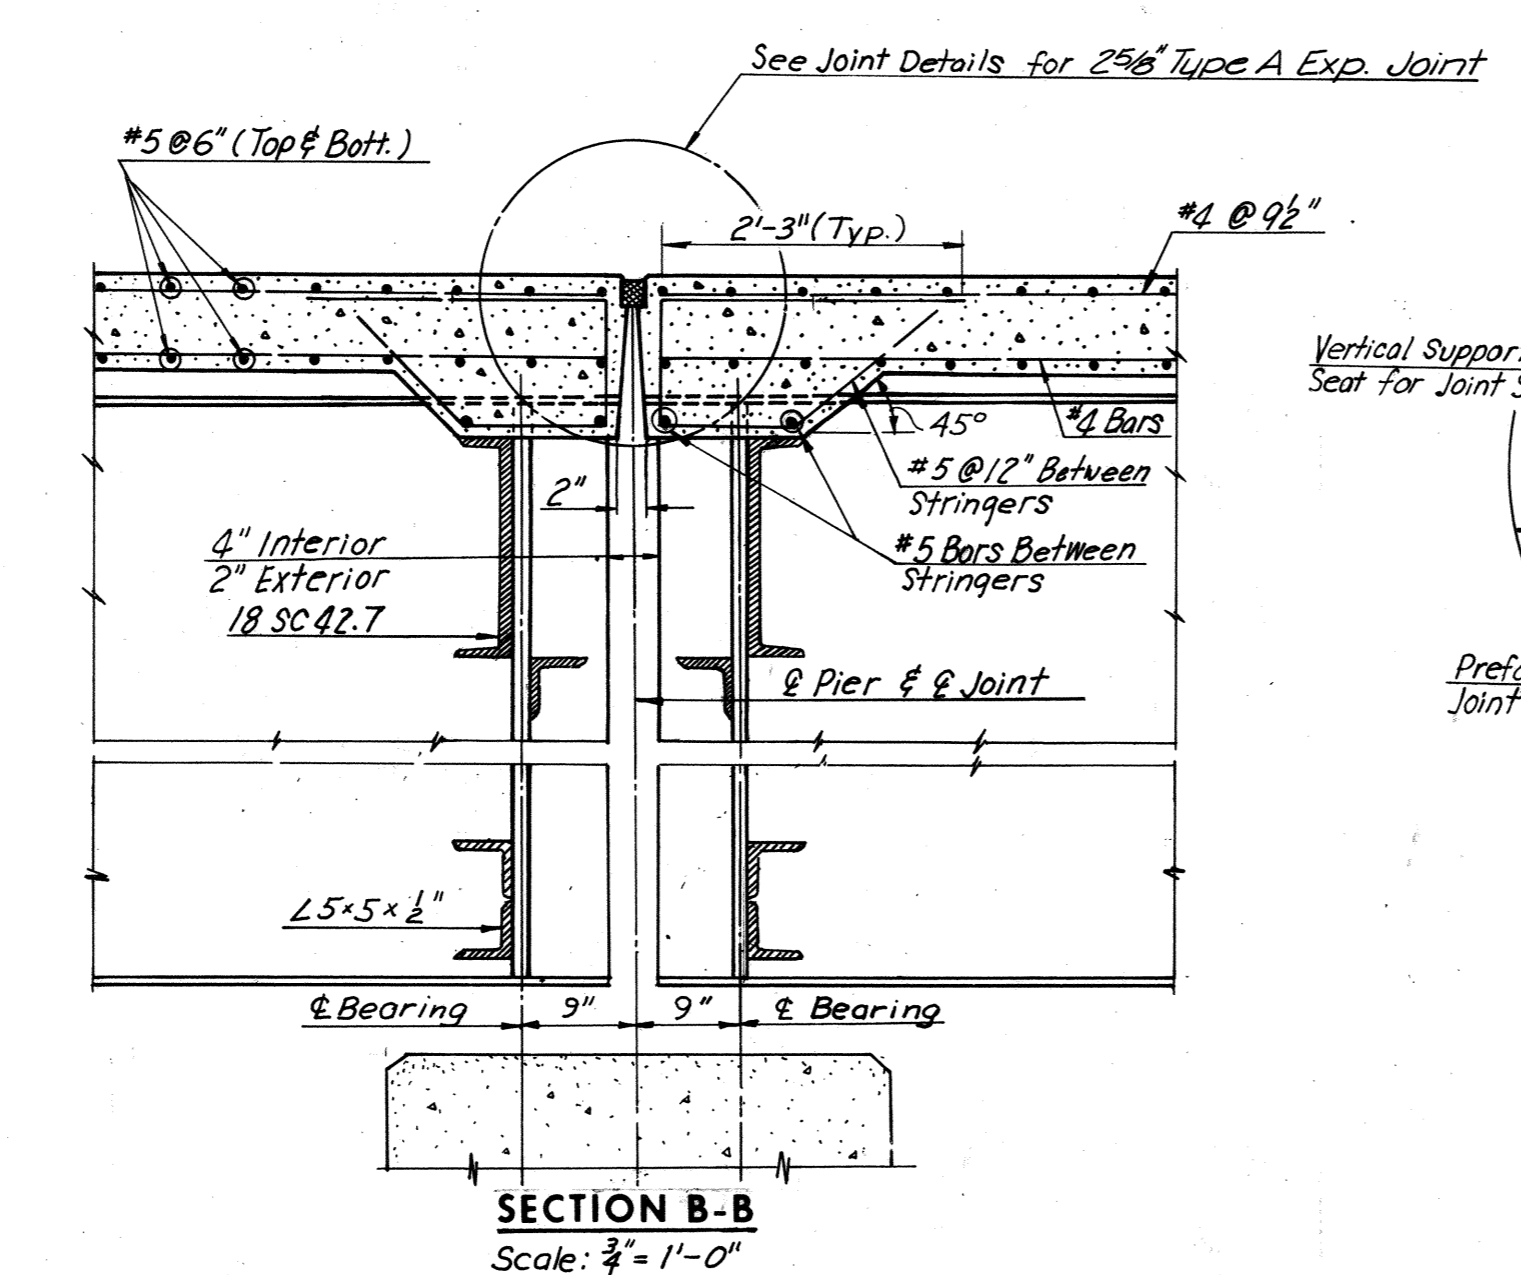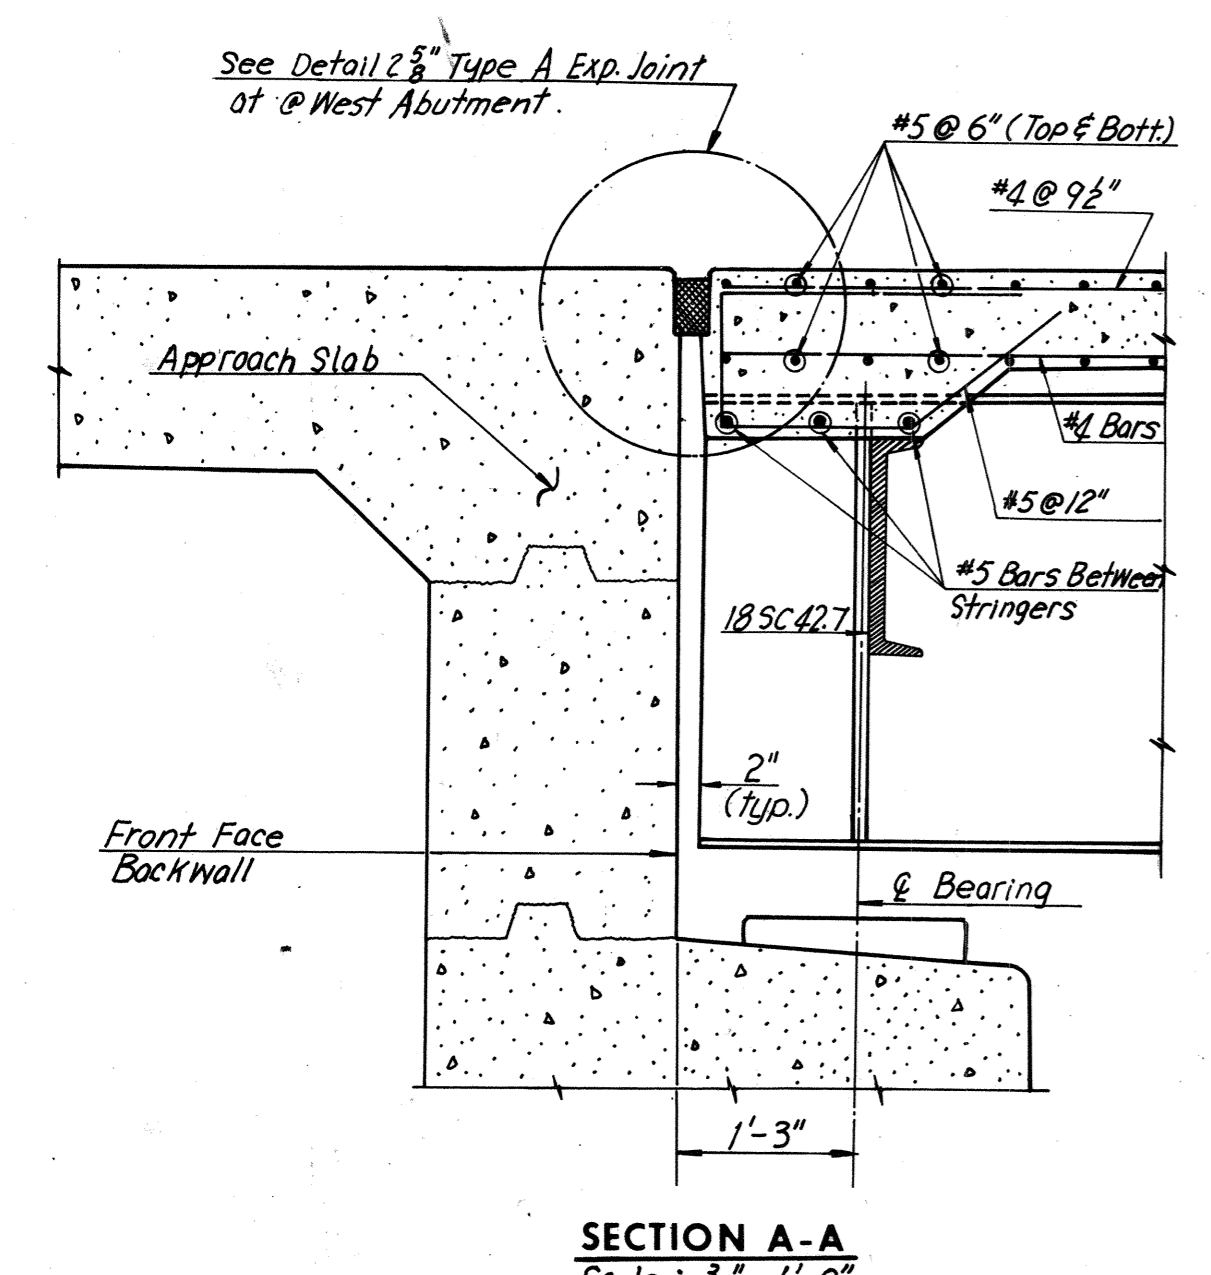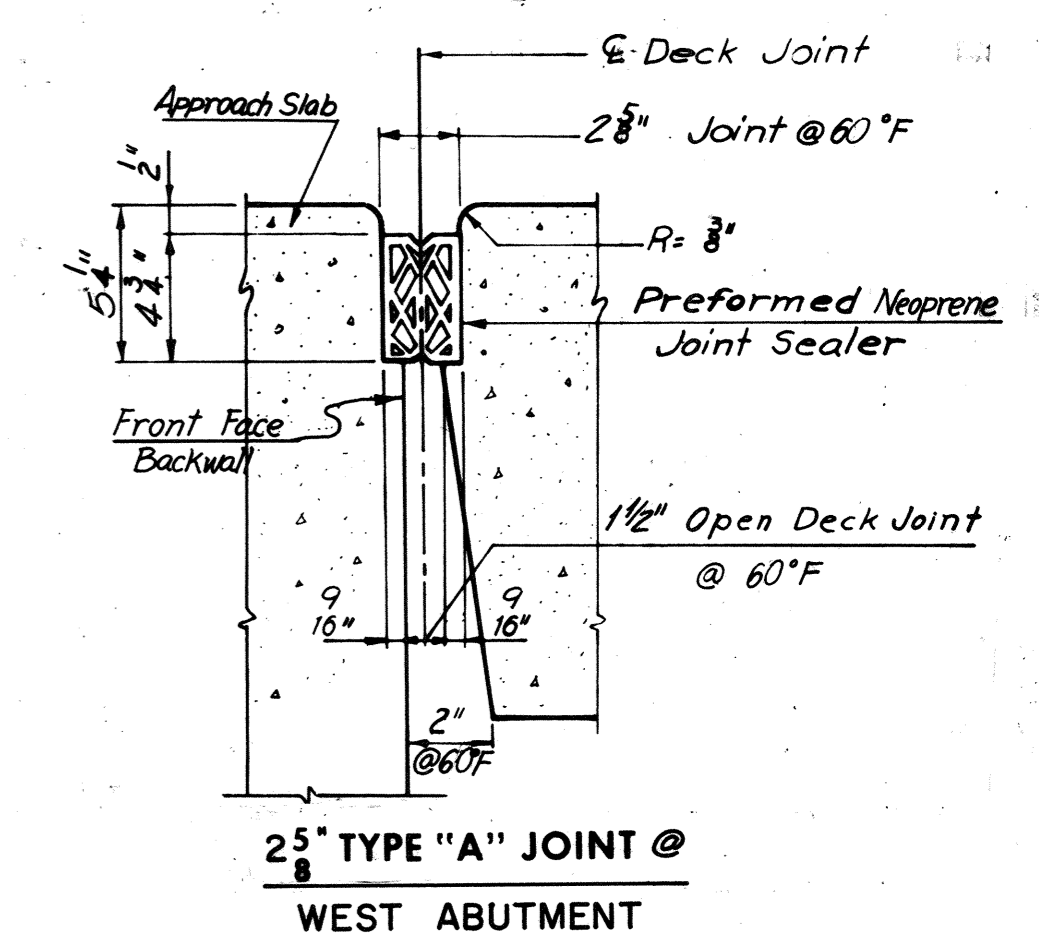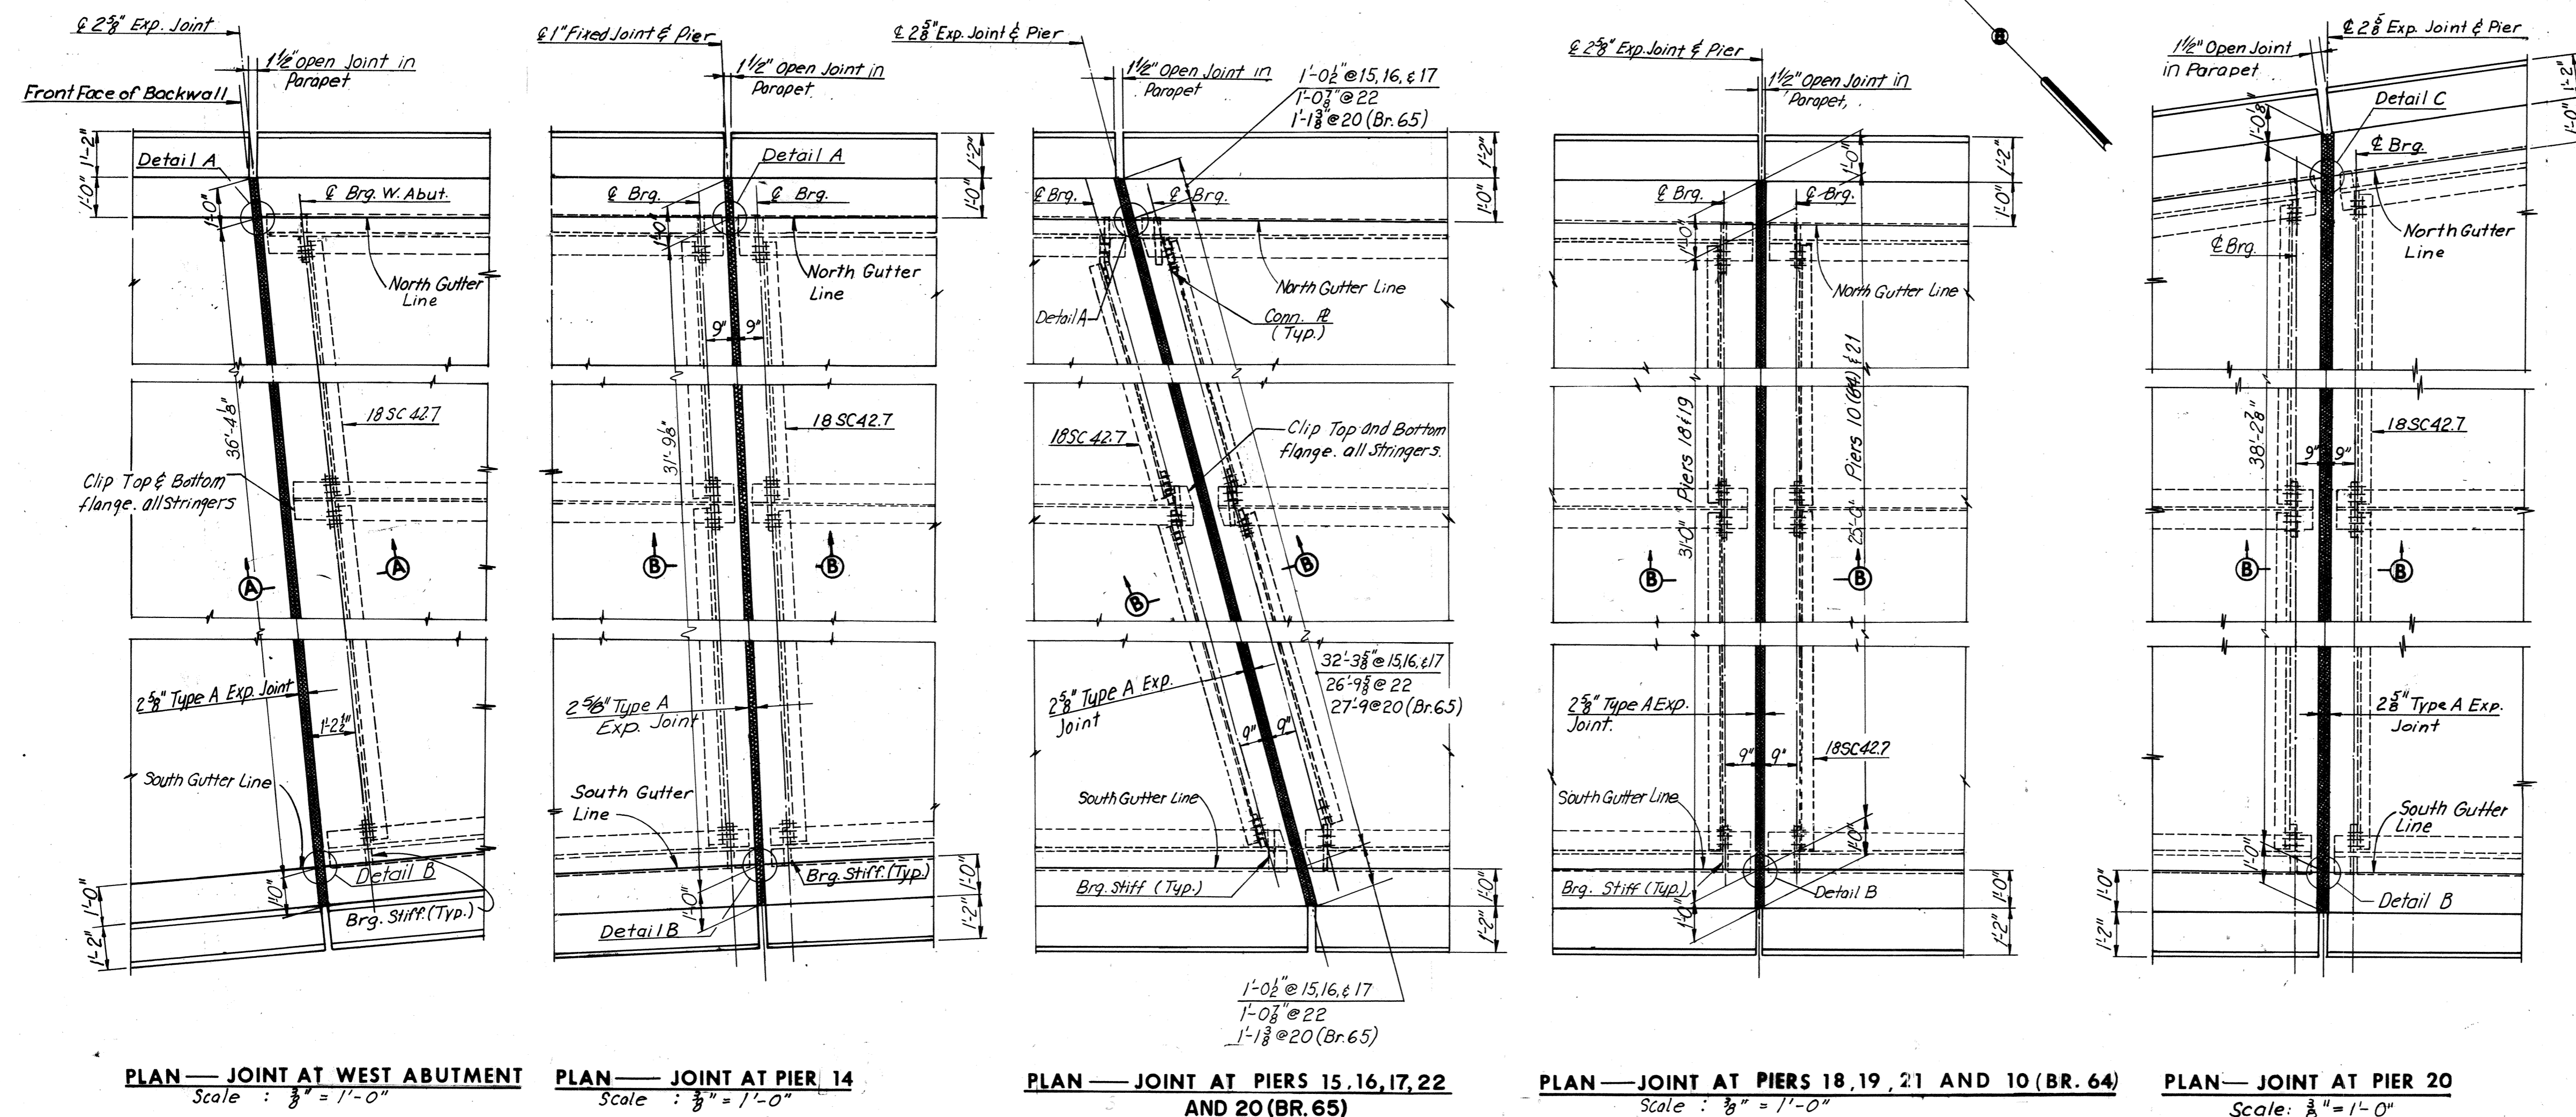

TREATMENT OF TYPE "A" JOINT AT GUTTER
No Scale

Note: All horizontal dimensions of Sections shown above are normal to \perp joint.

Note: It is absolutely essential that the openings for the preformed neoprene joint sealers be accurately formed and constructed to smooth, straight lines. The size of opening shall be adjusted to allow for anticipated dead load rotation of the ends of the slab and for the temperature at the time of construction.

Note: All horizontal dimensions shown above are normal to \perp joint.

BY	DATE			
MADE	GSH	10-1-68		
CHECKED	J.D.	11-19-68	1	As Built
IN CHARGE			NO.	REVISION
			BY	DATE
			TEM	10-76

RICHMOND METROPOLITAN AUTHORITY
RICHMOND EXPRESSWAY SYSTEM
DOWNTOWN EXPRESSWAY

BRIDGE NO. 63
WESTBOUND ROADWAY OVER
12TH ST. - R.R. TRACKS AND 16TH ST.

JOINT DETAILS

SCALE: As Noted
CONTRACT NO.: 10
SHEET NO. 24 OF 29

HOWARD, NEEDLES, TAMMEN & BERGENDOFF
consulting engineers
NEW YORK ALEXANDRIA KANSAS CITY


AS BUILT

Bridge 64

(Ramp from Southbound I-95 to Westbound Downtown Expressway “Rte. 195” over East Cary Street, Dock Street and CSX RR)

Record Set Plans

RICHMOND EXPRESSWAY SYSTEM			
SECTION	PROJECT	SHEET NO.	TOTAL SHEETS
10	DOWNTOWN EXPRESSWAY	99	265


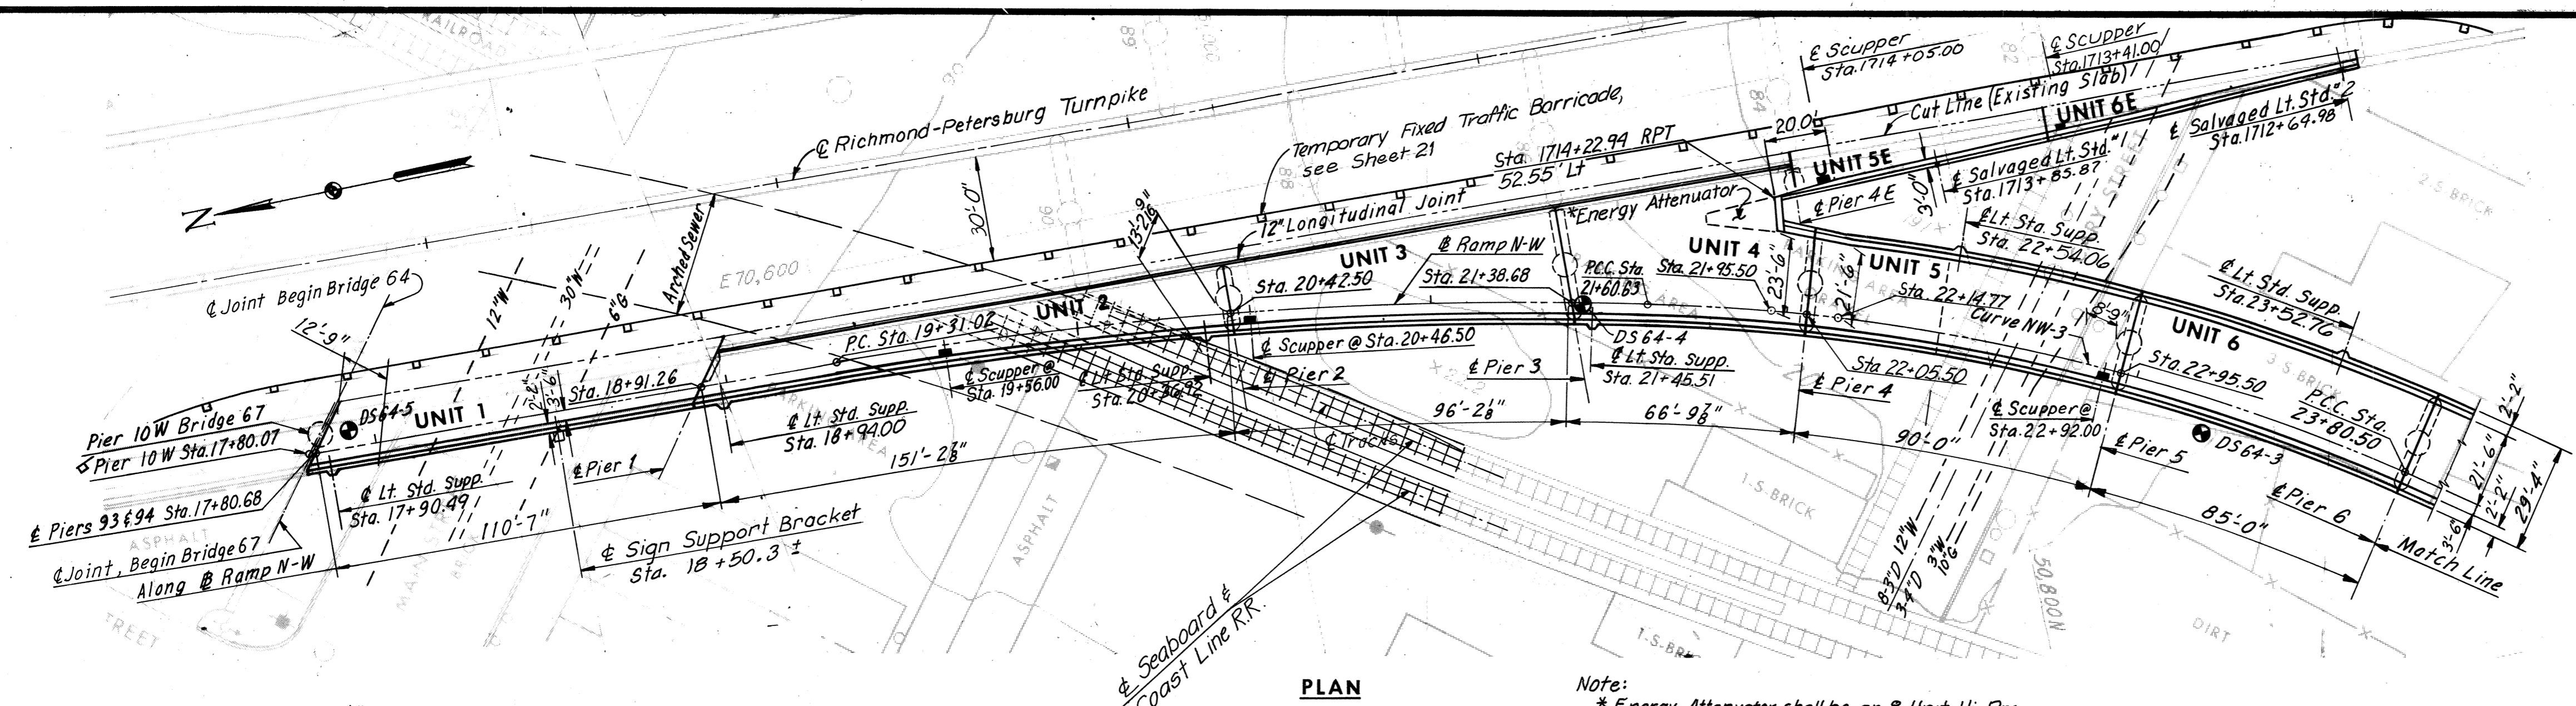


INDEX

INDEX	SHEET
GENERAL PLAN AND ELEVATION	1
GENERAL PLAN AND ELEVATION	2
LAYOUT PLAN	3
PIERS 1 AND 2	4
PIERS 3 AND 4E	5
PIER 4	6
PIER 5	7
PIERS 6 AND 7	8
PIER 8	9
PIER 9	10
PIER 10	11
FRAMING PLAN - UNITS 1 AND 2	12
FRAMING PLAN - UNITS 3 AND 4	13
FRAMING PLAN AND DECK PLAN - UNITS 5E AND 6E	14
FRAMING PLAN - UNITS 5 AND 6	15
FRAMING PLAN - UNITS 7 AND 8	16
FRAMING PLAN - UNITS 9 AND 10	17
FRAMING DETAILS	18
DECK PLAN - UNITS 1 AND 2	19
DECK PLAN - UNITS 3 AND 4	20
DECK PLAN - UNITS 5 AND 6	21
DECK PLAN - UNITS 7 AND 8	22
DECK PLAN - UNITS 9 AND 10	23
SUPERSTRUCTURE DETAILS	24
JOINT DETAILS	25
JOINT DETAILS	26
BORING LOGS	27
BORING LOGS	28
STANDARD DETAILS	S1 THRU S7


Note:
*Energy Attenuator shall be an B-Unit Hi-Dro Cell Sandwich Unit as supplied by Hydro-Cell, Ltd, 11 Lincoln Ave., New Rochelle, N.Y. 10801, or approved equal.

Note:
For General Notes, see Sheet 2.
For Quantity Table, see Sheet 2.

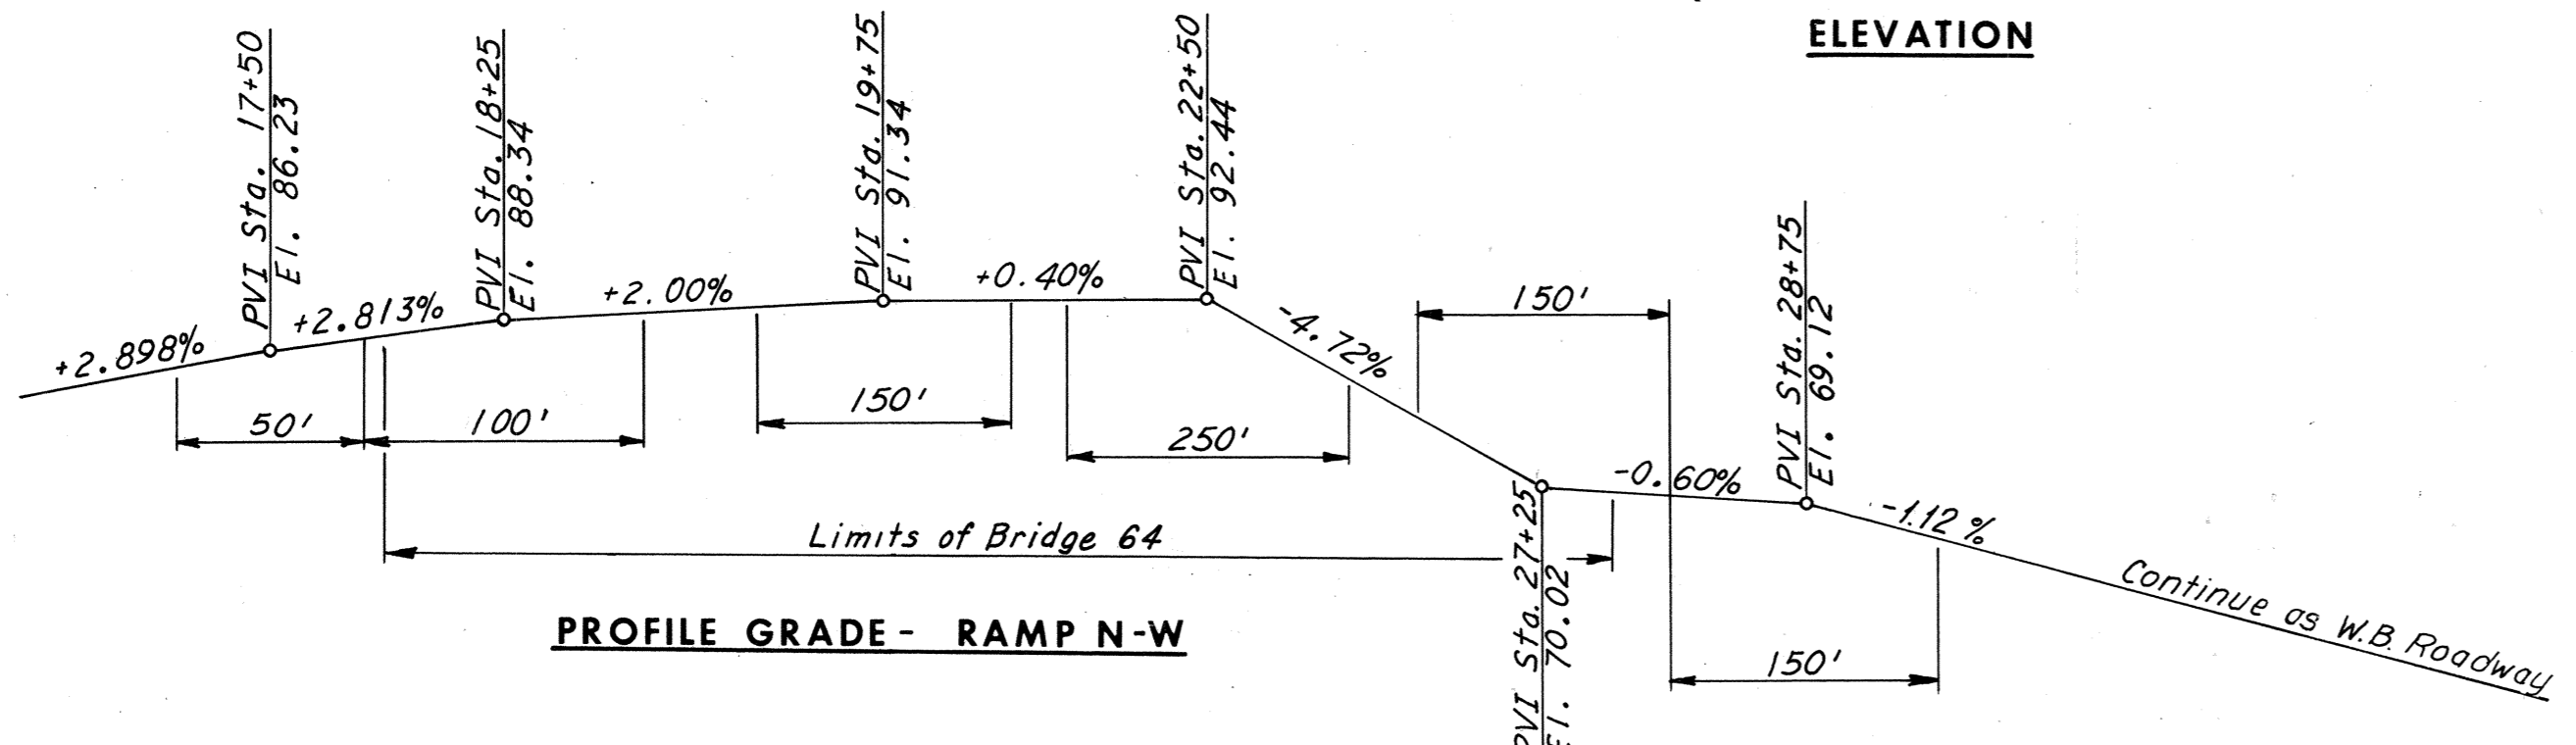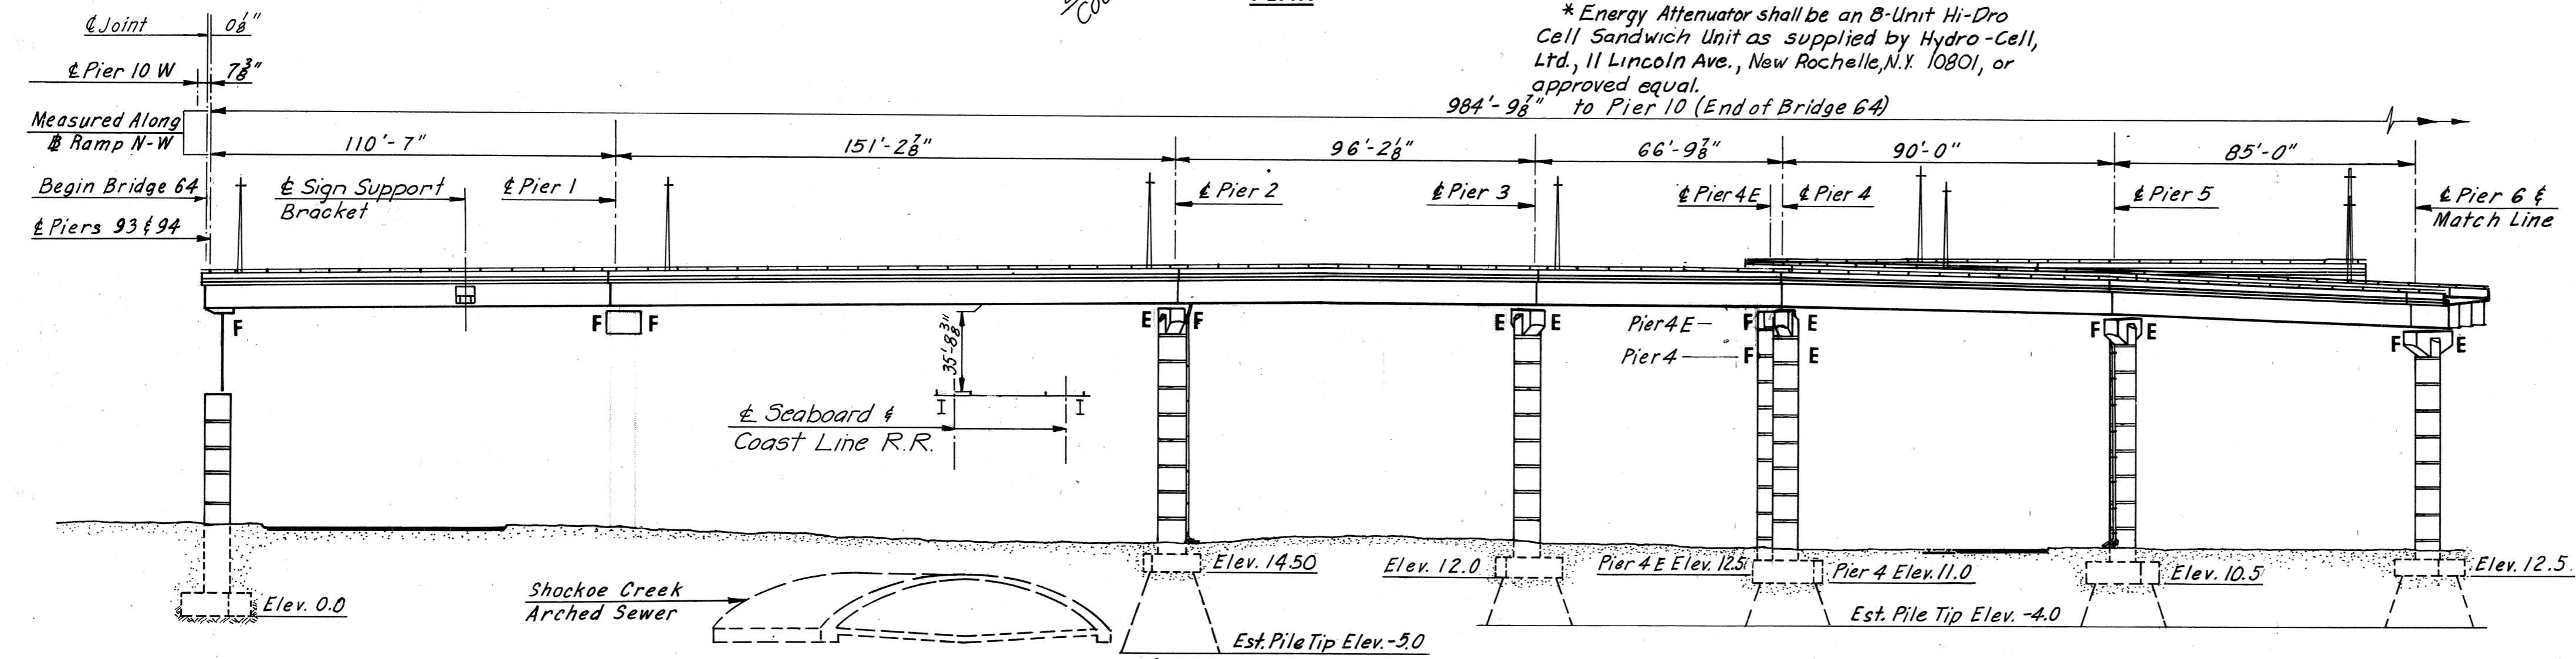

HORIZONTAL CURVE DATA

R. P. Turnpike		Ramp N-W	
Curve: R.P.T.-1	Curve: R.P.T.-2	Curve: NW-1	Curve: NW-2
P.I. = Sta. 1704+68.83	P.I. = Sta. 1723+07.01	P.I. = Sta. 13+42.50	P.I. = Sta. 20+46.21
Δ = 15° 03' 56.2"	Δ = 33° 27' 06.8"	Δ = 32° 01' 34"	Δ = 11° 28' 49.9"
D = 17° 00' 00"	D = 4° 00' 00"	D = 3° 51' 35.6"	D = 5° 00'
T = 757.65'	T = 430.45'	T = 426.01'	T = 115.19'
L = 1,506.56'	L = 836.30'	L = 829.72'	L = 229.61'
R = 3,729.58'	R = 1,432.39'	R = 1,484.39'	R = 1,145.92'
Curve: NW-3	Curve: NW-4	Curve: NW-5	
P.I. = Sta. 22+71.93	P.I. = Sta. 25+55.02	P.I. = Sta. 28+25.38	
Δ = 21° 59' 14.9"	Δ = 64° 48' 04"	Δ = 26° 18' 00"	
D = 10° 00' 00"	D = 20° 50' 05.4"	D = 10° 00' 00"	
T = 111.31'	T = 174.52'	T = 133.86'	
L = 219.88'	L = 311.02'	L = 263.00'	
R = 572.96'	R = 275.00'	R = 572.96'	

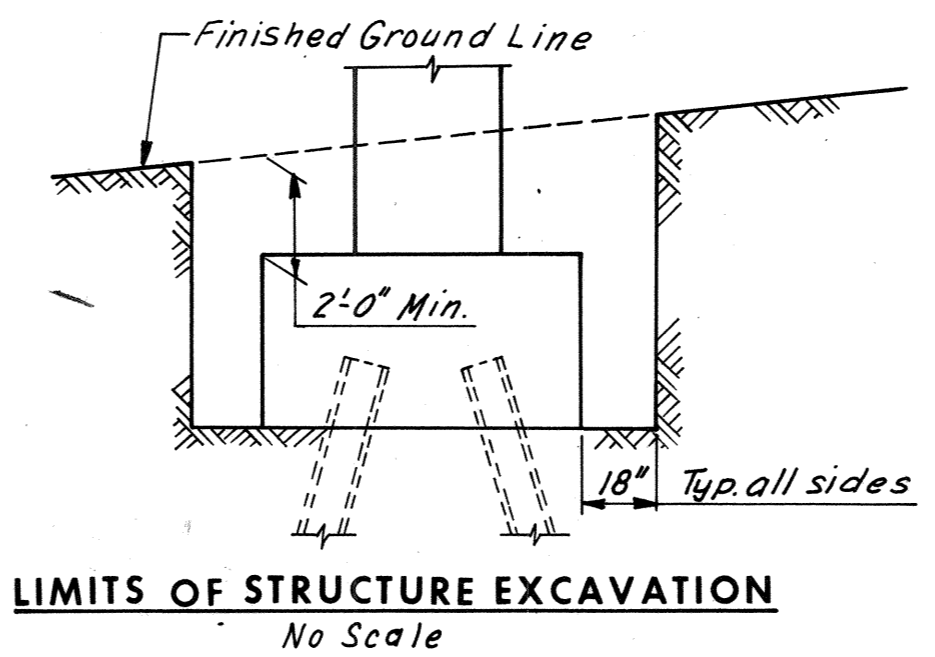

NO.	REVISION	BY	DATE
4	As Built	TEM	6-77
	Seaboard Coast Line Add. to Plant El.	K.D.P.	6-74
	Sign Support Bracket & Sheet 12a added	L.B.P.	8-74
	Added Sta.	REG	1-13-75

RICHMOND METROPOLITAN AUTHORITY
RICHMOND EXPRESSWAY SYSTEM
DOWNTOWN EXPRESSWAY



BRIDGE NO. 64
RAMP N-W CONNECTION FROM
RICHMOND-PETERSBURG TURNPIKE
GENERAL PLAN AND ELEVATION

HOWARD, NEEDLES, TAMMEN & BERGENDOFF
consulting engineers
NEW YORK ALEXANDRIA KANSAS CITY

SCALE: 1" = 30'-0"
CONTRACT NO.: 10
SHEET NO. 1 OF 28

AS BUILT

RICHMOND EXPRESSWAY SYSTEM			
SECTION	PROJECT	SHEET NO.	TOTAL SHEETS
10	DOWNTOWN EXPRESSWAY	100	265

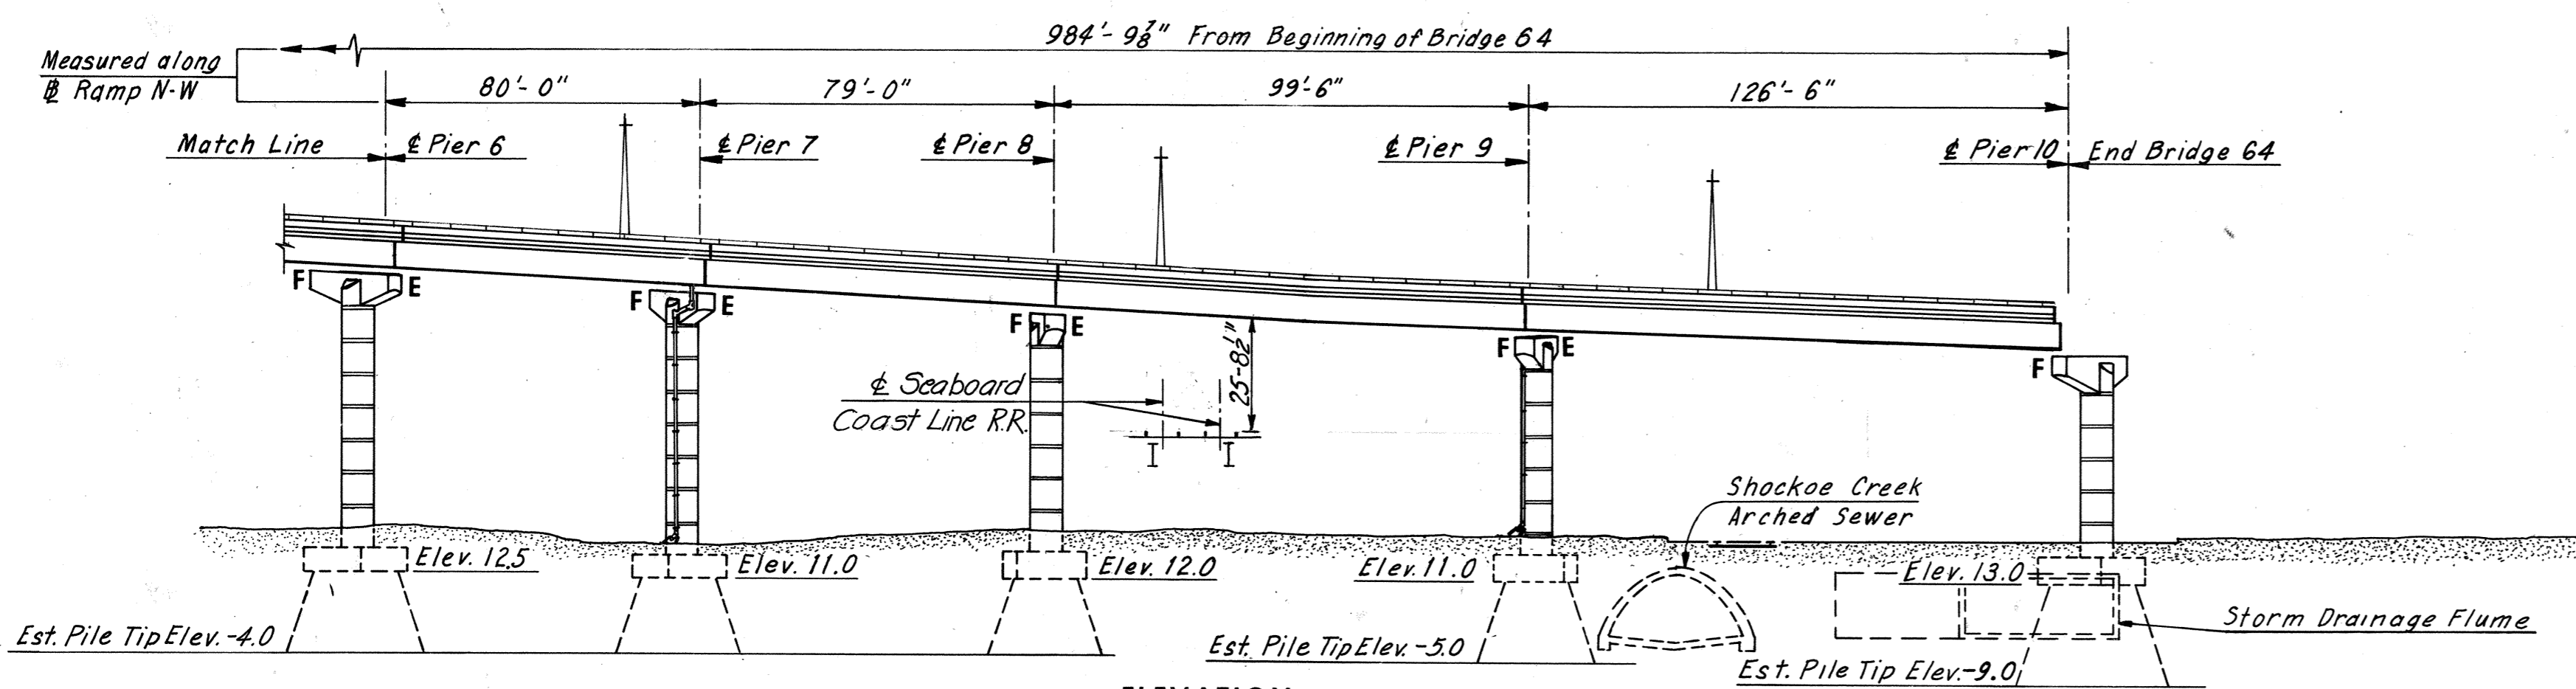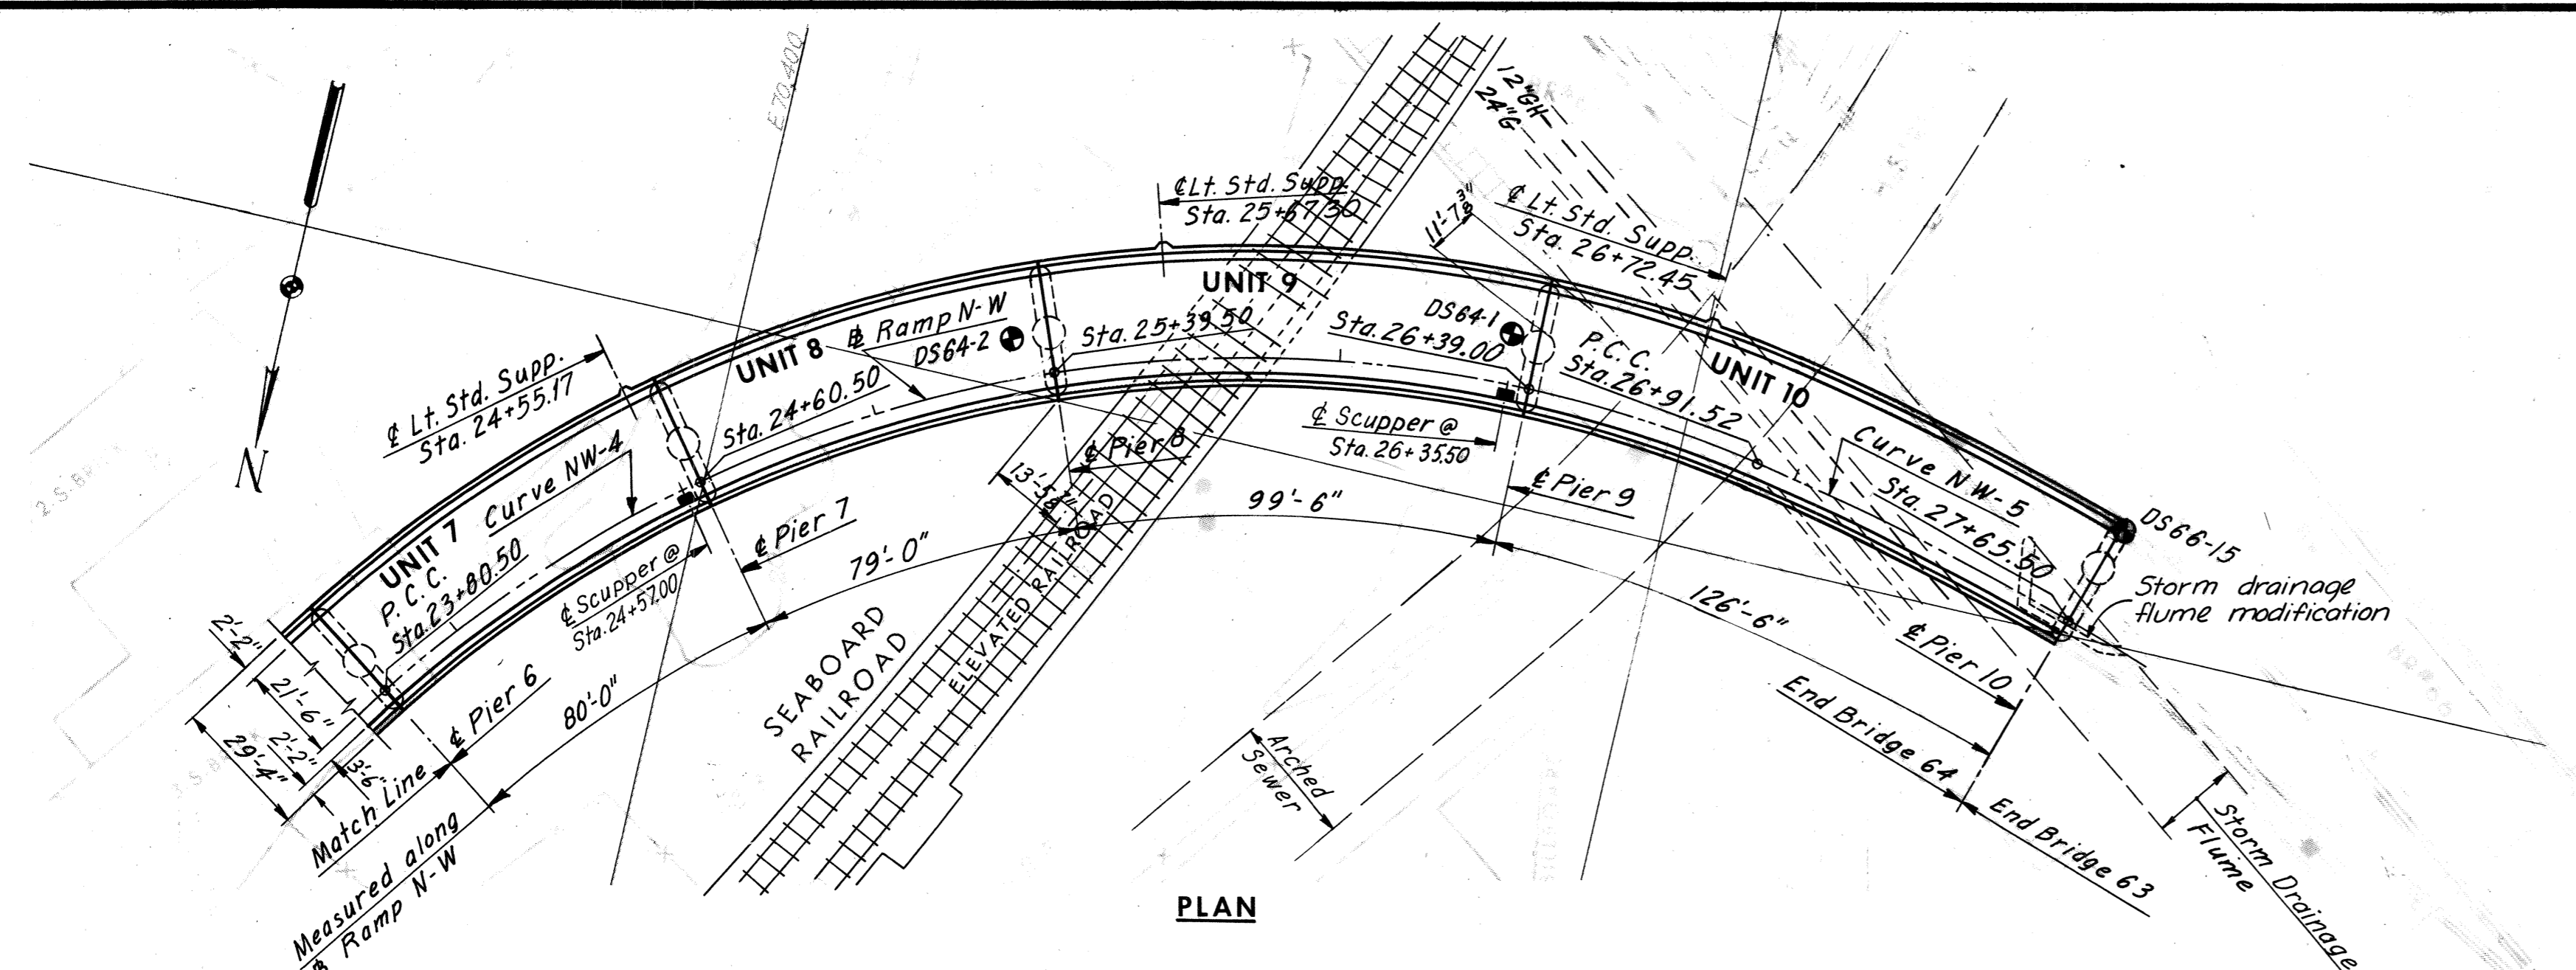

ESTIMATED QUANTITIES

	Structure Excavation Cu. Yds.	Concrete (#) Cu. Yds.	Reinforcing Steel Lbs.	Str. Steel Mild Carbon Lbs.	Str. Steel High Strength Lbs.	Aluminum Railing (1-Rail) Lin. Ft.	Steel Piles 10BP42 Lin. Ft.
Superstructure	--	1,023.8	213,790	768,100	413,900	1,600	---
Substructure	1,125	1,484.1	236,580	2,000	---	---	145
Total	1,125	2,507.9	450,370	770,100	413,900	1,600	145

	Steel Piles 12BP53 Lin. Ft.	Sheet Piling Lump Sum	Metal Conduit Lin. Ft.	Energy Attenuator 8-Unit Each	Bridge Drainage Metal Work Lbs.	Modifications to R.P. Turnpike Bridge Lump Sum	Modifications to Storm Drainage Flume Cu. Yds.
Superstructure	---	--	1,075	1	13,030	1	--
Substructure	3,035	1	--	--	--	--	116
Total	3,035	1	1,075	1	13,030	1	116

* All Concrete for Superstructure shall be Class A4 and for Substructure Class A3.

BY	DATE	Seaboard & Coast Line Add. To Plans	K.D.P.	6-74
MADE	AMH 1-13-69	Str. Steel Quantity	R.B.H.	9-74
CHECKED	GCC 4-28-69	As Built	TEM	6-77
IN CHARGE	NO.	REVISION	BY	DATE

GENERAL NOTES:

ROADWAY: One variable width roadway transitioning from a widening of Southbound roadway of Richmond-Petersburg Turnpike to a ramp with 25'-0" clear roadway connecting with W.B. Roadway (Br. 63).

CAPACITY: Dead load includes 15 lbs. per sq. ft. for future wearing surface. Live load, HS 20-44 loading and alternate military loading.

SPECIFICATIONS: GENERAL: Virginia Department of Highway Road and Bridge Specifications 1970.
DESIGN: A.A.S.H.O. Standard Specifications for Highway Bridges 1973, modified by Special Design provisions.
WELDING: 1972 Standard Specifications for Welded Highway and Railway Bridges of The American Welding Society.
CONTRACT SPECIAL PROVISIONS: Specifications and Contract Special Provisions referred to above are necessary to make these plans complete.

DATUM: City of Richmond

TEMPERATURE: The normal temperature referred to in the plans is 60°F. The temperature range for movement is 0° F. to 120° F.

DIMENSIONS: All dimensions are measured horizontally and vertically unless otherwise noted.

EXCAVATION: Excavation below subgrade and cut slope template shall be classified as Structure Excavation. All excavation above these limits shall be classified as Regular Excavation and is not included in the Structural Quantities.

FOUNDATIONS: Footings shall rest on firm material. Foundation material shall be dry and special attention is called to Section 401.05 of Standard Specifications and to the Contract Special Provisions, concerning preparation of foundations for footings.

CONCRETE NOTES: Concrete in superstructure shall be Class A 4. All other concrete shall be Class A 3. All exposed edges and corners shall have a 3" chamfer or fillet unless otherwise noted. Care in the method of vibration, the use of low-slump concrete, and other means shall be employed to prevent downgrade movement of newly placed slab concrete. Finishing Concrete Surfaces: See Standard Architectural Detail Sheets and the Contract Special Provisions for types and details. All reinforcing bar dimensions on the detailed drawings are to centers of bars unless otherwise noted. Clear distance between reinforcing steel and face to concrete shall be as noted on the plans. All bar laps shall be 30 diameters of the smaller diameter bar unless otherwise noted. All reinforcing steel shall conform to ASTM A615 Grade 40.

STEEL NOTES: Structural steel shall conform to A.S.T.M. Designations A36, A572 - Grade 50 and A588 as noted. See Special Provisions. All field connections shall be made with high strength bolts. High strength bolts shall be 1/2" diameter unless otherwise noted and shall conform to A.S.T.M. Specification A-325.

Note: For Curve Data and Profile Grade, see Sheet 1. For Layout Plan, see Sheet 3.

AS BUILT


RICHMOND METROPOLITAN AUTHORITY
RICHMOND EXPRESSWAY SYSTEM
DOWNTOWN EXPRESSWAY

BRIDGE NO. 64
RAMP N-W CONNECTION FROM
RICHMOND-PETERSBURG TURNPIKE
GENERAL PLAN AND ELEVATION

HOWARD, NEEDLES, TAMMEN & BERGENDOFF
 Consulting Engineers
 NEW YORK ALEXANDRIA KANSAS CITY


SCALE: 1" = 30'-0"
 CONTRACT NO. 10
 SHEET NO. 2 OF 28

RICHMOND EXPRESSWAY SYSTEM			
SECTION	PROJECT	SHEET NO.	TOTAL SHEETS
10	DOWNTOWN EXPRESSWAY	109	265

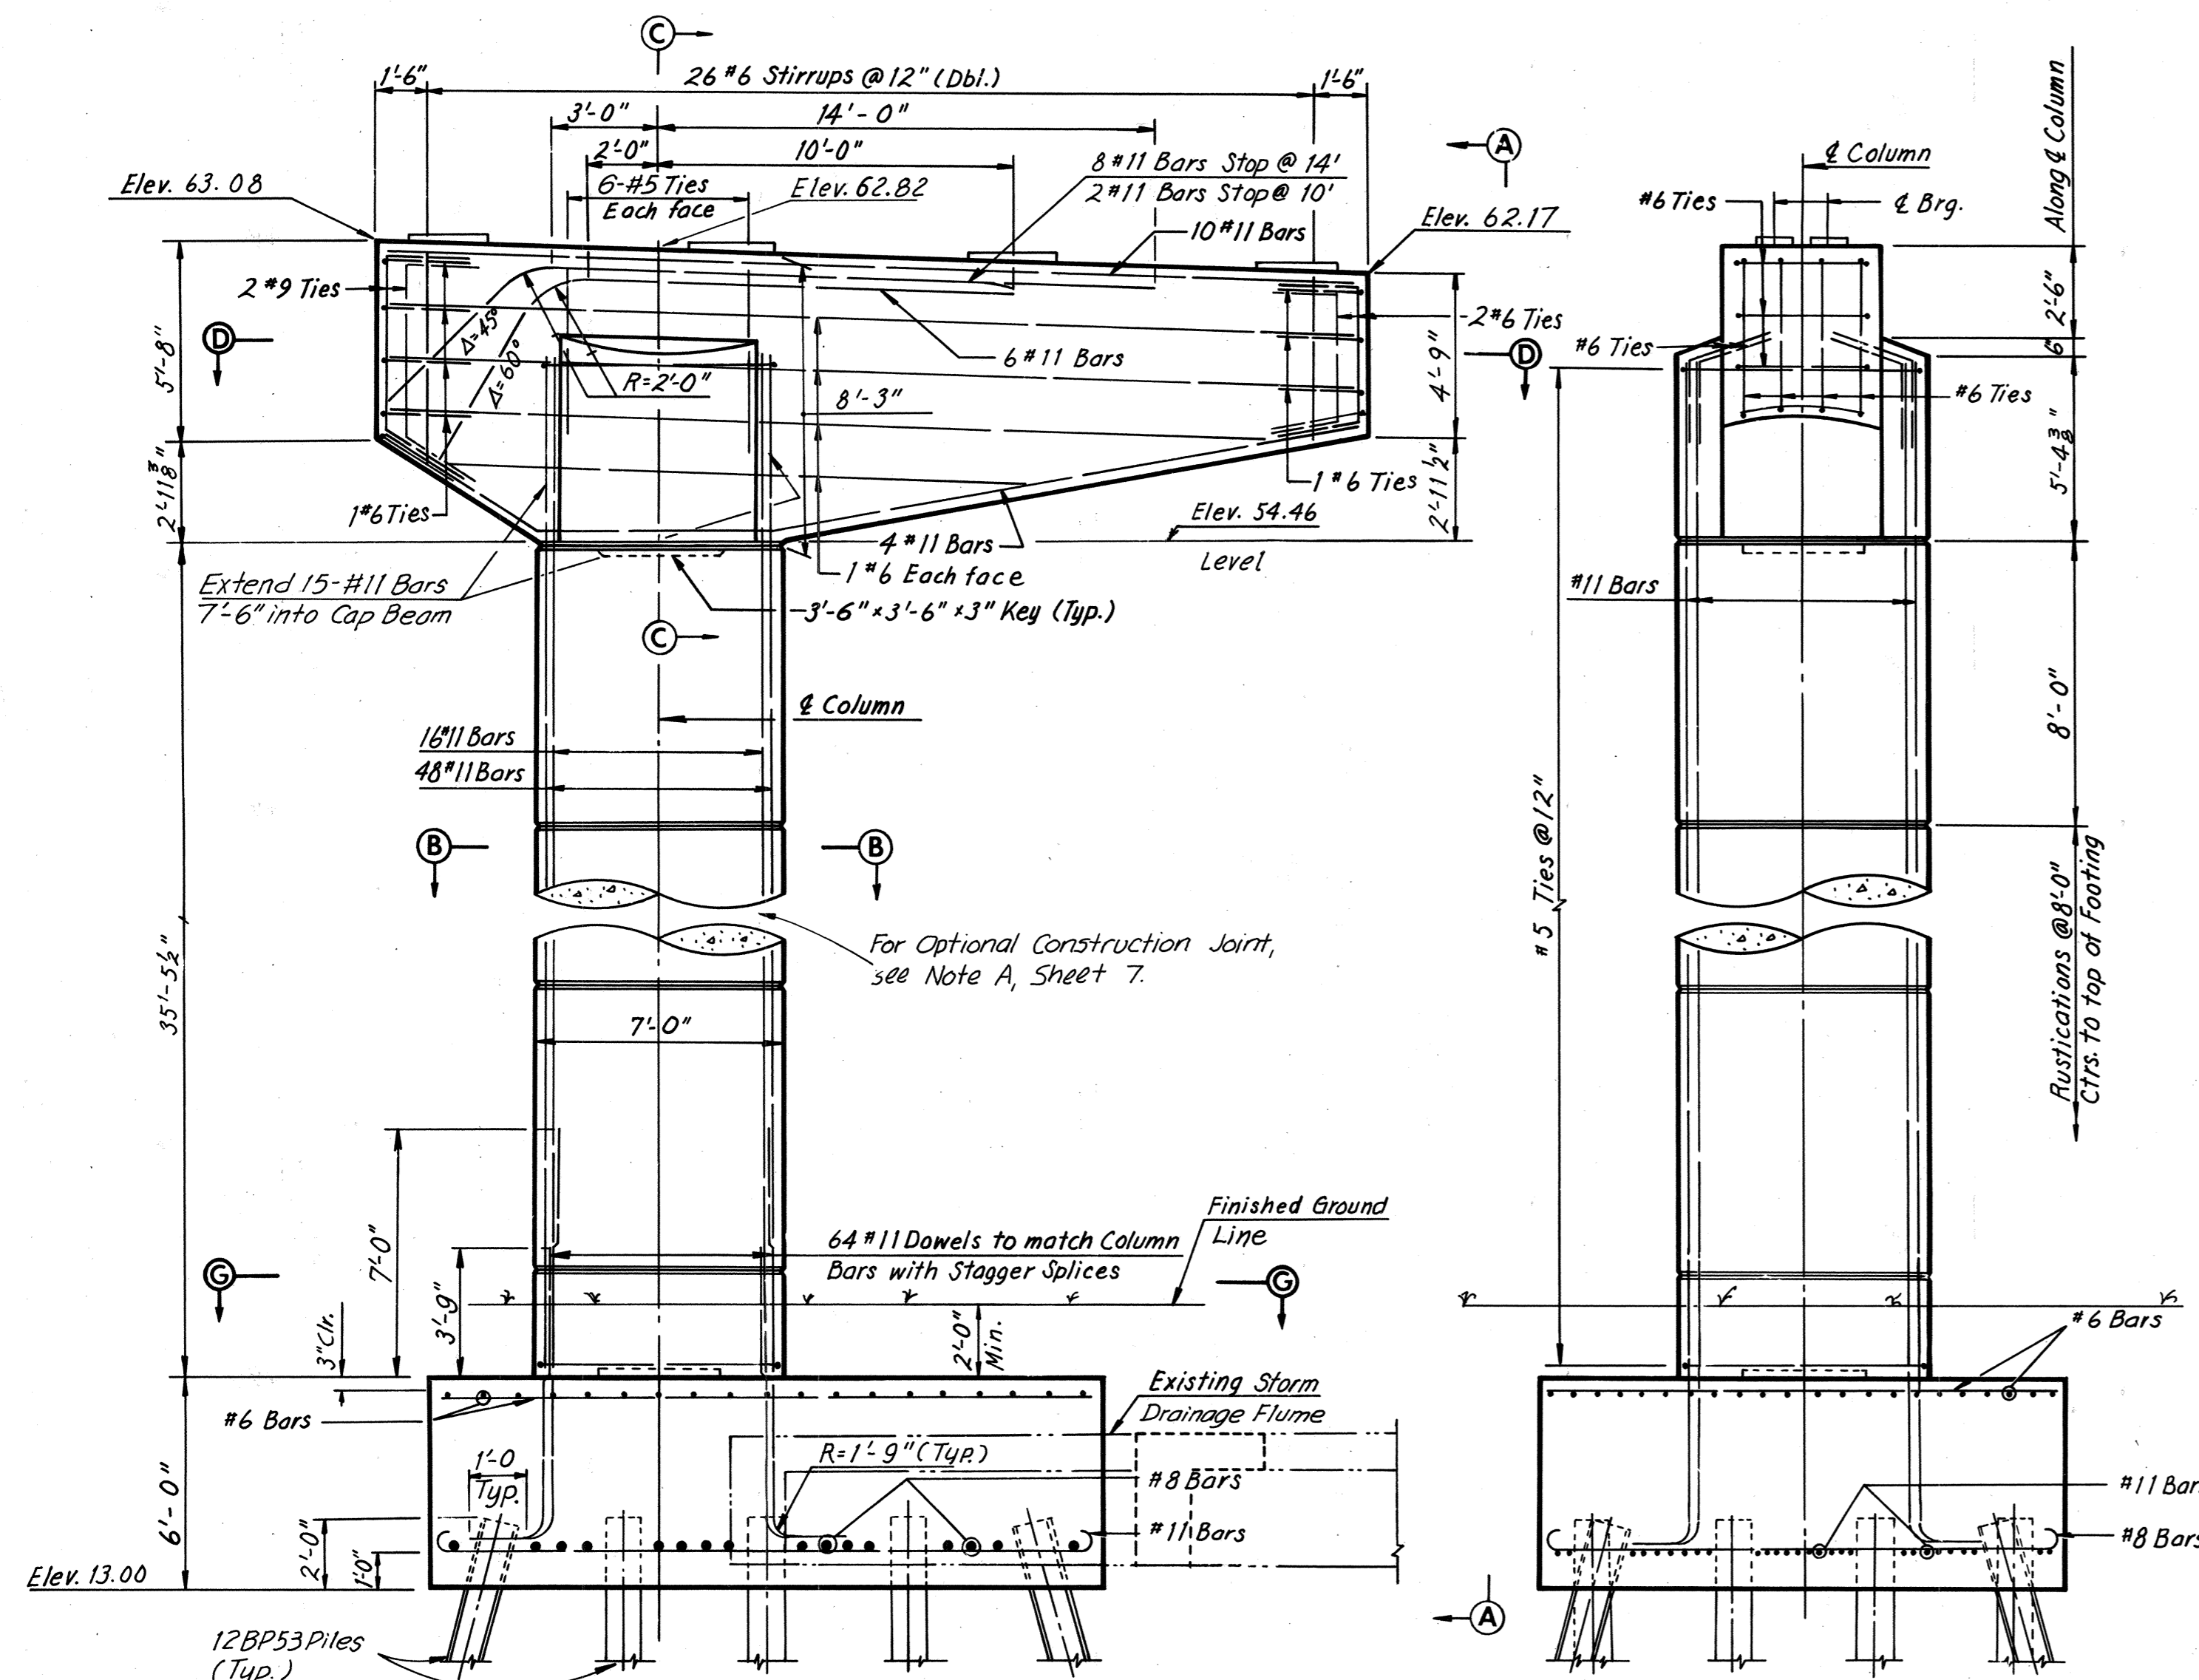


ELEVATION
Scale: 1/4" = 1'-0"


VIEW A-A
Scale: 1/4" = 1'-0"

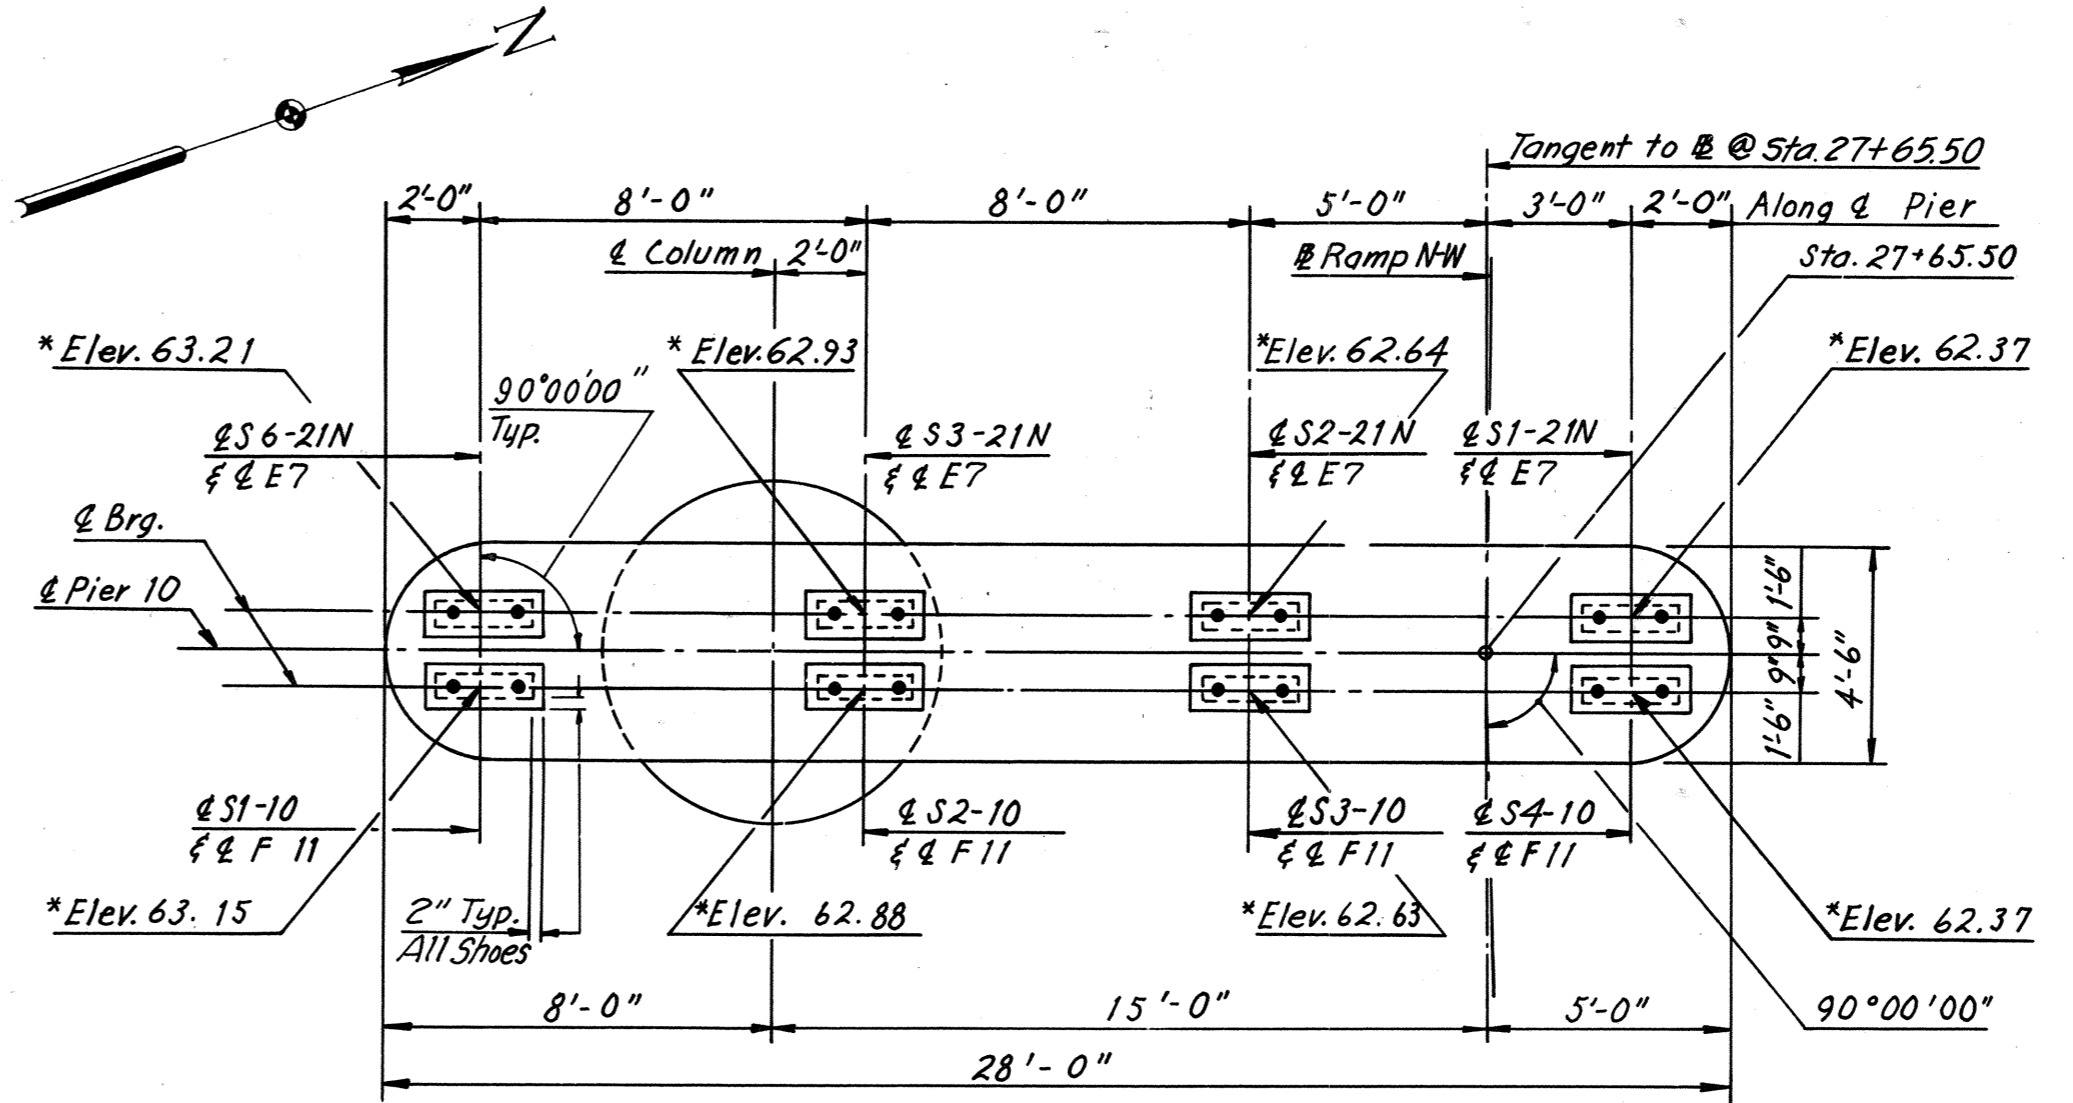

PLAN
Scale: 1/4" = 1'-0"

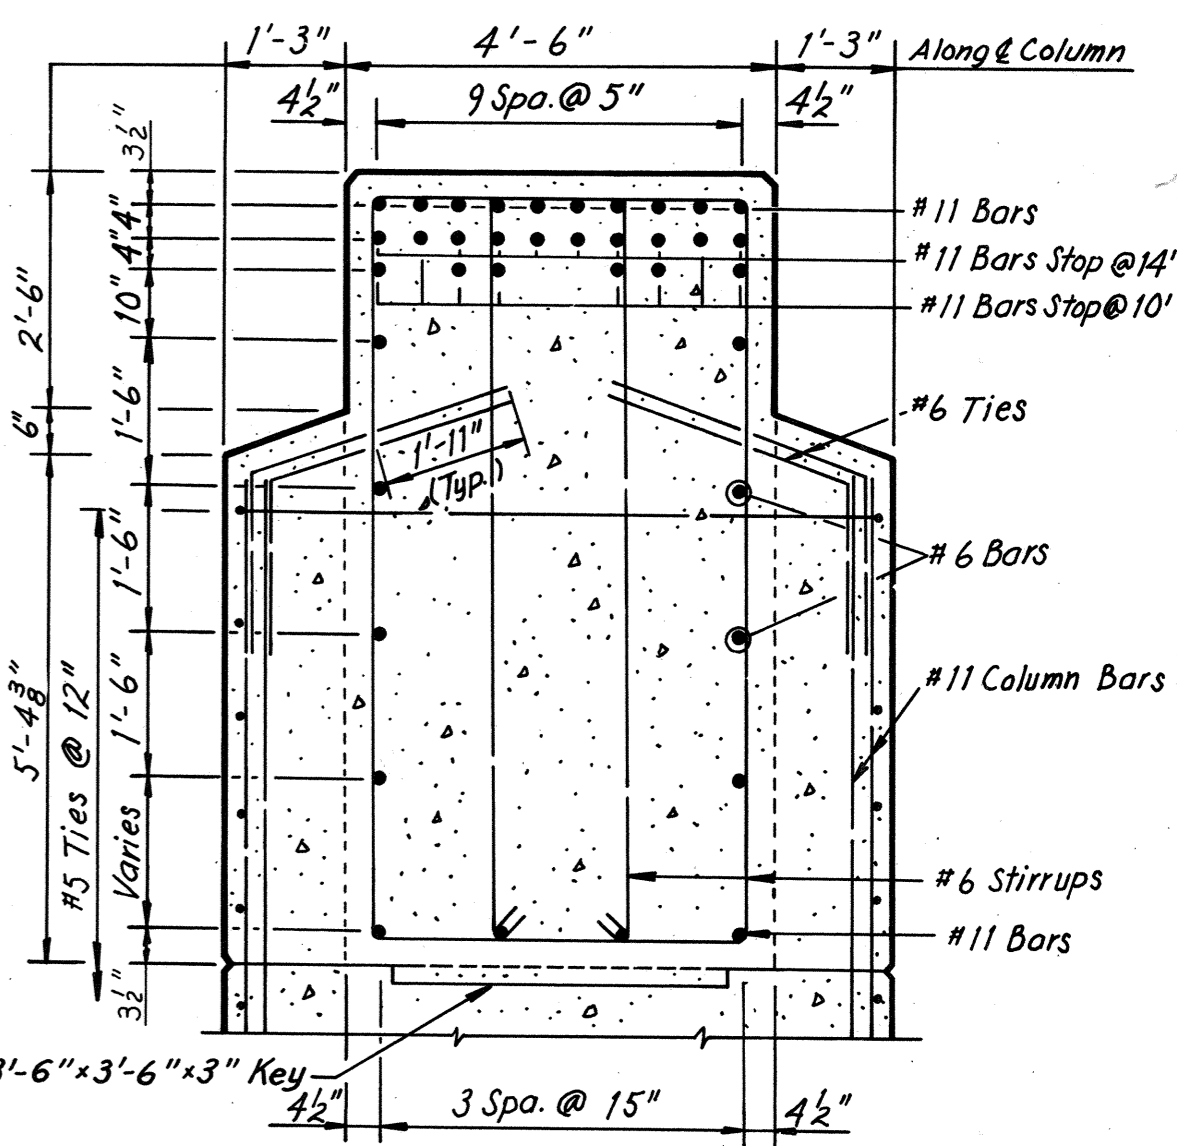

SECTION C-C
Scale: 1/2" = 1'-0"

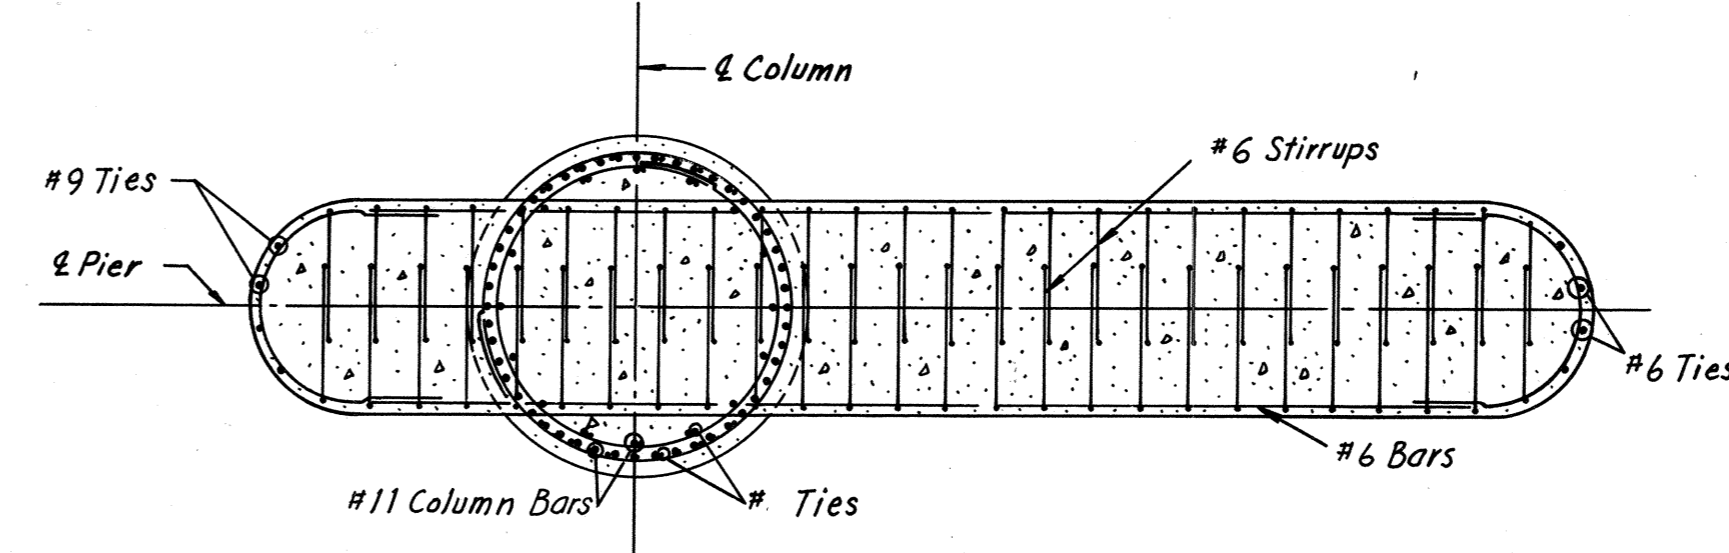


SECTION D-D
Scale: 1/4" = 1'-0"

Note: Footing elevations are approximate only and may be varied to suit field conditions as directed by the Engineer. Vertical shaft reinforcing shall not be cut until these elevations are established. Where elevations change more than 2 ft., redesign will be required. * Denotes the Top Pad Elevation.


Notes: All piles shall be 12BP53 Steel Piles (Design Capacity = 57 tons)

For Standard Shoe Details, see Sheet 31. For Framing Plan, see Sheet 17. Estimated Pile Tip Elevation is -9.0 feet. For Rustication Details, see Sheet 9. For 12BP53 Steel Pile Details, see Sheet 9.


Note: Piles located within 10 ft. (horizontal distance) of Storm Drainage Flume shall be pre-bored to an Elevation 5 ft. below bottom of sewer.

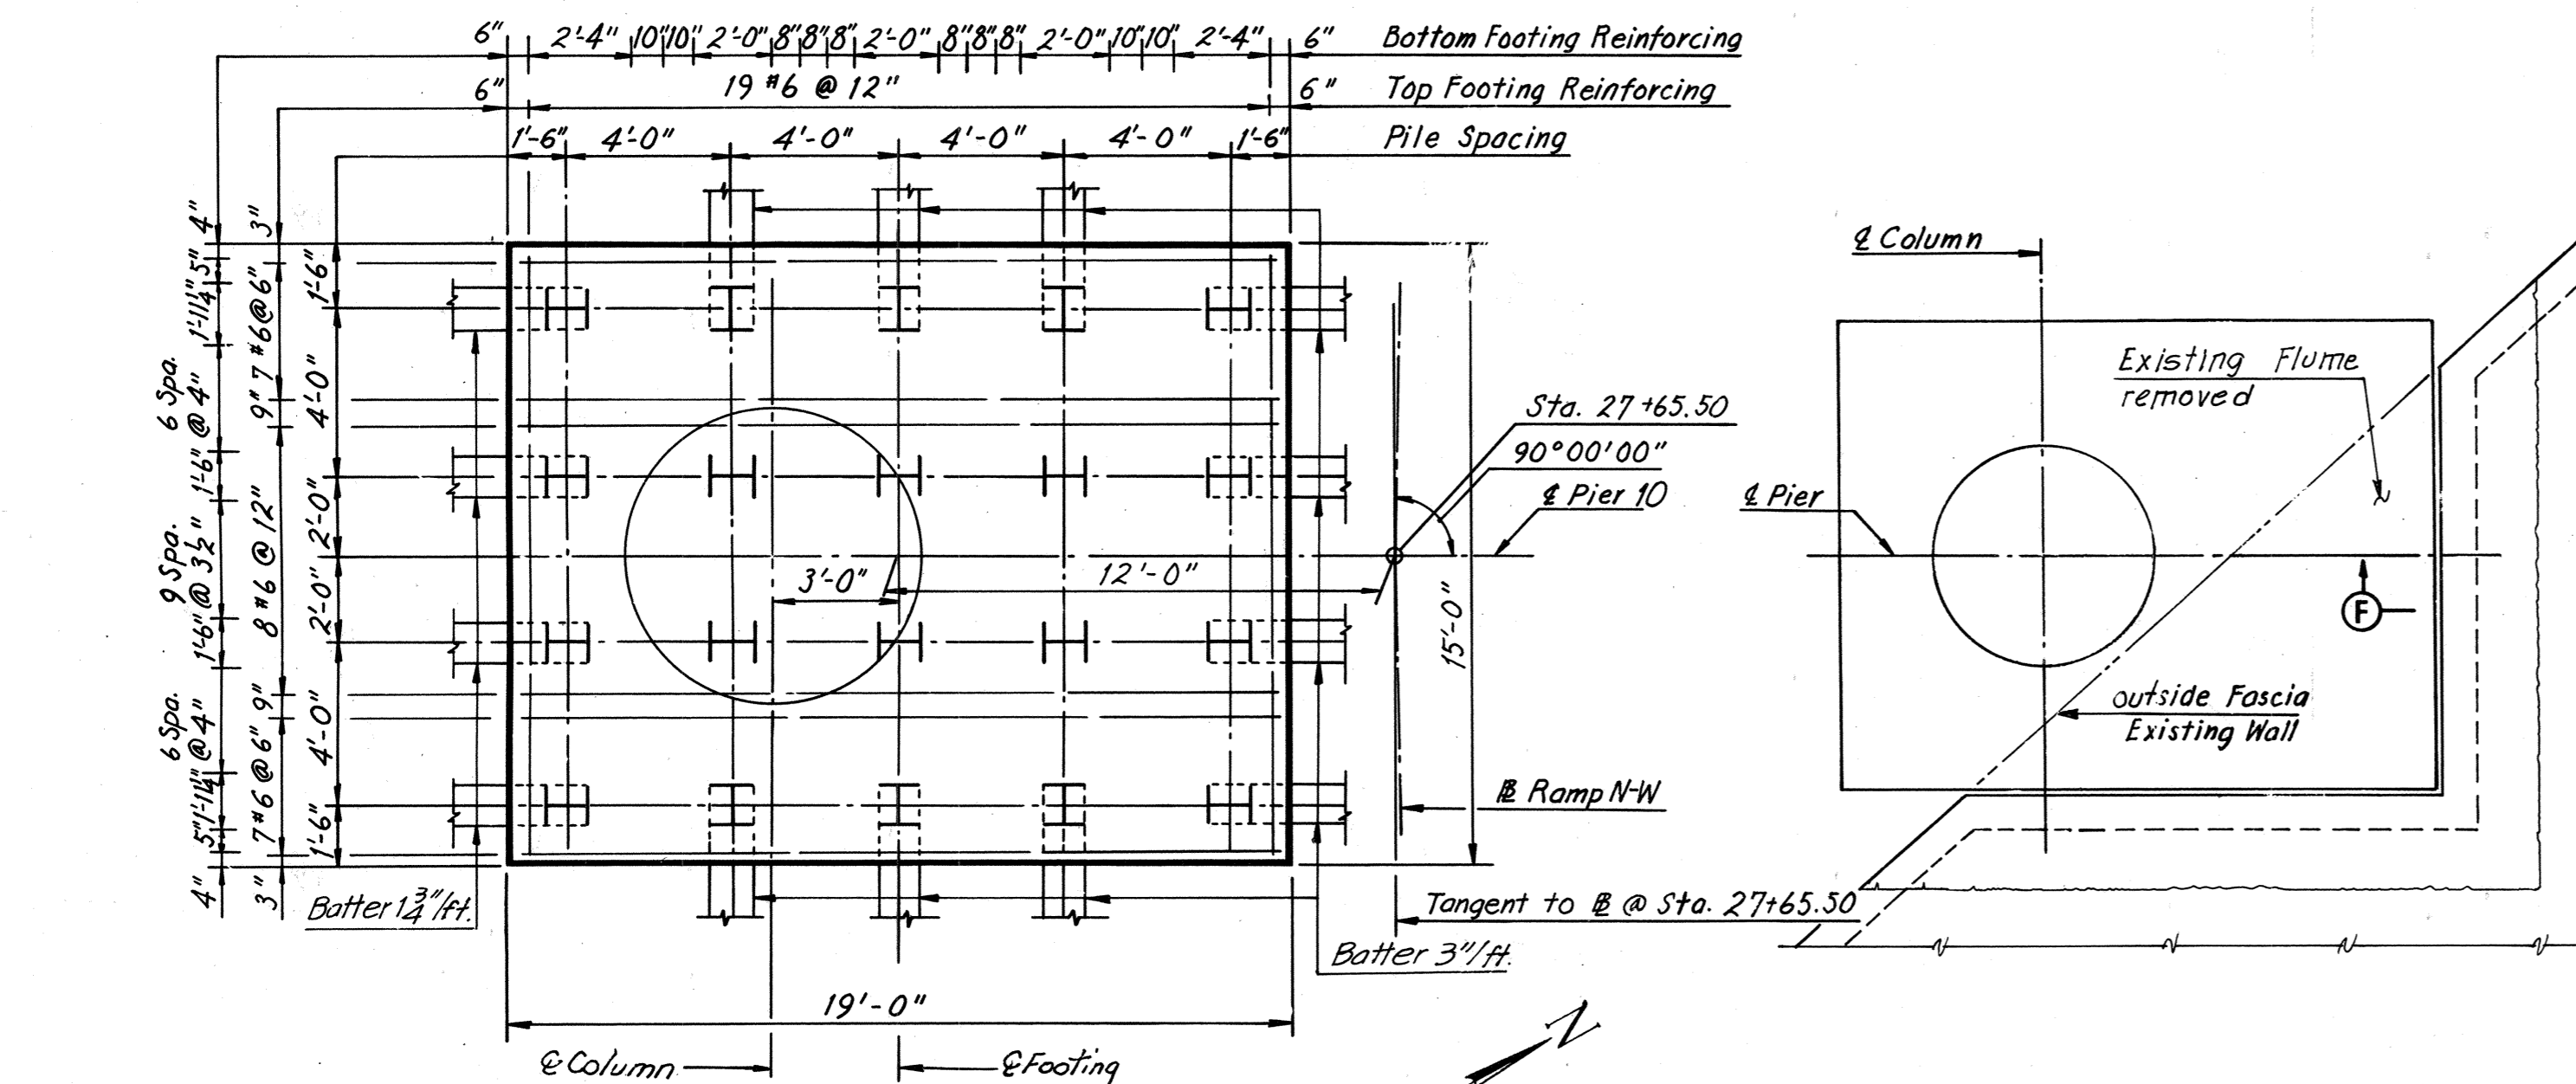


FOOTING PLAN
Scale: 1/4" = 1'-0"

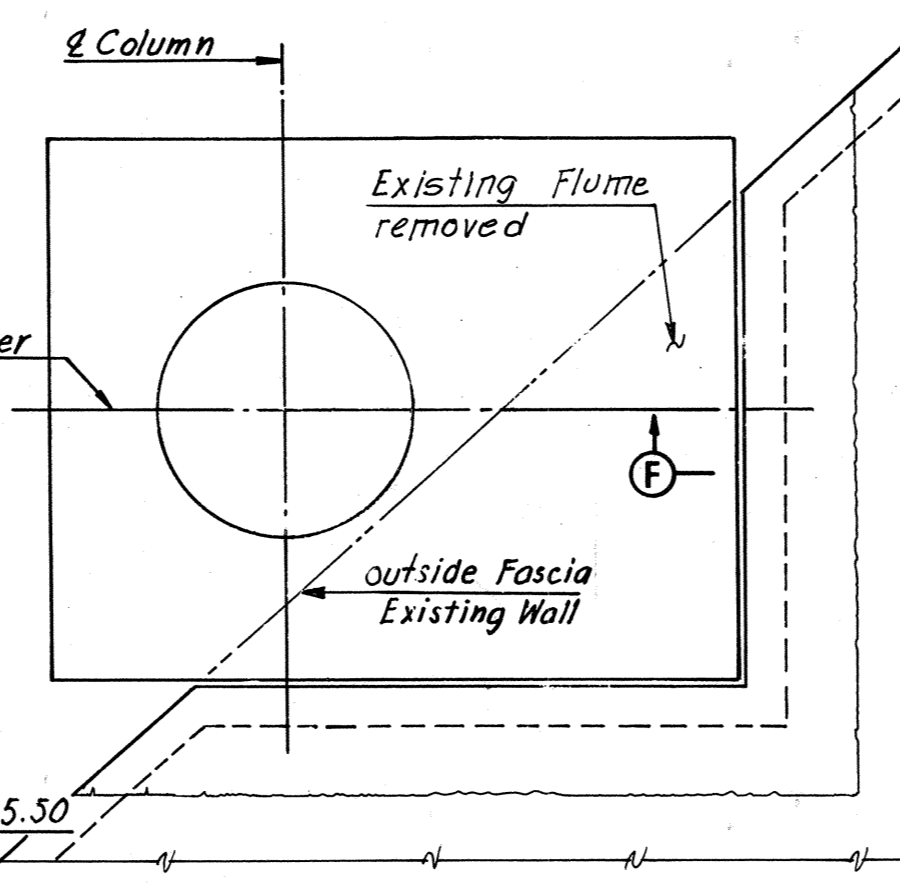

VIEW G-G
Scale: 3/8" = 1'-0"

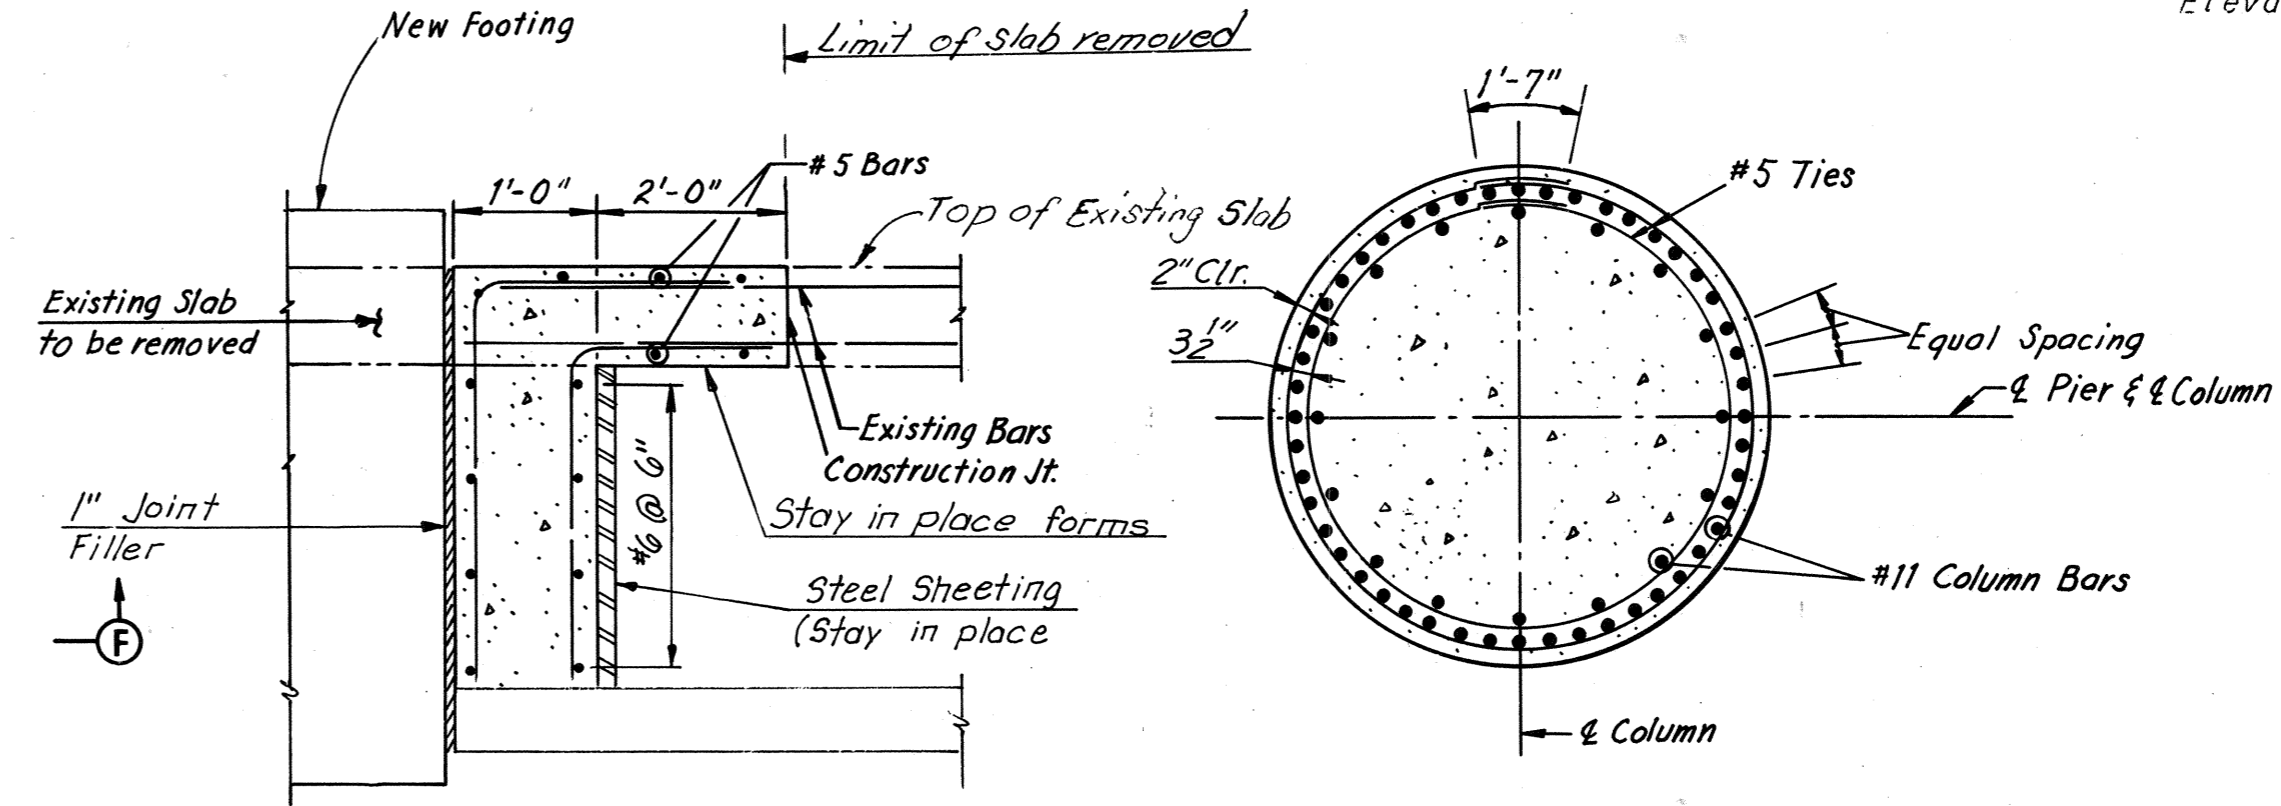

SECTION B-B
Scale: 3/8" = 1'-0"

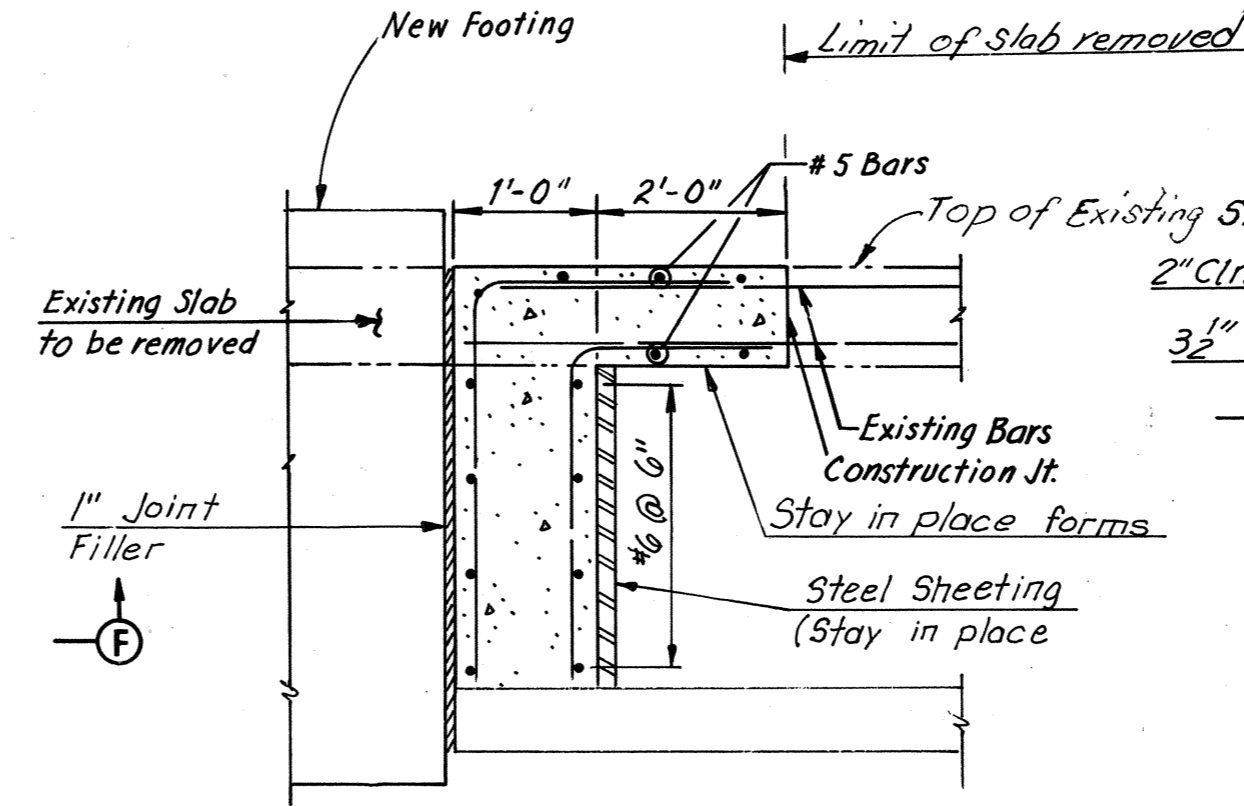

SECTION F-F
Scale: 1/2" = 1'-0"

FOOTING FOR PIER 10 IS ECCENTRIC AS SHOWN ON FOOTING PLAN

BY	DATE	Note Added	PRM#
MADE	Y.C.P. 3-10-69	2 As Built	T&M G-77
CHECKED	K.C.I. 4-17-69		
IN CHARGE			

RICHMOND METROPOLITAN AUTHORITY
RICHMOND EXPRESSWAY SYSTEM
DOWNTOWN EXPRESSWAY




BRIDGE NO. 64
RAMP N-W CONNECTION FROM
RICHMOND-PETERSBURG TURNPIKE
PIER 10

HOWARD, NEEDLES, TAMMEN & BERGENDOFF
consulting engineers
NEW YORK ALEXANDRIA KANSAS CITY


SCALE: *As Noted*
CONTRACT NO.: 10
SHEET NO. 11 OF 28

AS BUILT


RICHMOND EXPRESSWAY SYSTEM			
SECTION	PROJECT	SHEET NO.	TOTAL SHEETS
10	DOWNTOWN EXPRESSWAY	110	265

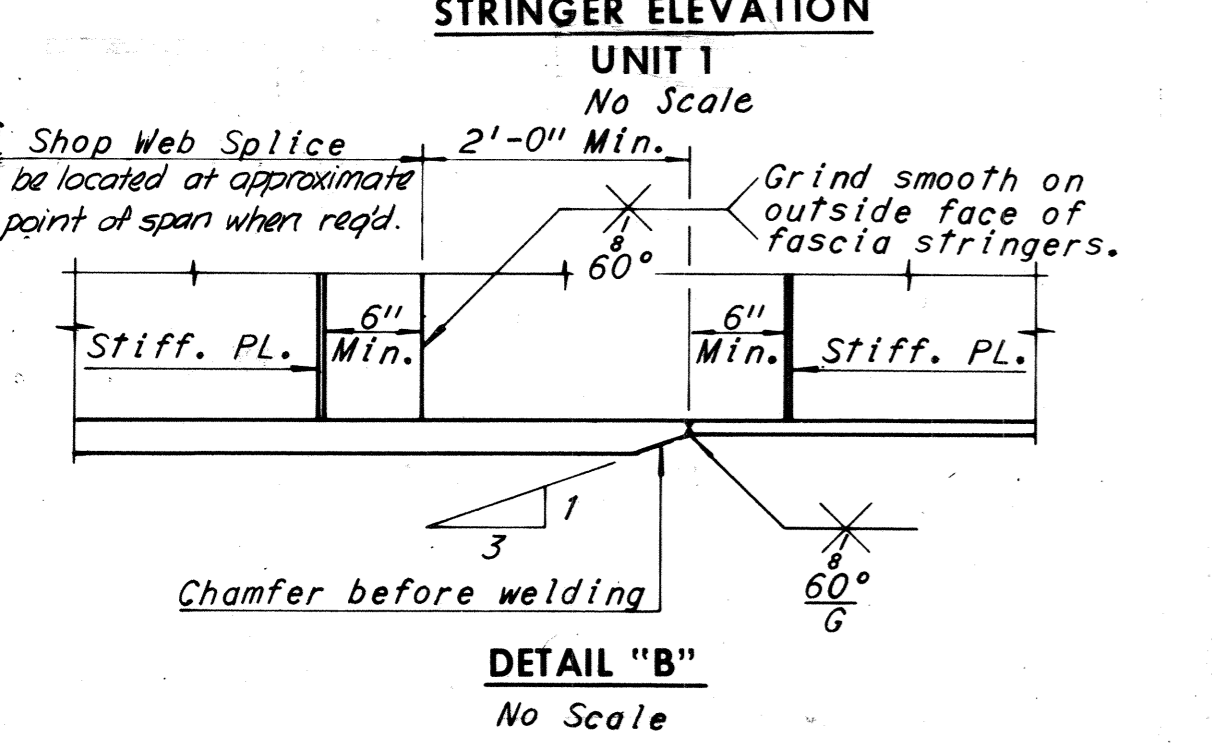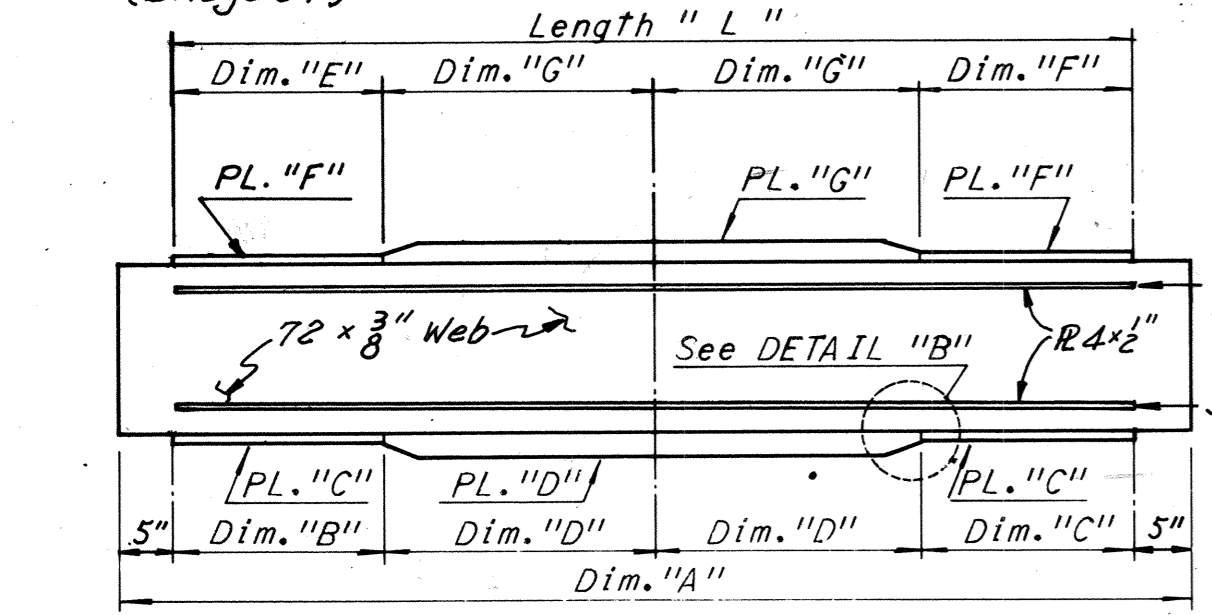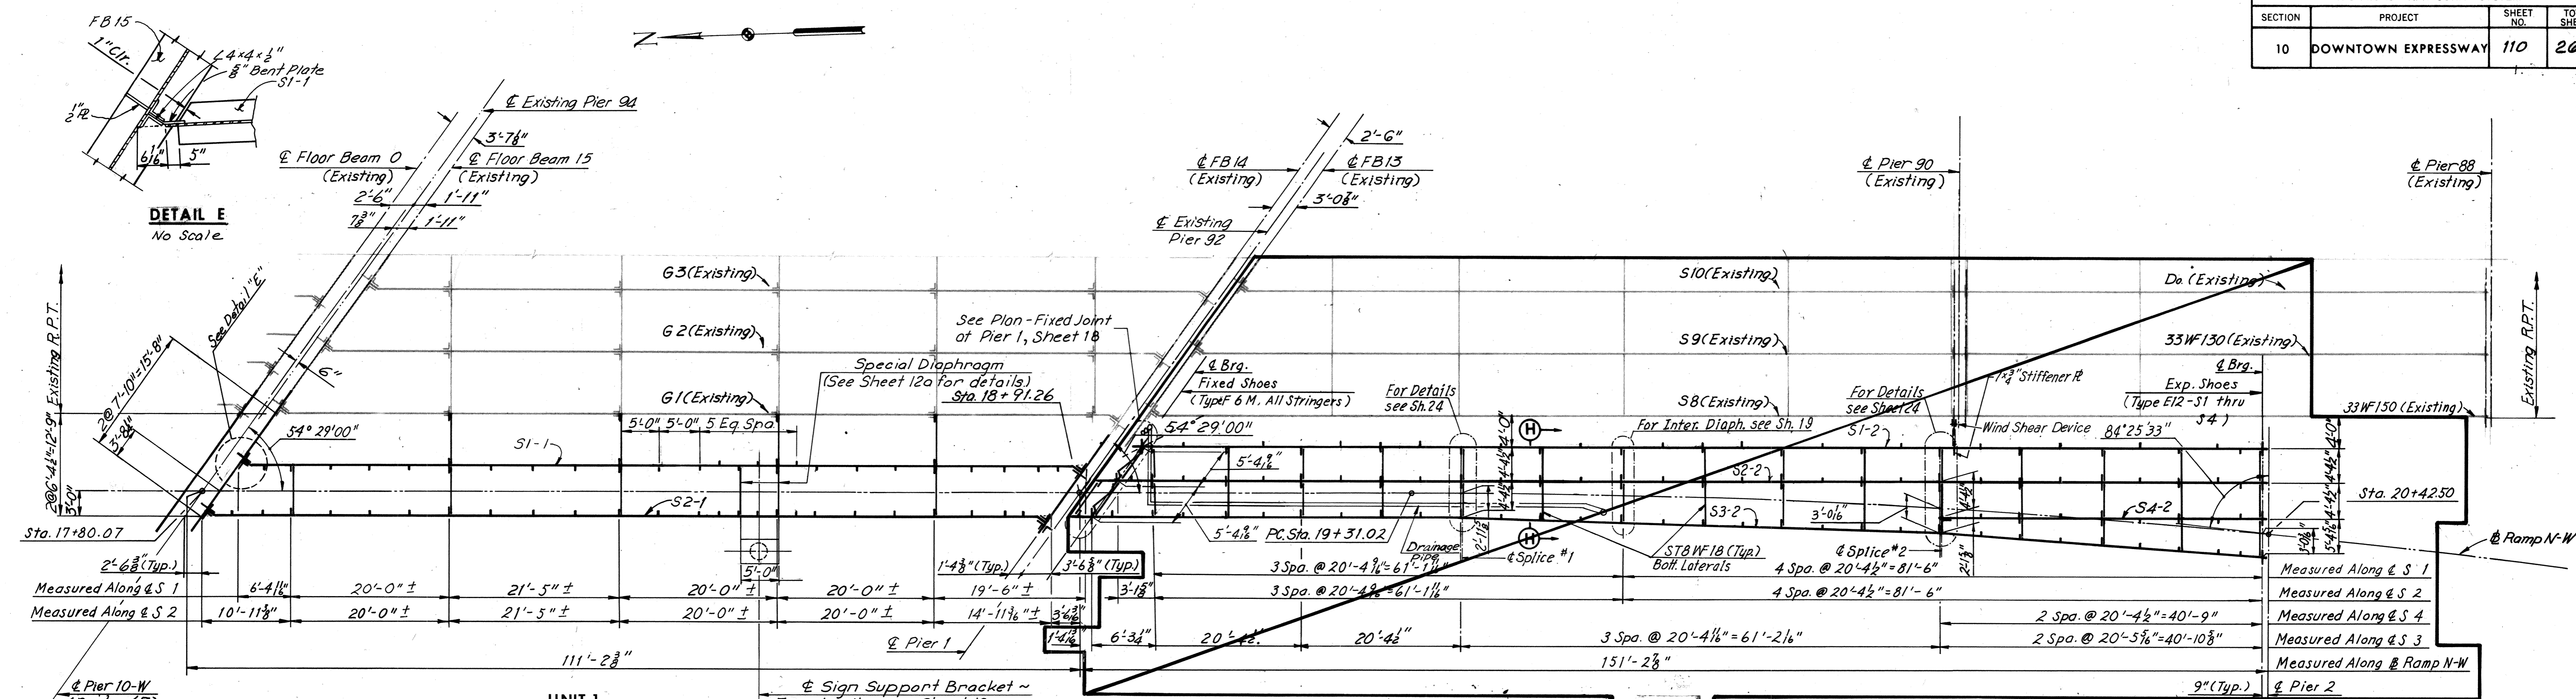

UNIT 1
 Note: Dimensions shown on the plans for existing structural metalwork are in accordance with drawings prepared for the original construction. The Contractor shall verify all necessary dimensions of existing structural metalwork prior to fabrication of new metalwork. New Diaphragms are to match Existing Diaphragms in Unit 1.

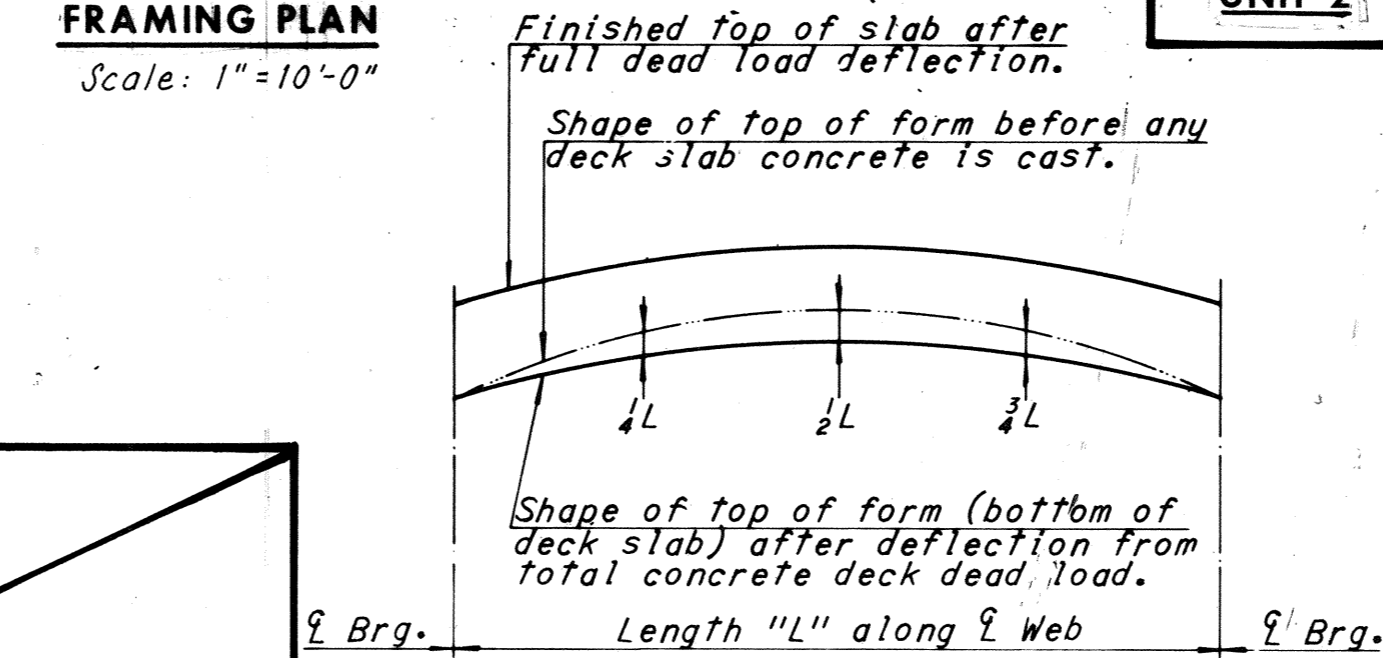

NOTE TO CONTRACTOR
 Deflections given are those anticipated to occur in the stringer upon placement of the total concrete deck dead load. In practice, the stringers in place are not likely to have the exact camber to compensate for these deflections during construction. The residual amounts shall be provided by adjusting forms to vary the thickness of the concrete haunch between the bottom of the slab and the top of stringer without altering the slab thickness.

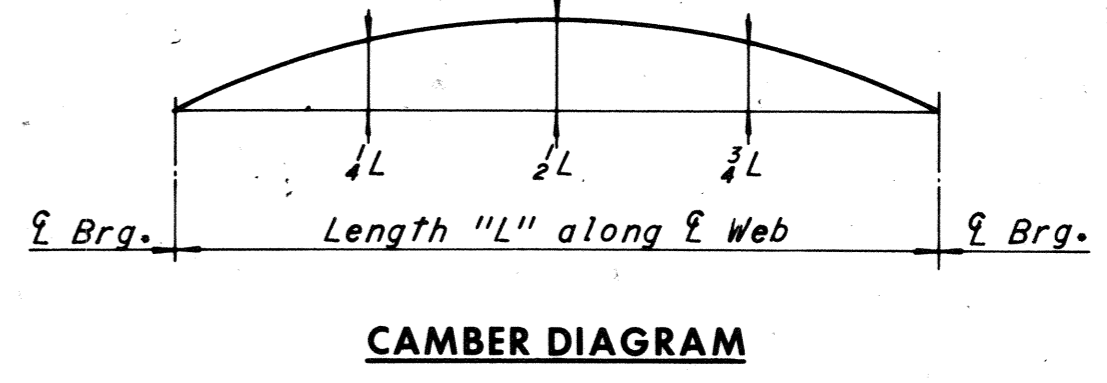

NOTE TO FABRICATOR
 The stringers shall be fabricated with an upward camber amounting to the tabulated value. This will provide approximate compensation for deflection under full dead load and for conformity with finished grade.

SHOE SCHEDULE

EXPANSION SHOE		FIXED SHOE	
TYPE	NO REQD	TYPE	NO REQD
E 12	4	F 6 M	3

UNIT	STRINGER	Dim. "A"	LENGTH	Dim. "B"	Dim. "C"	Dim. "D"	Dim. "E"	Dim. "F"	Dim. "G"	PL. "C"	PL. "D"	PL. "F"	PL. "G"	MAX. SHEAR STUD SPACING					DEAD LOAD DEFLECTION SCHEDULE			CAMBER SCHEDULE		
														0.0L-0.1L*	0.1L-0.2L	0.2L-0.3L	0.3L-0.4L	0.4L-0.5L	1/4L	1/2L	3/4L	1/4L	1/2L	3/4L
1	S1-1	106'-3 3/8"	105'5 3/8"	23'-0 1/8"	23'-0"	29'-8 3/8"	23'-0 1/8"	23'-0"	29'-8 3/8"	18x4"	18x1 1/4"	18x4"	18x1 1/4"	—	—	—	—	—	7/8"	1 1/2"	7/8"	2 3/16"	2 1/8"	2 1/8"
	S2-1	106'-3 3/8"	105'-5 7/8"	23'-0 1/8"	23'-0"	29'-8 3/8"	23'-0 1/8"	23'-0"	29'-8 3/8"	18x4"	18x1 1/4"	18x4"	18x1 1/4"	—	—	—	—	—	7/8"	1 1/2"	7/8"	2 3/16"	2 1/8"	2 3/16"
2	S1-2	143'-6 3/8"	142'-7 1/4"	19'-0"	19'-0"	52'-0"	—	—	71'-3 3/8"	24x1 1/2"	24x2 1/2"	—	18x1"	24"	24"	24"	24"	—	1 3/16"	2 9/16"	1 3/16"	5 1/16"	5"	3 1/16"
	S2-2	149'-2 3/8"	145'-9 3/8"	20'-0"	20'-0"	52'-6"	—	—	72'-10 1/8"	24x1 1/2"	24x2 1/2"	—	18x1"	24"	24"	24"	24"	—	1 3/16"	2 9/16"	1 3/16"	4 3/4"	6 3/16"	4 1/4"
	S3-2	152'-6 3/8"	149'-0 3/8"	20'-0"	22'-0 1/8"	53'-6"	—	—	74'-0 3/8"	24x1 1/2"	24x2 1/2"	—	18x1"	24"	24"	24"	24"	—	2 1/4"	3 1/8"	2 1/4"	6 1/8"	8 7/16"	6 1/8"
	S4-2	41'-4"	41'-9"	—	—	20'-4 1/2"	—	—	20'-4 1/2"	—	12x4"	—	12x4"	24"	24"	24"	24"	—	0	1 1/16"	0	1 1/16"	1 1/16"	1 1/16"

MADE	BY	DATE	REVISION	BY	DATE
Y.C.P	2-11-69				
S.C.C	4-24-69				

Note: * Spacing begins at termination of 6 spaces @ 4". All steel shall be A36 unless otherwise shown. Note: For revisions to Unit 2, see Sheet 12a.





RICHMOND METROPOLITAN AUTHORITY
RICHMOND EXPRESSWAY SYSTEM
DOWNTOWN EXPRESSWAY

BRIDGE NO. 64
RAMP N-W CONNECTION FROM
RICHMOND-PETERSBURG TURNPIKE
FRAMING PLAN- UNITS 1











HOWARD, NEEDLES, TAMMEN & BERGENDOFF consulting engineers
 NEW YORK ALEXANDRIA KANSAS CITY

SCALE: As Noted
 CONTRACT NO. 10
 SHEET NO. 12 OF 28

AS BUILT

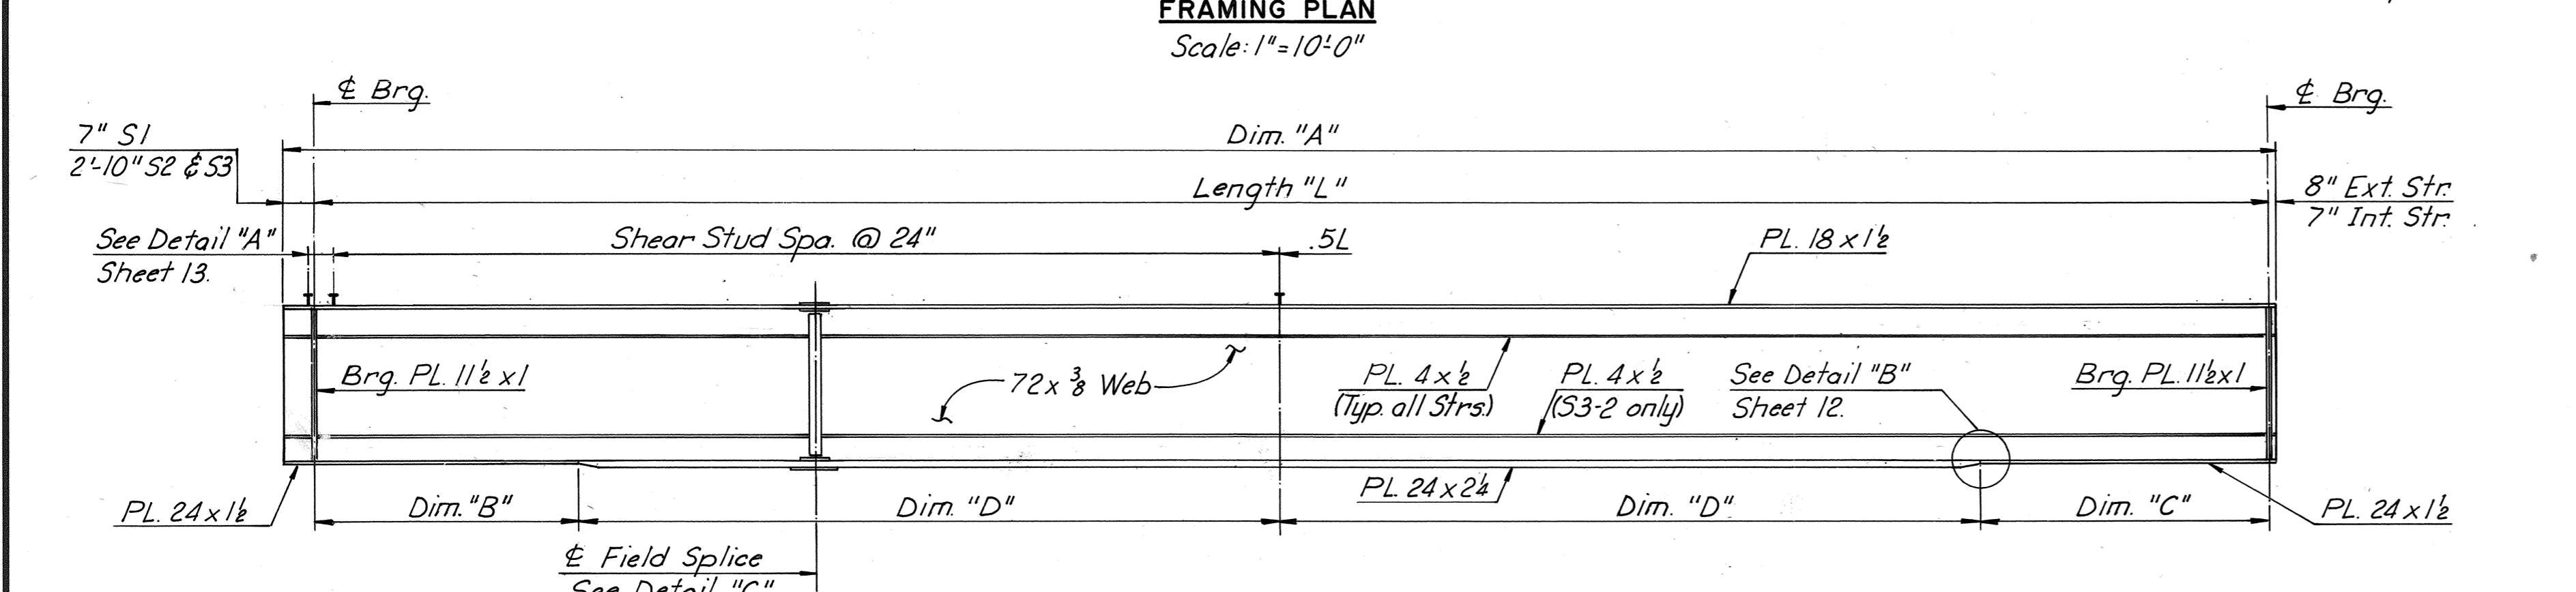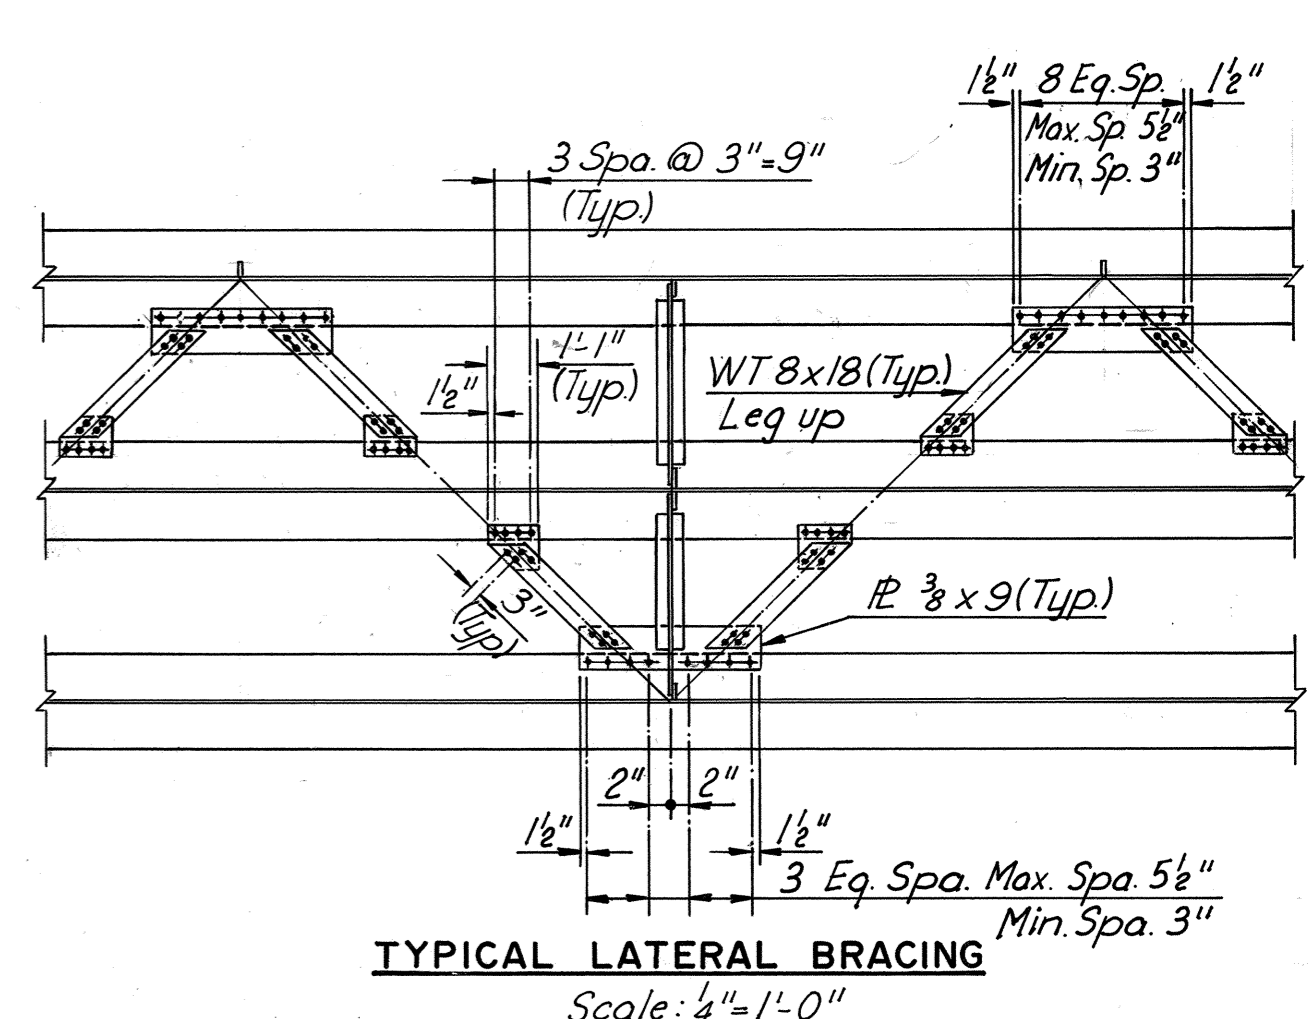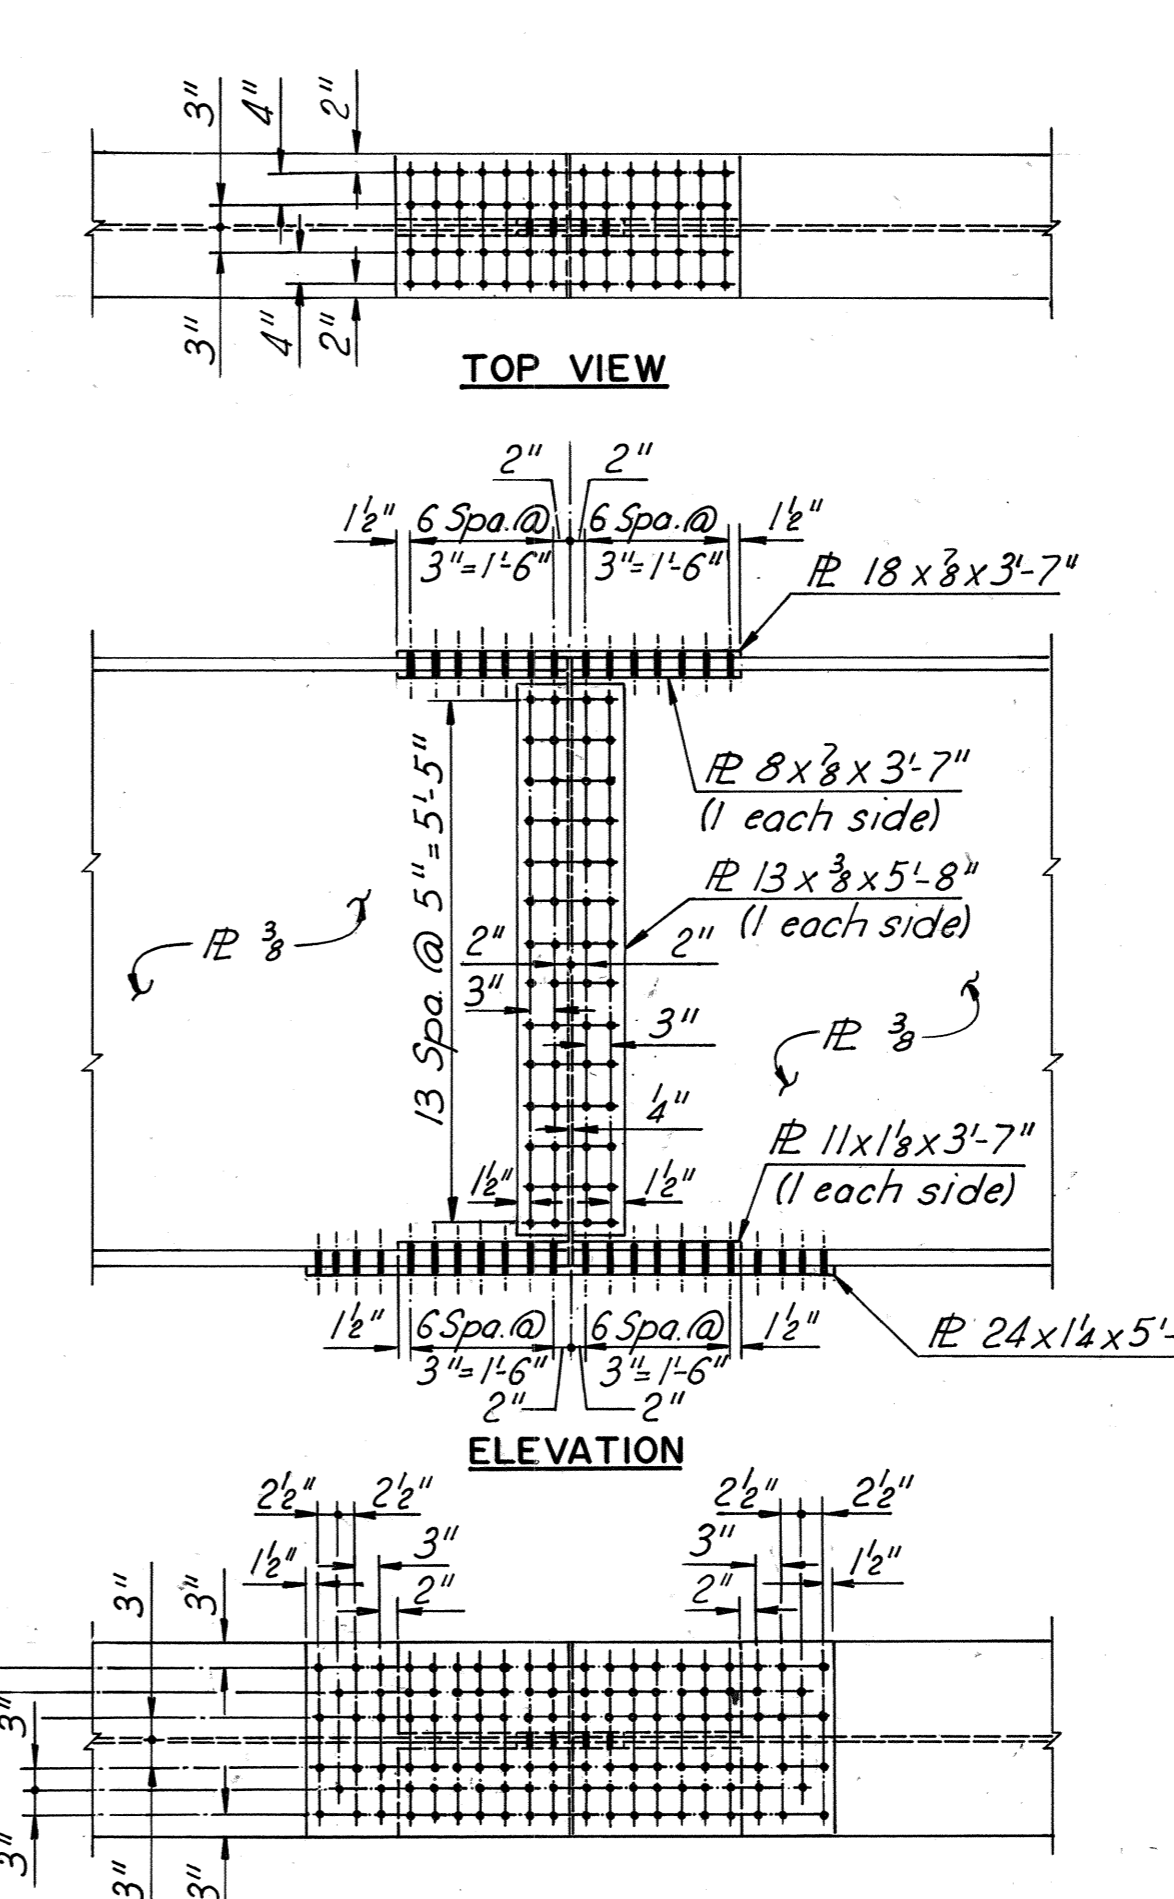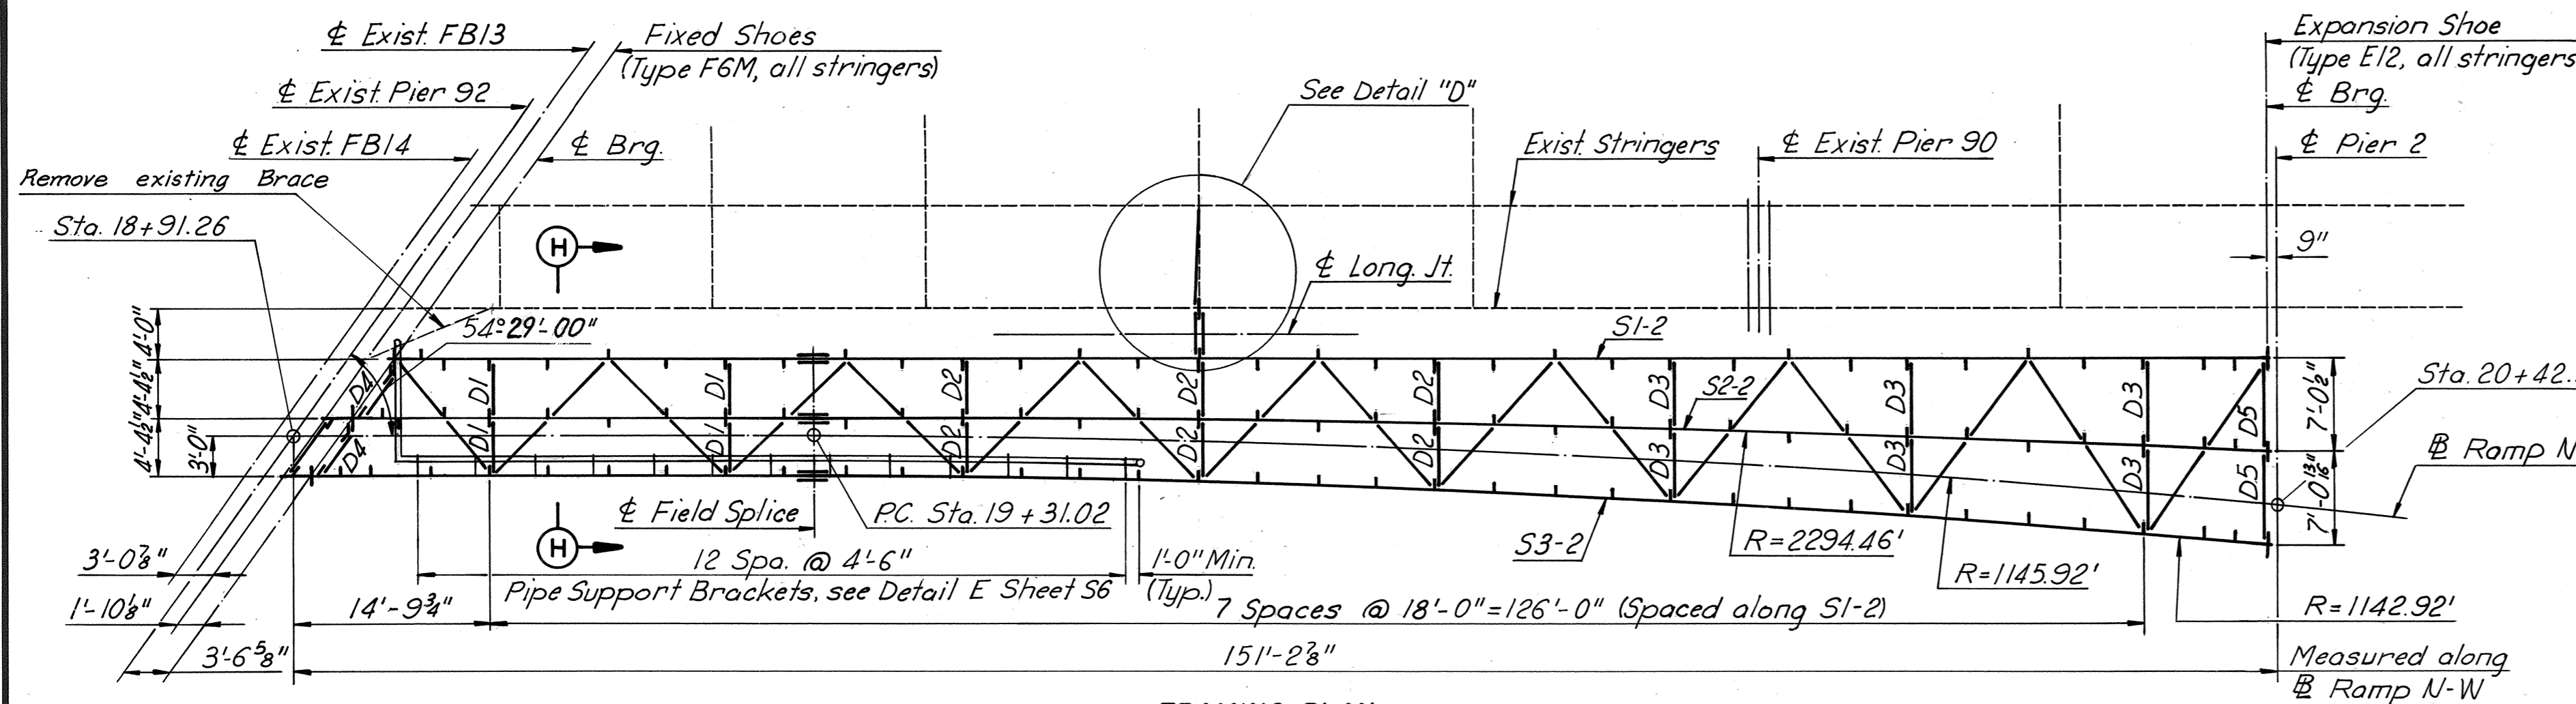

STRINGER SCHEDULE					DEAD LOAD DEFLECTION SCHEDULE						CAMBER SCHEDULE			
STRINGER	LENGTH "L"	DIM. "A"	DIM. "B"	DIM. "C"	DIM. "D"	DUE TO CONCRETE			DUE TO STEEL			CAMBER		
						1/4L	1/2L	3/4L	1/4L	1/2L	3/4L	1/4L	1/2L	3/4L
S1-2	142'-7 1/16"	143'-9 9/16"	19'-0"	19'-7 1/16"	52'-0"	1 3/16"	1 1/16"	1 3/8"	3/4"	1 1/16"	3/4"	3 3/8"	4 1/8"	3 3/8"
S2-2	145'-9 3/8"	149'-2 3/8"	20'-0"	20'-9 3/8"	52'-6"	1 9/16"	2 1/4"	1 3/8"	3/8"	1 7/16"	3/8"	4 3/8"	6 1/4"	4 3/8"
S3-2	149'-1"	152'-6 1/8"	20'-0"	22'-1"	53'-6"	1 3/8"	2 1/2"	1 3/8"	1 5/16"	1 1/4"	1 5/16"	5 1/16"	7 1/8"	5 1/8"

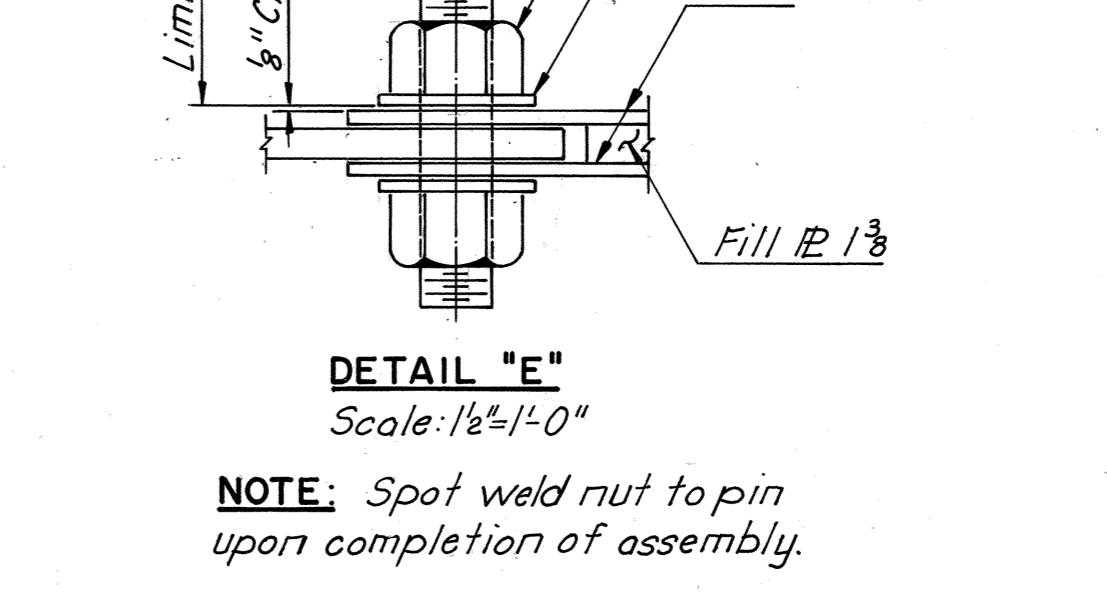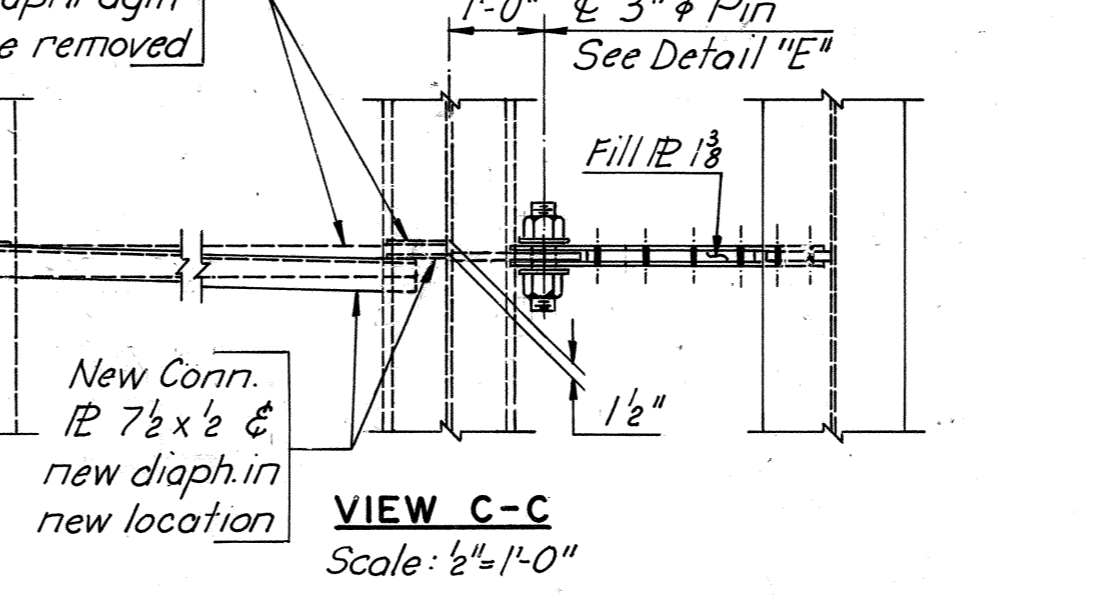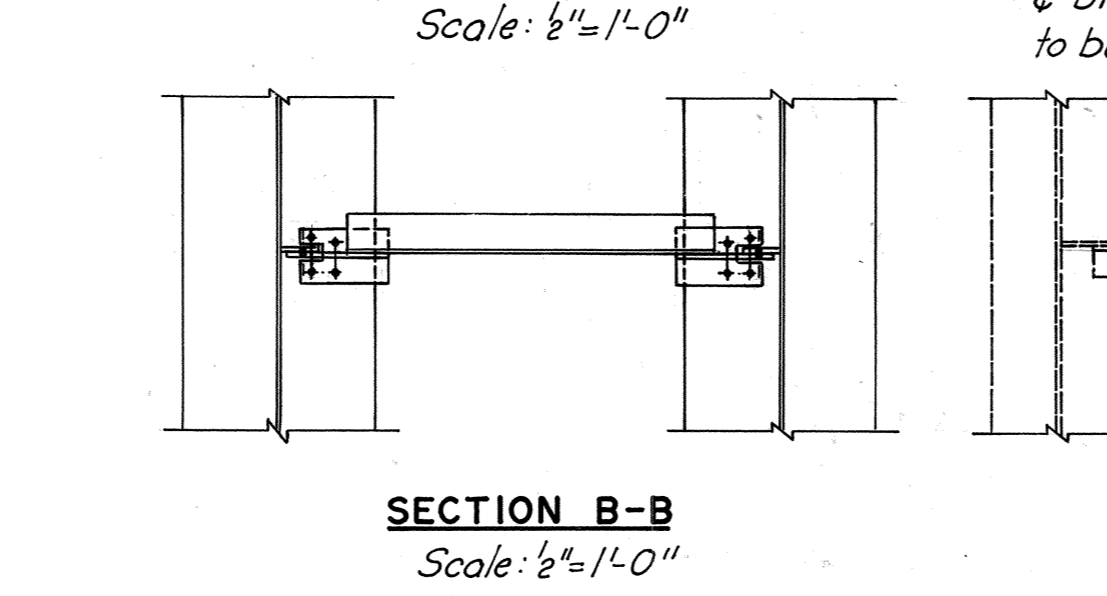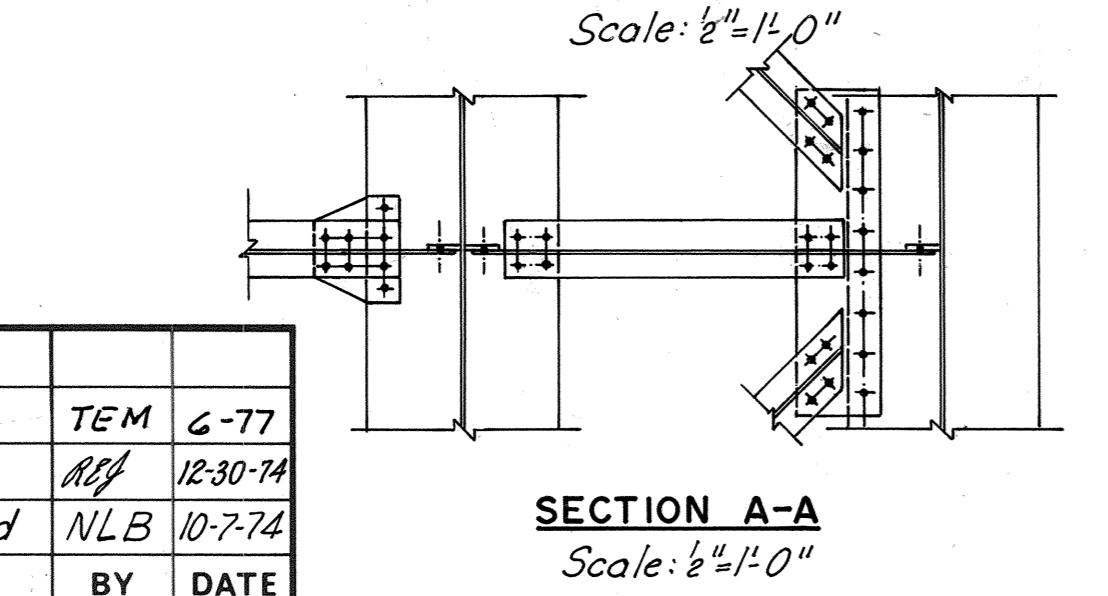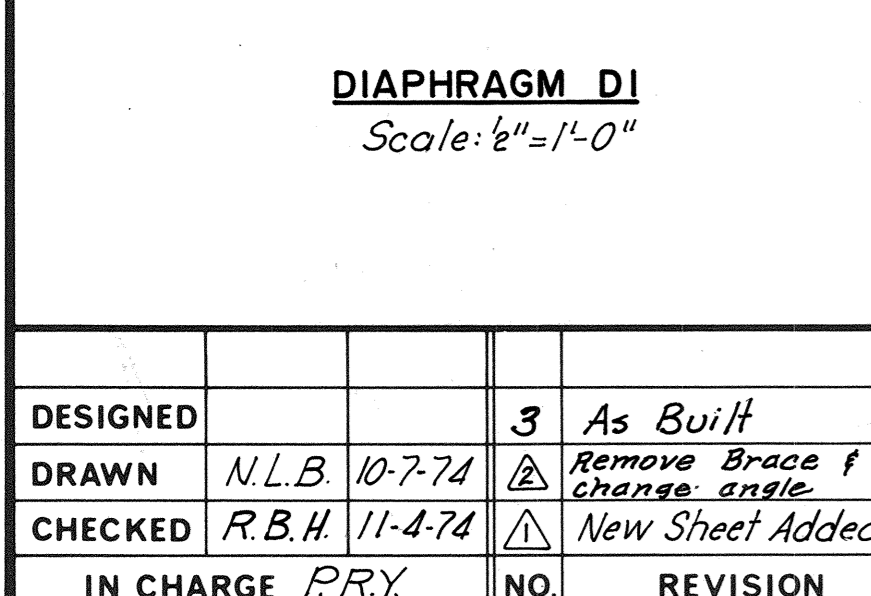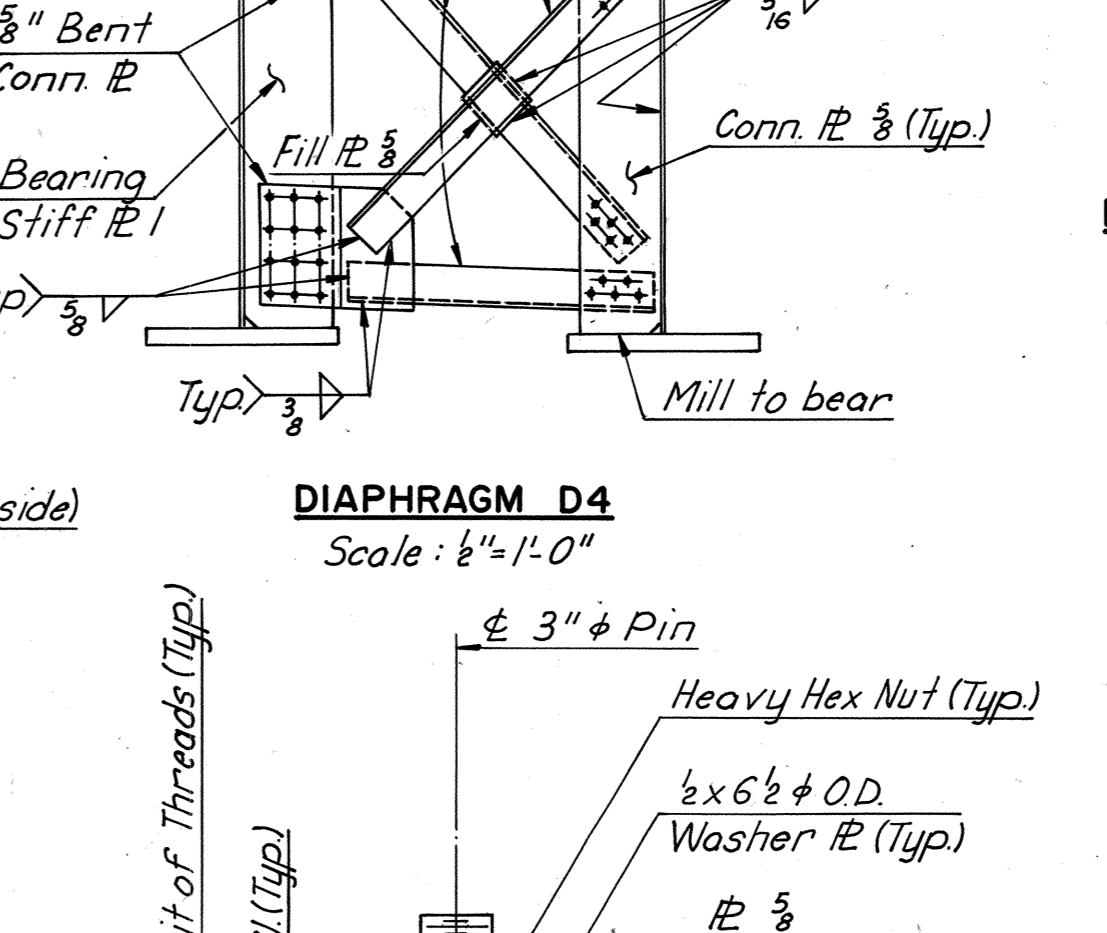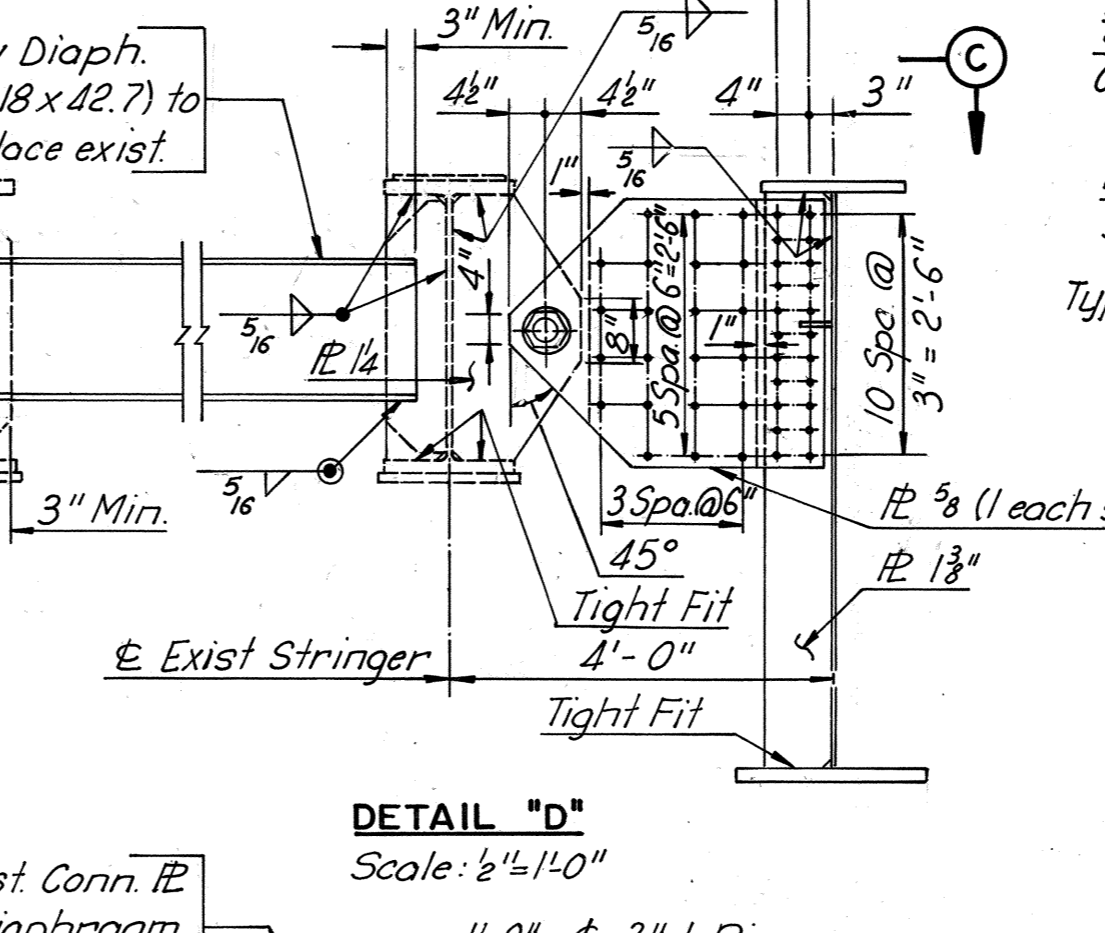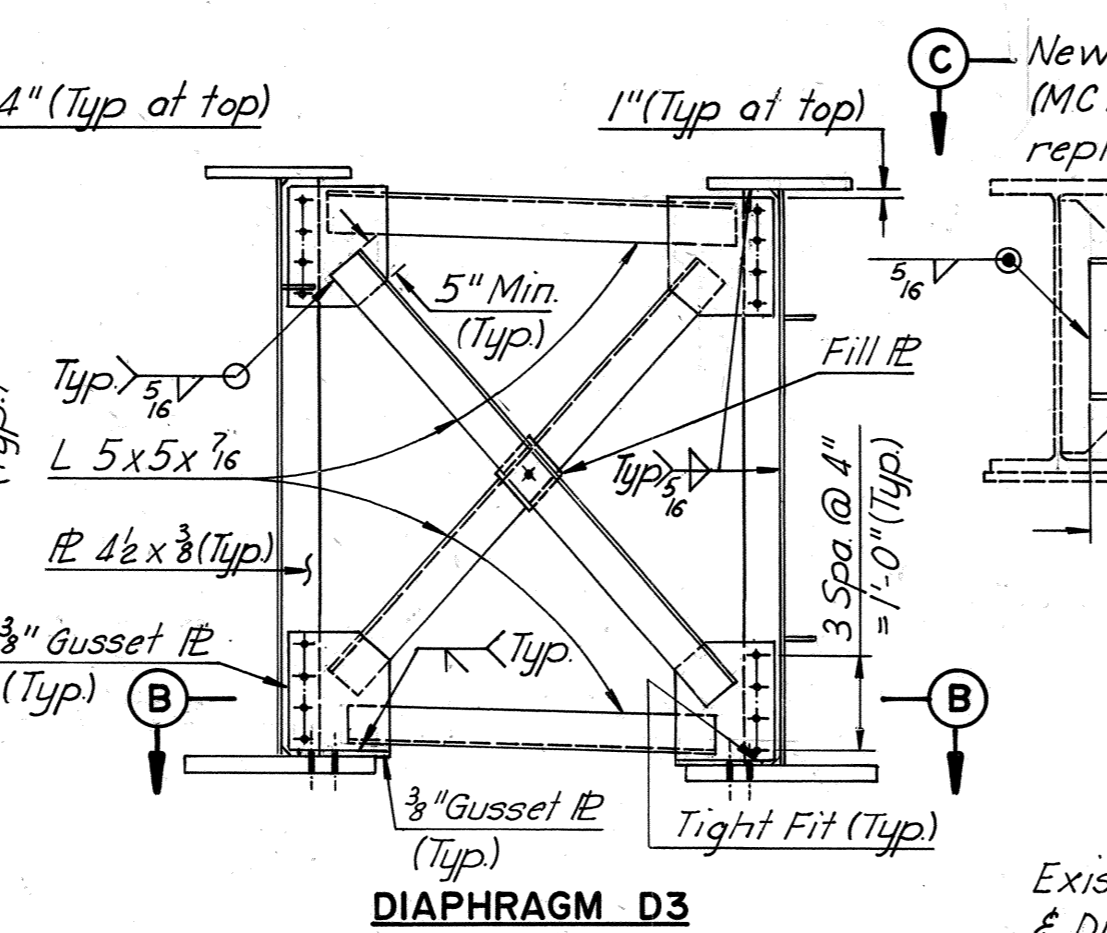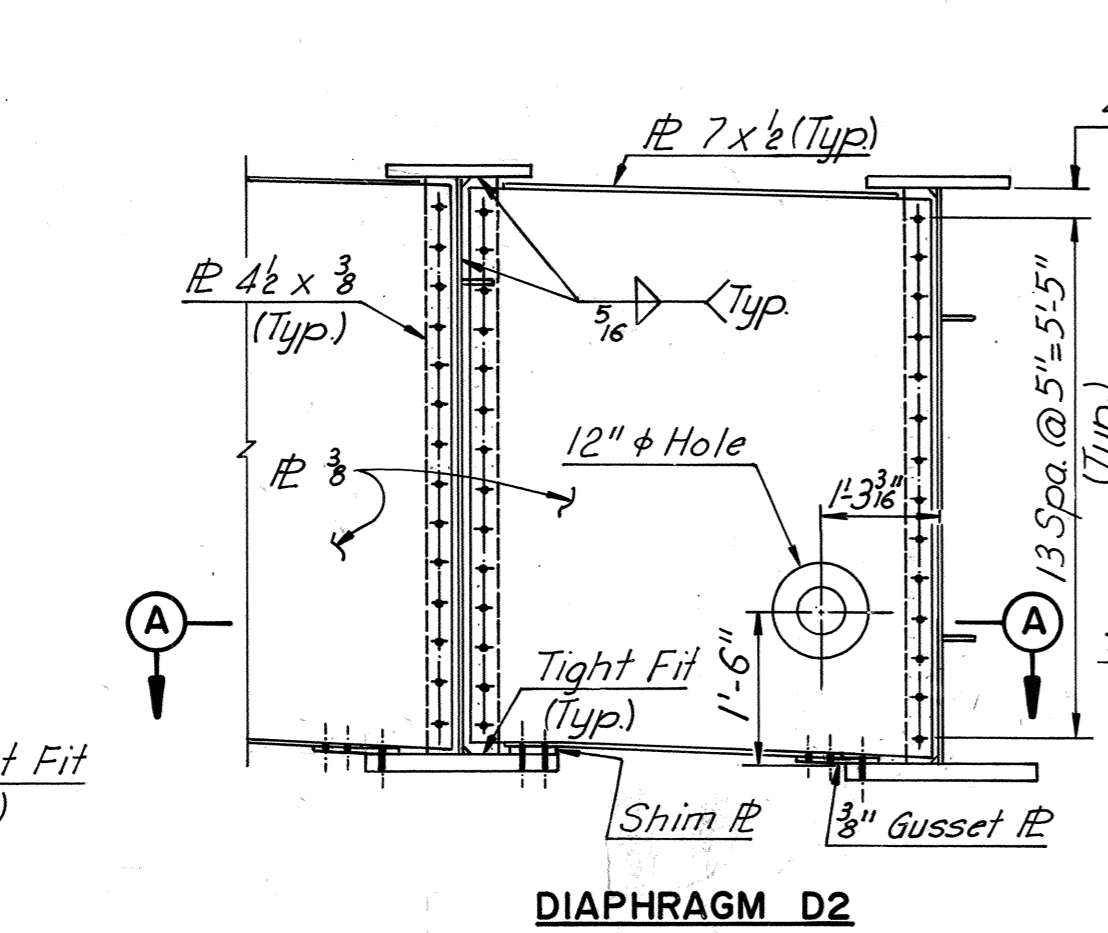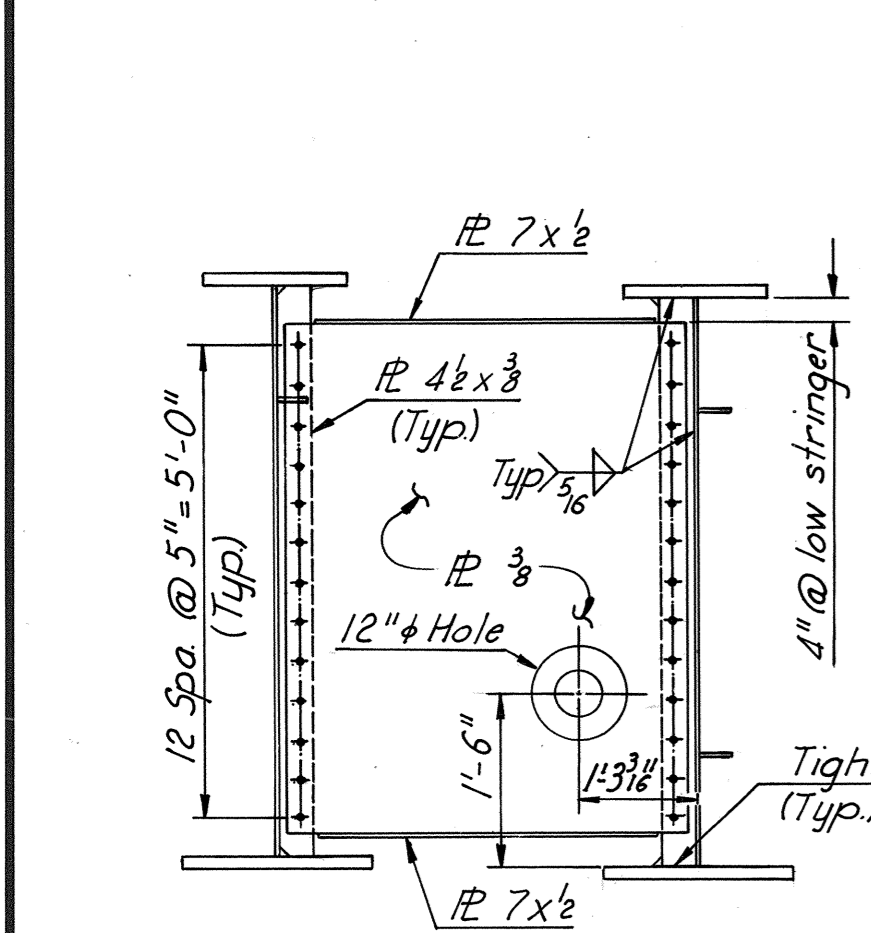

NOTE:
 1. For Diaphragm D5 use type shown as end diaphragm section B-B, Sheet 20.
 2. For notes not shown, see Sheet 12.
 3. For Section H-H see Sheet 19.

DESIGNED		3	As Built	TEM	6-77
DRAWN	N.L.B. 10-7-74	1	Remove Brace & change angle	NLB	12-30-74
CHECKED	R.B.H. 11-4-74	1	New Sheet Added	NLB	10-7-74
IN CHARGE	P.R.Y.	NO.	REVISION	BY	DATE

AS BUILT

RICHMOND METROPOLITAN AUTHORITY
RICHMOND EXPRESSWAY SYSTEM
 DOWNTOWN EXPRESSWAY


BRIDGE NO. 64
 RAMP N-W CONNECTION FROM
 RICHMOND-PETERSBURG TURNPIKE
 FRAMING PLAN-UNIT 2

SCALE AS NOTED
 DATE _____ SHEET 12b OF 28

HOWARD, NEEDLES, TAMMEN & BERGENDOFF
 CONSULTING ENGINEERS
 Alexandria, Virginia


HNTB

RICHMOND EXPRESSWAY SYSTEM			
SECTION	PROJECT	SHEET NO.	TOTAL SHEETS
10-	DOWNTOWN EXPRESSWAY	176	265

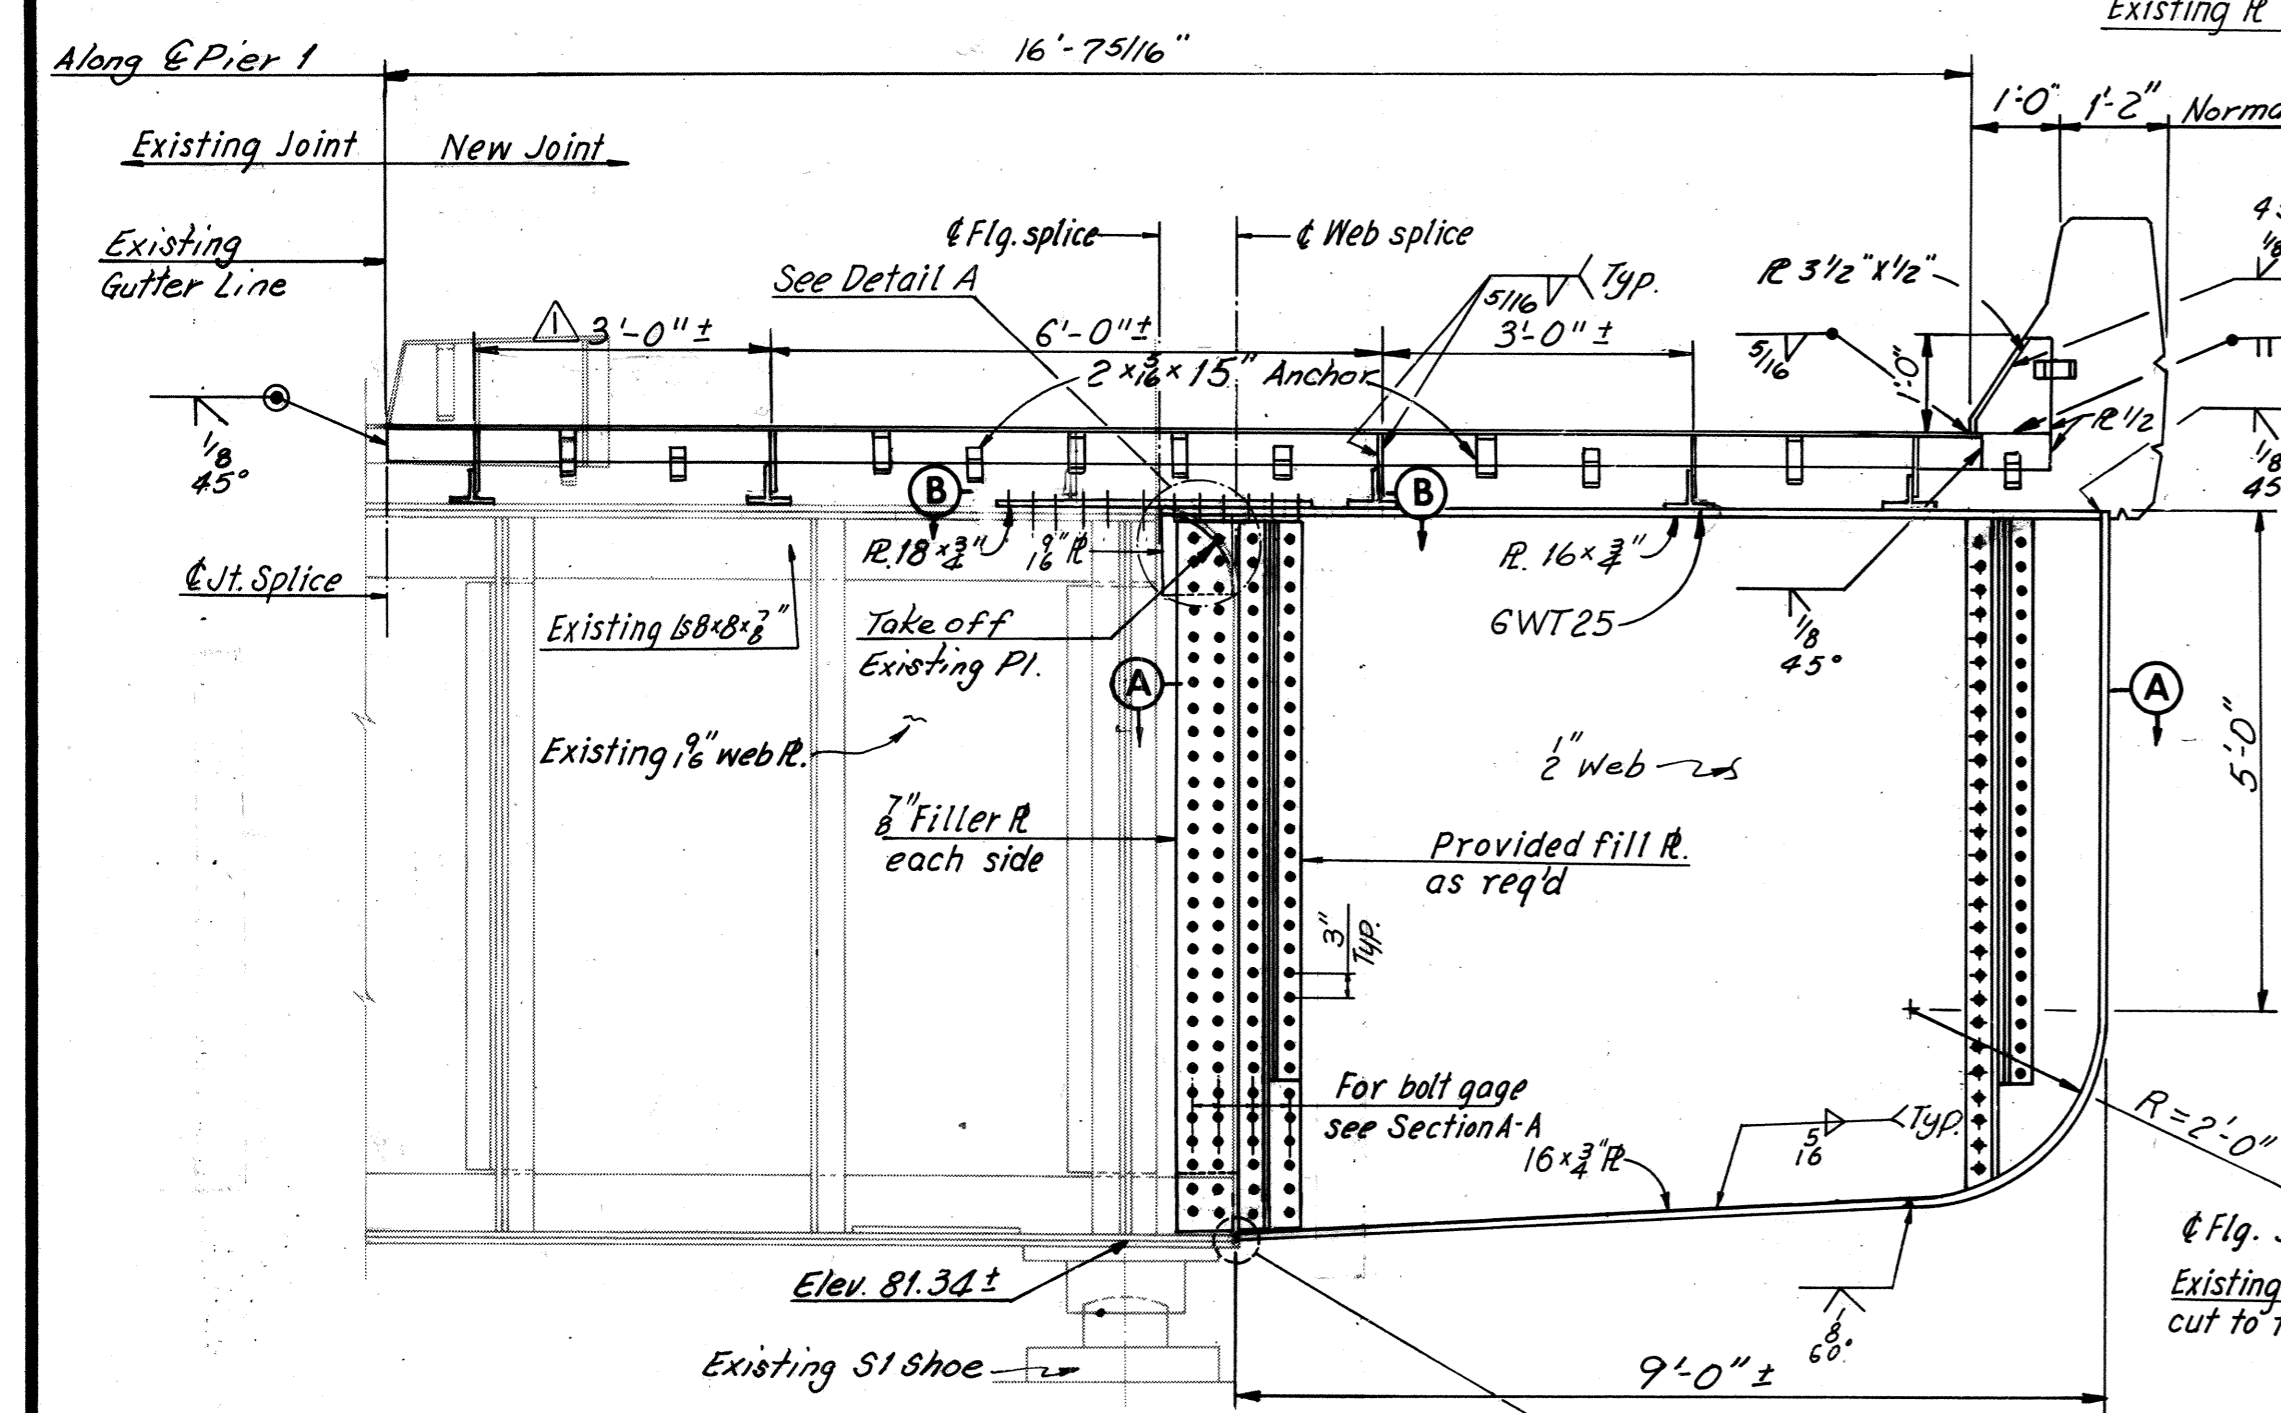


ELEVATION - FLOORBEAM 14
Scale 1/2" = 1'-0"


Bolts - 7/8" ϕ H. S. Bolts, ASTM Spec. A-325 unless otherwise noted.

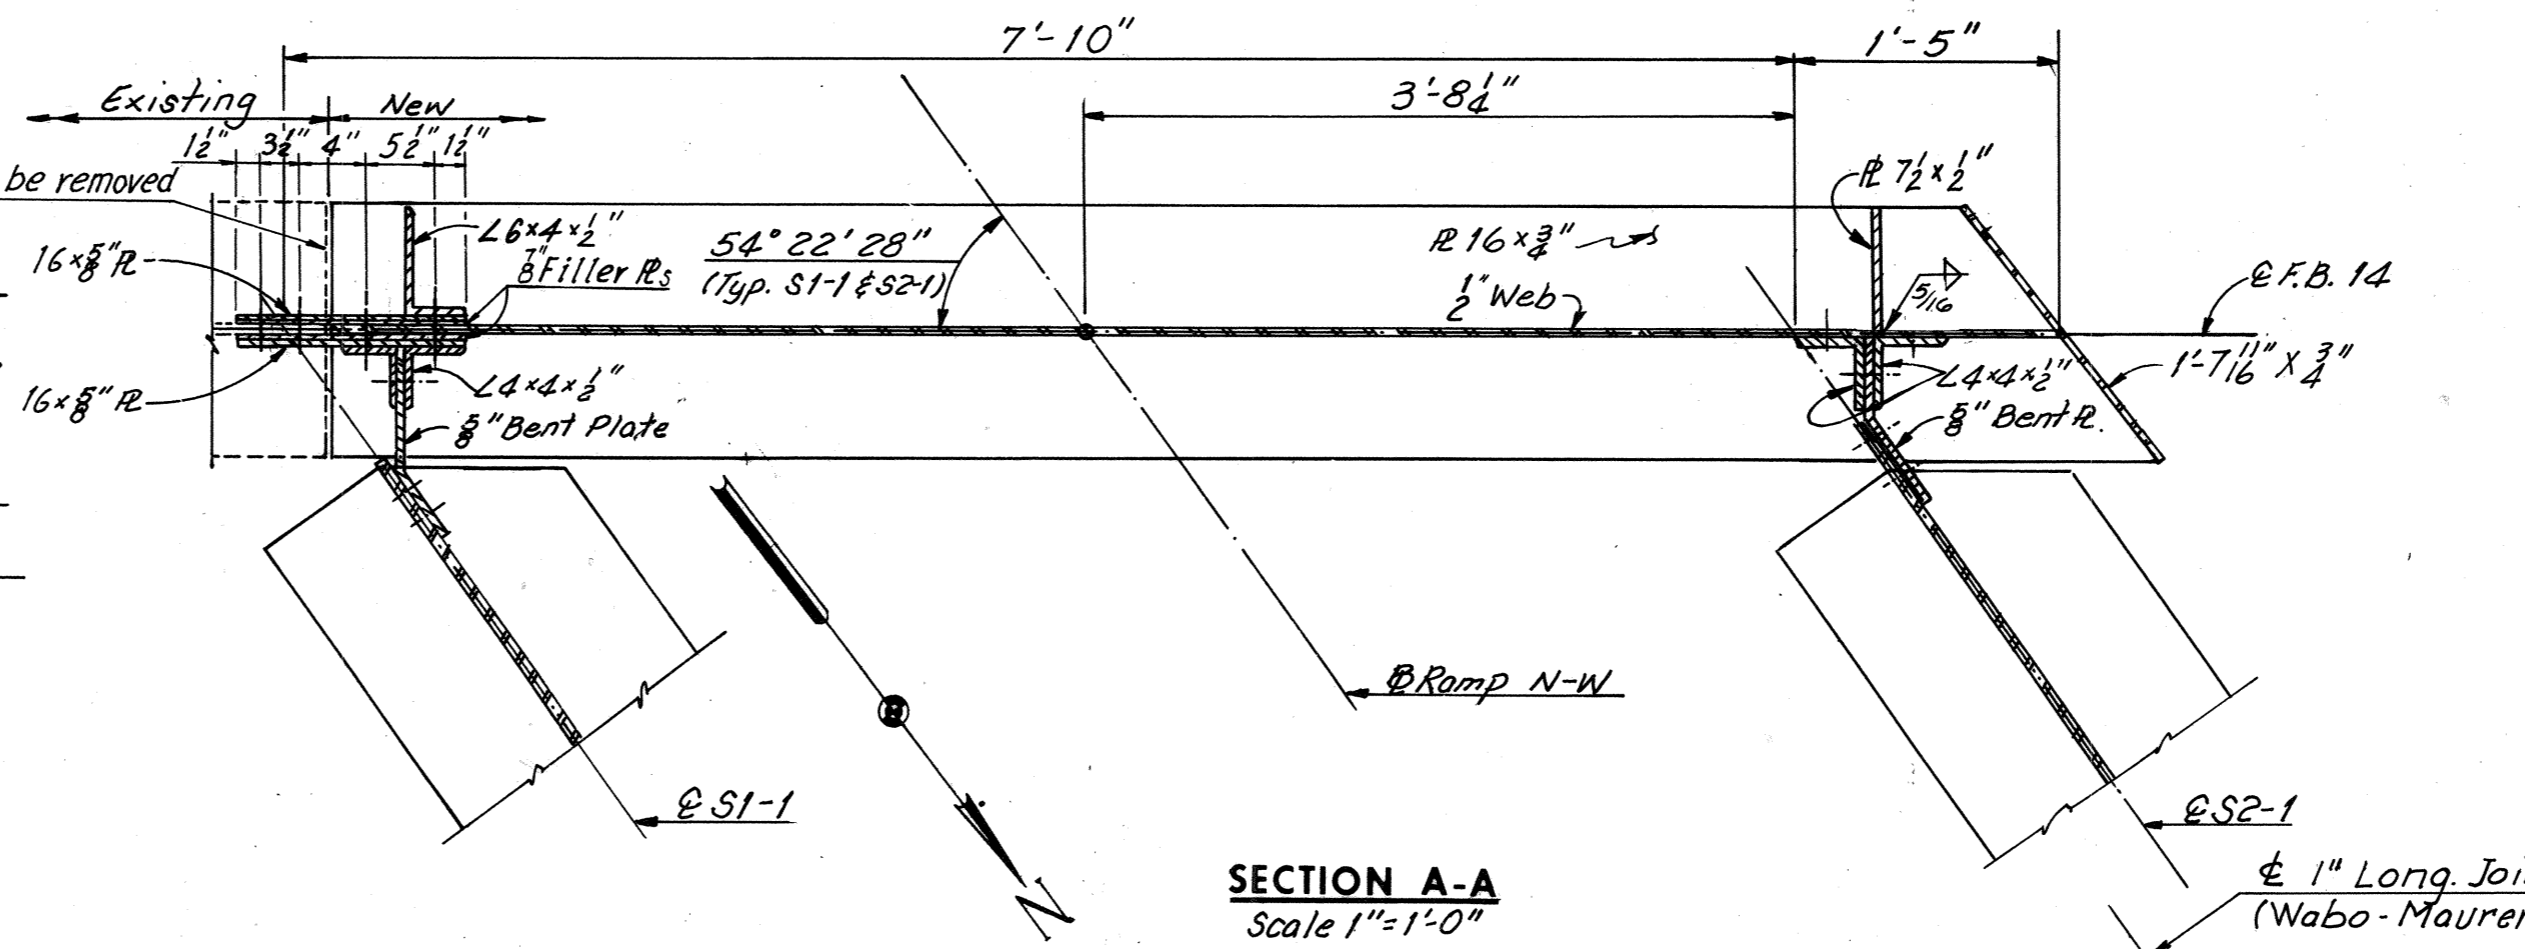

SECTION A-A
Scale 1" = 1'-0"

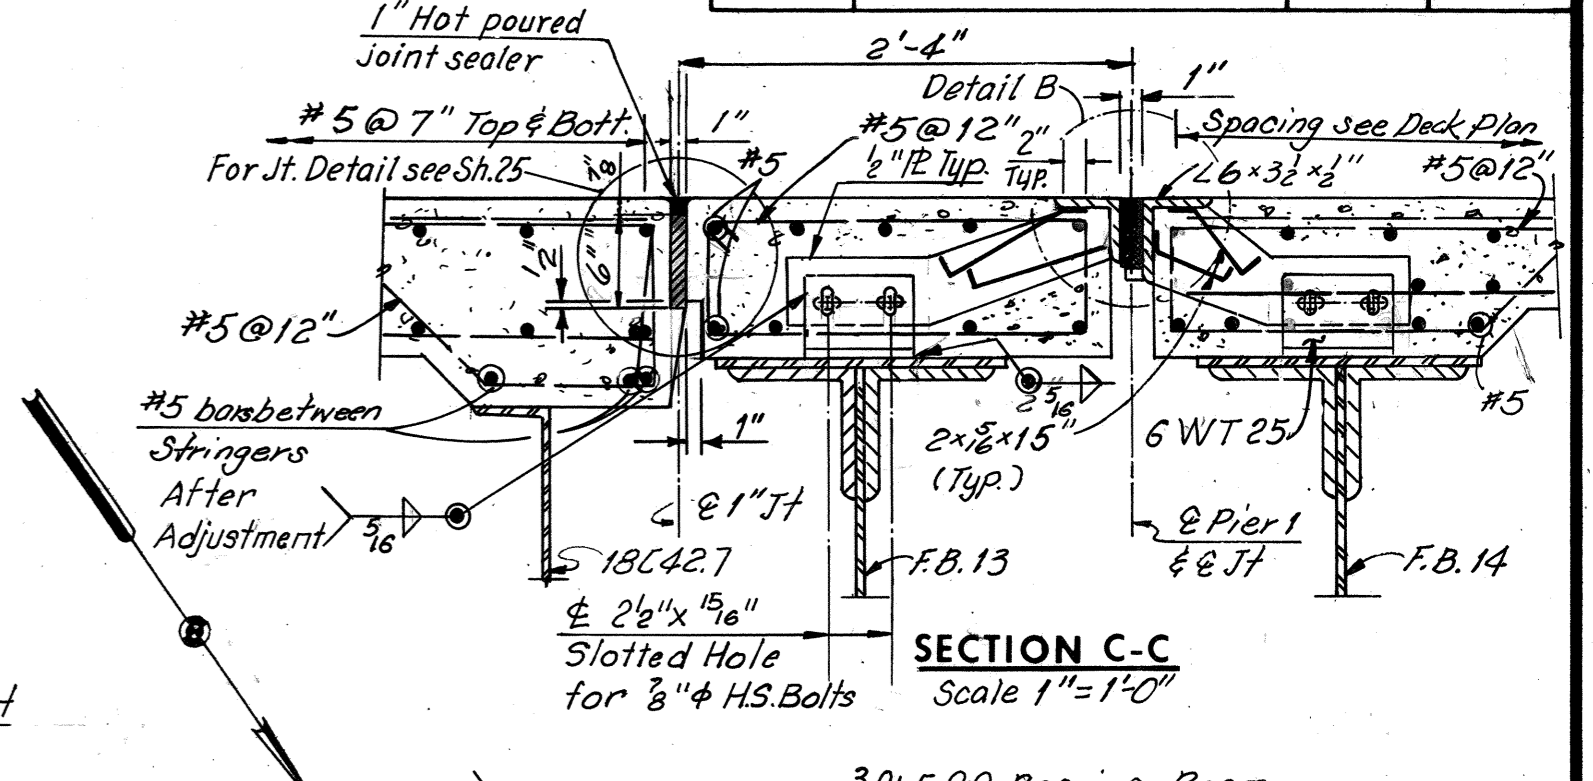


SECTION C-C
Scale 1" = 1'-0"

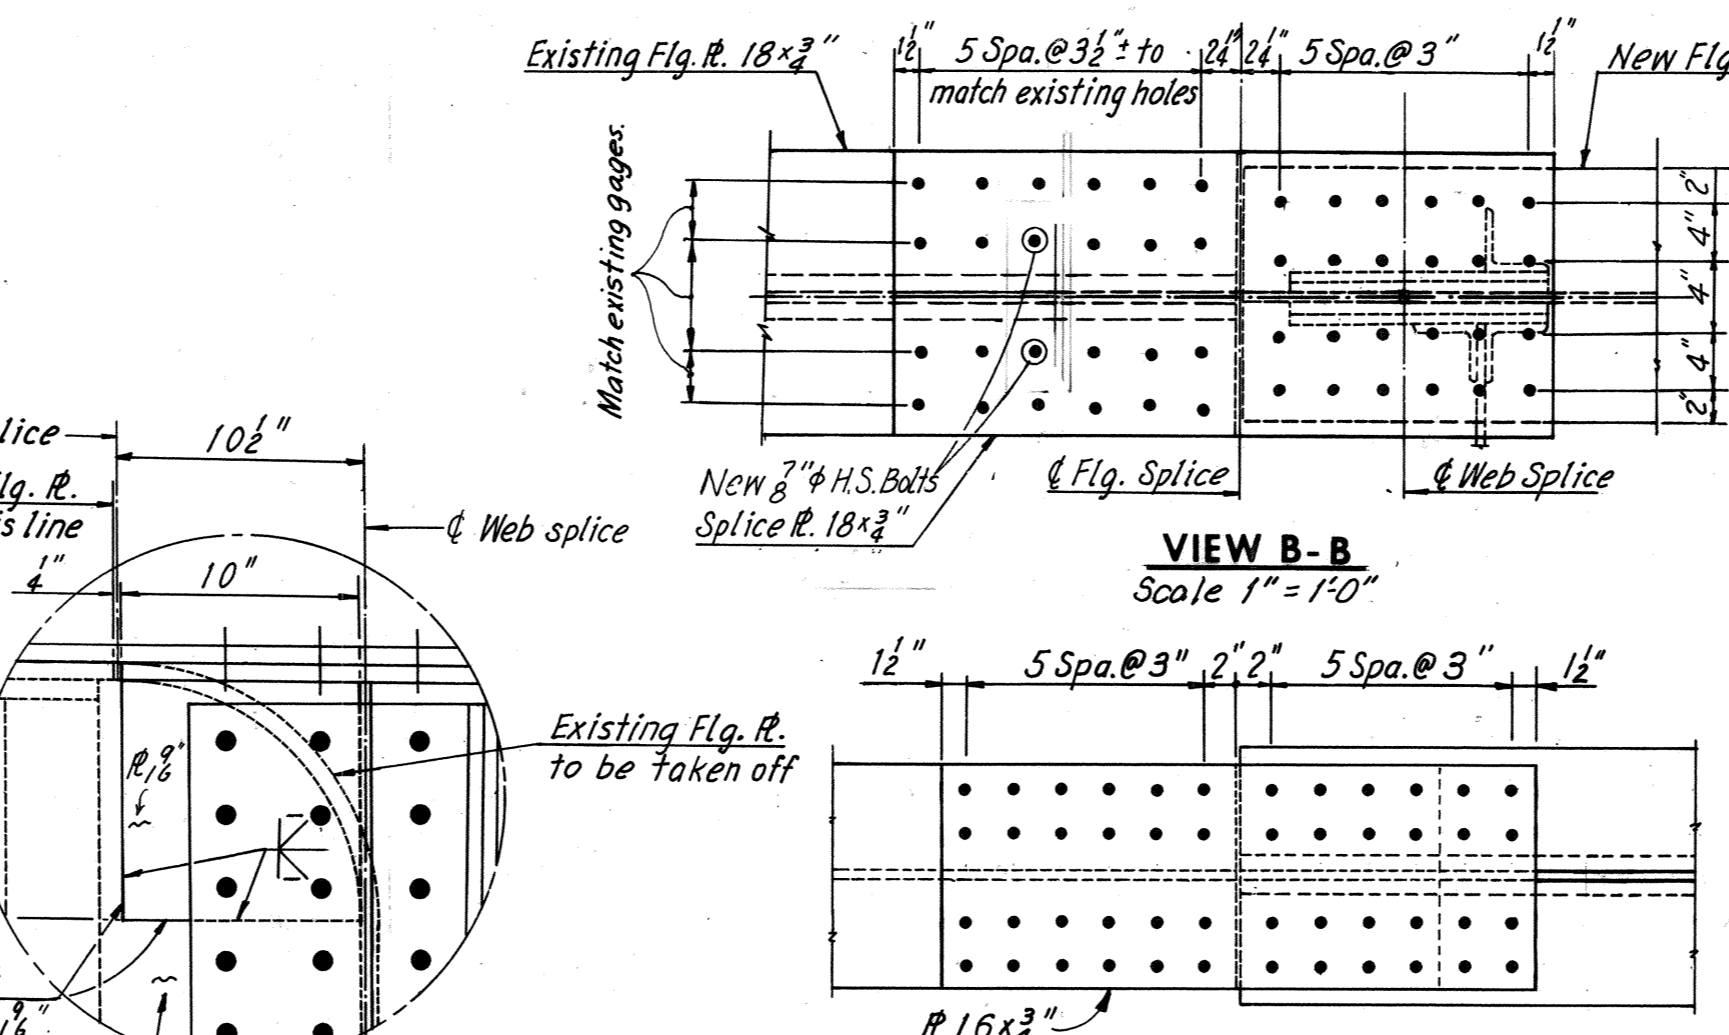


VIEW B-B
Scale 1" = 1'-0"

VIEW F-F
Scale 1" = 1'-0"

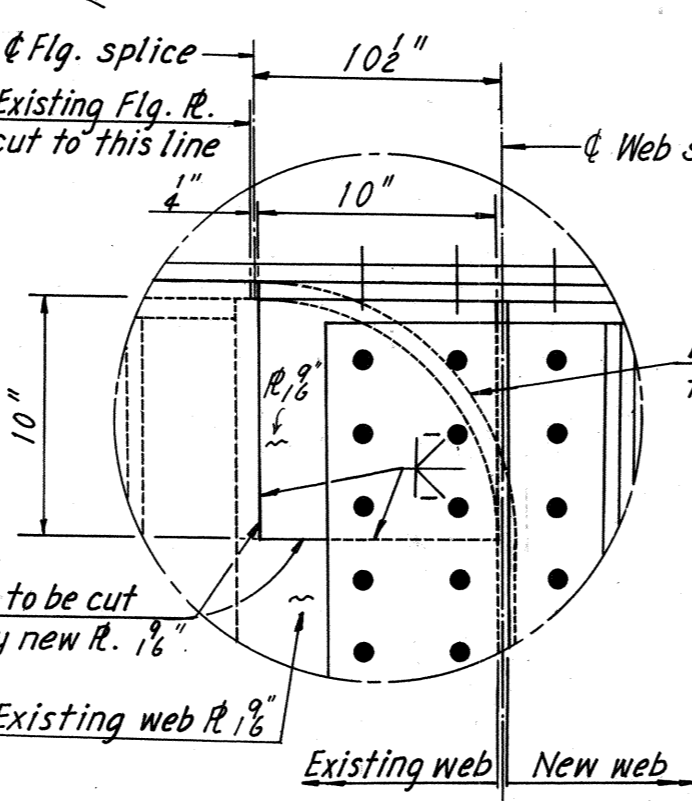


DETAIL A
Scale 3/4" = 1'-0"

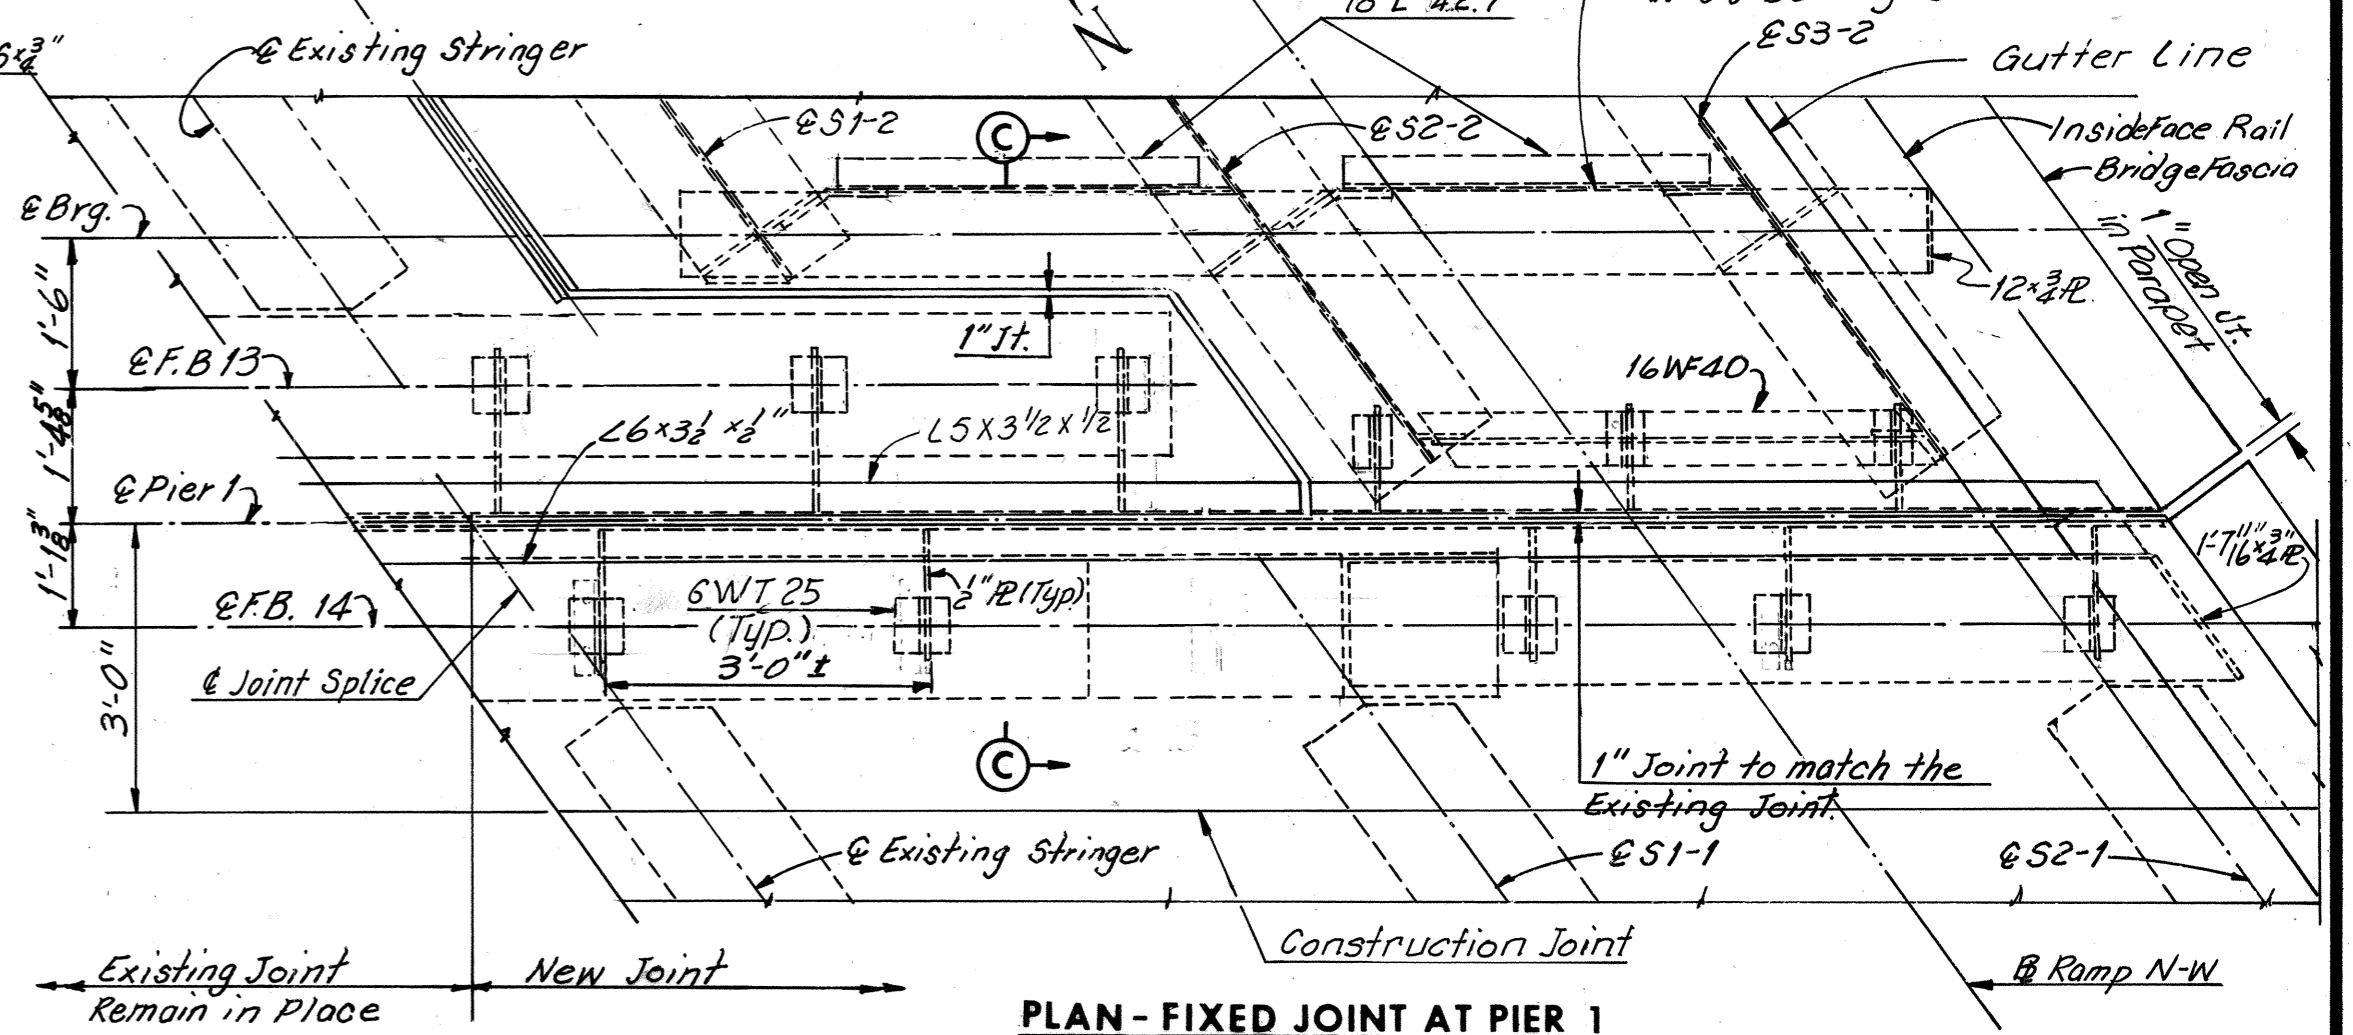


PLAN - FIXED JOINT AT PIER 1
Scale 1/2" = 1'-0"

Note: 1" Joint at pier 1 is to match the existing joint. The Contractor shall verify the location of joint.

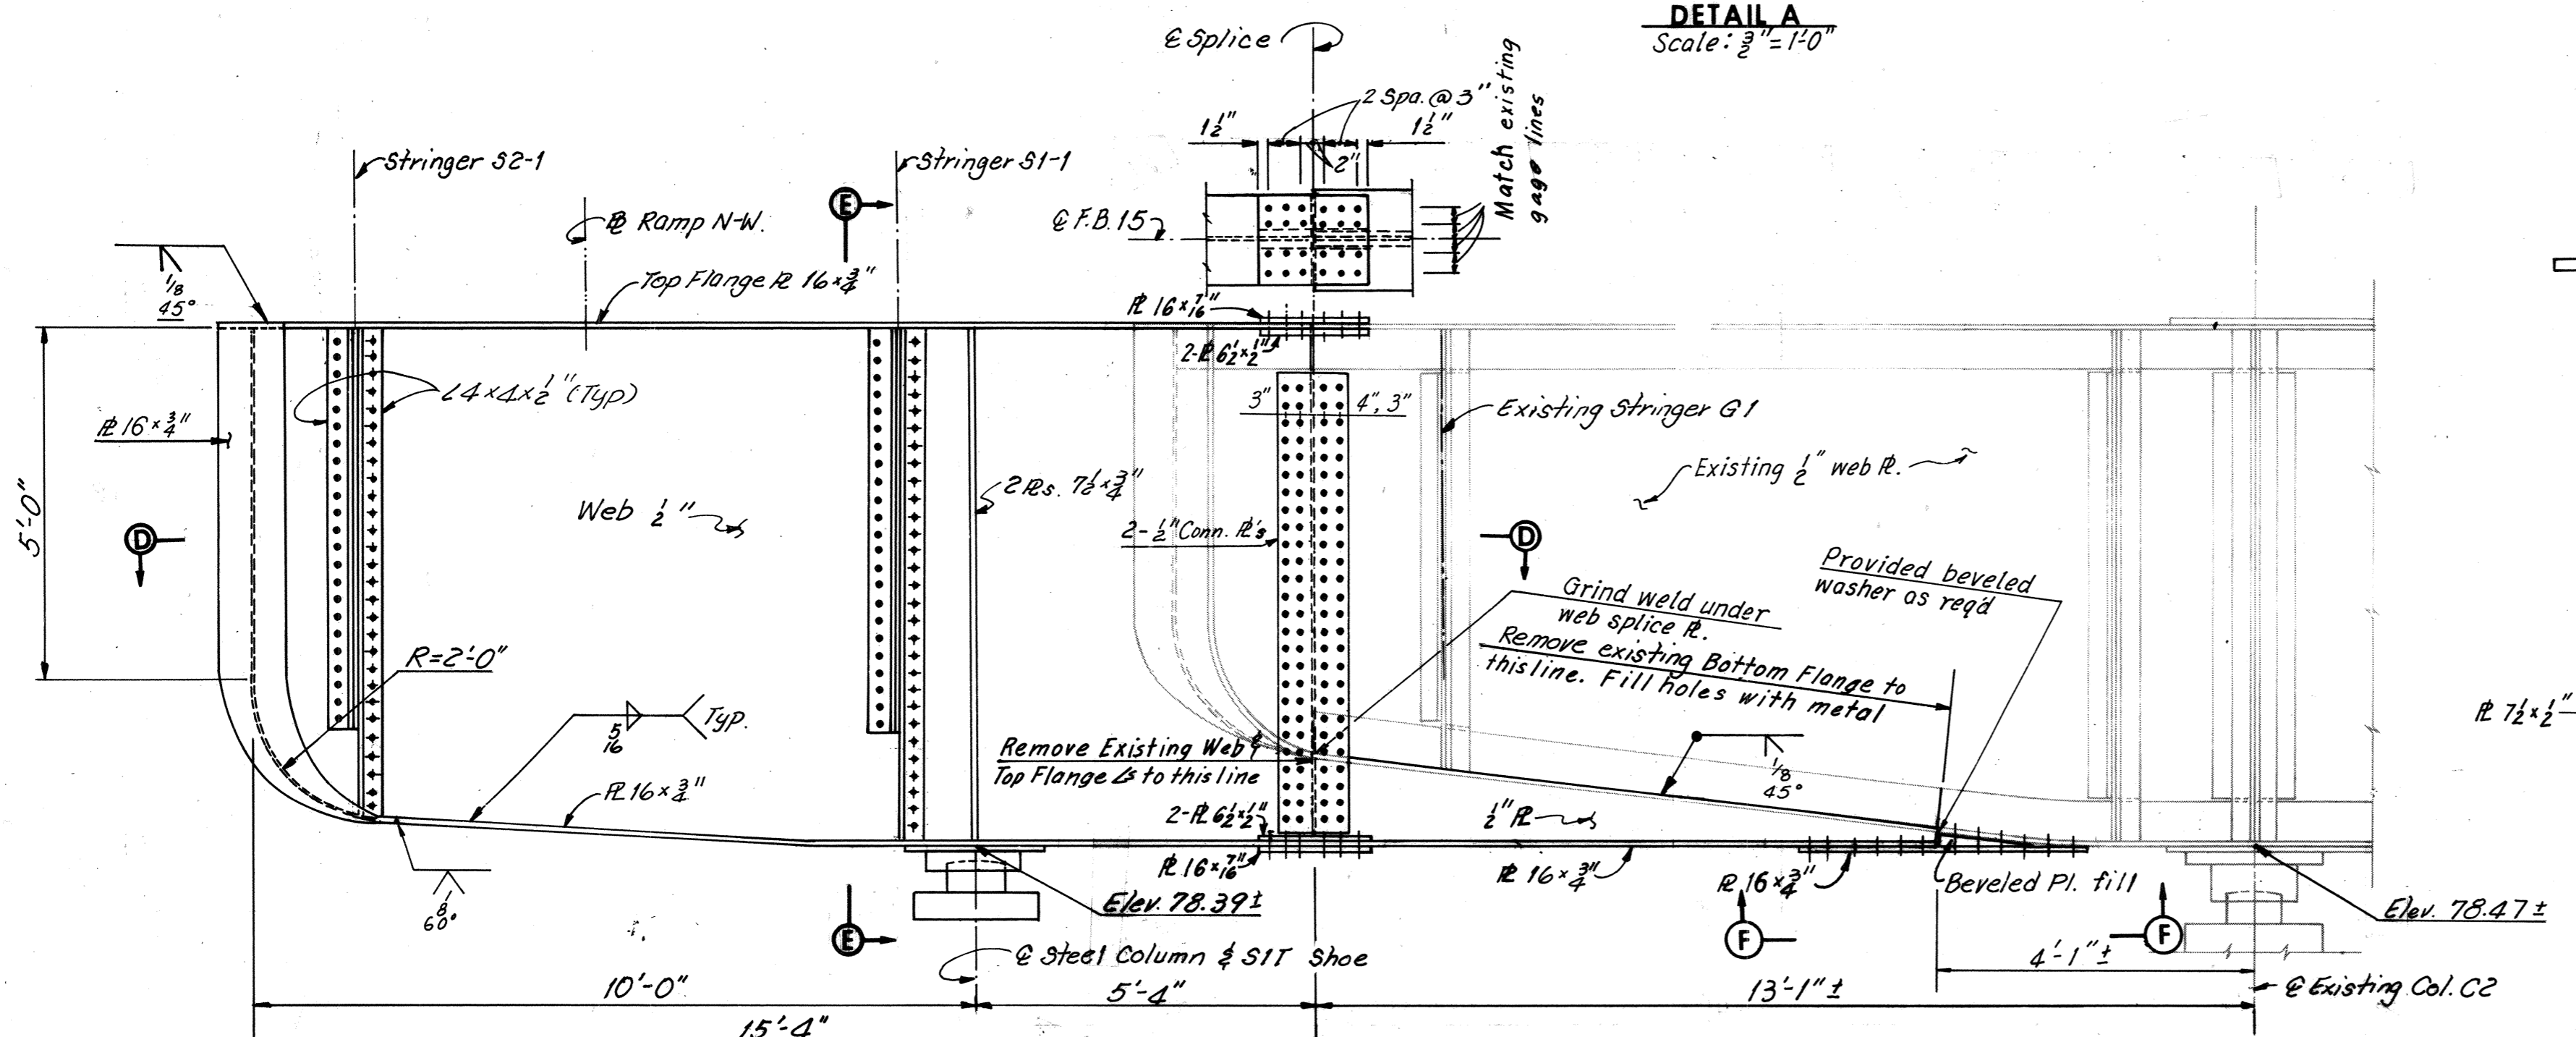

ELEVATION - FLOORBEAM 15
Scale 1/2" = 1'-0"

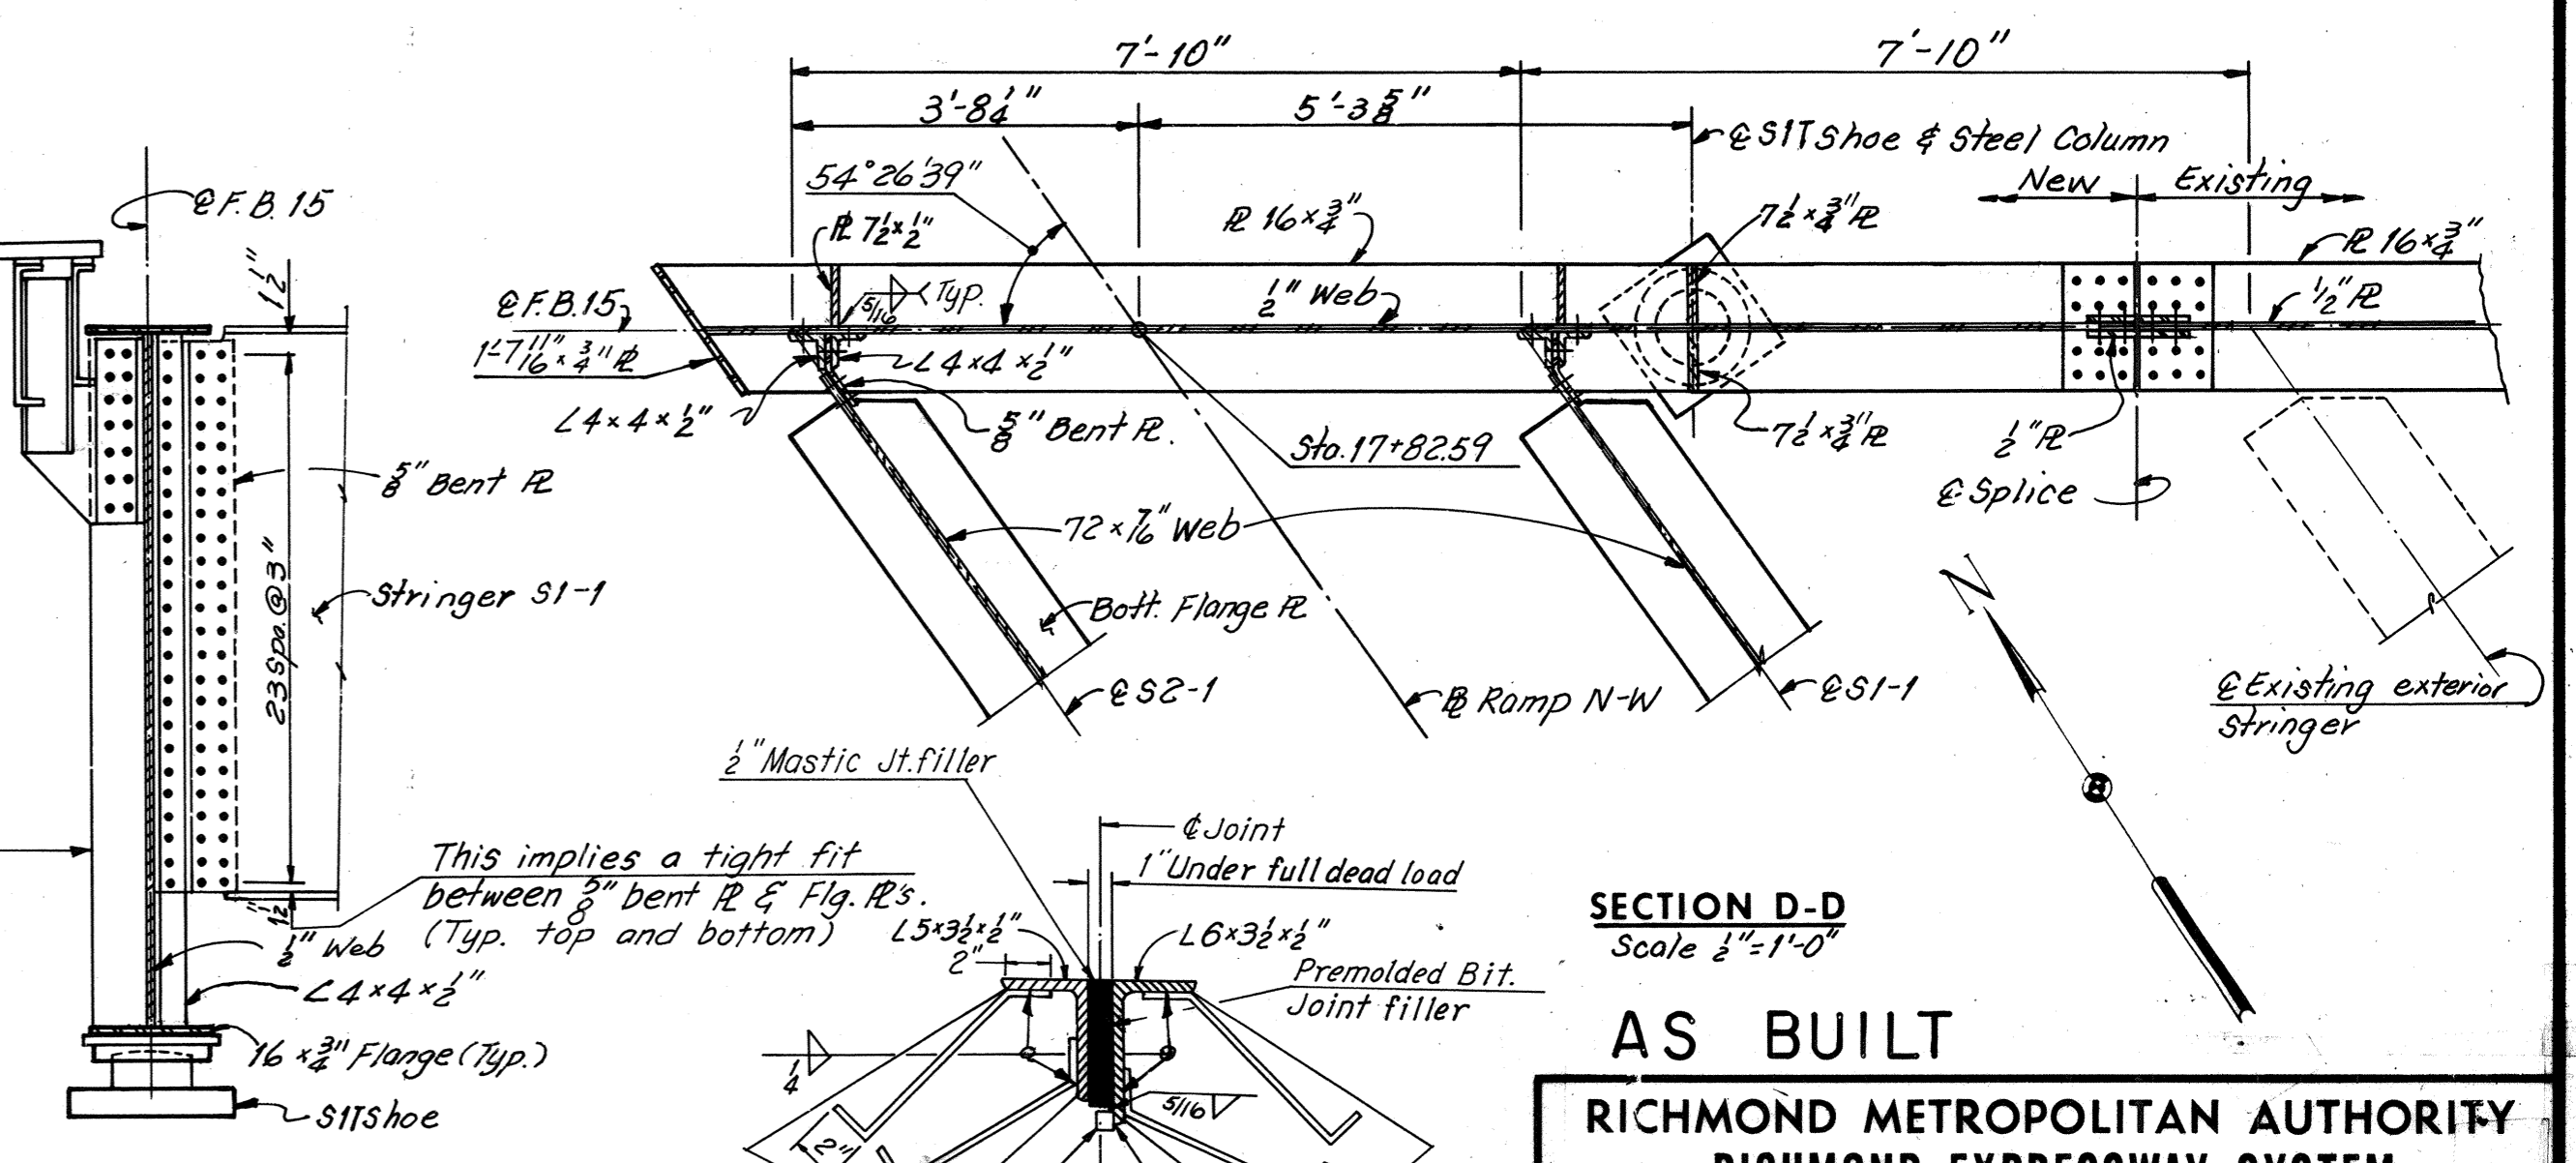

SECTION E-E
Scale 1/2" = 1'-0"

DETAIL B
No Scale

SECTION D-D
Scale 1/2" = 1'-0"

AS BUILT


RICHMOND METROPOLITAN AUTHORITY
RICHMOND EXPRESSWAY SYSTEM
DOWNTOWN EXPRESSWAY
BRIDGE NO. 64
RAMP N-W CONNECTION FROM
RICHMOND-PETERSBURG TURNPIKE
FRAMING DETAILS

BY	DATE	2	As Built	TEM	G-77
MADE	G.C.C.	3-13-69	Unit 2 End Depth to Pier 1 revised	LBP	10-31-74
CHECKED	Y.C.P.	4-25-69	L3x3x3 Support Changed to 6W175		
IN CHARGE					
NO.	REVISION	BY	DATE		

Note: Dimensions shown on the plans for existing structural metalwork are in accordance with drawings prepared for the original construction. The Contractor shall verify all necessary dimensions of existing structural metalwork prior to fabrication of new metalwork.








Note: For Joint Details at F.B. 15, see Sheet 42 Bridge 67. For Framing plan, see Sheet 12. For Steel Column Details, see Sheet 28 Bridge 67. For SIT Shoe Details, see Sheet 47 Bridge 67. All Elevations are to be verified by the Contractor.

HOWARD, NEEDLES, TAMMEN & BERGENDOFF consulting engineers NEW YORK ALEXANDRIA KANSAS CITY	SCALE: As Noted	CONTRACT NO.: 10	SHEET NO. 18 OF 28
---	-----------------	------------------	--------------------

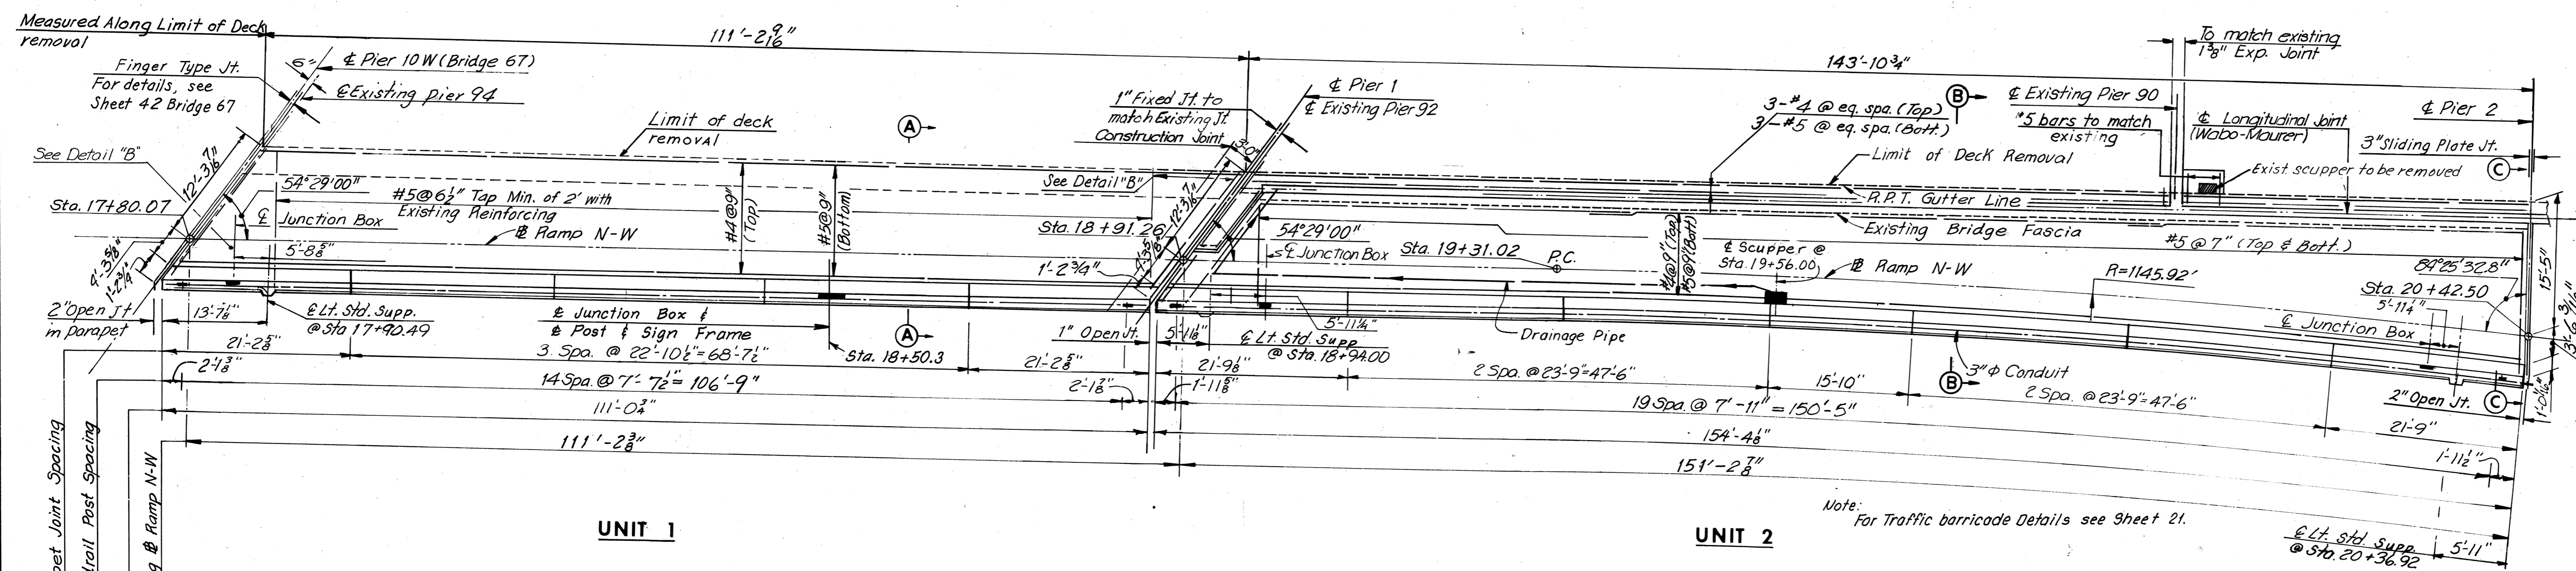

ELEVATION TABLE			
STATION	ELEV. A	ELEV. B	ELEV. C
17+77.57	87.11	-	-
17+80	87.17	87.07	86.78
17+80.07	-	87.07	-
17+87.21	-	-	87.00
17+90	87.44	87.35	87.07
18+00	87.70	87.61	87.35
18+10	87.95	87.87	87.63
18+20	88.19	88.12	87.90
18+30	88.43	88.36	88.15
18+40	88.66	88.59	88.40
18+50	88.88	88.81	88.64
18+60	89.09	89.03	88.87
18+70	89.29	89.24	89.10
18+80	89.49	89.44	89.32
18+88.75	89.65	-	-
18+90	89.67	89.64	89.57
18+91.26	-	89.66	-
18+98.42	-	-	89.72
19+00	89.87	89.84	89.78
19+10	90.06	90.03	89.98
19+20	90.23	90.22	90.18
19+30	90.40	90.39	90.37
19+40	90.56	90.55	90.54
19+50	90.71	90.71	90.71
19+60	90.84	90.85	90.88
19+70	90.95	90.98	91.04
19+80	91.05	91.10	91.20
19+90	91.15	91.21	91.35
20+00	91.24	91.31	91.49
20+10	91.31	91.39	91.64
20+20	91.38	91.47	91.77
20+30	91.43	91.54	91.91
20+40	91.47	91.59	92.04
20+41.28	-	-	92.06
20+42.50	-	91.60	-
20+42.84	91.49	-	-

Elevations given in the Elevation Table may require adjustment in the field.

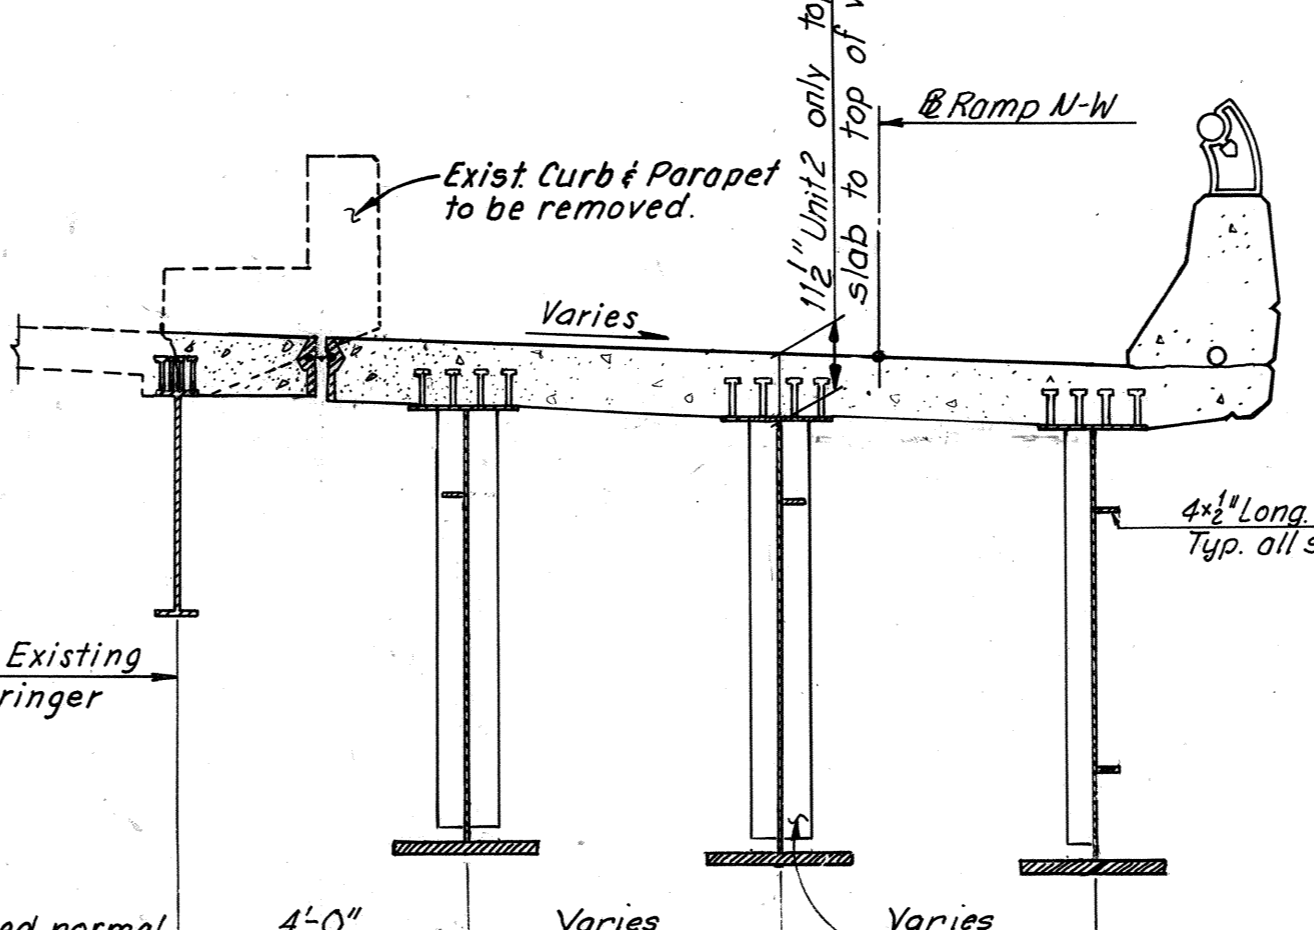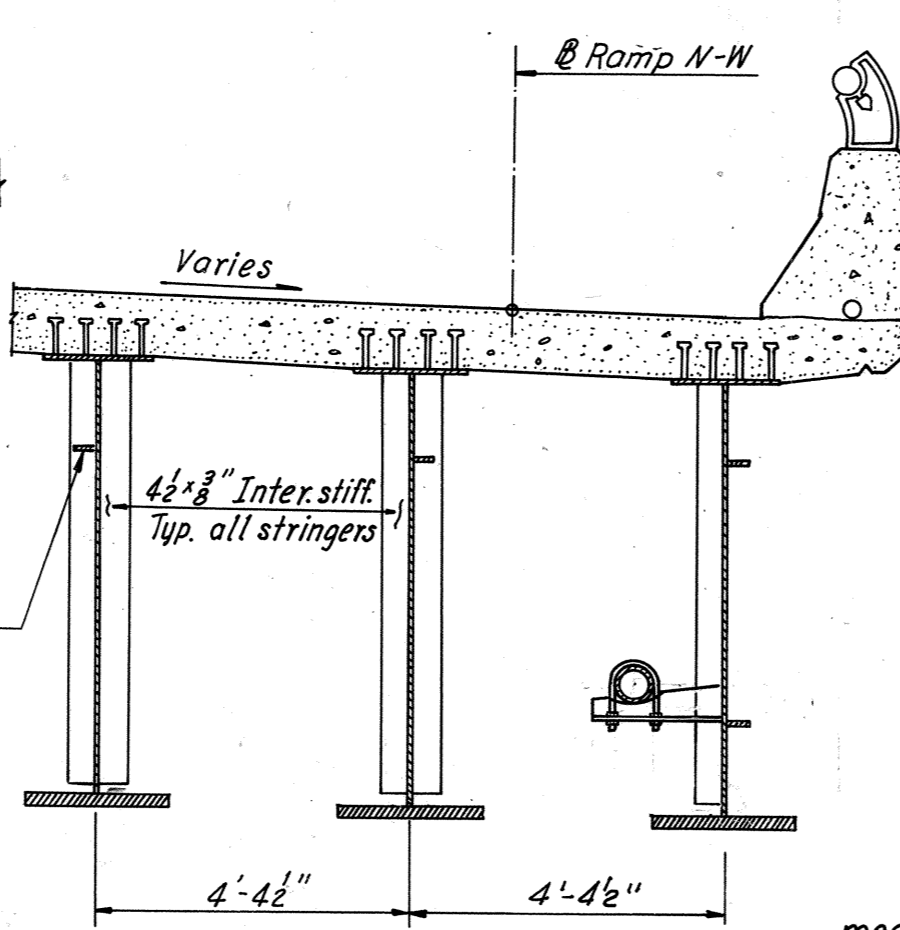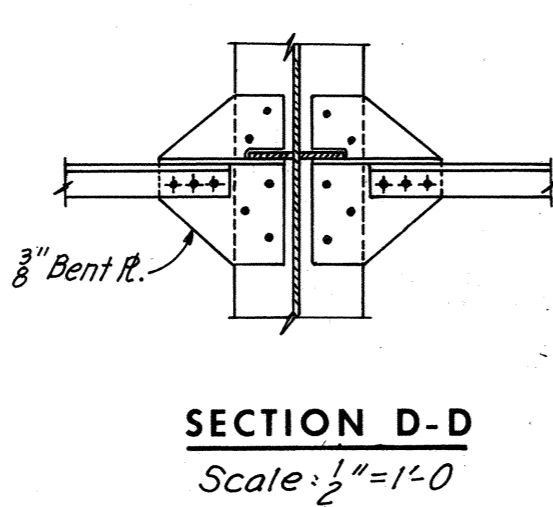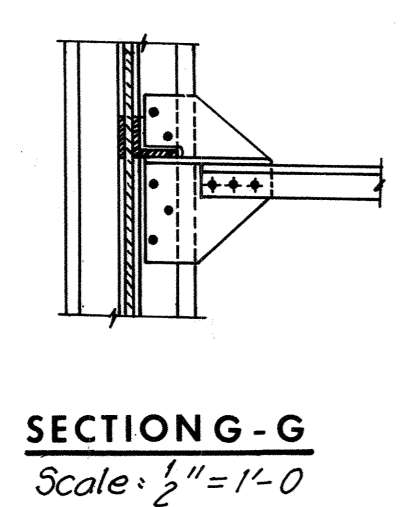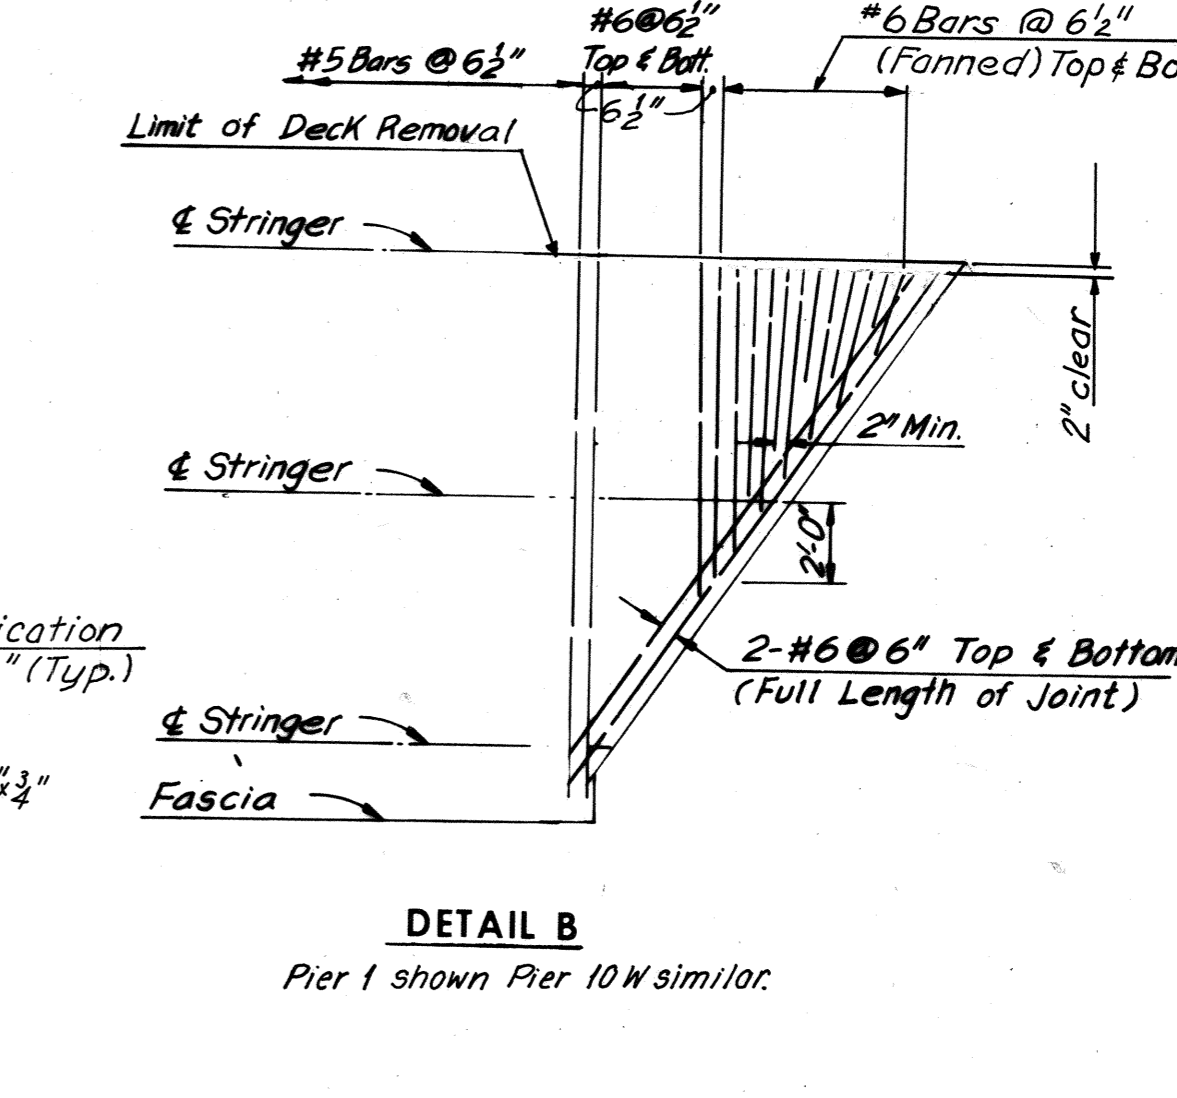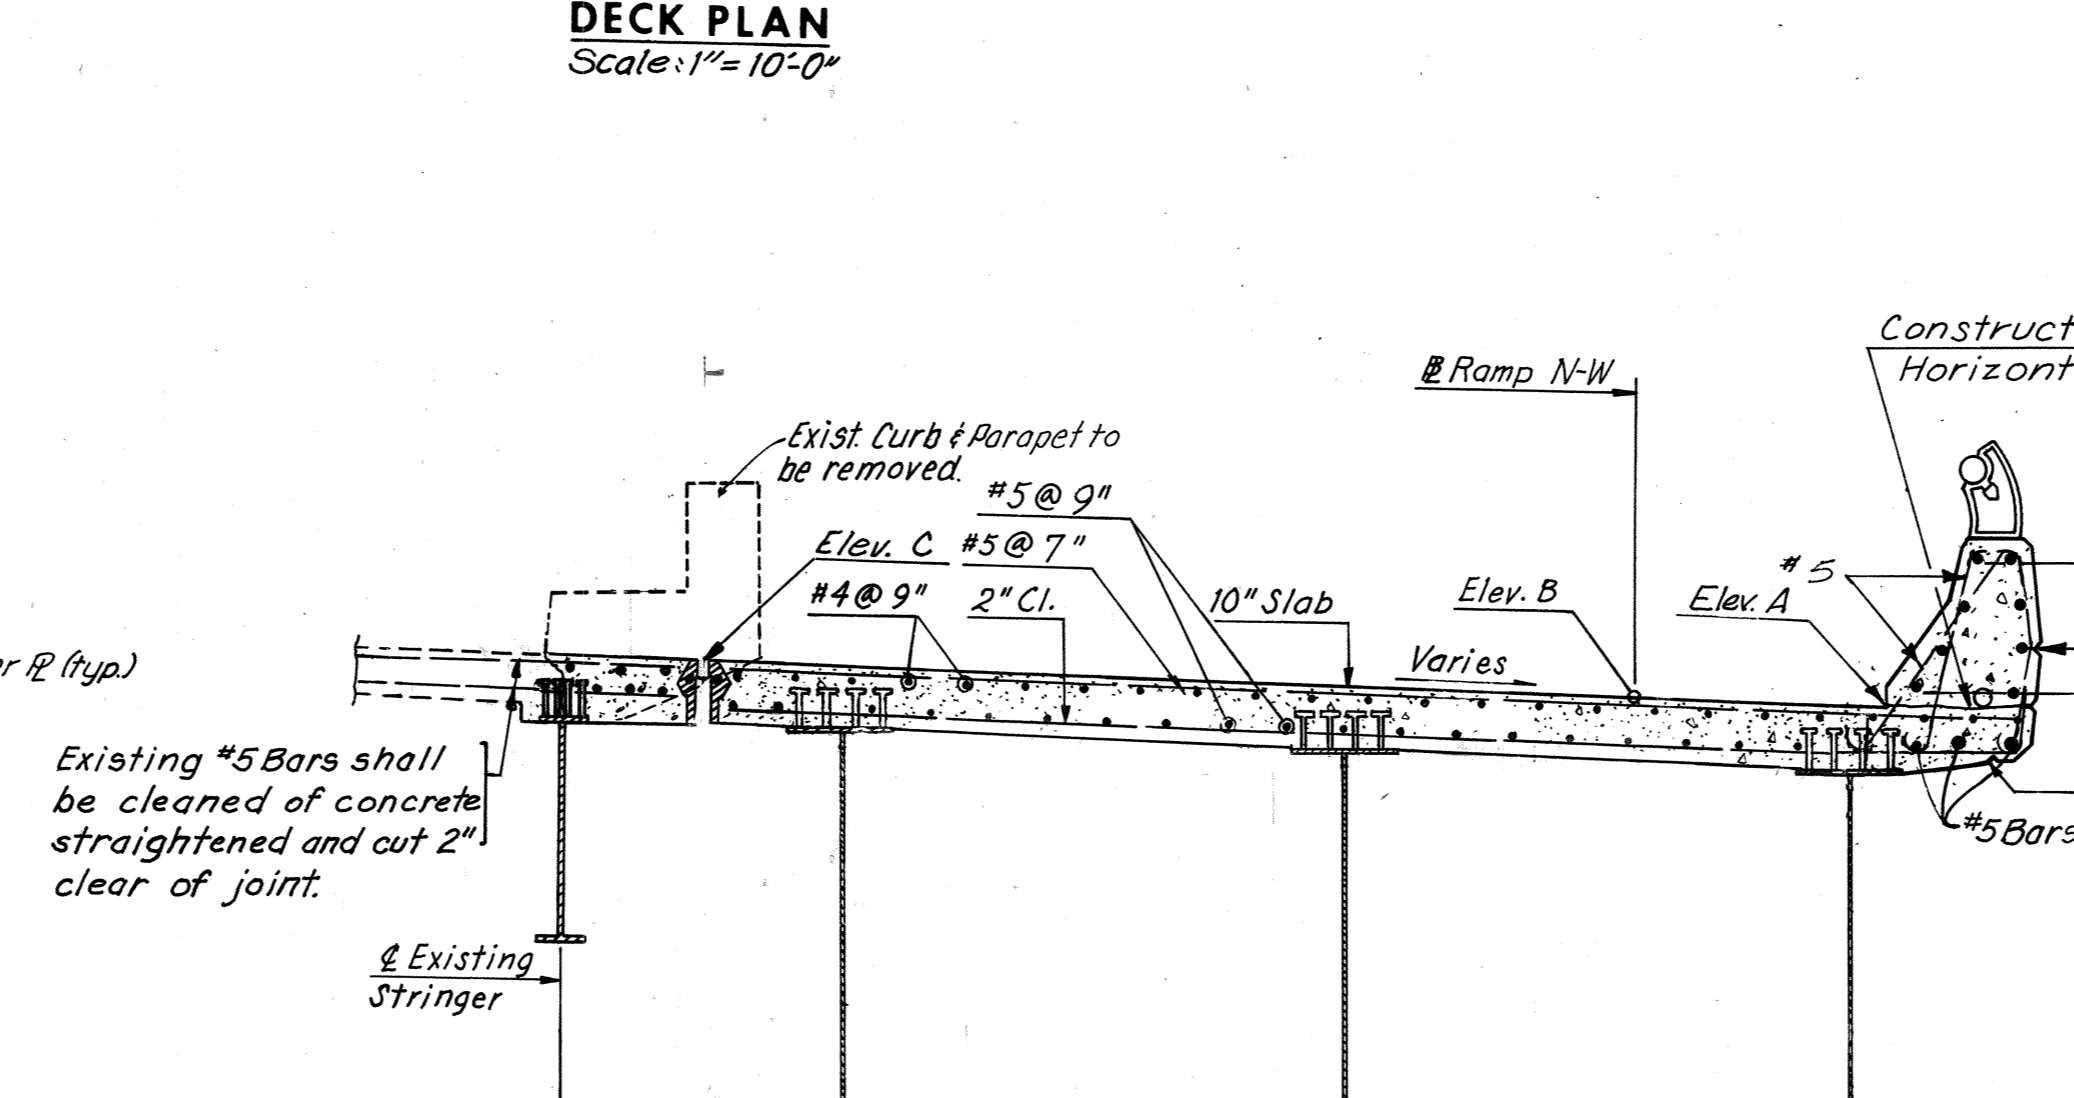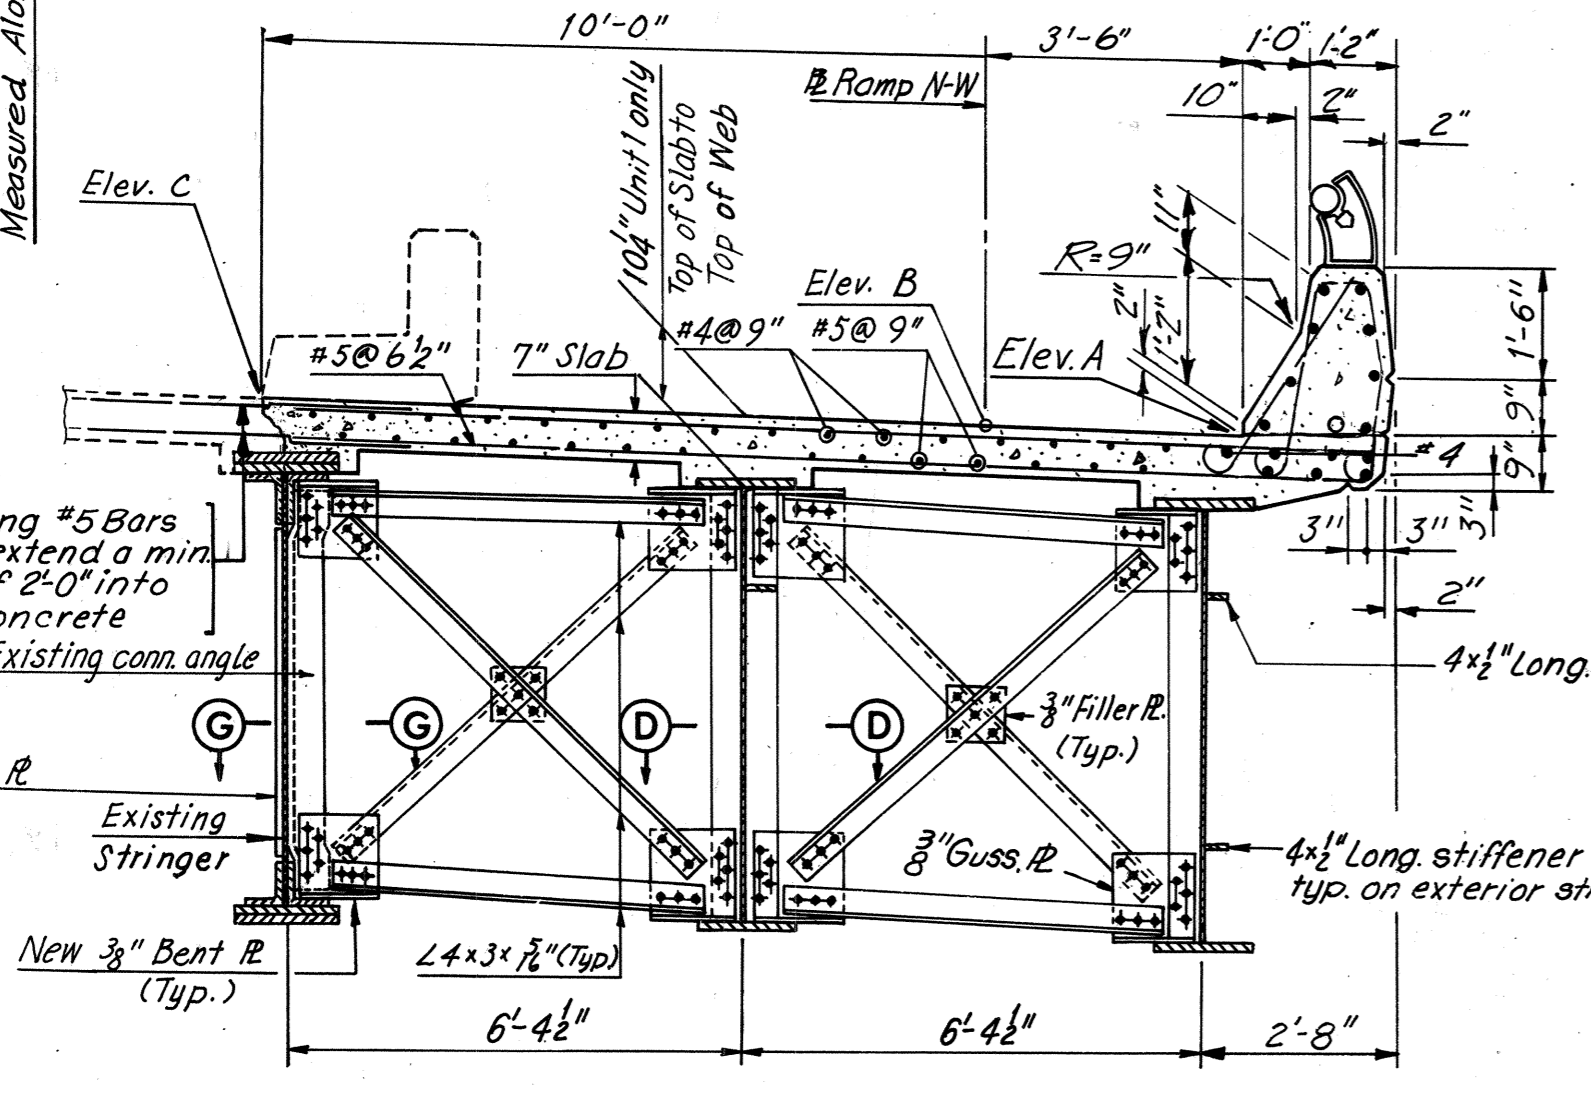

Notes:
For Joint Details, see Sheet 18, 25 and Sheet 42 Bridge 67.
Elevation C is to be confirmed by contractor.
For Framing Plan, see Sheet 12.
For Steel and Concrete Quantities, see Sheet 2.
For Handrail Details, see Sheet S3.
For Lighting Details, see Sheet S4.
For Standard Drainage Details, see Support Type 11 Sheet S6.

RICHMOND METROPOLITAN AUTHORITY
RICHMOND EXPRESSWAY SYSTEM
DOWNTOWN EXPRESSWAY

BRIDGE NO. 64
RAMP N-W CONNECTION FROM
RICHMOND-PETERSBURG TURNPIKE
DECK PLAN UNITS 1 AND 2

HOWARD, NEEDLES, TAMMEN & BERGENDOFF
consulting engineers
ALEXANDRIA KANSAS CITY

SCALE: As Noted
CONTRACT NO.: 10
SHEET NO. 19 OF 28

4 As Built	TEM	G-77
BY	DATE	Note for Table of Elevations
MADE	Y.C.P. 2-12-69	Chg. of Pier Angle Added Jun. Box
CHECKED	SCC. 4-24-69	Deck Plan Sect. A-A, B-B, C-C, H-H, Det. B
IN CHARGE	NO.	REVISION BY DATE
		DWB 1-28-75
		ABG 1-13-75
		TEM 10-31-74

AS BUILT

RICHMOND EXPRESSWAY SYSTEM			
SECTION	PROJECT	SHEET NO.	TOTAL SHEETS
10	DOWNTOWN EXPRESSWAY	118	265

Elevations given in the Elevation Table may require adjustment in the field.

ELEVATION TABLE			
* STATION	ELEV. A	ELEV. B	ELEV. C
20+41.28	---	---	92.06
+42.50	---	91.61	---
+42.49	91.44	---	---
+50.00	91.49	91.64	92.21
+60.00	91.52	91.68	92.34
+70.00	91.54	91.72	92.52
+80.00	91.58	91.76	92.65
+90.00	91.61	91.80	92.80
21+00.00	91.64	91.84	93.00
+10.00	91.66	91.88	93.22
+20.00	91.70	91.92	93.38
+30.00	91.74	91.96	93.53
21+34.10	---	---	93.59
21+38.68	---	91.98	---
21+39.33	91.76	---	---
+40.00	91.76	91.98	93.67
+50.00	91.76	91.98	93.80
+60.00	91.73	91.95	93.92
+70.00	91.69	91.91	94.01
+80.00	91.63	91.85	94.09
+90.00	91.55	91.77	94.14
21+95.50	---	---	93.18
22+00.00	91.44	91.66	93.05
+05.50	91.39	91.60	92.91

GUTTER LINE ELEVATION		
STATION	ELEV. D	ELEV. E
1714+22.95	94.22	93.73
1714+17.85	94.27	93.85

* Station along @ Ramp N-W.
 ** Station along @ R.P.T..




Notes:
 Elevation C is along W. edge of longitudinal joint before Sta. 21+60.00 and along W. Nose Gutter line after Sta. 21+60.00.
 For elevation D and elevation E, see Section C-C.
 For Joint Details, see Sheet 26.
 For Framing Plan, see Sheet 13.
 For Steel and Concrete Quantities, see Sheet 2.
 For Handrail Details, see Sheet S3.
 For Lighting Details, see Sheet S4.
 For Superstructure details, see Sheet 24.
 For Traffic Barricade Detail, see Sheet 21.

RICHMOND METROPOLITAN AUTHORITY
RICHMOND EXPRESSWAY SYSTEM
DOWNTOWN EXPRESSWAY

BRIDGE NO. 64
RAMP N-W CONNECTION FROM
RICHMOND-PETERSBURG TURNPIKE
DECK PLAN - UNITS 3 AND 4

HOWARD, NEEDLES, TAMMEN & BERGENDOFF
 consulting engineers
 NEW YORK ALEXANDRIA KANSAS CITY

SCALE: As Noted
 CONTRACT NO. 10
 SHEET NO. 20 OF 28

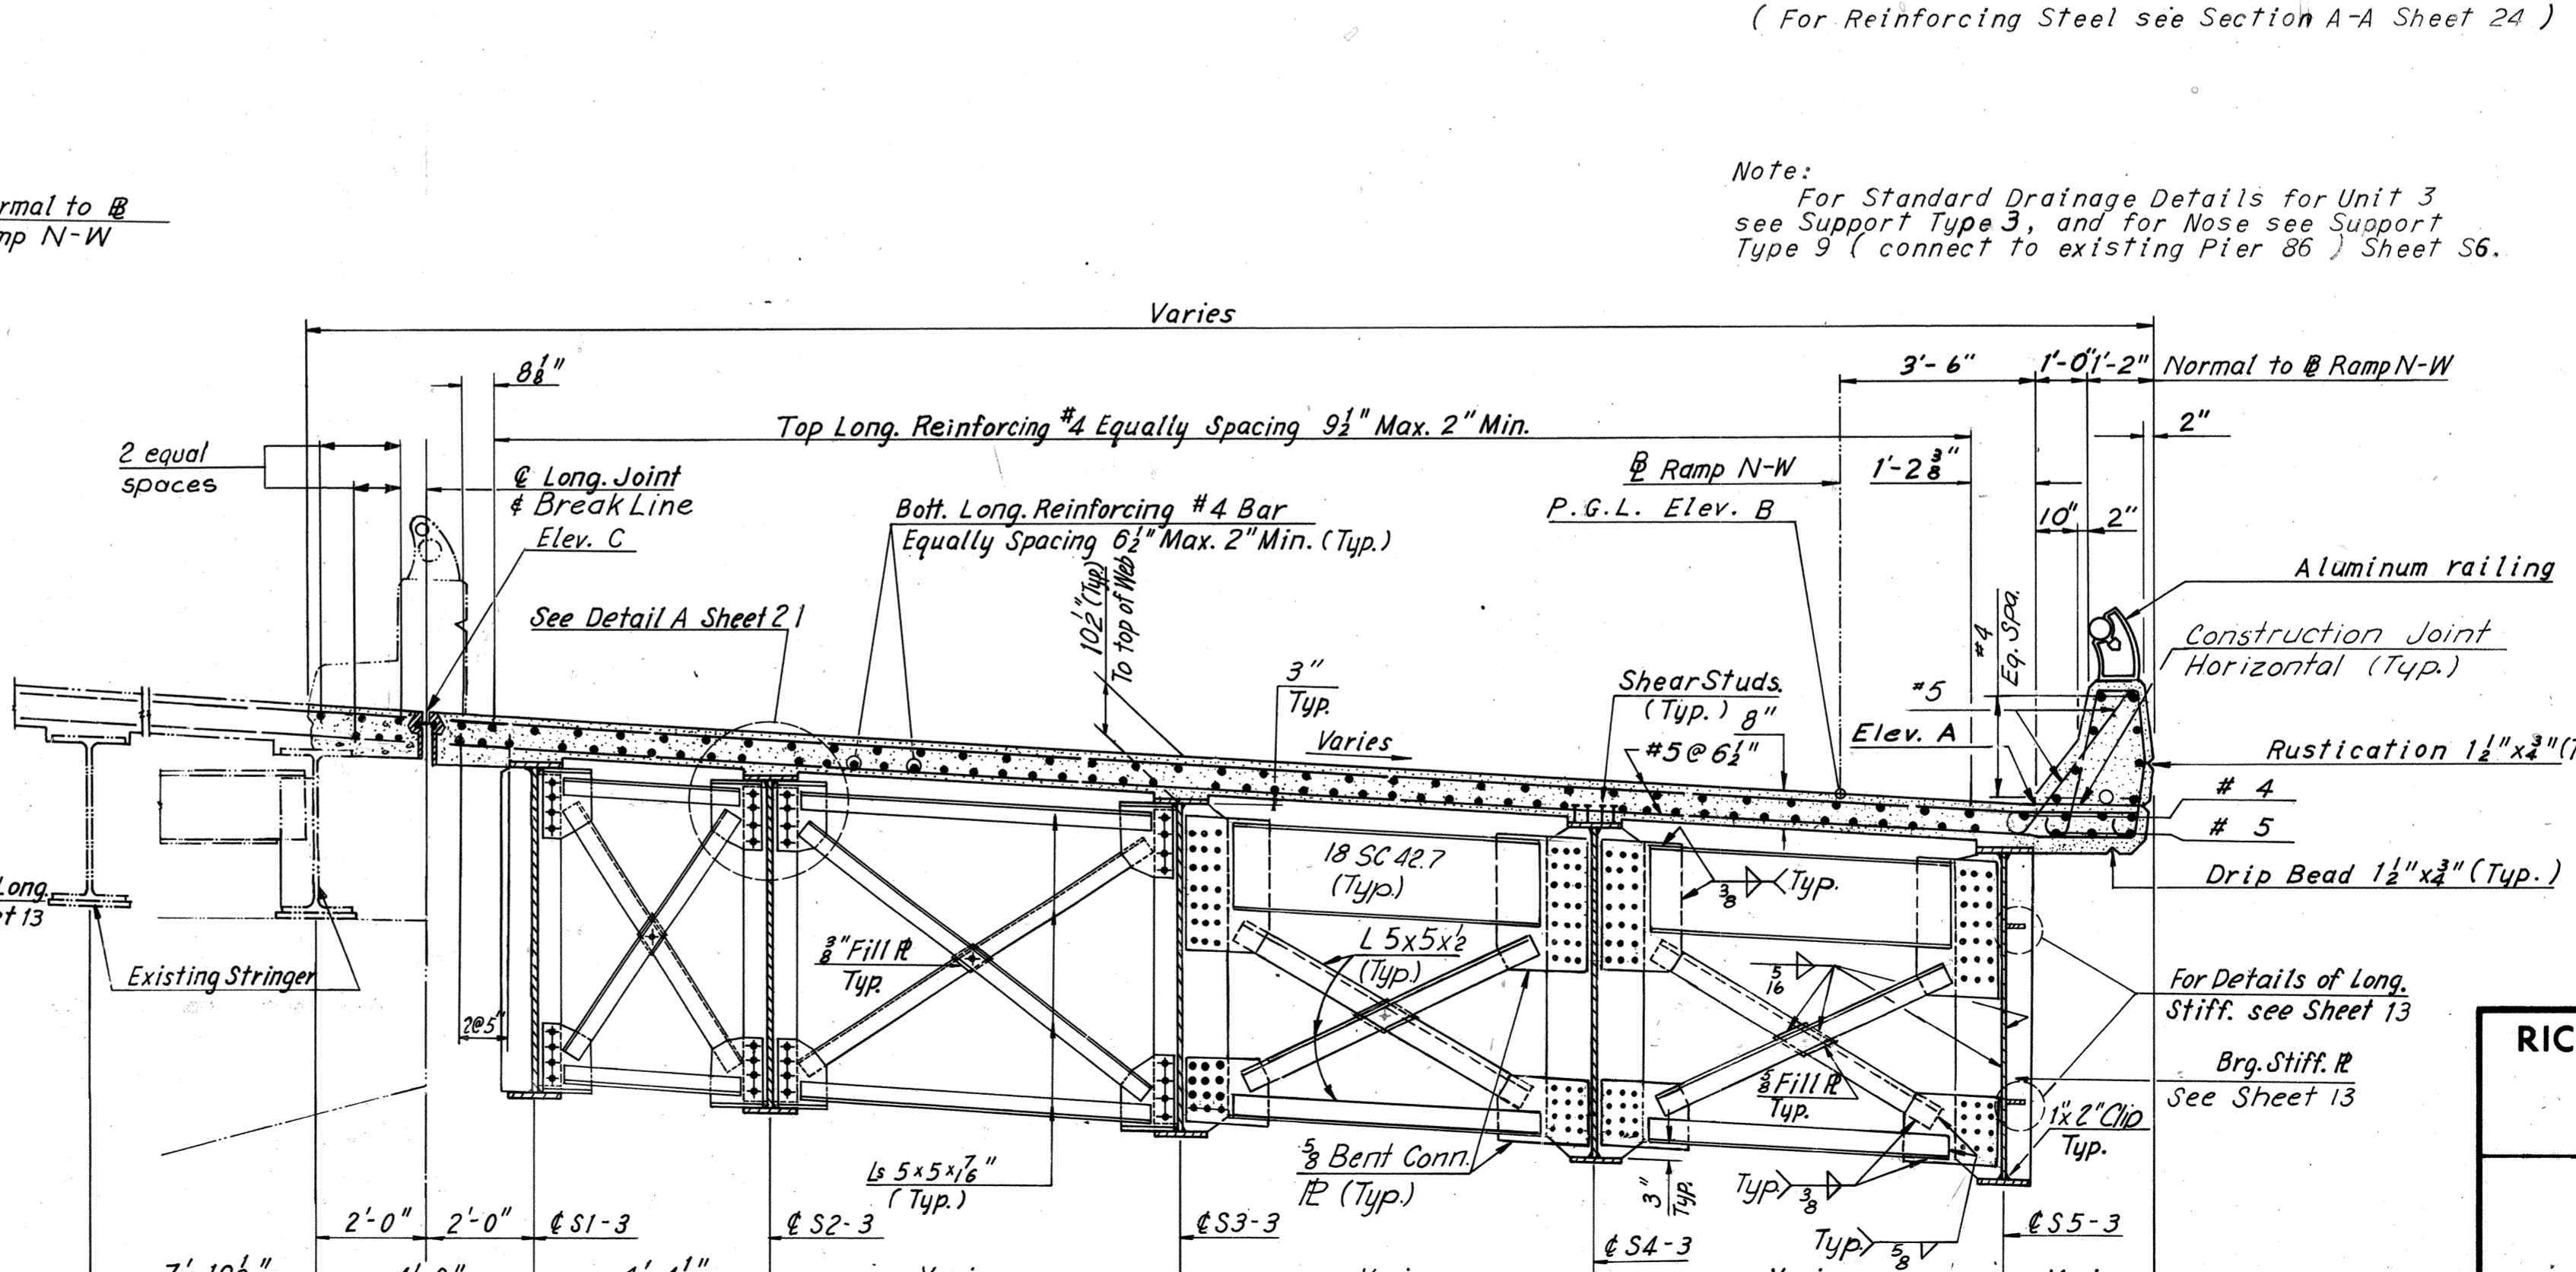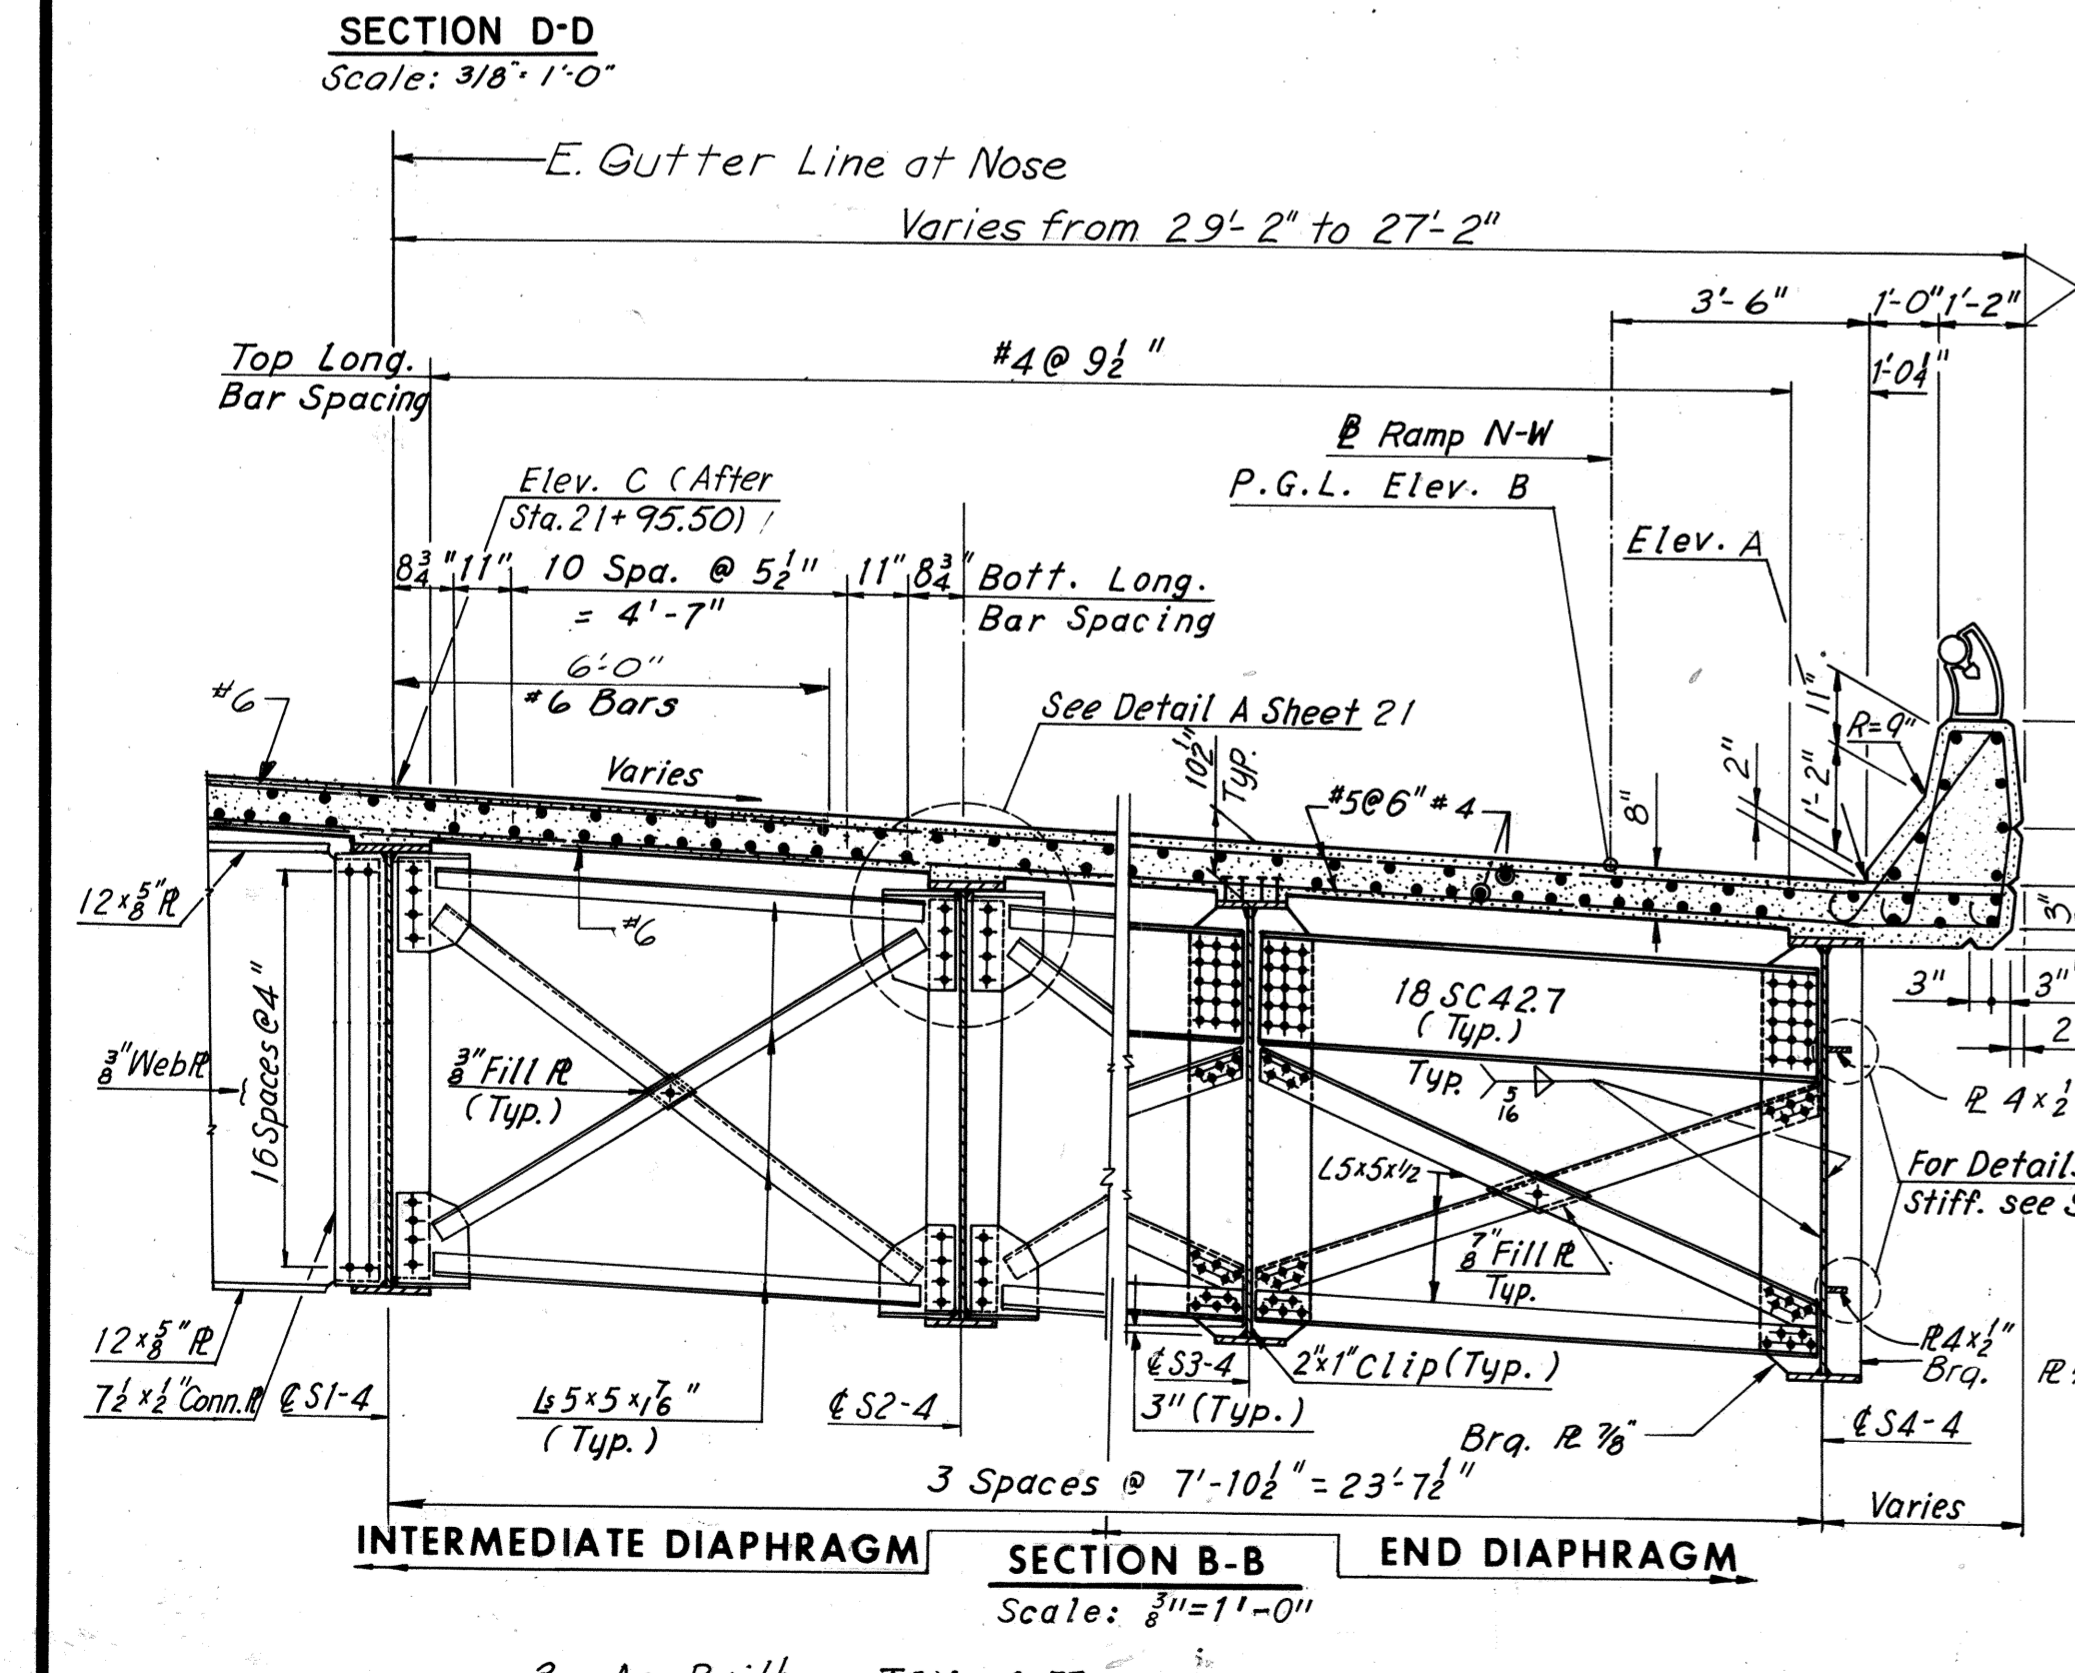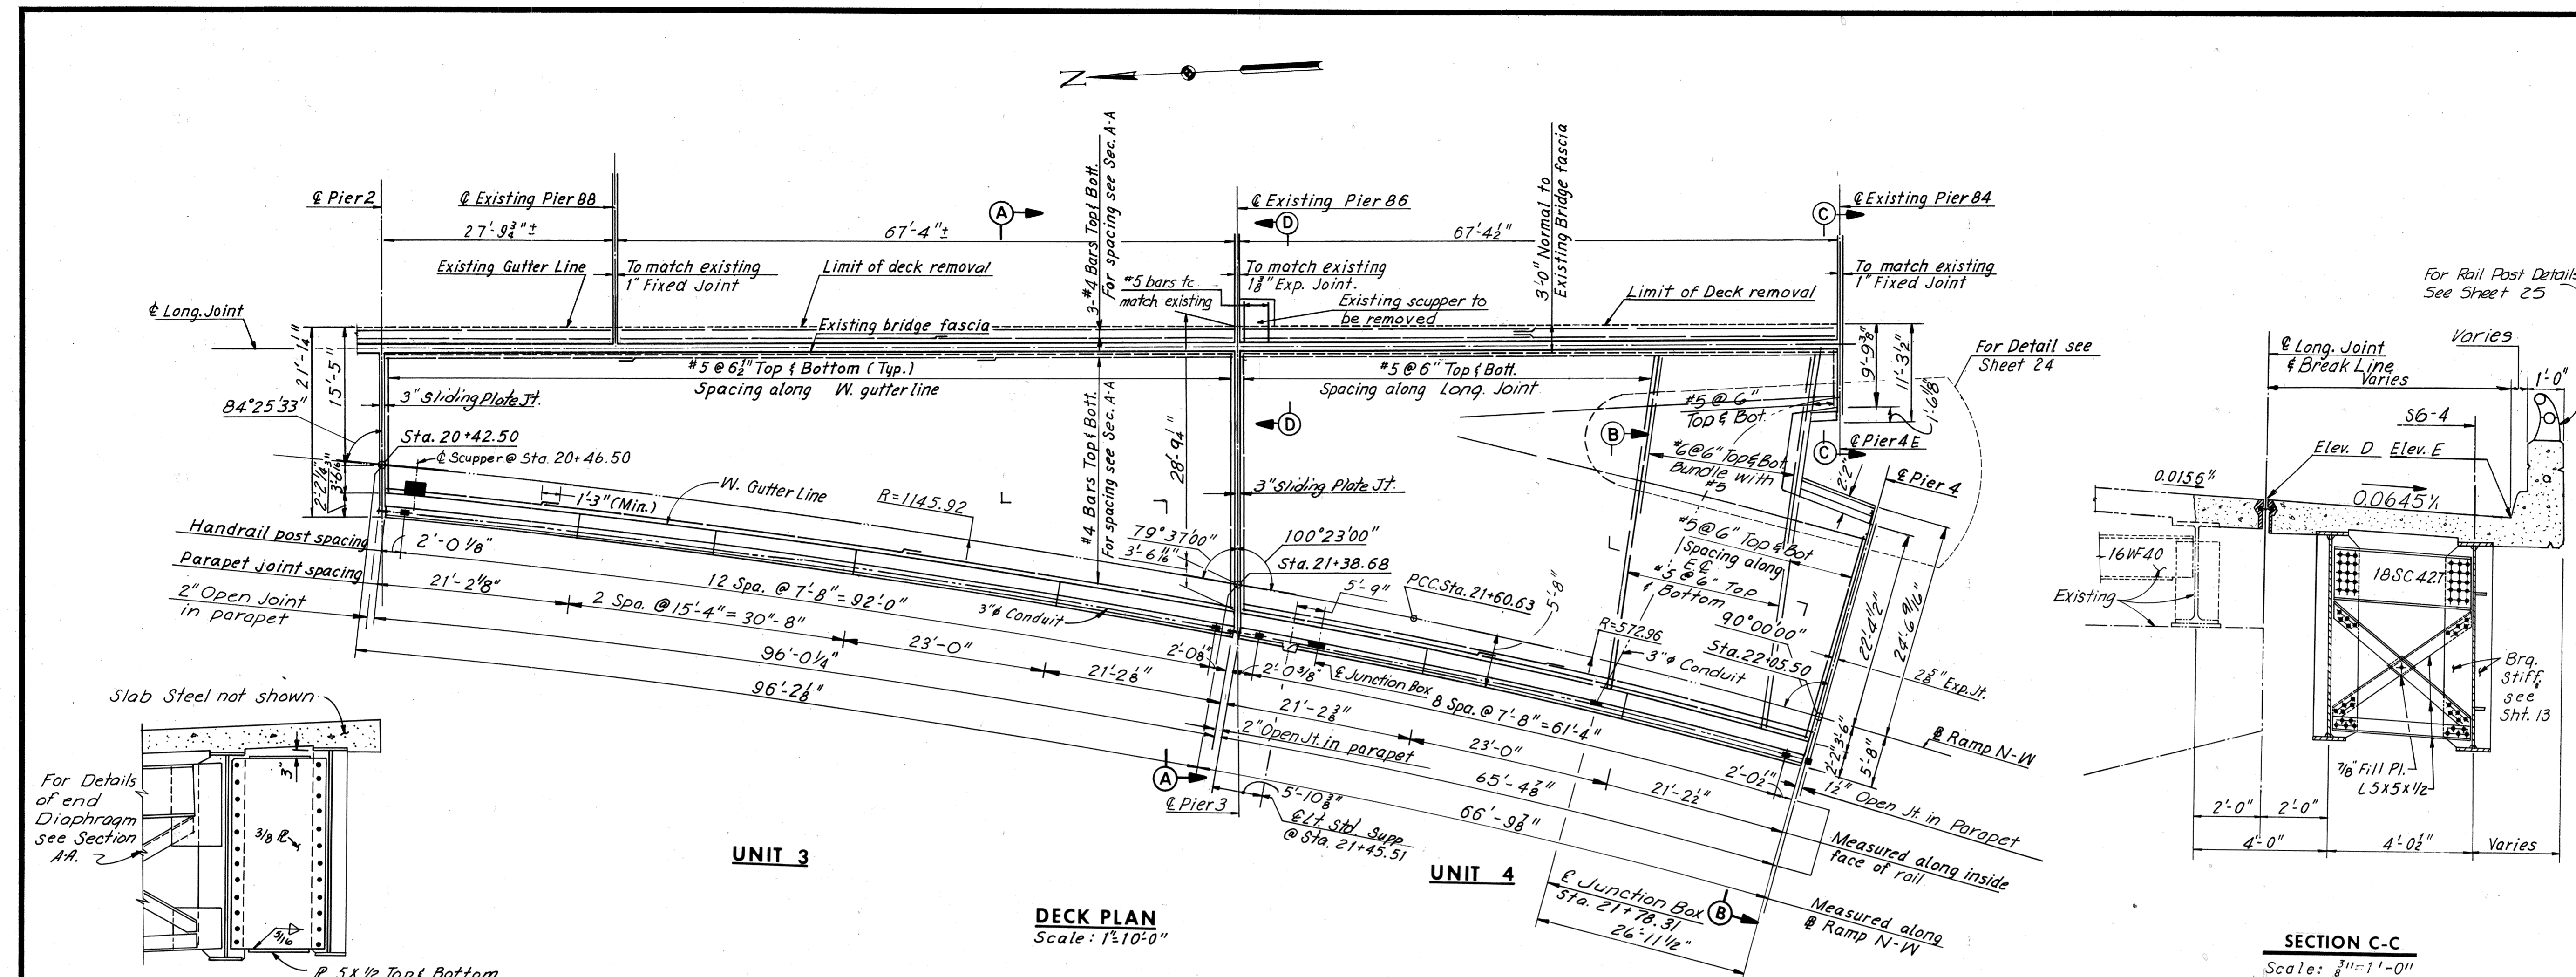

NO.	REVISION	BY	DATE


BY	DATE	REVISION	DATE
K.C.T.	2-19-69		
G.C.C.	4-17-69		

AS BUILT

RICHMOND EXPRESSWAY SYSTEM			
SECTION	PROJECT	SHEET NO.	TOTAL SHEETS
10	DOWNTOWN EXPRESSWAY	119	265


ELEVATION TABLE

STATION	ELEV. A	ELEV. B	ELEV. C
22+00.00	91.47	91.66	92.97
05.50	91.41	91.60	92.90
10.00	91.36	91.54	92.83
20.00	91.22	91.40	92.67
30.00	91.02	91.23	92.52
40.00	90.84	91.05	92.34
50.00	90.63	90.84	92.13
60.00	90.40	90.61	91.90
70.00	90.16	90.37	91.66
80.00	89.89	90.10	91.39
90.00	89.60	89.81	91.10
95.50	89.43	89.64	90.93
23+00.00	89.29	89.50	90.79
10.00	88.97	89.18	90.47
20.00	88.62	88.83	90.12
30.00	88.25	88.46	89.75
40.00	87.86	88.07	89.36
50.00	87.45	87.66	88.95
60.00	87.01	87.22	88.51
70.00	86.56	86.77	88.06
80.00	86.09	86.30	87.59
80.50	86.07	86.28	87.47
90.00	85.62	85.83	87.12

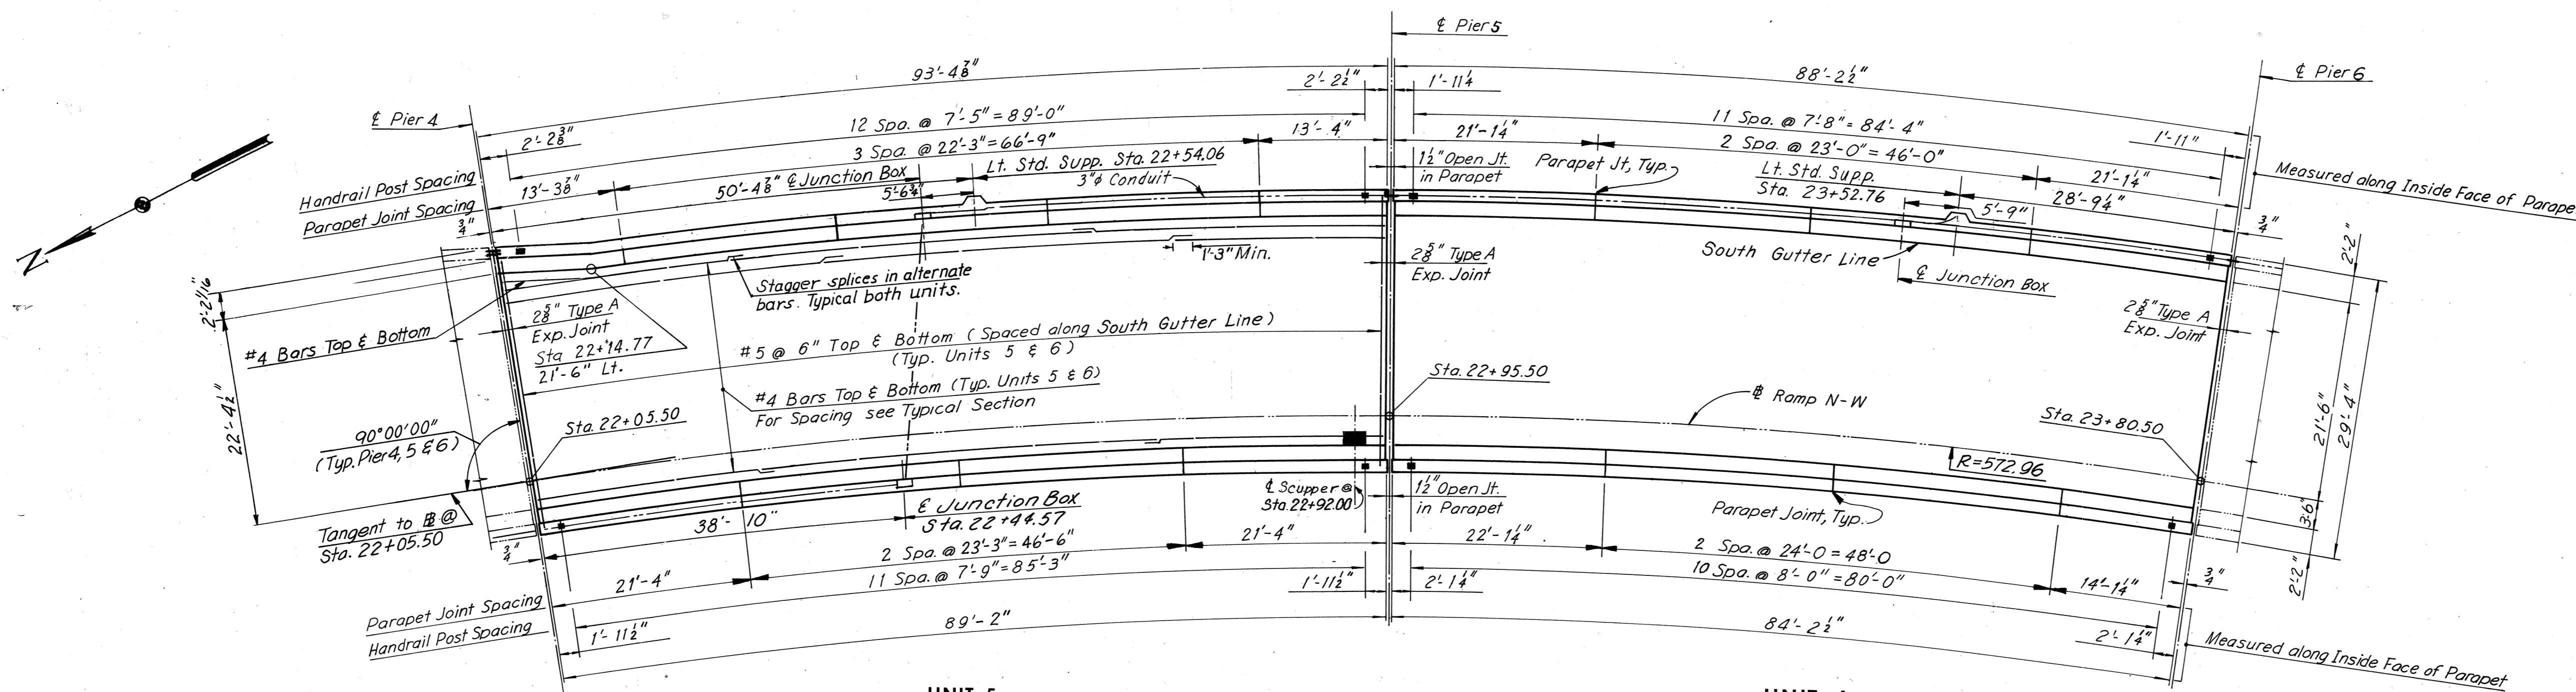


UNIT 5 **UNIT 6**


DECK PLAN
Scale: 1" = 10'-0"

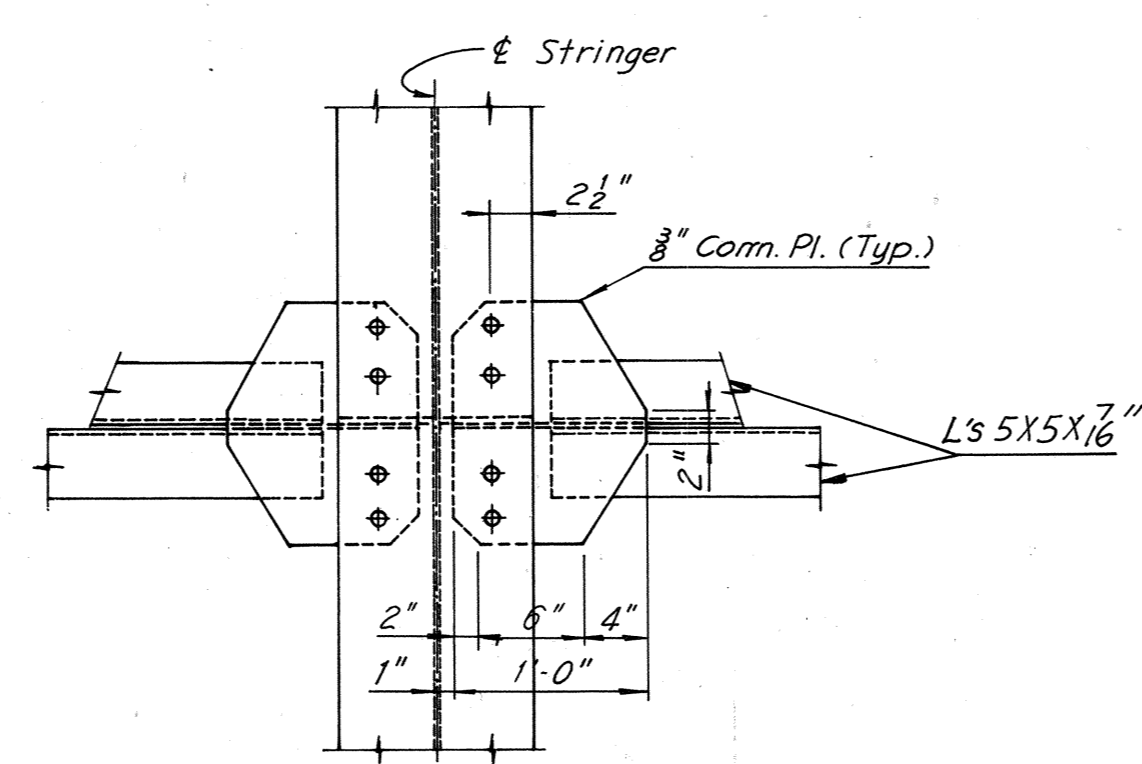


VIEW B-B
Scale: 1" = 1'-0"

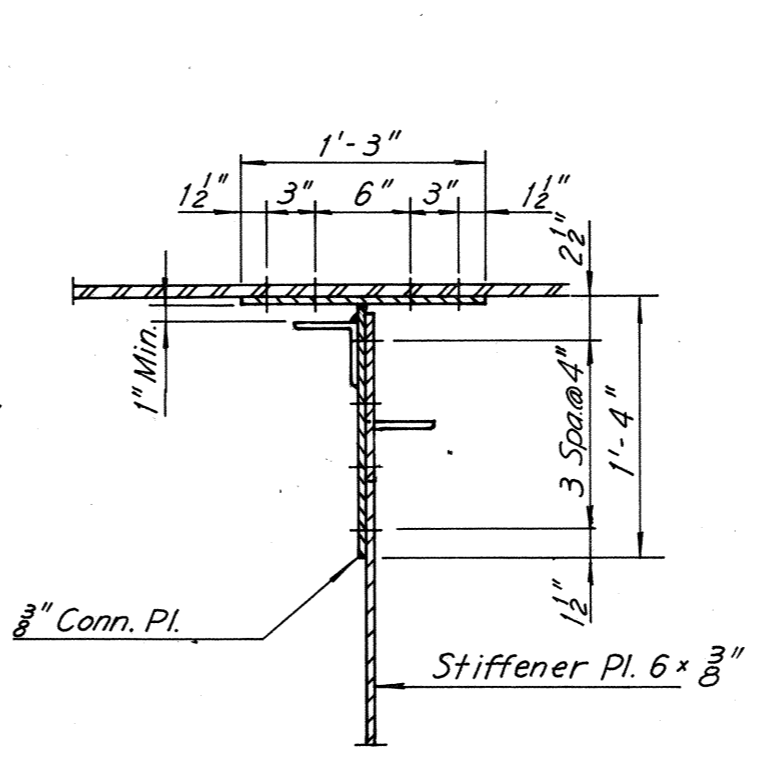


SECTION A-A
Scale: 1" = 1'-0"

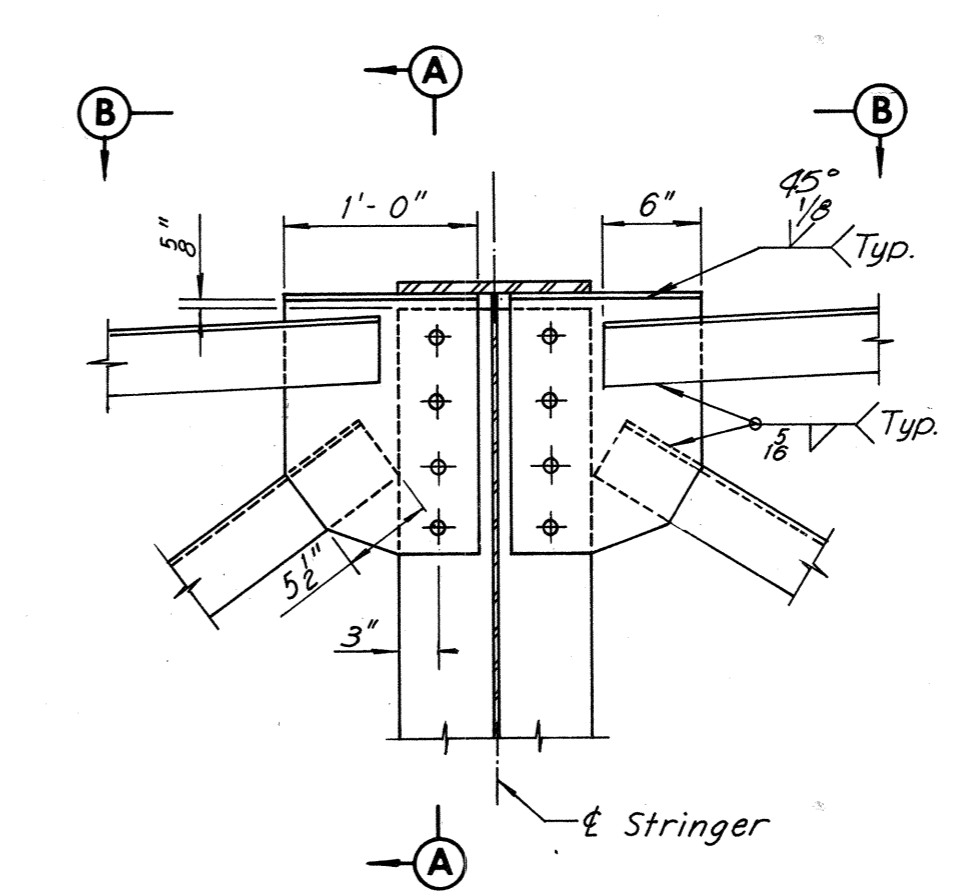

DETAIL A
Scale: 1" = 1'-0"

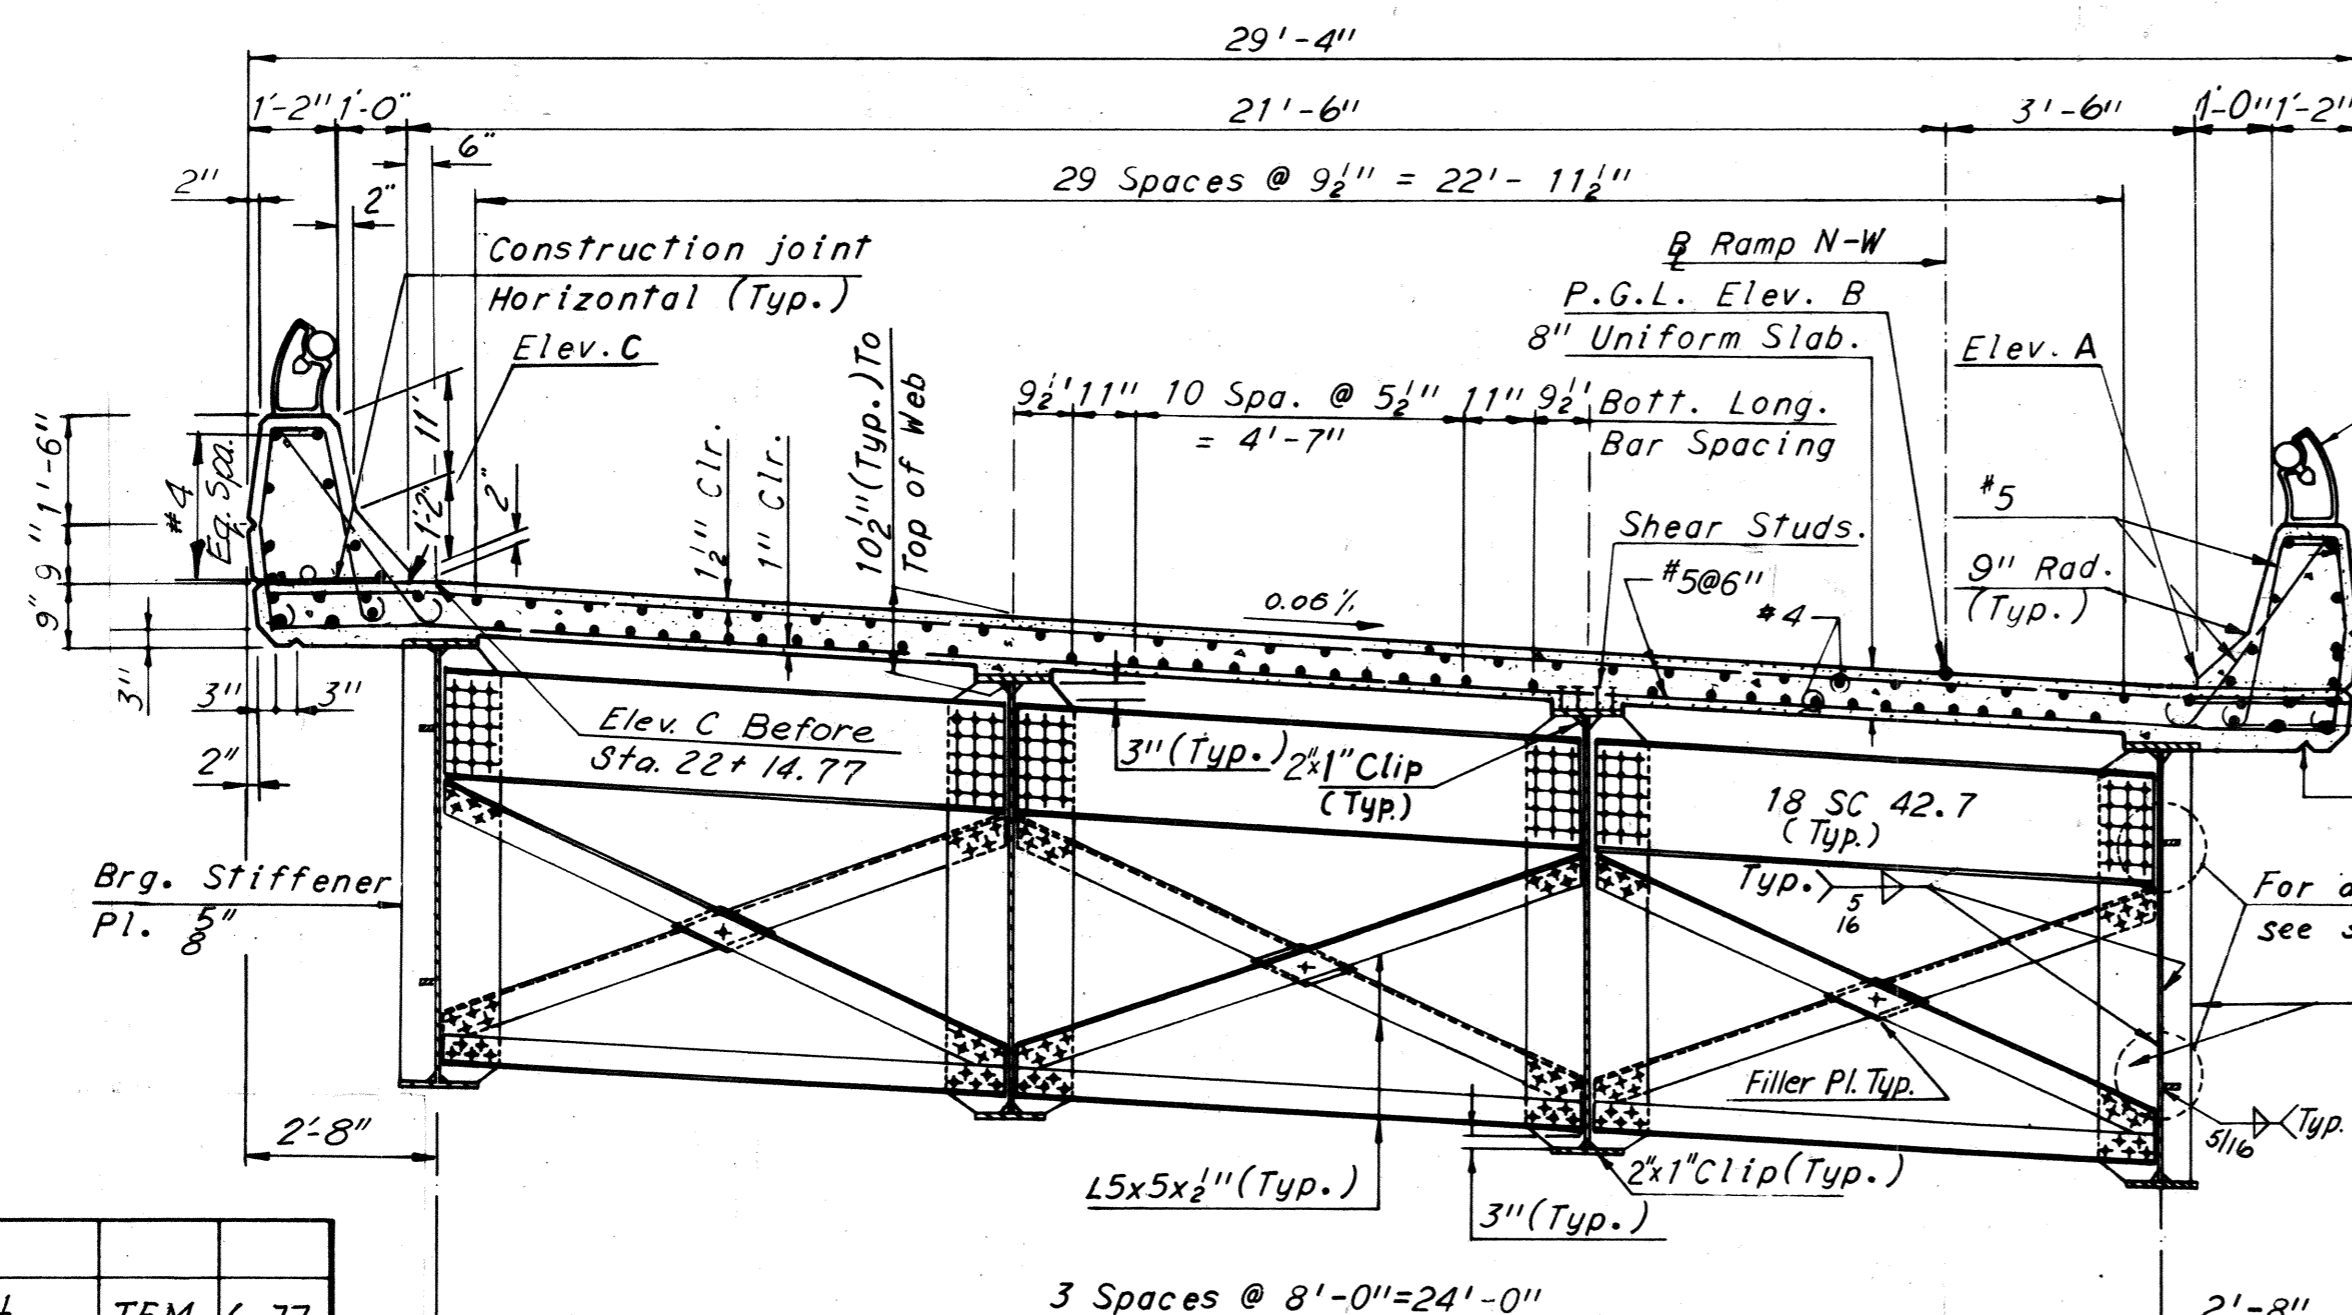

TYPICAL SECTION-END DIAPHRAGM
Scale: 3/8" = 1'-0"

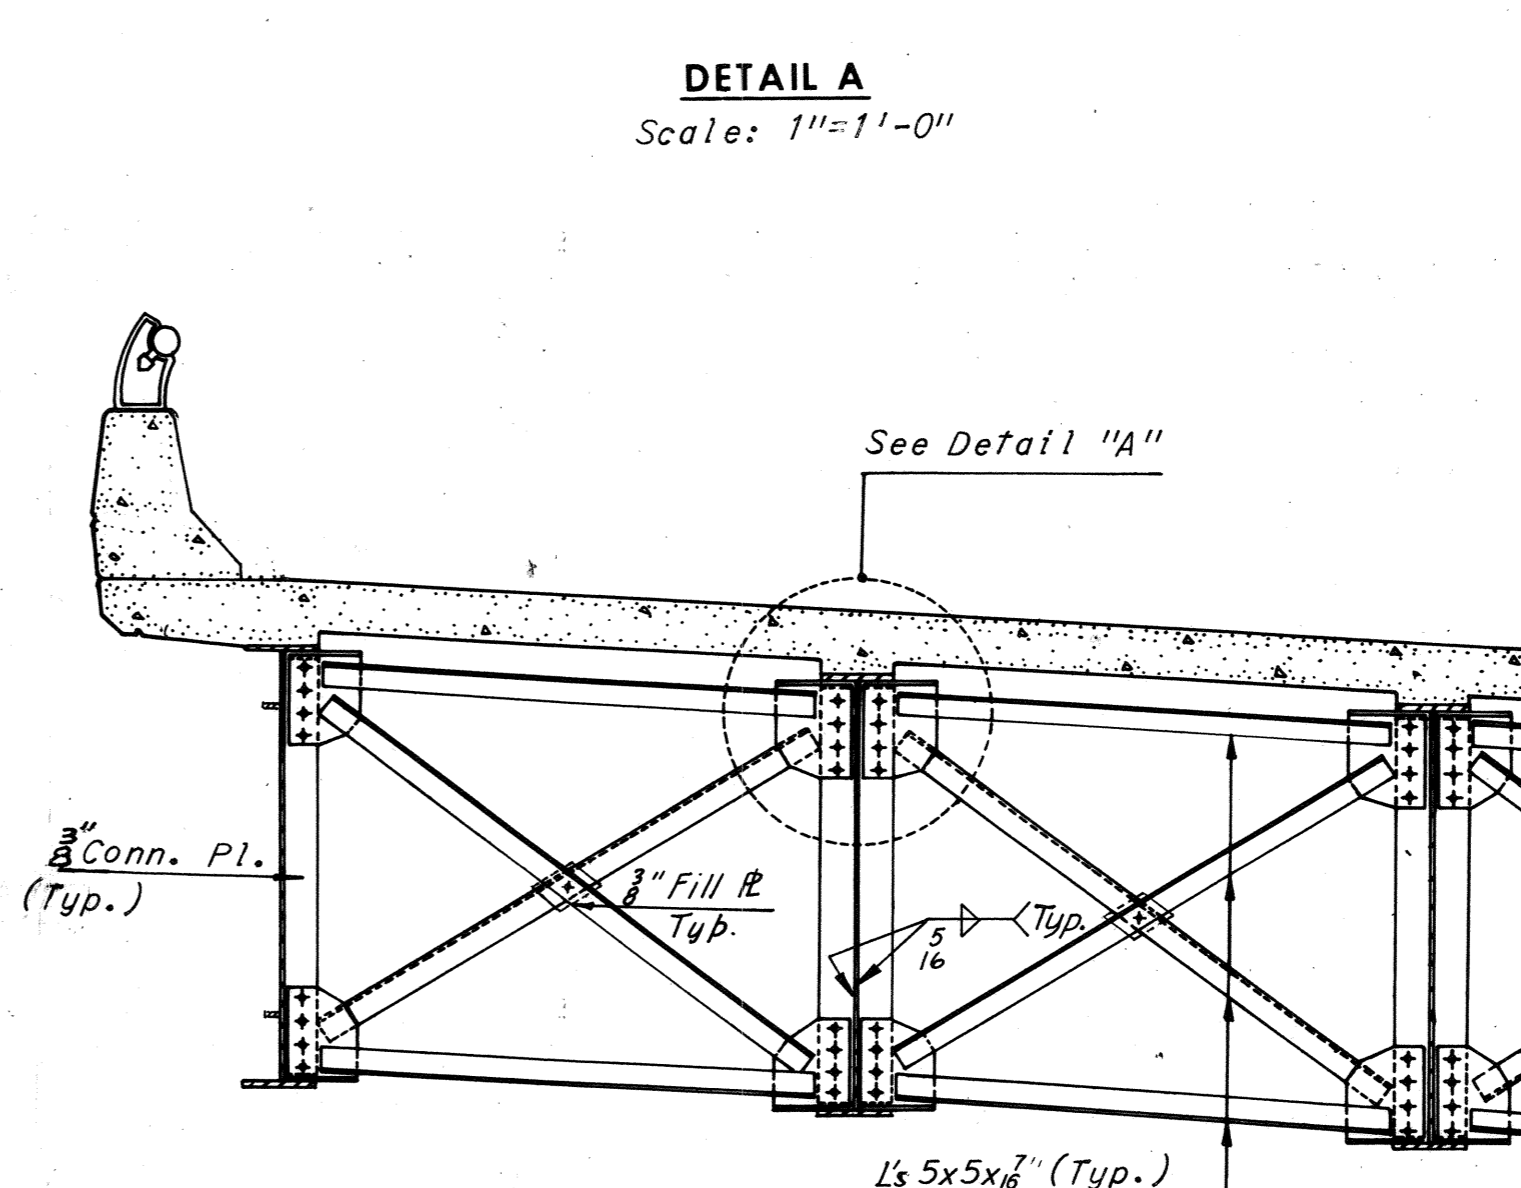

INTERMEDIATE DIAPHRAGM
Scale: 3/8" = 1'-0"

Notes:
For Joint Details, see Sheet 26.
For Framing Plan, see Sheet 15.
For Steel and Concrete Quantities, see Sheet 2.
For Handrail Details, see Sheet S3.
For Lighting Details, see Sheet S4.
For Standard Drainage Details, see Support Type 3 Sheet S6.

BY	DATE	NO.	REVISION	BY	DATE
MADE	MHH 9-4-68	2	As Built	TEM	6-77
CHECKED	R.C. 10-17-68	1	Deck Elev. Rev.	EJM	10-11-74
IN CHARGE					

RICHMOND METROPOLITAN AUTHORITY
RICHMOND EXPRESSWAY SYSTEM
DOWNTOWN EXPRESSWAY







BRIDGE NO. 64
RAMP N-W CONNECTION FROM
RICHMOND-PETERSBURG TURNPIKE
DECK PLAN-UNITS 5 AND 6

HOWARD, NEEDLES, TAMMEN & BERGENDOFF
consulting engineers
NEW YORK ALEXANDRIA KANSAS CITY
SCALE: *As shown*
CONTRACT NO. **10**
SHEET NO. **21** OF **28**

AS BUILT

RICHMOND EXPRESSWAY SYSTEM			
SECTION	PROJECT	SHEET NO.	TOTAL SHEETS
10	DOWNTOWN EXPRESSWAY	120	265

ELEVATION TABLE			
STATION	ELEV. A	ELEV. B	ELEV. C
23+80.00	86.09	86.30	87.59
+80.50	86.07	86.28	87.57
+90.00	85.62	85.83	87.12
24+00.00	85.15	85.36	86.65
+10.00	84.68	84.89	86.18
+20.00	84.21	84.42	85.71
+30.00	83.73	83.94	85.23
+40.00	83.26	83.47	84.76
+50.00	82.79	83.00	84.29
+60.00	82.32	82.53	83.82
+60.50	82.29	82.50	83.79
+70.00	81.85	82.06	83.35
+80.00	81.37	81.58	82.87
+90.00	80.90	81.11	82.40
25+00.00	80.43	80.64	81.93
+10.00	79.96	80.17	81.46
+20.00	79.49	79.70	80.99
+30.00	79.01	79.22	80.51
+39.50	78.57	78.78	80.07
+40.00	78.54	78.75	80.04

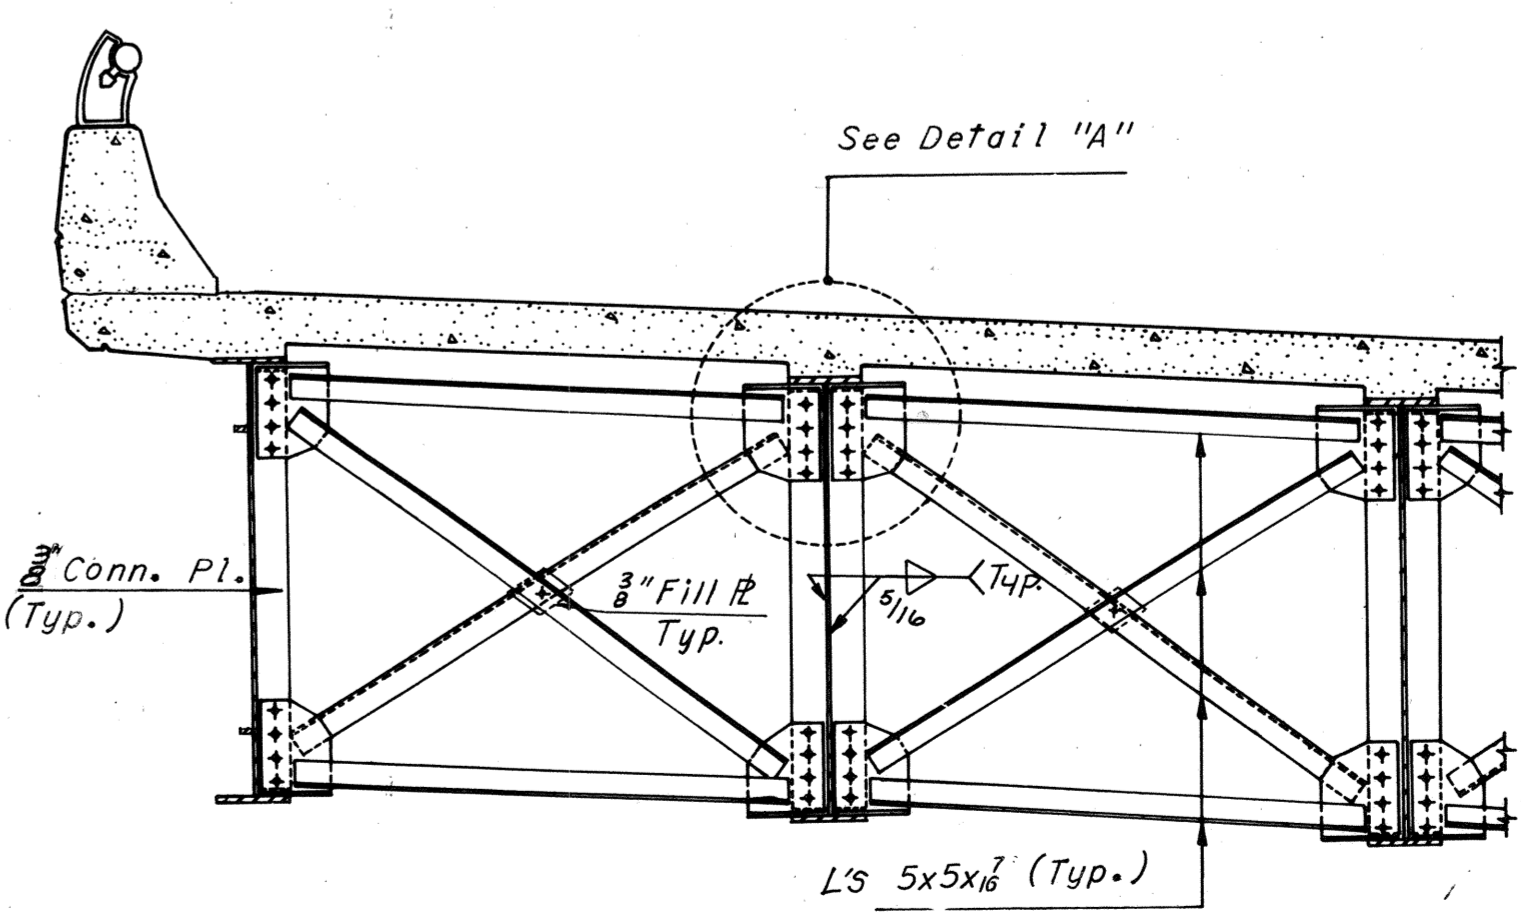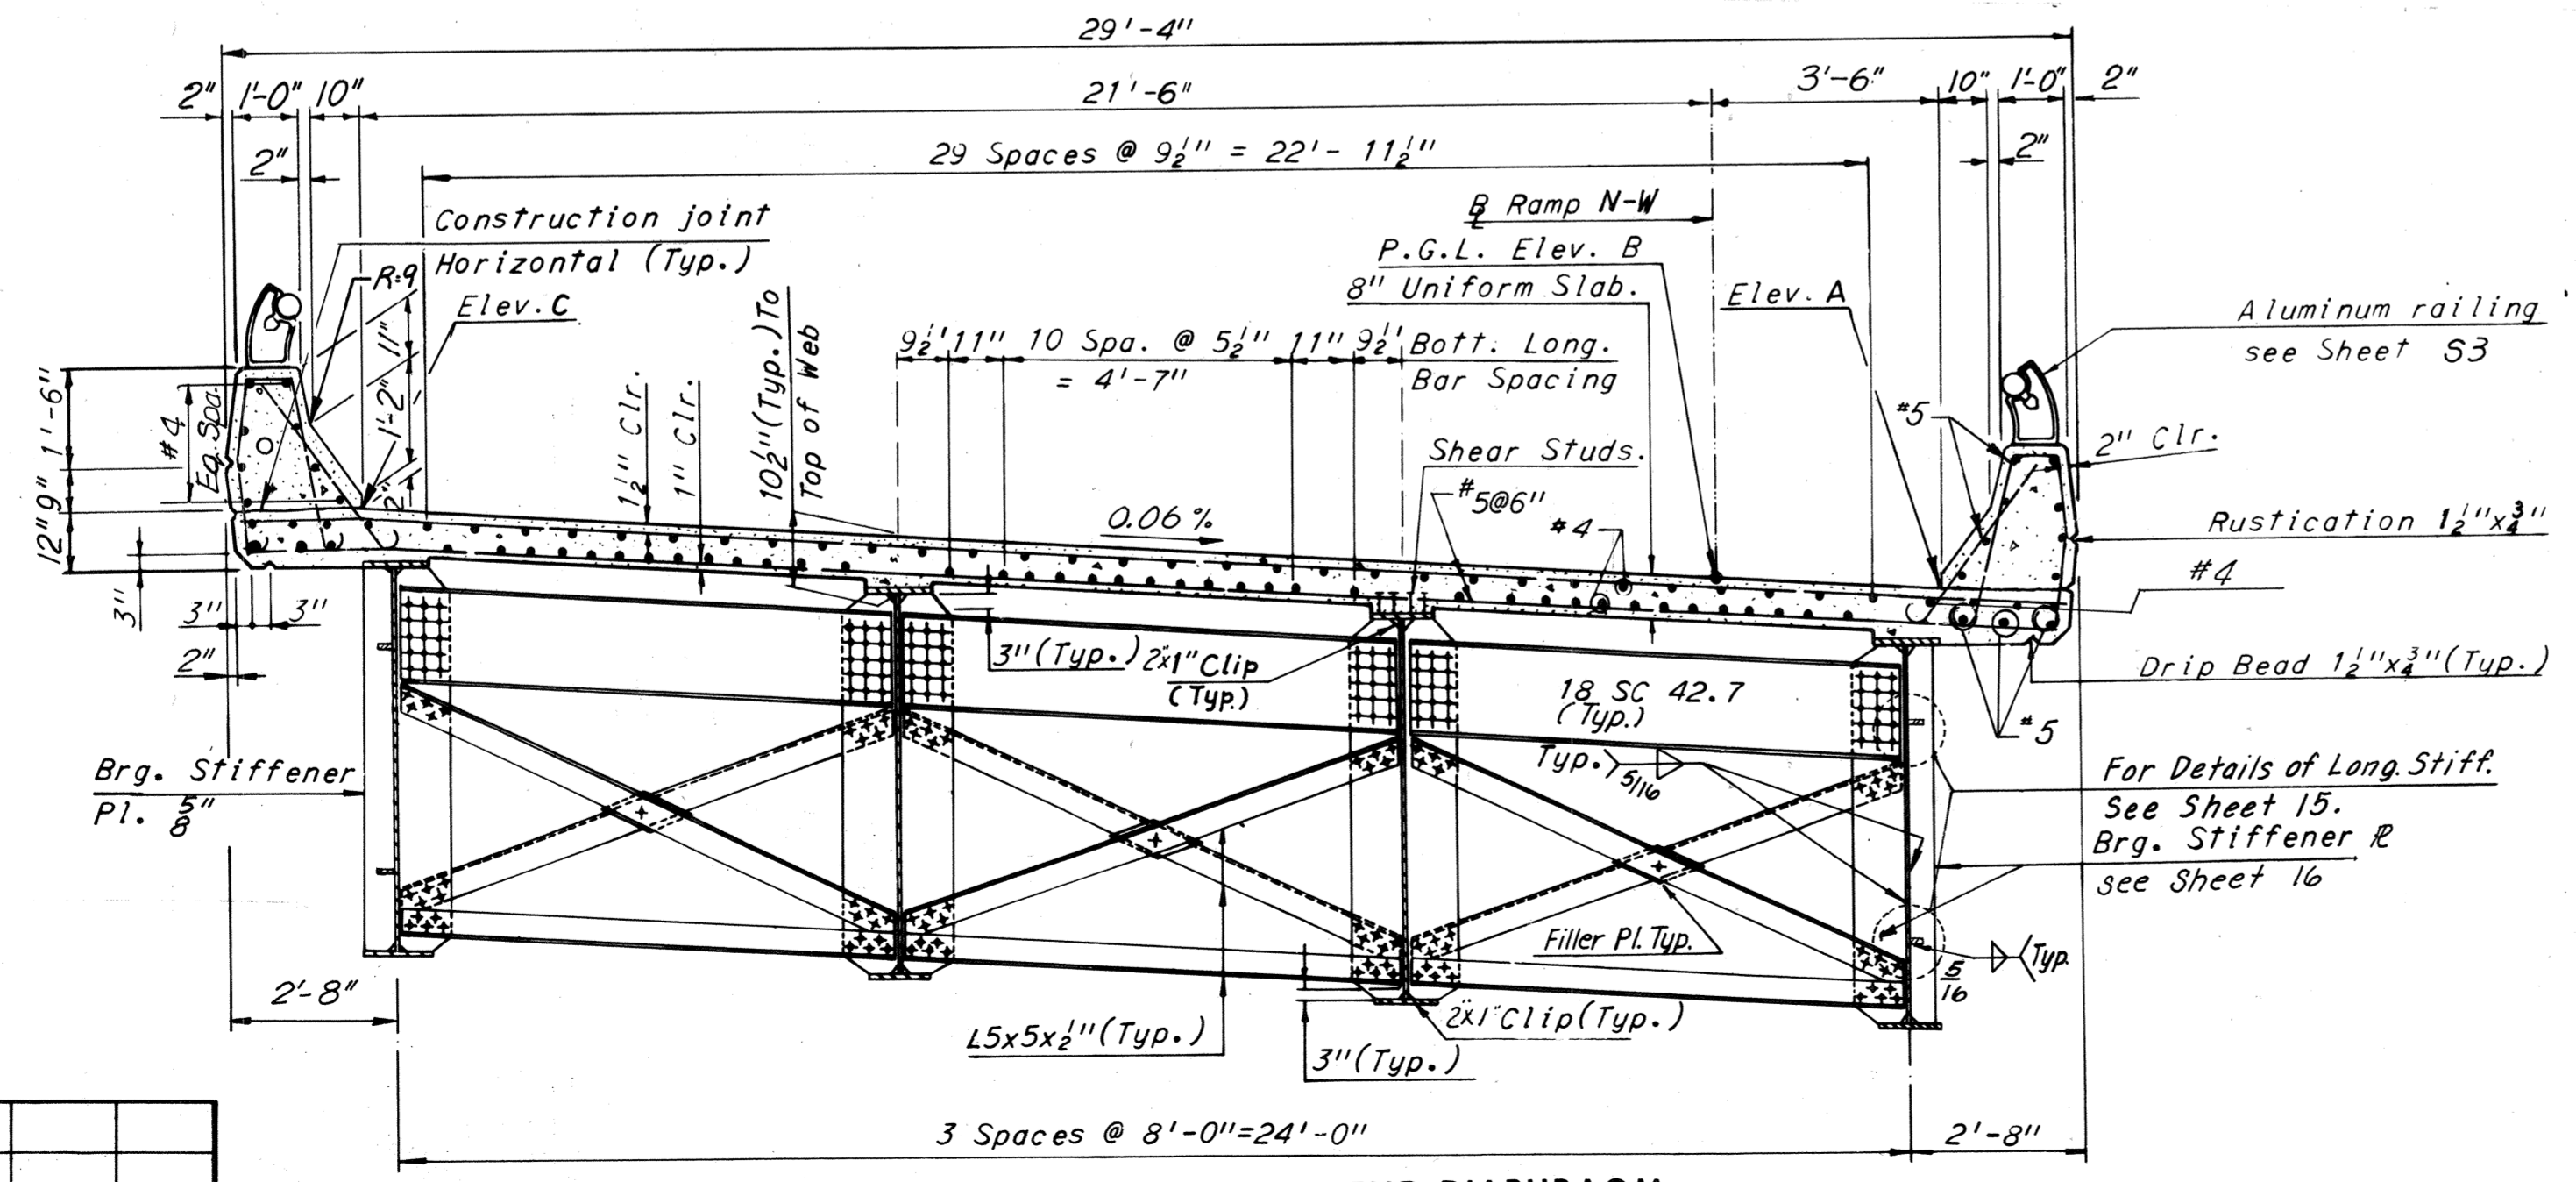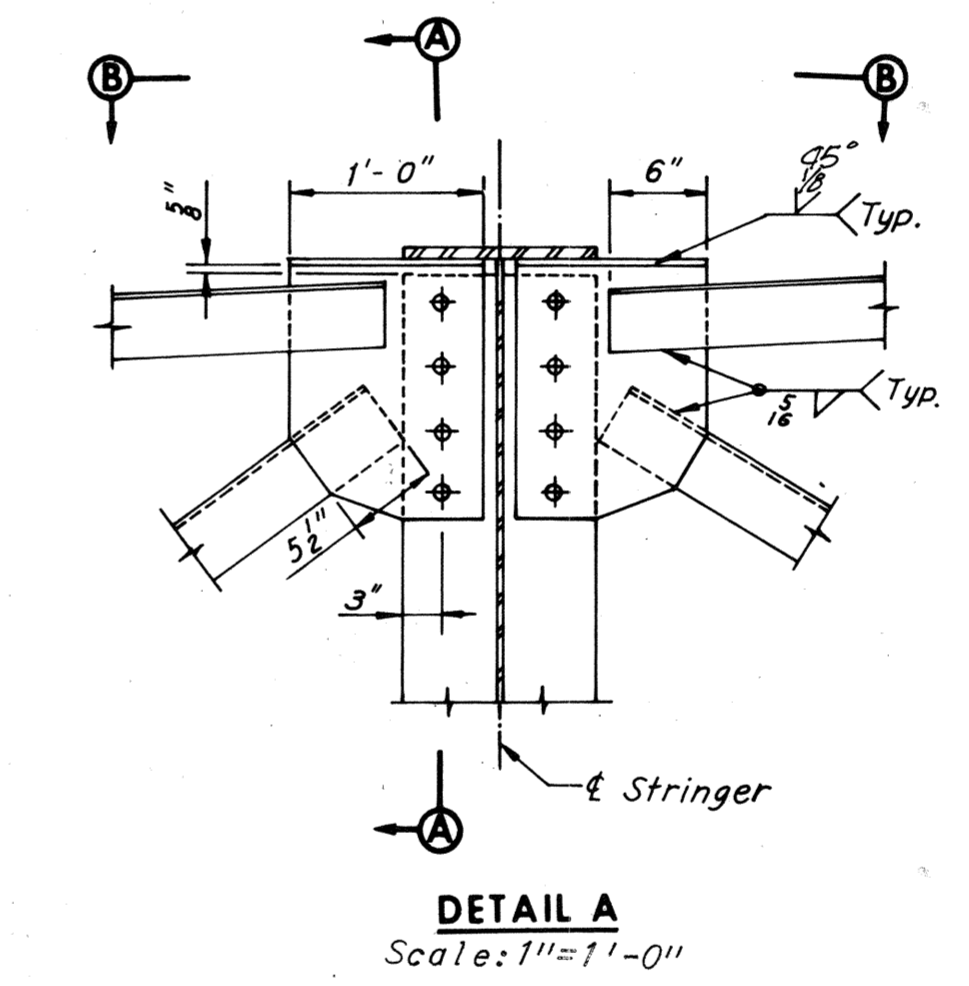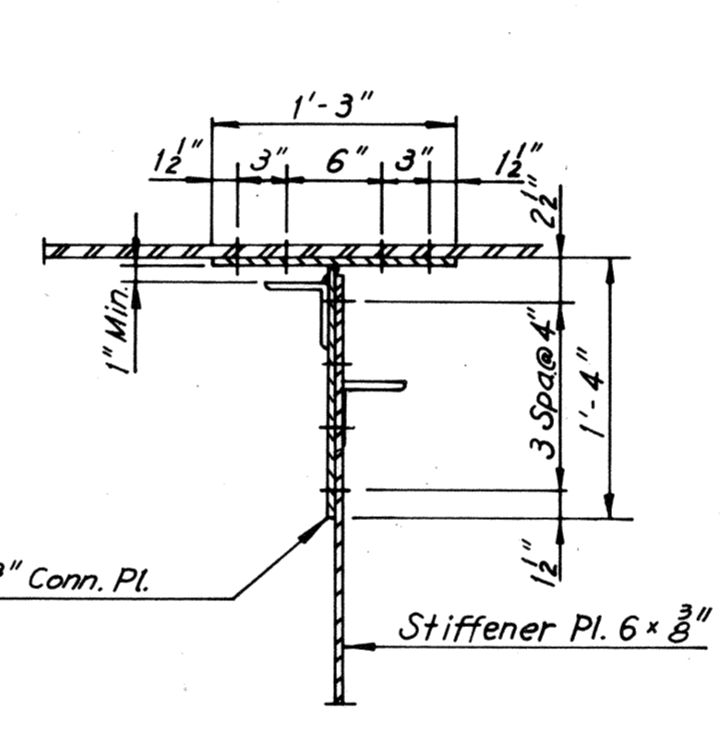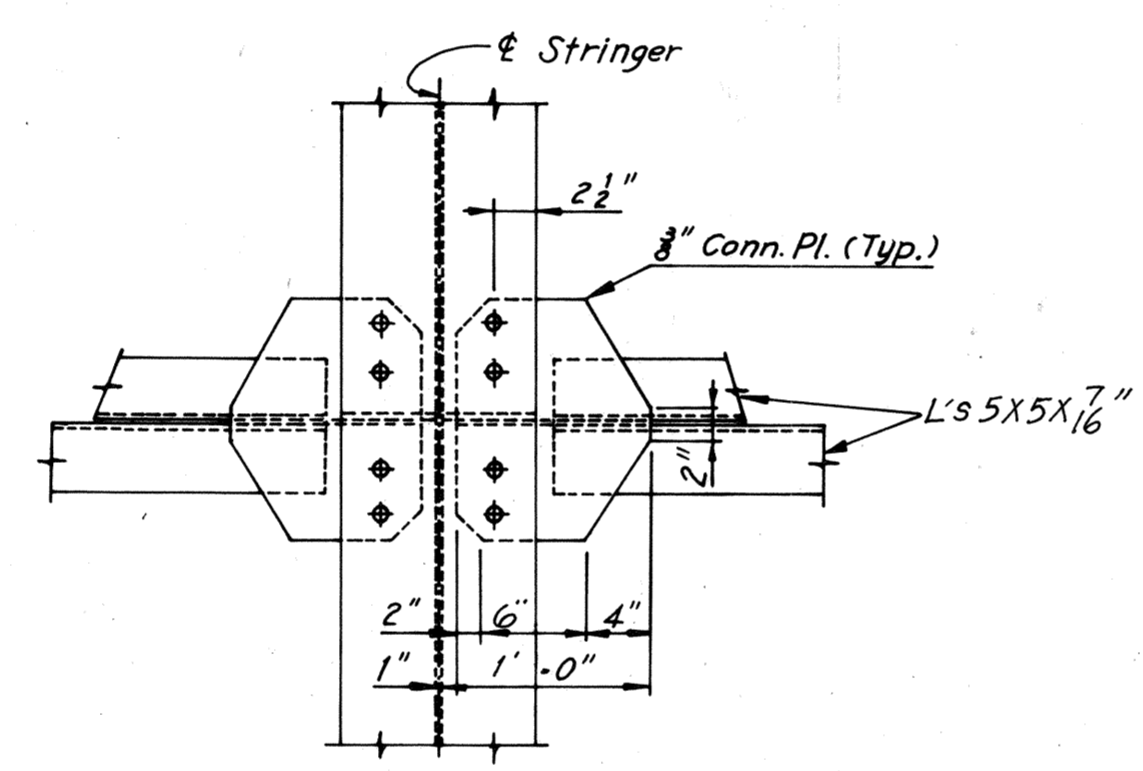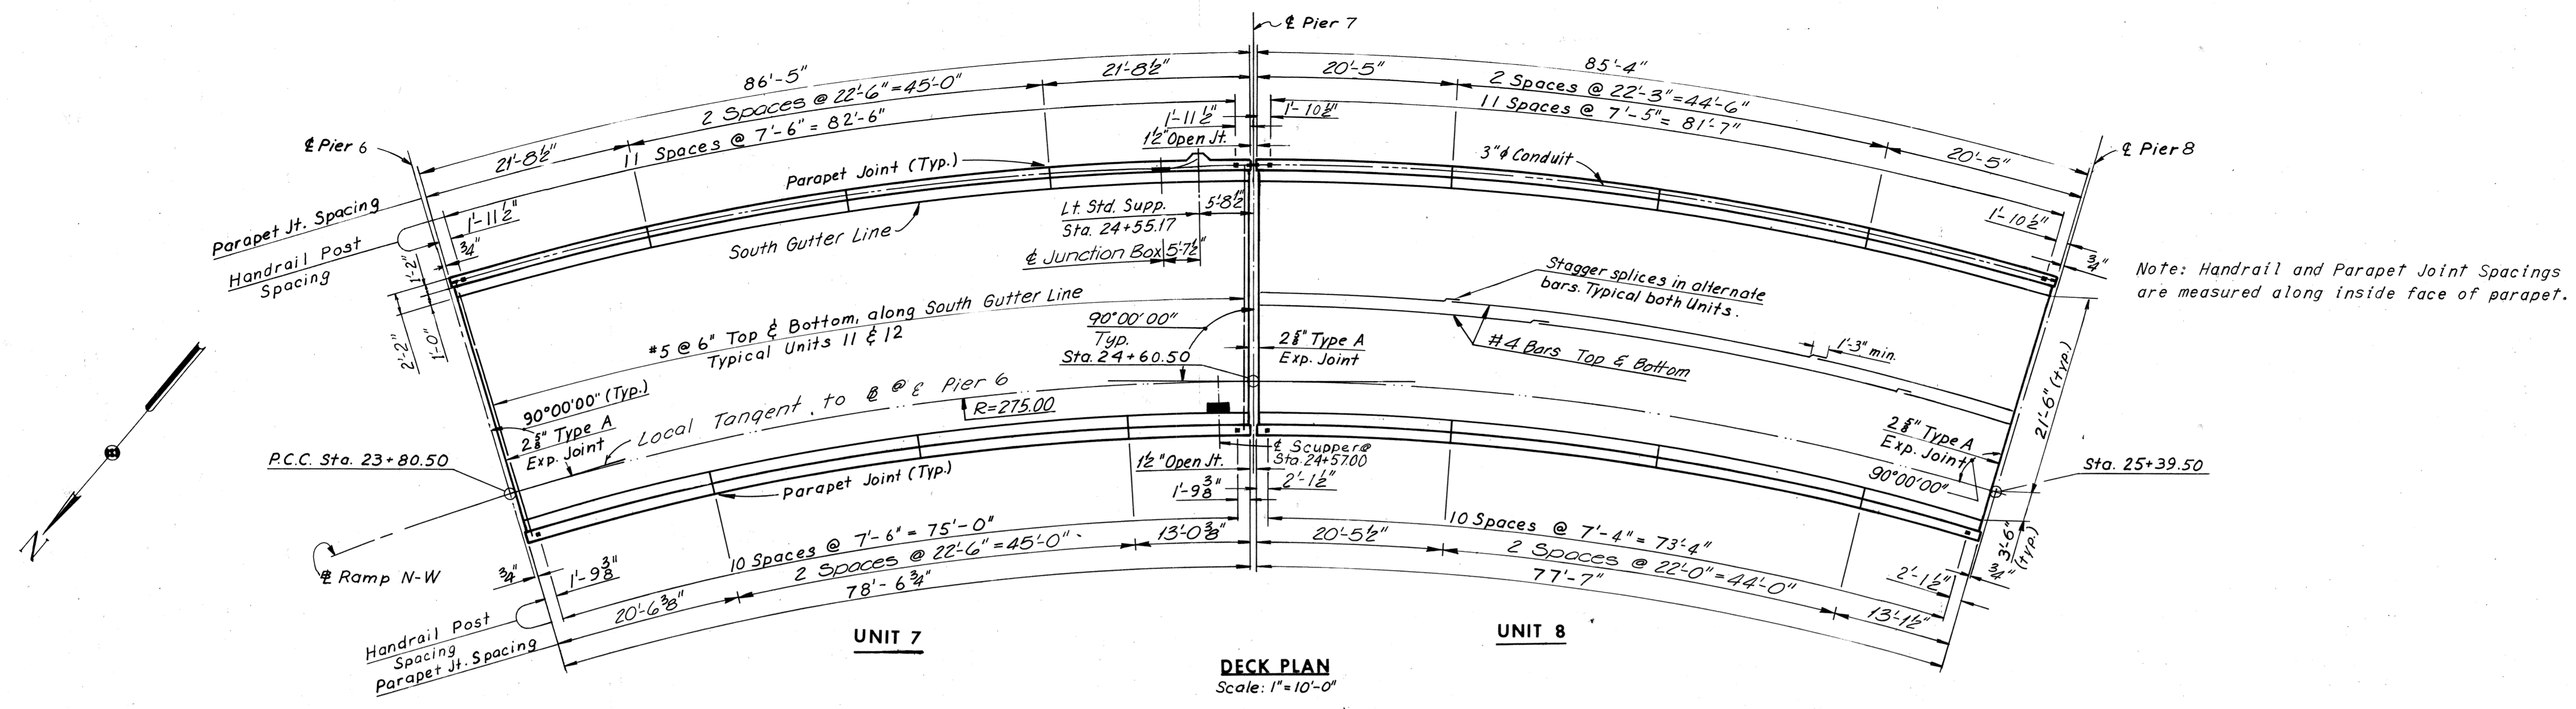

Notes:
 For Joint Details, see Sheet 26.
 For Framing Plan, see Sheet 16.
 For Steel and Concrete Quantities, see Sheet 2.
 For Handrail Details, see Sheet S3.
 For Lighting Details, see Sheet S4.
 For Standard Drainage Details, see Support Type 3 Sheet S6.

BY	DATE				
MADE	J.D.	8-20-68			
CHECKED	R.C.	10-17-68	1	As Built	TEM 6-77
IN CHARGE			NO.	REVISION	BY DATE

RICHMOND METROPOLITAN AUTHORITY
RICHMOND EXPRESSWAY SYSTEM
DOWNTOWN EXPRESSWAY


BRIDGE NO. 64
RAMP N-W CONNECTION FROM
RICHMOND-PETERSBURG TURNPIKE
DECK PLAN UNITS 7 AND 8

SCALE: As shown
 HOWARD, NEEDLES, TAMMEN & BERGENDOFF
 consulting engineers
 NEW YORK ALEXANDRIA KANSAS CITY
 CONTRACT NO. 10
 SHEET NO. 22 28

AS BUILT


RICHMOND EXPRESSWAY SYSTEM			
SECTION	PROJECT	SHEET NO.	TOTAL SHEETS
10	DOWNTOWN EXPRESSWAY	121	265

ELEVATION TABLE			
STATION	ELEV. A	ELEV. B	ELEV. C
25+30.00	79.01	79.22	80.51
25+39.50	78.57	78.78	80.07
25+40.00	78.54	78.75	80.04
25+50.00	78.07	78.28	79.57
25+60.00	77.60	77.81	79.10
25+70.00	77.13	77.34	78.63
25+80.00	76.65	76.86	78.15
25+90.00	76.18	76.39	77.68
26+00.00	75.71	75.92	77.21
26+10.00	75.24	75.45	76.74
26+20.00	74.77	74.98	76.27
26+30.00	74.29	74.50	75.79
26+39.00	73.87	74.08	75.37
26+40.00	73.82	74.03	75.32
26+50.00	73.35	73.56	74.85
26+60.00	72.89	73.10	74.39
26+70.00	72.46	72.67	73.96
26+80.00	72.06	72.27	73.56
26+90.00	71.68	71.89	73.18
27+00.00	71.33	71.54	72.83
27+10.00	71.02	71.22	72.43
27+20.00	70.75	70.93	72.05
27+30.00	70.49	70.66	71.69
27+40.00	70.27	70.42	71.37
27+50.00	70.07	70.21	71.07
27+60.00	69.90	70.03	70.40
27+65.50	69.82	69.94	70.67
27+70.00	69.76	69.87	70.56

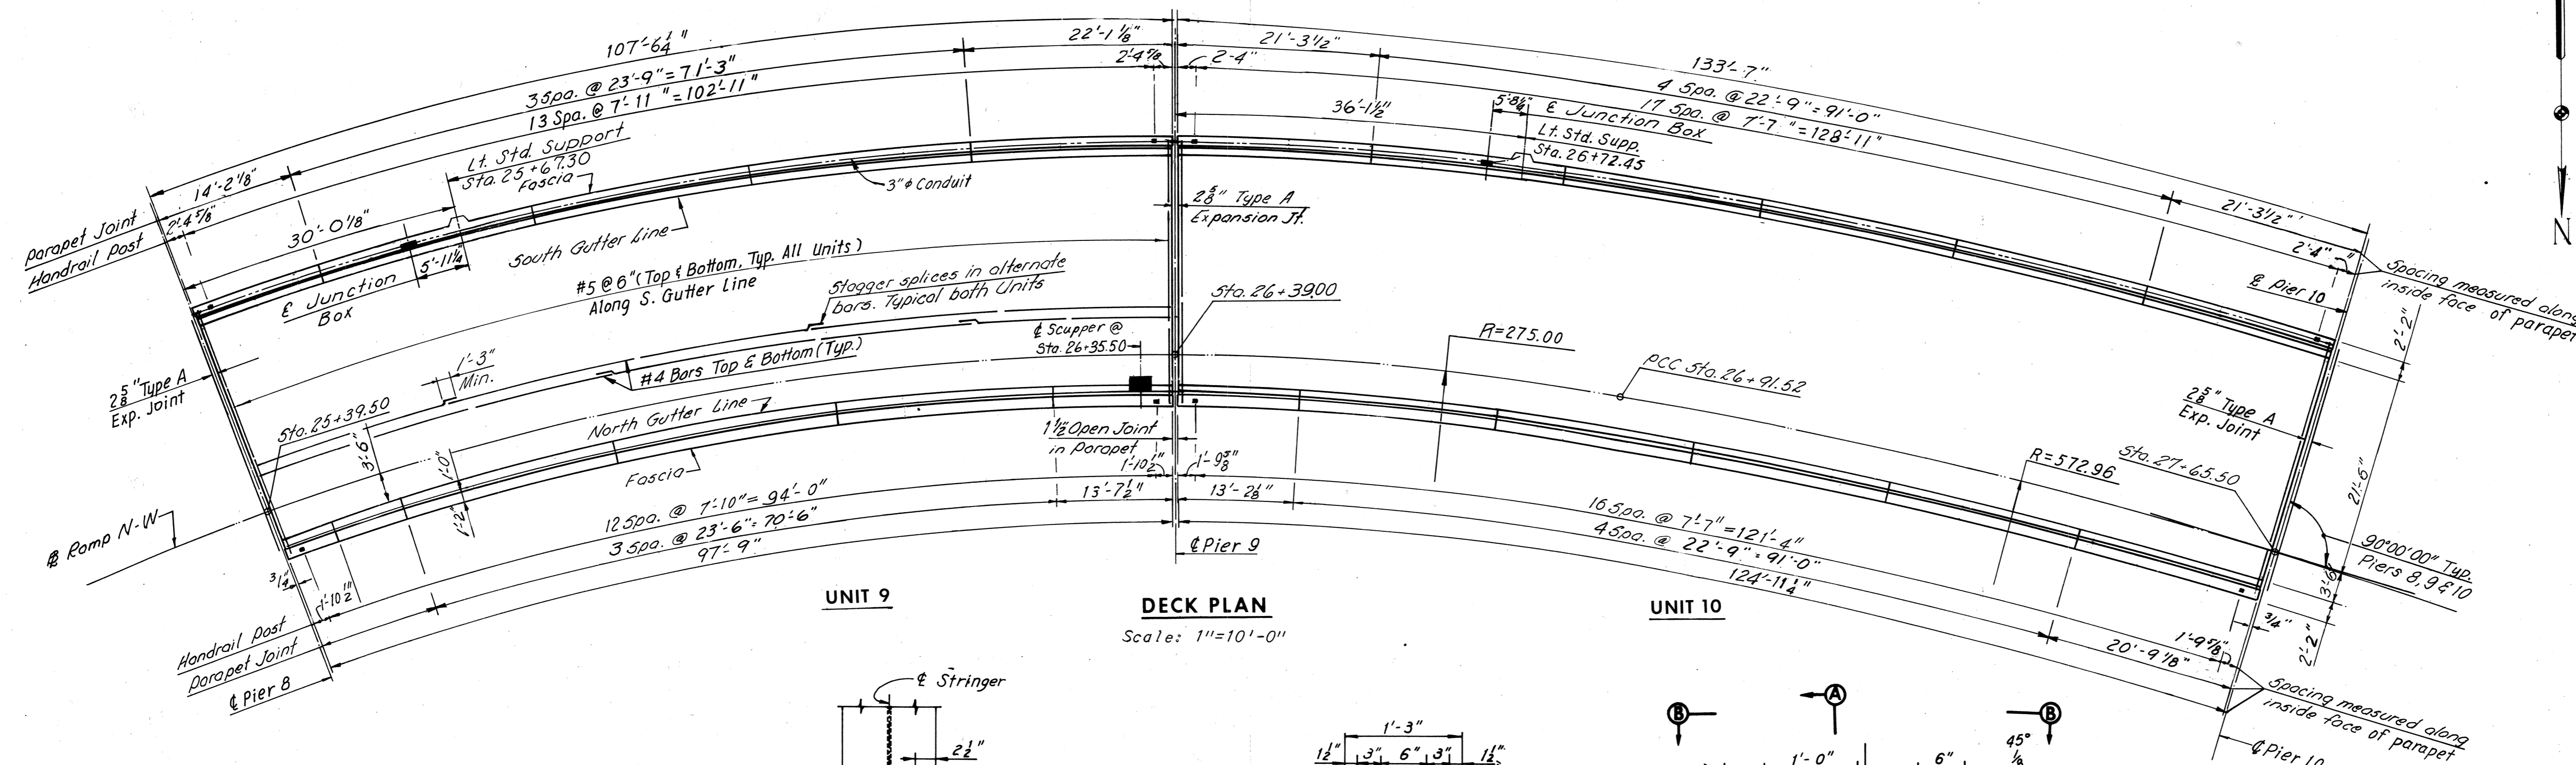


UNIT 9 DECK PLAN
Scale: 1"=10'-0"


UNIT 10 DECK PLAN
Scale: 1"=10'-0"

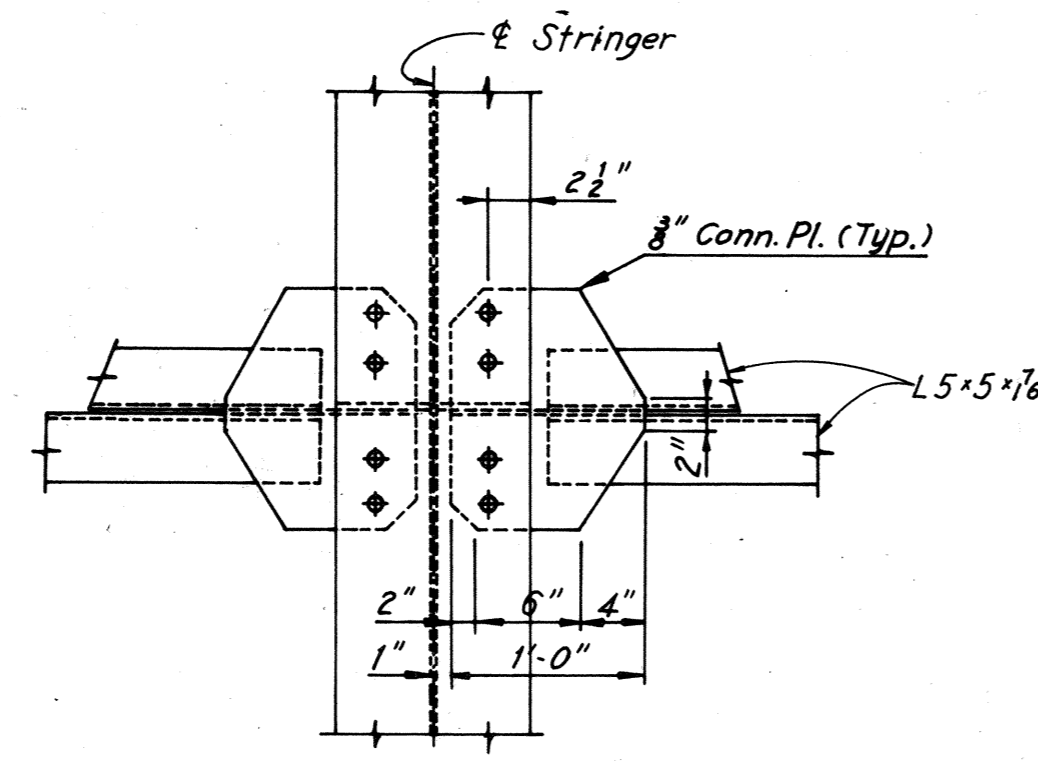


VIEW B-B
Scale: 1"=1'-0"

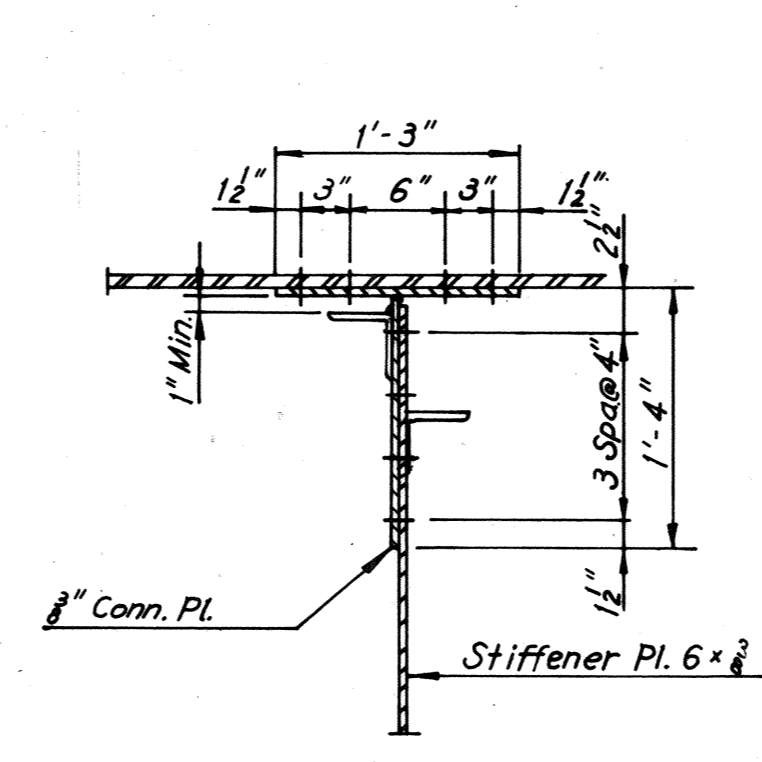


SECTION A-A
Scale: 1"=1'-0"

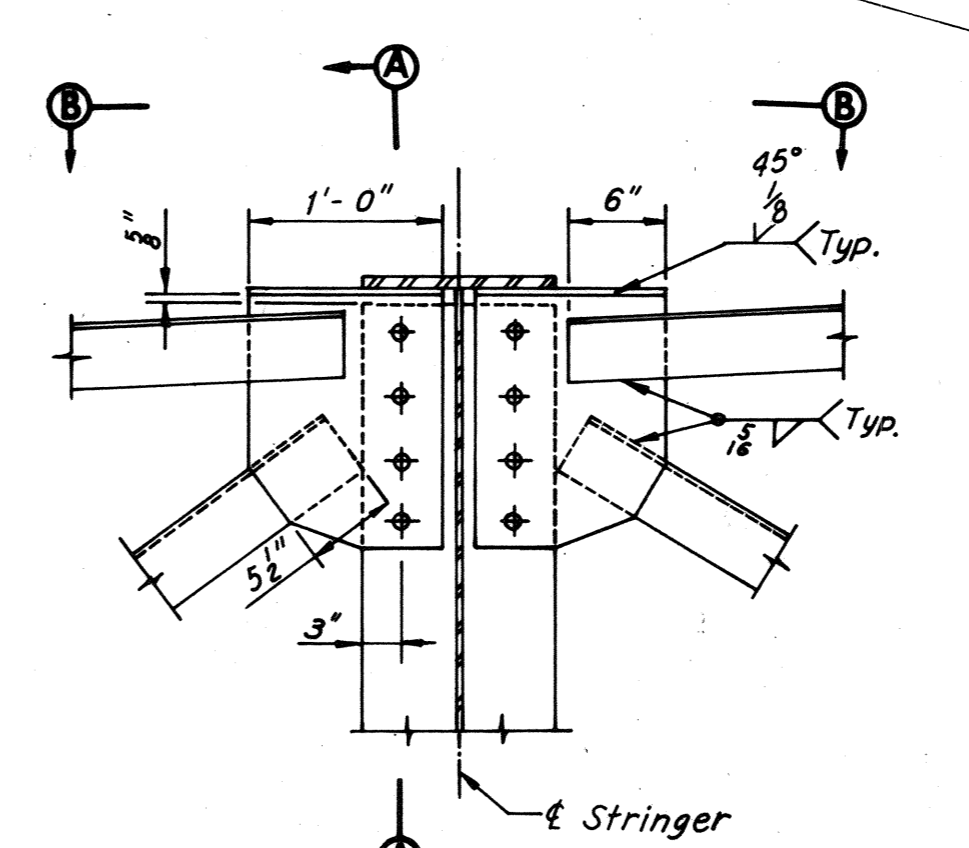

DETAIL A
Scale: 1"=1'-0"

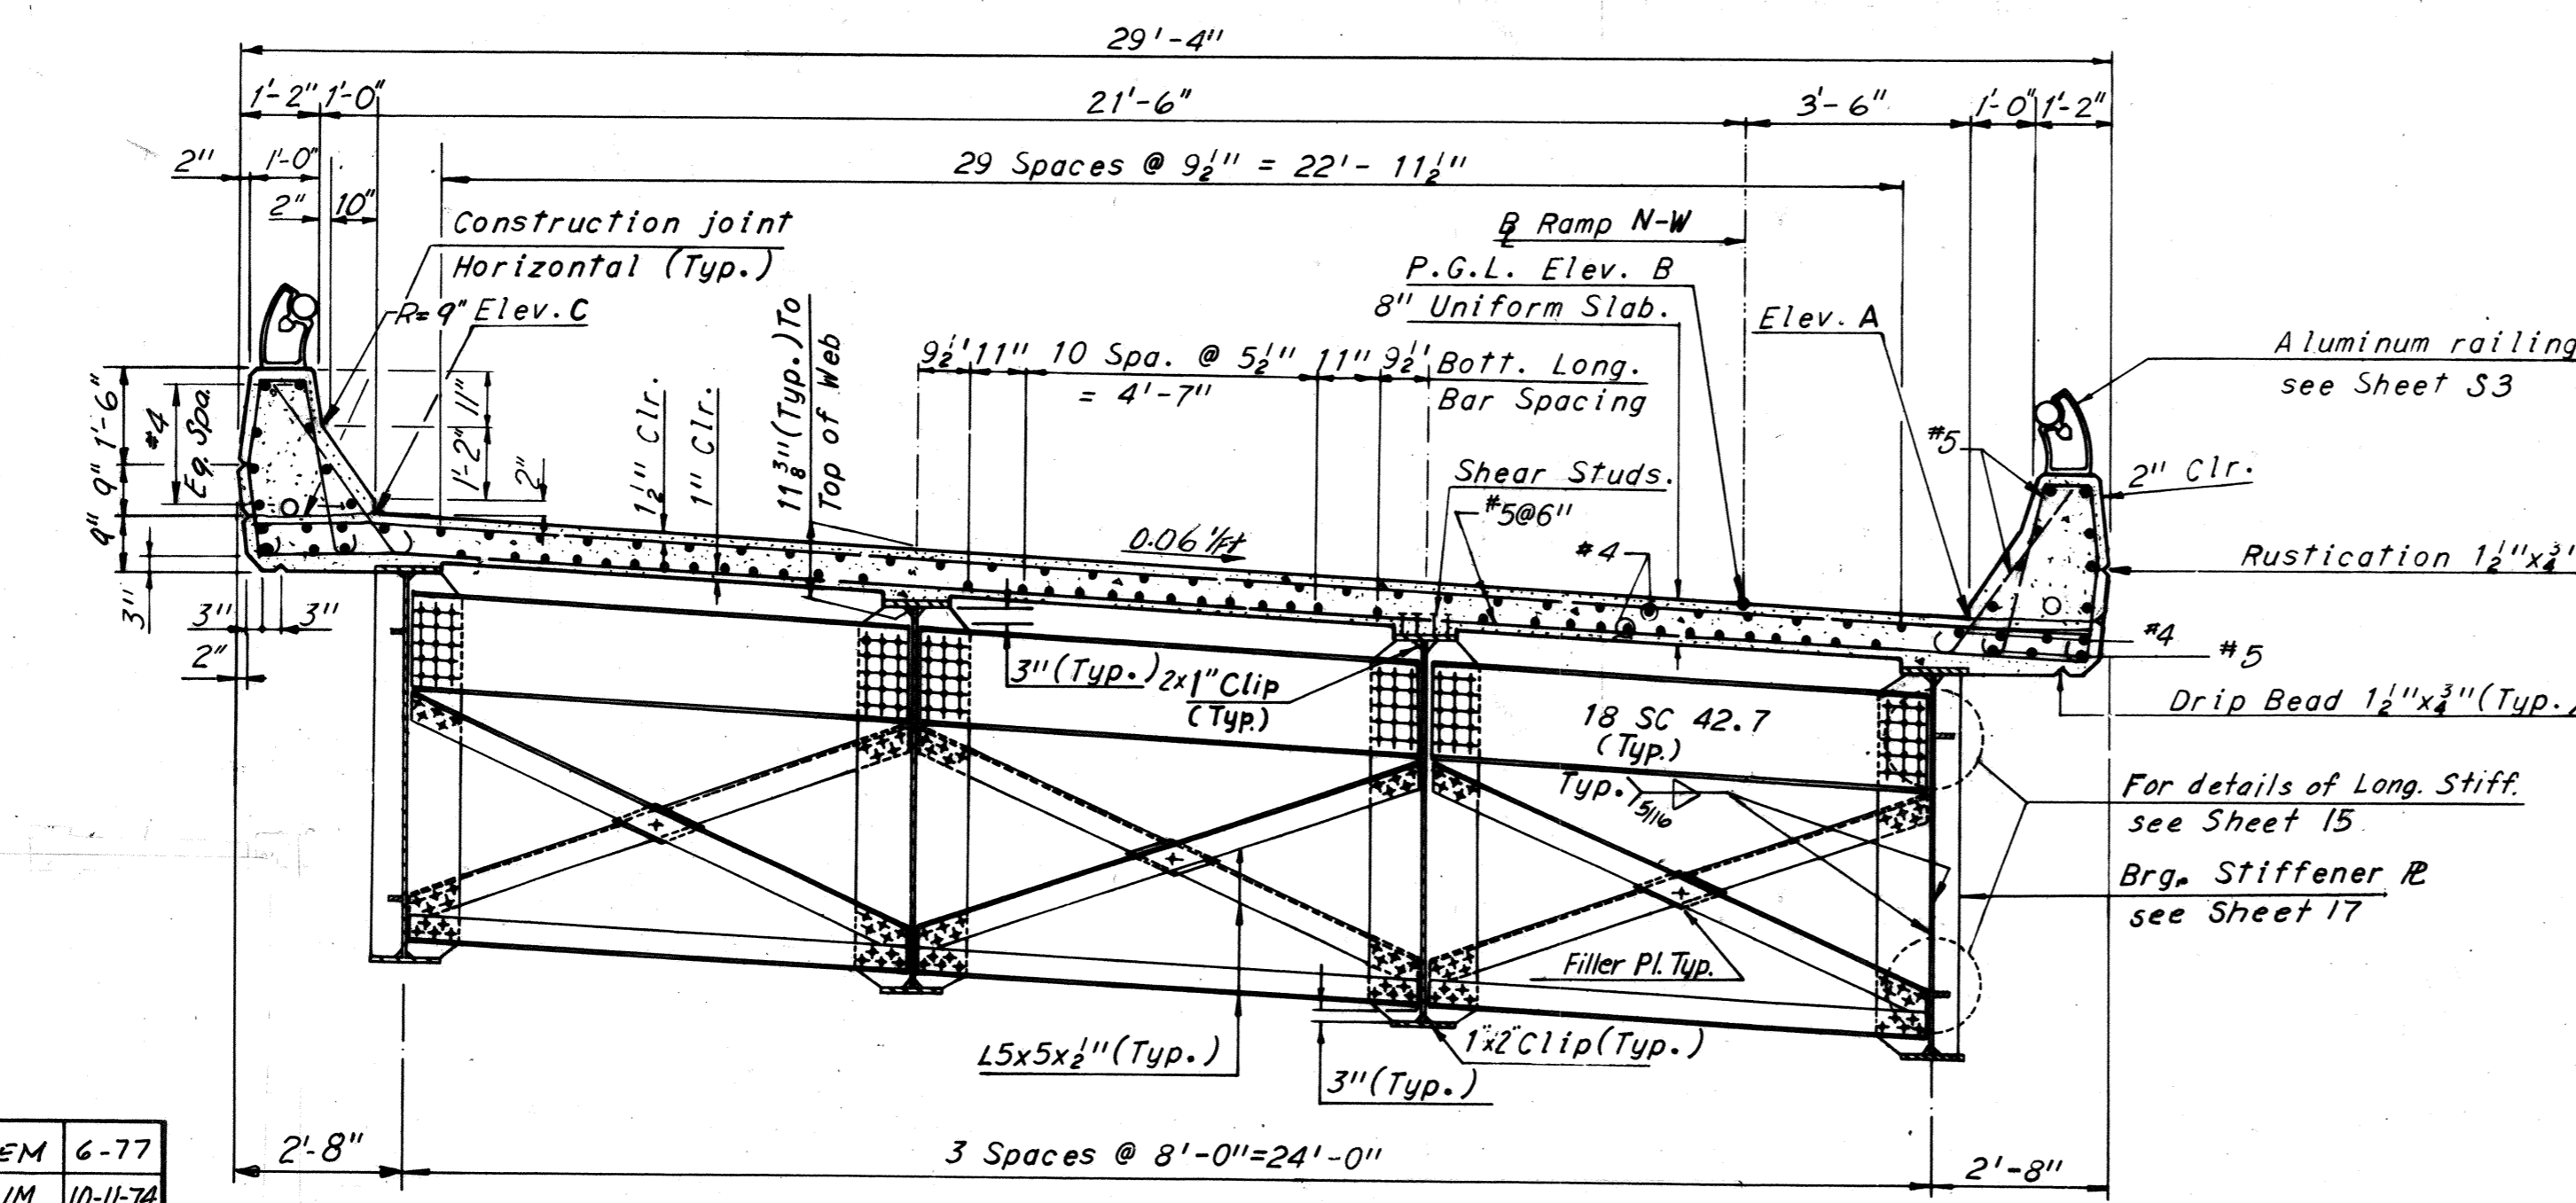

TYPICAL SECTION - END DIAPHRAGM
Scale: 3/8"=1'-0"

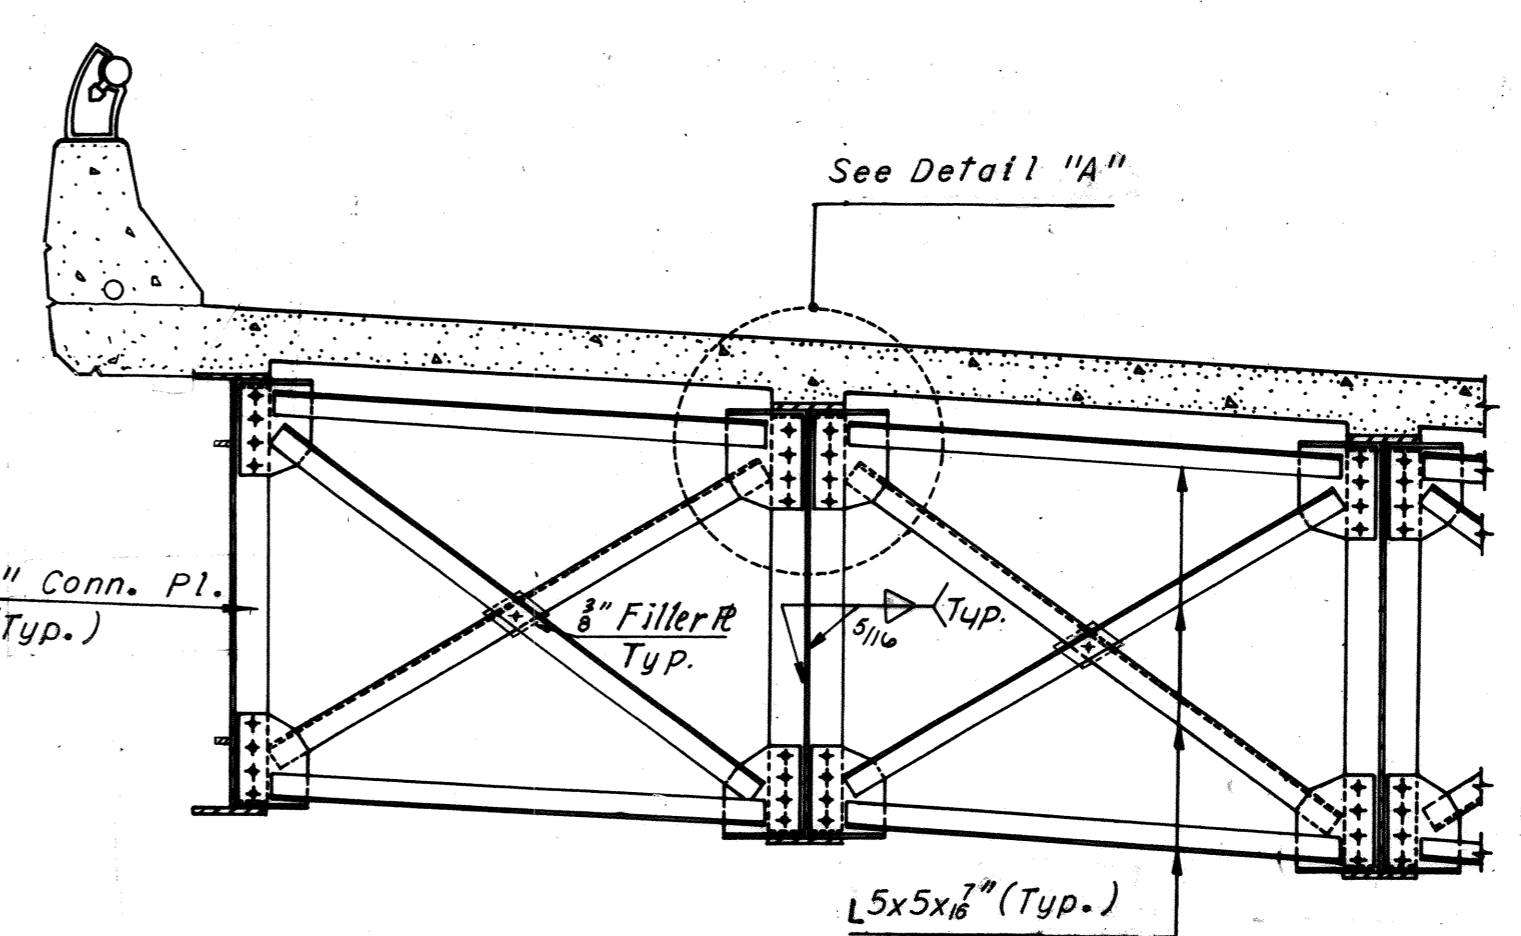

INTERMEDIATE DIAPHRAGM
Scale: 3/8"=1'-0"

Notes:
For Joint Details, see Sheet 26.
For Framing Plan, see Sheet 17.
For Steel and Concrete Quantities, see Sheet 2.
For Handrail Details, see Sheet S3.
For Lighting Details, see Sheet S4.
For Standard Drainage Details, see Support Type 3 Sheet S6.

RICHMOND METROPOLITAN AUTHORITY
RICHMOND EXPRESSWAY SYSTEM
DOWNTOWN EXPRESSWAY

BRIDGE NO. 64
RAMP N-W CONNECTION FROM
RICHMOND-PETERSBURG TURNPIKE
DECK PLAN - UNITS 9 AND 10






HOWARD, NEEDLES, TAMMEN & BERGENDOFF
consulting engineers
NEW YORK ALEXANDRIA KANSAS CITY

SCALE: As shown
CONTRACT NO. 10
SHEET NO. 23 OF 28

NO.	REVISION	BY	DATE
2	As Built	TEM	6-77
1	Changed Deck Elev.	EJM	10-11-74
1	Revised Fascia to Stringer Dimension	TEM	10-11-74


AS BUILT

RICHMOND EXPRESSWAY SYSTEM			
SECTION	PROJECT	SHEET NO.	TOTAL SHEETS
10	DOWNTOWN EXPRESSWAY	122	265

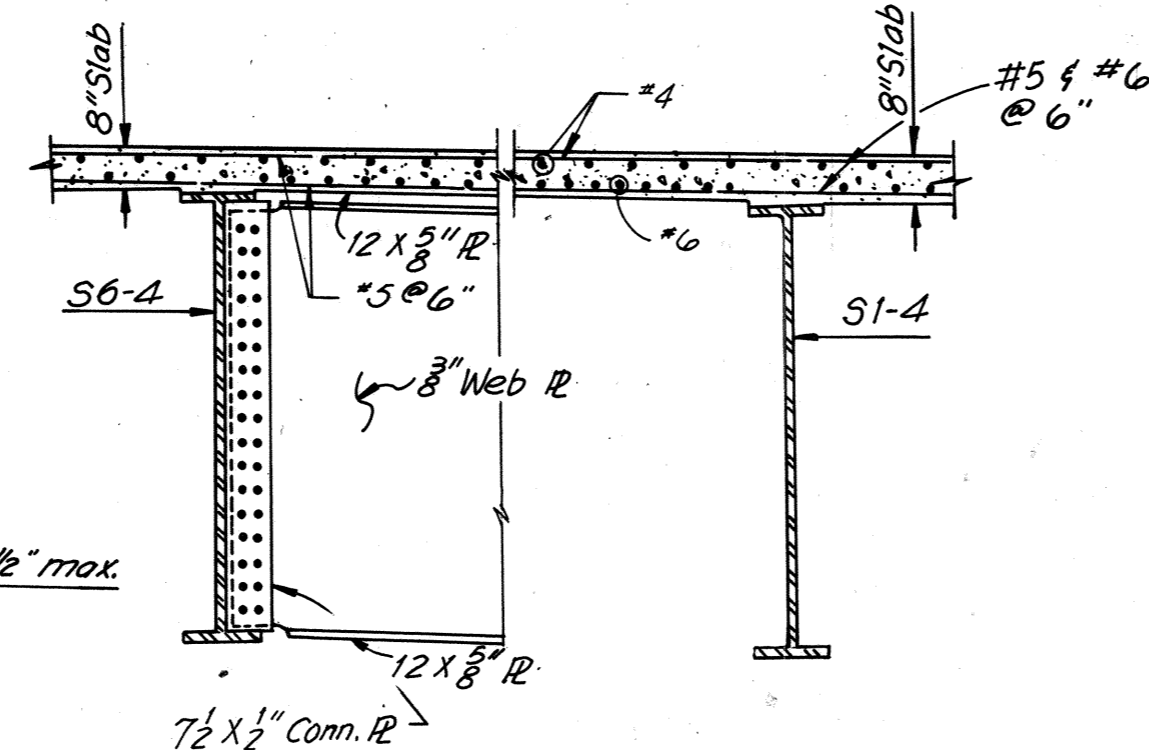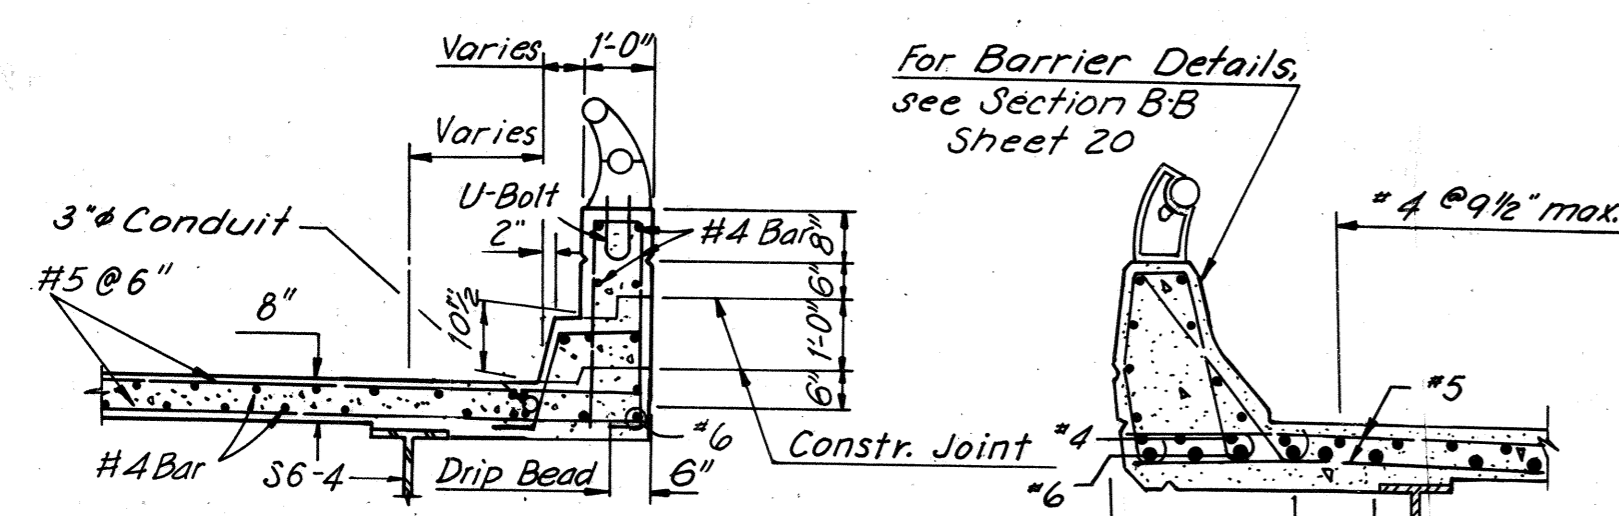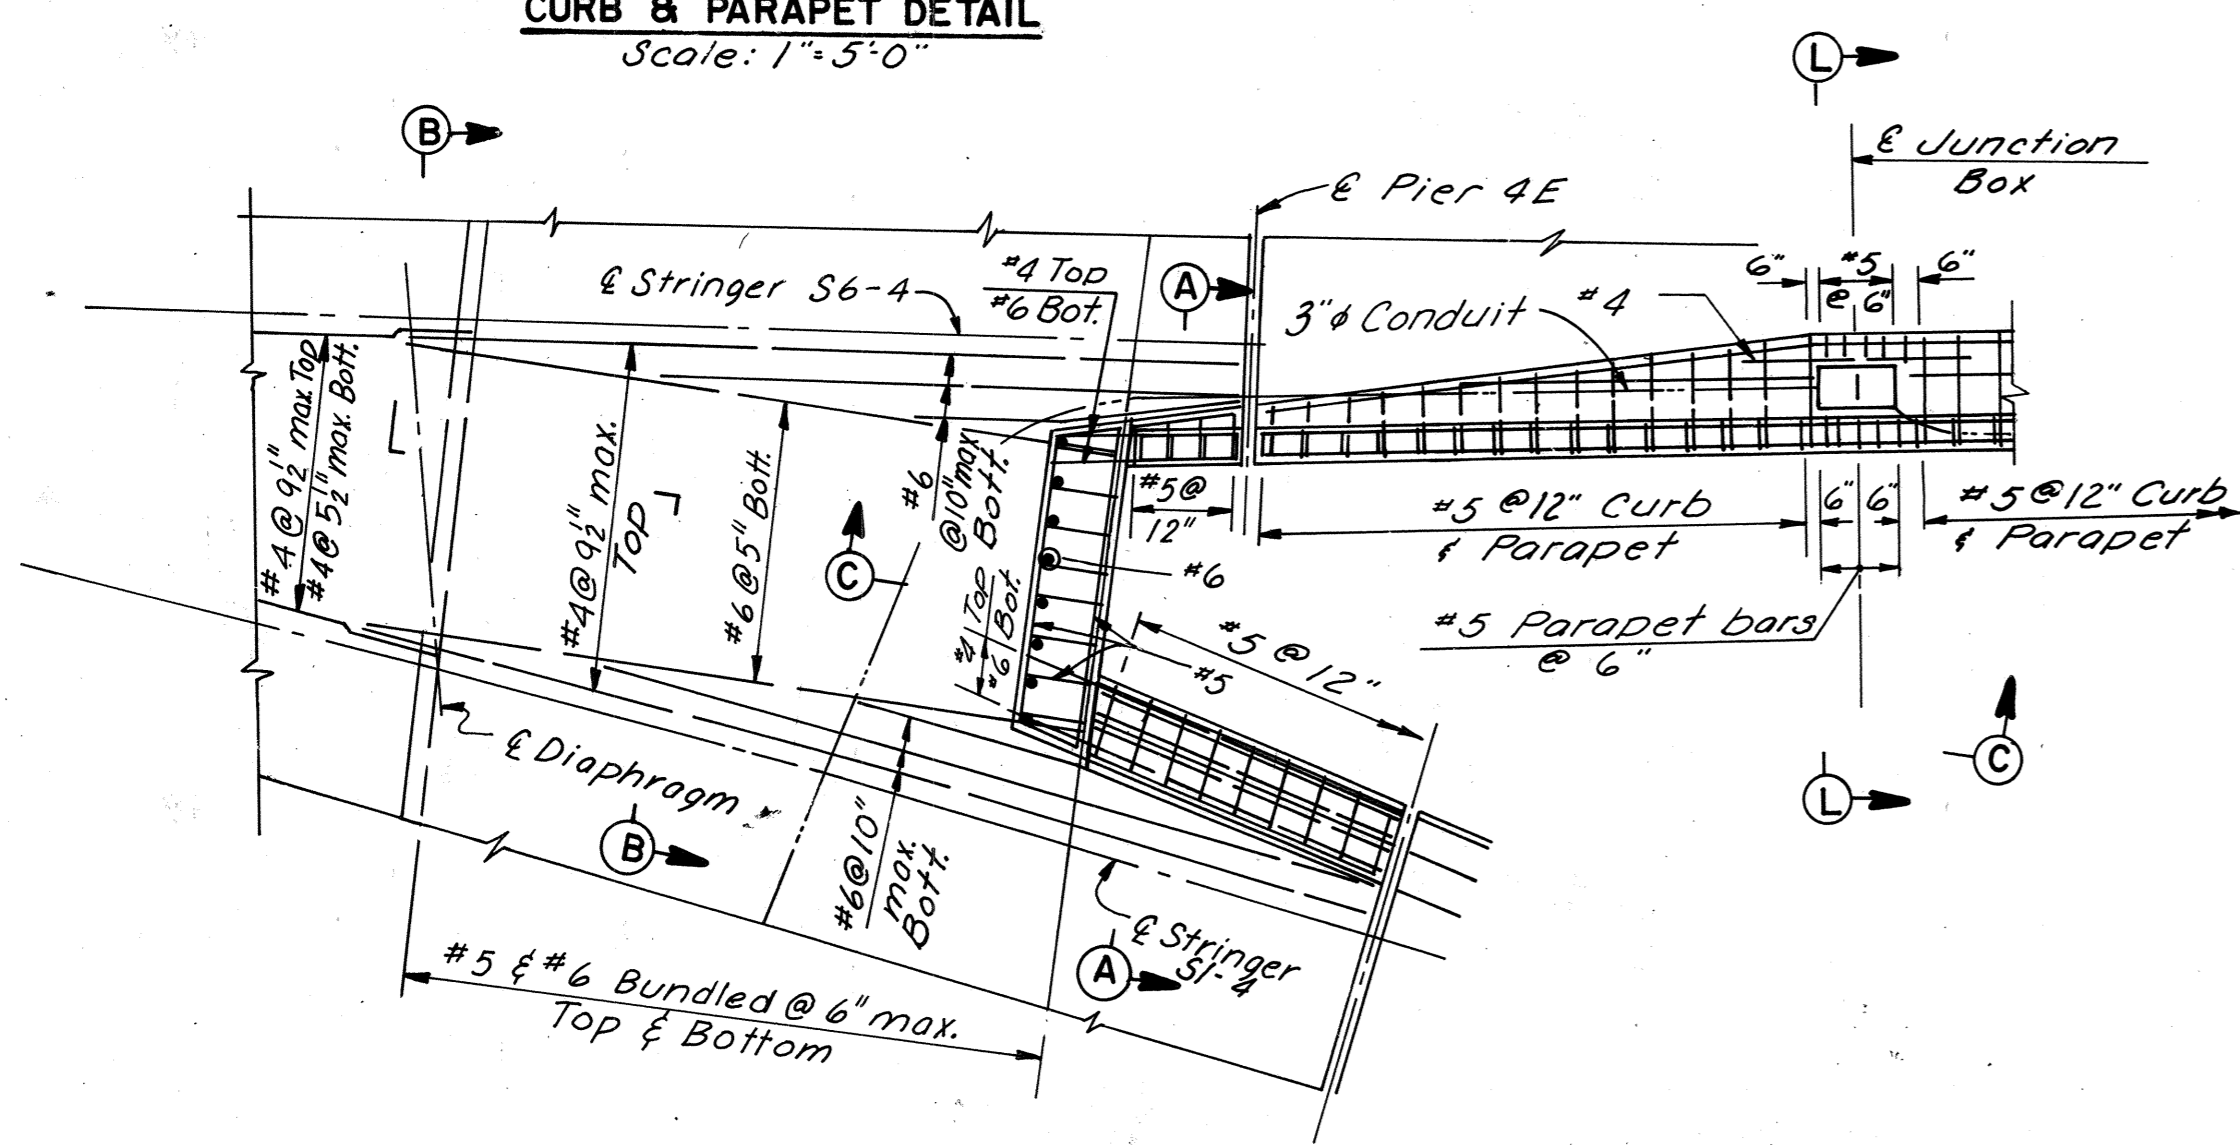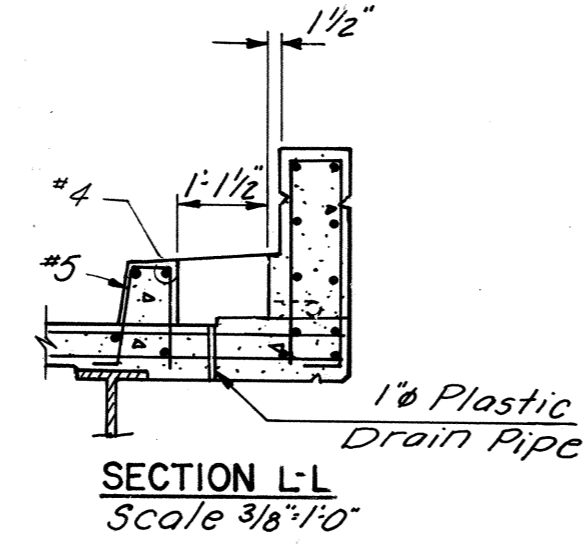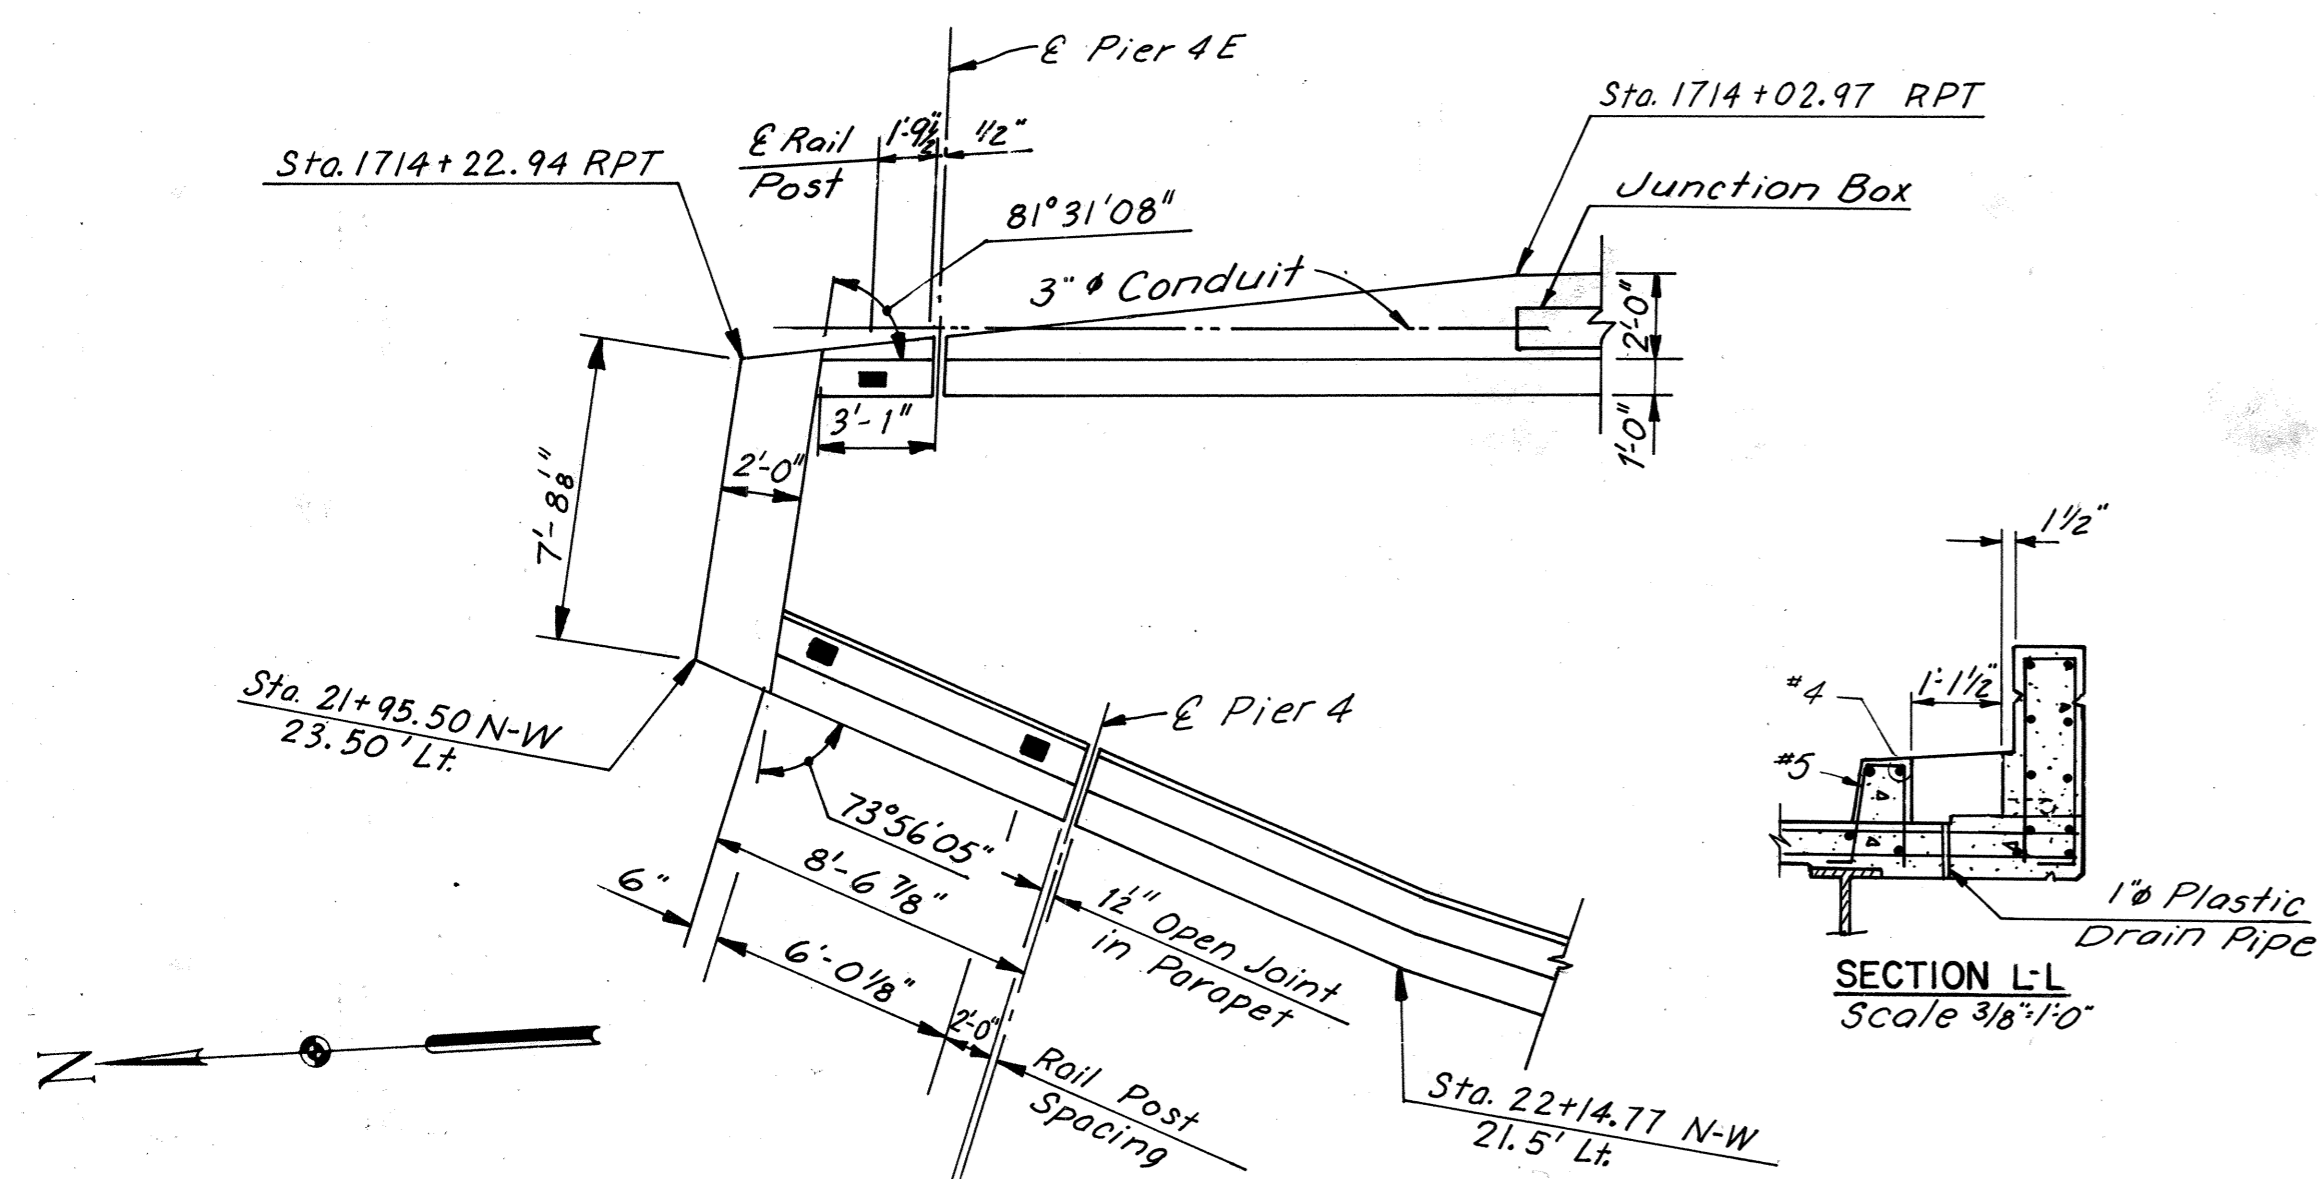


SECTION A-A
Scale: 3/8"=1'-0"


SECTION B-B
Scale: 3/8"=1'-0"

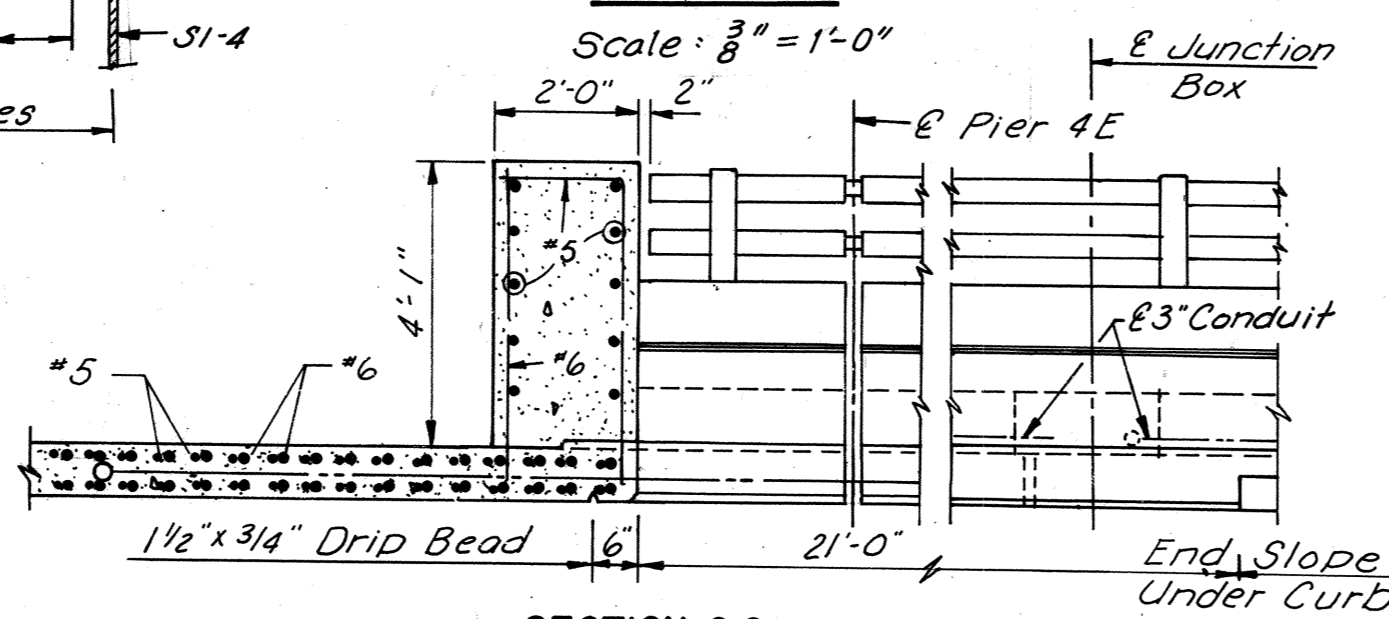


SECTION C-C
Scale: 3/8"=1'-0"

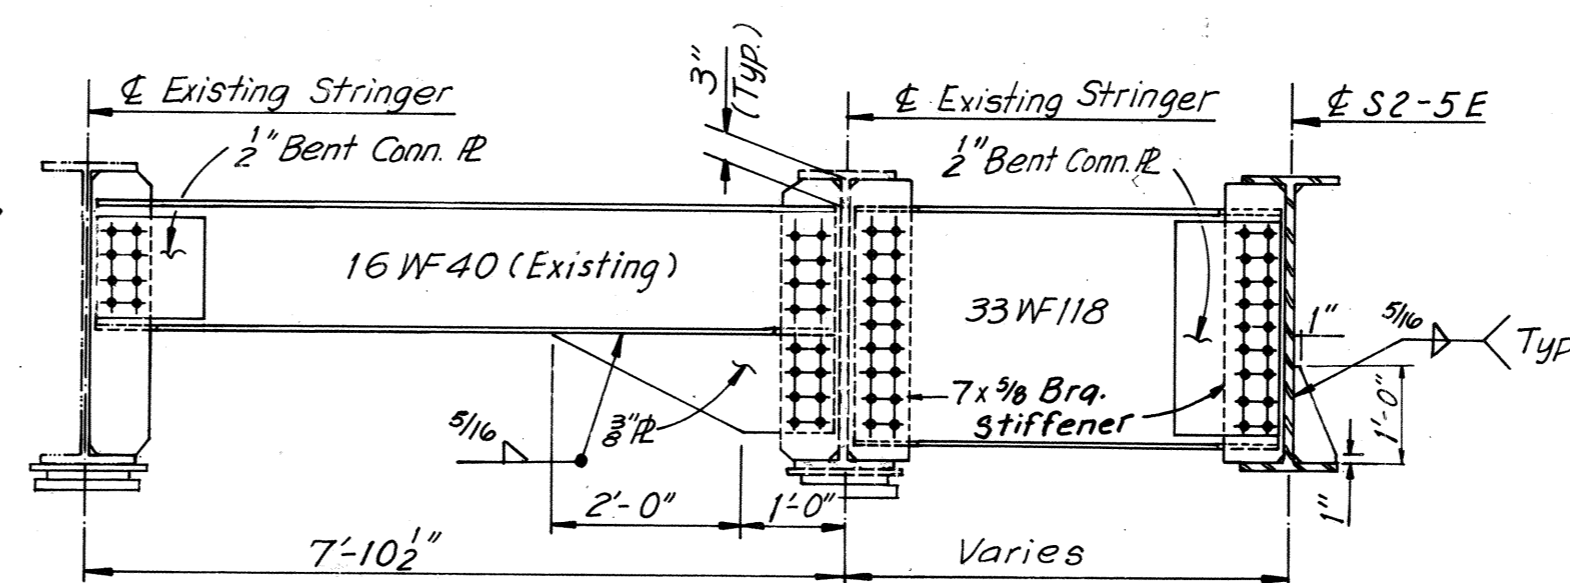


SECTION D-D
Scale: 1/2"=1'-0"

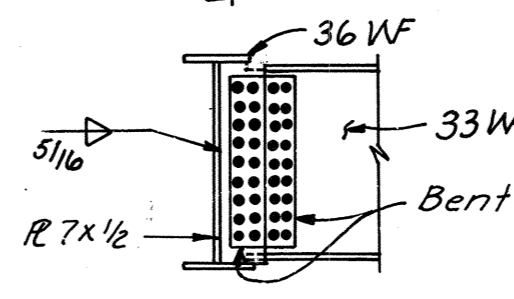


SECTION M-M
Scale: 3/8"=1'-0"

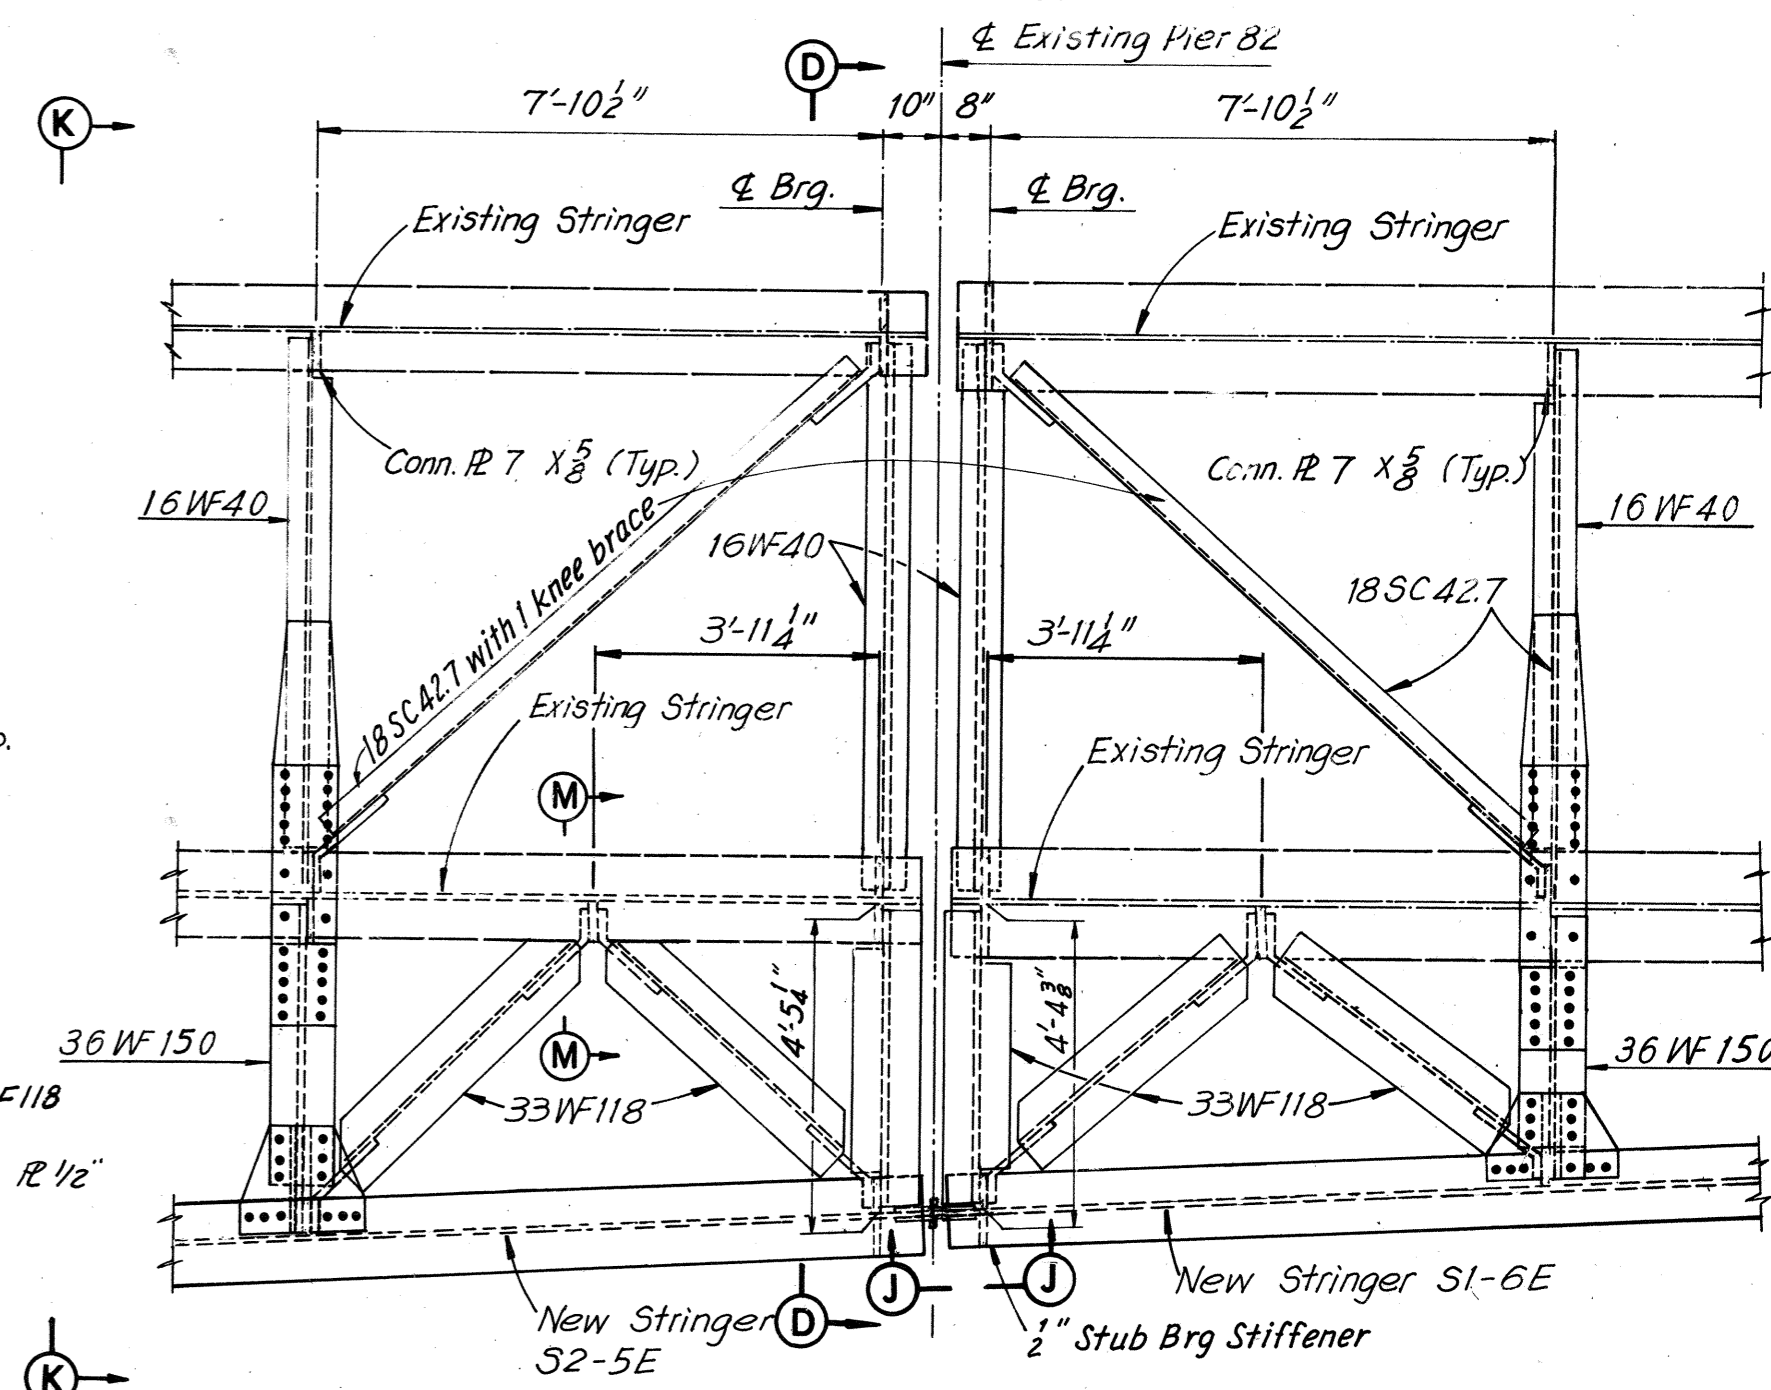

DETAIL B
Scale: 3/8"=1'-0"

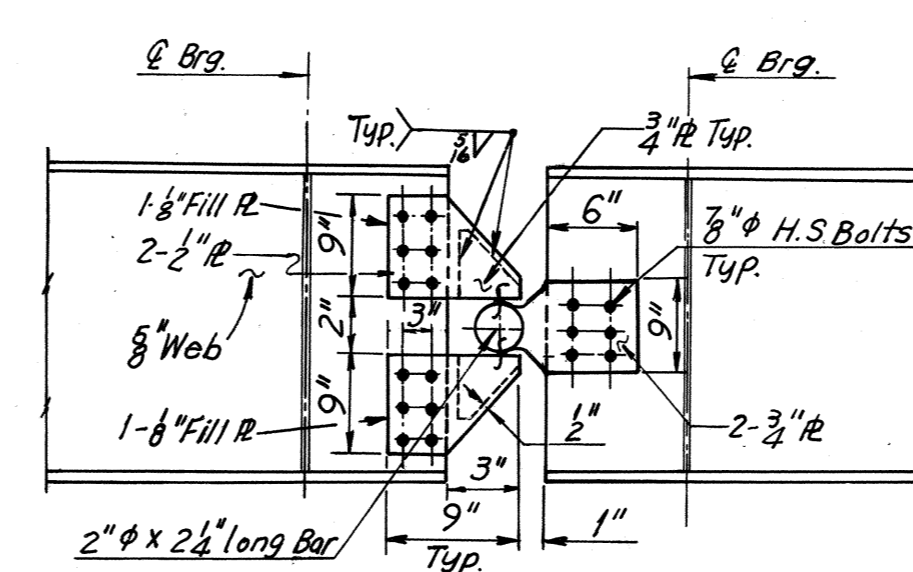

VIEW J-J
No Scale

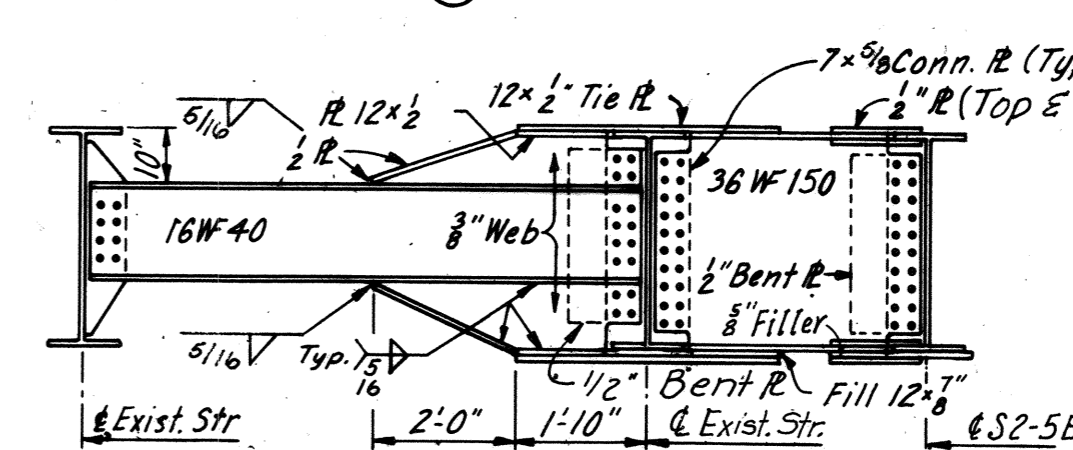

SECTION K-K
Scale: 3/8"=1'-0"

BY	DATE				
MADE	SCC 2-28-69	Z	As Built	TEM	6-77
CHECKED	K.C.T. 3-24-69		Unit 2 Details Deleted	TEM	10-74
IN CHARGE	G.C.C. 4-21-69				
	NO.	REVISION	BY	DATE	





RICHMOND METROPOLITAN AUTHORITY
RICHMOND EXPRESSWAY SYSTEM
DOWNTOWN EXPRESSWAY

BRIDGE NO. 64
RAMP N-W CONNECTION FROM
RICHMOND-PETERSBURG TURNPIKE
SUPERSTRUCTURE DETAILS

SCALE: As Noted
HOWARD, NEEDLES, TAMMEN & BERGENDOFF
consulting engineers
NEW YORK ALEXANDRIA KANSAS CITY
CONTRACT NO. 10
SHEET NO. 24 OF 28








AS BUILT

RICHMOND EXPRESSWAY SYSTEM			
SECTION	PROJECT	SHEET NO.	TOTAL SHEETS
10	DOWNTOWN EXPRESSWAY	123	265

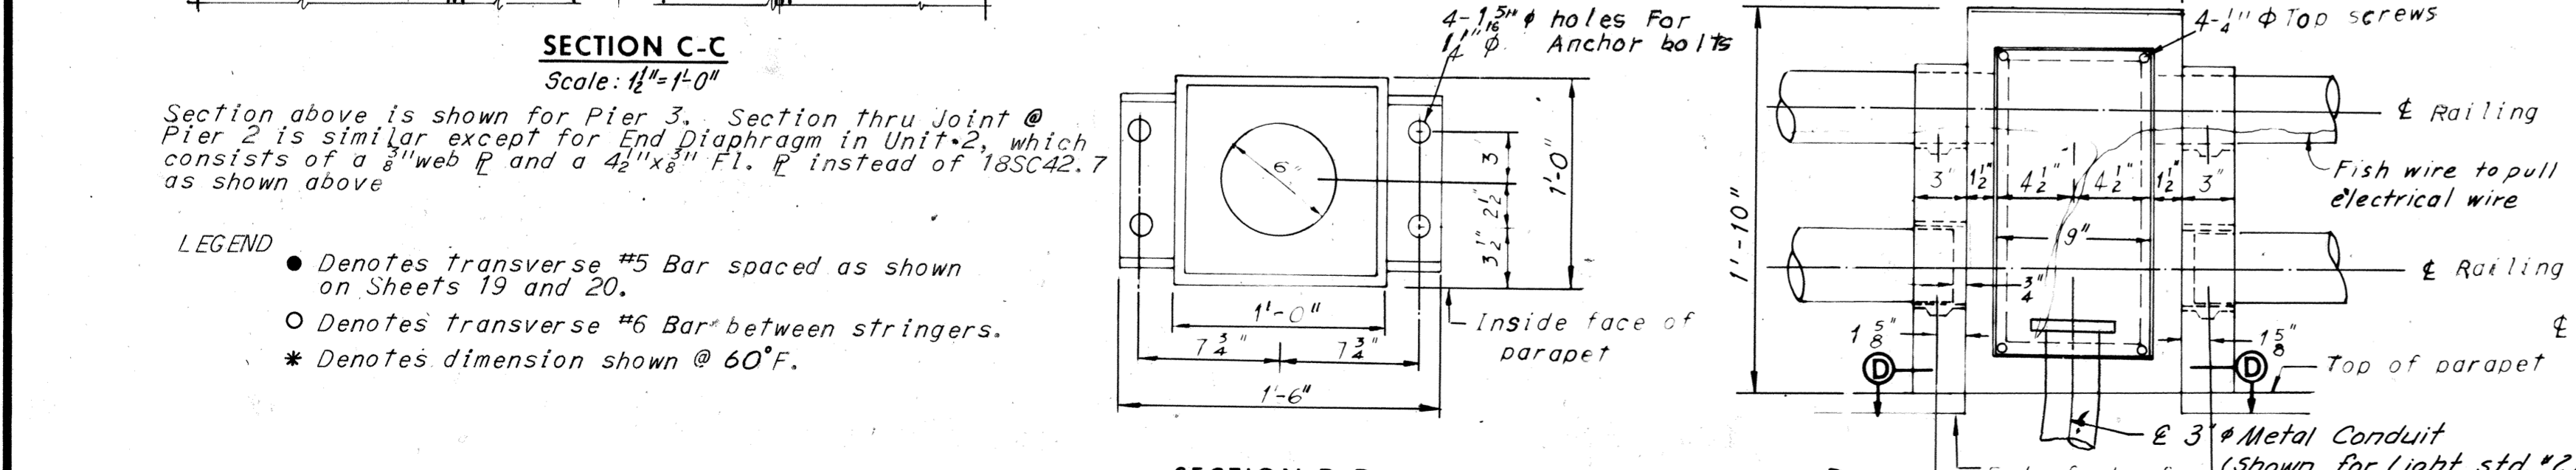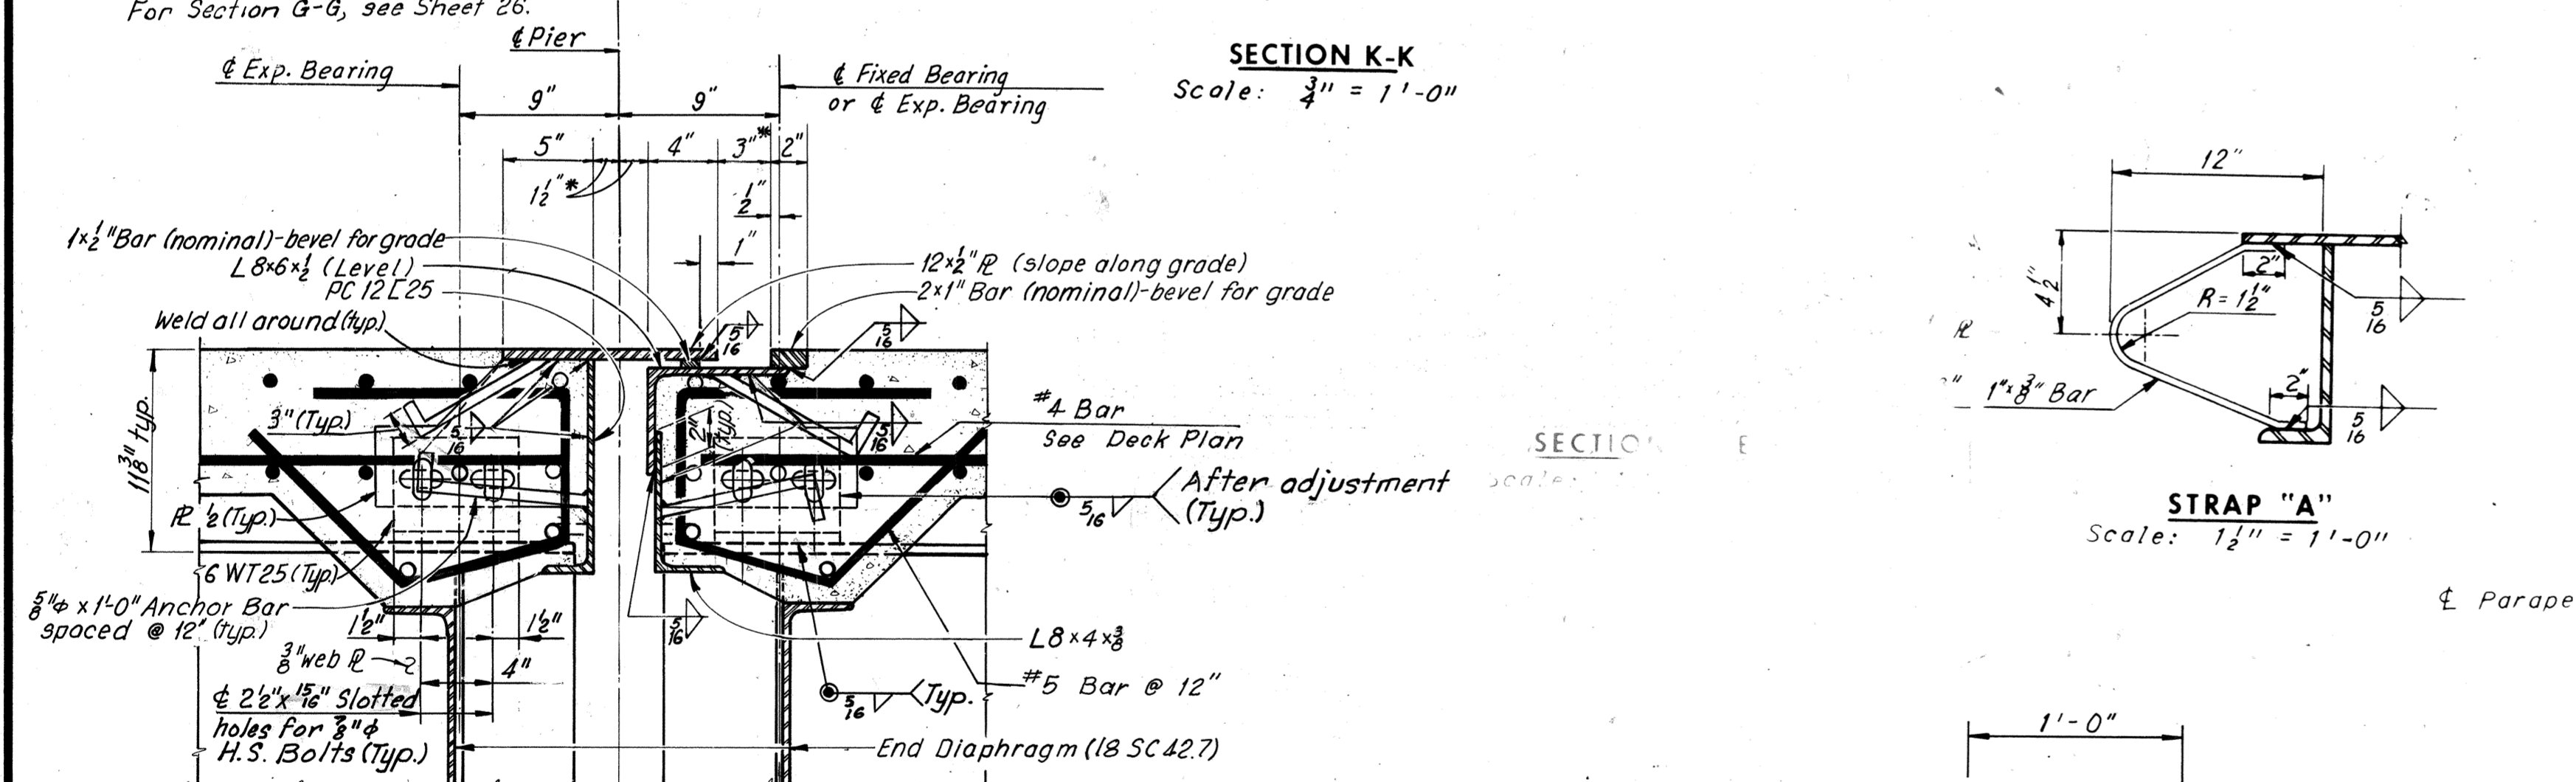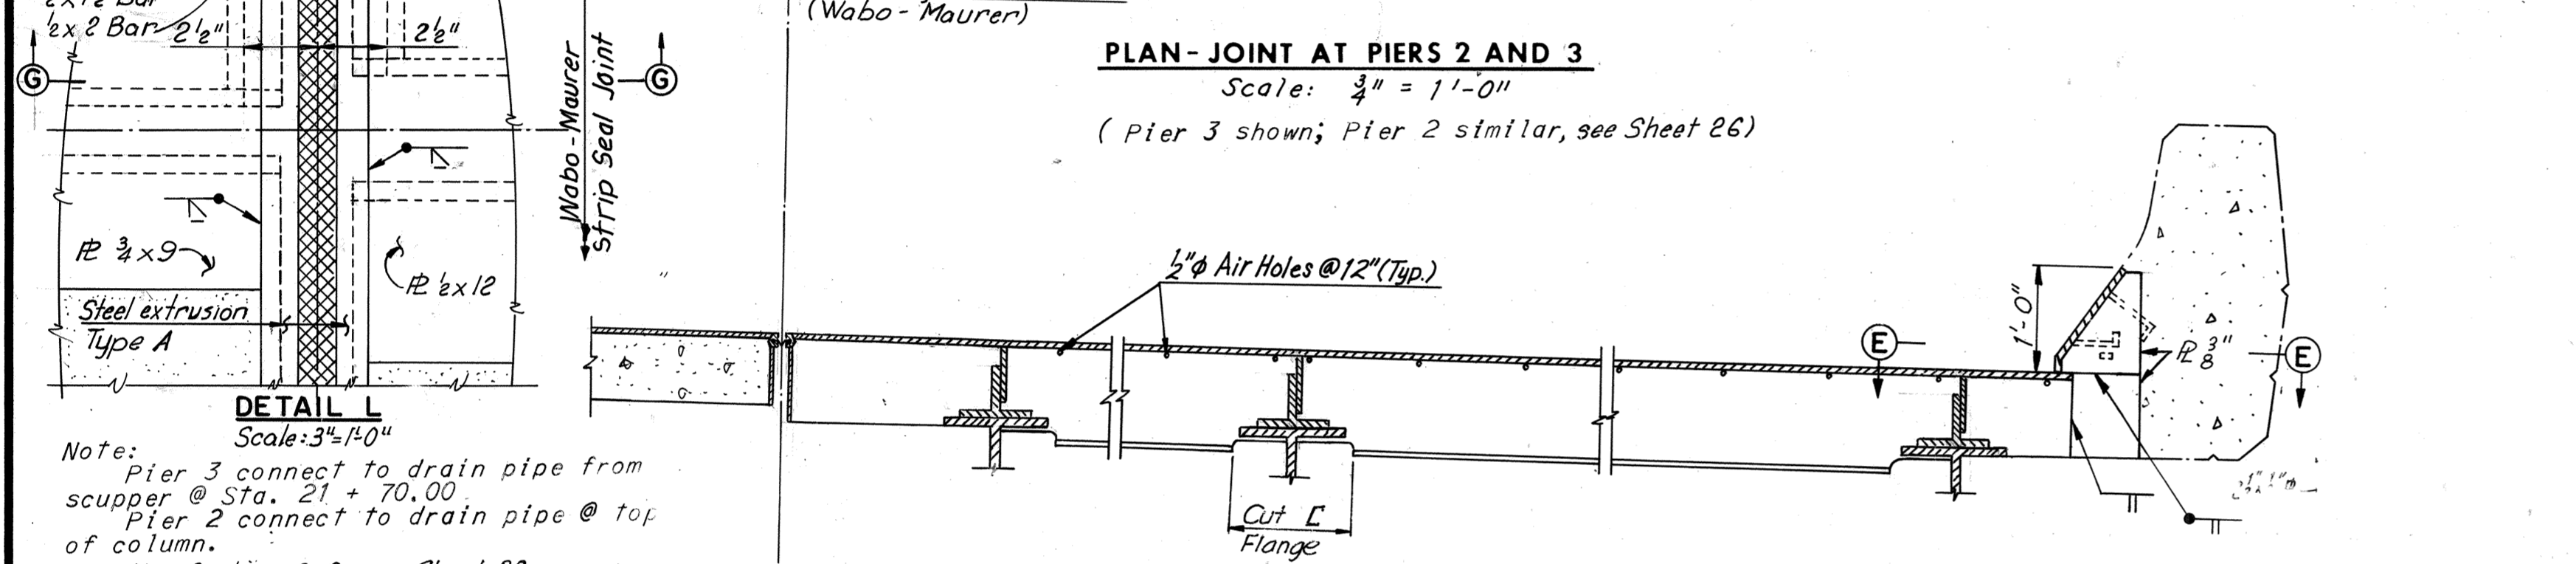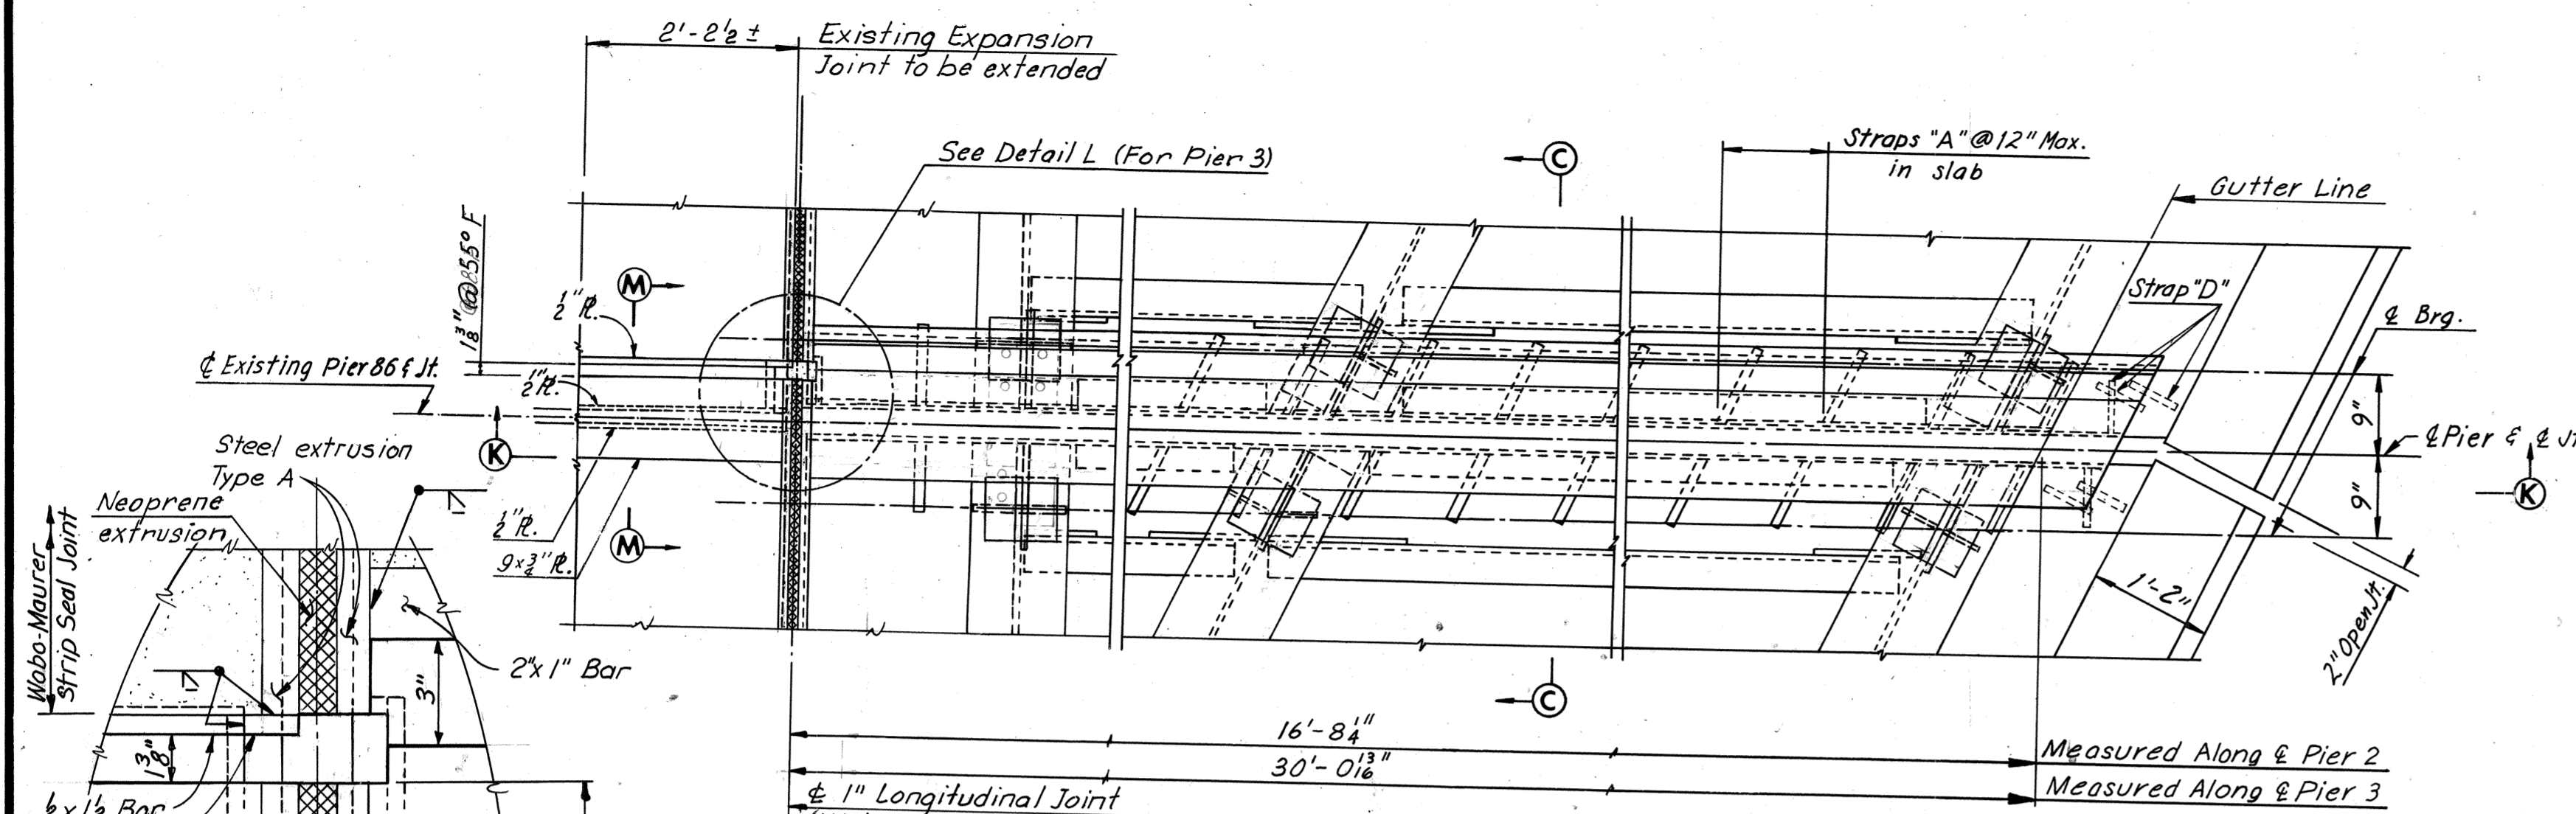

2 As Built		TEM G-77	
MADE	Y.C.P. 3-20-69	NO.	REVISION
CHECKED	G.C.C. 4-21-69	BY	DATE
IN CHARGE			

Sect. G-G & Det. A moved to Sh. 26.
 Long. Jt. changed to Wabo-Maurer.
 Slab & Pier 2 supports changed to 6 WT 25.

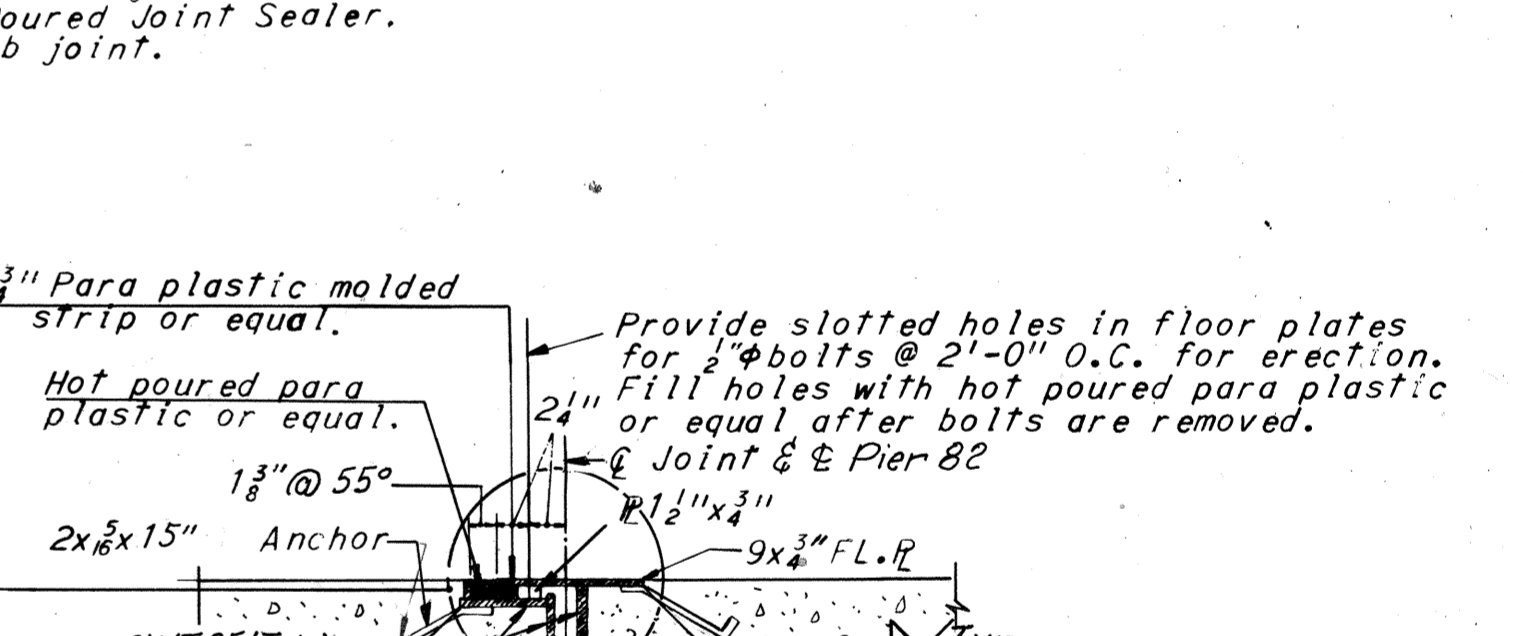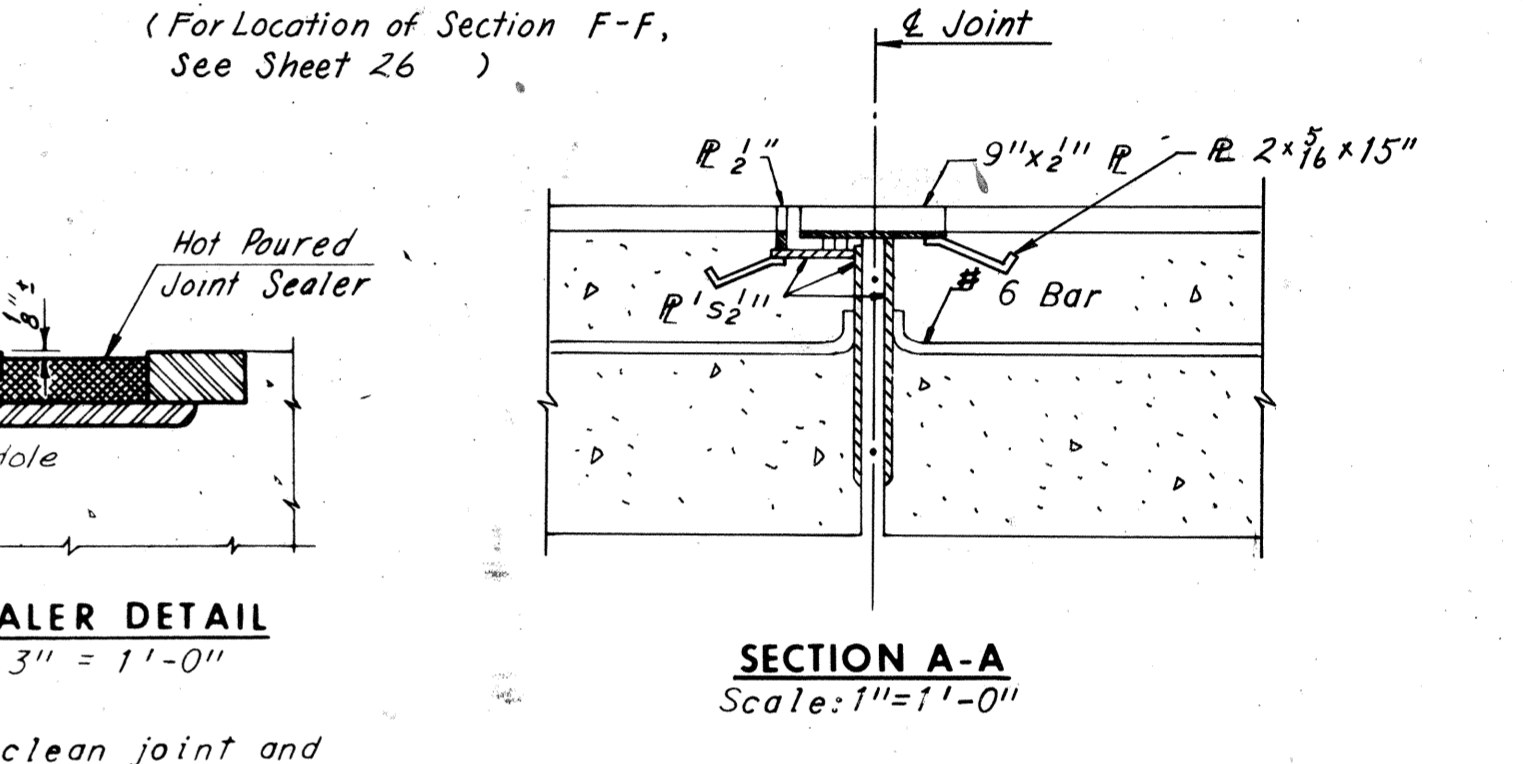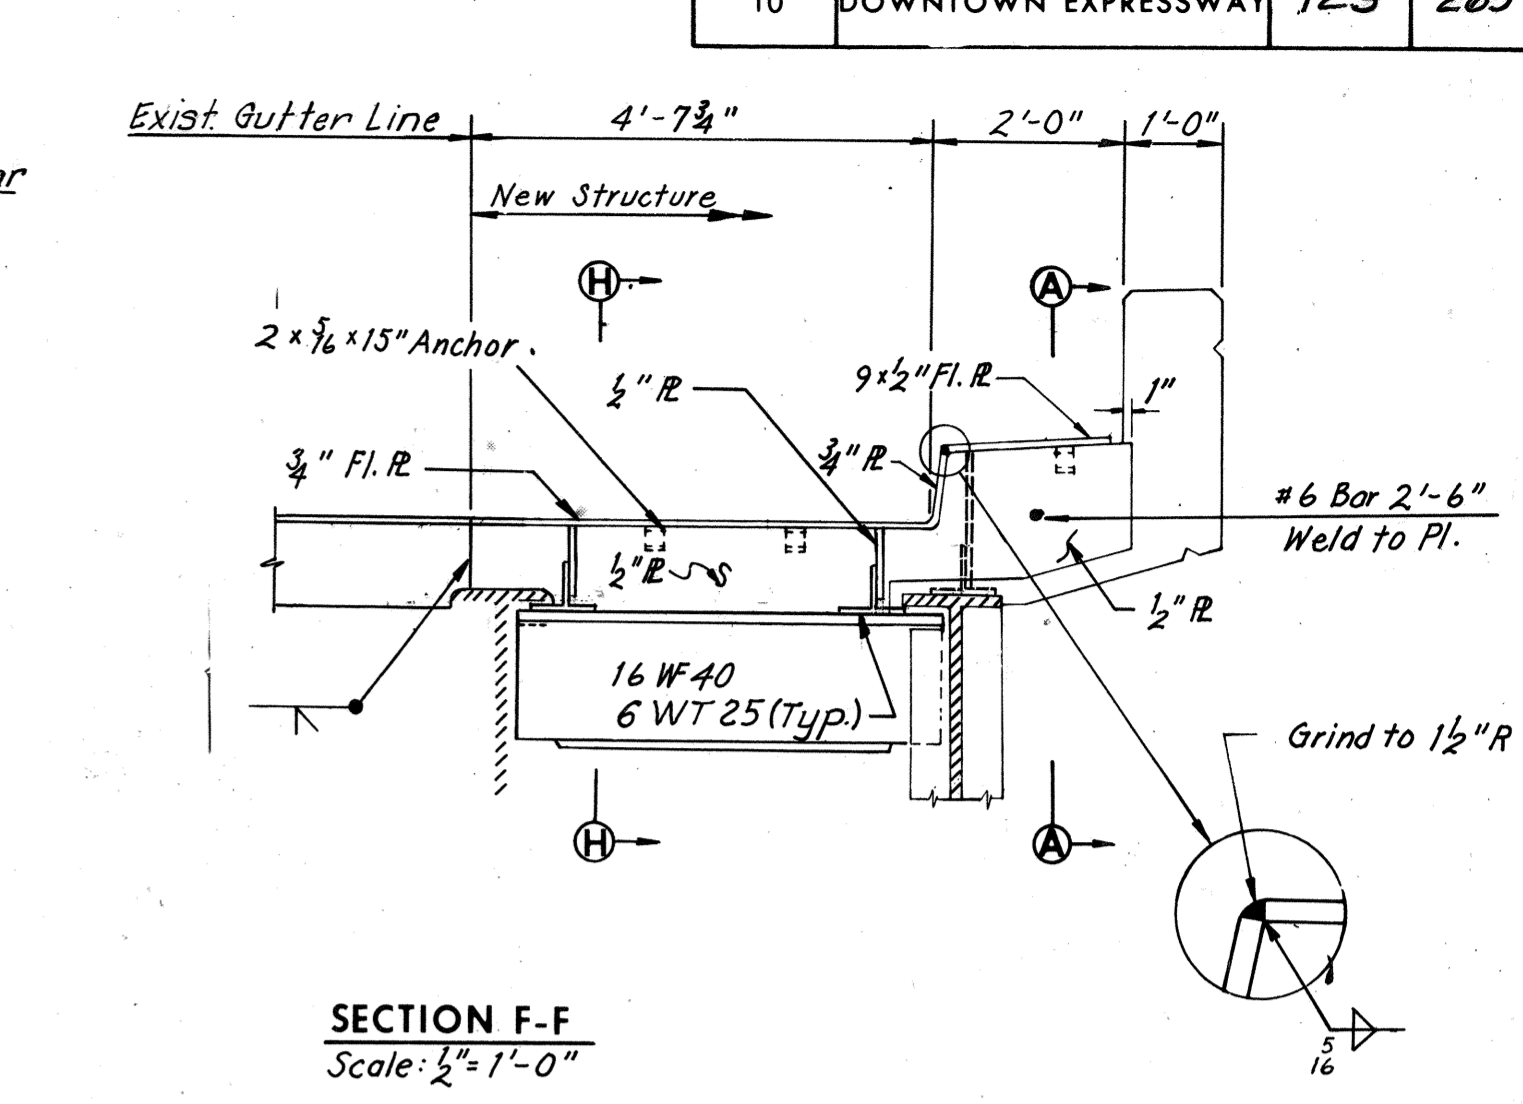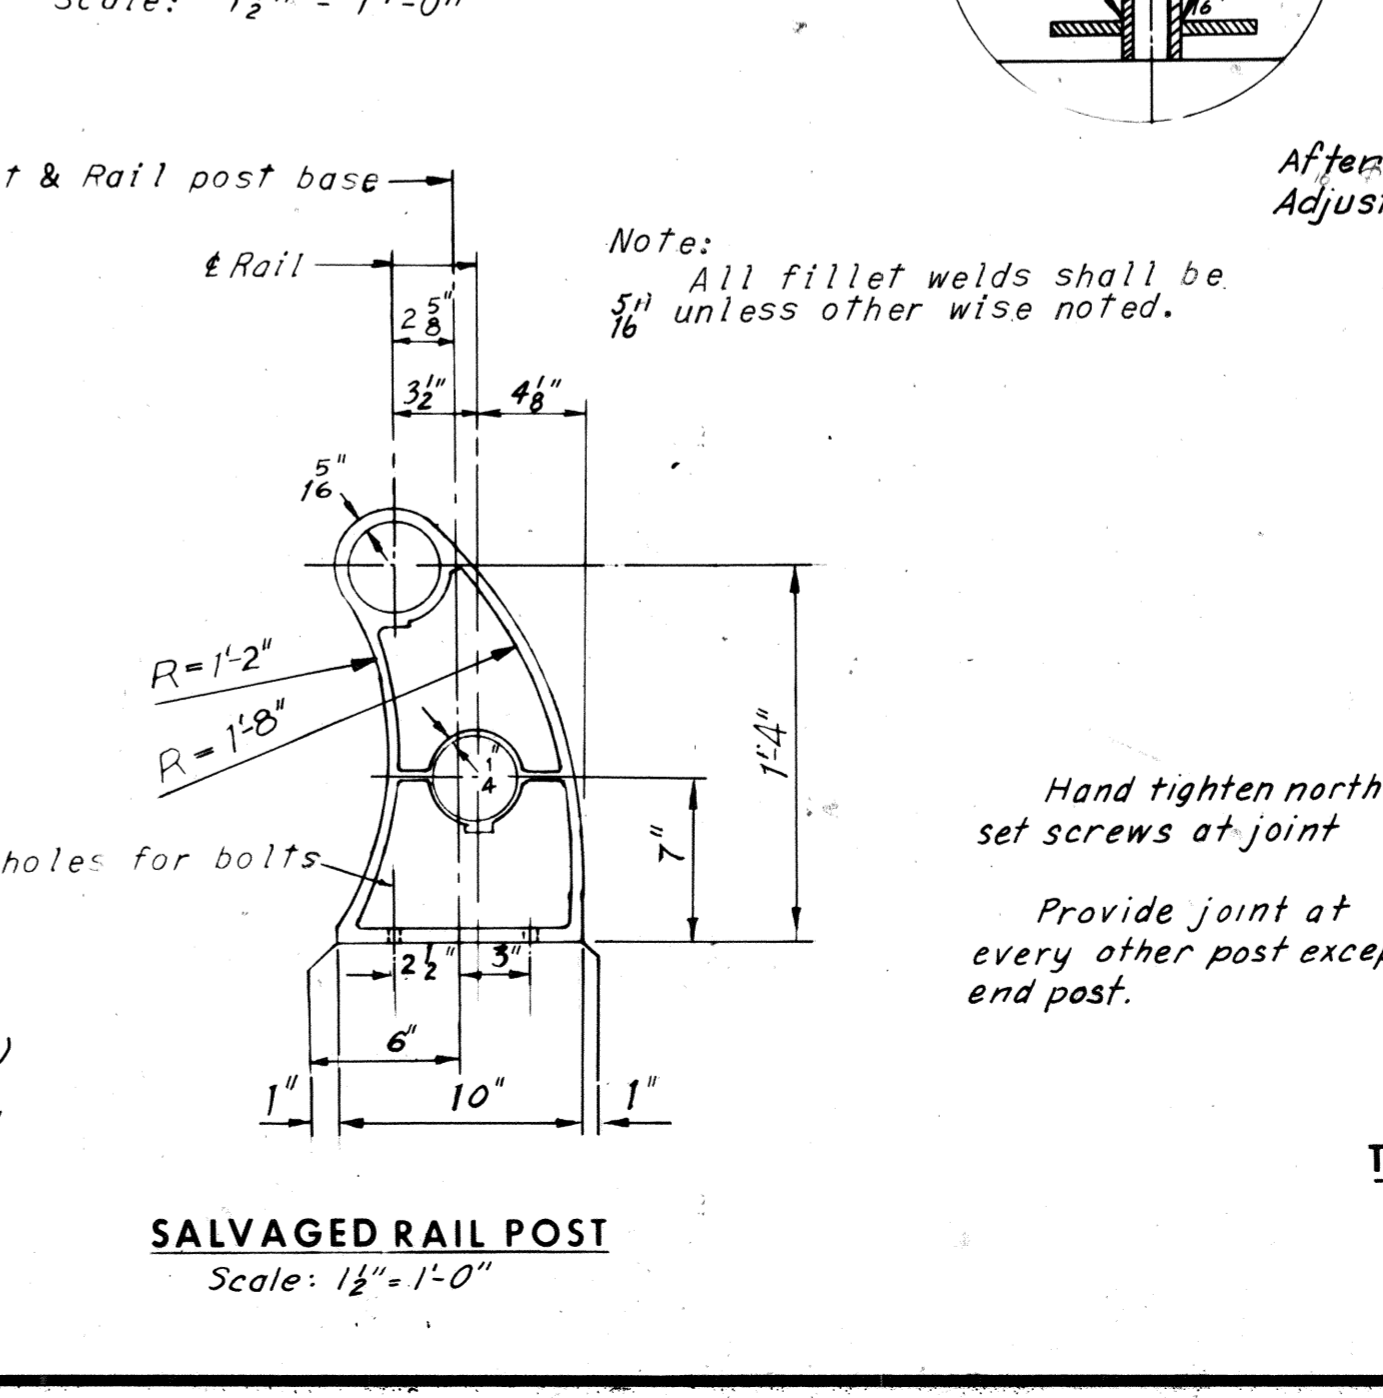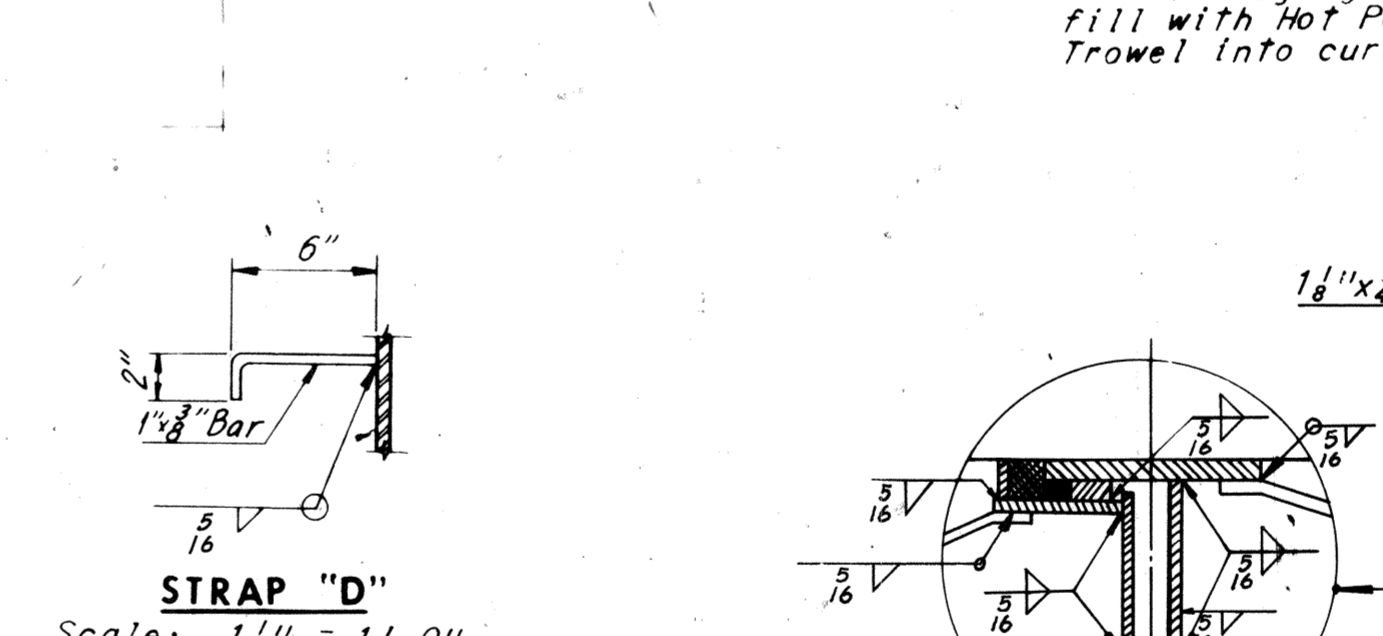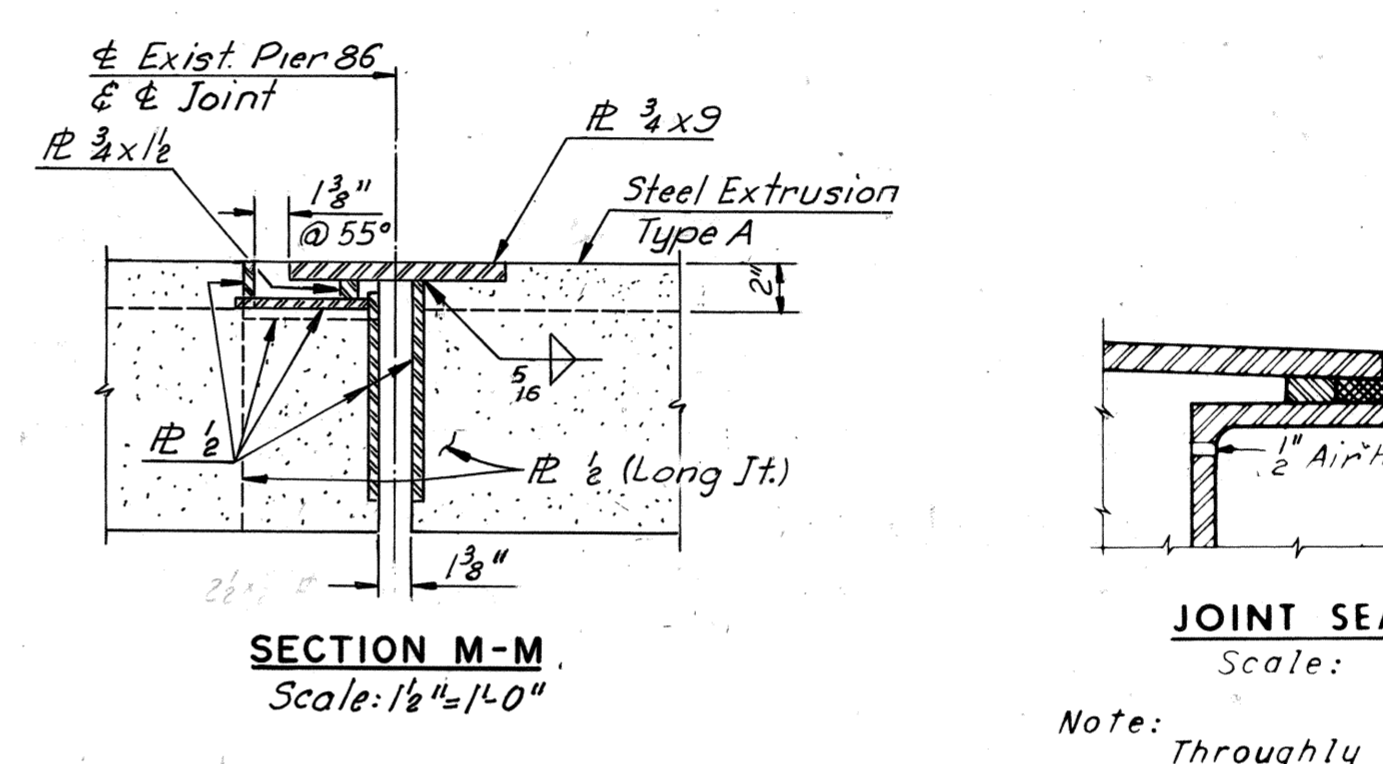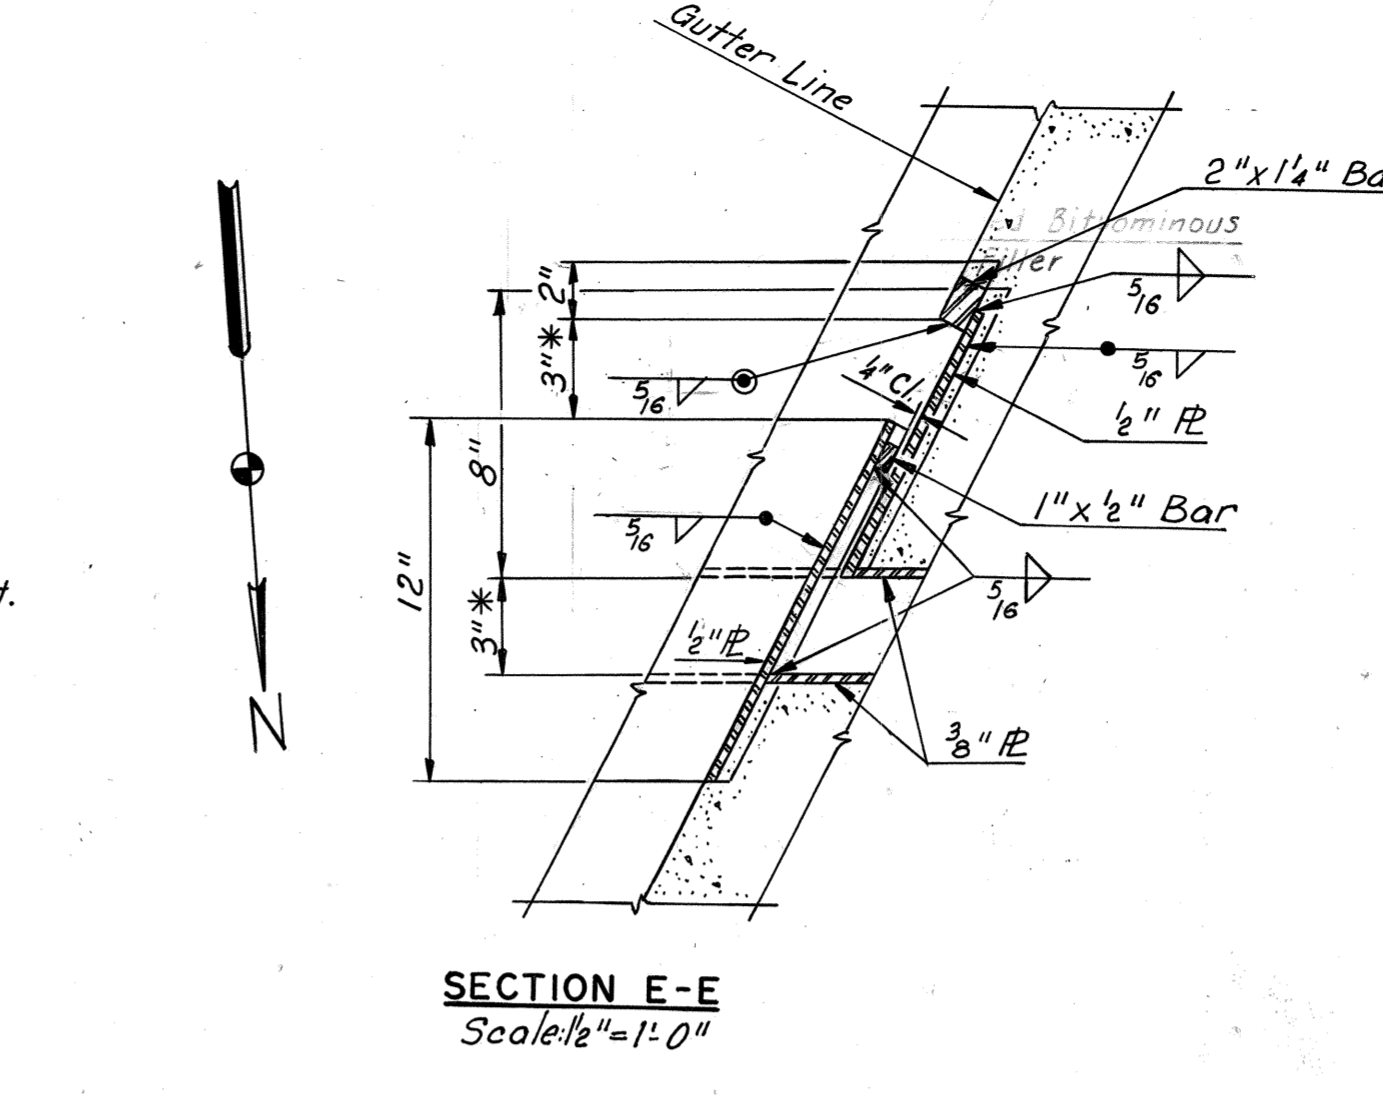

Note: All fillet welds shall be 5/16" unless otherwise noted.

Hand tighten north set screws at joint. Provide joint at every other post except end post.

TYPICAL JOINT
 No Scale

JOINT DETAILS

Note: All metal work in joints is to be included in Superstr. A36 Str. Steel.

RICHMOND METROPOLITAN AUTHORITY
RICHMOND EXPRESSWAY SYSTEM
DOWNTOWN EXPRESSWAY

BRIDGE NO. 64
RAMP N-W CONNECTION FROM
RICHMOND-PETERSBURG TURNPIKE

HOWARD, NEEDLES, TAMMEN & BERGENDOFF
 consulting engineers
 NEW YORK ALEXANDRIA KANSAS CITY


SCALE: As Noted
 CONTRACT NO. 10
 SHEET NO. 25 OF 28

AS BUILT


RICHMOND EXPRESSWAY SYSTEM			
SECTION	PROJECT	SHEET NO.	TOTAL SHEETS
10	DOWNTOWN EXPRESSWAY	124	265

NOTES FOR FILLED JOINTS:

Joints shall be free of cracked and spalled areas and their faces shall be free of all foreign matter, curing compound, oils, greases and dirt. All faces must be sandblasted or brushed with a mechanical rotary wire brush. Just prior to sealing, the joint shall be blown out with oil-free and water-free compressed air.

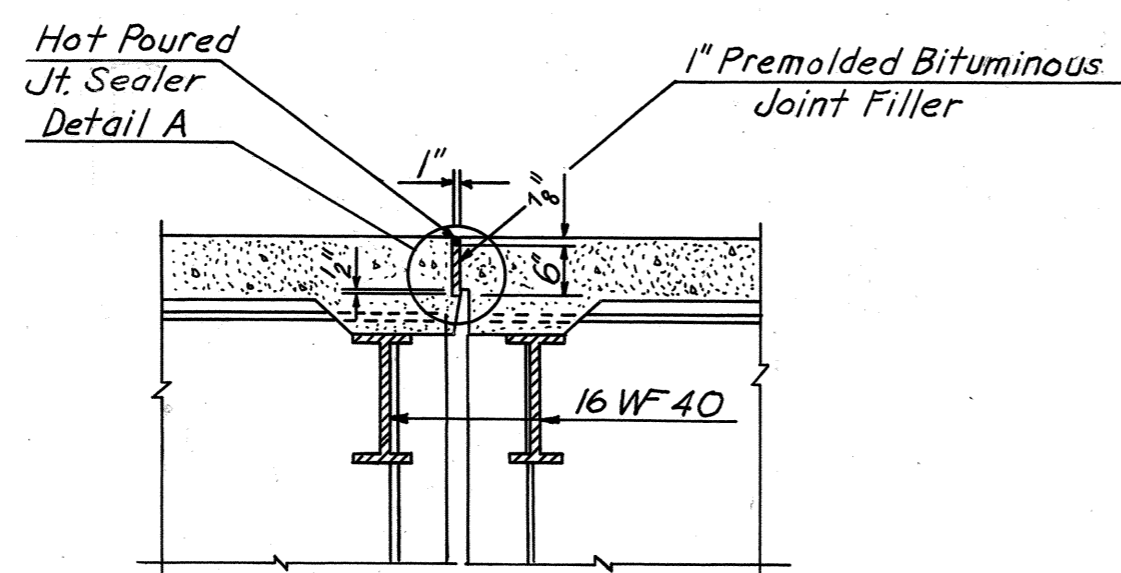


TYPICAL SECTION THRU 1" FIXED JOINT
Scale: 1/2"=1'-0"

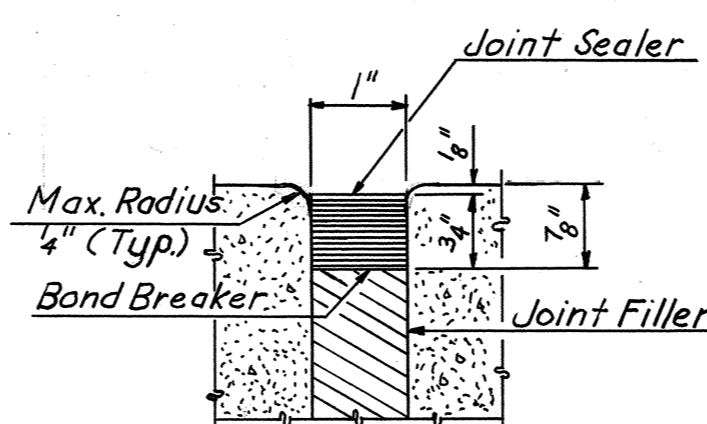

DETAIL A
No Scale

Note: Joint filler material and copper flashing to be included in price bid for Superstr. Concrete

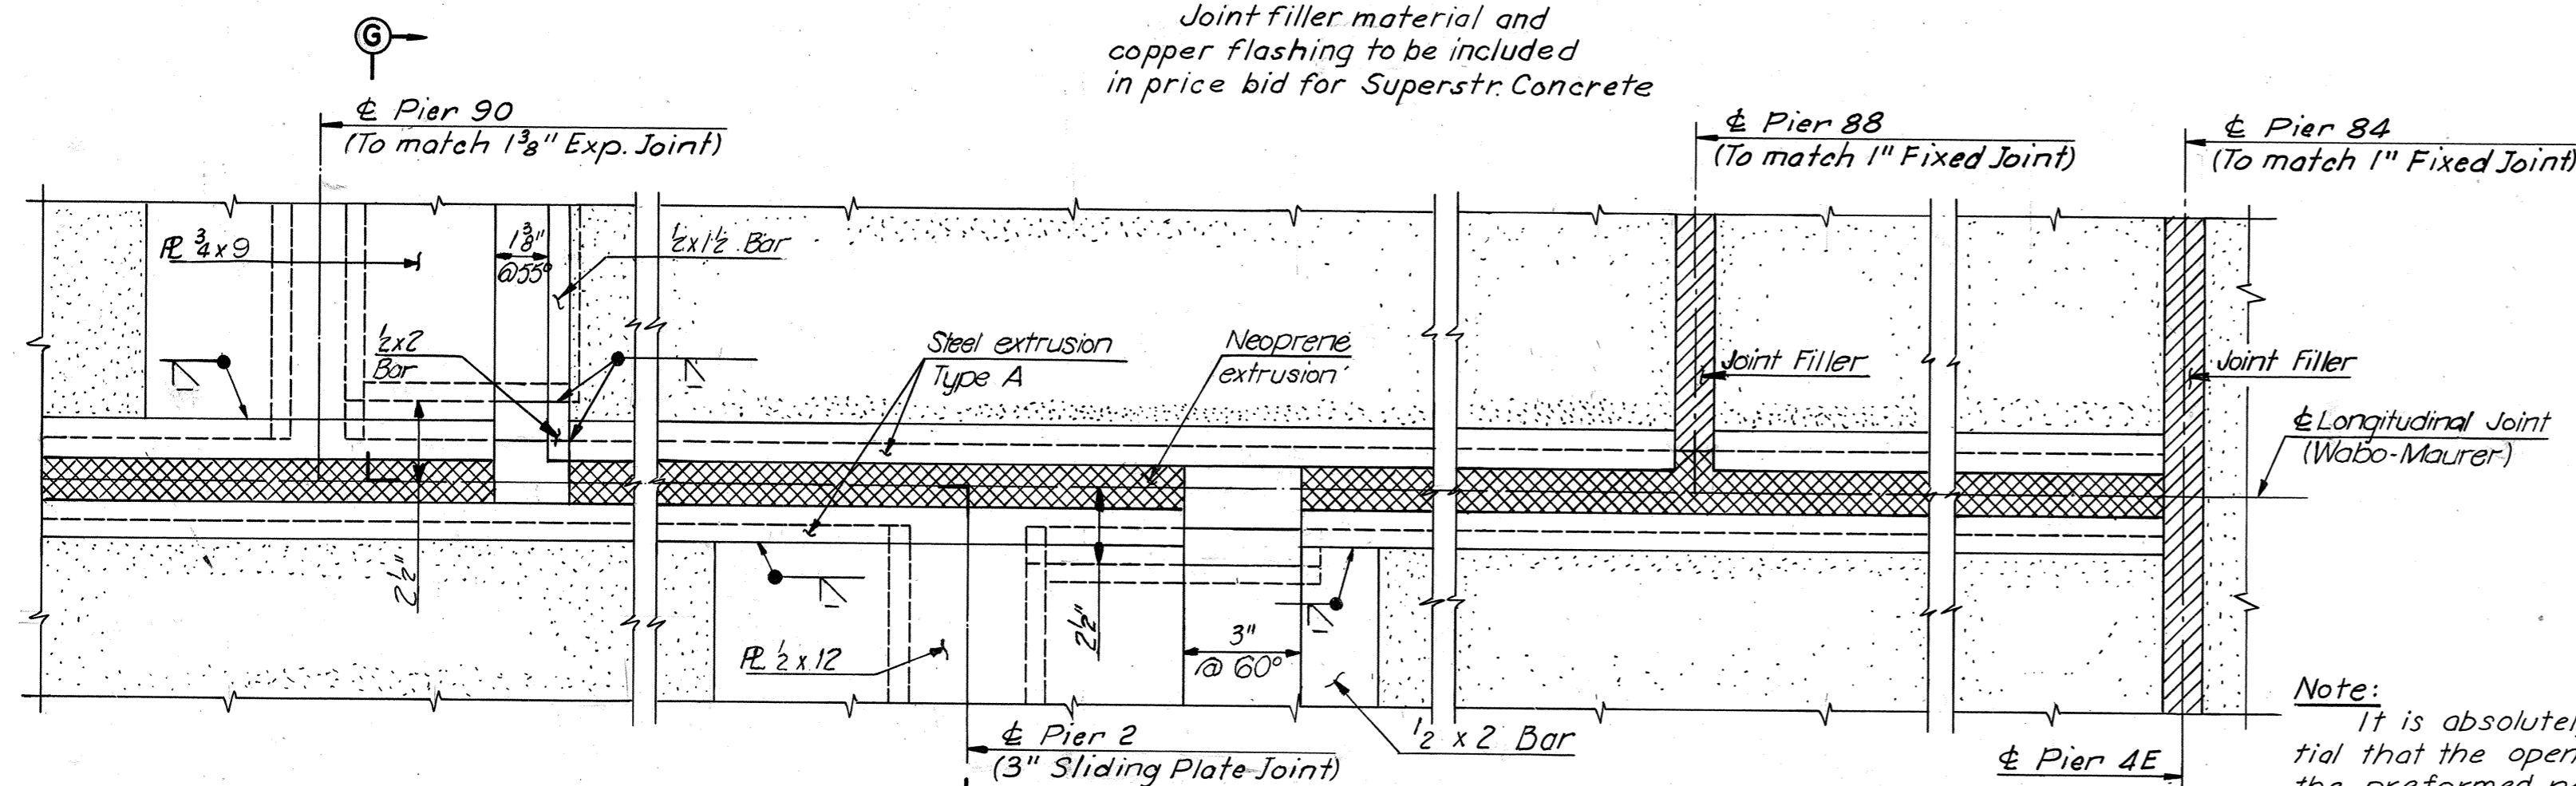

PLAN-LONGITUDINAL JOINT
Scale: 3/8"=1'-0"


NOTE: For Plan of Pier 3 & existing Pier 86, see Sheet 25.

Note: It is absolutely essential that the openings for the preformed neoprene joint sealers be accurately formed and constructed to smooth, straight lines. The size of opening shall be adjusted to allow for anticipated dead load rotation of the ends of the slab and for the temperature at the time of construction.


NOTES FOR WABO-MAURER JOINT:

Do not use steel extrusions as screed support. Steel extrusion shall conform to ASTM A36. Structural steel shall conform to ASTM A588. Steel assembly shall be shop welded to convenient lengths and butt welded in the field to desired length. Joint shall conform to grade of deck slab. Steel assembly shall be sandblasted in the shop prior to painting. Steel assembly shall receive one shop coat of epoxy zinc paint.

Neoprene extrusion shall be roughened with a wire brush before bonding to steel extrusion with Bon Lastic Adhesive. Groove in steel extrusion to be blown out with oil-free and water-free compressed air prior to installation of Neoprene extrusion. The Wabo-Maurer joint assembly shall be installed in accordance with manufacturer's recommended construction methods.

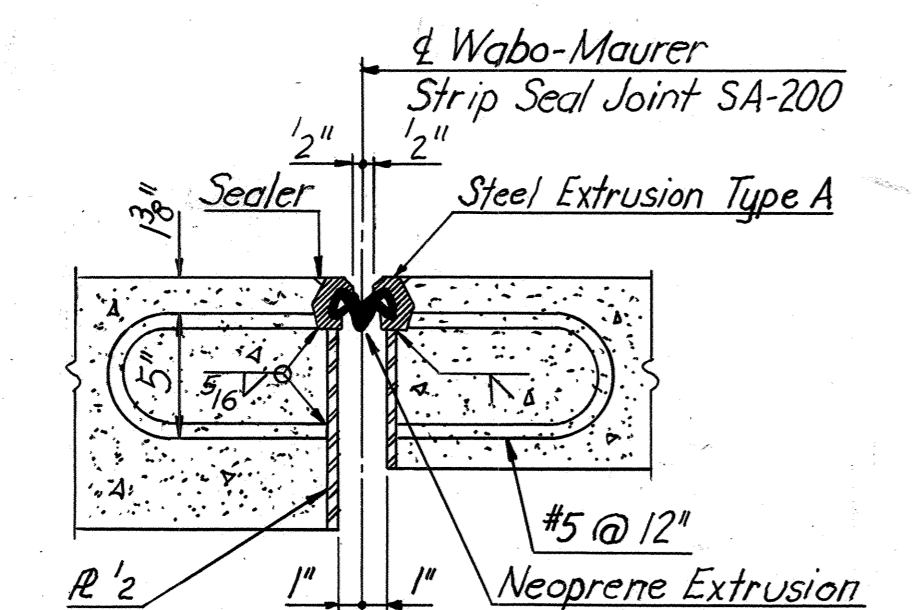


TYPICAL SECTION THRU WABO-MAURER JOINT
Scale: 1/2"=1'-0"

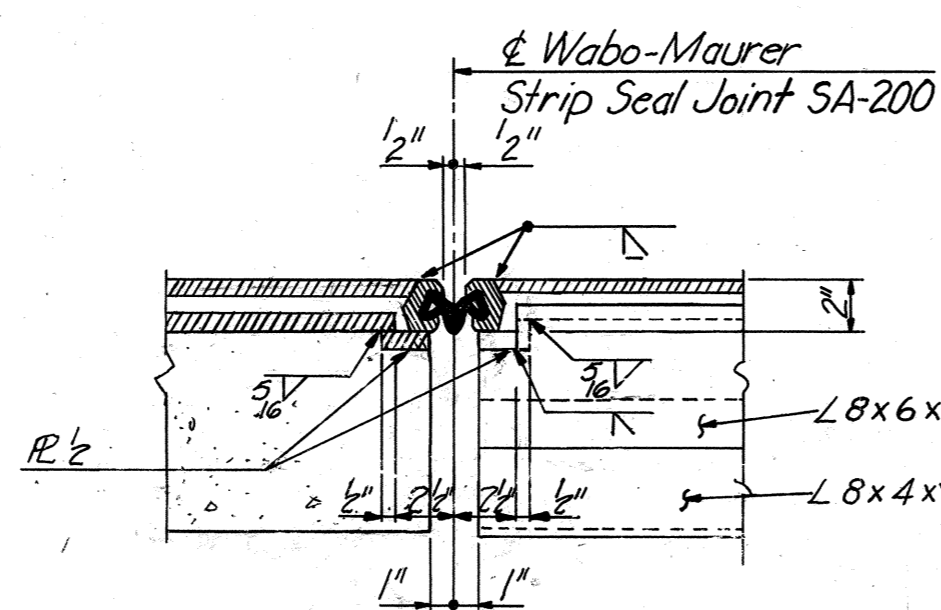


SECTION G-G
Scale: 1/2"=1'-0"


NOTE: Steel extrusion of Wabo-Maurer Joint to rest & slide on P.L. For location of Sect. G-G, see Plan-Long. Joint above & Detail L. Sheet 25.

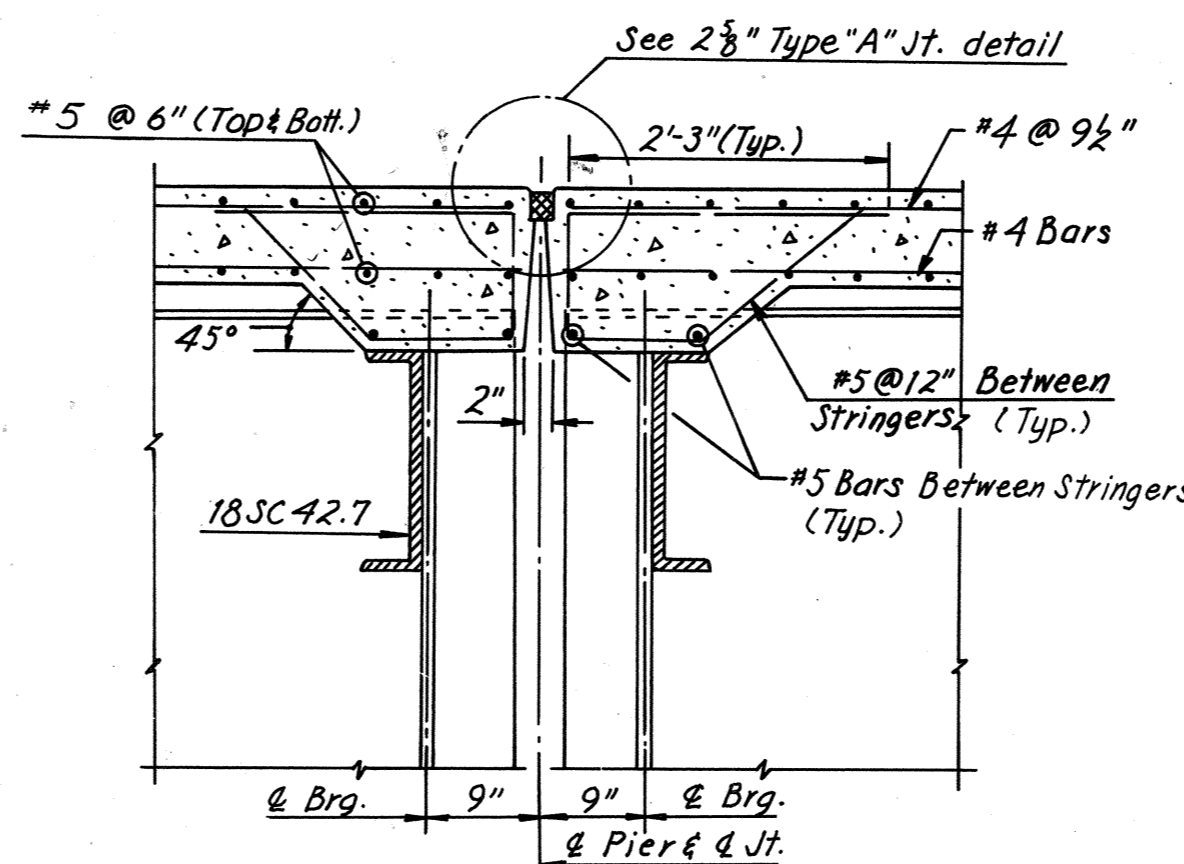


SECTION B-B
Scale: 3/8"=1'-0"

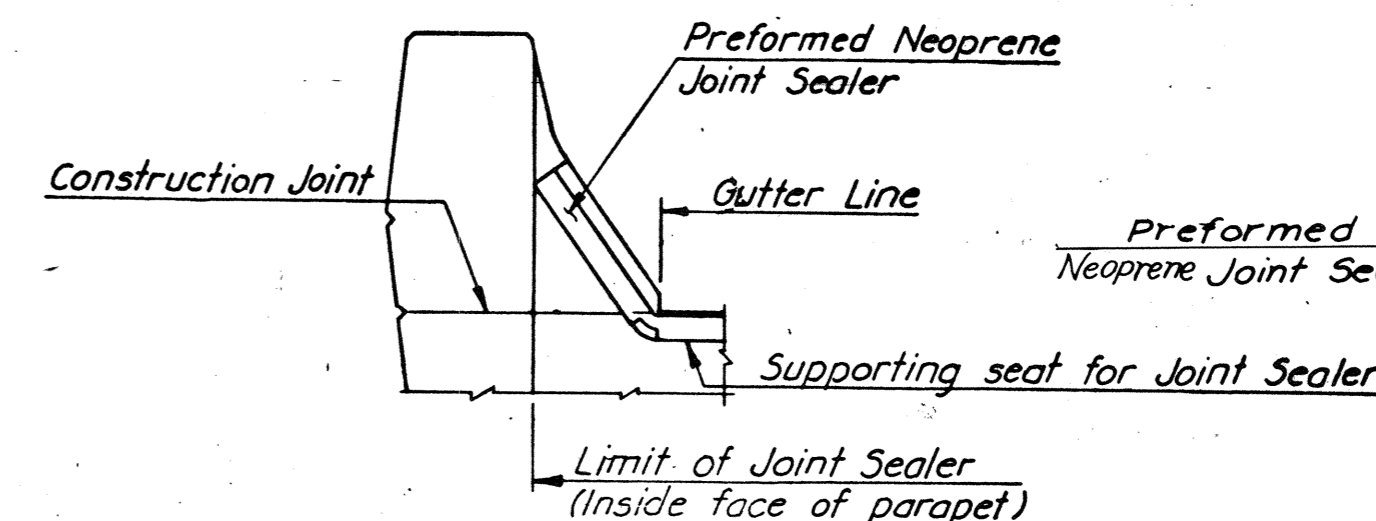


TREATMENT OF TYPE "A" JOINT AT GUTTER
PIERS 4,5,6,7,8 AND 9
No Scale

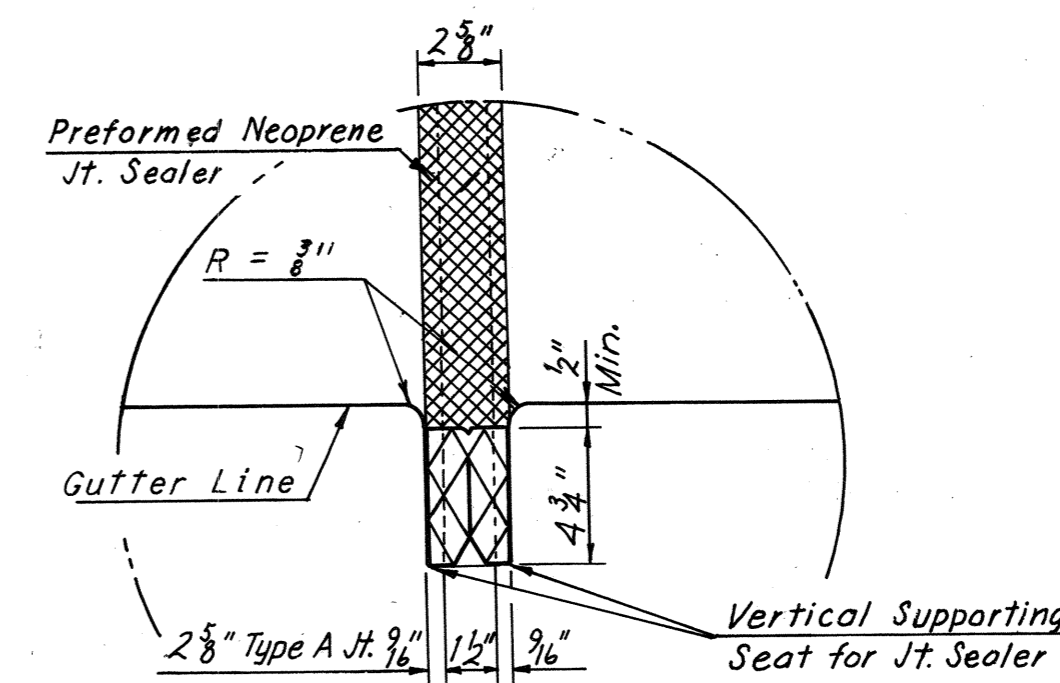


DETAIL B
No Scale

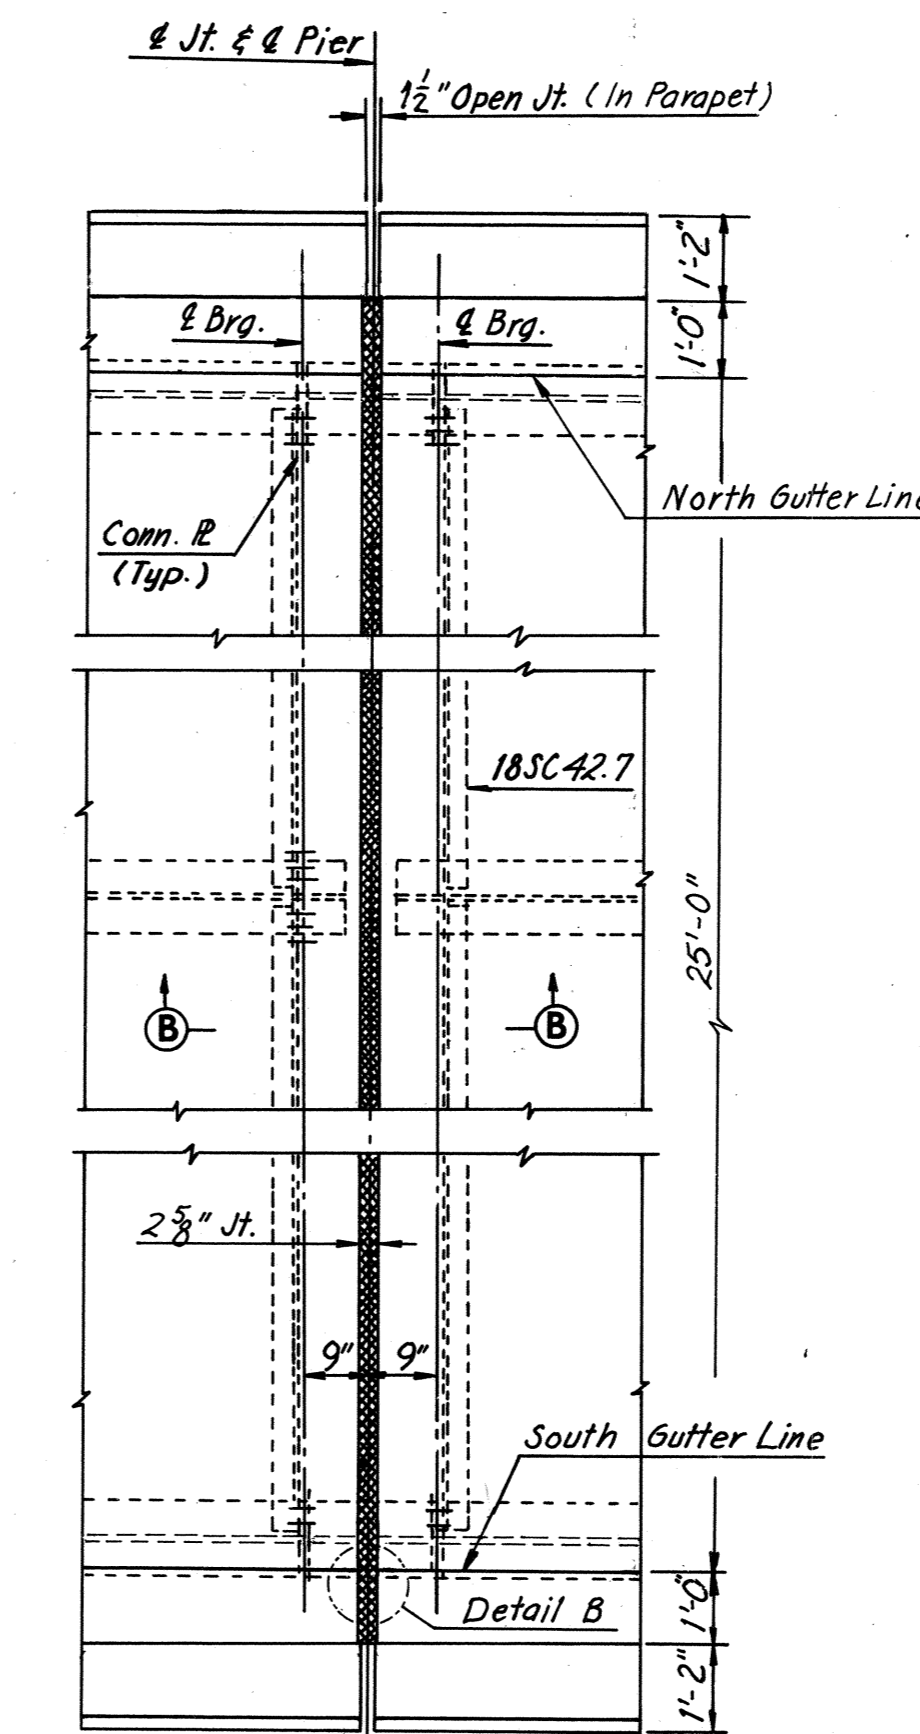

PLAN-JOINT AT PIERS 4, 5, 6, 7, 8 AND 9
Scale: 3/8"=1'-0"

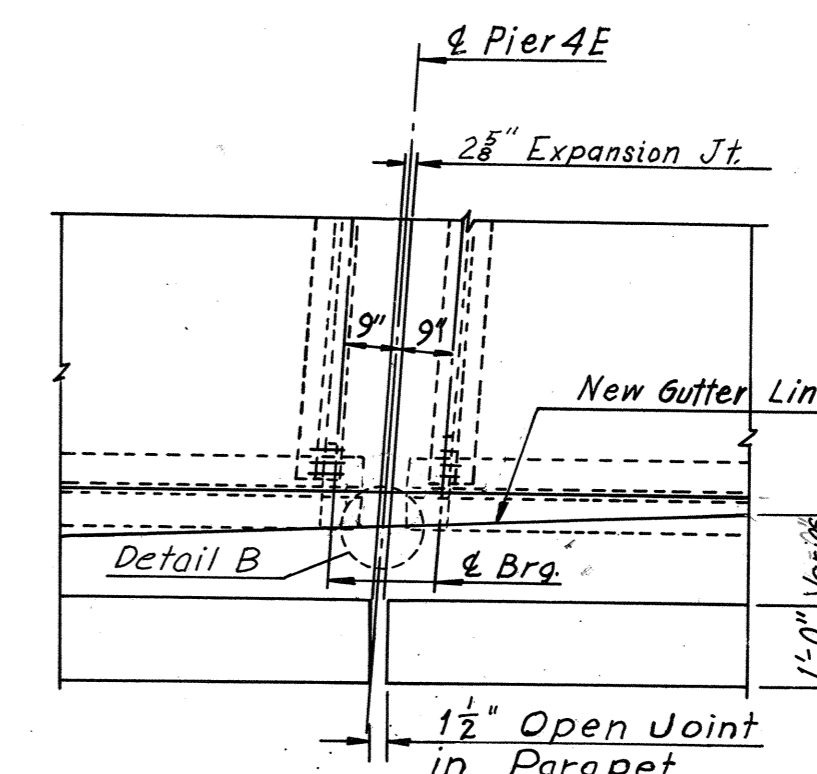


PLAN-JOINT AT PIER 4E
Scale: 3/8"=1'-0"

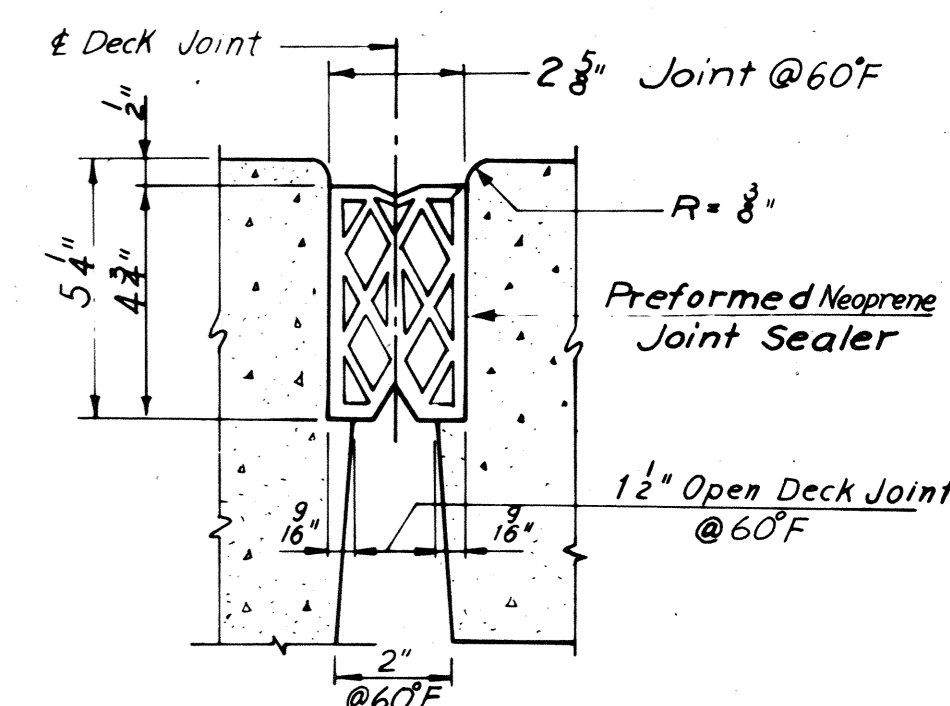

EXPANSION JOINT DETAILS


2 1/2" TYPE "A" JOINT

PREFORMED NEOPRENE JOINT SEALER FOR 2 1/2" TYPE "A" JOINT

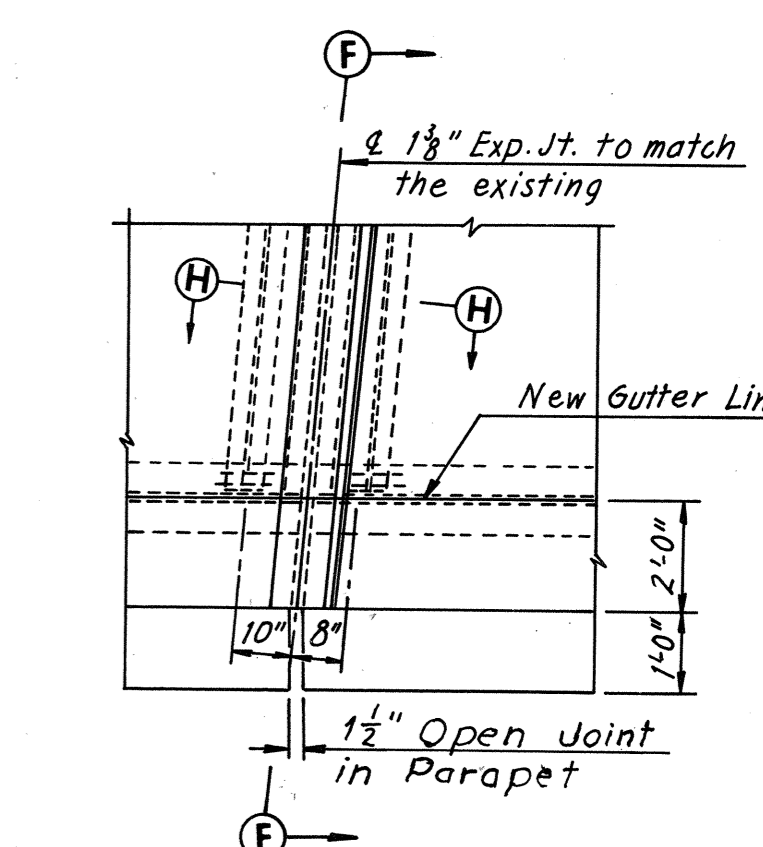

PLAN-JOINT AT EXISTING PIER 82
Scale: 3/8"=1'-0"

(For Section F-F & Section H-H, See Sheet 25)

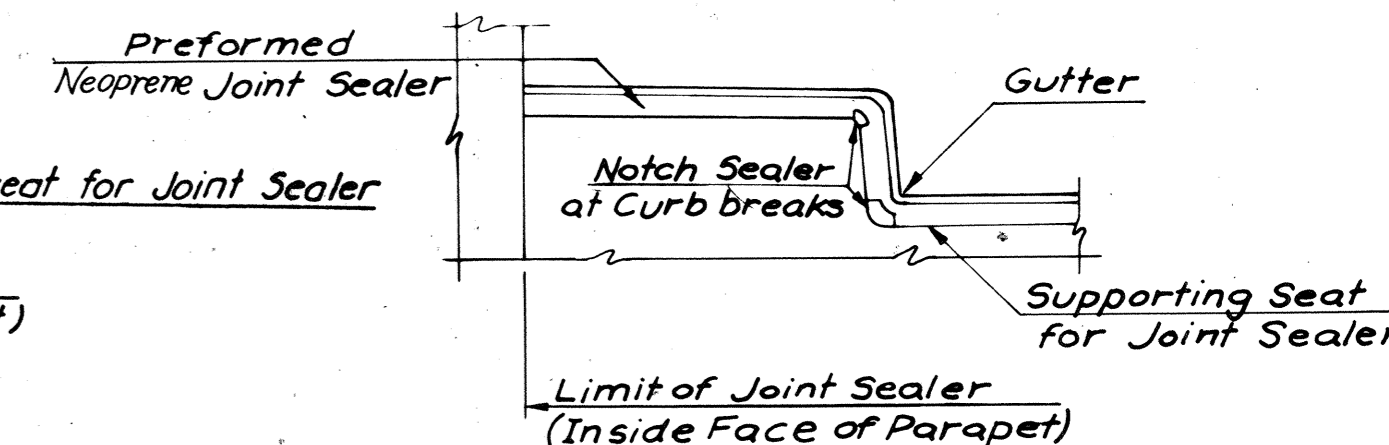

TREATMENT OF TYPE "A" JOINT AT CURB
PIER 4E
No Scale

BY	DATE	Z	As Built	TEM	G-77
MADE	Y.C.P. 3-18-69				
CHECKED	G.C.C. 4-21-69				
IN CHARGE					

RICHMOND METROPOLITAN AUTHORITY
RICHMOND EXPRESSWAY SYSTEM
DOWNTOWN EXPRESSWAY

BRIDGE NO. 64
RAMP N-W CONNECTION FROM
RICHMOND-PETERSBURG TURNPIKE
JOINT DETAILS

HOWARD, NEEDLES, TAMMEN & BERGENDOFF
consulting engineers
NEW YORK ALEXANDRIA KANSAS CITY

SCALE: *As Noted*
CONTRACT NO. **10**
SHEET NO. **26** OF **28**


AS BUILT

Bridge 65

(Ramp from Northbound I-95 to Westbound Downtown Expressway “Rte. 195” over NS RR and CSX RR)

Record Set Plans

RICHMOND EXPRESSWAY SYSTEM			
SECTION	PROJECT	SHEET NO.	TOTAL SHEETS
11	DOWNTOWN EXPRESSWAY	26	97

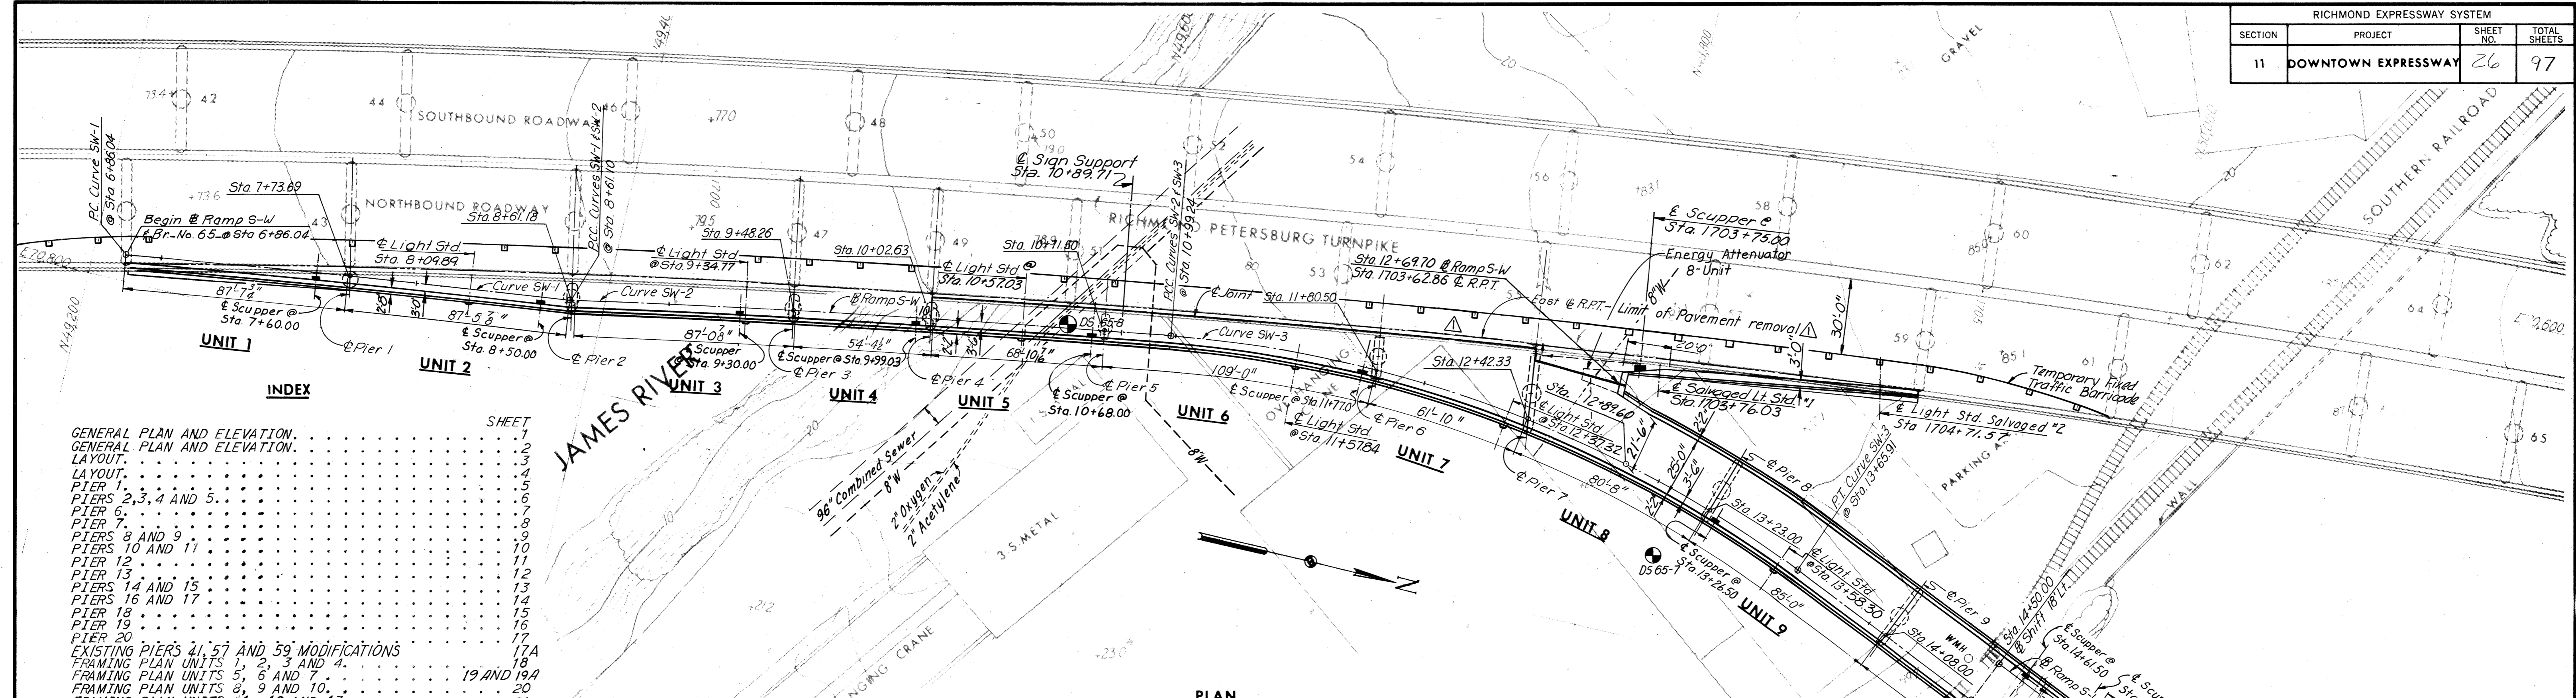


INDEX


GENERAL PLAN AND ELEVATION.....	SHEET 1
GENERAL PLAN AND ELEVATION LAYOUT.....	2
LAYOUT.....	3
PIER 1.....	4
PIERS 2, 3, 4 AND 5.....	5
PIER 6.....	6
PIERS 8 AND 9.....	7
PIERS 10 AND 11.....	8
PIER 12.....	9
PIER 13.....	10
PIERS 14 AND 15.....	11
PIERS 16 AND 17.....	12
PIER 18.....	13
PIER 19.....	14
PIER 20.....	15
EXISTING PIERS 21, 57 AND 59 MODIFICATIONS.....	17A
FRAMING PLAN UNITS 1, 2, 3 AND 4.....	18
FRAMING PLAN UNITS 5, 6 AND 7.....	19 AND 19A
FRAMING PLAN UNITS 8, 9 AND 10.....	20
FRAMING PLAN UNITS 11, 12 AND 13.....	21
FRAMING PLAN UNITS 14, 15 AND 16.....	22
FRAMING PLAN UNITS 17 AND 18.....	23
FRAMING PLAN UNITS 19 AND 20.....	24
DECK PLAN UNITS 1, 2, 3 AND 4.....	25
DECK PLAN UNITS 5, 6 AND 7.....	26
DECK PLAN UNITS 8, 9 AND 10.....	27
DECK PLAN UNITS 11, 12 AND 13.....	28
DECK PLAN UNITS 14, 15 AND 16.....	29
DECK PLAN UNITS 17 AND 18.....	30
DECK PLAN UNITS 19 AND 20.....	31
SUPERSTRUCTURE DETAILS.....	32
FIRE PROTECTION DETAILS (DELETED).....	33
JOINT DETAILS.....	34 AND 35
BORING LOGS.....	36 THRU 38
FRAMING PLAN UNITS 8 AND 8W.....	20A

PLAN

PROFILE GRADE DATA

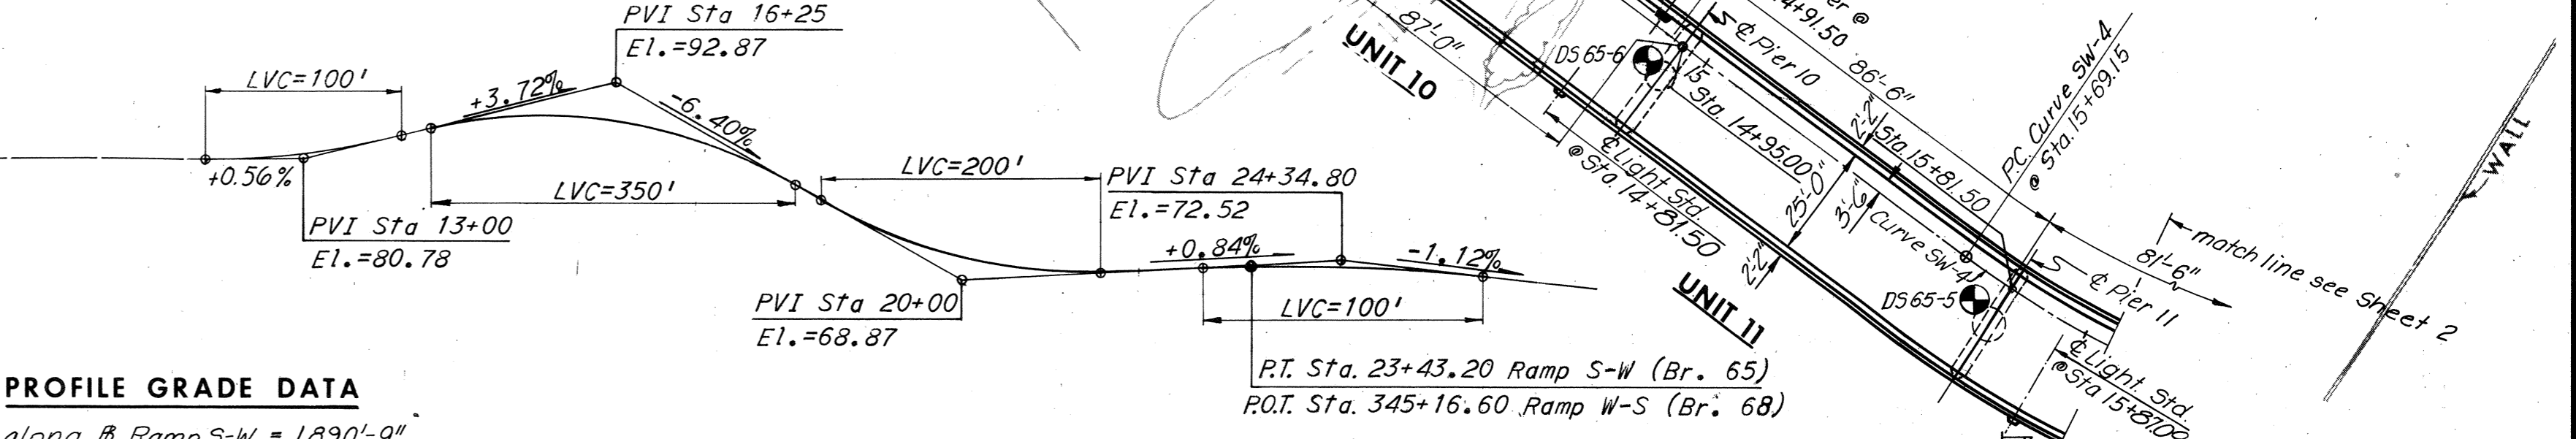


ELEVATION

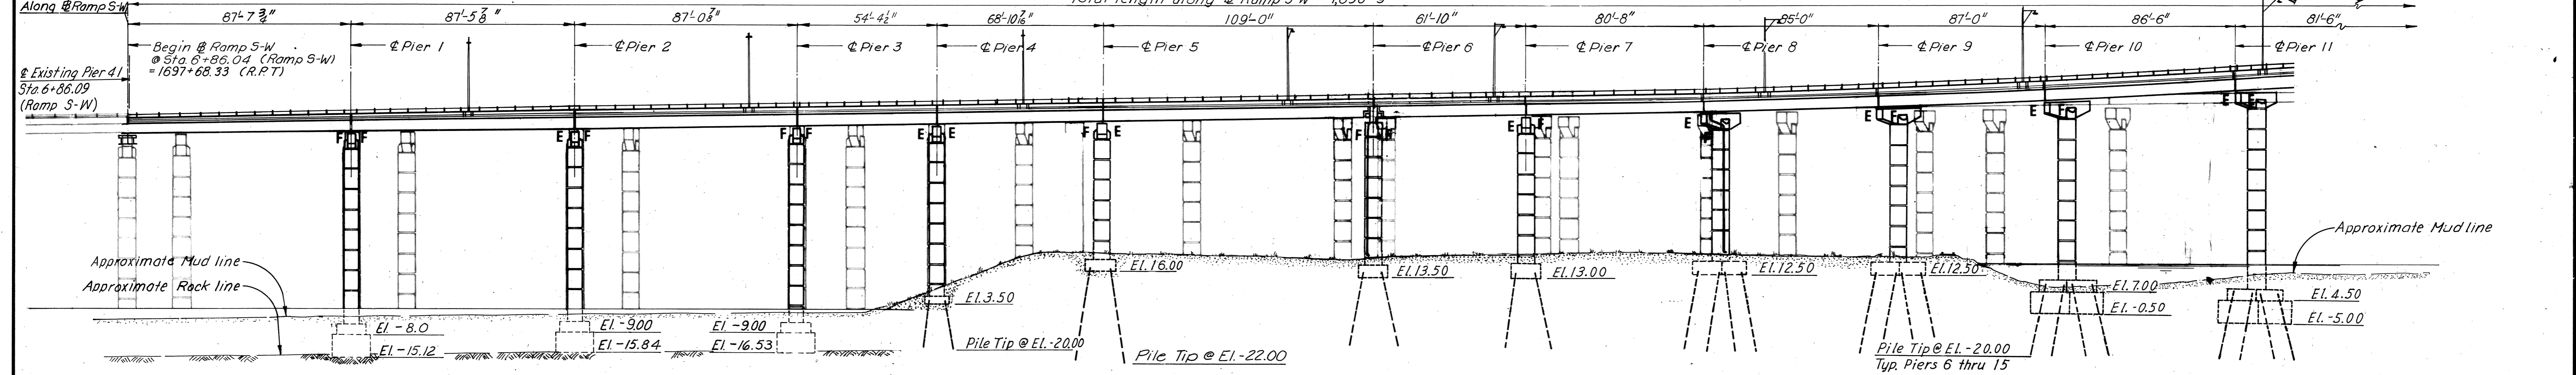

Notes:
 For General Plan and Elevation Units 12 thru 20 see Sheet 2.
 For Layout of Ramp S-W, see Sheets 3 and 4.
 For Estimated Quantities, see Sheet 4.
 For Boring Logs, see Sheets 36 thru 38.
 For General Notes, see Sheet 4.

NO.	REVISION	BY	DATE
1	Sheet 20a Added	TEM	9-9-75
2	Profile Ramp W-S	TEM	9-8-75
3	Limit of pavement removal & Sheet 17A added	DBP	8-25-75

Substructure Note: Footings for Piers 1, 2 and 3 shall be founded on concrete seals socketed 1'-0" into solid rock.

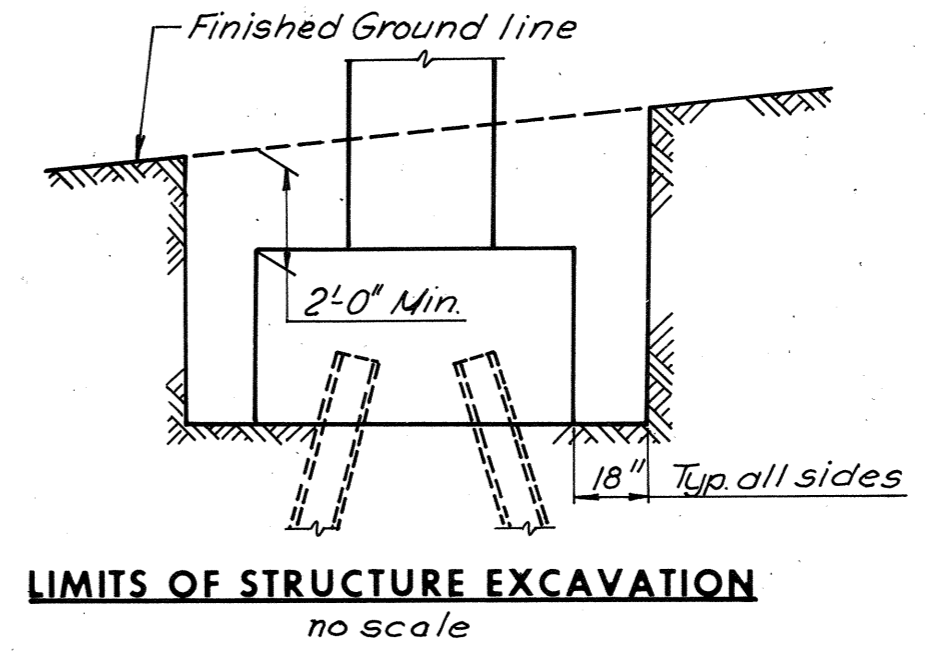

LIMITS OF STRUCTURE EXCAVATION
no scale

AS BUILT



RICHMOND METROPOLITAN AUTHORITY
RICHMOND EXPRESSWAY SYSTEM
DOWNTOWN EXPRESSWAY

BRIDGE NO. 65
RAMP S-W CONNECTION FROM
RICHMOND-PETERSBURG TURNPIKE
GENERAL PLAN AND ELEVATION

HOWARD, NEEDLES, TAMMEN & BERGENDOFF
 consulting engineers
 NEW YORK ALEXANDRIA KANSAS CITY

SCALE: 1"=30'-0"
 CONTRACT NO. 11
 SHEET NO. 1 OF 38

RICHMOND EXPRESSWAY SYSTEM			
SECTION	PROJECT	SHEET NO.	TOTAL SHEETS
11	DOWNTOWN EXPRESSWAY	27	97

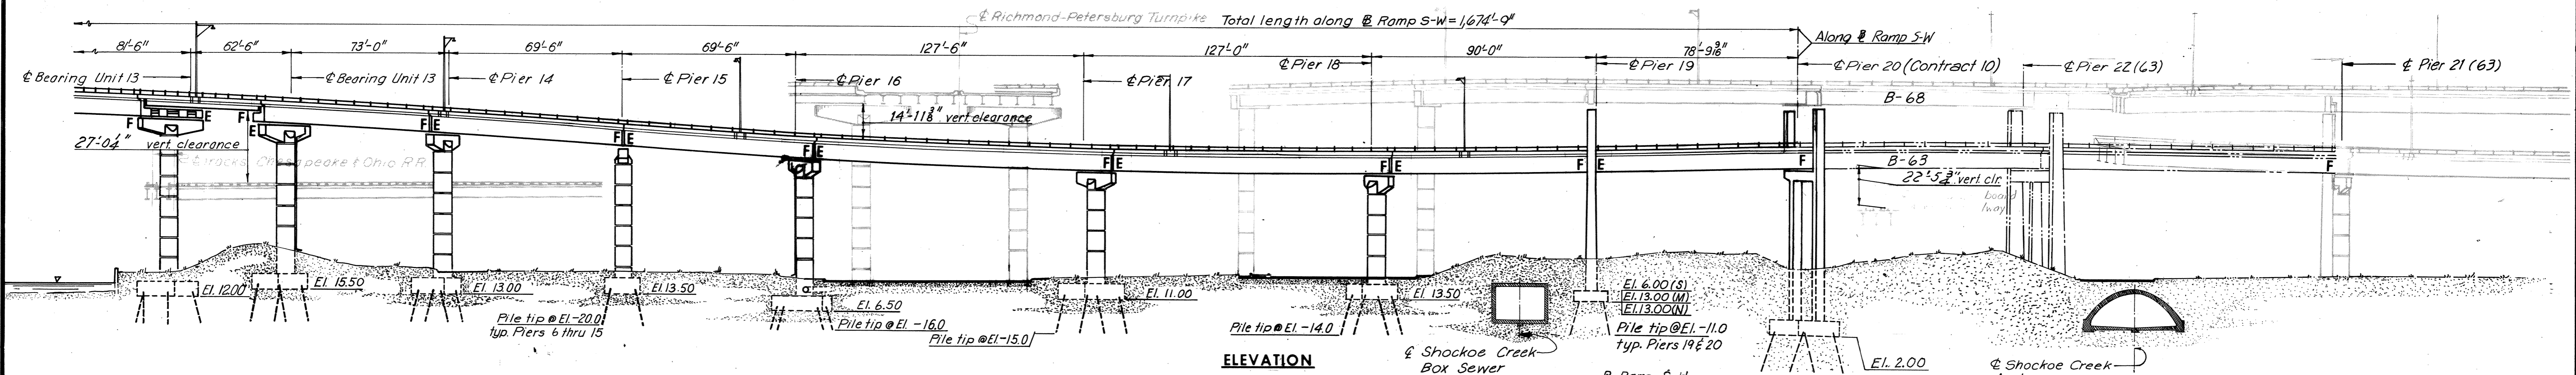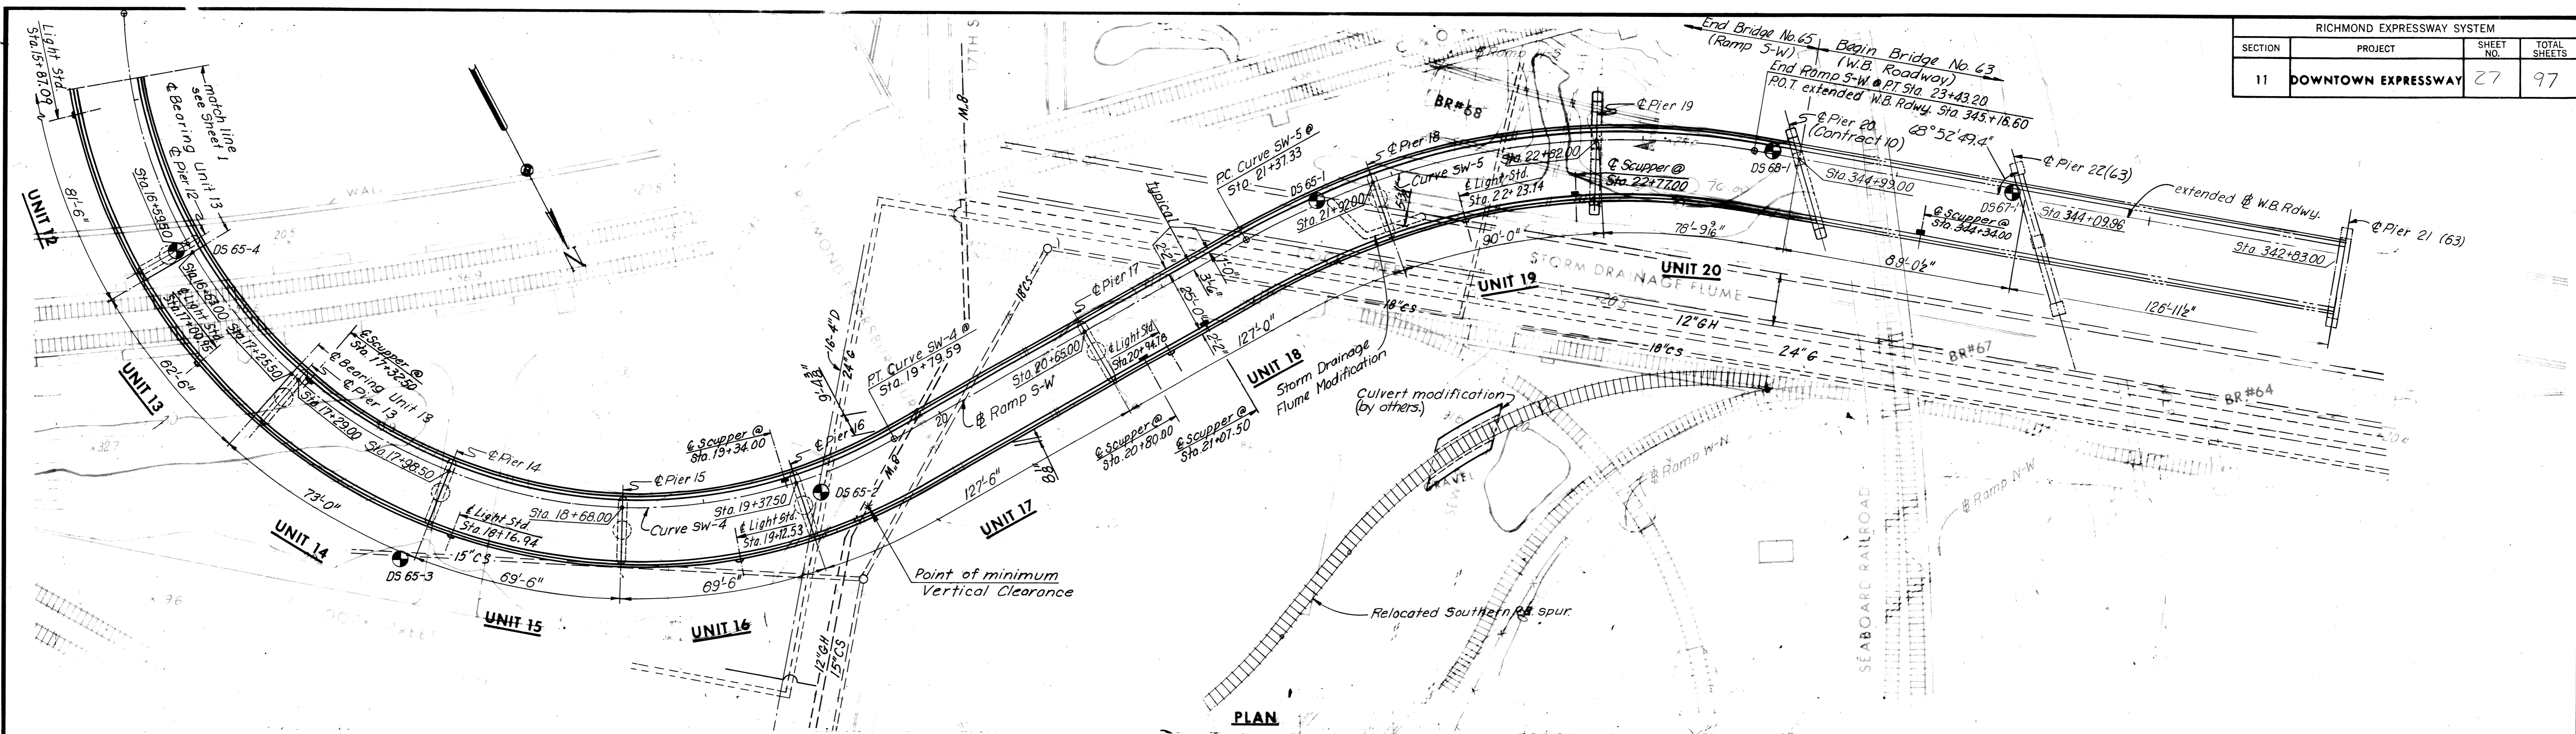

ELEVATION

<p>Curve: SW-1</p> <p>P.I. = Sta. 7+73.58 Δ = 1°45'02" D = 1°00' T = 87.53' L = 175.05' R = 5,729.58'</p>	<p>Curve: SW-2</p> <p>P.I. = Sta. 9+80.19 Δ = 2°24'12" D = 1°00'33" T = 119.09' L = 238.14' R = 5,677.58'</p>	<p>Curve: SW-3</p> <p>P.I. = Sta. 12+36.15 Δ = 3°00'00" D = 1°00' T = 136.91' L = 266.67' R = 477.47'</p>
---	---	---

<p>Curve: SW-4</p> <p>P.I. = Sta. 18+95.05 Δ = 11°25'03" D = 28°21'51" T = 325.90' L = 410.44' R = 202.00'</p>	<p>Curve: SW-5</p> <p>P.I. = Sta. 22+44.51 Δ = 39°19'04" D = 19°05'55" T = 107.17' L = 205.87' R = 300.00'</p>
--	--

@ Richmond-Petersburg Turnpike	
<p>Curve: R.P.T.-1</p> <p>P.I. = Sta. 1704+68.83 Δ = 15°03'56" D = 1°00' T = 757.65' L = 1,506.56' R = 5,729.58'</p>	<p>Curve: R.P.T.-2</p> <p>P.I. = Sta. 1723+07.01 Δ = 33°27'07" D = 4°00' T = 430.45' L = 836.30' R = 1,432.39'</p>

Notes:
 For General Plan and Elevation Units 1 thru 11, see Sheet 1.
 For Layout of Ramp S-W, see Sheets 3 and 4.
 For Estimated Quantities, see Sheet 4.
 For Boring Logs, see Sheets 36 thru 38.
 For General Notes, see Sheet 4.

HORIZONTAL CURVE DATA

AS BUILT

RICHMOND METROPOLITAN AUTHORITY
RICHMOND EXPRESSWAY SYSTEM
DOWNTOWN EXPRESSWAY


BRIDGE NO. 65
RAMP S-W CONNECTION FROM
RICHMOND-PETERSBURG TURNPIKE
GENERAL PLAN AND ELEVATION

HOWARD, NEEDLES, TAMMEN & BERGENDOFF
 consulting engineers
 NEW YORK ALEXANDRIA KANSAS CITY

SCALE: 1"=30'-0"
 CONTRACT NO. 11
 SHEET NO. 2 OF 38

BY	DATE				
MADE	J.V.	4-2-69			
CHECKED	K.C.P.	5-28-69			
IN CHARGE			NO.	REVISION	BY DATE

RICHMOND EXPRESSWAY SYSTEM			
SECTION	PROJECT	SHEET NO.	TOTAL SHEETS
11	DOWNTOWN EXPRESSWAY	28	97

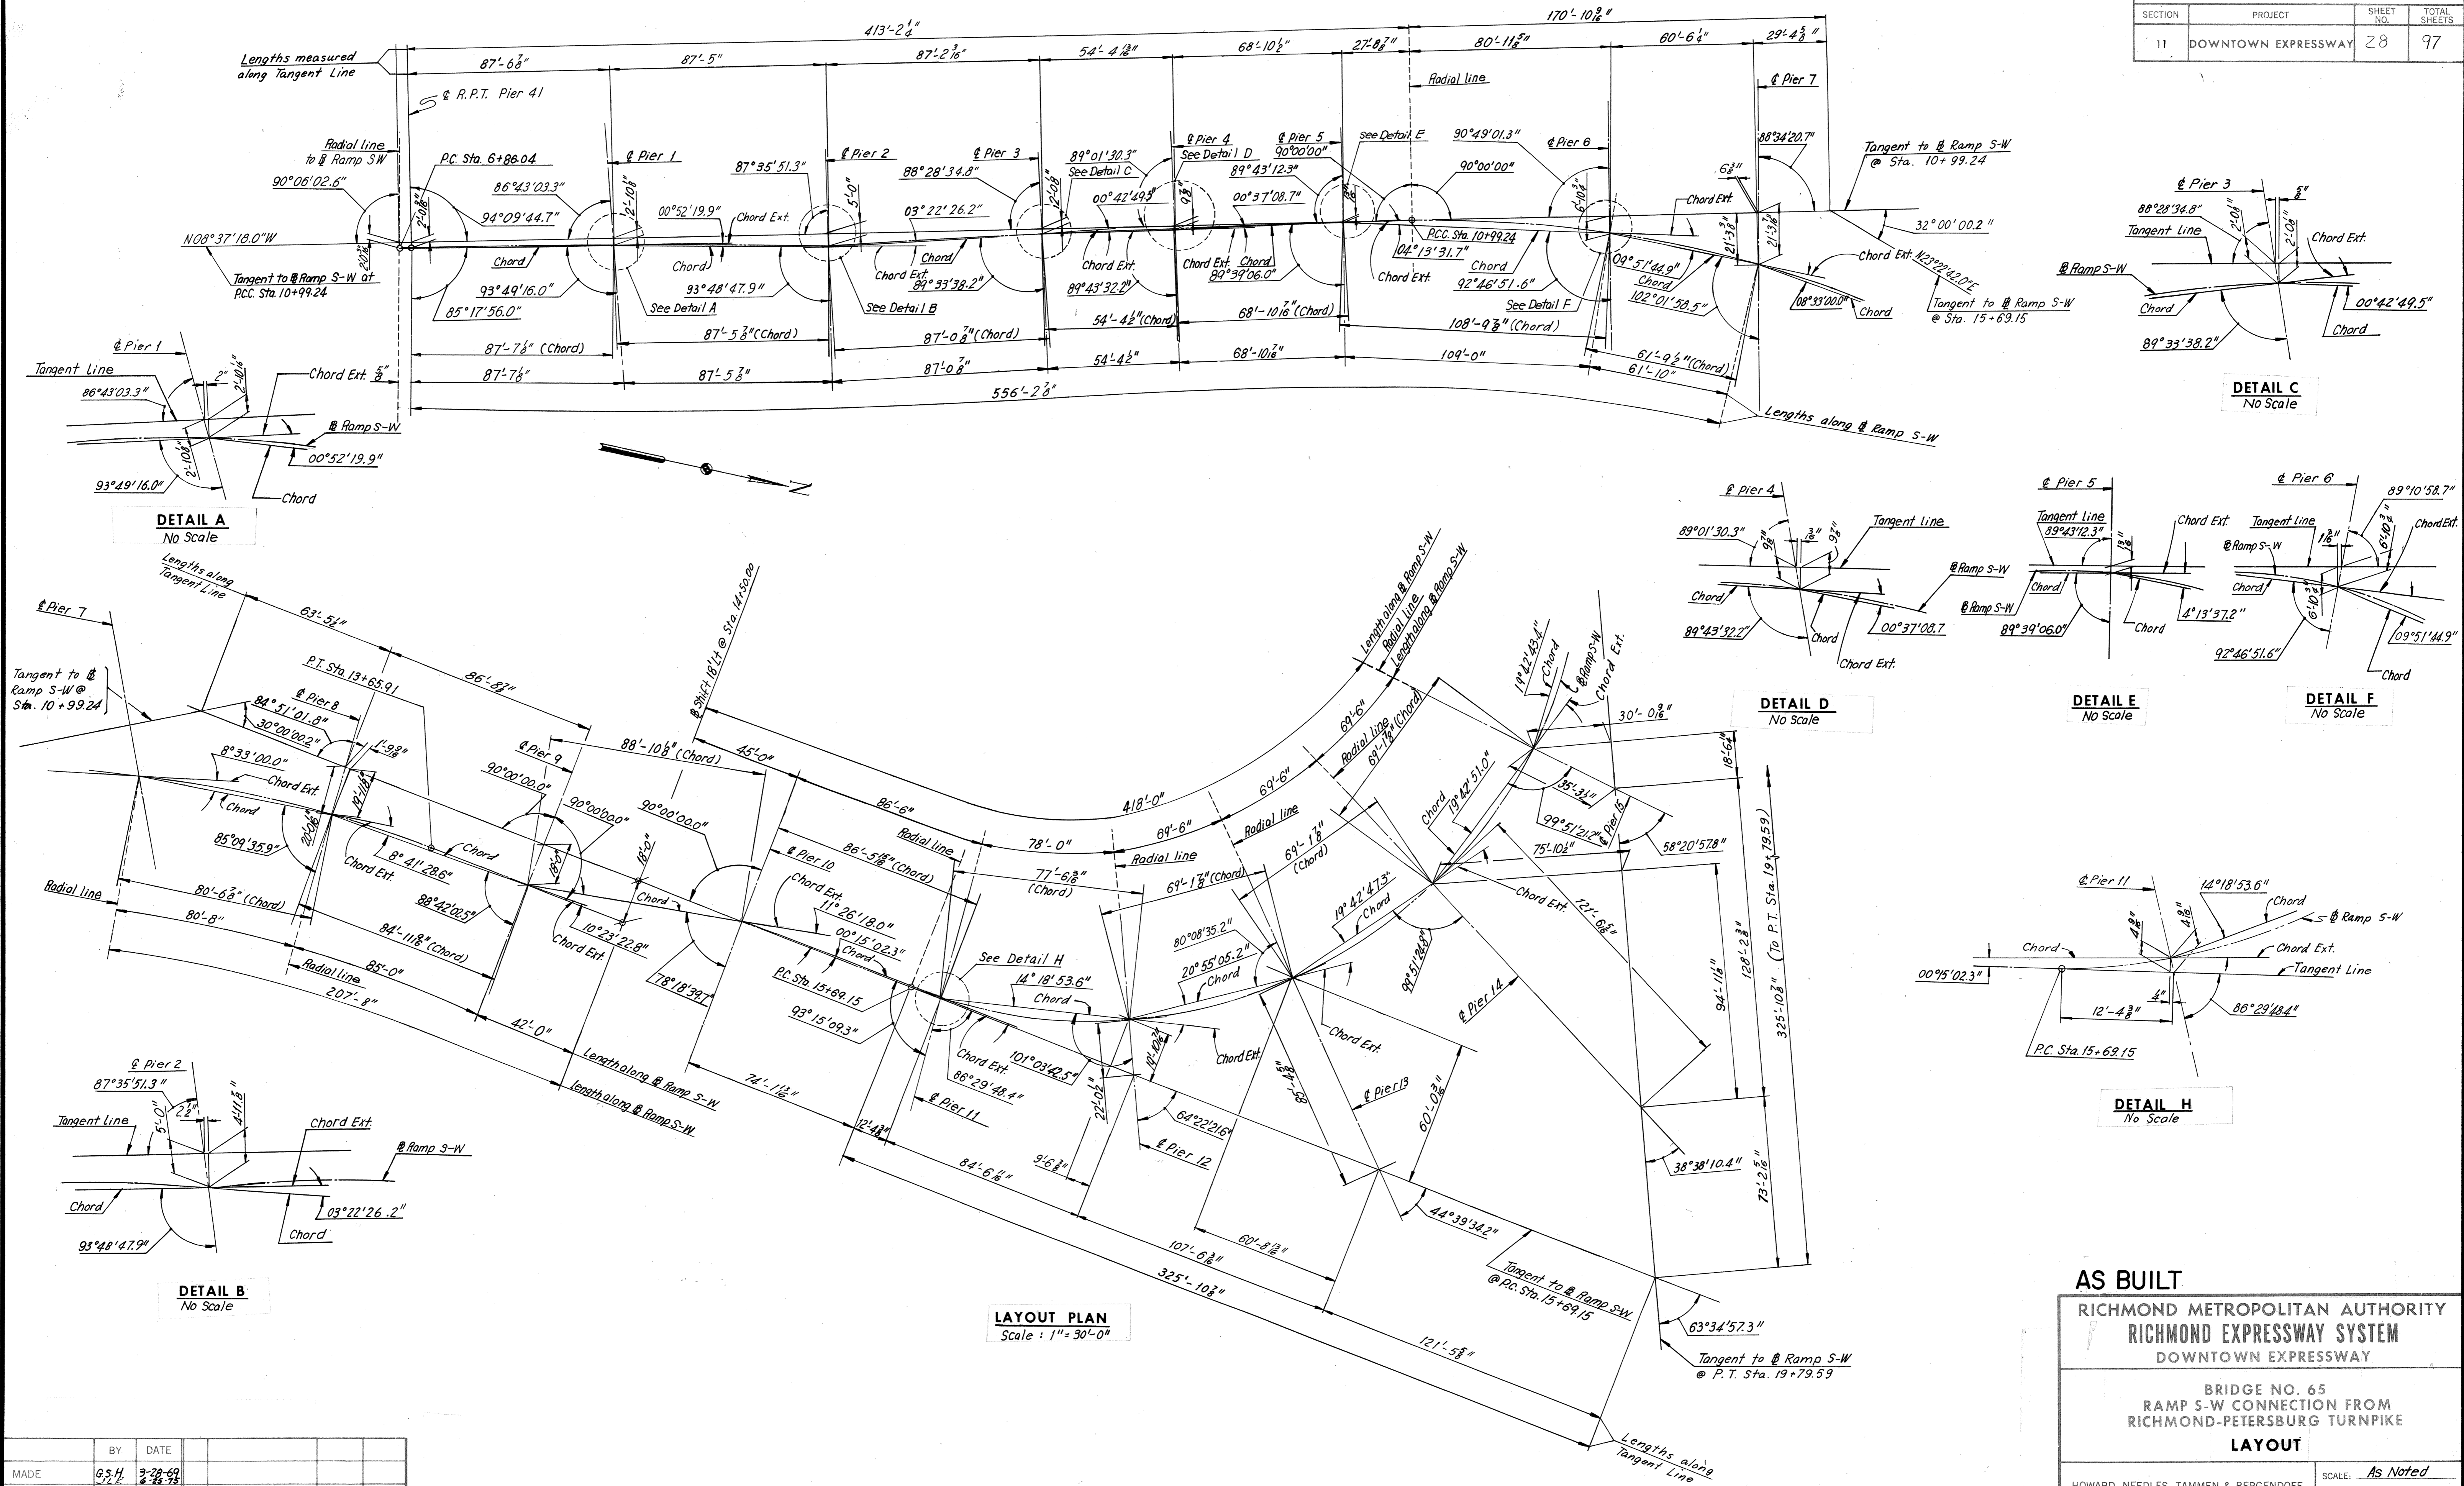

BY	DATE				
MADE	G.S.H.	3-28-69			
CHECKED	K.C.T.	5-7-69			
IN CHARGE	C.W.S.	7-7-72			
NO.	REVISION	BY	DATE		

AS BUILT

RICHMOND METROPOLITAN AUTHORITY
RICHMOND EXPRESSWAY SYSTEM
DOWNTOWN EXPRESSWAY





BRIDGE NO. 65
RAMP S-W CONNECTION FROM
RICHMOND-PETERSBURG TURNPIKE

LAYOUT

HOWARD, NEEDLES, TAMMEN & BERGENDOFF
consulting engineers
NEW YORK ALEXANDRIA KANSAS CITY

SCALE: As Noted
CONTRACT NO. 11
SHEET NO. 3 OF 38

RICHMOND EXPRESSWAY SYSTEM			
SECTION	PROJECT	SHEET NO.	TOTAL SHEETS
11	DOWNTOWN EXPRESSWAY	29	97

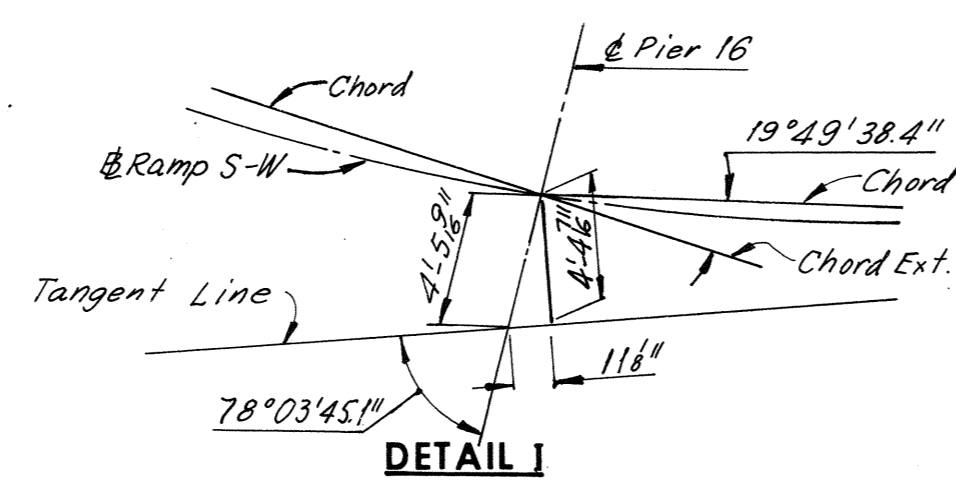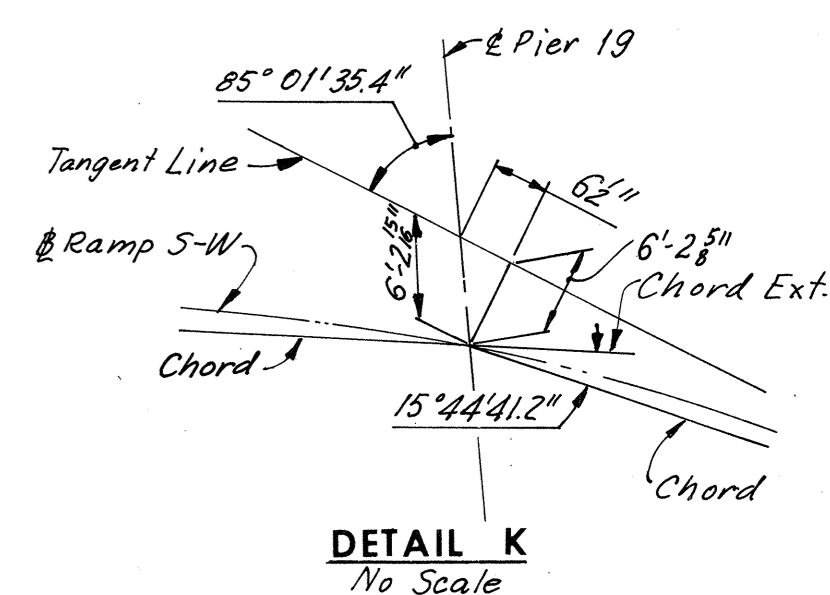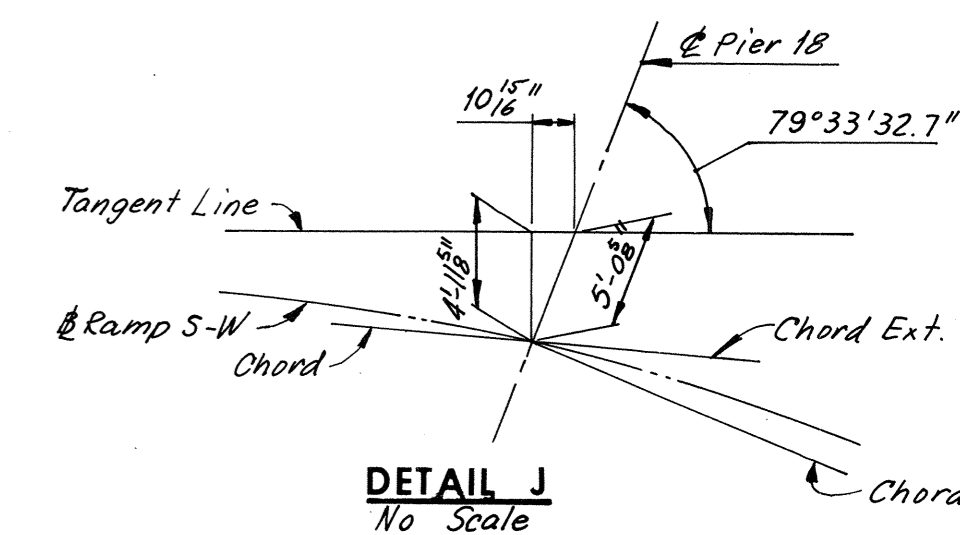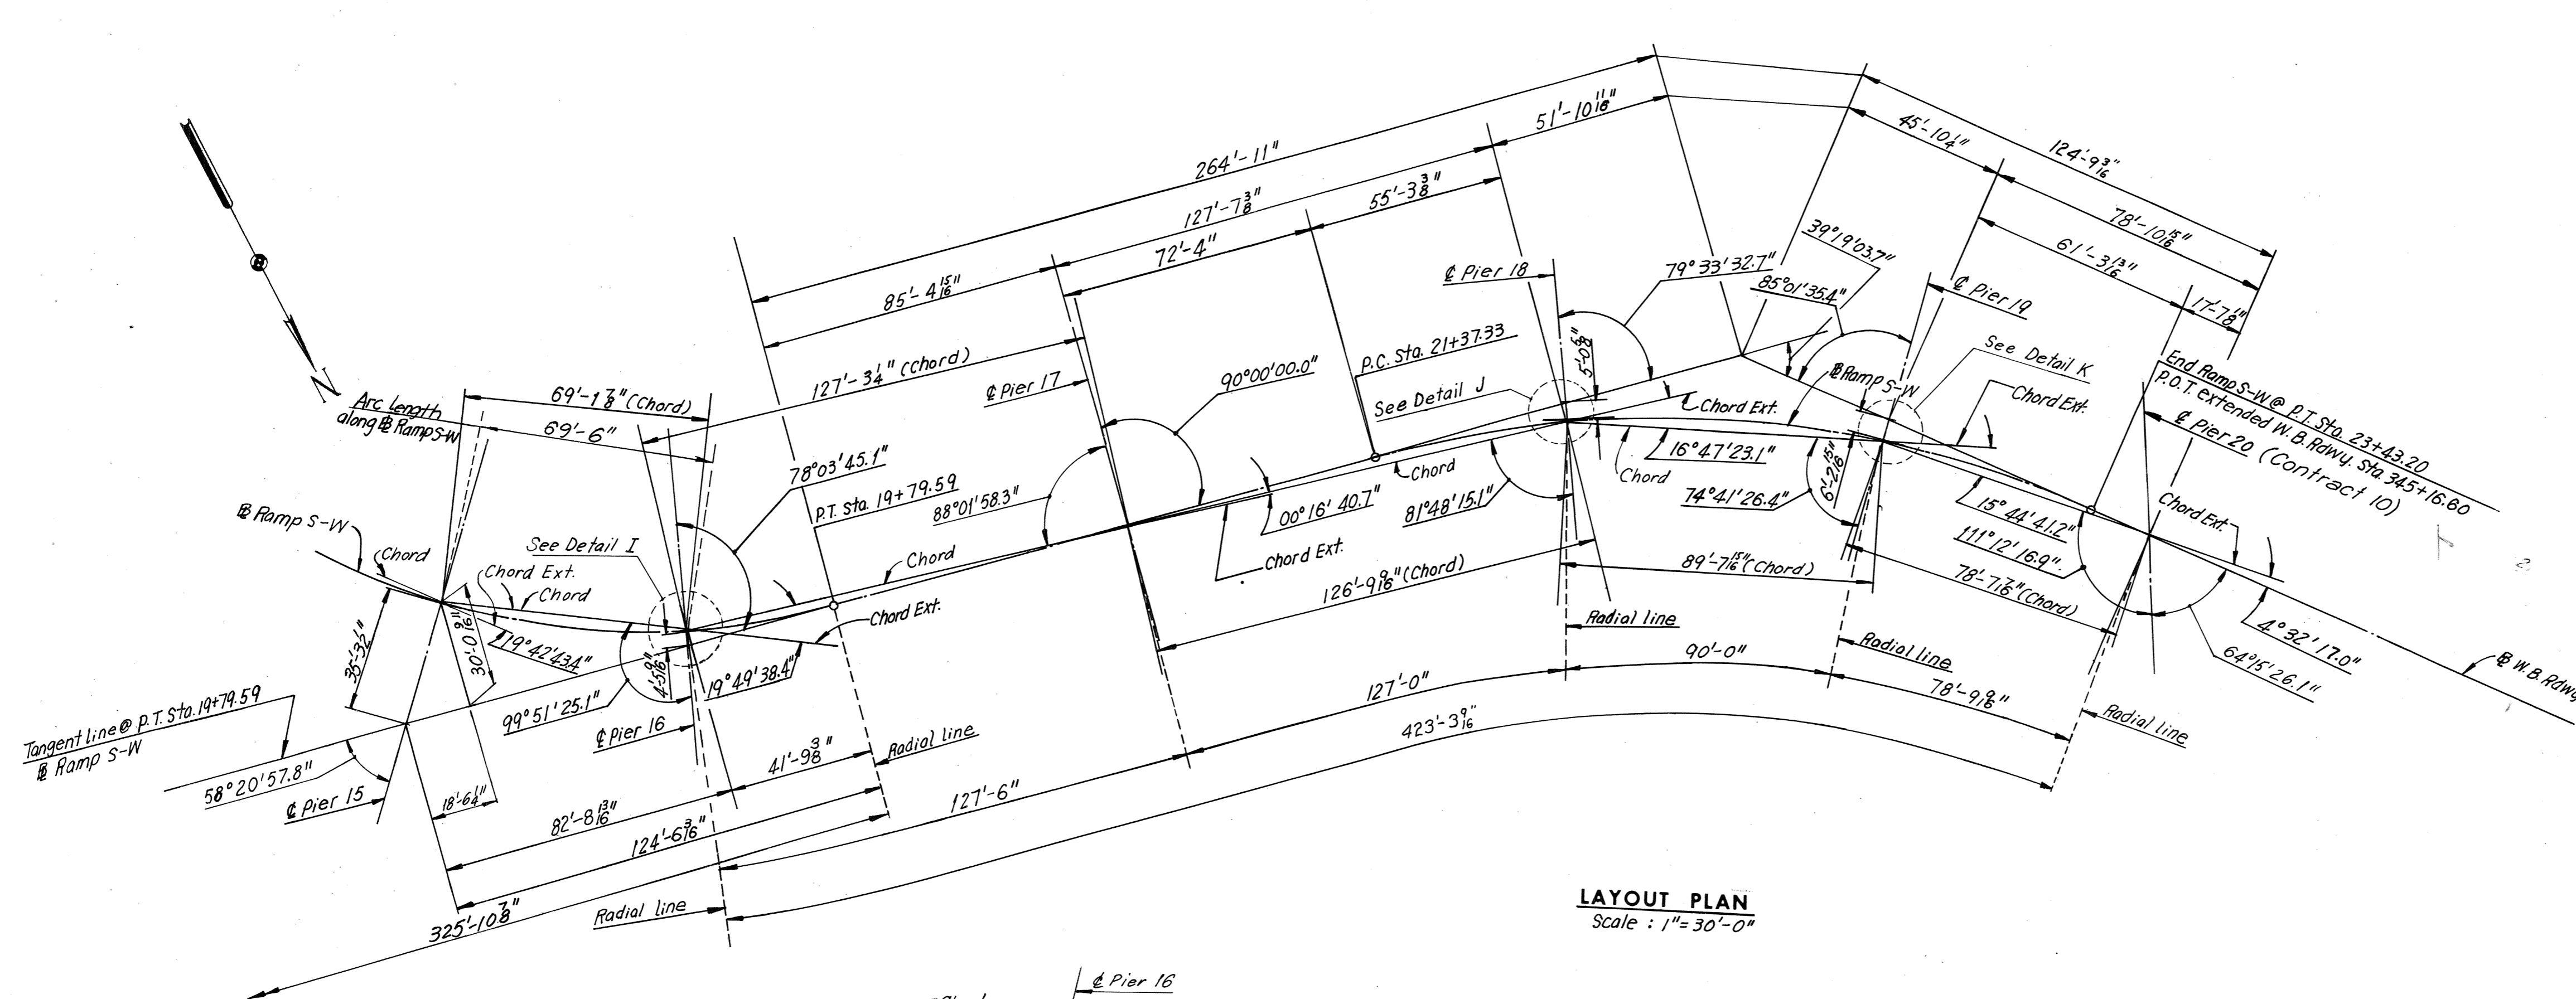

LAYOUT PLAN
Scale: 1"=30'-0"

ESTIMATED QUANTITIES

	Structure Excavation Cu. Yds.	Concrete (±) Cu. Yds.	Reinforcing Steel Lbs.	Str. Steel Mild Carbon Lbs.	Str. Steel High Strength Lbs.	Aluminum Rolling (1-Rail) Lin. Ft.	Steel Piles 10BP42 Lin. Ft.	Steel Piles 12BP53 Lin. Ft.
Superstructure	---	1454.8	340,730	1,074,600	476,400	2,820	---	---
Substructure	2,741 *	2,702.8	386,910	15,100	12,000	---	1,152	7,497
Total	2,741 *	4157.6 †	727,640	1,089,700	488,400	2,820	1,152	7,497

	Temporary Barricade Lin. Ft.	Tremie Concrete Class T3 Cu. Yds.	Metal Conduit Lin. Ft.	Energy Attenuator 8-Unit Each	Modifications To R.P. Turn pike Bridge Lump Sum	Bridge Drainage Metal Work Lbs.	Modifications to Storm Drain. Flume Cu. Yds.	Pipe Support @ Pier 16 Lump Sum
Superstructure	---	---	1800	1	1	19,960	48	---
Substructure	---	472.6	---	---	---	---	---	1
Total	---	840	472.6	1800	1	19,960	48	1

GENERAL NOTES:

ROADWAY: One 25'-0" clear roadway transitioning into a 13'-6" widening of existing Richmond-Petersburg Turnpike.

CAPACITY: Dead load includes 15 lbs. per sq. ft. for future wearing surface. Live load HS 20-44 loading and alternate military loading.

SPECIFICATIONS:

GENERAL: Virginia Department of Highway Road and Bridge Specifications 1970.
DESIGN: A.A.S.H.O. Standard Specifications for Highway Bridges 1973, modified by Special Design provisions.
WELDING: 1972 Structural Welding Code of the American Welding Society.
CONTRACT SPECIAL PROVISIONS: Specifications and Contract Special Provisions referred to above are necessary to make these plans complete.

DATUM:

City of Richmond

TEMPERATURE:

The normal temperature referred to in the plans is 60°F. The temperature range for movement is 0°F to 120°F.

DIMENSIONS:

All dimensions are measured horizontally and vertically unless otherwise noted.

EXCAVATION:

Excavation below subgrade and cut slope template shall be classified as Structure Excavation. All excavation above these limits shall be classified as Regular Excavation and is not included in the Structural Quantities.

Foundations:

Footings shall rest on firm material. Foundation material shall be dry and special attention is called to Section 401.05 of General Specifications and to the Contract Special Provisions concerning preparation of foundations for footings. Concrete in superstructure shall be Class A4. All other concrete shall be Class A3 except that footing seals shall be Tremie Concrete Class T3 as indicated on the detailed drawings. All exposed edges and corners shall have a 1/4" chamfer or fillet unless otherwise noted. Care in the method of vibration, the use of low-slump concrete, and or other means shall be employed to prevent downgrade movement of newly placed slab concrete. Finishing Concrete Surfaces: See Standard Architectural Detail Sheets and the Contract Special Provisions for types and details. All reinforcing steel shall be deformed bars conforming to ASTM A615 Grade 40. All reinforcing bar dimensions on the detailed drawings are to centers of bars unless otherwise noted. Clear distance between reinforcing steel and face of concrete shall be as noted on the plans. All bar laps shall be 30 diameters of the smaller diameter bar unless otherwise noted.

Steel Notes:

Structural steel shall conform to A.S.T.M. Designations A36, A572-Grade 50 and A588 as noted. See Special Provisions. All field connections shall be made with high strength bolts. High strength bolts shall be 1/2" diameter unless otherwise noted and shall conform to A.S.T.M. Specification A-325.

* Including 757 Cu. Yds. of "Underwater" Excavation for Piers 1, 2, 3, 10 and 11.

† All Concrete for Superstructure shall be Class A4 and for Substructure Class A3. Concrete for footing seals shall be Tremie Concrete Class T3 and is listed separately.

BY	DATE	Conc. & Reinf. Quant.	TEM	DATE
MADE	G.S.H. 3-28-69	Layout Dim. and % at Pier 16	TEM	7-76
CHECKED	K.C.T. 5-7-69	Concrete & Struc. Steel Quant.	TEM	8-75
IN CHARGE	NO.	REVISION	BY	DATE

AS BUILT







RICHMOND METROPOLITAN AUTHORITY
RICHMOND EXPRESSWAY SYSTEM
DOWNTOWN EXPRESSWAY

BRIDGE NO. 65
RAMP S-W CONNECTION FROM
RICHMOND-PETERSBURG TURNPIKE
LAYOUT

HOWARD, NEEDLES, TAMMEN & BERGENDOFF
consulting engineers
NEW YORK ALEXANDRIA KANSAS CITY

SCALE: As Noted
CONTRACT NO. 11
SHEET NO. 4 OF 38

RICHMOND EXPRESSWAY SYSTEM			
SECTION	PROJECT	SHEET NO.	TOTAL SHEETS
11	DOWNTOWN EXPRESSWAY	35	97

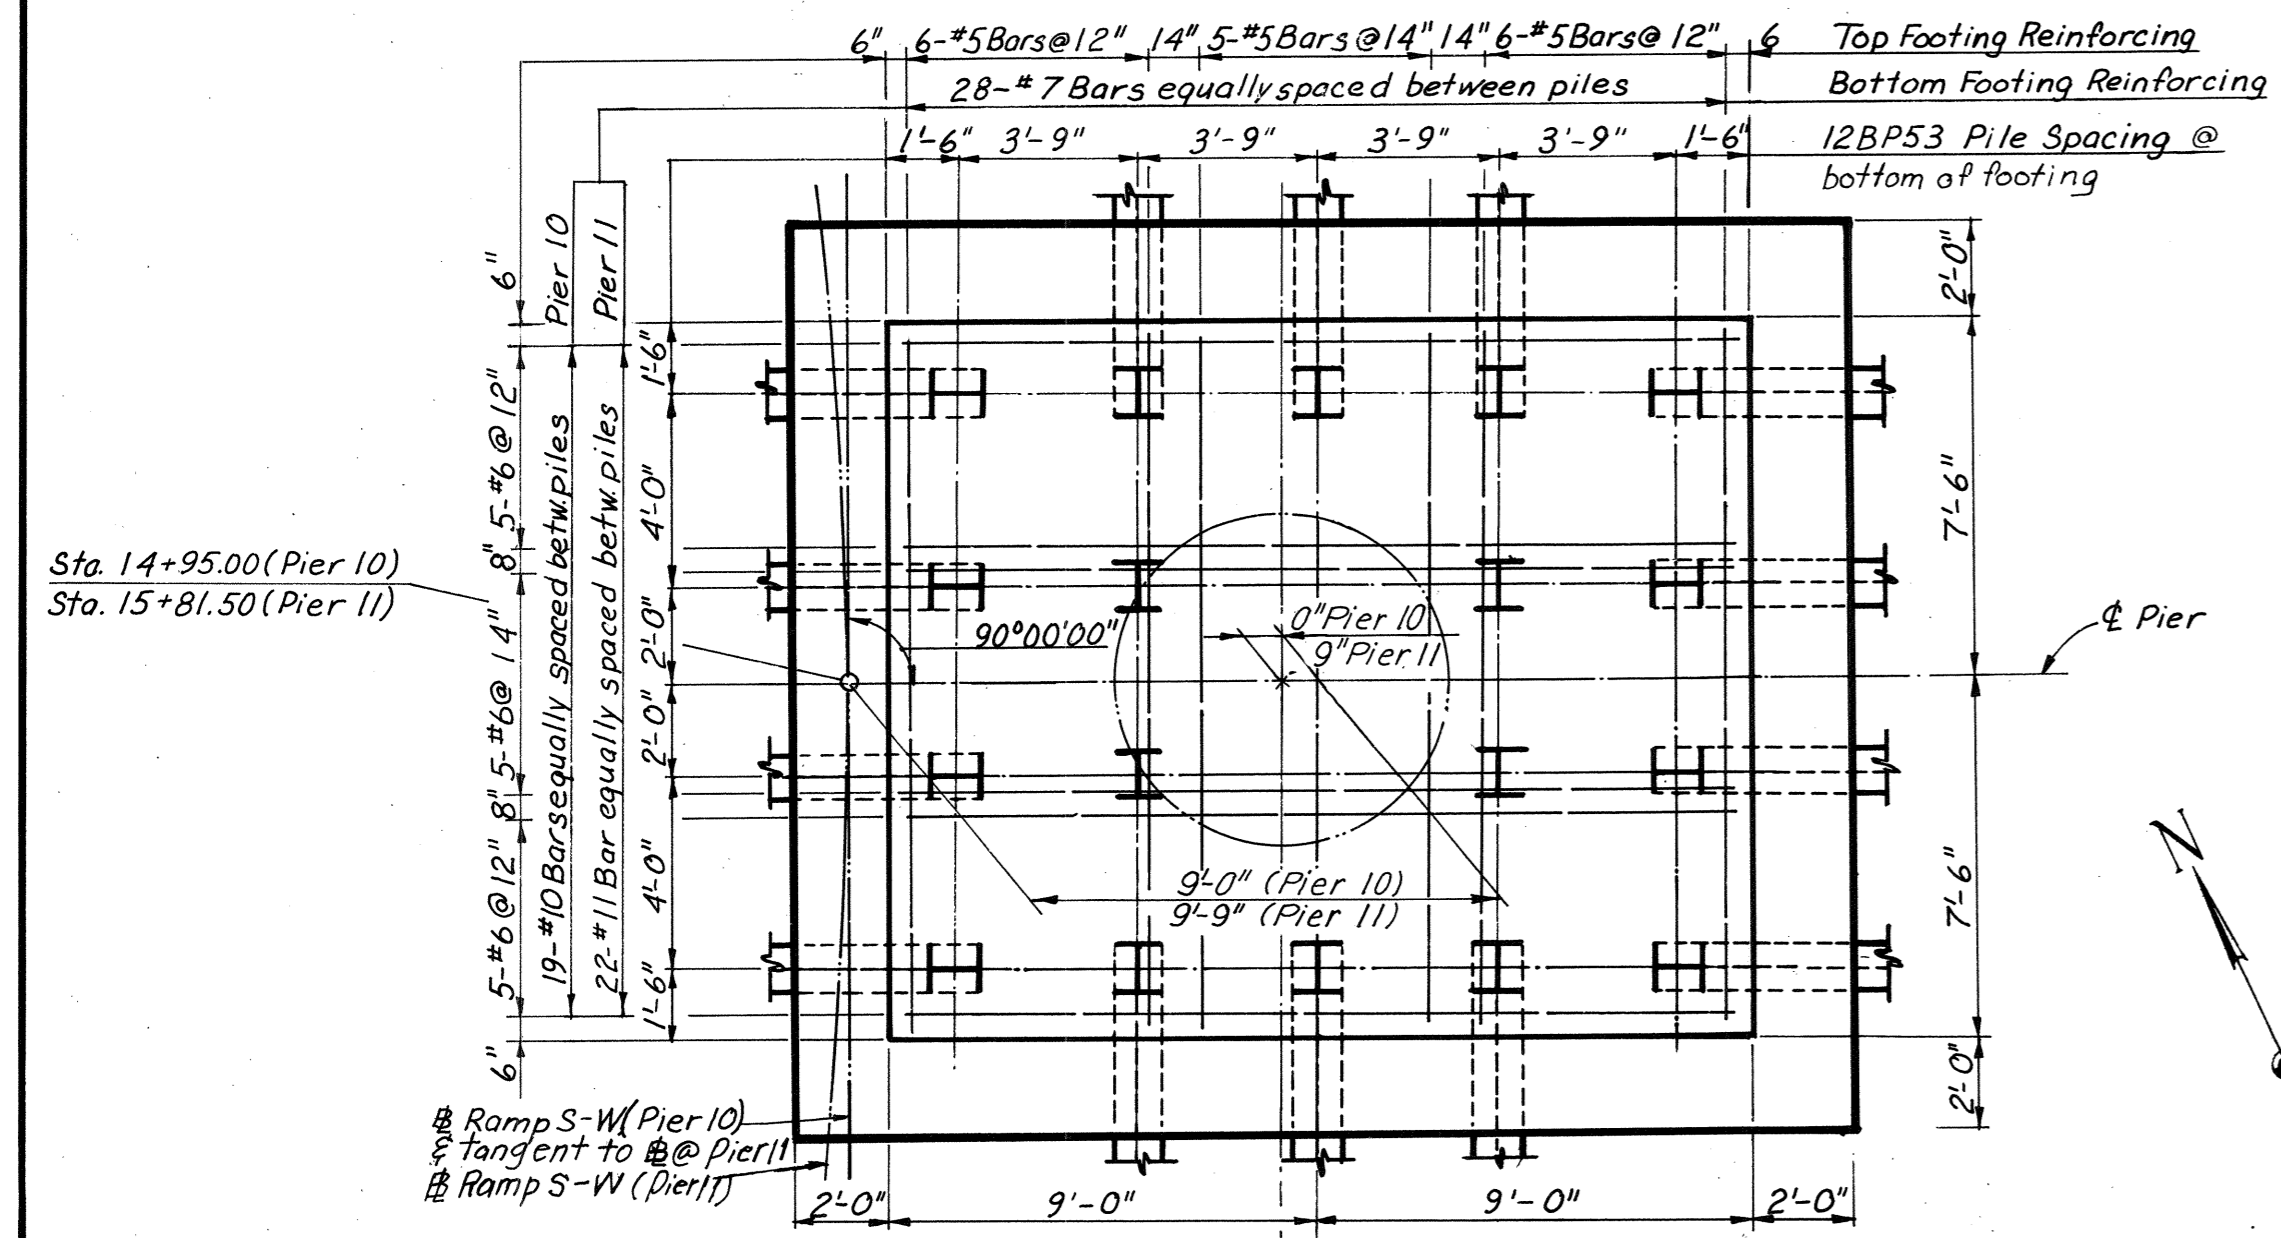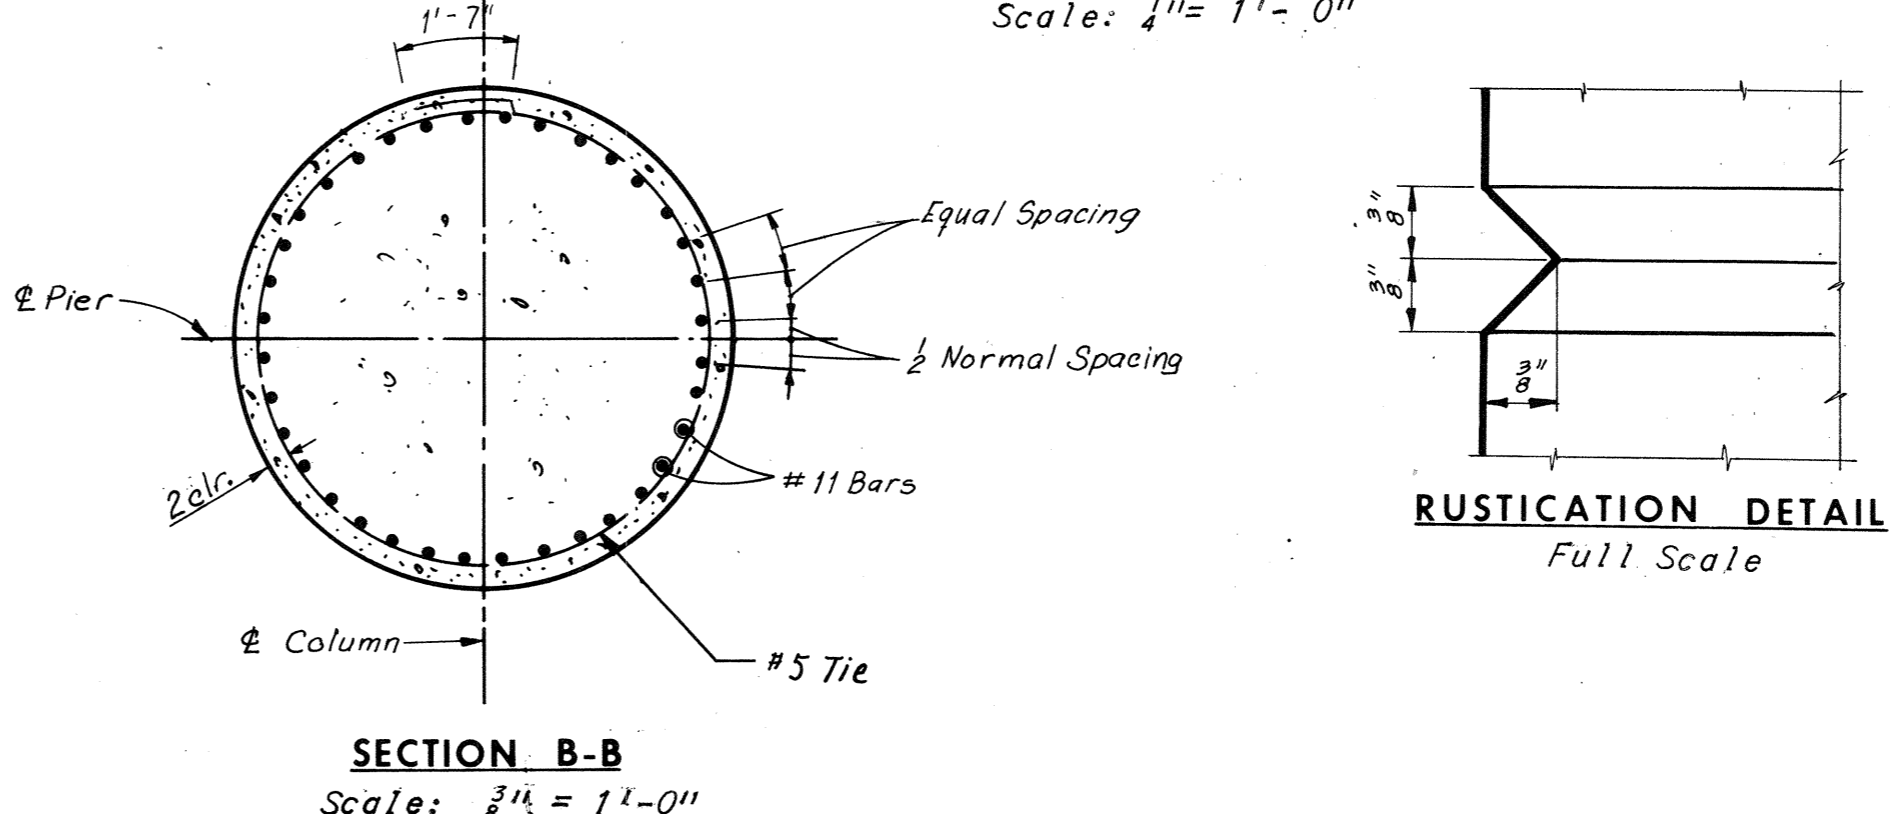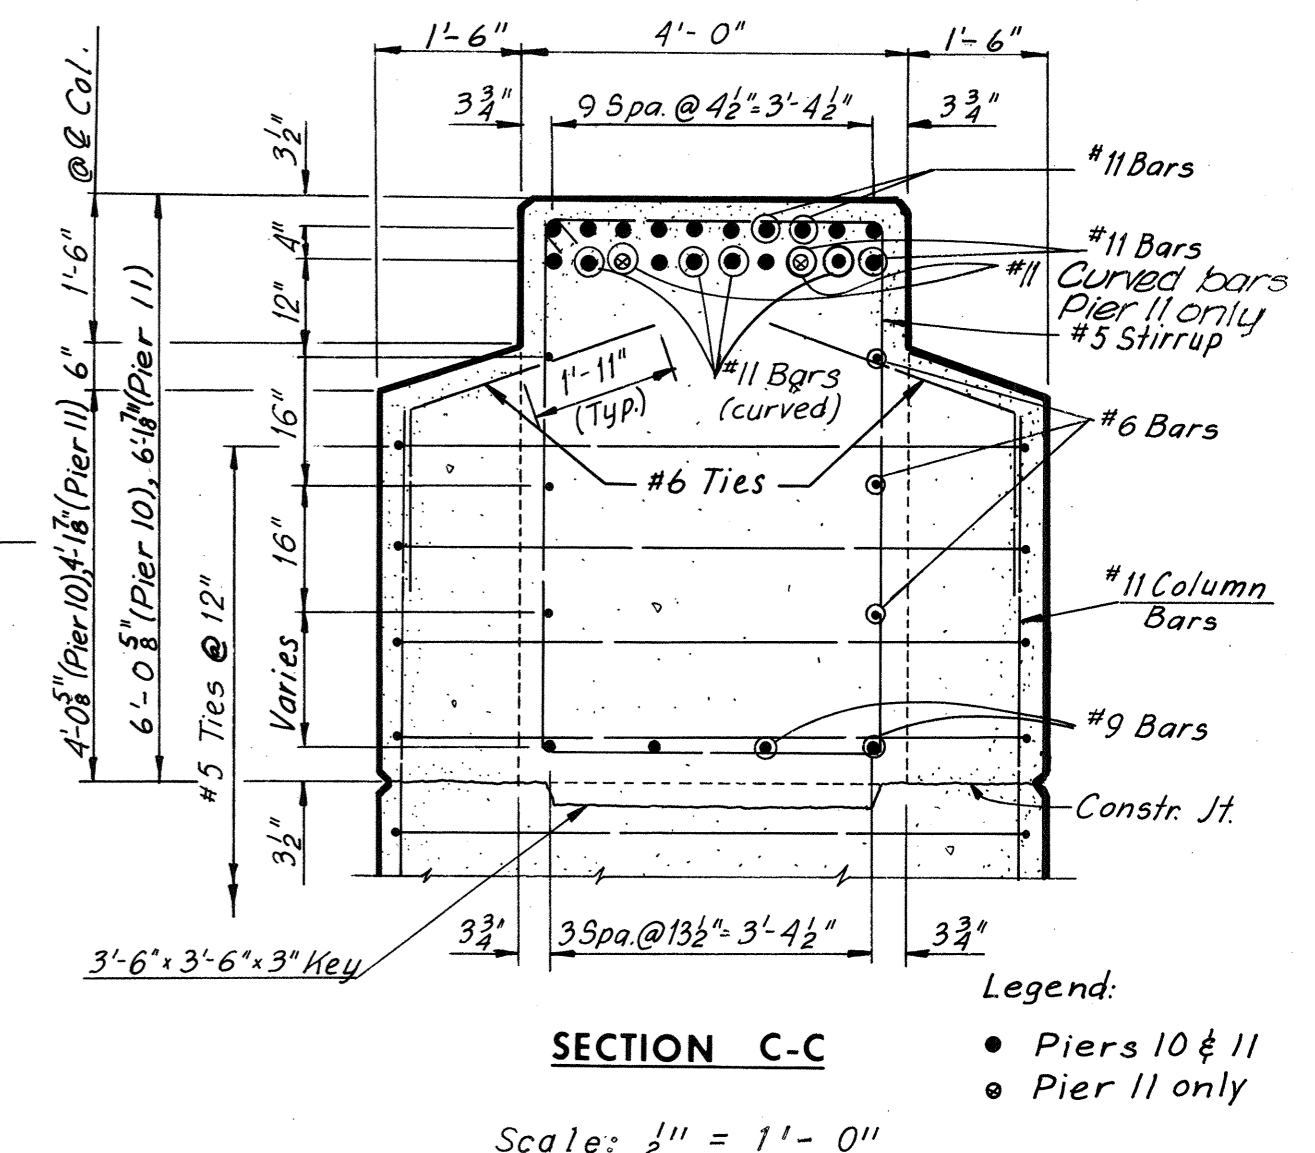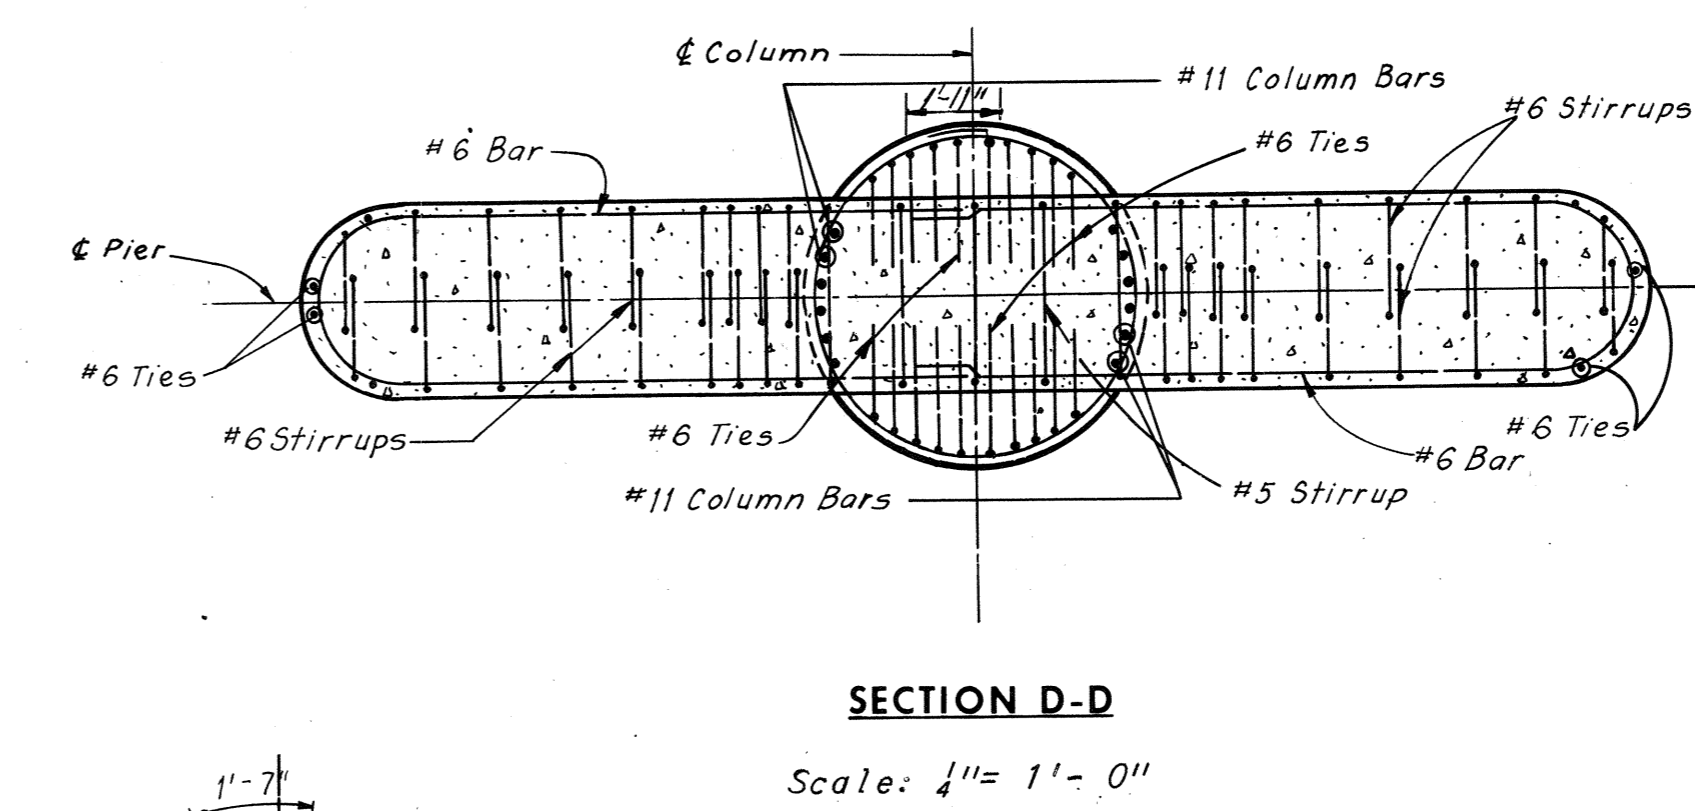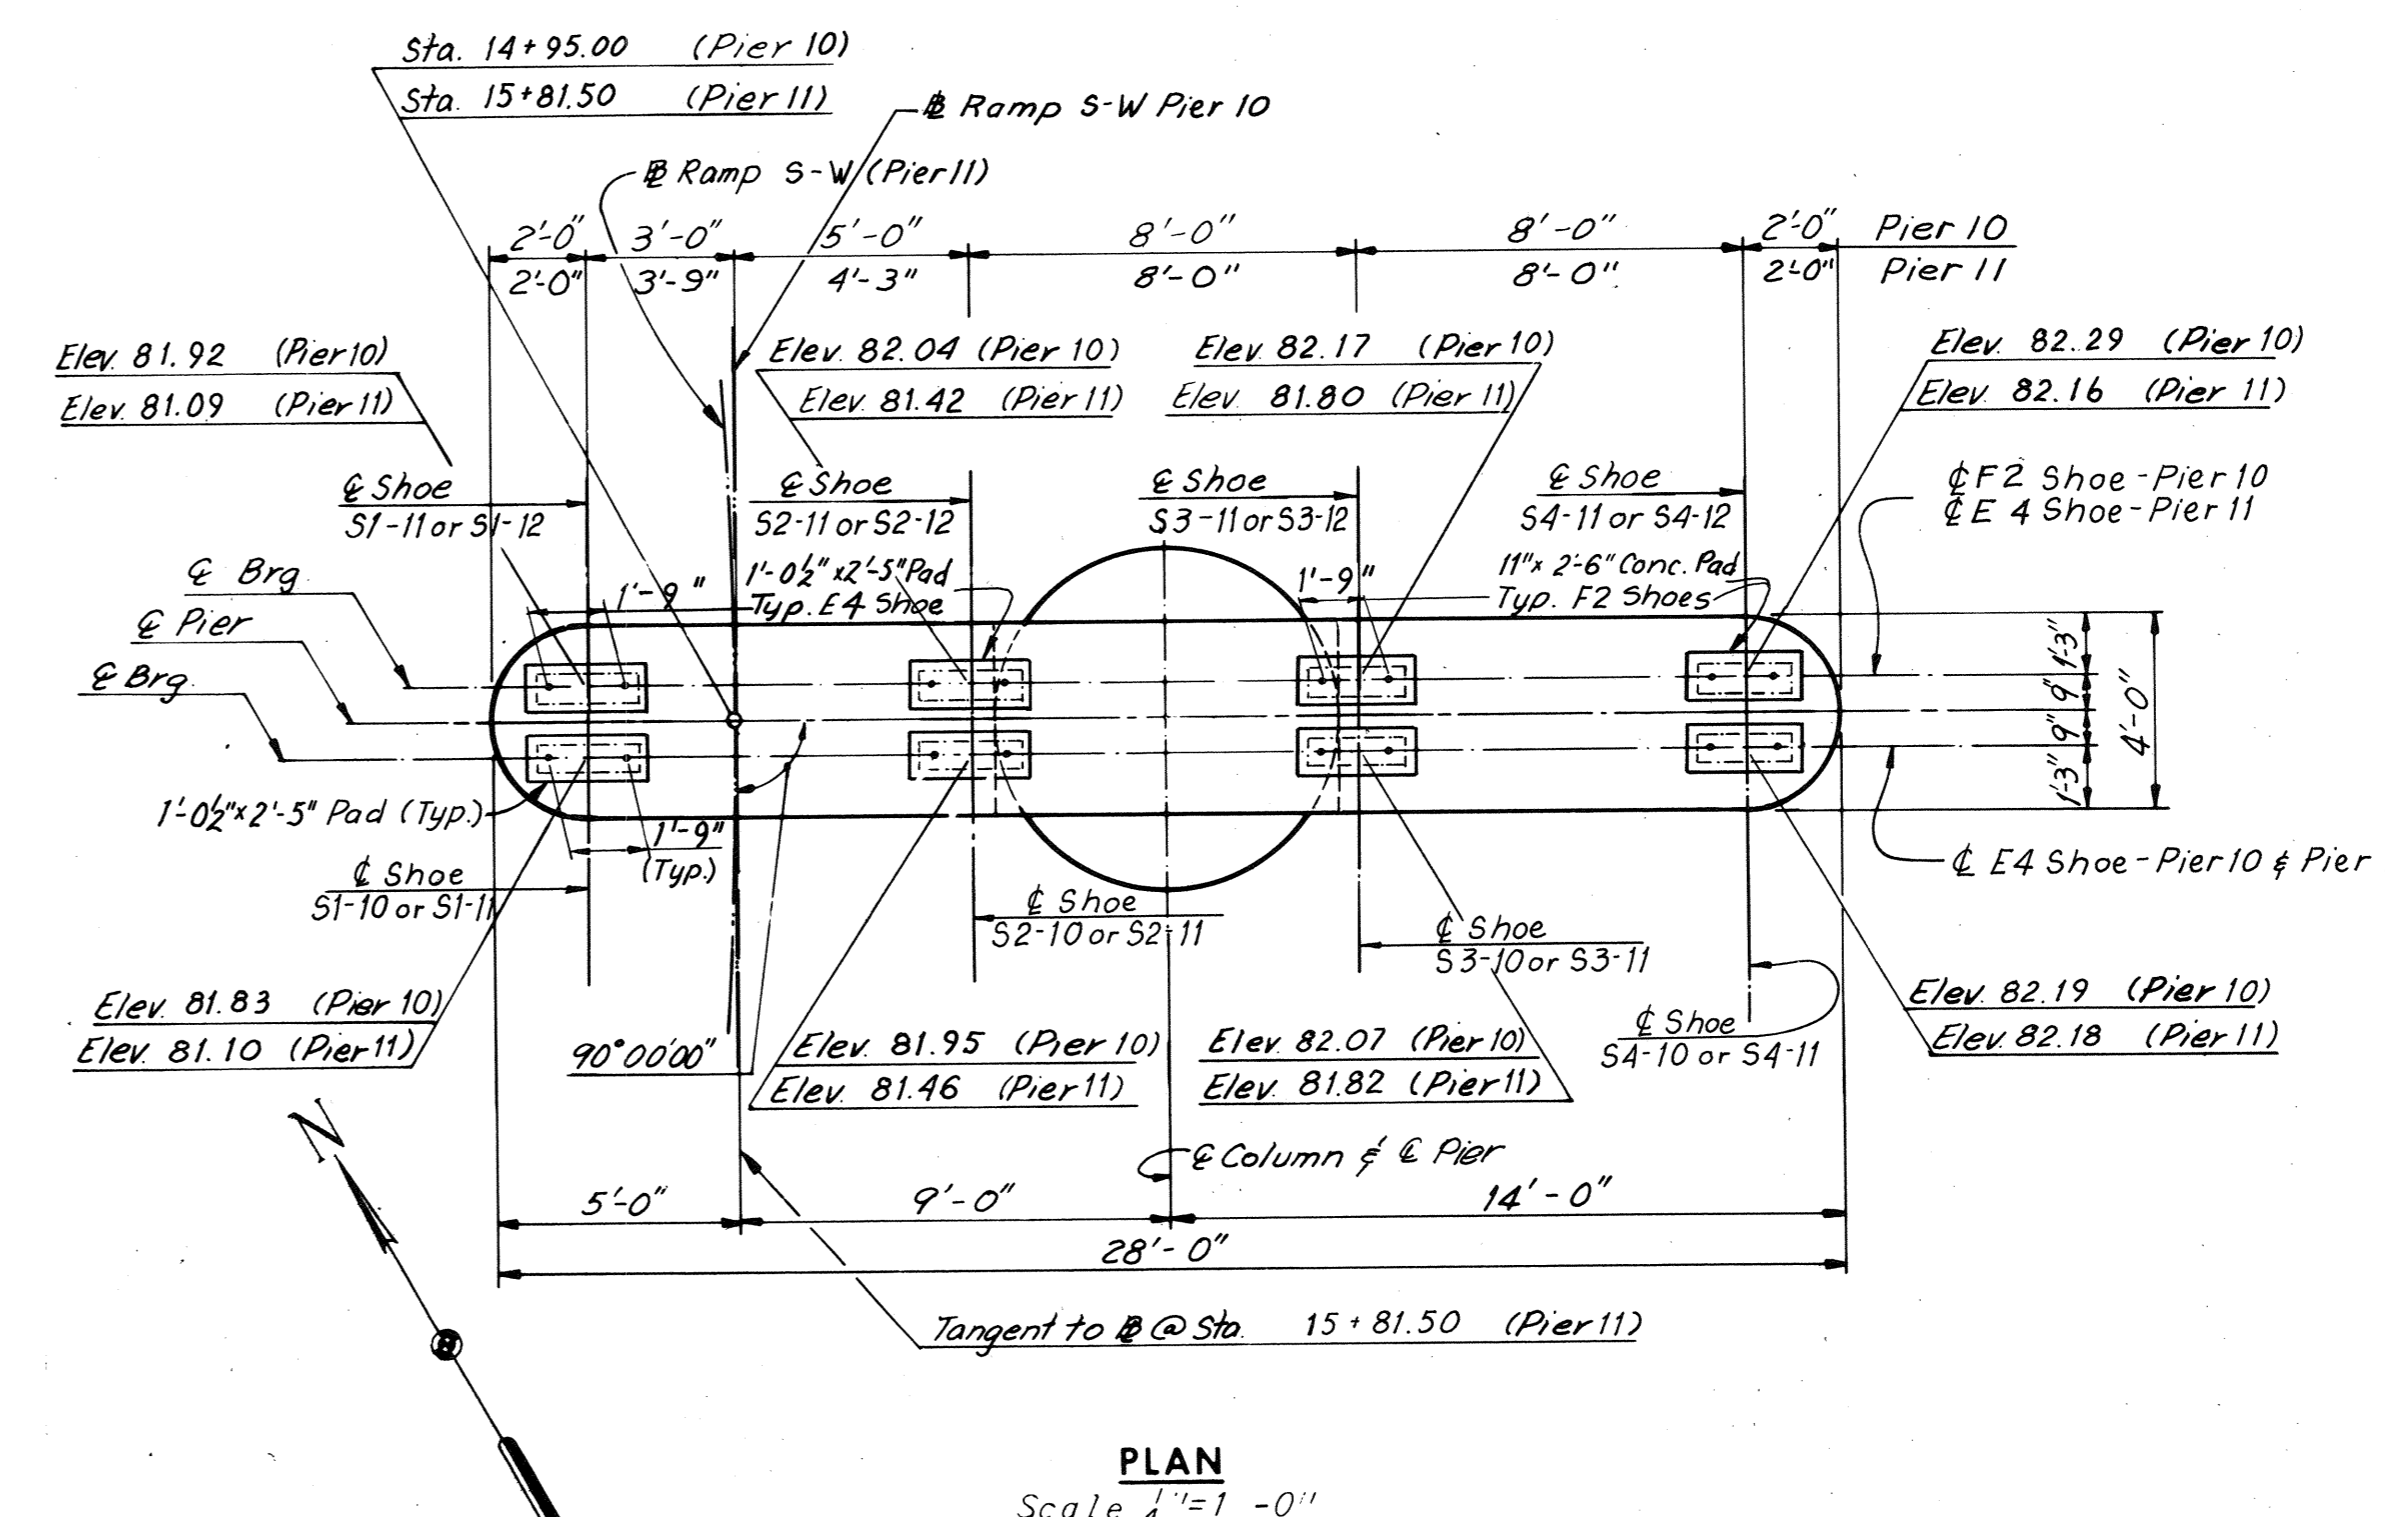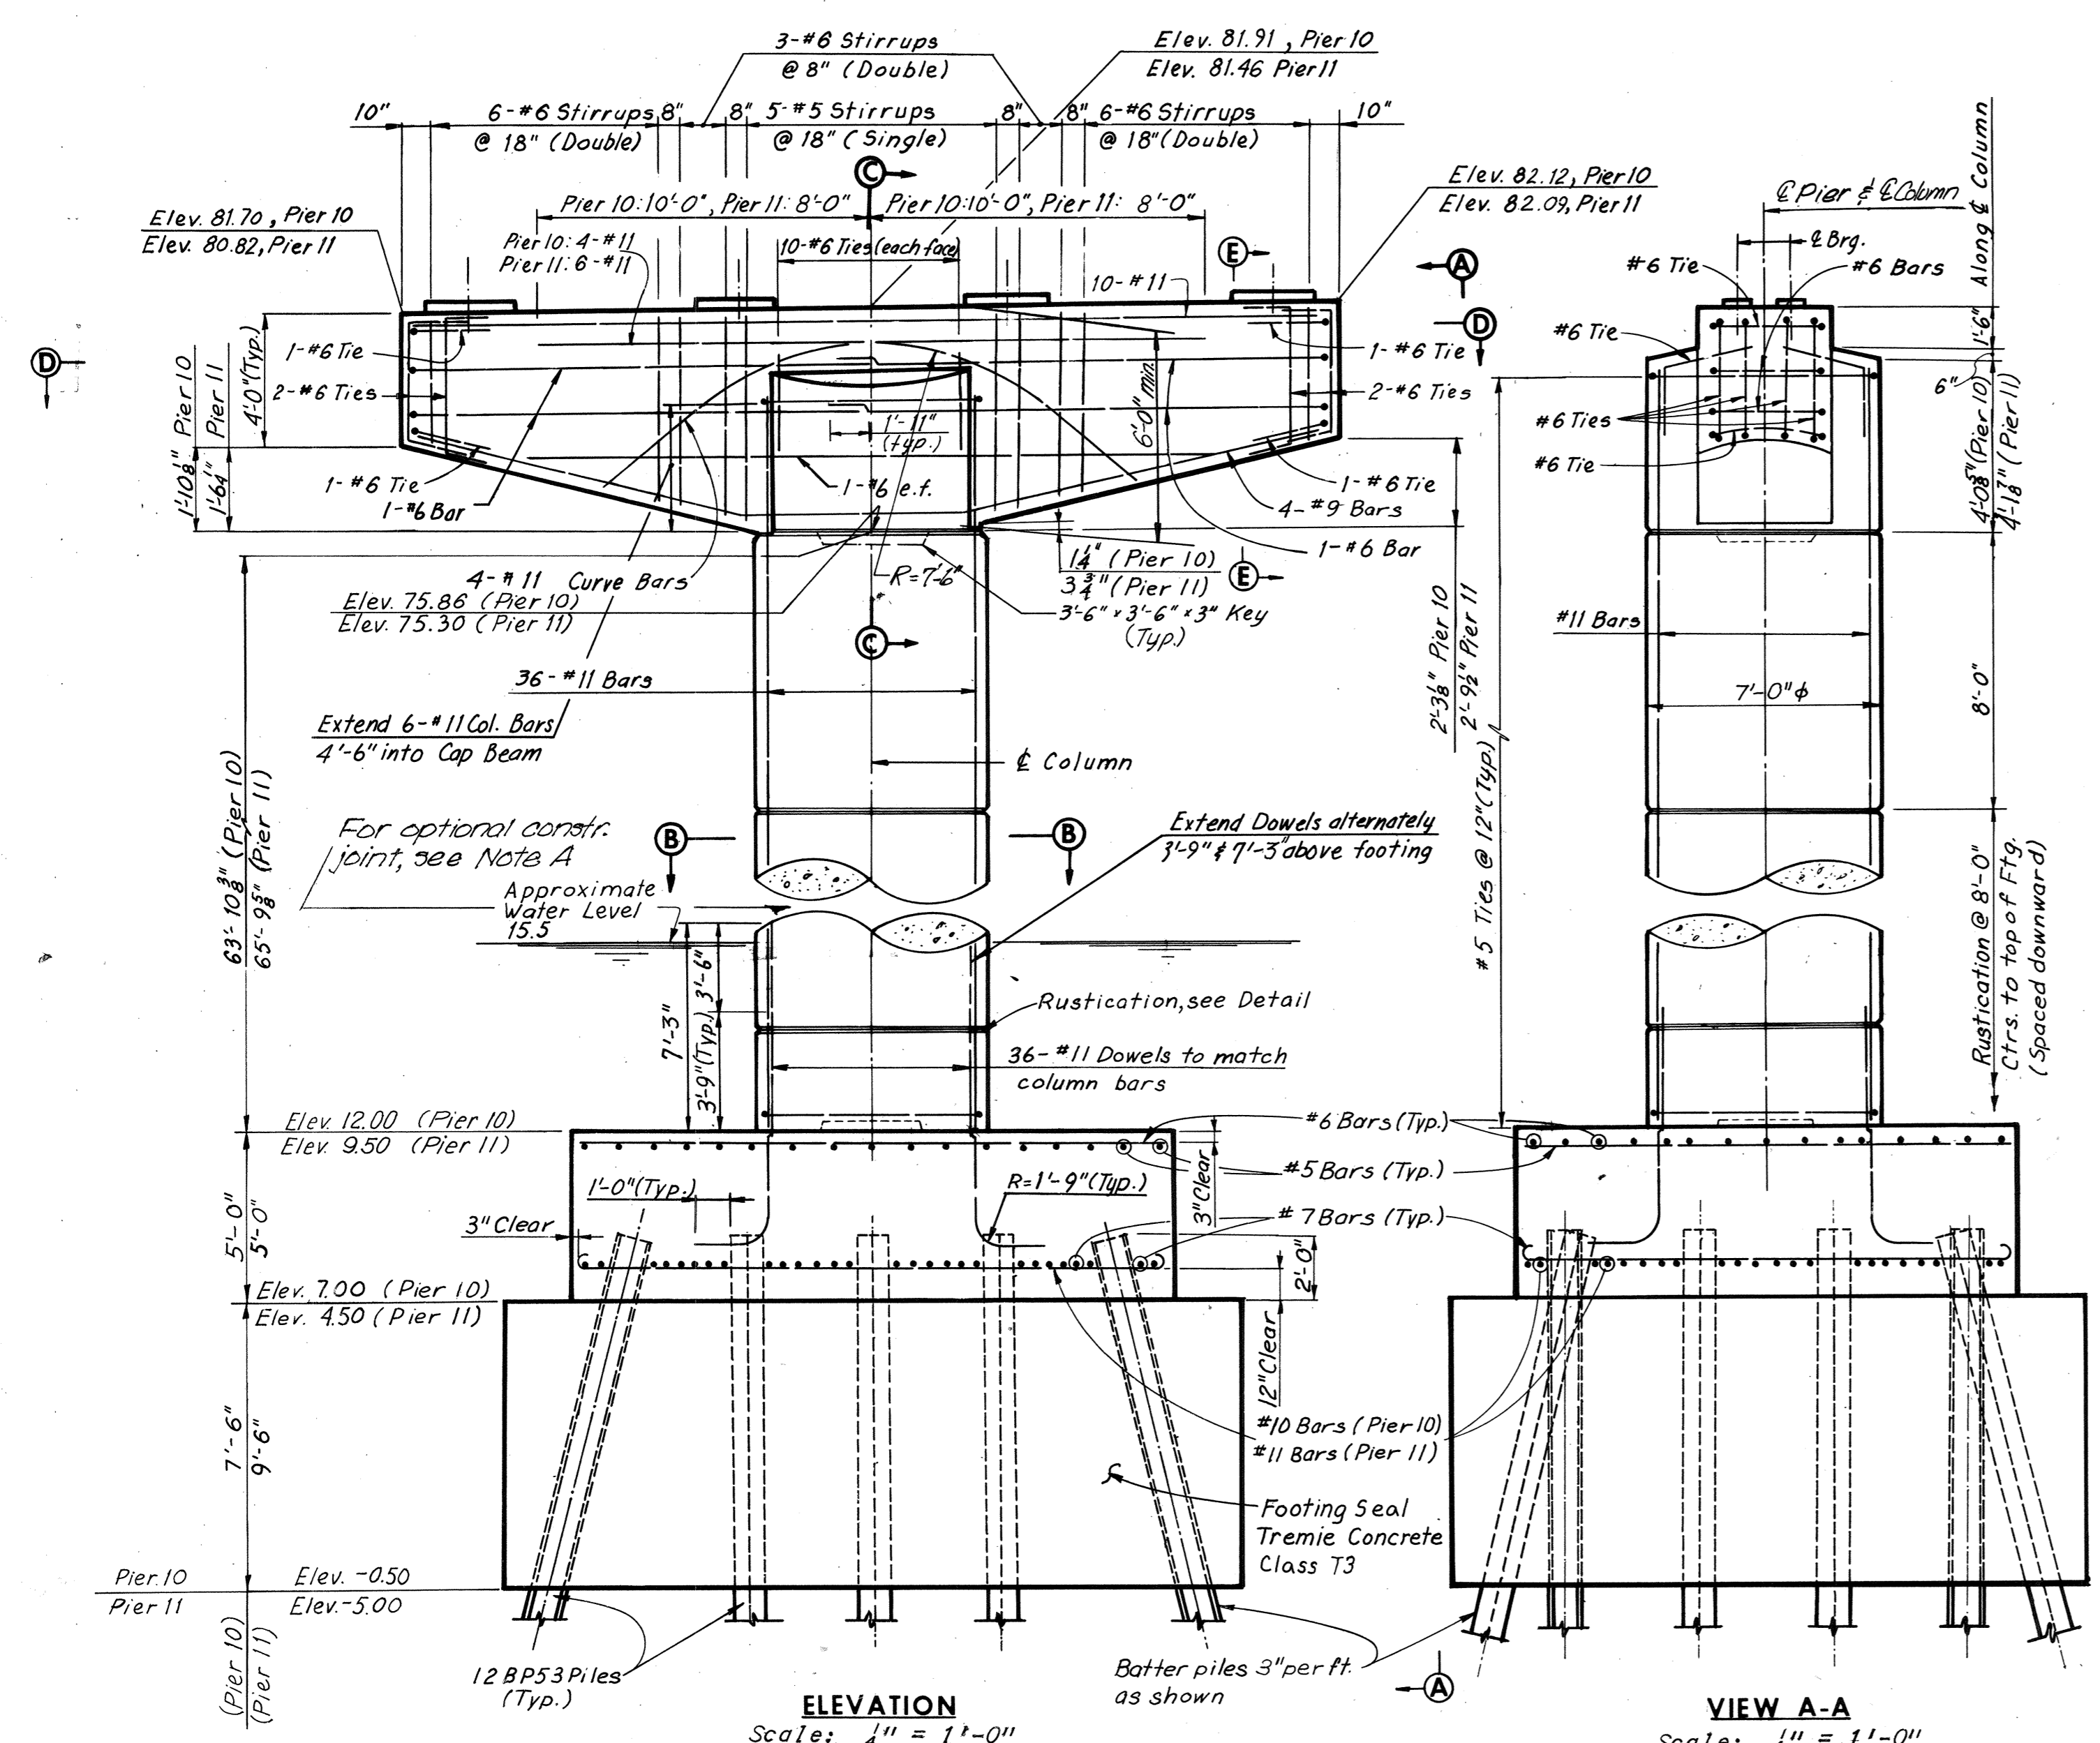

Note:
Bottom reinforcement shown in View A-A is for Pier 11 only. Bottom reinforcement for Pier 10 is similar except in size & number.

Note:
For layout of Piers 10 and 11 See Sheet 3.
Pile dimensions given on Footing Plan are measured at bottom of Footing (Elev. 7.00 Pier 10 and Elev. 4.50 Pier 11).

NOTE A
A construction joint will be permitted at a rustication near mid-height of the column. The column reinforcement may be lap spliced near the construction joint. The lap at the splice shall be a minimum of 3'-6". Splices shall be staggered at least 3'-3" between adjacent bars.

Note:
Footing elevations are approximate only and may be varied to suit field conditions as directed by the Engineer. Vertical shaft reinforcement shall not be cut until these elevations are established. Where elevations change more than 2 ft., redesign will be required.

Notes:
All piles shall be 12BP53 Steel Piles (Design capacity = 57 tons).
Batter piles 3" per ft. as shown.
For Standard Shoe Details see Sheet S1 & S2.
For Framing Plans see Sheet 20 & 21.
Estimated Pile Tip elevation -20.0

AS BUILT

RICHMOND METROPOLITAN AUTHORITY
RICHMOND EXPRESSWAY SYSTEM
DOWNTOWN EXPRESSWAY



BRIDGE NO. 65
RAMP S-W CONNECTION FROM
RICHMOND-PETERSBURG TURNPIKE
PIERS 10 AND 11

SCALE: As Noted
CONTRACT NO.: 11
SHEET NO. 10 OF 38




HOWARD, NEEDLES, TAMMEN & BERGENDOFF
consulting engineers
NEW YORK ALEXANDRIA KANSAS CITY

MADE	CHEKED	IN CHARGE	BY	DATE	NO.	REVISION	BY	DATE
CEB/JP	GSH			12-18-68				
				1-24-69				

RICHMOND EXPRESSWAY SYSTEM			
SECTION	PROJECT	SHEET NO.	TOTAL SHEETS
11	DOWNTOWN EXPRESSWAY	50	97

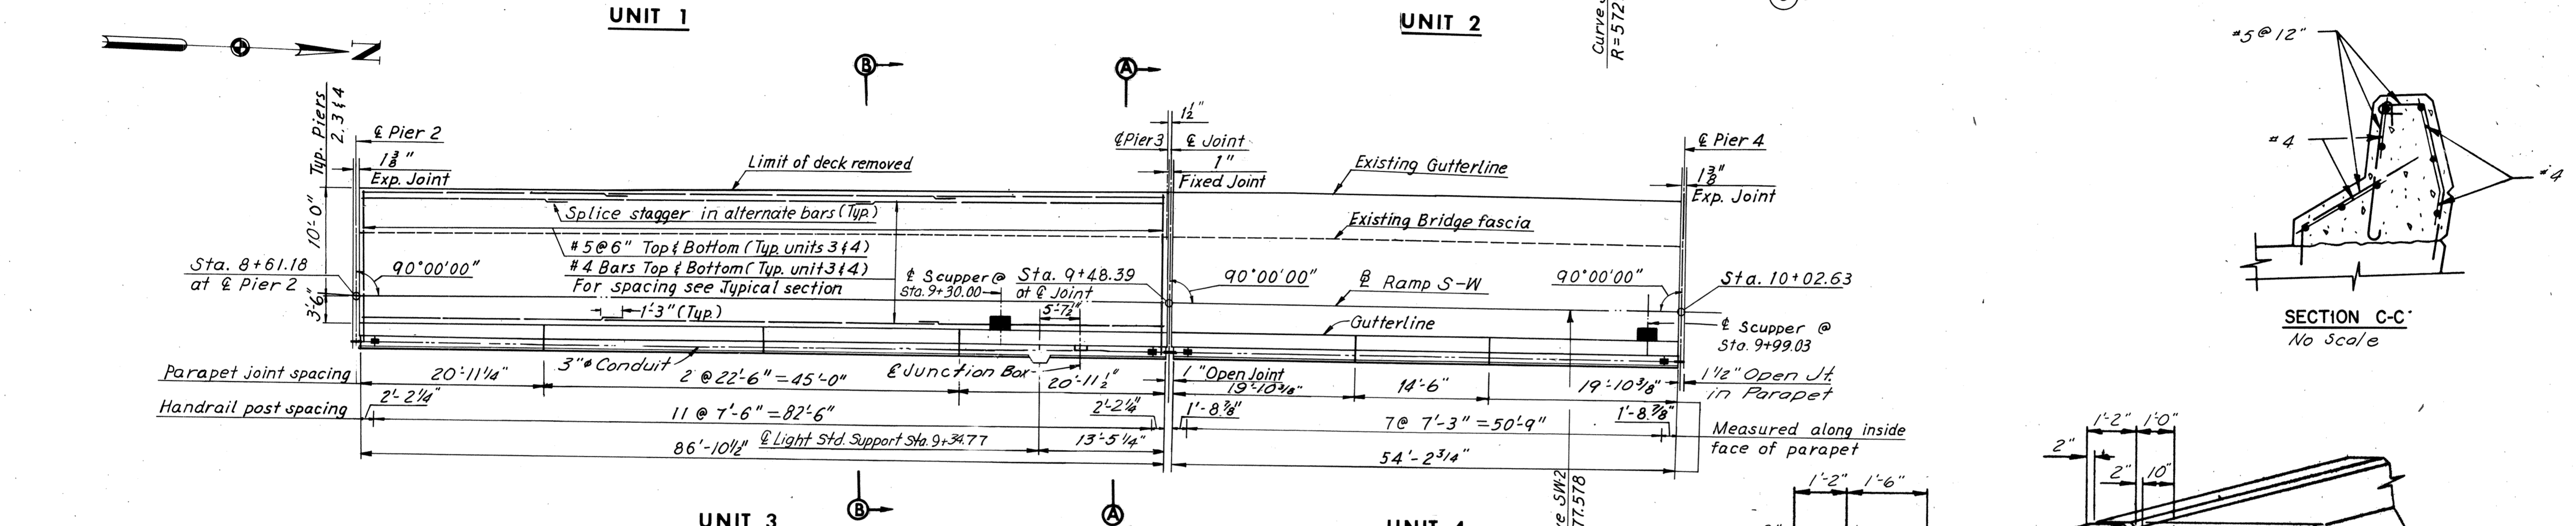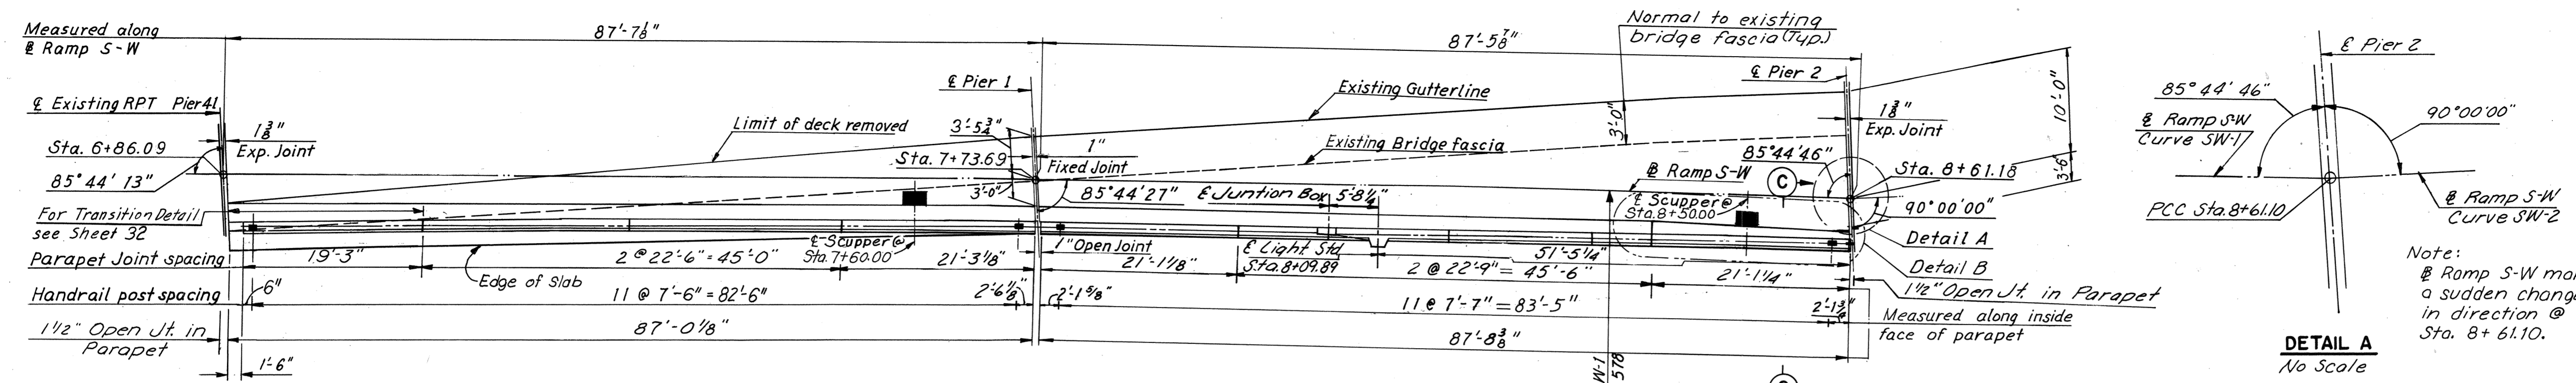


DECK PLAN
Scale: 1"=10'-0"

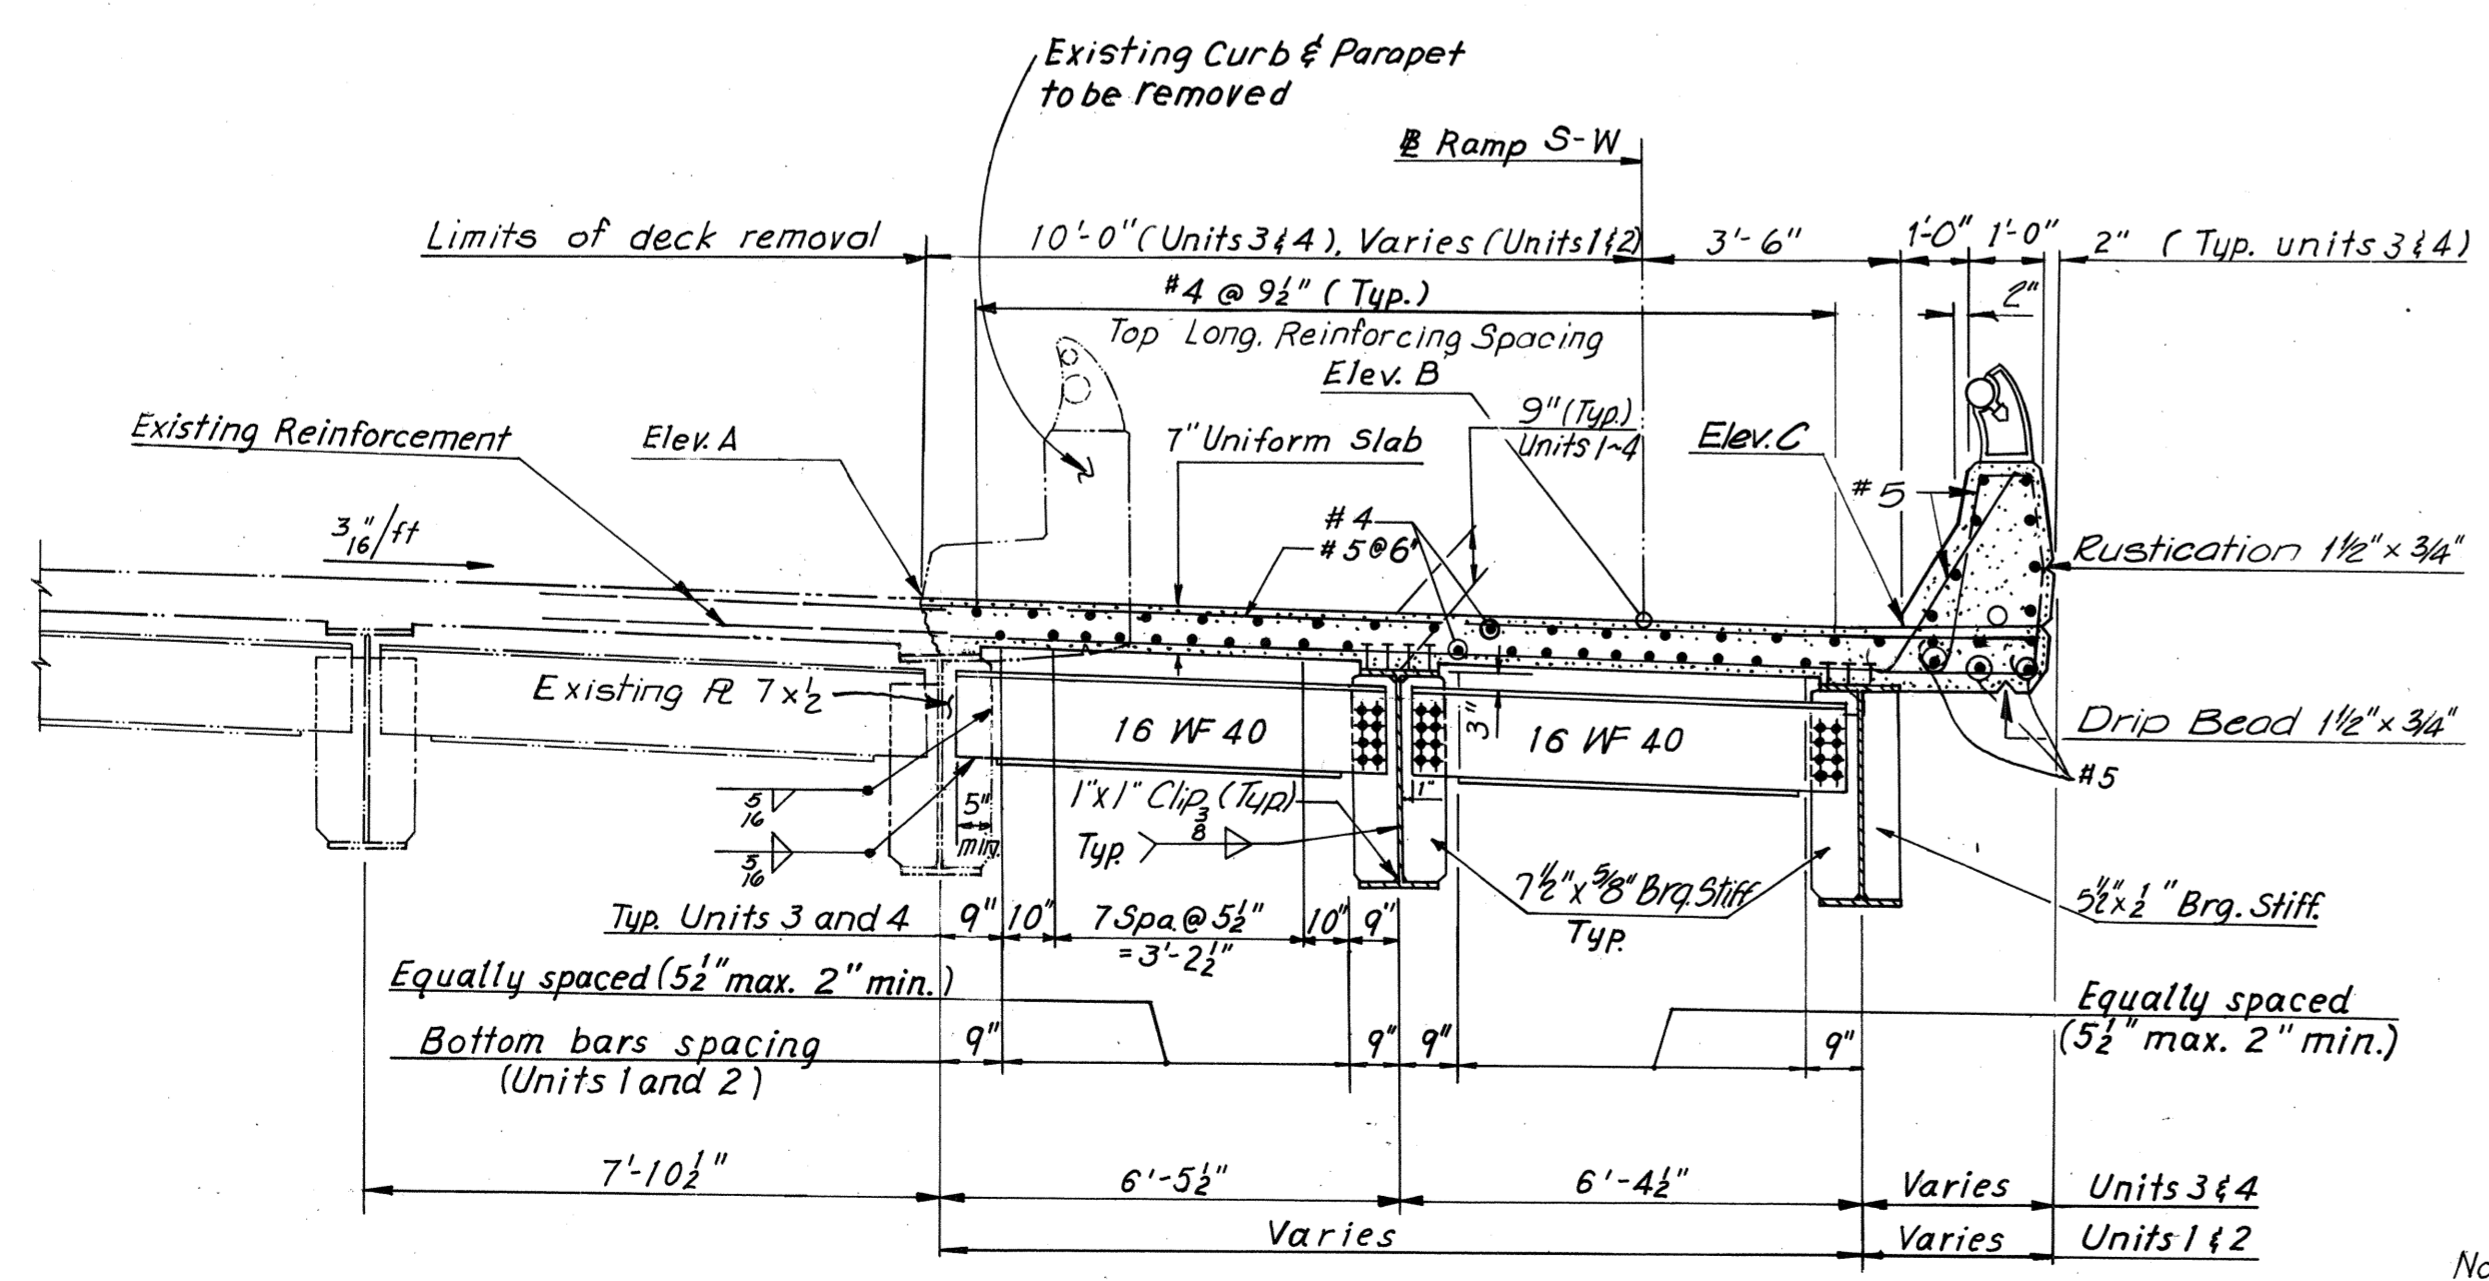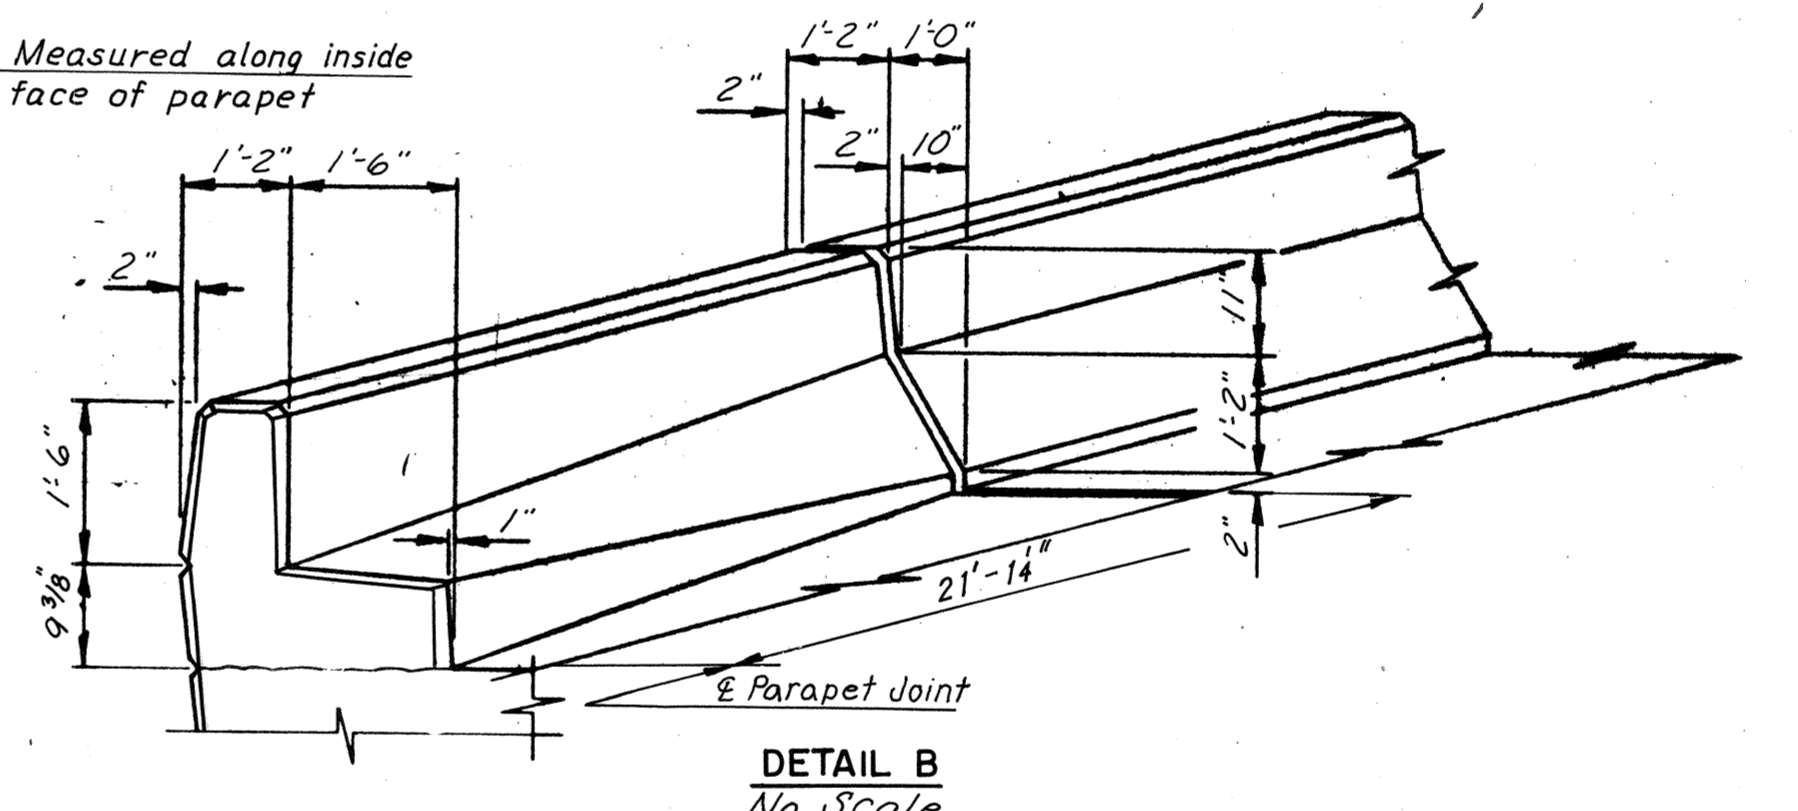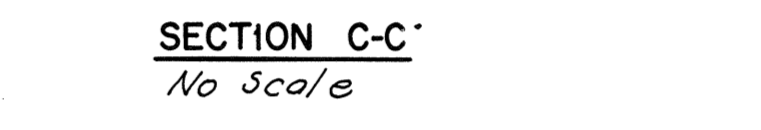

END DIAPHRAGM

SECTION A-A

Scale: 3/8" = 1'-0"

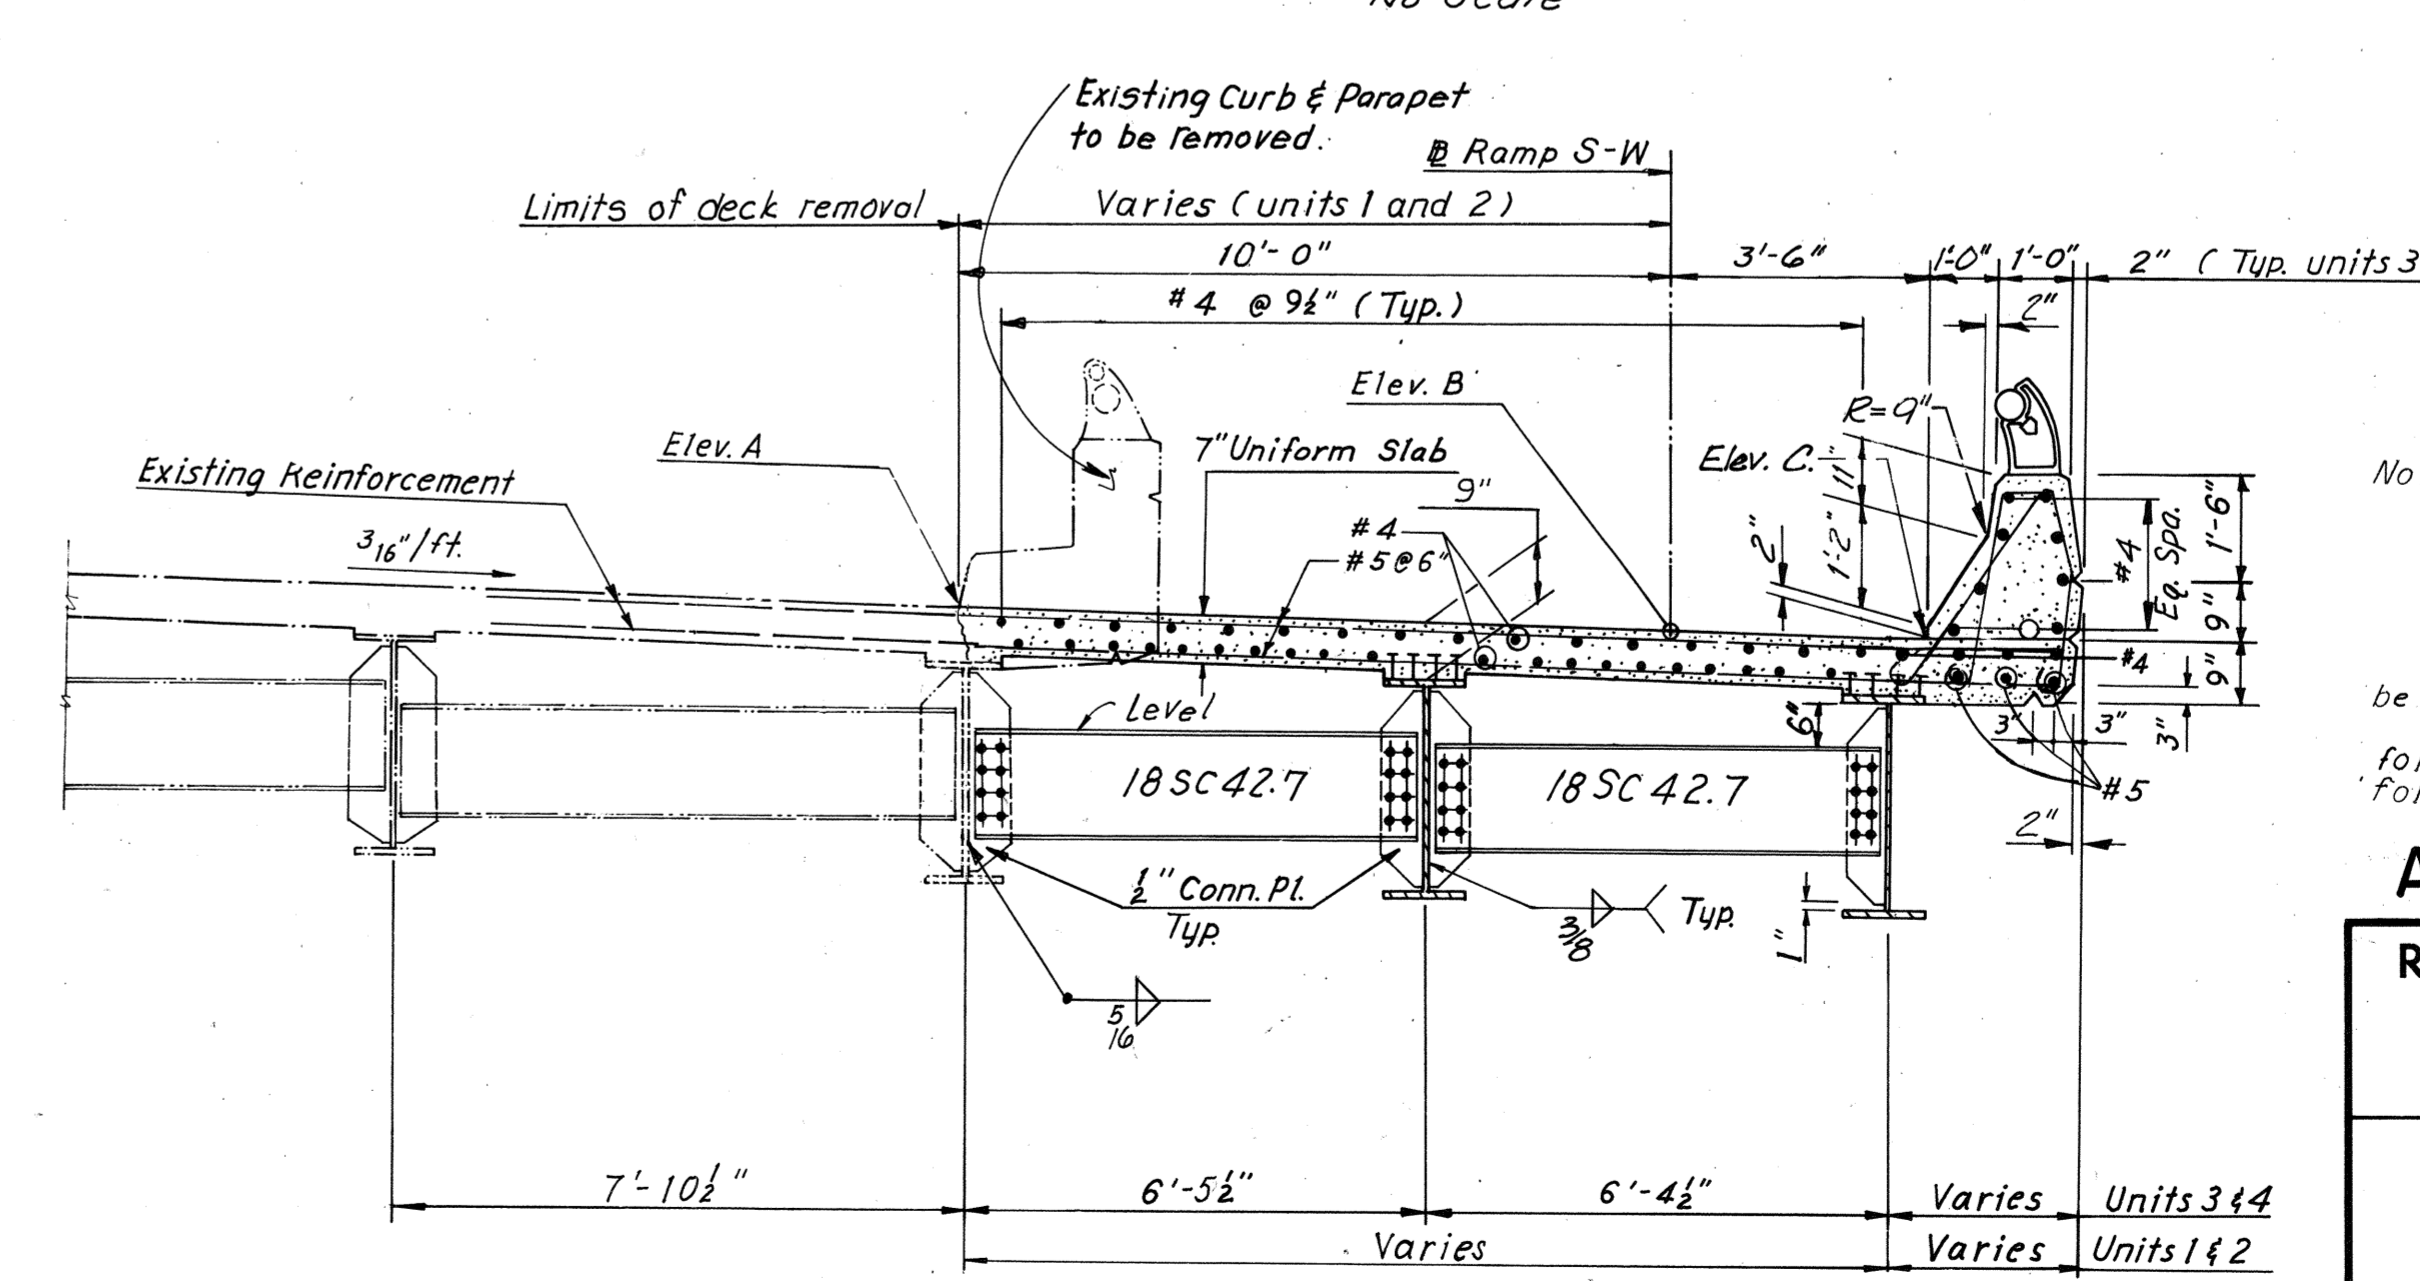

INTERMEDIATE DIAPHRAGM

SECTION B-B

Scale: 3/8" = 1'-0"

ELEVATION TABLE			
STATION	ELEV. A	ELEV. B	ELEV. C
6+86.09	—	72.84	—
+90.00	—	72.90	72.85
7+00.00	—	73.05	73.00
+10.00	—	73.19	73.15
+20.00	—	73.35	73.30
+30.00	73.50	73.49	73.45
+40.00	73.66	73.64	73.60
+50.00	73.82	73.79	73.75
+60.00	73.98	73.94	73.89
+70.00	74.14	74.09	74.04
+73.69	74.20	74.15	74.10
+80.00	74.30	74.24	74.19
+90.00	74.46	74.39	74.34
8+00.00	74.62	74.54	74.49
+10.00	74.79	74.69	74.64
+20.00	74.95	74.84	74.79
+30.00	75.11	74.99	74.94
+40.00	75.27	75.15	75.09
+50.00	75.43	75.29	75.23
+60.00	75.59	75.44	75.39
+61.18	75.61	75.45	75.40
+70.00	75.75	75.60	75.54
+80.00	75.91	75.76	75.70
+90.00	76.08	75.92	75.86
9+00.00	76.24	76.08	76.02
+10.00	76.40	76.24	76.19
+20.00	76.56	76.40	76.35
+30.00	76.72	76.56	76.51
+40.00	76.88	76.73	76.67
+48.39	77.02	76.86	76.81
+50.00	77.04	76.89	76.83
+60.00	77.20	77.05	76.99
+70.00	77.37	77.21	77.15
+80.00	77.53	77.37	77.32
+90.00	77.69	77.53	77.48
10+00.00	77.85	77.69	77.64
+02.63	77.89	77.74	77.68

Note A:
Elev. A from Sta. 6+86.09 to 10+02.63 is given along the existing Gutter Line R.P.T. and is radial to the existing Base Line R.P.T. at the respective stations as given along the Base Line Ramp S-W. Cross Slope is radial to the Base Line R.P.T. Elev. A is to be field verified. Minor adjustments may be required.

Note:
For Framing plan, see Sheet 18.
For Joint Details, see Sheet 18.
For Quantities, see Sheet 4.
For Handrail Detail, see Sheet S3.
Elev. A is to be confirmed by contractor.
Cross Slope in Units 1 and 2 should be normal to R.P.T.
For Drainage Details see Support Type 6 for Units 1, 2 and 3, and Support Type 5 for Unit 4, see Sheets 55 & 56.

AS BUILT

RICHMOND METROPOLITAN AUTHORITY
RICHMOND EXPRESSWAY SYSTEM
DOWNTOWN EXPRESSWAY


BRIDGE NO. 65
RAMP S-W CONNECTION FROM
RICHMOND-PETERSBURG TURNPIKE
DECK PLAN UNITS 1, 2, 3 AND 4

HOWARD, NEEDLES, TAMMEN & BERGENDOFF
consulting engineers
NEW YORK ALEXANDRIA KANSAS CITY





SCALE: As Noted
CONTRACT NO. 11
SHEET NO. 25 OF 38

BY	DATE	REVISION	BY	DATE
HCT	11-2-68	Deck Elev.	T.E.M.	9-8-75
JLK	6-27-75	Limits of deck removal Sect A & B	T.E.M.	8-25-75
YCP	1-17-69			
IN CHARGE				

RICHMOND EXPRESSWAY SYSTEM			
SECTION	PROJECT	SHEET NO.	TOTAL SHEETS
11	DOWNTOWN EXPRESSWAY	51	97

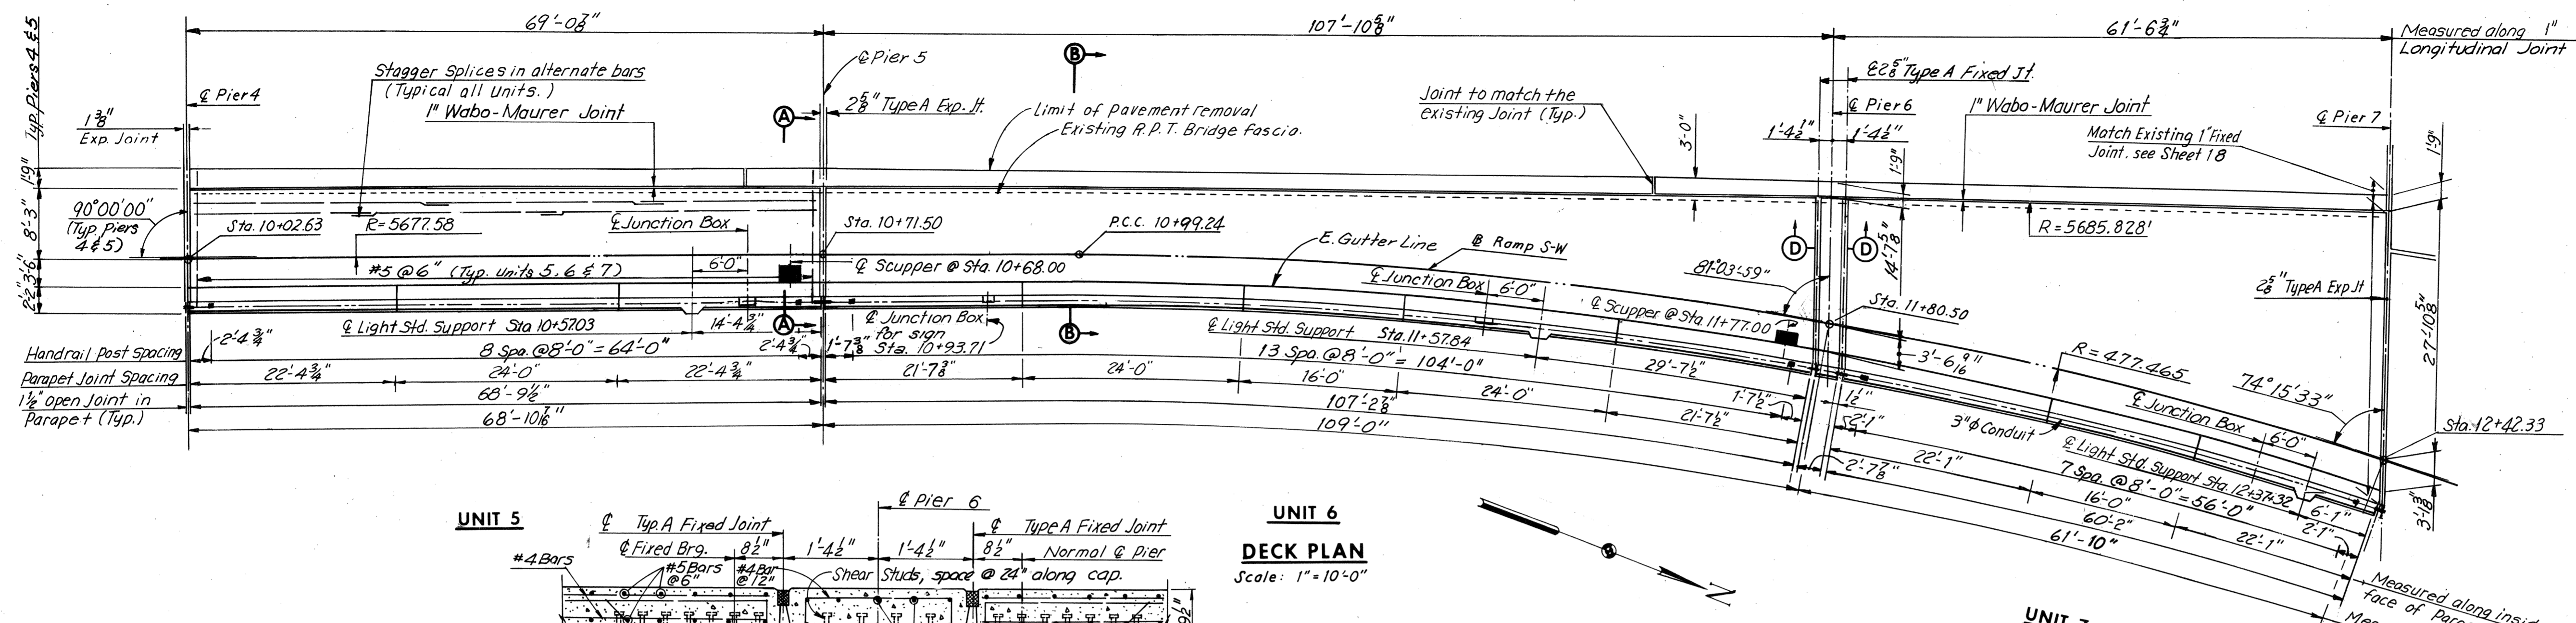

ELEVATION TABLE			
STATION	ELEV. A	ELEV. B	ELEV. C
10+02.63	77.83	77.74	77.68
+10	77.95	77.86	77.80
+20	78.12	77.02	77.96
+30	78.27	78.18	78.12
+40	78.44	78.34	78.29
+50	78.60	78.50	78.45
+60	78.76	78.66	78.61
+70	78.92	78.82	78.77
+71.50	78.94	78.85	78.80
+80	79.08	78.97	78.91
+90	79.24	79.11	79.04
11+00	79.40	79.24	79.16
+10	79.57	79.36	79.27
+20	79.73	79.47	79.36
+30	79.89	79.57	79.45
+40	80.05	79.66	79.53
+50	80.21	79.74	79.60
+60	80.37	79.82	79.68
+70	80.53	79.90	79.76
+79.11	80.67	79.97	79.83
+80	80.69	79.98	79.84
+80.50	80.70	79.98	79.84
+81.89	80.72	80.00	79.86
+90	80.86	80.06	79.92
12+00	81.01	80.14	80.00
+10	81.17	80.22	80.08
+20	81.33	80.29	80.15
+30	81.48	80.36	80.22
+40	81.64	80.43	80.29
+42.33	81.68	80.45	80.31

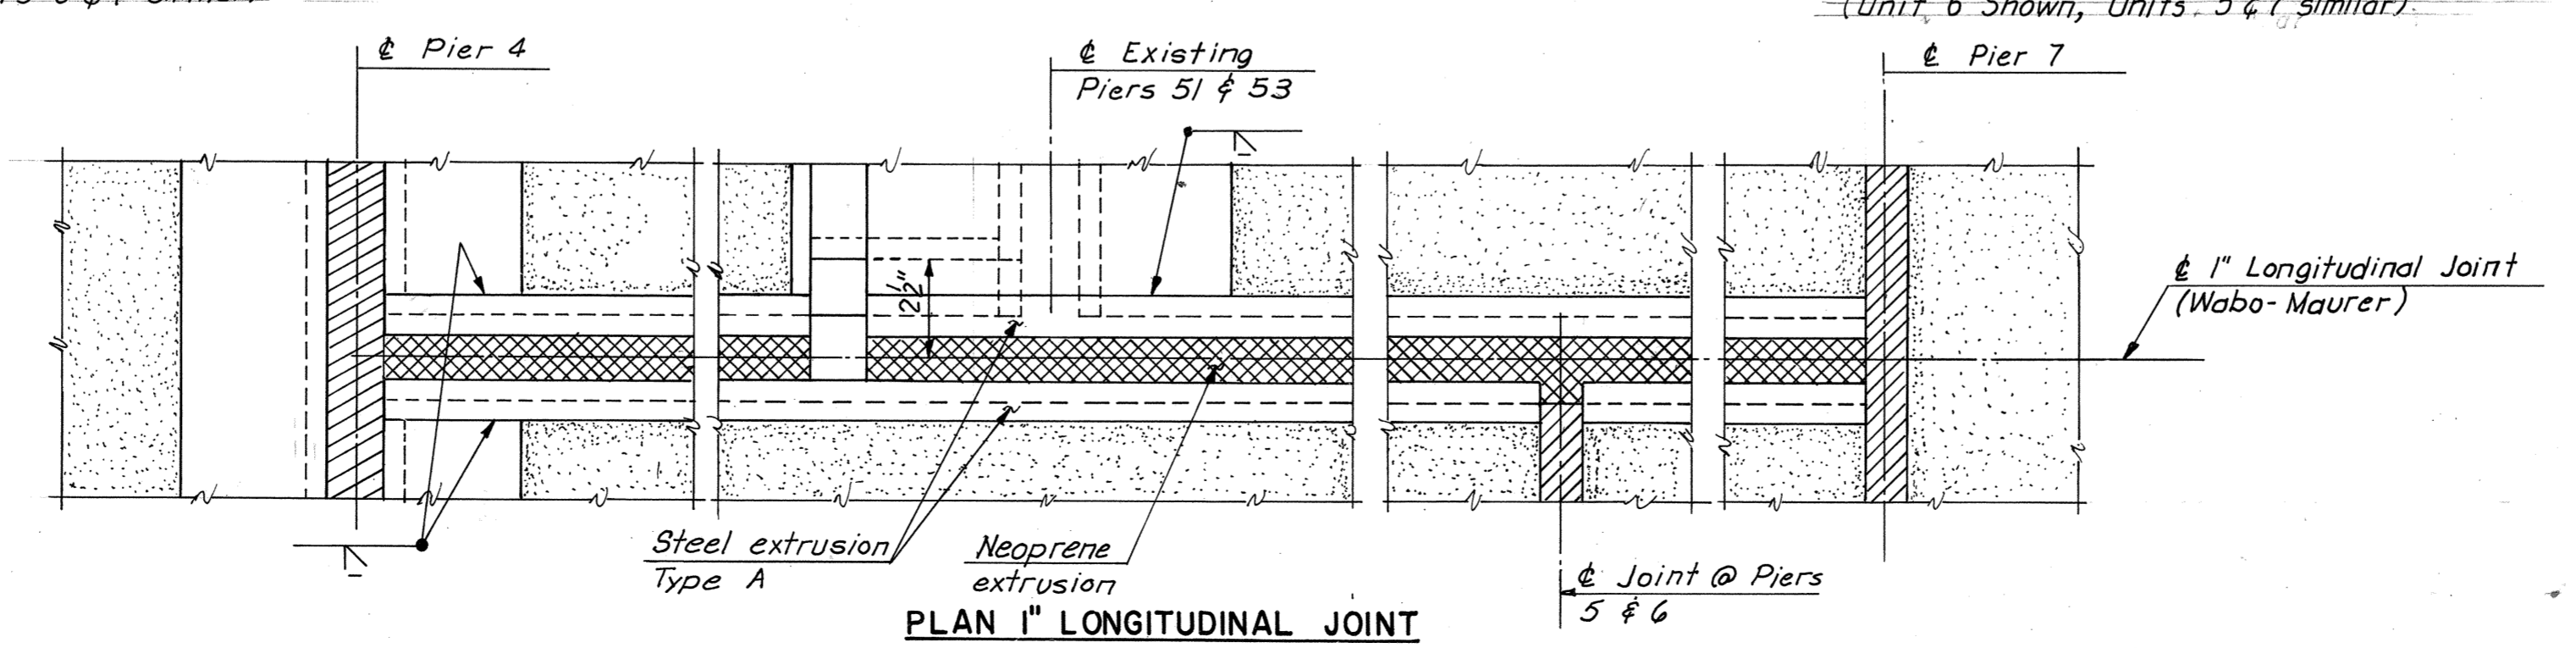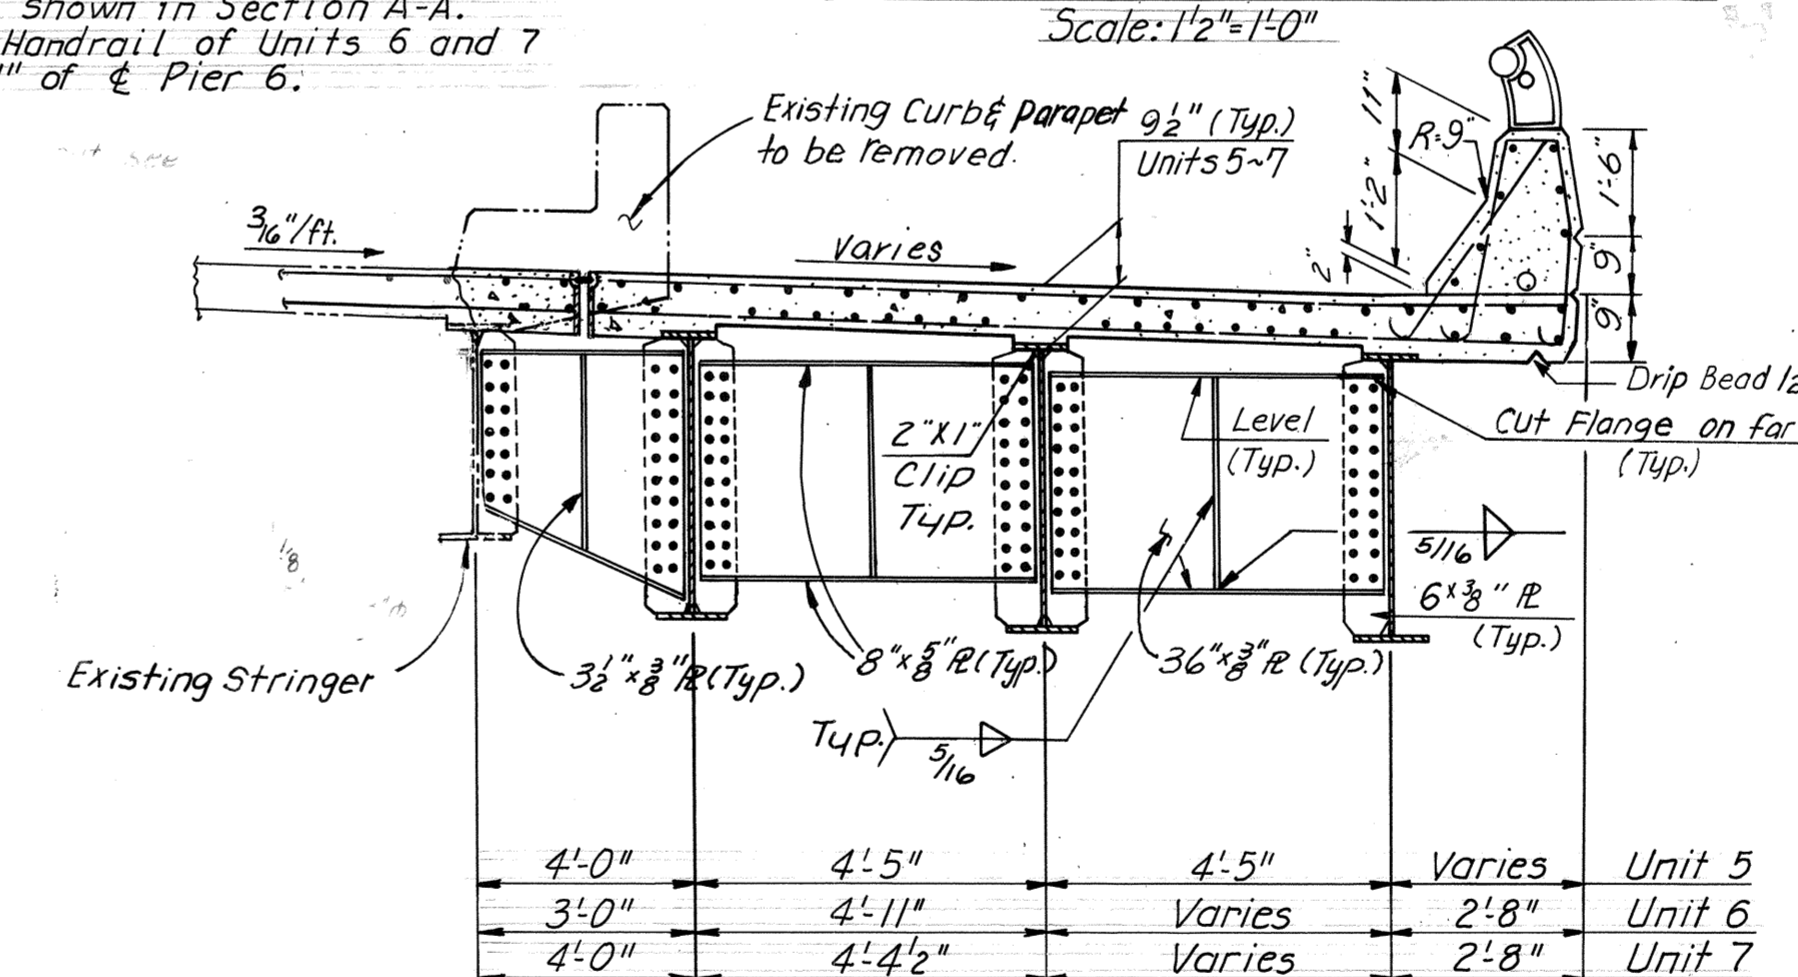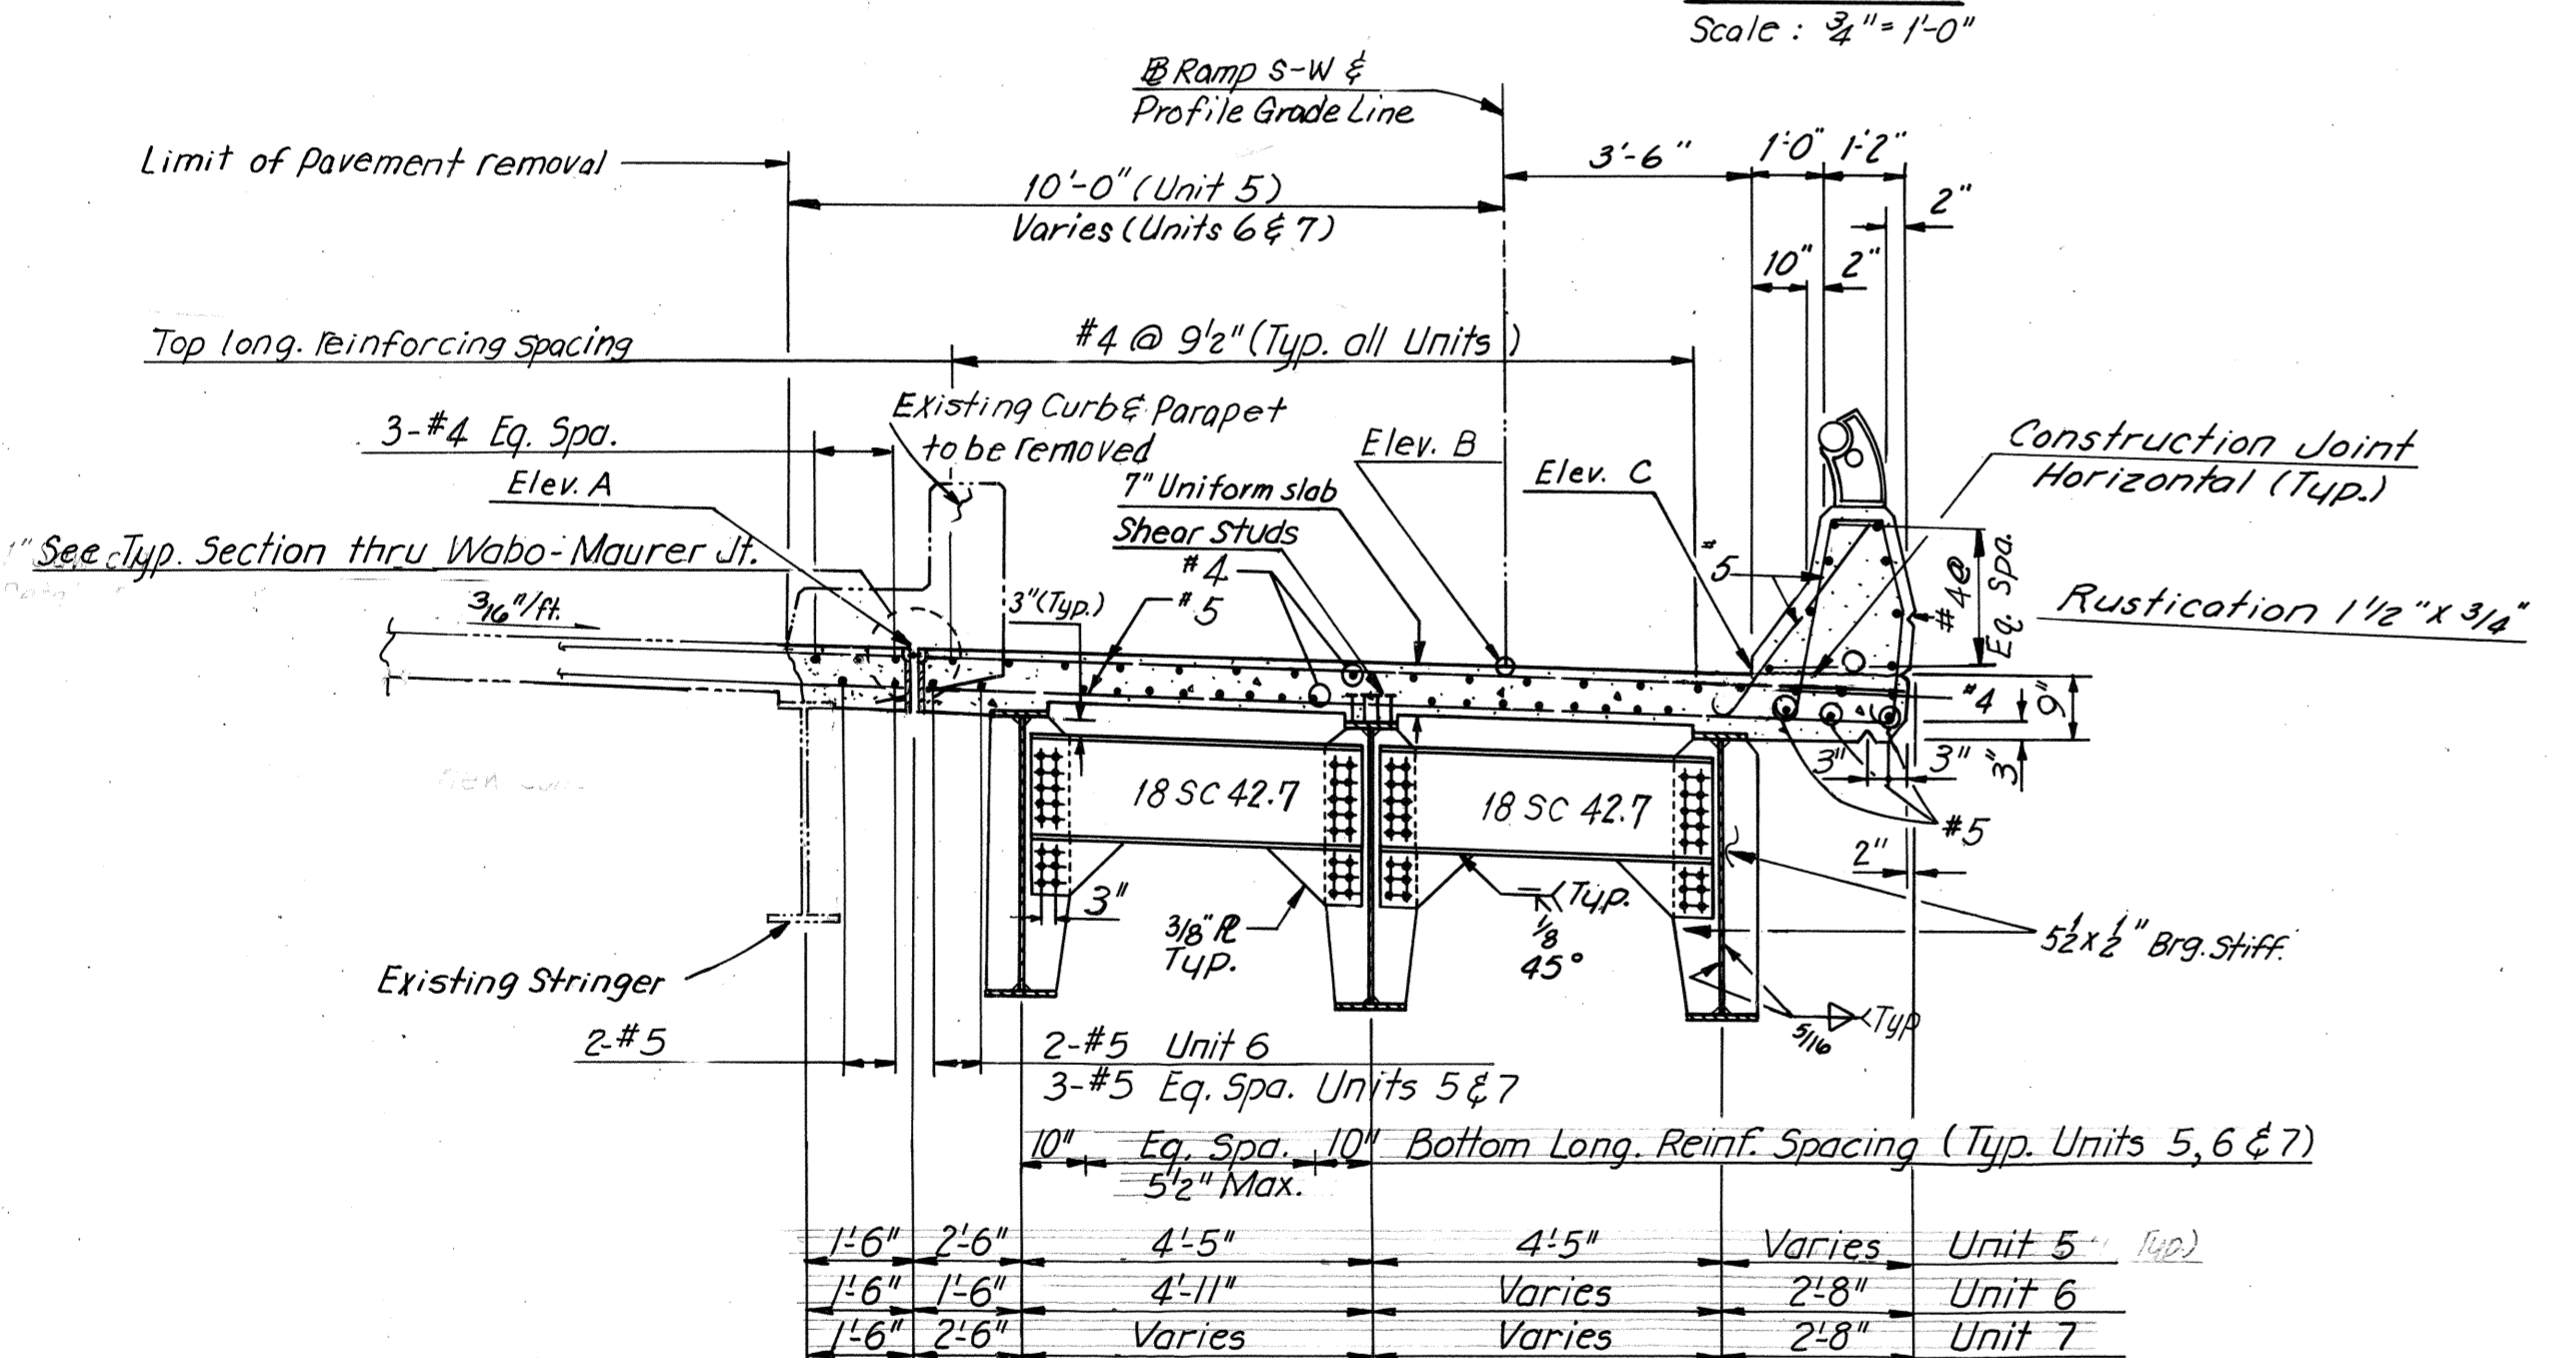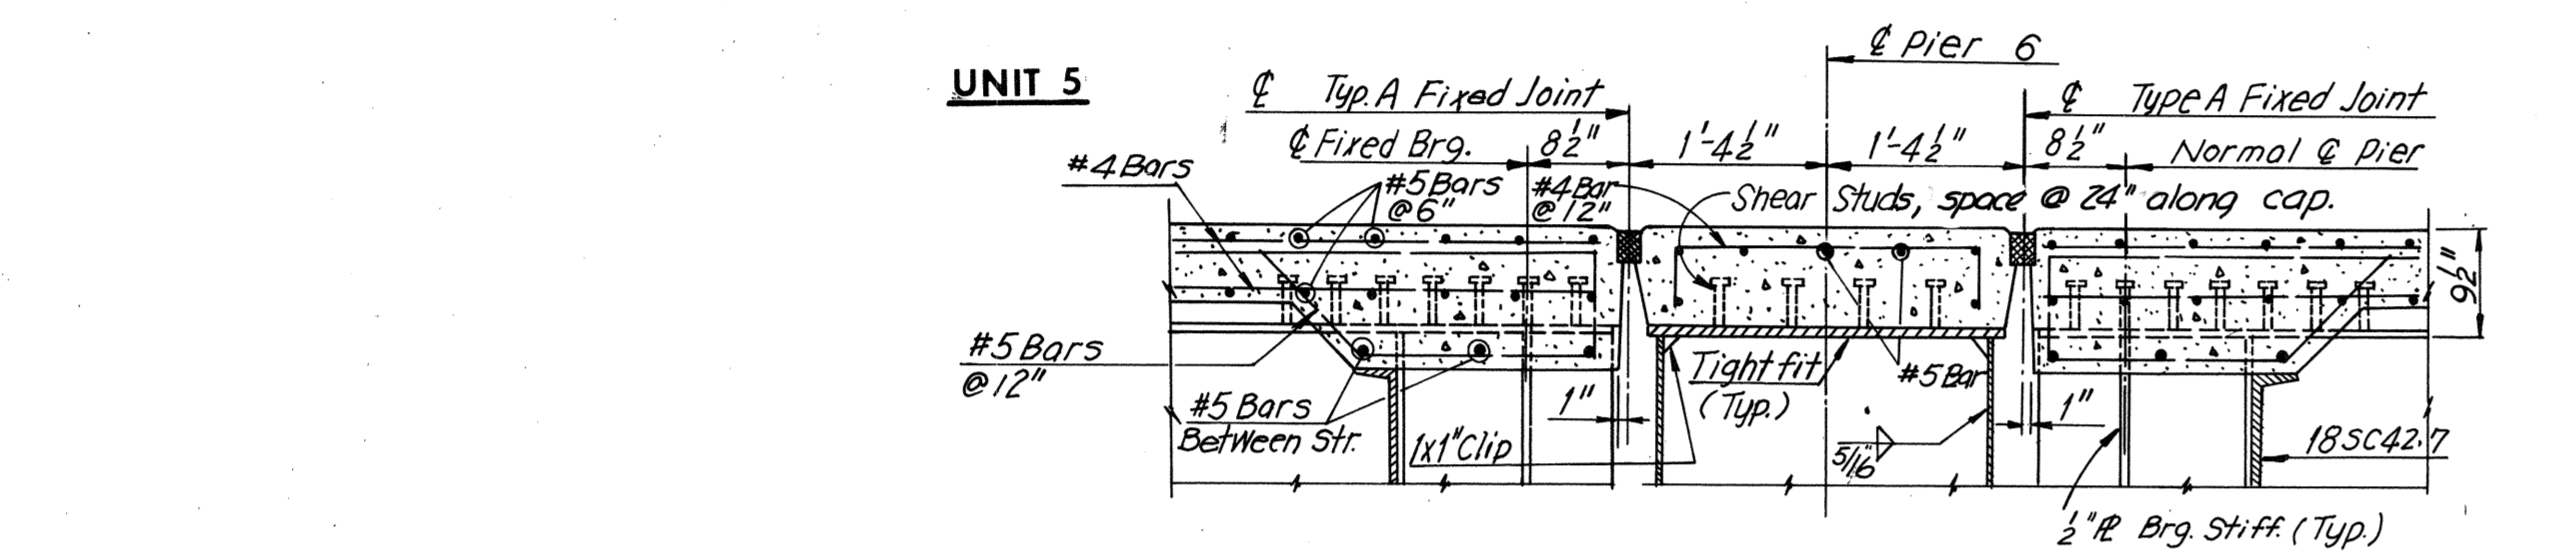

Notes for Wabo-Maurer Joint:
 Do not use steel extrusions as screed support.
 Steel extrusion shall conform to ASTM A36.
 Structural steel shall conform to ASTM A588.
 Steel assembly shall be shop welded to convenient lengths and butt welded in the field to desired length. Joint shall conform to grade of deck slab.
 Steel assembly shall be sandblasted in the shop prior to painting.
 Steel assembly shall receive one shop coat of epoxy zinc paint.
 Neoprene extrusion shall be roughened with a wire brush before bonding to steel extrusion with Bon Lastic Adhesive. Groove in steel extrusion to be blown out with oil-free and water-free compressed air prior to installation of Neoprene extrusion.
 The Wabo-Maurer joint assembly shall be installed in accordance with manufacturer's recommended construction methods.

NO.	REVISION	BY	DATE
1	Deck Elev	TEM	5-76
2	Deck Elev & Dim.	TEM	9-8-75
3	Limit of pavement removal & 1" Longit. joint revised, Det. A removed & Wabo-Maurer joint added	G.B.P.	8-25-75

AS BUILT

RICHMOND METROPOLITAN AUTHORITY
RICHMOND EXPRESSWAY SYSTEM
DOWNTOWN EXPRESSWAY

BRIDGE NO. 65
RAMP S-W CONNECTION FROM
RICHMOND-PETERSBURG TURNPIKE
DECK PLAN UNITS 5, 6 AND 7










HOWARD, NEEDLES, TAMMEN & BERGENDOFF
 consulting engineers
 W. YORK ALEXANDRIA KANSAS CITY

SCALE: As Noted
 CONTRACT NO. 11
 SHEET NO. 26 OF 38

RICHMOND EXPRESSWAY SYSTEM			
SECTION	PROJECT	SHEET NO.	TOTAL SHEETS
11	DOWNTOWN EXPRESSWAY	52	97

* Elev. given along E of joint along lines radial to Ramp S-W

ELEVATION TABLE			
STATION	ELEV. A	ELEV. B	ELEV. C
12+42.33	81.38	80.45	80.31
12+40	*81.53		
12+50	*81.62	80.50	80.36
12+60	*81.72	80.57	80.43
12+70	*81.82	80.68	80.54
12+80	81.72	80.81	80.66
12+90	81.83	80.98	80.83
13+00	82.03	81.17	81.03
13+10	82.26	81.40	81.26
13+20	82.53	81.67	81.52
13+23	82.62	81.75	81.61
13+30	82.80	81.96	81.82
13+40	83.07	82.28	82.15
13+50	83.37	82.64	82.52
13+60	83.67	83.01	82.90
13+70	83.96	83.38	83.29
13+80	84.26	83.76	83.68
13+90	84.56	84.13	84.06
14+00	84.86	84.50	84.44
14+08	85.10	84.80	84.75
14+10	85.16	84.87	84.82
14+20	85.47	85.24	85.20
14+30	85.76	85.62	85.60
14+40	86.06	85.99	85.98
14+50	86.36	86.36	86.36
14+60	86.71	86.72	86.79
14+70	87.03	87.05	87.19
14+80	87.32	87.35	87.57
14+90	87.57	87.62	87.91
14+95	87.69	87.74	88.08

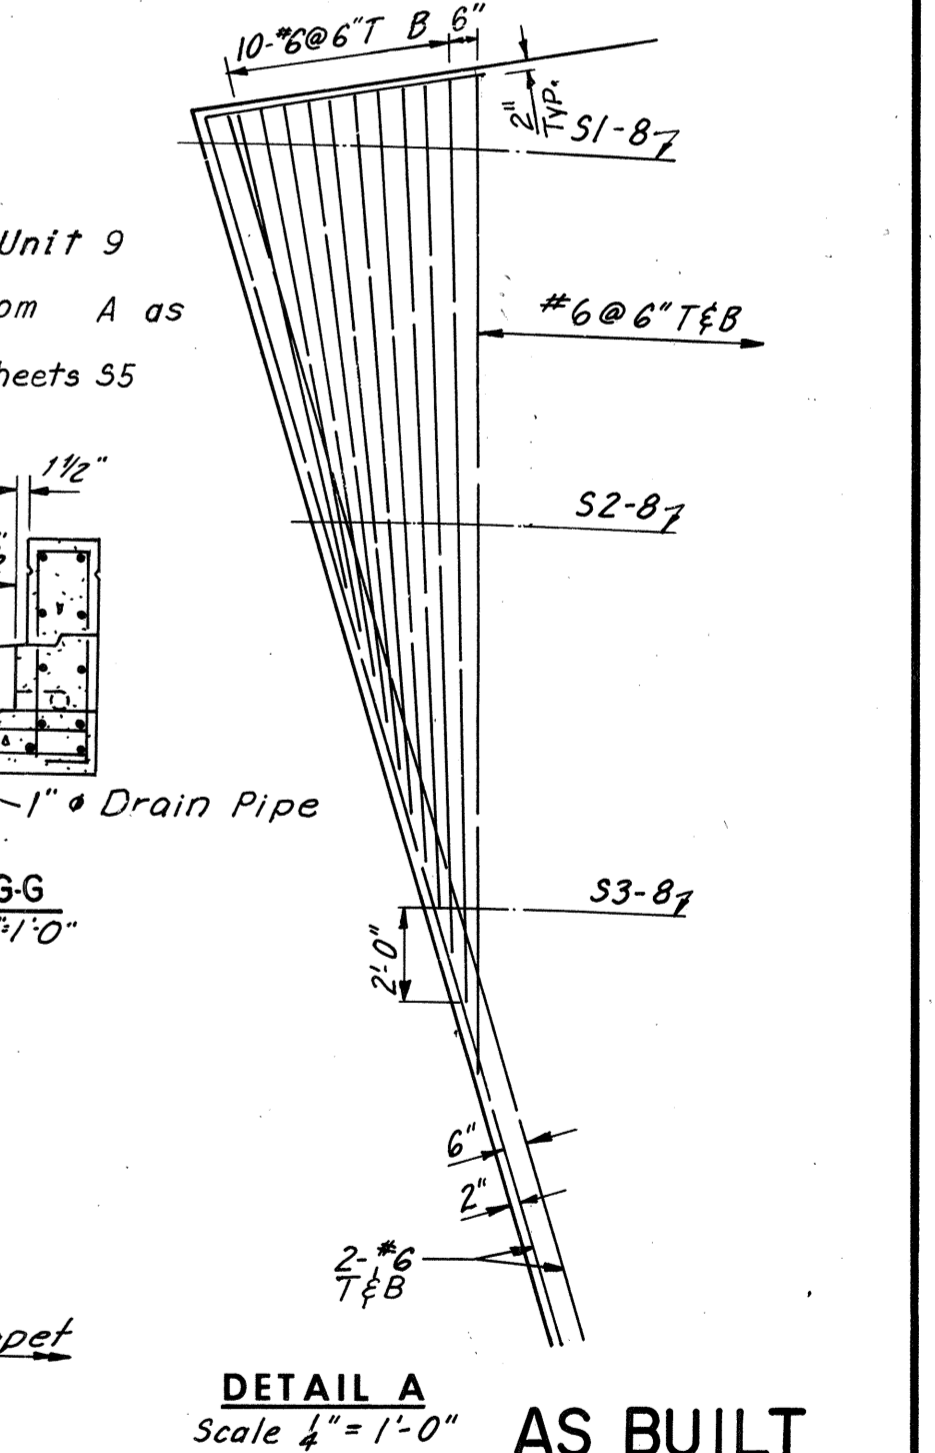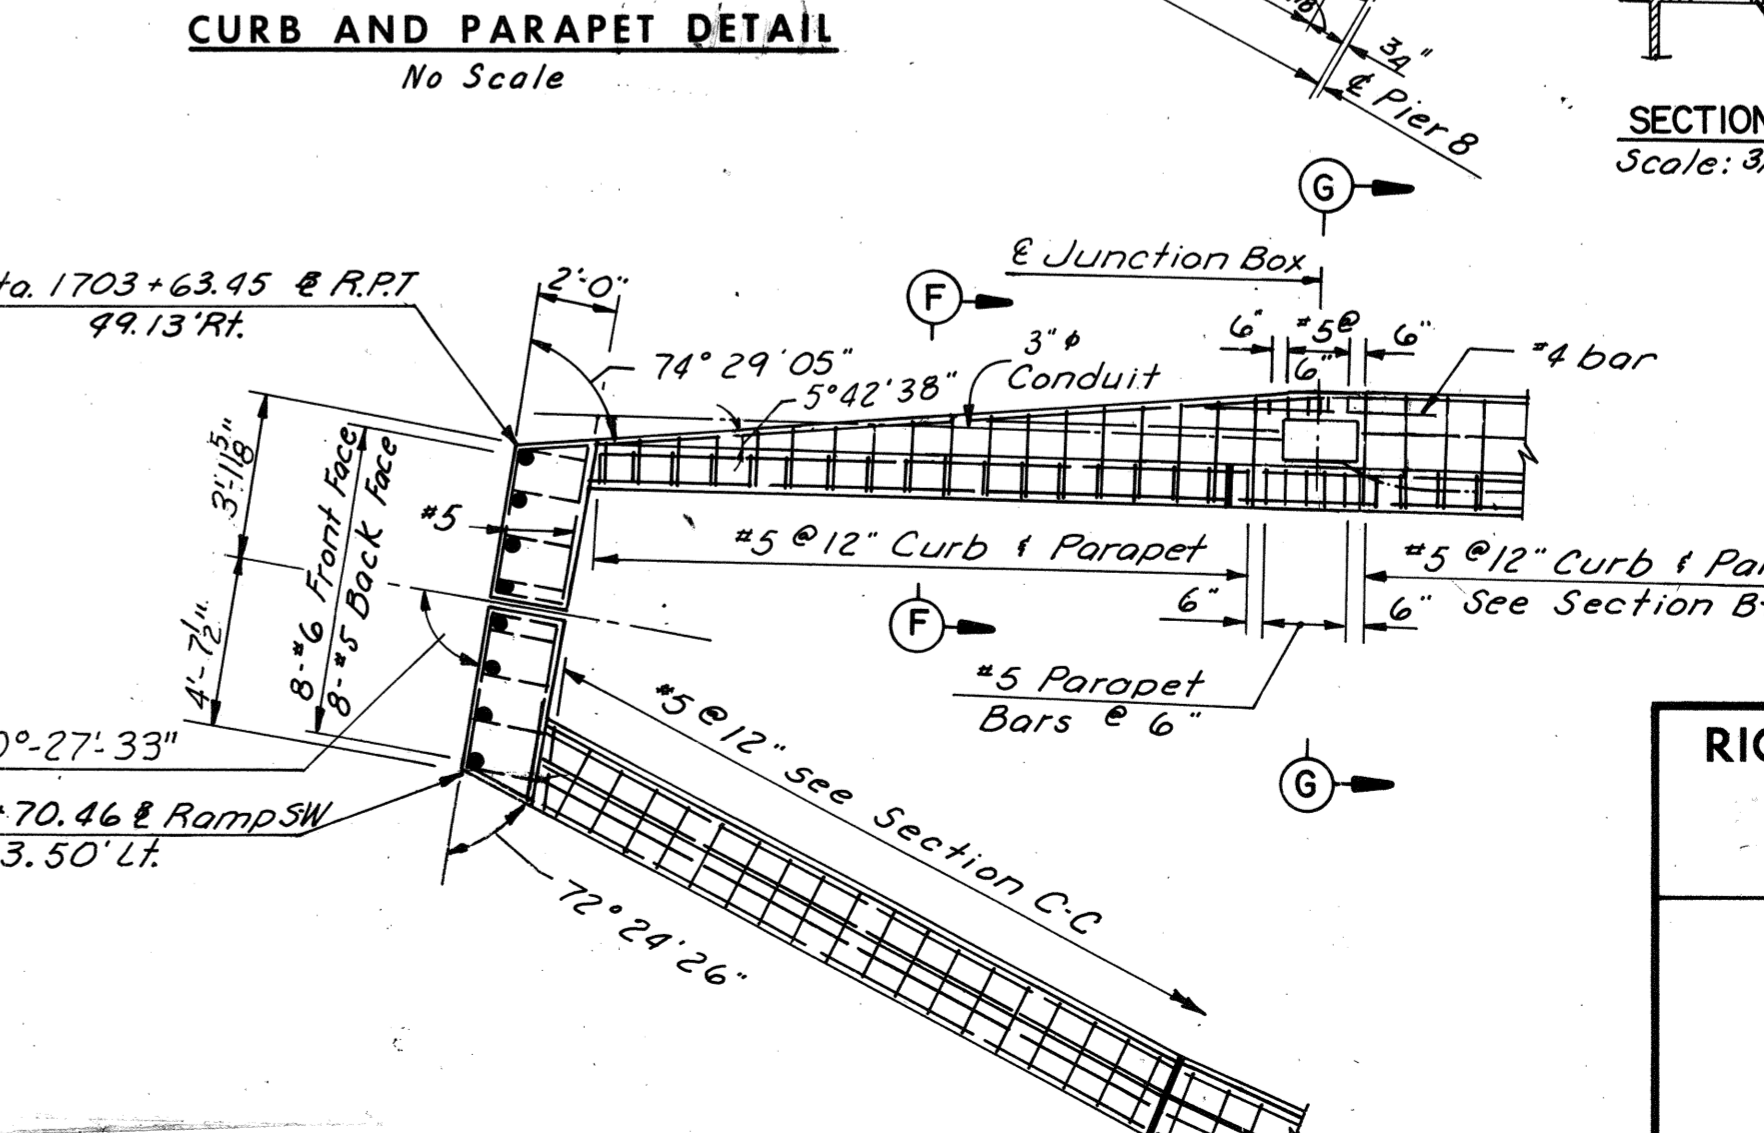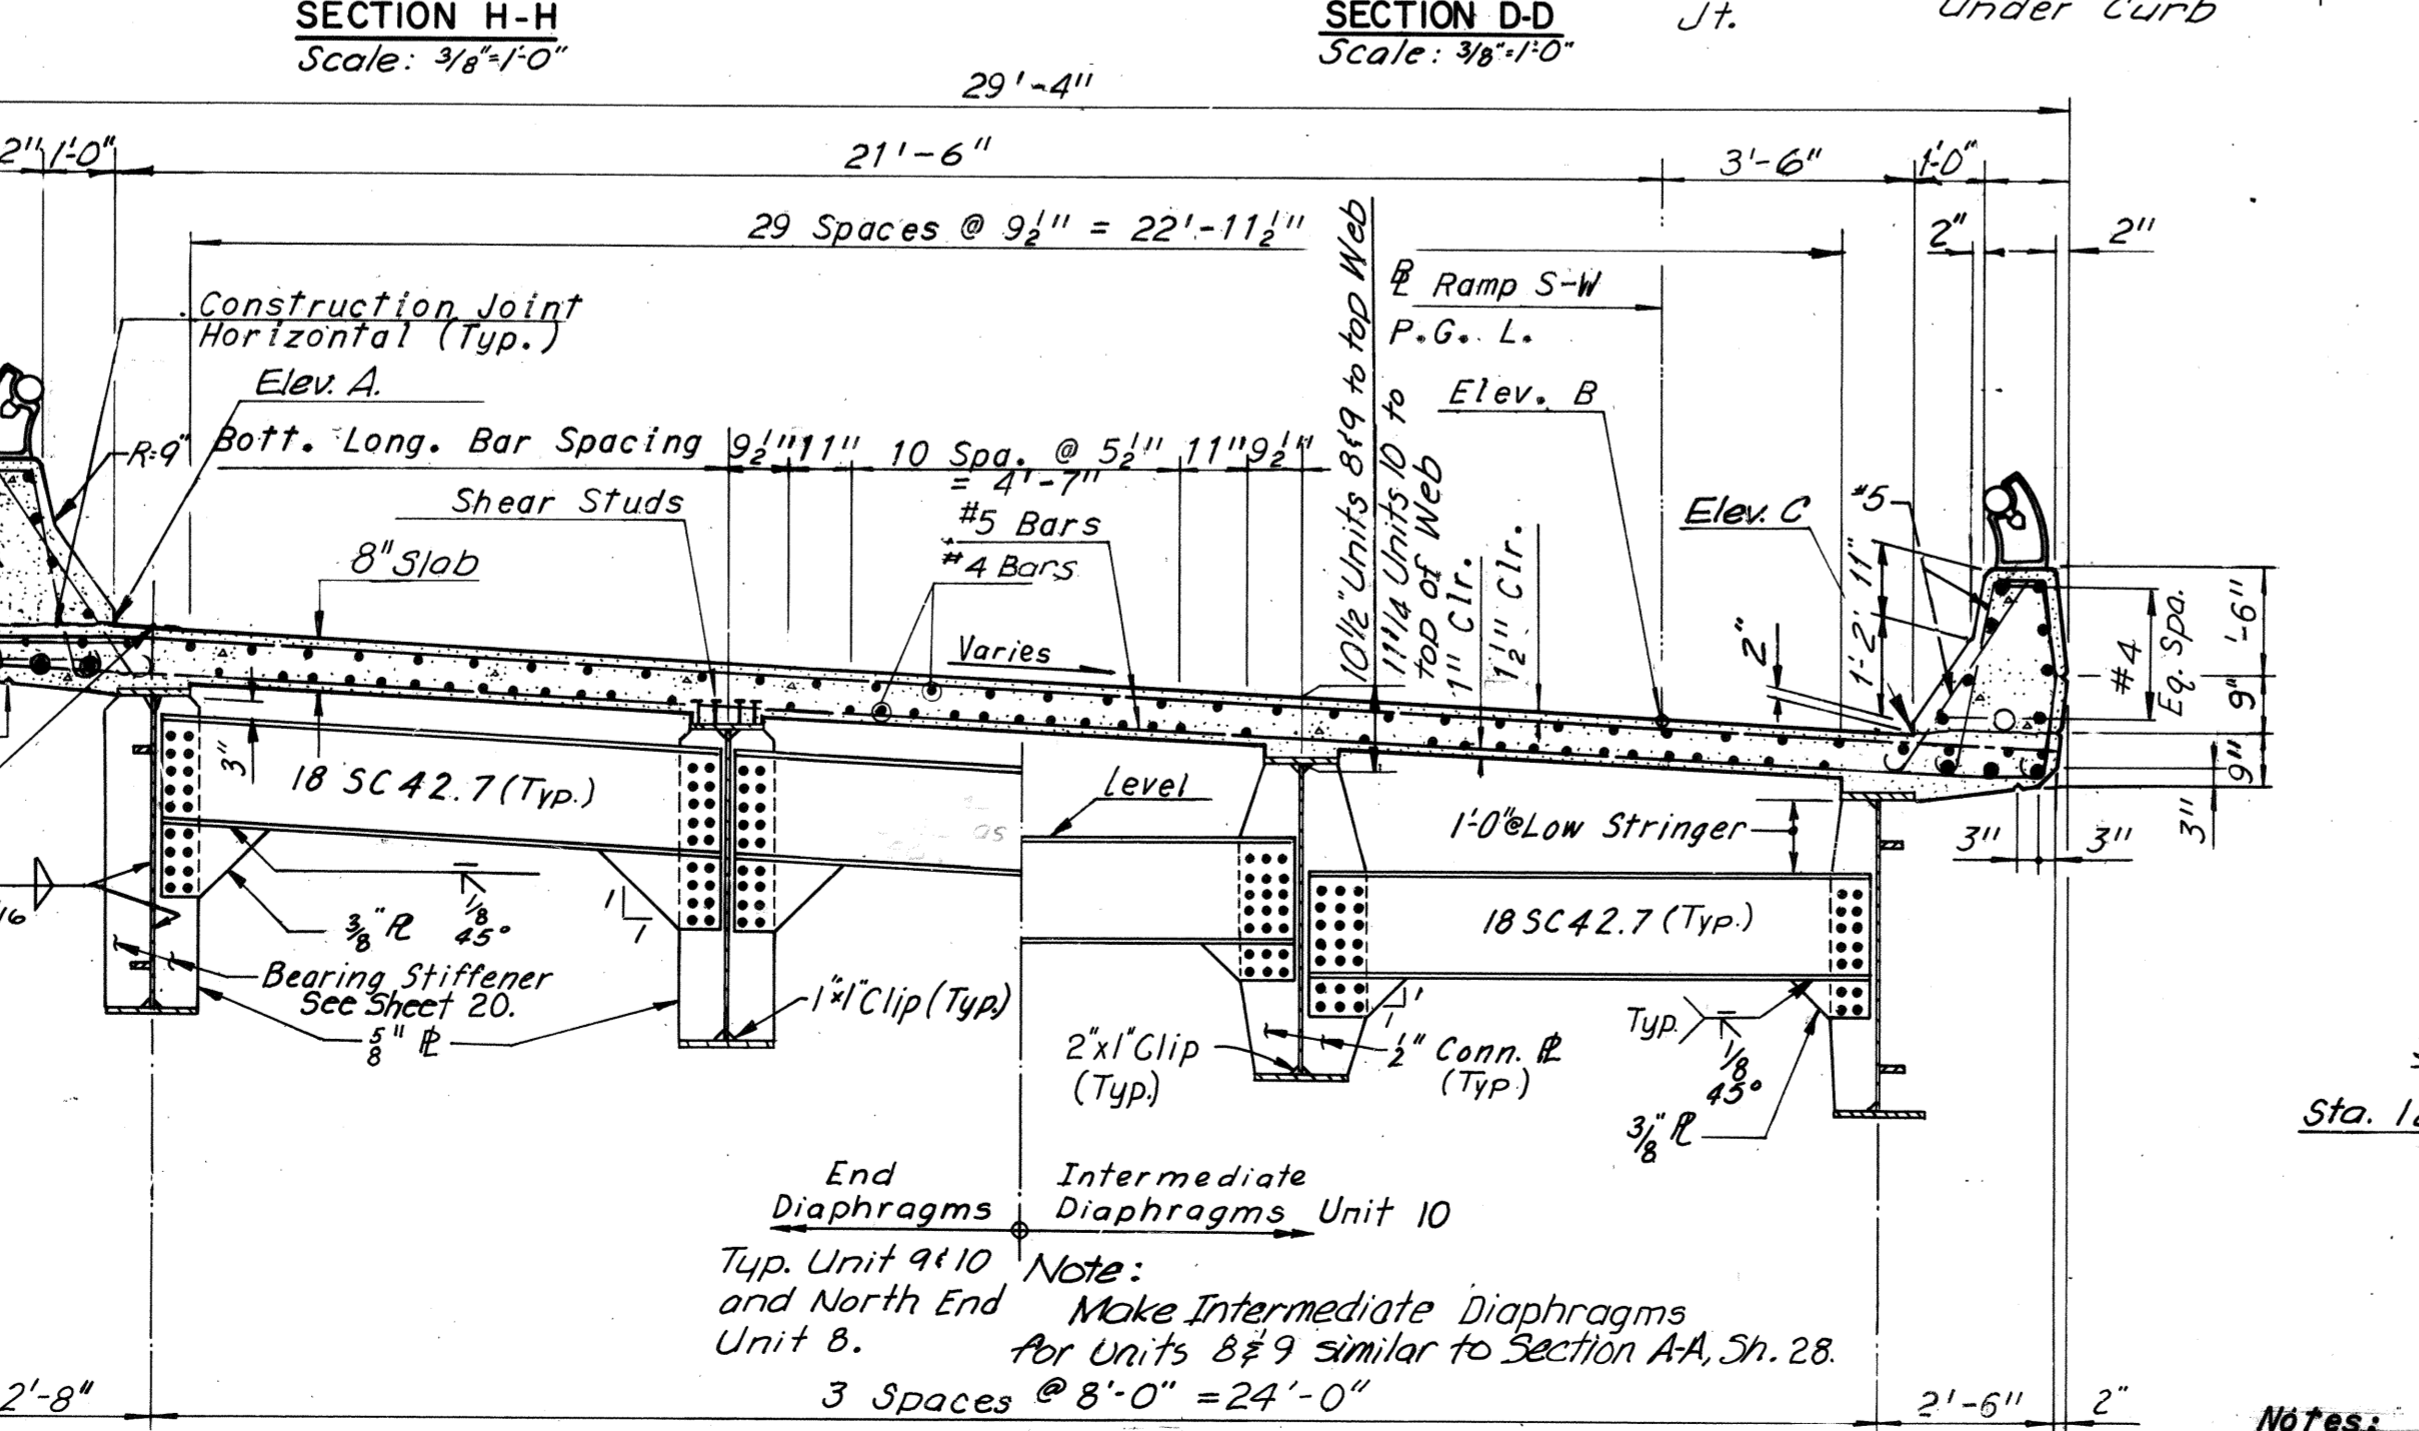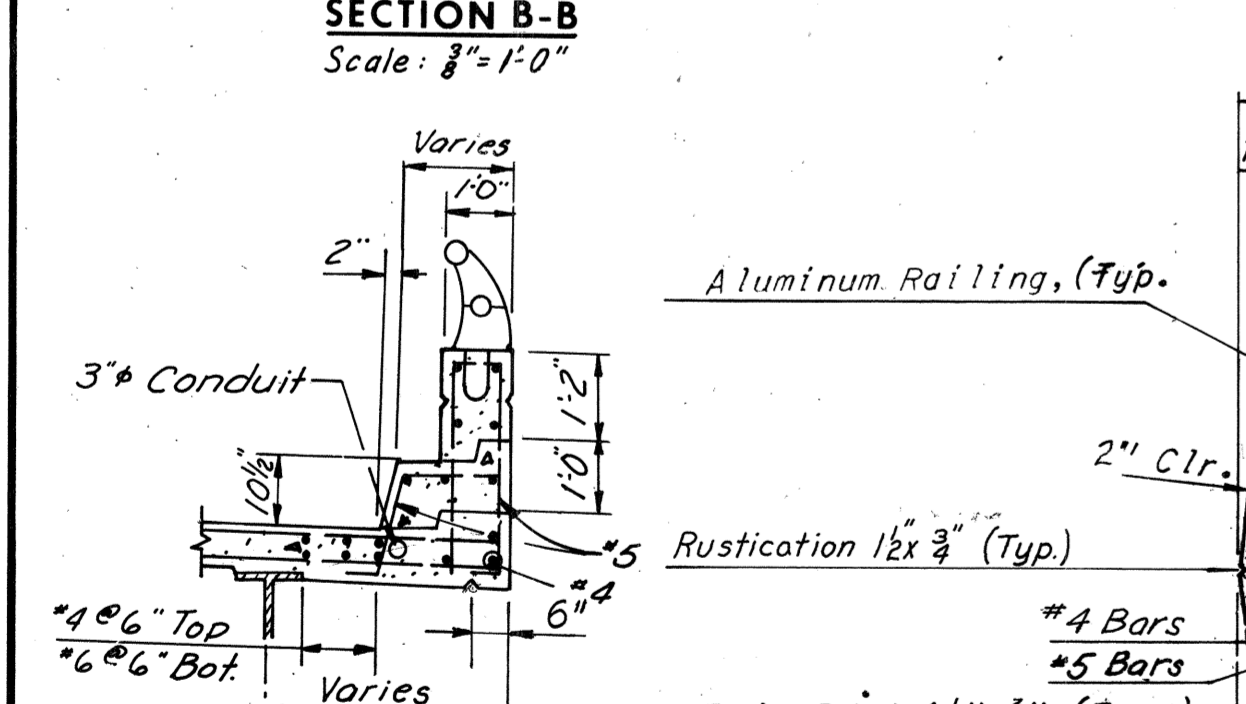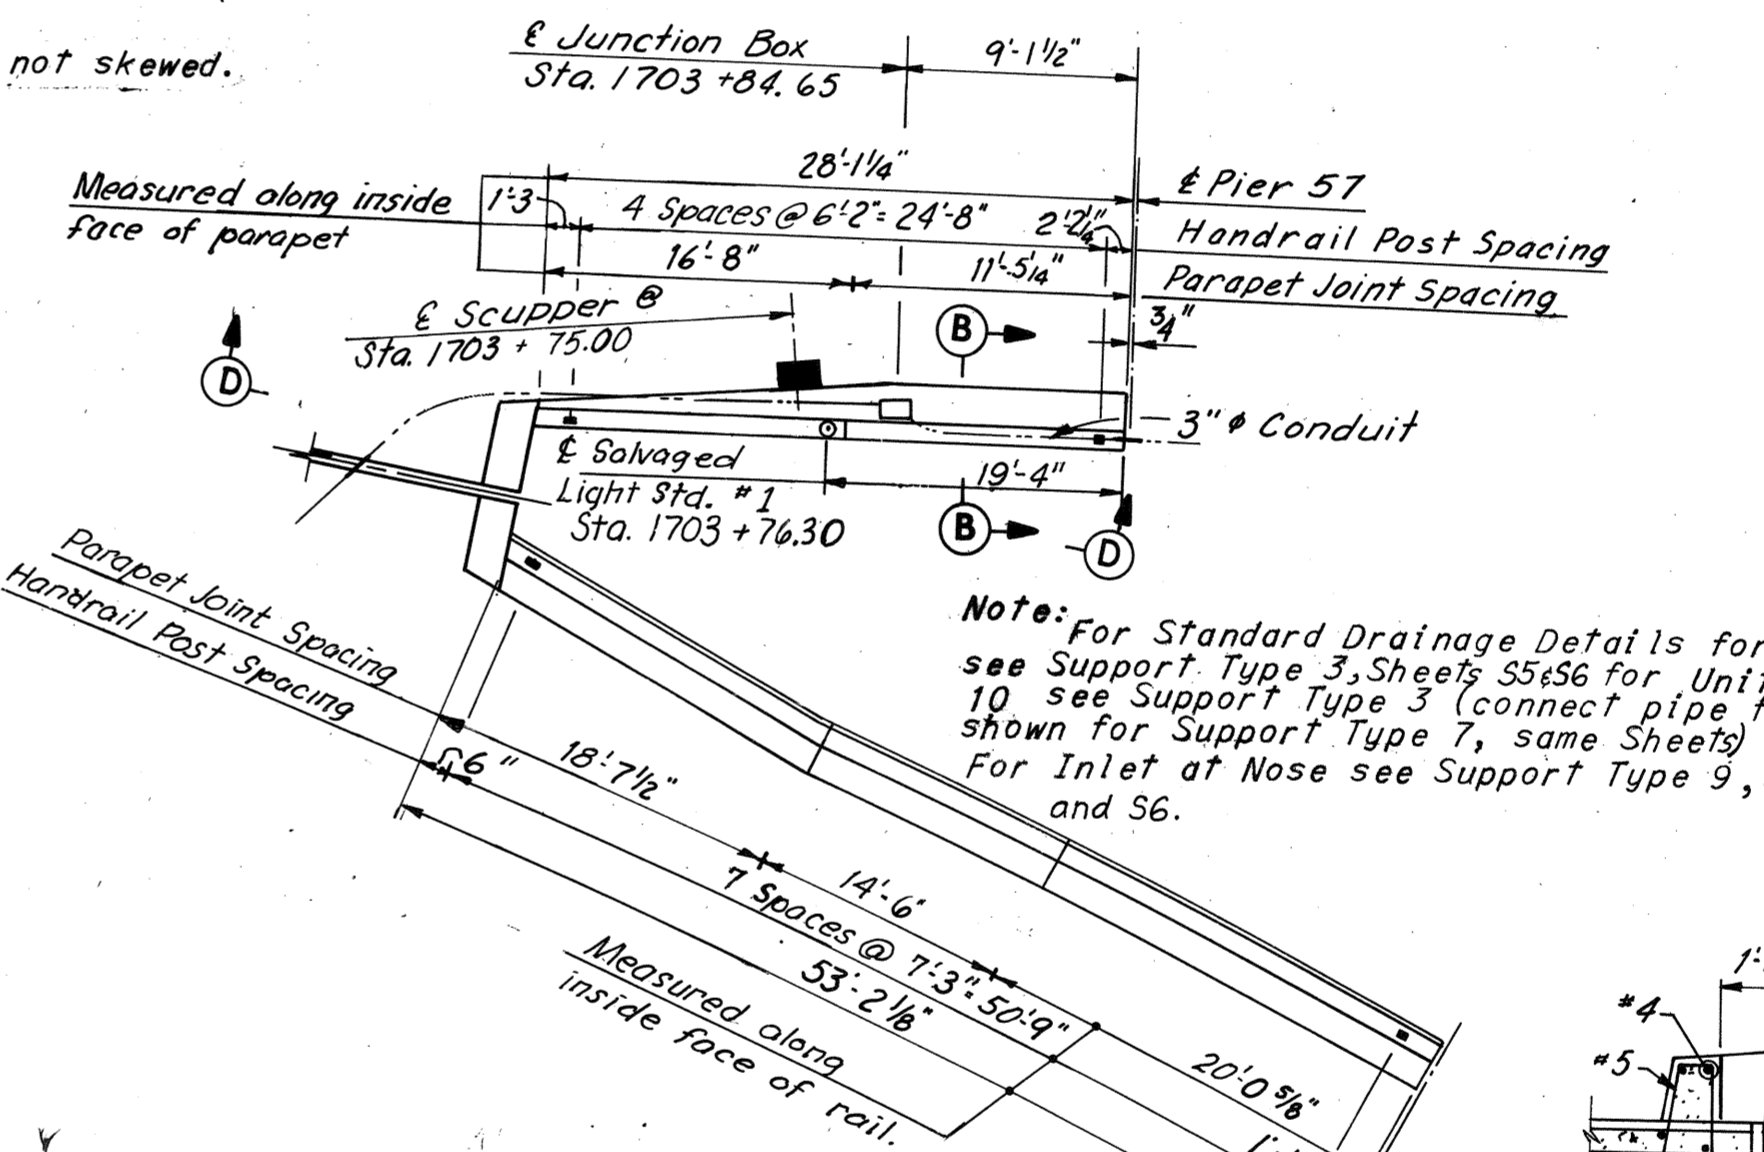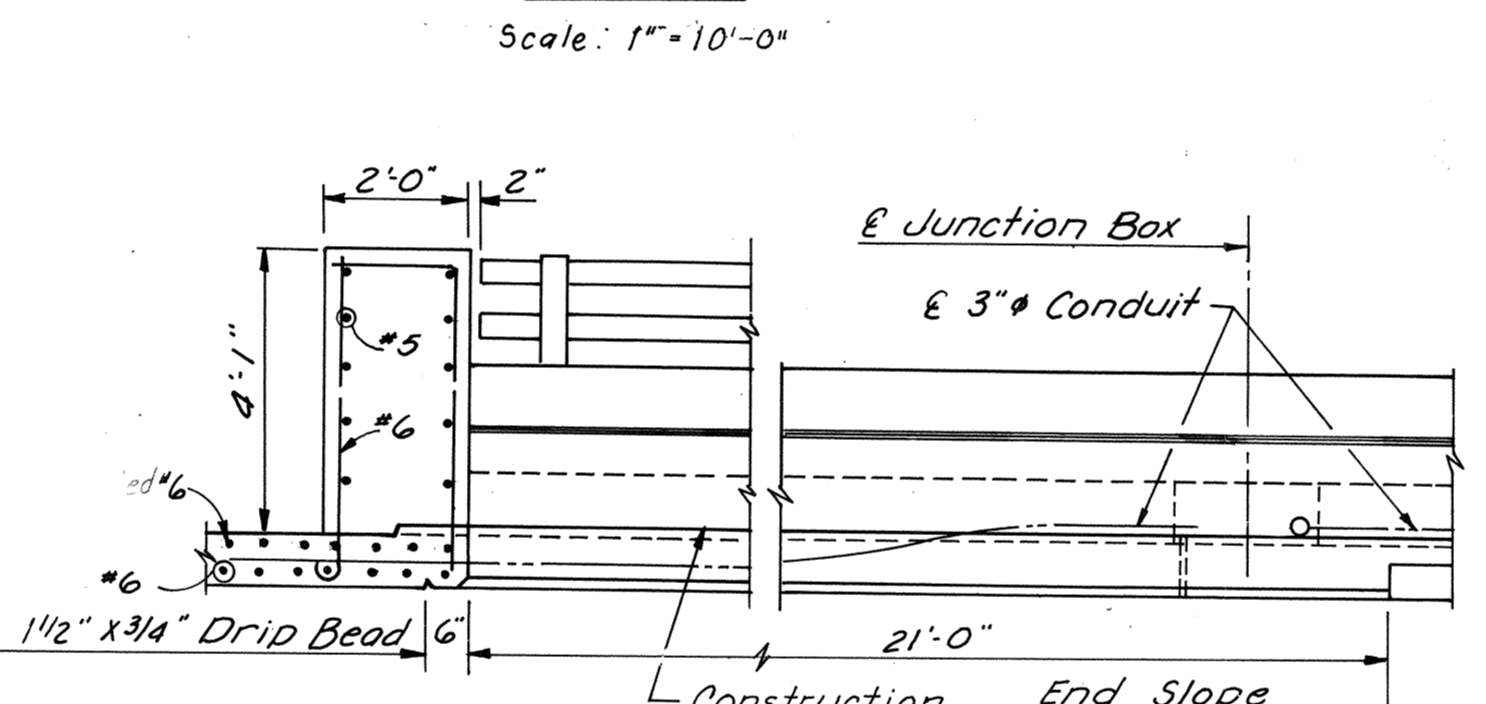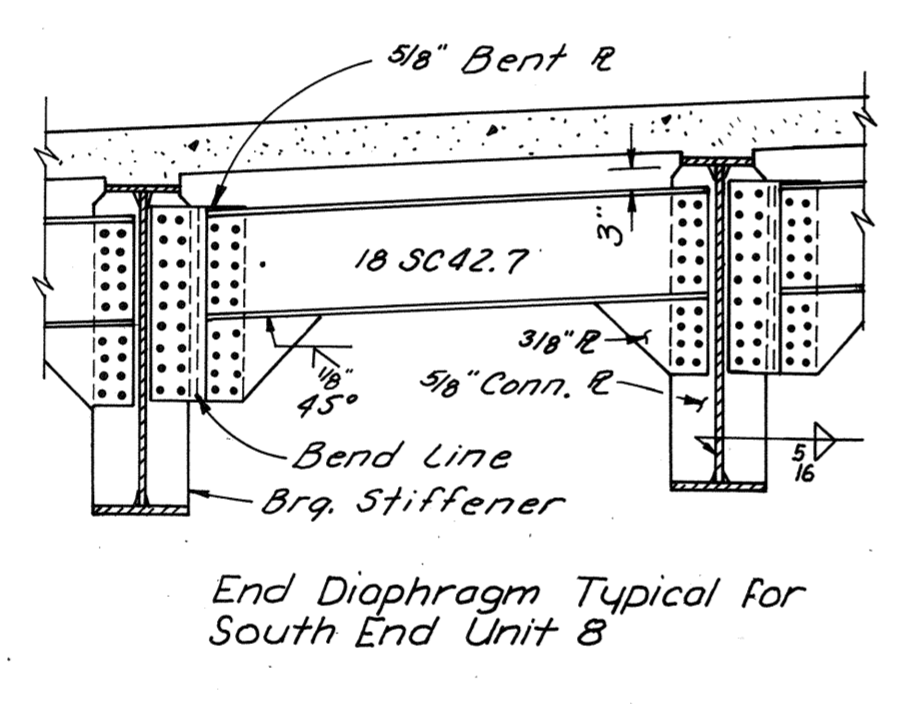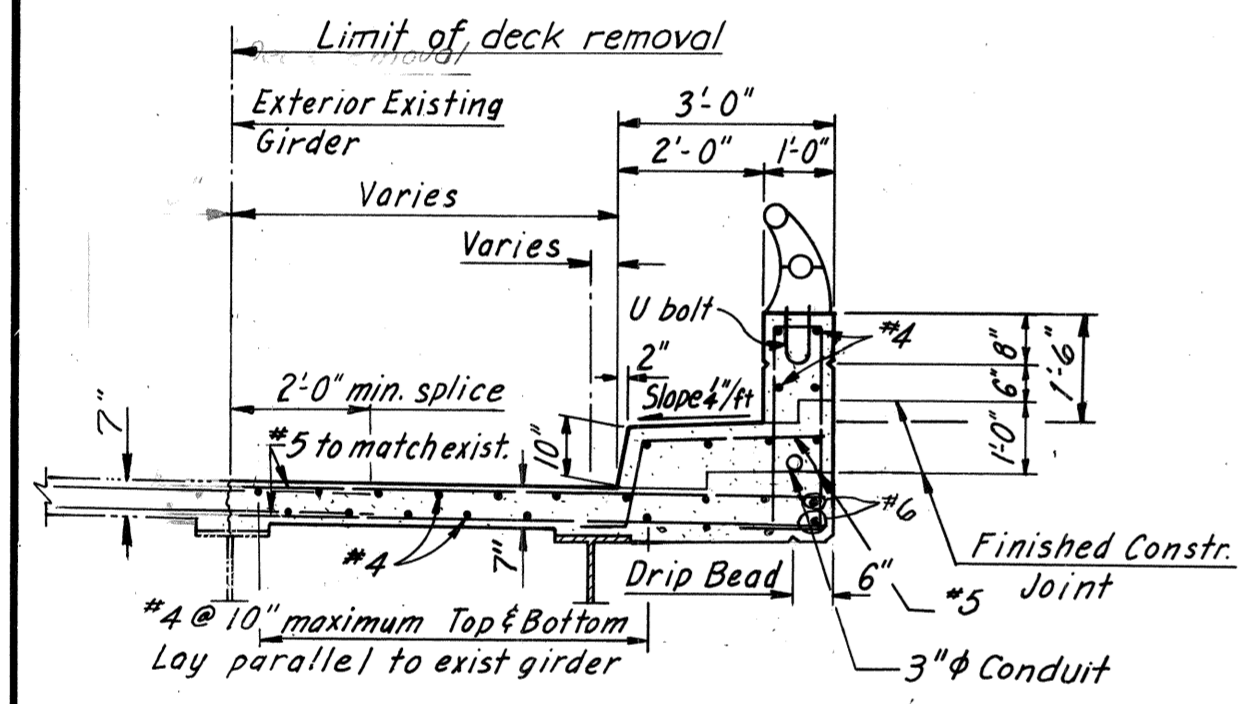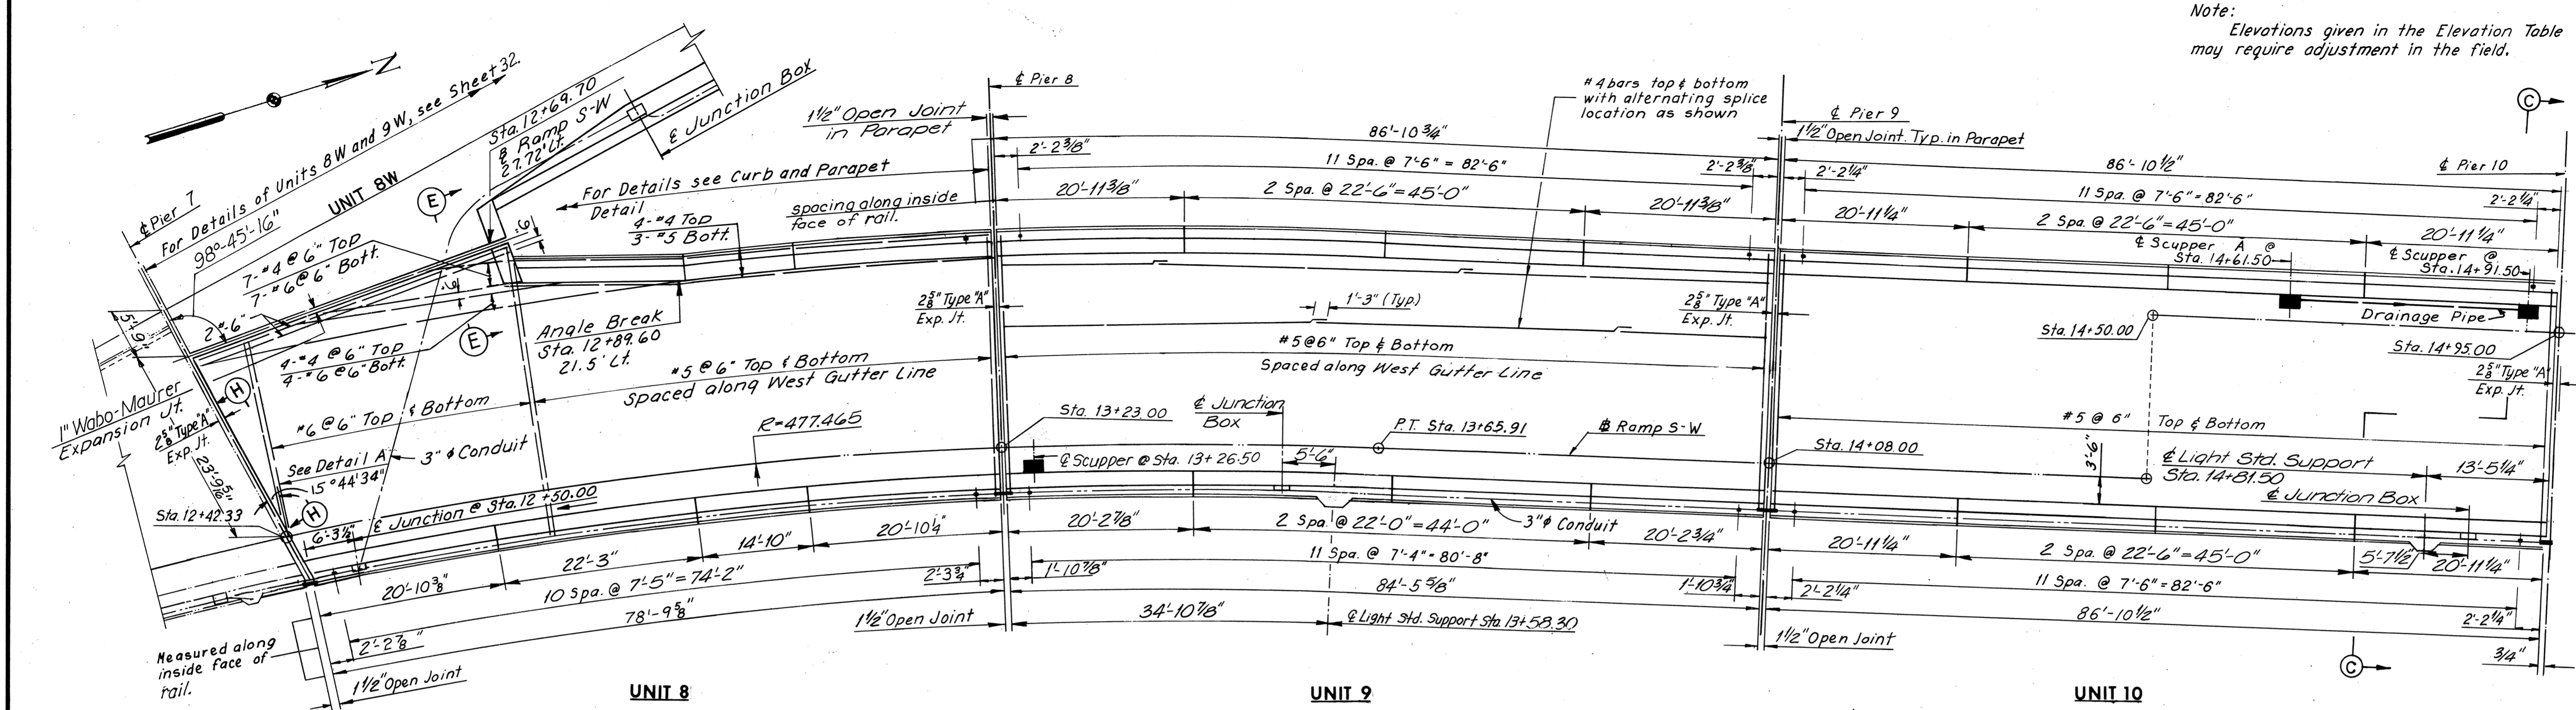

NO.	REVISION	BY	DATE
1	Diaph note on Sect C-C	TEM	8-25-75
2	Limit of slab removal, joint, slab thickness & #6 bundled bars rev.	A.B.P.	8-25-75

NO.	REVISION	BY	DATE
1	Section B-B	TEM	11-76
2	Joint Location	PRY	10-76
3	Deck Elev.	TEM	9-8-75

Notes:
 For Framing Plan see Sheet 20.
 For Joint Details, see Sheet 34 & 35.
 For Quantities see Sheet 4.
 For Handrail Details, see Sheet 33.


RICHMOND METROPOLITAN AUTHORITY
RICHMOND EXPRESSWAY SYSTEM
DOWNTOWN EXPRESSWAY

BRIDGE NO. 65
RAMP S-W CONNECTION FROM
RICHMOND-PETERSBURG TURNPIKE
DECK PLAN UNITS 8.9 AND 10


HOWARD, NEEDLES, TAMMEN & BERGENDOFF
 Consulting Engineers
 NEW YORK ALEXANDRIA KANSAS CITY

SCALE: As Noted
 CONTRACT NO. 11
 SHEET NO. 27 of 38

RICHMOND EXPRESSWAY SYSTEM			
SECTION	PROJECT	SHEET NO.	TOTAL SHEETS
11	DOWNTOWN EXPRESSWAY	53	97

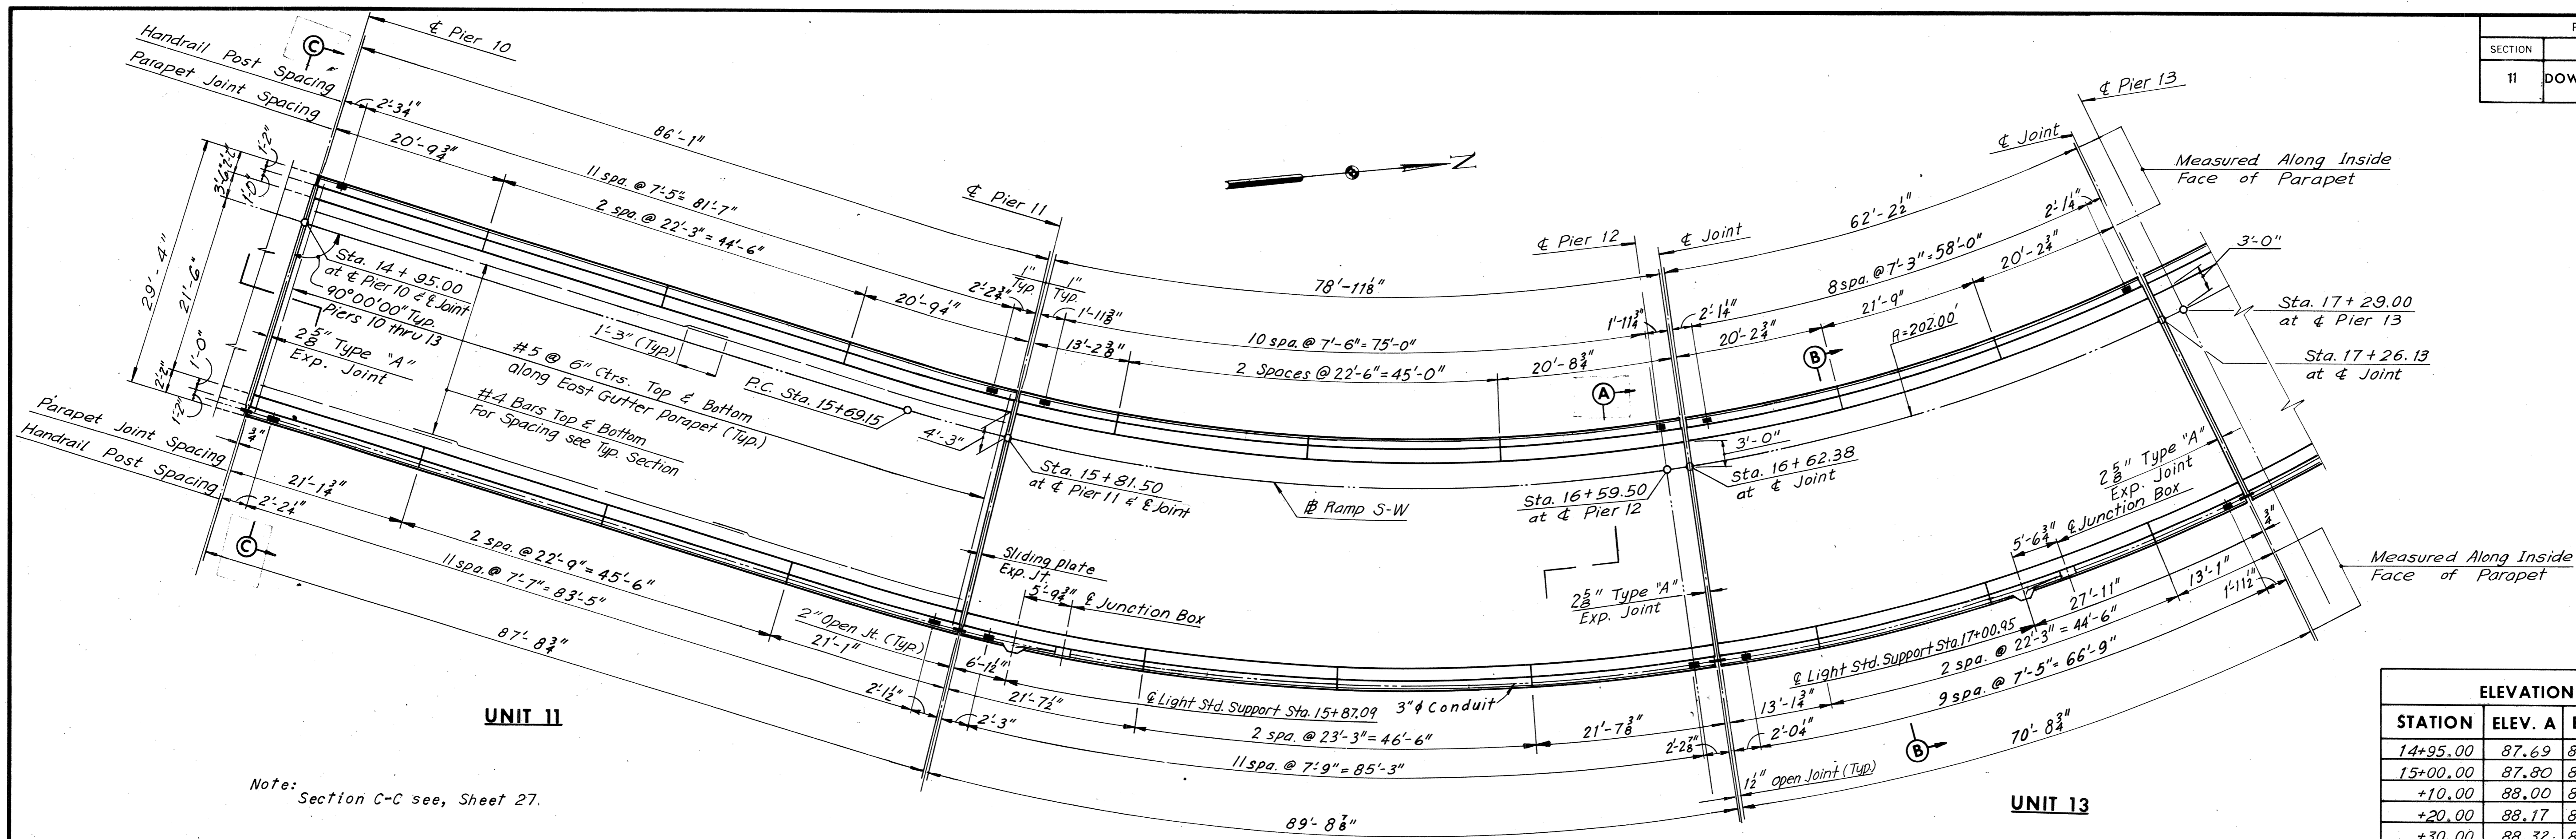

ELEVATION TABLE			
STATION	ELEV. A	ELEV. B	ELEV. C
14+95.00	87.69	87.74	88.07
15+00.00	87.80	87.86	88.23
+10.00	88.00	88.07	88.51
+20.00	88.17	88.26	88.77
+30.00	88.32	88.41	89.00
+40.00	88.42	88.54	89.20
+50.00	88.51	88.63	89.37
+60.00	88.57	88.70	89.51
+70.00	88.60	88.74	89.63
+80.00	88.60	88.75	89.71
+81.50	88.60	88.75	89.72
+90.00	88.57	88.73	89.76
16+00.00	88.50	88.69	89.80
+10.00	88.42	88.61	89.79
+20.00	88.31	88.51	89.73
+30.00	88.17	88.37	89.63
+40.00	88.00	88.21	89.49
+50.00	87.81	88.02	89.31
+59.50		87.81	
+60.00	87.59	87.80	89.09
+62.38	87.53	87.74	89.03
+70.00	87.34	87.55	88.84
+80.00	87.06	87.27	88.56
+90.00	86.75	86.96	88.26
17+00.00	86.41	86.62	87.91
+10.00	86.05	86.26	87.55
+20.00	85.65	85.86	87.15
+26.12	85.40	85.61	86.90
+29.00		85.49	

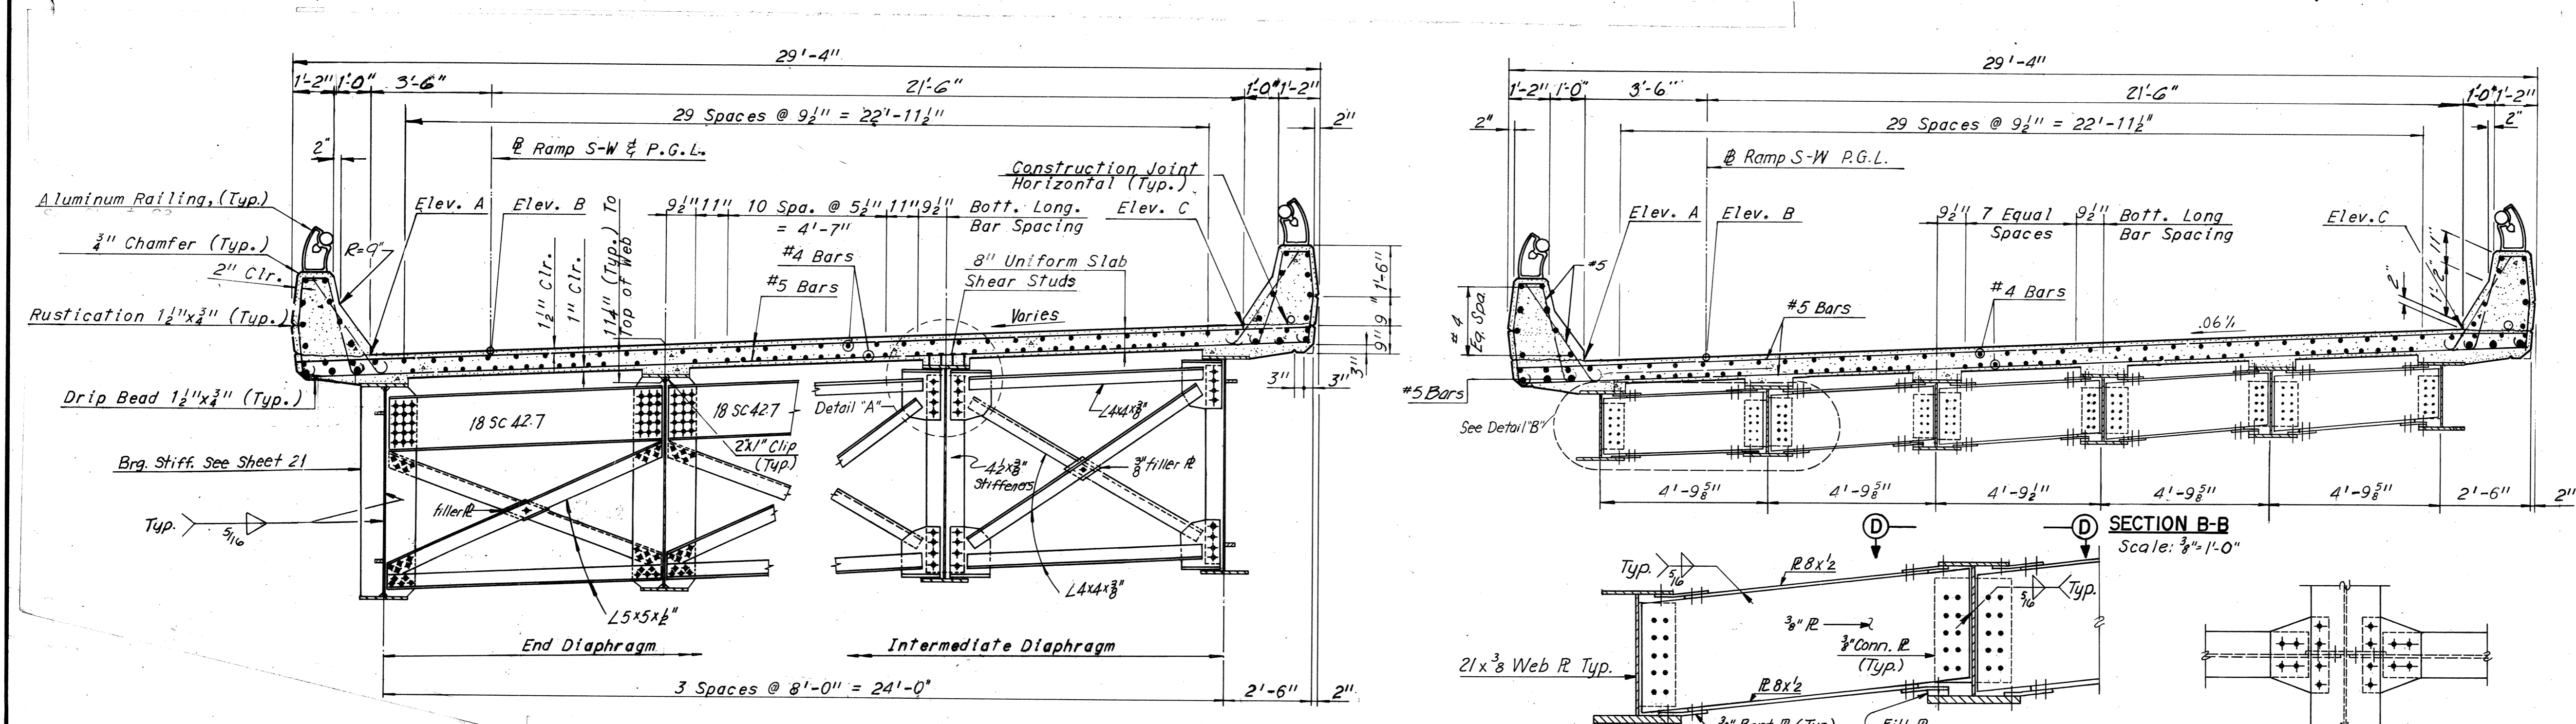

BY	DATE				
MADE	SCC	10-31-68			
CHECKED	G.S.H.	1-14-69	Detail B & View D-D revised	A.S.P.	8-25-76
IN CHARGE					

RICHMOND METROPOLITAN AUTHORITY
RICHMOND EXPRESSWAY SYSTEM
DOWNTOWN EXPRESSWAY

BRIDGE NO. 65
RAMP S-W CONNECTION FROM
RICHMOND-PETERSBURG TURNPIKE
DECK PLAN UNITS 11 12 AND 13




HOWARD, NEEDLES, TAMMEN & BERGENDOFF
 consulting engineers
 NEW YORK ALEXANDRIA KANSAS CITY

SCALE: _____
 CONTRACT NO. 11
 SHEET NO. 28 OF 38

AS BUILT

RICHMOND EXPRESSWAY SYSTEM			
SECTION	PROJECT	SHEET NO.	TOTAL SHEETS
11	DOWNTOWN EXPRESSWAY	54	97

ELEVATION TABLE			
STATION	ELEV. A	ELEV. B	ELEV. C
17+29.00	85.28	85.49	86.78
+30.00	85.23	85.44	86.73
+40.00	84.78	84.99	86.28
+50.00	84.30	84.51	85.80
+60.00	83.74	84.00	85.29
+70.00	83.25	83.46	84.75
+80.00	82.68	82.89	84.18
+90.00	82.09	82.30	83.59
+98.50	81.56	81.77	83.06
18+00.00	81.46	81.67	82.96
+10.00	80.82	81.03	82.82
+20.00	80.18	80.39	81.68
+30.00	79.54	79.75	81.04
+40.00	78.90	79.11	80.40
+50.00	78.26	78.47	79.74
+60.00	77.62	77.83	79.12
+68.00	77.11	77.32	78.61
+70.00	76.98	77.19	78.48
+80.00	76.36	76.57	77.86
+90.00	75.75	75.96	77.25
19+00.00	75.12	75.33	76.62
19+10.00	74.52	74.72	75.93
19+20.00	73.93	74.12	75.24
19+30.00	73.37	73.54	74.57
19+37.50	72.98	73.13	74.09

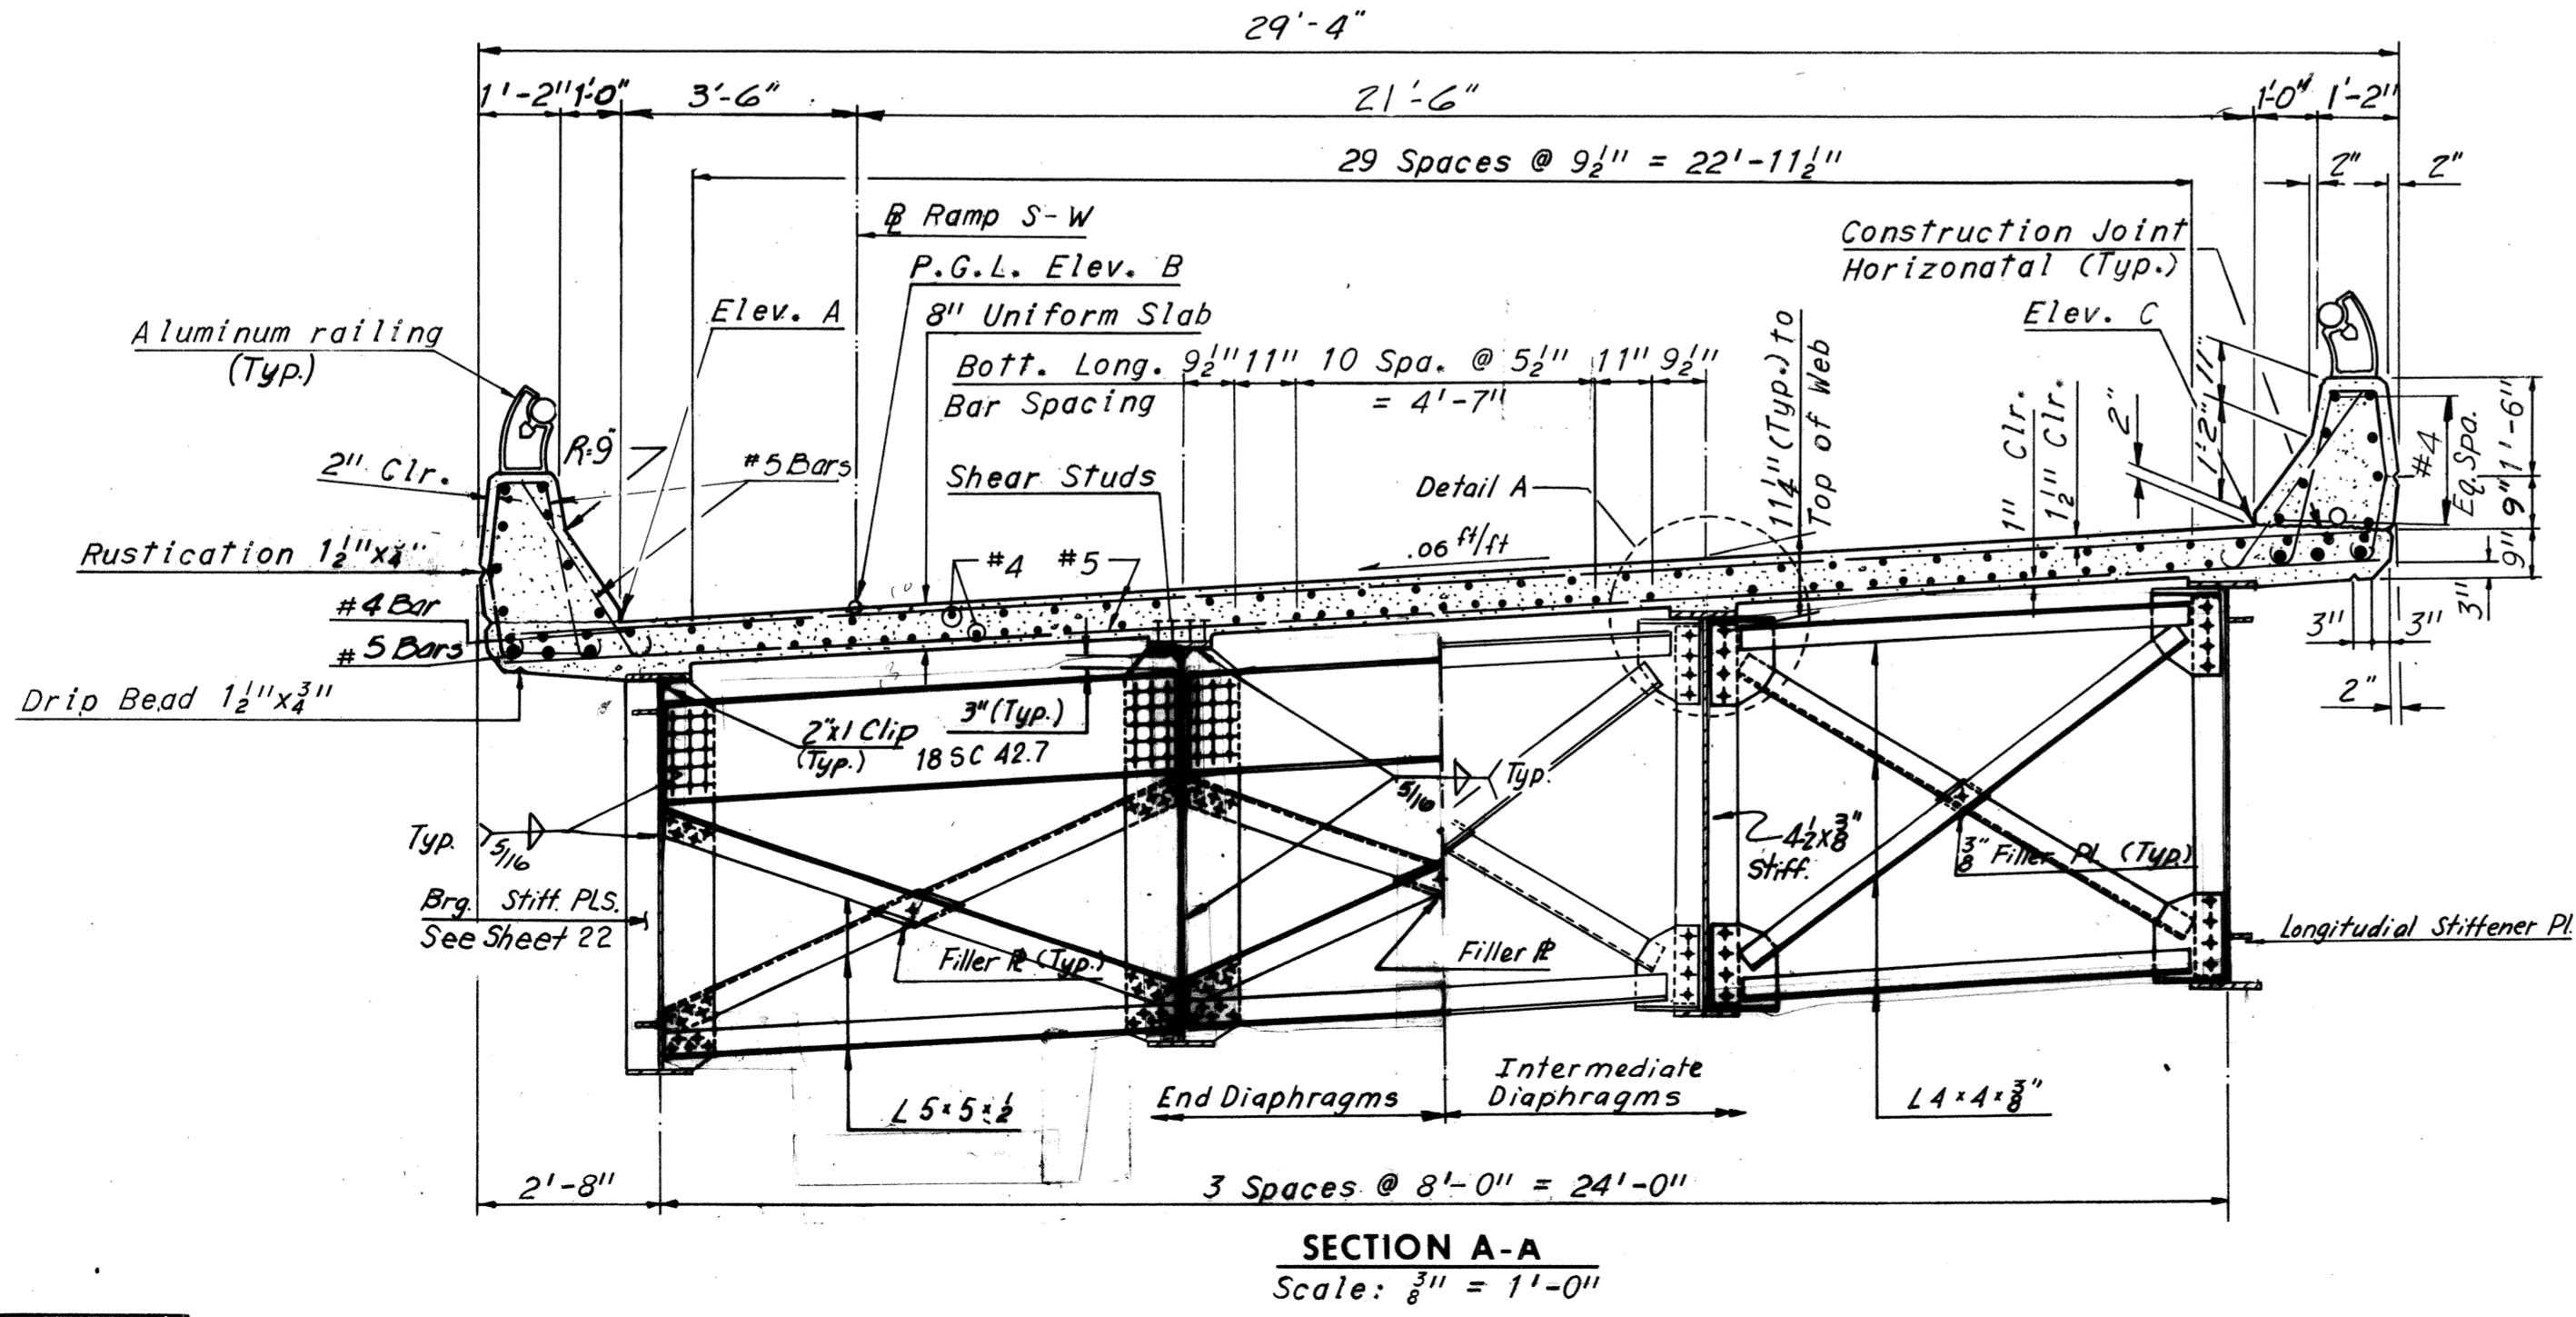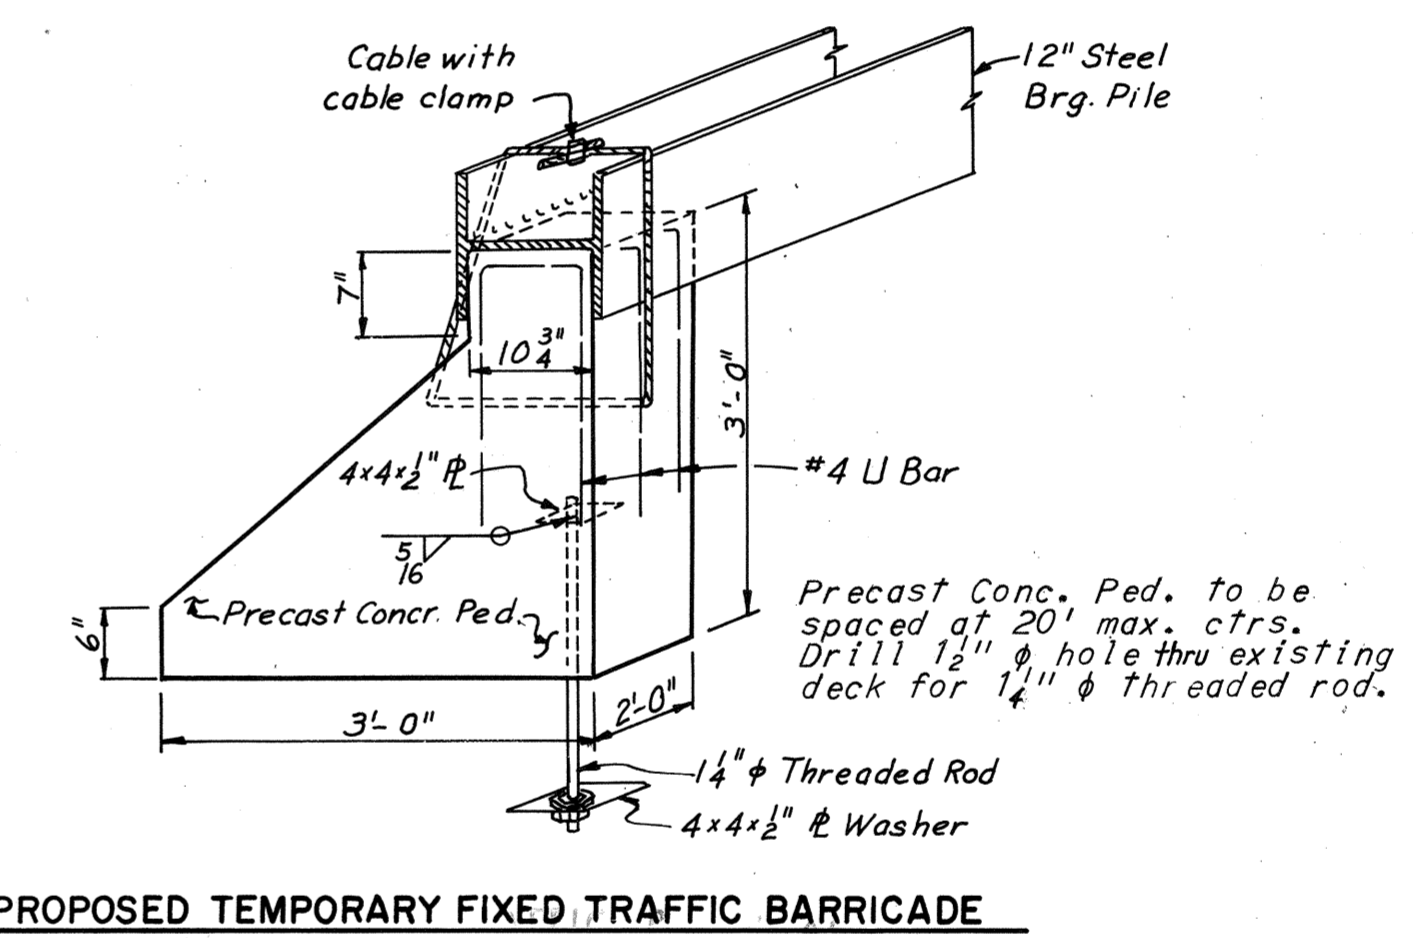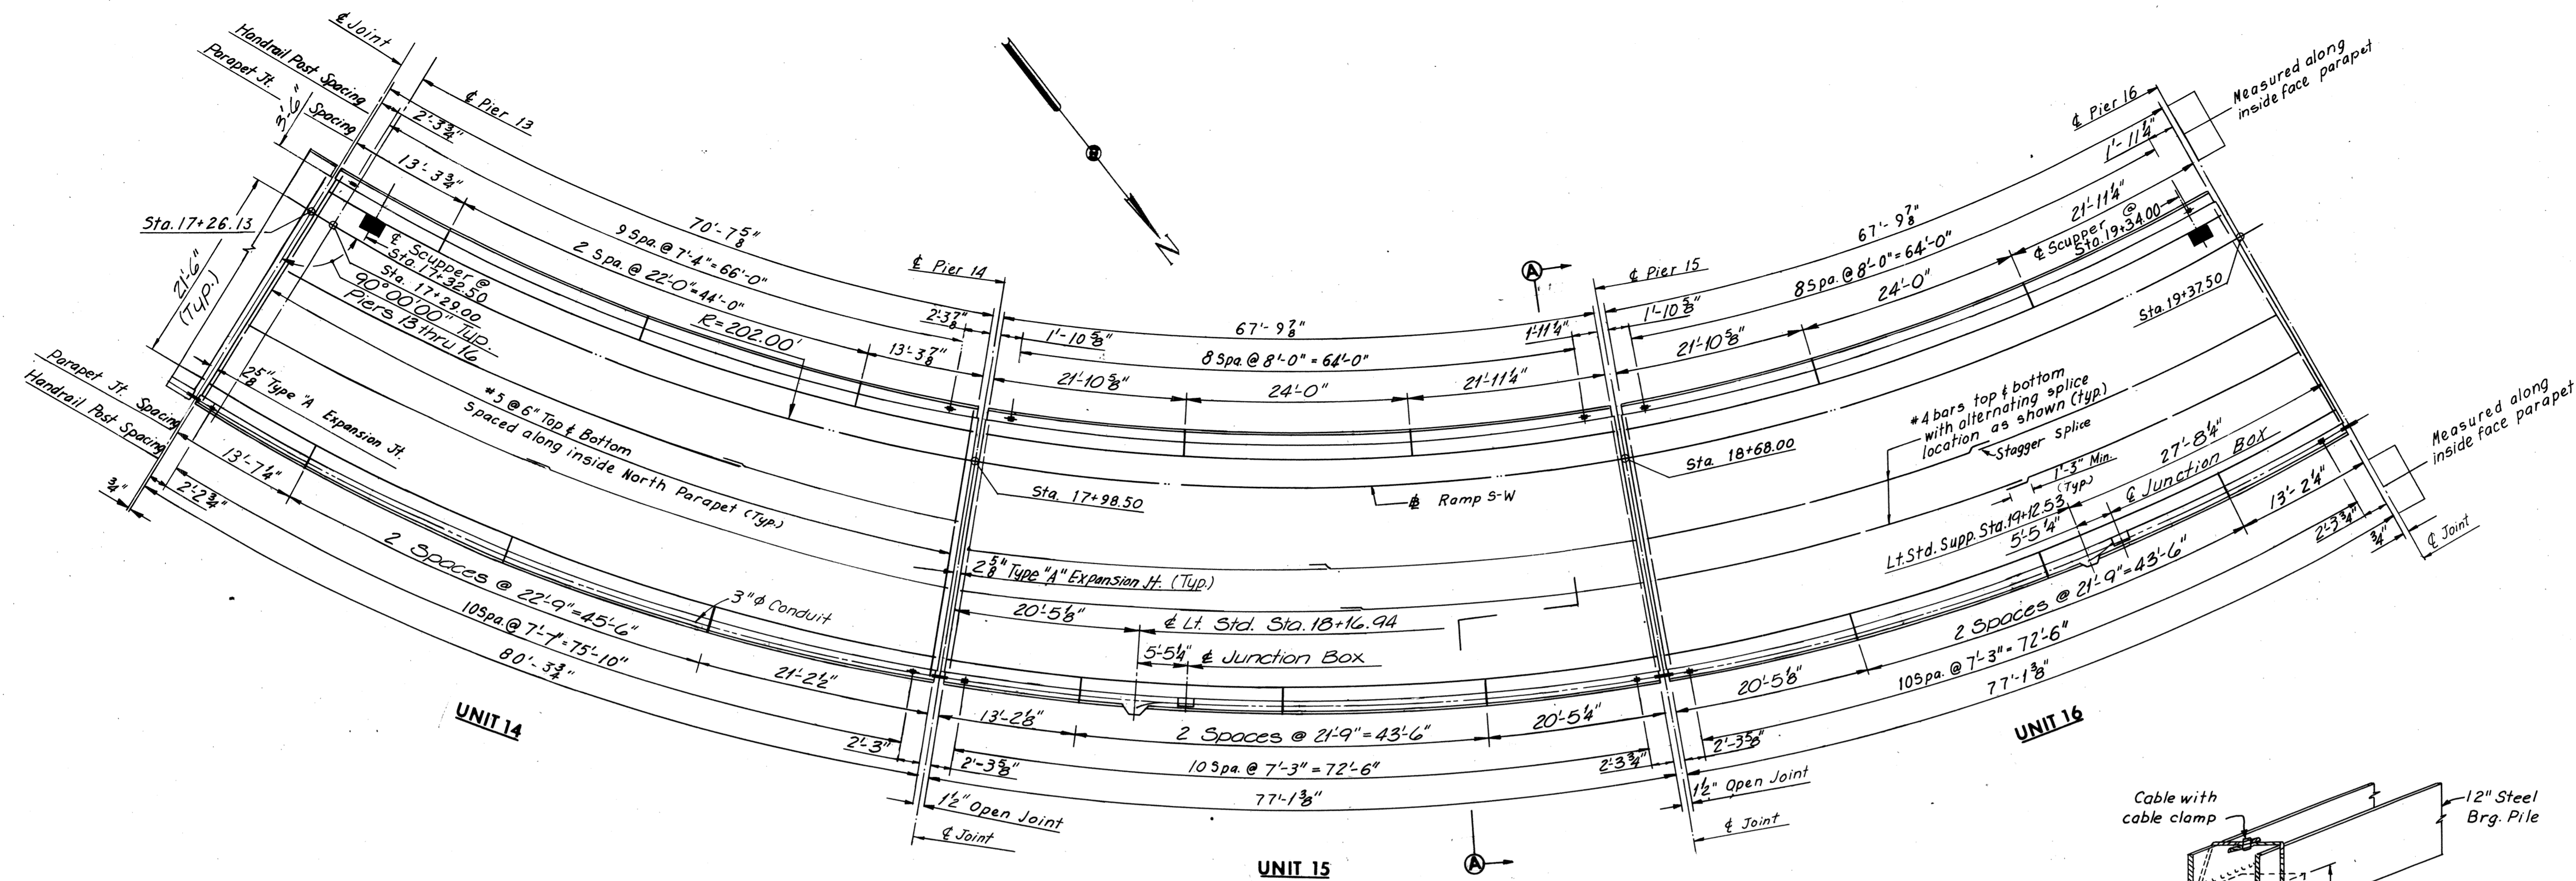

Notes:
 For Framing Plan see Sheet 22
 For Joint Details, see Sheet 34 & 35
 For Quantities see Sheet 4
 For Handrail Details, see Sheet S3.

Note: For Standard Drainage Details for Units 14 and 16, see Support Type 3 Sheets S5 & S6.

Note:
 For Detail A, see Sheet 31.

BY	DATE	NO.	REVISION	BY	DATE
MADE	C.E.B. 12-10-68				
CHECKED	Y.C.P. 1-15-69				
IN CHARGE					

AS BUILT


RICHMOND METROPOLITAN AUTHORITY
RICHMOND EXPRESSWAY SYSTEM
DOWNTOWN EXPRESSWAY

BRIDGE NO. 65
RAMP S-W CONNECTION FROM
RICHMOND-PETERSBURG TURNPIKE
DECK PLAN UNITS 14, 15 AND 16



HOWARD, NEEDLES, TAMMEN & BERGENDOFF
 consulting engineers
 NEW YORK ALEXANDRIA KANSAS CITY

SCALE: As Noted
 CONTRACT NO. 11
 SHEET NO. 29 OF 38



RICHMOND EXPRESSWAY SYSTEM			
SECTION	PROJECT	SHEET NO.	TOTAL SHEETS
11	DOWNTOWN EXPRESSWAY	55	97

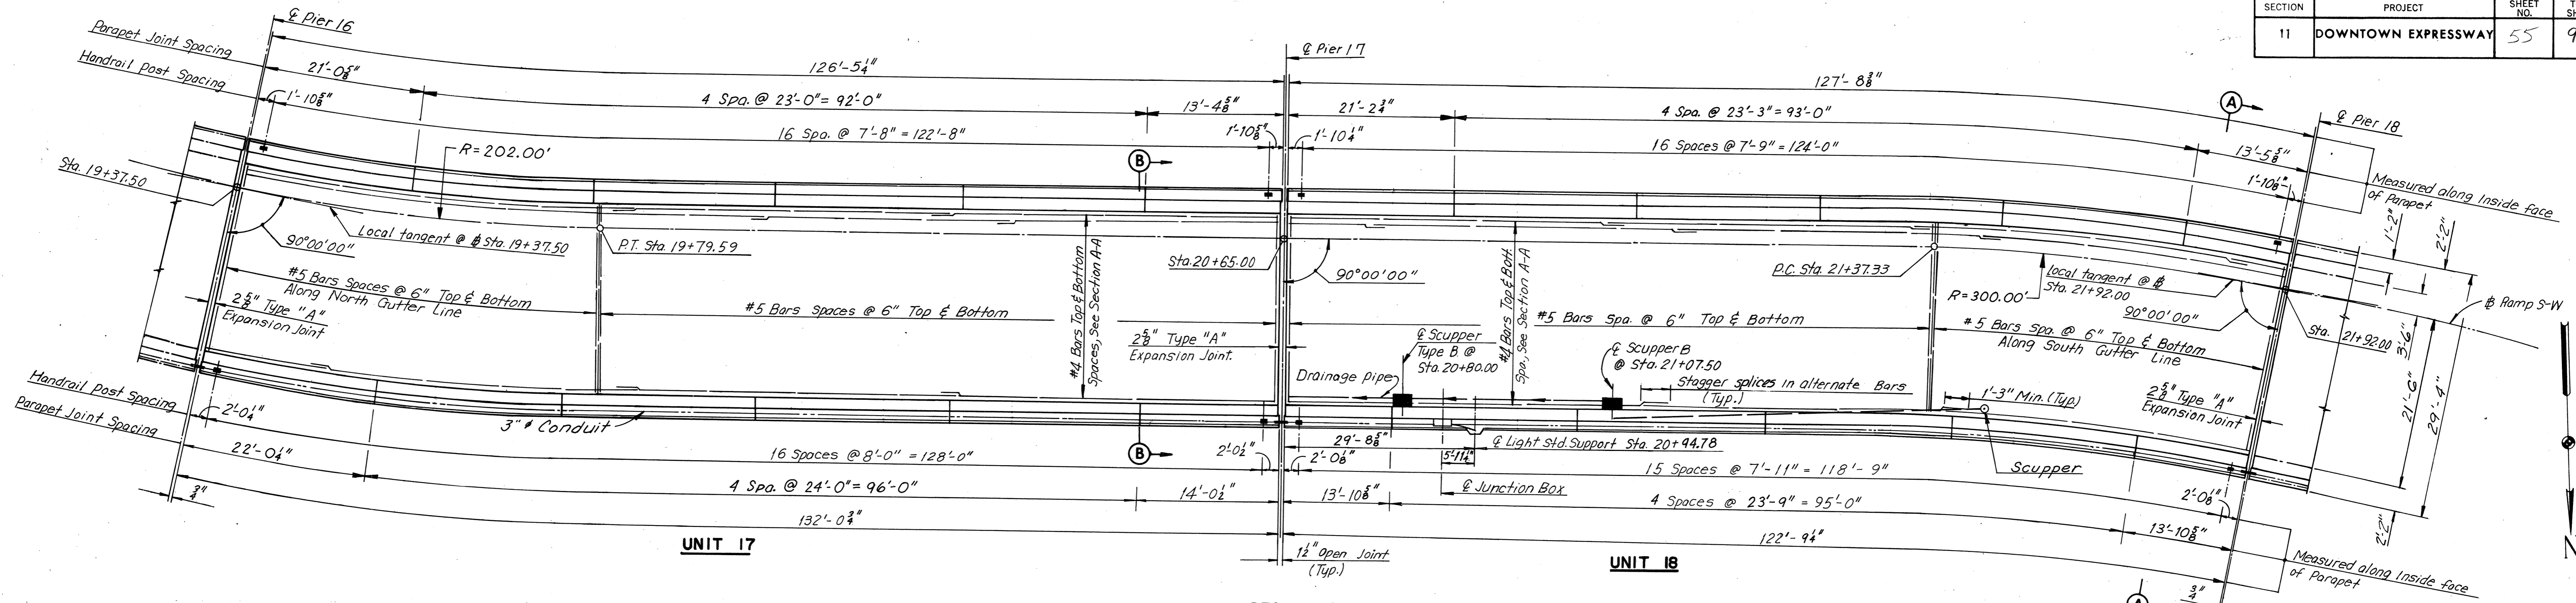

Notes:
 For Framing Plan see Sheet 23.
 For Joint Details, see Sheet 35.
 For Quantities, see Sheet 4.
 For Handrail Details see Sheet 53.
 For Standard Drainage Details for Unit 18, see Support Type 3, Sheets 55 & 56 (connect pipe from A to pipe from B as shown for Support Type 7).

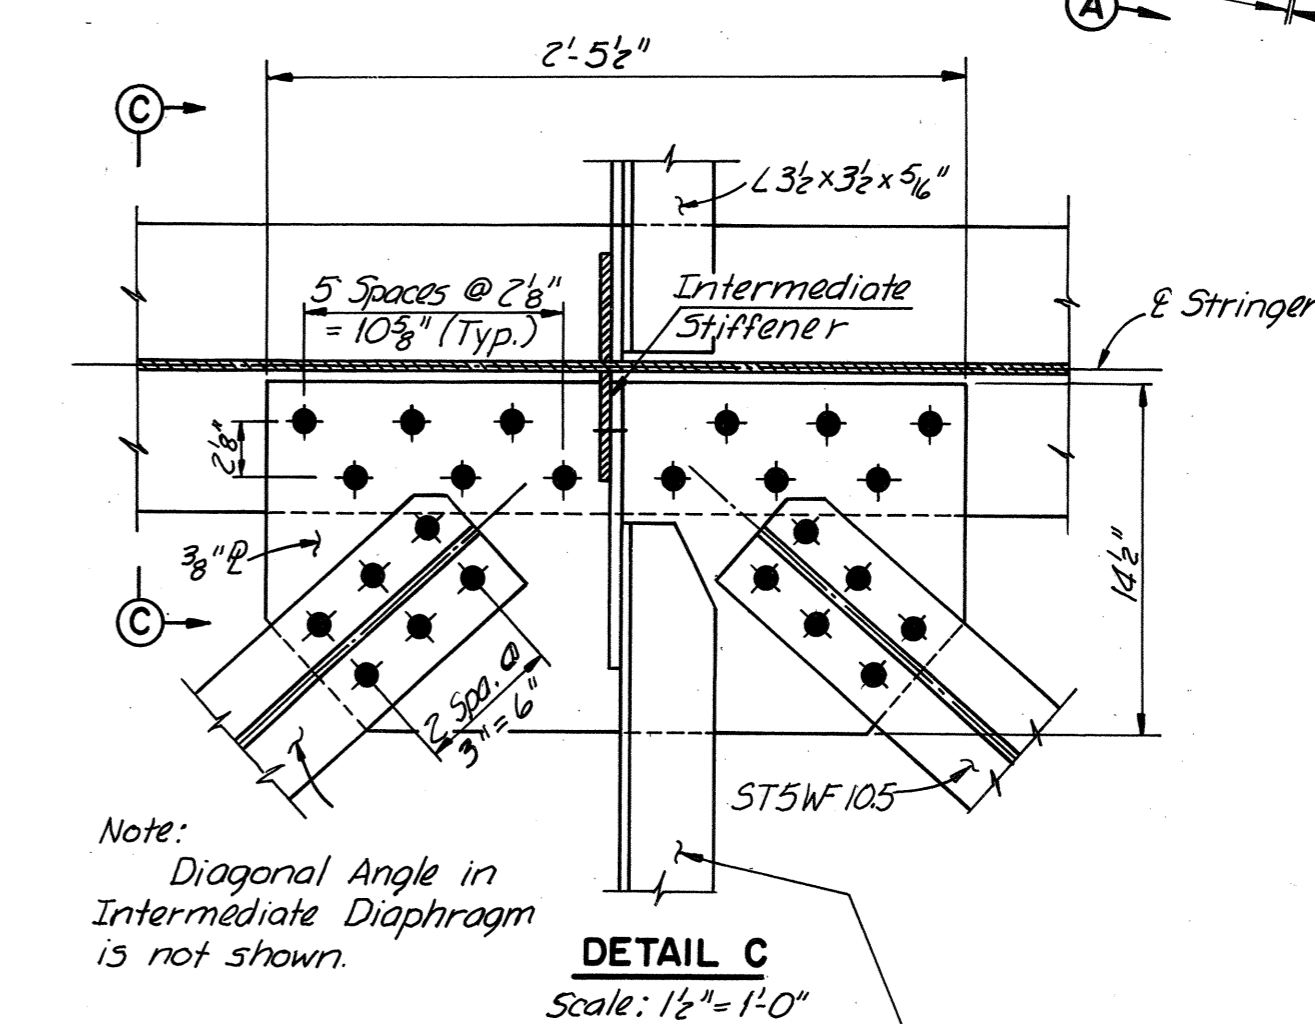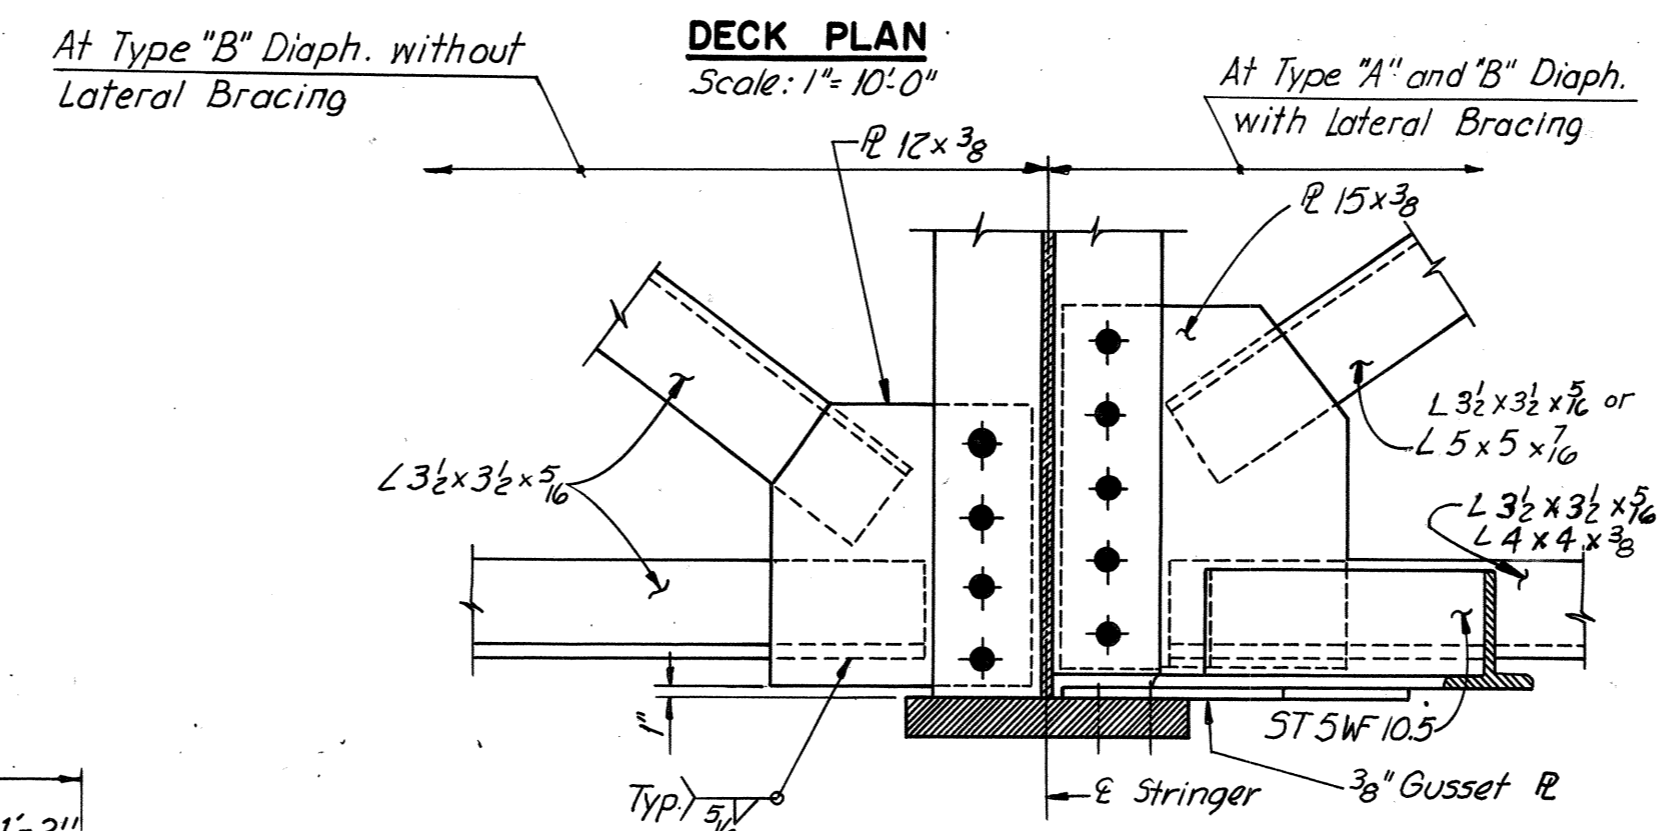

ELEVATION TABLE			
STATION	ELEV. A	ELEV. B	ELEV. C
19+37.50	72.98	73.13	74.09
+40.00	72.85	73.00	73.94
+50.00	72.38	72.52	73.38
+60.00	71.95	72.08	72.86
+70.00	71.56	71.68	72.37
+80.00	71.21	71.31	71.97
+90.00	70.89	70.98	71.49
20+00.00	70.61	70.68	71.11
+10.00	70.36	70.42	70.77
+20.00	70.15	70.20	70.46
+30.00	69.98	70.01	70.18
+40.00	69.85	69.86	69.94
+50.00	69.74	69.74	69.74
+60.00	69.68	69.66	69.56
+65.00	69.66	69.64	69.48
+70.00	69.65	69.62	69.42
+80.00	69.67	69.61	69.30
+90.00	69.71	69.64	69.23
21+00.00	69.79	69.71	69.20
+10.00	69.89	69.79	69.18
+20.00	70.00	69.88	69.15
+30.00	70.10	69.96	69.13
+40.00	70.19	70.05	69.12
+50.00	70.29	70.13	69.10
+60.00	70.40	70.21	69.07
+70.00	70.50	70.30	69.06
+80.00	70.59	70.38	69.09
+90.00	70.68	70.47	69.18
+92.00	70.70	70.49	69.20

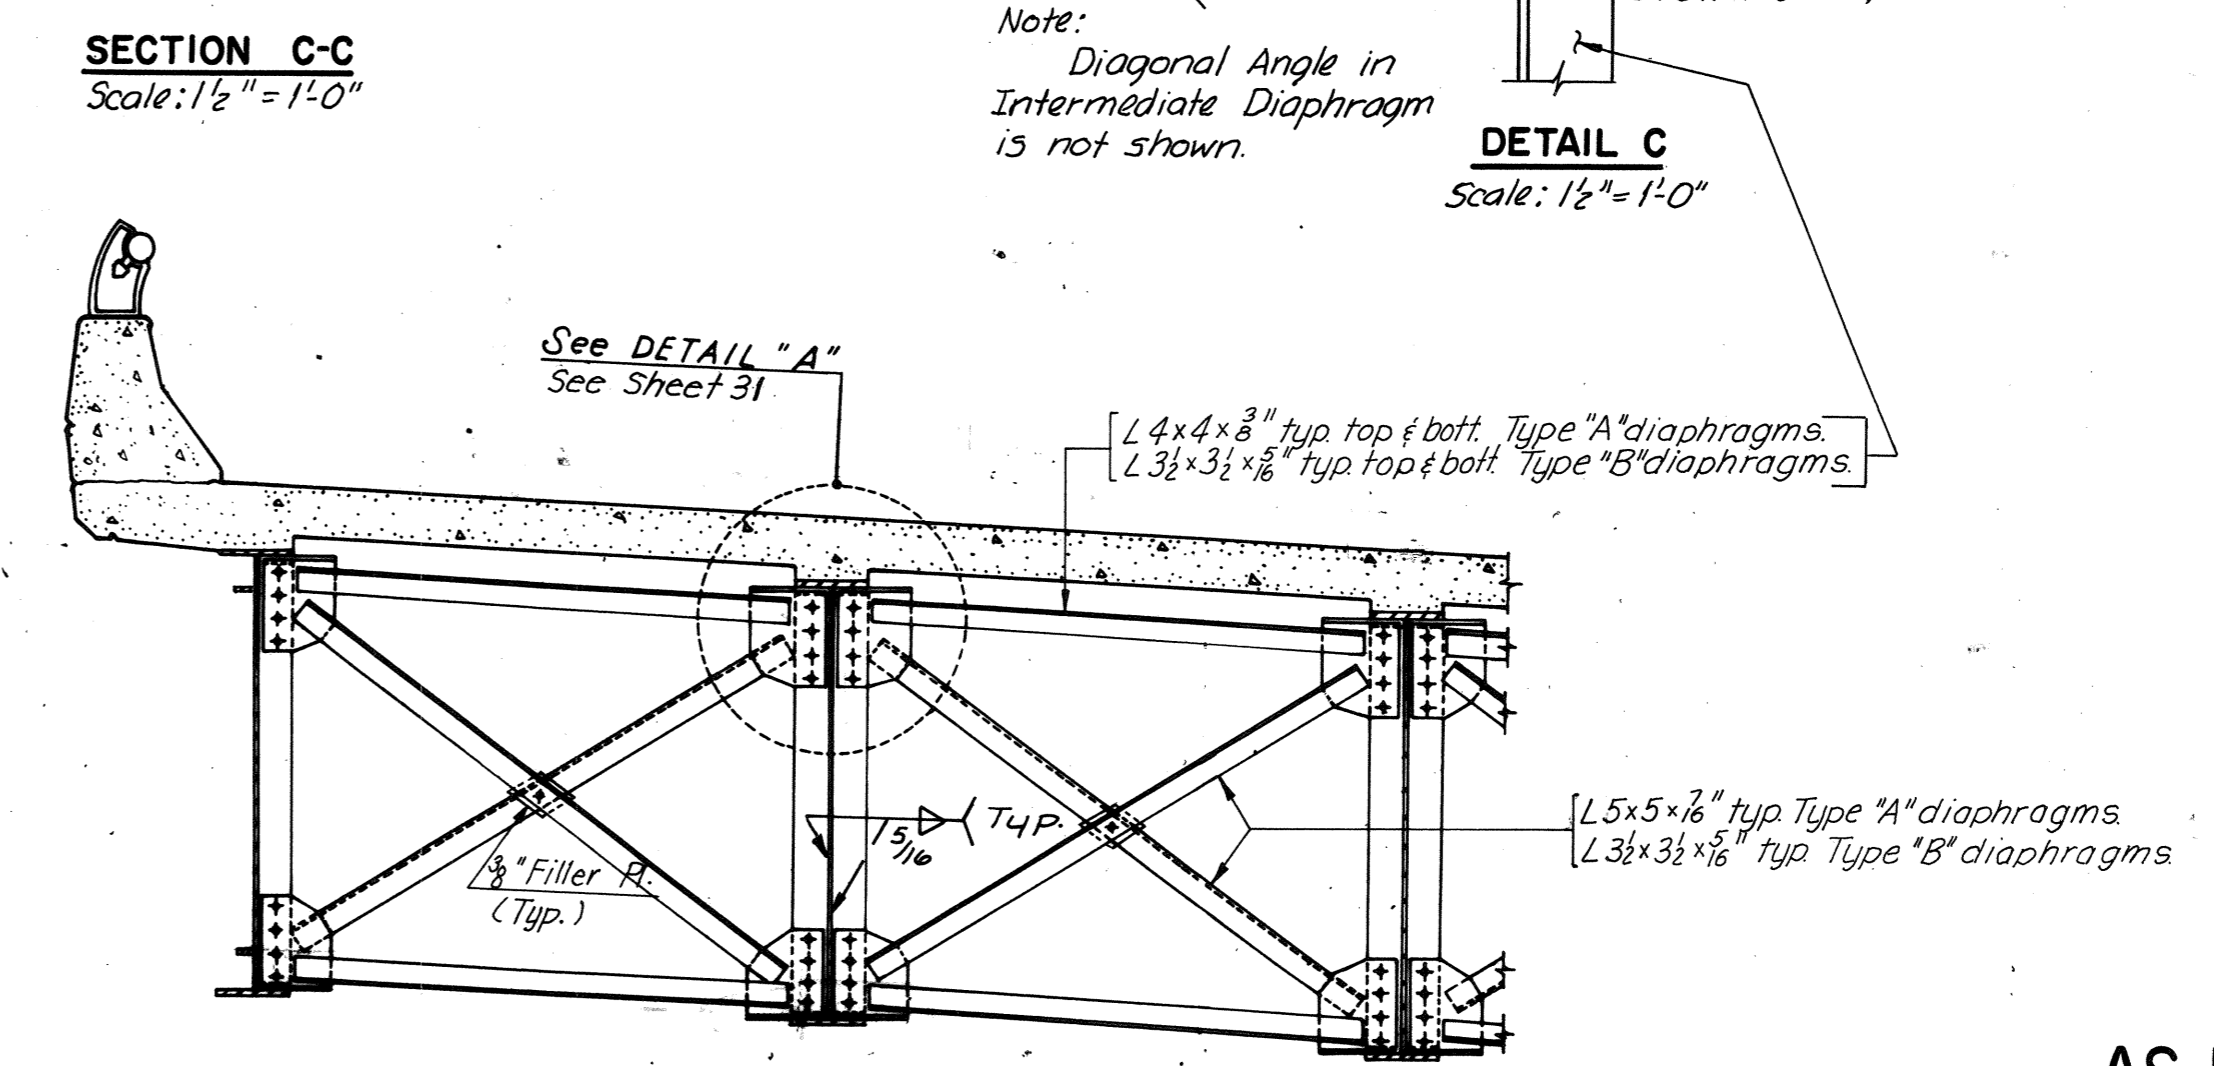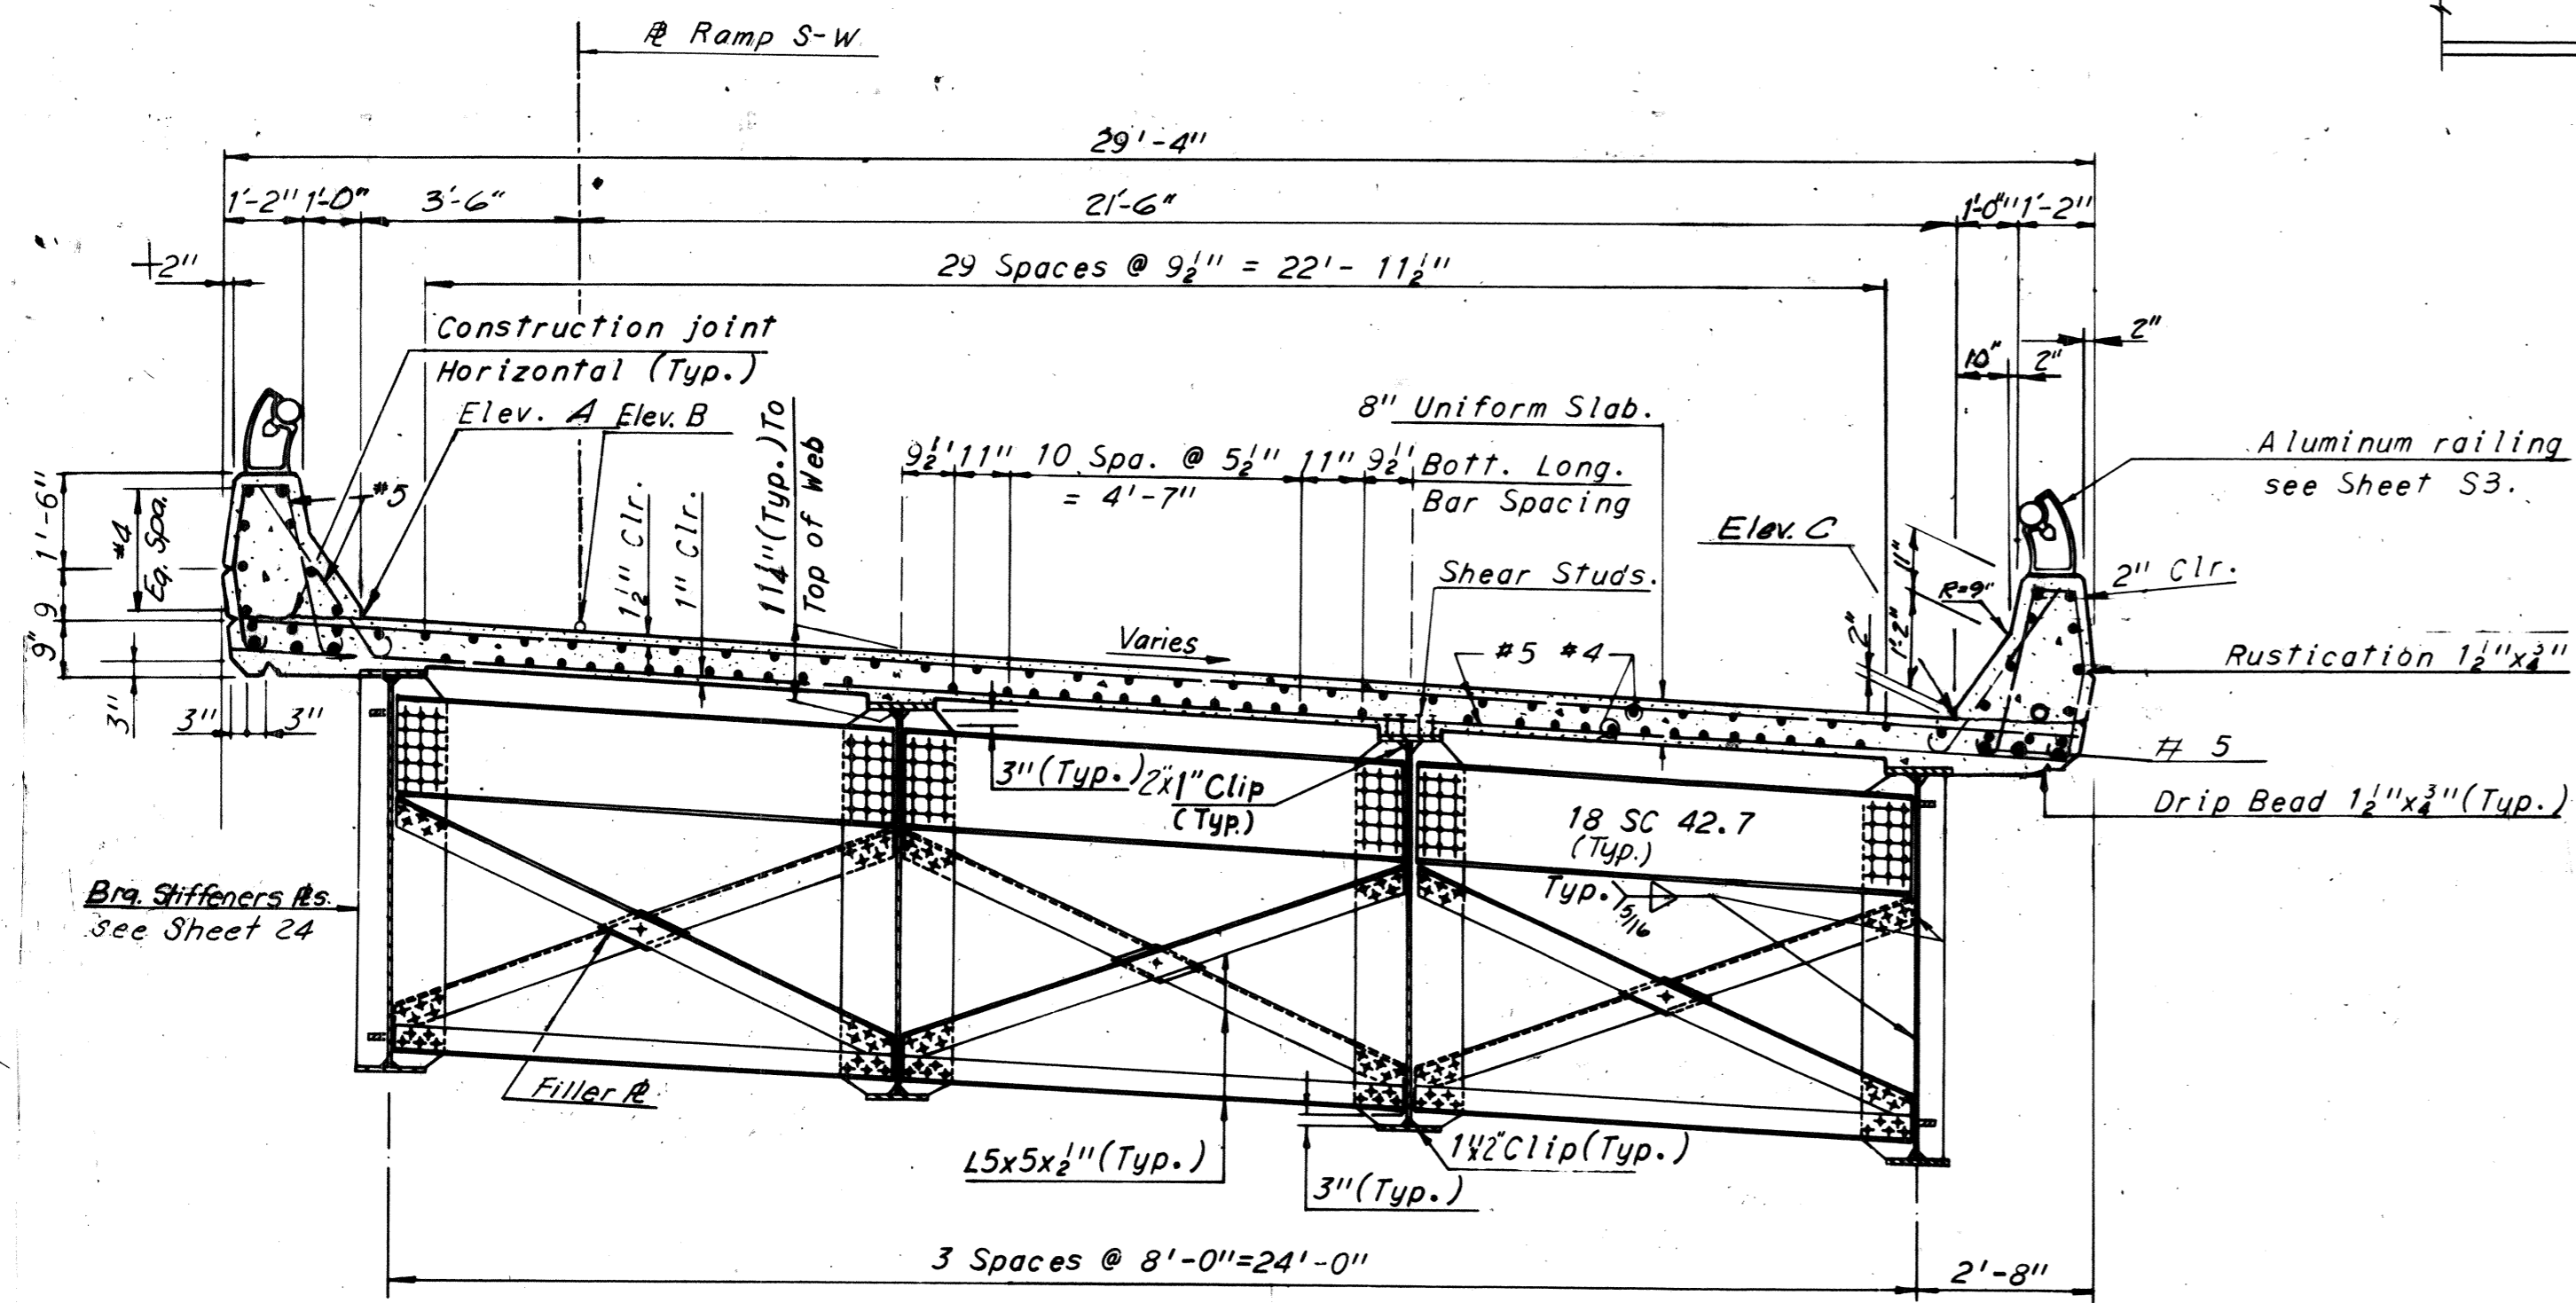

Note:
 For location of End diaphragms See Sheet 23.

Note:
 For location of Intermediate diaphragms Types "A" and "B" see Sheet 23.

BY	DATE				
MADE	R.C.	11.18.68			
CHECKED	Y.C.P.	1-14-69	Diaph.	TEM	3-76
IN CHARGE			NO.	REVISION	BY DATE

AS BUILT


RICHMOND METROPOLITAN AUTHORITY
RICHMOND EXPRESSWAY SYSTEM

BRIDGE NO. 65
RAMP S-W CONNECTION FROM
RICHMOND-PETERSBURG TURNPIKE
DECK PLAN UNITS 17 AND 18




HOWARD, NEEDLES, TAMMEN & BERGENDOFF
 consulting engineers
 NEW YORK ALEXANDRIA KANSAS CITY

SCALE: As Noted
 CONTRACT NO. 11
 SHEET NO. 30 OF 38




RICHMOND EXPRESSWAY SYSTEM			
SECTION	PROJECT	SHEET NO.	TOTAL SHEETS
II	DOWNTOWN EXPRESSWAY	56	97

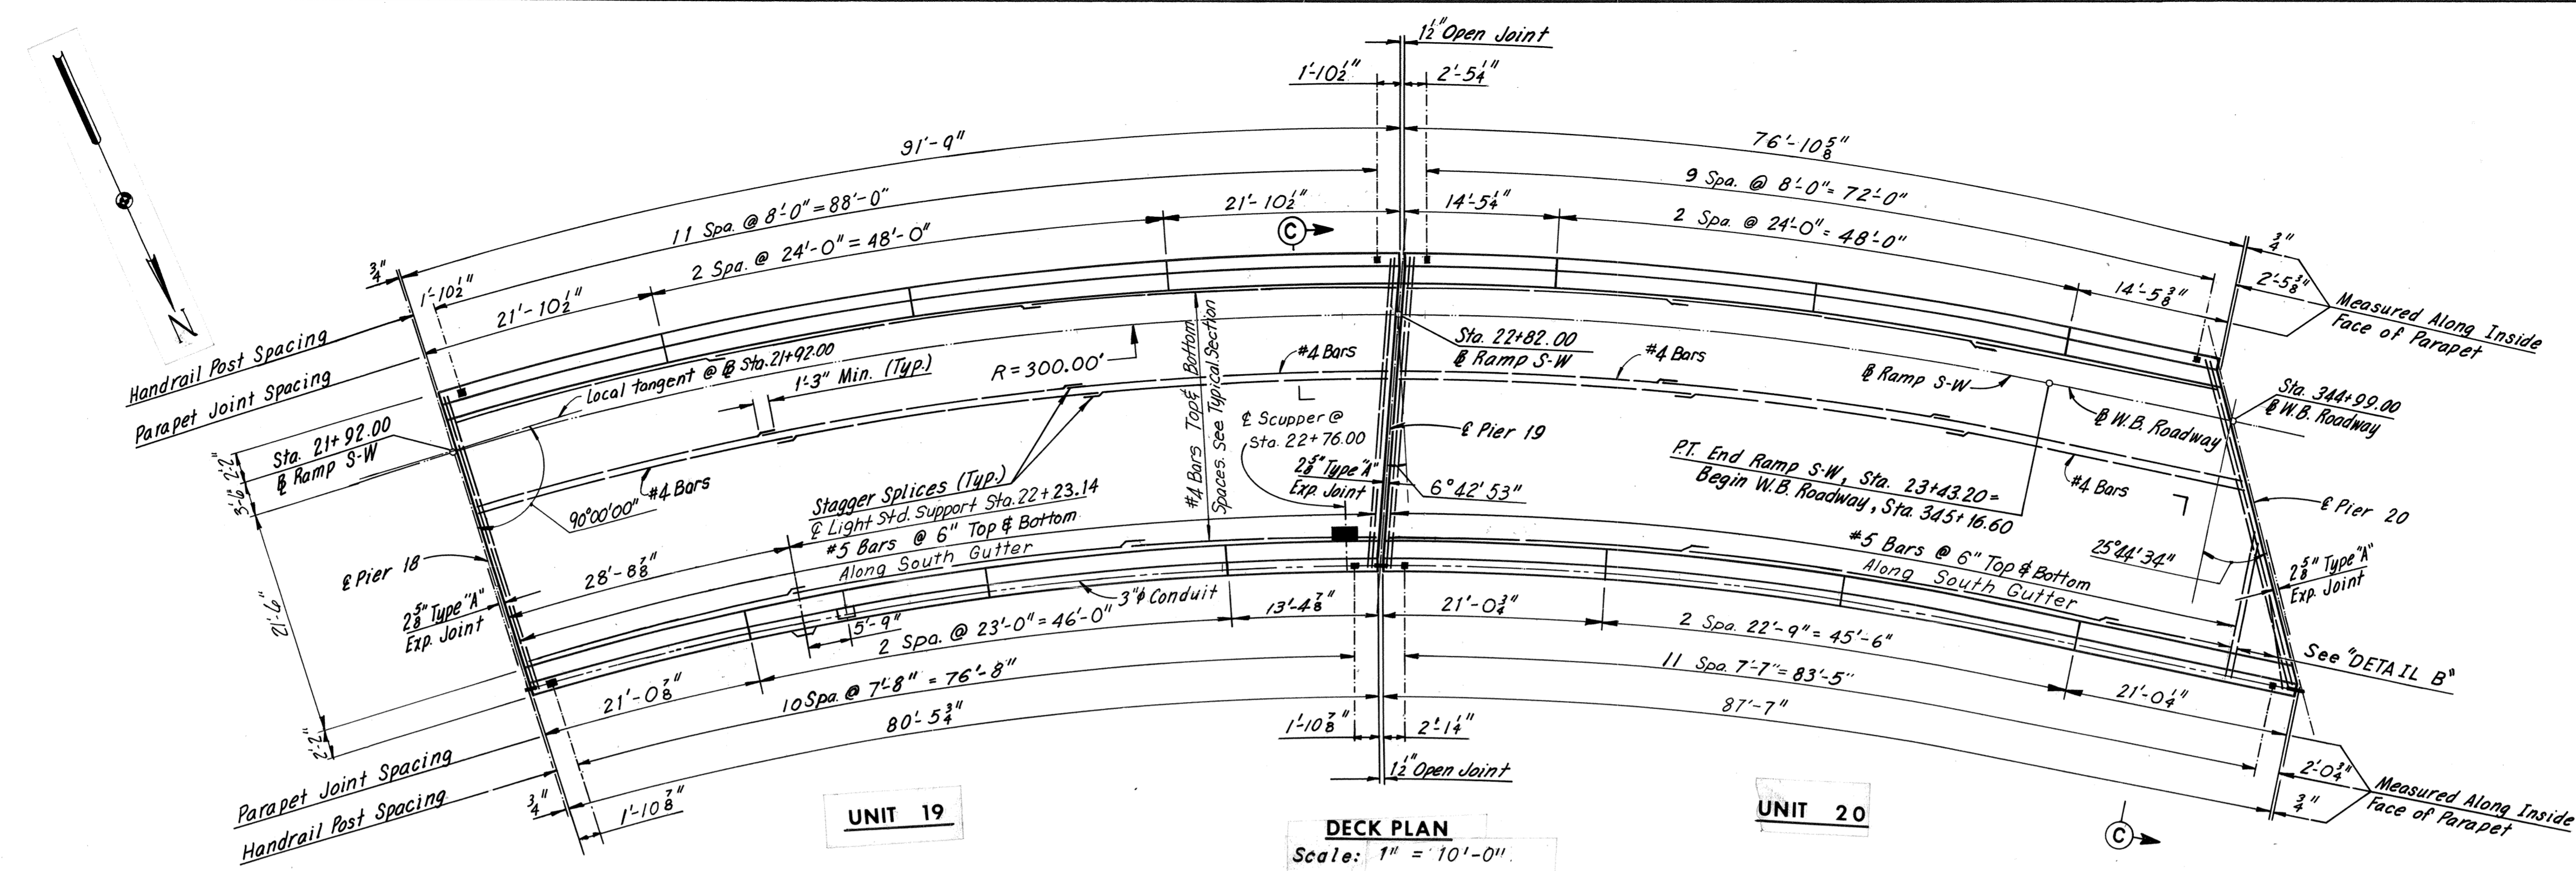

ELEVATION TABLE			
STATION	ELEV. A	ELEV. B	ELEV. C
21+92.00	70.70	70.49	69.26
22+00.00	70.76	70.55	69.32
+10.00	70.84	70.63	69.40
+20.00	70.93	70.72	69.49
+30.00	71.01	70.80	69.57
+40.00	71.09	70.88	69.65
+50.00	71.18	70.97	69.74
+60.00	71.26	71.05	69.82
+70.00	71.35	71.14	69.91
22+79.34	—	—	69.99
+80.00	71.43	71.22	69.99
+82.00	—	71.24	—
22+82.35	71.45	—	—
+90.00	71.51	71.30	70.07
23+00.00	71.60	71.39	70.14
+10.00	71.67	71.47	70.32
+20.00	71.74	71.56	70.48
+30.00	71.81	71.64	70.59
+40.00	71.88	71.72	70.75
23+43.20	71.90	71.75	70.80
345+16.60	71.90	71.75	70.80
345+10.00	71.95	71.81	70.91
345+00.45	72.02	—	—
345+00.00	72.03	71.89	71.07
344+99.00	—	71.90	—
344+88.87	—	—	71.25

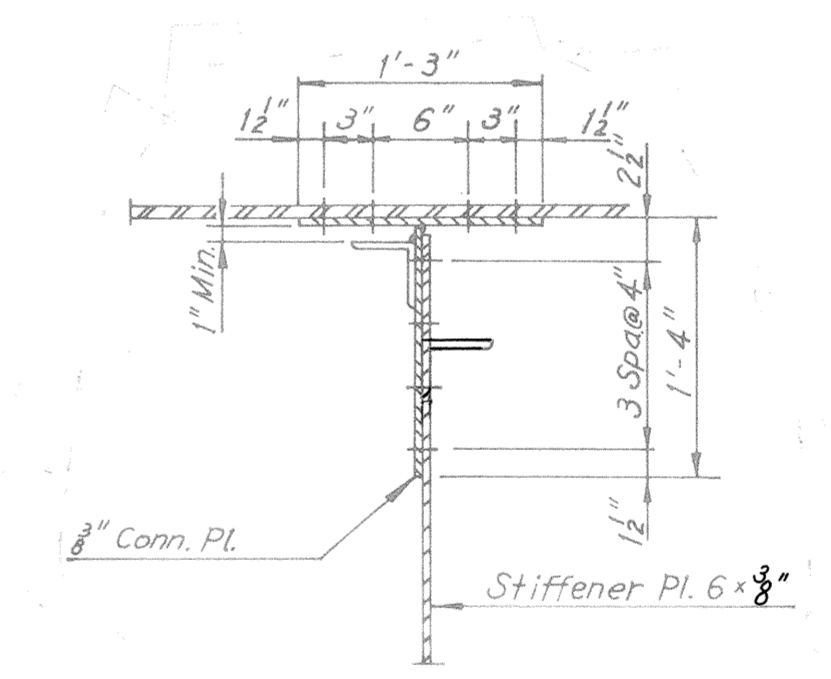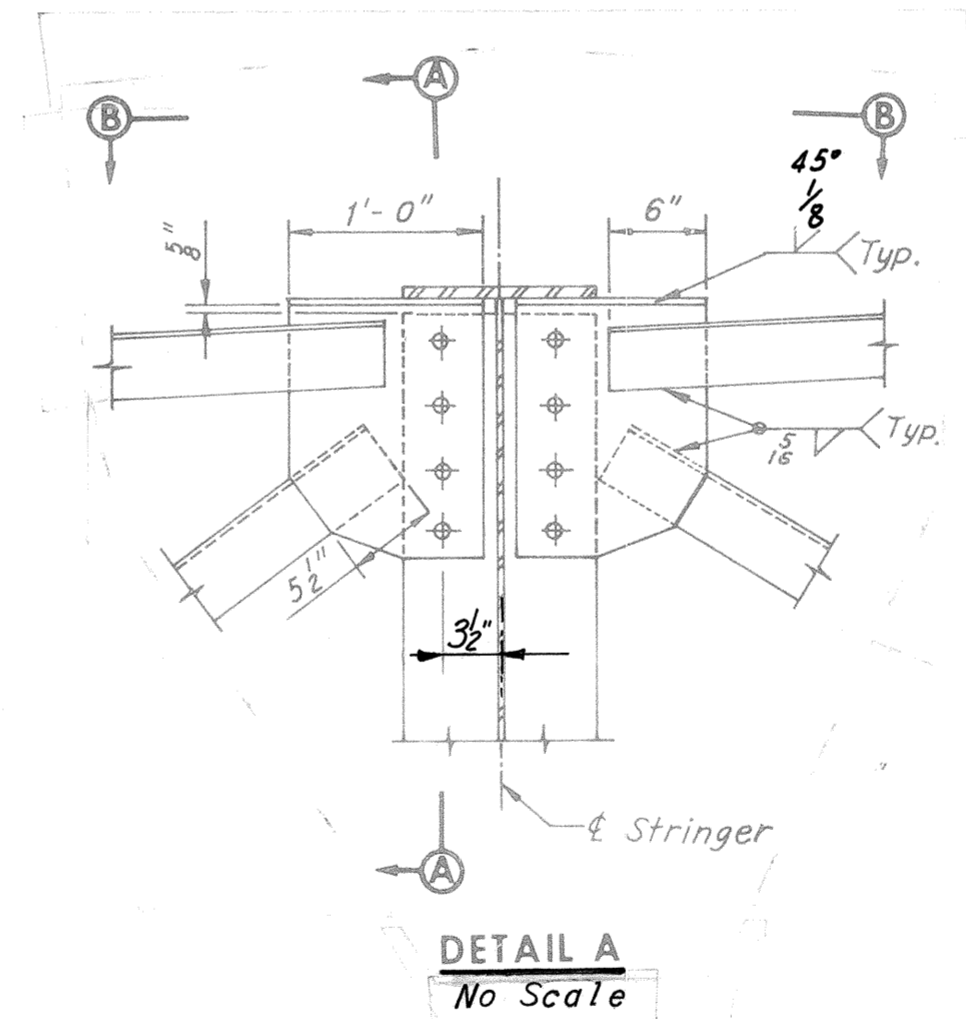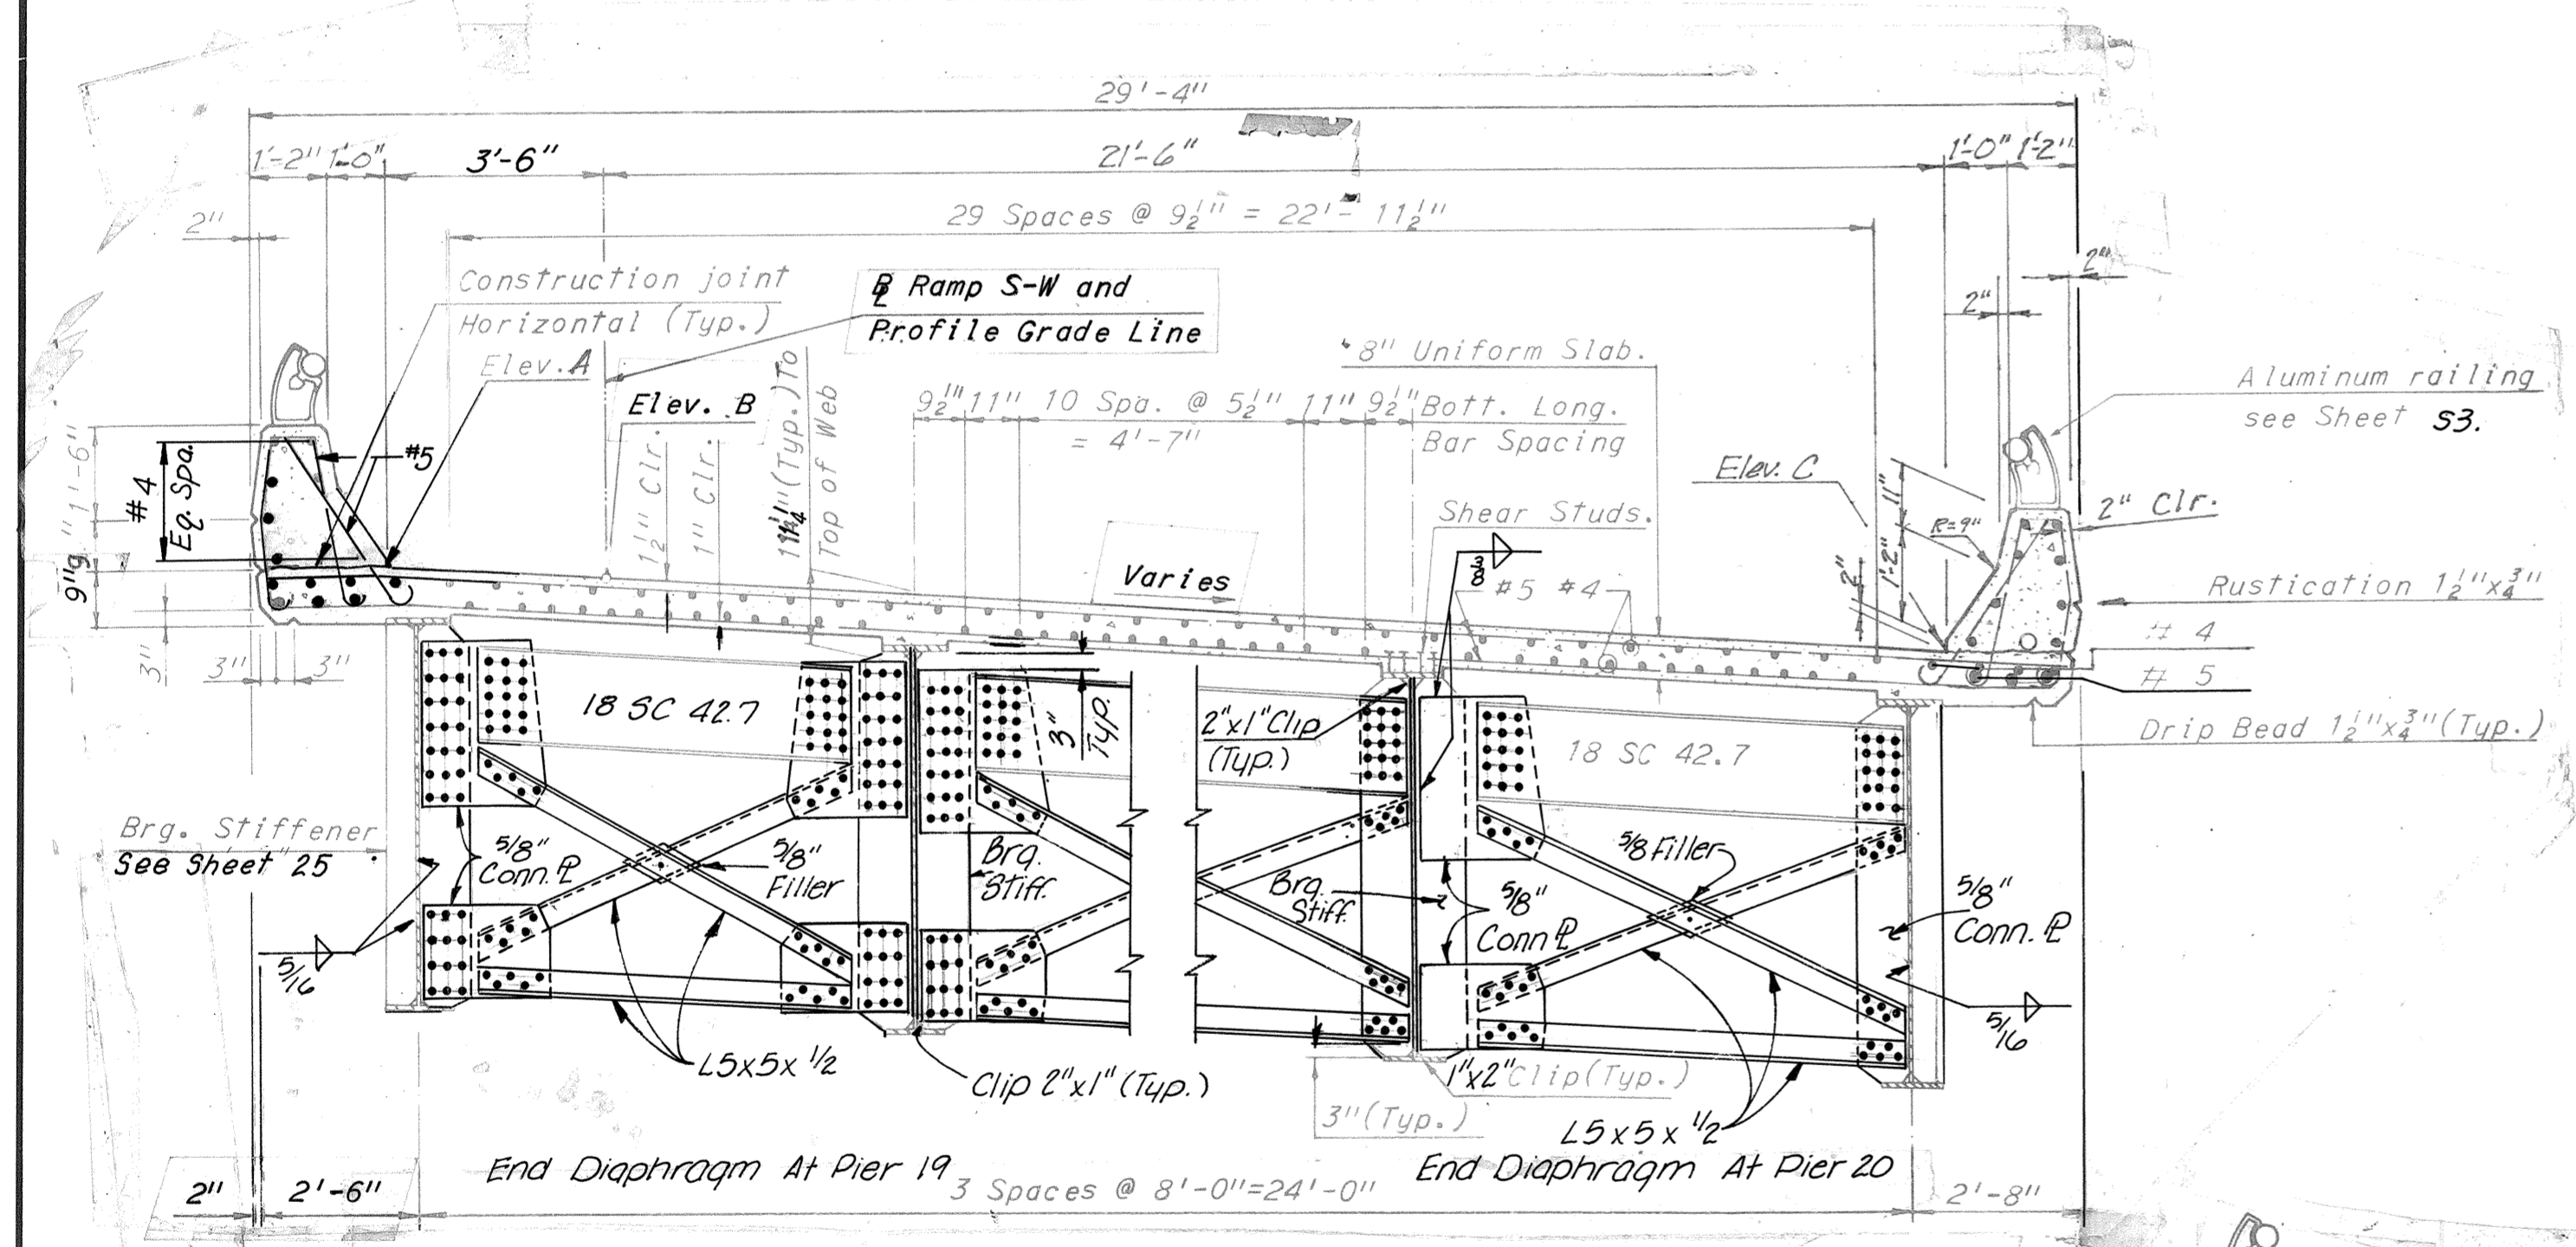

Notes:
 For Framing Plan see Sheet 24
 For Joint Details, see Sheet 37 & 38
 For Quantities see Sheet 4
 For Handrail Details, see Sheet 53.
 Note: For Standard Drainage Details for Unit 20 see Support Type 2 Sheet 55.

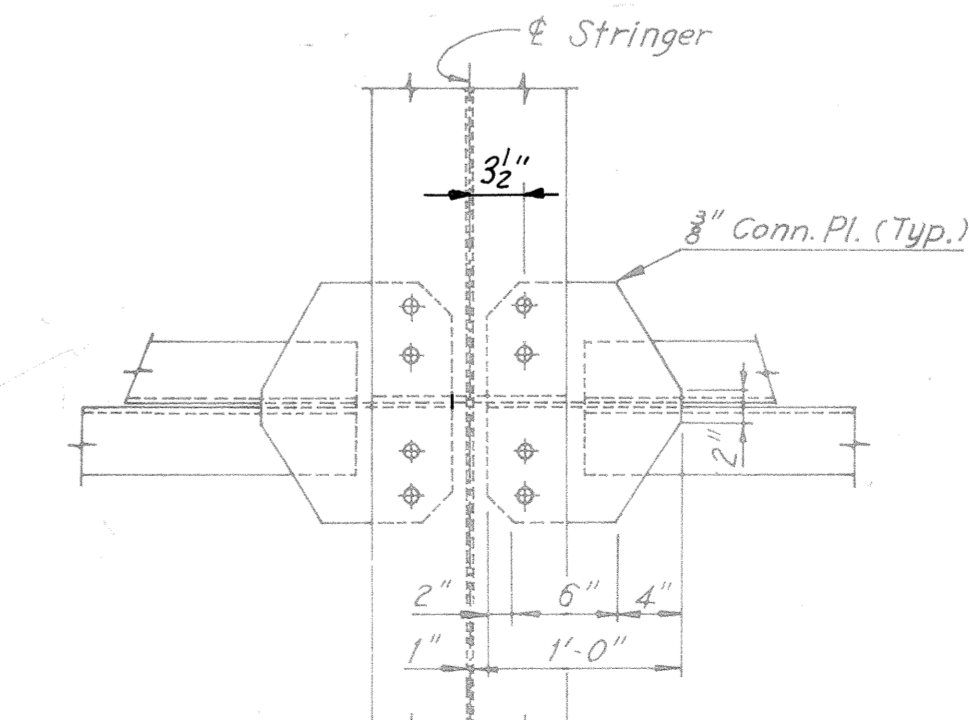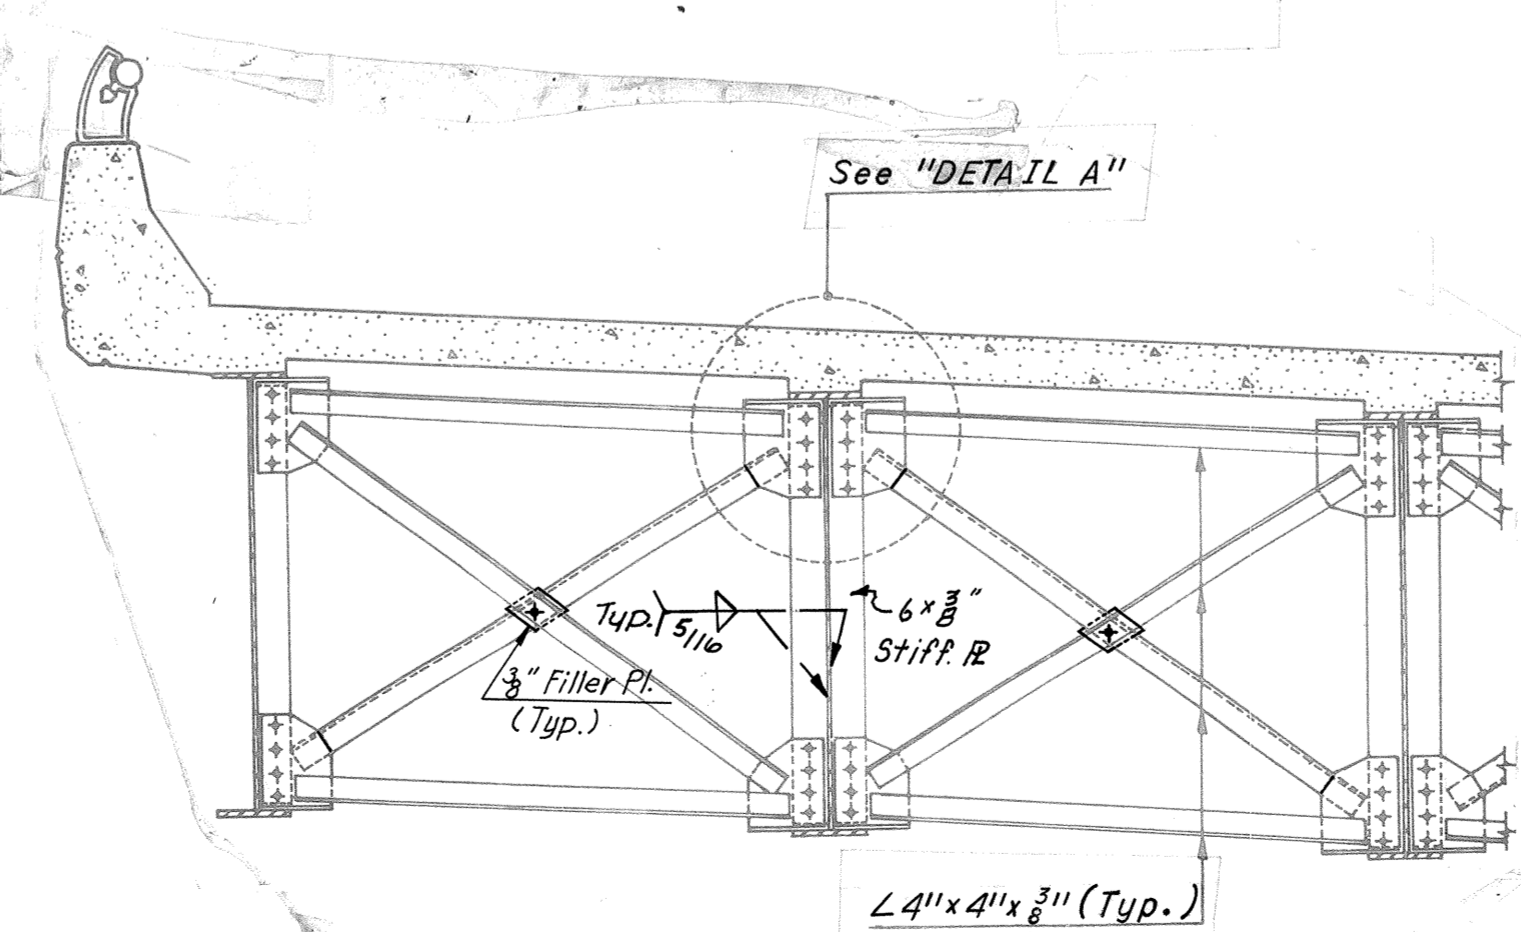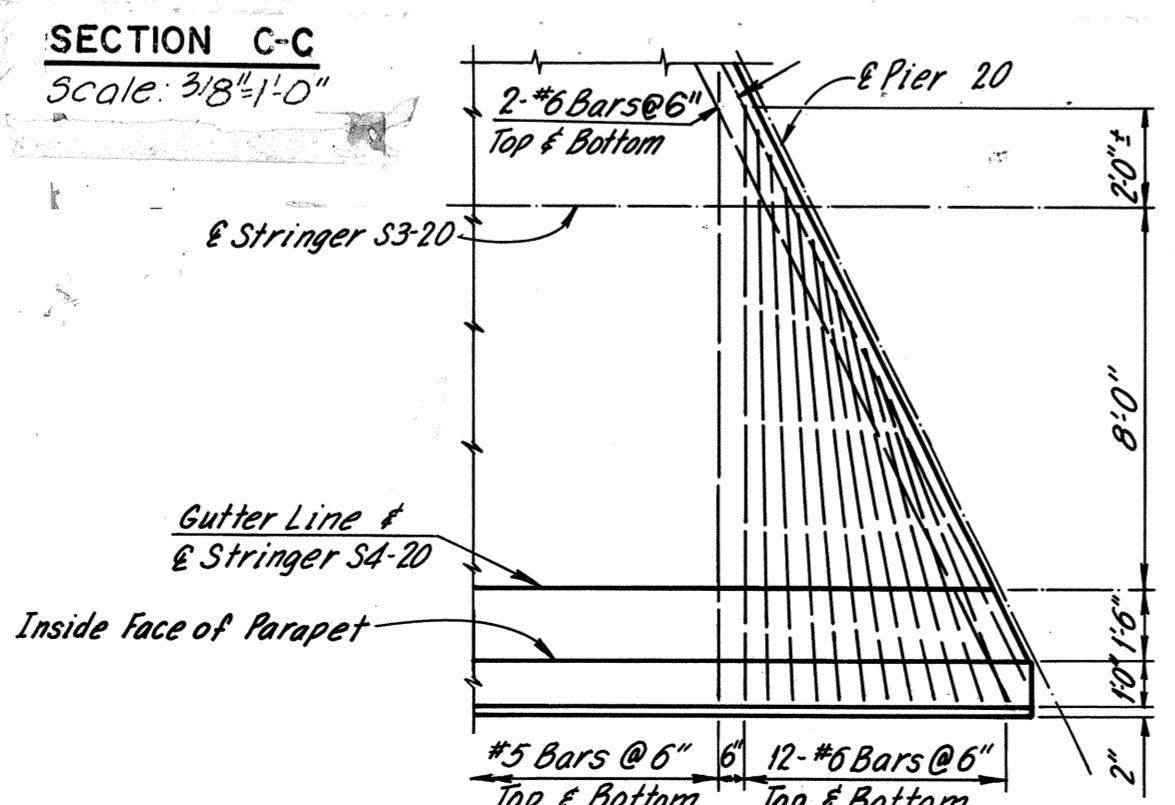

MADE	BY	DATE	NO.	REVISION	BY	DATE
	D.E.S.					
CHECKED	Y.C.P	1-14-69			TEM	8-76
IN CHARGE						

AS BUILT
RICHMOND METROPOLITAN AUTHORITY
RICHMOND EXPRESSWAY SYSTEM
 DOWNTOWN EXPRESSWAY



BRIDGE NO. 65
 RAMP S-W CONNECTION FROM
 RICHMOND-PETERSBURG TURNPIKE

DECK PLAN - UNITS 19 AND 20


HOWARD, NEEDLES, TAMMEN & BERGENDOFF
 consulting engineers
 NEW YORK ALEXANDRIA KANSAS CITY

SCALE: As Noted
 CONTRACT NO. 11
 SHEET NO. 31 OF 38



RICHMOND EXPRESSWAY SYSTEM			
SECTION	PROJECT	SHEET NO.	TOTAL SHEETS
11	DOWNTOWN EXPRESSWAY	57	97

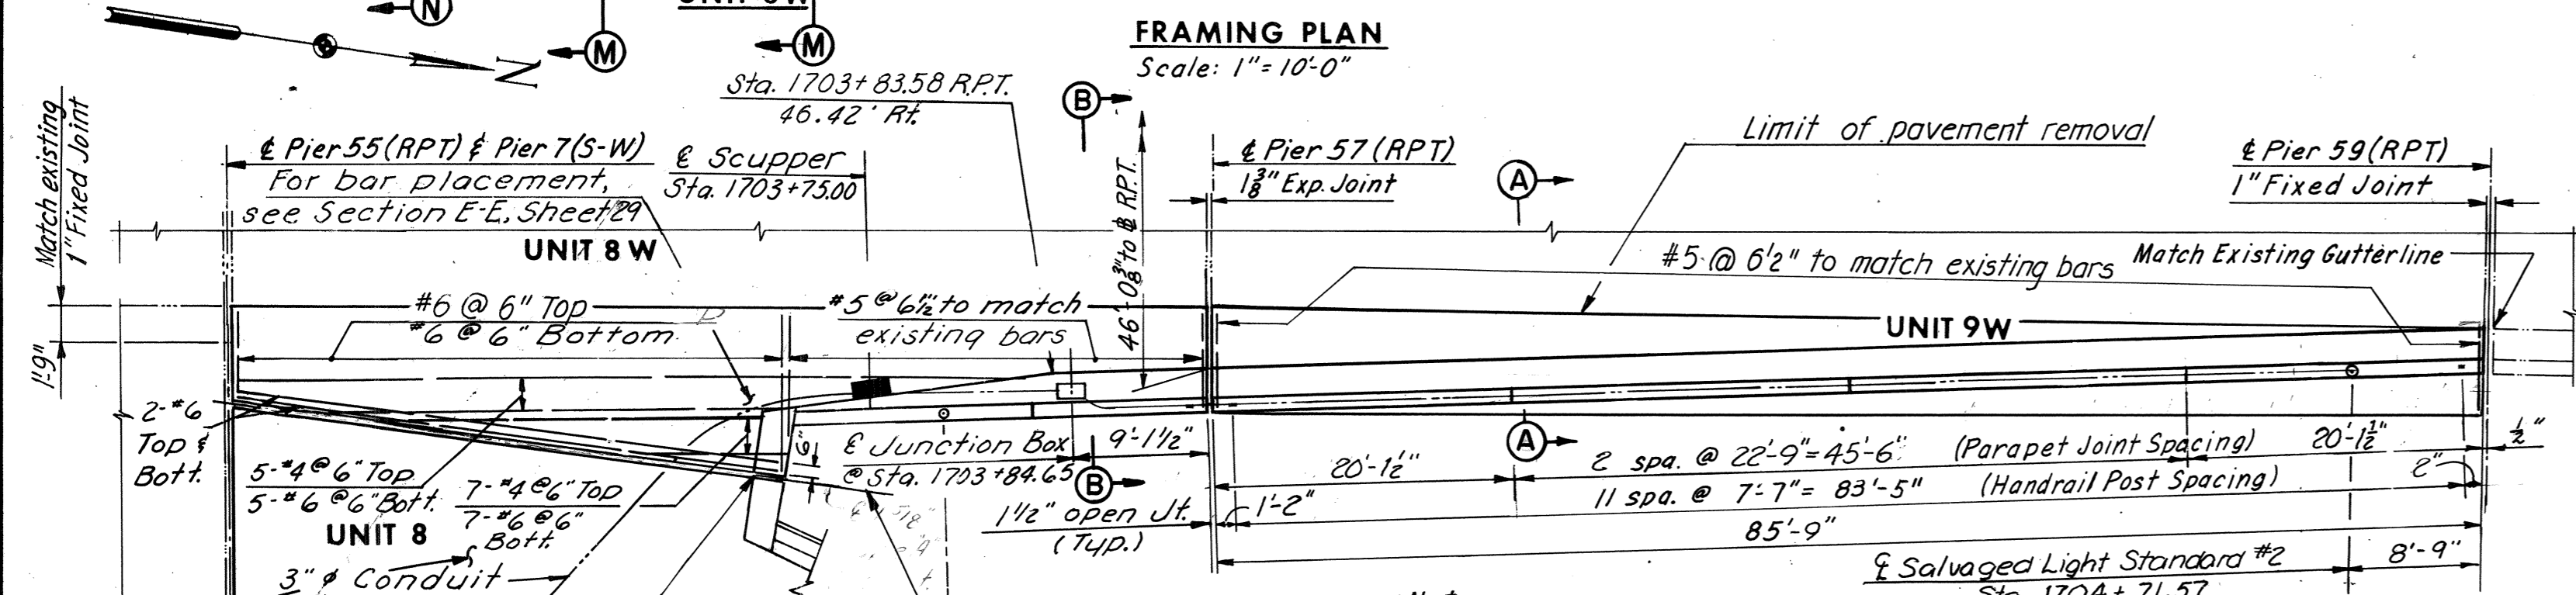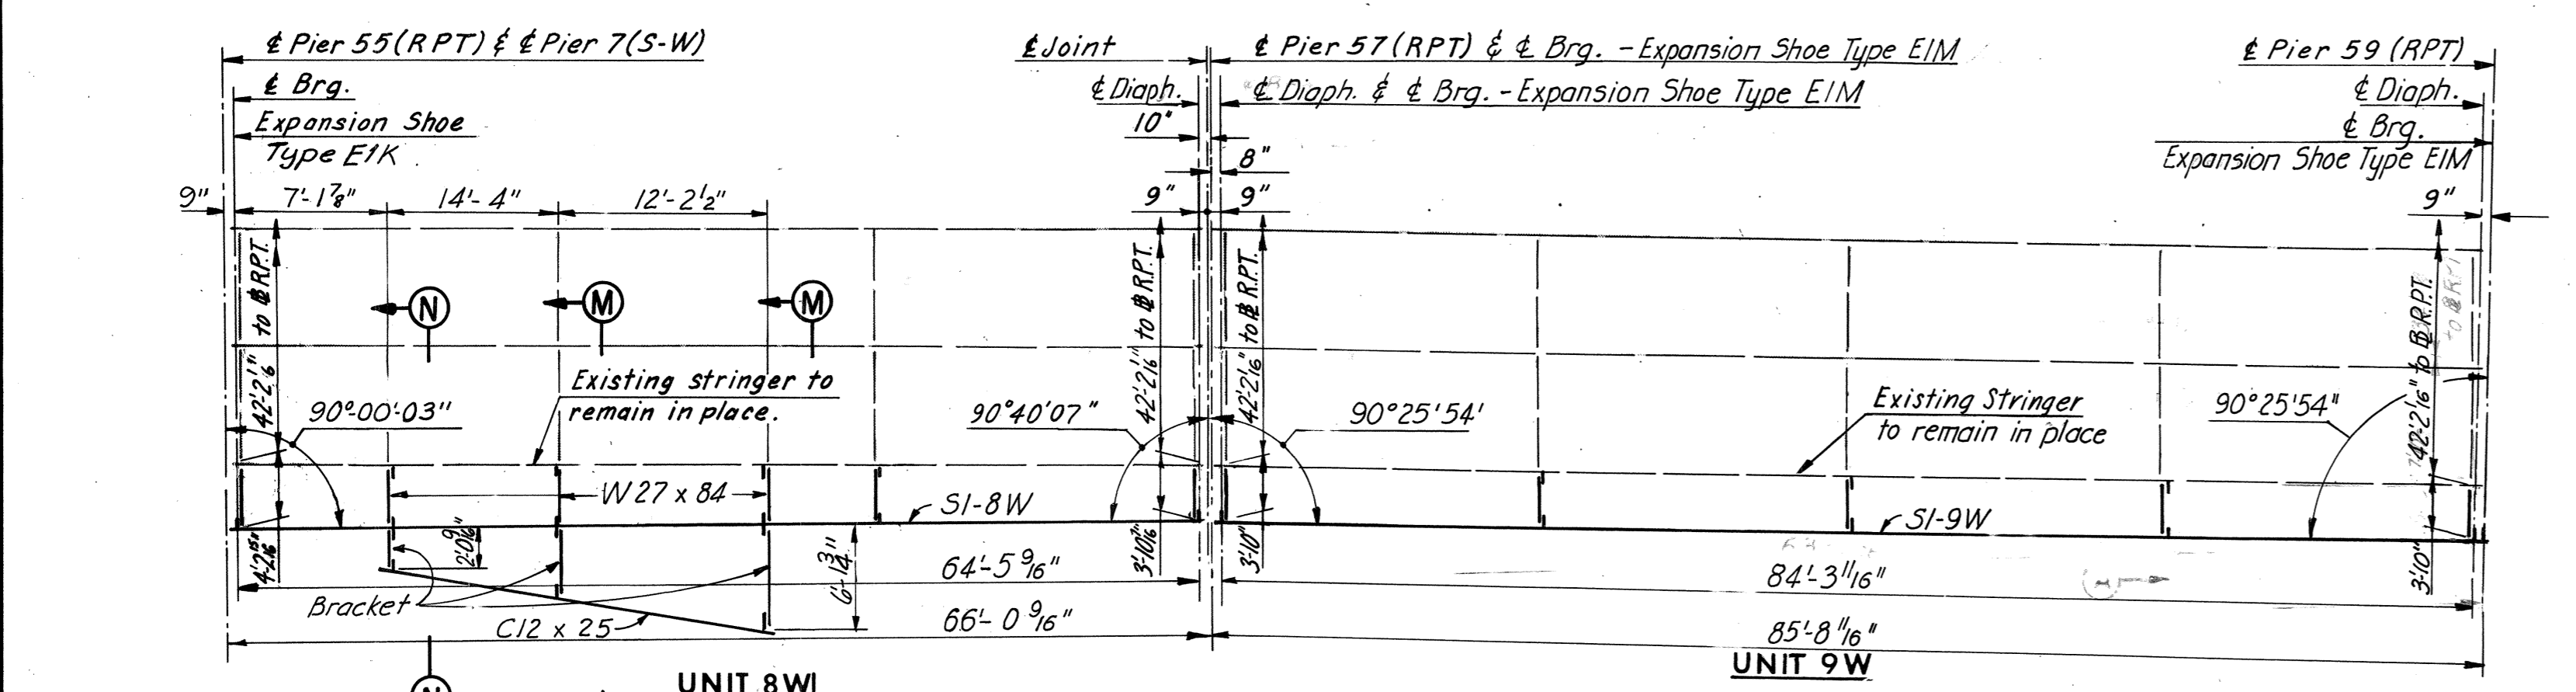



Note:
 For Fixed Joint Details at Pier 55, see Sheet 18.
 For Section B-B, see Sheet 27.
 For further details of nose and parapet, see Sheet 27.
 For location of Transition Detail see Unit 1, Sheet 25.
 For diagrams and notes of Dead Load Deflection and Camber, see Sheet 20.
 For Sections M-M & N-N see Sheet 20a.

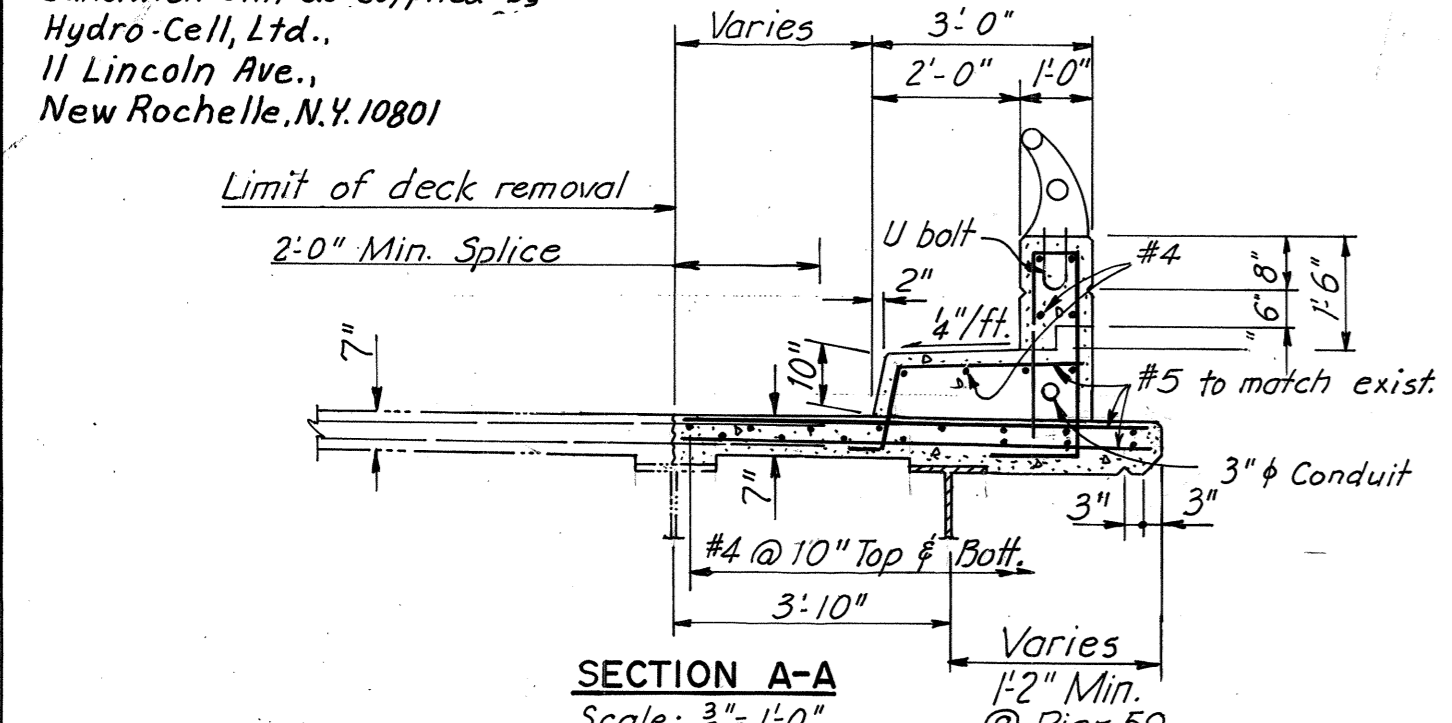

STRINGER	DEAD LOAD DEFLECTION SCHEDULE			CAMBER SCHEDULE		
	1/4L	1/2L	3/4L	1/4L	1/2L	3/4L
SI-8W	1 1/8"	1 3/8"	1 3/8"	1 1/8"	1 1/8"	1"
SI-9W	1 1/2"	1 7/8"	1 1/2"	2"	2 1/4"	2"





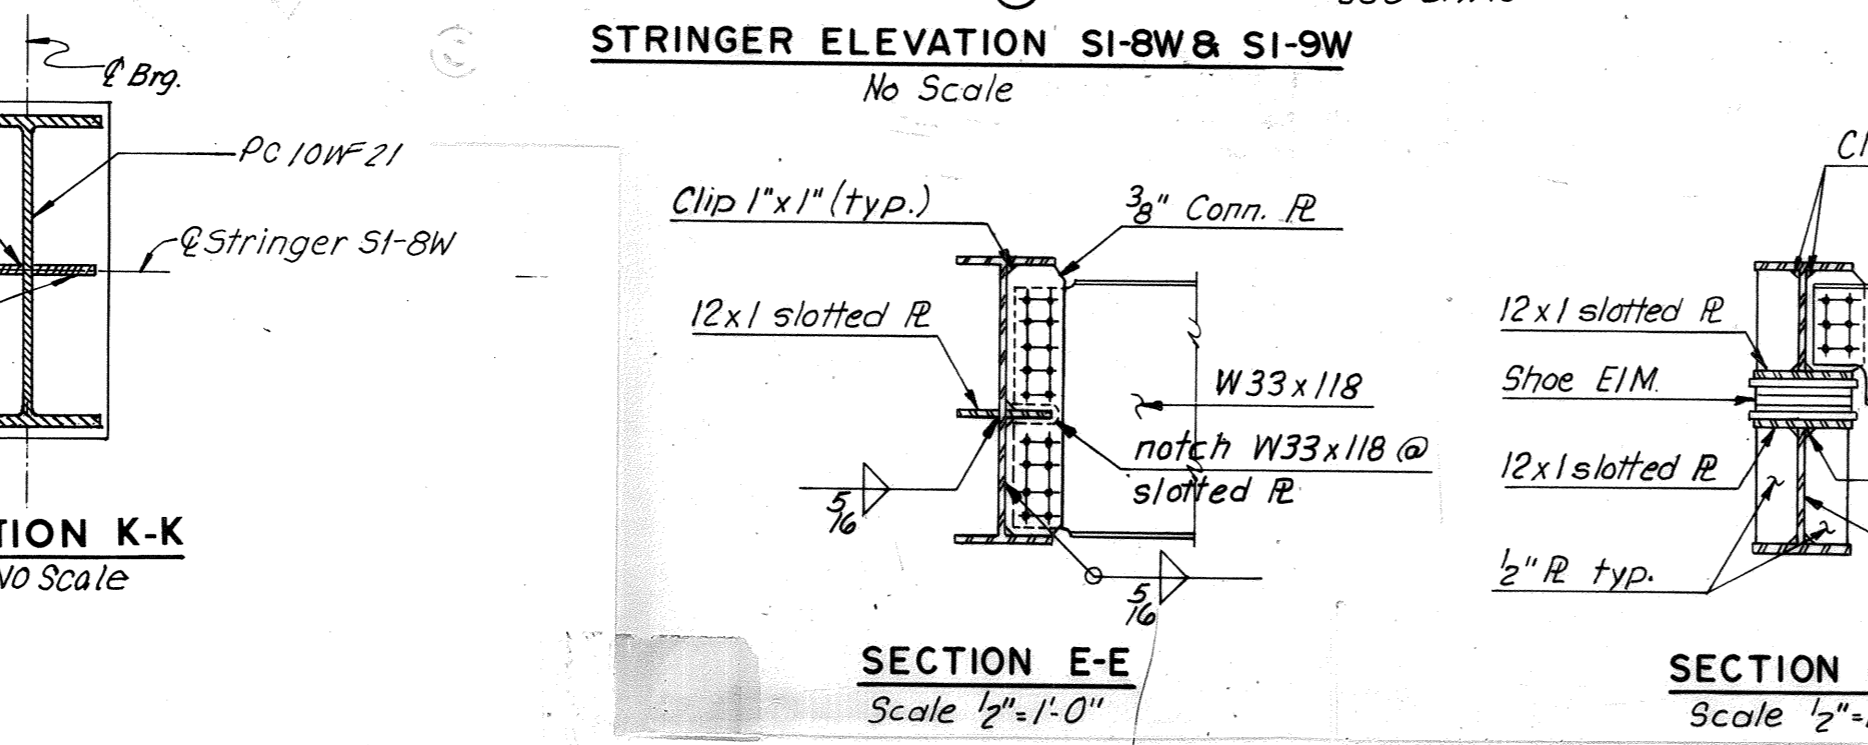
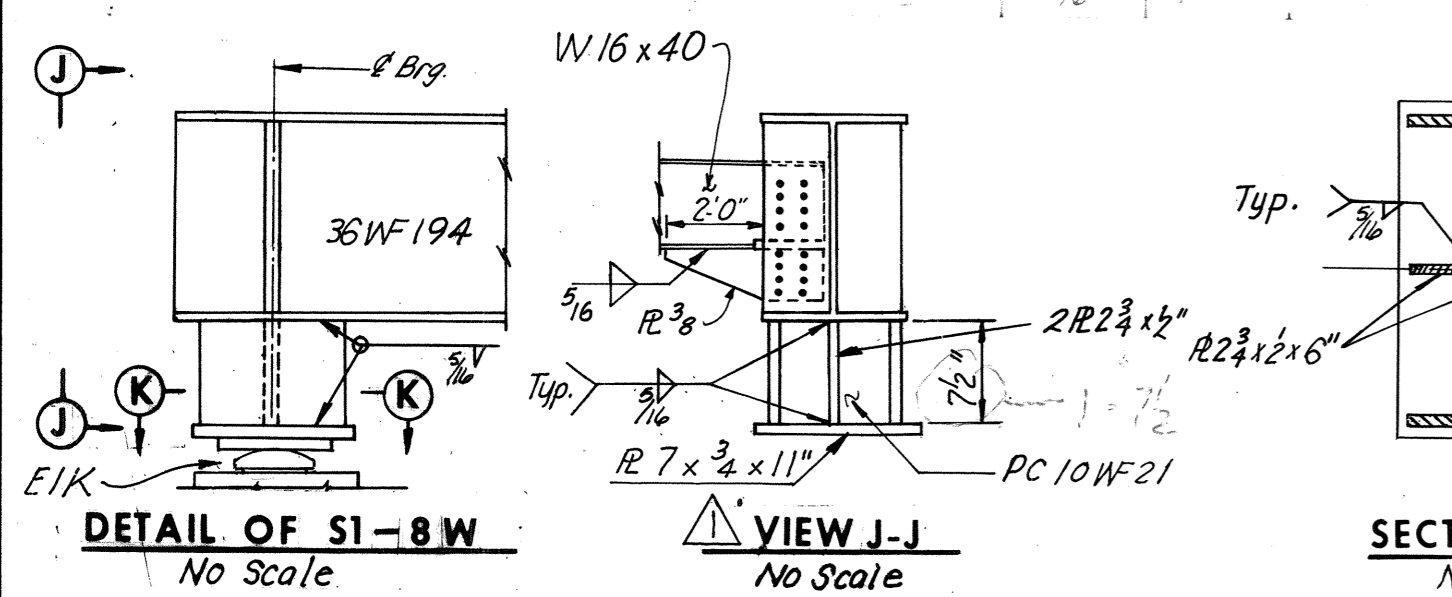


BY	DATE	DESCRIPTION	PRY.	DATE
AMH	2-19-69	Dimensions Added	TEM	9-9-75
KCT	5-8-69	Angle @ Pier 7	T.E.M.	9-5-75
		Major revisions	A.B.P.	8-25-78

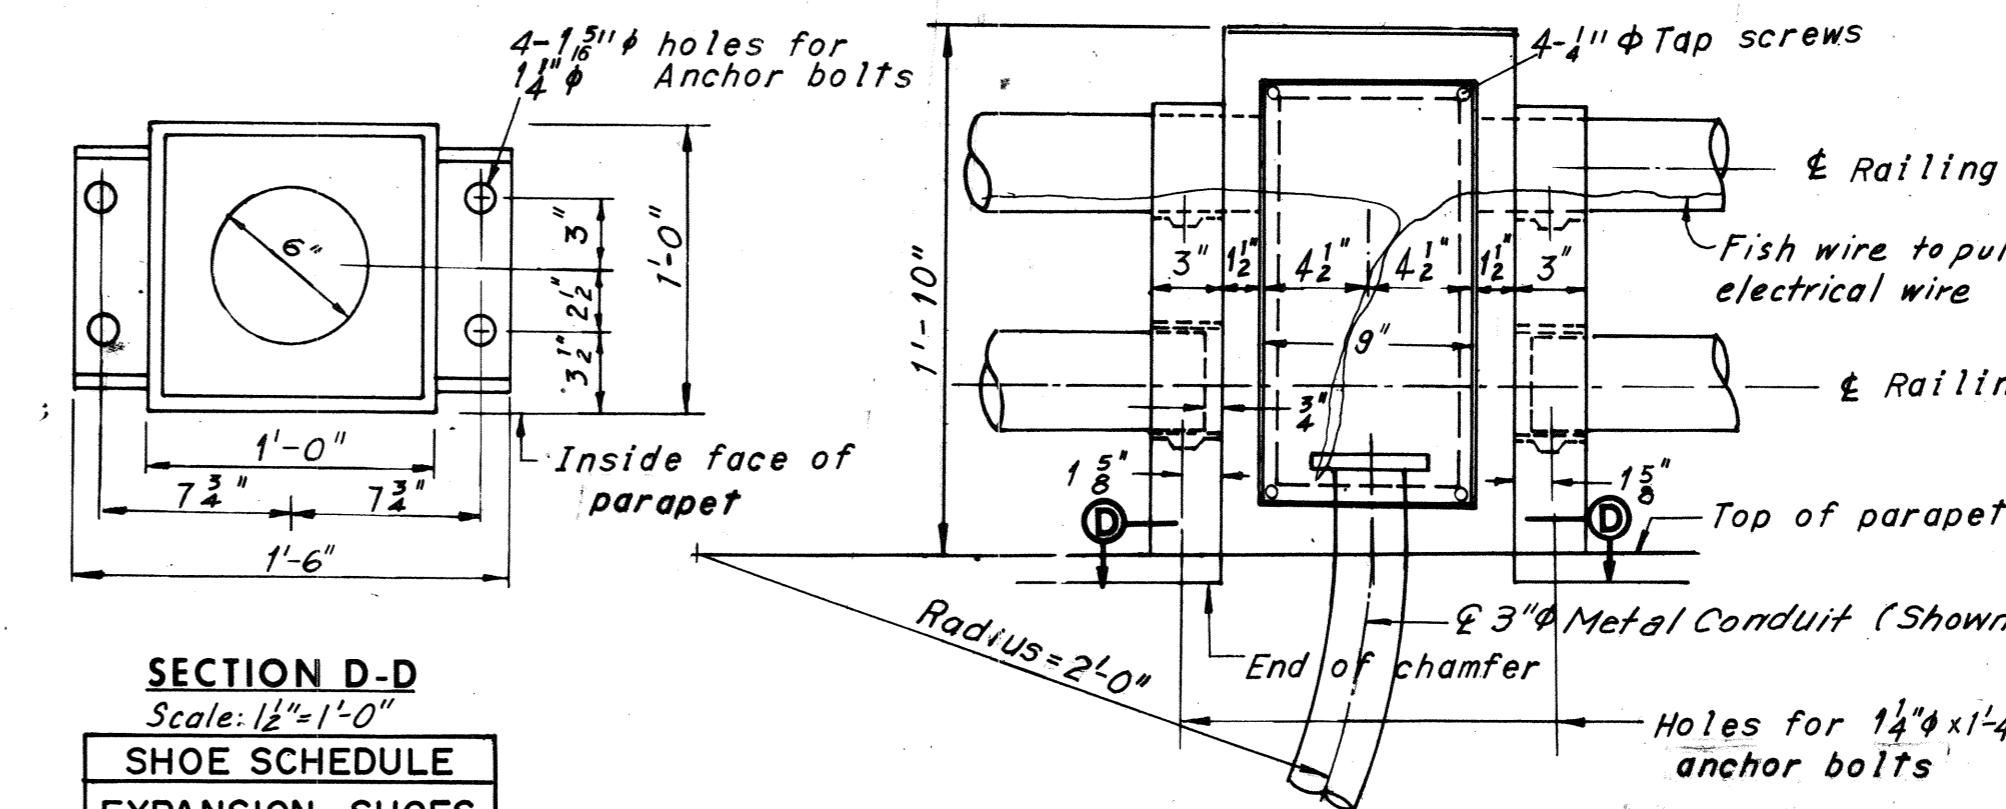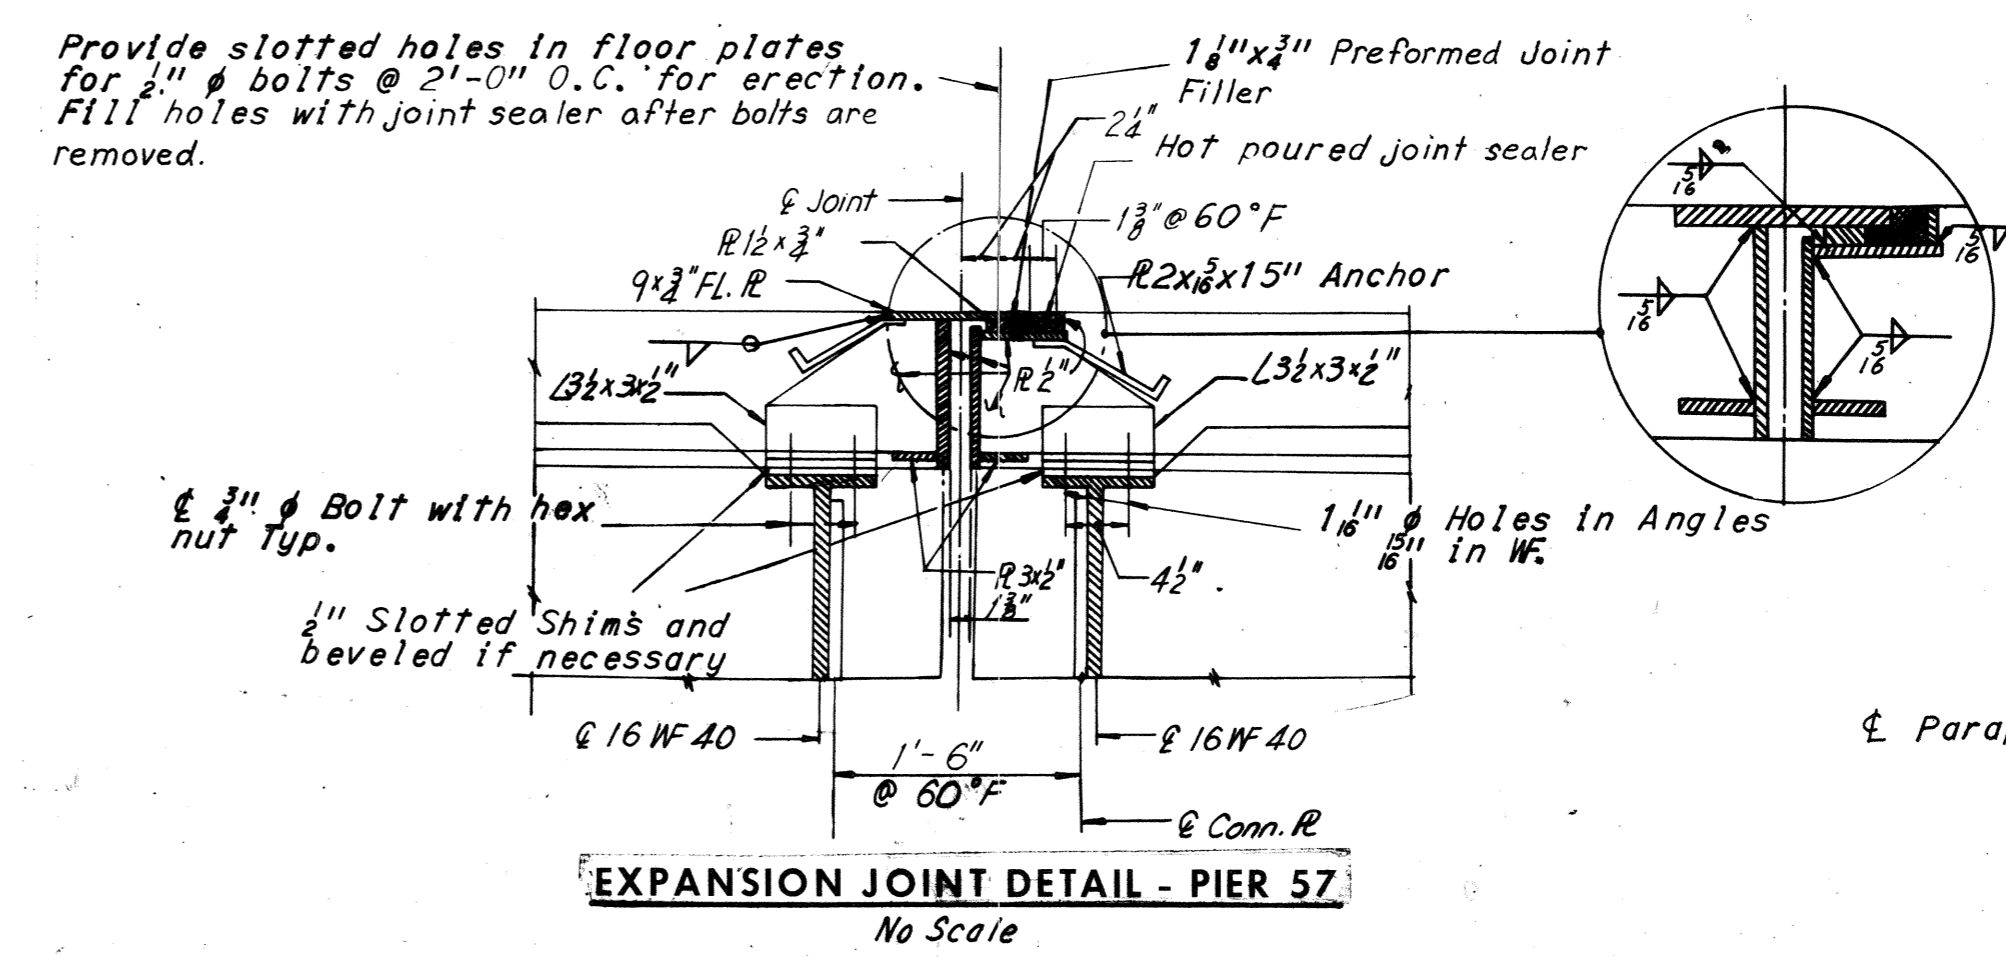

SECTION D-D
Scale: 1/2" = 1'-0"

SHOE SCHEDULE	
TYPE	NO. REQD.
EIM	3
EIK	1

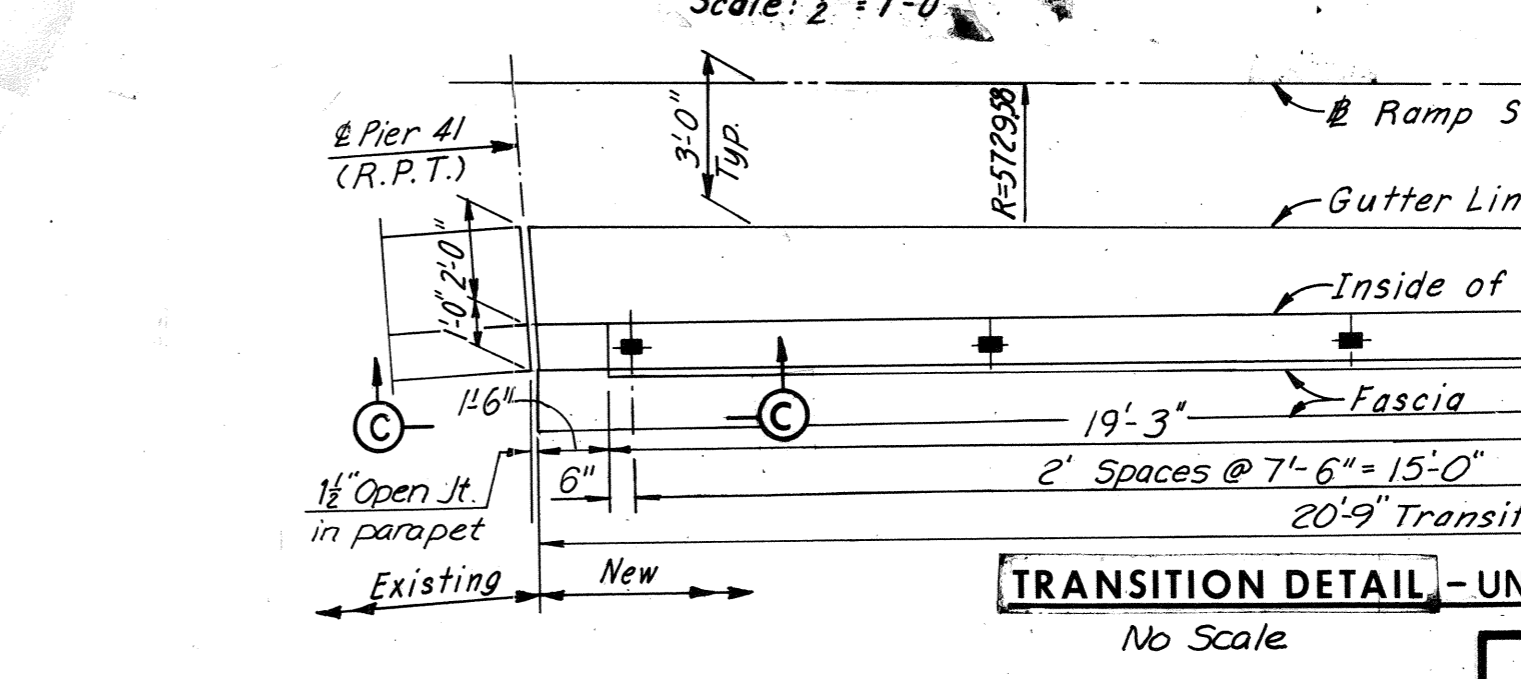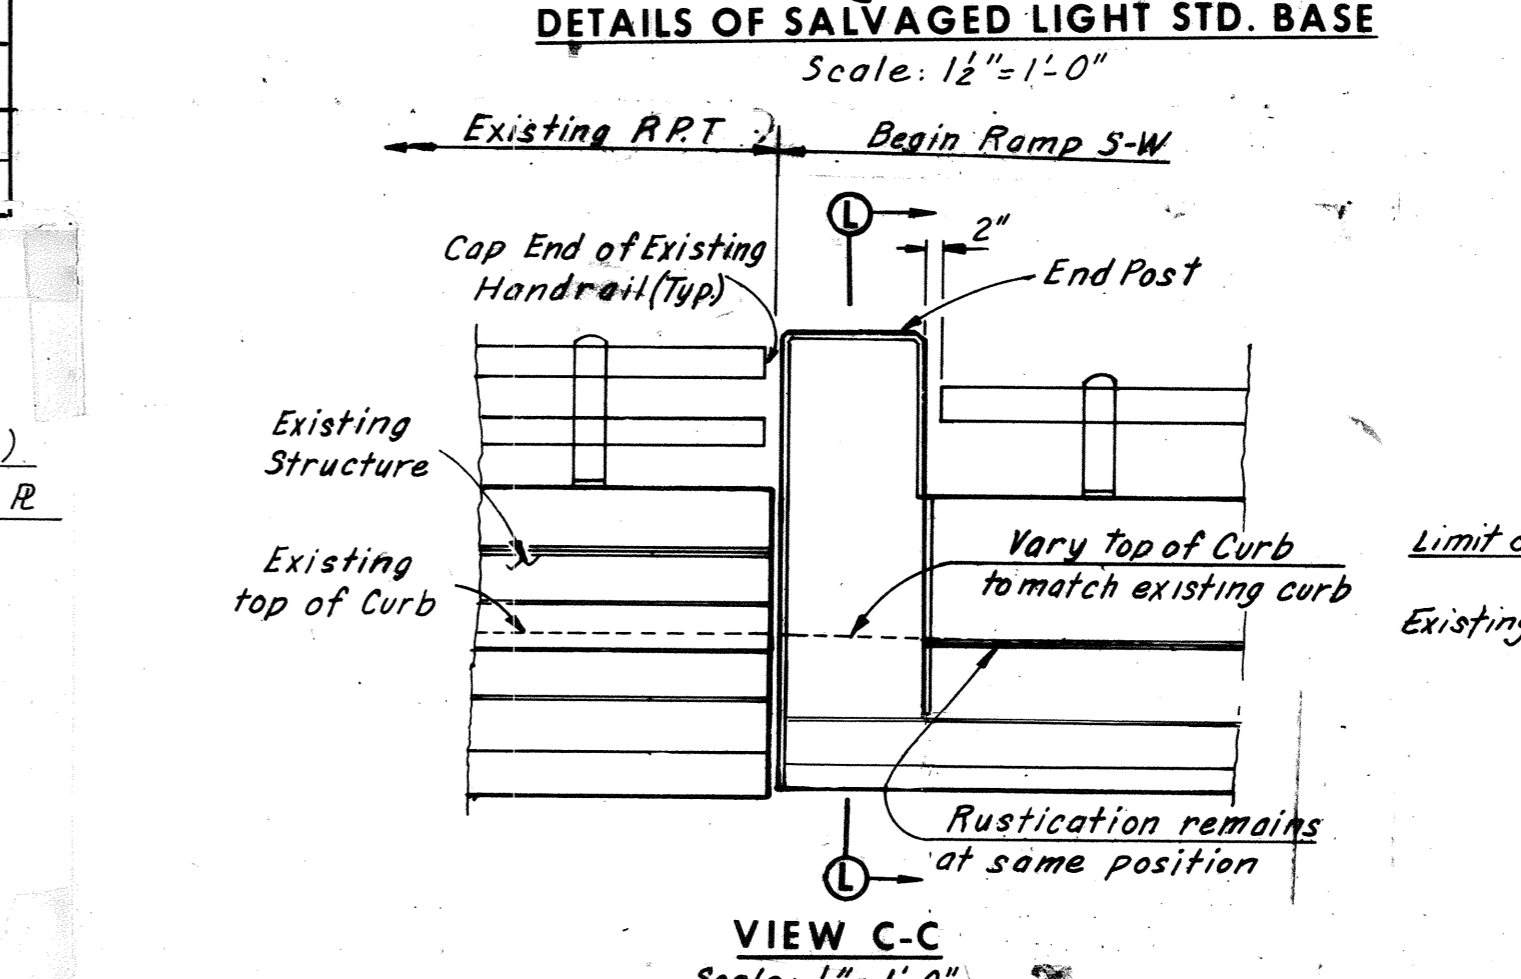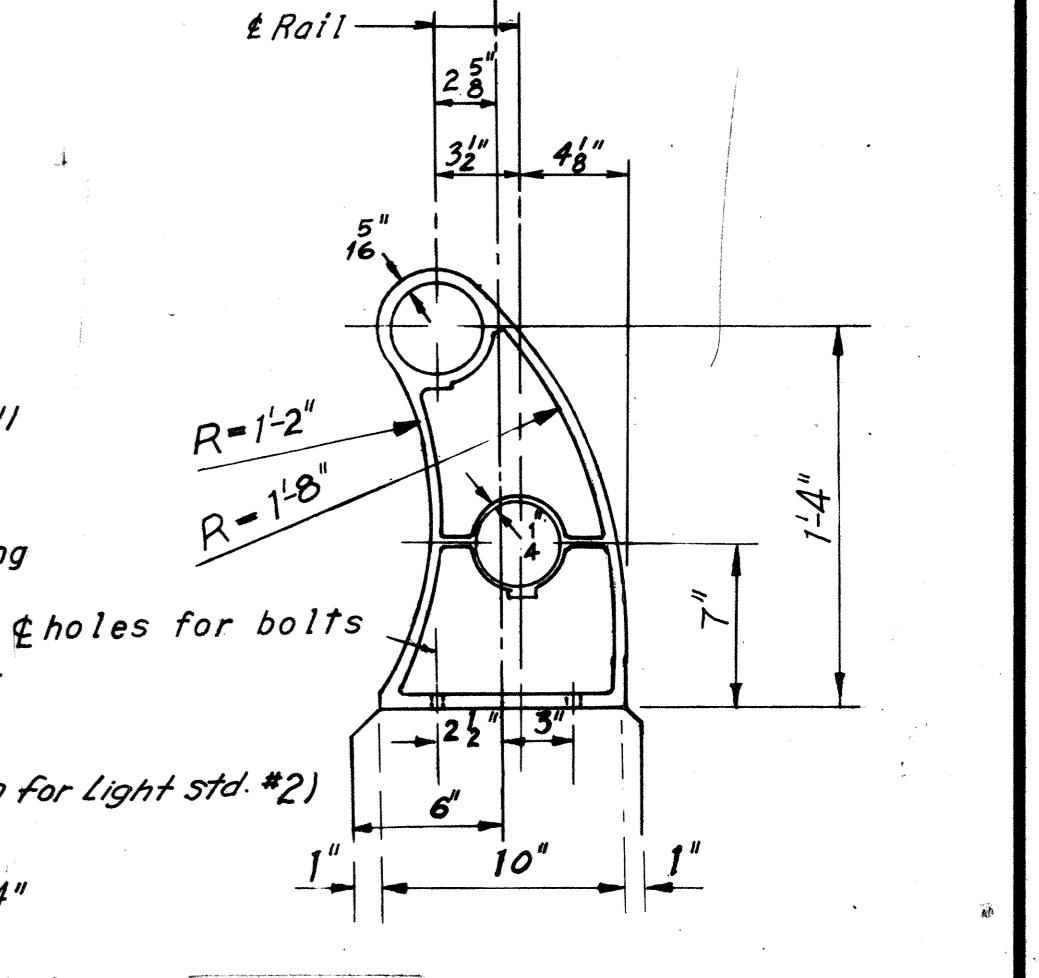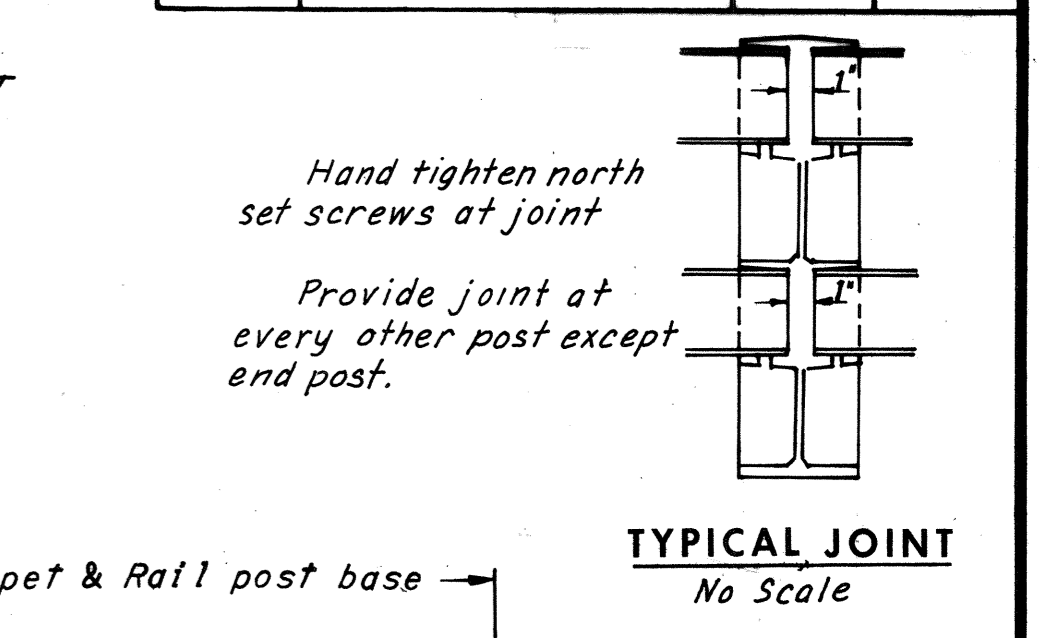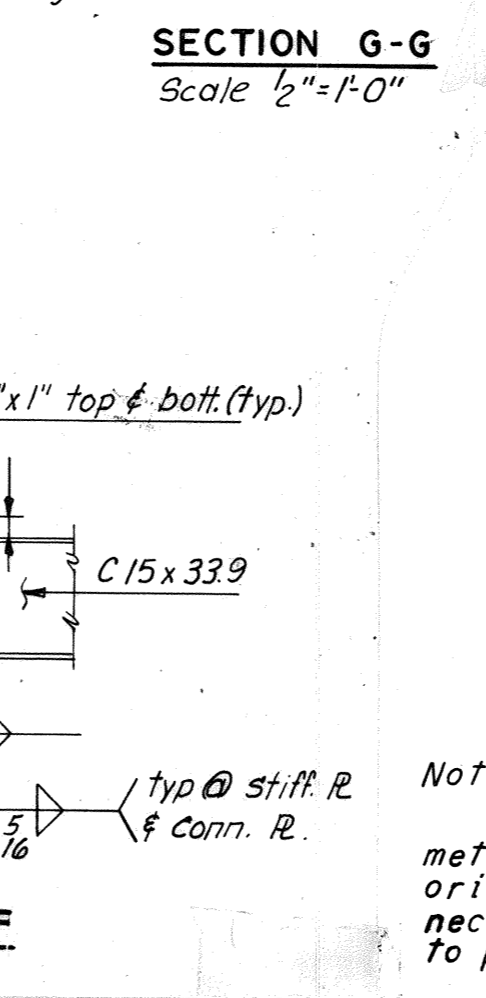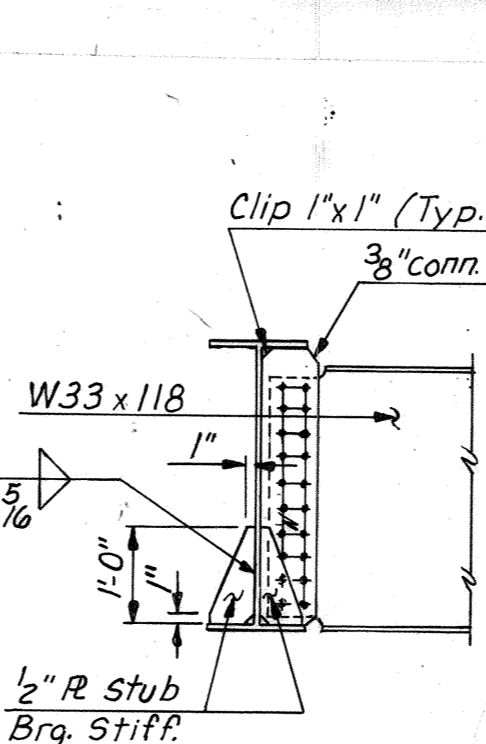

Note:
 Dimensions shown on the plans for existing structural metalwork are in accordance with drawings prepared for the original construction. The Contractor shall verify all necessary dimensions of existing structural metalwork prior to preparation of shop drawings for new metalwork.
 New Diaphragms are to match Existing Diaphragms unless otherwise shown.

RICHMOND METROPOLITAN AUTHORITY
RICHMOND EXPRESSWAY SYSTEM
DOWNTOWN EXPRESSWAY

BRIDGE NO. 65
RAMP S-W CONNECTION FROM
RICHMOND-PETERSBURG TURNPIKE
SUPERSTRUCTURE DETAILS

HOWARD, NEEDLES, TAMMEN & BERGENDOFF
 Consulting Engineers
 NEW YORK ALEXANDRIA KANSAS CITY


SCALE: As Noted
 CONTRACT NO. 11
 SHEET NO. 32 OF 38

ELASTOMERIC EXP. DAM ADJUSTMENT SCHEDULE									
TEMPERATURE AT TIME OF DECK LAYOUT									
120°									
100°									
80°									
60°									
40°									
20°									
0°									
BOLT SPACING DIM "X"	7 ⁵ / ₈ "	7 ⁷ / ₈ "	8 ¹ / ₈ "	8 ³ / ₈ "	8 ⁵ / ₈ "	8 ⁷ / ₈ "	9 ¹ / ₈ "	9 ³ / ₈ "	9 ⁵ / ₈ "
RECESS WIDTH DIM "Y" (-0, +1/4")	9 ⁵ / ₈ "	9 ⁷ / ₈ "	10 ¹ / ₈ "	10 ³ / ₈ "	10 ⁵ / ₈ "	10 ⁷ / ₈ "	11 ¹ / ₈ "	11 ³ / ₈ "	11 ⁵ / ₈ "
SLAB OPENING DIM "W"	1"	1 ¹ / ₄ "	1 ¹ / ₂ "	1 ³ / ₄ "	2"	2 ¹ / ₄ "	2 ¹ / ₂ "	2 ³ / ₄ "	3"




NOTES
 *Dimension shown is at 60° F. For Dim. "W", "X" and "Y" adjustment due to temperature change, see Adjustment Schedule.
 Reinforced Elastomeric Expansion Dam, Transflex type 200A or Onflex type 25, to be installed in accordance with the manufacturer's specifications. The manufacturer's representative shall be present during installation.
 Shop drawings, showing complete details and dimensions of the dam and other pertinent information for installation of a practical leakproof joint, shall be prepared in accordance with these specifications. Review of shop drawings by the Engineer shall be required prior to installation of the expansion dam.

TRANSFLEX 200A
 Curb and gutter sections shall be a one piece molded section or shall be pre-assembled by the manufacturer and all joints therein vulcanized. Units of the dam shall have tongue and groove joints at the ends of all units to provide for a positive leakproof connection between adjacent units.



ONFLEX 25
 Elastomeric membrane shall be one piece premolded unit extending full length of the aluminum extrusion. Aluminum extrusions to be continuous with mitered and welded joints at the gutter lines.

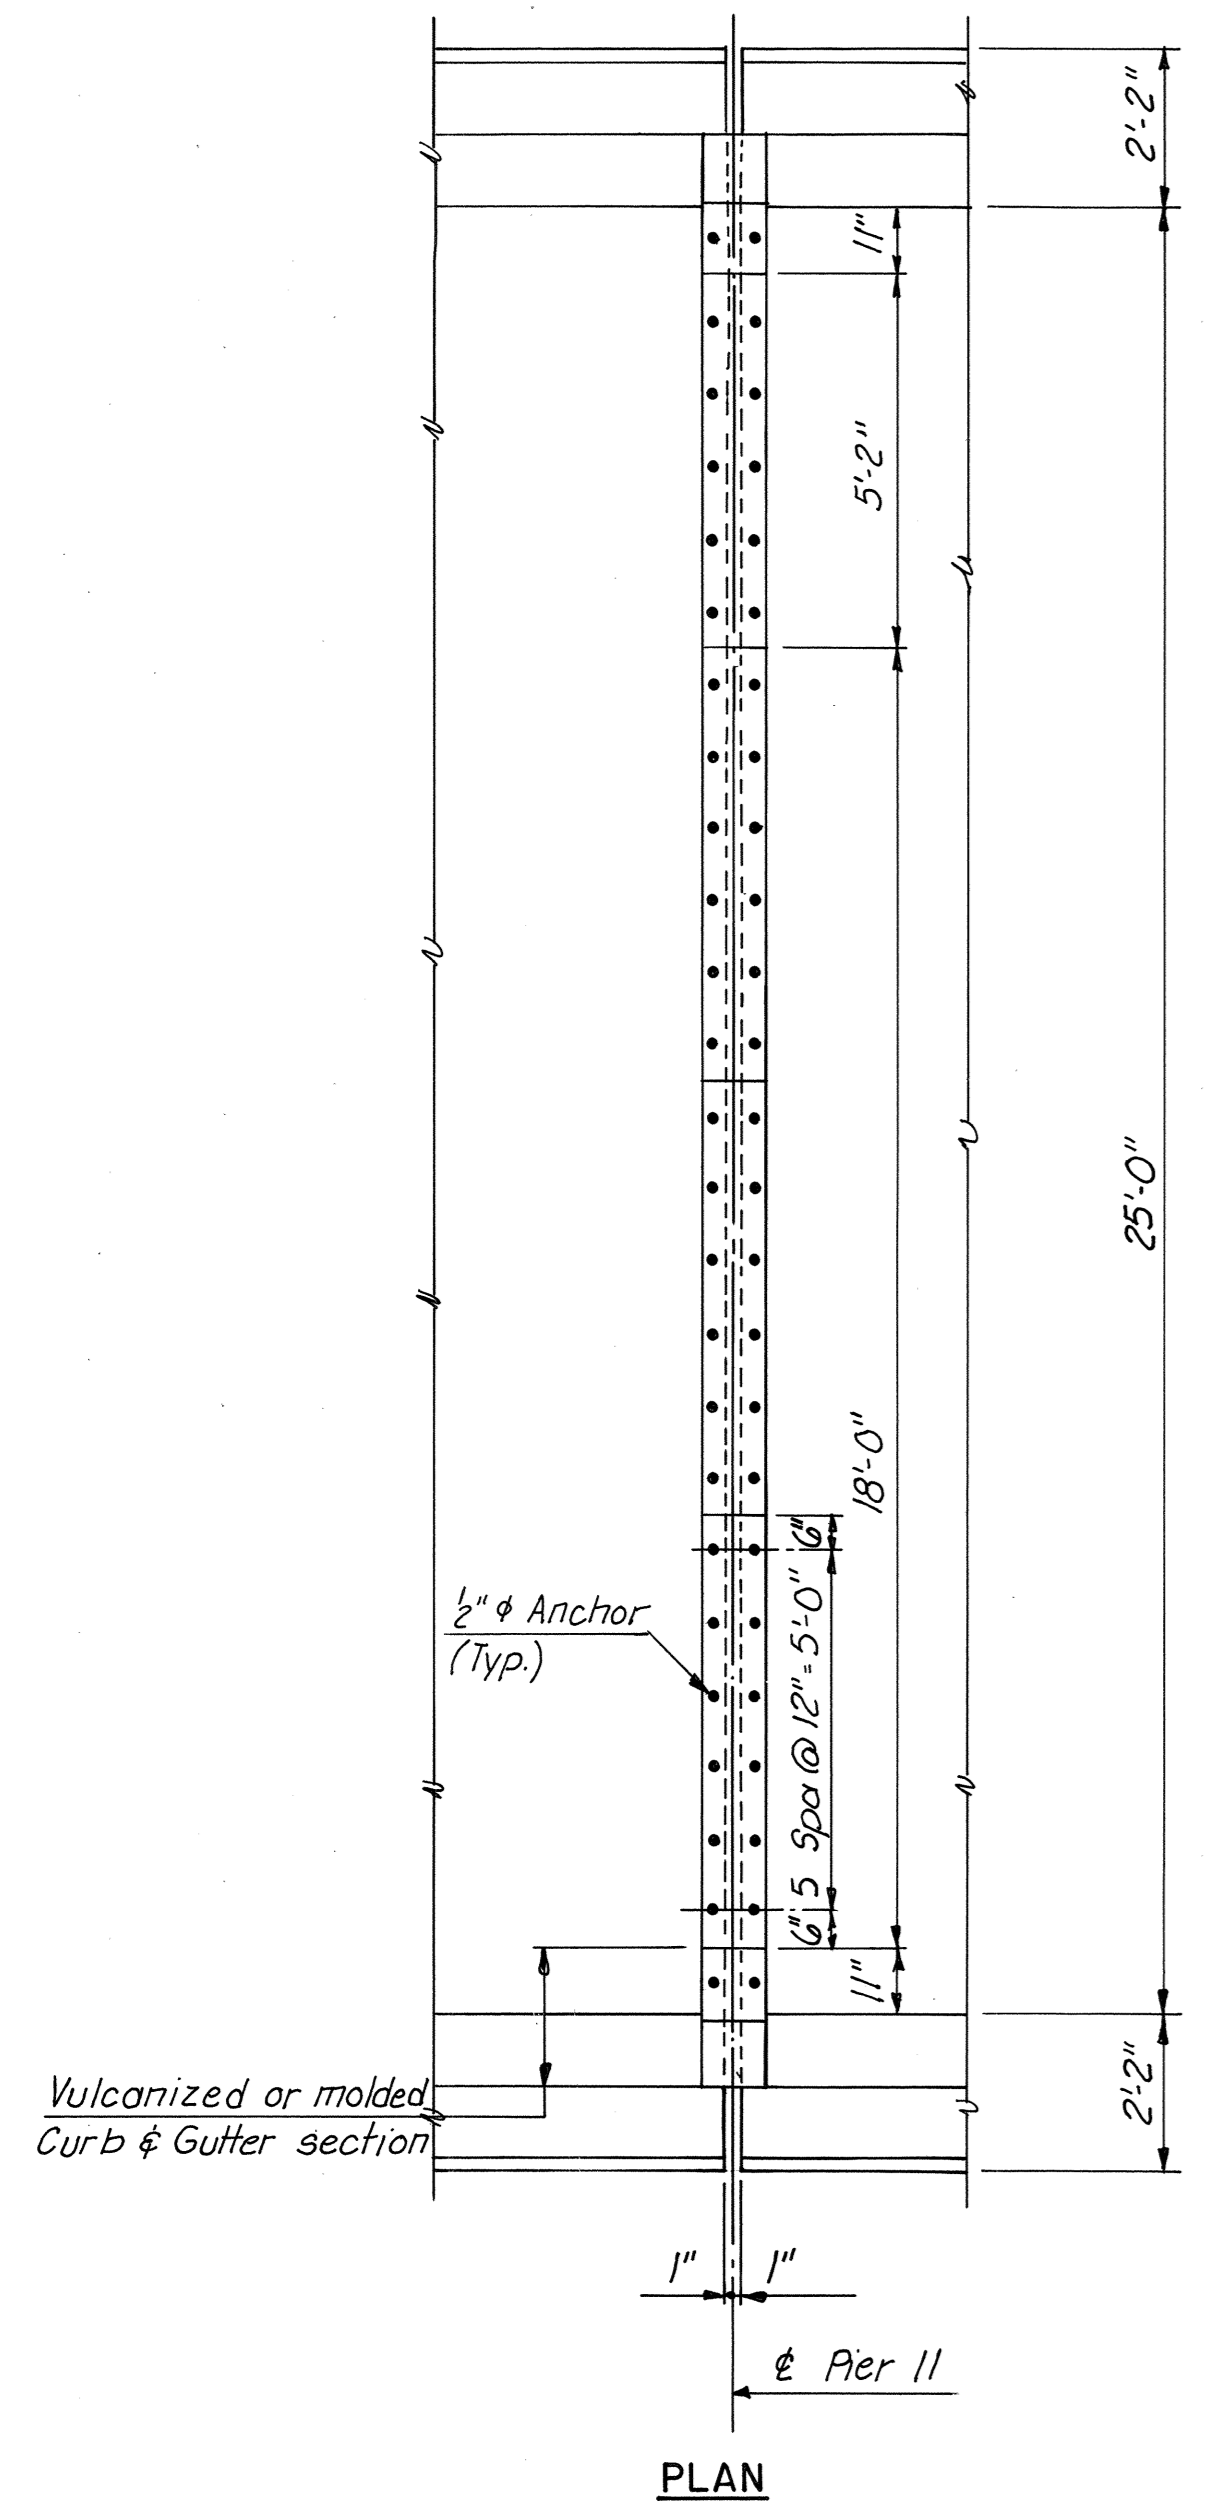

NOTE
 Plan is shown for Transflex 200A. Onflex 25 is similar except as noted under Notes Onflex 25.

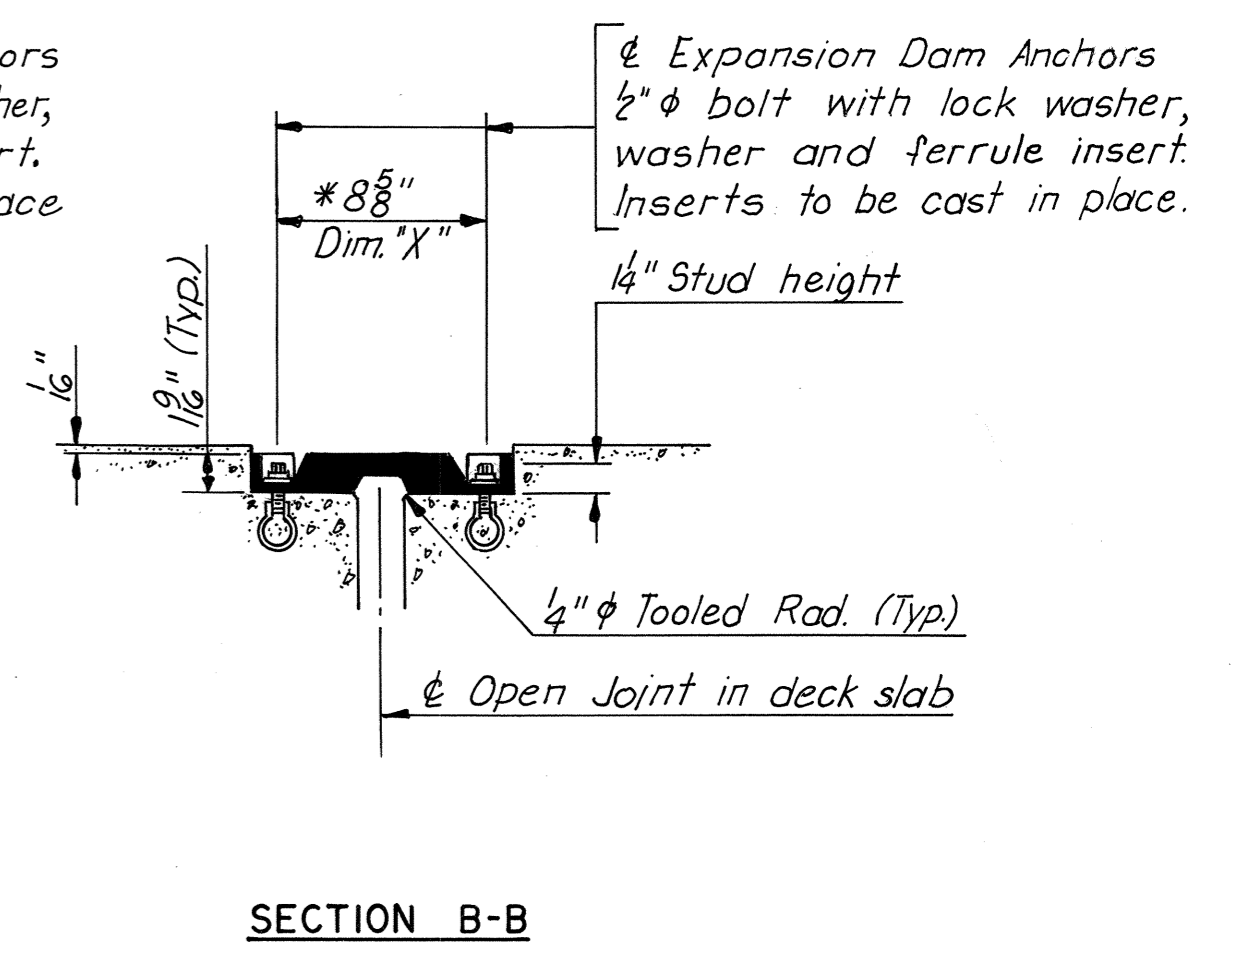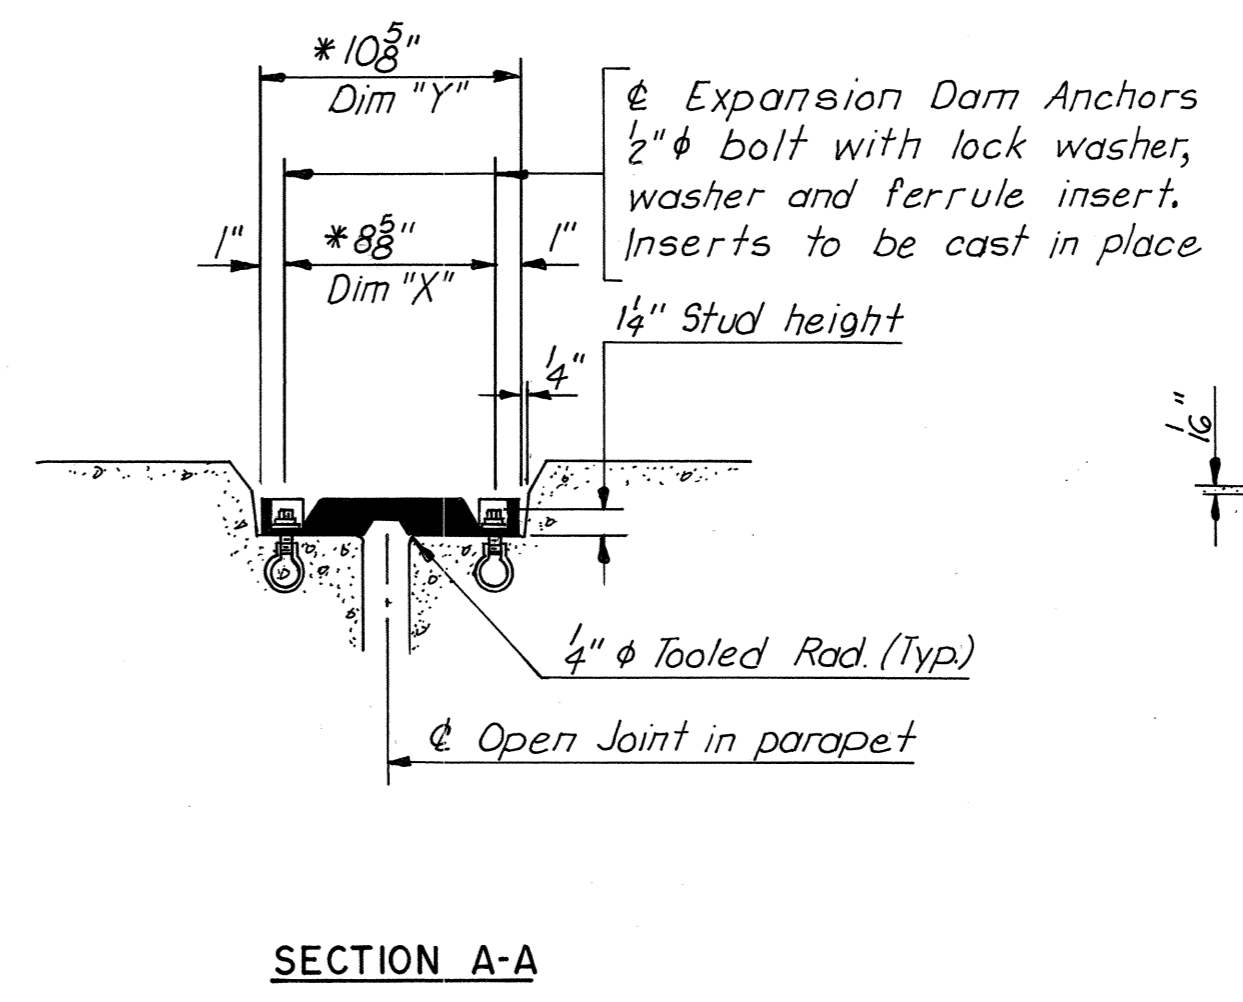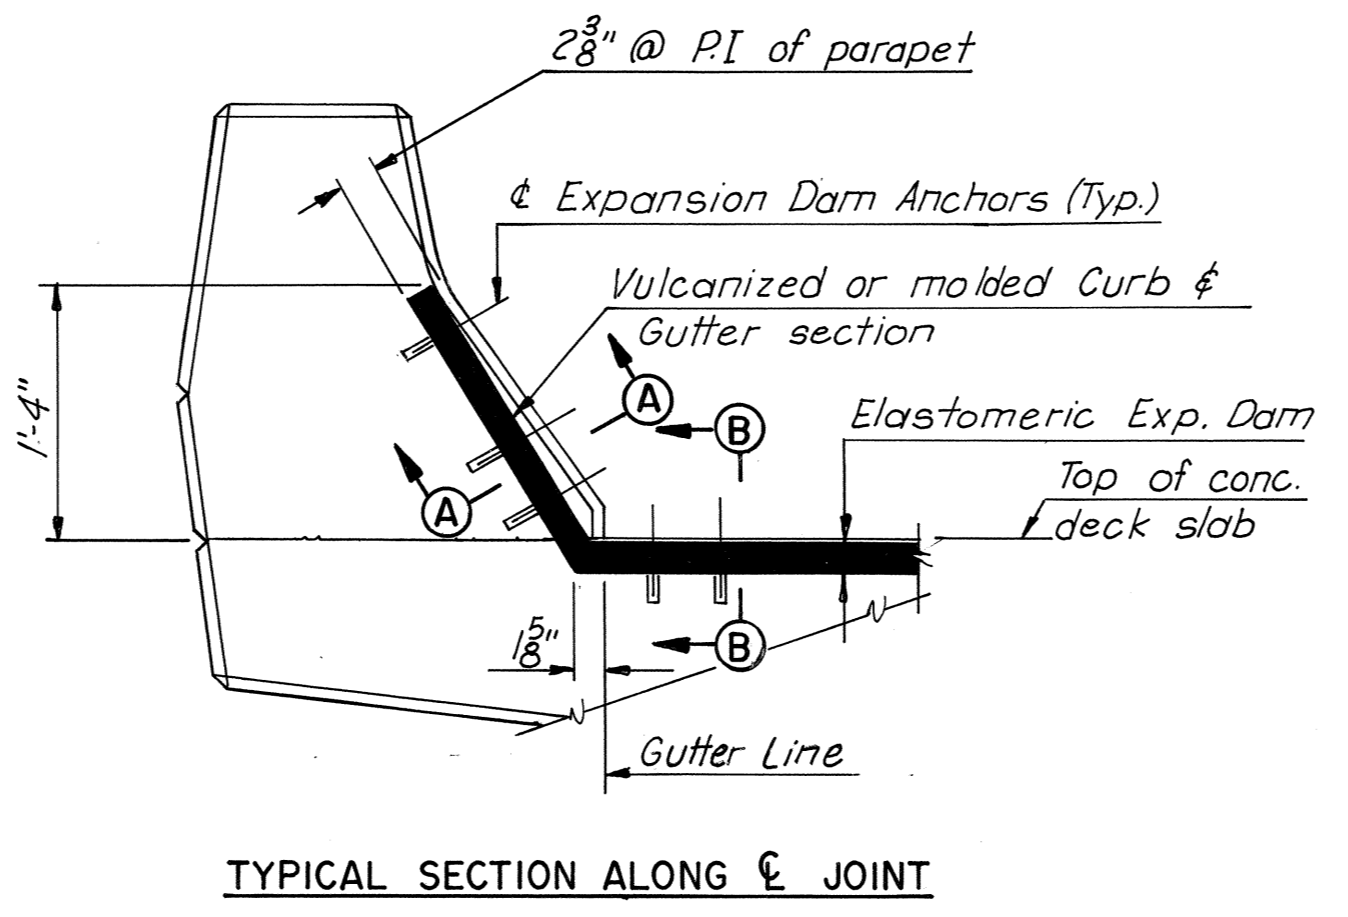

TRANSFLEX 200A JOINT DETAILS

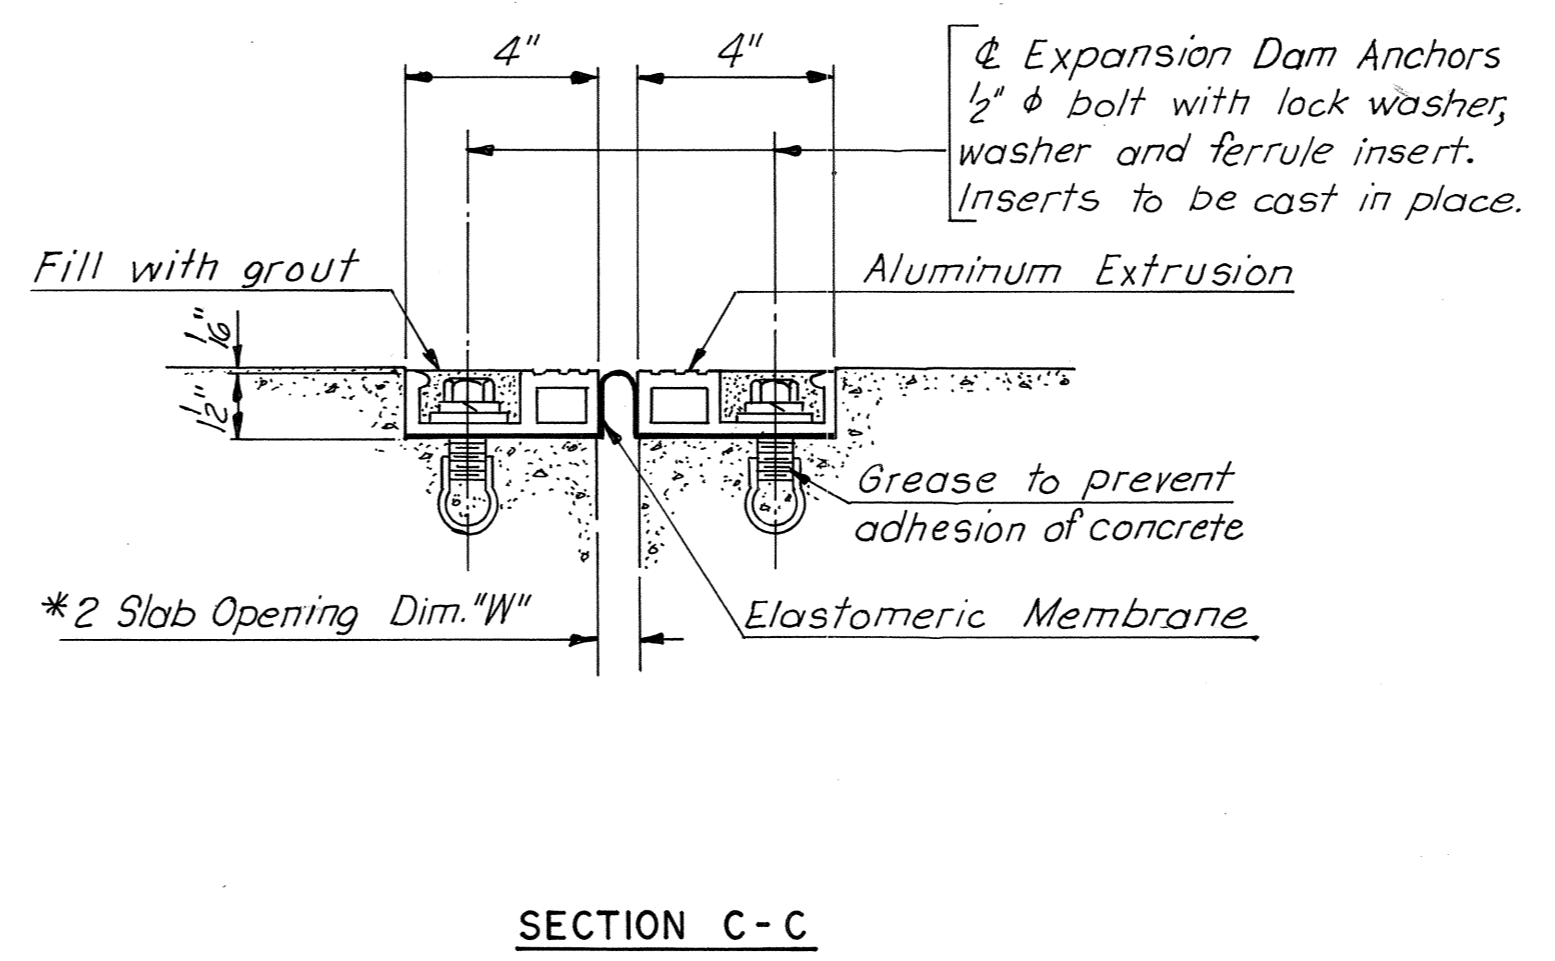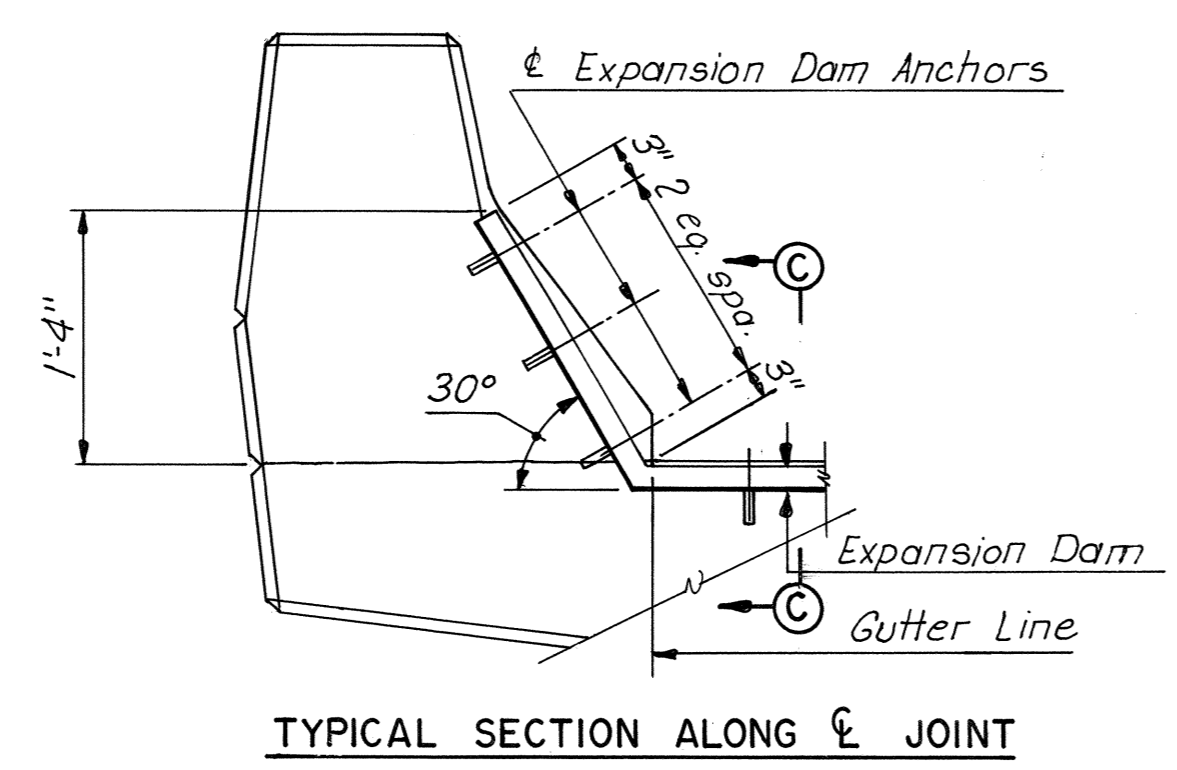

ONFLEX 25 JOINT DETAILS


DESIGNED					
DRAWN	TEM	9-30-76			
CHECKED			1 New Sheet	TEM	9-30-76
IN CHARGE			NO. REVISION	BY	DATE

AS BUILT
RICHMOND METROPOLITAN AUTHORITY
RICHMOND EXPRESSWAY SYSTEM
 DOWNTOWN EXPRESSWAY
 BRIDGE NO. 65
 RAMP S-W CONNECTION FROM
 RICHMOND-PETERSBURG TURNPIKE
 JOINT DETAILS - PIER II

SCALE _____
 DATE _____ SHEET 34A OF _____


HOWARD, NEEDLES, TAMMEN & BERGENDOFF
 CONSULTING ENGINEERS
 Alexandria, Virginia **HNTB**

RICHMOND EXPRESSWAY SYSTEM			
SECTION	PROJECT	SHEET NO.	TOTAL SHEETS
11	DOWNTOWN EXPRESSWAY	59	97

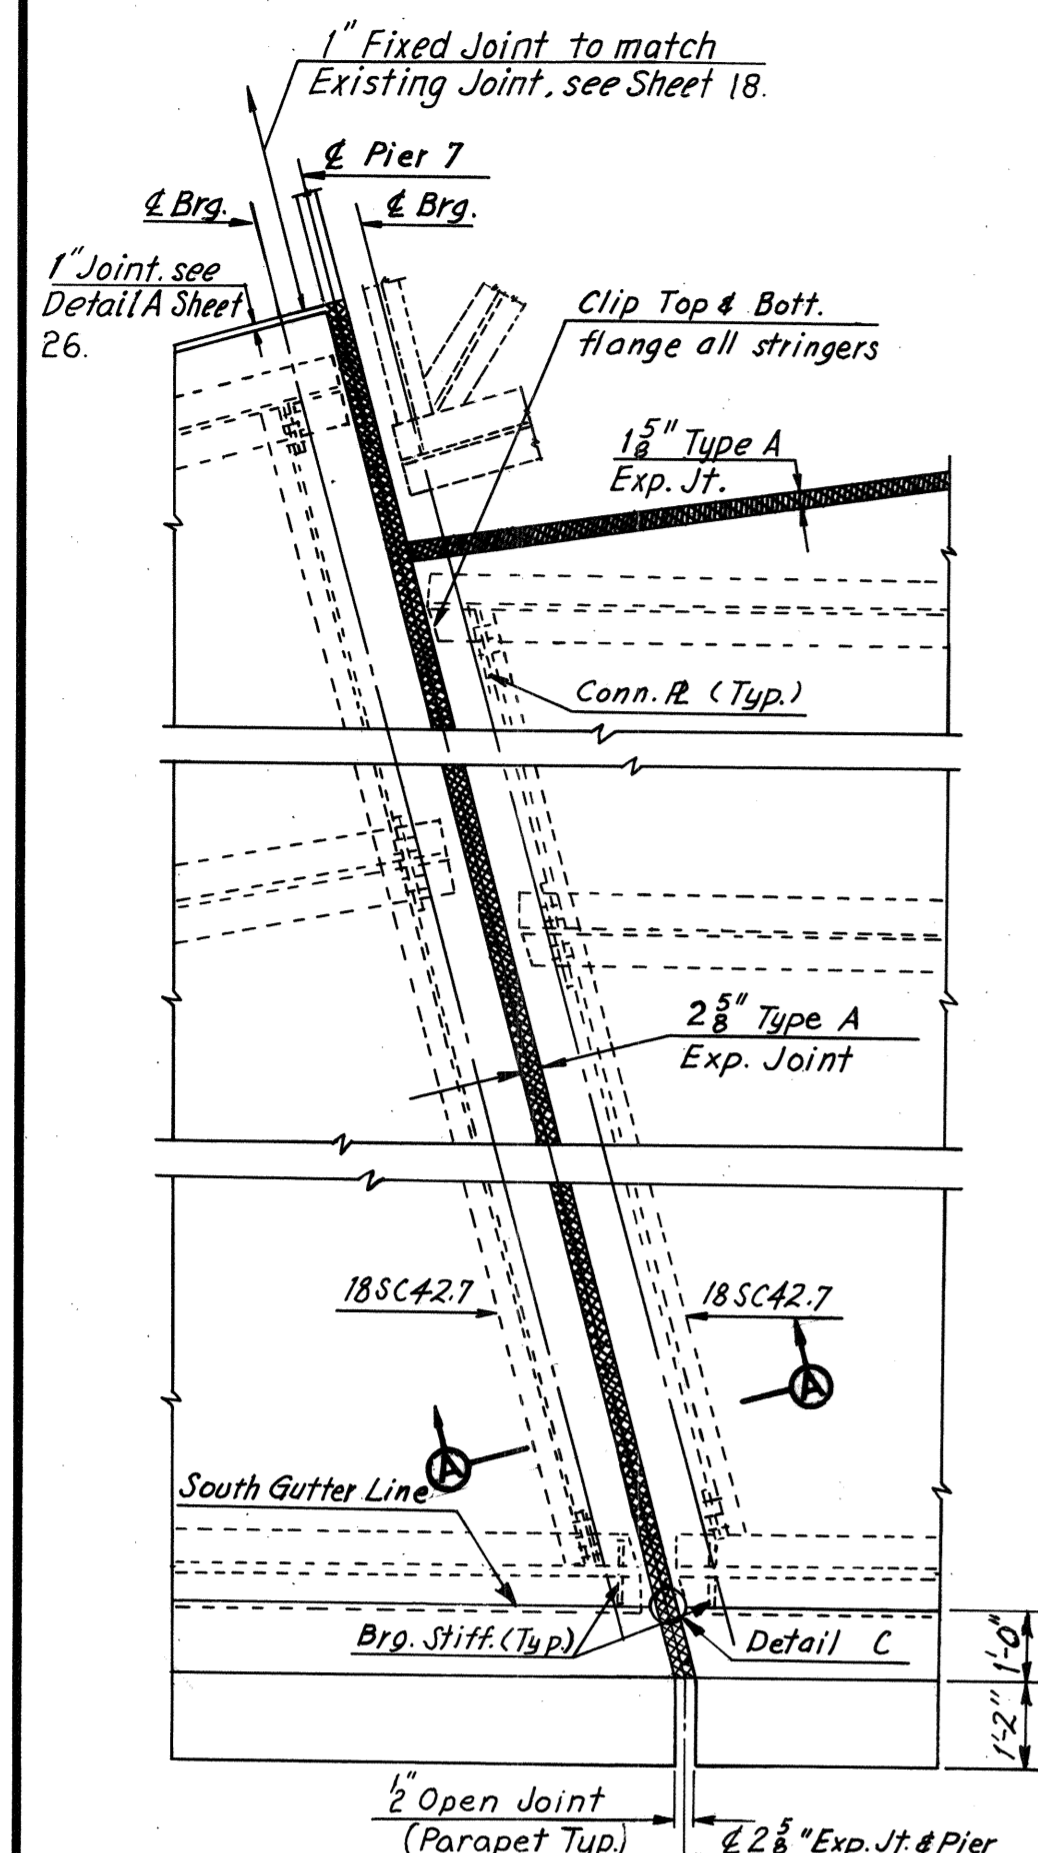


PLAN — JOINT AT PIER 7
Scale: 3/8" = 1'-0"


Note: For Detail C, See Sheet 35.

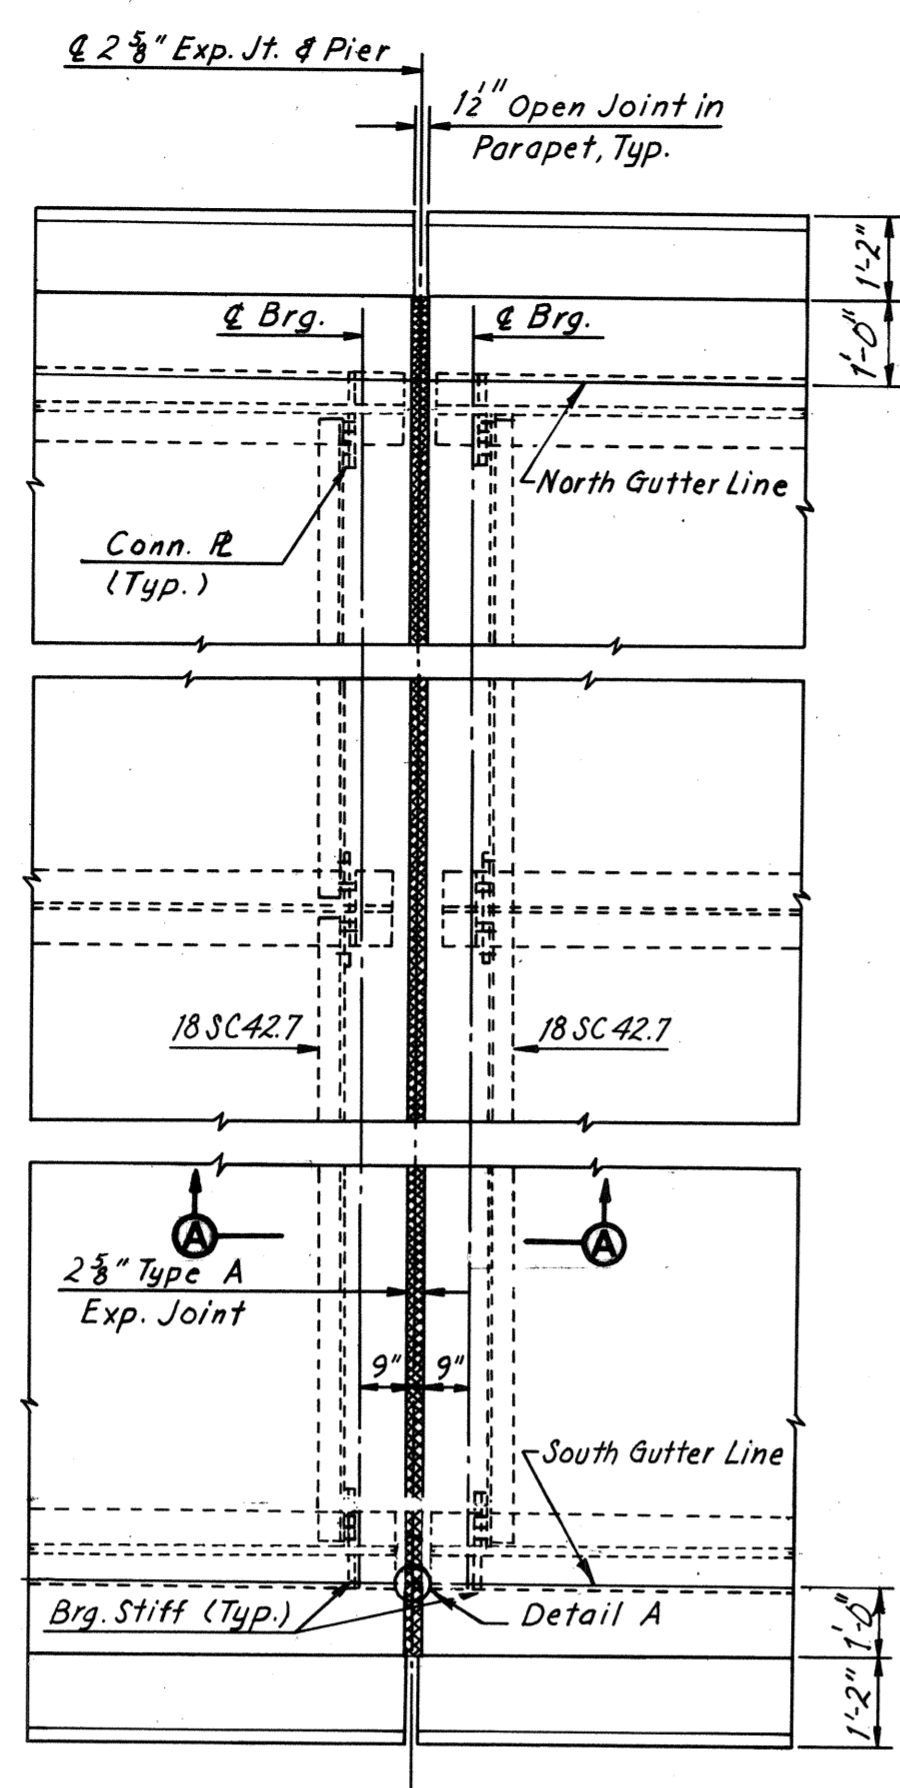


PLAN — JOINT AT PIERS 8, 9, 10, 17 AND 18
Scale: 3/8" = 1'-0"
(Piers 4 and 5 similar)

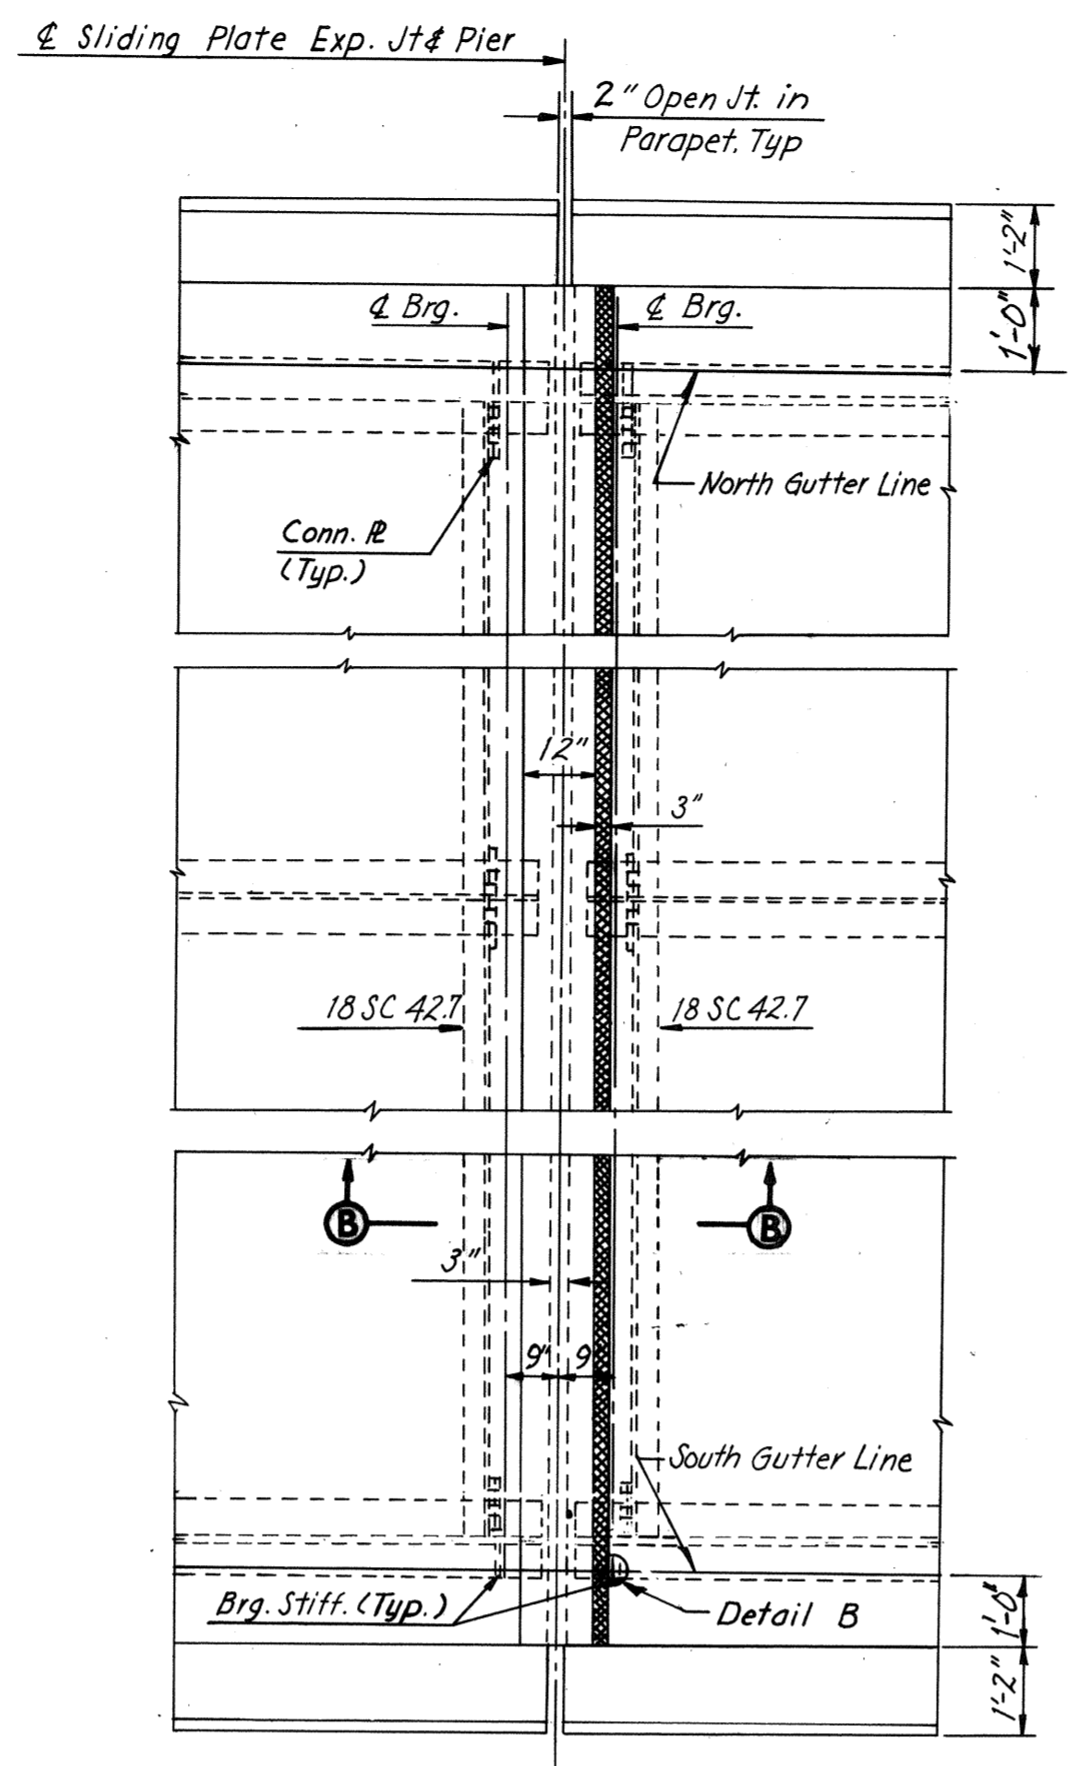


PLAN — JOINT AT PIER 11
Scale: 3/8" = 1'-0"

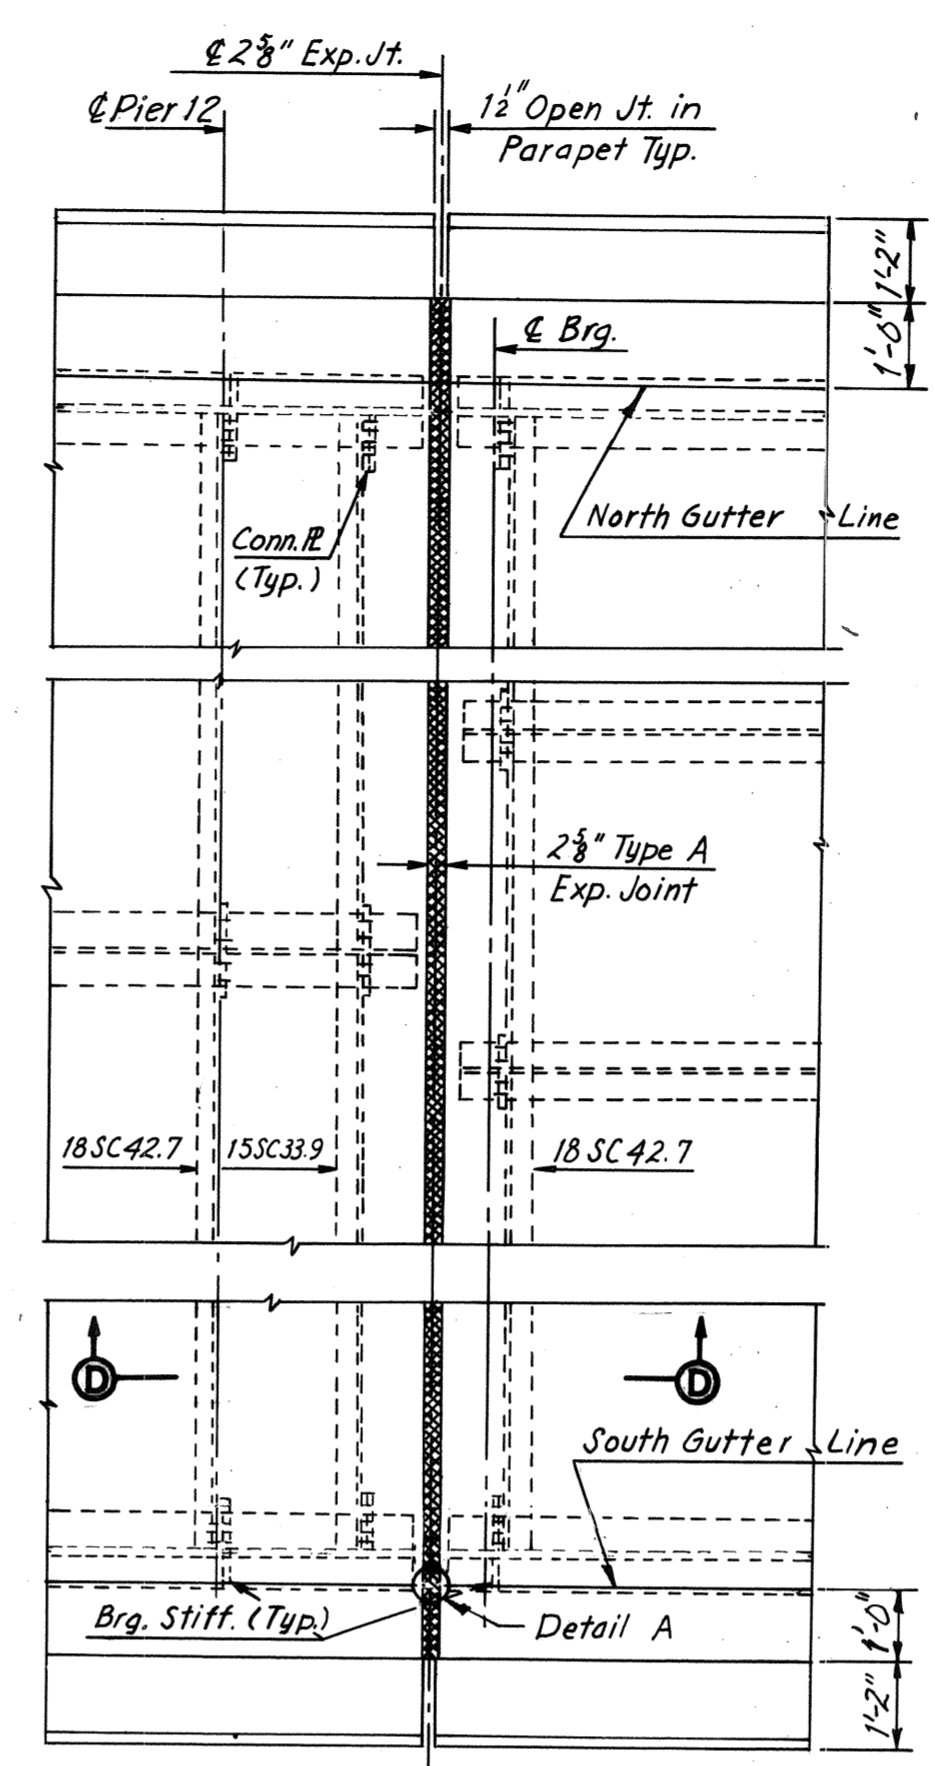


PLAN — JOINT AT PIER 12
Scale: 3/8" = 1'-0"

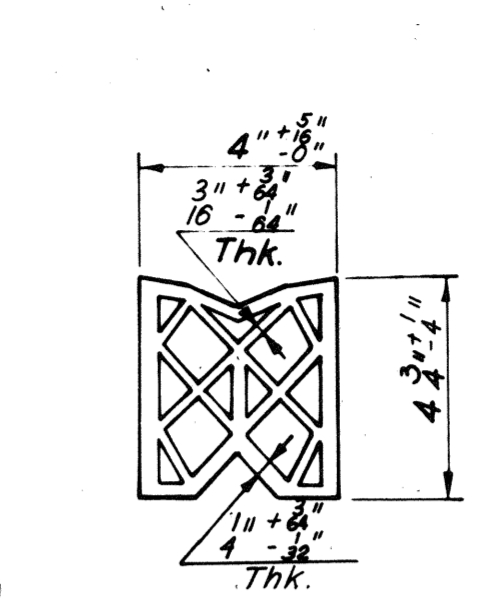


PREFORMED NEOPRENE JOINT SEALER FOR 2 3/8" TYPE "A" JOINT

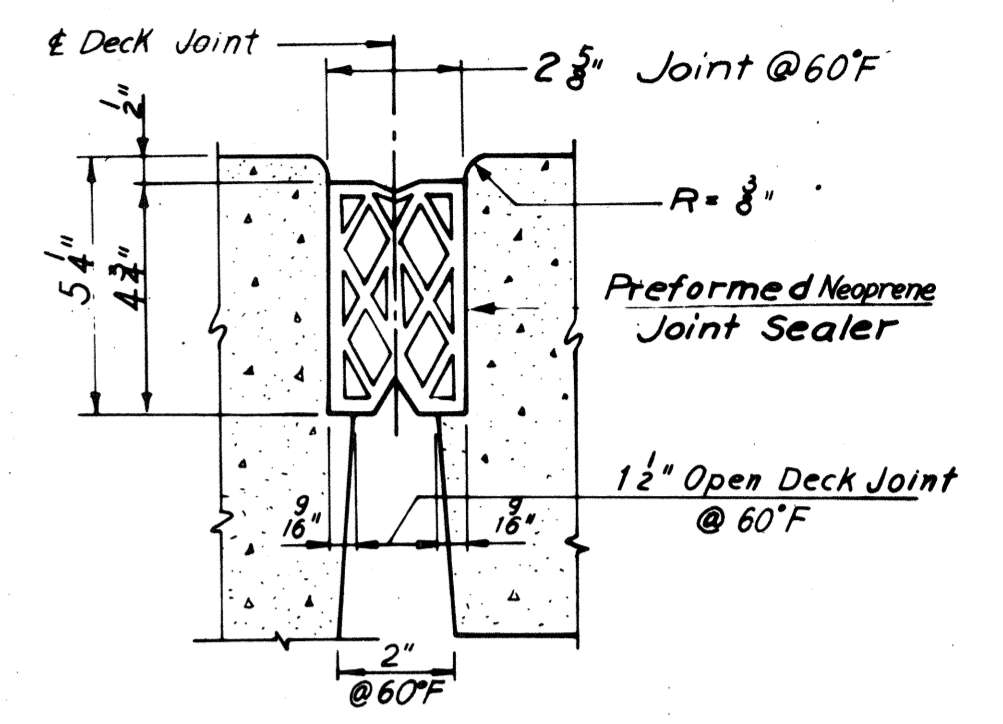


2 3/8" TYPE "A" JOINT

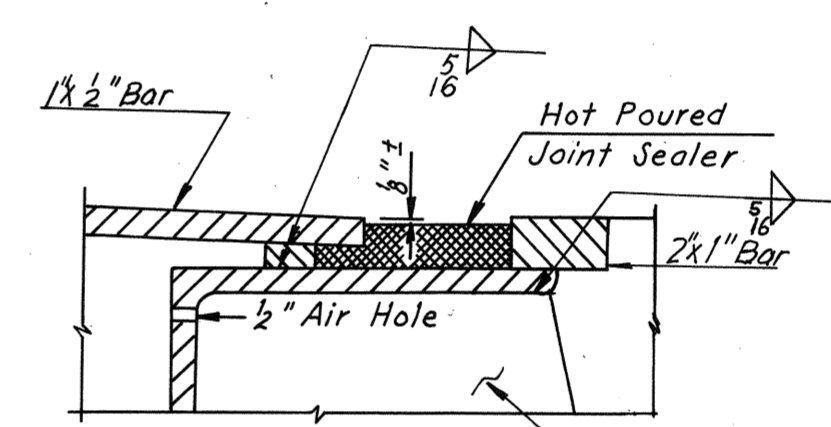

DETAIL B
Scale: 3/4" = 1'-0"

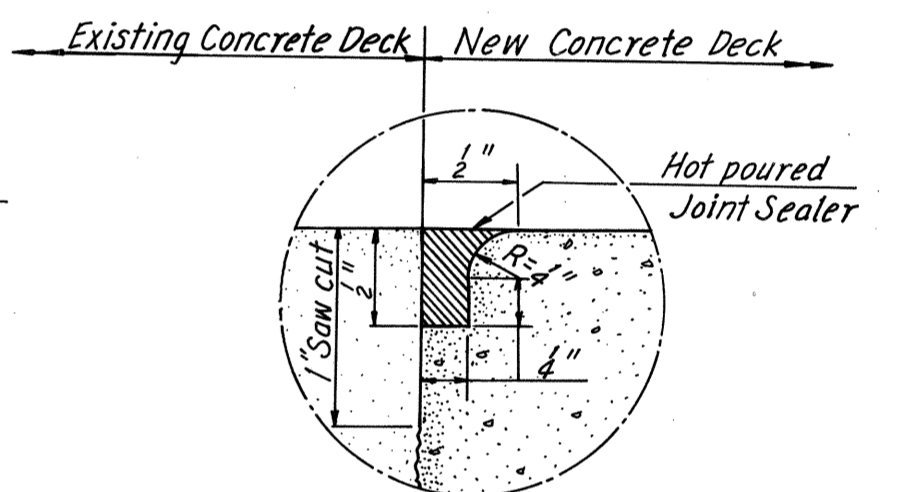


DETAIL D
Full Scale

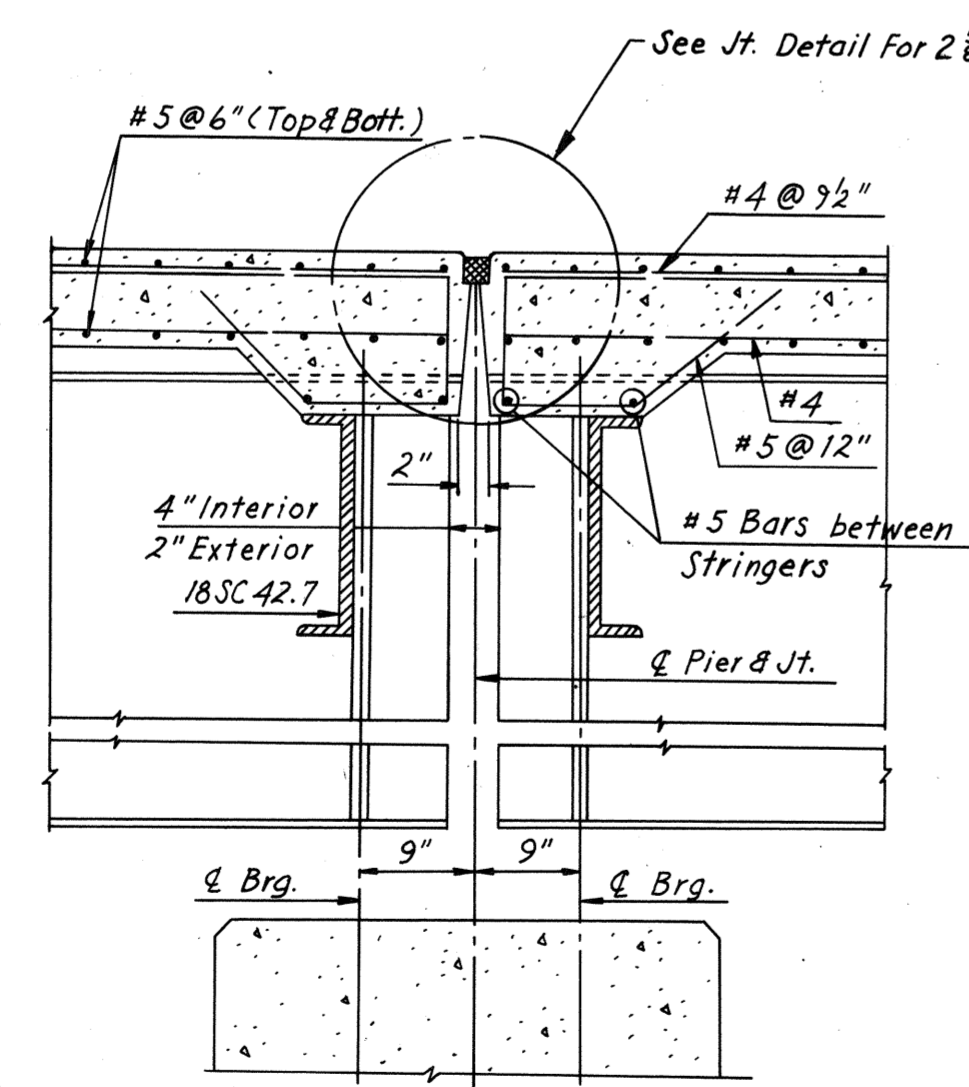


SECTION A-A
Scale: 3/4" = 1'-0"


For Piers 17 and 18 see Section C-C, Sheet 35.

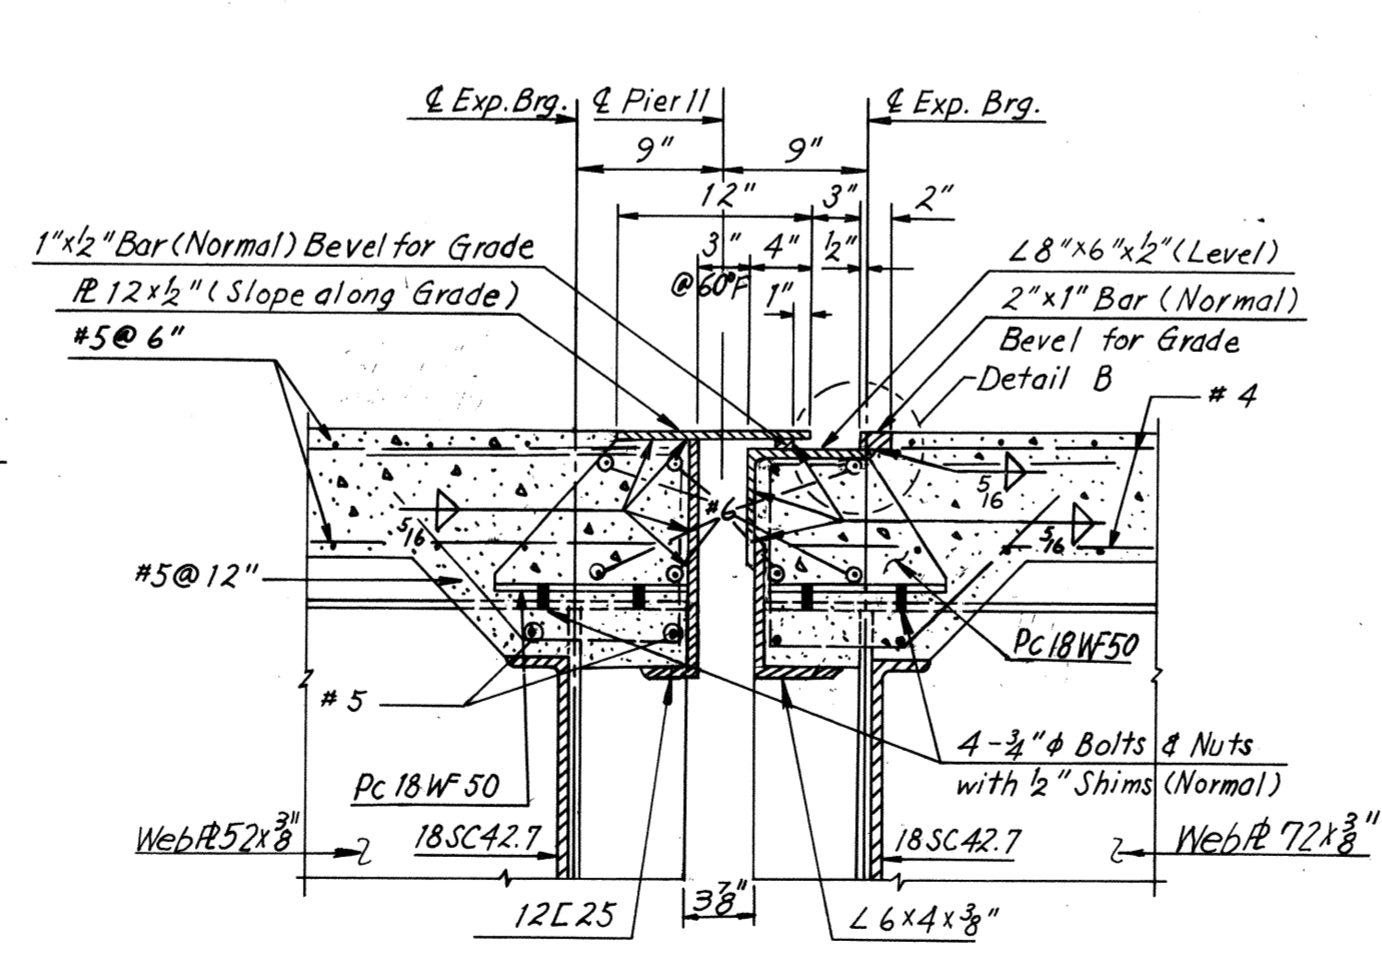

SECTION B-B
Scale: 1" = 1'-0"

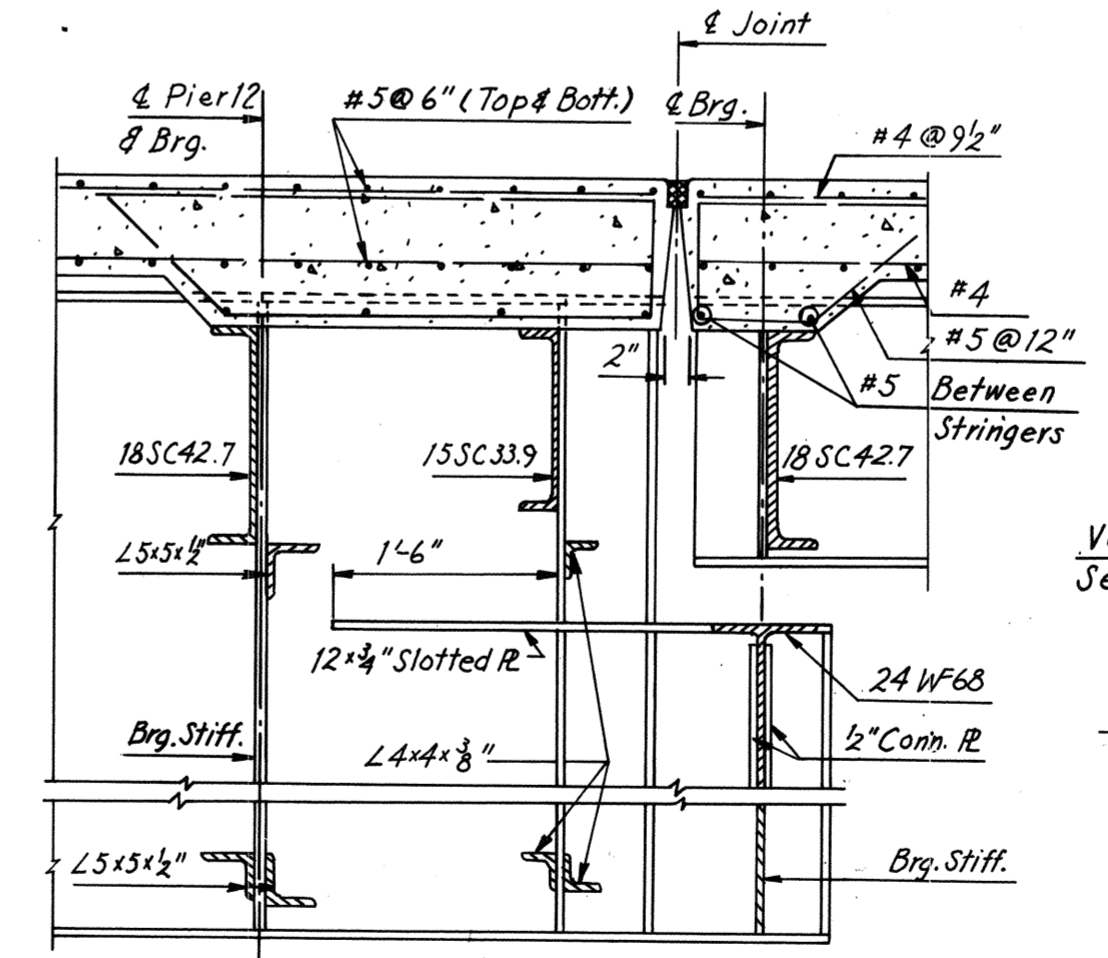

SECTION D-D
Scale: 3/4" = 1'-0"

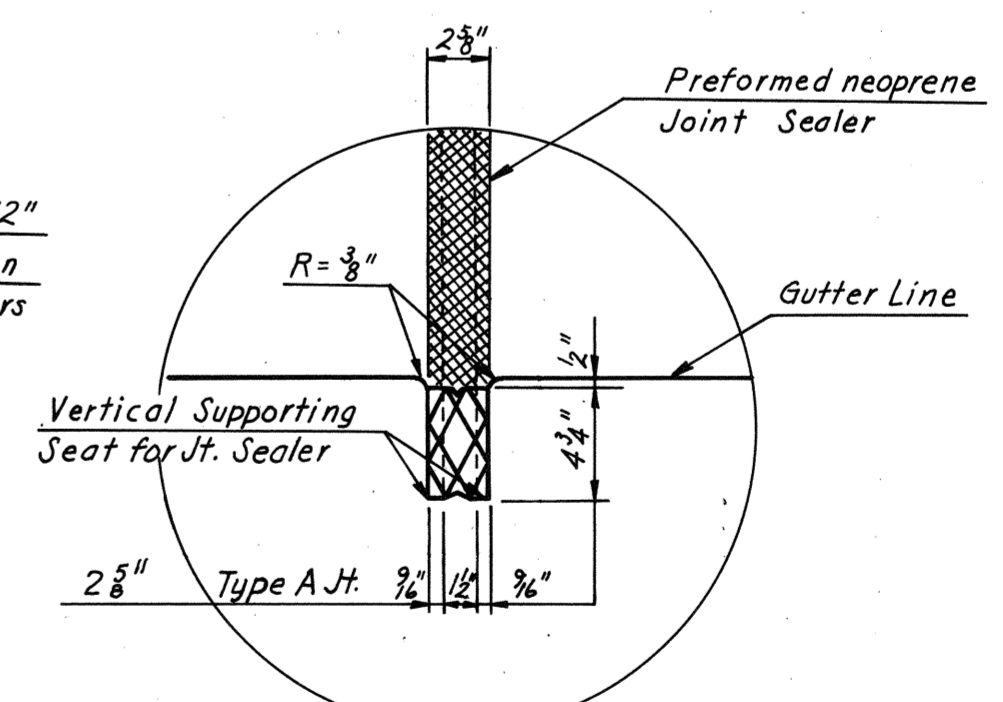

DETAIL A
No Scale

Note: It is absolutely essential that the openings for the preformed neoprene joint sealers be accurately formed and constructed to smooth, straight lines. The size of opening shall be adjusted to allow for anticipated dead load rotation of the ends of the slab and for the temperature at the time of construction.

Note: All horizontal dimensions shown above are normal to & Joint.

BY	DATE	NO.	REVISION	BY	DATE
MADE	Y.C.P	12-18-68			
CHECKED	G.S.H.	1-29-69			
IN CHARGE					


AS BUILT

RICHMOND METROPOLITAN AUTHORITY
RICHMOND EXPRESSWAY SYSTEM
DOWNTOWN EXPRESSWAY


BRIDGE NO. 65
RAMP S-W CONNECTION FROM
RICHMOND-PETERSBURG TURNPIKE
JOINT DETAILS

HOWARD, NEEDLES, TAMMEN & BERGENDOFF
consulting engineers
NEW YORK ALEXANDRIA KANSAS CITY


SCALE: As Noted
CONTRACT NO. 11
SHEET NO. 34 OF 38

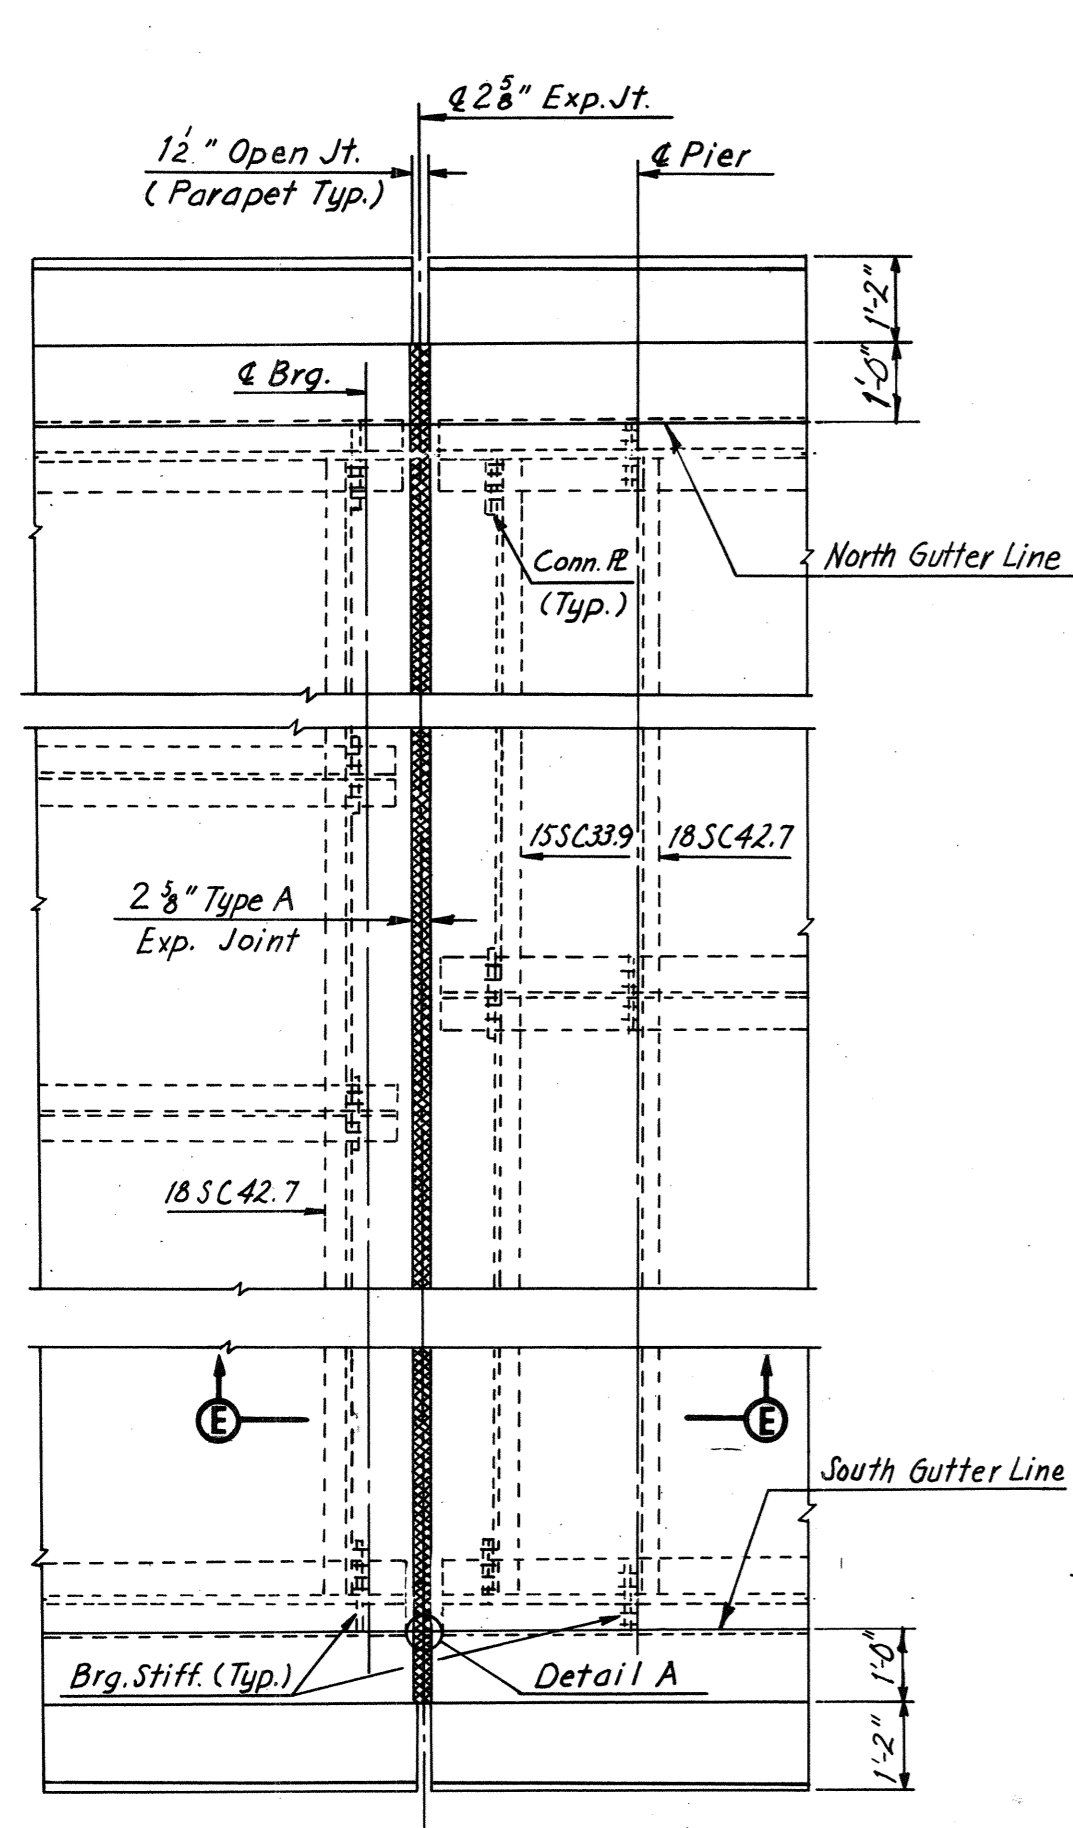


PLAN — JOINT AT PIER 13
Scale: 3/8" = 1'-0"

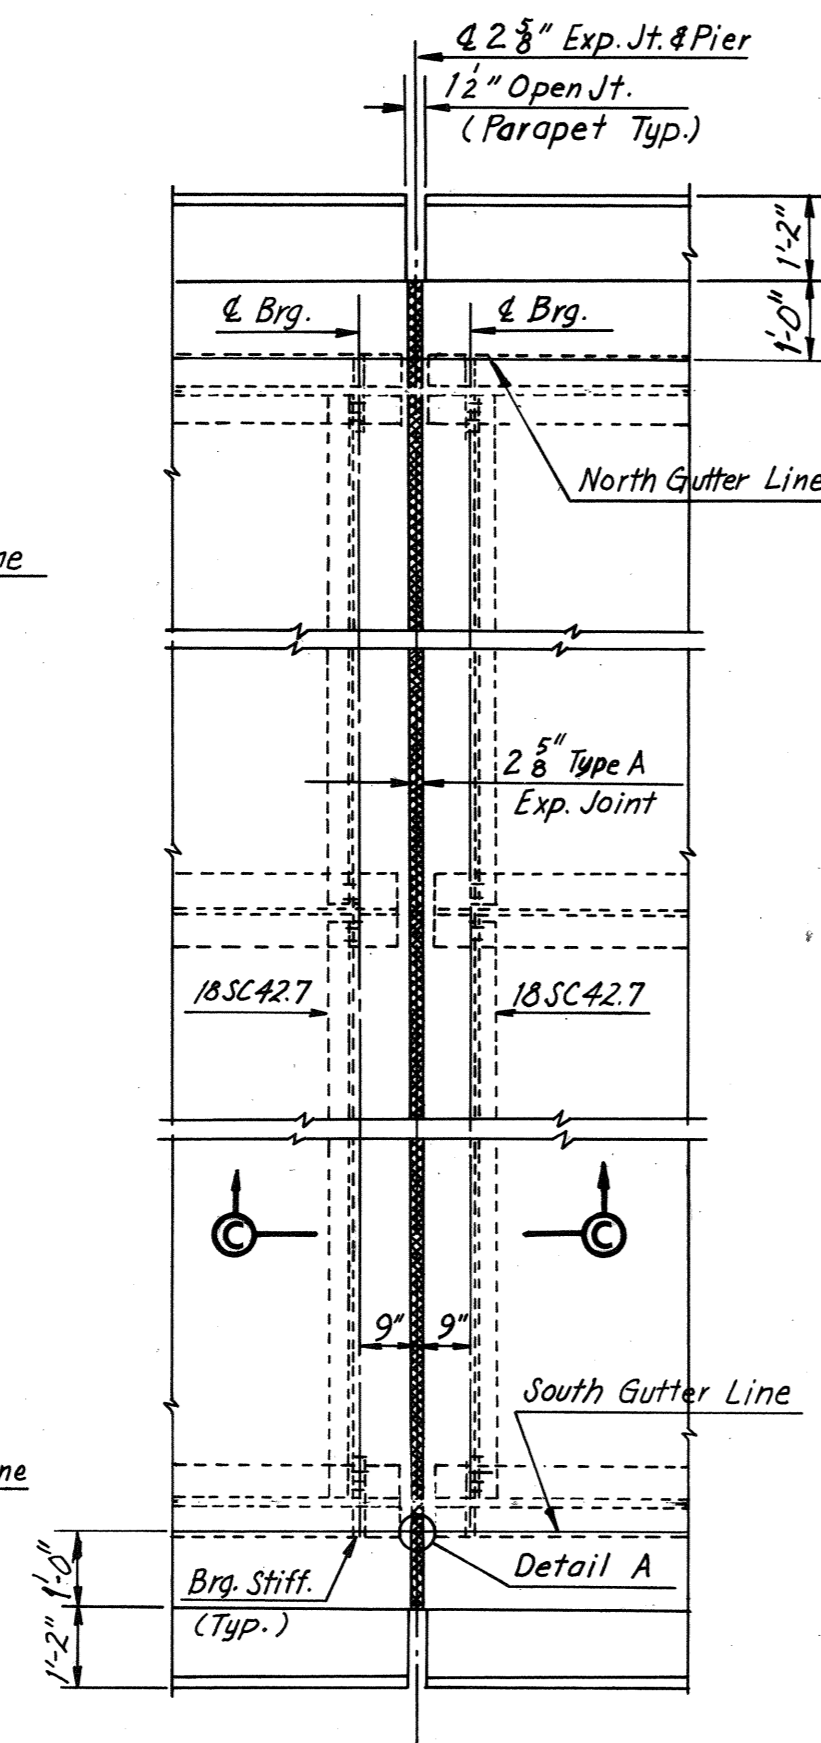

PLAN — JOINT AT PIERS 14, 15 AND 16
Scale: 3/8" = 1'-0"

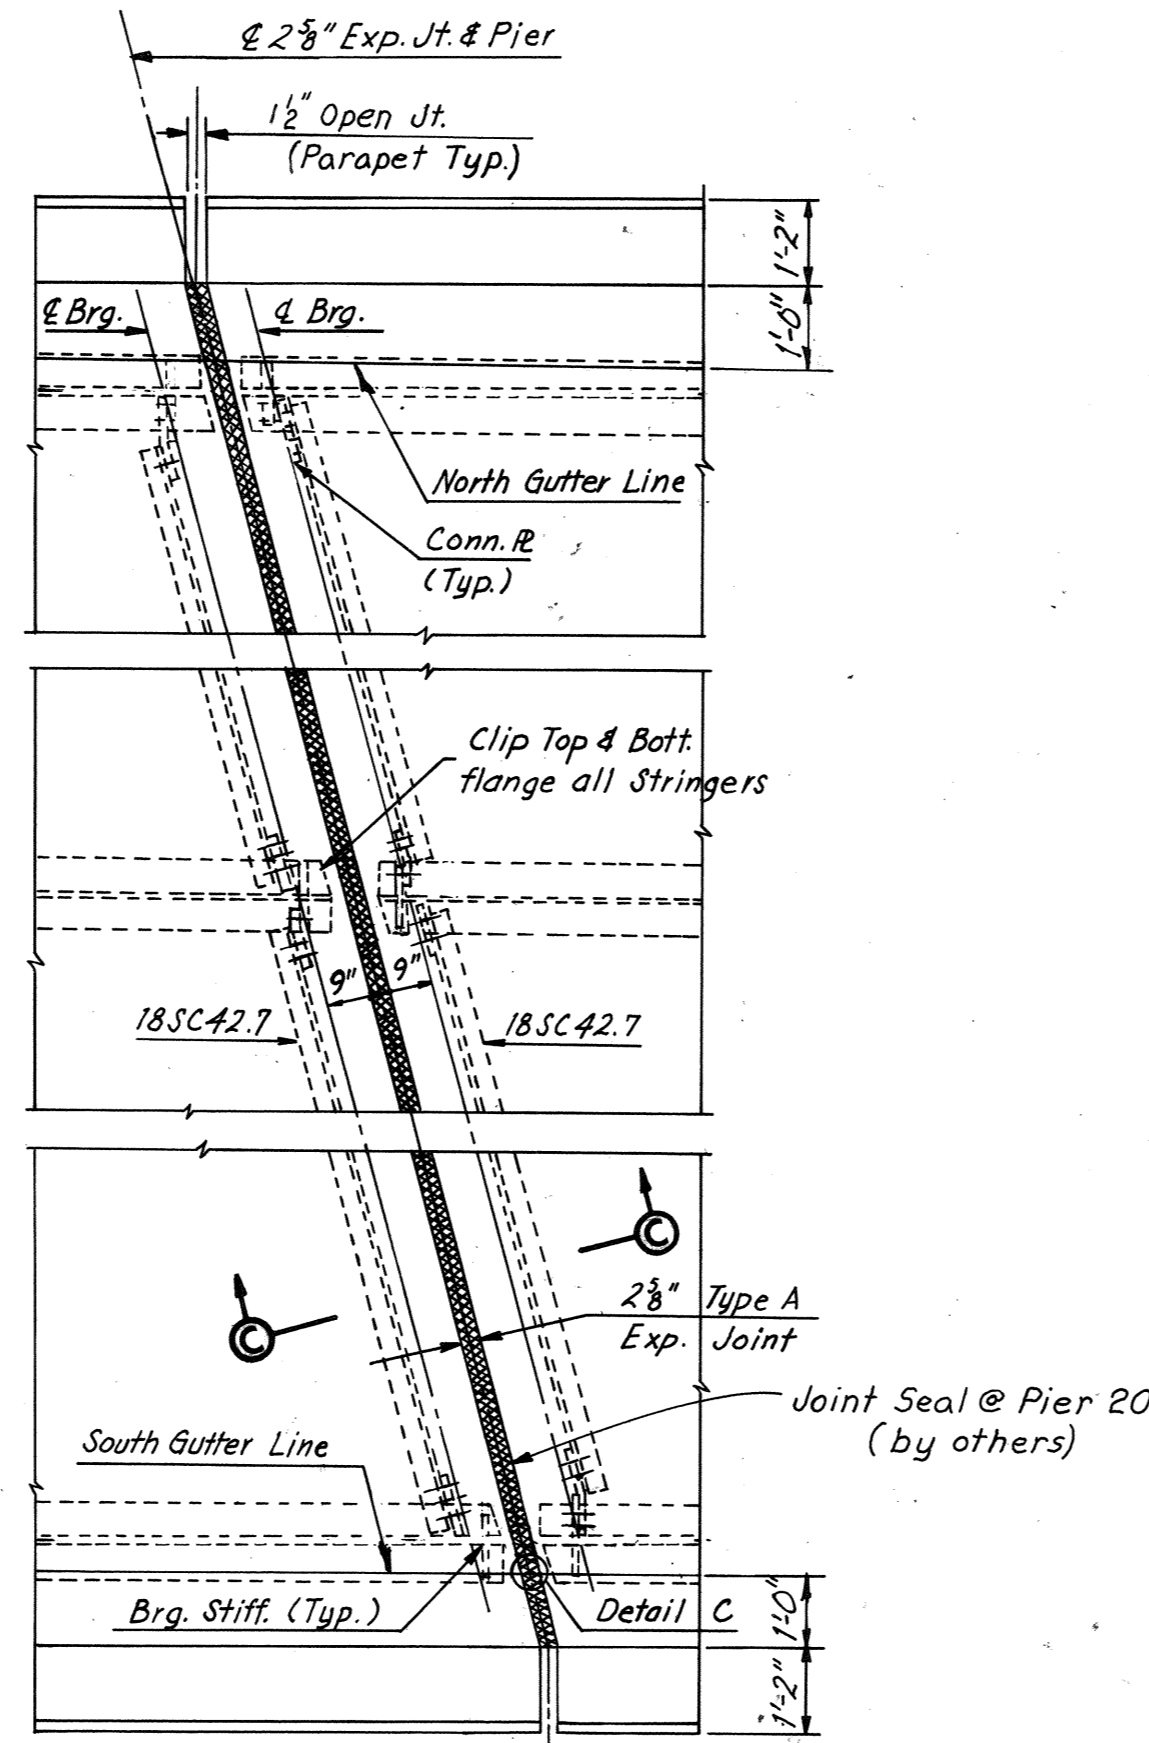


PLAN — JOINT AT PIERS 19 AND 20
Scale: 3/8" = 1'-0"

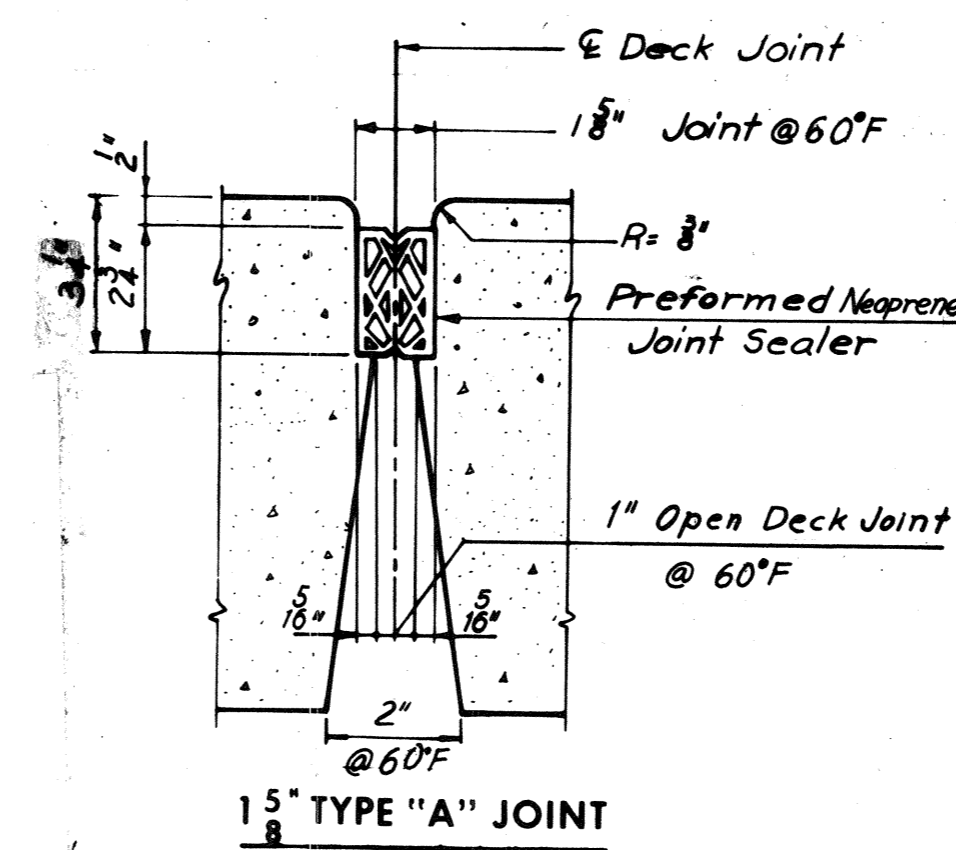


PREFORMED NEOPRENE JOINT SEALER FOR 1 5/8" TYPE "A" JOINT

Curb portion of existing expansion joints is to be removed beyond the curbline an amount sufficient for performance of single bevel groove weld between existing and new pair of L's 4x3 1/2". The weld is to be finished flush with the angles on roadway face of joint.

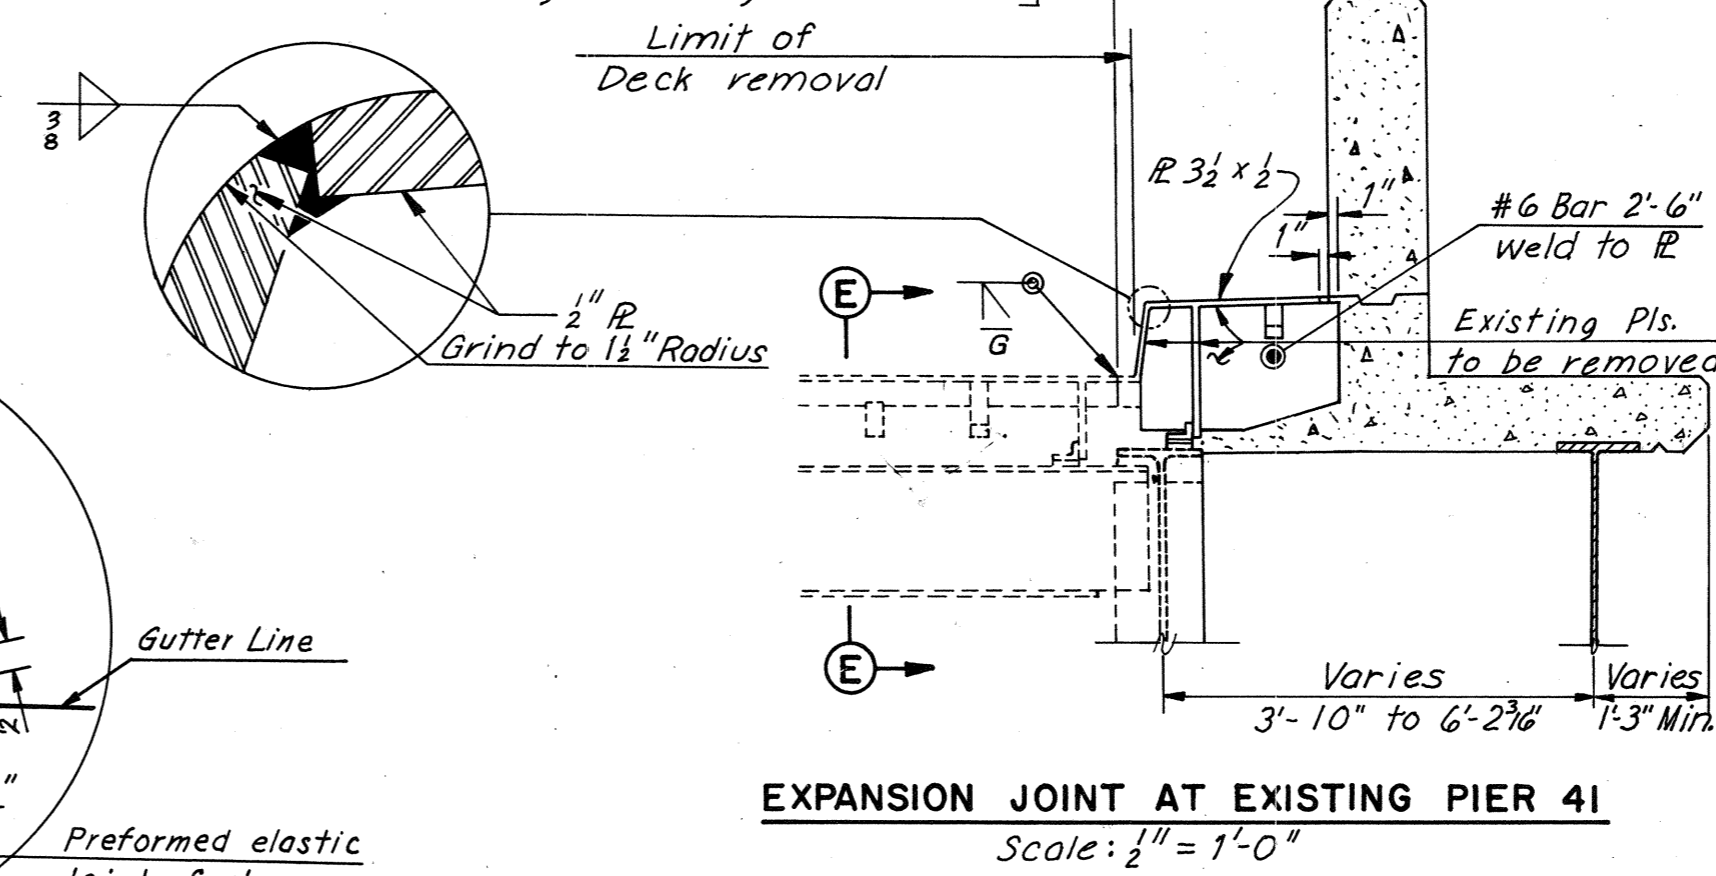


EXPANSION JOINT AT EXISTING PIER 41
Scale: 1/2" = 1'-0"

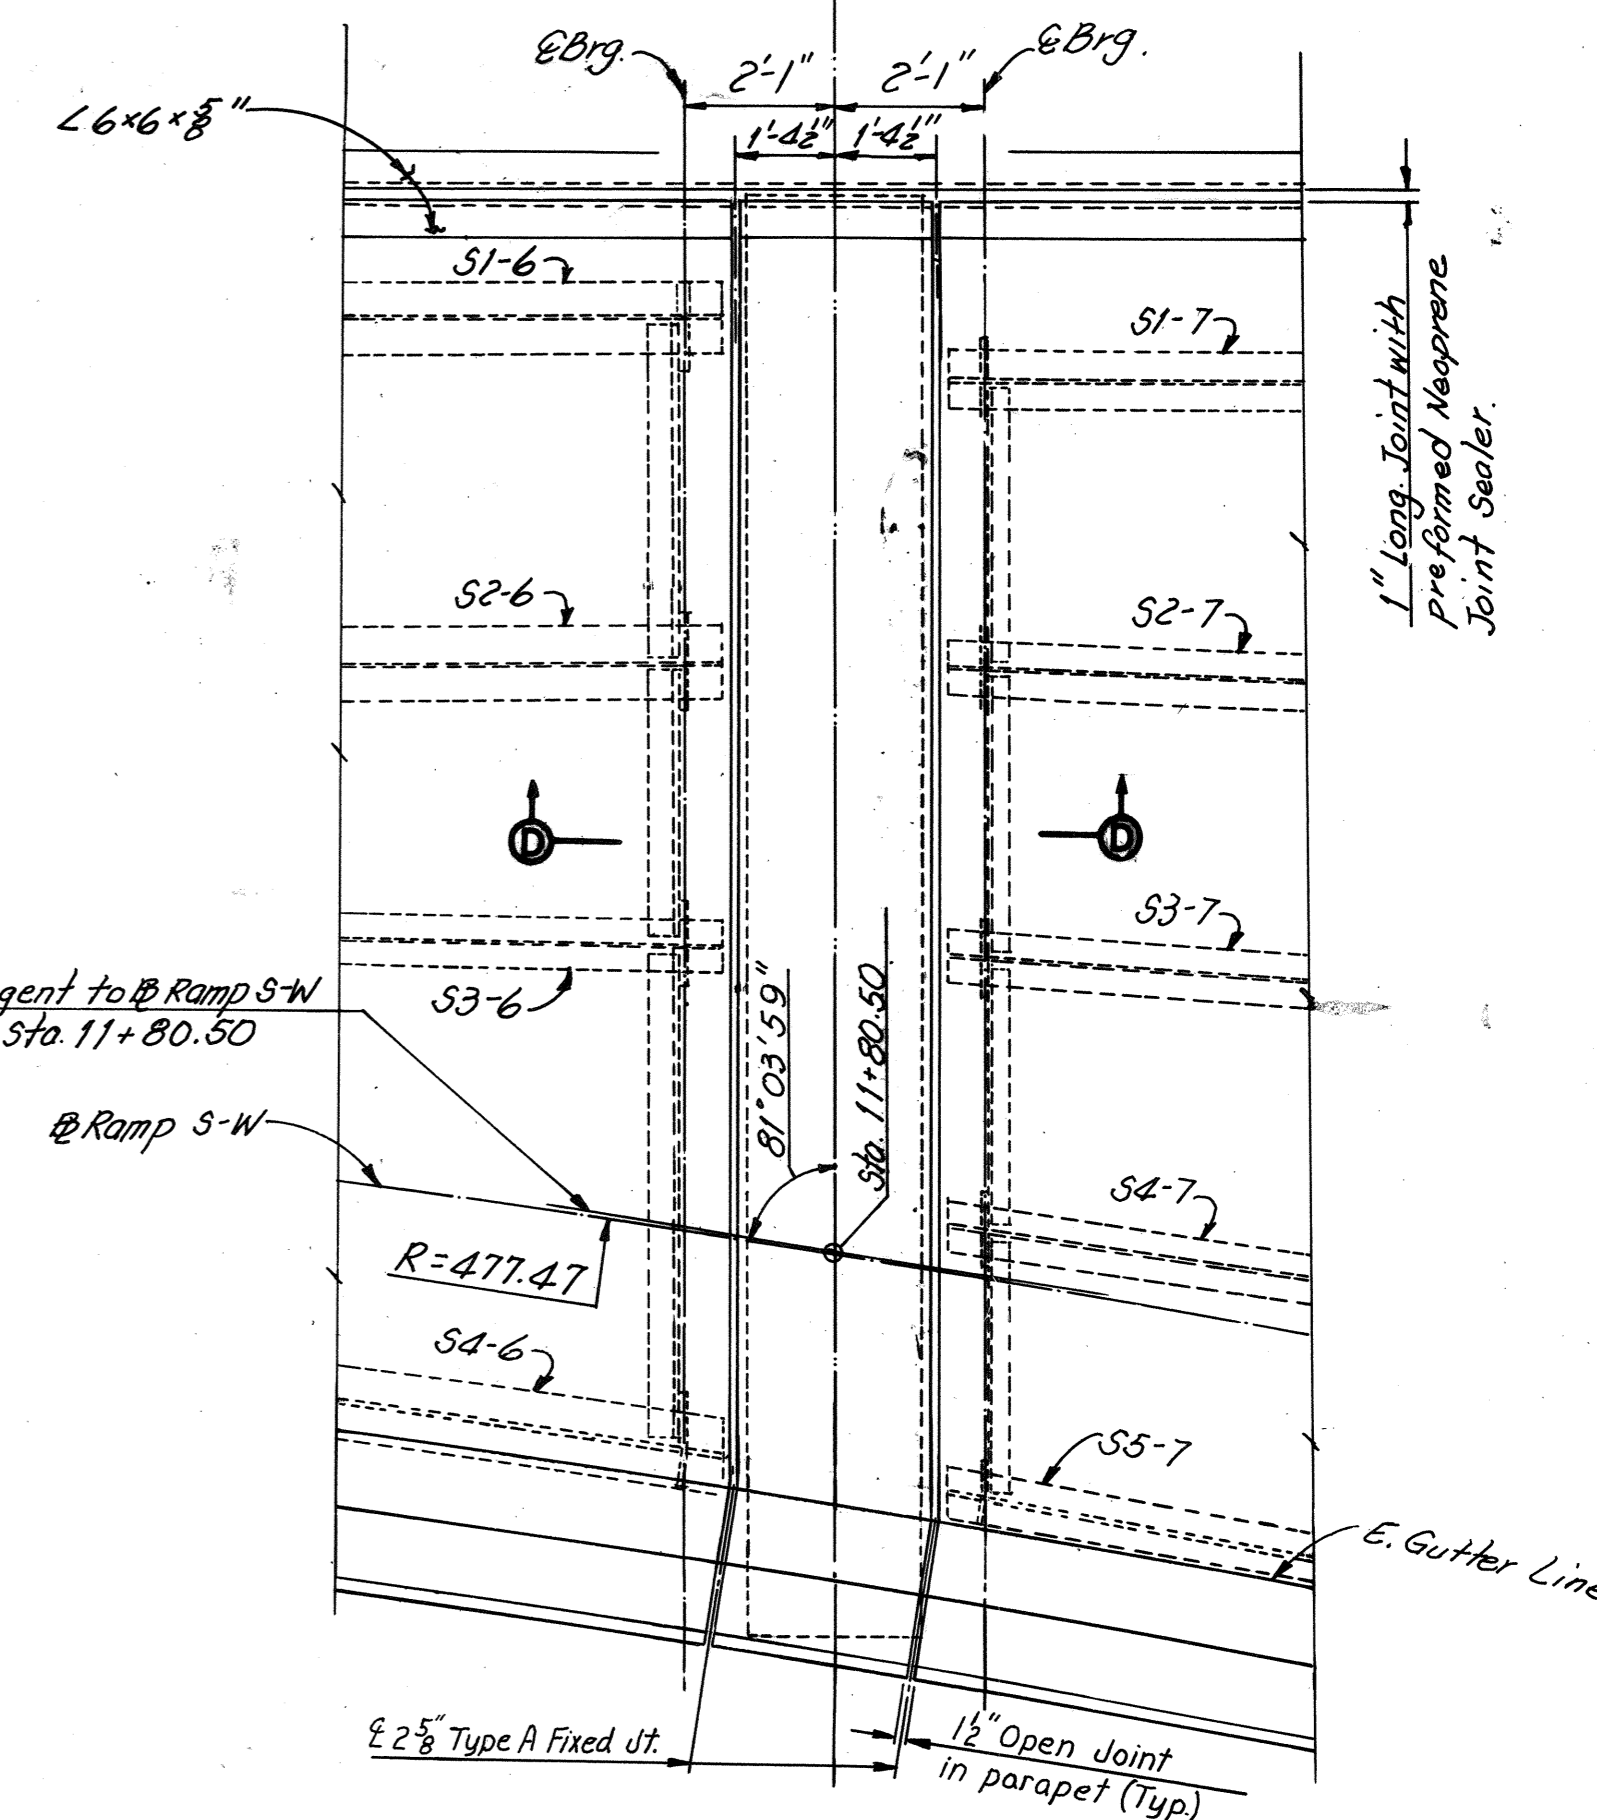


PLAN — JOINT AT PIER 6
Scale: 3/8" = 1'-0"


Note: For Section D-D, see Sheet 7 & 26.

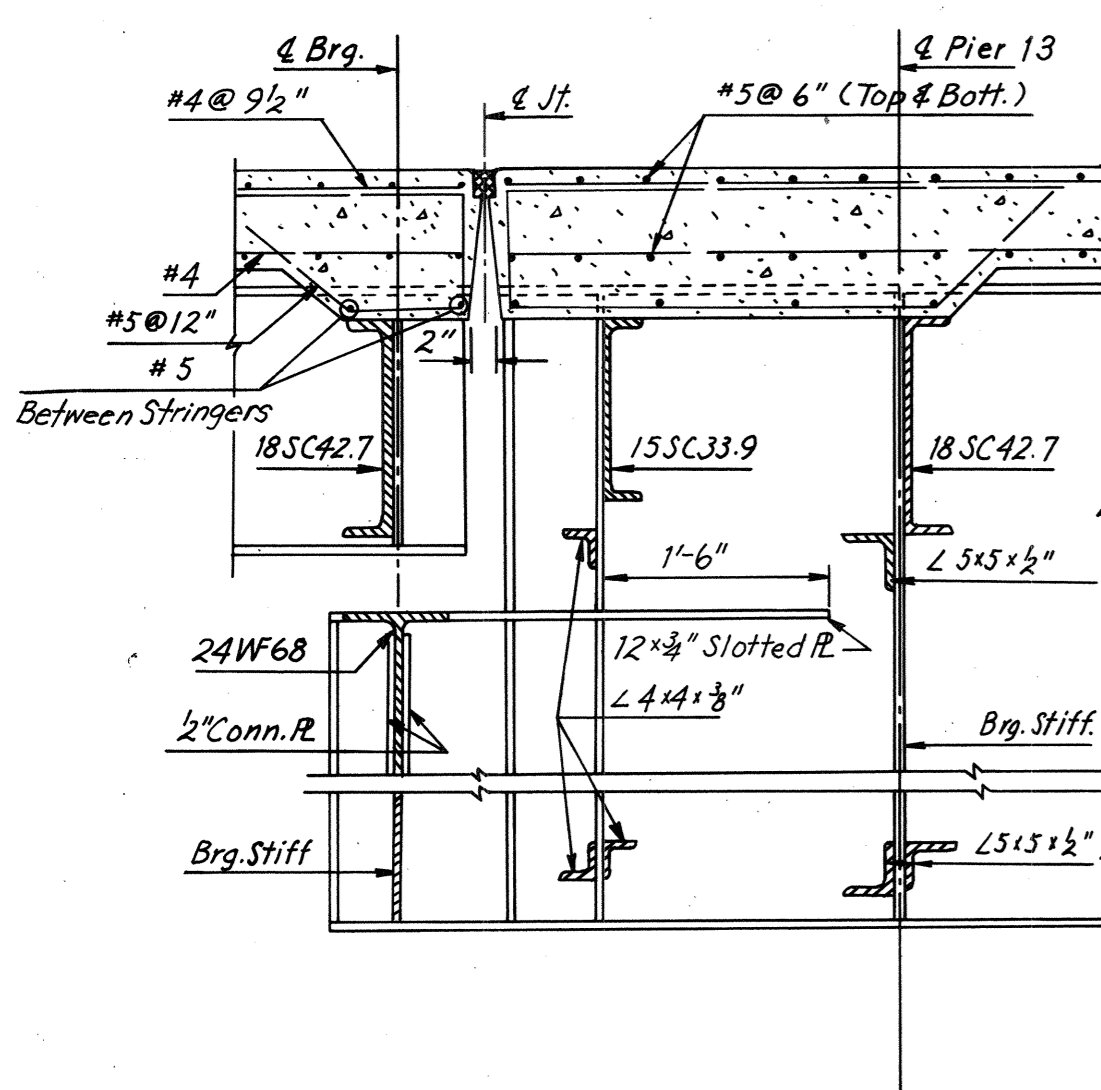


SECTION E-E
Scale: 3/4" = 1'-0"

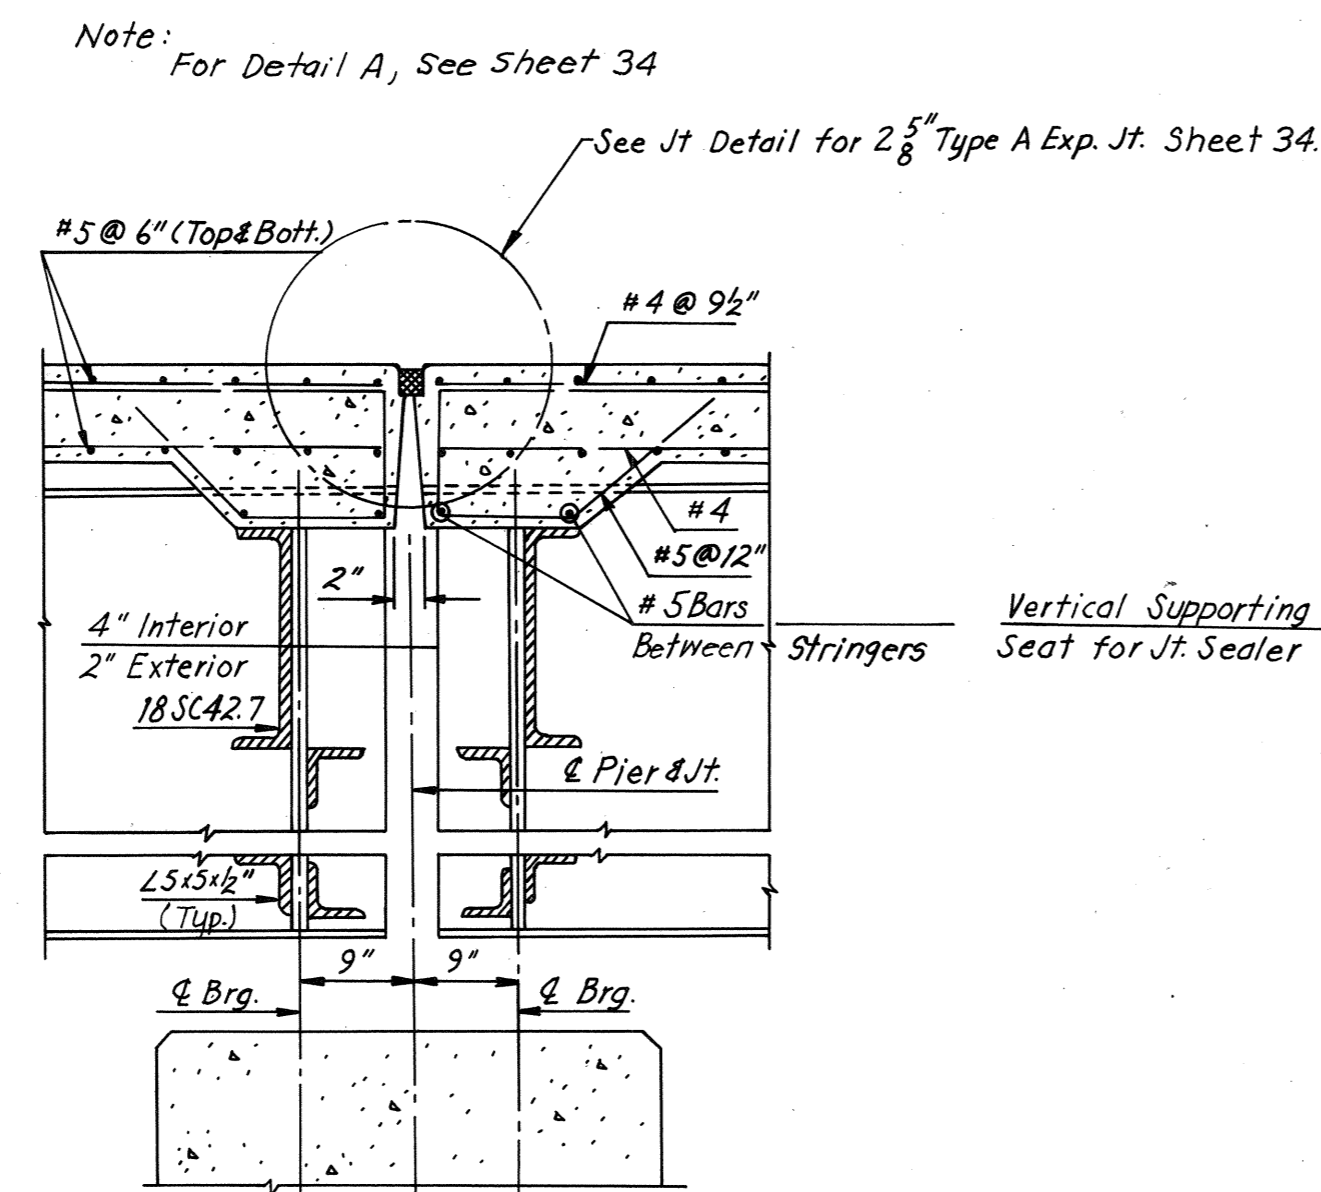


SECTION C-C
Scale: 3/4" = 1'-0"

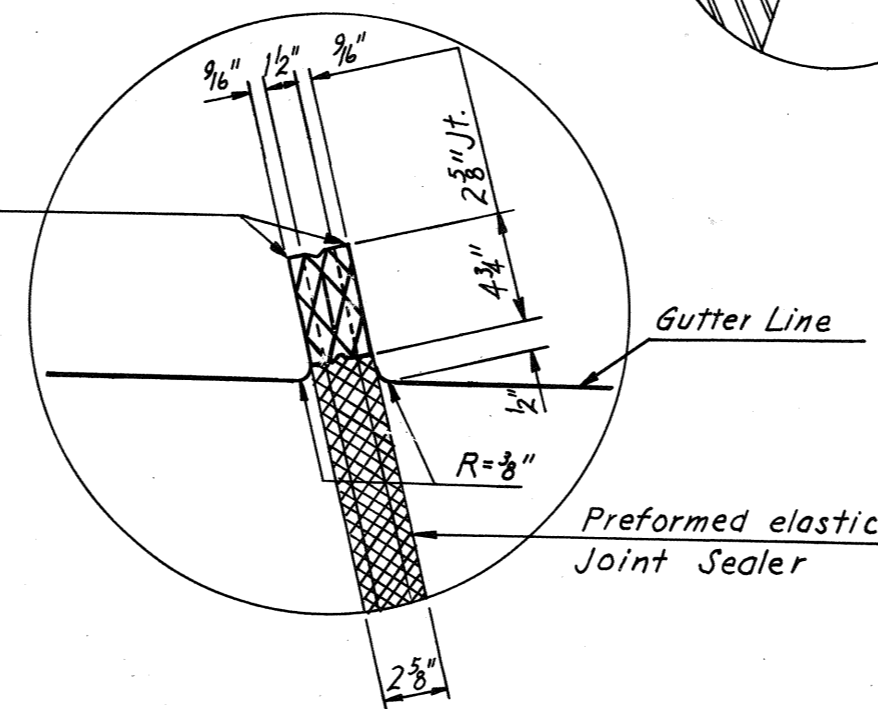

DETAIL C
No Scale

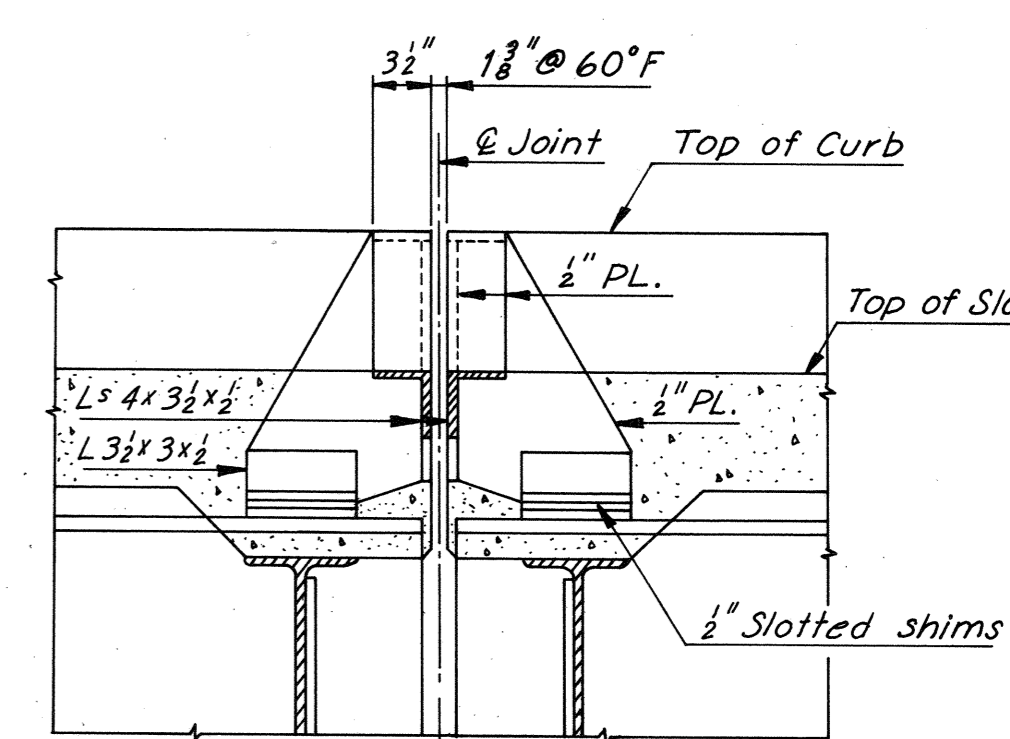

SECTION E-E
Scale: 1" = 1'-0"

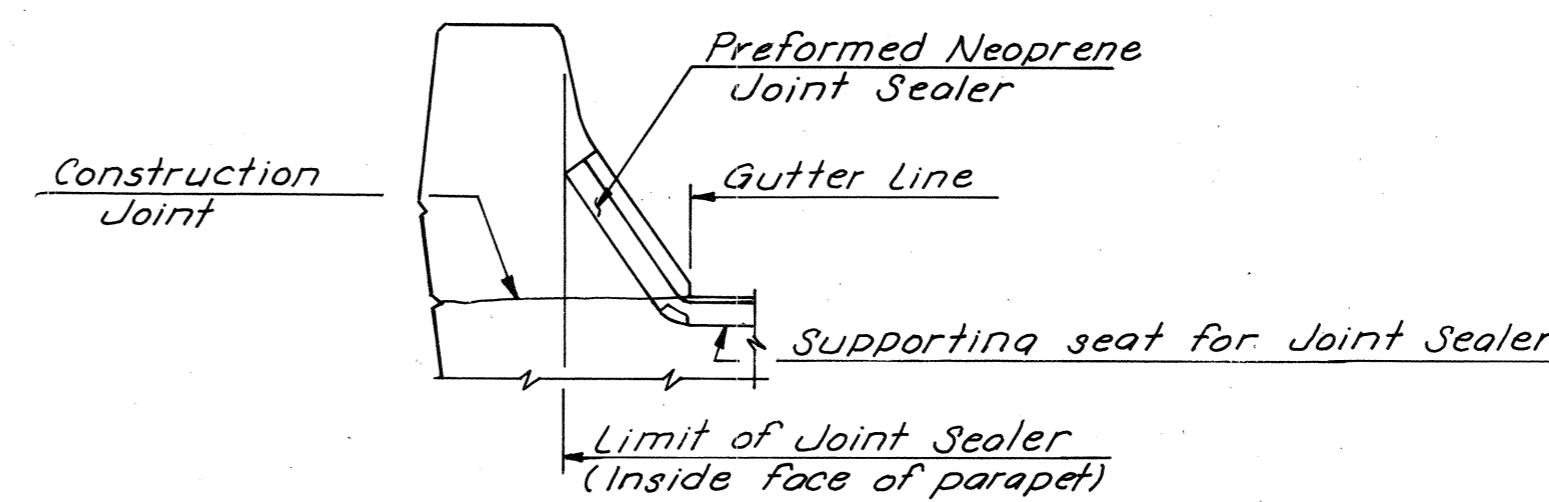

TREATMENT OF TYPE "A" JOINT AT GUTTER
No Scale

Note: All horizontal dimensions shown above are normal to E Joint.

Note: All horizontal dimension of sections shown above are normal to E joint and pier.

Notes: For Details of bearing stiffeners and connection plates, see Framing Plan Sheets. For End Diaphragms, See Cross Sections-Deck Plan Sheets.

BY	DATE			
MADE	Y.C.P.	12-18-68		
CHECKED	G.S.H.	1-28-69	Revised Exp. Jt. at Pier 41	TEM 9-9-75
IN CHARGE				
	NO.	REVISION	BY	DATE

AS BUILT
RICHMOND METROPOLITAN AUTHORITY
RICHMOND EXPRESSWAY SYSTEM
DOWNTOWN EXPRESSWAY
BRIDGE NO. 65
RAMP S-W CONNECTION FROM
RICHMOND-PETERSBURG TURNPIKE
JOINT DETAILS


SCALE: As Noted
HOWARD, NEEDLES, TAMMEN & BERGENDOFF
consulting engineers
NEW YORK ALEXANDRIA KANSAS CITY
CONTRACT NO. 11
SHEET NO. 35 OF 38

Bridge 66



(Eastbound Downtown Expressway “Rte. 195” over Virginia Street and South 14th Street)

Record Set Plans

RICHMOND EXPRESSWAY SYSTEM			
SECTION	PROJECT	SHEET NO.	TOTAL SHEETS
10	DOWNTOWN EXPRESSWAY	127	265

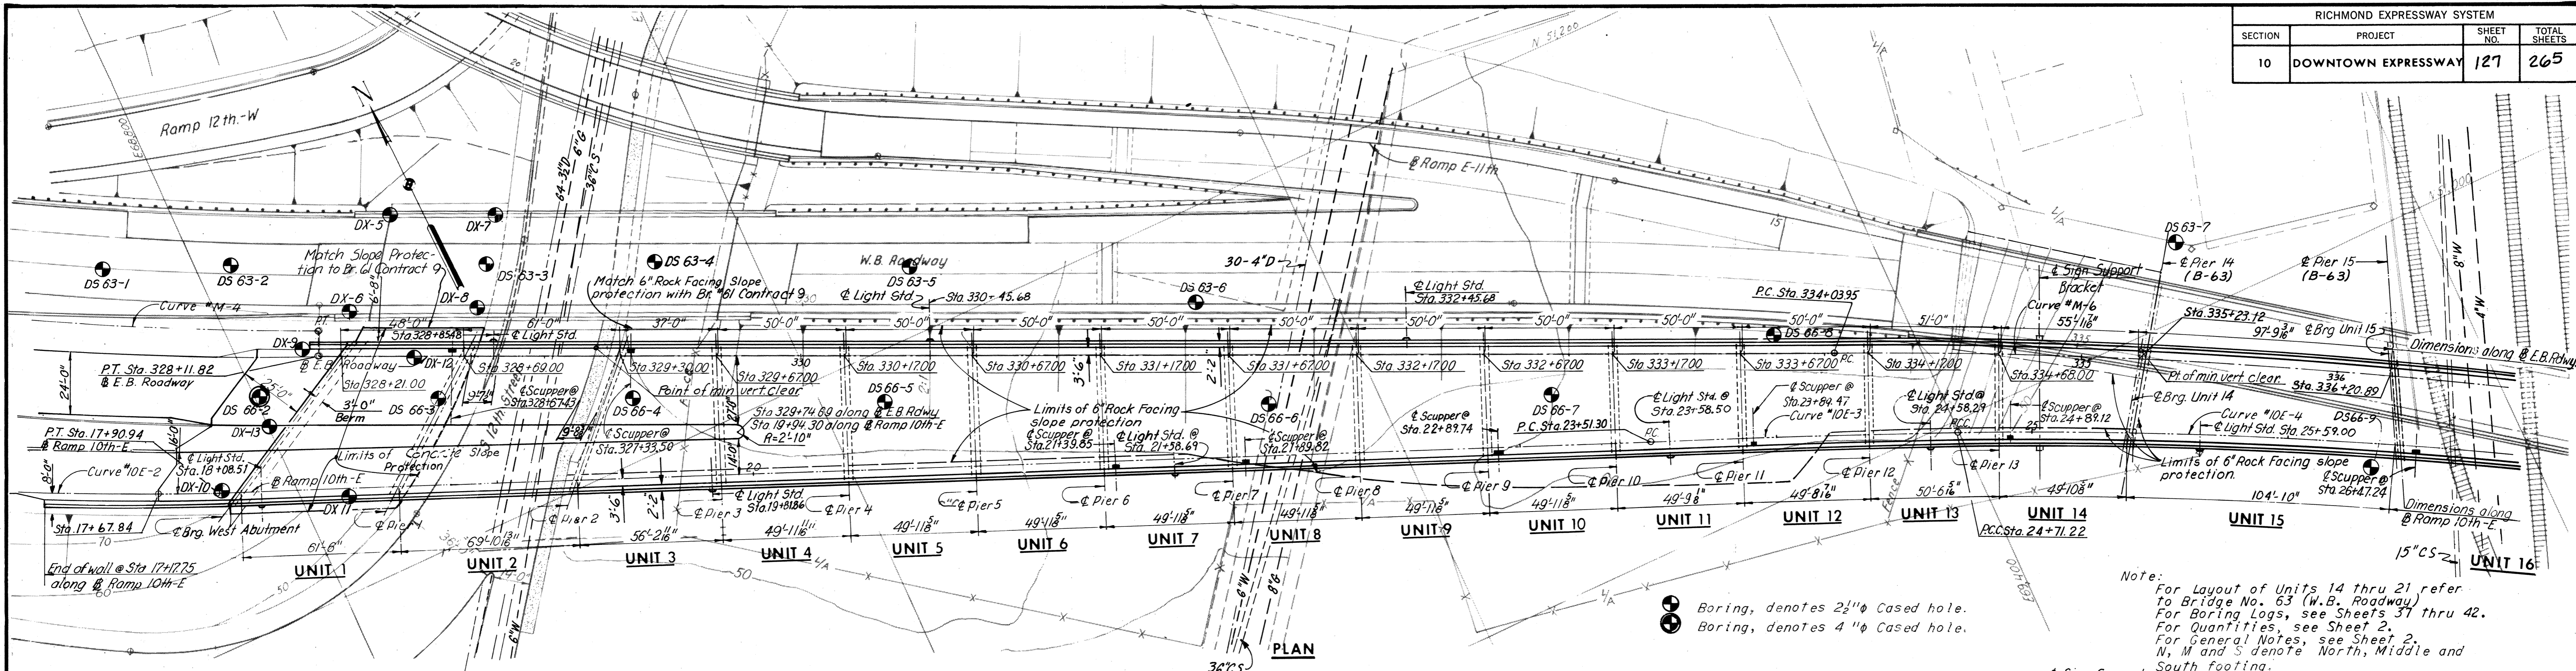


Note:
 For Layout of Units 14 thru 21 refer to Bridge No. 63 (W.B. Roadway)
 For Boring Logs, see Sheets 31 thru 42.
 For Quantities, see Sheet 2.
 For General Notes, see Sheet 2.
 N, M and S denote North, Middle and South footing.

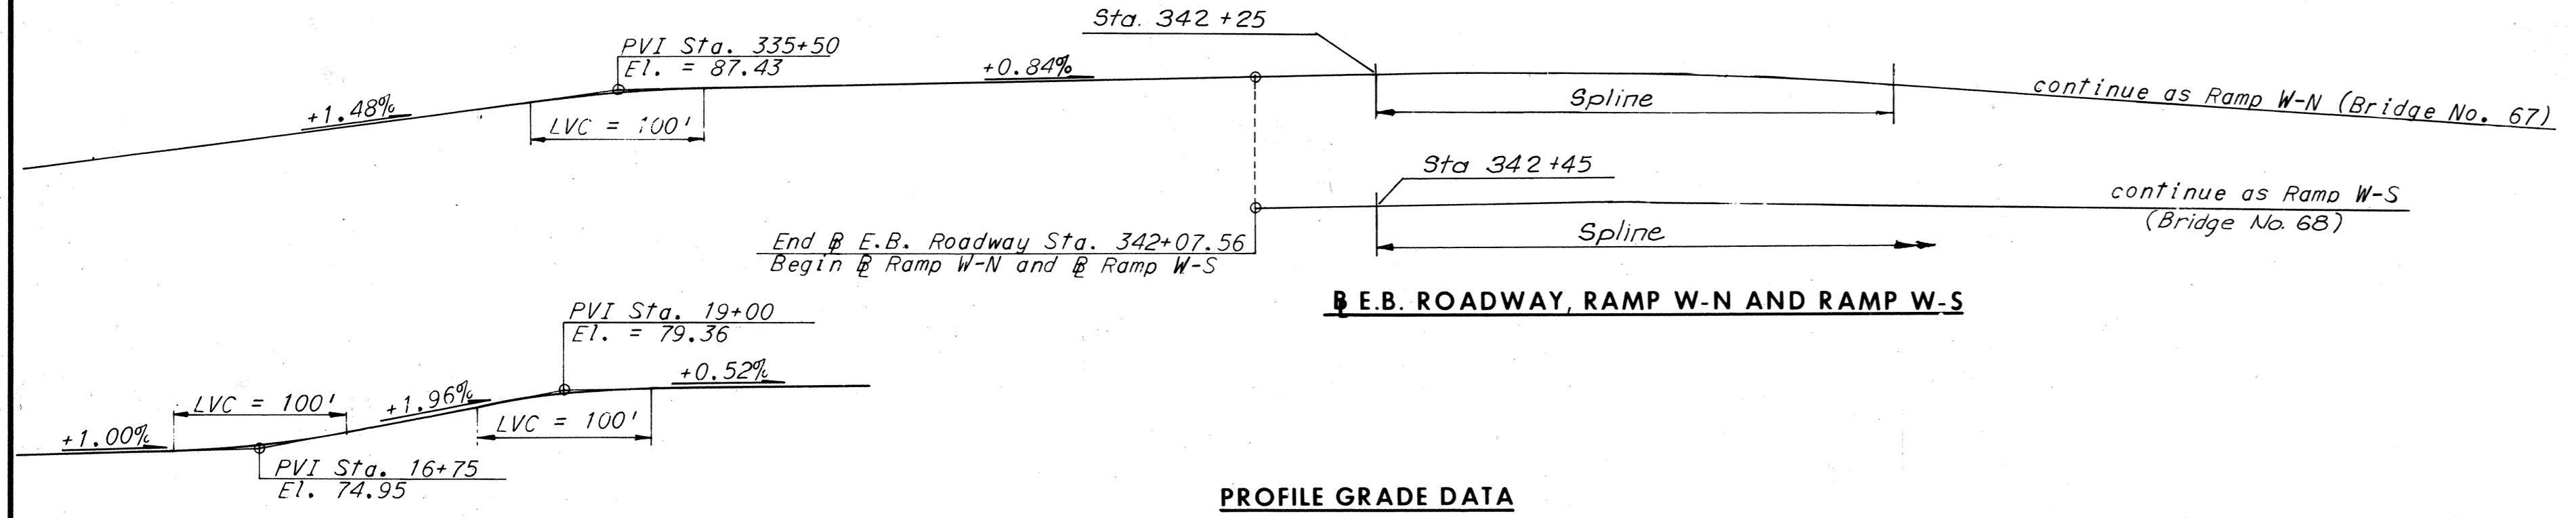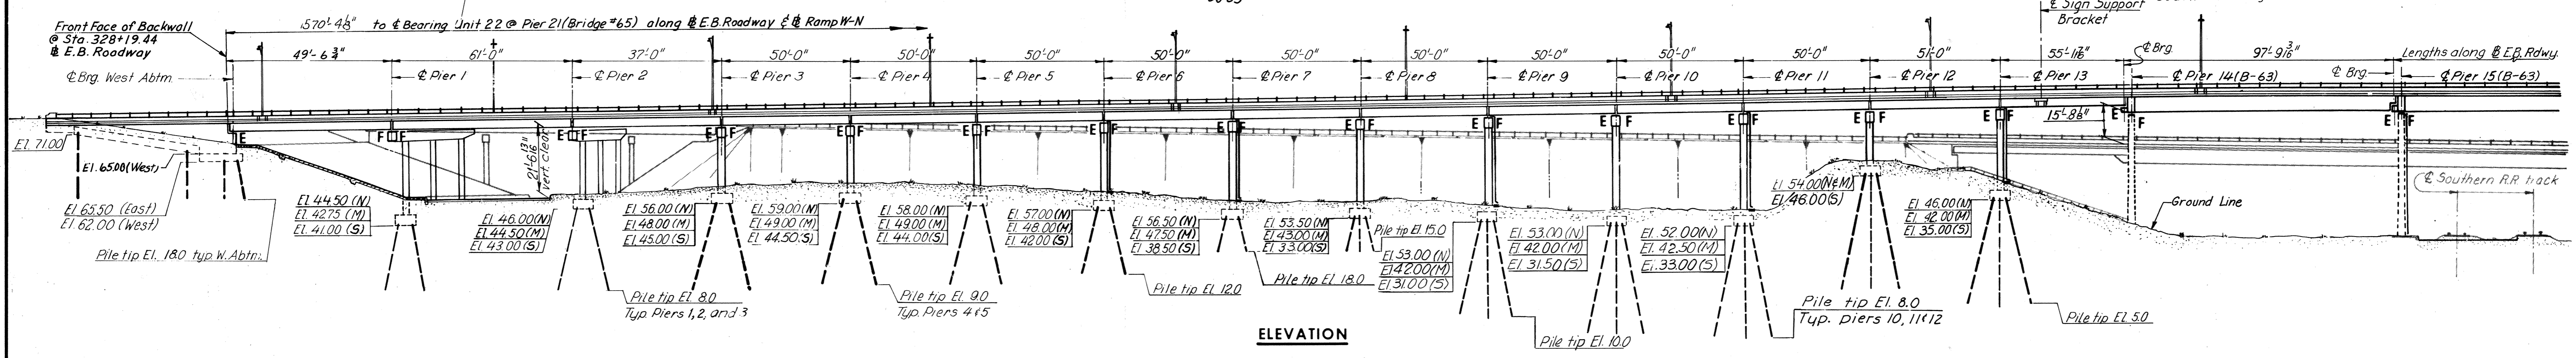

NO.	REVISION	BY	DATE
3	As Built	TEM	8-76
	Sign Support Bracket & Sh. 16A & 20A added	R.B.H.	9-74
	Footing elev. & piles, Piers 8, 9, 10, 11, 12 & 13	R.B.H.	8-74

Horizontal Curve Data	
Downtown Expressway Curve: M-2 P.I. = 326+57.21 Δ = 12°25'03" D = 4°00' T = 155.83' L = 310.44' R = 1,432.40'	E.B. Roadway Curve: M-6 P.I. = 336+40.09 Δ = 11°45'56" D = 2°30' T = 236.14' L = 470.62' R = 2,291.83'
Ramp 10th-E Curve: 10E-2 P.I. = 17+36.87 Δ = 6°29'42" D = 6°00' T = 54.18' L = 108.25' R = 954.93'	Ramp 10th-E Curve: 10E-3 P.I. = 24+11.27 Δ = 1°11'57" D = 1°00' T = 59.97' L = 119.93' R = 5,729.58'
Ramp W-N Curve: W-N-1 P.I. = 345+25.47 Δ = 64°53'49" D = 11°27'33" T = 317.90' L = 566.33' R = 500.00'	Ramp W-N Curve: W-N-2 P.I. = 26+80.64 Δ = 12°30'55" D = 3°00' T = 209.42' L = 417.18' R = 1,909.86'

INDEX	SHEET
GENERAL PLAN AND ELEVATION	1
GENERAL PLAN AND ELEVATION	2
WEST ABUTMENT	3
WEST ABUTMENT DETAILS	4
WEST ABUTMENT RETAINING WALL	5
PIER 1	6
PIER 2	7
PIERS 3 AND 4	8
PIERS 5 AND 6	9
PIERS 7 AND 8	10
PIERS 9 AND 10	11
PIERS 11 AND 12	12
PIER 13	13
FRAMING PLAN UNITS 1, 2, 3 AND 4	14
FRAMING PLAN UNITS 5, 6, 7, 8 AND 9	15
FRAMING PLAN UNITS 10, 11, 12, 13 AND 14	16
FRAMING PLAN UNITS 15 AND 16	17
FRAMING PLAN UNITS 17 AND 18	18
FRAMING PLAN UNITS 19 AND 20	19
FRAMING PLAN UNITS 21 AND 22	20
FRAMING PLAN UNIT 23	21
FRAMING DETAILS PIERS 14, 15 AND 16	22
FRAMING DETAILS PIERS 17, 18, 19 AND 20	23
FRAMING DETAILS PIER 21	24
FRAMING DETAILS PIER 22 (BR 63)	25
FRAMING DETAILS UNITS 21 AND 22	26
FRAMING DETAILS UNITS 18, 21 AND 22	27
DECK PLAN UNITS 1, 2, 3 AND 4	28
DECK PLAN UNITS 5, 6, 7, 8 AND 9	29
DECK PLAN UNITS 10, 11, 12, 13 AND 14	30
DECK PLAN UNITS 15 AND 16	31
DECK PLAN UNITS 17 AND 18	32
DECK PLAN UNITS 19 AND 20	33
DECK PLAN UNITS 21 AND 22	34
DECK PLAN UNIT 23	35
JOINT DETAILS	36
SUPERSTRUCTURE DETAILS	37 AND 38
APPROACH SLABS AND ROCK FACING SLOPE PROTECTION	39
CONCRETE SLAB SLOPE PROTECTION DETAILS	40
BORING LOGS	41 THRU 46
STANDARD DETAILS	51 THRU 57

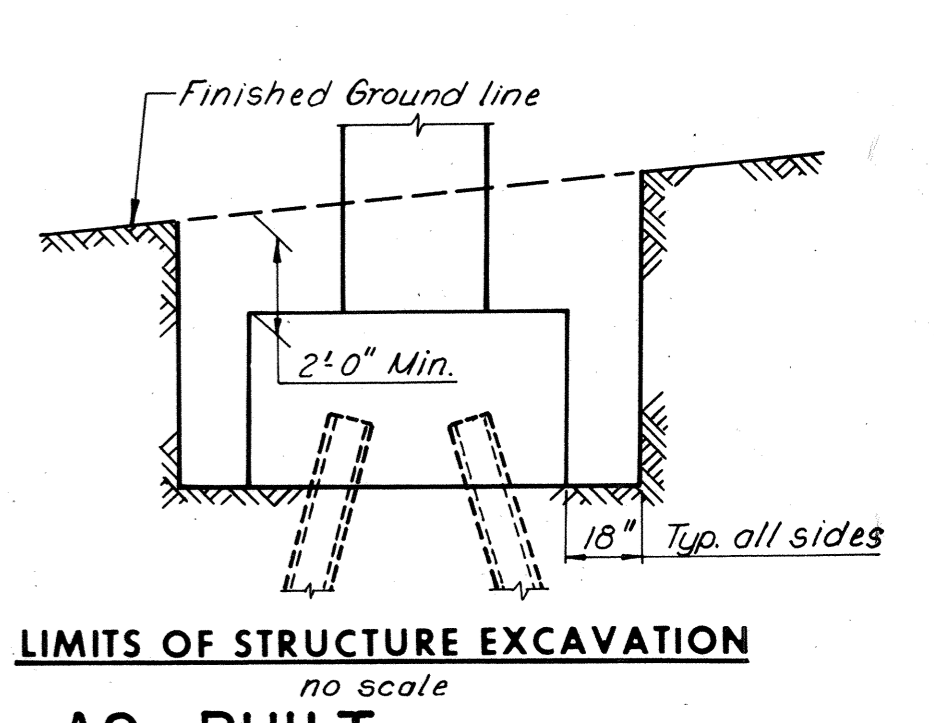


RICHMOND METROPOLITAN AUTHORITY
RICHMOND EXPRESSWAY SYSTEM
DOWNTOWN EXPRESSWAY

BRIDGE NO. 66
EASTBOUND ROADWAY OVER
12TH ST. - R.R. TRACKS AND 16TH ST.
GENERAL PLAN AND ELEVATION

HOWARD, NEEDLES, TAMMEN & BERGENDOFF
 consulting engineers
 NEW YORK ALEXANDRIA KANSAS CITY

SCALE: 1"=30'
 CONTRACT NO. 10
 SHEET NO. 1 OF 46

RICHMOND EXPRESSWAY SYSTEM			
SECTION	PROJECT	SHEET NO.	TOTAL SHEETS
10	DOWNTOWN EXPRESSWAY	128	265

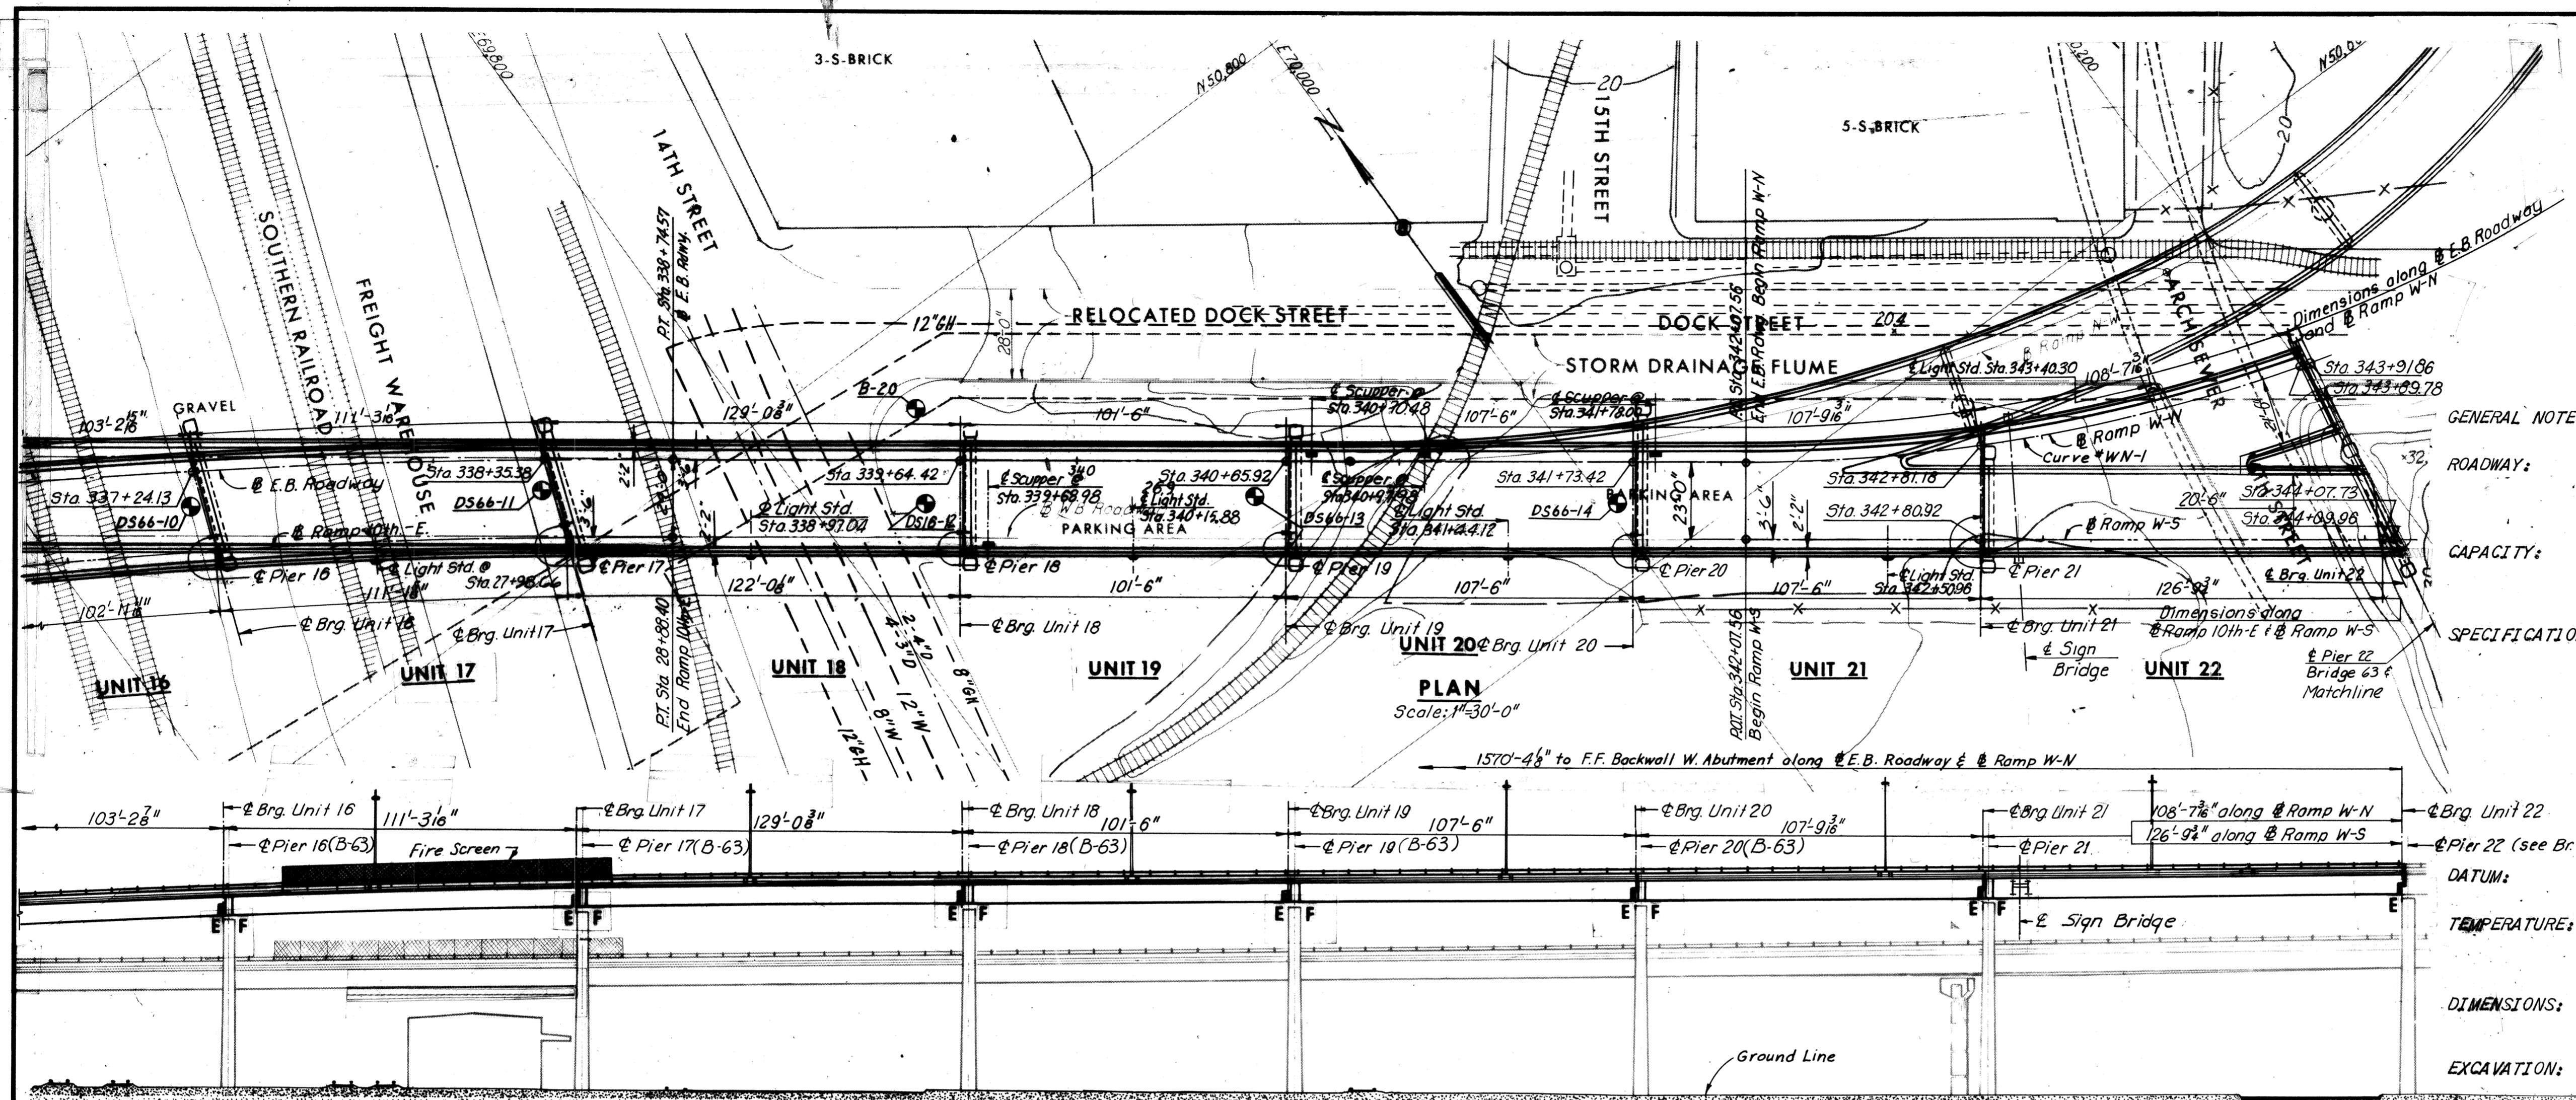

GENERAL NOTES:

ROADWAY: One variable width roadway transitioning from E.B. Roadway Downtown Expressway and Ramp 10th-E into Ramps W-N and W-S (Bridges No. 67 and 68)

CAPACITY: Dead load includes 15 Lbs. per sq. ft. for future wearing surface. Live load, HS 20-44 loading and alternate military loading.

SPECIFICATIONS:

GENERAL: Virginia Department of Highway Road and Bridge Specifications 1970

DESIGN: A.A.S.H.O. Standard Specifications for Highway Bridges 1973 modified by Special Design provisions.

WELDING: 1972 Structural Welding Code of the American Welding Society.

CONTRACT SPECIAL PROVISIONS: Specifications and Contract Special Provisions referred to above are necessary to make these plans complete

DATUM: City of Richmond

TEMPERATURE: The normal temperature referred to in the plans is 60°F. The temperature range for movement is 0°F to 120°F.

DIMENSIONS: All dimensions are measured horizontally and vertically unless otherwise noted.

EXCAVATION: Excavation below subgrade and cut slope template shall be classified as Structure Excavation. All excavation above these limits shall be classified as Regular Excavation and is not included in the Structural Quantities.

FOUNDATIONS: Footings shall rest on firm material. Foundation material shall be dry and special attention is called to Section 401.05 of General Specifications and to the Contract Special Provisions, concerning preparation of foundations for footings.


Notes:
 For Vertical and Horizontal Curve Data see Sheet 1.
 For Layout of Units 14 thru 22 refer to Bridge No. 63 (Westbound Roadway).

ESTIMATED QUANTITIES

	Structure Excavation Cu. Yds.	Concrete (#) Cu. Yds.	Reinforcing Steel Lbs.	Str. Steel Mild Carbon Lbs.	Str. Steel High Strength Lbs.	Aluminum Railing (1-Rail) Lin. Ft.	Porous Backfill Cu. Yds.	Underdrain 5" Dia. Pipe Lin. Ft.	Steel Piles 10BP42 Lin. Ft.
Superstructure	--	2,237.6	530,060	1,564,700	567,800	3,241	--	--	---
Substructure	1,835	1,256.6	155,030	---	---	84	34	150	9,410
Total	1,835	3,494.2 #	685,890	1,564,700	567,800	3,325	34	150	9,410


	Asphalt Damp-proofing Sq. Yds.	Approach Slab Concrete (#) Cu. Yds.	Fire Screen Lin. Ft.	Approach Slab Reinforcing Steel (Lbs.)	Metal Conduit Lin. Ft.	Concrete Slope Protection Sq. Yds.	Bridge Drainage Metal Work Lbs.	Rock Facing Slope Prot. Sq. Yds.	Energy Attenuator Each
Superstructure	--	--	210	---	2,214	--	11,870	--	1
Substructure	105	91.5	---	23,870	92	559	--	3,320	---
Total	105	91.5 #	210	23,870	2,306	559	11,870	3,320	1

All Concrete for Superstructure shall be Class A4 and for Substructure Class A3.

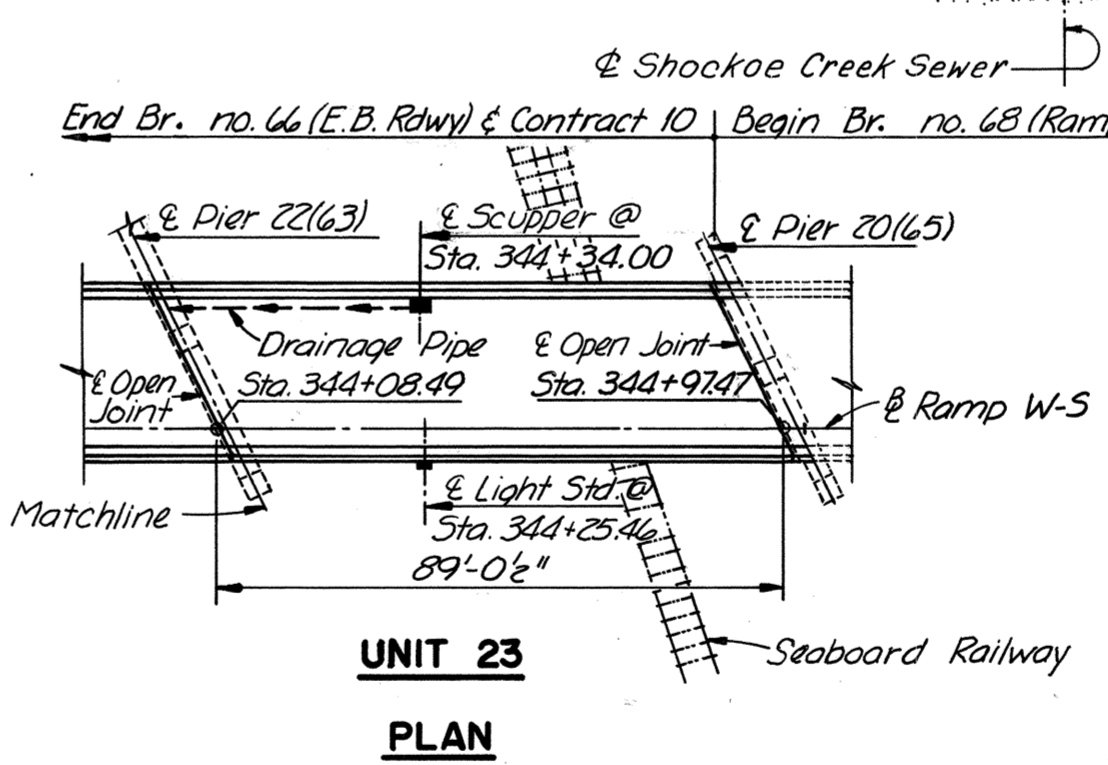

CONCRETE NOTES: Concrete in superstructure shall be Class A-4. All other concrete shall be Class A-3. All exposed edges and corners shall have a 3/4" chamfer or fillet unless otherwise noted. Care in the method of vibration, the use of low-slump concrete, and or other means shall be employed to prevent downgrade movement of newly placed slab concrete. Finishing Concrete Surfaces: See Standard Architectural Detail Sheets and the Contract Special Provisions for types and details. All reinforcing steel shall be deformed bars conforming to ASTM A615 Grade 40. All reinforcing bar dimensions on the detailed drawings are to centers of bars unless otherwise noted. Clear distance between reinforcing steel and face of concrete shall be as noted on the plans. All bar laps shall be 30 diameters of the smaller diameter bar unless otherwise noted.

STEEL NOTES: Structural steel shall conform to A.S.T.M. Designations A36, A572 - Grade 50 and A588 as noted. See Special Provisions. All field connections shall be made with high strength bolts. High strength bolts shall be 7/8" diameter unless otherwise noted and shall conform to A.S.T.M. Specification A-325.

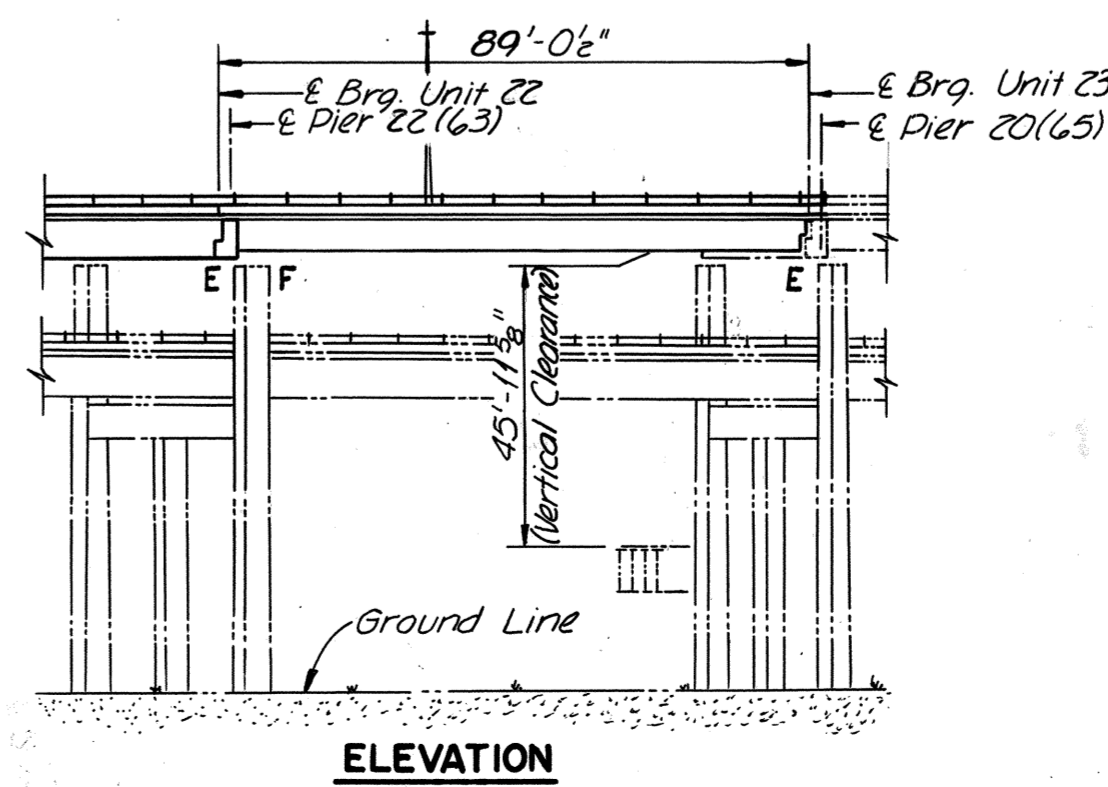

RICHMOND METROPOLITAN AUTHORITY
RICHMOND EXPRESSWAY SYSTEM
DOWNTOWN EXPRESSWAY

BRIDGE NO. 66
EASTBOUND ROADWAY OVER
12TH ST. - R.R. TRACKS AND 16TH ST.
GENERAL PLAN AND ELEVATION


HOWARD, NEEDLES, TAMMEN & BERGENDOFF
 consulting engineers
 NEW YORK ALEXANDRIA KANSAS CITY

SCALE: *As Noted*
 CONTRACT NO. 10
 SHEET NO. 2 of 46

BY	DATE	REVISION	BY	DATE
MADE	J.V. 1-9-69	Span Fixities & R.R. name added	PRMS	4-19-74
CHECKED	G.C.C. 5-26-69	Sign Bridge added	R.B.H.	9-74
IN CHARGE		3 As Built	TEM	8-76




AS BUILT

RICHMOND EXPRESSWAY SYSTEM			
SECTION	PROJECT	SHEET NO.	TOTAL SHEETS
10	DOWNTOWN EXPRESSWAY	154	265

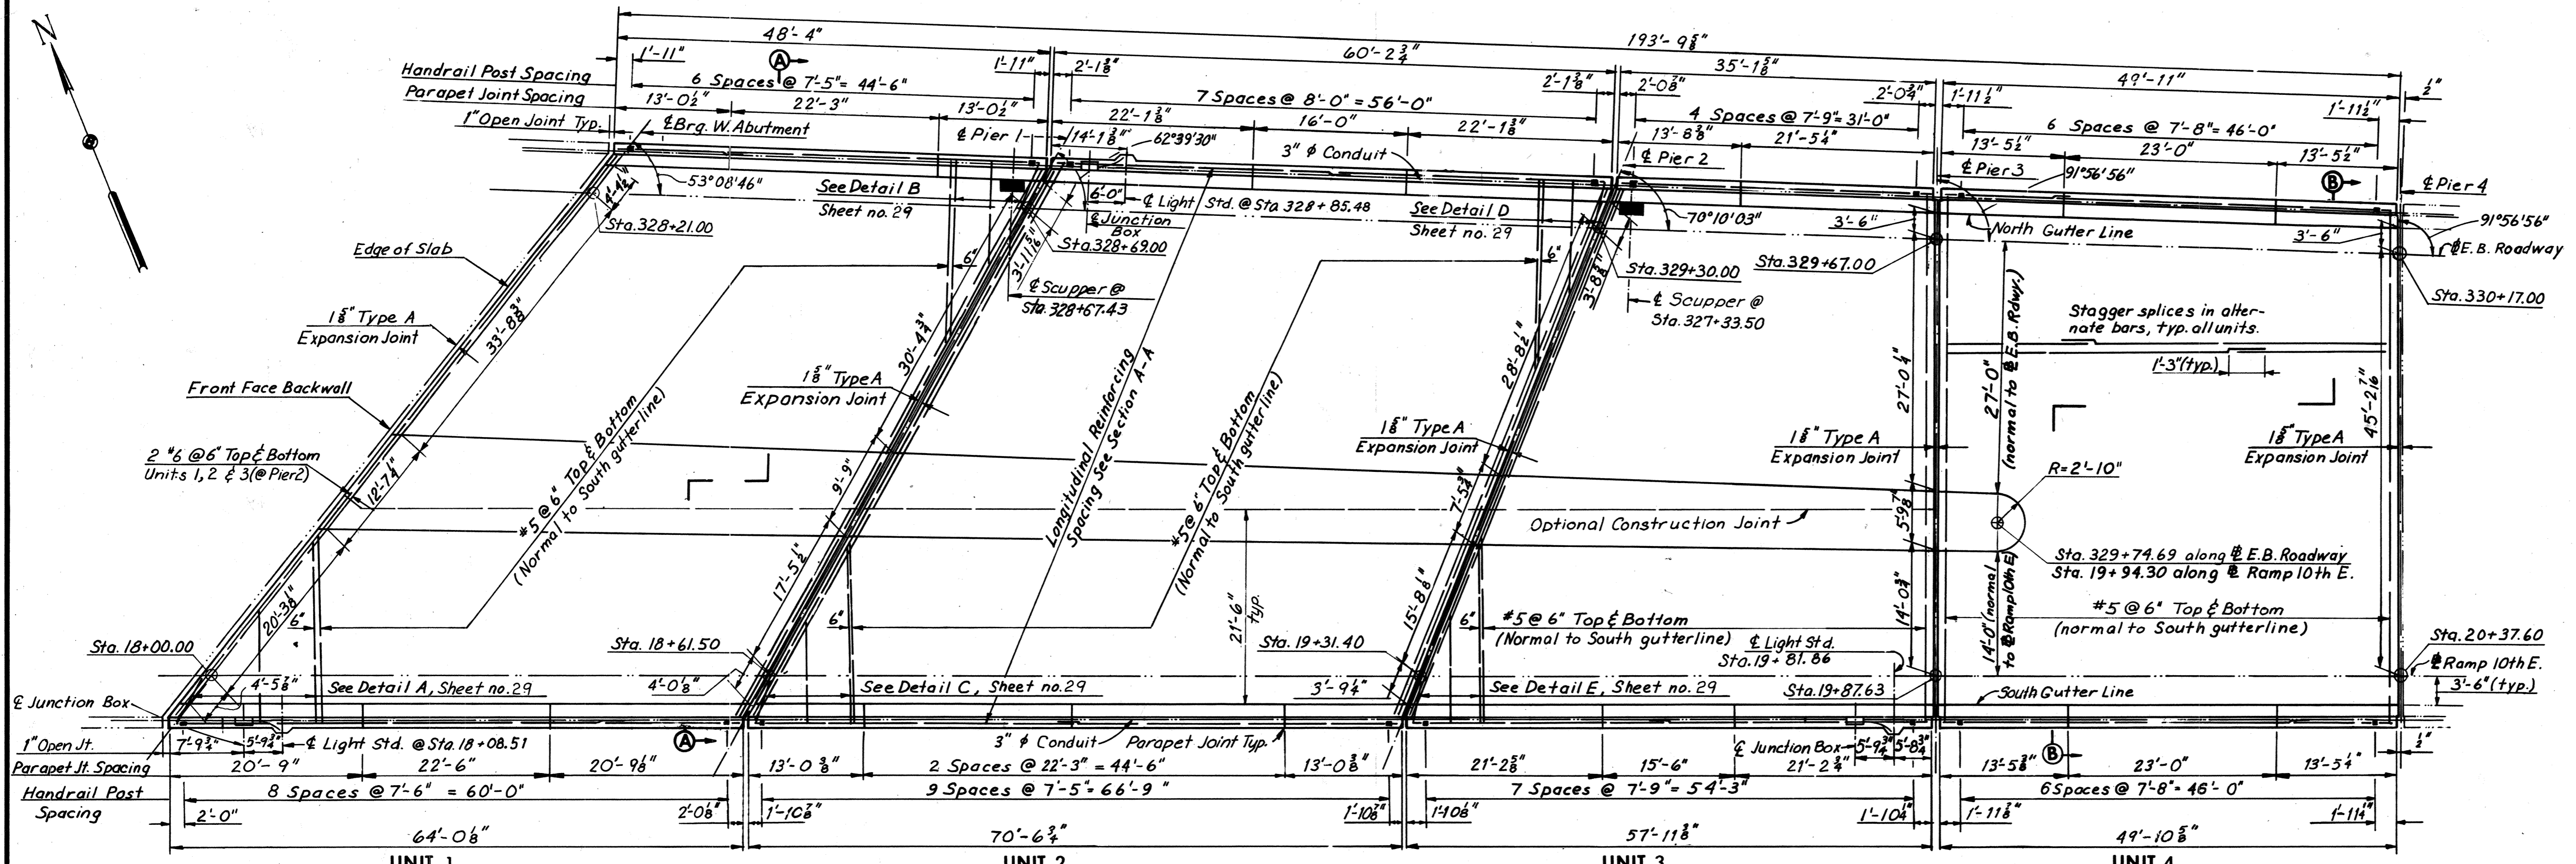

ELEVATION TABLE					
STATION	ELEV. A	ELEV. B	ELEV. C	ELEV. E	ELEV.
328+00.00	76.13	76.33	77.81		
+00.00			77.81		
+10.00	76.29	76.48	77.91		
+20.00	76.44	76.63	78.00		
+21.00		76.64			
+23.62	76.50				
+30.00	76.61	76.77	78.10		
+40.00	76.76	76.92	78.19		
+50.00	76.91	77.07	78.28		
+55.04			78.33		
+60.00	77.07	77.22	78.38		
+69.00		77.35			
+70.00	77.22	77.37	78.47		
+70.81	77.25				
+80.00	77.38	77.51	78.57		
+90.00	77.53	77.66	78.66		
329+00.00	77.68	77.81	78.75		
+10.00	77.84	77.96	78.85		
+20.00	77.99	78.11	78.94		
+20.26			78.95		
+30.00	78.16	78.25	79.04		
+31.26	78.17				
+40.00	78.31	78.40	79.13		
+50.00	78.46	78.55	79.22		
+60.00	78.62	78.70	79.32		
+66.88	78.73				
+67.00		78.80			
+67.92			79.39		
+70.00	78.77	78.85	79.41		
+80.00	78.93	78.99	79.88	79.94	
+90.00	79.08	79.14	79.93	79.99	
330+00.00	79.23	79.29	79.98	80.03	80.08
+10.00	79.39	79.44	80.03	80.08	
+16.88	79.51				
+17.00		79.54			
+18.54			80.08		
+18.64				80.12	
+20.00	79.54	79.59	80.08	80.13	

Note: For Elevations along Ramp 10th East, see Sheet 33.

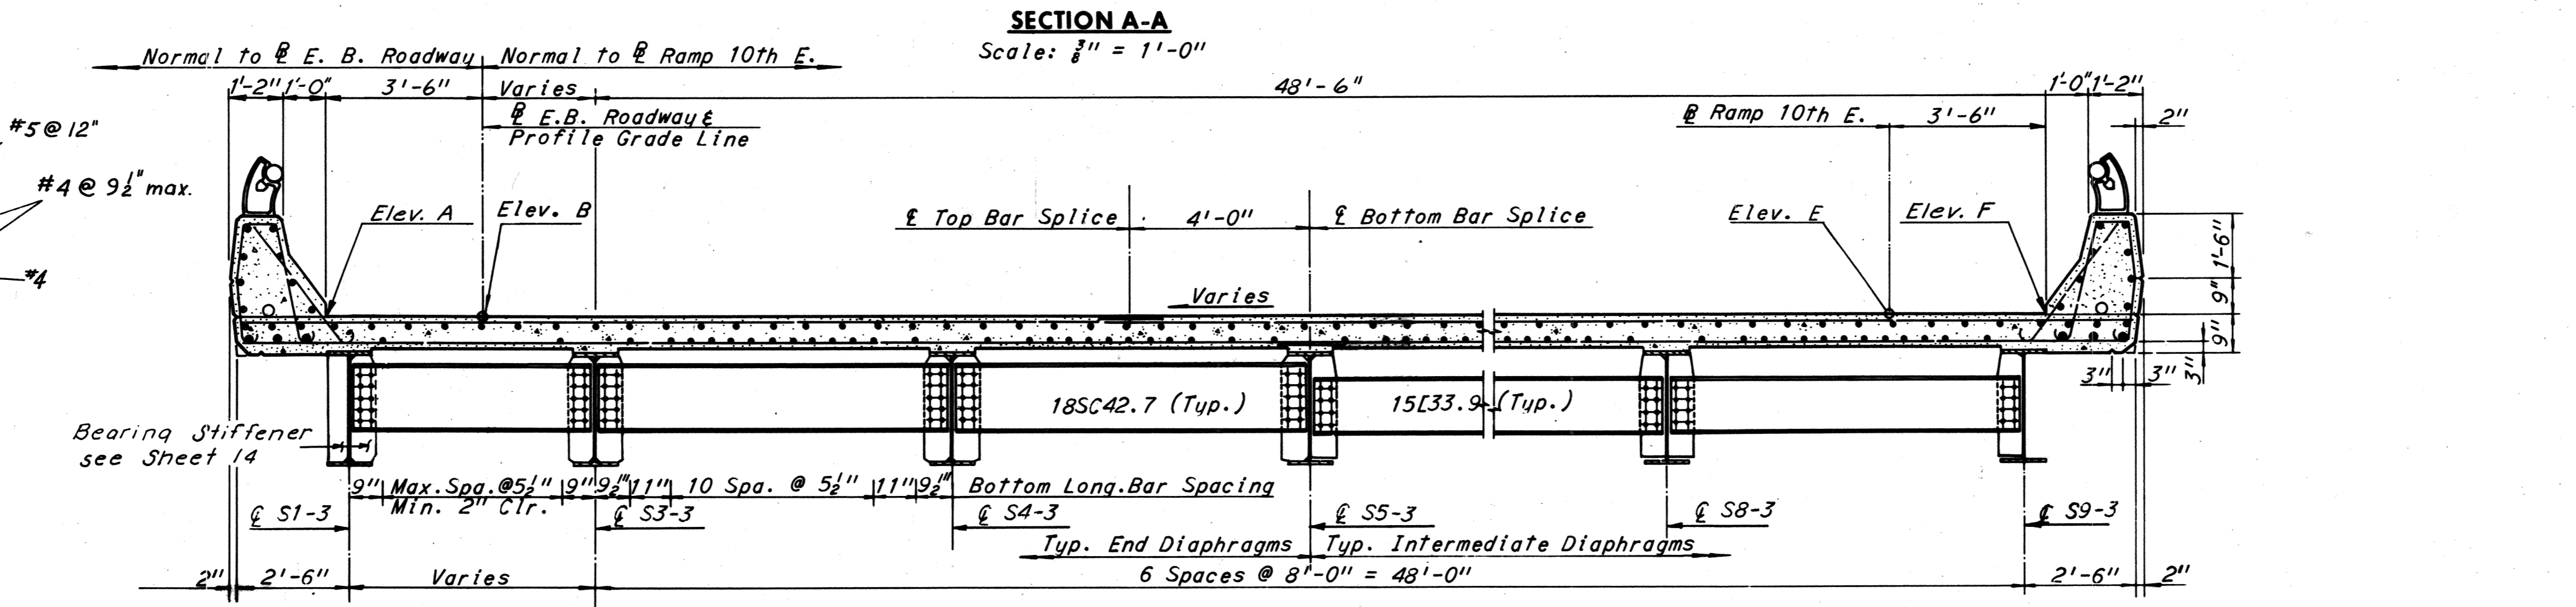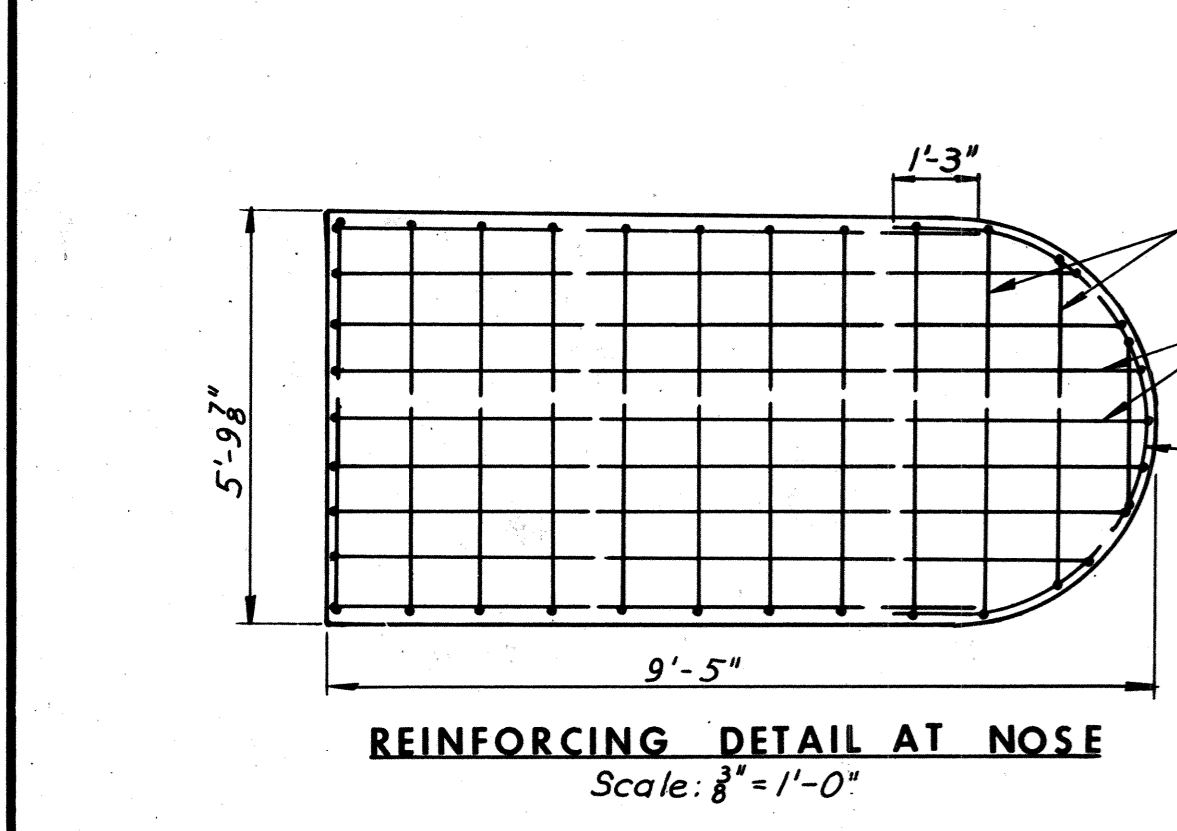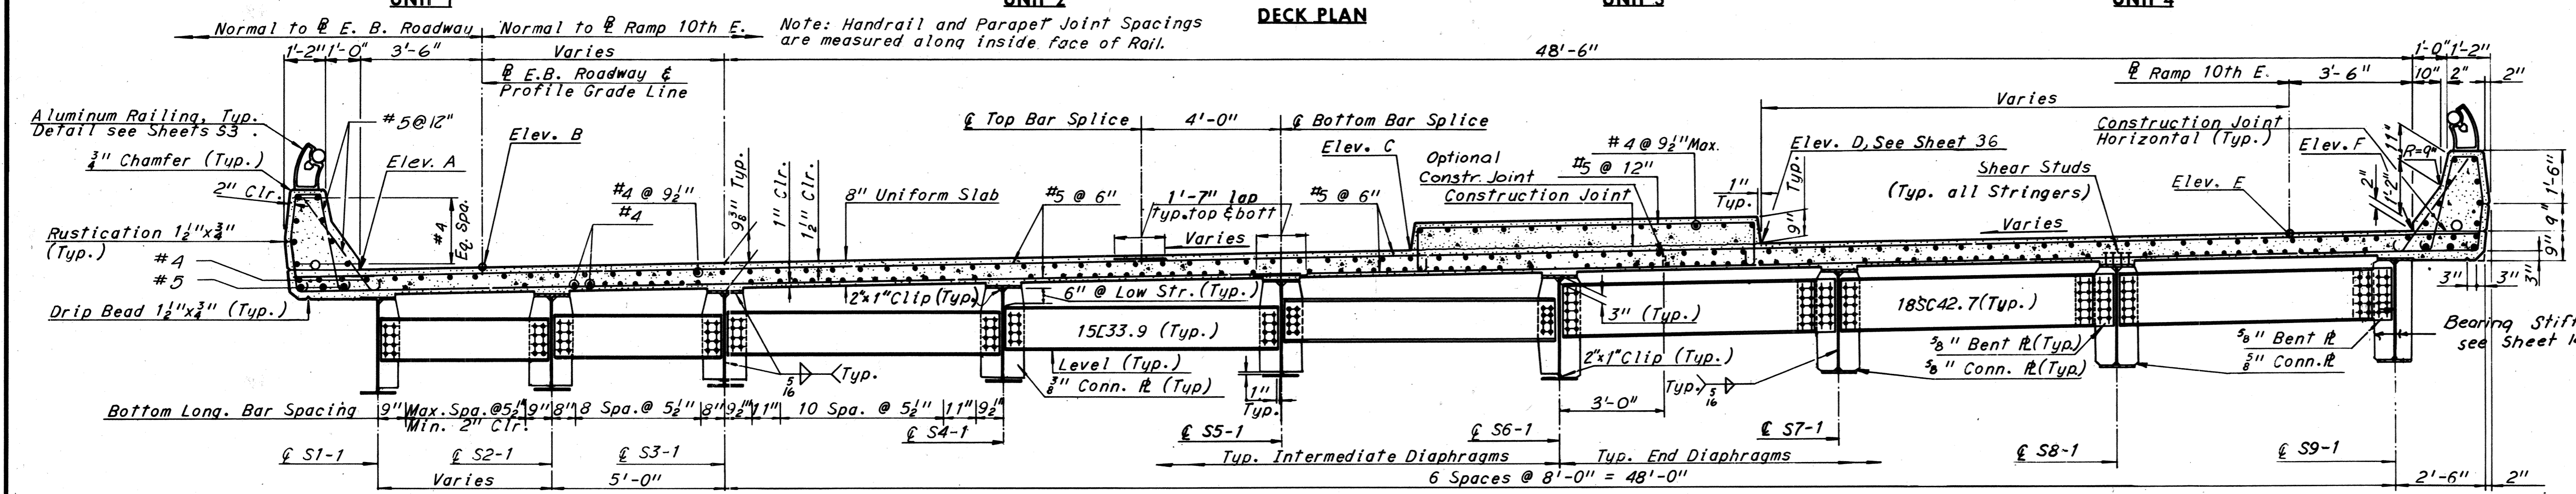

Notes:
 For Joint Details, see Sheet 37.
 For Framing Plan, see Sheet 14.
 For Handrail Details, see Sheet 53.
 For Superstructure quantities, see Sheet 2.
 For Details A, B, C, D and E, see Sheet 29.
 For Standard Drainage Details, see Support Type 1, Sheet S5 & S6.

BY	DATE	Bar Space Added	PRMS	4-19-74
MADE	J.D.	8-6-68	Z As Built	T.E.M. 8-76
CHECKED	J.V.	10-23-68		
IN CHARGE				

Note: Transverse dimensions given in Sections A-A and B-B are normal to Ramp 10th-E.

AS BUILT


RICHMOND METROPOLITAN AUTHORITY
RICHMOND EXPRESSWAY SYSTEM
DOWNTOWN EXPRESSWAY

BRIDGE NO. 66
EASTBOUND ROADWAY OVER
12TH ST. - R.R. TRACKS AND 16TH ST.
DECK PLAN - UNITS 1,2,3 AND 4


HOWARD, NEEDLES, TAMMEN & BERGENDOFF
 consulting engineers
 NEW YORK ALEXANDRIA KANSAS CITY

SCALE: 1"=10' Unless shown
 CONTRACT NO.: 10
 SHEET NO. 28 OF 46

RICHMOND EXPRESSWAY SYSTEM			
SECTION	PROJECT	SHEET NO.	TOTAL SHEETS
10	DOWNTOWN EXPRESSWAY	155	265

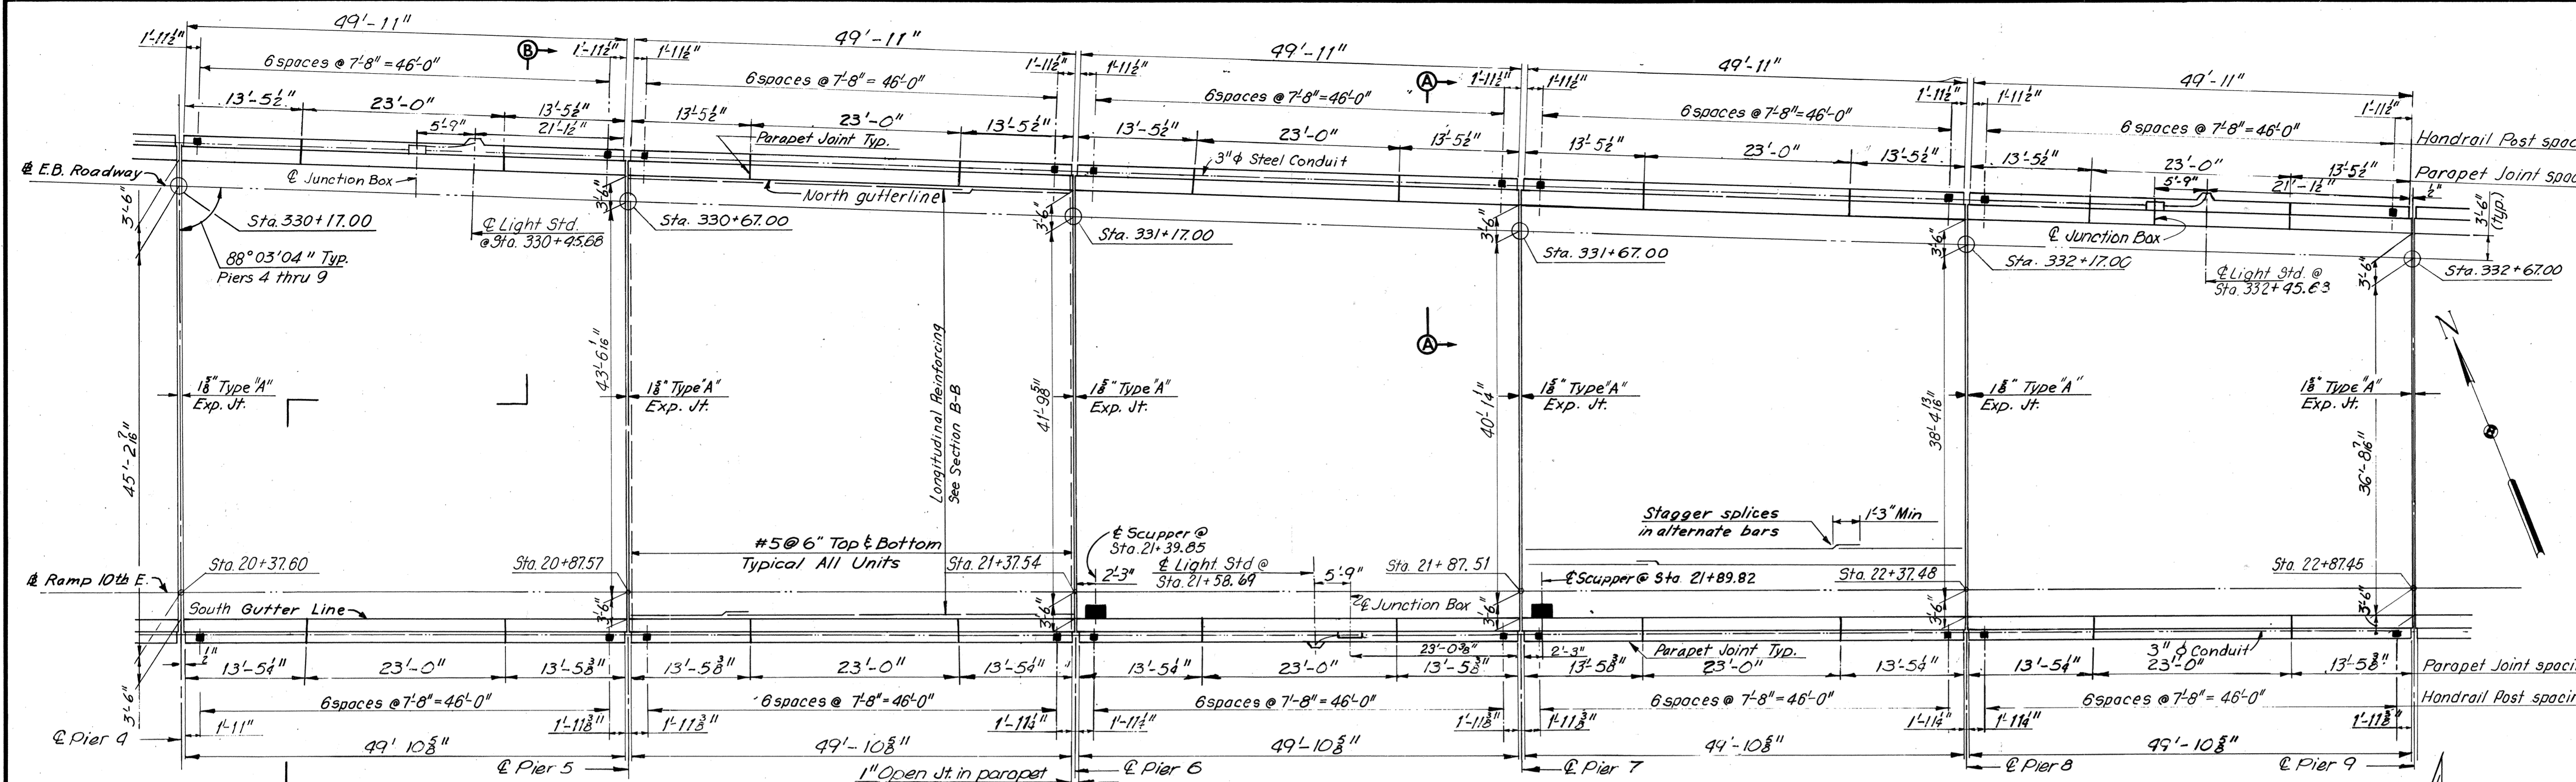

ELEVATION TABLE			
STATION	ELEV. A	ELEV. B	ELEV. C
330+10.00	79.99	79.44	80.08
+16.88	79.50	--	--
+17.00	--	79.54	--
+18.66	--	--	80.12
+20.00	79.54	79.59	80.13
+30.00	79.71	79.73	80.16
+40.00	79.86	79.88	80.21
+50.00	80.02	80.03	80.27
+60.00	80.17	80.18	80.32
+66.88	80.28	--	--
+67.00	--	80.28	--
+68.60	--	--	80.36
+70.00	80.32	80.33	80.37
+80.00	80.48	80.47	80.43
+90.00	80.63	80.62	80.49
331+00.00	80.79	80.77	80.54
+10.00	80.94	80.92	80.60
+16.88	81.05	--	--
+17.00	--	81.02	--
+18.54	--	--	80.65
+20.00	81.09	81.07	80.66
+30.00	81.26	81.21	80.72
+40.00	81.41	81.36	80.78
+50.00	81.57	81.51	80.84
+60.00	81.72	81.66	80.92
+66.88	81.82	--	--
+67.00	--	81.76	--
+68.48	--	--	81.00
+70.00	81.87	81.81	81.01
+80.00	82.02	81.95	81.12
+90.00	82.17	82.10	81.25
332+00.00	82.32	82.25	81.40
+10.00	82.47	82.40	81.56
+16.88	82.57	--	--
+17.00	--	82.50	--
+18.42	--	--	81.69
+20.00	82.62	82.55	81.71
+30.00	82.76	82.69	81.86
+40.00	82.91	82.84	82.02
+50.00	83.06	82.99	82.17
+60.00	83.21	83.14	82.33
+66.88	83.31	--	--
+67.00	--	83.24	--
+68.37	--	--	82.46
+70.00	83.36	83.29	82.48

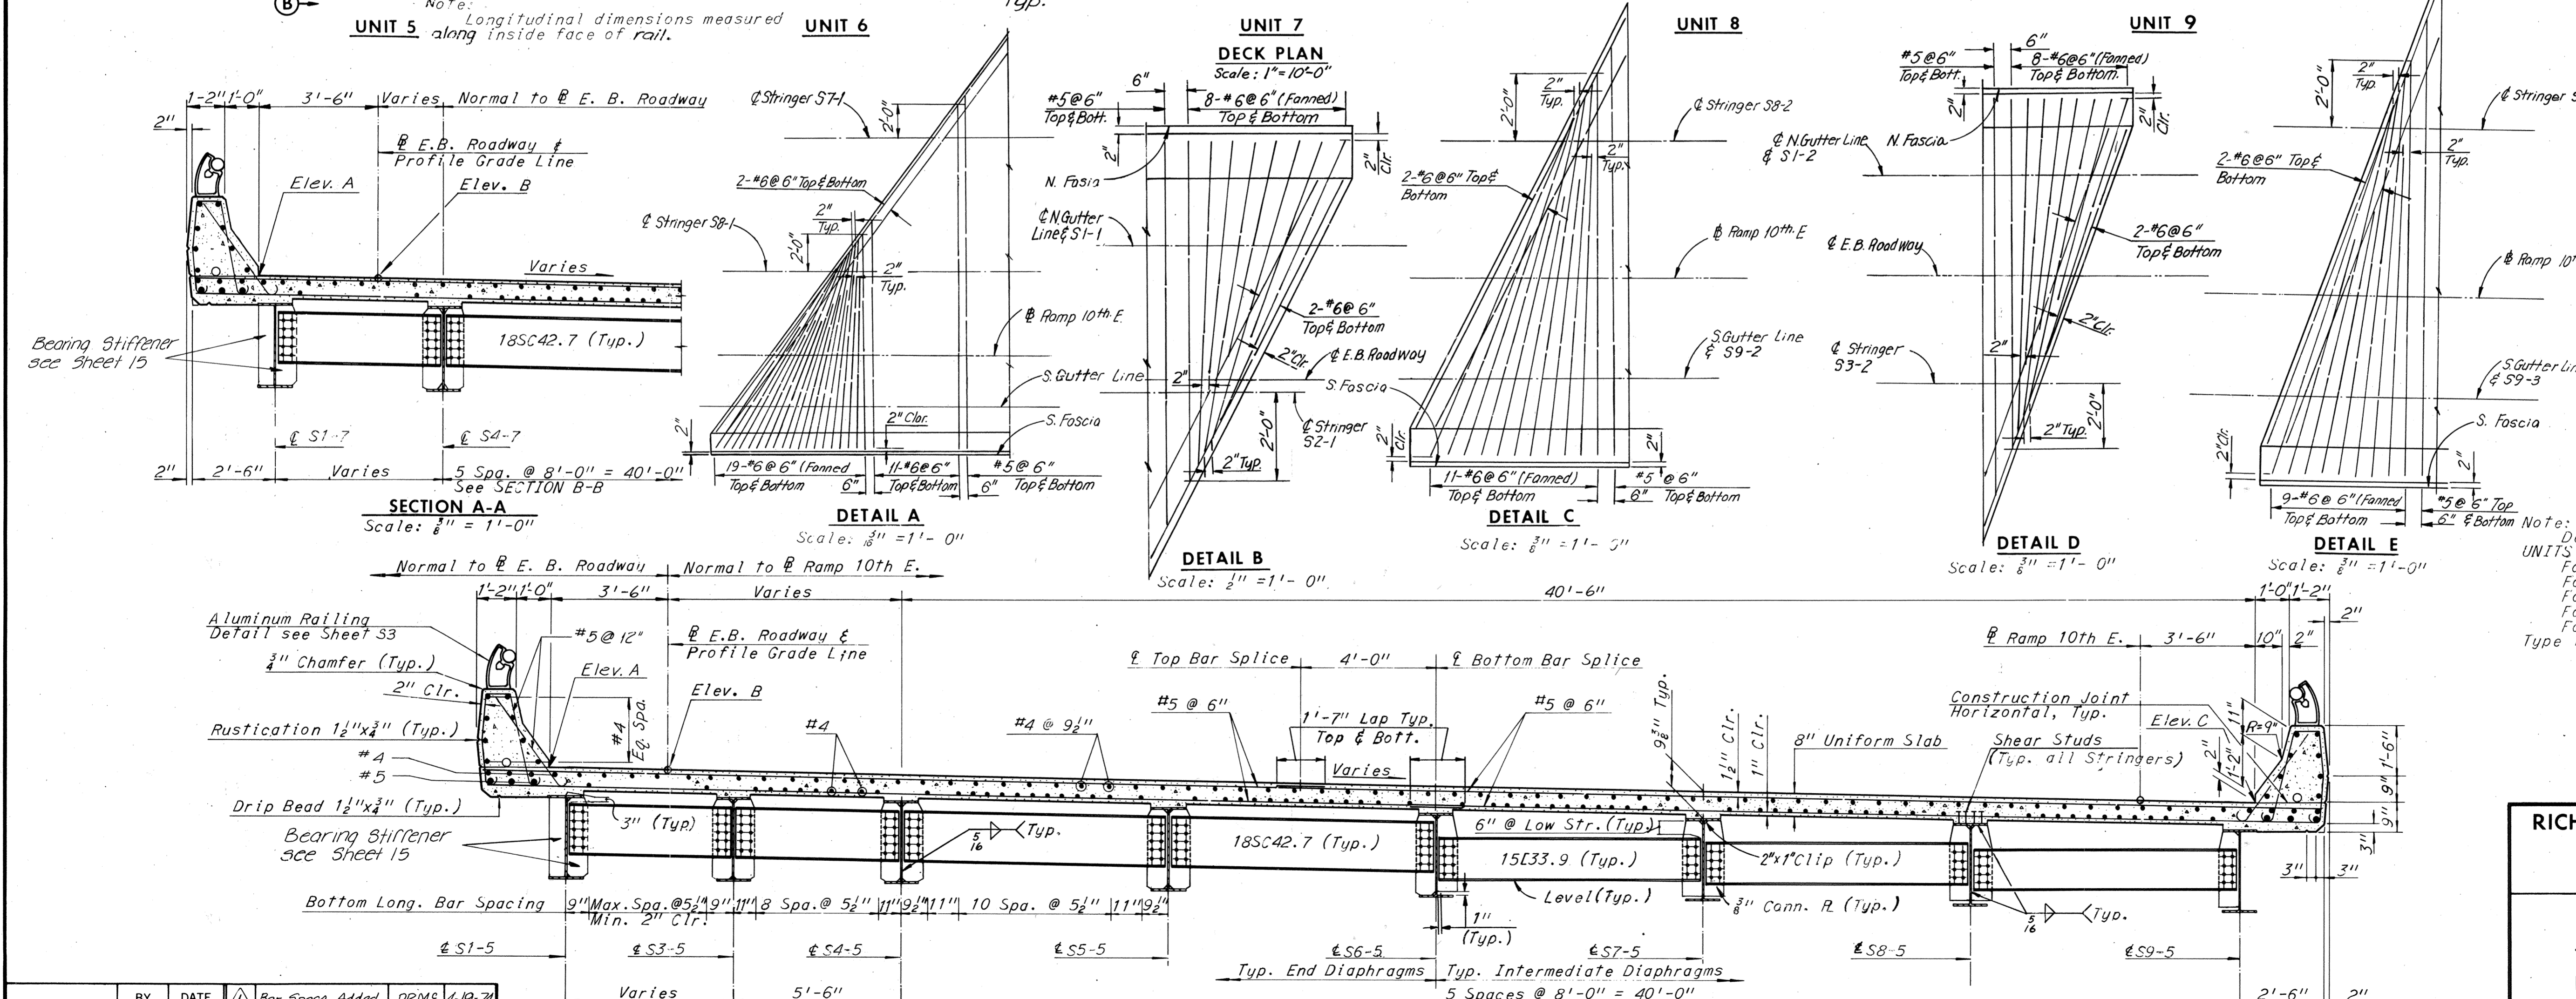

Details A through E belong to DECK-PLAN-UNITS 1, 2, 3 and 4, see Sheet 28
 For Joint Details, see Sheet 37
 For Framing Plan, see Sheet 15.
 For Handrail Details, see Sheet S3.
 For Superstructure Quantities, see Sheet 2.
 For Standard Drainage Details, see Support Type 1, Sheet S5496.

BY	DATE	Bar Space Added	PRMS
SHS	8-2-68	2 As Built	4-19-74
AHH	11-1-68		TEM 8-76

RICHMOND METROPOLITAN AUTHORITY
RICHMOND EXPRESSWAY SYSTEM
DOWNTOWN EXPRESSWAY


BRIDGE NO. 66
EASTBOUND ROADWAY OVER
12TH ST. - R.R. TRACKS AND 16TH ST.
DECK PLAN-UNITS 5, 6, 7, 8, AND 9

HOWARD, NEEDLES, TAMMEN & BERGENDOFF
 Consulting Engineers
 NEW YORK ALEXANDRIA KANSAS CITY

SCALE: As Noted
 CONTRACT NO. 10
 SHEET NO. 29 OF 46



AS BUILT

RICHMOND EXPRESSWAY SYSTEM			
SECTION	PROJECT	SHEET NO.	TOTAL SHEETS
10	DOWNTOWN EXPRESSWAY	156	265

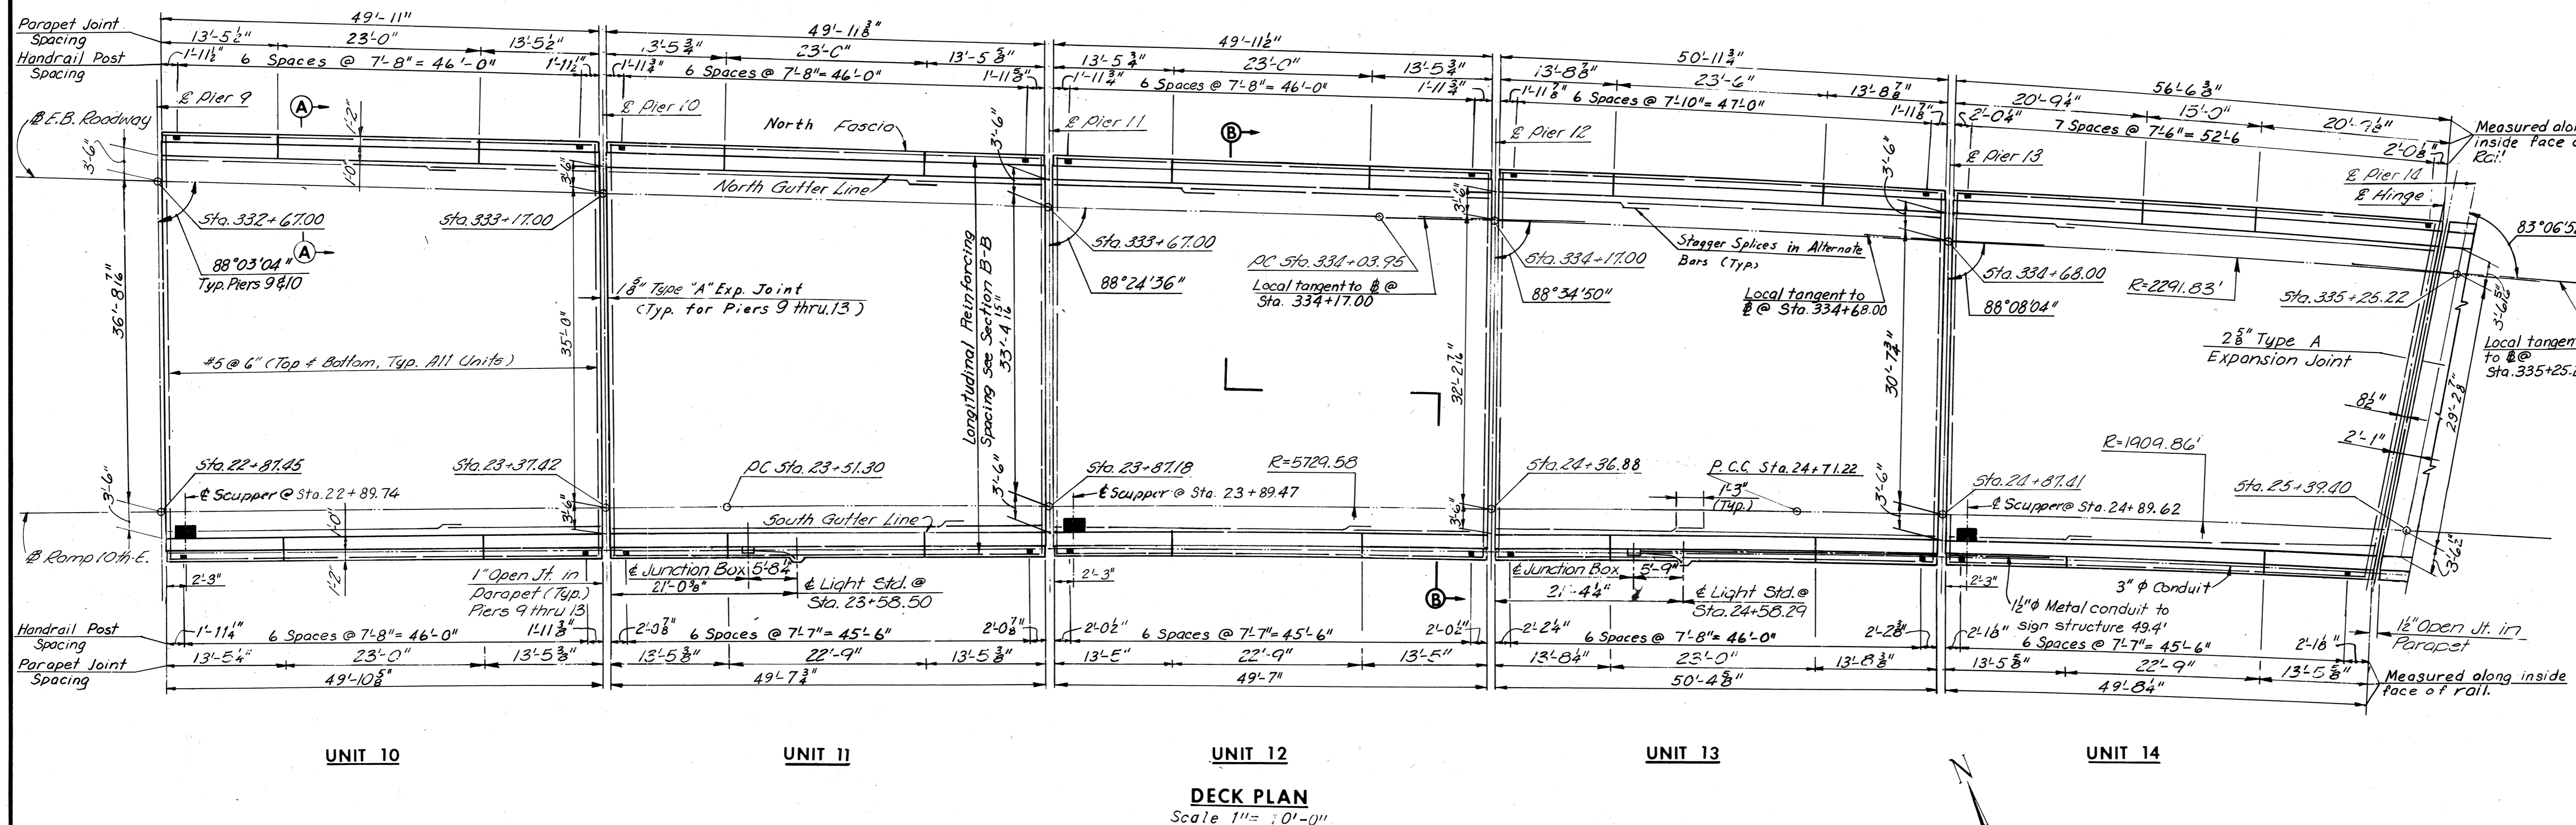

ELEVATION TABLE

STATION	ELEV. A	ELEV. B	ELEV. C
332+60.00	83.21	83.14	82.33
332+66.88	83.31	---	---
332+67.00	---	83.24	---
332+68.37	---	---	82.46
332+70.00	83.36	83.29	82.48
332+80.00	83.50	83.43	82.64
332+90.00	83.65	83.58	82.79
333+00.00	83.80	83.73	82.95
333+10.00	83.95	83.88	83.10
333+16.88	84.05	---	---
333+17.00	---	83.98	---
333+18.31	---	---	83.21
333+20.00	84.10	84.03	83.23
333+30.00	84.25	84.17	83.35
333+40.00	84.40	84.32	83.45
333+50.00	84.56	84.47	83.54
333+60.00	84.71	84.62	83.62
333+66.90	84.82	---	---
333+67.00	---	84.72	---
333+68.02	---	---	83.69
333+70.00	84.86	84.77	83.70
333+80.00	85.03	84.91	83.78
333+90.00	85.18	85.06	83.86
334+00.00	85.34	85.21	83.94
334+10.00	85.49	85.36	84.03
334+16.91	85.60	---	---
334+17.00	---	85.46	---
334+17.88	---	---	84.10
334+20.00	85.64	85.51	84.12
334+30.00	85.80	85.65	84.20
334+40.00	85.95	85.80	84.30
334+50.00	86.11	85.95	84.39
334+60.00	86.26	86.10	84.49
334+67.89	86.38	---	---
334+68.00	---	86.22	---
334+69.11	---	---	84.63
334+70.00	86.41	86.25	84.61
334+80.00	86.56	86.39	84.74
334+90.00	86.71	86.54	84.88
335+00.00	86.86	86.69	85.04
335+10.00	87.01	86.84	85.20
335+20.00	87.15	86.97	85.35
335+25.64	87.23	---	---
335+25.22	---	87.04	---
335+21.29	---	---	85.36
335+30.00	87.29	87.11	85.49

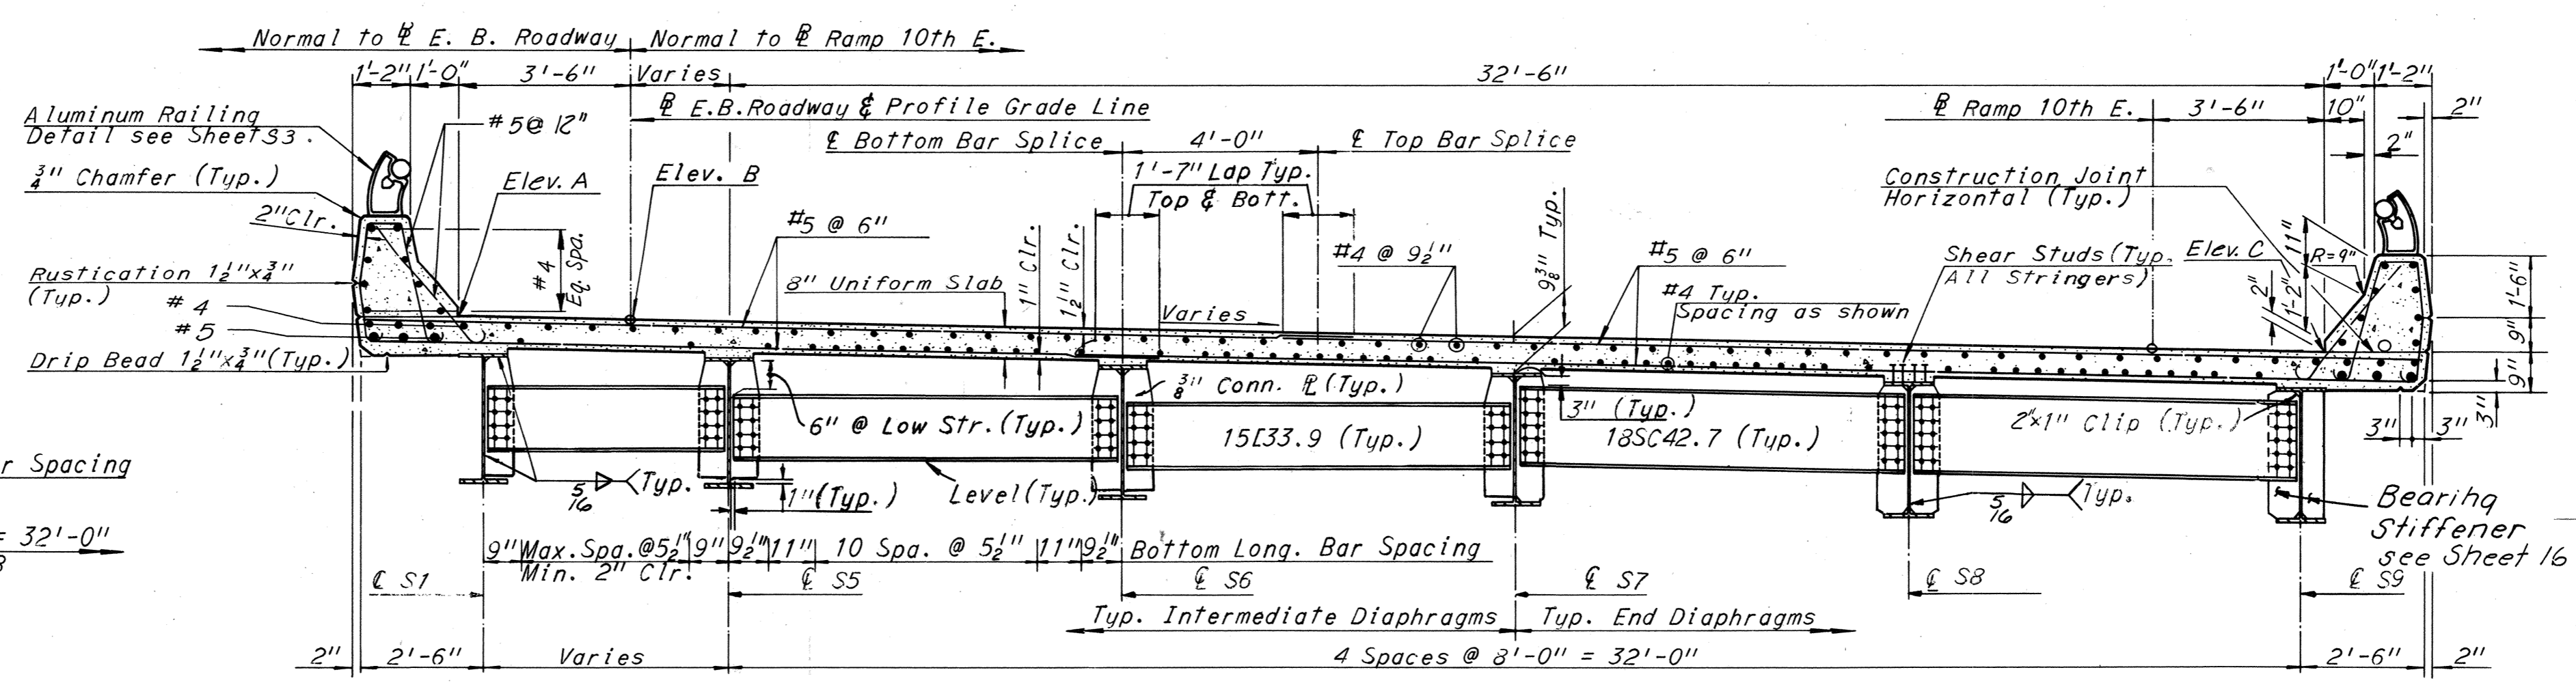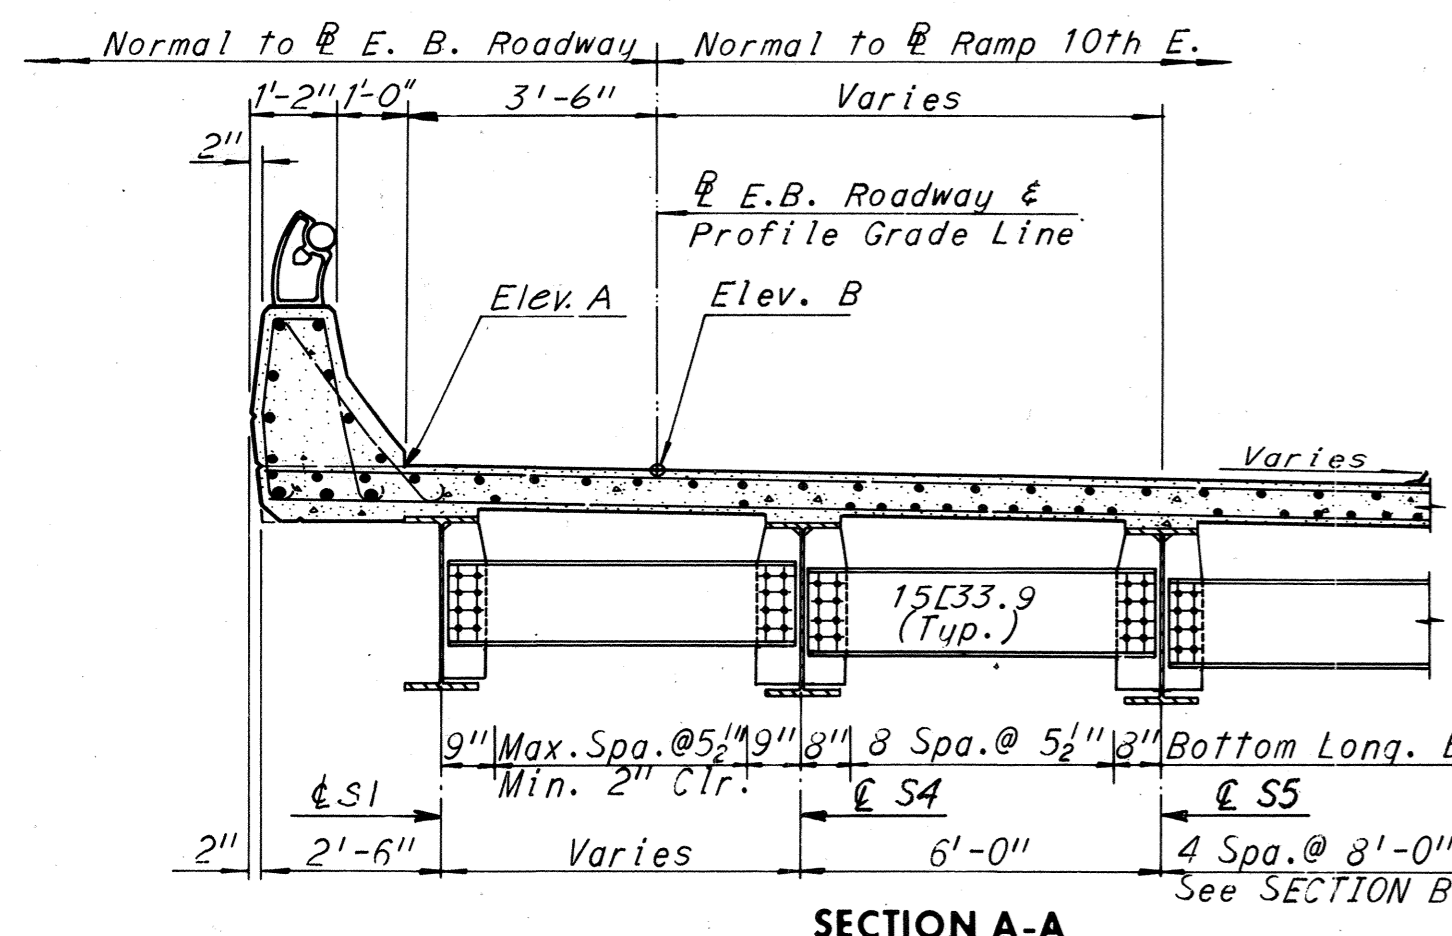

Notes:
 For Joint Details, see Sheet 37
 For Framing Plan, see Sheet 16
 For Handrail Details, see Sheet 53
 For Superstructure Quantities, see Sheet 2.
 For Standard Drainage Details, see Support Type 1, Sheet S5E56.

RICHMOND METROPOLITAN AUTHORITY
RICHMOND EXPRESSWAY SYSTEM
DOWNTOWN EXPRESSWAY

BRIDGE NO. 66
EASTBOUND ROADWAY OVER
12TH ST - R.R. TRACKS AND 16TH ST.
DECK PLAN - UNITS 10, 11, 12, 13 AND 14

HOWARD, NEEDLES, TAMMEN & BERGENDOFF
 consulting engineers
 NEW YORK ALEXANDRIA KANSAS CITY

SCALE: As Noted
 CONTRACT NO.: 10
 SHEET NO. 30 OF 46




BY	DATE	Bar Space Added	PRMS	4-19-74		
MADE	HJC	8-5-68	2	As Built	TEM	8-76
CHECKED	JD	10-21-68				
IN CHARGE						

AS BUILT

RICHMOND EXPRESSWAY SYSTEM			
SECTION	PROJECT	SHEET NO.	TOTAL SHEETS
10	DOWNTOWN EXPRESSWAY	157	265

ELEVATION TABLE

STATION	ELEV. A	ELEV. B	ELEV. C
335+10.00	87.01	86.84	85.20
+20.00	87.15	86.97	85.35
+21.29	—	—	85.36
+25.22	87.22	—	—
+30.00	87.18	87.11	85.50
+40.00	87.40	87.23	85.64
+50.00	87.53	87.35	85.76
+60.00	87.63	87.46	85.89
+70.00	87.74	87.57	86.01
+80.00	87.85	87.67	86.11
+90.00	87.93	87.76	86.23
336+00.00	88.02	87.85	86.33
+10.00	88.10	87.93	86.42
+20.00	88.17	88.02	86.52
+22.38	88.21	—	—
+23.00	—	88.04	—
+28.25	—	—	86.60
+30.00	88.27	88.10	86.61
+40.00	88.36	88.19	86.70
+50.00	88.44	88.27	86.80
+60.00	88.52	88.35	86.89
+70.00	88.61	88.44	86.98
+80.00	88.69	88.52	87.08
+90.00	88.78	88.61	87.17
337+00.00	88.86	88.69	87.28
+10.00	88.94	88.77	87.35
+20.00	89.03	88.86	87.49
+25.48	89.08	—	—
+26.26	—	88.91	—
+30.00	89.11	88.94	87.53
+32.60	—	—	87.55
337+40.00	89.20	89.03	87.62

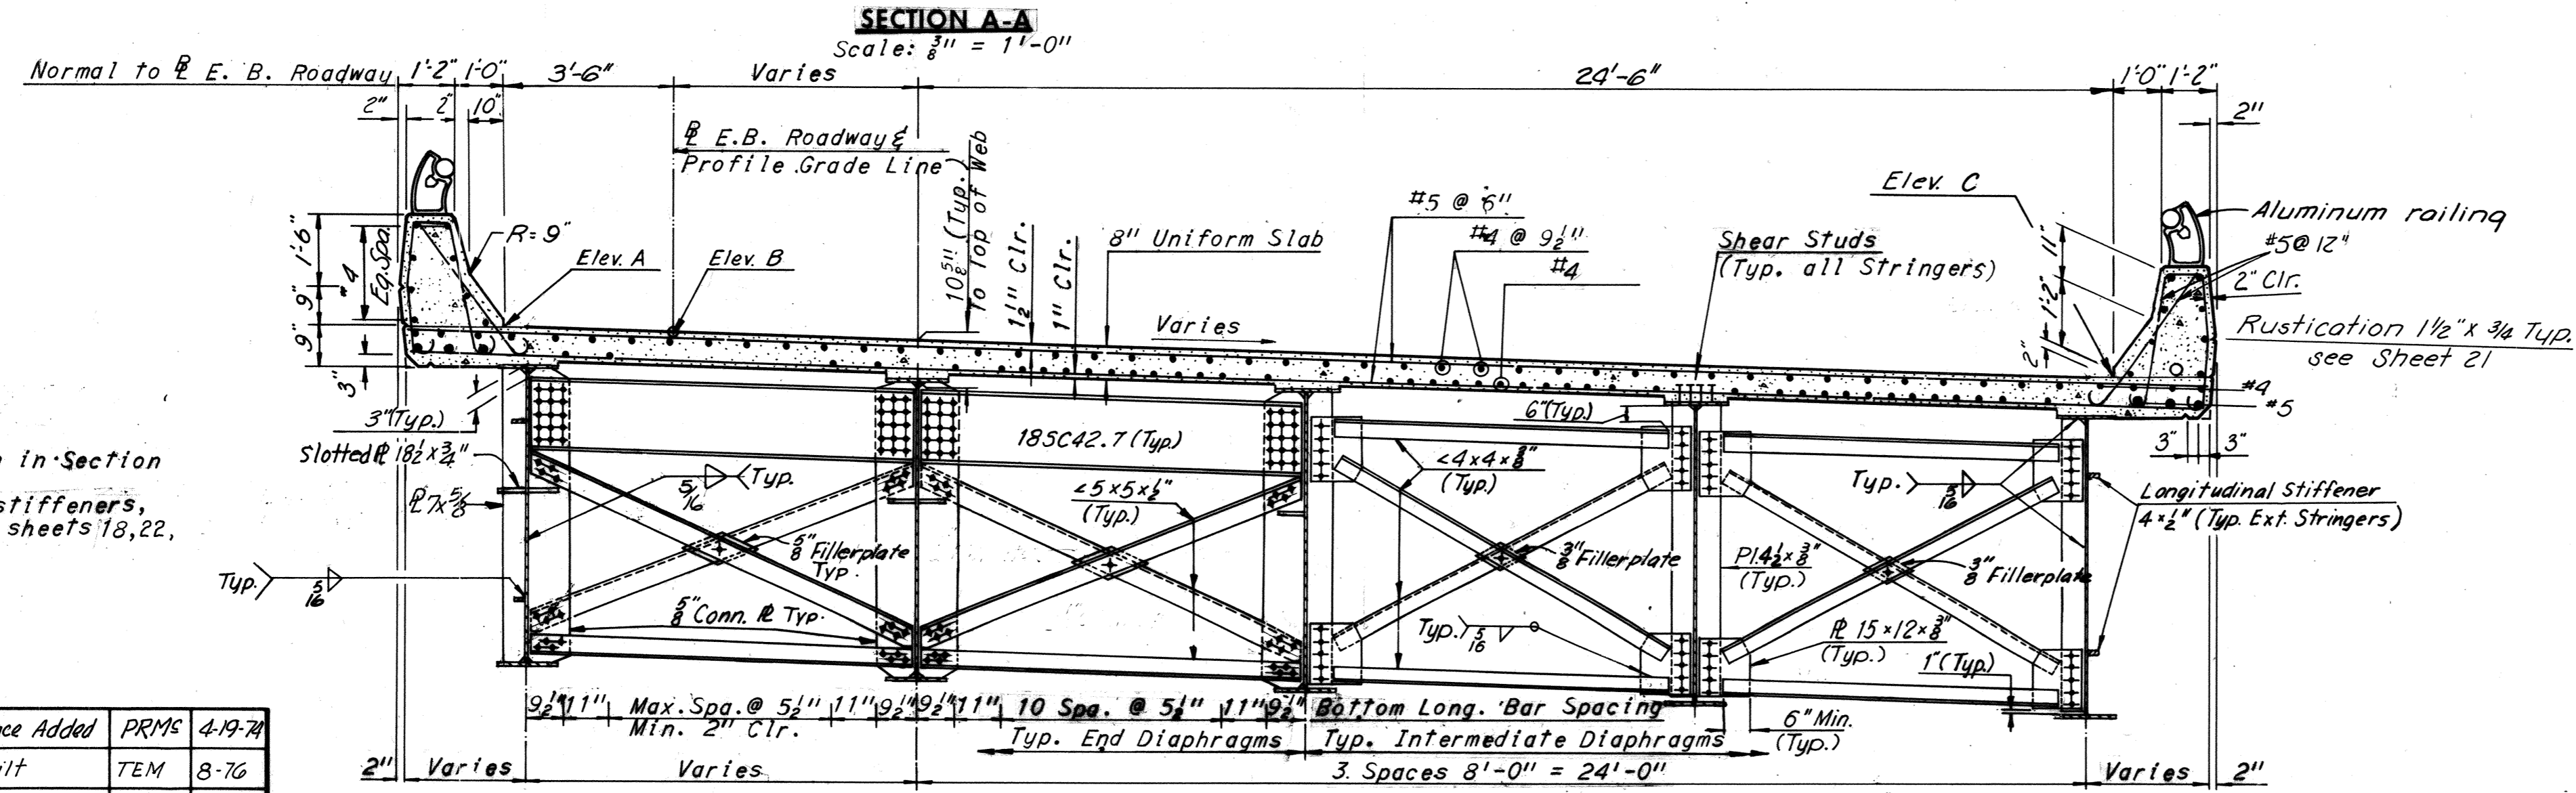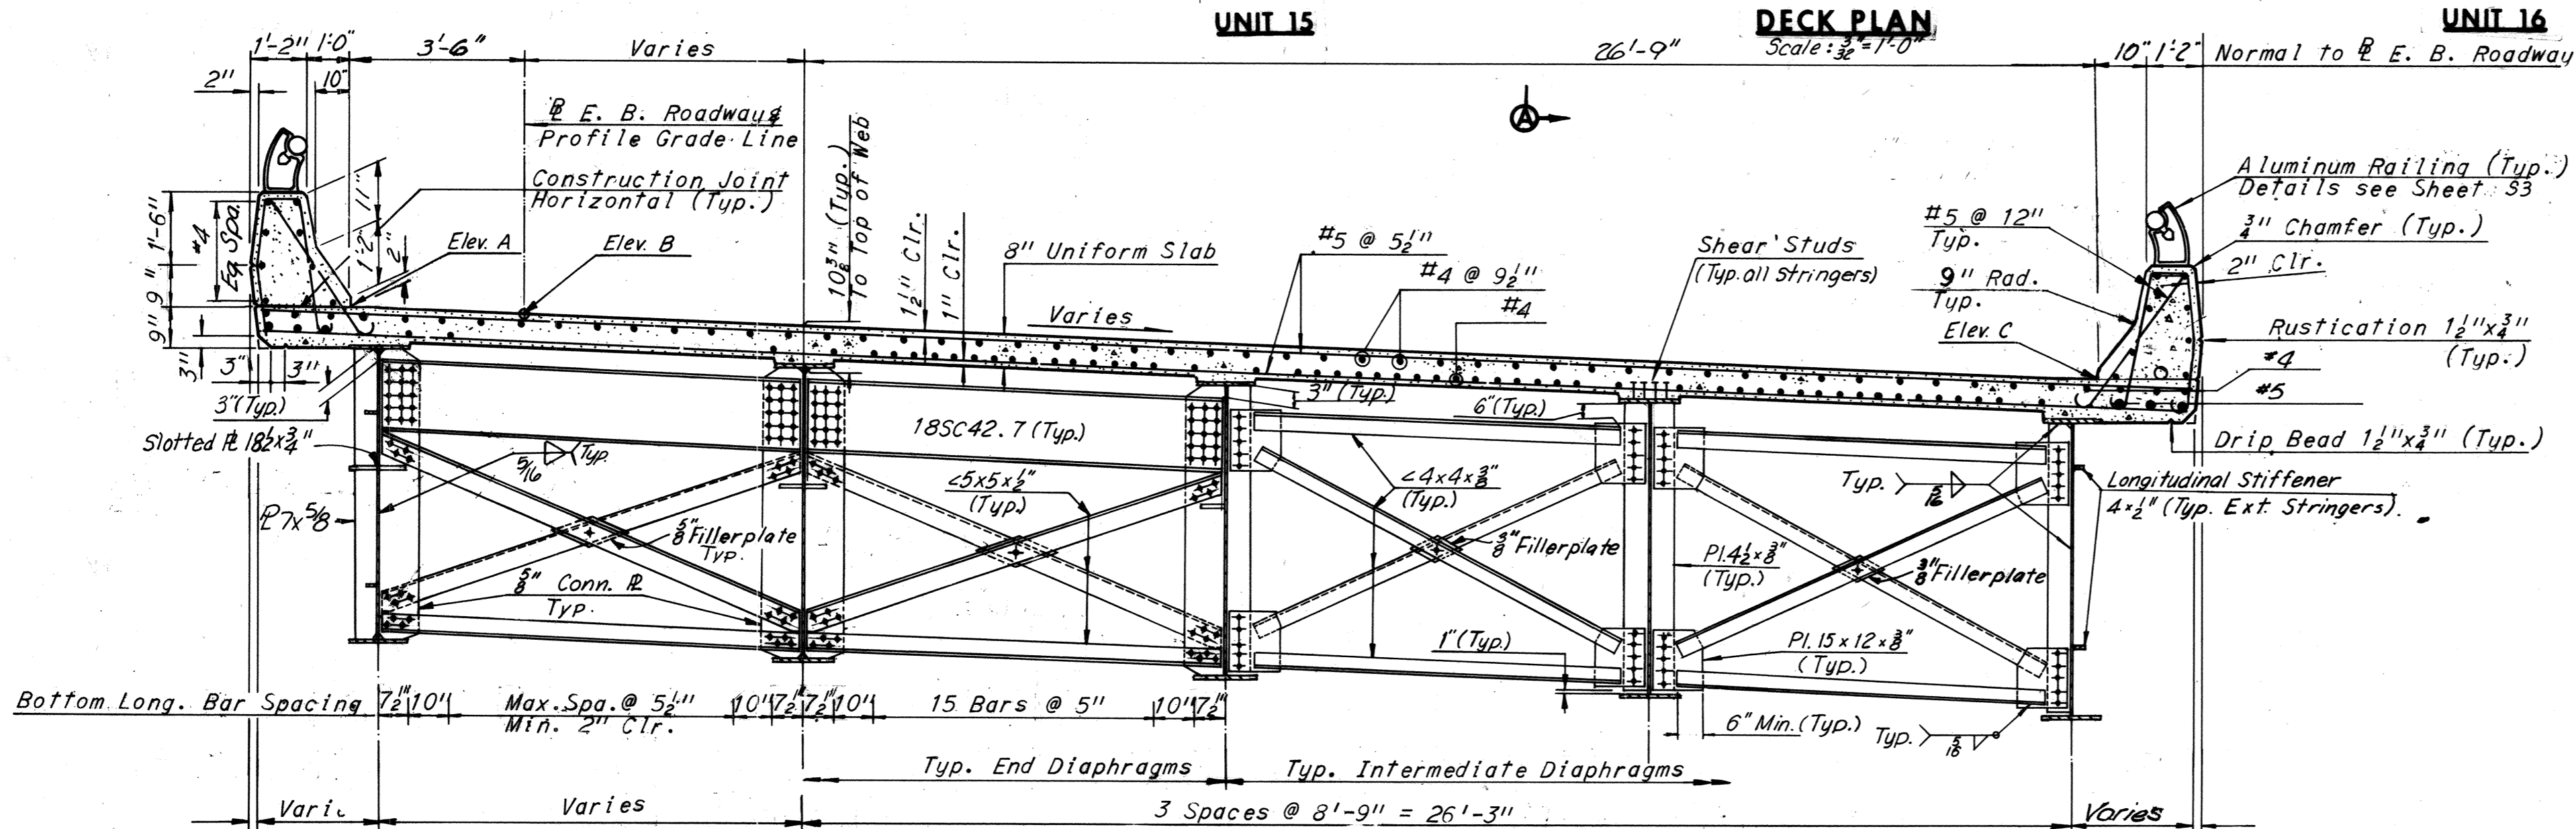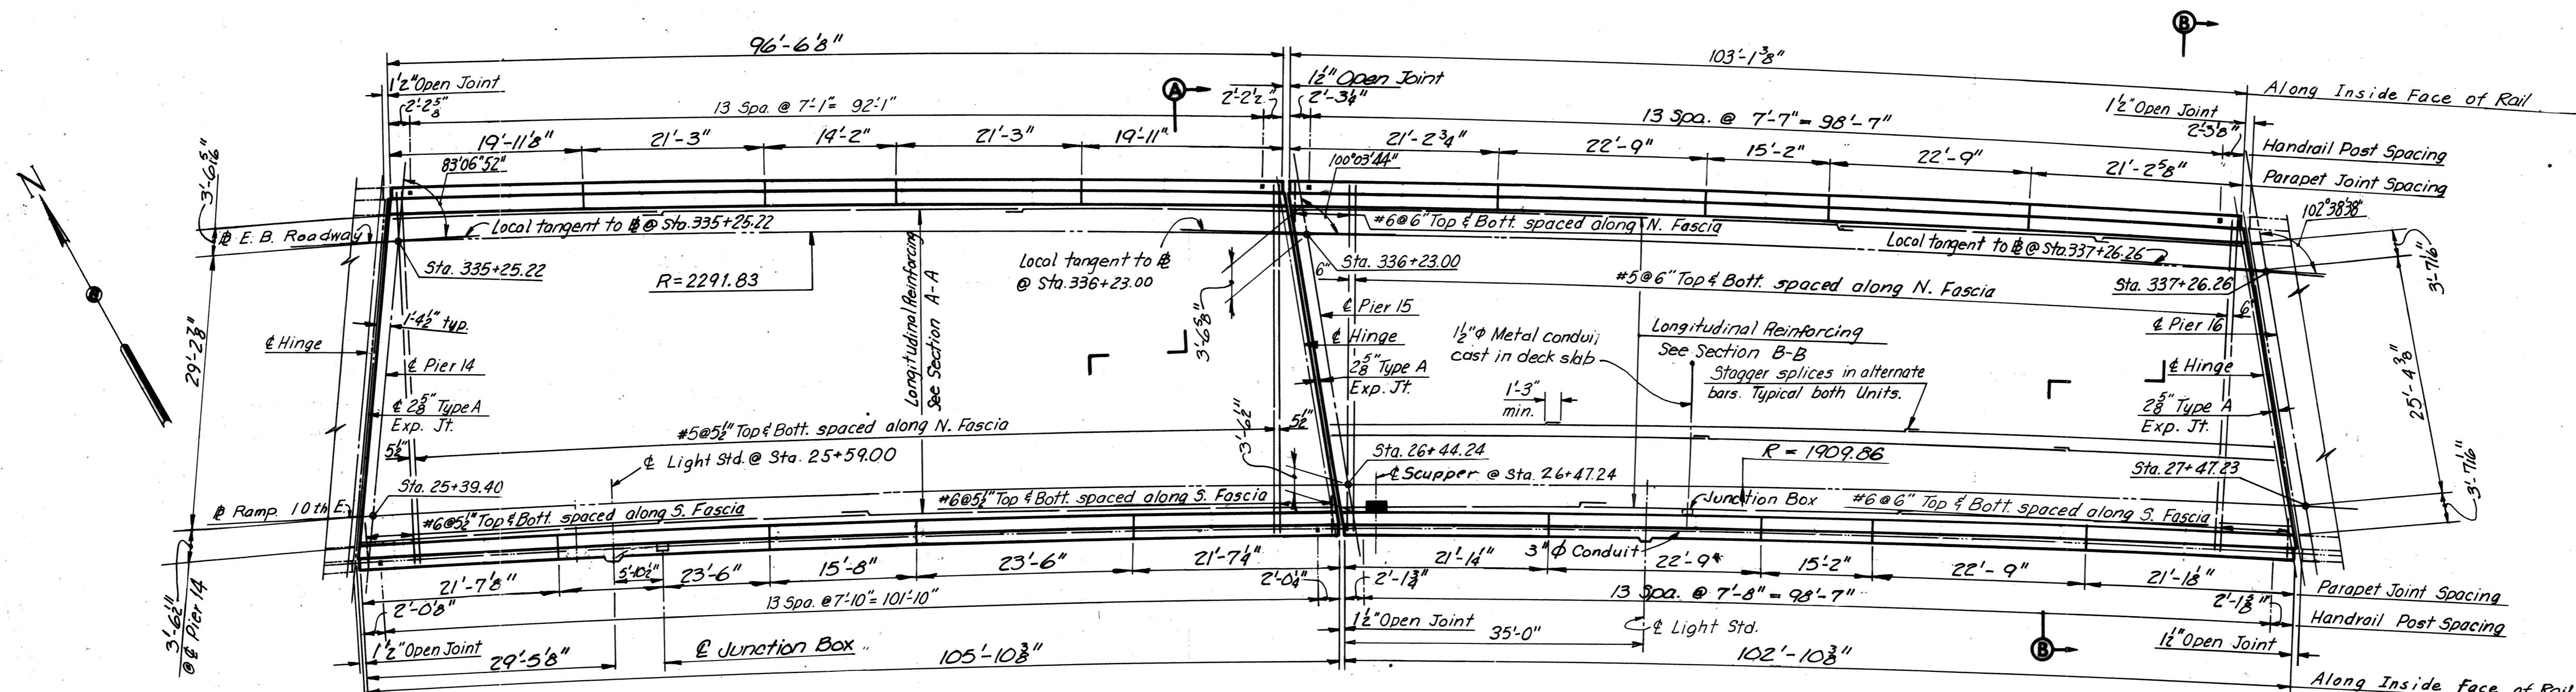

Notes:
 For details not shown in Section B-B, see Section A-A.
 For details of brg. stiffeners, long. stiffeners, see sheets 18, 22, and 23.

Notes:
 For Joint Details, see Sheet 38.
 For Framing Plan, see Sheet 17.
 For Handrail Details, see Sheet 53.
 For Superstructure quantities, see Sheet 2.
 For Standard Drainage Details, see Support Type 2 Sheet 55/56.

BY	DATE	Bar Space Added	PRMS	4-19-78		
MADE	RLM	8-6-68	2	As Built	TEM	8-76
CHECKED	SCC	10-21-68				
IN CHARGE	NO.	REVISION	BY	DATE		

RICHMOND METROPOLITAN AUTHORITY
RICHMOND EXPRESSWAY SYSTEM
DOWNTOWN EXPRESSWAY


BRIDGE NO. 66
EASTBOUND ROADWAY OVER
12TH ST. - R.R. TRACKS AND 16TH ST.
DECK PLAN-UNITS 15 AND 16

HOWARD, NEEDLES, TAMMEN & BERGENDOFF
 consulting engineers
 NEW YORK ALEXANDRIA KANSAS CITY



SCALE: As Noted
 CONTRACT NO. 10
 SHEET NO. 31 OF 46

AS BUILT

RICHMOND EXPRESSWAY SYSTEM			
SECTION	PROJECT	SHEET NO.	TOTAL SHEETS
10	DOWNTOWN EXPRESSWAY	158	265

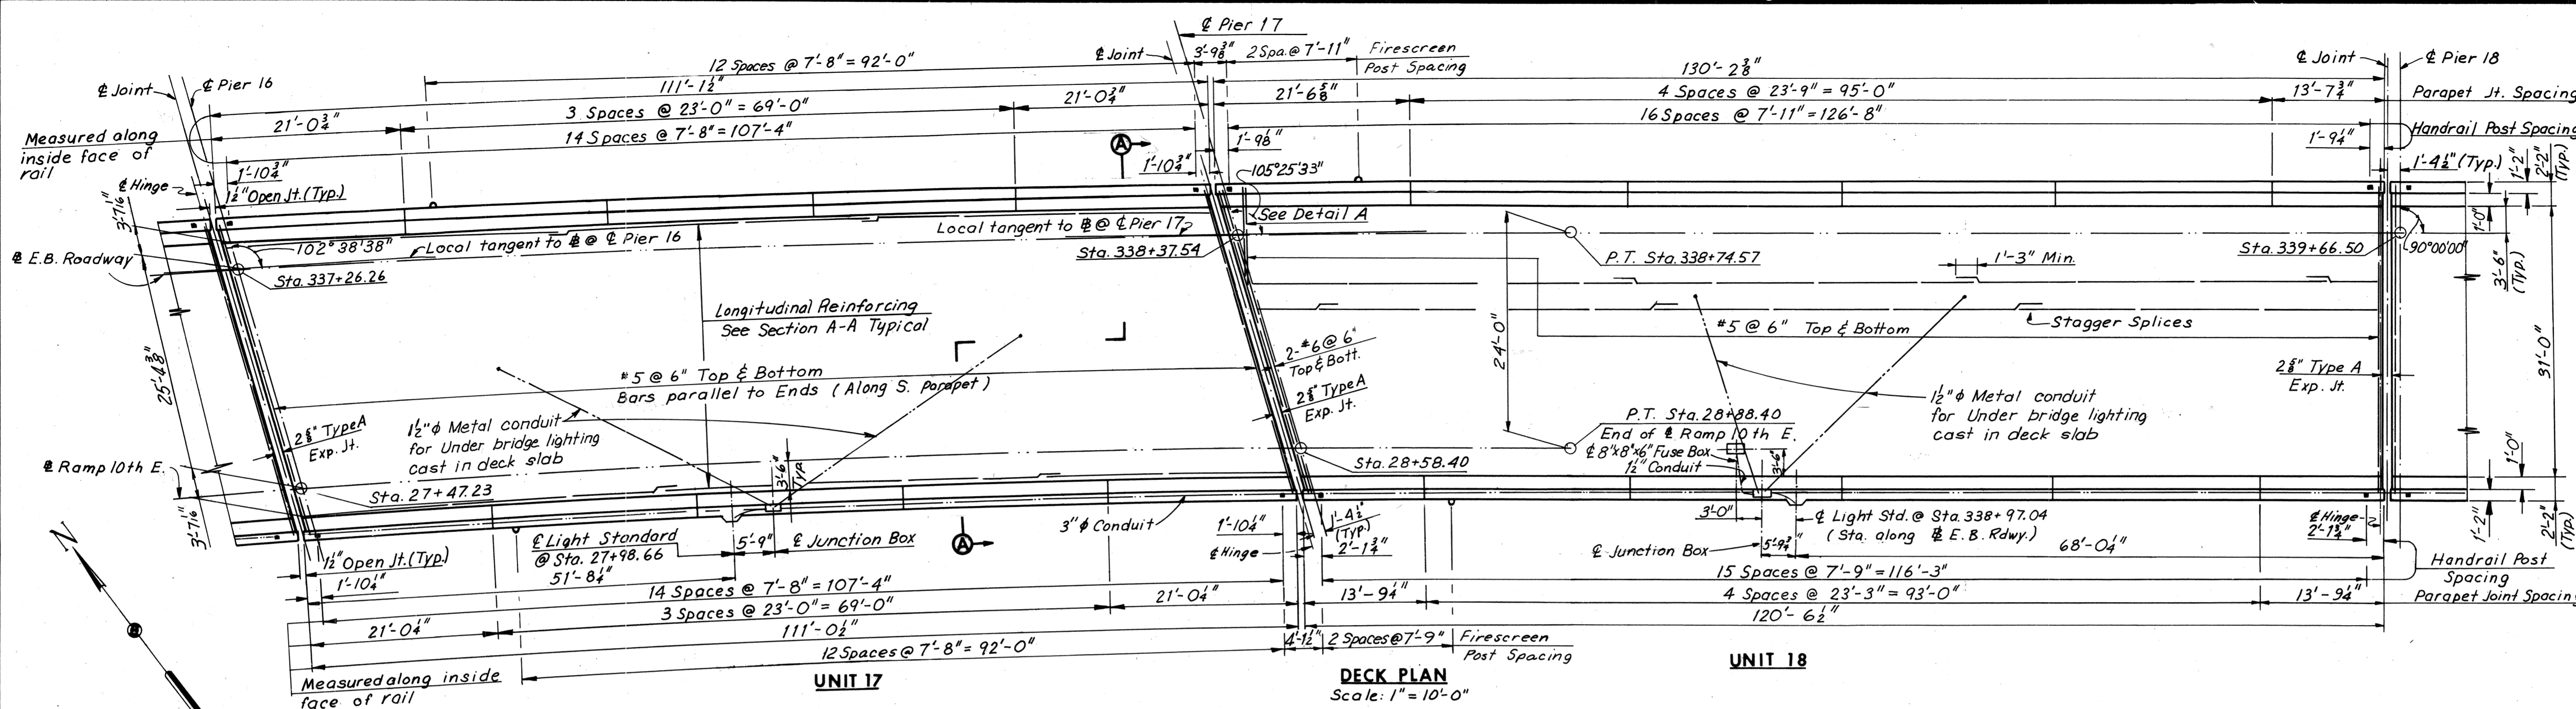

ELEVATION TABLE			
STATION	ELEV. A	ELEV. B	ELEV. C
337+20.00	89.03	88.86	87.44
+25.48	89.08	--	--
+26.26	--	88.91	--
+30.00	89.11	88.94	87.53
+32.60	--	--	87.55
+40.00	89.20	89.03	87.62
+50.00	89.28	89.11	87.71
+60.00	89.36	89.19	87.80
+70.00	89.45	89.28	87.89
+80.00	89.53	89.36	87.98
+90.00	89.62	89.45	88.07
338+00.00	89.70	89.53	88.18
+10.00	89.78	89.61	88.30
+20.00	89.86	89.70	88.43
+30.00	89.93	89.78	88.57
+36.58	89.99	--	--
+37.54	--	89.85	--
+40.00	90.01	89.87	88.71
+45.13	--	--	88.78
+50.00	90.09	89.95	88.85
+60.00	90.17	90.03	88.99
+70.00	90.25	90.12	89.13
+80.00	90.32	90.20	89.26
+90.00	90.40	90.29	89.40
339+00.00	90.48	90.37	89.54
+10.00	90.55	90.45	89.69
+20.00	90.63	90.54	89.83
+30.00	90.70	90.62	89.96
+40.00	90.78	90.71	90.10
+50.00	90.86	90.79	90.24
+60.00	90.94	90.87	90.38
+66.50	90.99	90.93	90.47
+70.00	91.02	90.96	90.52

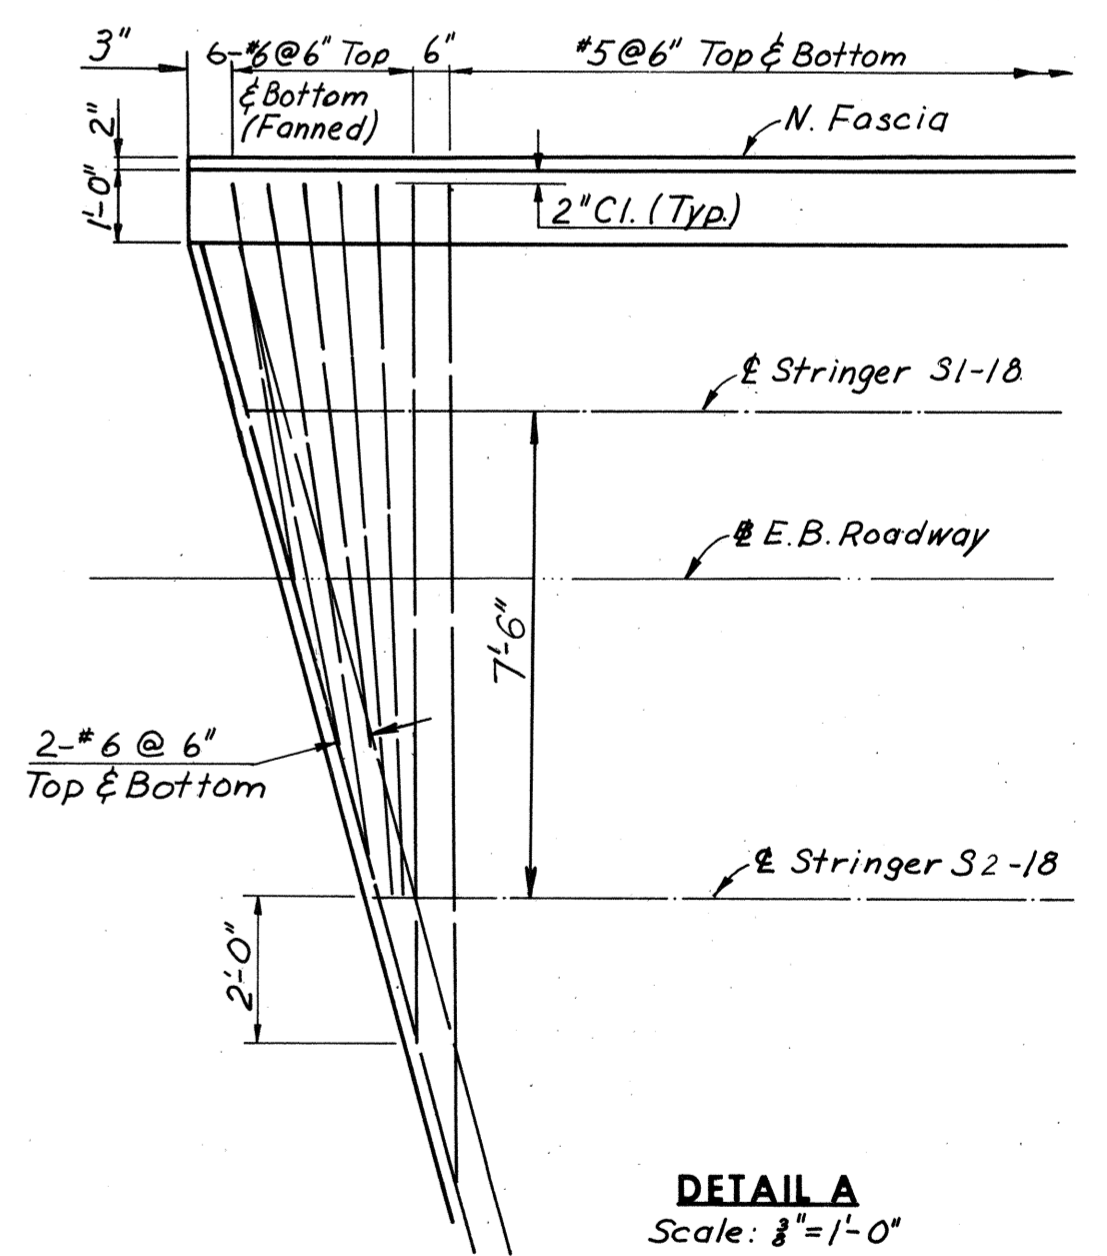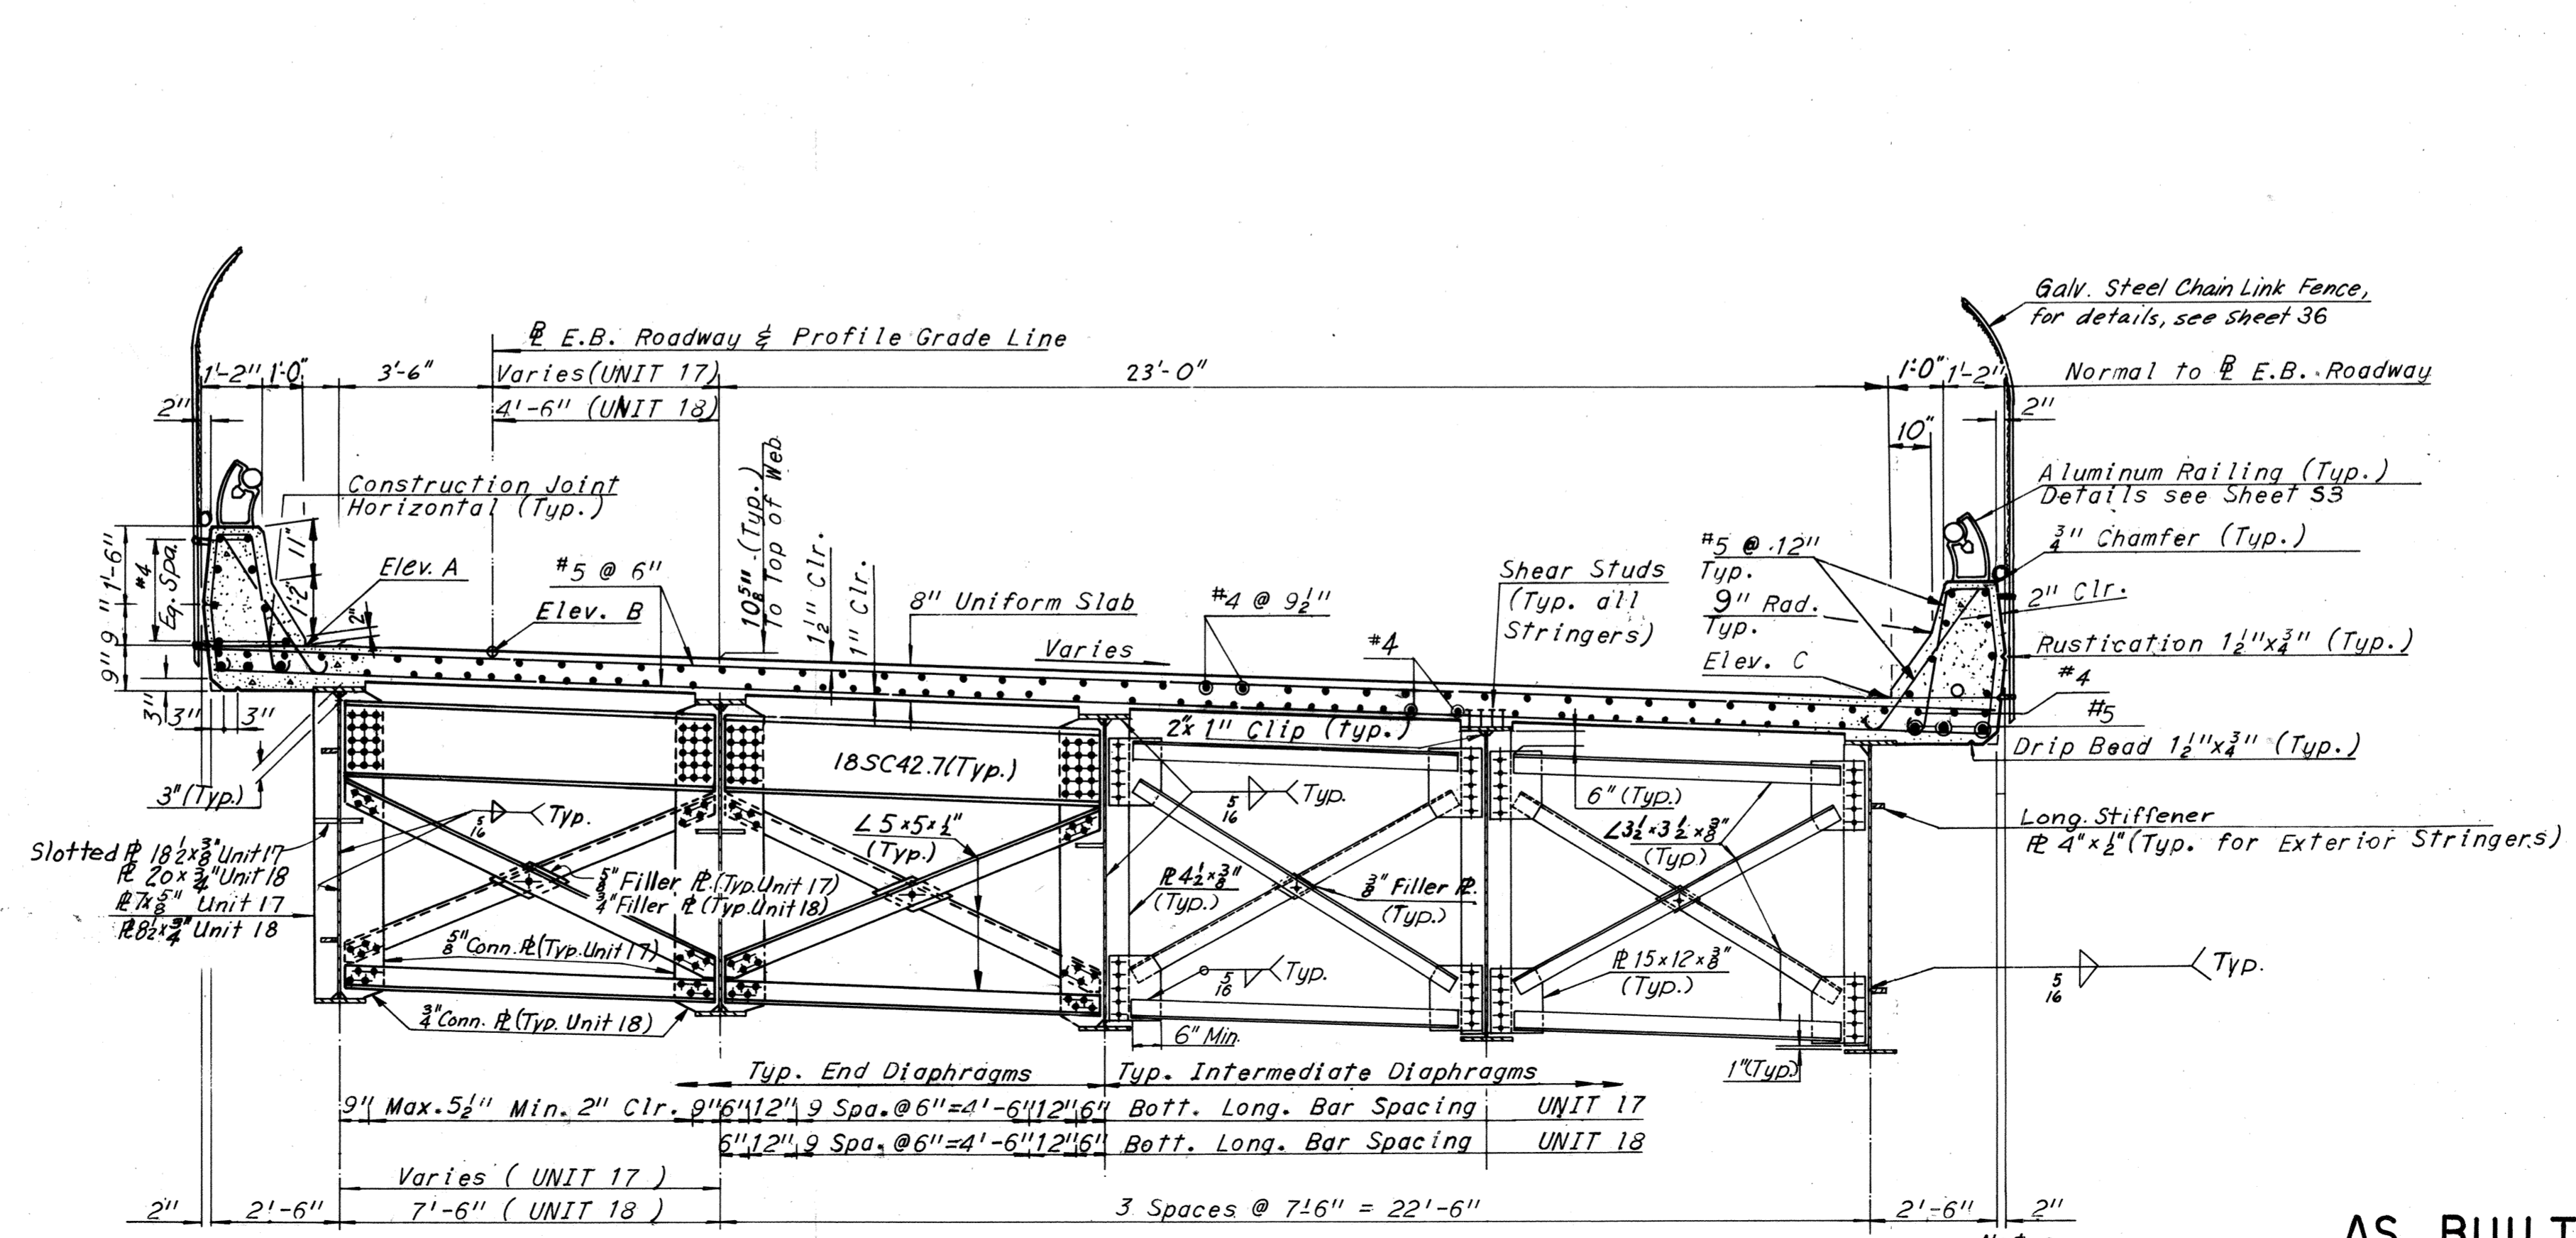

BY	DATE	NO.	REVISION	BY	DATE
MADE	J.D. 8-9-68				
CHECKED	R.C. 10-18-68	1	As Built	TEM	8-76
IN CHARGE					

SECTION A-A
Scale: 3/8" = 1'-0"

Notes:
For Joint Details, see Sheet 38.
For Framing Plan, see Sheet 18.
For Handrail Details, see Sheet 93.
For Superstructure quantities, see Sheet 2.

AS BUILT

RICHMOND METROPOLITAN AUTHORITY
RICHMOND EXPRESSWAY SYSTEM
DOWNTOWN EXPRESSWAY

BRIDGE NO. 66
EASTBOUND ROADWAY OVER
12TH ST. - R.R. TRACKS AND 16TH ST.


DECK PLAN - UNITS 17 AND 18

HOWARD, NEEDLES, TAMMEN & BERGENDOFF
consulting engineers
NEW YORK ALEXANDRIA KANSAS CITY


SCALE: 1/8" = 1'-0"
CONTRACT NO. 10
SHEET NO. 32 OF 46

RICHMOND EXPRESSWAY SYSTEM			
SECTION	PROJECT	SHEET NO.	TOTAL SHEETS
10	DOWNTOWN EXPRESSWAY	159	265


ELEVATION TABLE			
STATION	ELEV. A	ELEV. B	ELEV. C
339+60.00	90.94	90.87	90.38
+66.50	90.99	90.93	90.47
+70.00	91.02	90.96	90.52
+80.00	91.09	91.04	90.65
+90.00	91.17	91.13	90.79
340+00.00	91.24	91.21	90.94
+10.00	91.32	91.29	91.08
+20.00	91.40	91.38	91.22
+30.00	91.47	91.46	91.35
+40.00	91.55	91.55	91.49
+50.00	91.63	91.63	91.63
+60.00	91.71	91.71	91.77
+68.00	91.77	91.78	91.88
+70.00	91.79	91.80	91.91
+80.00	91.86	91.88	92.04
+90.00	91.94	91.97	92.18
341+00.00	92.02	92.05	92.32
+10.00	92.09	92.13	92.47
+20.00	92.17	92.22	92.61
+30.00	92.24	92.30	92.74
+40.00	92.32	92.39	92.87
+50.00	92.40	92.47	92.99
+60.00	92.47	92.55	93.09
+70.00	92.57	92.64	93.19
+75.50	92.61	92.68	93.23
+80.00	92.65	92.72	93.27

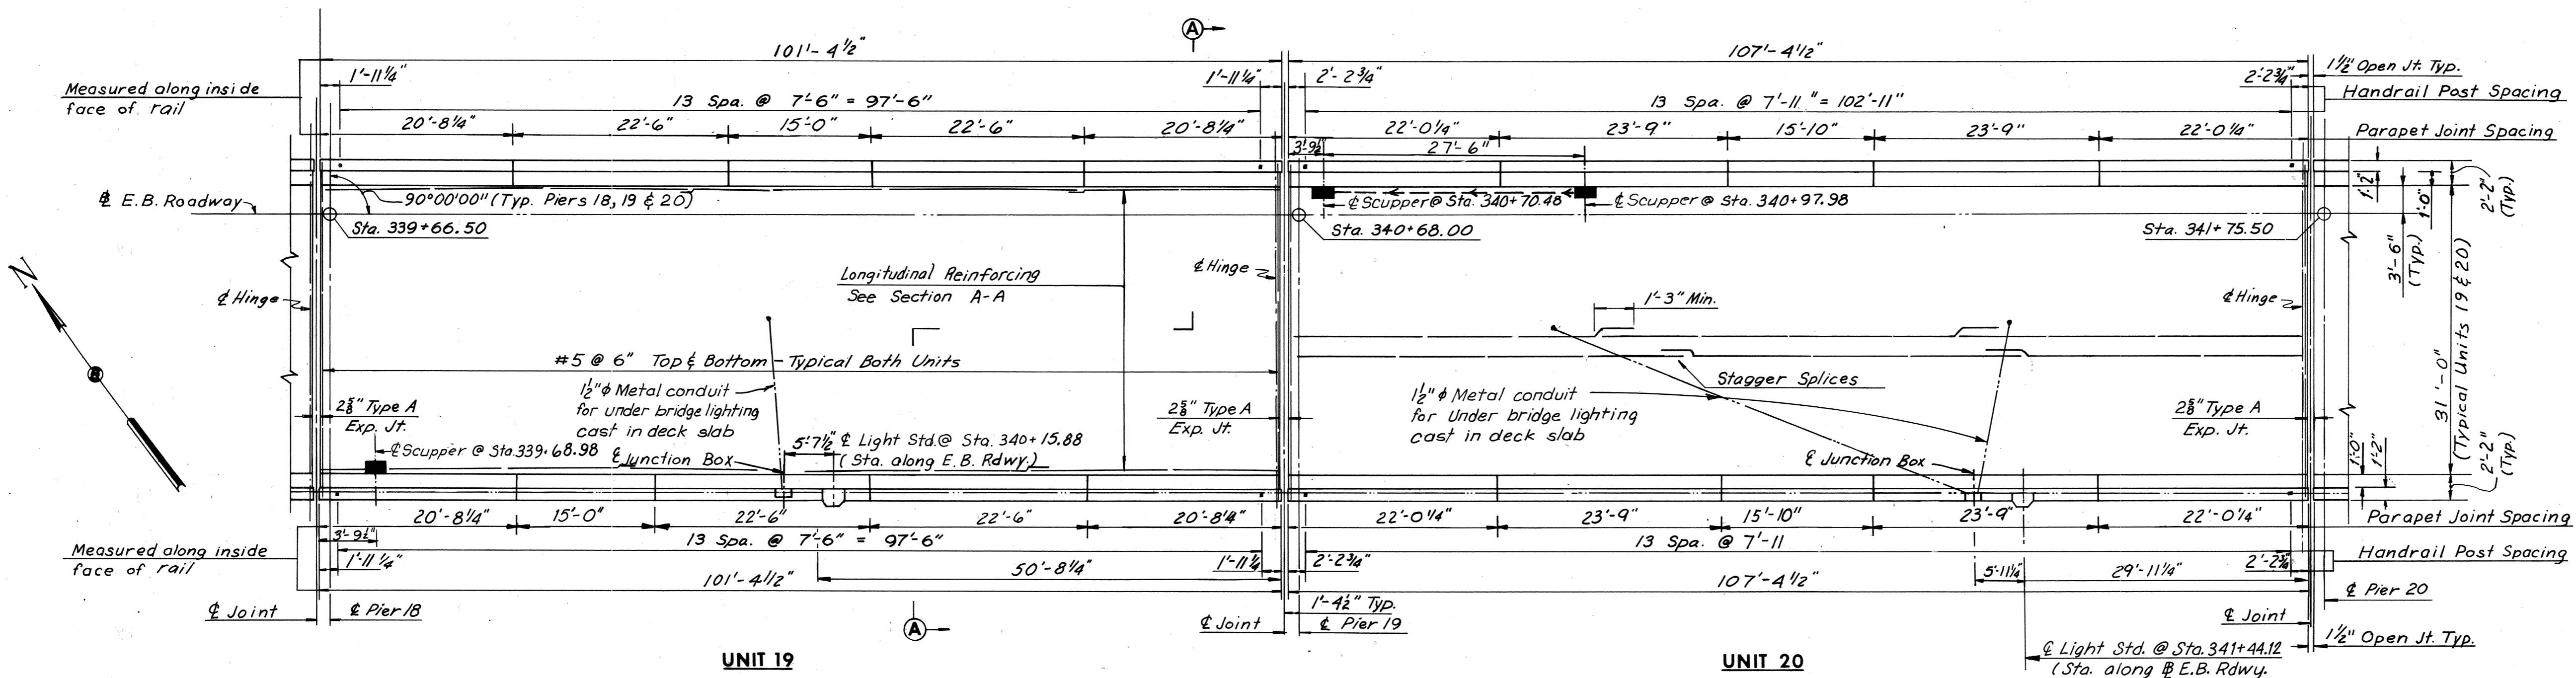


Note: For Standard Drainage details for Unit 19
See Support Type 2 Sheet 55 and for Unit 20
Support Type 7 Sheet 56.

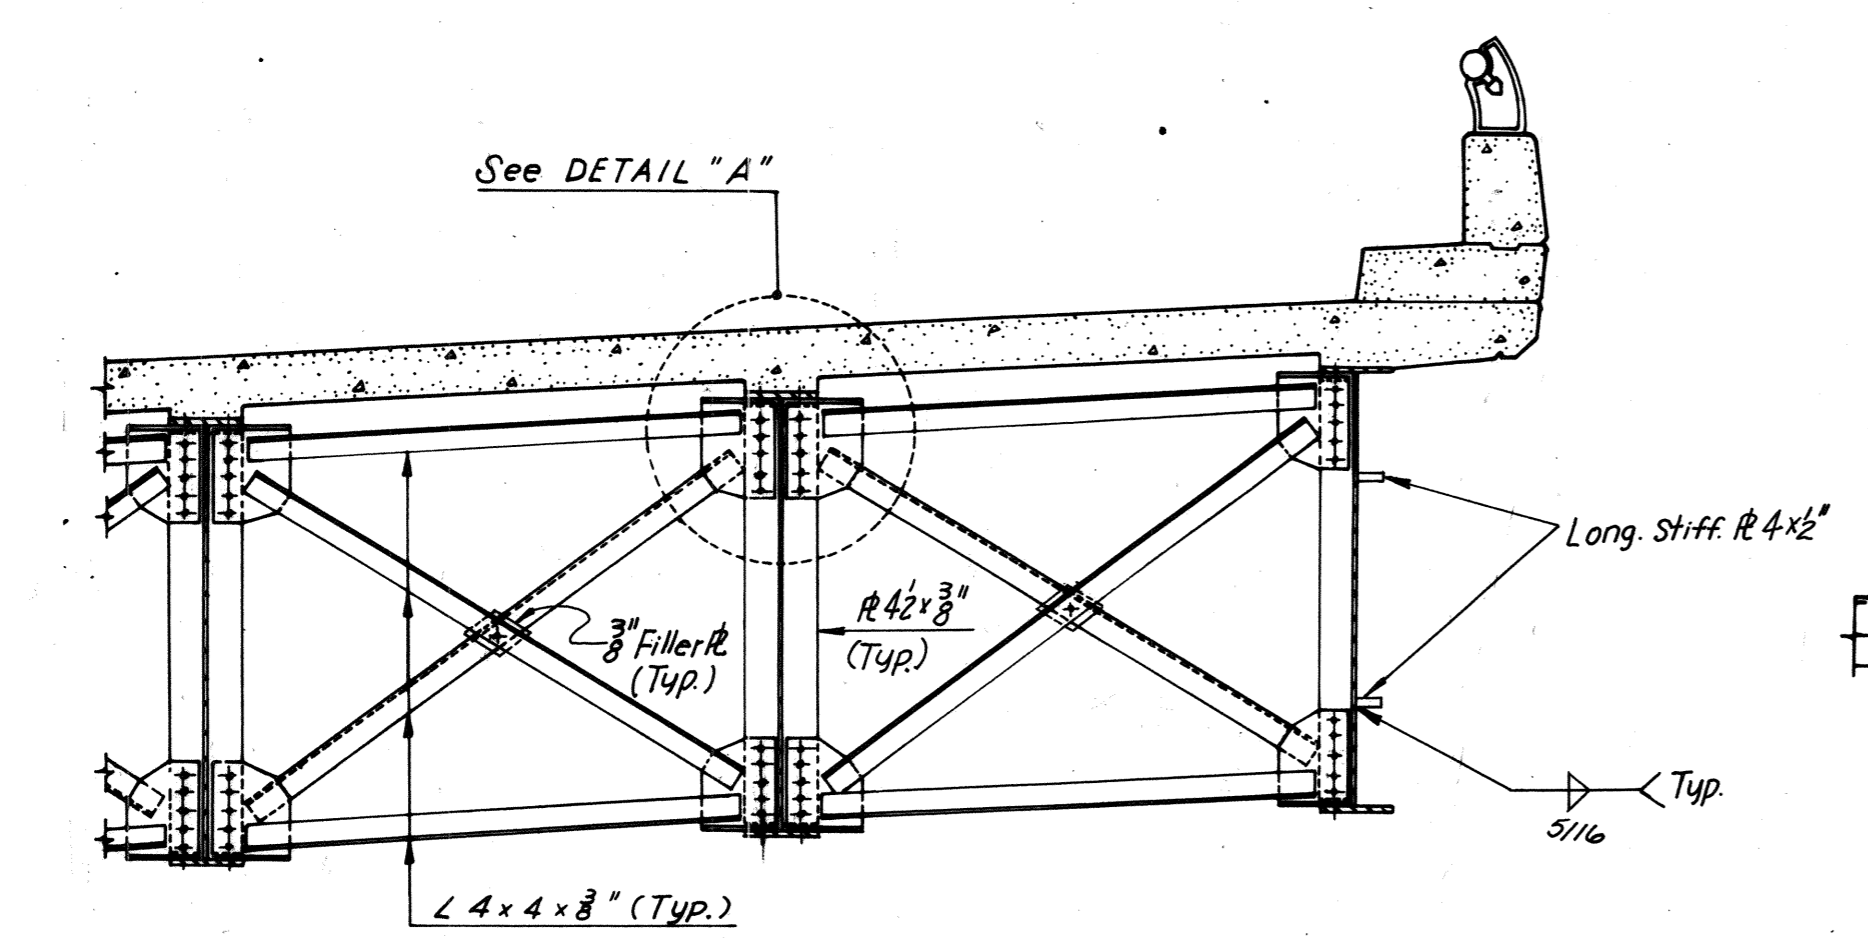


INTERMEDIATE DIAPHRAGM
Scale: $\frac{3}{8}'' = 1'-0''$

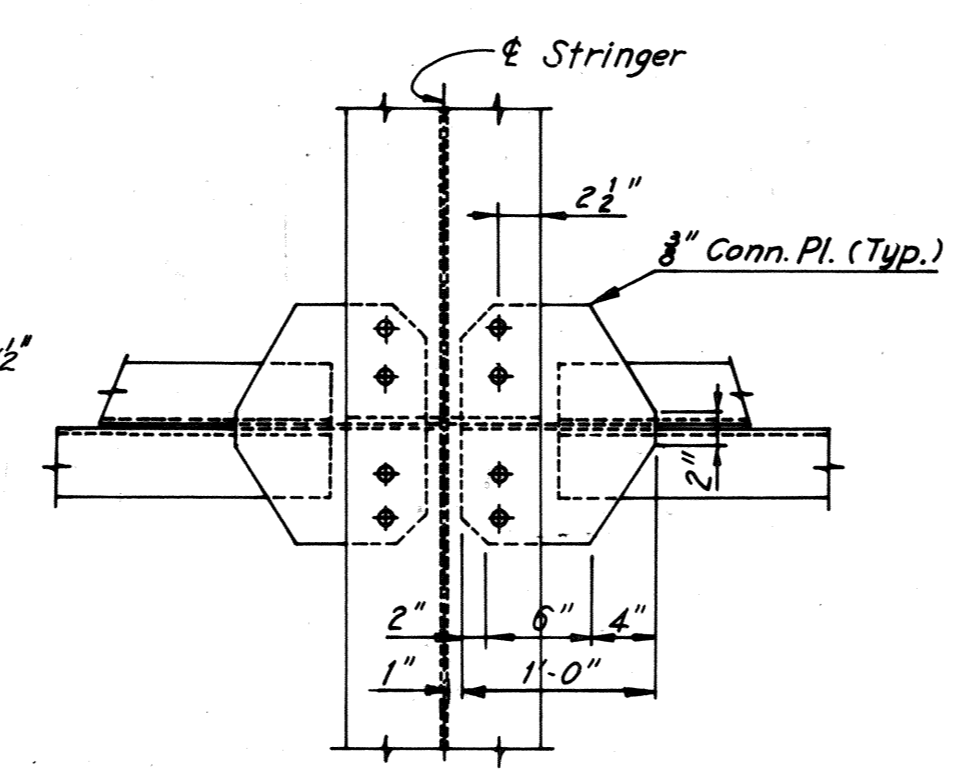


VIEW B-B
Scale: $1'' = 1'-0''$

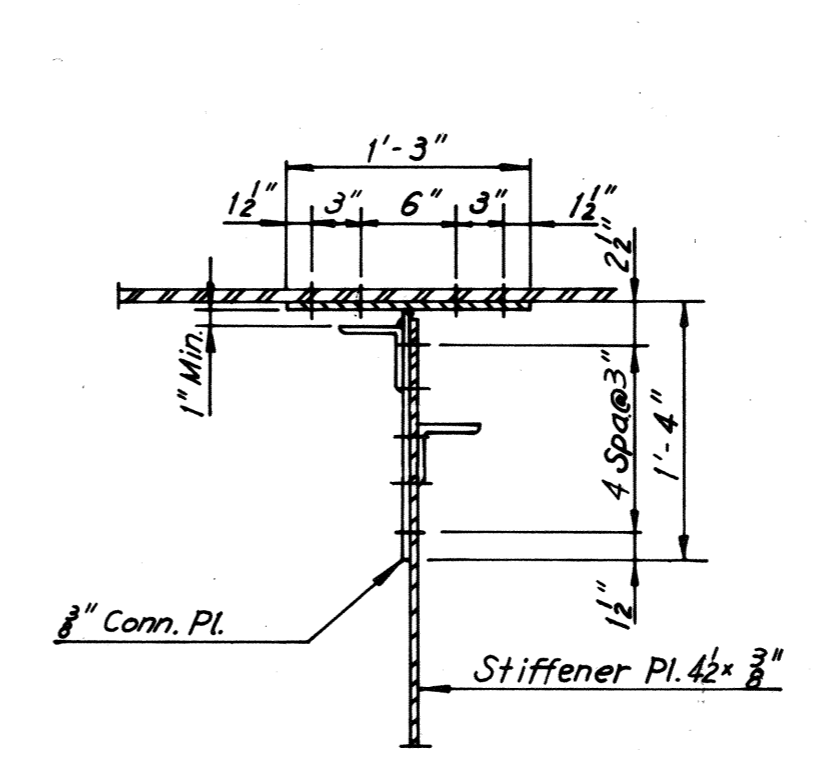

SECTION D-D
Scale: $1'' = 1'-0''$

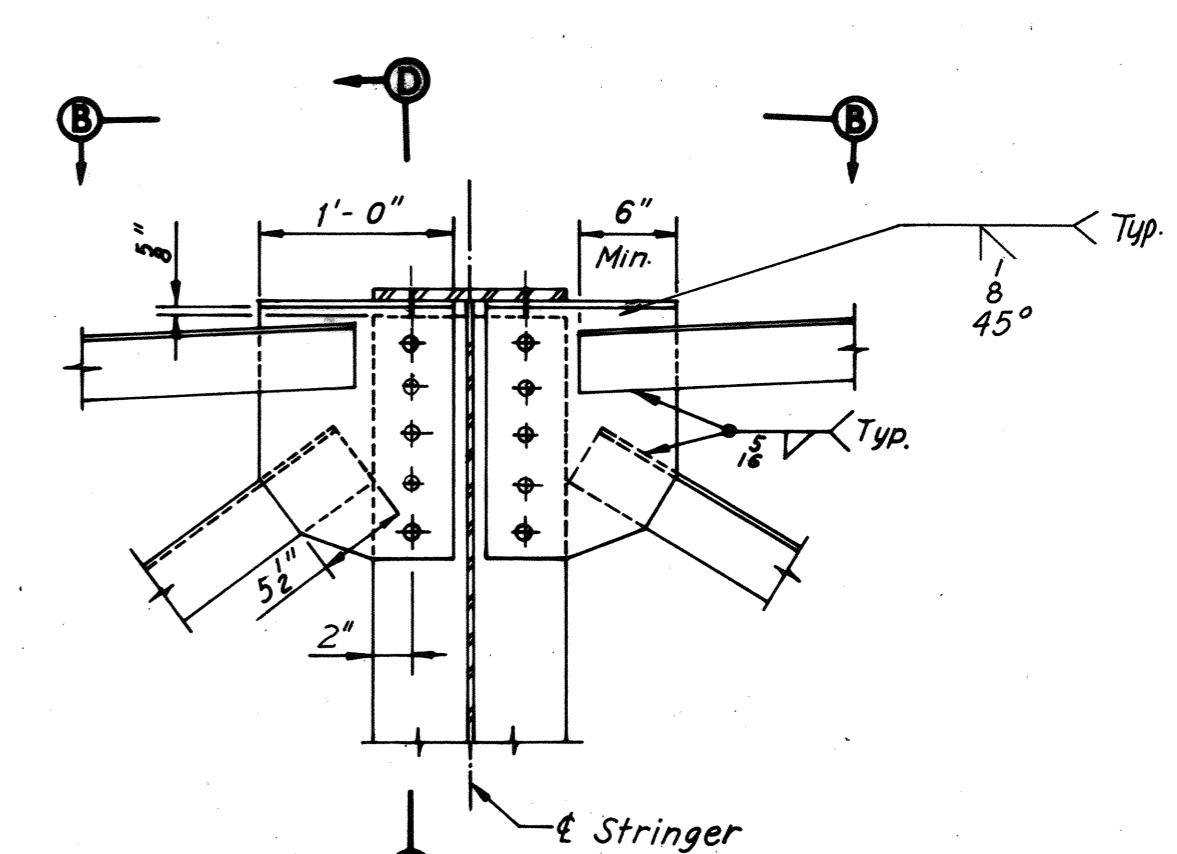

DETAIL A
Scale: $1'' = 1'-0''$

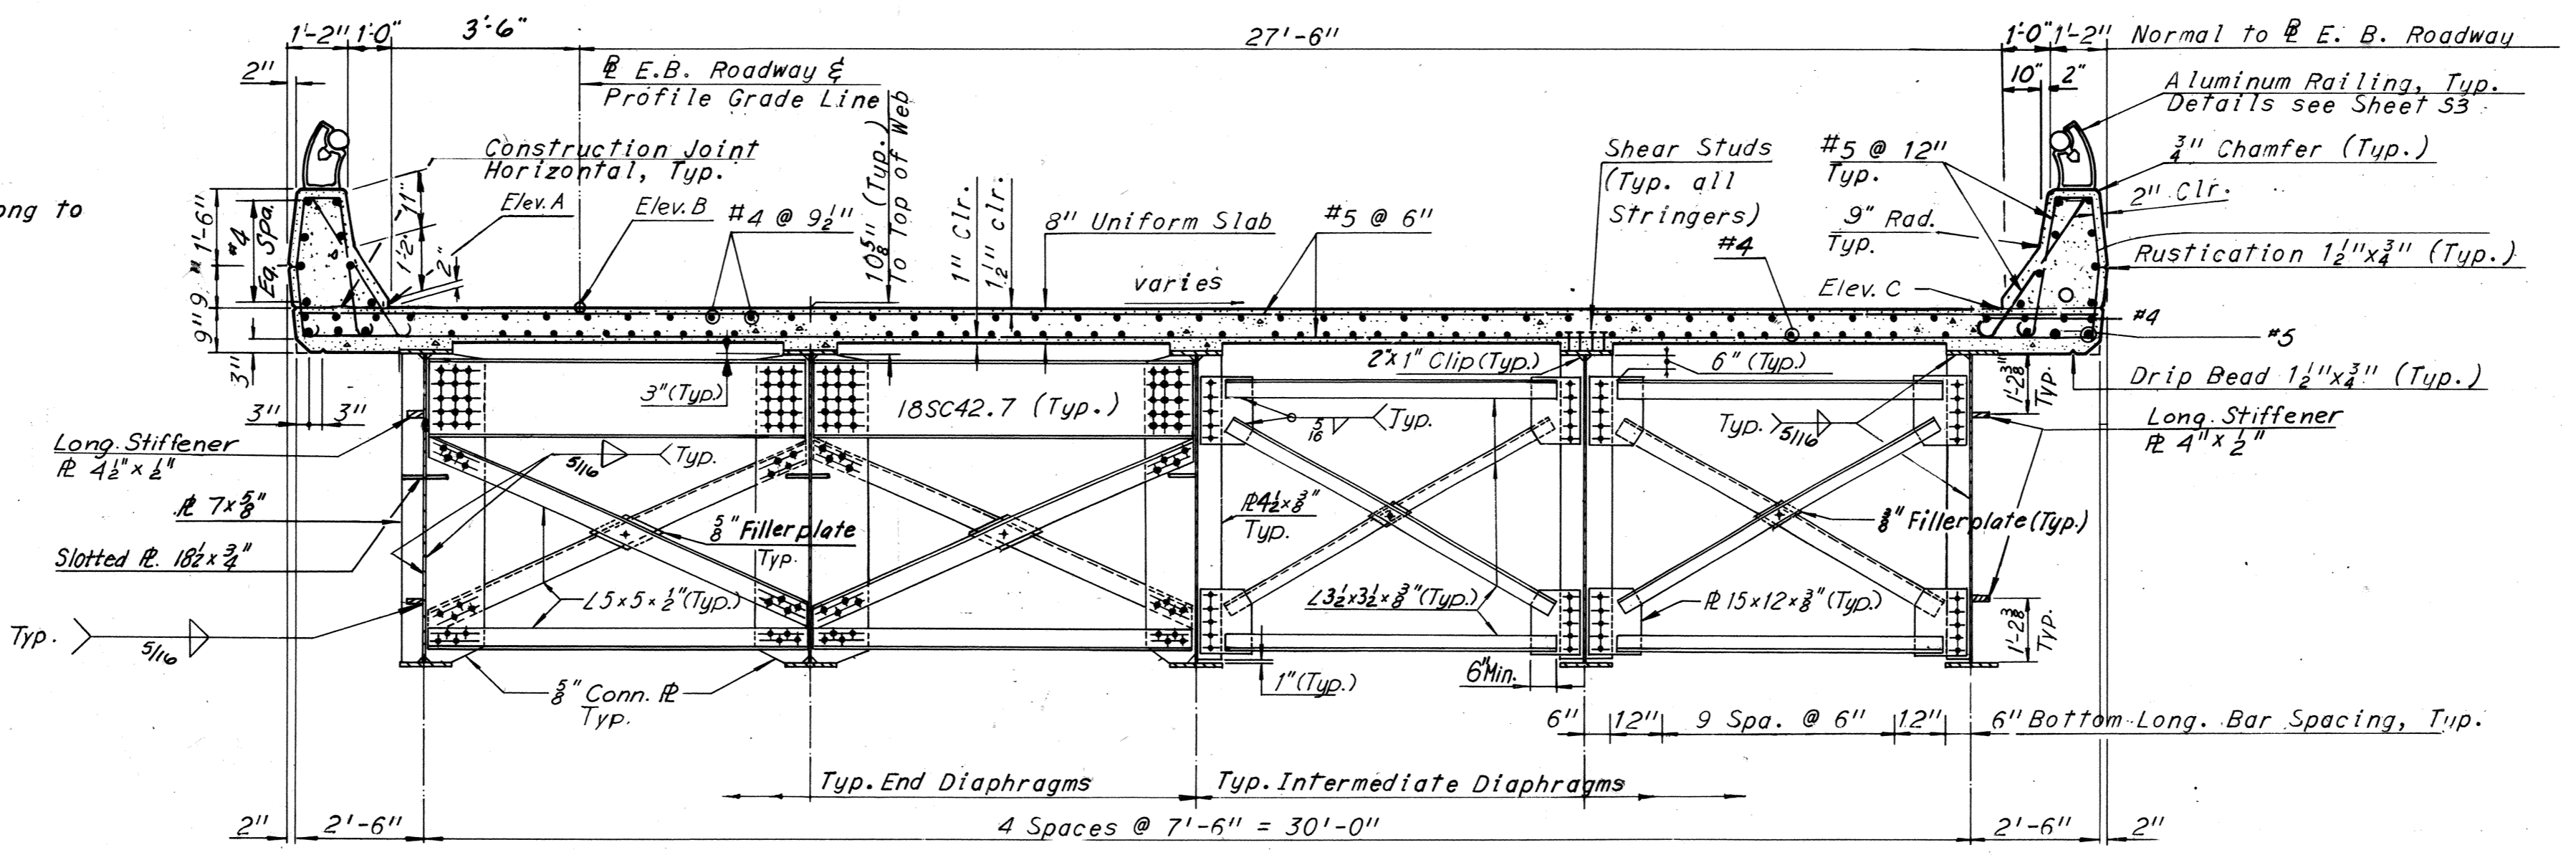

SECTION A-A
Scale: $\frac{3}{8}'' = 1'-0''$

Note: Intermediate Diaphragm Details belong to
Units 21 and 22, see Sheet 34

Note: For details of brg. stiffeners,
see sheets 19 & 23

Notes:
For Joint Details, see Sheet 38
For Framing Plan, see Sheet 19
For Handrail Details, see Sheet 53
For Superstructure quantities, see Sheet 2.

BY	DATE	REVISION	BY	DATE
MADE	SHS	8-2-68		
CHECKED	R.C.	10-18-68	As Built	TEM 8-76
IN CHARGE				

**RICHMOND METROPOLITAN AUTHORITY
RICHMOND EXPRESSWAY SYSTEM
DOWNTOWN EXPRESSWAY**

**BRIDGE NO. 66
EASTBOUND ROADWAY OVER
12TH ST. - R.R. TRACKS AND 16TH ST.
DECK PLAN-UNITS 19 AND 20**







HOWARD, NEEDLES, TAMMEN & BERGENDOFF
consulting engineers
NEW YORK ALEXANDRIA KANSAS CITY
SCALE: As Noted
CONTRACT NO. 10
SHEET NO. 33 OF 46

AS BUILT

RICHMOND EXPRESSWAY SYSTEM			
SECTION	PROJECT	SHEET NO.	TOTAL SHEETS
10	DOWNTOWN EXPRESSWAY	160	265

ELEVATION TABLE			
STATION	ELEV. A	ELEV. B	ELEV. C
341+75.50	92.61	92.68	—
+80.00	92.65	92.72	—
+90.00	92.74	92.81	—
342+00.00	92.82	92.89	—
+10.00	92.90	92.97	—
+20.00	92.98	93.06	—
+30.00	93.06	93.15	—
+40.00	93.14	93.24	—
+50.00	93.21	93.32	—
+60.00	93.26	93.38	—
+70.00	93.32	93.45	—
+80.00	93.35	93.49	—
+90.00	93.37	93.52	—
343+00.00	93.39	93.55	—
+10.00	93.40	93.57	—
+20.00	93.38	93.56	—
+30.00	93.35	93.54	—
+40.00	93.30	93.50	—
+50.00	93.22	93.43	—
+60.00	93.14	93.35	94.64
+70.00	93.02	93.23	94.52
+80.00	92.86	93.07	94.36
+90.00	92.66	92.87	94.16

ELEVATION TABLE			
STATION	ELEV. D	ELEV. E	ELEV. F
342+07.56	93.50	93.43	—
+10.00	93.52	93.45	—
+20.00	93.61	93.54	—
+30.00	93.69	93.62	—
+40.00	93.78	93.71	—
+50.00	93.87	93.80	—
+60.00	93.97	93.90	—
+70.00	94.08	94.01	—
+80.00	94.20	94.13	—
+90.00	94.31	94.24	—
343+00.00	94.42	94.35	—
+10.00	94.53	94.46	—
+20.00	94.64	94.57	—
+30.00	94.74	94.67	—
+40.00	94.84	94.77	—
+50.00	94.93	94.86	—
+60.00	95.01	94.94	94.53
+70.00	95.07	95.00	94.59
+80.00	95.14	95.07	94.69
+90.00	95.18	95.12	94.79
344+00.00	95.21	95.16	94.89
+10.00	95.22	95.18	94.96

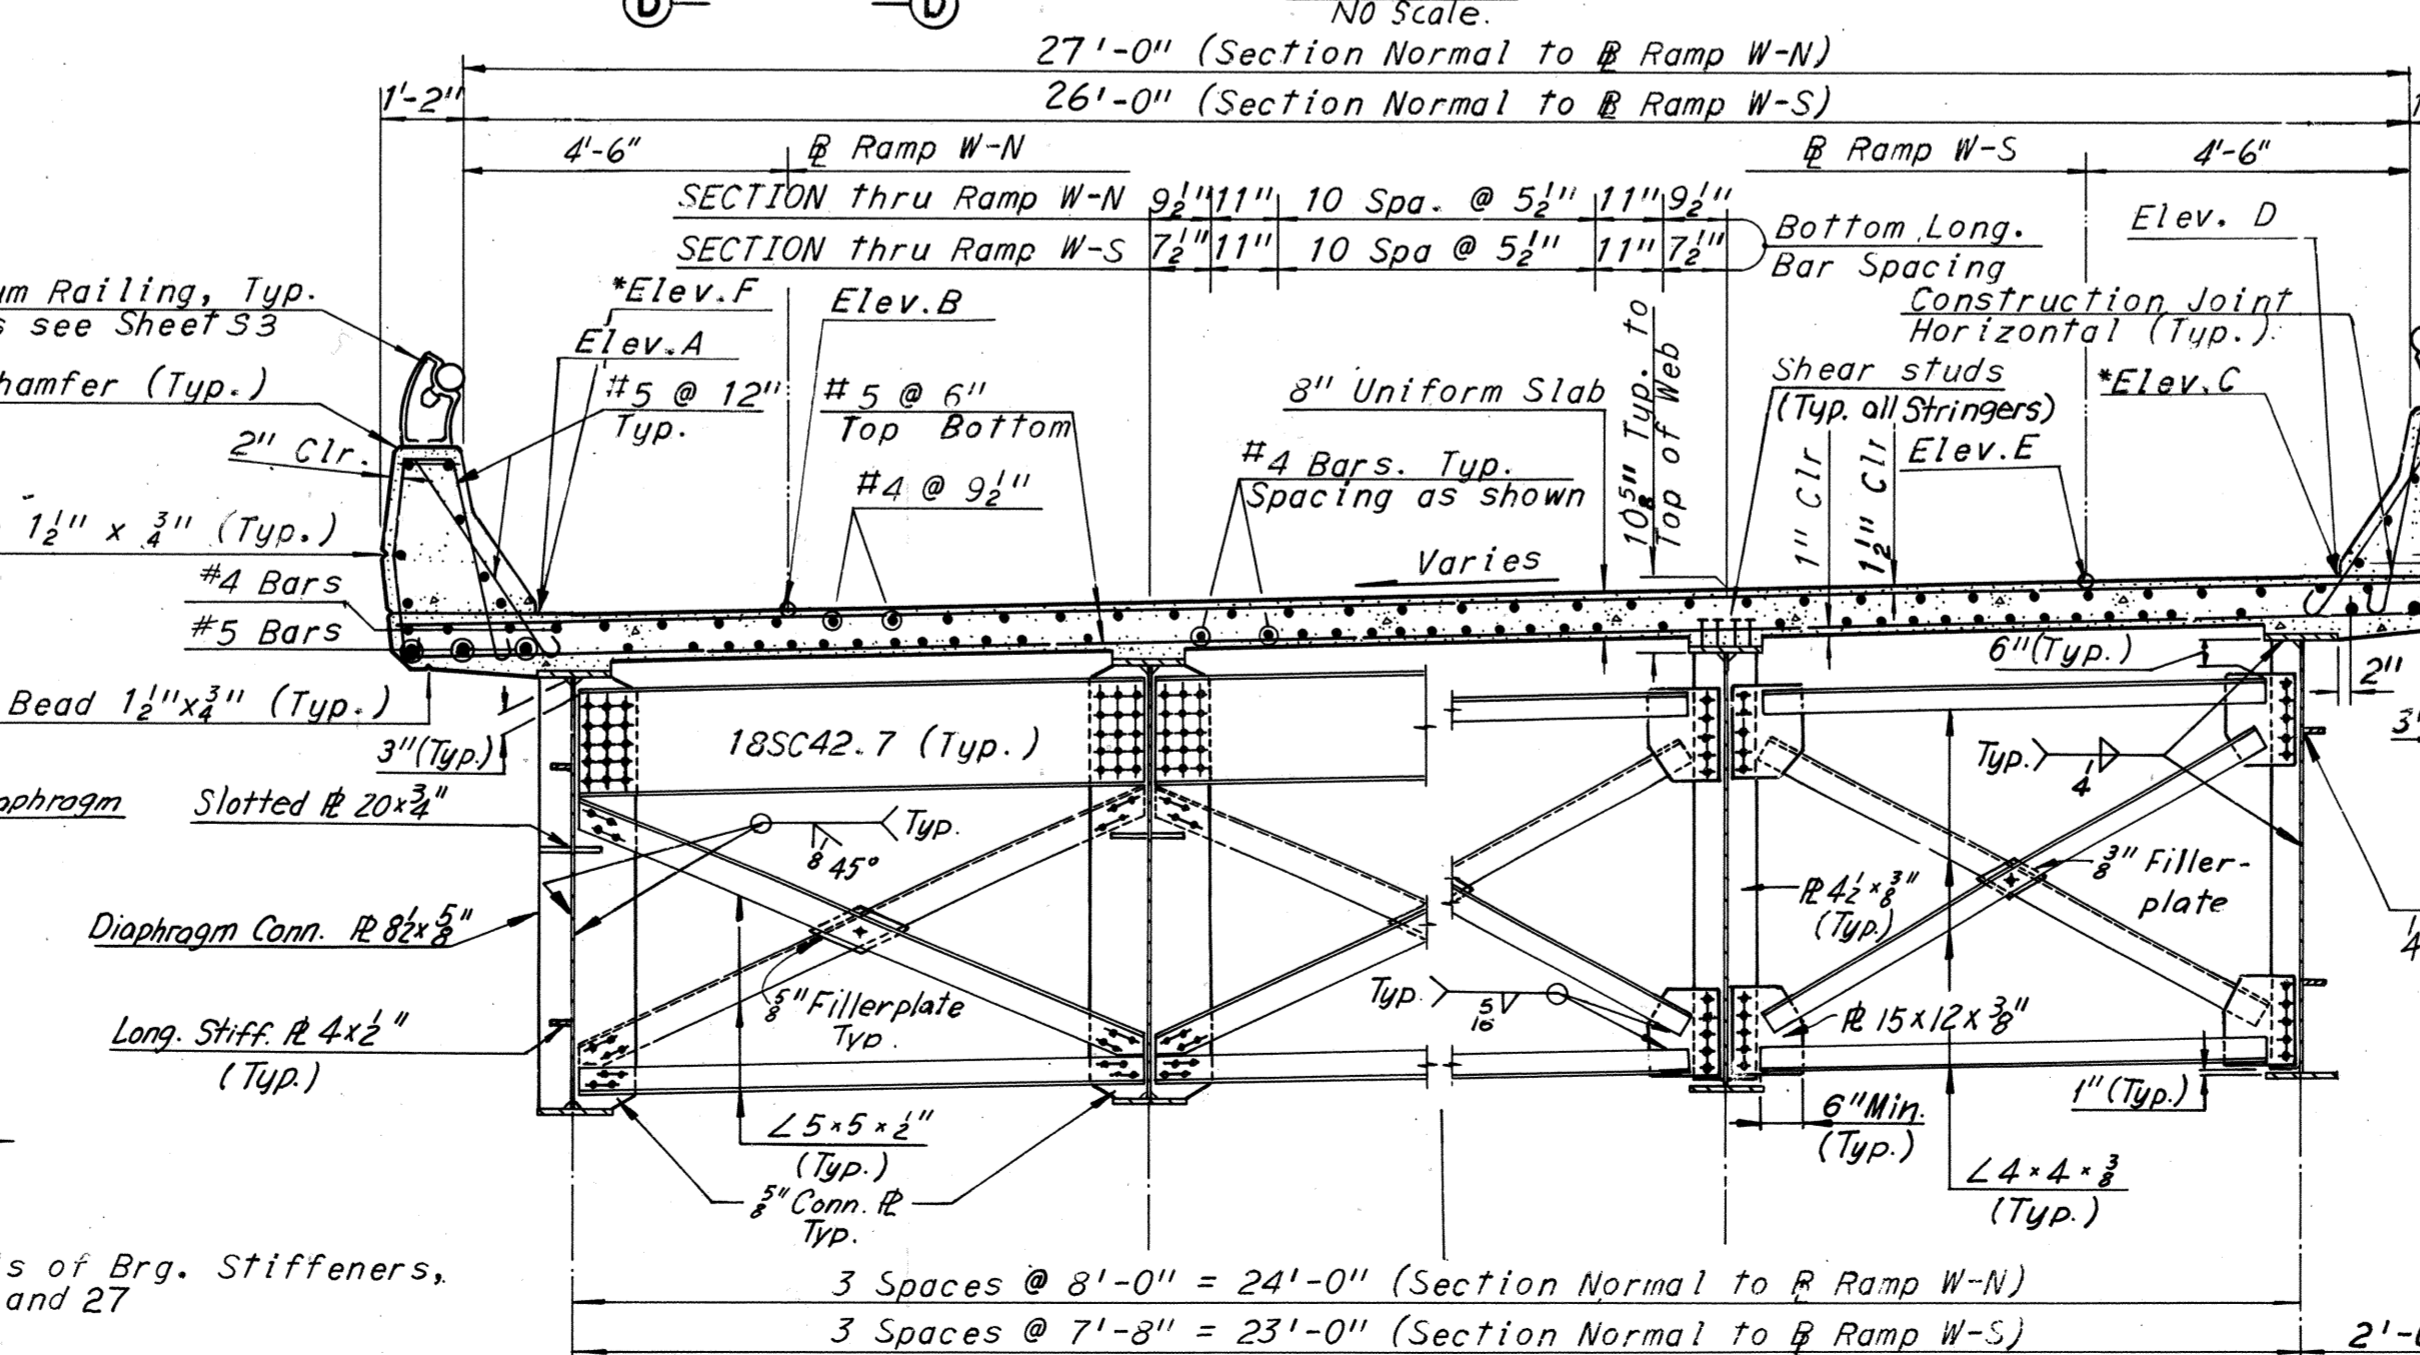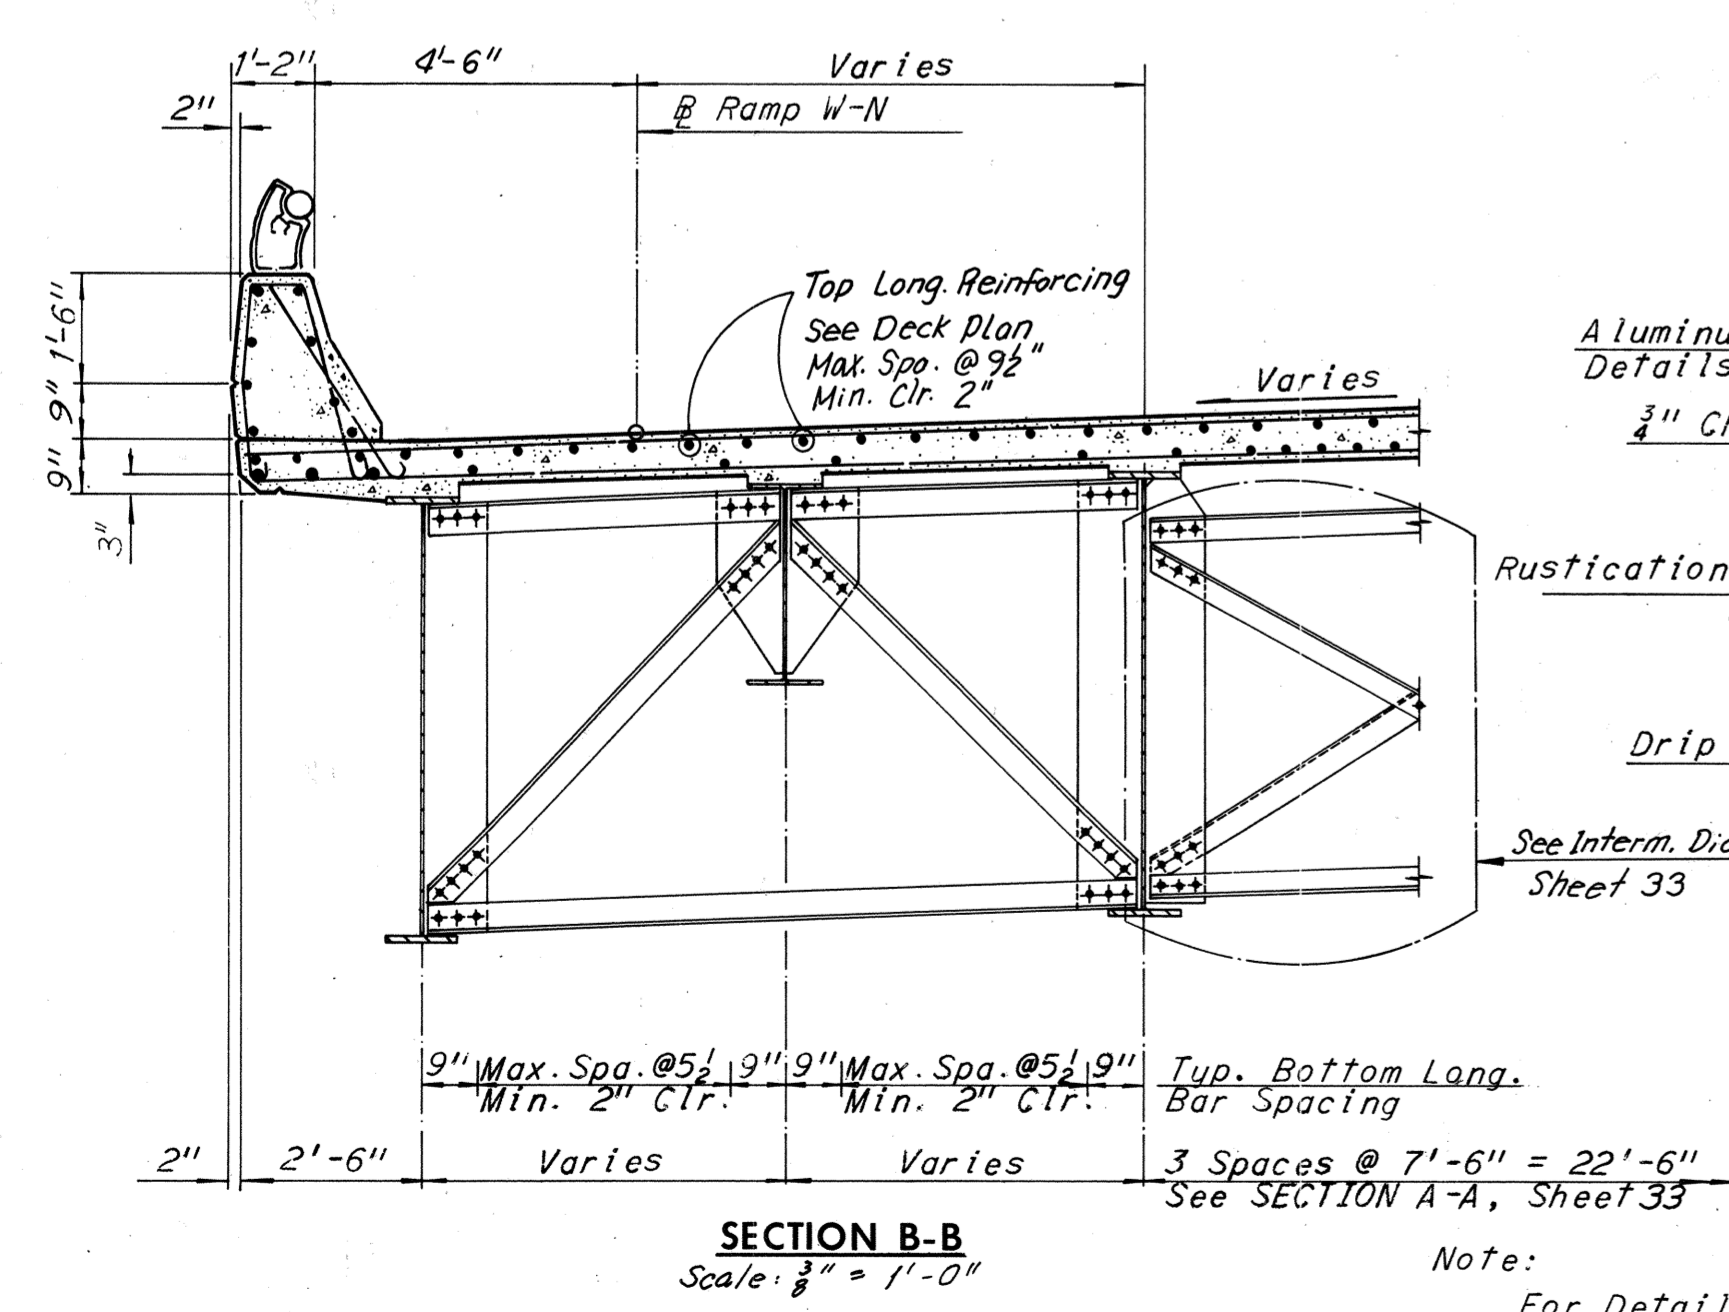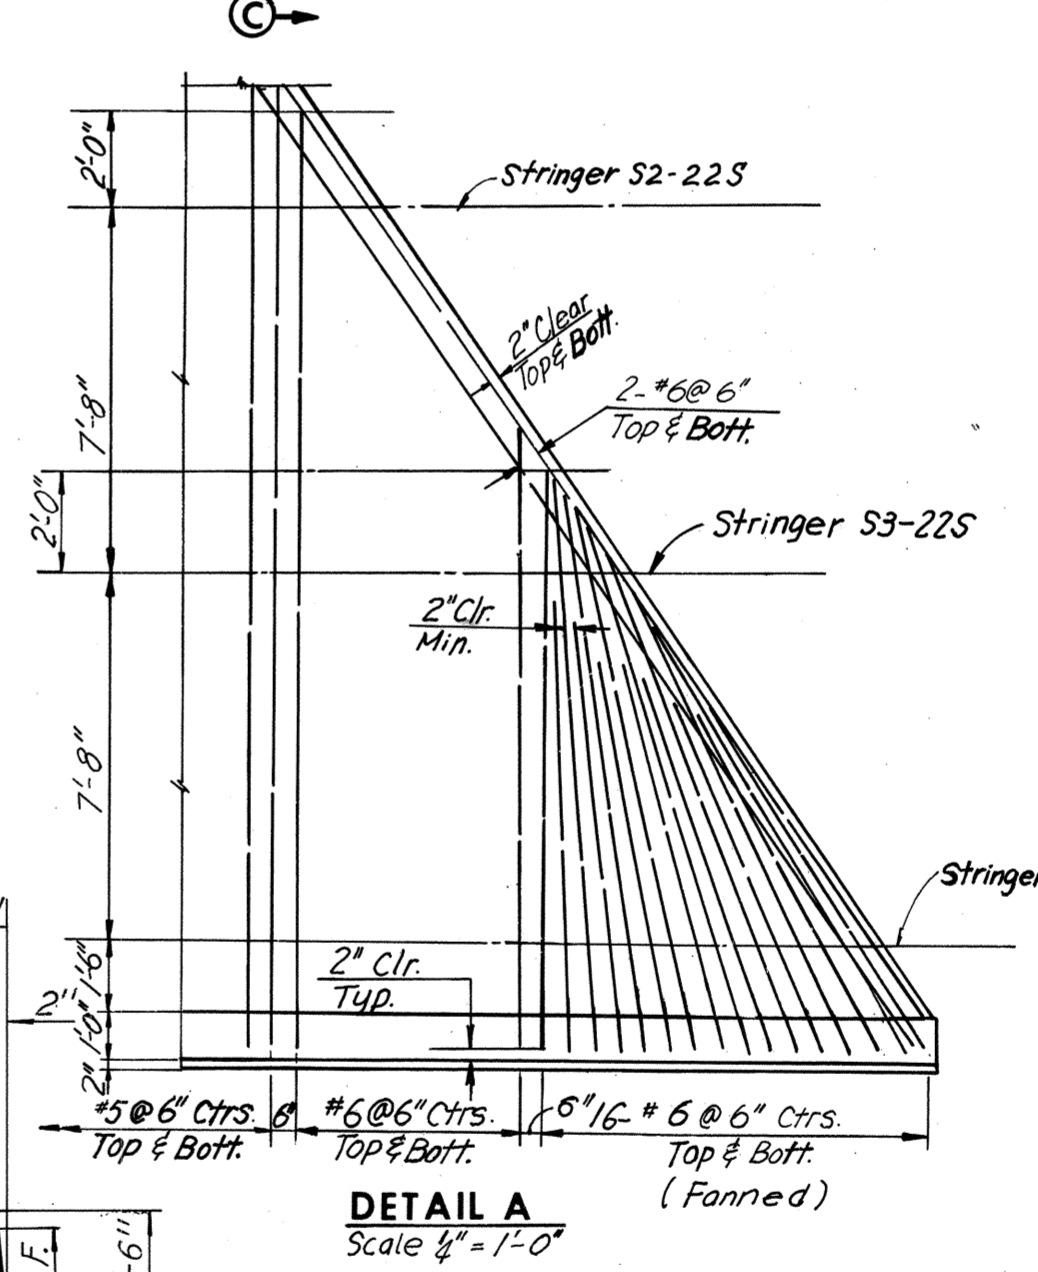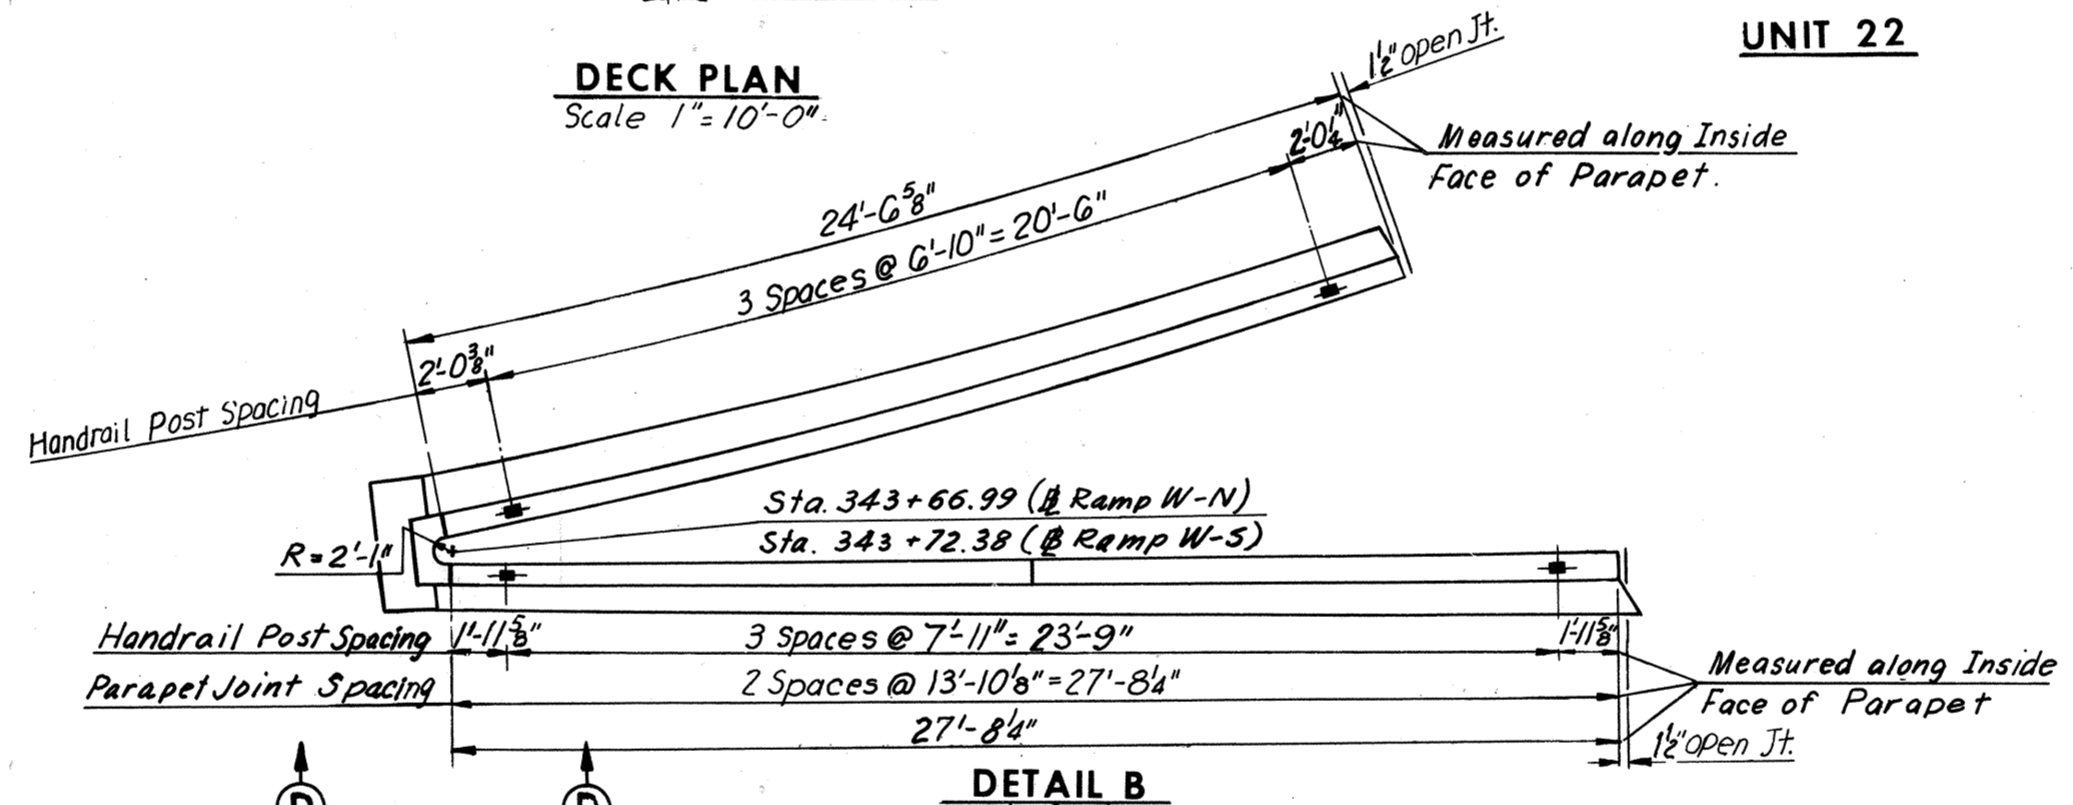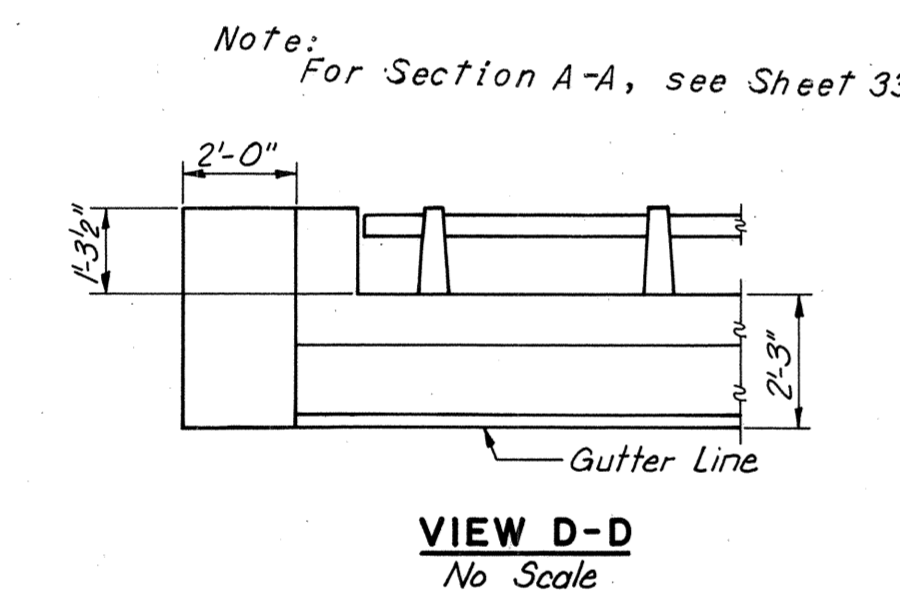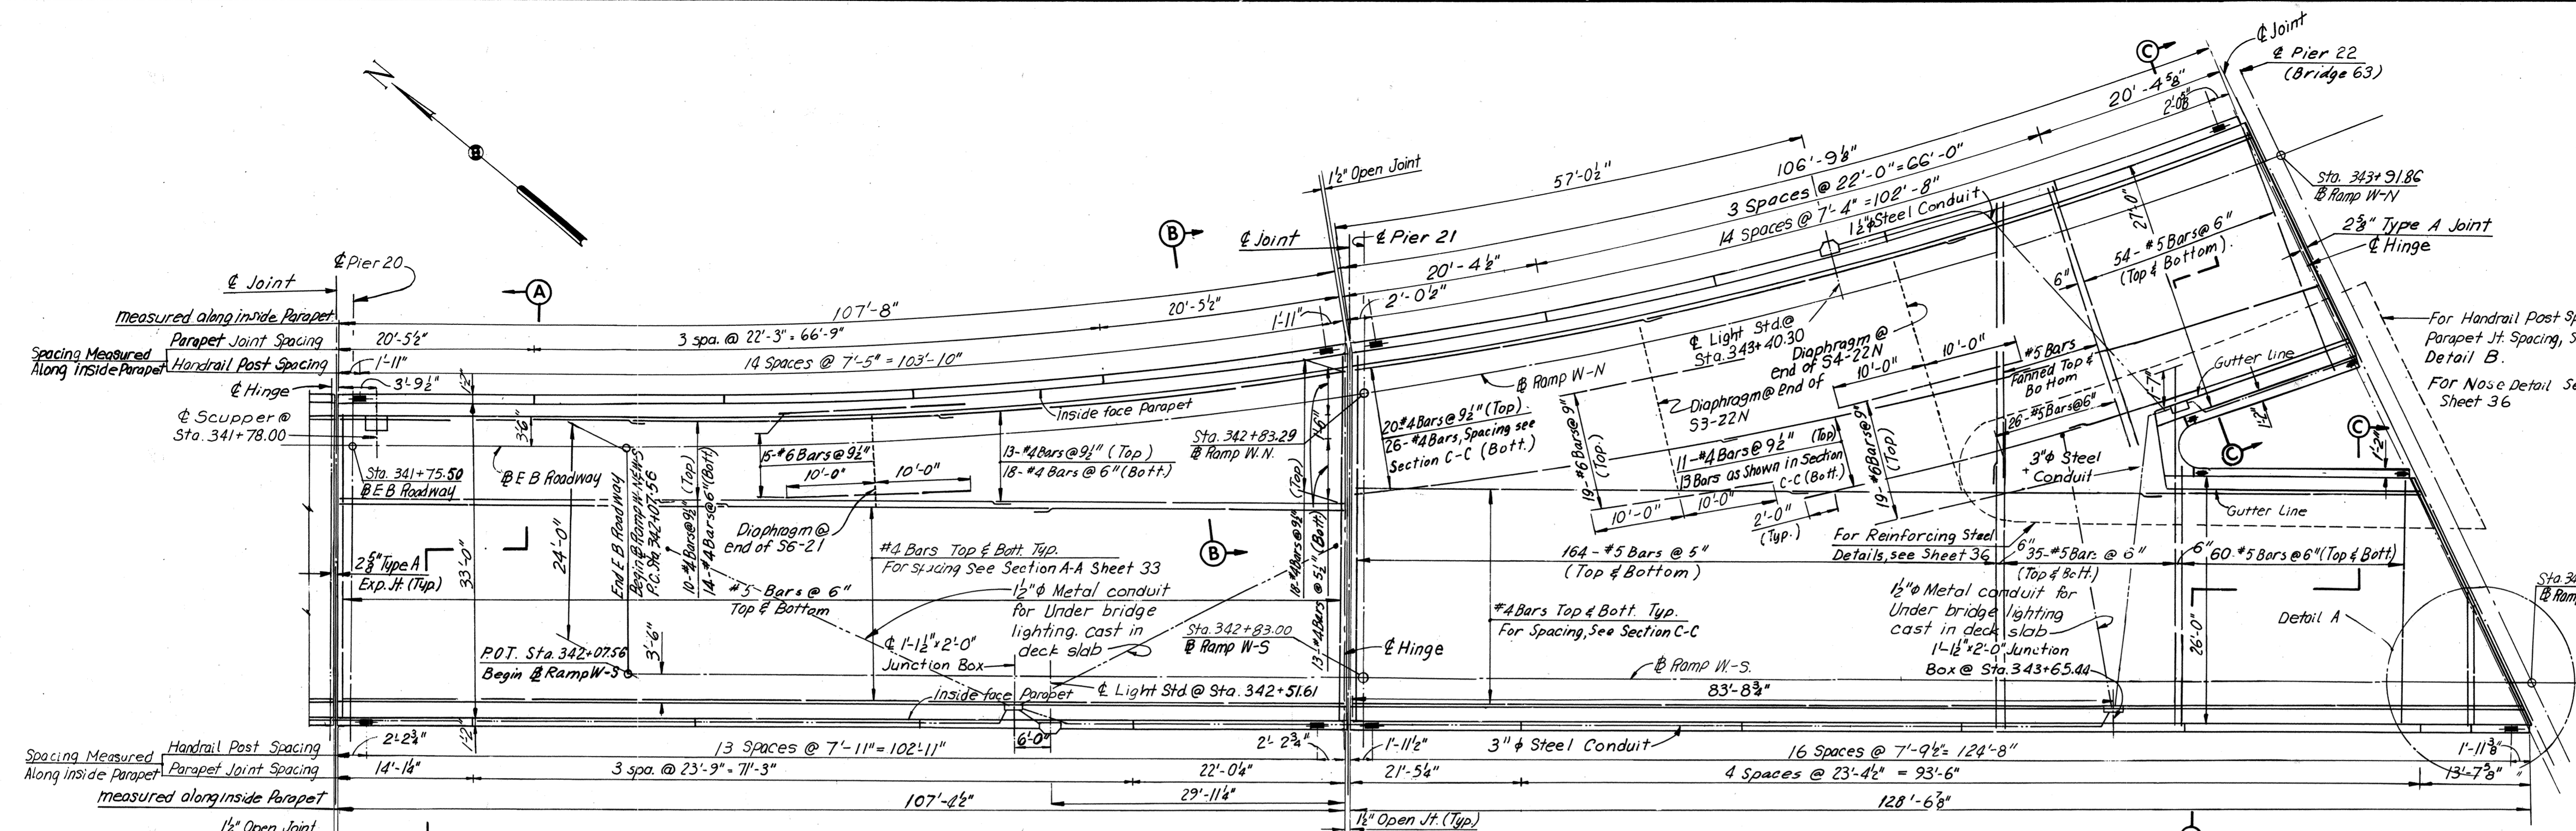

Notes:
 * Elev. C indicates the elevation of nose north gutter line.
 * Elev. F indicates the elevation of nose south gutter line.

BY	DATE	NO.	REVISION	BY	DATE
MADE	G.S.H. 08-09-68				
CHECKED	S.C.C. 10-25-68	1	As Built	TEM	8-76
IN CHARGE					

Note:
 For Details of Brg. Stiffeners, see Sheets 20 and 27

Note:
 Intermediate Diaphragms shown can only be used where stringers are straight. For Intermediate Diaphragm Details of curved stringers, see Sheet 33.

RICHMOND METROPOLITAN AUTHORITY
RICHMOND EXPRESSWAY SYSTEM
DOWNTOWN EXPRESSWAY

BRIDGE NO. 66
EASTBOUND ROADWAY OVER
12TH ST. - R.R. TRACKS AND 16TH ST.
DECK PLAN - UNITS 21 AND 22


HOWARD, NEEDLES, TAMMEN & BERGENDOFF
 consulting engineers
 NEW YORK ALEXANDRIA KANSAS CITY

SCALE: As Noted
 CONTRACT NO.: 10
 SHEET NO. 34 OF 46




AS BUILT

RICHMOND EXPRESSWAY SYSTEM			
SECTION	PROJECT	SHEET NO.	TOTAL SHEETS
10	DOWNTOWN EXPRESSWAY	161	265

ELEVATION TABLE			
STATION	ELEV. A	ELEV. B	ELEV. C
344+00.00	95.21	95.16	94.89
+10.00	95.22	95.18	94.96
+20.00	95.21	95.18	95.02
+30.00	95.19	95.17	95.06
+40.00	95.14	95.13	95.08
+50.00	95.08	95.08	95.08
+60.00	95.01	95.02	95.10
+70.00	94.91	94.94	95.10
+80.00	94.81	94.85	95.10
+90.00	94.69	94.75	95.08
345+00.00	94.47	94.06	93.99
+10.00	94.51	94.02	93.94
+20.00	94.55	93.98	93.89
+30.00	94.60	93.94	93.83
+40.00	94.65	93.89	93.76
+50.00	94.65	93.83	93.69
+60.00	94.66	93.76	93.61
+70.00	94.66	93.68	93.52
+73.84	94.66	--	--
+77.08	--	--	93.44
+78.00	--	93.61	--
+80.00	94.66	93.59	93.41
345+90.00	94.62	93.49	93.29
346+00.00	94.56	93.37	93.17
+10.00	94.47	93.25	93.05
+20.00	94.35	93.12	92.91
+30.00	94.20	92.97	92.76
+40.00	94.06	92.82	92.61
+41.63	--	--	92.59
+41.66	94.02	--	--

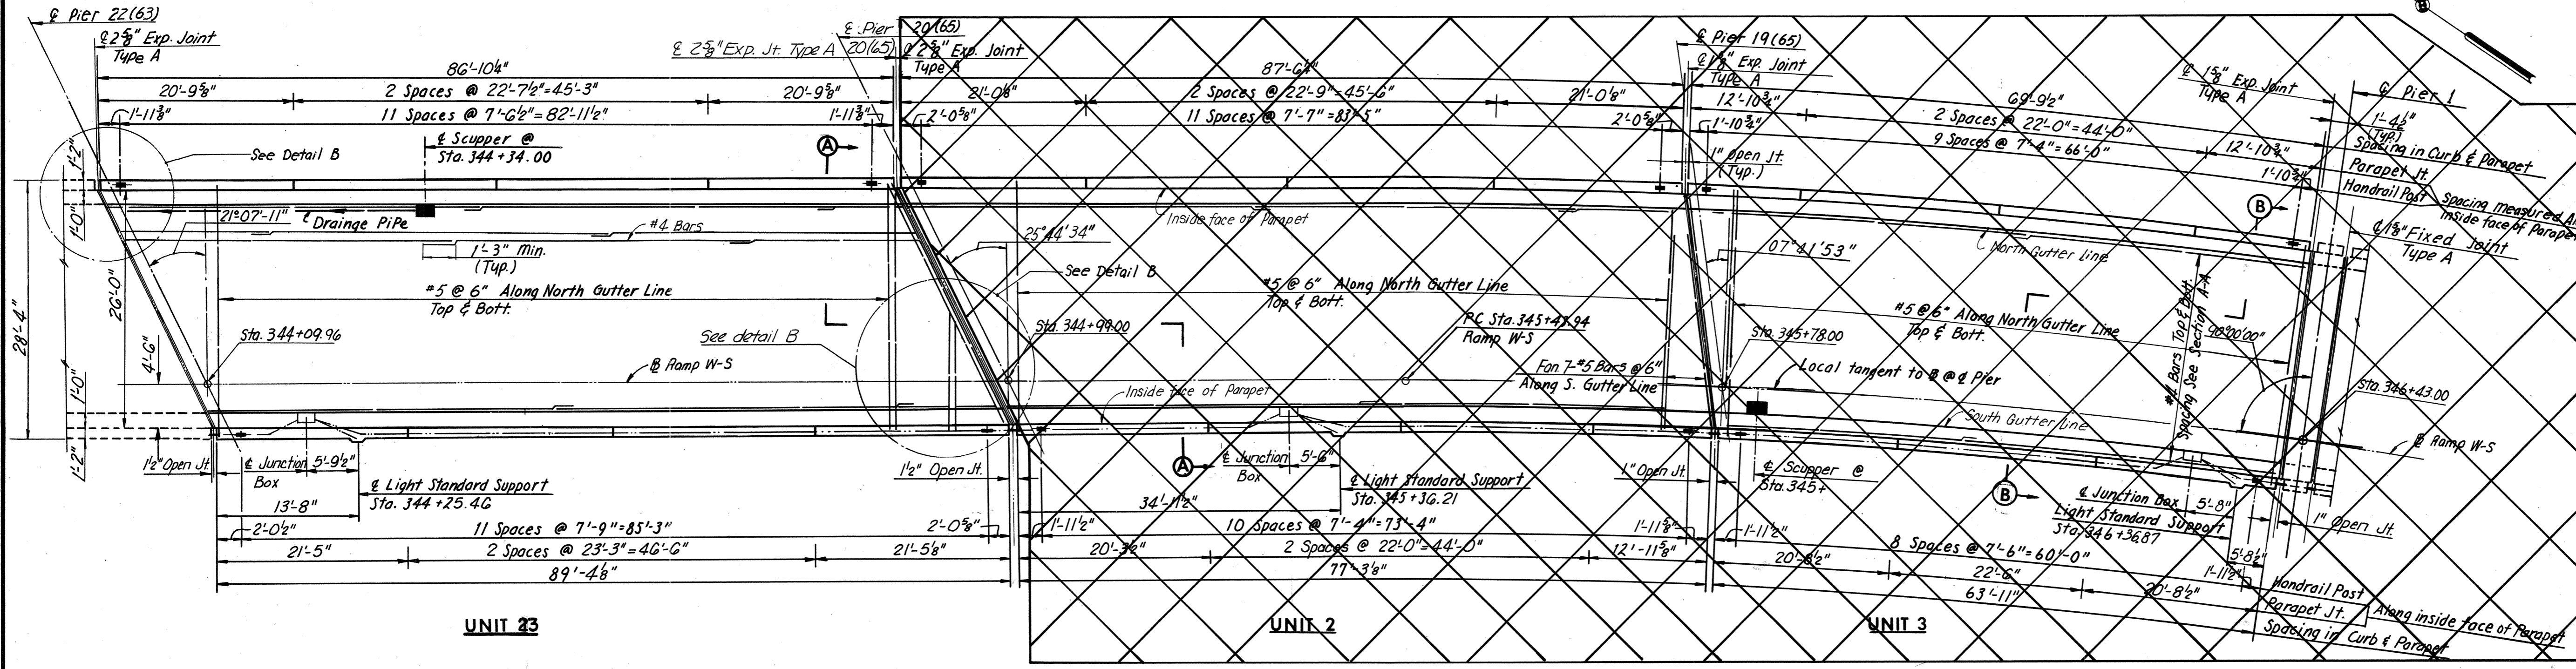

DECK PLAN
Scale: 1"=10'-0"
Note: Section B-B, See Sheet 20.

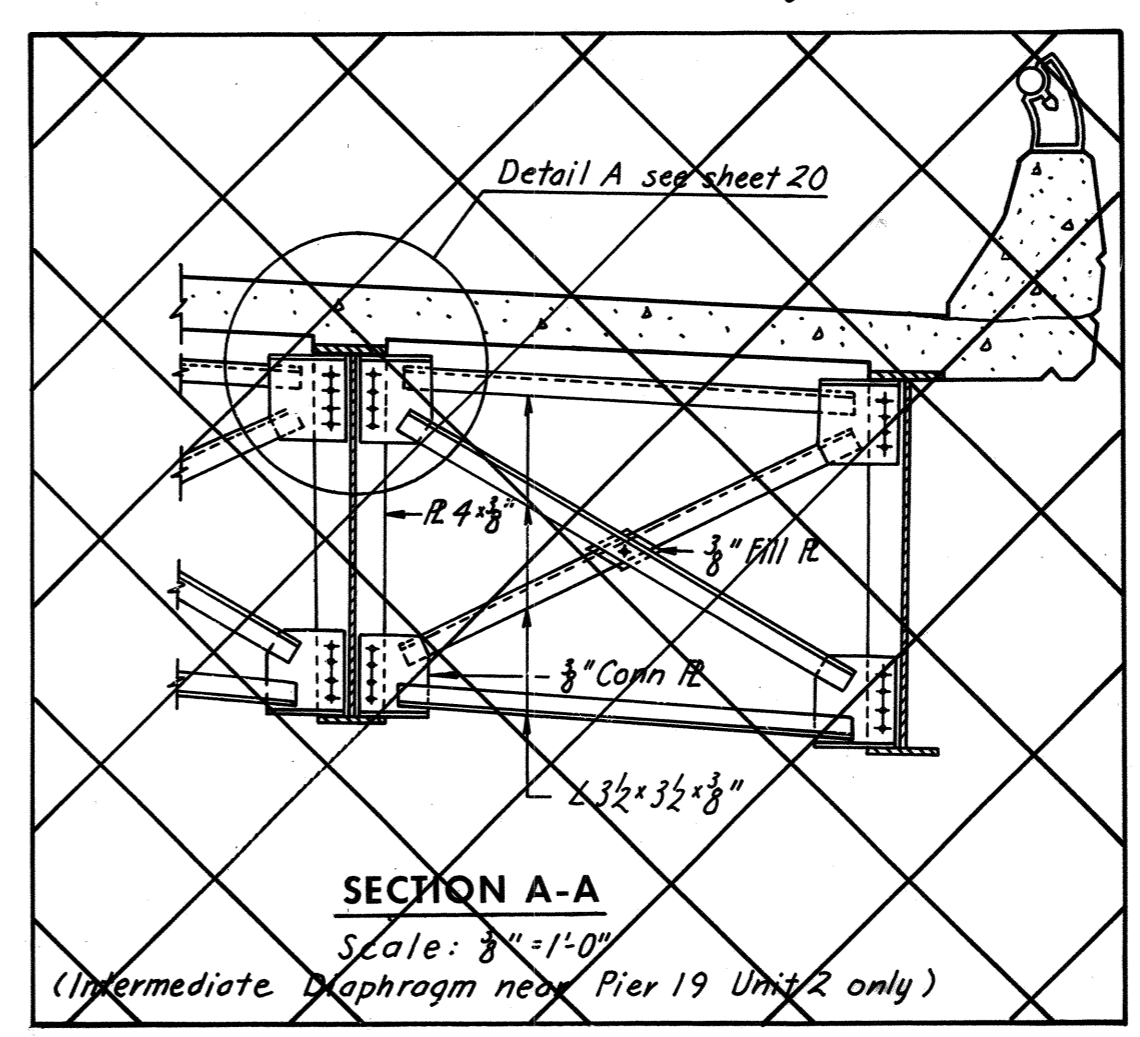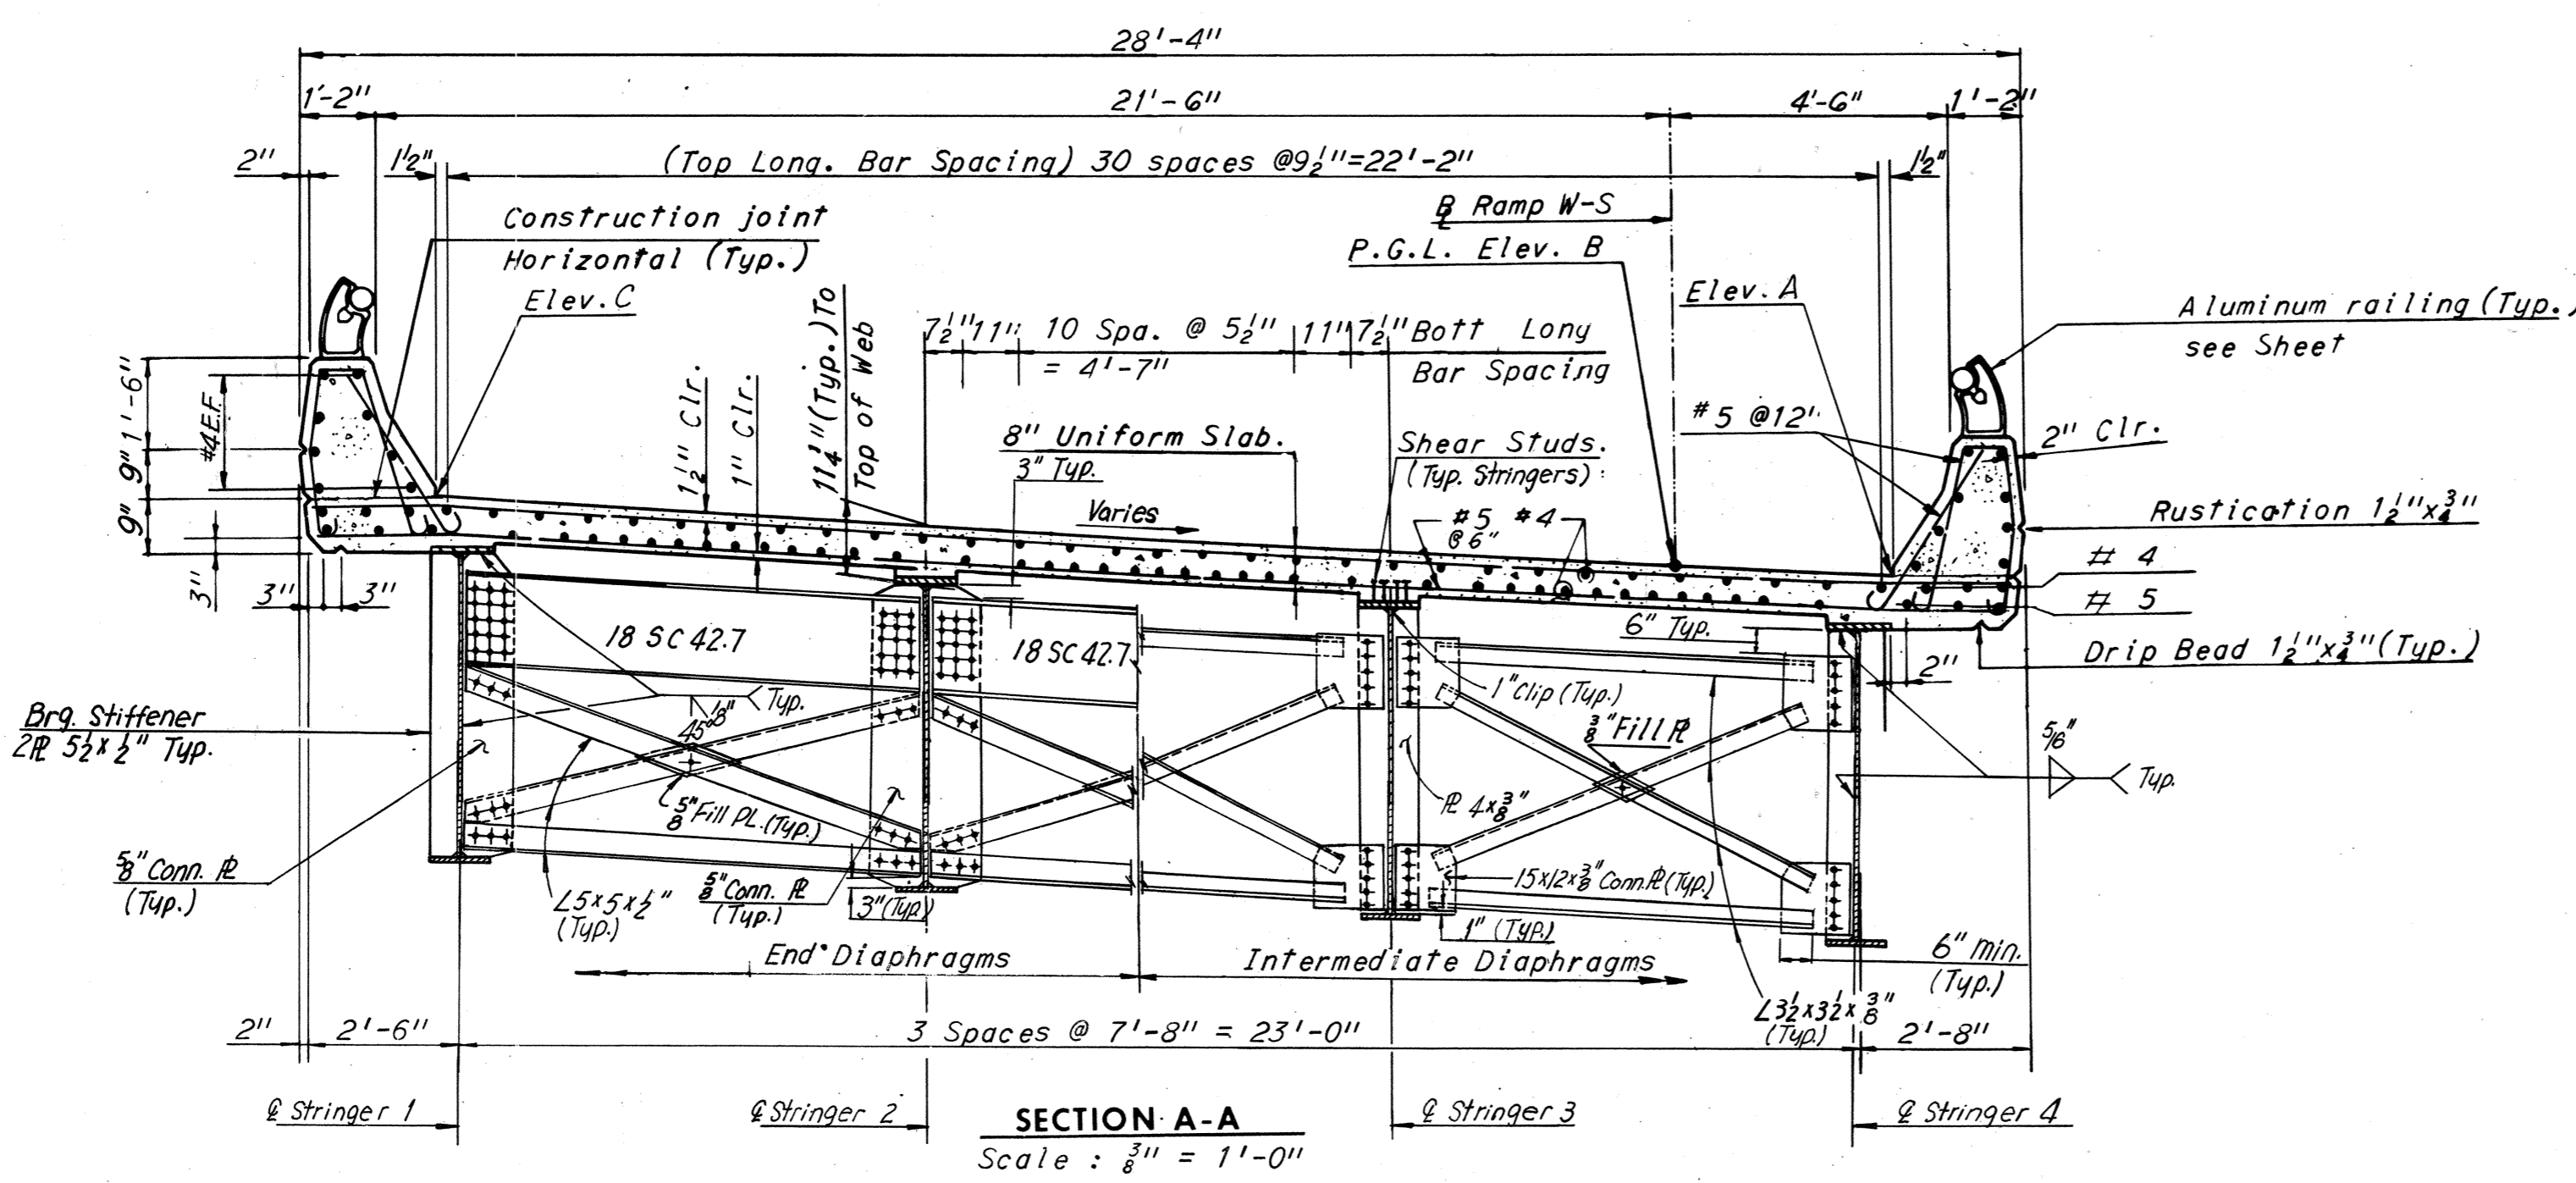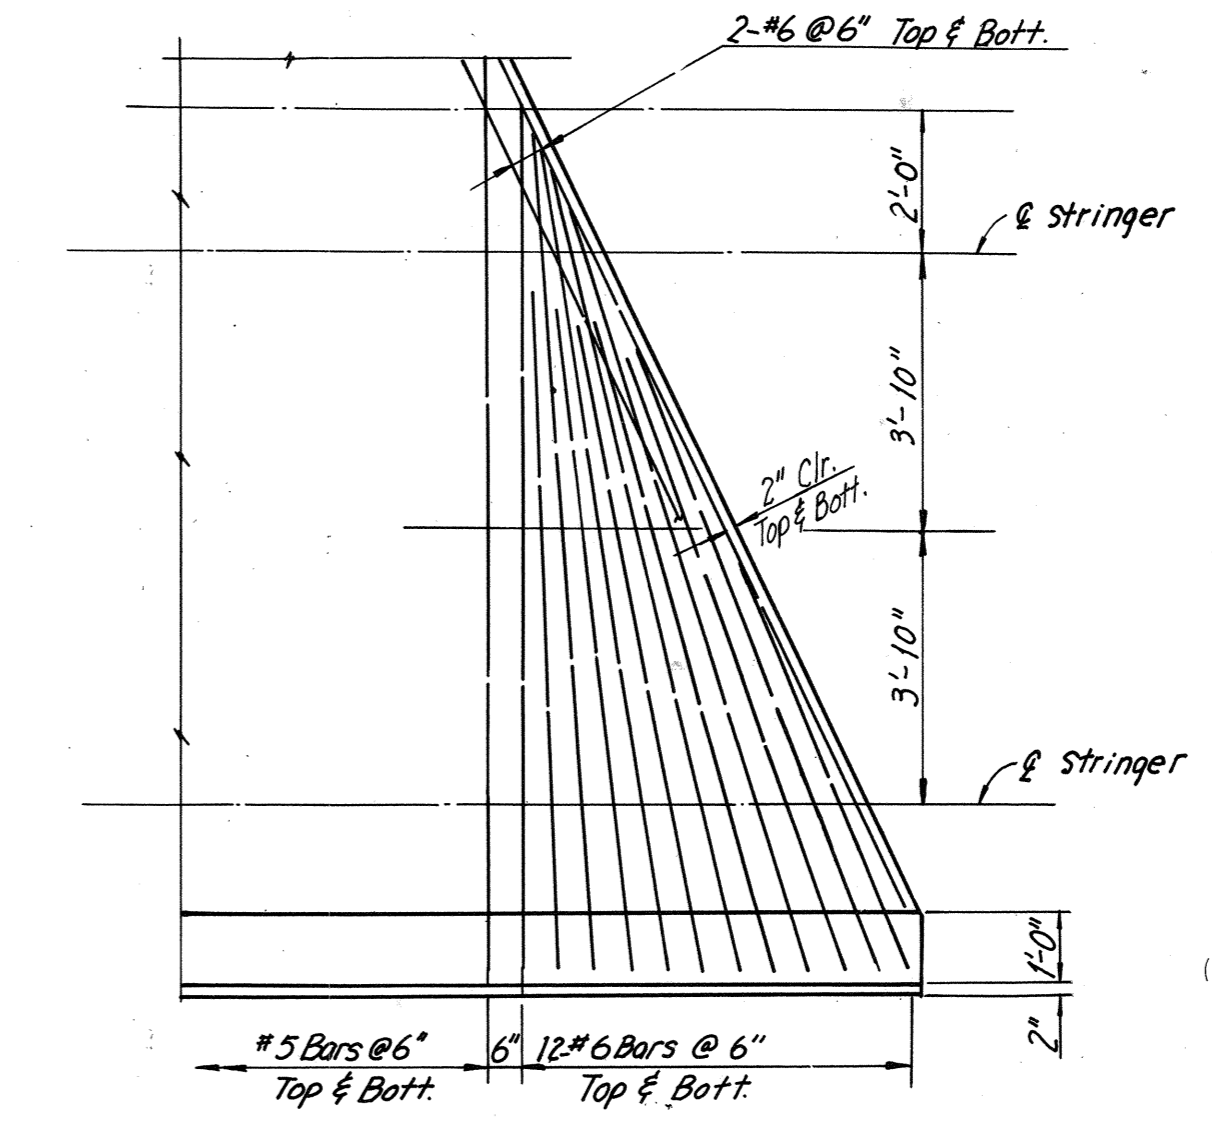

Notes
For Framing Plan, see Sheet 21.
For Standard Lighting Details, see Sheet S4.
For Standard Drainage Details, see Support Type 2 Sheet S5&S6.
For Joint Details, see Sheet 38.
For Standard Handrail Details, see Sheet S3.

RICHMOND METROPOLITAN AUTHORITY
RICHMOND EXPRESSWAY SYSTEM
DOWNTOWN EXPRESSWAY


BRIDGE NO. 66
EASTBOUND ROADWAY OVER
12TH ST.-R.R. TRACKS AND 16TH ST.
DECK PLAN — UNIT 23

HOWARD, NEEDLES, TAMMEN & BERGENDOFF
consulting engineers
NEW YORK ALEXANDRIA KANSAS CITY

SCALE: As Noted
CONTRACT NO. 10
SHEET NO. 35 OF 46


BY	DATE	REVISION	BY	DATE
MADE	G.S.H. 10-29-68	2 As Built	TEM	8-76
CHECKED	A.H.H. 12-13-68			
IN CHARGE				

AS BUILT

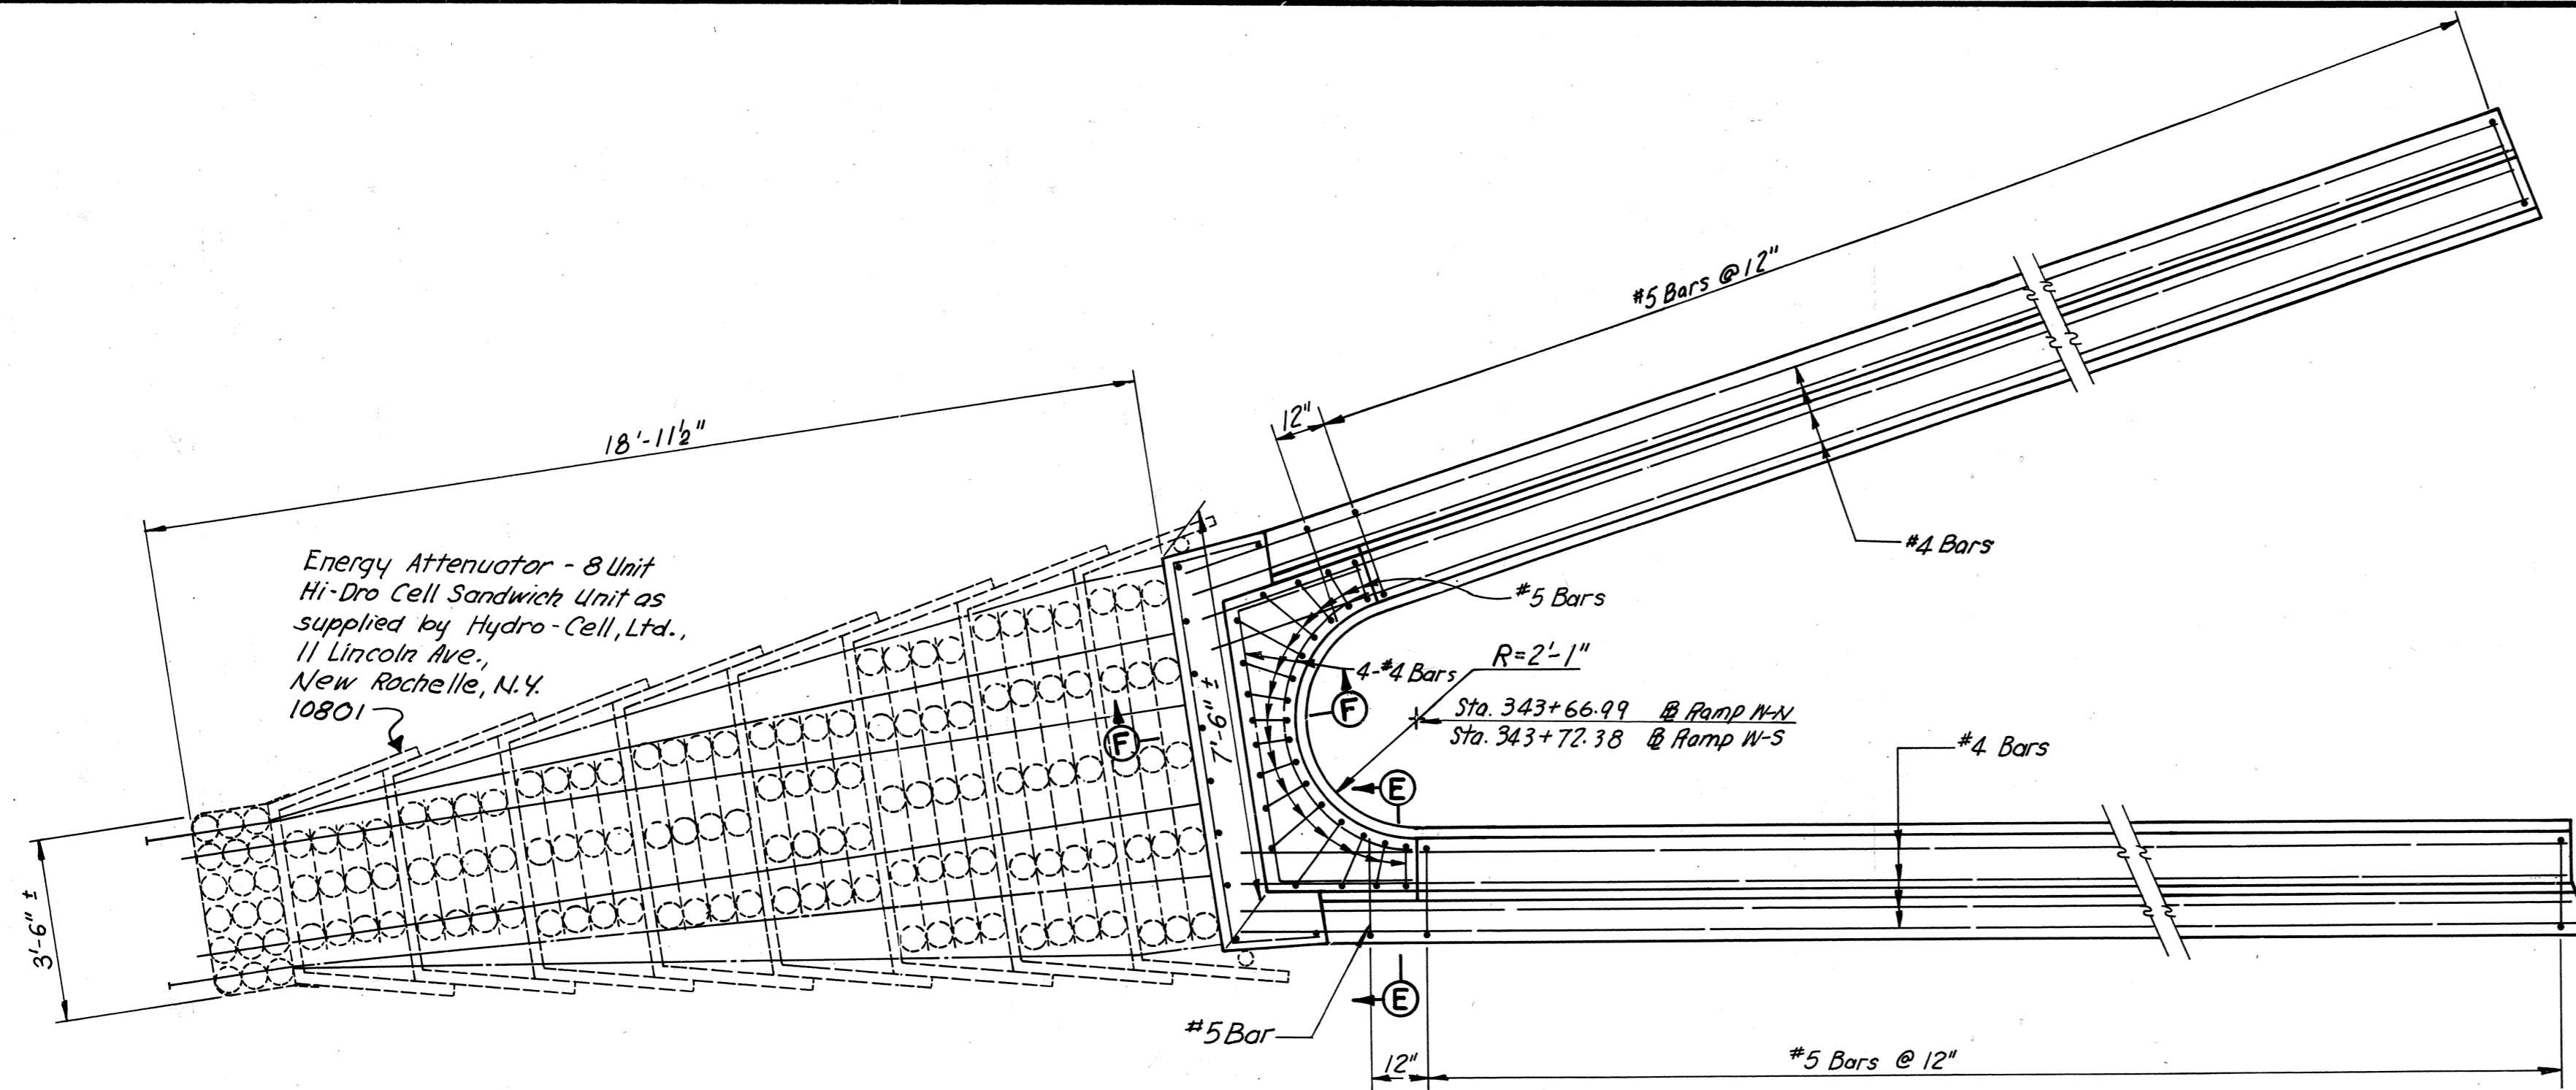


Note: Reinforcing Steel in curb and parapet is shown. For typical section thru curb and parapet, see Section C-C Sheet 34.

CURB AND PARAPET REINFORCING STEEL DETAIL
Scale: 3/8" = 1'-0"

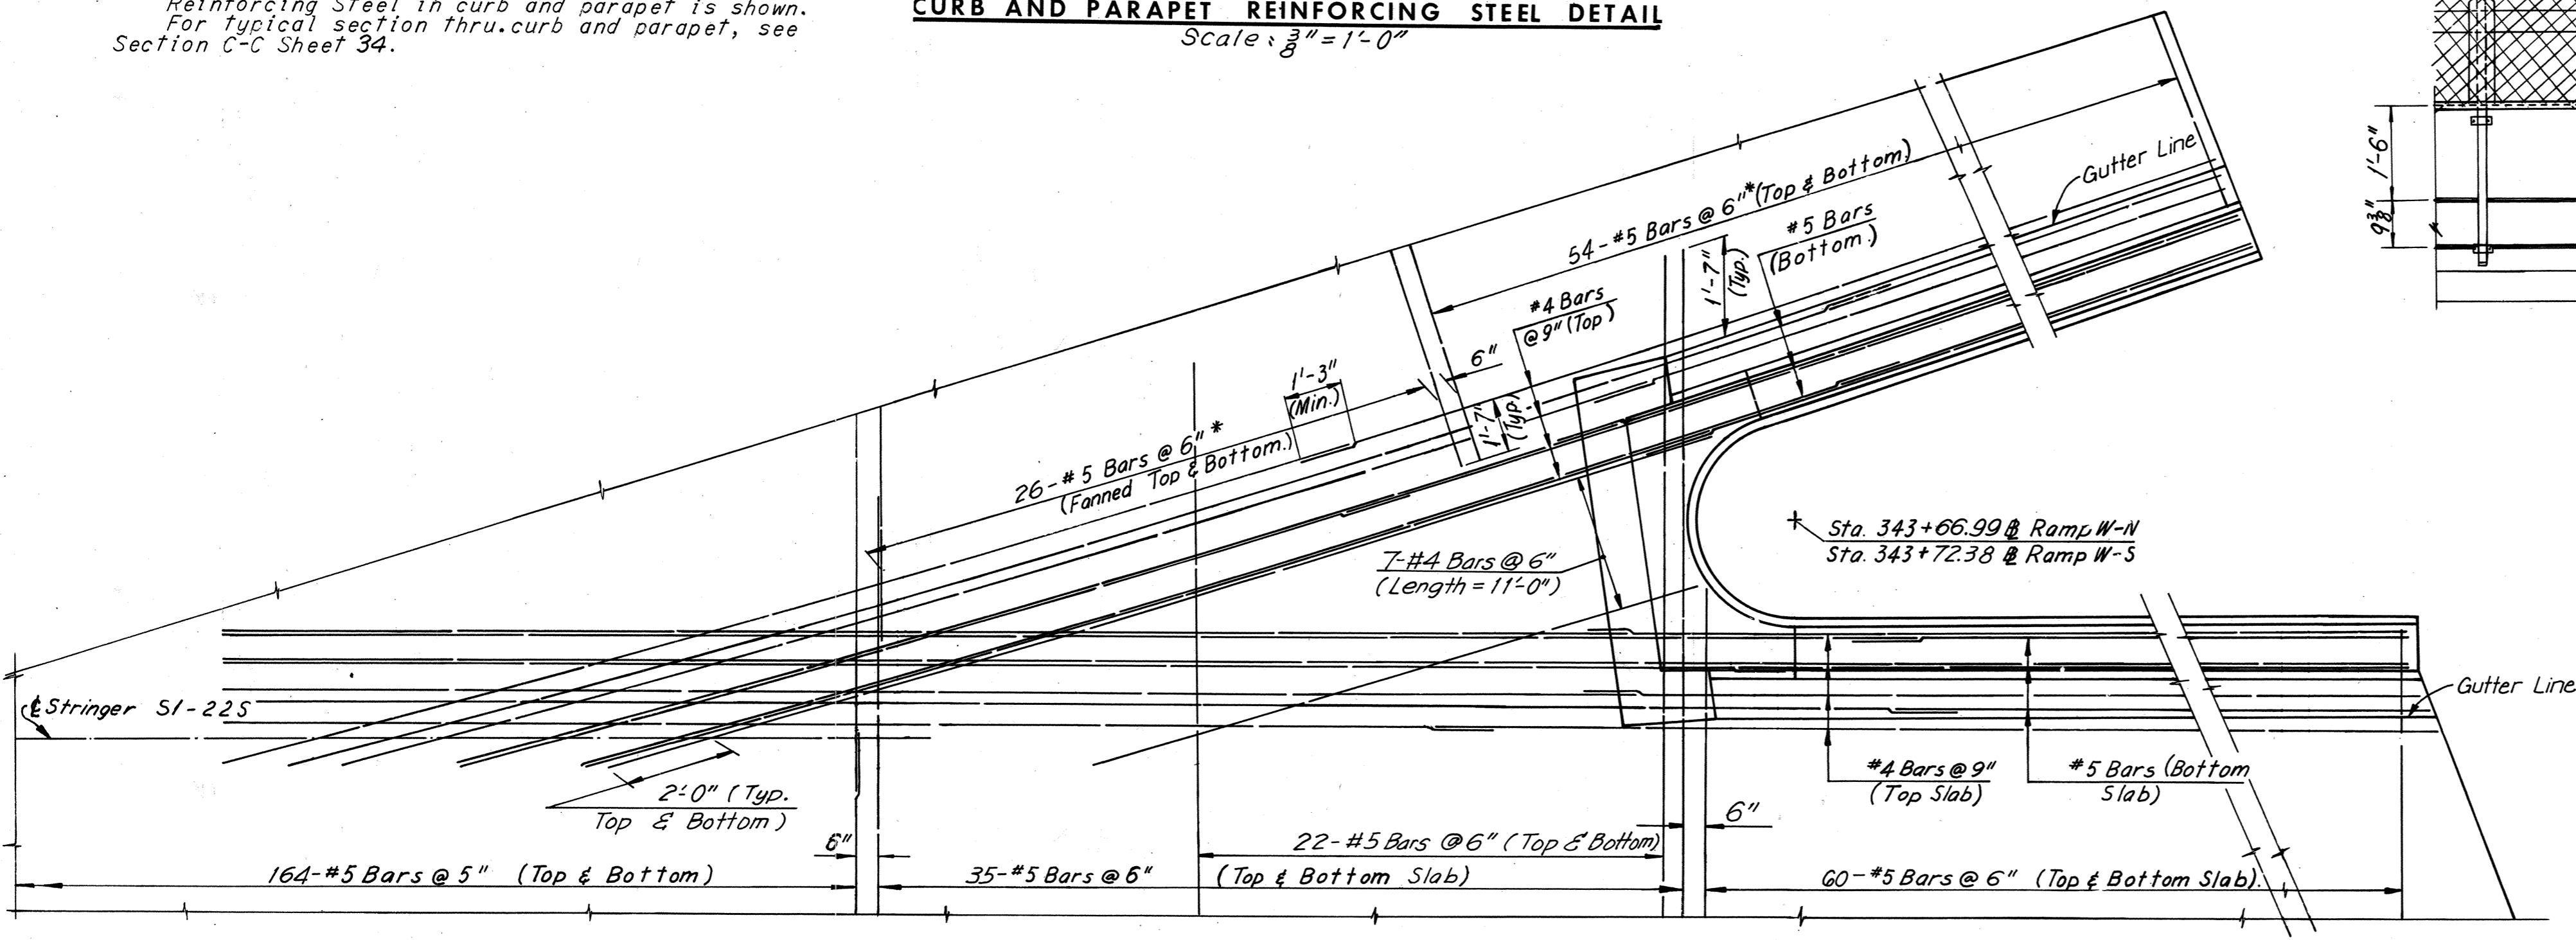


Note: Reinforcing Steel in Slab is shown.
* Spacing measured along north curb of nose.


SLAB REINFORCING STEEL DETAIL
Scale: 3/8" = 1'-0"

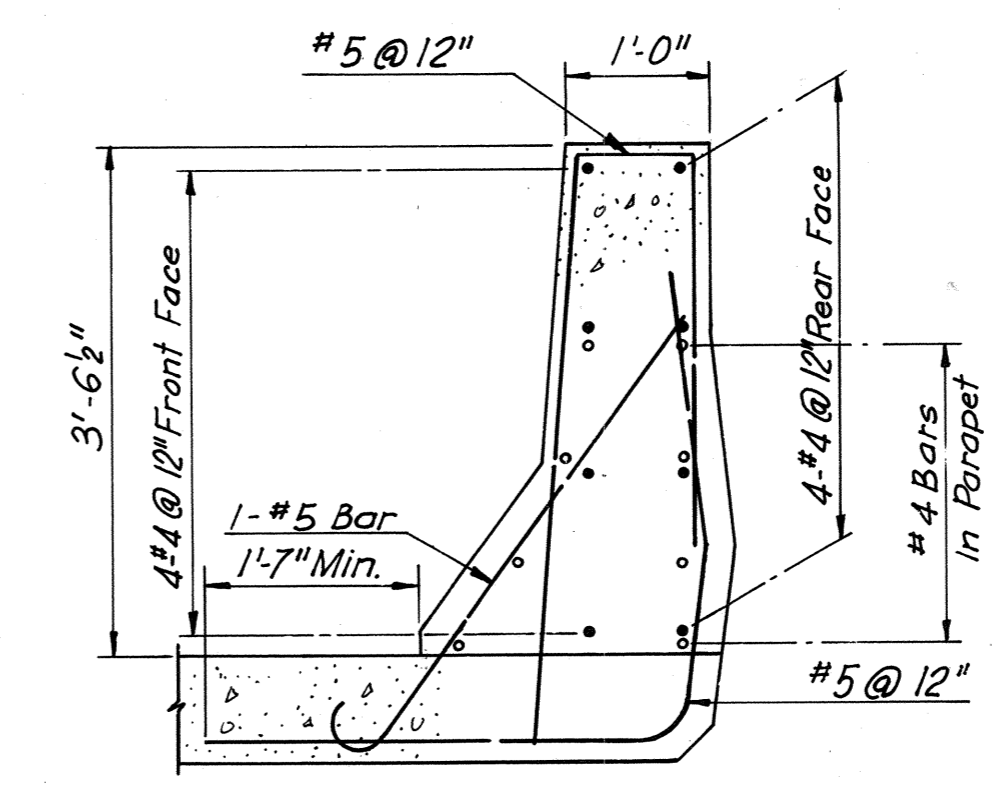


SECTION E-E
(Deck Steel Not Shown)
Scale: 3/4" = 1'-0"

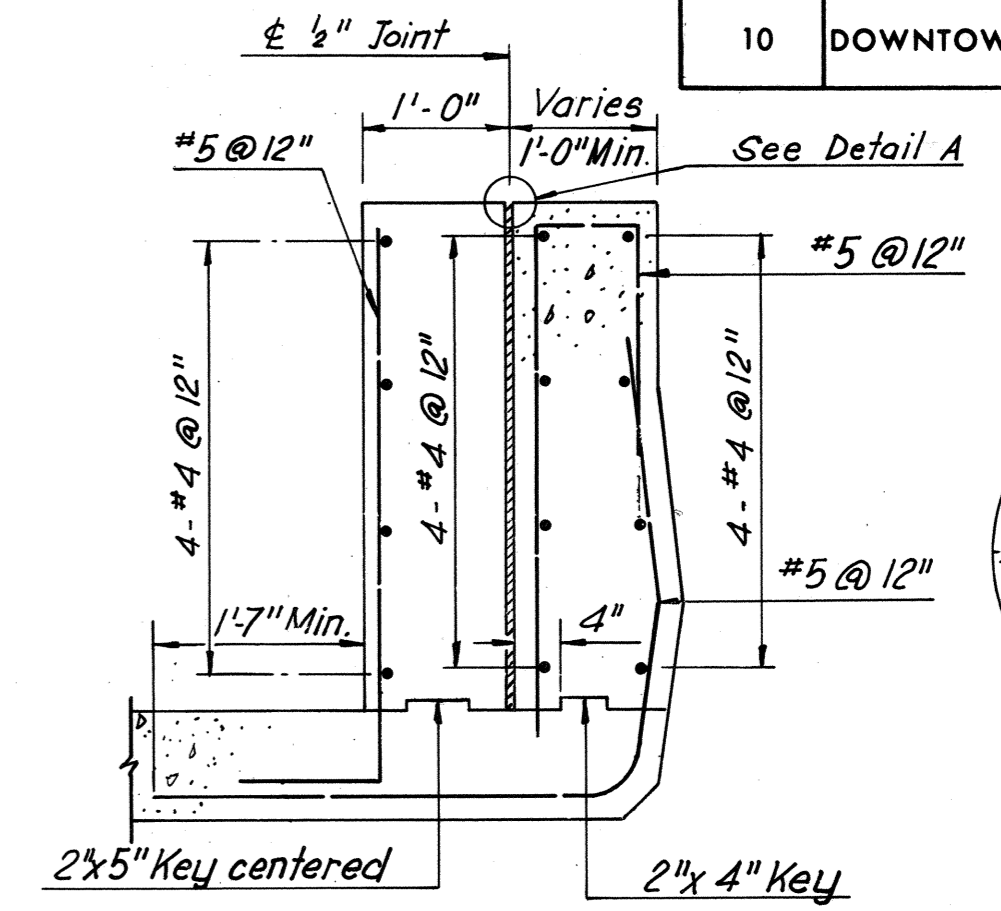


SECTION F-F
(Deck Steel Not Shown)
Scale: 3/4" = 1'-0"

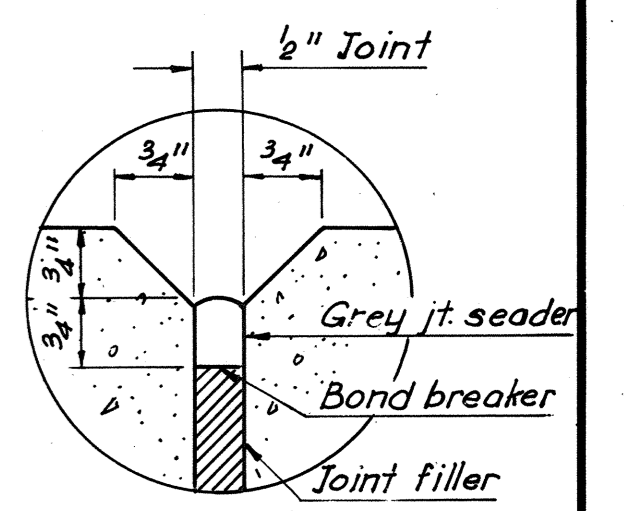


DETAIL A
Scale: Half Size

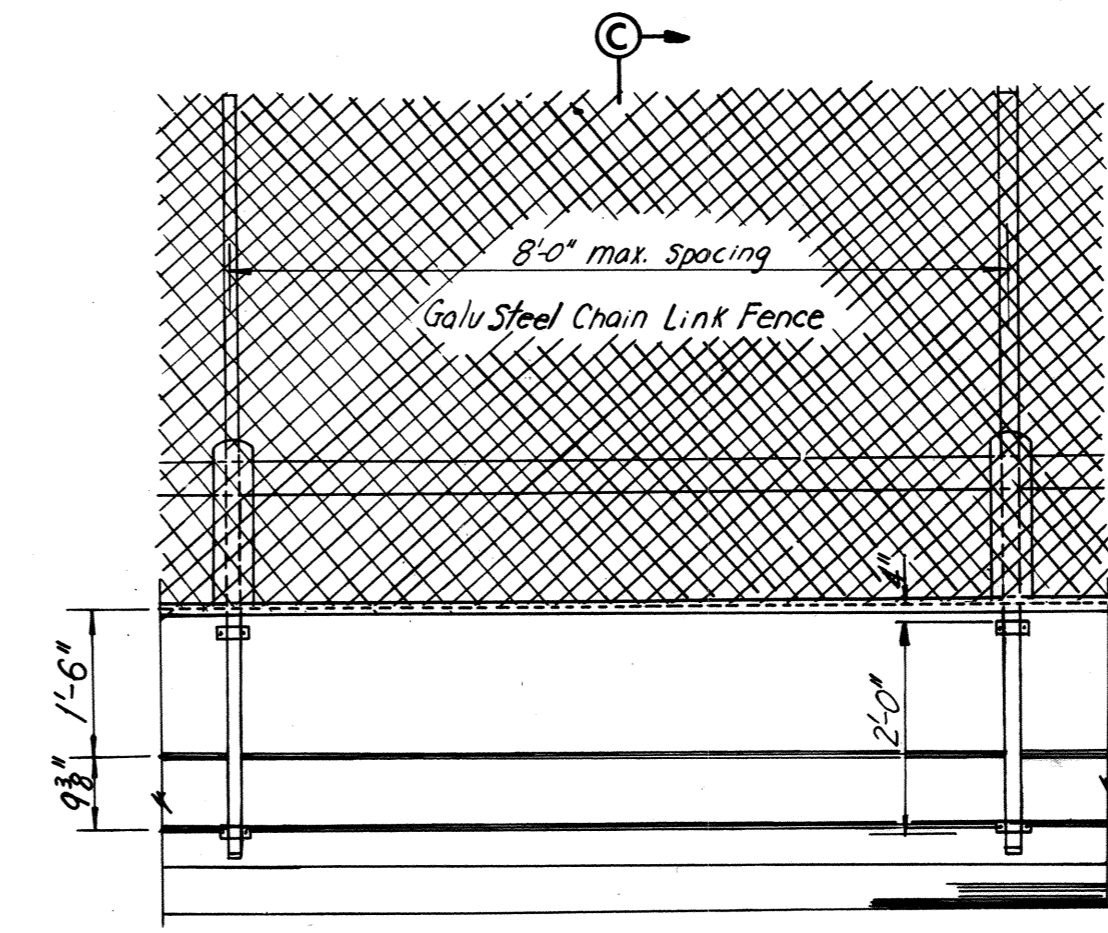

ELEVATION VIEW

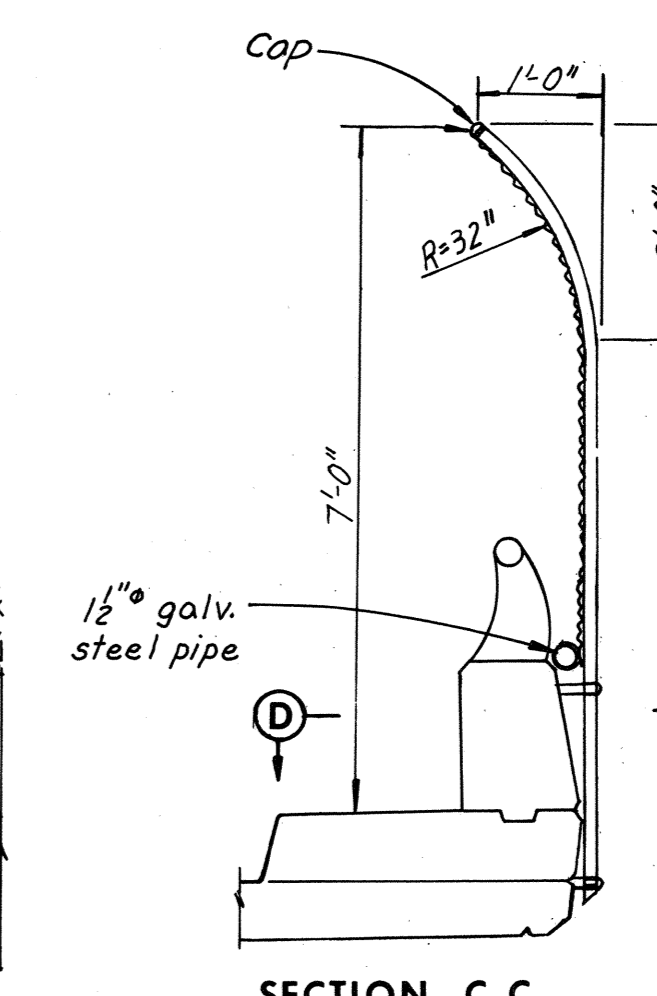

SECTION C-C

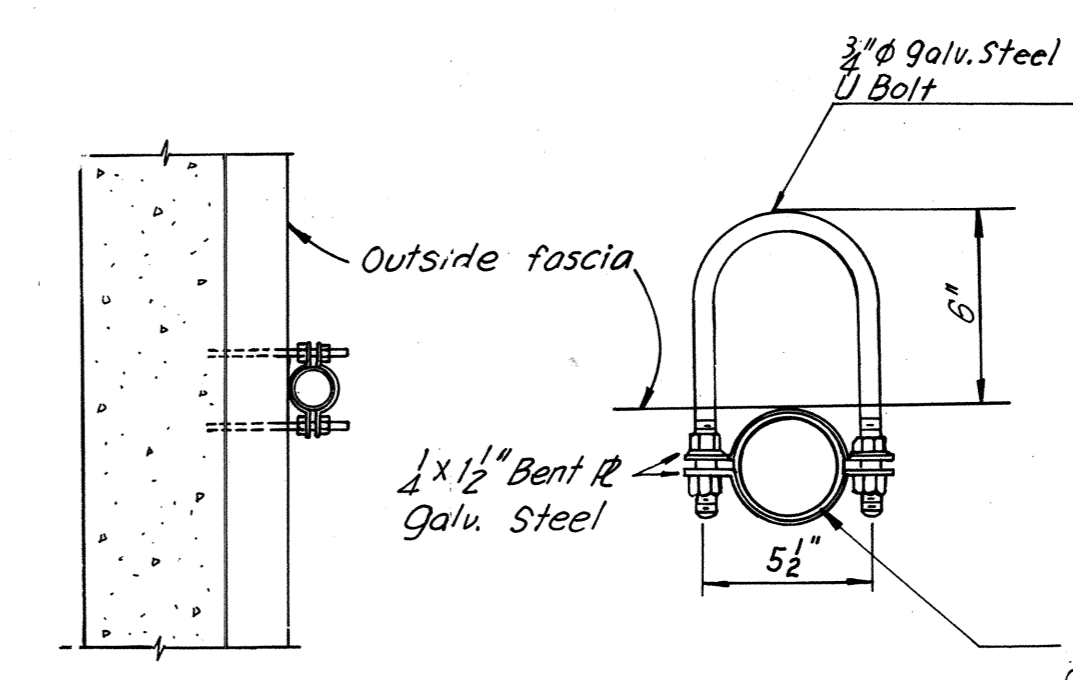

SECTION D-D

FENCE POST CLAMP

FIRE SCREEN DETAILS
No Scale.

Note: For location of fence, see Sheet 32. For location of nose, see Sheet 34.

ELEVATION TABLE			
STATION	ELEV. D	ELEV. E	ELEV. F
17 + 90.00	76.88	77.20	77.26
+ 57.59	—	—	77.41
18 + 00.00	77.08	77.40	77.46
+ 10.00	77.28	77.60	77.66
+ 12.70	77.33	—	—
+ 20.00	77.48	77.79	77.85
+ 30.00	77.68	77.99	78.05
+ 40.00	77.87	78.18	78.24
+ 50.00	78.07	78.38	78.44
+ 59.82	—	—	78.63
+ 60.00	78.26	78.57	78.63
+ 61.50	—	78.60	—
+ 70.00	78.44	78.74	78.80
+ 70.04	78.44	—	—
+ 80.00	78.60	78.90	78.96
+ 90.00	78.75	79.05	79.11
19 + 00.00	78.88	79.18	79.24
+ 10.00	79.00	79.30	79.36
+ 20.00	79.11	79.40	79.46
+ 30.00	79.20	79.49	79.55
+ 30.20	—	—	79.55
+ 31.40	—	79.50	—
+ 37.22	79.25	—	—
+ 40.00	79.27	79.56	79.62
+ 50.00	79.33	79.62	79.68
+ 60.00	79.39	79.67	79.73
+ 70.00	79.44	79.72	79.78
+ 80.00	79.49	79.78	79.84
+ 87.63	79.53	79.82	79.88
+ 90.00	79.55	79.83	79.89
+ 94.30	79.58	79.85	79.91
20 + 00.00	—	79.88	79.94

Note: See Sheet 28 for Location of Elevations above.

BY	DATE				
MADE	654/PTA	12-14-68			
CHECKED	JD	2-19-69	1	As Built	TEM. 8-76
IN CHARGE			NO.	REVISION	BY DATE

AS BUILT

RICHMOND METROPOLITAN AUTHORITY
RICHMOND EXPRESSWAY SYSTEM
DOWNTOWN EXPRESSWAY


BRIDGE NO. 66
EASTBOUND ROADWAY OVER
12TH ST. - R.R. TRACKS AND 16TH ST.

SUPERSTRUCTURE DETAILS

HOWARD, NEEDLES, TAMMEN & BERGENDOFF
consulting engineers
NEW YORK ALEXANDRIA KANSAS CITY

SCALE: As Noted
CONTRACT NO. 10
SHEET NO. 36 OF 46

RICHMOND EXPRESSWAY SYSTEM			
SECTION	PROJECT	SHEET NO.	TOTAL SHEETS
10	DOWNTOWN EXPRESSWAY	163	265

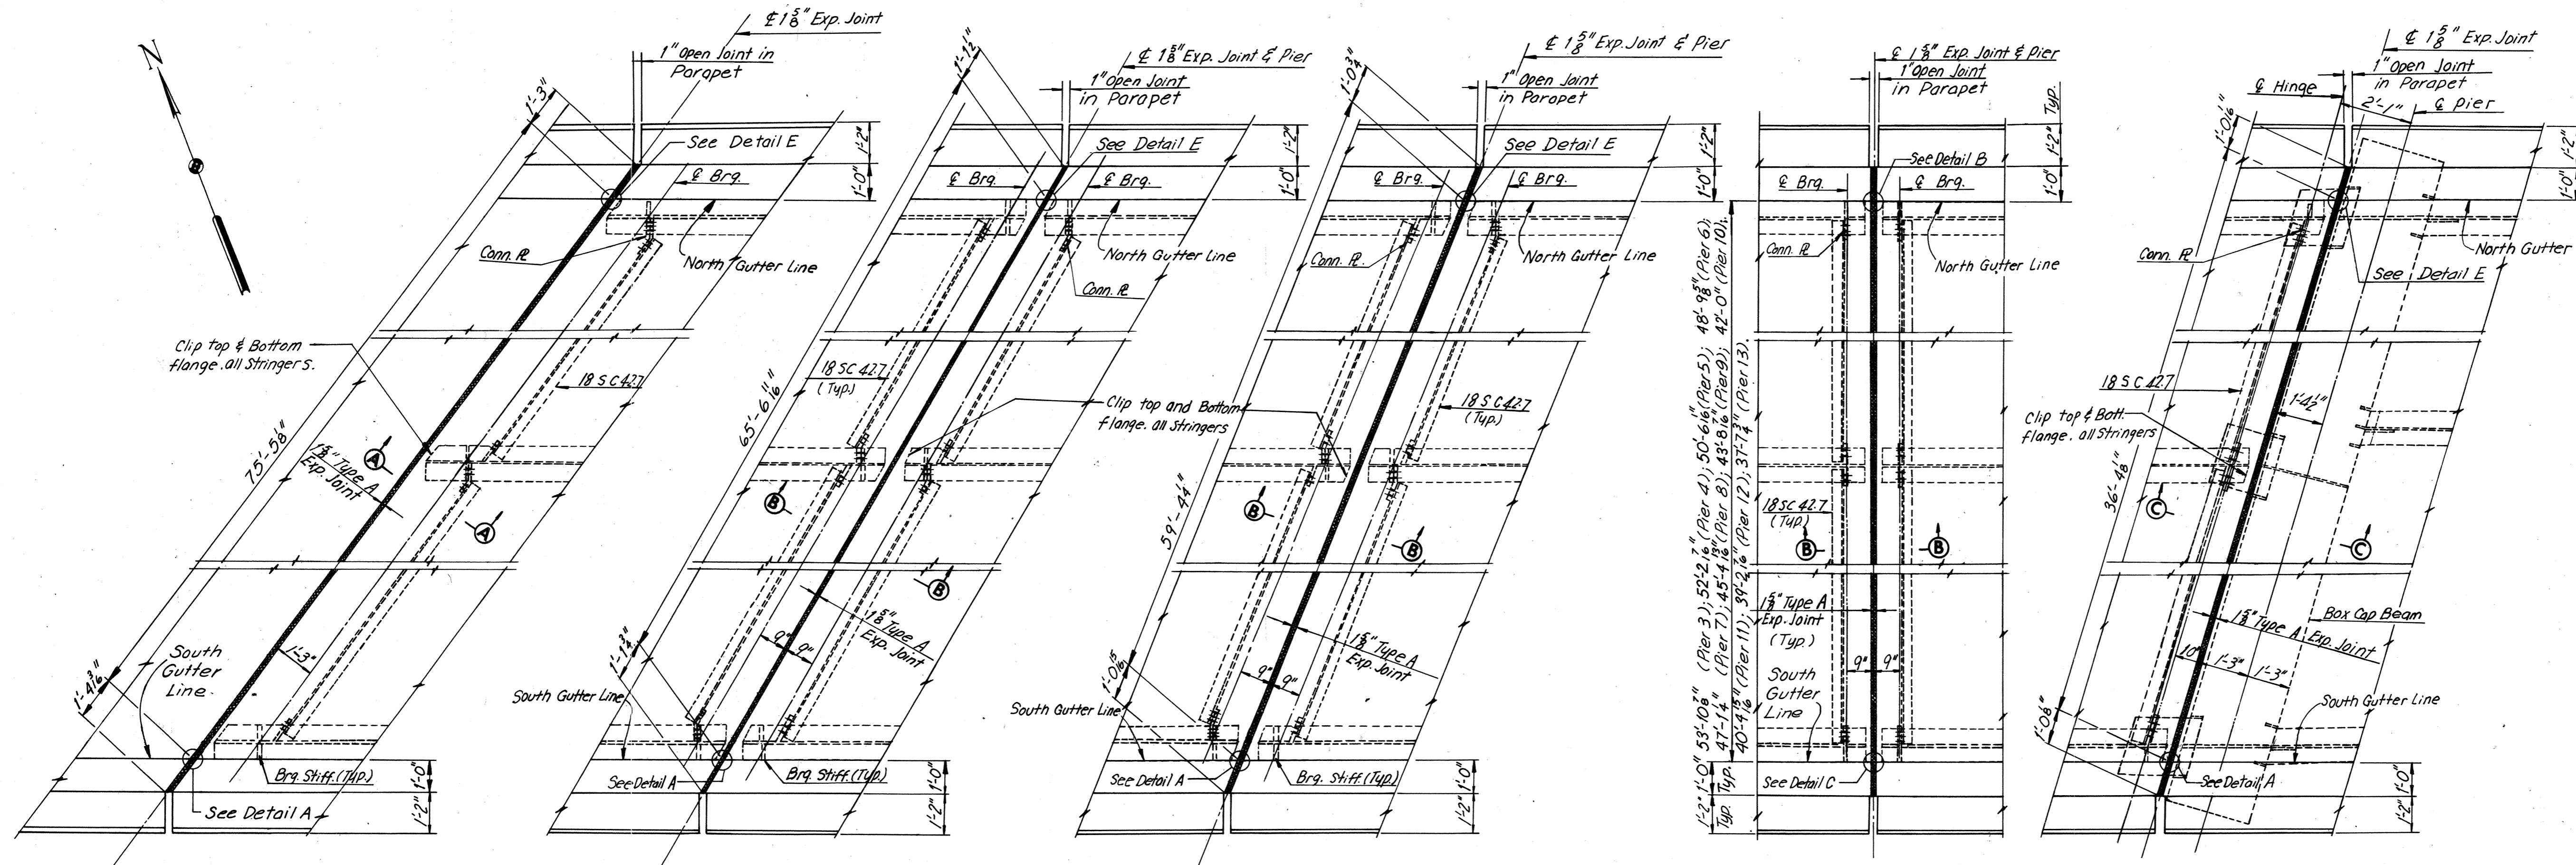


PLAN — JOINT AT WEST ABUTMENT
Scale: 3/8" = 1'-0"

PLAN — JOINT AT PIER 1
Scale: 3/8" = 1'-0"


PLAN — JOINT AT PIER 2
Scale: 3/8" = 1'-0"

PLAN — JOINT AT PIERS 3 THRU. 13
Scale: 3/8" = 1'-0"

PLAN — JOINT AT PIER 14
Scale: 3/8" = 1'-0"

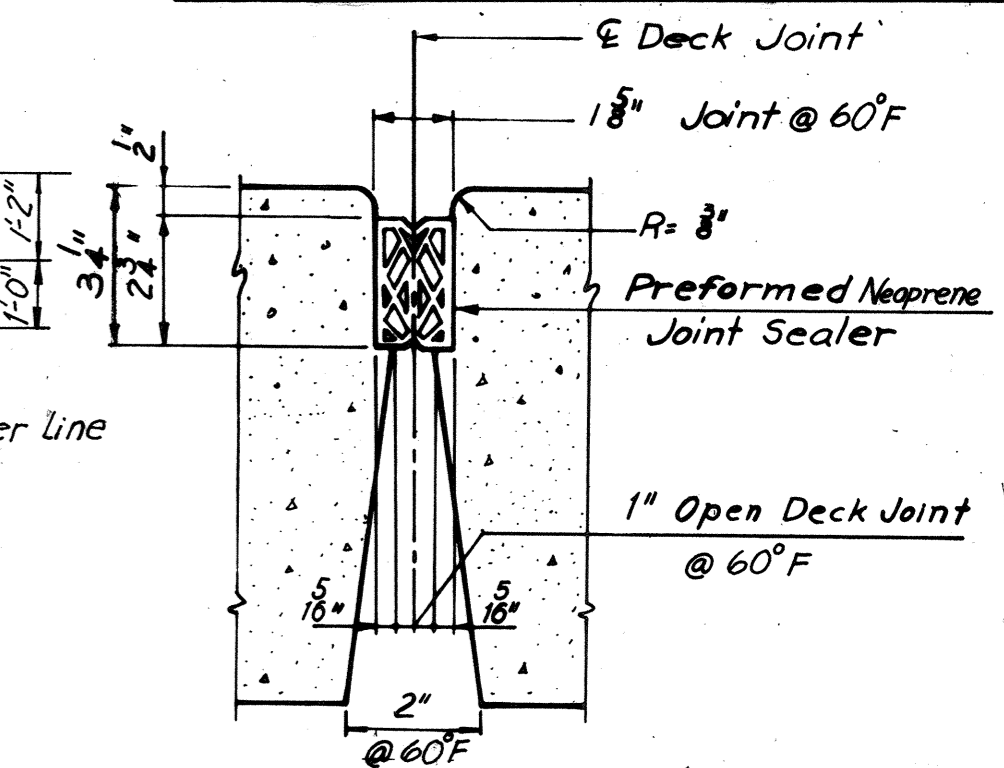


15" TYPE "A" EXPANSION JOINT
Note: For Joint Detail @ Abutment see Detail D.

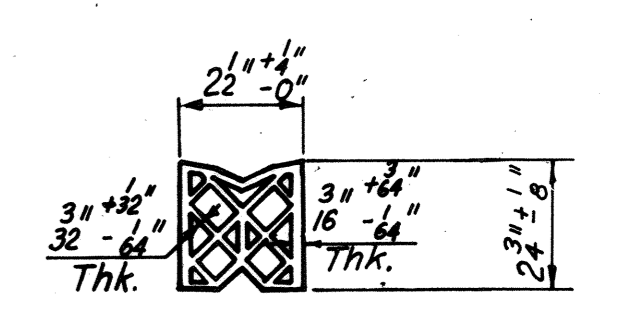


PREFORMED NEOPRENE JOINT SEALER FOR 15" TYPE "A" EXPANSION JOINT


Note: End of stringers and connection R's shall be plumb.

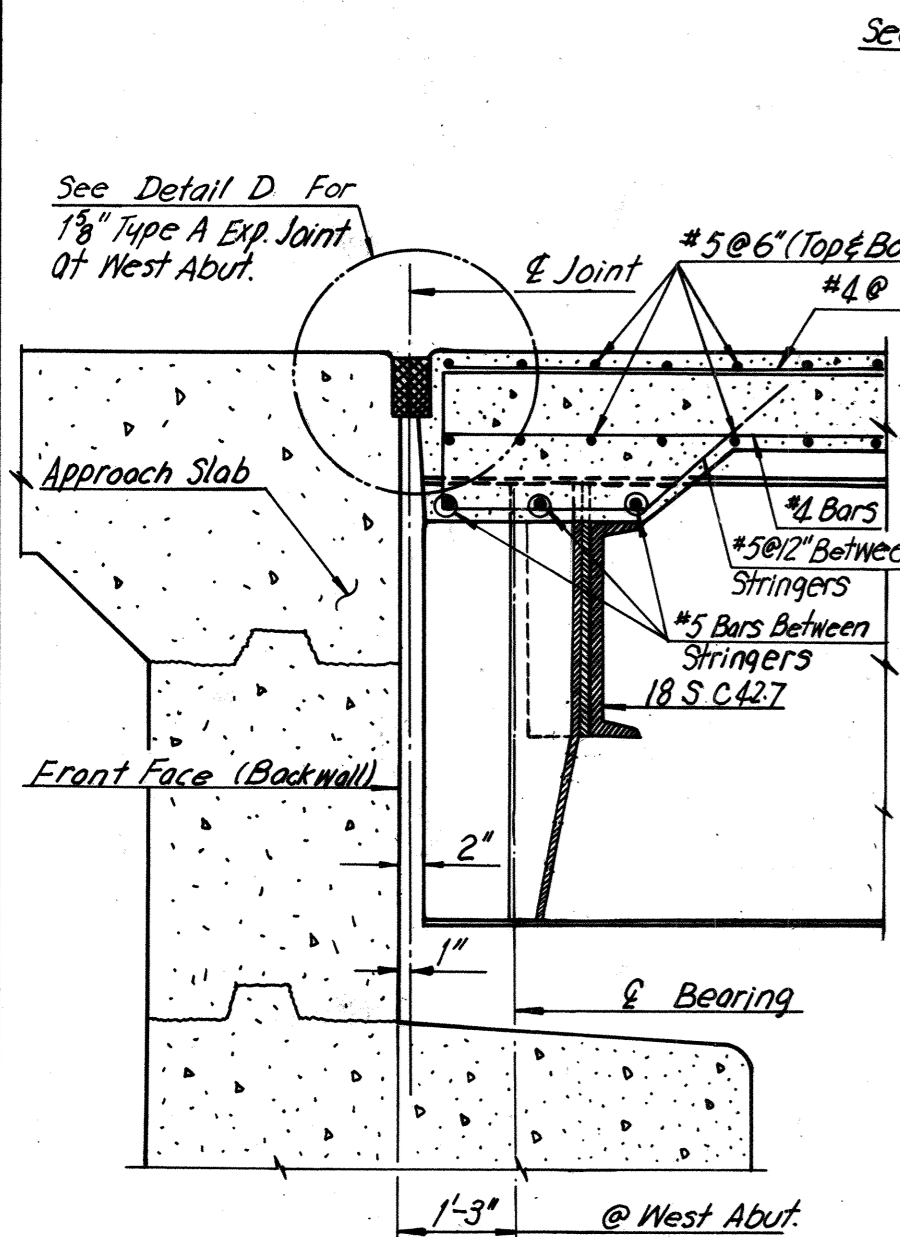


SECTION A-A
Scale: 3/4" = 1'-0"

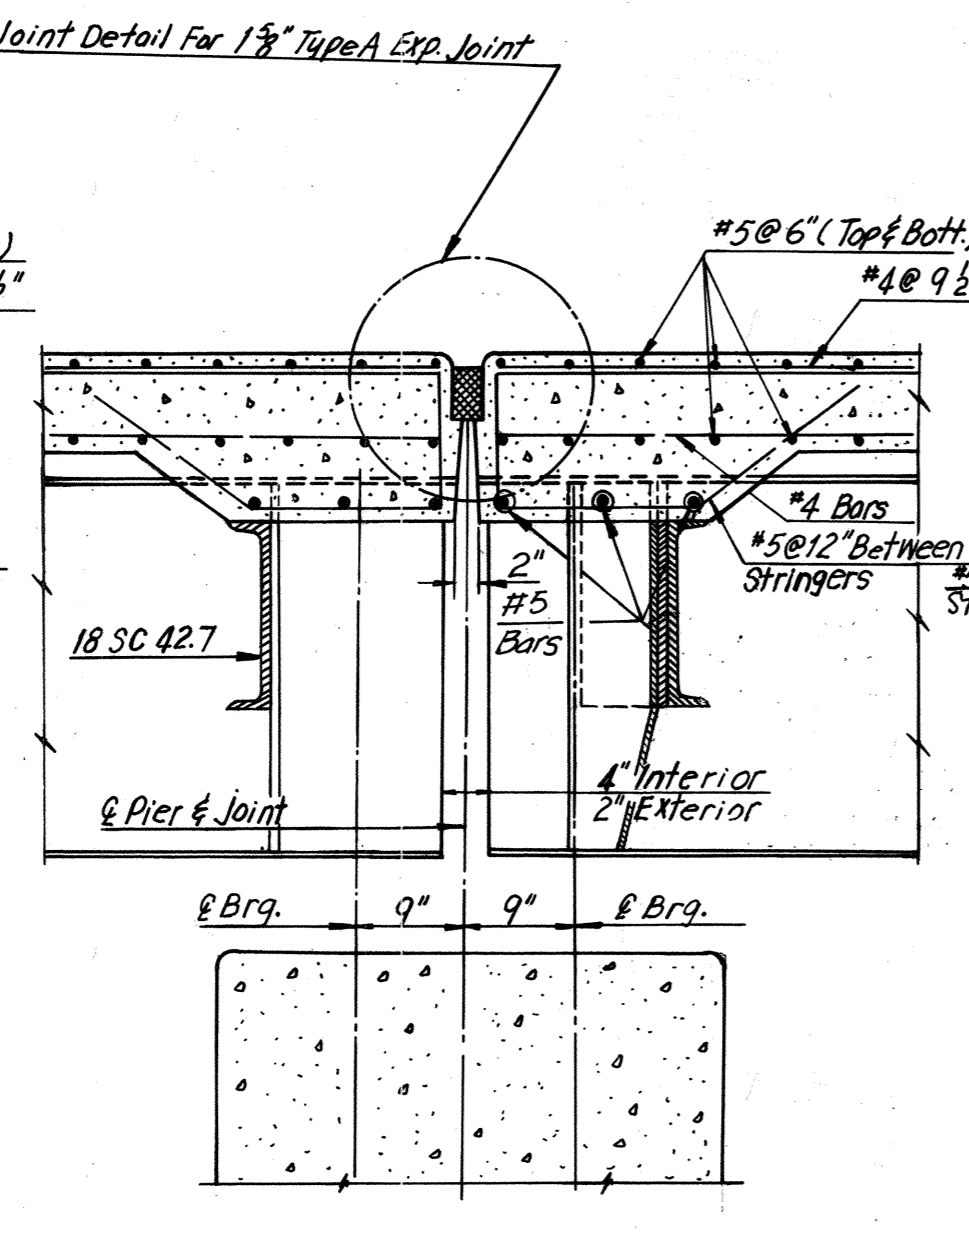


SECTION B-B
Scale: 3/4" = 1'-0"

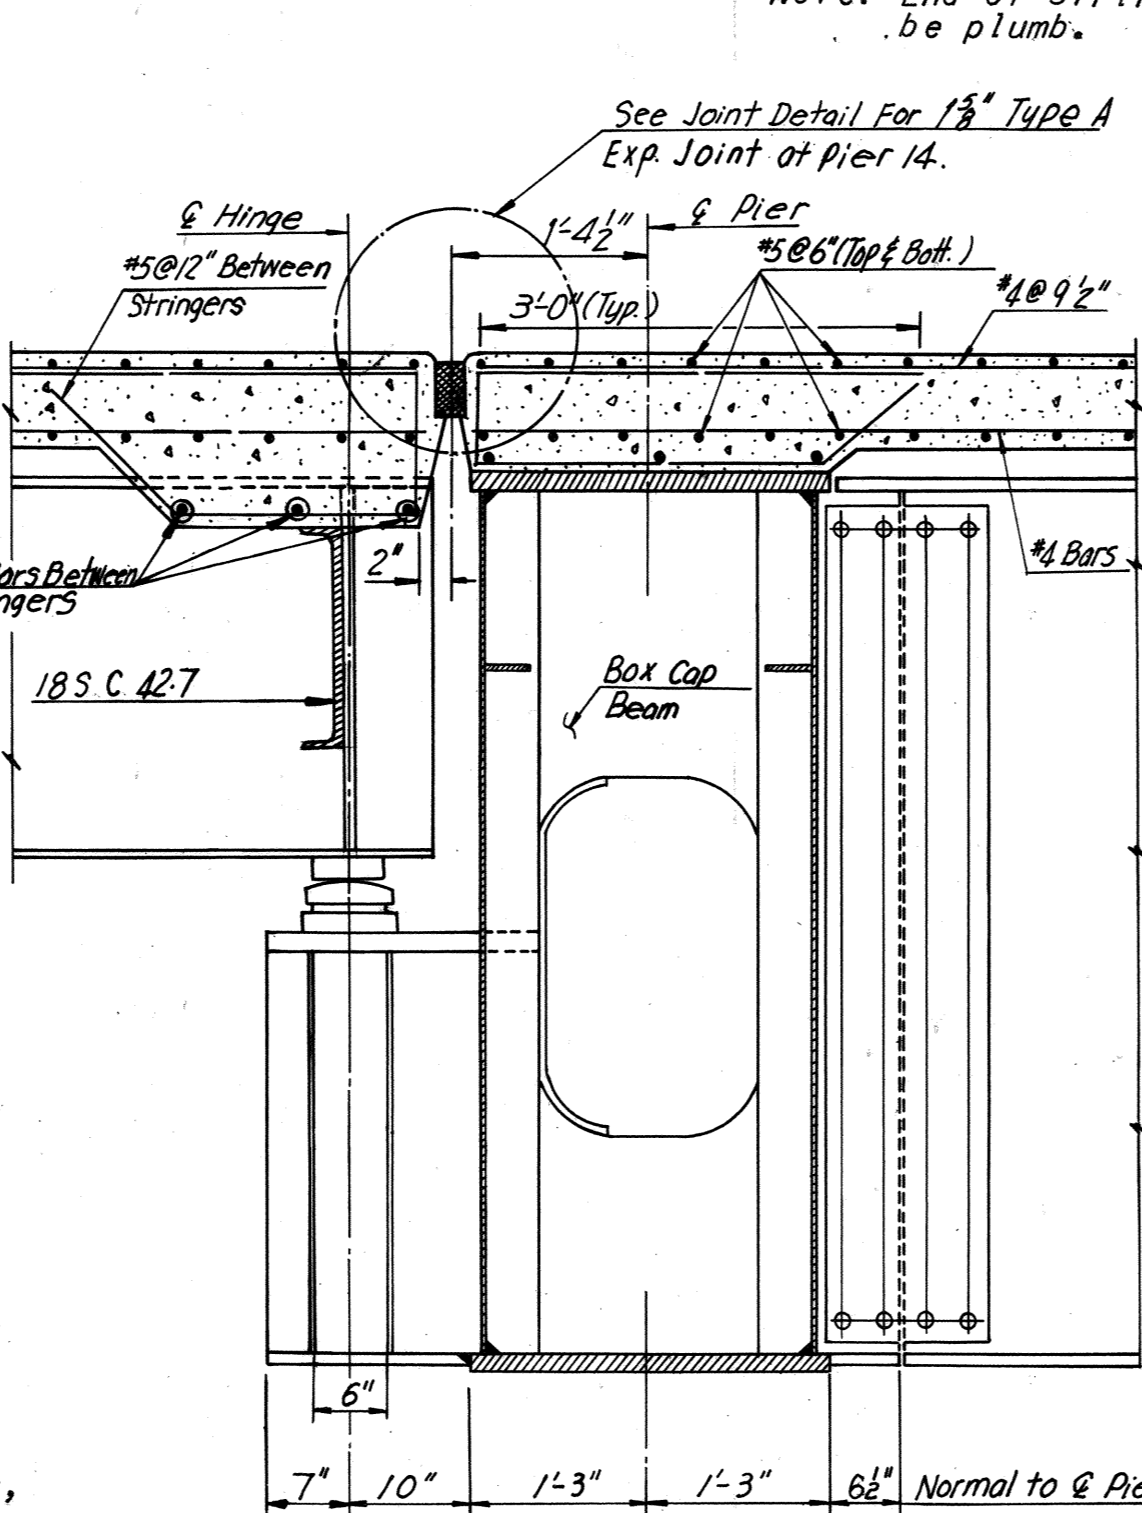


SECTION C-C
Scale: 3/4" = 1'-0"

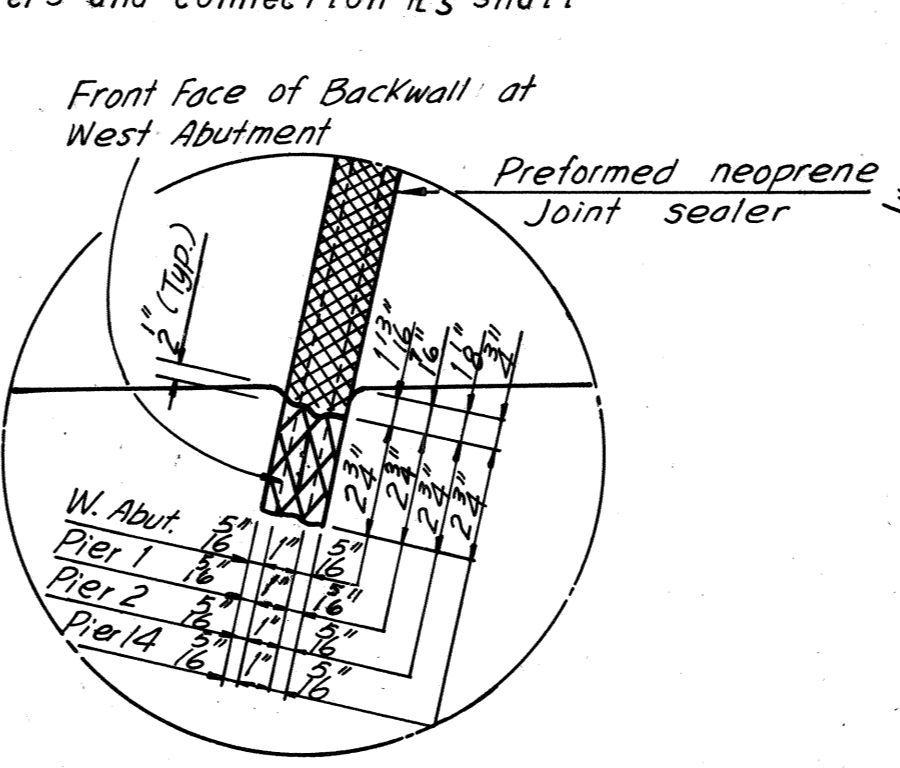


DETAIL A
No Scale

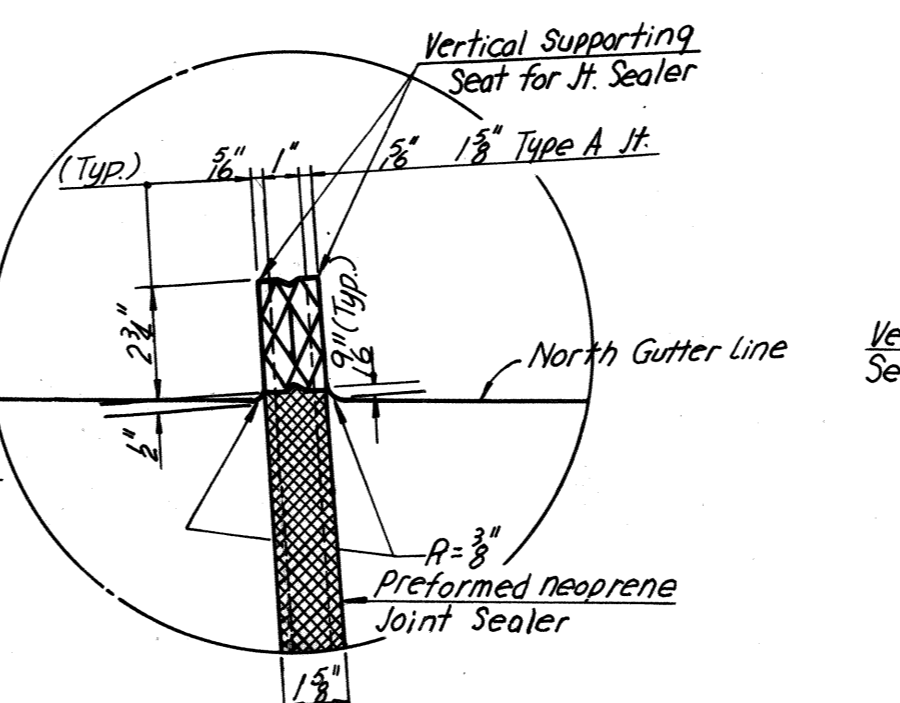


DETAIL B
No Scale
Typical for Piers 3 thru 13.

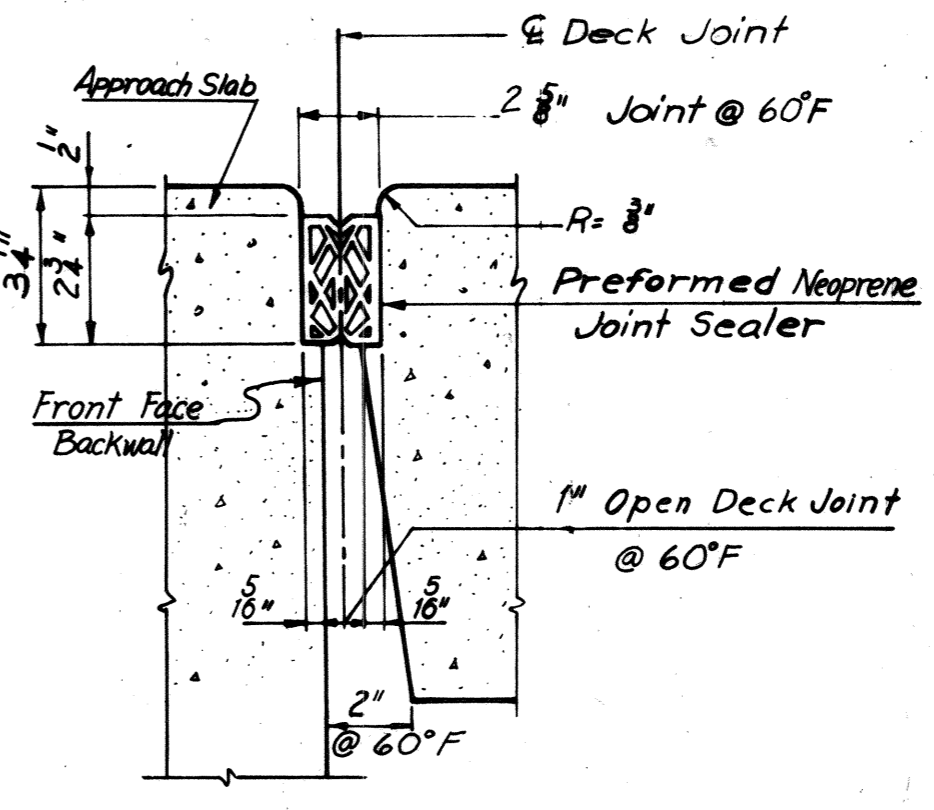

DETAIL D
No Scale

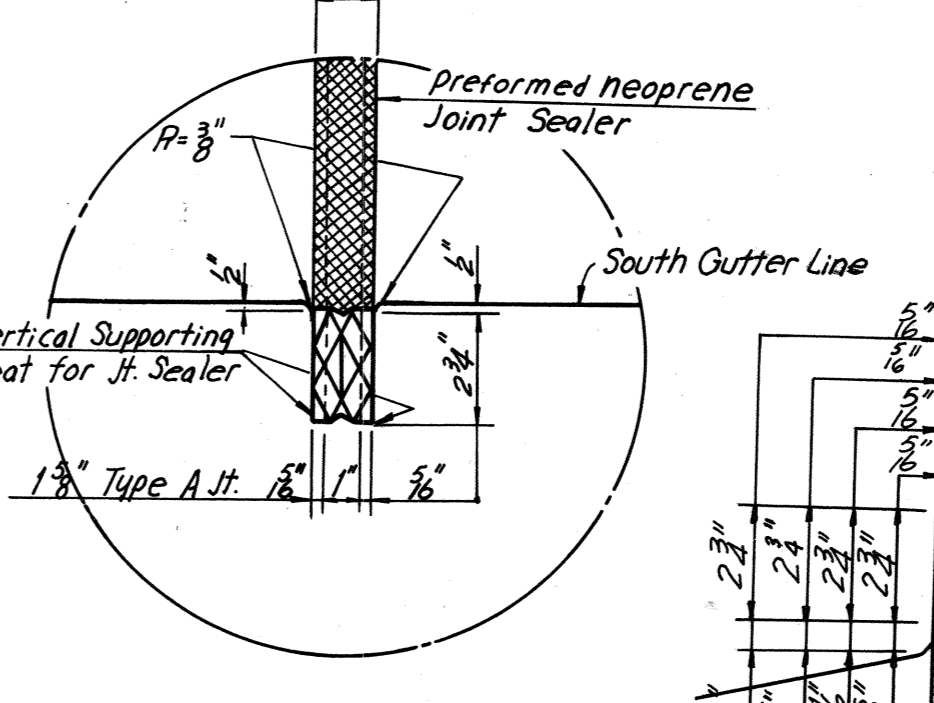

DETAIL C
No Scale
Typical for Piers 3 thru 13.

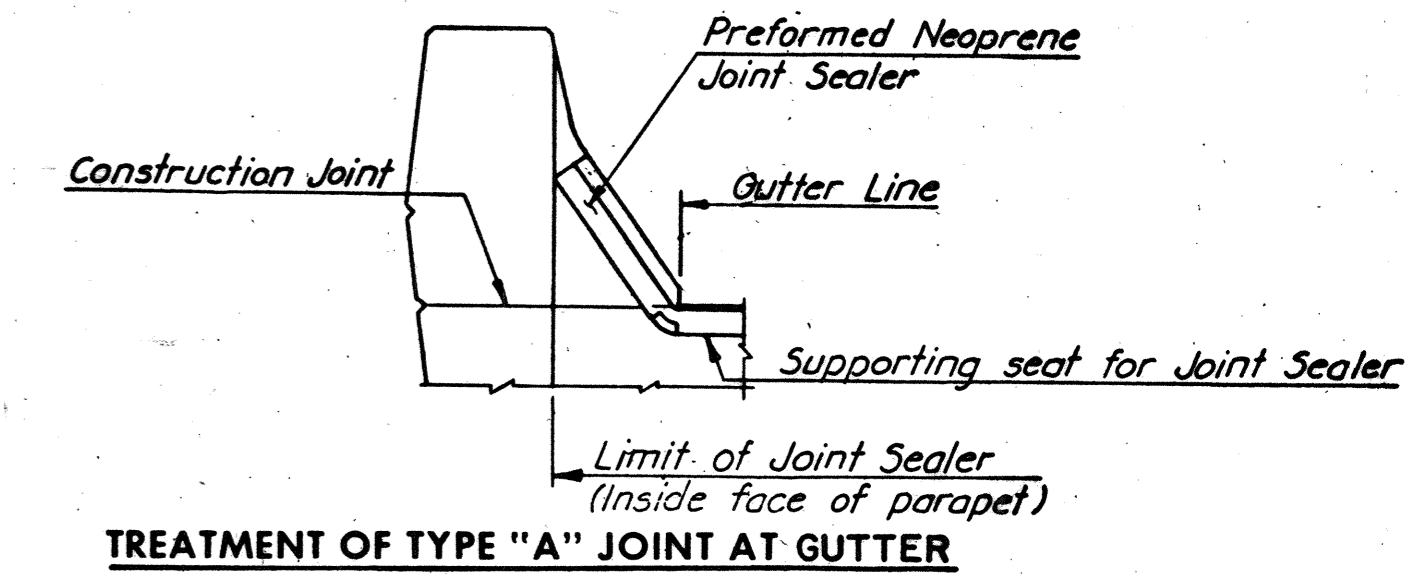

TREATMENT OF TYPE "A" JOINT AT GUTTER

AS BUILT
RICHMOND METROPOLITAN AUTHORITY
RICHMOND EXPRESSWAY SYSTEM
DOWNTOWN EXPRESSWAY

BRIDGE NO. 66
EASTBOUND ROADWAY O.V.
12TH ST. - R.R. TRACKS AND 161
JOINT DETAILS

HOWARD, NEEDLES, TAMMEN & BERGENDOFF
consulting engineers
NEW YORK ALEXANDRIA KANSAS CITY
SCALE: As Noted
CONTRACT NO. 10
SHEET NO. 37 OF 46


Note: All horizontal dimensions of Sections shown above are normal to & joint and pier.

Note: For details of bearing stiffeners, see Deck Plan Sheets 28, 29, & 30.


Note: It is absolutely essential that the openings for the preformed neoprene joint sealers be accurately formed and constructed to smooth, straight lines. The size of opening shall be adjusted to allow for anticipated dead load rotation of the ends of the slab and for the temperature at the time of construction.

BY	DATE	NO.	REVISION	BY	DATE
MADE	G.S.H. 10/0-68				
CHECKED	C.E.B. 2-5-69	1	As Built	TEM	8-76
IN CHARGE					


RICHMOND EXPRESSWAY SYSTEM			
SECTION	PROJECT	SHEET NO.	TOTAL SHEETS
10	DOWNTOWN EXPRESSWAY	164	265

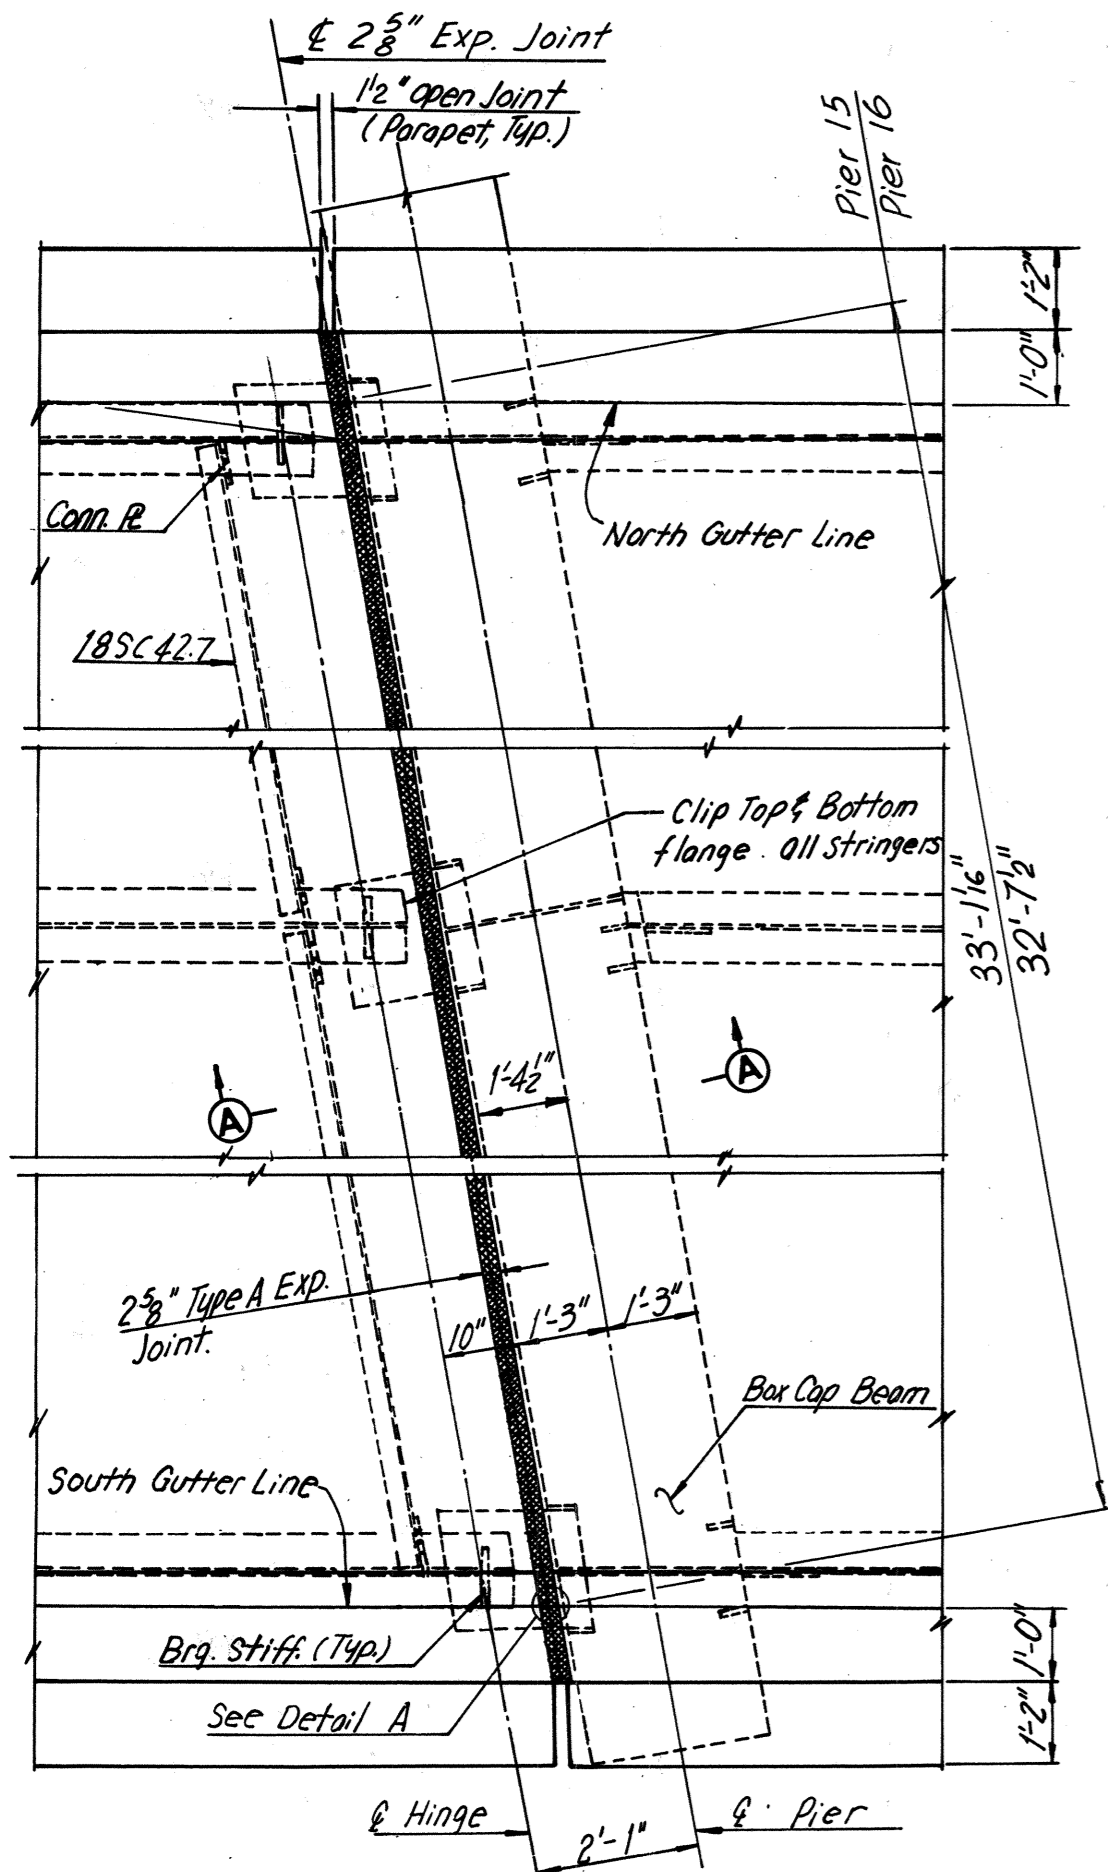


PLAN — JOINT AT PIERS 15 AND 16
Scale 3/8" = 1'-0"

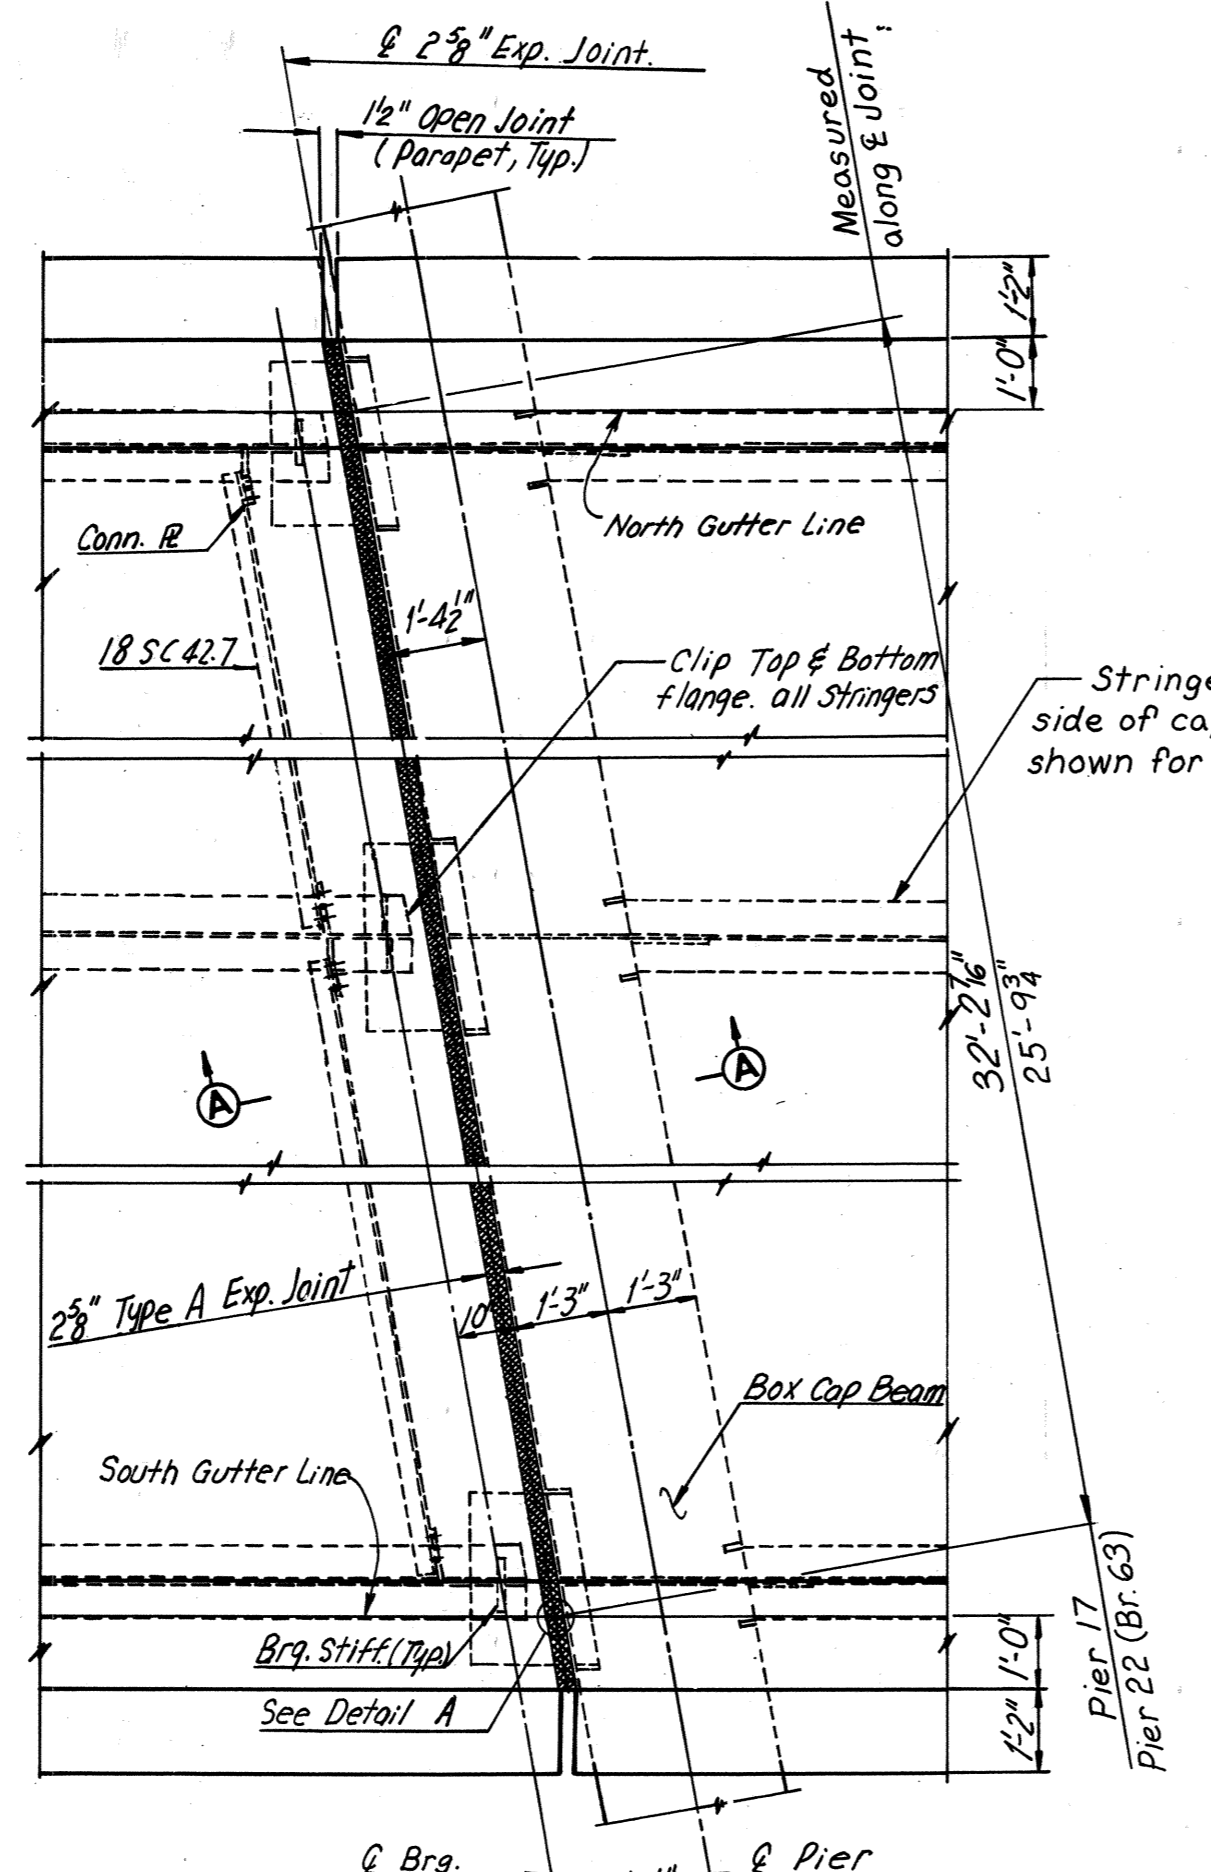


PLAN — JOINT AT PIER 17 AND PIER 22 (BR. 63)
Scale 3/8" = 1'-0"

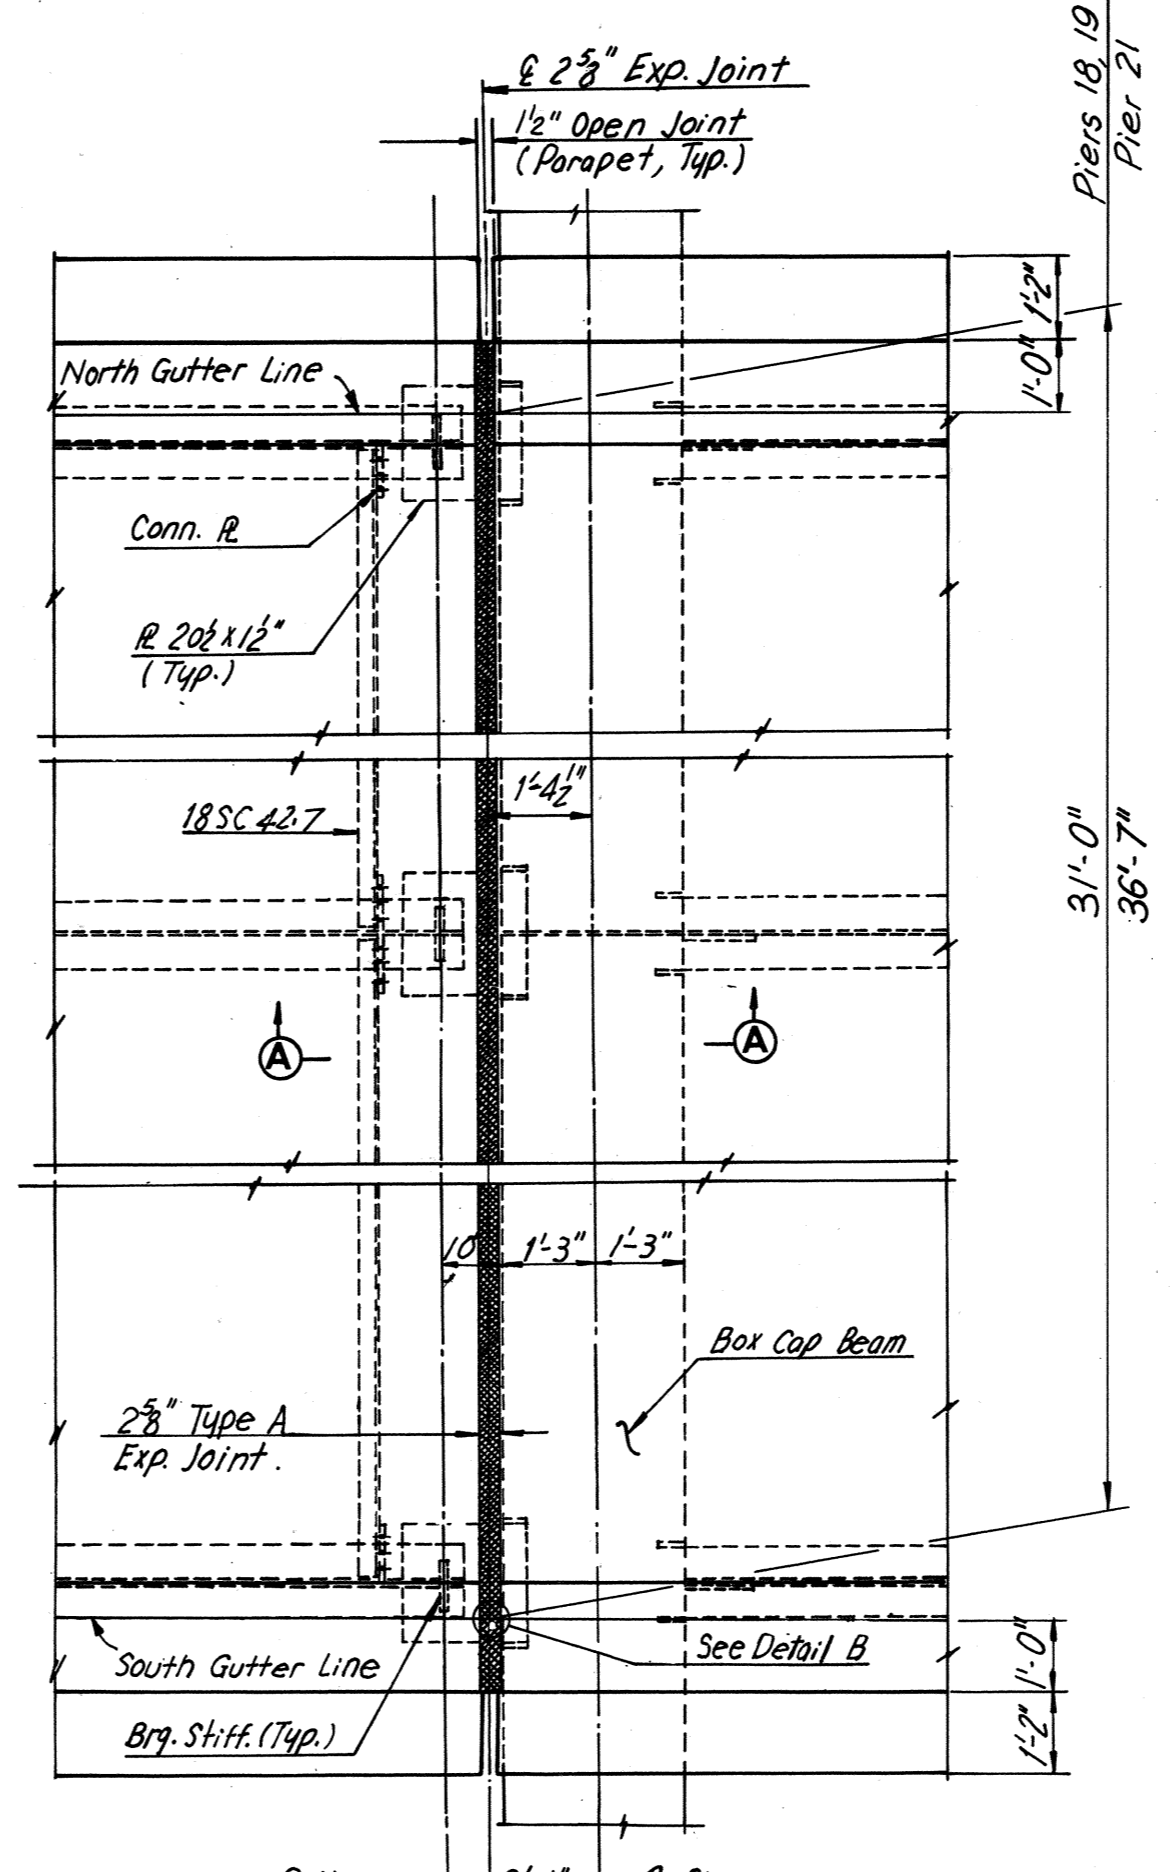

PLAN — JOINT AT PIERS 18, 19, 20 AND 21 (BRIDGE 63)
Scale 3/8" = 1'-0"

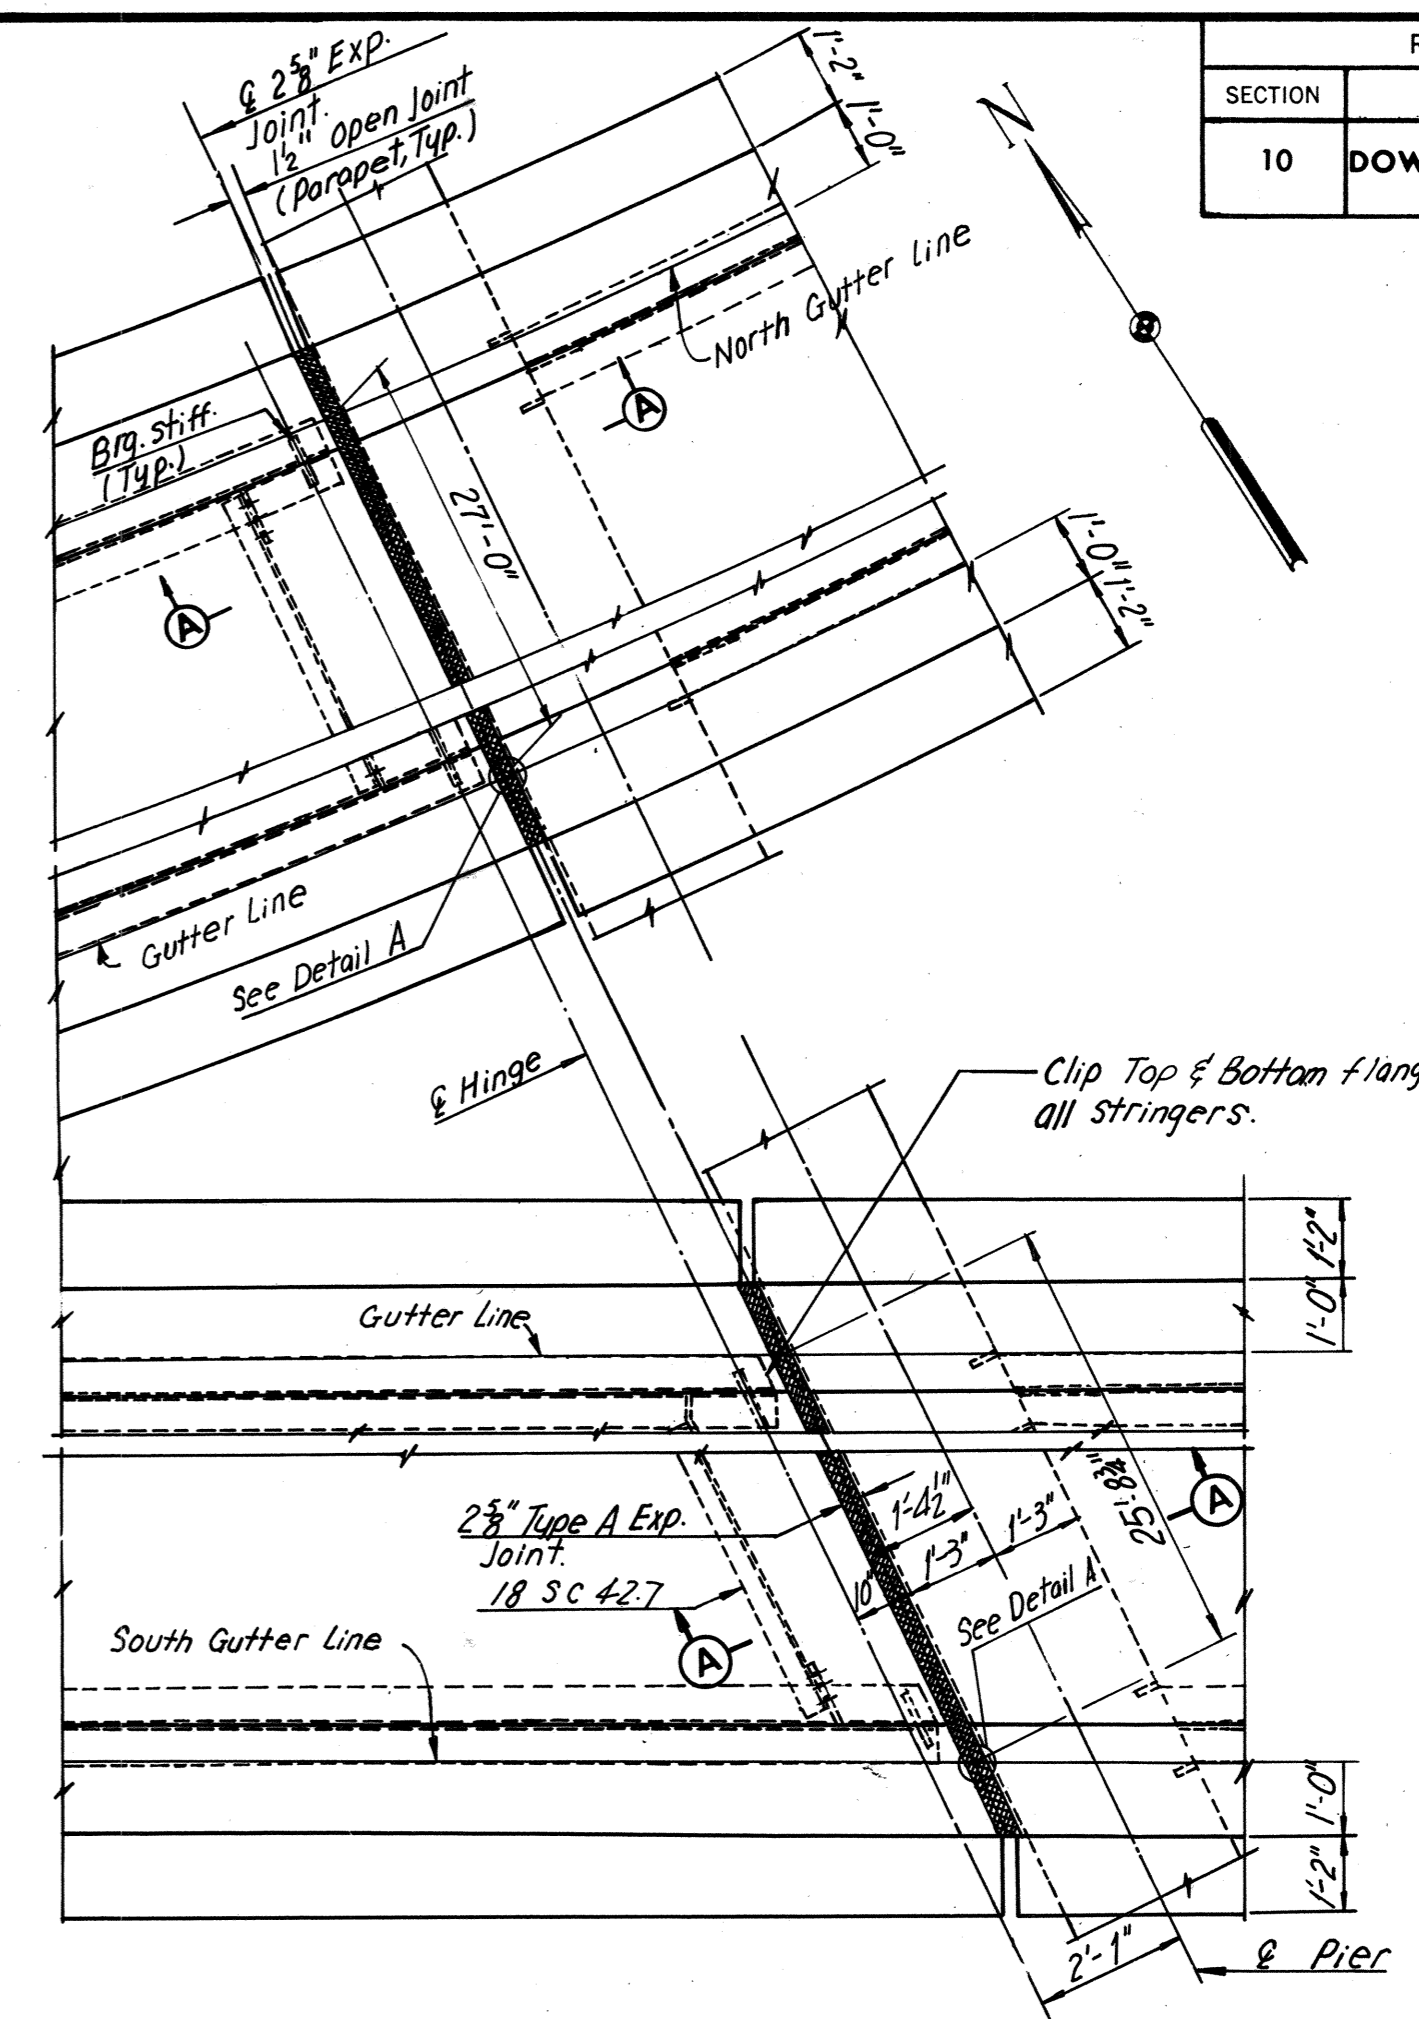


PLAN — JOINT AT PIER 22 (BRIDGE 63)
Scale 3/8" = 1'-0"

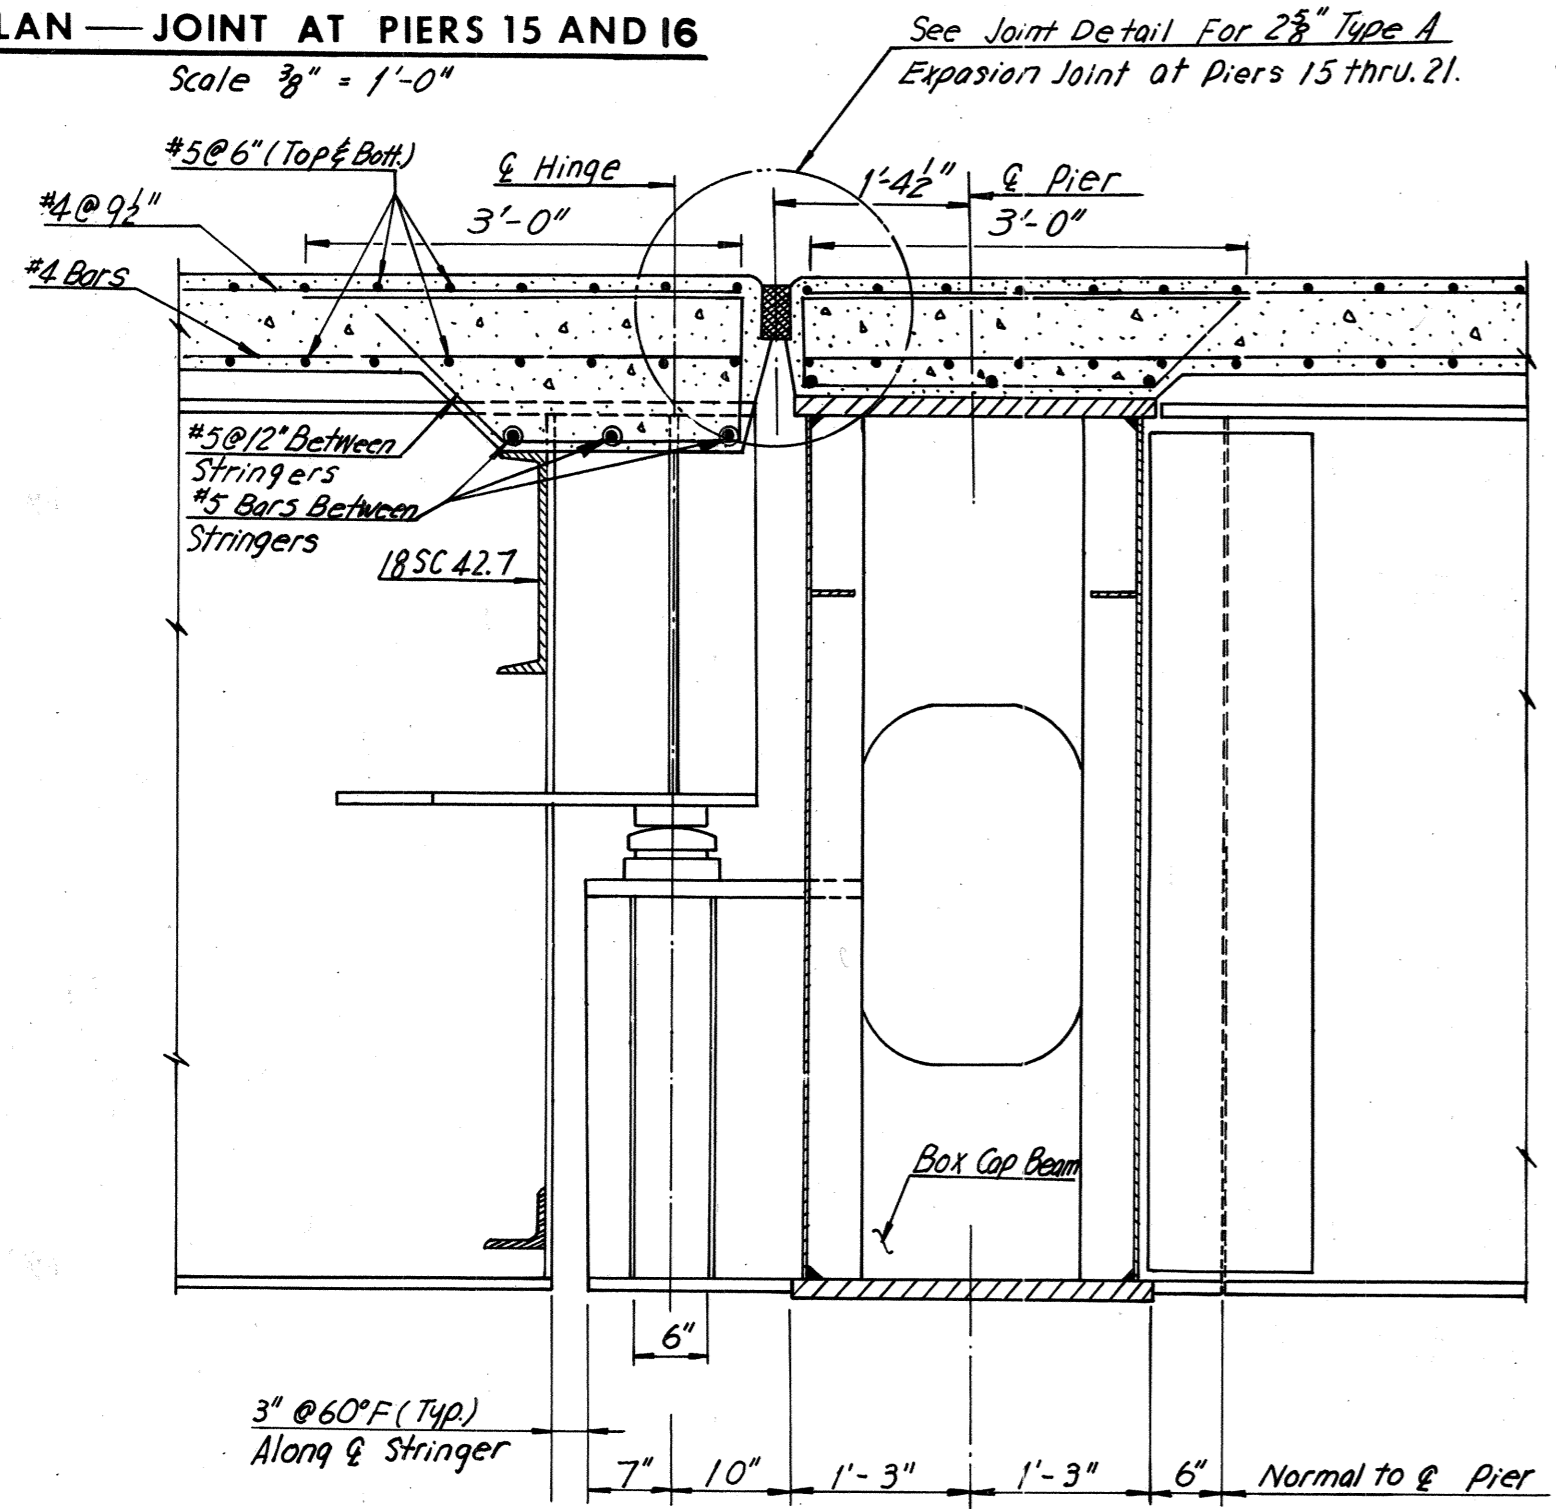


SECTION A-A
Scale 3/4" = 1'-0"


Note: End of stringers and connection R's shall be plumb.

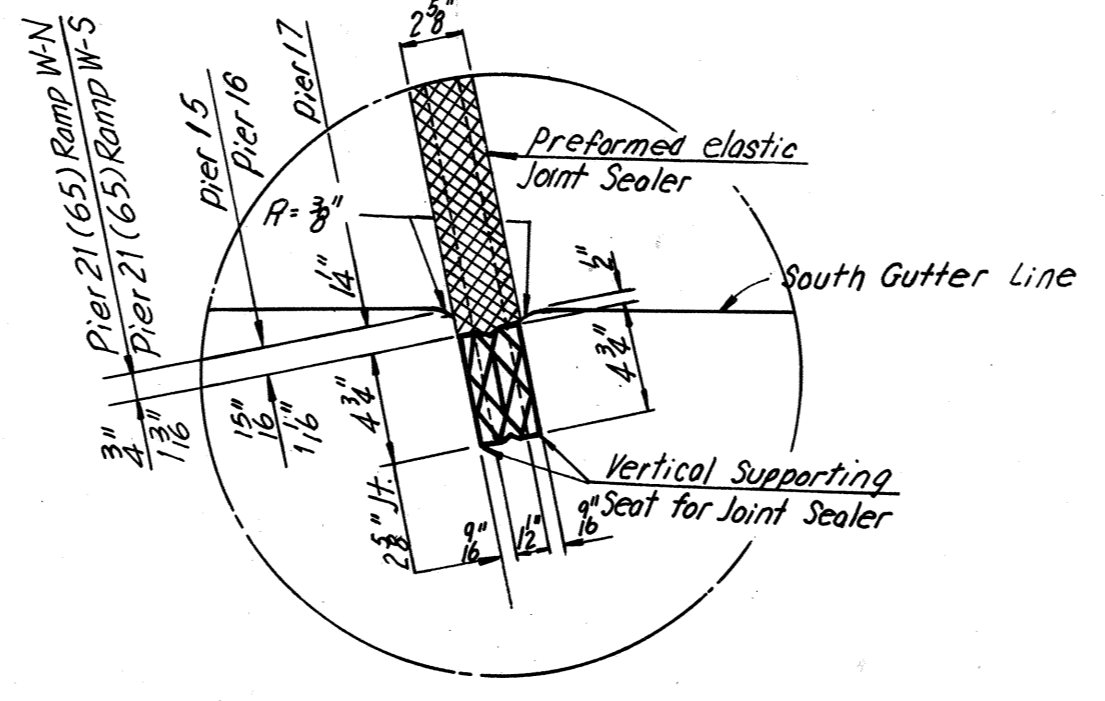


DETAIL A
No Scale
Typical for Piers 15 thru 17 & Pier 21 (Br. 63)

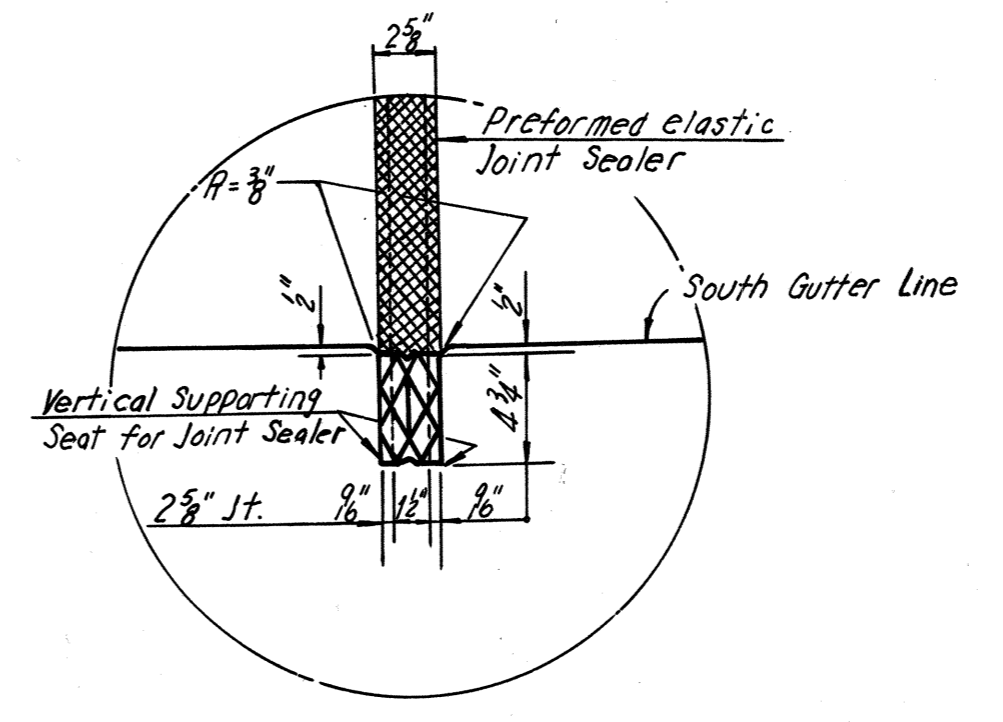

DETAIL B
No Scale
Typical for Piers 18 thru 20 & Pier 21 (Br. 63)

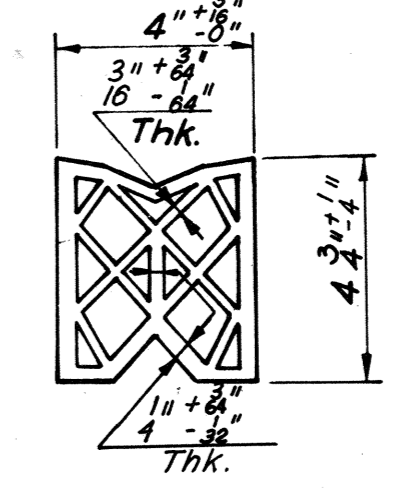

PREFORMED NEOPRENE JOINT SEALER
FOR 2 1/2" TYPE "A" EXPANSION JOINT
No Scale

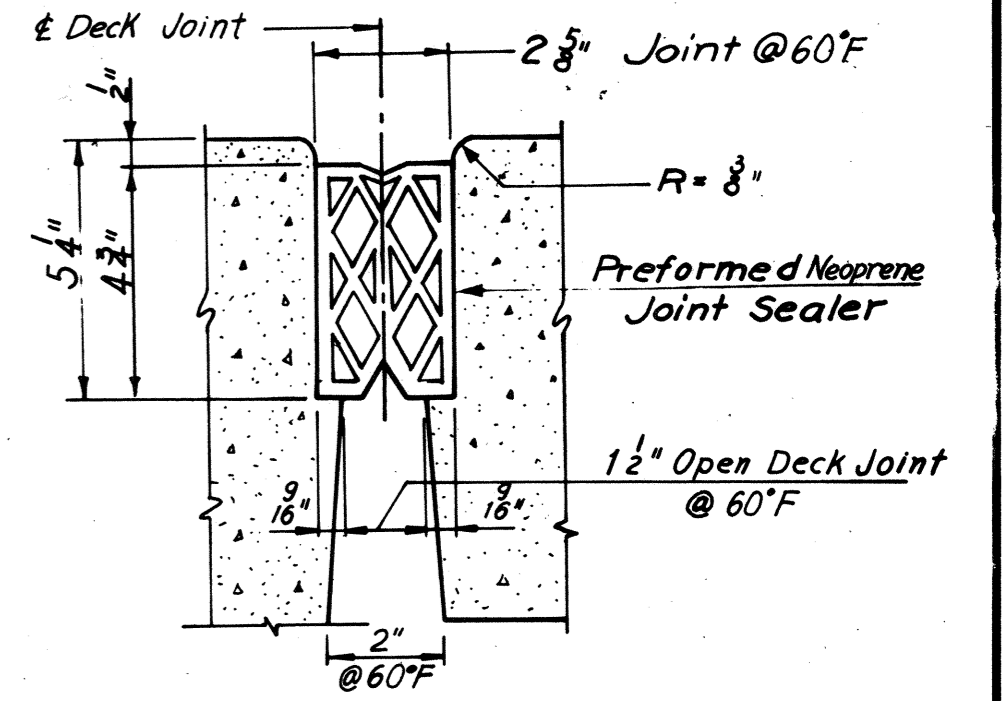


2 3/8" TYPE "A" EXPANSION JOINT
No Scale

Note: All horizontal dimensions shown above are normal to Q Joint.

Note: All horizontal dimensions of Section shown above are normal to Q joint and pier.

Note: For details of bearing stiffeners, see Framing Plan Sheets 17 thru 21.

Note: It is absolutely essential that the openings for the preformed neoprene joint sealers be accurately formed and constructed to smooth, straight lines. The size of opening shall be adjusted to allow for anticipated dead load rotation of ends of the slab and for the temperature at the time of construction.

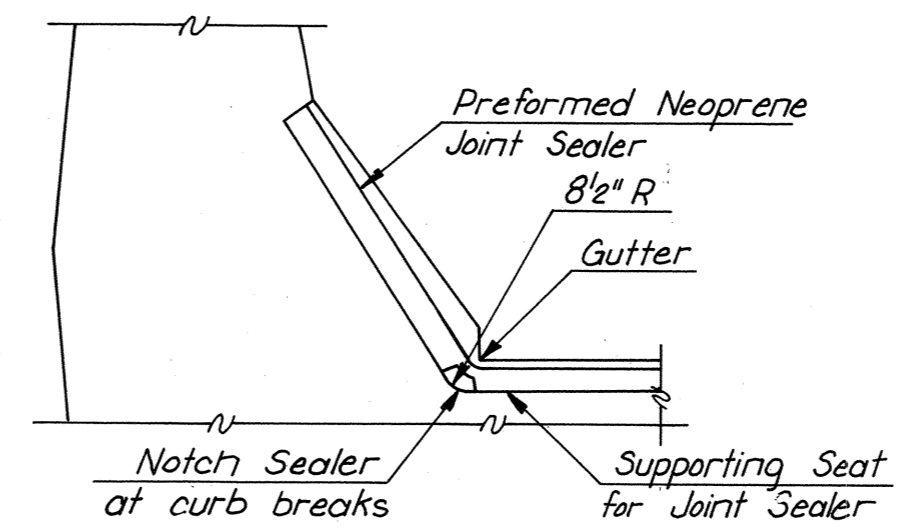

TREATMENT OF TYPE "A" JOINT AT CURB
No Scale

BY	DATE				
MADE	G.S.H.	10-15-68			
CHECKED	C.E.B.	2-5-69	1	As Built	TEM 8-76
IN CHARGE			NO.	REVISION	BY DATE

RICHMOND METROPOLITAN AUTHORITY
RICHMOND EXPRESSWAY SYSTEM
DOWNTOWN EXPRESSWAY

BRIDGE NO. 66
 EASTBOUND ROADWAY OVER
 12TH ST. - R.R. TRACKS AND 16TH ST.

JOINT DETAILS

HOWARD, NEEDLES, TAMMEN & BERGENDOFF
 consulting engineers
 NEW YORK ALEXANDRIA KANSAS CITY

SCALE: As Noted
 CONTRACT NO.: 10
 SHEET NO. 38 OF 46


AS BUILT

Bridge 67

(Ramp from Eastbound Downtown Expressway “Rte. 195” to Northbound I-95 over Dock Street, East Cary Street, East Main Street “Rte. 60” and CSX RR)


Record Set Plans

RICHMOND EXPRESSWAY SYSTEM			
SECTION	PROJECT	SHEET NO.	TOTAL SHEETS
10	DOWNTOWN EXPRESSWAY	173	265

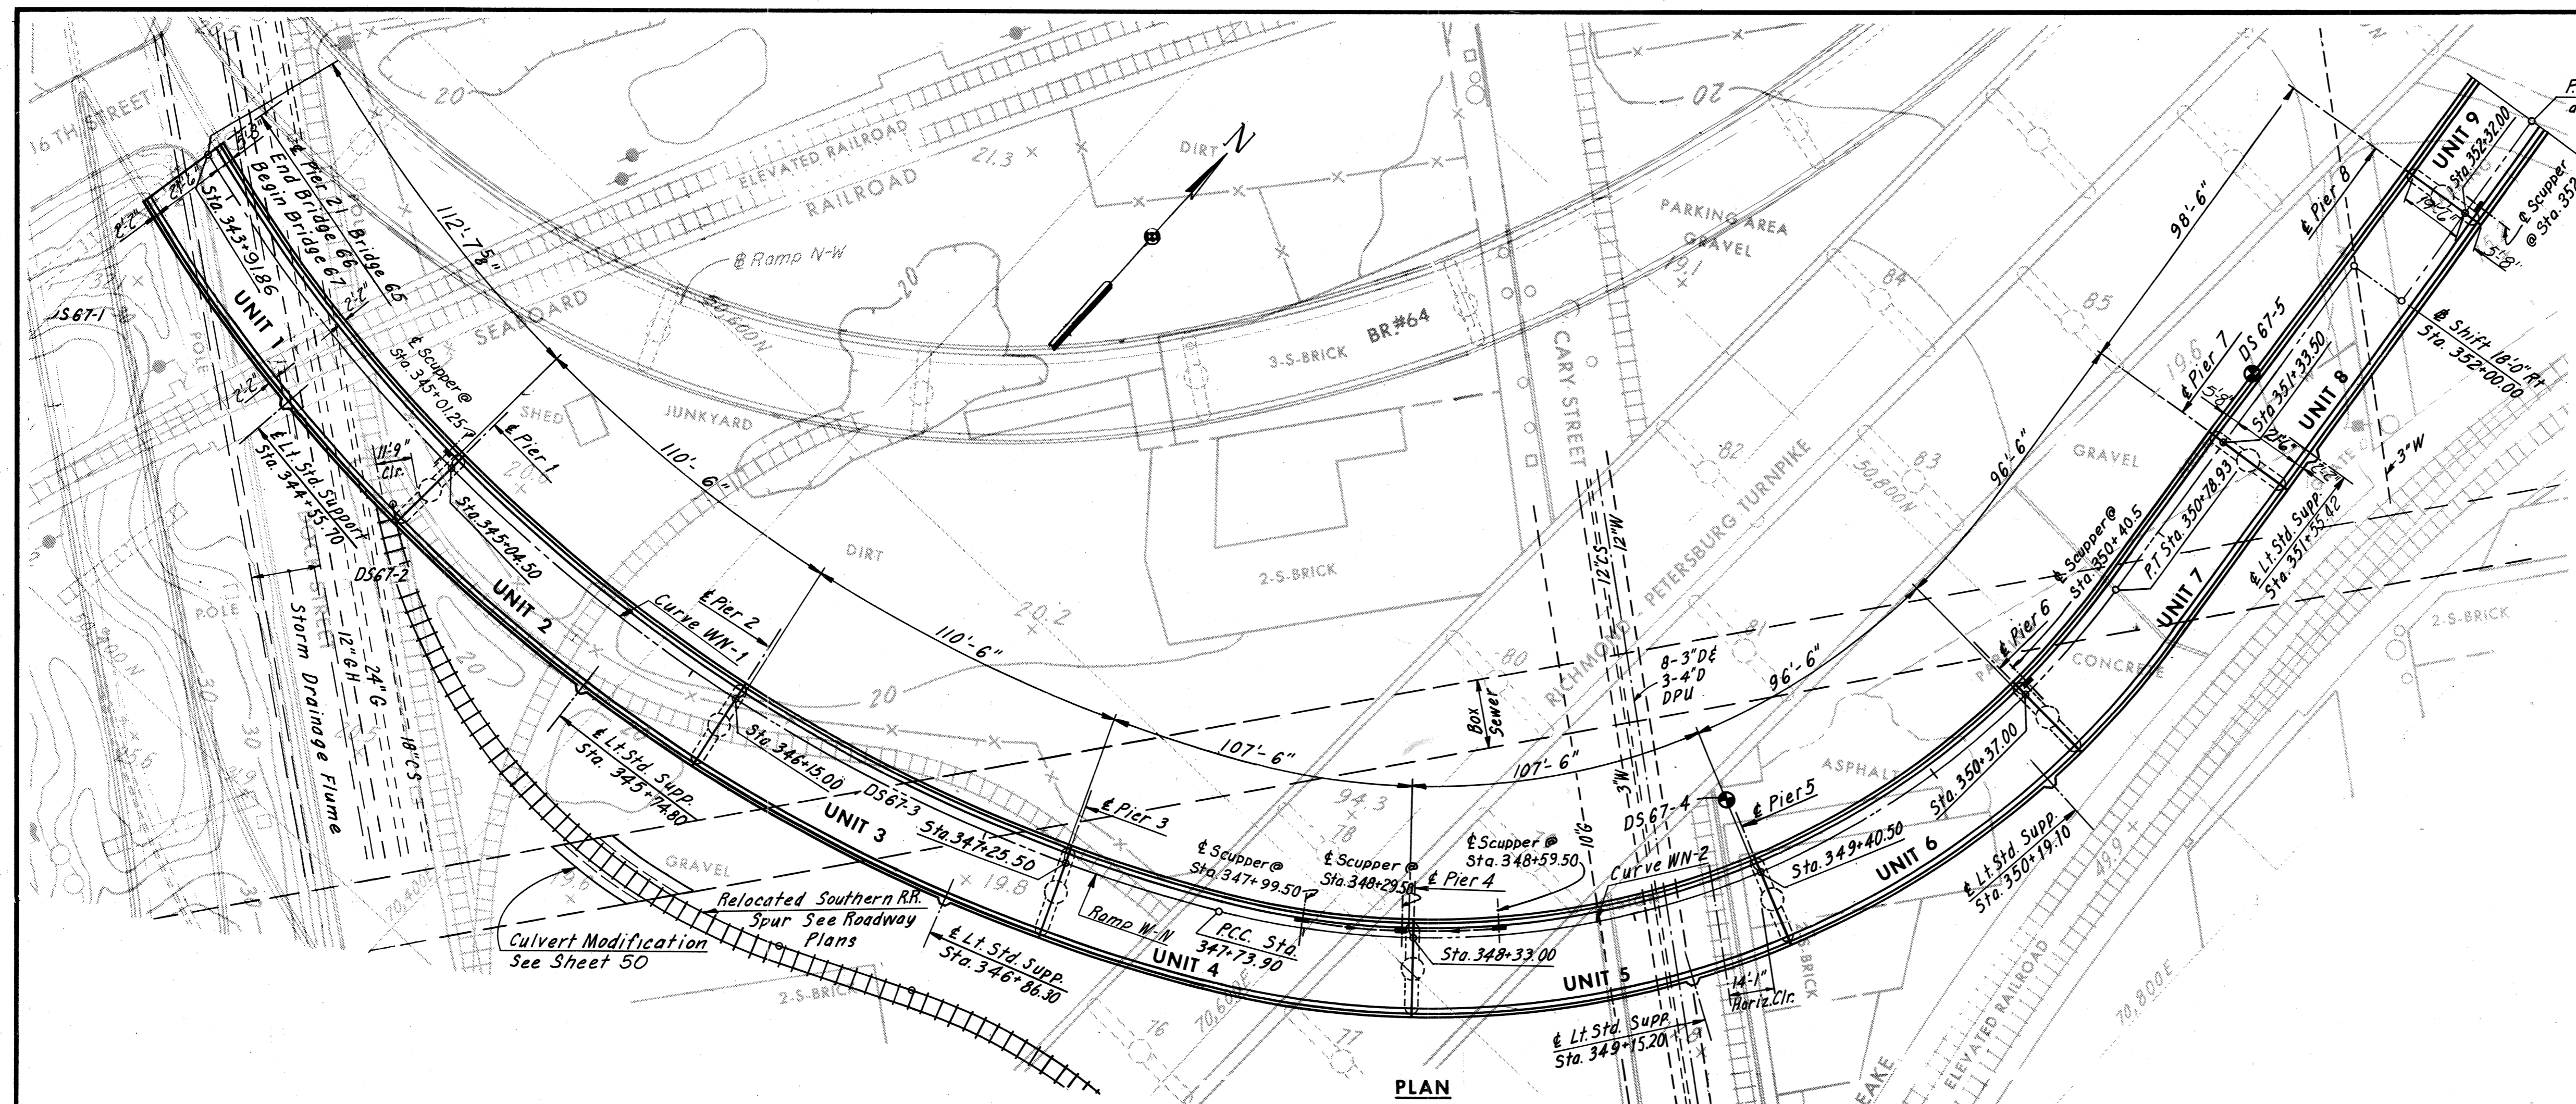

INDEX


GENERAL PLAN AND ELEVATION	1
GENERAL PLAN AND ELEVATION	2
LAYOUT	3
PIERS 1 AND 2	4
PIER 3	5
PIERS 4 AND 5	6
PIER 6	7
PIER 7	8
PIERS 8 AND 9	9
PIER 10E	10
PIERS 11 AND 12E	11
PIER 13E	12
PIERS 10W AND 12W	13
PIERS 13W AND 14	14
NORTH ABUTMENT	15
NORTH ABUTMENT DETAILS	16
NORTH ABUTMENT RETAINING WALL MODIFICATION	17
FRAMING PLAN - UNITS 1 AND 2	18
FRAMING PLAN - UNITS 3 AND 4	19
FRAMING PLAN - UNITS 5 AND 6	20
FRAMING PLAN - UNITS 7 AND 8	21
FRAMING PLAN - UNIT 9 AND FRAMING DETAILS	22
FRAMING PLAN - UNIT 10	23
GIRDER ELEVATIONS - UNIT 10	24
FRAMING PLAN - UNITS 11, 12, 13, 14 AND 15	25
FRAMING PLAN - UNITS 11, 12, 13, 14 AND 15	26
FLOORBEAM 16 AND STEEL COLUMNS	27
DECK PLAN - UNITS 1 AND 2	28
DECK PLAN - UNITS 3 AND 4	29
DECK PLAN - UNITS 5 AND 6	30
DECK PLAN - UNITS 7 AND 8	31
DECK PLAN - UNIT 9 - AND SUPERSTRUCTURE DETAILS	32
DECK PLAN - UNIT 10	33
DECK PLAN - UNITS 11, 12, 13, 14 AND 15	34
STRESS SHEET TRUSS SPAN	35
TOP LATERAL SYSTEM	36
BOTTOM LATERAL SYSTEM	37
TRUSS DETAILS P.P. 0 TO P.P. 6	38
TRUSS DETAILS P.P. 7 TO P.P. 10	39
TRUSS DETAILS P.P. 11 TO P.P. 12	40
FLOORBEAM 0 AND JOINT DETAILS	41
INTERMEDIATE FLOOR BEAMS	42
MISCELLANEOUS DETAILS	43
FLOORBEAM 12 AND JOINT DETAILS	44
DECK PLAN - TRUSS SPAN	45
SHOE DETAILS AND DECK ELEVATIONS	46
JOINT DETAILS	47
SLOPE PROTECTION DETAILS	48 THRU 49
BORING LOGS	50
STANDARD DETAILS	51 THRU 54

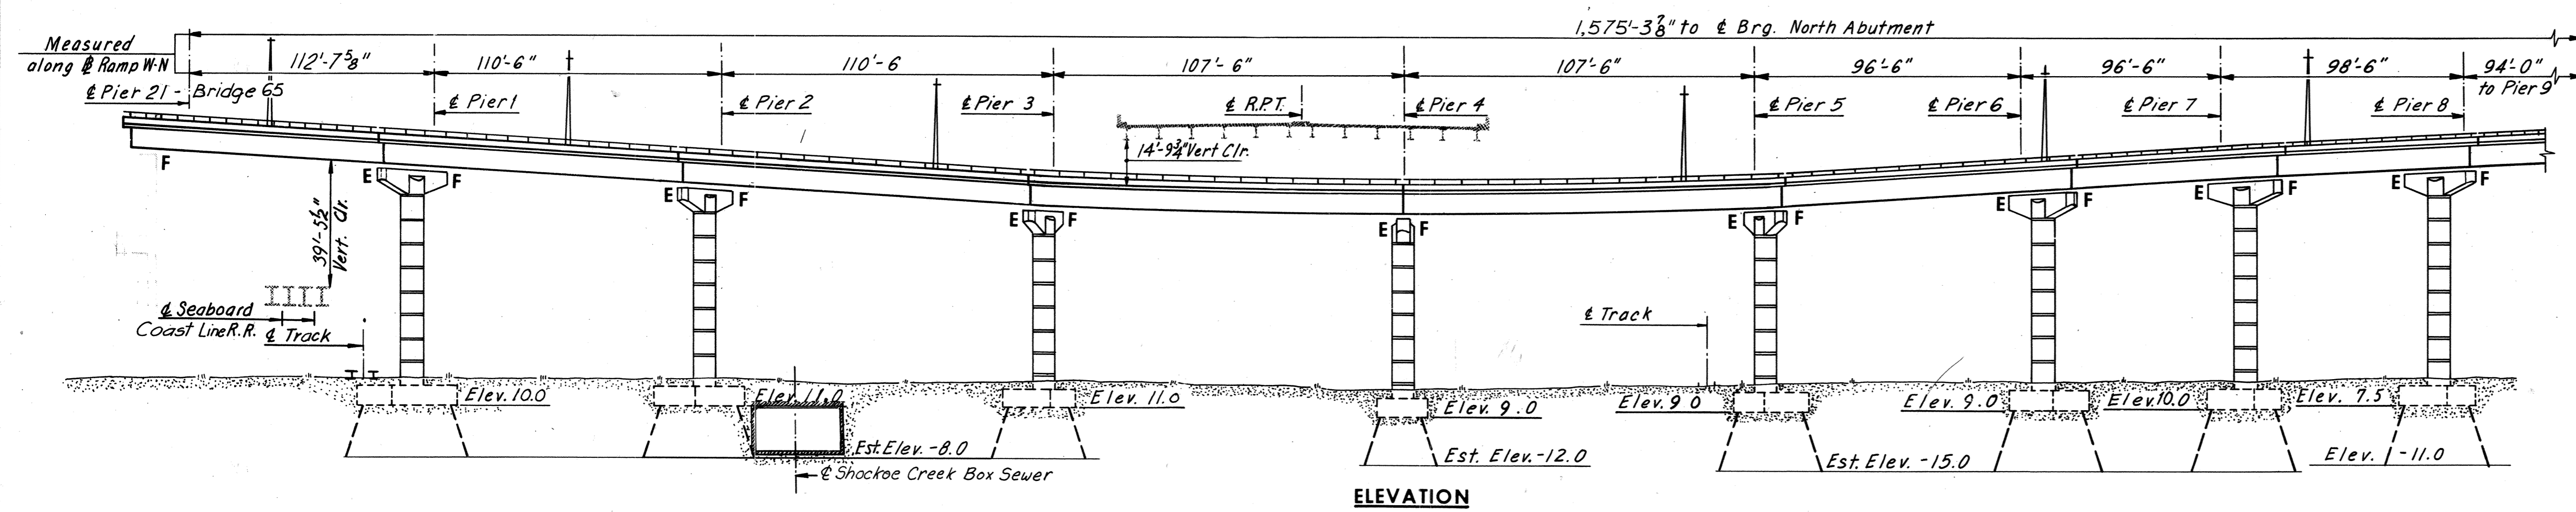

Note:
For General Notes, see Sheet 4.
For Quantity Table, see Sheet 3

CURVE DATA

@ R.P.T.		@ Ramp W-N		@ Ramp N-W	
Curve: R.P.T.-1	Curve: R.P.T.-2	Curve: WN-1	Curve: WN-2	Curve: WN-3	Curve: WN-4
P.I. = Sta. 1704+68.83	P.I. = Sta. 1723+07.01	P.I. = Sta. 345+25.47	P.I. = Sta. 349+47.64	P.I. = Sta. 353+19.15	P.I. = Sta. 13+42.50
Δ = 15°03'56"	Δ = 35°27'40"	Δ = 64°53'49"	Δ = 69°32'15"	Δ = 6°23'54"	Δ = 32°01'34"
D = 1°00'	D = 4°00'	D = 11°27'13"	D = 12°28'10"	D = 6°00'	D = 5°51'36"
T = 757.65'	T = 430.45'	T = 317.90'	T = 173.75'	T = 53.38'	T = 426.01'
L = 1,506.56'	L = 836.30'	L = 566.33'	L = 305.03'	L = 106.64'	L = 829.72'
R = 5,729.58'	R = 1,432.39'	R = 500.00'	R = 255.00'	R = 954.93'	R = 1,484.39'
		Curve: WN-4	Curve: WN-5	Curve: WN-6	
		P.I. = Sta. 355+39.85	P.I. = Sta. 358+17.39	P.I. = Sta. 361+67.68	
		Δ = 5°01'11"	Δ = 13°10'51"	Δ = 19°35'06"	
		D = 1°30'	D = 6°00'	D = 4°09'03"	
		T = 167.43'	T = 110.33'	T = 238.25'	
		L = 334.65'	L = 219.68'	L = 471.85'	
		R = 3,819.72'	R = 954.93'	R = 1,380.39'	

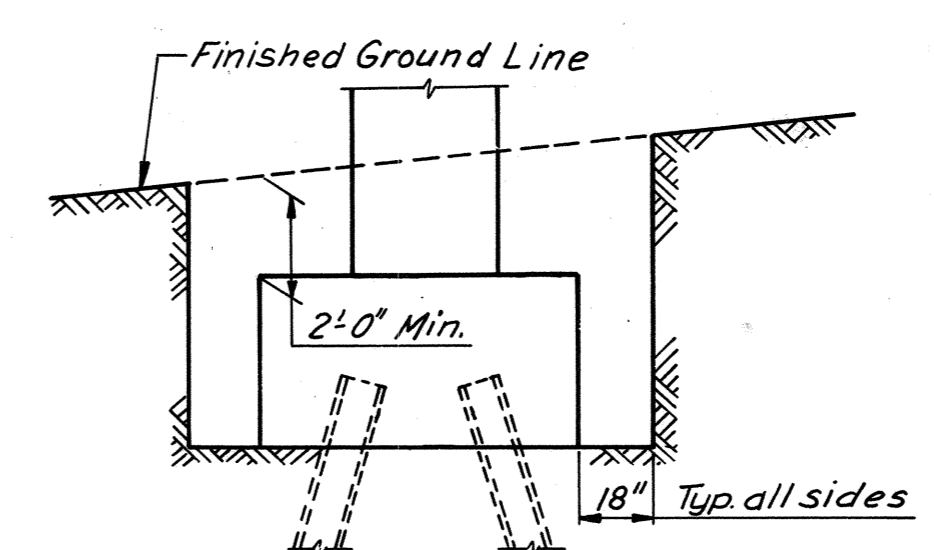

LIMITS OF STRUCTURE EXCAVATION
No Scale

BY	DATE	3	As Built	TEM	6-77
MADE	AMH	3-5-69	Light Sta. Location Unit B	JLK	6-6-75
CHECKED	KC T	5-12-69	Sheets 42 & 45 added	L.B.P.	3-5-75
IN CHARGE					

RICHMOND METROPOLITAN AUTHORITY
RICHMOND EXPRESSWAY SYSTEM
DOWNTOWN EXPRESSWAY





BRIDGE NO. 67
RAMP W-N CONNECTION TO
RICHMOND-PETERSBURG TURNPIKE
GENERAL PLAN AND ELEVATION

HOWARD, NEEDLES, TAMMEN & BERGENDOFF
consulting engineers
NEW YORK ALEXANDRIA KANSAS CITY

SCALE: 1" = 30'-0"
CONTRACT NO.: 10
SHEET NO. 1 OF 54

AS BUILT

RICHMOND EXPRESSWAY SYSTEM			
SECTION	PROJECT	SHEET NO.	TOTAL SHEETS
10	DOWNTOWN EXPRESSWAY	174	265

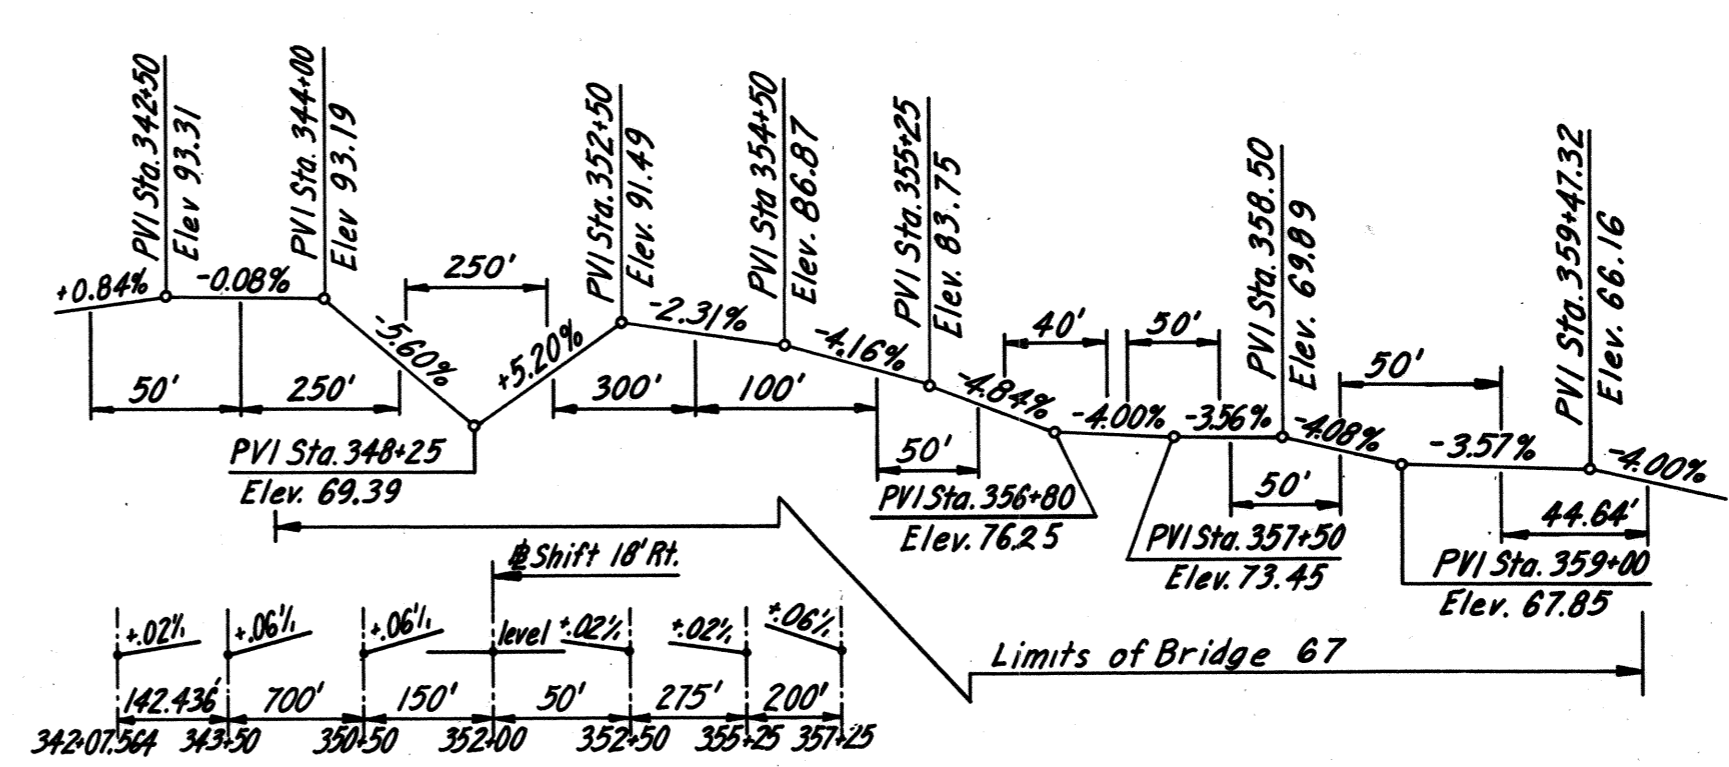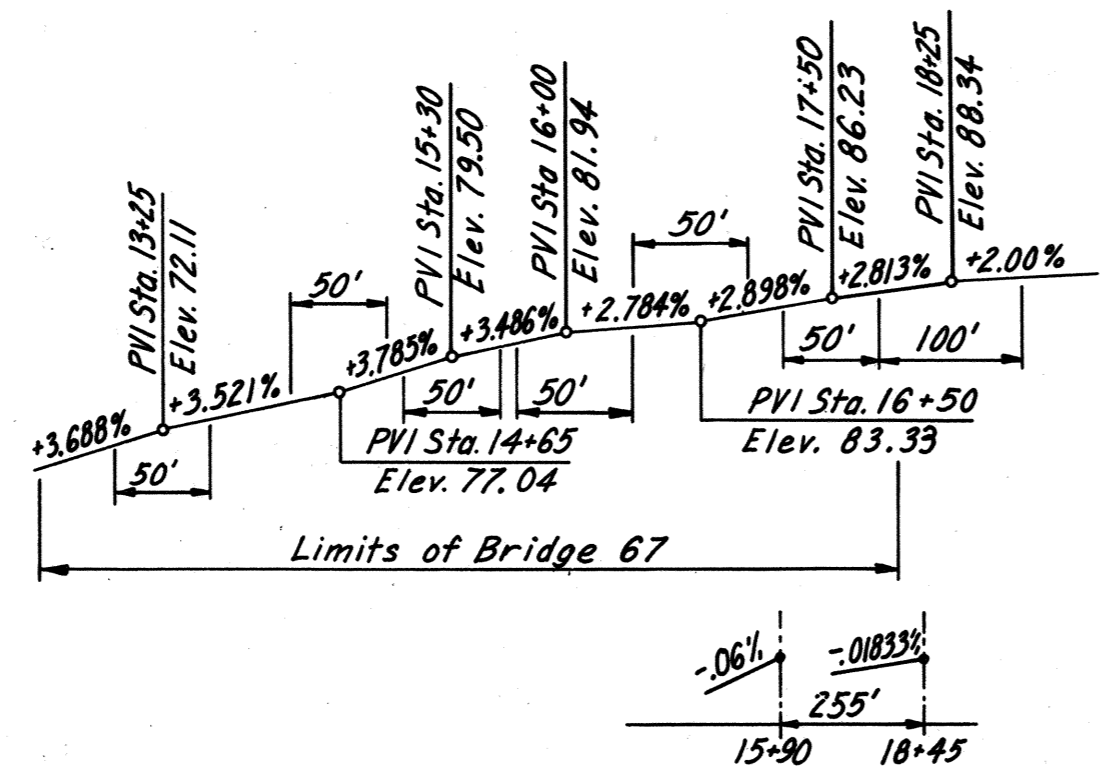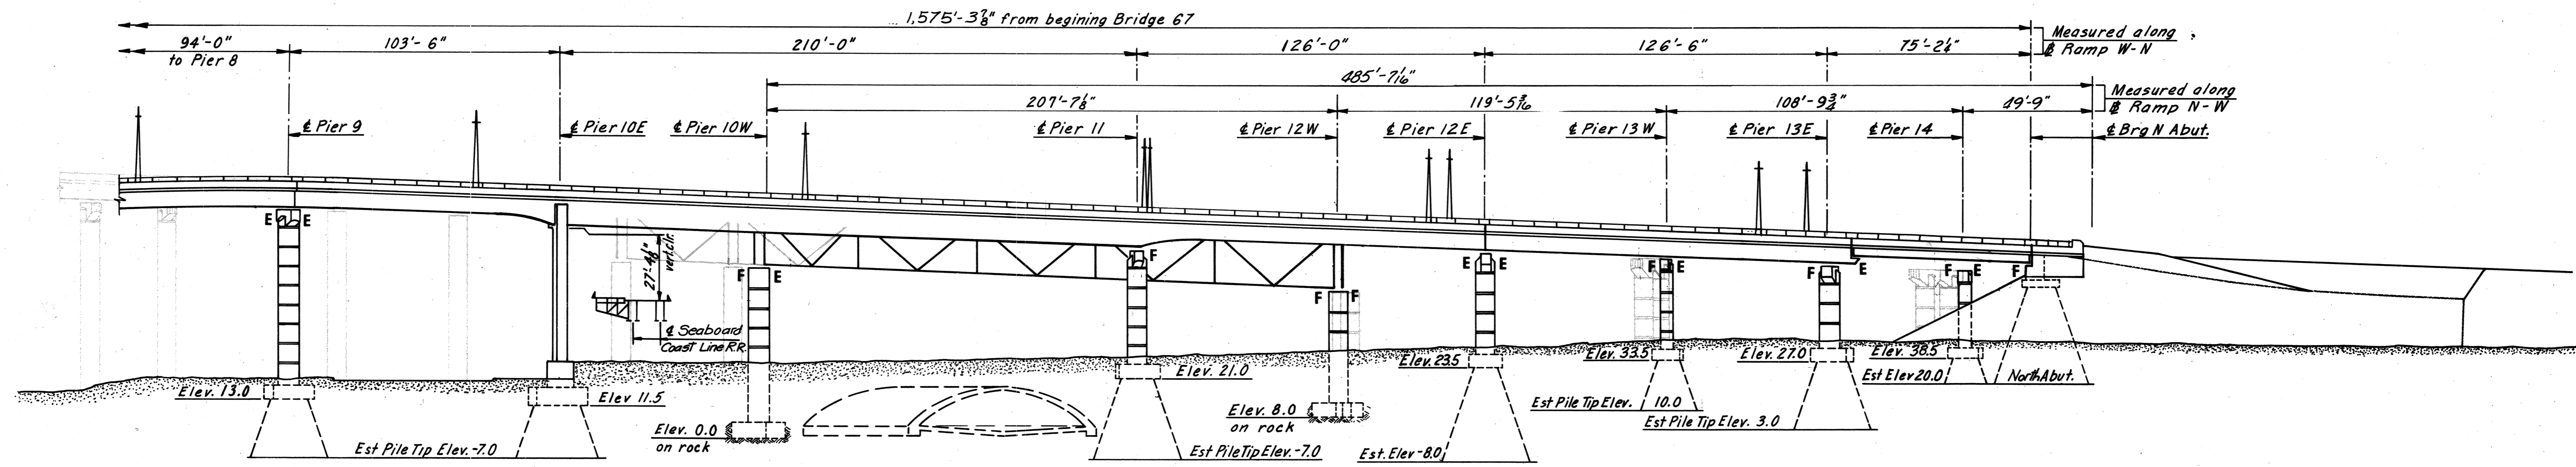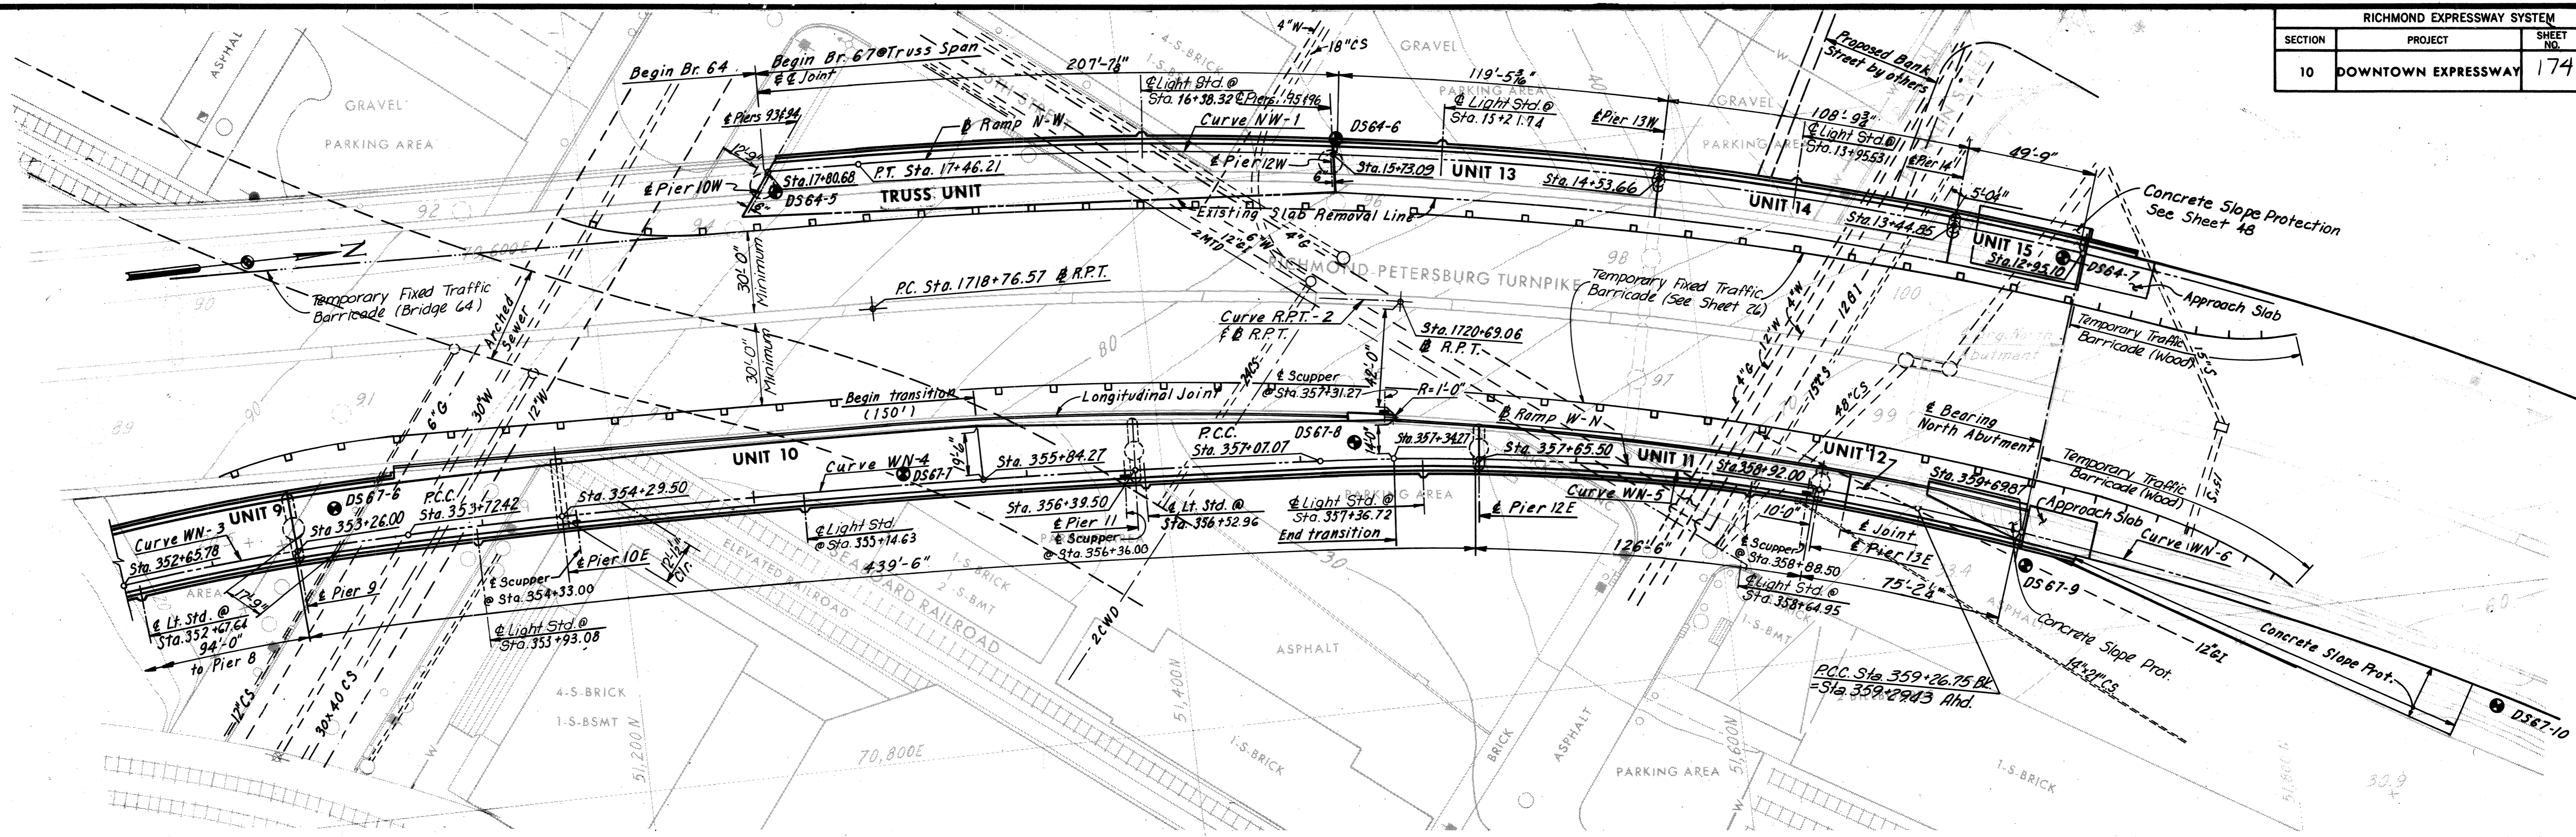

RICHMOND METROPOLITAN AUTHORITY
RICHMOND EXPRESSWAY SYSTEM
DOWNTOWN EXPRESSWAY


BRIDGE NO. 67
RAMP W-N CONNECTION TO
RICHMOND-PETERSBURG TURNPIKE
GENERAL PLAN AND ELEVATION

HOWARD, NEEDLES, TAMMEN & BERGENDOFF
consulting engineers
NEW YORK ALEXANDRIA KANSAS CITY

SCALE: *As Noted*
CONTRACT NO.: 10
SHEET NO. 2 OF 54

BY	DATE	NO.	REVISION	BY	DATE
AMH	12-30-68	2	As Built	TEM	6-77
KCT	5-12-69	1	Revised Plans & Sheet Sta. & Board Length	DWB	1-24-75

RICHMOND EXPRESSWAY SYSTEM			
SECTION	PROJECT	SHEET NO.	TOTAL SHEETS
10	DOWNTOWN EXPRESSWAY	175	265

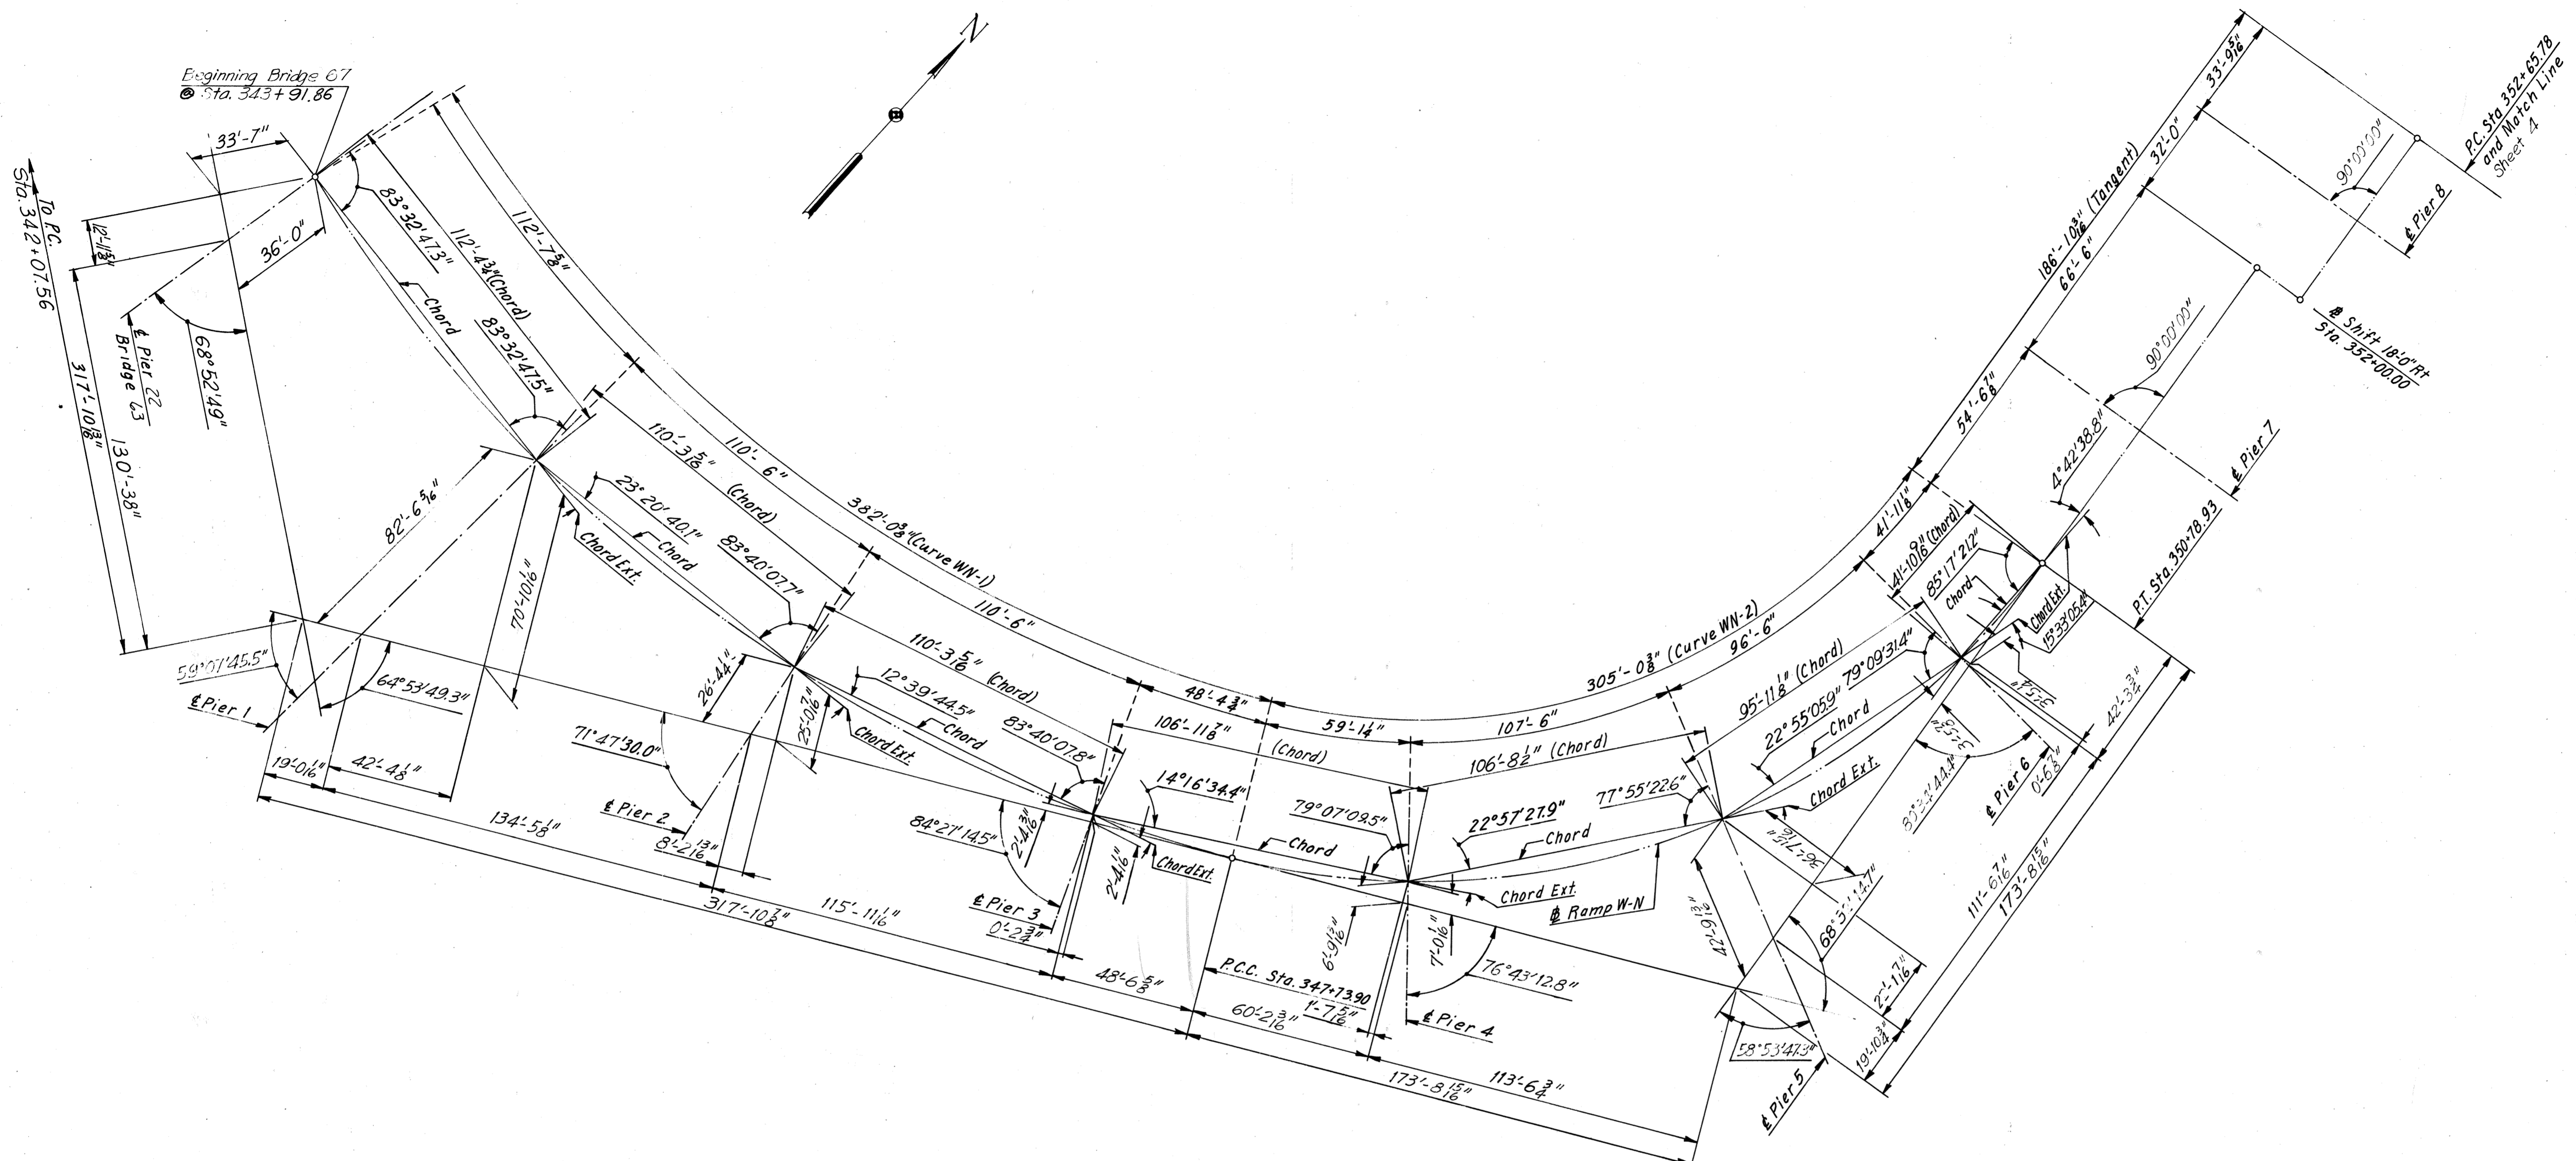

ESTIMATED QUANTITIES

	Structure Excavation	Concrete (+)	Reinforcing Steel	Str. Steel Mild Carbon	Str. Steel High Strength	Aluminum Railing (1-Rail)	Porous Backfill	Underdrain 6" Dia. Pipe	Steel Piles 10BP42	Steel Piles 12BP53
	Cu. Yds.	Cu. Yds.	Lbs.	Lbs.	Lbs.	Lin. Ft.	Cu. Yds.	Lin. Ft.	Lin. Ft.	Lin. Ft.
Superstructure	---	1,729.0	394,000	1,852,700	550,750	2,930	---	---	---	---
Substructure	2,821	2,456.0	376,600	125,200	1,850	---	14	27	630	5,745
Total	2,821	4,185.0 *	770,600	1,977,900	552,600	2,930	14	27	630	5,745

LAYOUT SKETCH
Scale: 1"=30'-0"

	Steel Piles 14BP73	Asphalt Damp proofing	Approach Slab Concrete(+)	Approach Slab Reinforcing Steel	Metal Conduit 3" Dia.	Sheet Piling	Bridge Drainage Metal Work	Concr. Slab Slope Prot.	Modifications To existing Shackoe Creek Box Sewer	Modifications To R.P. Turnpike Bridge	Elastomeric Expansion Dam Type 250	Elastomeric Expansion Dam Type 400A
	Lin. Ft.	Sq. Yds.	Cu. Yds.	Lbs.	Lin. Ft.	Lump Sum	Lbs.	Sq. Yds.	Lump Sum	Lump Sum	Lin. Ft.	Lin. Ft.
Superstructure	---	---	---	---	2,030	--	14,020	---	---	1	18	25
Substructure	760	27	38.0	7900	--	1	---	291	1	-	--	--
Total	760	27	38.0 *	7900	2,030	1	14,020	291	1	1	18	25

* All Concrete for Superstructure shall be Class A4 and for Substructure Class A3.

BY	DATE				
MADE	AMH	3-28-69			
CHECKED	KCT	5-5-69	1	As Built	TEM 6-77
IN CHARGE			NO.	REVISION	BY

RICHMOND METROPOLITAN AUTHORITY
RICHMOND EXPRESSWAY SYSTEM
DOWNTOWN EXPRESSWAY



BRIDGE NO. 67
RAMP W-N CONNECTION TO
RICHMOND-PETERSBURG TURNPIKE
LAYOUT

HOWARD, NEEDLES, TAMMEN & BERGENDOFF
consulting engineers
NEW YORK ALEXANDRIA KANSAS CITY



SCALE: *As Noted*
CONTRACT NO.: 10
SHEET NO. 3 OF 54

AS BUILT

RICHMOND EXPRESSWAY SYSTEM			
SECTION	PROJECT	SHEET NO.	TOTAL SHEETS
10	DOWNTOWN EXPRESSWAY	176	265

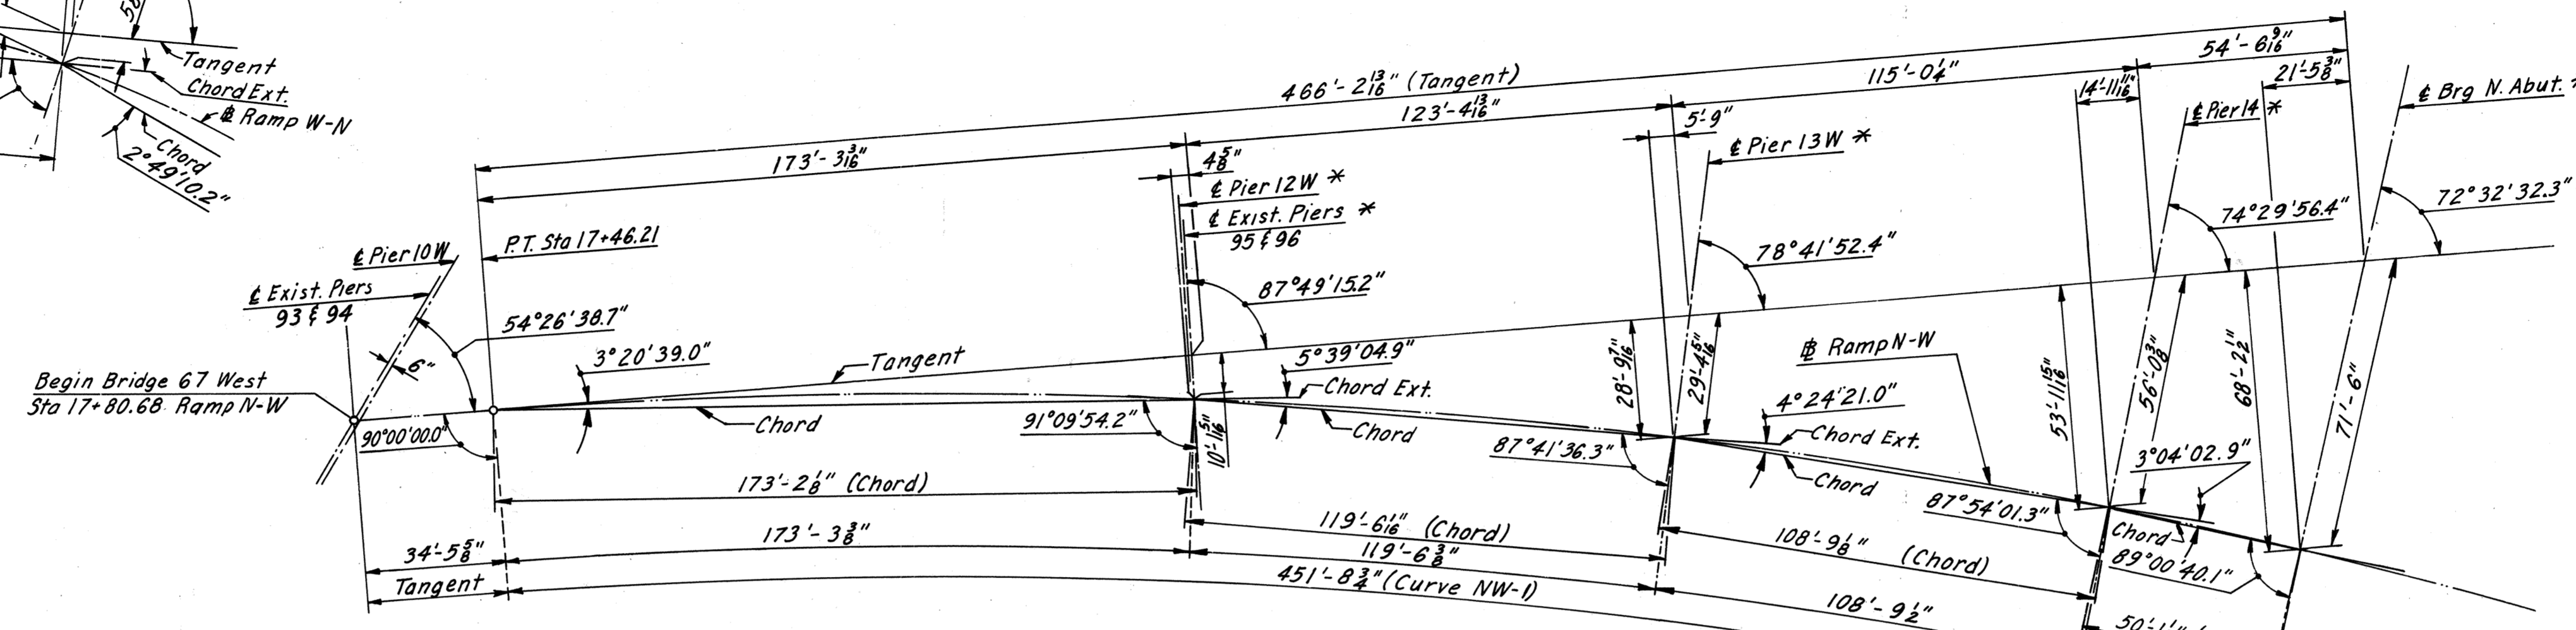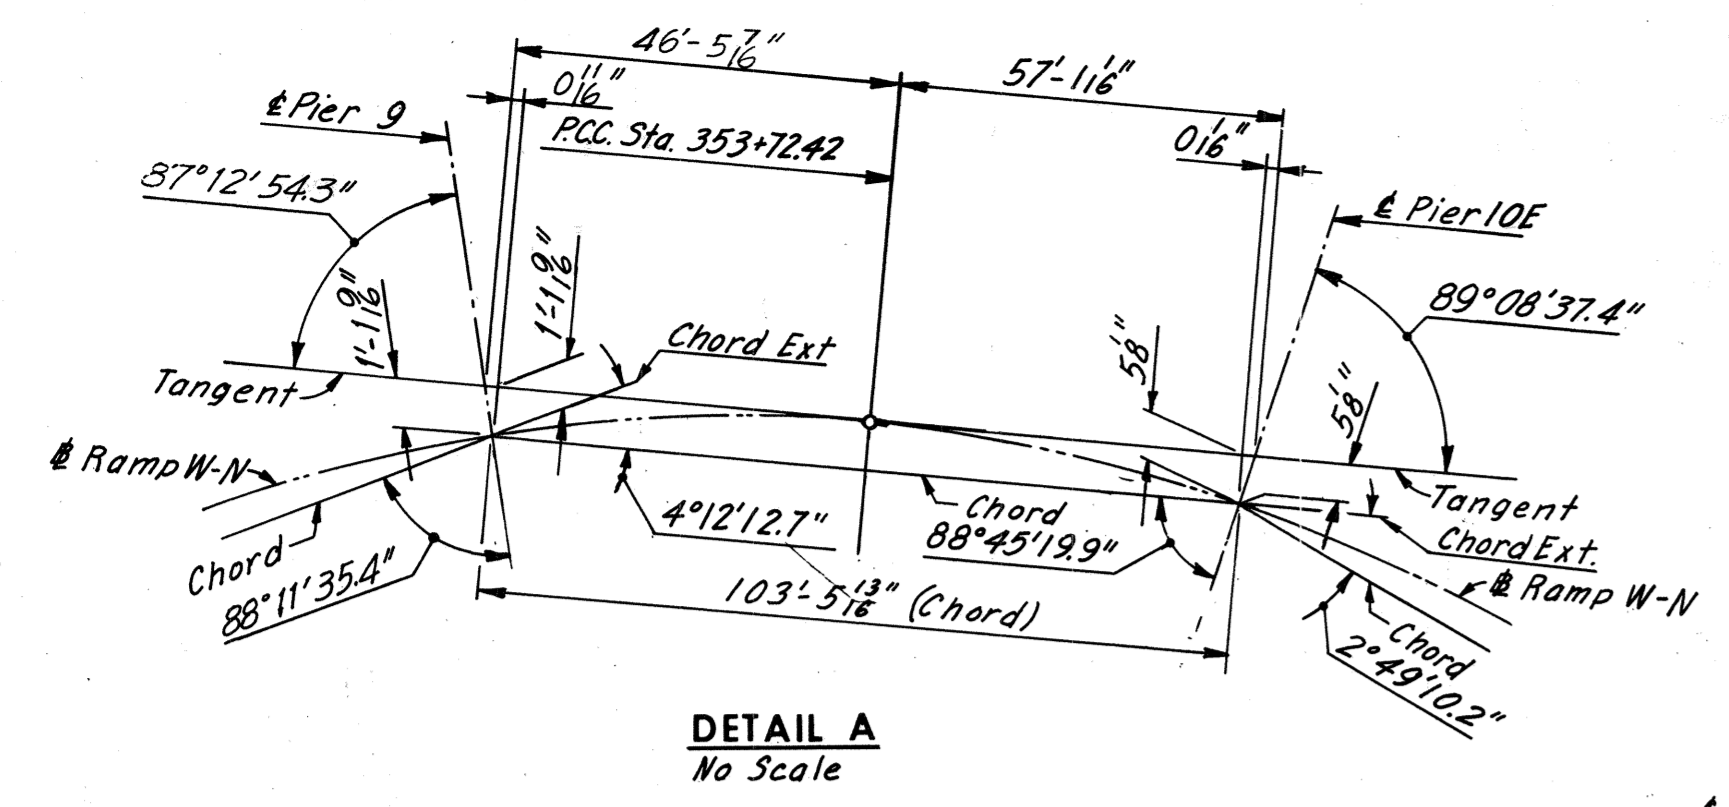

*Note:
The centerline shown is for layout only. See abutment and pier drawings for exact locations of columns.

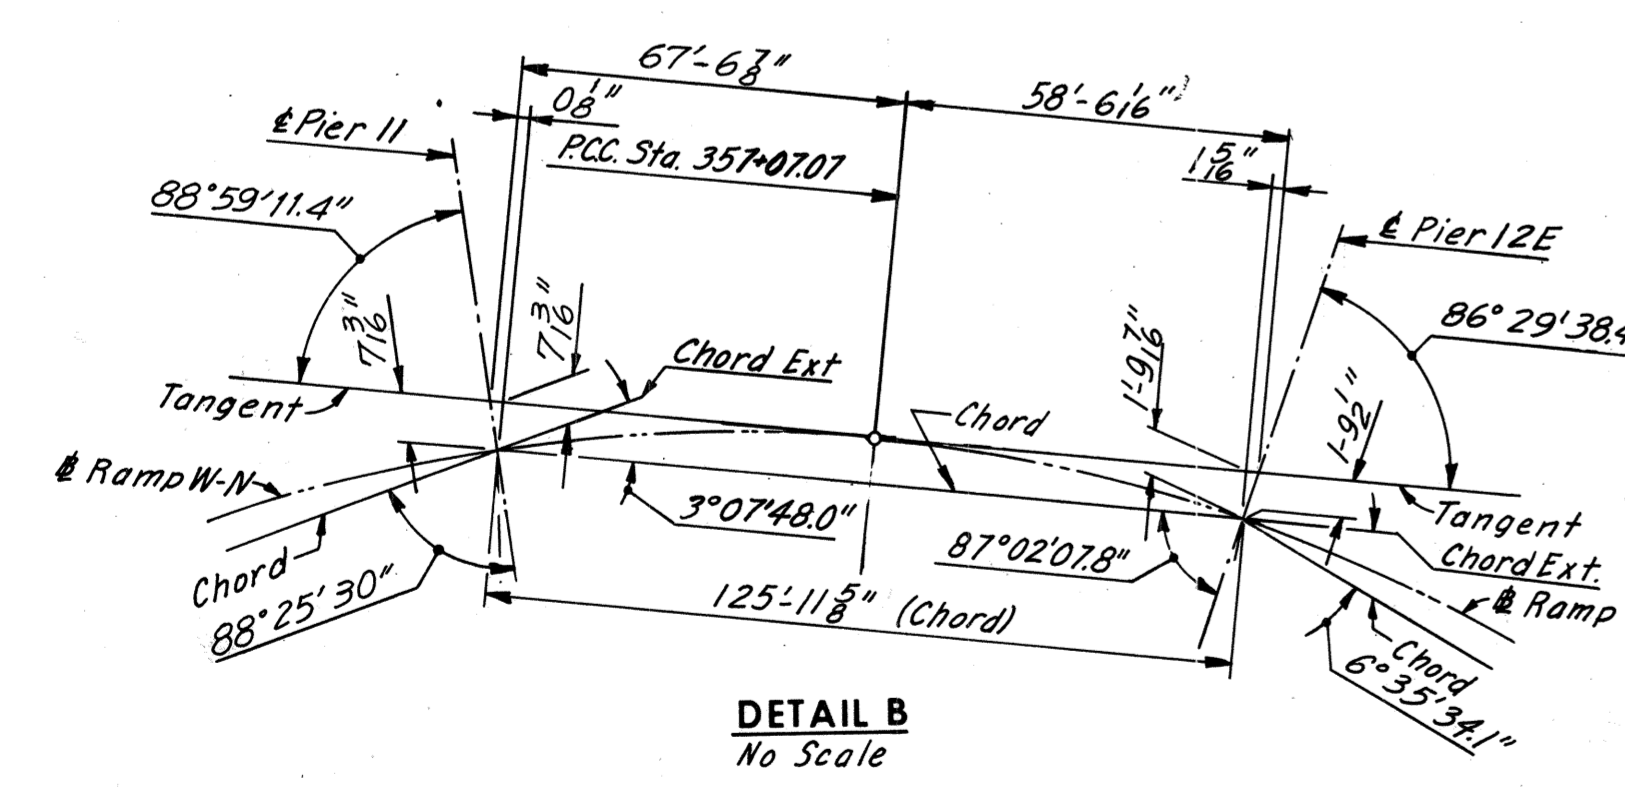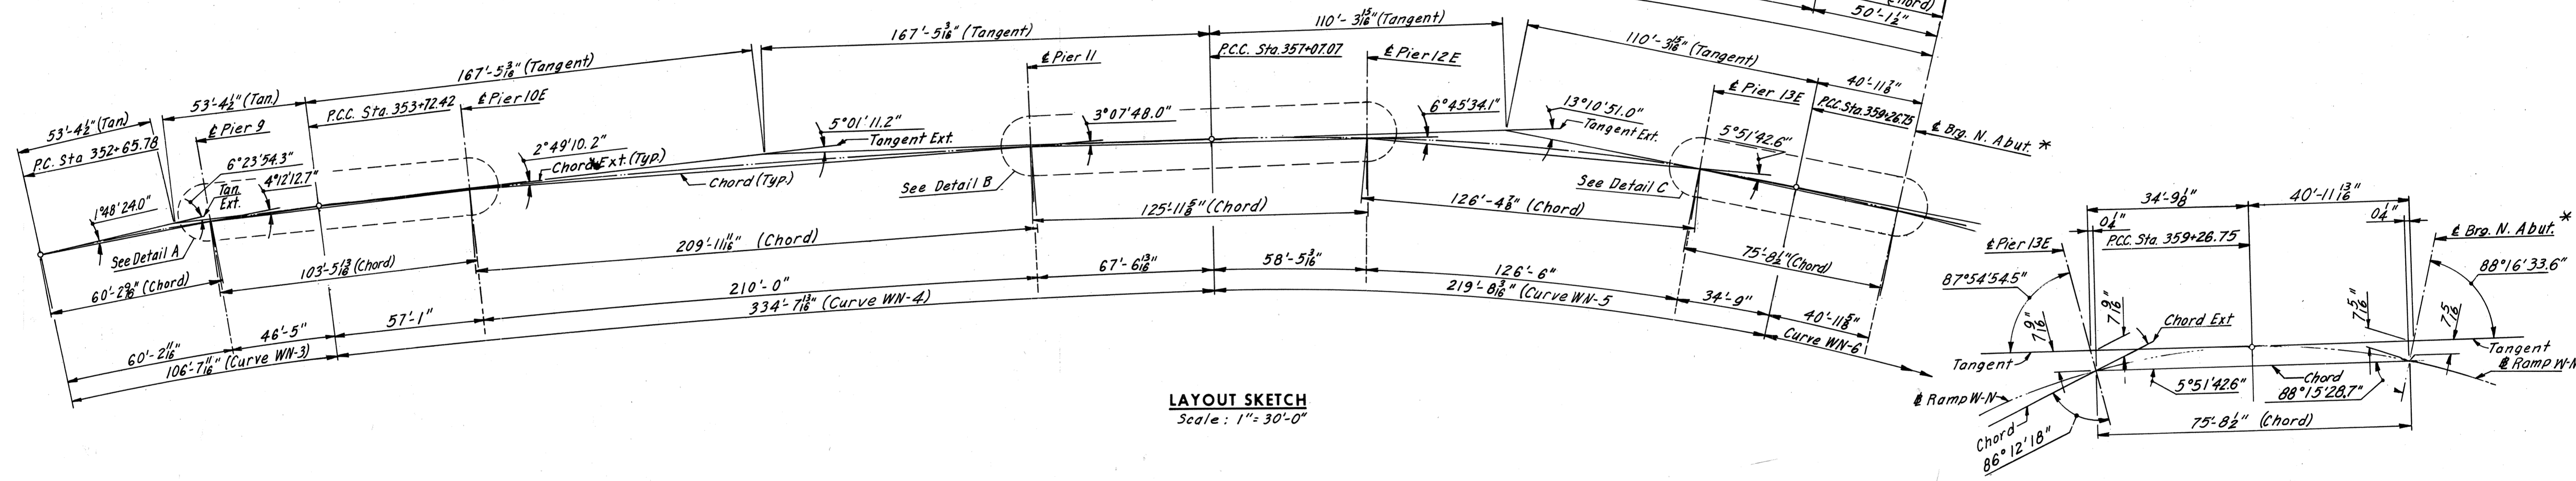

GENERAL NOTES:

ROADWAY: One variable width roadway connecting Br. 66 (E.B. Roadway) with Richmond-Petersburg Turnpike.

face to face of railing is 27'-0" thru the Ramp section, transitioning to 13'-0" widening along Northbound Lanes of the R.P.T. Also included is 13'-0" widening of Southbound Lanes of the R.P.T. from North Abutment to Pier 94.

CAPACITY: Dead load includes 15 lbs. per sq. ft. for future wearing surface. Live load: HS 20-44 loading and alternate military loading.

SPECIFICATIONS:

GENERAL: Virginia Department of Highway Road and Bridge Specifications 1970.

DESIGN: A.A.S.H.O. Standard Specifications for Highway Bridges, 1973, modified by Special Design Provisions.

WELDING: 1972 Standard Specifications for Welded Highway and Railway Bridges of the American Welding Society.

CONTRACT SPECIAL PROVISIONS: Specifications and Contract Special Provisions referred to above are necessary to make these plans complete.

DATUM: City of Richmond

TEMPERATURE: The normal temperature referred to in the plans is 60° F. The temperature range for movement is 0° F. to 120° F.

DIMENSIONS: All dimensions are measured horizontally and vertically unless otherwise noted.

EXCAVATION: Excavation below subgrade and cut slope template shall be classified as Structure Excavation. All excavation above these limits shall be classified as Regular Excavation and is not included in the Structural Quantities.

FOUNDATIONS: Footings shall rest on firm material. Foundation material shall be dry and special attention is called to Section 401.05 of Standard Specifications and to the Contract Special Provisions, concerning preparation of Foundations for footings.

CONCRETE NOTES: Concrete in superstructure shall be Class A-4. All other concrete shall be Class A-3. All exposed edges and corners shall have a 3/4" chamfer or fillet unless otherwise noted. Care in the method of vibration, the use of low-slump concrete, and or other means shall be employed to prevent downgrade movement of newly placed slab concrete. Finishing Concrete Surfaces: See Standard Architectural Detail Sheets and the Contract Special Provisions for types and details. All reinforcing bar dimensions on the detailed drawings are to centers of bars unless otherwise noted. Clear distance between reinforcing steel and face to concrete shall be as noted on the plans. All bar laps shall be 30 diameters of the smaller diameter bar unless otherwise noted. All reinforcing steel shall conform to ASTM 615 Grade 40.

STEEL NOTES: Structural steel shall conform to A.S.T.M. Designations A36, A572 - Grade 50 and A588 as noted. See Special Provisions. All field connections shall be made with high strength bolts. High strength bolts shall be 1/2" diameter unless otherwise noted and shall conform to A.S.T.M. Specification A-325.

BY	DATE	△	Note Added	K/S	12-11-74
MADE	AMH	3-27-69	2	As Built	TEM 6-77
CHECKED	KCT	5-6-69			
IN CHARGE			NO.	REVISION	BY DATE

**RICHMOND METROPOLITAN AUTHORITY
RICHMOND EXPRESSWAY SYSTEM
DOWNTOWN EXPRESSWAY**














**BRIDGE NO. 67
RAMP W-N CONNECTION TO
RICHMOND-PETERSBURG TURNPIKE
LAYOUT**

HOWARD, NEEDLES, TAMMEN & BERGENDOFF
consulting engineers
NEW YORK ALEXANDRIA KANSAS CITY

SCALE: As Noted
CONTRACT NO.: 10
SHEET NO. 4 OF 54

AS BUILT

RICHMOND EXPRESSWAY SYSTEM			
SECTION	PROJECT	SHEET NO.	TOTAL SHEETS
10	DOWNTOWN EXPRESSWAY	177	265

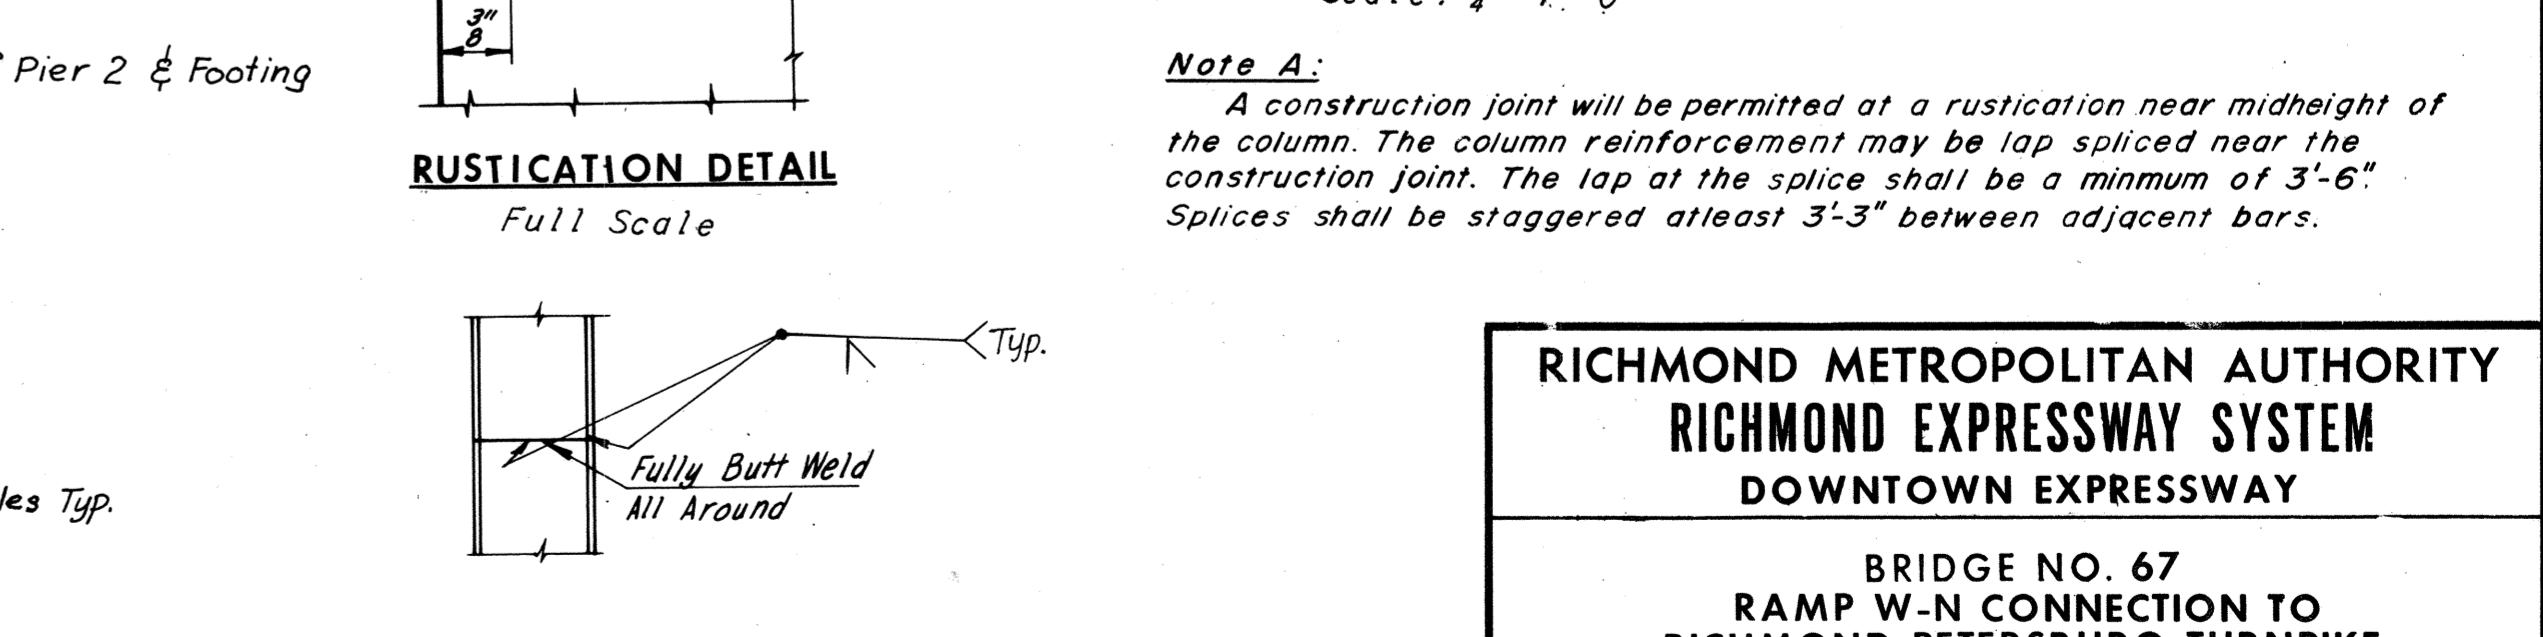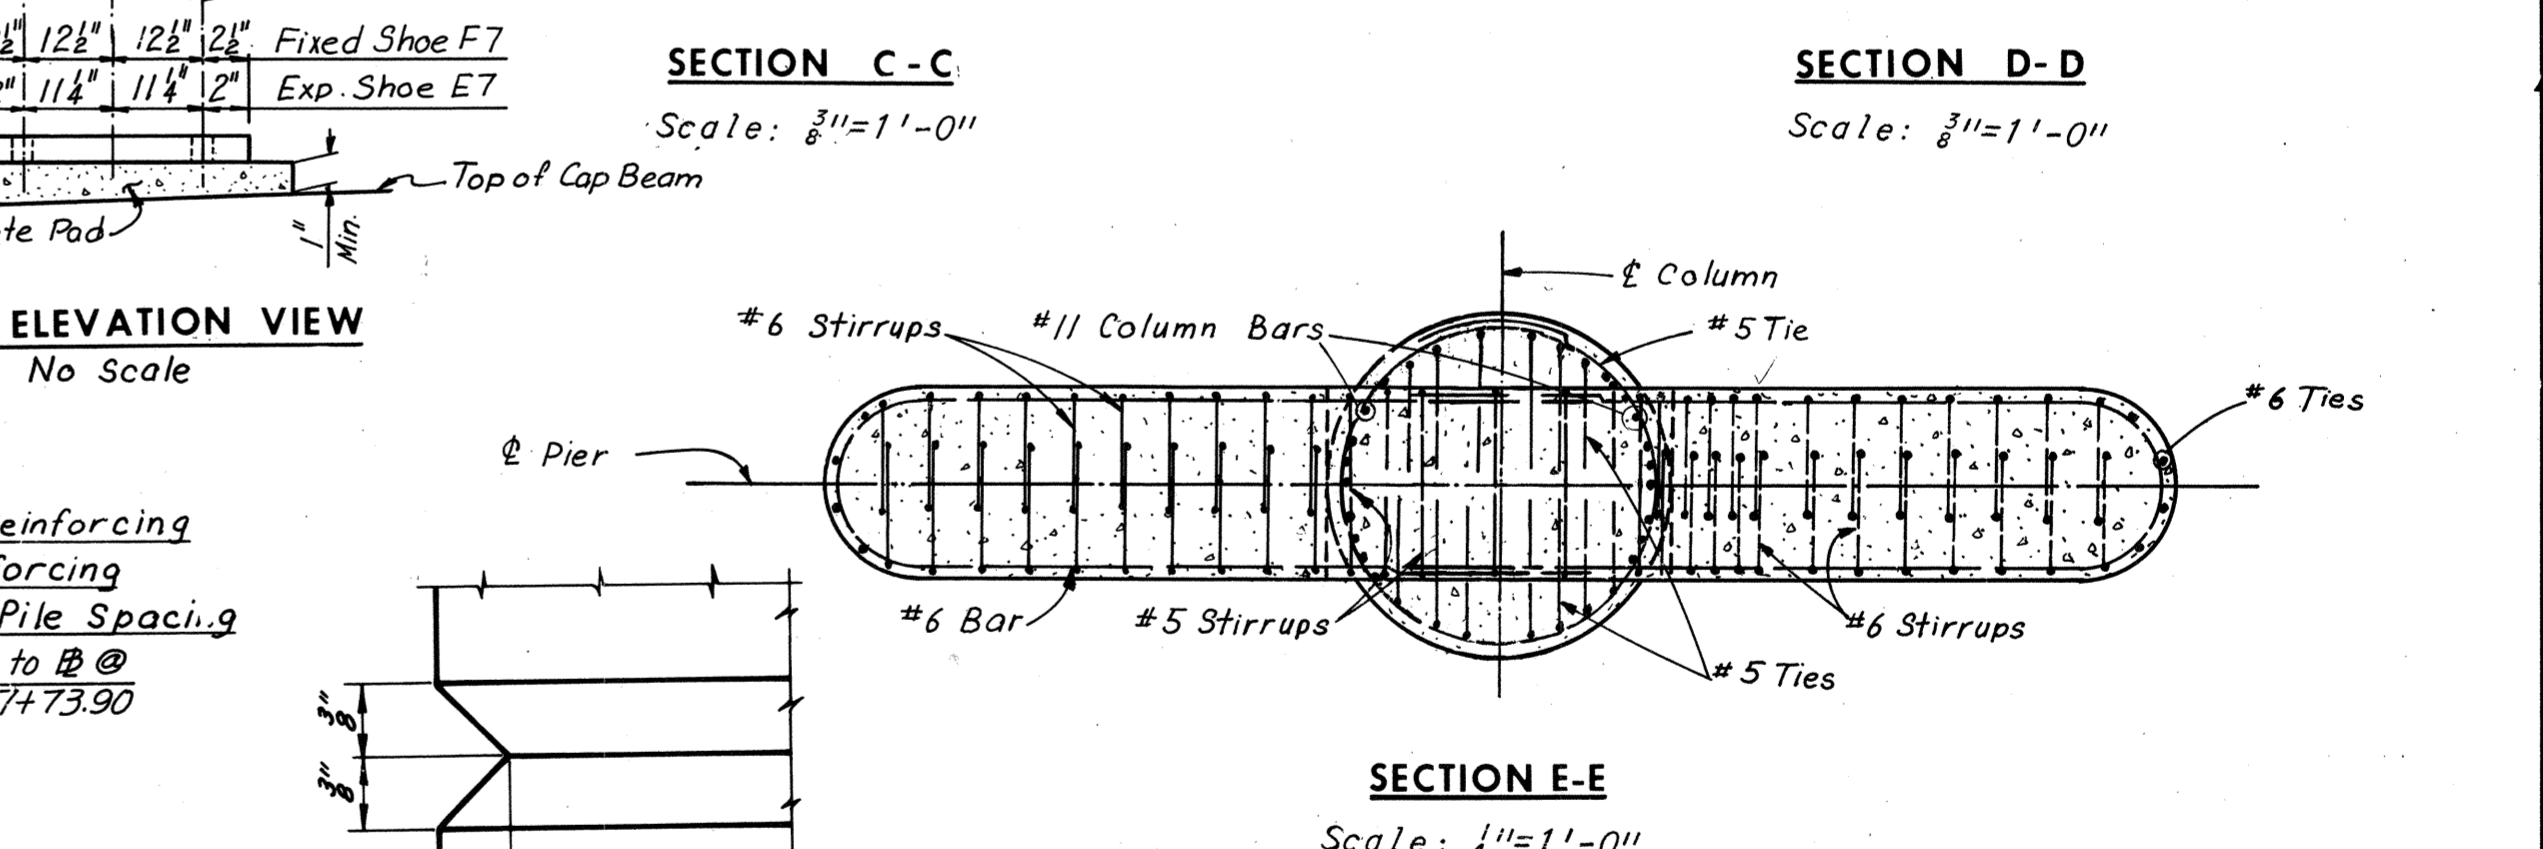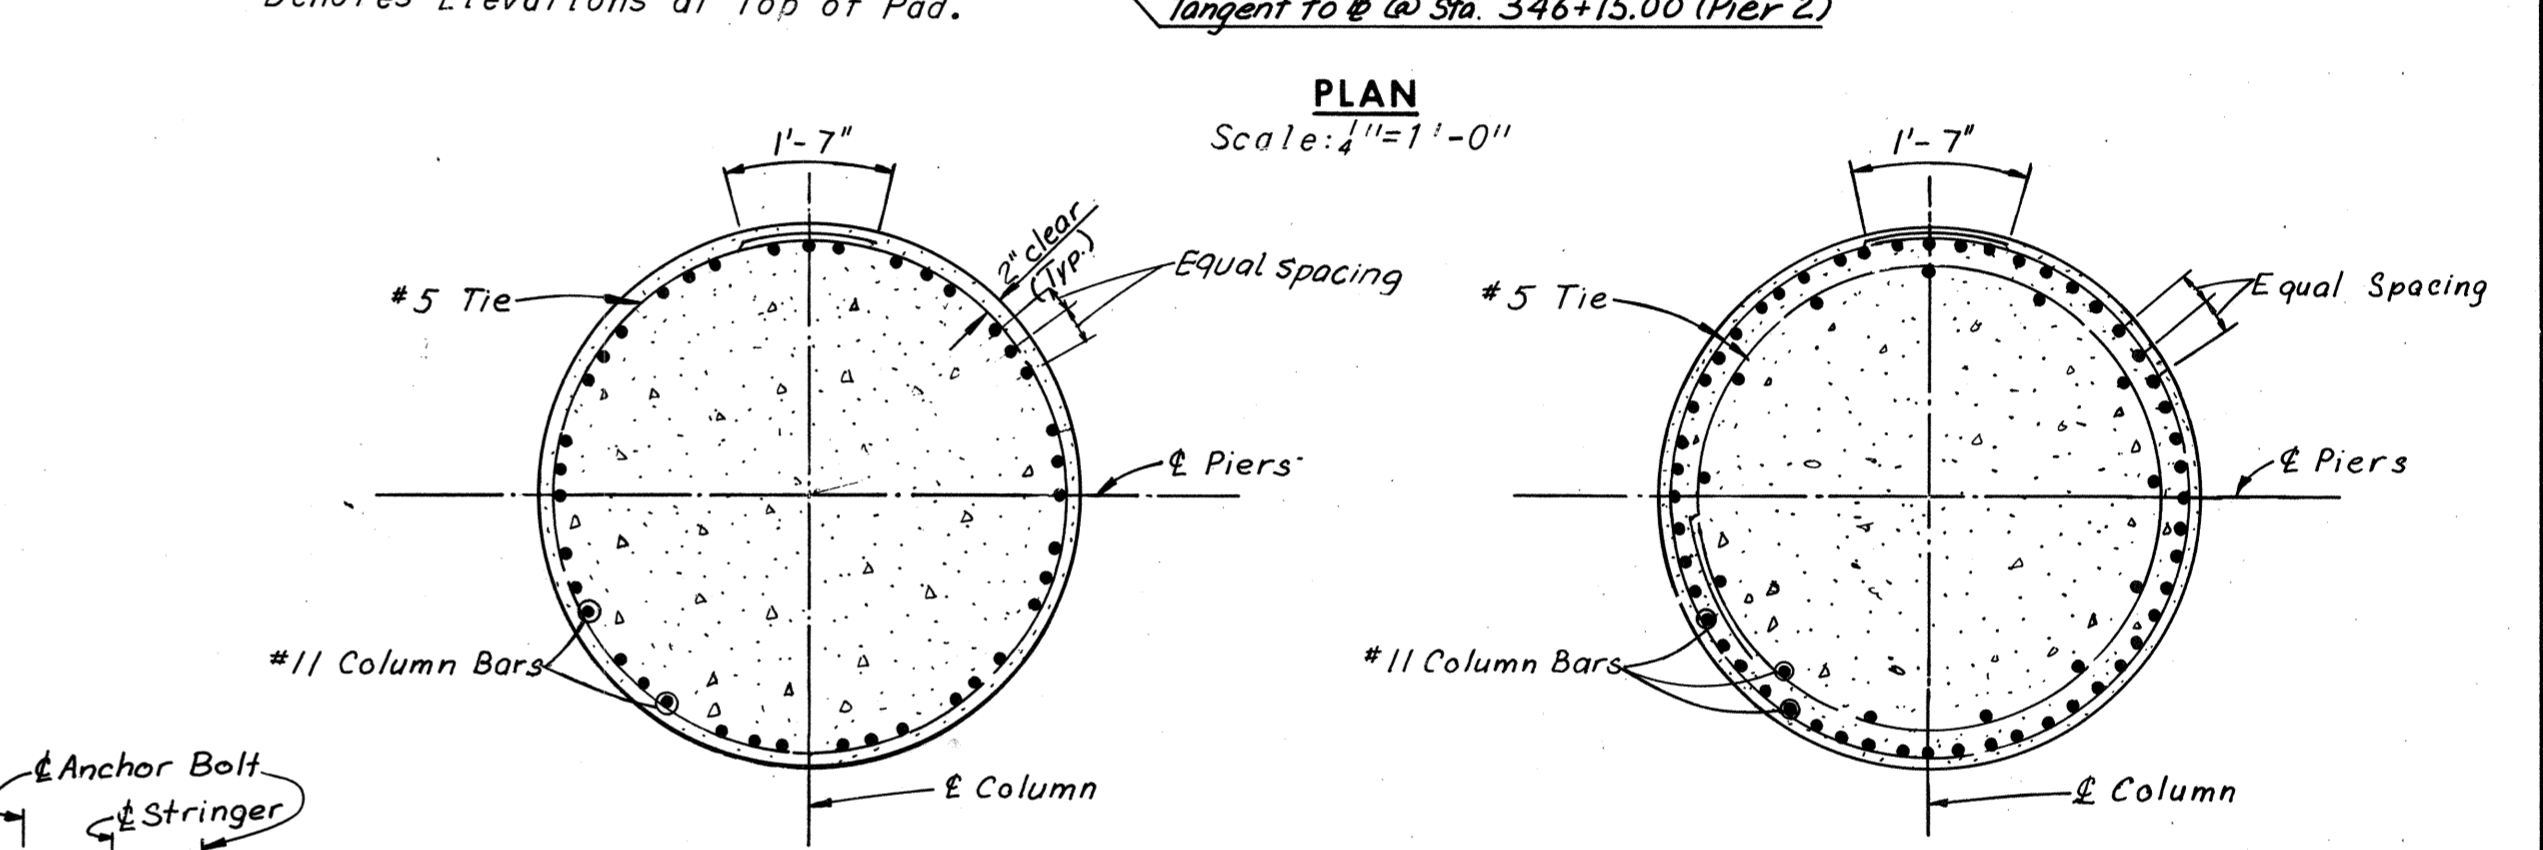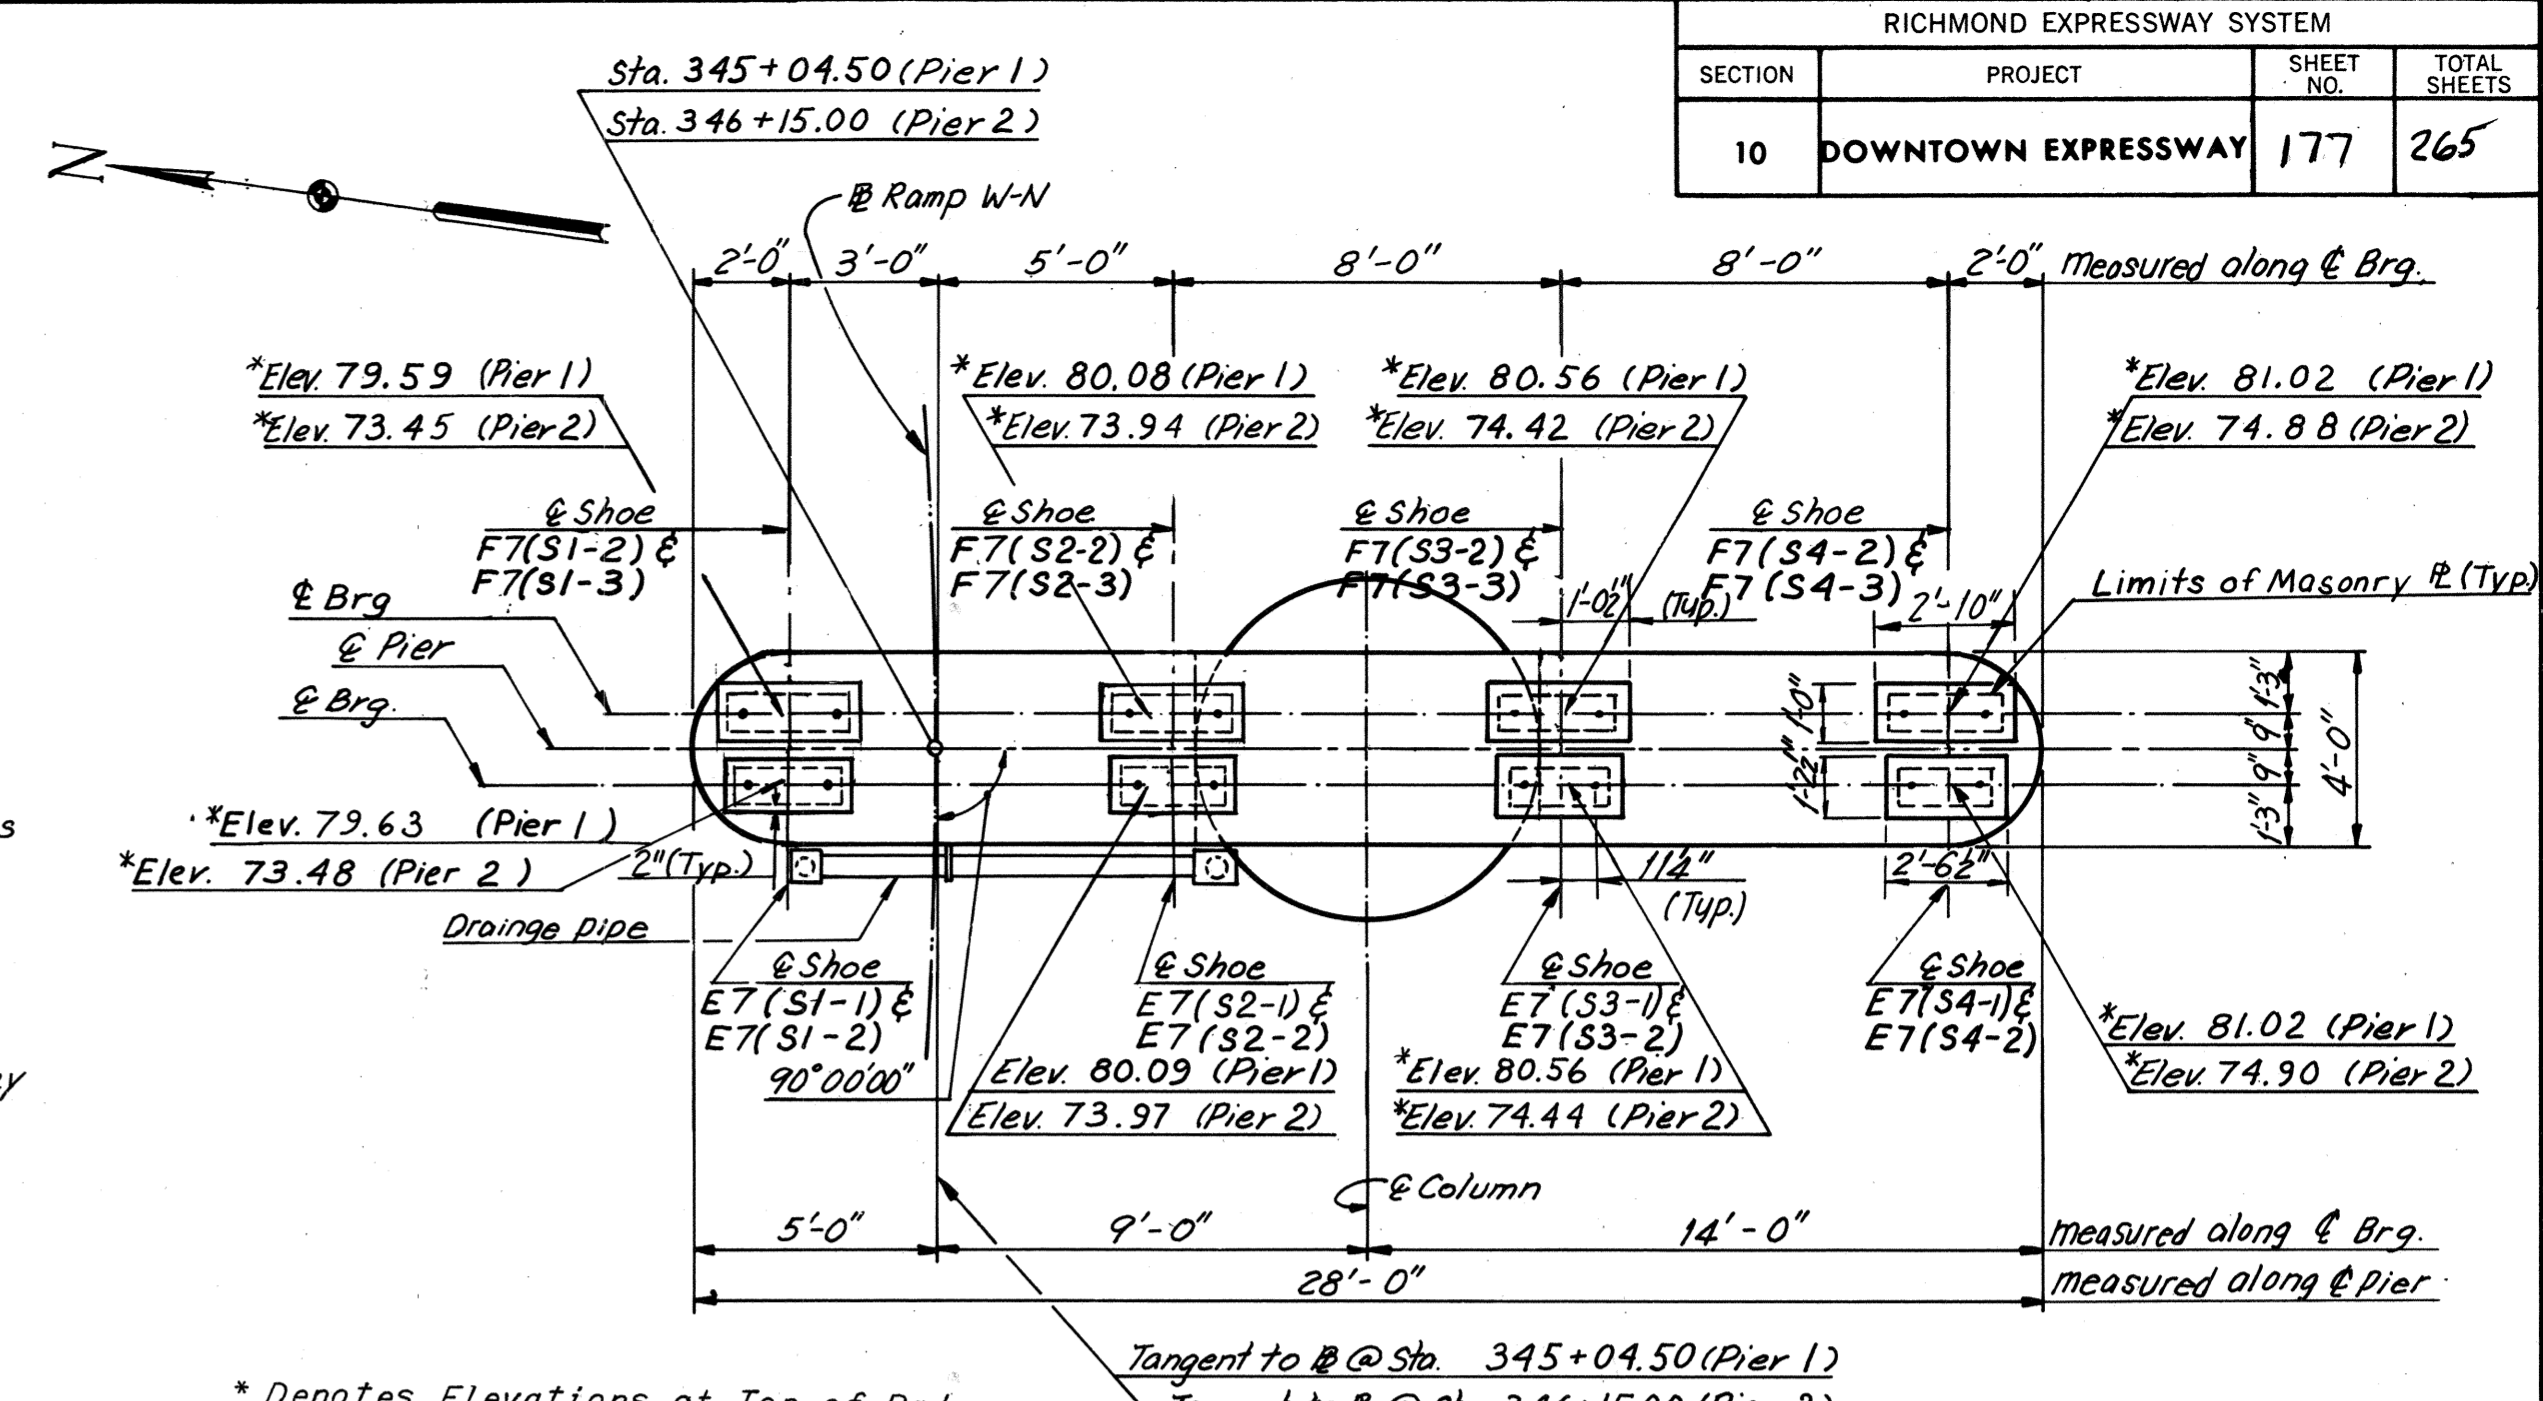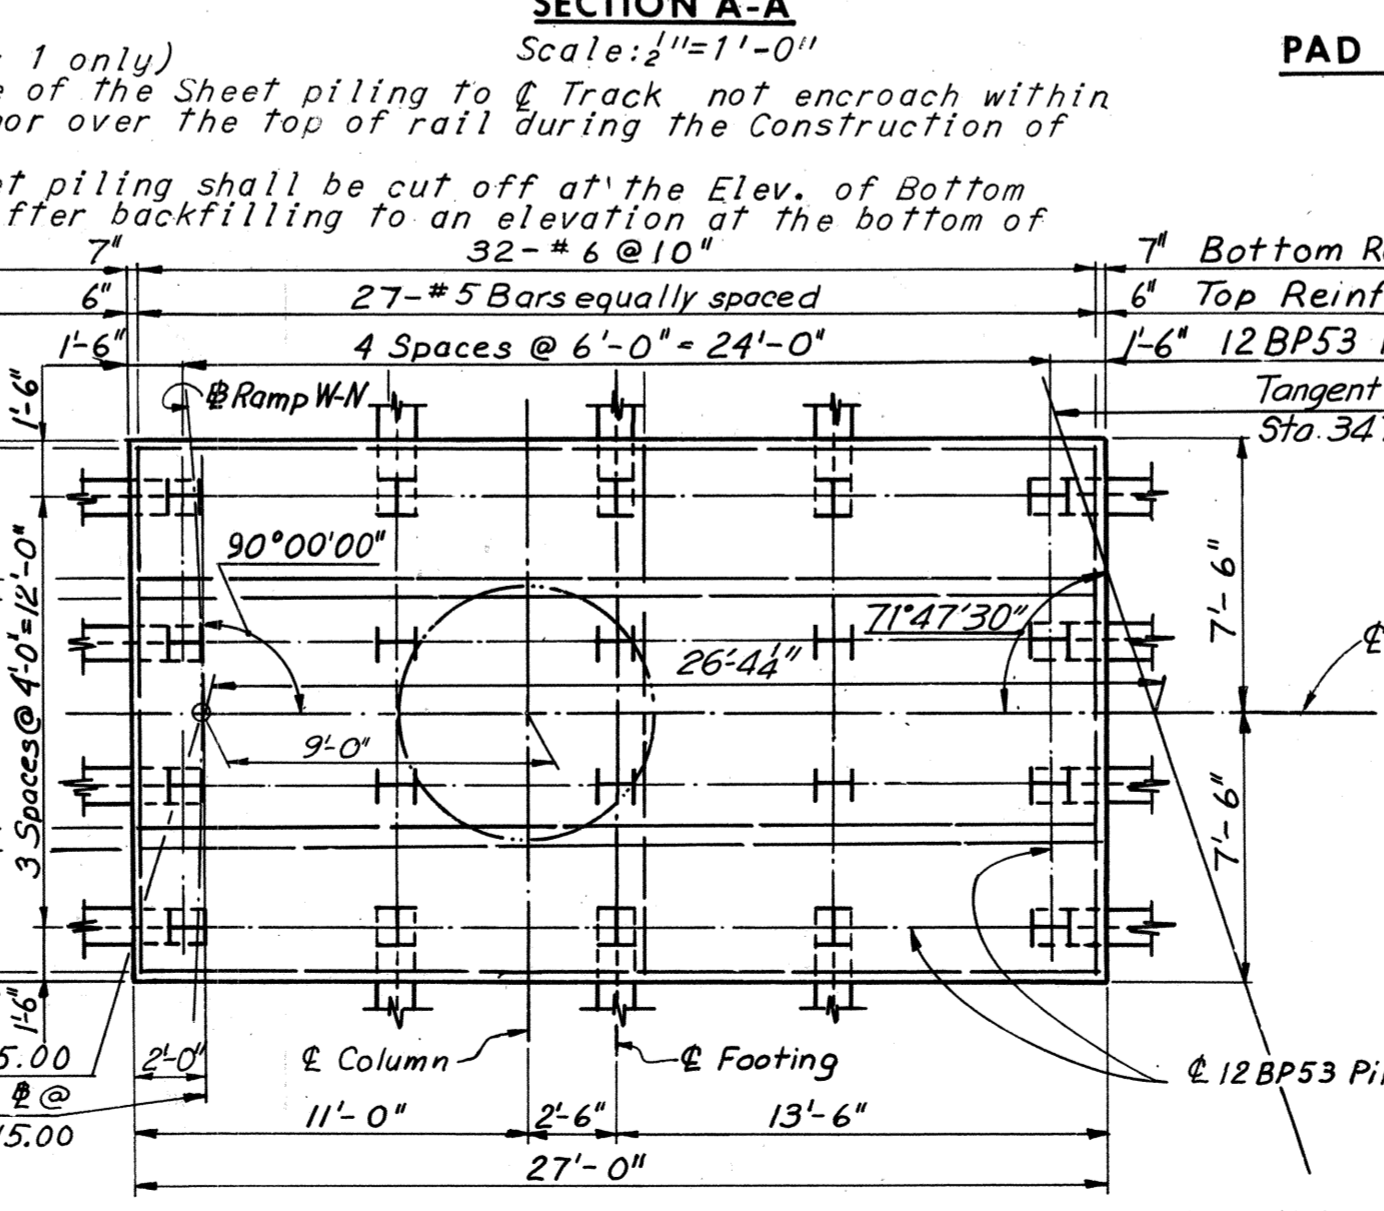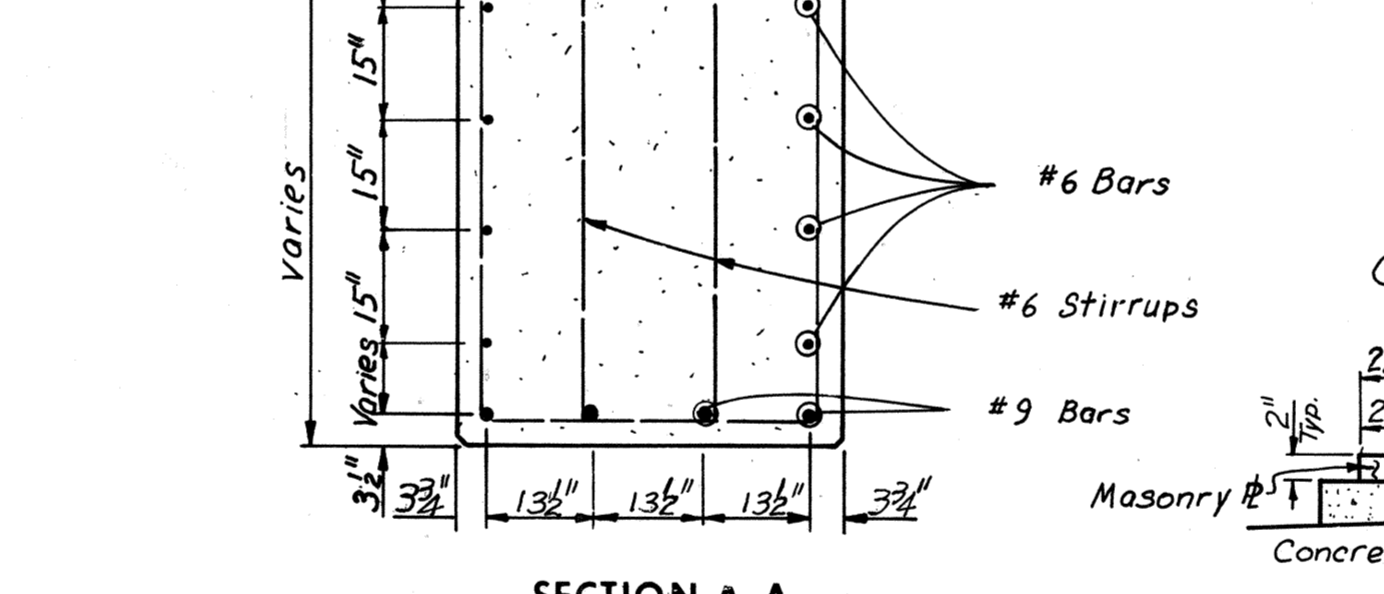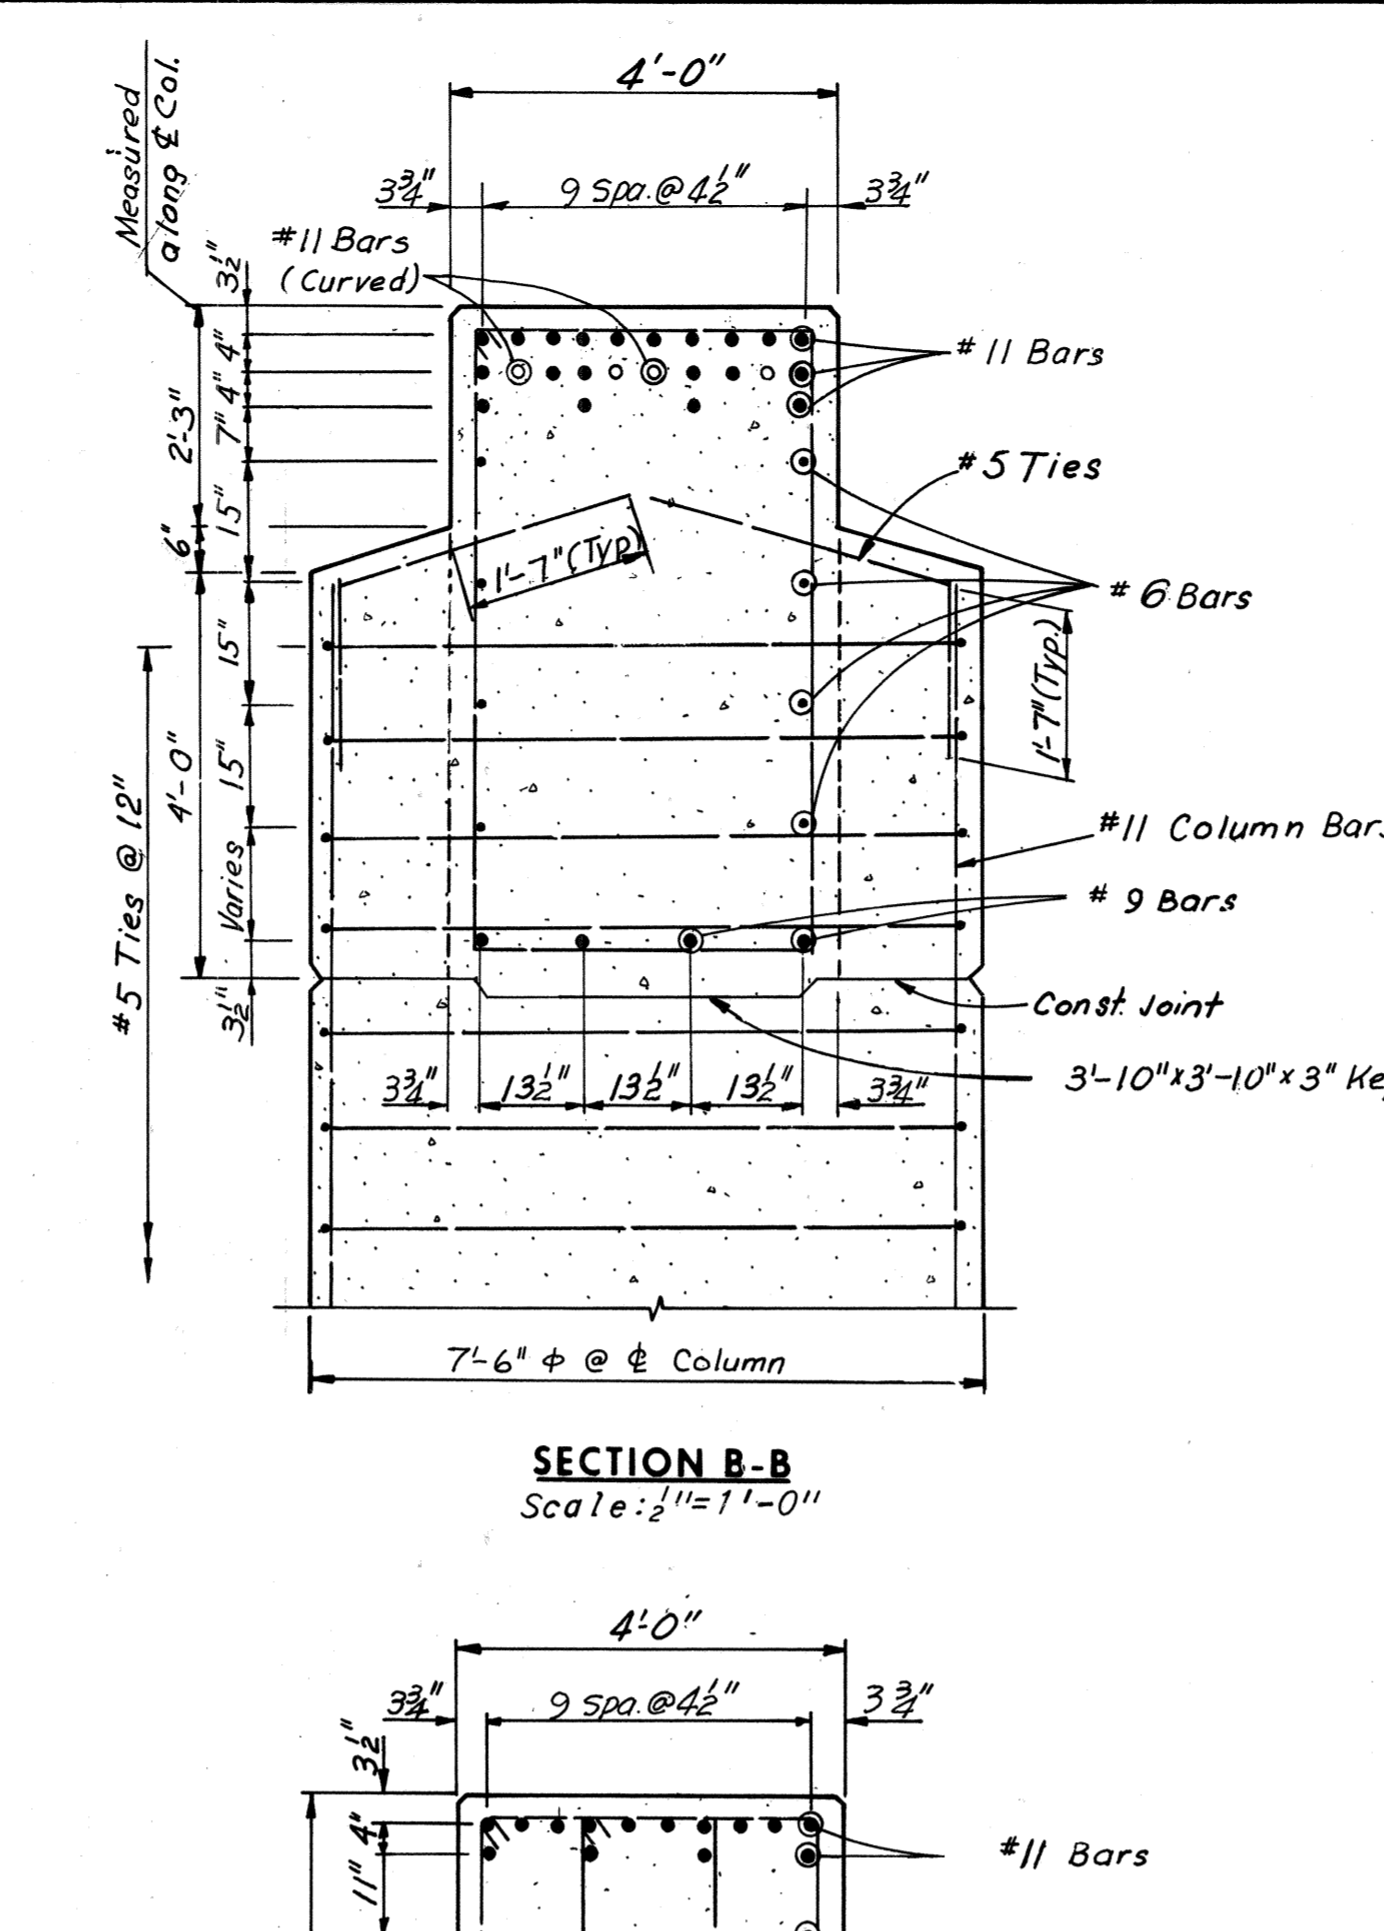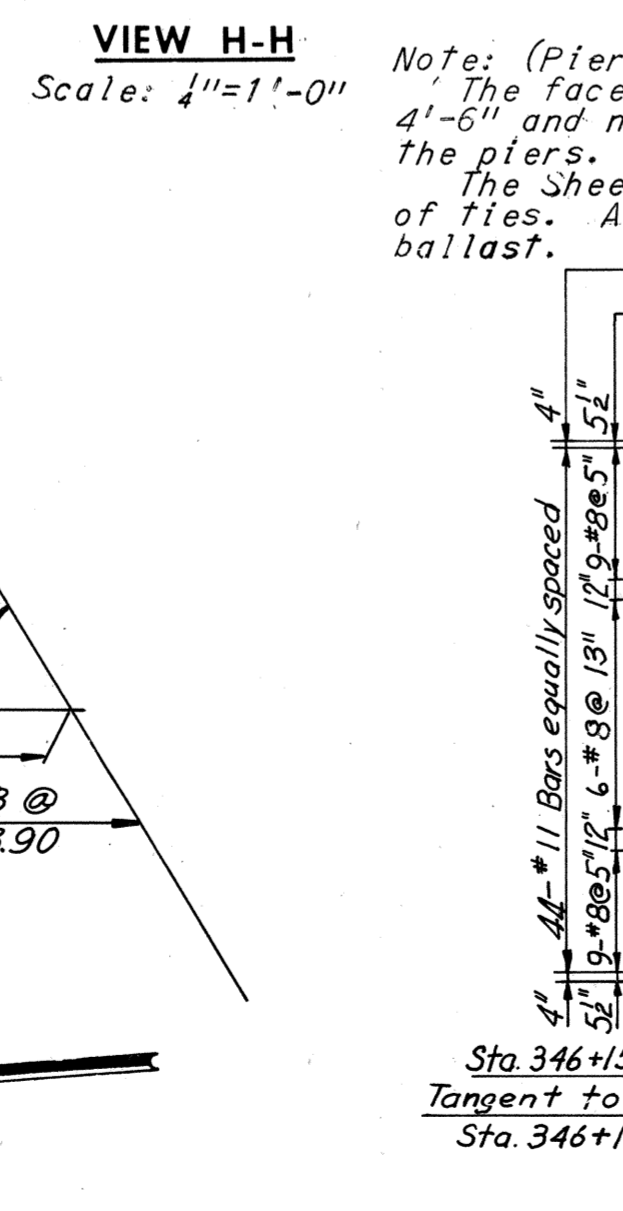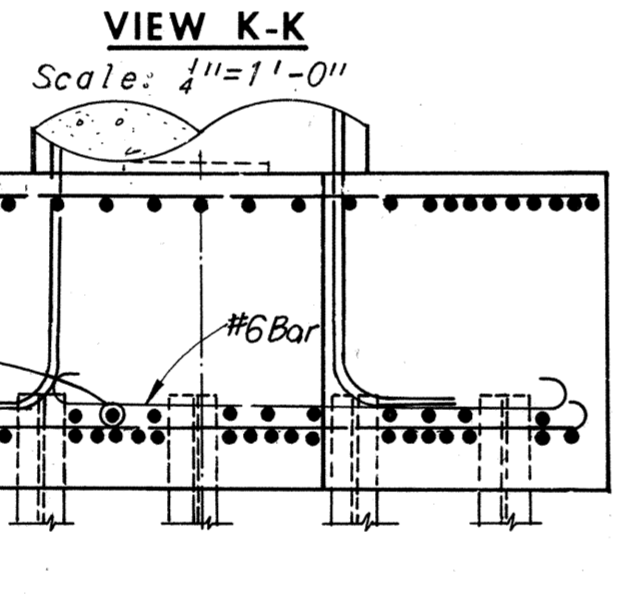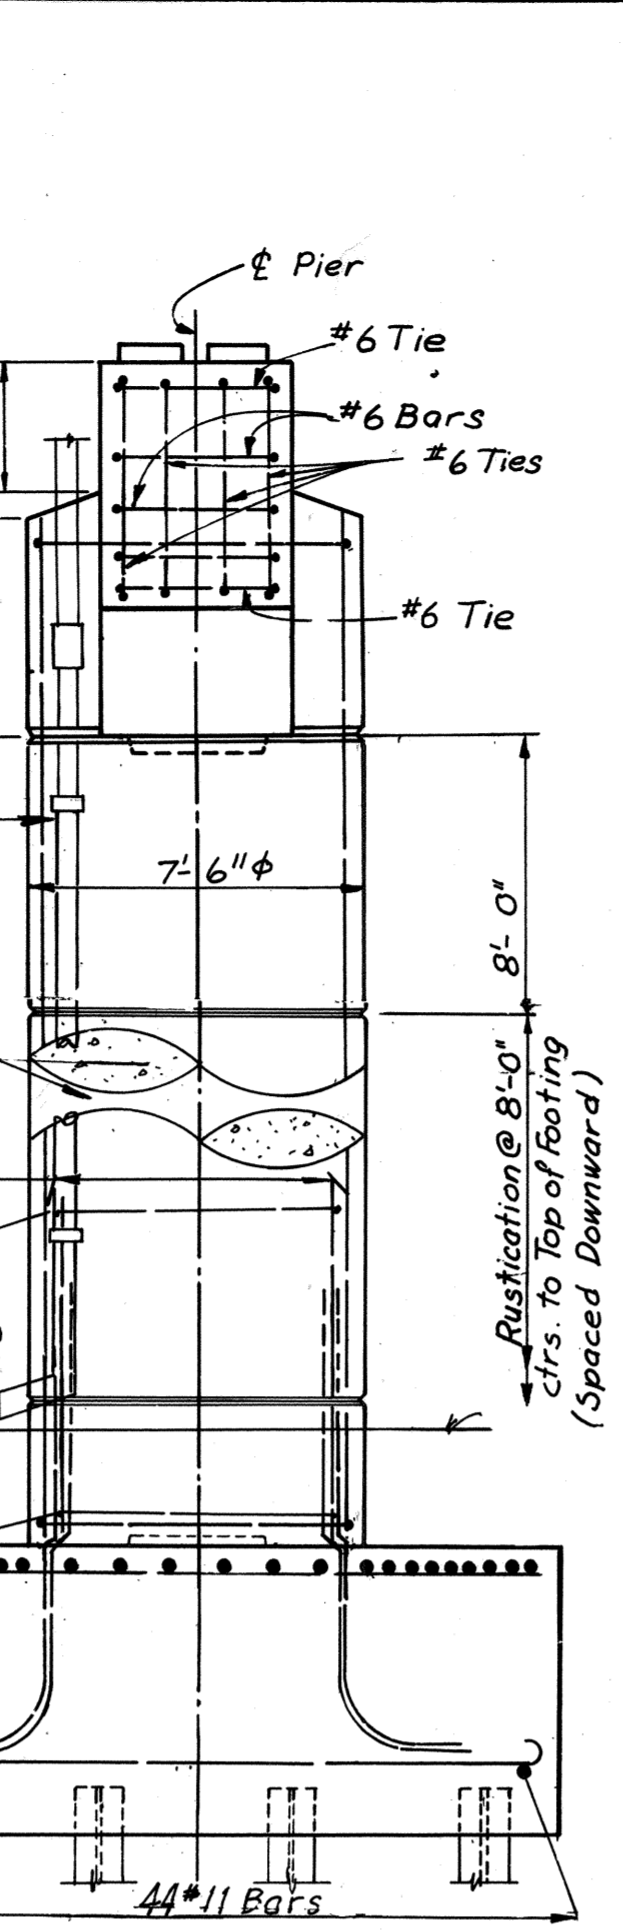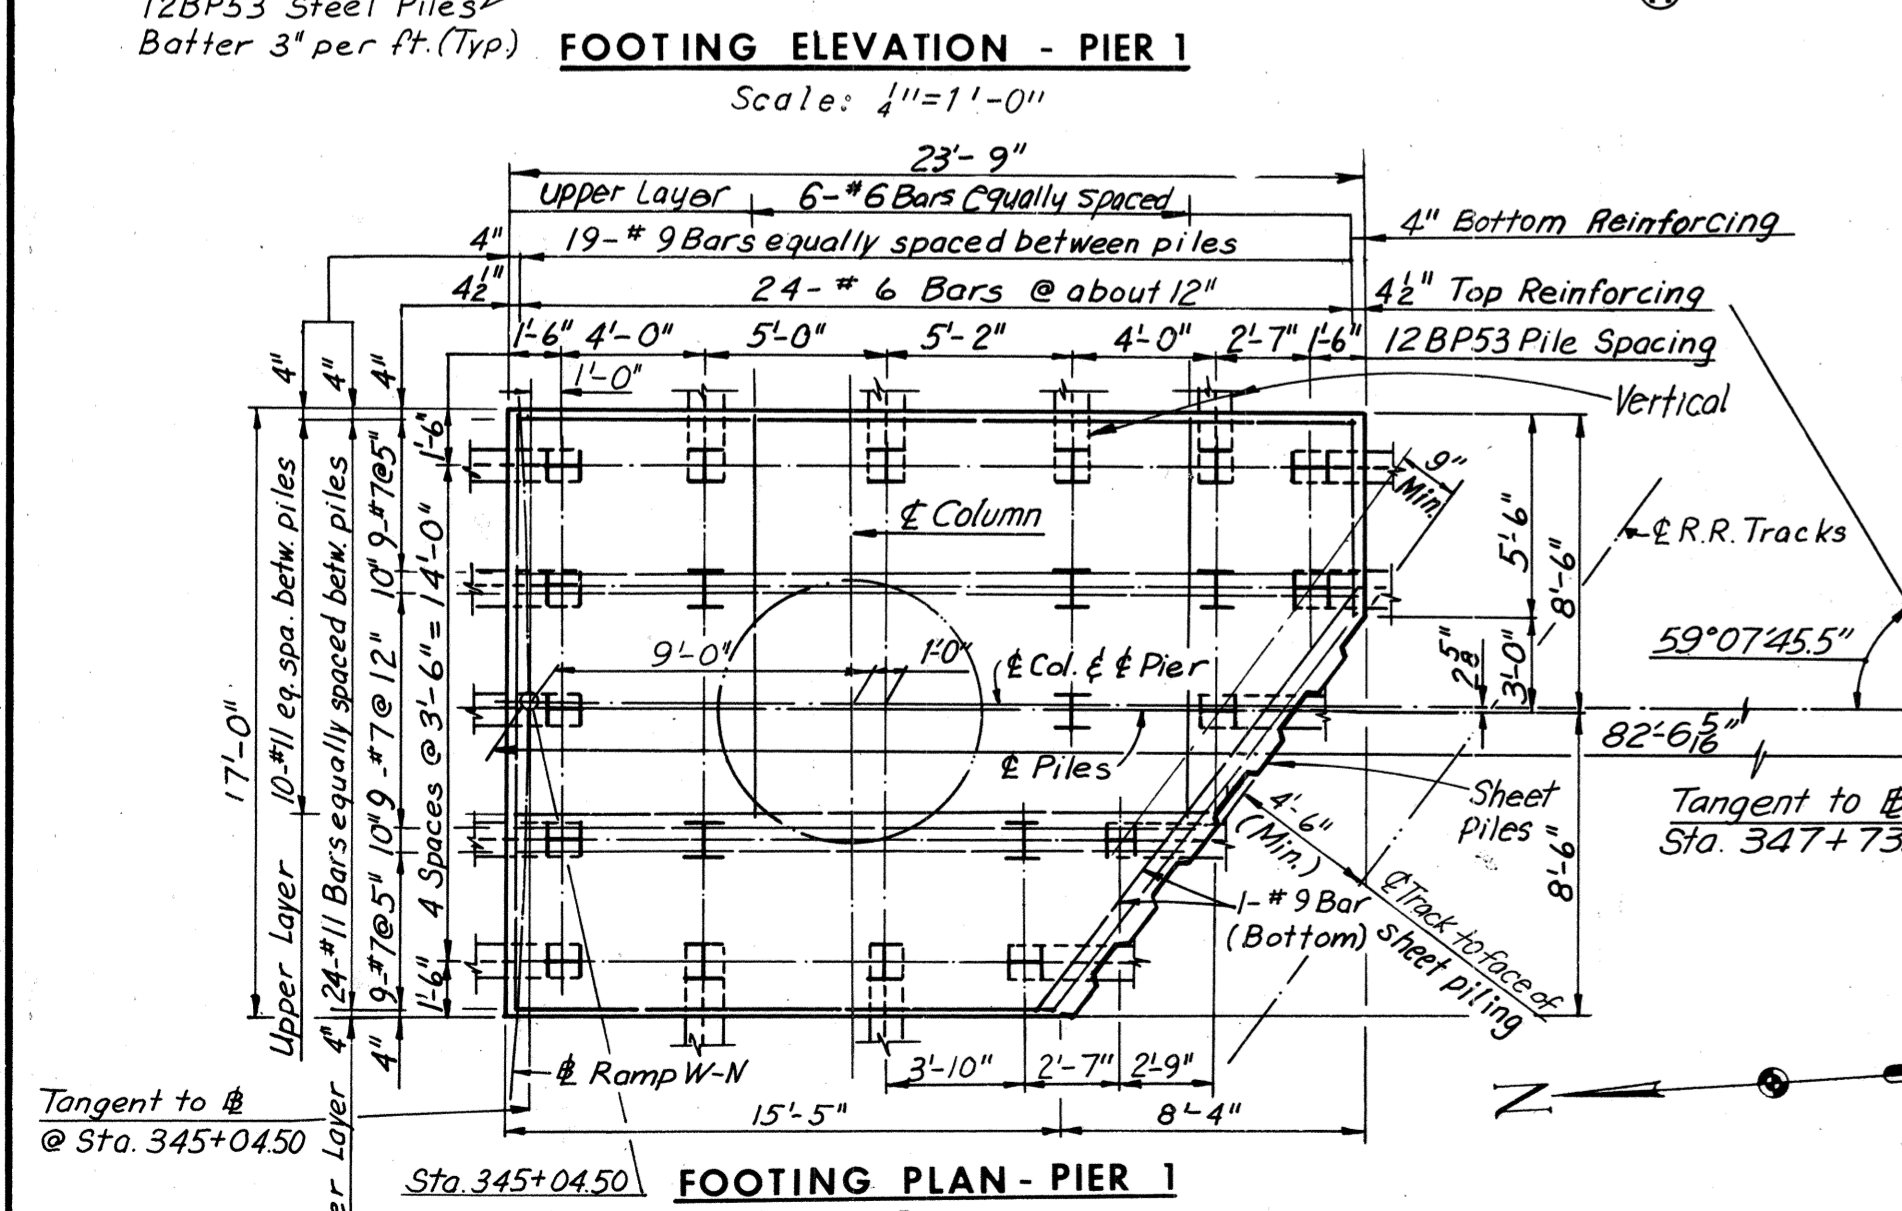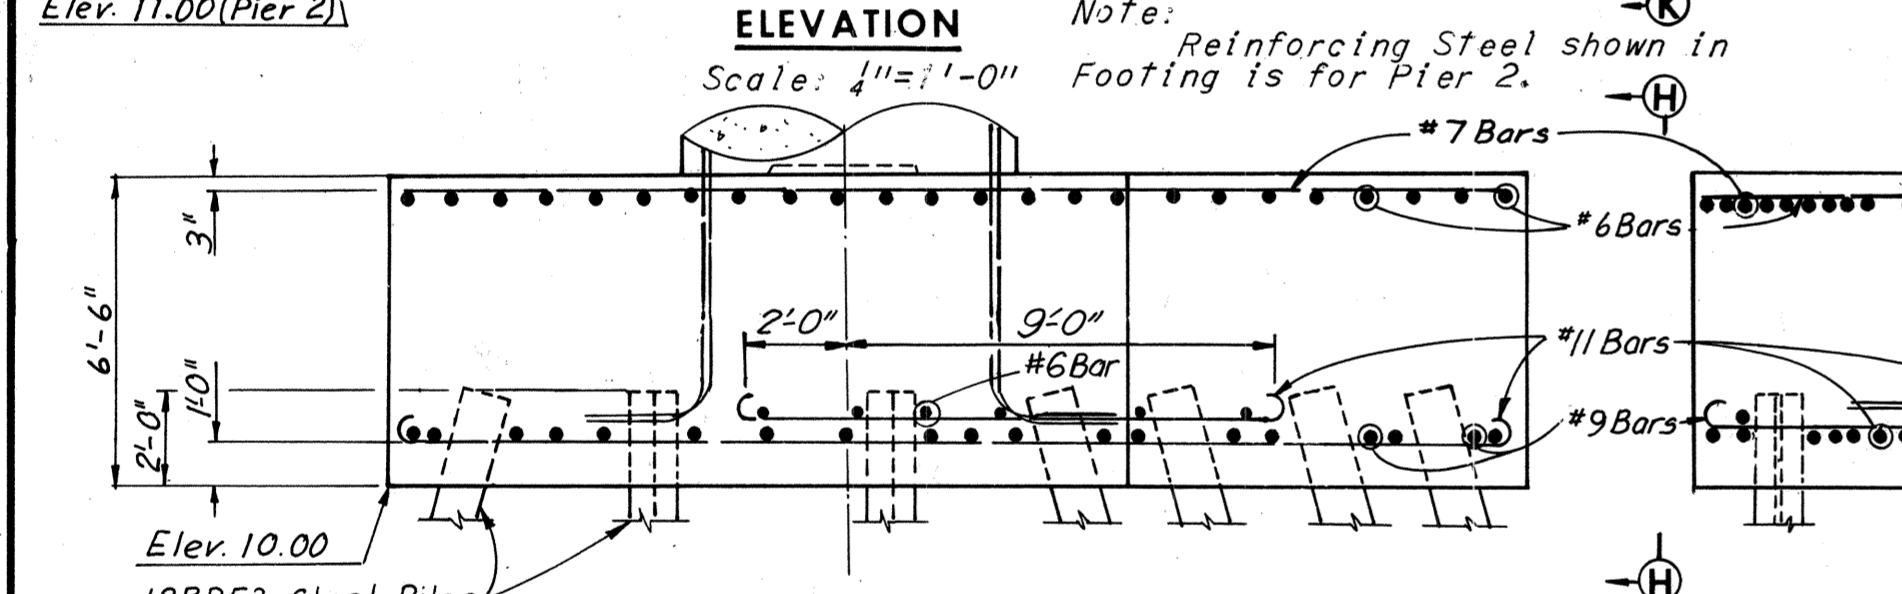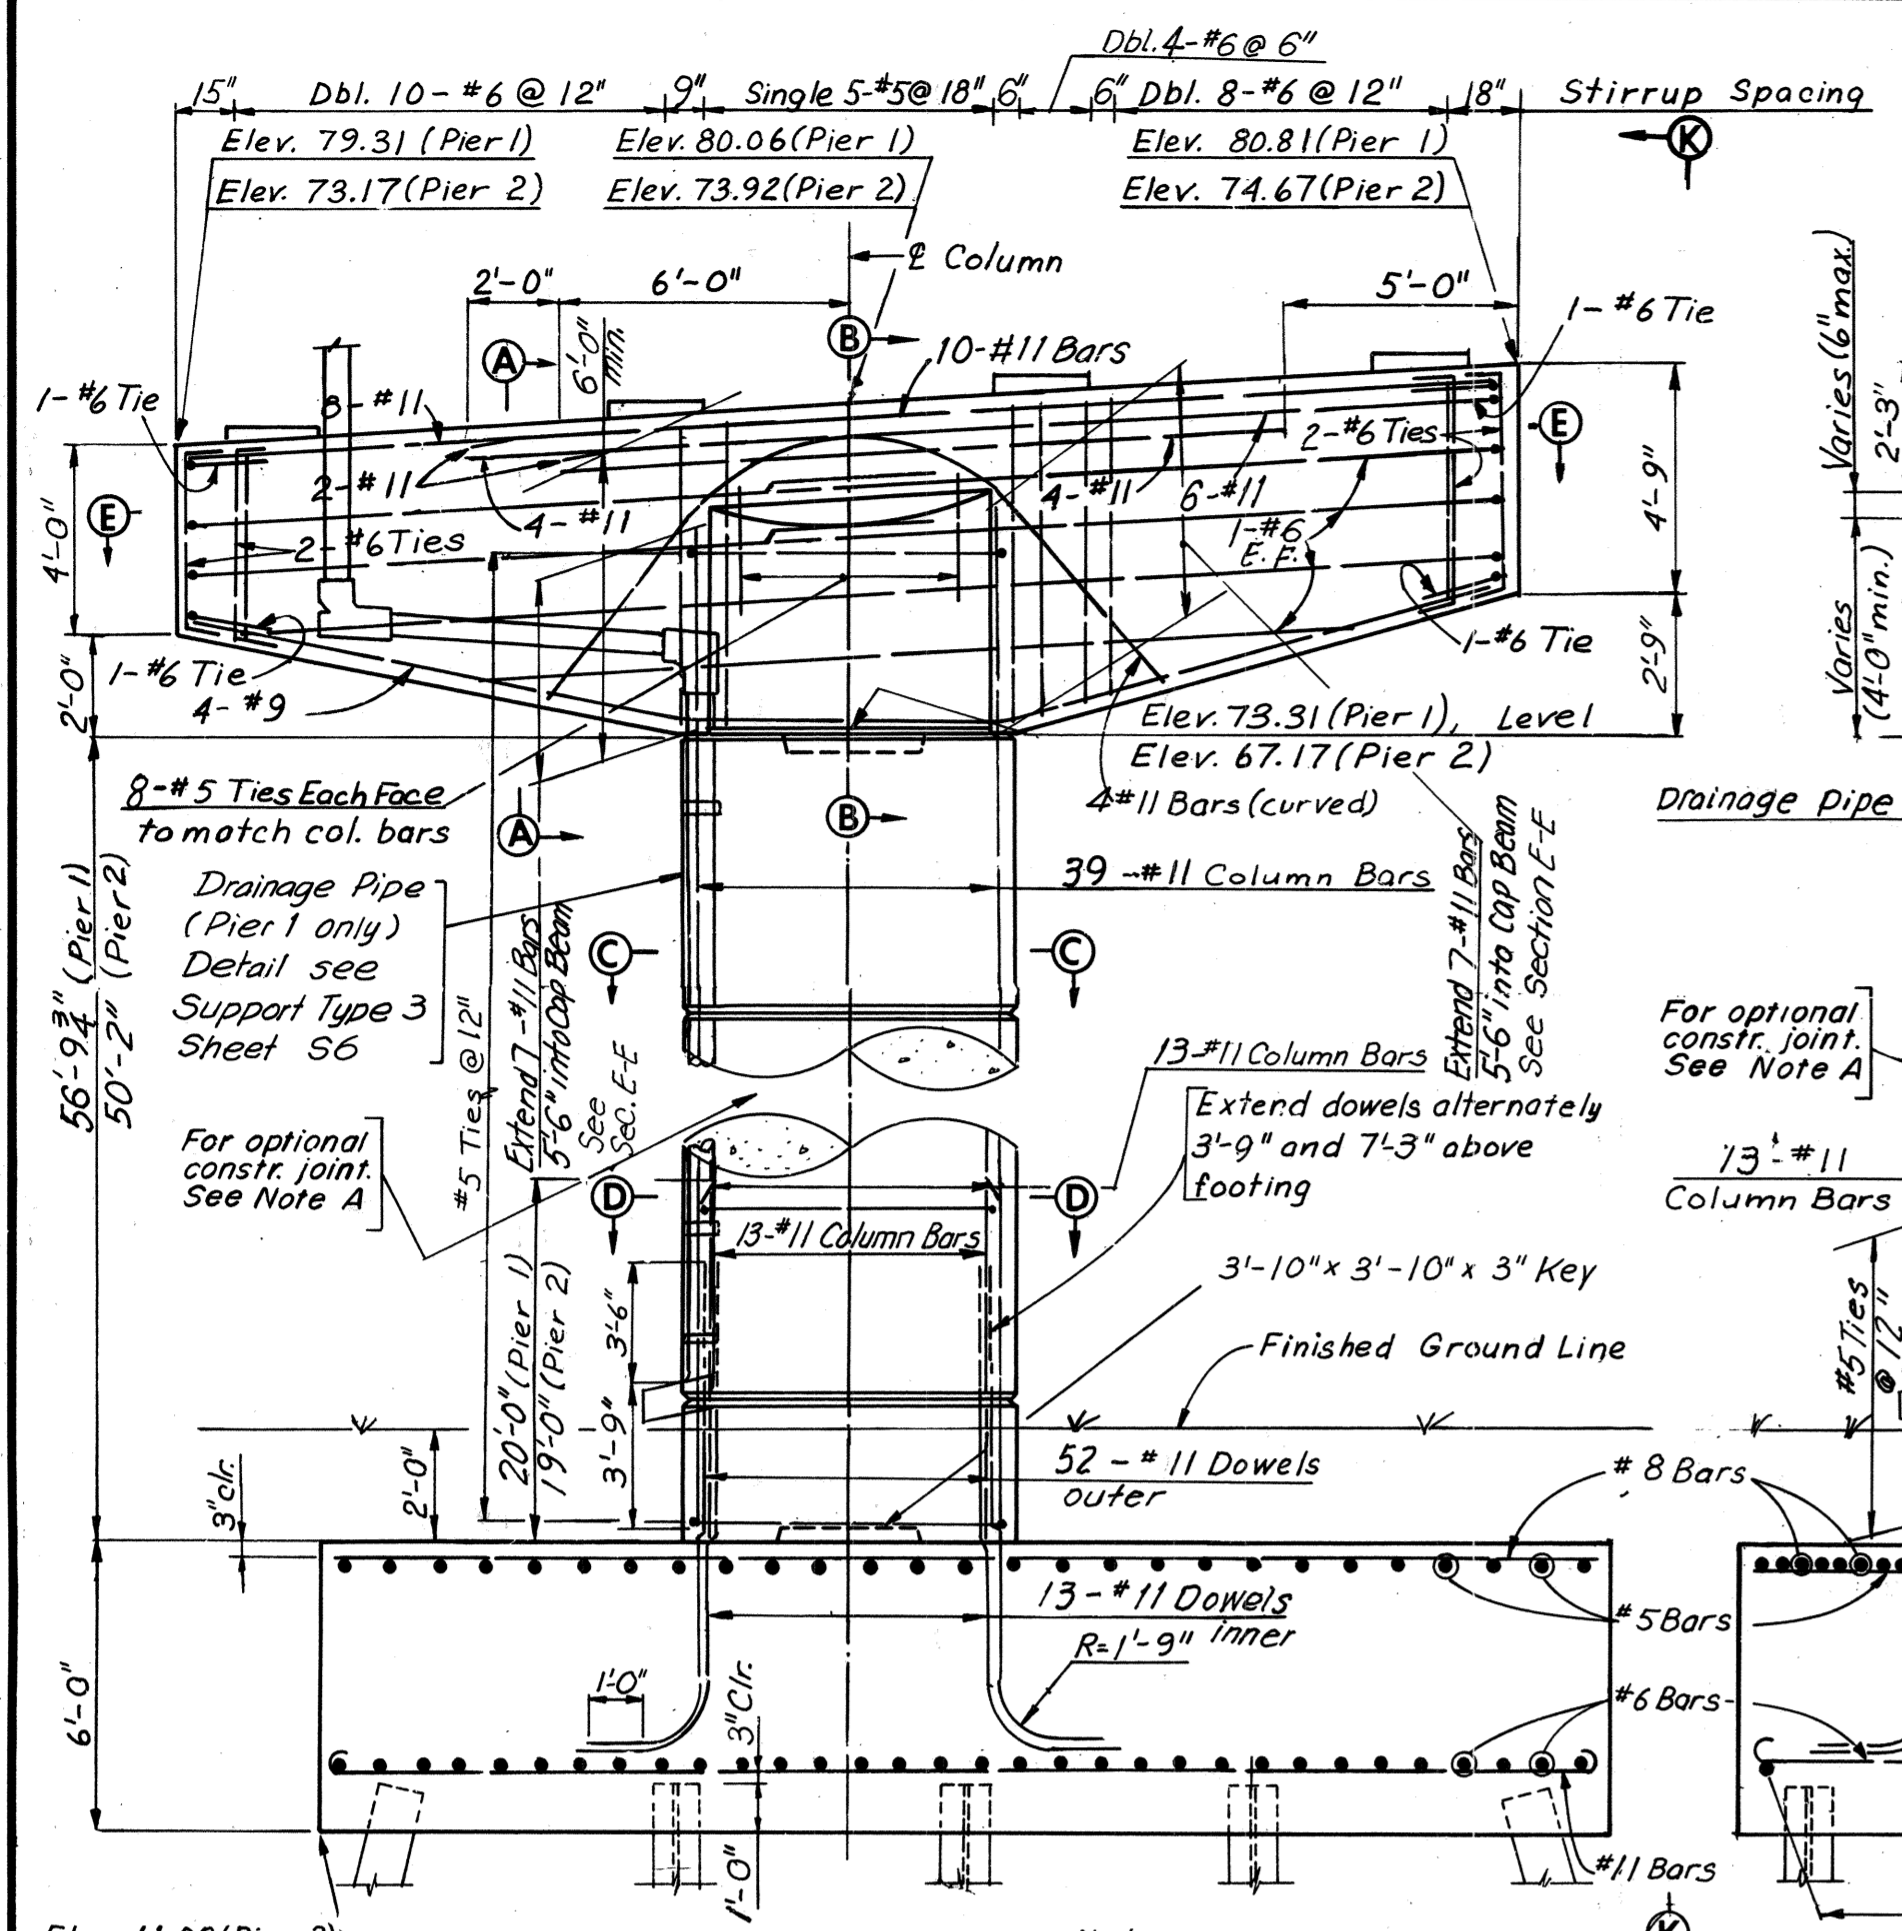

BY	DATE	REVISION	BY	DATE
J.D.	9-16-68			
G.S.H.	4-21-69	1 As Built	TEM	6-77

FOOTING PLAN - PIER 2
Scale: 3/8" = 1'-0"

FOOTINGS FOR PIERS 1 AND 2 ARE ECCENTRIC AS SHOWN ON FOOTING PLANS ABOVE

RICHMOND METROPOLITAN AUTHORITY
RICHMOND EXPRESSWAY SYSTEM
DOWNTOWN EXPRESSWAY







BRIDGE NO. 67
RAMP W-N CONNECTION TO
RICHMOND-PETERSBURG TURNPIKE
PIERS 1 AND 2

HOWARD, NEEDLES, TAMMEN & BERGENDOFF
consulting engineers
NEW YORK ALEXANDRIA KANSAS CITY

SCALE: As Noted
CONTRACT NO. 10
SHEET NO. 5 OF 54

AS BUILT

RICHMOND EXPRESSWAY SYSTEM			
SECTION	PROJECT	SHEET NO.	TOTAL SHEETS
10	DOWNTOWN EXPRESSWAY	179	265

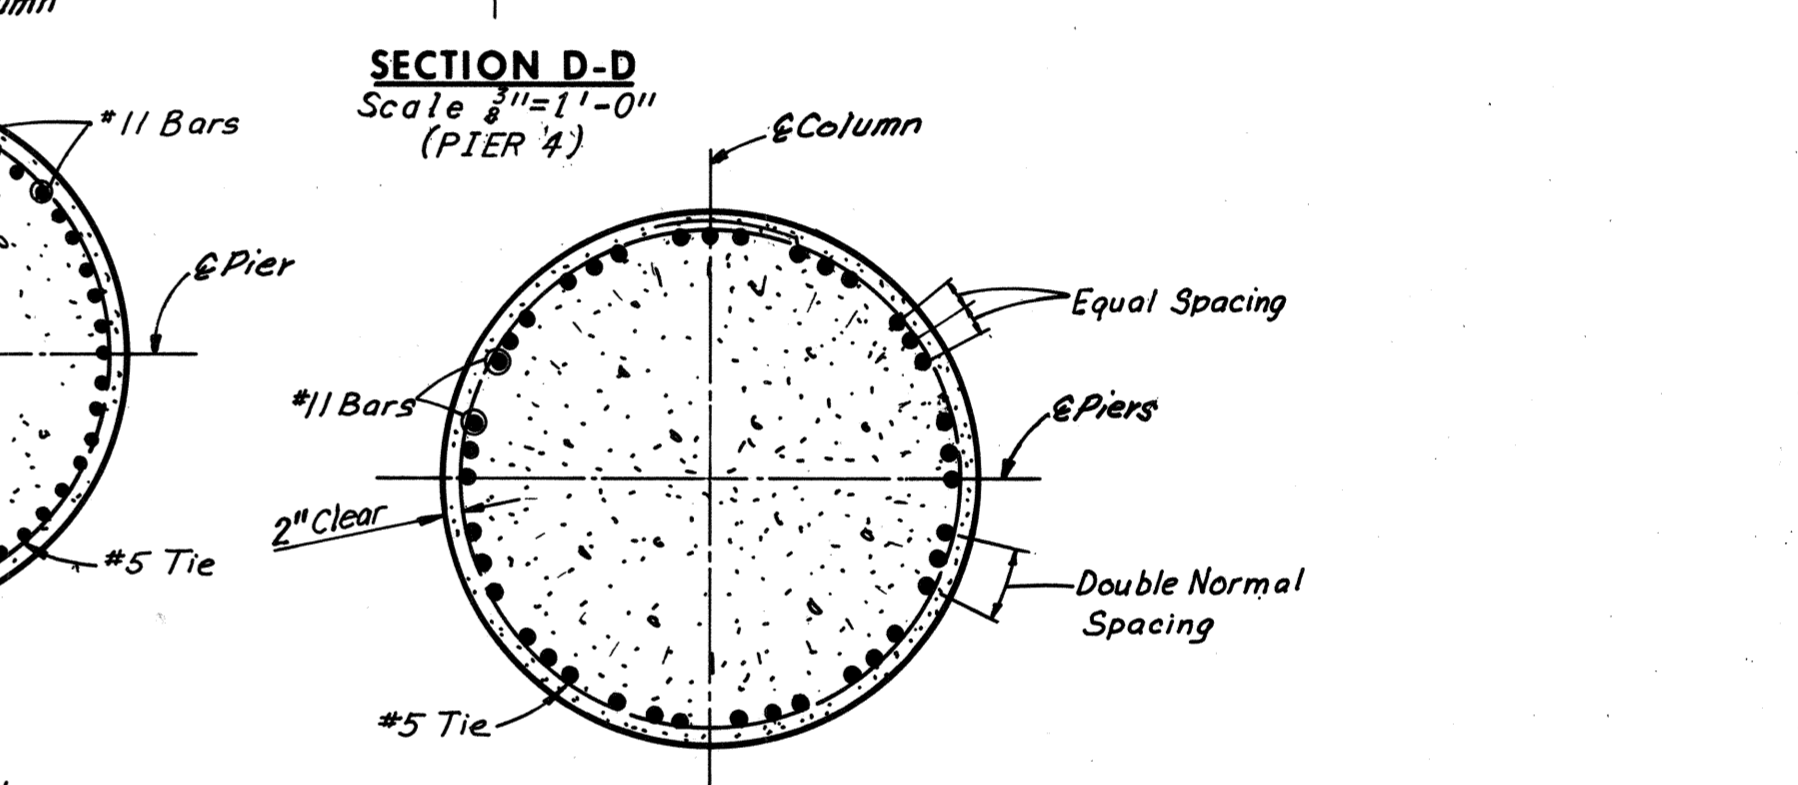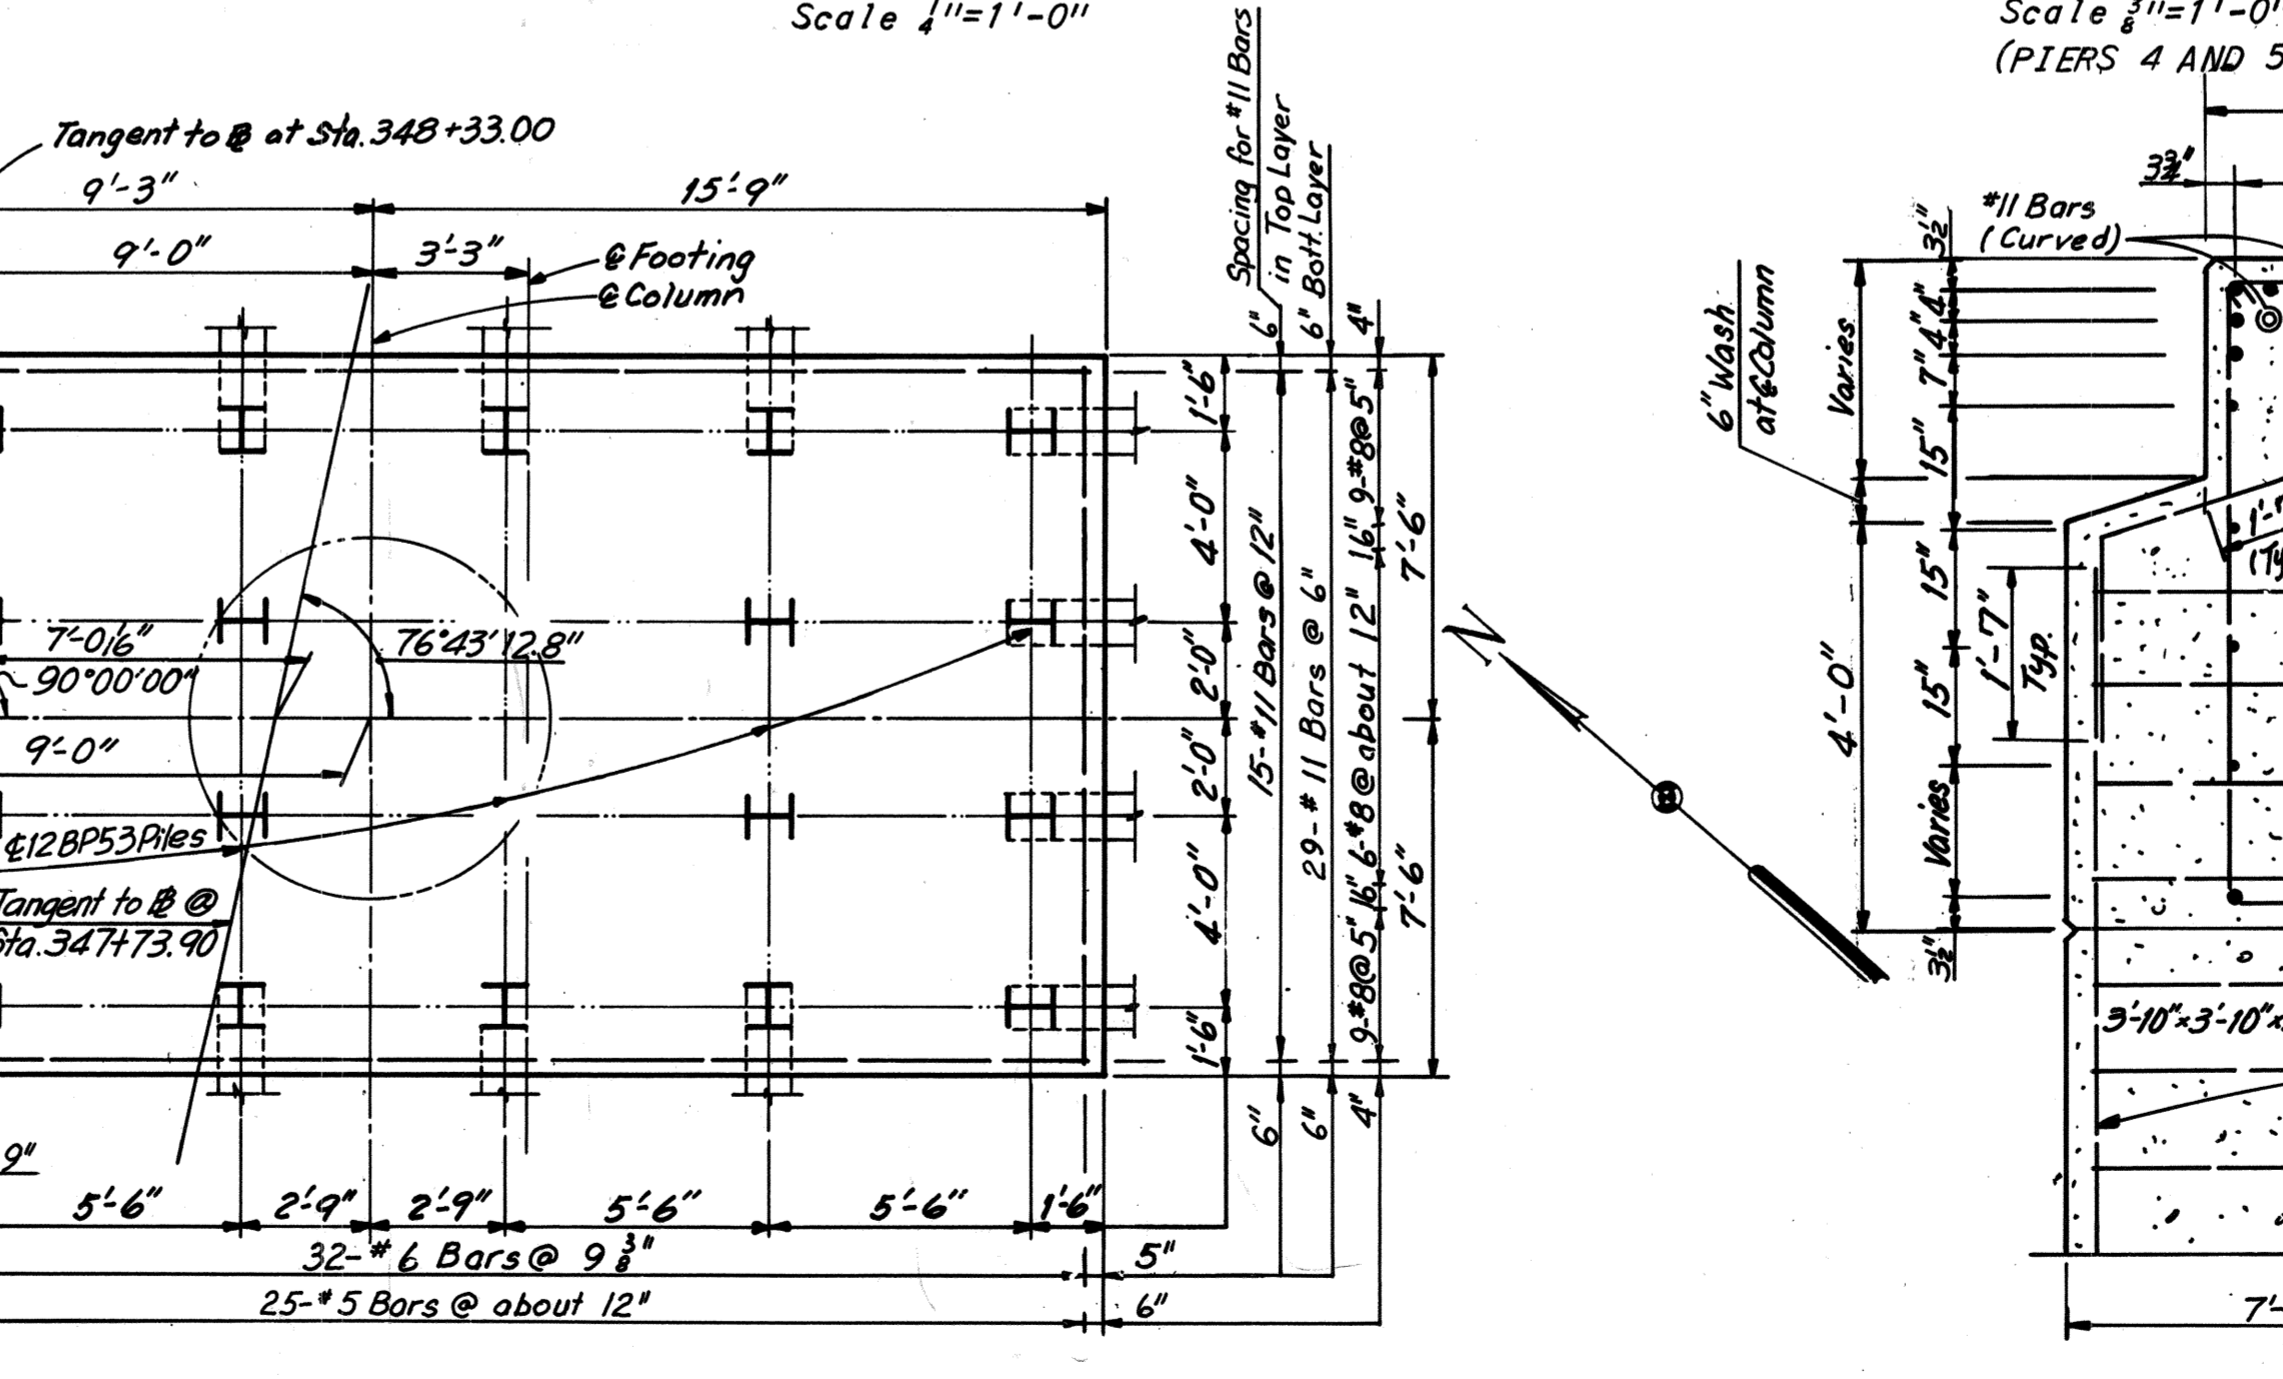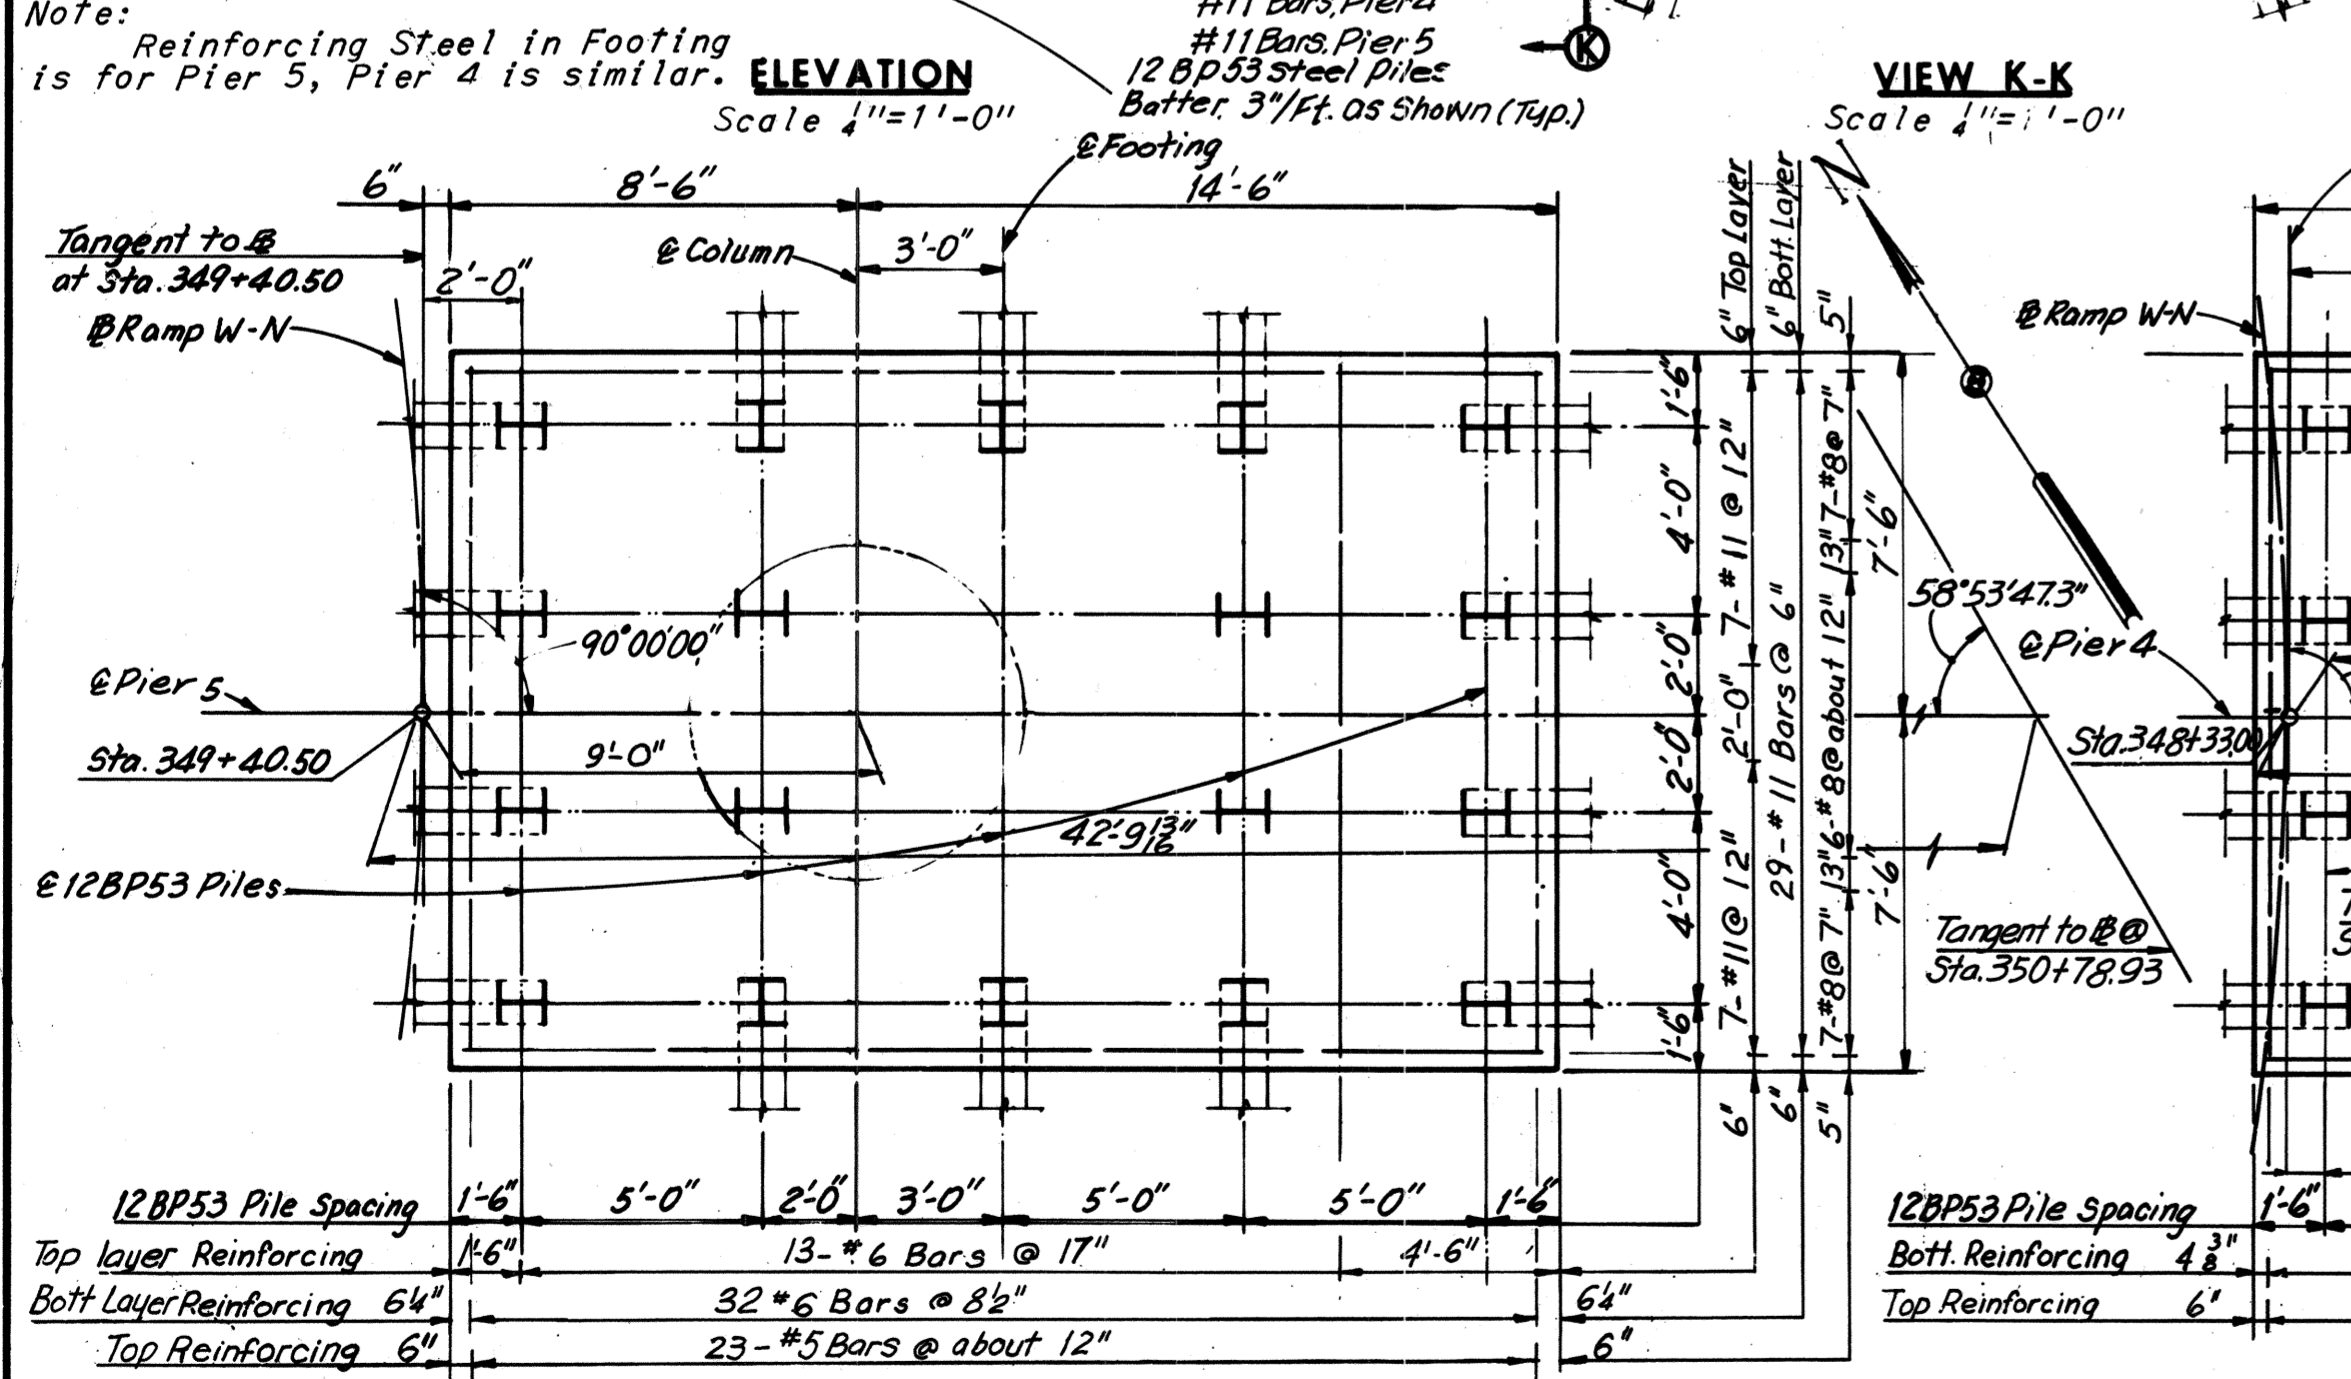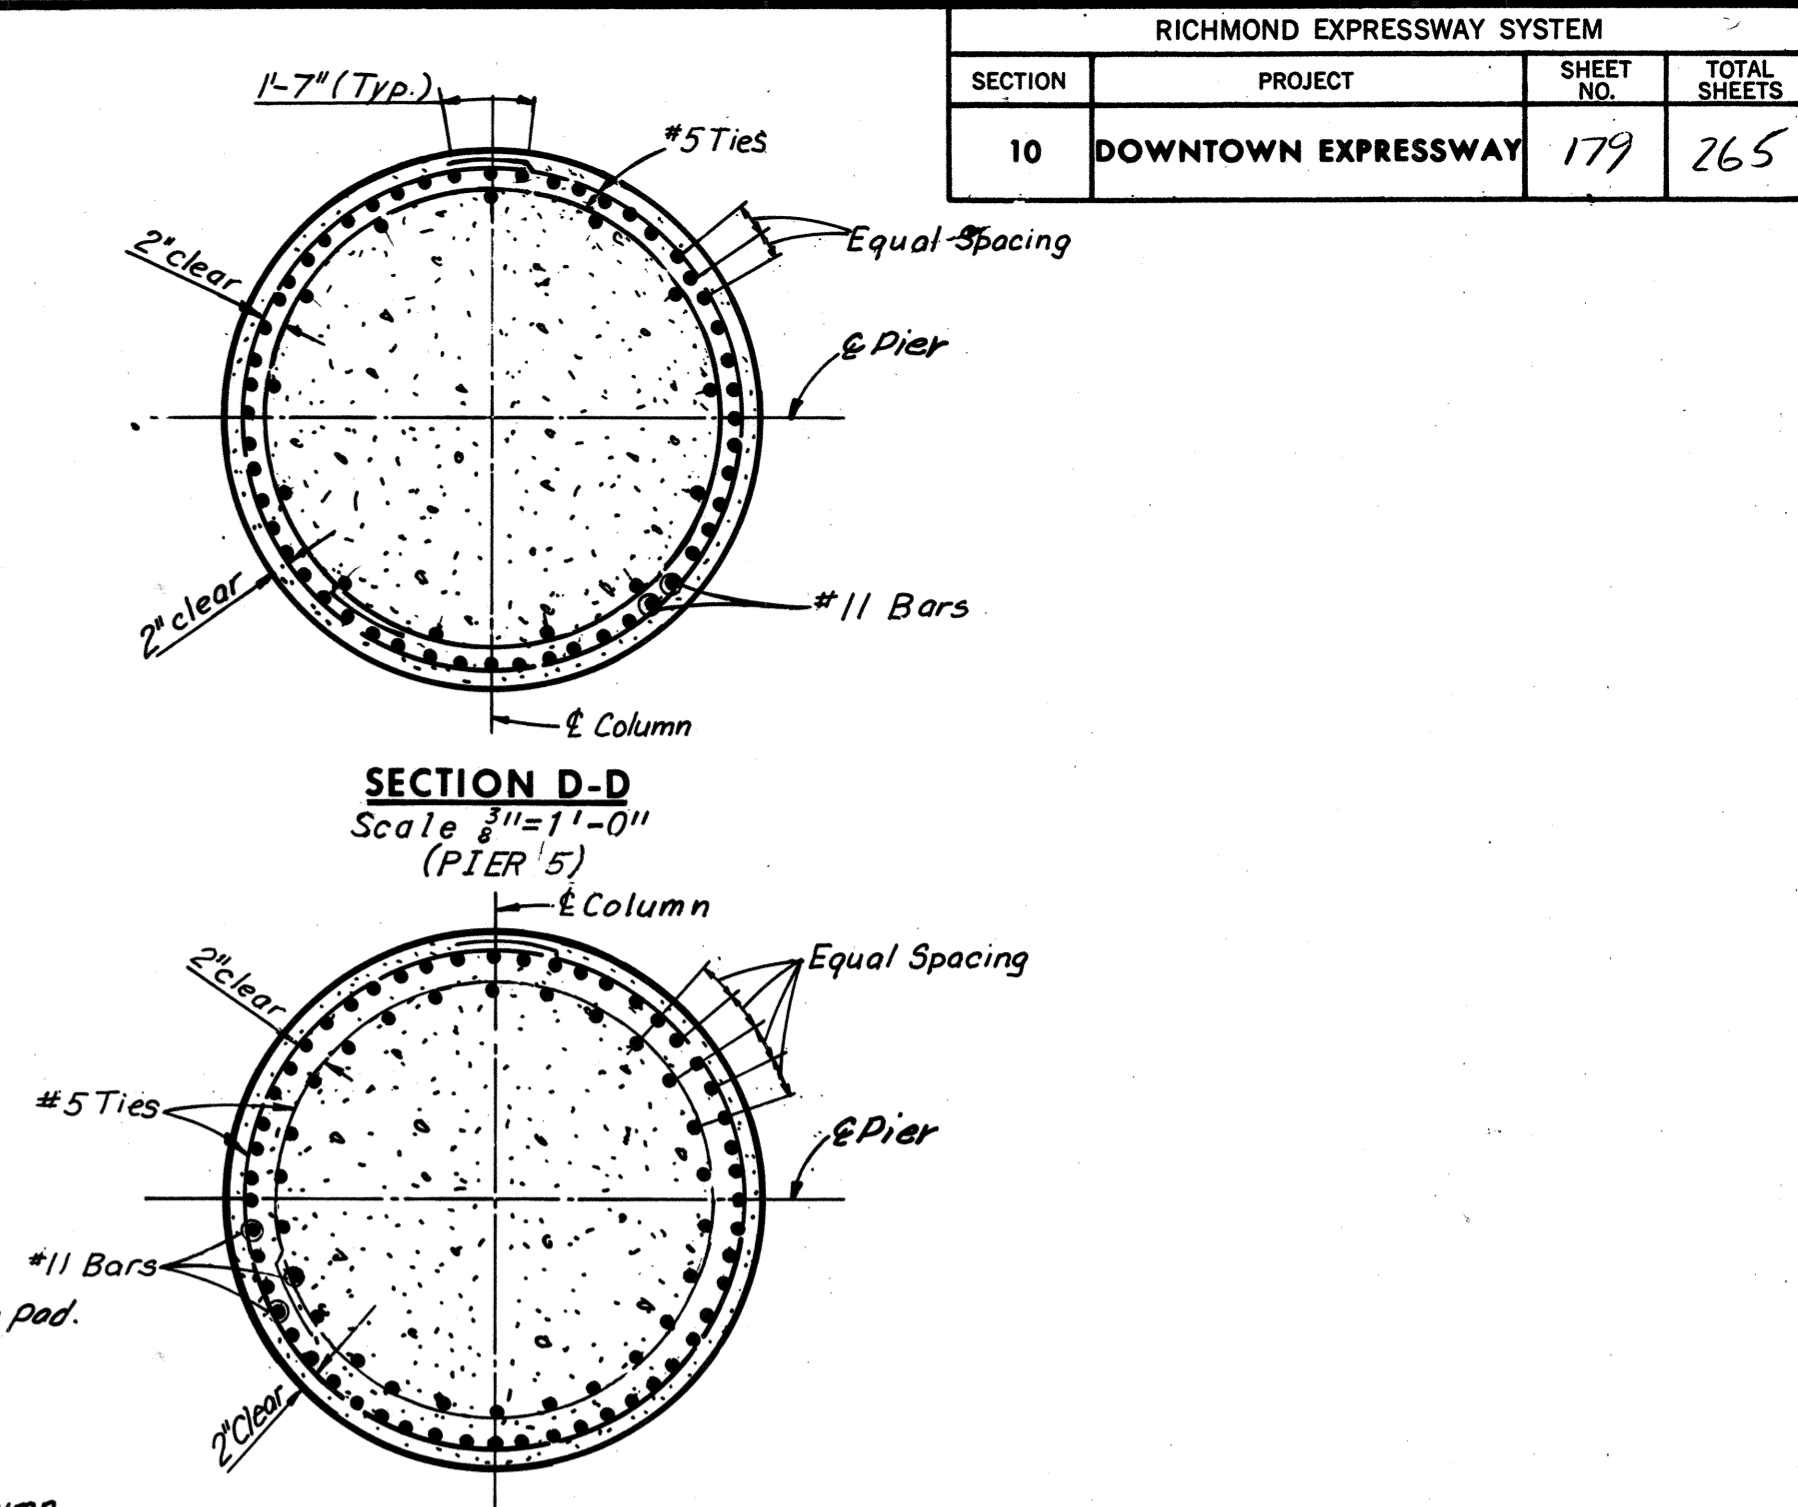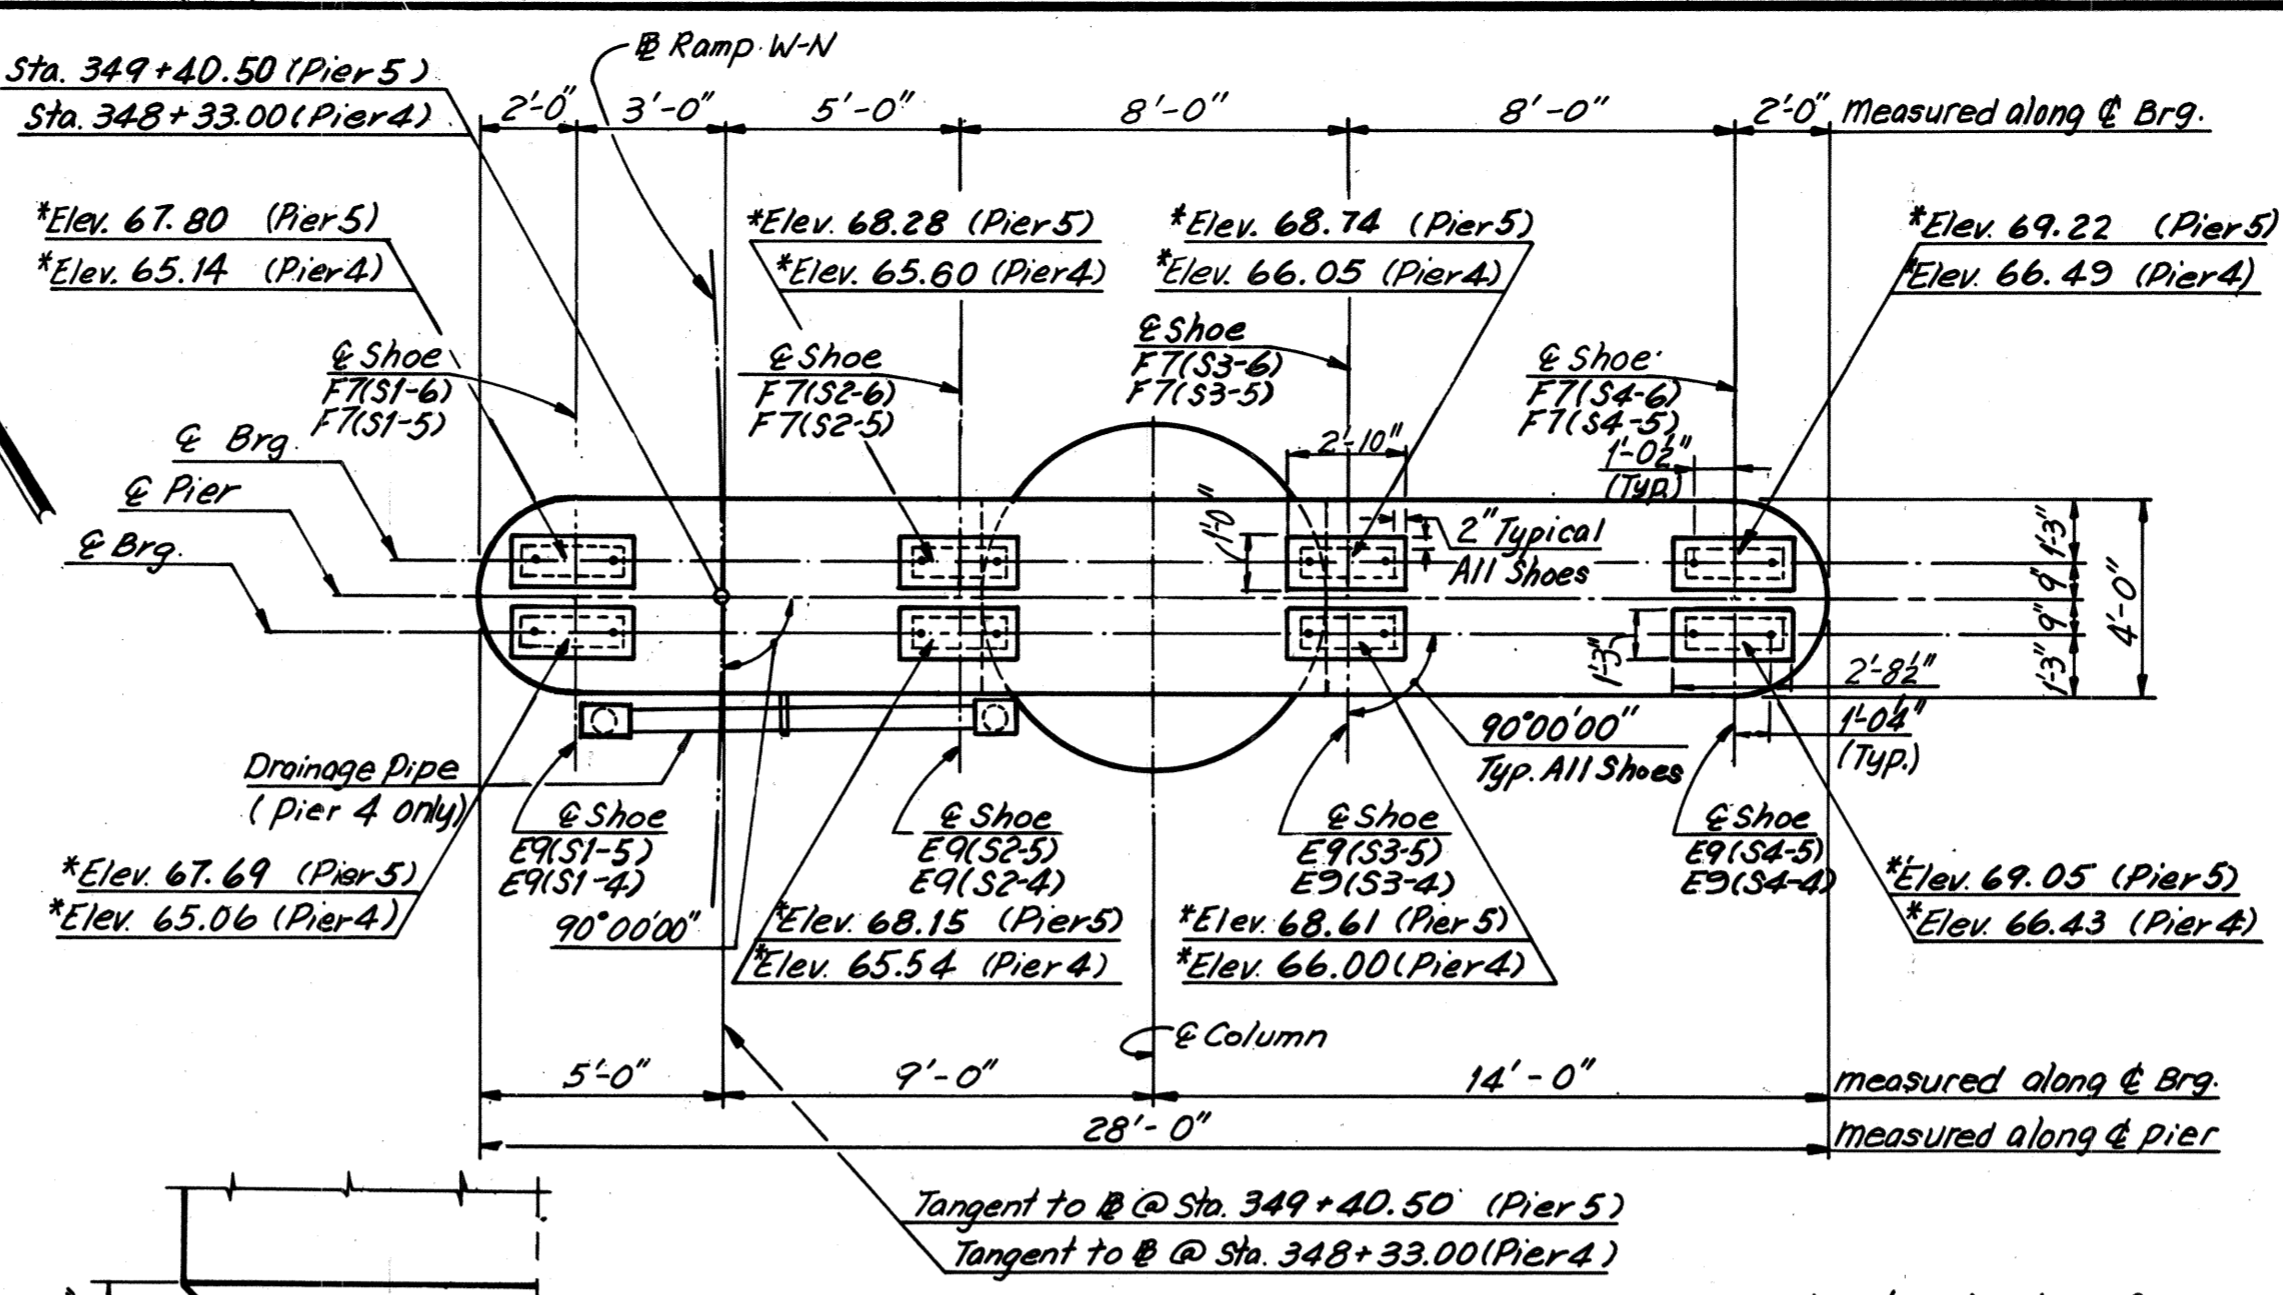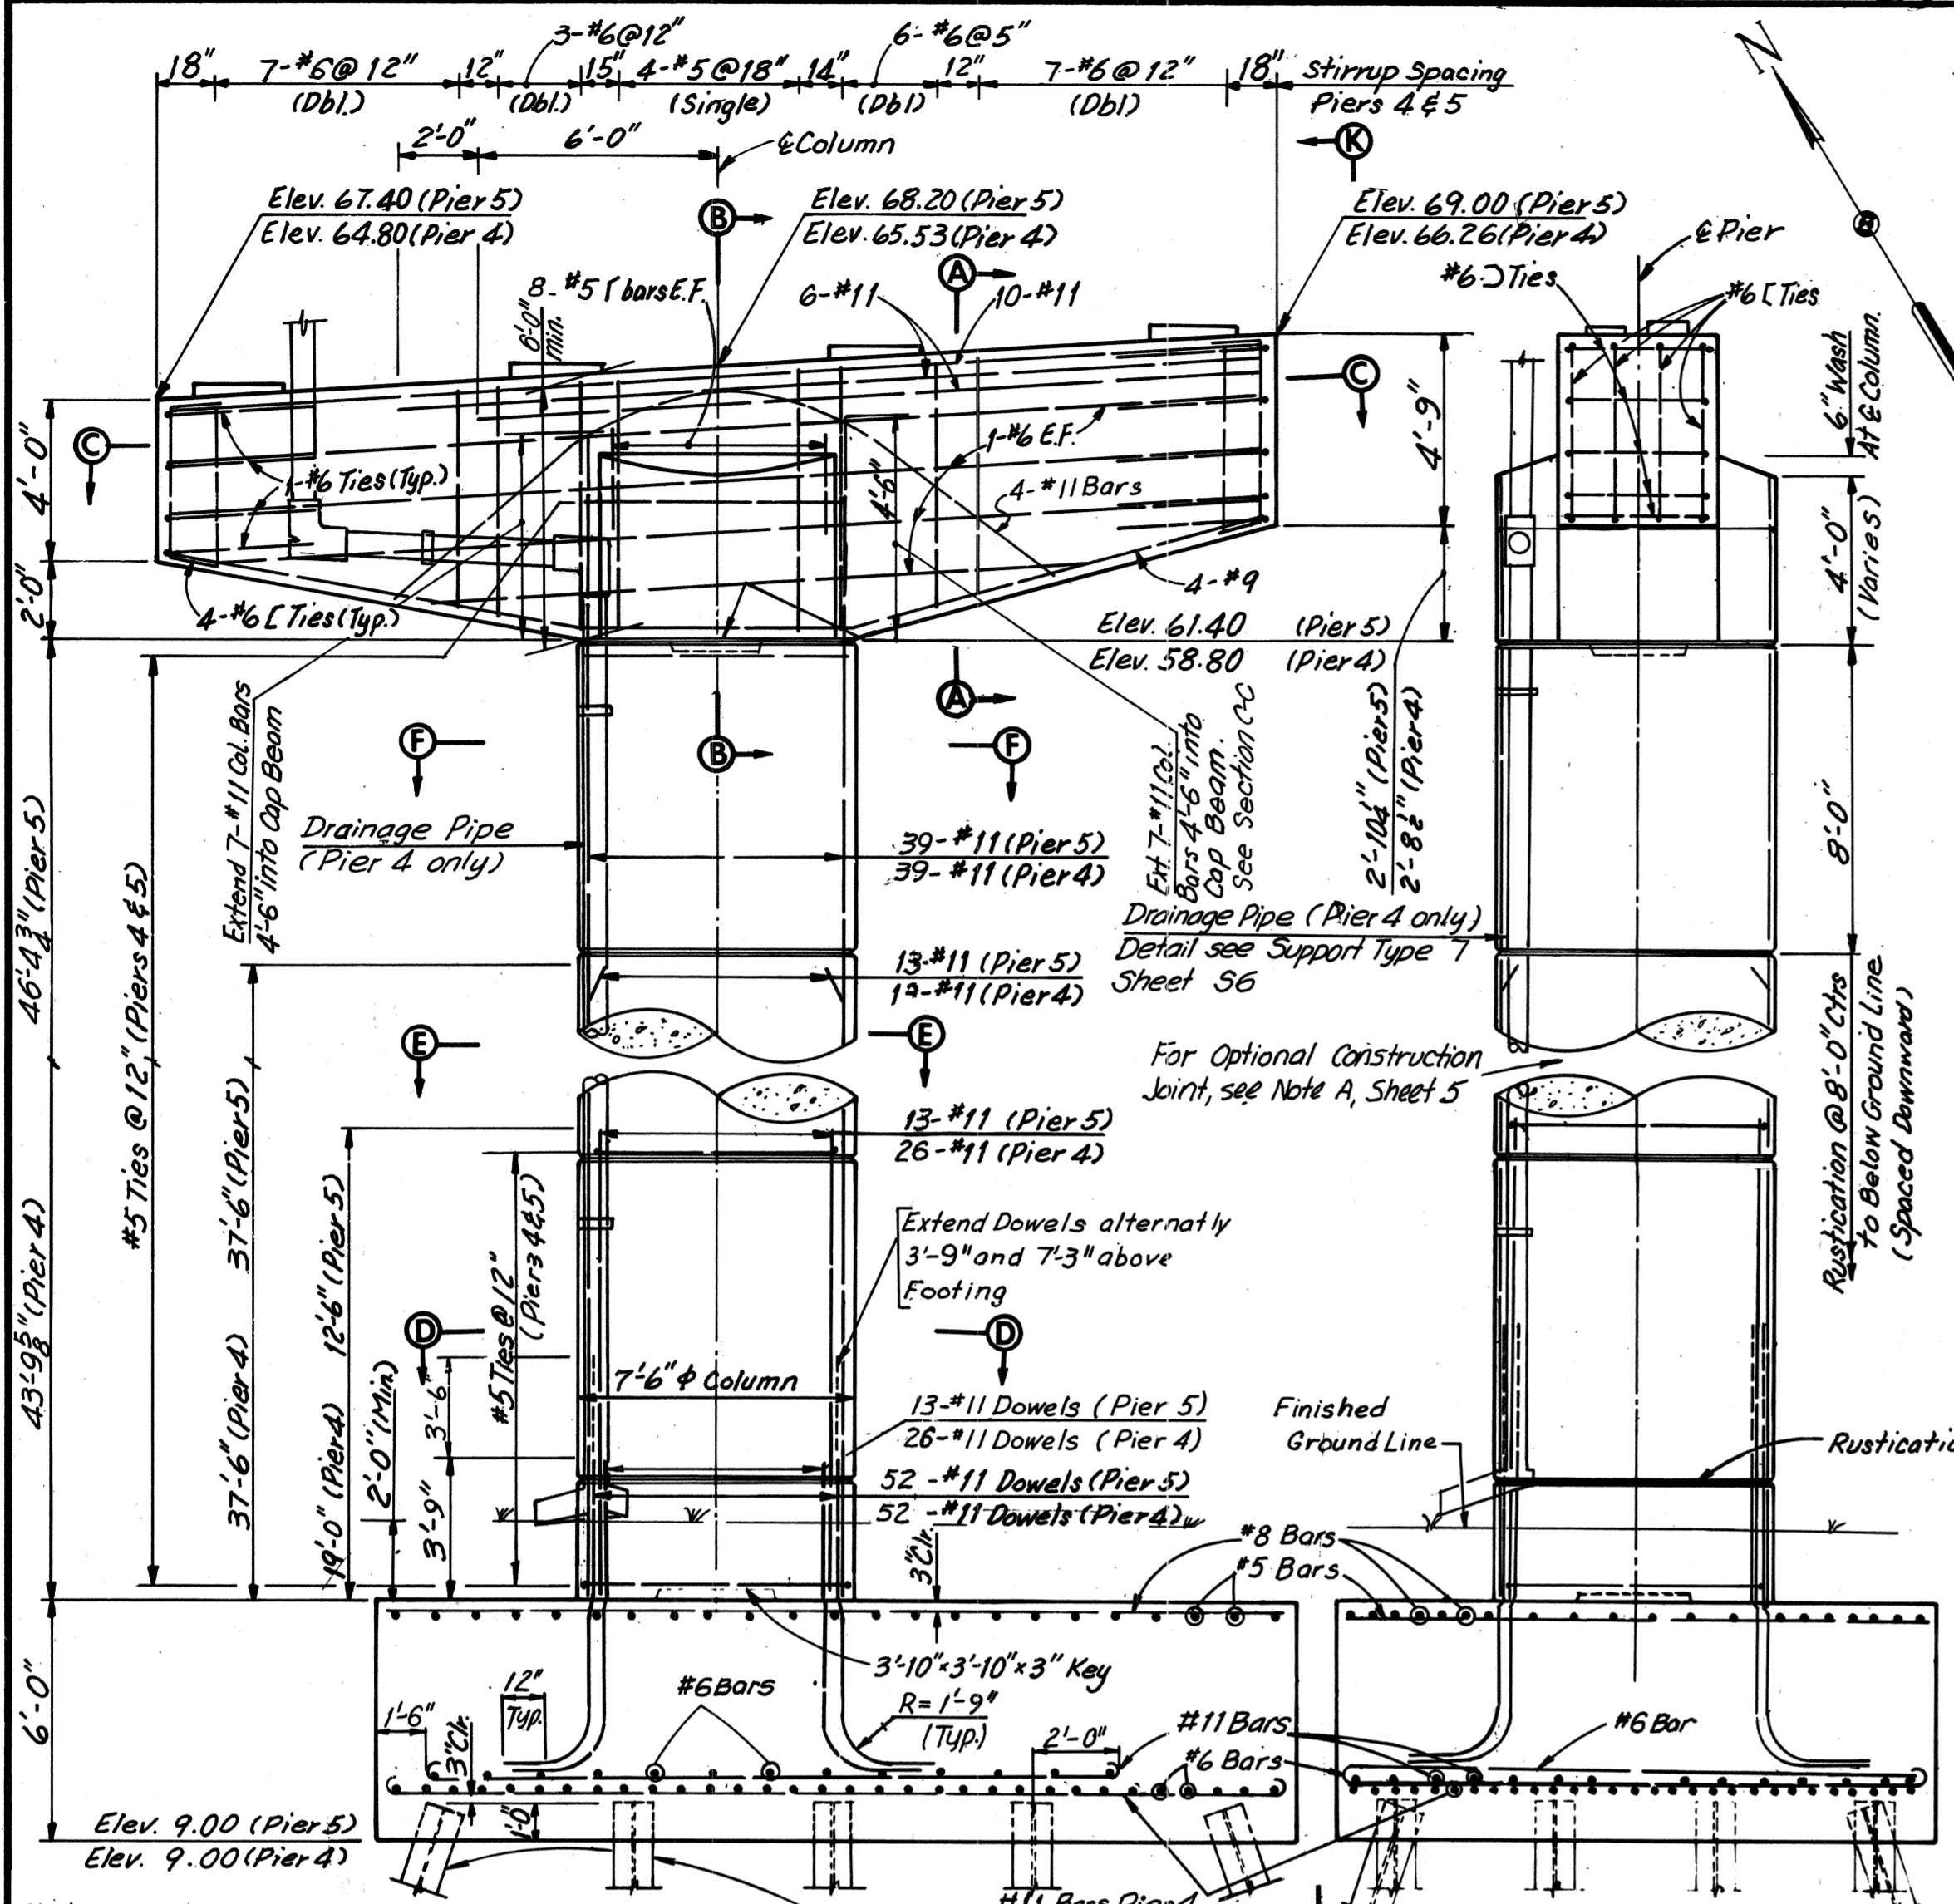


BY	DATE	Note Added	LRH	4-19-74		
MADE	G.C.C.	9-14-68	2	As Built	TEM	6-77
CHECKED	J.D.	9-17-68				
IN CHARGE			NO.	REVISION	BY	DATE

Note: Footing elevations are approximate only and may be varied to suit field conditions as directed by the Engineer. Vertical shaft reinforcing shall not be cut until these elevations are established. Where elevations change more than 2ft., redesign will be required.

Note: All piles shall be 12BP53 Steel Piles (Design capacity = 57 tons). Batter all piles 3" per foot where shown. For Standard Shoe details, see Sheets S1 & S2. For Framing Plan, see Sheet 20 & 21. Estimated Pile Tip Elevation -12.00 (Pier 4) and -15.00 (Pier 5).

FOOTINGS FOR PIERS 4 AND 5 ARE ECCENTRIC AS SHOWN ON FOOTING PLANS ABOVE

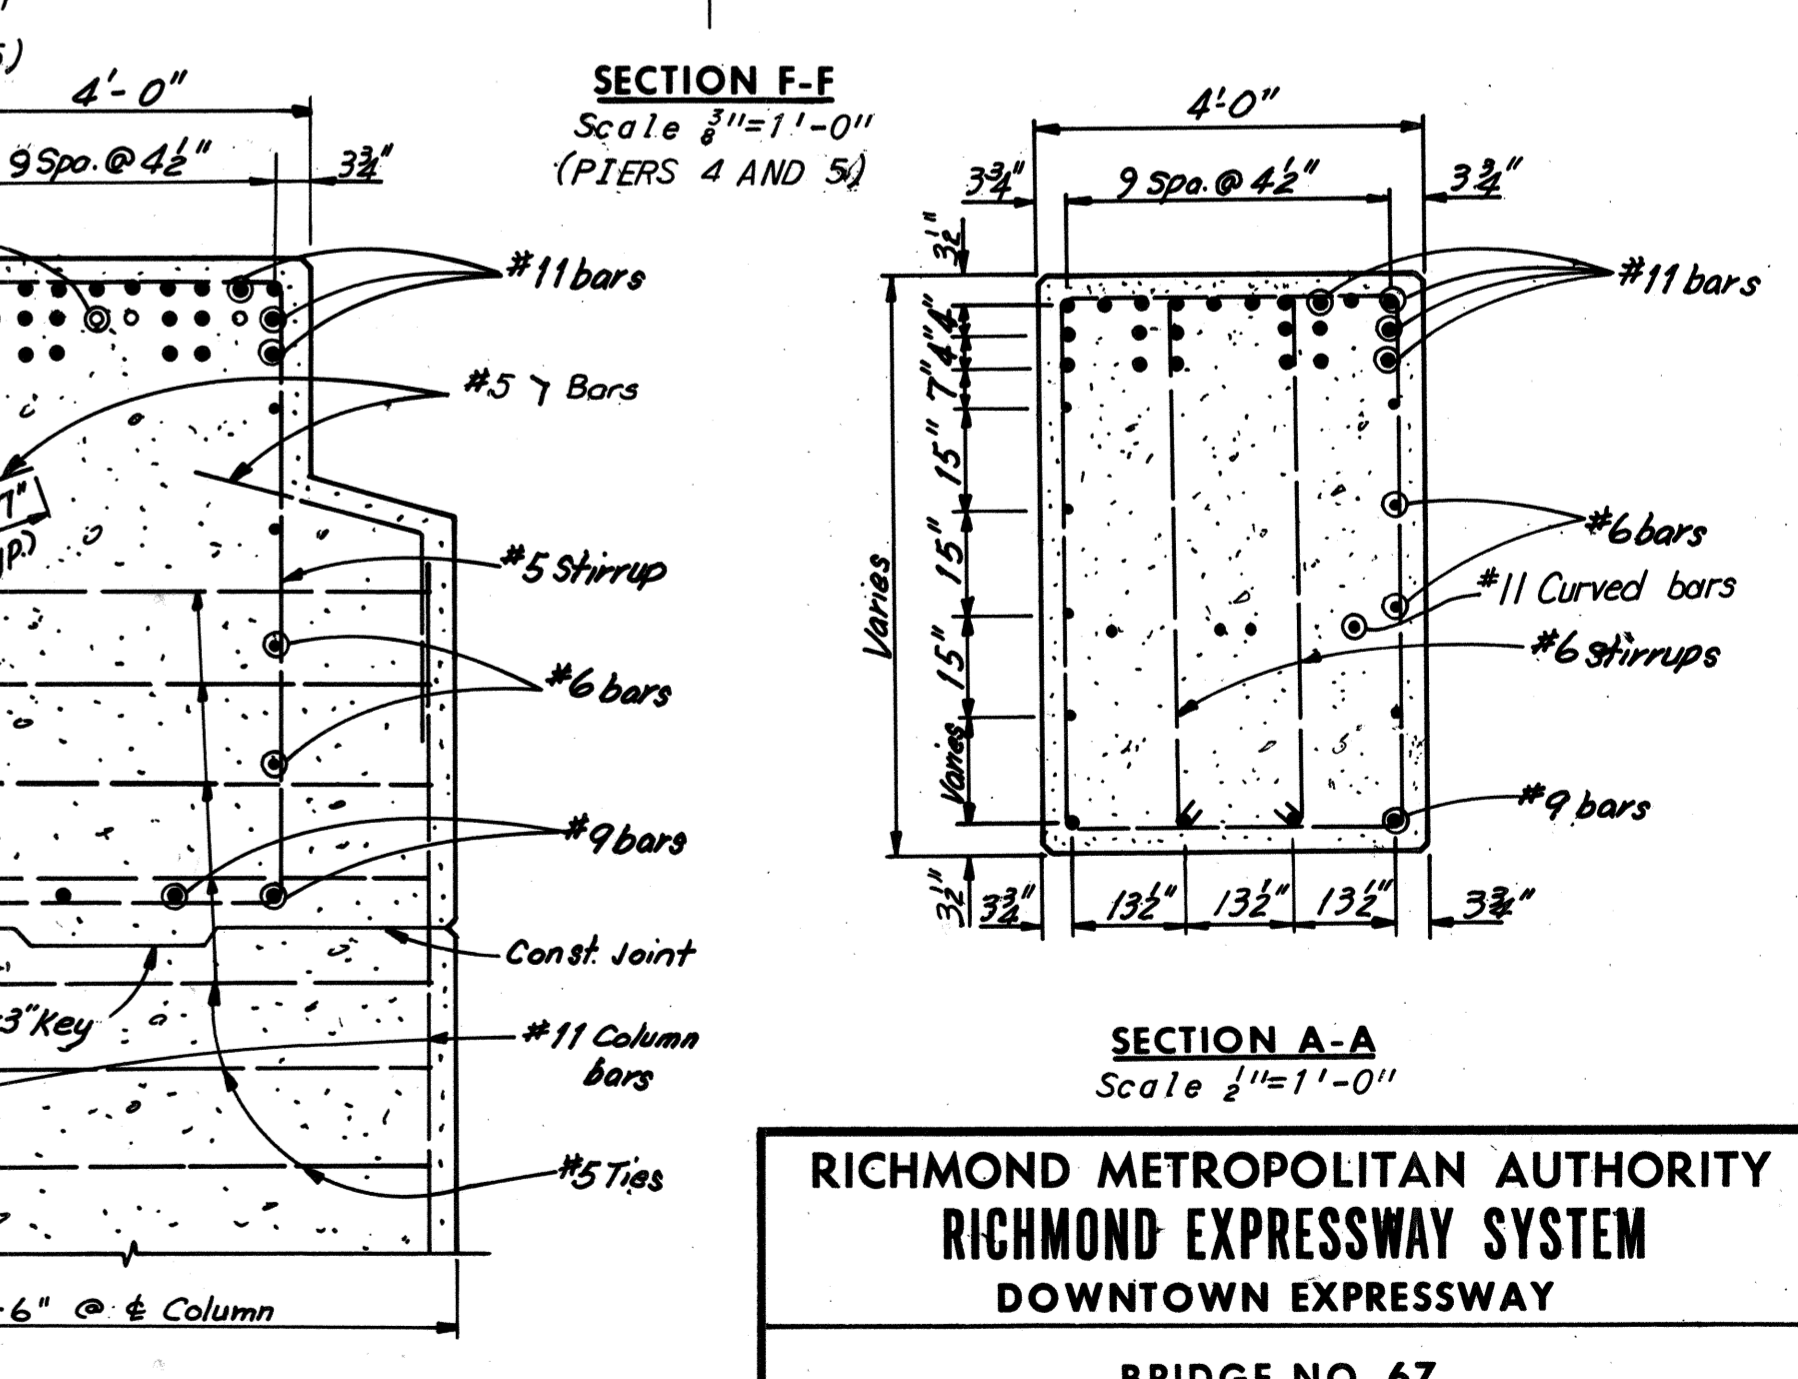

SECTION B-B
Scale 1/2"=1'-0"

AS BUILT

RICHMOND METROPOLITAN AUTHORITY
RICHMOND EXPRESSWAY SYSTEM
DOWNTOWN EXPRESSWAY







BRIDGE NO. 67
RAMP W-N CONNECTION TO
RICHMOND-PETERSBURG TURNPIKE
PIERS 4 AND 5

HOWARD, NEEDLES, TAMMEN & BERGENDOFF
consulting engineers
NEW YORK ALEXANDRIA KANSAS CITY

SCALE: As Noted
CONTRACT NO.: 10
SHEET NO. 7 OF 54

RICHMOND EXPRESSWAY SYSTEM			
SECTION	PROJECT	SHEET NO.	TOTAL SHEETS
10	DOWNTOWN EXPRESSWAY	196	265

SHOE SCHEDULE			
EXP. SHOE	FIXED SHOE		
TYPE	NO.	TYPE	NO.
E2	8	SP-1	4

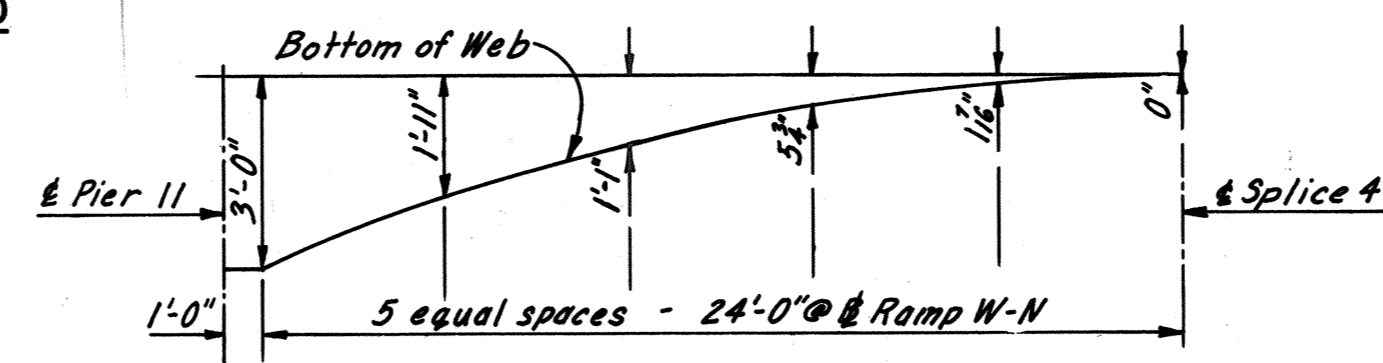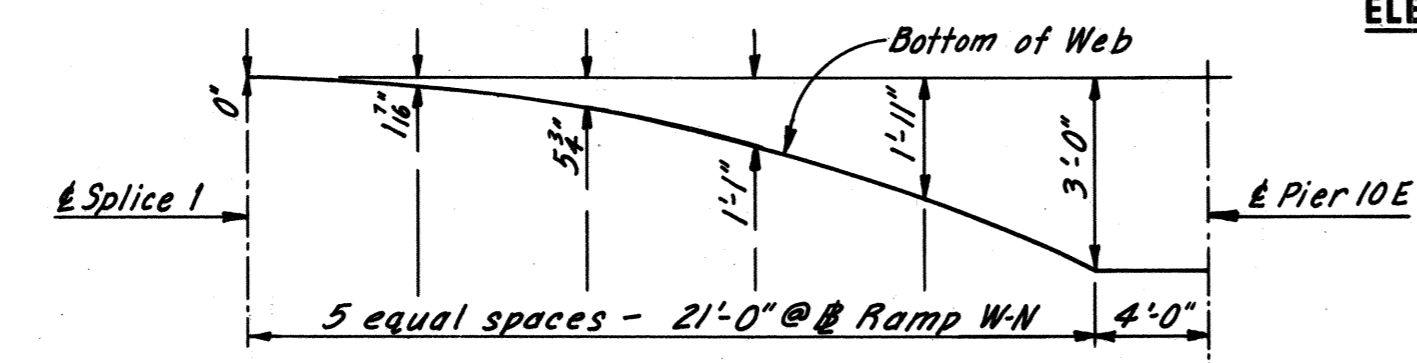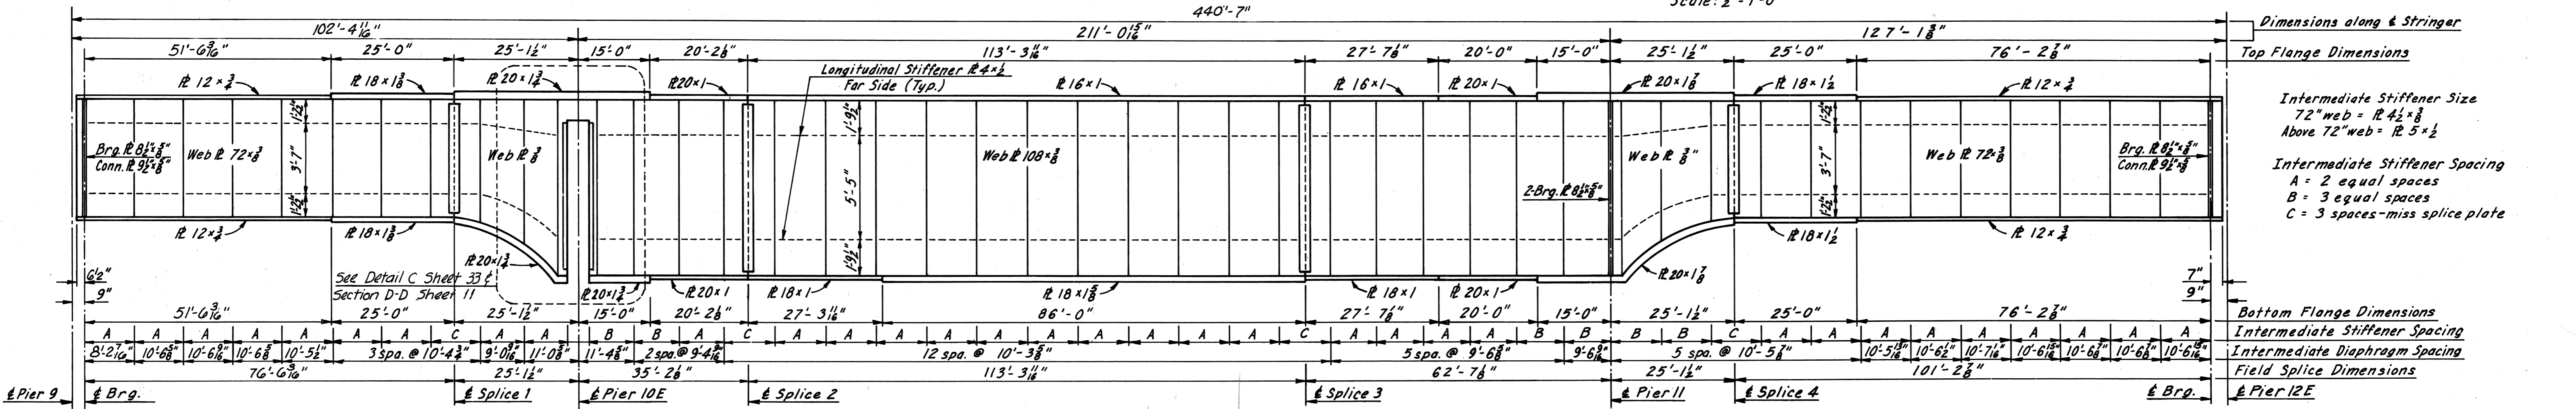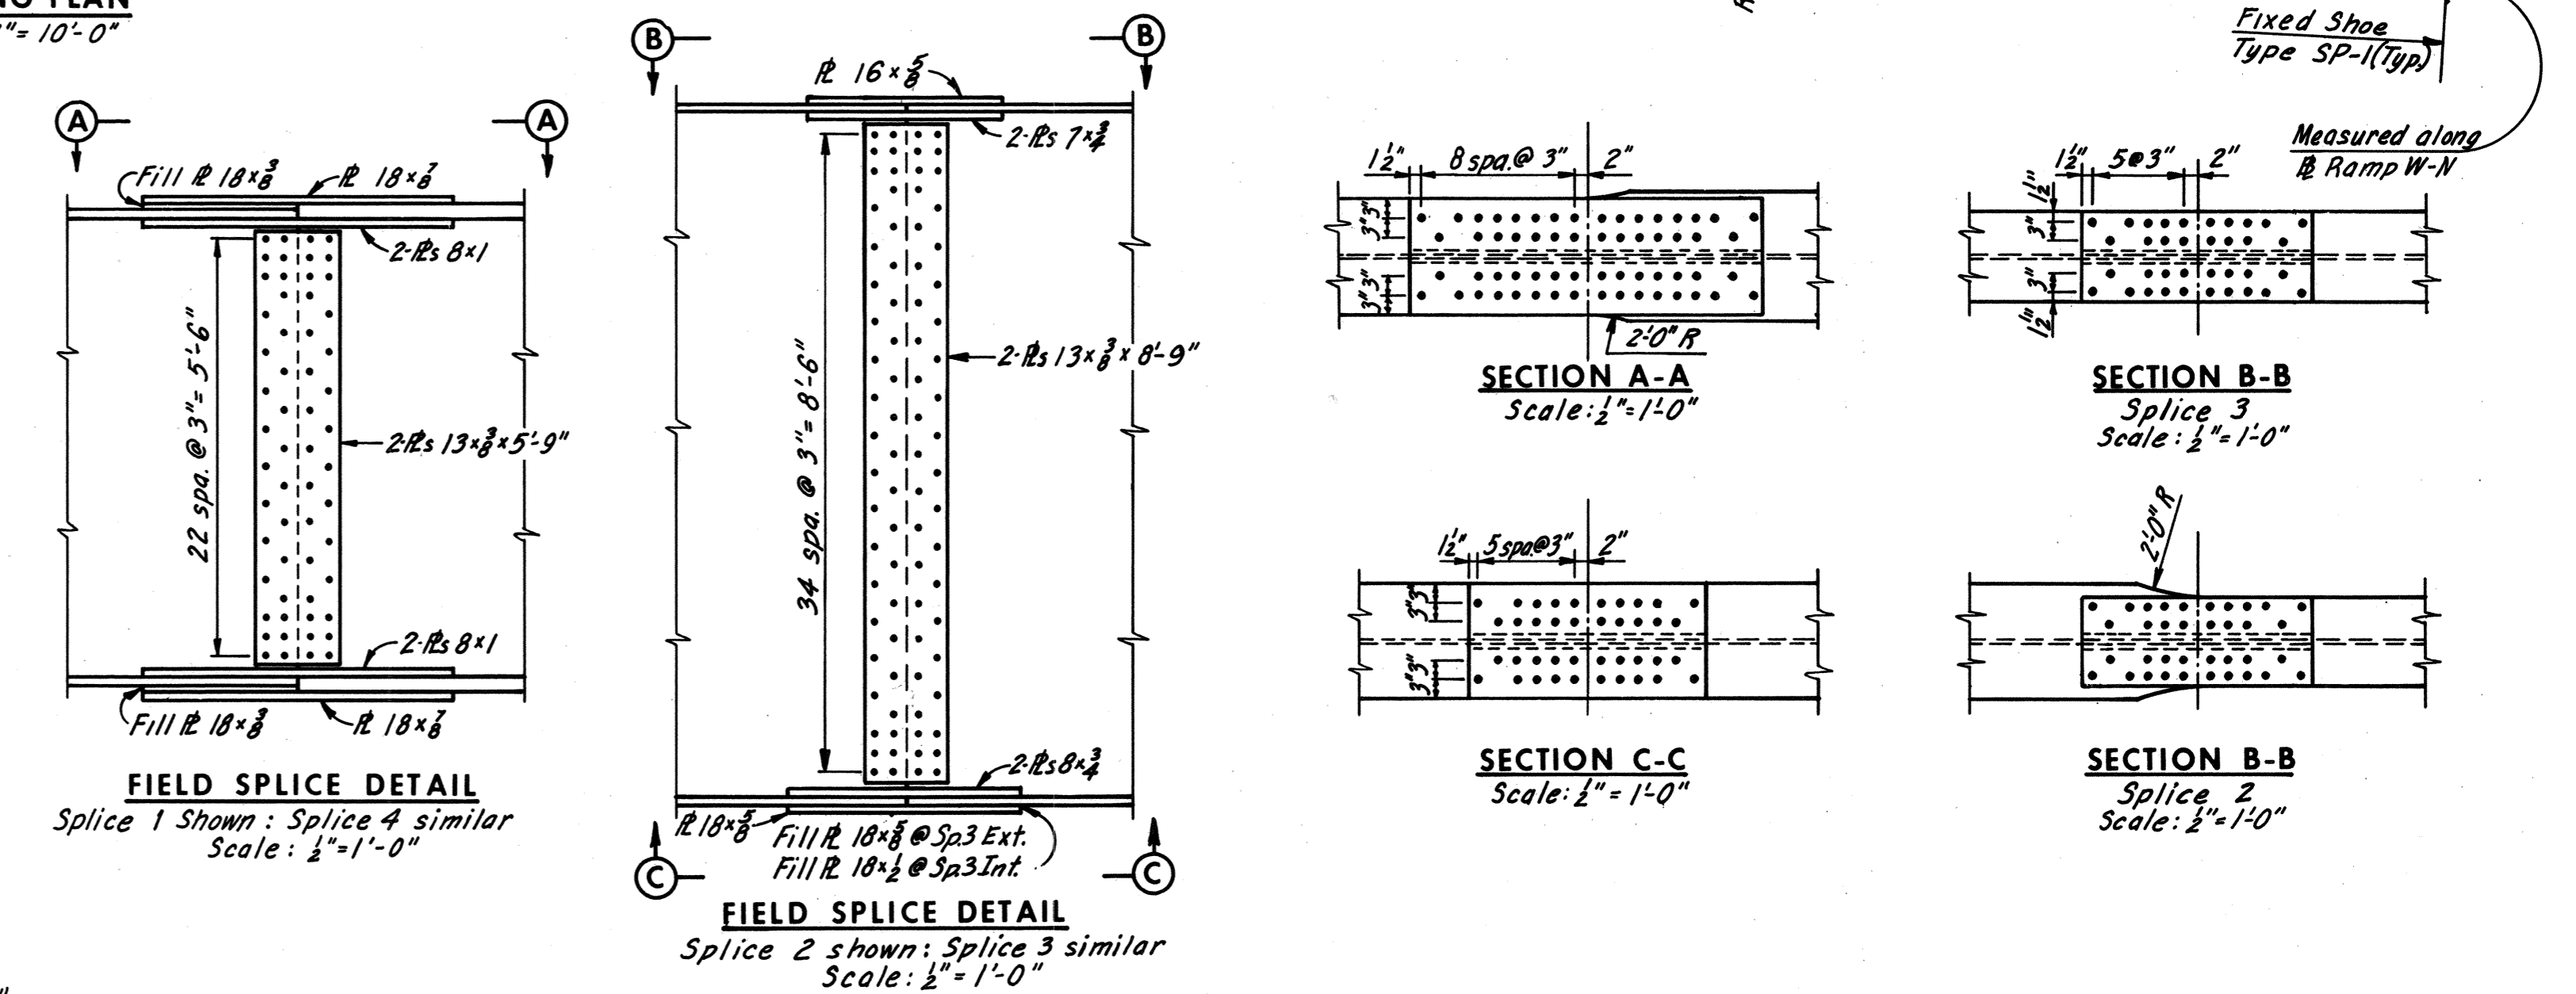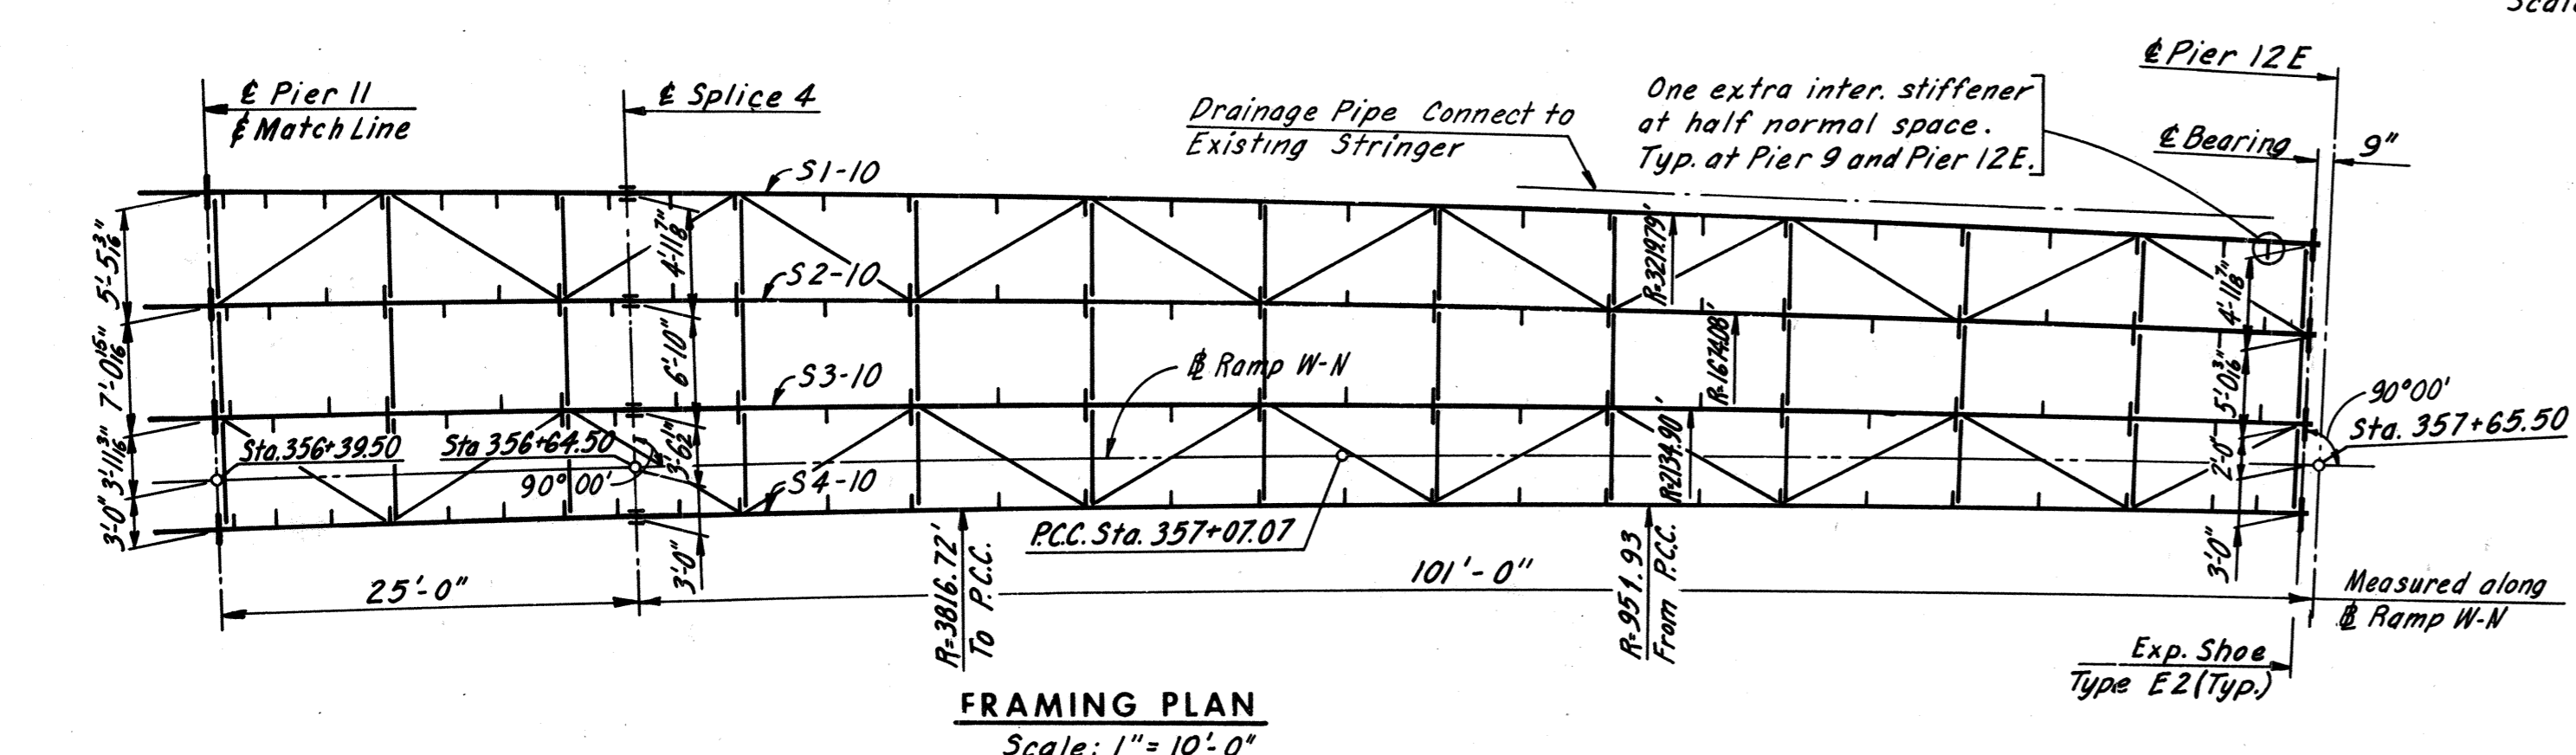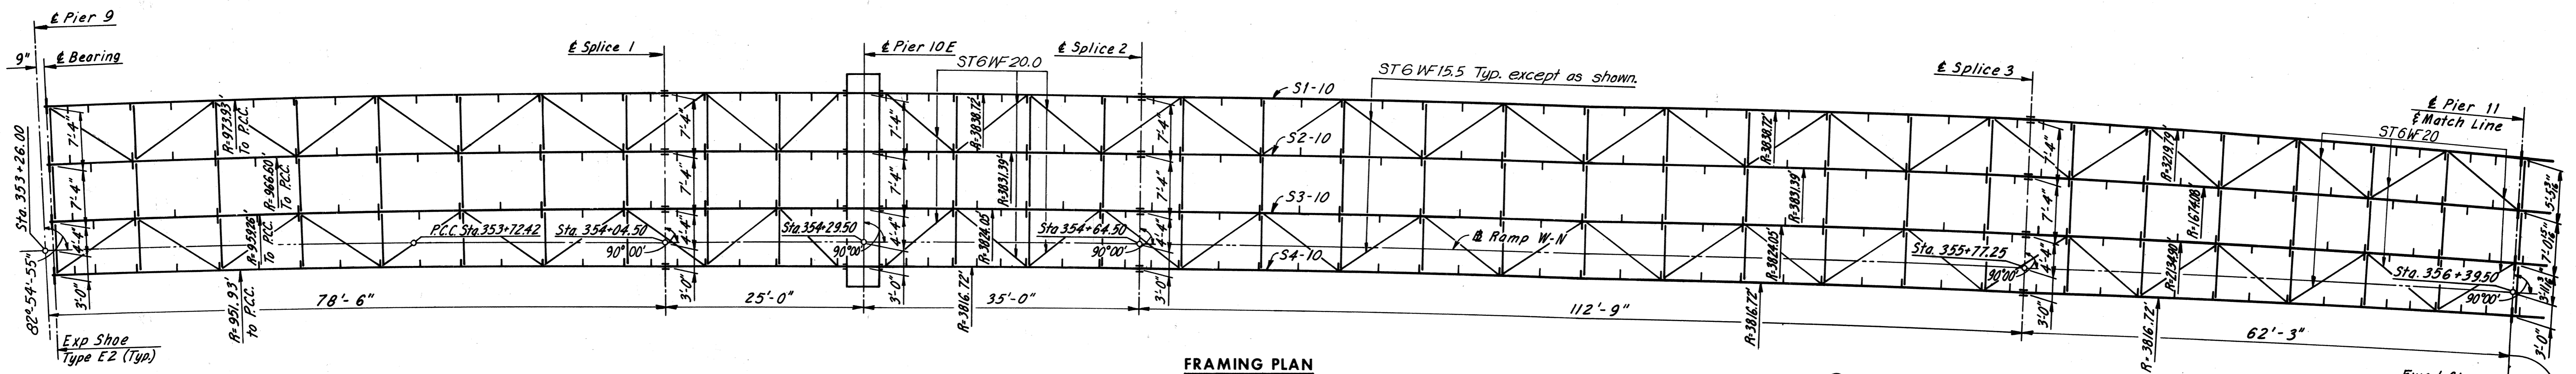

Notes:
 For Deck Plan, see Sheet 34.
 For Shoe Details, see Sheet S2.
 For Details of Intermediate Diaphragms, see Sheet 25.
 For Details of End Diaphragms, see Section D-D Sheet 33.
 For Details of Lateral Bracing, see Sheet 25.
 All steel is A36 unless otherwise noted.
 For Joint Details, see Sheet 49.
 For Web to Flange Weld, see Note, Sheet 20.

RICHMOND METROPOLITAN AUTHORITY
RICHMOND EXPRESSWAY SYSTEM
DOWNTOWN EXPRESSWAY

BRIDGE NO. 67
RAMP W-N CONNECTION TO
RICHMOND-PETERSBURG TURNPIKE
FRAMING PLAN- UNIT 10




HOWARD, NEEDLES, TAMMEN & BERGENDOFF
 consulting engineers
 NEW YORK ALEXANDRIA KANSAS CITY

SCALE: As Noted
 CONTRACT NO.: 10
 SHEET NO. 24 OF 54

BY	DATE	REVISION	BY	DATE
AMH	2-28-69	2 As Built	TEM	6-77
JD	4-26-69			

AS BUILT

RICHMOND EXPRESSWAY SYSTEM			
SECTION	PROJECT	SHEET NO.	TOTAL SHEETS
10	DOWNTOWN EXPRESSWAY	197	265

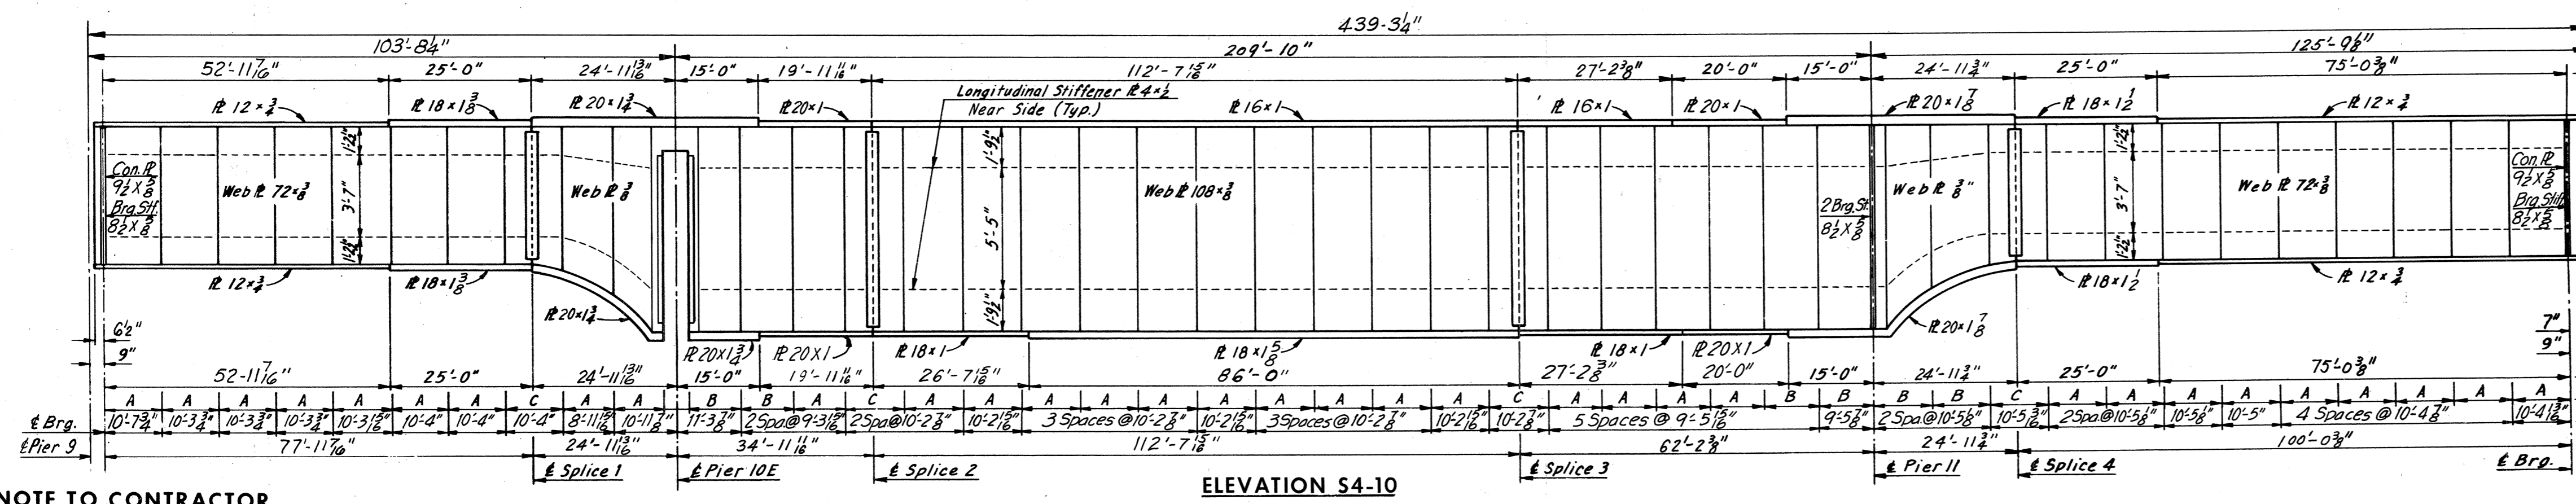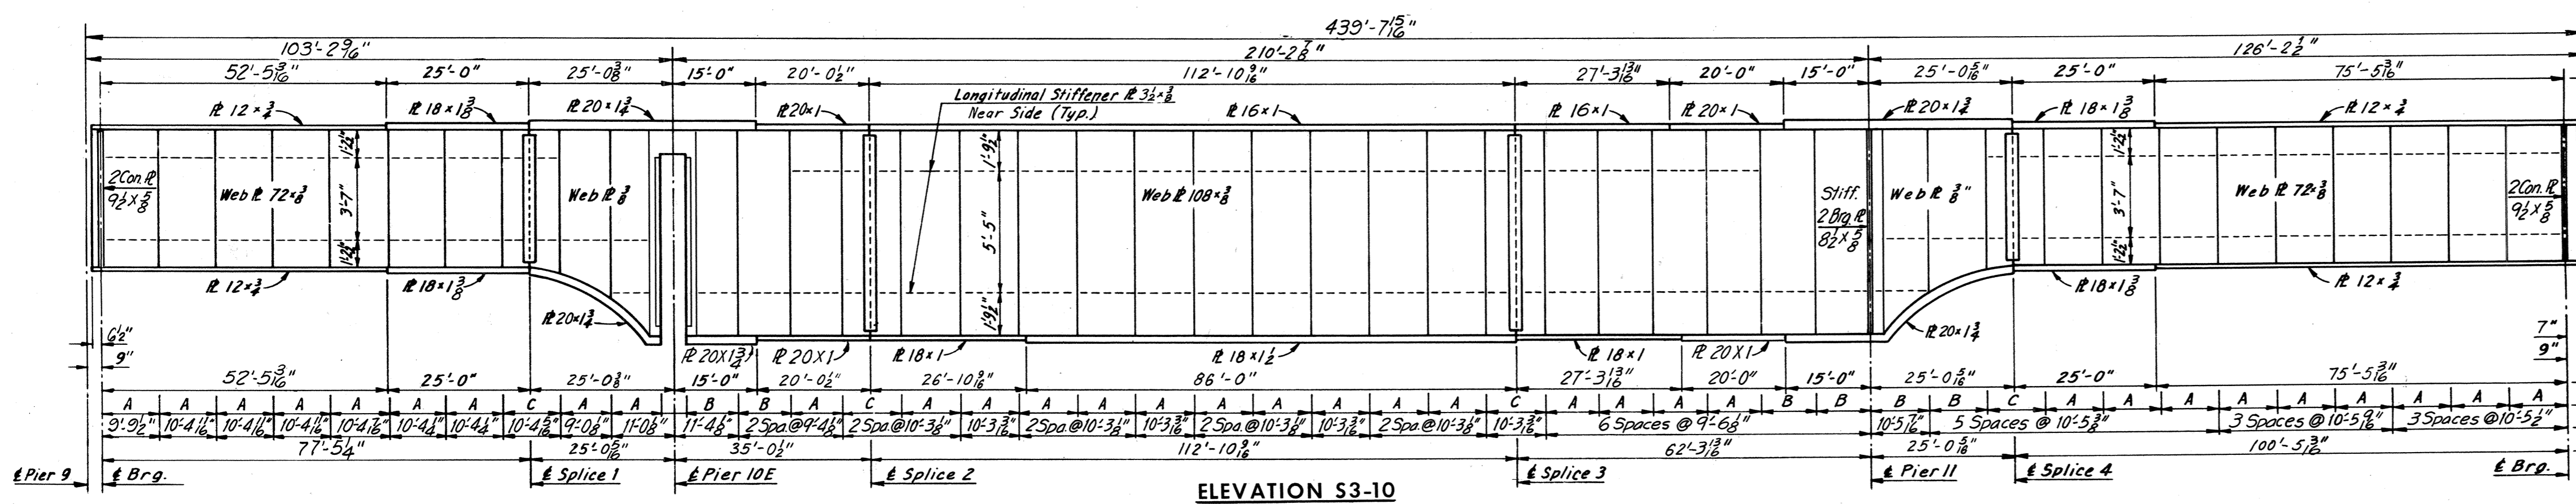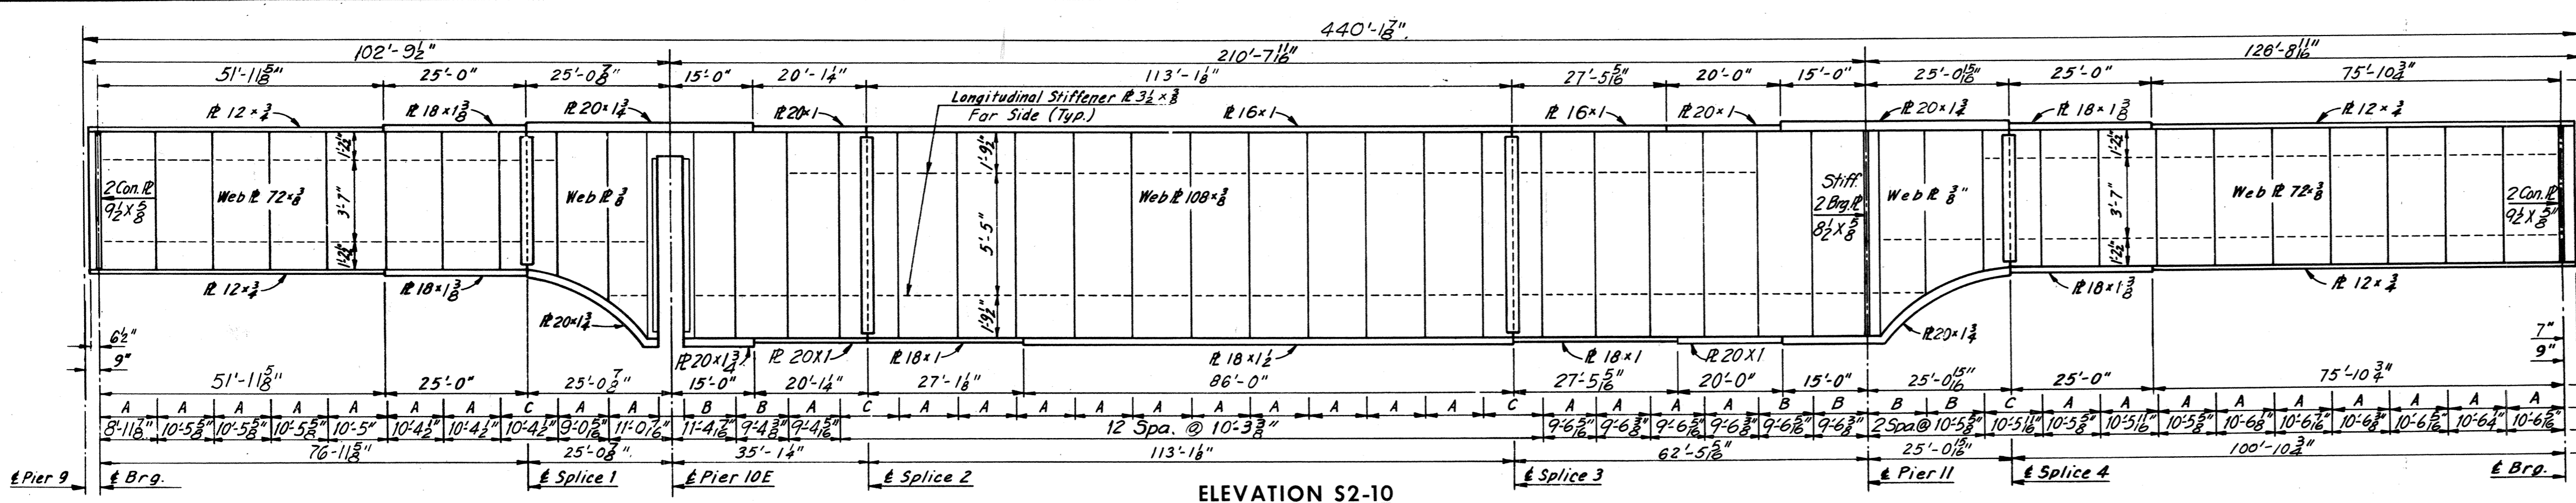

STRINGER	ELEV. A	ELEV. B	ELEV. C	ELEV. D	ELEV. E	ELEV. F
S1-10	88.50	87.37	85.60	80.87	76.81	72.72
S2-10	88.35	87.23	85.46	80.65	76.57	72.42
S3-10	88.21	87.08	85.31	80.43	76.24	72.12
S4-10	88.06	86.93	85.16	80.20	75.93	71.82

NOTE TO CONTRACTOR

Deflections given are those anticipated to occur in the stringer upon placement of the total concrete deck dead load. In practice, the stringers in place are not likely to have the exact camber to compensate for these deflections during construction. The residual amounts shall be provided by adjusting forms to vary the thickness of the concrete haunch between the bottom of the slab and the top of stringer without altering the slab thickness.


NOTE TO FABRICATOR

The stringers shall be fabricated with an upward camber amounting to the tabulated value. This will provide approximate compensation for deflection under full dead load and for conformity with finished grade.


DEAD LOAD DEFLECTION DIAGRAM

Exterior Stringer S1-10
Interior Stringer S2-10
Exterior Stringer S4-10

DEAD LOAD DEFLECTION DIAGRAM

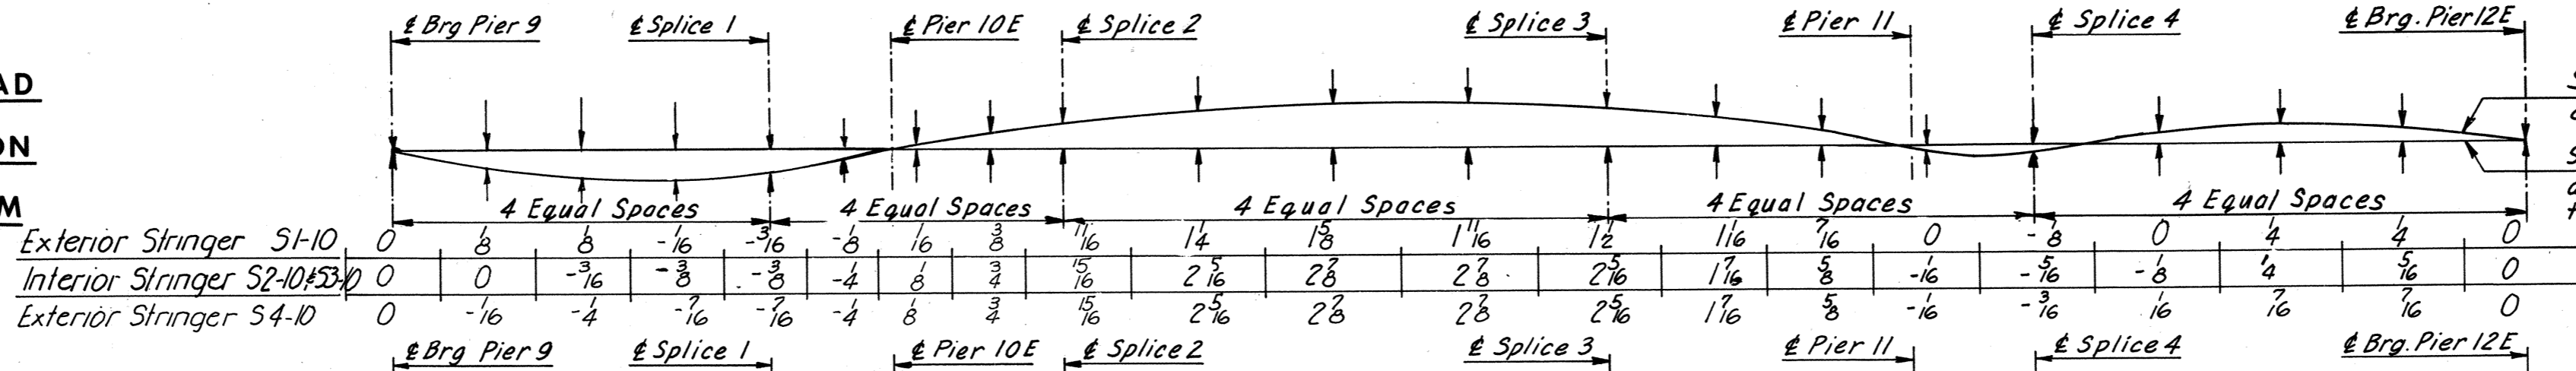

CAMBER DIAGRAM

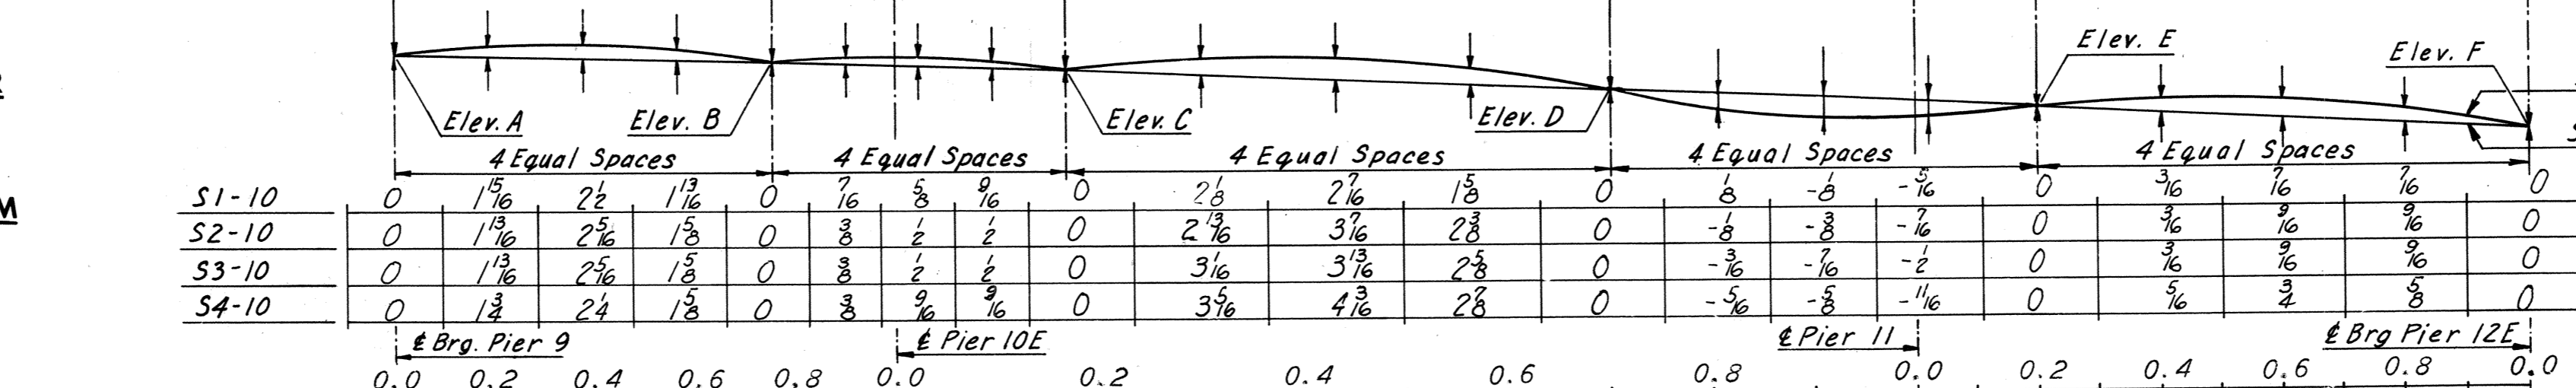

MAX. SHEAR STUD SPACING

Stringer	0.0	0.2	0.4	0.6	0.8	0.0	0.2	0.4	0.6	0.8	0.0	0.2	0.4	0.6	0.8	0.0
Exterior Stringers	21	24	24	24	24	24	24	24	24	24	24	24	24	24	24	24
Interior Stringers	21	24	24	24	24	24	24	24	24	24	24	24	24	24	24	20

Note: For Deck Plan, see Sheet 34. All Steel shall be A36 unless otherwise noted. For Details not shown, see Section D-D, sheet 11, and Detail C, sheet 33. For Web to Flange Weld size, see Note, Sheet 20.

RICHMOND METROPOLITAN AUTHORITY RICHMOND EXPRESSWAY SYSTEM DOWNTOWN EXPRESSWAY

BRIDGE NO. 67 RAMP W-N CONNECTION TO RICHMOND-PETERSBURG TURNPIKE GIRDER ELEVATIONS - UNIT 10


HOWARD, NEEDLES, TAMMEN & BERGENDOFF consulting engineers ALEXANDRIA KANSAS CITY

AS BUILT

BY	DATE	Note Added	LRH	4-19-74
MADE	AMH	Z 288-69	TEM	6-77
CHECKED	JD	4-29-69		
IN CHARGE				

SCALE: No Scale CONTRACT NO: 10 SHEET NO. 25 OF 54

RICHMOND EXPRESSWAY SYSTEM			
SECTION	PROJECT	SHEET NO.	TOTAL SHEETS
10	DOWNTOWN EXPRESSWAY	198	265

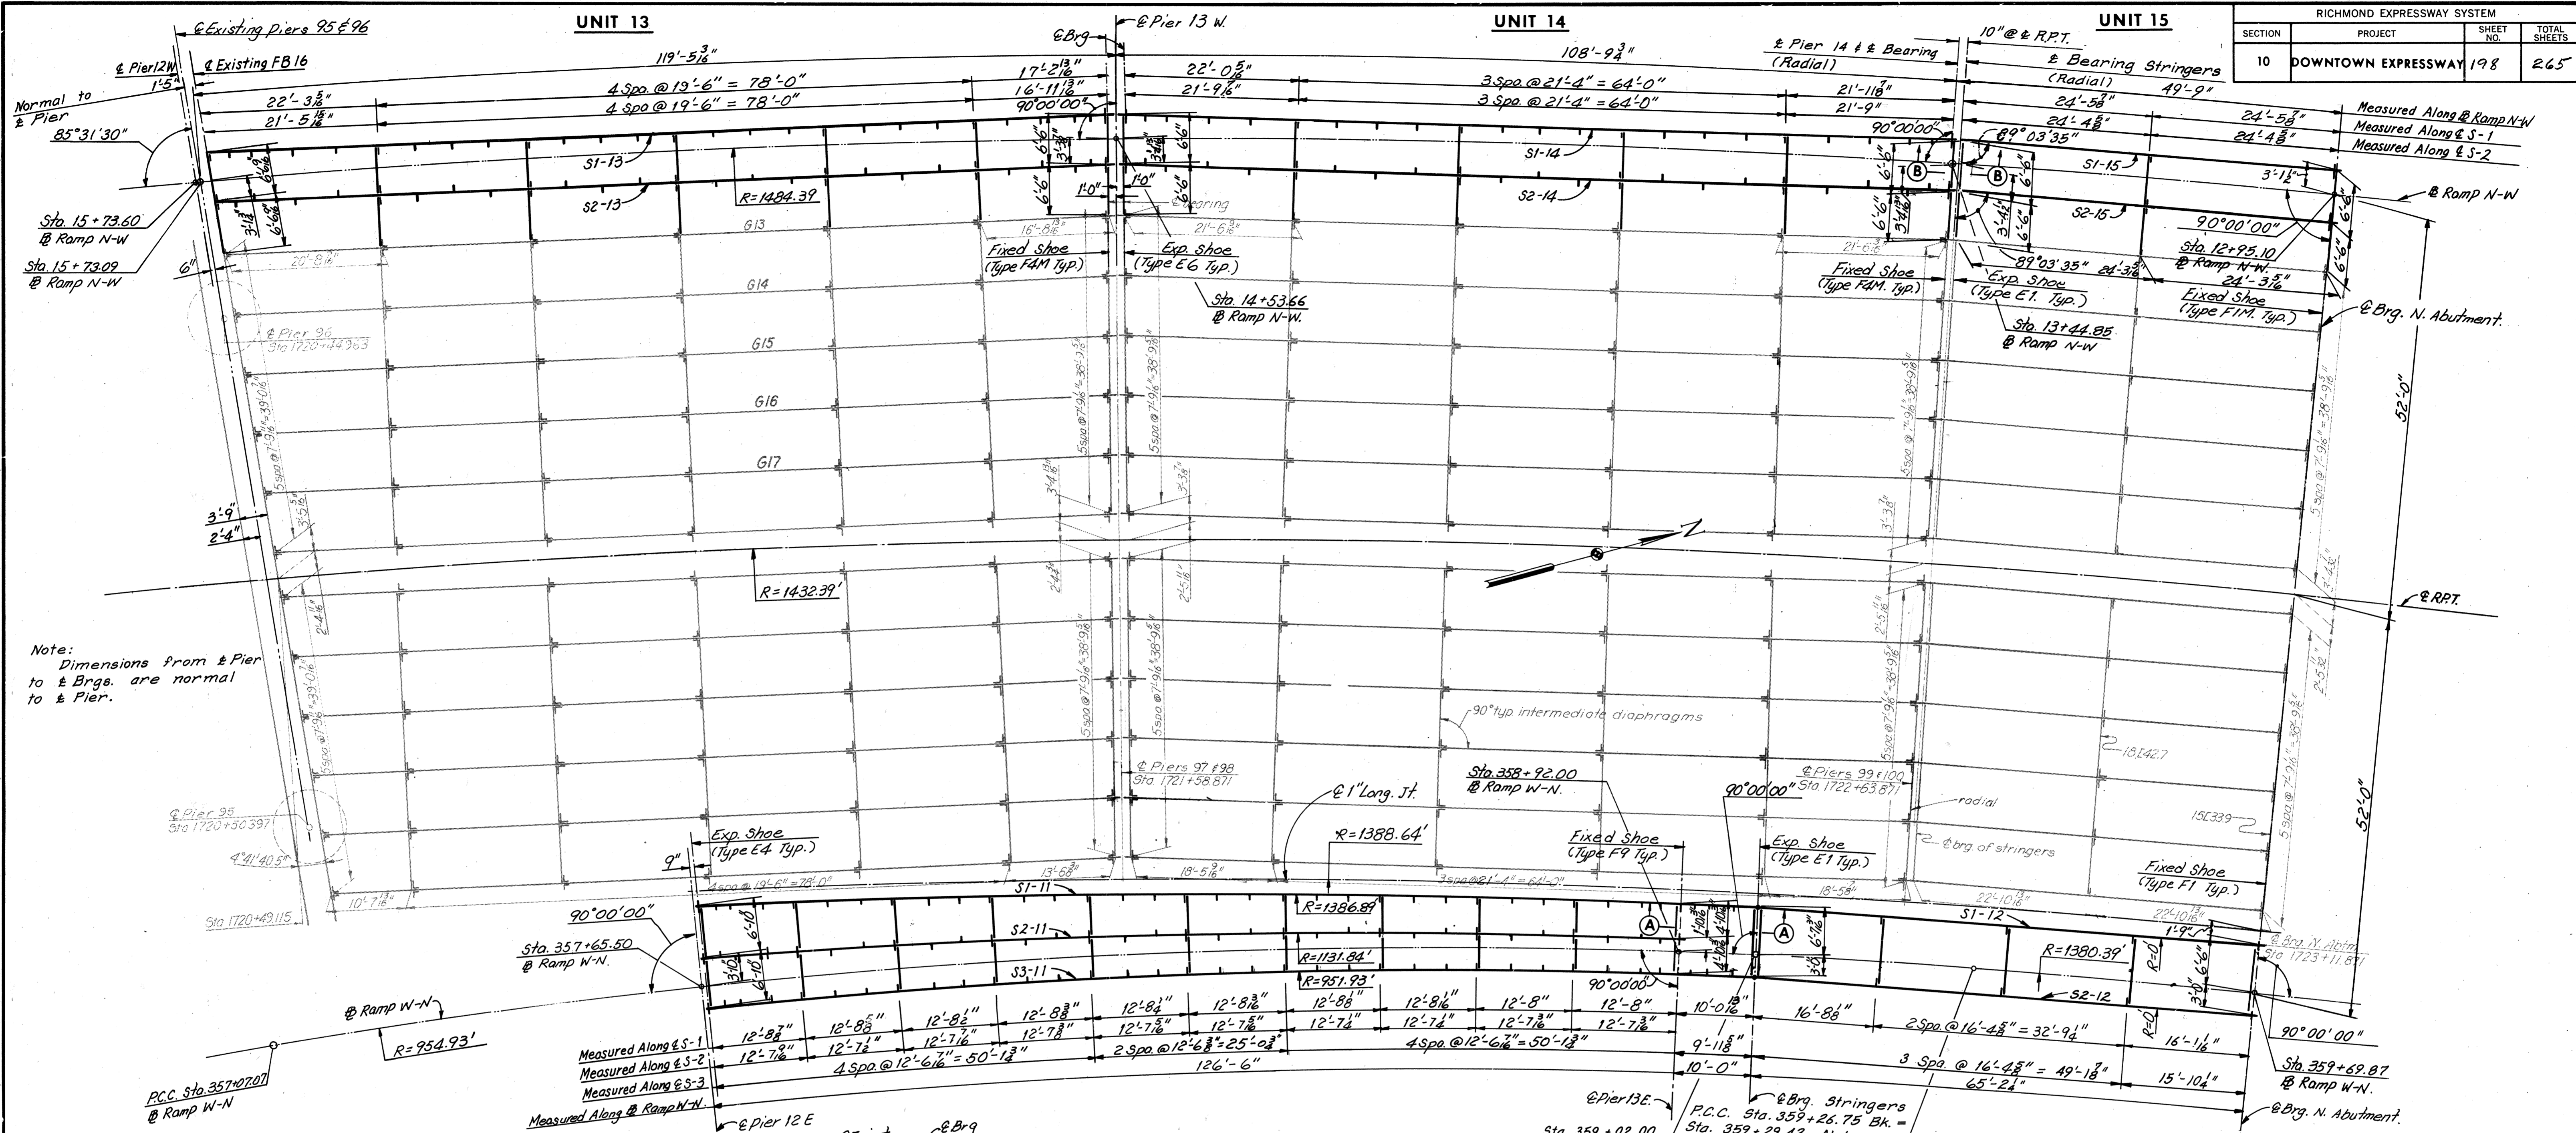


Note:
Dimensions from & Pier
to & Brgs. are normal
to & Pier.

Note:
For Stringer Elevation, see Sheet 27.
For Stringer Schedule, see Sheet 27.
For Camber Schedule, see Sheet 27.
For FB 16 Details, see Sheet 28.
For Deck Plan, see Sheet 35.
For Shoe Details, see Sheets 51 & 52.


Note:
Dimensions shown on the plans for existing structural
metalwork are in accordance with drawings prepared for the
original construction. The Contractor shall verify all
necessary dimensions of existing structural metalwork prior
to fabrication of new metalwork.
New Diaphragms are to match Existing Diaphragms, in Units
13, 14 and 15.

BY	DATE	REVISION	BY	DATE
Y.C.P.	2-24-69	1	DWB	12-11-74
K.C.T.	4-26-69	3	TEM	6-77

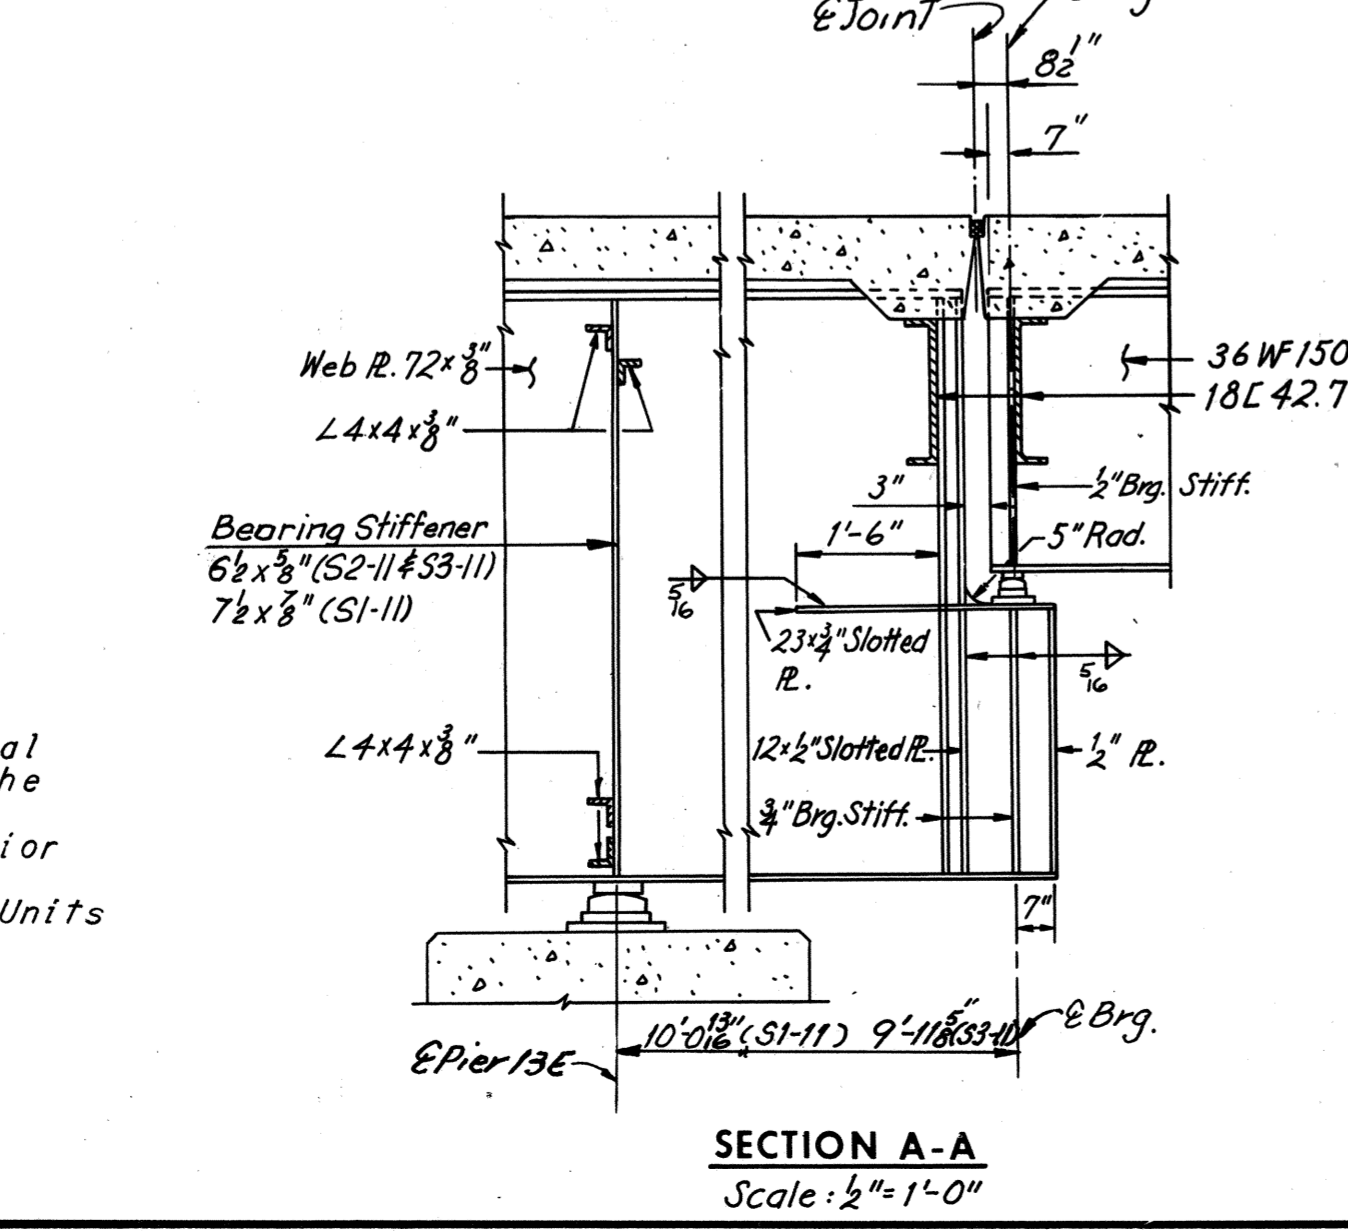

FRAMING PLAN
Scale: 1" = 10'-0"

Note:
Intermediate stiffener PIs. 4x3/4" shall
be equally spaced between diaphragms as
shown. The first two stiffener spaces at
the end of stringers shall be one-half the
normal spacing within the panel.

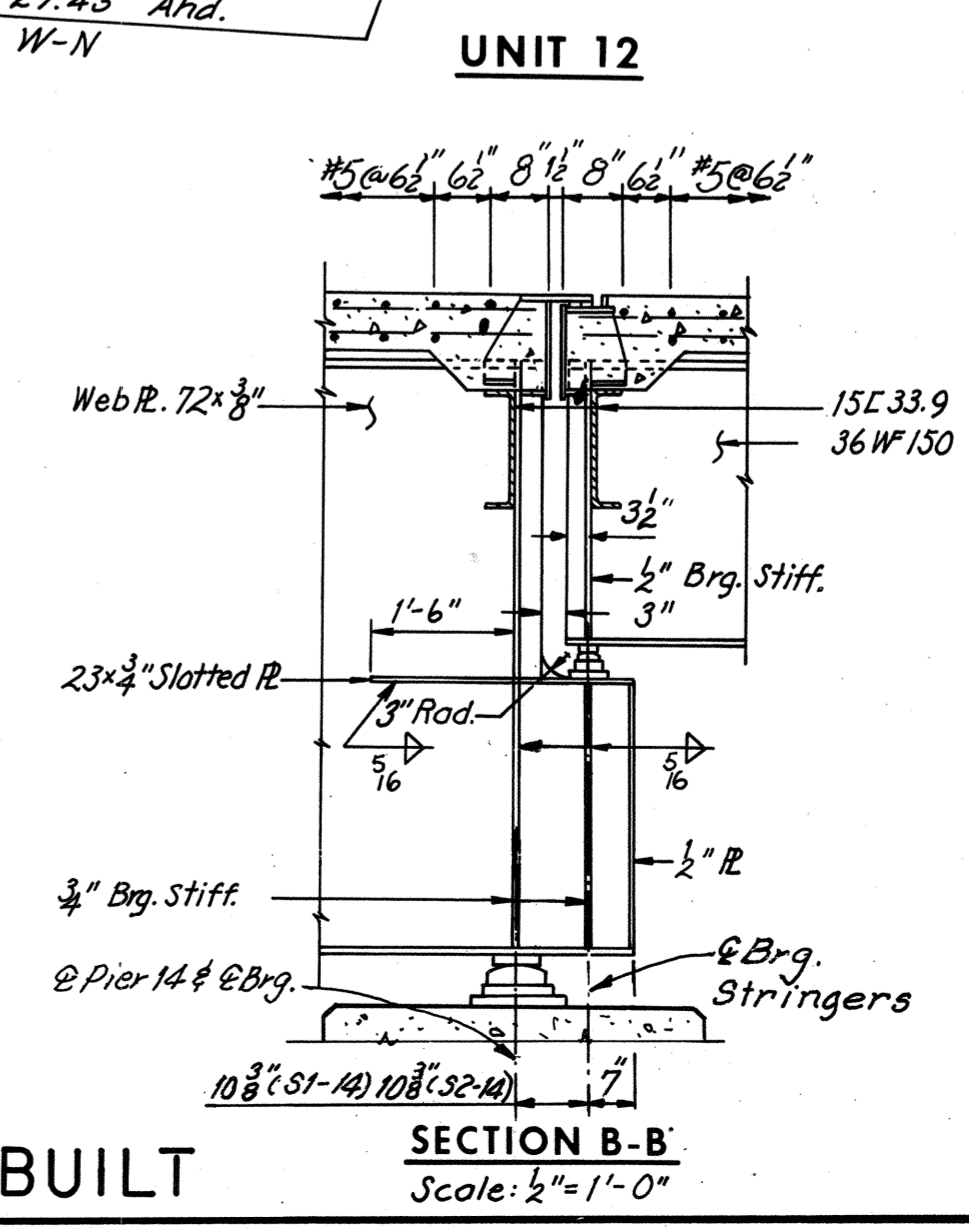

AS BUILT

SECTION B-B
Scale: 1/2" = 1'-0"


SHOE SCHEDULE			
FIXED SHOES		EXPANSION SHOES	
TYPE	NO. REQD.	TYPE	NO. REQD.
F1	2	E1	4
F1M	2	E4	3
F4M	4	E6	2
F9	3	-	-

RICHMOND METROPOLITAN AUTHORITY
RICHMOND EXPRESSWAY SYSTEM
DOWNTOWN EXPRESSWAY

BRIDGE NO. 67
RAMP W-N CONNECTION TO
RICHMOND-PETERSBURG TURNPIKE
FRAMING PLAN - UNITS 11, 12, 13, 14 AND 15


HOWARD, NEEDLES, TAMMEN & BERGENDOFF
consulting engineers
NEW YORK ALEXANDRIA KANSAS CITY

SCALE: *As Noted*
CONTRACT NO.: 10
SHEET NO. 26 OF 54

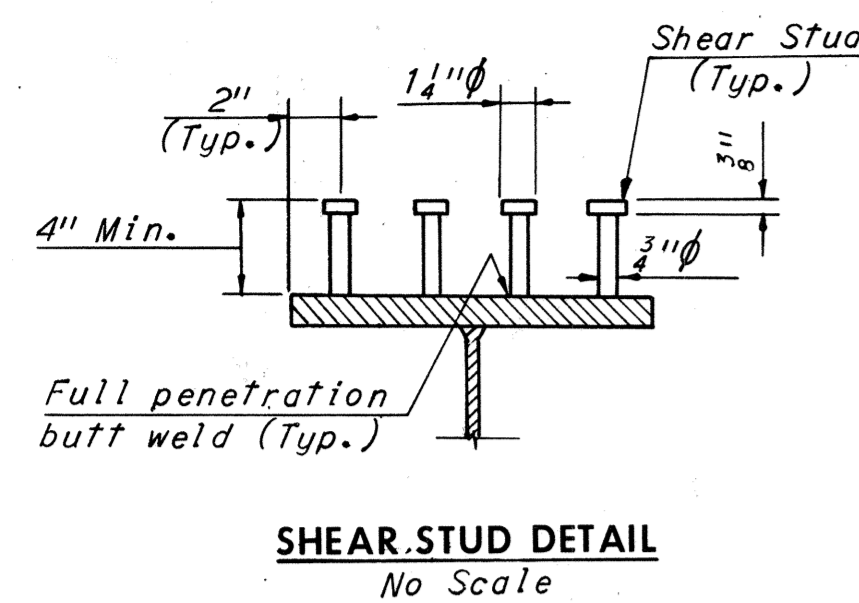


SHEAR STUD NOTE

Capacity = 3,400 lbs. per stud.
 The Contractor may, if he elects, use three 1/2" diameter studs at the same longitudinal spacing in lieu of the four 3/4" diameter studs shown.
 Stud rows shall be placed parallel to the main deck reinforcing.
 Shear stud spacing shown is maximum spacing.

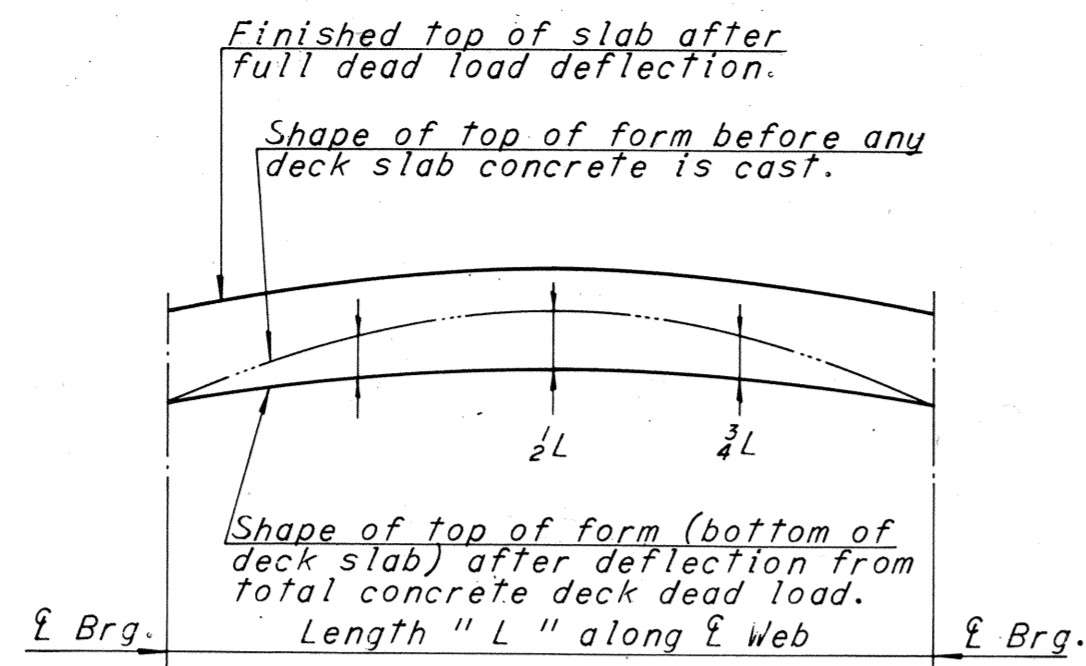

NOTE TO CONTRACTOR






Deflections given are those anticipated to occur in the stringer upon placement of the total concrete deck dead load.
 In practice, the stringers in place are not likely to have the exact camber to compensate for these deflections during construction. The residual amounts shall be provided by adjusting forms to vary the thickness of the concrete haunch between the bottom of the slab and the top of stringer without altering the slab thickness.

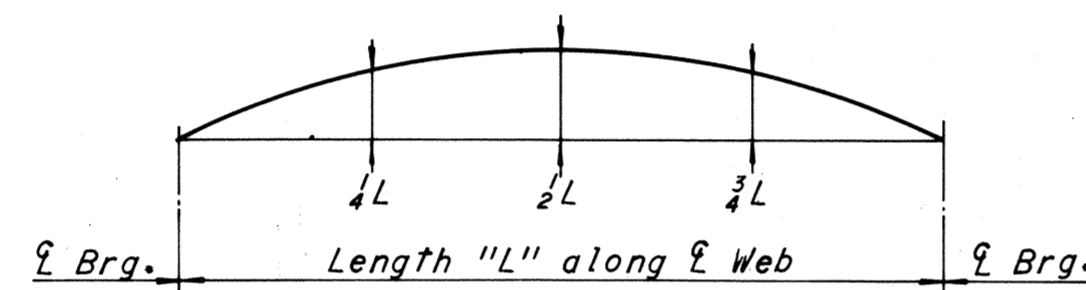


NOTE TO FABRICATOR

The stringers shall be fabricated with an upward camber amounting to the tabulated value. This will provide approximate compensation for deflection under full dead load and for conformity with finished grade.

Note: Stringers having a total camber of less than 1" are not required to be shop cambered, but should be turned so that any mill tolerance deviation from straightness will be in the direction shown by the Camber Diagram.
 If stringers are not cambered, distance top of stringers to top of slab will vary along the stringer in accordance with the offset dimensions shown in the Camber Diagram, and with minimum distance as shown in Cross-Section on Sheet

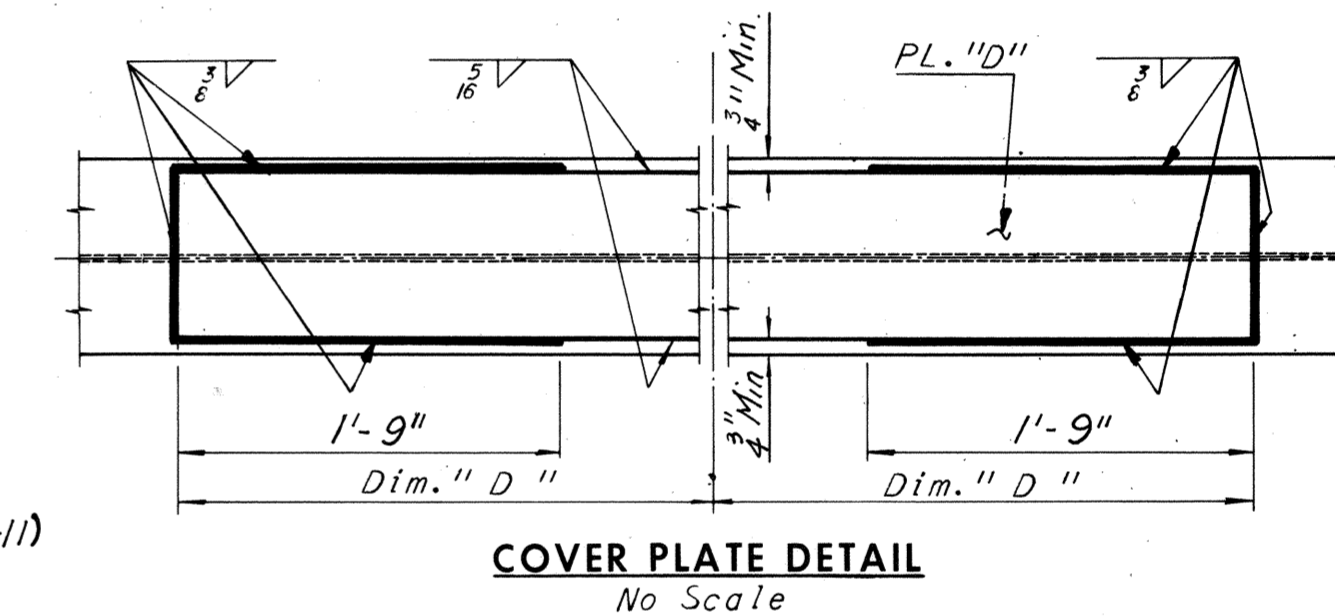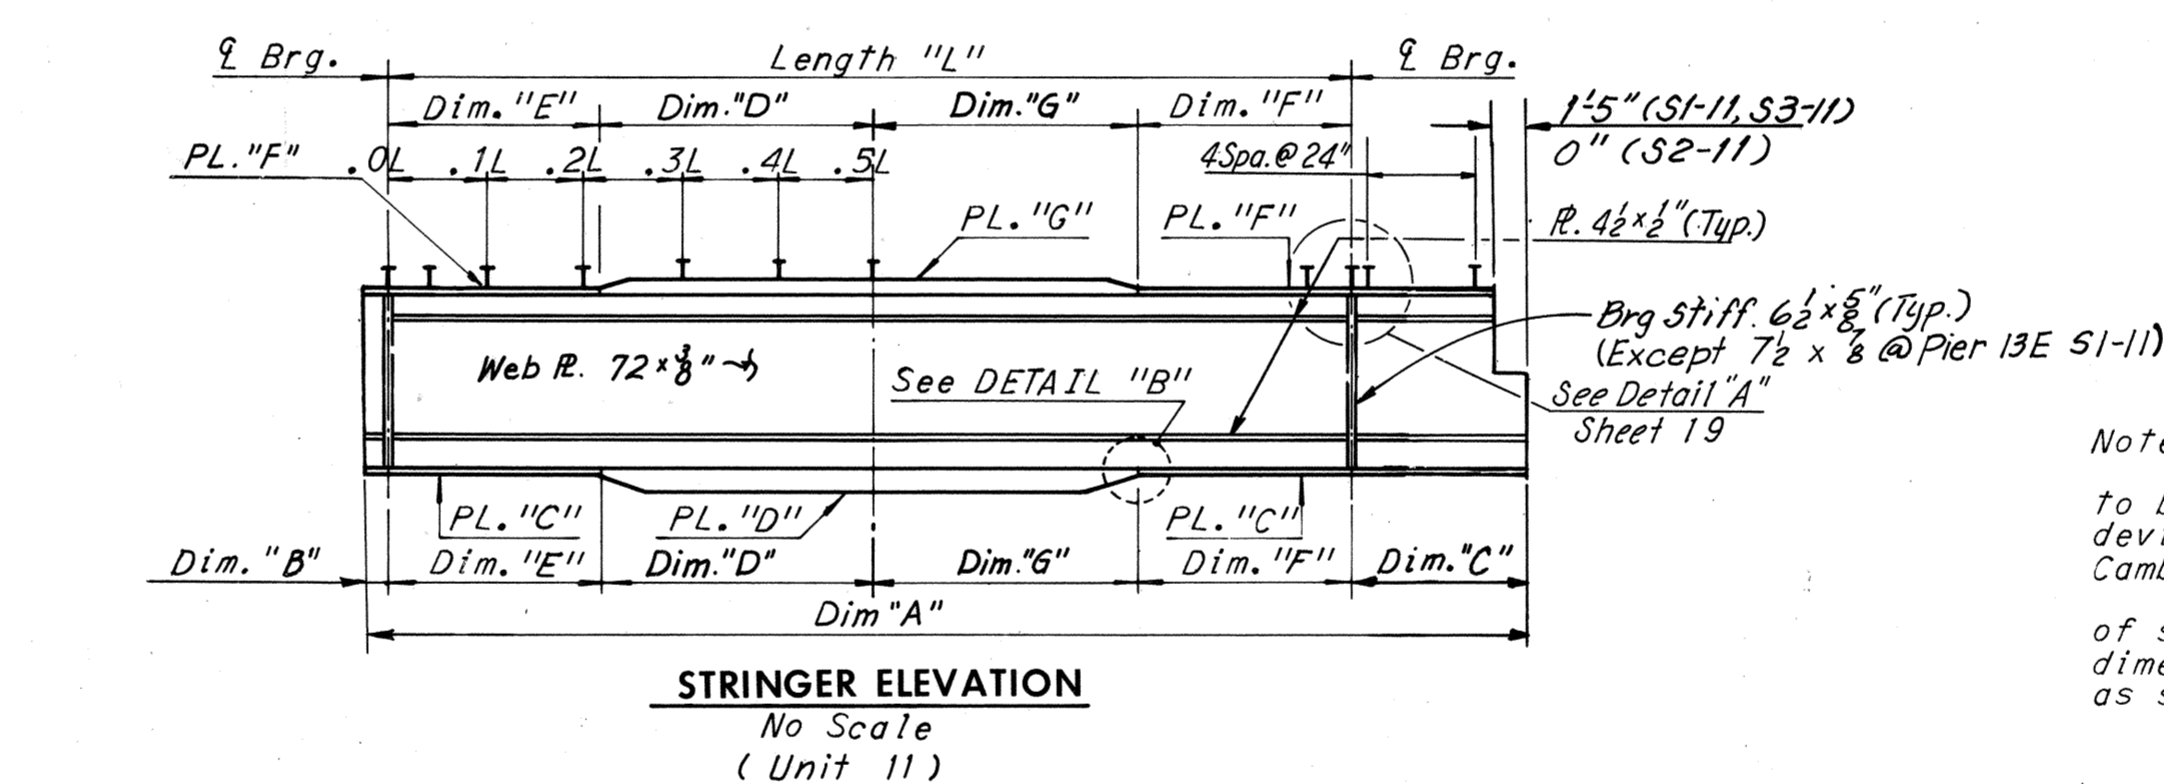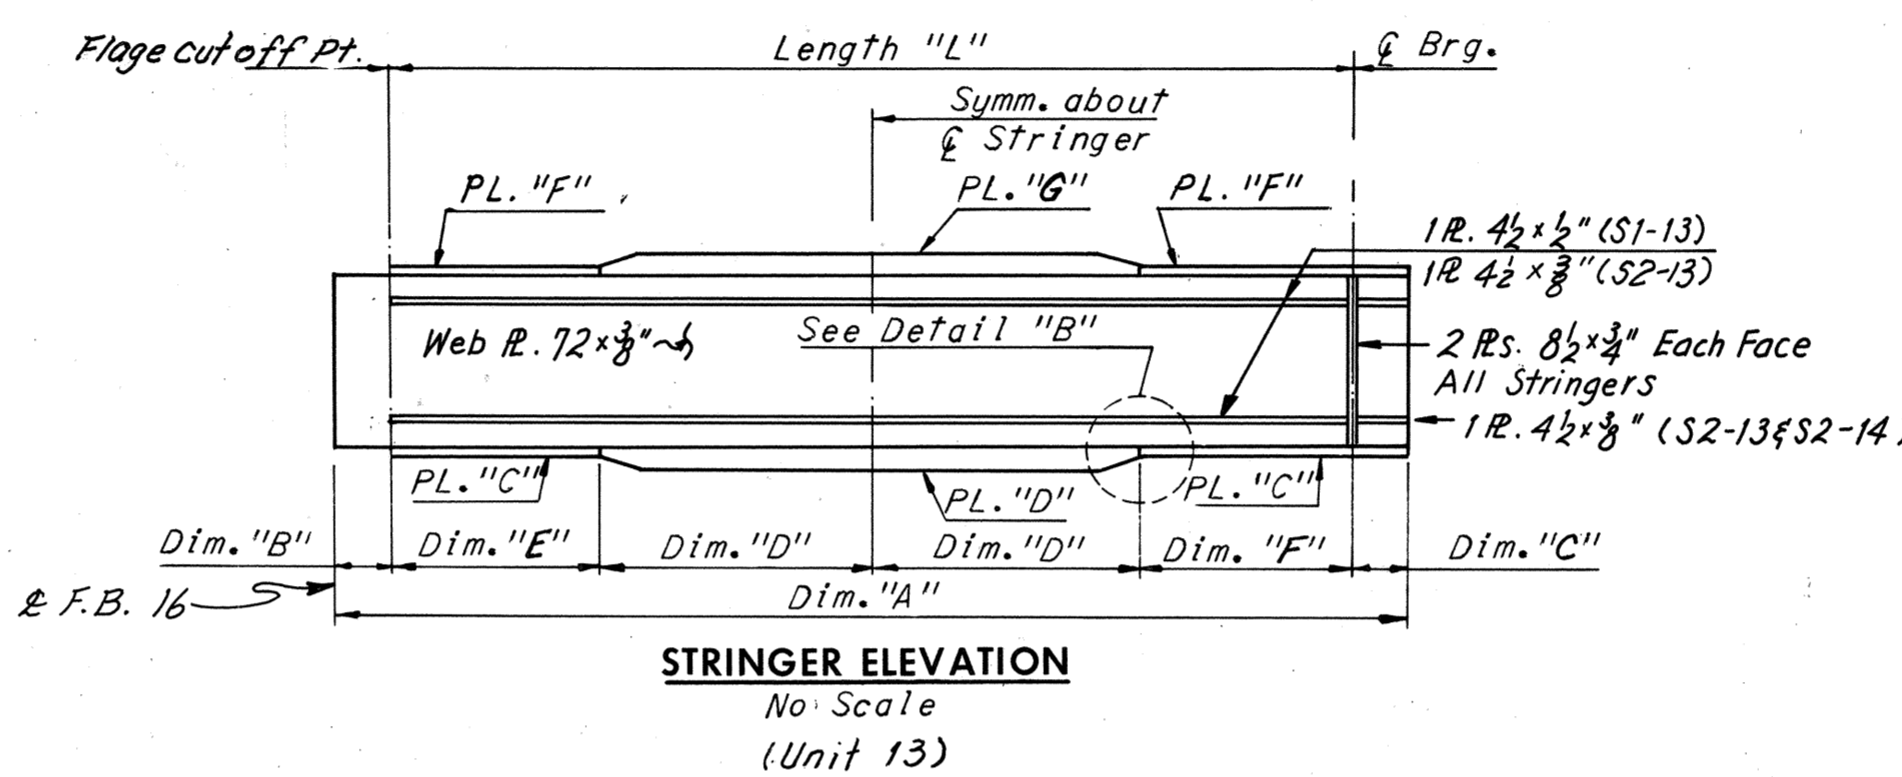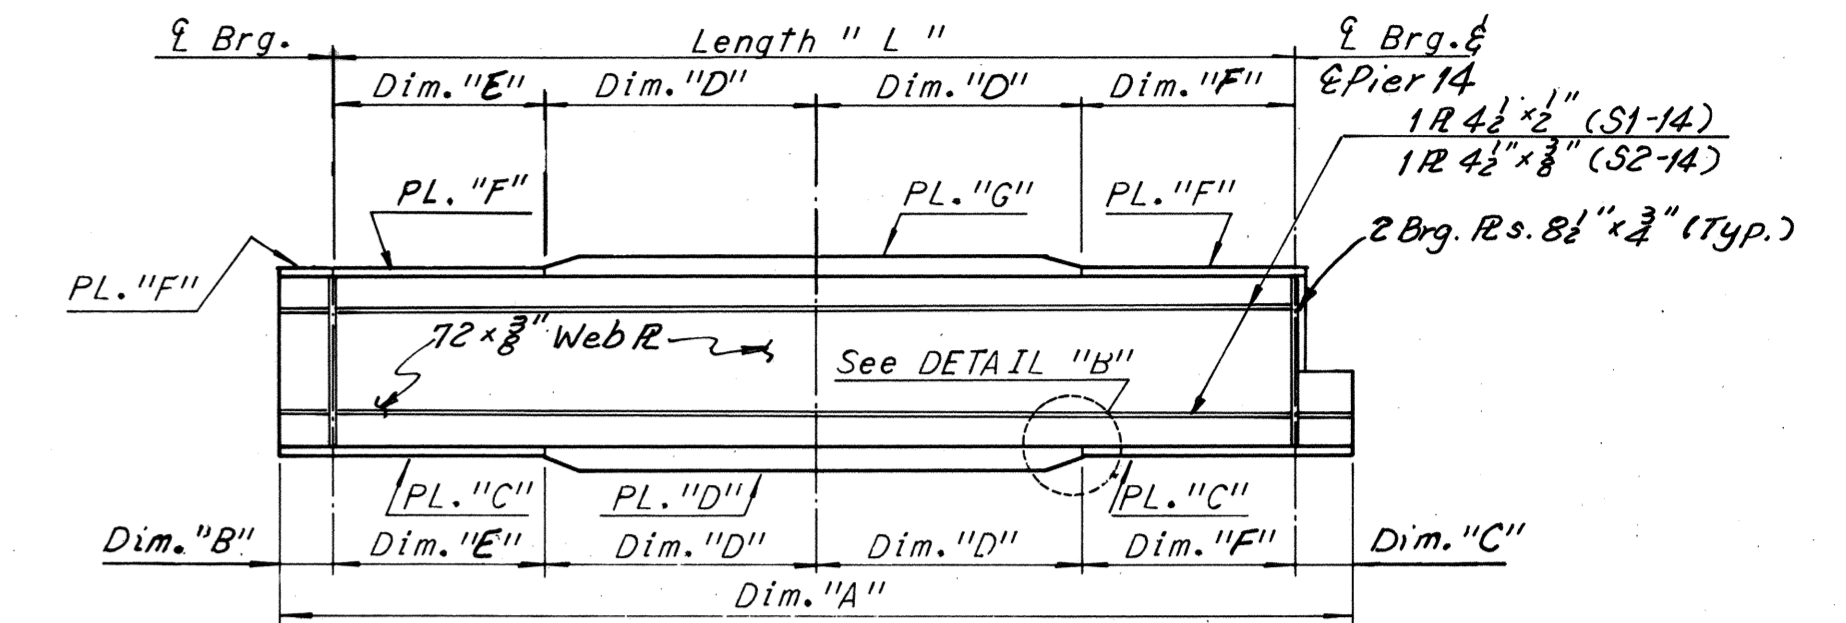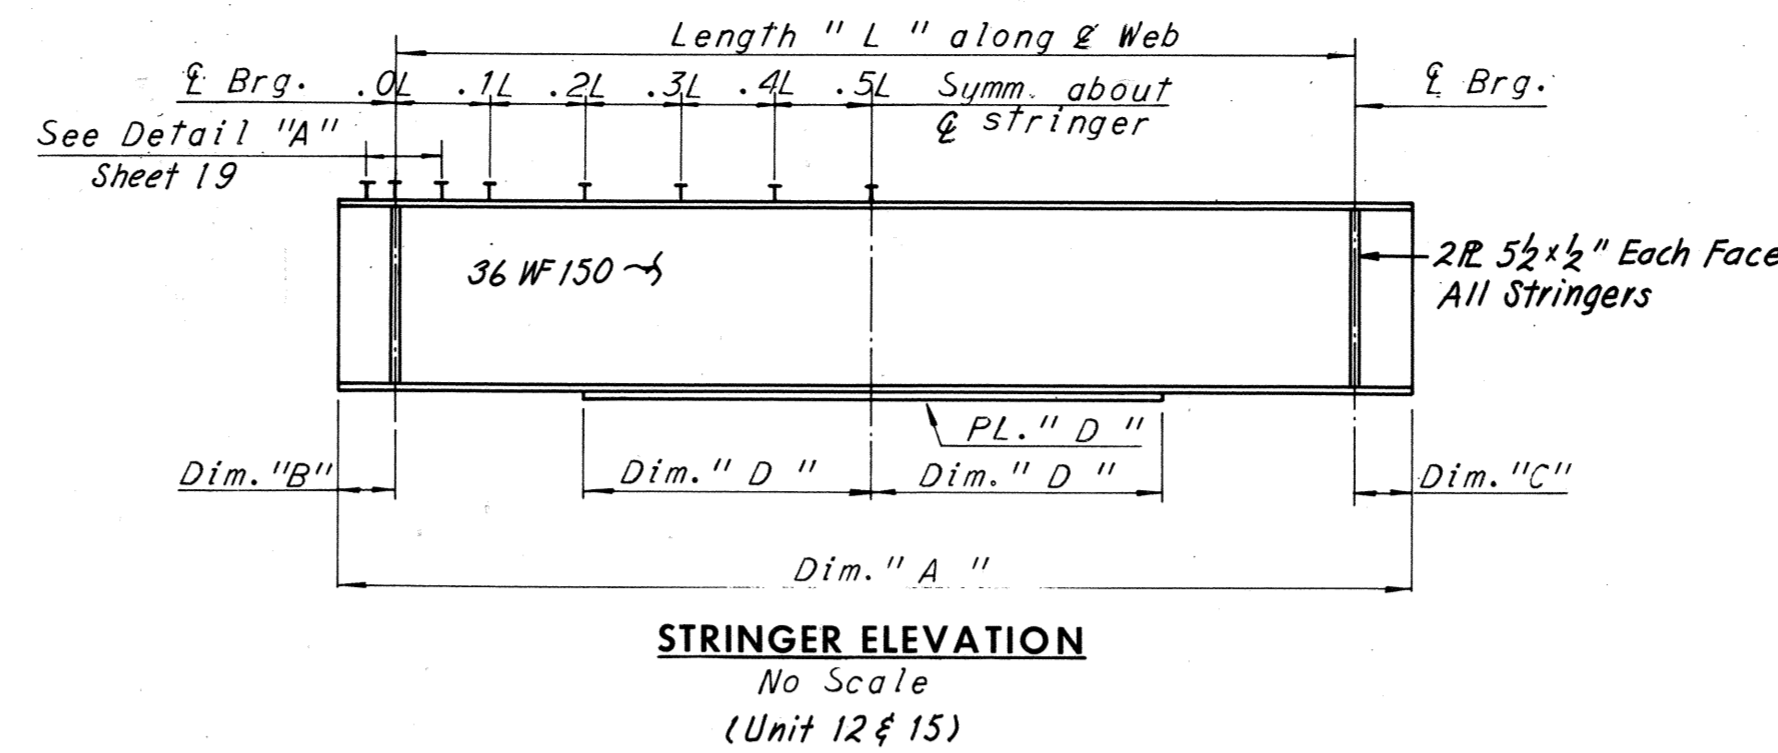

Note: Stringers having a total camber of less than 1" are not required to be shop cambered, but should be turned so that any mill tolerance deviation from straightness will be in the direction shown by the Camber Diagram.
 If stringers are not cambered, distance top of stringers to top of slab will vary along the stringer in accordance with the offset dimensions shown in the Camber Diagram, and with minimum distance as shown in cross-section on Sheet 35.

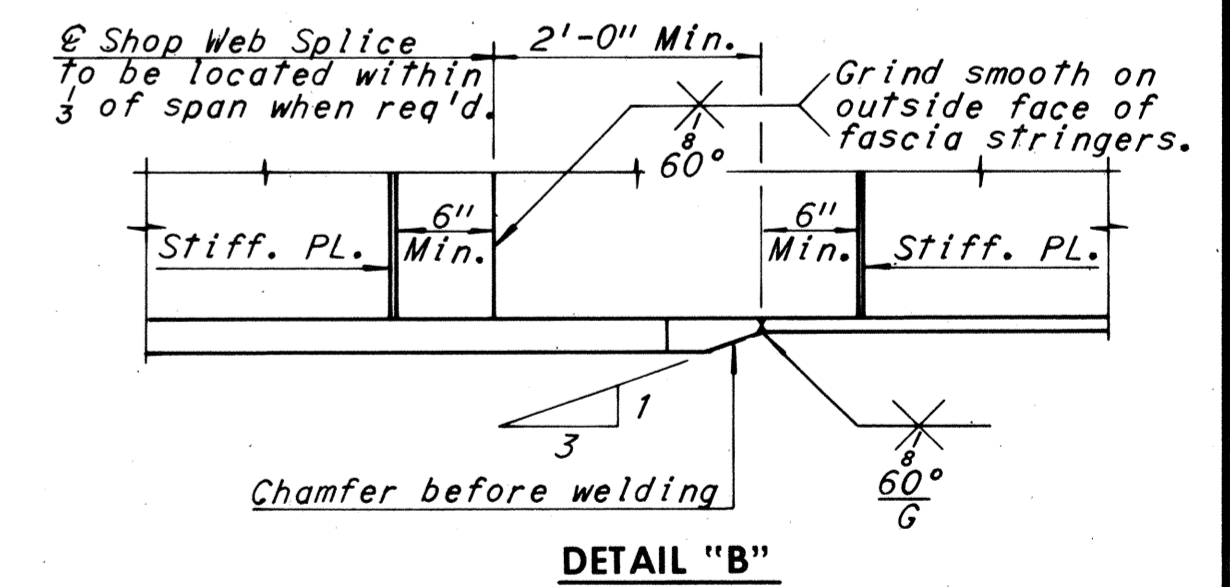

NOTE: Web to flange weld size see sheet 20.

UNIT	STRINGER	Dim. "A"	LENGTH "L"	Dim. "B"	Dim. "C"	Dim. "D"	Dim. "E"	Dim. "F"	Dim. "G"	PL. "C"	PL. "D"	PL. "F"	PL. "G"	MAX. SHEAR STUD SPACING					DEAD LOAD DEFLECTION SCHEDULE			CAMBER SCHEDULE				
														0.0L-0.1L*	0.1L-0.2L	0.2L-0.3L	0.3L-0.4L	0.4L-0.5L	1/4L	1/2L	3/4L	1/4L	1/2L	3/4L		
11	S1-11	138'-1 1/2"	126'-11"	7"	10'-7 1/2"	38'-0"	25'-5 1/2"	25'-5 1/2"	38'-0"	16'-1 3/8"	18 x 2"	12 x 1"	16 x 1"	17"	19"	24"	24"	24"	24"	24"	1 1/2	1 3/4	1 1/2	2 3/4	3 3/8	2 9/8
	S2-11	127'-3 3/8"	126'-1 1/2"	7"	7"	31'-6 1/2"	31'-6 1/2"	31'-6 1/2"	31'-6"	14 x 1 1/2"	16 x 2"	12 x 1"	12 x 1"	18"	20 1/2"	24"	24"	24"	24"	24"	1 1/2	2 1/2	1 1/2	2 1/2	4 3/8	3 3/8
	S3-11	136'-5 7/8"	125'-4 1/2"	7"	10'-6 3/8"	37'-8"	25'-0 3/8"	18'-6 3/8"	44'-2"	14 x 1"	14 x 2"	12 x 3/4"	12 x 1"	22"	24"	24"	24"	24"	24"	24"	1 3/8	2 1/8	1 1/2	2 5/8	4	2 1/2
12	S1-12	66'-9 1/2"	65'-6 1/2"	7"	8"	24'-0"	-	-	-	36W 150	10 1/2 x 3/4"	-	-	8"	9"	11"	12 1/2"	15"	15"	9/16	3/4	3/4	3/4	1	1 1/8	1 1/8
	S3-12	66'-5 1/2"	65'-0 1/2"	7"	10"	23'-9"	-	-	-	36W 150	10 1/2 x 3/4"	-	-	10"	11"	14 1/2"	17 1/2"	24"	24"	1 3/8	1 1/2	1 3/8	1 1/2	1 1/2	1 1/2	
	S1-13	118'-4 3/8"	116'-7 1/2"	11"	10 1/2"	37'-0"	21'-3 3/8"	21'-3 3/8"	-	-	18 x 1"	18 x 1 1/2"	18 x 1"	18 x 1 3/8"	-	-	-	-	-	1 3/8	1 3/8	1 3/8	1 3/8	1 3/8	1 3/8	1 3/8
13	S2-13	117'-4 1/2"	115'-6 3/8"	11"	10 1/2"	36'-0"	21'-9 3/8"	21'-9 3/8"	-	-	18 x 1"	18 x 1 1/2"	18 x 1"	18 x 1 1/2"	-	-	-	-	-	1 1/2	1 1/2	1 1/2	1 1/2	1 1/2	1 1/2	
	S1-14	110'-4 1/2"	108'-0 3/8"	10 1/2"	1'-5 3/8"	35'-0"	19'-0 3/8"	19'-0 3/8"	-	-	18 x 1"	18 x 1 1/2"	18 x 1"	18 x 1 1/2"	-	-	-	-	-	1	1 3/8	1	1 1/2	1 3/8	1 3/8	
	S2-14	109'-10 3/8"	107'-6 1/2"	10 1/2"	1'-5 3/8"	35'-0"	18'-9 1/4"	18'-9 1/4"	-	-	18 x 1"	18 x 1 1/2"	18 x 1"	18 x 1 1/2"	-	-	-	-	-	7/8	1 1/2	7/8	1 1/2	1 1/2	1 1/2	
14	S1-15	50'-1 1/2"	48'-11 3/8"	3 1/2"	10"	-	-	-	-	36W 150	-	-	-	-	-	-	-	-	-	5/8	7/8	5/8	3/4	1/2	3/8	
	S2-15	49'-8 1/2"	48'-9 3/8"	3 1/2"	8"	-	-	-	-	36W 150	-	-	-	-	-	-	-	-	-	5/8	3/8	5/8	5/8	1/2	5/8	

* Spacing begins at termination of 6 spaces @ 4".

NOTE: All steel shall be A36 unless otherwise shown. Longitudinal stiffeners of exterior stringer shall be located on the exterior face of the stringer.

BY	DATE	REVISION	DATE
MADE	K.C.P. 2-26-69	2 As Built	TEM 6-77
CHECKED	K.C.T. 4-28-69		
IN CHARGE	NO.	REVISION	BY DATE

AS BUILT


RICHMOND METROPOLITAN AUTHORITY
 RICHMOND EXPRESSWAY SYSTEM
 DOWNTOWN EXPRESSWAY

BRIDGE NO. 67
 RAMP W-N CONNECTION TO
 RICHMOND-PETERSBURG TURNPIKE
 FRAMING PLAN - UNITS 11,12,13,14 AND 15

HOWARD, NEEDLES, TAMMEN & BERGENDOFF
 consulting engineers
 NEW YORK ALEXANDRIA KANSAS CITY


SCALE: No Scale
 CONTRACT NO.: 10
 SHEET NO. 27 of 54

RICHMOND EXPRESSWAY SYSTEM			
SECTION	PROJECT	SHEET NO.	TOTAL SHEETS
10	DOWNTOWN EXPRESSWAY	200	265

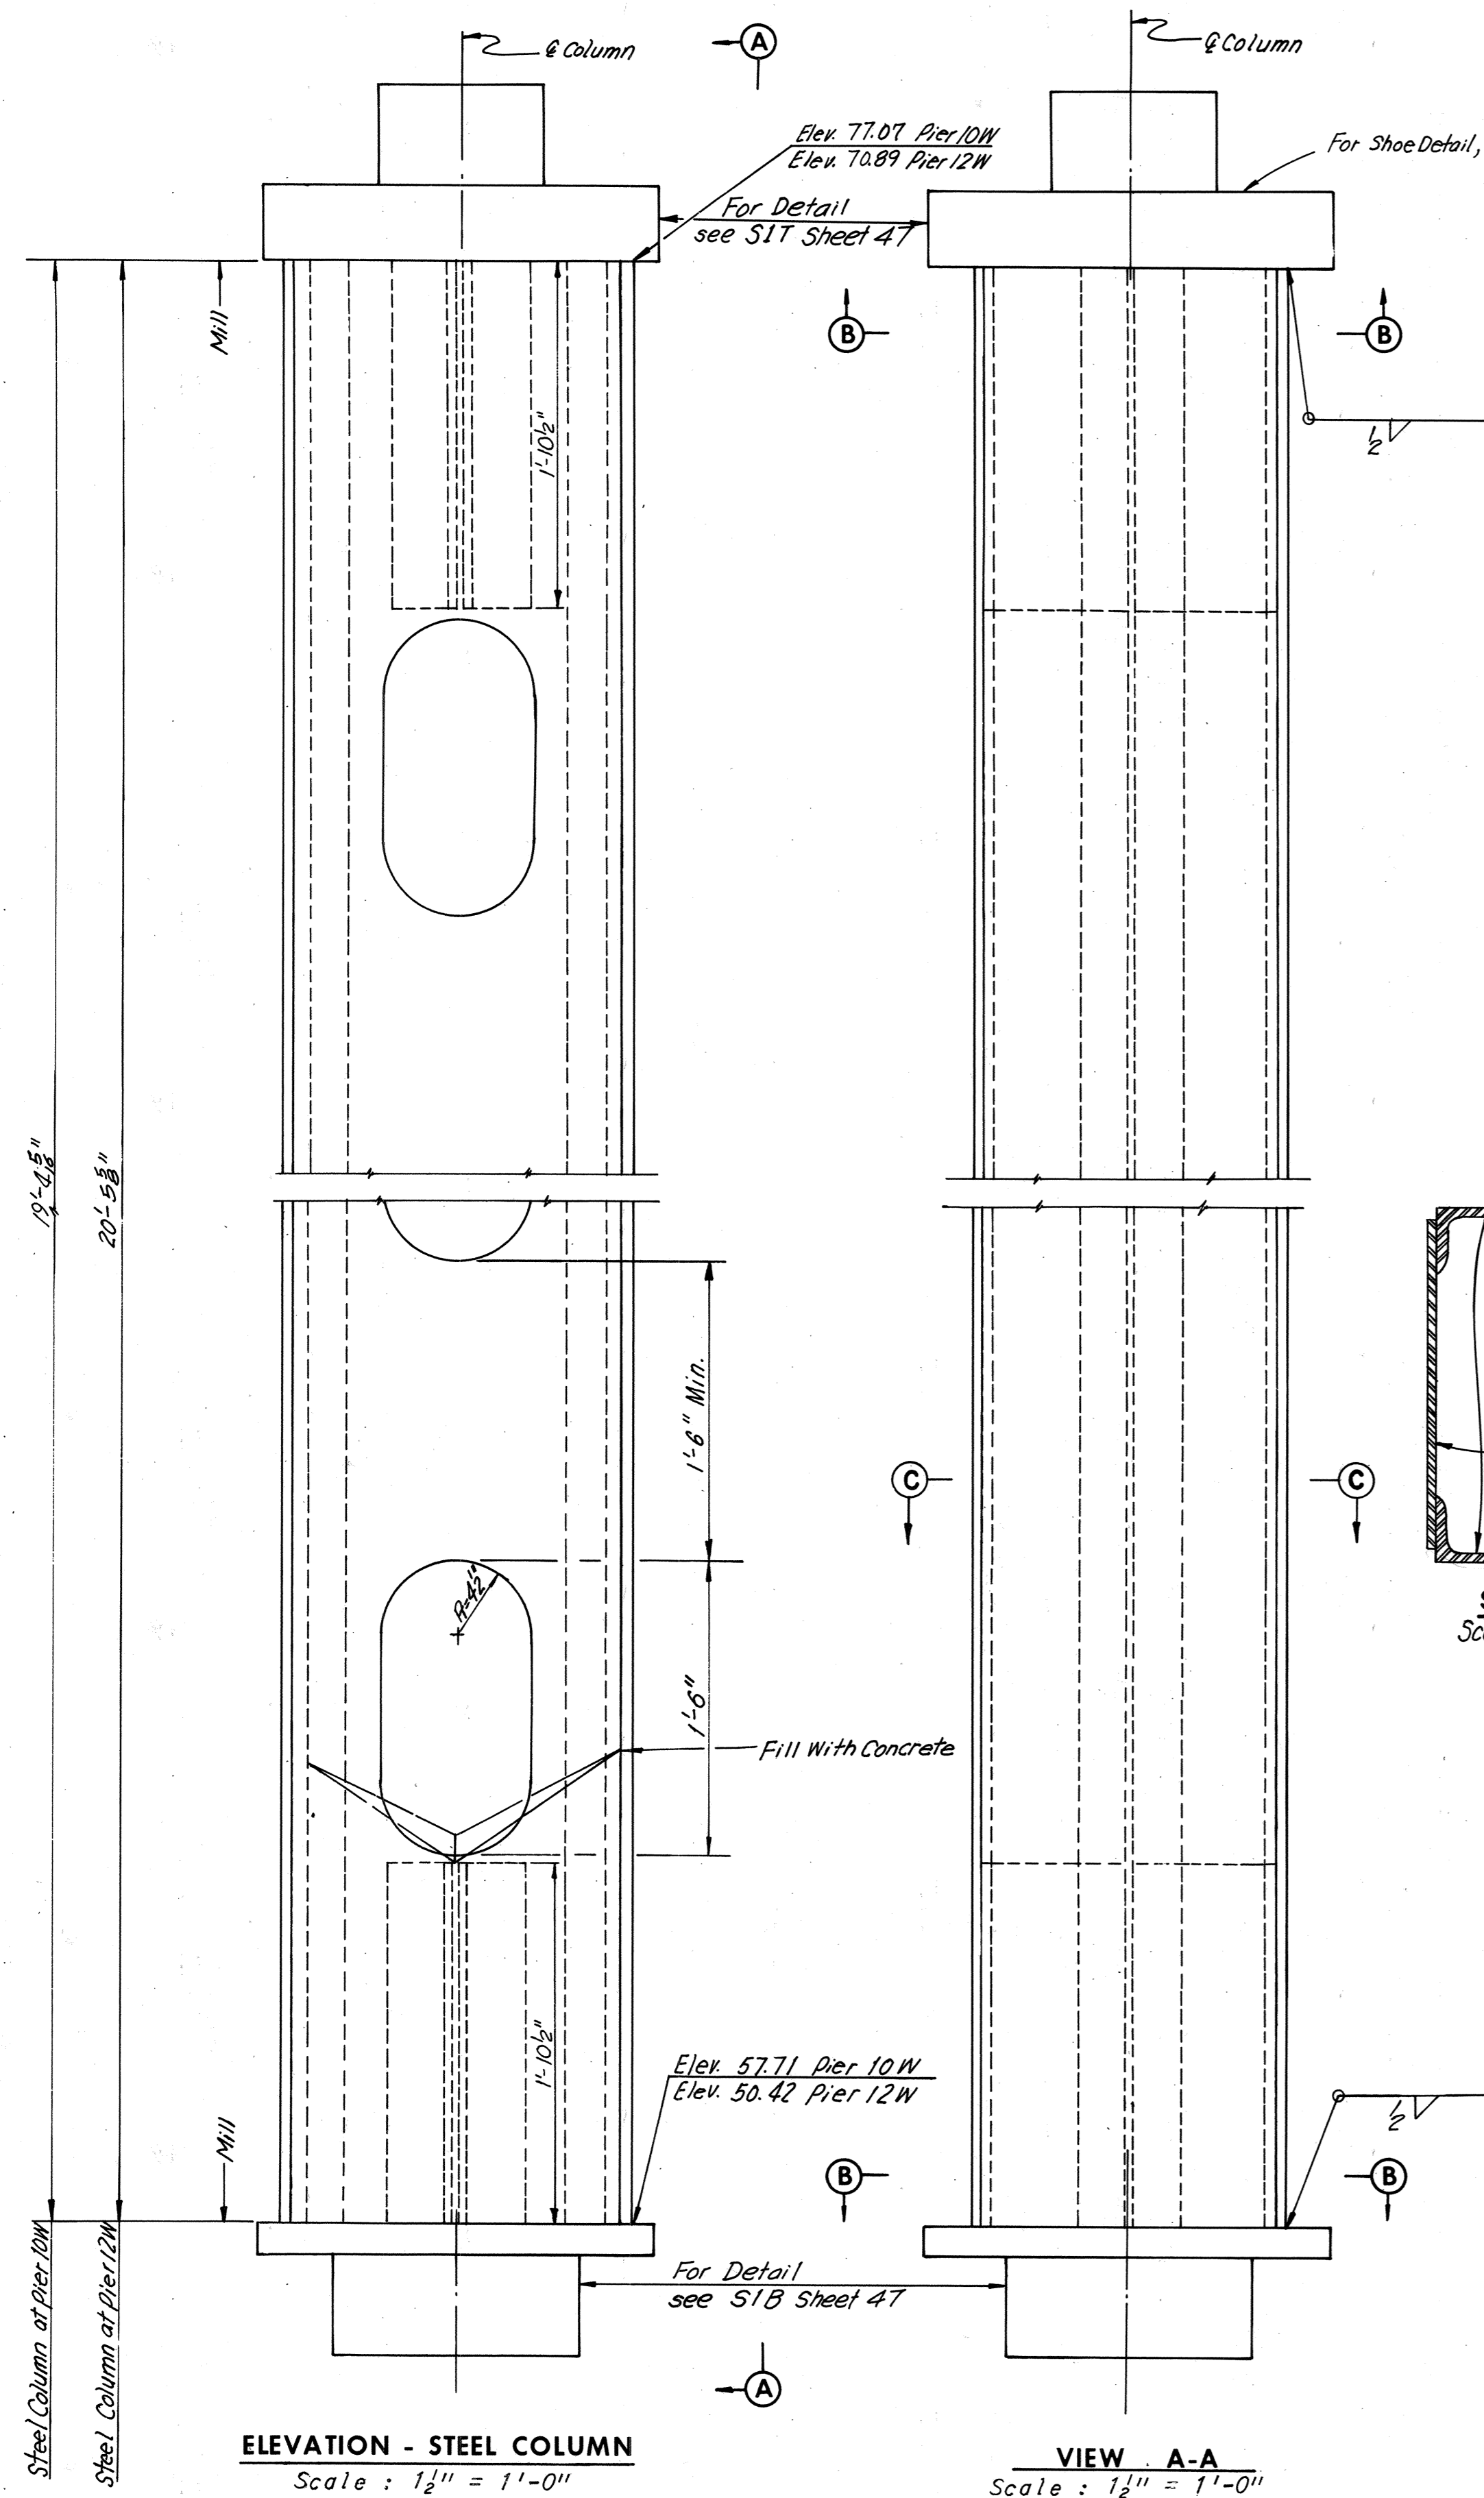


ELEVATION - STEEL COLUMN
Scale: 1/2" = 1'-0"


VIEW A-A
Scale: 1/2" = 1'-0"

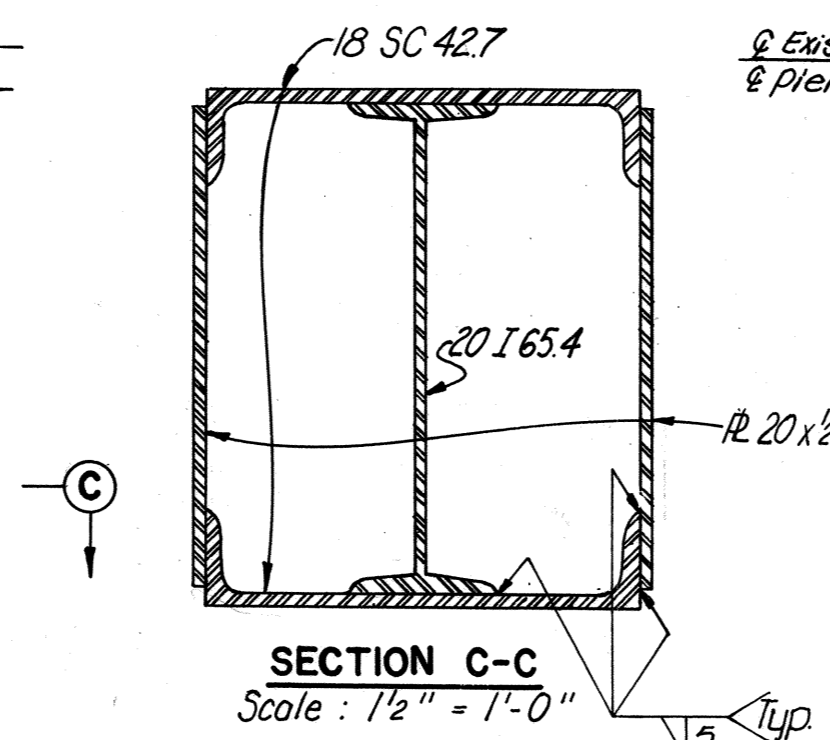


SECTION C-C
Scale: 1/2" = 1'-0"

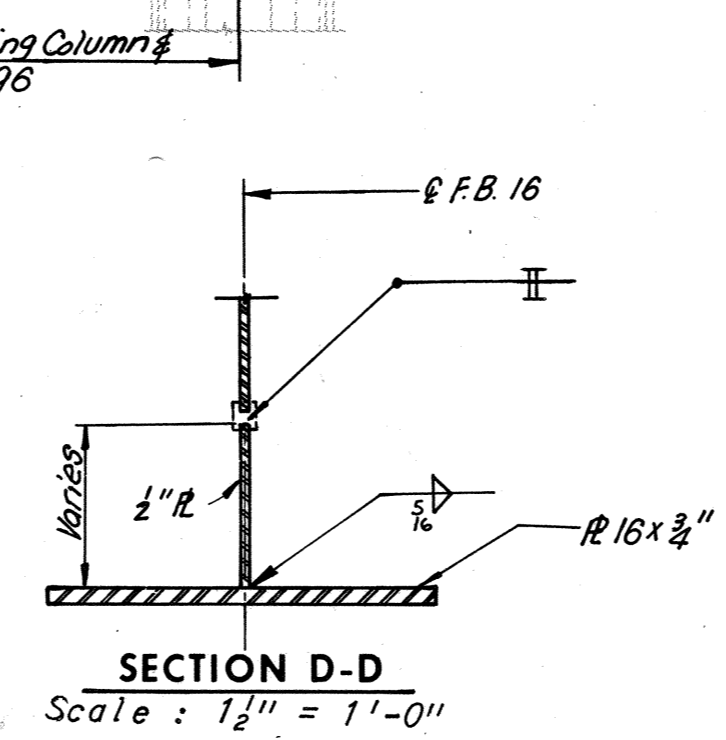


SECTION D-D
Scale: 1/2" = 1'-0"

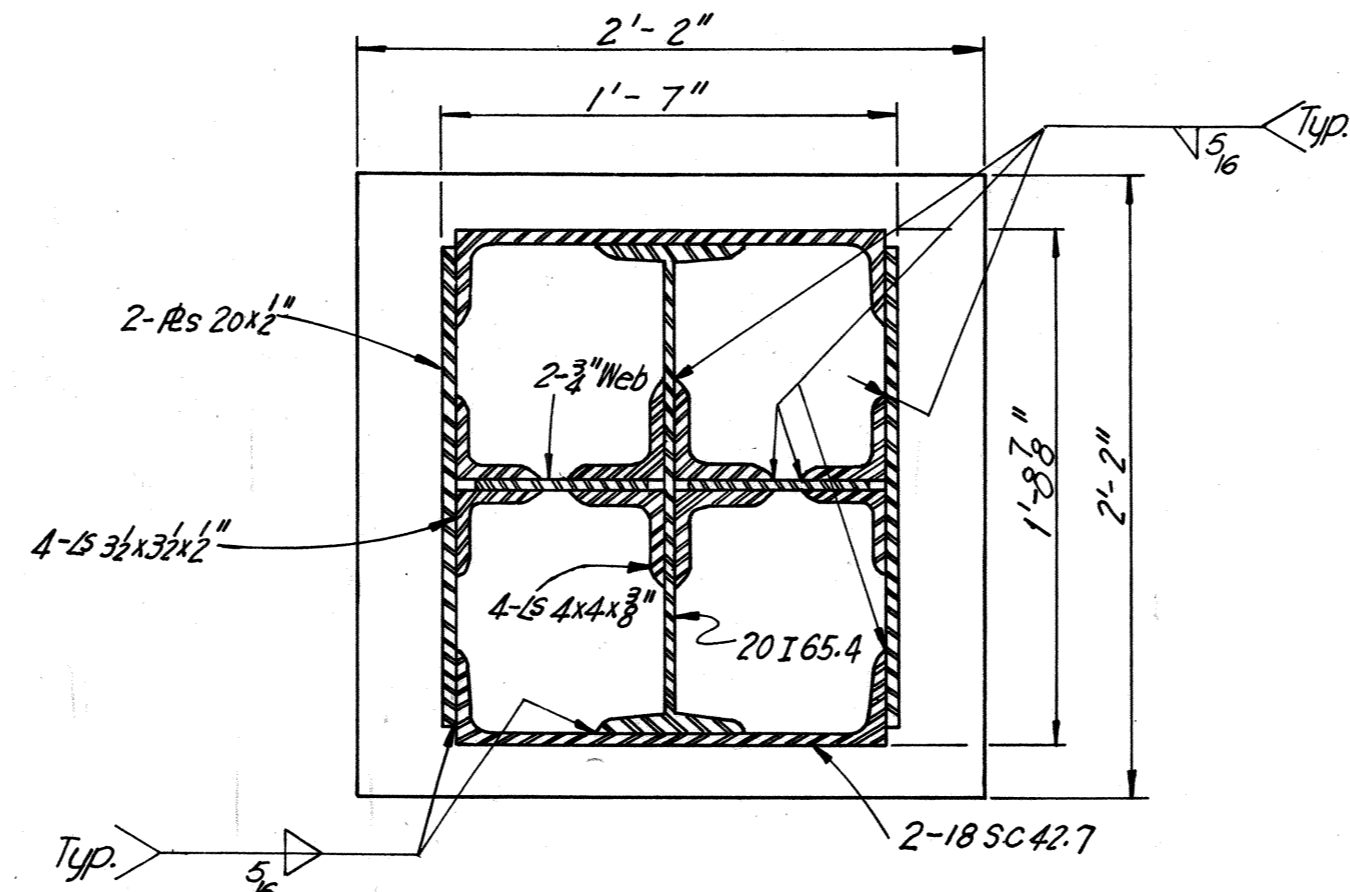


SECTION B-B
Scale: 1/2" = 1'-0"

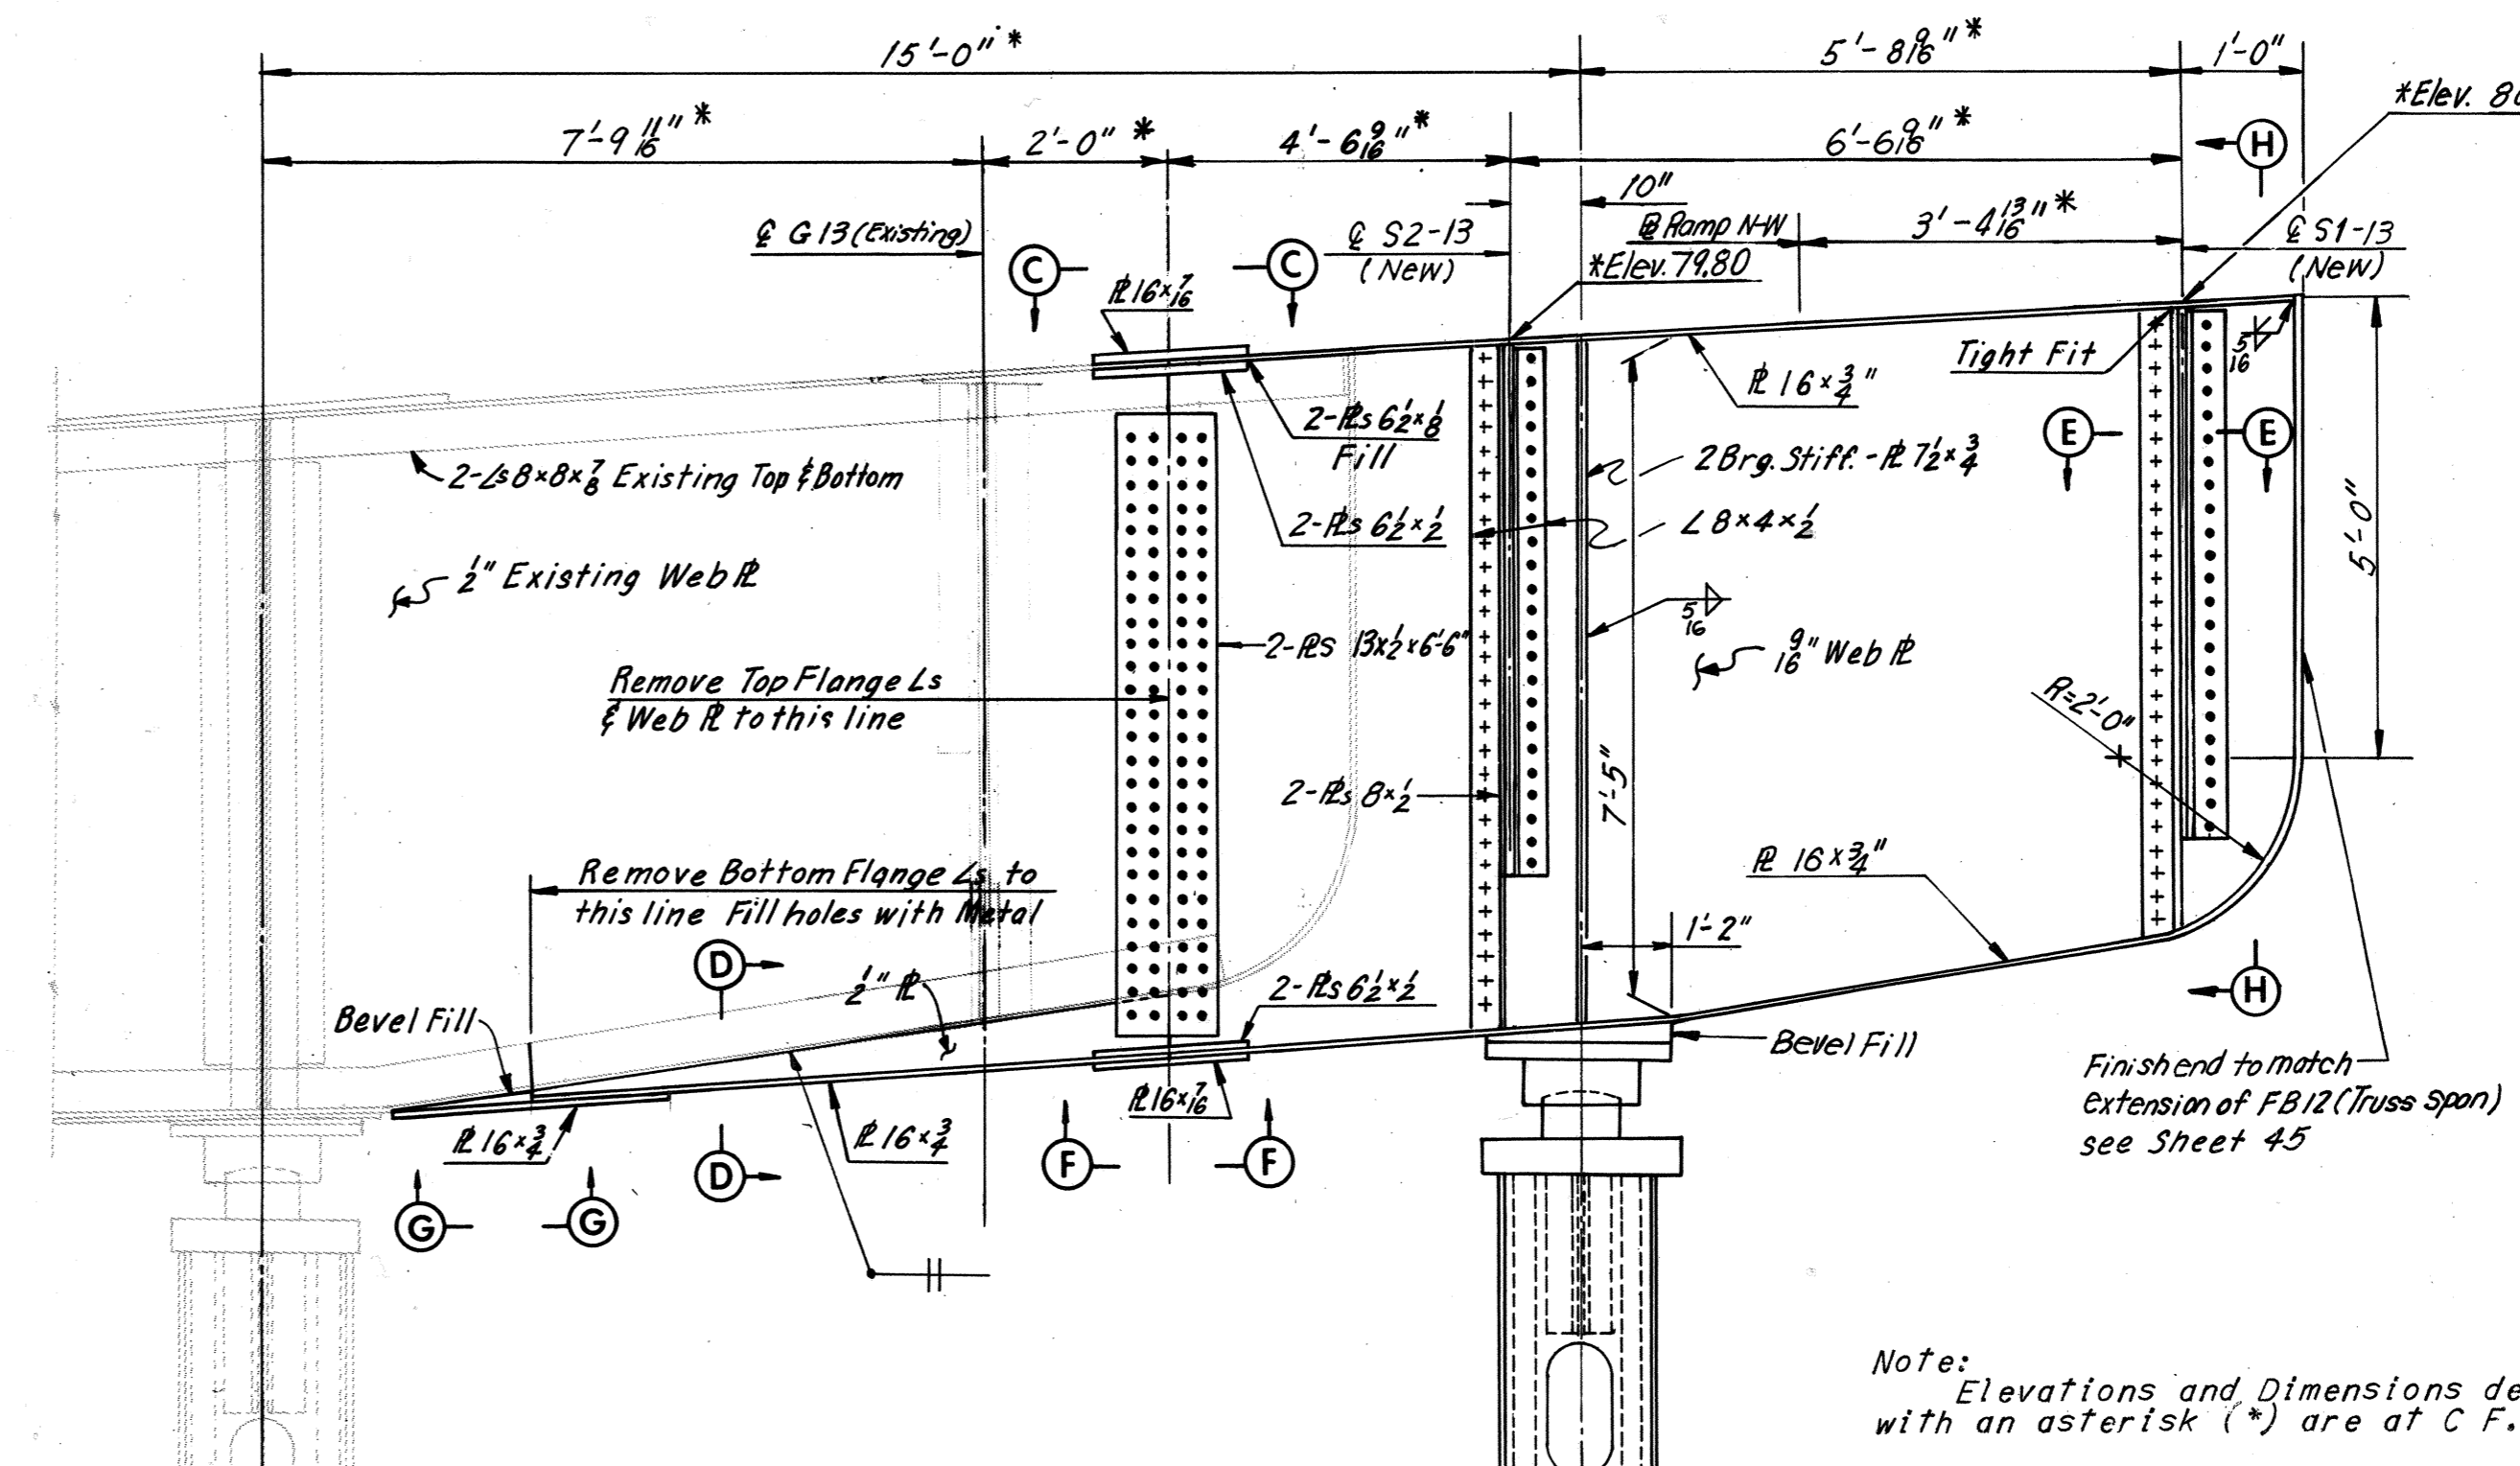


ELEVATION - FLOORBEAM 16
Scale: 1/2" = 1'-0"

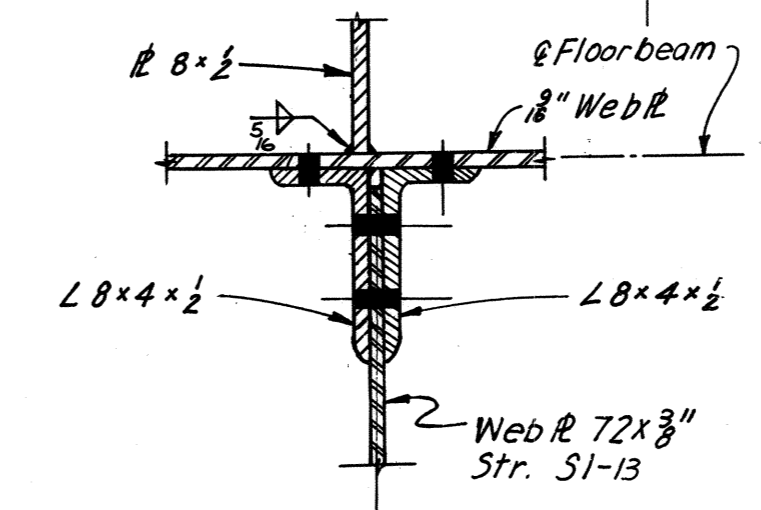


SECTION E-E
Scale: 1/2" = 1'-0"

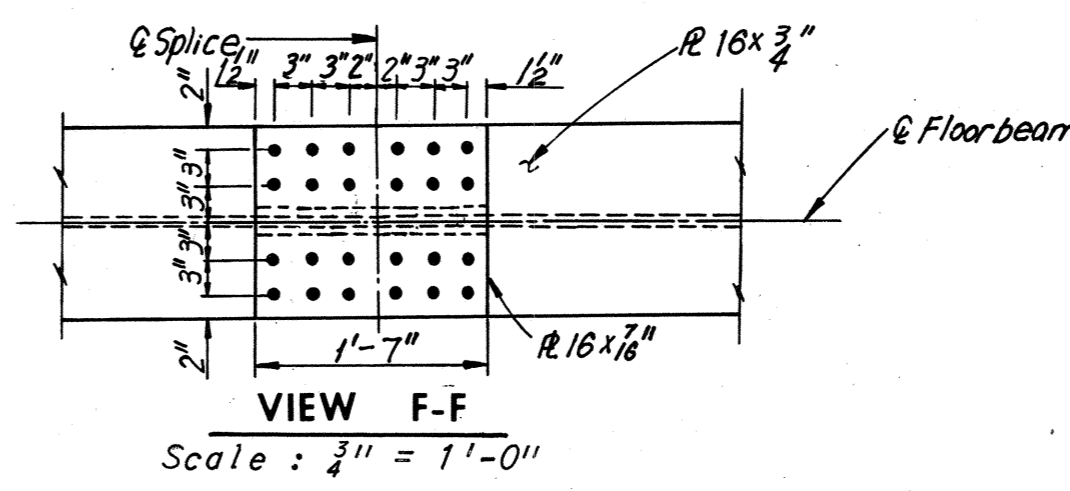

VIEW F-F
Scale: 3/4" = 1'-0"

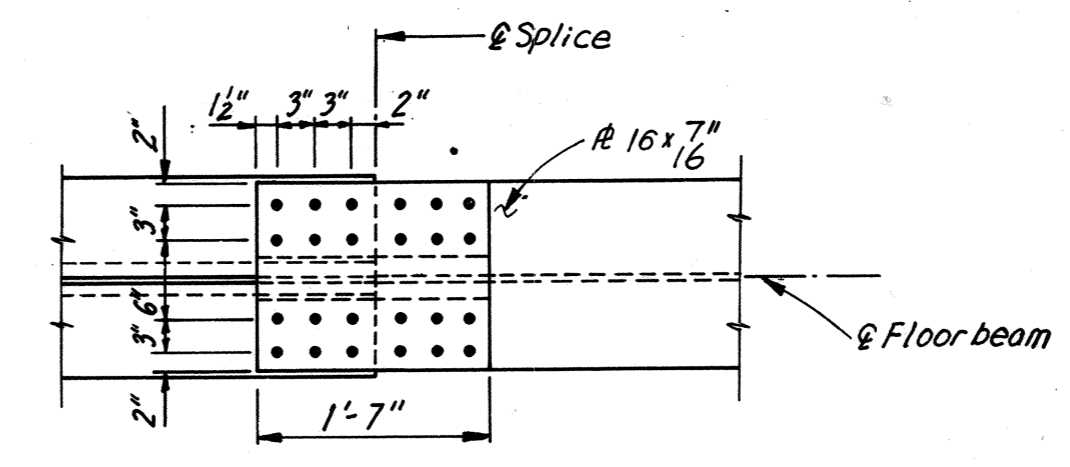

VIEW C-C
Scale: 3/4" = 1'-0"

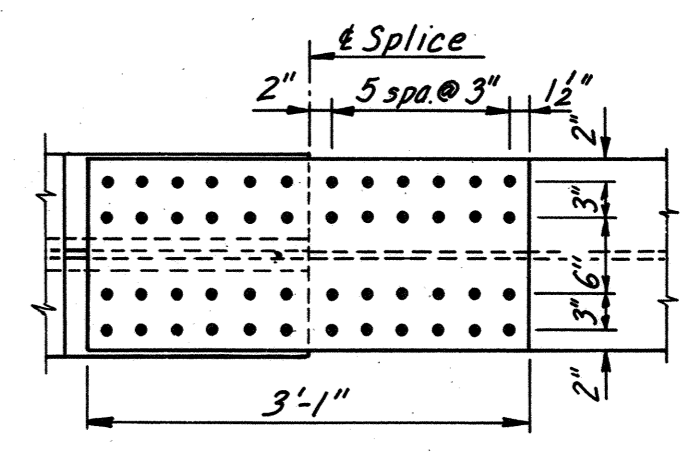

VIEW G-G
Scale: 3/4" = 1'-0"

Note: Elevations and Dimensions denoted with an asterisk (*) are at C.F.B. 16.

NO.	REVISION	BY	DATE
3	As Built	TEM	6-77
	Revised Elev.	RJF	1-24-75
	Bolts Deleted	T.E.M.	10-74
	Webbed Conn.		

RICHMOND METROPOLITAN AUTHORITY
RICHMOND EXPRESSWAY SYSTEM
DOWNTOWN EXPRESSWAY

BRIDGE NO. 67
RAMP W-N CONNECTION TO
RICHMOND-PETERSBURG TURNPIKE
FLOORBEAM 16 AND STEEL COLUMNS






HOWARD, NEEDLES, TAMMEN & BERGENDOFF
consulting engineers
NEW YORK ALEXANDRIA KANSAS CITY

SCALE: As Noted
CONTRACT NO.: 10
SHEET NO. 28 OF 54



AS BUILT

RICHMOND EXPRESSWAY SYSTEM			
SECTION	PROJECT	SHEET NO.	TOTAL SHEETS
'0	DOWNTOWN EXPRESSWAY	201	265

ELEVATION TABLE			
STATION	ELEV. A	ELEV. B	ELEV. C
343+80.00	92.86	93.07	94.36
90.00	92.66	92.87	94.16
90.43	92.65	92.86	94.15
91.86	92.61	92.82	94.11
344+00.00	92.40	92.61	93.90
10.00	92.09	92.30	93.59
20.00	91.73	91.94	93.28
30.00	91.32	91.53	92.82
40.00	90.86	91.07	92.36
50.00	90.34	90.55	91.84
60.00	89.79	90.00	91.29
70.00	89.26	89.47	90.76
80.00	88.72	88.93	90.22
90.00	88.14	88.35	89.64
345+00.00	87.55	87.76	89.05
04.50	87.28	87.49	88.72
10.00	86.94	87.15	88.44
20.00	86.35	86.56	87.85
30.00	85.75	85.96	87.25
40.00	85.17	85.38	86.67
50.00	84.58	84.79	86.08
60.00	84.02	84.23	85.52
70.00	83.46	83.67	84.96
80.00	82.90	83.11	84.40
90.00	82.34	82.55	83.84
346+00.00	81.78	81.99	83.28
10.00	81.22	81.43	82.72
15.00	80.94	81.15	82.44
20.00	80.66	80.87	82.16

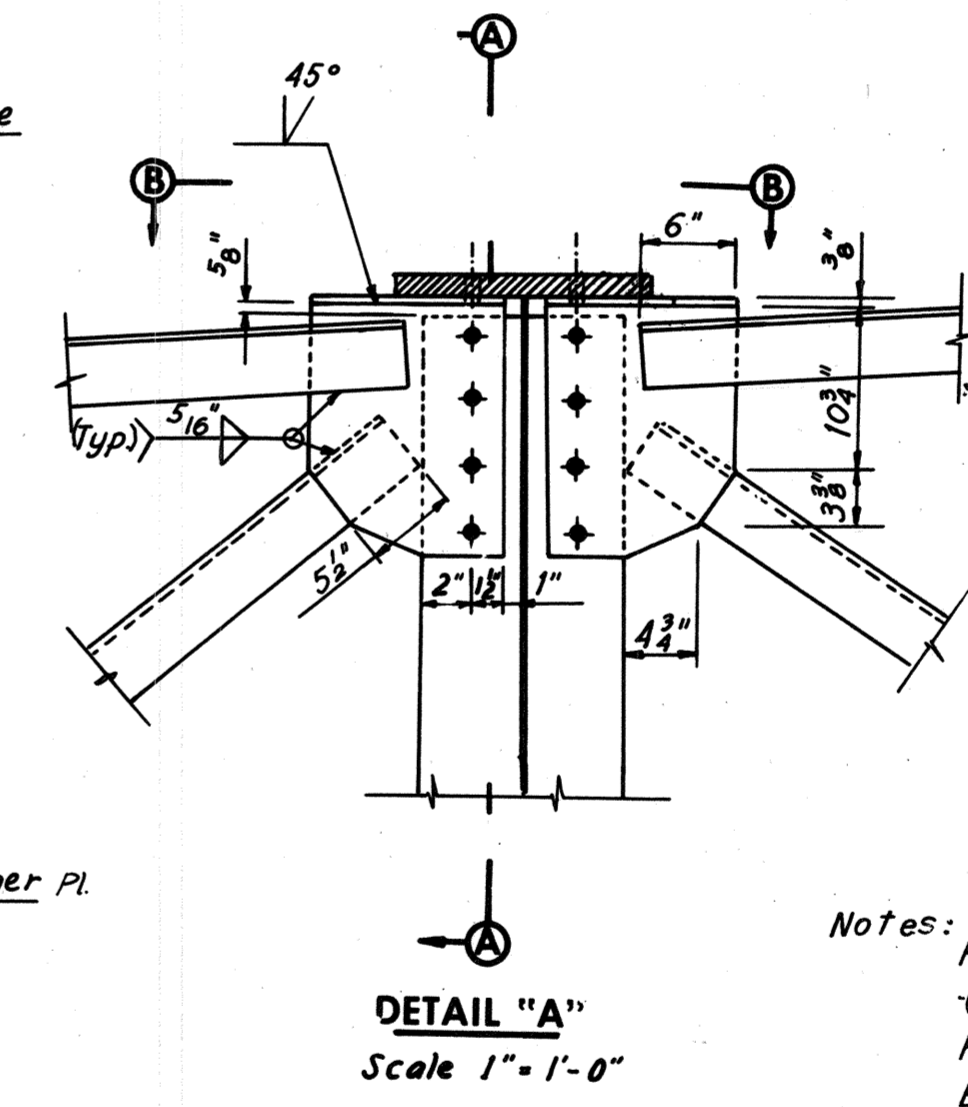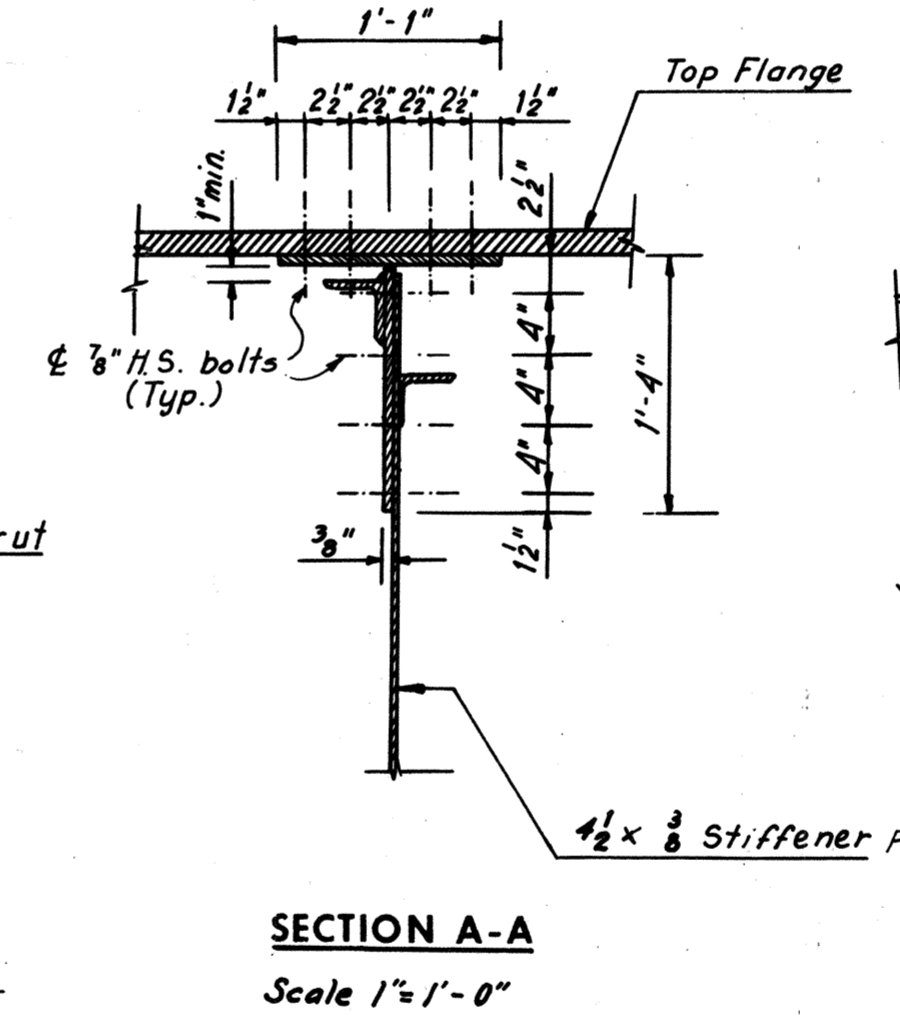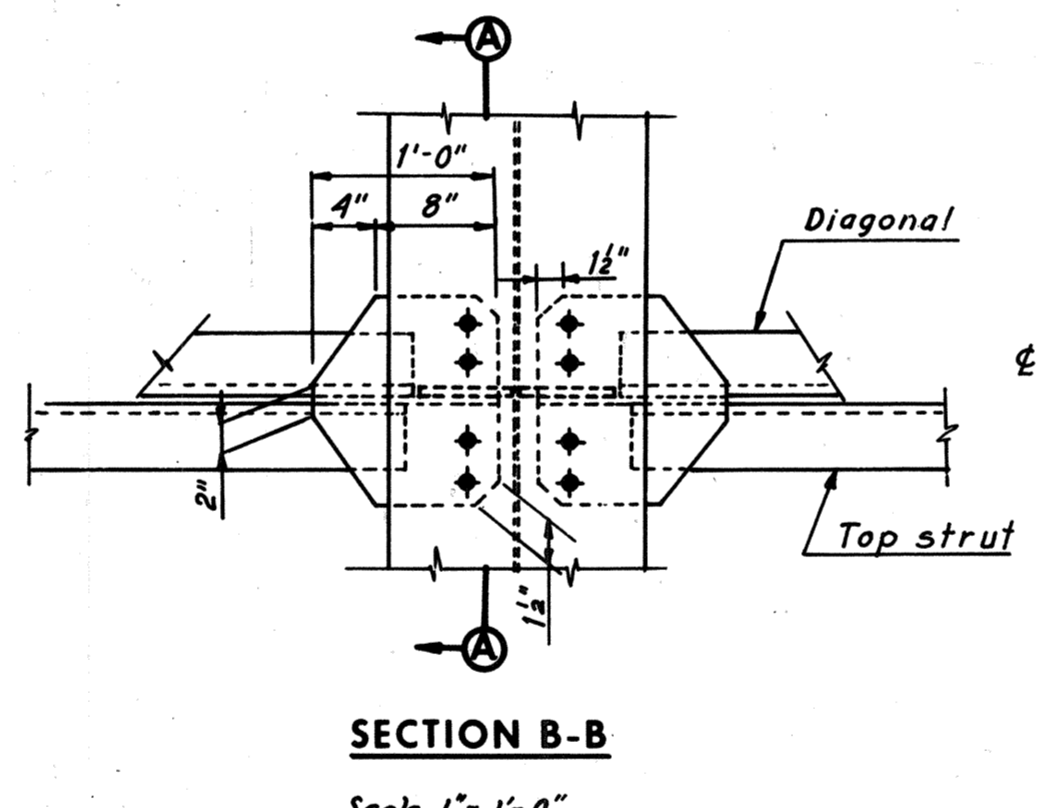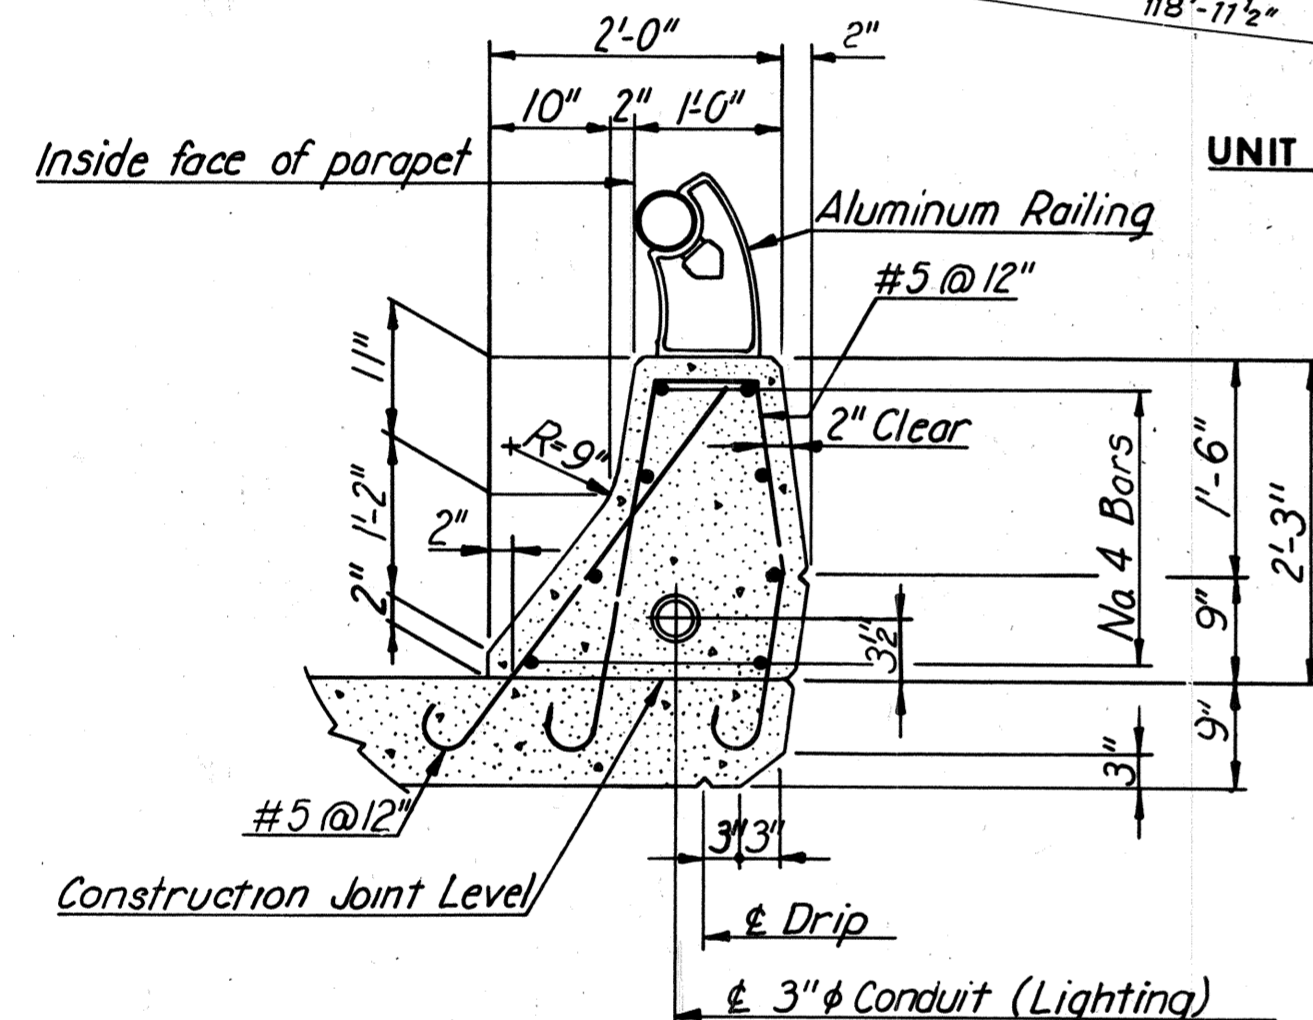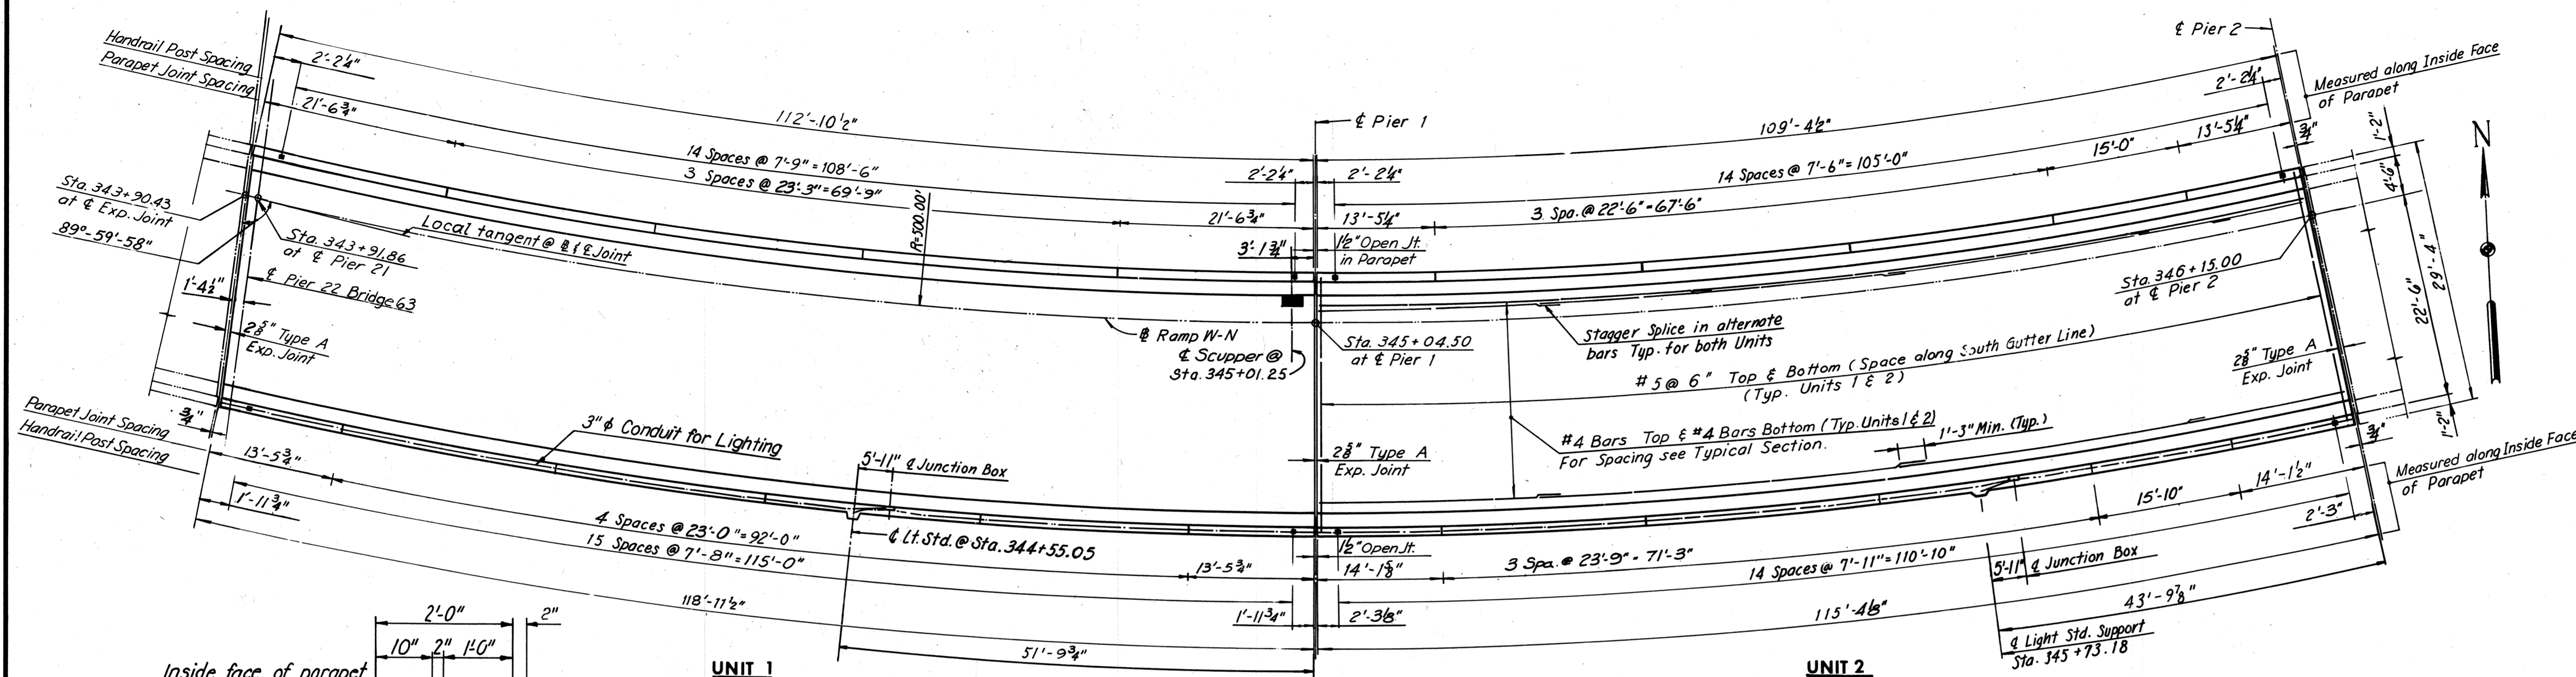

Notes:
For Layout of Pier 21 see Sheet 2 of Bridge #65 (Ramp S-W).
For Framing Details of Pier 21 see Sheet 20 of Bridge #66 (E.B. Roadway).
Piers 1 and 2 both are radial to @ Ramp N-W (Curve NW-1)
For intermediate diaphragm and transverse stiffener spacing see Sheet 19.
For Handrail Details see Sheet 53.
For Lighting Details see Sheet 54.
For Standard Drainage Details see Support Type 3 Sheet 56.
For Joint Details see Sheet 48.

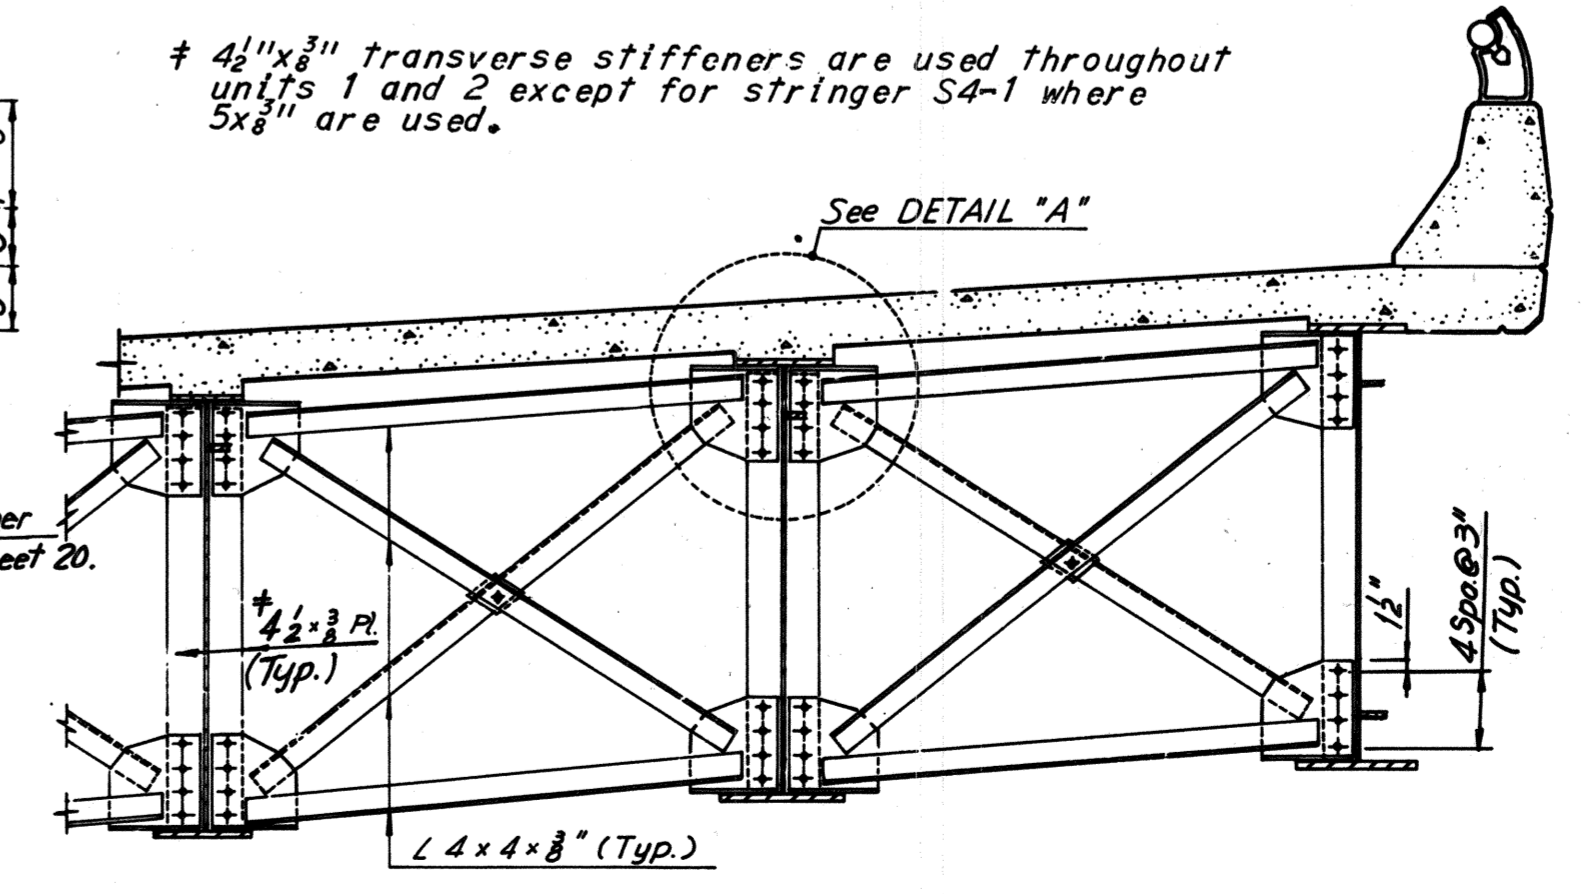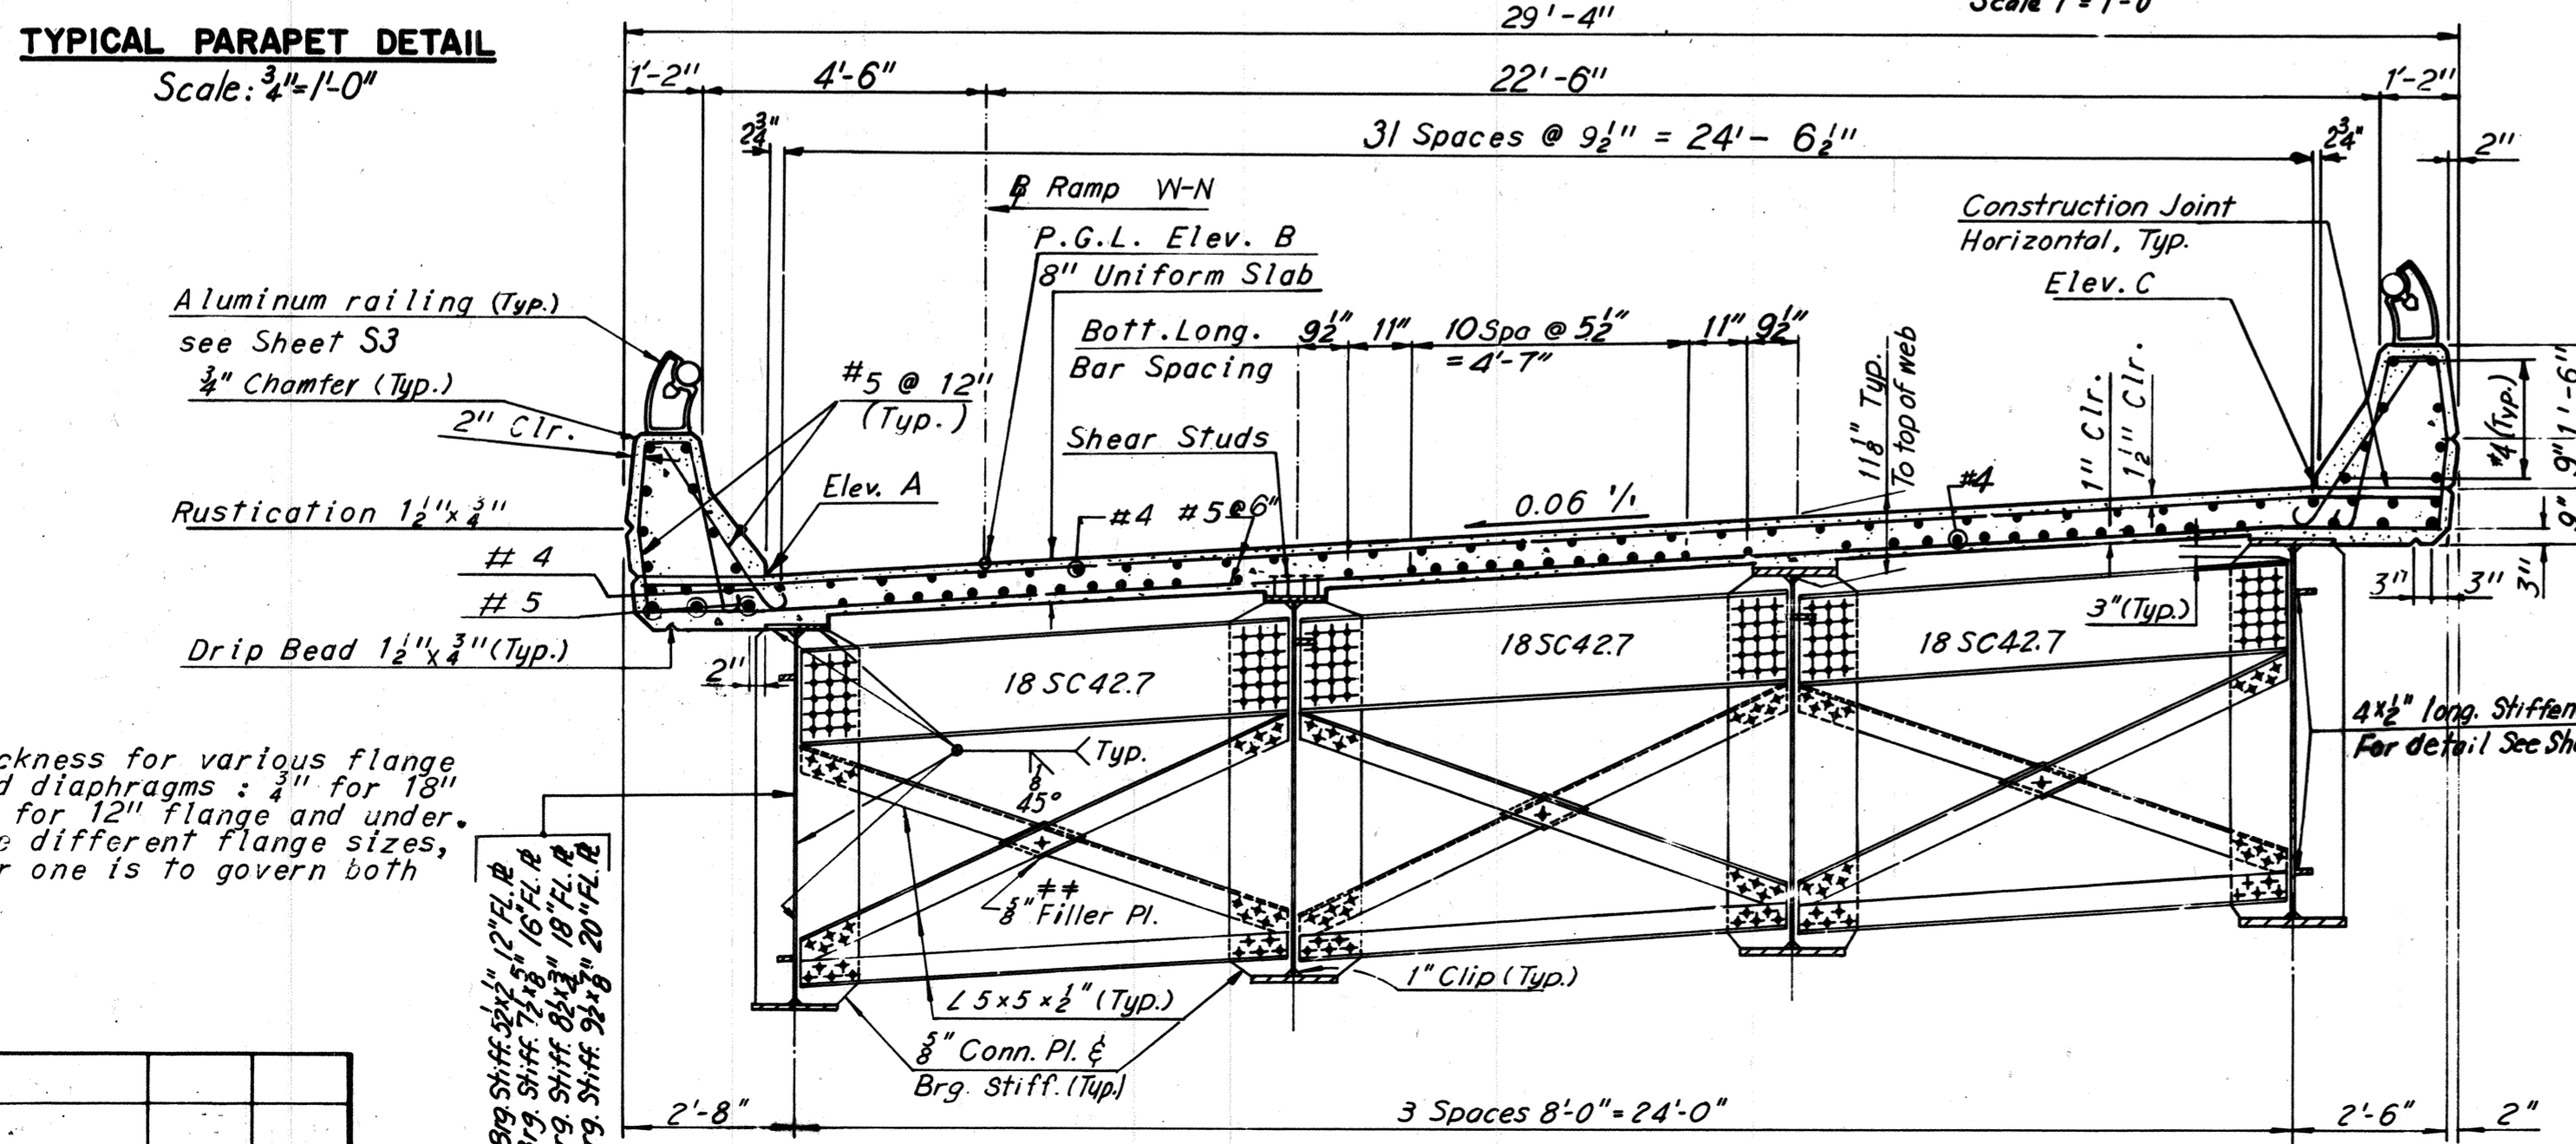

** The following conn. & thickness for various flange sizes shall be used at end diaphragms: 3/4" for 18" flange, 5/8" for 15" and 2" for 12" flange and under. In bays where girders have different flange sizes, the conn. & for the bigger one is to govern both conn. &'s.

BY	DATE				
MADE	M.H.H. 8-17-68				
CHECKED	S.C.C. 11-4-68	As Built	TEM	G-77	
IN CHARGE					

RICHMOND METROPOLITAN AUTHORITY
RICHMOND EXPRESSWAY SYSTEM
DOWNTOWN EXPRESSWAY

BRIDGE NO. 67
RAMP W-N CONNECTION TO
RICHMOND-PETERSBURG TURNPIKE
DECK PLAN - UNITS 1 AND 2


HOWARD, NEEDLES, TAMMEN & BERGENDOFF
consulting engineers
NEW YORK ALEXANDRIA KANSAS CITY

SCALE: As Noted
CONTRACT NO.: 10
SHEET NO. 29 OF 54

AS BUILT

RICHMOND EXPRESSWAY SYSTEM			
SECTION	PROJECT	SHEET NO.	TOTAL SHEETS
10	DOWNTOWN EXPRESSWAY	202	265

ELEVATION TABLE			
STATION	ELEV. A	ELEV. B	ELEV. C
346+10.00	81.22	81.43	82.72
+15.00	80.94	81.15	82.44
+20.00	80.66	80.87	82.16
+30.00	80.10	80.31	81.60
+40.00	79.54	79.75	81.04
+50.00	78.98	79.19	80.48
+60.00	78.42	78.63	79.92
+70.00	77.86	78.07	79.36
+80.00	77.30	77.51	78.80
347+00.00	76.18	76.39	77.68
+10.00	75.64	75.85	77.14
+20.00	75.15	75.36	76.65
+25.50	74.89	75.10	76.39
+30.00	74.69	74.90	76.19
+40.00	74.29	74.50	75.79
+50.00	73.92	74.13	75.42
+60.00	73.60	73.81	75.10
+70.00	73.32	73.53	74.82
+80.00	73.08	73.29	74.58
+90.00	72.89	73.10	74.39
348+00.00	72.74	72.95	74.24
+10.00	72.63	72.84	74.13
+20.00	72.57	72.78	74.07
+30.00	72.55	72.76	74.05
+33.00	72.55	72.76	74.05
+40.00	72.57	72.78	74.07

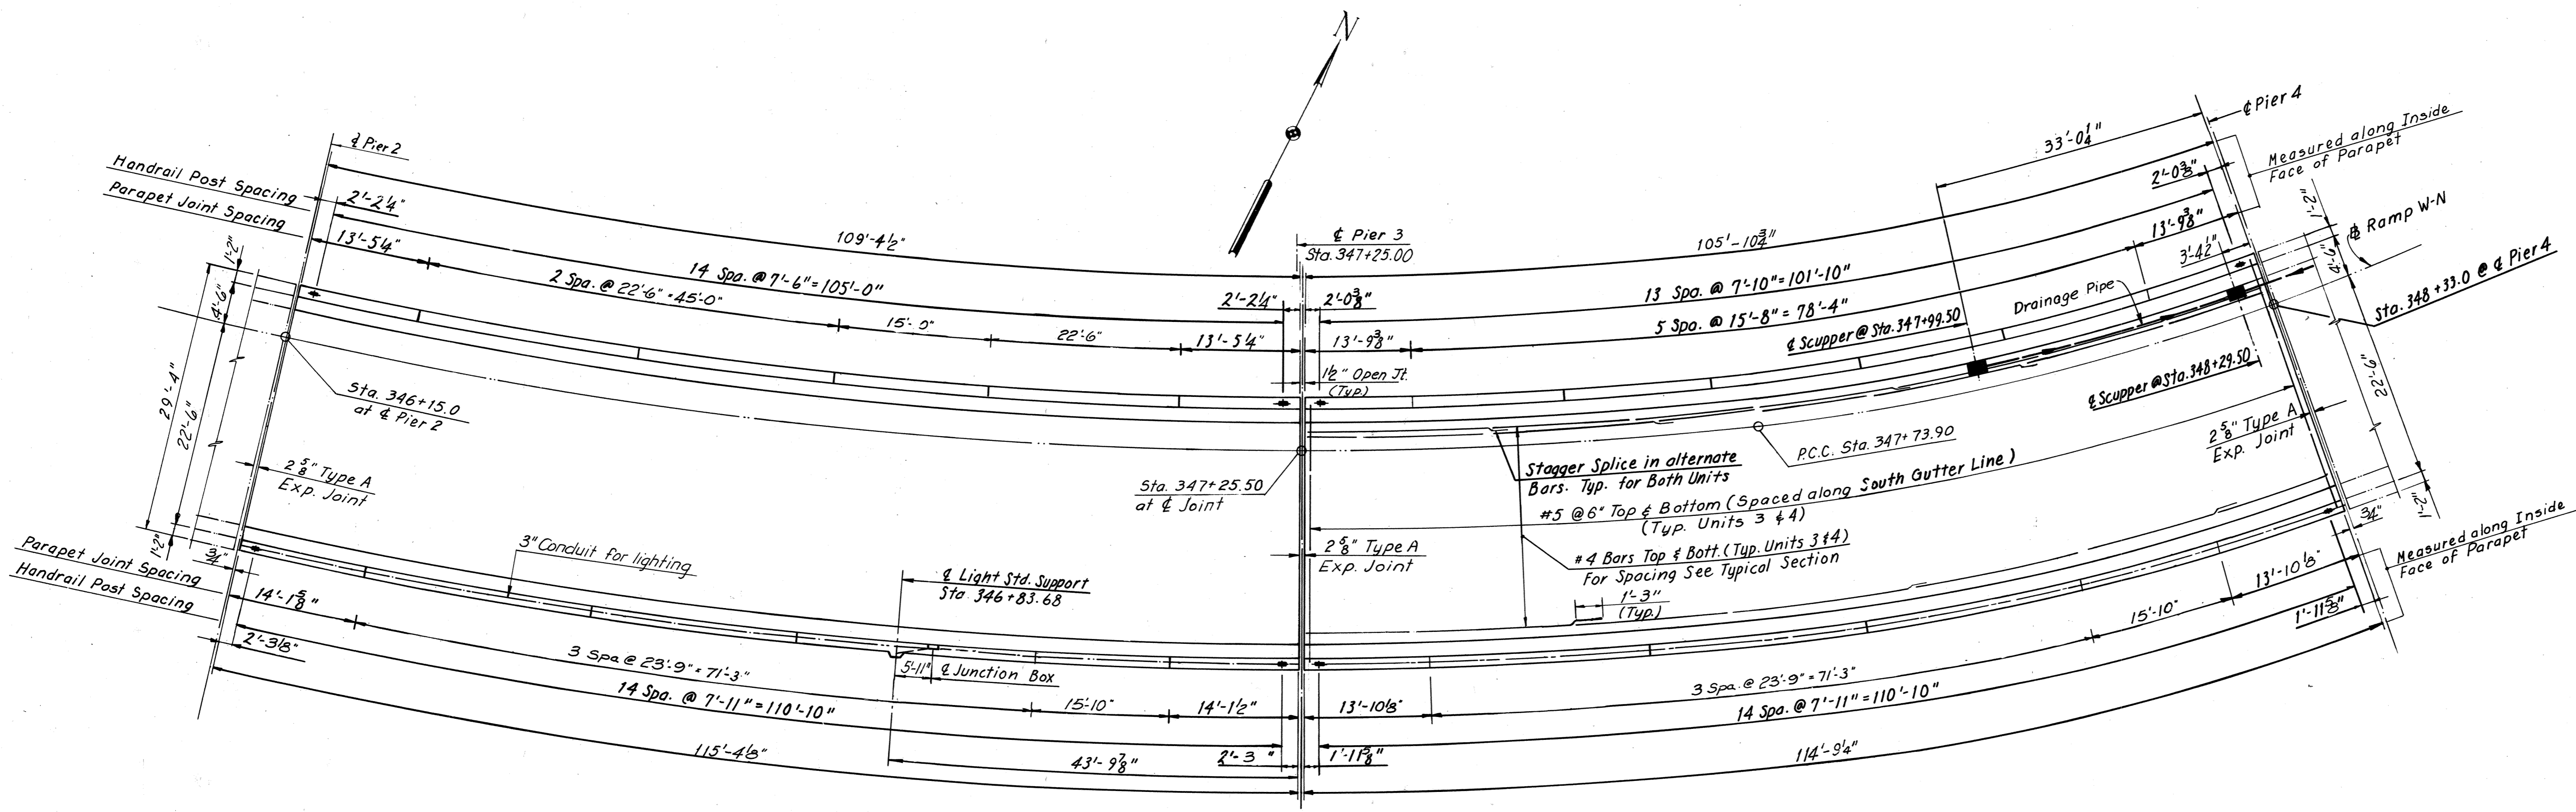



UNIT 3

UNIT 4

DECK PLAN
Scale: 1"=10'-0"

Notes:
 Piers 2, 3 and 4 are all radial to Ramp W-N (Curves WN-1 and WN-2).
 For intermediate diaphragm and transverse stiffener spacing see Sheet 20.
 For Details of diaphragm connections to top and bottom flanges of stringers see Sheet 29.
 For Handrail Details see Sheet 53.
 For Lighting Details see Sheet 54.
 For Standard Drainage Details see Support Type 3, Sheet 56.
 (Pipes between Scuppers in Unit 4 to be connected as shown for Support Type 7, Sheet 56.)
 For Typical Parapet Detail, see Sheet 29.
 For Joint Details see Sheet 48.

* All intermediate diaphragms in Unit 3 and the first three in Unit 4 consist of L5x4x1/2. Last five intermediate diaphragms in Unit 4 consist of L5x5x7/8.

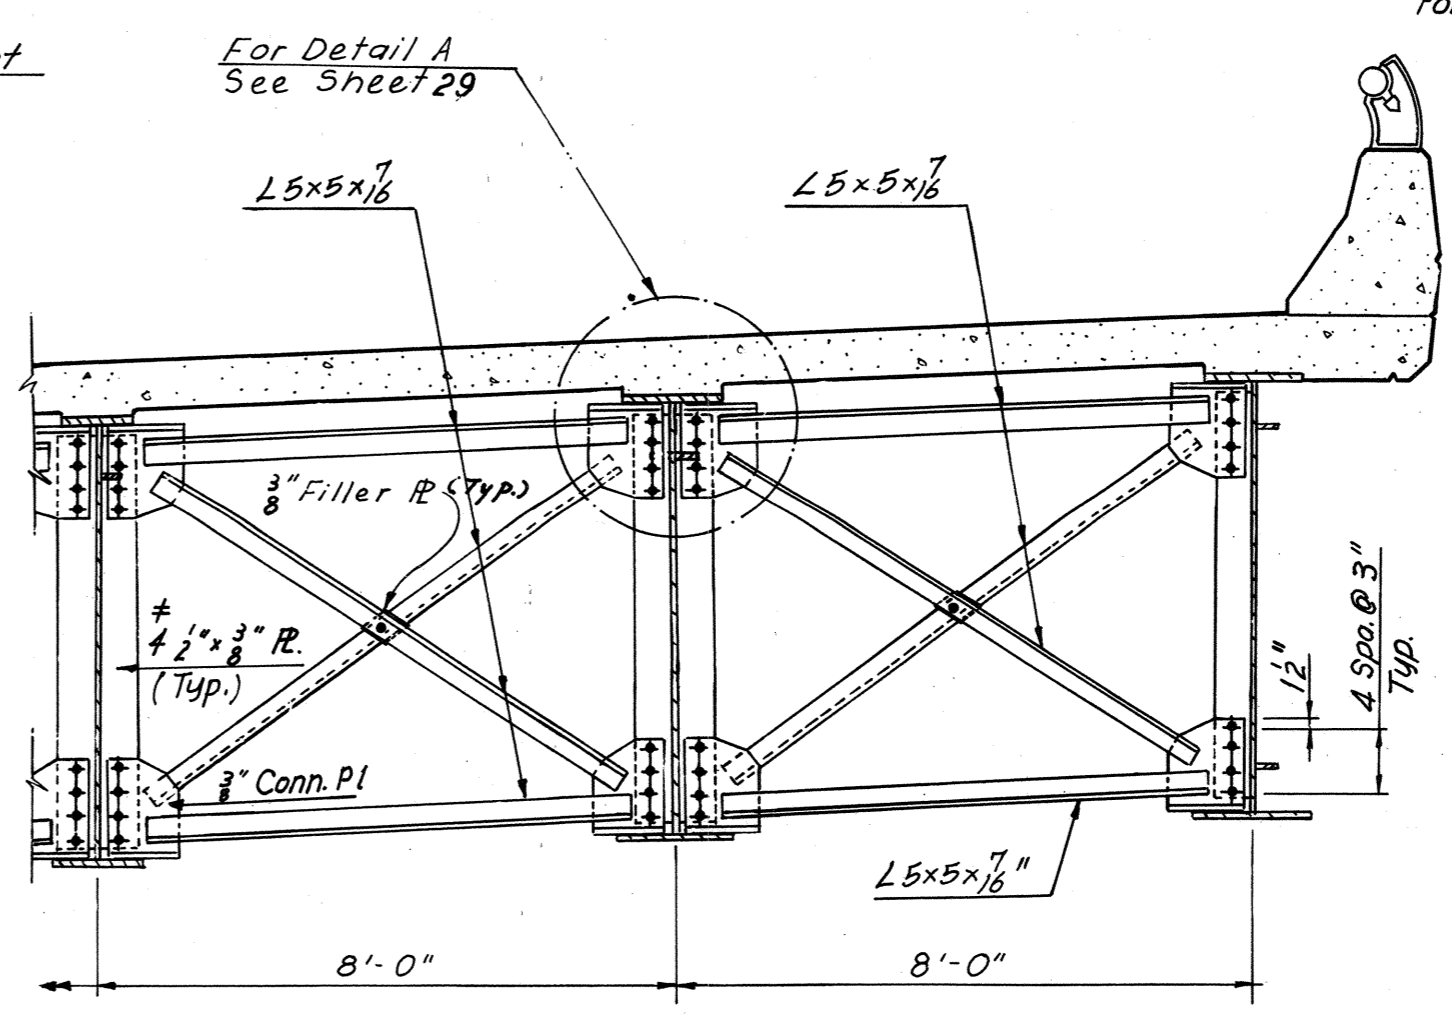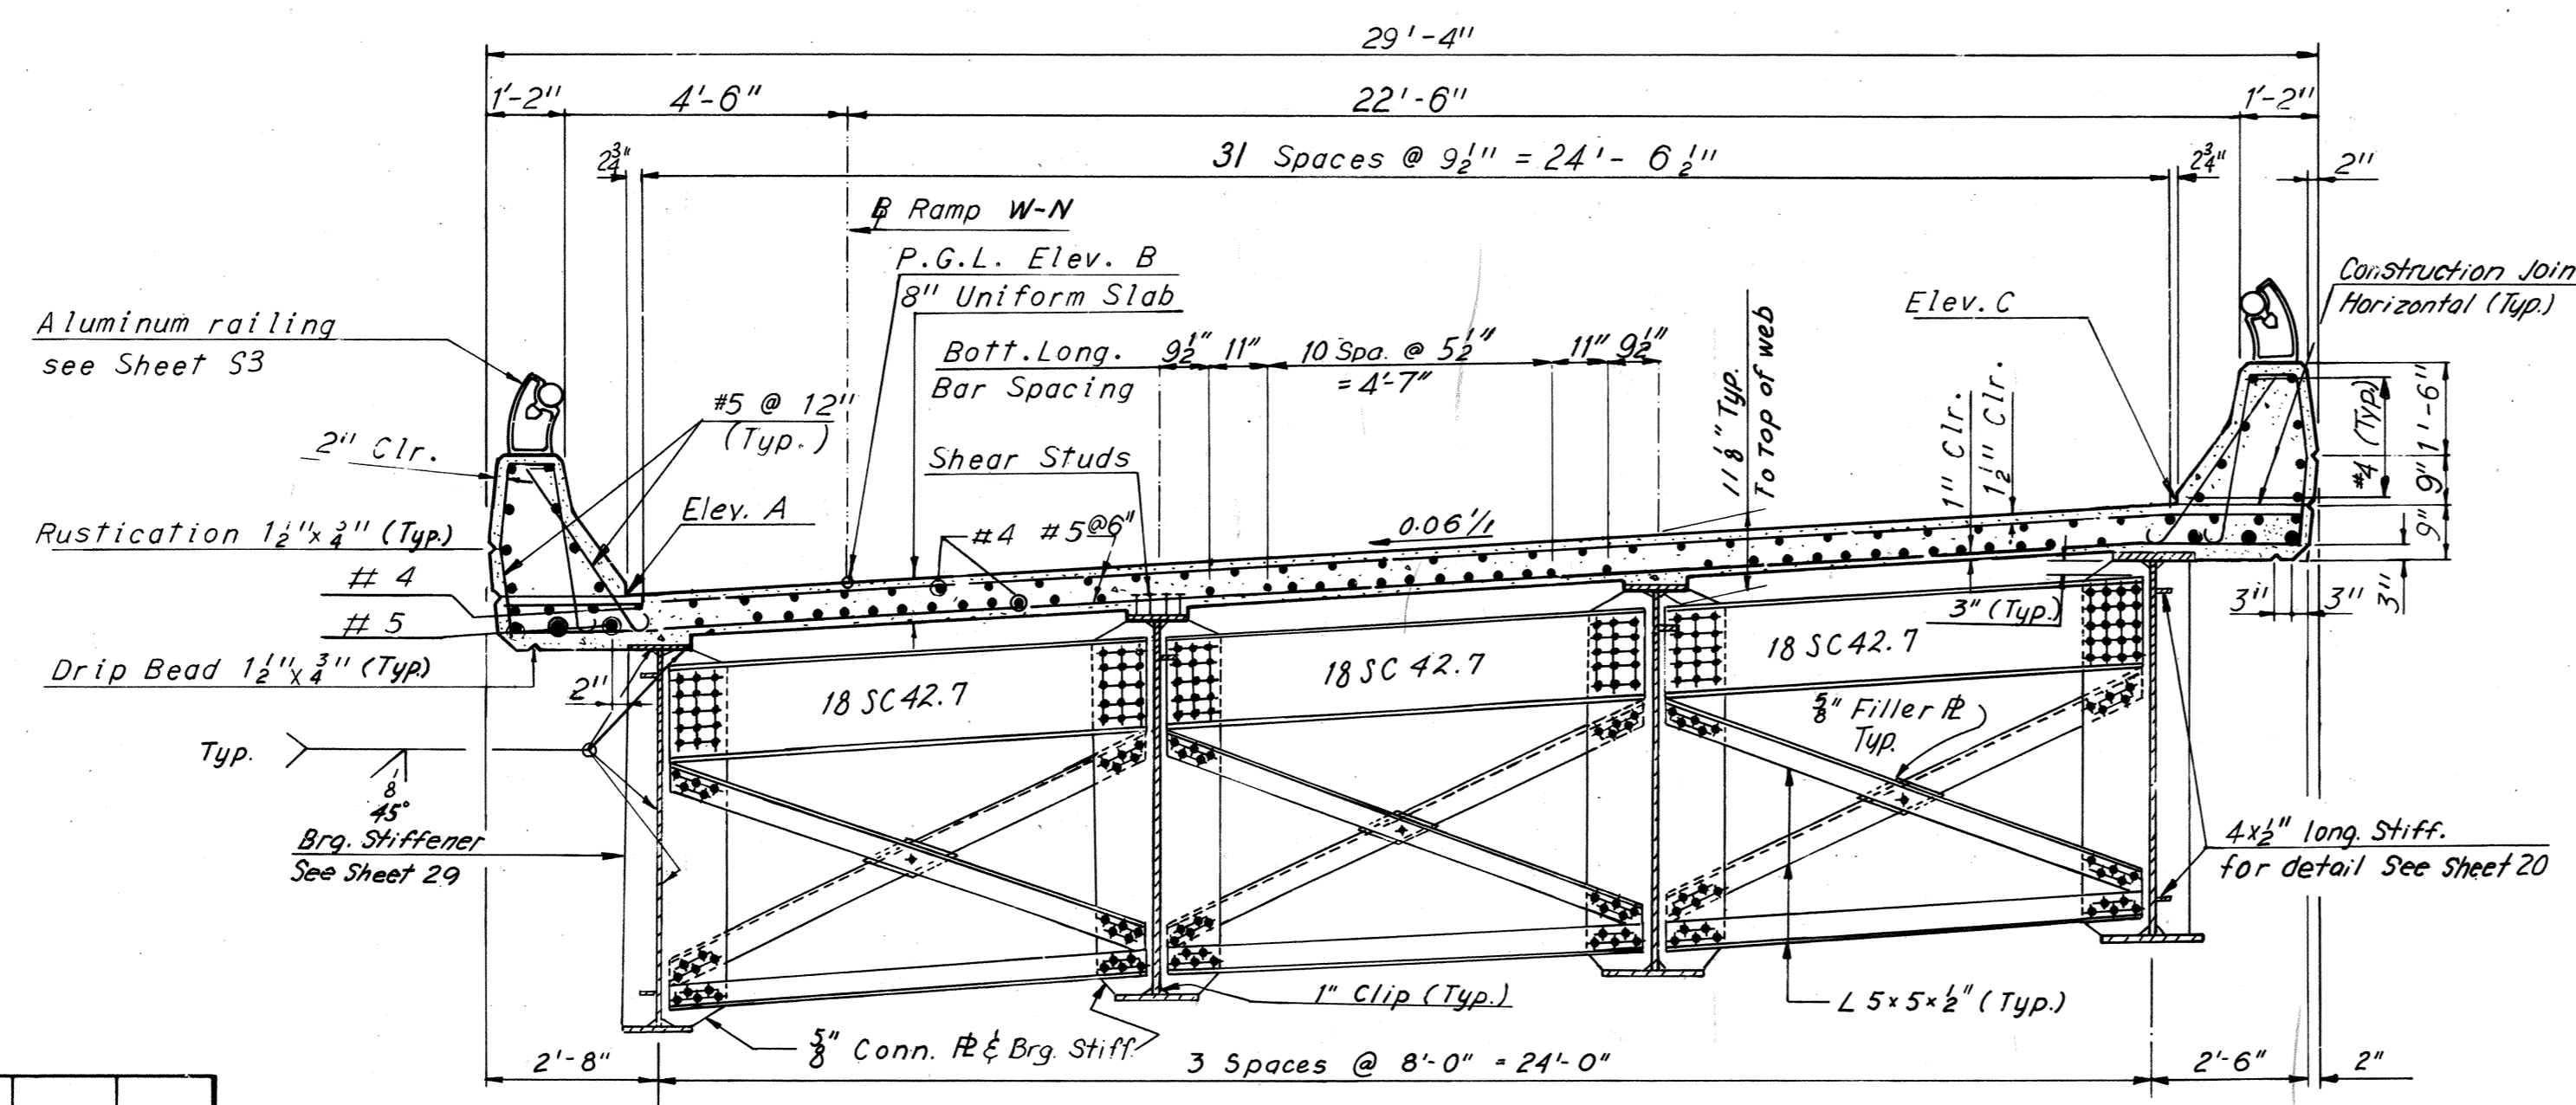

BY	DATE	REVISION	BY	DATE
MADE	C.E.B.	2 As Built	TEM	6-77
CHECKED	KCT	11-4-68	Revised angle size Intermediate Diap.	1-24-75
IN CHARGE				

RICHMOND METROPOLITAN AUTHORITY
RICHMOND EXPRESSWAY SYSTEM
 DOWNTOWN EXPRESSWAY

BRIDGE NO. 67
 RAMP W-N CONNECTION TO
 RICHMOND-PETERSBURG TURNPIKE
DECK PLAN UNITS 3 AND 4


HOWARD, NEEDLES, TAMMEN & BERGENDOFF
 consulting engineers
 NEW YORK ALEXANDRIA KANSAS CITY

SCALE: As noted
 CONTRACT NO. 10
 SHEET NO. 30 OF 54

AS BUILT

RICHMOND EXPRESSWAY SYSTEM			
SECTION	PROJECT	SHEET NO.	TOTAL SHEETS
10	DOWNTOWN EXPRESSWAY	2.03	265

ELEVATION TABLE			
STATION	ELEV. A	ELEV. B	ELEV. C
348+33.00	72.55	72.76	74.05
+40.00	72.57	72.78	74.07
+50.00	72.64	72.85	74.14
+60.00	72.75	72.96	74.25
+70.00	72.90	73.11	74.40
+80.00	73.10	73.31	74.60
+90.00	73.34	73.55	74.84
349+00.00	73.62	73.83	75.12
+10.00	73.95	74.16	75.45
+20.00	74.31	74.52	75.81
+30.00	74.73	74.94	76.23
+40.00	75.18	75.39	76.68
+40.50	75.21	75.42	76.71
+50.00	75.68	75.89	77.18
+60.00	76.20	76.41	77.70
+70.00	76.72	76.93	78.22
+80.00	77.24	77.45	78.74
+90.00	77.76	77.97	79.27
350+00.00	78.28	78.49	79.78
+10.00	78.80	79.01	80.30
+20.00	79.32	79.53	80.82
+30.00	79.84	80.05	81.34
+37.00	80.21	80.41	81.69
+40.00	80.36	80.57	81.84

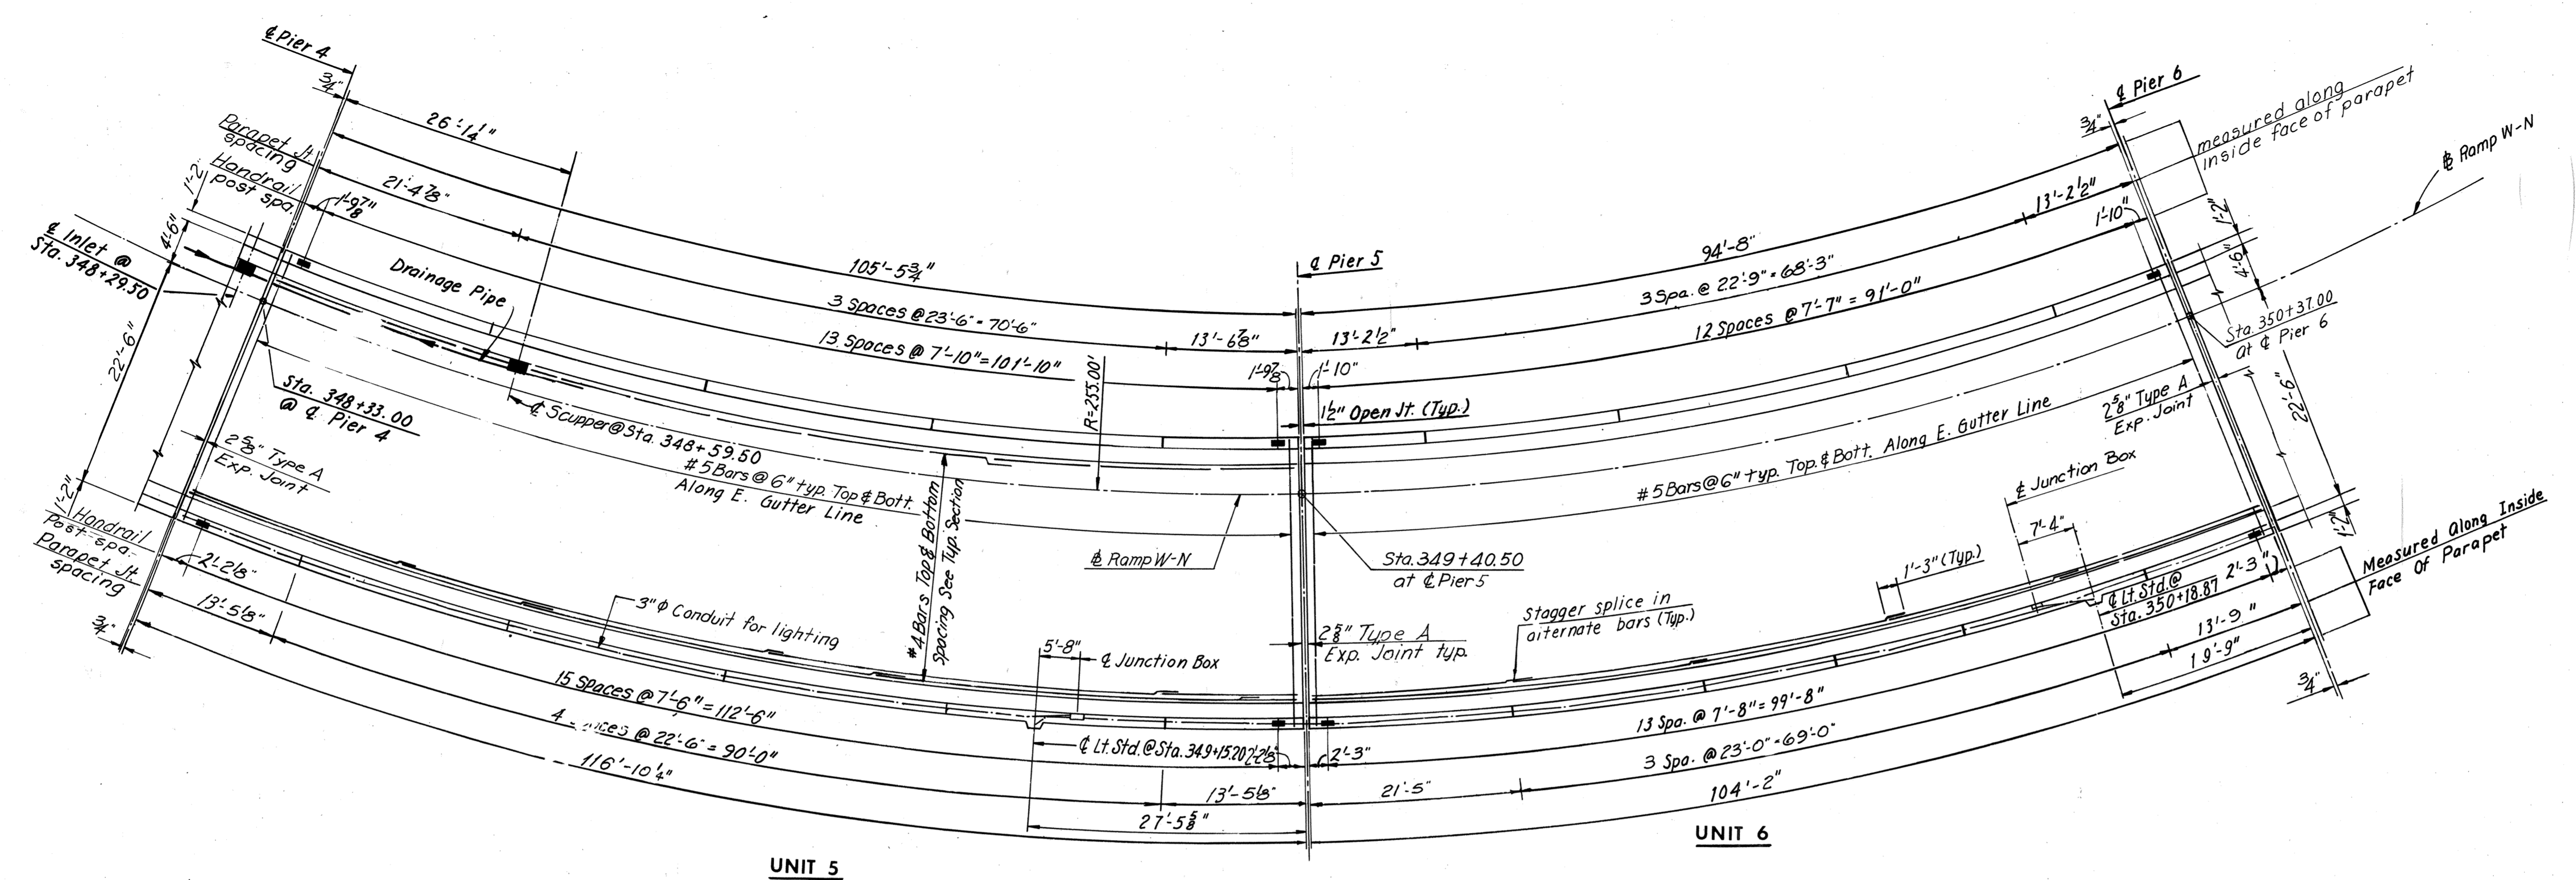


UNIT 5


UNIT 6

DECK PLAN

Scale: 1" = 10'-0"

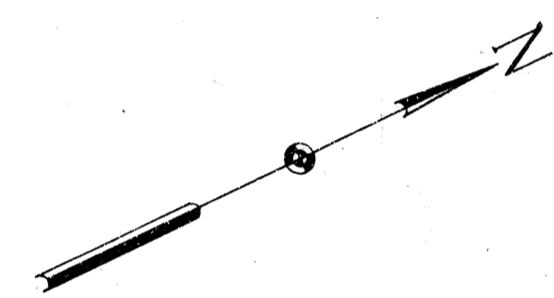


Notes:
 Piers 4, 5 and 6 are all radial to Ramp W-N (Curve WN-2)
 For Details of diaphragm connections to top and bottom flanges of stringers see Sheet 29.
 For intermediate diaphragm and transverse stiffener spacings see Sheet 21.
 For Handrail Details see Sheet 53.
 For Lighting Details see Sheet 54.
 For Standard Drainage Details see Support Type 7 Sheet 50.
 For Typical Parapet Detail, see Sheet 29.
 For Joint Details see Sheet 48.

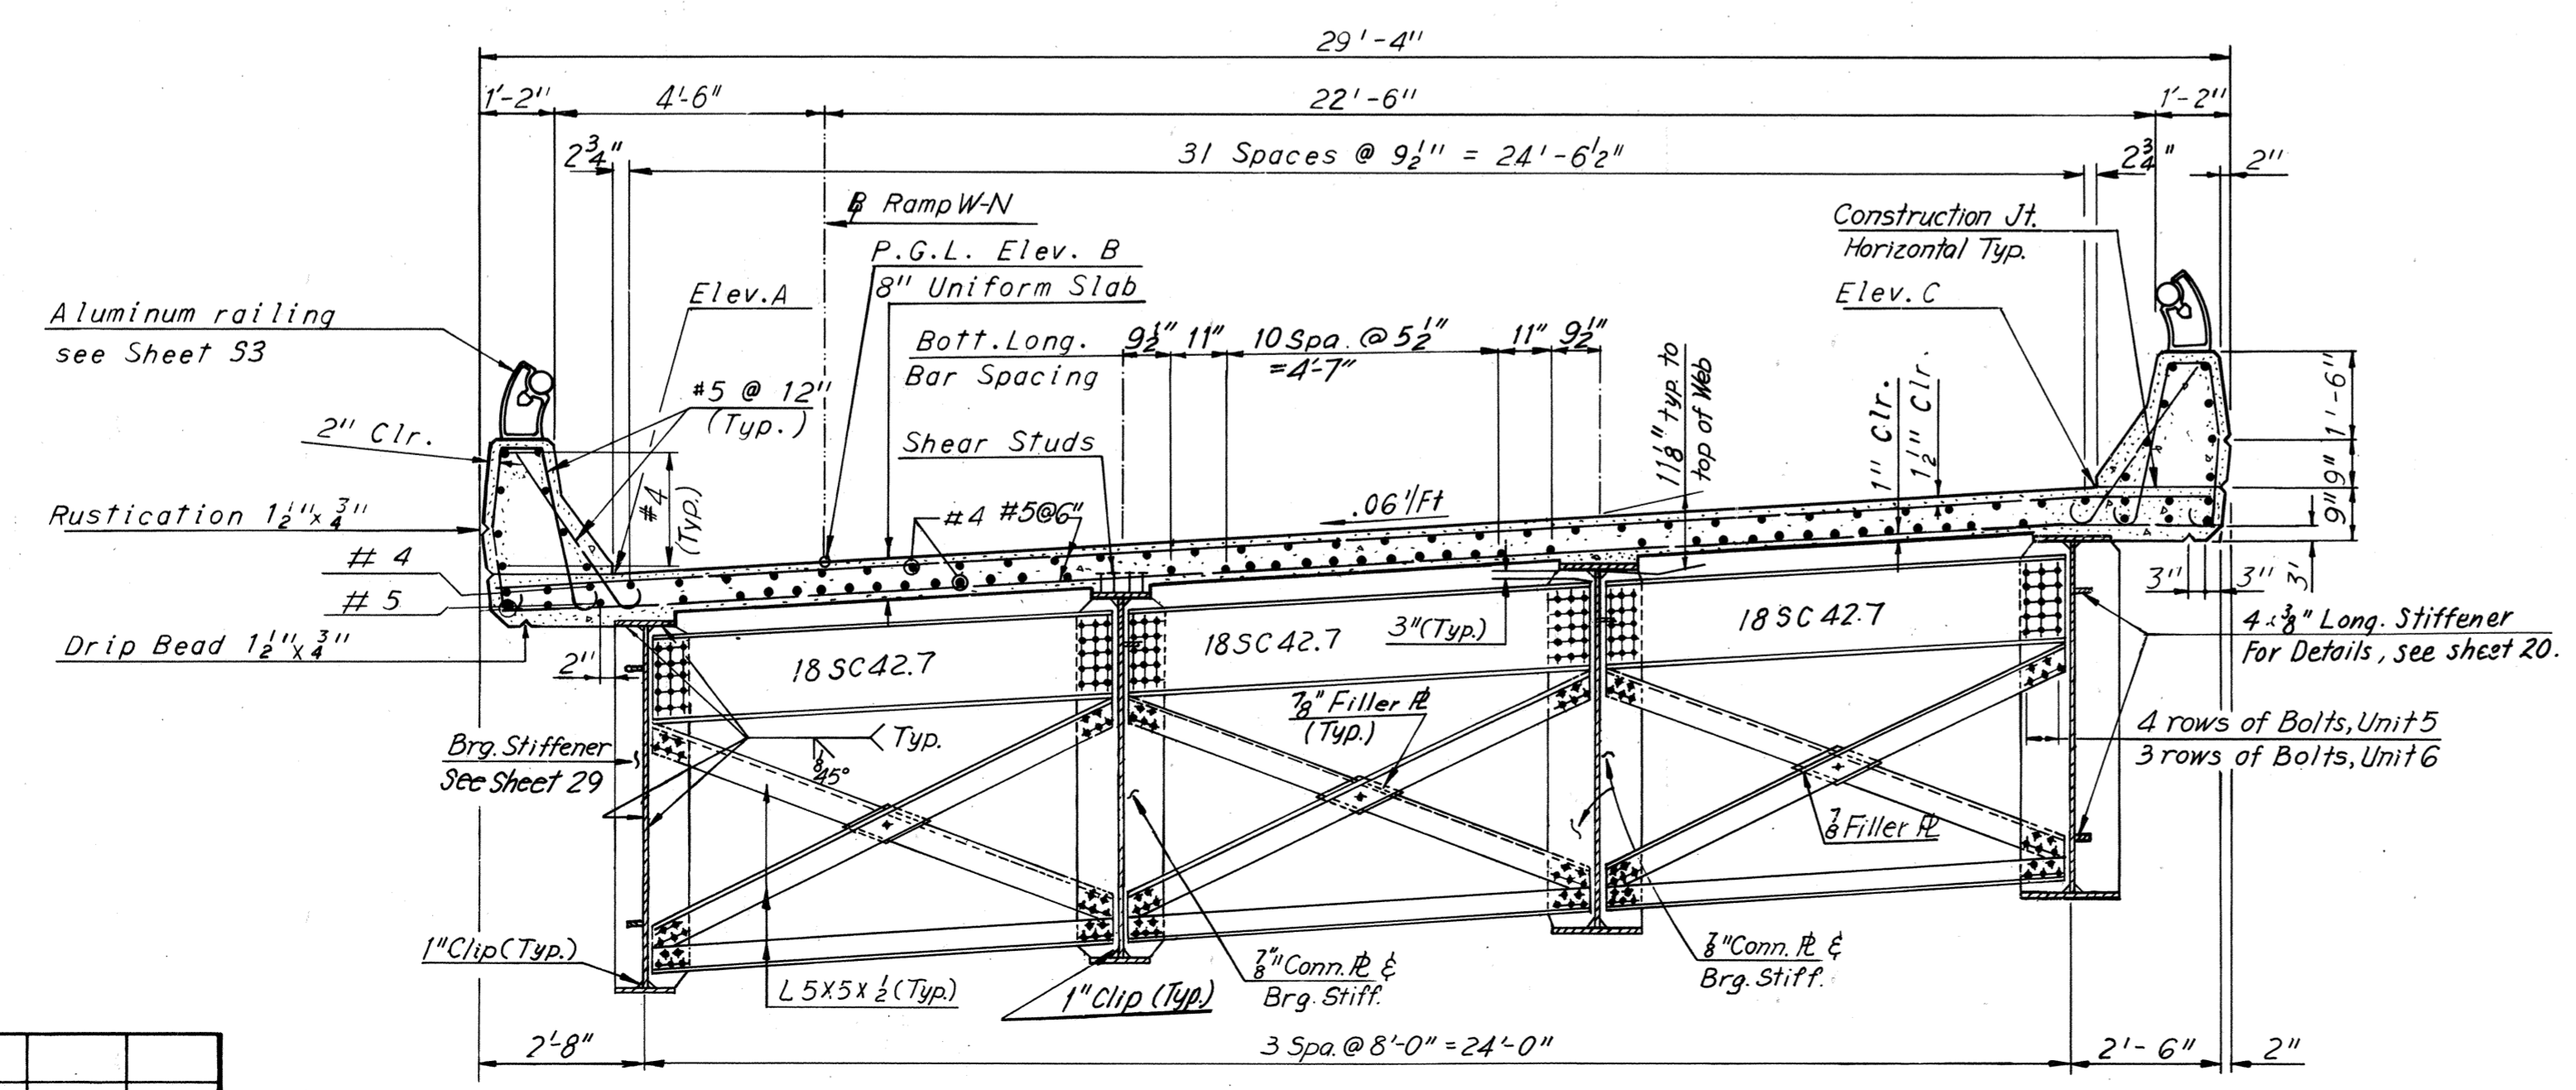

TYPICAL SECTION - END DIAPHRAGM

Scale: 3/8" = 1'-0"

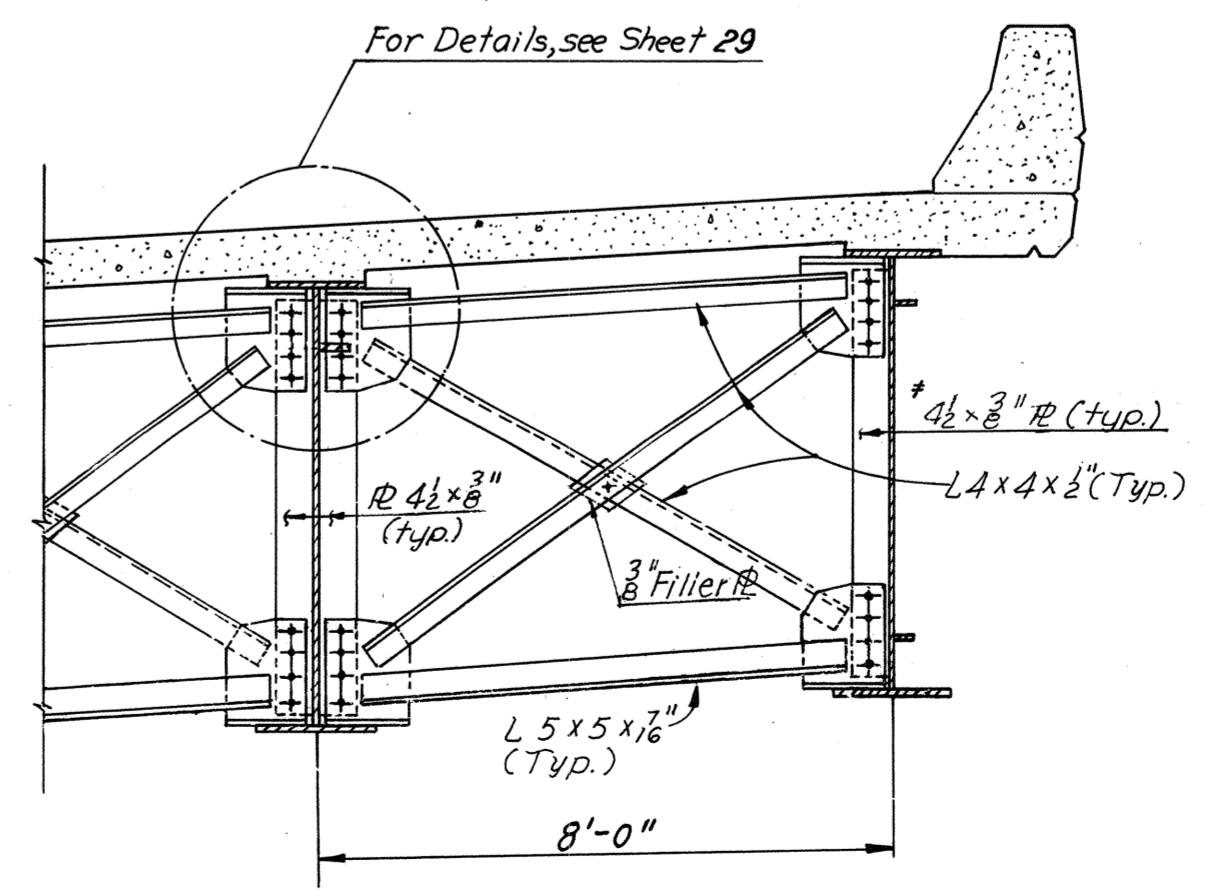

INTERMEDIATE DIAPHRAGM

Scale: 3/8" = 1'-0"

4x3/8 transverse stiffeners are used throughout Units 5 and 6 except for Stringer S4-5 where 5x3/8 are used.

BY	DATE	NO.	REVISION	BY	DATE
MADE	AHH 8-26-68				
CHECKED	KCT 11-1-68	1	As Built	TEM	6-77
IN CHARGE					

RICHMOND METROPOLITAN AUTHORITY
 RICHMOND EXPRESSWAY SYSTEM
 DOWNTOWN EXPRESSWAY

BRIDGE NO. 67
 RAMP W-N CONNECTION TO
 RICHMOND-PETERSBURG TURNPIKE
 DECK PLAN - UNITS 5 AND 6


HOWARD, NEEDLES, TAMMEN & BERGENDOFF
 consulting engineers
 NEW YORK ALEXANDRIA KANSAS CITY

AS BUILT


SCALE: As Noted
 CONTRACT NO.: 10
 SHEET NO. 31 OF 54

RICHMOND EXPRESSWAY SYSTEM			
SECTION	PROJECT	SHEET NO.	TOTAL SHEETS
10	DOWNTOWN EXPRESSWAY	204	265

ELEVATION TABLE			
STATION	ELEV. A	ELEV. B	ELEV. C
350+37.00	80.21	80.41	81.69
+40.00	80.36	80.57	81.84
+50.00	80.89	81.09	82.33
+60.00	81.41	81.61	82.80
+70.00	81.94	82.13	83.25
+80.00	82.49	82.65	83.68
+90.00	83.02	83.17	84.11
351+00.00	83.55	83.69	84.55
+10.00	84.07	84.20	84.97
+20.00	84.56	84.68	85.37
+30.00	85.04	85.13	85.73
+33.50	85.20	85.29	85.86
+40.00	85.49	85.57	86.08
+50.00	85.91	85.97	86.40
+60.00	86.31	86.36	86.70
+70.00	86.69	86.71	86.97
+80.00	87.03	87.05	87.22
+90.00	87.35	87.35	87.44
352+00.00	87.64	87.64	87.64
+10.00	87.97	87.89	87.88
+20.00	88.28	88.13	88.10
+30.00	88.56	88.33	88.30
+32.00	88.62	88.37	88.34

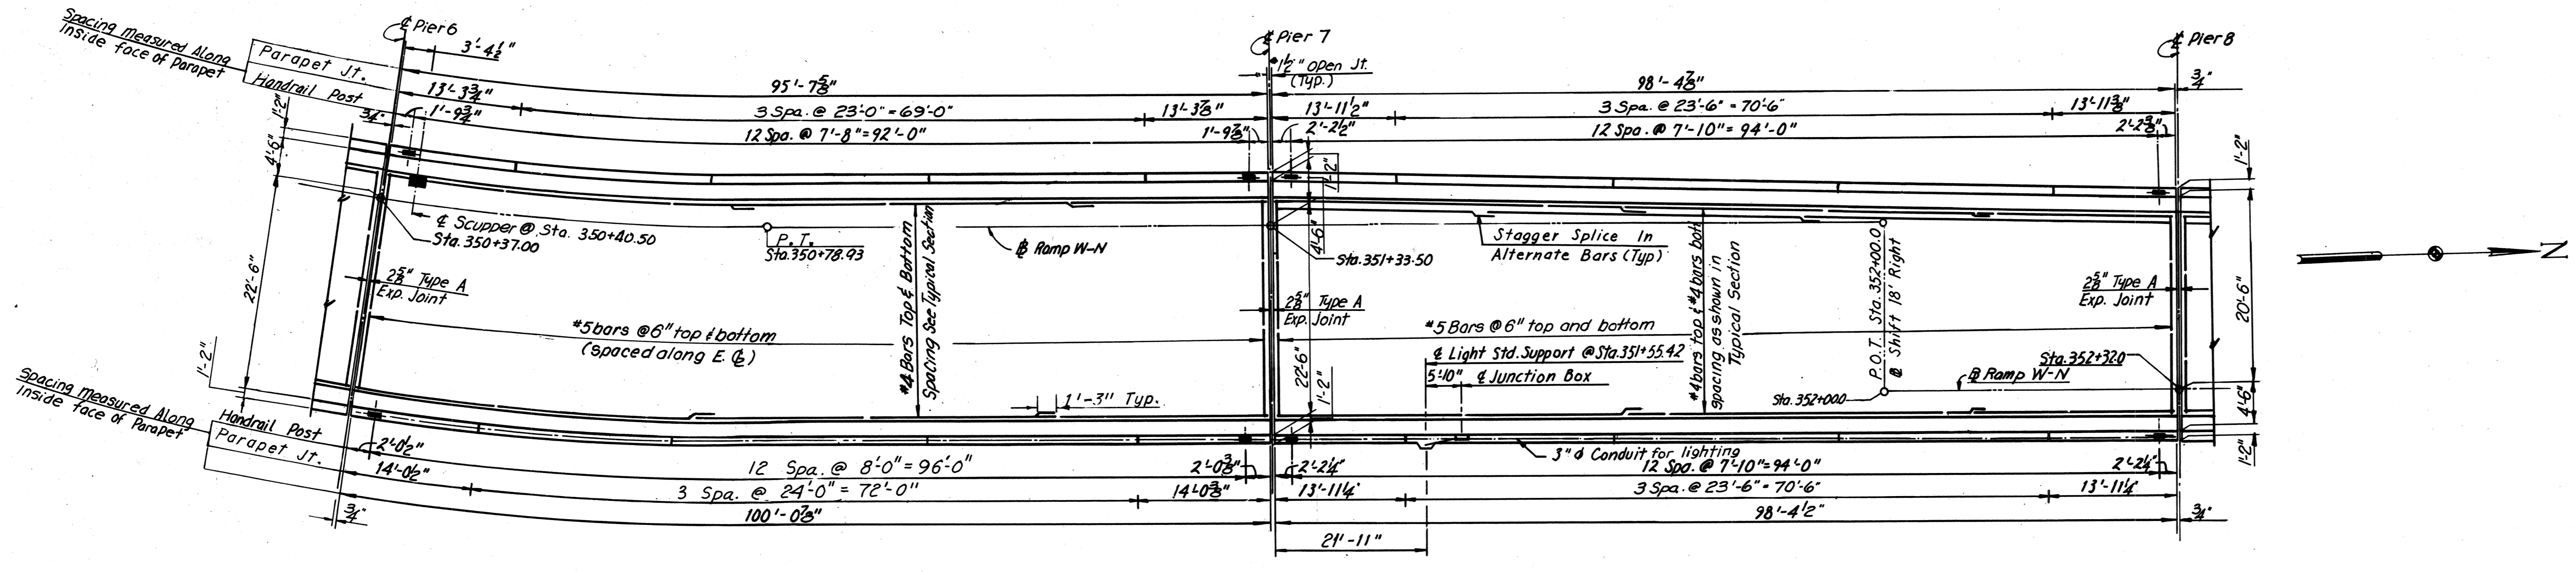


UNIT 7 **UNIT 8**
DECK PLAN
 Scale 1" = 10'-0"

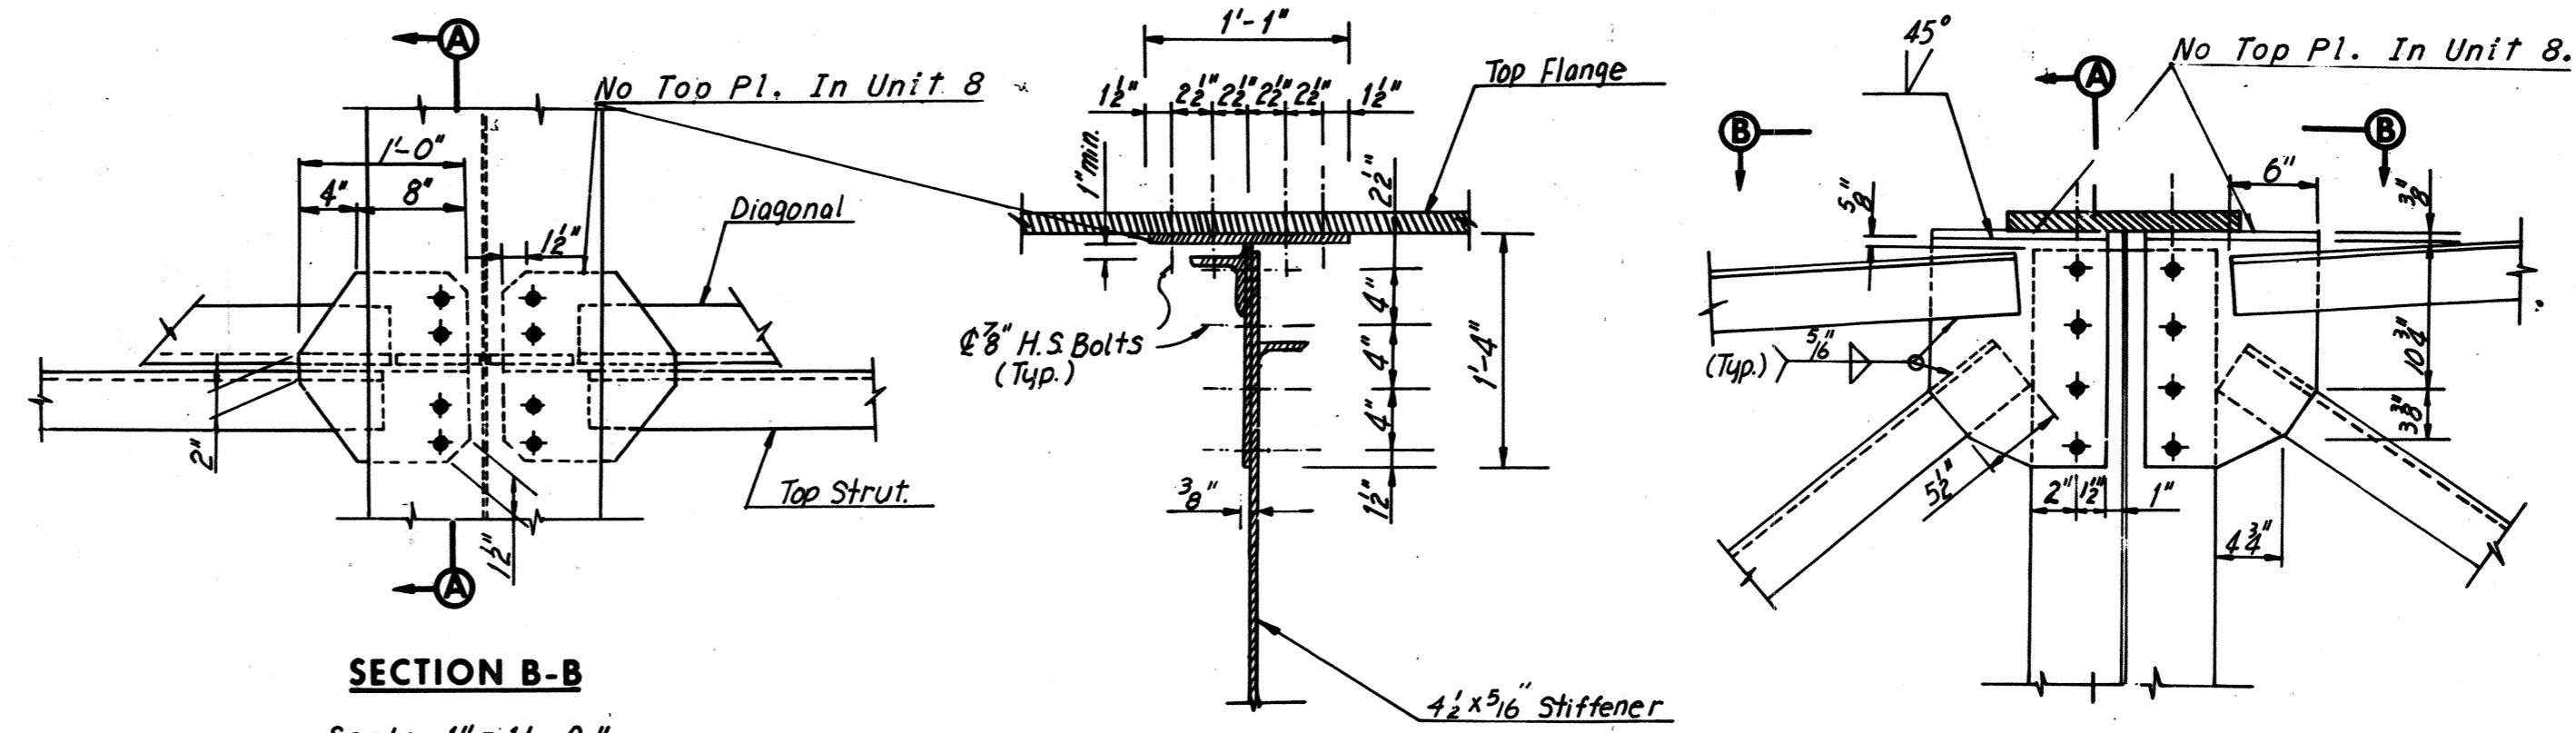


SECTION B-B

SECTION A-A
 Scale: 1" = 1'-0"

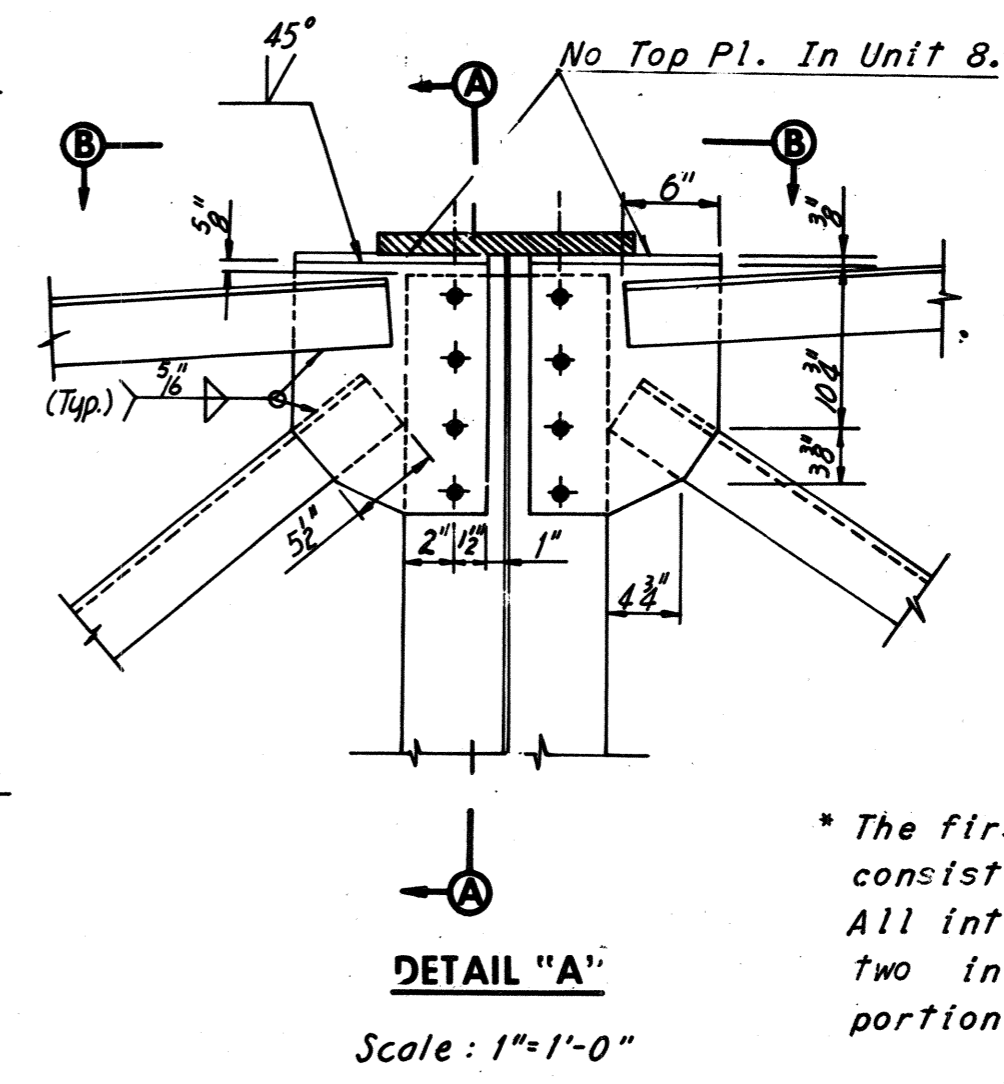

DETAIL "A"
 Scale: 1" = 1'-0"

* The first three intermediate diaphragms in Unit 7 consist of Ls4x4x2 (curved portion of roadway). All intermediate diaphragms in Unit 8 and the last two in Unit 7 consist of Ls3 1/2 x 3 1/2 x 8 (tangent portion of roadway).

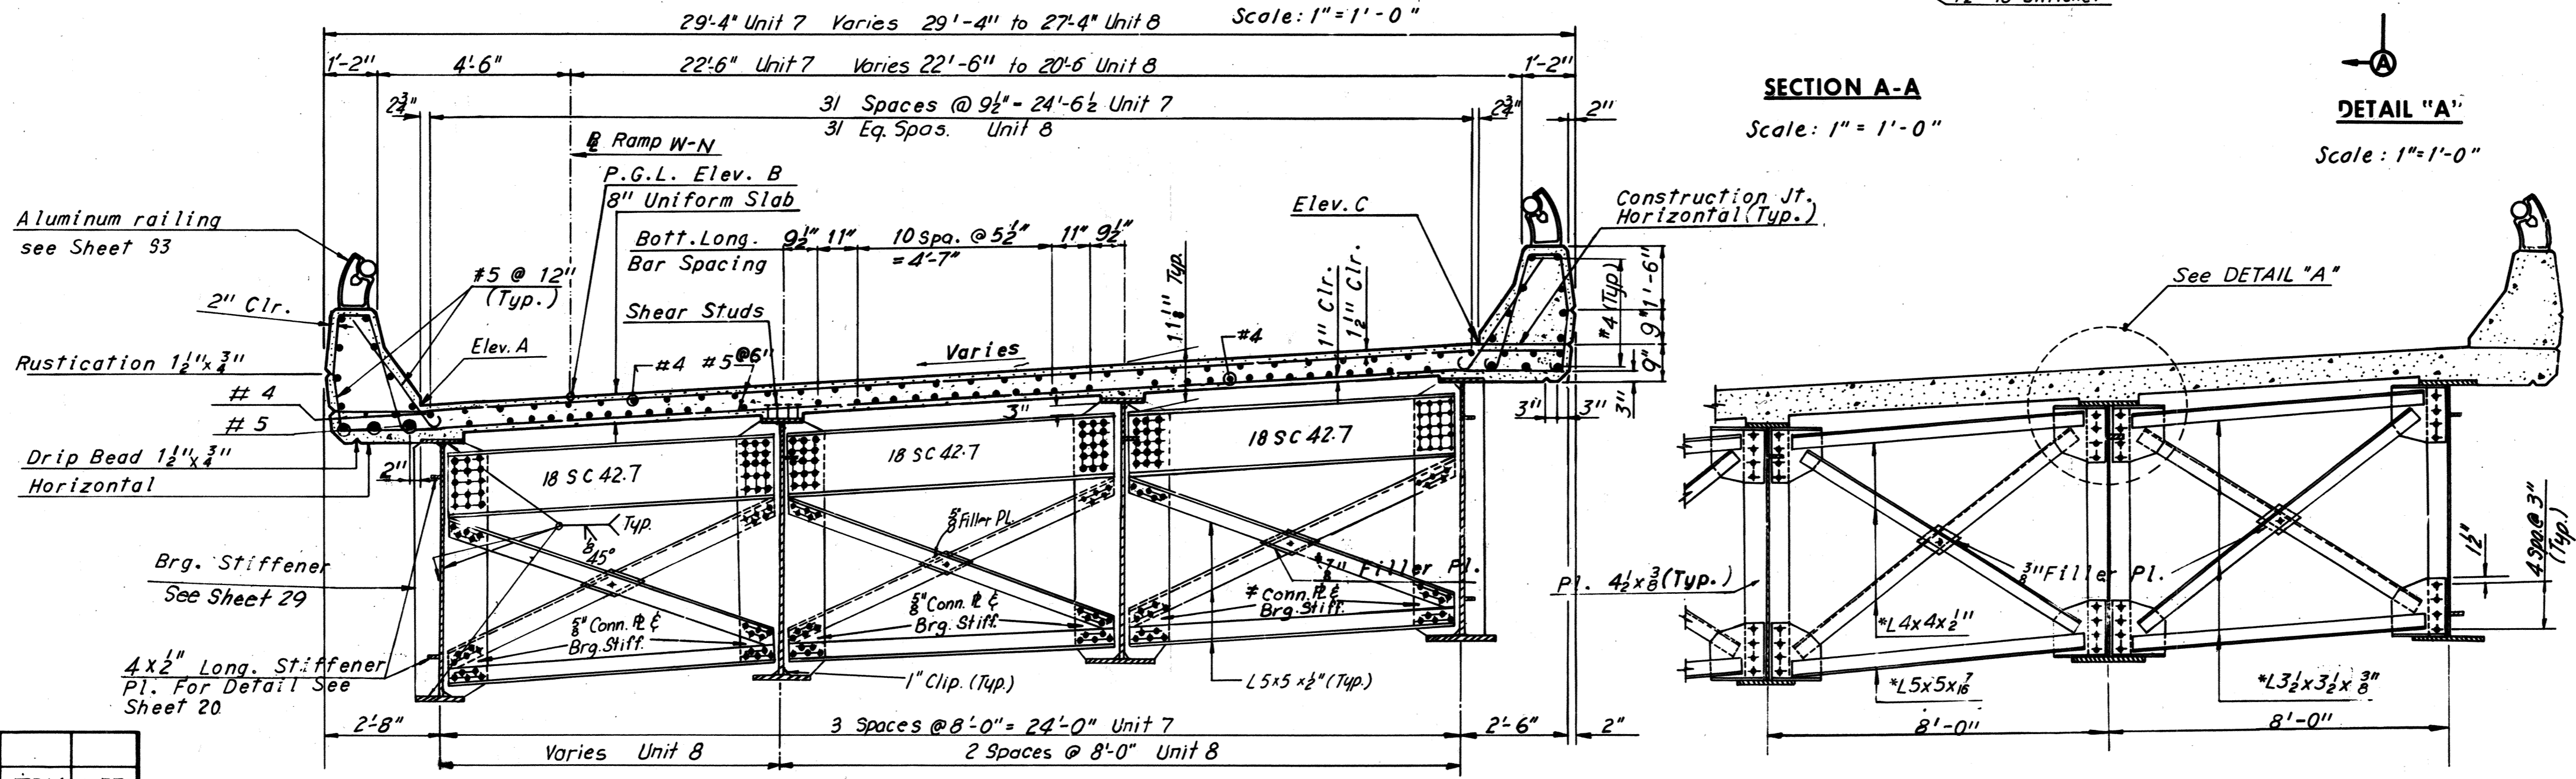

TYPICAL SECTION—END DIAPHRAGM
 Scale 5/8" = 1'-0"

INTERMEDIATE DIAPHRAGM
 Scale 3/8" = 1'-0"

AS BUILT

Notes: For intermediate diaphragm and transverse stiffener spacings see Sheet 22. For Handrail Details see Sheet 53. For Lighting Details see Sheet 54. For Standard Drainage Details see Support Type 3 Sheet 36. For Typical Parapet Details, see Sheet 29.

BY	DATE	REVISION	BY	DATE
MADE	GSH 09-22-68	2 As Built	TEM	6-77
CHECKED	KCT 11-1-68	Light Sta. Location	JLK	6-6-75
IN CHARGE				

RICHMOND METROPOLITAN AUTHORITY
RICHMOND EXPRESSWAY SYSTEM
DOWNTOWN EXPRESSWAY

BRIDGE NO. 67
RAMP W-N CONNECTION TO
RICHMOND-PETERSBURG TURNPIKE
DECK PLAN UNITS - 7 AND 8


HOWARD, NEEDLES, TAMMEN & BERGENDOFF
 consulting engineers
 NEW YORK ALEXANDRIA KANSAS CITY

SCALE: As Noted
 CONTRACT NO. 10
 SHEET NO. 32 OF 54



RICHMOND EXPRESSWAY SYSTEM			
SECTION	PROJECT	SHEET NO.	TOTAL SHEETS
10	DOWNTOWN EXPRESSWAY	205	265

ELEVATION TABLE			
STATION	ELEV A	ELEV B	ELEV C
352+30.00	88.57	88.33	88.22
32.00	88.63	88.37	88.33
40.00	88.83	88.52	88.46
50.00	89.06	88.67	88.60
60.00	89.20	88.81	88.74
70.00	89.30	88.91	88.84
80.00	89.39	89.00	88.93
90.00	89.44	89.05	88.98
353+00.00	89.47	89.08	89.01
10.00	89.48	89.09	89.02
20.00	89.46	89.07	89.00
26.00	89.44	89.05	88.98
30.00	89.42	89.03	88.96


Note: Connect Lighting Conduit in existing structure with Junction Box at nose of new part of structure.

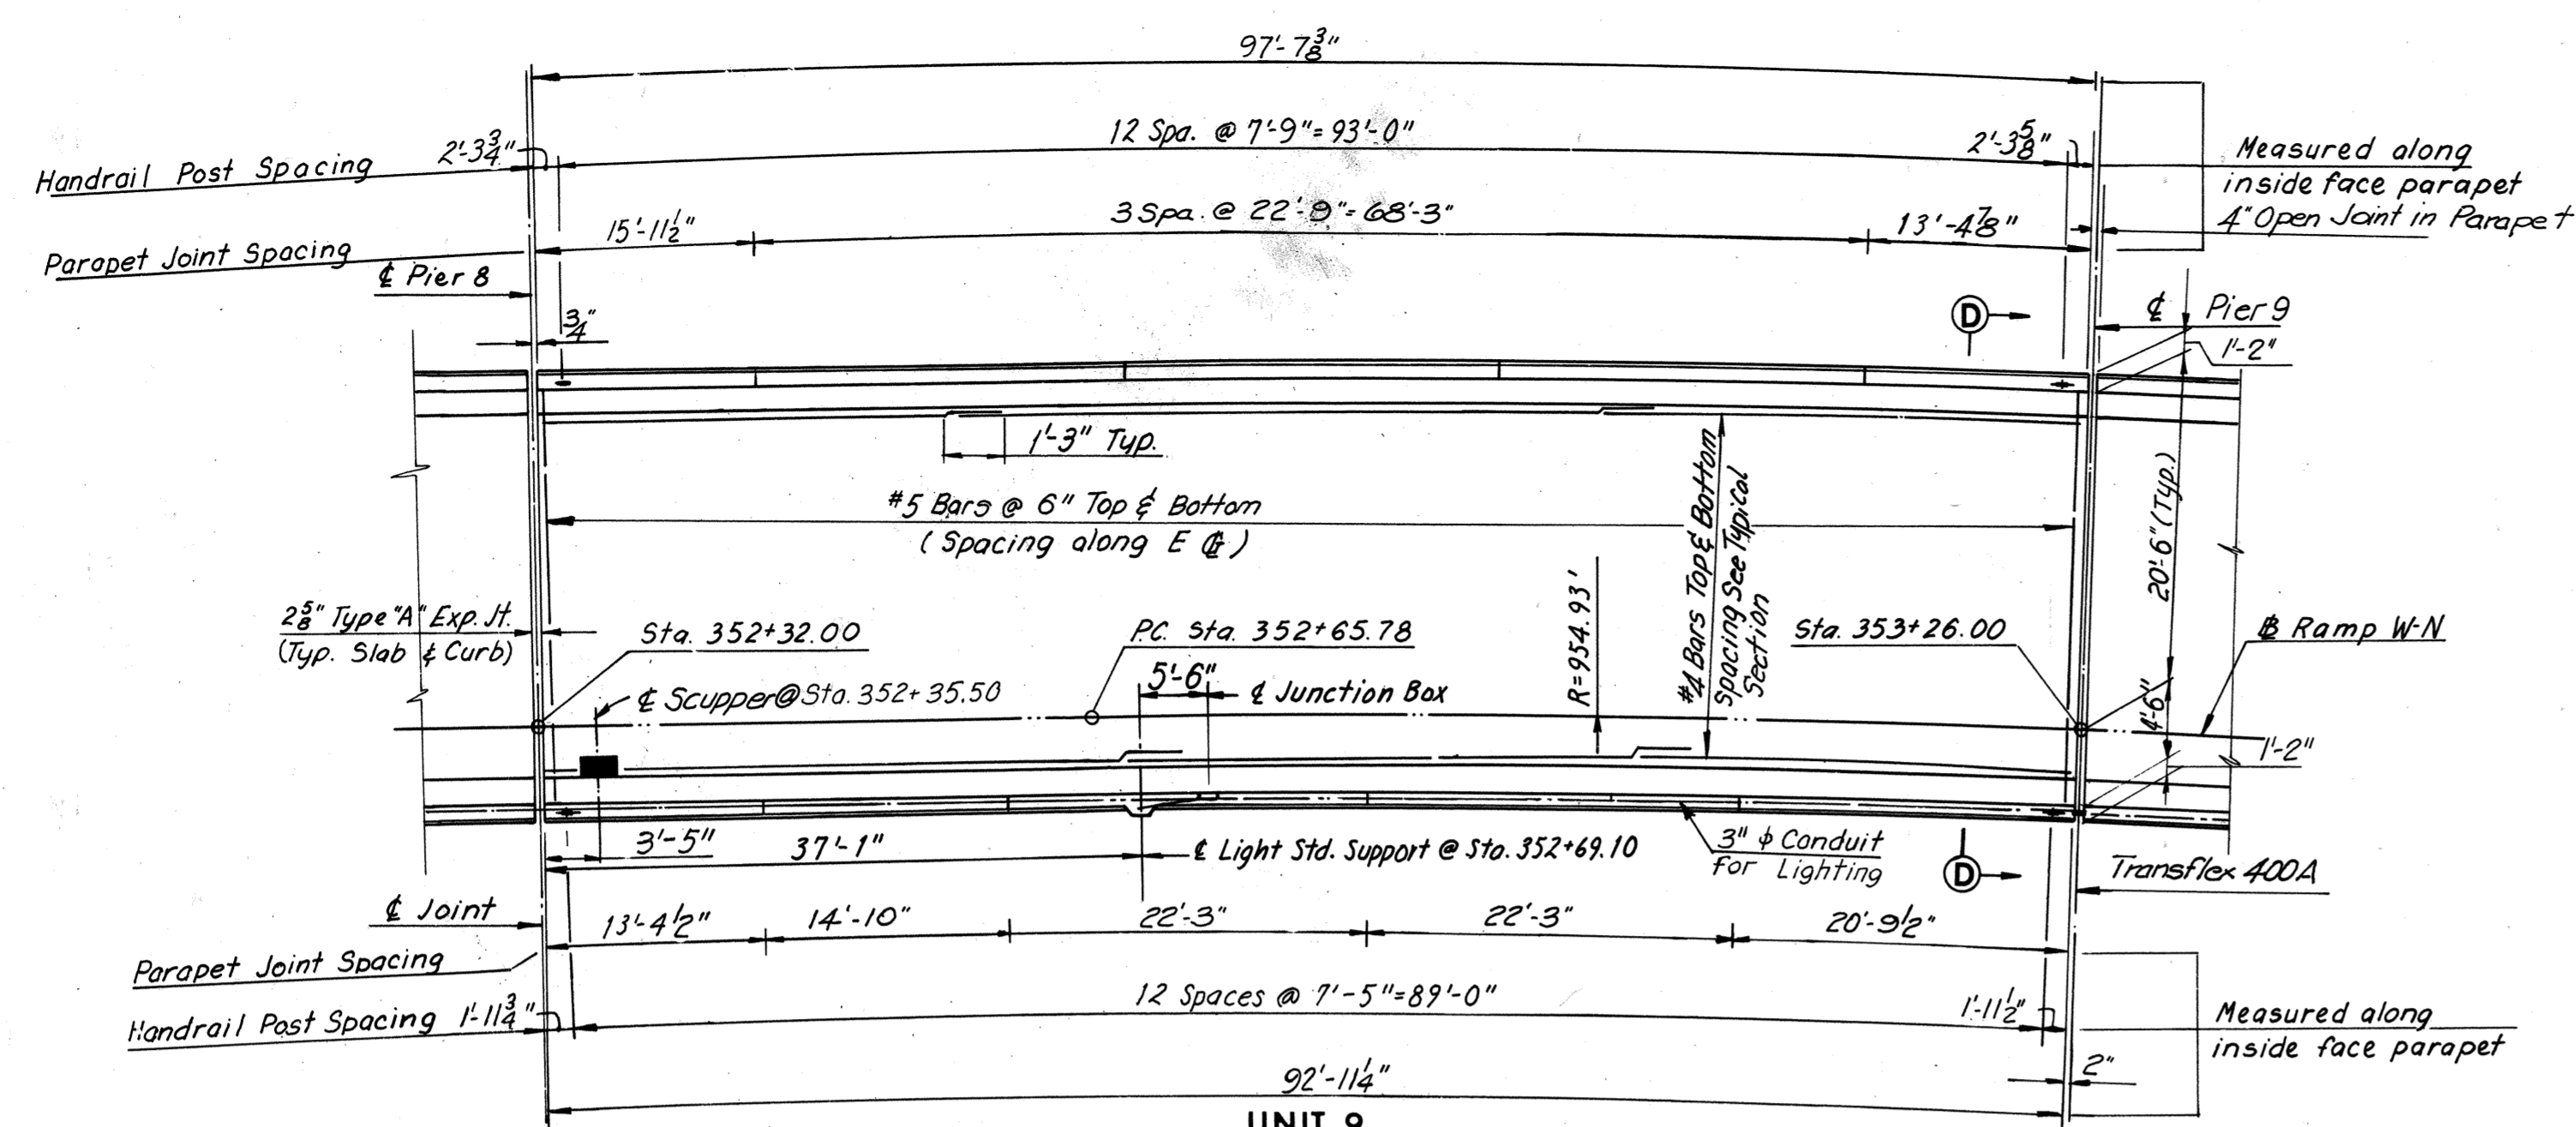


DECK PLAN
Scale: 1" = 10'-0"

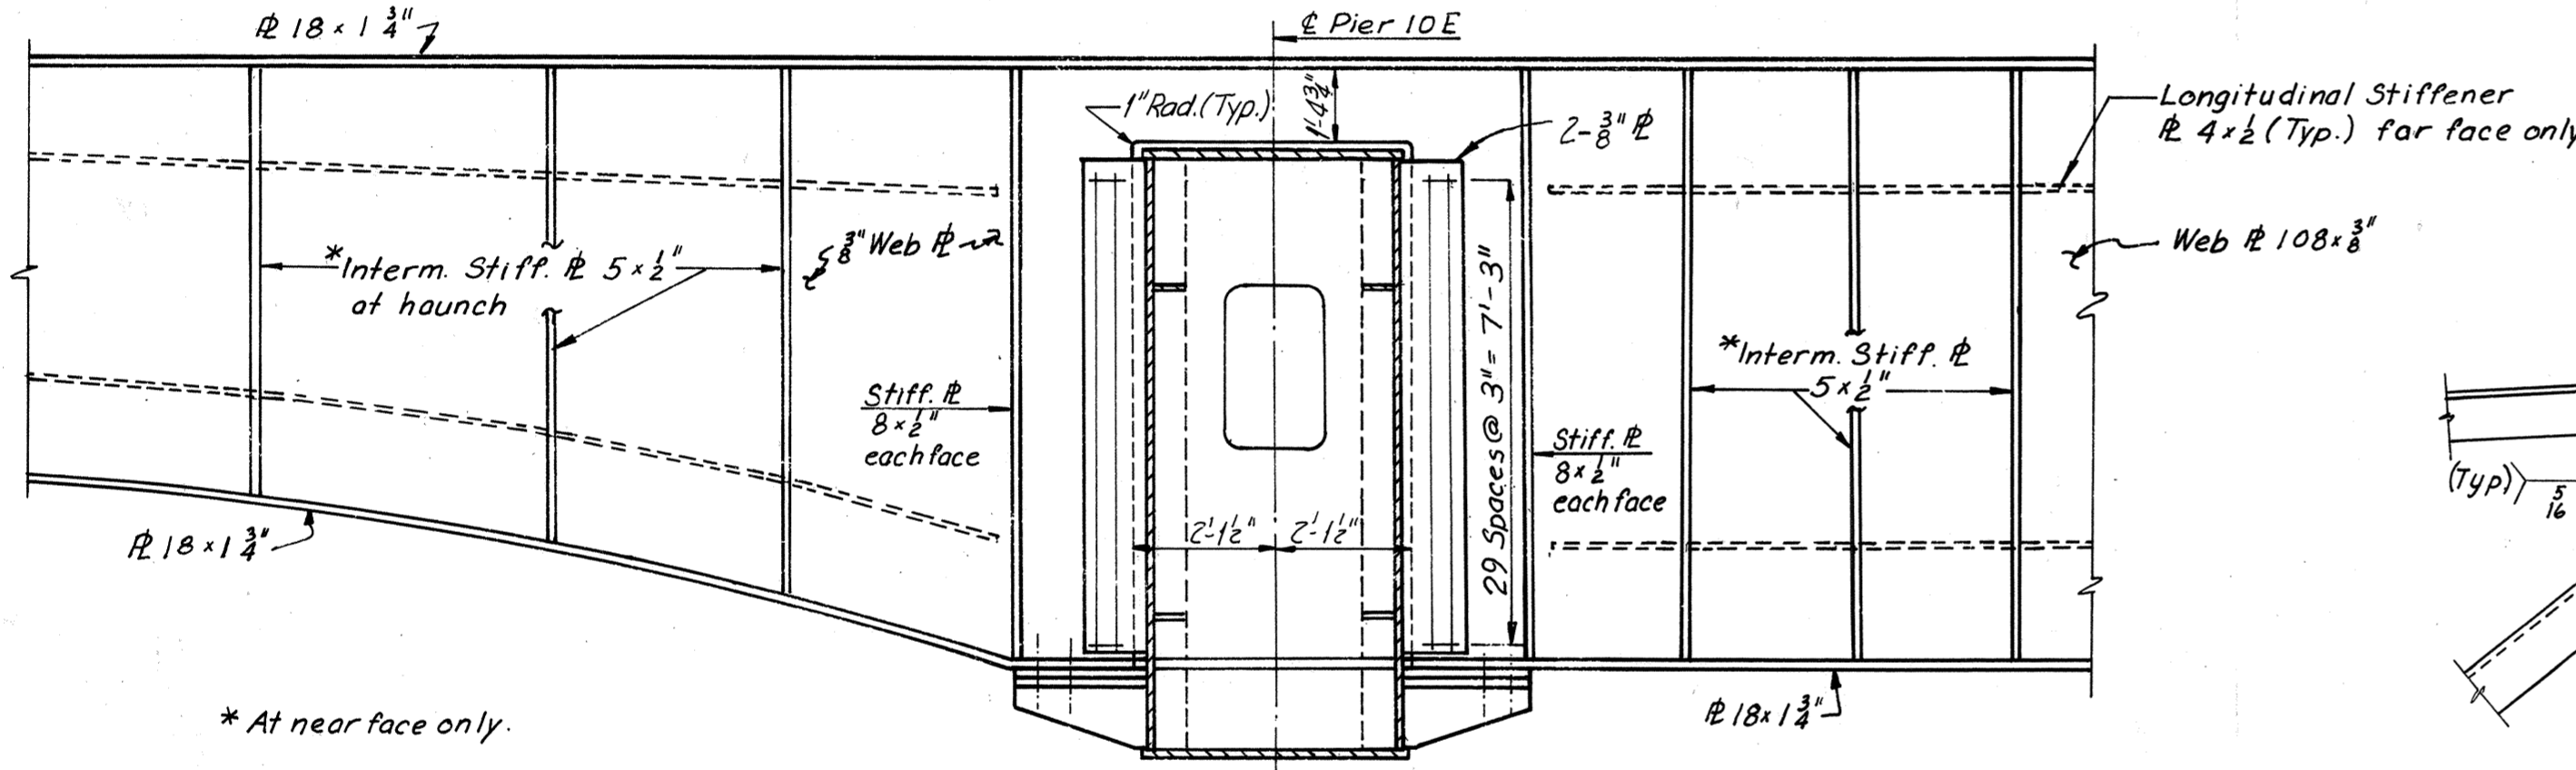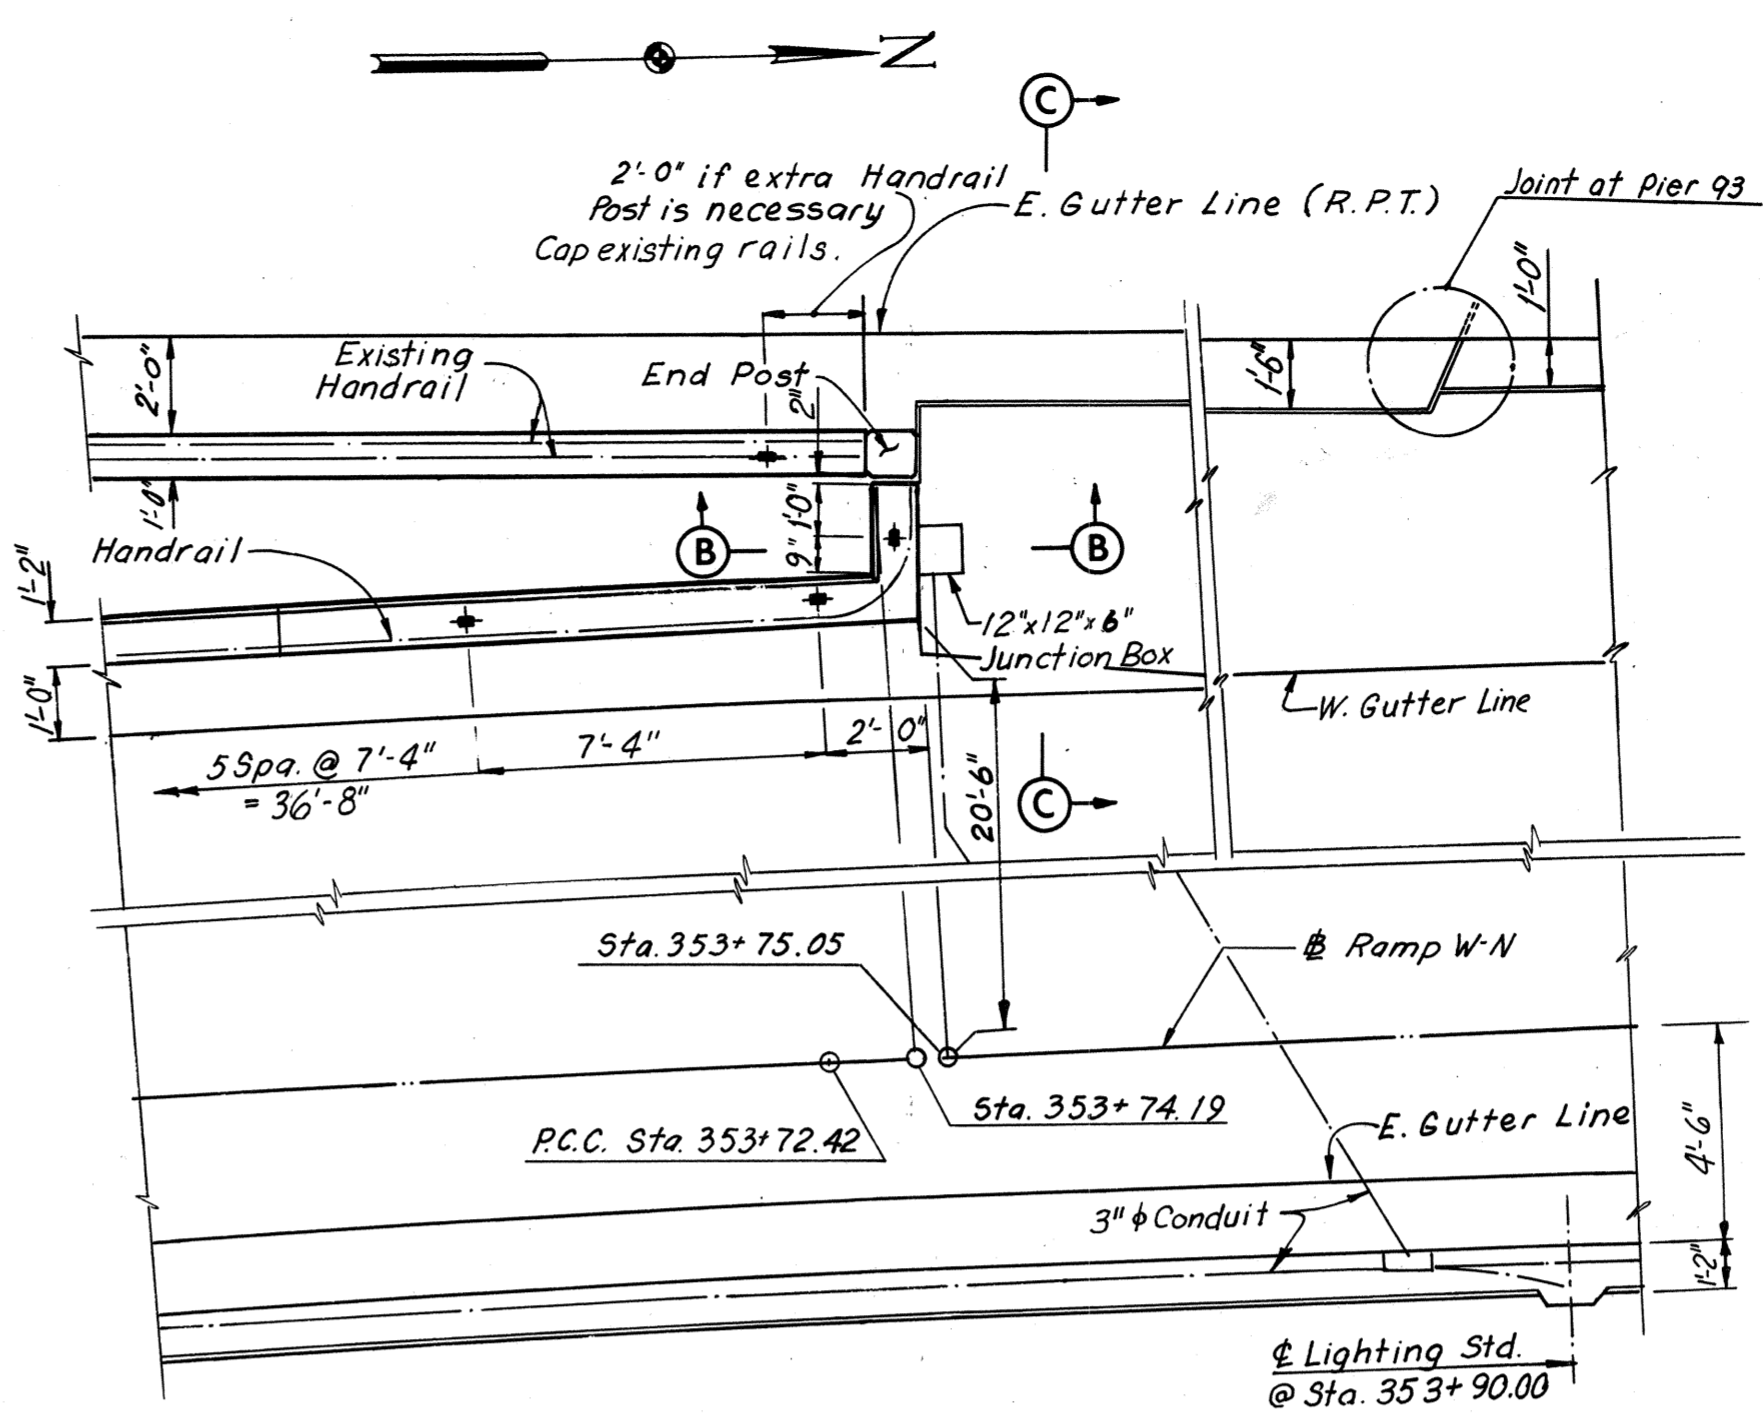


DETAIL C
Scale: 3/8" = 1'-0"

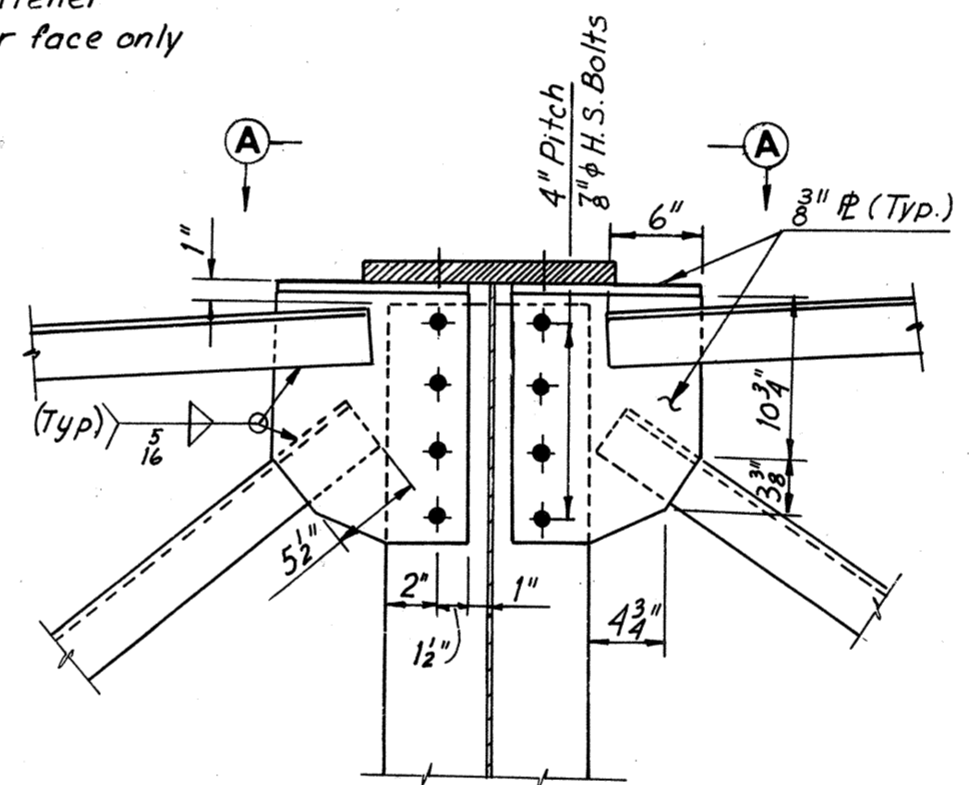


DETAIL A
Scale: 1" = 1'-0"

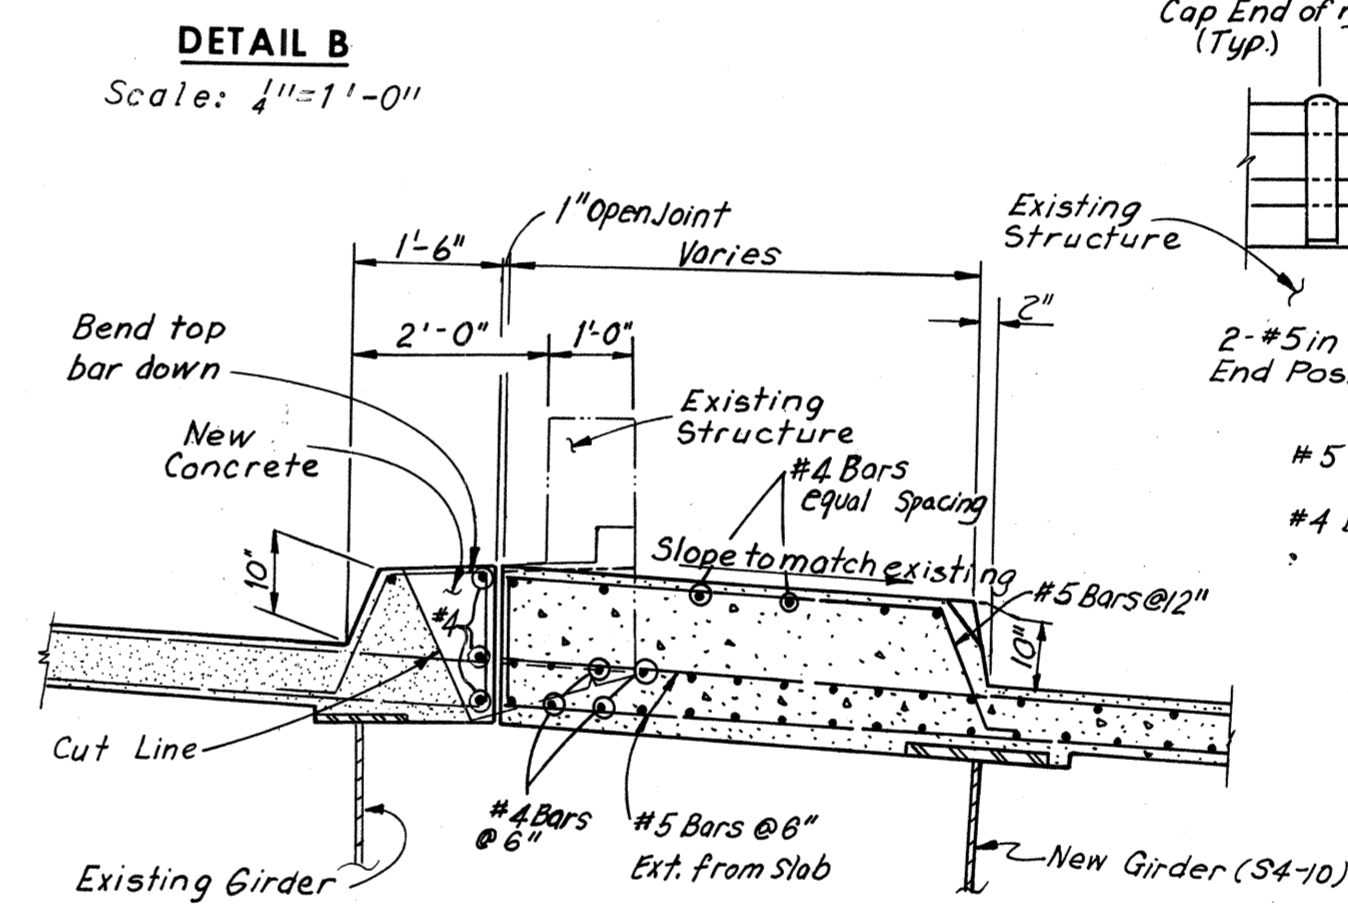


SECTION C-C
Scale: 1/2" = 1'-0"

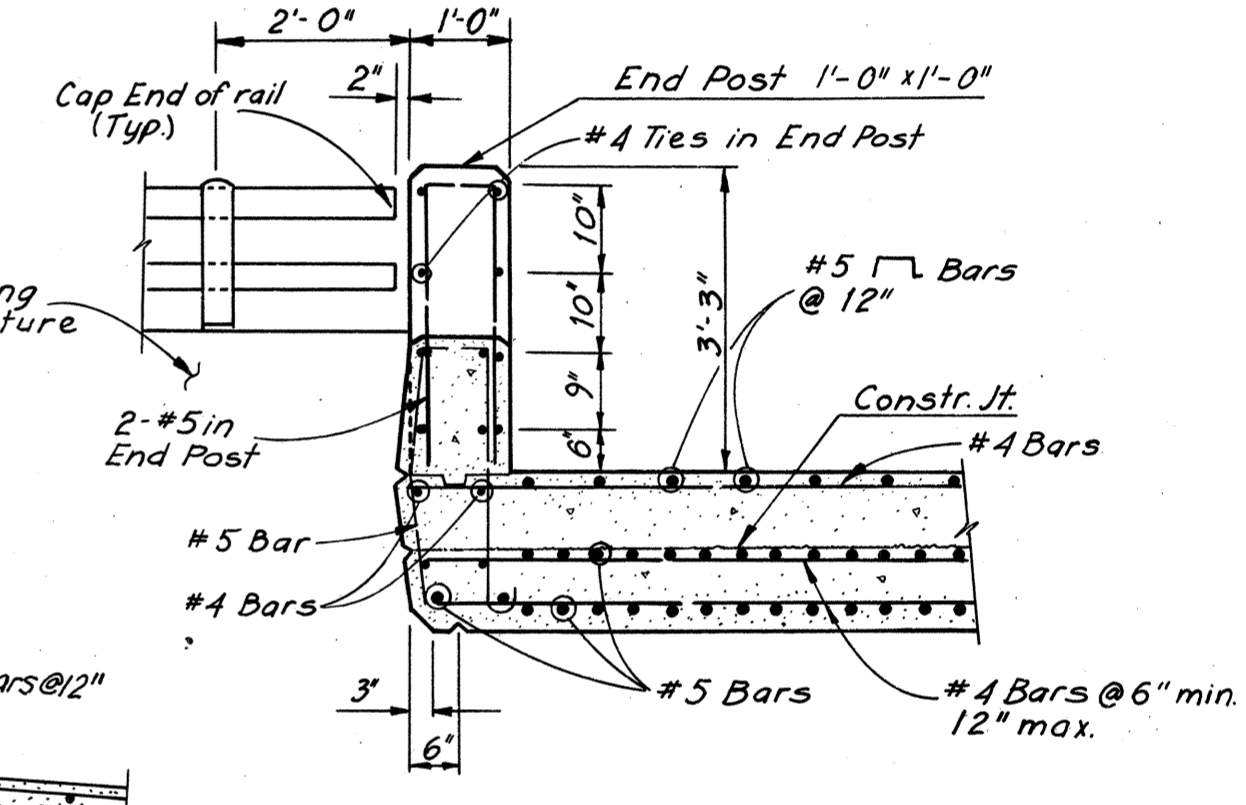


SECTION B-B
Scale: 1/2" = 1'-0"

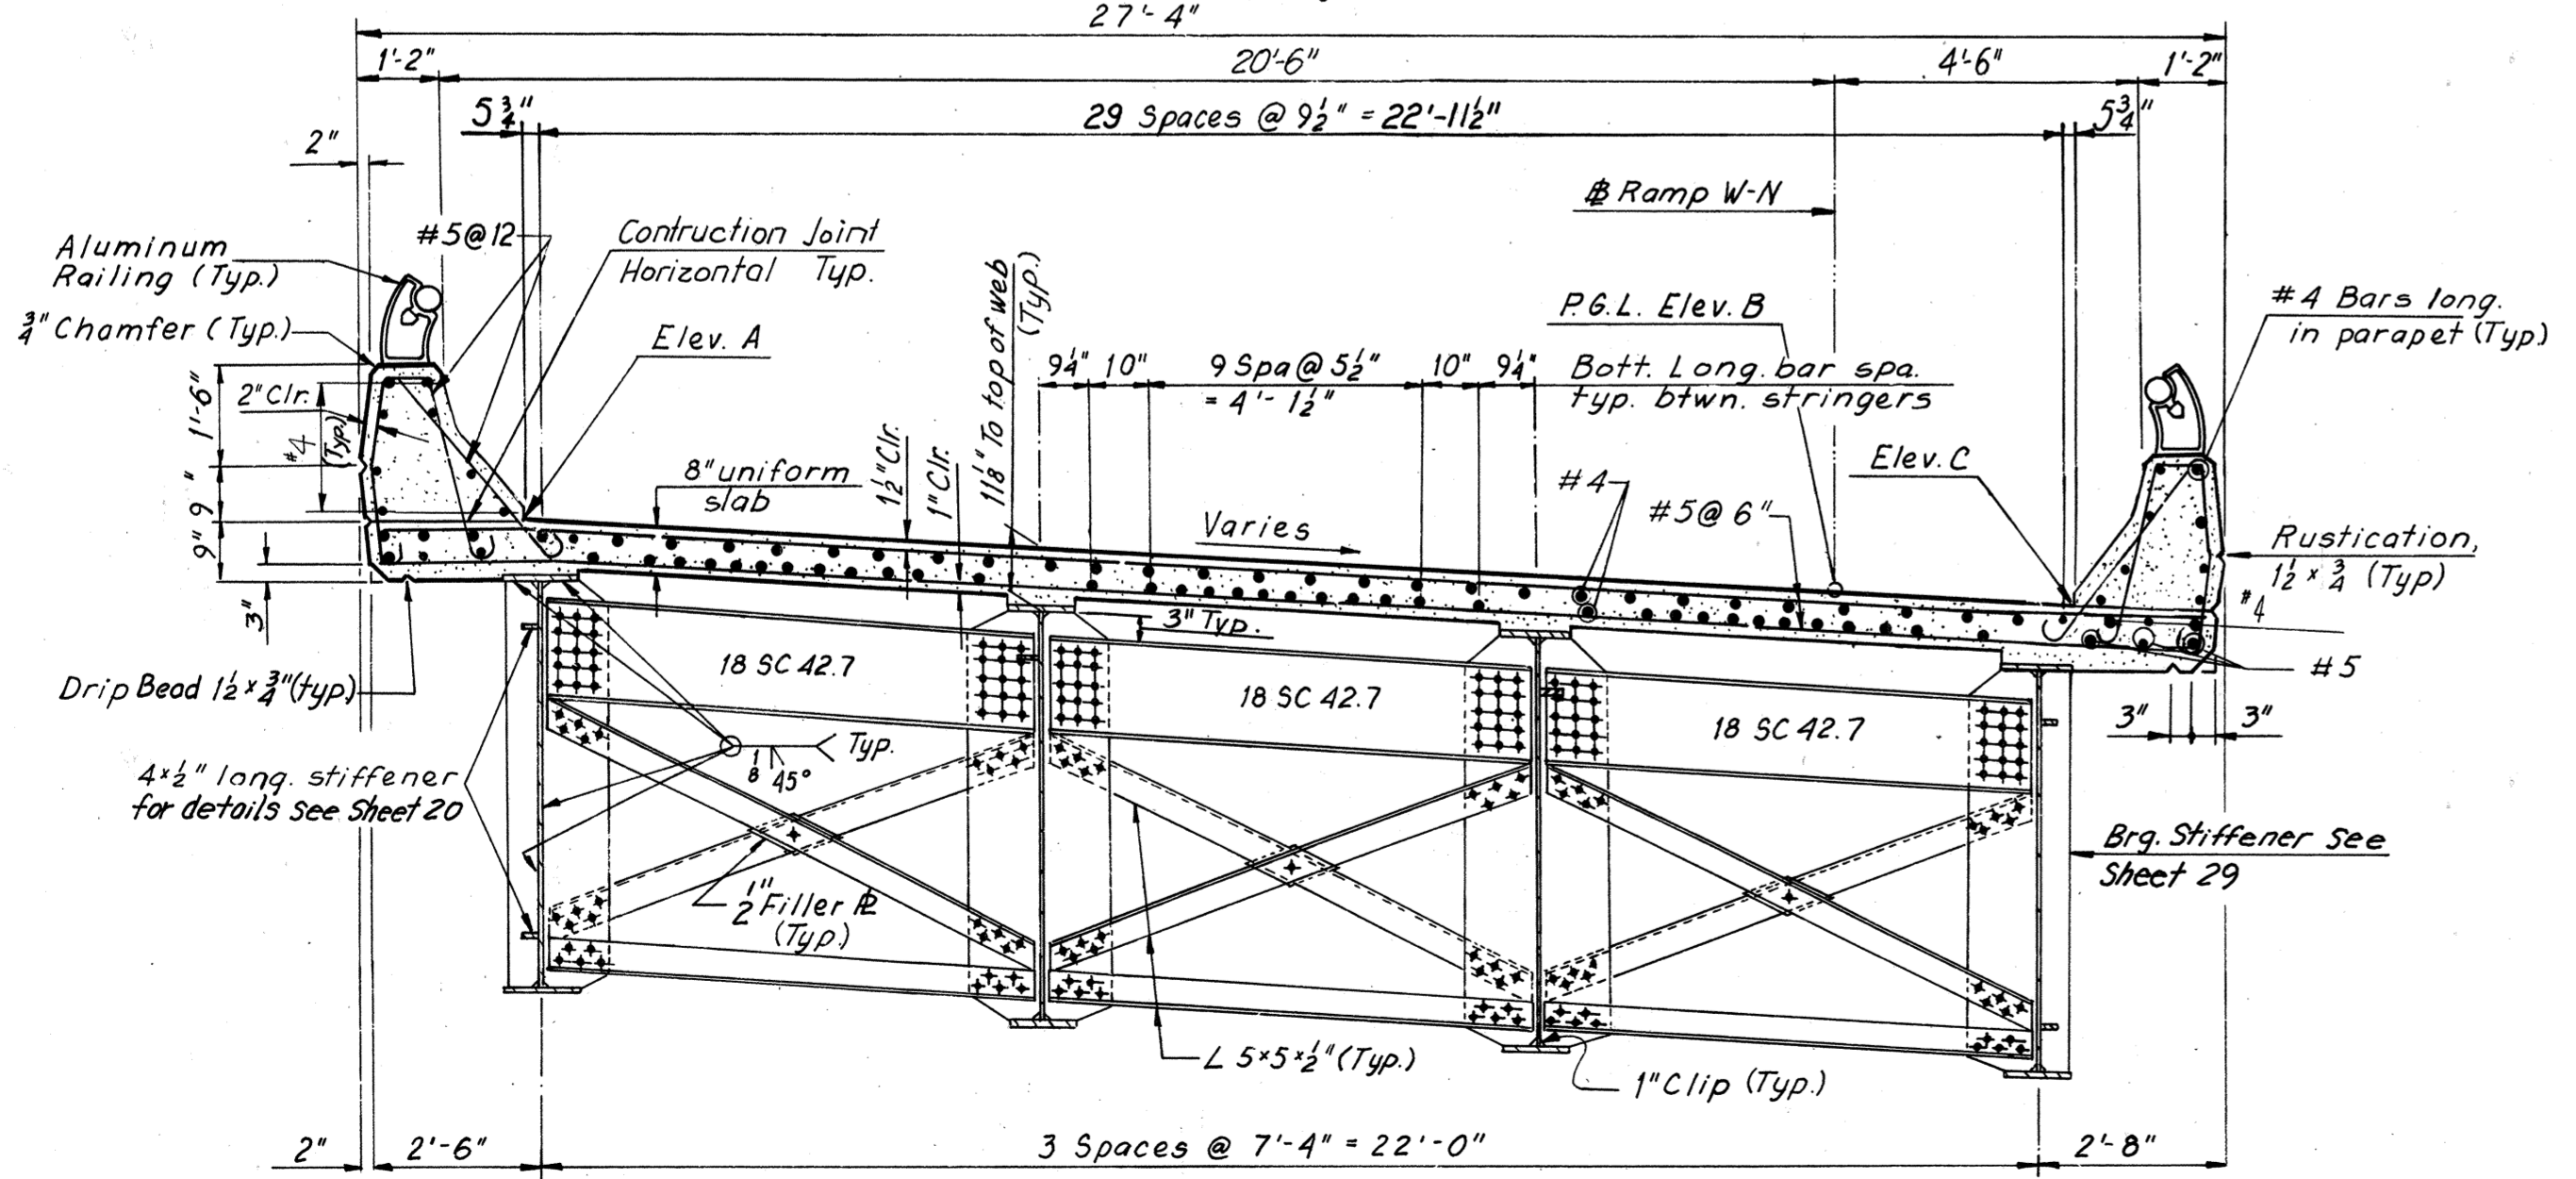

SECTION D-D - END DIAPHRAGM
Scale: 3/8" = 1'-0"

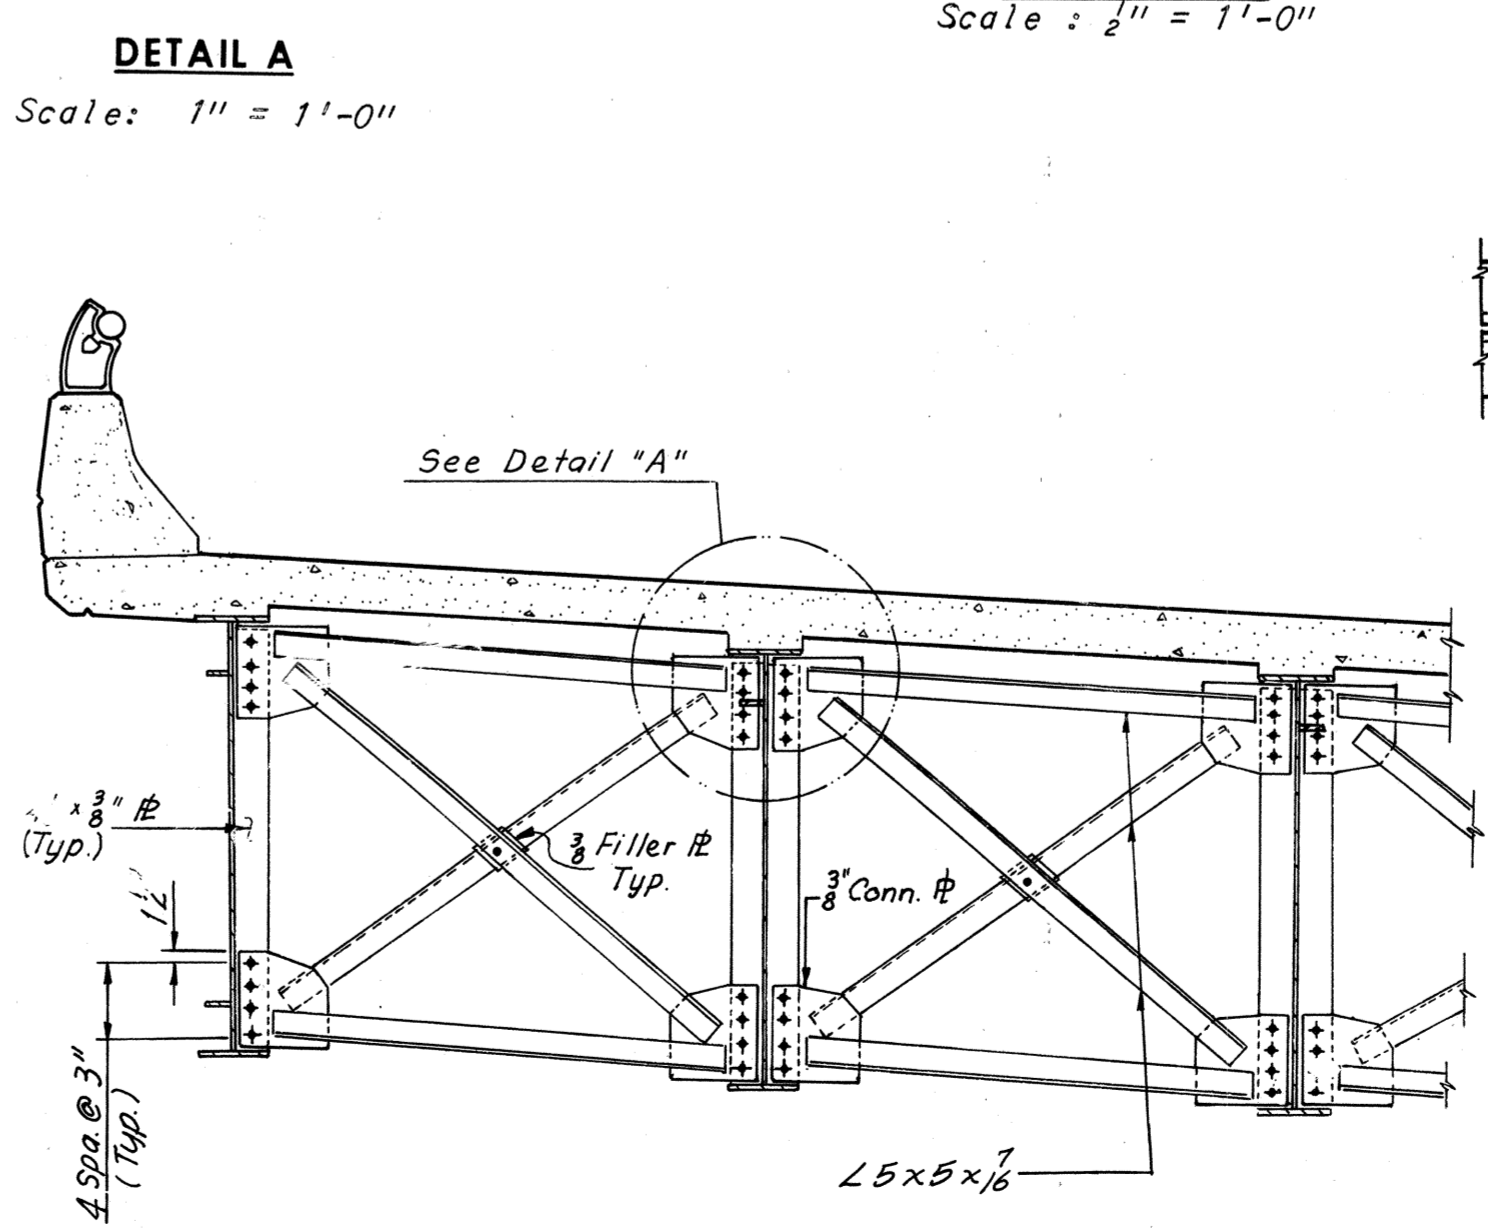

INTERMEDIATE DIAPHRAGM-UNIT 9
Scale: 3/8" = 1'-0"

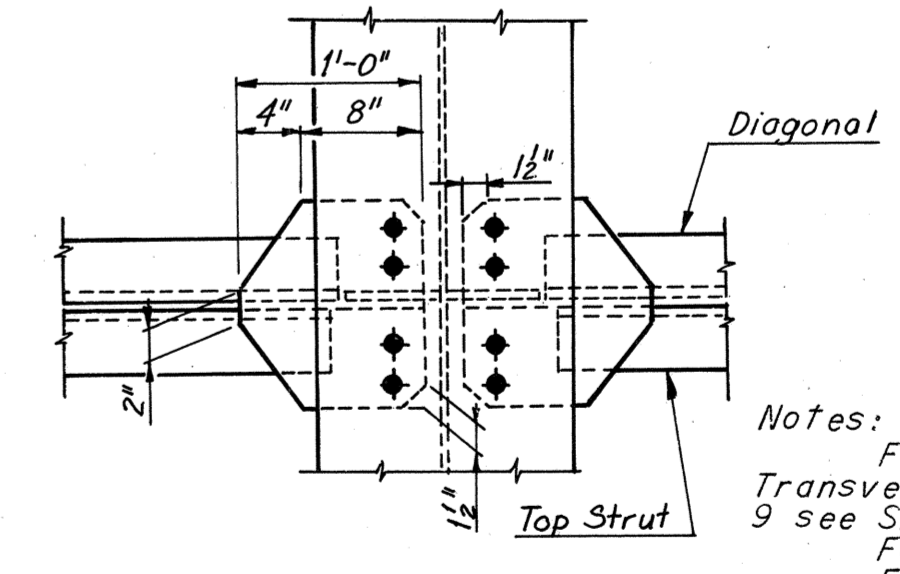

VIEW A-A
Scale: 1" = 1'-0"

Notes:
For Intermediate Diaphragm and Transverse Stiffener Spacing for Unit 9 see Sheet 23.
For Handrail Details see Sheet 53.
For Lighting Details see Sheet 54.
For Location of Detail B see Sheet 34.
For Standard Drainage Details see Support Type 3 Sheet 56.
For Location of Detail C see Stringer S1-10 Sheet 24.
For Typical Parapet Detail, see Sheet 29.

BY	DATE	REVISION	BY	DATE
MADE	C.E.B.	3-7-69	2 As Built	TEM 6-77
CHECKED	A.M.H.	4-21-69	Revised 2 sizes, Intermediate Diaphragm	R.P. 1-24-75
IN CHARGE				

Unit 9 shown, Unit 10 Diaphragm similar

RICHMOND METROPOLITAN AUTHORITY
RICHMOND EXPRESSWAY SYSTEM
DOWNTOWN EXPRESSWAY

BRIDGE NO. 67
RAMP W-N CONNECTION TO
RICHMOND-PETERSBURG TURNPIKE
DECK PLAN AND SUPERSTRUCTURE DETAILS
UNIT 9






HOWARD, NEEDLES, TAMMEN & BERGENDOFF
consulting engineers
NEW YORK ALEXANDRIA KANSAS CITY

SCALE: As Noted
CONTRACT NO.: 10
SHEET NO. 33 OF 54

AS BUILT

RICHMOND EXPRESSWAY SYSTEM			
SECTION	PROJECT	SHEET NO.	TOTAL SHEETS
10	DOWNTOWN EXPRESSWAY	206	265

ELEVATION TABLE			
STATION	ELEV. A	ELEV. B	ELEV. C
353+26.00	88.98	89.05	89.43
+30.00	88.96	89.03	89.41
+40.00	88.89	88.96	89.34
+50.00	88.80	88.87	89.25
+60.00	88.68	88.75	89.13
+70.00	88.54	88.61	88.99
+80.00	88.37	88.44	88.82
+90.00	88.17	88.24	88.62
354+00.00	87.96	88.03	88.41
+10.00	87.72	87.79	88.17
+20.00	87.46	87.53	87.91
+29.50	87.19	87.26	87.64
+30.00	87.17	87.24	87.62
+40.00	86.88	86.95	87.33
+50.00	86.57	86.64	87.02
+60.00	86.24	86.31	86.69
+70.00	85.89	85.96	86.34
+80.00	85.52	85.59	85.97
+90.00	85.13	85.20	85.58
355+00.00	84.72	84.79	85.17
+10.00	84.30	84.37	84.75
+20.00	83.86	83.93	84.33
+30.00	83.41	83.48	83.90
+40.00	82.94	83.02	83.46
+50.00	82.45	82.54	83.02
+60.00	81.97	82.06	82.57
+70.00	81.48	81.57	82.12
+80.00	80.99	81.09	81.68
+90.00	80.49	80.61	81.23
356+00.00	80.00	80.12	80.77
+10.00	79.51	79.64	80.31
+20.00	79.02	79.15	79.85
+30.00	78.53	78.67	79.39
+39.50	78.06	78.21	78.95
+40.00	78.04	78.19	78.92
+50.00	77.55	77.70	78.46
+60.00	77.06	77.22	77.99
+70.00	76.58	76.74	77.53
+80.00	76.11	76.29	77.10
+90.00	75.67	75.86	76.68
357+00.00	75.25	75.45	76.28
+10.00	74.85	75.05	75.88
+20.00	74.44	74.65	75.48
+30.00	74.04	74.25	75.09
+40.00	73.65	73.86	—
+50.00	73.27	73.48	—
+60.00	72.89	73.10	—
+65.50	72.69	72.90	—

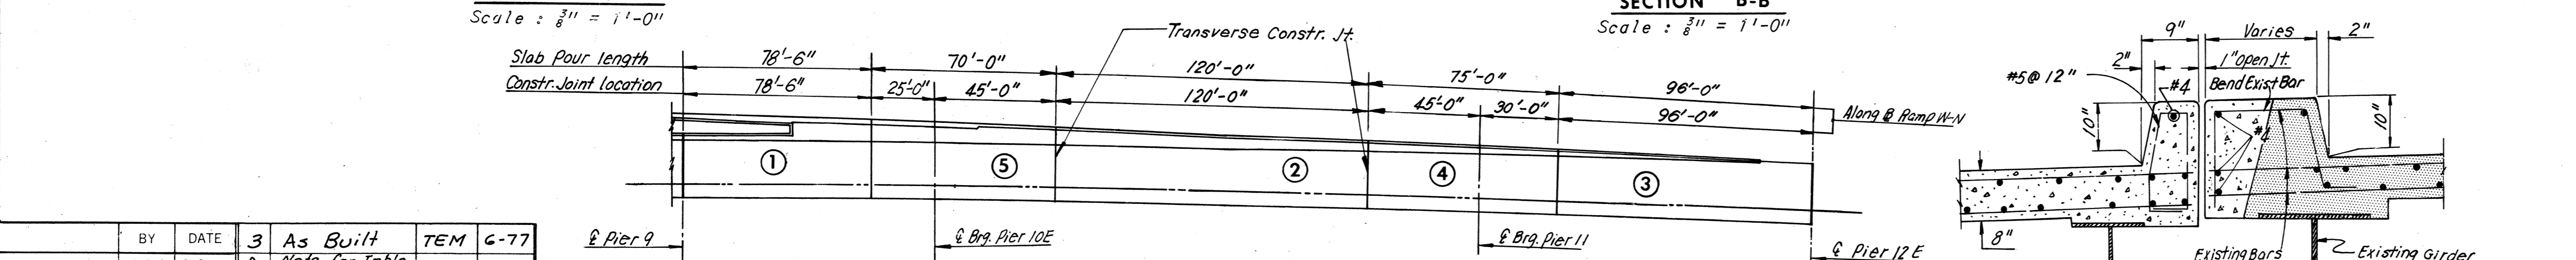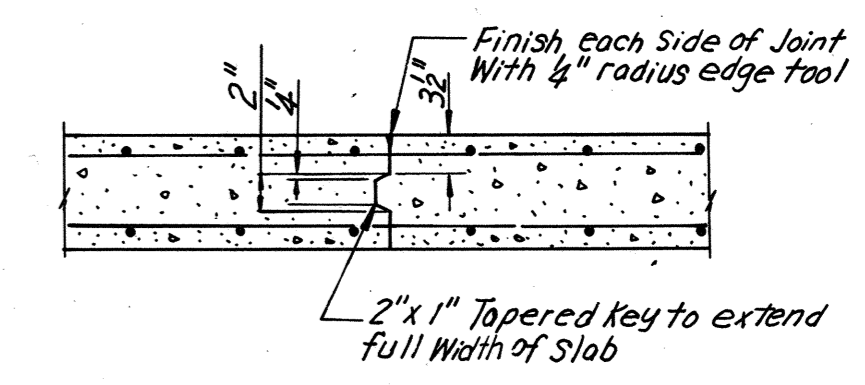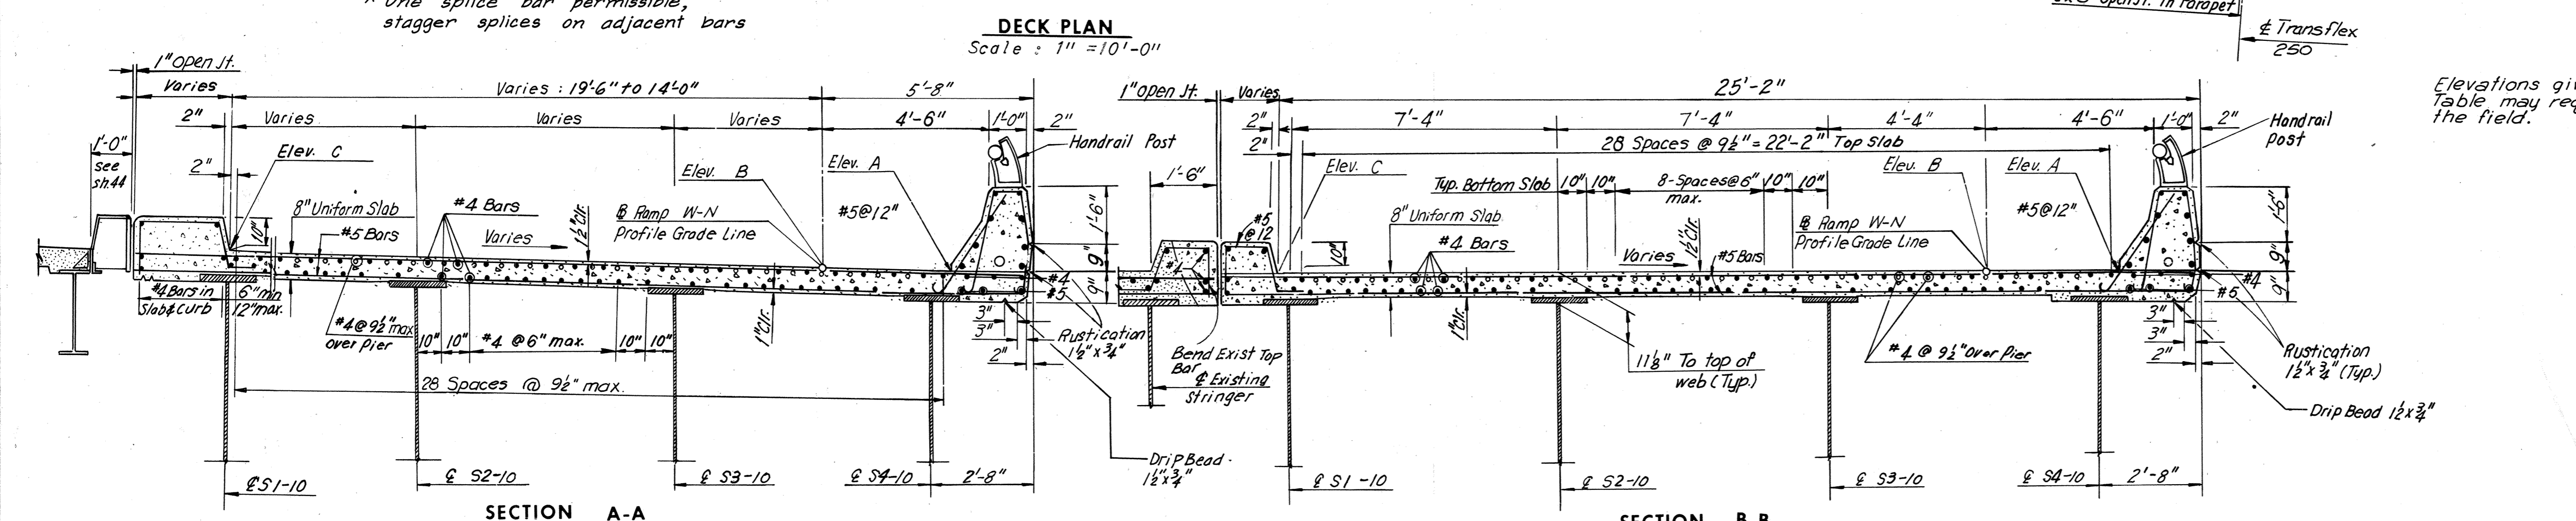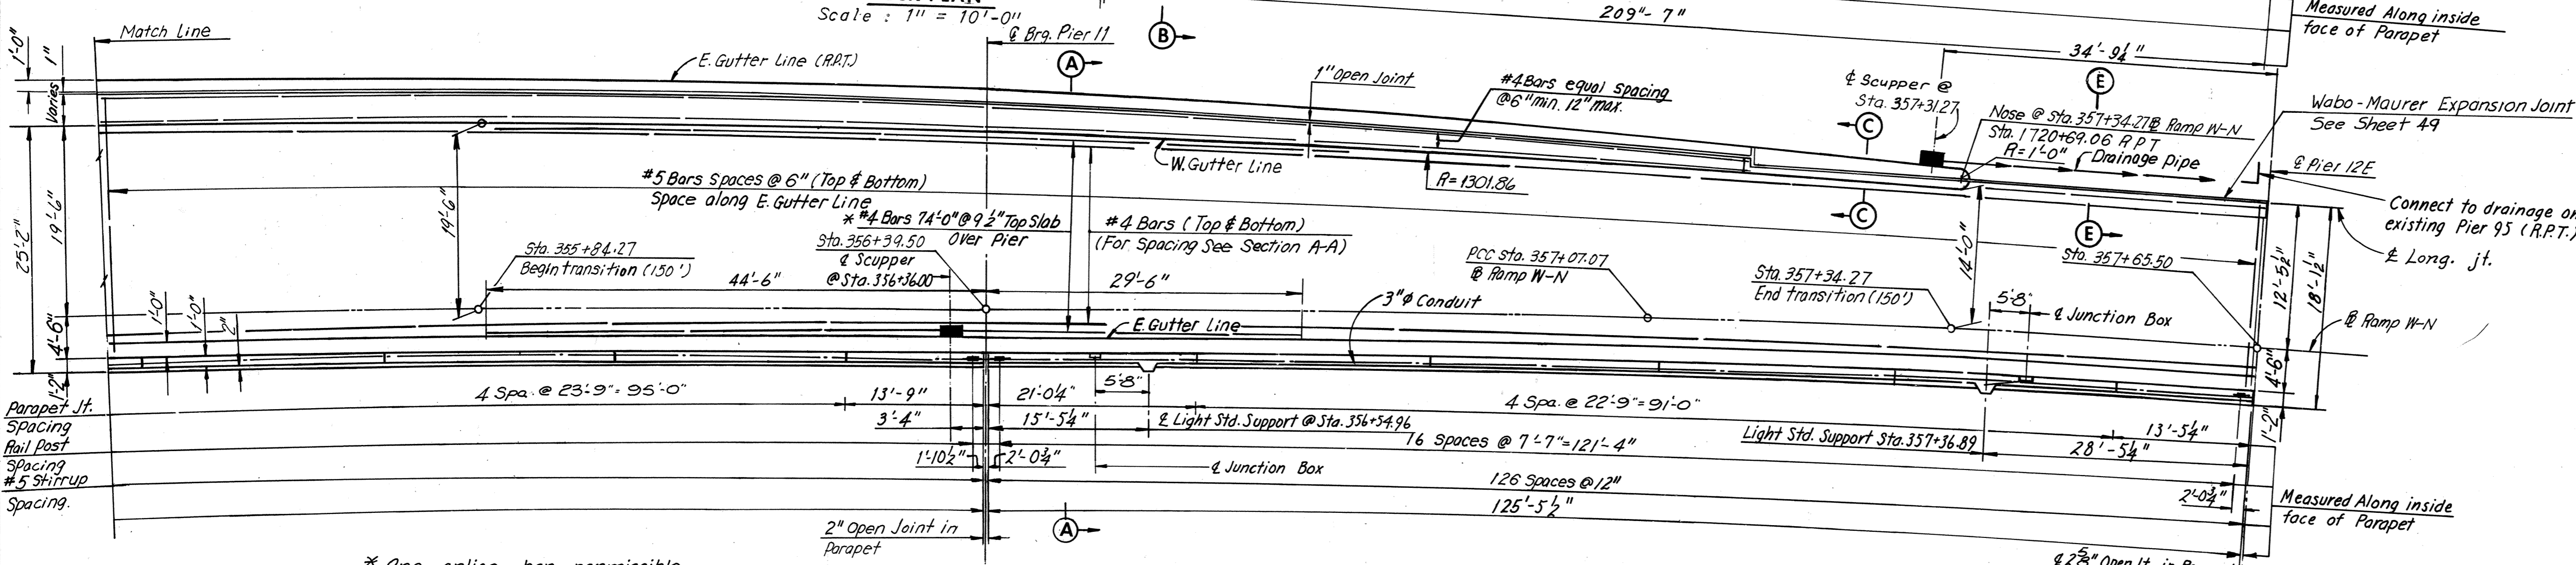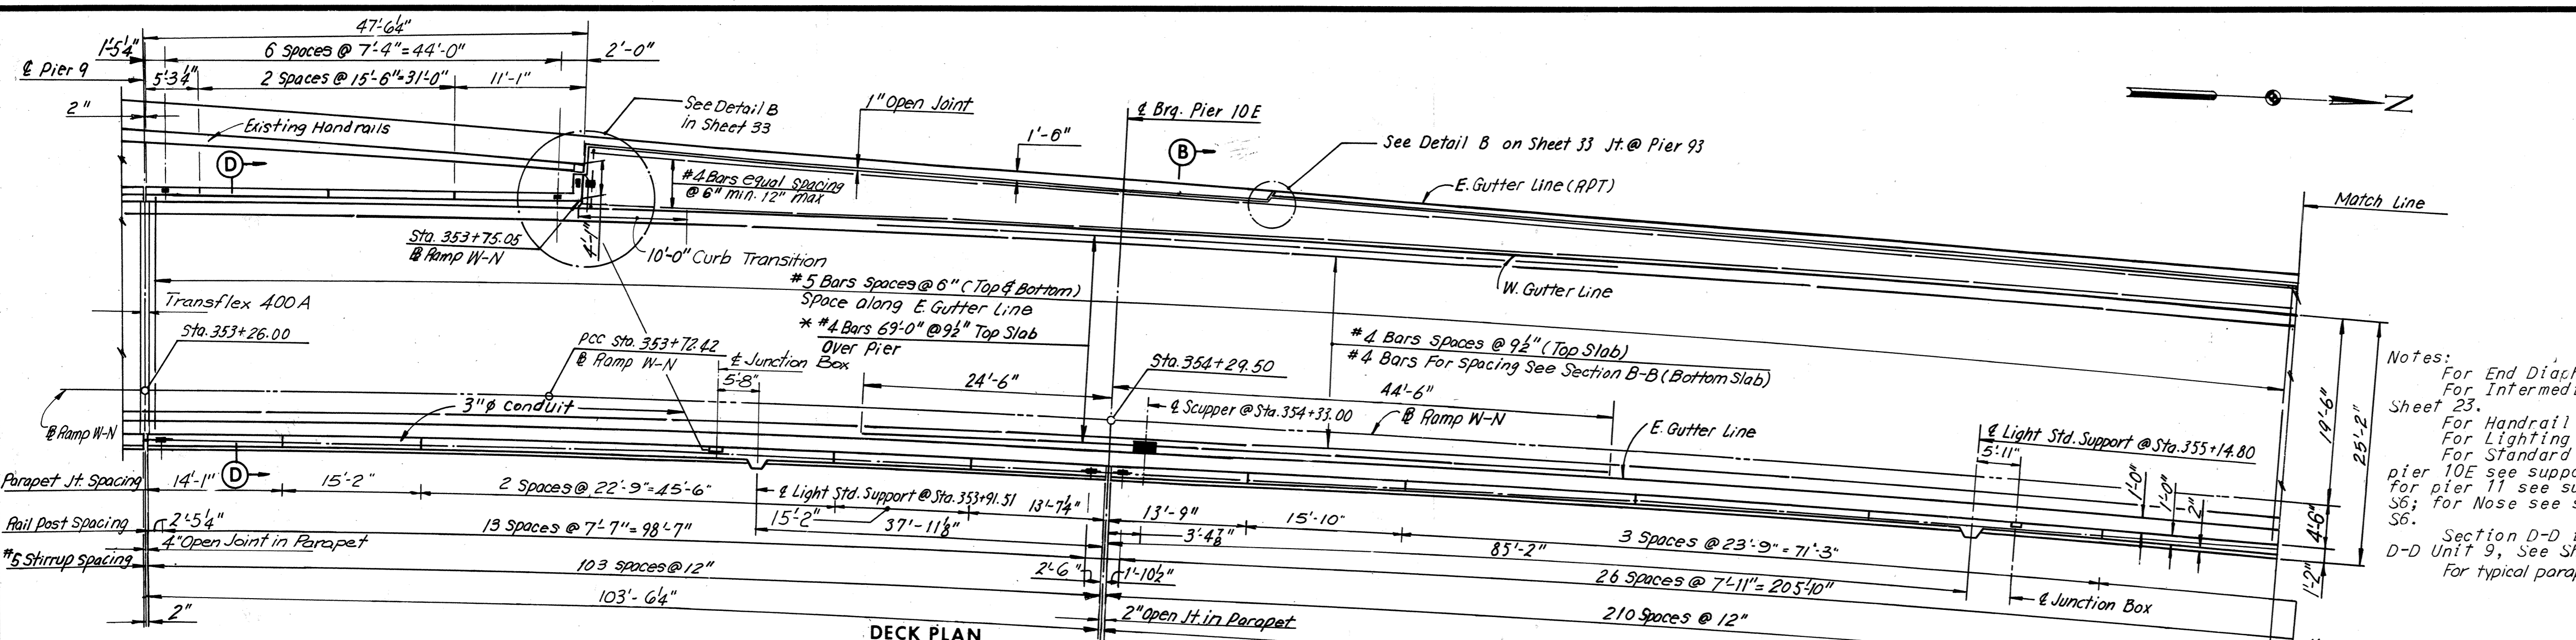

Notes:
 For End Diaphragms see, Sheet 33.
 For Intermediate Diaphragms see, Sheet 23.
 For Handrail Details see, Sheet 33.
 For Lighting Details see, Sheet 34.
 For Standard Drainage Details for pier 10E see support Type 10, sheet S6; for pier 11 see support Type 9, sheet S6; for Nose see support Type 9, sheet S6.
 Section D-D is similar to Section D-D Unit 9, See Sheet 33.
 For typical parapet Details, see Sheet 29.

Elevations given in the Elevation Table may require adjustment in the field.

BY	DATE	3	As Built	TEM	G-77
MADE	G.S.H	2-26-69	△	DWB	1-28-75
CHECKED	AMH	4-23-69	△	RJF	1-24-75
IN CHARGE	NO.	REVISION	BY	DATE	

AS BUILT


RICHMOND METROPOLITAN AUTHORITY
 RICHMOND EXPRESSWAY SYSTEM
 DOWNTOWN EXPRESSWAY

BRIDGE NO. 67
 RAMP W-N CONNECTION TO
 RICHMOND-PETERSBURG TURNPIKE
 DECK PLAN — UNIT 10

HOWARD, NEEDLES, TAMMEN & BERGENDOFF
 consulting engineers
 NEW YORK ALEXANDRIA KANSAS CITY

SCALE: As Noted
 CONTRACT NO.: 10
 SHEET NO. 34 OF 54

RICHMOND EXPRESSWAY SYSTEM			
SECTION	PROJECT	SHEET NO.	TOTAL SHEETS
10	DOWNTOWN EXPRESSWAY	207	265

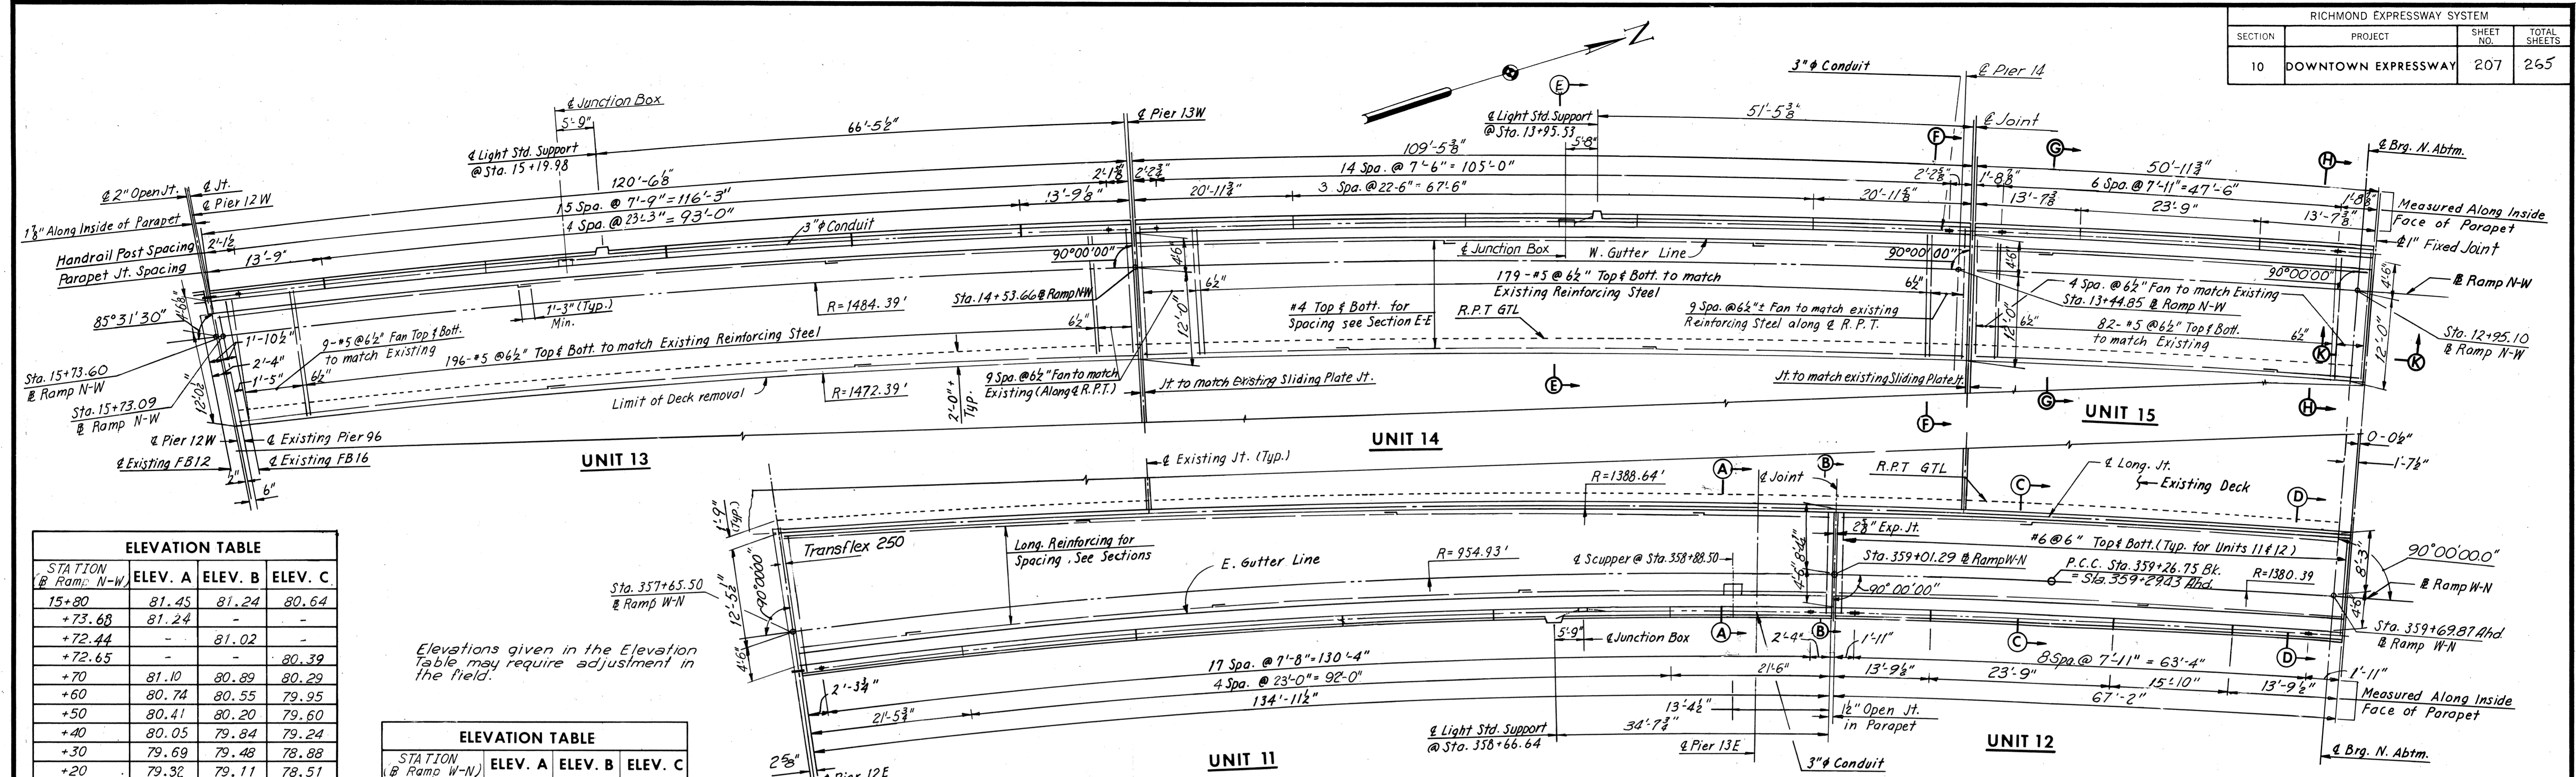



STATION @ Ramp N-W	ELEV. A	ELEV. B	ELEV. C
15+80	81.45	81.24	80.64
+73.68	81.24	-	-
+72.44	-	81.02	-
+72.65	-	-	80.39
+70	81.10	80.89	80.29
+60	80.74	80.55	79.95
+50	80.41	80.20	79.60
+40	80.05	79.84	79.24
+30	79.69	79.48	78.88
+20	79.32	79.11	78.51
+10	78.95	78.74	78.14
15+00	78.57	78.36	77.76
14+90	78.20	77.99	77.39
+80	77.82	77.61	77.01
+70	77.45	77.24	76.64
+60	77.08	76.87	76.27
+53.40	76.85	76.64	76.04
+50	76.72	76.51	75.91
+40	76.37	76.16	75.56
+30	76.02	75.81	75.21
+20	75.67	75.46	74.86
+10	75.31	75.10	74.50
14+00	74.96	74.75	74.15
13+90	74.61	74.40	73.80
+80	74.26	74.05	73.45
+70	73.91	73.70	73.10
+60	73.55	73.34	72.74
+50	73.20	72.99	72.39
+44.61	73.01	72.80	72.20
+40	72.85	72.64	72.04
+30	72.49	72.28	71.68
+20	72.13	71.92	71.32
+10	71.77	71.56	70.96
13+00	71.40	71.19	70.59
12+92.81	71.12	70.91	70.31

STATION @ Ramp W-N	ELEV. A	ELEV. B	ELEV. C
357+60	72.89	73.10	74.28
+65.50	72.69	72.90	73.65
+70	72.53	72.74	73.48
+80	72.17	72.38	73.09
+90	71.82	72.03	72.70
358+00	71.46	71.67	72.32
+10	71.10	71.31	71.94
+20	70.75	70.96	71.56
+30	70.39	70.60	71.19
+40	70.02	70.23	70.80
+50	69.65	69.86	70.41
+60	69.26	69.47	70.01
+70	68.86	69.07	69.60
+80	68.46	68.67	69.18
+90	68.06	68.27	68.78
+92	67.98	68.19	68.70
359+00	67.67	67.88	68.38
+02.00	67.60	67.81	68.31
+10	67.24	67.50	68.00
+20	66.93	67.14	67.63
+30	66.57	66.78	67.27
+40	66.20	66.41	66.91
+50	65.82	66.03	66.53
+60	65.44	65.65	66.14
+69.39	65.06	65.27	65.78
+70	65.04	65.25	65.75

Elevations given in the Elevation Table may require adjustment in the field.

Note:
 For Sections E-E, F-F, G-G and H-H, see Sheet 47.
 For Framing Plan, see Sheet 26.
 For Joint Details, see Sheet 48 and 49.
 Elevation C is to be confirmed by Contractor.
 For Handrail Details, see Sheet 33.
 For Typical Parapet Details, see Sheet 28.

BY	DATE	3	As Built	TEM	G-77
MADE	Y.C.P. G.C.C.	2-27-69		DWB	1-28-75
CHECKED	K.C.T.	5-1-69		DWB	1-17-75
IN CHARGE	NO.	REVISION	BY	DATE	

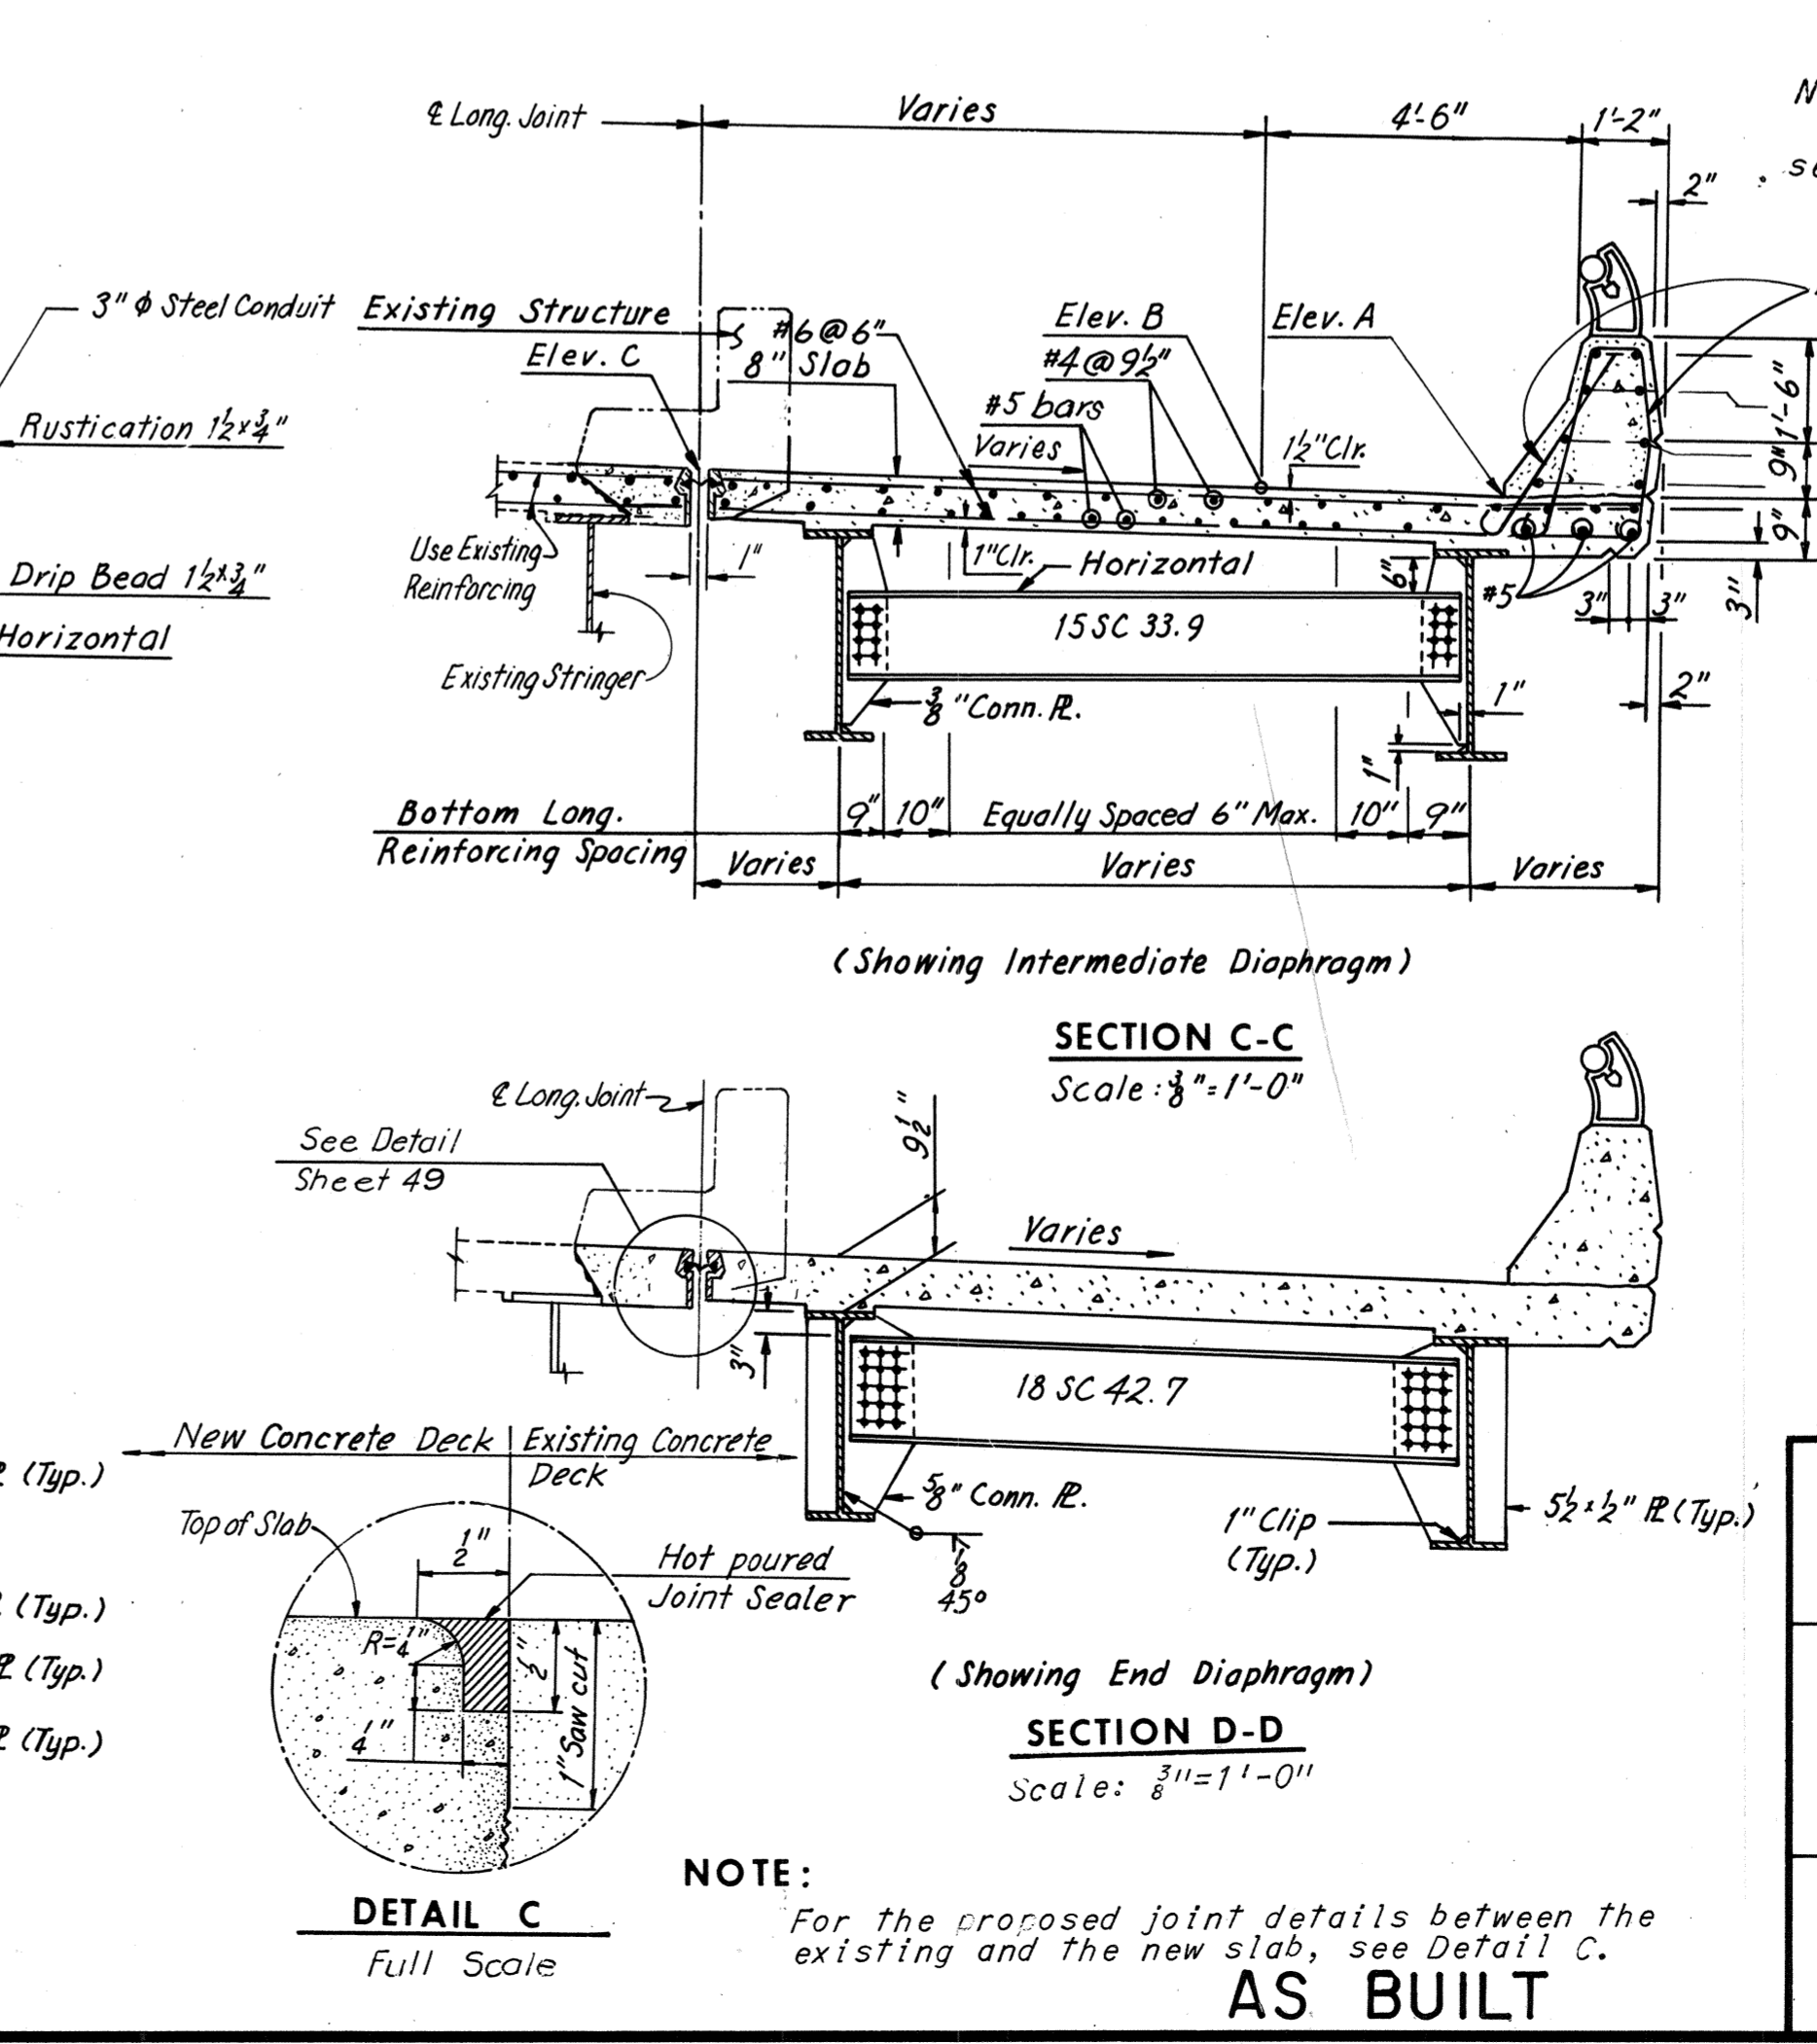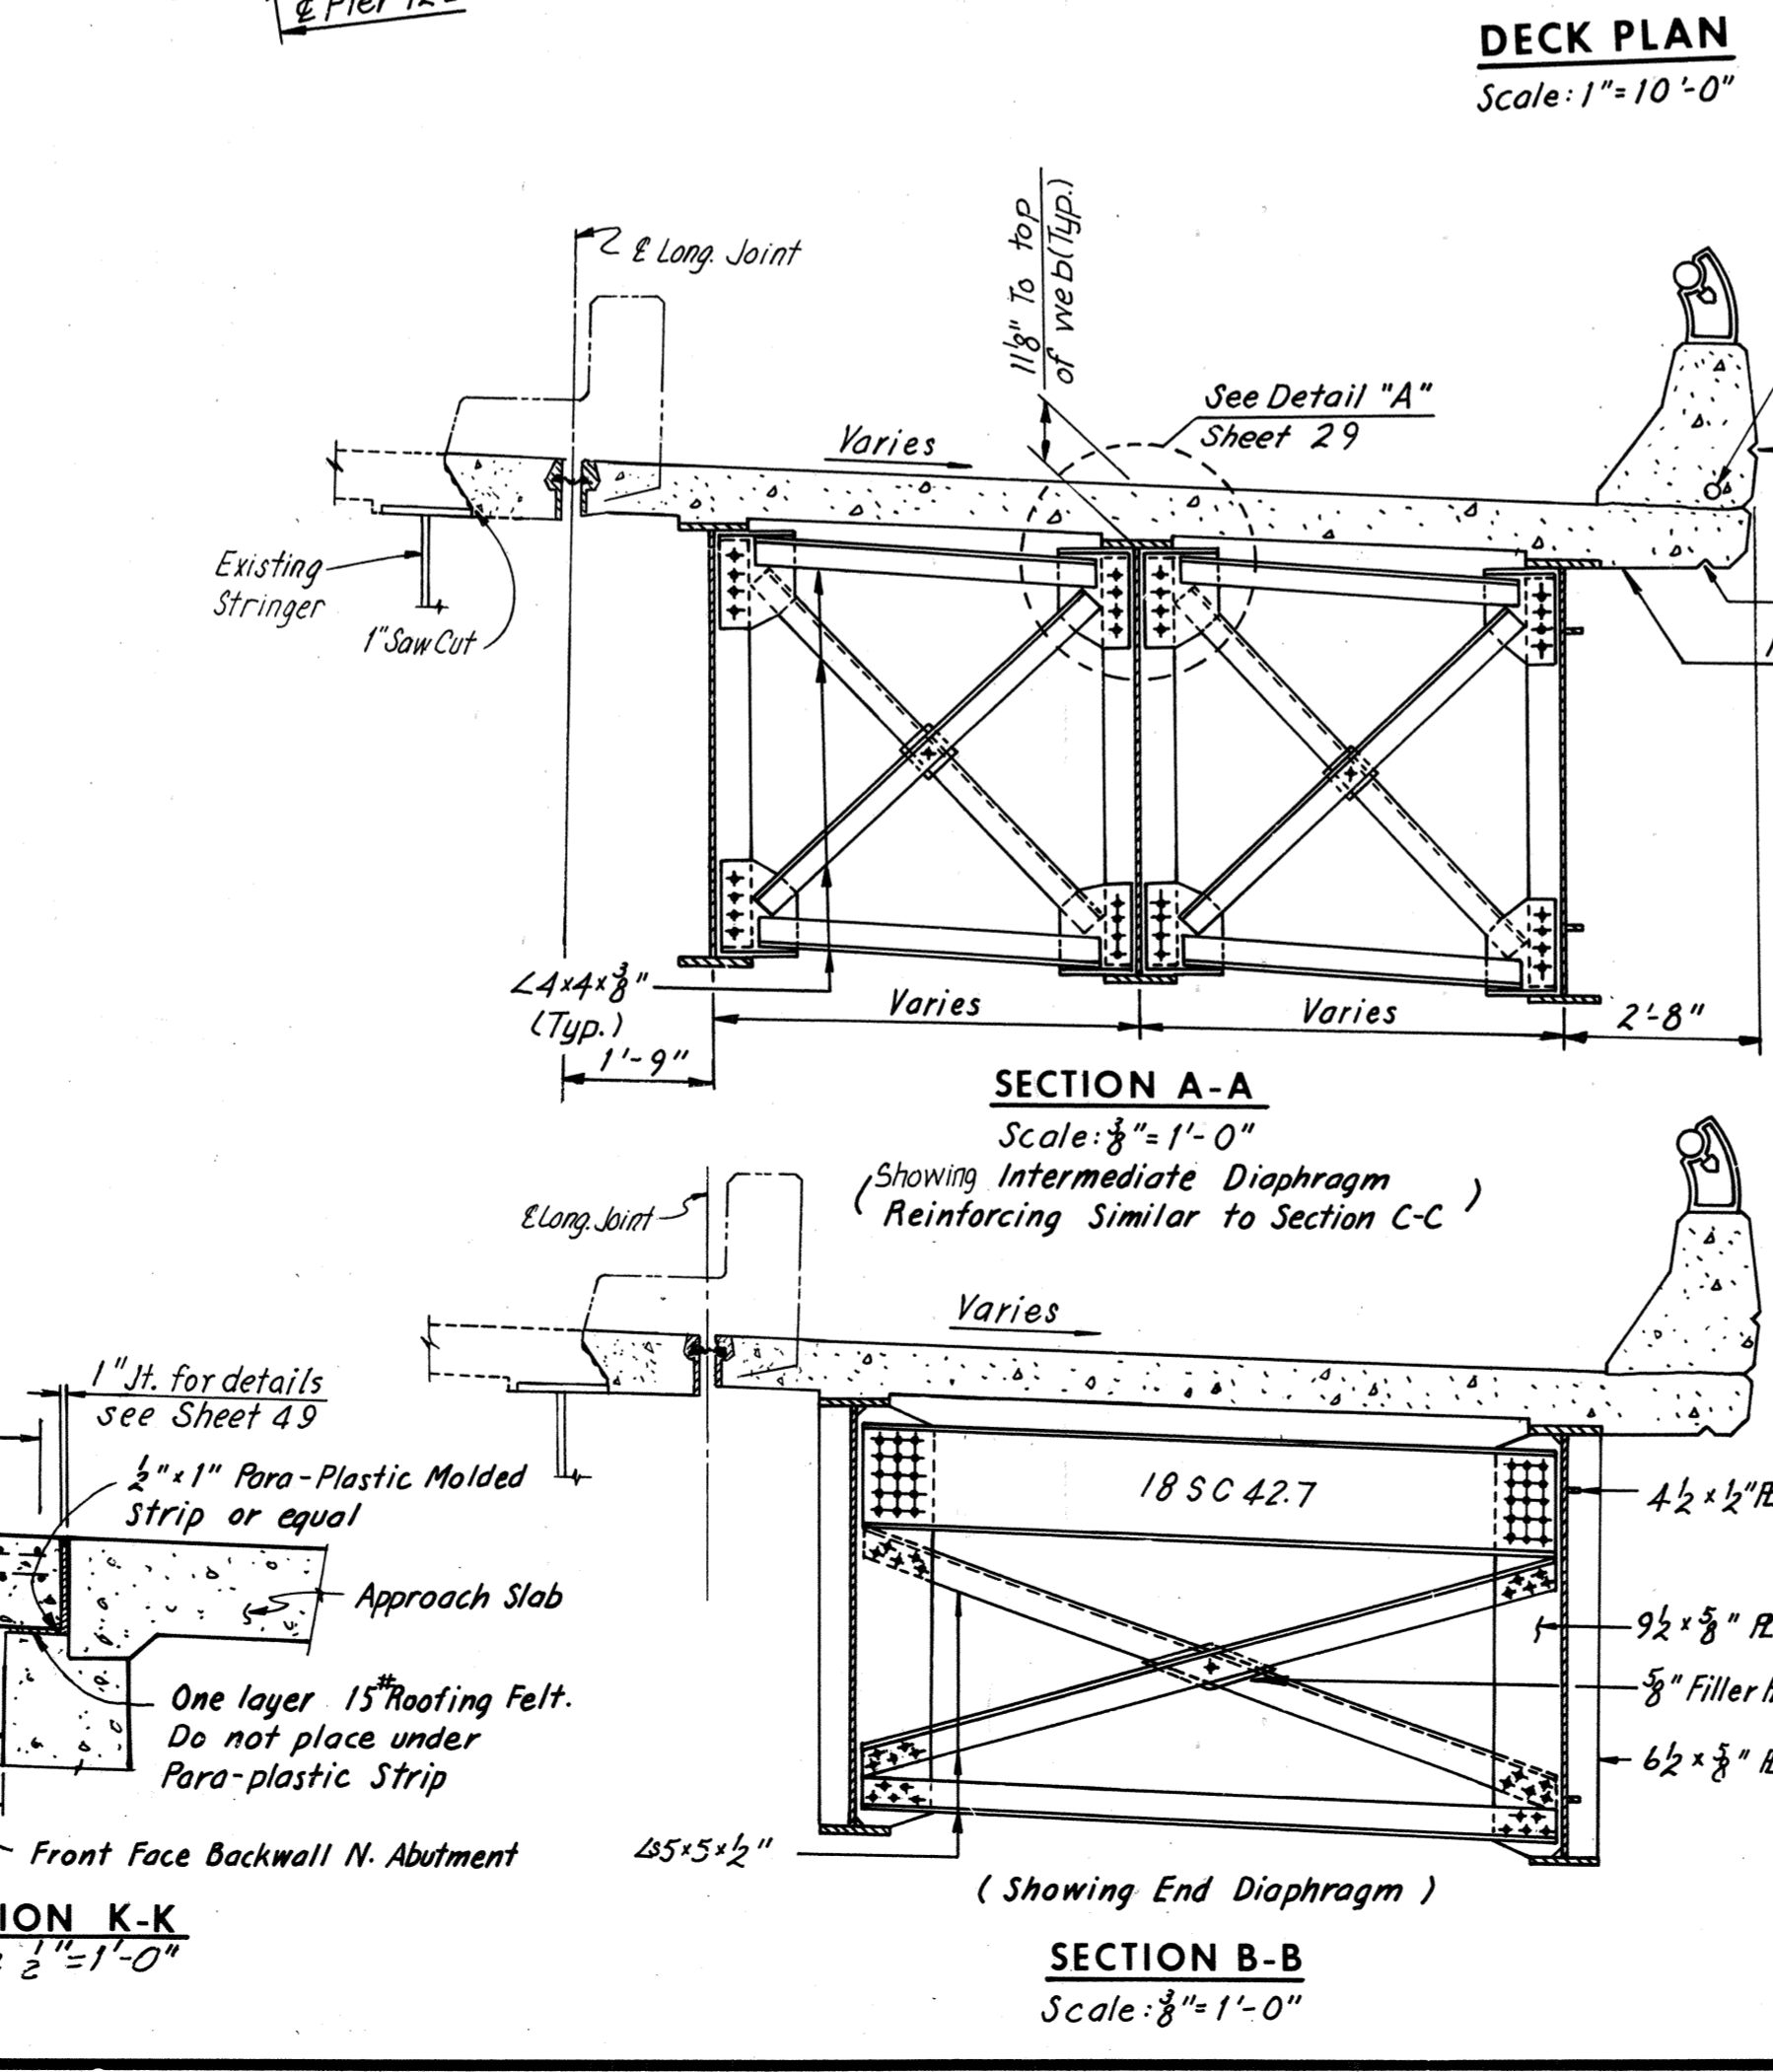

Note:
 For Standard Drainage Details for Unit 11 see Support Type 3 Sheet 36.

NOTE:
 For the proposed joint details between the existing and the new slab, see Detail C.
AS BUILT


RICHMOND METROPOLITAN AUTHORITY
RICHMOND EXPRESSWAY SYSTEM
 DOWNTOWN EXPRESSWAY

BRIDGE NO. 67
 RAMP W-N CONNECTION TO
 RICHMOND-PETERSBURG TURNPIKE
DECK PLAN-UNITS 11, 12, 13, 14 AND 15


HOWARD, NEEDLES, TAMMEN & BERGENDOFF
 consulting engineers
 NEW YORK ALEXANDRIA KANSAS CITY

SCALE: As Noted
 CONTRACT NO.: 10
 SHEET NO. 35 OF 54


RICHMOND EXPRESSWAY SYSTEM			
SECTION	PROJECT	SHEET NO.	TOTAL SHEETS
10	DOWNTOWN EXPRESSWAY	220	265

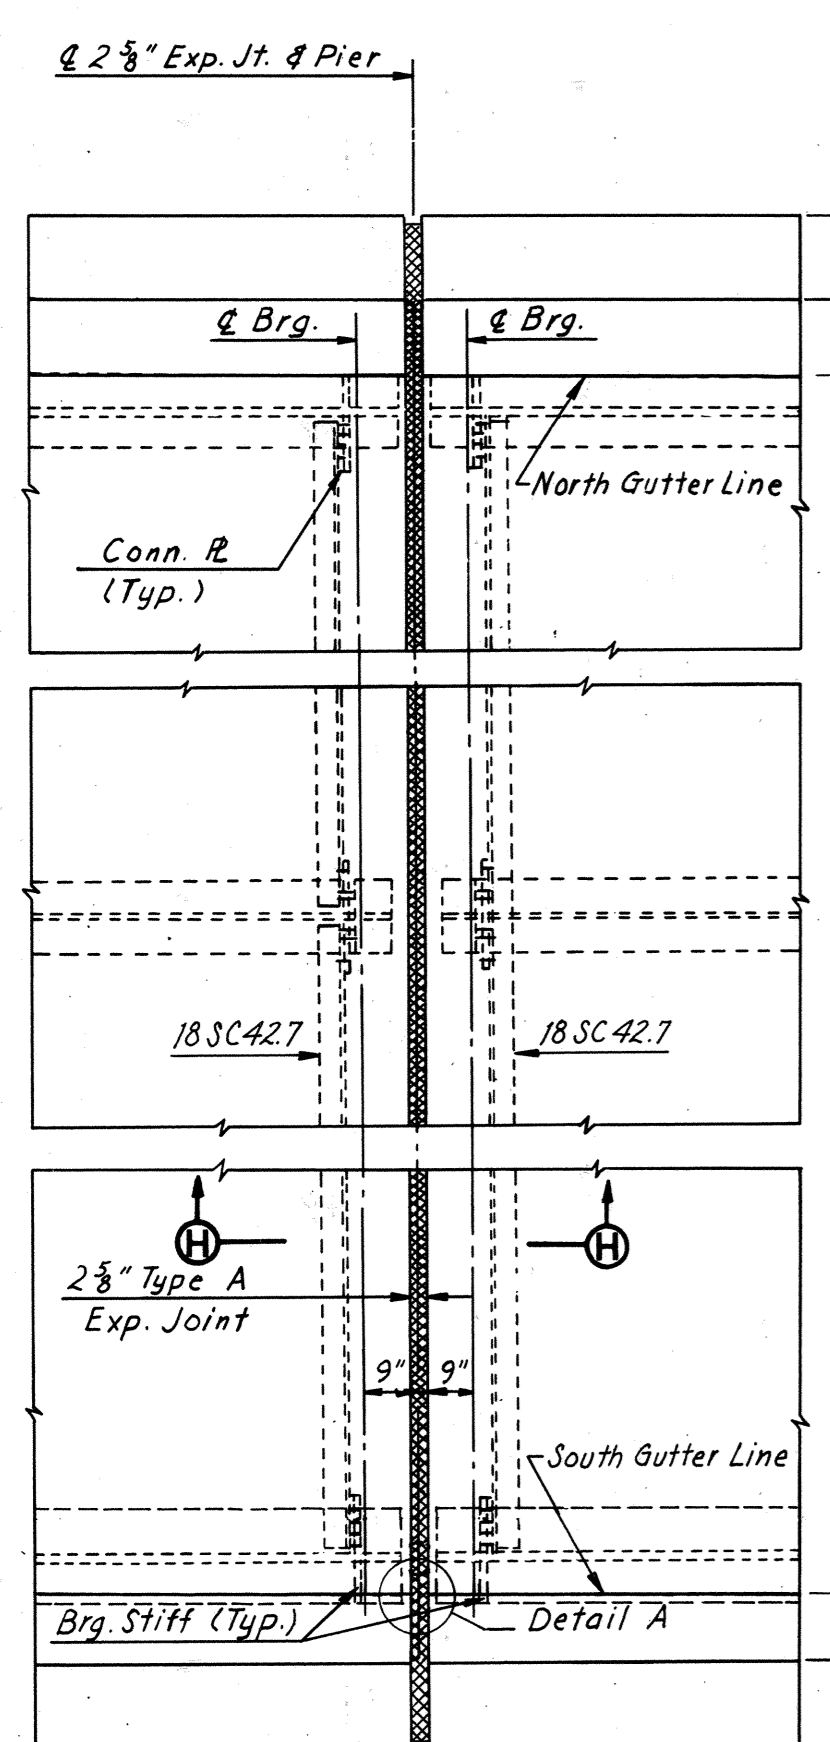


PLAN - JOINT AT PIERS 1 THRU 8
Scale: 3/8" = 1'-0"

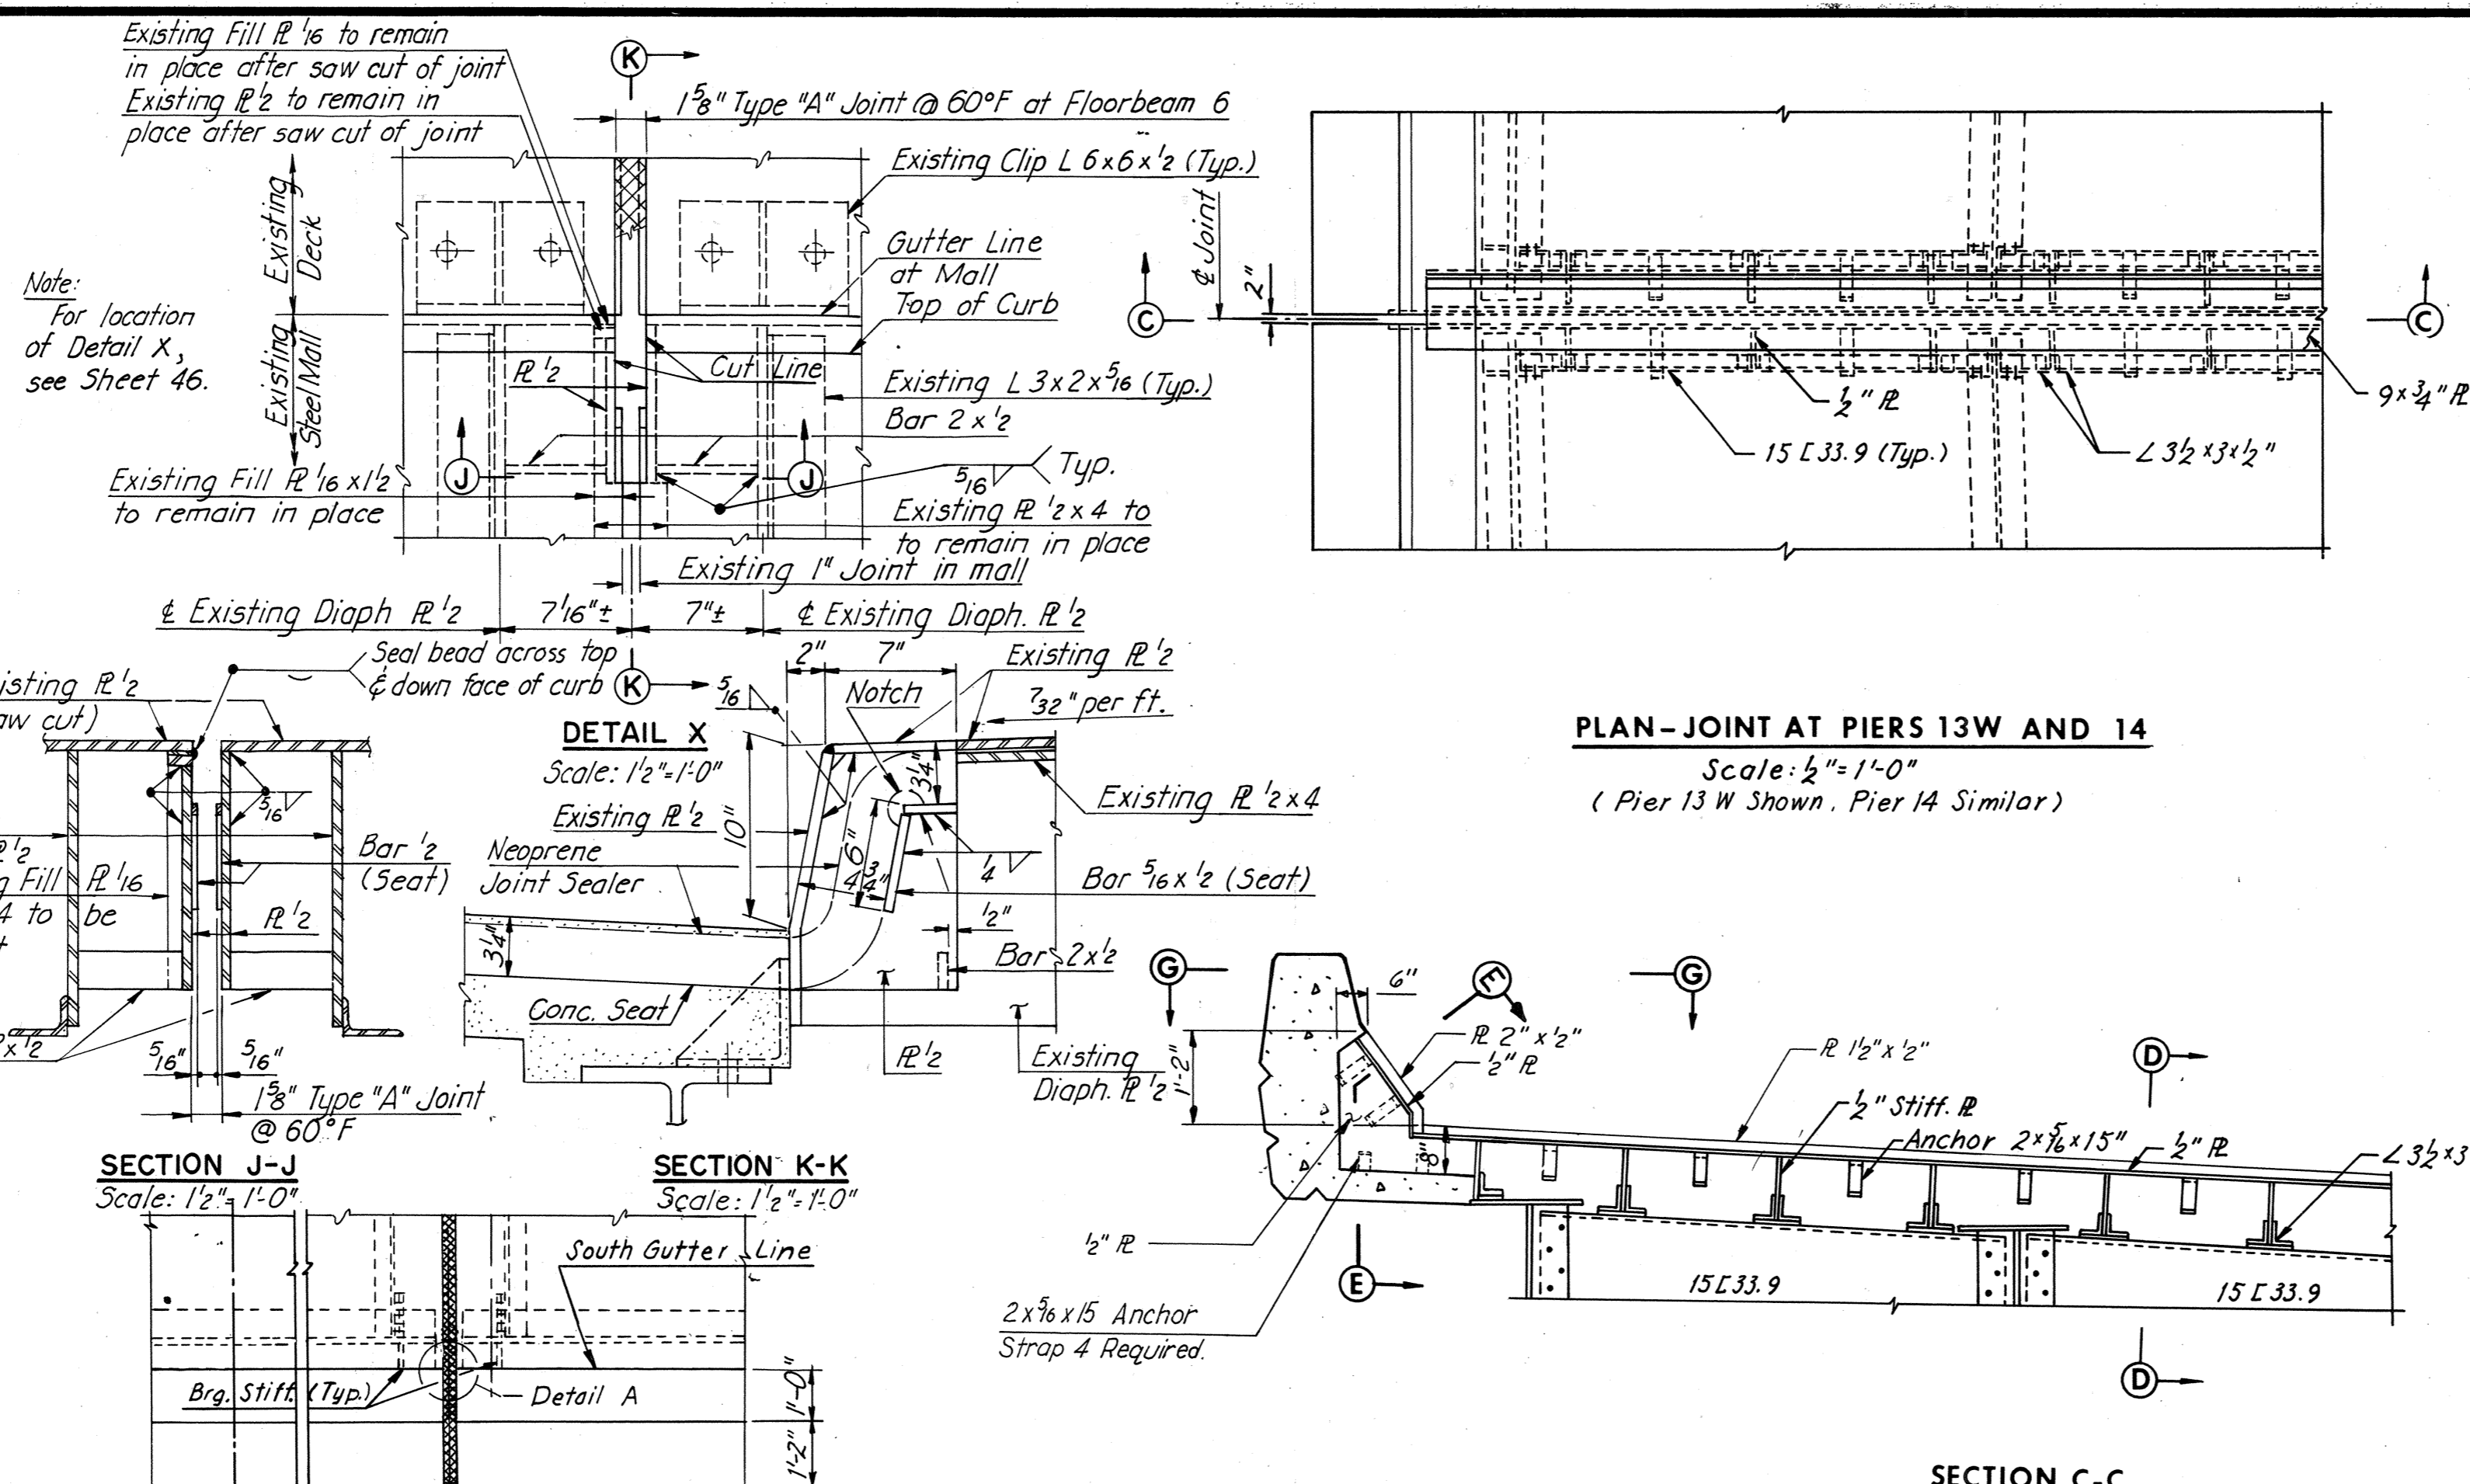


PLAN - JOINT AT PIERS 13W AND 14
Scale: 1/2" = 1'-0"
(Pier 13 W Shown, Pier 14 Similar)

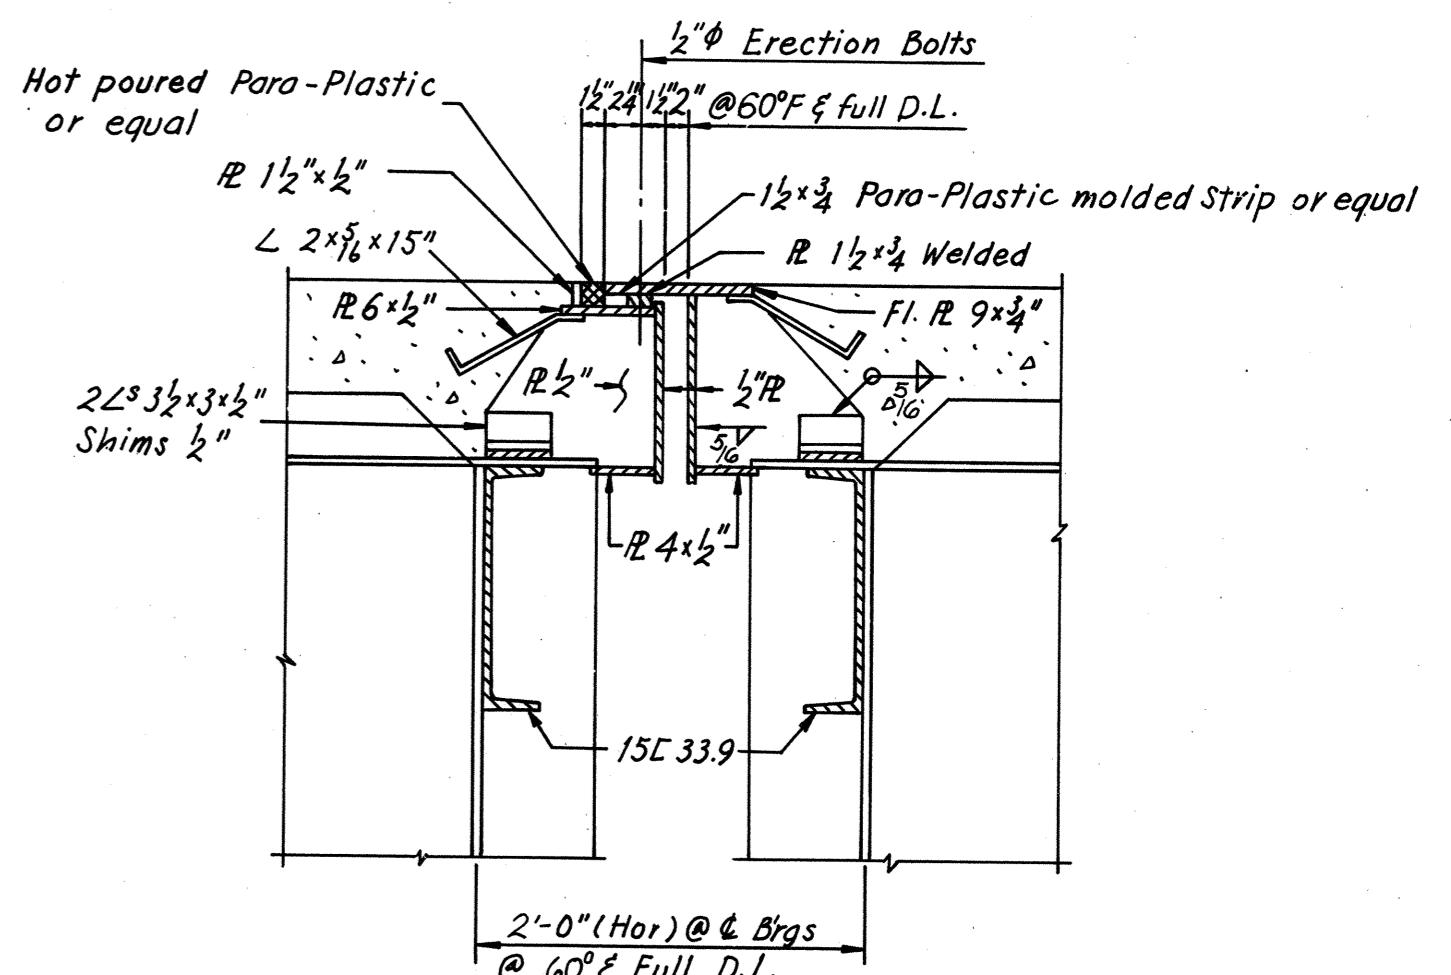


SECTION D-D
Scale: 1" = 1'-0"
(Pier 13 W shown, Pier 14 similar)

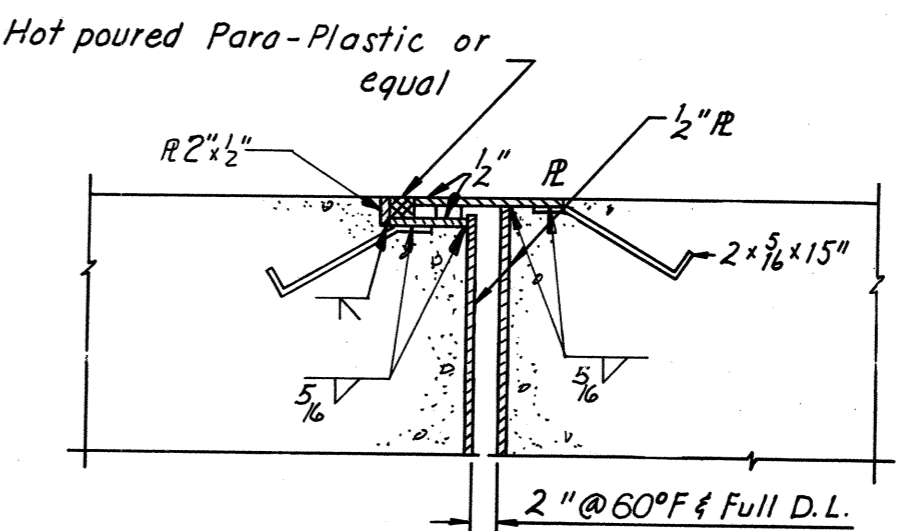


SECTION C-C
Scale: 1/2" = 1'-0"

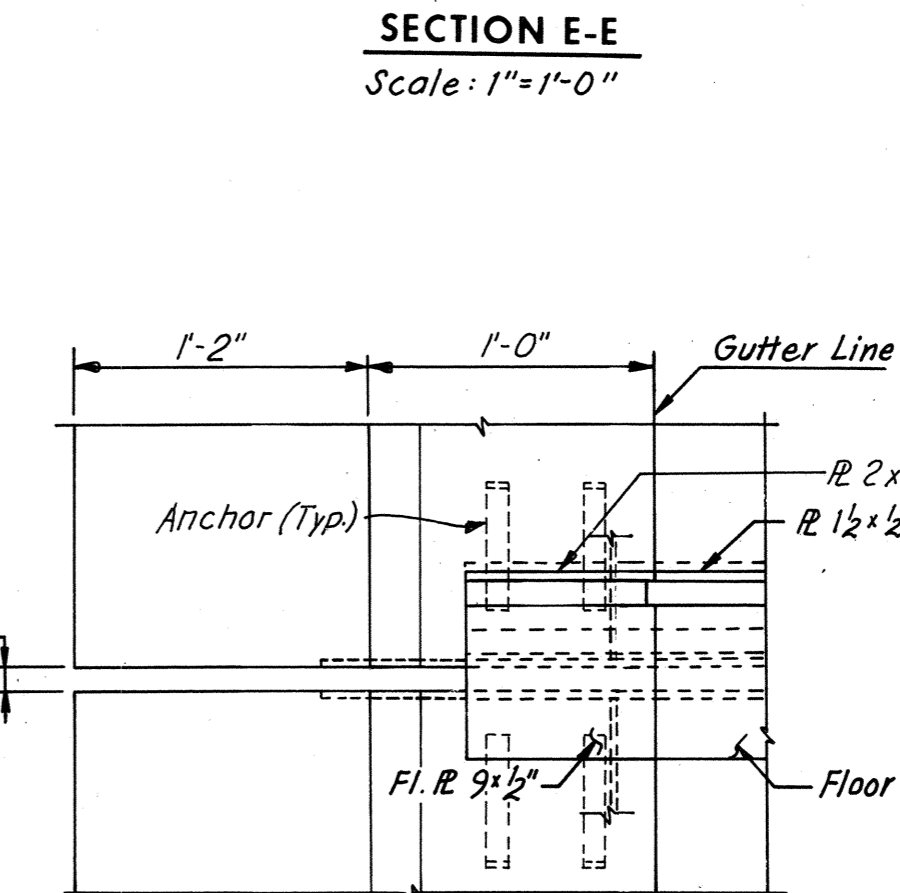


SECTION E-E
Scale: 1" = 1'-0"

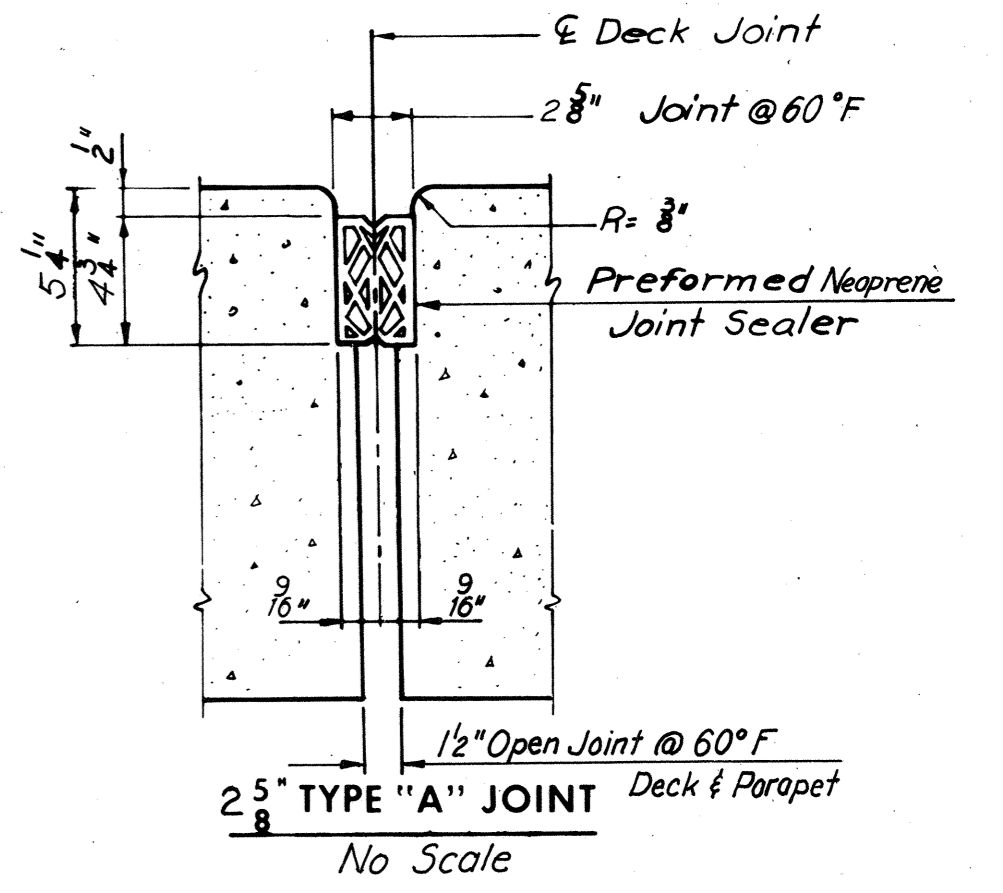


PREFORMED NEOPRENE JOINT SEALER
FOR 2 1/2" TYPE "A" JOINT
No Scale

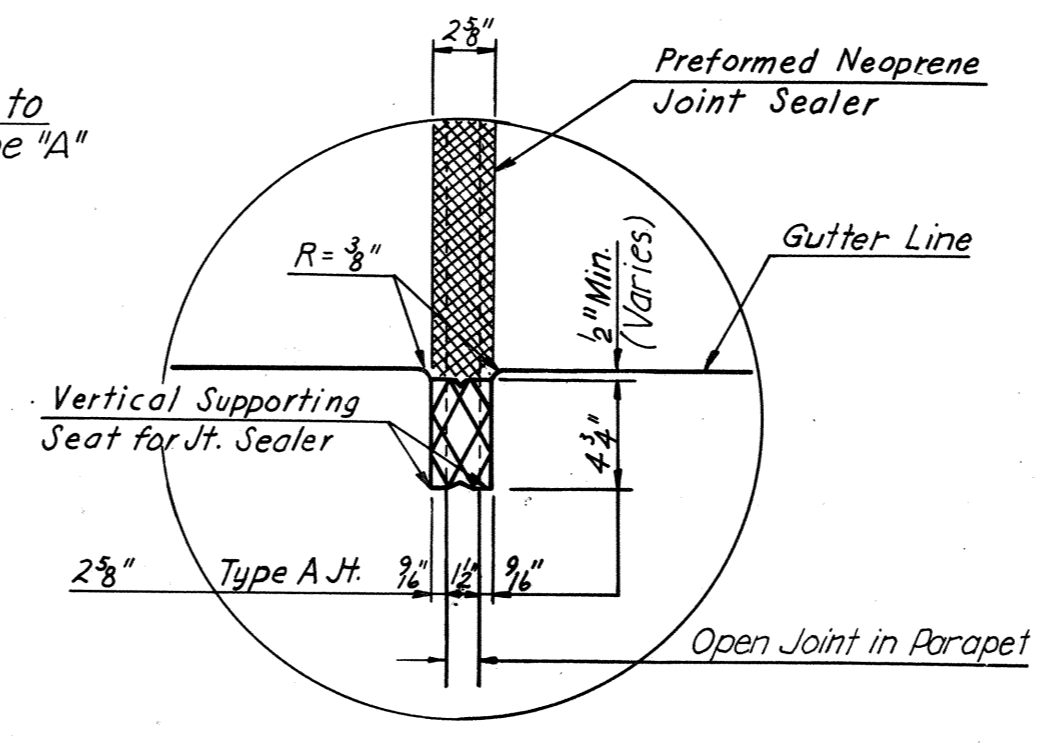

DETAIL A
No Scale

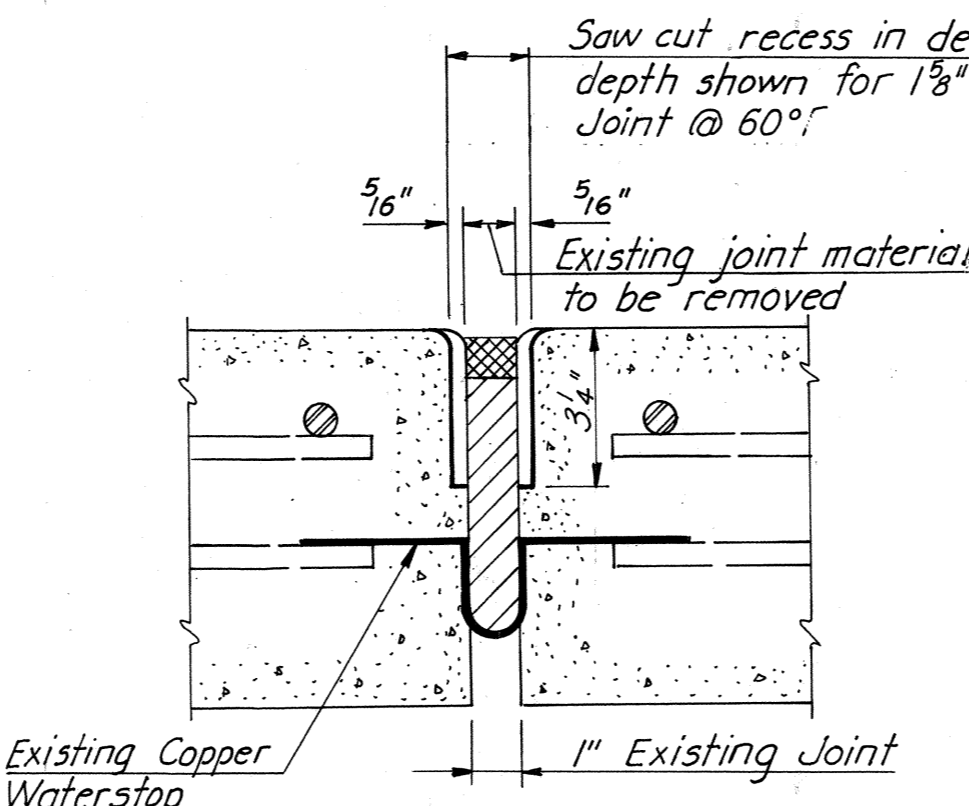


TYPICAL SECTION THRU EXISTING DECK JOINT AT FLOORBEAM 6
Scale: 3/8" = 1'-0"

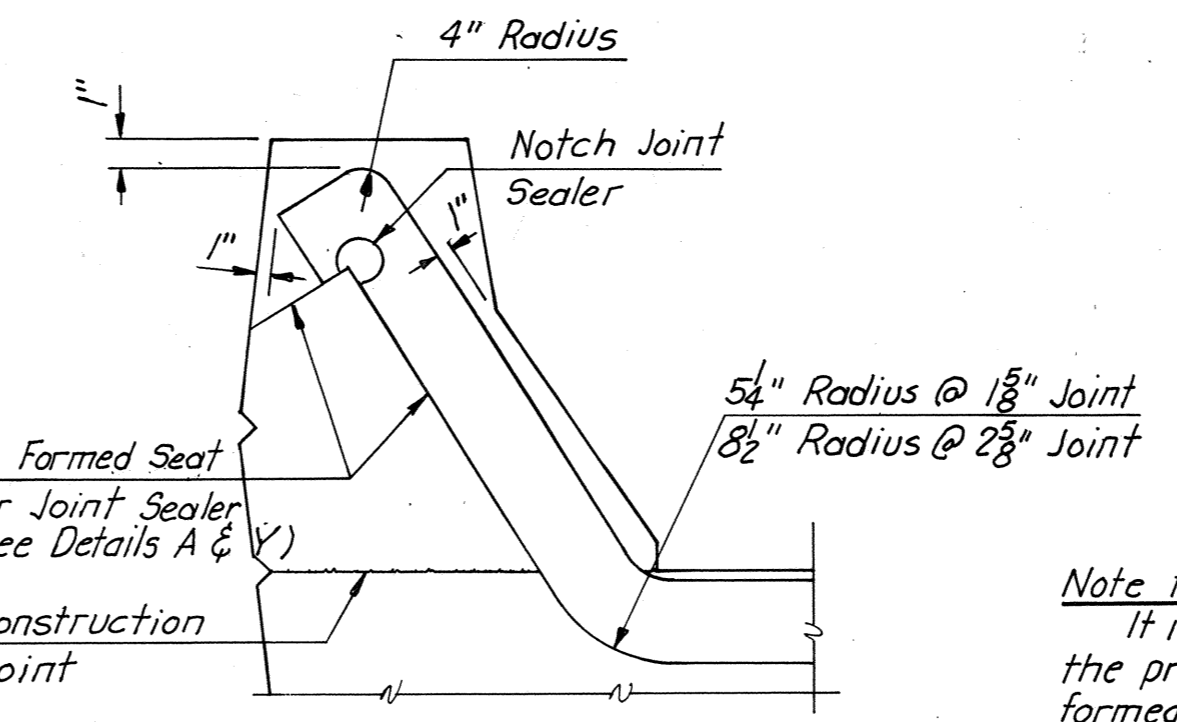


TREATMENT OF TYPE "A" JOINT AT CURB
No Scale

Note for Type "A" Joints:
It is absolutely essential that the opening for the preformed Neoprene joint sealers be accurately formed and constructed to smooth, straight lines. The size of opening shall be adjusted to allow for anticipated dead load rotation of the ends of the slab and for the temperature of the time of construction.


AS BUILT

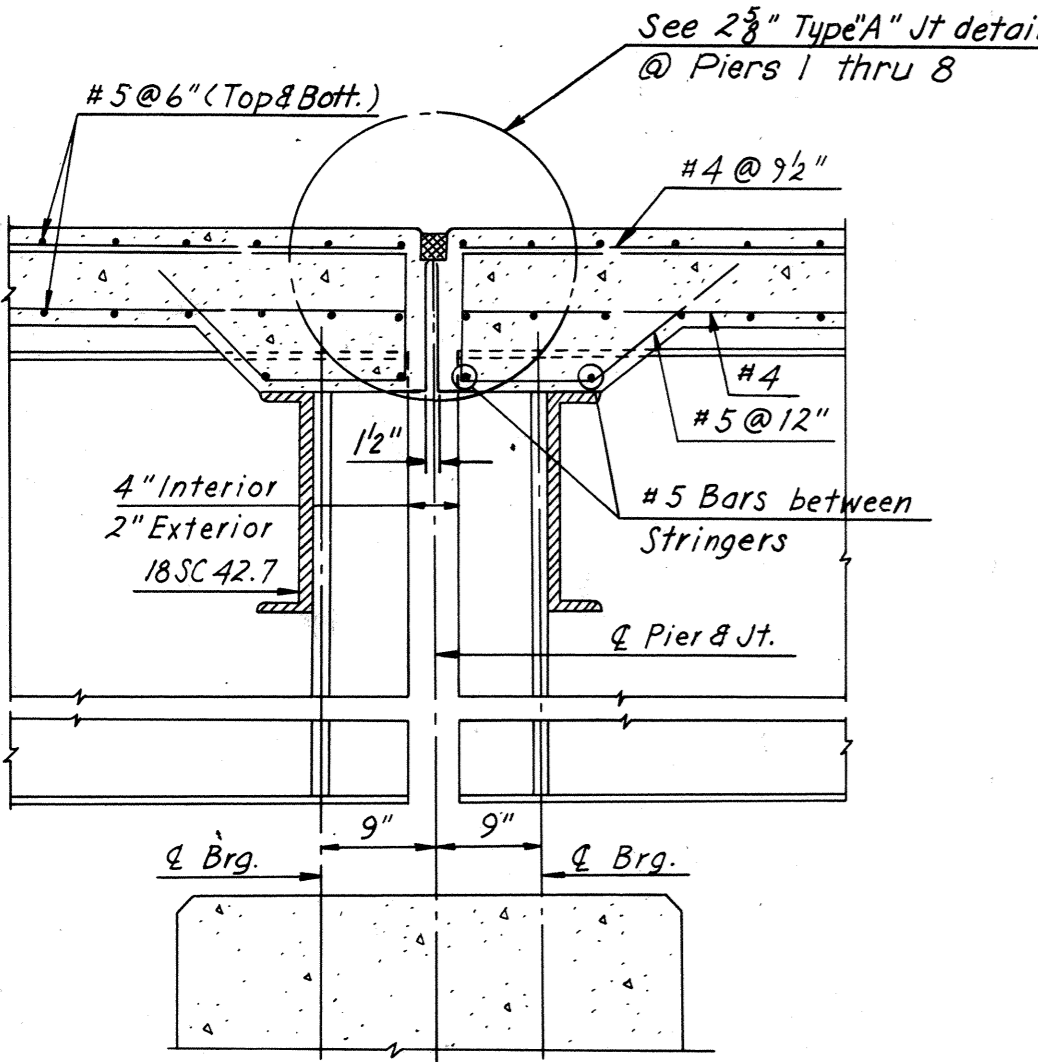


SECTION H-H
Scale: 1/4" = 1'-0"

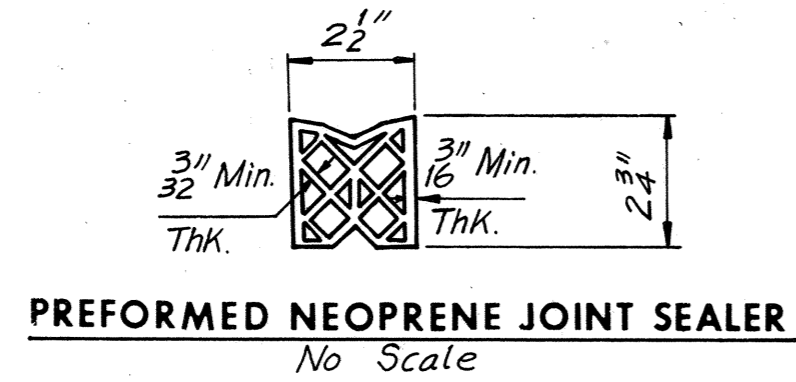

PREFORMED NEOPRENE JOINT SEALER
No Scale

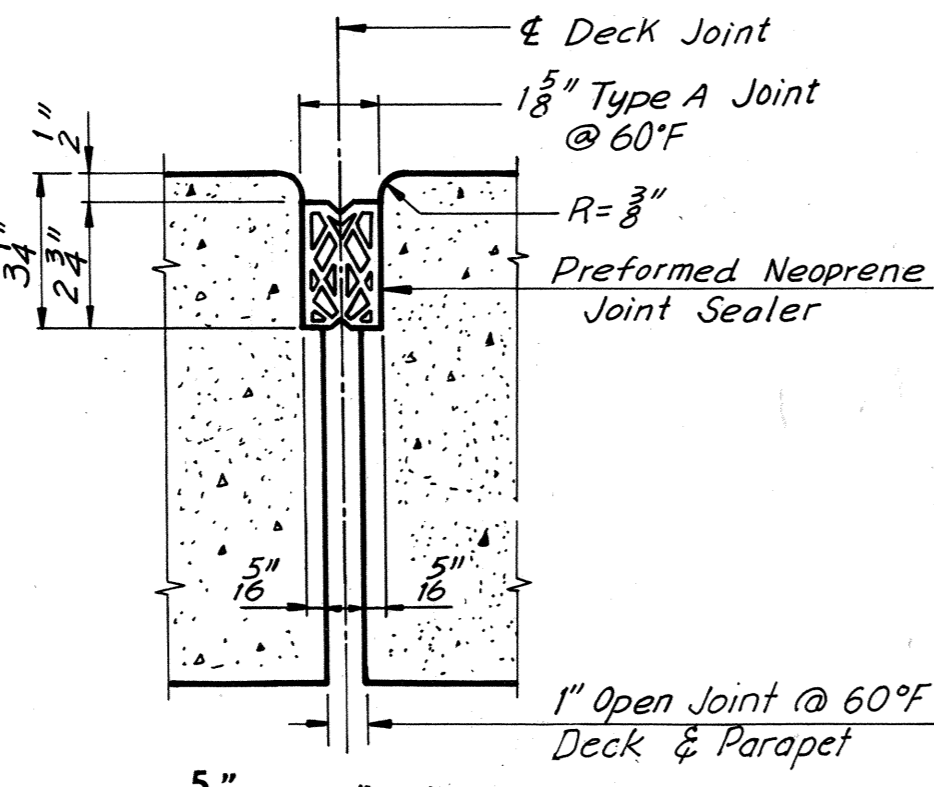

1 1/2" TYPE "A" JOINT
Scale: 3/8" = 1'-0"

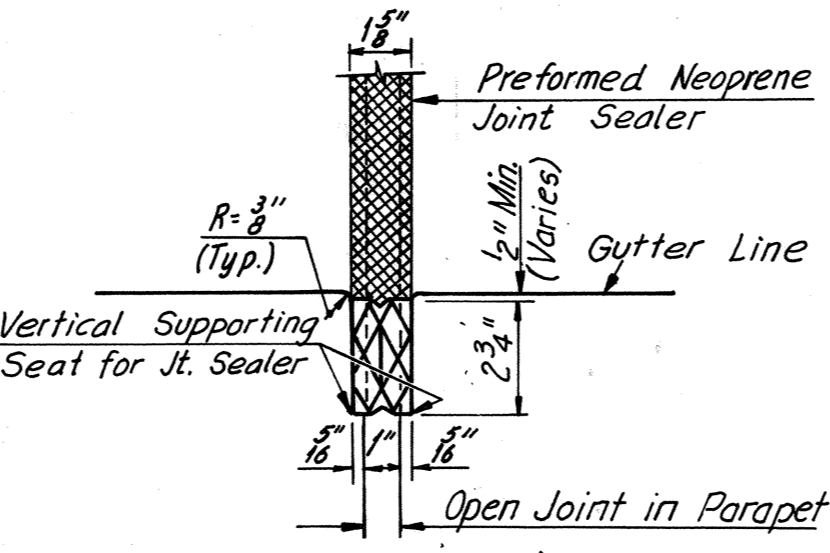

DETAIL Y
No Scale

BY	DATE	3	As Built	TEM	6-77
MADE	Y.C.P.	3-25-69	Joint Det. for exist. joint & Mall added	d.B.P.	2-25-75
CHECKED	G.S.H.	7-10-69	1 1/2" Type A Joint details added	d.B.P.	2-7-75
IN CHARGE	NO.	REVISION	BY	DATE	


**RICHMOND METROPOLITAN AUTHORITY
RICHMOND EXPRESSWAY SYSTEM
DOWNTOWN EXPRESSWAY**

**BRIDGE NO. 67
RAMP W-N CONNECTION TO
RICHMOND-PETERSBURG TURNPIKE
JOINT DETAILS**


HOWARD, NEEDLES, TAMMEN & BERGENDOFF
consulting engineers
NEW YORK ALEXANDRIA KANSAS CITY

SCALE: As Noted
CONTRACT NO.: 10
SHEET NO. 48 OF 54


RICHMOND EXPRESSWAY SYSTEM			
SECTION	PROJECT	SHEET NO.	TOTAL SHEETS
10	DOWNTOWN EXPRESSWAY	221	265

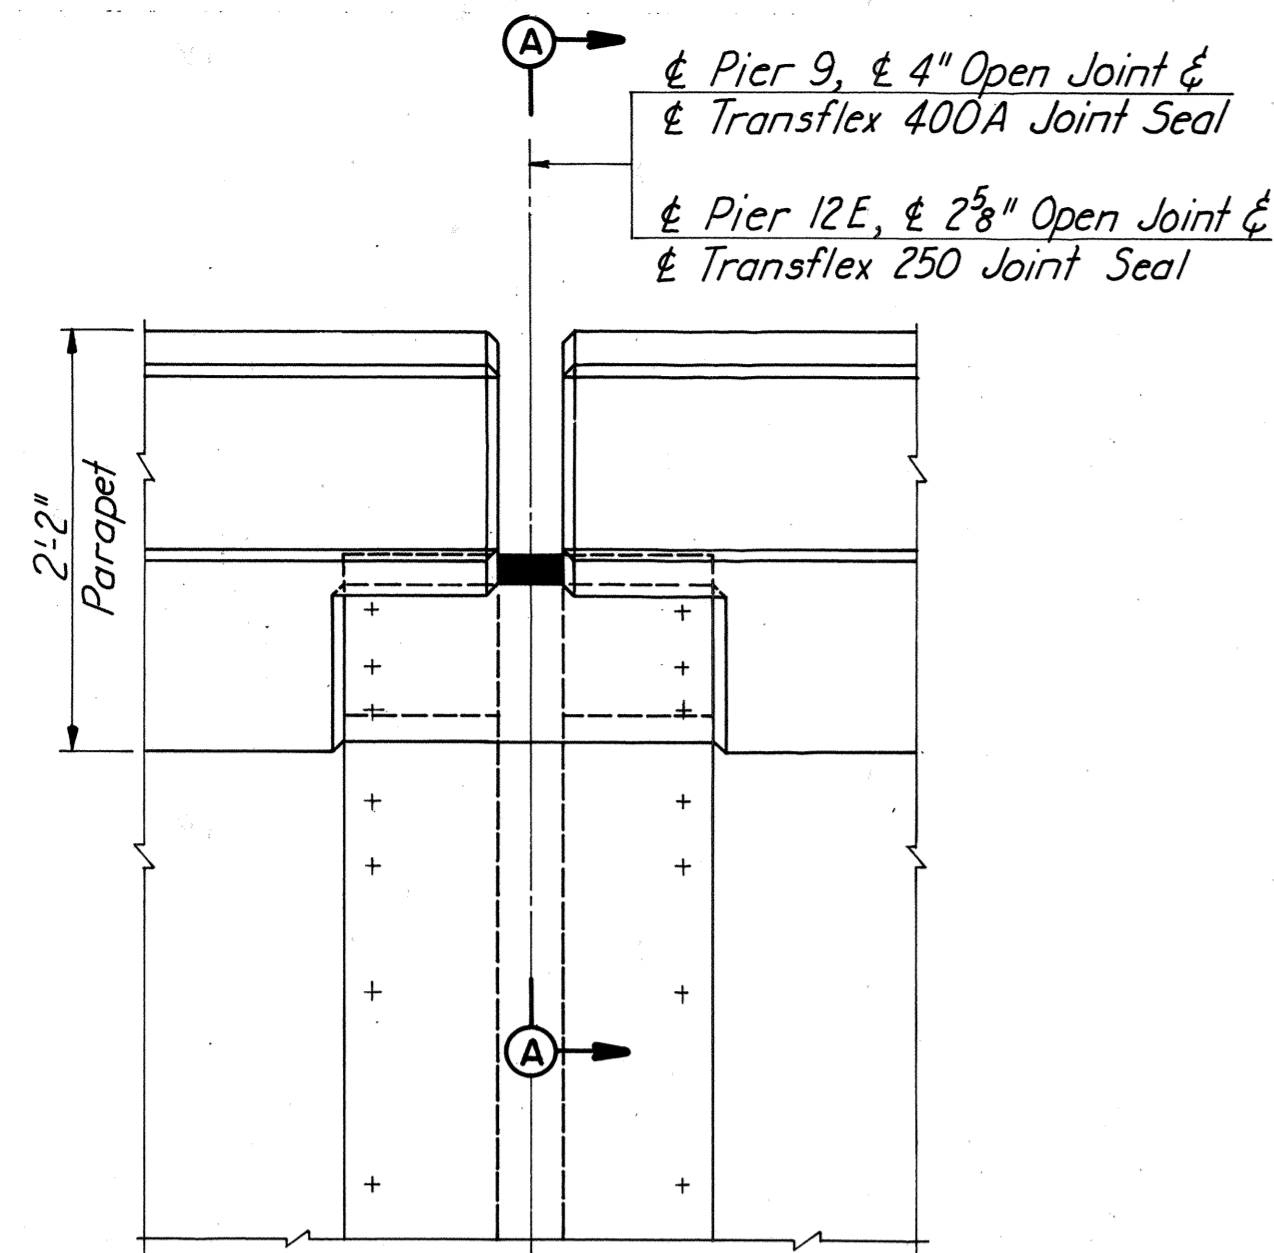

PARTIAL PLAN OF JOINTS AT PIERS 9 & 12E
Scale: 1/4"=1'-0"

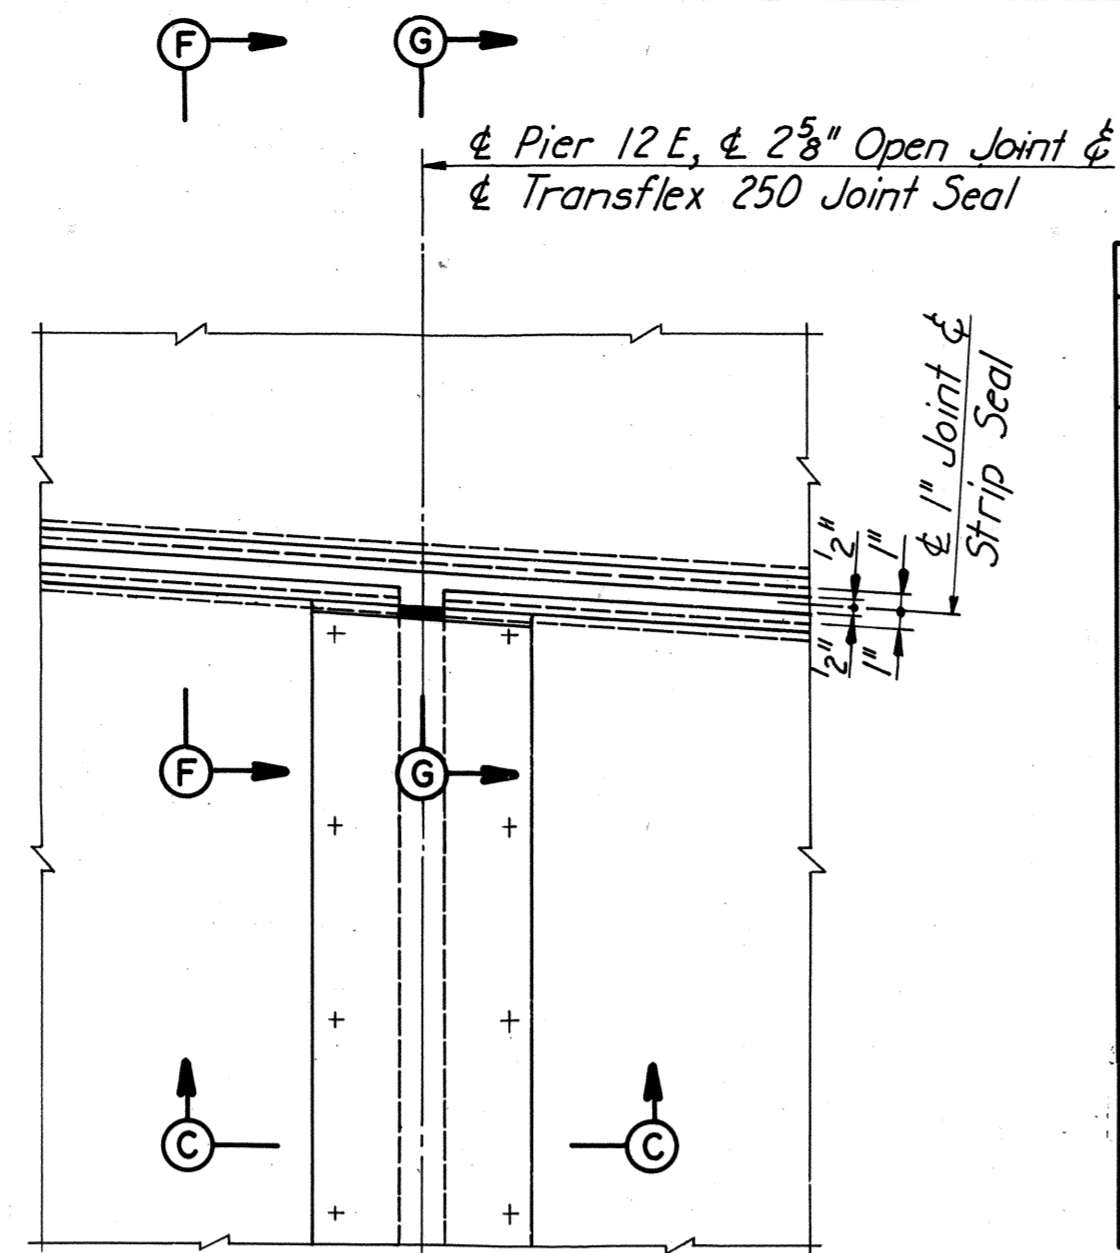


PARTIAL PLAN OF JOINT AT PIER 12E
Scale: 1/4"=1'-0"

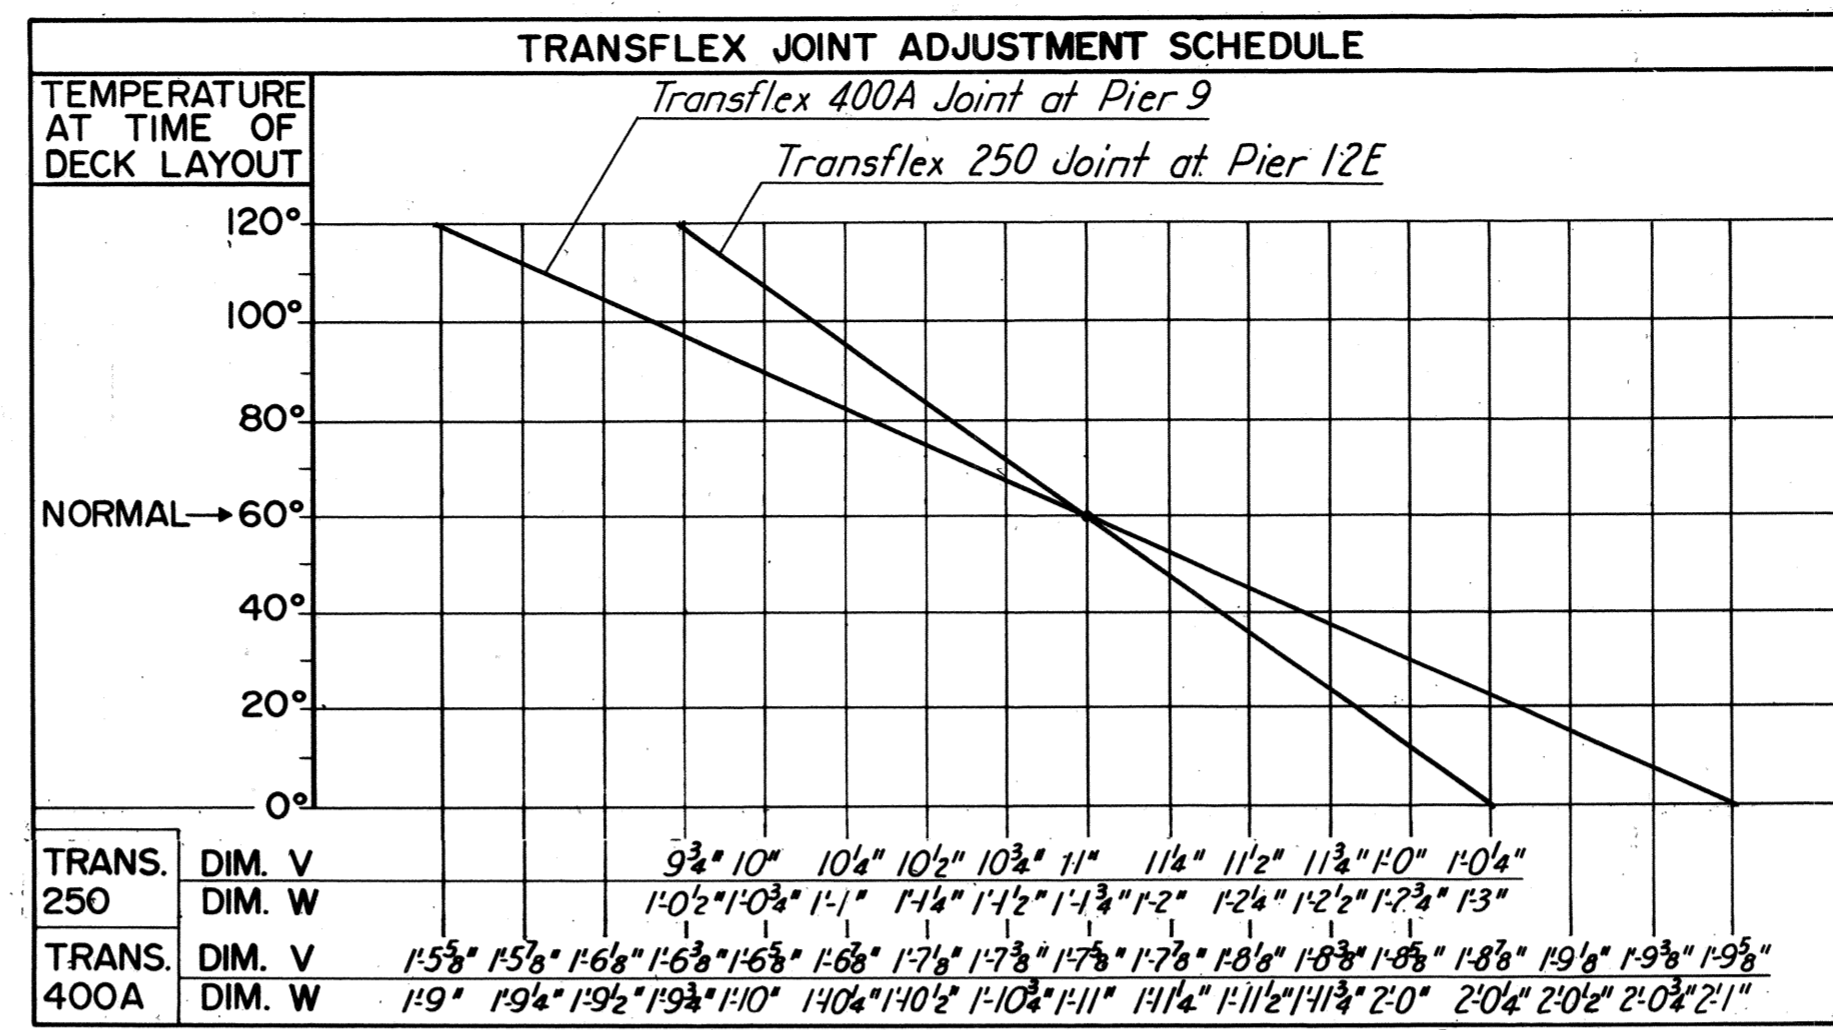


NOTES FOR FILLED JOINTS:
Joints shall be free of cracked and spalled areas and their faces shall be free of all foreign matter, curing compound, oils, greases and dirt. All faces must be sandblasted or brushed with a mechanical rotary wire brush. Just prior to sealing, the joint shall be blown out with oil-free and water-free compressed air.

NOTES FOR WABO-MAURER JOINTS:
Do not use steel extrusions as screed support. Steel extrusion shall conform to ASTM A36. Structural steel shall conform to ASTM A588. Steel assembly shall be shop welded to convenient lengths and butt welded in the field to desired length. Joint shall conform to grade of deck slab. Steel assembly shall be sandblasted in the shop prior to painting.


Steel assembly shall receive one shop coat of epoxy zinc paint. Neoprene extrusion shall be roughened with a wire brush before bonding to steel extrusion with Bon Lastic Adhesive. Groove in steel extrusion to be blown out with oil-free and water-free compressed air prior to installation of Neoprene extrusion. The Wabo-Maurer joint assembly shall be installed in accordance with manufacturer's recommended construction methods.

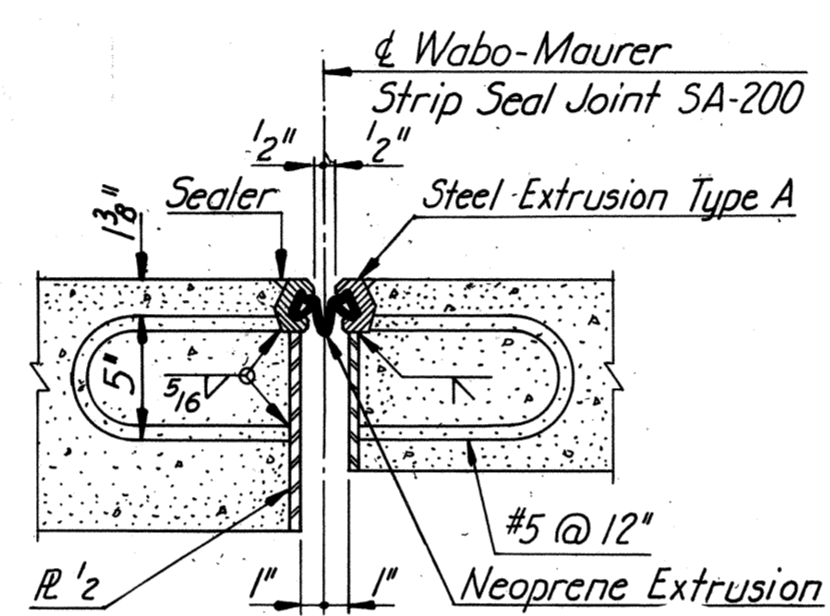


SECTION F-F
Scale: 1/2"=1'-0"

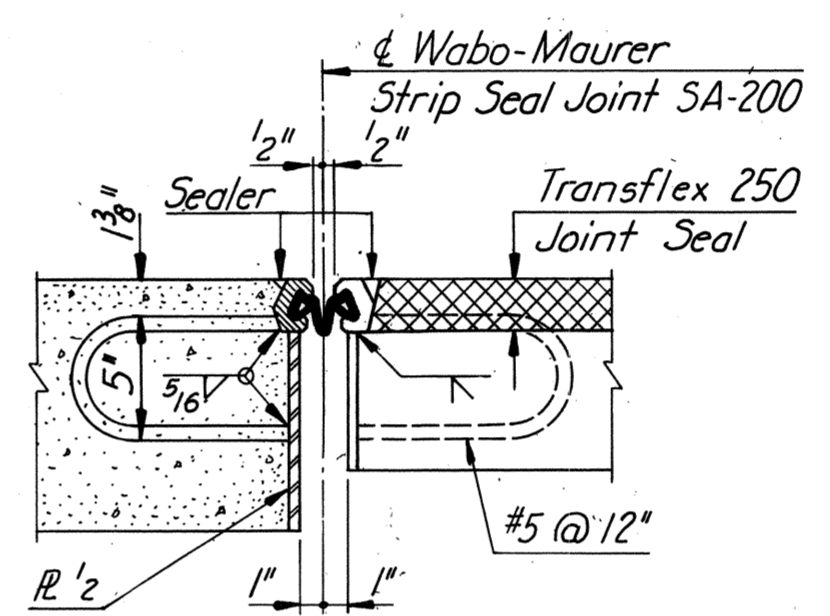


SECTION G-G
Scale: 1/2"=1'-0"

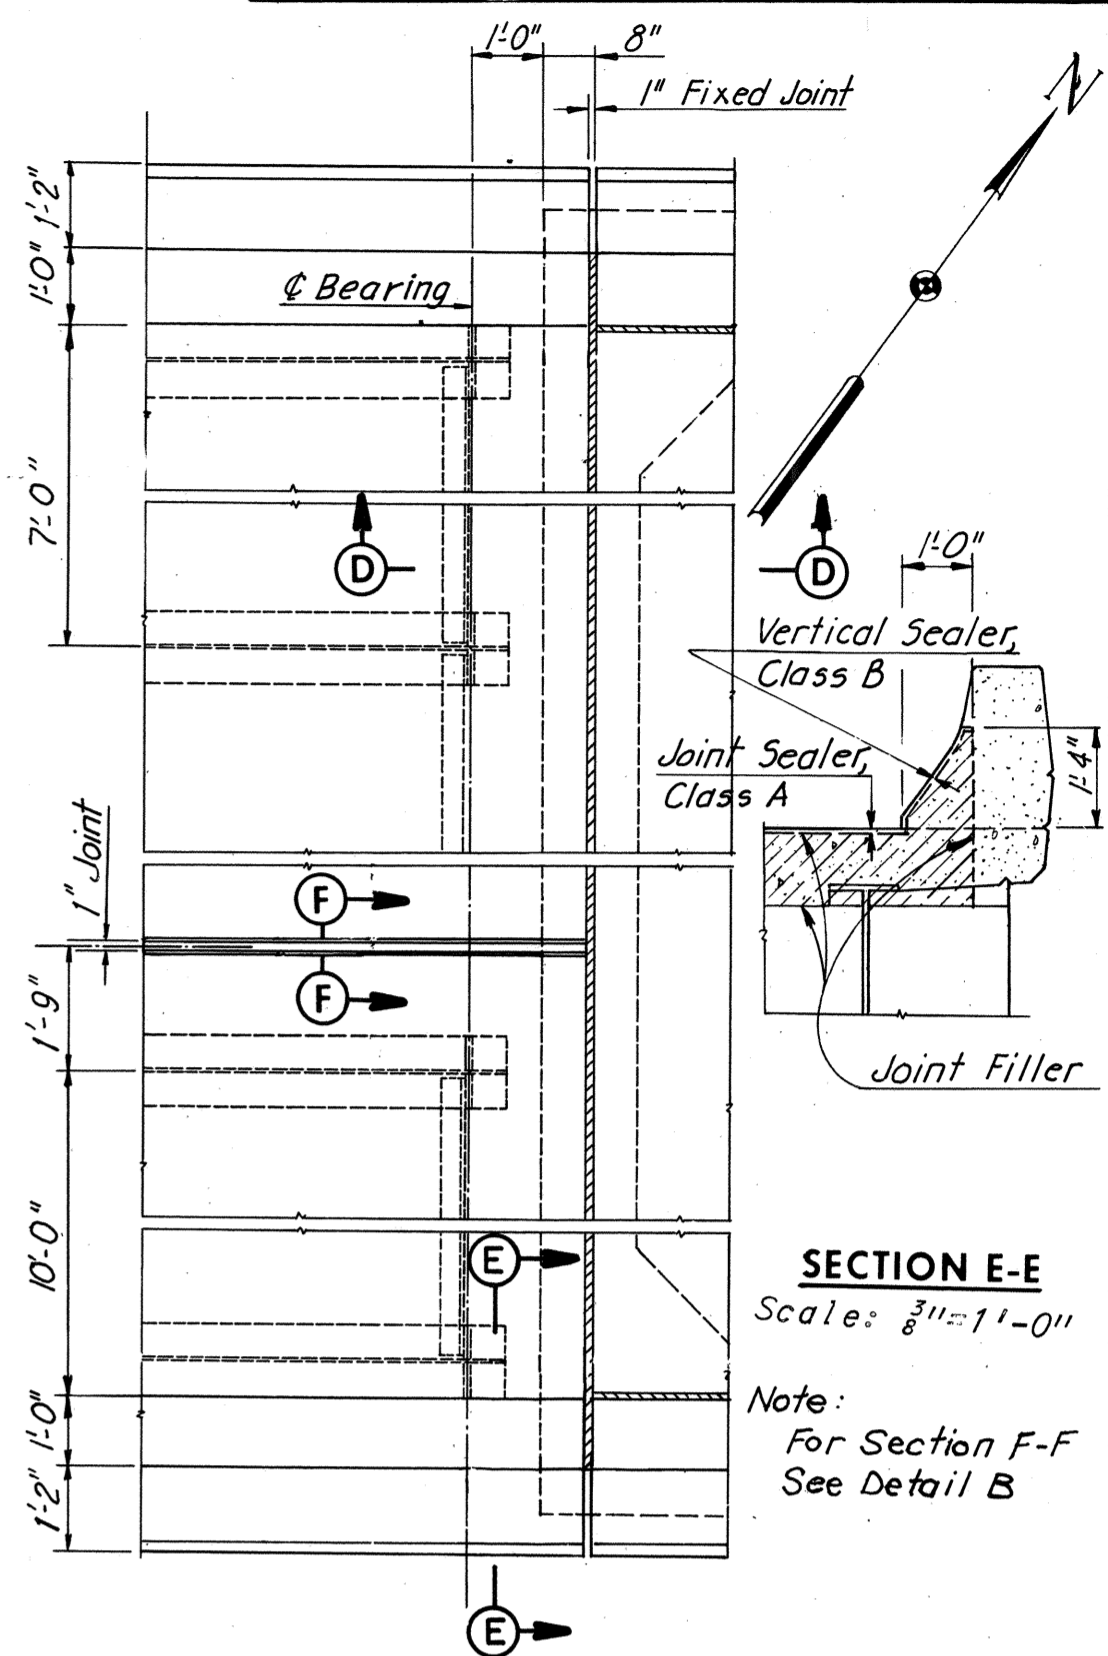


PLAN JOINT AT NORTH ABUTMENT
Scale: 3/8"=1'-0"

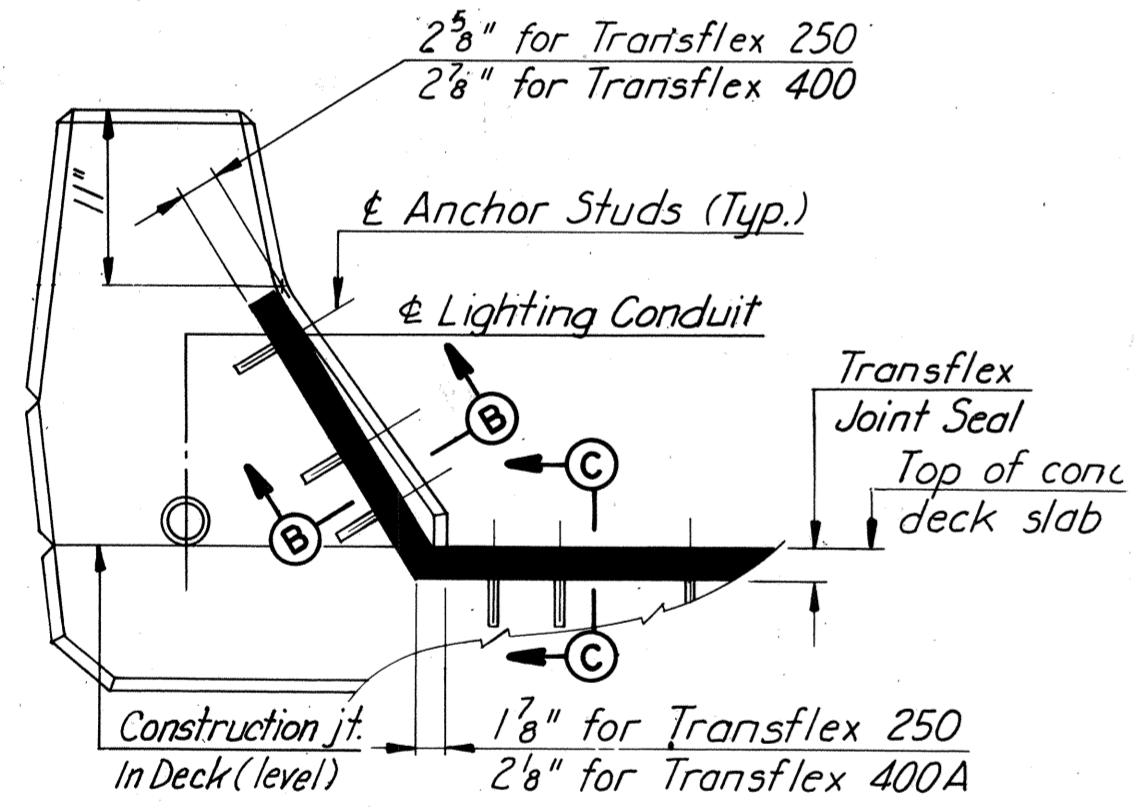


SECTION A-A
Scale: 1/4"=1'-0"

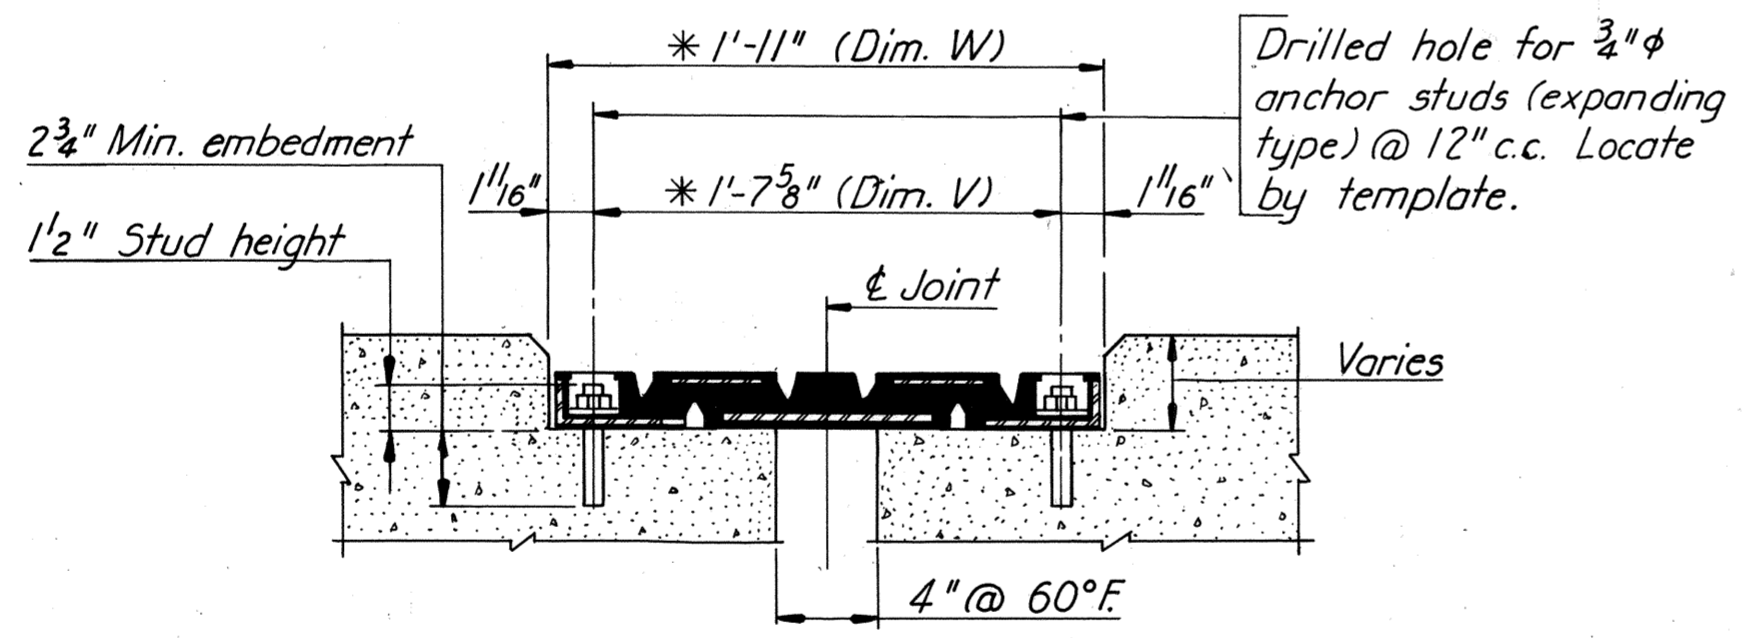


SECTION B-B TRANSFLEX 400A JOINT
Scale: 1/2"=1'-0"

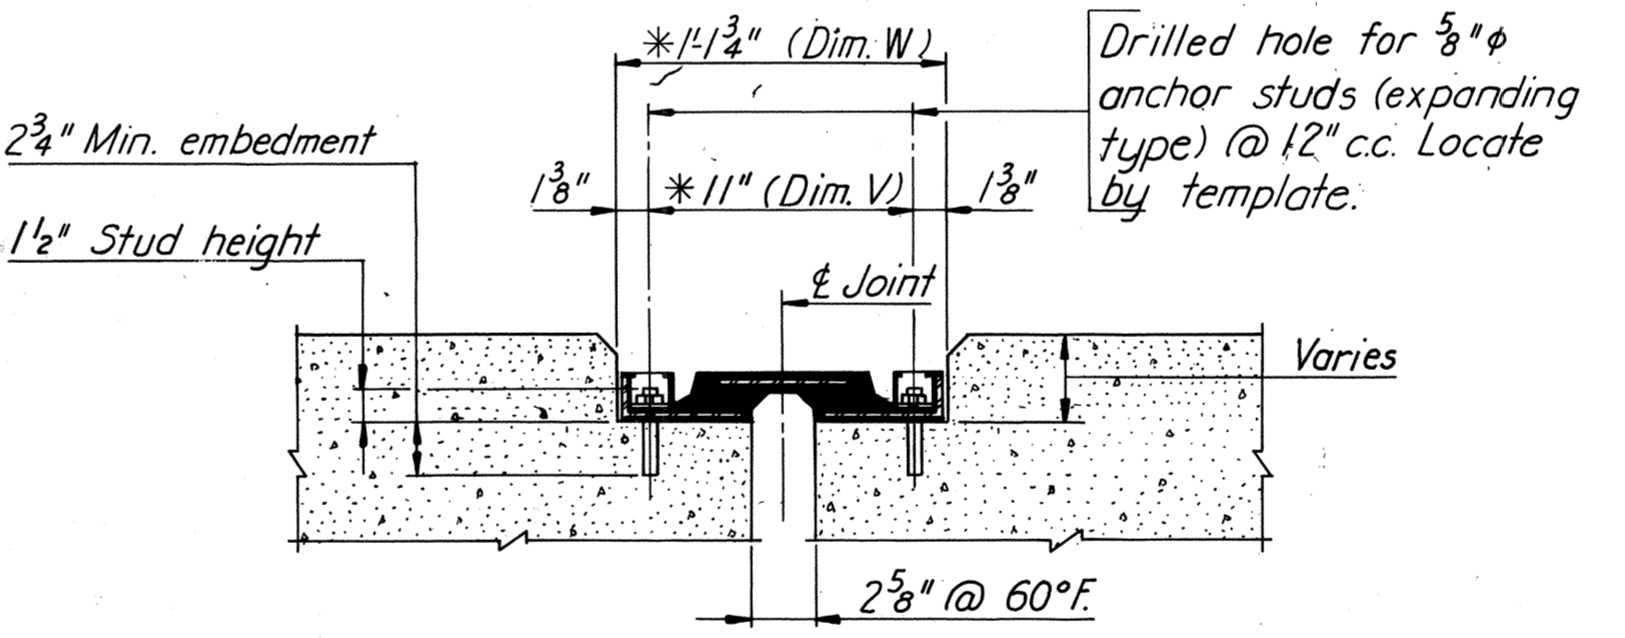

SECTION B-B TRANSFLEX 250 JOINT
Scale: 1/2"=1'-0"

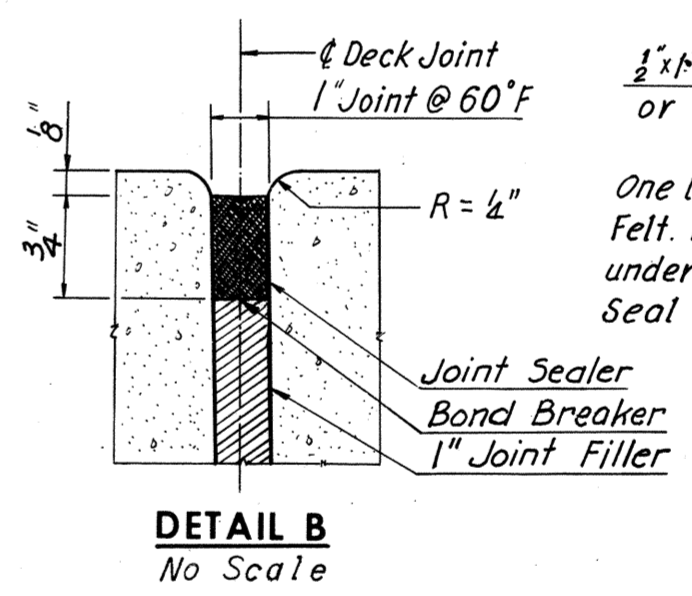


DETAIL B
No Scale

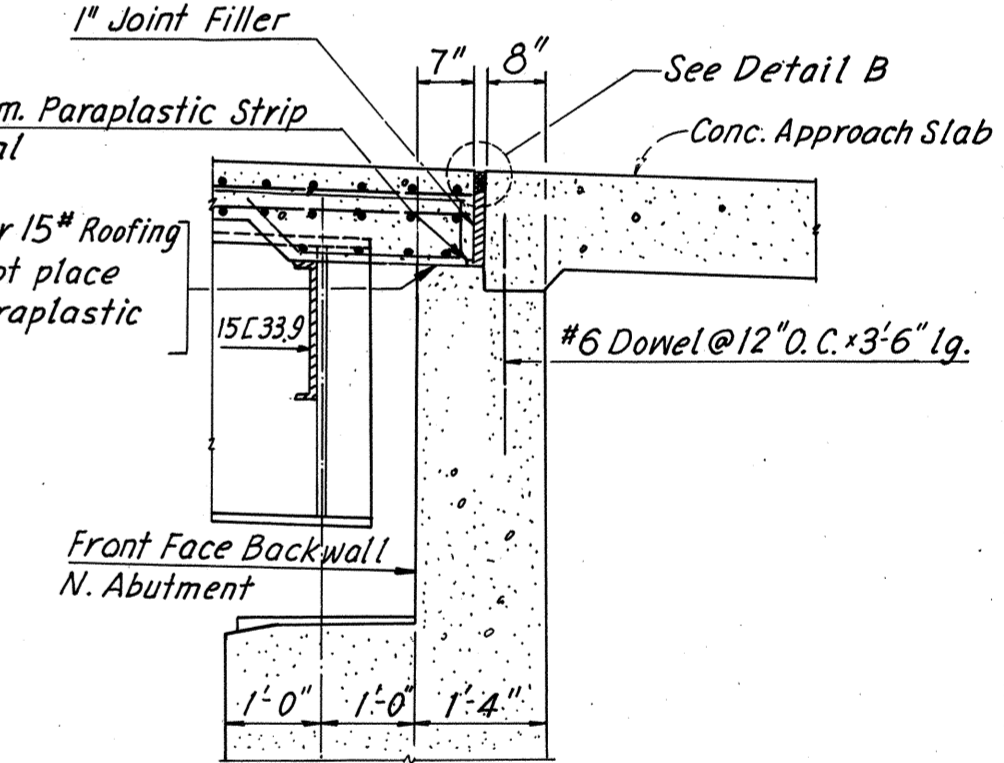


SECTION D-D
Scale: 1/2"=1'-0"

NOTES FOR TRANSFLEX JOINTS:
* Dimension shown is at 60°F. For Dim. V and W adjustment due to temperature change, see Joint Adjustment Schedule. Anchors may be drilled in as shown, or cast-in-place Swedge bolts, 6" long. If they are drilled in, care shall be exercised in placing the deck reinf. steel so that the bars will not interfere with the drilling. Transflex Seals shall be installed in accordance with manufacturer's recommendations.

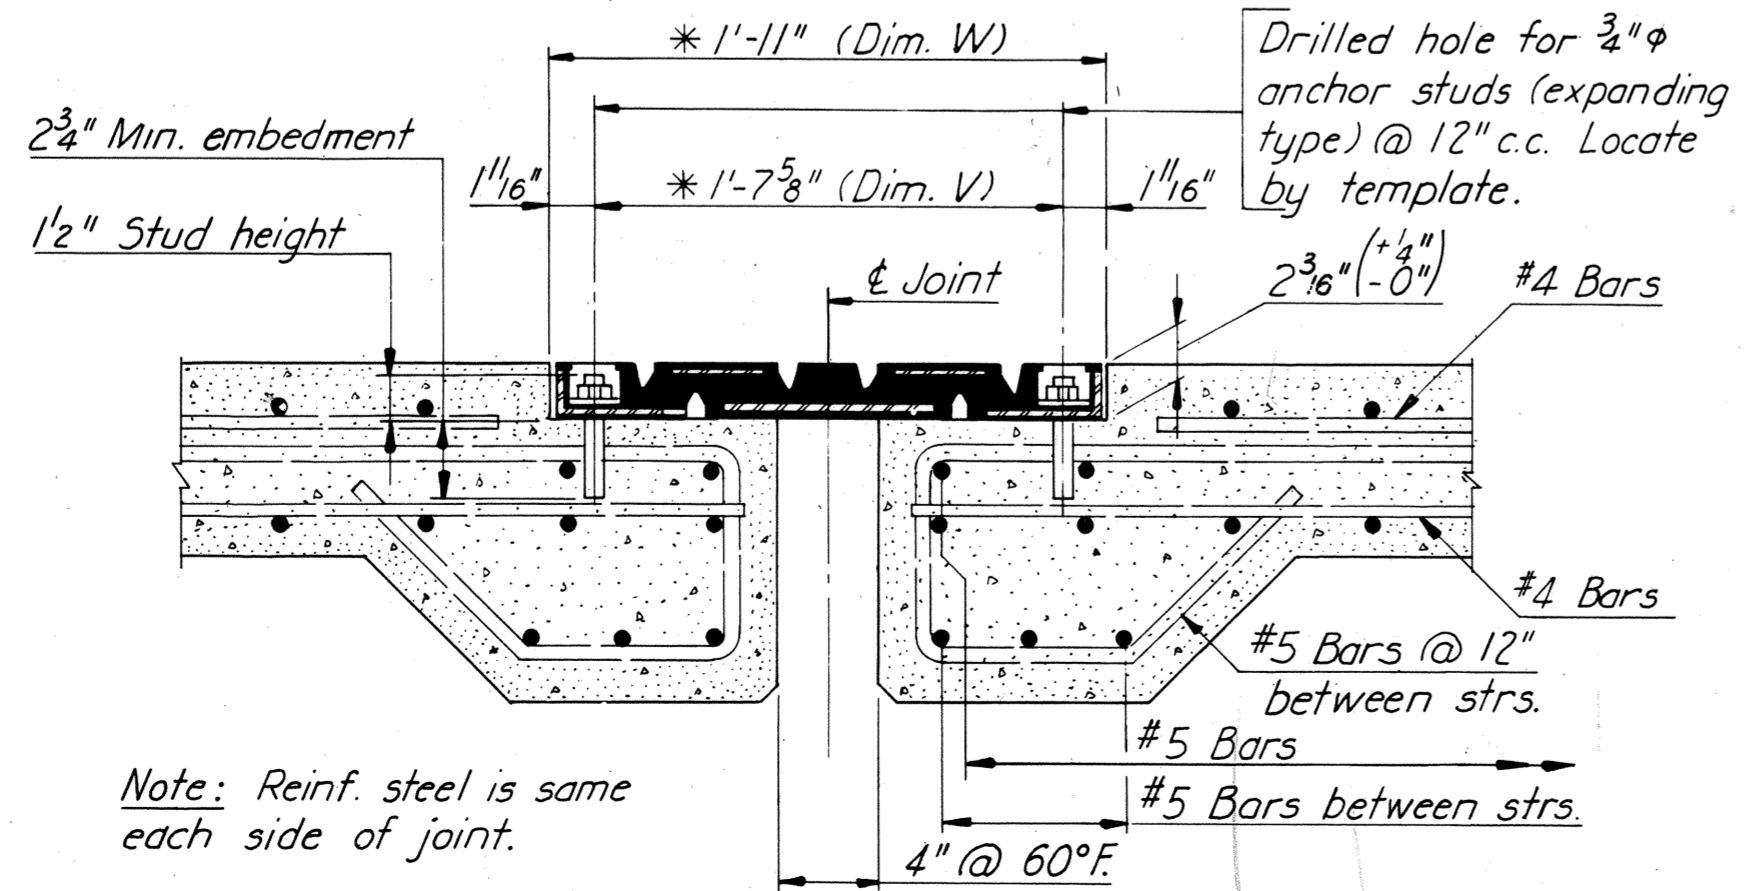

SECTION C-C TRANSFLEX 400A JOINT
Scale: 1/2"=1'-0"

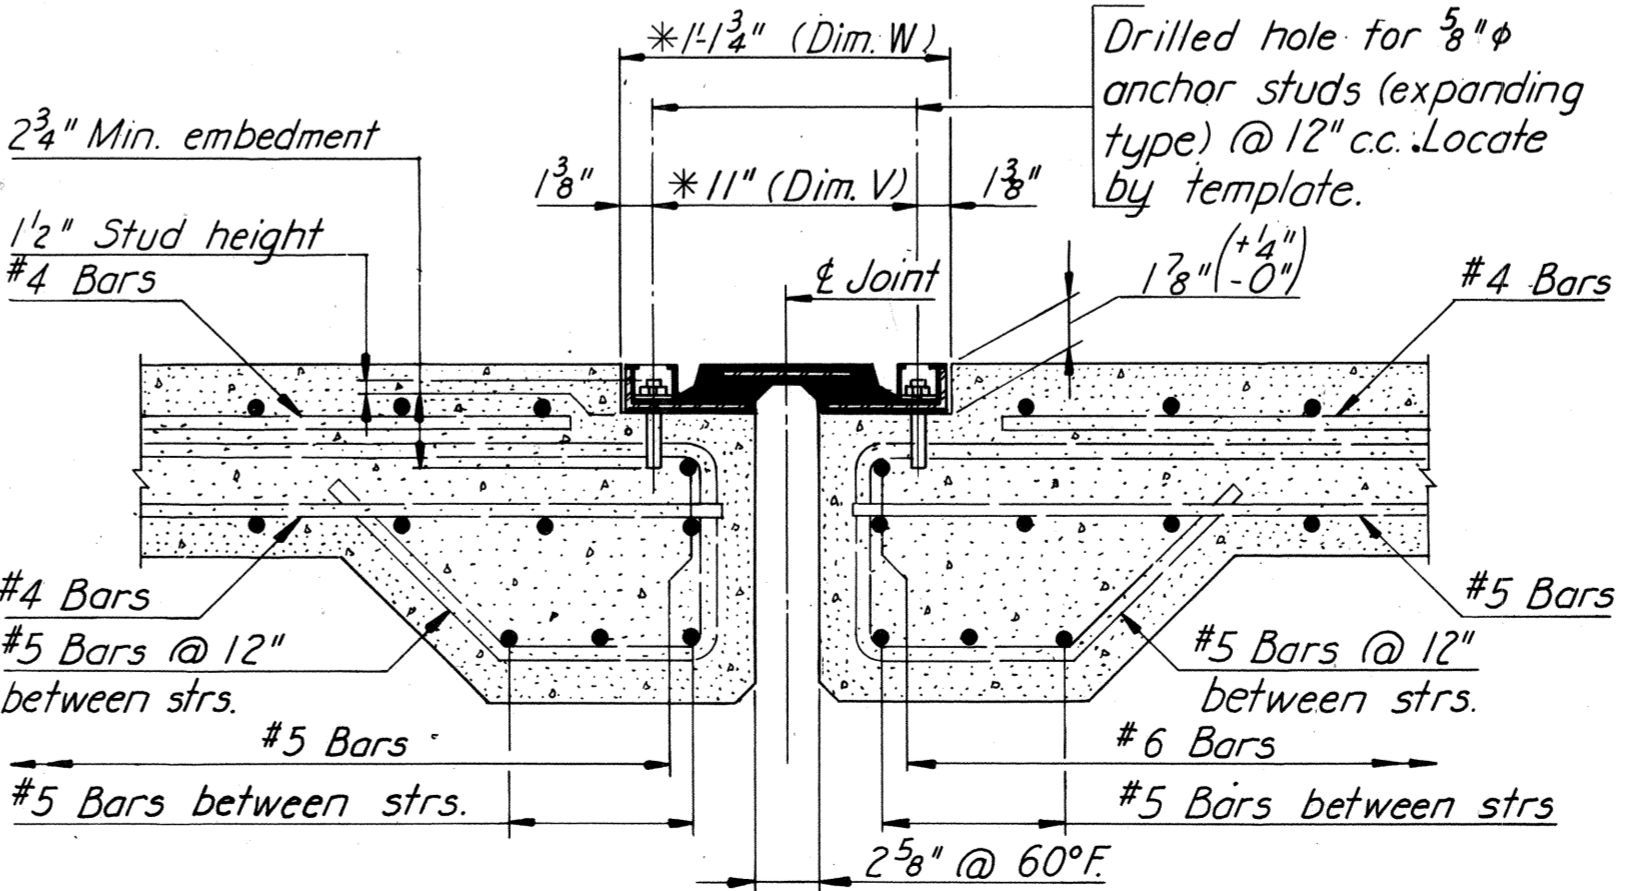

SECTION C-C TRANSFLEX 250 JOINT
Scale: 1/2"=1'-0"

Note: Transflex 250 Joints and Transflex 400A Joints shall be paid for as Elastomeric Expansion Dams, Type 250 and Elastomeric Expansion Dams, Type 400A respectively. The neoprene and the steel be considered a incidental pay item to the bridge structural steel.

BY	DATE			
MADE	K.C.T.	4-3-69		
CHECKED	G.S.H.	7-17-69	As Built	TEM 6-77
IN CHARGE				

AS BUILT

RICHMOND METROPOLITAN AUTHORITY
RICHMOND EXPRESSWAY SYSTEM
DOWNTOWN EXPRESSWAY

BRIDGE NO. 67
RAMP W-N CONNECTION TO
RICHMOND-PETERSBURG TURNPIKE

JOINT DETAILS

SCALE: As Noted
CONTRACT NO.: 10
SHEET NO. 49 OF 54

HOWARD, NEEDLES, TAMMEN & BERGENDOFF
consulting engineers
NEW YORK ALEXANDRIA KANSAS CITY


Bridge 68

**(Ramp from Eastbound Downtown Expressway “Rte. 195” to Southbound I-95 over East Byrd Street, NS
RR and CSX RR)**

Record Set Plans

RICHMOND EXPRESSWAY SYSTEM			
SECTION	PROJECT	SHEET NO.	TOTAL SHEETS
11	DOWNTOWN EXPRESSWAY	64	97

INDEX	SHEET
GENERAL PLAN AND ELEVATION	1
GENERAL PLAN AND ELEVATION	2
LAYOUT	3
PIERS 1 AND 2	4 AND 4A
PIER 3	5
PIER 4	6
PIER 5	7
PIERS 6 AND 7	8
PIERS 8, 9 AND 10	9
PIERS 11 AND 12	10
PIERS 13 AND 14	11
FRAMING PLAN UNITS 2 AND 3	12
FRAMING PLAN UNITS 4, 5 AND 6	13
FRAMING PLAN UNITS 7, 8, AND 9	14
FRAMING PLAN UNITS 10, 11 AND 12	15
FRAMING PLAN UNITS 13 THRU 18	16 AND 16A
FRAMING DETAILS	17
FRAMING DETAILS 2 AND 3	18
DECK PLAN UNITS 4, 5 AND 6	19
DECK PLAN UNITS 7, 8 AND 9	20
DECK PLAN UNITS 10, 11 AND 12	21
DECK PLAN UNITS 13 THRU 18	22
SUPERSTRUCTURE DETAILS	23
JOINT DETAILS	24
BORING LOGS	25 AND 26
STANDARD SHEETS	27 AND 28
EXISTING PIERS 42 & 44 MODIFICATIONS	51 THRU 56
	11A

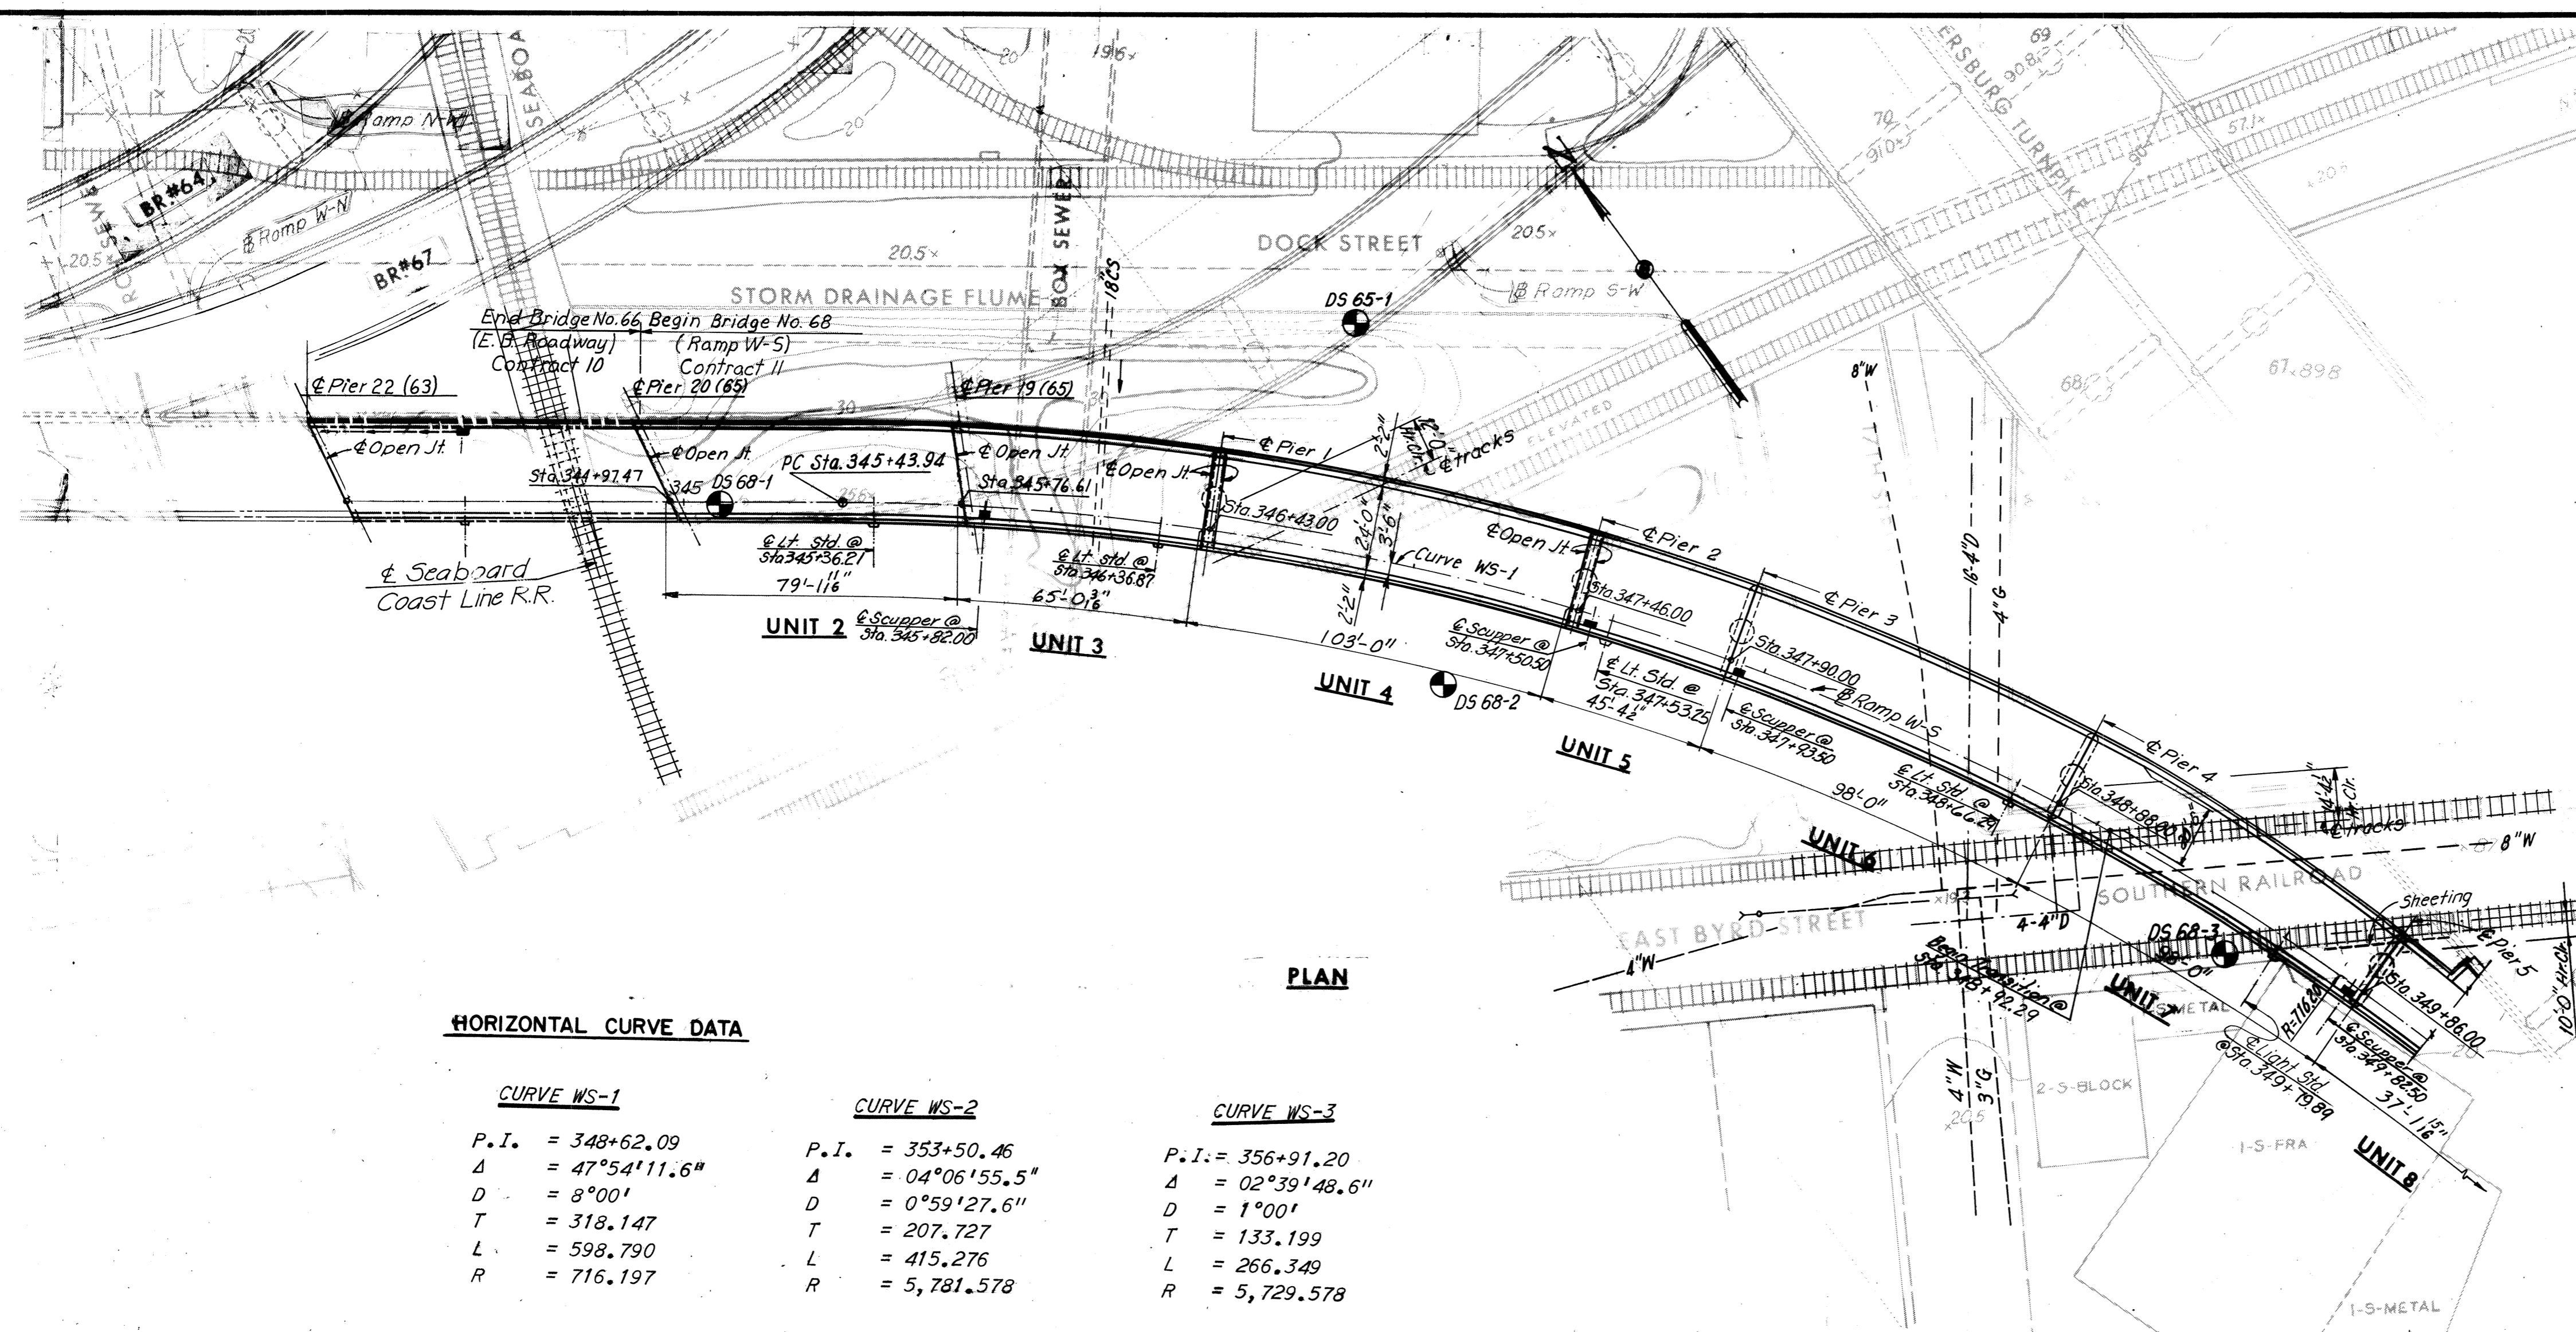

HORIZONTAL CURVE DATA

CURVE WS-1		CURVE WS-2		CURVE WS-3	
P.I.	= 348+62.09	P.I.	= 353+50.46	P.I.	= 356+91.20
Δ	= 47°54'11.6"	Δ	= 04°06'55.5"	Δ	= 02°39'48.6"
D	= 8°00'	D	= 0°59'27.6"	D	= 1°00'
T	= 318.147	T	= 207.727	T	= 133.199
L	= 598.790	L	= 415.276	L	= 266.349
R	= 716.197	R	= 5,781.578	R	= 5,729.578

GENERAL NOTES

- ROADWAY:** One 24'-0" clear roadway transitioning into a 13'-6" widening of existing Richmond-Petersburg Turnpike.
- CAPACITY:** Dead load includes 15lbs. per sq.ft. for future wearing surface. Live load HS 20-44 loading and alternate military loading.
- SPECIFICATIONS:**
 - GENERAL:** Virginia Department of Highway Road and Bridge Specifications 1970.
 - DESIGN:** A.A.S.H.O. Standard Specifications for Highway Bridges 1973, modified by Special Design provisions.
 - WELDING:** 1972 Structural Welding Code of the American Welding Society.

DATUM:

City of Richmond

TEMPERATURE:

The normal temperature referred to in the plans is 60°F. The temperature range for movement is 0°F to 120°F.

DIMENSIONS:

All dimensions are measured horizontally and vertically unless otherwise noted.

EXCAVATION:

Excavation below subgrade and cut slope template shall be classified as Regular Excavation. All excavation above these limits shall be classified as Regular Excavation and is not included in the Structural Quantities.

FOUNDATIONS:


Footings shall rest on firm material. Foundation material shall be dry and special attention is called to Section 401.05 of General Specifications and to the Contract Special Provisions, concerning preparation of foundations for footings.

CONCRETE NOTES:

Concrete in superstructure shall be Class A-4. All other concrete shall be Class A-3. All exposed edges and corners shall have a 3" chamfer or fillet unless otherwise noted. Care in the method of vibration, the use of low-slump concrete, and or other means shall be employed to prevent downgrade movement of newly placed slab concrete. Finishing Concrete Surfaces: See Standard Architectural Detail Sheets and the Contract Special Provisions for types and details. All reinforcing steel shall be deformed bars conforming to ASTM A615 Grade 40. All reinforcing bar dimensions on the detailed drawings are to centers of bars unless otherwise noted. Clear distance between reinforcing steel and face of concrete shall be as noted on the plans. All bar laps shall be 30 diameters of the smaller diameter bar unless otherwise noted.


STEEL NOTES:

Structural steel shall conform to A.S.T.M. Designations A36, A572-Grade 50 and A588 as noted. See Special Provisions. All field connections shall be made with high strength bolts. High strength bolts shall be 1" diameter unless otherwise noted and shall conform to A.S.T.M. Specification A-325.

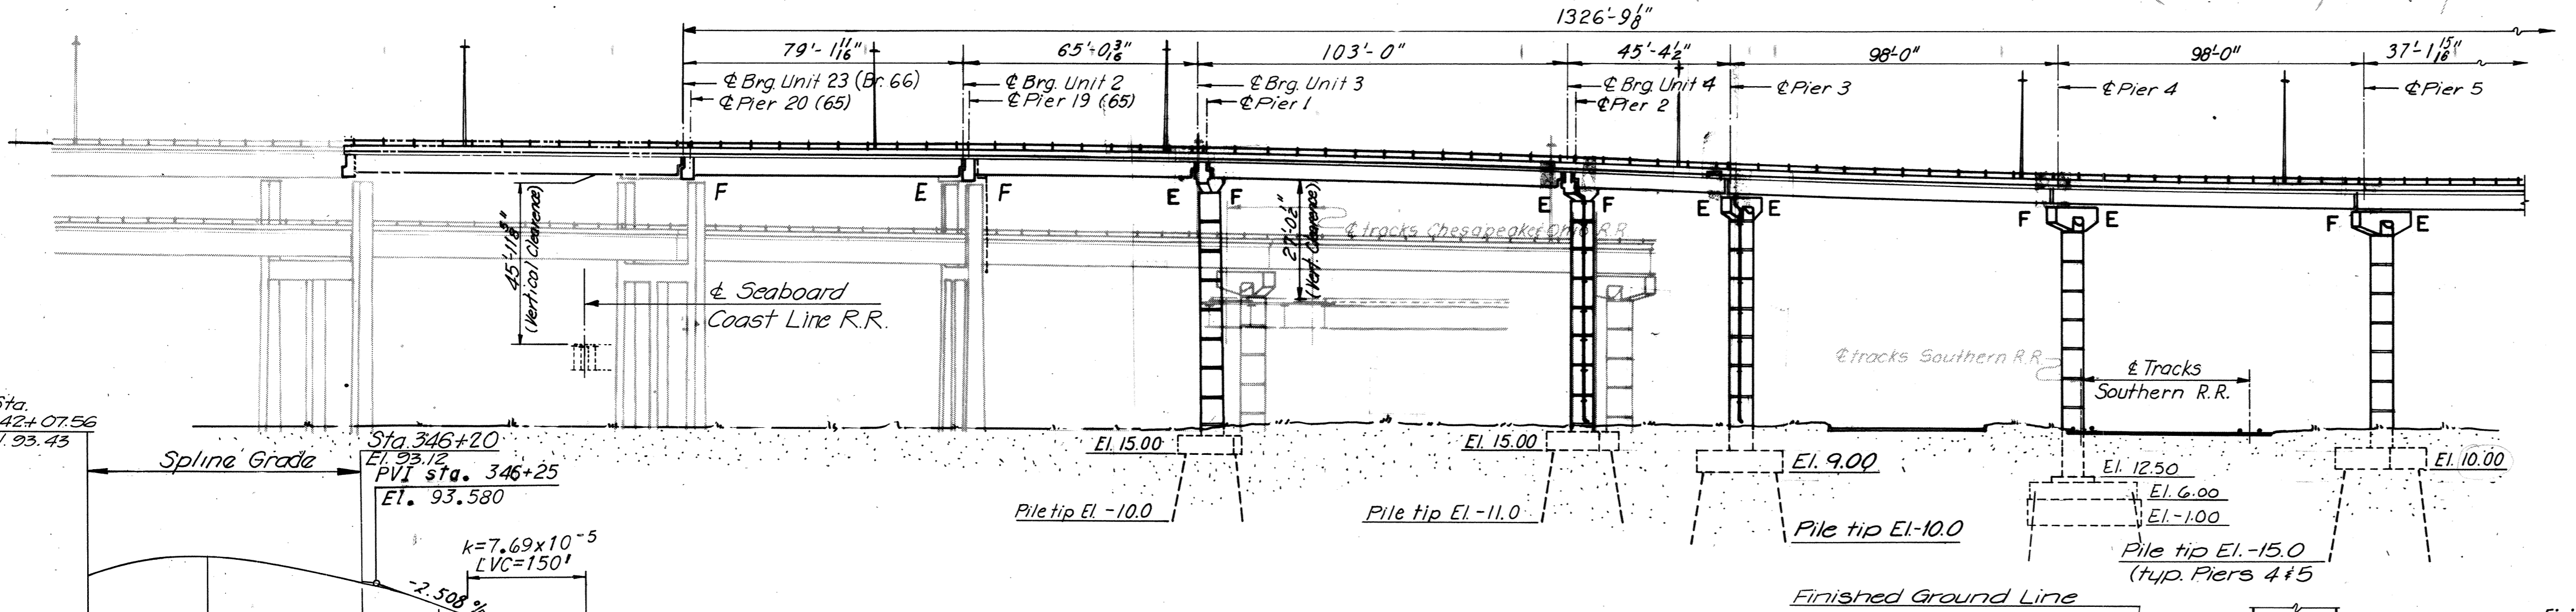

ELEVATION

Sta. 342+07.56
El. 93.43
Spline Grade
Sta. 346+20
El. 93.12
PVI Sta. 346+25
El. 93.580
k=7.69x10⁻⁵
LVC=150'
-2.50%
LVC=105'
k=5.32x10⁻⁵
0.20%
Sta. 344+15±
95.19± H.P.
PVI Sta. 349+50
El. 85.430

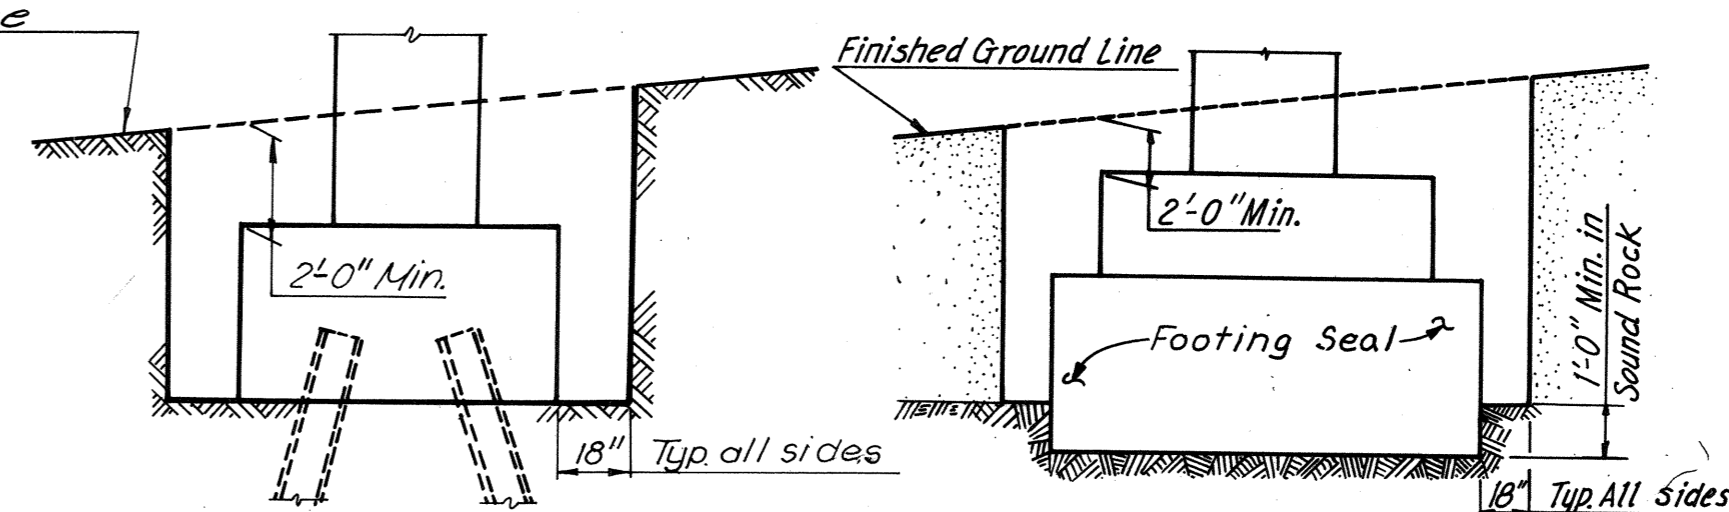

AS BUILT
RICHMOND METROPOLITAN AUTHORITY
RICHMOND EXPRESSWAY SYSTEM
DOWNTOWN EXPRESSWAY
BRIDGE NO. 68
RAMP W-S CONNECTION TO
RICHMOND-PETERSBURG TURNPIKE
GENERAL PLAN AND ELEVATION

LIMITS OF STRUCTURE EXCAVATION


No Scale

BY	DATE	REVISION	BY	DATE
J.V.	4-2-69	Profile Grade W-S, Index	TEM	8-26-75
G.S.H.	7-16-69	Seaboard Coast Line Added	TEM	6-74


△ PROFILE GRADE ▣ RAMP W-S

HOWARD, NEEDLES, TAMMEN & BERGENOFF consulting engineers NEW YORK ALEXANDRIA KANSAS CITY	SCALE: 1"=30' CONTRACT NO. 11 SHEET NO. 1 OF 28
--	---

RICHMOND EXPRESSWAY SYSTEM			
SECTION	PROJECT	SHEET NO.	TOTAL SHEETS
11	DOWNTOWN EXPRESSWAY	65	97

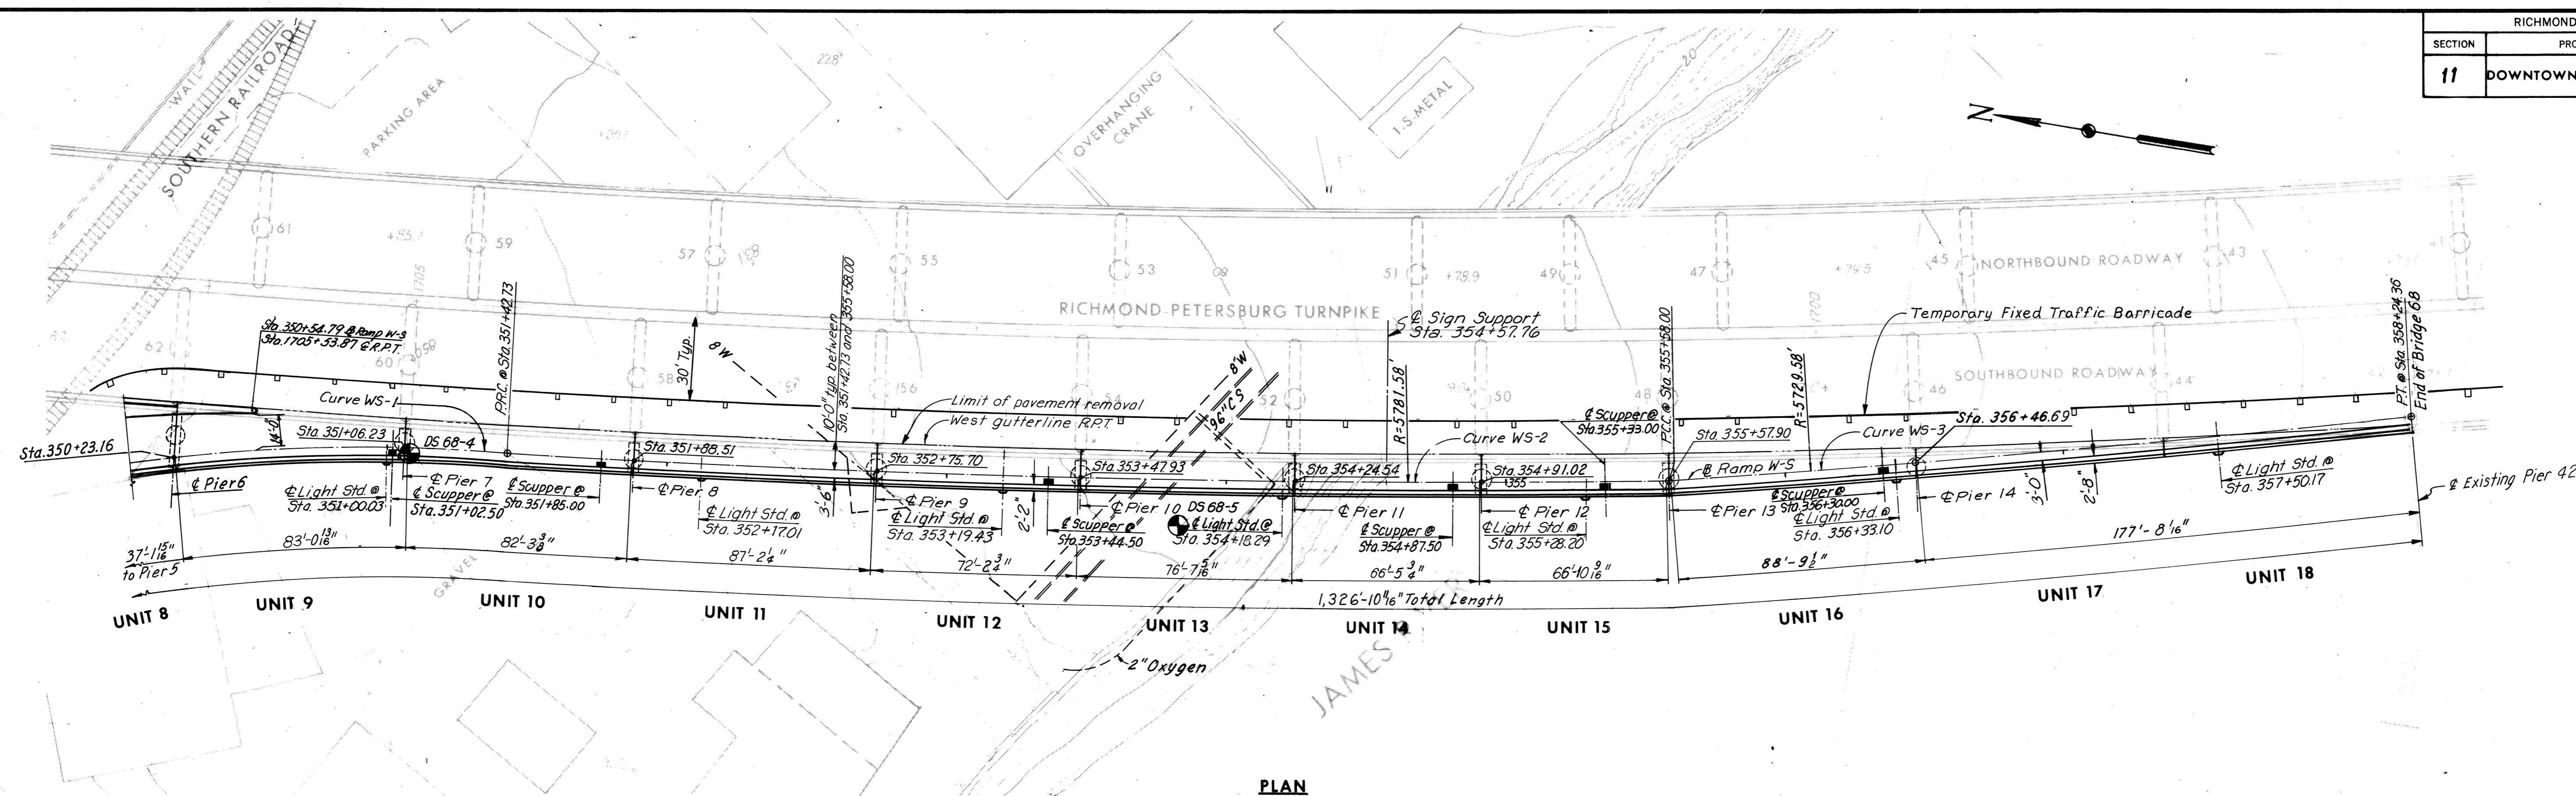

PLAN

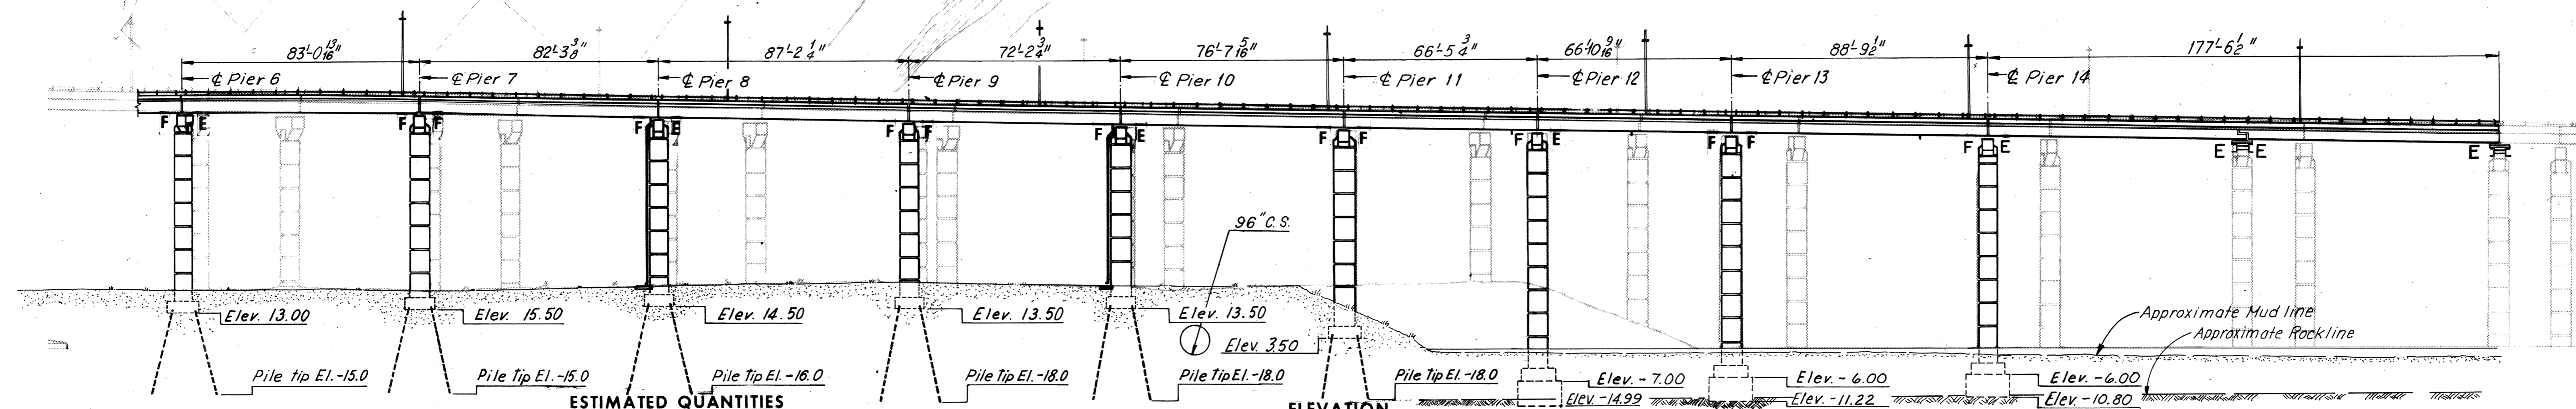

ELEVATION

ESTIMATED QUANTITIES

	Structure Excavation	Concrete	Reinforcing Steel	Str. Steel Mild carbon	Str. Steel High Strength	Aluminum Railing (1-rail)	Steel Piles 10BP42
	Cu. Yds.	Cu. Yds.	Lbs.	Lbs.	Lbs.	Lin. Ft.	Lin. Ft.
Superstructure	----	888.7	215,200	600,400	255,600	1,849	-----
Substructure	1,415*	1,751.0	245,300	31,600	8,400	---	2,630
Total	1,415*	2,639.7	460,500	632,000	264,000	1,849	2,630

	Steel Piles 12BP53	Tremie Concrete Class T3	Sheeting Pier 5	Metal Conduit	Bridge Drainage	Modifications to R.P. Turnpike Bridge	Modifications to Existing Retaining Wall	Temporary Barricade
	Lin. Ft.	Cu. Yds	Lump Sum	Lin. Ft.	metal work Lbs.	Lump Sum	Cu. Yds.	Lin. Ft.
Superstructure	---	---		1,310	11,450	1	50	
Substructure	1,412	173.3	1	---	---	---	---	
Total	1,412	173.3	1	1,310	11,450	1	50	990

* Including 365 Cu. Yds. of "Underwater" Excavation for Piers 12, 13 and 14.
 * All concrete for Superstructure shall be Class A4 and for Substructure Class A3. Concrete for Footing Seals shall be Tremie Concrete, Class T3 and is listed separately.

BY	DATE	REVISION	BY	DATE
MADE	J.V. 4-3-69			
CHECKED	G.S.H. 7-16-69	At Pier 44 # 42	T.E.M. 8-26-75	
IN CHARGE		Struct. Steel Quant.		

AS BUILT


RICHMOND METROPOLITAN AUTHORITY
RICHMOND EXPRESSWAY SYSTEM
DOWNTOWN EXPRESSWAY

BRIDGE NO. 68
RAMP W-S CONNECTION TO
RICHMOND-PETERSBURG TURNPIKE
GENERAL PLAN AND ELEVATION

HOWARD, NEEDLES, TAMMEN & BERGENDOFF
 consulting engineers
 NEW YORK ALEXANDRIA KANSAS CITY

SCALE: 1"=30'
 CONTRACT NO. 11
 SHEET NO. 2 OF 28

RICHMOND EXPRESSWAY SYSTEM			
SECTION	PROJECT	SHEET NO.	TOTAL SHEETS
11	DOWNTOWN EXPRESSWAY	66	97

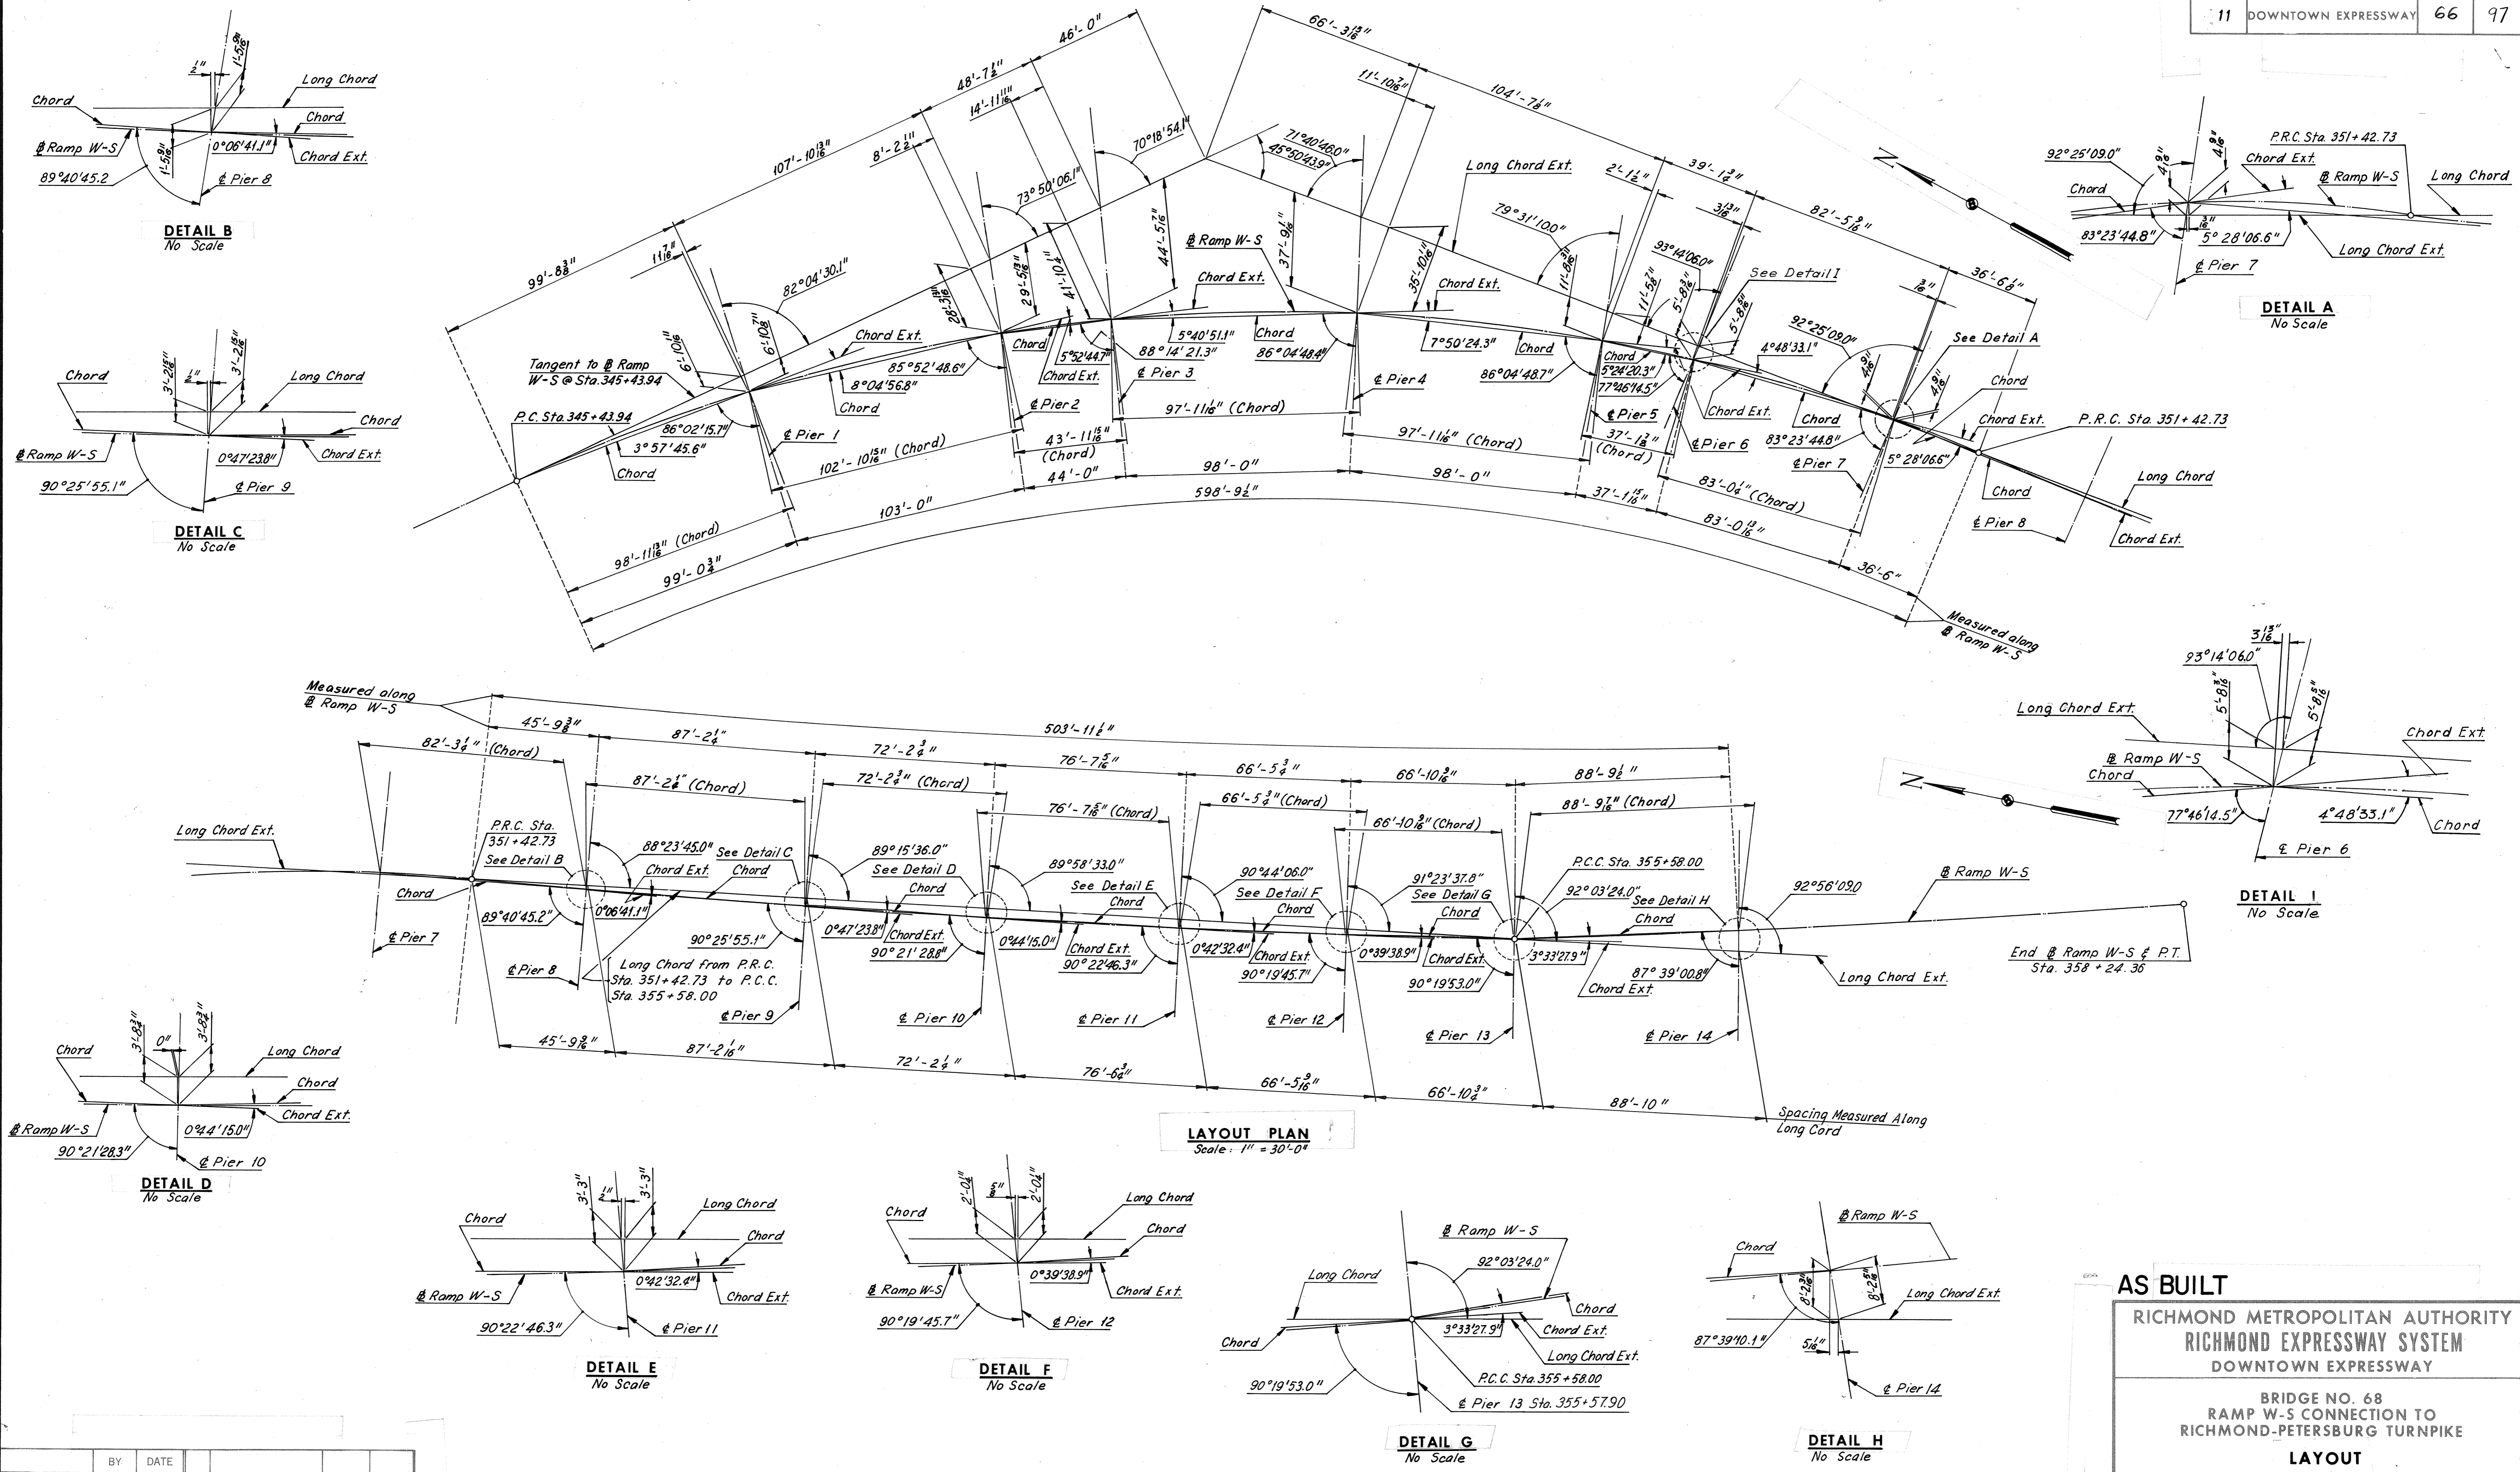

BY	DATE				
MADE	PTA	3-24-69			
CHECKED	J.D.	4-22-69			
IN CHARGE			NO.	REVISION	BY DATE

AS BUILT

RICHMOND METROPOLITAN AUTHORITY
RICHMOND EXPRESSWAY SYSTEM
DOWNTOWN EXPRESSWAY


BRIDGE NO. 68
RAMP W-S CONNECTION TO
RICHMOND-PETERSBURG TURNPIKE

LAYOUT

SCALE: As Noted

HOWARD, NEEDLES, TAMMEN & BERGENDORF
consulting engineers
NEW YORK ALEXANDRIA KANSAS CITY

CONTRACT NO. 11
SHEET NO. 3 OF 28

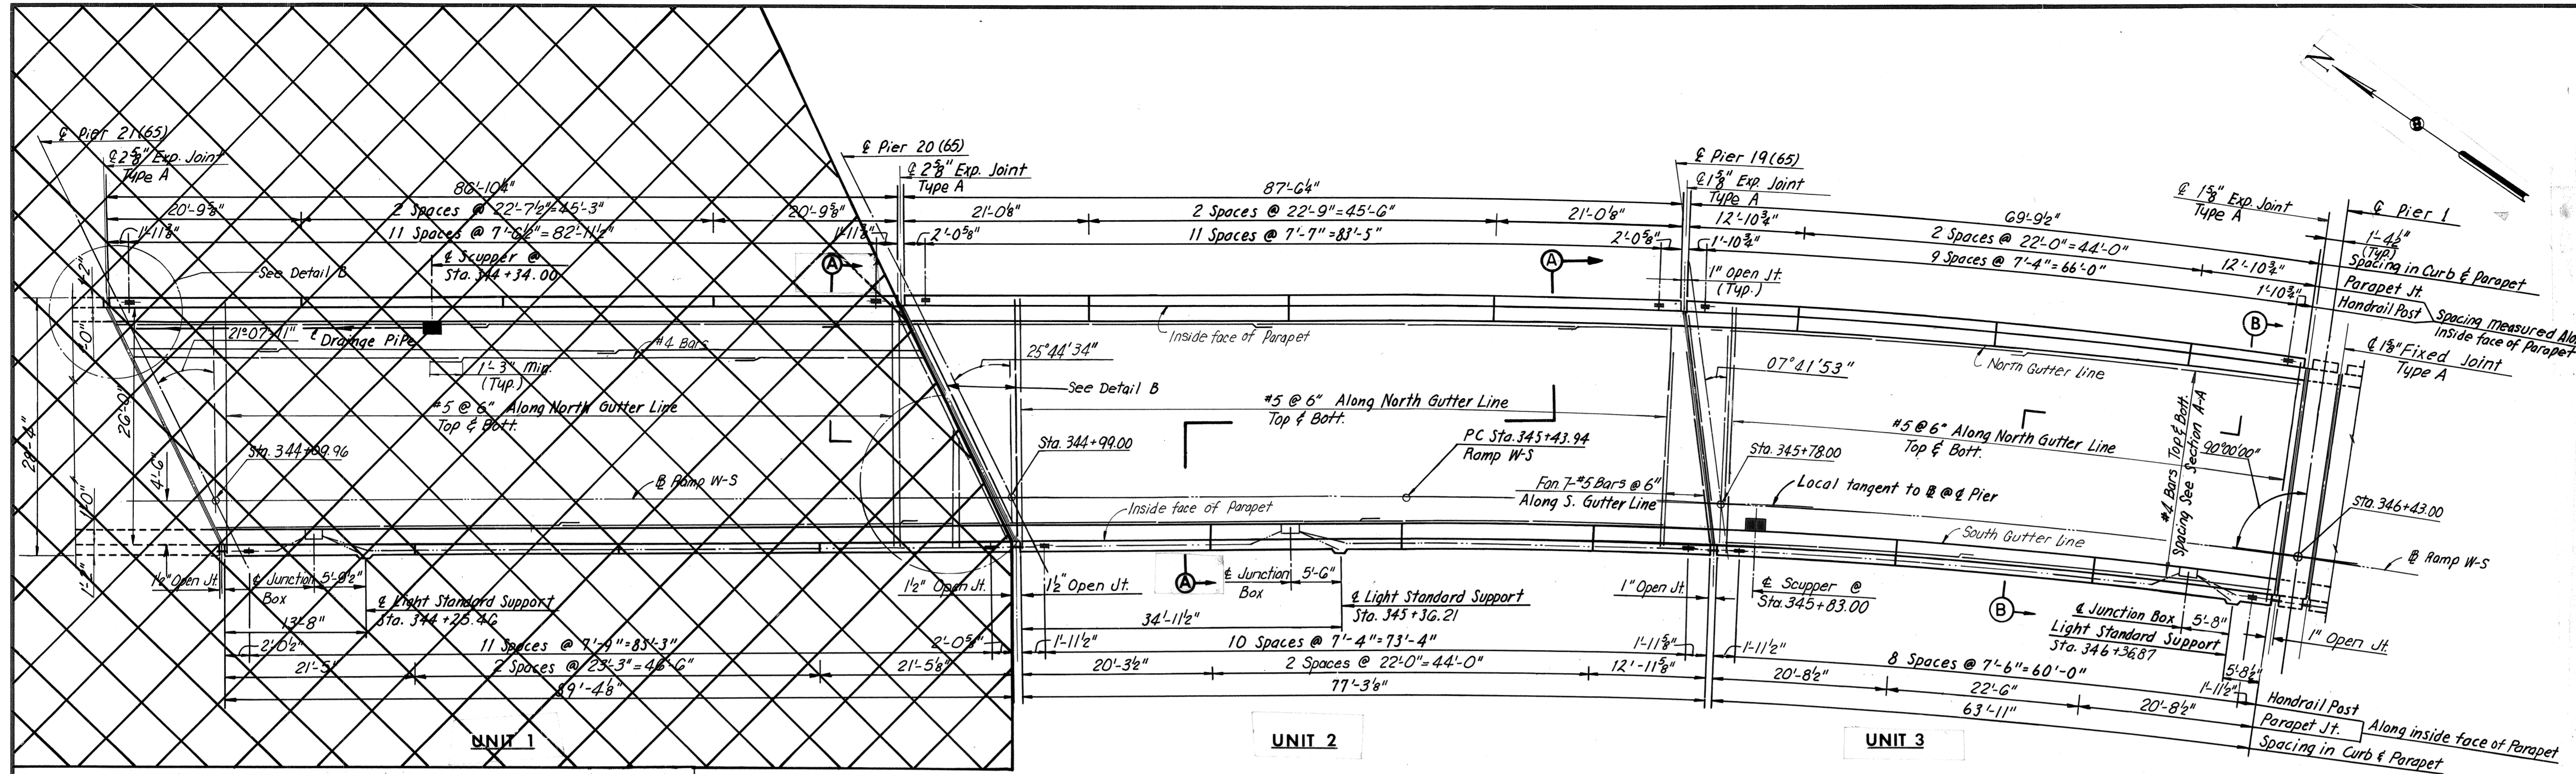



ELEVATION TABLE

STATION	ELEV. A	ELEV. B	ELEV. C
344+00.57	94.89	---	---
344+00.00	94.89	95.16	95.21
+09.84	---	---	95.22
+09.96	---	95.18	---
+10.00	94.96	95.18	95.22
+20.00	95.02	95.18	95.21
+30.00	95.06	95.17	95.19
+40.00	95.08	95.13	95.14
+50.00	95.08	95.08	95.08
+60.00	95.10	95.02	95.01
+70.00	95.10	94.94	94.91
+80.00	95.10	94.85	94.81
+87.57	95.08	---	---
+90.00	95.08	94.75	94.69
+99.16	---	---	94.59
344+99.00	---	94.66	---
345+00.00	95.06	94.65	94.58
+10.00	95.03	94.54	94.46
+20.00	95.01	94.44	94.34
+30.00	94.99	94.33	94.22
+40.00	94.96	94.22	94.09
+50.00	94.92	94.10	93.96
+60.00	94.88	93.98	93.84
+70.00	94.84	93.86	93.69
+73.84	94.82	---	---
+77.08	---	---	93.58
+78.00	---	93.75	---
+80.00	94.79	93.72	93.54
345+90.00	94.74	93.59	93.39
346+00.00	94.67	93.44	93.73
+10.00	94.51	93.28	93.07
+20.00	94.35	93.12	92.91
+30.00	94.20	92.97	92.76
+40.00	94.05	92.82	92.61
+41.63	---	---	92.59
+41.66	94.02	---	---

Note:
 Pier 20(65) and Pier 19(65)
 denotes Piers 21, 20 and 19 of Bridge 65 (Ramp S-W).


DECK PLAN
 Scale: 1/8" = 1'-0"

Note:
 Section B-B, See Sheet 20.

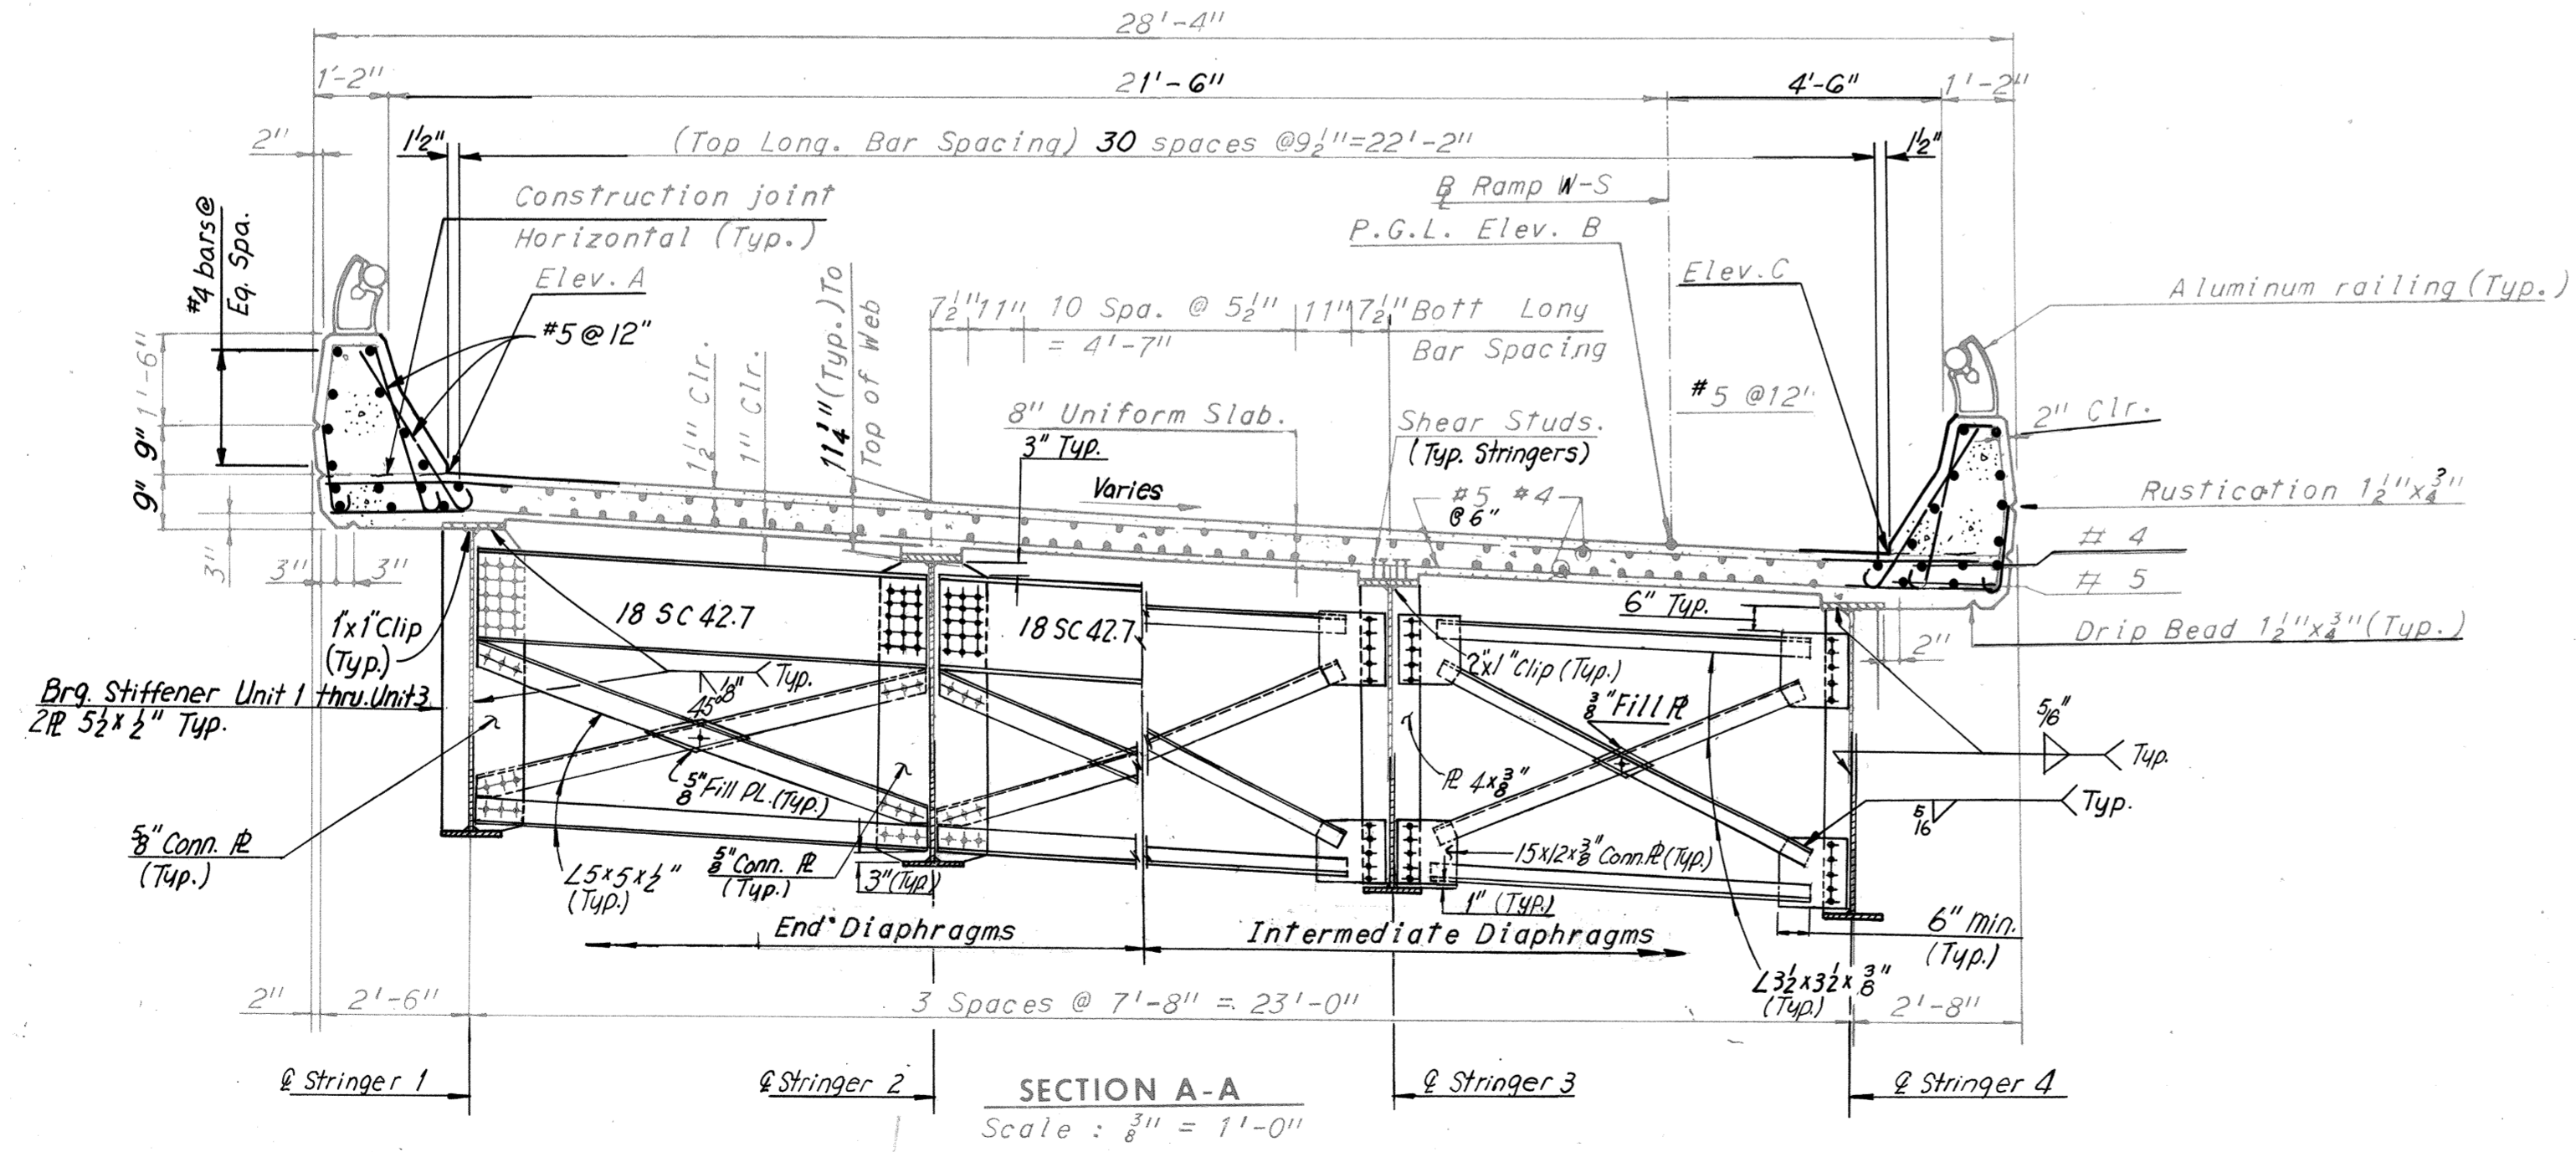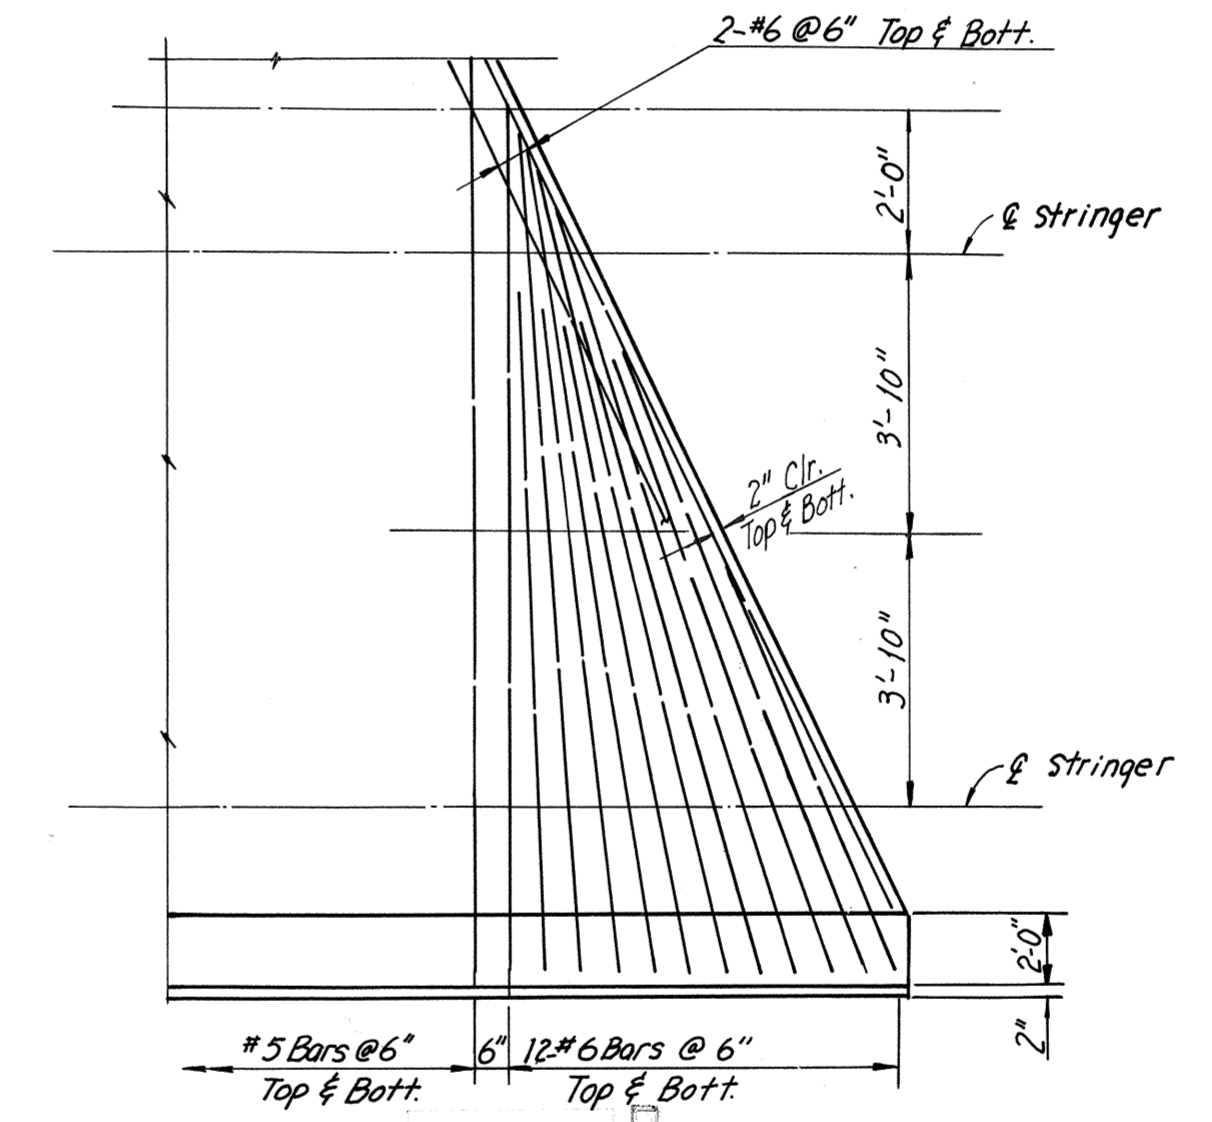

Note:
 End Diaphragm for Unit 3, see Sheet 20.

SECTION A-A
 Scale: 3/8" = 1'-0"
 (Intermediate Diaphragm near Pier 19 Unit 2 only)

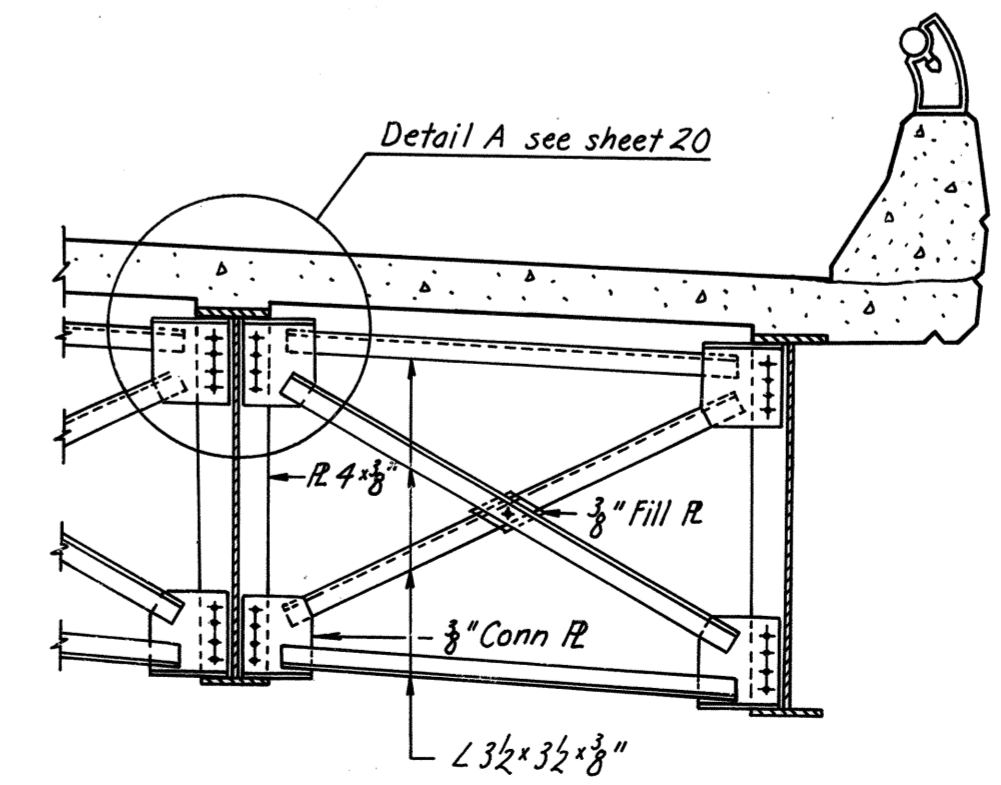


Notes
 For Framing Plan, see Sheet 12.
 For Standard Lighting Details, see Sheet S4.
 For Standard Drainage Details, see Support Type 2 Sheets S5 and S6.
 For Joint Details, see Sheet 25.
 For Standard Handrail Details, see Sheet S3.






AS BUILT
 RICHMOND METROPOLITAN AUTHORITY
 RICHMOND EXPRESSWAY SYSTEM
 DOWNTOWN EXPRESSWAY
 BRIDGE NO. 68
 RAMP W-5 CONNECTION TO
 RICHMOND-PETERSBURG TURNPIKE
 DECK PLAN — UNITS 1, 2 AND 3
 HOWARD, NEEDLES, TAMMEN & BERGENDOFF
 consulting engineers
 NEW YORK ALEXANDRIA KANSAS CITY
 SCALE: As Noted
 CONTRACT NO. 11
 SHEET NO. 19 OF 28

MADE	BY	DATE	NO.	REVISION	BY	DATE
	GSH	10-24-68		Elev. Table	TEM	3-76
	AHH	12-13-68		Rev. Elev. Table	SSS	12-75

RICHMOND EXPRESSWAY SYSTEM			
SECTION	PROJECT	SHEET NO.	TOTAL SHEETS
11	DOWNTOWN EXPRESSWAY	83	97

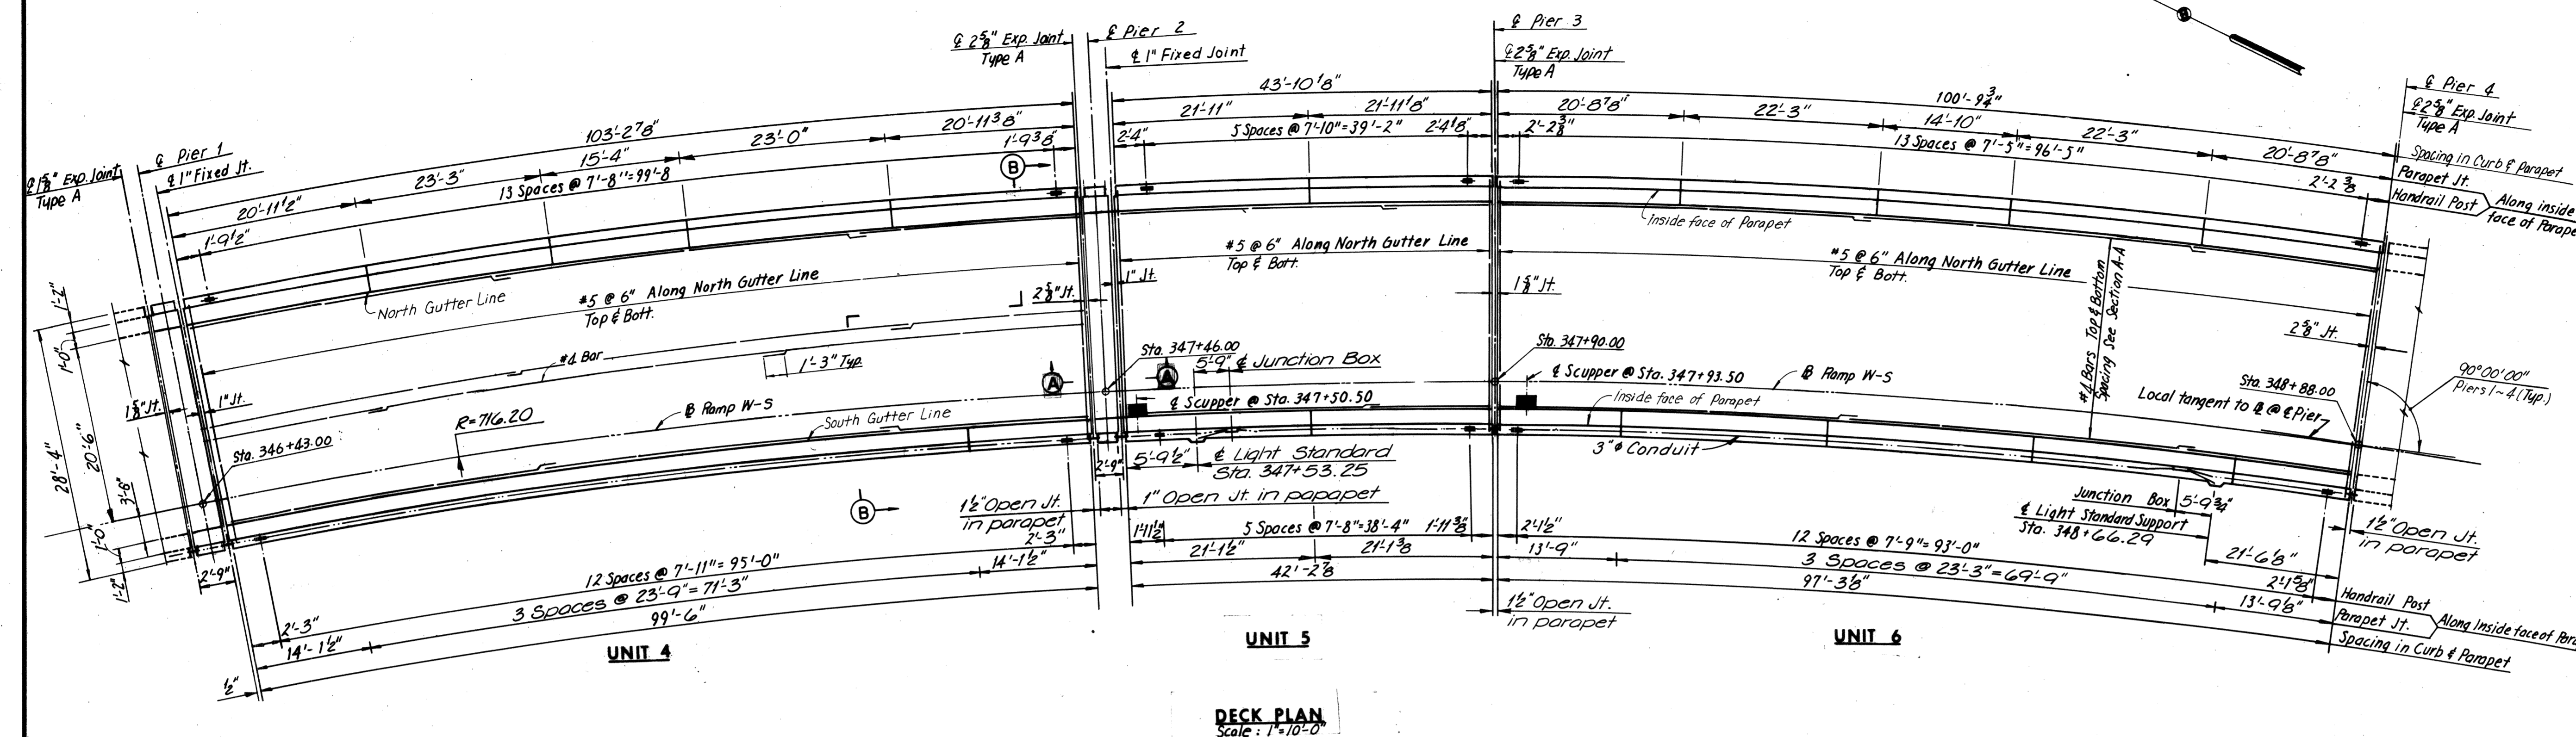

ELEVATION TABLE			
STATION	ELEV. A	ELEV. B	ELEV. C
346+43.00	94.00	92.77	92.56
+50.00	93.88	92.65	92.44
+60.00	93.71	92.48	92.27
+70.00	93.32	92.29	92.08
+80.00	93.32	92.09	91.88
346+90.00	93.11	91.88	91.67
347+00.00	92.90	91.67	91.46
+10.00	92.67	91.44	91.23
+20.00	92.43	91.20	90.99
+30.00	92.18	90.95	90.74
+40.00	91.93	90.70	90.49
+44.62	---	---	90.37
+44.66	91.81	---	---
+46.00	91.78	90.55	90.34
+50.00	91.68	90.45	90.24
+60.00	91.42	90.19	89.98
+70.00	91.17	89.94	89.73
+80.00	90.92	89.69	89.48
347+90.00	90.67	89.44	89.23
348+00.00	90.42	89.19	88.98
+10.00	90.17	88.94	88.73
+20.00	89.92	88.69	88.48
+30.00	89.67	88.44	88.23
+40.00	89.42	88.19	87.98
+50.00	89.17	87.94	87.73
+60.00	88.92	87.69	87.48
+70.00	88.67	87.44	87.23
+80.00	88.42	87.19	86.98
348+88.00	88.23	87.00	86.79

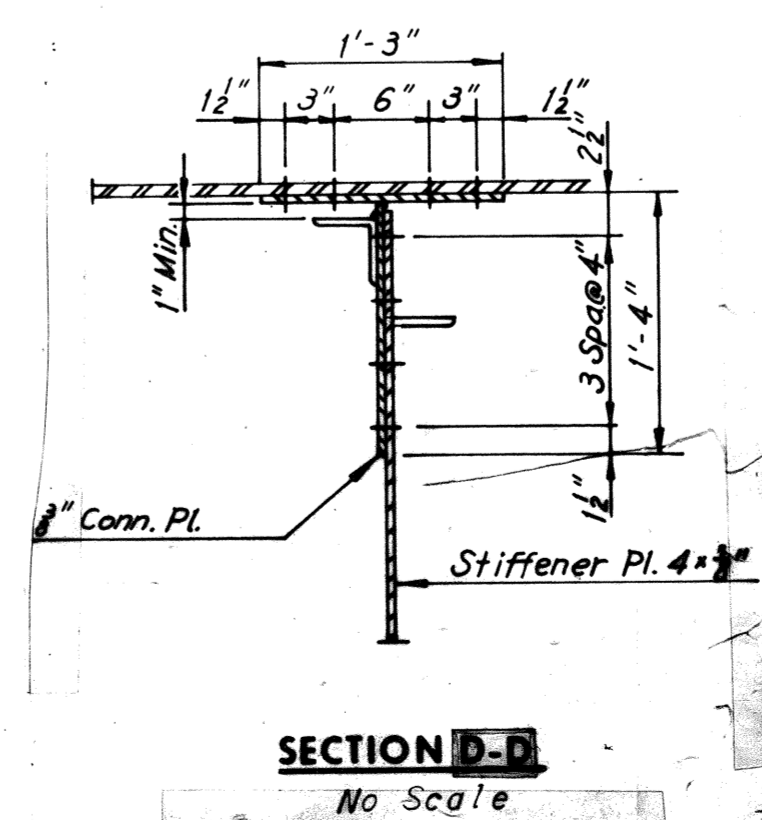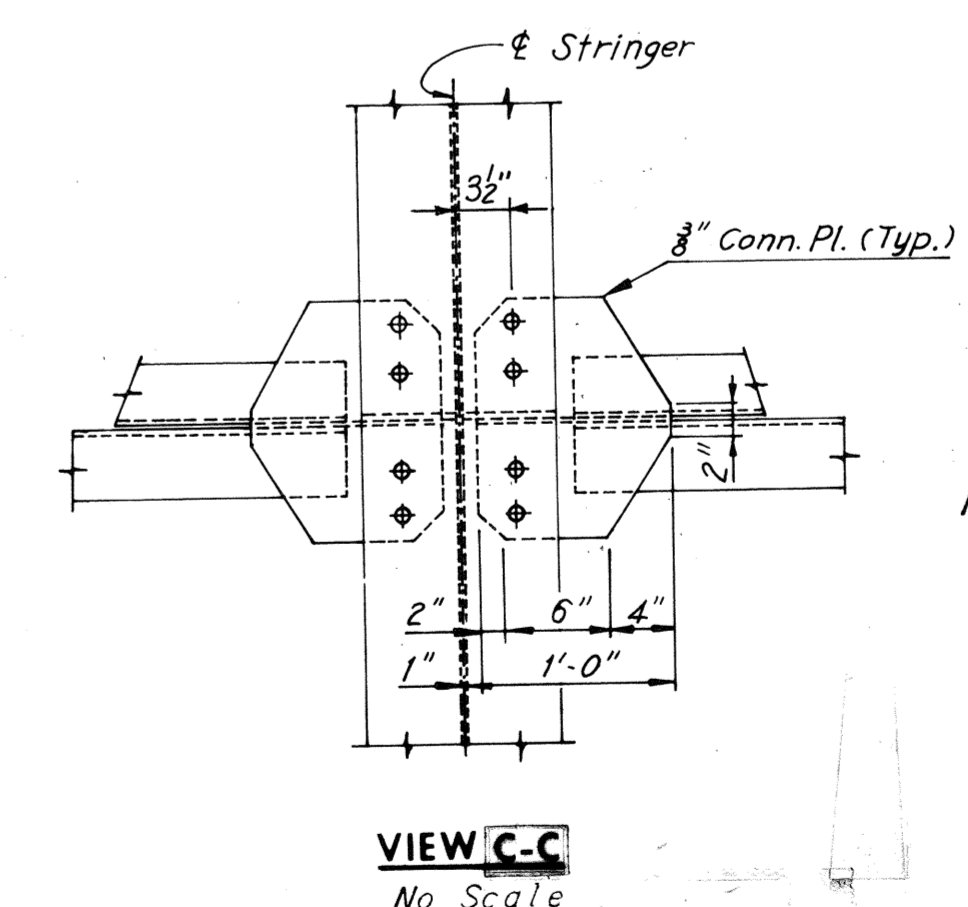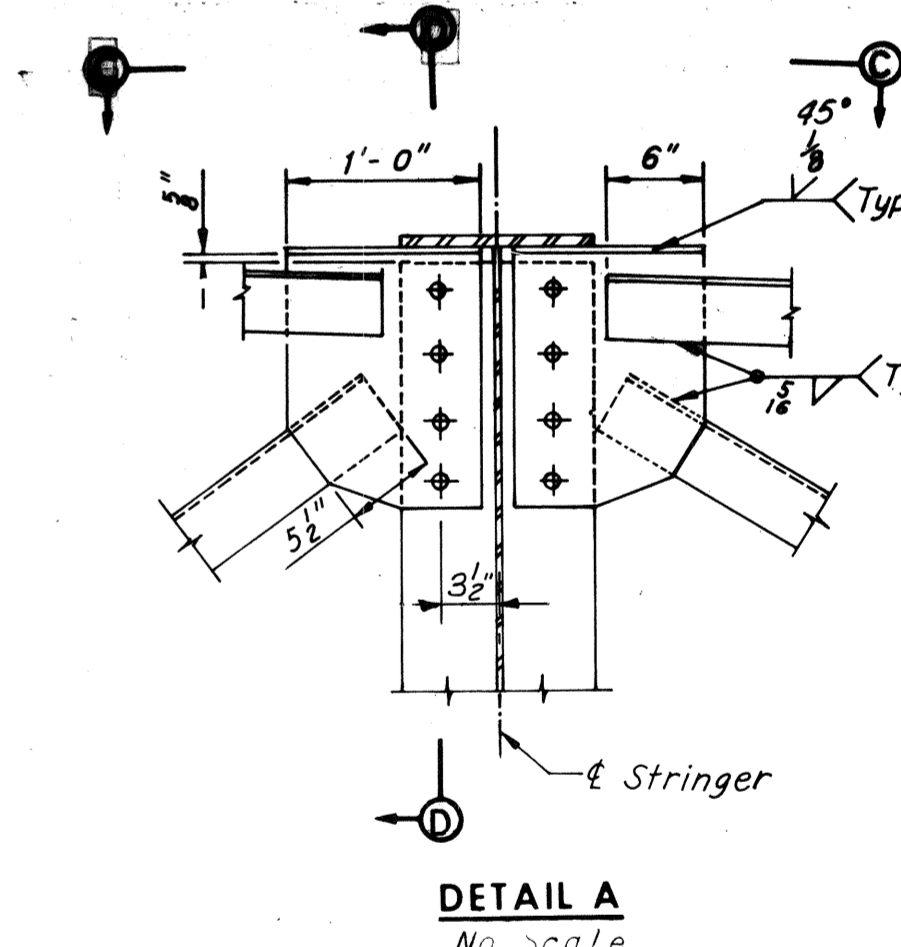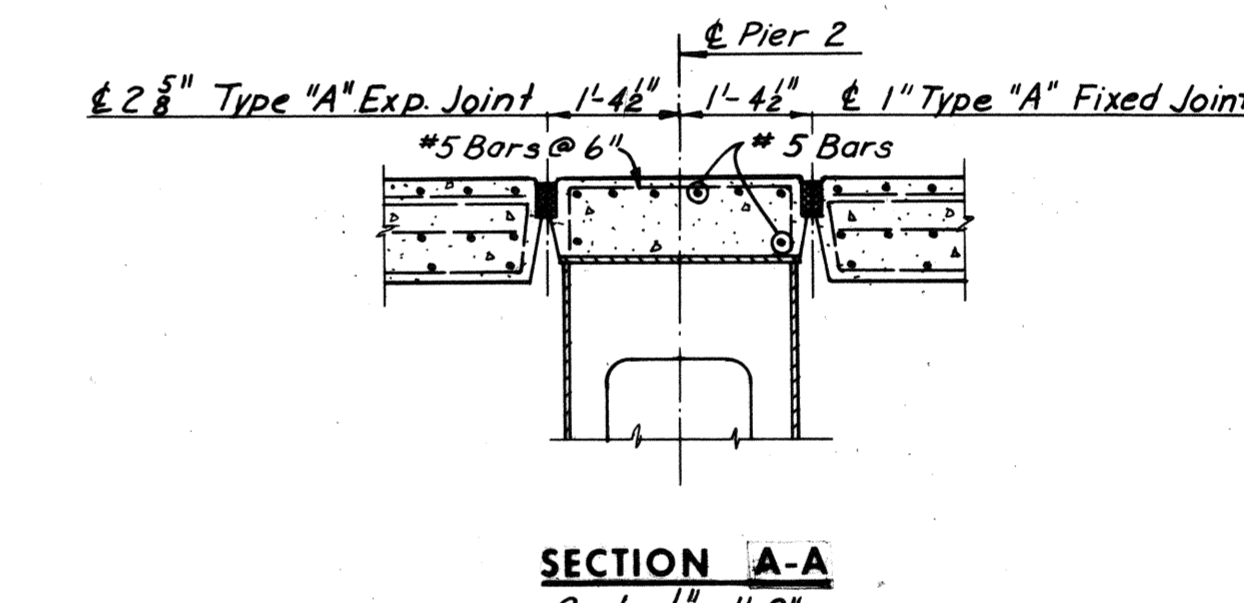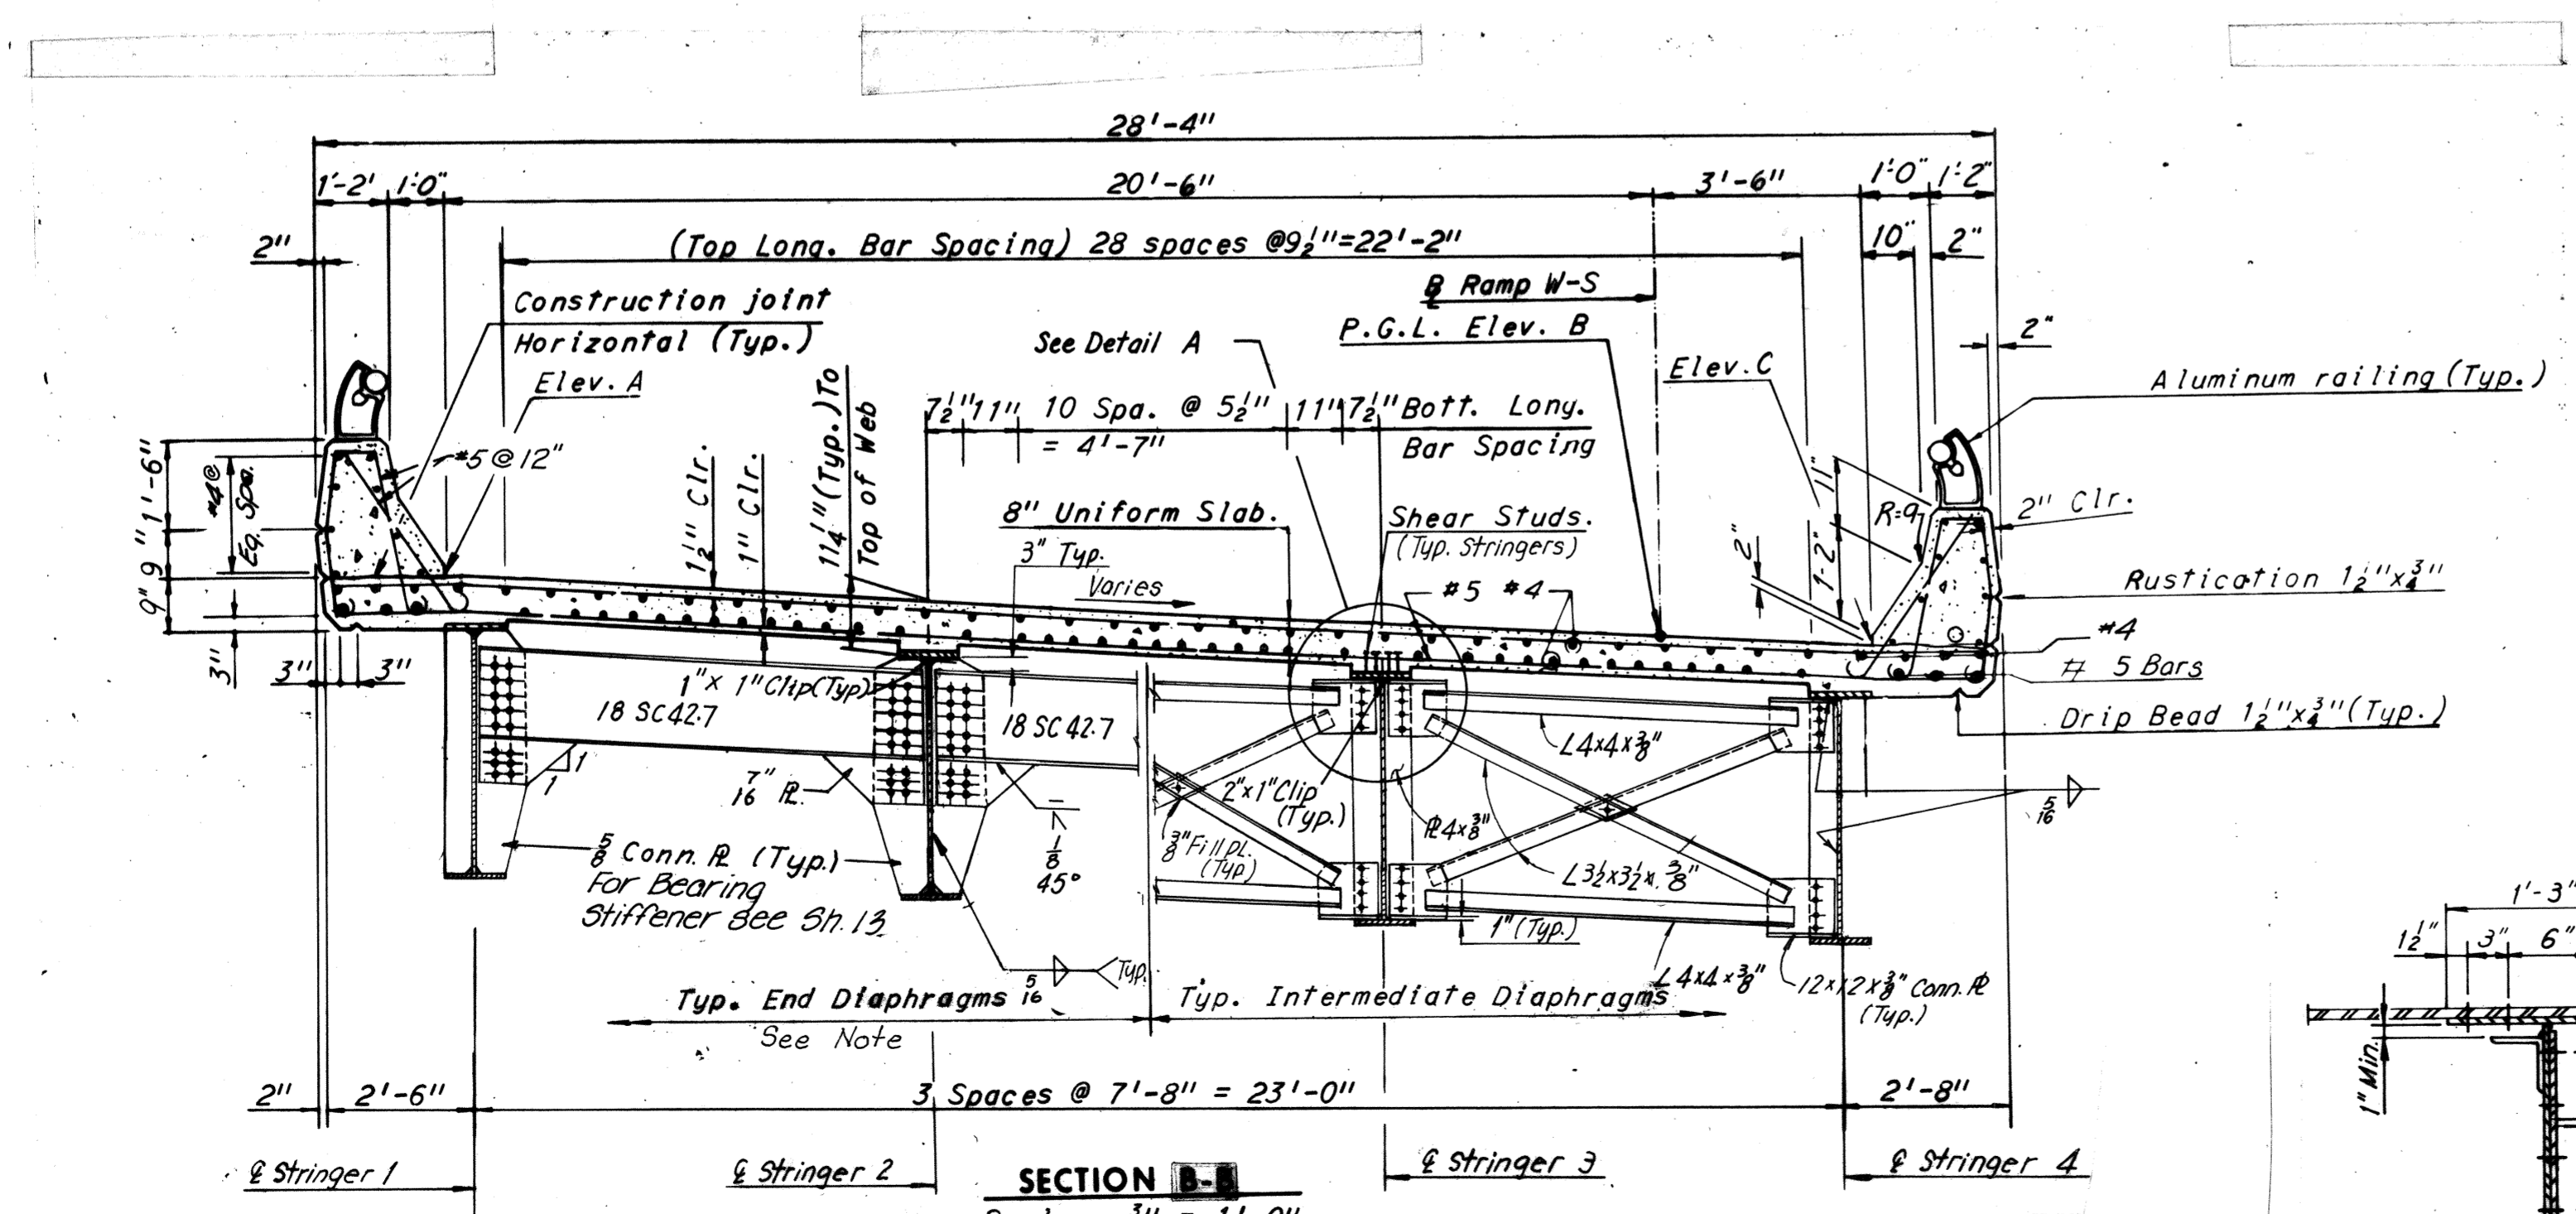

Notes
 For Framing Plan see Sheet 13.
 For Joint Details see Sheet 25.
 For Standard Lighting Details see Sheet 54.
 For Standard Handrail Details see Sheet 53.
 For Standard Drainage Details see Support Type 4 Sheets 55 & 56.

AS BUILT

RICHMOND METROPOLITAN AUTHORITY
RICHMOND EXPRESSWAY SYSTEM
DOWNTOWN EXPRESSWAY

BRIDGE NO. 68
RAMP W-S CONNECTION TO
RICHMOND-PETERSBURG TURNPIKE
DECK PLAN - UNITS 4, 5 AND 6






HOWARD, NEEDLES, TAMMEN & BERGENDOFF
 consulting engineers
 NEW YORK ALEXANDRIA KANSAS CITY

SCALE: As Noted
 CONTRACT NO.: 11
 SHEET NO. 20 OF 28

BY	DATE	NO.	REVISION	BY	DATE
MADE	G.S.H. 10-31-68	1	Dim. in Det. A and view C-C	TEM	8-76
CHECKED	A.H.H. 12-13-68	2	Corrected dimension	SSS	12-75
IN CHARGE					

RICHMOND EXPRESSWAY SYSTEM			
SECTION	PROJECT	SHEET NO.	TOTAL SHEETS
11	DOWNTOWN EXPRESSWAY	84	97

ELEVATION TABLE			
STATION	ELEV. A	ELEV. B	ELEV. C
348+88.00	88.20	87.00	86.79
+90	88.18	86.95	86.74
349+00.00	87.94	86.73	86.52
+10	87.72	86.53	86.32
+20	87.50	86.34	86.13
+30	87.30	86.16	85.95
+40	87.12	86.01	85.80
+50	86.95	85.86	85.65
+60	86.72	85.74	85.54
+70	86.51	85.62	85.44
+80	86.32	85.53	85.36
+86	86.21	85.48	85.32
+90	86.15	85.44	85.30
350+00.00	85.99	85.38	85.25
+10	85.85	85.33	85.21
+20	85.74	85.29	84.19
+22.57			85.18
+23.24		85.28	
+26.05	85.76		
+30	85.72	85.26	85.15
+40	85.49	85.18	85.10
+50	85.32	85.05	84.94
+54.79	85.25	85.03	84.94
+60	85.17	84.88	84.81
+70	84.99	84.71	84.64
+80	84.85	84.60	84.52
+90	84.69	84.45	84.37
351+00.00	84.51	84.29	84.21
+06.23	84.40	84.31	84.29

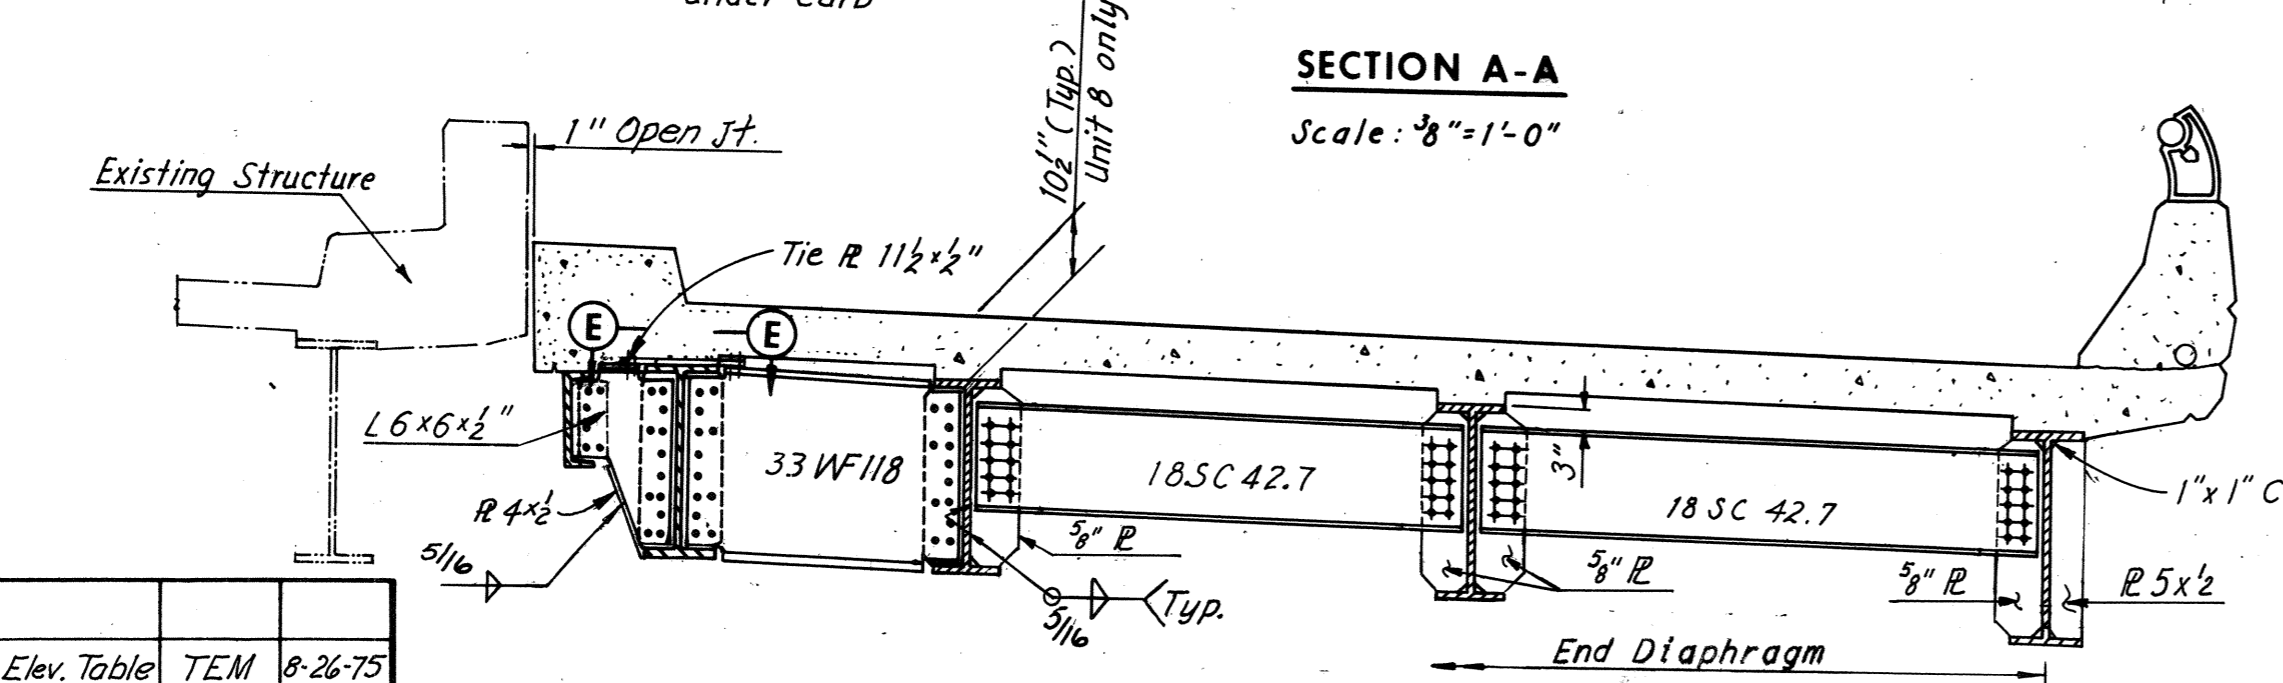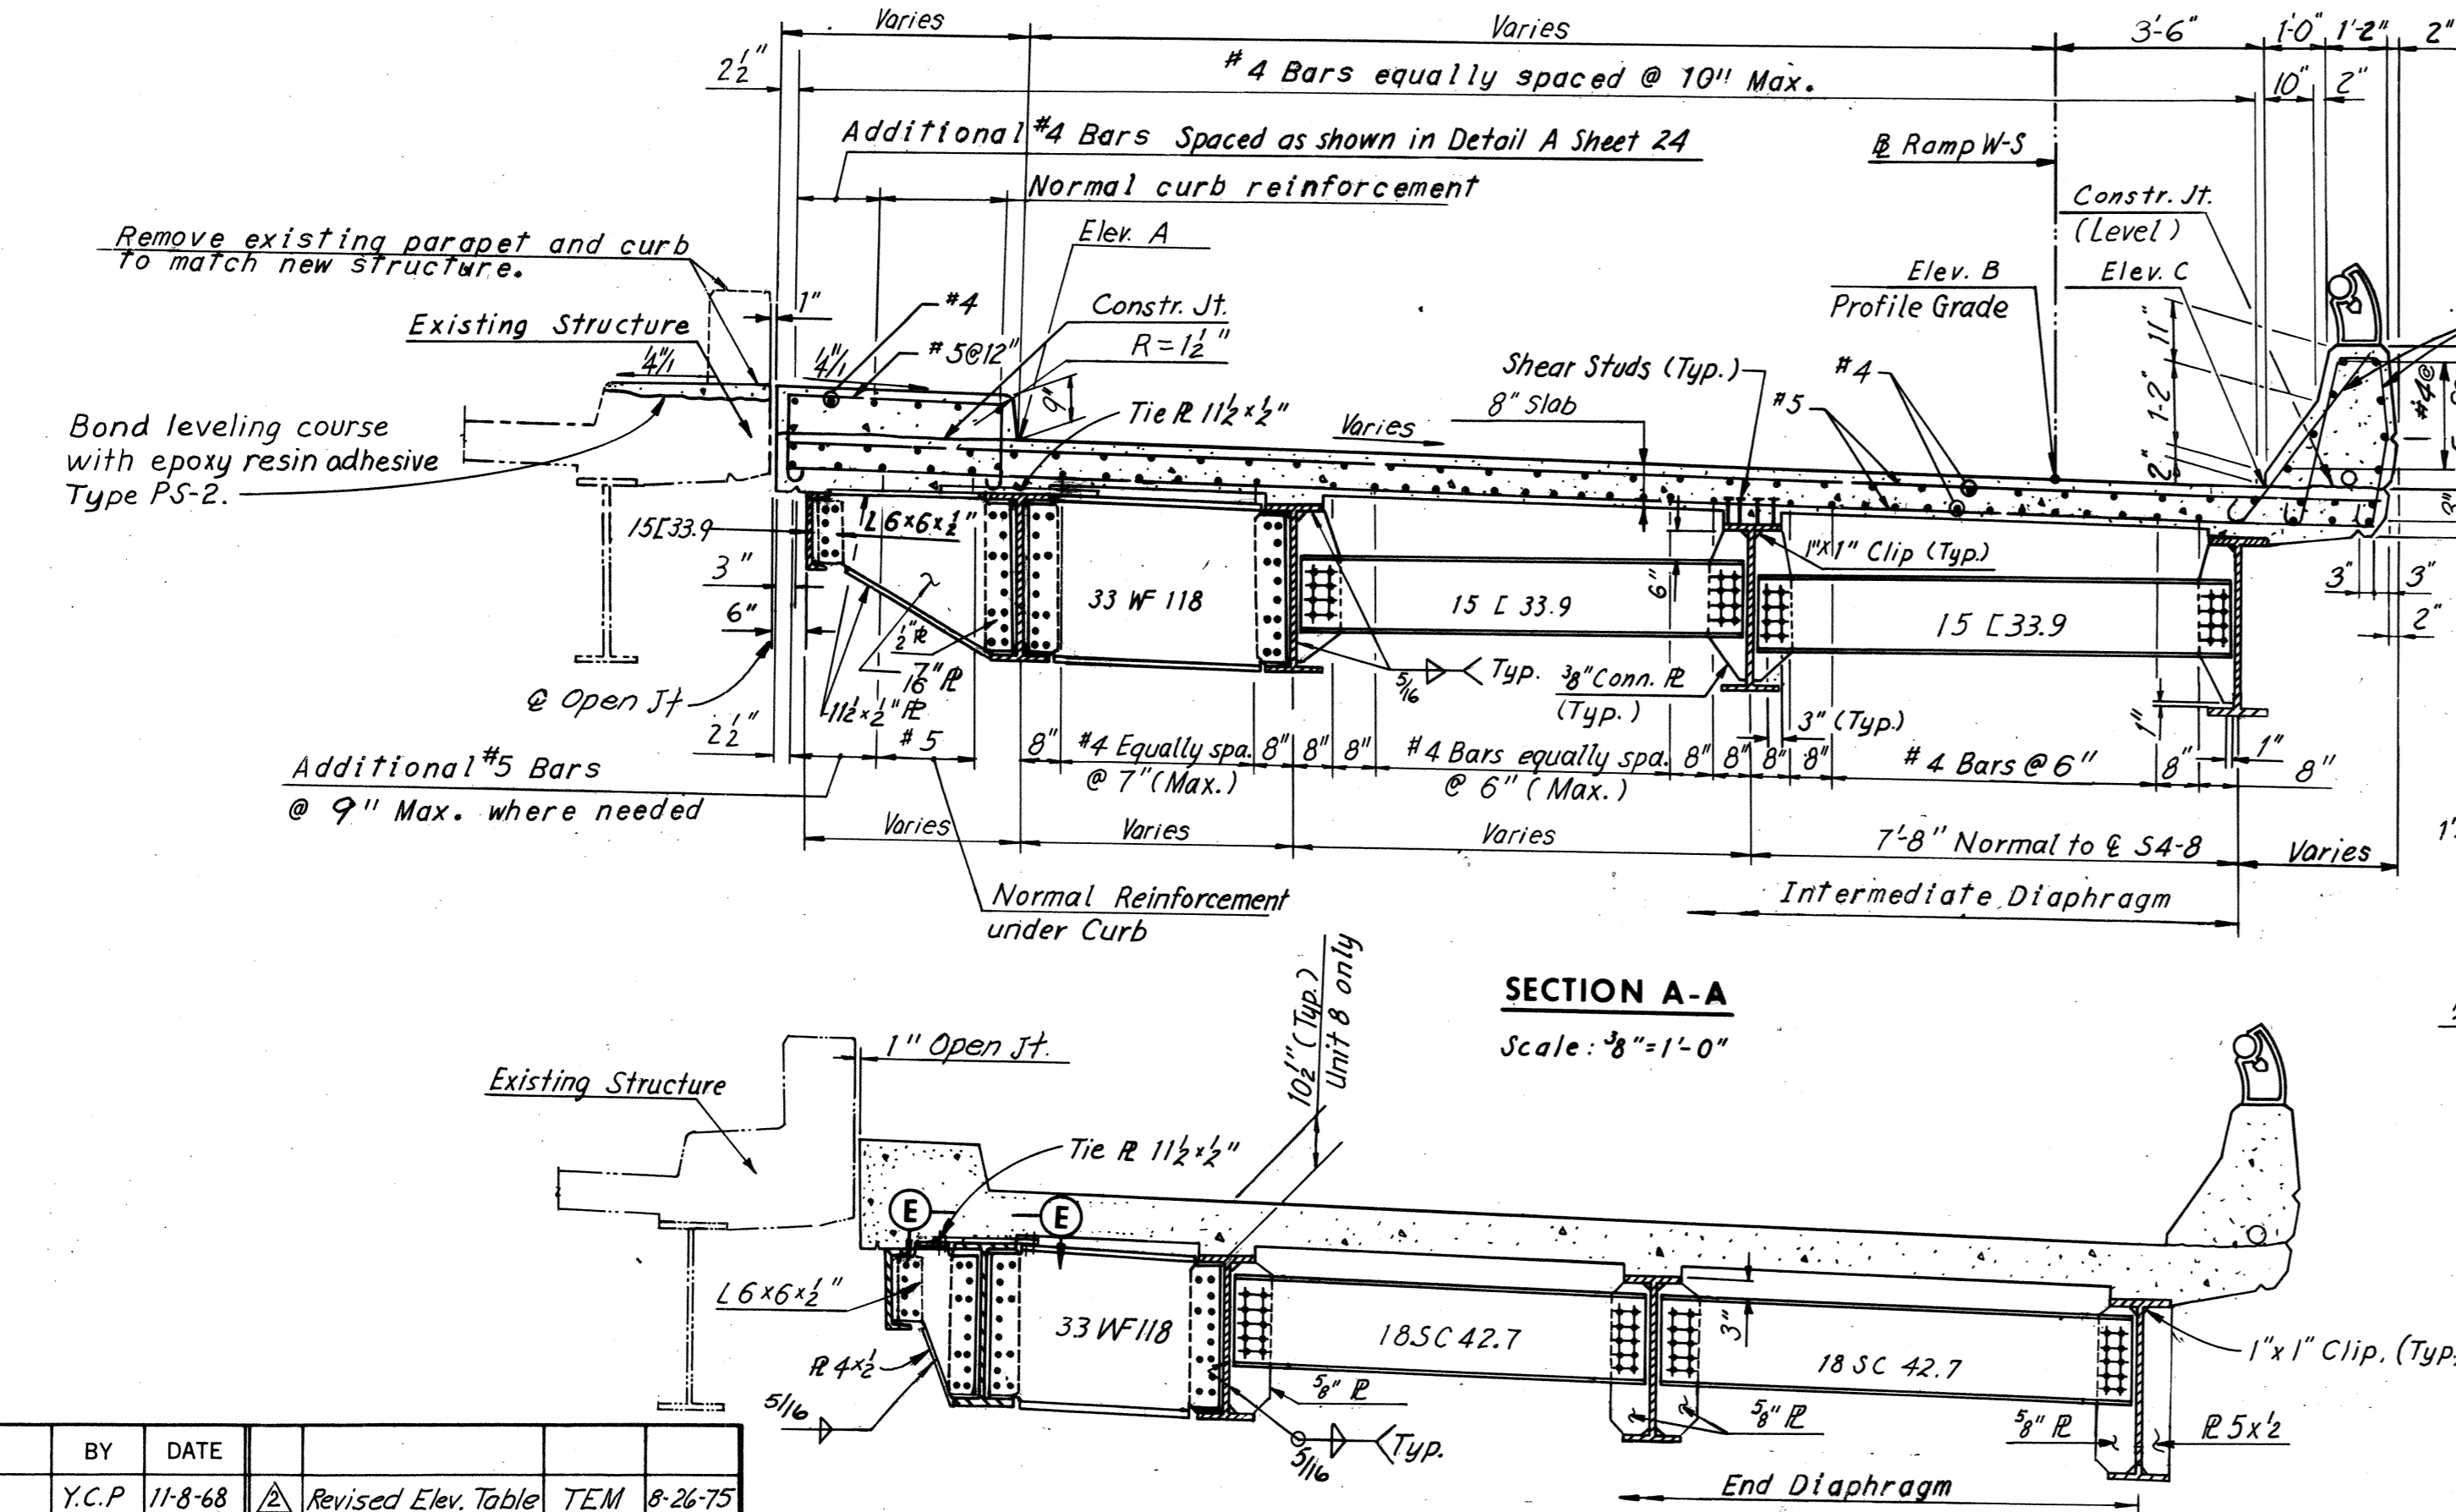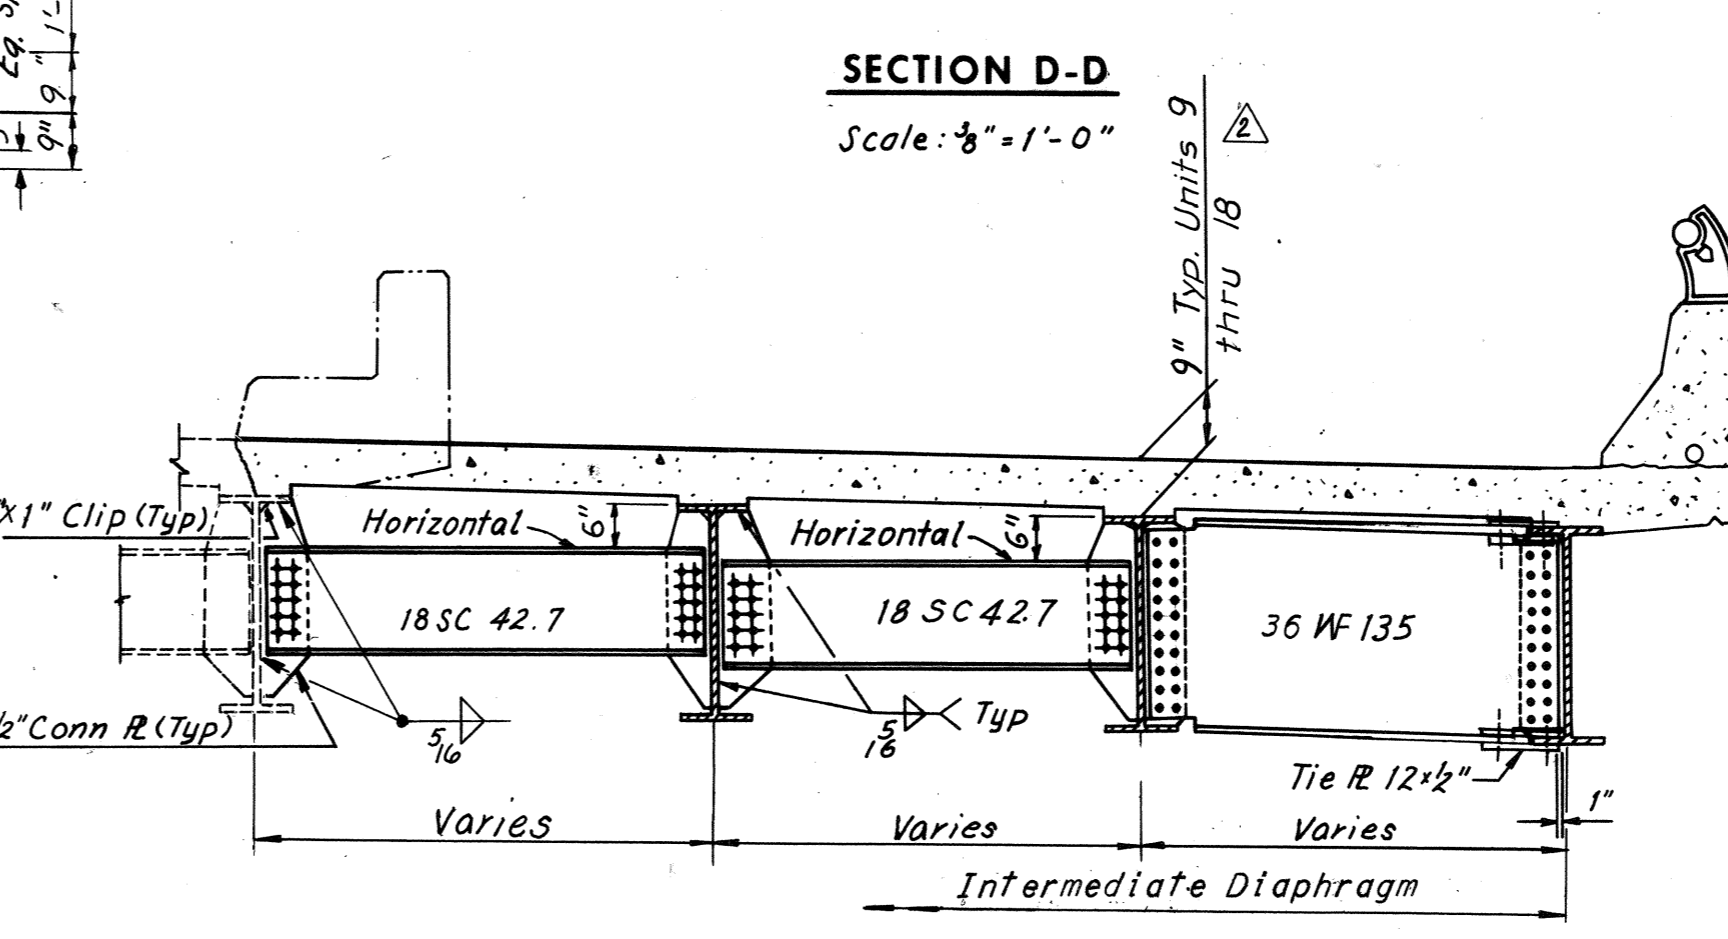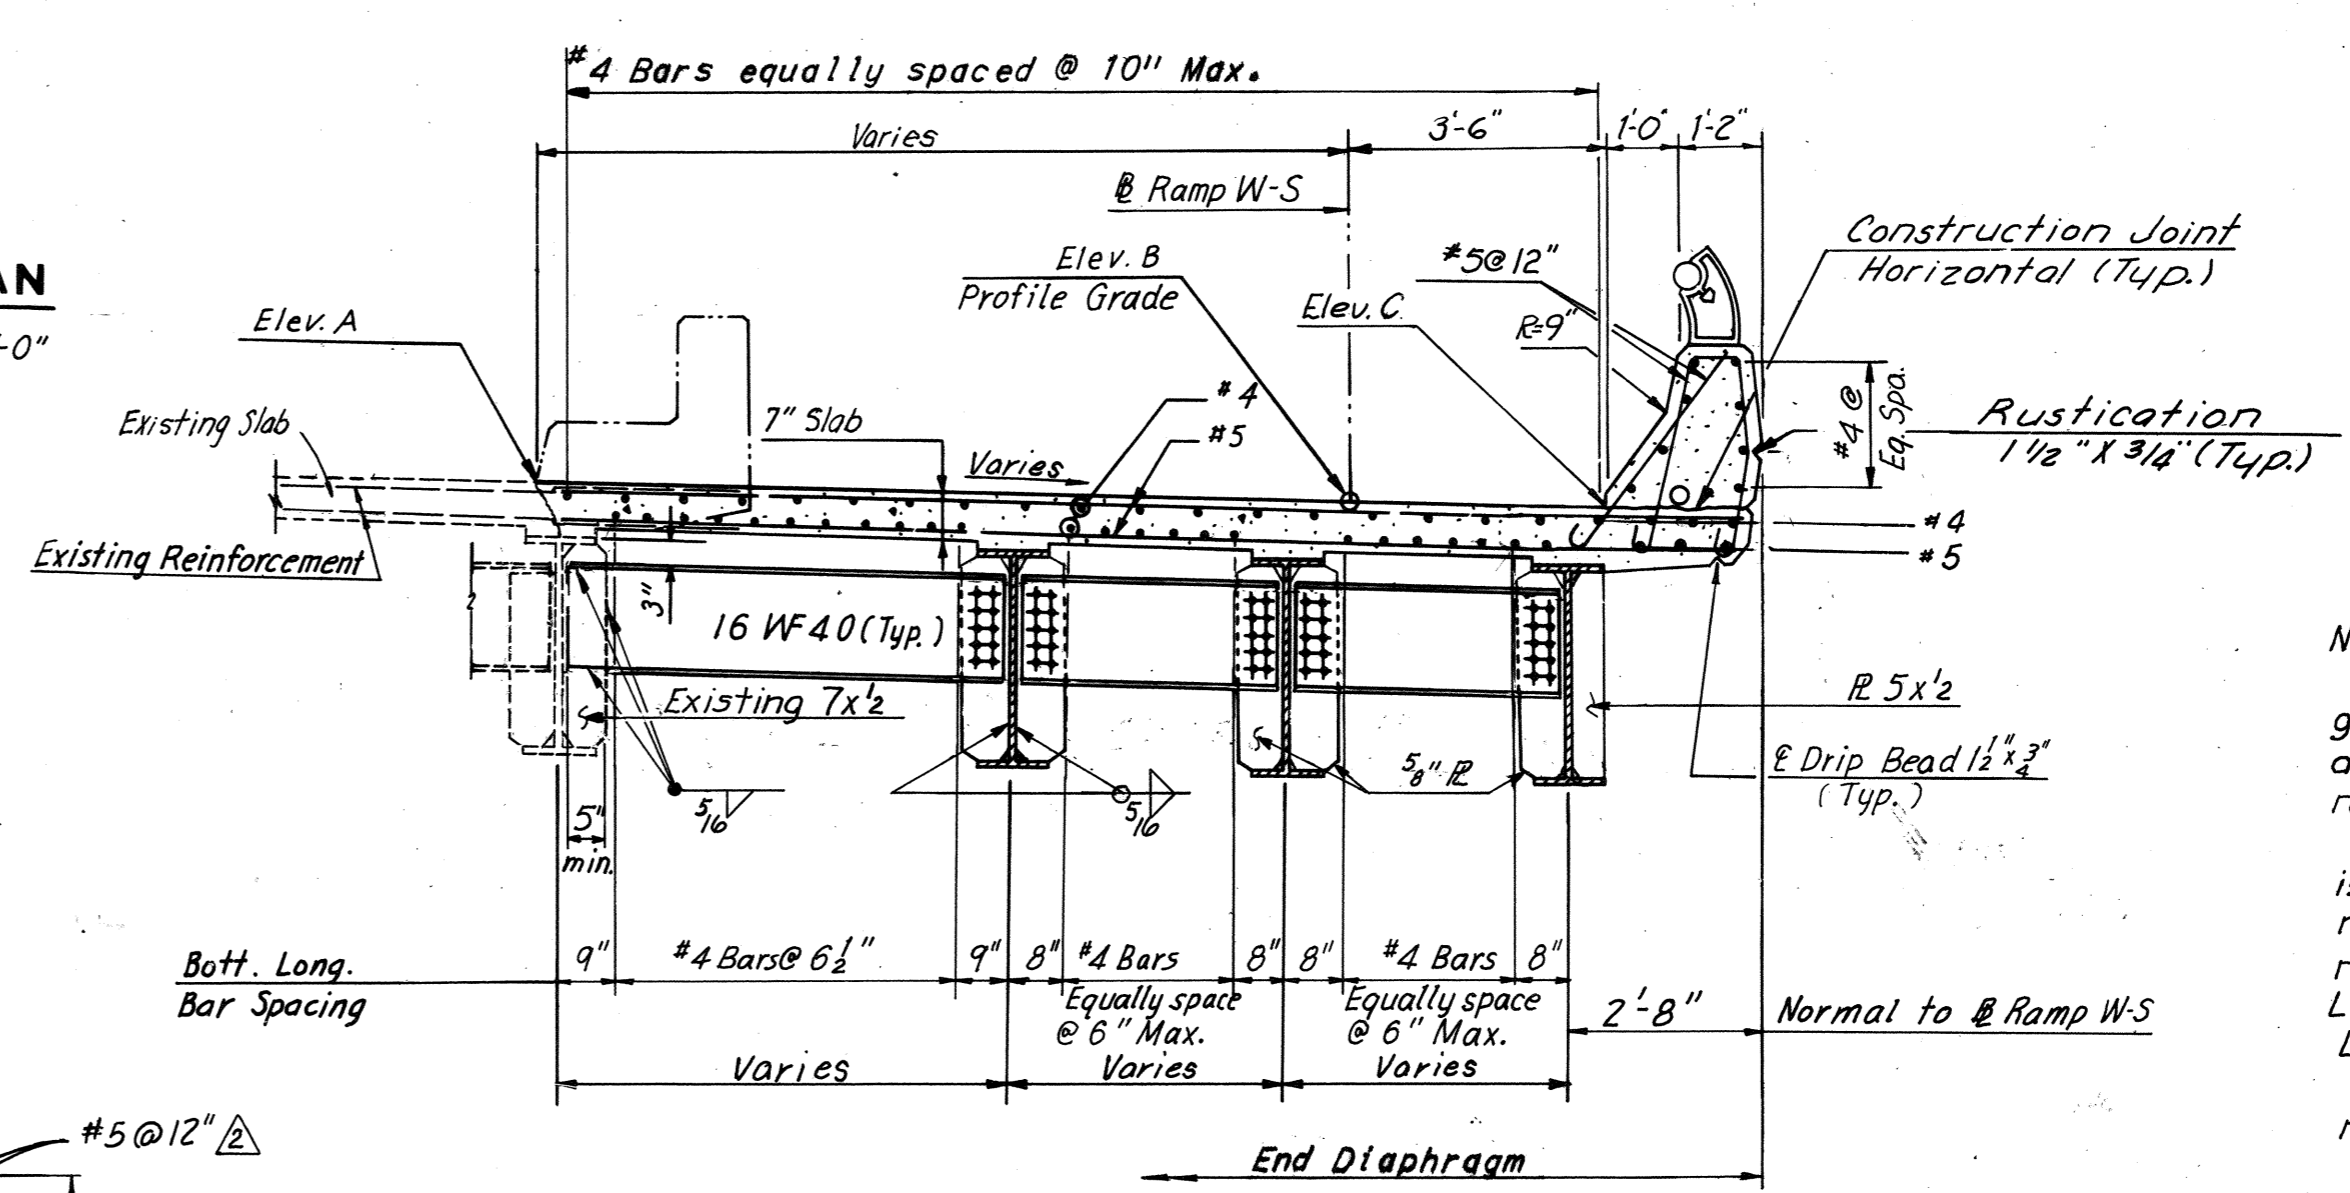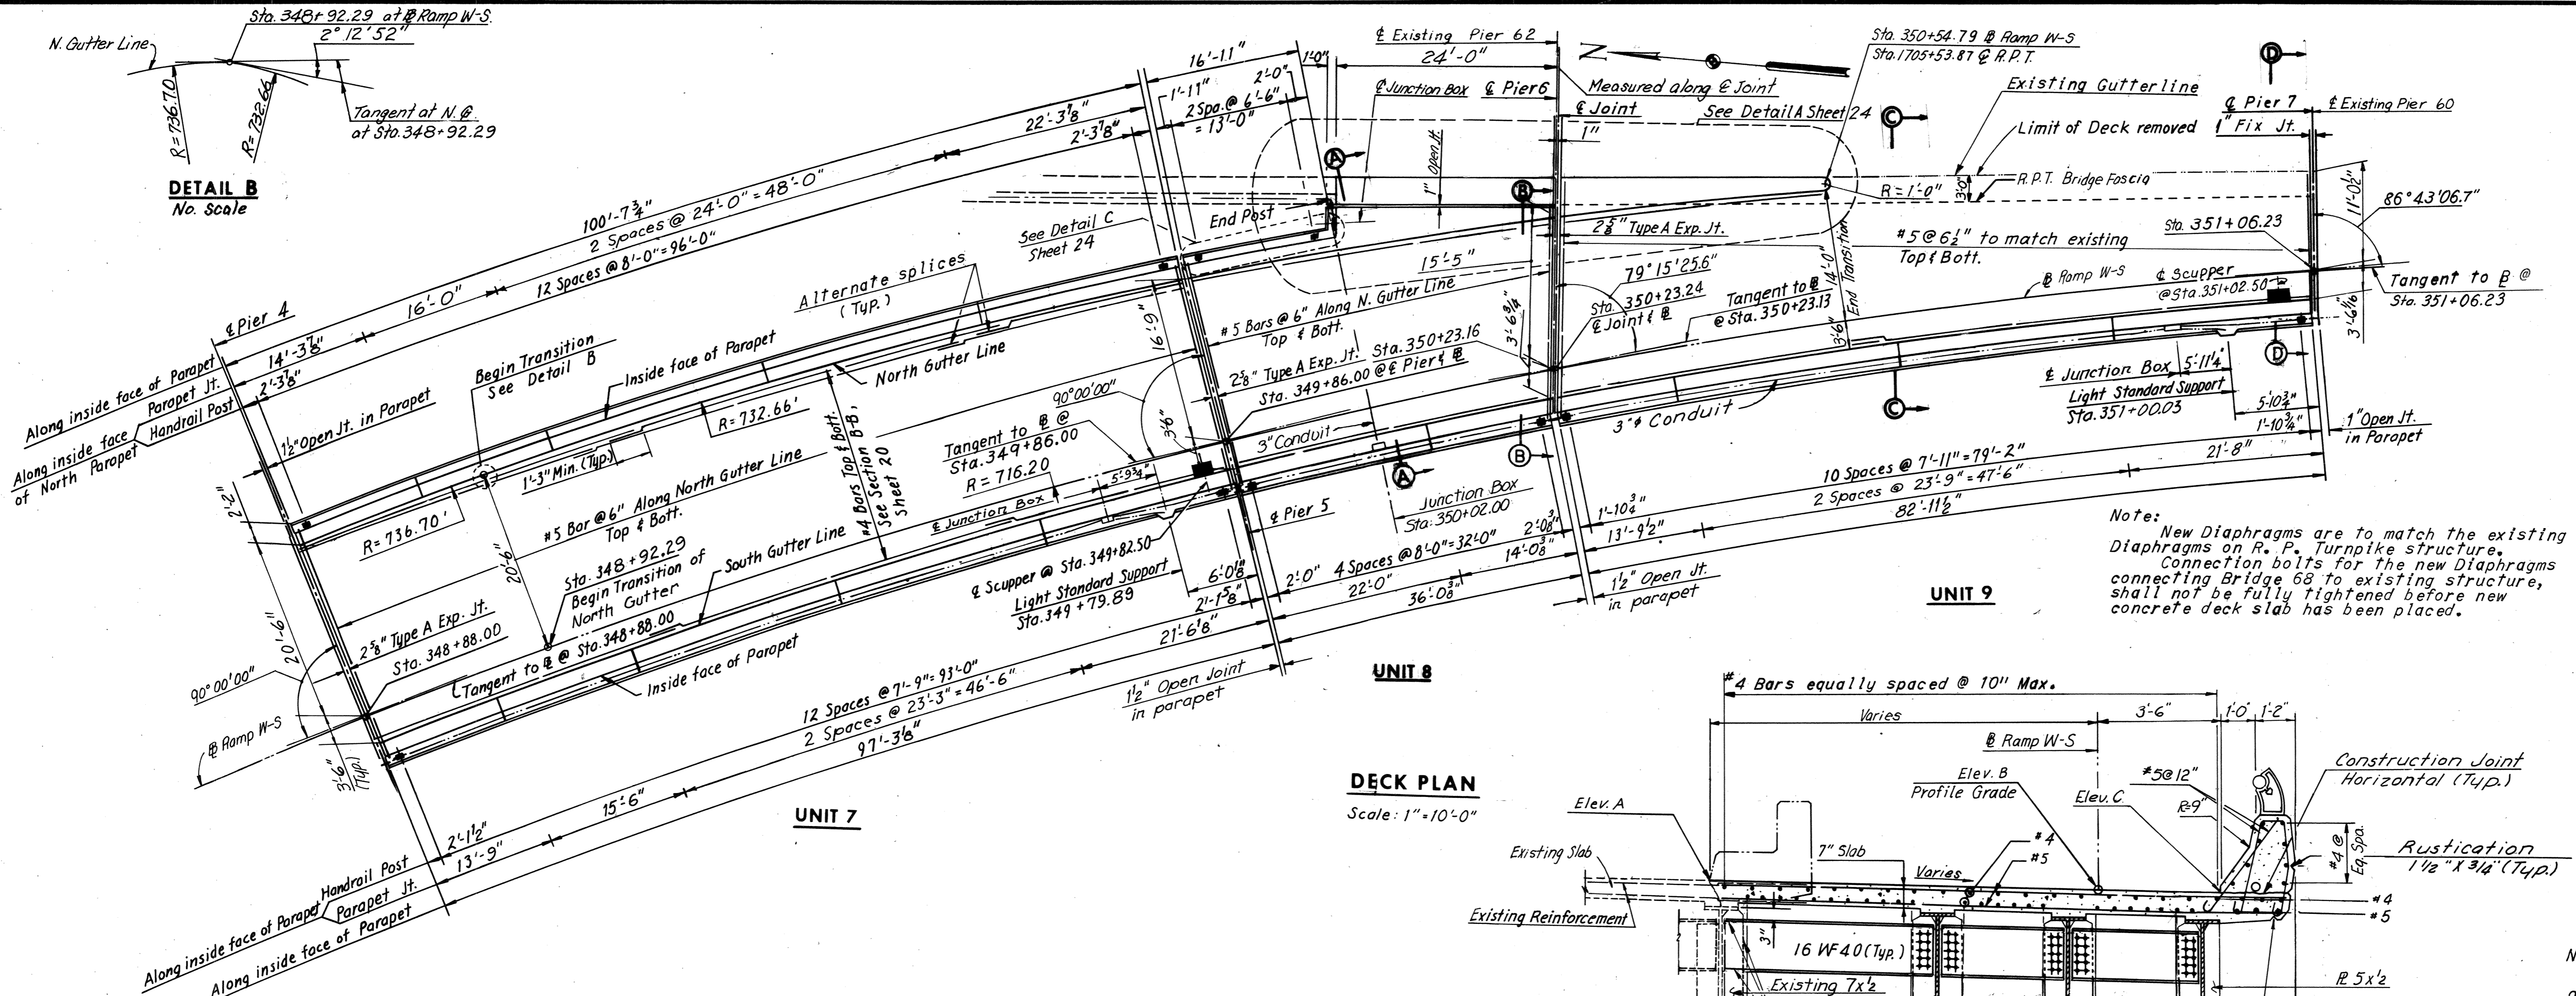

Note:
New Diaphragms are to match the existing Diaphragms on R. P. Turnpike structure. Connection bolts for the new Diaphragms connecting Bridge 68 to existing structure, shall not be fully tightened before new concrete deck slab has been placed.

Note A:
Elev. A between Sta. 348+88 and 350+54.79 is given along the East Gutter Line Ramp W-5 and are radial to the Base Line Ramp W-5 at the respective stations.
Elev. A from Sta. 350+54.79 to the End of Bridge is given along existing Gutter Line R.P.T. and are radial to the existing Base Line R.P.T. at the respective stations as given along the Base Line Ramp W-5. Cross Slope is radial to the Base Line R.P.T.
Elev. A is to be field verified. Minor adjustments may be required.

Note:
Existing No.5 transverse steel top & bottom to remain in place and be cleaned of concrete. Existing steel shall extend a minimum of 2'-0" into new concrete. Bottom reinf. shall be straightened.

Notes:
For Framing Plan Details see Sheet 14.
For Intermediate Diaphragm Details, Conn. R. Details and Reinforcement in Unit 7, see Section A-A of Sheet 20.
For Standard Handrail Details, see Sheet S3.
For Standard Lighting Details, see Sheet S4.
For Joint Details, see Sheet 25.
For Standard Drainage Details for Unit 7 see Support Type 3 and for Unit 9 see Support Type 5, both on Sheets S5 & S6.
End Diaphragms for Unit 7 @ pier 4 and-5 see Section A-A Sheet 20.

BY	DATE	REVISION	BY	DATE
Y.C.P	11-8-68	Revised Elev. Table	TEM	8-26-75
D.E.S	1-16-69	End Diaph. Conn. at exist. string	TEM	8-75
NO.				

Note:
Section E-E, See Section G-G on Sheet 24.

RICHMOND METROPOLITAN AUTHORITY
RICHMOND EXPRESSWAY SYSTEM
DOWNTOWN EXPRESSWAY


BRIDGE NO. 68
RAMP W-5 CONNECTION TO
RICHMOND-PETERSBURG TURNPIKE
DECK PLAN-UNITS 7, 8 AND 9

HOWARD, NEEDLES, TAMMEN & BERGENDOFF
 consulting engineers
 NEW YORK ALEXANDRIA KANSAS CITY

SCALE: As Noted
 CONTRACT NO.: 11
 SHEET NO. 21 OF 28

AS BUILT



RICHMOND EXPRESSWAY SYSTEM			
SECTION	PROJECT	SHEET NO.	TOTAL SHEETS
11	DOWNTOWN EXPRESSWAY	85	97

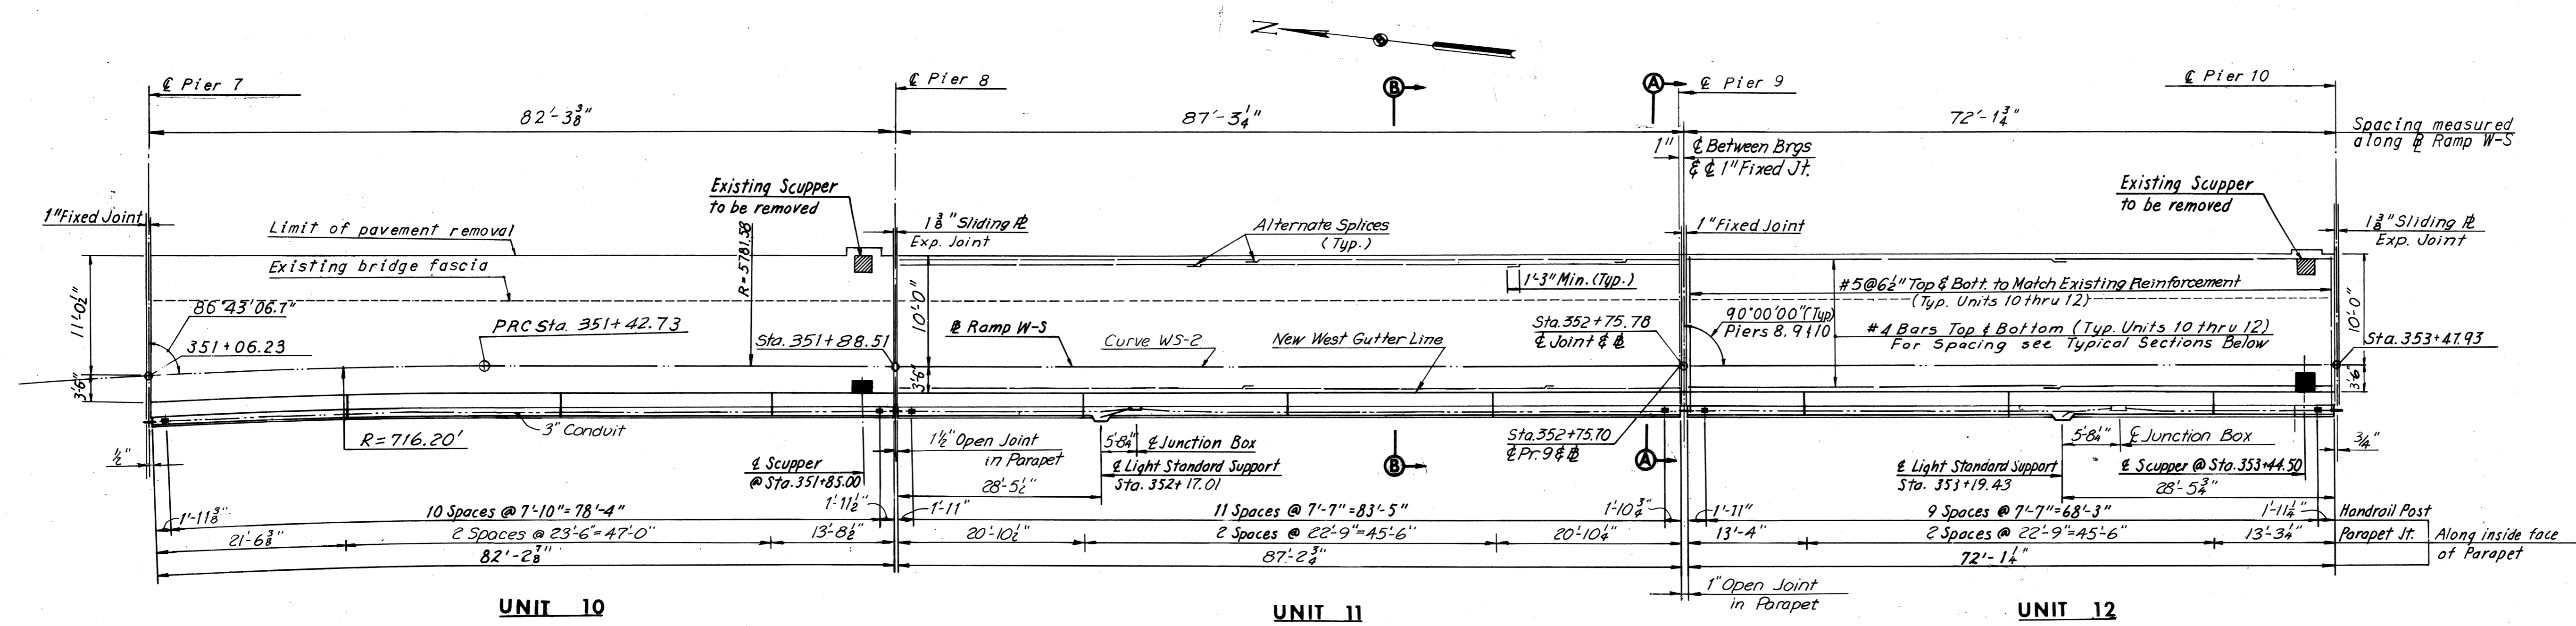


ELEVATION TABLE			
STATION	ELEV. A	ELEV. B	ELEV. C
+06.23	84.52	84.34	84.29
+10	84.39	84.18	84.10
+20	84.23	84.02	83.94
+30	84.07	83.85	83.78
+40	83.90	83.70	83.62
+50	83.77	83.57	83.49
+60	83.56	83.36	83.28
+70	83.42	83.21	83.15
+80	83.26	83.05	82.99
+88.51	83.13	83.03	82.99
+90	83.12	83.01	82.98
352+00	82.94	82.85	82.82
+10	82.76	82.69	82.66
+20	82.60	82.53	82.50
+30	82.45	82.37	82.34
+40	82.29	82.21	82.19
+50	82.17	82.06	82.03
+60	82.01	81.90	81.87
+70	81.85	81.74	81.71
+75.78	81.81	81.67	81.62
+80	81.73	81.60	81.55
+90	81.56	81.44	81.39
353+00	81.41	81.28	81.23
+10	81.25	81.12	81.08
+20	81.04	80.95	80.92
+30	80.93	80.80	80.76
+40	80.75	80.64	80.60
+47.93	80.65	80.52	80.48

Note:
New Diaphragms are to match the existing Diaphragms on R. P. Turnpike structure. Connection bolts for the new Diaphragms connecting Bridge 68 to existing structure, shall not be fully tightened before new concrete deck slab has been placed.

Note:
See Note A Sheet 21 of this set.

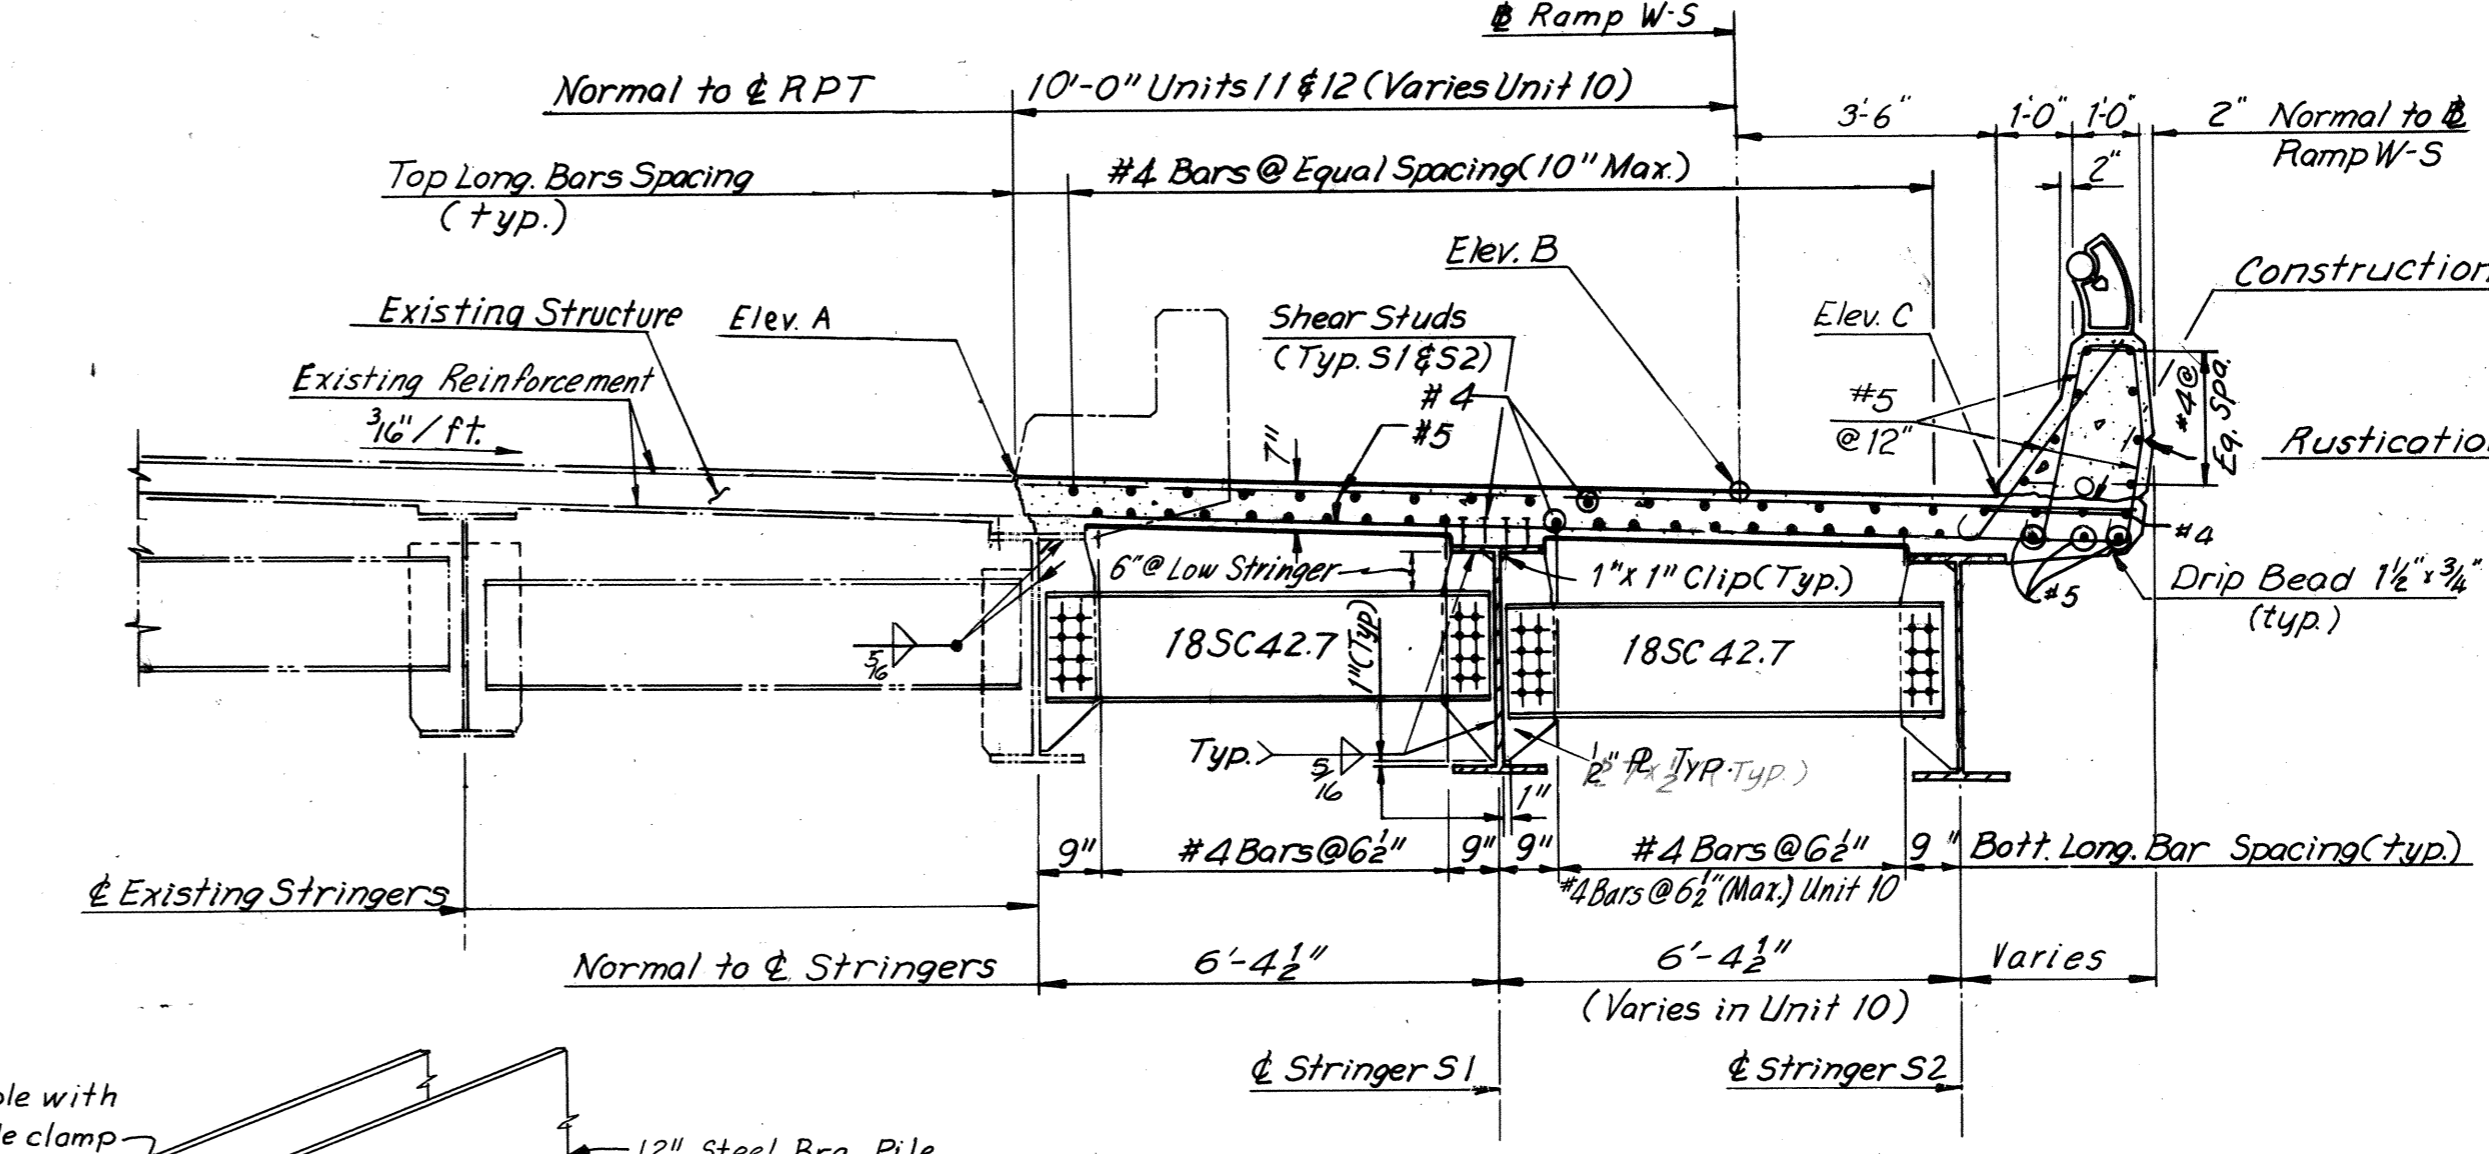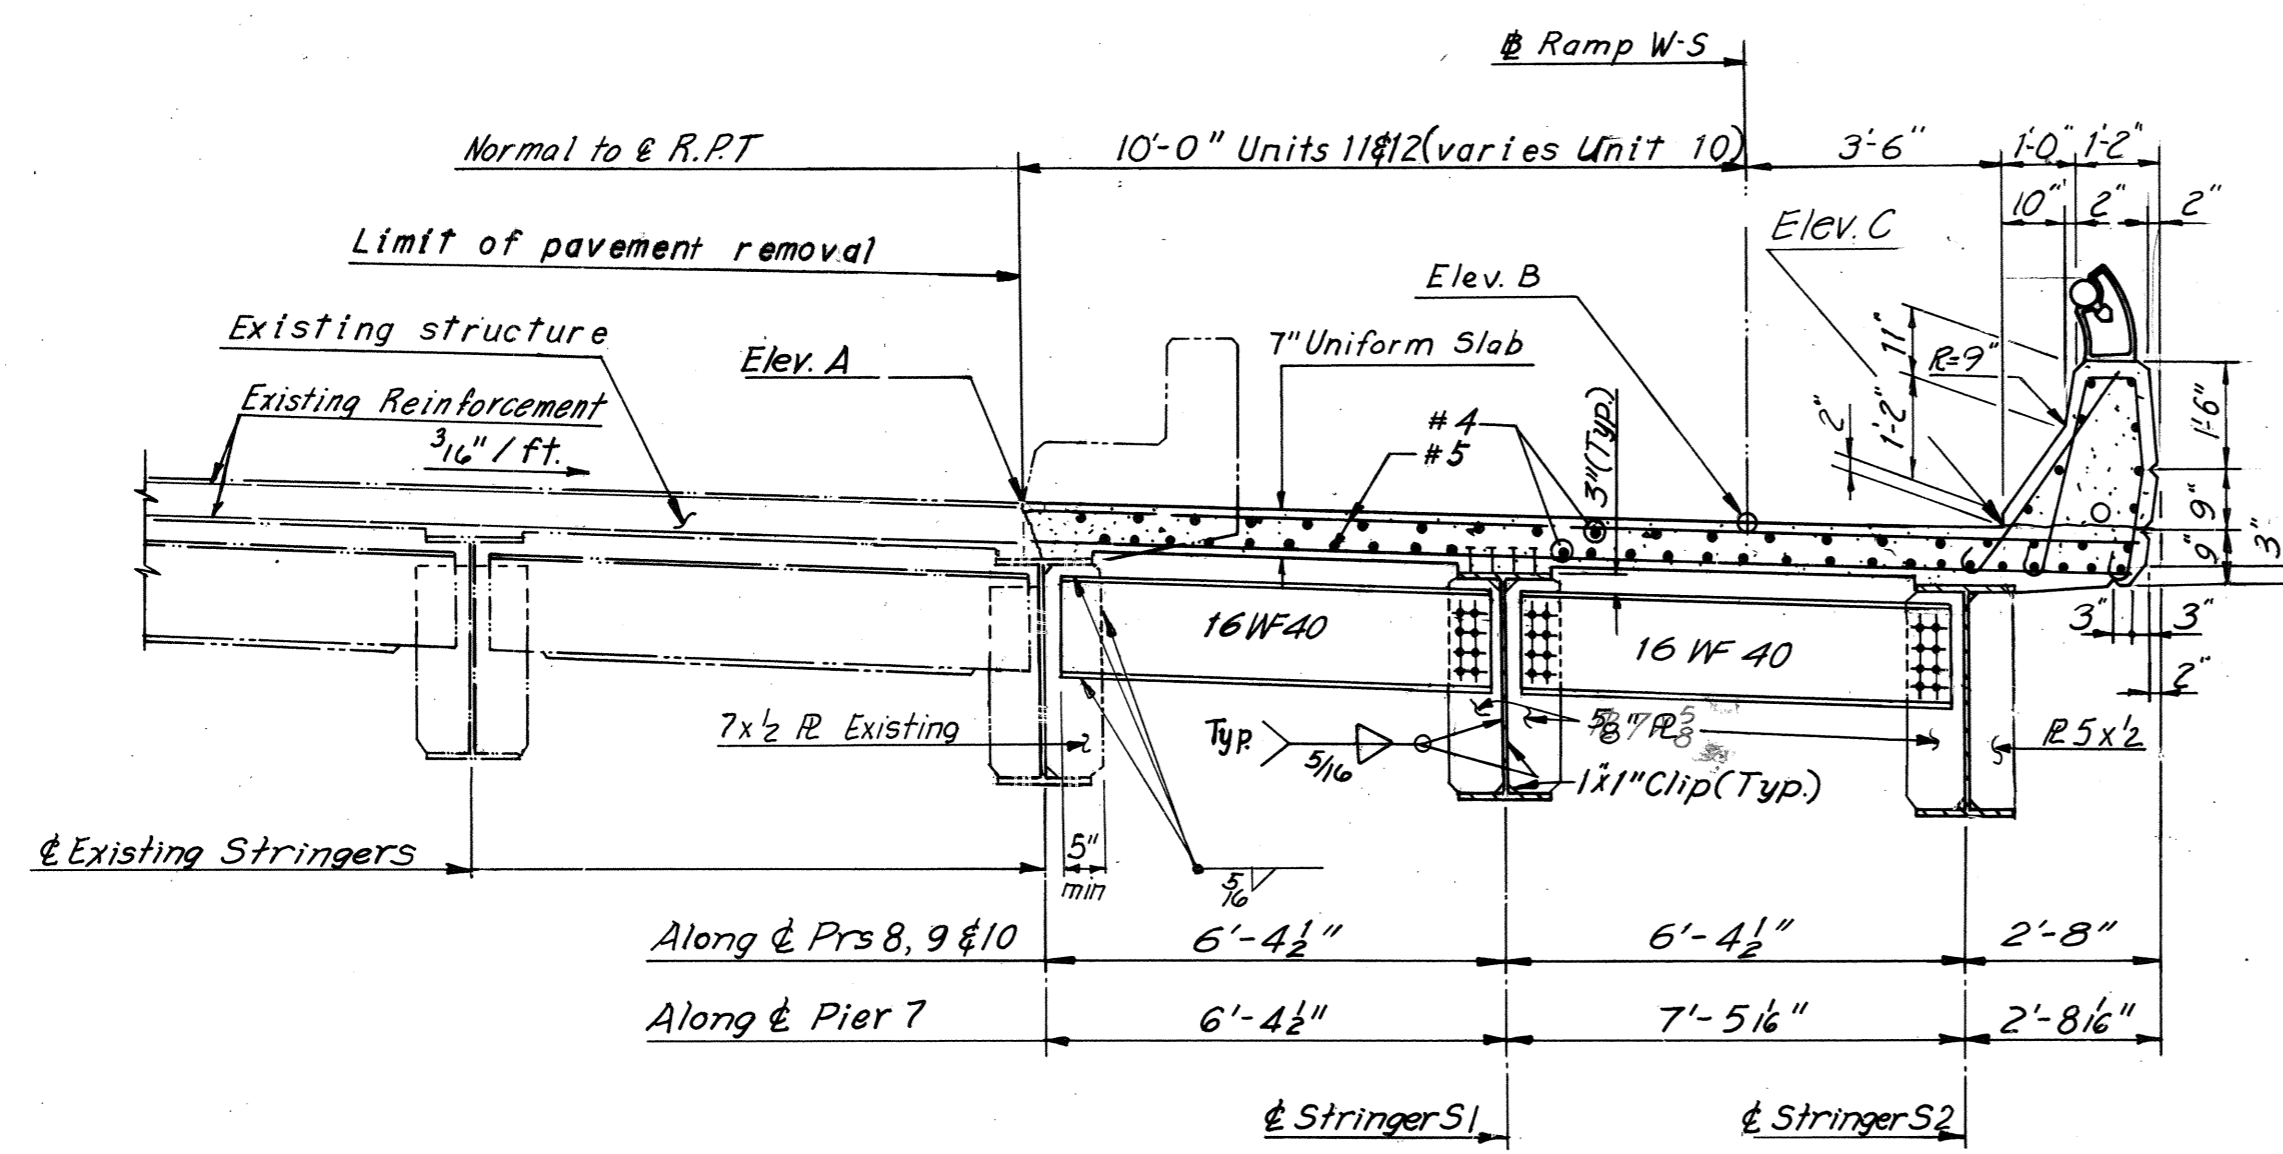

Note:
Existing No. 5 transverse steel to remain in place and be cleared of concrete. Existing steel shall extend a minimum of 2'-0" into new concrete. Bottom reinf. shall be straightened.

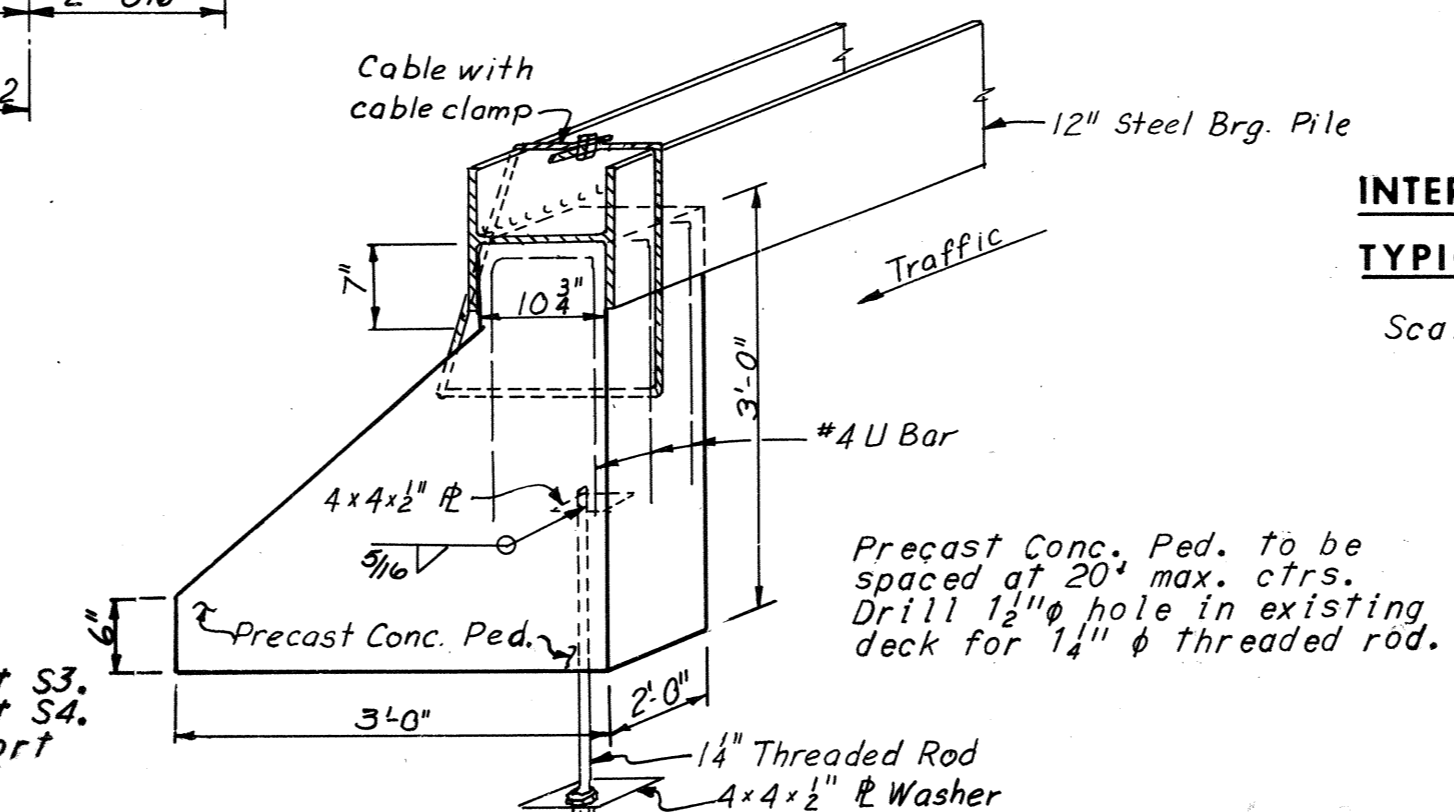

Notes
For Framing Plan Details see Sheet 15
For Joint Details see Sheet 25
For Quantities see Sheet 2
For Standard Handrail Details, see Sheet S3.
For Standard Lighting Details, see Sheet S4.
For Standard Drainage Details, see Support Type 9 on Sheets S5 & S6.

MADE	CHECKED	IN CHARGE	BY	DATE	NO.	REVISION	BY	DATE

AS BUILT

RICHMOND METROPOLITAN AUTHORITY
RICHMOND EXPRESSWAY SYSTEM
DOWNTOWN EXPRESSWAY

BRIDGE NO. 68
RAMP W-S CONNECTION TO
RICHMOND-PETERSBURG TURNPIKE
DECK PLAN - UNITS 10, 11 AND 12




HOWARD, NEEDLES, TAMMEN & BERGENDOFF
consulting engineers
NEW YORK ALEXANDRIA KANSAS CITY

SCALE: As Noted
CONTRACT NO. 11
SHEET NO. 22 OF 28

RICHMOND EXPRESSWAY SYSTEM			
SECTION	PROJECT	SHEET NO.	TOTAL SHEETS
11	DOWNTOWN EXPRESSWAY	86	97

ELEVATION TABLE			
STATION	ELEV. A	ELEV. B	ELEV. C
353+47.93	80.65	80.52	80.48
+50	80.63	80.49	80.44
+60	80.43	80.32	80.28
+70	80.29	80.17	80.12
+80	80.11	80.00	79.97
+90	79.97	79.85	79.81
354+00.00	79.82	79.69	79.65
+10	79.64	79.53	79.49
+20	79.48	79.37	79.33
+24.62	79.43	79.30	79.26
+30	79.33	79.22	79.17
+40	79.18	79.06	79.01
+50	79.00	78.89	78.86
+60	78.85	78.74	78.70
+70	78.69	78.58	78.54
+80	78.51	78.41	78.38
354+90	78.35	78.25	78.22
+91.02	78.34	78.24	78.21
355+00.00	78.18	78.09	78.06
+10	78.06	77.95	77.90
+20	77.85	77.77	77.75
+30	77.67	77.61	77.59
+40	77.54	77.46	77.43
+50	77.36	77.29	77.27
+57.82	77.27	77.17	77.15
+60	77.22	77.14	77.11
+70	77.03	76.98	76.96
+80	76.85	76.82	76.81
+90	76.66	76.66	76.66
356+00.00	76.50	76.51	76.51
+10	76.34	76.35	76.36
+20	76.17	76.20	76.21
+30	76.03	76.05	76.06
+40	75.87	75.90	75.91
+46.69	75.80	75.80	75.81
+50	75.71	75.74	75.76
+60	75.73	75.66	75.60
+70	75.35	75.40	75.45
+80	75.24	75.27	75.30
+90	75.11	75.13	75.15
357+00.00	74.94	74.96	75.00
+10	74.78	74.81	74.85
+20	74.65	74.67	74.70
+30	74.52	74.53	74.55
+35.49	74.44	74.45	74.47
+40	74.35	74.36	74.40
+50	74.17	74.18	74.25
+60	74.01	74.01	74.10
+70	—	74.00	73.94
+80	—	73.85	73.79
+90	—	73.70	73.64
358+00.00	—	73.55	73.49
+10	—	73.39	73.33
+20	—	73.24	73.19
+24.24	—	73.18	73.13

Note: See Note A Sheet 21.

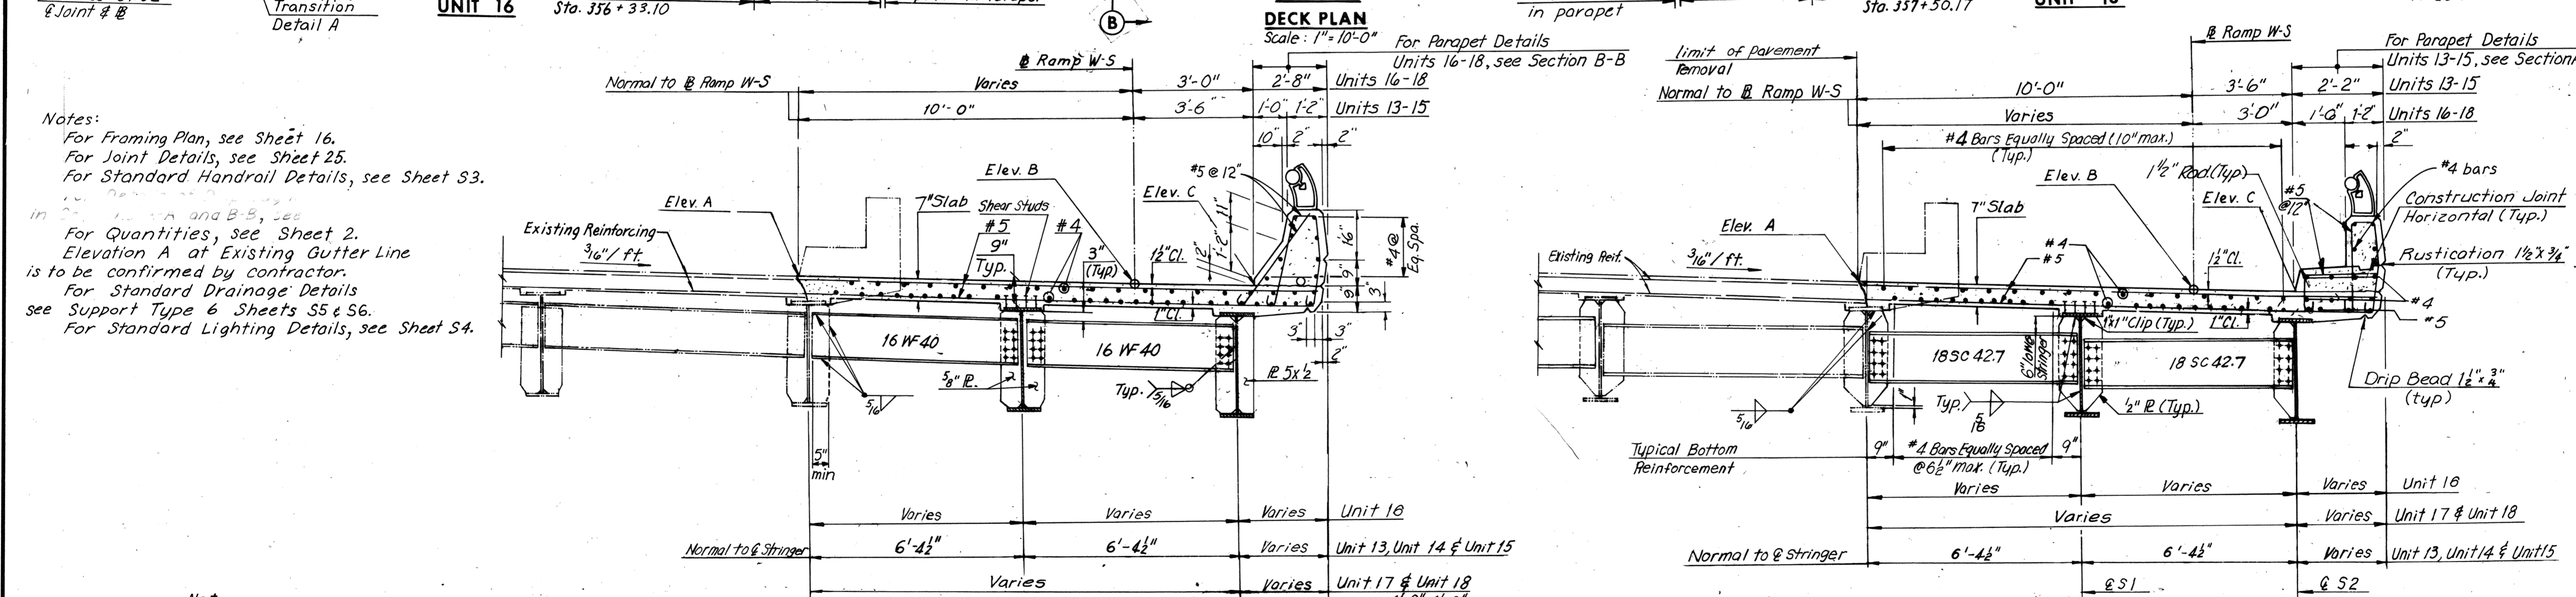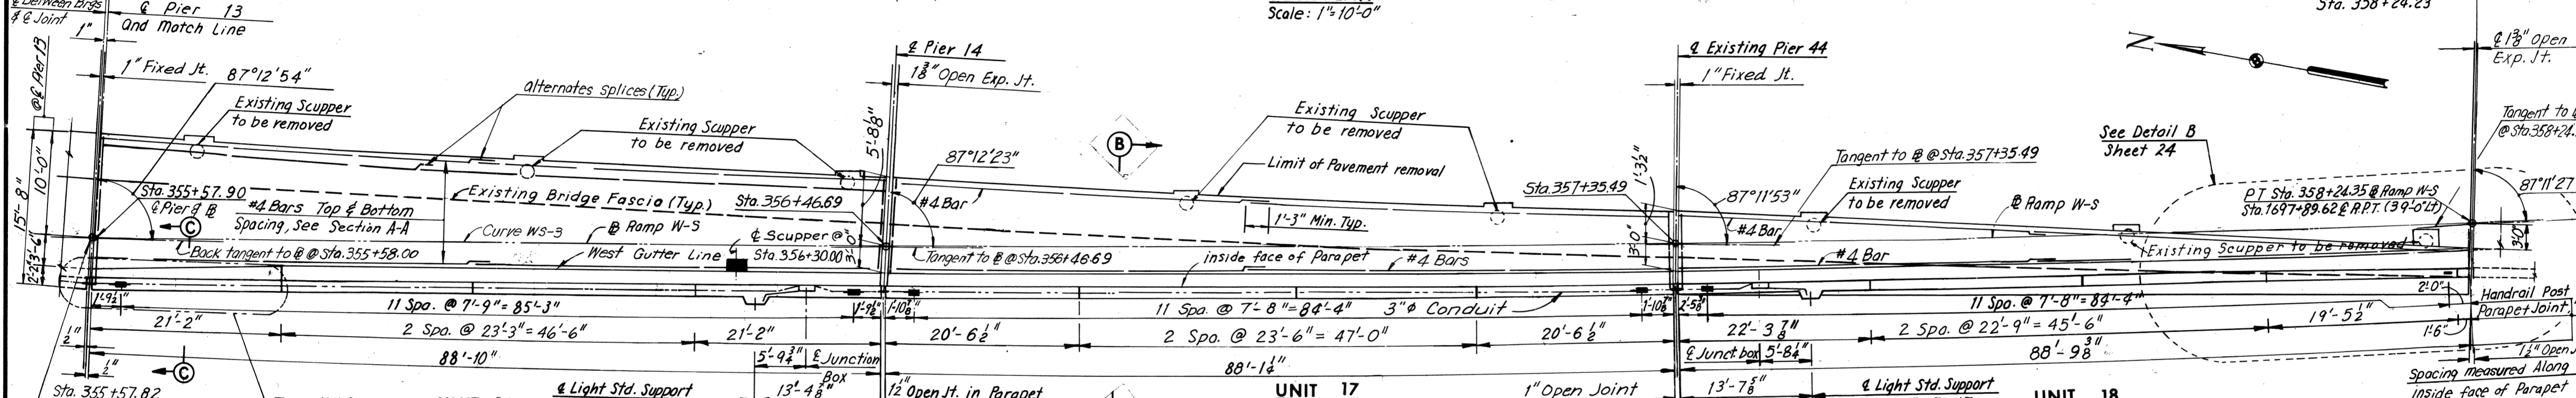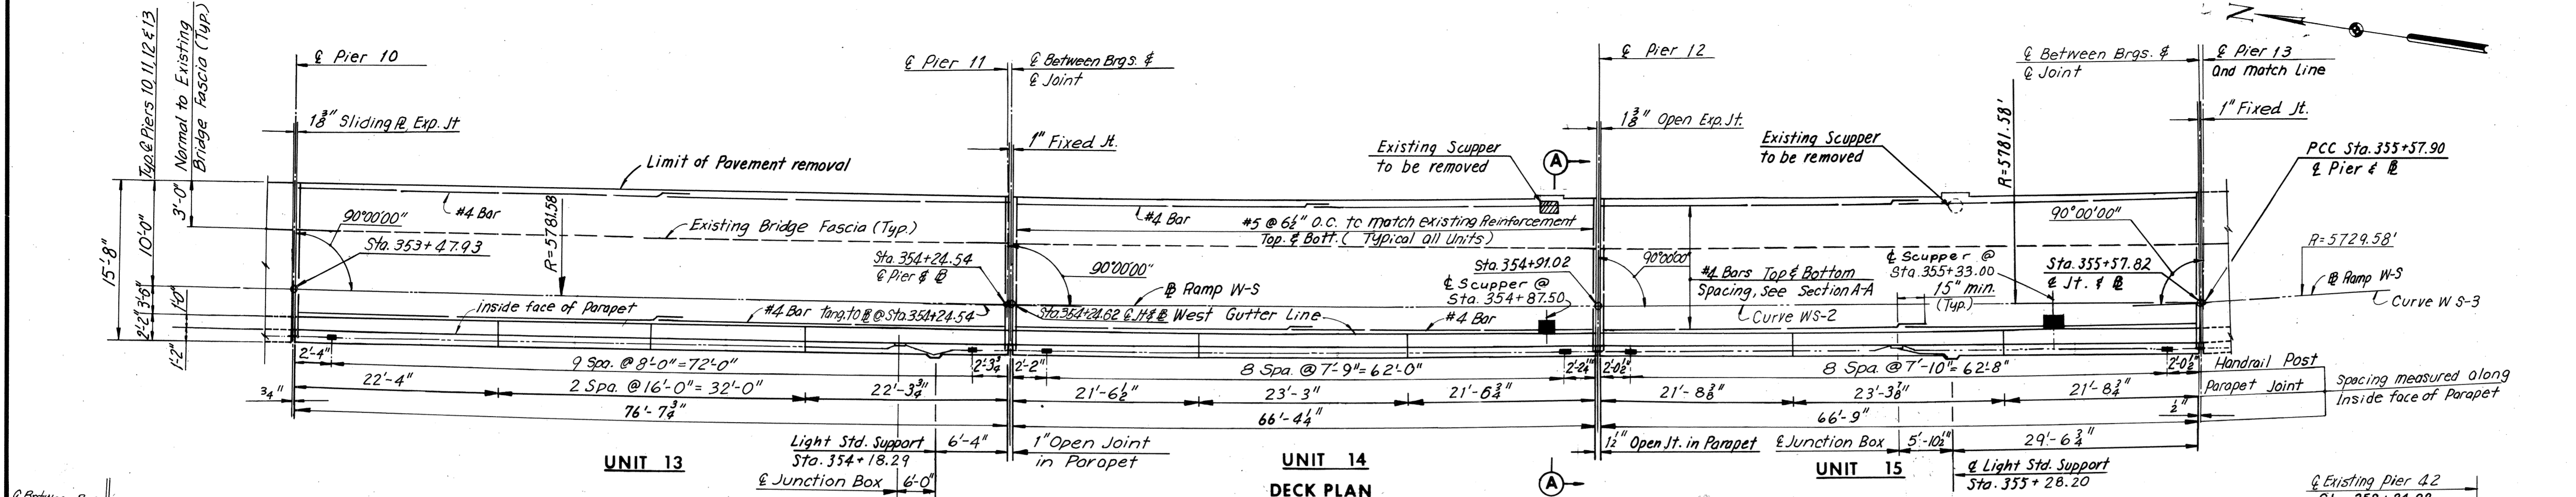

Notes:
 For Framing Plan, see Sheet 16.
 For Joint Details, see Sheet 25.
 For Standard Handrail Details, see Sheet S3.
 For Quantities, see Sheet 2.
 Elevation A at Existing Gutter Line is to be confirmed by contractor.
 For Standard Drainage Details, see Support Type 6 Sheets S5 & S6.
 For Standard Lighting Details, see Sheet S4.

Note:
 New Diaphragms are to match the existing Diaphragms on R. P. Turnpike structure. Connection bolts for the new Diaphragms connecting Bridge 68 to existing structure, shall not be fully tightened before new concrete deck slab has been placed.

AS BUILT

RICHMOND METROPOLITAN AUTHORITY
RICHMOND EXPRESSWAY SYSTEM
DOWNTOWN EXPRESSWAY


BRIDGE NO. 68
RAMP W-S CONNECTION TO
RICHMOND-PETERSBURG TURNPIKE
DECK PLAN — UNITS 13 THRU. 18

HOWARD, NEEDLES, TAMMEN & BERGENDOFF
 consulting engineers
 NEW YORK ALEXANDRIA KANSAS CITY


SCALE: As Noted
 CONTRACT NO.: 11
 SHEET NO. 23 OF 28

BY	DATE	NO.	REVISION	BY	DATE
MADE	GSH 11-12-68		Revised Elev. Table	TEM	8-26-75
CHECKED	D.E.S. 1-17-69		End Diaphragm Conn. at exist. String	TEM	8-26-75
IN CHARGE					


RICHMOND EXPRESSWAY SYSTEM			
SECTION	PROJECT	SHEET NO.	TOTAL SHEETS
11	DOWNTOWN EXPRESSWAY	87	97

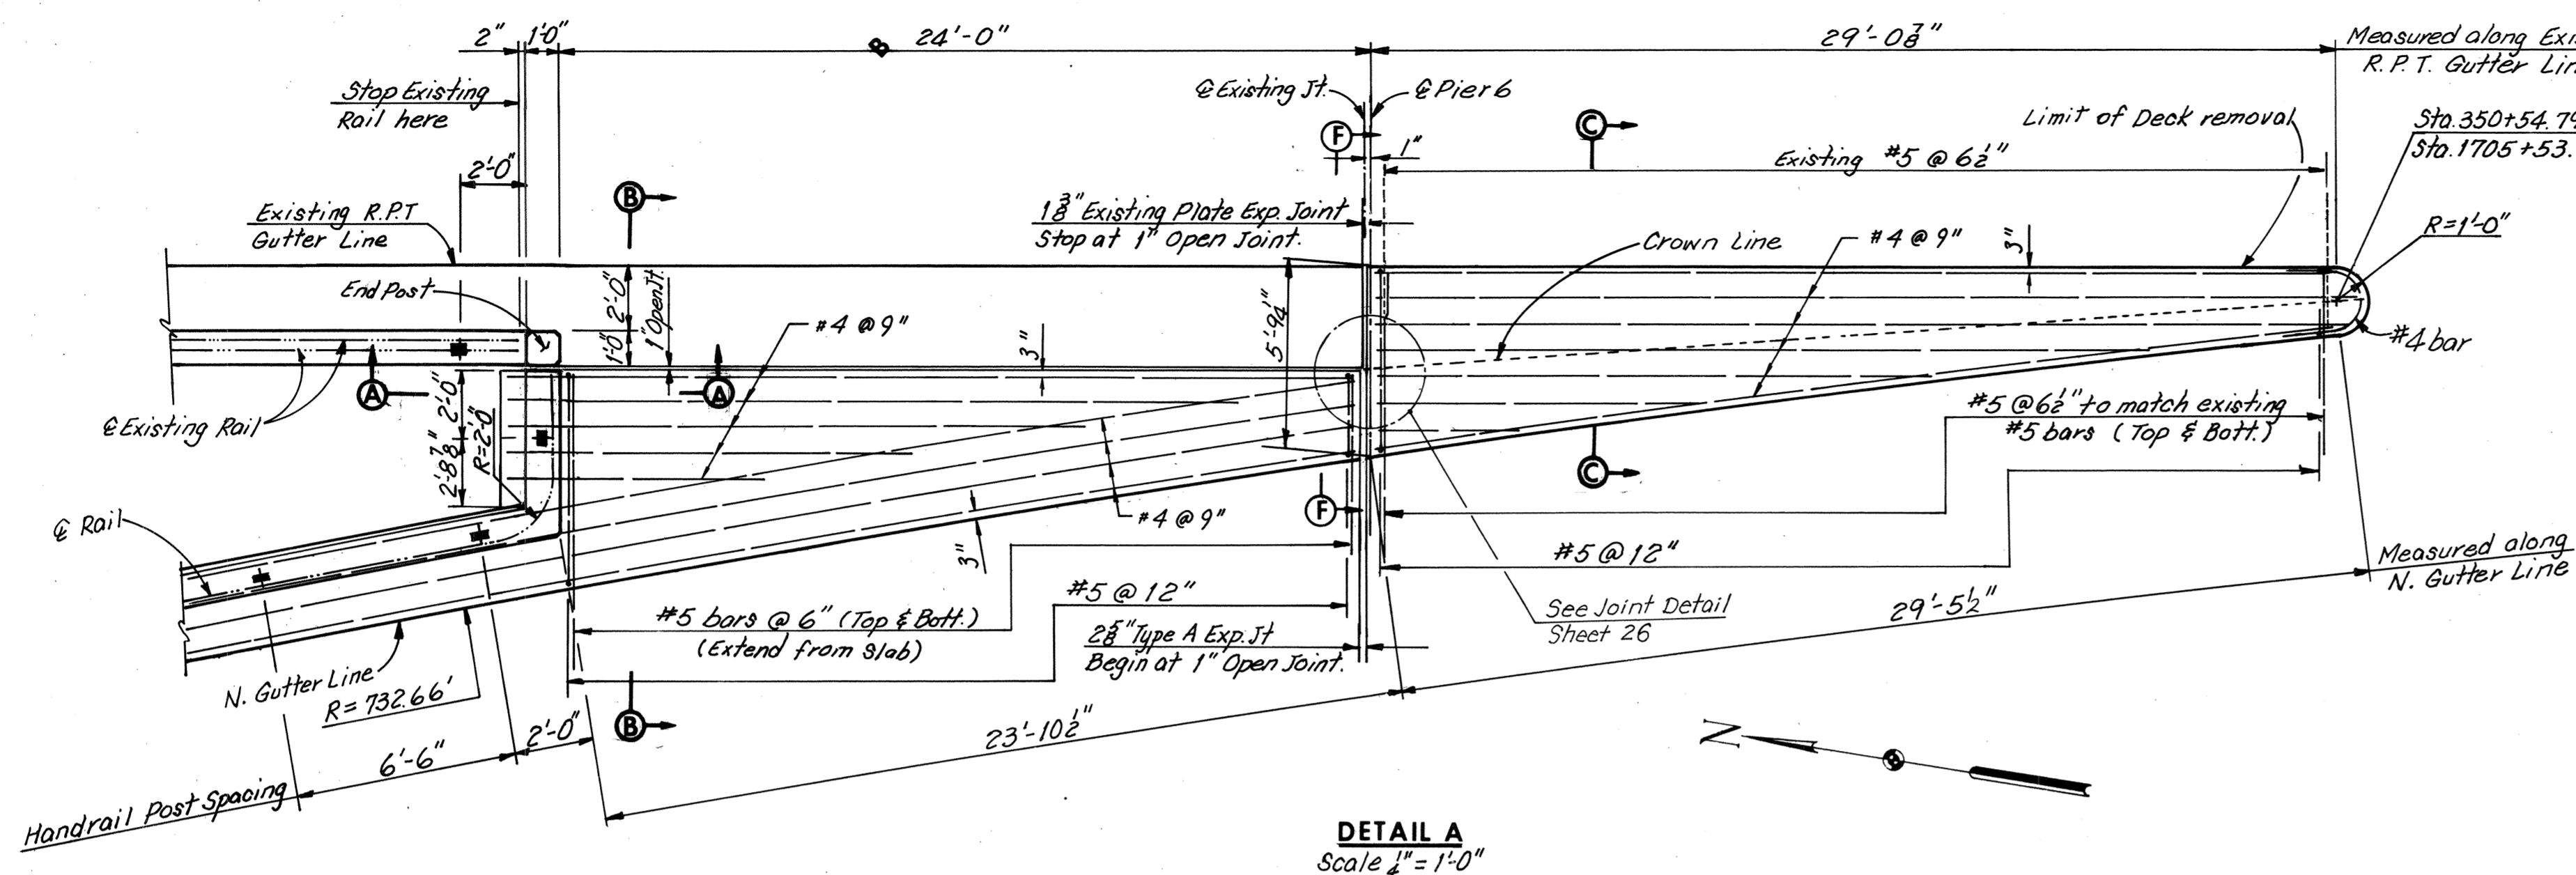

DETAIL A
Scale 1/4" = 1'-0"

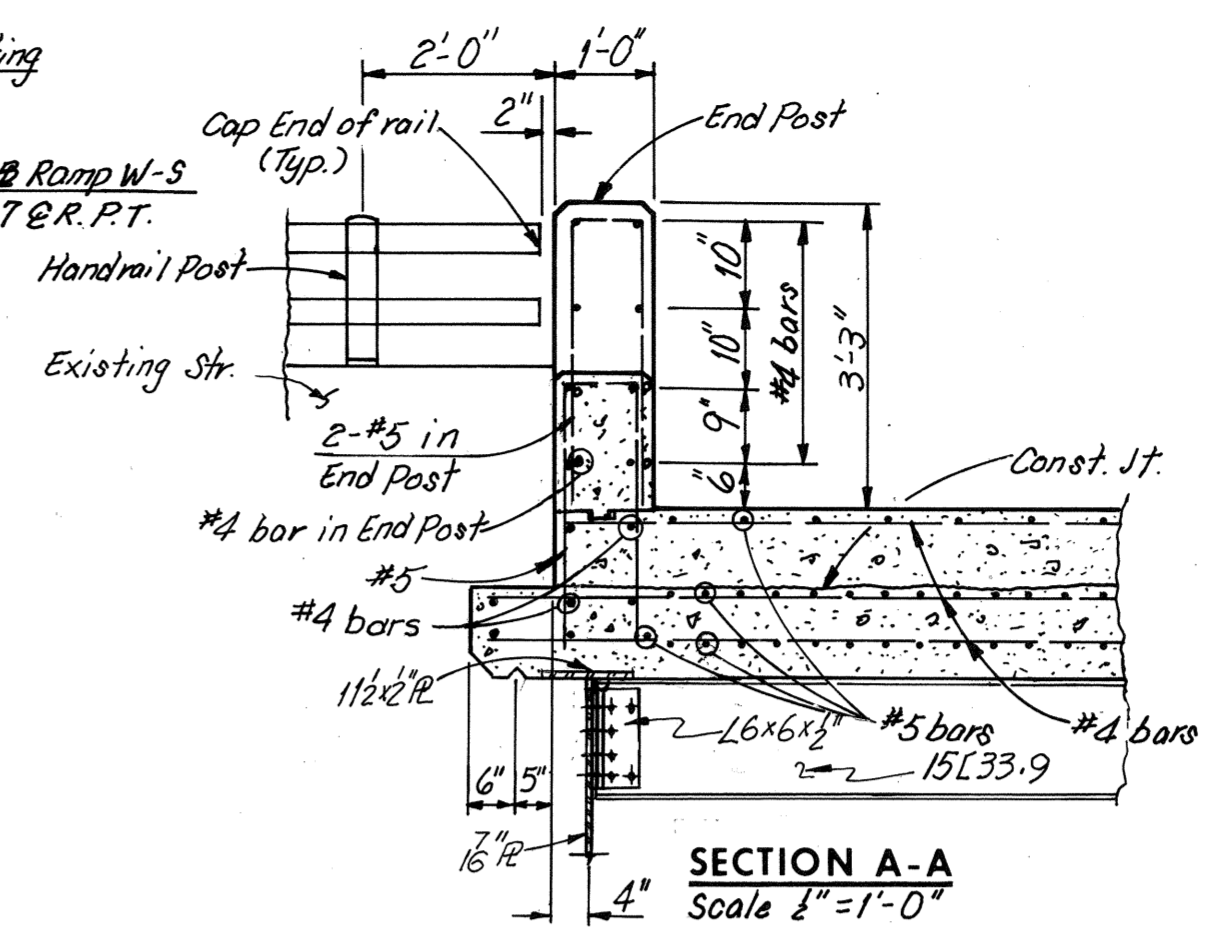


SECTION A-A
Scale 1/2" = 1'-0"

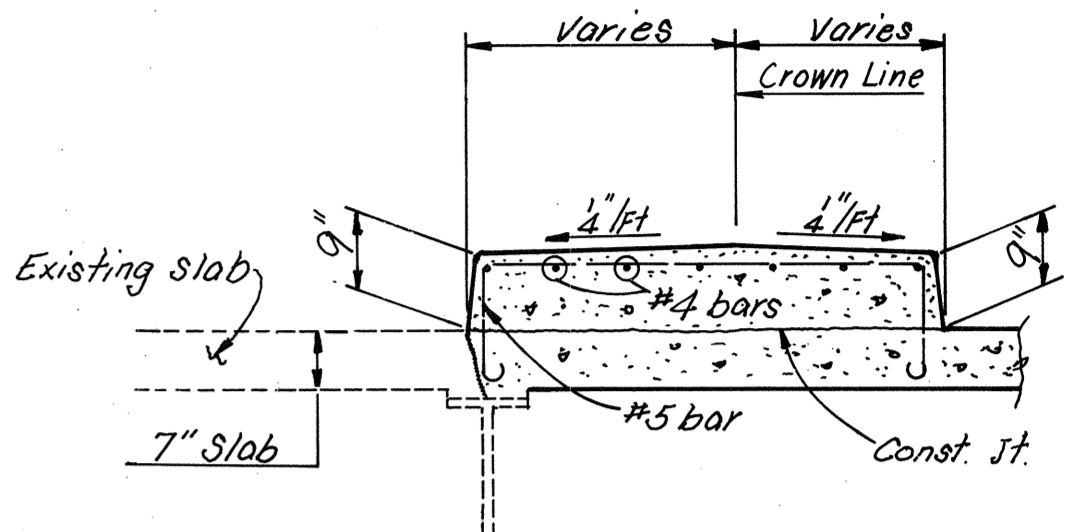


SECTION C-C
Scale 1/2" = 1'-0"

(Reinforcing in Slab not shown)

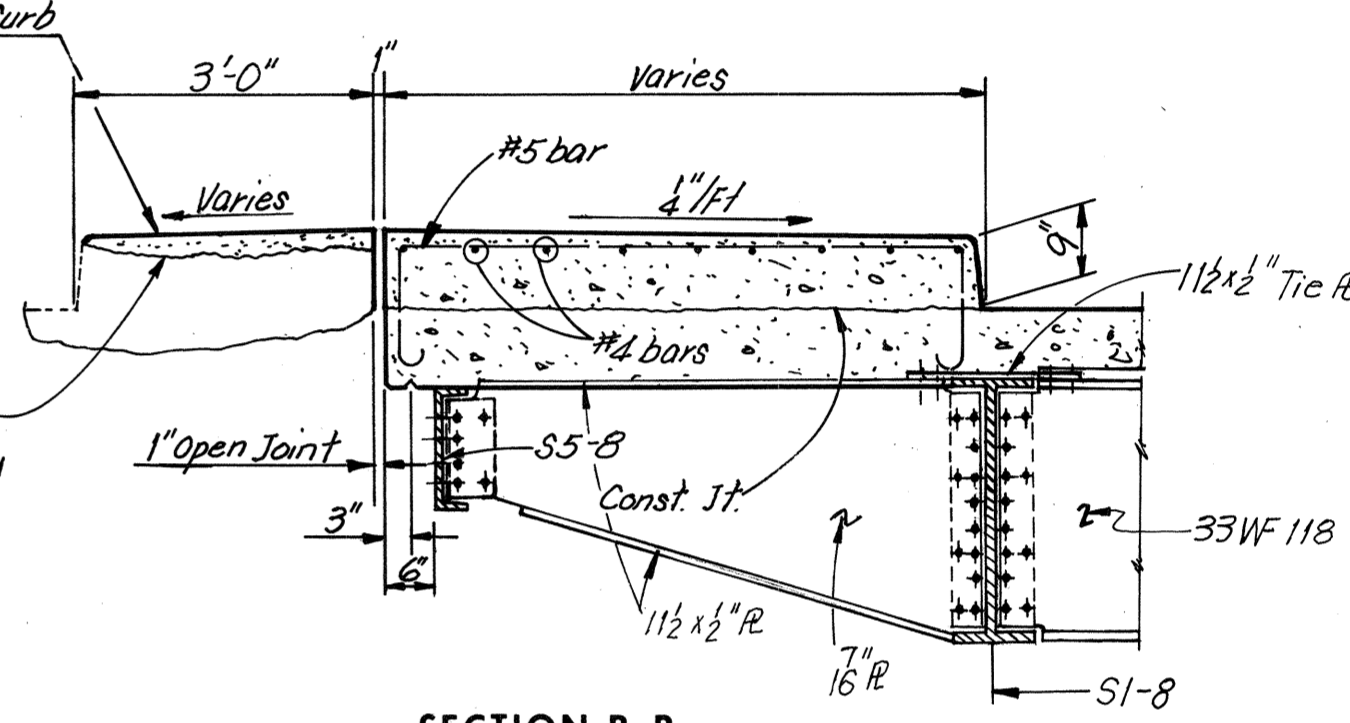


SECTION B-B
Scale 1/2" = 1'-0"


(Reinforcing in Slab not shown)

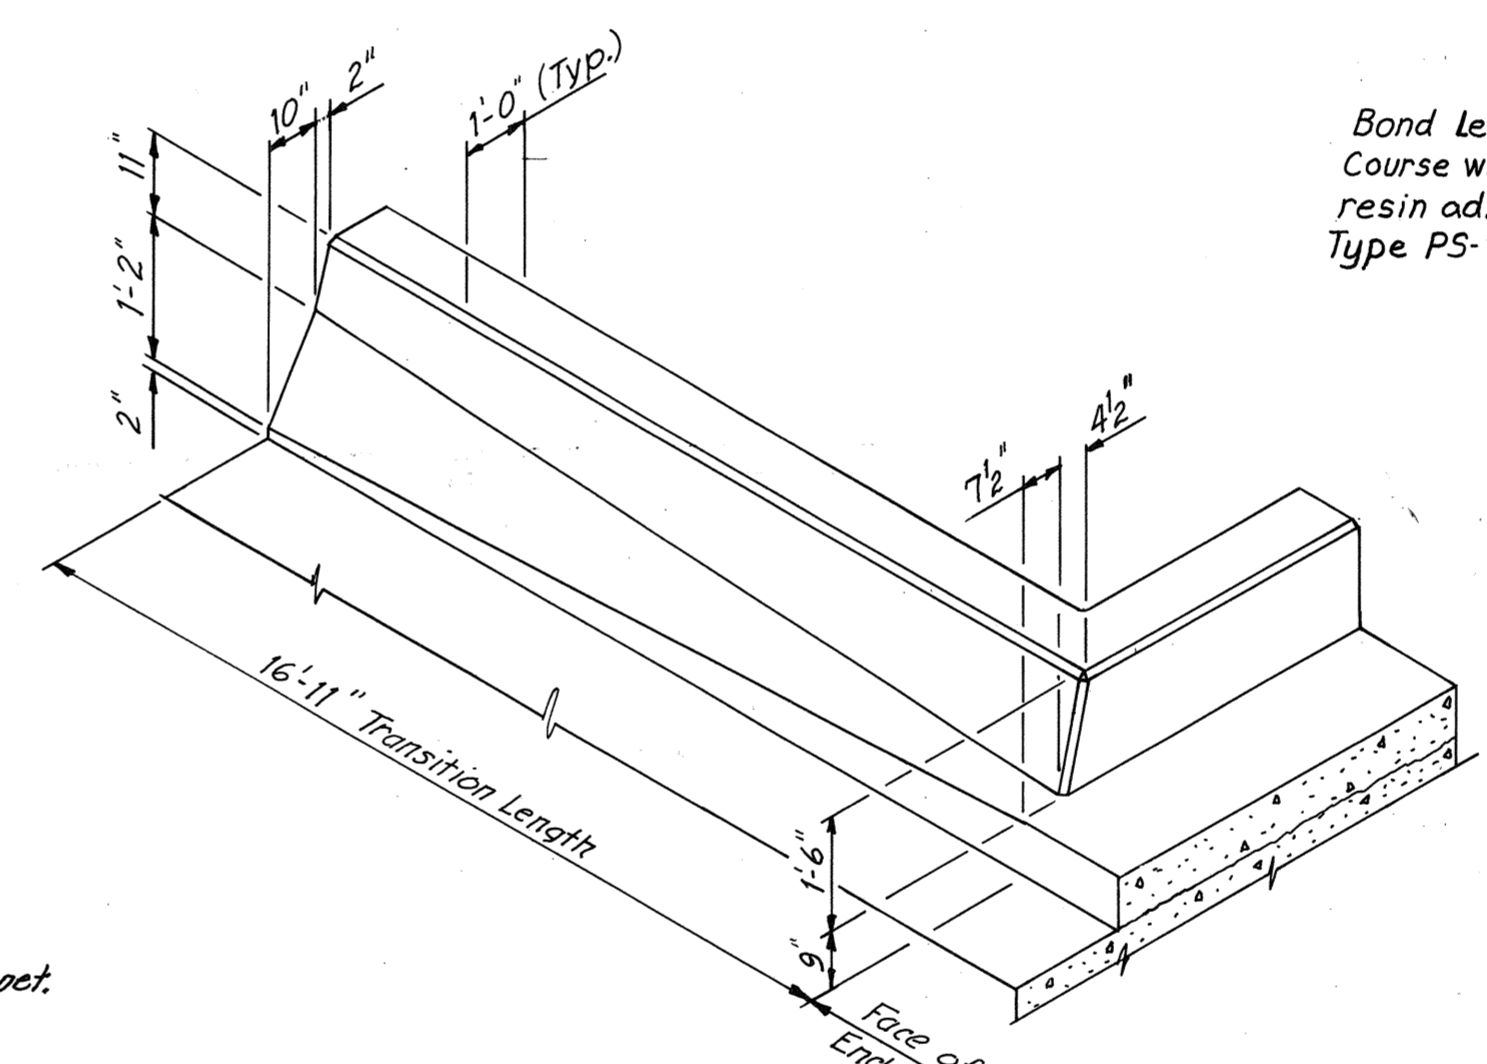


DETAIL C
No Scale

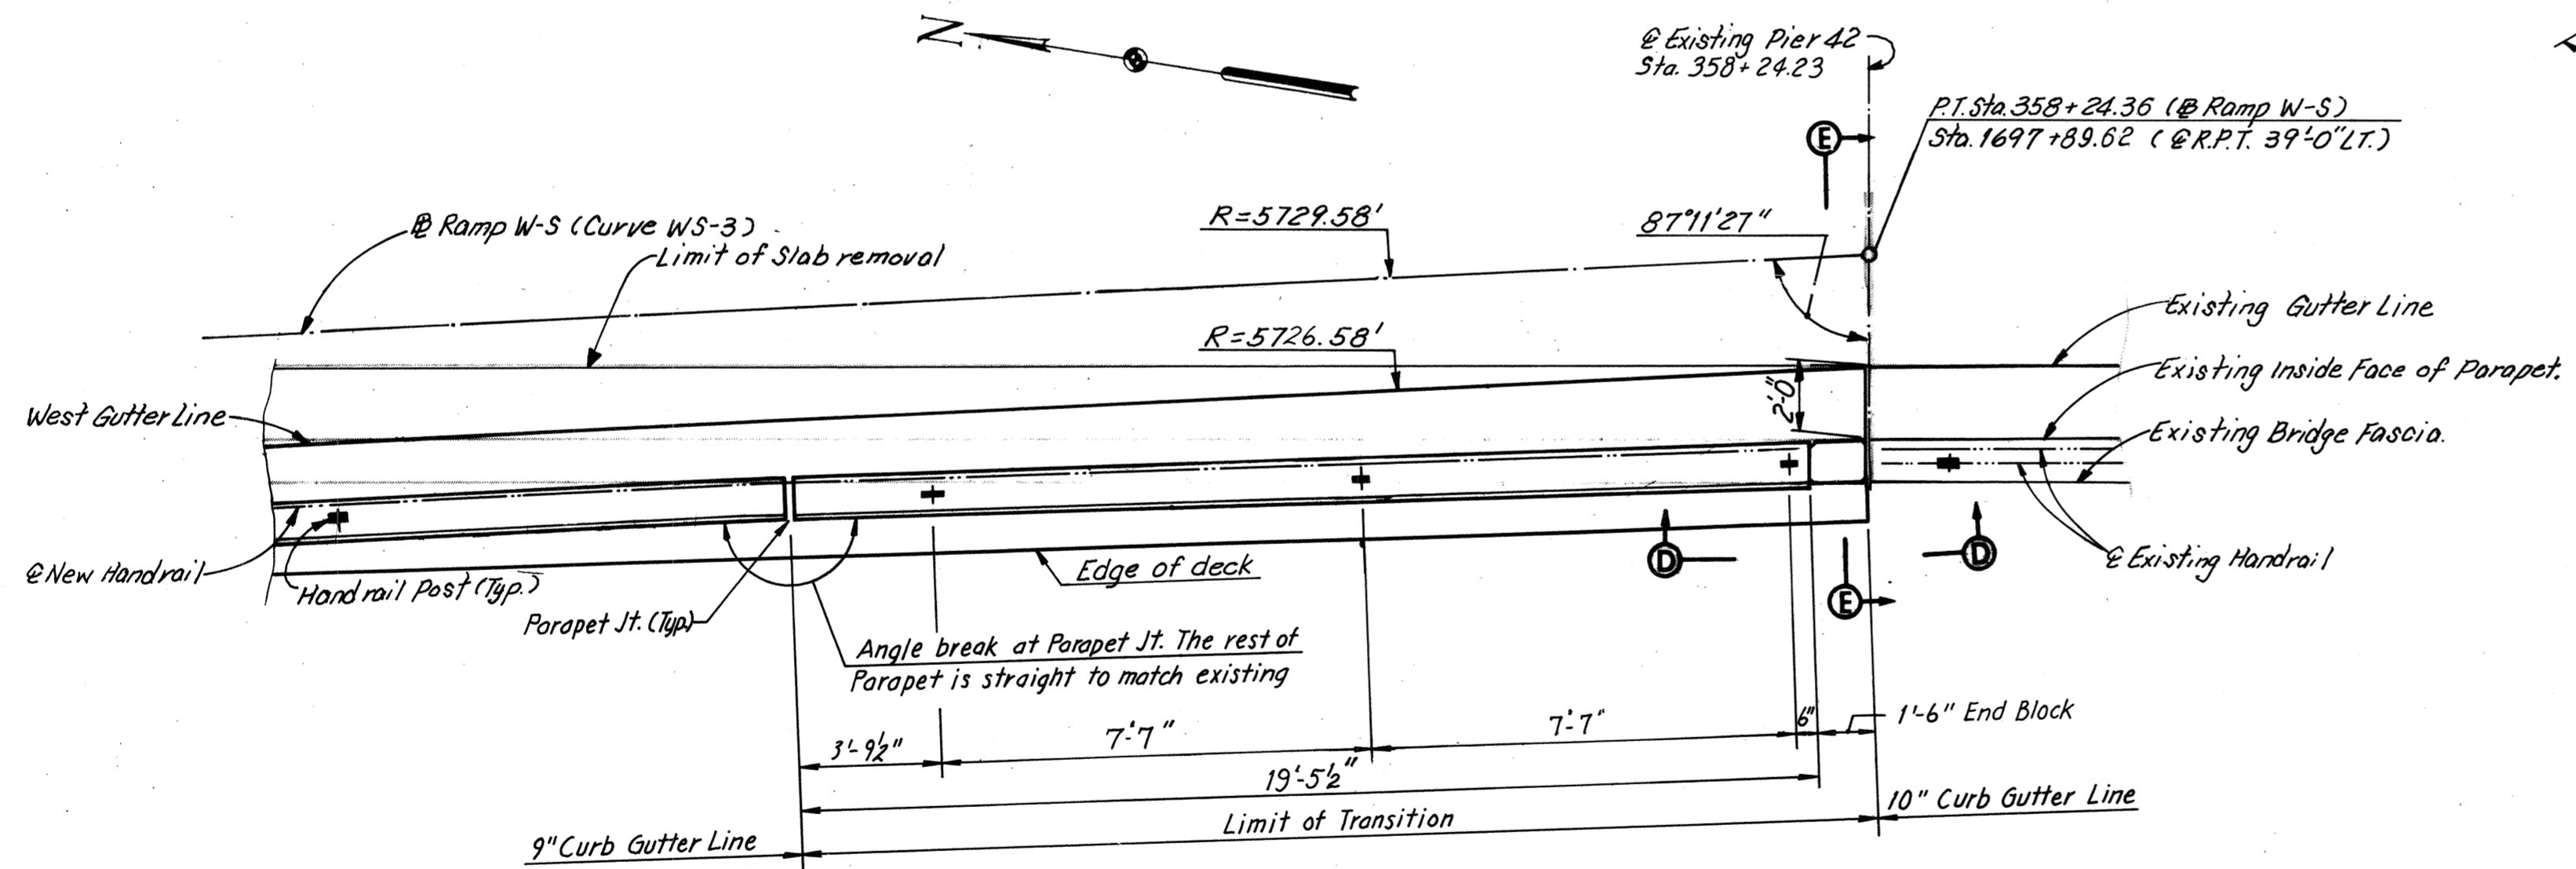


DETAIL B
No Scale

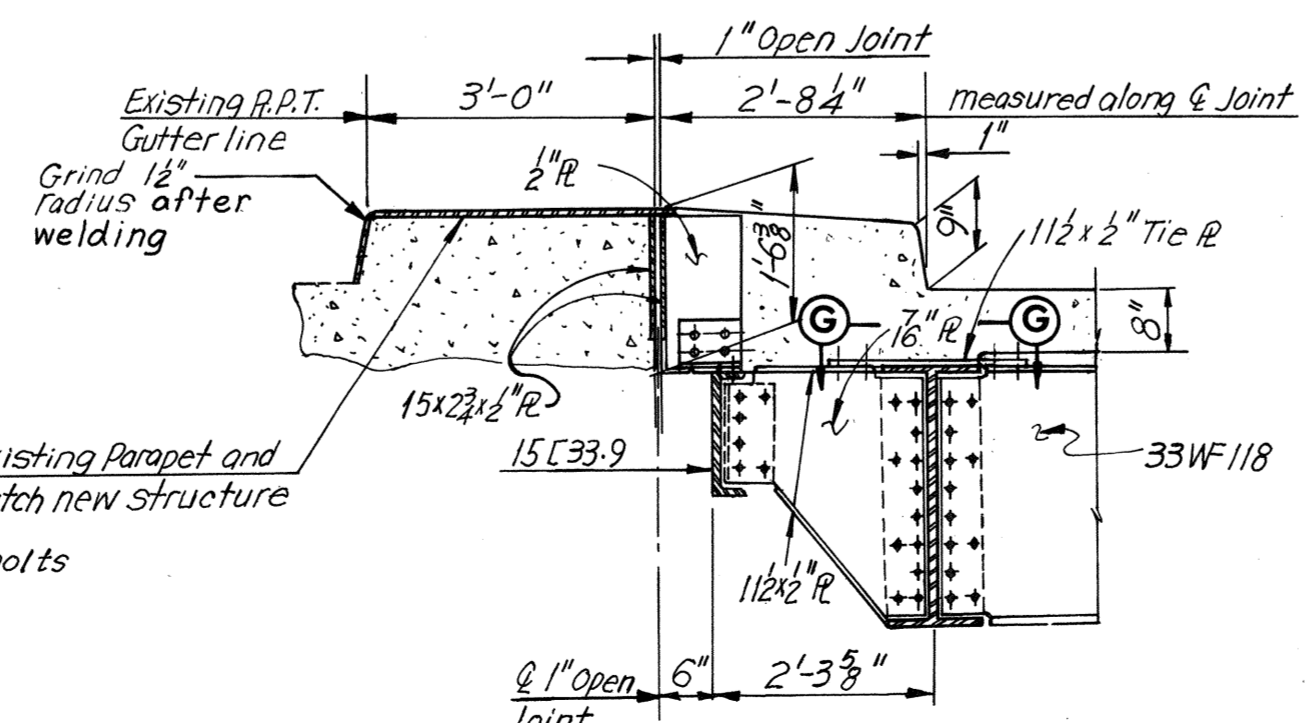


SECTION F-F
Scale 1/2" = 1'-0"

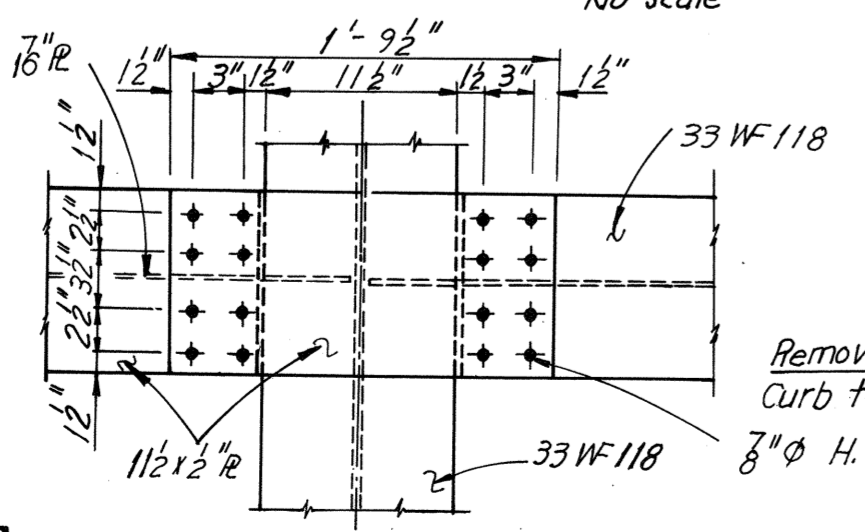

SECTION G-G
Scale 1" = 1'-0"

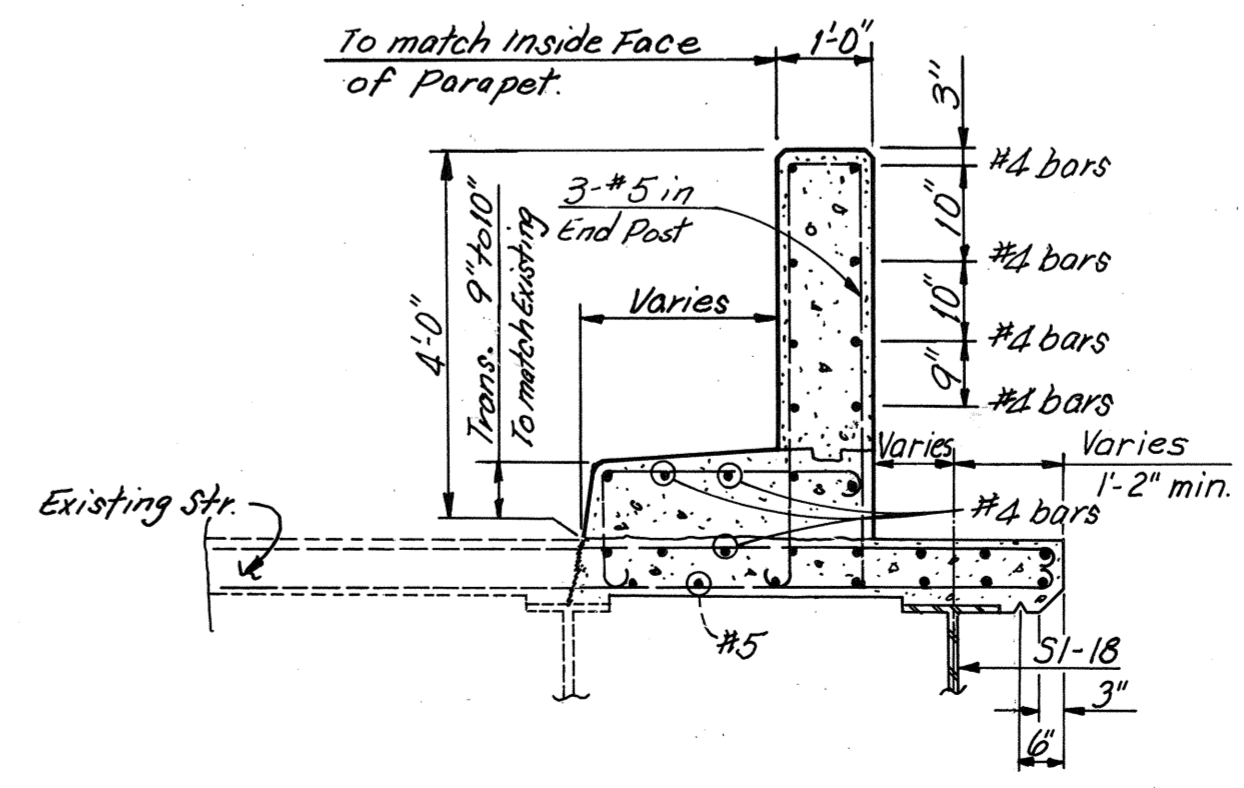

SECTION E-E
Scale 1/2" = 1'-0"

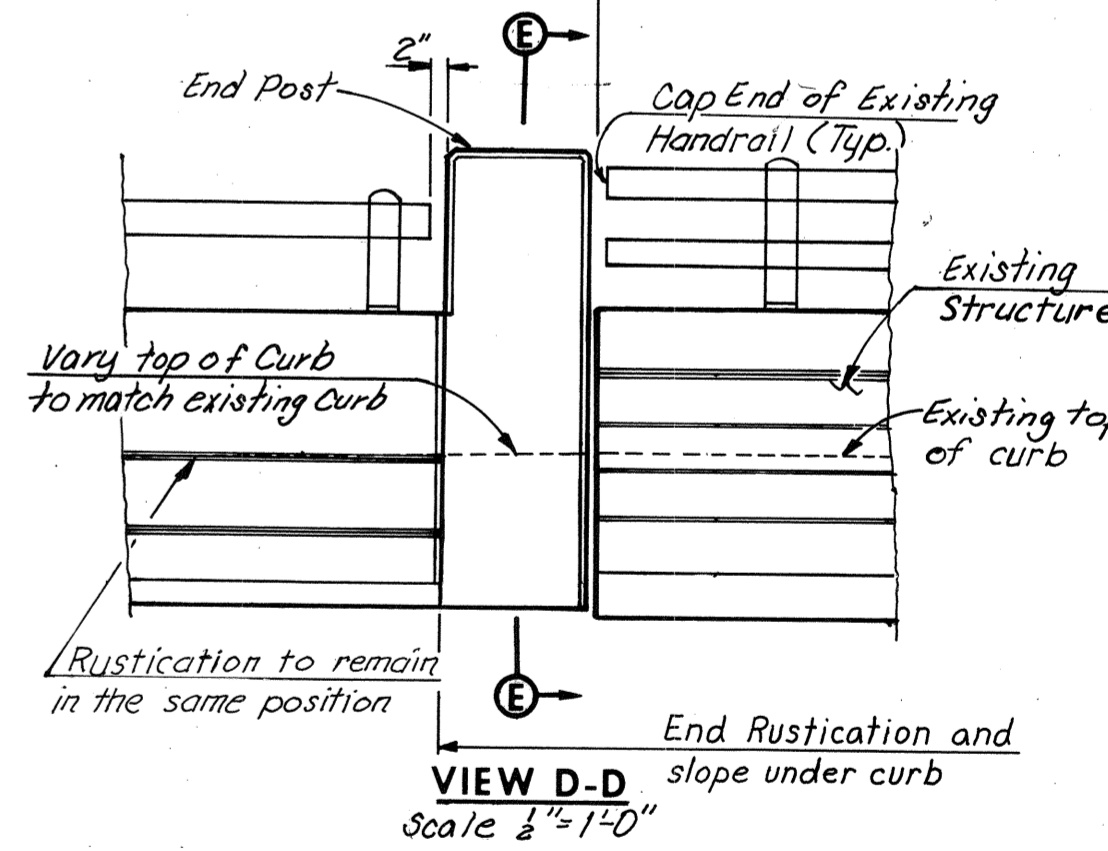

VIEW D-D
Scale 1/2" = 1'-0"


Notes:
For location of Details A and C, see Sheet 21.
For location of Detail B, see Sheet 23.

AS BUILT
RICHMOND METROPOLITAN AUTHORITY
RICHMOND EXPRESSWAY SYSTEM
DOWNTOWN EXPRESSWAY
BRIDGE NO. 68
RAMP W-S CONNECTION TO
RICHMOND-PETERSBURG TURNPIKE
SUPERSTRUCTURE DETAILS


HOWARD, NEEDLES, TAMMEN & BERGENDOFF
consulting engineers
NEW YORK ALEXANDRIA KANSAS CITY
SCALE: As Noted
CONTRACT NO. 11
SHEET NO. 24 OF 28

BY	DATE	NO.	REVISION	BY	DATE
MADE	G.C.C. 1-29-69	1	Det. A & Sect. A-A	TEM	4-76
CHECKED	Y.C.P. 2-3-69	2	Section E-E	TEM	8-26-75
IN CHARGE					


RICHMOND EXPRESSWAY SYSTEM			
SECTION	PROJECT	SHEET NO.	TOTAL SHEETS
11	DOWNTOWN EXPRESSWAY	88	97

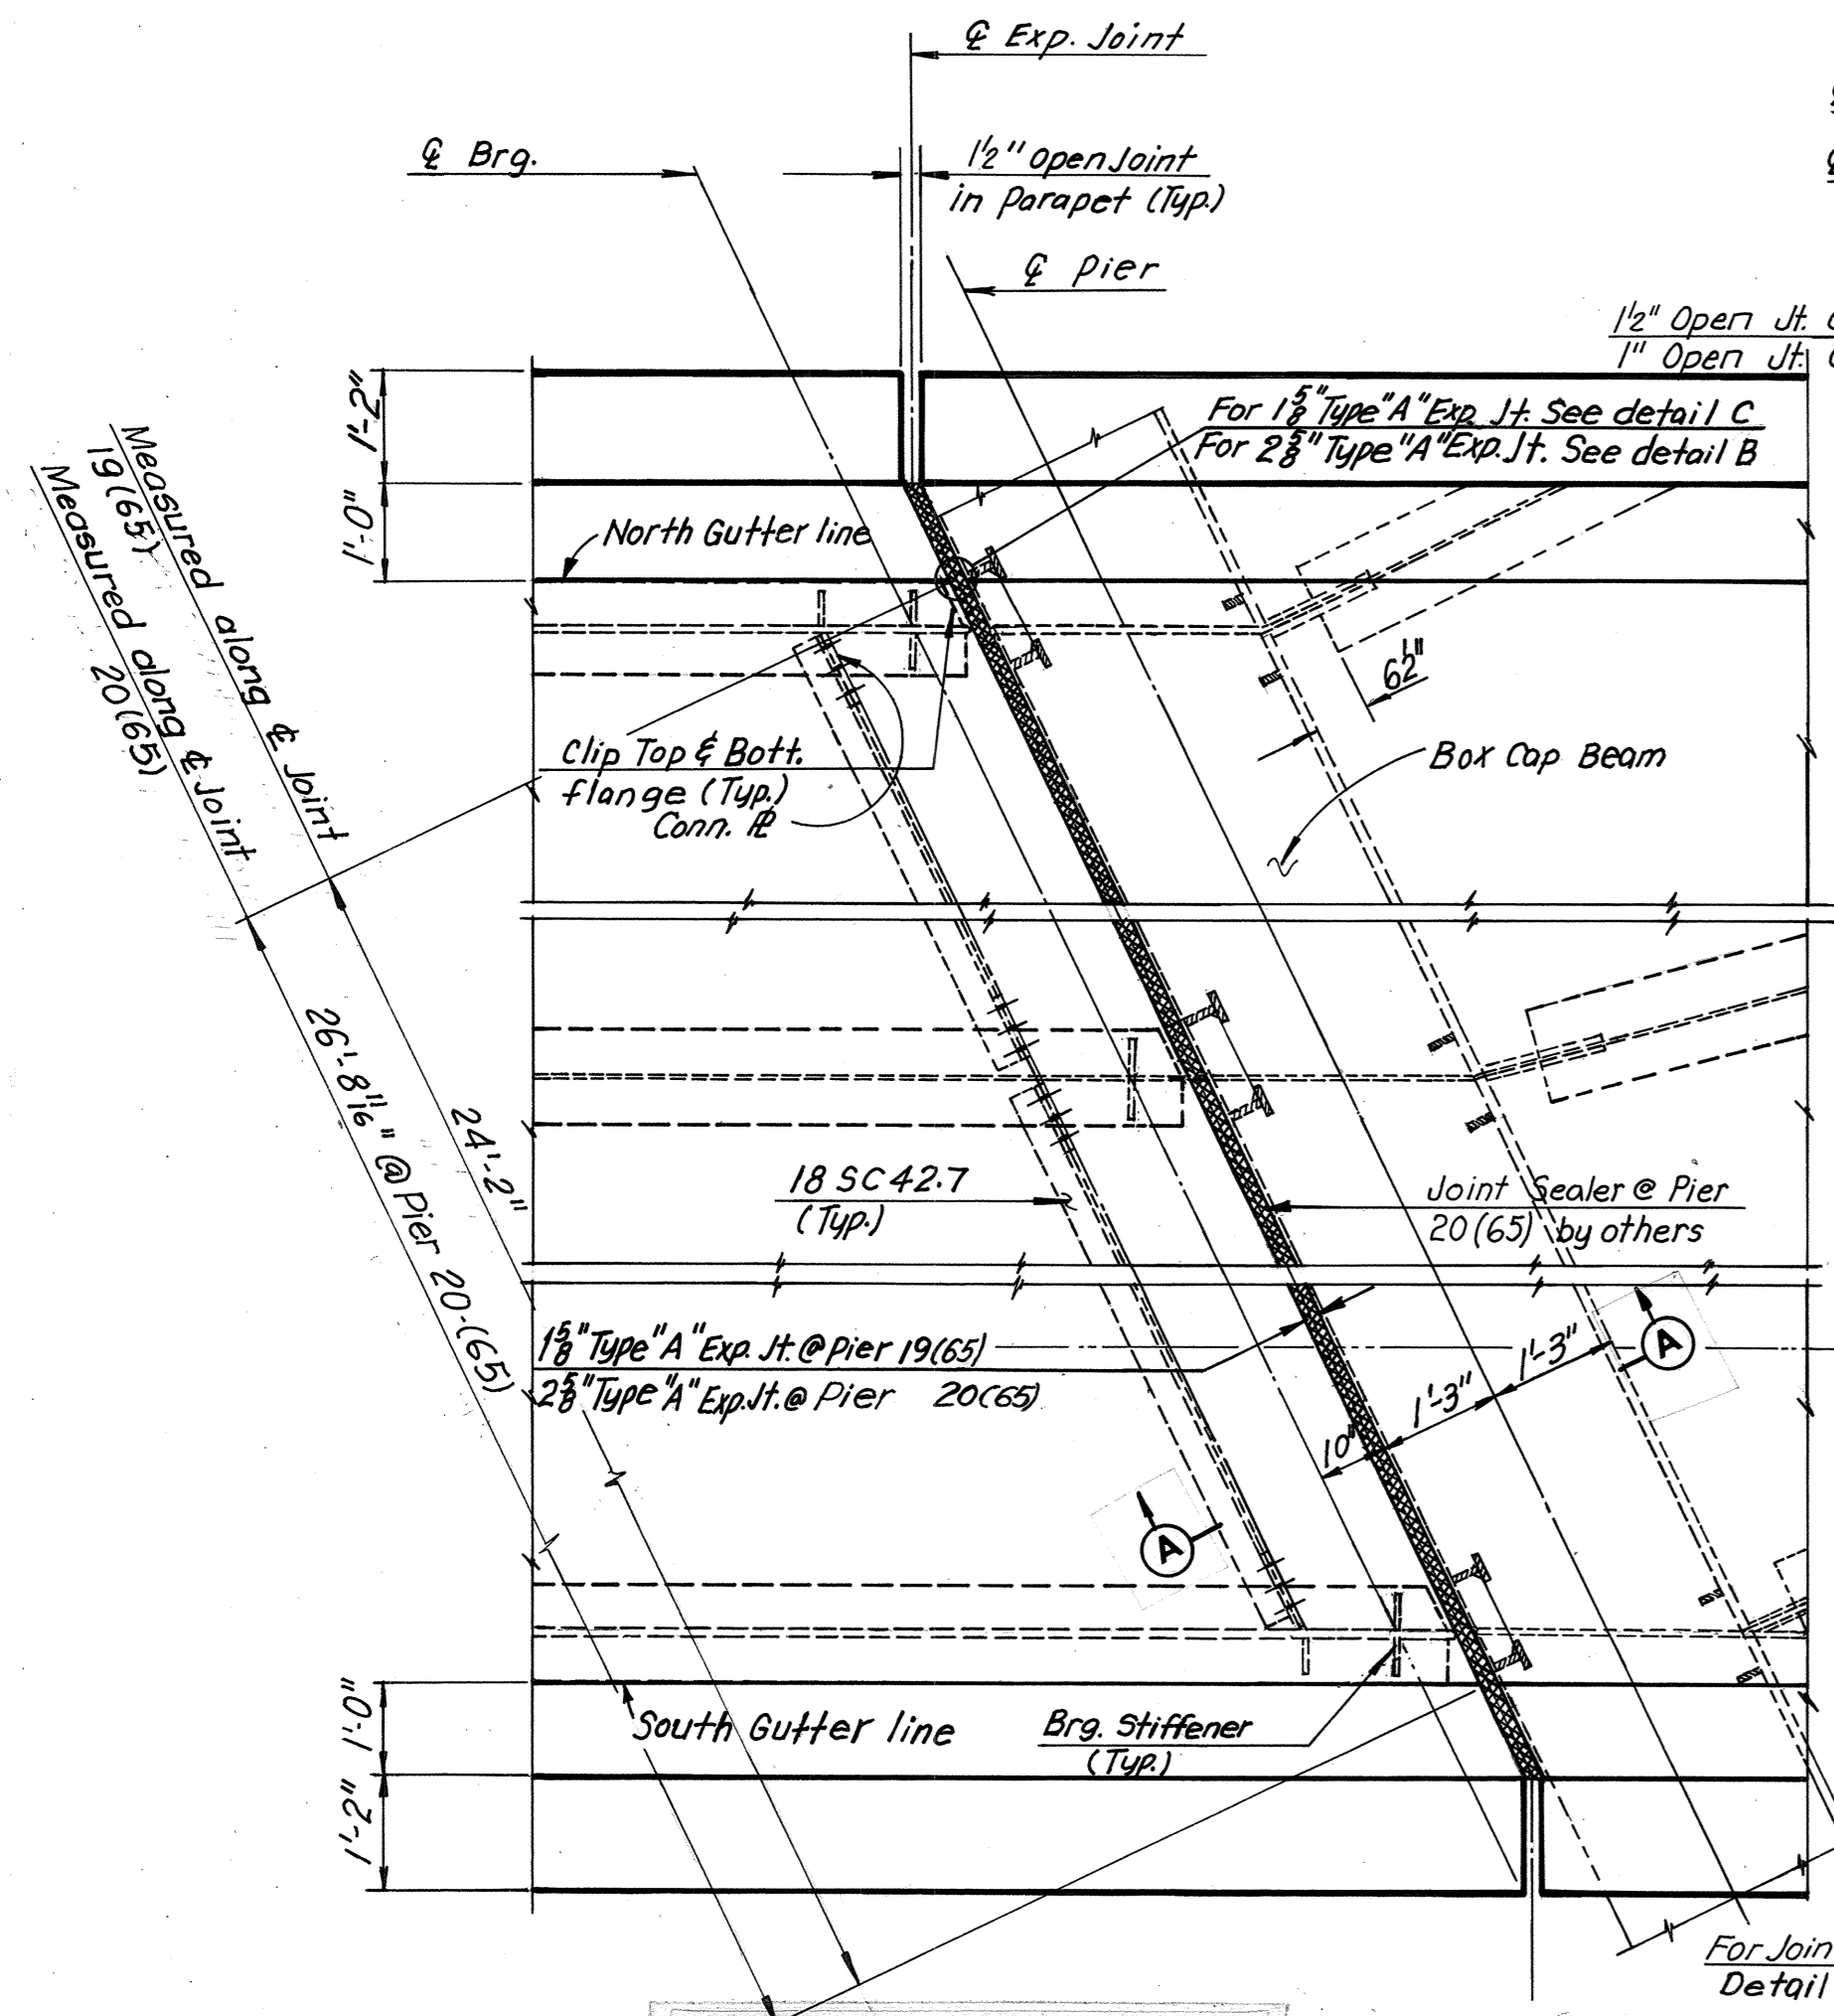


PLAN - JOINT AT PIERS 19 (65) AND 20(65)
Scale: 1/2" = 1'-0"

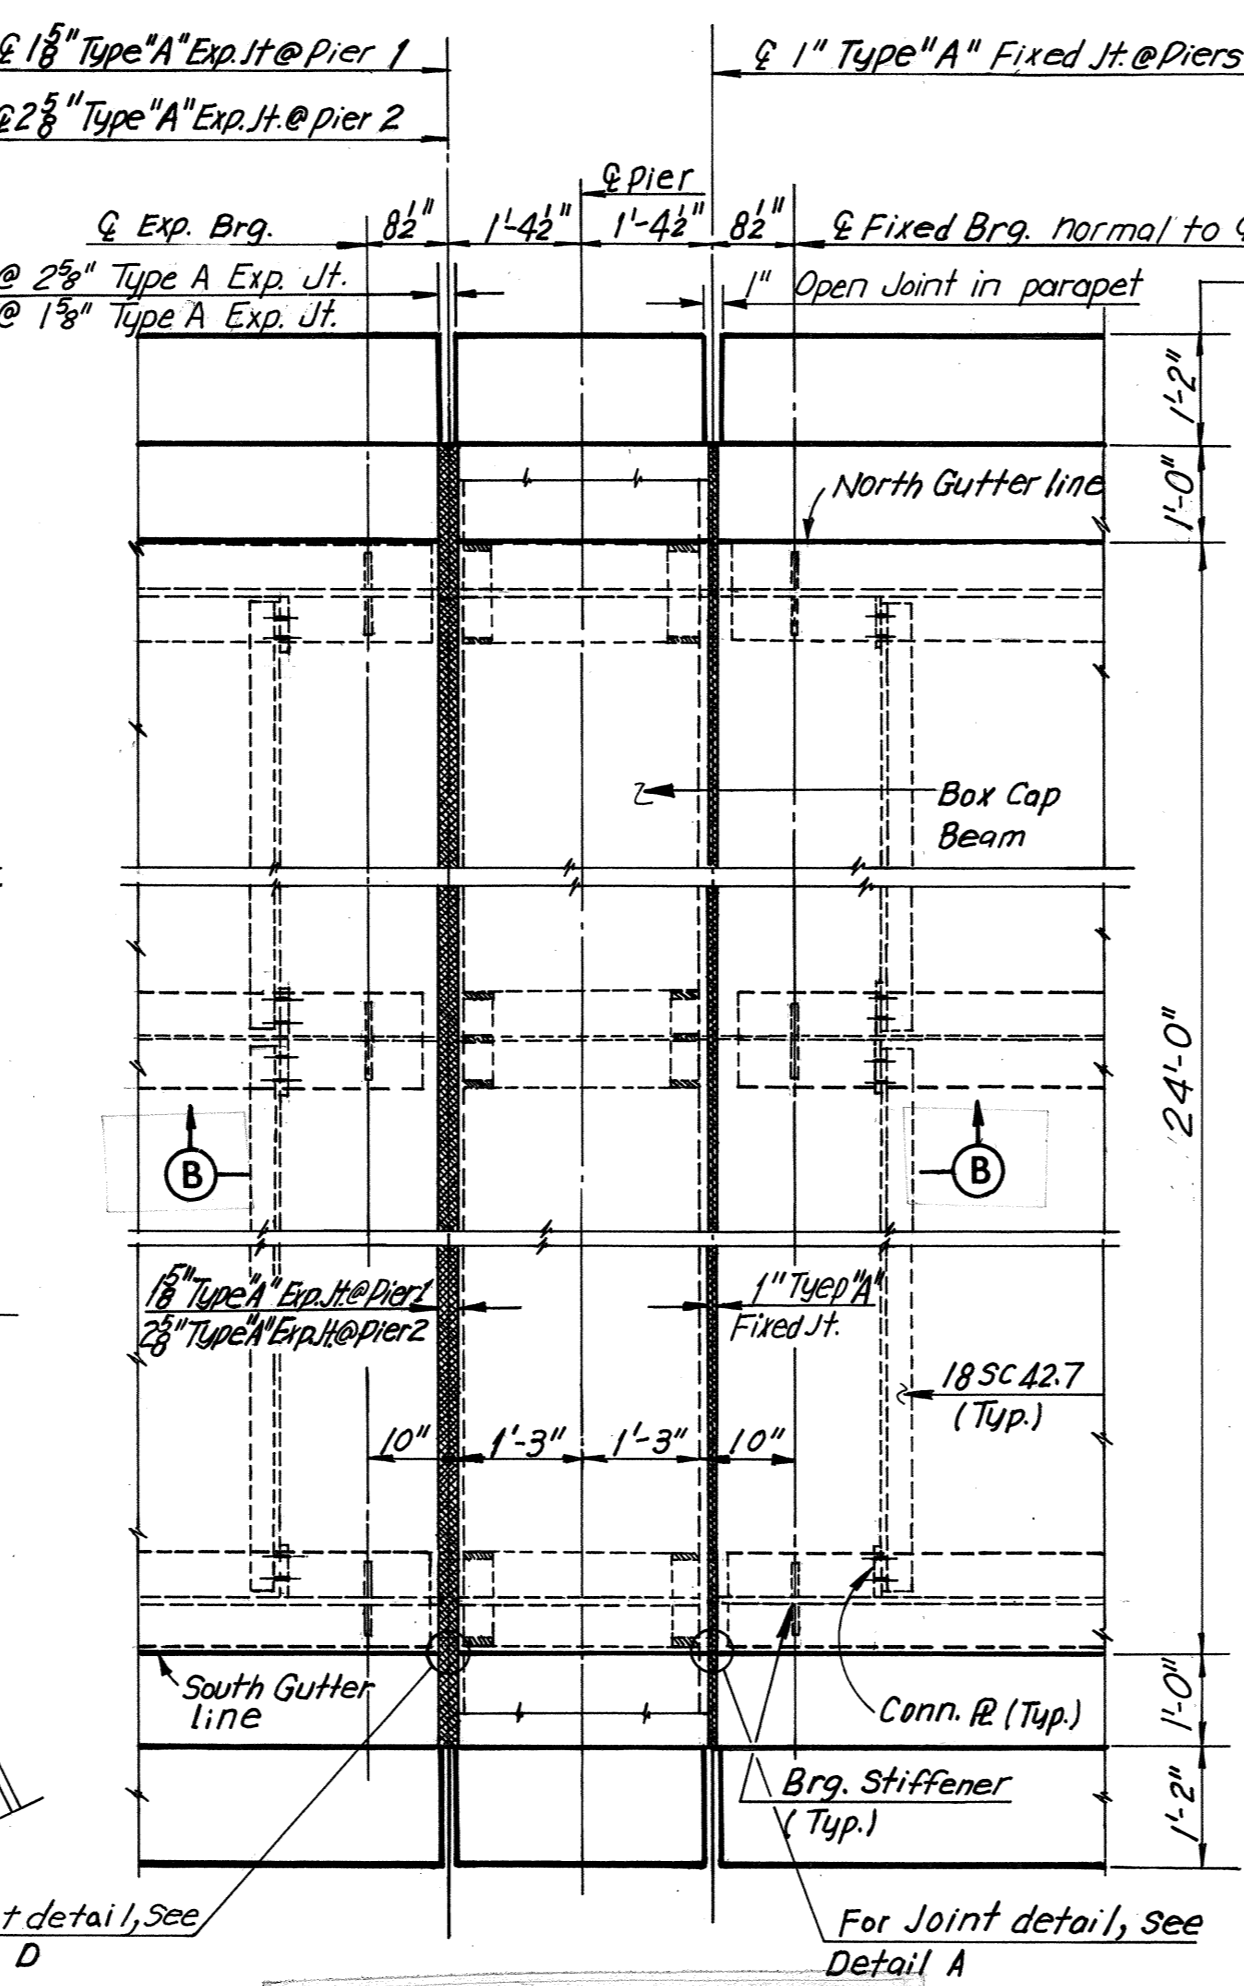


PLAN - JOINT AT PIERS 1 AND 2
Scale: 1/2" = 1'-0"

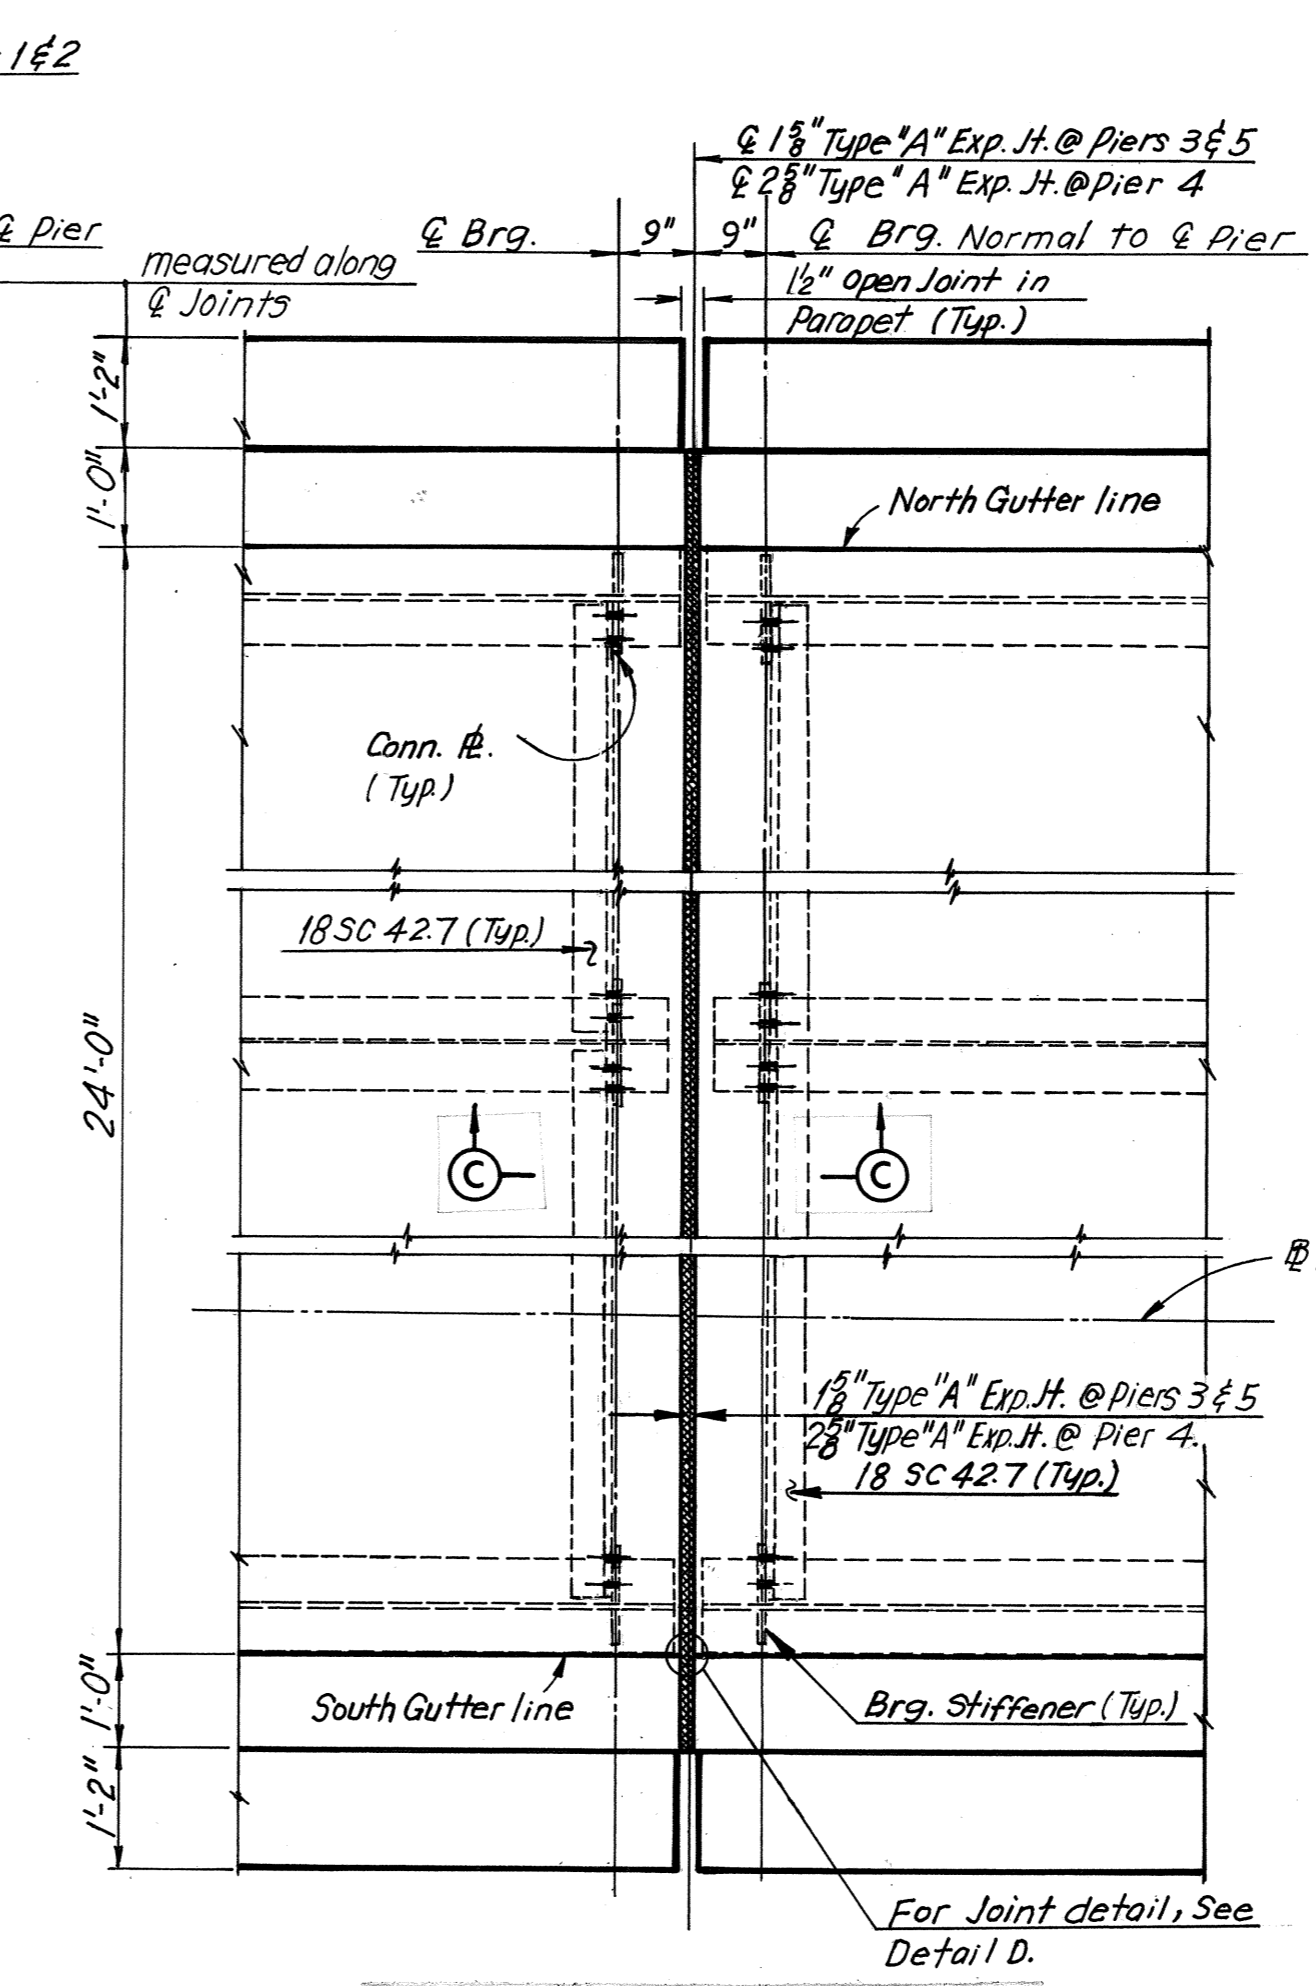


PLAN - JOINT AT PIERS 3, 4 AND 5
Scale: 1/2" = 1'-0"

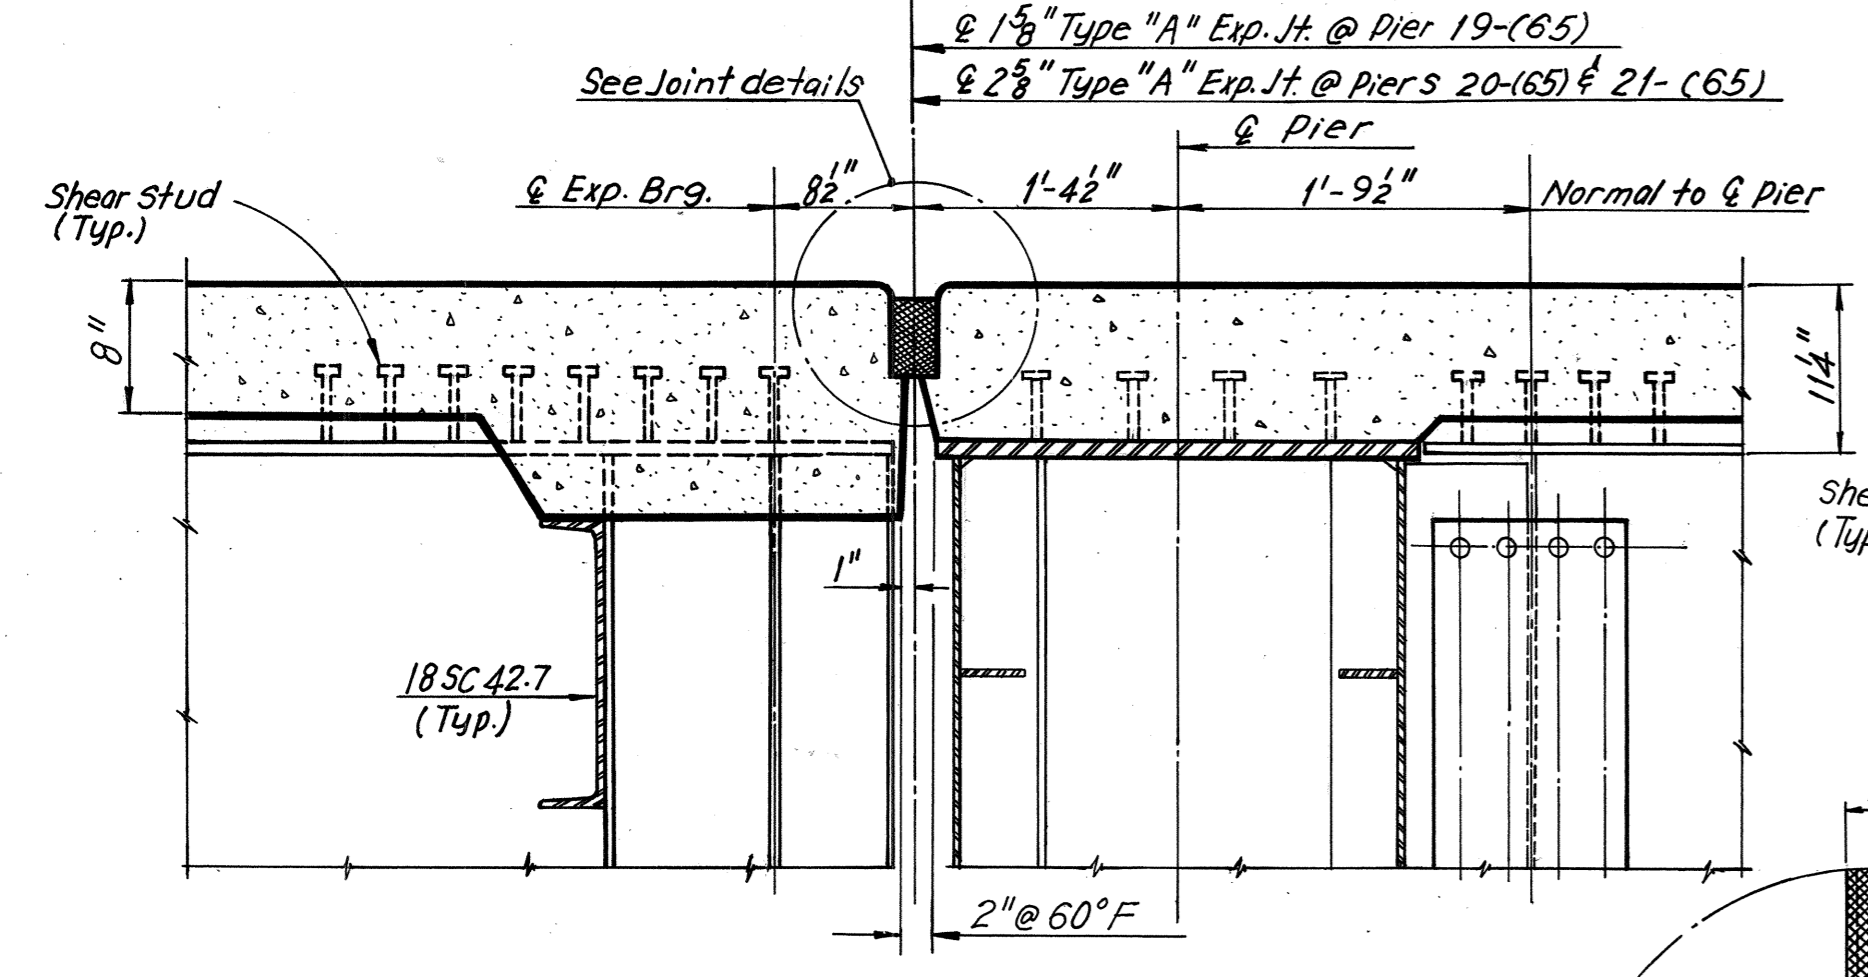

SECTION A-A
Scale: 1" = 1'-0"

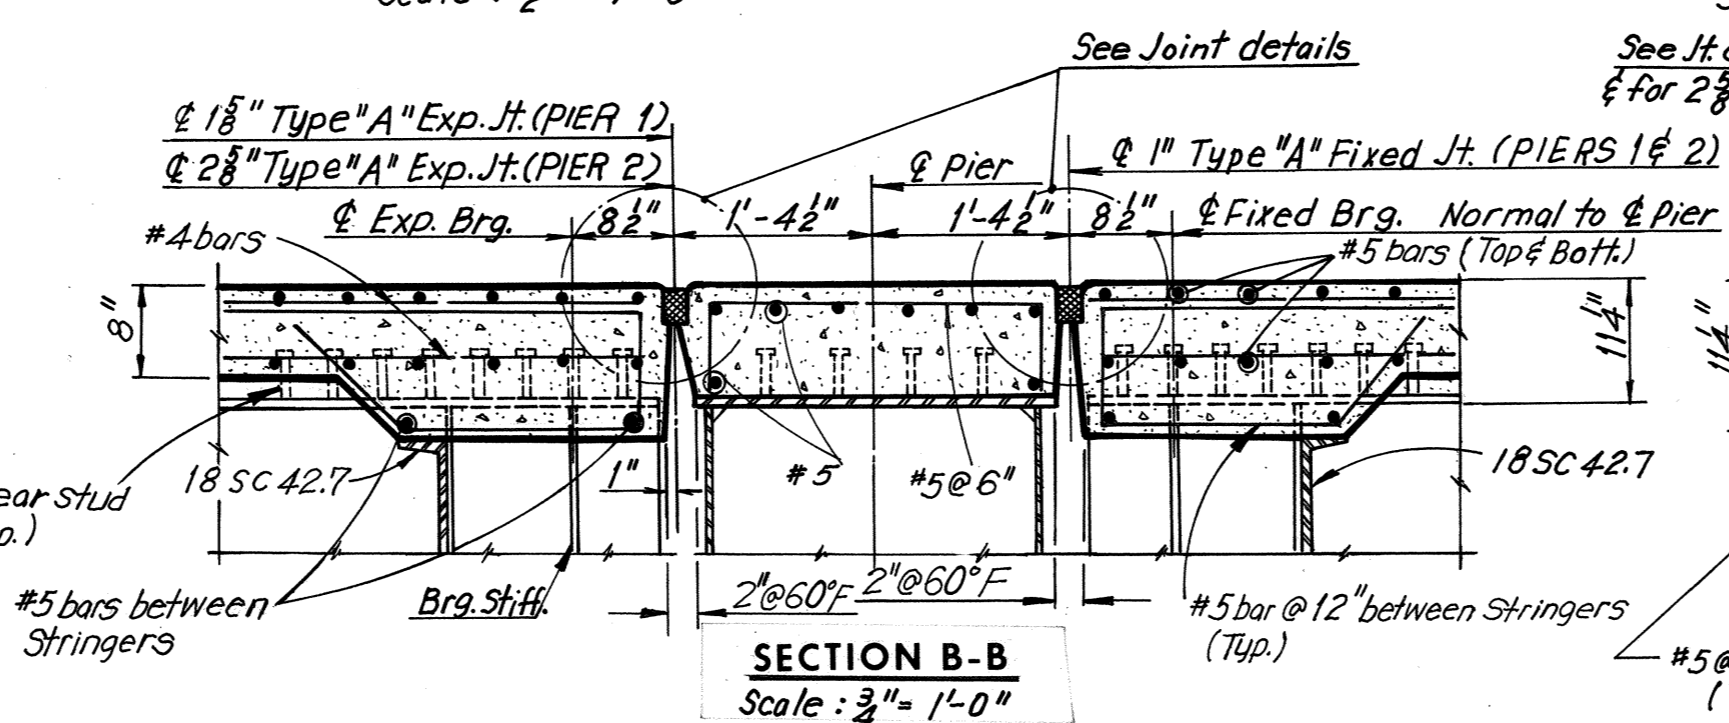


SECTION B-B
Scale: 3/4" = 1'-0"

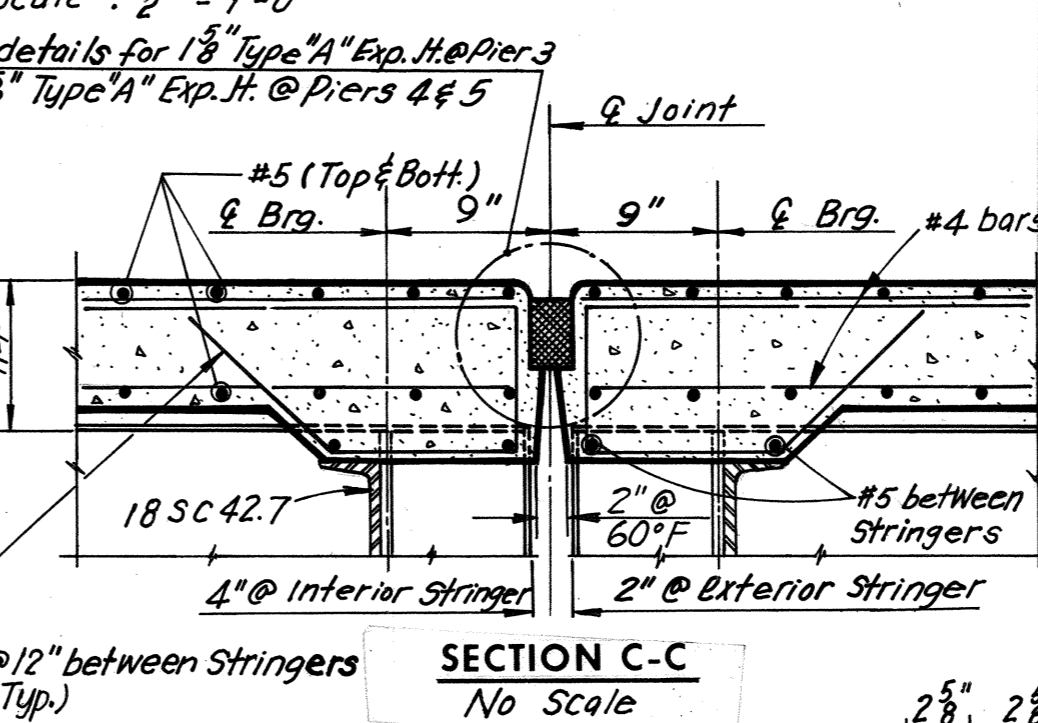


SECTION C-C
No Scale


Note: Reinforcings of Section A-A are similar to Section B-B.
Note: Horizontal dimensions as shown in the cross sections are normal to & joint.

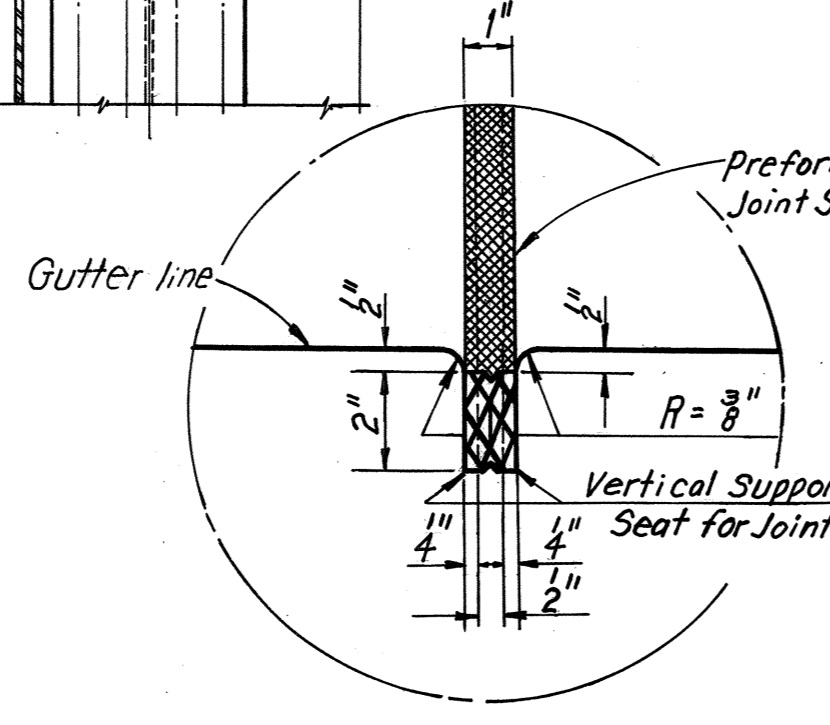


DETAIL A
Scale: 3" = 1'-0"

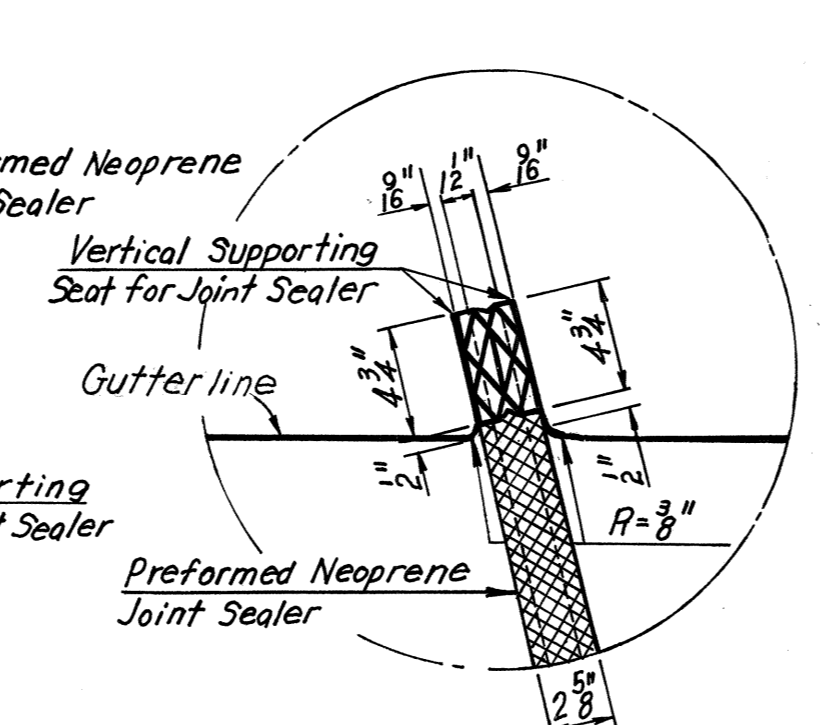


DETAIL B
Scale: 1 1/2" = 1'-0"

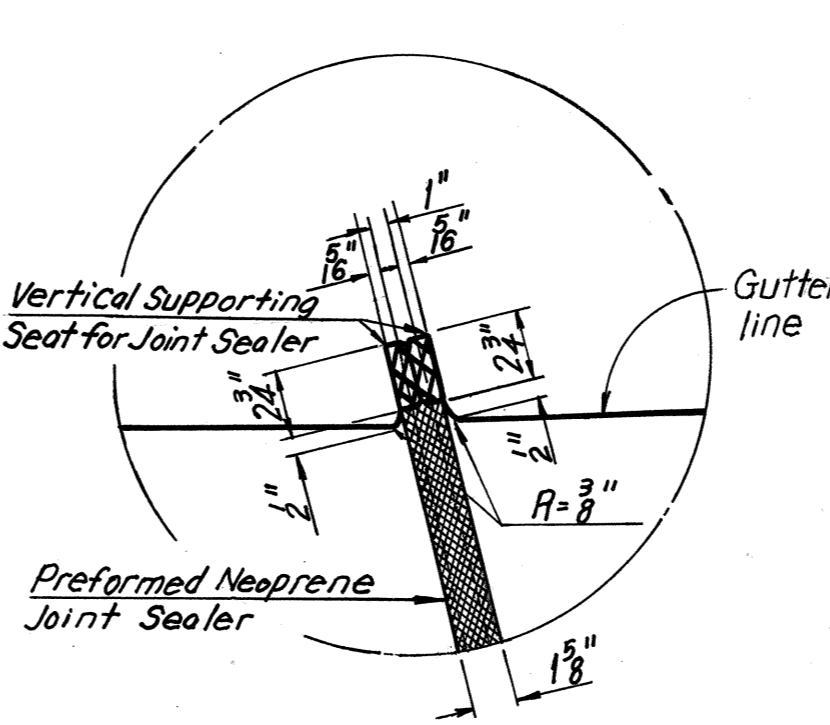


DETAIL C
Scale: 1 1/2" = 1'-0"

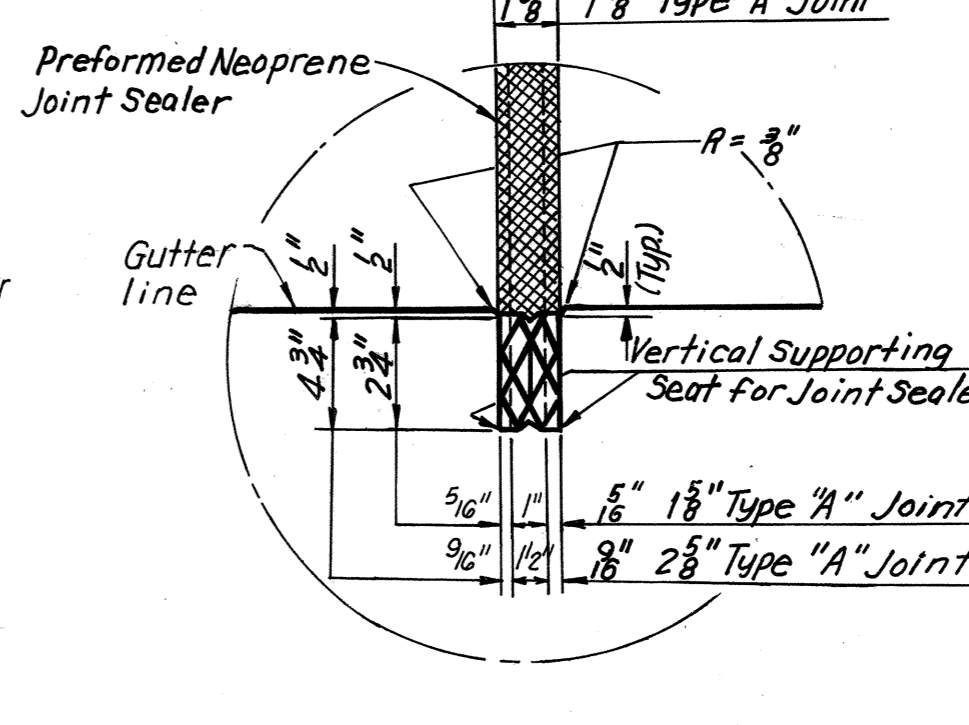


DETAIL D
No Scale

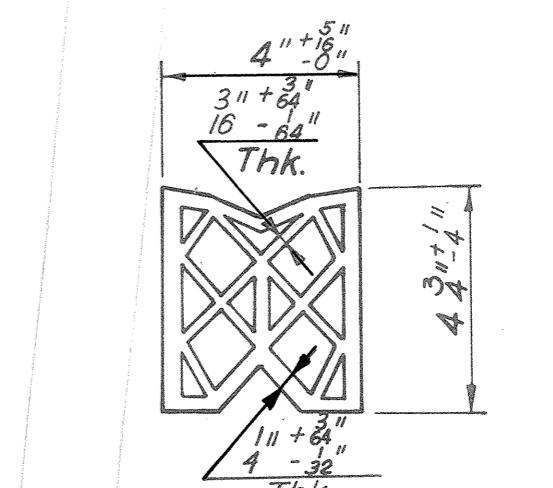


PREFORMED NEOPRENE JOINT SEALER FOR 2 3/8" TYPE "A" JOINT

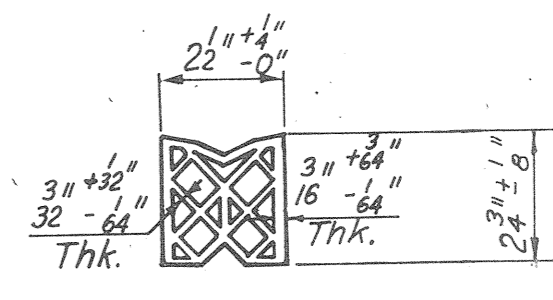


PREFORMED NEOPRENE JOINT SEALER FOR 1 5/8" TYPE "A" JOINT

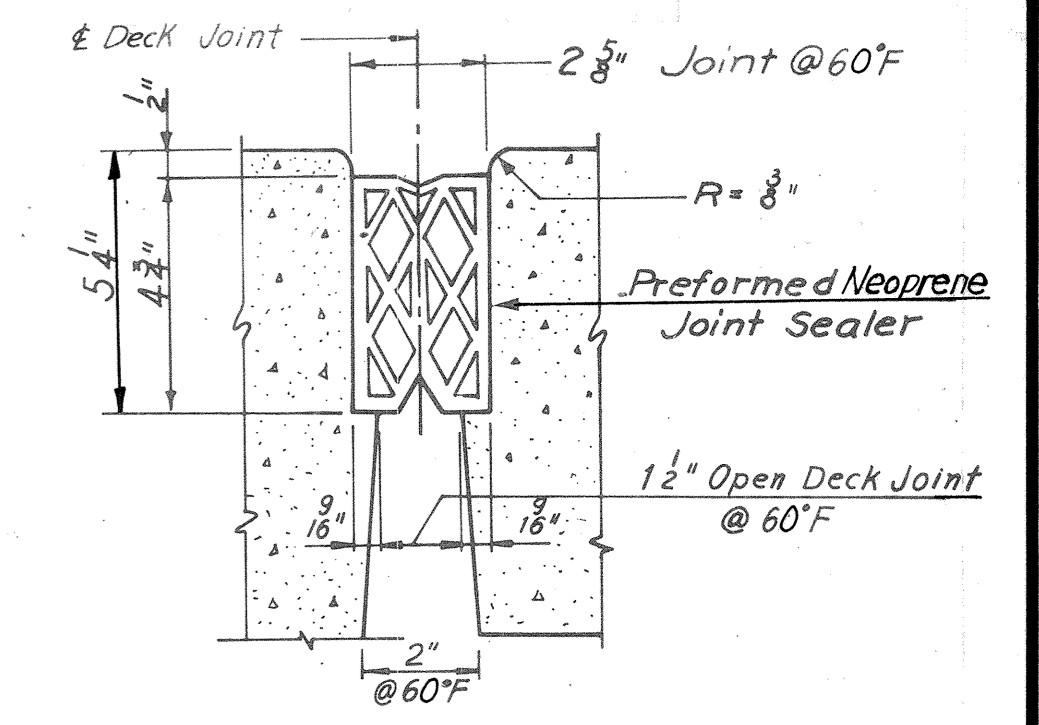


2 5/8" TYPE "A" JOINT

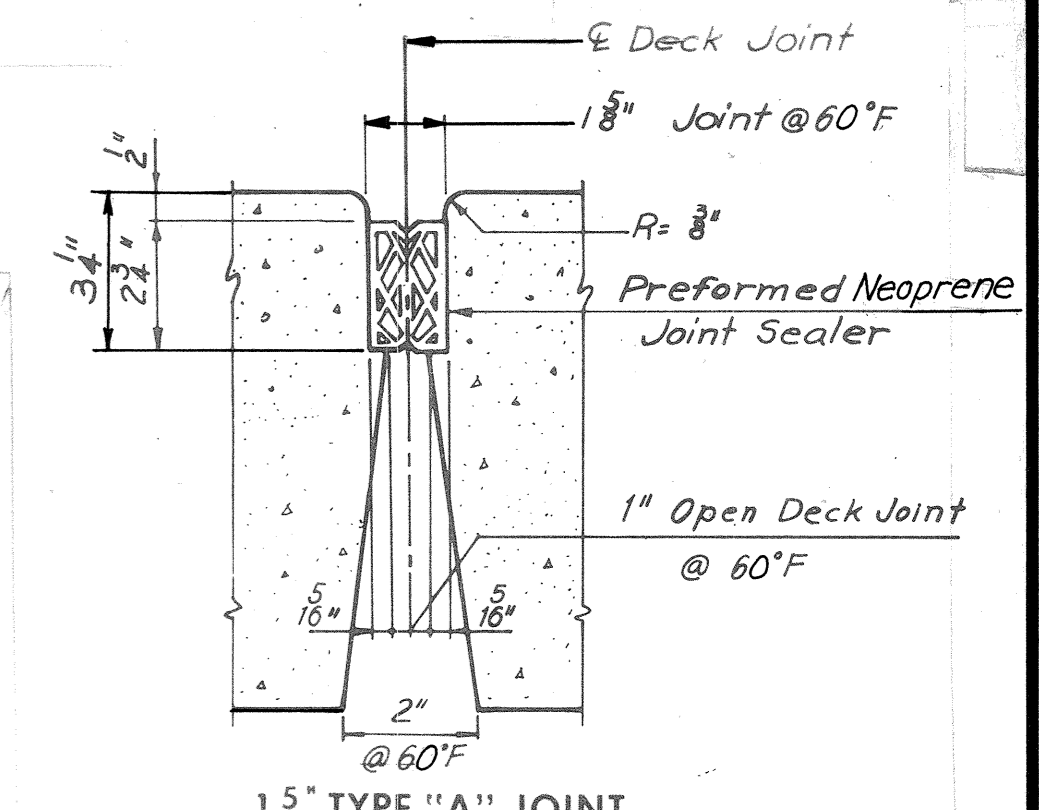

1 5" TYPE "A" JOINT

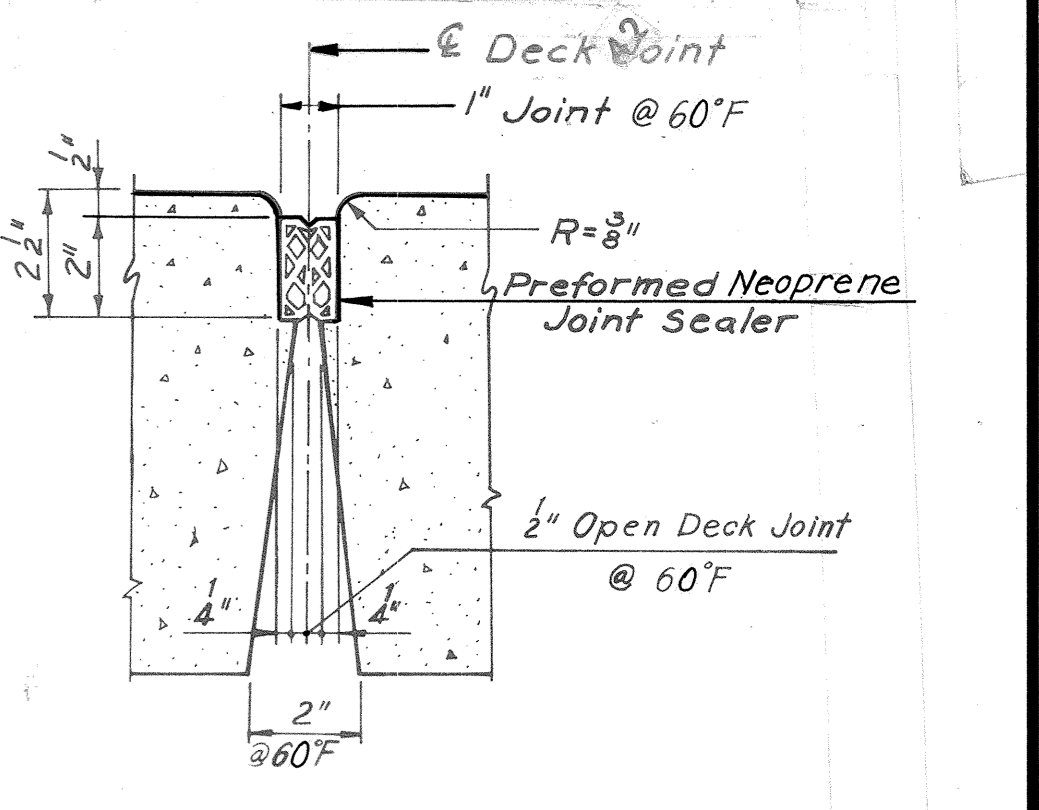

1" TYPE "A" JOINT

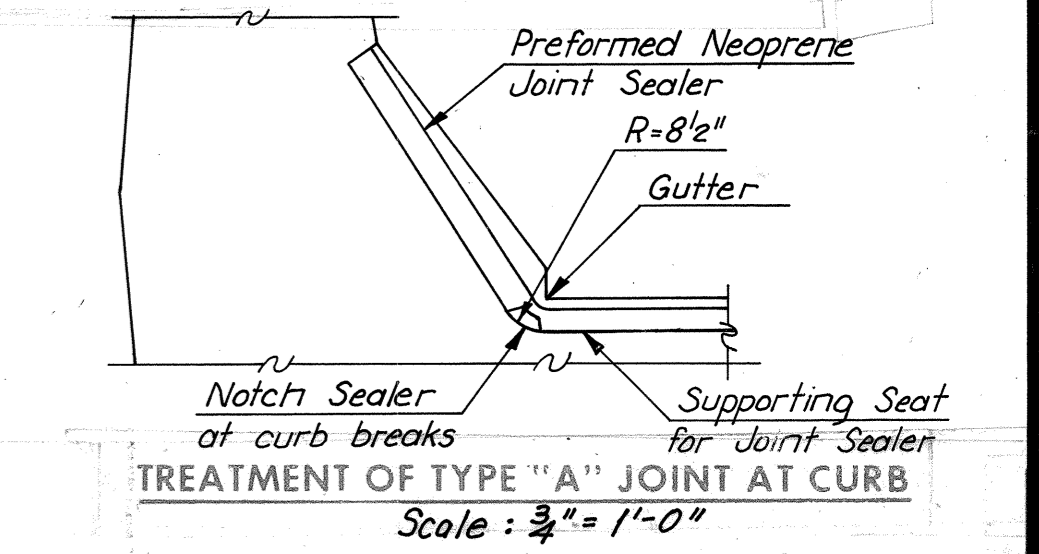

TREATMENT OF TYPE "A" JOINT AT CURB
Scale: 3/4" = 1'-0"

RICHMOND METROPOLITAN AUTHORITY
RICHMOND EXPRESSWAY SYSTEM
DOWNTOWN EXPRESSWAY









BRIDGE NO. 68
RAMP W-S CONNECTION TO
RICHMOND-PETERSBURG TURNPIKE

JOINT DETAILS

HOWARD, NEEDLES, TAMMEN & BERGENDOFF consulting engineers
NEW YORK ALEXANDRIA KANSAS CITY

SCALE: As Noted
CONTRACT NO. 11
SHEET NO. 25 OF 28

AS BUILT

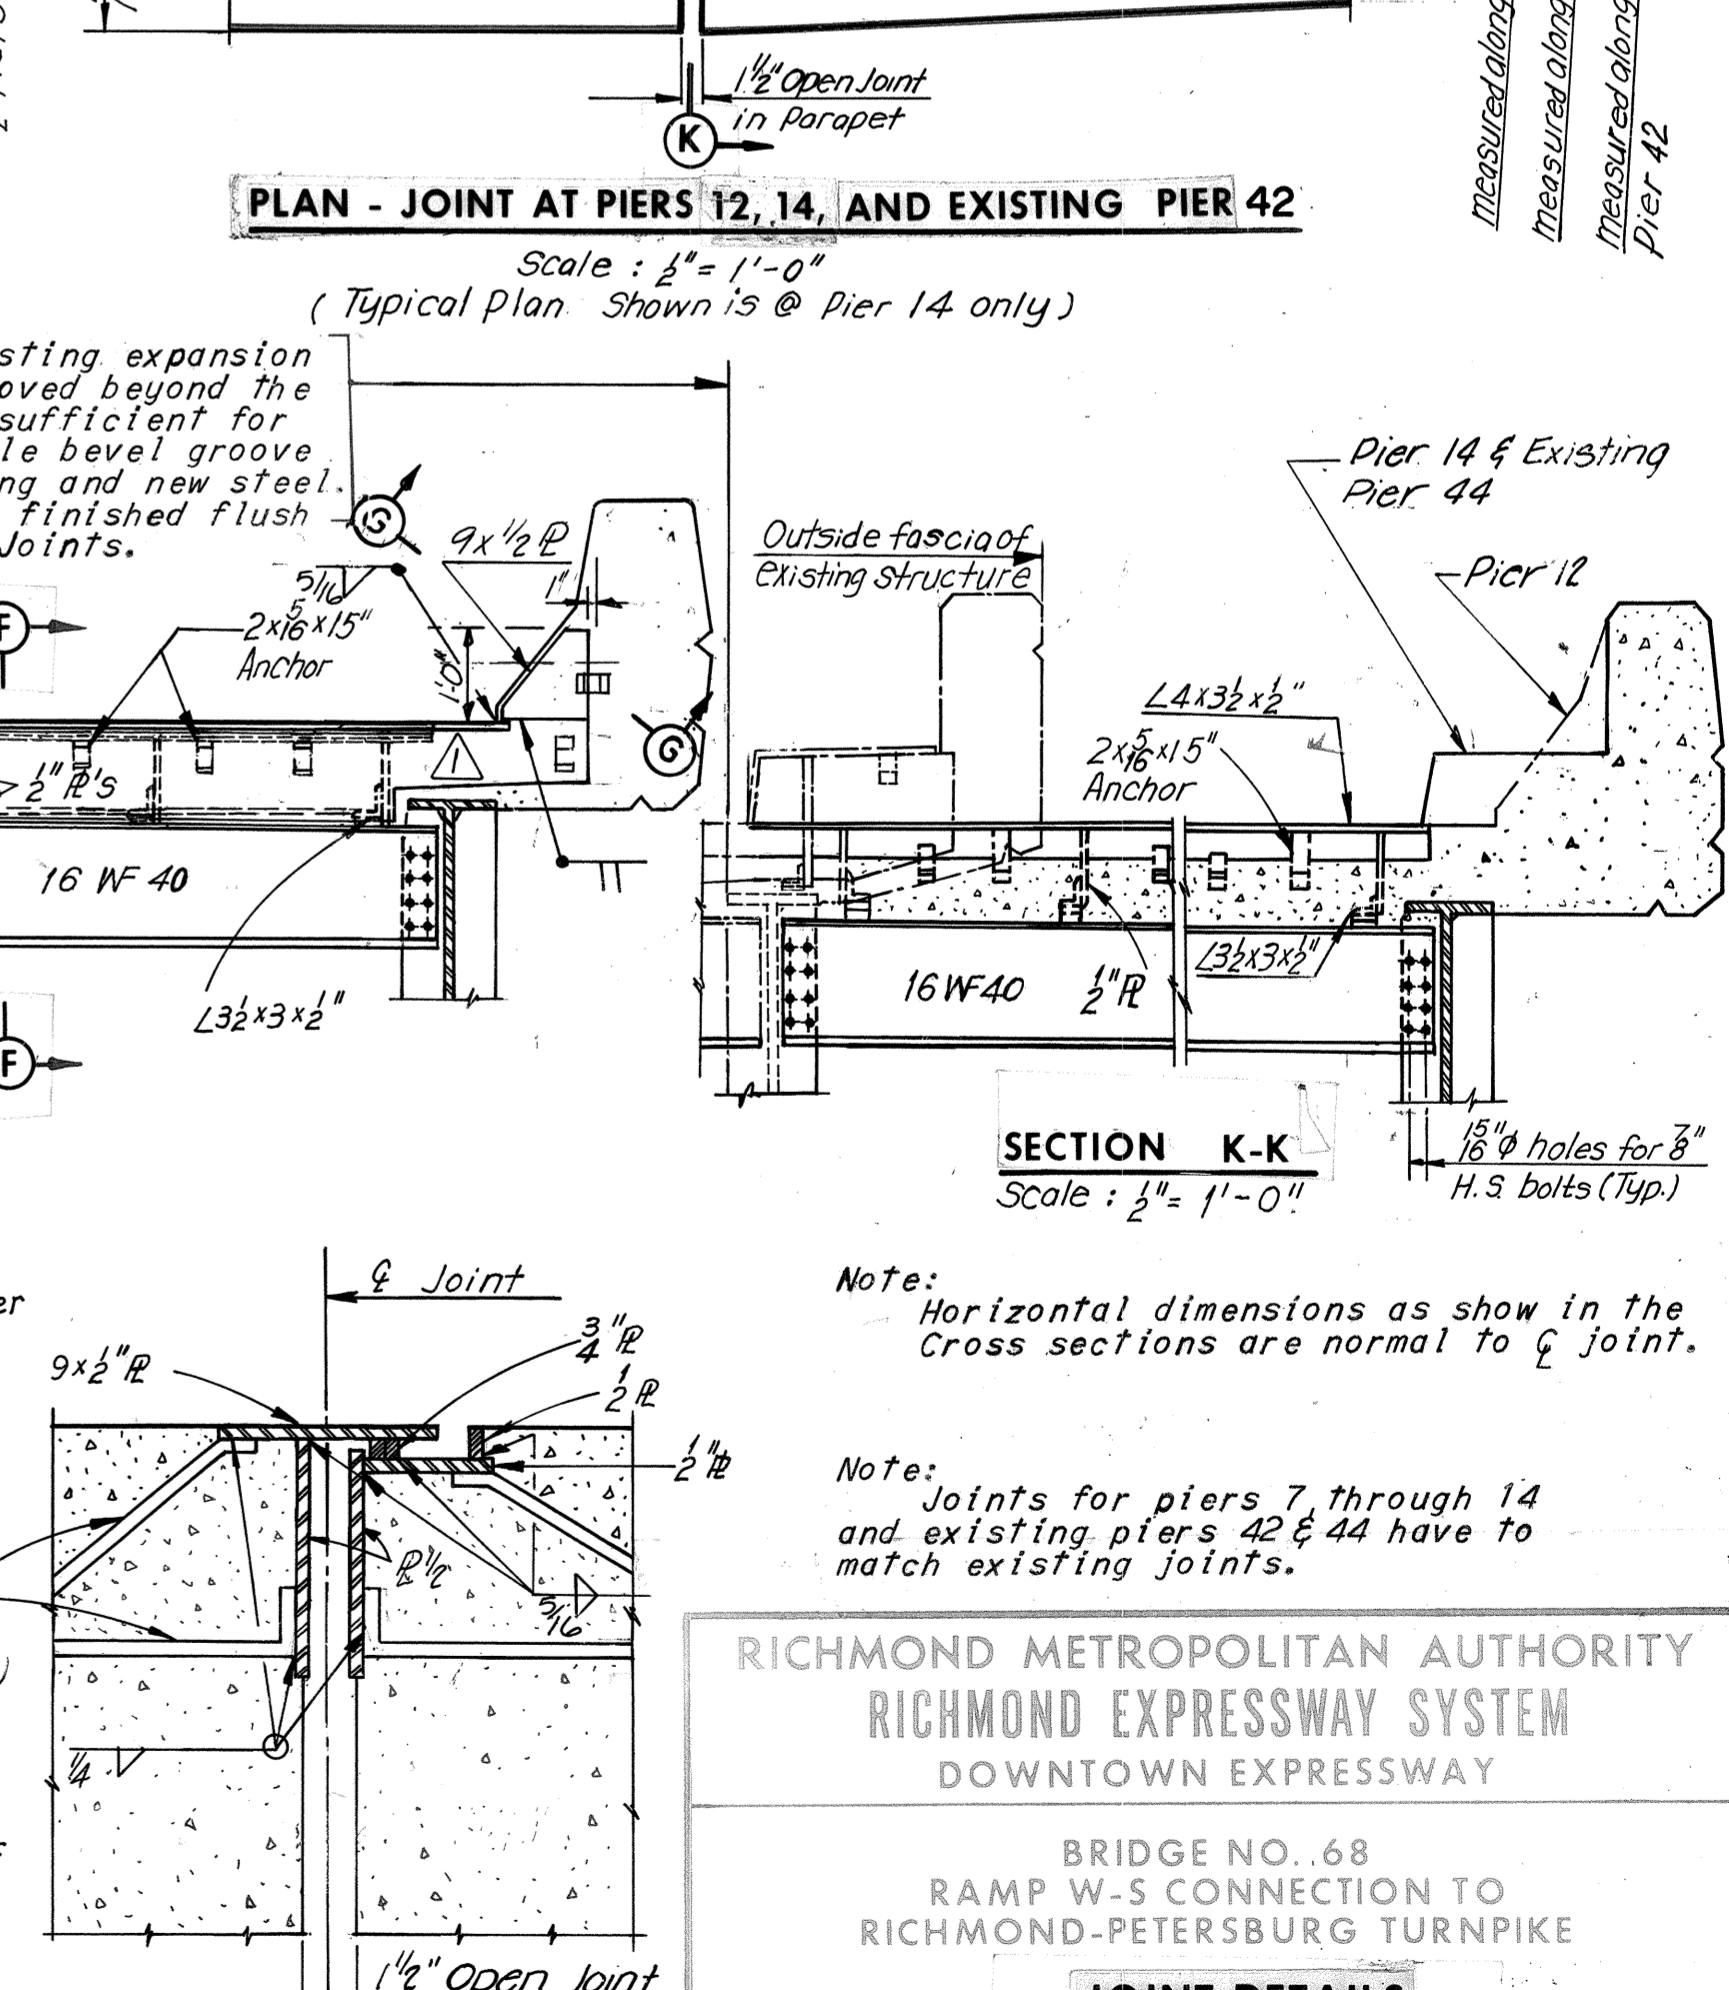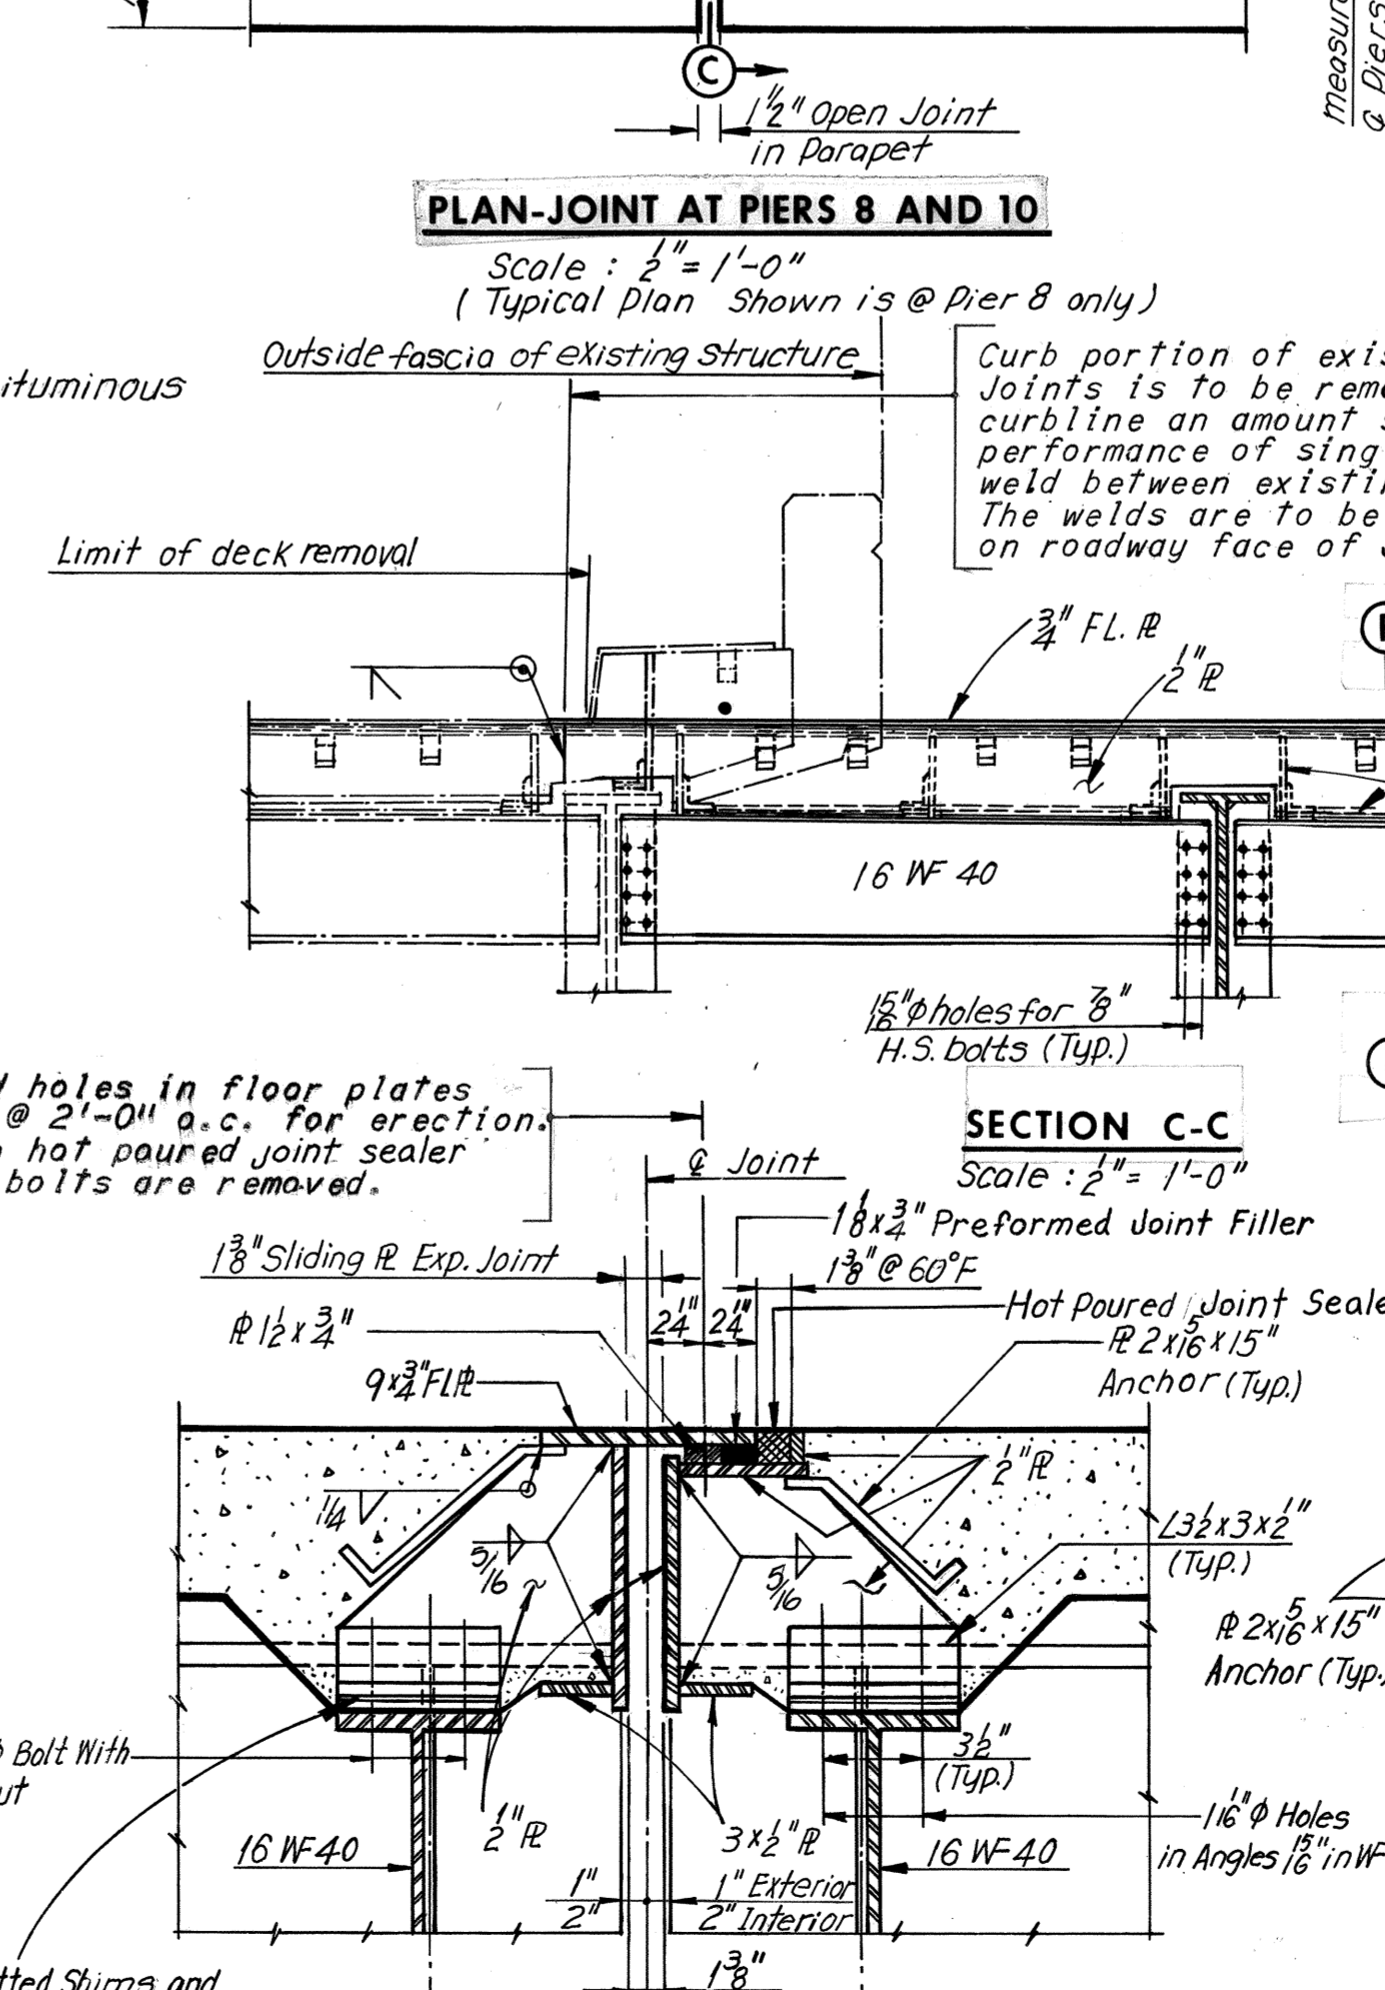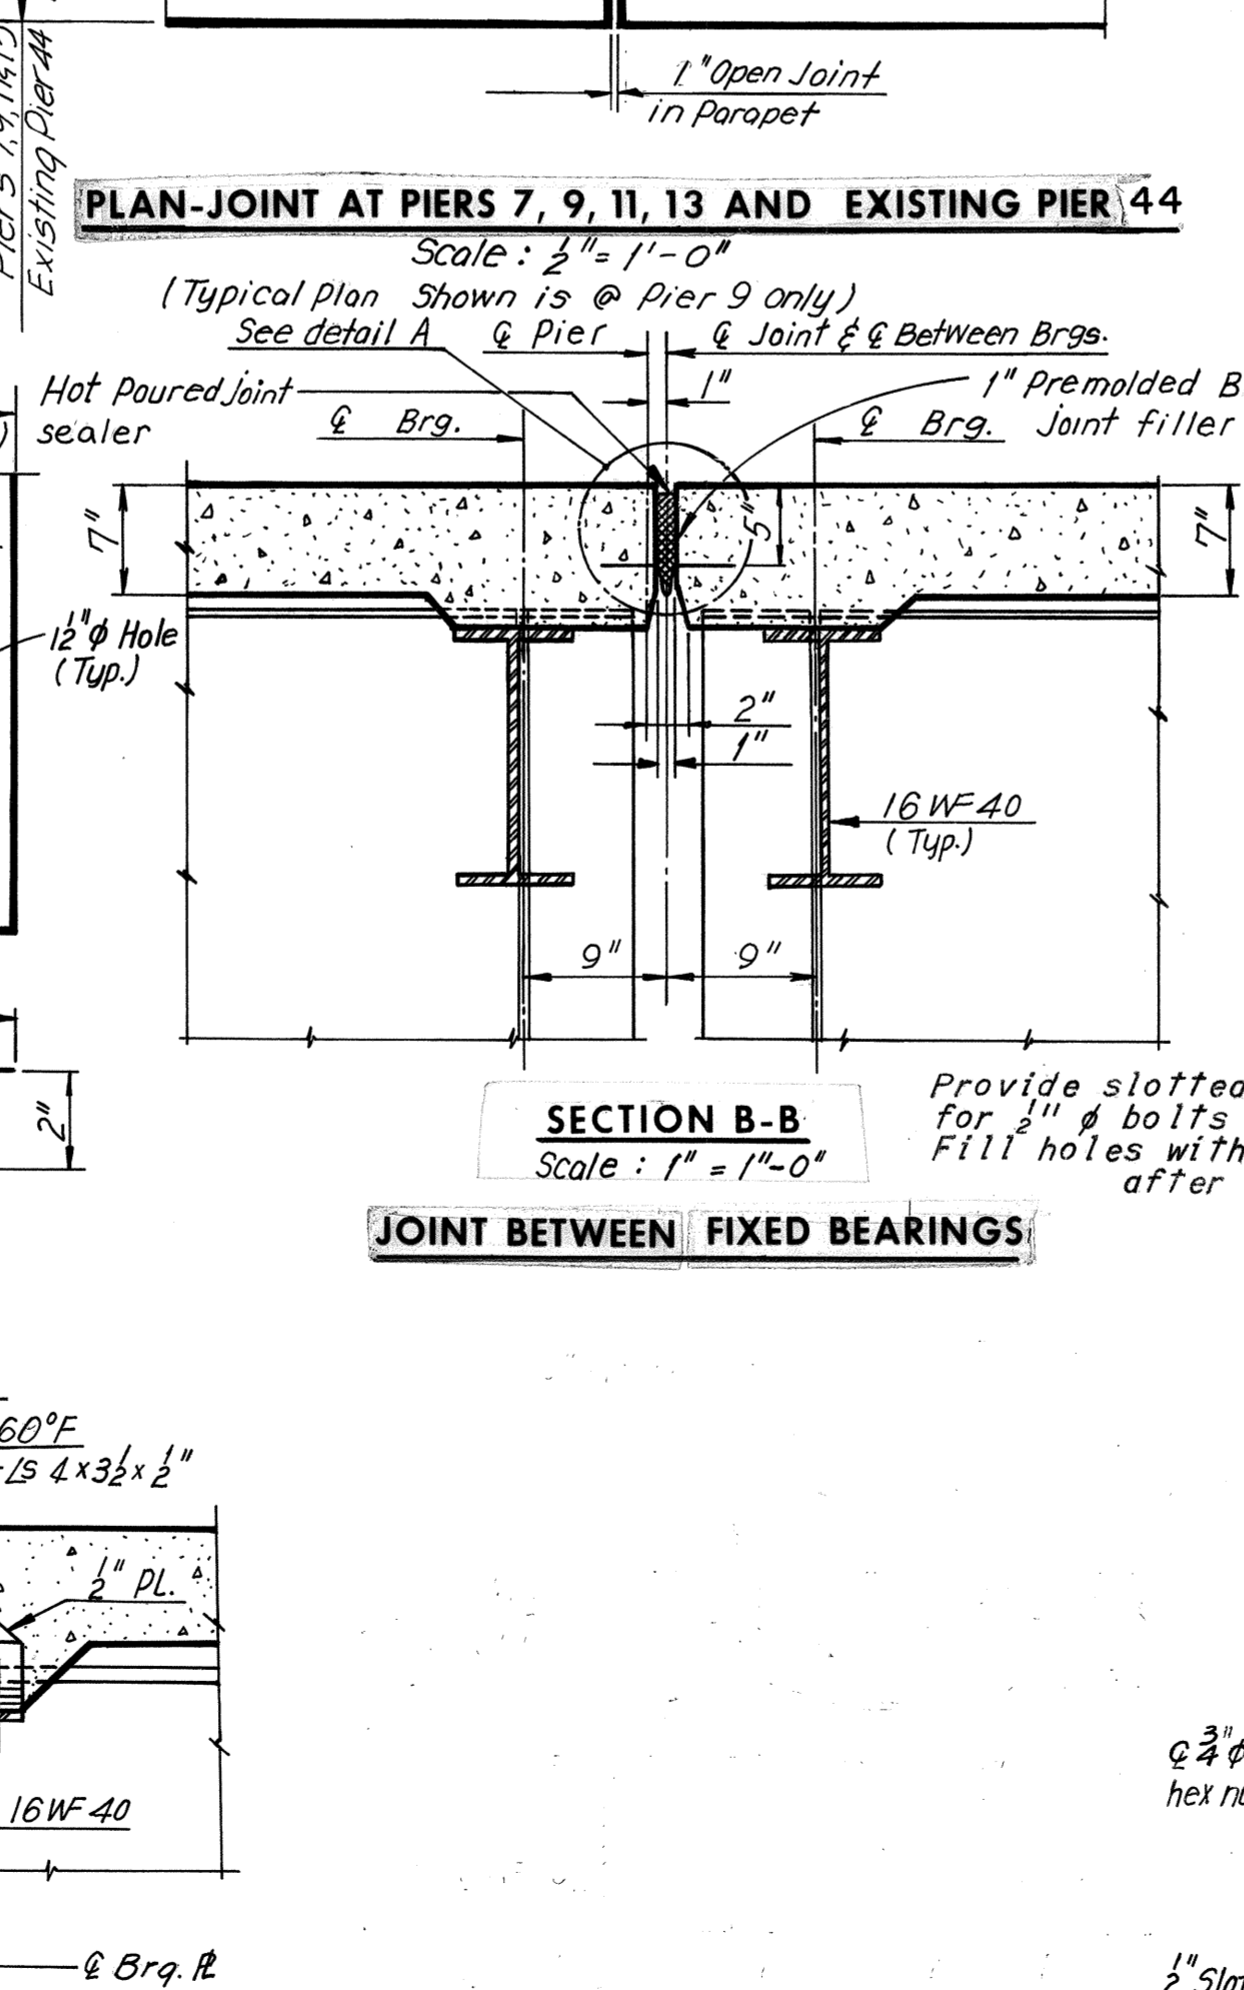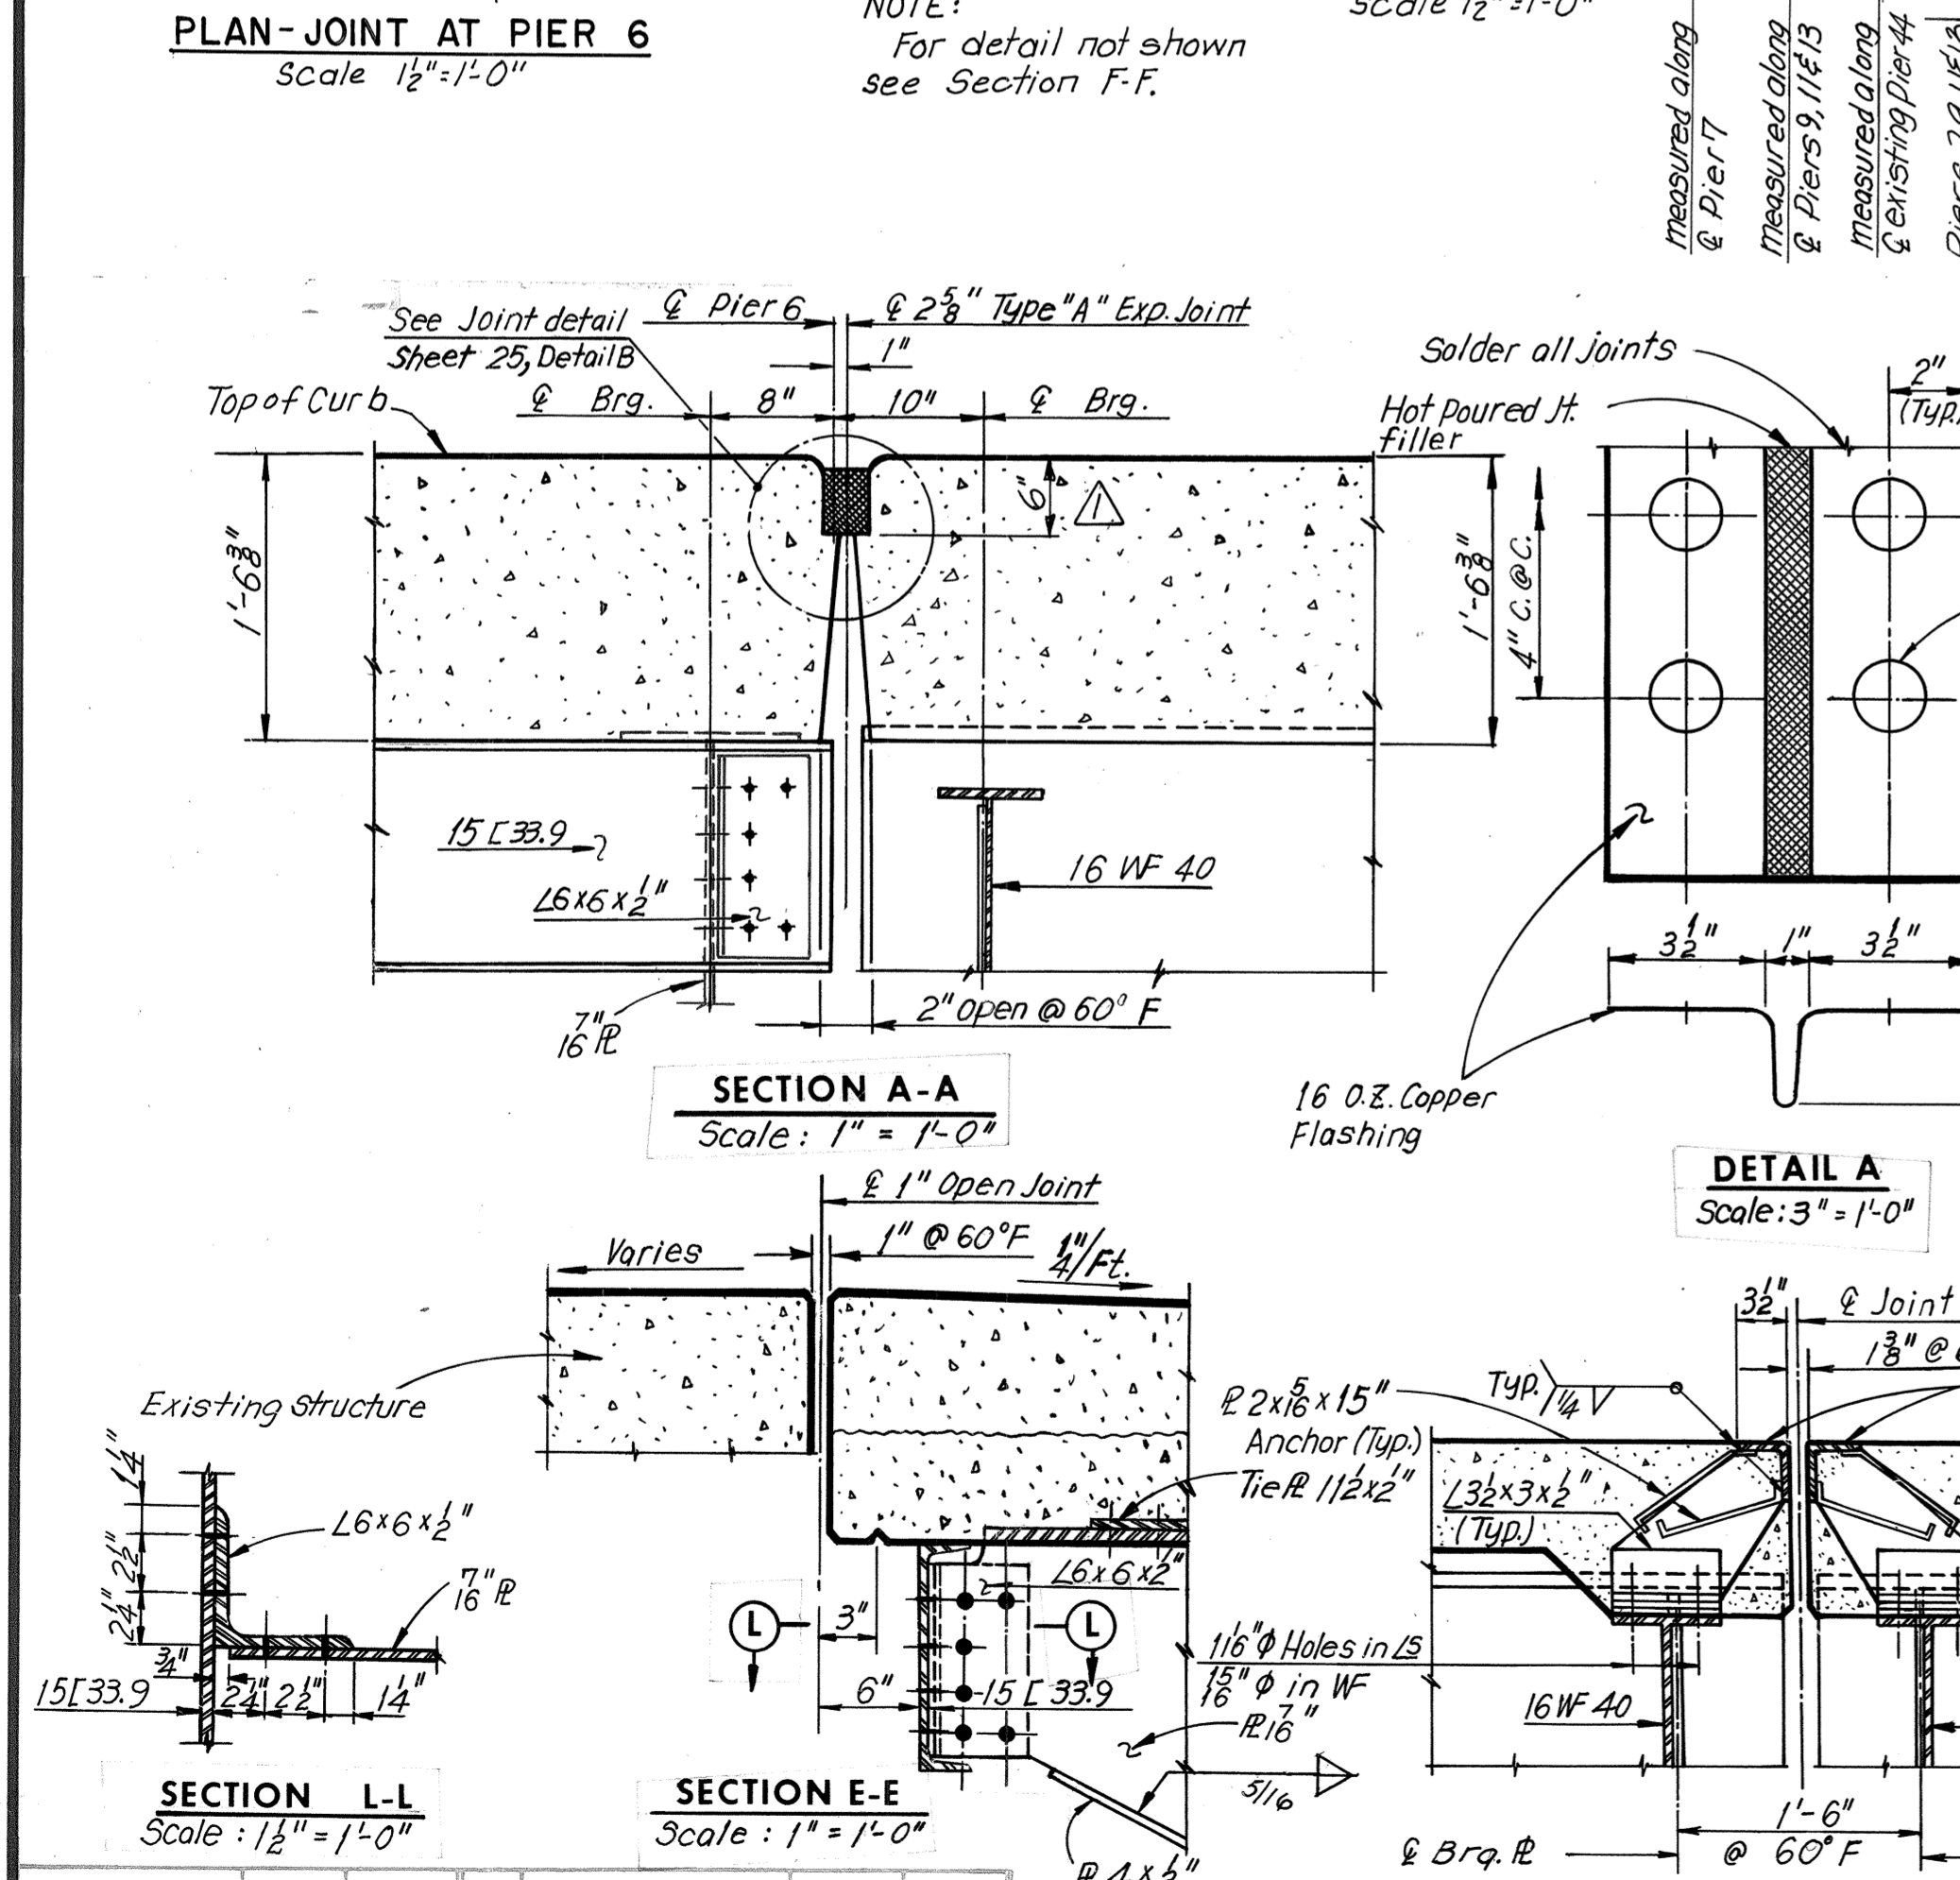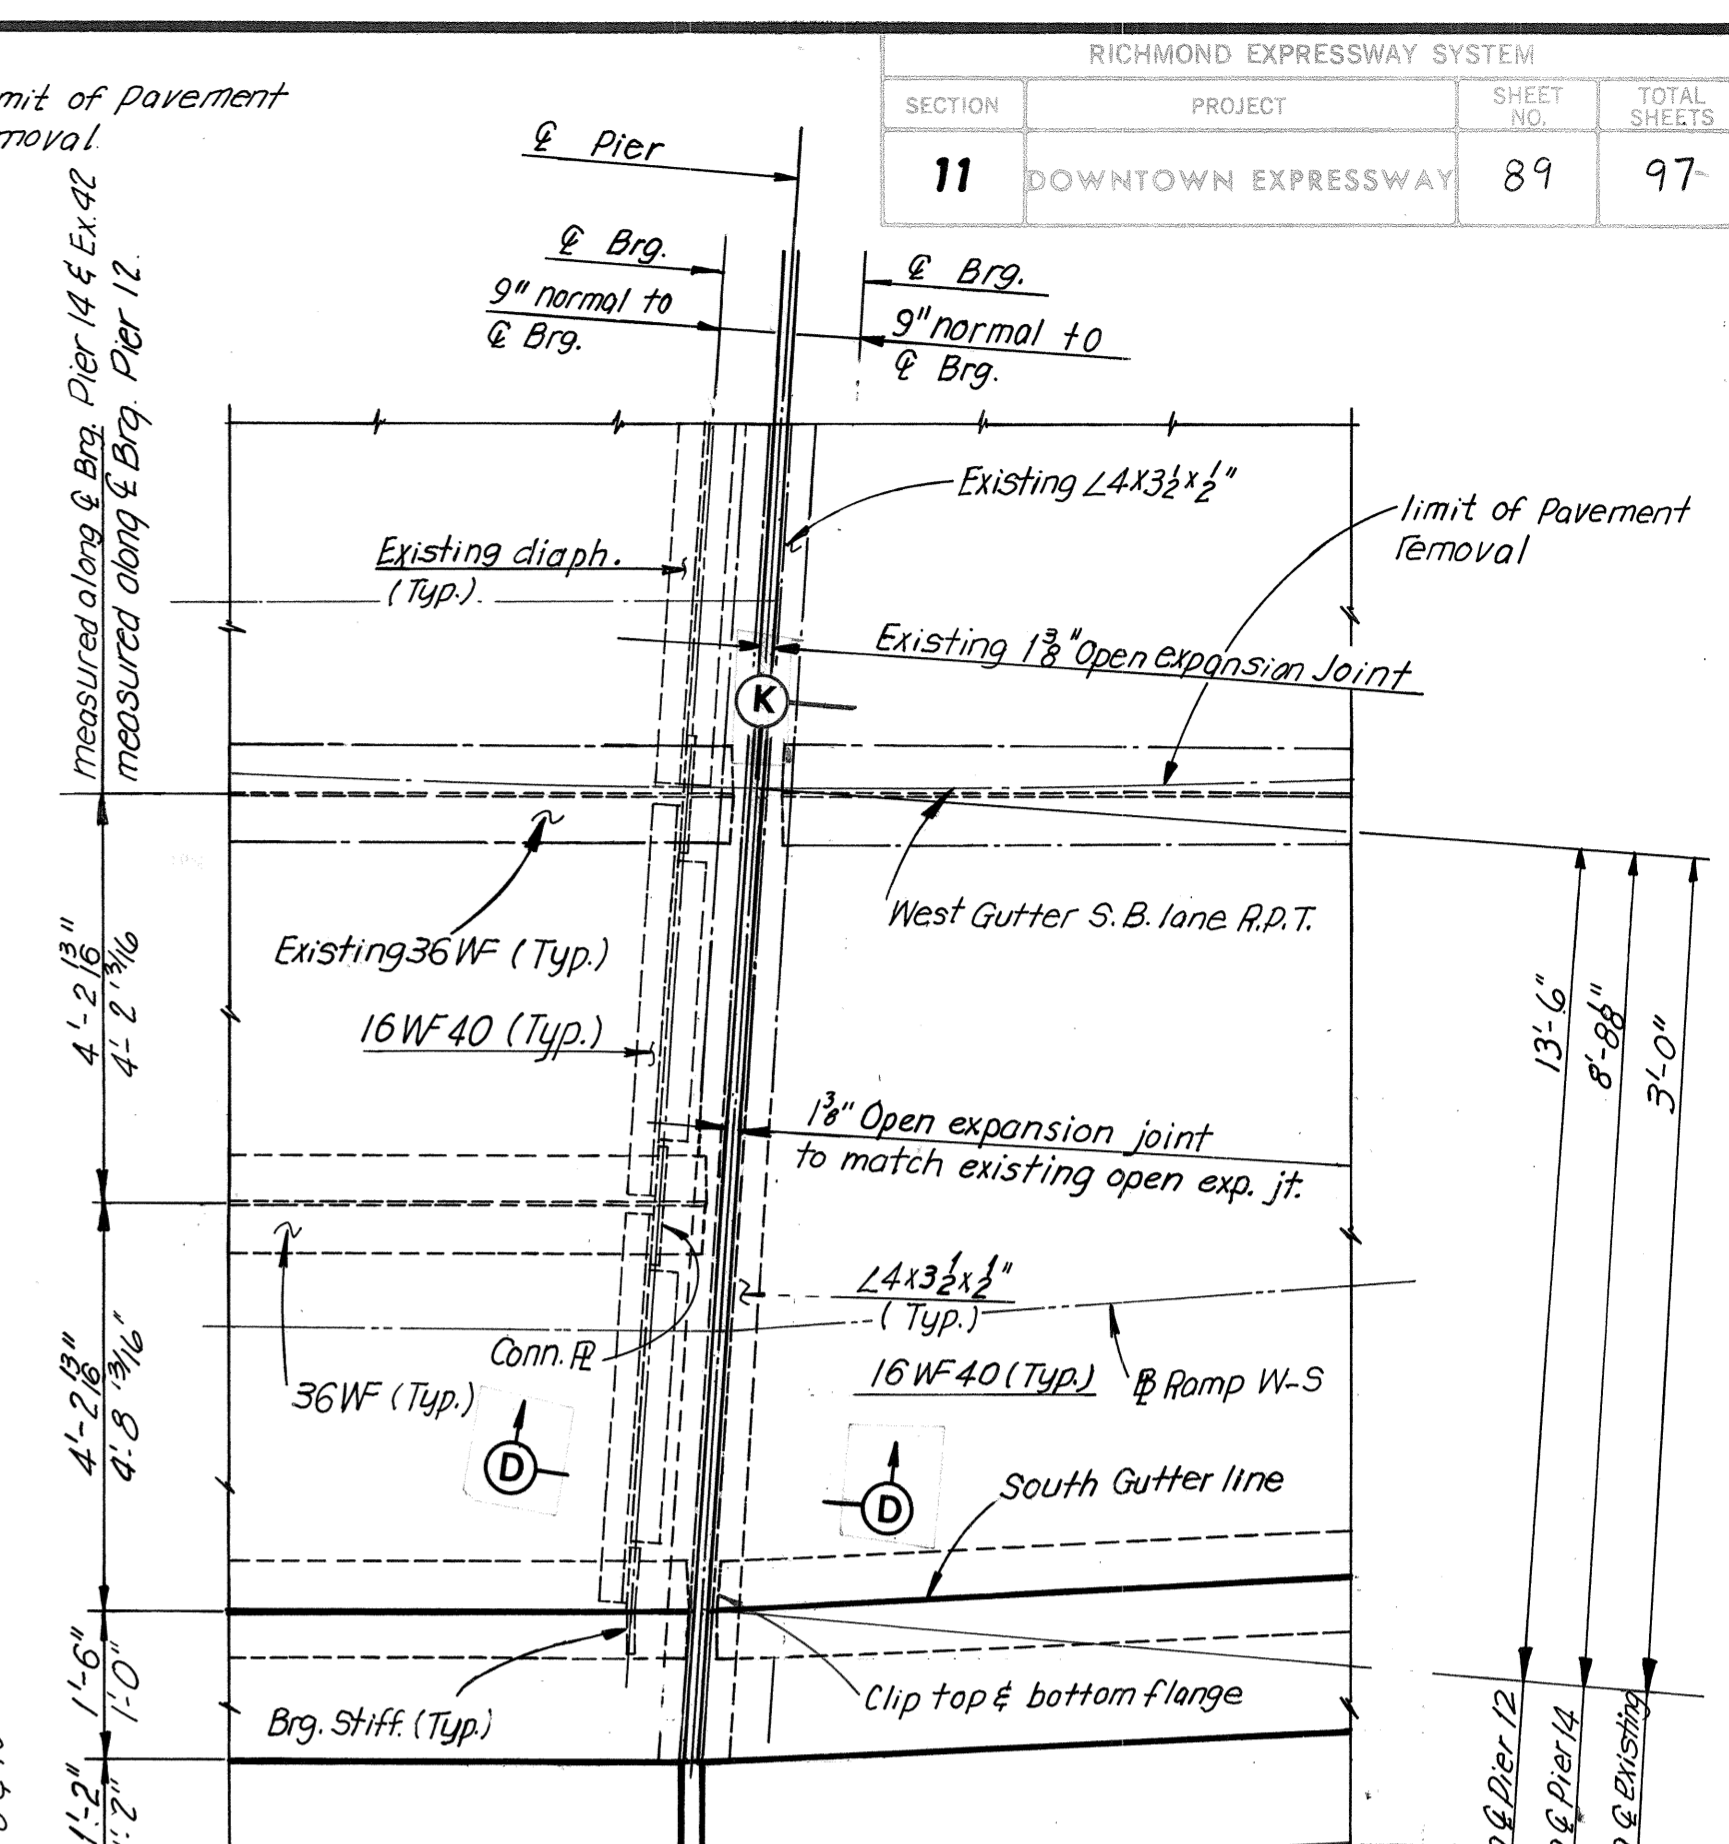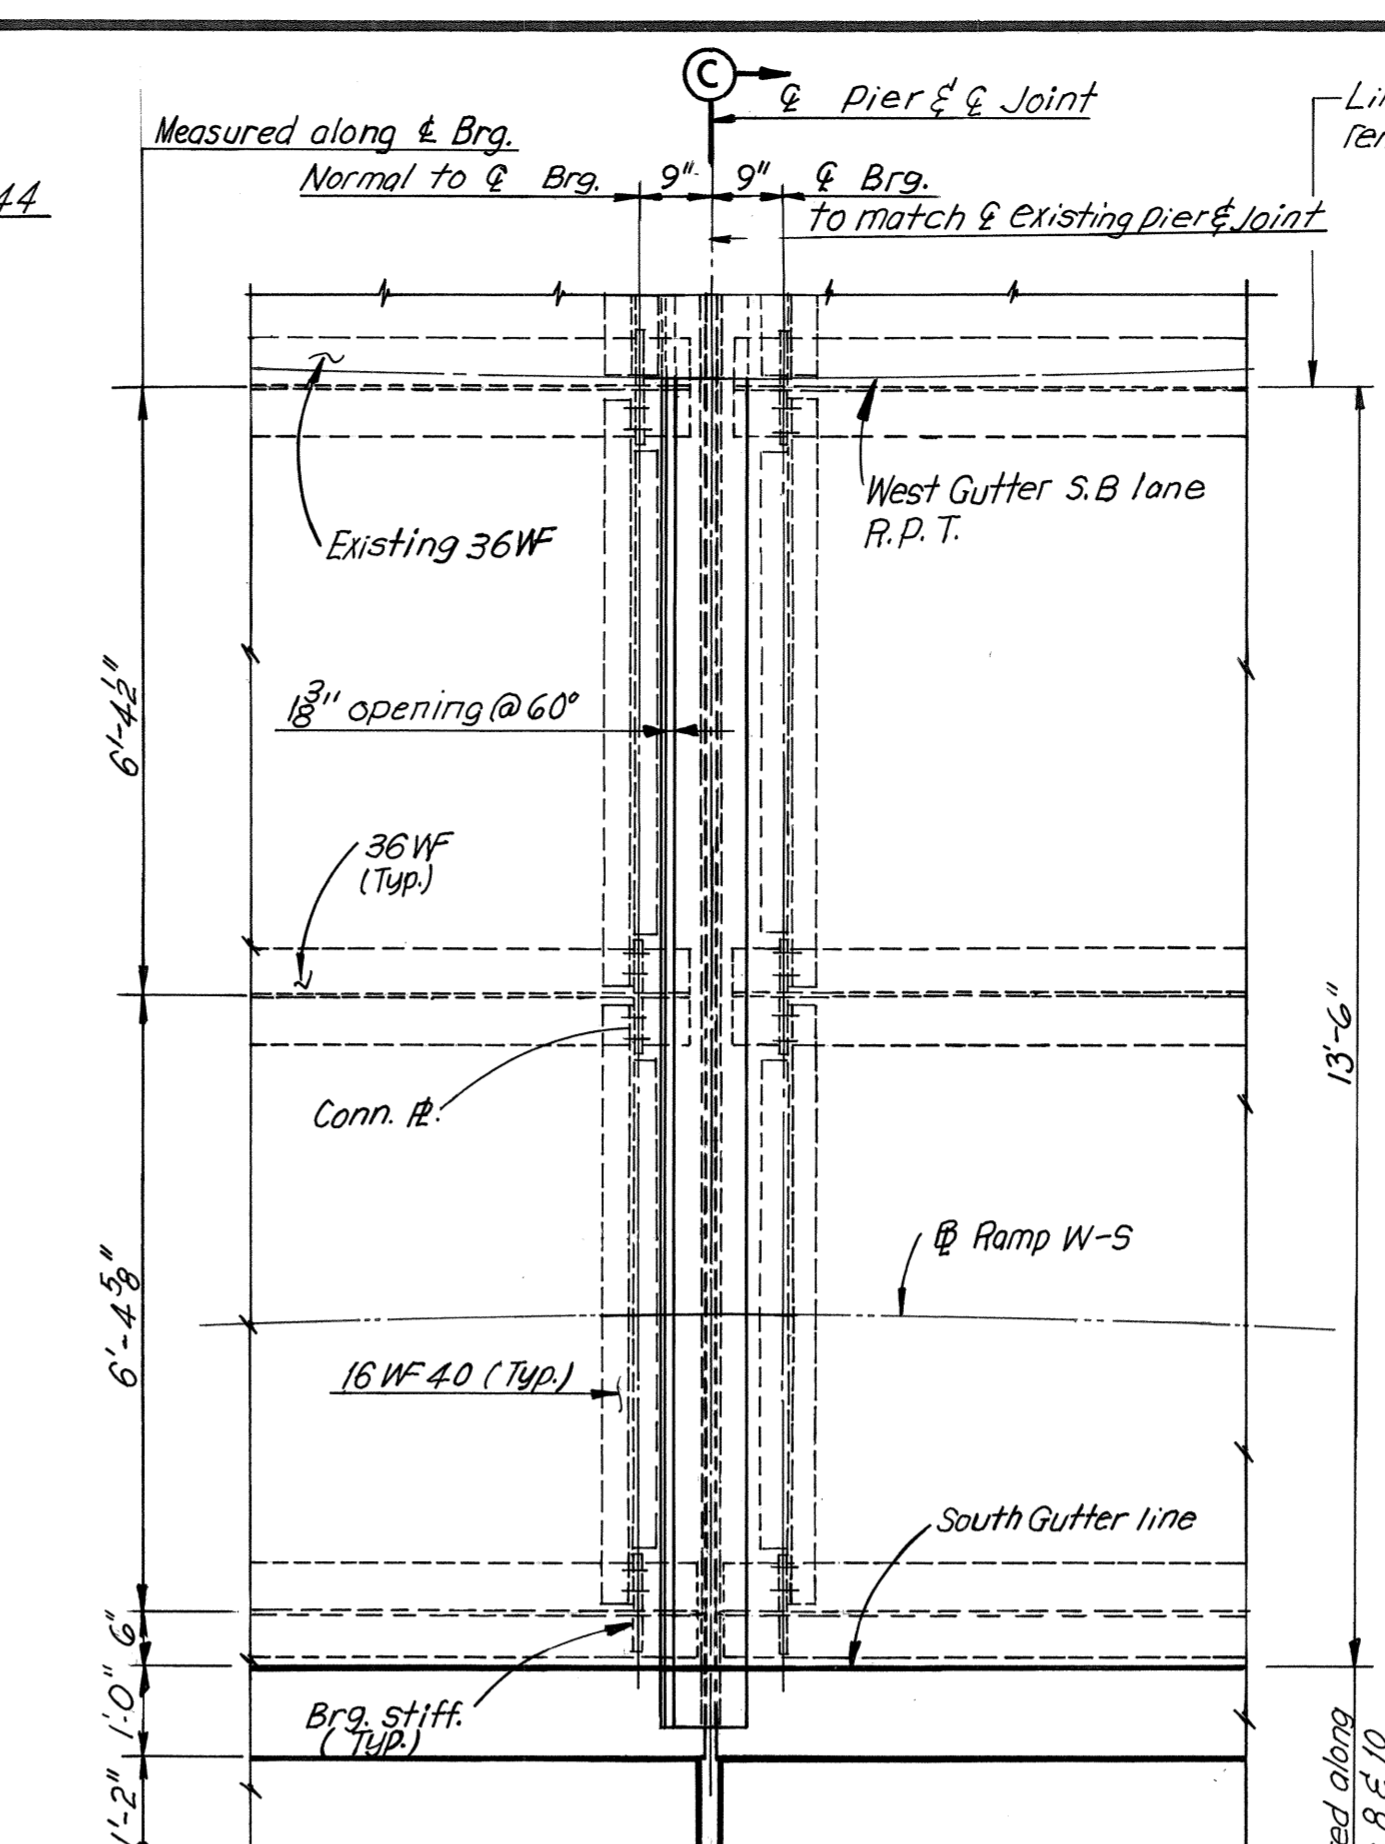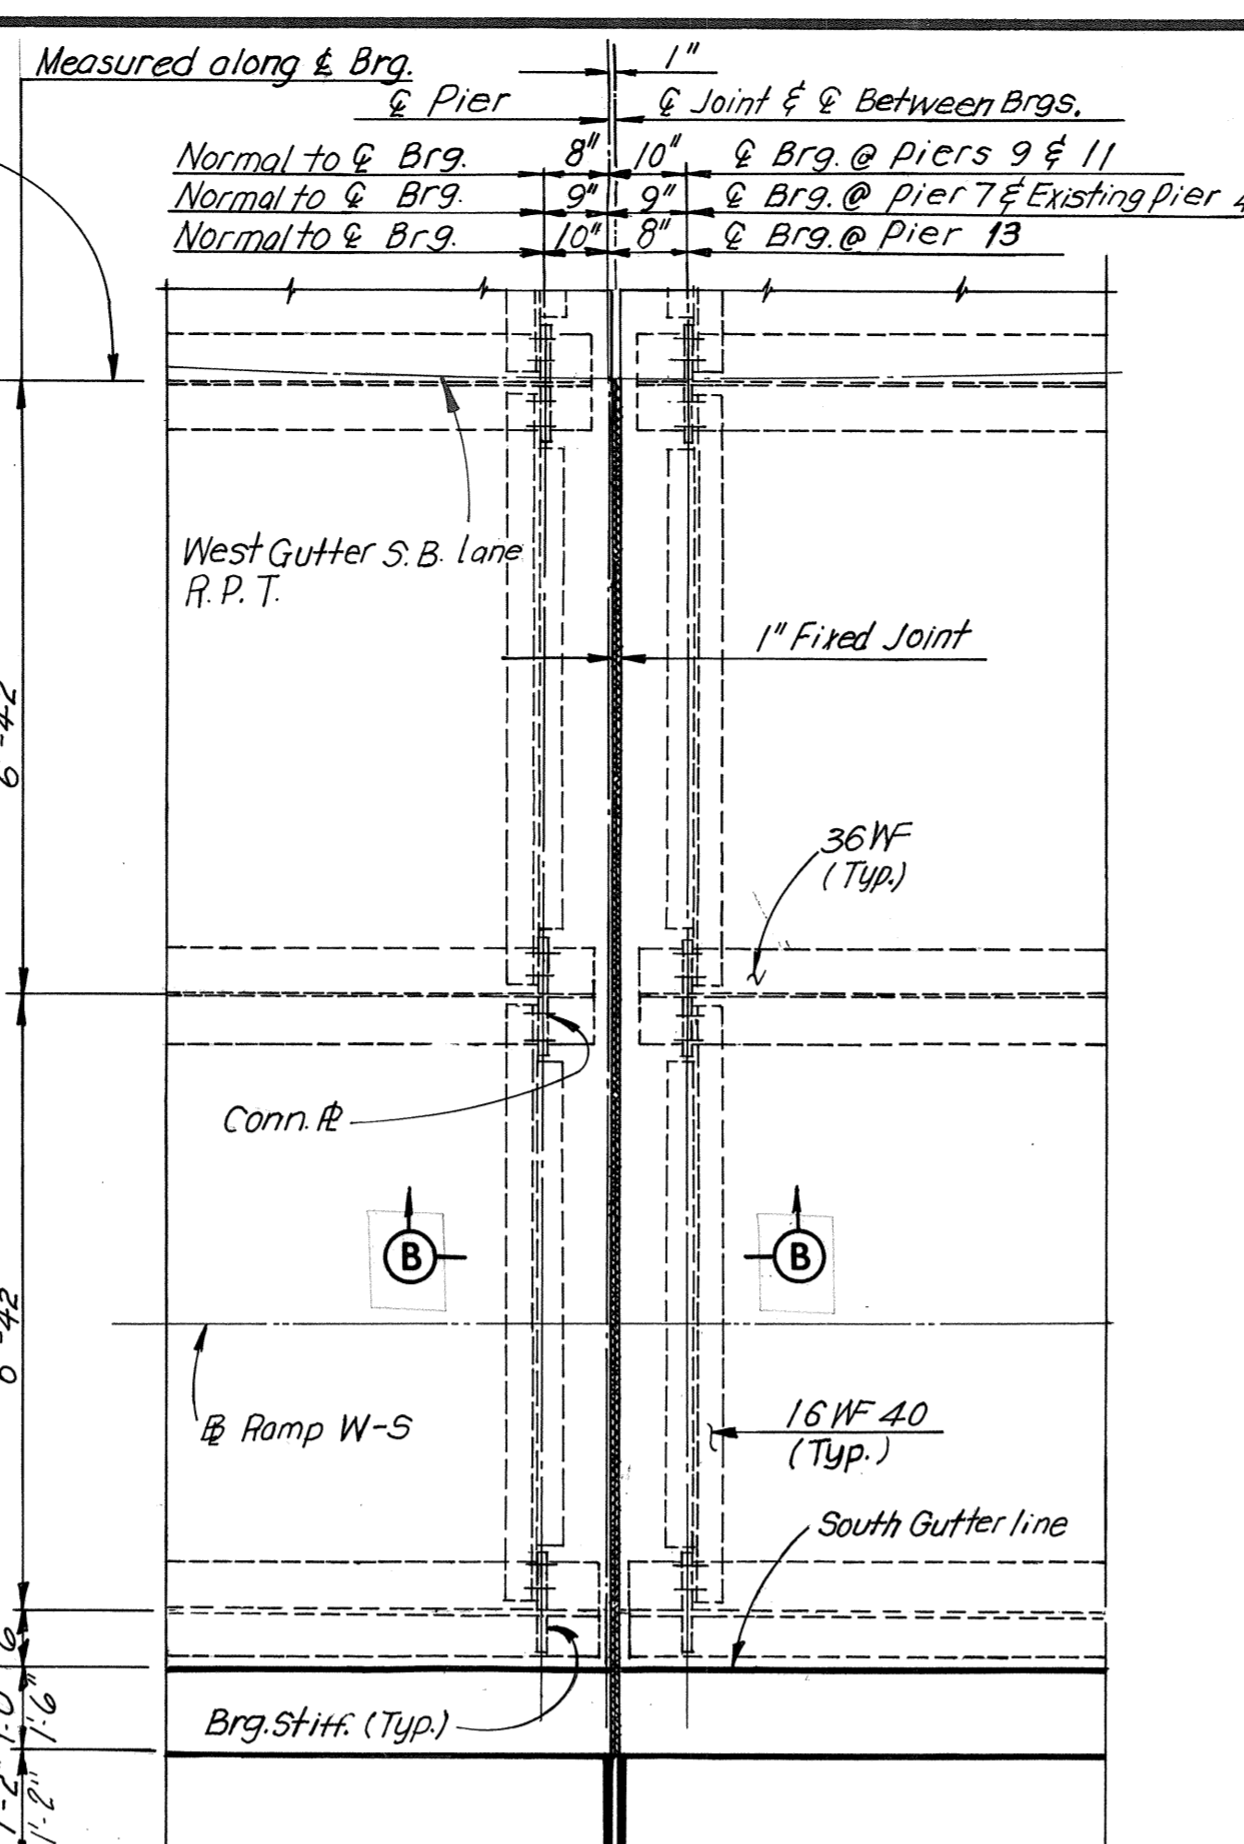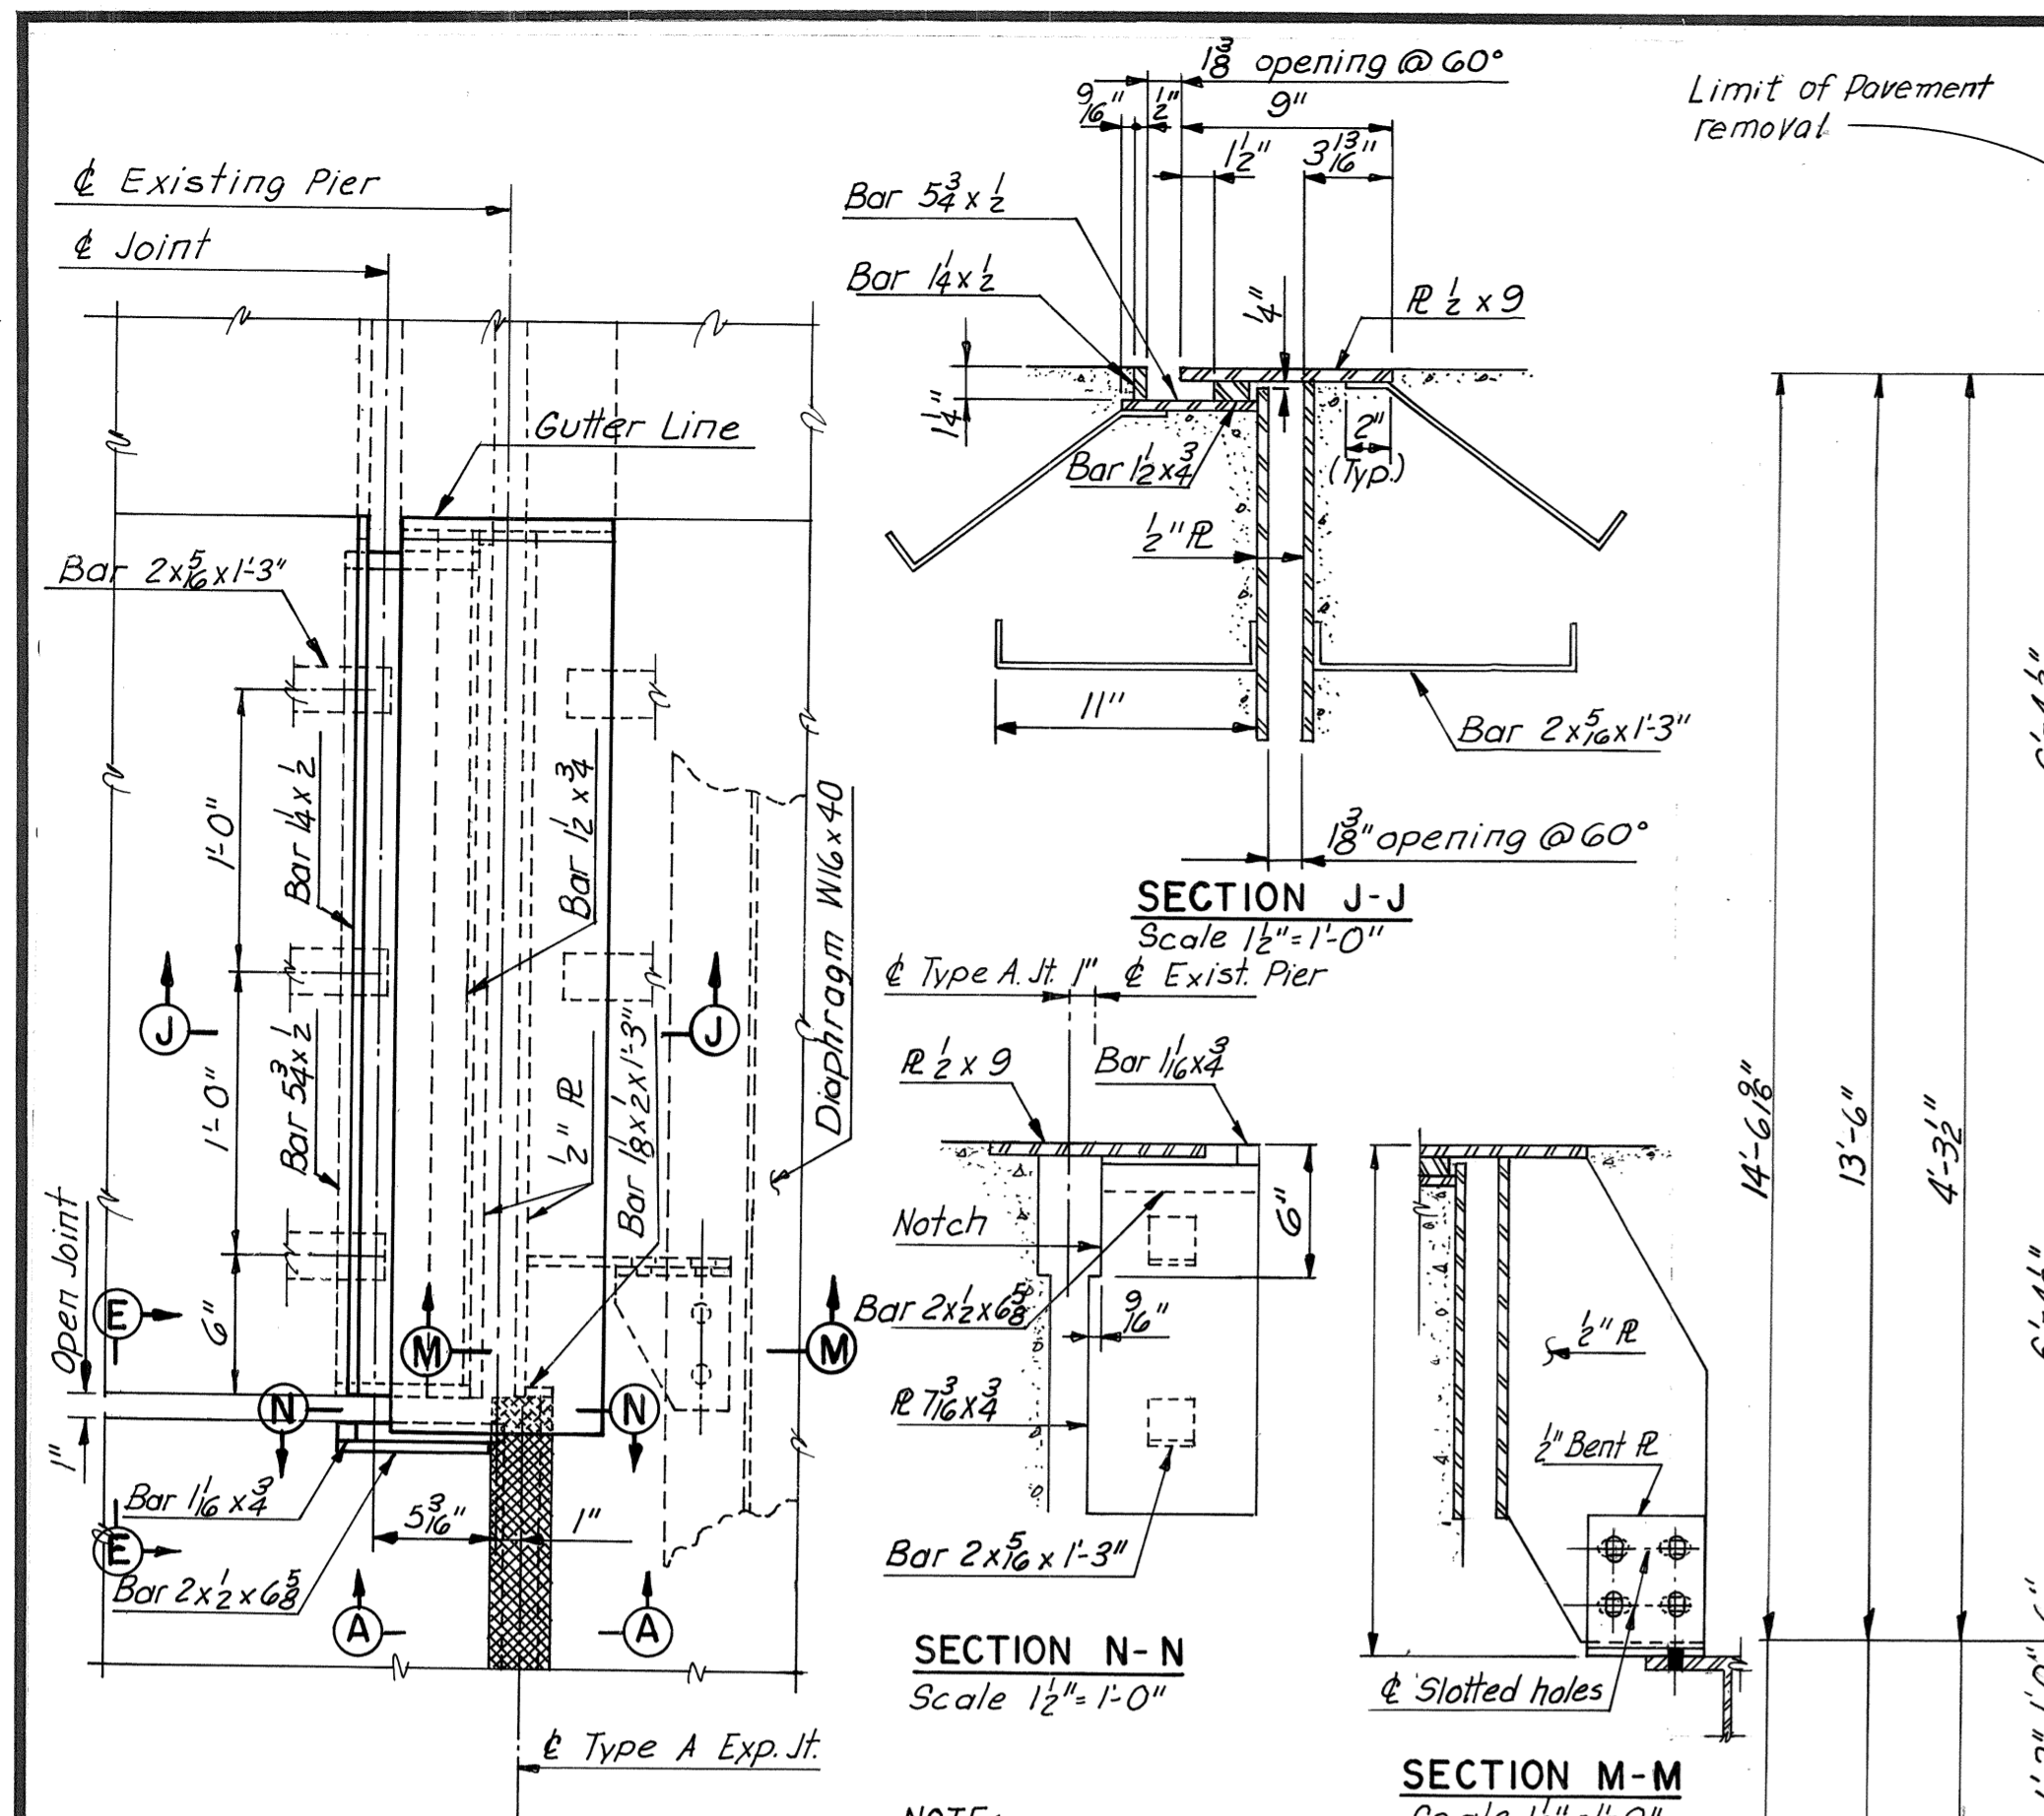

BY	DATE		
MADE	G.S.H. 10-10-69		
CHECKED	V.C.P. 10-17-69	Joint Details @ Piers 6, 8 & 10	TEM. 12-8-76
IN CHARGE			

Note: Reinforcing of all Sections are not shown.

RICHMOND METROPOLITAN AUTHORITY
RICHMOND EXPRESSWAY SYSTEM
DOWNTOWN EXPRESSWAY

BRIDGE NO. 68
RAMP W-S CONNECTION TO
RICHMOND-PETERSBURG TURNPIKE

JOINT DETAILS

HOWARD, NEEDLES, TAMMEN & BERGENDOFF
CONSULTING ENGINEERS
NEW YORK ALEXANDRIA KANSAS CITY

SCALE: As Noted

CONTRACT NO. 11
SHEET NO. 26 OF 28