


TS-03 APPENDIX B: REFERENCE DRAWINGS

The purpose of the TS-03 APPENDIX B Reference Drawings is to provide a general description of certain of the scope and technical requirements of RMTA’s Toll Collection System, and RMTA DOES NOT REPRESENT OR WARRANT THAT THE INFORMATION CONTAINED IN TS-03 APPENDIX B REFERENCE DRAWINGS IS EITHER COMPLETE OR ACCURATE OR IN CONFORMITY WITH THE REQUIREMENTS OF RMTA-PROVIDED APPROVALS. All Proposers are advised that the Work to be undertaken under the RFP is to be performed by the winning Proposer, and each Proposer, by submitting a proposal, understands and agrees that RMTA shall not be responsible or liable in any respect for any losses whatsoever suffered by any Proposer by reason of any use of any information contained in TS-03 APPENDIX B Reference Drawings. Each Proposer further acknowledges and agrees that, by submitting a proposal, (a) if and to the extent it or anyone on its behalf uses any of such information in any way, such use is made on the basis that the Proposer, and not RMTA, has approved and is responsible for such information, and (b) the Proposer is capable of conducting and is obligated hereunder to conduct any and all studies, analyses, diligence and investigations as it deems advisable to verify or supplement such information, and that any use of such information is in all respects at each Proposer’s own risk and in its own discretion.

TABLE OF CONTENTS

1. Tolling Locations.....	2
2. Boulevard Bridge Toll Plaza.....	3
3. DTE Toll Plaza (Administrative Building & Toll Plaza)	13
4. DTE Open Road Tolling.....	25
5. DTE Ramp Toll Plaza.....	57
6. DTE Ramp Toll Plaza (11 th St Ramp Widening)	64
7. Douglasdale Ramp Toll Plaza.....	68
8. Northbound Powhite Parkway Toll Plaza (Administrative Building & Toll Plaza)	73
9. Northbound Powhite Parkway Toll Plaza (1978 Widening)	85
10. Northbound Powhite Parkway Toll Plaza (1989 Widening)	92
11. Northbound Powhite Parkway Toll Plaza (2006 Partial Demo Plan)	94
12. Powhite Parkway Toll Plaza (Toll Gantry Shop Drawings)	101
13. Southbound Powhite Parkway Toll Plaza (Administrative Building & Toll Plaza)	108
14. Forest Hill Avenue Ramps.....	130
15. Forest Hill Avenue Ramps (Ramp from SB Powhite Parkway to Forest Hill Ave Widening)	135

RMA EXPRESSWAY SYSTEM

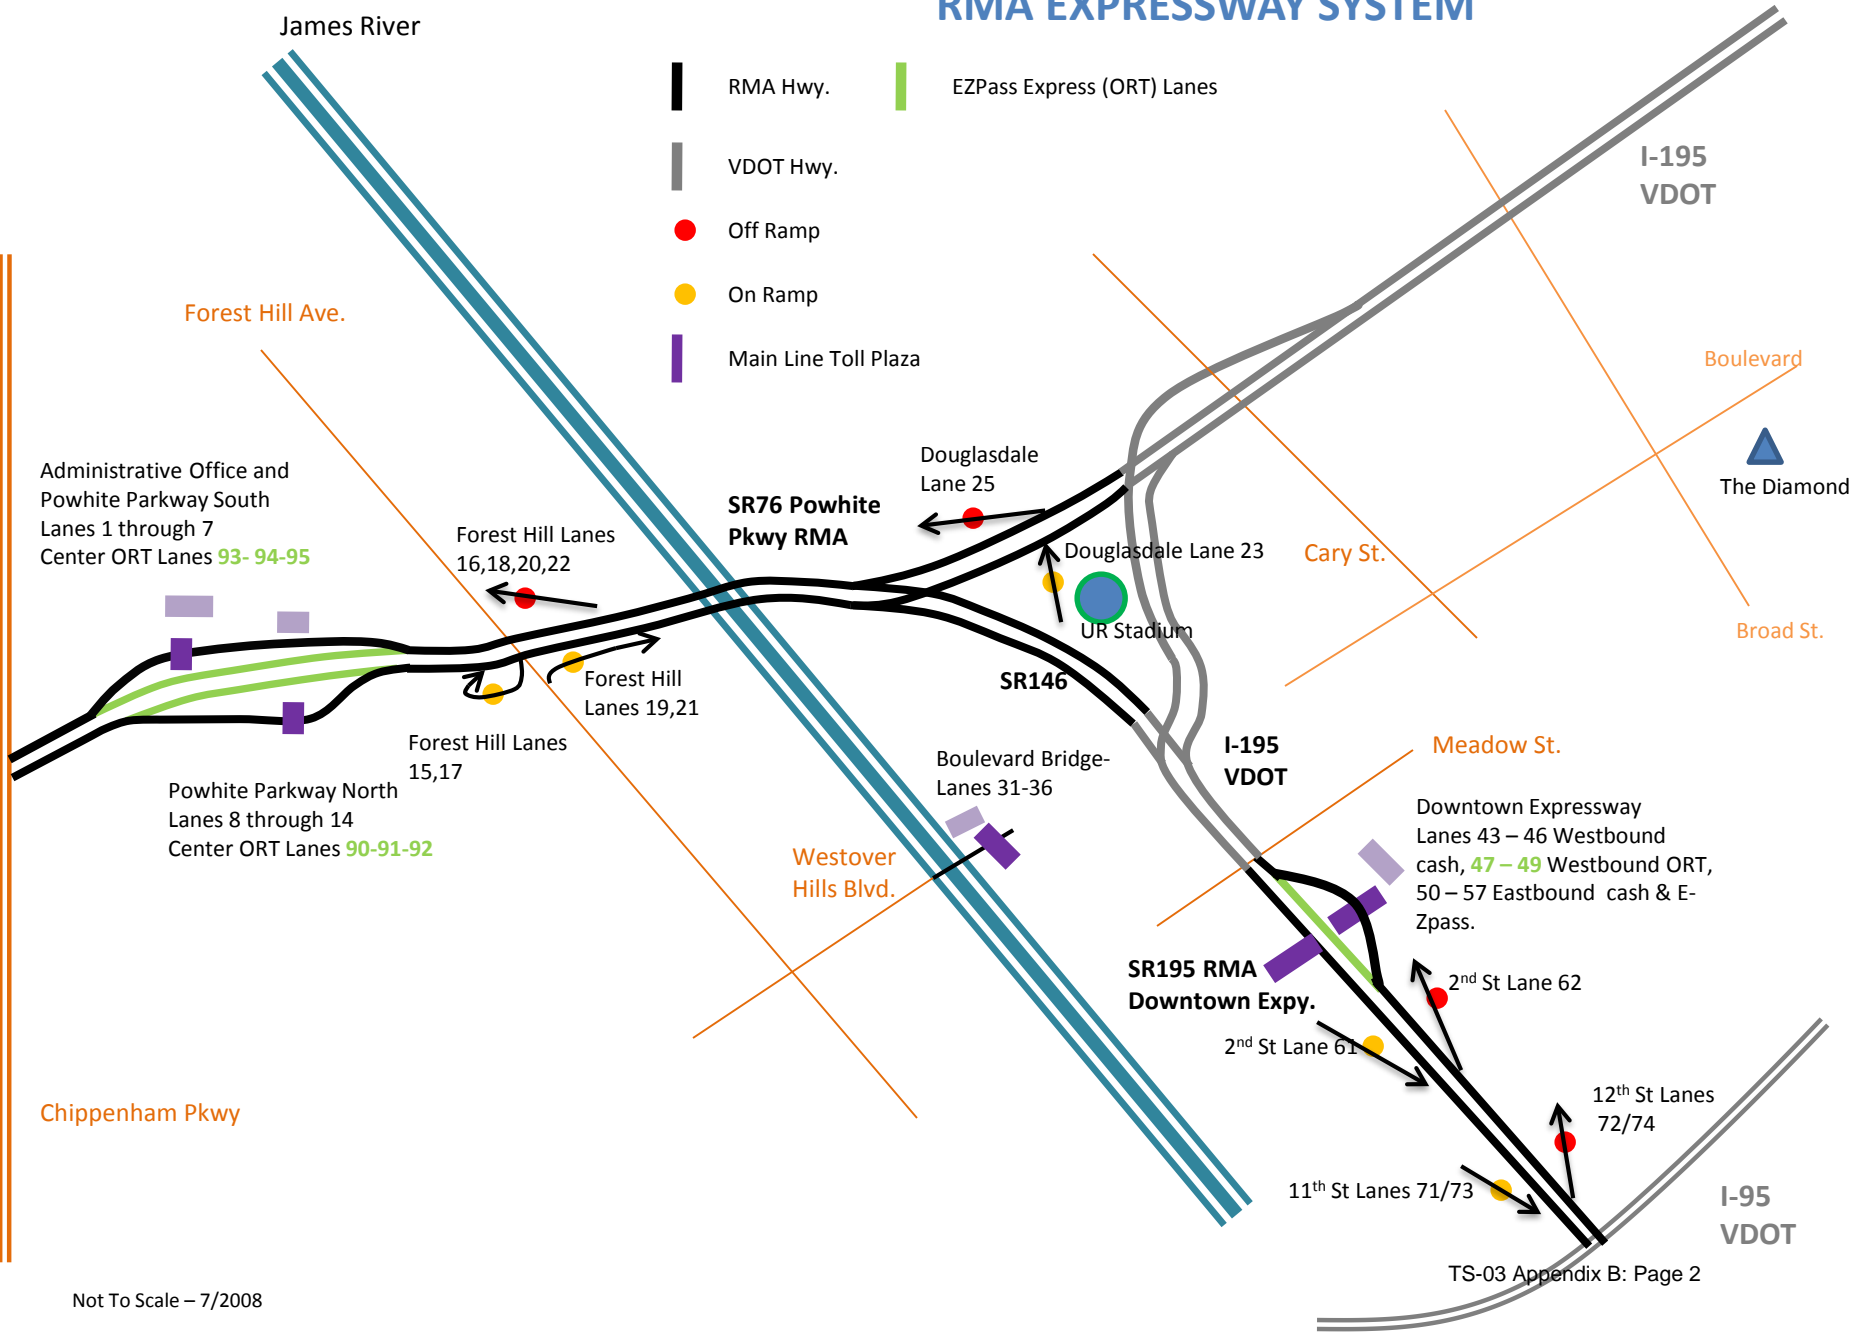


BOULEVARD BRIDGE TOLL PLAZA

TOLL PLAZA AND ADMINISTRATION BUILDING

RICHMOND EXPRESSWAY SYSTEM			
SECTION	PROJECT	SHEET NO.	TOTAL SHEETS
(7B)	Boulevard Bridge Rehabilitation	8	10



█ DENOTES BLOCKOUT FOR TOLL GATES

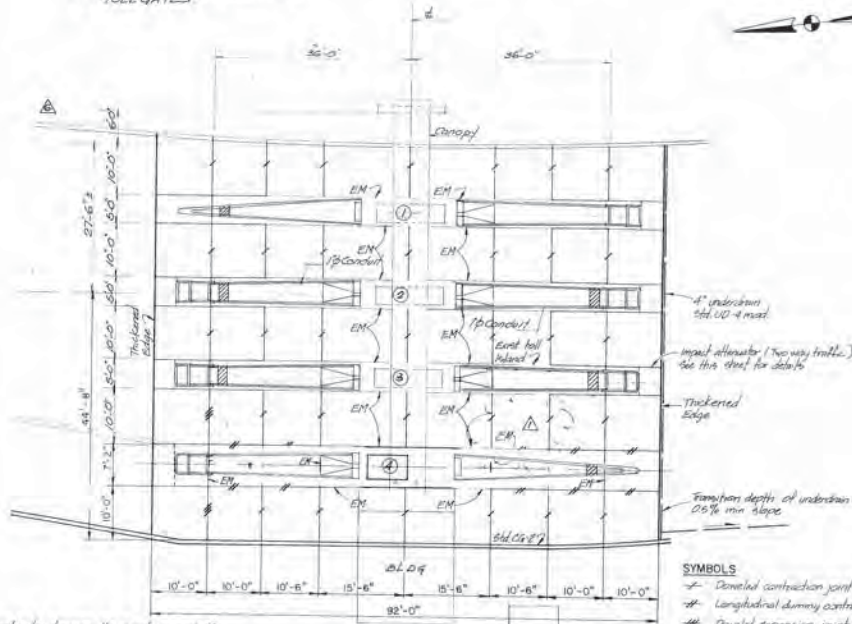

Note: If the contractor damages the existing asphalt pavement to remain in the toll island area, the area must be repaired in such a manner as to provide a straight line where the original saw cut was made.

- SYMBOLS**
- Denoted contraction joint
 - #— Longitudinal dummy contraction joint
 - #— Denoted expansion joint
 - EM 1/2" perforated expansion
 - 2C Saw cut existing asphalt pavement

GATE PEDESTAL ELEVATION

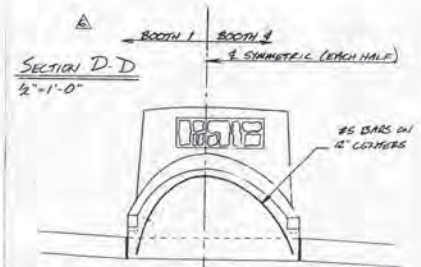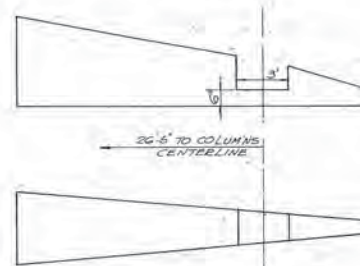


- NOTES:**
- SEE NOTE SHEET 7 (SECTION A-A) REGARDING OPTIONAL CONSTRUCTION JOINT & #5 DOWELS.
 - SLAB LEVEL & LONGITUDINAL REINFORCING SIMILAR TO SECTION A-A (SHEET 7).

ISLANDS NOT REQUIRING IMPACT ATTENUATORS



UNDERDRAIN AT STA. 59+53.2

NTS

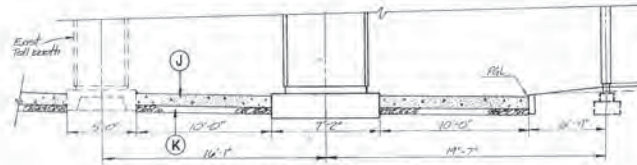

- LEGEND**
- (J) 9" Reinforced hydraulic cement concrete pavement
 - (K) 6" Subbase aggregate type I, 21A

Note: All existing islands to be demolished to 14" below proposed grade to receive 5" 21A subbase & 9" reinforced concrete pavement (see typical section at toll island, this sheet). Bunker blocks (exist) to remain & incorporated into proposed islands as shown on sheet 7. Slabs supporting existing beams to remain. Existing beams to be demolished - see architectural plans for details.

Drawn	By	Date	Added	EM	colloid	PHT	7/92
Drawn	PHT	2-92	15/2/92	15/2/92	15/2/92	15/2/92	3/93
Checked	PHY	2-92					
Approved	EDW	2-92	No	Revision	By	Date	

RECORD DRAWING

ma RICHMOND METROPOLITAN AUTHORITY
RICHMOND EXPRESSWAY SYSTEM


BLVD. BRIDGE TOLL PLAZA
PAVING DETAILS AND
NEW TOLL ISLANDS

HOWARD NEEDLES TAMMEN & BERGENDOFF ENGINEERS ALEXANDRIA, VA	PIRATES HNTB
Scales: AS SHOWN	Dates: 3-92
Contract No. C-172	Sheet: 8



HNTB
 HOWARD NEEDLES TAMMEN & BERENSON
 ARCHITECTS ENGINEERS PLANNERS
 92 CANAL CENTER PLAZA
 ALEXANDRIA, VIRGINIA 22304
 TEL: (703) 682-2200

ma Richmond Metropolitan Authority

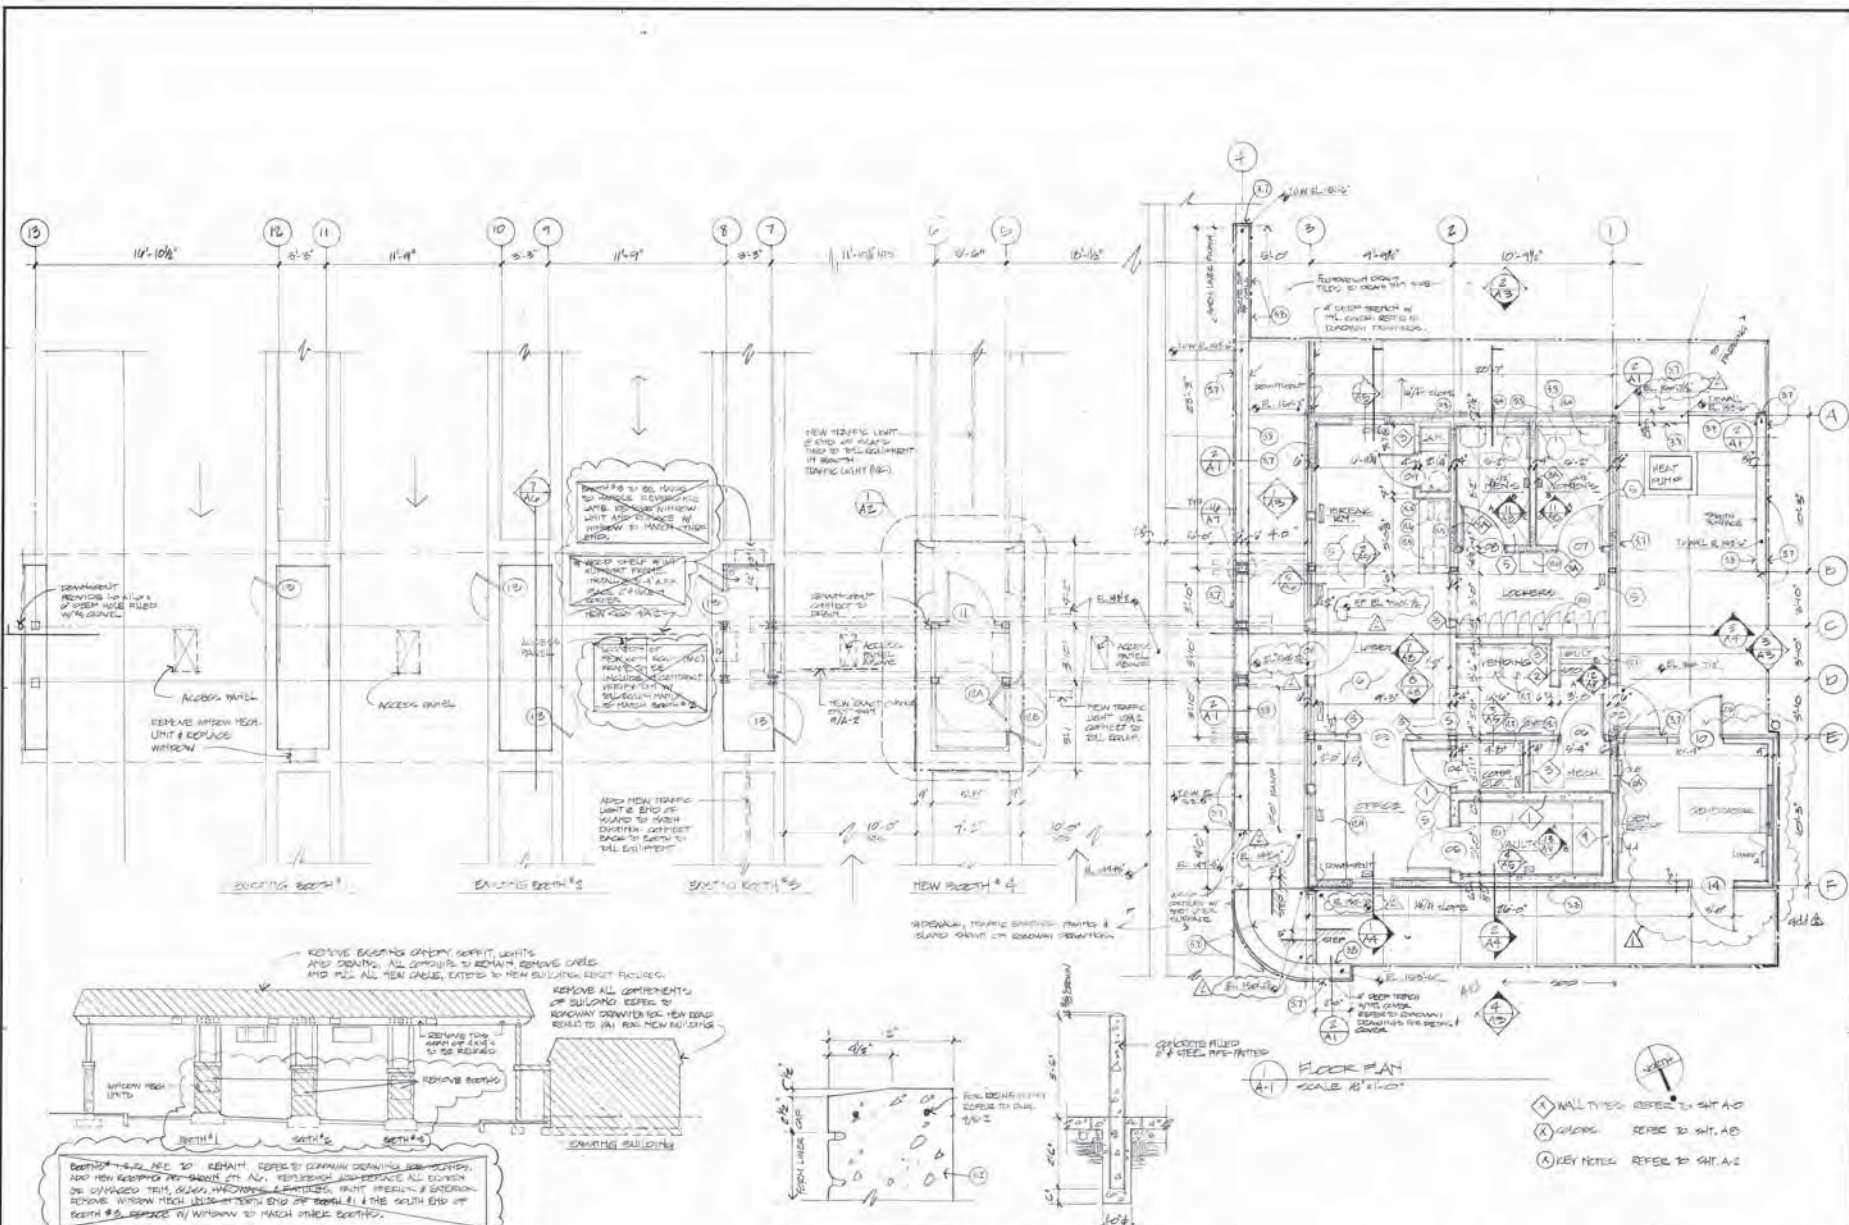


PROJECT NO. H251
 DATE: _____
 DRAWN BY: _____
 CHECKED BY: _____
 REVISED DATE: _____

BOULEVARD BRIDGE TOLL PLAZA BUILDING
 DRAWING TITLE: FLOOR PLAN

CONTRACT NO. 17B
36.3
 DRAWING NUMBER: A-1

Revision # 1	DL	7-18-72
Addendum # 2	DL	4-23-78
No.	Revision	By Date

RECORD DRAWING

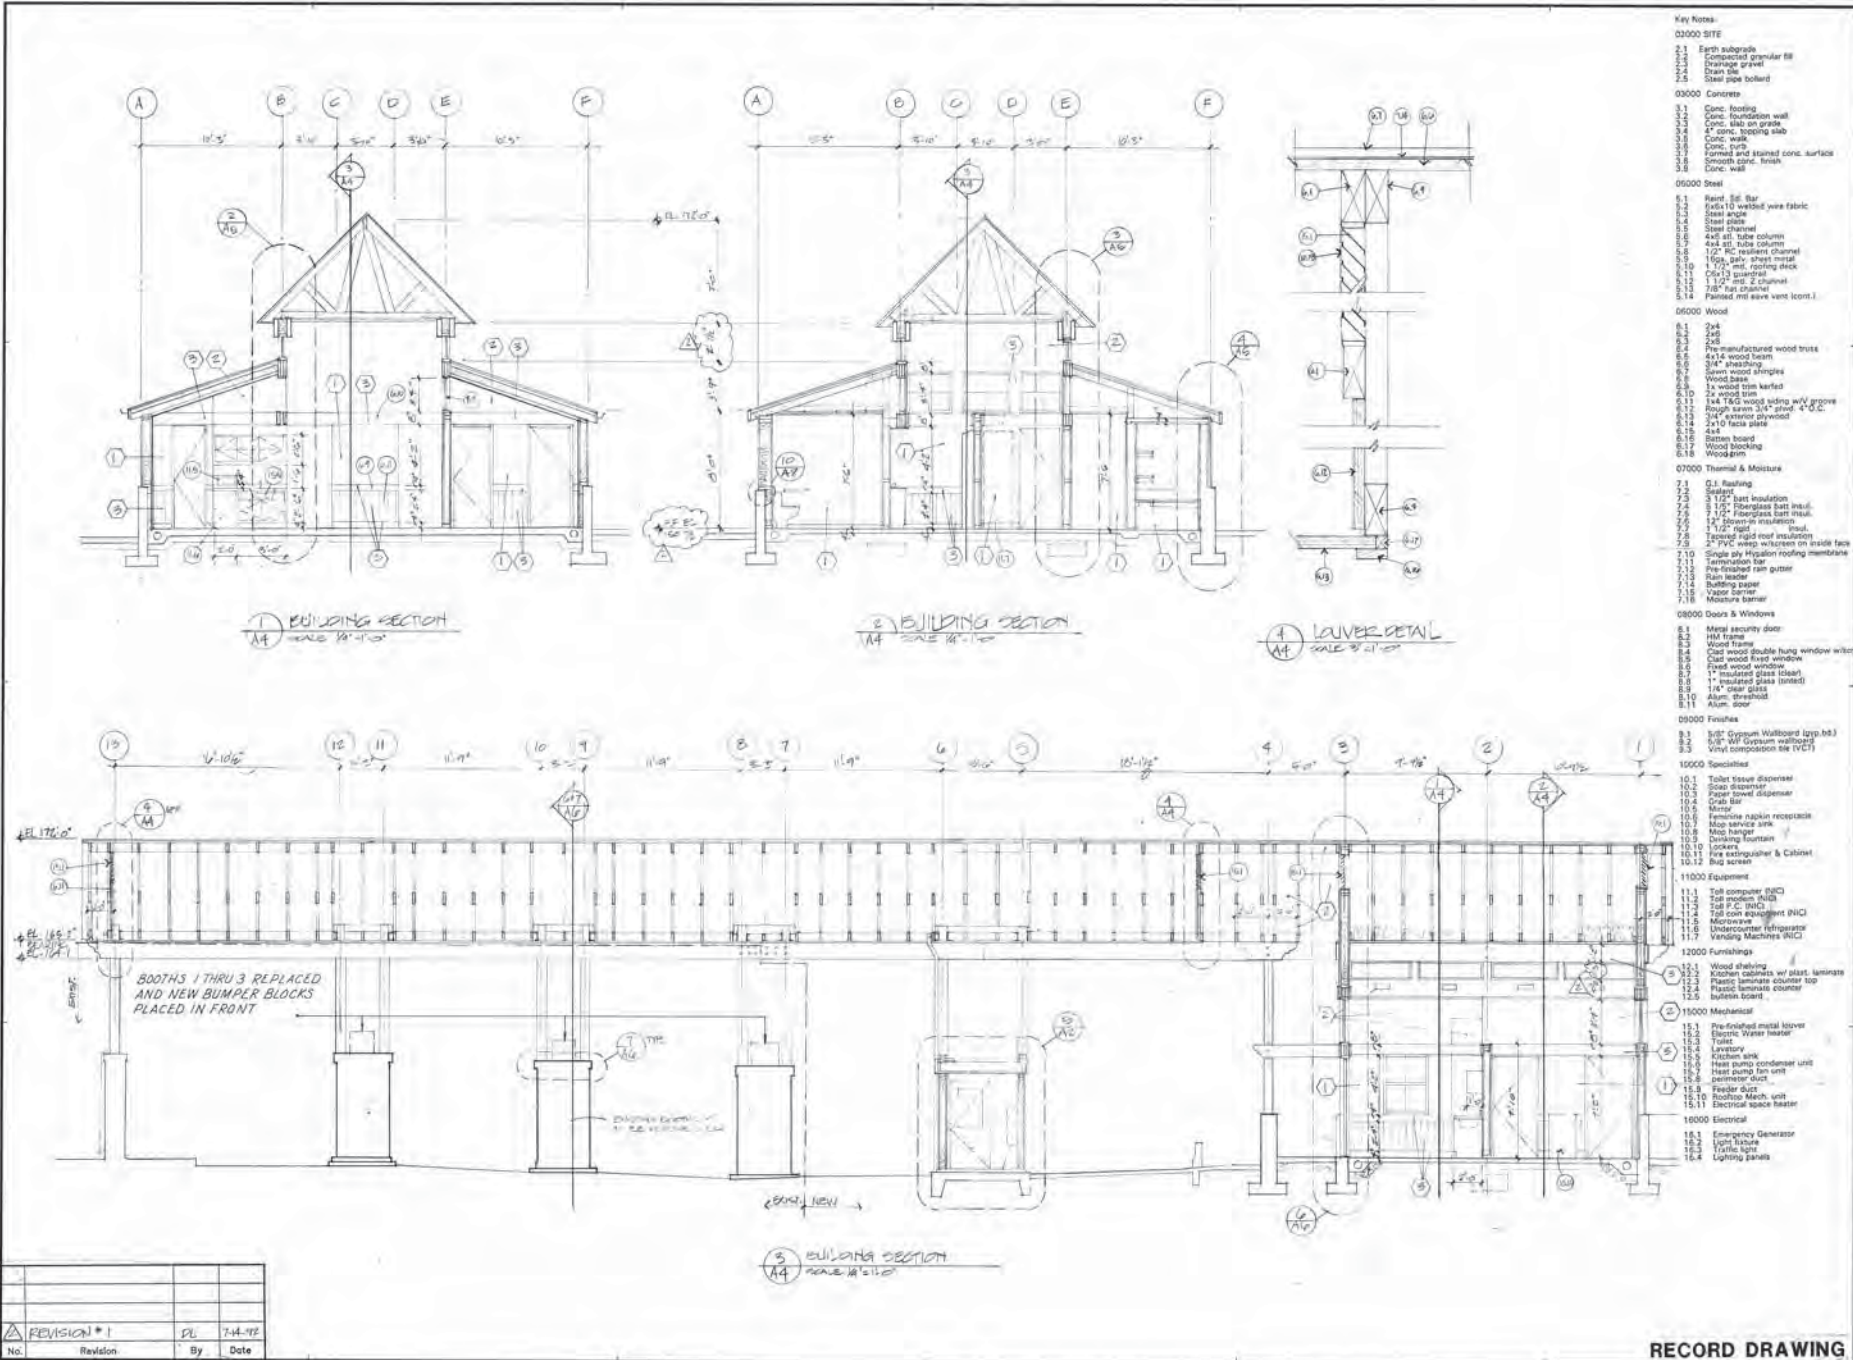

- Key Notes:**
- 02000 SITE
 - 2.1 Earth subgrade
 - 2.2 Compacted granular fill
 - 2.3 Drainage gravel
 - 2.4 Clean fill
 - 2.5 Steel pipe bollard
 - 03000 Concrete
 - 3.1 Conc. footing
 - 3.2 Conc. foundation wall
 - 3.3 Conc. slab on grade
 - 3.4 4" conc. topping slab
 - 3.5 Conc. walls
 - 3.6 Conc. curbs
 - 3.7 Formed and stained conc. surface
 - 3.8 Smooth conc. finish
 - 3.9 Conc. wall
 - 05000 Steel
 - 5.1 Reinft. 6d. Bar
 - 5.2 6x10 welded wire fabric
 - 5.3 Steel angle
 - 5.4 Steel plate
 - 5.5 Steel channel
 - 5.6 4x4 sq. tube column
 - 5.7 4x4 sq. tube column
 - 5.8 12" RC insuln. channel
 - 5.9 16ga. galv. sheet metal
 - 5.10 1" x 1/2" x 1/4" metal roofing sheet
 - 5.11 C6x13 structural
 - 5.12 1 1/2" x 1/2" x 1/4" channel
 - 5.13 7/8" x 1/2" channel
 - 5.14 Painted and eave vent (cont.)
 - 06000 Wood
 - 6.1 2x4
 - 6.2 2x6
 - 6.3 2x8
 - 6.4 Pre-manufactured wood truss
 - 6.5 4x14 wood beam
 - 6.6 3/4" sheathing
 - 6.7 Sawn wood stringer
 - 6.8 1x4 wood trim kerfed
 - 6.9 2x wood trim
 - 6.10 1x4 T&G wood siding w/V groove
 - 6.11 Rough swn 3/4" x 4" x 10'
 - 6.12 3/4" exterior plywood
 - 6.13 2x10 face plate
 - 6.14 4x4
 - 6.15 Bottom board
 - 6.16 Wood blocking
 - 6.17 Moisture
 - 07000 Thermal & Moisture
 - 7.1 G.I. Rafting
 - 7.2 3/4" batt insulation
 - 7.3 1 1/2" batt insulation
 - 7.4 Fiberglass batt insul.
 - 7.5 Fiberglass batt insul.
 - 7.6 1" x 1/2" x 1/4" insuln.
 - 7.7 1 1/2" rigid insul. board
 - 7.8 Tapered rigid roof membrane
 - 7.9 2" PVC wrap w/straps on inside face
 - 7.10 Single ply Hypalon roofing membrane
 - 7.11 Termination bar
 - 7.12 Pre-finished rain gutter
 - 7.13 Rain leader
 - 7.14 Building paper
 - 7.15 Vapor barrier
 - 7.16 Moisture barrier
 - 08000 Doors & Windows
 - 8.1 Metal security door
 - 8.2 Mill frame
 - 8.3 Wood frame
 - 8.4 Cold wood double hung window
 - 8.5 Cold wood fixed window
 - 8.6 Cold wood window
 - 8.7 1" insulated glass (clear)
 - 8.8 1" insulated glass (tinted)
 - 8.9 1/4" clear glass
 - 8.10 Alum. threshold
 - 8.11 Alum. door
 - 09000 Finishes
 - 9.1 3/8" Gypsum Wallboard (900 MB)
 - 9.2 1/2" Gypsum wallboard
 - 9.3 Vinyl composition tile (VCT)
 - 10000 Schedules
 - 10.1 Toilet tissue dispenser
 - 10.2 Soap dispenser
 - 10.3 Paper towel dispenser
 - 10.4 Grab bar
 - 10.5 Mirror
 - 10.6 Female nipple receptacle
 - 10.7 Soap service sink
 - 10.8 Mop hanger
 - 10.9 Cleaning bucket
 - 10.10 lockers
 - 10.11 fire extinguisher & Cabinet
 - 10.12 Bug screen
 - 11000 Equipment
 - 11.1 Full comp. (PUC)
 - 11.2 Tall modern (PUC)
 - 11.3 Tall (PUC)
 - 11.4 Tall coin equipment (PUC)
 - 11.5 Microwave
 - 11.6 Undercounter refrigerator
 - 11.7 Vending Machine (VCT)
 - 12000 Furnishings
 - 12.1 Wood shelving
 - 12.2 Kitchen cabinets w/ solid laminate
 - 12.3 Plastic laminate counter top
 - 12.4 Plastic laminate counter
 - 12.5 Bulletin board
 - 13000 Mechanical
 - 13.1 Pre-finished metal louvers
 - 13.2 Electric space heater
 - 13.3 Toilet
 - 13.4 Lavatory
 - 13.5 Kitchen sink
 - 13.6 Heat pump condenser unit
 - 13.7 Heat pump fan unit
 - 13.8 Centrifugal duct
 - 13.9 Fan coil unit
 - 13.10 Booth/ Mech. unit
 - 13.11 Electrical space heater
 - 16000 Electrical
 - 16.1 Emergency Generator
 - 16.2 Light fixture
 - 16.3 Light fixture
 - 16.4 Lighting panels



31 CANAL CENTER PLAZA
ALEXANDRIA, VIRGINIA 22314
TEL. (703) 844-2300



PROJECT NO.
DATE:
DRAWN BY:
CHECKED BY:
REVISED DATE:

COLLEARD
BECHTOLD
TOLL PLAZA
BUILDING

DRAWING TITLE

BUILDING
SECTIONS


CONTRACT NO. 17B
36.6

DRAWING NUMBER


A-4

RECORD DRAWING


No.	Revision	By	Date
1	REVISION	PL	7-14-12

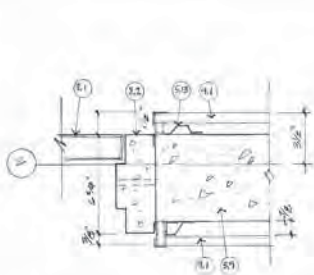


1 JAMB DETAIL
SCALE 3/4" = 1'-0"

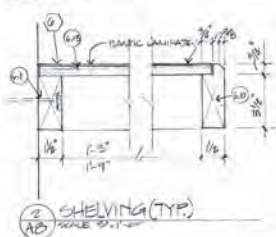


2 SHELVING (TYP.)
SCALE 3/4" = 1'-0"

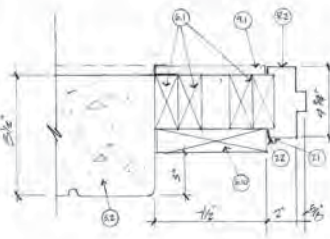

3 JAMB DETAIL
SCALE 3/4" = 1'-0"

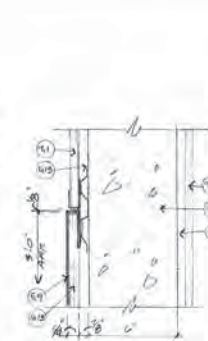


4 WALL DETAIL
SCALE 3/4" = 1'-0"

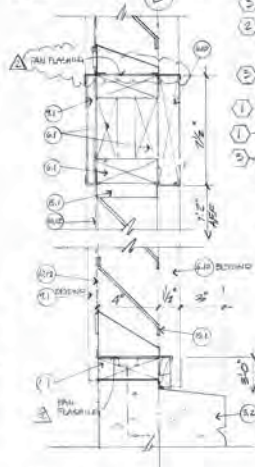


6 VOLT DILL
SCALE 3/4" = 1'-0"




7 LOBBY WALL ELEVATION
SCALE 3/4" = 1'-0"

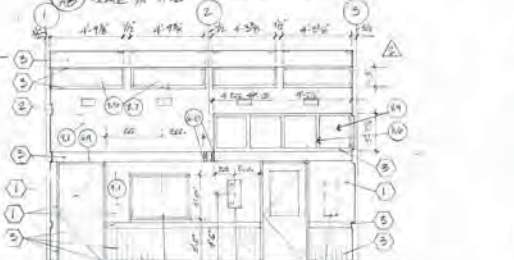

8 LOBBY WALL ELEVATION
SCALE 3/4" = 1'-0"

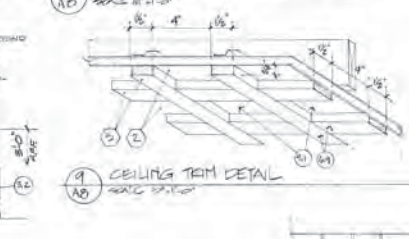

9 CEILING TRIM DETAIL
SCALE 3/4" = 1'-0"

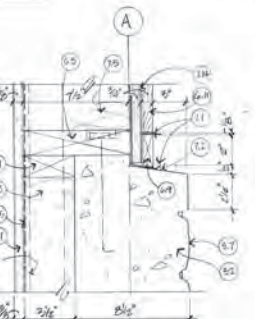


10 WALL DETAIL
SCALE 3/4" = 1'-0"




11 MEN'S TOILET ROOMS ELEVATION (W/OUT DOOR)
SCALE 3/4" = 1'-0"



12 WALL STORAGE WALL ELEVATIONS
SCALE 3/4" = 1'-0"

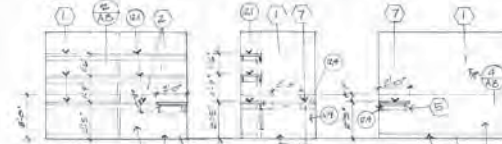

13 VAULT WALL ELEVATIONS
SCALE 3/4" = 1'-0"

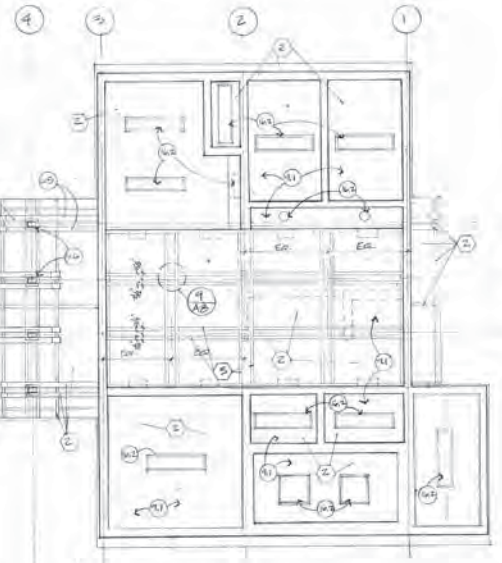

14 REFLECTED CEILING PLAN
SCALE 3/4" = 1'-0"

- Key Notes
- 03000 SITE
- 2.1 Earth subgrade
 - 2.2 Compacted granular fill
 - 2.3 Drainage gravel
 - 2.4 Drain tile
 - 2.5 Steel pipe bollard
- 03100 Concrete
- 3.1 Conc. footing
 - 3.2 Conc. foundation wall
 - 3.3 Conc. slab on grade
 - 3.4 Conc. topping slab
 - 3.5 Conc. wall
 - 3.6 Conc. curb
 - 3.7 Form and trowel conc. surface
 - 3.8 Smooth conc. finish
 - 3.9 Conc. wall
- 05000 Steel
- 5.1 Steel bar
 - 5.2 #4x10 twisted wire fabric
 - 5.3 Steel angle
 - 5.4 Steel plate
 - 5.5 Steel channel
 - 5.6 4x4 sq. tube column
 - 5.7 4x4 sq. tube column
 - 5.8 1/2" RC resilient channel
 - 5.9 1/2" RC resilient channel
 - 5.10 1/2" x 1/2" steel mesh
 - 5.11 2x12 int. roofing deck
 - 5.12 2x12 int. roofing deck
 - 5.13 2x12 int. 2 channel
 - 5.14 7/8" x 1/2" steel channel
 - 5.15 Painted int. w/ave vents (incl.)
- 06000 Wood
- 6.1 2x4
 - 6.2 2x6
 - 6.3 2x8
 - 6.4 Pre-manufactured wood truss
 - 6.5 4x4 wood beam
 - 6.6 3/4" sheathing
 - 6.7 3/4" wood shingles
 - 6.8 Wood base
 - 6.9 1x wood trim kerfed
 - 6.10 2x wood trim
 - 6.11 1x4 T&G wood siding w/ply grieve
 - 6.12 Rough sawn 3/4" pine 4"x6"
 - 6.13 3/4" exterior plywood
 - 6.14 2x10 face plate
 - 6.15 4x4
 - 6.16 Butane board
 - 6.17 Wood blocking
 - 6.18 Wood trim
- 07000 Plaster & Masonry
- 7.1 G.I. lathing
 - 7.2 Slat
 - 7.3 1/2" poly insulation
 - 7.4 5/8" Fiberglas batt insul.
 - 7.5 1/2" Fiberglas batt insul.
 - 7.6 1/2" poly-in insulation
 - 7.7 1/2" G.I. lath
 - 7.8 Tapered rigid roof insulation
 - 7.9 2" PVC wedge insulation on stud face
 - 7.10 Single ply Hypalon roofing membrane
 - 7.11 Terrazzo tile
 - 7.12 Pre-finished ran gutter
 - 7.13 Alum. ladder
 - 7.14 Building paper
 - 7.15 Vapor barrier
 - 7.16 Moisture barrier
- 08000 Doors & Windows
- 8.1 Metal security door
 - 8.2 HD frame
 - 8.3 Wood frame
 - 8.4 Cold wood double hung window w/wacrest
 - 8.5 Cold wood fixed window
 - 8.6 Fixed wood window
 - 8.7 1" insulated glass (leak)
 - 8.8 Insulated glass (leak)
 - 8.9 1/4" clear glass
 - 8.10 Alum. threshold
 - 8.11 Alum. door
- 09000 Finishes
- 9.1 3/8" Gypsum Wallboard (gyp. bd.)
 - 9.2 5/8" WF Gypsum wallboard
 - 9.3 Vinyl composition tile (VCT)
- 10000 Specialties
- 10.1 Toilet tissue dispenser
 - 10.2 Soap dispenser
 - 10.3 Paper towel dispenser
 - 10.4 Grab Bar
 - 10.5 Mirror
 - 10.6 Feminine napkin receptacle
 - 10.7 Mop service sink
 - 10.8 Mop hanger
 - 10.9 Drinking fountain
 - 10.10 Lockers
 - 10.11 Fire extinguisher & Cabinet
 - 10.12 Bug screen
- 11000 Equipment
- 11.1 Toll computer (NIC)
 - 11.2 Toll modem (NIC)
 - 11.3 P.C. (NIC)
 - 11.4 Toll coin equipment (NIC)
 - 11.5 Microwave
 - 11.6 Undercounter refrigerator
 - 11.7 Vending Machines (NIC)
- 12000 Furnishings
- 12.1 Wood shelving
 - 12.2 Kitchen cabinets w/ plast. laminate
 - 12.3 Plastic laminate counter top
 - 12.4 Plastic laminate counter
 - 12.5 Silestone
- 13000 Mechanical
- 13.1 Pre-finished metal louver
 - 13.2 Electric Water Heater
 - 13.3 Toilet
 - 13.4 Lavatory
 - 13.5 Kitchen sink
 - 13.6 Kitchen coldwater unit
 - 13.7 Heat pump fan unit
 - 13.8 Exhaust duct
 - 13.9 Feeder duct
 - 13.10 Roostop Mech. vent
 - 13.11 Electric Water Heater
- 14000 Electrical
- 14.1 Emergency Generator
 - 14.2 Light fixture
 - 14.3 Traffic light
 - 14.4 Lighting panels

WORK SCHEDULE				
NO.	DATE	REVISION	BY	DATE
1	CARRIAGE HOUSE	5/8/11	ELSON	5/8/11
2	SHELL WHITE	5/7/10	ELSON	5/7/10
3	WOOD COLOR TO BE SELECTED FROM 1 MANUF. STANDARD			
4	INTERIOR	5/11/10	ELSON	5/11/10
FLOOR TILE				
4	TRAP	5/11/10	ARMSTRONG	5/11/10
5	GRAND TRAP	5/11/10	ARMSTRONG	5/11/10
PLASTIC LAMINATE				
6	GRAND TRAP	5/11/10	PLANT	5/11/10
7	TANNY WHITE	5/11/10	PLANT	5/11/10
BASE (TRIPPER)				
8	50-MARCH WHITE			



HNTB
HOWARD NEEDLES TAMM & BERENSON
ARCHITECTS ENGINEERS PLANNERS
40 CANAL CENTER PLAZA
ALEXANDRIA, VIRGINIA 22304
TEL: (703) 841-2700



PROJECT NO. 14287
DATE: _____
DRAWN BY: EL
CHECKED BY: _____
REvised DATE: _____

BULEVARD
BRIDGE TOLL
PLAZA BUILDING


DRAWING TITLE:
REFLECTED CEILING
PLAN, INTERIOR
ELEVATIONS

CONTRACT NO. 17B
36.10
DRAWING NUMBER


A-B

RECORD DRAWING

RICHMOND EXPRESSWAY SYSTEM			
SECTION	PROJECT	SHEET NO.	TOTAL SHEETS
CITE	BOULEVARD BRIDGE		

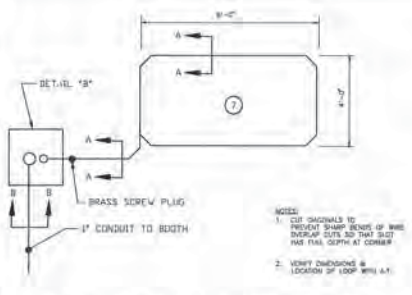


SLOT PLAN - VEHICLE DETECTION LOOP
NORTHBOUND AS SHOWN SOUTHBOUND OPP. HAND
N.T.S.

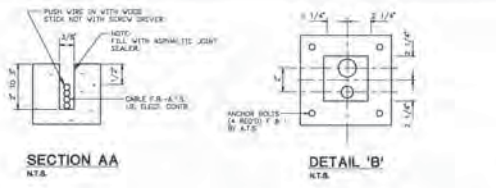


SECTION AA
N.T.S.


DETAIL 'B'
N.T.S.

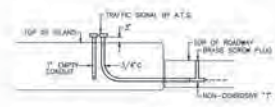


SECTION BB
N.T.S.

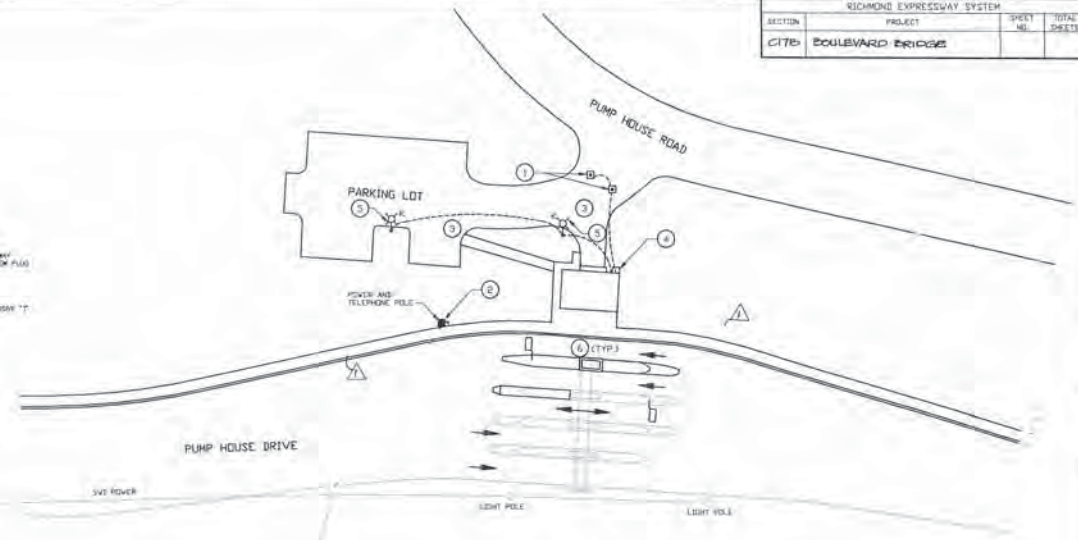


ELECTRICAL SITE PLAN
SCALE 1/4"=1'-0"

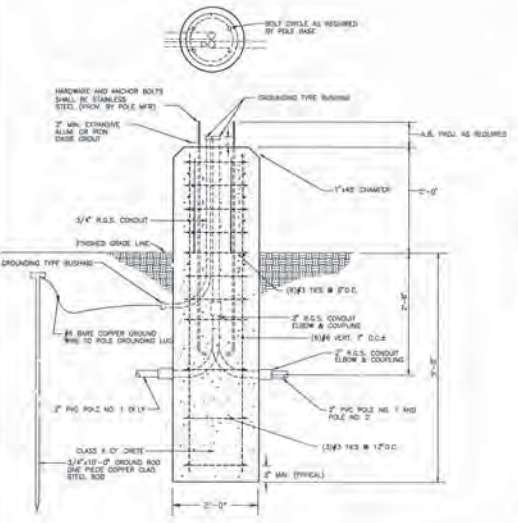


NEW POLE FOUNDATION DETAIL
N.T.S.

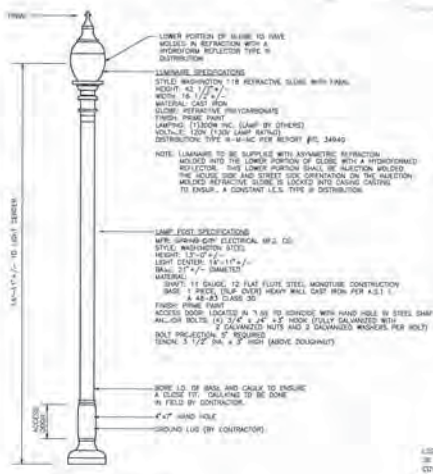

NEW POLE ELEVATION
N.T.S.

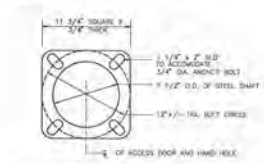

BASE PLATE DETAIL
N.T.S.

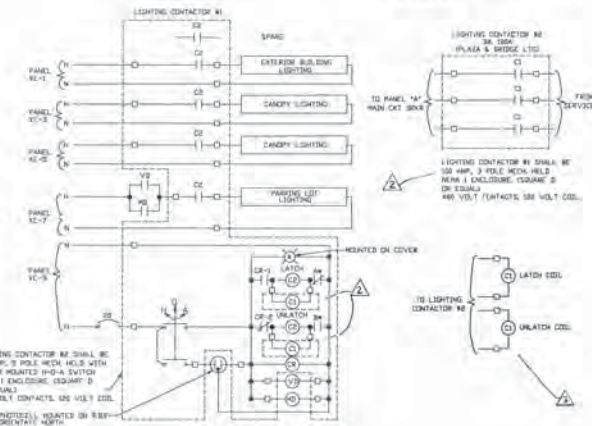

LIGHTING CONTROL SCHEMATIC - SITE
SCALE 1/8"=1'-0"
LOCATED IN ROOM 488

- KEYED NOTES:**
- EMBEDDED VEHICLE DETECTOR ON CENTER LINE OF ENTRANCE AND EXIT LANES. SEE DETAIL ON THIS SHEET.
 - LIGHT AND POWER POLES. RELOCATED AS PART OF ROADWAY WORK.
 - CARE MUST BE TAKEN NOT TO DAMAGE EXISTING TREES. RUN ALL CONDUIT UNDER ALREADY DISTURBED CONSTRUCTION AREA UNDER NEW PAVEMENT.
 - SEE POWER PLAN FOR UNDERGROUND CONDUITS IN THIS AREA.
 - AREA LIGHTING POLE. SEE DETAILS ON THIS SHEET.
 - CONDUIT AND WIRING FOR AUTOMATIC HOLD SYSTEM (A.F.S.) CONTROL AND POWER INSIDE EACH BOOTH IS NOT SHOWN.
 - LOOP DETECTOR CABLE SUPPLIED BY A.T.S. VENDOR AND INSTALLED BY CONTRACTOR. ALL OTHER WIRE AND CONDUIT FURNISHED BY CONTRACTOR. SEE "SLOT PLAN DETAIL" THIS SHEET.

CONTRACT NO. 17B
36.21

RICHMOND METROPOLITAN AUTHORITY
RICHMOND EXPRESSWAY SYSTEM
BLVD. BRIDGE (OLL PLAZA)
ELECTRICAL SITE PLAN

HOWARD NEEDLES TAMMEN & BERGENSDORFF
Architects
Engineers
ALBANY, VA
PLANNERS


HNTB
Professional Engineer

Scale: 1"=30'(L&D) Date: 2-92 Contract No.: C-17B Sheet: E1 of 10

By	Date	Revision	By	Date	
Designed	HCB	3-17-92	CLARIFY NOTE & DETAILS	HCB	2-27-92
Drawn	BSA	3-17-92	Revisions #1	DL	7-14-92
Checked			Revisions #2	DL	4-23-93
Approved			Revision	By	Date



RECORD DRAWING

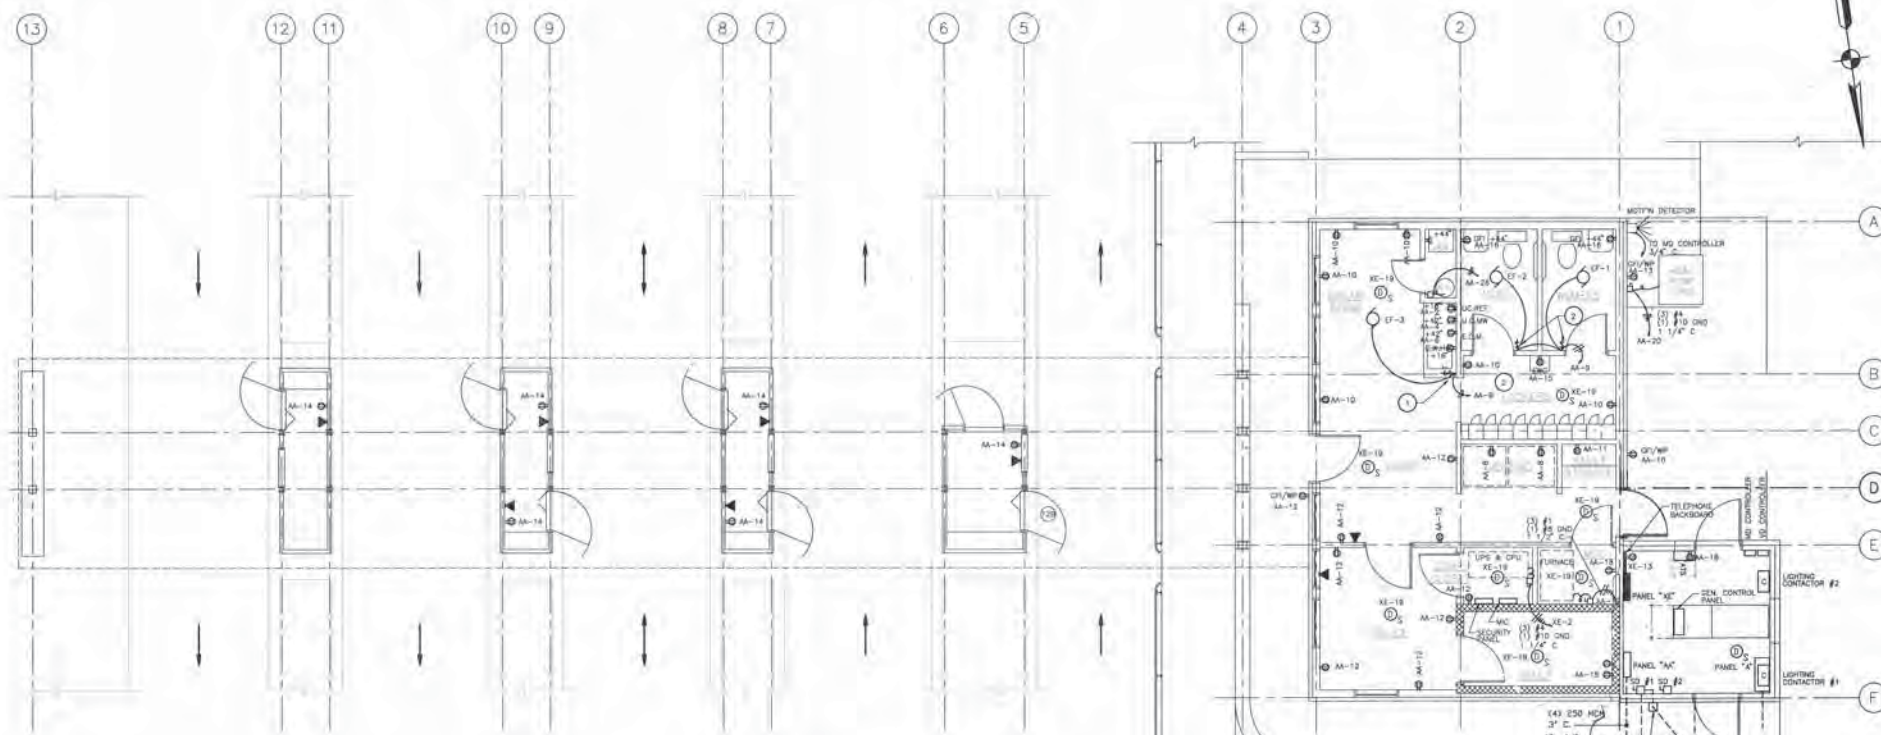

- KEYED NOTES:**
- 1 BOND TRANSFORMER HOUSING TO NEUTRAL AND GROUND PER NEC 250-5.
 - 2 NOT USED ON THIS SHEET.
 - 3 SUPPLEMENTAL GROUND ELECTRODE: (1) 3/4" x 10'-0" COPPER WELD GROUND ROD WITH GROUND LOOP 12" FROM TRANSFORMER PAD. CONDUCTOR IS #1/2 AWG 90 COPPER. CONNECTIONS ARE BY THERMIC WELD PROCESS. INSTALL 1/2" MIN. BELOW GRADE BOND GROUND BAR TO COLD WATER PIPE (AHEAD OF WATER METER IN JUNCTION CLOSED) AND TO SUPPLEMENTAL GROUND ELECTRODE SYSTEM.
 - 4 NOT USED ON THIS SHEET.
 - 5 NOT USED ON THIS SHEET.
 - 6 (1) 3" RGS CONDUIT, STUB AT 10'-0" OUTSIDE BUILDING LINE (FOR FUTURE USE FOR ROAD AND BRIDGE LIGHTING CIRCUITS).
 - 7 4" RGS CONDUIT, STUB AT 10'-0" FROM EDGE OF TRANSFORMER PAD. (FOR UTILITY PRIMARY FEEDER. COORDINATE EXACT REQUIREMENTS, INCLUDING PAD CONSTRUCTION DETAILS WITH UTILITY).
 - 8 UPS AND COMPUTER EQUIPMENT BY OWNER. EXACT REQUIREMENTS INCLUDING MAINTENANCE BYPASS EQUIPMENT TO BE DETERMINED LATER.
 - 9 NOT USED ON THIS SHEET.
 - 10 NOT USED ON THIS SHEET.
 - 11 1P-20A HP RATED TIMER SWITCH (0-120 MIN. RANGE)
 - 12 1P-20A HP RATED MANUAL STARTER (TOGGLE SWITCH TYPE)

KEYED NOTES: VOID

- 1 1P-20A HP RATED TIMER SWITCH (0-120 MIN. RANGE)
- 2 1P-20A HP RATED MANUAL STARTER (TOGGLE SWITCH TYPE)
- 3 (1) 3/4" x 10'-0" COPPER WELD GROUND ROD SPACED 12" FROM TRANSFORMER PAD. CONDUCTOR IS #1/2 AWG 90 COPPER. CONNECTIONS ARE BY THERMIC WELD PROCESS. INSTALL 1/2" MIN. BELOW GRADE BOND GROUND BAR TO COLD WATER PIPE (AHEAD OF WATER METER IN JUNCTION CLOSED) AND TO SUPPLEMENTAL GROUND ELECTRODE SYSTEM AND SHALL NOT BE CONNECTED TO SERVICE GROUND.
- 4 (1) 3" RGS CONDUIT, STUB AT 10'-0" OUTSIDE BUILDING LINE. FOR FUTURE USE FOR ROAD AND BRIDGE LIGHTING CIRCUITS.
- 5 4" RGS CONDUIT, STUB AT 10'-0" FROM EDGE OF TRANSFORMER PAD. (FOR UTILITY PRIMARY FEEDER. COORDINATE EXACT REQUIREMENTS, INCLUDING PAD CONSTRUCTION DETAILS WITH UTILITY).



CONTRACT NO. 17B-36.23

RICHMOND METROPOLITAN AUTHORITY
RICHMOND EXPRESSWAY SYSTEM
 BLVD. BRIDGE TOLL PLAZA
 POWER PLAN

HOWARD NEEDLES TAMMEN & BERGENDOFF
 Engineers
 ALEXANDRIA, VA

HNTB

Scale: 1/4"=1'-0" Date: 2-98 Contract No: C-17B Sheet: 23 of 23

By	Date	REVISIONS	By	Date
Designed	HCR		HCR/PL	2-2-98
Drawn		Revision #1	CL	7-14-98
Checked		Revision #2	CL	4-28-98
Approved				

RECORD DRAWING

RICHMOND EXPRESSWAY SYSTEM		SHEET	TOTAL SHEETS
SECTION	PROJECT	NO.	NO.
CTB	BOULEVARD BRIDGE		


LIGHTING FIXTURE SCHEDULE

TYPE	TYPE	LENS - DIFFUSER	HOOPS SHALL BE FINISHED AND COMPLETELY WASHED AND LIGHT SEAL UNLESS OTHERWISE NOTED	FINISH	NOTE
1	FLUORESCENT - STRAIGHT	1 - CLEAR			
2	FLUORESCENT - STRAIGHT	1 - PRISM			
3	FLUORESCENT - STRAIGHT	1 - PRISM			
TYPE	MTC	LAMP	HOM FIXT DIM	BEAM CONTROL	DOOR	TRIM	BOOBY	ALUMINUM EQUIPMENT	REFERENCE							
TYPE	QUANTITY	WATT	WATT	LENS	DIFF	THICK	REFL	BATT	MAT	FIN	MAT	FIN	MAT	FIN	MANUFACTURER	CAT NO./SERIES
A	S	F	2	40	1" x 4"										ESM	170
B	S	F	2	40	1" x 4"										ESM	170
C	W	CF	2	13	1 1/2" x 1 1/2"										ESM	170
D	W	CF	2	13	1 1/2" x 1 1/2"										ESM	170
E	S	I	2	75	20	8 3/4" x 8 3/4"									ESM	170
F	R	CF	2	13	1 1/2" x 1 1/2"										ESM	170
G	W	F	2	40	1" x 4"										ESM	170
H	R	MI	1	175	14" x 14"										ESM	170
I	R	MI	1	175	14" x 14"										ESM	170
J	S	FL	1	85	12" x 12"										ESM	170
K	S	P	1	1	1										ESM	170
L	S	F	2	75	20	8 3/4" x 8 3/4"									ESM	170
M	S	MI	1	75	14" x 14"										ESM	170

PANEL SCHEDULE		DESIGNATION:	PANEL "A"	MANUFACTURER:	100 AMP MAIN DKT BKR			
		LOCATION:	GENERATOR ROOM	BUS SIZE:	100 AMP			
		VOLTAGE:	208Y/120 VOLT	PANEL MOUNTING:	SURFACE			
		PHASE:	3 PHASE 4 WIRE	ALL BREAKERS:	10,000 A.I.C. (MIN.)			
DKT NO	LOAD DESCRIPTION	PHASE	W	V	D	D	LOAD DESCRIPTION	DKT NO
1	TOILET - BRUSH & JETTER	1	1.00	20	1	1.00	RECEPT - REFRIGERATOR	2
2	TOILET - BRUSH & JETTER	2	1.00	20	1	1.00	RECEPT - MICROWAVE	3
3	TOILET - BRUSH & JETTER	3	1.00	20	1	1.00	RECEPT - COFFEE MAKER	4
4	TOILET - BRUSH & JETTER	1	1.00	20	1	1.00	RECEPT - VENDING MACHINES	5
5	TOILET - BRUSH & JETTER	2	1.00	20	1	1.00	RECEPT - BREAK & LOCKER ROOMS	6
6	TOILET - BRUSH & JETTER	3	1.00	20	1	1.00	RECEPT - OFFICE & LOBBY	7
7	TOILET - BRUSH & JETTER	1	1.00	20	1	1.00	RECEPT - TALKING	8
8	TOILET - BRUSH & JETTER	2	1.00	20	1	1.00	RECEPT - TALKING	9
9	TOILET - BRUSH & JETTER	3	1.00	20	1	1.00	RECEPT - TALKING	10
10	TOILET - BRUSH & JETTER	1	1.00	20	1	1.00	RECEPT - TALKING	11
11	TOILET - BRUSH & JETTER	2	1.00	20	1	1.00	RECEPT - TALKING	12
12	TOILET - BRUSH & JETTER	3	1.00	20	1	1.00	RECEPT - TALKING	13
13	TOILET - BRUSH & JETTER	1	1.00	20	1	1.00	RECEPT - TALKING	14
14	TOILET - BRUSH & JETTER	2	1.00	20	1	1.00	RECEPT - TALKING	15
15	TOILET - BRUSH & JETTER	3	1.00	20	1	1.00	RECEPT - TALKING	16
16	TOILET - BRUSH & JETTER	1	1.00	20	1	1.00	RECEPT - TALKING	17
17	TOILET - BRUSH & JETTER	2	1.00	20	1	1.00	RECEPT - TALKING	18
18	TOILET - BRUSH & JETTER	3	1.00	20	1	1.00	RECEPT - TALKING	19
19	TOILET - BRUSH & JETTER	1	1.00	20	1	1.00	RECEPT - TALKING	20
20	TOILET - BRUSH & JETTER	2	1.00	20	1	1.00	RECEPT - TALKING	21
21	TOILET - BRUSH & JETTER	3	1.00	20	1	1.00	RECEPT - TALKING	22
22	TOILET - BRUSH & JETTER	1	1.00	20	1	1.00	RECEPT - TALKING	23
23	TOILET - BRUSH & JETTER	2	1.00	20	1	1.00	RECEPT - TALKING	24
24	TOILET - BRUSH & JETTER	3	1.00	20	1	1.00	RECEPT - TALKING	25
25	TOILET - BRUSH & JETTER	1	1.00	20	1	1.00	RECEPT - TALKING	26
26	TOILET - BRUSH & JETTER	2	1.00	20	1	1.00	RECEPT - TALKING	27
27	TOILET - BRUSH & JETTER	3	1.00	20	1	1.00	RECEPT - TALKING	28
28	TOILET - BRUSH & JETTER	1	1.00	20	1	1.00	RECEPT - TALKING	29
29	TOILET - BRUSH & JETTER	2	1.00	20	1	1.00	RECEPT - TALKING	30
TOTAL CONNECTED LOAD:			28.80	20.38	28.20	TOTAL = 87.48 KVA		

PANEL SCHEDULE		DESIGNATION:	PANEL "A"	MANUFACTURER:	150 AMP MAIN DKT BKR			
		LOCATION:	GENERATOR ROOM	BUS SIZE:	150 AMP			
		VOLTAGE:	208Y/120 VOLT	PANEL MOUNTING:	SURFACE			
		PHASE:	3 PHASE 4 WIRE	ALL BREAKERS:	10,000 A.I.C. (MIN.)			
DKT NO	LOAD DESCRIPTION	PHASE	W	V	D	D	LOAD DESCRIPTION	DKT NO
1	TOILET - BRUSH & JETTER	1	1.00	20	1	1.00	RECEPT - REFRIGERATOR	2
2	TOILET - BRUSH & JETTER	2	1.00	20	1	1.00	RECEPT - MICROWAVE	3
3	TOILET - BRUSH & JETTER	3	1.00	20	1	1.00	RECEPT - COFFEE MAKER	4
4	TOILET - BRUSH & JETTER	1	1.00	20	1	1.00	RECEPT - VENDING MACHINES	5
5	TOILET - BRUSH & JETTER	2	1.00	20	1	1.00	RECEPT - BREAK & LOCKER ROOMS	6
6	TOILET - BRUSH & JETTER	3	1.00	20	1	1.00	RECEPT - OFFICE & LOBBY	7
7	TOILET - BRUSH & JETTER	1	1.00	20	1	1.00	RECEPT - TALKING	8
8	TOILET - BRUSH & JETTER	2	1.00	20	1	1.00	RECEPT - TALKING	9
9	TOILET - BRUSH & JETTER	3	1.00	20	1	1.00	RECEPT - TALKING	10
10	TOILET - BRUSH & JETTER	1	1.00	20	1	1.00	RECEPT - TALKING	11
11	TOILET - BRUSH & JETTER	2	1.00	20	1	1.00	RECEPT - TALKING	12
12	TOILET - BRUSH & JETTER	3	1.00	20	1	1.00	RECEPT - TALKING	13
13	TOILET - BRUSH & JETTER	1	1.00	20	1	1.00	RECEPT - TALKING	14
14	TOILET - BRUSH & JETTER	2	1.00	20	1	1.00	RECEPT - TALKING	15
15	TOILET - BRUSH & JETTER	3	1.00	20	1	1.00	RECEPT - TALKING	16
16	TOILET - BRUSH & JETTER	1	1.00	20	1	1.00	RECEPT - TALKING	17
17	TOILET - BRUSH & JETTER	2	1.00	20	1	1.00	RECEPT - TALKING	18
18	TOILET - BRUSH & JETTER	3	1.00	20	1	1.00	RECEPT - TALKING	19
19	TOILET - BRUSH & JETTER	1	1.00	20	1	1.00	RECEPT - TALKING	20
20	TOILET - BRUSH & JETTER	2	1.00	20	1	1.00	RECEPT - TALKING	21
21	TOILET - BRUSH & JETTER	3	1.00	20	1	1.00	RECEPT - TALKING	22
22	TOILET - BRUSH & JETTER	1	1.00	20	1	1.00	RECEPT - TALKING	23
23	TOILET - BRUSH & JETTER	2	1.00	20	1	1.00	RECEPT - TALKING	24
24	TOILET - BRUSH & JETTER	3	1.00	20	1	1.00	RECEPT - TALKING	25
25	TOILET - BRUSH & JETTER	1	1.00	20	1	1.00	RECEPT - TALKING	26
26	TOILET - BRUSH & JETTER	2	1.00	20	1	1.00	RECEPT - TALKING	27
27	TOILET - BRUSH & JETTER	3	1.00	20	1	1.00	RECEPT - TALKING	28
28	TOILET - BRUSH & JETTER	1	1.00	20	1	1.00	RECEPT - TALKING	29
29	TOILET - BRUSH & JETTER	2	1.00	20	1	1.00	RECEPT - TALKING	30
TOTAL CONNECTED LOAD:			10.69	12.88	10.11	TOTAL = 35.62 KVA		

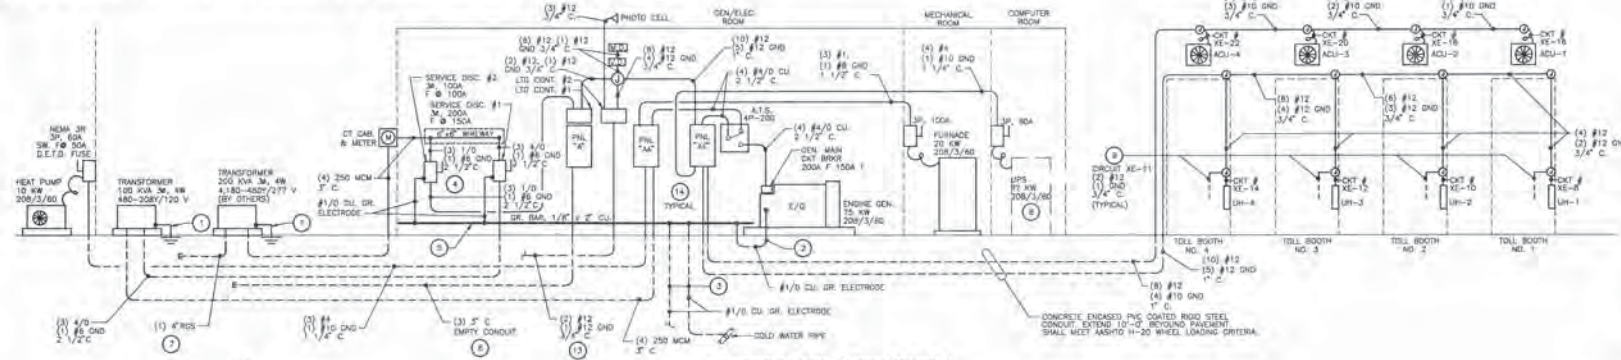

ELECTRICAL POWER RISER DIAGRAM
SCALE N.T.S.

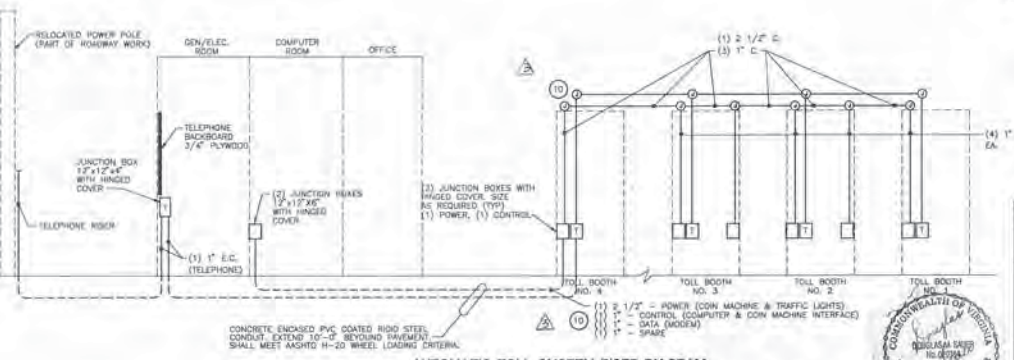

AUTOMATIC TOLL SYSTEM RISER DIAGRAM
TELEPHONE SYSTEM RISER DIAGRAM
SCALE N.T.S.

PANEL SCHEDULE		DESIGNATION:	PANEL "A"	MANUFACTURER:	100 AMP MAIN DKT BKR			
		LOCATION:	GENERATOR ROOM	BUS SIZE:	100 AMP			
		VOLTAGE:	480Y/277 VOLT	PANEL MOUNTING:	SURFACE			
		PHASE:	3 PHASE, 4 WIRE	ALL BREAKERS:	10,000 A.I.C. (MIN.)			
DKT NO	LOAD DESCRIPTION	PHASE	W	V	D	D	LOAD DESCRIPTION	DKT NO
1	TOLL PLAZA LIGHTING	1	1.50	20	1	1.50	BROOD LIGHTING	2
2	TOLL PLAZA LIGHTING	2	1.50	20	1	1.50	BROOD LIGHTING	3
3	TOLL PLAZA LIGHTING	3	1.50	20	1	1.50	BROOD LIGHTING	4
4	TOLL PLAZA LIGHTING	1	1.50	20	1	1.50	BROOD LIGHTING	5
5	TOLL PLAZA LIGHTING	2	1.50	20	1	1.50	BROOD LIGHTING	6
6	TOLL PLAZA LIGHTING	3	1.50	20	1	1.50	BROOD LIGHTING	7
7	SPARE	1	0.00	20	1	0.00	SPARE	8
8	SPARE	2	0.00	20	1	0.00	SPARE	9
9	SPARE	3	0.00	20	1	0.00	SPARE	10
10	SPARE	1	0.00	20	1	0.00	SPARE	11
11	SPARE	2	0.00	20	1	0.00	SPARE	12
TOTAL CONNECTED LOAD:			2.80	3.80	2.80	TOTAL = 8.40 KVA		

By	Date	Revision	By	Date
Designed	HCR 3-13-92	1	HCR	2-23-93
Drawn	BSA 3-13-92	2	EL	7-14-92
Checked		3	HCR	4-28-92
Approved				


- KEYED NOTES:**
1. ROAD TRANSFORMER HOUSING TO NEUTRAL AND GROUND PER NEC 250-28.
 2. GENERATOR POWER IS SEPARATELY SERVED SYSTEM.
 3. SUPPLEMENTAL GROUNDING ELECTRODE (A) 3/4" x 10'-0" CORNER WELD GROUND ROD WITH GROUND LOOP 12" x 4" ANCHOR TRANSFORMER PAIS. CONDUCTOR IS #1/2" ANCHOR CONDUCTOR. CONDUCTORS ARE BE THINNE WELD PROCESS INSTALLED 1/2" BELOW GRADE. ROAD GROUND BAR TO TOLD WATER PIPE (LINED BY WATER METER IN JUNCTION BOX) AND TO SUPPLEMENTAL GROUND ELECTRODE SYSTEM.
 4. GROUND SERVICE EQUIPMENT PER NEC 250-28.
 5. MOUNT GROUND BAR (1" x 1/2" ANCHOR BOLT AND NORTH WALL, WITH EXPANSION ANCHORS, 1" SPACER AND 3/4" CAP

DTE TOLL PLAZA

ORIGINAL PLANS

ADMINISTRATION BUILDING & TOLL PLAZA

RICHMOND EXPRESSWAY SYSTEM			
SECTION	PROJECT	SHEET	TOTAL SHEETS
8	DOWNTOWN EXPRESSWAY	70	

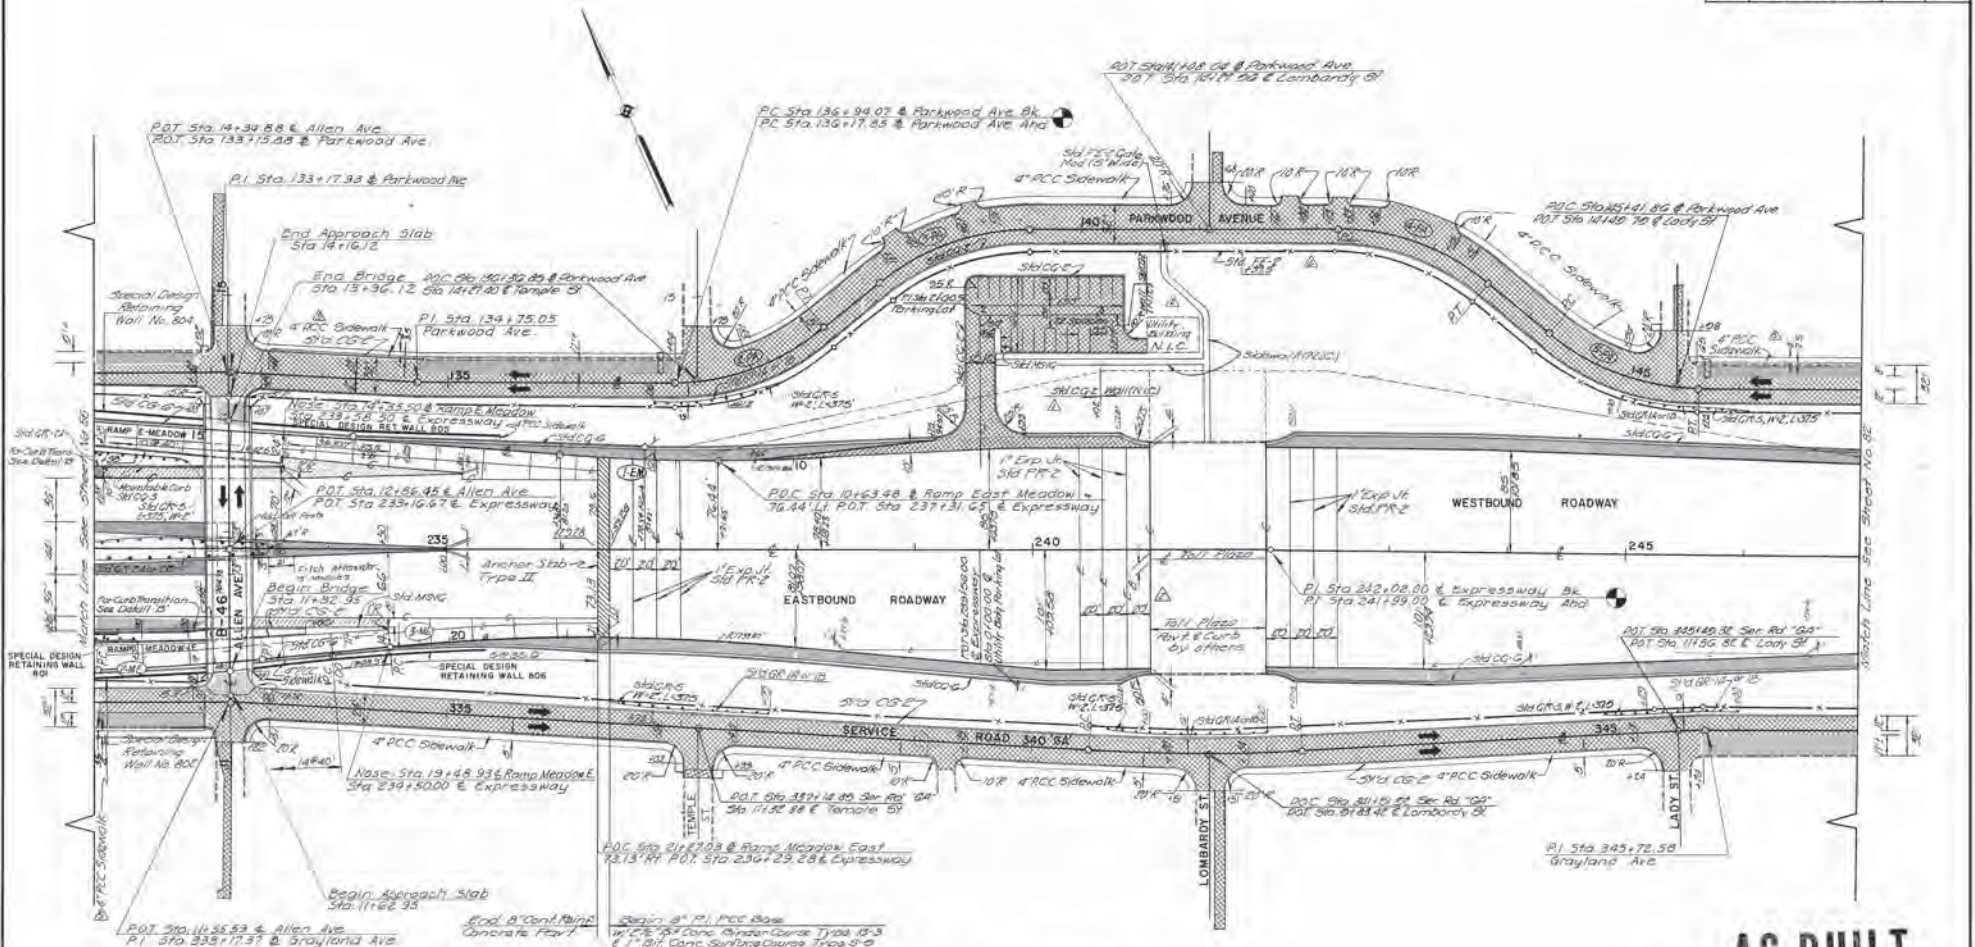

- LEGEND**
- Discontinuous Concrete Road Shoulder
 - Concrete Bridge Approach Slab
 - Existing Pavement to be Resurfaced
 - Discontinuous Concrete Pavement
 - 6" Bitum 2" C Base bonded with E
 - Bituminous Concrete Road 3-5
 - Longitudinal Joint
 - Construction Joint
 - Transverse Joint

NOTE
 For curb transition detail
 see sheet
 for profile see sheet


AS BUILT

RICHMOND METROPOLITAN AUTHORITY
 RICHMOND EXPRESSWAY SYSTEM
 DOWNTOWN EXPRESSWAY

PAVEMENT PLAN
 STA. 232+00 TO STA. 247+00


AMERICAN ENGINEERS Richmond, Virginia	SCALE: 1" = 50'
HOWARD, NEEDLES, TAMMEN & BERENSON CHESAPEAKE	CONTRACT NO. 8 SHEET NO. 70

NO.	REVISION	BY	DATE
1	ADD Sidewalk	DCJ	2-76
2	REV Sidewalk	WMM	11-82
3	REV Sidewalk	RKL	8-11-88
4	REV Sidewalk	WMM	12-8-94
5	REV Sidewalk	WMM	9-28-94

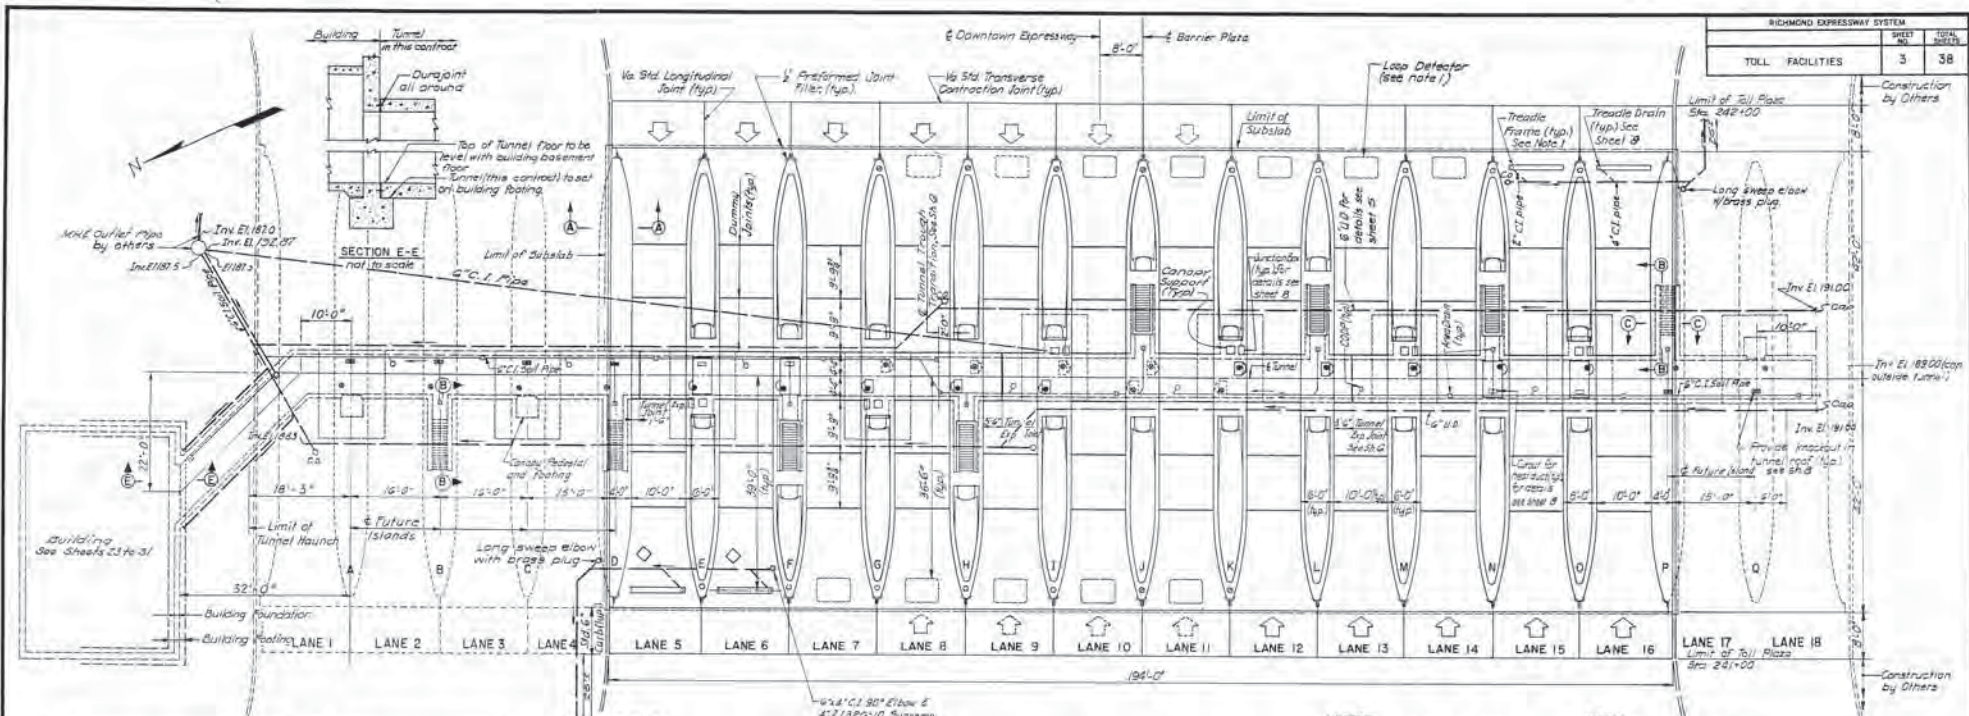

RICHMOND EXPRESSWAY SYSTEM		
SHEET NO.	TOTAL SHEETS	
3	38	

TOLL FACILITIES

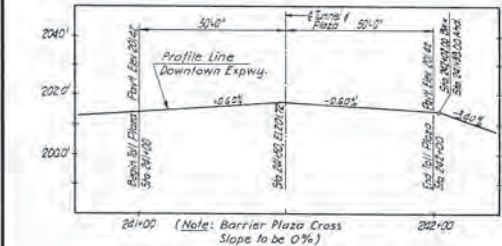

PROFILE AT DOWNTOWN BARRIER PLAZA
 Horiz: 1:20'
 Scale: Vert: 1/4" = 1'

PLAN
DOWNTOWN BARRIER PLAZA
 1/4" = 1'-0"

- LEGEND:**
- Location of Future Traffic Signal
 - Traffic Signal
 - Automatic Toll Machine (A.T.M.)
 - Future Automatic Toll Machine
 - Toll Booth
 - Proposed Coin Tube
 - Future Coin Tube

- NOTES:**
- 1) To be placed by Toll Equipment Contractor prior to the paving, under this Contract.
 - 2) Tunnel drainage trough to begin at the building foundation.
 - 3) C.O.D.P. = Clean out drain pipe.
 - 4) Sections A-A, B-B and C-C appear on Sheet 4.

BY	DATE	NO.	REVISION	BY	DATE
MADE	W.J.K. 5-68	2	Initial Working Copy	J.H.T.	2-70
CHECKED	D.E.N. 5-68	1	Final Check	D.E.N.	6-68
IN CHARGE	H.D.S.				

AS BUILT


RICHMOND METROPOLITAN AUTHORITY
RICHMOND EXPRESSWAY SYSTEM

DOWNTOWN BARRIER PLAZA
PLAN

HOWARD, NEEDLES, TAMMEN & BERGENDOFF
 CONSULTING ENGINEERS
 NEW YORK ALEXANDRIA KANSAS CITY

SCALE: AS NOTED
 CONTRACT NO. 2253
 SHEET NO. 3 OF 38















RICHMOND EXPRESSWAY SYSTEM			
SECTION	PROJECT	SHEET NO.	TOTAL SHEETS
TF-3	TOLL FACILITIES	5	38

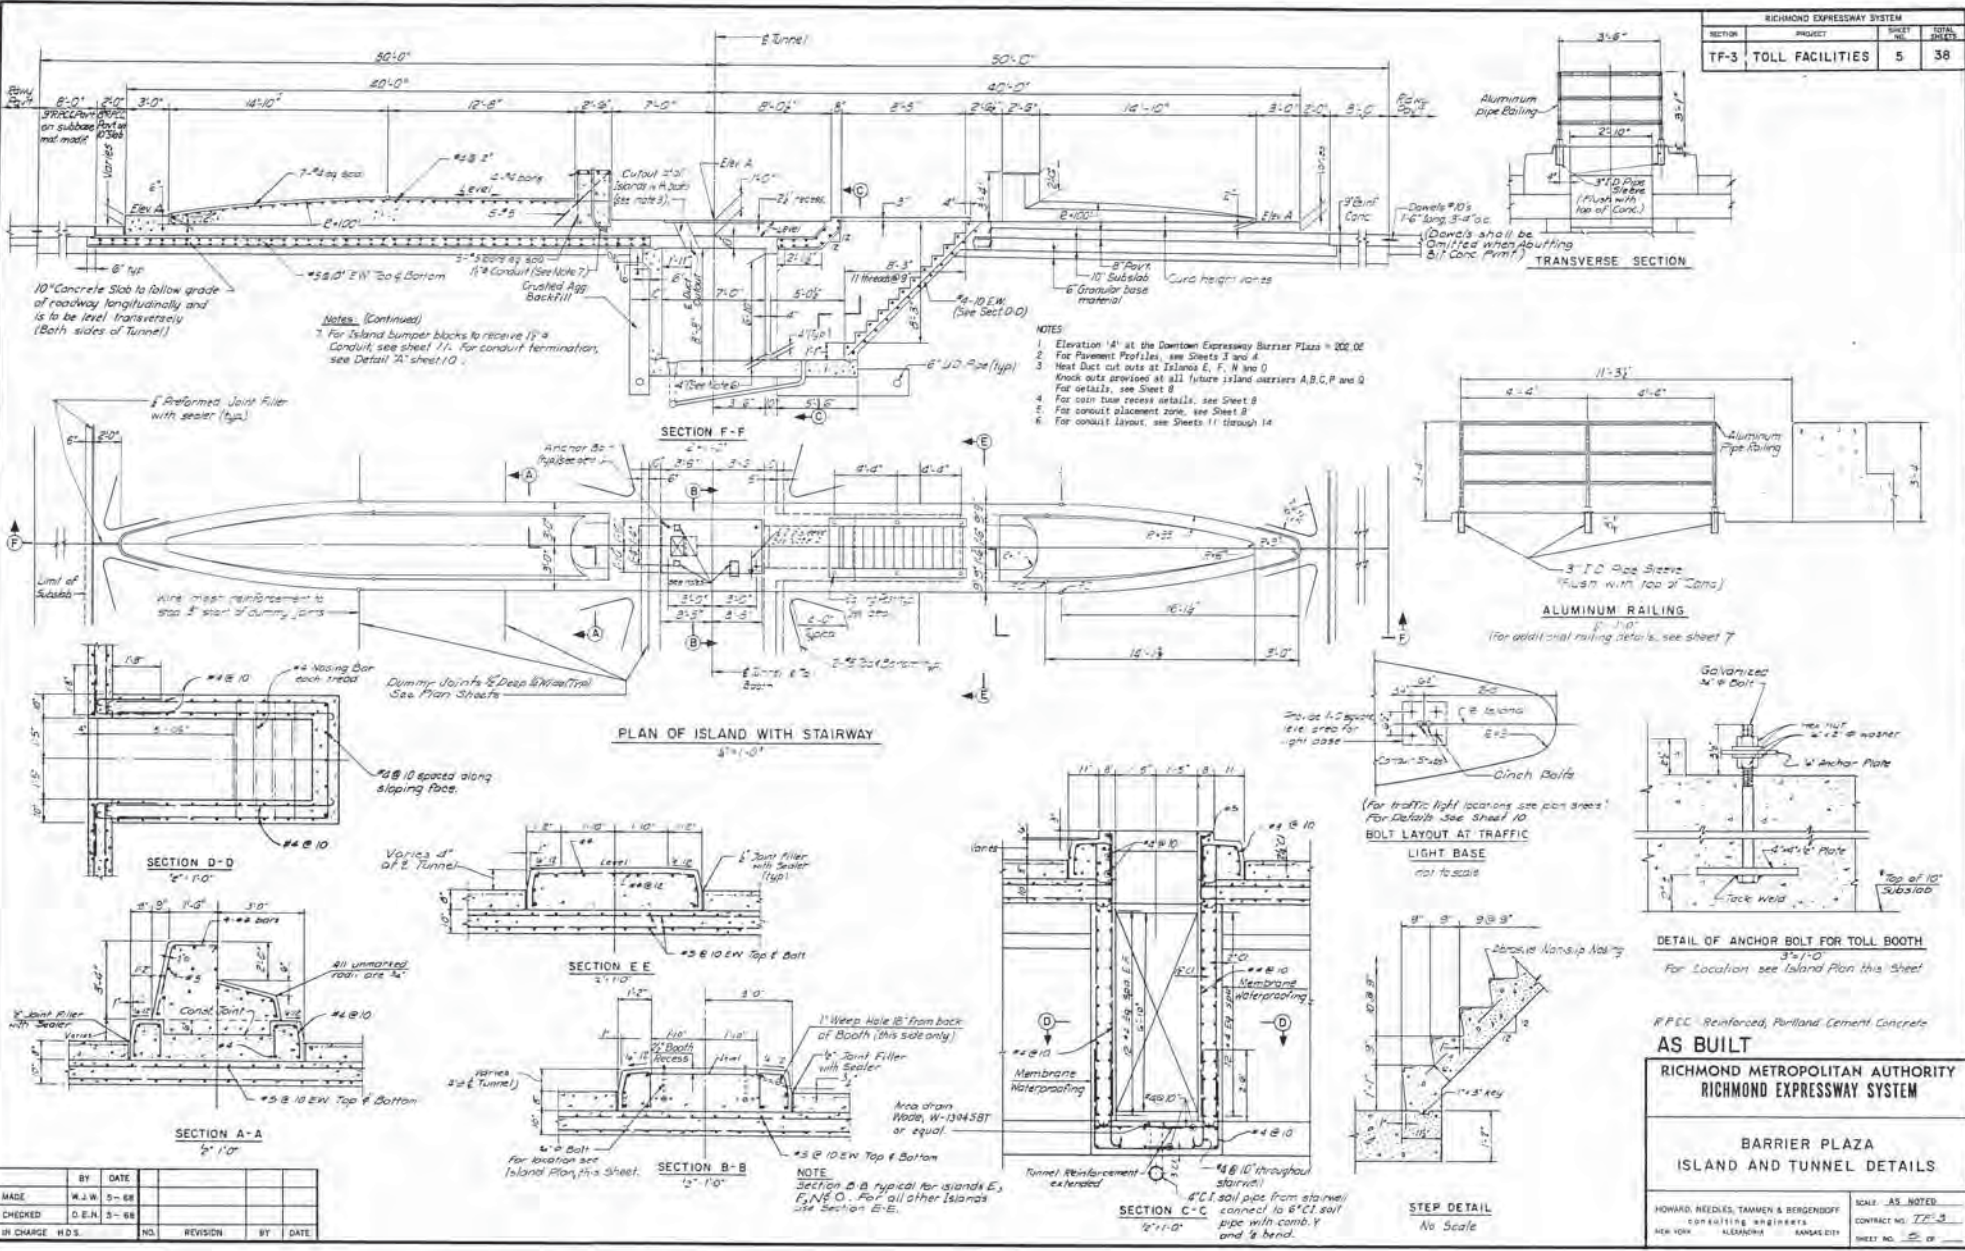

BY	DATE	NO.	REVISION	BY	DATE
MADE	M.J.W.	3-88			
CHECKED	D.E.N.	3-88			
IN CHARGE	H.D.S.				

R.P.C.C. Reinforced, Portland Cement Concrete
AS BUILT
 RICHMOND METROPOLITAN AUTHORITY
 RICHMOND EXPRESSWAY SYSTEM
**BARRIER PLAZA
 ISLAND AND TUNNEL DETAILS**
 HOWARD, NEEDLES, TAMMEN & BERGENSOFF
 CONSULTING ENGINEERS
 NEW YORK ALBANY BANGOR
 SCALE: AS NOTED
 CONTRACT NO. TF-3
 SHEET NO. 5

RICHMOND EXPRESSWAY SYSTEM			
SECTION	PROJECT	SHEET NO.	TOTAL SHEETS
TF-3	TOLL FACILITIES	6	38

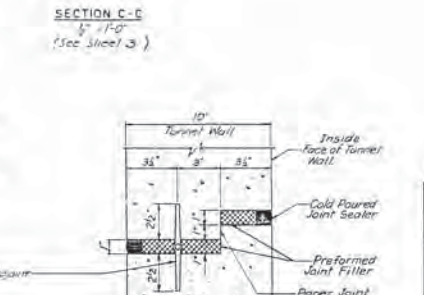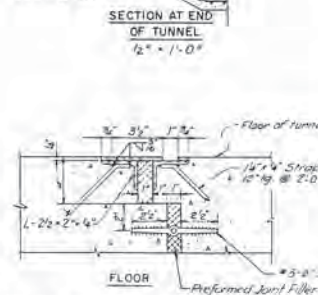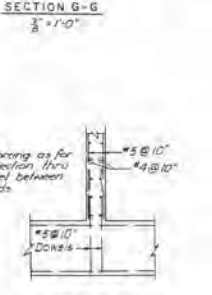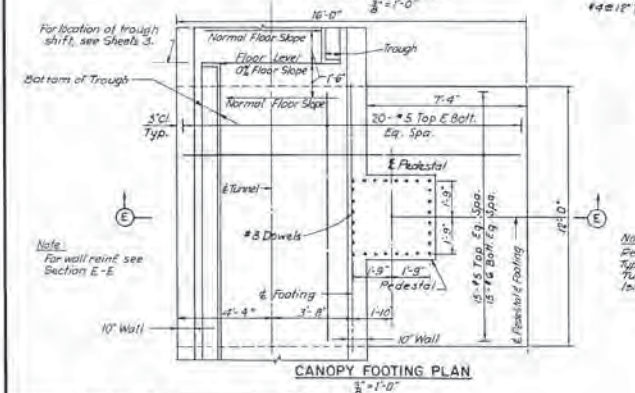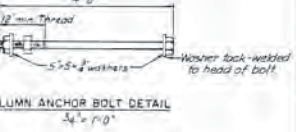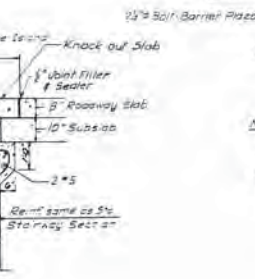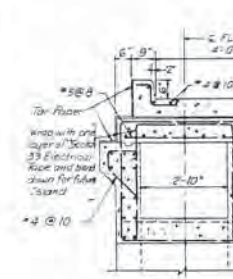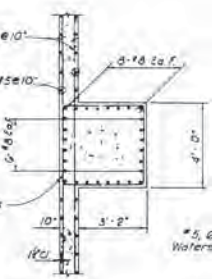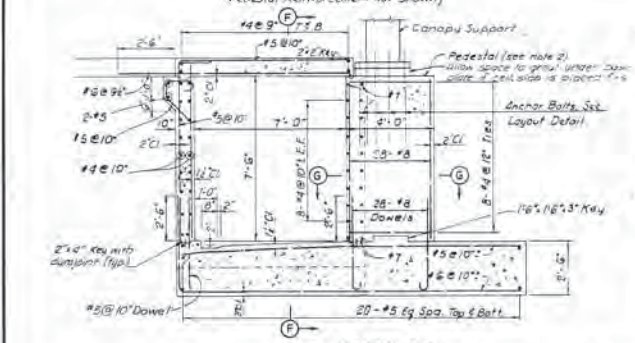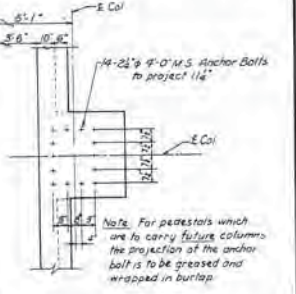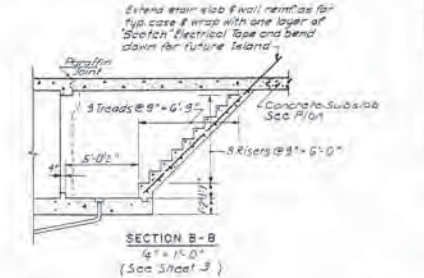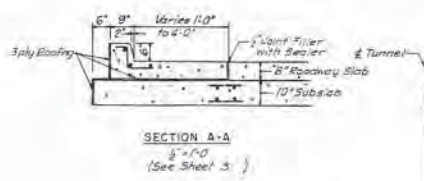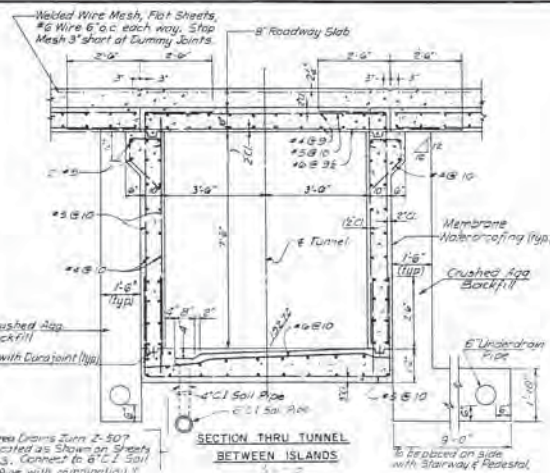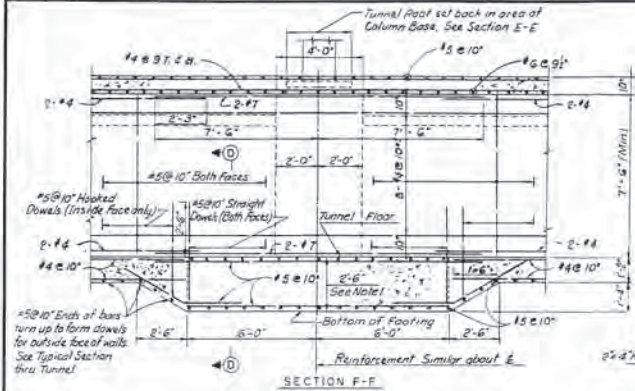







Notes:
 1) Top of Canopy Footing will parallel slope of tunnel floor.
 2) Canopy Pedestal shall be vertical of all times.

AS BUILT
 RICHMOND METROPOLITAN AUTHORITY
 RICHMOND EXPRESSWAY SYSTEM
 BARRIER PLAZA
 TUNNEL DETAILS


BY	DATE	NO.	REVISION	BY	DATE
MADE	W.J.W	5-68			
CHECKED	D.E.N	5-68	Final Check	D.E.N	6-68
IN CHARGE	H.D.S				

HOWARD, REEDLES, TAMMER & BERGENDOFF CONSULTING ENGINEERS NEW YORK ALEXANDRIA RANAS CITY		SCALE: AS NOTED
CONTRACT NO. 77-3		SHEET NO. 6 OF 38






RICHMOND EXPRESSWAY SYSTEM			
SECTION	PROJECT	SHEET NO.	TOTAL SHEETS
TF-3	TOLL FACILITIES	8	38

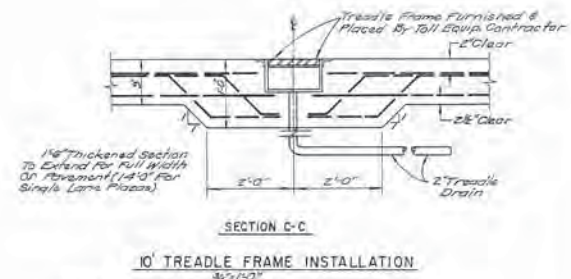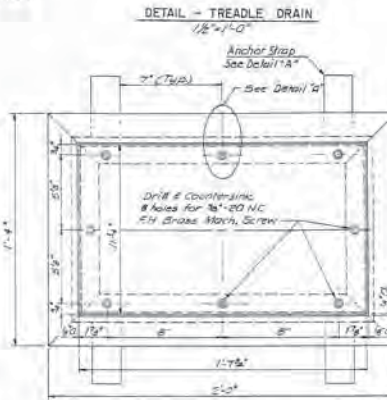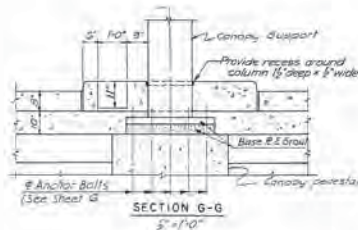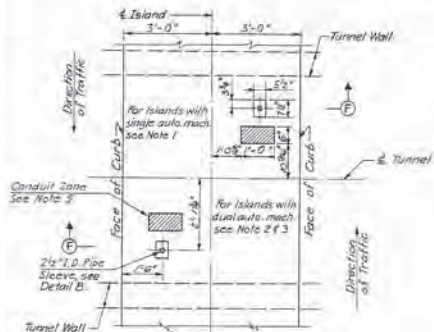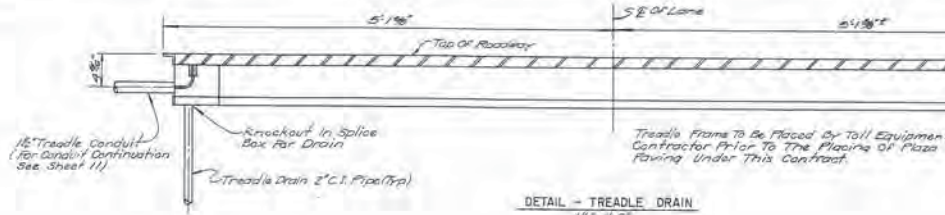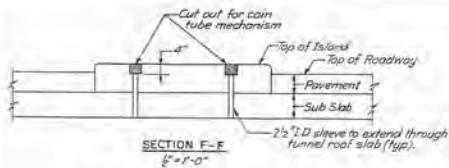

CONDUIT ZONE & PIPE SLEEVE LOCATION FOR AUTOMATIC TOLL MACHINE
1/2'-1'-0"
(Location and dimension of Conduit Zones and Pipe sleeves are similar for each Direction of Traffic.)

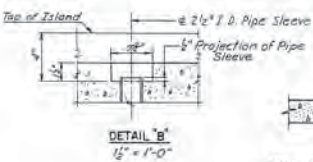

COIN TUBE DETAIL AT FUTURE ISLAND LOCATION
No Scale

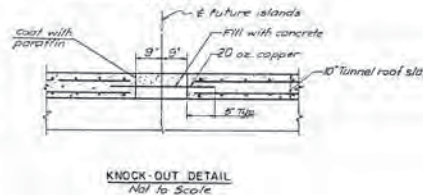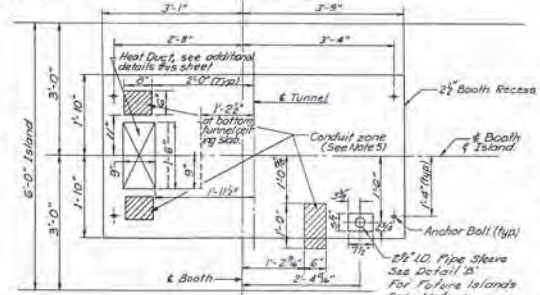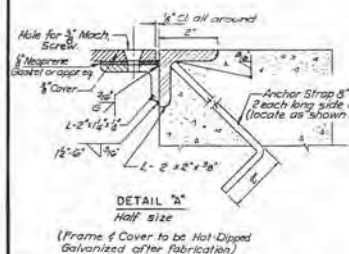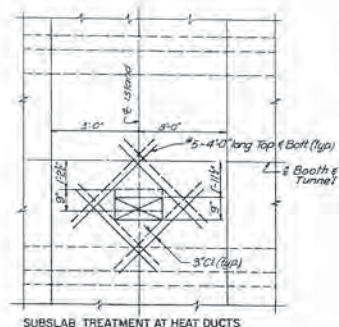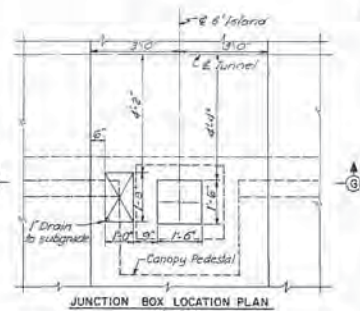

NOTES

- Islands E, F, L, M, N & Q will have a single coin tube and recess for automatic machine.
- Islands G, H, I & K will have dual coin tubes and tube recesses for automatic machines. One location at each island will be for future automatic machines.
- Island J will have dual coin tubes and tube recessed for future automatic machines.
- All future island locations will have a single coin tube. Sleeve to be threaded and plugged.
- Conduits to or from toll booths or automatic machines are to be placed totally within the zones shown. For conduit layouts and stubbing details, see Sheets 10, 12, 13 & 14.

AS BUILT

RICHMOND METROPOLITAN AUTHORITY
RICHMOND EXPRESSWAY SYSTEM

MISCELLANEOUS DETAILS

HOWARD, NEEDLES, TAMMEN & BENGENDORF
CONSULTING ENGINEERS
NEW YORK ALEXANDRIA KANSAS/CITY



SCALE: AS NOTED
CONTRACT NO. IFE-3
SHEET NO. 8 OF 38

BY	DATE	3	Utility Locations	E.J.M.	12-77
MADE	W.J.W.	5-68	Final Plans	P.H.T.	2-79
CHECKED	D.E.N.	5-68	Final Check	D.E.N.	6-68
IN CHARGE	W.D.S.	NO.	REVISION	BY	DATE







UTILITY LOCATIONS BARRIER PLAZA TOLL BOOTHS
3'-1'-0"
NOTE: Utility Locations in Tunnel Ceiling Slab Future Islands A, B, C, F, E, G Similar

NOTES:

- LANES 7,8,9,12,13 & 14 ARE TO RECEIVE EXACT CHANGE SIGNS, SEE DETAIL.
- LIGHT UNITS ARE TO BE PLACED IN FRONT OF EXACT CHANGE SIGNS. THE LIGHT UNITS ARE TO BE FOCUSED ON THE HORIZONTAL E OF THE PANEL. LIGHT UNIT BALLASTS WILL BE EXPOSED.
- A 3'-0" WIDE SECTION OF ISLAND WHOSE CENTER REPRESENTS THE COL. E INCLUDING A 4'-0" WIDE AND 10" HIGH CONC. FILLER BELOW ARE INCLUDED IN THIS CONTRACT. THE JUNCTION BOX SHOWN IN SECTION E-B WILL BE OWNER SUPPLIED BUT INSTALLED UNDER THIS CONTRACT. ALL WORK SHOWN IN SECTION C-C IS PART OF THIS CONTRACT. PROPER JOINT SEAL AND CURB DIMENSIONS TO FIT WITH THE EXISTING MUST BE PROVIDED.

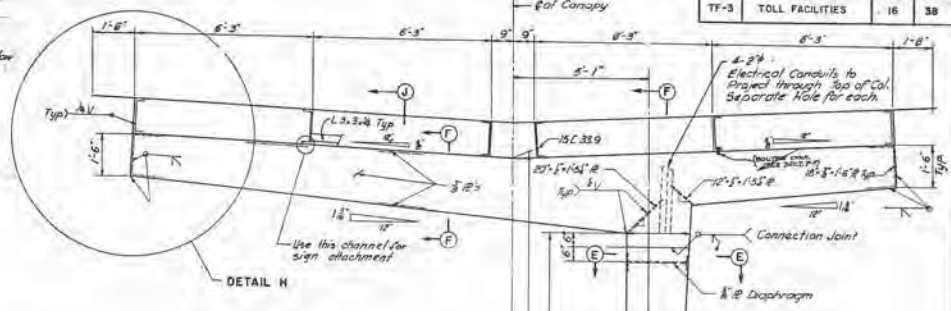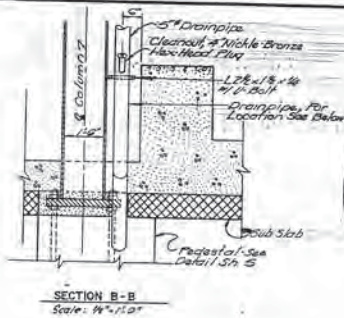

RICHMOND EXPRESSWAY SYSTEM		
SECTION	SHEET NO.	TOTAL SHEETS
TF-3	TOLL FACILITIES	16 OF 38

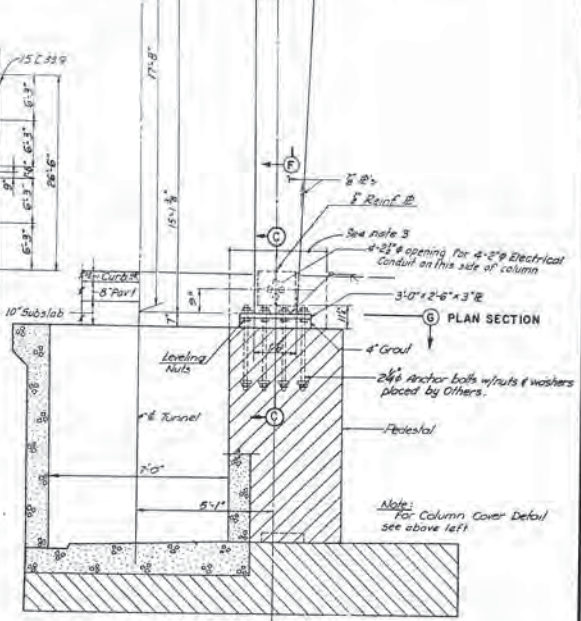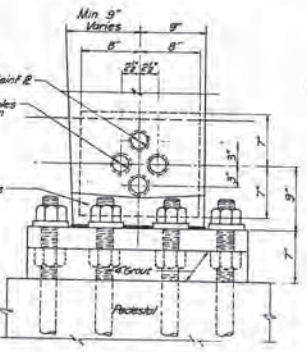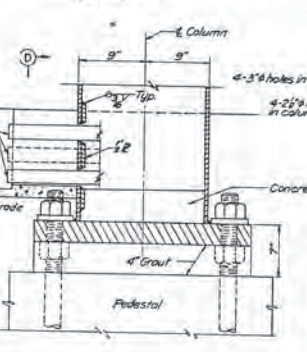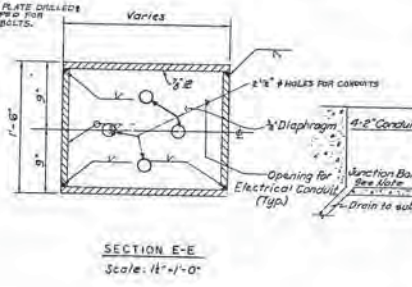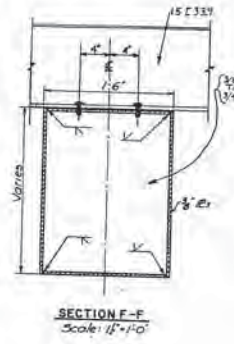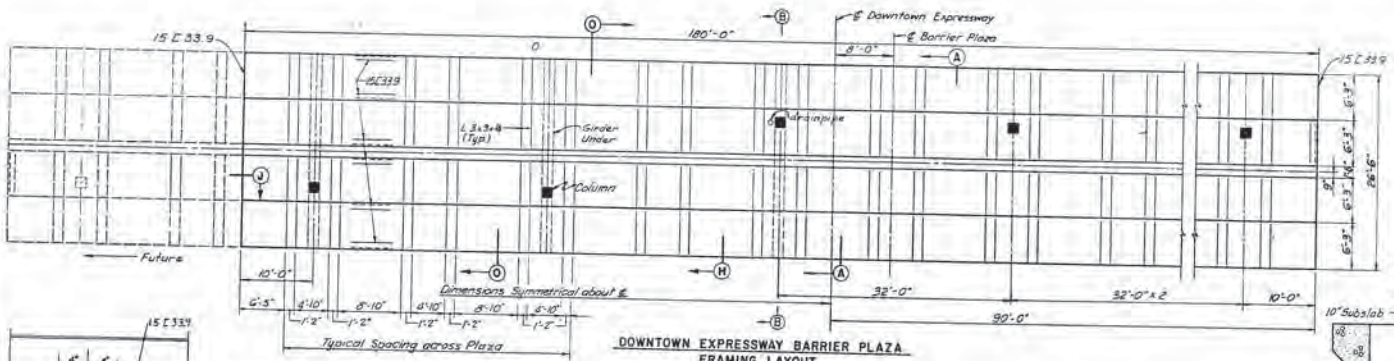

AS BUILT
RICHMOND METROPOLITAN AUTHORITY
RICHMOND EXPRESSWAY SYSTEM




CANOPY FRAMING & DETAILS

IN CHARGE	J.P.F.	NO.	REVISION	BY	DATE
MADE	KL	9-15-74			
CHECKED	KL	9-15-74	1	See Attached to RHT	3/75

HOWARD, NEEDLES, TAMMEN & BERGENDOFF
CONSULTING ENGINEERS
NEW YORK ALEXANDRIA KANSAS CITY

SCALE: As Shown
CONTRACT NO. TF-3
SHEET NO. 16 OF 38

RICHMOND EXPRESSWAY SYSTEM			
SECTION	PROJECT	SHEET NO.	TOTAL SHEETS
TF-3	UTILITY BUILDING	29	38

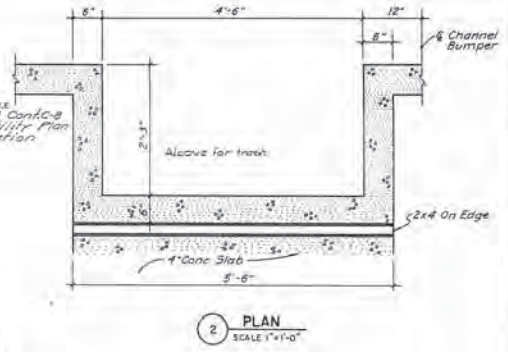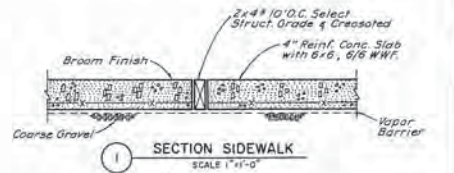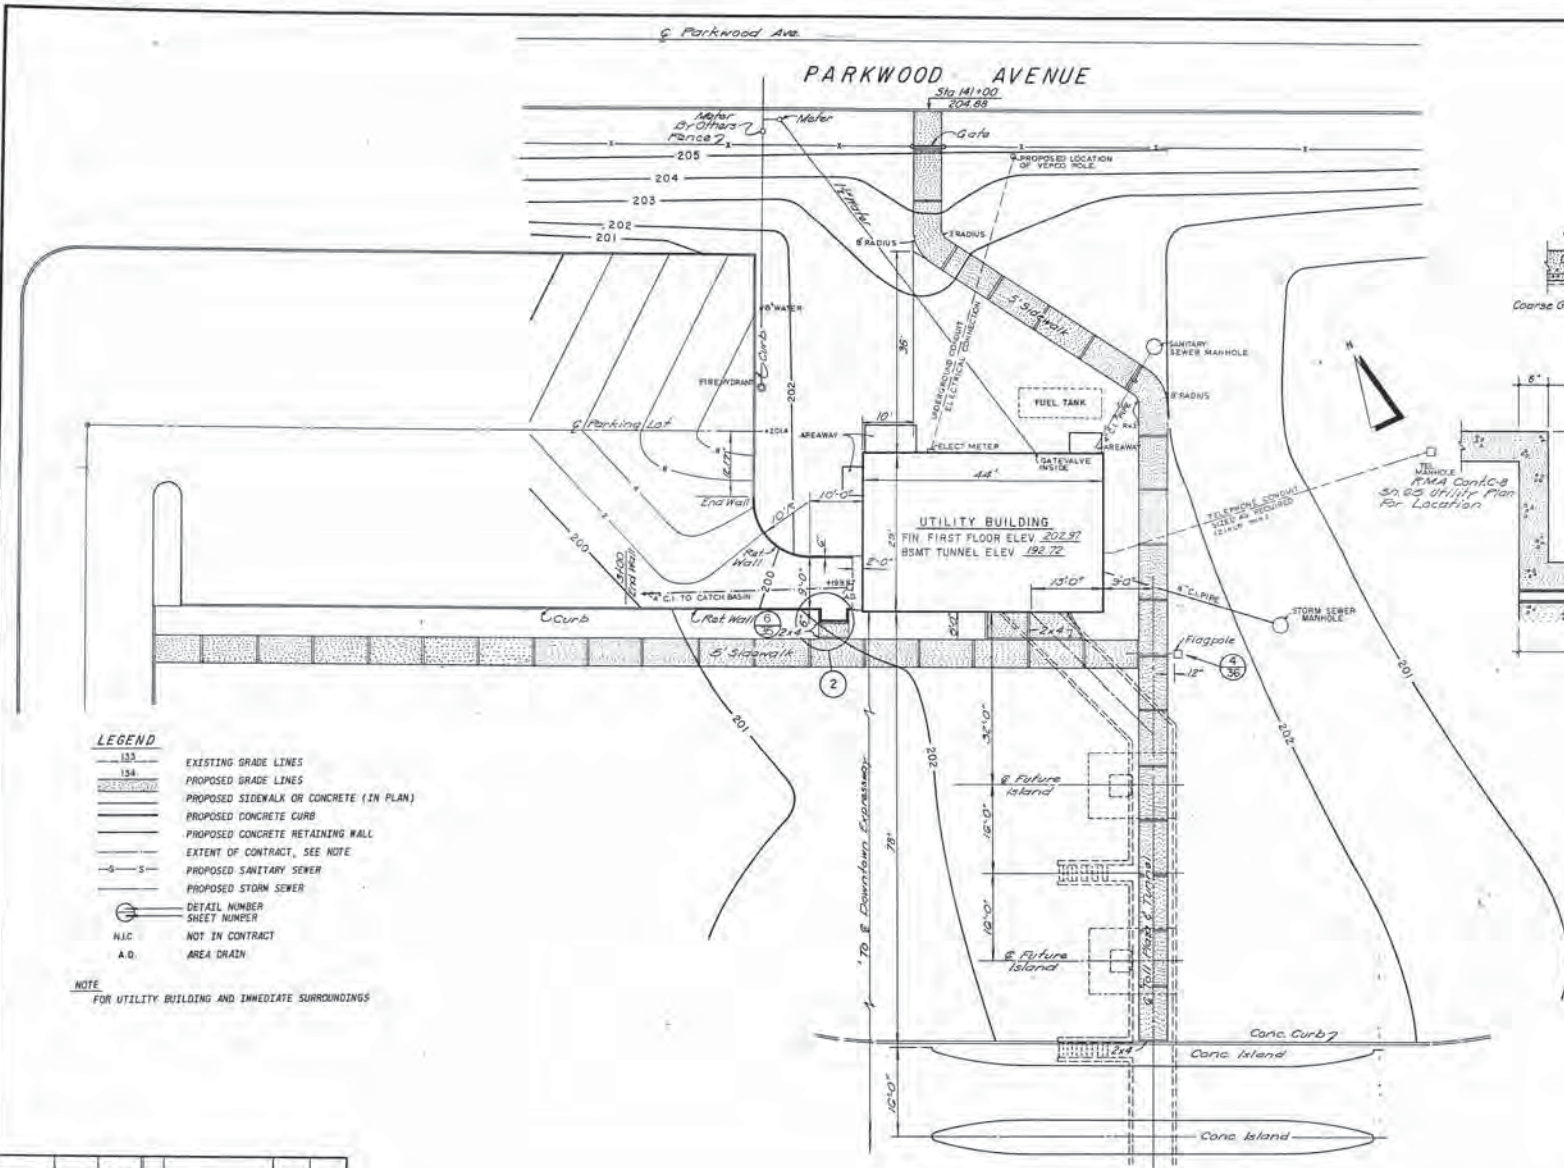

- LEGEND**
- 133 EXISTING GRADE LINES
 - 134 PROPOSED GRADE LINES
 - PROPOSED SIDEWALK OR CONCRETE (IN PLAN)
 - PROPOSED CONCRETE CURB
 - PROPOSED CONCRETE RETAINING WALL
 - EXTENT OF CONTRACT, SEE NOTE
 - PROPOSED SANITARY SEWER
 - PROPOSED STORM SEWER
 - DETAIL NUMBER SHEET NUMBER
 - N.I.C. NOT IN CONTRACT
 - A.O. AREA DRAIN

NOTE
FOR UTILITY BUILDING AND IMMEDIATE SURROUNDINGS

SITE PLAN
SCALE: 3/32"=1'-0"

AS BUILT
RICHMOND METROPOLITAN AUTHORITY
RICHMOND EXPRESSWAY SYSTEM

UTILITY BUILDING
SITE PLAN & DETAILS







SCALE As Shown	SHEET 29 OF 38
DATE Sept 15, 74	

HOWARD, NEEDLES, TAMMEN & BERENDORFF
CONSULTING ENGINEERS
Alexandria, Virginia

HNTB

DESIGNED	RL	9-15-74			
DRAWN	D.A.S.	9-15-74			
CHECKED	HL	9-15-74			
IN CHARGE	J.P.F.		NO.	REVISION	BY DATE

RICHMOND EXPRESSWAY SYSTEM			
SECTION	PROJECT	SHEET NO.	TOTAL SHEETS
TF-3	UTILITY BUILDING	32	38

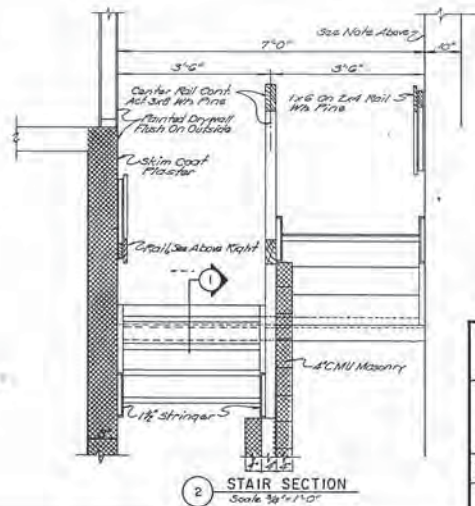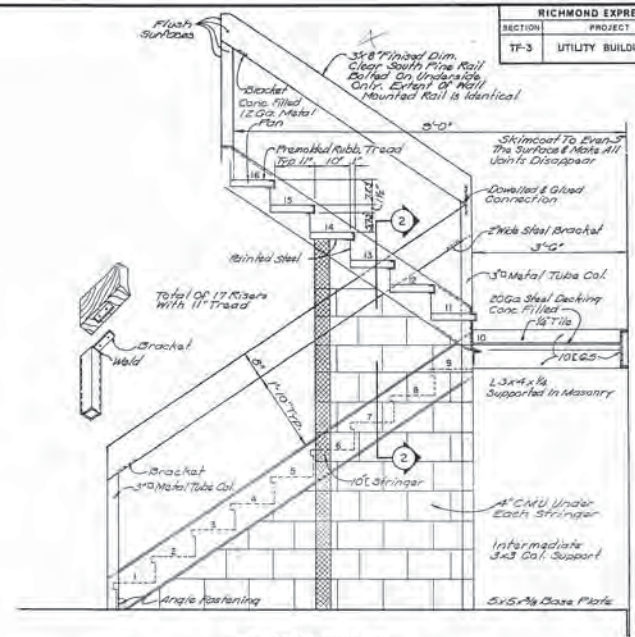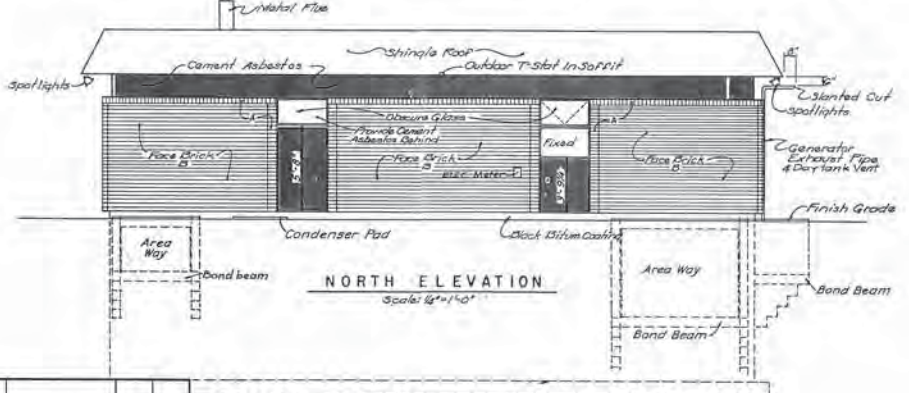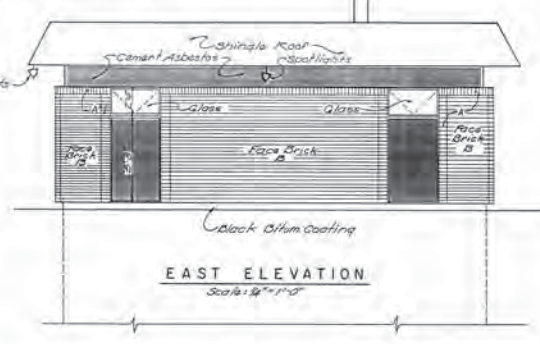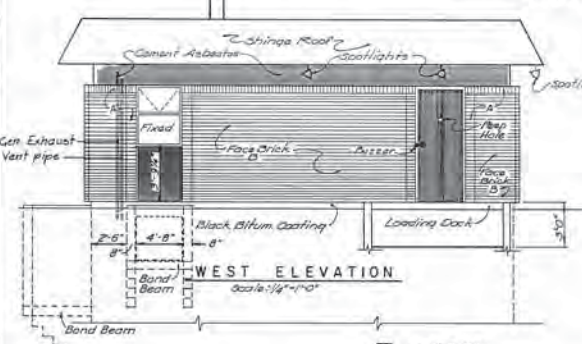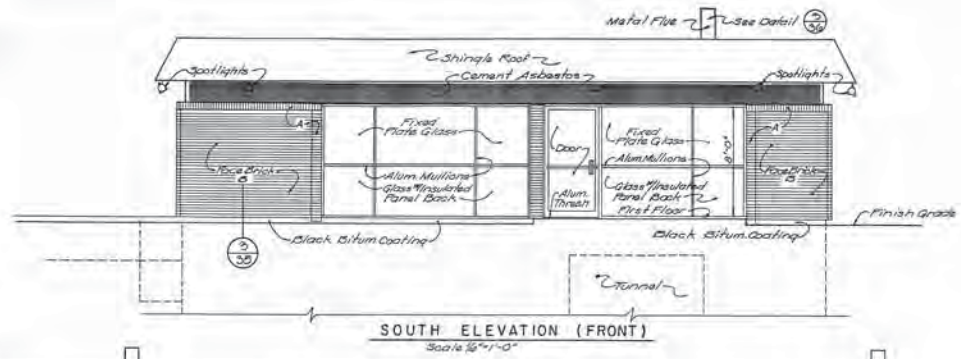

DESIGNED	KL	9-15-74			
DRAWN	OAS	9-15-74			
CHECKED	KL	9-15-74			
IN CHARGE	JRF		NO	REVISION	BY DATE

AS BUILT

RICHMOND METROPOLITAN AUTHORITY
RICHMOND EXPRESSWAY SYSTEM

UTILITY BUILDING
ELEVATIONS & SECTIONS

SCALE As Shown
DATE Sep 19, 74

SHEET 32 OF 38



HOWARD, NEEDLES, TAMMEN & BERGENDOFF
CONSULTING ENGINEERS
Alexandria, Virginia

HNTB

RICHMOND EXPRESSWAY SYSTEM			
SECTION	PROJECT	SHEET NO.	TOTAL SHEETS
TF-3	UTILITY BUILDING	38	38

LEGEND

- ⊠ FLUORESCENT FIXTURE, LETTER INDICATES TYPE
 - ⊡ INCANDESCENT FIXTURE, LETTER INDICATES TYPE
 - ⊞ EMERGENCY LIGHT-IN CEILING
 - ⊞ EMERGENCY LIGHT-WALL MOUNTED
 - ⊞ EXIT LIGHT
 - ⊞ DIMMER
 - ⊞ DUPLEX WALL RECEPTACLE OUTLET
 - ⊞ RANGE RECEPTACLE
 - ⊞ SINGLE POLE SWITCH
 - ⊞ THREEWAY SWITCH
 - ⊞ DOOR RELEASE SYSTEM
 - ⊞ TELEPHONE OUTLET
 - ⊞ INTERCOM SYSTEM TELEPHONE OUTLET
 - ⊞ ELECTRIC CLOCK OUTLET
 - ⊞ TRANSFORMER FOR DOOR RELEASE SYSTEM
 - ⊞ PANEL BOARD
 - ⊞ WIRING CONCEALED IN WALLS OR CEILING
 - ⊞ WIRING CONCEALED IN FLOOR
 - ⊞ HOME RUN WITH PANEL & CIRC DESIGNATION
-
- ⊞ CURRENT TRANSFORMER & METERING EQUIPMENT
 - ⊞ MAIN DISTRIBUTION PANEL BOARD - P
 - ⊞ PANEL BOARD - LA
 - ⊞ PANEL BOARD - LB
 - ⊞ AUTO TRANSFER SWITCH
 - ⊞ EMERGENCY GENERATOR PANEL - LG
 - ⊞ GENERATOR CONTROL PANEL
 - ⊞ RECORDER ROOM PANEL BOARD
 - ⊞ GENERATOR SET (AS SHOWN CONTINUOUS)
 - ⊞ INTERCOM PANEL
 - ⊞ DISCONNECT SWITCH (A00A & FUSES) (ZESA)
-
- ① CIRCUL PUMP #1 (ZONE-1), 1/2 HP, 115 V, 1/2, 60-2#12
 - ② CIRCUL PUMP #2 (ZONE-2), 1/2 HP, 115 V, 1/2, 60-2#12
 - ③ CIRCUL PUMP #3 (TUNNEL), 1/2 HP, 208 V, 3/4, 60-2#12
 - ④ EXHAUST FAN (KITCHEN)
 - ⑤ EXHAUST FAN (MEN TOILET)
 - ⑥ EXHAUST FAN (WOMEN TOILET)
 - ⑦ DAMPER MOTOR #1
 - ⑧ DAMPER MOTOR #2
 - ⑨ DAMPER MOTOR #3
 - ⑩ DAMPER MOTOR #4
 - ⑪ OIL BURNER, 1/2 HP, 115 V, 1/2, 60-2#12
 - ⑫ SPARE 2#12
 - ⑬ CONDENSER WATER PUMP, 208 V, 3/4, 60-2#12
 - ⑭ CONDENSER UNIT #1 (3 HP, 208 V)
 - ⑮ CONDENSER UNIT #2 (3 HP, 208 V)
 - ⑯ A/C AIR HANDLING UNIT #1 (HP)
 - ⑰ HYAC UNIT (1 HP)
 - ⑱ GENERATOR DAY TANK PUMP

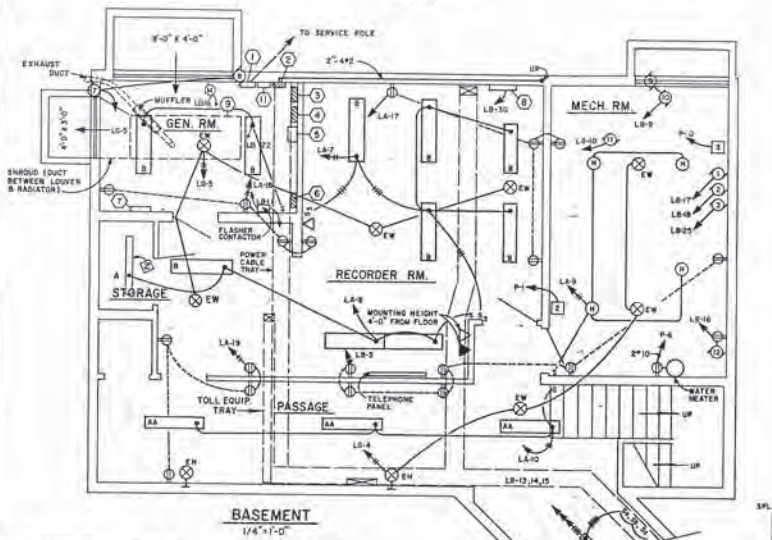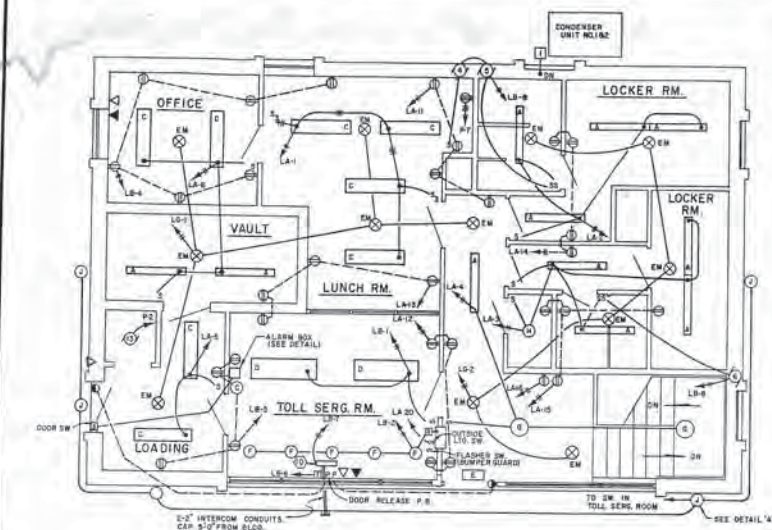

MAIN DISTRIBUTION PANEL-P

CIRC NO.	POLE	TRIP	DESCRIPTION
1	2	20 A	AC UNIT #3 (2HW)
2	2	20 A	SPARE
3	2	20 A	SPARE
4	3	20 A	SPARE
5	3	50 A	KITCHEN UNIT 8.5 KW
6	2	30 A	ELECT. W.H. UTILITY (A.W.)
7	2	25 A	DISH WASTER
8	2	20 A	A/C UNIT
9	3	30 A	SPARE
10	3	50 A	HVAC UNIT (THP & 10KW)
11	3	50 A	SPARE
12	3	150 A	CONDENSERS, #1 & 2 (6A3.0KW)
14	3	150 A	PANEL BOARD LA
15	3	150 A	PANEL BOARD LB
16	3	SPACE	
17	3	SPACE	

PANEL BOARD-LB

CIRC NO.	POLE	TRIP	DESCRIPTION
1	1	20 A	LTG. 1ST FLOOR
2,4,5	1	20 A	RECEPT. 1ST FLOOR & BASEMENT DR ALARM
6	1	20 A	DOOR RELEASE SYSTEM
7	1	20 A	INTERCOM PANEL
8	1	20 A	EXHAUST FAN (THREE)
9	1	20 A	DAMPER MOTORS #3 & 4
10	1	20 A	OIL BURNER
11	1	20 A	FLASHER CONTACTOR (BUMPER GUARD)
12	1	20 A	TUNNEL HEATER FANS (THREE)
13,14,16	1	20 A	LIGHTING TUNNEL (A/B LIGHTS)
15	1	20 A	LIGHTING TUNNEL (A/B LIGHTS)
17	1	20 A	CIRCULATOR PUMP #1
18	1	20 A	CIRCULATOR PUMP #2
19	1	20 A	STAIRCASE LTG. (TUNNEL)
20	3	50 A	AIR COMPRESSOR (CONTROL)
21	1	20 A	SPARE
22	1	20 A	LIGHTS GENERATOR RM
23	1	20 A	LIGHTING TUNNEL (C LIGHTS)
24	1	20 A	SPARE
25	3	20 A	CIRCULATOR PUMP #3 (TUNNEL)
26	3	50 A	TOLL ISLAND "E"
27	3	50 A	P/RO-P (RECORD RM)
28	3	50 A	TOLL ISLANDS "F" & "H"
29	3	50 A	TOLL ISLAND "G"
30	3	50 A	TOLL ISLAND "I"
31	3	50 A	TOLL ISLAND "J"
32	3	50 A	TOLL ISLAND "M"
33	3	50 A	TOLL ISLANDS "O" & "N"
34	3	50 A	TOLL ISLAND "Q"

PANEL BOARD-LA

CIRC NO.	POLE	TRIP	DESCRIPTION
1	1	20 A	LTG. 1ST FLOOR
2	1	20 A	LTG. BASEMENT
3	1	20 A	RECEPTACLES 1ST FLOOR
4	1	20 A	ELECT. WATER COOLER
5	1	20 A	RECEPTACLES BASEMENT
6	1	20 A	OUTSIDE FLOOD LIGHTING
7	1	20 A	SPARE
8	1	20 A	SPARE
9	1	20 A	SPARE
10	1	20 A	SPARE
11	1	20 A	SPARE
12	1	20 A	SPARE
13	1	20 A	SPARE
14	1	20 A	SPARE
15	1	20 A	SPARE
16	1	SPACE	
17	1	SPACE	



PANEL BOARD - R

CIRC NO.	POLE	TRIP	DESCRIPTION
1	1	20 A	RECORDER ROOM CIRCS.
2	1	20 A	SPARE

PANEL BOARD - LG

CIRC NO.	POLE	TRIP	DESCRIPTION
1	1	20 A	LTG. 1ST FLOOR (EMG)
2	1	20 A	LTG. 1ST FLOOR (EMG)
3	1	20 A	LTG. BASEMENT (EMG)
4	1	20 A	LTG. BASEMENT (EMG)
5	1	20 A	DAMPER MOTORS #1 & 2
6	1	20 A	SPARE
7	1	20 A	SPARE
8	1	SPACE	
9	1	SPACE	
10	1	SPACE	

GENERAL NOTES:
 FOR LIGHTING: FIXTURE SCHEDULE SEE SPEC'S
 TOLL ISLAND: 2' BETWEEN LANES 10 & 11 REQUIRES NO INDIVIDUAL CT

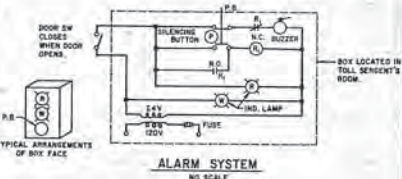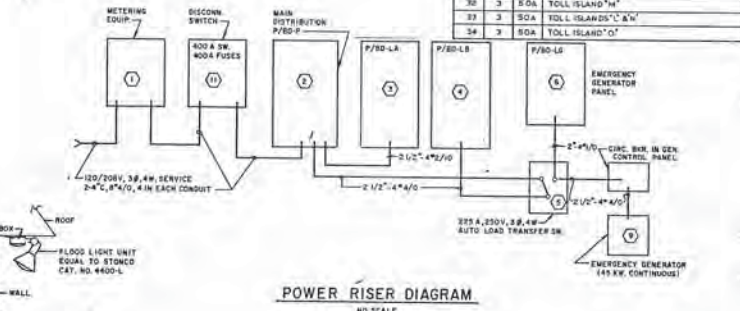

AS BUILT

RICHMOND METROPOLITAN AUTHORITY
RICHMOND EXPRESSWAY SYSTEM

UTILITY BUILDING
ELECTRICAL

SCALE AS NOTED
 DATE _____ SHEET 38 OF 38


HOWARD, NEEDLES, TAMMEN & BERENDORFF
 CONSULTING ENGINEERS
 Alexandria, Virginia

HNTB


DESIGNED				
DRAWN				
CHECKED				
IN CHARGE				

DOWNTOWN EXPRESSWAY (DTE) OPEN ROAD TOLLING


ORIGINAL PLANS

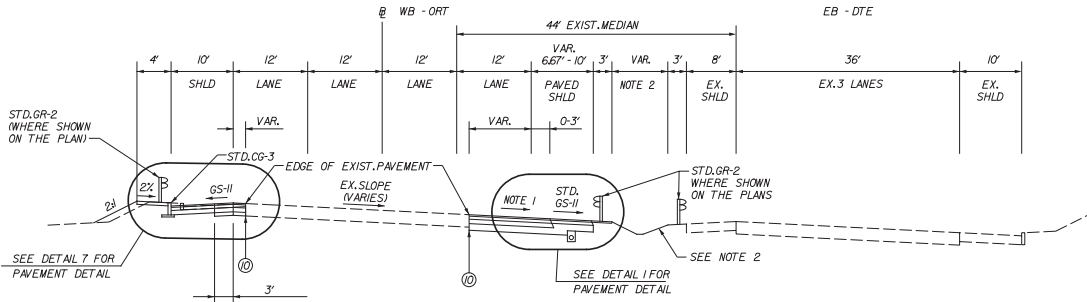

STA. 103+25 TO 104+95 ONLY
WB-ORT (RTE. 195)
Sta. 100+00.00 to Sta. 113+86.26 RT.
Sta. 114+69.23 to Sta. 115+00.00 RT.
Sta. 103+25.00 to Sta. 104+95.00 LT.

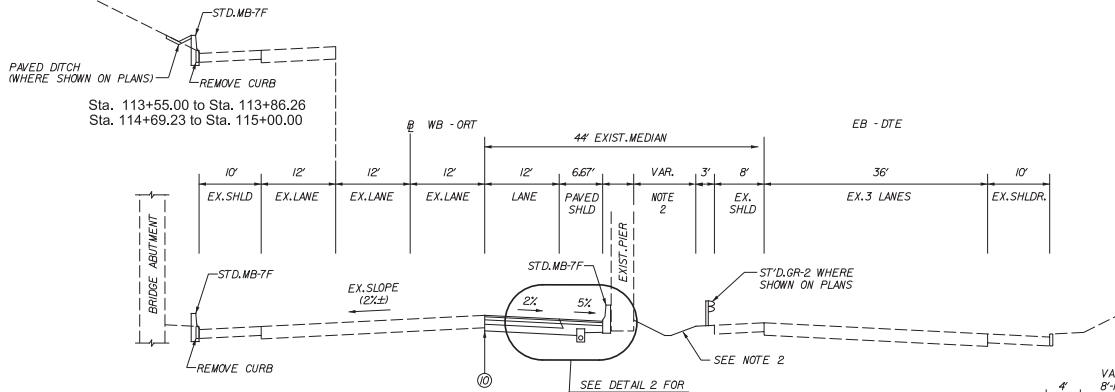

WB-ORT AT MEADOW STREET BRIDGE
Sta. 113+86.26 to Sta. 114+69.23 RT.
Sta. 113+55.00 to Sta. 115+00.00 LT.

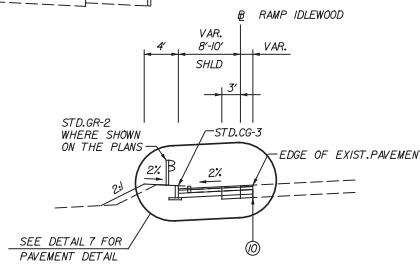


RAMP IDLEWOOD
Sta. 10+00.00 to Sta. 15+32.07

LEGEND

- | | |
|---|---|
| ① SURFACE COURSE, 1 1/2 IN. ASPHALT CONCRETE TYPE SMA-95 @ 165 LBS./SY. | ⑩ SAWCUT |
| ② INTERMEDIATE COURSE, 2.0 IN. ASPHALT CONCRETE TYPE IM-19.0A | ⑪ 1 1/2 IN. ASPHALT CONCRETE TYPE SMA-95A @ 165 LBS./SY. |
| ③ INTERMEDIATE COURSE, 3.0 IN. ASPHALT CONCRETE TYPE SMA-19.0 | ⑫ 3 IN. ASPHALT CONCRETE TYPE IM-19.0A |
| ④ BASE COURSE, 4.0 IN. ASPHALT CONCRETE TYPE BM-25.0A | ⑬ LEVELING COURSE, VAR. DEPTH ASPHALT CONCRETE TYPE SMA-19.0, 2" MIN. |
| ⑤ SUBBASE, 6.0 IN. UNTREATED AGGREGATE MATERIAL TYPE I, SIZE NO. 21-B | ⑭ REMOVE AND REPLACE EXISTING PAVEMENT ALONG THE EDGE AS SHOWN IN YDOT STD.WP-2. SEE DETAIL 9 SHIT 2(3) FOR REPLACED PAVEMENT |
| ⑥ MILL EXISTING PAVEMENT TO A DEPTH OF 1.5 IN. AND OVERLAY WITH ASPHALT CONCRETE TYPE SMA-95 @ 165 LBS./SY. | ⑮ VAR. DEPTH, ASPHALT CONCRETE TYPE BM-25.0, 3" MIN. |
| ⑦ STD.UD-4 UNDERDRAIN REQ'D. | ⑯ NOT USED |
| ⑧ SUBBASE, VAR. THICKNESS, UNTREATED AGGREGATE MATERIAL TYPE I, SIZE NO. 21-B | ⑰ HYDRAULIC CEMENT CONCRETE SIDEWALK, # |
| ⑨ SUBBASE, 4.0 IN. UNTREATED AGGREGATE MATERIAL TYPE I, SIZE NO. 21-B | ⑱ NOT USED |
| | ⑲ SURFACE COURSE, VAR. DEPTH ASPHALT CONCRETE TYPE SMA-9.5, 1.5" MIN. |


NOTES

- SEE PROFILES FOR CROSS SLOPES.
- SEE CROSS SECTIONS FOR DITCH LOCATIONS AND INVERTS.
- SEE SHEET 21(3) FOR DITCH TYPICAL SECTION.

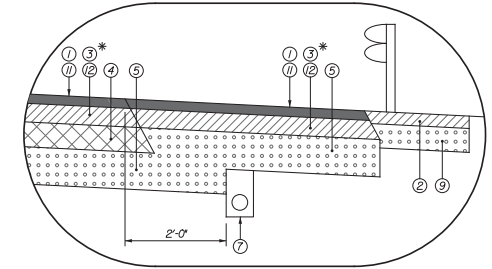


* USE ① & ② WB ORT STA. 100+00 TO 115+00
USE ① & ③ WB ORT STA. 115+00 TO END OF PROJECT

DETAIL 1
NTS

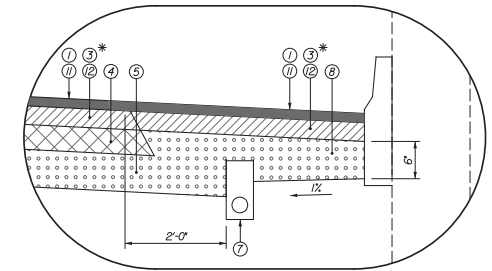

DETAIL 2
NTS

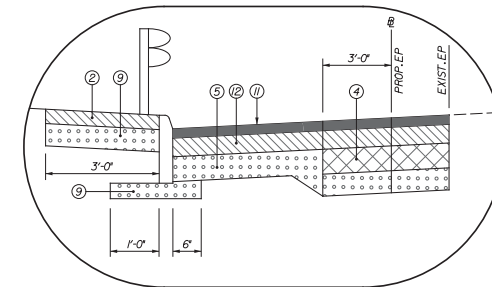











DETAIL 7
NTS

DATE: 05/15/14
TIME: 09:40 AM
USER: JLM


REVISIONS




HNTB 2900 S. QUINCY STREET, SUITE 200 ARLINGTON, VIRGINIA (703) 824-5100	Richmond Metropolitan Authority RICHMOND DOWNTOWN EXPRESSWAY	
	DOWNTOWN EXPRESSWAY OPEN ROAD TOLLING TYPICAL SECTIONS	
Scale: 1"=10'-0"	Date: FEB. 25, 2011	Contract No.: DTEORH-2011
		Sheet: 2(1)

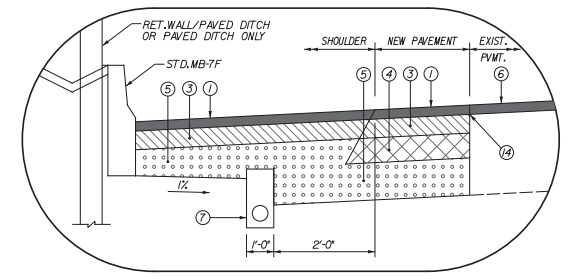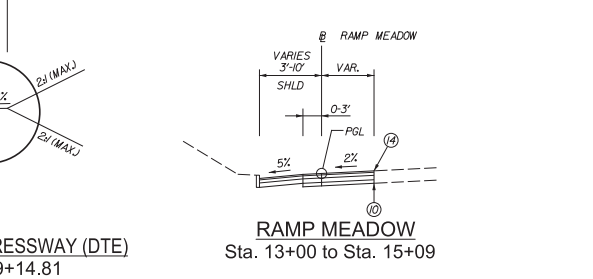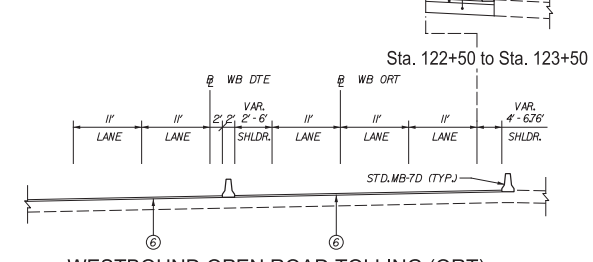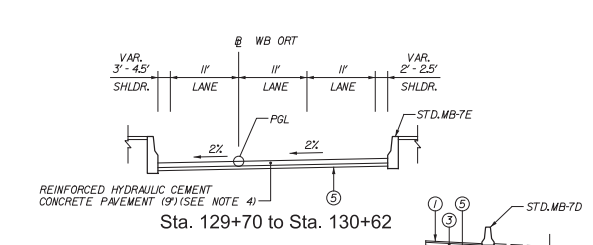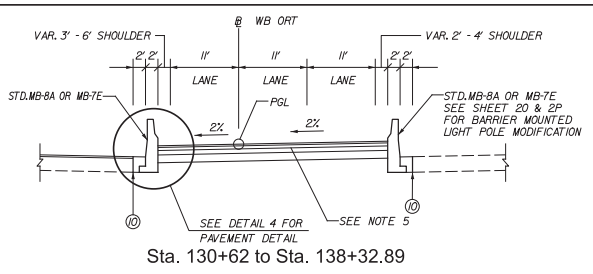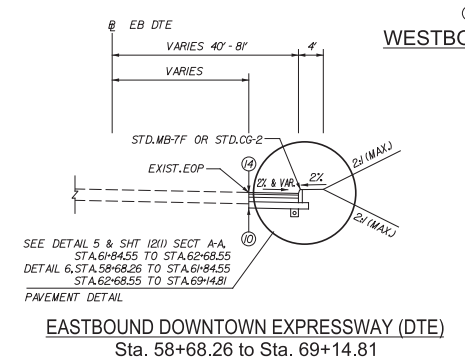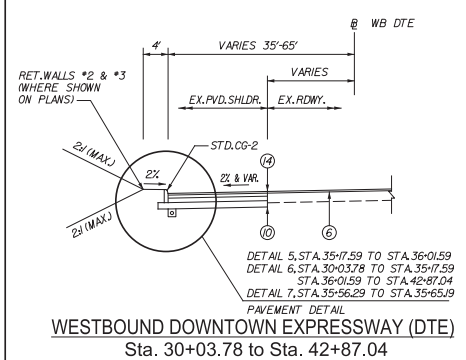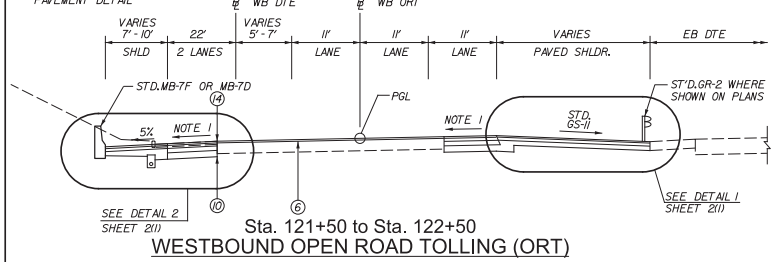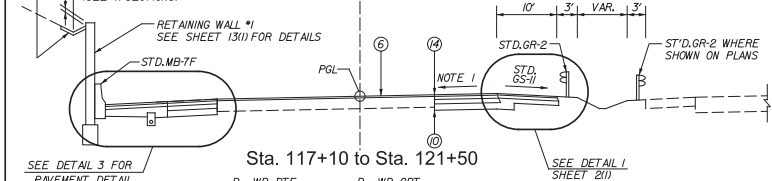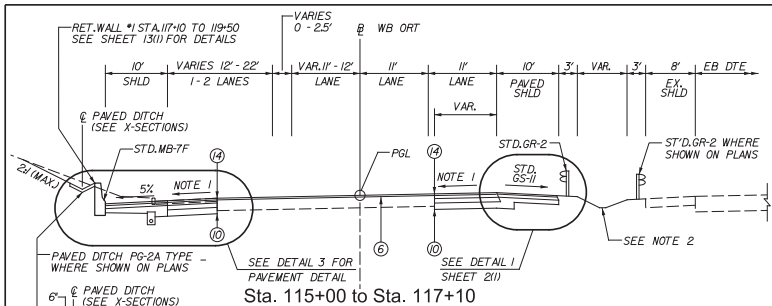


DETAIL 3
NTS

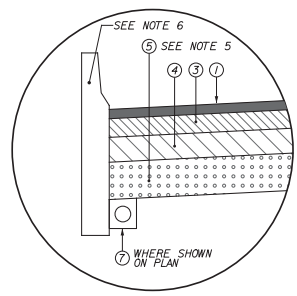


DETAIL 4
NTS

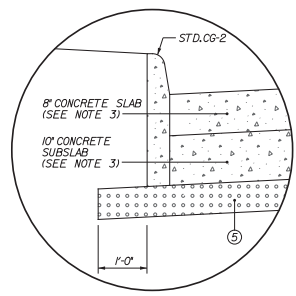

DETAIL 5
NTS

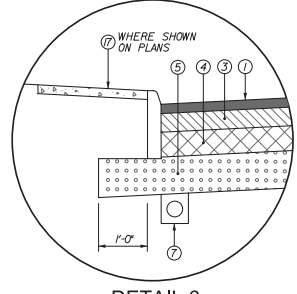

DETAIL 6
NTS

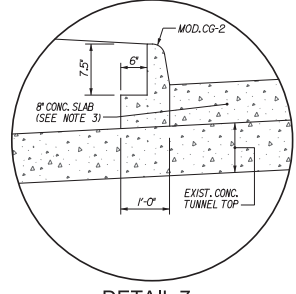

DETAIL 7
NTS

LEGEND

- (1) SURFACE COURSE, 1 1/2 IN. ASPHALT CONCRETE TYPE SMA-9.5 @ 165 LBS./SY.
- (2) INTERMEDIATE COURSE, 2.0 IN. ASPHALT CONCRETE TYPE IM-190A
- (3) INTERMEDIATE COURSE, 3.0 IN. ASPHALT CONCRETE TYPE SMA-190
- (4) BASE COURSE, 4.0 IN. ASPHALT CONCRETE TYPE BM-250A
- (5) SUBBASE, 6.0 IN. UNTREATED AGGREGATE MATERIAL TYPE 1, SIZE NO. 21-B
- (6) MILL EXISTING PAVEMENT TO A DEPTH OF 1.5" AND OVERLAY WITH ASPHALT CONCRETE TYPE SMA-9.5 @ 165 LBS./SY.
- (7) STD. UD-4 UNDERDRAIN
- (8) SUBBASE, VAR. THICKNESS, UNTREATED AGGREGATE MATERIAL TYPE 1, SIZE NO. 21-B
- (9) SUBBASE, 4.0 IN. UNTREATED AGGREGATE MATERIAL TYPE 1, SIZE NO. 21-B
- (10) SAWCUT
- (11) 1 1/2 IN. ASPHALT CONCRETE TYPE SMA-9.5 @ 165 LBS./SY.
- (12) 3 IN. ASPHALT CONCRETE TYPE IM-190A
- (13) LEVELING COURSE, VAR. DEPTH ASPHALT CONCRETE TYPE SMA-190, 2" MIN.
- (14) REMOVE AND REPLACE EXISTING PAVEMENT ALONG THE EDGE AS SHOWN IN VDOT STD. WP-2. SEE DETAIL 9 SHT 2(3) FOR REPLACED PAVEMENT
- (15) VAR. DEPTH, ASPHALT CONCRETE TYPE BM-250, 3" MIN.
- (16) NOT USED
- (17) HYDRAULIC CEMENT CONCRETE SIDEWALK, 4"
- (18) NOT USED
- (19) SURFACE COURSE, VAR. DEPTH ASPHALT CONCRETE TYPE SMA-9.5, 1.5" MIN.

NOTES

1. SEE PROFILES FOR CROSS SLOPES.
2. SEE CROSS SECTIONS FOR DITCH LOCATIONS AND INVERTS.
3. SEE TOLL PLAZA PLANS FOR PAVEMENT DETAILS. 10' SLAB NOT REQ'D. OVER EXISTING TUNNEL.
4. SEE SHEET 2M FOR DETAILS.
5. ASPHALT LAYERS SHALL BE PLACED UPON EXISTING CONCRETE SLAB FROM STATION 130+62 TO 134+47.
6. STD. MB-7 & MB-8A BARRIER SHALL BE DOWELLED TO EXISTING 10" CONC. SLAB STA. 130+62 TO 134+47 IN ACCORDANCE WITH STD. MB-7D. COST FOR DOWELLING SHALL BE INCIDENTAL TO THE COST OF CONC. BARRIER.



richmond metropolitan authority
RICHMOND DOWNTOWN EXPRESSWAY



DOWNTOWN EXPRESSWAY OPEN ROAD TOLLING
TYPICAL SECTIONS

HNTB
2800 S. QUINCY STREET, SUITE 200
ARLINGTON, VIRGINIA
(703) 824-5100

Scale: 1"=10'-0" Date: FEB. 25, 2011 Contract No.: DTEOR1-2011 Sheet: 2(2)

04/25/2011 4:41 PM Tuesday, September 20, 2011

9-611 REVISED WHITE & EBOTE SECTIONS AND NOTE 3 ADDED DETAIL 7.
REVISIONS

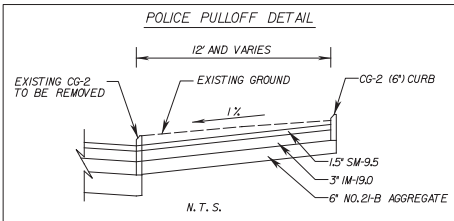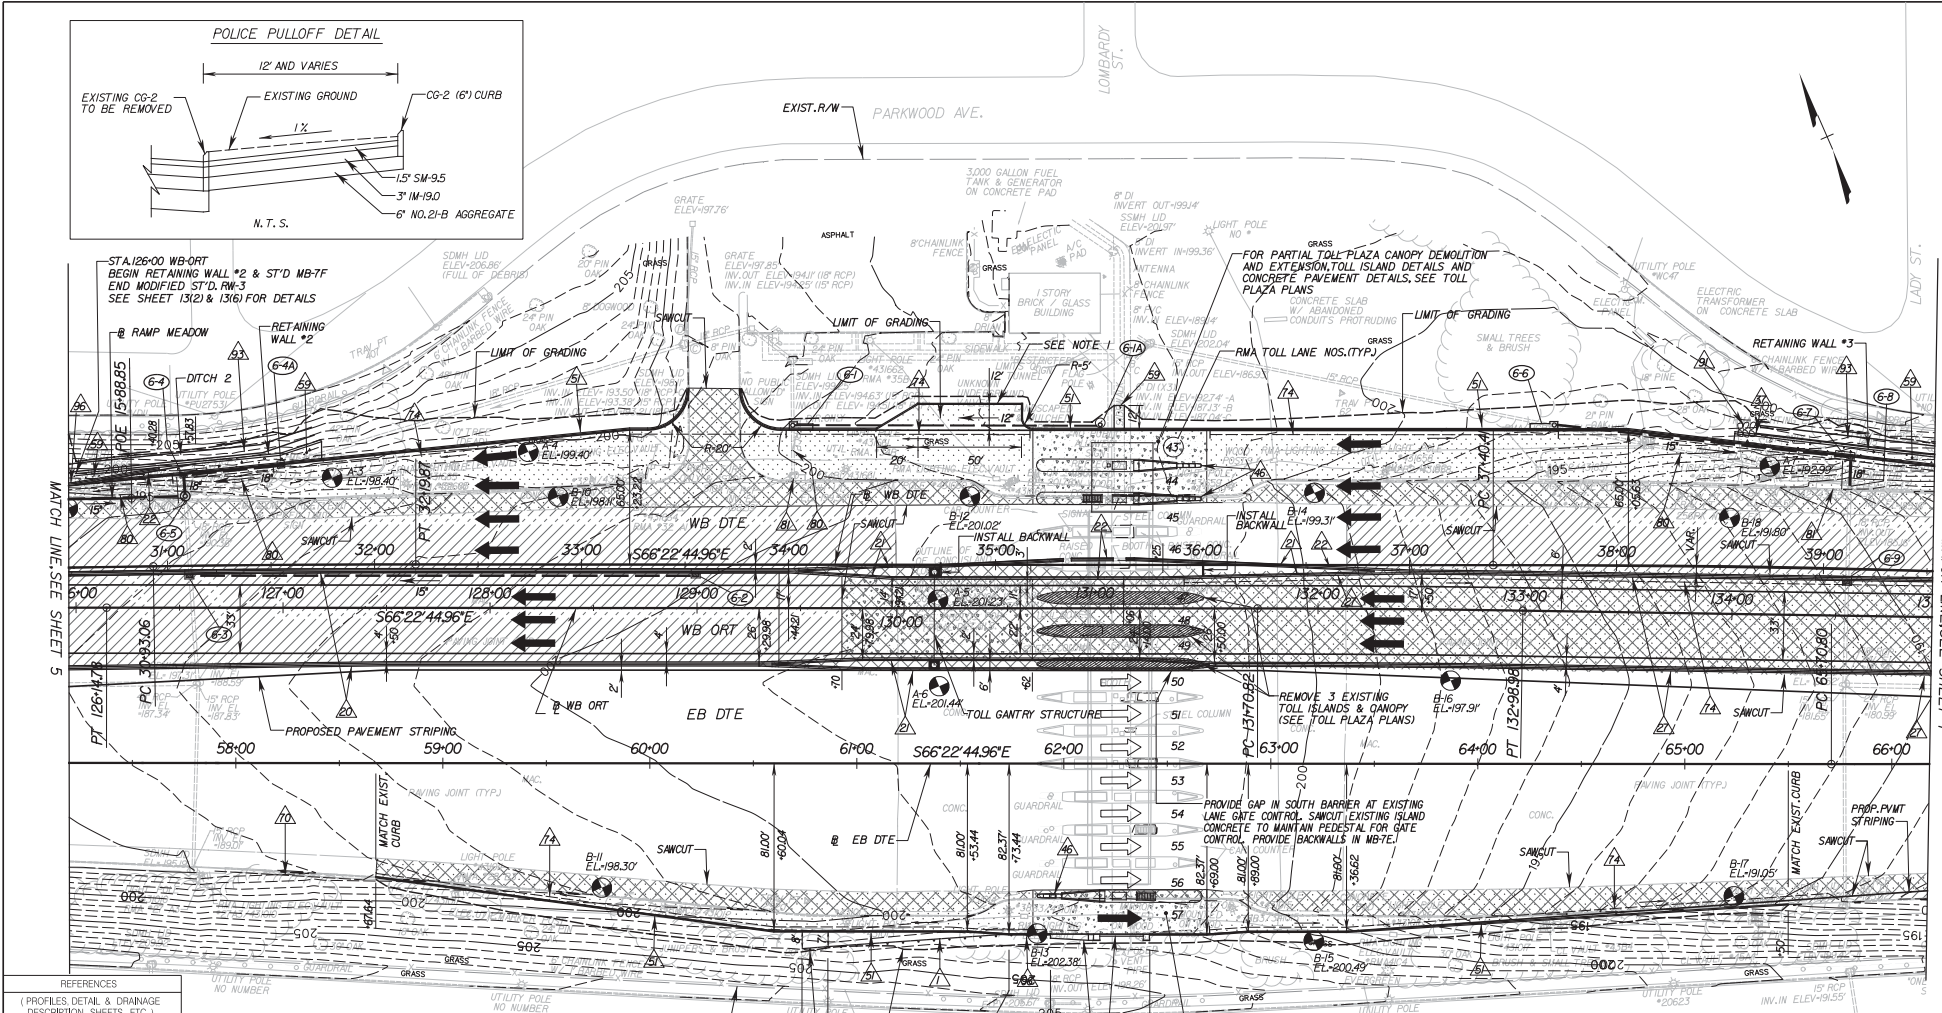

MATCH LINE SEE SHEET 5

MATCH LINE SEE SHEET 7

REFERENCES

- (PROFILES DETAIL & DRAINAGE DESCRIPTION SHEETS, ETC.)
- LEGEND**
- GEOMETRIC LAYOUT PLAN 1K(1)
- TYPICAL SECTIONS 2(2)
- E&S PLAN - PHASE I 6(1)
- E&S PLAN - PHASE II 6(2)
- PROFILE WB-ORT 6A
- PROFILE EB-DTE 6B
- PROFILE WB-DTE 6C
- TOLL PLAZA PLANS 12(1)-12(14)
- DRAINAGE TABULATIONS 1K
- RET. WALLS #2 & #3 13(2)
- MEDIAN BARRIER PROFILES 20
- MEDIAN BARRIER DETAILS 20(2P)
- IMPACT ATTENUATOR 20(1)

CONSTRUCTION NOTE LEGEND

- △ ST'D. GR-2 GUARDRAIL
- △ ST'D. GR-6 GUARDRAIL TERMINAL
- △ ST'D. FOA-2 FIXED OBJECT ATTACHMENT TYPE 1
- △ ST'D. MB-7D - 32" CONCRETE MEDIAN BARRIER
- △ ST'D. MB-7E - 32" CONCRETE MEDIAN BARRIER
- △ ST'D. MB-7F - 32" CONCRETE MEDIAN BARRIER
- △ ST'D. MB-8A - 32" CONCRETE BIFURCATED MEDIAN BARRIER (3 TO 4 BIFURCATED)
- △ CAST-IN PLACE RETAINING WALL
- △ IMPACT ATTENUATOR (TL-3 >45 MPH DES.SP)
- △ IMPACT ATTENUATOR (TL-2 <45 MPH DES.SP)
- △ ST'D. CG-2 CURB
- △ HYDRAULIC CEMENT CONCRETE SIDEWALK #4
- △ NON-PERFORATED OUTLET PIPE
- △ ST'D. UD-4 UNDERDRAIN
- △ REMOVE EXISTING PIPE
- △ REMOVE EXISTING DRAINAGE STRUCTURE
- △ CLASS I DRY RIPRAP
- △ PAVED DITCH PG-2A, TYPE E
- △ ST'D. FOA-1 FIXED OBJECT ATTACHMENT TYPE 1

PAVEMENT LEGEND

- PROPOSED ASPHALT SHOULDER
- PROPOSED ASPHALT PAVEMENT
- PROPOSED CONCRETE PAVEMENT
- PROPOSED ASPHALT PAVING & OVERLAY
- DEMOLITION OF PAVEMENT

NOTE:
I. CONTRACTOR SHALL REFER TO POLICE PULLOFF DETAIL



SEE SHEET 6(3) FOR FURTHER TOLL PLAZA DETAILS

RM RICHMOND METROPOLITAN AUTHORITY
RICHMOND DOWNTOWN EXPRESSWAY


ROADWAY PLAN
STA. 126+00.00 TO STA. 135+00.00 WB ORT

HNTB

2900 S. QUINCY STREET, SUITE 200
ARLINGTON, VIRGINIA
(703) 824-5100

Scale: 1"=30'-0"
Date: FEB. 25, 2011
Contract No.: DTEOR-1-2011
Sheet: 6


P&S 15036 - Oct 2010
W-15036-01 - October 03, 2012

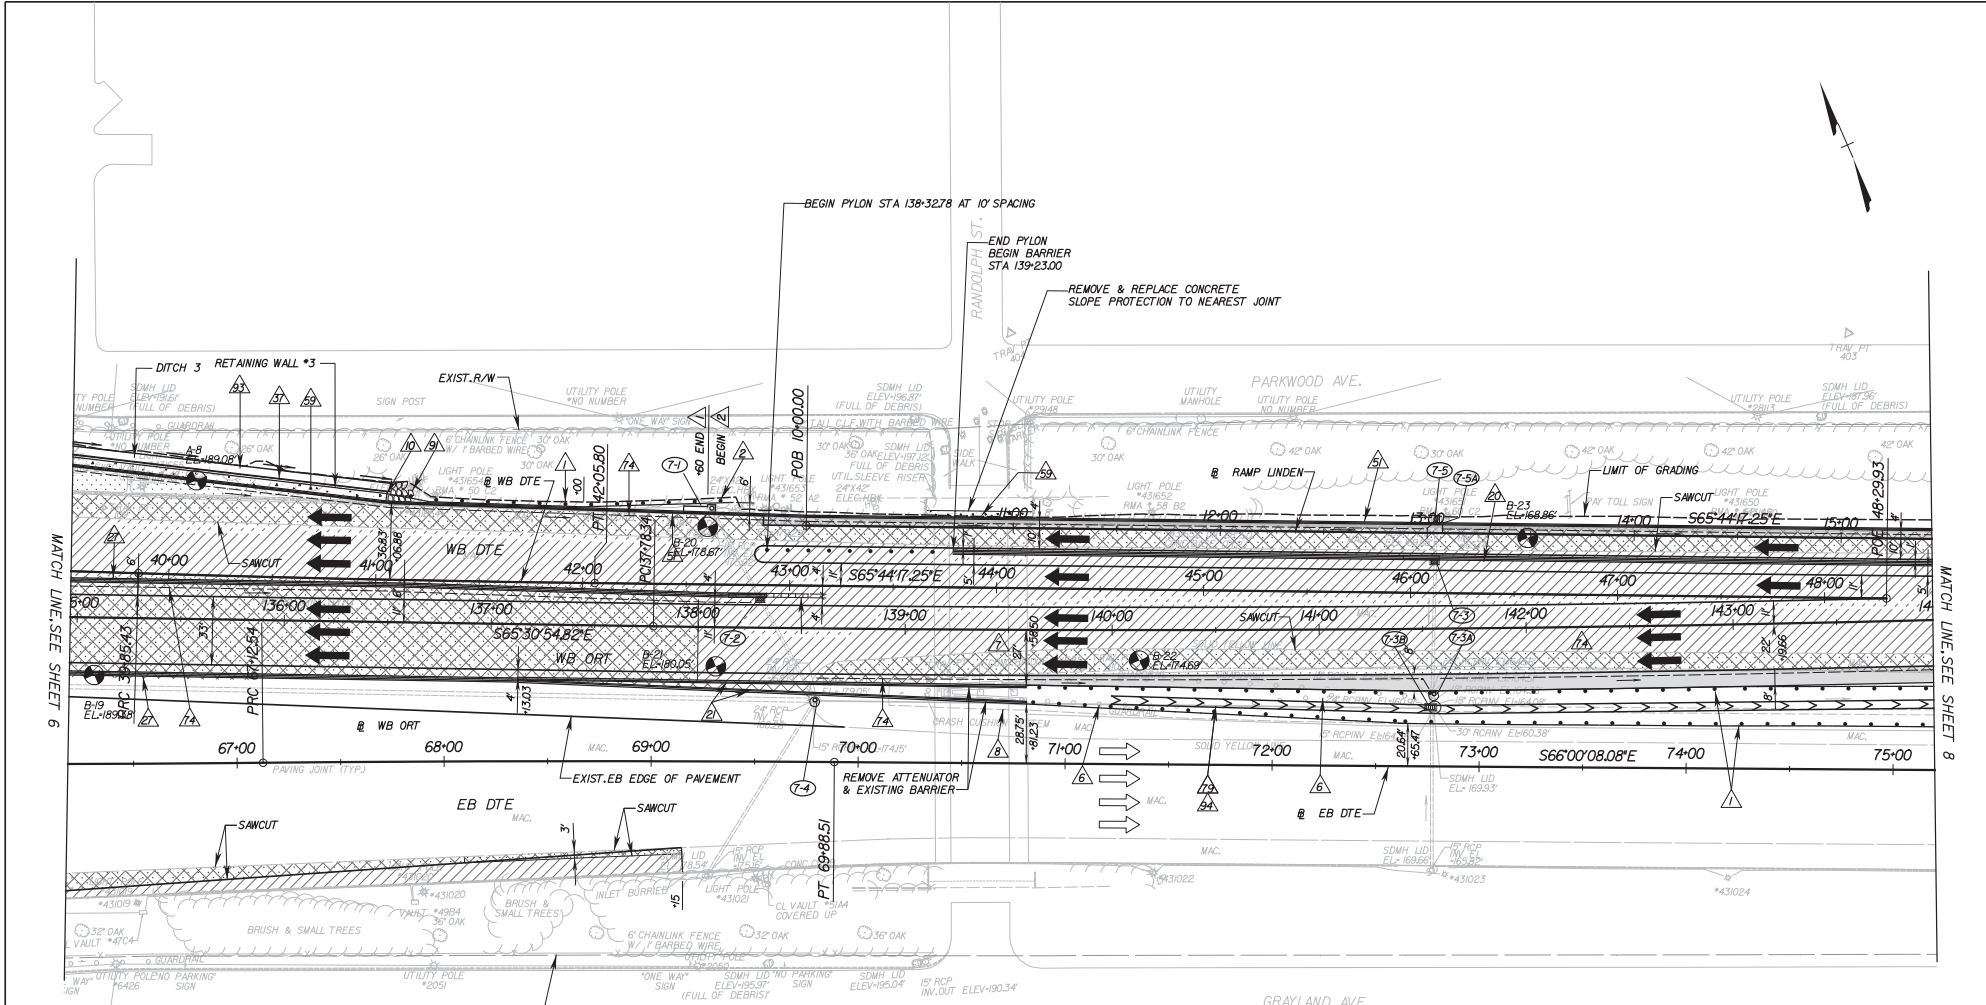

REFERENCES	
(PROFILES DETAIL & DRAINAGE DESCRIPTION SHEETS, ETC.)	
LEGEND	
GEOMETRIC LAYOUT PLAN	16(1)
TYPICAL SECTIONS	2(3)
E&S PLAN - PHASE I	7(1)
E&S PLAN - PHASE II	7(2)
PROFILE WB-ORT	7A
PROFILE EB-DTE	7B
PROFILE WB-DTE	7C
PROFILE RAMP LINDEN	7D
DRAINAGE TABULATIONS	1K
RETAINING WALL #3	13(2)
MEDIAN BARRIER PROFILES	2D
MEDIAN BARRIER DETAILS	2M2P
IMPACT ATTENUATOR	2D(1)
10-B-12 REVISED BARRIER ON RAMP, ADDED PYLONS 3A REVISED BARRIER RIGHT OF WB-ORT BASELINE	
REVISIONS	

CONSTRUCTION NOTE LEGEND	
	ST'D.GR-2 GUARDRAIL
	ST'D.GR-6 GUARDRAIL
	REMOVAL OF EXISTING GUARDRAIL
	ST'D.FOA-2 FIXED OBJECT ATTACHMENT TYPE I
	ST'D.FOA-2 FIXED OBJECT ATTACHMENT TYPE II
	ST'D.FOA-1 FIXED OBJECT ATTACHMENT TYPE I
	ST'D.MB-7D - 32" CONCRETE MEDIAN BARRIER
	ST'D.MB-7E - 32" CONCRETE MEDIAN BARRIER
	ST'D.MB-8A - 32" CONCRETE, BIFURCATED MEDIAN BARRIER (10 TO 4' BIFURCATED)
	CONCRETE GRAVITY WALL (RW-3)
	IMPACT ATTENUATOR (TL-3) 45mph DESIGN SPEED
	ST'D.CG-2 CURB
	HYDRAULIC CEMENT CONCRETE SIDEWALK, 4"
	ST'D.UD-4 UNDERDRAIN
	ST'D.EC-2 PROTECTIVE COVERING
	CLASS I DRY RIPRAP
	PAVED DITCH PG-2A, TYPE E
	GRADED FLAT BOTTOM DITCH

PAVEMENT LEGEND	
	PROPOSED ASPHALT SHOULDER
	PROPOSED ASPHALT PAVEMENT
	PROPOSED CONCRETE PAVEMENT
	PROPOSED ASPHALT PLANING & OVERLAY
	DEMOLITION OF PAVEMENT

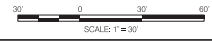

RM RICHMOND METROPOLITAN AUTHORITY
RICHMOND DOWNTOWN EXPRESSWAY

DOWNTOWN EXPRESSWAY OPEN ROAD TOLLING


HNTB
ROADWAY PLAN
STA. 135+00.00 TO STA. 144+00.00 WB ORT

2900 S. QUINCY STREET, SUITE 200
ARLINGTON, VIRGINIA
(703) 824-5100

Scale: 1"=30'-0"
Date: FEB. 25, 2011
Contract No.: DTEOR-2011
Sheet: 7

04/25/2017 04:16
Tuesday, October 02, 2012

Level: Check, Print Stamp, Originator, Checker, Rechecked, Validator, Date

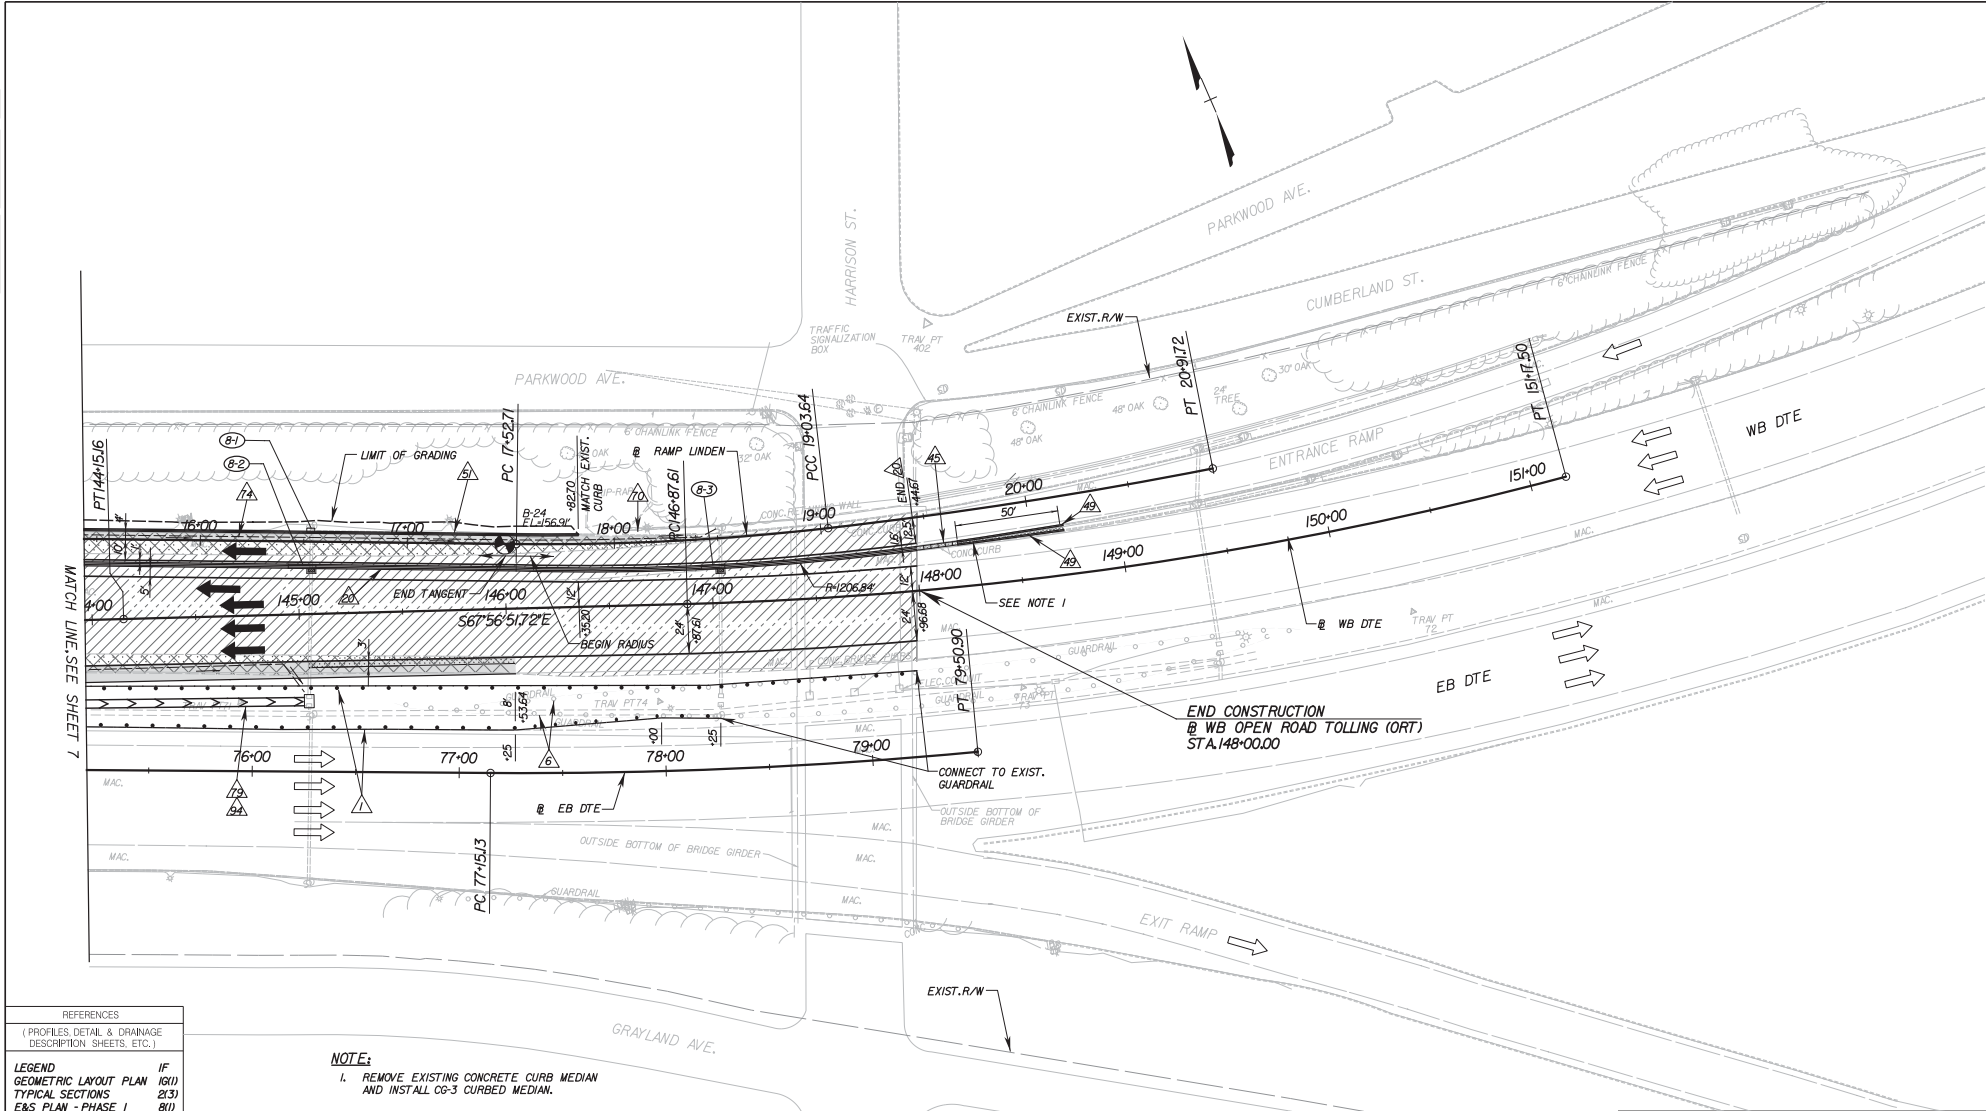

REFERENCES	
(PROFILES DETAIL & DRAINAGE DESCRIPTION SHEETS, ETC.)	
LEGEND	IF
GEOMETRIC LAYOUT PLAN	16(1)
TYPICAL SECTIONS	2(3)
E&S PLAN - PHASE I	8(1)
E&S PLAN - PHASE II	8(2)
PROFILE WB-ORT	8A
PROFILE RAMP LINDEN	8B
DRAINAGE TABULATIONS	1K
IMPACT ATTENUATOR	20(1)

NOTE:
 1. REMOVE EXISTING CONCRETE CURB MEDIAN AND INSTALL CG-3 CURBED MEDIAN.

CONSTRUCTION NOTE LEGEND

- ▲ ST'D.GR-2 GUARDRAIL
- ▲ REMOVAL OF EXISTING GUARDRAIL
- ▲ ST'D.MB-7D - 32" CONCRETE MEDIAN BARRIER
- ▲ IMPACT ATTENUATOR (TL-3>45mph DESIGN SPEED)
- ▲ ST'D CG-3 CURB
- ▲ ST'D CG-2 CURB
- ▲ NON-PERFORATED OUTLET PIPE
- ▲ ST'D.EW-12 ENDWALL
- ▲ ST'D.UD-4 UNDERDRAIN
- ▲ ST'D.EC-2 PROTECTIVE COVERING
- ▲ PAVED DITCH PG-2A TYPE E
- ▲ GRADED FLAT BOTTOM DITCH

PAVEMENT LEGEND

- PROPOSED ASPHALT SHOULDER
- PROPOSED ASPHALT PAVEMENT
- PROPOSED CONCRETE PAVEMENT
- PROPOSED ASPHALT PLANING & OVERLAY
- DEMOLITION OF PAVEMENT

REVISIONS
10-8-12 REVISED BARRIER LOCATION, ADDED CURB AHEAD OF ATTENUATOR

HNTB

2900 S. QUINCY STREET, SUITE 200
 ARLINGTON, VIRGINIA
 (703) 824-5100

richmond metropolitan authority
 RICHMOND DOWNTOWN EXPRESSWAY
 DOWNTOWN EXPRESSWAY OPEN ROAD TOLLING

ROADWAY PLAN
STA. 144+00.00 TO STA. 148+00.00 WB ORT

Scale: 1"=30'-0"


Date: FEB. 25, 2011

Contract No.: DTEOR1-2011

Sheet: 8

04/27/2015 04:11
 Tuesday, October 02, 2012

Level: Check, Print, Stamp, Signatures, Date, Originator, Name/Title, Checker, Name/Title, Designer, Name/Title, Validator, Name/Title

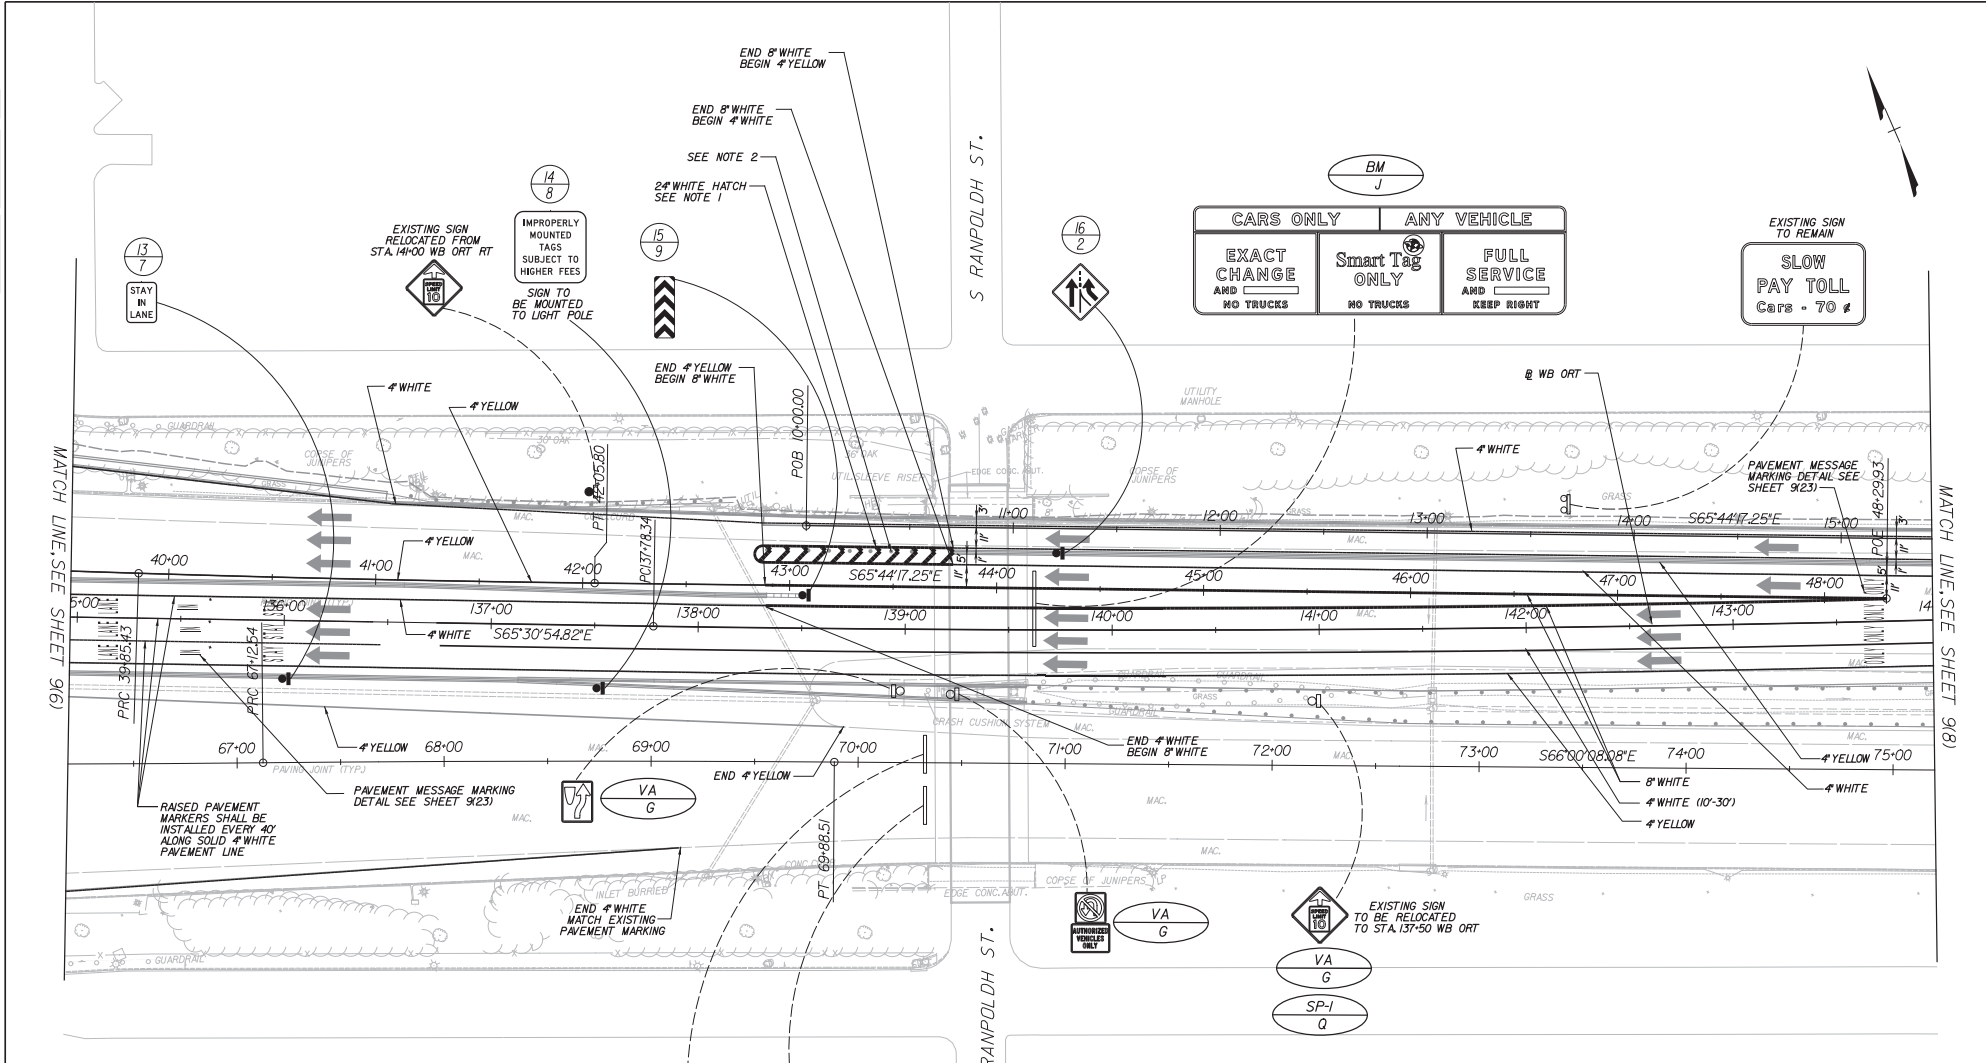

13
7
STAY IN LANE

EXISTING SIGN RELOCATED FROM STA. 141+00 WB ORT RT

14
8
IMPROPERLY MOUNTED TAGS SUBJECT TO HIGHER FEES
SIGN TO BE MOUNTED TO LIGHT POLE

15
9
24" WHITE HATCH
SEE NOTE 1

END 8" WHITE BEGIN 4" WHITE
SEE NOTE 2

16
2
EXISTING SIGN TO BE RELOCATED TO STA. 137+50 WB ORT

BM
J
CARS ONLY ANY VEHICLE
EXACT CHANGE AND NO TRUCKS Smart Tag ONLY NO TRUCKS FULL SERVICE AND KEEP RIGHT
SLOW PAY TOLL Cars - 70¢

EXISTING SIGN TO REMAIN
SLOW PAY TOLL Cars - 70¢

RAISED PAVEMENT MARKERS SHALL BE INSTALLED EVERY 40' ALONG SOLID 4" WHITE PAVEMENT LINE

PAVEMENT MESSAGE MARKING DETAIL SEE SHEET 916

VA
G

END 4" YELLOW

VA
G

EXISTING SIGN TO BE RELOCATED TO STA. 137+50 WB ORT

VA
G

SP-1
Q

Bryd St - 2nd St 1/2
60 7th St - 9th St 1
95 NORTH - SOUTH 2
Belvidere St
EXIT ONLY

EXISTING SIGN TO REMAIN

EXISTING SIGN TO REMAIN

NOTES:
1) CONTRACTOR SHALL REFER TO PAGE 3-61 OF THE VIRGINIA SUPPLEMENT TO THE MANUAL ON UNIFORM TRAFFIC CONTROL DEVICES 2011 EDITION.
2) CONTRACTOR SHALL INSTALL (9) PYLONS AT 40' SPACING STARTING AT THE BEGINNING OF THE CONCRETE MEDIAN BARRIER

richmond metropolitan authority
RICHMOND DOWNTOWN EXPRESSWAY

DOWNTOWN EXPRESSWAY OPEN ROAD TOLLING

SIGNING & PAVEMENT MARKING PLAN
STA. 135+00.00 TO STA. 144+00.00 WB ORT

HNTB
2900 S. QUINCY STREET, SUITE 200
ARLINGTON, VIRGINIA
(703) 824-5100


Scale: 1" = 30'-0"
Date: FEB. 25, 2011
Contract No.: DTEOR-2011
Sheet: 9/9

10-8-12	REVISED BARRIER RAMP LONDON
	ADDED HATCH
REVISIONS	



TS-03 Appendix B: Page 35

Level: Check, Print, Stamp, Signatures
 Date: _____
 Originator: _____
 Checker: _____
 Designer: _____
 Validator: _____

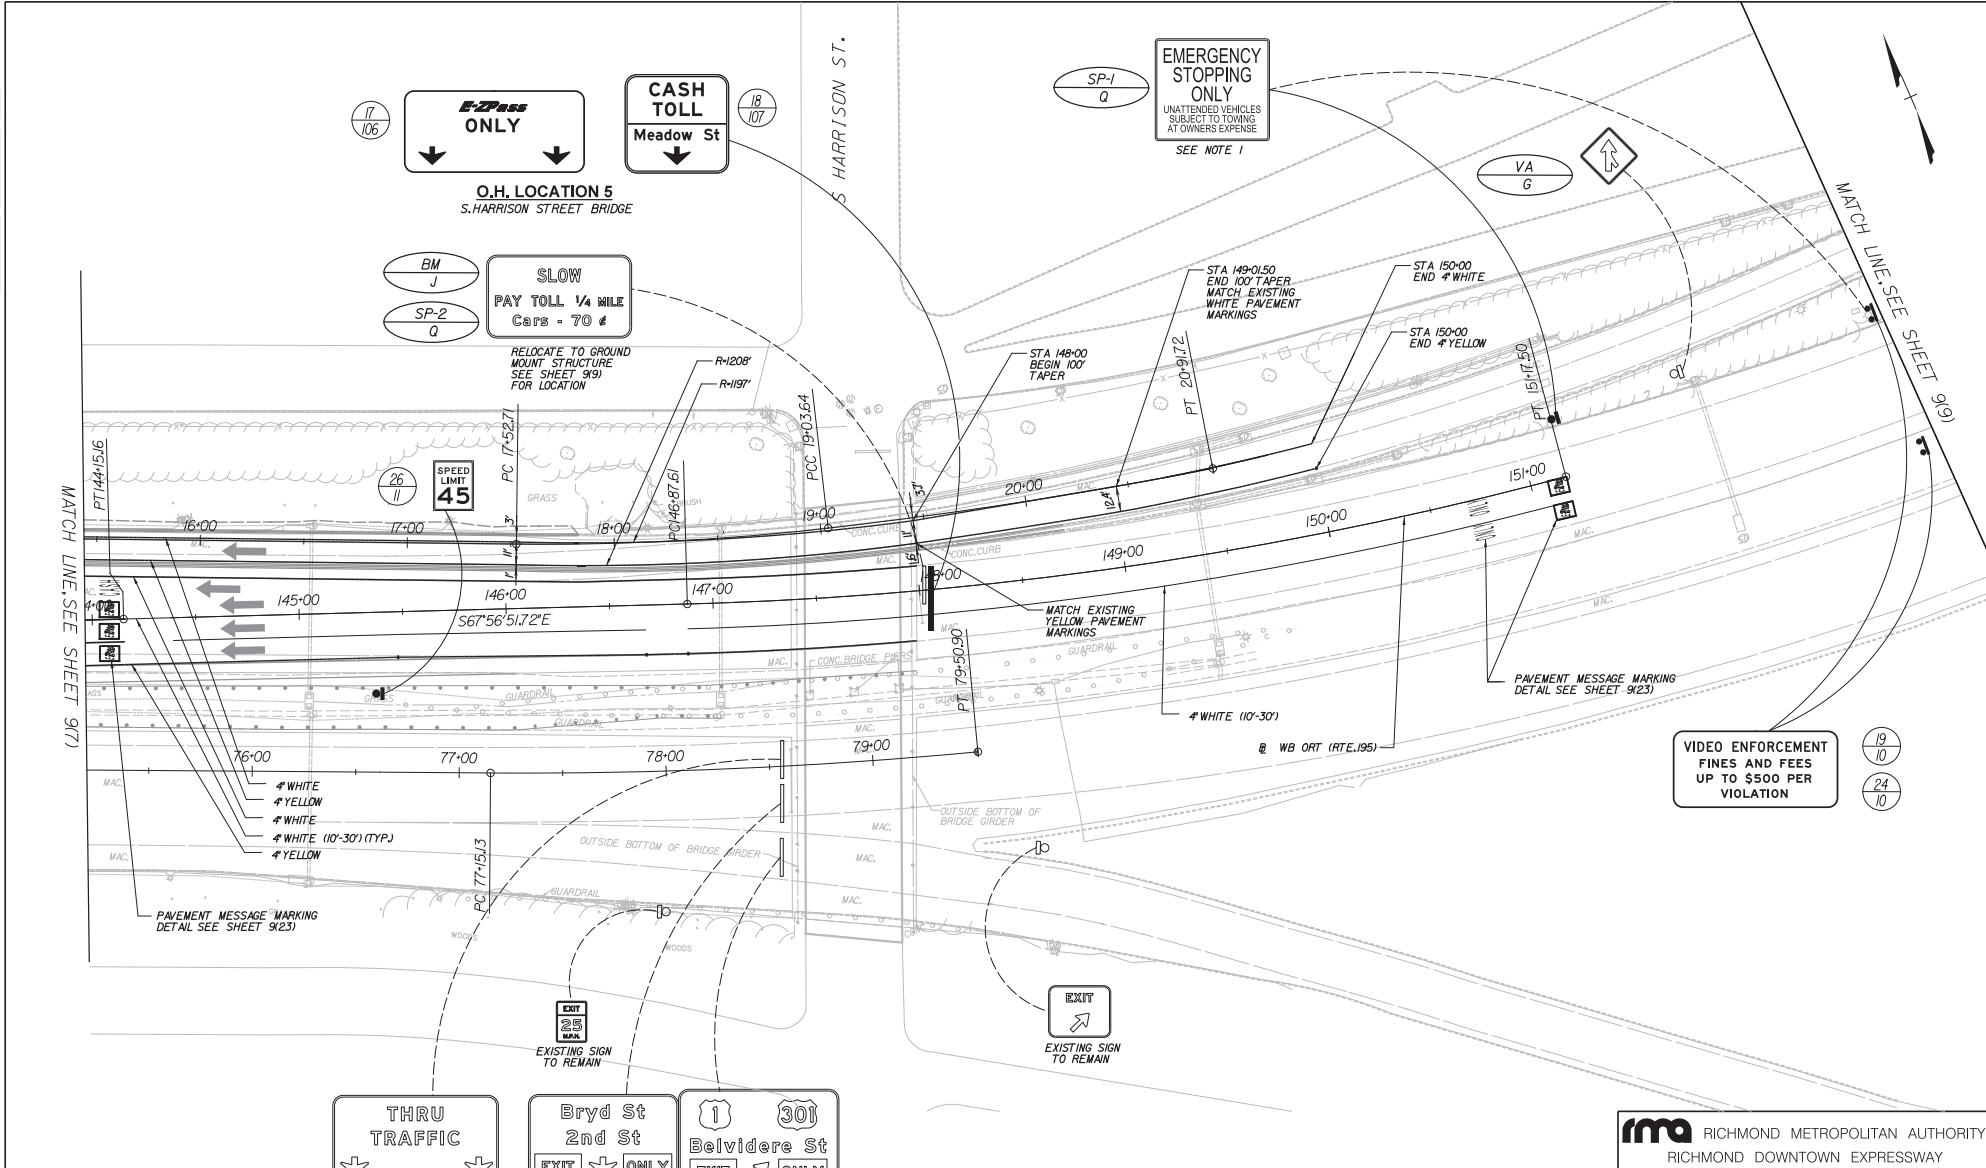


MATCH LINE, SEE SHEET 97J

MATCH LINE, SEE SHEET 99J

TS-03(09) - Rev. 02, 2012
 Tuesday, October 02, 2012


NO.	DATE	REVISIONS
10-8-12		REVISED BARRIER AND STRIPING
5-18-12		REVISED SIGN LOCATIONS AND ADDED SIGN (SP-1/Q) TO BE RELOCATED

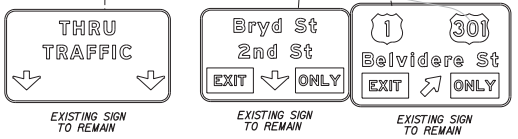


NOTES:
 1) EXISTING POLE MOUNTED SIGN TO BE RELOCATED TO GROUND MOUNTED POST AT POSITION SHOWN.




 2900 S. QUINCY STREET, SUITE 200 ARLINGTON, VIRGINIA (703) 824-5100	richmond metropolitan authority RICHMOND DOWNTOWN EXPRESSWAY DOWNTOWN EXPRESSWAY OPEN ROAD TOLLING		
	SIGNING & PAVEMENT MARKING PLAN STA. 144+00.00 TO STA. 151+21.05 WB ORT		
Scale: 1"=30'-0"	Date: FEB. 25, 2011	Contract No.: DTEOR-2011	Sheet: 9/8

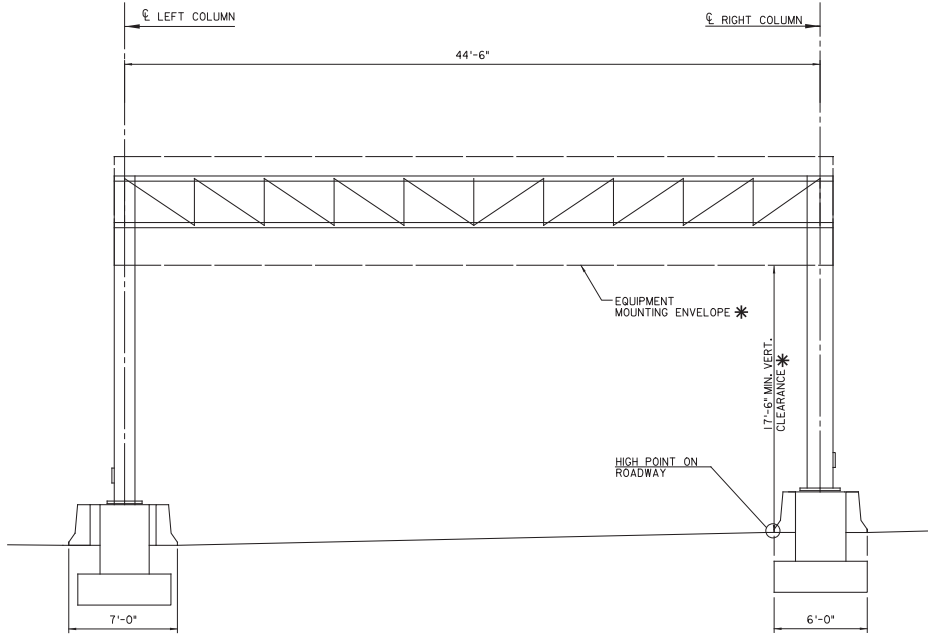

TYPICAL GANTRY STRUCTURE ELEVATION
(LOOKING EAST)
SCALE: 1/4" = 1'-0"

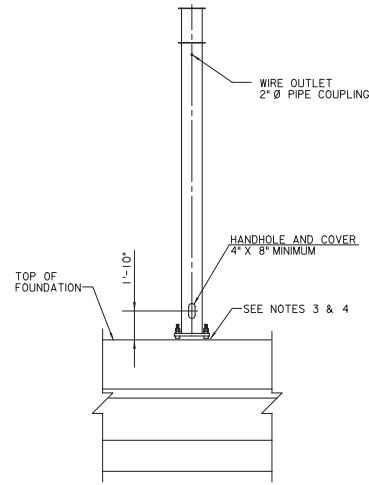

END VIEW
SCALE: 1/4" = 1'-0"

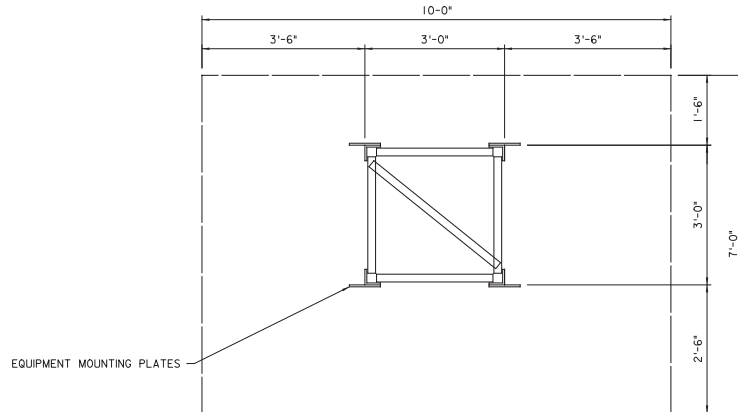

TYPICAL SECTION
EQUIPMENT MOUNTING ENVELOPE *
SCALE: 3/4" = 1'-0"

NOTE: THE EQUIPMENT MOUNTING PLATES SHALL BE INCLUDED WITH THE GANTRY. THE CONTRACTOR SHALL COORDINATE SIZE, NUMBER AND LOCATION OF PLATES WITH THE TOLL INTEGRATOR PRIOR TO GANTRY FABRICATION. THE TOLL INTEGRATOR IS RESPONSIBLE FOR INSTALLATION OF TOLL EQUIPMENT TO THE PLATES INCLUDING ANY OTHER SUPPORT BRACKETS OR MEMBERS REQUIRED.

* NOTE: THE EQUIPMENT MOUNTING ENVELOPE AND VERTICAL CLEARANCE FOR THE GANTRY SHALL BE CONFIRMED BY THE ENGINEER AND OWNER'S SELECTED TOLL INTEGRATOR.

OVERHEAD TOLL GANTRY NOTES

GENERAL

1. ALL DIMENSIONS SHOWN ARE APPROXIMATE. THE CONTRACTOR SHALL DETERMINE ALL SPAN LENGTHS, END FRAME HEIGHTS, COLUMN HEIGHTS AND ROADWAY DIMENSIONS REQUIRED TO INSTALL THE STRUCTURE.
2. THE CONTRACTOR SHALL COORDINATE THE FOUNDATION DESIGN WITH ALL OTHER EXISTING AND PROPOSED WORK IN THE VICINITY OF THE GANTRY.
3. THE MAXIMUM SPACE BETWEEN THE BOTTOM OF THE BASE PLATE AND THE TOP OF THE FOUNDATION SHALL BE NO MORE THAN THE DIAMETER OF THE ANCHOR BOLT PLUS ONE INCH.
4. NO MORTAR, GROUT, OR CONCRETE SHALL BE PLACED BETWEEN BOTTOM OF BASE PLATE AND TOP OF PEDESTAL.
5. FOUNDATION RECOMMENDATIONS ARE PROVIDED IN SECTION 5.3.4 OF THE FINAL GEOTECHNICAL REPORT BY FROEHLING & ROBERTSON DATED NOVEMBER 18, 2010.

DESIGN

ALL DESIGN AND DETAILS OF CONSTRUCTION SHALL CONFORM TO THE APPLICABLE REQUIREMENTS OF THE FOLLOWING:

- A. 2002 (17TH EDITION) AASHTO STANDARD SPECIFICATIONS FOR HIGHWAY BRIDGES, WITH INTERIMS THROUGH 2004
- B. 2009 AASHTO STANDARD SPECIFICATIONS FOR STRUCTURAL SUPPORTS FOR HIGHWAY SIGNS, LUMINAIRES AND TRAFFIC SIGNALS

LIVE LOAD: THE WIND LOAD SHALL BE CALCULATED USING AN IMPORTANCE FACTOR (ip) = 1.0

DEAD LOAD:

- A. 10 PSF APPLIED OVER THE ENTIRE AREA OF STRUCTURE IN ADDITION TO THE SELF WEIGHT OF THE STRUCTURE.
- B. A SINGLE 200 LB LOAD APPLIED TO ANY AND ALL NODES, CHORDS AND CONNECTIONS ON THE STRUCTURE.

CAMBER: THE OVERHEAD TOLLING GANTRY SHALL HAVE A RESIDUAL UPWARD CAMBER OF SPAN/1000.

MATERIALS

STRUCTURAL STEEL:	
HSS SHAPES & TUBING	ASTM A500 GRADE B
WIDE FLANGE SHAPES	ASTM A709
ALL OTHER SHAPES AND PLATES	ASTM A36 MIN.
CONCRETE:	
CONCRETE	F _c = 3,000 PSI
REINFORCING STEEL	ASTM A615 GRADE 60

BOLTS:	
HIGH STRENGTH BOLTS	ASTM A325
ANCHOR BOLTS	ASTM F1554

ALL STEEL ITEMS SHALL BE GALVANIZED IN ACCORDANCE WITH ASTM A123 OR A153

WELDING

WELDING AND WELDING INSPECTION FOR STRUCTURES SHALL CONFORM TO THE CURRENT EDITIONS OF THE ANSI/AASHTO/AWS D1.5-02 BRIDGE WELDING CODE AND ANSI/AWS D1.1-02 STRUCTURAL WELDING CODE. WELDING OF STRUCTURAL ALUMINUM, IF APPLICABLE, SHALL CONFORM TO AWS D1.2-03. E70XX LOW HYDROGEN ELECTRODES SHALL BE USED FOR STRUCTURAL STEEL WELDS. NO WELDING OF ALUMINUM SHALL BE PERMITTED.

BOLTED CONNECTIONS

HIGH STRENGTH BOLTS SHALL BE ASTM A325. THREADS SHALL BE EXCLUDED FROM THE SHEAR PLANE. UNLESS OTHERWISE NOTED, FIELD CONNECTIONS SHALL BE BOLTED USING HIGH STRENGTH BOLTS AND BOLT SIZE SHALL BE MIN. 3/4" DIAMETER. BUTT WELDS SHALL BE FULL (COMPLETE) PENETRATION WELDS. PROVIDE BACKUP PLATES AS REQUIRED.

DESIGN INTENT

THESE ARE DESIGN CRITERIA DOCUMENTS. PRELIMINARY PLANS NOT TO BE USED FOR CONSTRUCTION. THESE PLANS ARE PROVIDED FOR INFORMATIONAL PURPOSES ONLY, INTENDED TO ESTABLISH THE PROPOSED PROJECT'S DESIGN AND CONSTRUCTION INTENT, QUALITY, AND CHARACTER. CONTRACTOR SHALL USE THESE PLANS IN ACCORDANCE WITH THE SPECIFICATIONS.

THE CONTRACTOR IS RESPONSIBLE FOR THE DESIGN AND DETAILING OF THE GANTRY STRUCTURE AND FOUNDATIONS. THE CONTRACTOR SHALL COORDINATE WITH THE ENGINEER AND TOLL INTEGRATOR AS NECESSARY FOR REQUIRED EQUIPMENT LOCATIONS AND LOADING AND ANY DESIGN RESTRICTIONS OR REQUIREMENTS.

ma RICHMOND METROPOLITAN AUTHORITY
RICHMOND DOWNTOWN EXPRESSWAY

DOWNTOWN EXPRESSWAY OPEN ROAD TOLLING

HNTB

**SIGNING AND PAVEMENT MARKING
TOLL GANTRY ELEVATION**


2900 S. QUINCY STREET, SUITE 200
ARLINGTON, VIRGINIA
(703) 824-5100

Scale:	Date:	Contract No.:	Sheet:
AS SHOWN	FEB. 25, 2011	DTEOH-2011	9(29)

TS-03 (02/2011) - Rev. 1
Tuesday, March 15, 2011

REVISIONS

- (A) EXISTING CONDUIT**
4 * 6 CIRCUITS 1A,B,C
4 * 6 CIRCUITS 2A,2B,2C
4 * 6 CIRCUITS 3A,3B,3C
4 * 6 CIRCUITS 4A,4B,4C
- (B) (3) (3)**
3' - 4 * 6 CIRCUITS 1A,B,C
4 * 6 CIRCUITS 2A,2B,2C
4 * 6 CIRCUITS 3A,3B,3C
4 * 6 CIRCUITS 4A,4B,4C
1 * 6 EGC
- (C) (2)**
2' - 4 * 6 CIRCUITS 3A,3B,3C
1 * 6 EGC
- (D) PROPOSED BORE (4)**
4' - 4 * 6 CIRCUITS 3A,3B,3C
1 * 6 EGC
- (E) EXISTING CONDUIT**
4 * 6 CIRCUITS 3A,3B,3C
- (F) EXISTING CONDUIT**
2 * 6 CIRCUIT 3A
- (G) EXISTING CONDUIT**
4 * 6 CIRCUITS 1A,B,C
4 * 6 CIRCUITS 2A,2B,2C
4 * 6 CIRCUITS 3A,3B,3C
4 * 6 CIRCUITS 4A,4B,4C
- (H) (2) (2)**
2' - 4 * 6 CIRCUITS 1A,B,C
4 * 6 CIRCUITS 3A,3B,3C
1 * 6 EGC
2' - SPARE
- (I) (2) (2)**
2' - 4 * 6 CIRCUITS 2A,2B,2C
4 * 6 CIRCUITS 4A,4B,4C
1 * 6 EGC
2' - SPARE

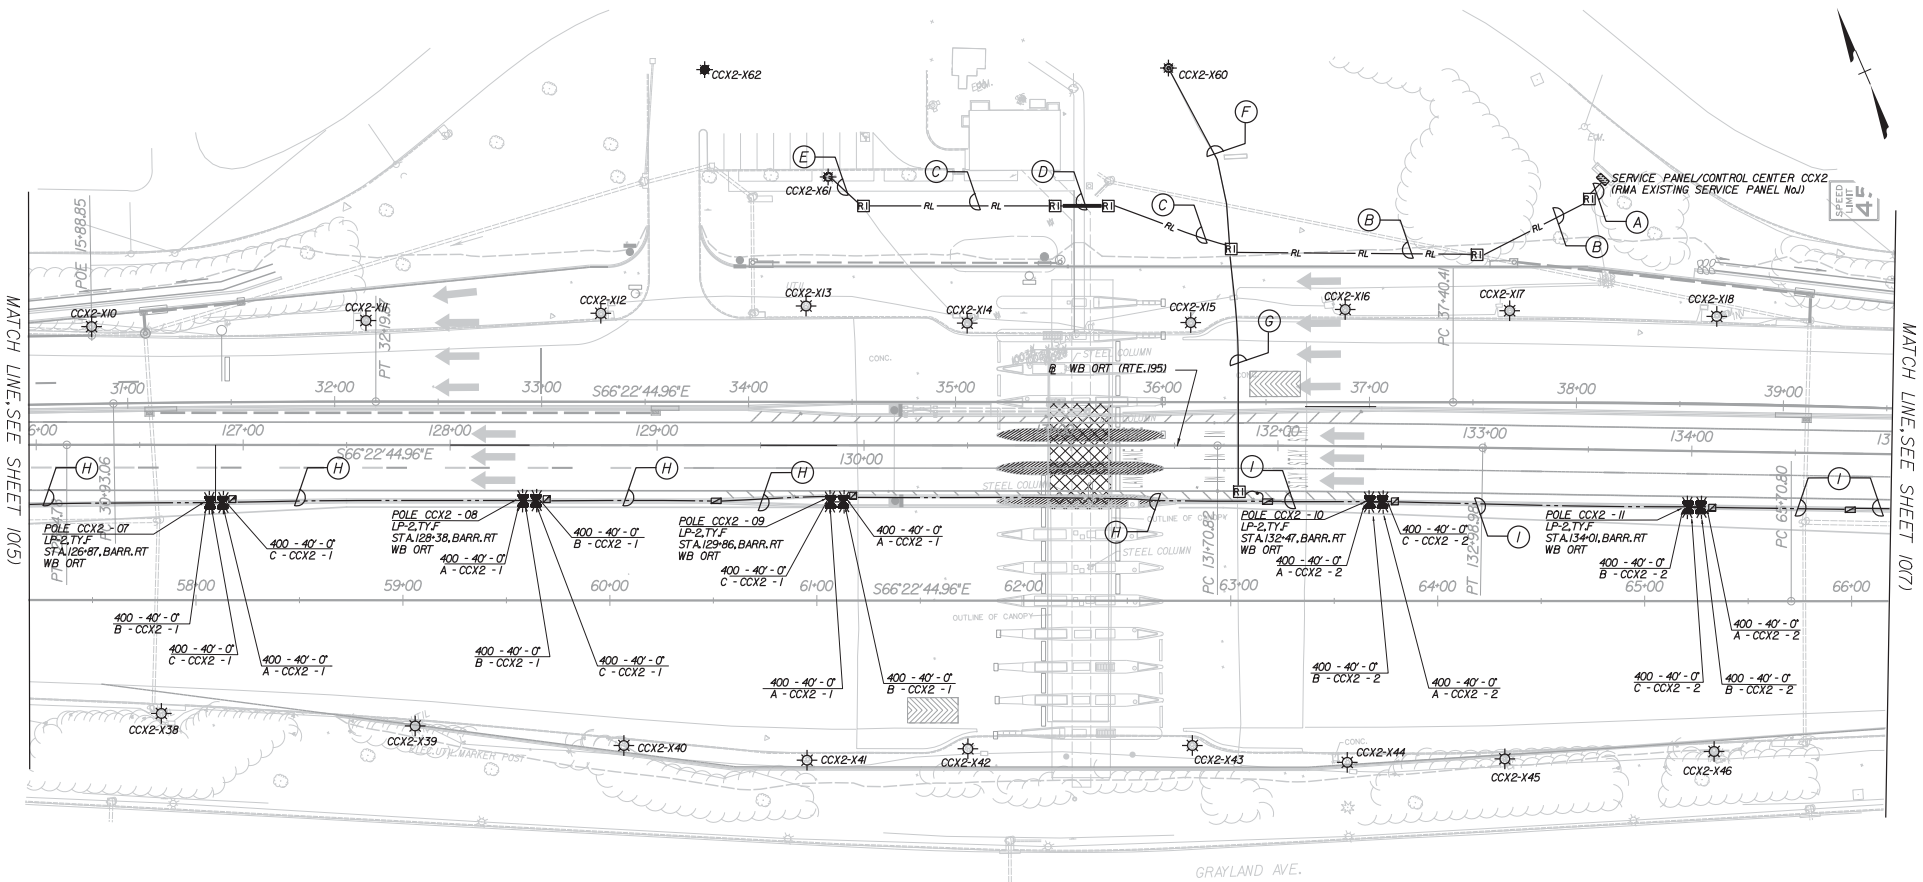

T:\03\1015\03_05.dwg
Tuesday, March 15, 2011

REVISIONS



rma RICHMOND METROPOLITAN AUTHORITY
RICHMOND DOWNTOWN EXPRESSWAY


DOWNTOWN EXPRESSWAY OPEN ROAD TOLLING

HNTB
2900 S. QUINCY STREET, SUITE 200
ARLINGTON, VIRGINIA
(703) 824-5100

LIGHTING & ELECTRICAL DISTRIBUTION PLANS
STA. 126+00.00 TO STA. 135+00.00 WB ORT

Scale: 1"=30'-0"
Date: FEB. 25, 2011
Contract No.: DTEOH-2011
Sheet: 10(6)

(A) 2'-4" #6 CIRCUITS 2A2B2C 4" #6 CIRCUITS 4A4B4C 1" #6 EGC 2" - SPARE	(B) PROPOSED BORE 4'-4" #6 CIRCUITS 4A4B4C 1" #6 EGC	(C) 2'-4" #6 CIRCUITS 4A4B4C 1" #2 EGC	(D) EXISTING CONDUIT 4" #6 CIRCUITS 4A4B4C
--	---	---	--

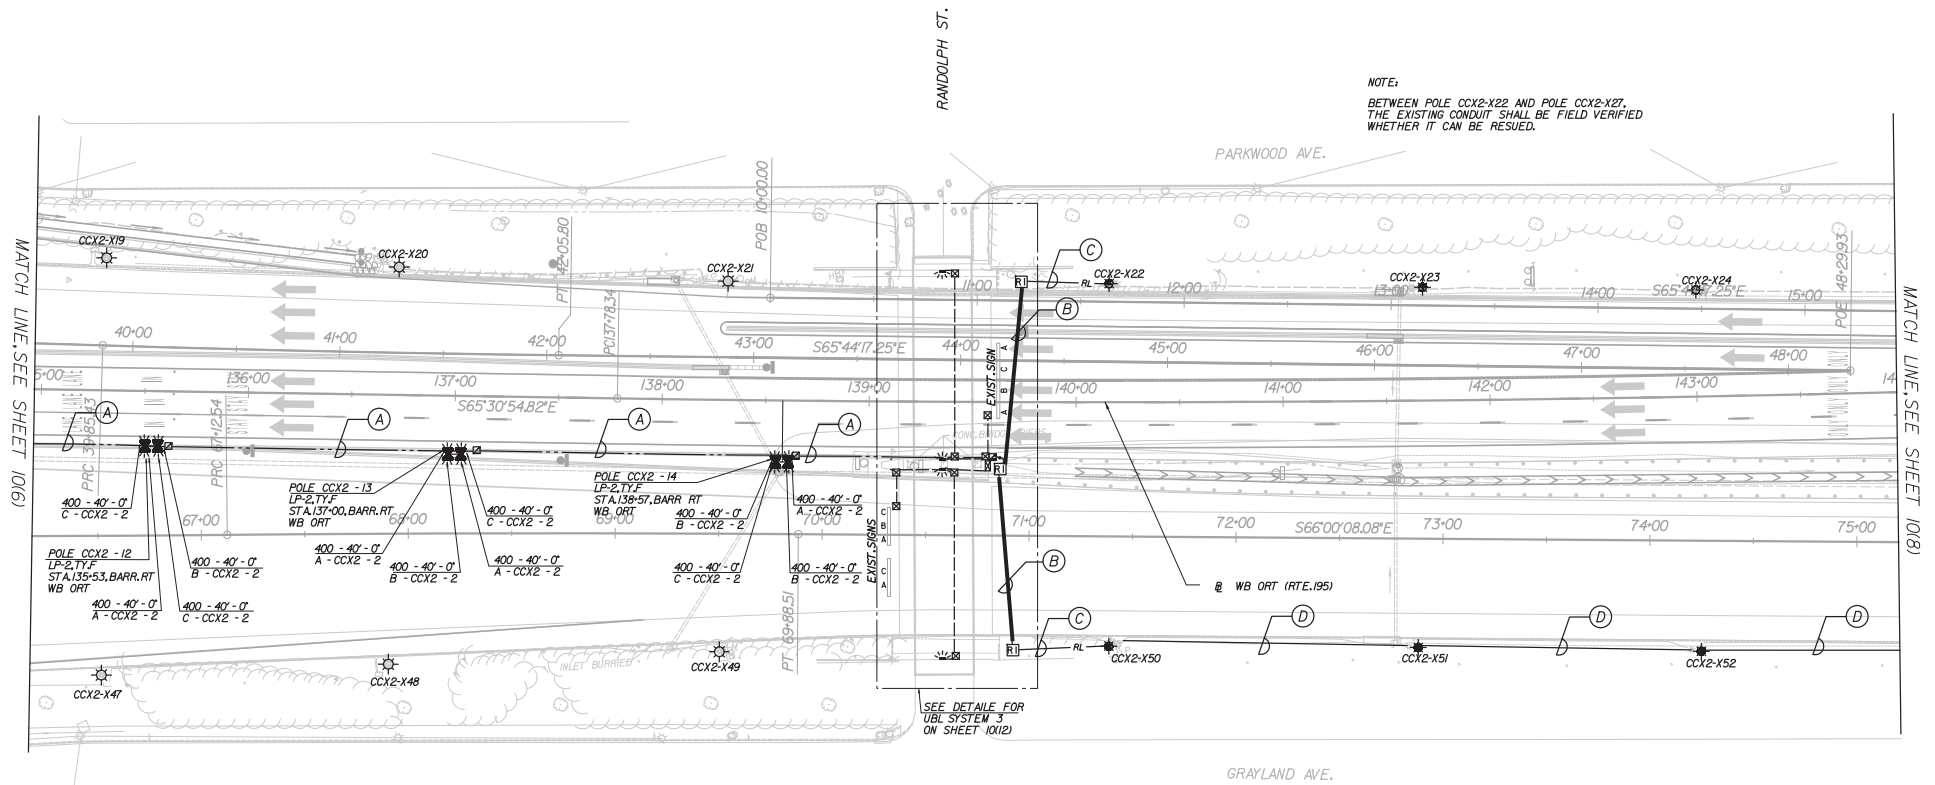

T:\031010\031010.dwg
 Tuesday, March 5, 2011

NO.	REVISIONS


RICHMOND METROPOLITAN AUTHORITY
 RICHMOND DOWNTOWN EXPRESSWAY

HNTB
 2900 S. QUINCY STREET, SUITE 200
 ARLINGTON, VIRGINIA
 (703) 824-5100

DOWNTOWN EXPRESSWAY OPEN ROAD TOLLING
LIGHTING & ELECTRICAL DISTRIBUTION PLANS
STA. 135+00.00 TO STA. 144+00.00 WB ORT



Scale: 1"=30'-0"	Date: FEB. 25, 2011	Contract No.: DTEOR-2011	Sheet: 10(7)
------------------	---------------------	--------------------------	--------------

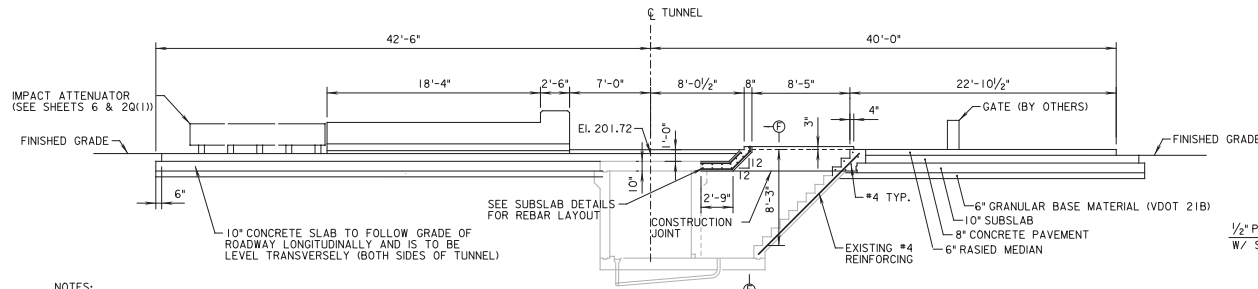


SECTION A-A
SCALE: 3/8" = 1'-0"


NOTES:
FOR 8" PAVEMENT AND 10" SUBSLAB DETAILS, SEE SHEET 12(4).

FOR DETAILS OF THE CONDUIT AND JUNCTION BOXES EMBEDDED IN THE ISLANDS, SEE TOLL PLAZA ELECTRICAL PLANS.


THE PROVISIONS OF SECTIONS 412 AND 413 OF THE SPECIFICATIONS SHALL BE ADHERED TO IN PERFORMING THIS WORK.

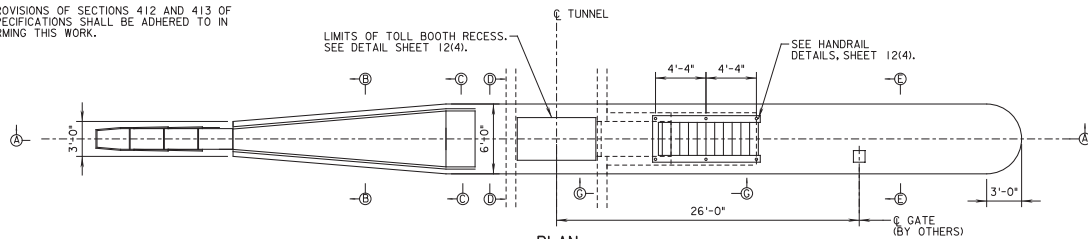


PLAN
SCALE: 3/8" = 1'-0"

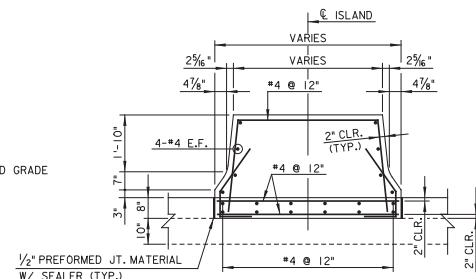

SECTION B-B
SCALE: 1/2" = 1'-0"

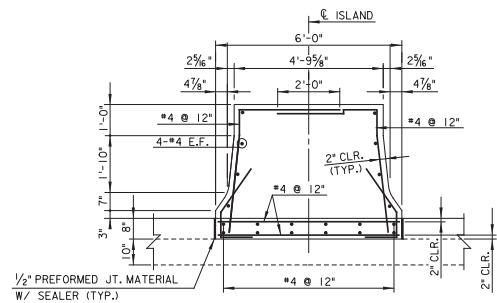


SECTION C-C
SCALE: 1/2" = 1'-0"

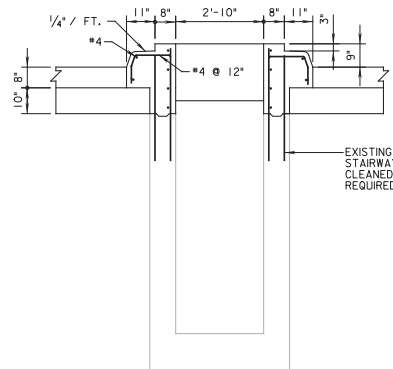


SECTION F-F
SCALE: 1/2" = 1'-0"


EXISTING #4 PROVIDED DURING ORIGINAL STAIRWAY CONSTRUCTION SHALL BE CLEANED AND STRAIGHTENED AS REQUIRED

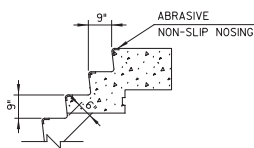

STEP DETAIL
NO SCALE

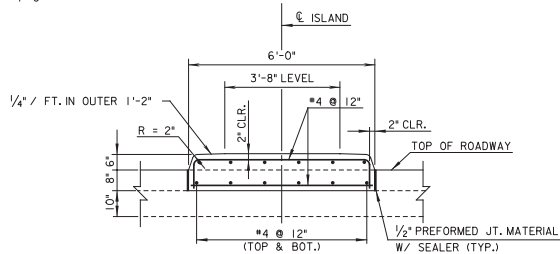


SECTION E-E
SCALE: 1/2" = 1'-0"

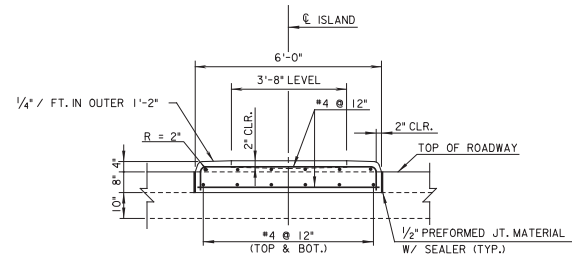

SECTION D-D
SCALE: 1/2" = 1'-0"

NOTE: FOR SECTION BELOW TOLL BOOTH, SEE TOLL BOOTH RECESS DETAIL, SHEET 12(4).

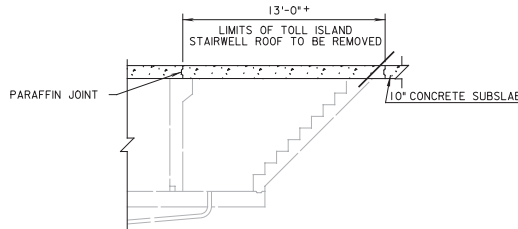

SECTION G-G (EXISTING)
SCALE: 1/4" = 1'-0"

NO.	REVISIONS


richmond metropolitan authority
RICHMOND DOWNTOWN EXPRESSWAY

DOWNTOWN EXPRESSWAY OPEN ROAD TOLLING


HNTB
2800 S. QUINCY STREET, SUITE 200
ARLINGTON, VIRGINIA
(703) 824-5100

TOLL PLAZA ISLAND D AND P DETAILS


Scale: AS NOTED	Date: FEB. 25, 2011	Contract No.: DTEOH-2011	Sheet: 12(2)
-----------------	---------------------	--------------------------	--------------

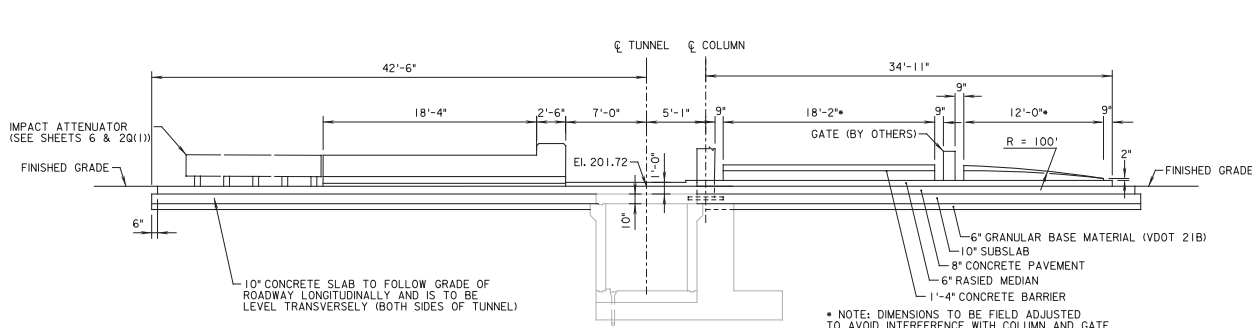

SECTION A-A
SCALE: 3/8" = 1'-0"

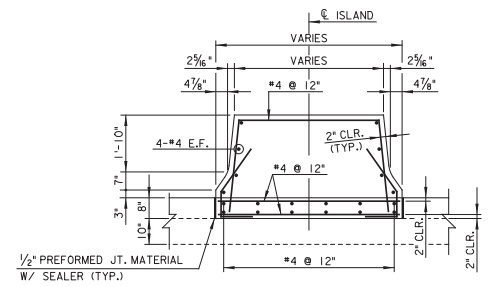


SECTION B-B
SCALE: 1/2" = 1'-0"

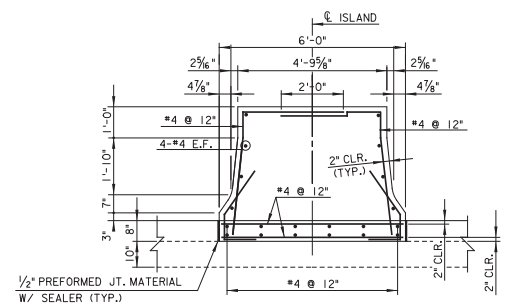


SECTION C-C
SCALE: 1/2" = 1'-0"

NOTES:
FOR 8" PAVEMENT AND 10" SUBSLAB DETAILS, SEE SHEET 12(4).
FOR DETAILS OF THE CONDUIT AND JUNCTION BOXES EMBEDDED IN THE ISLANDS, SEE TOLL PLAZA ELECTRICAL PLANS.
THE PROVISIONS OF SECTIONS 412 AND 413 OF THE SPECIFICATIONS SHALL BE ADHERED TO IN PERFORMING THIS WORK.

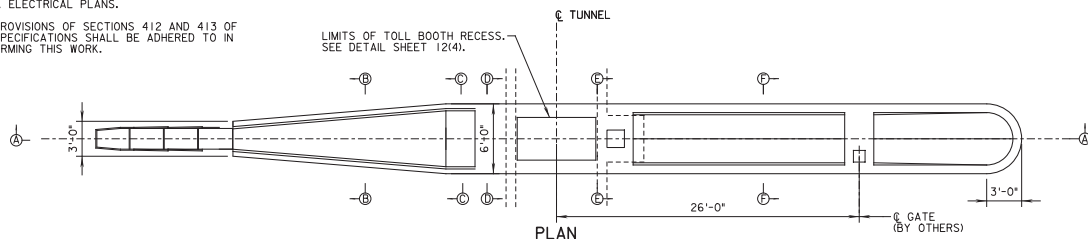


PLAN
SCALE: 3/8" = 1'-0"

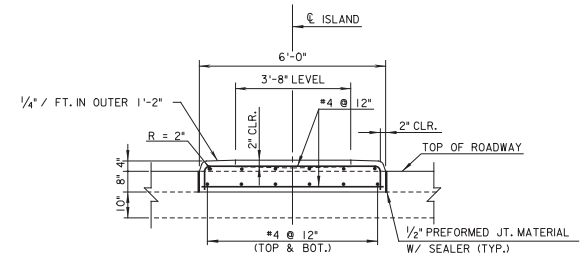


SECTION D-D
SCALE: 1/2" = 1'-0"

NOTE: FOR SECTION BELOW TOLL BOOTH, SEE TOLL BOOTH RECESS DETAIL SHEET 12(4).

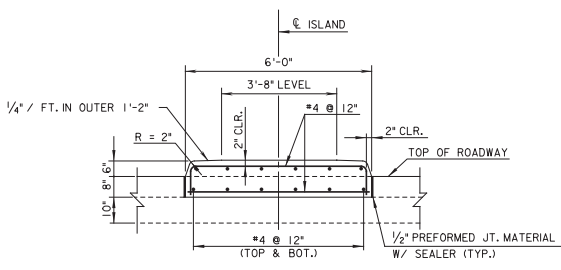

SECTION E-E
SCALE: 1/2" = 1'-0"

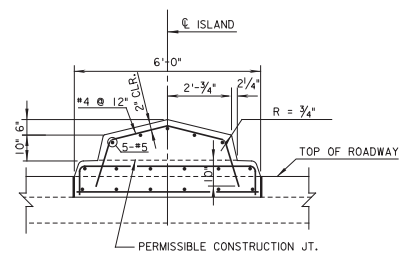

SECTION F-F
SCALE: 1/2" = 1'-0"

NOTE: FOR MEDIAN DIMENSIONS NOT LABELED SEE SECTION E-E

NO.	DATE	DESCRIPTION
A	10-25-11	ADDED CONCRETE BARRIER ON TOP OF MEDIAN ADDED SECTION F-F
REVISIONS		


richmond metropolitan authority
RICHMOND DOWNTOWN EXPRESSWAY

DOWNTOWN EXPRESSWAY OPEN ROAD TOLLING

HNTB
TOLL PLAZA ISLAND C DETAILS

2900 S. QUINCY STREET, SUITE 200
ARLINGTON, VIRGINIA
(703) 824-5100


Scale:	Date:	Contract No.:	Sheet:
AS NOTED	FEB. 25, 2011	DTEOR-2011	12(3)

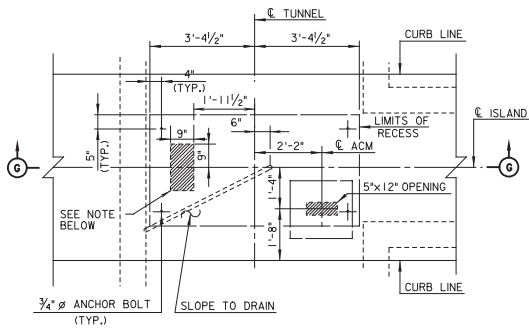

PLAN OF TOLL BOOTH RECESS


SCALE: 1/2" = 1'-0"

NOTE: 18" X 9" OPENING IN TUNNEL CEILING IS EXISTING. TOP 5" OF OPENING IS CAPPED WITH UNREINFORCED CONCRETE. CONTRACTOR SHALL REMOVE CAP AND MAINTAIN OPENING THROUGH ISLAND.

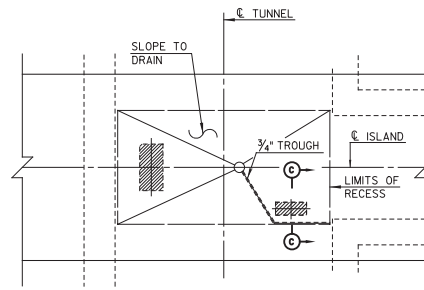


PLAN OF TOLL BOOTH DRAINAGE

SCALE: 1/2" = 1'-0"

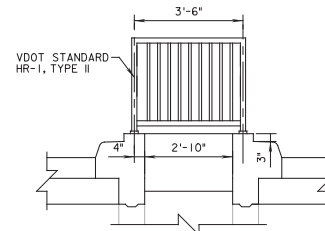

ALUMINUM RAILING TRANSVERSE SECTION ISLANDS D & P


SCALE: 1/2" = 1'-0"

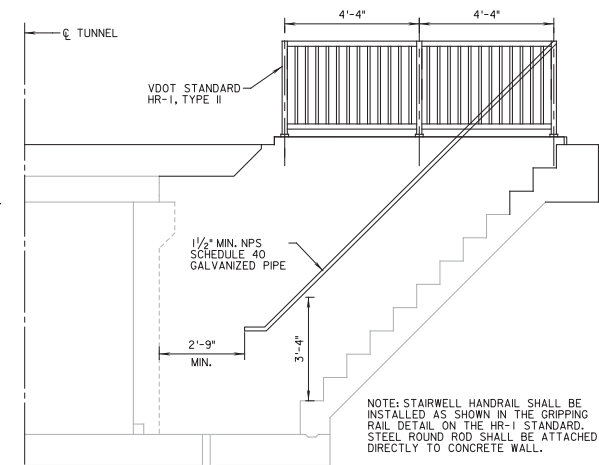

ALUMINUM RAILING LONGITUDINAL SECTION ISLANDS D & P


SCALE: 1/2" = 1'-0"

NOTE: STAIRWELL HANDRAIL SHALL BE INSTALLED AS SHOWN IN THE GRIPPING RAIL DETAIL ON THE HR-1 STANDARD. STEEL ROUND ROD SHALL BE ATTACHED DIRECTLY TO CONCRETE WALL.

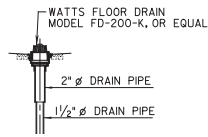


FLOOR DRAIN DETAIL

N.T.S.

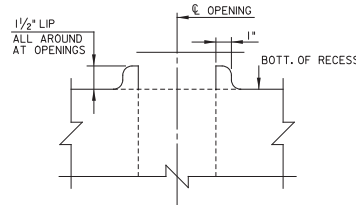

SECTION C-C


SCALE: 3" = 1'-0"

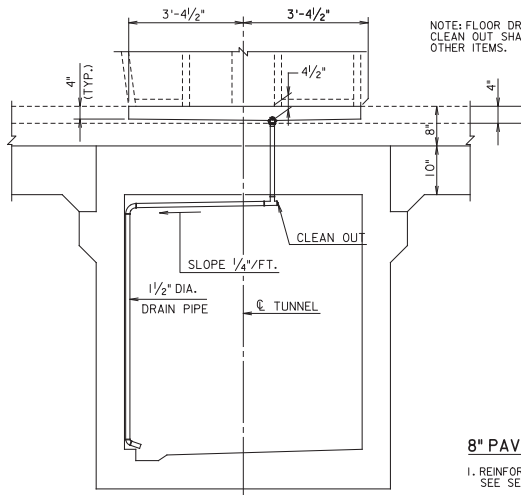

SECTION G-G

N.T.S.

NOTE: FLOOR DRAIN, PVC DRAIN PIPE AND CLEAN OUT SHALL BE INCIDENTAL TO OTHER ITEMS.

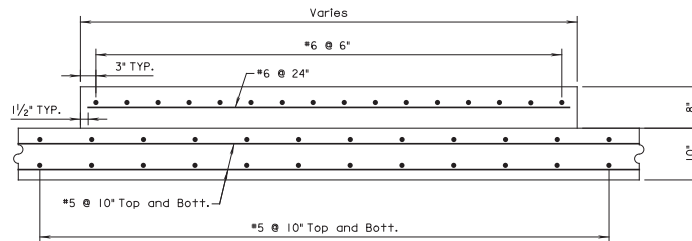

8" PAVEMENT SLAB AND 10" SUBSLAB DETAILS


SCALE: 1" = 1'-0"

8" PAVEMENT SLAB NOTES

1. REINFORCING BARS SHALL BE GLASSFIBER REINFORCED POLYMER (GFRP). SEE SECTION 316 FOR GFRP DETAILS.
2. REINFORCING BARS SHALL BE SECURED USING PLASTIC TIES, NYLON TIES, OR PLASTIC SNAP TIES. NO METAL TIES SHALL BE USED.
3. PLASTIC OR NON-METALLIC CHAIRS SHALL BE USED TO ELEVATE REBAR AT LOCATIONS SHOWN. CHAIRS SHALL BE SECURED TO 10" SLAB BY METHOD(S) APPROVED BY THE ENGINEER.
4. CONTRACTOR TO COORDINATE PLACEMENT OF LOOPS WITH TOLL INTEGRATOR AND ENGINEER PRIOR TO POURING CONCRETE.
5. CONCRETE SHALL BE CLASS A4.
6. SEE VDOT STANDARD PR-3 FOR DETAILS NOT SHOWN ON THIS SHEET.

10" SUBSLAB NOTES

1. REINFORCING BARS SHALL BE ASTM A615, GRADE 60.
2. CONCRETE SHALL BE CLASS A3.
3. DOWELS CONNECTING PROPOSED AND EXISTING SUB-SLABS SHALL BE #6 BARS SPACED AT 18" O.C. DOWELS SHALL PROJECT A MINIMUM OF 9" INTO NEW AND EXISTING CONCRETE.

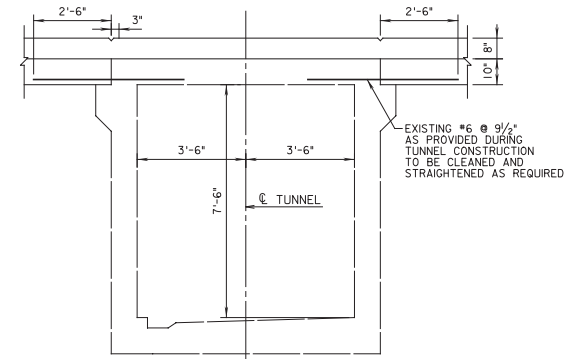

SECTION THRU TUNNEL BETWEEN ISLANDS

SCALE: 1/2" = 1'-0"

EXISTING #6 @ 9 1/2" AS PROVIDED DURING TUNNEL CONSTRUCTION TO BE CLEANED AND STRAIGHTENED AS REQUIRED

RASTRUP/SL/SL/SL
 Tuesday, October 25, 2011

NO.	DATE	DESCRIPTION
1	10-25-11	MODIFIED DIMENSIONS ON SECTION G-G
REVISIONS		

 RICHMOND METROPOLITAN AUTHORITY
 RICHMOND DOWNTOWN EXPRESSWAY


DOWNTOWN EXPRESSWAY OPEN ROAD TOLLING

HNTB

**TOLL PLAZA
TOLL ISLAND DETAILS**

2800 S. QUINCY STREET, SUITE 200
ARLINGTON, VIRGINIA
(703) 824-5100

Scale: AS NOTED	Date: FEB. 25, 2011	Contract No.: DTEORH-2011	Sheet: 12(4)
--------------------	------------------------	------------------------------	-----------------

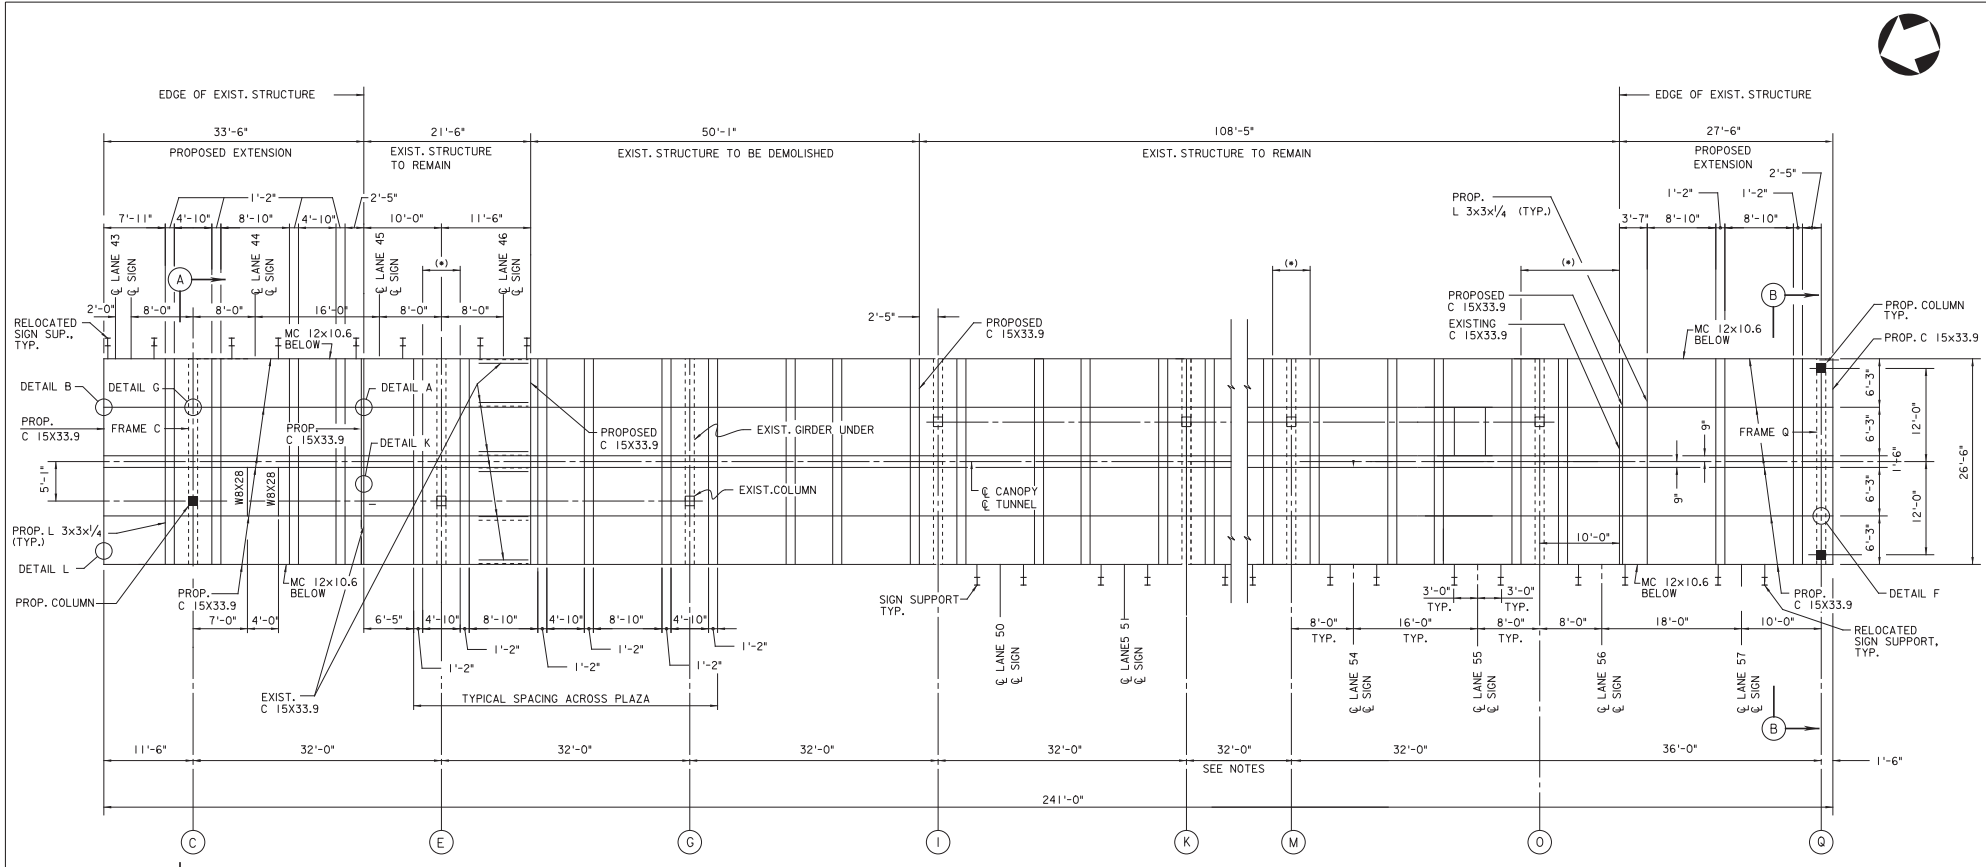

FRAMING PLAN

SCALE: 1/8" = 1'-0"

(*) ALL 6 EXISTING C 15X33.9 IN THIS AREA SHALL BE REINFORCED WITH #5X16, SEE DETAIL I ON SHEET 12(10). THIS SHALL BE COMPLETED PRIOR TO ANY CANOPY REMOVAL OR EXTENSION WORK.

NOTES:

- LOCATION OF SIGN SUPPORTS FOR LANES 52 AND 53 BETWEEN AXIS K AND M ARE THE SAME AS BETWEEN AXIS M AND O.
- FOR SECTIONS A-A AND B-B, SEE SHEETS 12(8) AND 12(9).
- FOR CANOPY EXTENSION DETAILS AND SIGN SUPPORT DETAILS, SEE SHEETS 12(10) AND 12(11).
- RELOCATED X-ARROW LED SIGN SUPPORTS ARE NOT SHOWN FOR CLARITY. SEE SHEET 12(11) FOR DETAILS.


8/8/2010 10:57 AM Tuesday, March 5, 2011

REVISIONS

<p>2900 S. QUINCY STREET, SUITE 200 ARLINGTON, VIRGINIA (703) 824-5100</p>	RICHMOND METROPOLITAN AUTHORITY RICHMOND DOWNTOWN EXPRESSWAY DOWNTOWN EXPRESSWAY OPEN ROAD TOLLING	
	TOLL PLAZA CANOPY FRAMING PLAN	
Scale: 1/8" = 1'-0"	Date: FEB. 25, 2011	Contract No.: DTEOH-2011
		Sheet: 12(7)

04/25/10 (5/10) AM
 Tuesday, March 15, 2011


REVISIONS

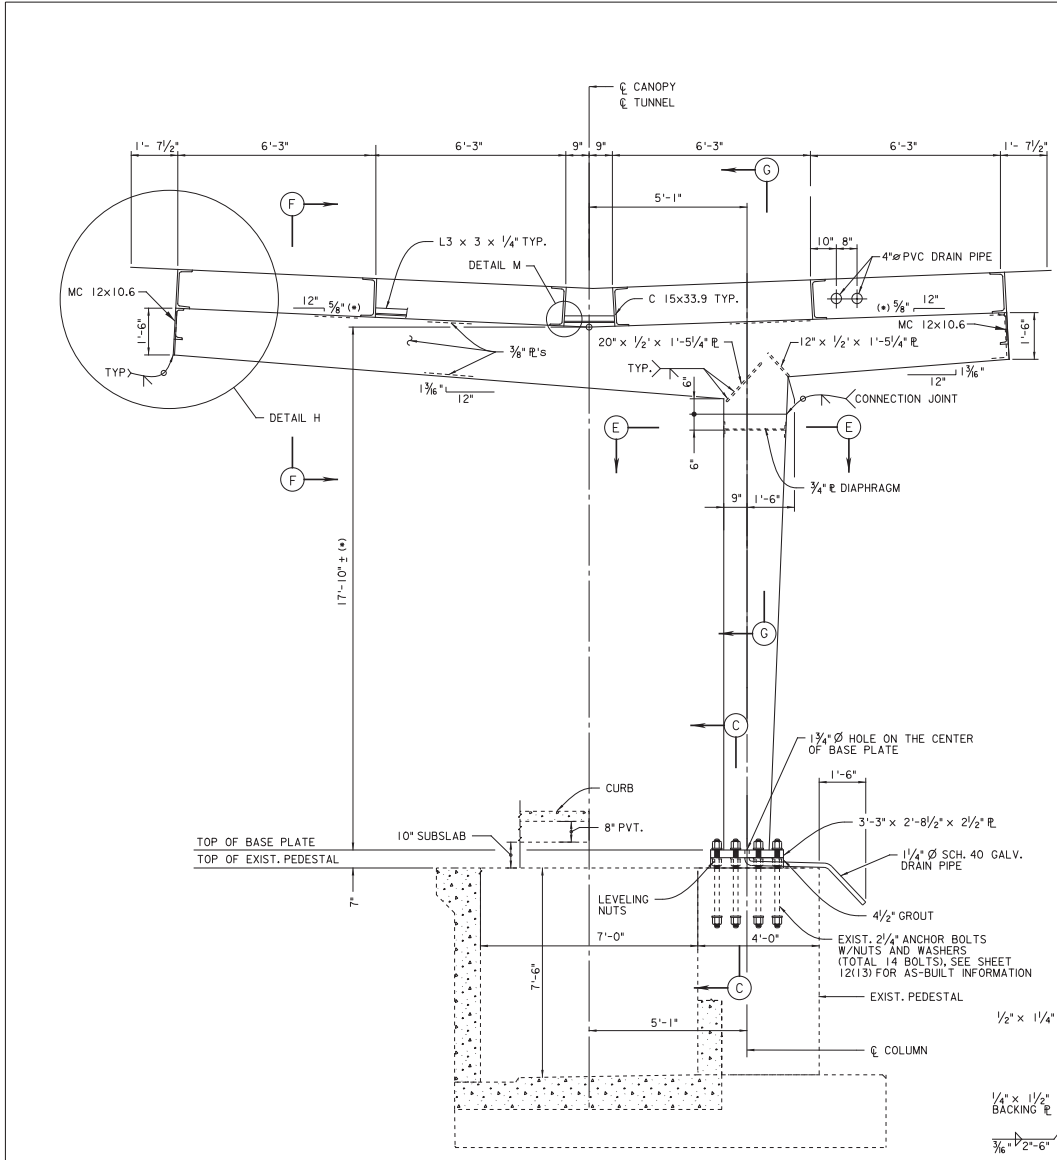

SECTION A-A
SCALE: 1/2" = 1'-0"


(*) 17'-10" IS BASED ON 17'-8" DIMENSION PER ORIGINAL DESIGN PLANS PLUS 2" ADJUSTMENT AT C OF CANOPY FOR THE ROOF SLOPE. ELEVATIONS OF THE TOP OF THE PROPOSED FRAME "C" AT ALL C15X33.9 LOCATIONS SHALL BE 2" HIGHER THAN ELEVATIONS OF THE TOP OF EXIST. FRAME "E" AT THE SAME LOCATIONS. CONTRACTOR IS RESPONSIBLE FOR SURVEYING OF EXIST. FRAME "E" BEFORE FABRICATION OF PROPOSED FRAME "C". IF REQUIRED, FRAME HEIGHT AND SLOPES OF THE FRAME TOP SHALL BE ADJUSTED.

NOTES:
 FOR LOCATION OF SECTION A-A, SEE SHEET 12(7).
 FOR DETAILS M AND H, SEE SHEET 12(11).
 LOCATION OF EXISTING ANCHOR BOLTS SHALL BE FIELD VERIFIED BY CONTRACTOR.
 GROUT BELOW BASE PLATE AND 1/4" Ø DRAIN PIPE SHALL BE INCIDENTAL.

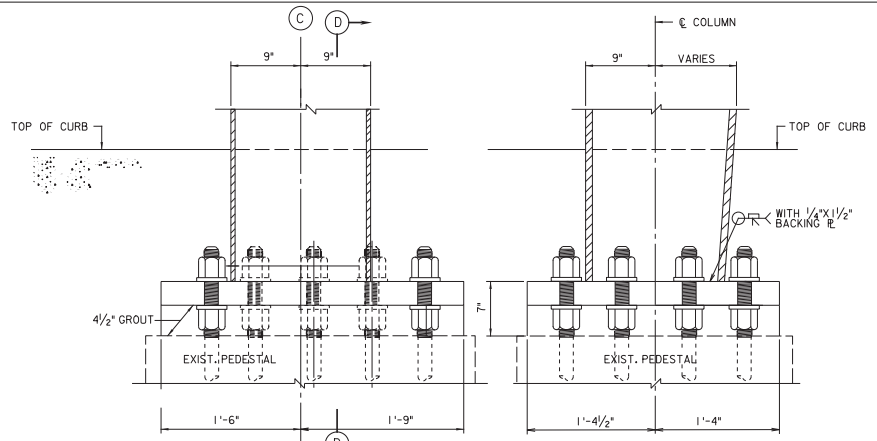


SECTION C-C
SCALE: 1/2" = 1'-0"
FOR EXIST. ANCHOR BOLT LOCATION, SEE SHEET 12(13).


SECTION D-D
SCALE: 1/2" = 1'-0"

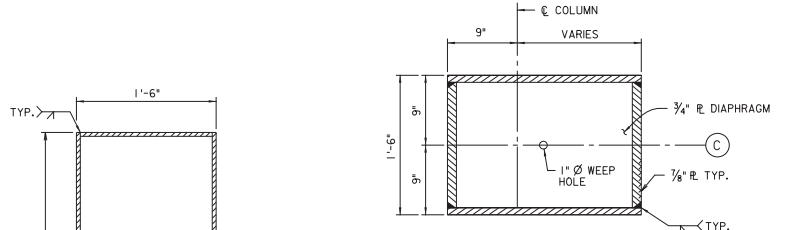


SECTION E-E
SCALE: 1/2" = 1'-0"

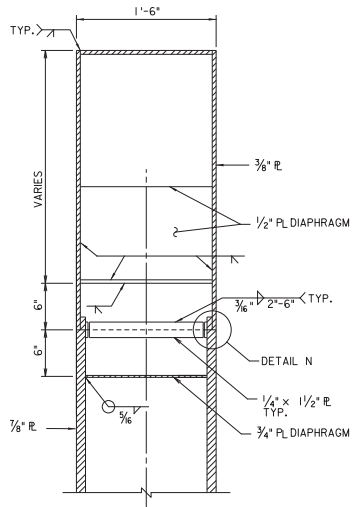

SECTION G-G
SCALE: 1/2" = 1'-0"

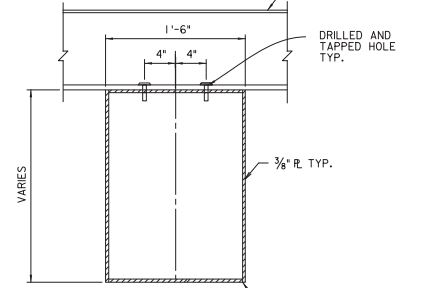

SECTION F-F
SCALE: 1/2" = 1'-0"

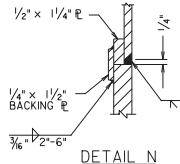

DETAIL N
SCALE: 3" = 1'-0"


richmond metropolitan authority
 RICHMOND DOWNTOWN EXPRESSWAY

DOWNTOWN EXPRESSWAY OPEN ROAD TOLLING

HNTB **TOLL PLAZA CANOPY FRAME C DETAILS**


2800 S. QUINCY STREET, SUITE 200
 ARLINGTON, VIRGINIA
 (703) 824-5100

Scale: AS NOTED	Date: FEB. 25, 2011	Contract No.: DTEOH-2011	Sheet: 12(8)
--------------------	------------------------	-----------------------------	-----------------

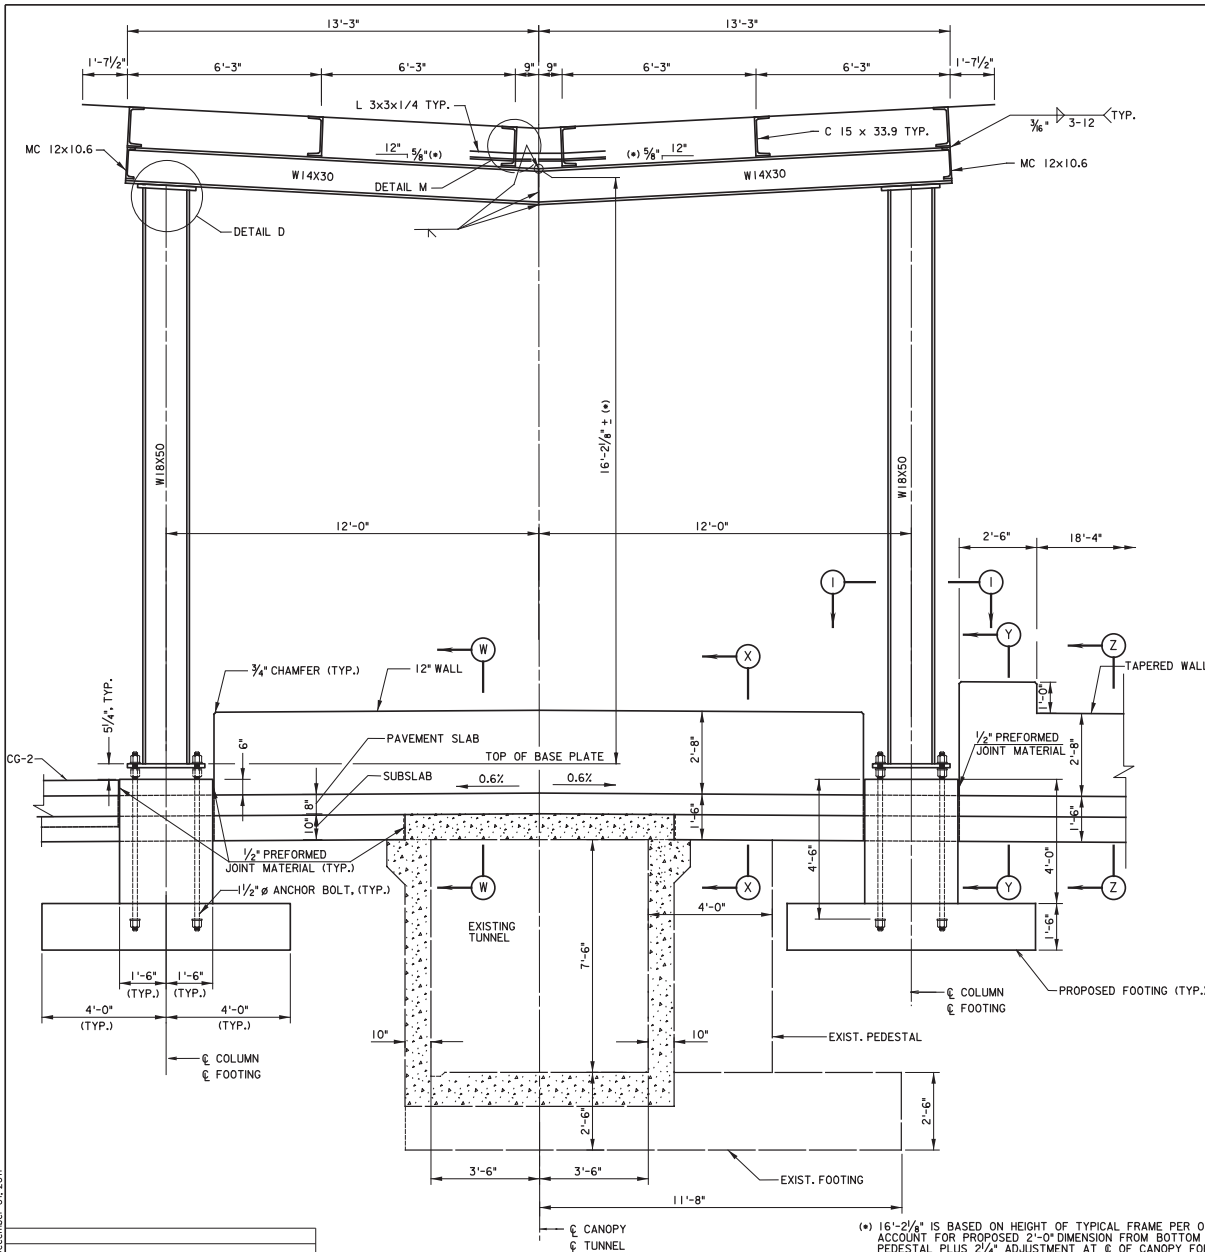


SECTION B-B
SCALE: 1/2" = 1'-0"

(*) 16'-2 1/8" IS BASED ON HEIGHT OF TYPICAL FRAME PER ORIGINAL DESIGN PLANS MODIFIED TO ACCOUNT FOR PROPOSED 2'-0" DIMENSION FROM BOTTOM OF SUBSLAB TO TOP OF FOOTING PEDESTAL PLUS 2/4" ADJUSTMENT AT ϵ OF CANOPY FOR THE ROOF SLOPE. ELEVATION OF THE PROPOSED FRAME "Q" AT ALL C15X33.9 LOCATIONS SHALL BE 2/4" HIGHER THAN ELEVATIONS OF THE TOP OF EXIST. FRAME "Q" AT THE SAME LOCATIONS. CONTRACTOR IS RESPONSIBLE FOR SURVEYING THE EXIST. FRAME "Q" PRIOR TO FABRICATION OF PROPOSED FRAME "Q". IF REQUIRED, FRAME HEIGHT AND SLOPES OF THE FRAME TOP SHALL BE ADJUSTED.

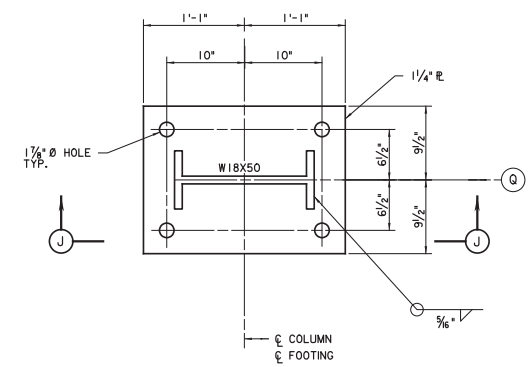

SECTION I-I
SCALE: 1 1/2" = 1'-0"

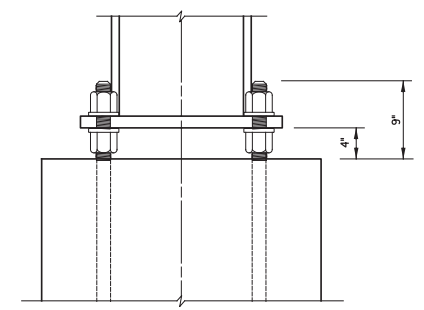

SECTION J-J
SCALE: 1 1/2" = 1'-0"


- NOTES:
 FOR LOCATION OF SECTION B-B, SEE SHEET 12(7).
 FOR DETAIL D, SEE SHEET 12(10).
 FOR DETAIL M, SEE SHEET 12(11).
 FOR FOOTING, SEE SHEET 12(13).
 FOR 8" PAVEMENT AND 10" SUBSLAB DETAILS, SEE SHEET 12(4).
 FOR SECTIONS W-W, X-X, Y-Y AND Z-Z, SEE SHEET 12(5A).

848715(0) 01.dwg
 Thursday, December 01, 2011

NO.	DATE	DESCRIPTION

#30# ADDED CONCRETE WALLS AND CO-2
 REVISIONS

HNTB	RICHMOND METROPOLITAN AUTHORITY RICHMOND DOWNTOWN EXPRESSWAY DOWNTOWN EXPRESSWAY OPEN ROAD TOLLING TOLL PLAZA CANOPY FRAME Q DETAILS		
	2800 S. QUINCY STREET, SUITE 200 ARLINGTON, VIRGINIA (703) 824-5100		
Scale: AS NOTED	Date: FEB. 25, 2011	Contract No.: DTEOR1-2011	Sheet: 12(9)

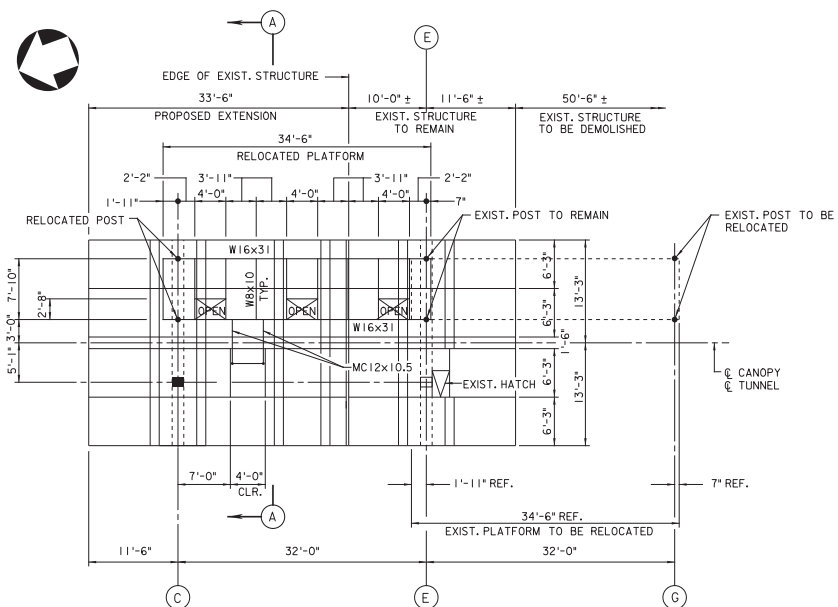


RELOCATED ROOF PLATFORM - NORTH
FRAMING PARTIAL PLAN
SCALE: 1/8" = 1'-0"

HVAC PLATFORM IS EXISTING BETWEEN COLUMN LINES "E" AND "G" AND SHALL BE RELOCATED TO COLUMN LINES "C" AND "E".

ALL DIMENSION AND MEMBER SIZES FOR RELOCATED PLATFORM ARE SHOWN AS REFERENCE ONLY. THIS INFORMATION IS TAKEN FROM PLAN SET "RICHMOND METROPOLITAN AUTHORITY (RMA), DOWNTOWN EXPRESSWAY & POWHITE PARKWAY TOOL BOOTH MECHANICAL SYSTEMS UPGRADES" SHEETS NOS. A-102 REV. 0, S-101 REV. 1 AND S-201 REV. 1 JAN 2003.

ALL DIMENSIONS AND ELEVATIONS SHALL BE FIELD VERIFIED BY THE CONTRACTOR.

CONTRACTOR SHALL FIELD VERIFY CONDITION OF EXISTING POSTS ON COLUMN LINE "G" PRIOR TO INSTALLATION ON COLUMN LINE "C." IF EXISTING POSTS CAN NOT BE REUSED, NEW POSTS SHALL BE FABRICATED. NEW POSTS SHALL MATCH THE EXISTING POSTS AND IF REQUIRED THE HEIGHT SHALL BE ADJUSTED AS NEEDED. THE TOP OF RELOCATED PLATFORM SHALL BE LEVEL.

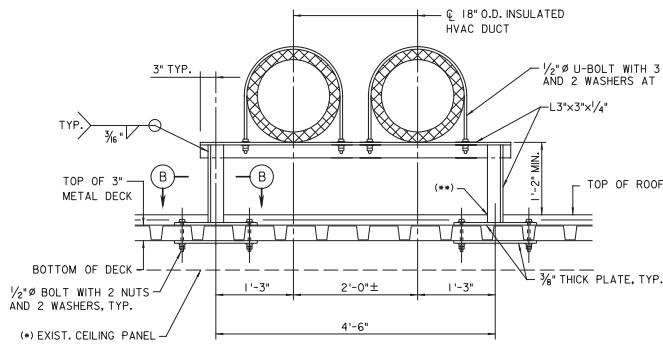


HVAC DUCT SUPPORT DETAIL
SCALE: 1" = 1'-0"


ALL DUCT SUPPORT STEEL, BOLTS, NUTS AND WASHERS SHALL BE HOT-DIP GALVANIZED.

(*) WHEN SUPPORT IS INSTALLED ON EXISTING ROOF, THE CEILING PANEL SHALL BE REMOVED AND REINSTALLED AFTER DUCT SUPPORT INSTALLATION.

(**) WHEN SUPPORT IS INSTALLED ON EXISTING ROOF, REMOVE EXISTING PLY FELTS AND INSULATION BOARD AROUND SUPPORT. ROOFING MATERIAL SHALL BE PUT BACK AFTER PLATE AND ANGLE INSTALLATION. IN ADDITION, CONTRACTOR SHALL INSTALL FLASHING AND CANT STRIP AROUND ANGLE TO PREVENT LEAKING.

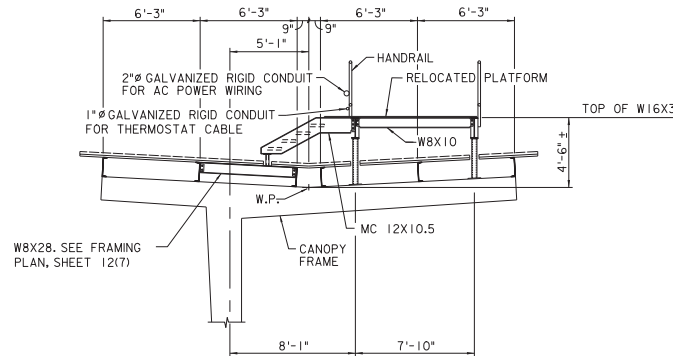


SECTION A-A
1/4" = 1'-0"
FOR LOCATION OF ROOF PENETRATION FOR ELECTRICAL CONDUITS, SEE SHEET 12(14).

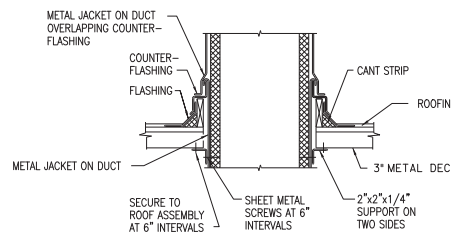


TYPICAL DUCT THRU ROOF DETAIL
SCALE: NONE

SEAL ALL EXPOSED JOINTS WITH SUITABLE MASTIC OR FOIL BACKED TAPE TO PREVENT LEAKING.

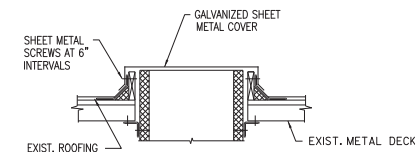

EXISTING SEALED DUCT ROOF PENETRATION DETAIL
SCALE: NONE

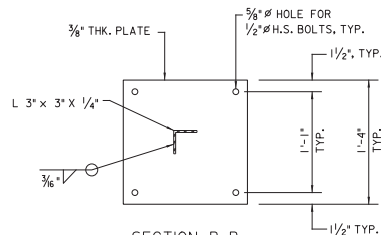

SECTION B-B
SCALE: 1/2" = 1'-0"

NOTES:
FOR LOCATION OF ROOF PENETRATION DETAILS AND HVAC DUCT SUPPORTS, SEE SHEET 12(14).

rma RICHMOND METROPOLITAN AUTHORITY
RICHMOND DOWNTOWN EXPRESSWAY

DOWNTOWN EXPRESSWAY OPEN ROAD TOLLING


HNTB
TOLL PLAZA CANOPY
CANOPY EXTENSION DETAILS 3

2900 S. QUINCY STREET, SUITE 200
ARLINGTON, VIRGINIA
(703) 824-5100


Scale:	Date: FEB. 25, 2011	Contract No.: DTEOH-2011	Sheet: 12(12)
--------	------------------------	-----------------------------	------------------

B:\P\151151.dwg
Tuesday, March 15, 2011


REVISIONS

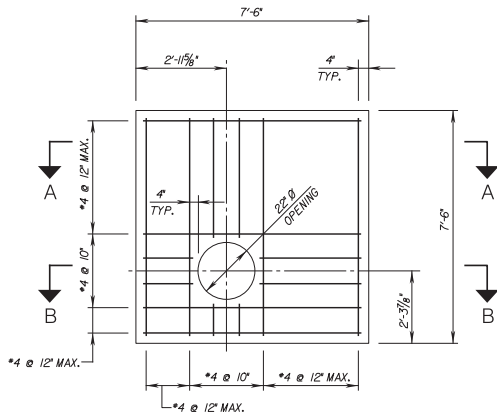

PLAN

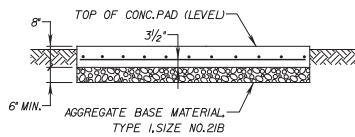

SECTION A-A

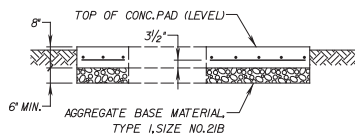


SECTION B-B

NOTES

1. CONCRETE SHALL BE CLASS A3. DEFORMED REINFORCING BARS SHALL CONFORM TO ASTM A615 GRADE 60.
2. PAD DIMENSIONS AND LAYOUT SHOWN SHALL BE USED FOR THE CONTRACT SPECIFIED TRAFFIC UNIT. IF A DIFFERENT UNIT IS APPROVED, CONTRACTOR IS REQUIRED TO SUBMIT PAD LAYOUT TO THE ENGINEER FOR REVIEW AND APPROVAL.
3. CONTRACTOR SHALL INSTALL THE BURIED DUCT ABOVE THE TOP OF PAD ELEVATION PRIOR TO POURING PAD CONCRETE.
4. CONTRACTOR SHALL VERIFY DIMENSIONS OF ACTUAL CURB AND UNIT SUPPLIED AND SUBMIT ANY DISCREPANCIES BETWEEN THE PAD LAYOUT AND UNIT TO THE ENGINEER.

PAD LAYOUT
NTS

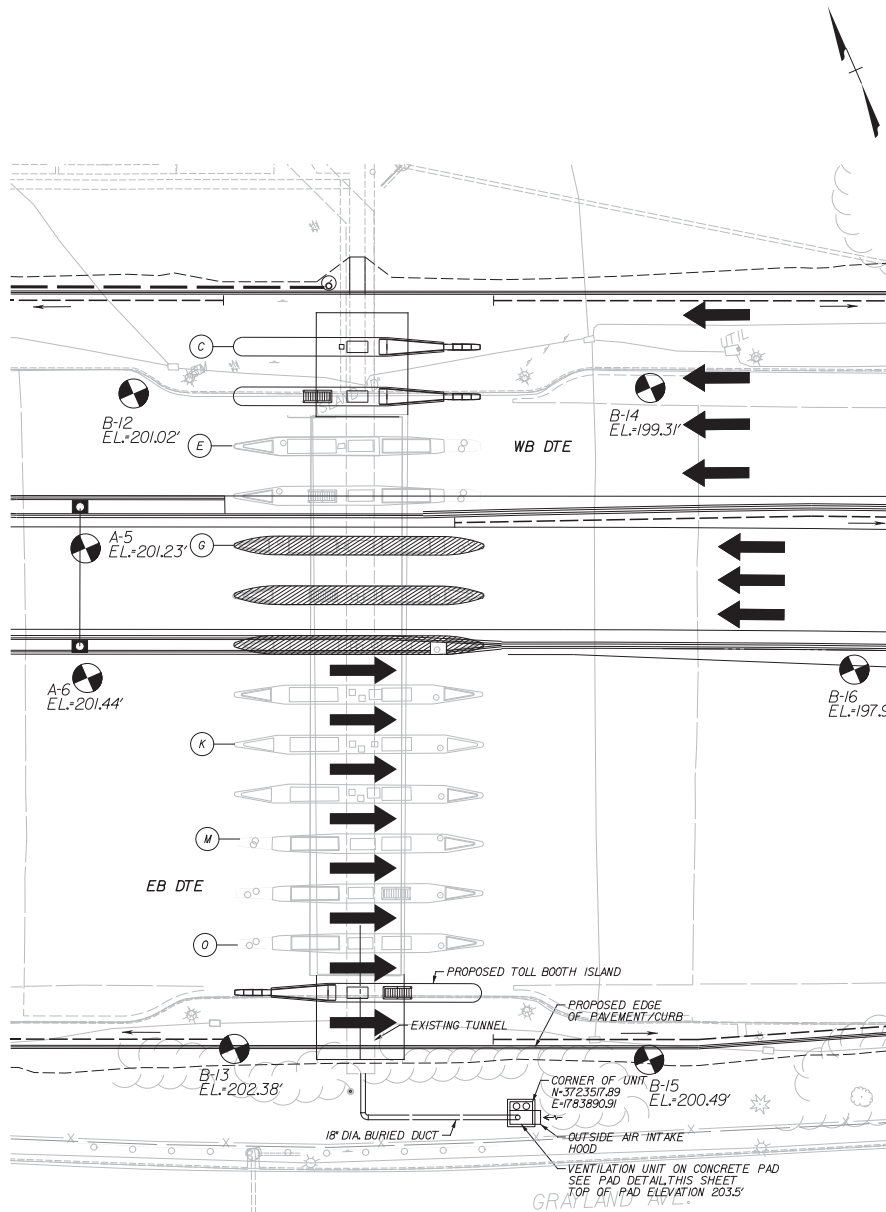

PLAN

GENERAL MECHANICAL NOTES:

1. ALL WORK SHALL CONFORM TO THE REQUIREMENTS OF VIRGINIA MECHANICAL CODE
2. VISIT SITE AND NOTE EXISTING CONDITION AFFECTING THE WORK PRIOR TO BIDDING. RELOCATION OF EXISTING SYSTEMS FOR THE INSTALLATION OF NEW WORK SHALL BE INCLUDED IN THE SCOPE OF THIS PROJECT.
3. COORDINATE ALL MECHANICAL WORK WITH THAT OF OTHER TRADES TO ENSURE PROPER AND ADEQUATE INTERFACE OF THEIR WORK WITH THE WORK OF THIS CONTRACTOR.
4. DEMOLITION: REMOVE ALL WORK AS INDICATED. REMOVE OR REROUTE EXISTING WORK TO SUIT NEW WORK. DO ALL CORE DRILLING, CUTTING AND PATCHING FOR INSTALLATION OF NEW WORK. EXISTING EQUIPMENT AND DEVICE SHALL BE REMOVED FROM SITE AT THE DIRECTION OF THE ENGINEER.
5. DAMAGES: CORRECT ALL DAMAGE TO EXISTING FINISHES, TUNNEL WALLS, FLOOR AND CEILING, OR SYSTEMS ASSOCIATED WITH THE INSTALLATION OF NEW WORK.
6. DRAWINGS ARE SCHEMATIC REPRESENTATION OF THE WORK TO BE PERFORMED AND ARE NOT INTENDED TO SHOW ALL DETAIL OF THE WORK. VERIFY LOCATIONS AND MEASUREMENTS OF ALL ITEMS AT PROJECT SITE PRIOR TO FABRICATION AND INSTALLATION.
7. PROVIDE NEC MINIMUM CODE CLEARANCE IN FRONT OF ANY ELECTRICAL EQUIPMENT (FRONT, BELOW, ABOVE, ETC.). ARRANGE EQUIPMENT SO THAT EQUIPMENT ACCESS CLEARANCE INDICATED ON DRAWINGS OR AS RECOMMENDED BY MANUFACTURER ARE PROVIDED.
8. PROVIDE ALL OFFSETS, FITTINGS AND TRANSITIONS REQUIRED TO CONNECT TO MECHANICAL EQUIPMENT.
9. ITEMS NOTED 'TYPICAL' ON ANY DRAWING SHEET APPLY TO THE ENTIRE DRAWING SET.
10. REFER TO ELECTRICAL DRAWINGS FOR POWER CONNECTIONS TO MECHANICAL EQUIPMENT.

ABBREVIATIONS

- FRP FIBER REINFORCED PLASTIC
OSA OUTSIDE AIR

irma RICHMOND METROPOLITAN AUTHORITY
RICHMOND DOWNTOWN EXPRESSWAY

DOWNTOWN EXPRESSWAY OPEN ROAD TOLLING

MECHANICAL PLAN

HNTB

2800 S. QUINCY STREET, SUITE 200
ARLINGTON, VIRGINIA
(703) 824-5100

Scale: 1" = 20'-0"
Date: FEB. 25, 2011
Contract No.: DTEOH-2011
Sheet: 14(1)


M&E/14/11/15/16/17/999/1000

REVISIONS


DTE RAMP TOLL PLAZAS

ORIGINAL PLANS


RICHMOND EXPRESSWAY SYSTEM		
TOLL FACILITIES	SHEET NO.	TOTAL SHEETS
	4	38

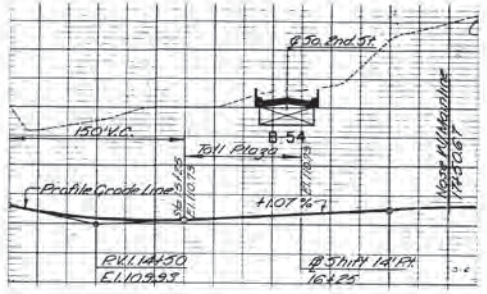


RAMP BYRD-E
Scale: 1"=10' Vert.
1"=50' Horiz.

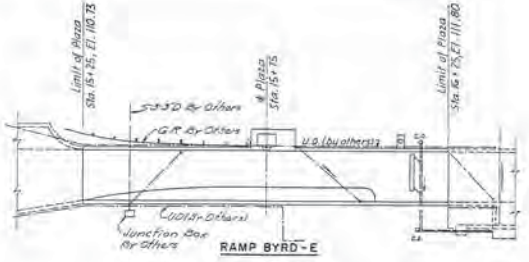


RAMP BYRD-E

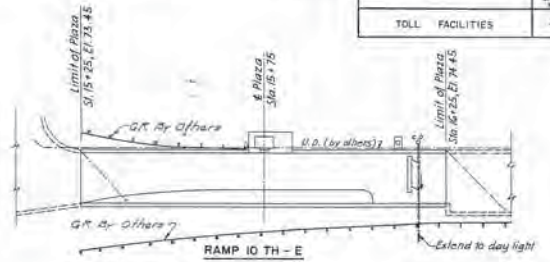


RAMP IO TH-E

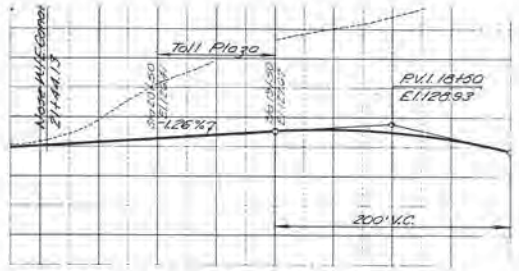


RAMP E-CANAL
Scale: 1"=10' Vert.
1"=50' Horiz.

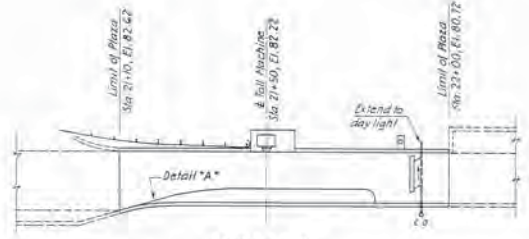


RAMP E-II TH

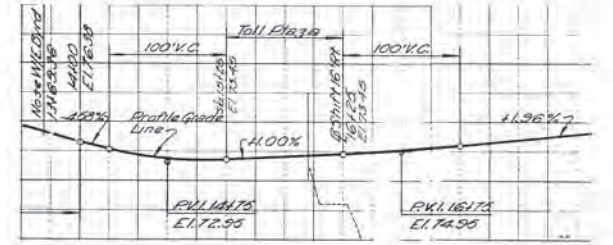

RAMP IO TH-E
Scale: 1"=10' Vert.
1"=50' Horiz.

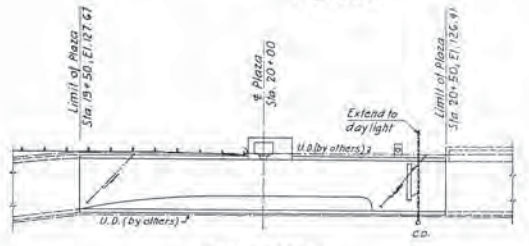

RAMP E-CANAL

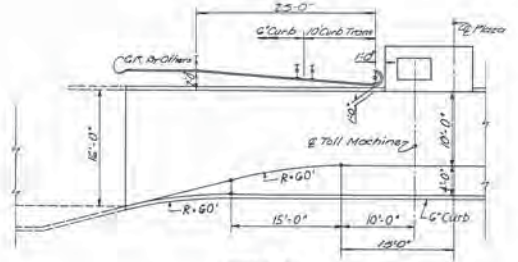

DETAIL "A"
RAMP E-II TH
Scale: 1/4"=1'-0"



RAMP E-IITH
Scale: 1"=10' Vert.
1"=50' Horiz.

AS BUILT

RICHMOND METROPOLITAN AUTHORITY
RICHMOND EXPRESSWAY SYSTEM










RAMP PLAZA LAYOUTS

HOWARD, NEEDLES, TAMMEN & BERGENOFF
CONSULTING ENGINEERS
1014 YORK ALEXANDRIA FARMAS CITY

SCALE: 1/4"=1'-0"
CONTRACT NO. 720
SHEET NO. 4 OF 38

BY	DATE			
MADE	D.E.N.	5-68		
CHECKED	W.J.W.	5-68	Final Check	W.J.W. 6-68
IN CHARGE	H.D.S.		NO	REVISION
				BY DATE

RICHMOND EXPRESSWAY SYSTEM		
SHEET NO.	TOTAL SHEETS	
TOLL FACILITIES	9	38

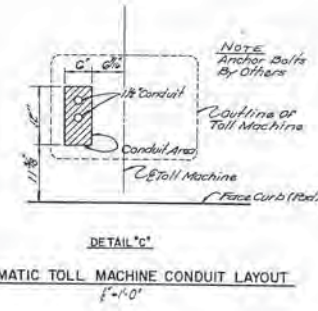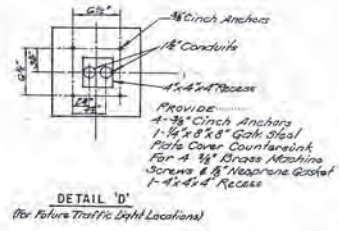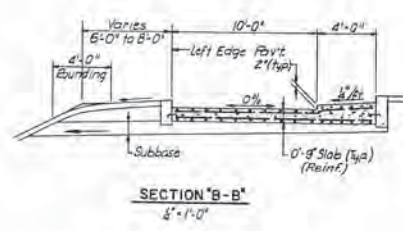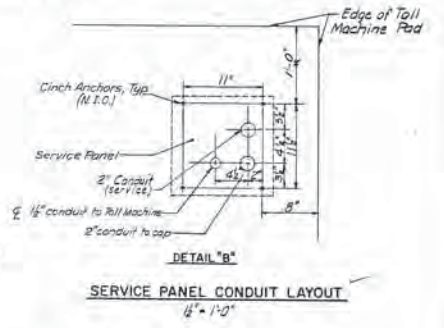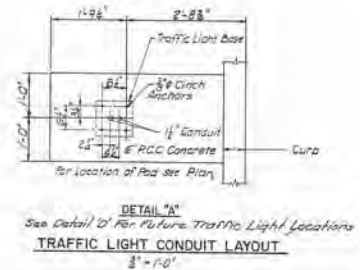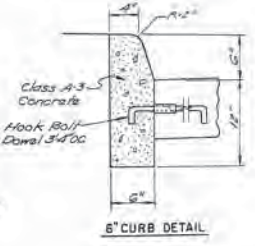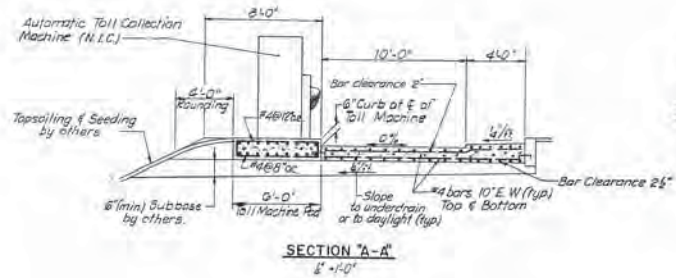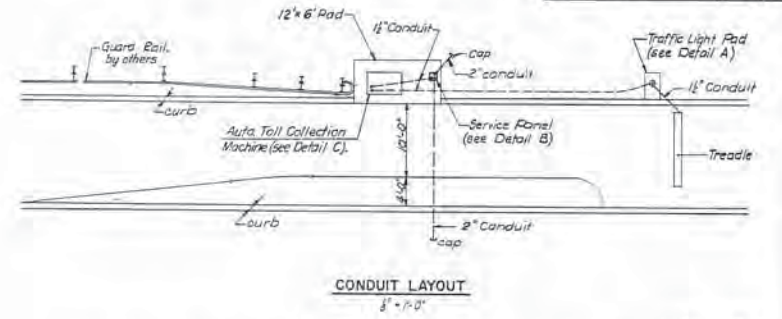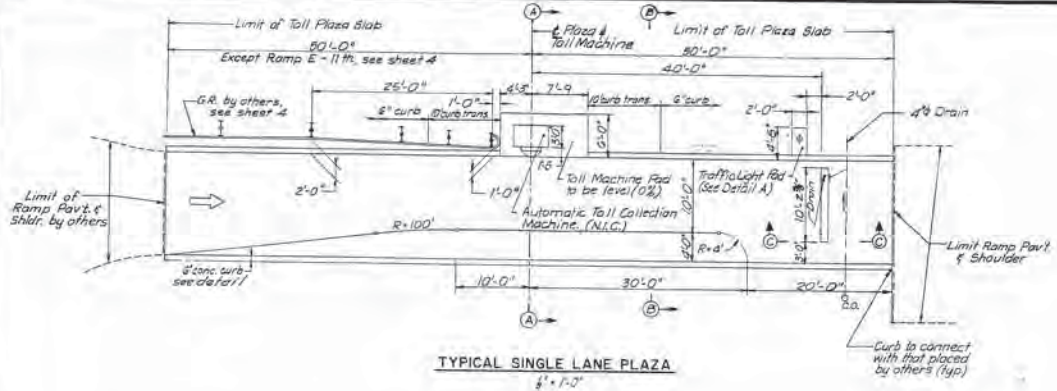

BY	DATE	NO.	REVISION	BY	DATE
3	Rev Toll Machine Conduit	PHT	4/70		
2	Rev Traffic Light Pad Reinf. Detail	PHT	2/70		
1	Final Check	D.E.N.	6-68		

AS BUILT


RICHMOND METROPOLITAN AUTHORITY
RICHMOND EXPRESSWAY SYSTEM

SINGLE LANE RAMP PLAZA
PLAN AND DETAILS

HOWARD, NEEDLES, TAMMEN & BERGENCOFF
consulting engineers
NEW YORK ALEXANDRIA KANSAS CITY

SCALE: AS NOTED
CONTRACT NO. 77-3
SHEET NO. 29 OF 38

RICHMOND EXPRESSWAY SYSTEM		
SECTION	PROJECT	SHEET NO.
9	DOWNTOWN EXPRESSWAY	58

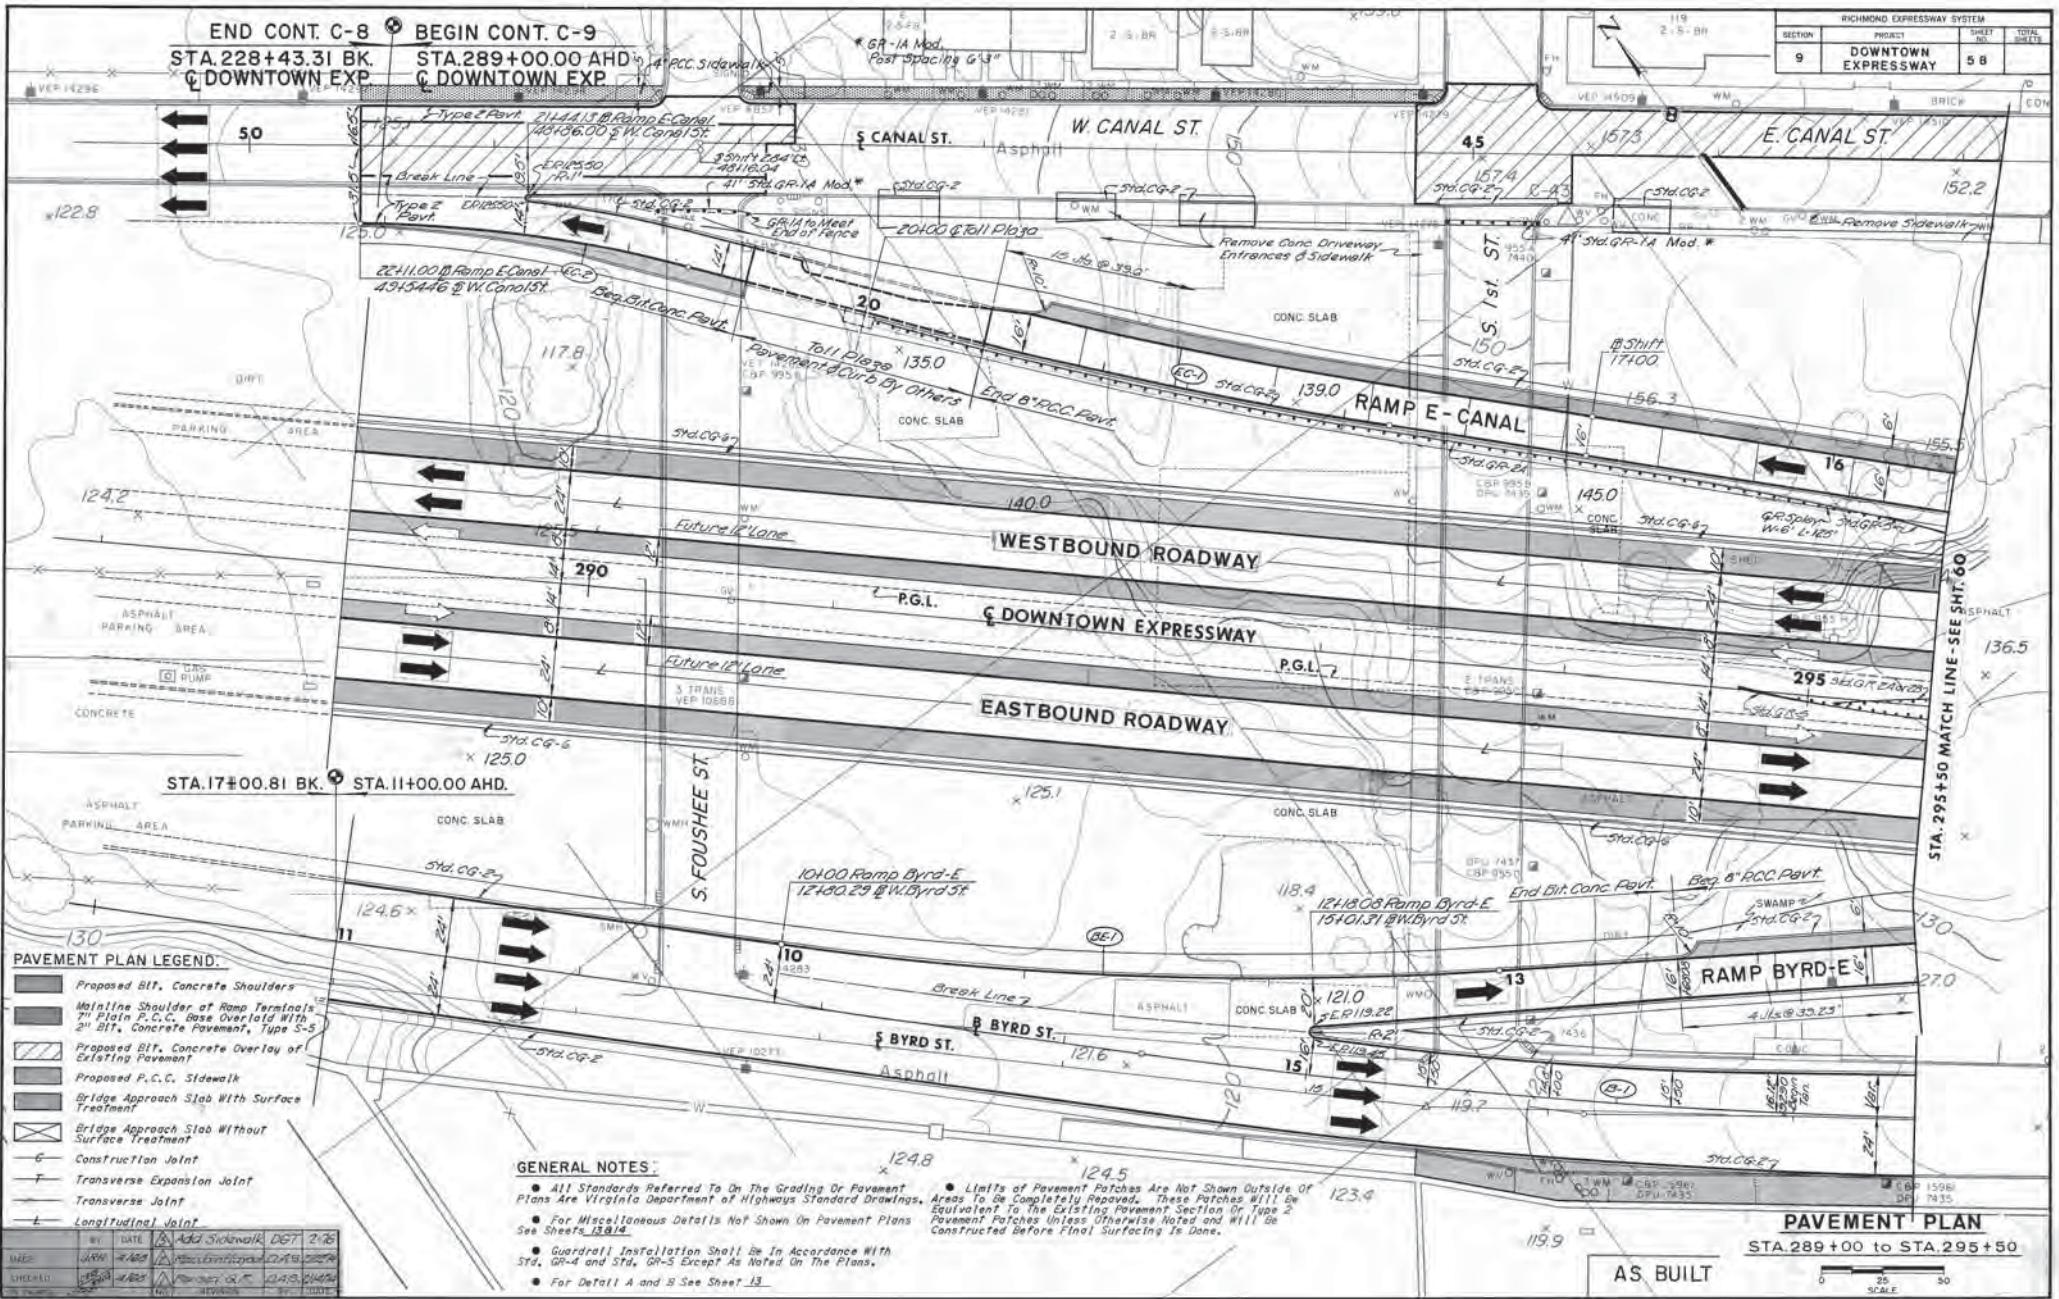

PAVEMENT PLAN LEGEND:

- Proposed BIT, Concrete Shoulders
- Mainline Shoulder of Ramp Terminals
- Proposed BIT, Concrete Overlay of Existing Pavement
- Proposed P.C.C. Sidewalk
- Bridge Approach Slab With Surface Treatment
- Bridge Approach Slab Without Surface Treatment
- Construction Joint
- Transverse Expansion Joint
- Transverse Joint
- Longitudinal Joint


GENERAL NOTES:

- All Standards Referred To On The Grading Or Pavement Plans Are Virginia Department of Highways Standard Drawings.
- For Miscellaneous Details Not Shown On Pavement Plans See Sheets 13A11A.
- Limits of Pavement Patches Are Not Shown Outside Of Areas To Be Completely Repaved. These Patches Will Be Equivalent To The Existing Pavement Section Or Type 2 Pavement Patches Unless Otherwise Noted and Will Be Constructed Before Final Surfacing Is Done.
- Guardrail Installation Shall Be In Accordance With Std. GR-4 and Std. GR-5 Except As Noted On The Plans.
- For Detail A and B See Sheet 13.

PAVEMENT PLAN
STA. 289+00 to STA. 295+50

AS BUILT



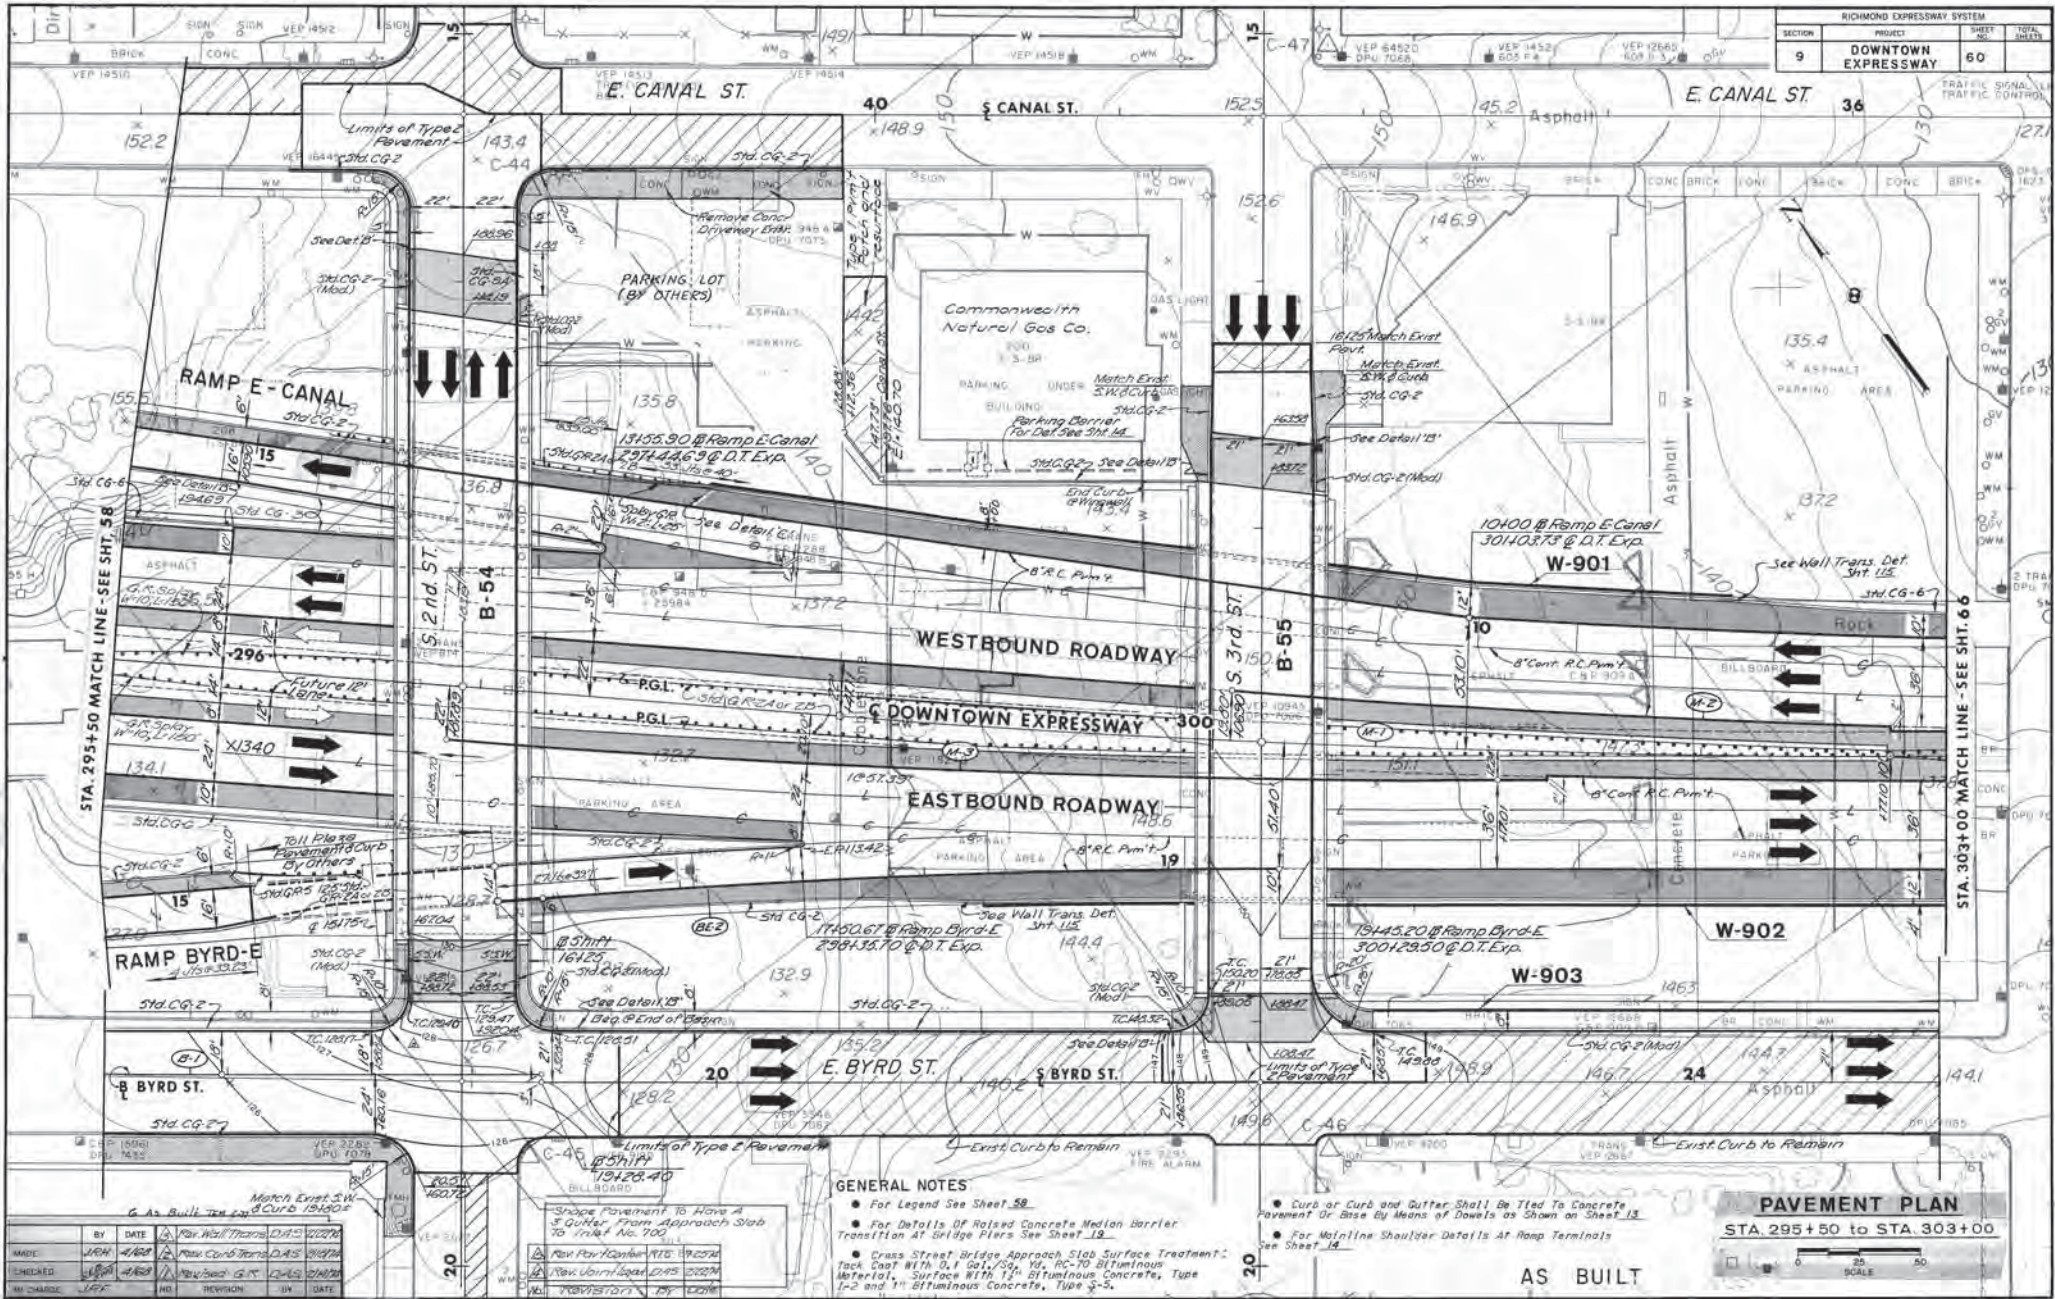

RICHMOND EXPRESSWAY SYSTEM			
SECTION	PROJECT	SHEET NO.	TOTAL SHEETS
9	DOWNTOWN EXPRESSWAY	60	

- GENERAL NOTES**
- For Legend See Sheet 58
 - For Details of Raised Concrete Median Barrier Transition At Bridge Piers See Sheet 19
 - Curb or Curb and Gutter Shall Be Tied To Concrete Pavement Or Base By Means of Dowels as Shown on Sheet 13
 - For Mainline Shoulder Details At Ramp Terminals See Sheet 14
 - Cross Street Bridge Approach Slab Surface Treatment: Tack Coat With 0.1 Gal./Sq. Yd. AC-10 Bituminous Material. Surface With 1.5" Bituminous Concrete, Type 1-2 and 1" Bituminous Concrete, Type 3-5.

PAVEMENT PLAN
 STA. 295+50 TO STA. 303+00



AS BUILT


BY	DATE	REV	DESCRIPTION	DATE
JRH	4/88	1	Rev Wall Trans	4/22/78
JRH	4/88	2	Rev Curb Trans	5/14/78
JRH	4/88	3	Rev Sign Legend	5/22/78
JRH	4/88	4	Rev Sign Legend	5/22/78

Shape Pavement to Have A 3" Gutter From Approach Slab To Inlet No. 700

Rev Pavement RTD: 1/25/78

Rev Sign Legend: 5/22/78

Rev Sign Legend: 5/22/78

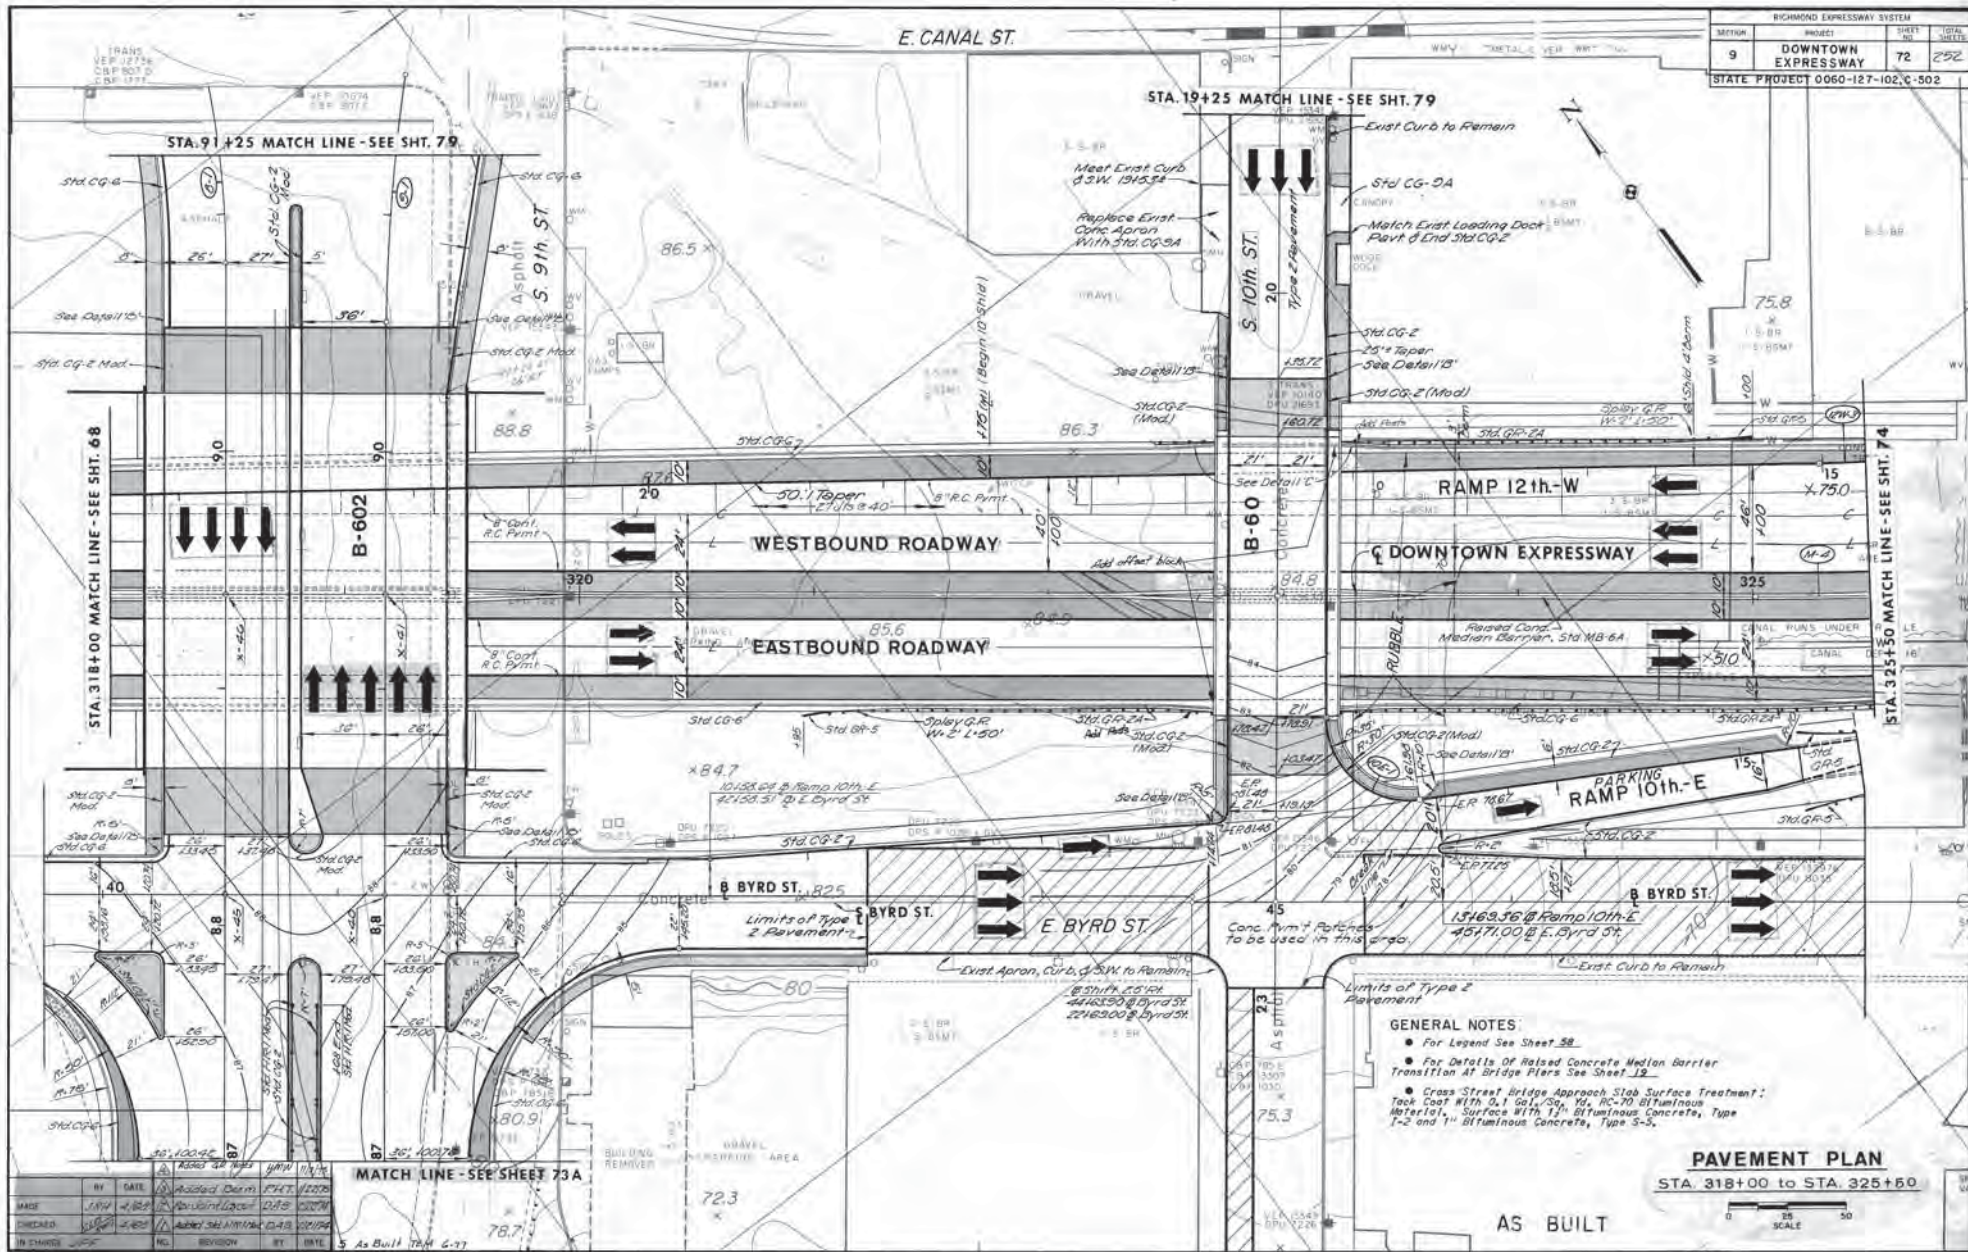

SECTION	PROJECT	SHEET NO.	TOTAL SHEETS
9	DOWNTOWN EXPRESSWAY	72	252

STATE PROJECT 0060-127-102-C-502

- GENERAL NOTES:**
- For Legend See Sheet 58
 - For Details Of Raised Concrete Median Barrier Transition At Bridge Piers See Sheet 12
 - Cross Street Bridge Approach Slab Surface Treatment: Took Coat With 0.1 Gal./Sq. Yd. RC-70 Bituminous Material, Surface With 1" Bituminous Concrete, Type 1-2 and 1 1/2 Bituminous Concrete, Type 3-5.


PAVEMENT PLAN
STA. 318+00 TO STA. 325+50

AS BUILT



NO.	REVISION	BY	DATE
1	As Built	TRM	6-27

RICHMOND EXPRESSWAY SYSTEM			
SECTION	PROJECT	SHEET NO.	TOTAL SHEETS
9	DOWNTOWN EXPRESSWAY	74	

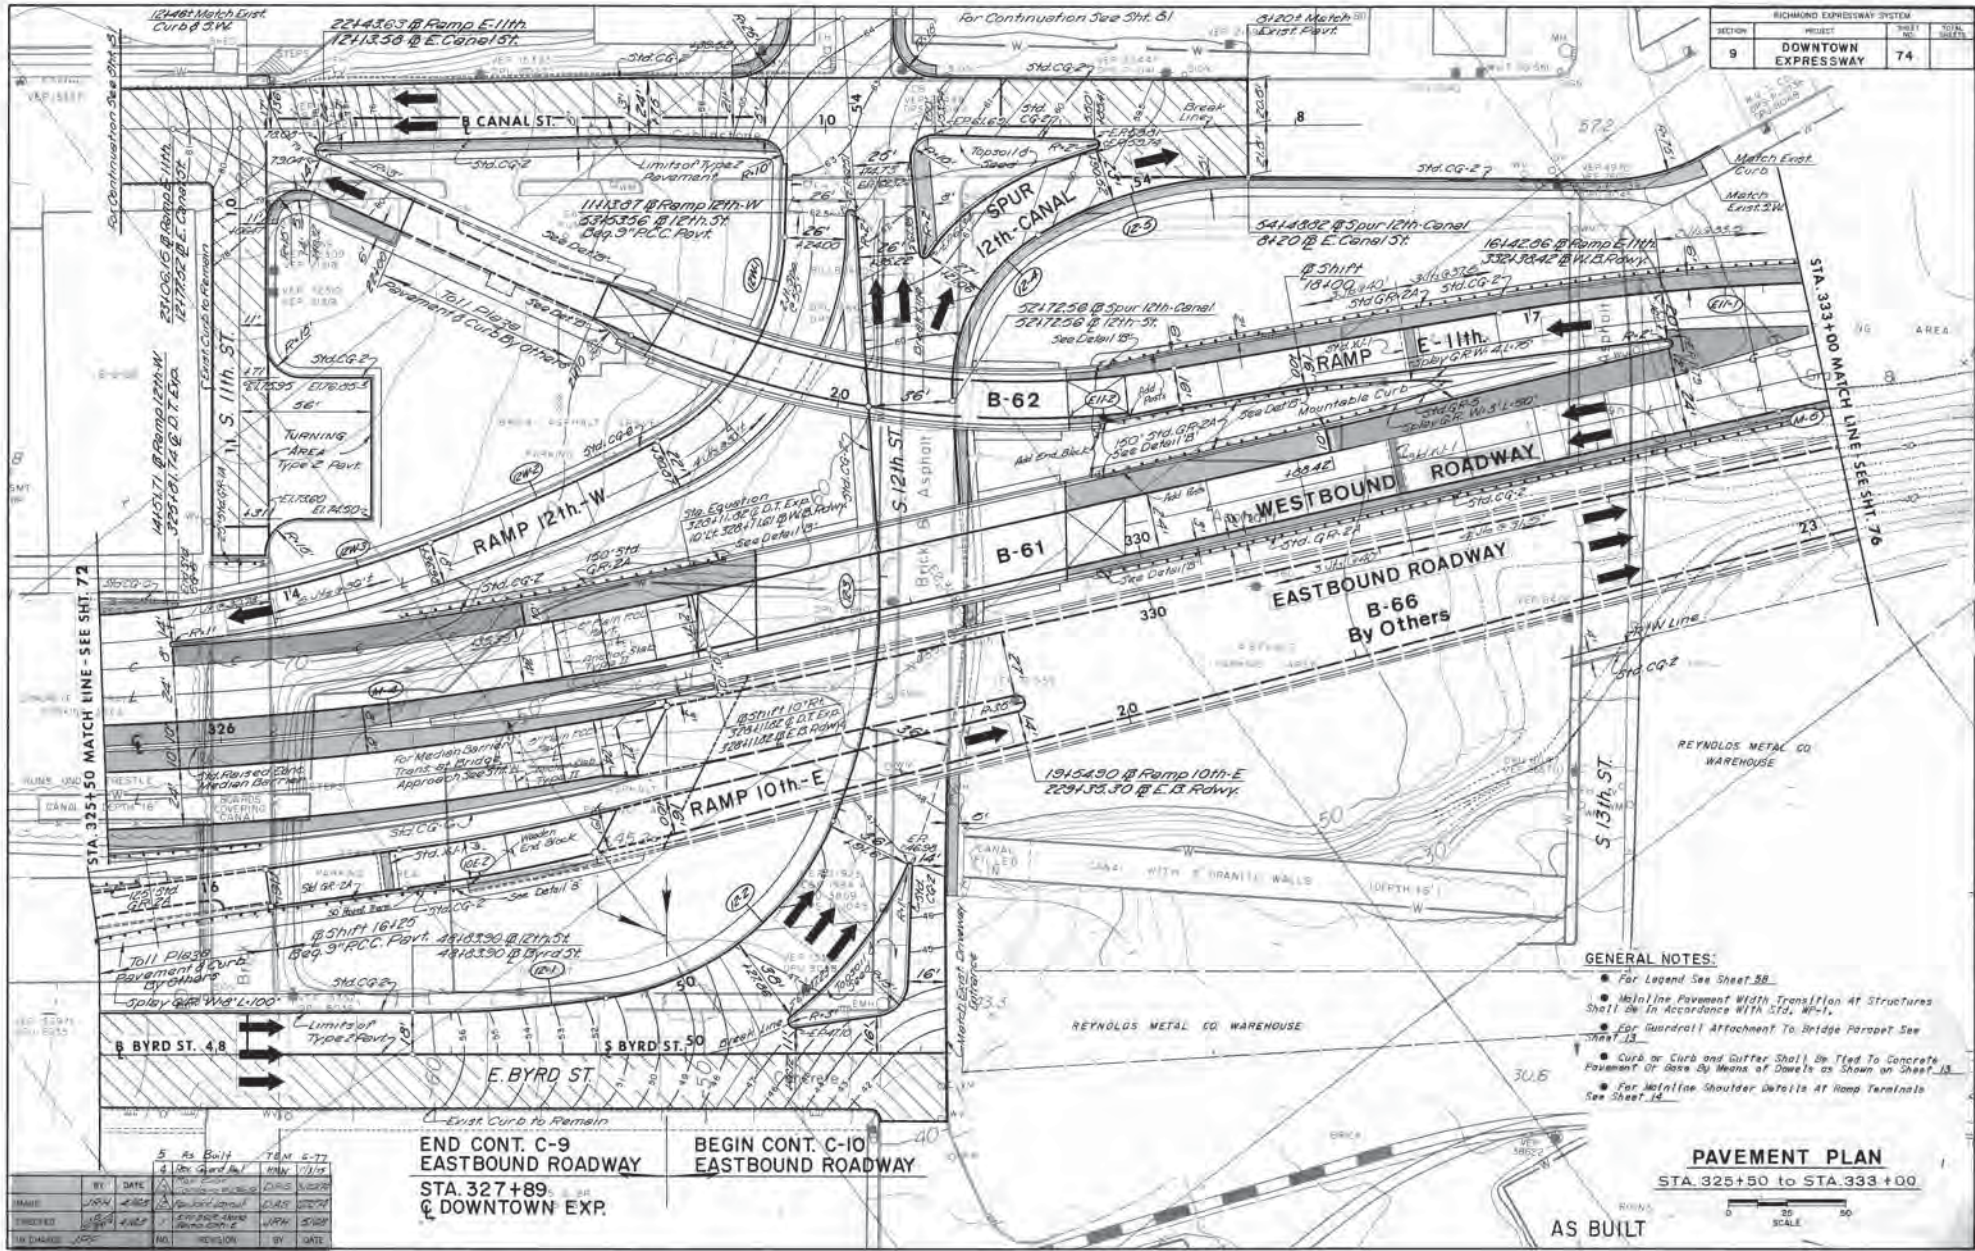

BY	DATE	REVISION	BY	DATE
5	As Built		TAM	5-77
4	Rev. Guardrail		WJW	7/10
3	Rev. Slope		WJW	10/87
2	Rev. Slope		WJW	10/87
1	Original		WJW	10/87

END CONT. C-9
EASTBOUND ROADWAY
STA. 327+89
& DOWNTOWN EXP.

BEGIN CONT. C-10
EASTBOUND ROADWAY

PAVEMENT PLAN
STA. 325+50 to STA. 333+00



AS BUILT

DTE RAMP TOLL PLAZAS


11TH ST RAMP WIDENING PLANS

RICHMOND EXPRESSWAY SYSTEM			
SECTION	PROJECT	SHEET NO.	TOTAL SHEETS
I 5	1990-1991 IMPROVEMENTS	2D(2)	



Colors:
Alternating black and reflectorized yellow stripes


OM-3 Modified
1'-10"

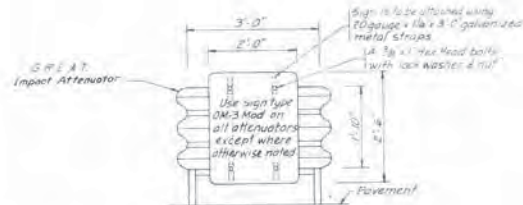


SIGN ATTACHMENT DETAIL
3/8" x 1'-0"

Note:
Signs are to be as specified in the current manual on Uniform Traffic Control Devices for Highways & Street, by the Federal Highway Administration.


ATTENUATOR SIGNING DETAILS

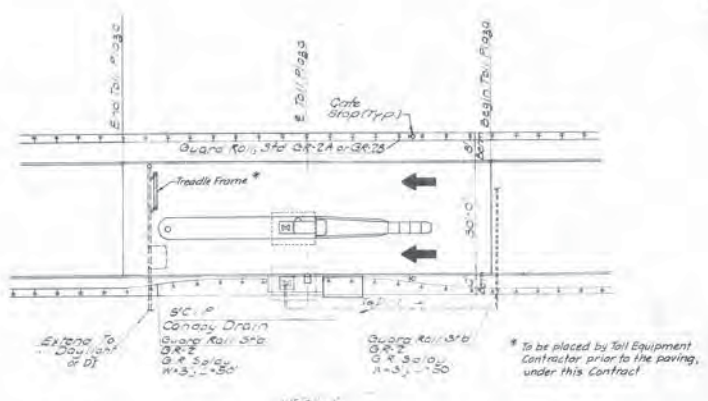

* To be placed by Toll Equipment Contractor prior to the paving, under this Contract.

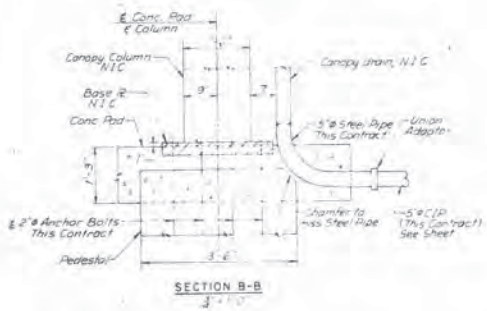


SECTION B-B
3'-0"

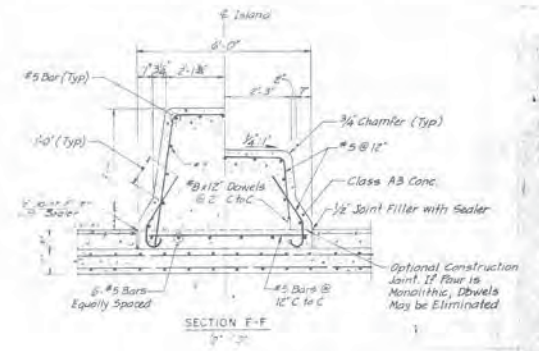

SECTION F-F
3'-0"

Note:
For Conduit Schedule, see sheet 2D (5)

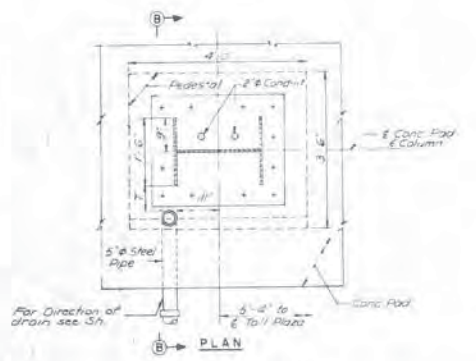

RAMP CANOPY DRAIN
3'-0"

By	Date				
Designed	FHT	1-91			
Drawn	CN	1-91			
Checked	ICM	1-91			
Approved	RBN	1-91	No.	Revision	By Date

- LEGEND:**
- Traffic Signal (N.I.C.)
 - Automatic Toll Machine
 - Toll Booth (N.I.C.)

ma RICHMOND METROPOLITAN AUTHORITY
RICHMOND EXPRESSWAY SYSTEM

TWO LANE RAMP TOLL PLAZA


DETAILS

HOWARD NEEDLES TAMMEN & BERGENDOFF
Engineers
ALEXANDRIA, VA.

HNTB
Planners

Scale: AS NOTED Date: JAN 1991 Contract No.: C-15 Sheet: 2D(2) of 2


RICHMOND EXPRESSWAY SYSTEM			
SECTION	PROJECT	SHEET NO.	TOTAL SHEETS
15	1990-1991 IMPROVEMENTS	4	

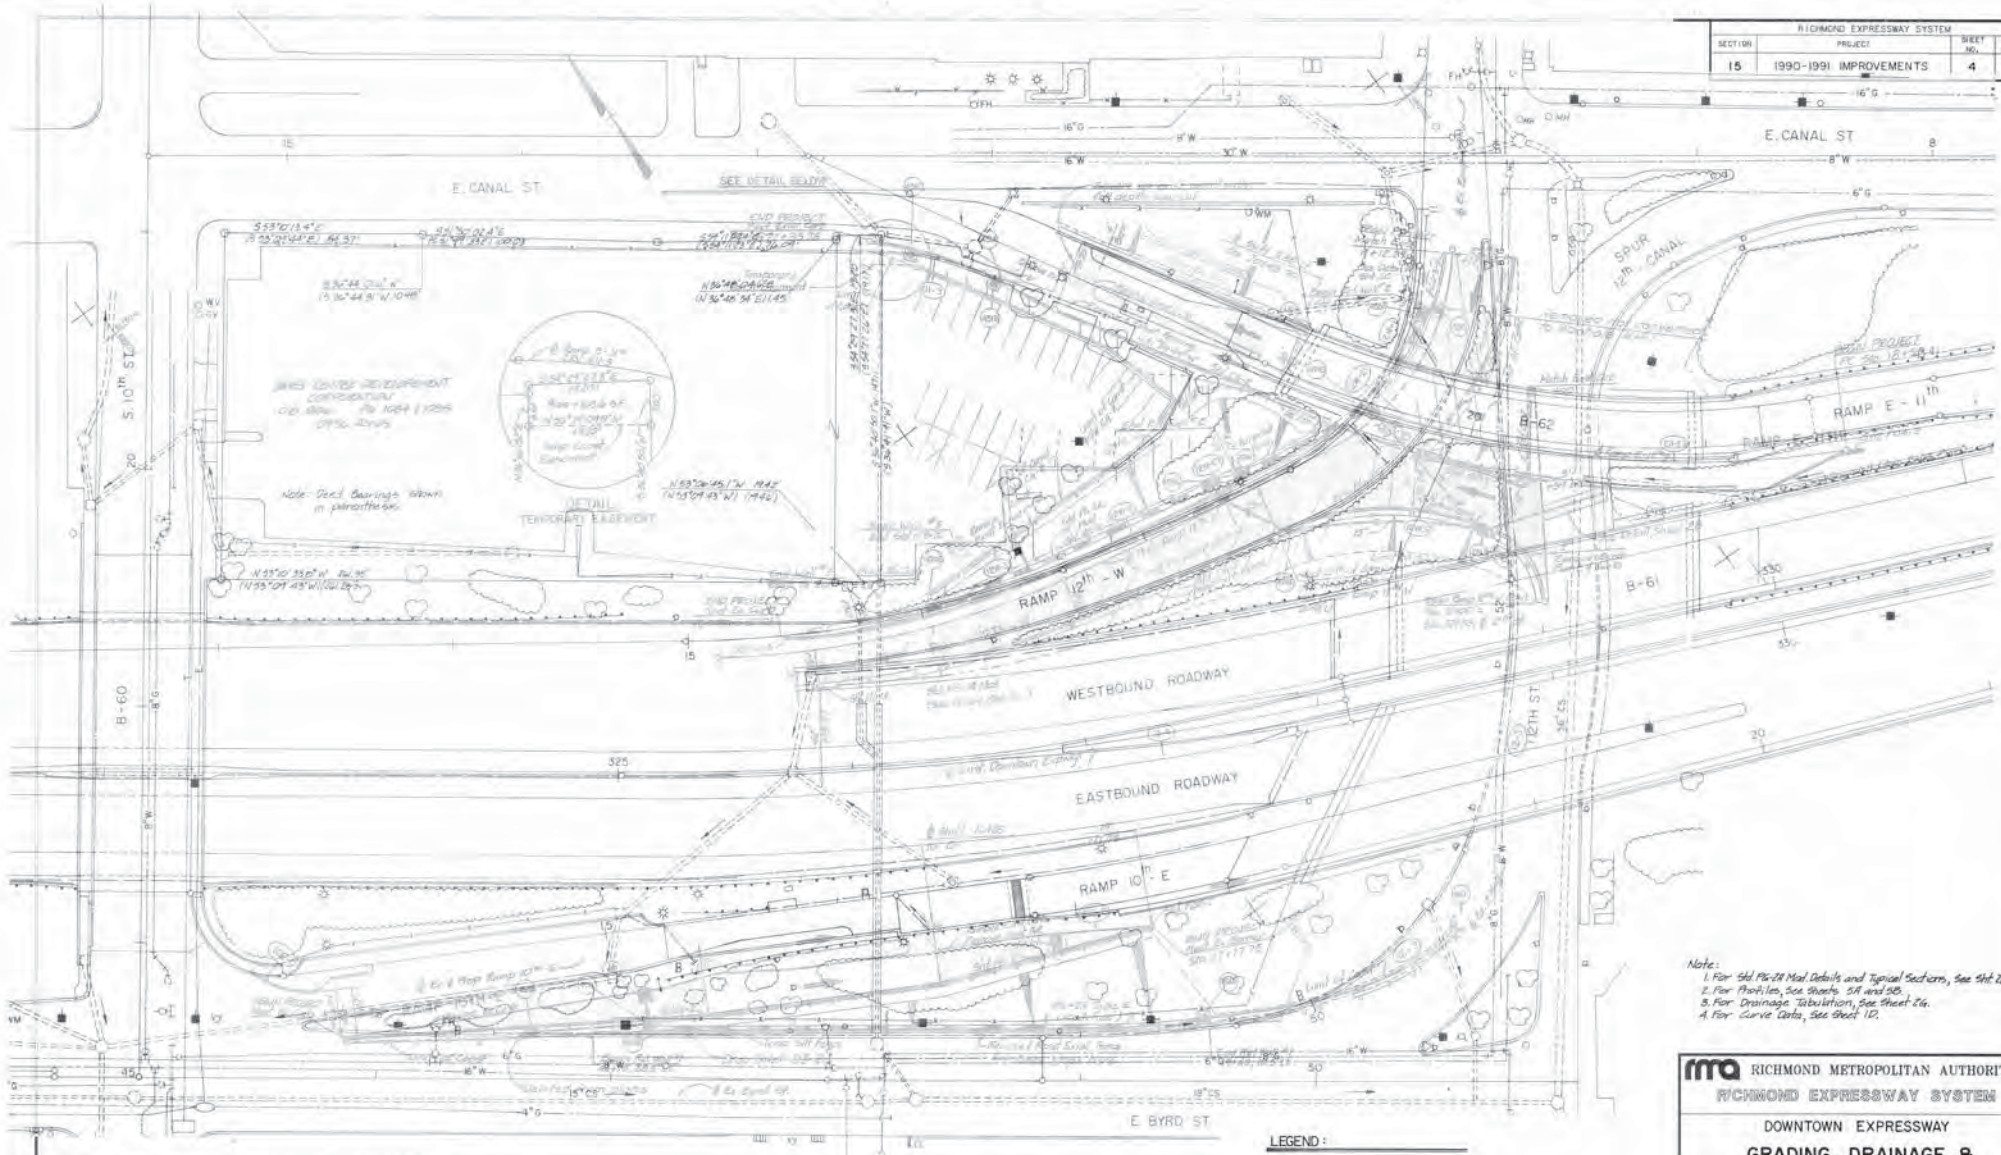

Note:
 1. For 34" PS-28 Mat Details and Typical Sections, See SHEET 15.
 2. For Profiles, See Sheets 27 and 28.
 3. For Drainage Distribution, See Sheet 26.
 4. For Curve Data, See Sheet 12.

	By	Date			
Designed					
Drawn					
Checked					
Approved			No.	Revision	By Date

- LEGEND:**
- FULL STRENGTH P.V.M.T.
 - PAVED SHOULDER
 - DEMOLITION OF PAVEMENT
 - DEMOLITION OF TOLL PLAZA

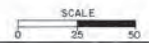

AS BUILT

ma RICHMOND METROPOLITAN AUTHORITY
 RICHMOND EXPRESSWAY SYSTEM
 DOWNTOWN EXPRESSWAY
GRADING, DRAINAGE & PAVEMENT PLAN


HOWARD NEEDLES TAMMEN & BERGENDOFF
 ALEXANDRIA, VA. **HNTB**

Scale: 1" = 25' Date: JAN. 1991 Contract No. C-15 Sheet: 4 of 4

DOUGLASDALE RAMP TOLL PLAZA

ORIGINAL PLANS

RICHMOND EXPRESSWAY SYSTEM			
SECTION	PROJECT	SHEET NO.	TOTAL SHEETS
4	BELTLINE EXPRESSWAY	75	155

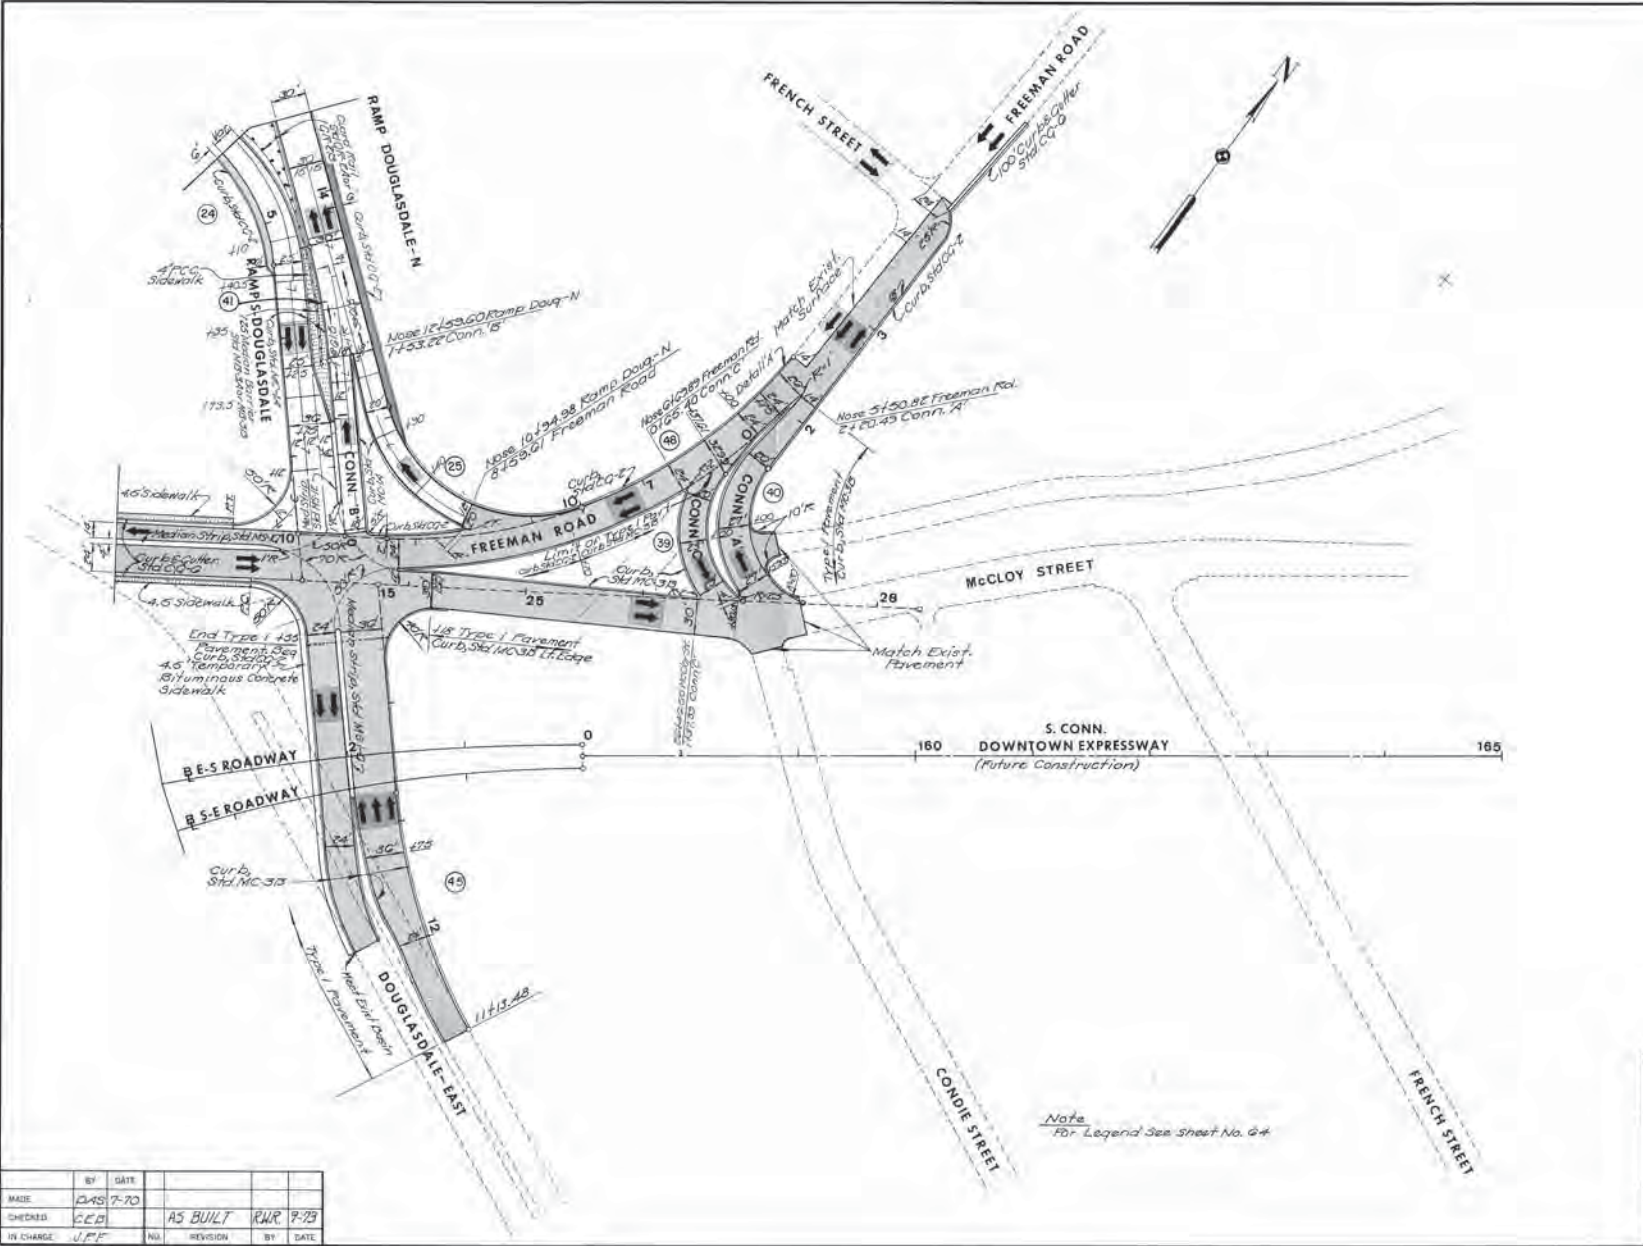

NO.	BY	DATE	REVISION	BY	DATE
1	U.P.F.	7-70	AS BUILT	R.W.R.	7-79

Note
For Legend See sheet No. 64


AS BUILT

RICHMOND METROPOLITAN AUTHORITY
RICHMOND EXPRESSWAY SYSTEM
BELTLINE EXPRESSWAY

PAVEMENT PLAN
STA. 10+50 TO STA. 165+00

HOWARD, NEEDLES, TAMMAY & BERGENDOFF CONSULTING ENGINEERS NEW YORK KENNESAW KANSAS CITY	SCALE: 1"=30' CONTRACT NO. 4 SHEET NO. 75 OF 155
---	--

RICHMOND EXPRESSWAY SYSTEM			
SHEET	PROJECT	SHEET	TOTAL
4	BELTLINE EXPRESSWAY	81	155

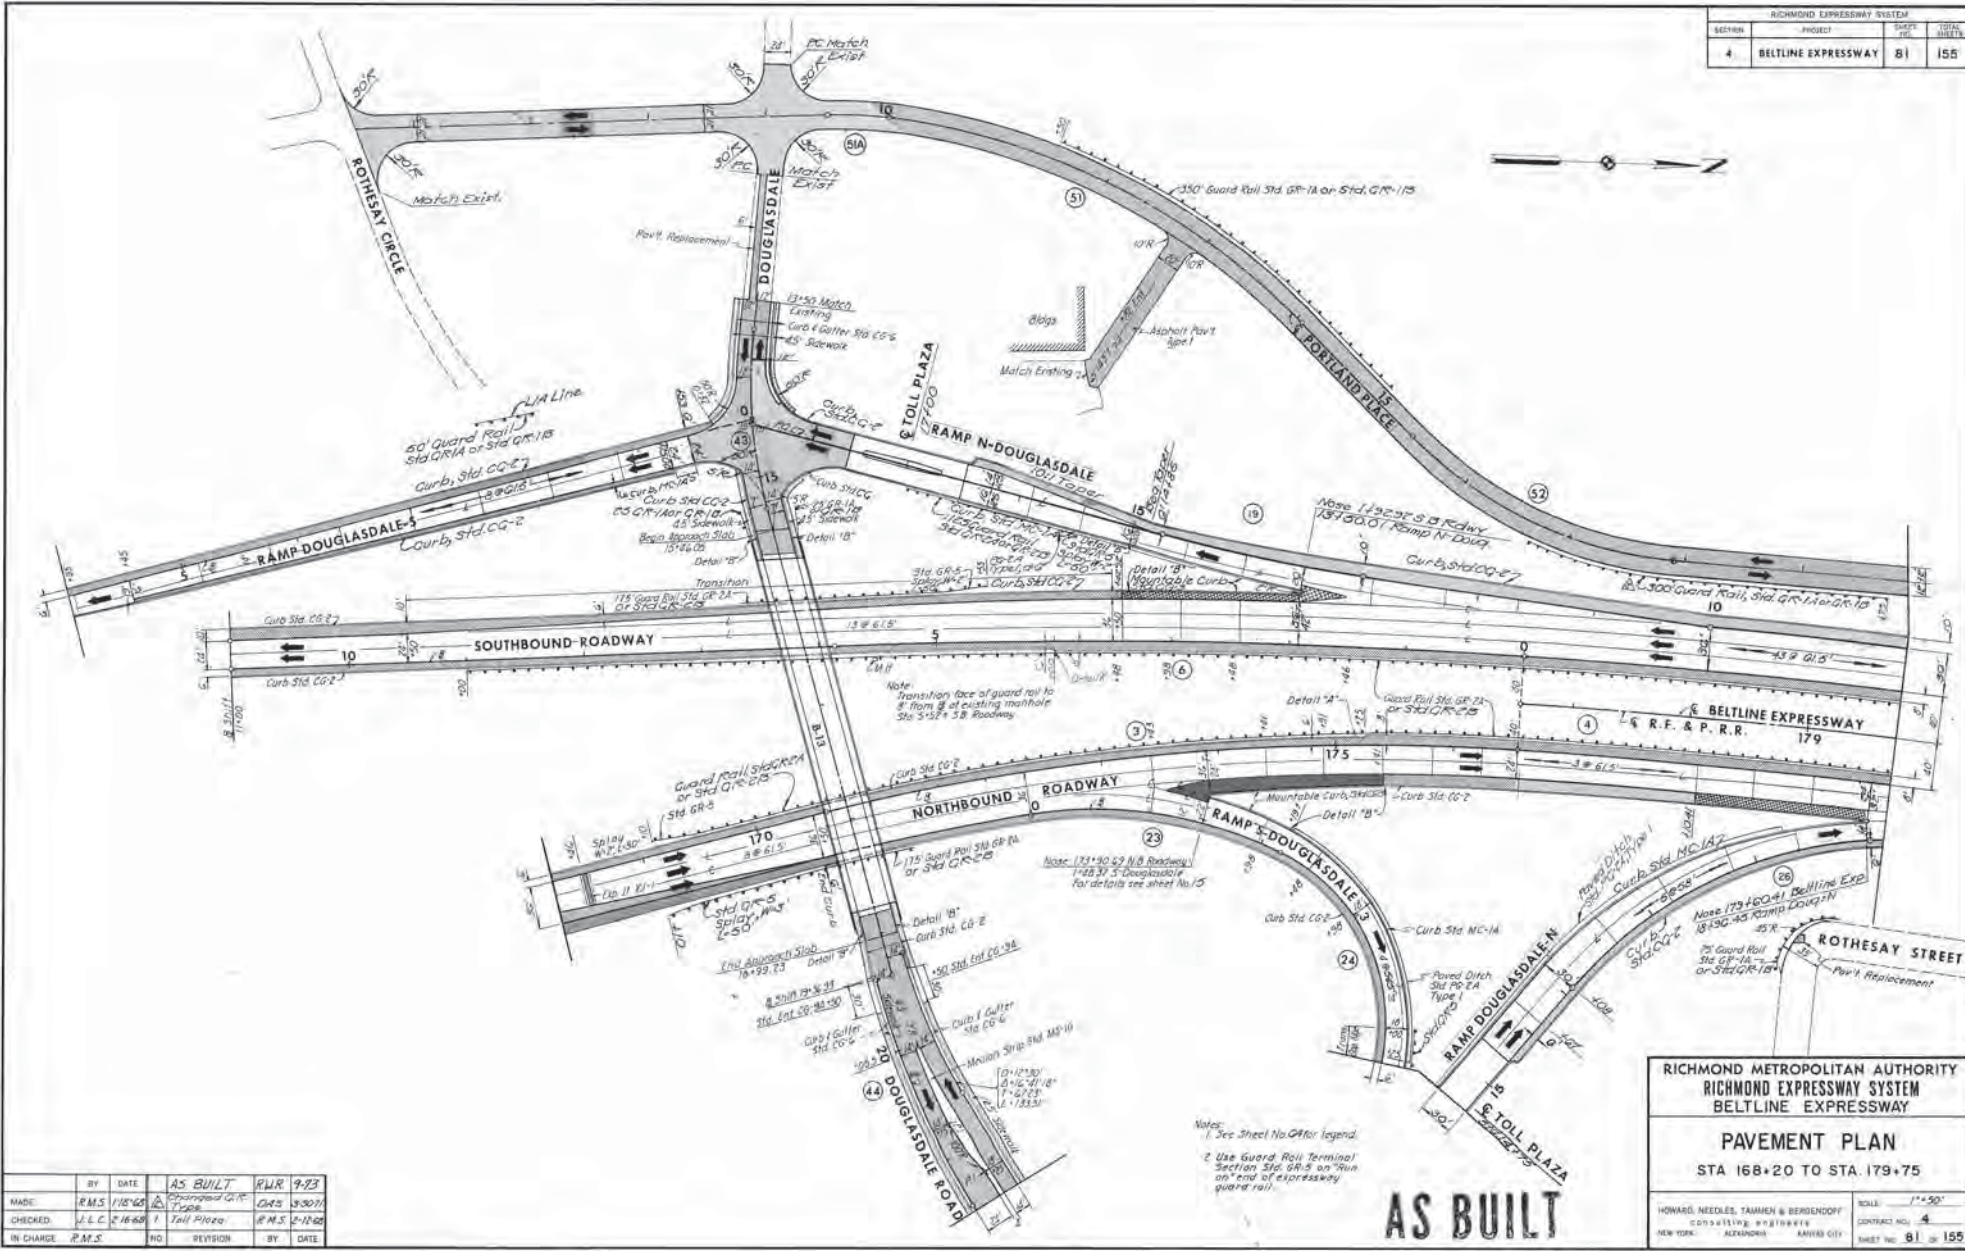

BY	DATE	AS BUILT	R.W.R.	9-23
MADE	R.M.S.	1/18/68	Checked G.R.	9-30-71
CHECKED	J.L.C.	2-16-68	Toll Plaza	R.M.S. 2-12-68
IN CHARGE	R.M.S.	NO	REVISION	BY DATE


RICHMOND METROPOLITAN AUTHORITY
RICHMOND EXPRESSWAY SYSTEM
BELTLINE EXPRESSWAY
PAVEMENT PLAN
STA 168+20 TO STA 179+75

HOWARD, NEEDLES, TAMMEN & BERGENDOFF
 CONSULTING ENGINEERS
 NEW YORK ALEXANDRIA BALTIMORE CITY

SCALE: 1" = 50'
 CONTRACT NO. 4
 SHEET NO. 81 OF 155


AS BUILT

RICHMOND EXPRESSWAY SYSTEM			
SECTION	PROJECT	SHEET NO.	TOTAL SHEETS
4	BELTLINE EXPRESSWAY	56	155

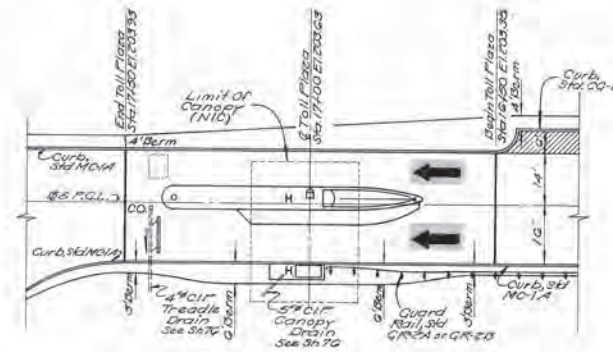

RAMP N-DOUGLASDALE
Scale 1/16" = 1'-0"

NOTES
 1. For Profiles See Sh. No. 35446
 2. C.O. in Pavement - 5' @ 1.90° Elbow
 3. 5' @ 1.90° - 1.0 Supra. Floor Level Clearance

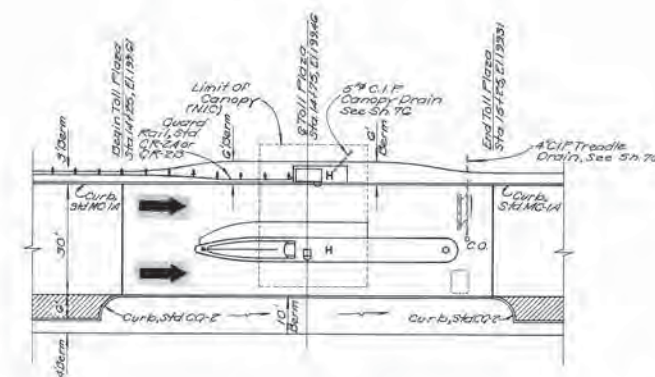

RAMP DOUGLASDALE-N
Scale 1/16" = 1'-0"

AS BUILT

RICHMOND METROPOLITAN AUTHORITY
RICHMOND EXPRESSWAY SYSTEM
BELTLINE EXPRESSWAY

MISCELLANEOUS
TOLL PLAZA DETAILS







HOWARD NEEDLES TAMMEN & BERGENDOFF
CONSULTING ENGINEERS
SAN JOSE ALBANY KANSAS CITY
SCALE: As Noted
CONTRACT NO. 4
SHEET NO. 56 OF 155

BY	DATE			
MADE	DAS	8-70		
CHECKED	WFO	8-70	AS BUILT	LWC 8-73
IN CHARGE	J.F.F.		NO REVISION	BY DATE

NORTHBOUND POWHITE PARKWAY TOLL PLAZA

ORIGINAL PLANS - ADMINISTRATION BUILDING & TOLL PLAZA

RICHMOND EXPRESSWAY SYSTEM			
SECTION	PROJECT	SHEET	TOTAL
2	POWHITE PARKWAY	43	188

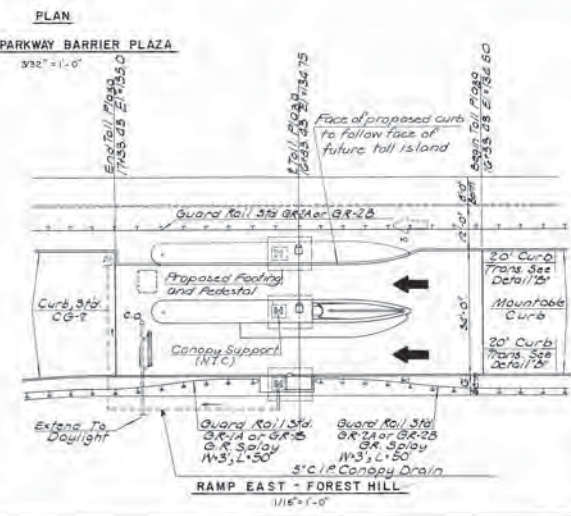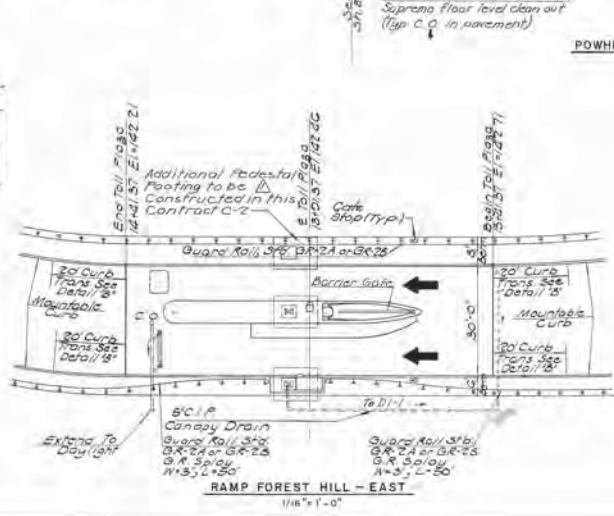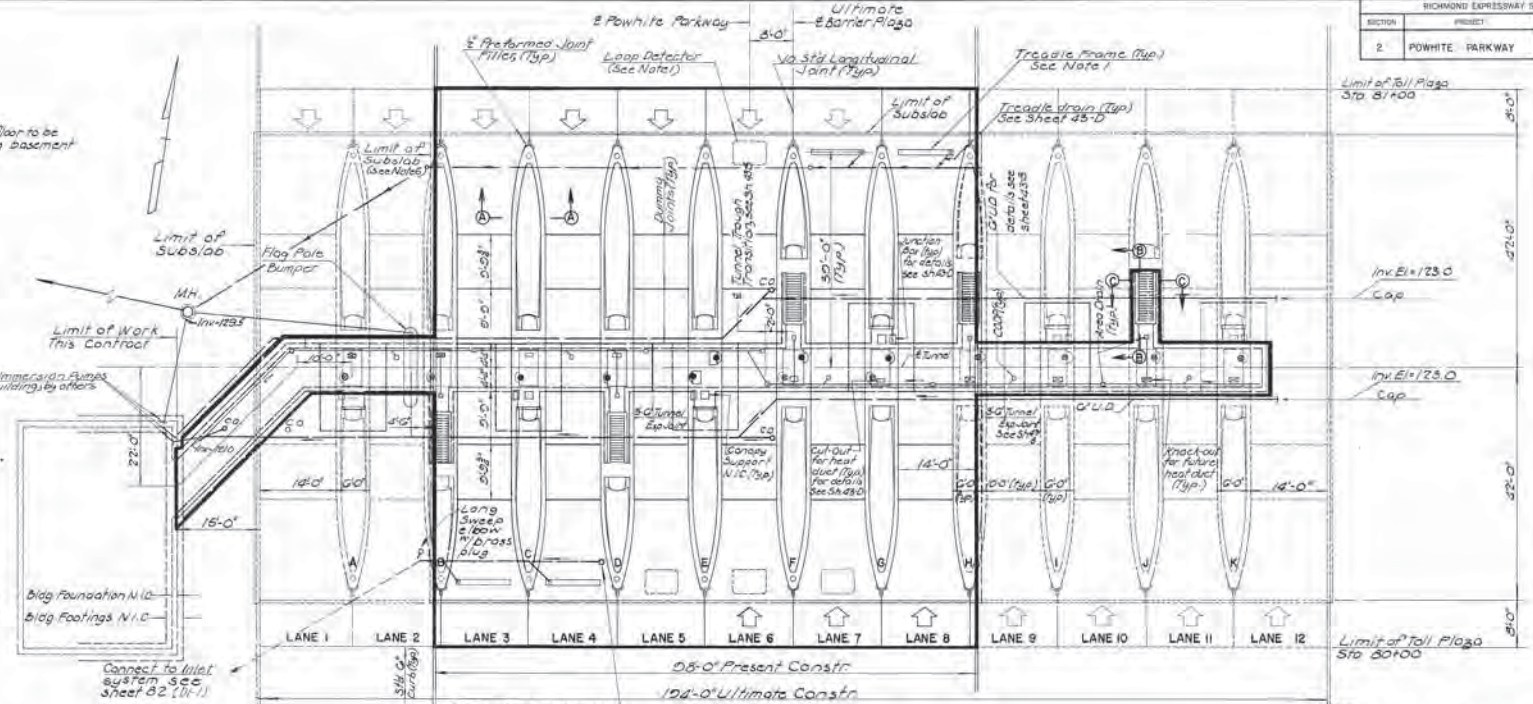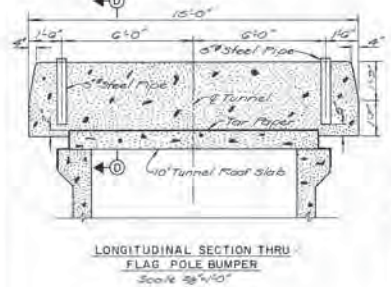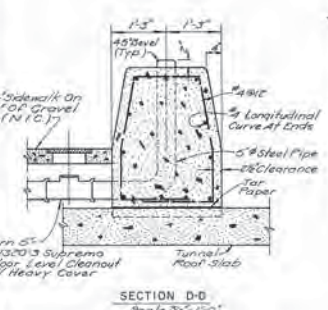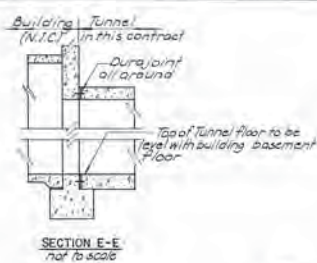

- NOTES:**
- To be placed by Toll Equipment Contractor prior to the paving, under this Contract.
 - Tunnel drainage trough to begin at the building foundation.
 - C.O.D.P. = Clean out Drain Pipe
 - Sections A-A, B-B and C-C appear on sheets 52-5
 - Place 1/2" Longitudinal hook bolts for future widening.

- LEGEND:**
- Location of future traffic signal
 - Traffic signal, (N.I.C.)
 - Automatic Toll Machine, (N.I.C.)
 - Future Automatic Toll Machine
 - Toll Booth, (N.I.C.)
 - Prop Coin Tubes
 - Future Coin Tubes

AS BUILT

RICHMOND METROPOLITAN AUTHORITY
RICHMOND EXPRESSWAY SYSTEM
POWHITE PARKWAY


MAINLINE B RAMP
TOLL PLAZA PLANS

HOWARD, WHEELER, TAMMEN & BERENSON
ARCHITECTS ENGINEERS
NEW YORK BOSTON WASHINGTON NORFOLK

SCALE: As Noted
CONTRACT NO. E-2
SHEET NO. 43 OF 188

MADE	BY	DATE	REV	DATE	BY	DATE
	RP	8/70	2	As BUILT	JRC	6/73
CHANGED	RWG					8/2/71
IN CHARGE	JPF					

RICHMOND EXPRESSWAY SYSTEM			
SECTION	PROJECT	SHEET NO.	TOTAL SHEETS
2	POWHITE PARKWAY	43-A	188

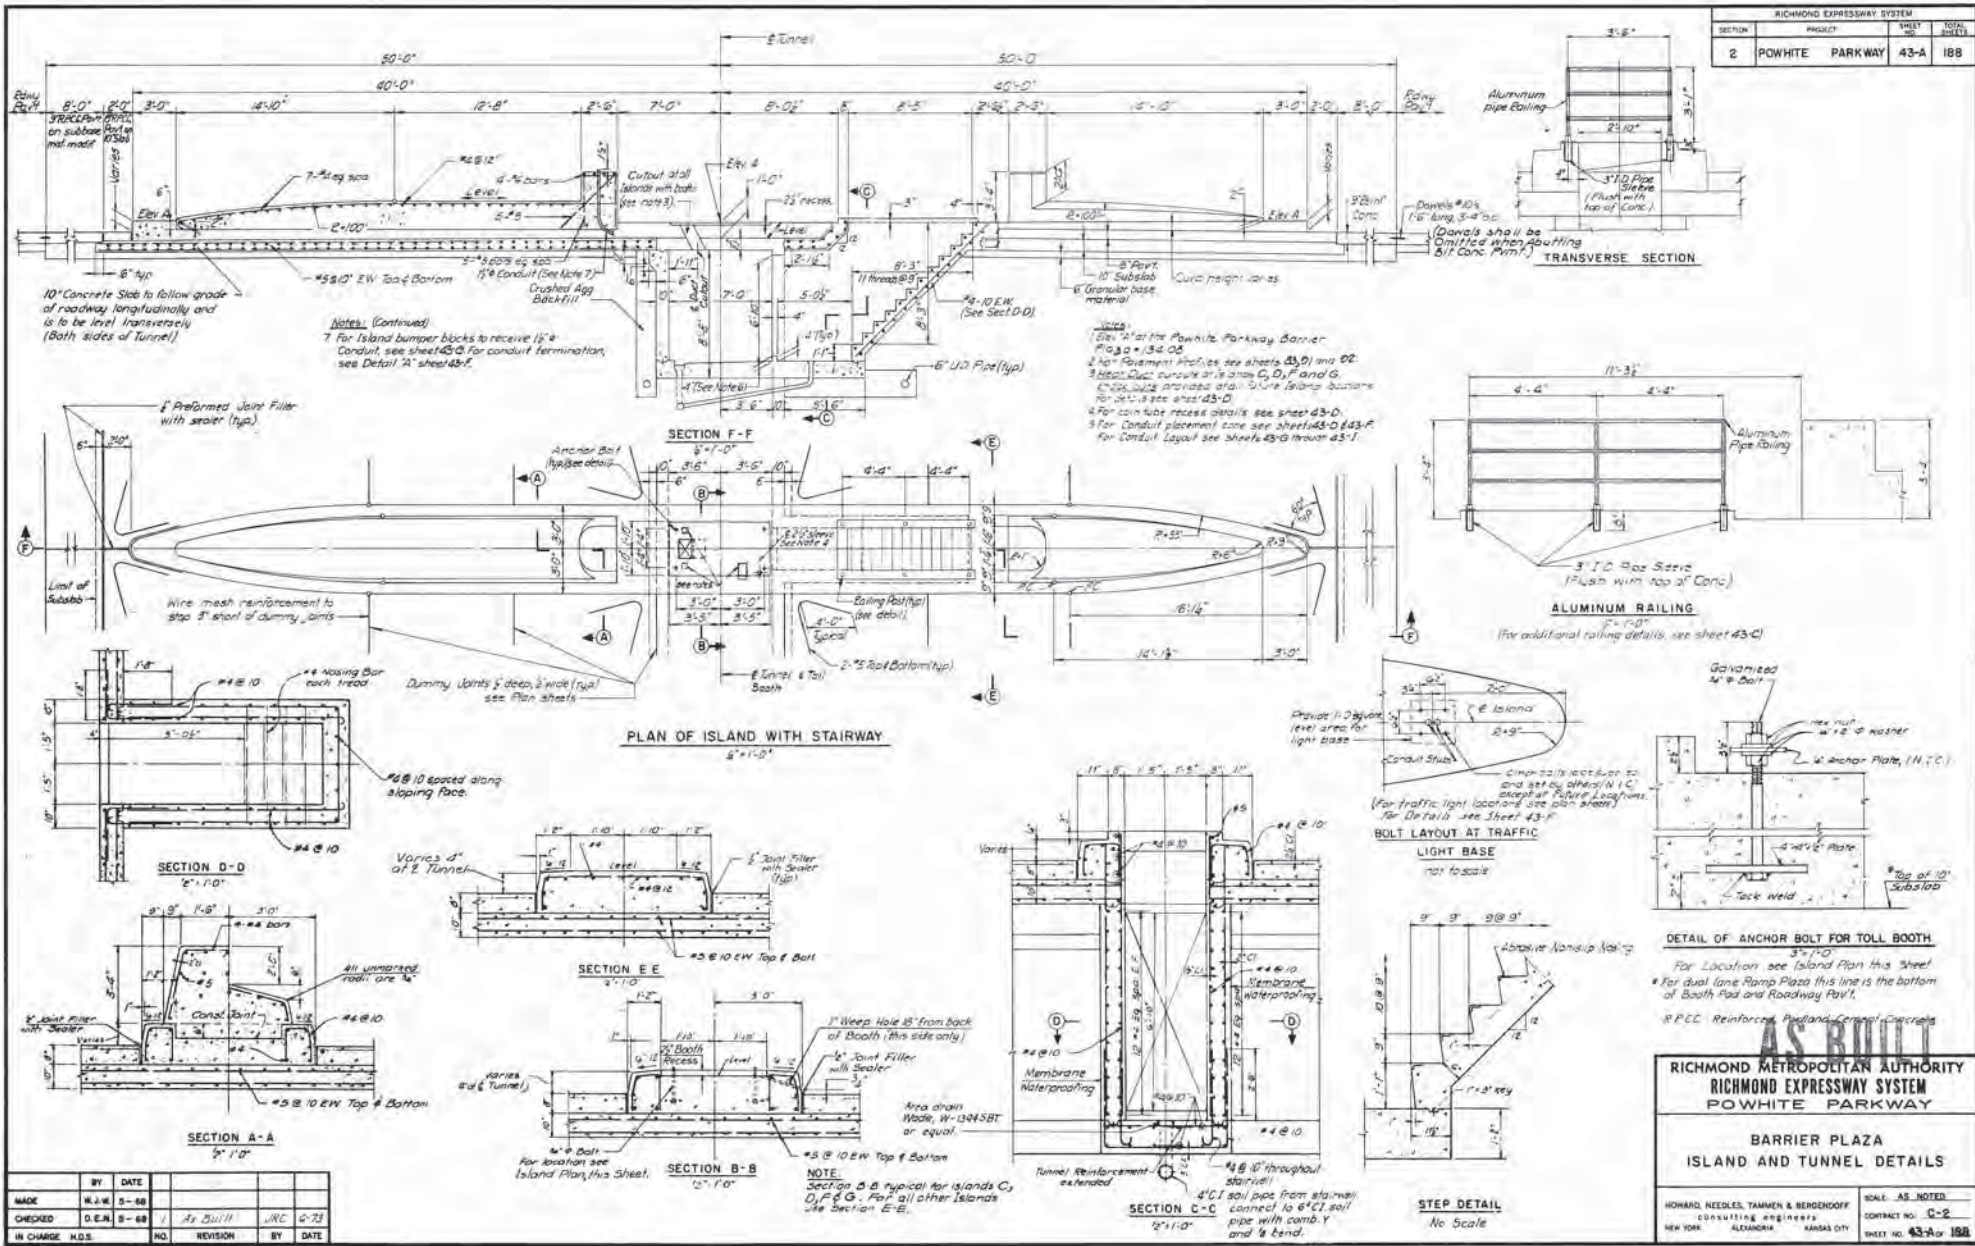

BY	DATE			
MADE	W.E.M.	5-68		
CHECKED	D.E.M.	8-68	J.A. Bull	J.R.C. 6-73
IN CHARGE	H.D.S.			
NO.	REVISION	BY	DATE	

AS BUILT




RICHMOND METROPOLITAN AUTHORITY
RICHMOND EXPRESSWAY SYSTEM
POWHITE PARKWAY

BARRIER PLAZA
ISLAND AND TUNNEL DETAILS


HOWARD, NEEDLES, TAMMEN & BERGENHOFF
 CONSULTING ENGINEERS
 NEW YORK ALEXANDRIA KANSAS CITY

SCALE: AS NOTED
 CONTRACT NO. C-2
 SHEET NO. 43-A OF 188


RICHMOND EXPRESSWAY SYSTEM			
SECTION	PROJECT	SHEET NO.	TOTAL SHEETS
2	POWHITE PARKWAY	43-B	188

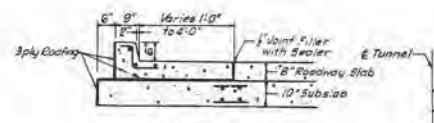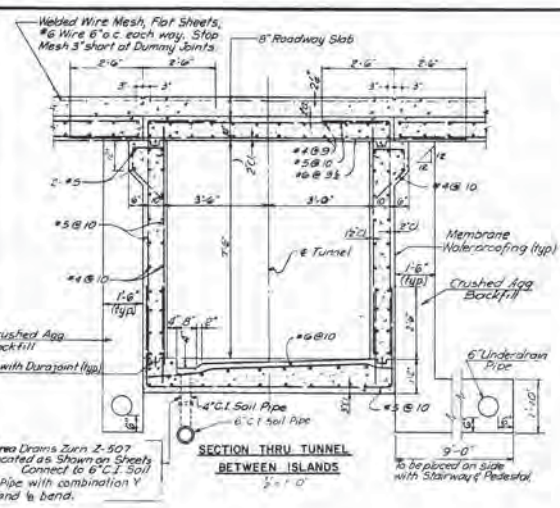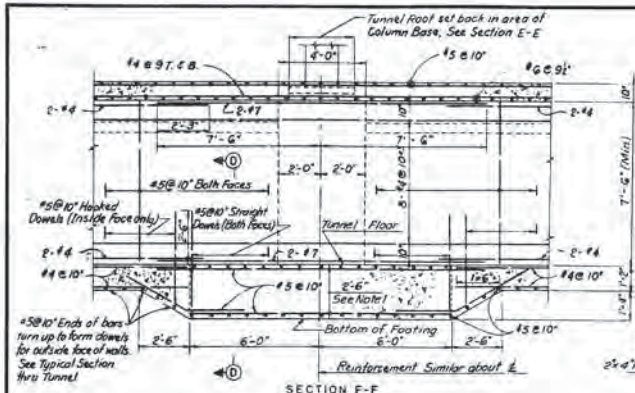


SECTION A-A
6'-9" x 10'-0"
(See Sheet 43)

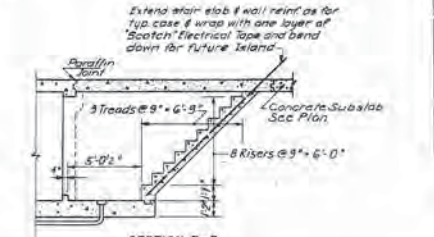


SECTION B-B
4'-0" x 14'-0"
(See Sheet 43)

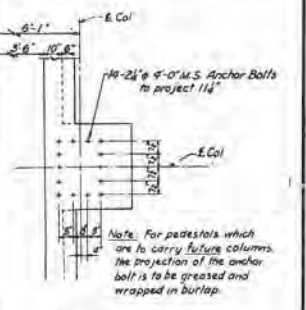


ANCHOR BOLT LAYOUT
BARRIER PLAZA CANOPY COLUMN
3#4 = 1'-0"

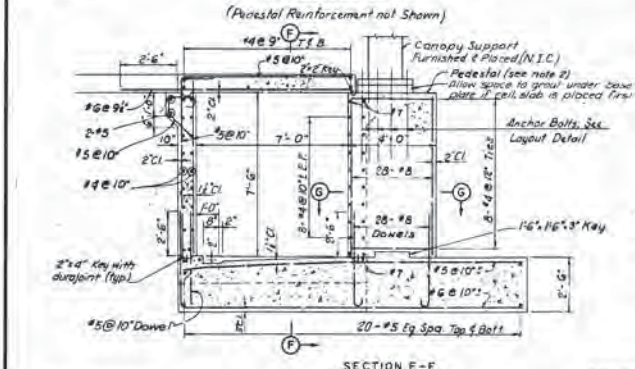


SECTION E-E
16'-0" x 3'-1-0"

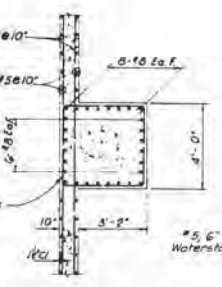


SECTION G-G
3'-0" x 10'-0"

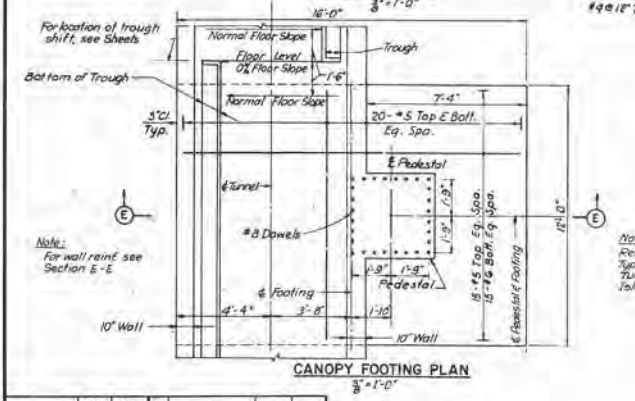


CANOPY FOOTING PLAN
16'-0" x 3'-1-0"

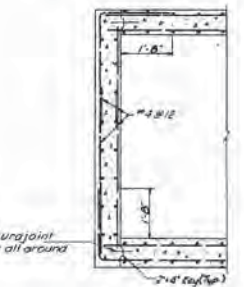

SECTION AT END OF TUNNEL
1'-0" x 4'-0"

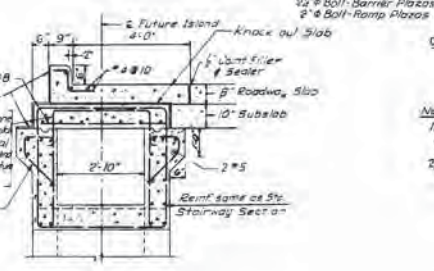


SECTION C-C
6'-9" x 10'-0"
(See Sheet 43)

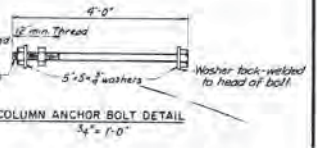


COLUMN ANCHOR BOLT DETAIL
4'-0" x 3'-0"

- Notes:
- 1) Top & Bot. of Canopy footing will parallel slope of tunnel floor.
 - 2) Canopy Pedestal shall be vertical at all times.

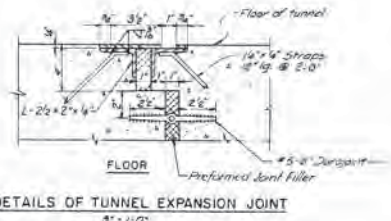

DETAILS OF TUNNEL EXPANSION JOINT
3'-0" x 10'-0"

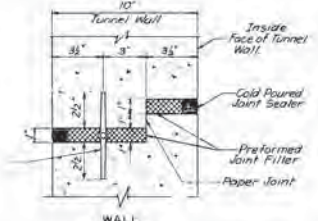

WALL
10" x 3'-0"

BY	DATE	BY	DATE
MADE	W.J.W. 5-88	Z	As Built J.K.C. 6-73
CHECKED	D.E.H. 8-88	J	Final Check D.E.H. 8-88
IN CHARGE	H.O.S.	NO.	REVISION

AS BUILT




RICHMOND METROPOLITAN AUTHORITY
RICHMOND EXPRESSWAY SYSTEM
POWHITE PARKWAY

BARRIER PLAZA
TUNNEL DETAILS




HOWARD, NEEDLES, TAMMEN & BERGENDOFF
CONSULTING ENGINEERS
NEW YORK ALBANY BANGOR CITY

SCALE - AS NOTED
CONTRACT NO. C-2
SHEET NO. 43-B OF 188


RICHMOND EXPRESSWAY SYSTEM			
SECTION	PROJECT	SHEET NO.	TOTAL SHEETS
2	POWHITE PARKWAY	43-D	186

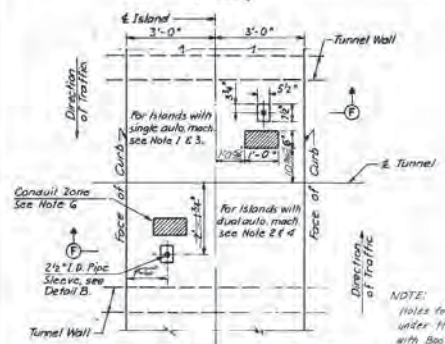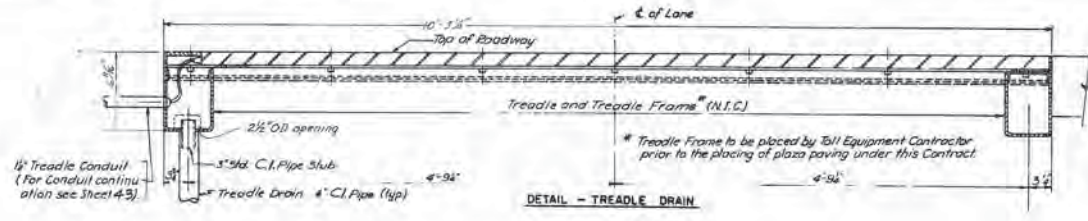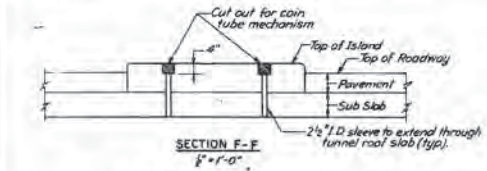



NOTE:
Notes for Coin Tubes as installed under this Contract did not fit with Booths & Con Machines as supplied. Non holes were drilled for machines, etc.

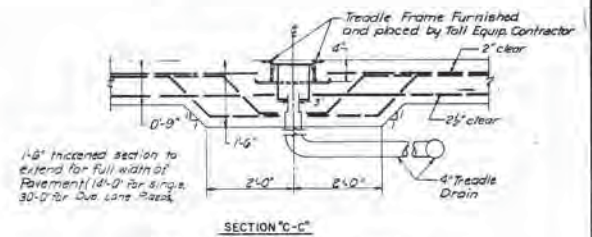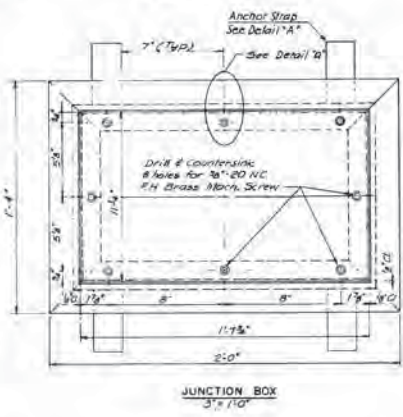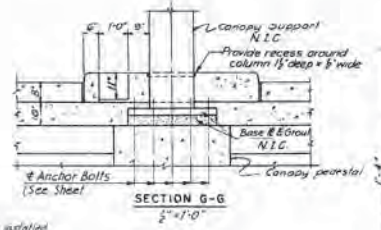



1'-0" increased section to extend for full width of Pavement (14'-0" for single, 30'-0" for dual lane Road)

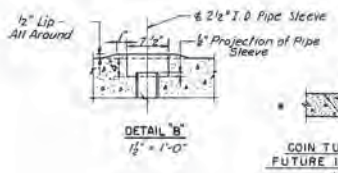


COIN TUBE DETAIL AT FUTURE ISLAND LOCATION
No Scale

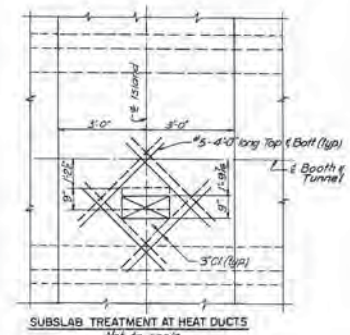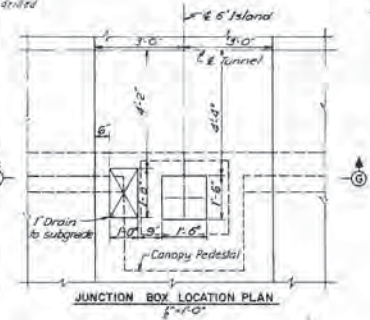

- NOTES:**
- Islands C & D will have a single coin tube and tube recess for automatic machines.
 - Islands E, F & G will have dual coin tubes and tube recesses for automatic machines. One location at each island will be for future automatic machines. See conduit layouts and Note 5.
 - All future island locations will have a single coin tube. Sleeve to be threaded and plugged.
 - For coin tube recesses at future automatic machine locations, plug 2 1/2 inch I.D. sleeve at bottom of recess, then coat bottom and sides of recess with paraffin and fill with concrete.
 - Conduits to or from toll booths or machines are to be placed totally within zones shown. For Conduit Layouts see details see Sheets 43-B through 43-I.

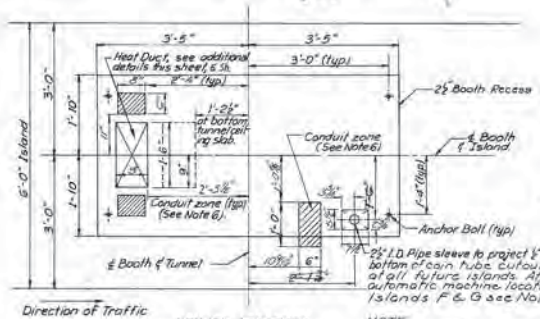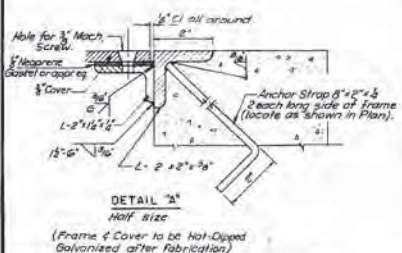

NOTE:
Utility Locations in Tunnel Calling Slab Future Island 43-B, 43-C are similar

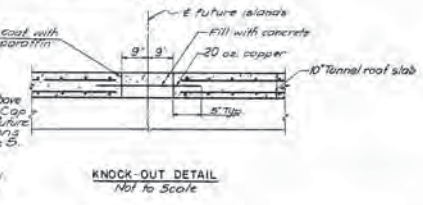

AS BUILT

RICHMOND METROPOLITAN AUTHORITY
RICHMOND EXPRESSWAY SYSTEM
POWHITE PARKWAY


MISCELLANEOUS DETAILS

HONARD, NEEDLES, TAMMEN & BERGENHOFF CONSULTING ENGINEERS
NEW YORK, ALEXANDRIA, BANGOR CITY


SCALE: AS NOTED
CONTRACT NO. C-2
SHEET NO. 43-D OF 186

IN CHARGE	H.O.S.	NO.	REVISION	BY	DATE
BY	DATE	3	As Built	JRC	6-23
MADE	W.J.M.	5-68	As Built	JRC	6-23
CHECKED	D.E.N.	5-68	Final Check	DEN	5-68


RICHMOND EXPRESSWAY SYSTEM			
SECTION	PROJECT	SHEET NO.	TOTAL SHEETS
TF-2	TOLL FACILITIES	12	26

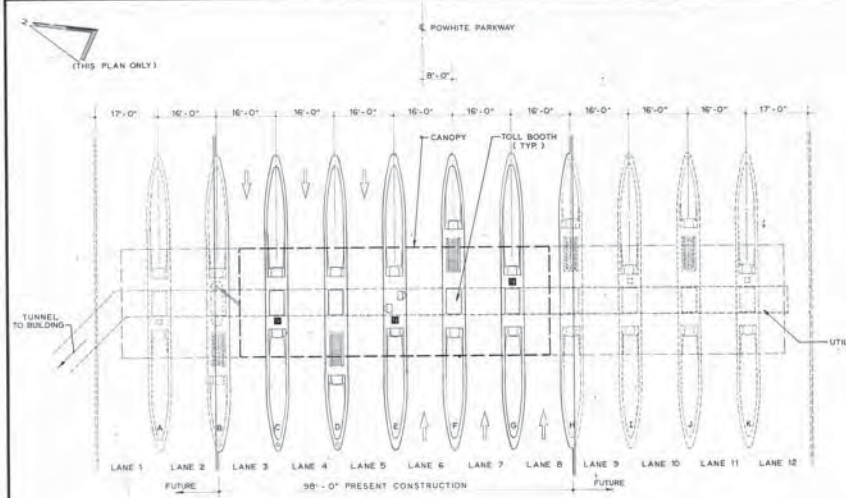


PLAN

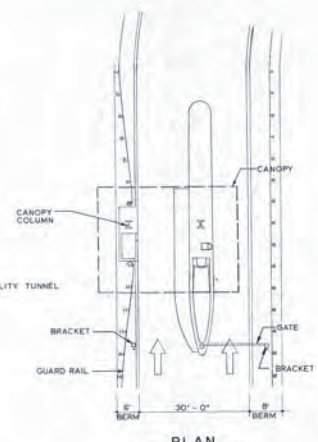


PLAN
RAMP FOREST HILL - EAST

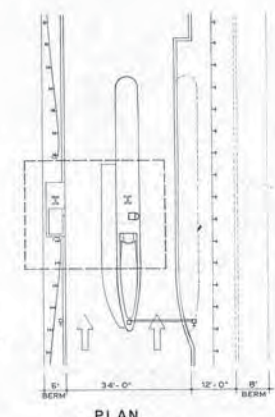


PLAN
RAMP EAST - FOREST HILL

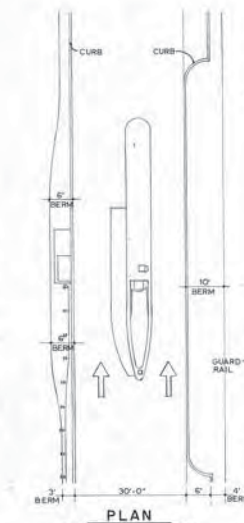


PLAN
RAMP DOUGLASDALE - NORTH

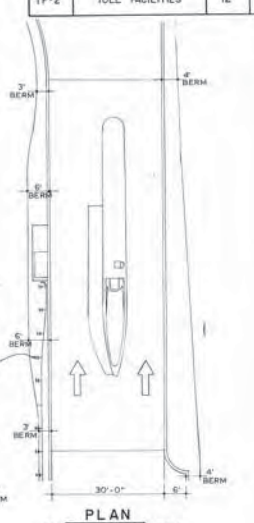


PLAN
RAMP NORTH - DOUGLASDALE

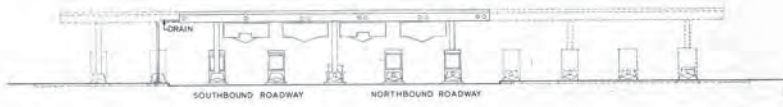

EAST ELEVATION

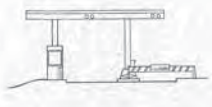

ELEVATION
RAMP FOREST HILL - EAST

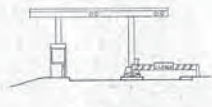

ELEVATION
RAMP EAST - FOREST HILL



ELEVATION
RAMP DOUGLASDALE - NORTH



ELEVATION
RAMP NORTH - DOUGLASDALE



WEST ELEVATION

NOTE: THIS SHEET IS INTENDED FOR ORIENTATION ONLY. PARTS OF THE WORK SHOWN HERE ARE INCLUDED IN THIS CONTRACT.

RICHMOND METROPOLITAN AUTHORITY
RICHMOND EXPRESSWAY SYSTEM
POWHITE PARKWAY

TOLL FACILITIES
PLANS & ELEVATIONS









HOWARD, NEEDLES, TAMMEN & BERGENDOFF
 consulting engineers
 NEW YORK ALEXANDRIA KANSAS CITY

SCALE: 1/16" = 1'-0"
 CONTRACT NO. TF-2
 SHEET NO. 12 OF 15

BY	DATE				
MADE	R.M.	7-31-75			
CHECKED	K.L.	2-20-76			
IN CHARGE	J.P.F.		NO.	REVISION	BY DATE

RICHMOND EXPRESSWAY SYSTEM			
Section	SHEET NO.	TOTAL SHEETS	
TF-2	TOLL FACILITIES	22	26

- NOTES:**
- LANES 4, 5, 6 AND 7 ARE TO RECEIVE EXACT CHANGE SIGNS, SEE DETAIL.
 - LIGHT UNITS ARE TO BE PLACED IN FRONT OF EXACT CHANGE SIGNS. THE LIGHT UNITS ARE TO BE FOCUSED ON THE HORIZONTAL C OF THE PANEL. LIGHT UNIT BALLASTS WILL BE EXPOSED.
 - A 3'-0" WIDE SECTION OF ISLAND WHOSE CENTER REPRESENTS THE COL C INCLUDING A 4'-0" WIDE AND 10" HIGH CONC. FILLER BELOW ARE INCLUDED IN THIS CONTRACT. THE JUNCTION BOX SHOWN IN SECTION B-B WILL BE OWNER SUPPLIED BUT INSTALLED UNDER THIS CONTRACT. ALL WORK SHOWN IN SECTION C-C IS PART OF THIS CONTRACT. PROPER JOINT SEAL AND CURB DIMENSIONS TO FIT WITH THE EXISTING MUST BE PROVIDED.

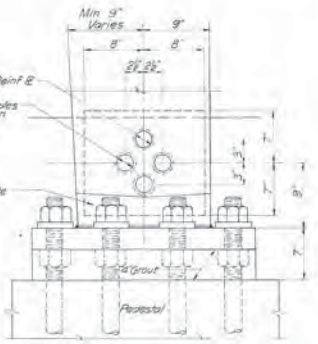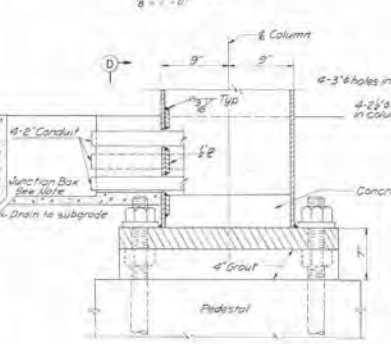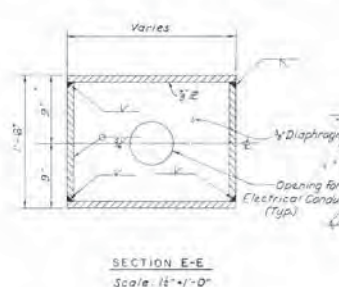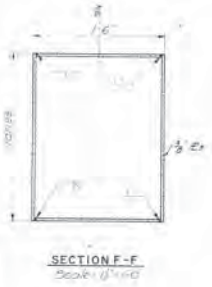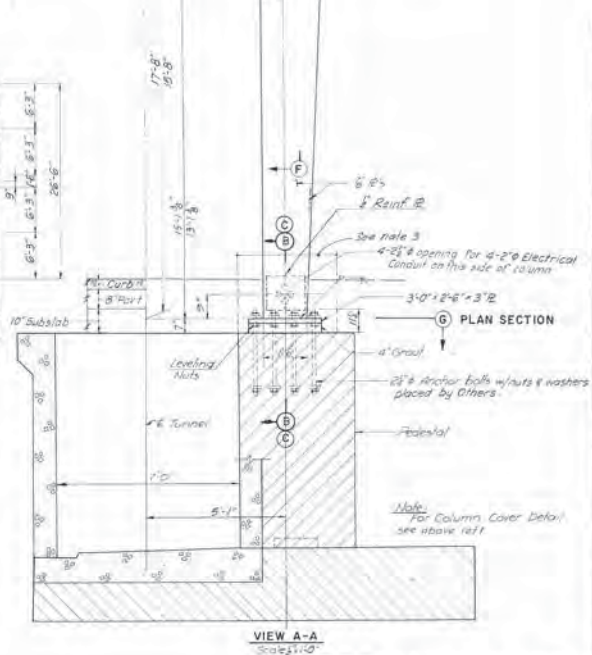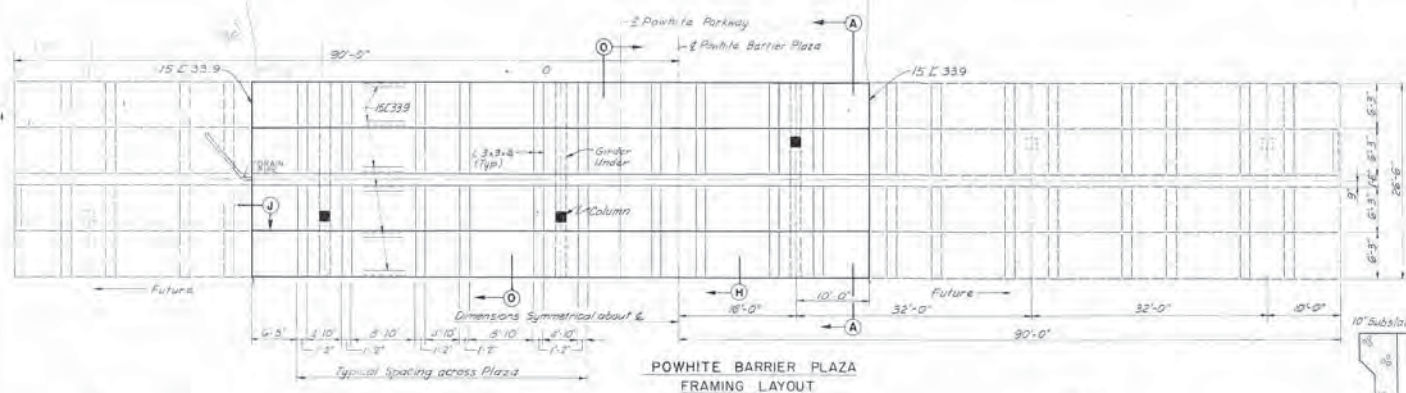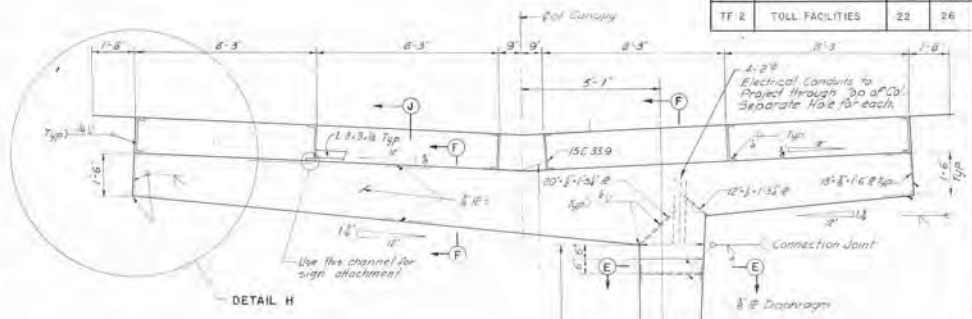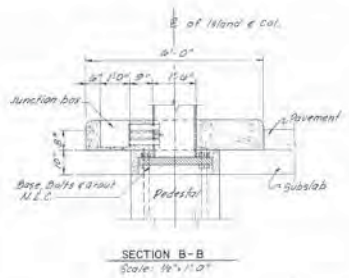

RICHMOND METROPOLITAN AUTHORITY
RICHMOND EXPRESSWAY SYSTEM
POWHITE PARKWAY

BARRIER PLAZA CANOPY FRAMING & DETAILS

HOWARD NEEDLES TAMMEN & BERGENDOFF CONSULTING ENGINEERS NEW YORK ALEXANDRIA ANNAPOLIS	SCALE: AS SHOWN CONTRACT NO.: TF-2 SHEET NO.: 11b OF 15
--	---

BY	DATE				
MADE	B.P.P.	7-31-71			
CHECKED	B.L.	7-30-71			
IN CHARGE	B.P.P.		NO.	REVISION	BY DATE

RICHMOND EXPRESSWAY SYSTEM			
SECTION	PROJECT	SHEET NO.	TOTAL SHEETS
TF-2	UTILITY BUILDING	2	26

INDEX OF SHEETS


UTILITY BUILDING

- 2 of 11 Site Plans
- 3 of 11 Plans & Misc.
- 4 of 11 Elevations & Sections
- 5 of 11 Sections & Details
- 6 of 11 Details & Schedules
- 7 of 11 Details
- 8 of 11 Htg. & AC & Refl. Cig. Plan
- 9 of 11 Mechanical & Controls
- 10 of 11 Electrical
- 11 of 11 Tunnel Electrical

LEGEND

- 133 --- EXISTING GRADE LINES
- 134 --- PROPOSED GRADE LINES
- PROPOSED SIDEWALK OR CONCRETE (IN PLAN)
- PROPOSED CONC. CURB, N.I.C.
- PROPOSED CONC. RETAINING WALL
- EXTENT OF CONTRACT, SEE NOTE
- PROPOSED SANITARY SEWER
- PROPOSED STORM SEWER
- ⊕ DETAIL NUMBER
- ⊕ SHEET NUMBER
- N.I.C. NOT IN CONTRACT
- A.D. AREA DRAIN

NOTE: FOR UTILITY BLDG. AND IMMEDIATE SURROUNDINGS.

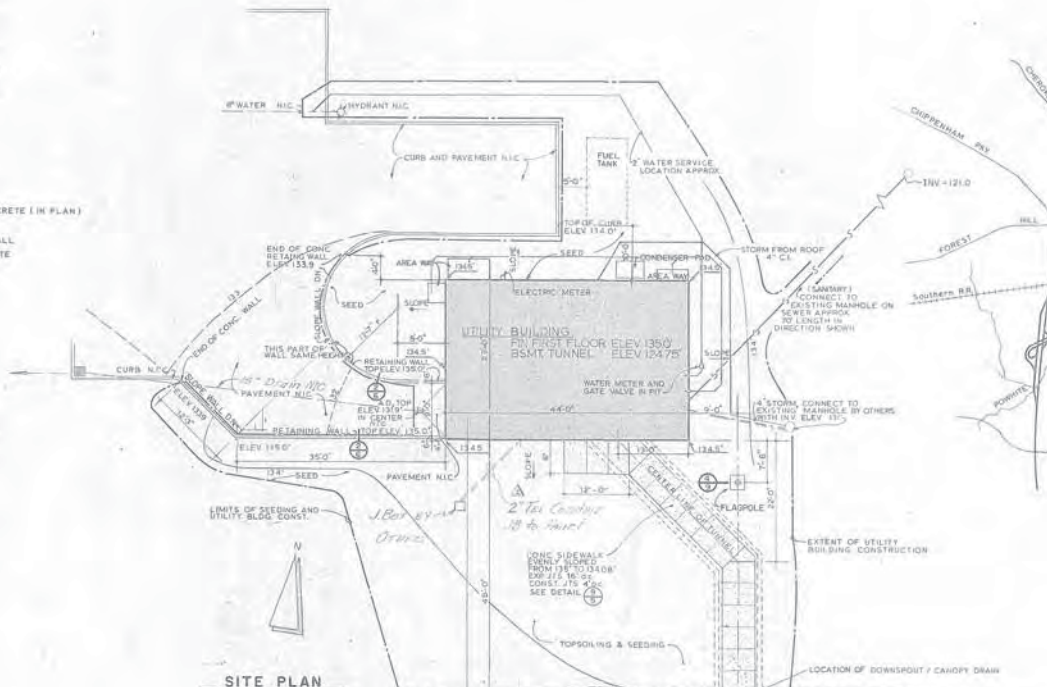

SITE PLAN
SCALE: 1/32" = 1'-0"

VICINITY MAP
NO SCALE

SUMMARY OF PAY ITEMS			
ITEM DESCRIPTION	UNIT	QUANTITY	
Utility Building - General Construction	--	L.S.	
Utility Building and Tunnel - Plumbing	--	L.S.	
Utility Building and Tunnel - HVAC	--	L.S.	
Utility Building and Tunnel - Electrical	--	L.S.	
Canopy at Barrier Plaza	--	L.S.	
Ramp Plaza With Canopy	EACH	2	
Ramp Plaza Without Canopy	EACH	2	
Installation of Toll Booth at Barrier Toll Plaza	EACH	4	
Mobilization	--	L.S.	


BY	DATE	NO.	REVISION	BY	DATE
MADE	KL	1-11-79			
CHECKED	KL	2-20-79			
IN CHARGE	ARR				

RICHMOND METROPOLITAN AUTHORITY
RICHMOND EXPRESSWAY SYSTEM
POWHITE PARKWAY


**UTILITY BUILDING
SITE PLANS**

HOWARD, NEEDLES, TAMMEN & BERGENOFF
CONSULTING ENGINEERS
NEW YORK ALBANY KANSAS CITY
SCALE: AS SHOWN
CONTRACT NO. TF-2
SHEET NO. 2 OF 11

RICHMOND EXPRESSWAY SYSTEM			
SECTION	PROJECT	SHEET NO.	TOTAL SHEETS
TP-2	UTILITY BUILDING	3	26

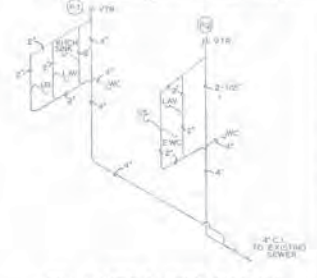

SOIL WASTE & VENT DIAGRAM

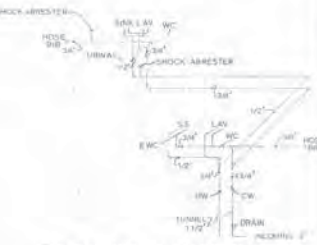


WATER PIPING DIAGRAM

LEGEND


- CONCRETE
- BRICK MASONRY
- CONCRETE MASONRY
- WOOD STUD PARTITION
- WINDOW
- VITR IN MASONRY
- ITEMS BY OTHERS
- AREA DRAIN
- FLOOR DRAIN

RICHMOND METROPOLITAN AUTHORITY
 RICHMOND EXPRESSWAY SYSTEM
 POWHITE PARKWAY
 UTILITY BUILDING
 PLANS & MISC.


HOWARD NEEDLES TAMMEN & BERGENCOFF
 CONSULTING ENGINEERS
 NEW YORK ALABAMA MEMPHIS OHIO
 SCALE: 1/4" = 1'-0"
 CONTRACT NO. TP-2
 SHEET NO. 3 OF 11

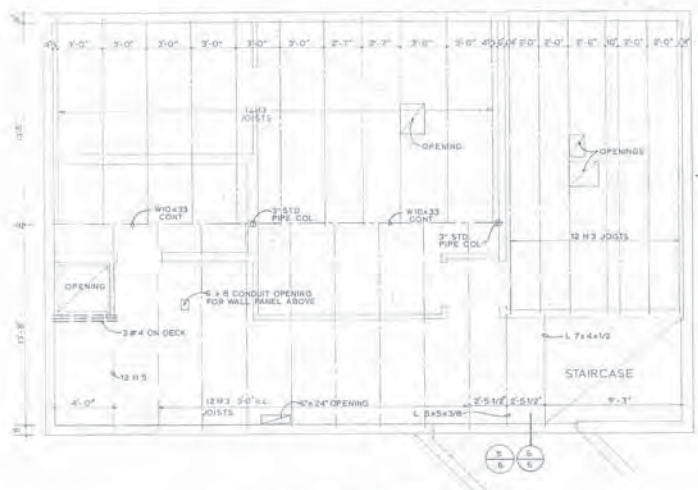


BASEMENT DECK PLAN
 SCALE: 1/4" = 1'-0"

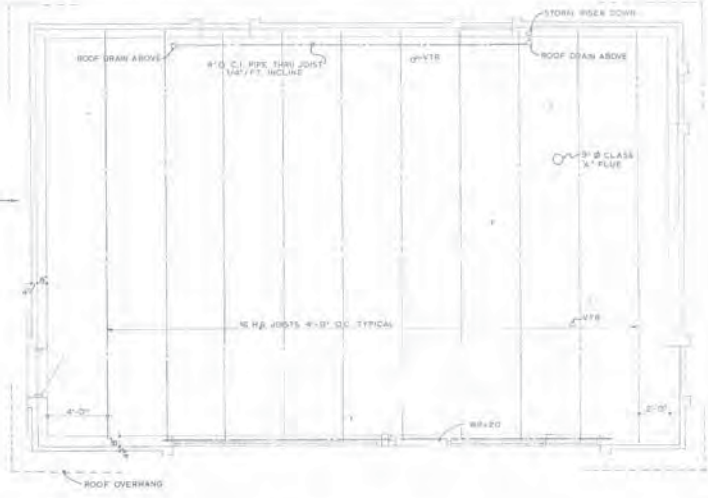

ROOF DECK PLAN
 SCALE: 1/4" = 1'-0"

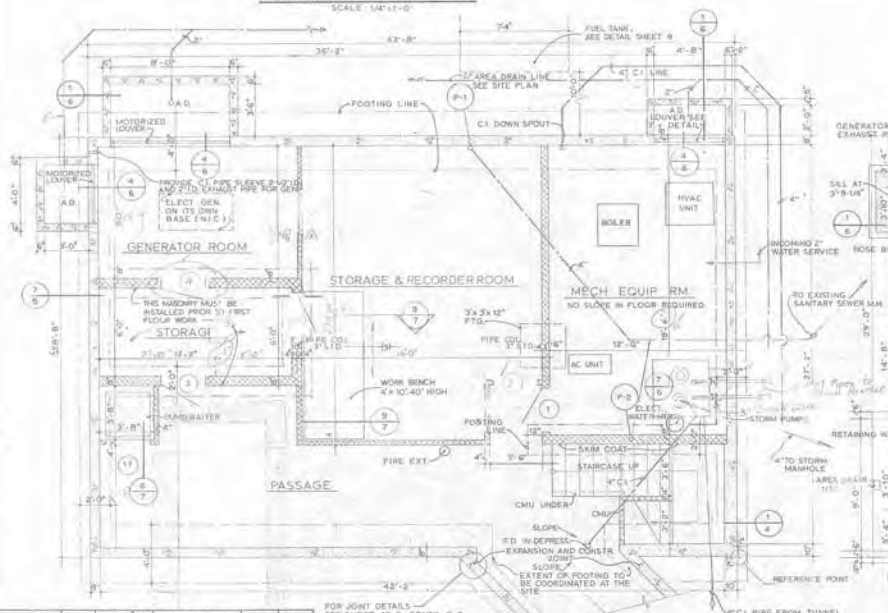

BASEMENT FLOOR PLAN
 SCALE: 1/4" = 1'-0"

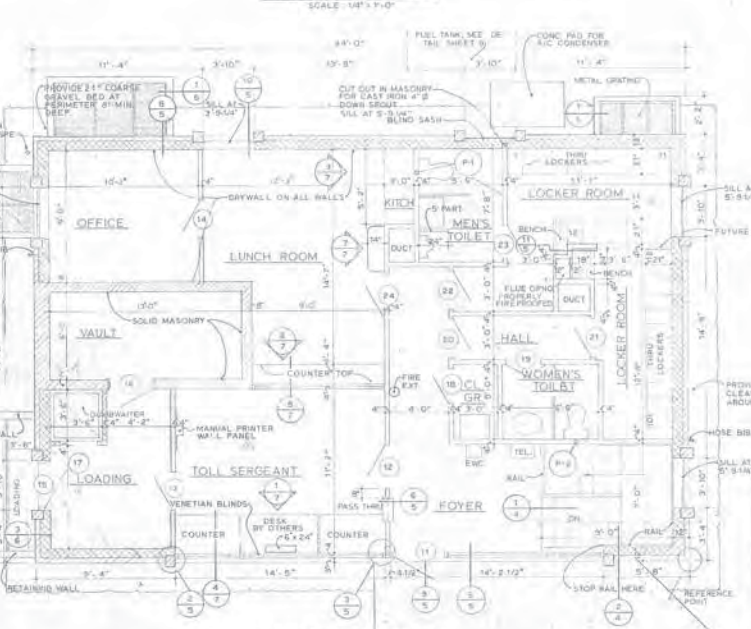


FIRST FLOOR PLAN
 SCALE: 1/4" = 1'-0"


BY	DATE	NO.	REVISION	BY	DATE
MADE	RAM	7-31-71			
CHECKED	KI	7-31-71			
IN CHARGE	JPS				

FOR JOINT DETAILS SEE SHEET 43-B, CONTR. C-1
 4" C.I. PIPE FROM TUNNEL FLOOR DRAINS BY OTHERS, CONNECTION PART OF THIS CONTRACT


RICHMOND EXPRESSWAY SYSTEM			
SECTION	PROJECT	SHEET NO.	TOTAL SHEETS
TF-2	UTILITY BUILDING	4	26

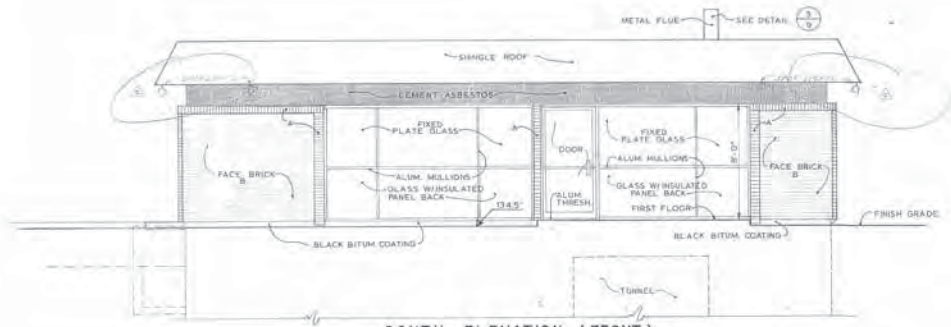


SOUTH ELEVATION (FRONT)
SCALE: 1/4" = 1'-0"

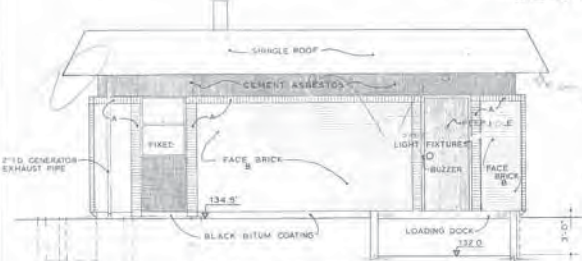


WEST ELEVATION
SCALE: 1/4" = 1'-0"

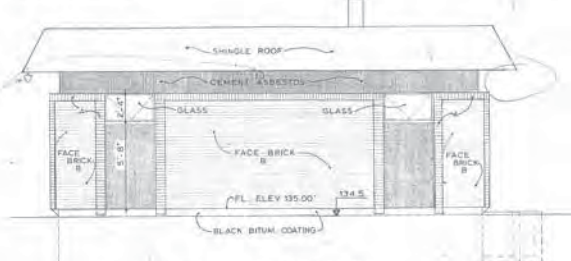


EAST ELEVATION
SCALE: 1/4" = 1'-0"

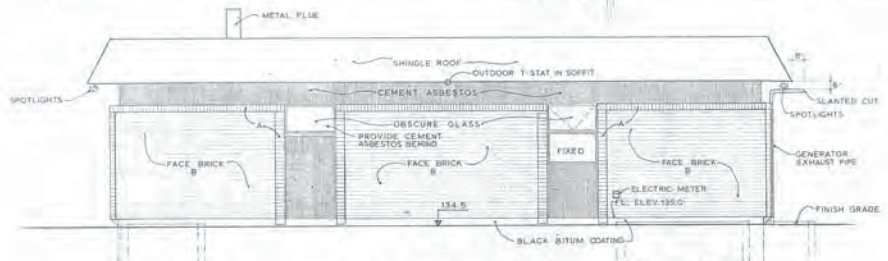

NORTH ELEVATION
SCALE: 1/4" = 1'-0"

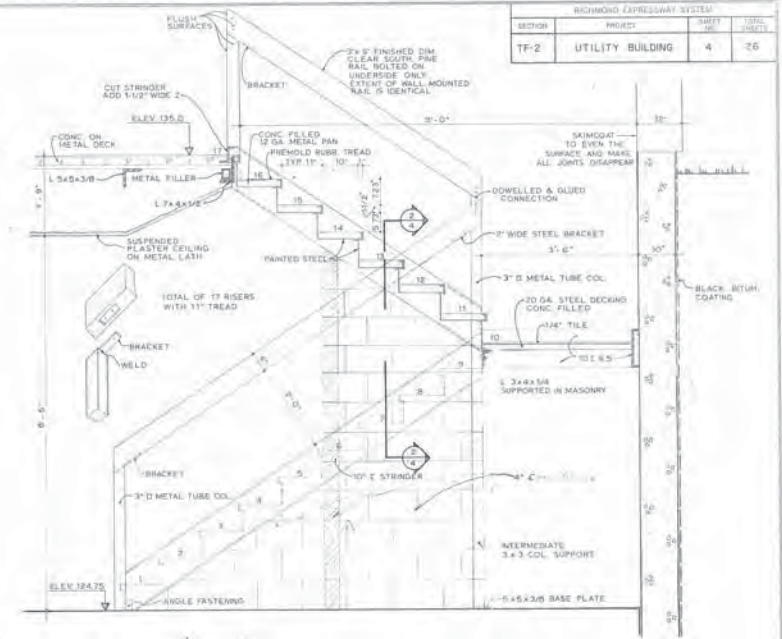

1 STAIR SECTION
SCALE: 3/8" = 1'-0"

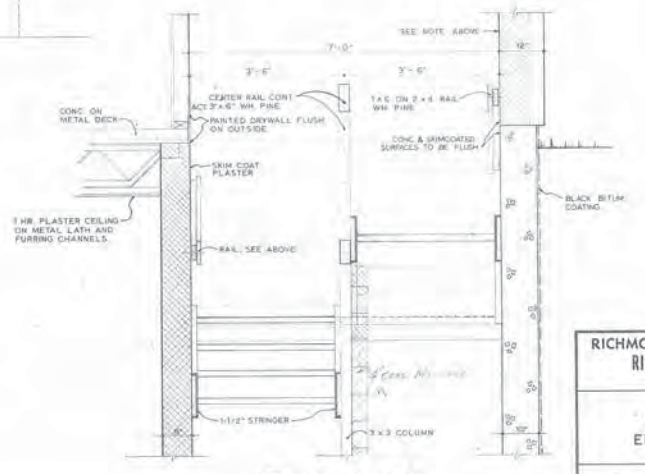

2 STAIR SECTION
SCALE: 3/8" = 1'-0"

BY	DATE	NO.	REVISION	BY	DATE
MADE	R.B.M.	7-31-71			
CHECKED	R.L.	7-31-71			
IN CHARGE	J.P.F.				


RICHMOND METROPOLITAN AUTHORITY
RICHMOND EXPRESSWAY SYSTEM
POWHITE PARKWAY

UTILITY BUILDING
ELEVATIONS & SECTIONS


HOWARD, NEEDLES, TAMMEN & BERGENDOFF
CONSULTING ENGINEERS
NEW YORK ALEXANDRIA WASHINGTON

SCALE: AS SHOWN
CONTRACT NO. TF-2
SHEET NO. 4 OF 11

RICHMOND EXPRESSWAY SYSTEM			
SECTION	PROJECT	SHEET NO.	TOTAL SHEETS
TF-2	UTILITY BUILDING	B	26

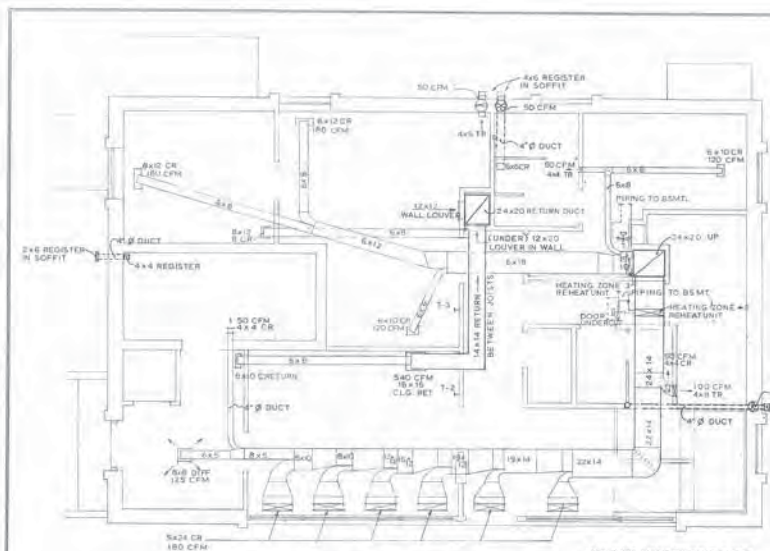

FIRST FLOOR HEATING PLAN

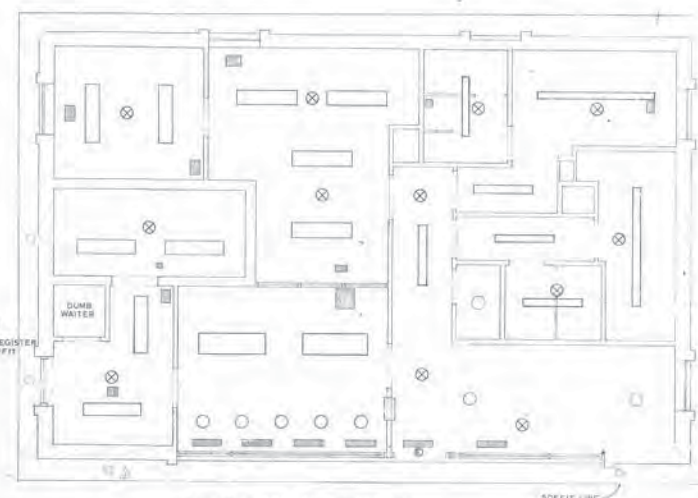


FIRST FLOOR CEILING PLAN

LEGEND


- PARTITION
 - 8x12 DUCT (SIZE)
 - FLUORESCENT FIXTURE
 - INCANDESCENT FIXTURE
 - EMERGENCY INCAND. FIXTURE
 - CLG AIR REGISTER
 - EXHAUST FAN
- ABBREVIATIONS**
- TR TOP REGISTER
 - CR CEILING REGISTER
 - CFM CUB. FT. / MIN.
 - CW COLD WATER

MOTOR SCHEDULE

1	PLUMB PUMP TANKS HWY 3	30 CFM	4.7 FT. HEAD	3/4 HP	208/230/0
2	CIRCULATOR 1	32 CFM	12 FT. HEAD	1/2 HP	115/170/0
3	CIRCULATOR 2	32 CFM	12 FT. HEAD	1/2 HP	115/170/0
4	EXHAUST FAN, KITCHEN	50 CFM			150/170/0 50 W
5	EXHAUST FAN, MEN TOILET	80 CFM			115/170/0 50 W
6	EXHAUST FAN, FEMALE TOILET	80 CFM			208/230/0 50 W
7	A/C AIRHANDL. UNIT	3000 CFM		2 HP	115/170/0 50 W
8	CONDENSING UNIT 1	3000 CFM		2 HP	208/230/0 30 KW
9	CONDENSING UNIT 2	3300 CFM		1 HP	208/230/0 30 KW
10	R/VAC UNIT	1300 CFM		1 HP	208/230/0 30 KW
11	DC BURNER			1/2 HP	115/170/0
12	DAMPER MOTOR 1			1/8 HP	115/170/0
13	DAMPER MOTOR 2			1/8 HP	115/170/0
14	DAMPER MOTOR 3			1/8 HP	115/170/0
15	DAMPER MOTOR 4			1/8 HP	115/170/0
16	SCWAGE EJECTOR			1/2 HP	115/170/0
17	UNIT HEATER 1			1/2 HP	115/170/0
18	UNIT HEATER 2			1/2 HP	115/170/0
19	UNIT HEATER 3			1/2 HP	115/170/0
20	UNIT HEATER 4			1/2 HP	115/170/0
21	TUNNEL HEATER 1			1/2 HP	115/170/0
22	TUNNEL HEATER 2			1/2 HP	115/170/0
23	DRY/WATER			1 HP	208/230/0
FOR RAMP 1 TOTAL 41 ELECTROMECH. ELEC. HEATER					240 V 1760 3 KW

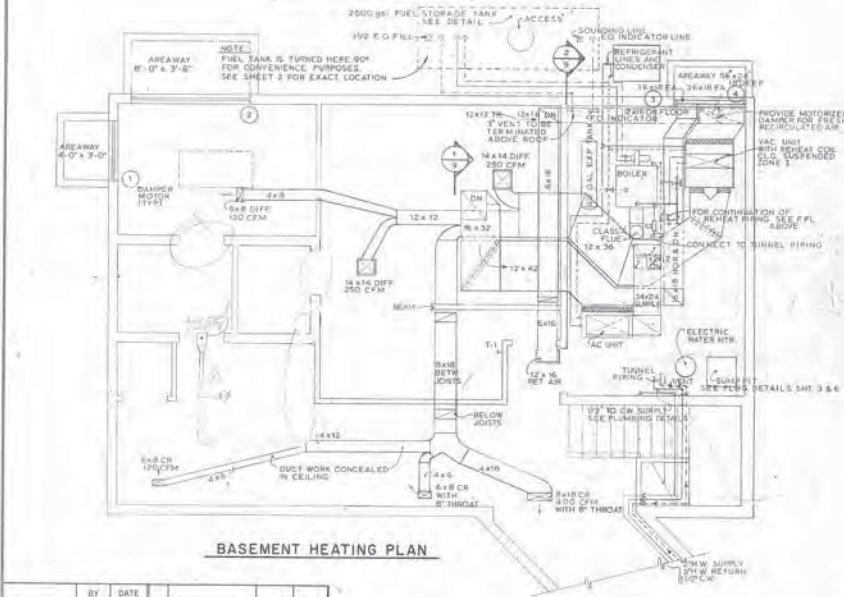

BASEMENT HEATING PLAN

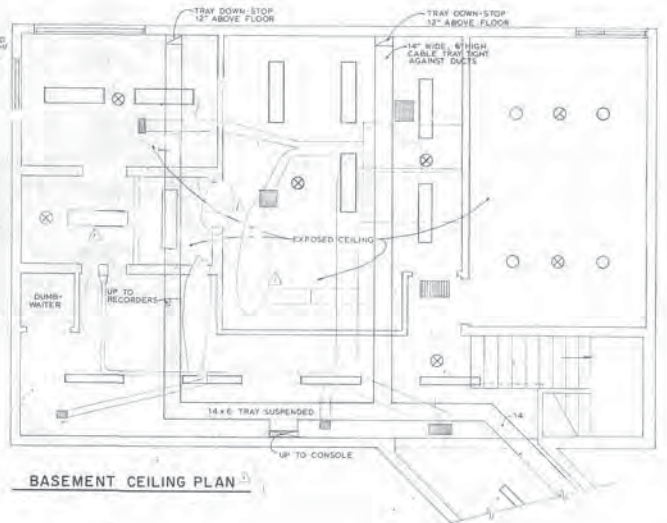

BASEMENT CEILING PLAN

	BY	DATE			
MADE	R.B.M.	7/21/77			
CHECKED	P.L.	7/21/77			
IN CHARGE	J.H.P.				
	NO.	REVISION	BY	DATE	

NOTE: PROVIDE CLEANOUTS AND ACCESS PANELS WHERE CODE AND CONVEYANCE REQUIRES



RICHMOND METROPOLITAN AUTHORITY
RICHMOND EXPRESSWAY SYSTEM
POWHITE PARKWAY

UTILITY BUILDING
HTG/AC AND REFL. CLG. PLAN

HOWARD, NEEDLES, TAMMEN & BERGENCOFF
CONSULTING ENGINEERS
NEW YORK, NEW YORK

SCALE: NOT TO SCALE
CONTRACT NO. TF-2
SHEET NO. B OF 11



RICHMOND EXPRESSWAY SYSTEM			
SECTION	PROJECT	DATE	NO.
TF2	UTILITY BUILDING	10	28

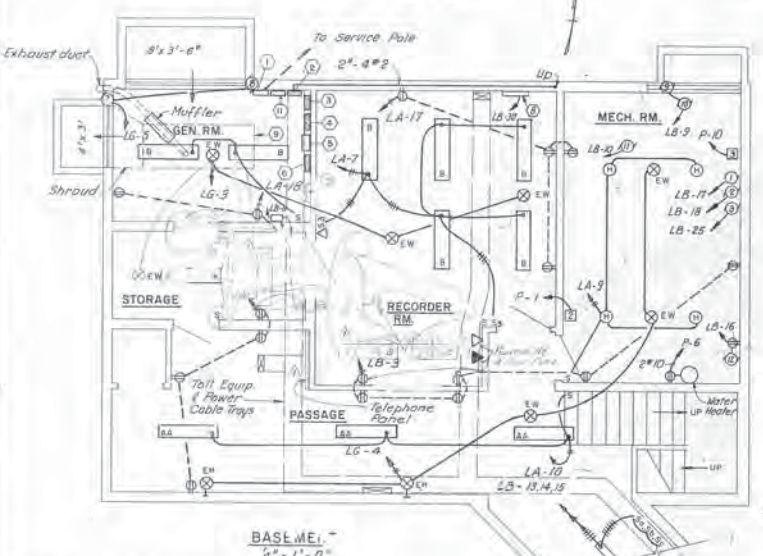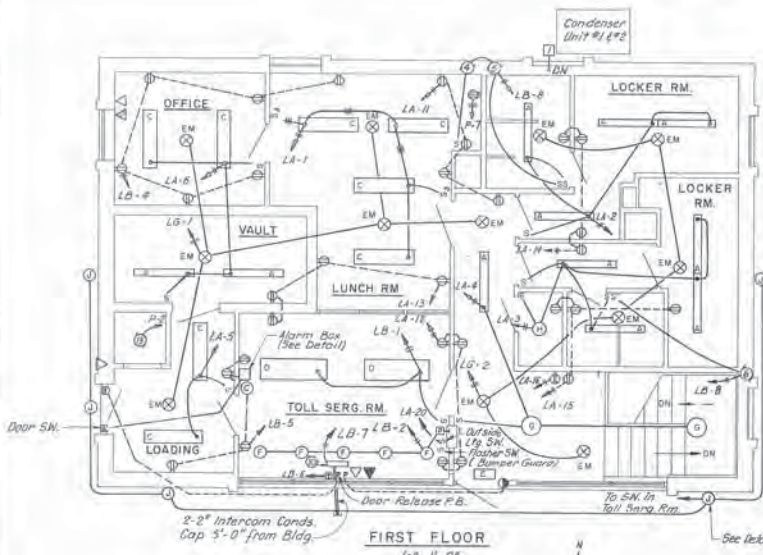

LEGEND

- ⊙ Fluorescent Fixture, Letter indicates type
 - ⊙ Incandescent Fixture, Letter indicates type
 - ⊙ Emergency Light - in ceiling
 - ⊙ Emergency Light - Wall Mounted
 - ⊙ Exit Light
 - ⊙ Dimmer
 - ⊙ Duplex Wall Receptacle Outlet
 - ⊙ Range Receptacle
 - ⊙ Single Pole Switch
 - ⊙ Three-way Switch
 - ⊙ Door Release system
 - ⊙ Telephone Outlet
 - ⊙ Intercom, System telephone Outlet
 - ⊙ Electric Clock outlet
 - ⊙ Transformer for Door Release system
 - ⊙ Panel Board
 - ⊙ Wiring Concealed in Walls or Ceiling
 - ⊙ Wiring Concealed in Floor
 - ⊙ LA-3 Home run with Panel & Circ. Designation
-
- ⊙ Current Transformer & Metering Equipment
 - ⊙ Main Distribution Panel Board - P
 - ⊙ Panel Board - LA
 - ⊙ Panel Board - LB
 - ⊙ Auto Transfer Switch
 - ⊙ Emergency Generator Panel - LG
 - ⊙ Generator Control Panel
 - ⊙ Recorder Room Panel Board - R
 - ⊙ Generator Set (45 KW Continuous)
 - ⊙ Inter Com Panel
 - ⊙ Disconnect SW. (400A) & Fuses (225 A)
-
- ① Circ. Pump #1 (Zone-1), 1/2 HP, 115V, 1φ, 60 co, 2#12
 - ② Circ. Pump #2 (Zone-2), 1/2 HP, 115V, 1φ, 60 co, 2#12
 - ③ Circ. Pump #3 (Tunnel) 1/2 HP, 208V, 3φ, 60 co, 4#12
 - ④ Exhaust Fan (Kitchen)
 - ⑤ Exhaust Fan (Men toilet) all 1/2 HP, 115V, 1φ, 60 co, 4#12
 - ⑥ Exhaust Fan (Women toilet)
 - ⑦ Damper Motor #1 of 1/2 HP, 115V, 1φ, 60 co, 2#12
 - ⑧ Damper Motor #2 #1/2 Connected to generator
 - ⑨ Damper Motor #3 Controls; 3/4 Connected to HVV Controls
 - ⑩ Damper Motor #4
 - ⑪ Oil Burner, 1/2 HP, 115V, 1φ, 60 co, 2#12
 - ⑫ Storm Sewage Ejector & HP, 115V, 1φ, 60 co, 2#12
 - ⑬ Dumb Waiter 1 HP, 208V, 3φ, 60 co, 4#12
 - ⑭ Condenser Unit #1 (2 HP & 30 KW) & Condenser Unit #2 (1 HP & 10 KW)
 - ⑮ HVAC Airhandling Unit (2 HP)
 - ⑯ HVAC Unit (1 HP)

General Notes:
1- For Lighting Fixture Schedule see Spec's.

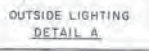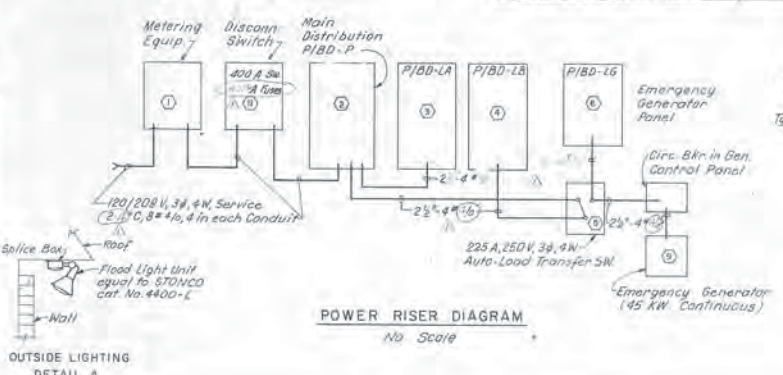


MAIN DISTRIBUTION PANEL - P		
Circ. No.	Pole/Trip	Description
1	2	20A AC Air Handling Unit (RHP)
2	2	20A Dumb Waiter (1HP)
3	2	20A Spare
4	2	20A Spare
5	3	20A Spare
6	2	30A Elect. M.H. Utility (4-KW)
7	2	50A Kitchen Unit (8.5 KW)
8	2	30A Spare
9	3	30A Spare
10	3	30A HVAC Unit (1HP & 10KW)
11	3	30A Spare
12	3	50A Condensers, #1 & #2 (@ 430KW)
13	3	50A Panel Board - LA
14	3	50A Panel Board - LB
15	3	Space
16	3	Space

PANEL BOARD - LA		
Circ. No.	Pole/Trip	Description
1	1	20A Ltg. 1st Floor
2	1	20A Ltg. Basement
3	1	20A Receptacles 1st Floor
4	1	20A Elect. Water Cooler
5	1	20A Receptacles Basement
6	1	20A Off side flood ltg
7	1	20A Spare
8	1	20A Spare
9	1	20A Spare
10	1	20A Spare
11	1	20A Spare
12	1	20A Spare
13	1	20A Spare
14	1	20A Spare
15	1	20A Spare
16	1	20A Spare

PANEL BOARD - LB		
Circ. No.	Pole/Trip	Description
1	1	20A Ltg. 1st Floor
2	1	20A Recept. 1st Fl. & Basement
3	1	20A Door Release system
4	1	20A Intercom Panel
5	1	20A Exhaust Fans (three)
6	1	20A Damper Motors #3 & #4
7	1	20A Oil Burner
8	1	20A Washer Contactor (Bumper Guard)
9	1	20A Tunnel Heater Fans (two)
10	1	20A Ltg. Tunnel
11	1	20A Storm Sewage Ejector
12	1	20A Circulator Pump #1
13	1	20A Circulator Pump #2
14	1	20A Stair Case Ltg. (Tunnel)
15	1	20A Spare
16	1	20A Spare
PANEL BOARD - R		
Circ. No.	Pole/Trip	Description
1	1	20A Recorder Room Circ.
2	1	20A Spaces

PANEL BOARD - LG		
Circ. No.	Pole/Trip	Description
1	1	20A Ltg. 1st Floor (Emp.)
2	1	20A Ltg. 1st Floor (Emp.)
3	1	20A Ltg. Basement (Emp.)
4	1	20A Ltg. Basement (Emp.)
5	1	20A Damper Motors #1 & #2
6	1	20A Spare
7	1	20A Spare
8	1	20A Spare
9	1	20A Spare
10	1	20A Spare

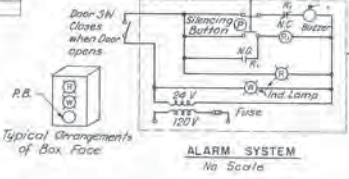

RICHMOND METROPOLITAN AUTHORITY
RICHMOND EXPRESSWAY SYSTEM

UTILITY BUILDING
ELECTRICAL

HOWARD NEEDLE TAMMEN & BERGENOFF
ELECTRICAL ENGINEERS
1000 BROADWAY, NEW YORK, N.Y. 10018
PHONE: (212) 512-2000
FAX: (212) 512-2001


DATE: 10-20-78
PROJECT: TS-2
SHEET NO. 10 OF 27

DATE	BY	REVISION
10-2-78	P.G.R.	1

NORTHBOUND POWHITE PARKWAY TOLL PLAZA

1978 WIDENING

RICHMOND EXPRESSWAY SYSTEM			
SECTION	PROJECT	SHEET NO.	TOTAL SHEETS
TF-4	POWHITE PARKWAY	1	

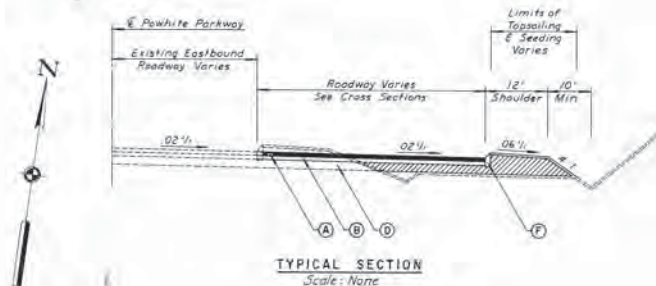


LEGEND:

- (A) 1 1/2" Bituminous Concrete Surface Course Type S-5.
- (B) 5 1/2" Bituminous Concrete Base Course Type B-3.
- (D) 12" Aggregate Subbase Course, Size 2 1/4, Prime Width of Pavement with 0.4 Gal./Sq. Yd. A1-2 or RC-250.
- (F) Mountable Curb, CG-3.

CONSTRUCTION SEQUENCE:

1. Preparation for placement of concrete slab for Toll Plaza expansion to include all necessary conduit, installing or connecting subsurface drainage where required, removing existing caps to stairways to tunnel, etc.
2. Installing and extending necessary conduit for lighting & communication to include light pole foundations and junction boxes.
3. Island construction with emphasis on Lanes 9 & 10 for automatic coin collection to relieve peak traffic backup.
4. Continuation of grading and pavement construction to provide access to expanded toll facilities. Put into operation new lighting and communications.
5. Completion of toll plaza island and equipment.
6. Final completion of pavement and toll plaza construction, including guard rail, sign relocation, pavement striping, etc.

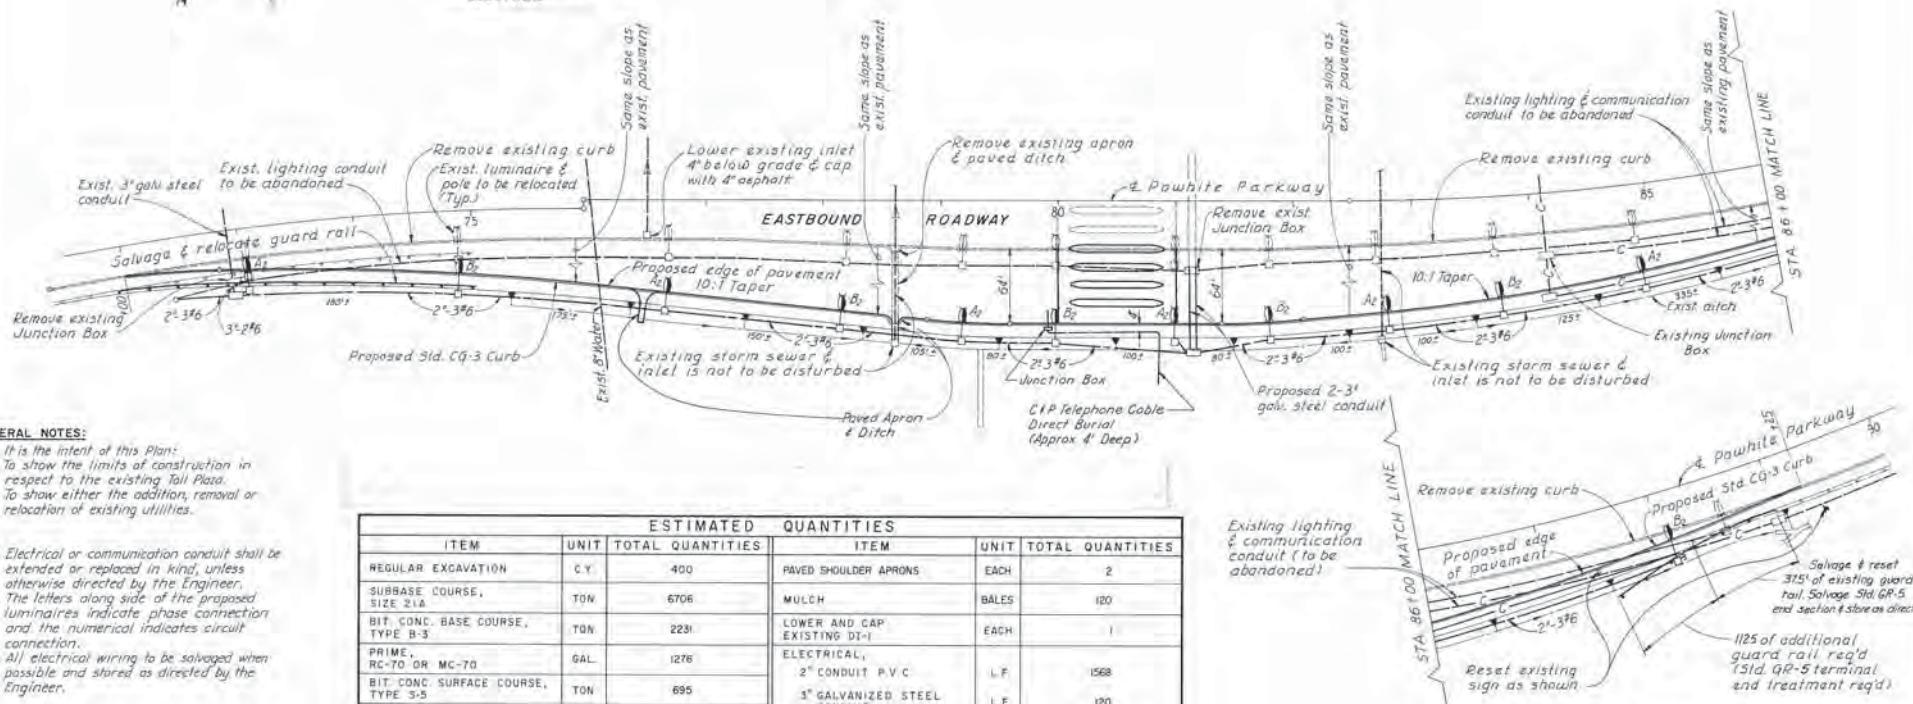

GENERAL NOTES:

1. It is the intent of this Plan:
 - a. To show the limits of construction in respect to the existing Toll Plaza.
 - b. To show either the addition, removal or relocation of existing utilities.
2. Electrical or communication conduit shall be extended or replaced in kind, unless otherwise directed by the Engineer.
 - a. The letters along side of the proposed luminaires indicate phase connection and the numerical indicates circuit connection.
 - b. All electrical wiring to be salvaged when possible and stored as directed by the Engineer.
3. Pavement striping shall be expanded to include expanded facility.
4. Rates of taper refer to offsets from centerline.

ESTIMATED QUANTITIES					
ITEM	UNIT	TOTAL QUANTITIES	ITEM	UNIT	TOTAL QUANTITIES
REGULAR EXCAVATION	C.Y.	400	PAVED SHOULDER APRONS	EACH	2
SUBBASE COURSE, SIZE 2 1/4	TON	6706	MULCH	BALES	120
BIT CONC. BASE COURSE, TYPE B-3	TON	2231	LOWER AND CAP EXISTING DI-1	EACH	1
PRIME, RC-70 DR MC-70	GAL.	1278	ELECTRICAL, 2" CONDUIT P.V.C.	L.F.	1568
BIT CONC SURFACE COURSE, TYPE S-5	TON	695	3" GALVANIZED STEEL CONDUIT	L.F.	120
CG-3	L.F.	1696	# 8 ELECTRICAL CONDUCTOR	L.F.	5970
REMOVAL, CG-3	L.F.	1740	CONCRETE JUNCTION BOX	EACH	2
REMOVE AND RELOCATE, STD. GR-2A OR GR-2B	L.F.	402	RESET LIGHT POLES	EACH	12
STD. GR-2A OR GR-2B	L.F.	213	COMMUNICATIONS, 2" METAL CONDUIT	L.F.	455
TOPSOIL, CLASS B	C.Y.	217	JUNCTION BOX	EACH	1
SEED	L.B.	200	SIGNING, RESET SPEED SIGN	EACH	1
TACK COAT	GAL.	175			

MADE	BY	DATE	NO.	REVISION	BY	DATE
	A.P.	9-75				
CHECKED	C.C.	9-75		Misc. Rev	PHI	9-75
IN CHARGE	J.P.F.					

RICHMOND METROPOLITAN AUTHORITY
RICHMOND EXPRESSWAY SYSTEM
POWHITE PARKWAY

EXPANSION OF POWHITE TOLL PLAZA
GRADING, PAVEMENT AND UTILITY PLAN
STA. 72+00 TO STA. 89+25 E.B.L.

HOWARD NEEDLES TAMMEN & BERGENHOFF CONSULTING ENGINEERS
 NEW YORK ALEXANDRIA KANSAS CITY

SCALE: 1" = 50'
 SHEET NO. 1 OF 18

AS BUILT

RICHMOND EXPRESSWAY SYSTEM			
SECTION	PROJECT	SHEET NO.	TOTAL SHEETS
TF-4	POWHITE PARKWAY	2	

SEQUENCE


- EXISTING EQUIPMENT TO REMAIN IN SERVICE.
- NEW COLLECTION EQUIPMENT TO BE INSTALLED ON ISLANDS H AND I AS THEY ARE COMPLETED.
- TOLL BOOTH AND EQUIPMENT TO SHIFT FROM ISLANDS F B G TO ISLANDS J B K IN SINGLE UNIT STAGES.
- EQUIPMENT TO BE SHIFTED FROM ISLAND E TO ISLAND F CAP CONDUIT ZONES ON ISLAND E TO ALLOW EASY FUTURE INSTALLATION OF UA MACHINE.
- NEXT LEVEL OF EXPANSION TO INCREASE PEAK NUMBER OF LANES TO FIVE EACH WAY.
- ULTIMATE LEVEL OF EXPANSION WOULD PROVIDE SIX LANES IN PEAK DIRECTION BY REVERSING LANES 7 AND 8.

NOTES:



- 1) To be placed by Toll Equipment Contractor prior to the paving, under this Contract.
- 2) Section B-B appears on sheet 4.

LEGEND:


- Location of future traffic signal.
- Traffic signal.
- Automatic Toll Machine.
- Future Automatic Toll Machine.
- Toll Booth.
- Construct Coin Tube & Plug.
- Existing Coin Tubes knock-out to be opened.
- Existing plugged coin tubes for future expansion.

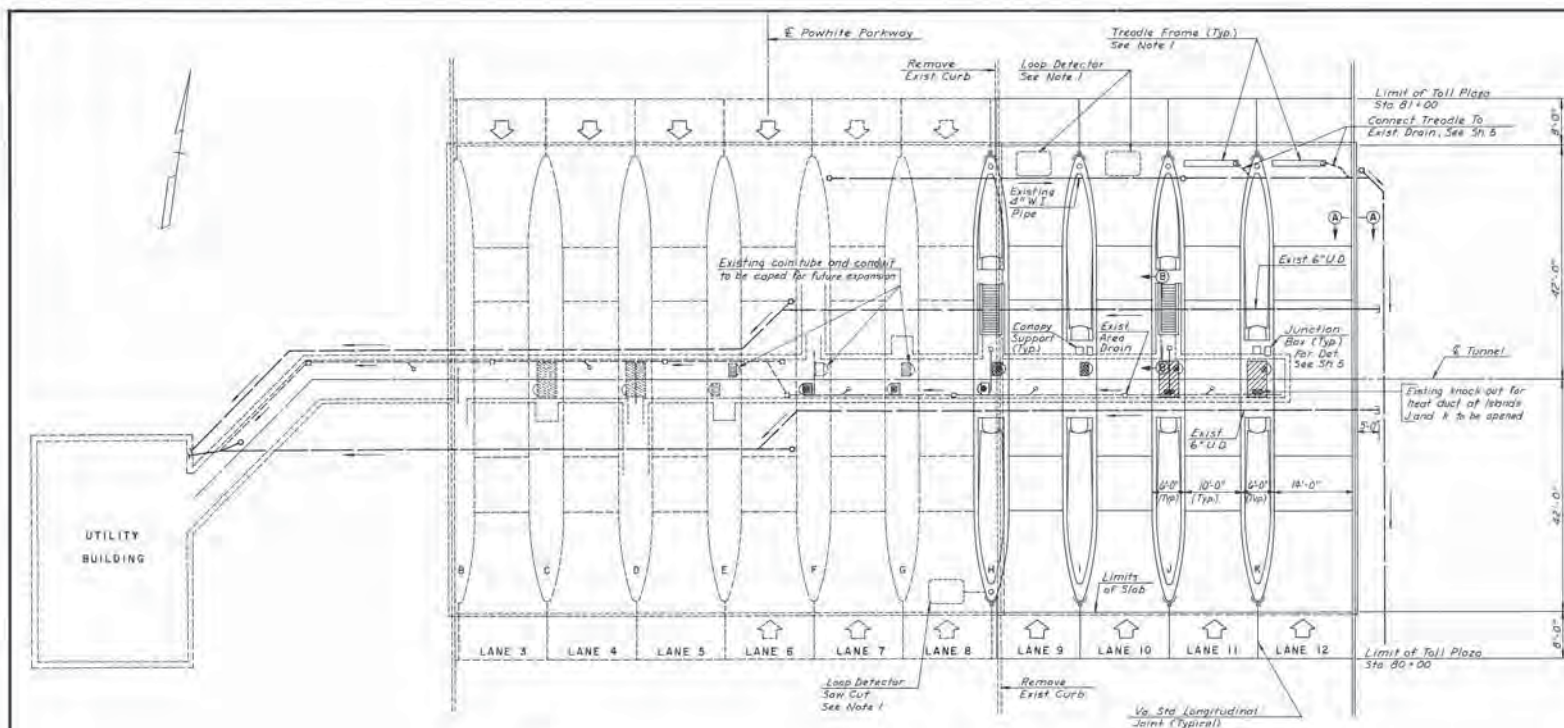


PLAN
Scale: 1/8" = 1'-0"

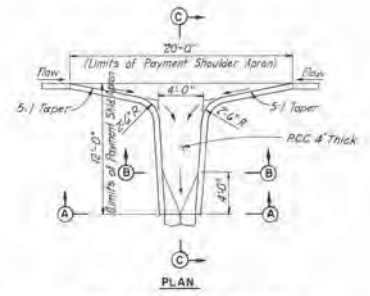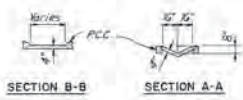

SPECIAL DESIGN SHOULDER APRON

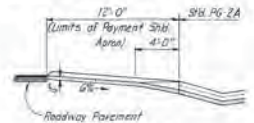

SECTION C-C

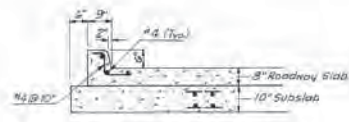

SECTION A-A
Scale: 1" = 1'-0"

DESIGNED	TEM	9-15-75			
DRAWN	TEM	9-19-75			
CHECKED	PHT	5-75	1	New Sheet	PHT 9-75
IN CHARGE	JRF				
NO.	REVISION	BY	DATE		

RICHMOND METROPOLITAN AUTHORITY
RICHMOND EXPRESSWAY SYSTEM
POWHITE PARKWAY
EXPANSION OF POWHITE TOLL PLAZA
TOLL PLAZA PLAN
AND NOTES







SCALE: As noted
 DATE: 9-75
 SHEET 2 OF 18

HOWARD NEEDLES TAMMEN & BERENDSON
 Alexandria, Virginia

HNTB

AS BUILT

RICHMOND EXPRESSWAY SYSTEM			
SECTION	PROJECT	SHEET NO.	TOTAL SHEETS
TF-4	POWHITE PARKWAY	3	

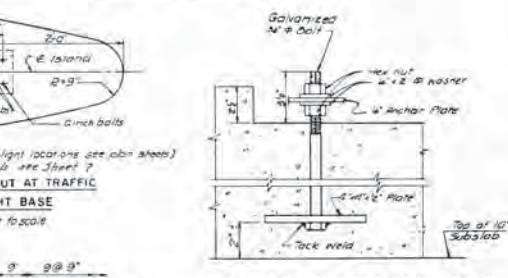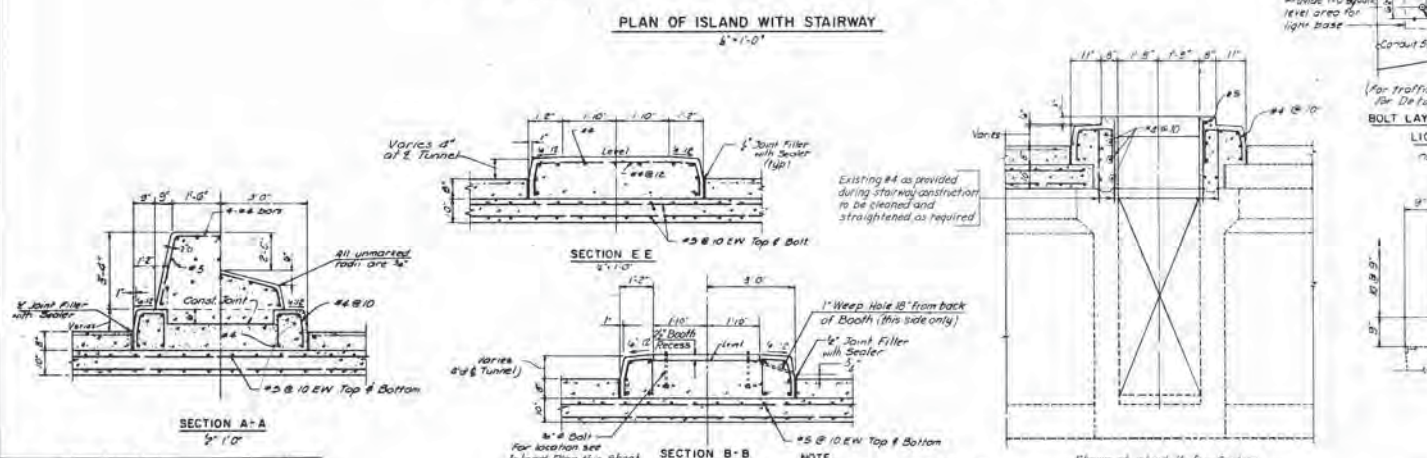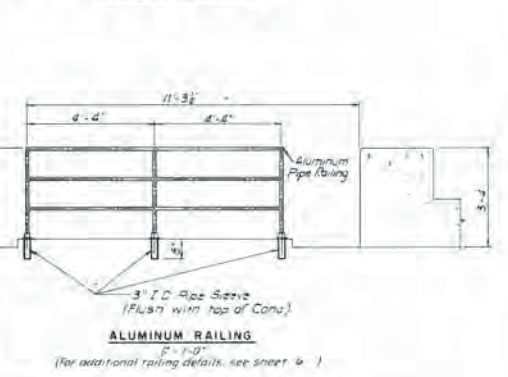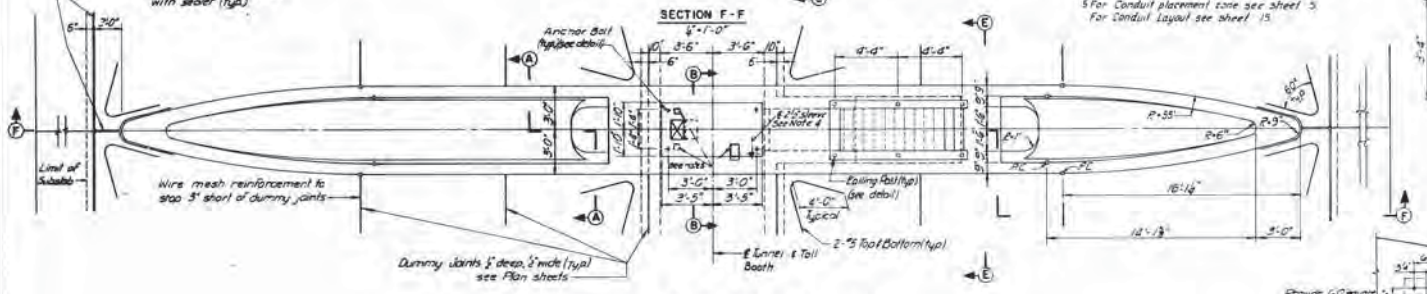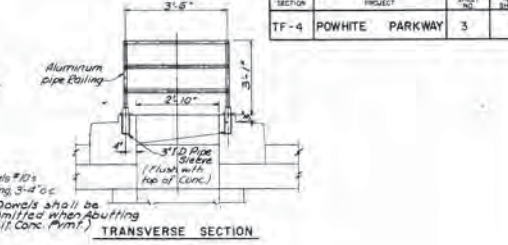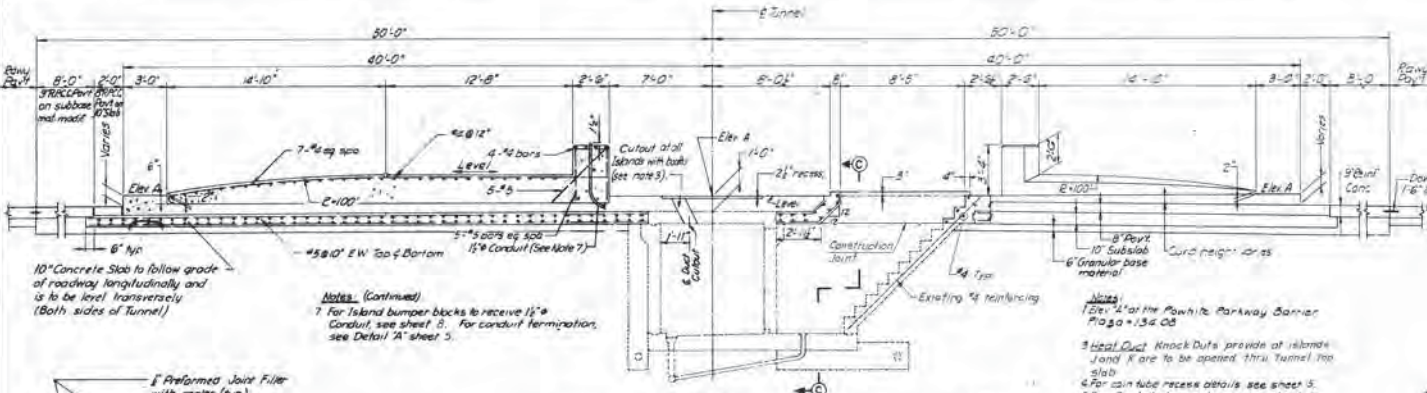

BY	DATE			
MADE	W.A.H.	5-68		
CHECKED	D.E.H.	5-68		
IN CHARGE	H.B.S.			

NOTE:
 Section B-B typical for islands J & K. For all other islands use Section E-E.

DETAIL OF ANCHOR BOLT FOR TOLL BOOTH
 For location see Island Plan this sheet








R.P.C.C. Reinforced, Portland Cement Concrete
AS BUILT

RICHMOND METROPOLITAN AUTHORITY
RICHMOND EXPRESSWAY SYSTEM
POWHITE PARKWAY

BARRIER PLAZA
ISLAND AND TUNNEL DETAILS

HOWARD, NEEDLES, TAMM & BERGENHOFF	SCALE: AS NOTED
CONSULTING ENGINEERS	CONTRACT NO.
NEW YORK ALEXANDRIA KANSAS CITY	SHEET NO. 3 OF 18

RICHMOND EXPRESSWAY SYSTEM			
SECTION	PROJECT	SHEET NO.	TOTAL SHEETS
TF-4	POWHITE PARKWAY	4	

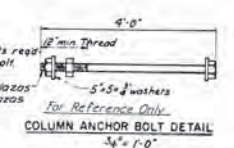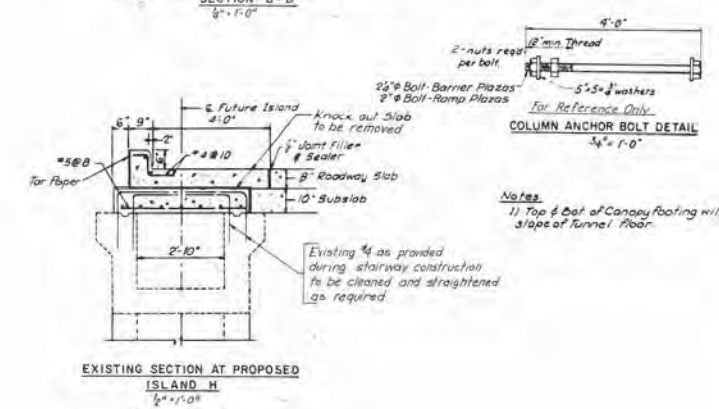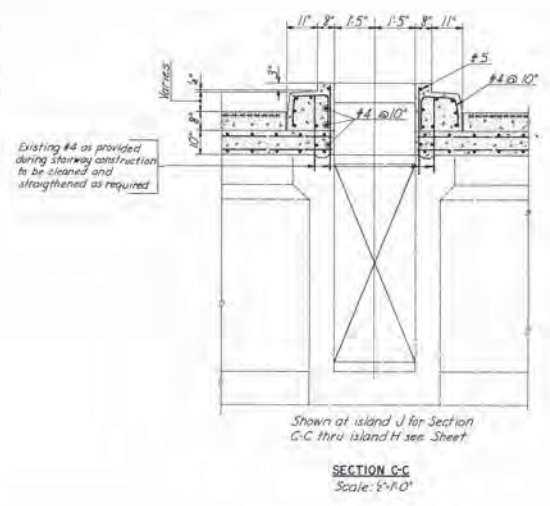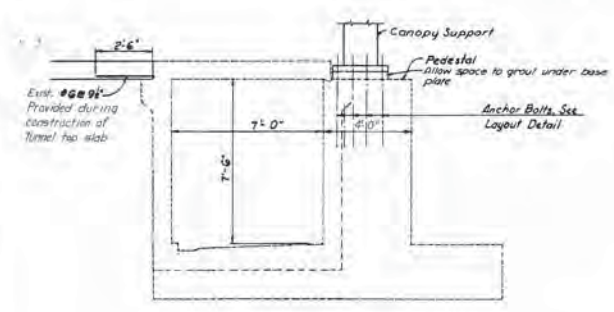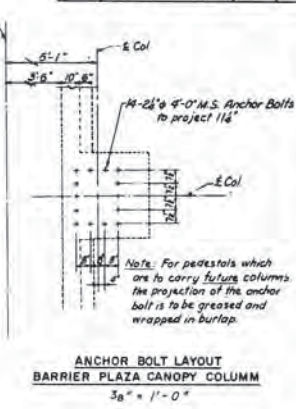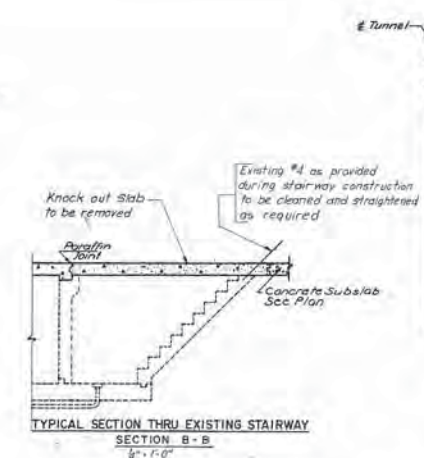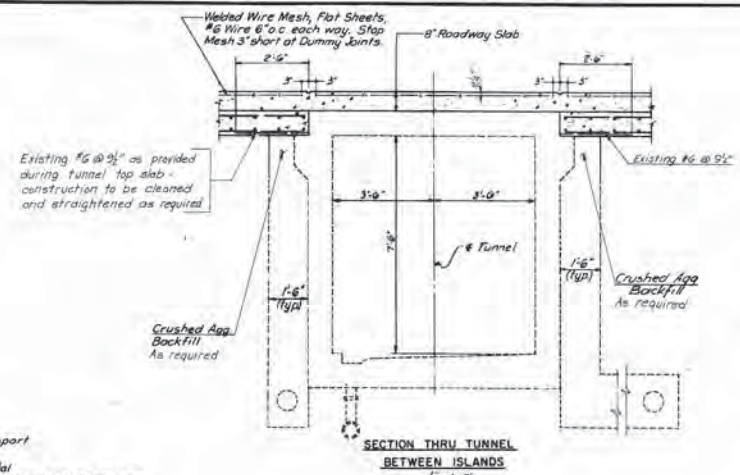

Notes:
1) Top of Bolts of Canopy footing will parallel slope of Tunnel Floor.

BY	DATE				
MADE	W.J.R.	5-68			
CHECKED	D.E.H.	5-68	Rev. Section A, Section Block	DHT	9-75
IN CHARGE	H.D.S.				

AS BUILT



RICHMOND METROPOLITAN AUTHORITY
RICHMOND EXPRESSWAY SYSTEM
POWHITE PARKWAY

BARRIER PLAZA
TUNNEL DETAILS


HOWARD, NEEDLES, TAMMEN & BERGENDOFF
 CONSULTING ENGINEERS
 NEW YORK ALEXANDRIA KANSAS CITY

SCALE: AS NOTED
 CONTRACT NO.:
 SHEET NO. 4 OF 18

RICHMOND EXPRESSWAY SYSTEM			
SECTION	PROJECT	SHEET NO.	TOTAL SHEETS
TF-4	POWHITE PARKWAY	5	

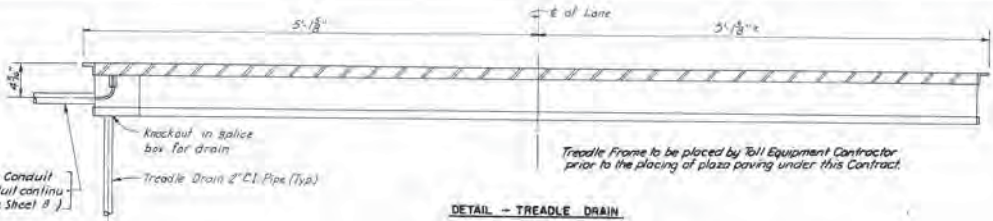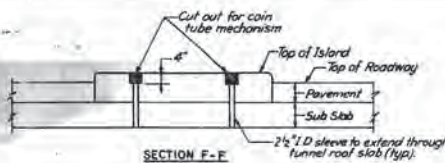


Treadle Frame to be placed by Toll Equipment Contractor prior to the placing of plaza paving under this Contract.


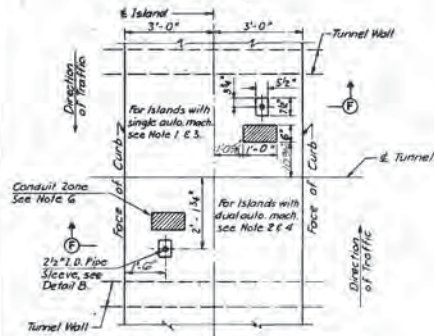


CONDUIT ZONE & PIPE SLEEVE LOCATION FOR AUTOMATIC TOLL MACHINE


(Location and dimension of Conduit Zones and Pipe sleeves are similar for each Direction of Traffic.)

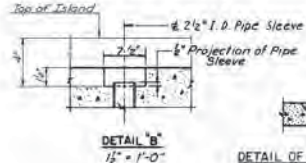


DETAIL OF EXISTING COIN TUBE AT ISLAND LOCATION

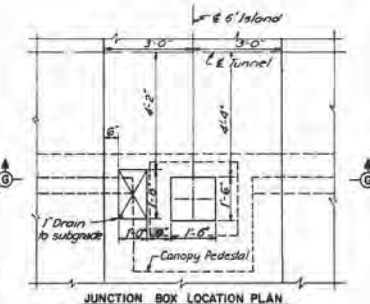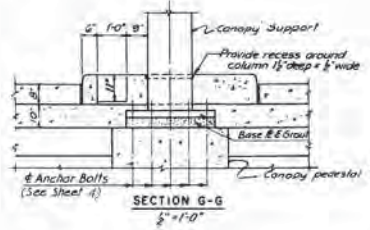


JUNCTION BOX LOCATION PLAN

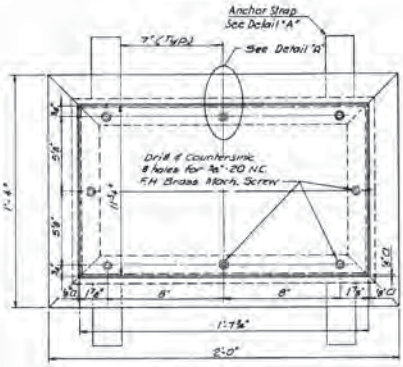

JUNCTION BOX

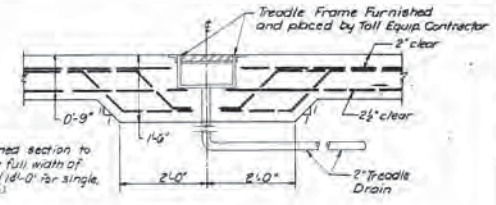


10' TREADLE FRAME INSTALLATION

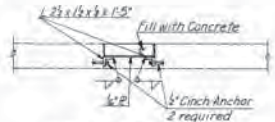

DETAIL OF HEAT DUCT PLUG AT ISLANDS F AND G


NOTES:

- Islands J, J and K will have a single coin tube and tube recess for automatic machine.
- Island H will have dual coin tubes and tube recesses for automatic machines. One coin tube will be for a future automatic machine. See Conduit Layout & Note 5.
- For coin tube recesses of future automatic machine locations, plug 2\"/>

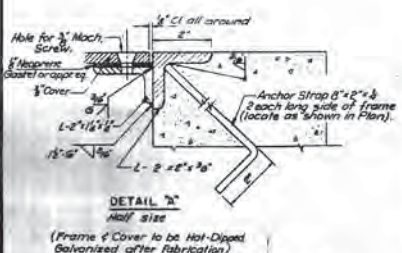


DETAIL D


(Frame & Cover to be Hot-Dipped Galvanized after Fabrication)

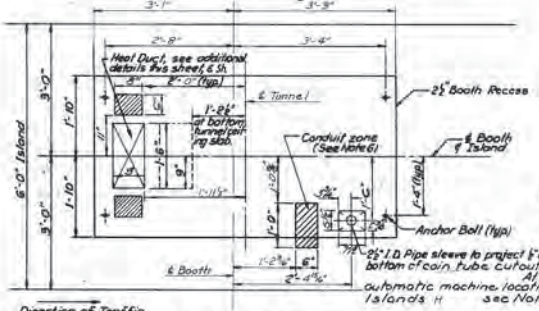

UTILITY LOCATIONS BARRIER PLAZA TOLL BOOTHS

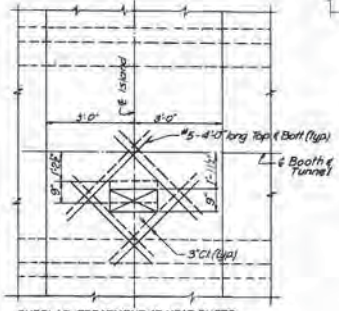

SUBSLAB TREATMENT AT HEAT DUCTS

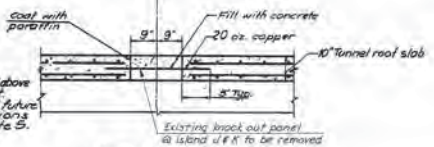

KNOCK-OUT DETAIL









BY	DATE			
MADE	M. J. W.	3-88		
CHECKED	D. E. H.	8-88	Mr. Single Drain	AWT 1-75
IN CHARGE	H.D.E.		NO.	REVISION

AS BUILT	
RICHMOND METROPOLITAN AUTHORITY RICHMOND EXPRESSWAY SYSTEM POWHITE PARKWAY	
MISCELLANEOUS DETAILS	
HOWARD, NEEDLES, TAMMER & BERGENHOFF CONSULTING ENGINEERS NEW YORK ALEXANDRIA KANSAS CITY	SCALE: AS NOTED CONTRACT NO.: SHEET NO. 5 OF 18

RICHMOND EXPRESSWAY SYSTEM		
SECTION	SHEET NO.	TOTAL SHEETS
TF-4	POWHITE PARKWAY	9

NOTES:

- LANES 4, 5, 6 AND 7 ARE TO RECEIVE EXACT CHANGE SIGNS. SEE DETAIL.
- LIGHT UNITS ARE TO BE PLACED IN FRONT OF EXACT CHANGE SIGNS. THE LIGHT UNITS ARE TO BE FOCUSED ON THE HORIZONTAL C OF THE PANEL. LIGHT UNIT BALLASTS WILL BE EXPOSED.
- A 3'-0" WIDE SECTION OF ISLAND WHOSE CENTER REPRESENTS THE COL. E INCLUDING A 4'-0" WIDE AND 10" HIGH CONC. FILLER BELOW ARE INCLUDED IN THIS CONTRACT. THE JUNCTION BOX SHOWN IN SECTION B-B WILL BE OWNER SUPPLIED BUT INSTALLED UNDER THIS CONTRACT. ALL WORK SHOWN IN SECTION C-C IS PART OF THIS CONTRACT. PROPER JOINT SEAL AND CURB DIMENSIONS TO FIT WITH THE EXISTING MUST BE PROVIDED.

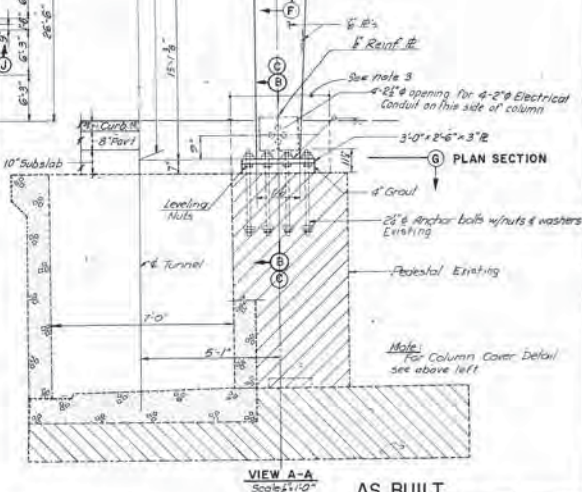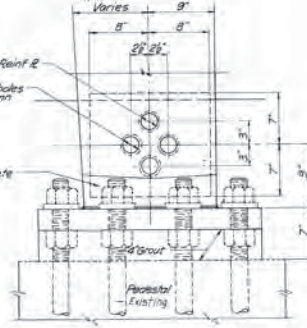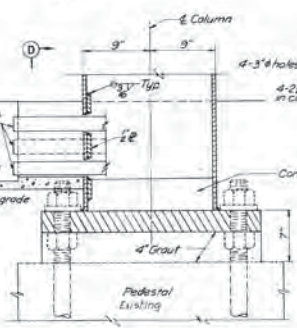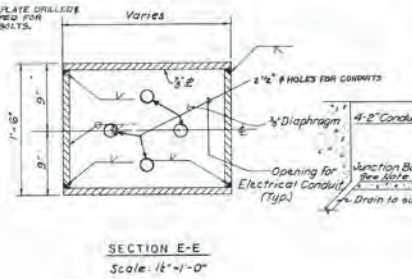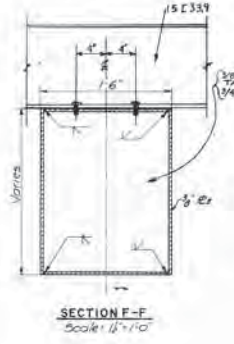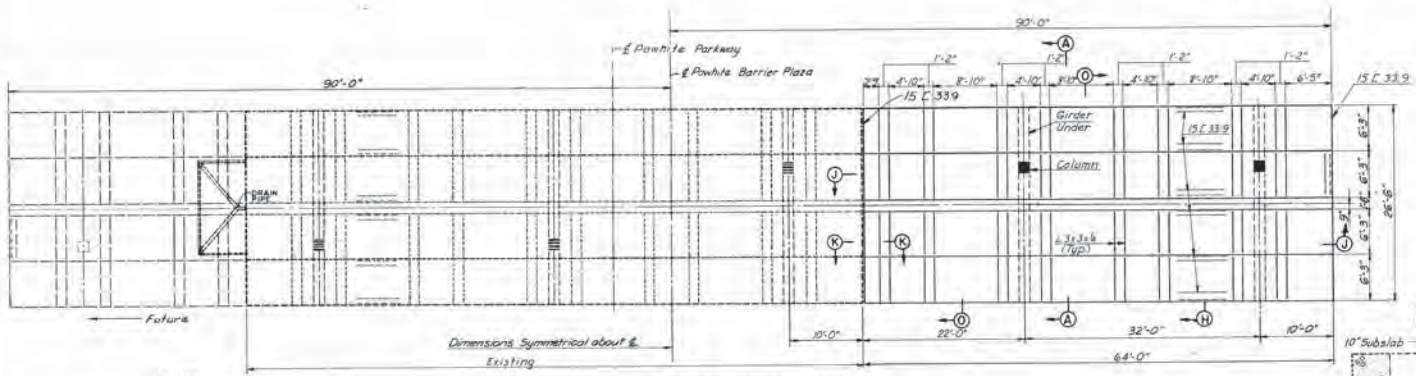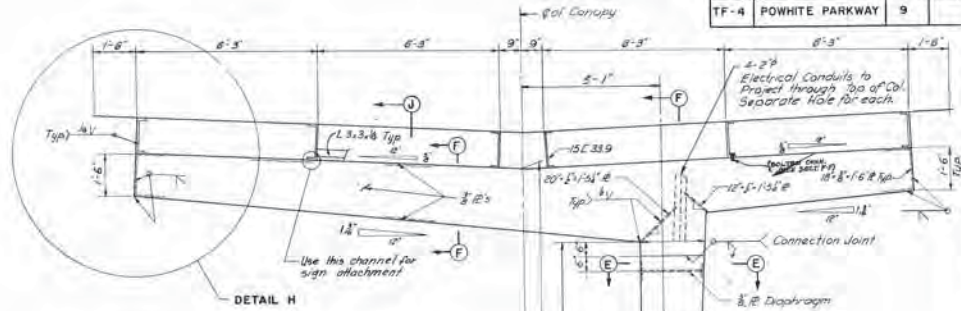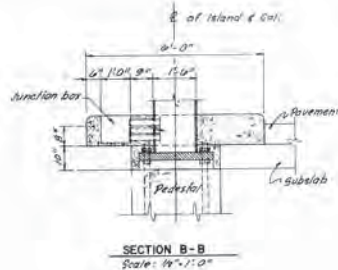

AS BUILT

NOTE:
For Section J-J and K-K see Sheet 18.


RICHMOND METROPOLITAN AUTHORITY RICHMOND EXPRESSWAY SYSTEM POWWHITE PARKWAY		SCALE: AS SHOWN
BARRIER PLAZA CANOPY FRAMING & DETAILS		CONTRACT NO.
HOWARD, NEEDLES, TAMMER & BERGENDORF CORPORATION NEW YORK ALEXANDRIA KANSAS CITY	DESIGNED BY	SHEET NO. 9 OF 18

BY	DATE			
MADE	R.B.M.	7-31-74		
CHECKED	K.L.	7-31-74	ADD SECTION J-J See Proj. Block	R.H.T. 9-75
IN CHARGE	J.P.P.	NO.	REVISION	BY DATE


NORTHBOUND POWHITE PARKWAY TOLL PLAZA

1989 WIDENING

RICHMOND EXPRESSWAY SYSTEM			
SECTION	PROJECT	SHEET NO.	TOTAL SHEETS
12	POWHITE PARKWAY	7	101

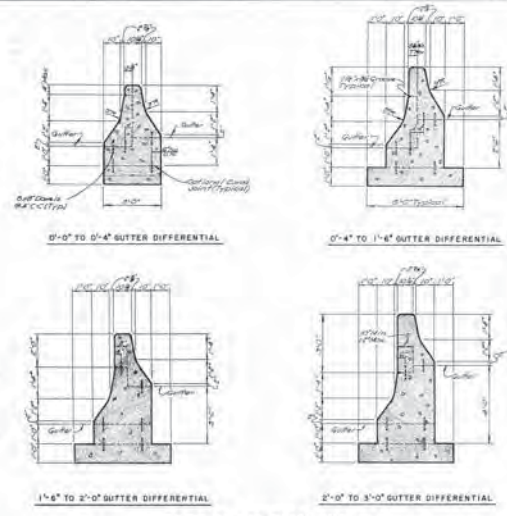

SPECIAL MEDIAN WALL

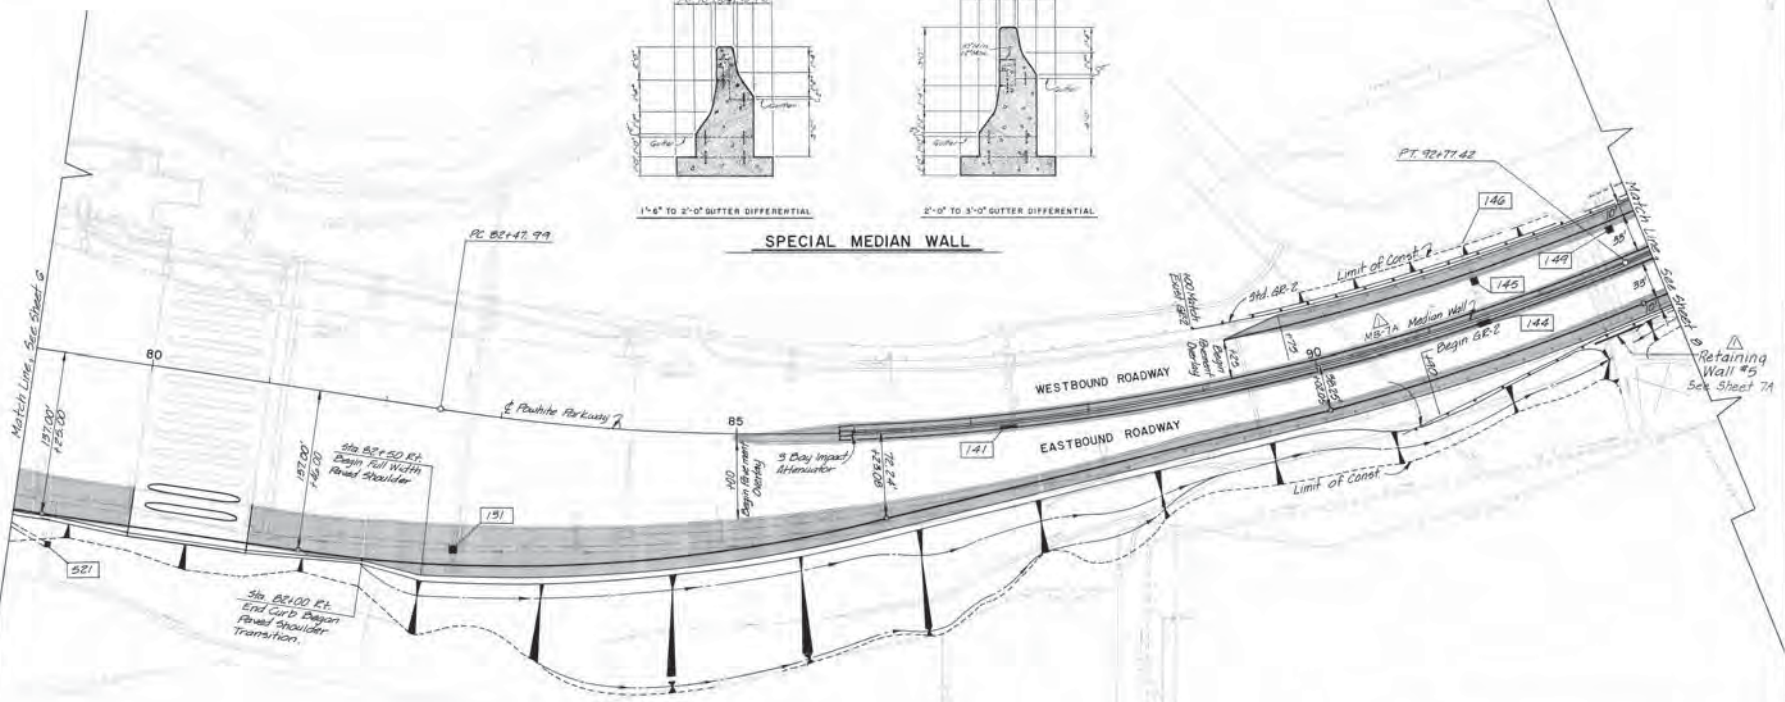

By	Date				
Designer	FJC	3/87			
Drawn	JLT	3/87			
Checked	RLV	3/87	As Built	TEM	3-89
Approved	DJA	5/87	No	Revision	By Date

AS BUILT

RICHMOND METROPOLITAN AUTHORITY
RICHMOND EXPRESSWAY SYSTEM
POWHITE PARKWAY


PAVING, GRADING & DRAINAGE PLAN
 Sta. 79+00 to Sta. 93+00

HOWARD NEEDLES TAMMEN & BERGENDOFF
 ENGINEERS
 45 HANOVER, VA


Scale: 1"=50'
 Date: MARCH 1987
 Contract No.: C-12
 Sheet: 7 of 101

NORTHBOUND POWHITE PARKWAY TOLL PLAZA

2006 PLANS FOR DEMOLITION OF PORTION OF TOLL PLAZA

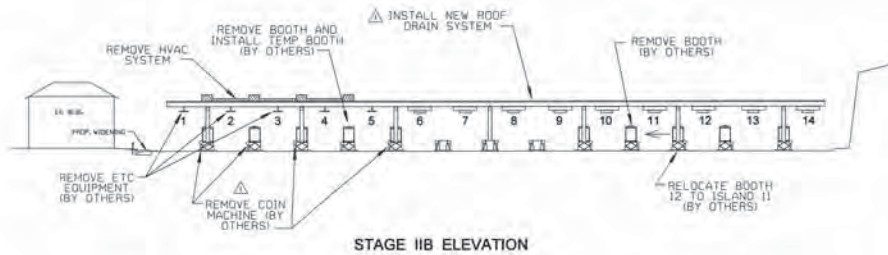


STAGE IIB ELEVATION

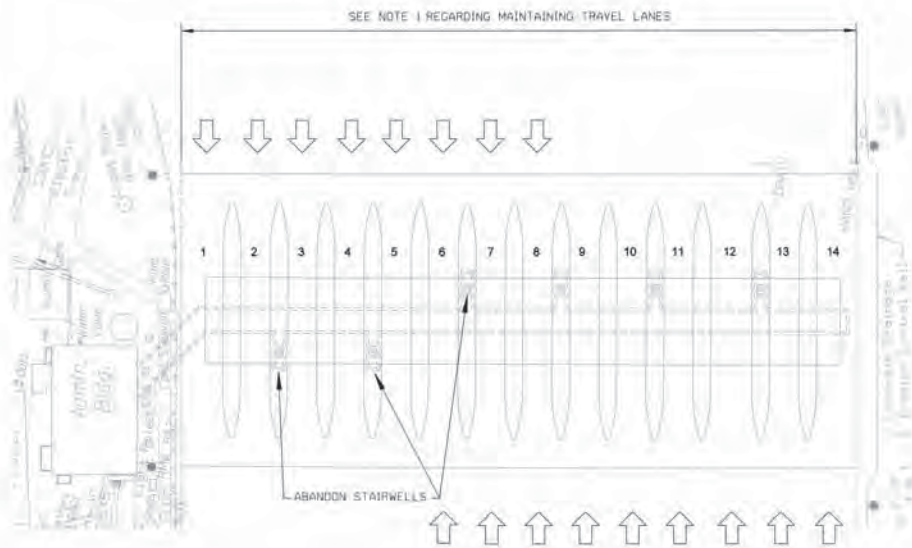


STAGE IIB PLAN

- NOTES:
1. CONTRACTOR SHALL COORDINATE WITH ENGINEER WHO WILL PROVIDE SINGLE AND/OR LANE CLOSURES FOR PERIODS LESS THAN 24 HOURS, OR FOR WEEKENDS, TO CREATE WORK ZONE, AS DESCRIBED IN CONTRACT DOCUMENTS.
 2. CONTRACTOR SHALL COORDINATE WITH ENGINEER TO ALLOW APPROPRIATE SCHEDULING OF TOLL PLAZA MODIFICATION WORK TO BE PERFORMED BY OTHERS.
 3. NO WORK IMPACTING SB TRAVEL LANES SHALL BE ALLOWED BETWEEN 3:00 PM AND 7:00 PM, MONDAY THROUGH FRIDAY.
 4. NO WORK IMPACTING NB TRAVEL LANES SHALL BE ALLOWED BETWEEN 6:00 AM AND 10:00 AM, MONDAY THROUGH FRIDAY.
 5. FOR ADDITIONAL SEQUENCE NOTES, SEE MAINTENANCE OF TRAFFIC SHEET OF APPROPRIATE STAGE.
 6. CONTRACTOR SHALL MAKE EVERY EFFORT TO SALVAGE EXISTING HVAC UNITS, SEE SPECIAL PROVISIONS.


ADDENDUM NO. 2:	5/17/06
ADDENDUM NO. 13:	5/10/06
REVISIONS	

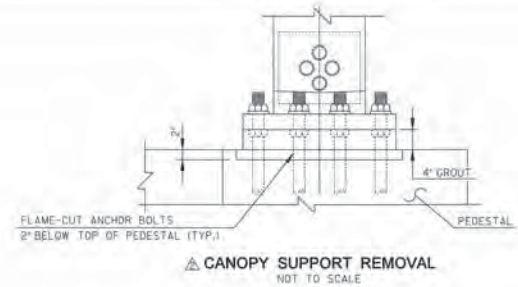


CANOPY SUPPORT REMOVAL
NOT TO SCALE

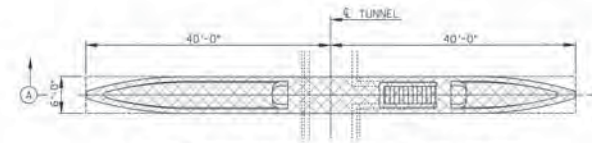


ISLAND DEMOLITION PLAN - ISLAND WITH STAIRS
NOT TO SCALE

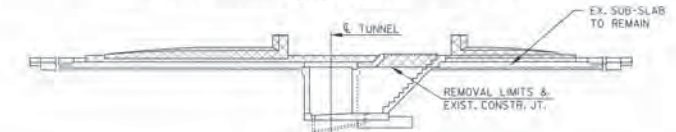

SECTION A-A
NOT TO SCALE

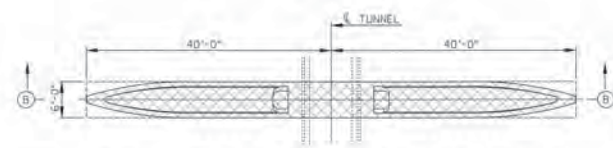

ISLAND DEMOLITION PLAN - ISLAND WITHOUT STAIRS
NOT TO SCALE

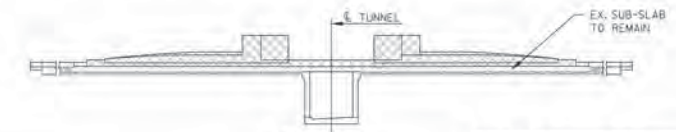

SECTION B-B
NOT TO SCALE

RM RICHMOND METROPOLITAN AUTHORITY
RICHMOND EXPRESSWAY SYSTEM


**POWHITE PARKWAY EXPRESS
TOLL LANES PROJECT
EX. TOLL PLAZA MODIFICATIONS
STAGE IIB**

HNTB


9175 GUILFORD ROAD, SUITE 100
COLUMBIA, MARYLAND 21046
800 543-1000

Scale:	1" = 30'	Date:	07/20/06	Contract No.:	FEL-2006	Sheet:	30 of 161
--------	----------	-------	----------	---------------	----------	--------	-----------


NOTE: THIS STAGE SHALL OCCUR WITHIN 1 WEEKEND

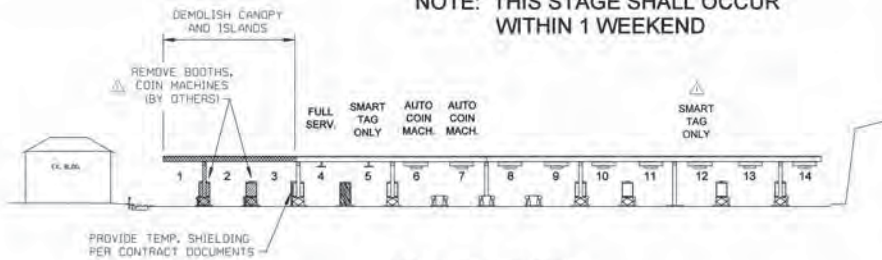


STAGE IIIA ELEVATION

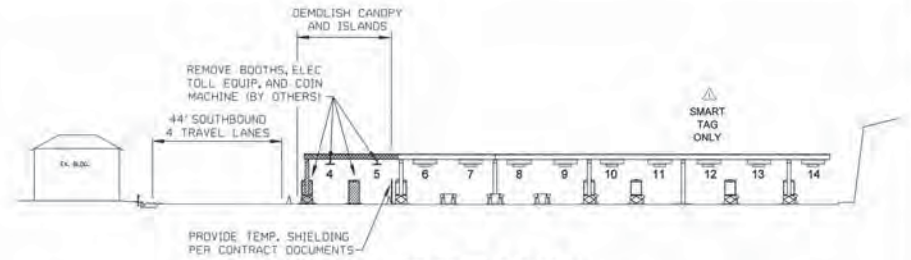

STAGE IIIB ELEVATION

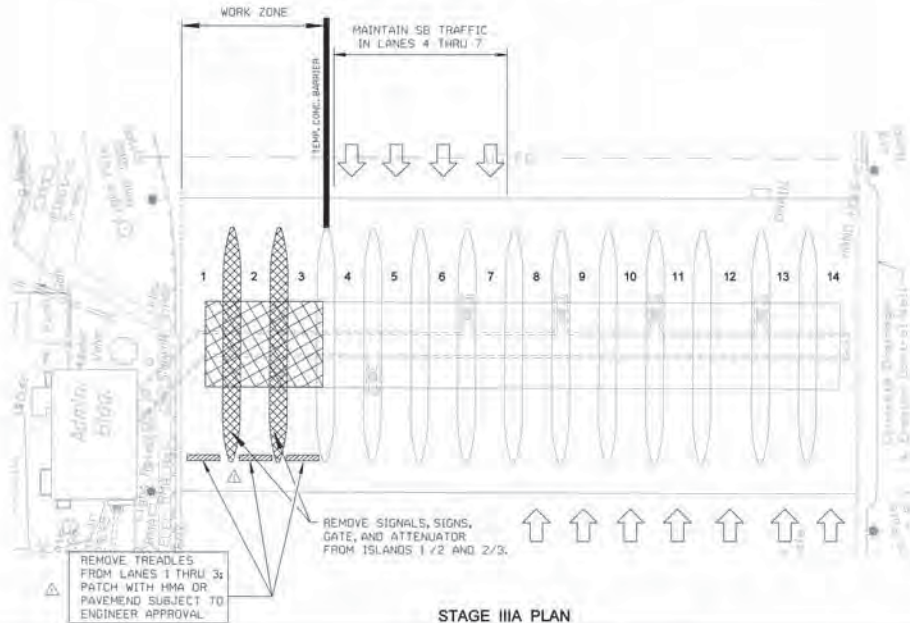

STAGE IIIA PLAN

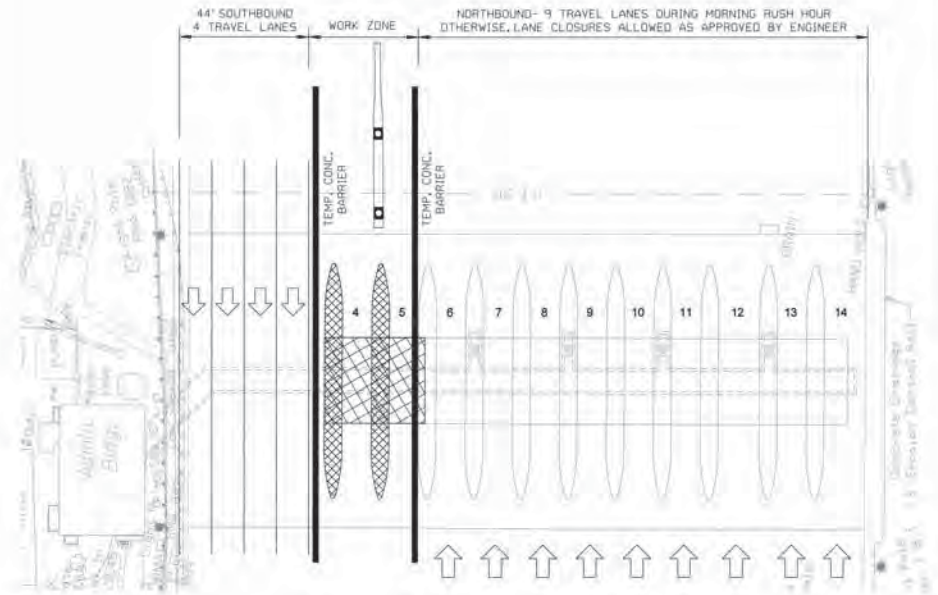

STAGE IIIB PLAN

NOTES:

1. CONTRACTOR SHALL COORDINATE WITH ENGINEER WHO WILL PROVIDE SINGLE AND/OR MULTIPLE LANE CLOSURES FOR PERIODS LESS THAN 24 HOURS, OR FOR WEEKENDS, TO CREATE WORK ZONE, AS DESCRIBED IN CONTRACT DOCUMENTS.
2. CONTRACTOR SHALL COORDINATE WITH ENGINEER TO ALLOW APPROPRIATE SCHEDULING OF TOLL PLAZA MODIFICATION WORK TO BE PERFORMED BY OTHERS.
3. NO WORK IMPACTING SB TRAVEL LANES SHALL BE ALLOWED BETWEEN 3:00 PM AND 7:00 PM, MONDAY THROUGH FRIDAY.
4. NO WORK IMPACTING NB TRAVEL LANES SHALL BE ALLOWED BETWEEN 6:00 AM AND 10:00 AM, MONDAY THROUGH FRIDAY.
5. FOR ADDITIONAL SEQUENCE NOTES, SEE MAINTENANCE OF TRAFFIC SHEET OF APPROPRIATE STAGE.

ADDENDUM NO. 12	3/10/06
REVISIONS	

RM RICHMOND METROPOLITAN AUTHORITY
RICHMOND EXPRESSWAY SYSTEM

HNTB

9175 GULFORD ROAD, SUITE 100
COLUMBIA, MARYLAND 21046
(301) 543-1000

**POWHITE PARKWAY EXPRESS
TOLL LANES PROJECT
EX. TOLL PLAZA MODIFICATIONS
STAGES IIIA & IIIB**


Scale	Notes	Contract No.	Sheets
1" = 20'	07/20/06	PEL-2006	31 of 161




STAGE III C ELEVATION



STAGE III D ELEVATION

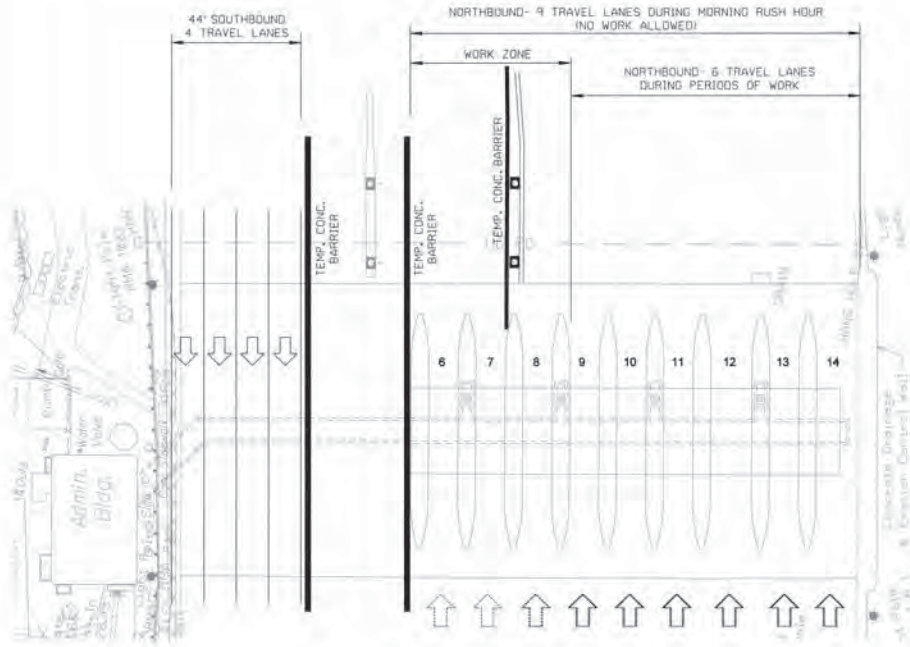

STAGE III C PLAN

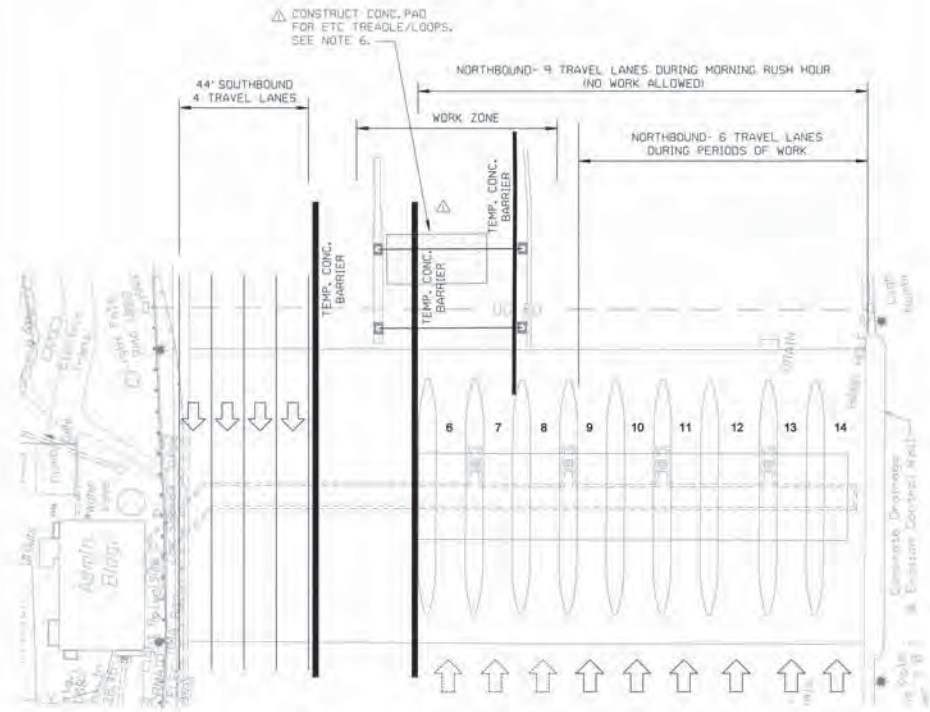

STAGE III D PLAN





- NOTES:
- CONTRACTOR SHALL COORDINATE WITH ENGINEER WHO WILL PROVIDE SINGLE AND/OR MULTIPLE LANE CLOSURES FOR PERIODS LESS THAN 24 HOURS, OR FOR WEEKENDS, TO CREATE WORK ZONE, AS DESCRIBED IN CONTRACT DOCUMENTS.
 - CONTRACTOR SHALL COORDINATE WITH ENGINEER TO ALLOW APPROPRIATE SCHEDULING OF TOLL PLAZA MODIFICATION WORK TO BE PERFORMED BY OTHERS.
 - NO WORK IMPACTING SB TRAVEL LANES SHALL BE ALLOWED BETWEEN 3:00 PM AND 7:00 PM, MONDAY THROUGH FRIDAY.
 - NO WORK IMPACTING NB TRAVEL LANES SHALL BE ALLOWED BETWEEN 6:00 AM AND 10:00 AM, MONDAY THROUGH FRIDAY.
 - FOR ADDITIONAL SEQUENCE NOTES, SEE MAINTENANCE OF TRAFFIC SHEET OF APPROPRIATE STAGE.

6. CONC. PAD FOR TREADLE SHALL BE CONSTRUCTED OVER A ONE WEEKEND PERIOD, BETWEEN FRI. 10:00 A.M. AND MON. 6:00 A.M. HIGH-EARLY STRENGTH CONCRETE SHALL BE USED.

ADDENDUM NO. 1: 3/10/06
REVISIONS

	RICHMOND METROPOLITAN AUTHORITY RICHMOND EXPRESSWAY SYSTEM		
	POWHITE PARKWAY EXPRESS TOLL LANES PROJECT EX. TOLL PLAZA MODIFICATIONS STAGES III C & III D		
9175 GULFORD ROAD, SUITE 100 COLUMBIA, MARYLAND 21046 (301) 543-1000	Scale: 1" = 20'	Date: 07/20/06	Contract No: PEL-2006 Sheet: 32 of 161

STAGES IVA AND IVB SHALL OCCUR WITHIN 1 WEEKEND.

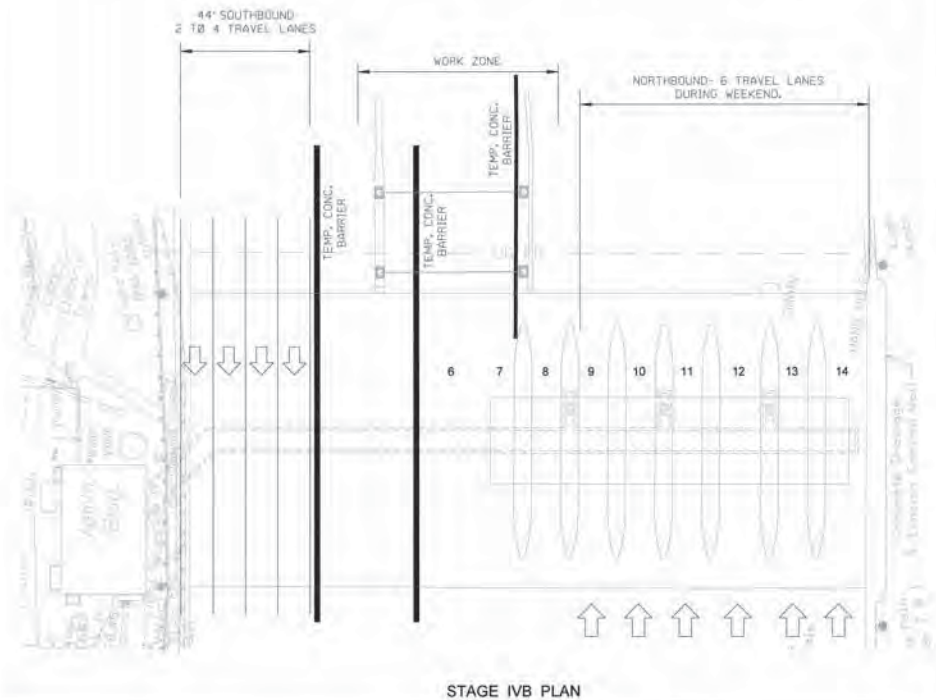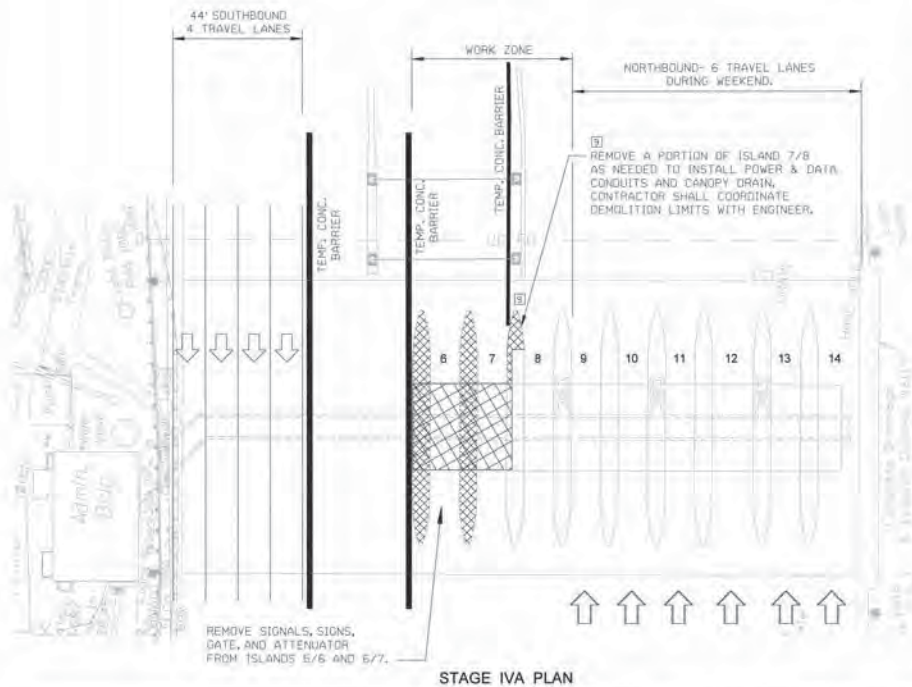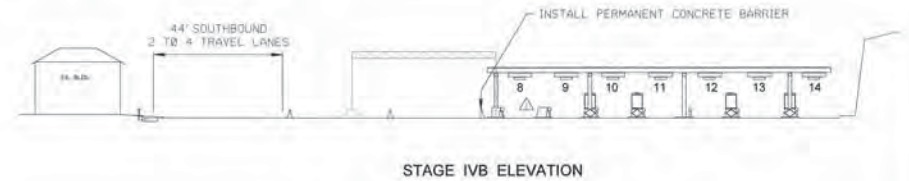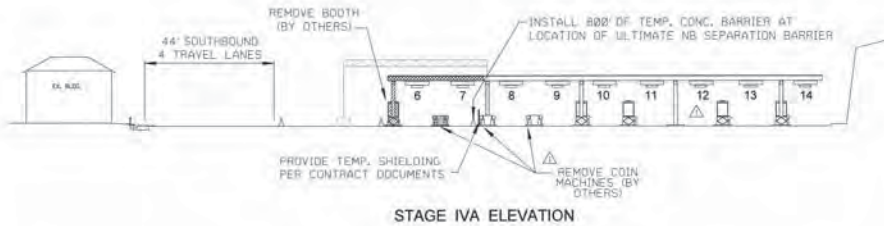

- NOTES:
1. CONTRACTOR SHALL COORDINATE WITH ENGINEER WHO WILL PROVIDE SINGLE AND/OR MULTIPLE LANE CLOSURES FOR PERIODS LESS THAN 24 HOURS, OR FOR WEEKENDS, TO CREATE WORK ZONE, AS DESCRIBED IN CONTRACT DOCUMENTS.
 2. CONTRACTOR SHALL COORDINATE WITH ENGINEER TO ALLOW APPROPRIATE SCHEDULING OF TOLL PLAZA MODIFICATION WORK TO BE PERFORMED BY OTHERS.
 3. NO WORK IMPACTING SB TRAVEL LANES SHALL BE ALLOWED BETWEEN 3:00 PM AND 7:00 PM, MONDAY THROUGH FRIDAY.
 4. NO WORK IMPACTING NB TRAVEL LANES SHALL BE ALLOWED BETWEEN 6:00 AM AND 10:00 AM, MONDAY THROUGH FRIDAY.
 5. FOR ADDITIONAL SEQUENCE NOTES, SEE MAINTENANCE OF TRAFFIC SHEET OF APPROPRIATE STAGE.

5/5/08: REVISED SHEET - SEE SHEET TC
 APPENDUM NO. 11 5/10/06
 REVISIONS



RM RICHMOND METROPOLITAN AUTHORITY
 RICHMOND EXPRESSWAY SYSTEM

HNTB

9175 GULFROAD ROAD, SUITE 400
 COLUMBIA, MARYLAND 21046
 (301) 543-1000

**POWHITE PARKWAY EXPRESS
 TOLL LANES PROJECT
 EX. TOLL PLAZA MODIFICATIONS
 STAGES IVA & IVB**

Scale: 1" = 20' Date: 3/06/08 Contract No. PEL-2006 Sheet: 31 of 161

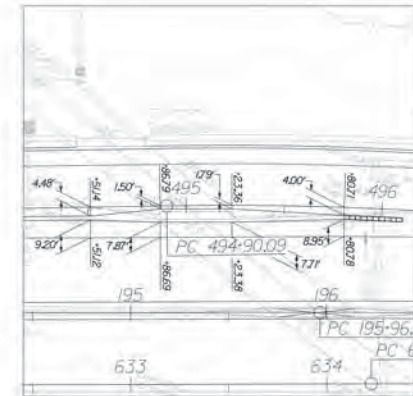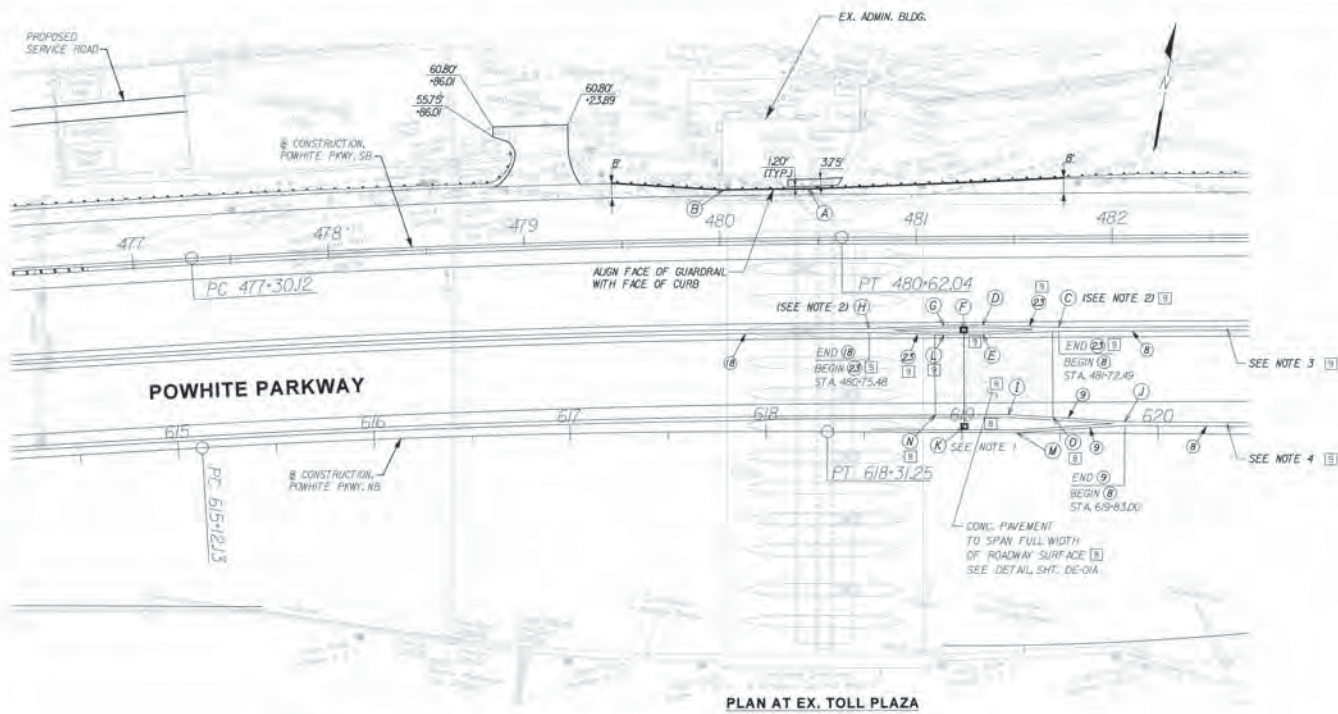

BARRIER TRANSITION PLAN AT POWHITE PARKWAY SB RAILROAD BRIDGE PIER

- NOTES:
1. SEE SHEETS SM-40 AND SM-41 FOR GANTRY FOUNDATION DETAILS.
 2. TRANSITION FROM THE 32" BARRIER HEIGHT TO A 50" BARRIER HEIGHT OVER A DISTANCE OF 6 FEET. SEE THE VDOT STANDARDS PAGE 50555 FOR ADDITIONAL BARRIER TRANSITION DETAILS.
 3. 2-1 CONDUITS TO BE INSTALLED IN CONCRETE MEDIAN BARRIER FROM GANTRY LOCATION TO DVAS POLE AT APPROXIMATE STA. 619+12. SEE SHEET L-01 FOR MORE DETAILS.
 4. 2-1 CONDUITS TO BE INSTALLED IN CONCRETE MEDIAN BARRIER FROM GANTRY LOCATION TO DVAS CAMERA MOUNTED ON LIGHT POLE 1P-15. SEE SHEET L-01 FOR MORE DETAILS.

HORIZONTAL CONTROL POINT SCHEDULE

POINT NO.	LOCATION	DESCRIPTION
(A)	STA. 480+45.49, 25.00' LT., POWHITE PKWY, SB	FACE OF CURB
(B)	STA. 480+01.69, 25.00' LT., POWHITE PKWY, SB	FACE OF CURB
(C)	STA. 481+72.49, 47.02' RT., POWHITE PKWY, SB	END BARRIER HORIZONTAL TRANSITION; END 50' BARRIER HEIGHT
(D)	STA. 481+33.63, 45.67' RT., POWHITE PKWY, SB	BEGIN BARRIER TRANSITION
(E)	STA. 481+33.63, 50.33' RT., POWHITE PKWY, SB	BEGIN BARRIER TRANSITION
(F)	STA. 481+23.98, 48.00' RT., POWHITE PKWY, SB	CENTER GANTRY FOUNDATION TY. 2A
(G)	STA. 481+33.96, 45.67' RT., POWHITE PKWY, SB	END BARRIER TRANSITION
(H)	STA. 480+75.48, 47.02' RT., POWHITE PKWY, SB	BEGIN BARRIER HORIZONTAL TRANSITION; BEGIN 50' BARRIER HEIGHT
(J)	STA. 619+23.59, 9.33' LT., POWHITE PKWY, NB	BEGIN BARRIER TRANSITION
(K)	STA. 619+83.00, 5.97' LT., POWHITE PKWY, NB	END BARRIER TRANSITION
(L)	STA. 619+27.81, 2.95' LT., POWHITE PKWY, NB	CENTER GANTRY FOUNDATION TY. 2B
(M)	STA. 481+33.96, 50.33' RT., POWHITE PKWY, SB	END BARRIER TRANSITION
(N)	STA. 619+27.81, 0.00', POWHITE PKWY, NB	BEGIN BARRIER TRANSITION
(O)	STA. 618+86.36, POWHITE PKWY, NB	LIMIT OF 9' CONC. PAVEMENT
(P)	STA. 619+46.36, POWHITE PKWY, NB	LIMIT OF 9' CONC. PAVEMENT

- LEGEND
- (M) Mod/Fnd. MB-7D, Concrete Median Barrier
 - (N) Mod/Fnd. MB-7E, Concrete Median Barrier
 - (O) Mod/Fnd. MB-8A, Type I Conc. Med. Barrier, See SH. DE-02
 - (P) S/S MB-82R, Conc. Med. Barrier

NO.	DATE	REVISIONS
10	4/10/08	REVISED SHEET - SEE SHEET 1C
11	3/5/08	REVISED SHEET - SEE SHEET 1C
12	10/20/07	REVISED GANTRY AREA - SEE SHEET 1E
13	7/20/04	ADDED SHEET

DE-06 OF 06

RM RICHMOND METROPOLITAN AUTHORITY
RICHMOND EXPRESSWAY SYSTEM





HNTB


975 GLEBEFORD ROAD SUITE 400
COLUMBIA, MARYLAND 21046
(800) 543-0000

**POWHITE PARKWAY EXPRESS
TOLL LANES PROJECT**
MISCELLANEOUS DETAILS

Scale: 1" = 30' Date: 3/06/08 Contract No.: FEL-2006 Sheet: 47 of 161

PAVEMENT LEGEND

-  PROPOSED FULL DEPTH PAVING
-  PROPOSED RESURFACING
-  FLEXIBLE PAVEMENT PAVING AREA
-  PAVEMENT / CONCRETE REMOVAL

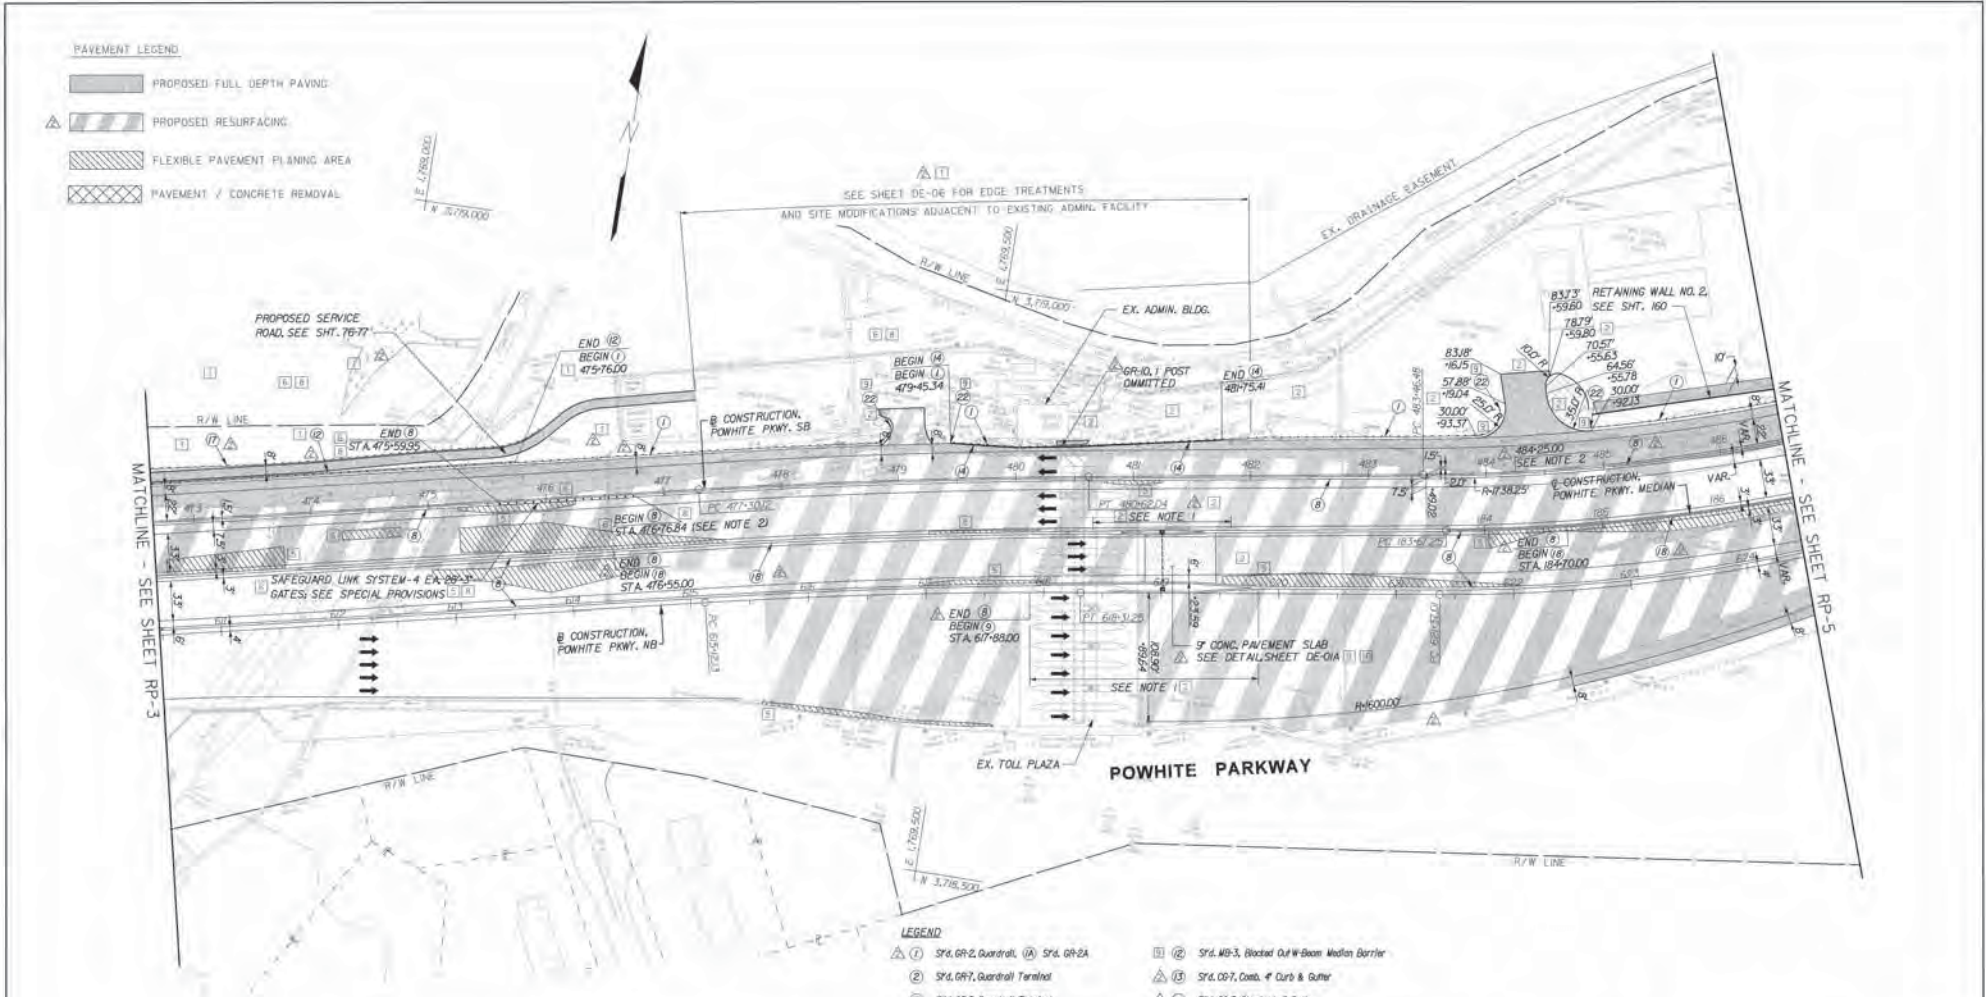

LEGEND

- (1) Sfg. GR-2, Guardrail (2) Sfg. GR-2A
- (3) Sfg. GR-7, Guardrail Terminal
- (4) Sfg. GR-9, Guardrail Terminal
- (5) Impact Attenuator (TL-3, 55 MPH) (6) (TL-2, 40 MPH)
- (7) Sfg. GR-FDA-2, Fixed Object Attachment, Type I
- (8) Sfg. GR-FDA-2, Fixed Object Attachment, Type II
- (9) Sfg. MB-5, W-Beam Median Barrier, Wood Post
- (10) Modified MB-7D, Concrete Median Barrier
- (11) Modified MB-7E, Concrete Median Barrier
- (12) Modified MB-7F, Concrete Median Barrier
- (13) Modified MB-8A Conc. Median Barrier, Tx, II, See Sheet DE-02
- (14) Sfg. MB-3, Blotched O/W-Beam Median Barrier
- (15) Sfg. CR-7, Conc. # Curb & Gutter
- (16) Sfg. CR-3, Standard # Curb
- (17) Constant Slope Concrete Median Barrier, See Sheet DE-04
- (18) # Concrete Slabwalk Per Section 504 Of Standard Specifications
- (19) Sfg. GR-6, Guardrail (Wood Post)
- (20) Sfg. GR-8A, Guardrail (Wood Post)
- (21) Modified MB-8A, Type I Conc. Med. Barrier, See SH. DE-02
- (22) Sfg. MB-8A, Type II Conc. Med. Barrier
- (23) Sfg. MB-8A, Type III Conc. Med. Barrier
- (24) Sfg. CR-6, Conc. # Curb & Gutter
- (25) Sfg. GR-6, Guardrail Terminal

NOTES:

- 1. SEE SHEET DE-06 FOR BARRIER TYPES AND TRANSITIONS AT NB ENTRY STRUCTURE.
- 2. CONCRETE MEDIAN BARRIER, MODIFIED TYPE 7D, FROM STA. 476+76.84 TO STA. 484+25 SHALL MATCH 2'-3" HEIGHT STANDARD AS SHOWN ON SH. DE-02.

NO.	DATE	REVISIONS
10	4/10/04	REVISED SHEET - SEE SHEET 10
9	3/5/04	REVISED SHEET - SEE SHEET 10
8	10/05/07	REVISED SHEET - SEE SHEET 10
7	9/2/07	REVISED SHEET - SEE SHEET 1B
6	3/27/07	REVISED SHEET - SEE SHEET 1B
5	7/20/04	REVISED SHEET - SEE SHEET 1B
4	6/23/04	SEE SHEET 1B
3	ADDENDUM NO. 21 - 5/17/06	

RM RICHMOND METROPOLITAN AUTHORITY
RICHMOND EXPRESSWAY SYSTEM

HNTB
1775 GOLFPORT ROAD, SUITE 100
COLUMBIA, MARYLAND 21046
(301) 543-1000

**POWHITE PARKWAY EXPRESS
TOLL LANES PROJECT**
ROADWAY PAVEMENT PLAN
STA. 472+65 TO STA. 486+50
CONSTR. POWHITE PARKWAY SB

Scale: 1" = 50'
Date: 3/06/06
Contract No.: PEL-2006
Sheet: 4 of 16



POWHITE PARKWAY TOLL PLAZA

TOLL GANTRY SHOP DRAWINGS

SHOP DRAWING REVIEW
HNTB Corporation

Review is for general compliance with contract documents. Sole responsibility for correctness of dimensions, details, quantities and safety during fabrication and erection shall remain with the Contractor.


- No Exceptions Taken
- Make Correction Noted By *AN*
- Amend and Resubmit
- Rejected - See Remarks Date *2/22/08*

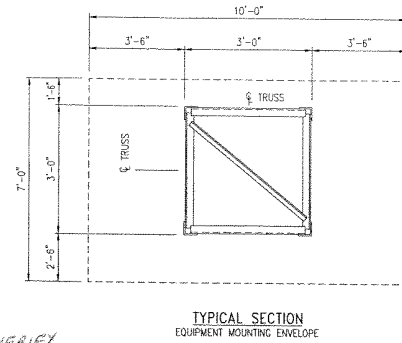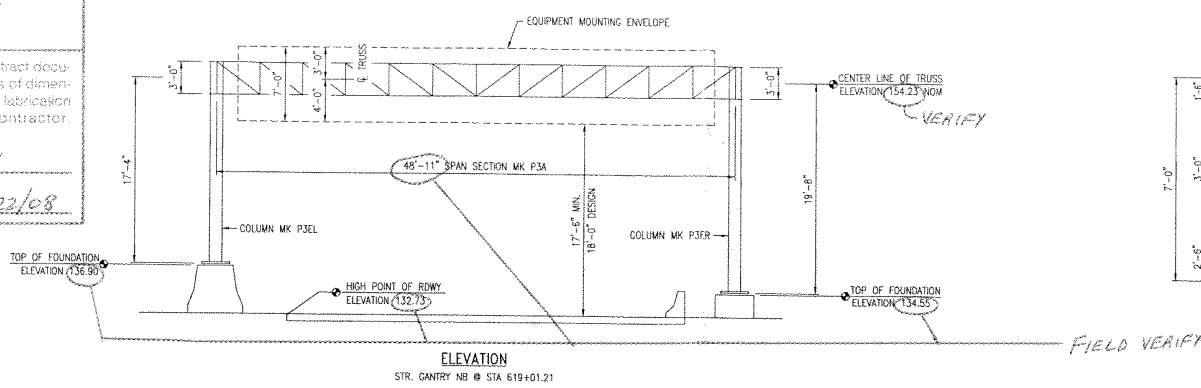


TYPICAL SECTION
EQUIPMENT MOUNTING ENVELOPE

FIELD VERIFY

ELEVATION
STR. GANTRY NB @ STA 619+01.21

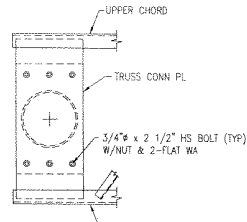


UPPER CONNECTION DETAIL
(LEFT COLUMN SHOWN, RIGHT COLUMN SIMILAR)

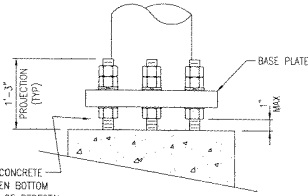

NO MORTAR, GROUT, OR CONCRETE SHALL BE PLACED BETWEEN BOTTOM OF BASE PLATE AND TOP OF PEDESTAL

BASE PLATE ERECTION

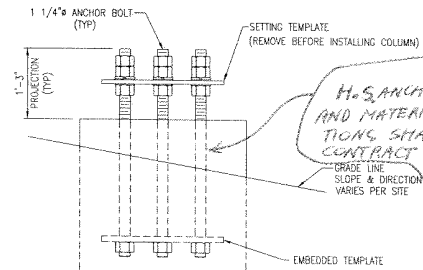


H.S. ANCHOR BOLT AND MATERIAL SPECIFICATIONS SHALL COMPLY WITH CONTRACT DRAWING SM-40 OF 41

TYPICAL FOUNDATION ELEVATION


FIELD VERIFY

GENERAL NOTES:
STRUCTURE DESIGN PER ASHTO STANDARD SPECS. FOR STRUCTURAL SUPPORTS FOR HIGHWAY SIGNS, LUMINAIRES AND TRAFFIC SIGNALS, 1994 EDITION.
DESIGN WIND SPEED 80 MPH.
ALL WELDING PER AWS D1.1 (LATEST EDITION).
STRUCTURE DESIGN BY HURTT FABRICATING CORP.
ANCHOR BOLT & FOUNDATION DESIGN BY HNTB.
EQUIPMENT MOUNTING BRACKETS & HARDWARE BY OTHERS.
FOUNDATION & ROADWAY ELEVATIONS PROVIDED BY VENTURE ELECTRIC CO. ON 2-5-08.
THE ELEVATIONS SHOWN ARE FOR REFERENCE AND RELATIONSHIP ONLY AND ARE NOT THE ACTUAL SITE ELEVATIONS.
17'-6" MINIMUM (18'-0" DESIGN) CLEARANCE FROM THE HIGH POINT OF THE ROADWAY TO THE BOTTOM OF THE EQUIPMENT MOUNTING ENVELOPE.
THE TRUSS TO COLUMN HIGH STRENGTH BOLT CONNECTIONS SHALL BE INSTALLED USING THE "TURN-OF-NUT" METHOD PER SECTION 407.06(g)(3) OF THE VDOT ROAD AND BRIDGE SPECIFICATIONS 2002.


ANCHOR NOTE:
USE STEEL SETTING & EMBEDDED TEMPLATES TO ASSURE PROPER ANCHOR BOLT LAYOUT & ALIGNMENT.
REUSE SETTING TEMPLATE AT SIMILAR LOCATIONS.

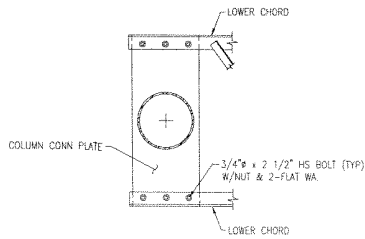

LOWER CONNECTION DETAIL
(LEFT COLUMN SHOWN, RIGHT COLUMN SIMILAR)

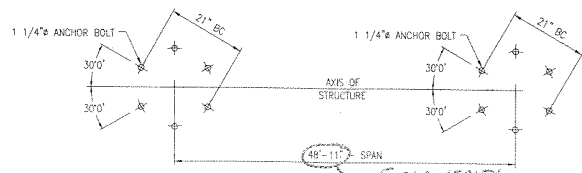

ANCHOR BOLT LAYOUT
LOC. GANTRY NB

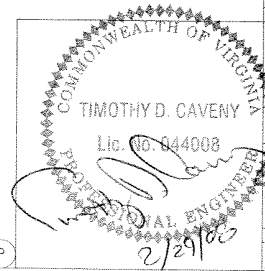

REV.					
PRINTS ISSUED					
FOR	#	DATE	FOR	#	DATE


HURTT FABRICATING CORP.
P.O. BOX 128
MARCELINE, MO 64658

CUSTOMER:
VENTURE ELECTRIC CO.


PROJECT:
CONTRACT NO. PVE-5008
WHITE PARKWAY EXPRESS LANES PROJECT
RICHMOND METROPOLITAN AUTHORITY

SUBJECT:
ERECTION DIAGRAM FOR LOC. NORTH BOUND
GANTRY @ STA 619+01.21

FILE: 4871 CH E1 PKG F DATE: 2-13-08 PKG: F
PRINTED FOR: DR BY: CH BY: JOB NO: SHEET
REWORKING METRO AUTHORITY JEC CNP HP-4871 E1

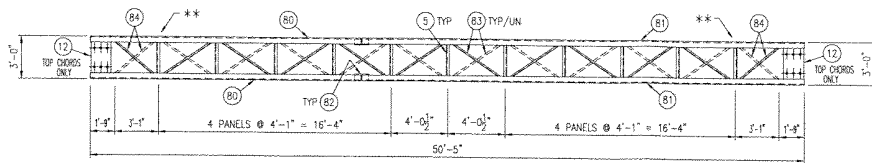


PLAN

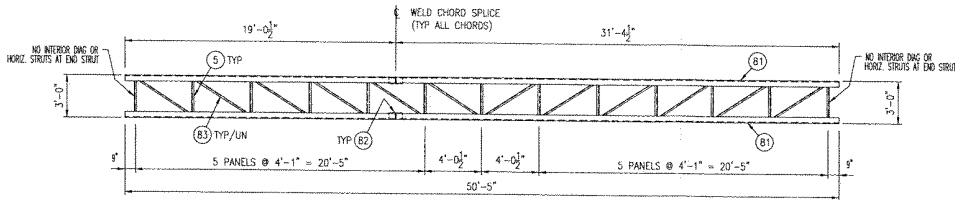


ELEVATION

ONE REQ'D - SPAN SECTION - MK P3A

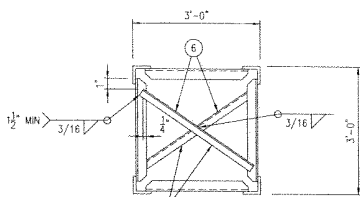


X-BRACE INTERIOR DIAGONALS AT BOTH ENDS OF EACH TRUSS SECTION.

TYPICAL TRUSS SECTION END

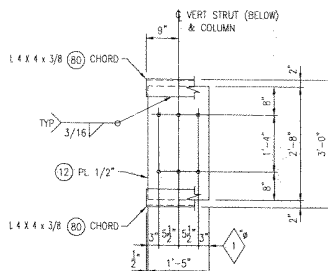


TOP CHORD MOUNTING PLATE


LEFT SECTION SHOWN
RIGHT SECTION SIMILAR

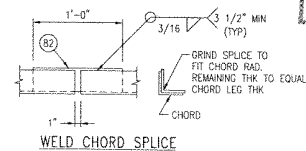

WELD CHORD SPLICE

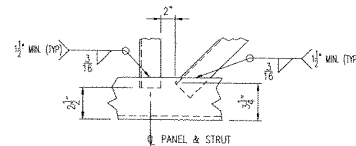


TYPICAL STRUT & DIAGONAL CONNECTION

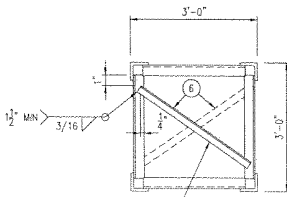

ALTERNATE DIRECTION OF INTERIOR DIAGONALS AT EACH PANEL POINT.

TYPICAL TRUSS SECTION

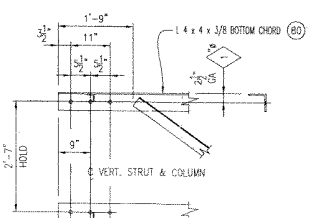

BOTTOM CHORD LAYOUT

LEFT SECTION SHOWN
RIGHT SECTION SIMILAR

BILL OF MATERIAL

QTY	MK	DESCRIPTION	LENGTH	REMARKS
4	80	L 4 x 4 x 3/8	19'-0"	
4	81	L 4 x 4 x 3/8	31'-4"	
4	82	L 4 x 4 x 3/8	1'-0"	
44	83	L 2 x 2 x 3/16	4'-4 1/8"	
4	84	L 2 x 2 x 3/16	3'-9"	
48	5	L 2 x 2 x 3/16	2'-7"	
13	6	L 2 x 2 x 3/16	3'-7"	
2	12	PL 1/2 X 17	2'-8"	
24	NO COLUMN	3/4" HSB	2 1/2"	W/NUT & 2-FLAT WASHER

SHOP DRAWING REVIEW
HNTB Corporation

Review is for general compliance with contract documents. Sole responsibility for correctness of dimensions, details, quantities and safety during fabrication and erection shall remain with the Contractor.

- No Exceptions Taken
- Make Correction Noted By *AW*
- Amend and Resubmit
- Rejected - See Remarks Date *3/22/08*

CAMBER NOTES:

PROVIDE 1/4" OF CAMBER AT CENTERLINE OF TRUSS


MATERIAL SPECIFICATIONS:

STEEL SHAPES & PLATE - ASTM A36
GALVANIZE AFTER FAB PER ASTM A123
HS BOLTS - ASTM A325 TYPE 1
NUTS - ASTM A563 DH
WASHERS - ASTM F436
GALVANIZE HARDWARE PER ASTM A153


REV:					
PRINTS ISSUED					
FOR	#	DATE	FOR	#	DATE

HURTT FABRICATING CORP.
P.O. BOX 128
MARCELINE, MO 64658

CUSTOMER: VENTURE ELECTRIC CO.
PROJECT: CONTRACT NO. PEL-2006
POWHE PARKWAY EXPRESS LANES PROJECT
RICHMOND METROPOLITAN AUTHORITY
SUBJECT: FABRICATION DETAILS FOR GANTRY TRUSS
LOC. NORTH BOUND GANTRY

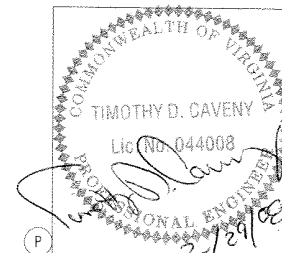

FILE:	4871 OH GANTRY TRUSS ENG P	DATE:	2-19-08	PKG:	F
PRINTED FOR:	DR BY:	CH BY:	JOB NO:	SHEET	
RICHMOND METRO AUTHORITY	JBS	TAP	HF-4871	1 OF 2	

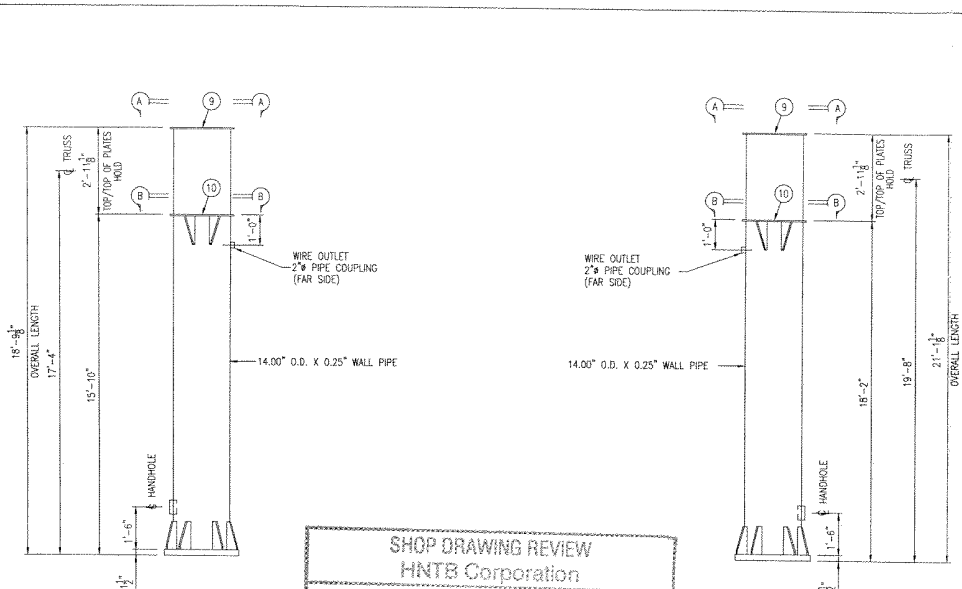


LEFT END COLUMN DETAIL
ONE REQ'D - MK P3EL

RIGHT END COLUMN DETAIL
ONE REQ'D - MK P3ER


SHOP DRAWING REVIEW
HNTB Corporation

Review is for general compliance with contract documents. Sole responsibility for correctness of dimensions, details, quantities and safety during fabrication and erection shall remain with the Contractor


No Exceptions Taken
 Make Correction Noted By AN
 Amend and Resubmit
 Rejected - See Remarks Date 3/22/08

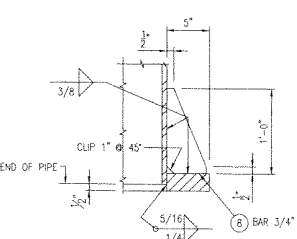



BASE PLATE WELD & GUSSET DETAIL

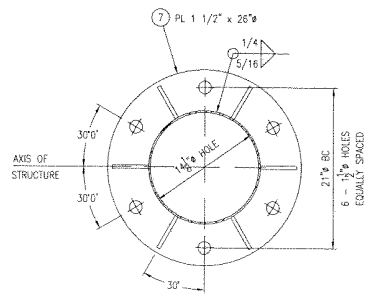


BASE PLATE DETAIL

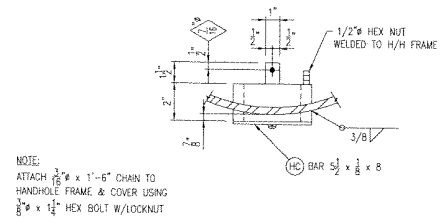


HANDHOLE DETAIL

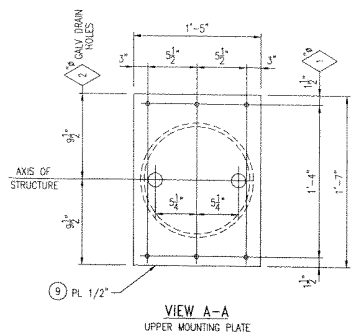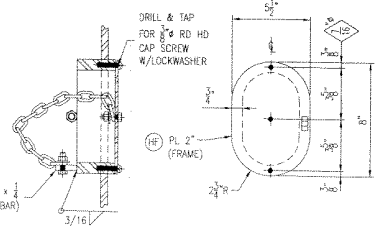

VIEW A-A
UPPER MOUNTING PLATE

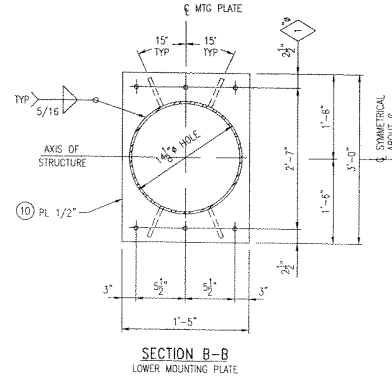

SECTION B-B
LOWER MOUNTING PLATE

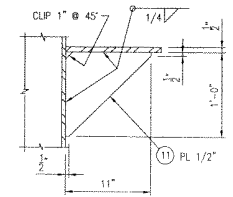

TRUSS CONNECTION GUSSET
REQUIRED @ BOTTOM CONNECTION ONLY

BILL OF MATERIAL				
QTY	MK	DESCRIPTION	LENGTH	REMARKS
1	P3EL	14.00\"/>		
1	P3ER	14.00\"/>		
2	7	PL 1 1/2 x 26\"/>		
12	8	PL 3/4 x 5	1'-0"	
2	9	PL 1/2 x 17	1'-7"	
2	10	PL 1/2 x 17	3'-6"	
8	11	PL 1/2 x 11	1'-0"	
2	HF	PL 2 x 5 1/2	0'-8"	
2	HC	BAR 5 1/2 x 1/8	0'-8"	
2	CB	BAR 1 x 1/4	0'-1 1/2"	
2	W/LOCK NUT	1/2\"/>		
4	W/LOCK BOLT	3/8\"/>		
4	W/LOCK W/LOCK NUT	3/4\"/>		
2	W/LOCK WASHER	3/16\"/>		
2		2\"/>		


MATERIAL SPECIFICATIONS:
 COLUMN PIPE - A500 GR B or API 5L X42, X52, or X60 (42 KSI MIN. YIELD)
 STEEL BARS & PLATES - ASTM A36
 GALV. STEEL AFTER FAB PER ASTM A123
 STD BOLTS, NUTS, & WASHERS - ASTM A307
 GALV. HARDWARE PER ASTM A153


REV.					
FOR	#	DATE	FOR	#	DATE

HURTT FABRICATING CORP.
 P.O. BOX 128
 MARCELINE, MO 64658


CUSTOMER: VENTURE ELECTRIC CO.
 PROJECT: CONTRACT NO. PEL-2008
 POWHITE PARKWAY EXPRESS LANES PROJECT
 RICHMOND METROPOLITAN AUTHORITY
 SUBJECT: FABRICATION DETAILS FOR GANTRY END COLUMNS
 LOC. NORTH BOUND GANTRY

FILE: 4871 GANTRY END COLUMN P&I DATE: 8-13-08 PKG: 1
 PRINTED FOR: DR BY: JDB NO: SHEET
 APPROVED METHOD AUTHORITY: JBS TAP HF-1871 2 OF 2

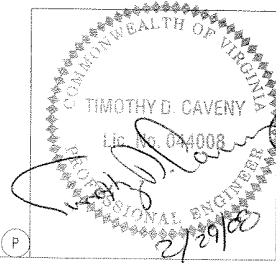


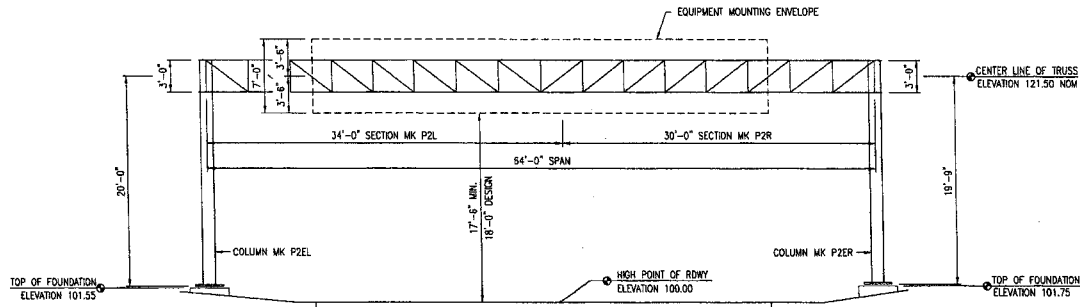


ELEVATION
STR. GANTRY SB

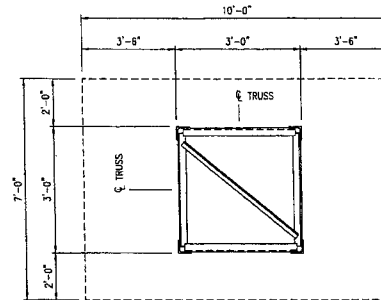

TYPICAL SECTION
EQUIPMENT MOUNTING ENVELOPE

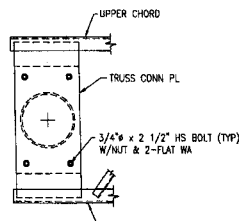


UPPER CONNECTION DETAIL
(LEFT COLUMN SHOWN, RIGHT COLUMN SIMILAR)

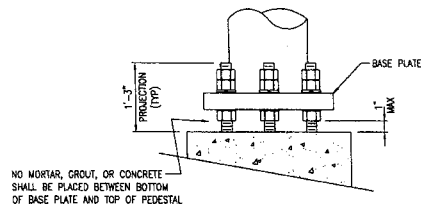


NO MORTAR, GROUT, OR CONCRETE SHALL BE PLACED BETWEEN BOTTOM OF BASE PLATE AND TOP OF PEDESTAL.

BASE PLATE ERECTION

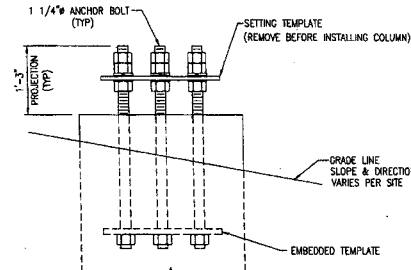


TYPICAL FOUNDATION ELEVATION

ANCHOR NOTE:
USE STEEL SETTING & EMBEDDED TEMPLATES TO ASSURE PROPER ANCHOR BOLT LAYOUT & ALIGNMENT.
REUSE SETTING TEMPLATE AT SIMILAR LOCATIONS.

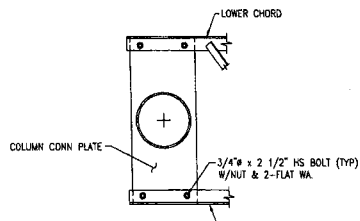

LOWER CONNECTION DETAIL
(LEFT COLUMN SHOWN, RIGHT COLUMN SIMILAR)

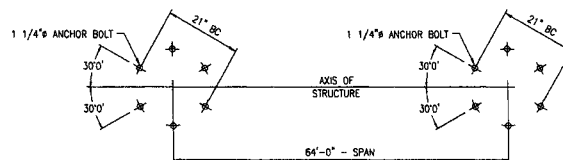

ANCHOR BOLT LAYOUT
LOC. GANTRY SB

GENERAL NOTES:

STRUCTURE DESIGN PER AASHTO STANDARD SPECS. FOR STRUCTURAL SUPPORTS FOR HIGHWAY SIGNS, LUMINAIRES AND TRAFFIC SIGNALS, 1994 EDITION.

DESIGN WIND SPEED 80 MPH.

ALL WELDING PER AWS D1.1 (LATEST EDITION).

STRUCTURE DESIGN BY HURTT FABRICATING CORP.

ANCHOR BOLT & FOUNDATION DESIGN BY HMBT.

EQUIPMENT MOUNTING BRACKETS & HARDWARE BY OTHERS.

FOUNDATION & ROADWAY ELEVATIONS PROVIDED BY VENTURE ELECTRIC CO. ON 6-12-07.

THE ELEVATIONS SHOWN ARE FOR REFERENCE AND RELATIONSHIP ONLY AND ARE NOT THE ACTUAL SITE ELEVATIONS.

17'-6" MINIMUM (18'-0" DESIGN) CLEARANCE FROM THE HIGH POINT OF THE ROADWAY TO THE BOTTOM OF THE EQUIPMENT MOUNTING ENVELOPE.

THE TRUSS SPLICE CONNECTION SHALL BE MADE USING HIGH STRENGTH BOLTS & DTI WASHERS. TIGHTENING SHALL CONFORM TO SECTION 407.06(b)(3) OF THE VDOT ROAD AND BRIDGE SPECIFICATIONS 2002 AND THE DTI MANUFACTURERS INSTRUCTIONS. THE TRUSS TO COLUMN HIGH STRENGTH BOLT CONNECTIONS SHALL BE INSTALLED USING THE TURN-OF-NUT METHOD PER SECTION 407.06(b)(3) OF THE VDOT ROAD AND BRIDGE SPECIFICATIONS 2002.

REV.					
PRINTS ISSUED					
FOR	#	DATE	FOR	#	DATE


HURTT FABRICATING CORP.
P.O. BOX 128
MARCELINE, MO 64658







CUSTOMER: VENTURE ELECTRIC CO.

PROJECT: CONTRACT NO. PEL-8008
POWITE PARKWAY EXPRESS LANES PROJECT
RICHMOND METROPOLITAN AUTHORITY


SUBJECT: ERECTION DIAGRAM FOR LOC. SOUTH BOUND GANTRY

FILE: 4871 OH EIB DATE: 6-22-07 PKG: B
PRINTED FOR: DR BY: CH BY: JOB NO: SHEET
RICHMOND METRO AUTHORITY TAP JBS HF-4871 R1

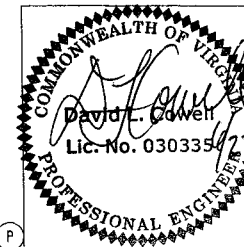

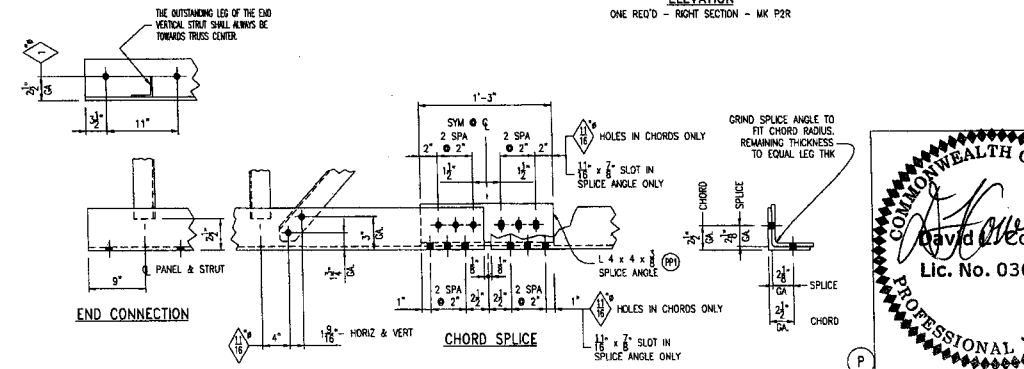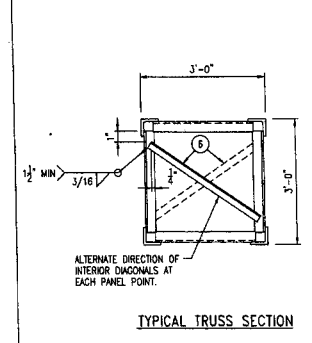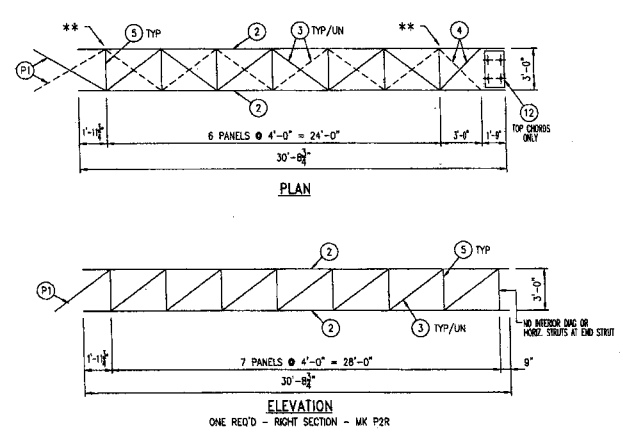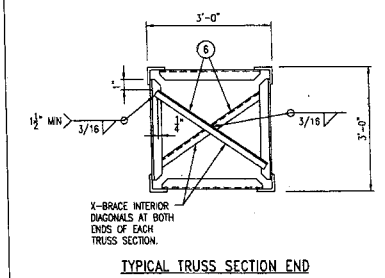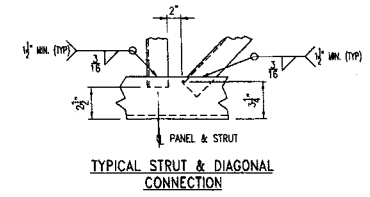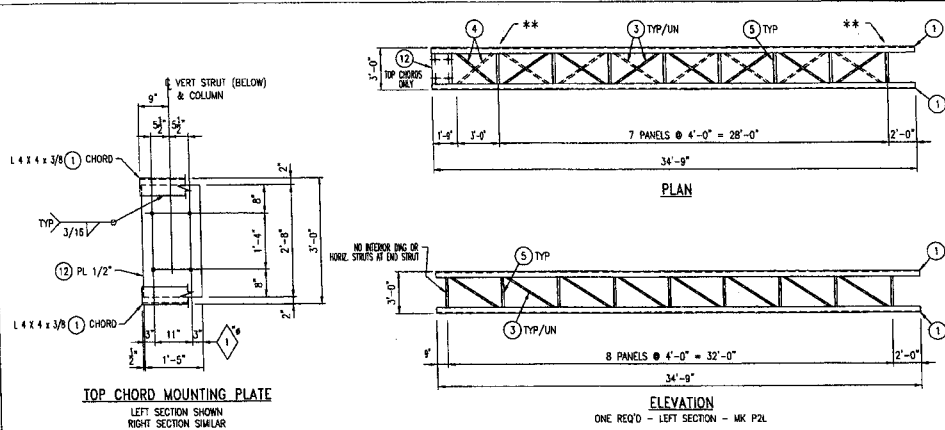

BILL OF MATERIAL				
QTY	MK	DESCRIPTION	LENGTH	REMARKS
4	1	L 4 x 4 x 3/8	34'-9"	
4	2	L 4 x 4 x 3/8	30'-8 3/4"	
4	PP1	L 4 x 4 x 3/8	1'-3"	
4	P1	L 2 1/2 x 2 1/2 x 1/4	4'-5 9/16"	
56	3	L 2 x 2 x 3/16	4'-3 5/16"	
4	4	L 2 x 2 x 3/16	3'-8 1/4"	
64	5	L 2 x 2 x 3/16	2'-7"	
19	6	L 2 x 2 x 3/16	3'-7"	
2	12	PL 1/2 X 17	2'-8"	
16	15V	5/8" HSB	2"	W/NUT & FLAT WASHER
16	15	5/8" D.T.I. WASHER	2"	W/NUT & FLAT WASHER
48	SP1C	5/8" HSB	2"	W/NUT & FLAT WASHER
48	SP1C	5/8" D.T.I. WASHER	2"	W/NUT & FLAT WASHER
16	END COLUMN	3/4" HSB	2 1/2"	W/NUT & 2-FLAT WASHER

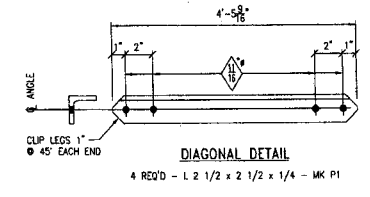

REV:			
FOR	DATE	FOR	DATE

PRINTS ISSUED

FOR	DATE	FOR	DATE	FOR	DATE

HURT FABRICATING CORP.
P.O. BOX 128
MARCELINE, MO 64658


CUSTOMER: VENTURE ELECTRIC CO.


PROJECT: CONTRACT NO. PEL-2006
POWNEY PARKWAY EXPRESS LANES PROJECT
RICHMOND METROPOLITAN AUTHORITY

SUBJECT: FABRICATION DETAILS FOR GANTRY TRUSS
LOC. SOUTH BOUND GANTRY


FILE: 4871 OH GANTRY TRUSS | **DATE:** 6-25-07 | **PKG:** B

PRINTED FOR: DR. BY: CH. BY: JOB NO: SHEET
BOBINO INFO AUTHORITY TAP JES HF-4871 1 OF 2


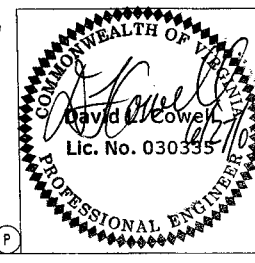


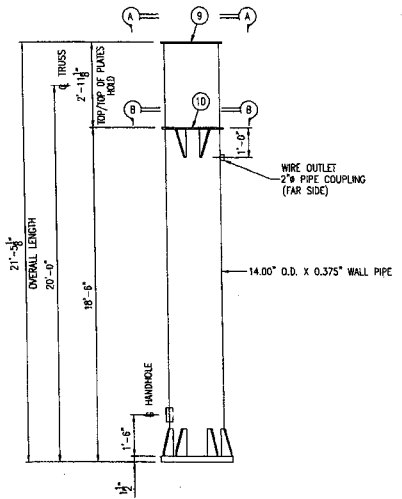


LEFT END COLUMN DETAIL
ONE REQ'D - MK P2EL

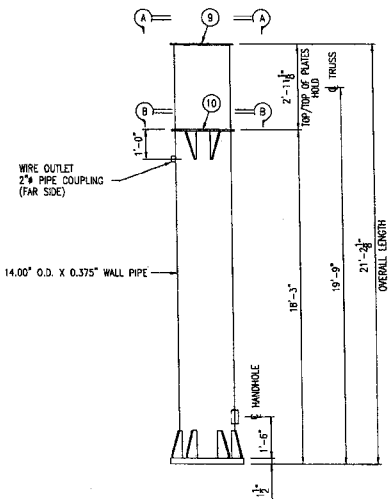


RIGHT END COLUMN DETAIL
ONE REQ'D - MK P2ER

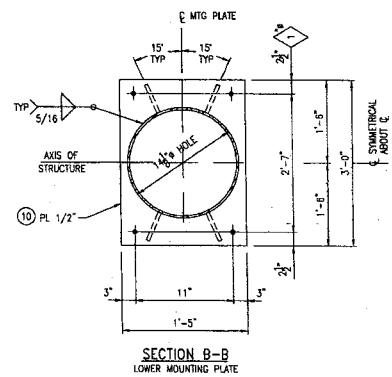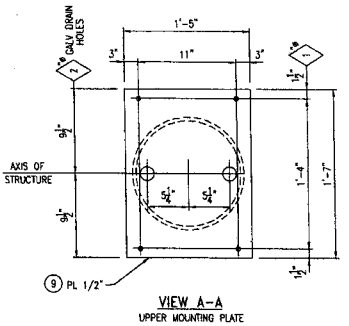


BILL OF MATERIAL				
QTY	MK	DESCRIPTION	LENGTH	REMARKS
1	P2EL	14.00\"/>		
1	P2ER	14.00\"/>		
2	7	PL 1 1/2 x 26\"/>		
12	8	PL 3/4 x 5	1'-0"	
2	9	PL 1/2 x 17	1'-7"	
2	10	PL 1/2 x 17	3'-0"	
8	11	PL 1/2 x 11	1'-0"	
2	HF	PL 2 x 5 1/2	0'-8"	
2	HC	BAR 5 1/2 x 1/8	0'-8"	
2	HK	BAR 1 1/2 x 3/8	0'-6"	
2	UN307	3/8\"/>		
2	UN307	3/8\"/>		
2		2\"/>		

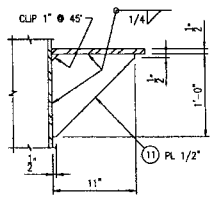


TRUSS CONNECTION GUSSET
REQUIRED @ BOTTOM CONNECTION ONLY

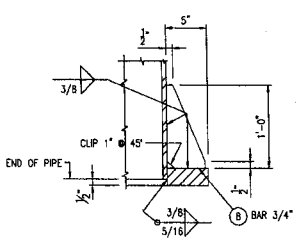



BASE PLATE WELD & GUSSET DETAIL

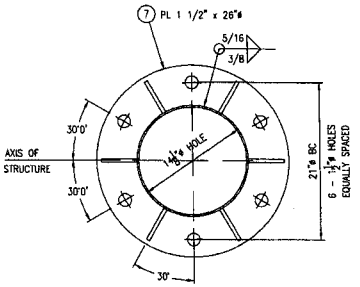

BASE PLATE DETAIL

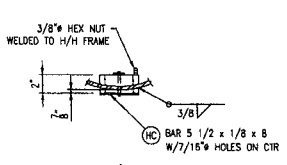

HANDHOLE DETAIL

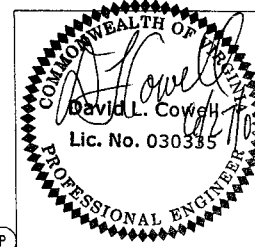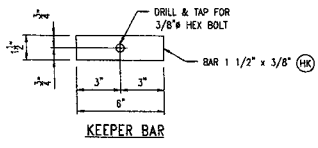

MATERIAL SPECIFICATIONS:
 COLUMN PIPE - A500 GR B or API 5L X42, X52, or X60 (42 KSI MIN. YIELD)
 3/8\"/>

REV:					
PRINTS ISSUED					
FOR	#	DATE	FOR	#	DATE


HURTT FABRICATING CORP.
 P.O. BOX 128
 MARCELINE, MO 64658

CUSTOMER: VENTURE ELECTRIC CO.
 PROJECT: CONTRACT NO. PEI-2006
 POWHITS PARKWAY EXPRESS LANES PROJECT
 RICHMOND METROPOLITAN AUTHORITY
 SUBJECT: FABRICATION DETAILS FOR GANTRY END COLUMNS
 LOC. SOUTH BOUND GANTRY


FILE: 4871 GANTRY END COLUMN DATE: 6-25-07 PKG: B
 PRINTED FOR: DR. BY: CH. BY: JOB NO: SHEET
 RICHMOND METRO AUTHORITY TAP JES HF-4871 2 OF 2

SOUTHBOUND POWHITE PARKWAY TOLL PLAZA

ORIGINAL PLANS - ADMINISTRATION BUILDING & TOLL PLAZA

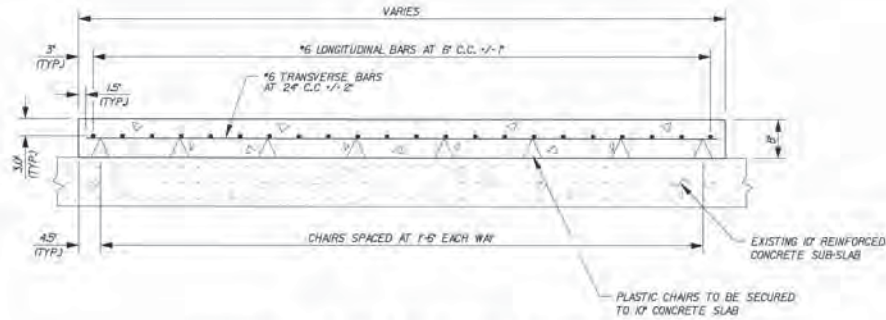

PROPOSED TOLL PLAZA 8" PAVEMENT SLAB SECTION
NTS

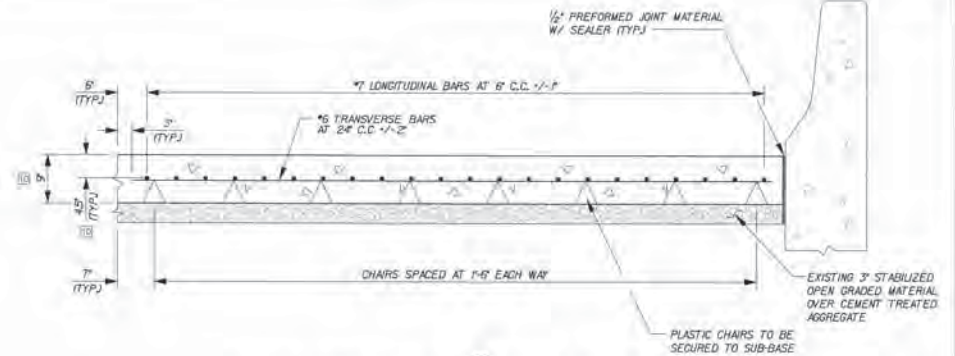


PROPOSED EXPRESS LANE 9" PAVEMENT SLAB SECTION
NTS

NOTES:


1. CONTRACTOR TO SUBMIT POUR SEQUENCE PRIOR TO POUR FOR APPROVAL BY THE ENGINEER.
2. SEE VDOT SPECIFICATION PR-3 AND PR-6 FOR DETAILS NOT SHOWN ON THIS SHEET.
3. SLAB CONCRETE SHALL BE TYPE AA, HIGH EARLY CONCRETE WITH NON-METALLIC FIBERGLASS ADDITIVE.
4. REINFORCING BARS SHALL BE V-ROD REINFORCING BARS MANUFACTURED BY CONCRETE PROTECTION SYSTEMS INC. OR ENGINEER APPROVED EQUAL.
5. REINFORCING BARS SHALL BE SECURED USING PLASTIC TIES, NYLON TIES, OR PLASTIC SNAP TIES. NO METAL TIES OR TIES CONTAINING METAL SHALL BE USED.
6. ALL WORK SHALL BE IN ACCORDANCE WITH MANUFACTURER'S SPECIFICATIONS AND AS DIRECTED BY THE ENGINEER.
7. PLASTIC OR NON-METALLIC (NON CORROSIVE) CHAIRS SHALL BE USED TO ELEVATE REBAR AT LOCATIONS SHOWN.
8. REBAR SHALL BE SECURED TO CHAIRS.
9. CHAIRS SHALL BE SECURED TO 10" SLAB OR 3" SUB-BASE BY METHOD(S) APPROVED BY ENGINEER.
10. CONTRACTOR TO COORDINATE PLACEMENT OF LOOPS WITH CRT CONTRACTOR PRIOR TO POURING CONCRETE AND PRIOR TO SAW-CUTTING JOINTS.

03/17/08 (M) REVISED SHEET - SEE SHEET 1C
03/15/08 (M) REVISED SHEET - SEE SHEET 1C
03/10/08 (M) - ADD'D SHEET -
REVISIONS

05-01A			
RM RICHMOND METROPOLITAN AUTHORITY RICHMOND EXPRESSWAY SYSTEM			
POWHITE PARKWAY EXPRESS TOLL LANES PROJECT			
MISCELLANEOUS ROADWAY DETAILS			
HNTB 1175 GULFORD ROAD, SUITE 100 COLUMBIA, MARYLAND 21046 (301) 548-1000	Scale:	Date:	Contract No.:
	NONE	3/06/08	PEL-2006
		Sheet:	426 of 151

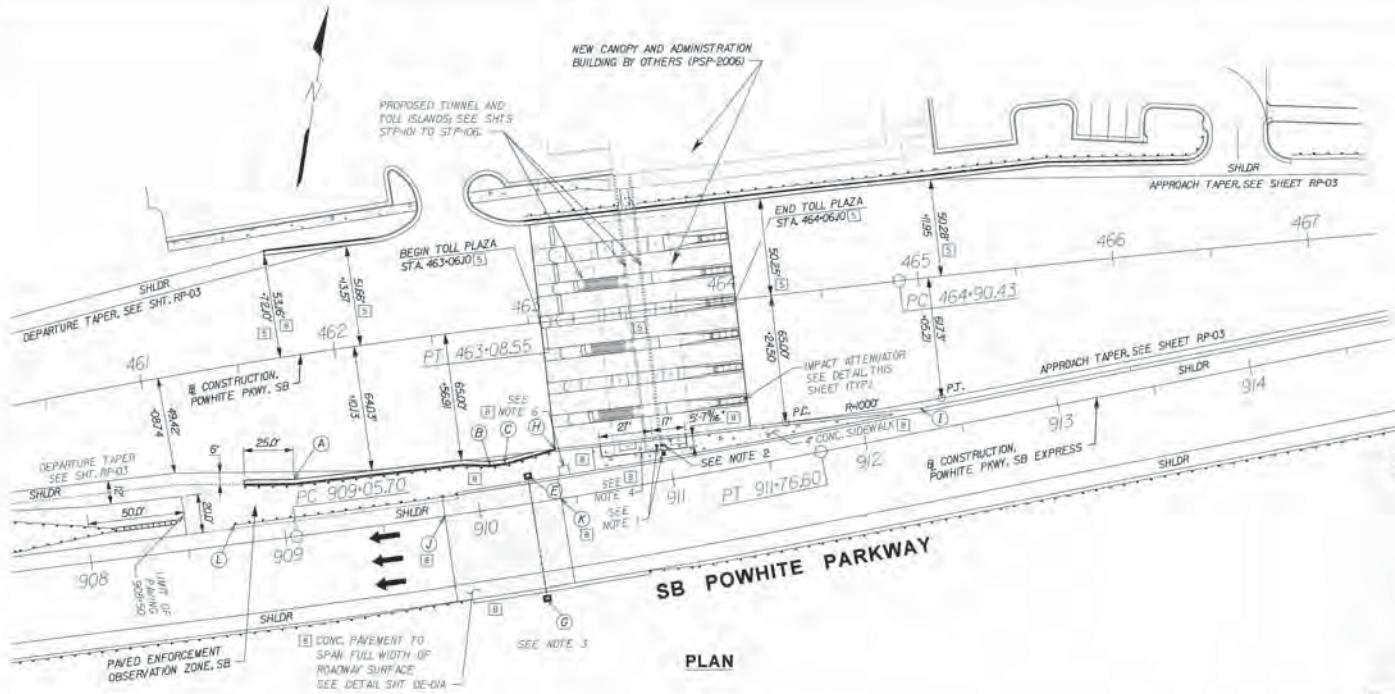


PLAN

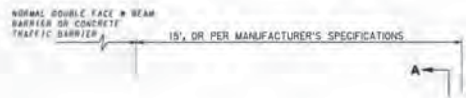

ATTENUATOR SHALL BE TRINITY TRAC "SHORTTRAC", OR ENERGY ABSORPTION SYSTEMS "QUAD GUARD" - 30'-03"-11" OR APPROVED EQUAL, AND SHALL BE INSTALLED PER MANUFACTURER'S SPECIFICATIONS AND RECOMMENDATIONS

PLAN

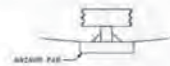

SECTION A-A

TOLL ISLAND ATTENUATOR DETAIL
NOT TO SCALE

HORIZONTAL CONTROL POINT SCHEDULE

POINT NO.	LOCATION	DESCRIPTION
(A)	STA. 461+69.06, 62.55' RT., POWHITE PKWY. SB	EDGE OF GUTTER PAN
(B)	STA. 462+71.5, 69.35' RT., POWHITE PKWY. SB	FACE OF CURB (SET BACK FOR INLET)
(C)	STA. 462+79.00, 69.35' RT., POWHITE PKWY. SB	FACE OF CURB (SET BACK FOR INLET)
(E)	STA. 910+27, 140' LT., POWHITE PKWY. SB EXPRESS	CENTER GANTRY FOUNDATION TY. I
(G)	STA. 910+27, 50.00' RT., POWHITE PKWY. SB EXPRESS	CENTER GANTRY FOUNDATION TY. I
(H)	STA. 463+06.05, 65.00' RT., POWHITE PKWY. SB	FACE OF CURB/END OF BARRIER
(I)	STA. 464+93.82, 65.67' RT., POWHITE PKWY. SB	BEGIN MEDIAN BARRIER TRANSITION
(J)	STA. 909+82, 0.00' RT., POWHITE PKWY. SB EXPRESS	LIMIT OF 9' CONC. PAVEMENT
(K)	STA. 910+42, 0.00' RT., POWHITE PKWY. SB EXPRESS	LIMIT OF 9' CONC. PAVEMENT
(L)	STA. 908+75, 10.00' LT., POWHITE PKWY. SB EXPRESS	BEGIN GUARD RAIL

- NOTES:
- ELECTRICAL EQUIPMENT TO BE INSTALLED BY OTHERS.
 - MECHANICAL EQUIPMENT TO BE INSTALLED BY OTHERS.
 - SEE SHEET SM-40 FOR GANTRY FOUNDATION DETAILS.
 - LIMITS OF 10" BASE SLAB WITH 8" (MIN) SURFACE SLAB PER SHEET STP-05 SECTION A-A.
 - SEE SHEET DE-05A FOR SPOT ELEVATIONS BETWEEN EXPRESS LANE AND TOLL PLAZA.
 - SEE SHEET DE-05A FOR CONCRETE PAD FOR OPT. EQUIPMENT ENCLOSURE.

NO.	DATE	REVISIONS
10	4/10/08	REVISED SHEET - SEE SHEET 1C
11	10/03/01	REVISED SHEET - SEE SHEET 1C
12	8/21/04	REVISED DIMENSION - SEE SHEET 1E
13	8/23/04	ADDED SHEET

DC-05 (R) 06

RM RICHMOND METROPOLITAN AUTHORITY
RICHMOND EXPRESSWAY SYSTEM


**POWHITE PARKWAY EXPRESS
TOLL LANES PROJECT**

MISCELLANEOUS DETAILS
NEW TOLL PLAZA

HNTB

875 GILDRUP ROAD, SUITE 300
COLUMBIA, MARYLAND 21046
(301) 543-1000

Scale:	Date:	Contract No.:	Sheet:
1" = 30'	3/05/08	TEL-2006	46 of 161

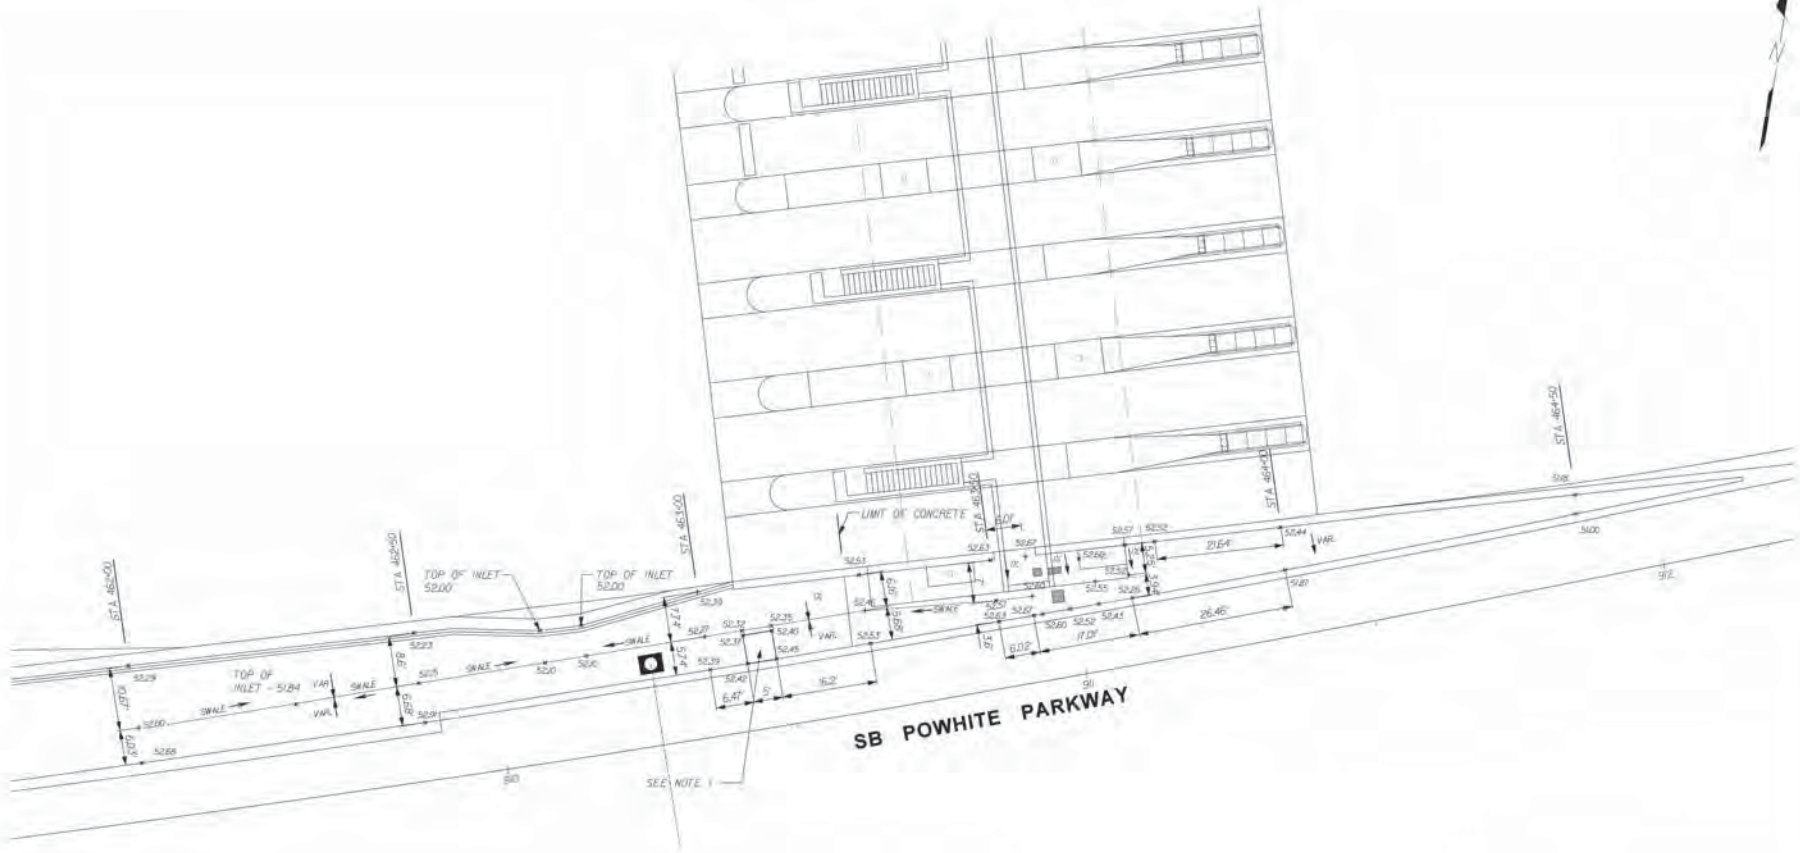

SB POWHITE PARKWAY

- NOTES:
1. CONCRETE PAD FOR ORT EQUIPMENT ENCLOSURE, COORDINATE EXACT LOCATION AND REQUIRED DEPTH OF PAD WITH ORT CONTRACTOR.
 2. COORDINATE PLACEMENT OF ORT CONDUITS AND EQUIPMENT WITH ORT CONTRACTOR PRIOR TO STARTING WORK.

PLAN

DE-05A OF D6


RM RICHMOND METROPOLITAN AUTHORITY
RICHMOND EXPRESSWAY SYSTEM

**POWHITE PARKWAY EXPRESS
TOLL LANES PROJECT**
MISCELLANEOUS DETAILS
NEW TOLL PLAZA

HNTB
9175 GUILFORD ROAD, SUITE 100
COLUMBIA, MARYLAND 21046
(301) 543-1000

Scale: 1" = 10'	Date: 10/03/01	Contract No: PEL-2006	Sheet: 46A of 161
--------------------	-------------------	--------------------------	----------------------

NO. 10/3/01F1-ADDED SHEET
REVISIONS

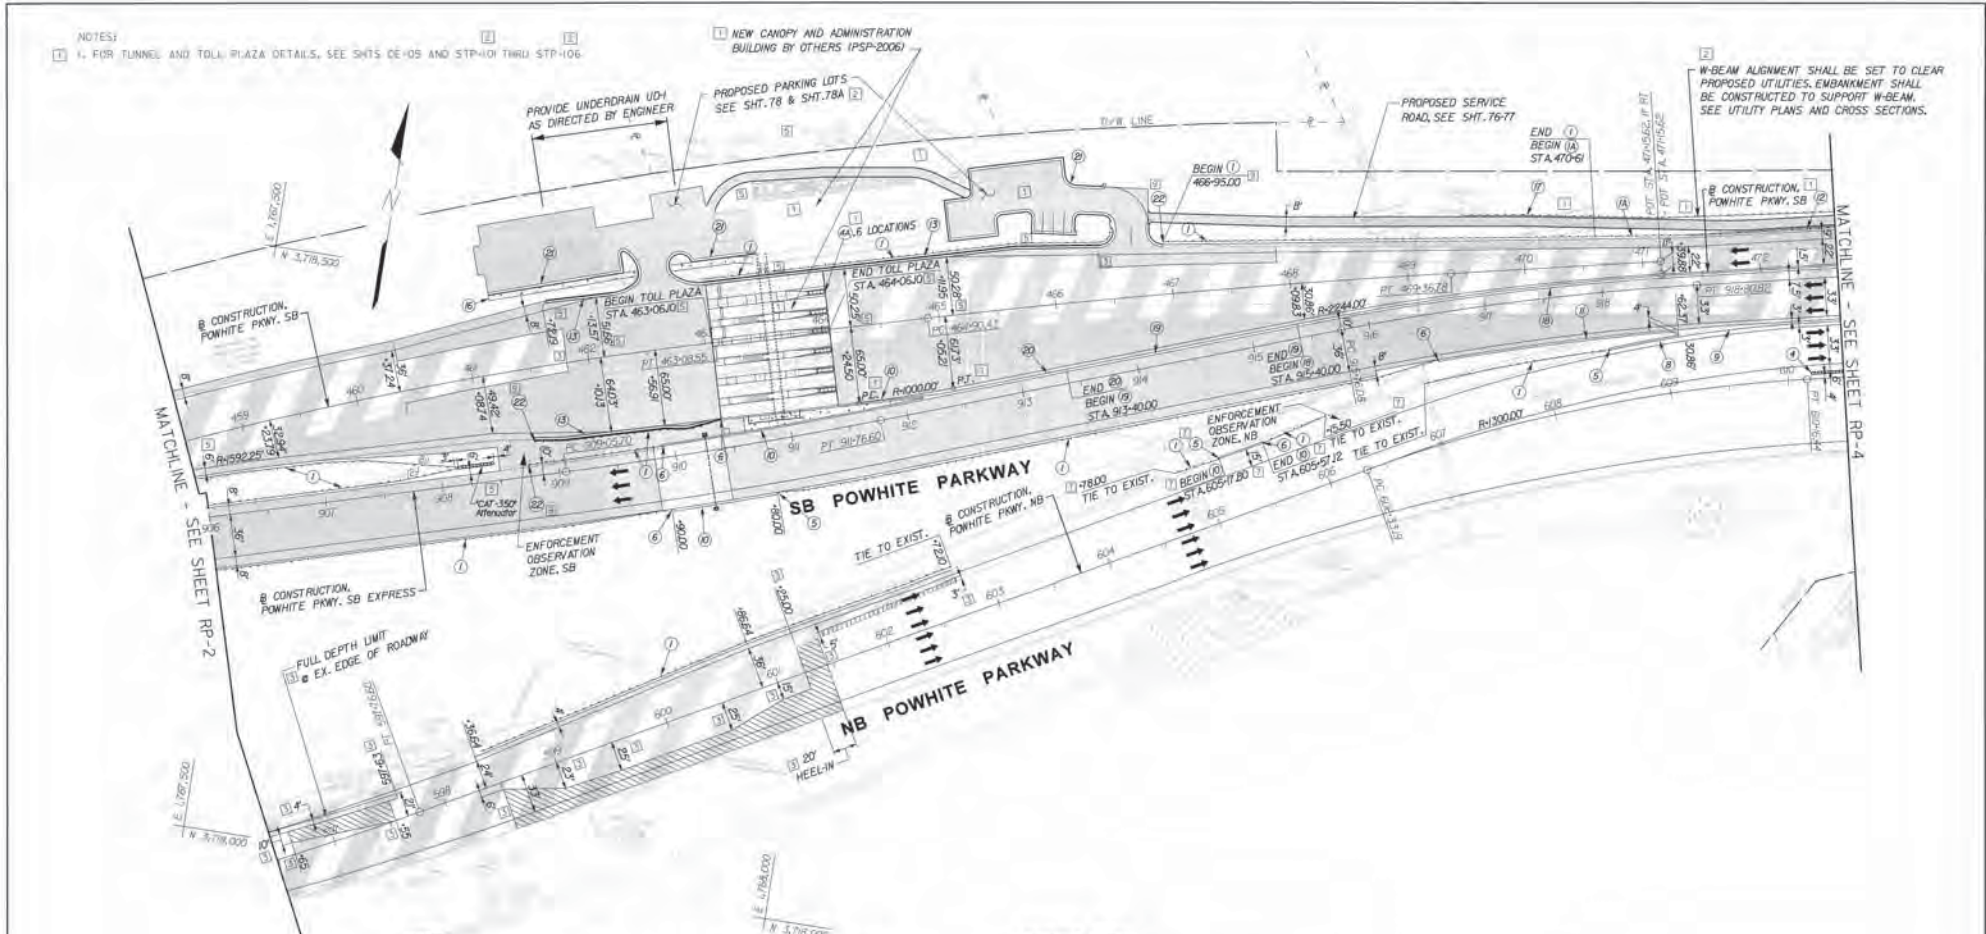

NOTES:
 1. FOR TUNNEL AND TOLL PLAZA DETAILS, SEE SHTS DE-05 AND STP-101 THRU STP-106

NEW CANOPY AND ADMINISTRATION BUILDING BY OTHERS (PSP-2006)

PROPOSED SERVICE ROAD, SEE SHT. 76-77

W-BEAM ALIGNMENT SHALL BE SET TO CLEAR PROPOSED UTILITIES. EMBANKMENT SHALL BE CONSTRUCTED TO SUPPORT W-BEAM. SEE UTILITY PLANS AND CROSS SECTIONS.

MATCHLINE - SEE SHEET RP-2

MATCHLINE - SEE SHEET RP-4

LEGEND

- 1) Sfd. GR-2, Guardrail, (A) Sfd. GR-2A
- 2) Sfd. GR-7, Concrete Curb & Gutter
- 3) Sfd. GR-9, Guardrail Terminal
- 4) Impact Attenuator (1) L.S. 3.55 MPH (A) (1) L.S. 40 MPH
- 5) Sfd. GR-FDA-2, Fixed Object Attachment, Type I
- 6) Sfd. GR-FDA-2, Fixed Object Attachment, Type II
- 7) Sfd. WB-5, W-Beam Median Barrier, West Post
- 8) Modified MB-7D, Concrete Median Barrier
- 9) Modified MB-7E, Concrete Median Barrier
- 10) Modified MB-7F, Concrete Median Barrier
- 11) Modified MB-8A Conc. Median Barrier, Ty. III, See Sheet DE-02
- 12) Sfd. WB-3, Blended Out W-Beam Median Barrier
- 13) Sfd. CP-7, Conc. Curb & Gutter
- 14) Sfd. CP-3, Standard Curb
- 15) Standard Slope Concrete Median Barrier, See Sheet DE-04
- 16) Concrete Stairway Per Section 504 of Standard Specifications
- 17) Sfd. GR-8, Guardrail (West Post)
- 18) Sfd. GR-8A, Guardrail (West Post)
- 19) Sfd. MB-9A, Type II Conc. Med. Barrier
- 20) Sfd. MB-9A, Type III Conc. Med. Barrier
- 21) Sfd. CP-6, Conc. Curb & Gutter
- 22) Sfd. GR-4, Guardrail Terminal

PAVEMENT LEGEND

- PROPOSED FULL DEPTH PAVING
- PROPOSED RESURFACING
- FLEXIBLE PAVEMENT PLANNING AREA
- PAVEMENT REMOVAL


3/5/06: REVISED SHEET - SEE SHEET 1C.
5/22/07: REVISED SHEET - SEE SHEET 1C.
5/27/07: REVISED SHEET - SEE SHEET 1B.
10/17/08: REVISED SHEET - SEE SHEET 1B.
7/20/06: SEE SHEET 1B.
5/23/06: SEE SHEET 1A.
ADDENDUM 02.21: 5/17/06: REPLACED SHEET
REVISIONS

HNTB
 915 GULFORD ROAD, SUITE 100
 COLUMBIA, MARYLAND 21046
 (301) 543-1000


RM RICHMOND METROPOLITAN AUTHORITY
 RICHMOND EXPRESSWAY SYSTEM

**POWHITE PARKWAY EXPRESS
 TOLL LANES PROJECT**
 ROADWAY PAVEMENT PLAN
 STA. 458+50 TO STA. 472+65
 CONSTR. POWHITE PARKWAY SB

Scale: 1" = 50'
 Date: 3/06/06
 Contract No.: PEL-2006
 Sheet: 60 of 151

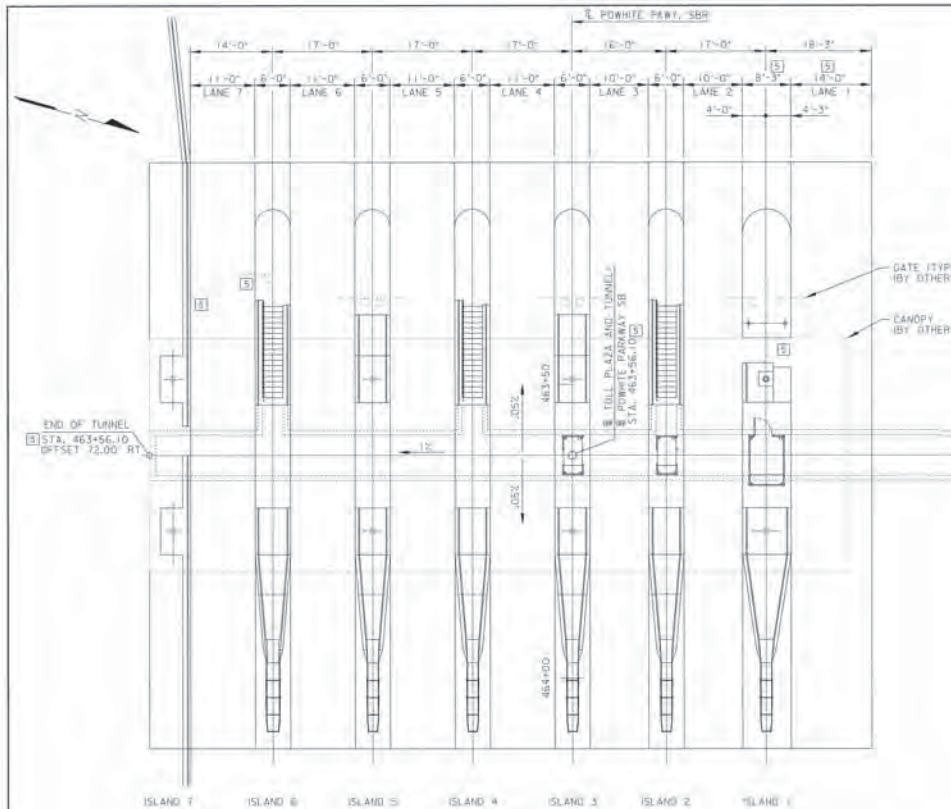

PLAN OF TOLL PLAZA
SCALE: 1" = 10'-0"

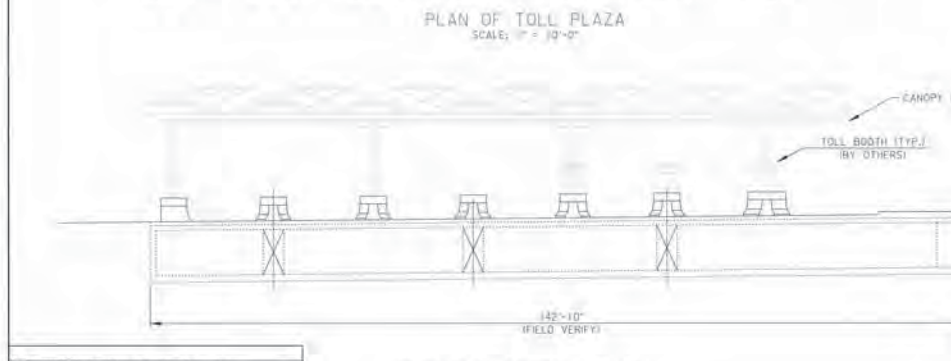

ELEVATION OF TOLL PLAZA
SCALE: 1" = 10'-0"

NO.	DATE	DESCRIPTION
1	3/27/07	REVISED ISLANDS 1, 6 & 7
2	7/20/04	REVISED SHEET SIZE AND TITLE BLOCK
3	8/23/06	ADDED SHEET

SPECIFICATIONS:
 CONSTRUCTION - VIRGINIA DEPARTMENT OF TRANSPORTATION, ROAD AND BRIDGE SPECIFICATIONS, 2002
 DESIGN - 2002 (11TH EDITION) AASHTO STANDARD SPECIFICATIONS FOR HIGHWAY BRIDGES, WITH INTERIMS THROUGH 2004

DESIGN LOADS:
 ROOF LIVE LOAD 20 PSF
 WIND 40 PSF
 FLAT ROOF SNOW LOAD 20 PSF

DESIGN STRENGTHS:
 CONCRETE FC = 3000 PSI
 REINF. STEEL FY = 60 KSI

STRUCTURAL STEEL MATERIAL SPECIFICATIONS:
 WIDE FLANGE SHAPES, CHANNELS, ANGLES AND PLATES ASTM A992
 STRUCTURAL TUBING AND PIPE ASTM A36
 HIGH STRENGTH BOLTS ASTM A500, GRADE C
 ANCHOR BOLTS ASTM A325X
 HARDENED STEEL WASHERS ASTM F1554, GRADE 55
 ASTM F436

GENERAL NOTES:

ALL SHOP CONNECTIONS SHALL BE WELDED AND ALL FIELD CONNECTIONS SHALL BE BOLTED.

ALL STRUCTURAL STEEL SHALL BE HOT-DIP GALVANIZED PER ASTM A123, UNLESS OTHERWISE NOTED. ALL BOLTS, ANCHOR BOLTS, WASHERS AND NUTS SHALL BE HOT-DIP GALVANIZED PER ASTM A153. THE LOWER CANOPY FRAMING STEEL SHALL BE PAINTED, SEE SPECIAL PROVISIONS.

ALL METAL ROOF DECK SHALL BE 3/8" GAGE, WIDE RIB TYPE B, GALVANIZED, WITH THE MINIMUM PROPERTIES DEFINED BY THE STEEL DECK INSTITUTE (SDI).

3/4" DIAMETER BOLTS SHALL BE USED FOR THE CANOPY STRUCTURE AND 1/2" DIAMETER BOLTS FOR ROOF SCREED STRUCTURES.

ALL SHOP AND FIELD WELDING SHALL BE PERFORMED BY QUALIFIED WELDERS IN ACCORDANCE WITH AWS D1.1-2002 USING E70XX ELECTRODES.

ALL HOLES REQUIRED IN STRUCTURAL STEEL MEMBERS FOR PIPING AND DUCTWORK SHALL BE SHOWN ON THE SHOP DRAWINGS AND BE MADE IN THE SHOP. NO HOLES SHALL BE CUT IN THE FIELD WITHOUT APPROVAL OF THE ARCHITECT/ENGINEER.

ALL BOLTED CONNECTIONS SHALL BE BEARING TYPE, NON SLIP-CRITICAL, TIGHTENED TO A "SNUG-TIGHT CONDITION" AS DEFINED BY AISC.

THE FRAME OF THE STEEL SKELETON SHALL BE CARRIED UP IRON AND PLUMB AND TEMPORARY BOLTING AND BRACING SHALL BE INTRODUCED TO SAFELY CARRY ALL LOADS TO WHICH THE STRUCTURE MAY BE SUBJECTED, INCLUDING EQUIPMENT AND OPERATION OF SAME. INDIVIDUAL COLUMNS MUST BE BRACED BEFORE BEAM CONNECTIONS ARE MADE AND BRACING SHALL BE LEFT IN PLACE AS LONG AS MAY BE REQUIRED FOR SAFETY.

AFTER COMPLETION OF ERECTION, THE OWNER SHALL ENGAGE AN INDEPENDENT TESTING AGENCY TO INSPECT HIGH STRENGTH BOLTED CONNECTIONS, TO PERFORM TESTS, AND TO PREPARE TEST REPORTS. THE TESTING AGENCY SHALL CONDUCT AND INTERPRET TESTS AND STATE IN EACH REPORT WHETHER THE TEST RESULTS COMPLY WITH THE REQUIREMENTS AND SPECIFICALLY STATE ANY DEVIATIONS THEREFROM. THE TESTING SHALL CONFORM TO THE REQUIREMENTS FOUND IN THE AISC "SPECIFICATION FOR STRUCTURAL JOINTS USING ASTM A325 AND A490 BOLTS", DATED JUNE 2000, WITH SUPPLEMENTS. BOLTS THAT ARE NEITHER NON SLIP CRITICAL NOR SUBJECT TO DIRECT TENSION NEED NOT BE INSPECTED FOR BOLT TENSION OTHER THAN TO INSURE THAT THE PILES OF THE CONNECTED ELEMENT HAVE BEEN BROUGHT INTO SNUG CONTACT. THE INDEPENDENT TESTING AGENCY SHALL SUBMIT THE INTENDED TEST PROCEDURES TO THE STRUCTURAL ENGINEER FOR REVIEW PRIOR TO BEGINNING TESTING.

FOUNDATIONS:
 FOUNDATIONS FOR THIS STRUCTURE AND SPREAD FOOTINGS BEARING ON EITHER FIRM VIRGIN SOIL OR COMPACTED STRUCTURAL FILL WITH AN ALLOWABLE BEARING CAPACITY OF 3000 PSF IN ACCORDANCE WITH THE OWNER'S GEOTECHNICAL ENGINEER'S REPORT BY FROELICH & ROBERTSON, INC. DATED OCTOBER, 2005. THE OWNER'S GEOTECHNICAL ENGINEER SHALL VERIFY, PRIOR TO POURING, THAT THE SOIL IS CAPABLE OF SUSTAINING SUCH A LOAD.

PREPARATION OF SOIL AND SUBGRADE BENEATH FOOTINGS AND SLABS ON GRADE SHALL BE IN ACCORDANCE WITH THE RECOMMENDATIONS OF THE OWNER'S GEOTECHNICAL ENGINEER'S REPORT AND THE PROJECT SPECIFICATIONS.

ALL BACKFILL BEHIND TUNNEL WALLS SHALL BE IN ACCORDANCE WITH THE RECOMMENDATIONS OF THE OWNER'S GEOTECHNICAL ENGINEER'S REPORT AND THE PROJECT SPECIFICATIONS.

ALL WALLS SUBJECT TO LATERAL LOAD DUE TO UNBALANCED FILL SHALL BE BRACED PLUMB UNTIL BACKFILL HAS BEEN PLACED AND COMPACTED AND SHALL REMAIN BRACED UNTIL THE PERMANENT STRUCTURE ABOVE AND BELOW IS IN PLACE AND CAPABLE OF RESISTING ALL LOADS.

THE CONTRACTOR SHALL VERIFY ALL FIELD MEASUREMENTS, EXISTING DIMENSION, ELEVATIONS, AND THE SHAPES OF SIZES OF EXISTING STRUCTURAL MEMBERS SHOWN ON THE CONTRACT DRAWINGS PRIOR TO BEGINNING WORK. THE ARCHITECT/ENGINEER SHALL BE NOTIFIED IN WRITING OF ALL DISCREPANCIES THAT WOULD RESULT IN REVISIONS TO THE CONTRACT DRAWINGS.

THE CONTRACTOR SHALL VERIFY ALL DRAWINGS FOR COORDINATION BETWEEN TRADES. HE SHALL LOCATE SLOTS, SLEEVES AND TRENCHES AS REQUIRED FOR MECHANICAL TRADES AND PROVIDE AND INSTALL ANCHORS, INSERTS, HANGERS, ETC. AS REQUIRED FOR VARIOUS OTHER TRADES.

THE CONTRACTOR SHALL BE RESPONSIBLE FOR THE DESIGN AND ERECTION OF ALL TEMPORARY BRACING, FORMWORK, SHEETING, SHORING AND UNDERPINNING NECESSARY TO PERFORM THE WORK.

THE CONTRACTOR SHALL BE RESPONSIBLE FOR ALL CONSTRUCTION MEANS, METHODS, TECHNIQUES, SEQUENCES AND PROCEDURES AND FOR SAFETY PRECAUTIONS AND PROGRAMS AS THEY RELATE TO THE WORK OF THIS PROJECT.


THE CONTRACTOR SHALL SUBMIT THE REQUIRED SHOP DRAWINGS FOR REVIEW PRIOR TO BEGINNING WORK. THE CONTRACTOR SHALL CHECK ALL DIMENSIONS AND ACCEPT FULL RESPONSIBILITY FOR DIMENSIONAL CORRECTNESS. UNDER NO CIRCUMSTANCES SHALL REPRODUCTIONS OF CONTRACT DRAWINGS BE USED AS SHOP DRAWINGS.

ALL STRUCTURAL STEEL SHOP DRAWINGS SHALL BE PREPARED UNDER THE DIRECT SUPERVISION OF PROFESSIONAL ENGINEER REGISTERED IN THE COMMONWEALTH OF VIRGINIA.


STP-101

RICHMOND METROPOLITAN AUTHORITY
RICHMOND EXPRESSWAY SYSTEM
POWHITE PARKWAY EXPRESS
TOLL LANES PROJECT
TOLL PLAZA
PLAN AND ELEVATION


875 GULFORD ROAD, SUITE 300 COLUMBIA, MARYLAND 21046 (410) 943-1000	Date: 3/27/07	Contract No.: PEL-2006	Sheet: 1588 of 181
---	---------------	------------------------	--------------------

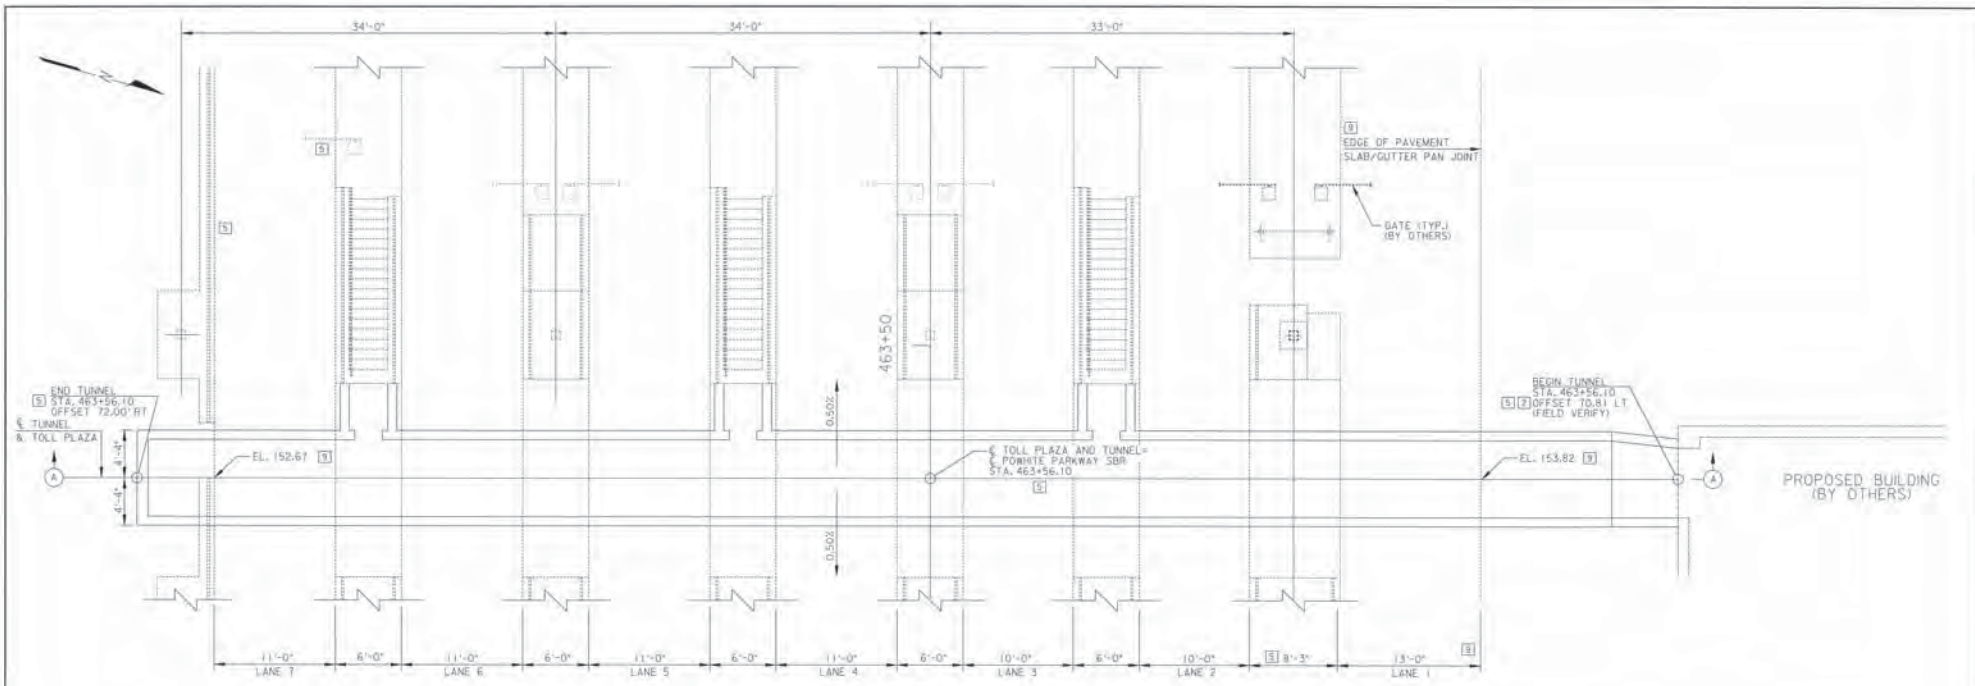

PLAN
SCALE: 3/8" = 1'-0"

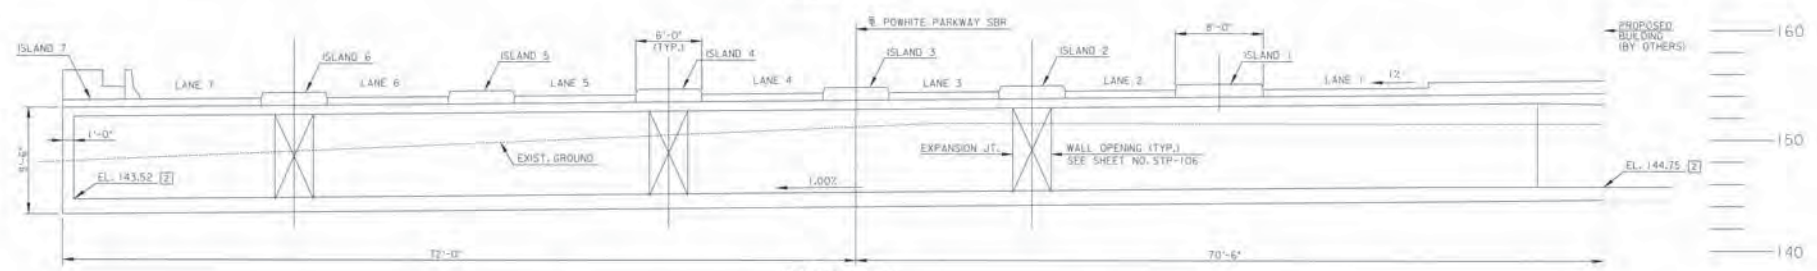

SECTION A-A
SCALE: 3/8" = 1'-0"

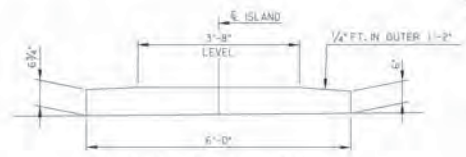

6" RAISED MEDIAN DETAILS
ISLANDS 2 THRU 6
SCALE: 3/8" = 1'-0"



6" RAISED MEDIAN DETAILS
ISLAND 1 (ONLY)
SCALE: 3/8" = 1'-0"

REVISIONS	
1	6/23/06: ADDED SHEET
2	7/20/06: REVISED SHEET SIZE AND TITLE BLOCK
3	3/27/07: REVISED TUNNEL LOCATION AND DETAILS
4	3/5/08: REVISED SHEET - SEE SHEET 1C

HNTB
975 GULFORD ROAD, SUITE 100
COLUMBIA, MARYLAND 21046
(410) 543-1000


STP-102

RM RICHMOND METROPOLITAN AUTHORITY
RICHMOND EXPRESSWAY SYSTEM

**POWHITE PARKWAY EXPRESS
TOLL LANES PROJECT**

TOLL PLAZA
TUNNEL PLAN & ELEVATION

Scale: AS SHOWN	Date: 3/06/08	Contract No.: PEL-2006	Sheet: 158C of 161
--------------------	------------------	---------------------------	-----------------------

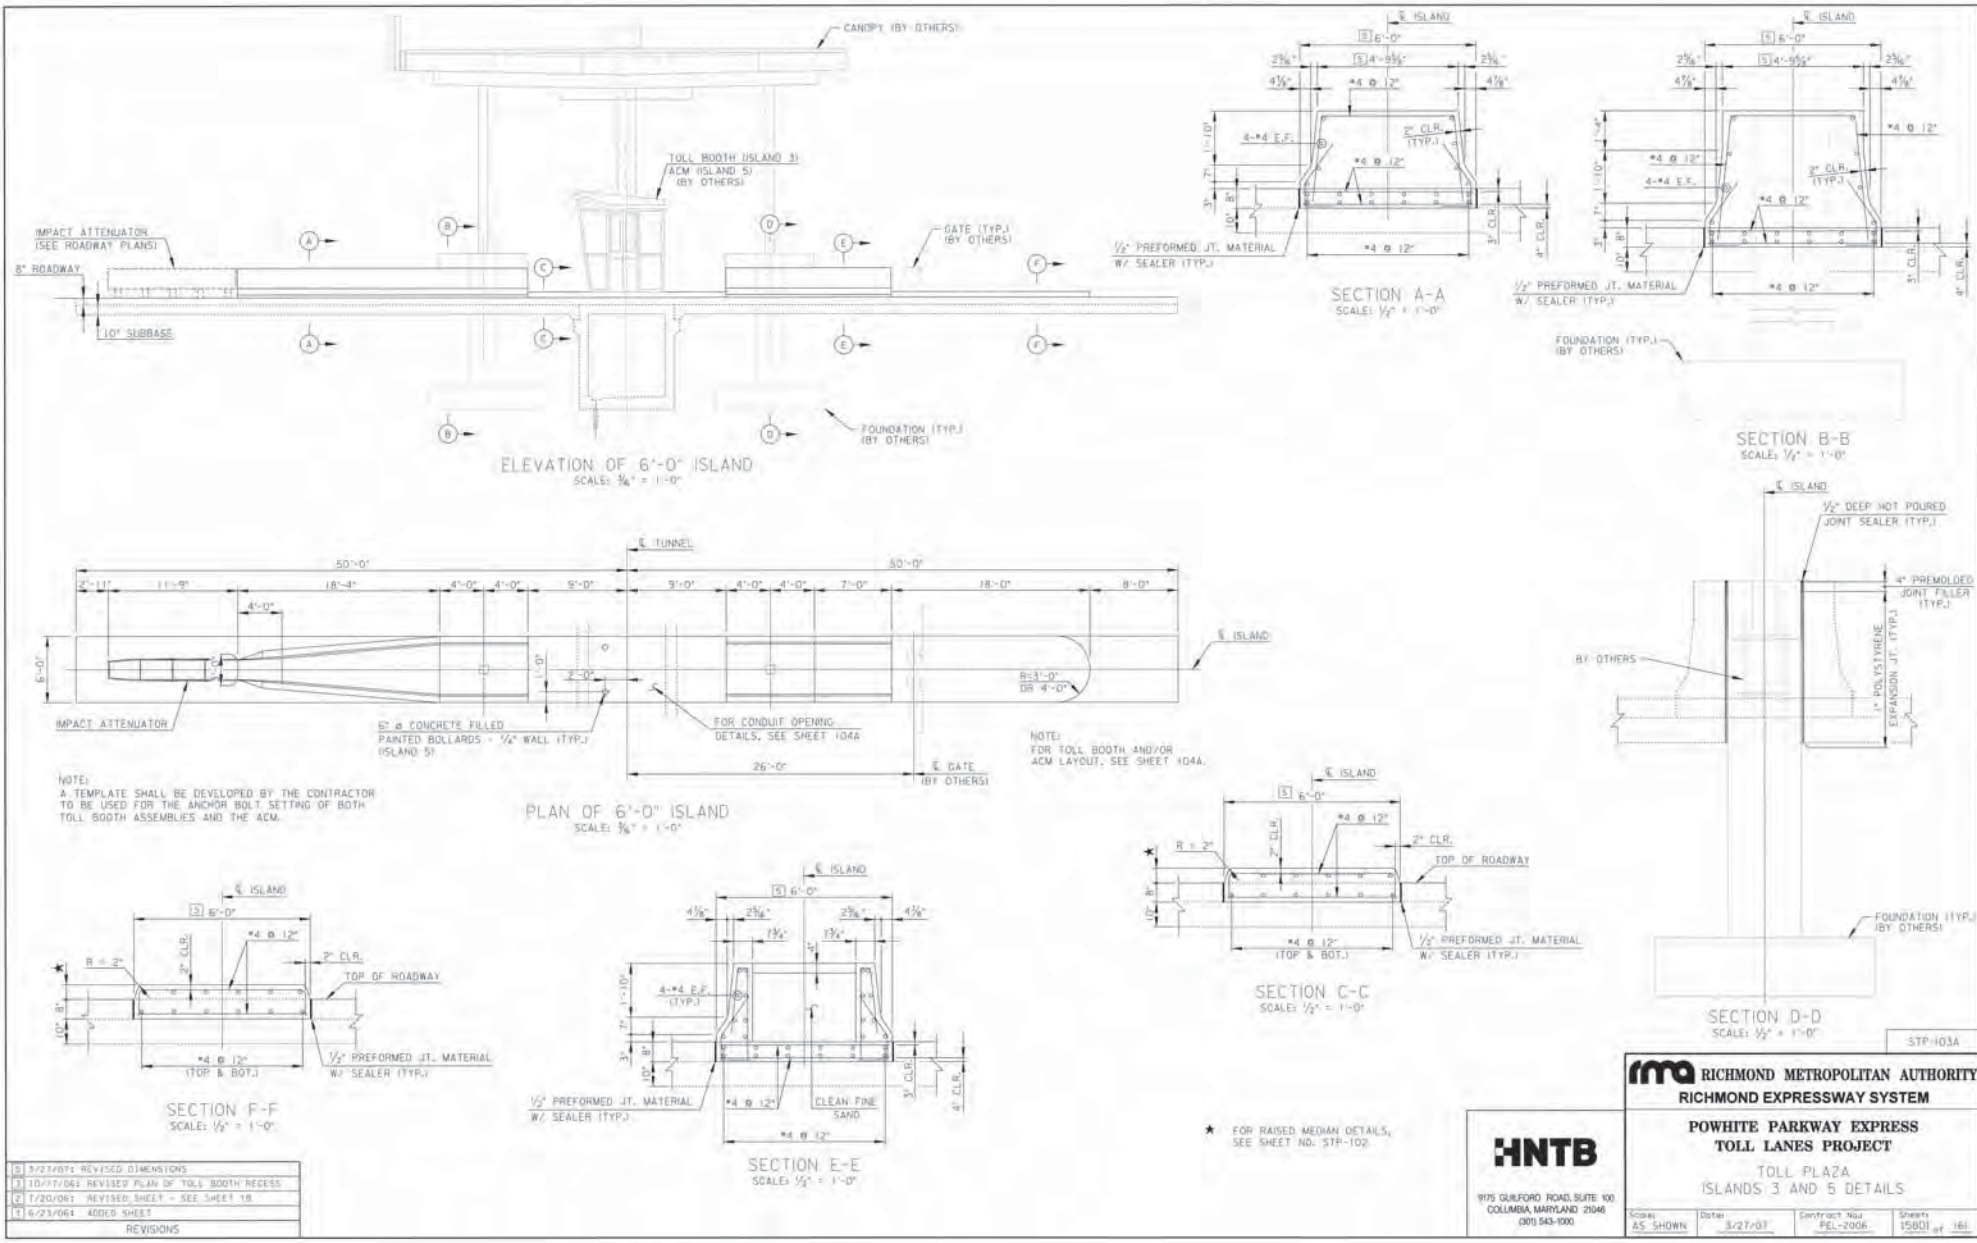

STP-103A


ma RICHMOND METROPOLITAN AUTHORITY
RICHMOND EXPRESSWAY SYSTEM

POWHITE PARKWAY EXPRESS
TOLL LANES PROJECT


TOLL PLAZA
ISLANDS 3 AND 5 DETAILS

9175 GUILFORD ROAD, SUITE 100
COLUMBIA, MARYLAND 21046
(410) 543-1000


Scale: AS SHOWN Date: 3/27/07 Contract No: PEL-2006 Sheets: 15801 of 161

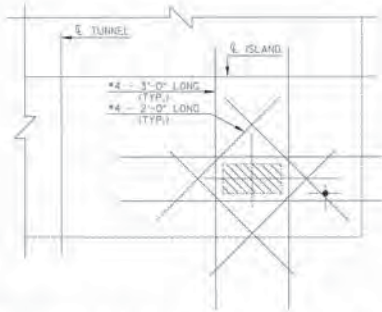


5 TYPICAL CUT OUT REINFORCEMENT DETAIL
(AT TUNNEL ROOF SLAB)
SCALE: 1/2" = 1'-0"

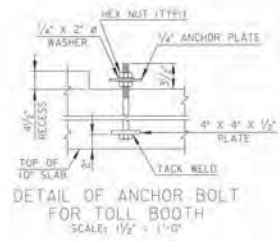


DETAIL OF ANCHOR BOLT
FOR TOLL BOOTH
SCALE: 1/2" = 1'-0"

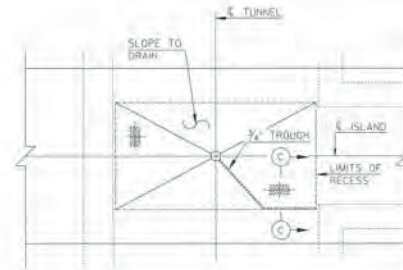


PLAN OF TOLL BOOTH DRAINAGE
SCALE: 1/2" = 1'-0"

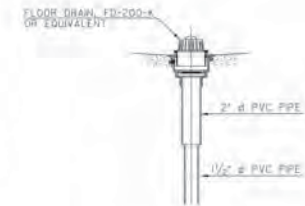


FLOOR DRAIN DETAIL
NO SCALE

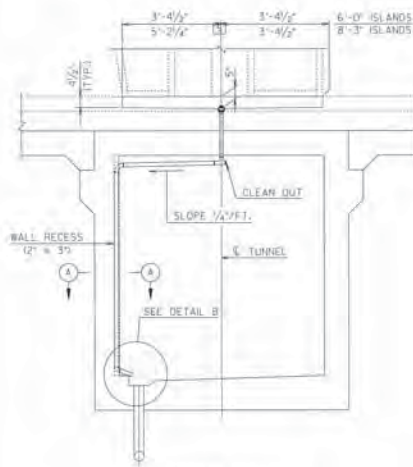


SECTION G-G
SCALE: 1/2" = 1'-0"
1

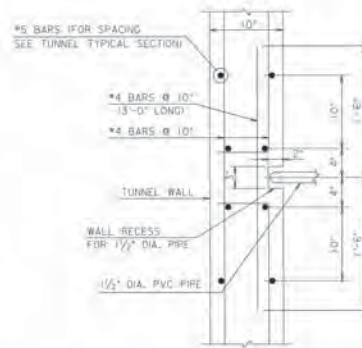

SECTION A-A
SCALE: 1/2" = 1'-0"
2

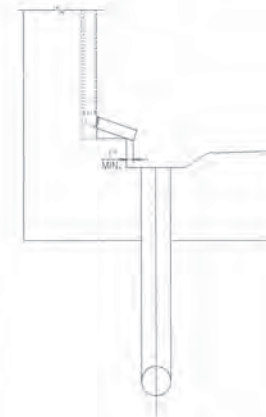

DETAIL B
SCALE: 1/2" = 1'-0"
3

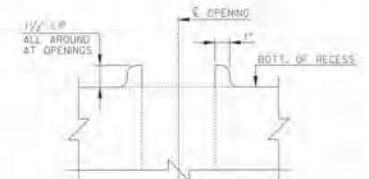


SECTION C-C
SCALE: 3" = 1'-0"

NOTE:
FOR LOCATION OF SECTION C-C,
SEE SHEET STP-103C OR STP-104A.




NO.	DATE	REVISIONS
15	3/27/07	REVISED CUT OUT DETAIL & SECT. F-F
14	10/17/06	ADDED A-A & DETAIL B; REVISED C-C
12	7/20/06	ADDED SHEET FOR DETAILS PREVIOUSLY SHOWN ON SHEET STP-103

HNTB	RM RICHMOND METROPOLITAN AUTHORITY RICHMOND EXPRESSWAY SYSTEM			
	POWHITE PARKWAY EXPRESS TOLL LANES PROJECT			
TOLL PLAZA TYPICAL DETAILS - II				
8175 GULFORD ROAD, SUITE 100 COLUMBIA, MARYLAND 21046 (410) 543-1000	Scale: AS SHOWN	Date: 3/21/07	Contract No. PEL-2006	Sheet: 15B02 of 161




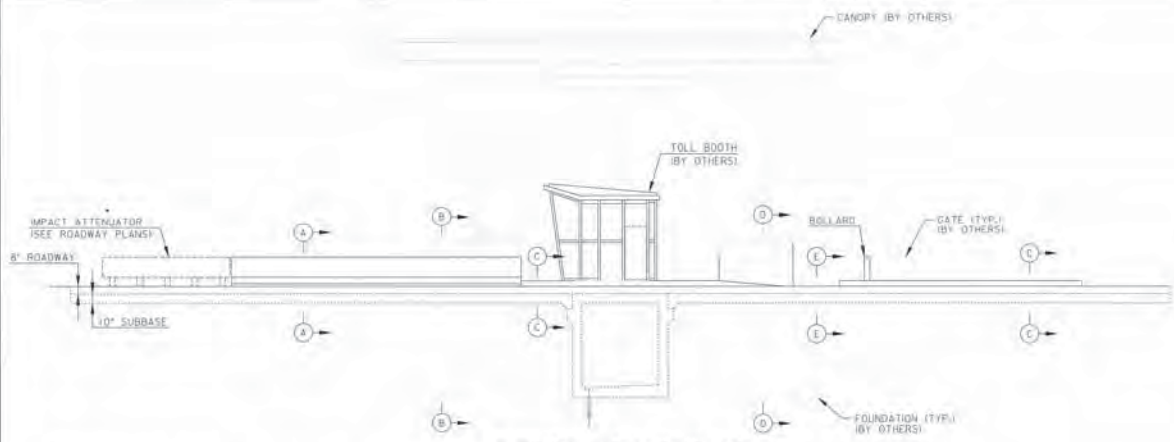


ELEVATION OF 8'-3" ISLAND
 ISLAND 1
 SCALE: 3/8" = 1'-0"

NOTE:
 A TEMPLATE SHALL BE DEVELOPED BY THE CONTRACTOR TO BE USED FOR THE ANCHOR BOLT SETTING OF BOTH TOLL BOOTH ASSEMBLIES AND THE ACM.

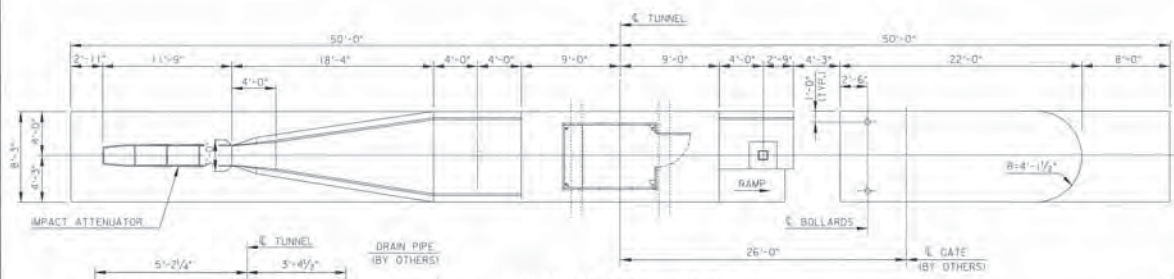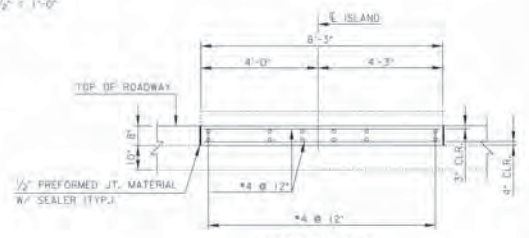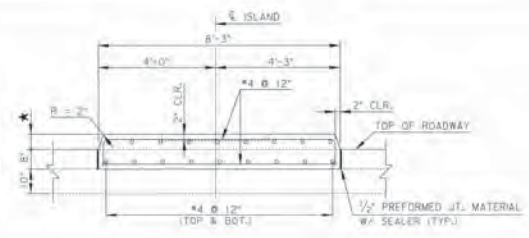

PLAN OF 8'-3" ISLAND
 SCALE: 3/8" = 1'-0"

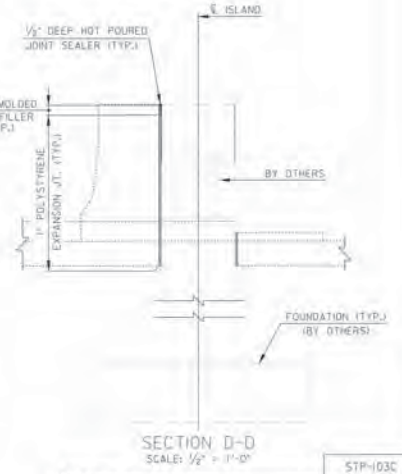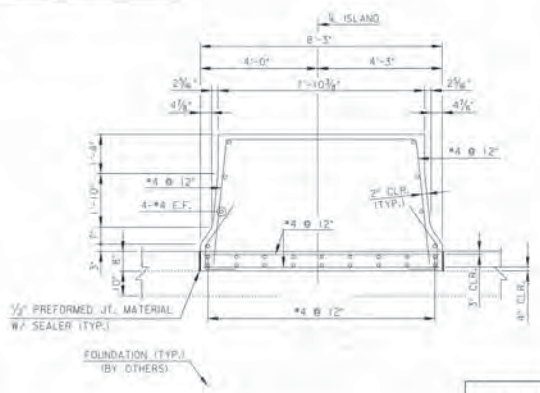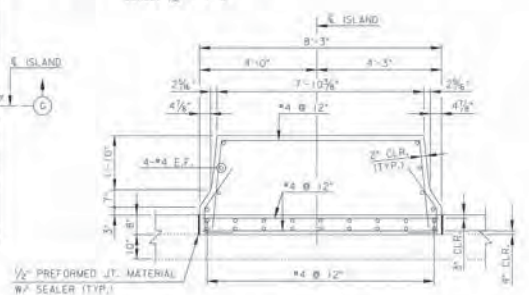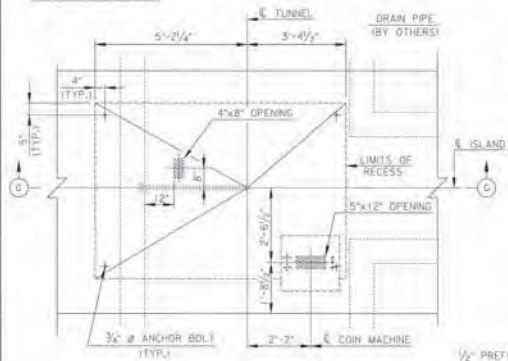


NOTE: FOR SECTION C-C, SEE SHEET STP-103B.


* FOR RAISED MEDIAN DETAILS, SEE SHEET NO. STP-1102

3/21/07: ADDED SHEET
REVISIONS




	RICHMOND METROPOLITAN AUTHORITY RICHMOND EXPRESSWAY SYSTEM			
	POWHITE PARKWAY EXPRESS TOLL LANES PROJECT			
	TOLL PLAZA ISLAND 1 DETAILS			
875 GULFORD ROAD, SUITE 100 COLUMBIA, MARYLAND 21046 (801) 943-1900	Scale: AS SHOWN	Date: 3/27/07	Contract No.: PEL-2006	Sheet: 15803 of 16

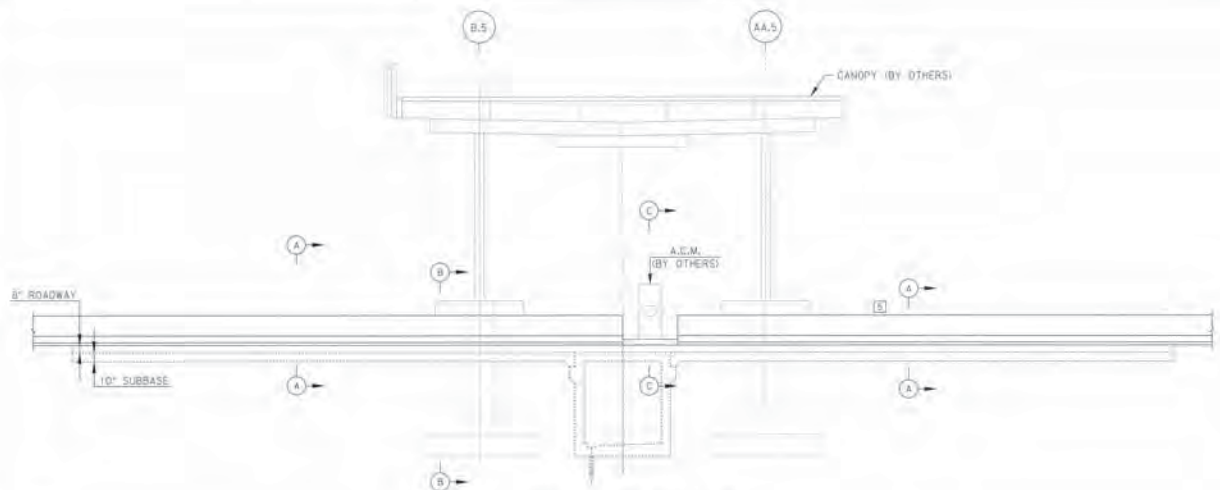

NOTE:
A TEMPLATE SHALL BE DEVELOPED BY THE CONTRACTOR TO BE USED FOR THE ANCHOR BOLT SETTING OF BOTH TOLL BOOTH ASSEMBLIES AND THE ACM.

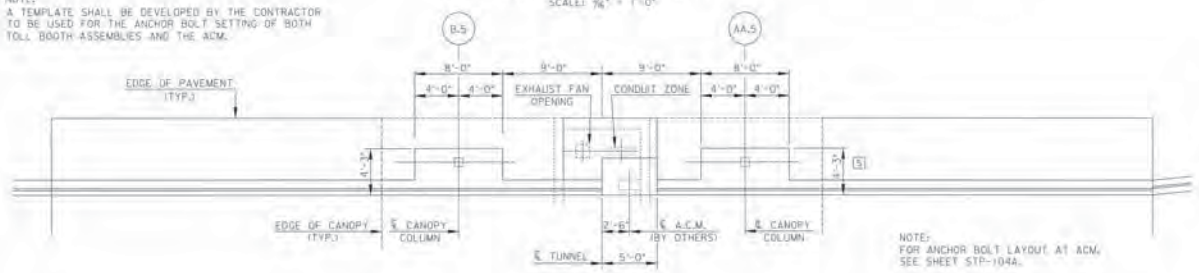

NOTE:
FOR ANCHOR BOLT LAYOUT AT ACM, SEE SHEET STP-104A.

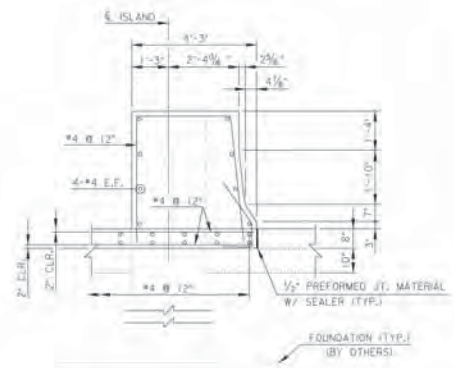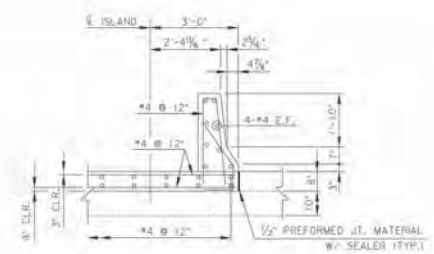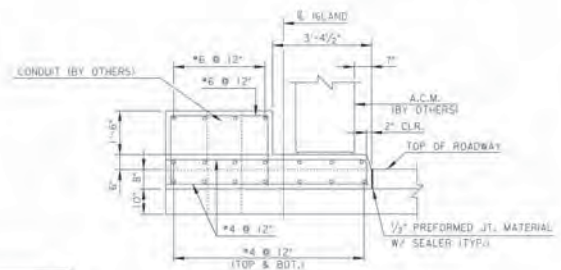

REVISIONS	
(5)	3/27/07 REMOVED DATE
(2)	7/20/06 REVISED SHEET SIZE AND TITLE BLOCK
(1)	8/23/06 ADDED SHEET


STP-105

ma RICHMOND METROPOLITAN AUTHORITY
RICHMOND EXPRESSWAY SYSTEM
**POWHITE PARKWAY EXPRESS
TOLL LANES PROJECT**
TOLL PLAZA
ISLAND 7 DETAILS

HNTB


9175 GUILFORD ROAD, SUITE 300
COLUMBIA, MARYLAND 21046
(801) 943-1000

Scale	Date	Contract No.	Sheet
AS SHOWN	3/27/07	PEL-2006	158 of 161

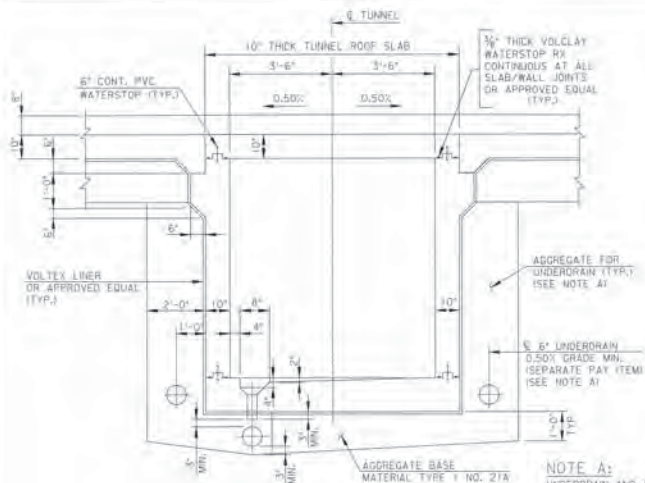


TYPICAL SECTION - BETWEEN ISLANDS
SCALE: 1/2" = 1'-0"

NOTE A:
UNDERDRAIN AND AGGREGATE FOR UNDERDRAIN SHALL BE PLACED AROUND THE OUTLINE OF THE STAIR WELLS. UNDERDRAIN SHALL BE SLOPED TO DRAIN.

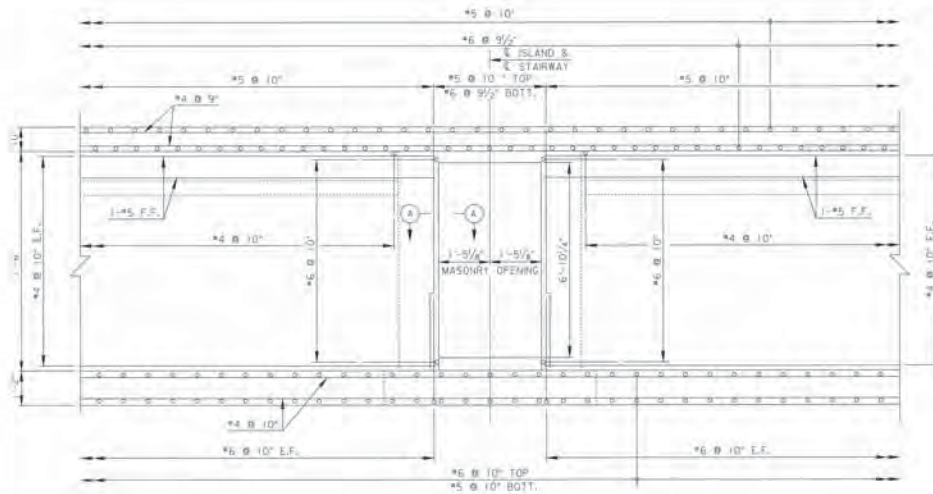


TUNNEL LONGITUDINAL SECTION
AT STAIRWAY ENTRANCE
SCALE: 1/2" = 1'-0"

NOTE A:
MASONRY OPENING SHALL BE FIELD VERIFIED AT EXISTING POINTS TOLL PLAZA WITH ENGINEER.

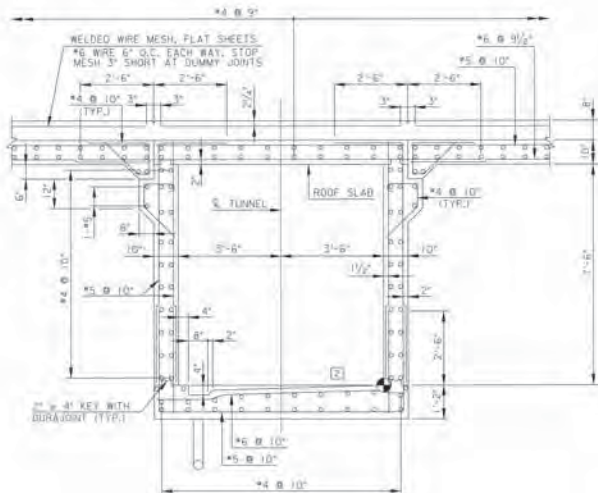

TUNNEL TYPICAL SECTION
SCALE: 1/2" = 1'-0"

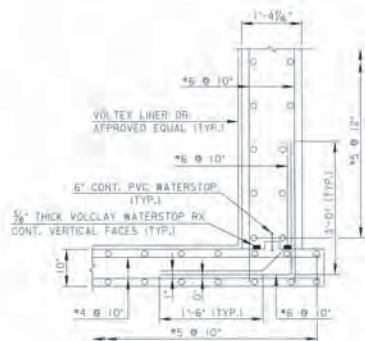

SECTION A-A
SCALE: 3/4" = 1'-0"



SECTION AT END OF TUNNEL
SCALE: 1/2" = 1'-0"

NO.	DATE	DESCRIPTION
1	3/27/07	REMOVED AND UPDATED DETAILS
2	7/20/06	REVISED SHEET - SEE SHEET 10
3	6/23/06	ADDED SHEET

REVISIONS

HNTB	STP-106A			
	RICHMOND METROPOLITAN AUTHORITY RICHMOND EXPRESSWAY SYSTEM POWHITE PARKWAY EXPRESS TOLL LANES PROJECT TOLL PLAZA MISCELLANEOUS TUNNEL DETAILS-1			
875 GUILFORD ROAD, SUITE 300 COLUMBIA, MARYLAND 21048 800.543.4000	Scale: AS SHOWN	Date: 3/27/07	Contract No: FEL-2006	Sheet: 15801 of 16

OWNER:
RICHMOND METROPOLITAN AUTHORITY
 878 EAST MAIN STREET
 SUITE 600
 RICHMOND, VA 23219
 TEL. 804.523.3200
 FAX. 804.523.3200

ARCHITECT:
HNTB
 HNTB ENGINEERING
 10000 Lakeside Drive
 Suite 1000
 Dallas, Texas 75243
 TEL. 972.968.8000
 FAX. 972.968.8000

ARCHITECT'S PLANS/PERMITS:
 HNTB ENGINEERING
 10000 Lakeside Drive
 Suite 1000
 Dallas, Texas 75243
 TEL. 972.968.8000
 FAX. 972.968.8000

MEP/STRUCTURAL:
HANKINS & ANDERSON
 480 SAGLER ROAD
 SUITE 200
 GLEN ALLEN, VA 22080
 TEL. 804.285.4171
 FAX. 804.271.8520

CIVIL/LANDSCAPE:
HNTB CORPORATION
 9719 GOLFWOOD ROAD
 COLUMBIA, MD 21046
 TEL. 301.543.1500
 FAX. 301.498.0270

RICHMOND METROPOLITAN AUTHORITY
 POWHITE PARKWAY SPLIT PLAZA TOLL FACILITY
 RICHMOND, VIRGINIA

GENERAL NOTES:

SPECIFICATIONS: - VIRGINIA DEPARTMENT OF TRANSPORTATION ROAD AND BRIDGE SPECIFICATIONS, 2003
DESIGN: - 2002 (11TH EDITION) AASHTO STANDARD SPECIFICATIONS FOR HIGHWAY BRIDGES, WITH INTERIMS THROUGH 2004

DESIGN LOADS:
 ROOF LIVE LOAD 20 PSF
 AND WIND 40 PSF
 FLAT ROOF SNOW LOAD 20 PSF

DESIGN STRENGTHS:

CONCRETE: F_c' = 3000 PSI
 REIN. STEEL: F_y = 60 KSI

STRUCTURAL STEEL:

MATERIAL SPECIFICATIONS:
 WIDE FLANGE SHAPES: ASTM A992
 CHANNELS, ANGLES AND PLATES: ASTM A36
 STRUCTURAL TUBING AND PIPE: ASTM A500, GRADE C
 HIGH STRENGTH BOLTS: ASTM A325X
 ANCHOR BOLTS: ASTM F1554, GRADE 55
 HARDENED STEEL WASHERS: ASTM F436

ALL SHOP CONNECTIONS SHALL BE WELDED AND ALL FIELD CONNECTIONS SHALL BE BOLTED.

ALL STRUCTURAL STEEL SHALL BE HOT-DIP GALVANIZED PER ASTM A123, UNLESS OTHERWISE NOTED. ALL BOLTS, ANCHOR BOLTS, WASHERS AND NUTS SHALL BE HOT-DIP GALVANIZED PER ASTM A153. THE LOWER CANOPY FRAMING STEEL SHALL BE PARTIALLY GALVANIZED PER ASTM A153.

ALL METAL ROOF DECK SHALL BE 3/4" Z2 GAUGE, WIDE RIB TYPE B, GALVANNEK, WITH THE MINIMUM PROPERTIES DEFINED BY THE STEEL DECK INSTITUTE (SDI).

3/4" DIAMETER BOLTS SHALL BE USED FOR THE CANOPY STRUCTURE AND 3/8" DIAMETER BOLTS FOR ROOF SCREEN STRUCTURES.

ALL SHOP AND FIELD WELDING SHALL BE PERFORMED BY QUALIFIED WELDERS IN ACCORDANCE WITH AWS D1.1-2008 USING E70XX ELECTRODES.

ALL HOLES REQUIRED IN STRUCTURAL STEEL MEMBERS FOR PIPING AND DUCTWORK SHALL BE SHOWN ON THE SHOP DRAWINGS AND BE MADE IN THE SHOP. NO HOLES SHALL BE CUT IN THE FIELD WITHOUT APPROVAL OF THE ARCHITECT/ENGINEER.

ALL BOLTED CONNECTIONS SHALL BE BEARING TYPE, NON SLIP-CRITICAL, TIGHTENED TO A "SNUG-TIGHT CONDITION" AS DEFINED BY AISC.

THE FRAME OF THE STEEL SKELETON SHALL BE CARRIED UP TRUE AND PLUMB AND TEMPORARY BOLTING AND BRACING SHALL BE INTRODUCED TO SAFELY CARRY ALL LOADS TO WHICH THE STRUCTURE MAY BE SUBJECTED, INCLUDING EQUIPMENT AND OPERATION OF SAME. INDIVIDUAL COLUMNS MUST BE BRACED BEFORE BEAM CONNECTIONS ARE MADE AND BRACING SHALL BE LEFT IN PLACE AS LONG AS MAY BE REQUIRED FOR SAFETY.

AFTER COMPLETION OF ERECTION, THE OWNER SHALL ENGAGE AN INDEPENDENT TESTING AGENCY TO INSPECT HIGH STRENGTH BOLTED CONNECTIONS, TO PERFORM TESTS, AND TO PREPARE TEST REPORTS. THE TESTING AGENCY SHALL CONDUCT AND INTERPRET TESTS AND STATE IN EACH REPORT WHETHER THE TEST RESULTS COMPLY WITH THE REQUIREMENTS AND SPECIFICALLY STATE ANY DEVIATIONS THERE FROM. THE TESTING SHALL CONFORM TO THE REQUIREMENTS FOUND IN THE AISC "SPECIFICATION FOR STRUCTURAL JOINTS USING ASTM A325 AND A490 BOLTS", DATED JUNE 2005, WITH SUPPLEMENTS. BOLTS THAT ARE NEITHER NON SLIP CRITICAL NOR SUBJECT TO DIRECT TENSION NEED NOT BE INSPECTED FOR BOLT TENSION OTHER THAN TO INSURE THAT THE FLUES OF THE CONNECTED ELEMENT HAVE BEEN BROUGHT INTO SNUG CONTACT. THE INDEPENDENT TESTING AGENCY SHALL SUBMIT THE WITNESSED TEST PROCEDURES TO THE STRUCTURAL ENGINEER FOR REVIEW PRIOR TO BEGINNING TESTING.

FOUNDATIONS:
 FOUNDATIONS FOR THIS STRUCTURE AND SPREAD FOOTINGS BEARING ON EITHER FIRM VIRGIN SOIL OR COMPACTED STRUCTURAL FILL WITH AN ALLOWABLE BEARING CAPACITY OF 3000 PSF IN ACCORDANCE WITH THE OWNER'S GEOTECHNICAL ENGINEER'S REPORT BY FROEHLING & ROBERTSON, INC. DATED OCTOBER 2005. THE OWNER'S GEOTECHNICAL ENGINEER SHALL VERIFY, PRIOR TO POURING, THAT THE SOIL IS CAPABLE OF SUSTAINING SUCH A LOAD.

PREPARATION OF SOIL AND SUBGRADE BENEATH FOOTINGS AND SLABS ON GRADE SHALL BE IN ACCORDANCE WITH THE RECOMMENDATIONS OF THE OWNER'S GEOTECHNICAL ENGINEER'S REPORT AND THE PROJECT SPECIFICATIONS.

ALL BACKFILL BEHIND TUNNEL WALLS SHALL BE IN ACCORDANCE WITH THE RECOMMENDATIONS OF THE OWNER'S GEOTECHNICAL ENGINEER'S REPORT AND THE PROJECT SPECIFICATIONS.

ALL WALLS SUBJECT TO LATERAL LOAD DUE TO UNBALANCED FILL SHALL BE BRACED PLUMB UNTIL BACKFILL HAS BEEN PLACED AND COMPACTED AND SHALL REMAIN BRACED UNTIL THE PERMANENT STRUCTURE ABOVE AND BELOW IS IN PLACE AND CAPABLE OF RESISTING ALL LOADS.


THE CONTRACTOR SHALL VERIFY ALL FIELD MEASUREMENTS, EXISTING DIMENSIONS, ELEVATIONS, AND THE SHAPES OF SIZES OF EXISTING STRUCTURAL MEMBERS SHOWN ON THE CONTRACT DRAWINGS PRIOR TO BEGINNING WORK. THE ARCHITECT/ENGINEER SHALL BE NOTIFIED IN WRITING OF ALL DISCREPANCIES THAT WOULD RESULT IN REVISIONS TO THE CONTRACT DRAWINGS.

THE CONTRACTOR SHALL VERIFY ALL DRAWINGS FOR COORDINATION BETWEEN TRADES, HE SHALL LOCATE SLOTS, SLEEVES AND TRENCHES AS REQUIRED FOR MECHANICAL TRADES AND PROVIDE AND INSTALL ANCHORS, INSERTS, HANGERS, ETC. AS REQUIRED FOR VARIOUS OTHER TRADES.


THE CONTRACTOR SHALL BE RESPONSIBLE FOR THE DESIGN AND ERECTION OF ALL TEMPORARY BRACING, FORMWORK, SHEETING, SHORING AND UNDERPINNING NECESSARY TO PERFORM THE WORK. THE CONTRACTOR SHALL BE RESPONSIBLE FOR ALL CONSTRUCTION MEANS, METHODS, TECHNIQUES, SEQUENCES AND PROCEDURES AND FOR SAFETY PRECAUTIONS AND PROGRAMS AS THEY RELATE TO THE WORK OF THIS PROJECT.

THE CONTRACTOR SHALL SUBMIT THE REQUIRED SHOP DRAWINGS FOR REVIEW PRIOR TO BEGINNING WORK. THE CONTRACTOR SHALL CHECK ALL DIMENSIONS AND ACCEPT FULL RESPONSIBILITY FOR DIMENSIONAL CORRECTNESS. UNDER NO CIRCUMSTANCES SHALL REPRODUCTIONS OF CONTRACT DRAWINGS BE USED AS SHOP DRAWINGS.


ALL STRUCTURAL STEEL SHOP DRAWINGS SHALL BE PREPARED UNDER THE DIRECTION SUPERVISION OF PROFESSIONAL ENGINEER REGISTERED IN THE COMMONWEALTH OF VIRGINIA.

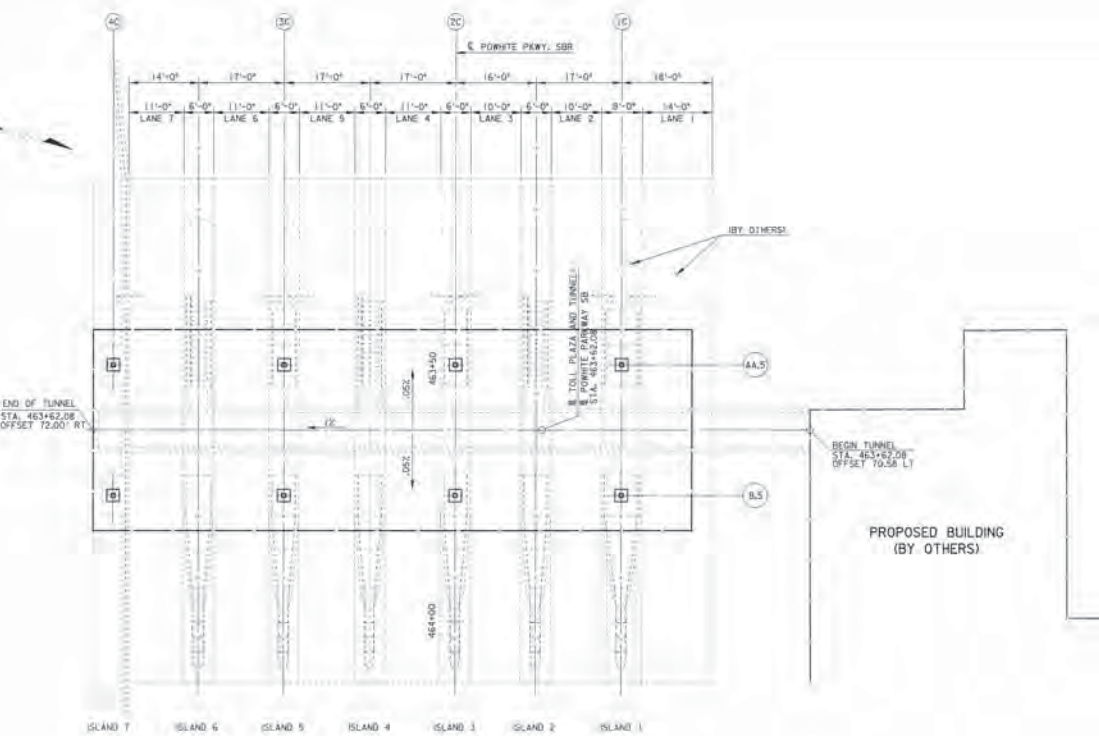

PLAN OF TOLL PLAZA
 SCALE: 1" = 10'-0"

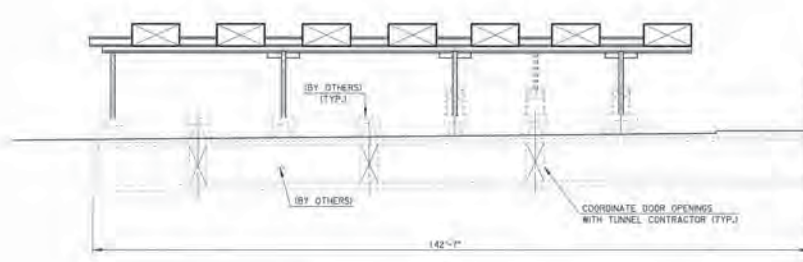


ELEVATION OF TOLL PLAZA
 SCALE: 1" = 10'-0"

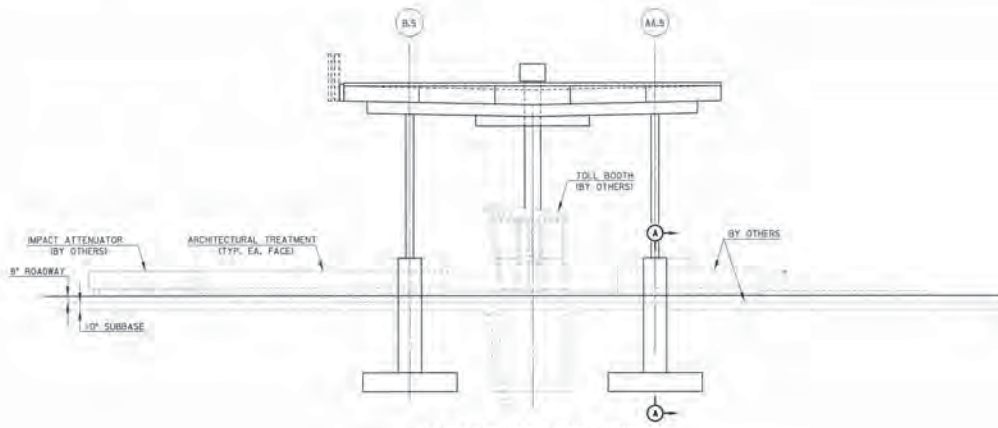


ELEVATION OF 6'-0" ISLAND

ISLANDS 3 & 5
ISLAND 1 SIMILAR
SCALE: 3/8" = 1'-0"

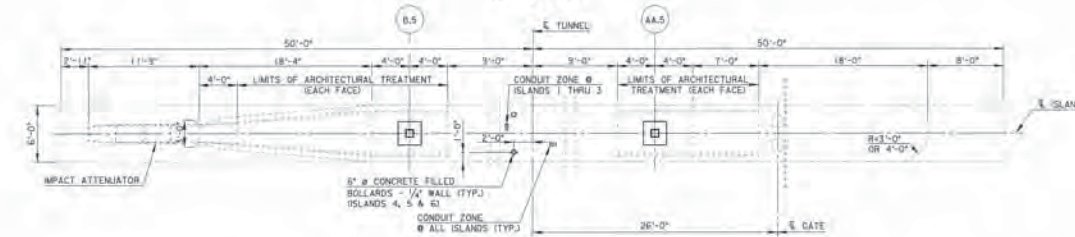


PLAN OF 6'-0" ISLAND

ISLANDS 3 & 5
ISLAND 1 SIMILAR
SCALE: 3/8" = 1'-0"

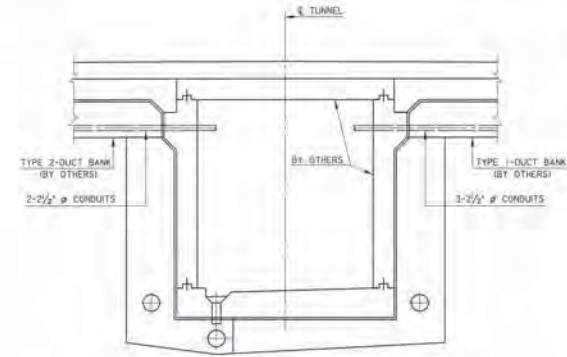


TYPICAL SECTION - BETWEEN ISLANDS

SCALE: 1/2" = 1'-0"

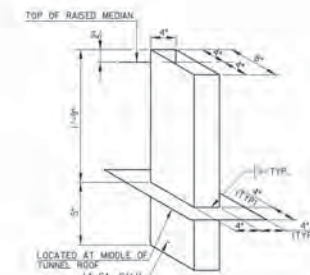


TUNNEL SLEEVE DETAIL

SCALE: 1/2" = 1'-0"

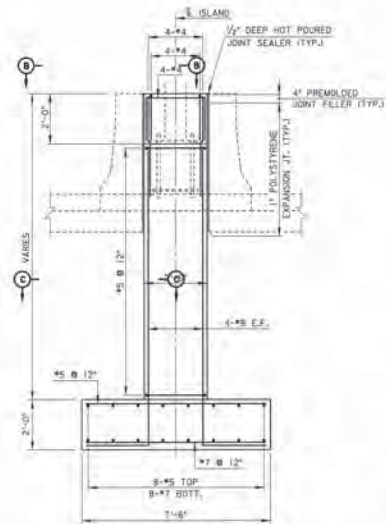


SECTION A-A

SCALE: 1/2" = 1'-0"

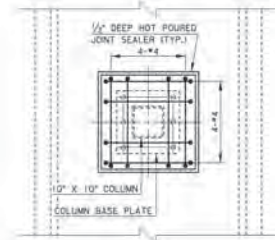


SECTION B-B

SCALE: 3/4" = 1'-0"

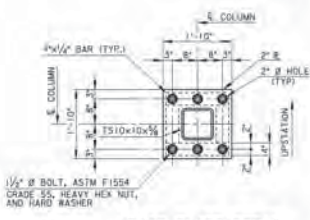


BASE PLATE DETAIL

SCALE: 3/4" = 1'-0"

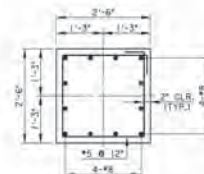


SECTION C-C

SCALE: 3/4" = 1'-0"

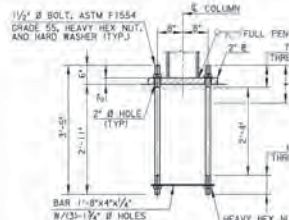


ANCHOR BOLT DETAIL

SCALE: 3/4" = 1'-0"

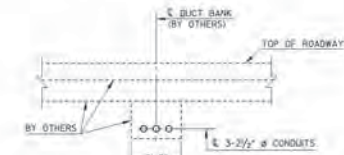

TYPE 1

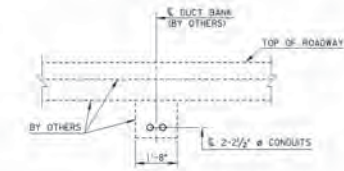

TYPE 2

TYPICAL DUCTBANK DETAILS

SCALE: 1/2" = 1'-0"

OWNER:
RICHMOND METROPOLITAN AUTHORITY
919 EAST MAIN STREET
SUITE 600
RICHMOND, VA 23216
TEL: 804.523.3000
FAX: 804.523.3300

ARCHITECT:
HNTB
HNTB ARCHITECTS
The HNTB Group
ARCHITECTS
PLANNERS
INTERIORS

MEP/STRUCTURAL:
HANKINS & ANDERSON
4800 SACLER ROAD
SUITE 200
DENVER, VA 23000
TEL: 804.285.4177
FAX: 804.217.8020

CIVIL/LANDSCAPE:
HNTB CORPORATION
8175 SUFFORD ROAD
COLUMBIA, MD 21046
TEL: 301.543.1000
FAX: 301.468.5070

RICHMOND METROPOLITAN AUTHORITY
POWHEE PARKWAY SPLIT PLAZA TOLL FACILITY
RICHMOND, VIRGINIA



1-1/2" @ BOLT, ASTM F1554 GRADE 55, HEAVY HEX NUT, AND HARD WASHER (TYP.)
TYPICAL TOLL ISLAND DETAILS - 1
3-11/16"

OWNER:
RICHMOND METROPOLITAN AUTHORITY
 515 EAST MAIN STREET
 SUITE 600
 RICHMOND, VA 23216
 TEL: 804.531.3500
 FAX: 804.531.3300


ARCHITECT:
HNTB
 HNTB ARCHITECTURE
 THE HNTB COMPANY
 ARCHITECTS
 ENVIRONMENTAL
 PLANNERS

MEP/STRUCTURAL:
HANKINS & ANDERSON
 480 SACHLER ROAD
 SUITE 200
 DENVER, VA 23001
 TEL: 804.285.4111
 FAX: 804.217.8520

CIVIL / LANDSCAPE:
HNTB CORPORATION
 975 GUILFORD ROAD
 COLUMBIA, MD 21048
 TEL: 301.643.1000
 FAX: 301.488.0070

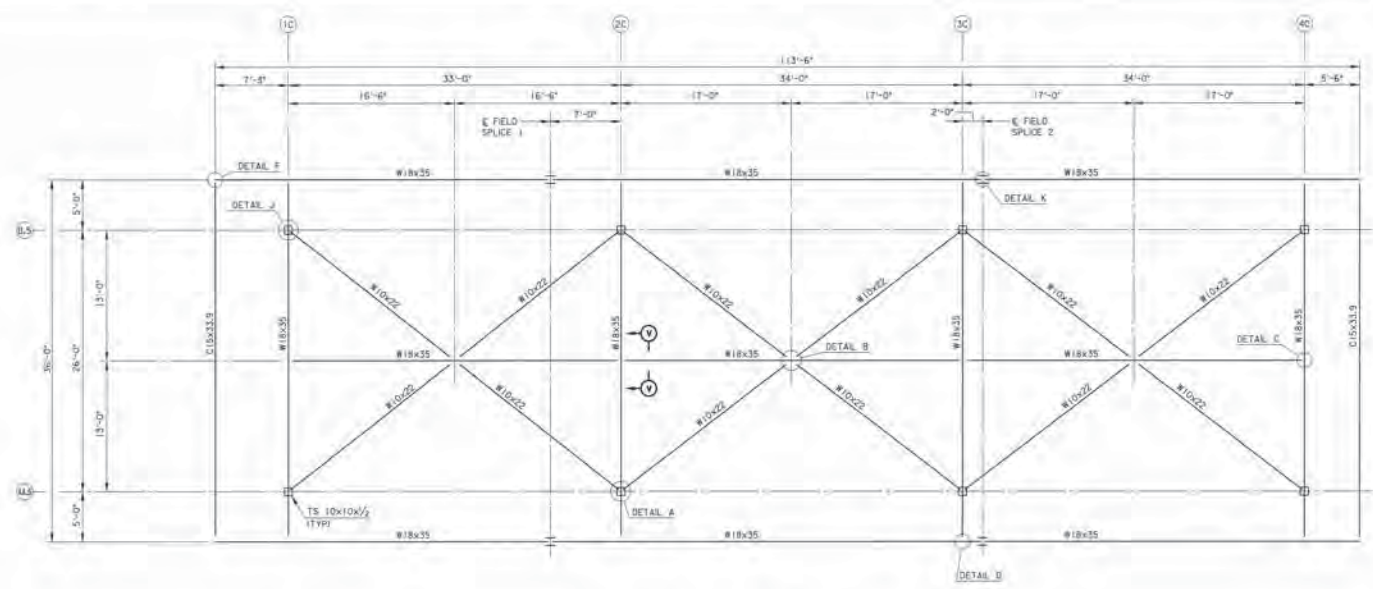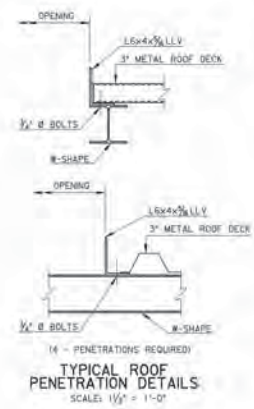

FRAMING PLAN - LOWER LEVEL
 SCALE: 1" = 5'-0"












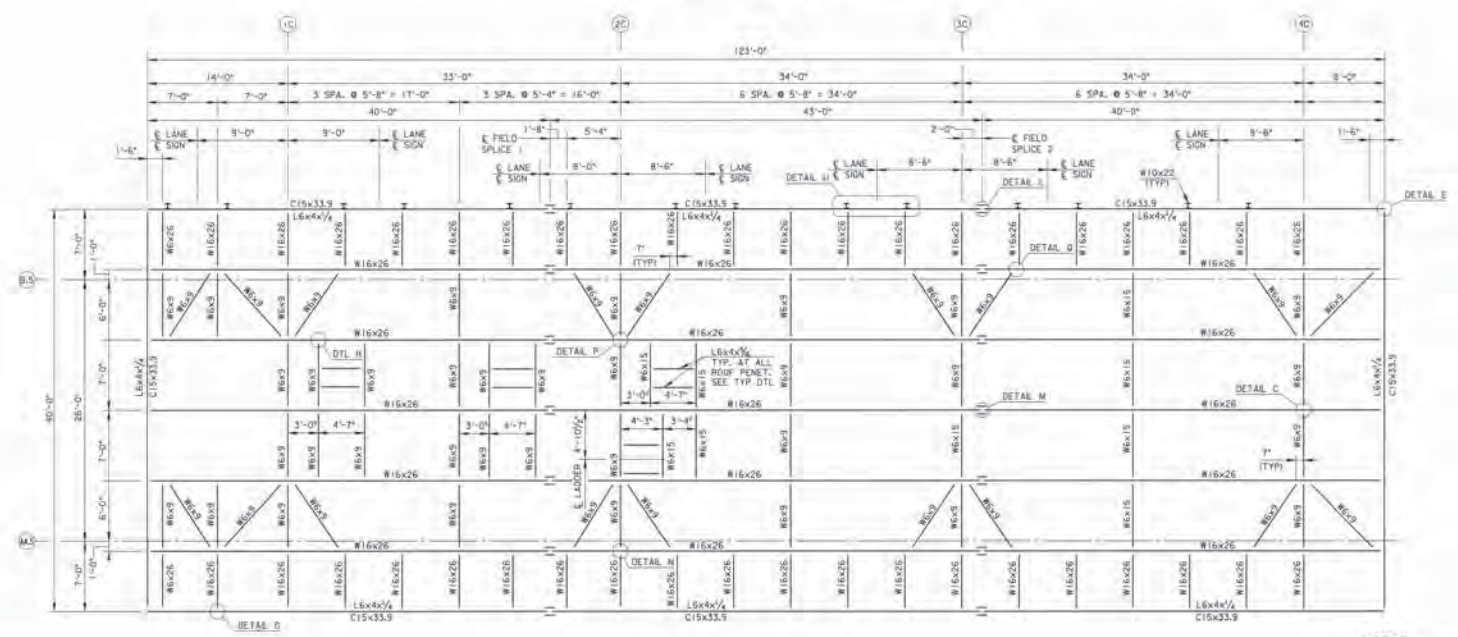


FRAMING PLAN - UPPER LEVEL
 SCALE: 1" = 5'-0"

- NOTES:**
1. FOR TYPICAL SECTION, SEE SHEET STP-108.
 2. FOR GENERAL NOTES, SEE SHEET STP-101.
 3. FOR FRAMING CONNECTION DETAILS, SEE SHEET STP-109 AND STP-110.
 4. FOR ROOF SCREEN FRAMING PLAN AND DETAILS, SEE SHEET STP-111.
 5. LOCATION OF W16x26 MAY BE ADJUSTED TO ACCOMMODATE W10x22 SIGN BRACKET CONNECTION.
 6. FOR SECTION V-V, SEE SHEET NO. STP-109.

RICHMOND METROPOLITAN AUTHORITY
POWHEE PARKWAY SPLIT PLAZA TOLL FACILITY
RICHMOND, VIRGINIA



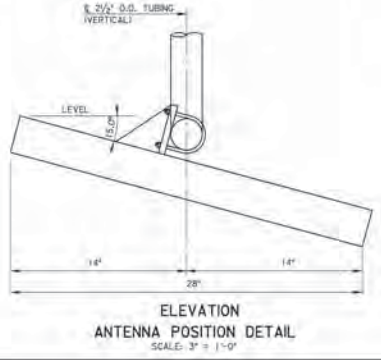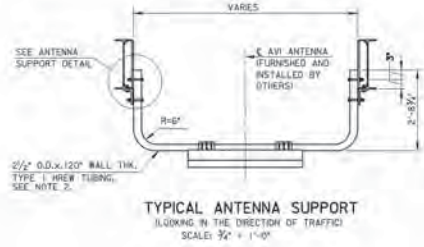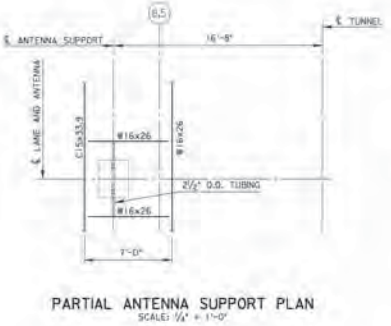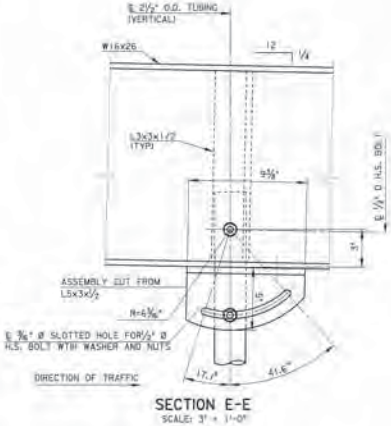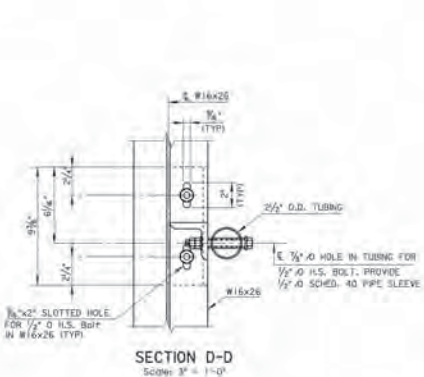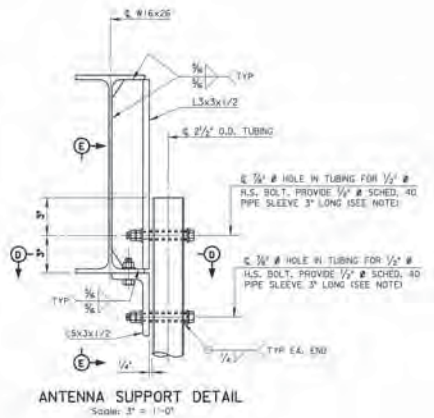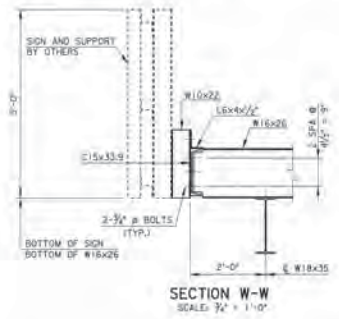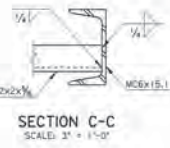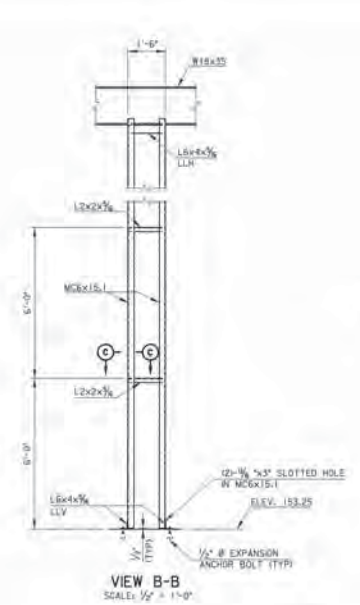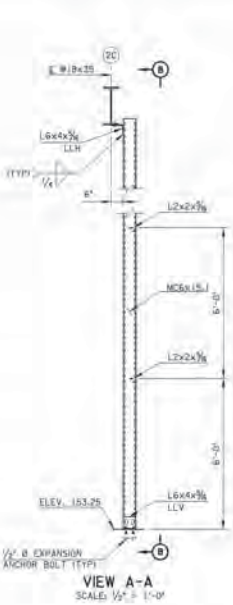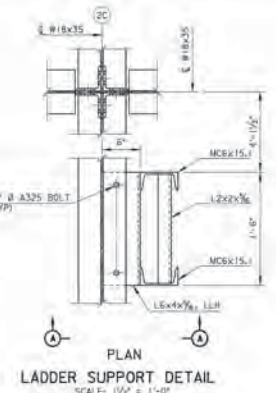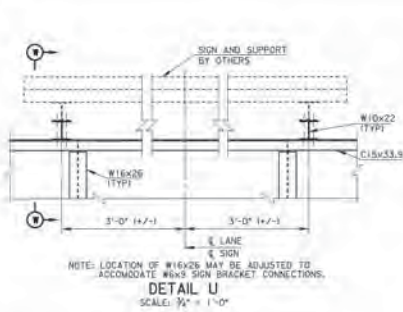

- NOTES:**
1. FOR INSTALLATION OF ELECTRICAL INFRASTRUCTURE AND EQUIPMENT SEE ELECTRICAL DRAWINGS.
 2. ANTENNA SUPPORT BRACKETS SHALL BE FABRICATED FROM ASTM S13 TYPE 1 HOT-ROLLED ELECTRICWELDED (HREW) MECHANICAL TUBING.
 3. STEEL MEMBERS AND PLATES FOR ANTENNA SUPPORT SHALL BE ASTM A709, GRADE 36 GALVANIZED TO ASTM-123.
 4. THE C15x33.9 AND W16x26 MEMBERS ARE CANOPY STEEL.

OWNER:
RICHMOND METROPOLITAN AUTHORITY
215 EAST MAIN STREET
SUITE 600
RICHMOND, VA 23219
TEL: 804.528.2500
FAX: 804.523.3333

ARCHITECT:
HNTB
HNTB ARCHITECTURE
The HNTB Companies
ARCHITECTS
ENGINEERS
PLANNERS
INTERIOR DESIGNERS
LANDSCAPE ARCHITECTS

MEP/STRUCTURAL
HANKINS & ANDERSON
4800 BACKLICK ROAD
SUITE 300
OLEN ALEX, VA 23060
TEL: 804.288.4171
FAX: 804.217.8520

CIVIL LANDSCAPE
HNTB CORPORATION
8175 GILKORD ROAD
COLUMBIA, MD 21046
TEL: 301.543.1000
FAX: 301.499.0270

RICHMOND METROPOLITAN AUTHORITY
POWHIE PARKWAY SPLIT PLAZA TOLL FACILITY
RICHMOND, VIRGINIA

NO.	REVISION	DATE	BY	CHKD.

DATE: 08/05/2010
TIME: 10:54 AM
DRAWN: J. B. BROWN
CHECKED: J. B. BROWN
SCALE: 3/4" = 1'-0"
SHEET: 3 OF 3
PROJECT: POWHIE PARKWAY SPLIT PLAZA TOLL FACILITY
DRAWING: CANOPY DETAILS
12-1



REVISION	NO.	DATE	DESCRIPTION
	1	10/27/06	ISSUED FOR CONSTRUCTION
	2	11/27/06	REVISED/ADDED DIMENSIONS
	1	11/27/06	NOTED WALLS & WINDOWS



PROPOSED BUILDING FOR:
RICHMOND METROPOLITAN AUTHORITY
 6204 FORTNE PARKWAY, CITY OF RICHMOND, VIRGINIA

FLOOR PLAN

DESIGNED BY: JIC
 CHECKED BY: JIC
 DATE: OCTOBER 15, 2006
 PROJECT NO. 06007

SCALE: 1/8" = 1'-0"

DRAWING NO. **4** of **16**

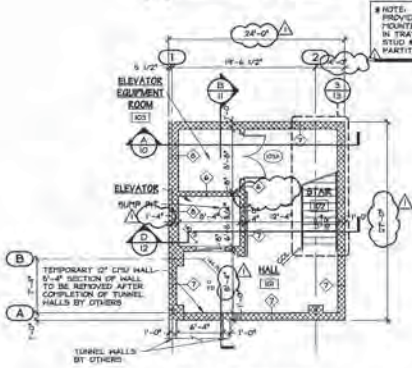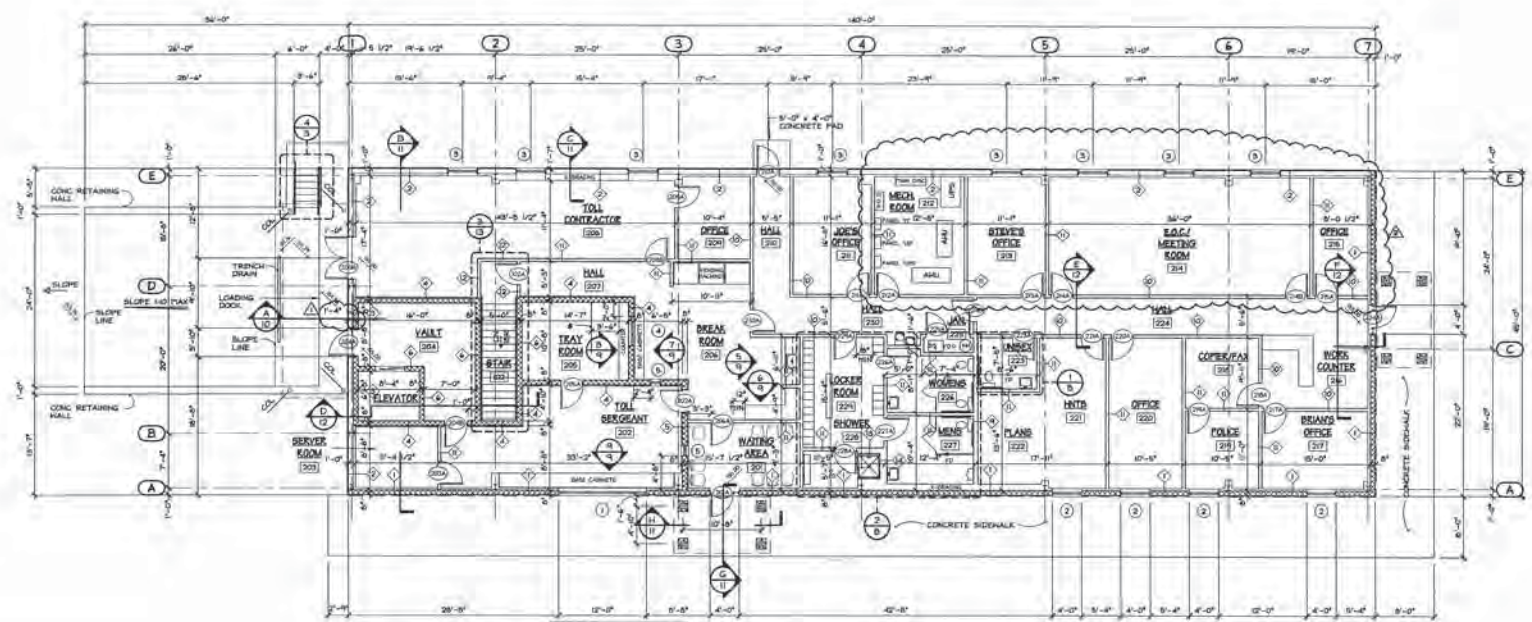

NOTE: PROVIDE FLOOR & WALL POINTED TOILET PARTITION IN TRAY BOOTH OF METAL STUO & GYPSUM BOARD PARTITION. LENGTH 7'






FLOOR PLAN
 SCALE: 1/8" = 1'-0"

WALL LEGEND

- 1/2" BRIT FACE CHU WALL TO 3'-4" AFF - METAL BUILDING HALL. DESIGN AT 3'-4" AFF. INTERIOR 4" x 20ga STEEL STUD HALL w/ 3 1/2" R-10 FG BATT INSUL w/ VAPOR BARRIER & 5/8" GYPSUM BOARD. PROVIDE VENT. BACKED R-10 FG INSULATION FROM TOP OF STUD HALL TO TOP OF METAL BUILDING HALL.
- METAL BUILDING HALL w/ INTERIOR 4" x 20ga STEEL STUD HALL w/ 3 1/2" R-10 FG BATT INSUL w/ VAPOR BARRIER & 5/8" GYPSUM BOARD. PROVIDE VENT. BACKED R-10 FG INSULATION FROM TOP OF STUD HALL TO TOP OF METAL BUILDING HALL.
- METAL BUILDING HALL w/ INTERIOR 6" CHU HALL.
- 6" CHU HALL w/ 1 1/2" x 20ga HAT CHANNELS & 5/8" GYPSUM BOARD.
- 6" CHU HALL w/ 1 1/2" x 20ga HAT CHANNELS & 5/8" GYPSUM BOARD EACH FACE.
- 6" CHU HALL.
- 12" CHU HALL.
- 14" CHU HALL.
- 4" x 20ga METAL STUDS @ 24" w/ 5/8" GYPSUM BOARD EACH FACE.
- 1 HOUR RATED HALL ASSEMBLY - UL DESIGN NUMB #2 x 20ga METAL STUDS @ 24" w/ 3 1/2" FG BOARD BATTIS & 5/8" FIRE RATED GYPSUM BOARD EACH FACE.
- 4" x 20ga METAL STUDS @ 24" w/ 3 1/2" FG BOARD BATTIS & 5/8" GYPSUM BOARD EACH FACE.
- 4" x 20ga METAL STUDS @ 24" w/ 3 1/2" R-10 FG BATT INSULATION w/ VAPOR BARRIER & 5/8" EXTERIOR GRADE GYPSUM BOARD ON INTERIOR FACE OF STAIRWELL & 5/8" GYPSUM BOARD ON TOLL CONTRACTOR & HALL FACE OF HALL.
- 4" x 20ga METAL STUDS @ 24" w/ 3 1/2" FG BOARD BATTIS & 5/8" GYPSUM BOARD EACH FACE.
- 11/2" CHASE HALL - 3 1/4" AIR SPACE BETWEEN 4" x 20ga STEEL STUD WALLS w/ 5/8" GYPSUM BOARD.

NOTE: PROVIDE MOISTURE RESISTANT GYPSUM BOARD IN ALL TOILET BOOTHS, SHOWER & STAIR.

3/8" NOT SCALE DRAWING FOR DIMENSIONS

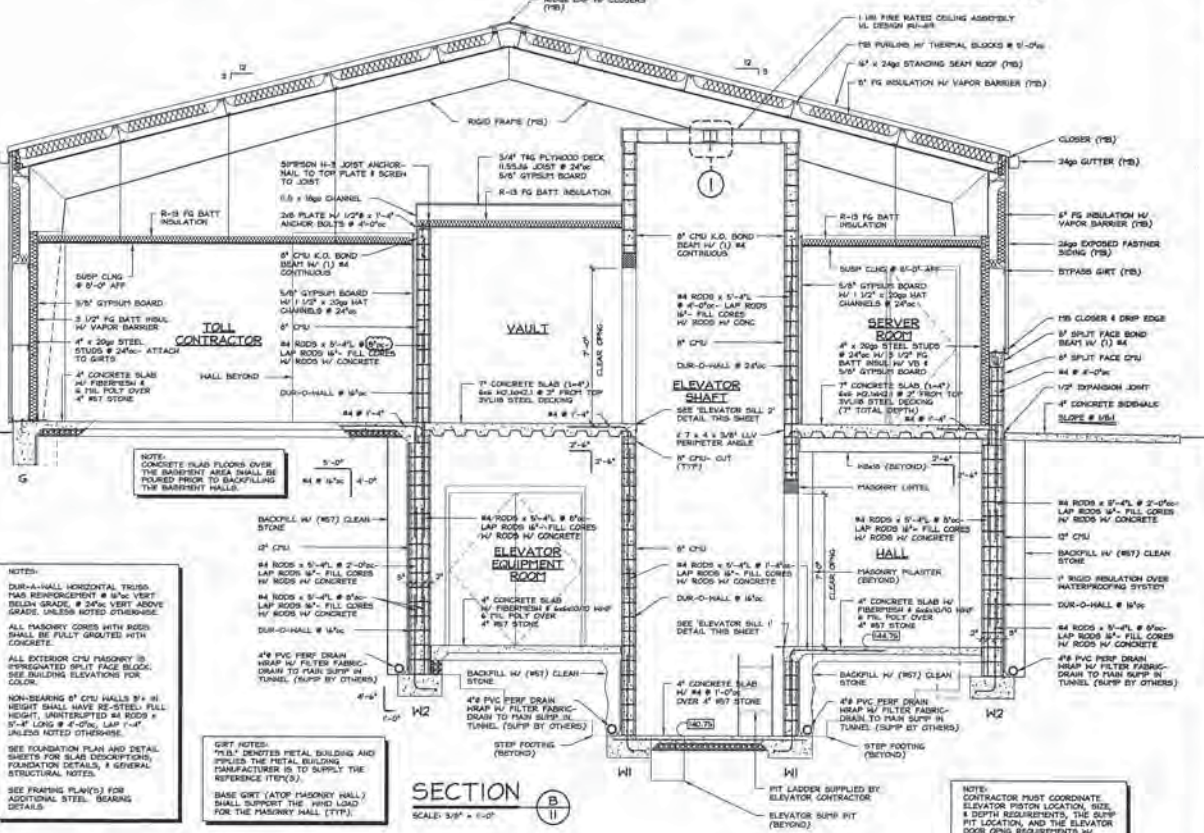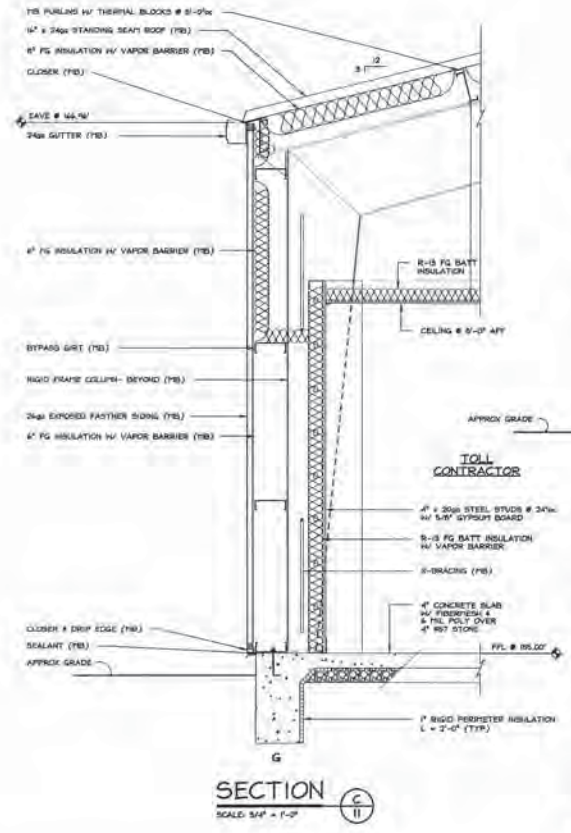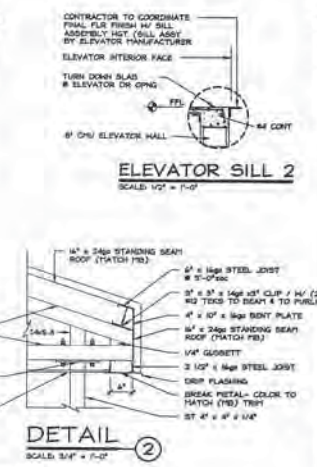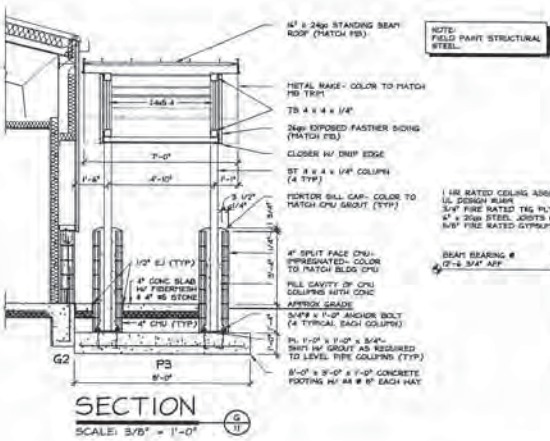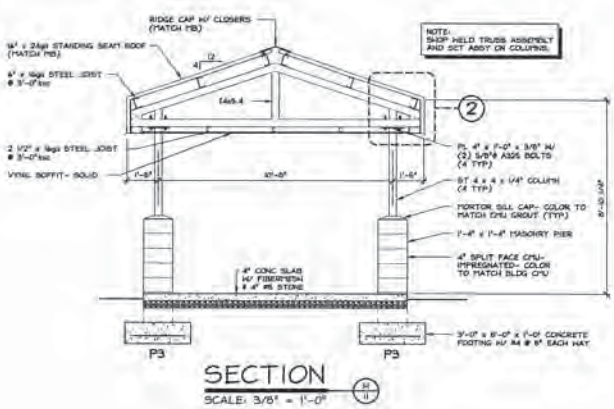

EDA
ENGINEERING DESIGN ASSOCIATES
ARCHITECTS • ENGINEERS • CONSTRUCTION MANAGERS
SURVEYORS • ENVIRONMENTAL SCIENTISTS

5625 LABURNUM AVENUE
RICHMOND, VIRGINIA 23231
PHONE: 804-236-0790
FAX: 804-236-0794

PO BOX 618
WICOMICO CHURCH 22879
PHONE: 804-580-2227
FAX: 804-580-3334



REVISION	NO.	DATE	DESCRIPTION
			ISSUED FOR CONSTRUCTION

PROPOSED BUILDING FOR:
RICHMOND METROPOLITAN AUTHORITY

6626 POWERS PARKWAY, CITY OF RICHMOND, VIRGINIA

BUILDING SECTIONS

DRAWN BY: SHERY HODGE
CHECKED BY: JIM
SCALE: 3/8" = 1'-0"
PROJECT NO. 0007


DATE: December 1, 2008

DRIVING NO. 11 of 16

ELECTRICAL SCHEDULE	
MARK	DESCRIPTION
1001	EXIT LIGHT, 1/2" DIRECTIONAL ARROW OPTION #
EL	EMERGENCY EGRESS LIGHT W/ BATTERY PACK
□	2x4 LAY-IN FLUORESCENT GOV. W/ (4) 40 WATT TUBES W/ PRISMATIC LENS
□	2x4 SURFACE MTD FLUORESCENT GOV. W/ (4) 40 WATT TUBES W/ PRISMATIC LENS
⊞	SINGLE POLE SWITCH
⊞	THREE-WAY SWITCH
⊞	DUPLEX OUTLET, 120 VOLT
⊞	DUPLEX OUTLET, 120 VOLT W/ GROUND FAULT INTERRUPT (GFI)
⊞	TELE OUTLET, PROVIDE BOX AND FULL STRING
⊞	DATA LINK OUTLET, PROVIDE BOX AND FULL STRING
⊞	TELE / DATA LINK OUTLET, PROVIDE BOX AND FULL STRING
⊞	ELECTRICAL WATER HEATER, 120V / 2000W ENERGY EFFICIENT TYPE
⊞	WATER COOLER, ADA COMPLIANT, 120V, 50 VOLT

ELECTRICAL NOTES

- THE ELECTRICAL WORK SHALL BE PER THE NATIONAL ELECTRICAL CODE AND ALSO CONFORM TO THE REQUIREMENTS OF THE LOCAL POWER COMPANY AND THE CITY OF RICHMOND, VIRGINIA.
- THE ELECTRICAL CONTRACTOR SHALL DETERMINE THE ELECTRICAL SERVICE REQUIREMENTS AND VERIFY THE VOLTAGE AVAILABLE FOR THE ELECTRICAL SERVICE.
- ALL MECHANICAL AND ELECTRICAL EQUIPMENT SHALL BE U.L. APPROVED.
- THE ELECTRICAL CONTRACTOR SHALL FURNISH ANY AND ALL ACCESSORY MATERIAL AND LABOR AS REQUIRED TO INSURE THE PROPER OPERATION AND CODE COMPLIANCE OF ALL MECHANICAL AND ELECTRICAL EQUIPMENT.
- THE CONTRACTOR SHALL SUPPLY AND INSTALL ALL POWER WIRING AND ASSOCIATED ITEMS (SWITCHES, STARTERS, FUSES, BREAKERS, PANEL BODIES, OUT-LETTS FOR THE PROPOSED MECHANICAL EQUIPMENT, I.E., HEATING, AIR CONDITIONING, FANS, EXHAUSTS, ETC. WHICH WILL BE SUPPLIED BY THE MECHANICAL CONTRACTOR. THE MECHANICAL CONTRACTOR SHALL PROVIDE AND INSTALL ALL LOW VOLTAGE CONTROL WIRING.
- CONTRACTOR SHALL VERIFY BRACK LOCATION AND RATING OF EQUIPMENT TO BE INSTALLED AND ACCORDS WITH ELECTRICAL INTERFACES AS RECOMMENDED BY THE MANUFACTURER.
- ALL WIRING SHALL HAVE COPPER CONDUCTORS, WIRE INSULATION RATING SHALL MATCH OR EXCEED EQUIPMENT RATING.
- WHERE PERMITTED BY CODE AND AUTHORITY HAVING JURISDICTION, TYPE FC CABLE MAY BE USED.
- DO NOT MIX RECEPTACLE CIRCUITS WITH LIGHTING CIRCUITS.
- LABEL CIRCUITS ON PANELS AND JUNCTION BOX COVERS USING ENDORSED OR PRINTED SELF-ADHESIVE TAPE.
- PROVIDE FOR ANY ADDITIONAL EGRESS / EXIT LIGHTING AS REQUIRED BY THE FIRE MARSHALL'S OFFICE.
- THE ELECTRICAL CONTRACTOR SHALL ROUNG-IN TELEPHONE / DATA COMMUNICATION BODIES WITH 3/4" CONDUIT AND SHALL EXTEND EMPTY CONDUIT 4' ABOVE THE CEILING. THE OWNER SHALL BE RESPONSIBLE FOR THE INSTALLATION OF THE PHONE / DATA COMMUNICATIONS SYSTEM.
- ALL EGRESS LIGHTING (INCLUDING BATTERY PACKS) # EXTERIOR SHALL PACK FITURED SHALL HAVE A 5-YR. (5YR.) WARRANTY.
- PANEL BODIES, DISCONNECTS, ETC. SHALL BE SQUARE D OR G.E. BRAND OR EQUAL AS APPROVED BY ENGINEER.
- ALL WIRING SHALL BE CONCEALED #WHERE POSSIBLE.
- ELECTRICAL OUTLETS IN THE TOILETS AND # BREAK RT# SINK COUNTERS SHALL BE GFI DUPLEX OUTLETS. MOUNT OUTLETS ABOVE THE LAVATORIES / COUNTERS.
- OWNER SHALL PAY ANY POWER COMPANY CHARGES FOR PERMANENT POWER.
- CONTRACTOR TO MAKE ALL ARRANGEMENTS FOR ELECTRICAL SERVICE TO INCLUDE LOAD LETTER.
- COORDINATE ALL WORK WITH THE MECHANICAL CONTRACTOR AND OTHER TRADES AS APPROPRIATE.

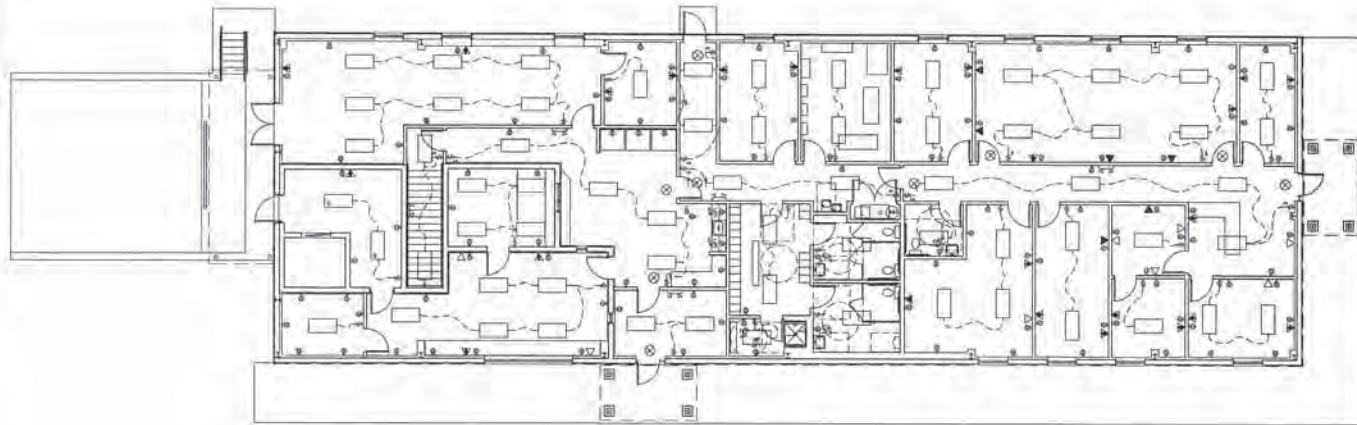

FIRST FLOOR
ELECTRICAL LAYOUT PLAN
SCALE: 1/8" = 1'-0"



BASEMENT
ELECTRICAL LAYOUT PLAN
SCALE: 1/8" = 1'-0"

EDDA
ENGINEERING DESIGN ASSOCIATES
ARCHITECTS • ENGINEERS • CONSTRUCTION MANAGERS
SURVEYORS • ENVIRONMENTAL SCIENTISTS

5626 LABURNUM AVENUE
RICHMOND, VIRGINIA 23231
PHONE: 804-234-0190
FAX: 804-236-0194

PO BOX 616
WICOMCO CHURCH 22879
PHONE: 804-580-2227
FAX: 804-580-3334



REVISION		DESCRIPTION	
NO.	DATE	BY/DATE	ISSUED FOR CONSTRUCTION

PROPOSED BUILDING FOR:
RICHMOND METROPOLITAN AUTHORITY

6524 POWERS TOWERWAY - CITY OF RICHMOND - VIRGINIA

ELECTRICAL LAYOUT PLAN


DRAWN BY: BARRY HOOVER
CHECKED BY: LEE
SCALE: 1/8" = 1'-0" DATE: November 14, 2008 PROJECT NO. 00007

DEWING NO.

15 of **16**



BASEMENT FLOOR PLAN - MECHANICAL
SCALE: 1/8" = 1'-0"

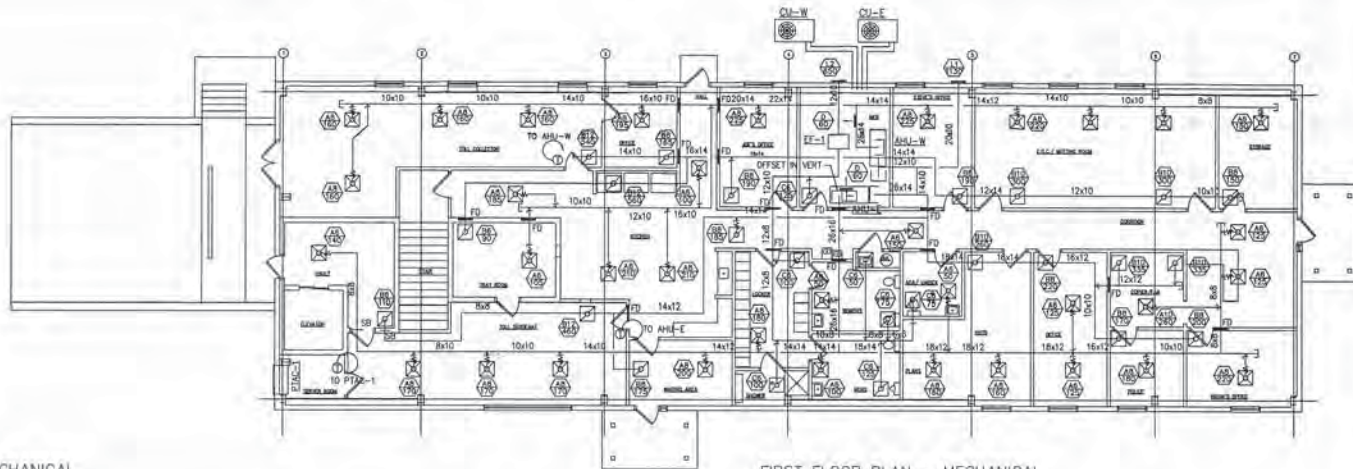

FIRST FLOOR PLAN - MECHANICAL
SCALE: 1/8" = 1'-0"

SPLIT SYSTEM AIR COOLED HEAT PUMP SCHEDULE

UNIT NUMBER	LOCATION AND AREAS SERVED	INDOOR UNIT										OUTDOOR CONDENSING UNIT										REMARKS																			
		FAN DATA				MOTOR DATA				DX COOLING COIL DATA		HEATING COIL DATA				SELECTION BASED ON		COMPRESSOR DATA					CONDENSER FAN DATA		SELECTION BASED ON																
		CFM	GA	EXTERNAL S.P. IN. W.G.	TOTAL S.P. IN. W.G.	HP	RPM	V	PH	HZ	NO. ROWS	PI	NO. CIRC.	FACE AREA S. F.	ENT. AIR TEMP. °F	LEAF TEMP. °F	SENSE. WBTU	TOTAL WBTU	CFM	ENT. AIR TEMP. °F	LEAF TEMP. °F	CAPACITY MSH	V	PH	HZ	KW	MANUFACTURER	MODEL NUMBER	UNIT NUMBER	NO.	INPUT KW SA	V	PH	HZ	HP	CFM	V	PH	HZ	MANUFACTURER	MODEL NUMBER
AHU-E	EAST OFFICES	2915	850	0.75	2.00	2	1725	230	3	60	4	12	1	11.2	61	67	75.8	99.2	2915	58	78	81.5	230	3	60	25	AM STD.	TWE120A3	CU-E	1	9.84	230	3	60	1	8200	230	1	60	AM STD.	TWA120A3
AHU-R	WEST OFFICES	2965	400	0.75	2.00	2	1725	230	3	60	4	12	1	11.2	60	80	76.7	95.9	2965	62	78	50.8	230	3	60	25	AM STD.	TWE120A3	CU-R	1	9.84	230	3	60	1	8200	230	1	60	AM STD.	TWA120A3

PACKAGED AIR CONDITIONING UNIT SCHEDULE

UNIT NUMBER	LOCATION AND AREAS SERVED	COOLING COIL DATA				HEATING COIL DATA				FAN DATA				SELECTION BASED ON		REMARKS		
		CFM	GA	COOLING TOTAL BTU/HR	CFM	GA	HEATING CAPACITY BTU/HR	V	PH	HZ	KW	CFM	WATTS	V	PH		HZ	MANUFACTURER
PAU-1	SERVER ROOM	300	50	11,700	310	50	10,600	230	1	60	2.0	310	1114	230	1	60	MOQUAY	PSM1010Z

AIR DISTRIBUTION DEVICE SCHEDULE

UNIT NUMBER	SERVICE	SHAPE	MATERIAL	THICK	FINISH	ACCESSORIES	SELECTION BASED ON		REMARKS
							MANUFACTURER	MODEL NUMBER	
A	SUPPLY	SQUARE	ALUMINUM	LAY IN	WHITE	GRID	TITUS	RA5	
B	RETURN	SQUARE	ALUMINUM	LAY IN	WHITE	GRID	TITUS	PAR	
C	EXHAUST	SQUARE	ALUMINUM	LAY IN	WHITE	GRID	TITUS	PAR	
D	SUPPLY	RECT	ALUMINUM	SURFACE	WHITE	GRID	TITUS	3FL	8x6
L1	O A INTAKE	RECT	ALUMINUM	SURFACE	WHITE	SR.BD.BS	RUSKIN	ELF2110	30x24
L2	EXHAUST	SQUARE	ALUMINUM	SURFACE	WHITE	SR.BD.BS	RUSKIN	ELF2110	18x18

GENERAL FAN SCHEDULE

UNIT NUMBER	LOCATION AND AREAS SERVED	TYPE	CFM	TOTAL S.P. IN. W.G.	FAN RPM	MOTOR DATA				SELECTION BASED ON		REMARKS
						HP	RPM	V	PH	HZ	MANUFACTURER	
EF-1	GENERAL EXHAUST	INLINE	800	1.00	UNIT	1/2	1330	115	1	60	PENNBARRY	Z102H

MECHANICAL SYMBOLS

SYMBOL	DESCRIPTION
	NEW DIFFUSER DESIGNATION (TOP - TYPE, HEX. DIAMETER, BOTTOM - CFM)
	NEW EQUIPMENT
	NEW DUCT
	NEW SUPPLY DIFFUSER
	NEW R/A OR EXHAUST GRILLE
	FLEXIBLE DUCT
	THERMOSTAT
	SPIN-IN TAP WITH VOLUME DAMPER
	SPIN-IN TAP W/O VOLUME DAMPER
	MANUAL VOLUME DAMPER
	REFRIGERANT LIQUID PIPE
	REFRIGERANT GAS PIPE
MECHANICAL ABBREVIATIONS	
AFF	ABOVE FINISHED FLOOR
BD	BACKDRAFT DAMPER
BS	BIRD SCREEN
CU	CONDENSING UNIT
EF	EXHAUST FAN
ODD	OPPOSED BLADE DAMPER
RA	RETURN AIR
SA	SUPPLY AIR
SB	SECURITY BARS
FD	FIRE DAMPER WITH ACCESS DOOR

MECHANICAL GENERAL NOTES

- ALL WORK SHALL BE PERFORMED IN ACCORDANCE WITH THE APPLICABLE STATE AND LOCAL CODES.
- THE ROUTING OF ALL DUCTWORK AND PIPING AS SHOWN ON THE DRAWING ARE DIAGRAMMATIC ONLY, INTENDING TO SHOW GENERAL RUNS AND LOCATIONS OF EQUIPMENT, DUCTWORK PIPING AND SPECIALTIES. THE CONTRACTOR SHALL COORDINATE WORK WITH ALL OTHER TRADES.
- NO DUCTWORK OR PIPING SHALL BE ROUTED OVER ELECTRICAL EQUIPMENT.
- ALL DUCTWORK AND PIPING SHALL BE ROUTED CONCEALED IN WALLS OR ABOVE CEILING EXCEPT IN MECHANICAL EQUIPMENT ROOM WHERE EXPOSED WORK IS ACCEPTABLE.
- ALL DUCTWORK SHALL BE CONSTRUCTED AND INSTALLED PER SMACNA.
- SUPPLY DUCTWORK SHALL BE LINED, GALVANIZED SHEET METAL WITH INSULATED FLEXIBLE BRANCH DUCTWORK NOT TO EXCEED 10'-0" IN LENGTH.
- RETURN AIR AND OUTSIDE AIR DUCTWORK SHALL BE LINED, GALVANIZED SHEET METAL.
- EXHAUST DUCTWORK SHALL BE GALVANIZED SHEET METAL. EXHAUST DUCTWORK FROM THE SHOWER ROOM SHALL BE ALUMINUM UNTIL IT CONNECTS TO THE MAIN DUCT.
- PROVIDE FIRE DAMPERS AND ACCESS DOORS AS SHOWN.
- PROVIDE SECURITY BARS AT ALL VAULT WALL PENETRATIONS.
- PROVIDE ELECTRICAL DISCONNECTS FOR ALL MECHANICAL EQUIPMENT.
- PROVIDE TYPE L COPPER REFRIGERANT LINES AS SIZED BY THE EQUIPMENT MANUFACTURER.
- PROVIDE CONDENSATE TRAPS AND DRAINS TO NEAREST FLOOR DRAIN AND TERMINATE WITH AN AIR CAP.

PROJ. NO. G280007
 PROJ. MGR. - CS
 DESIGNED BY - CLM
 DRAWN BY - EDU
 CHECKED BY - CS
 DATE - 11-30-08

REVISIONS

DRAWING TITLE
 FLOOR PLANS, LEGEND, NOTES
 AND SCHEDULES - MECHANICAL

PROJECT

PROPOSED BUILDING FOR:
 RICHMOND METROPOLITAN AUTHORITY

DATE: 11-30-08

**SOUTHWORTH
 MECHANICAL
 CORPORATION**

SHEET NO.


M-1

1 OF 1

FOREST HILL AVENUE RAMPS

TOLL PLAZA ORIGINAL PLANS

RICHMOND EXPRESSWAY SYSTEM			
SECTION	PROJECT	SHEET NO.	TOTAL SHEETS
2	POWHITE PARKWAY	86	188

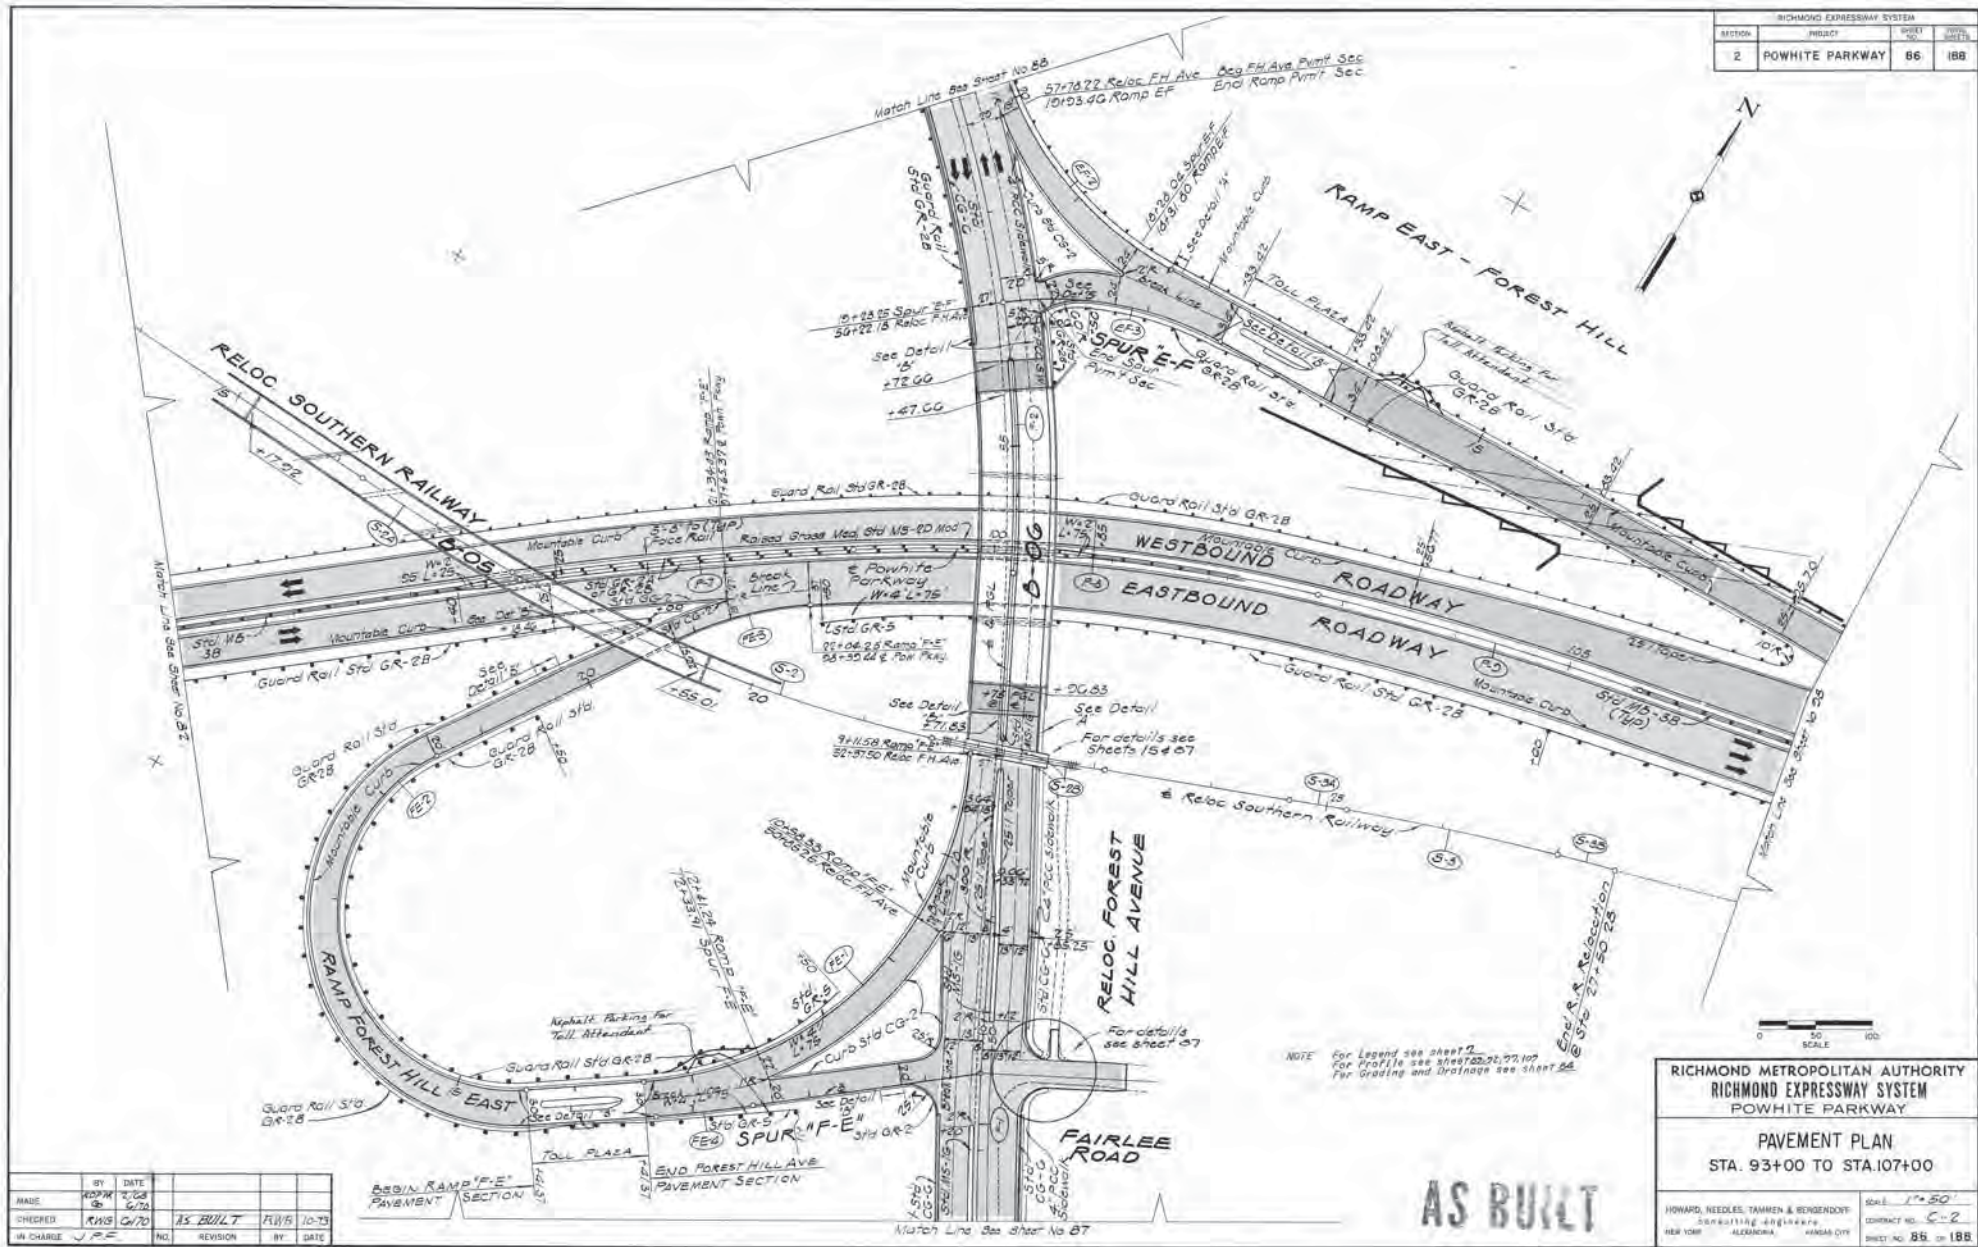

MADE	BY	DATE	REVISION	BY	DATE
	ADP/R	2/28			
	SB	5/24			
CHECKED	RWB	6/20	AS BUILT	FLH	10-23
IN CHARGE	JFC				






RICHMOND METROPOLITAN AUTHORITY
RICHMOND EXPRESSWAY SYSTEM
POWHITE PARKWAY

PAVEMENT PLAN
STA. 93+00 TO STA. 107+00

HOWARD, NEEDLES, TAMMEN & BERGENDORF
 CONSULTING ENGINEERS
 NEW YORK ALEXANDRIA HANSA CITY

SCALE: 1"=50'
 CONTRACT NO. C-2
 SHEET NO. 86 OF 188

RICHMOND EXPRESSWAY SYSTEM			
SECTION	PROJECT	SHEET	TOTAL SHEETS
2	POWHITE PARKWAY	43	188

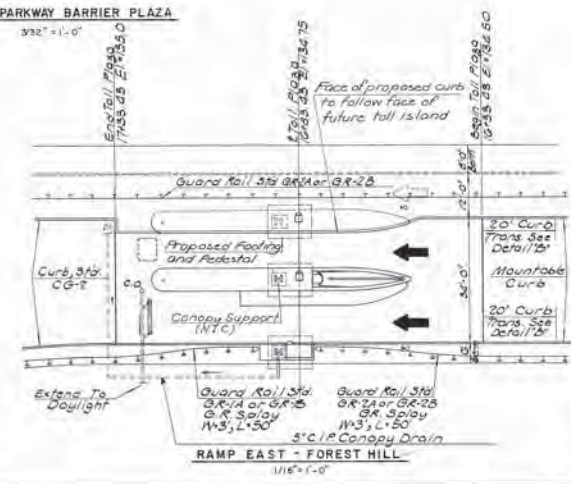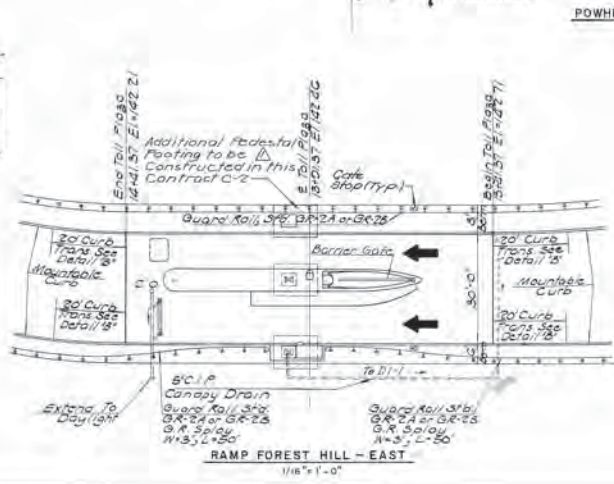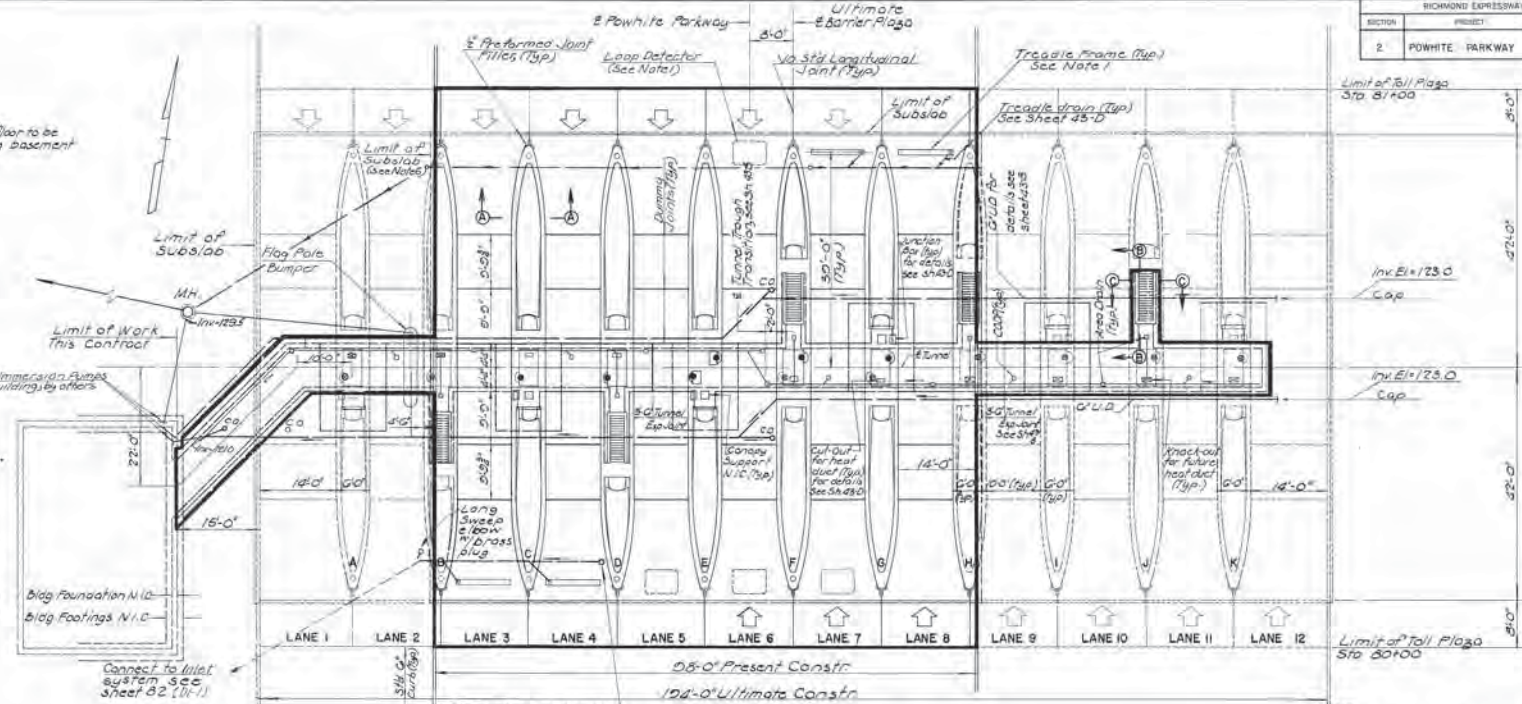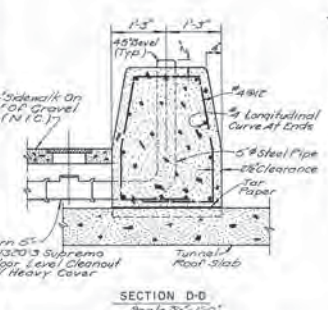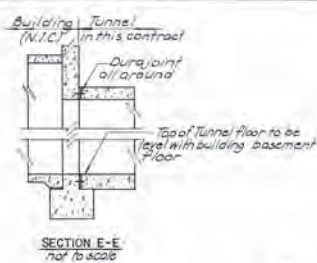

- NOTES:**
- To be placed by Toll Equipment Contractor prior to the paving, under this Contract.
 - Tunnel drainage trough to begin at the building foundation.
 - C.O.D.P. = Clean out Drain Pipe.
 - Sections A-A, B-B and C-C appear on sheets 52-5.
 - Place 2\"/>

- LEGEND:**
- Location of future traffic signal
 - Traffic signal, (N.I.C.)
 - Automatic Toll Machine, (N.I.C.)
 - Future Automatic Toll Machine
 - Toll Booth, (N.I.C.)
 - Prop Coin Tubes
 - Future Coin Tubes

AS BUILT

RICHMOND METROPOLITAN AUTHORITY
RICHMOND EXPRESSWAY SYSTEM
POWHITE PARKWAY


MAINLINE B RAMP
TOLL PLAZA PLANS

HOWARD, WHEELER, TAMMEN & BERENSON
CONSULTING ENGINEERS
NEW YORK BOSTON NORFOLK




SCALE: As Noted
CONTRACT NO. E-2
SHEET NO. 43 OF 188

MADE	BY	DATE	REV	DATE	BY	DATE
CHREAZI	RWG	8/70	2	As BUILT	JRC	8/73
IN CHARGE	JPF		NO.	REVISION	BY	DATE


RICHMOND EXPRESSWAY SYSTEM			
SECTION	PROJECT	SHEET	TOTAL SHEETS
2	POWHITE PARKWAY	43-E	188

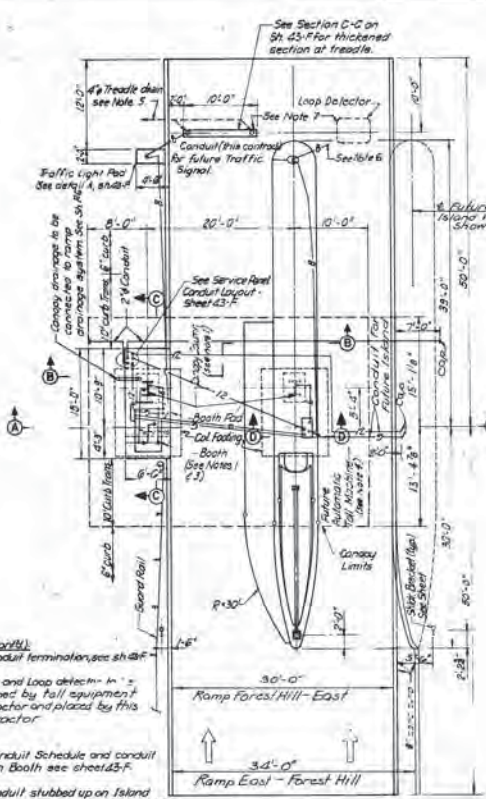


- NOTES (Cont'd)**
- 6 For conduit termination, see sheet 43-F.
 - 7 Treadle and loop detector are furnished by toll equipment contractor and placed by this contractor.
 - 8 For Conduit Schedule and conduit zone in Booth see sheet 43-F.
 - 9 All conduit stubbed up on Island one to be terminated as per Detail "H", all other conduit to be stubbed as per Detail "B" on sheet 43-F.
 - 10 For pedestals which are to carry future columns the anchor bolt projections are to be grouted and wrapped in burles.

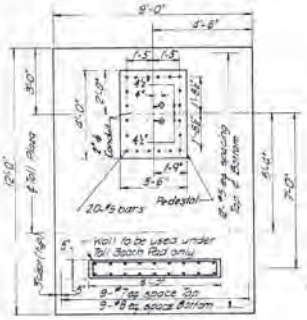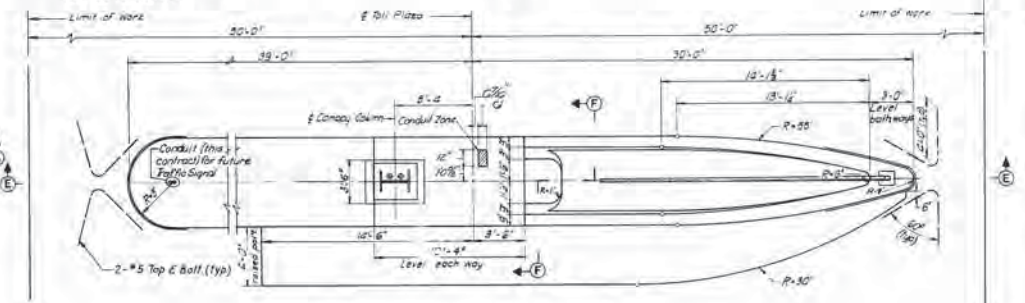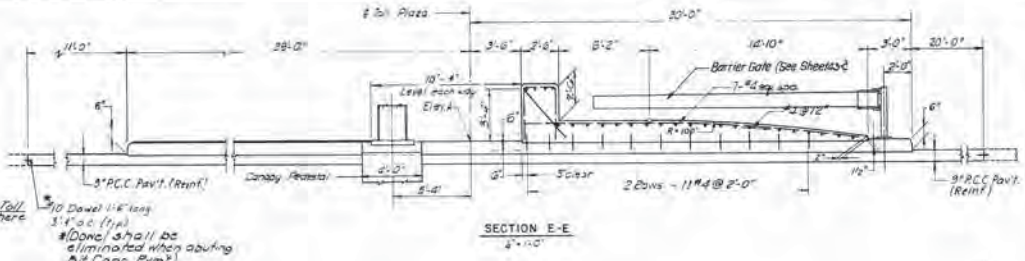


TYPICAL FOOTING PLAN
3'-10"

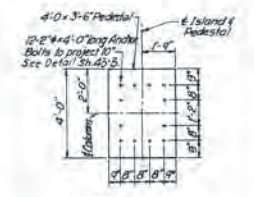


ANCHOR BOLT LAYOUT
3'-7'-0"

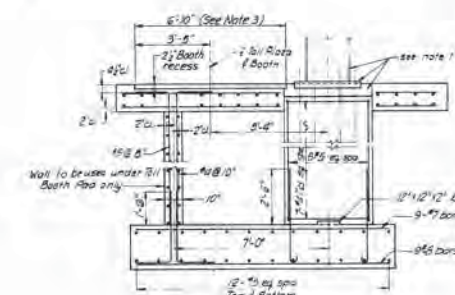


SECTION C-C
3'-10"

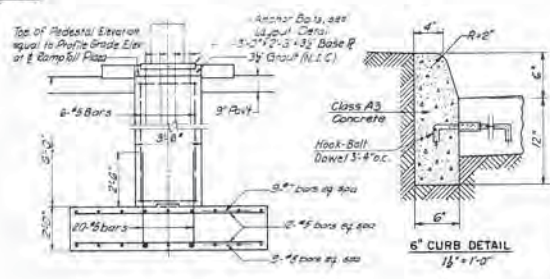

SECTION D-D
3'-10"

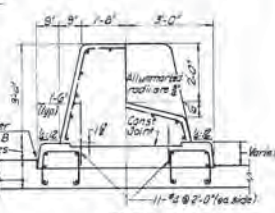

SECTION E-F
3'-10"

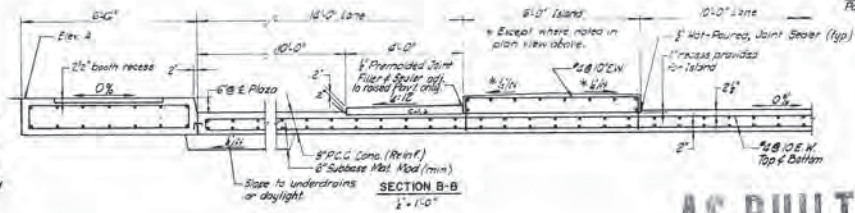

SECTION B-B
3'-10"

- NOTES**
- 1 Item not in this Contract.
 - 2 Elev. A equals Profile Grade elevation of the 1/2" Boll. Plaza, plus six (6) inches.
 - 3 Anchor bolt locations and booth recess dimensions the same as those on "Plan of Island with stairway" and details, Sh. 43-A.
 - 4 Automatic toll machine to be cinch anchored into place. Item and installation not in this Contract.
 - 5 Treadle drain to be connected to the area drainage system. Direction shown to be verified in the field. For treadle details, see Sh. 43-D.

BY	DATE	3	A3 Built	JRC	6-73
MADE	W.A.B.	6-88	2	Revised/ASB/Revised	7/1/93
CHECKED	D.E.H.	6-88	1	Final Check	D.E.H. 6-88
IN CHARGE	H.D.S.	NO.	REVISION	BY	DATE

RICHMOND METROPOLITAN AUTHORITY
RICHMOND EXPRESSWAY SYSTEM
POWHITE PARKWAY

PLAN AND DETAILS
TWO LANE RAMP TOLL PLAZA

SCALE: AS NOTED
 CONTRACT NO. C-2
 HOWARD, NEEDLES, TAMMEN & BERGENDOFF
 CONSULTING ENGINEERS
 NEW YORK ALEXANDRIA HANOVER CITY
 SHEET NO. 43-E OF 188

AS BUILT





FOREST HILL AVENUE RAMPS

WIDENING OF RAMP FROM S.B. POWHITE PARKWAY TO FOREST HILL
AVENUE

ORIGINAL PLANS FOR CONSTRUCTION OF RAMP FROM E.B. FOREST
HILL AVENUE TO N.B. POWHITE PARKWAY

RICHMOND EXPRESSWAY SYSTEM			
SECTION	PROJECT	SHEET NO.	TOTAL SHEETS
12	POWHITE PARKWAY	8	

GEOMETRIC TABLE					
NO.	STATION	OFFSET	NO.	STATION	OFFSET
1	PC 95+74.15		13	POT 13+59.87	50.0' Lt.
2	Nose 97+15.74	46.25' Rt.	14	PT 15+15.75	
3	PCC 98+79.09		15	POT 15+65.70	4.00' Lt.
4	PCC 98+72.43	38.25' Rt.	16	POT 16+65.70	4.00' Lt.
5	PCC 98+79.09	52.25' Rt.	17	PC 17+00.70	
6	P.I., N.C. 19+85.00	20.00' Lt.	18	PT 17+94.45	
7	PC 20+42.94	15.75' Lt.	19	PC 18+22.50	25.00' Lt.
8	Nose 20+83.01	19.54' Lt.	20	PCC 18+77.91	
9	PCC 21+52.54		21	105+77.00	59.12' Rt.
10	PC 11+95.07	40.40' Rt.	22	105+00.00	62.57' Rt.
11	PCC 12+52.95	22.00' Lt.	23	PT 105+62.94	
12	PCC 13+40.22				

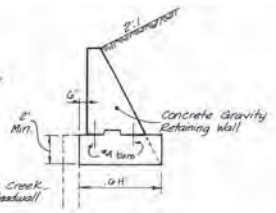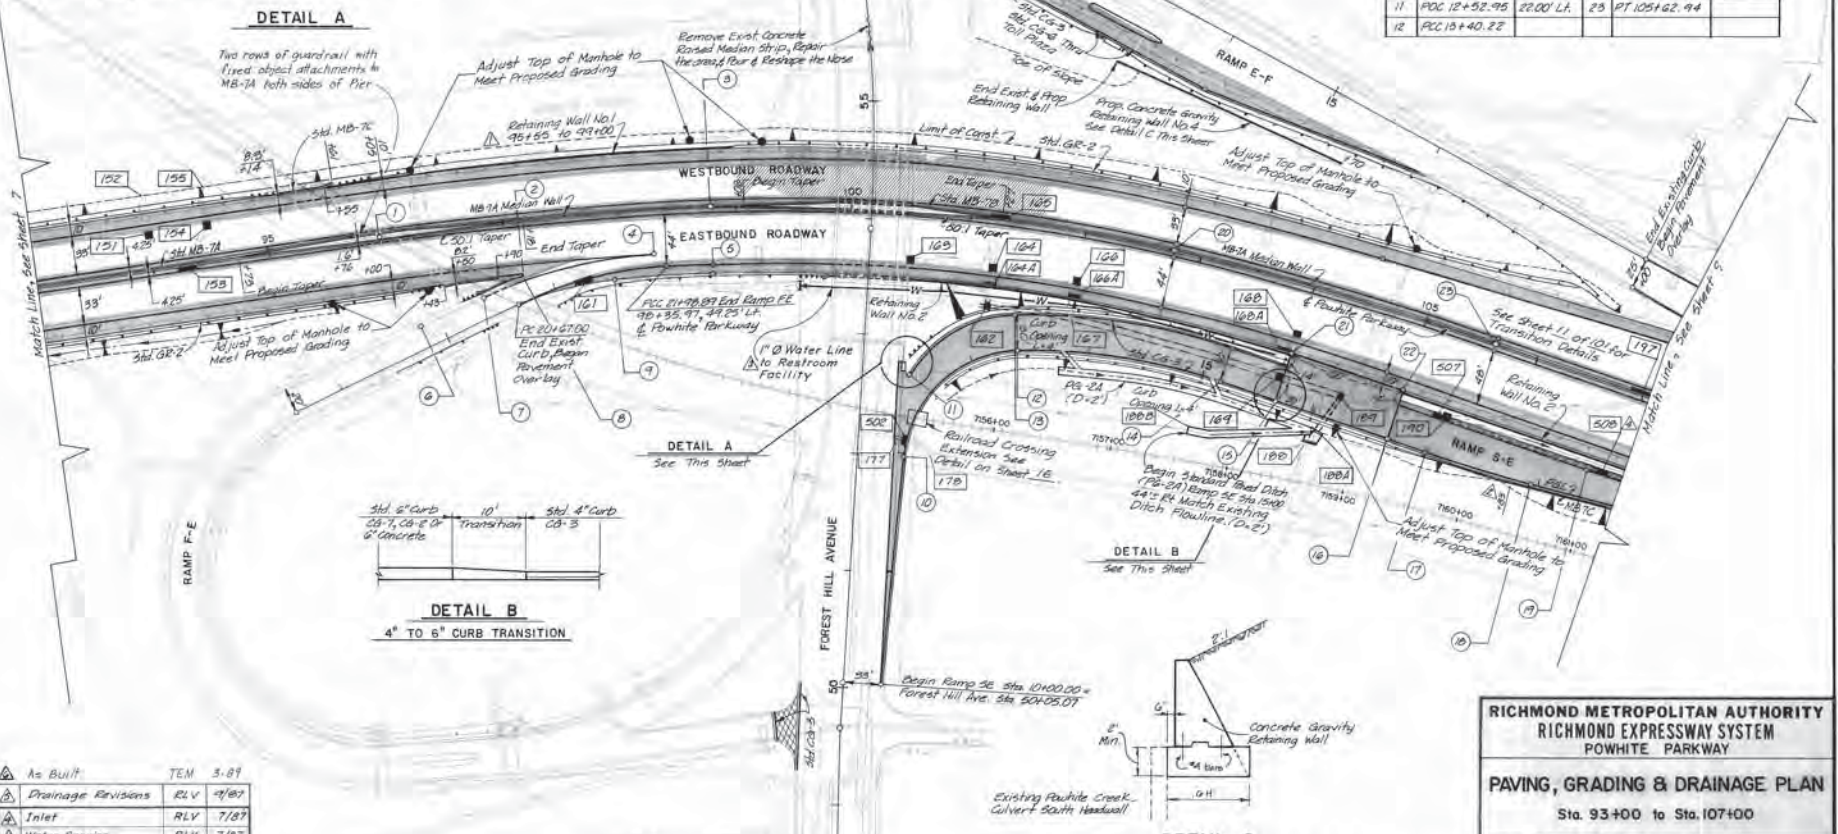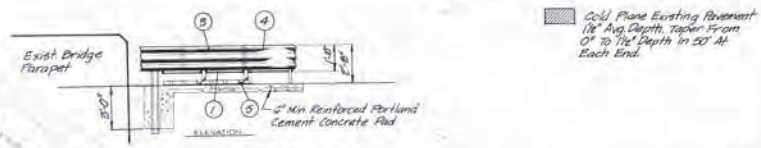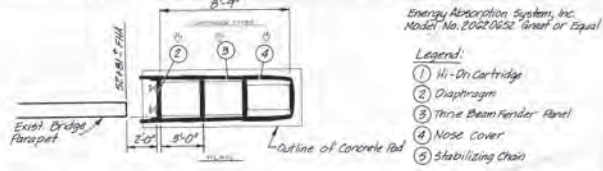

By	Date	As Built	TEM	3-89
		Drainage Revisions	RLV	4/87
		Water Service	RLV	7/87
		Elimination of Retaining Wall	RLV	5/88
		Addendum NO. 1	RLV	4/87
Approved	DJA 3/87	No.	Revision	By Date

RICHMOND METROPOLITAN AUTHORITY
RICHMOND EXPRESSWAY SYSTEM
POWHITE PARKWAY

PAVING, GRADING & DRAINAGE PLAN
 Sta. 93+00 to Sta. 107+00

HOWARD NEEDLER TAMMEN & BERGENSOFF
 ARCHITECTS
 ENGINEERS
 1000 MARKET STREET
 PHILADELPHIA, PA 19102

Scale: 1" = 50'
 Date: MARCH 1987
 Contract No: C-12
 Sheet: 8 of 8

AS BUILT