


TS-03 APPENDIX B: REFERENCE DRAWINGS

The purpose of the TS-03 APPENDIX B Reference Drawings is to provide a general description of certain of the scope and technical requirements of RMTA’s Toll Collection System, and RMTA DOES NOT REPRESENT OR WARRANT THAT THE INFORMATION CONTAINED IN TS-03 APPENDIX B REFERENCE DRAWINGS IS EITHER COMPLETE OR ACCURATE OR IN CONFORMITY WITH THE REQUIREMENTS OF RMTA-PROVIDED APPROVALS. All Proposers are advised that the Work to be undertaken under the RFP is to be performed by the winning Proposer, and each Proposer, by submitting a proposal, understands and agrees that RMTA shall not be responsible or liable in any respect for any losses whatsoever suffered by any Proposer by reason of any use of any information contained in TS-03 APPENDIX B Reference Drawings. Each Proposer further acknowledges and agrees that, by submitting a proposal, (a) if and to the extent it or anyone on its behalf uses any of such information in any way, such use is made on the basis that the Proposer, and not RMTA, has approved and is responsible for such information, and (b) the Proposer is capable of conducting and is obligated hereunder to conduct any and all studies, analyses, diligence and investigations as it deems advisable to verify or supplement such information, and that any use of such information is in all respects at each Proposer’s own risk and in its own discretion.

TABLE OF CONTENTS







1. Tolling Locations	2
2. Boulevard Bridge Toll Plaza.....	3
3. DTE Toll Plaza (Administration Building & Toll Plaza).....	14
4. DTE Open Road Tolling.....	26
5. DTE Open Road Tolling (Toll Gantry Shop Drawings and Structural Calculations)	58
6. DTE Ramp Toll Plaza.....	80
7. DTE Ramp Toll Plaza (11 th St Ramp Widening)	87
8. Douglasdale Ramp Toll Plaza	91
9. Northbound Powhite Parkway Toll Plaza (Administration Building & Toll Plaza)	96
10. Northbound Powhite Parkway Toll Plaza (1978 Widening)	108
11. Northbound Powhite Parkway Toll Plaza (1989 Widening)	115
12. Northbound Powhite Parkway Toll Plaza (2006 Partial Demo Plan)	117
13. Powhite Parkway Toll Plaza (Toll Gantry Shop Drawings and Structural Calculations).....	124
14. Southbound Powhite Parkway Toll Plaza (Administration Building & Toll Plaza)	175
15. Forest Hill Avenue Ramps	197
16. Forest Hill Avenue SB Off Ramp Widening & Original On Ramp to NB Powhite Parkway)	202

RMA EXPRESSWAY SYSTEM

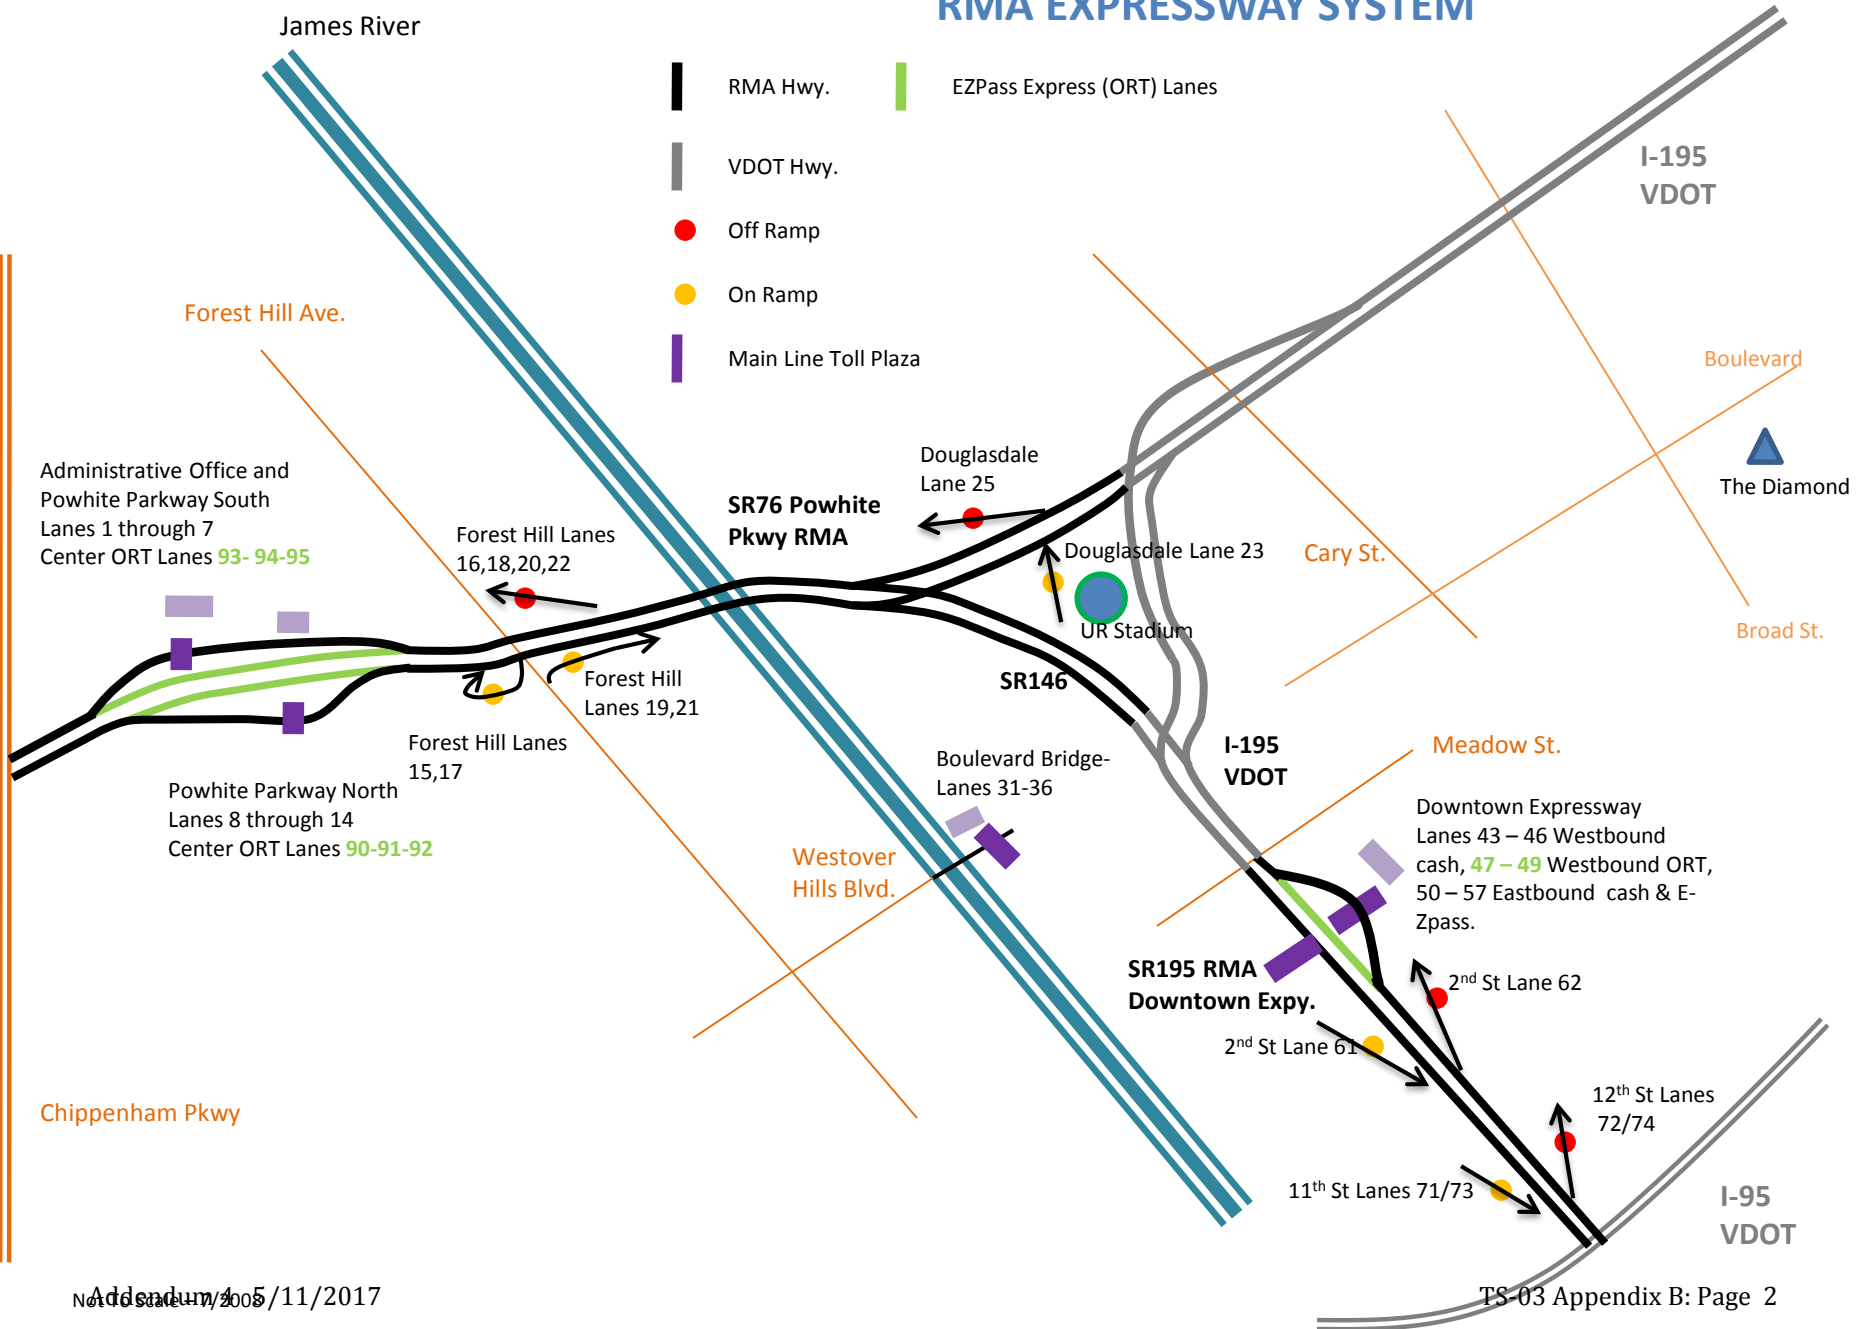

BOULEVARD BRIDGE TOLL PLAZA

TOLL PLAZA AND ADMINISTRATION BUILDING

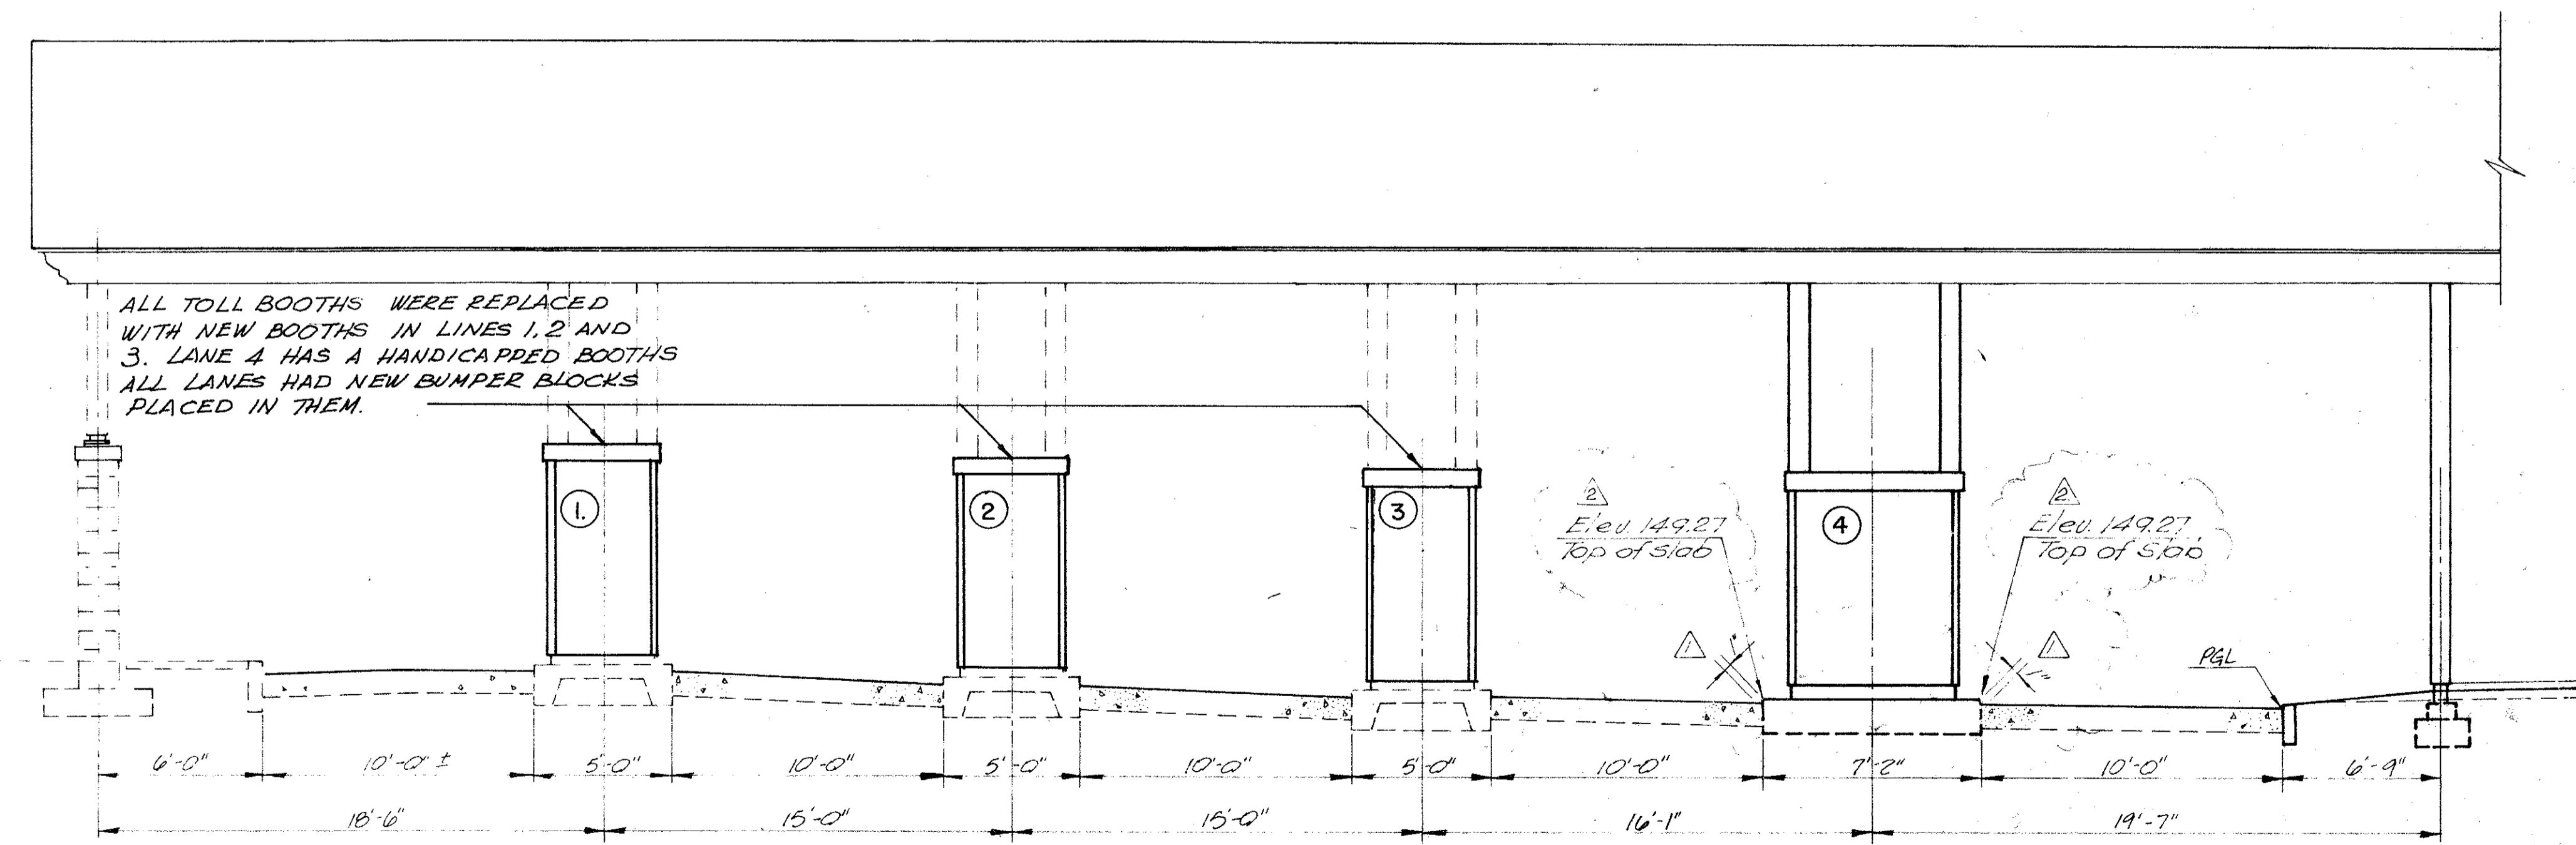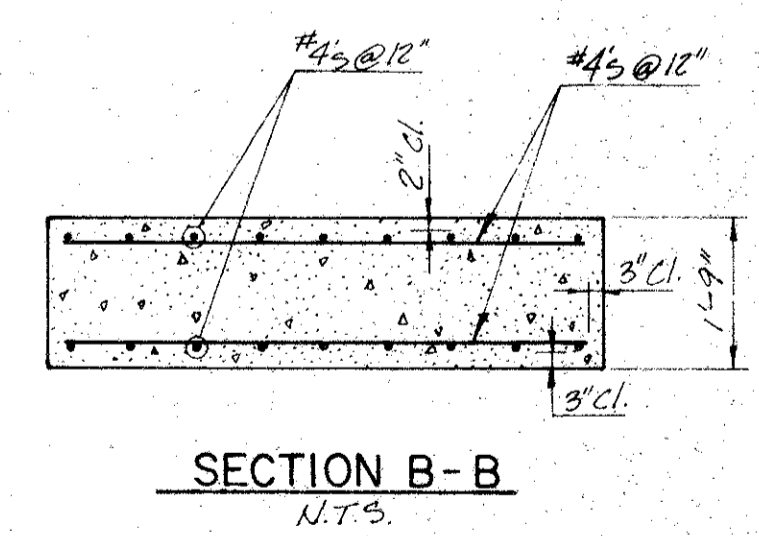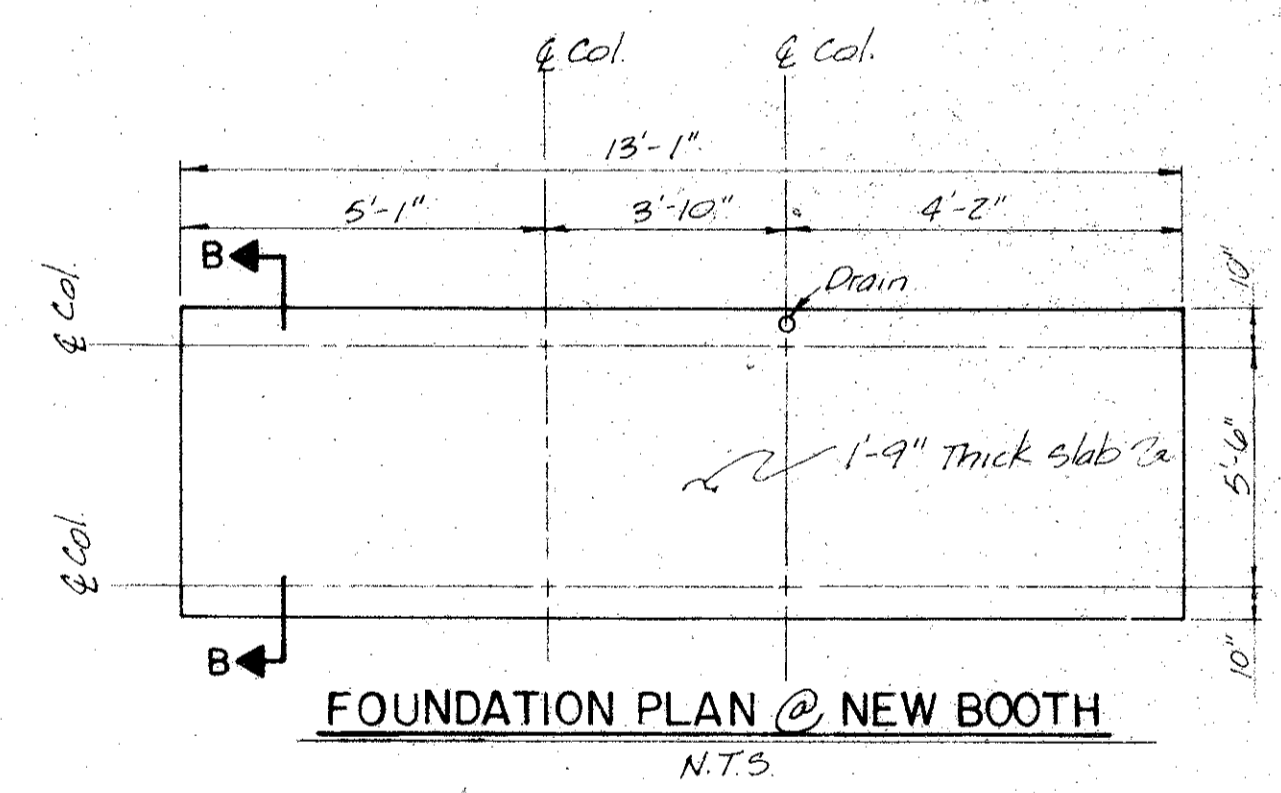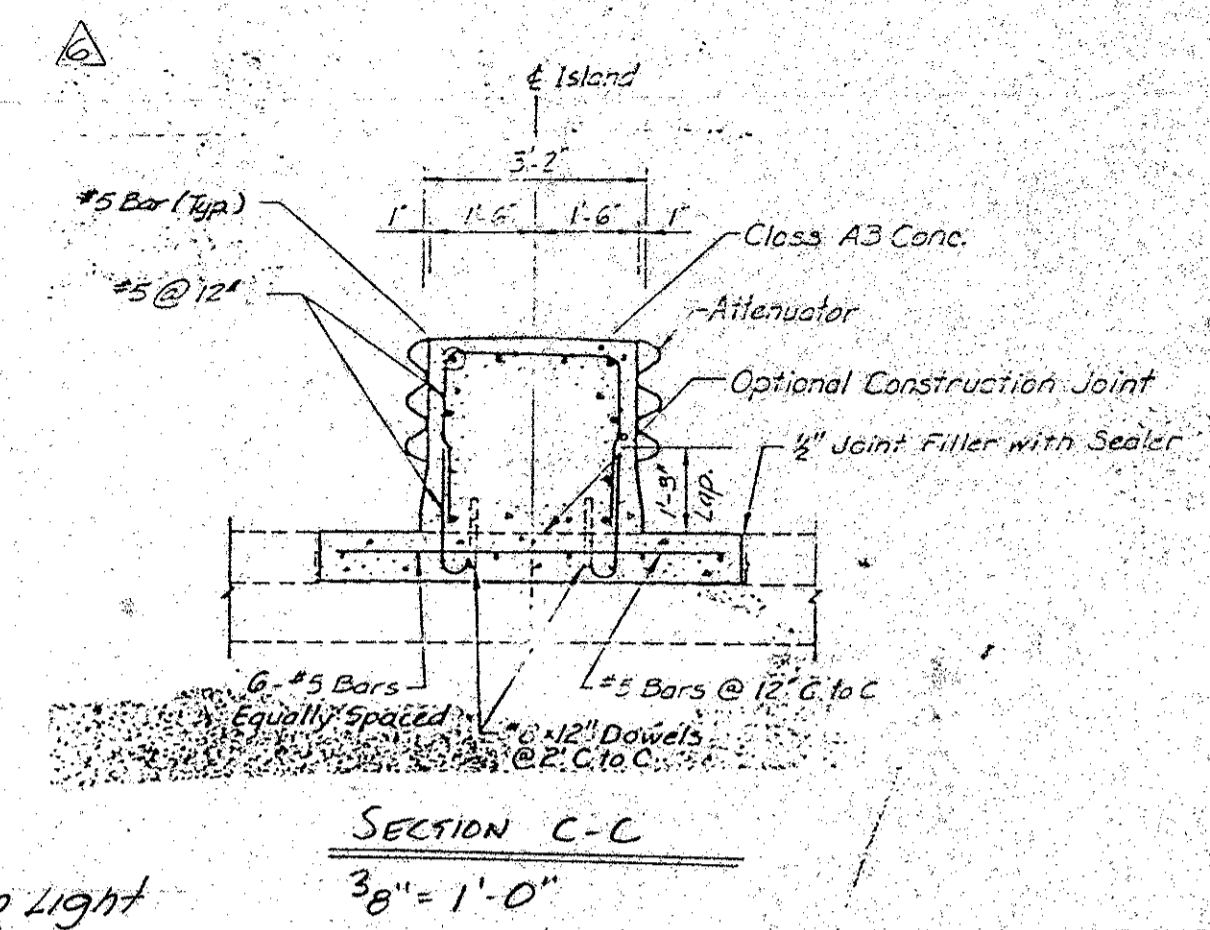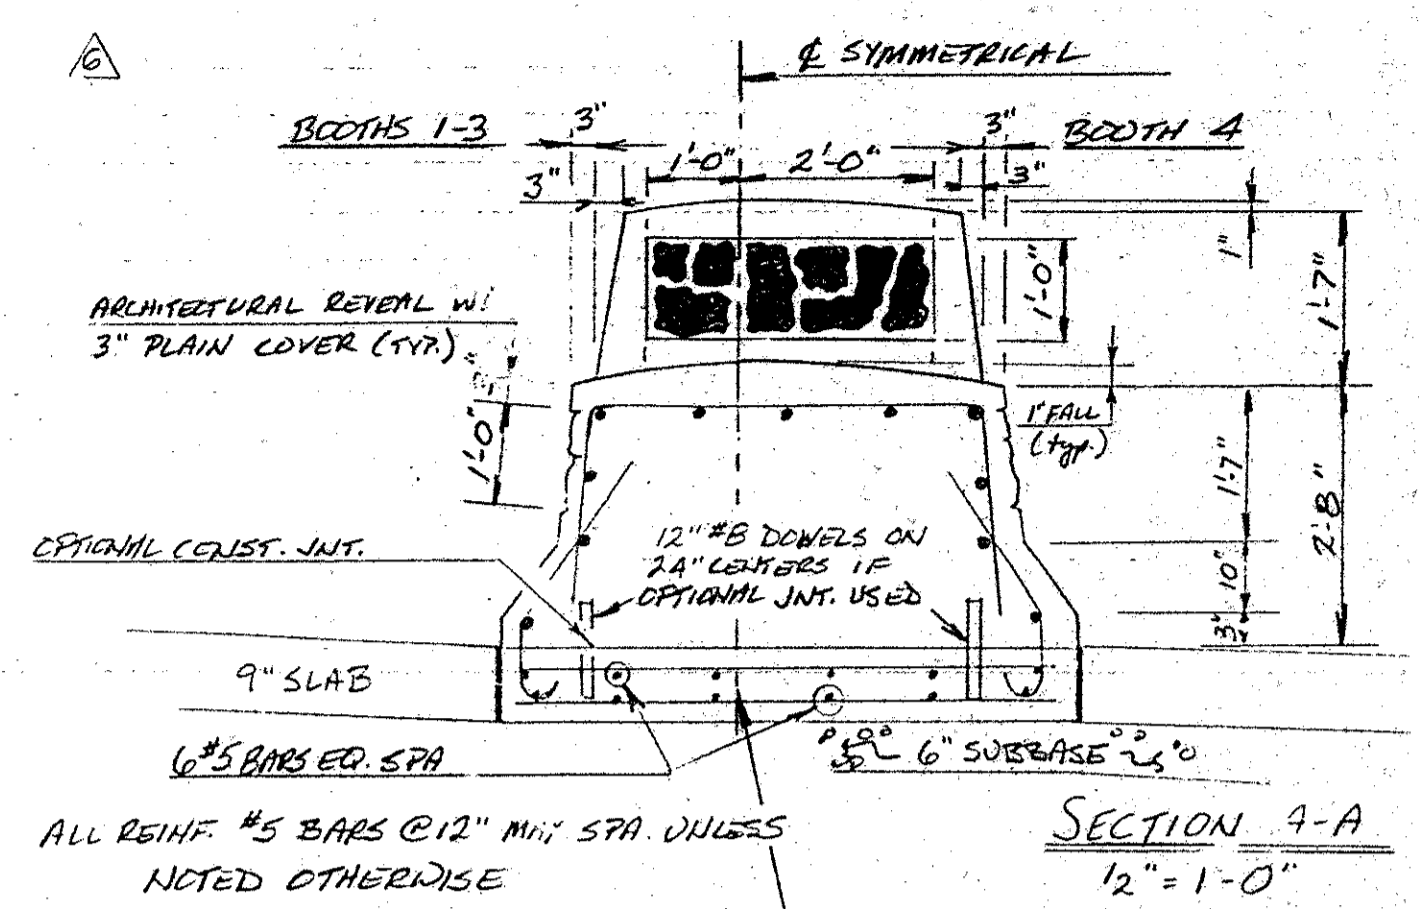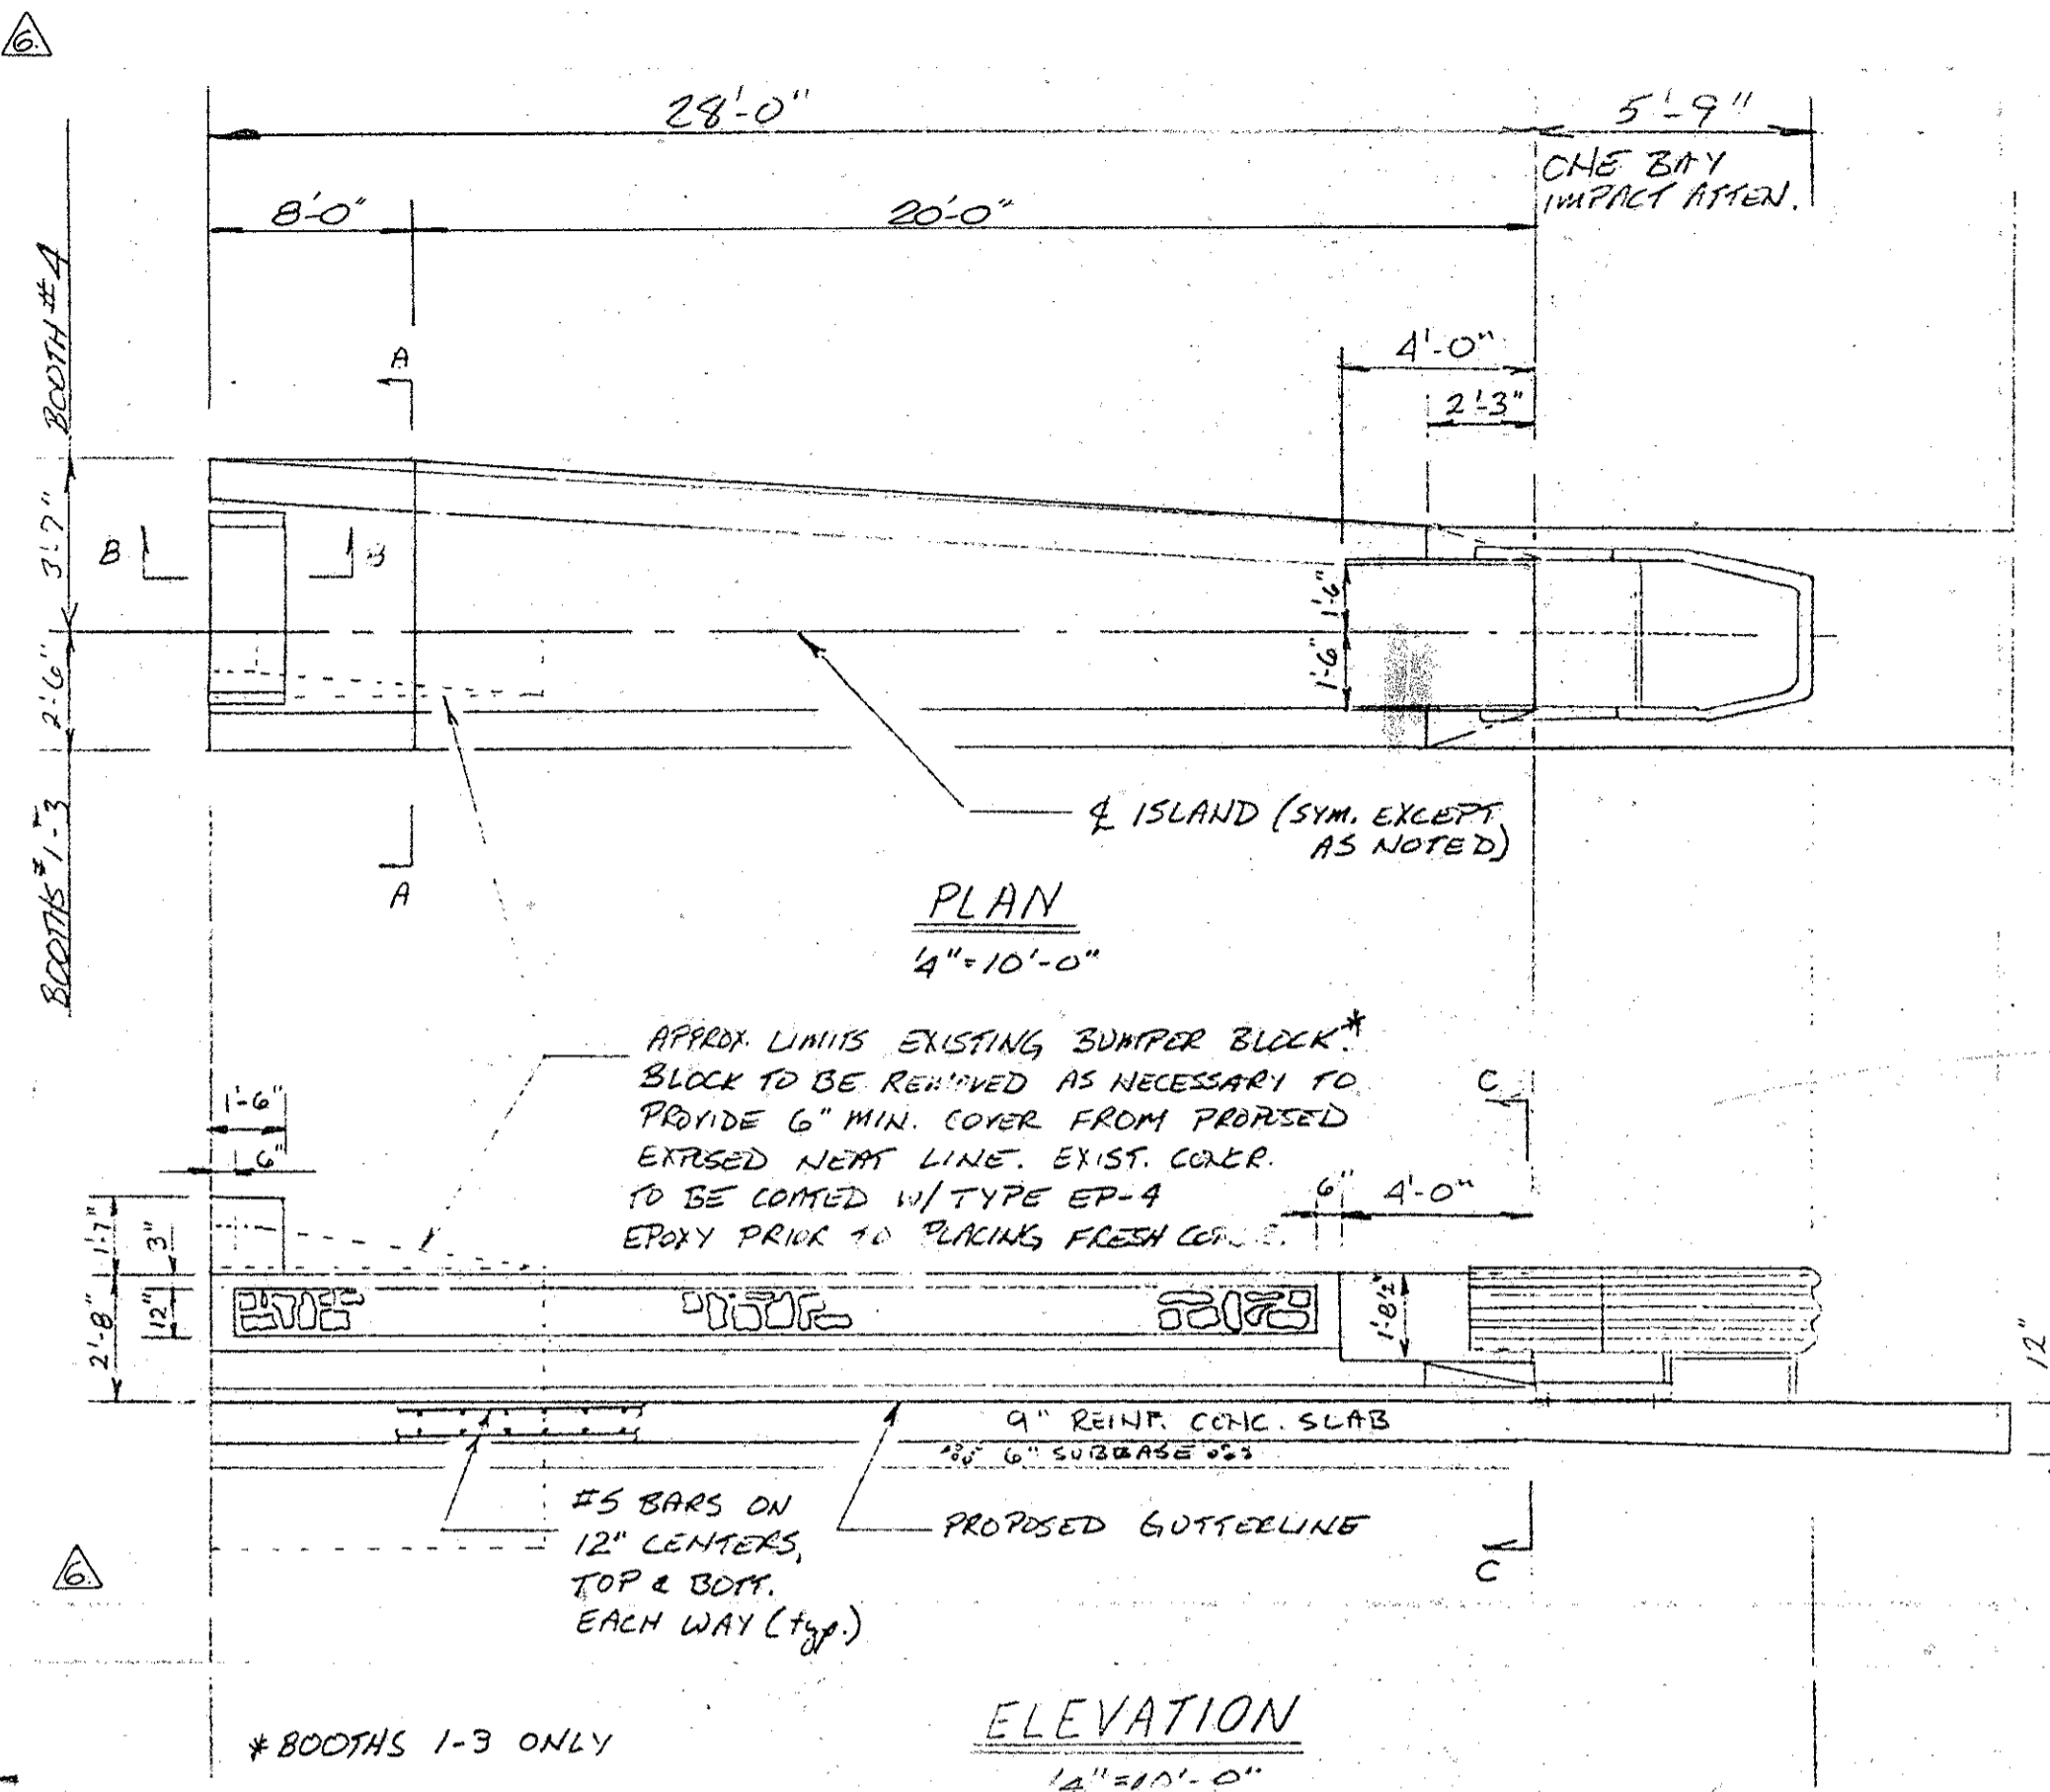

NORTH ELEVATION
 Scale: 1/4" = 1'-0"

Designed	PHT	2-92	Checked	PHT	2-92
Drawn	JLT	2-92	Approved	RBN	2-92
Revised					

ma RICHMOND METROPOLITAN AUTHORITY
 RICHMOND EXPRESSWAY SYSTEM
 BLVD. BRIDGE TOLL PLAZA
 NEW TOLL ISLANDS


HOWARD NEEDLES TAMMEN & BERGENDOFF
 Architects Engineers Planners
 ALEXANDRIA, VA. **HNTB**

Scale: AS SHOWN Date: 3-92 Contract No.: C-173 Sheet: 7

RECORD DRAWING

RICHMOND EXPRESSWAY SYSTEM			
SECTION	PROJECT	SHEET NO.	TOTAL SHEETS
17B	Boulevard Bridge Rehabilitation	8	



 DENOTES BLOCKOUT FOR TOLL GATES.

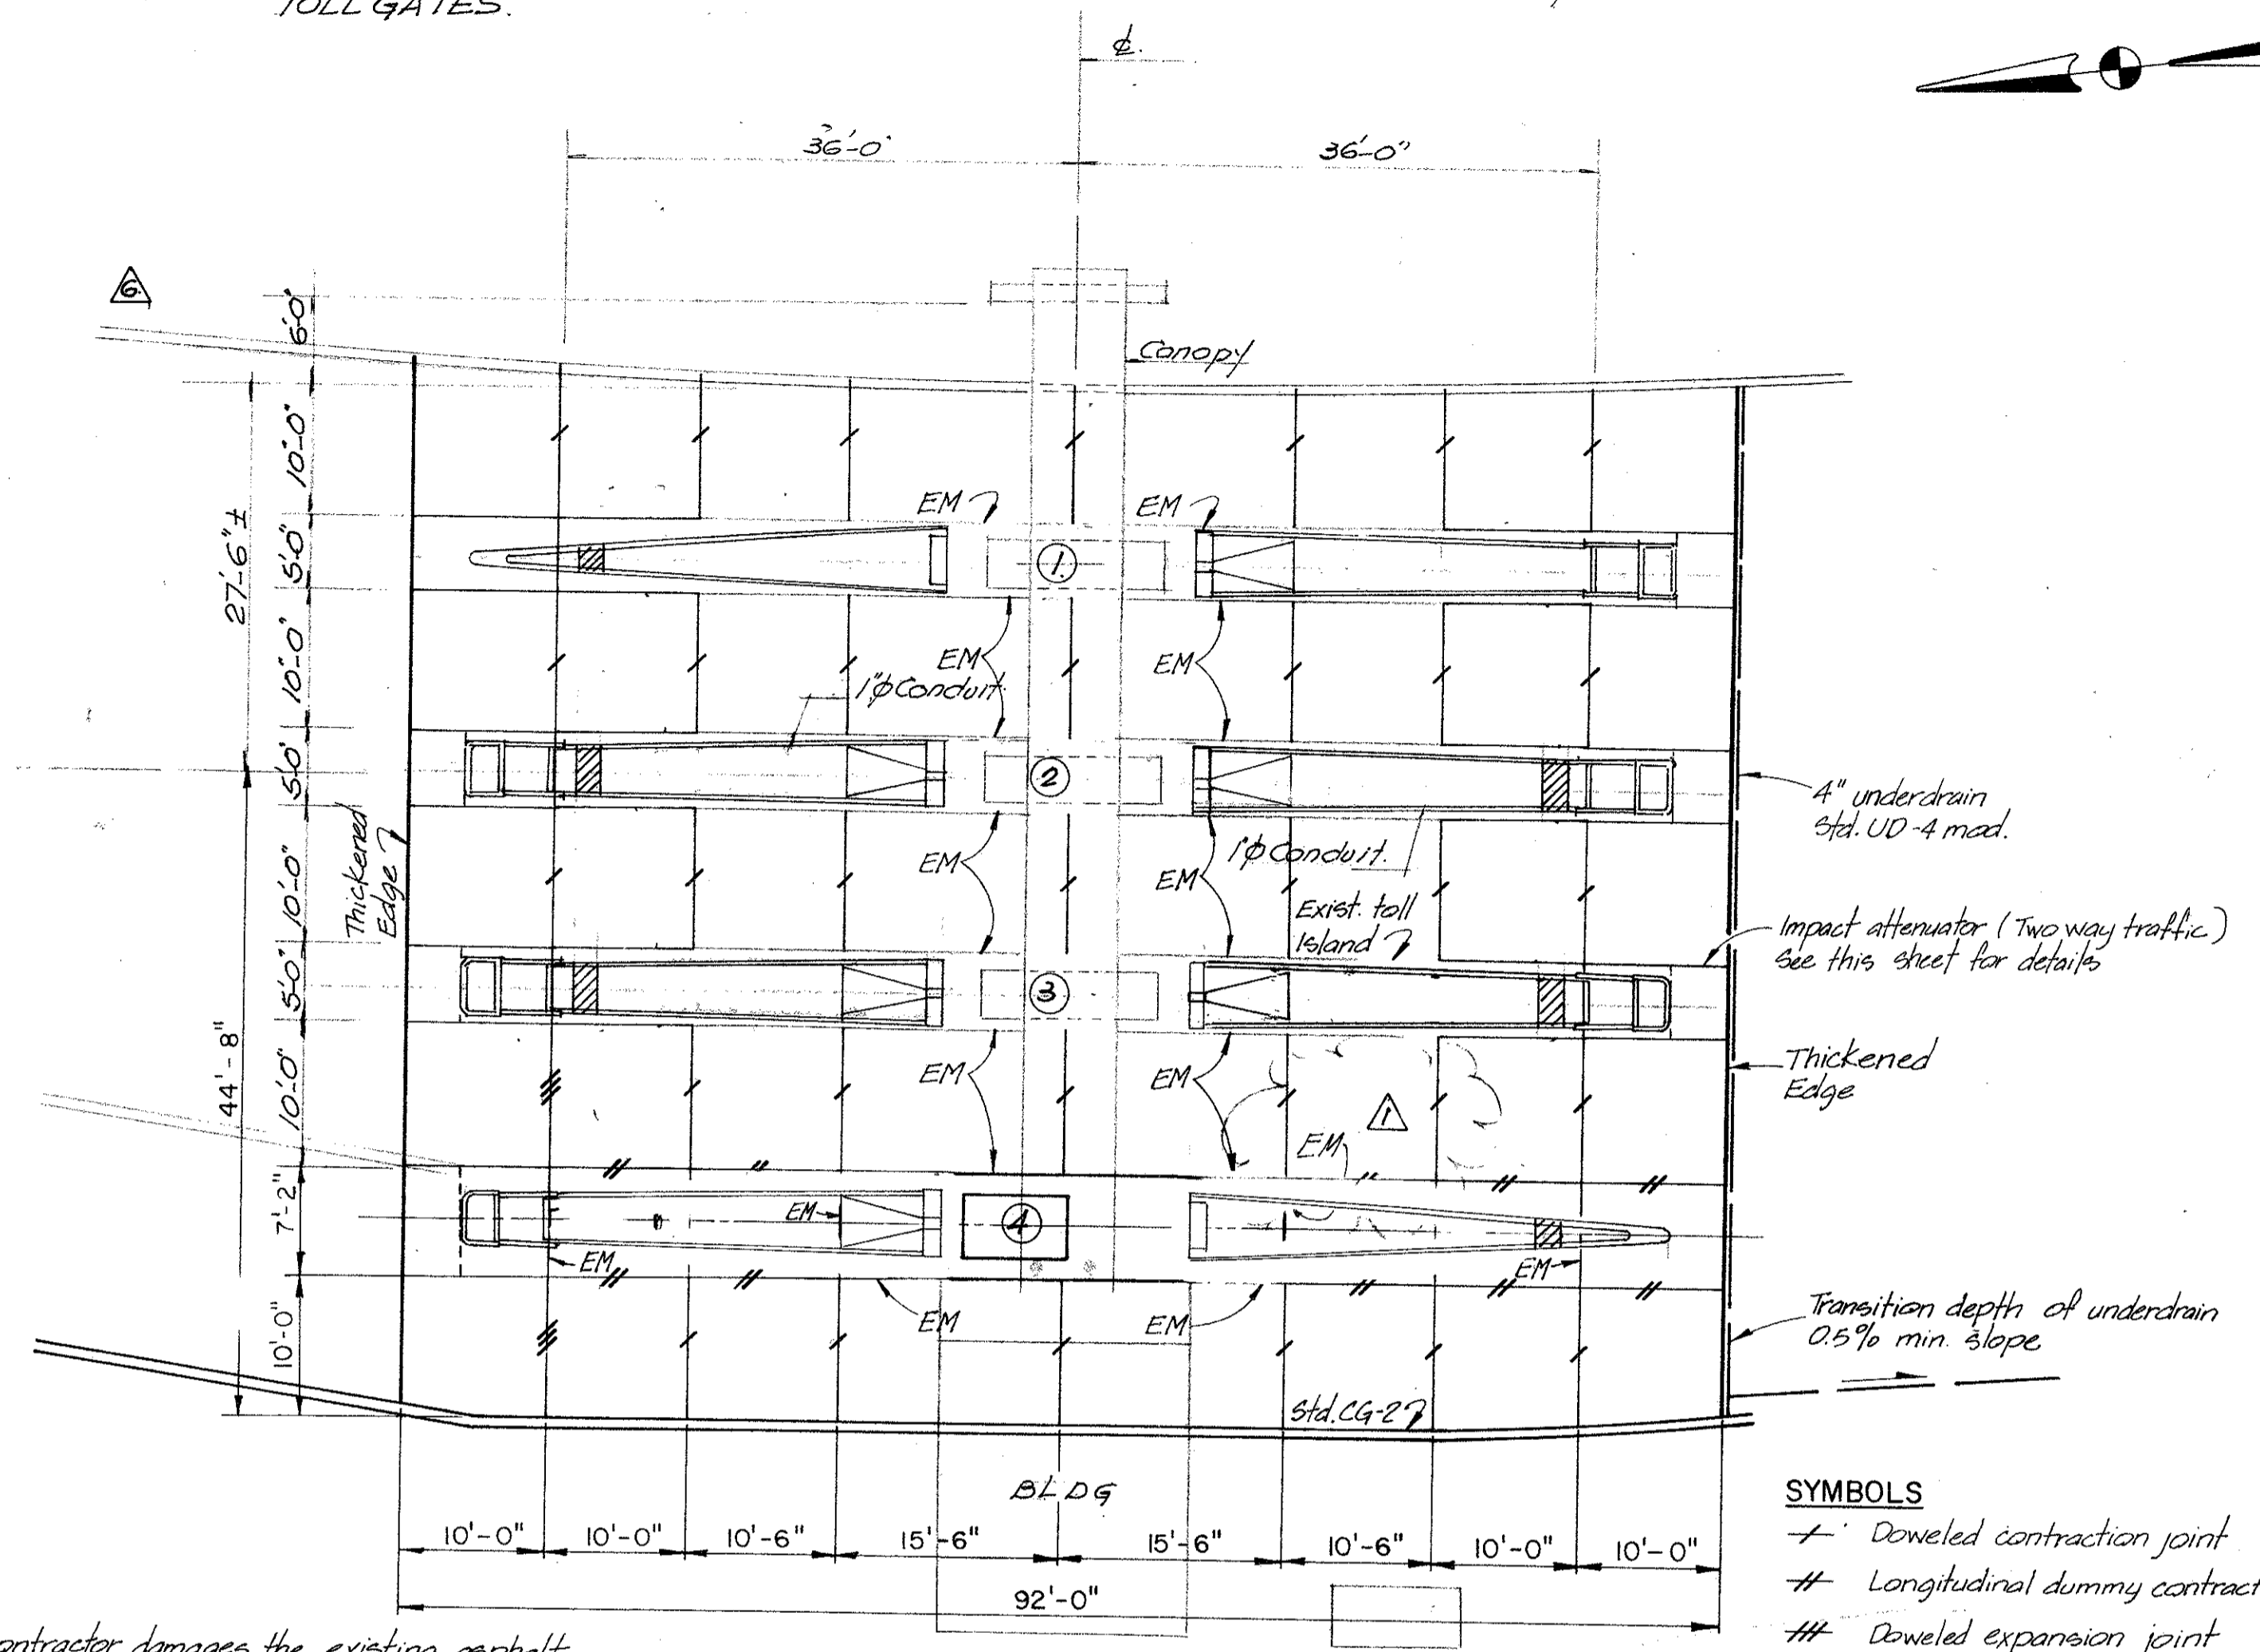

Note: If the contractor damages the existing asphalt pavement to remain in the toll island area, the area must be repaired in such a manner as to provide a straight line where the original saw cut was made.

- SYMBOLS**
- /- Doweled contraction joint
 - ## Longitudinal dummy contraction joint
 - /// Doweled expansion joint
 - EM 1/2" preformed expansion
 - SC saw cut existing asphalt pavement


GATE PEDESTAL ELEVATION

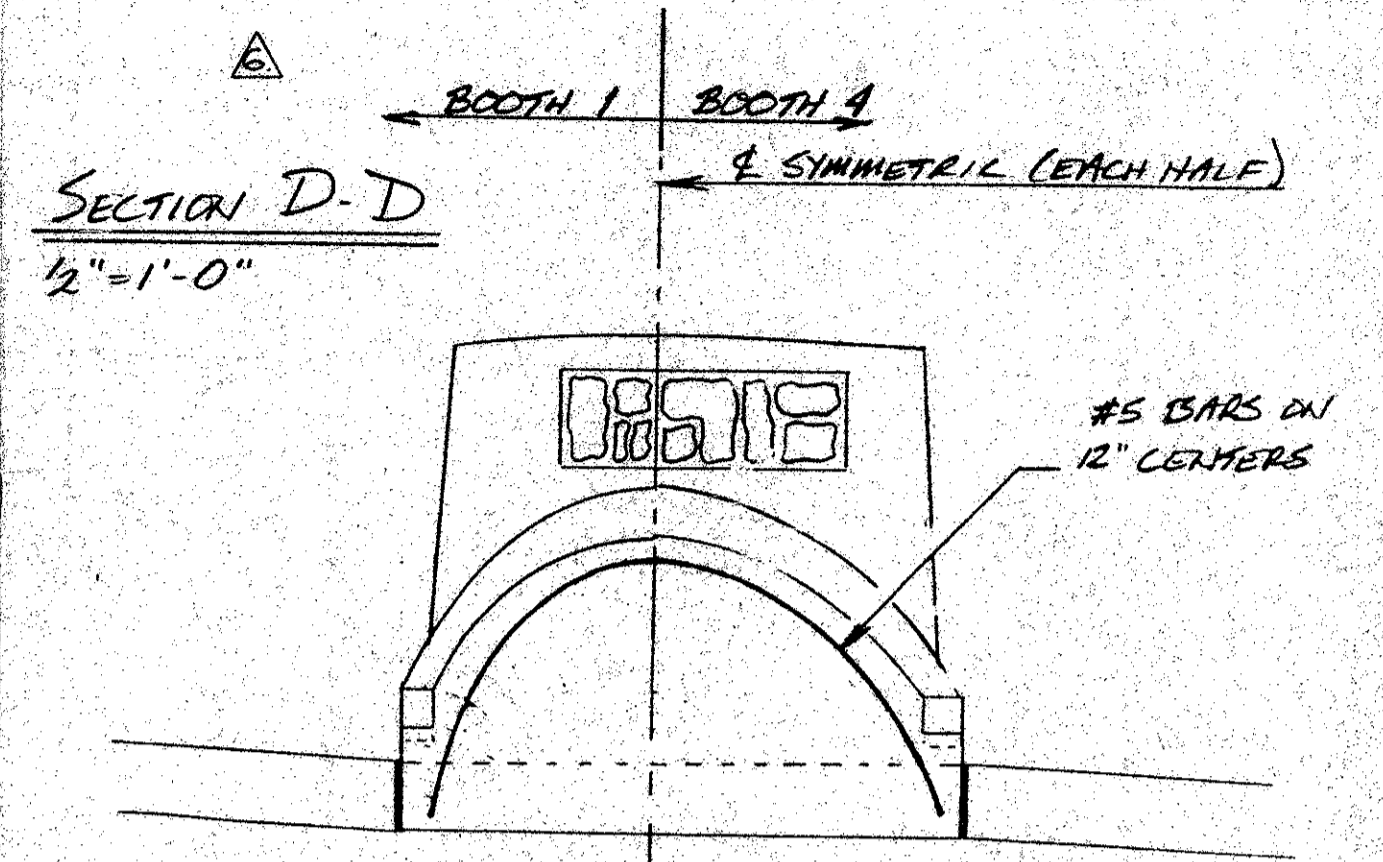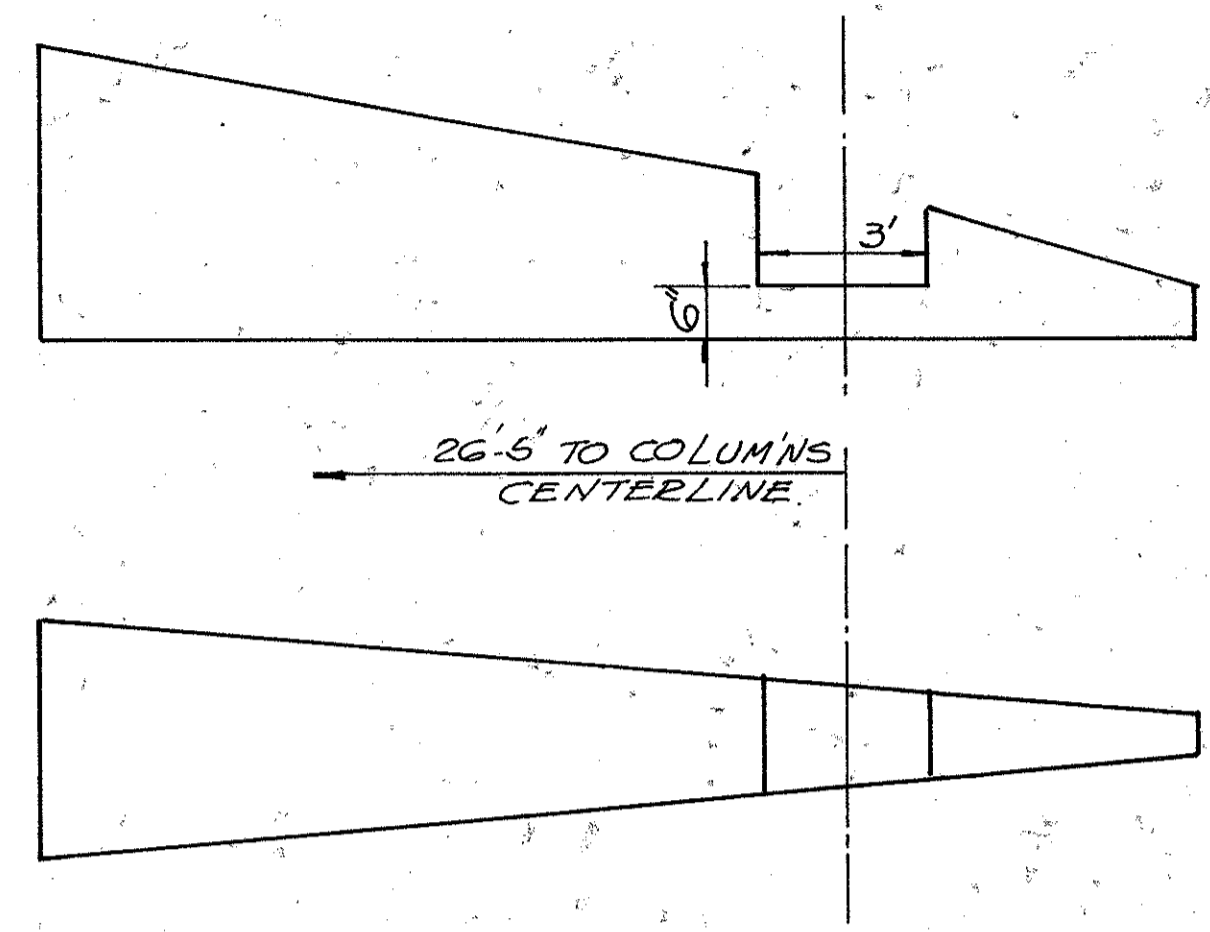


NOTES:

- SEE NOTE SHEET 7 (SECTION A-A) REGARDING OPTIONAL CONSTRUCTION JOINT & #5 BARS.
- SLAB LEVEL & LONGITUDINAL REINFORCING SIMILAR TO SECTION A-A (SHEET 7).

ISLANDS NOT REQUIRING IMPACT ATTENUATORS

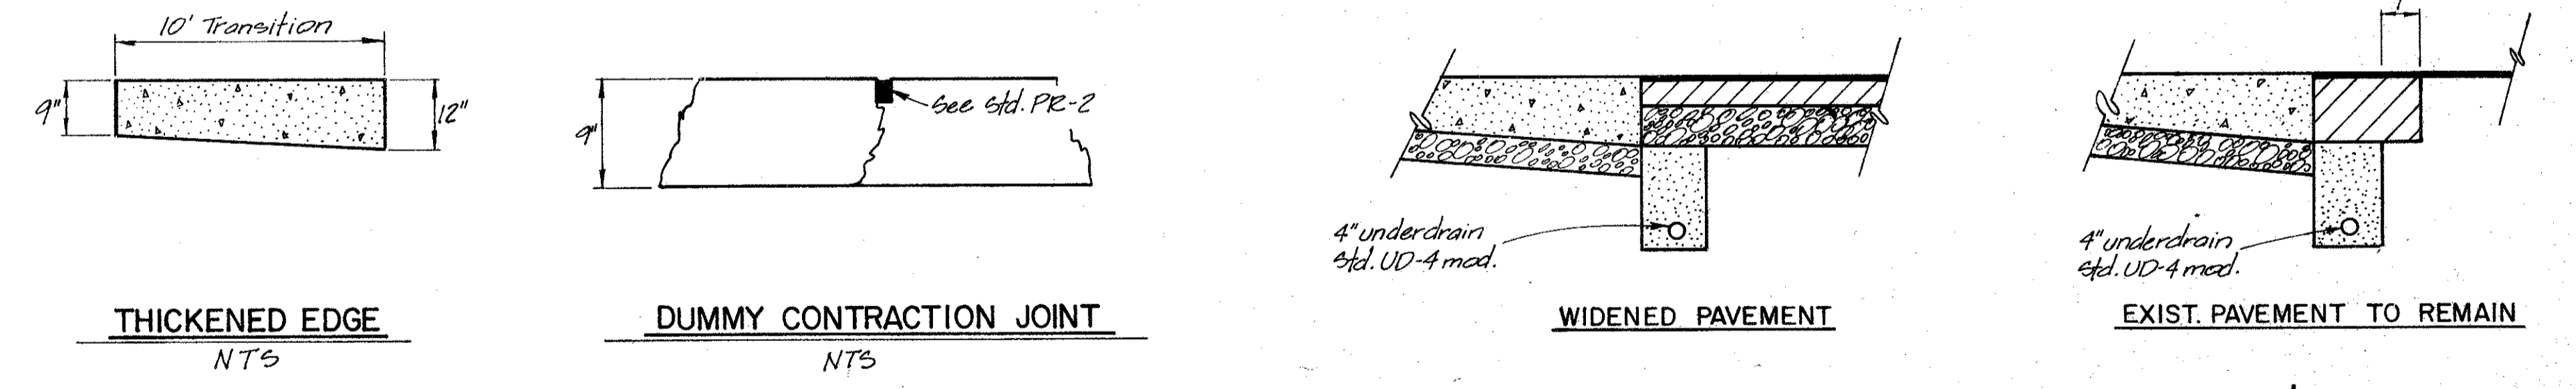

UNDERDRAIN AT STA. 59+53±

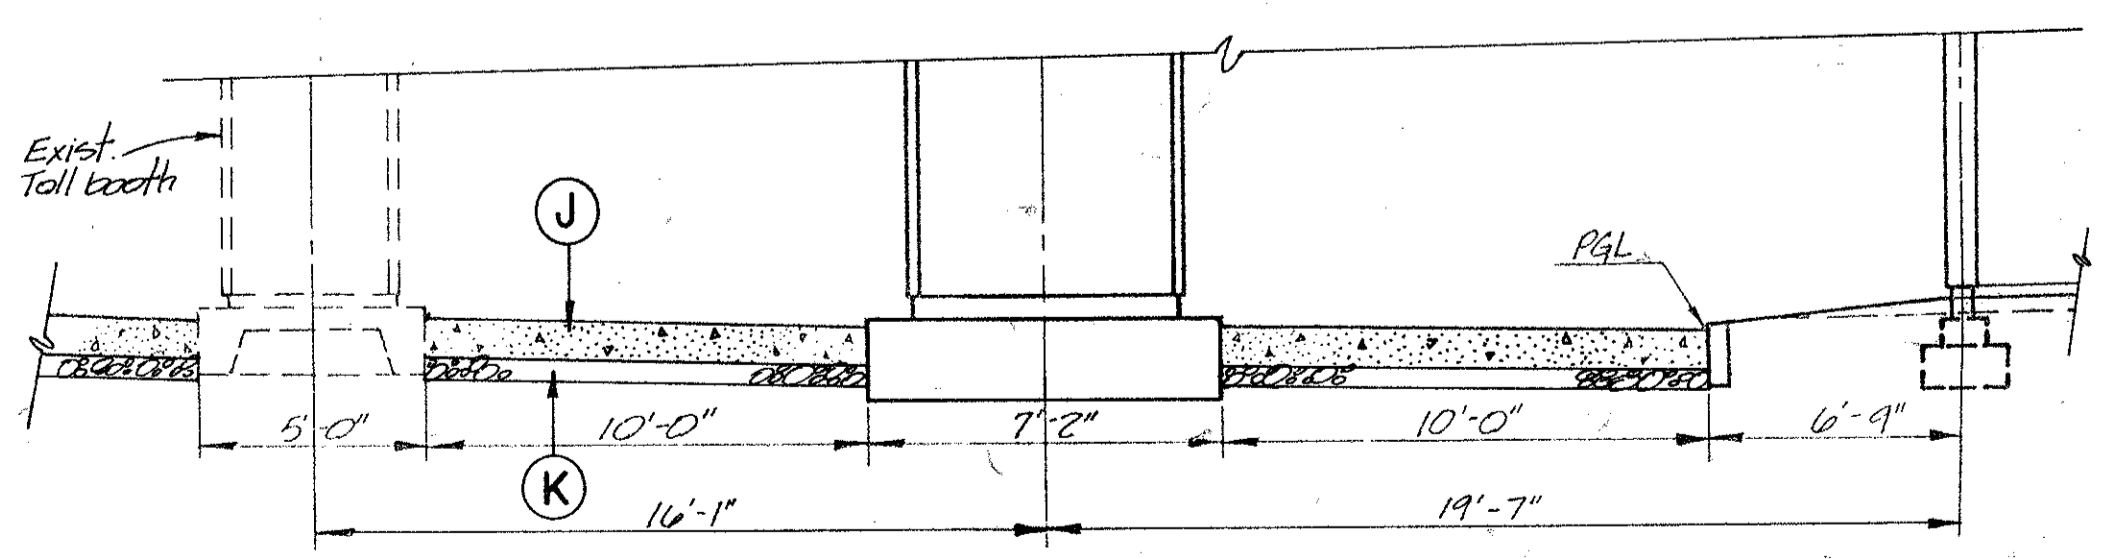

Note: ALL EXISTING ISLANDS TO BE DEMOLISHED TO 14" BELOW PROPOSED GATE TO RECEIVE 5" 21A SUBBASE & 9" REINFORCED CONCRETE PAVEMENT (SEE TYPICAL SECTION AT TOLL ISLAND, THIS SHEET). BUMPER BLOCKS (EXIST.) TO REMAIN & INCORPORATED INTO PROPOSED ISLANDS AS SHOWN ON SHEET 7. SLABS SUPPORTING EXISTING BOOTHS TO REMAIN. EXISTING BOOTHS TO BE DEMOLISHED - SEE ARCHITECTURAL PLANS FOR DETAILS.

- LEGEND**
- (J) 9" Reinforced hydraulic cement concrete pavement
 - (K) 6" Subbase aggregate type 1, 21A

Designed	By	Date	Added EM callout to islands paving and title.	PHT	7/92
Drawn	PHT	2-92		G.K.L.	3/93
Checked	SLT	2-92			
Approved	PHT	2-92			
	RBN	2-92	No.	Revision	By Date

RECORD DRAWING

ma RICHMOND METROPOLITAN AUTHORITY
RICHMOND EXPRESSWAY SYSTEM


BLVD. BRIDGE TOLL PLAZA
PAVING DETAILS AND
NEW TOLL ISLANDS

HOWARD NEEDLES TAMMEN & BERGENDOFF
Architects Engineers Planners
ALEXANDRIA, VA.

HNTB

Scale: AS SHOWN Date: 3-92 Contract No.: C-17B Sheet: 8 of

STR	LINE	LOCATION	DESCRIPTION	INV TO INV.	TOP	D' OR H'	COV.	REMARKS
1	1-2	55+15 BL 'B' PUMPHOUSE DR. LT.	DI-2B, MOD. III L=10'	126.0 - 123.5	134.9	5.5		
2	2-3	55+33 BL 'A' PUMPHOUSE DR. RT.	DI-2B, MOD. III L=10'	117.0 - 111.5	132.0	15.0		
3		55+05 BL 'A' PUMPHOUSE DR. LT.	EW-1					EC-1 TY. B 4.5 TONS RECD.
4		57+17 BL 'A' PUMPHOUSE DR. LT.	DI-12C, L=4'		137.2	5.2		
4-5		57+17 BL 'A' PUMPHOUSE DR. LT.	10'-18" RCP	132.0 - 131.5	137.4	64		
5-6		57+17 BL 'A' PUMPHOUSE DR. LT.	85'-18" RCP	131.0 - 130.0				
6		56+92 BL 'B' PUMPHOUSE DR. RT.	EW-1					EROSION CONTROL TO BE DETERMINED IN THE FIELD SEE DETAILS ON SHEET 10.
7		59+67 BL 'A' PUMPHOUSE DR. LT.	NEENAH TRANSVERSE DRAINAGE STRUCTURE, R-4999 CX, COVER TY. D					SEE DETAILS ON SHEET 10.
8		60+24 BL 'A' PUMPHOUSE DR. LT.	NEENAH TRANSVERSE DRAINAGE STRUCTURE, R-4999 CX, COVER TY. D					SEE DETAILS ON SHEET 10.
9		59+98 BL 'A' PUMPHOUSE DR. RT.	NEENAH TY. M TRENCH FRAME R-4996-A1 OR EQUIVALENT L=5'					SEE DETAILS ON SHEET 10.
9-11		59+96.25 BL 'A' PUMPHOUSE DR. RT.	90-DEGREE 6" BEND					RECEIVES ROOF DRAINAGE
10		59+96.25 BL 'A' PUMPHOUSE DR. RT.	6" X 4" REDUCER					
10-11		59+96.25 BL 'A' PUMPHOUSE DR. RT.	1.67'-4" DI PIPE, 90-DEGREE 4" BEND					
11		59+96.25 BL 'A' PUMPHOUSE DR. RT.	6" X 6" X 4" TEE					
11-13		59+50 BL 'A' PUMPHOUSE DR. RT.	45'-6" DI PIPE @ 6%					SEE DETAILS ON SHEET 10.
12		59+50 BL 'A' PUMPHOUSE DR. RT.	CLEAN OUT UNIT					
12-13		59+50 BL 'A' PUMPHOUSE DR. RT.	6" X 6" X 6" TEE					
13-14		59+50 BL 'A' PUMPHOUSE DR. RT.	72'-6" DI PIPE @ 3%					
14		59+45 BL 'A' PUMPHOUSE DR. RT.	EW-12					

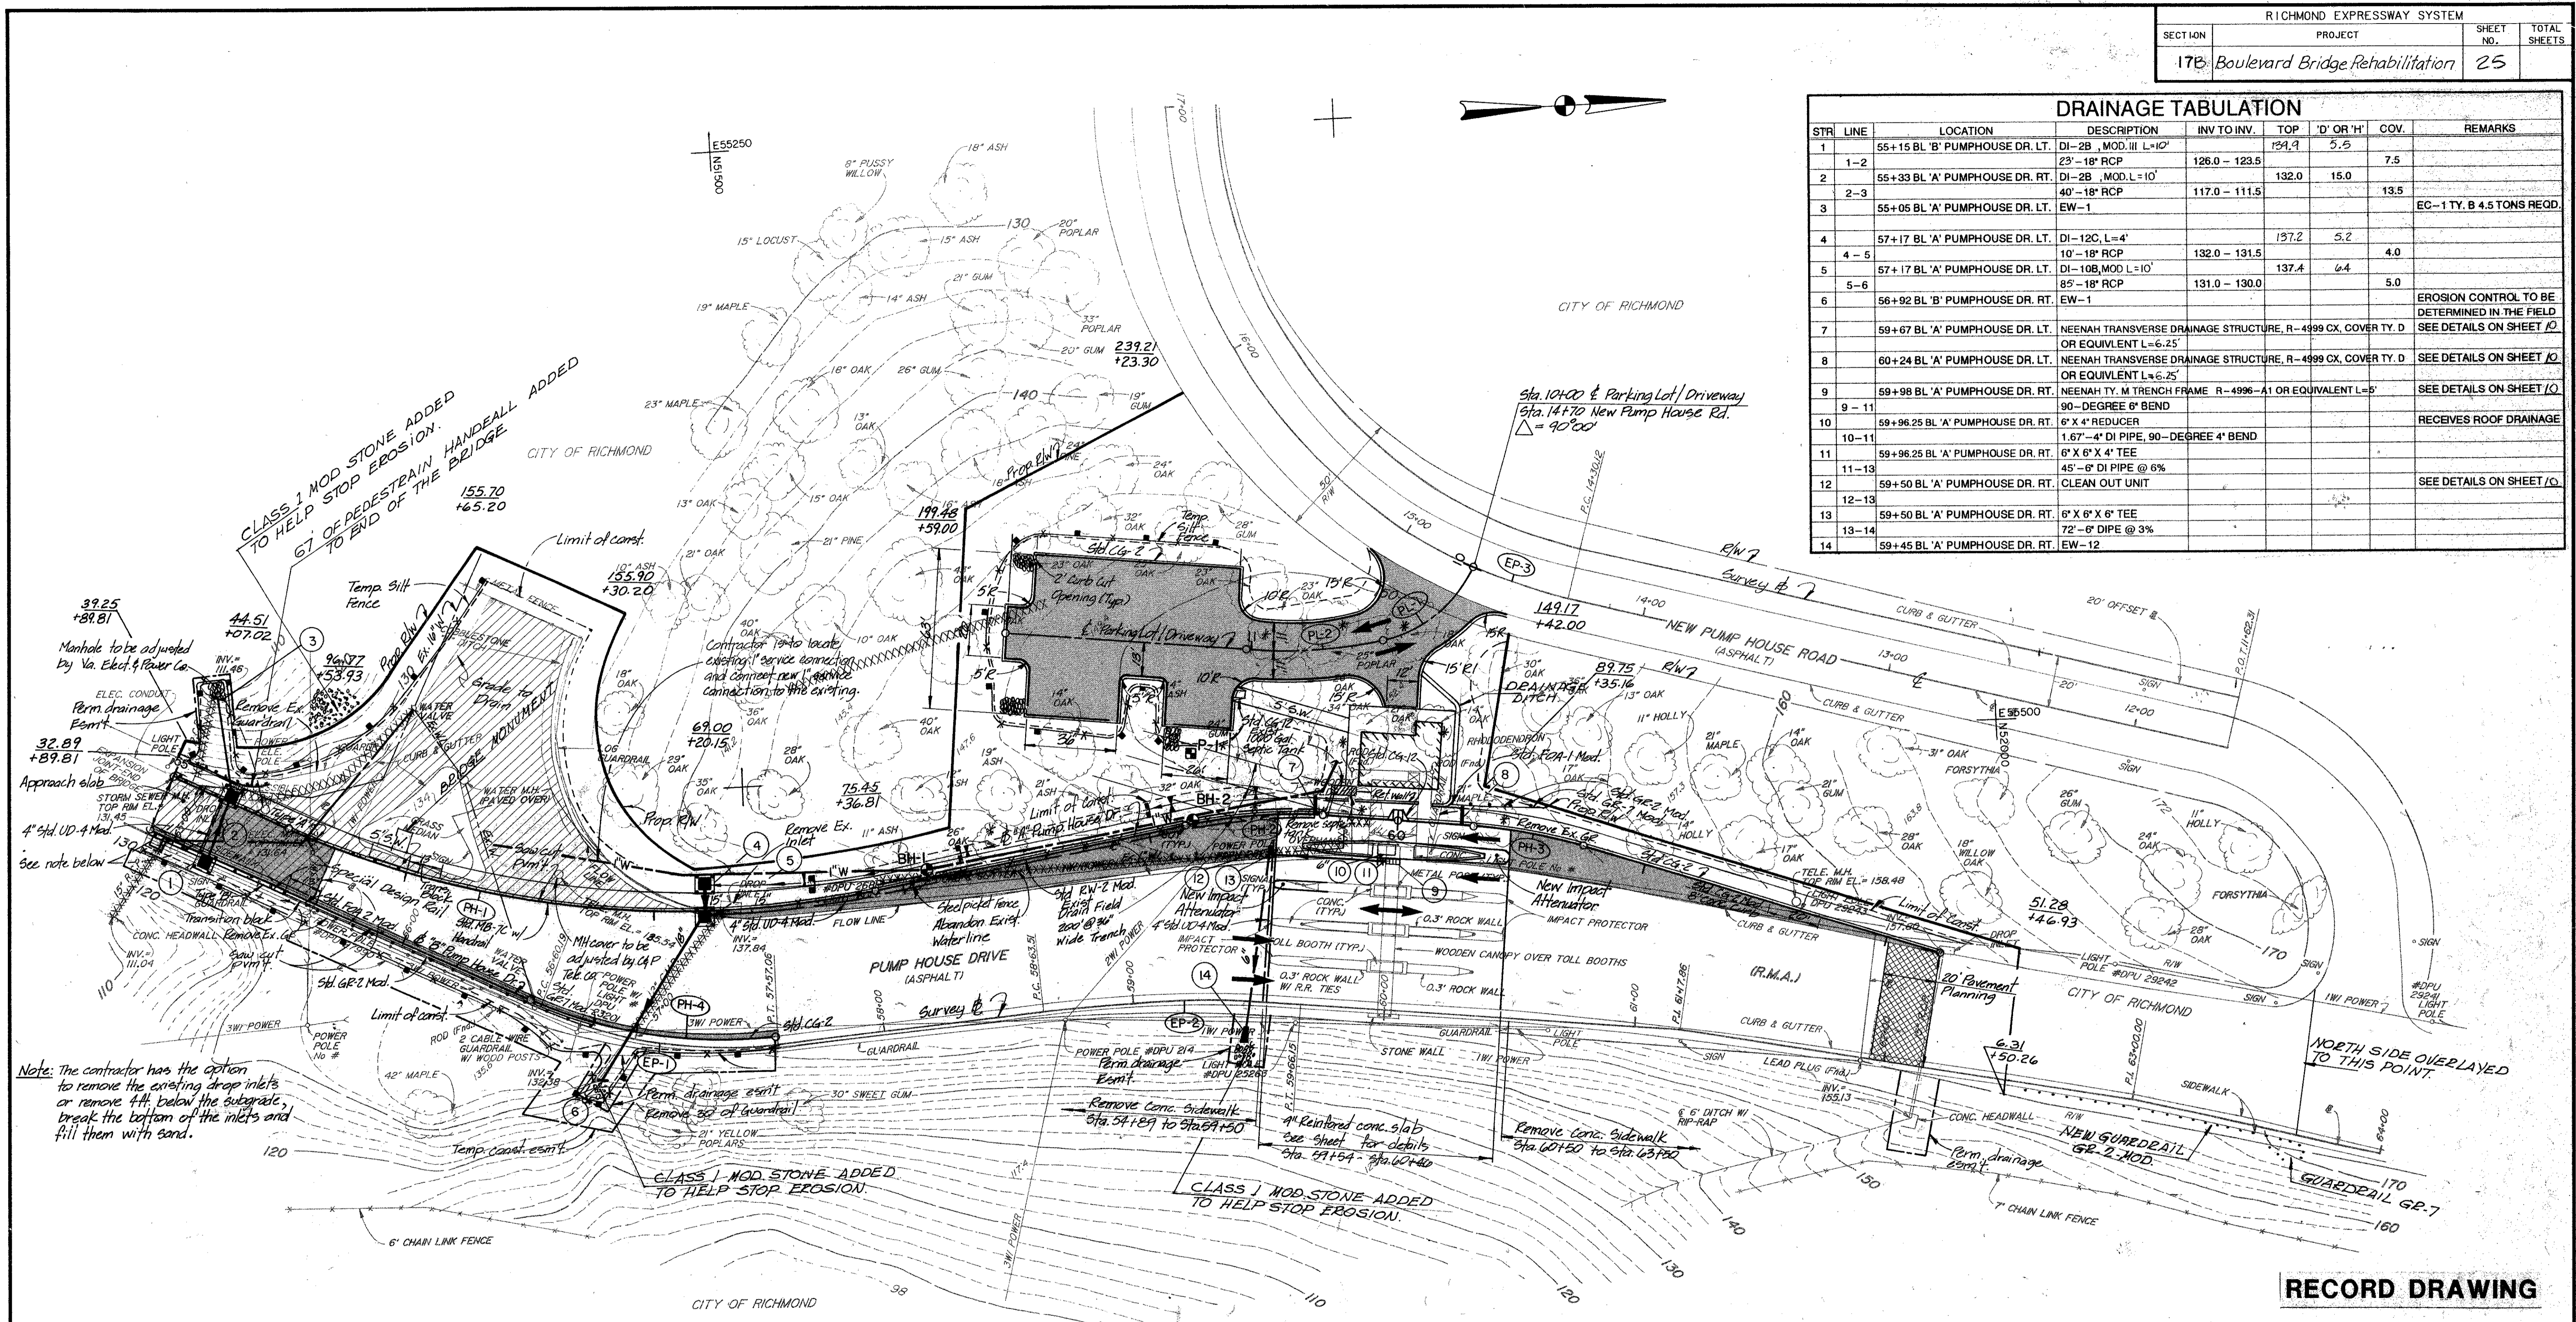

Note: The contractor has the option to remove the existing drop inlets or remove 4ft. below the subgrade, break the bottom of the inlets and fill them with sand.

By	Date	Revision	By	Date
Designed	VVS	3-92		
Drawn	JLT	3-92		
Checked	PNT	3-92		
Approved	RBN	3-92		

1-29-93
Reroute Watermain
GKL

* DROP INLETS #1 AND 2 MOVED DOWN HILL TO HELP ACCOM. CONTRACTOR IN BUILDING THESE INLETS.

- Note
- * Remove Exist Tree.
 - Removal of any tree must be verified and approved by field engineer.
 - R/W offset & Sta are from the survey #

LEGEND	
[Solid Grey]	NEW PAVEMENT
[Hatched]	DEMOLITION OF PAVEMENT
[Dotted]	PAVEMENT PLANNING
[Circle with dot]	BH BORING TEST HOLE
[Square with dot]	P-1 PERCOLATION TEST

RECORD DRAWING


ma RICHMOND METROPOLITAN AUTHORITY
RICHMOND EXPRESSWAY SYSTEM

BLVD. BRIDGE TOLL PLAZA
GRADING, DRAINAGE & PAVEMENT PLAN

HOWARD NEEDLES TAMMEN & BERGENDOFF
Architects Engineers Planners
ALEXANDRIA, VA.





HNTB

Scale: 1" = 30' Date: 3-92 Contract No. C-17B Sheet: 25 of 25

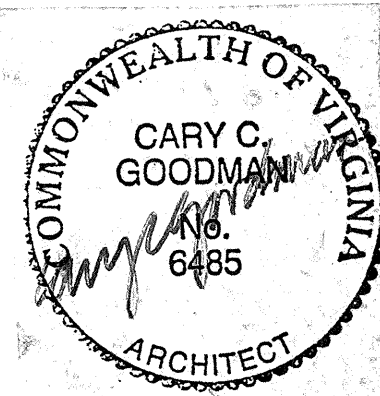

HNTB
 HOWARD NEEDLES TAMMEN & BERGENDOFF
 ARCHITECTS ENGINEERS PLANNERS
 99 CANAL CENTER PLAZA
 ALEXANDRIA, VIRGINIA 22314
 TEL. (703) 884-2700

ma Richmond Metropolitan Authority

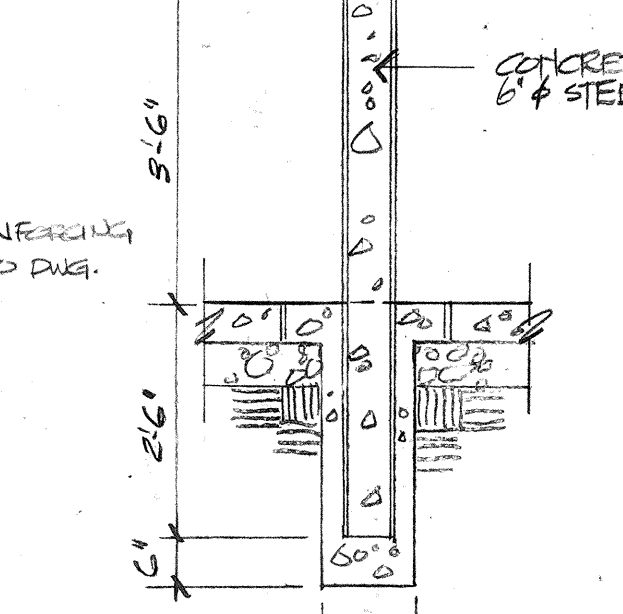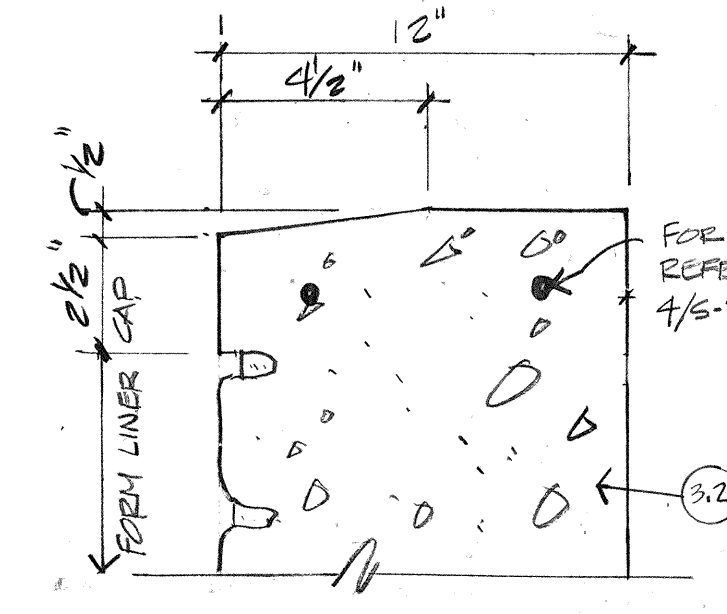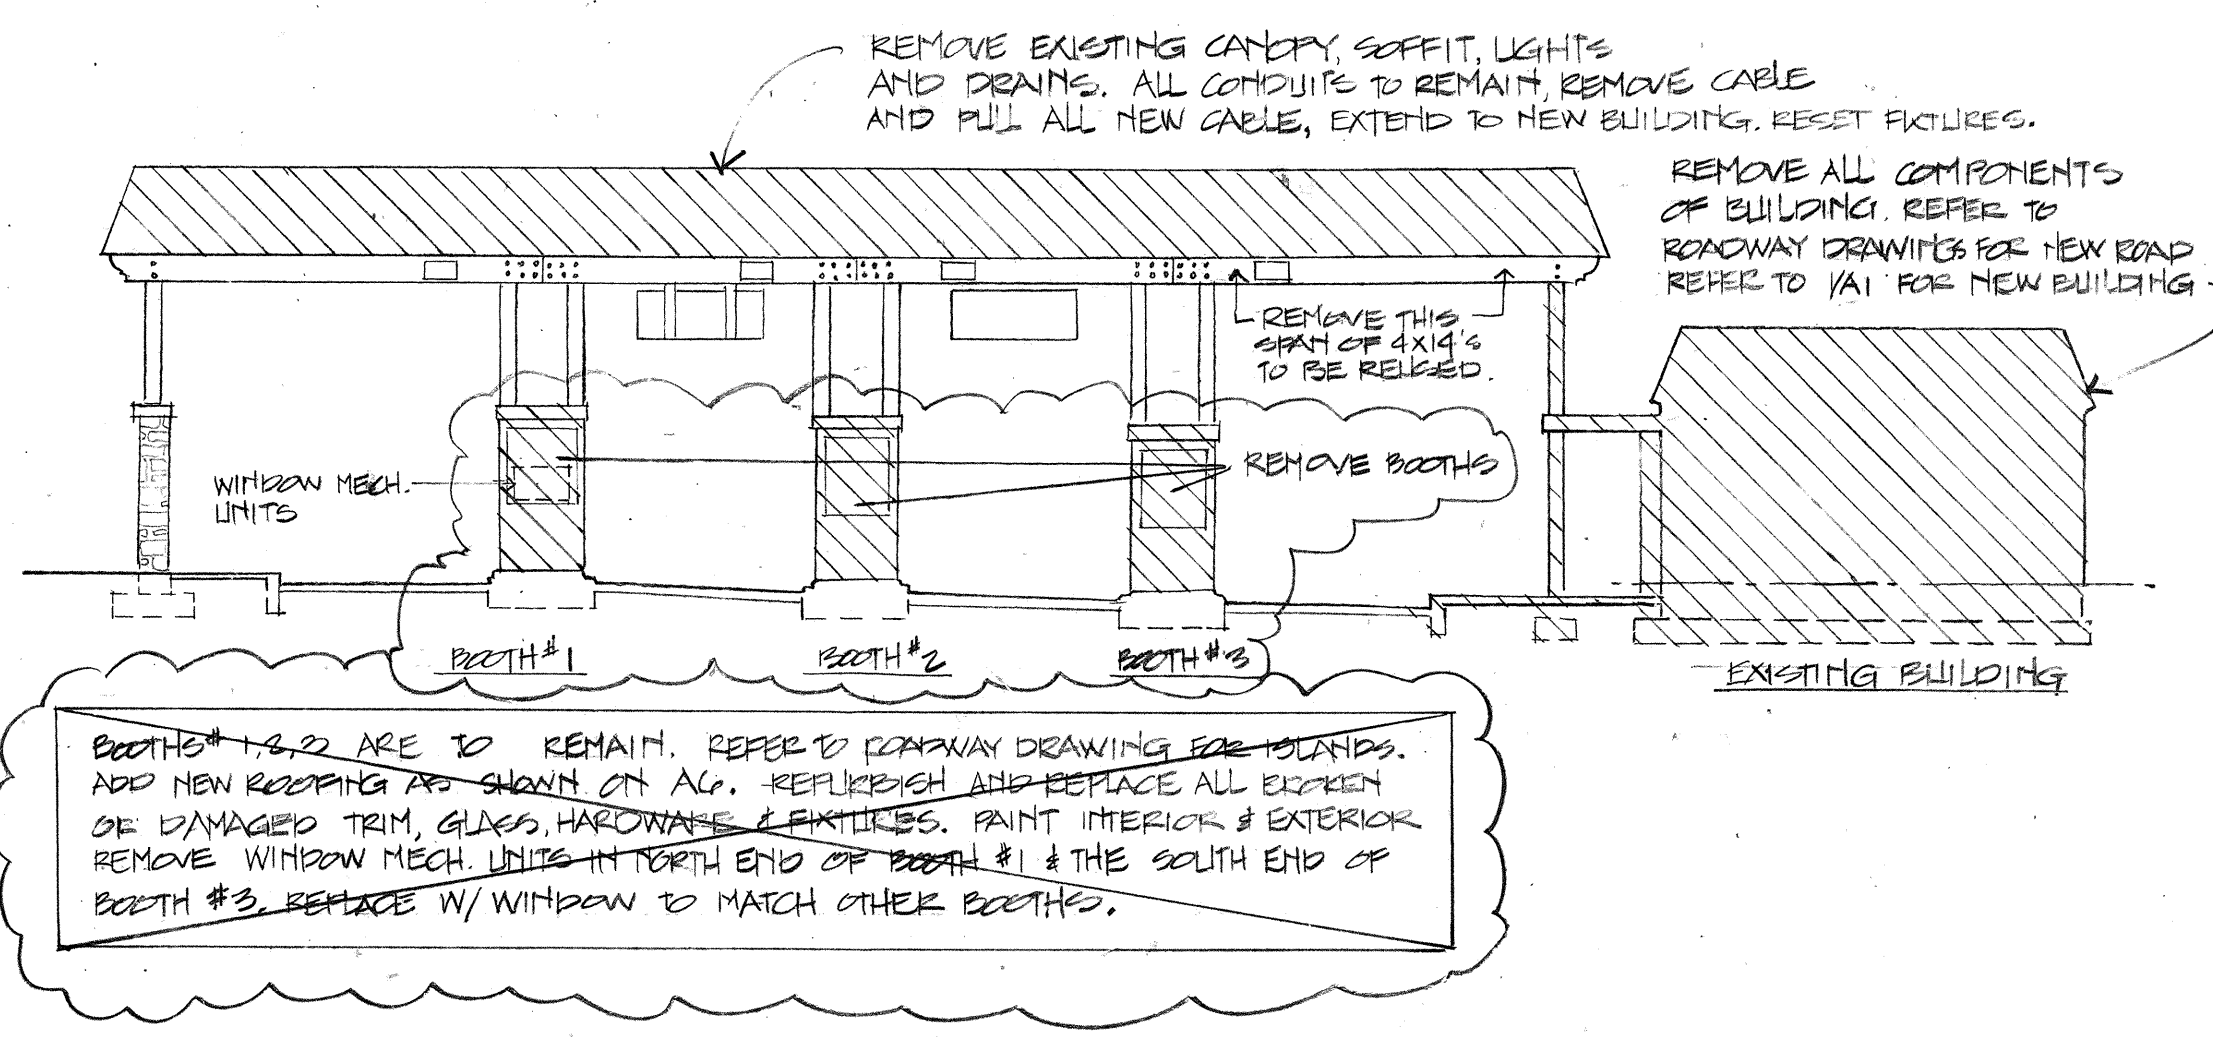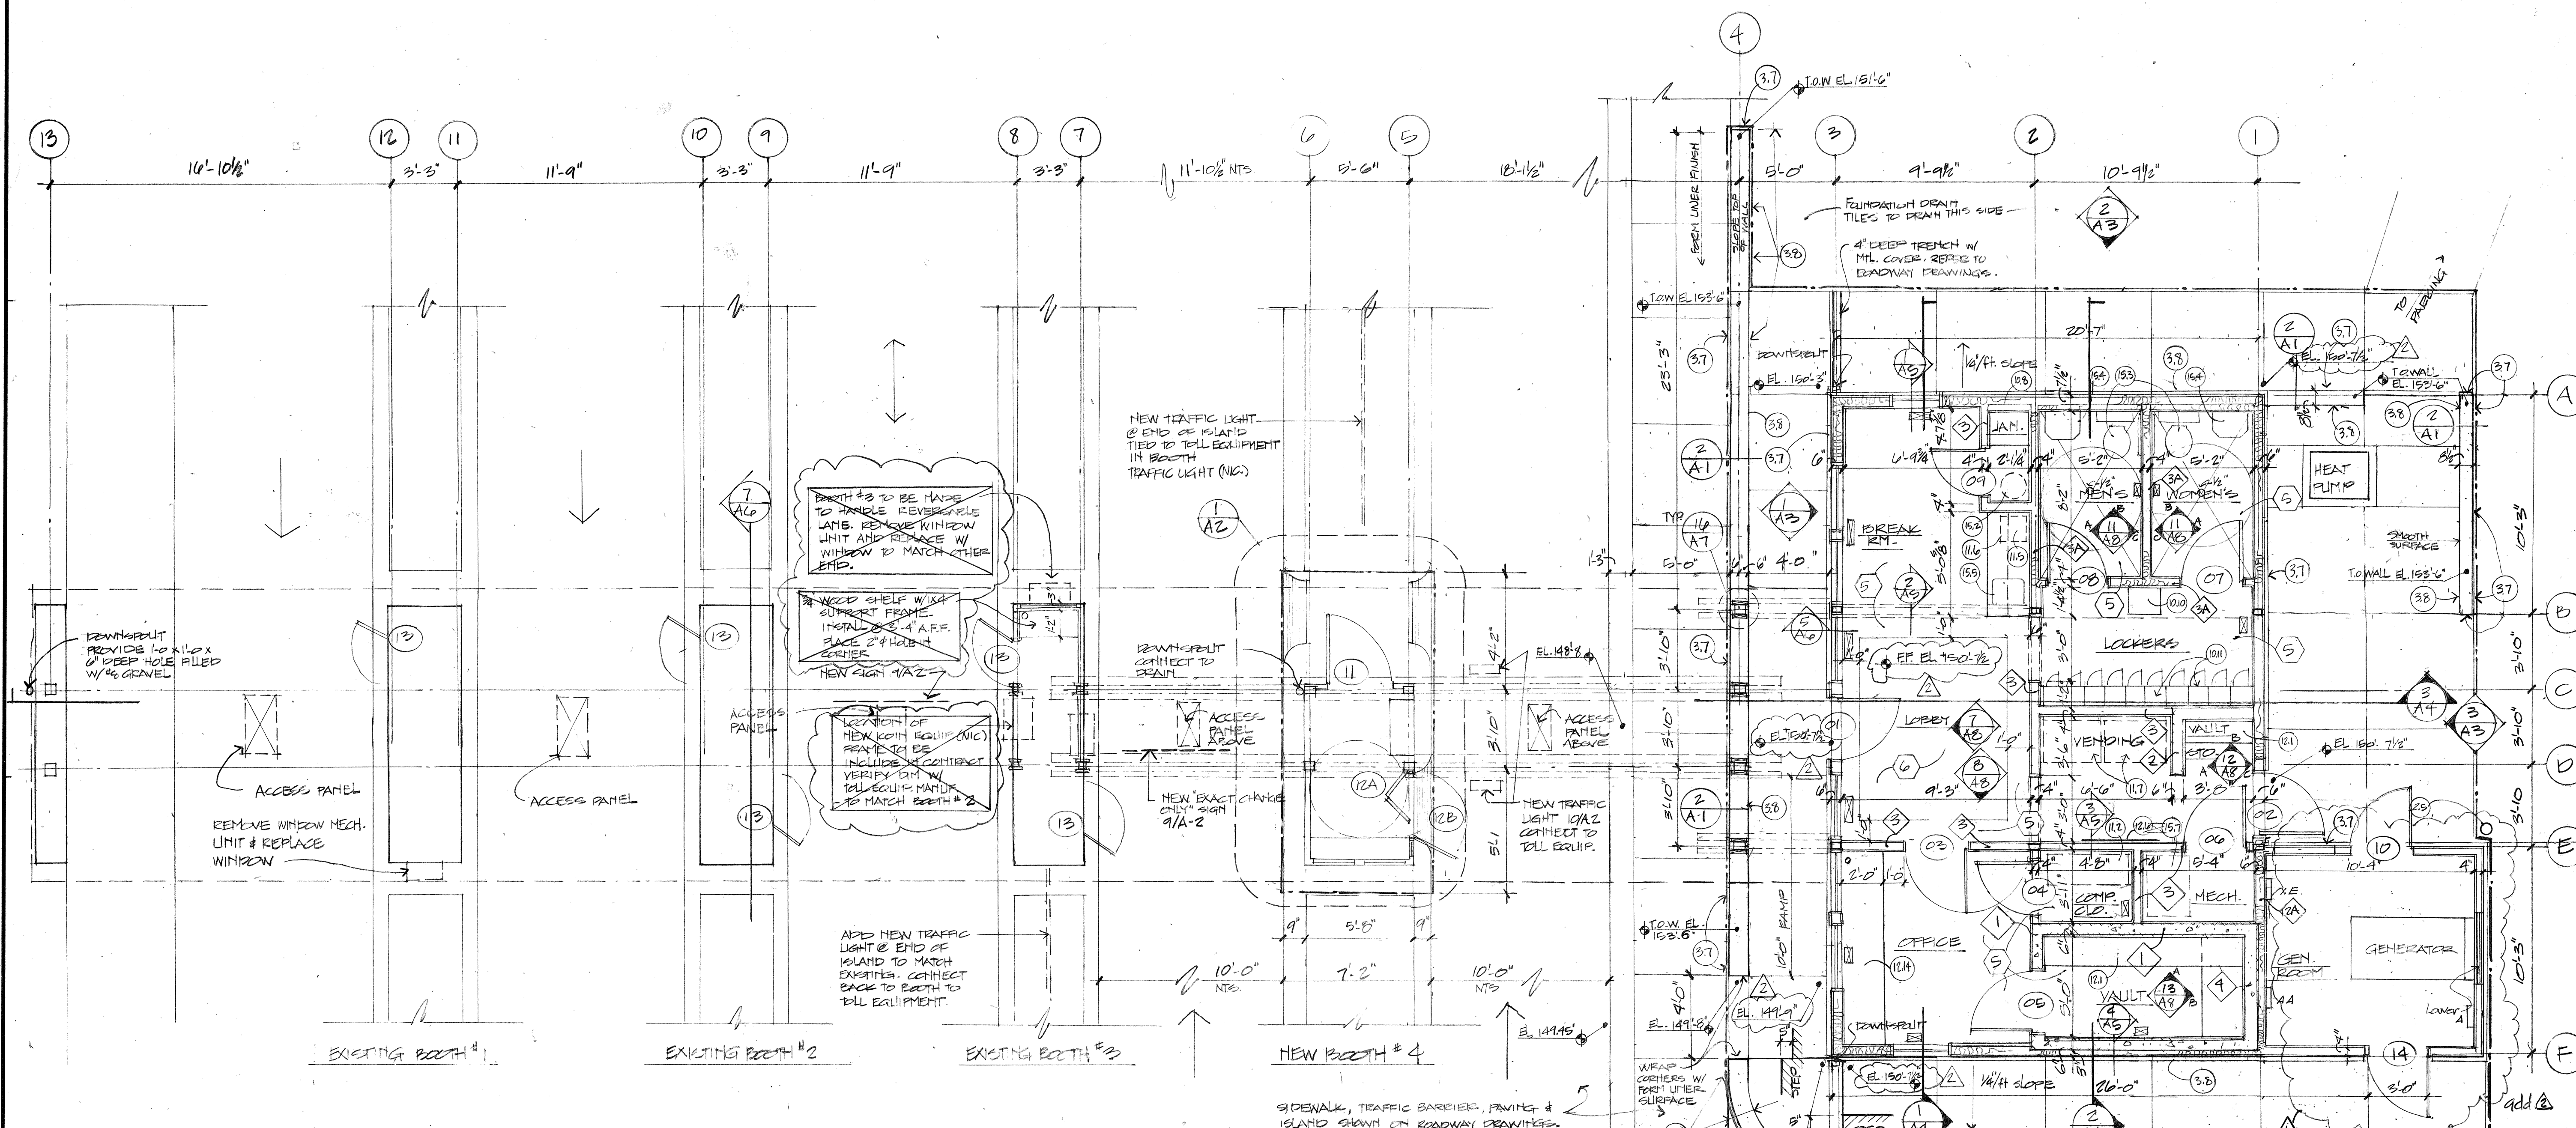

1 FLOOR PLAN
 SCALE 1/8"=1'-0"

- ⊠ WALL TYPES REFER TO SHT. A-0
- ⊞ COLORS REFER TO SHT. A-8
- ⊗ KEY NOTES REFER TO SHT. A-2

No.	Revision	By	Date
1	REVISION # 1	CL	7-14-92
2	ADDENDUM # 2	CL	4-23-98

PROJECT NO: 14237
 DATE: _____
 DRAWN BY: TD
 CHECKED BY: _____
 CHECKED BY: _____
 REVISED DATE: _____


BOULEVARD BRIDGE
 TOLL PLAZA
 BUILDING
 DRAWING TITLE:
 FLOOR PLAN

CONTRACT NO. 17B
36.3
 DRAWING NUMBER:


RECORD DRAWING

A-1

- Key Notes
- 02000 SITE
- Earth subgrade
 - Compacted granular fill
 - Drainage gravel
 - Drain tile
 - Steel pipe bollard
- 03000 Concrete
- Conc. footing
 - Conc. foundation wall
 - Conc. slab on grade
 - Conc. topping slab
 - Conc. walk
 - Conc. curb
 - Formed and stained conc. surface
 - Smooth conc. finish
 - Conc. wall
- 05000 Steel
- Reinf. Stl. Bar
 - 6x6x10 welded wire fabric
 - Steel angle
 - Steel plate
 - Steel channel
 - 4x8 stl. tube column
 - 4x4 stl. tube column
 - 1/2" RC resilient channel
 - 16ga. galv. sheet metal
 - 1 1/2" mtl. roofing deck
 - C6x13 guardrail
 - 1 1/2" mtl. Z channel
 - 7/8" hat channel
 - Painted mtl. eave vent (cont.)
- 06000 Wood
- 2x4
 - 2x8
 - 2x8
 - Pre-manufactured wood truss
 - 4x14 wood beam
 - 3/4" sheathing
 - Sawn wood shingles
 - Wood base
 - 1x wood trim kerfed
 - 2x wood trim
 - 1x4 T&G wood siding w/v groove
 - Rough sawn 5/4" plwd. 4" O.C.
 - 3/4" exterior plywood
 - 2x10 fascia plate
 - 4x4
 - Batten board
 - Wood blocking
 - Wood trim
- 07000 Thermal & Moisture
- G.I. flashing
 - Sealant
 - 3/2" batt insulation
 - 5/8" Fiberglass batt insul.
 - 7/2" Fiberglass batt insul.
 - 2" blown-in insulation
 - 1 1/2" rigid insul.
 - Tapered rigid roof insulation
 - 2" PVC weep w/ screen on inside face
 - Single ply Hypalon roofing membrane
 - Termination bar
 - Pre-finished rain gutter
 - Rain leader
 - Building paper
 - Vapor barrier
 - Moisture barrier
- 08000 Doors & Windows
- Metal security door
 - HM frame
 - Wood frame
 - Clad wood double hung window w/screen
 - Clad wood fixed window
 - Fixed wood window
 - 1" insulated glass (clear)
 - 1" insulated glass (tinted)
 - 1/4" clear glass
 - Alum. threshold
 - Alum. door
- 09000 Finishes
- 5/8" Gypsum Wallboard (gyp.bd.)
 - 5/8" WP Gypsum wallboard
 - Vinyl composition tile (VCT)
- 10000 Specialties
- Toilet tissue dispenser
 - Soap dispenser
 - Paper towel dispenser
 - Grab Bar
 - Mirror
 - Feminine napkin receptacle
 - Mop service sink
 - Mop hanger
 - Drinking fountain
 - Lockers
 - Fire extinguisher & Cabinet
 - Bug screen
- 11000 Equipment
- Toll computer (NIC)
 - Toll modem (NIC)
 - Toll P.C. (NIC)
 - Toll coin equipment (NIC)
 - Microwave
 - Undercounter refrigerator
 - Vending Machines (NIC)
- 12000 Furnishings
- Wood shelving
 - Kitchen cabinets w/ plast. laminate
 - Plastic laminate counter top
 - Plastic laminate counter bulletin board
- 15000 Mechanical
- Pre-finished metal louver
 - Electric Water heater
 - Toilet
 - Lavatory
 - Kitchen sink
 - Heat pump condenser unit
 - Heat pump fan unit
 - perimeter duct
 - Feeder duct
 - Rooftop Mech. unit
 - Electrical-space heater
- 16000 Electrical
- Emergency Generator
 - Light fixture
 - Traffic light
 - Lighting panels

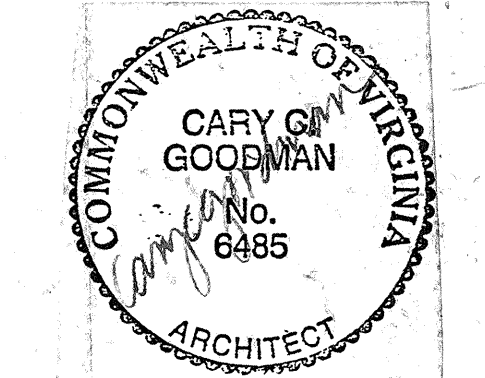

HNTB
 HOWARD NEEDLES TAMMEN & BERGENOFF
 ARCHITECTS ENGINEERS PLANNERS
 99 CANAL CENTER PLAZA
 ALEXANDRIA, VIRGINIA 22314
 TEL. (703) 684-2700

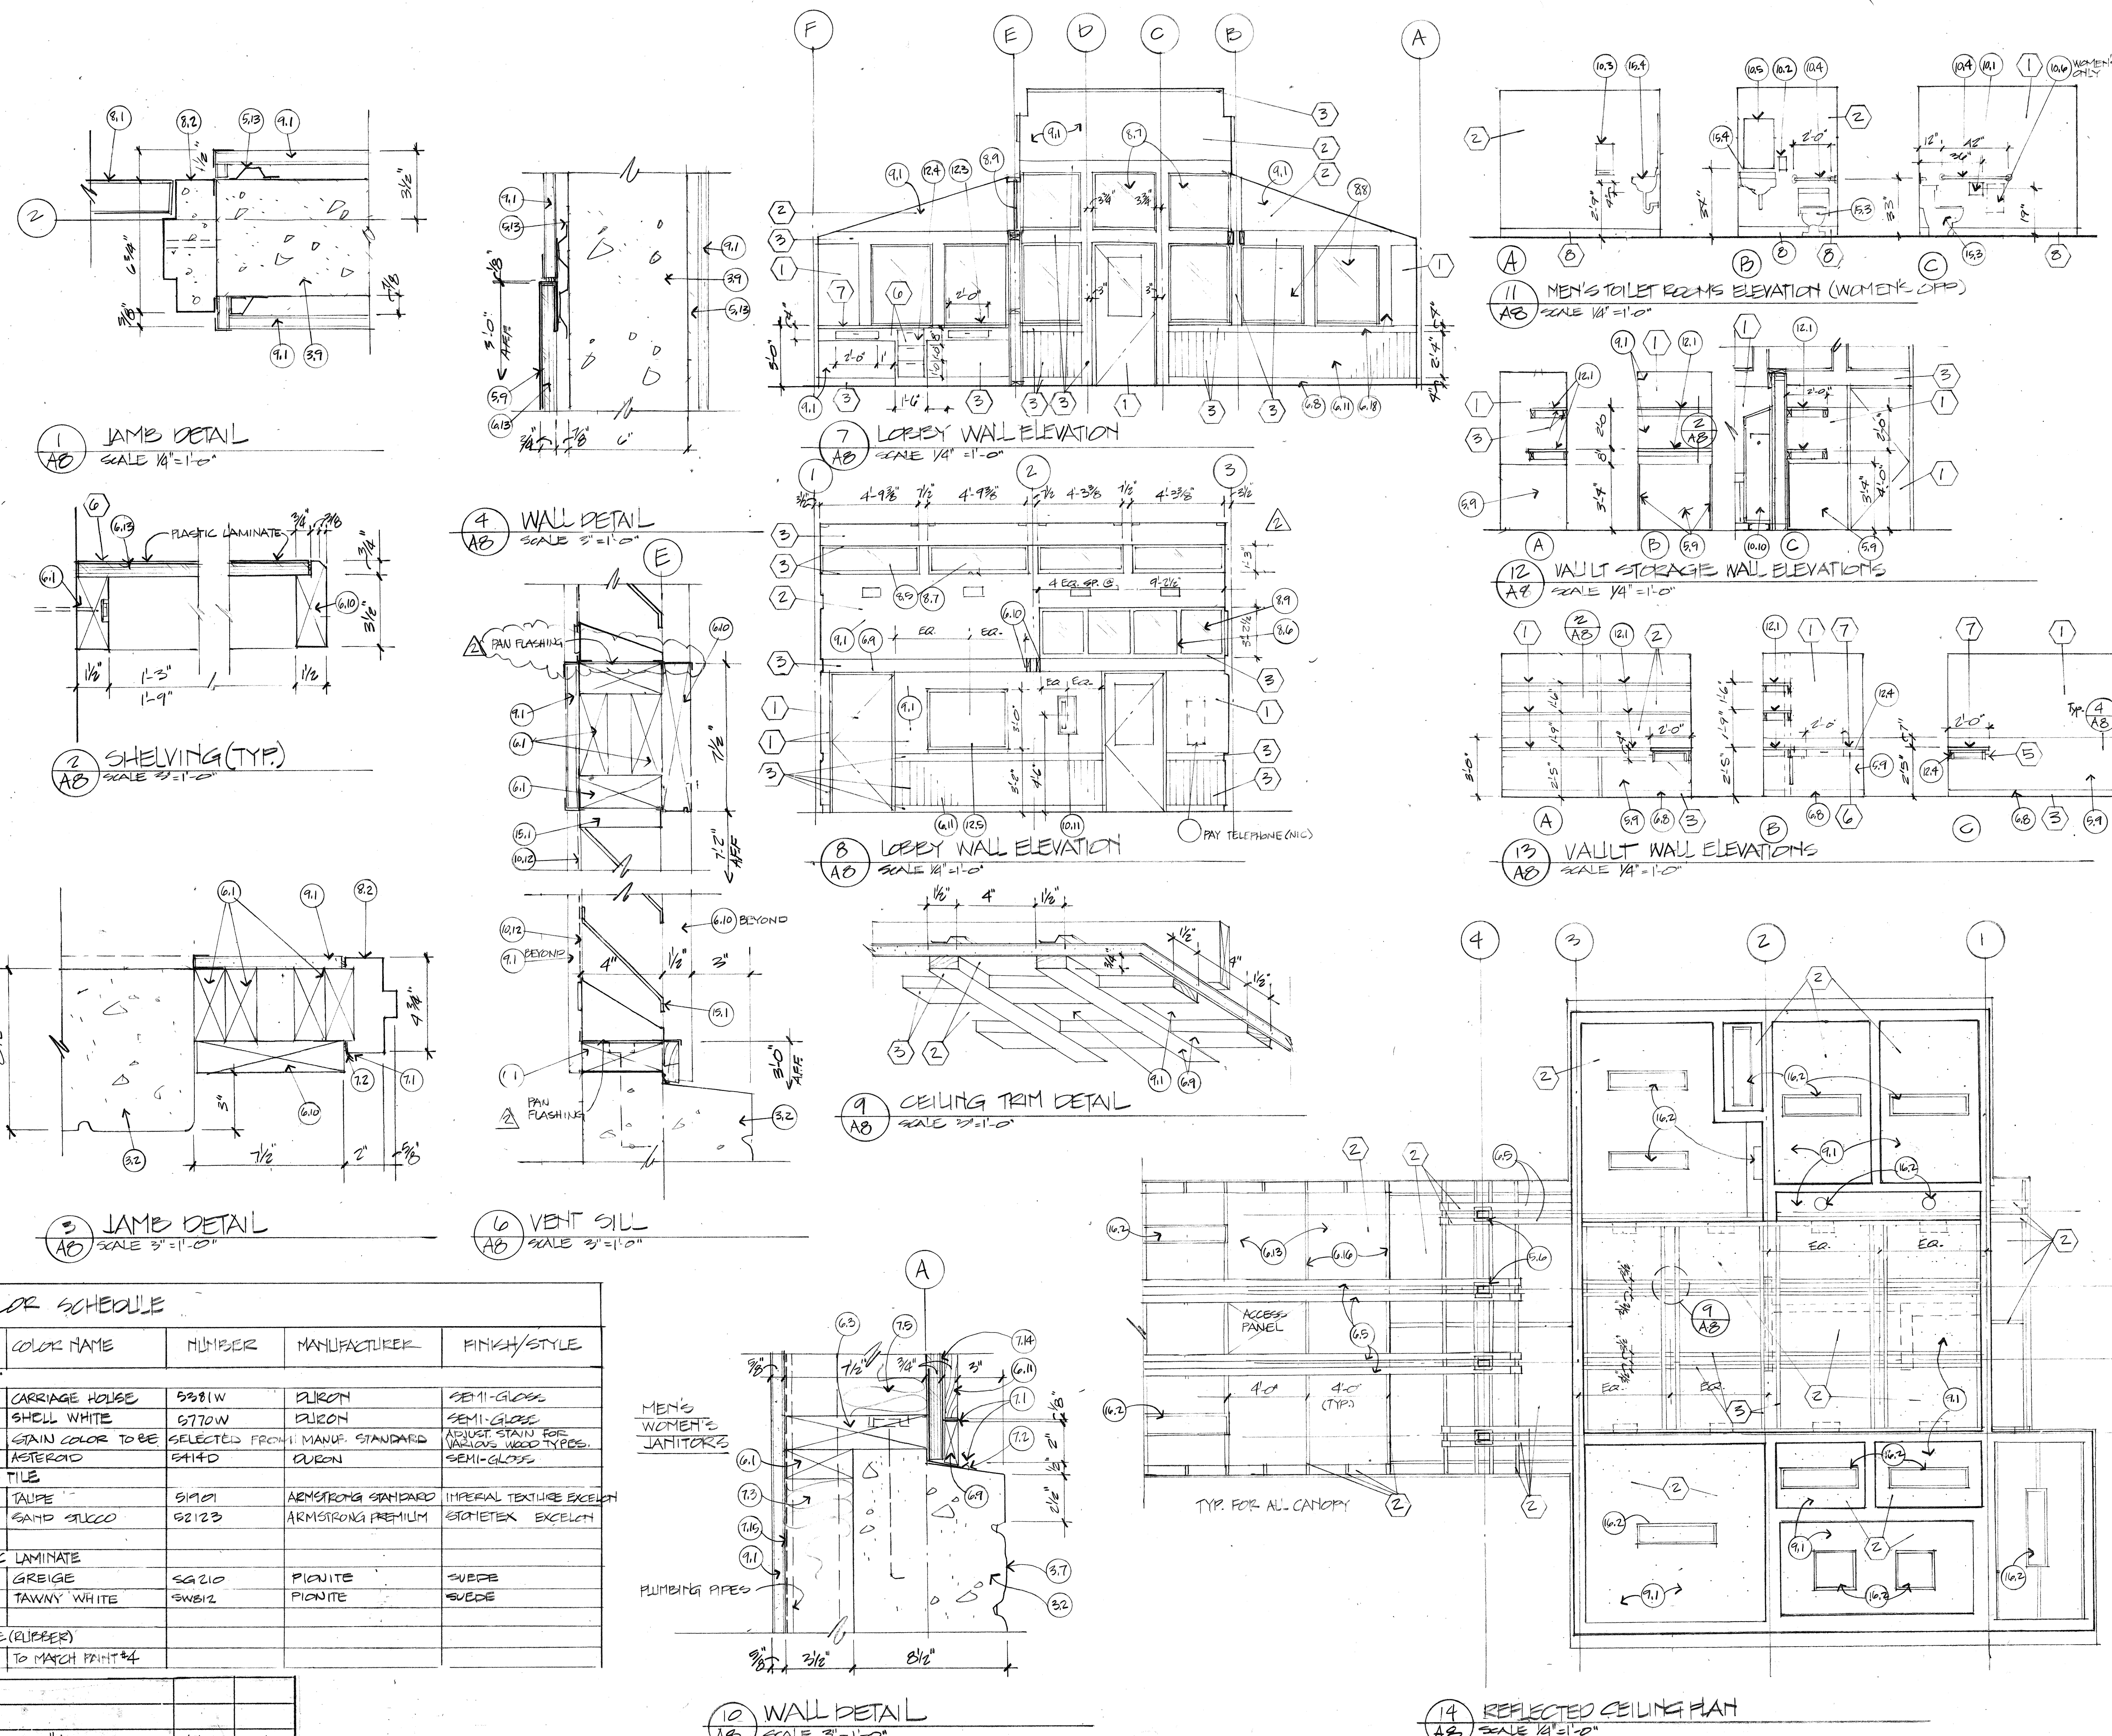

COLOR SCHEDULE

COLOR NAME	NUMBER	MANUFACTURER	FINISH/STYLE
PAINT			
1 CARRIAGE HOUSE	9381W	DUREON	SEMI-GLOSS
2 SHELL WHITE	6770W	DUREON	SEMI-GLOSS
3 STAIN COLOR TO BE SELECTED FROM MANUF. STANDARD			ADJUST STAIN FOR VARIOUS WOOD TYPES.
4 ASTEROID	6414D	DUREON	SEMI-GLOSS
FLOOR TILE			
4 TAUPE	91921	ARMSTRONG STANDARD	IMPERIAL TEXTURE EXCELCH
5 SAND SUCCO	92123	ARMSTRONG PREMIUM	GEOMETEX EXCELCH
PLASTIC LAMINATE			
6 GREIGE	SG210	PIONITE	SWEDE
7 TAWNY WHITE	SWS12	PIONITE	SWEDE
BASE (RUBBER)			
8 TO MATCH PAINT #4			

Revision #1

No.	Revision	By	Date
1		EL	7-14-92

PROJECT NO: 14237
 DATE: _____
 DRAWN BY: EL
 CHECKED BY: _____
 CHECKED BY: _____
 REVISED DATE: _____


**BOULEVARD
 BRIDGE TOLL
 PLAZA BUILDING**

DRAWING TITLE:
**REFLECTED CEILING
 PLAN, INTERIOR
 ELEVATIONS**

CONTRACT NO. 17B
36.10

DRAWING NUMBER:
A-8

RECORD DRAWING

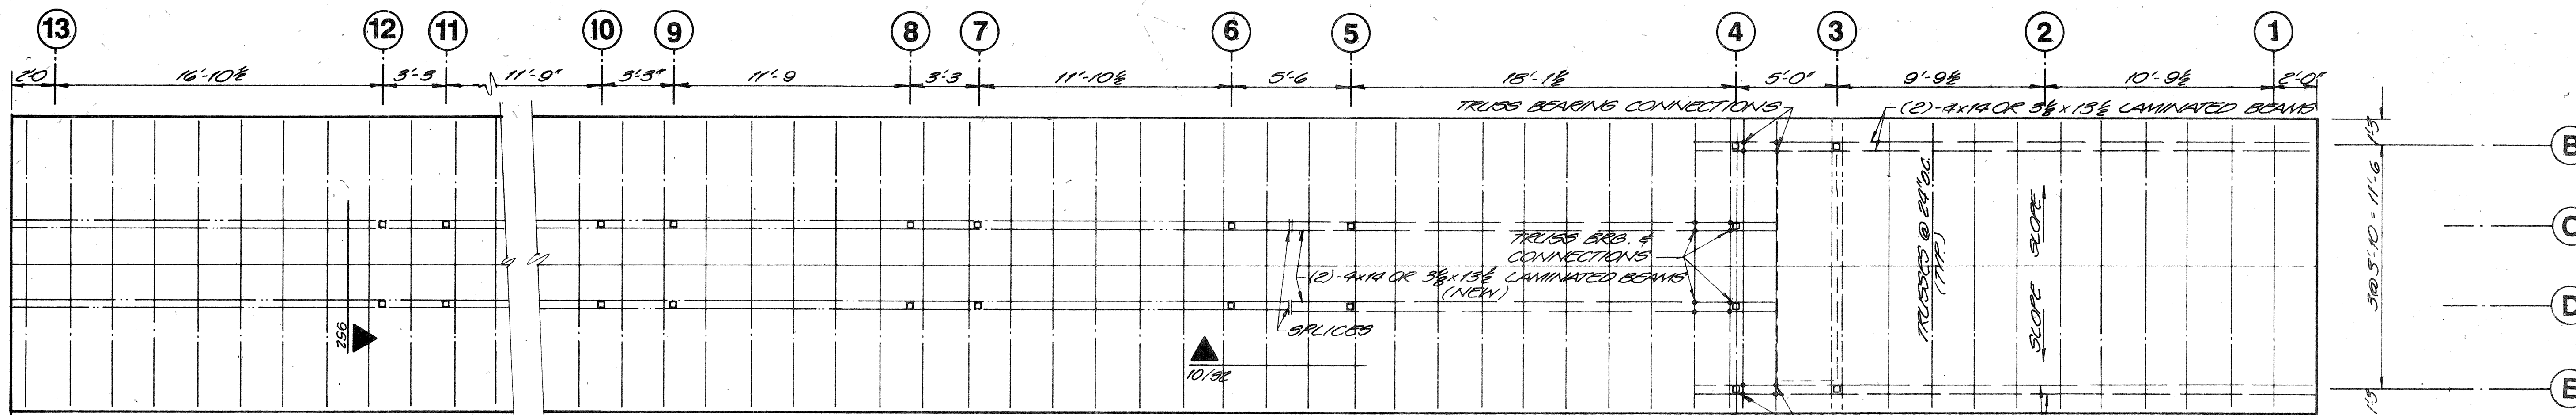



SEE DETAIL 91.52 FOR SECTION OF ADDITIONAL STEEL REQ'D. TYP. FOR GRID LINES 7-12

EXISTING STEEL COLUMNS & WOOD BEAMS TO REMAIN. NEW TRUSSES & ROOF SYSTEM

ENTIRELY NEW WORK REUSE EXISTING 4x4 BEAMS TO SPLICE


SEE DETAIL 10.52 FOR NEW BOOTH STRUCT. STL. FOR FOUNDATION, SEE DETAILS 11.52 & 12.52 FOR BASE PLATE SEE DETAIL 13.52

UPPER ROOF FRAMING PLAN
1/4" = 1'-0"

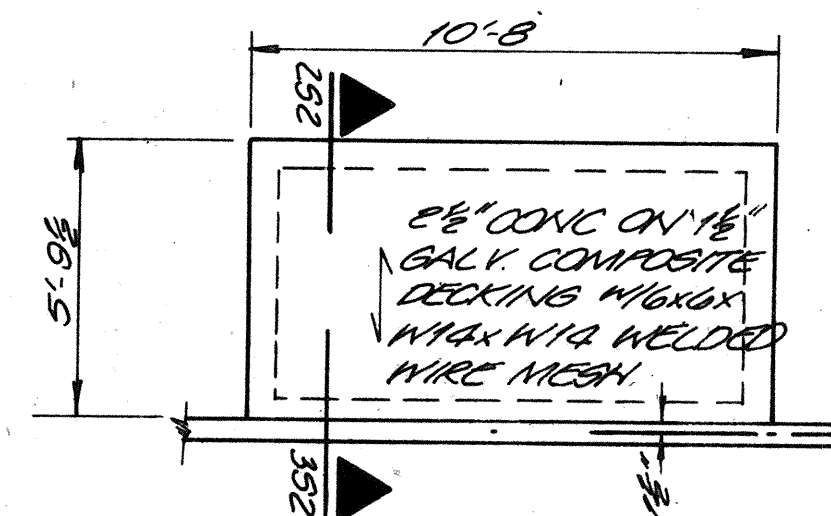
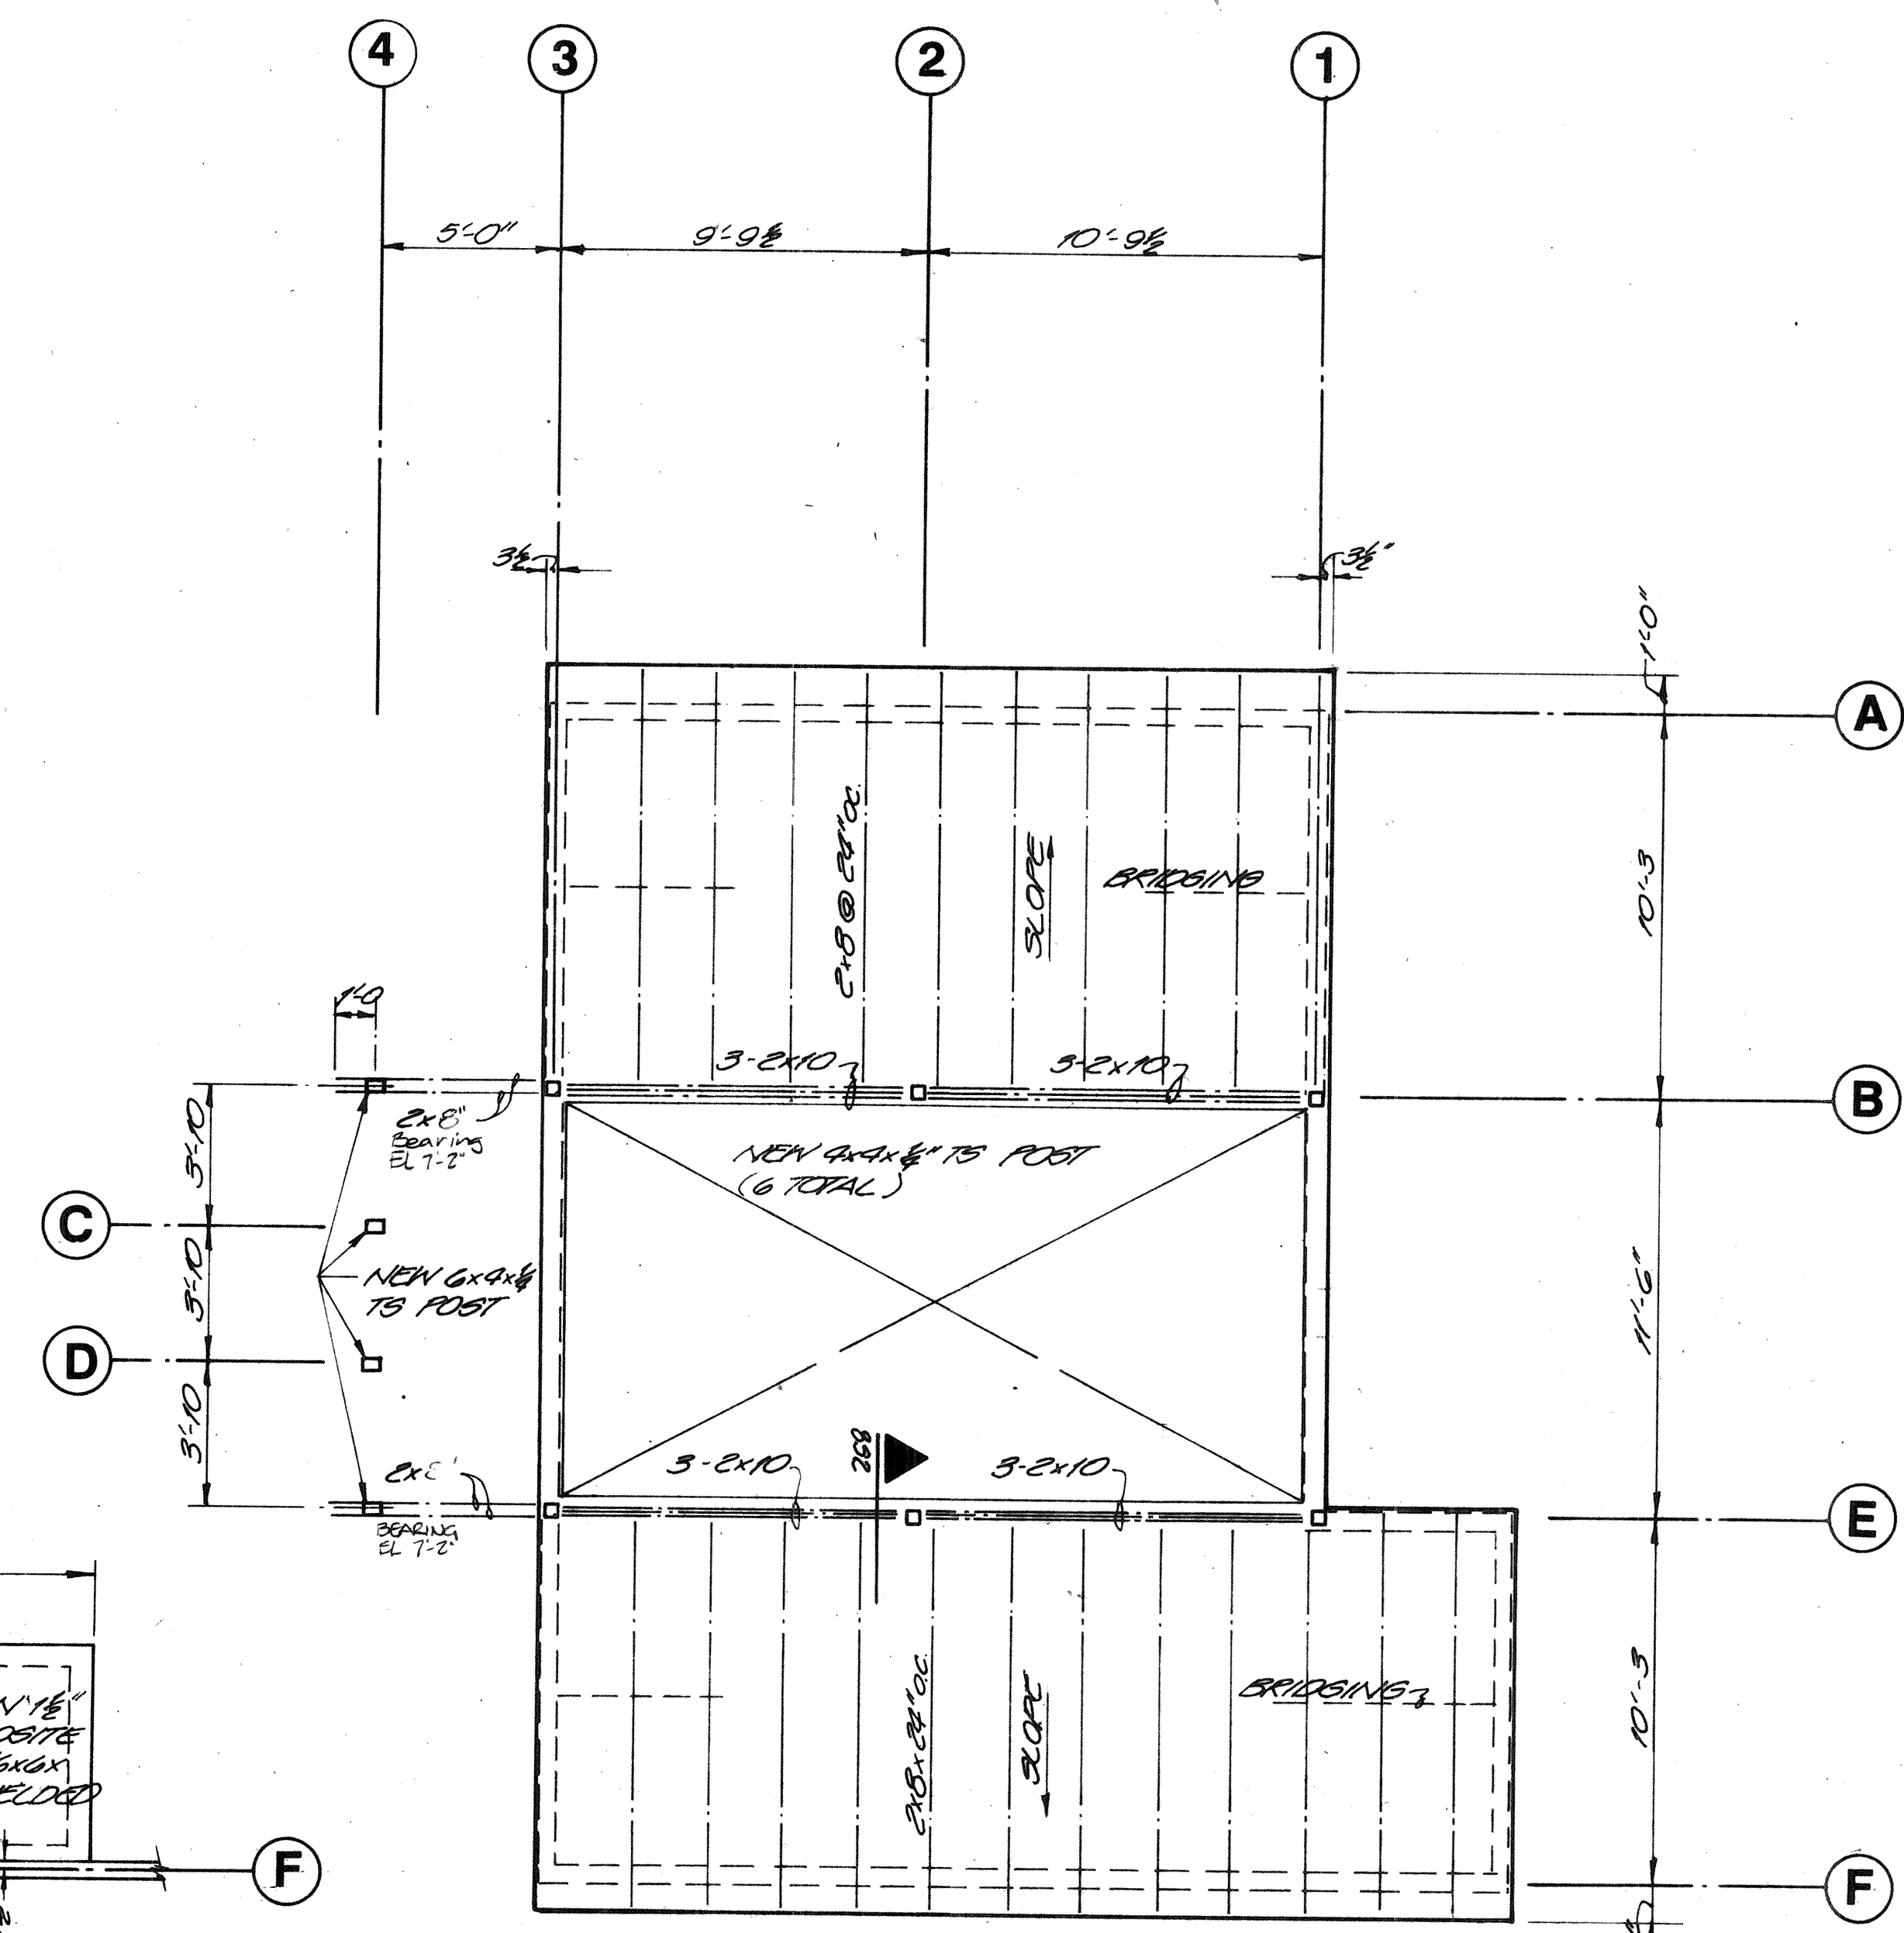


VAULT ROOF FRAMING PLAN
1/4" = 1'-0"

LOWER ROOF FRAMING PLAN
1/4" = 1'-0"

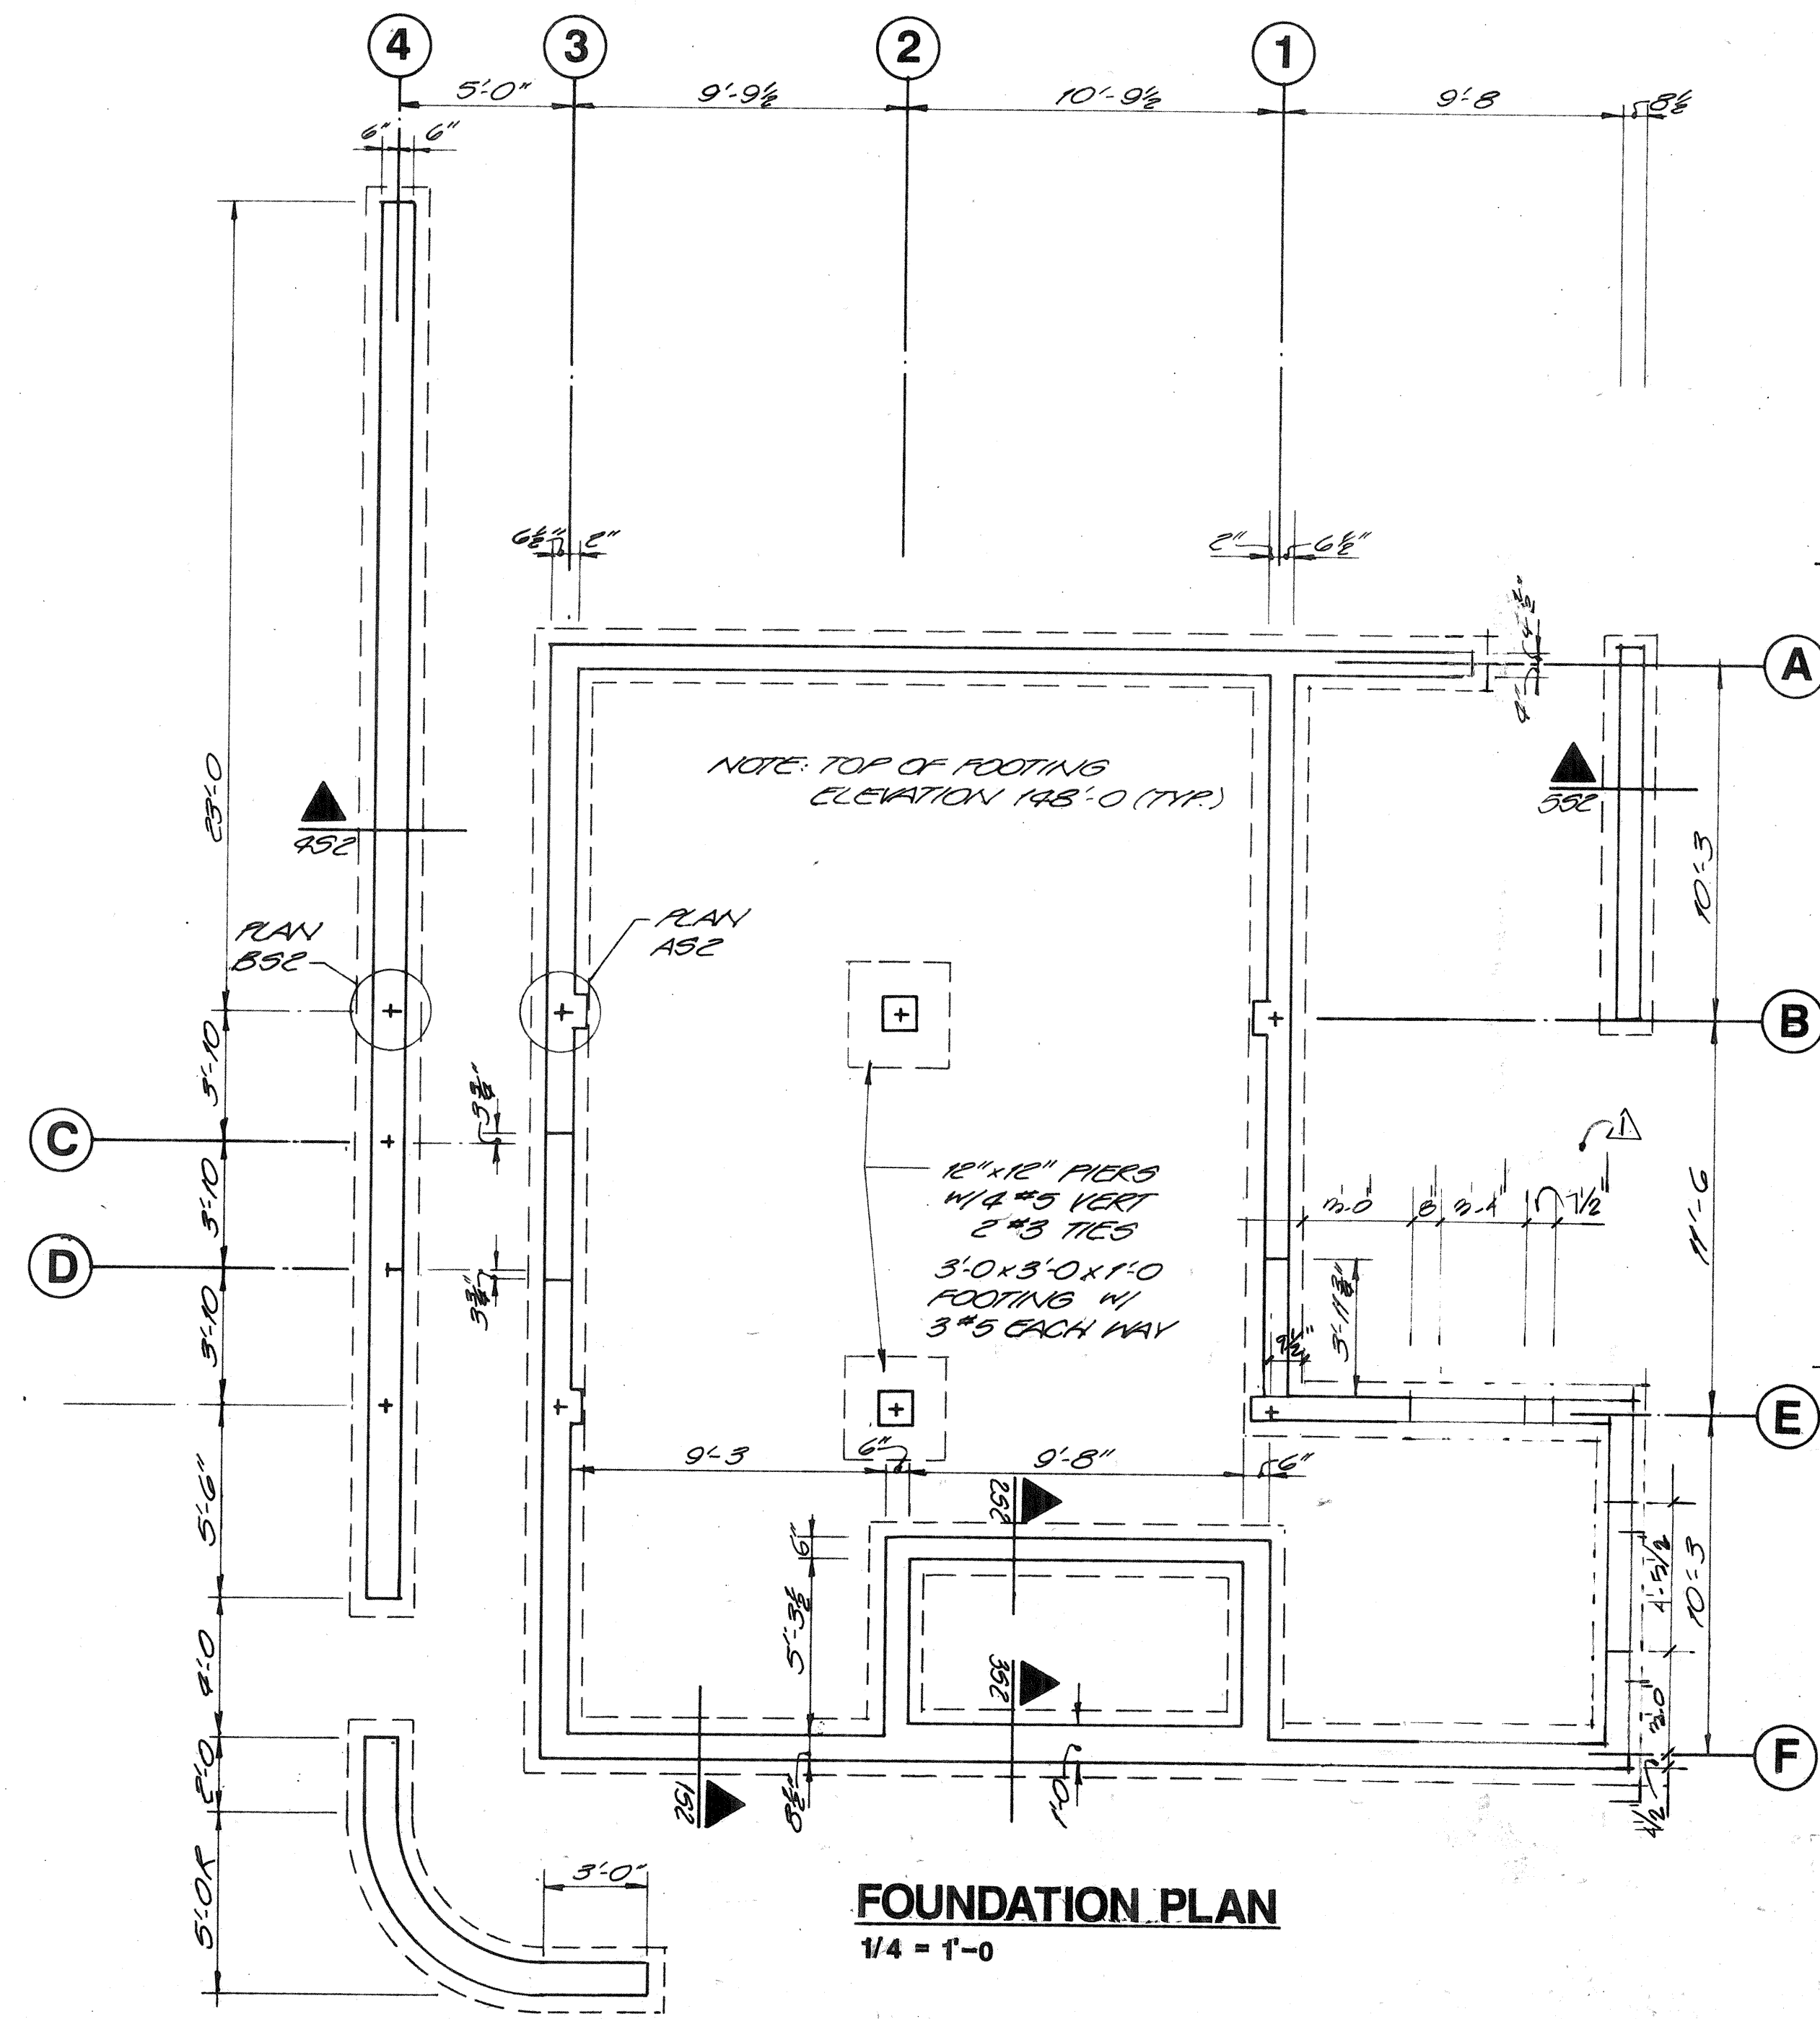

FOUNDATION PLAN
1/4" = 1'-0"

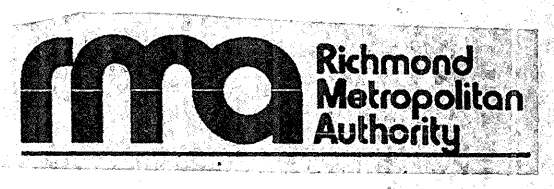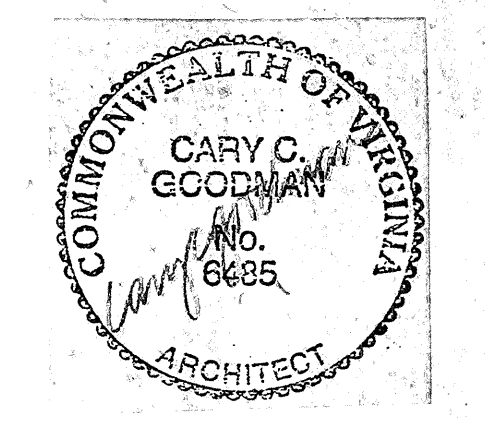

PROJECT NO:	
DATE:	
DRAWN BY:	RL
CHECKED BY:	
REVISION DATE:	

BOLLEVAARD
BRIDGE TOLL PLAZA
BUILDING


DRAWING TITLE:
FRAMING
PLANS

CONTRACT NO. 17B
36.12
DRAWING NUMBER:


S-1

RECORD DRAWING


RICHMOND EXPRESSWAY SYSTEM			
SECTION	PROJECT	SHEET NO.	TOTAL SHEETS
C17B	BOULEVARD BRIDGE		

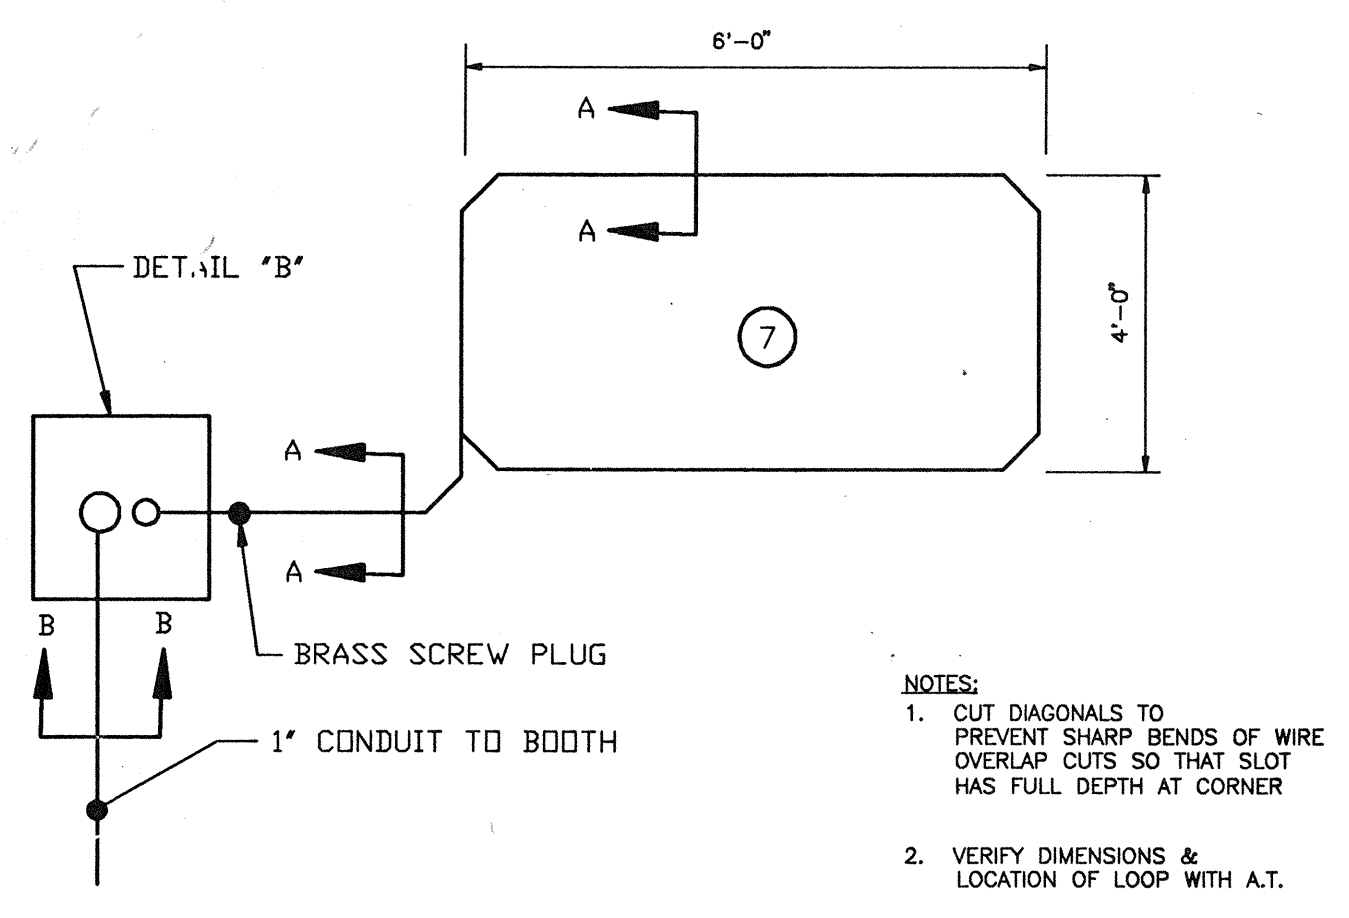


SLOT PLAN - VEHICLE DETECTION LOOP
NORTHBOUND AS SHOWN SOUTHBOUND OPP. HAND
N.T.S.

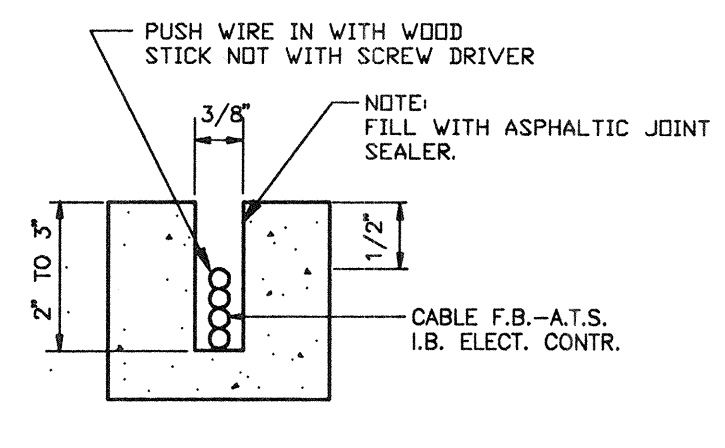


SECTION AA
N.T.S.

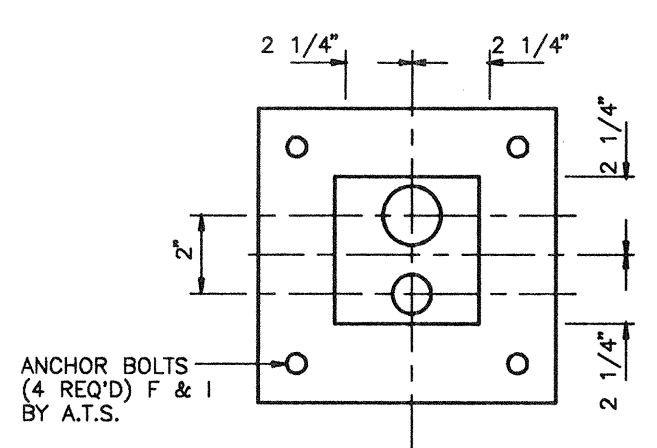


DETAIL 'B'
N.T.S.

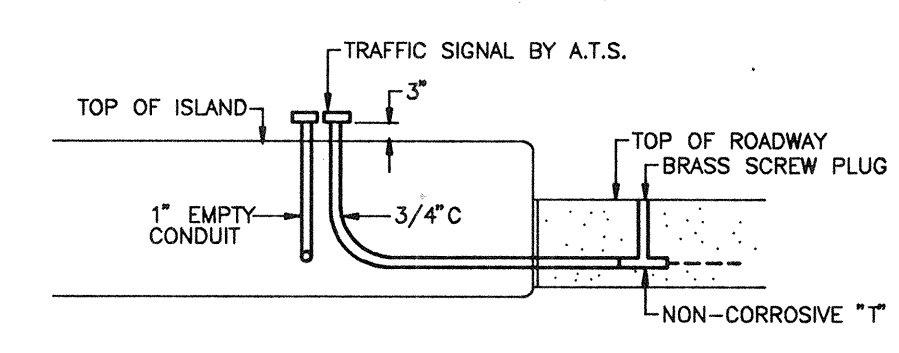


SECTION BB
N.T.S.

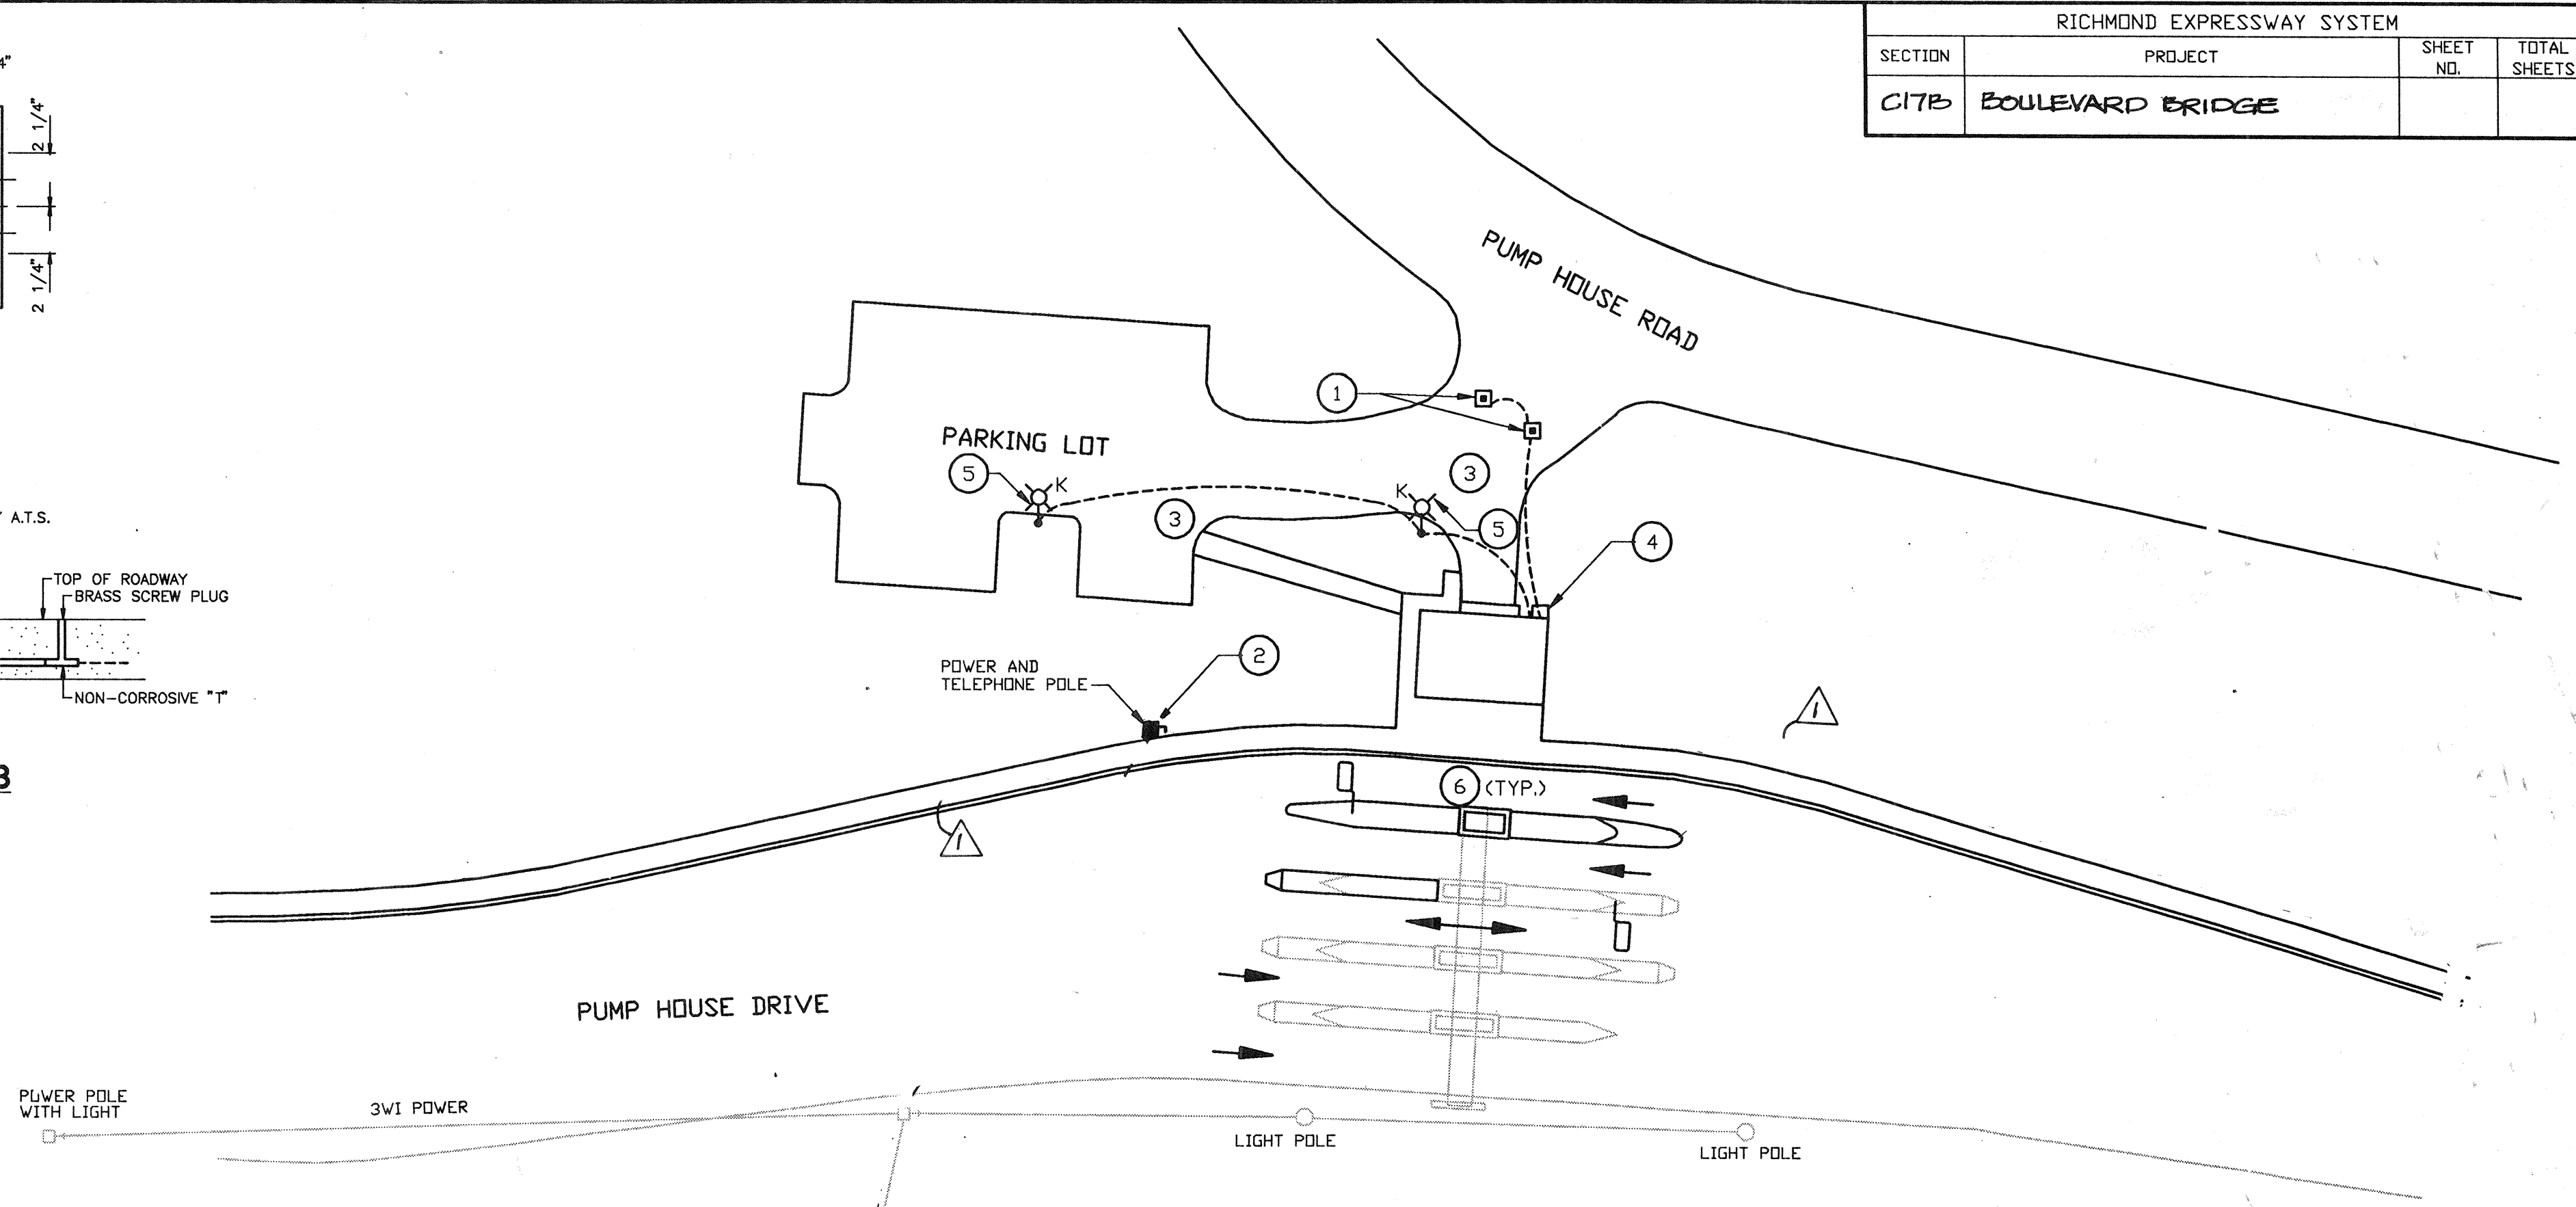


ELECTRICAL SITE PLAN
SCALE: 1"=30'-0"

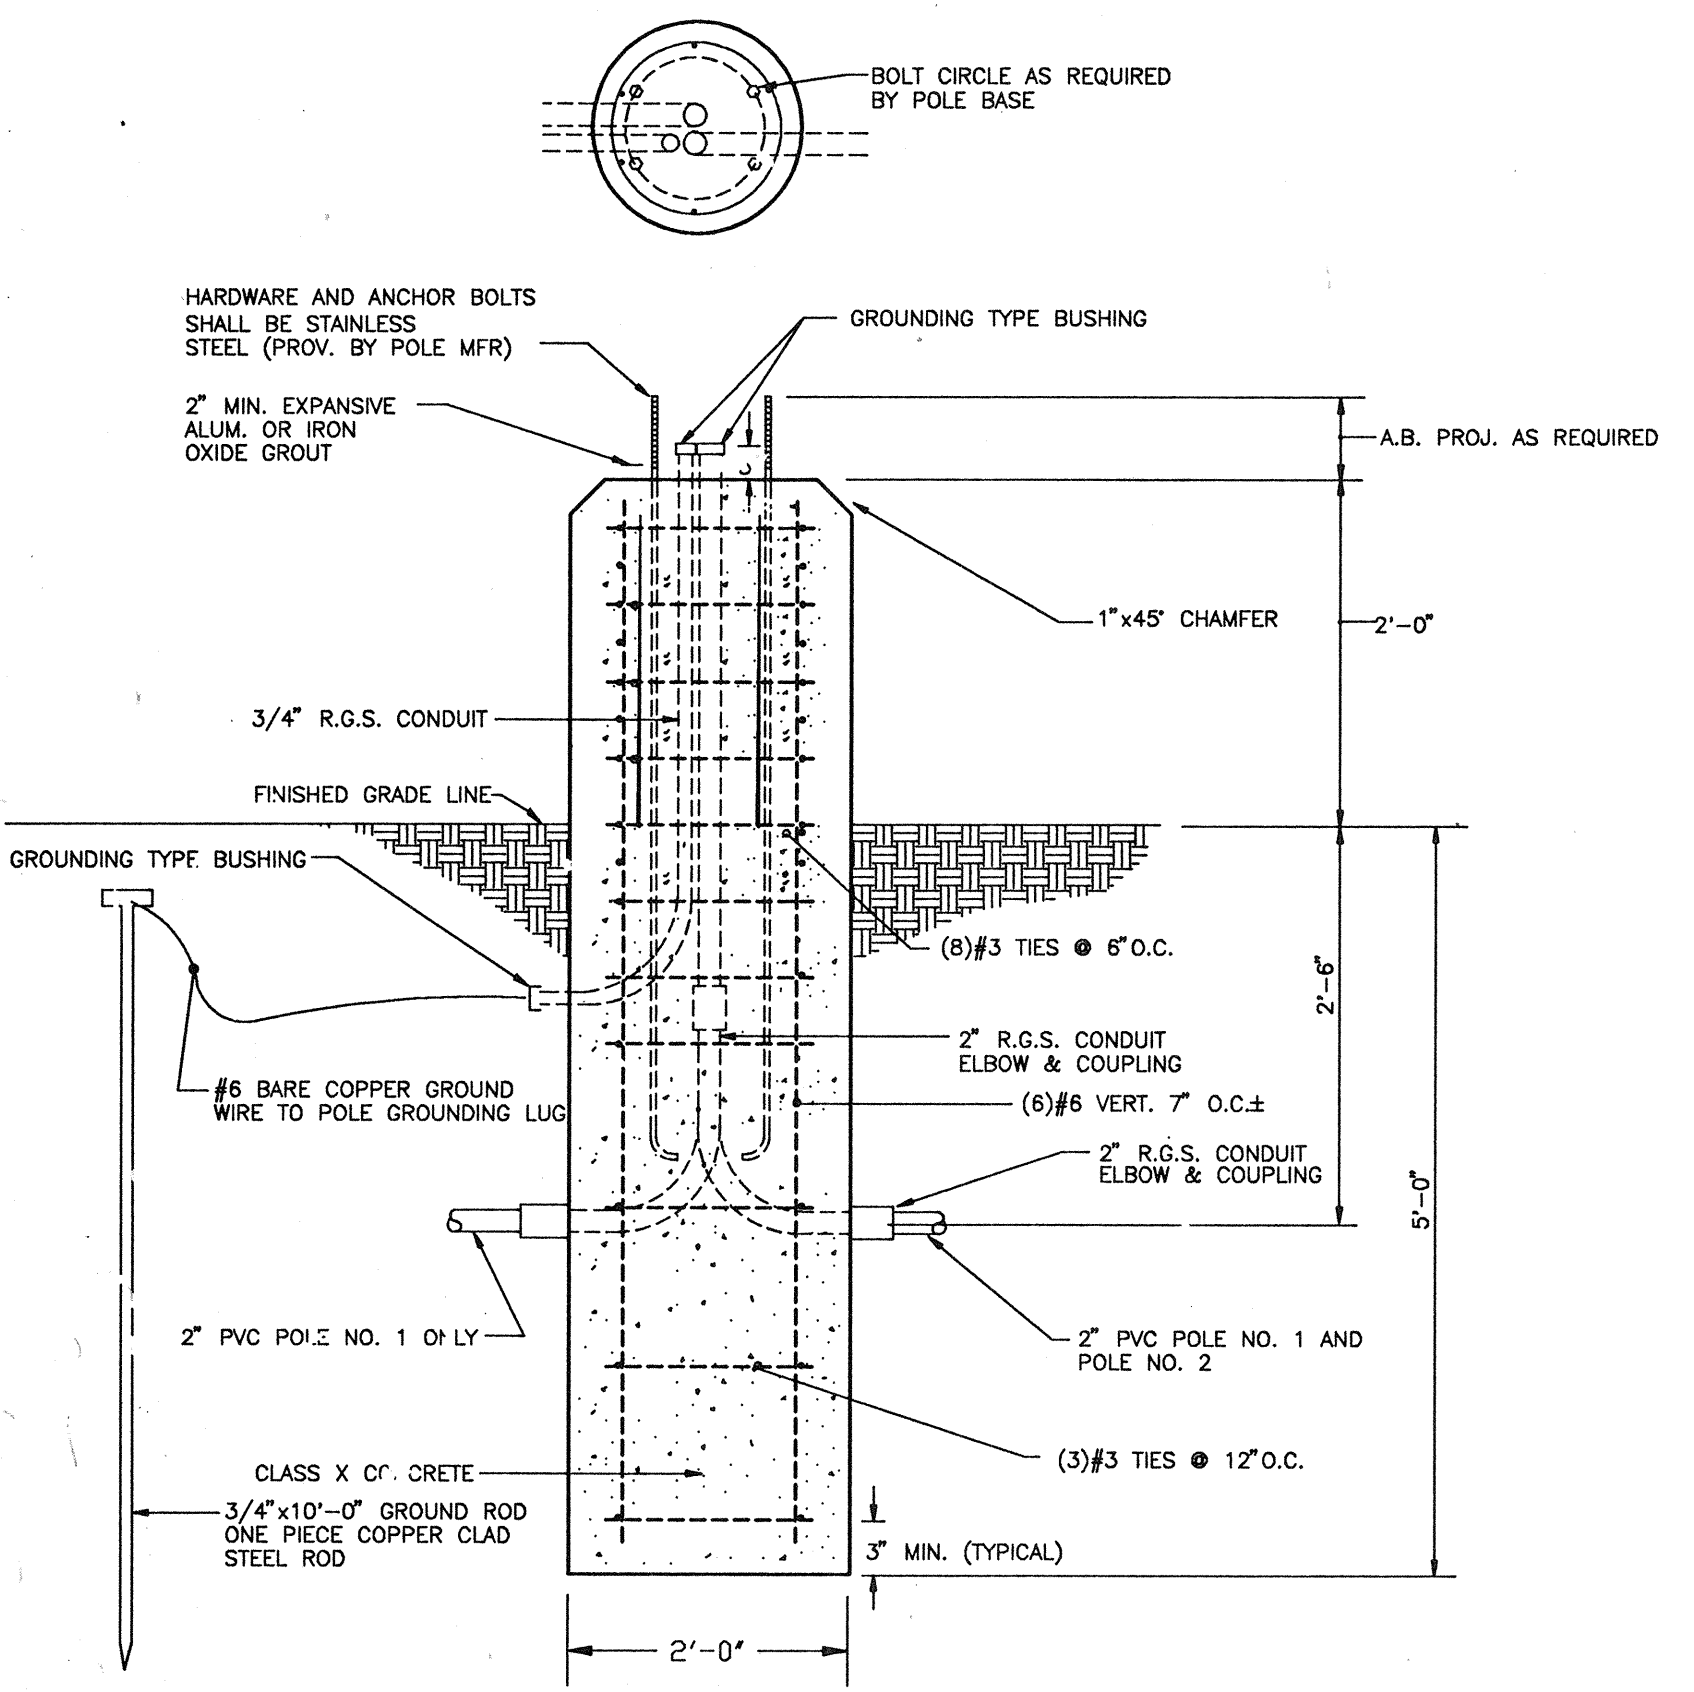


NEW POLE FOUNDATION DETAIL
N.T.S.

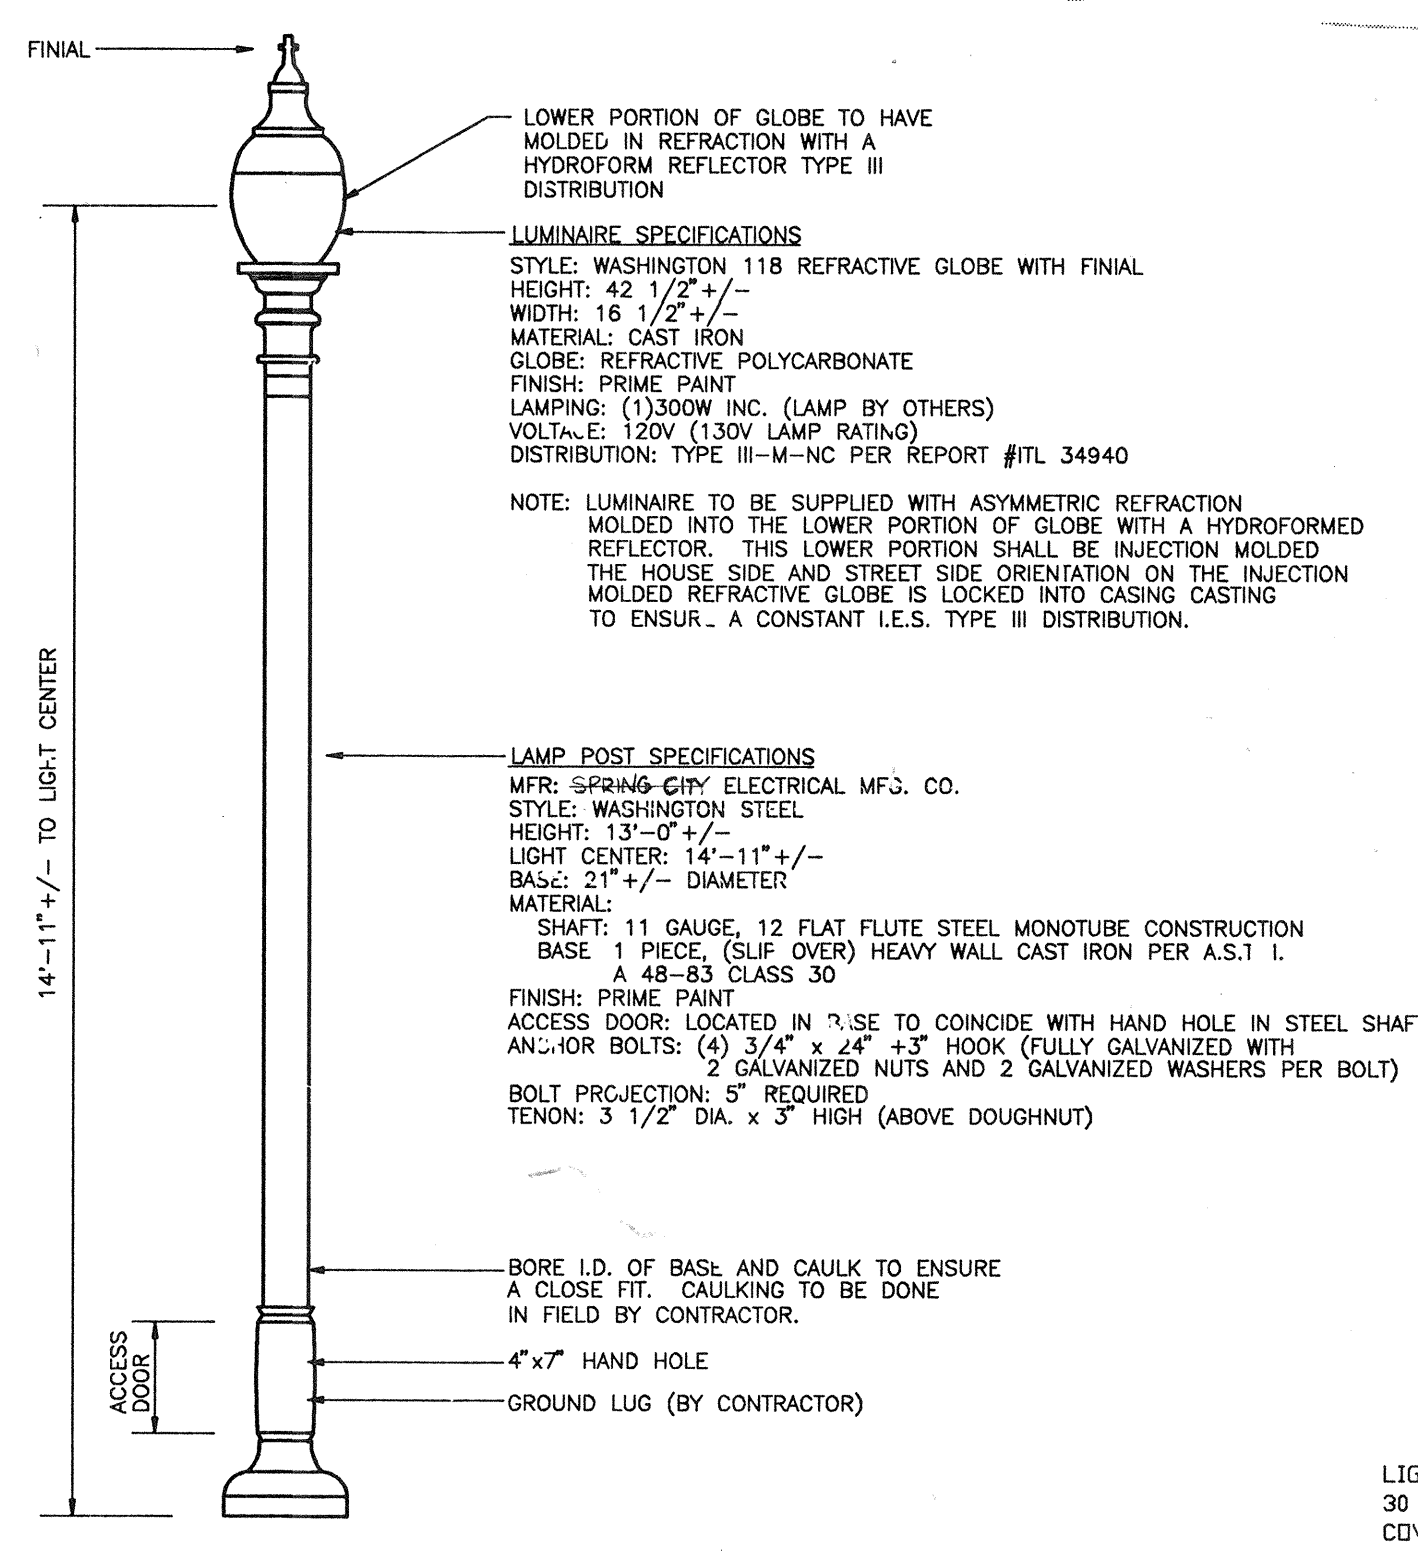

NEW POLE ELEVATION
N.T.S.

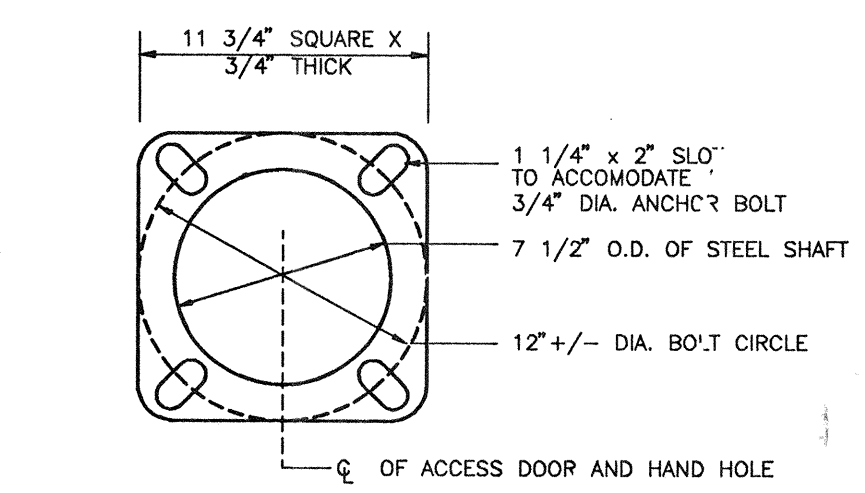

BASE PLATE DETAIL
N.T.S.

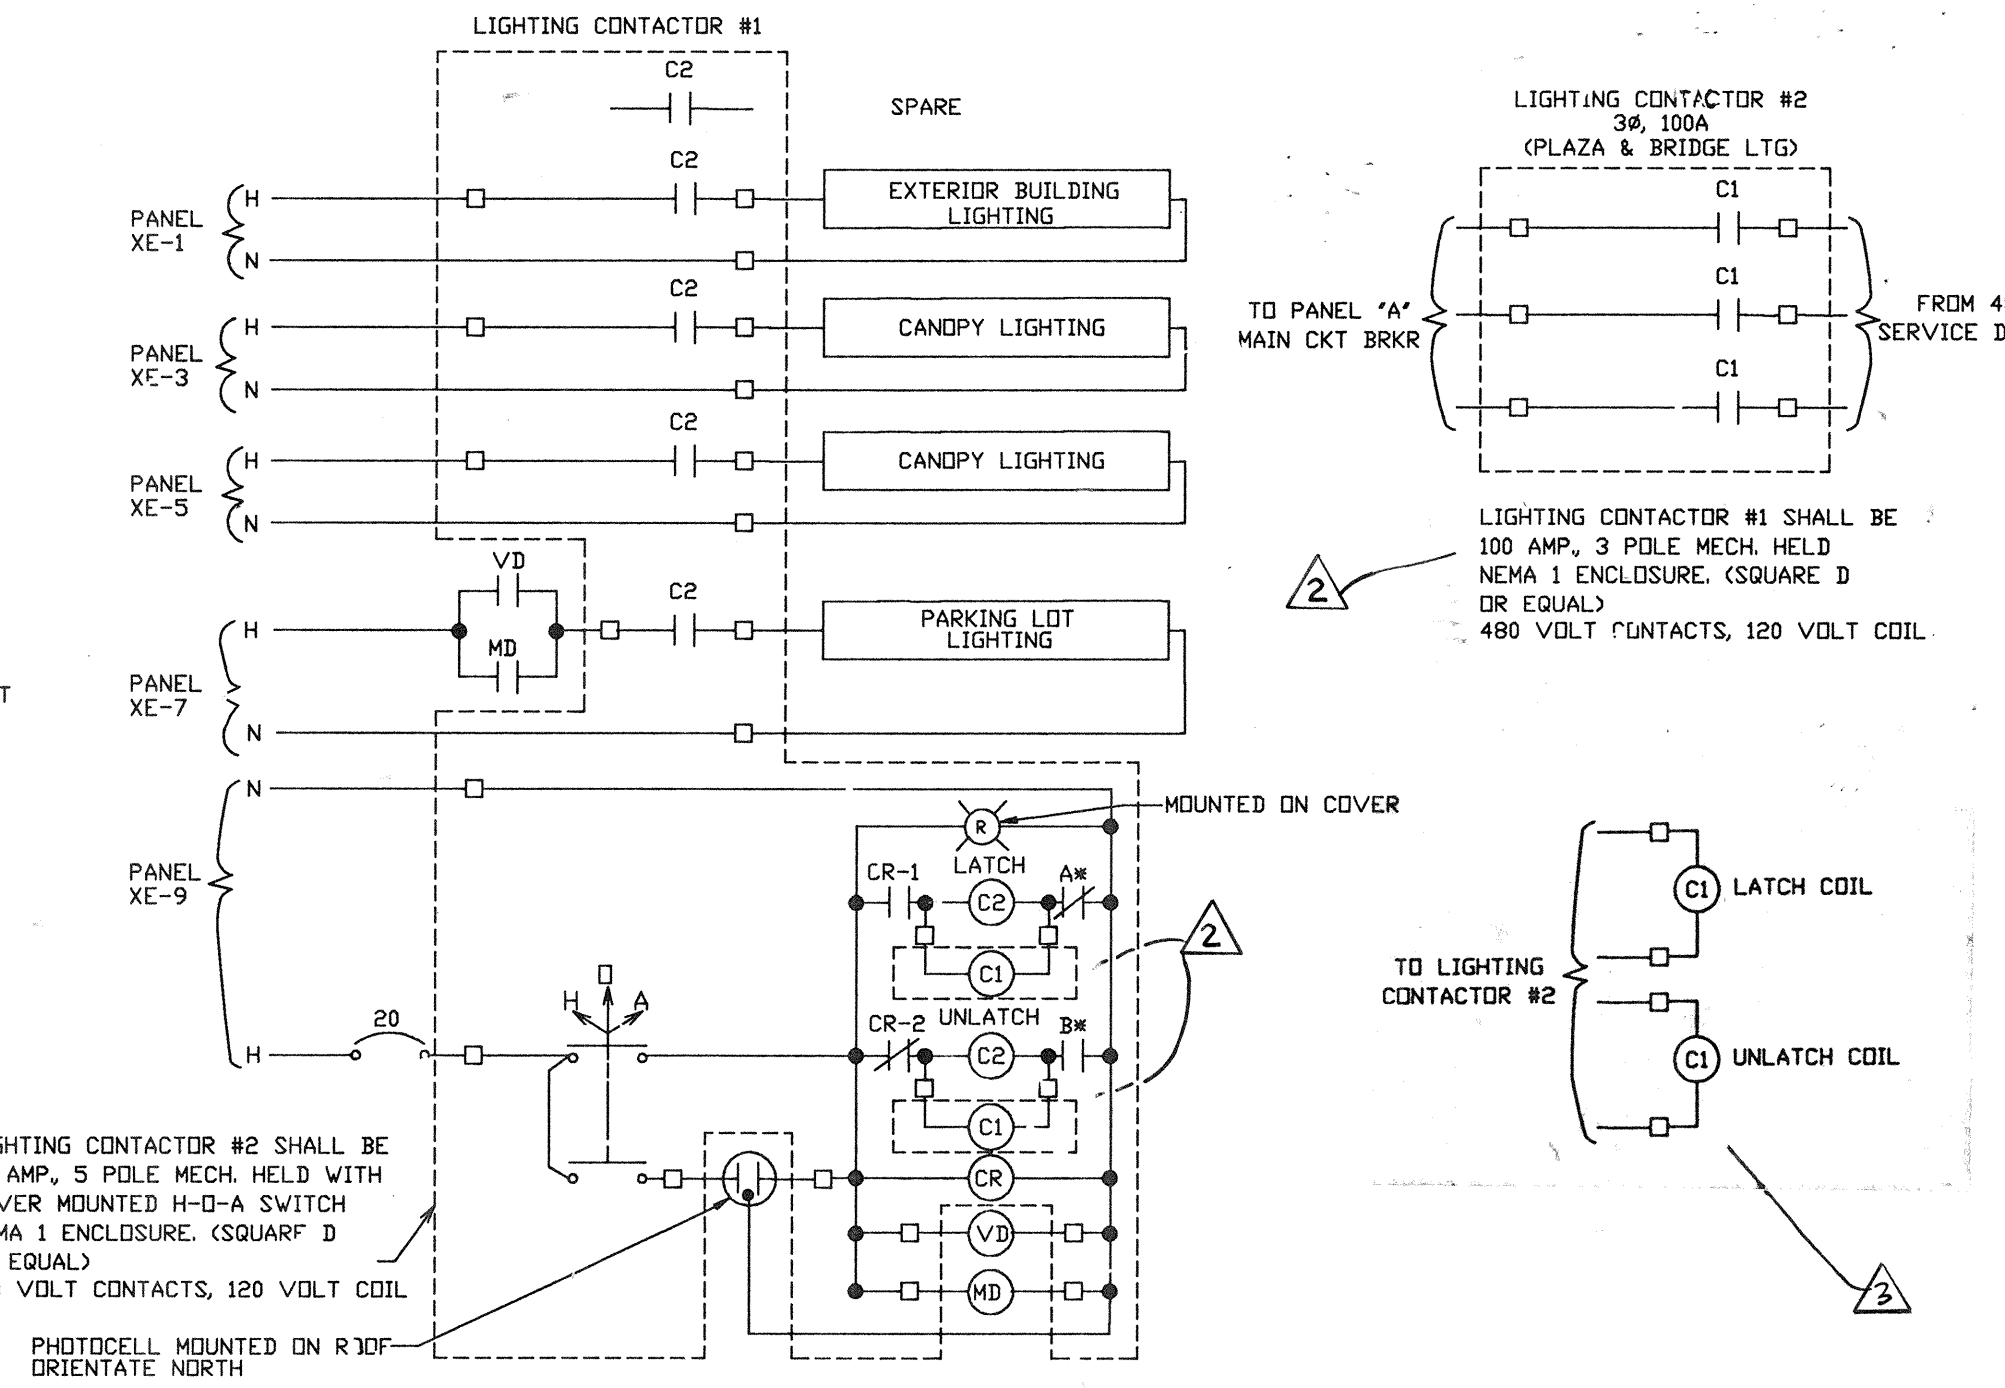

- NOTES:**
1. THE PHOTOELECTRICAL CELL SHALL BE SPECIFICATION GRADE WITH A GASKETED WEATHERPROOF, DIE CAST ZINC ENCLOSURE AND A 1" DIAMETER HERMETICALLY SEALED CADMIUM SULFIDE CELL. THE UNIT SHALL HAVE BUILT-IN TIME DELAY, AND F.T. ADJUSTMENT OF TURN-ON TIME. IN THE EVENT OF PHOTO-CELL FAILURE, LIGHTING SHALL REMAIN ON. MOUNT PHOTO-CELL WITH CELL ORIENTED TO THE NORTH. THE UNIT SHALL BE RATED 120 VOLT. MANUFACTURER SHALL BE IORR SERIES 2100, OR EQUAL.
 2. CONTACTS "AM" & "BM" ARE COIL CLEARING CONTACTS THAT ARE SUPPLIED WITH LIGHTING CONTACTOR.
 3. MD MOTION DETECTOR ACTIVATES PARKING LOT LIGHTS. PROVIDE ADJUSTABLE TIMER TO DROP LIGHTS OUT (0-30 MIN. RANGE).
 4. VD MAGNETIC VEHICLE DETECTOR EMBEDDED IN PAVEMENT. ACTIVATES PARKING LOT LIGHTS. PROVIDE ADJUSTABLE TIMER TO DROP LIGHTS OUT (0-30 MIN. RANGE).


LIGHTING CONTROL SCHEMATIC - SITE
SCALE: N.T.S. LOCATED IN ROOM A188

- KEYED NOTES:**
1. EMBEDDED VEHICLE DETECTOR ON CENTER LINE OF ENTRANCE AND EXIT LANES. SEE DETAIL ON THIS SHEET.
 2. LIGHT AND POWER POLES. RELOCATED AS PART OF ROADWAY WORK.
 3. CARE MUST BE TAKEN NOT TO DAMAGE EXISTING TREES. RUN ALL CONDUIT UNDER ALREADY DISTURBED CONSTRUCTION AREA UNDER NEW PAVEMENT.
 4. SEE POWER PLAN FOR UNDERGROUND CONDUITS IN THIS AREA.
 5. AREA LIGHTING POLE. SEE DETAILS ON THIS SHEET.
 6. CONDUIT AND WIRING FOR AUTOMATIC TOLL SYSTEM (A.T.S.) CONTROL AND POWER INSIDE EACH BOOTH IS NOT SHOWN.
 7. LOOP DETECTOR CABLE SUPPLIED BY A.T.S. VENDOR AND INSTALLED BY CONTRACTOR. ALL OTHER WIRE AND CONDUIT FURNISHED BY CONTRACTOR. SEE "SLOT PLAN DETAIL" THIS SHEET.


CONTRACT NO. 17B
36.21

RICHMOND METROPOLITAN AUTHORITY
RICHMOND EXPRESSWAY SYSTEM
BLVD. BRIDGE TOLL PLAZA
ELECTRICAL SITE PLAN

HOWARD NEEDLES TAMMEN & BERGENDOFF Architects	Engineers ALEXANDRIA, VA.	Planners HNTB
Scale: 1"=30'(UN)	Date: 2-92	Contract No. C-17B
		Sheet: EI 06

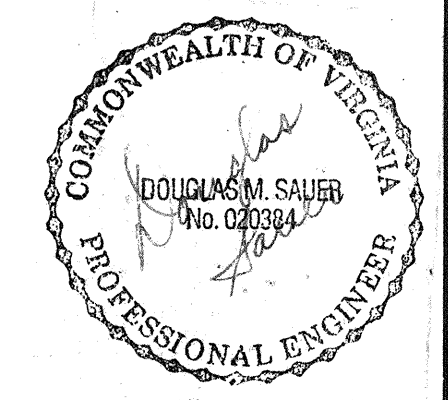


RECORD DRAWING

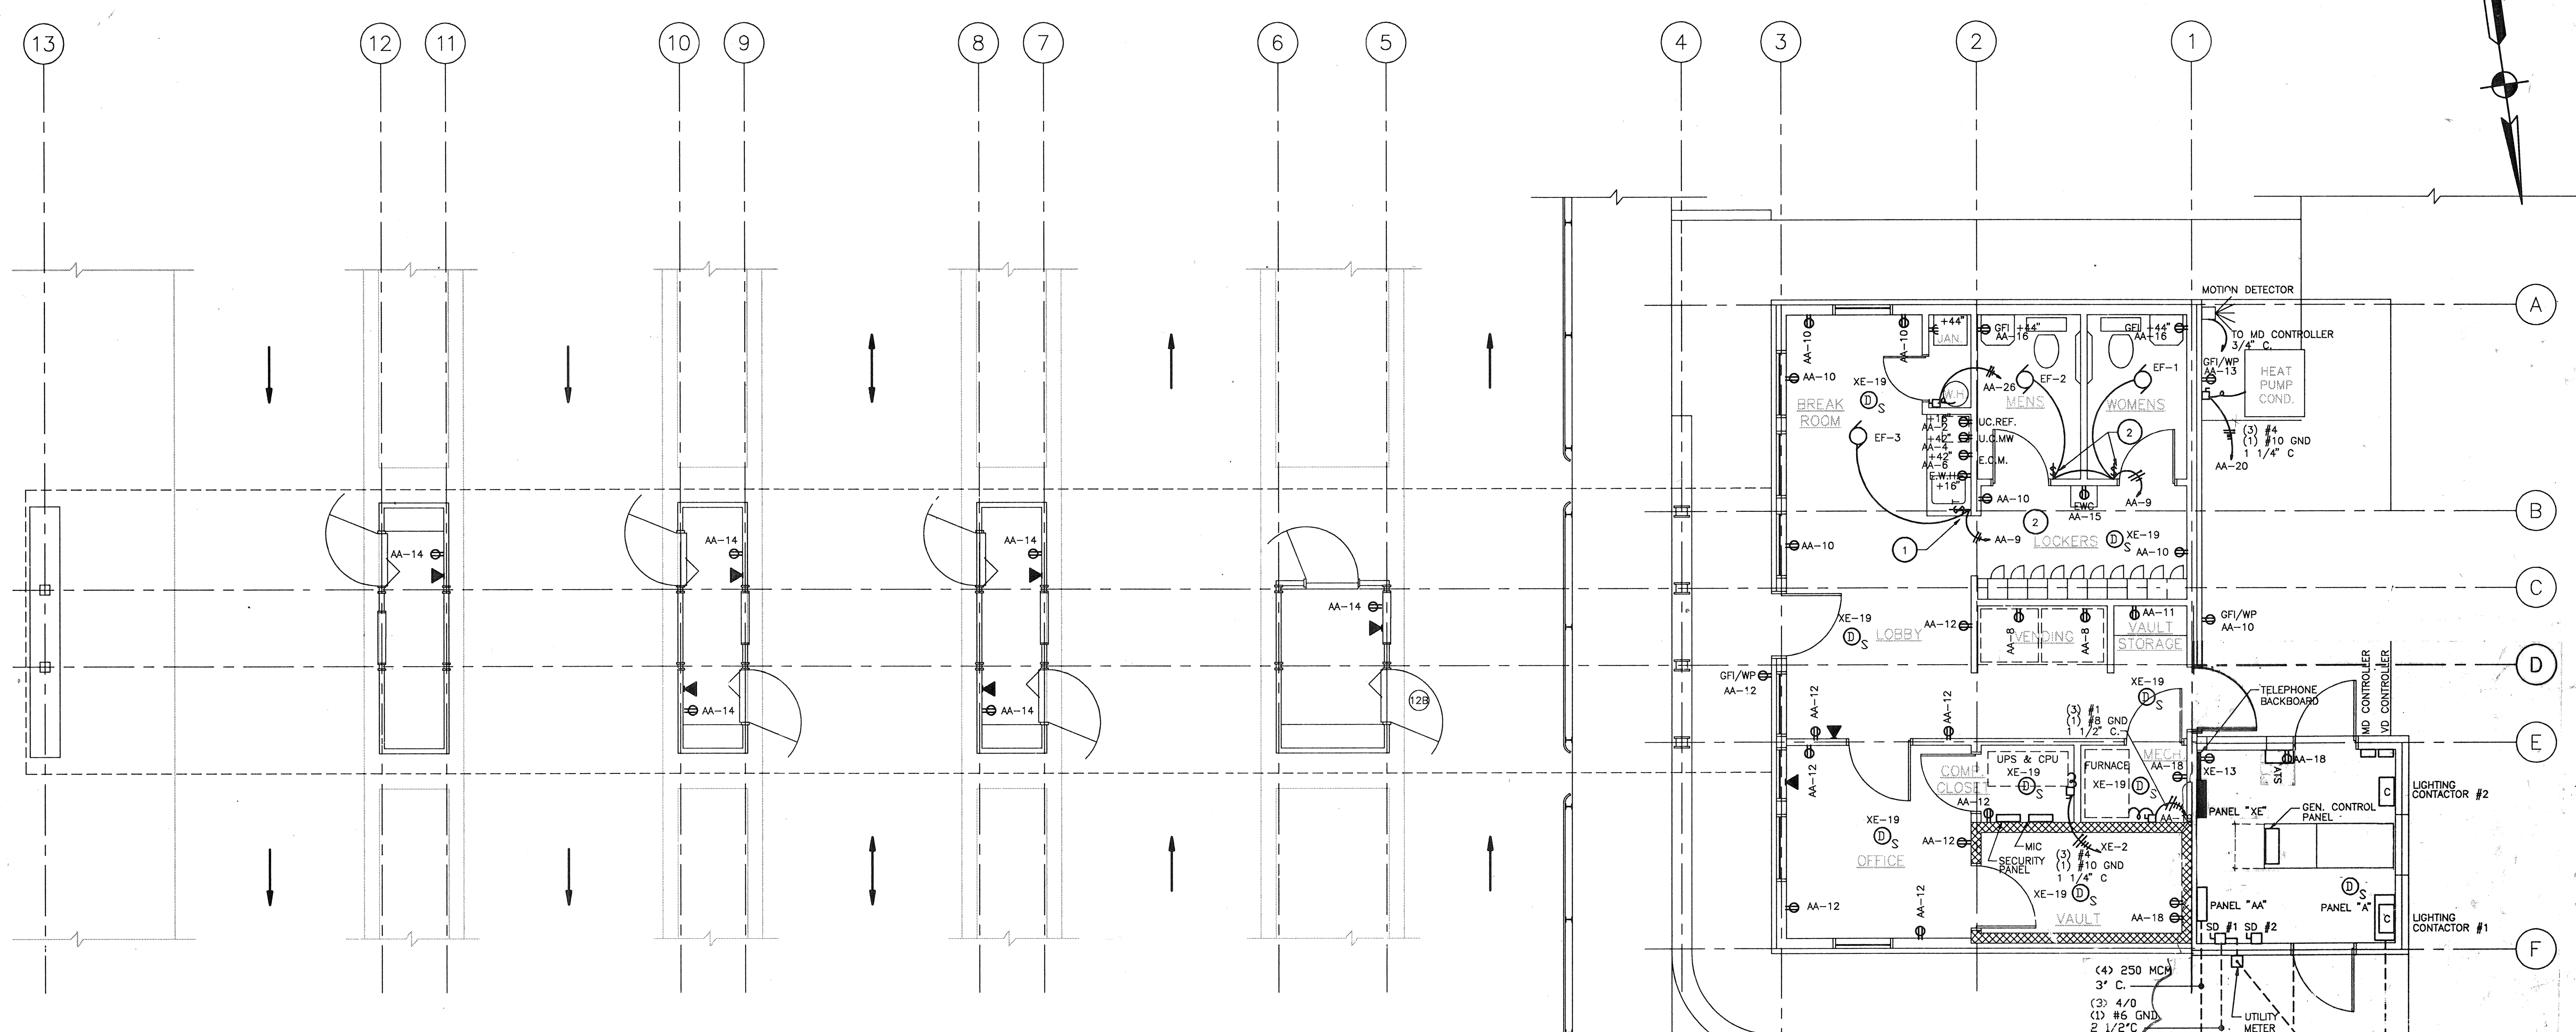

- KEYED NOTES:**
- 1 BOND TRANSFORMER HOUSING TO NEUTRAL AND GROUND PER NEC 250-5.
 - 2 NOT USED ON THIS SHEET.
 - 3 SUPPLEMENTAL GROUND ELECTRODE. (4) 3/4" x 10'-0" COPPER WELD GROUND ROD WITH GROUND LOOP 12" ± AROUND TRANSFORMER PADS. CONDUCTOR IS #10 AWG SD COPPER. CONNECTIONS ARE BY THERMIC WELD PROCESS. INSTALL 18" MIN. BELOW GRADE. BOND GROUND BAR TO COLD WATER PIPE (AHEAD OF WATER METER IN JANITORS CLOSET) AND TO SUPPLEMENTAL GROUND ELECTRODE SYSTEM.
 - 4 NOT USED ON THIS SHEET.
 - 5 NOT USED ON THIS SHEET.
 - 6 (3) 3" RGS CONDUITS, STUB AT 10'-0" OUTSIDE BUILDING LINE. (FOR FUTURE USE FOR ROAD AND BRIDGE LIGHTING CIRCUITS).
 - 7 4" RGS CONDUIT, STUB AT 10'-0" FROM EDGE OF TRANSFORMER PAD. (FOR UTILITY PRIMARY FEEDER. COORDINATE EXACT REQUIREMENTS, INCLUDING PAD CONSTRUCTION DETAILS WITH UTILITY)
 - 8 UPS AND COMPUTER EQUIPMENT BY OWNER. EXACT REQUIREMENTS INCLUDING MAINTENANCE BYPASS EQUIPMENT TO BE DETERMINED LATER.
 - 9 NOT USED ON THIS SHEET.
 - 10 NOT USED ON THIS SHEET.
 - 11 1P-20A HP RATED TIMER SWITCH. (0-120 MIN. RANGE)
 - 12 1P-20A HP RATED MANUAL STARTER. (TOGGLE SWITCH TYPE)

- KEYED NOTES: VOID**
- 1 1P-20A HP RATED TIMER SWITCH. (0-120 MIN. RANGE)
 - 2 1P-20A HP RATED MANUAL STARTER. (TOGGLE SWITCH TYPE)
 - 3 (3) 3/4" x 10'-0" COPPER WELD GROUND ROD, SPACED 15'-0" APART ON AN EQUILATERAL TRIANGLE. CONDUCTOR IS #4 AWG SD COPPER. CONNECTIONS ARE BY THERMIC WELD PROCESS. INSTALL 18" MIN. BELOW GRADE. GENERATOR GROUND IS A SEPARATELY DERIVED SYSTEM AND SHALL NOT BE CONNECTED TO SERVICE GROUND.
 - 4 (3) 3" HSG CONDUITS, STUB AT 10'-0" OUTSIDE BUILDING LINE. (FOR FUTURE USE FOR ROAD AND BRIDGE LIGHTING CIRCUITS).
 - 5 4" PVC CONDUIT, STUB AT 10'-0" FROM EDGE OF TRANSFORMER PAD. (FOR UTILITY PRIMARY FEEDER. COORDINATE EXACT REQUIREMENTS, INCLUDING PAD CONSTRUCTION DETAILS WITH UTILITY)

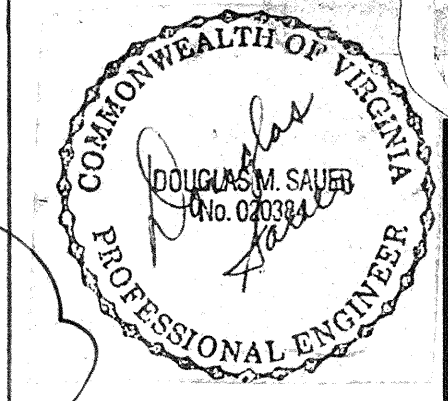

CONTRACT NO. 17B
36.23

RICHMOND METROPOLITAN AUTHORITY
RICHMOND EXPRESSWAY SYSTEM
BLVD. BRIDGE TOLL PLAZA
POWER PLAN

HOWARD NEEDLES TAMMEN & BERGENDOFF
Architects Engineers Planners
ALEXANDRIA, VA. **HNTB**

Scale: 1/4" = 1'-0" Date: 2-92 Contract No. C-17B Sheet: E2 of

	By	Date			
Designed	HCR		CLARIFY NOTES & DETAILS	HCR/DL	2-2-93
Drawn			Revision #1	DL	7-14-92
Checked			Addendum #2	DL	4-23-92
Approved			No. Revision	By	Date

RECORD DRAWING

LIGHTING FIXTURE SCHEDULE

TYPE: CODE ON DWG C --- GROUND P --- POLE R --- RECESSED RP --- RECESSED PLASTER S --- SURFACE U --- UNIVERSAL WALL W --- WALL SUSP --- SUSPENDED	TYPE: EL --- ELECTROLUMINESCENT FL --- FLUORESCENT-STRAIGHT FU --- FLUORESCENT-U SHAPE FO --- OCTRON FLUO FOC --- OCT. FLUORALUMINE FC --- COMPACT FLUORESCENT I --- INCANDESCENT M --- MERCURY VAPOR Q --- QUARTZ MH --- METAL HALIDE TH --- TUNGSTEN HALOGEN HPS --- HIGH PRESSURE SODIUM	LENS-DIFFUSER: CLASS F --- FRESNEL G --- GLASS T --- TEMPERED AC --- ACRYLIC (VIRGIN) FL --- FLAT MILK WHITE PR --- PRISMATIC POL --- POLYCARBONATE ASY --- ASYMMETRIC REFL: A --- PAINTED ALUM. AA --- ANODIZED ALUM. AL --- ALZAK ALUM. PS --- PAINTED STEEL SA --- SPECULAR ALUM. SSA --- SEMI SPECULAR ALUM.	DOORS SHALL BE HINGED AND COMPLETE W/ LATCH AND LIGHT SEAL UNLESS OTHERWISE NOTED. SM --- STAD. MAG. LT --- LOW TEMP. (-20° F) ESM --- ENER. SAV. MAGNETIC TBM --- TB MAG. TBE --- TB ELEC. HPF --- HIGH POWER FACTOR	NOTES:															
MATERIAL: A --- ALUMINUM S --- STEEL AA --- ANODIZED ALUMINUM CA --- CAST ALUM. EA --- EXTRUDED ALUM. PB --- PAINTED MATTE BLACK SS --- STAINLESS STEEL POR --- PORCELAIN	FINISH: P --- PAINTED AA --- ANODIZED ALUM. PB --- PAINTED MATTE BLACK PP --- POLYESTER POWDER PW --- PAINTED MATTE WHITE PBR --- PAINTED DARK BRONZE PMB --- PAINTED MEDIUM BRONZE	BAFF: BG --- BLACK MULTI-GROOVE PB --- PAINTED MATTE BLACK PAR --- PARABOLIC LOUVER PW --- PAINTED WHITE * --- SEE REMARKS	REFERENCE:																
LAMP	NOM. WATT	NOM. DIM.	BEAM CONTROL	DOOR	TRIM	BODY	AUXILIARY EQUIPMENT	REFERENCE											
TYPE	QUAN	BULB	LENS	DIFF	THICK	REFL	BAFF	MAT	FIN	MAT	FIN	MAT	FIN	MAT	FIN	BALLAST	VOLT	MANUFACTURER	CAT. NO./SERIES
A	S	F	2	CW	40	1"x4"	PR	AC	.1"	S	PW	S	PW	S	PW	ESM	120	KLP	ANB240
B	SUSP	F	2	CW	40	1"x4"	PR	AC	.1"	AA	PW	A	PW	A	PW	ESM	120	LIGHTOLIER	CD11-3342
C	W	CF	2	---	13	6 1/2"x11"	---	---	PS	PW	---	S	PW	S	PW	---	120	LITECONTROL	W-ID-307213-BW
E	S	I	2	TS	20	8 3/4"x10 5/8"	---	---	---	A	A	---	A	A	---	---	120	McPHILBEN	SOLW-6-G
F	R	CF	2	---	13	7 3/8"	---	---	AL	---	---	A	PW	A	---	---	120	LIGHTOLIER	1800-2-13-BK
G	W	F	2	CW	20	1"x2"	PR	AC	.1"	S	PW	S	PW	S	PW	---	120	KLP	CWBX-220-HPFH
H	R	MH	1	---	175	14"x14"	T	PR	.156"	---	A	PP	S	PP	S	PP	120	FAIL SAFE	HOR-MC-100-83-AP
HH	W	MH	1	---	175	17"x15"	PR	G	---	---	A	P	A	P	---	---	120	HOLOPHANE	WLX-175MH-BL-FU
J	S	FU	1	RS	40	12"x12"	PR	AC	.1"	---	A	P	A	P	---	---	120	KIRLIN	92240-SM
K	P	I	1	CW	130	---	---	---	---	---	ALKCOA	A	---	---	---	---	120	SPRING CITY	WASHINGTON 118
L	S	F	2	TS	20	12"x2.4"	---	---	---	---	S	P	S	P	---	---	120	ALKCO	---
M	S	MH	1	---	75	---	---	---	---	---	S	PP	S	PP	S	PP	120	MIROFLECTOR	MIRO-T

PANEL SCHEDULE

DESIGNATION: PANEL "AA"
LOCATION: GENERATOR ROOM
VOLTAGE: 208Y/120 VOLT
PHASE: 3 PHASE, 4 WIRE

MAINS: 225 AMP MAIN CKT BKR
BUS SIZE: 225 AMP
PANEL MOUNTING: SURFACE
ALL BREAKERS: 10,000 A.I.C. (MIN.)


CKT NO	LOAD DESCRIPTION	KVA	CKT BRKR	AMPS	POLE	A	B	C	CKT BRKR	AMPS	POLE	KVA	LOAD DESCRIPTION	CKT NO
1	LTG-RESETEROOMS & JANITOR	0.30	20	1	1.90	---	---	---	20	1	1.60	---	RECEPT-UC. REFRIGERATOR	2
3	LTG-BREAK ROOM	0.35	20	1	---	1.95	---	---	20	1	1.60	---	RECEPT-MICROWAVE	4
5	LTG-VAULT & OFFICE	0.60	20	1	---	---	2.20	---	20	1	1.60	---	RECEPT-COFFEE MAKER	6
7	LTG-LOBBY	0.20	20	1	1.80	---	---	---	20	1	1.60	---	RECEPT-VENDING MACHINES	8
9	EF1, EF2, EF3	1.00	20	1	---	2.20	---	---	20	1	1.20	---	RECEPT-BREAK & LOCKER ROOMS	10
11	RECEPT-VAULT STORAGE	0.20	20	1	---	---	1.40	---	20	1	1.20	---	RECEPT-OFFICE & LOBBY	12
13	RECEPT-OUTDOOR	0.20	20	1	1.00	---	---	---	20	1	0.80	---	RECEPT-TOLLBOOTH	14
15	EWC	1.60	20	1	---	2.00	---	---	20	1	0.40	---	RECEPT-TOILET ROOMS	16
17	SPARE	---	---	---	---	---	---	0.40	20	1	0.40	---	RECEPT-VAULT	18
19	FURNACE	6.70	20	3	10.20	---	---	---	60	3	3.50	---	HEAT PUMP	20
---	---	6.70	---	---	---	---	---	---	---	---	---	---	---	---
---	---	6.70	---	---	---	---	---	---	---	---	---	---	---	---
---	---	6.70	---	---	---	---	---	---	---	---	---	---	---	---
25	ATS - NORMAL FEED	14.0	150	3	14.00	---	---	---	20	2	1.00	---	WATER HEATER	26
---	---	14.0	---	---	---	---	---	---	---	---	---	---	---	---
---	---	14.0	---	---	---	---	---	---	---	---	---	---	---	---
TOTAL CONNECTED LOAD:	---	28.90	30.35	28.20	---	---	---	---	TOTAL =	87.45	KVA	---	---	---

PANEL SCHEDULE

DESIGNATION: PANEL "XE"
LOCATION: GENERATOR ROOM
VOLTAGE: 208Y/120 VOLT
PHASE: 3 PHASE, 4 WIRE

MAINS: 150 AMP MAIN CKT BKR
BUS SIZE: 225 AMP
PANEL MOUNTING: SURFACE
ALL BREAKERS: 10,000 A.I.C. (MIN.)

CKT NO	LOAD DESCRIPTION	KVA	CKT BRKR	AMPS	POLE	A	B	C	CKT BRKR	AMPS	POLE	KVA	LOAD DESCRIPTION	CKT NO
1	LTG - BLDG. EXTERIOR	0.80	20	1	6.80	---	---	---	60	3	6.00	---	UPS	2
3	LTG - CANOPY	2.0	20	1	---	8.00	---	---	---	---	---	---	---	---
5	LTG - CANOPY	2.0	20	1	---	---	8.00	---	---	---	---	---	---	---
7	LTG - PARKING LOT	0.60	20	1	1.35	---	---	---	20	1	0.75	---	UNIT HEATER UH-1	8
9	LIGHTING CONTACTOR	0.50	20	1	---	1.25	---	---	20	1	0.75	---	UNIT HEATER UH-2	10
11	LTG/RECEPT BOOTHS 1-4	1.24	20	1	---	---	1.99	---	20	1	0.75	---	UNIT HEATER UH-3	12
13	TELEPHONE BACKBOARD	0.20	20	1	.95	---	---	---	20	1	0.75	---	UNIT HEATER UH-4	14
15	MASTER INTERCOM STATION	0.20	20	1	---	1.82	---	---	20	1	1.62	---	AIR CONDITIONER ACU-1	16
17	SECURITY PANEL	0.50	20	1	---	---	2.12	---	20	1	1.62	---	AIR CONDITIONER ACU-2	18
19	SMOKE DETECTORS	0.20	20	1	1.82	---	---	---	20	1	1.62	---	AIR CONDITIONER ACU-3	20
21	BUILDING LIGHTS	0.20	20	1	1.82	---	---	---	20	1	1.62	---	AIR CONDITIONER ACU-4	22
23	SPARE GENERATOR	---	---	---	---	---	---	X	20	1	---	---	SPARE	24
25	SPARE	---	---	---	---	---	---	---	---	---	---	---	SPARE	26
27	SPARE	---	---	---	---	---	---	---	---	---	---	---	SPARE	28
29	SPARE	---	---	---	---	---	---	---	---	---	---	---	SPARE	30
TOTAL CONNECTED LOAD:	---	10.92	12.89	12.11	---	---	---	---	TOTAL =	35.92	KVA	---	---	---

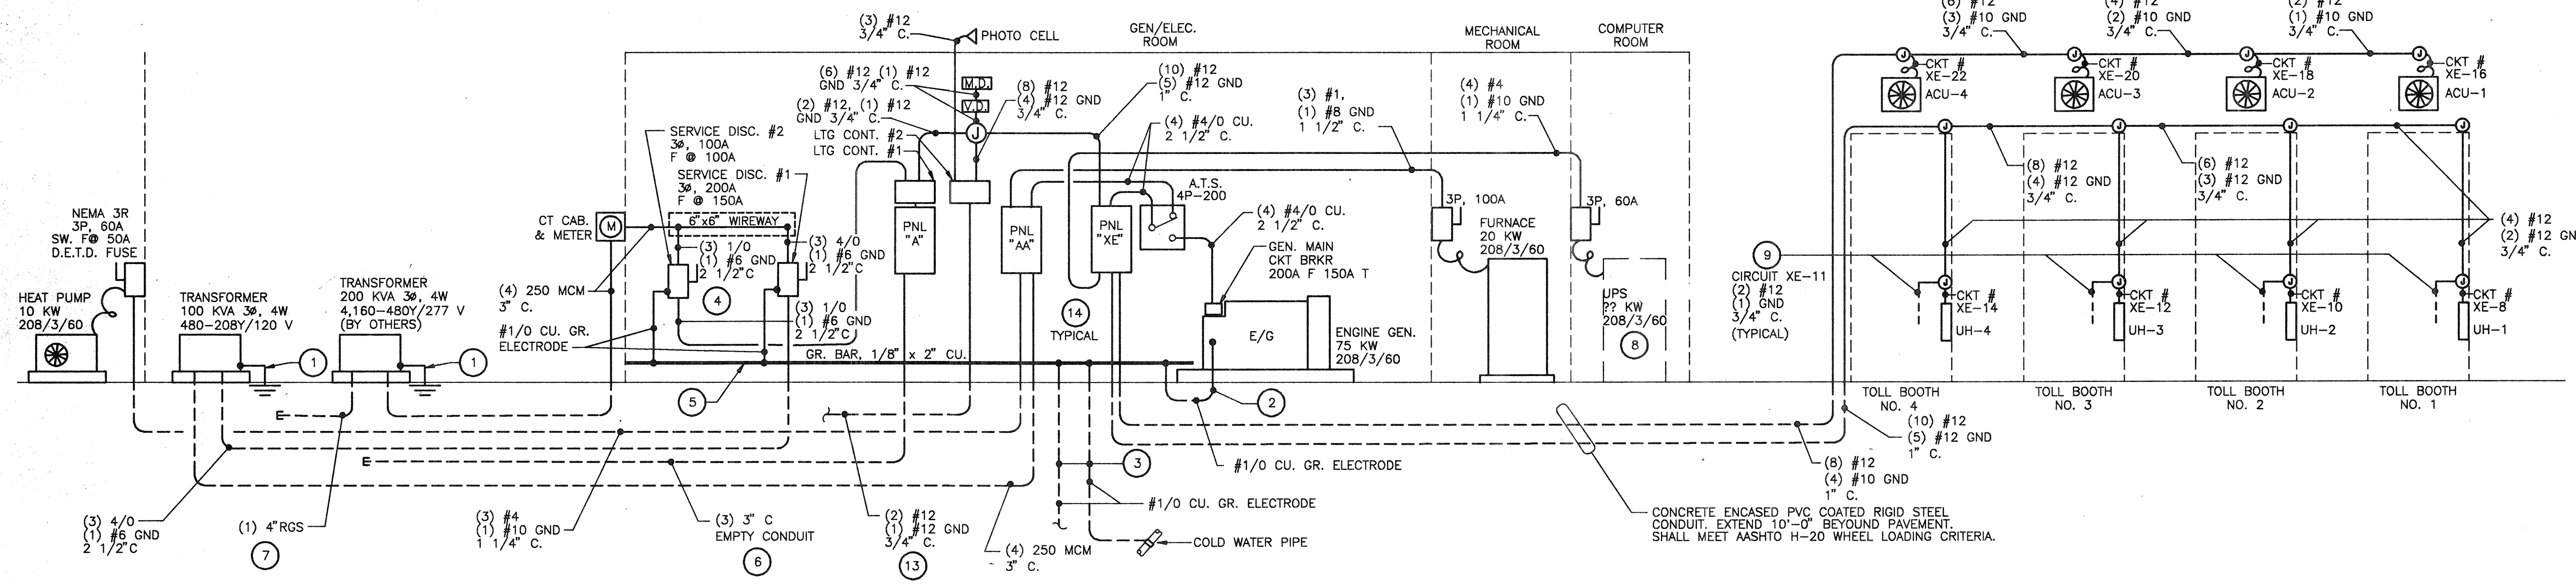


- KEYED NOTES:**
- BOND TRANSFORMER HOUSING TO NEUTRAL AND GROUND PER NEC 250-5.
 - GENERATOR POWER IS SEPARATELY DERIVED SYSTEM. GROUND PER NEC 250-26.
 - SUPPLEMENTAL GROUND ELECTRODE: (4) 3/4" x 10'-0" COPPER WELD GROUND ROD WITH GROUND LOOP 12" ± AROUND TRANSFORMER PADS. CONDUCTOR IS #1/0 AWG SD COPPER. CONNECTIONS ARE BY THERMIC WELD PROCESS. INSTALL 18" MIN. BELOW GRADE. BOND GROUND BAR TO COLD WATER PIPE (AHEAD OF WATER METER IN JANITORS CLOSET) AND TO SUPPLEMENTAL GROUND ELECTRODE SYSTEM.
 - GROUND SERVICE EQUIPMENT PER NEC 250-26.
 - MOUNT GROUND BAR 12" A.F.F. ALONG EAST AND NORTH WALL, WITH EXPANSION ANCHORS, 1" SPACER AND 3/8" CAP SCREWS, SPACED AT 2'-0" O.C. GROUND ALL EQUIPMENT HOUSING IN GEN/ELEC. ROOM BY BONDING TO GROUND BAR, PER NEC 250.
 - (3) 3" RGS CONDUIT, STUB AT 10'-0" OUTSIDE BUILDING LINE. (FOR FUTURE USE FOR ROAD AND BRIDGE LIGHTING CIRCUITS).
 - 4" RGS CONDUIT, STUB AT 10'-0" FROM EDGE OF TRANSFORMER PAD. (TRANSFORMER AND PRIMARY FEEDER BY OTHERS. CONCRETE PAD AND SECONDARY SERVICE AND CONNECTIONS PART OF THIS CONTRACT).
 - COMPUTER EQUIPMENT BY OWNER. EXACT REQUIREMENTS INCLUDING MAINTENANCE BYPASS EQUIPMENT TO BE DETERMINED LATER.
 - TO BOOTH INTERIOR LIGHTS AND RECEPTACLES.
 - USE SEPARATE RACEWAY FOR EACH FUNCTION (CONDUIT & JUNCTION BOX). COLOR CODE JUNCTION BOXES AS FOLLOWS:
TELEPHONE - BLUE
POWER - RED
CONTROL - GREEN
DATA - YELLOW
SPARE - NONE
 - NOT USED ON THIS SHEET.
 - NOT USED ON THIS SHEET.
 - CIRCUIT XE-7 TO PARKING LOT LIGHTS.
 - BRANCH CIRCUIT WIRING AND CONDUITS WITHIN BUILDING ARE NOT SHOWN.

PANEL SCHEDULE

DESIGNATION: PANEL "A"
LOCATION: GENERATOR ROOM
VOLTAGE: 480Y/277 VOLT
PHASE: 3 PHASE, 4 WIRE

MAINS: 100 AMP MAIN CKT BKR
BUS SIZE: 100 AMP
PANEL MOUNTING: SURFACE
ALL BREAKERS: 35,000 A.I.C. (MIN.)

CKT NO	LOAD DESCRIPTION	KVA	CKT BRKR	AMPS	POLE	A	B	C	CKT BRKR	AMPS	POLE	KVA	LOAD DESCRIPTION	CKT NO
1	TOLL PLAZA LIGHTING	1.50	20	1	2.80	---	---	---	20	1	1.3	---	BRIDGE LIGHTING	2
3	TOLL PLAZA LIGHTING	1.50	20	1	---	2.80	---	---	20	1	1.3	---	BRIDGE LIGHTING	4
5	TOLL PLAZA LIGHTING	1.50	20	1	---	---	2.80	---	20	1	1.3	---	BRIDGE LIGHTING	6
7	SPARE	---	---	---	---	---	---	---	20	1	---	---	SPARE	8
9	---	---	---	---	---	---	---	---	20	1	---	---	---	10
11	---	---	---	---	---	---	---	---	20	1	---	---	---	12
TOTAL CONNECTED LOAD:	---	2.80	2.80	2.80	---	---	---	---	TOTAL =	8.40	KVA	---	---	---

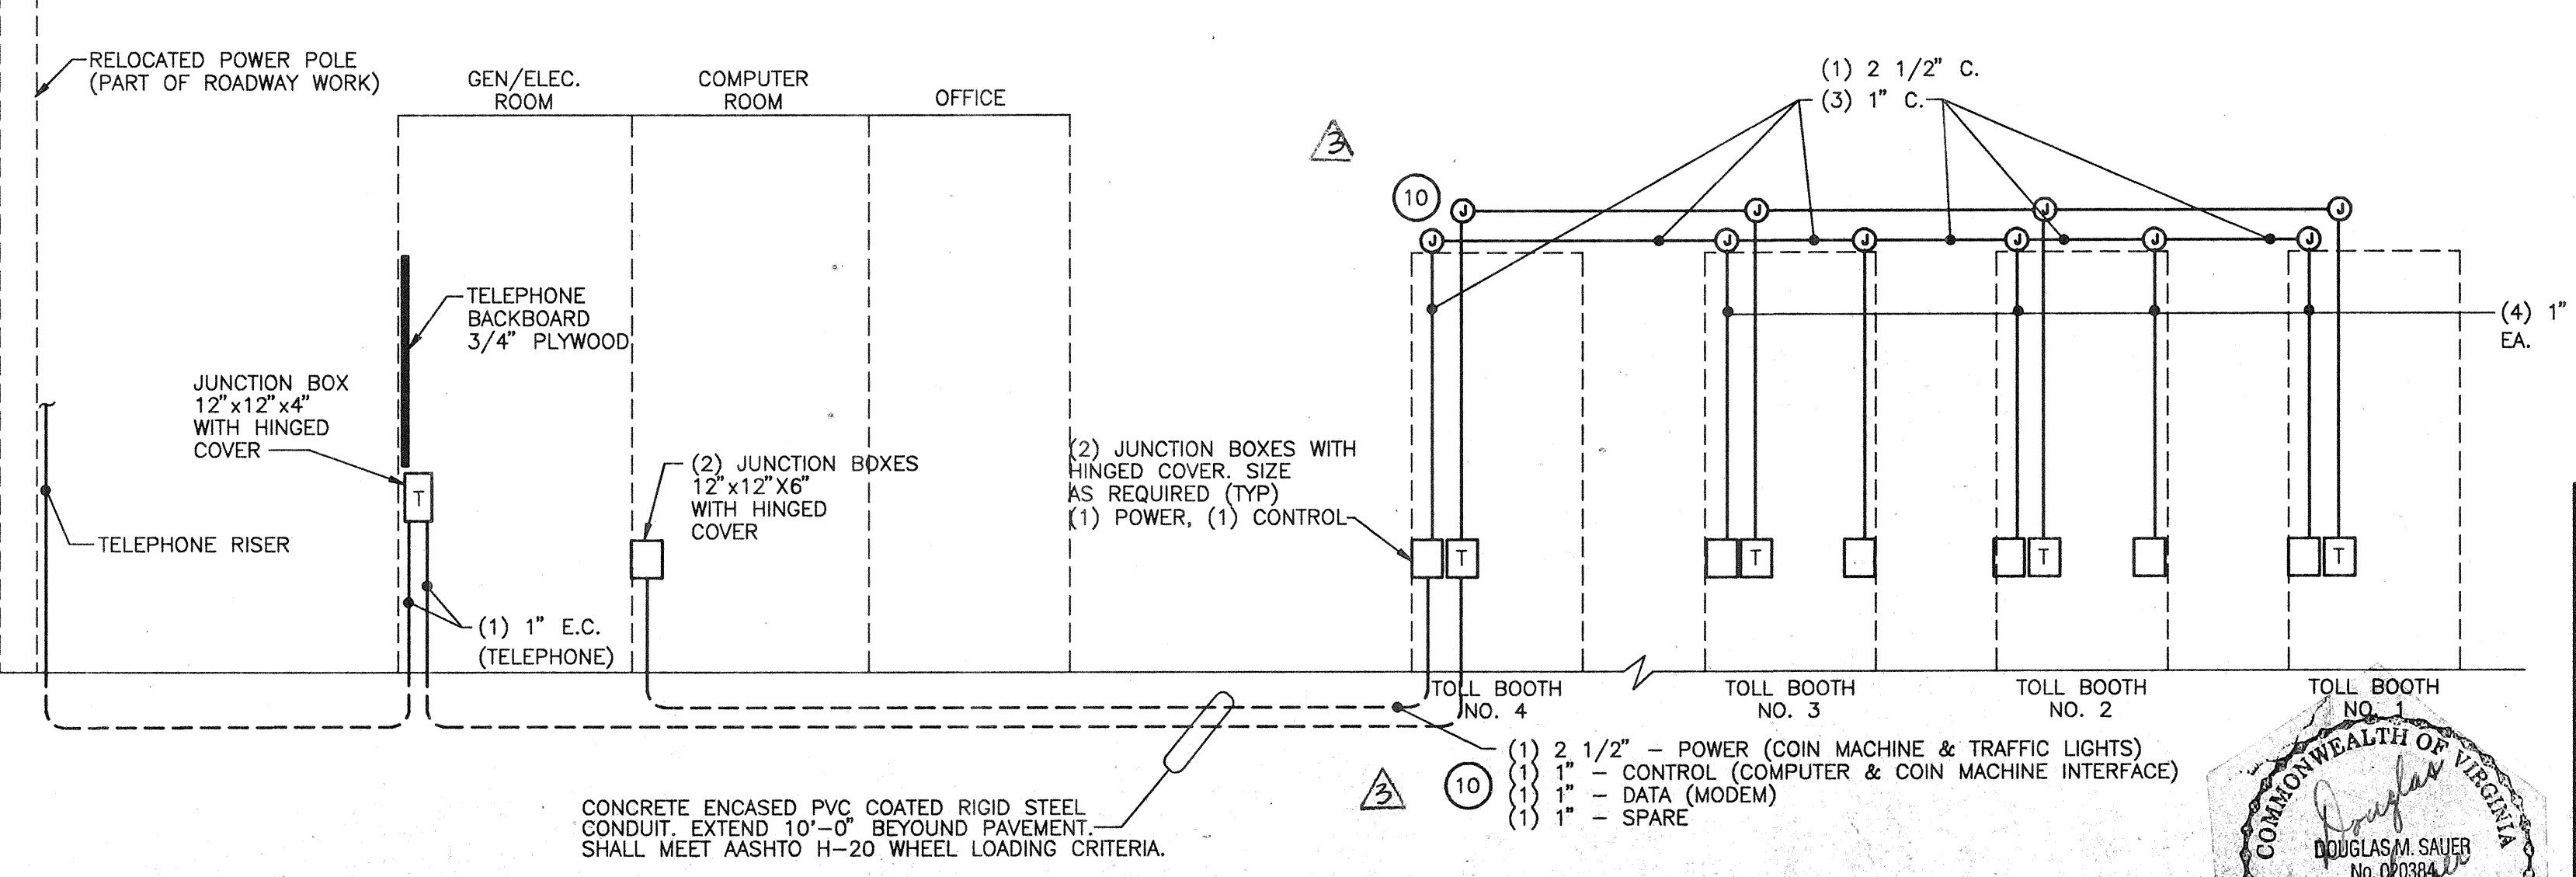

By	Date	Revision	By	Date		
Designed	HCR	3-13-92	CLARIFY NOTES & DETAILS	HCR	2-2-93	
Drawn	BSA	3-13-92	REVISION #1	EL	7-14-92	
Checked			Addendum #2	HCR	4-23-92	
Approved			No.	Revision	By	Date

CONTRACT NO. 17B
36.24

RICHMOND METROPOLITAN AUTHORITY
RICHMOND EXPRESSWAY SYSTEM
BLVD. BRIDGE TOLL PLAZA
SCHEDULES

HOWARD NEEDLES TAMMEN & BERGENDOFF
Architects Engineers Planners
ALEXANDRIA, VA

HNTB


Scale: NONE Date: 2-92 Contract No. C-17B Sheet: E4 of

DTE TOLL PLAZA

ORIGINAL PLANS

ADMINISTRATION BUILDING & TOLL PLAZA

RICHMOND EXPRESSWAY SYSTEM			
SECTION	PROJECT	SHEET NO.	TOTAL SHEETS
8	DOWNTOWN EXPRESSWAY	70	

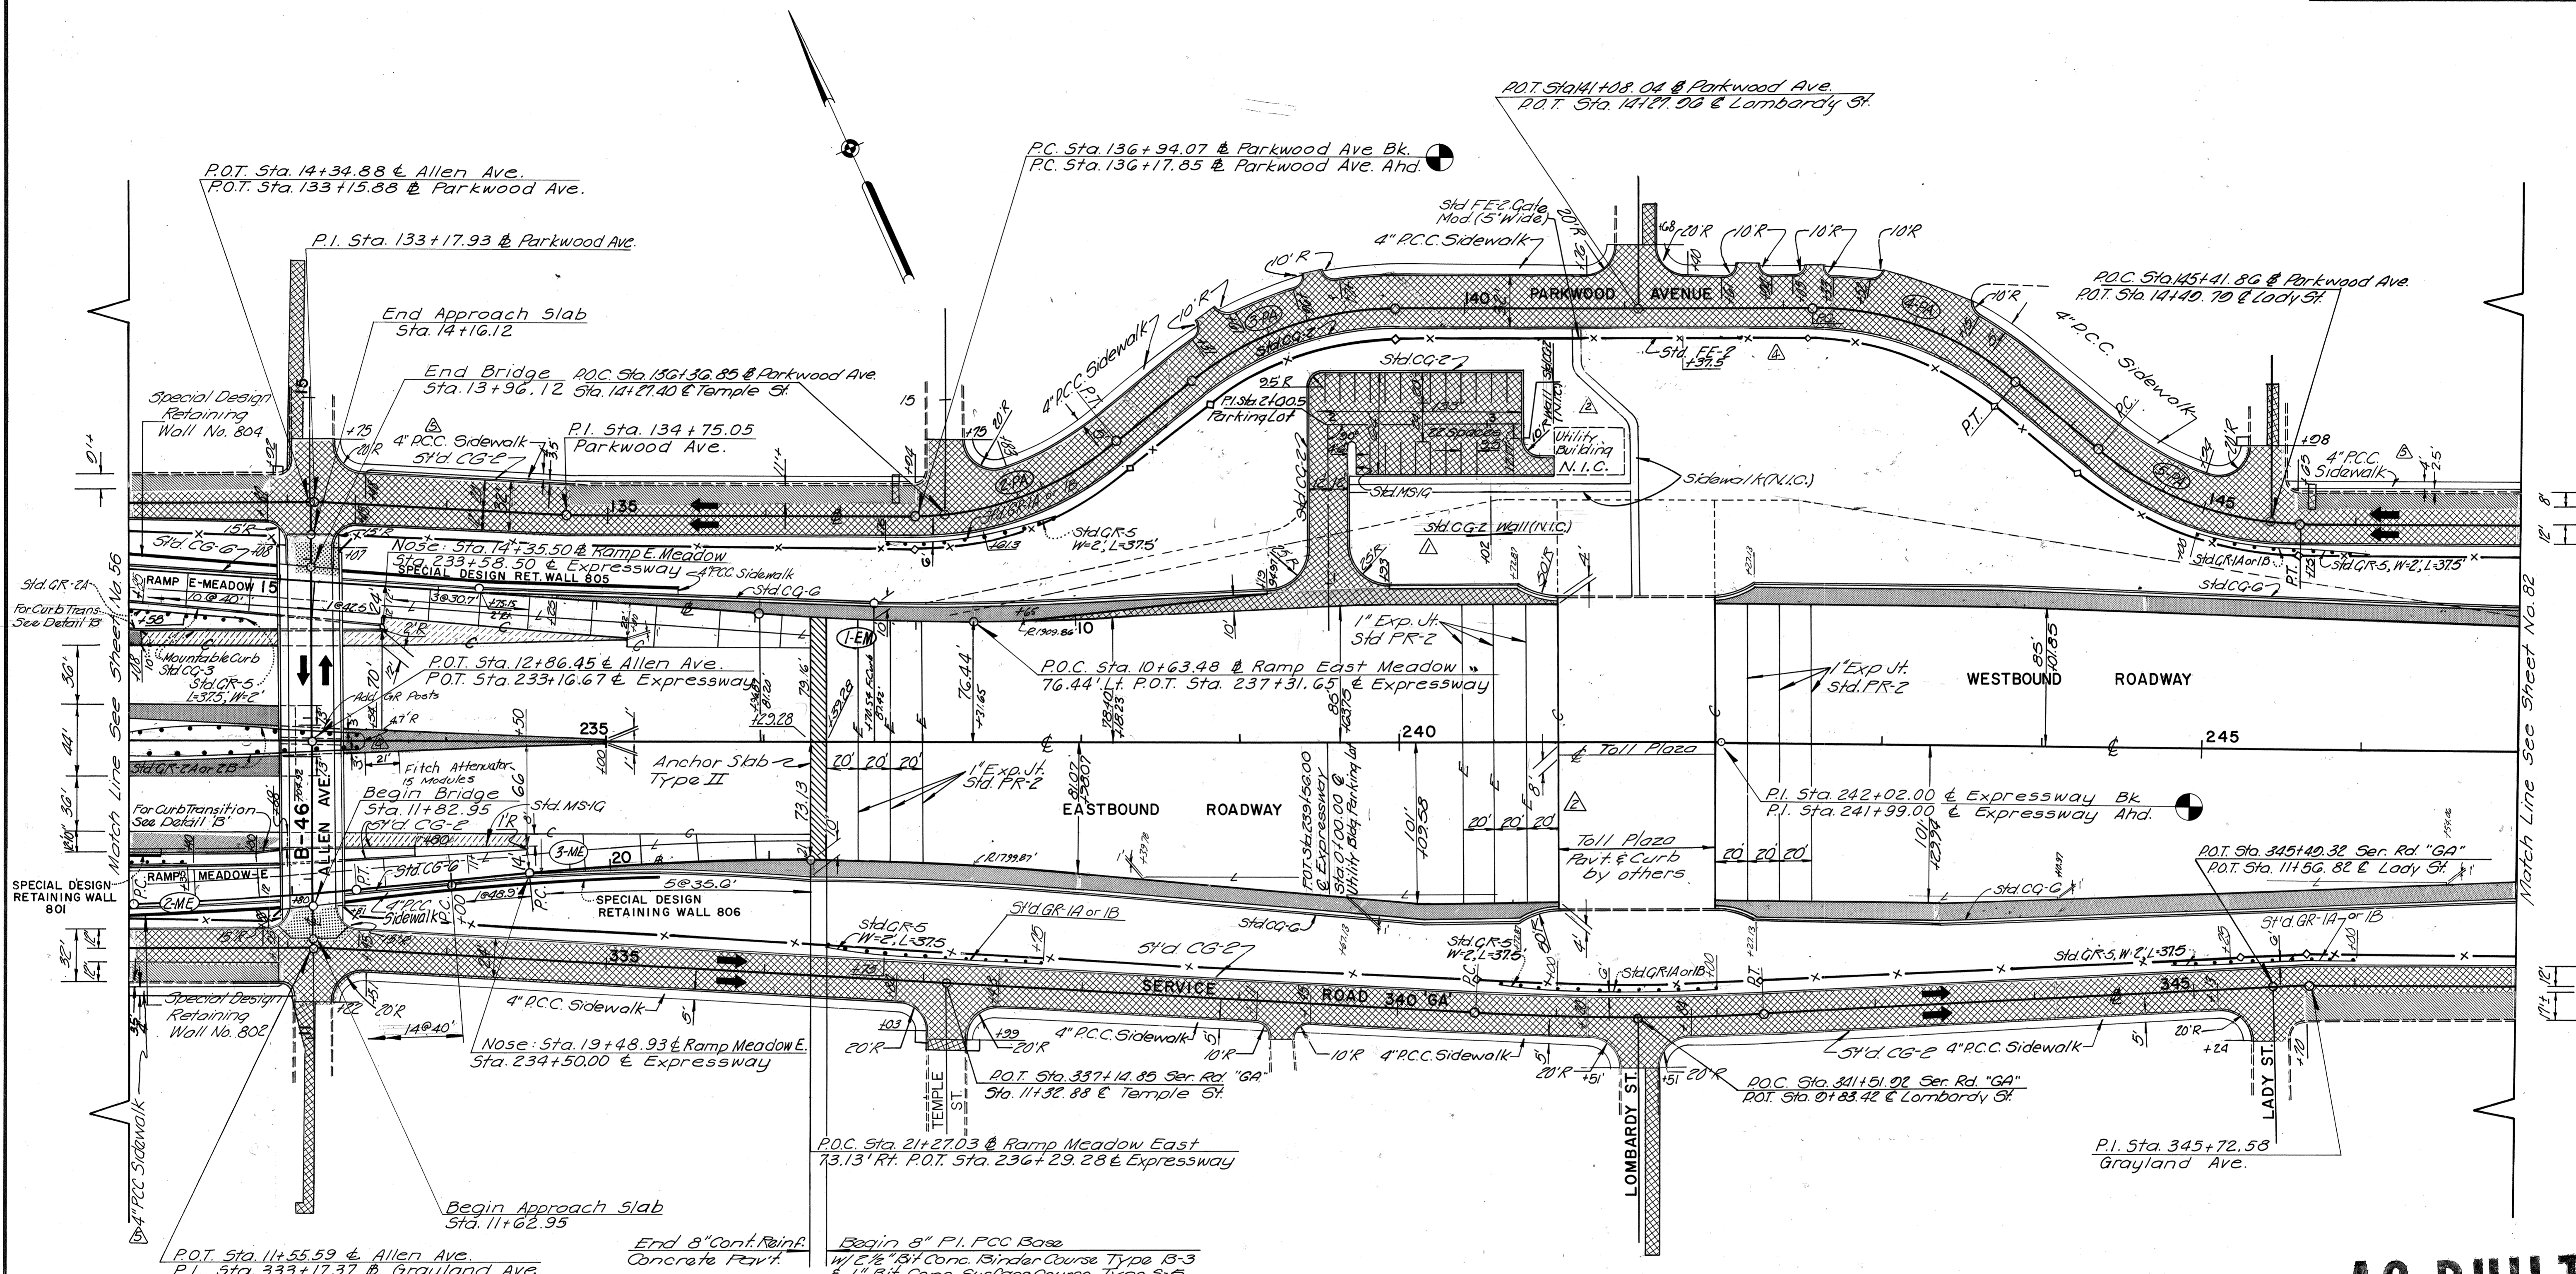

MADE	CHECKED	IN CHARGE	BY	DATE	NO.	REVISION	BY	DATE

NO.	REVISION	BY	DATE
1	Add Sidewalk	DGT	2-76
2	Rev. Median Section & delete GIS	HMW	11-3-75
3	Add Pavement	R.R.L.	8/21/75
4	Revise walk loc. Toll Plaza	P.H.T.	10-5-74
5	Rev. Park Area	P.H.T.	3-28-74

- LEGEND**
- Bituminous Concrete Paved Shoulder
 - Concrete Bridge Approach Slabs
 - Existing Pavement to be Resurfaced
 - Bituminous Concrete Pavement
 - 6" Plain P.C.C. Base topped with 2" Bituminous Concrete type 3-5.
 - Longitudinal Joint
 - Construction Joint
 - Transverse Joint

Note:
For Curb Transition Detail 'B' See Sheet _____
For profile see sheet _____



AS BUILT

**RICHMOND METROPOLITAN AUTHORITY
RICHMOND EXPRESSWAY SYSTEM
DOWNTOWN EXPRESSWAY**

**PAVEMENT PLAN
STA. 232+00 TO STA. 247+00**

AMERICAN ENGINEERS Richmond, Virginia	SCALE: 1" = 50'
HOWARD, NEEDLES, TAMMEN & BERGENDOFF General Consultants	CONTRACT NO.: 8
	SHEET NO. ____ OF ____

RICHMOND EXPRESSWAY SYSTEM		
TOLL FACILITIES	SHEET NO. 3	TOTAL SHEETS 38

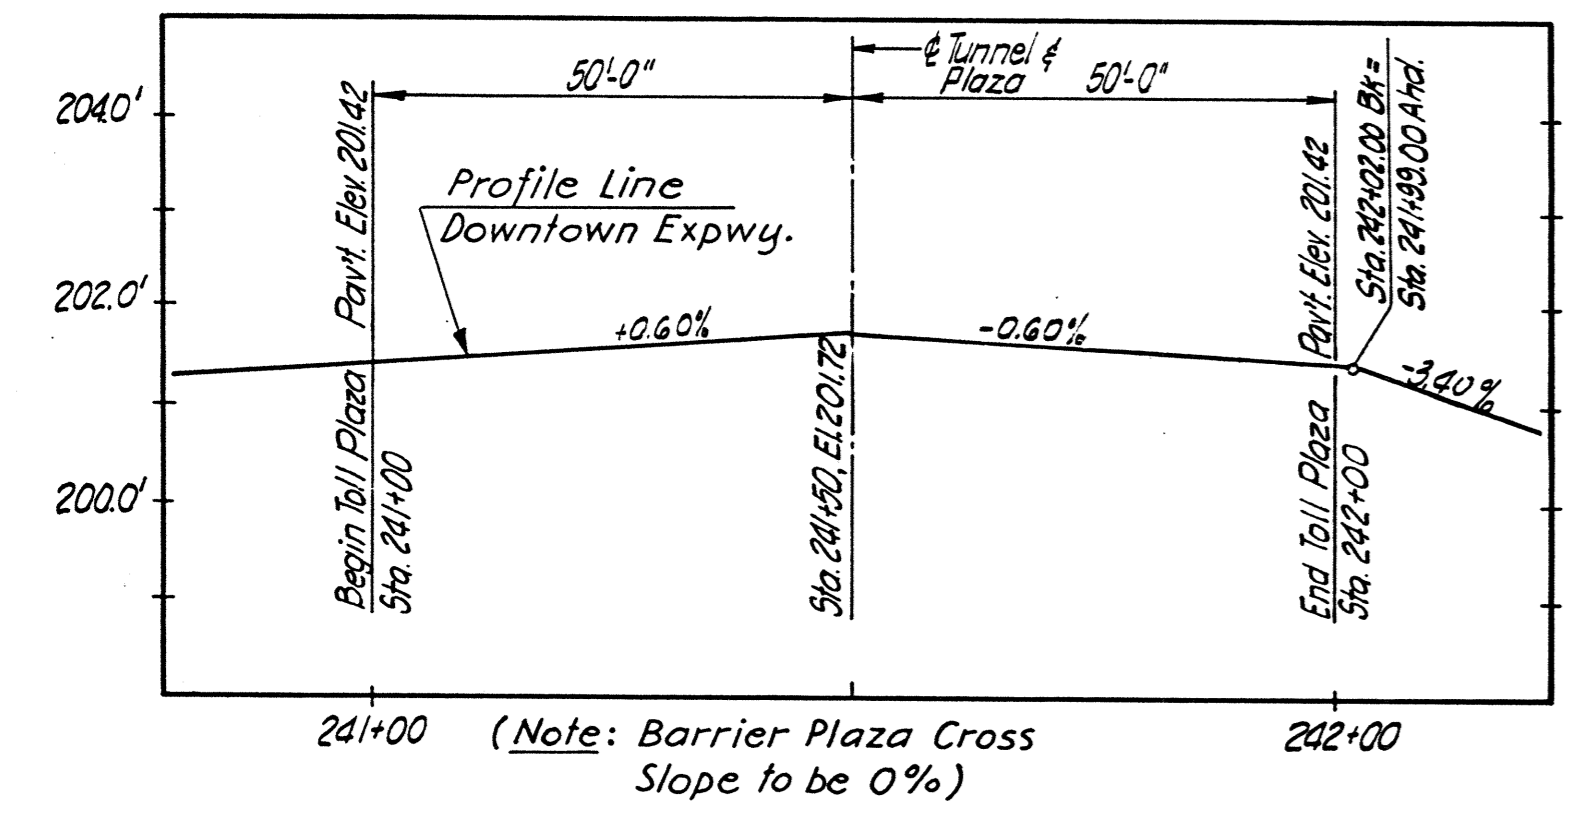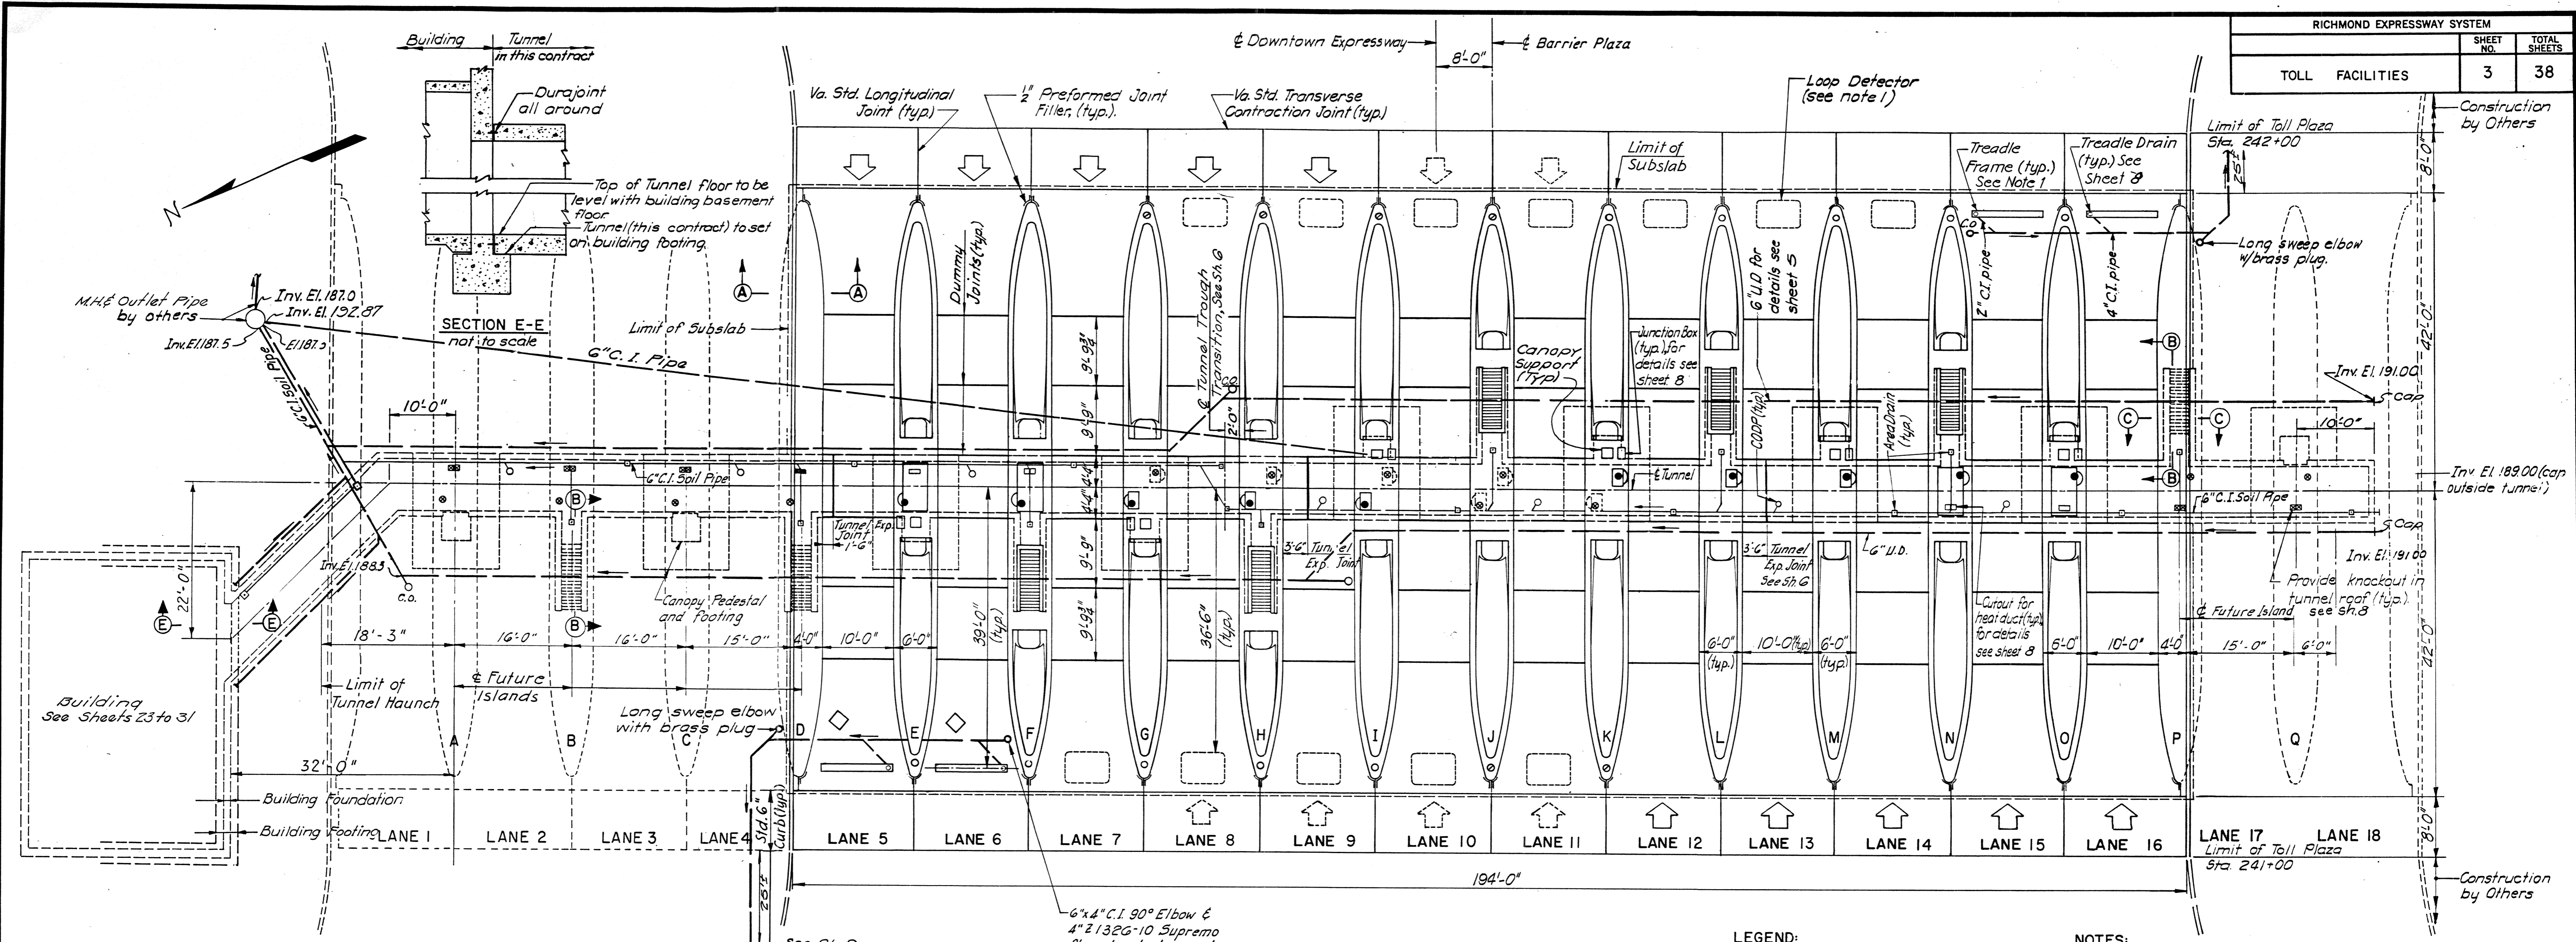

PROFILE AT DOWNTOWN BARRIER PLAZA
 Scale: Horiz: 1"=20'
 Vert: 1"=2'

PLAN
DOWNTOWN BARRIER PLAZA
 3/4"=1'-0"

LEGEND:

- Location of future traffic signal.
- Traffic signal.
- Automatic Toll Machine, (N.I.C.)
- Future Automatic Toll Machine.
- Toll Booth
- Proposed Coin Tube
- Future Coin Tube

NOTES:

- 1) To be placed by Toll Equipment Contractor prior to the paving, under this contract.
- 2) Tunnel drainage trough to begin at the building foundation.
- 3) C.O.D.P. = Clean out drain pipe.
- 4) Sections A-A, B-B and C-C appear on Sheet 6.

BY	DATE	REVISION	BY	DATE
MADE	W. J. W. 5-68	2 Added Heating Duct & New Treadle Drain	P.H.T.	2-75
CHECKED	D. E. N. 5-68	1 Final Check	D.E.N.	6-68
IN CHARGE	H.D.S.	NO.	REVISION	BY

AS BUILT


RICHMOND METROPOLITAN AUTHORITY
RICHMOND EXPRESSWAY SYSTEM

DOWNTOWN BARRIER PLAZA
PLAN

HOWARD, NEEDLES, TAMMEN & BERGENDOFF
 consulting engineers
 NEW YORK ALEXANDRIA KANSAS CITY

SCALE: AS NOTED
 CONTRACT NO. TF-3
 SHEET NO. 3 OF

RICHMOND EXPRESSWAY SYSTEM			
SECTION	PROJECT	SHEET NO.	TOTAL SHEETS
TF-3	TOLL FACILITIES	5	38

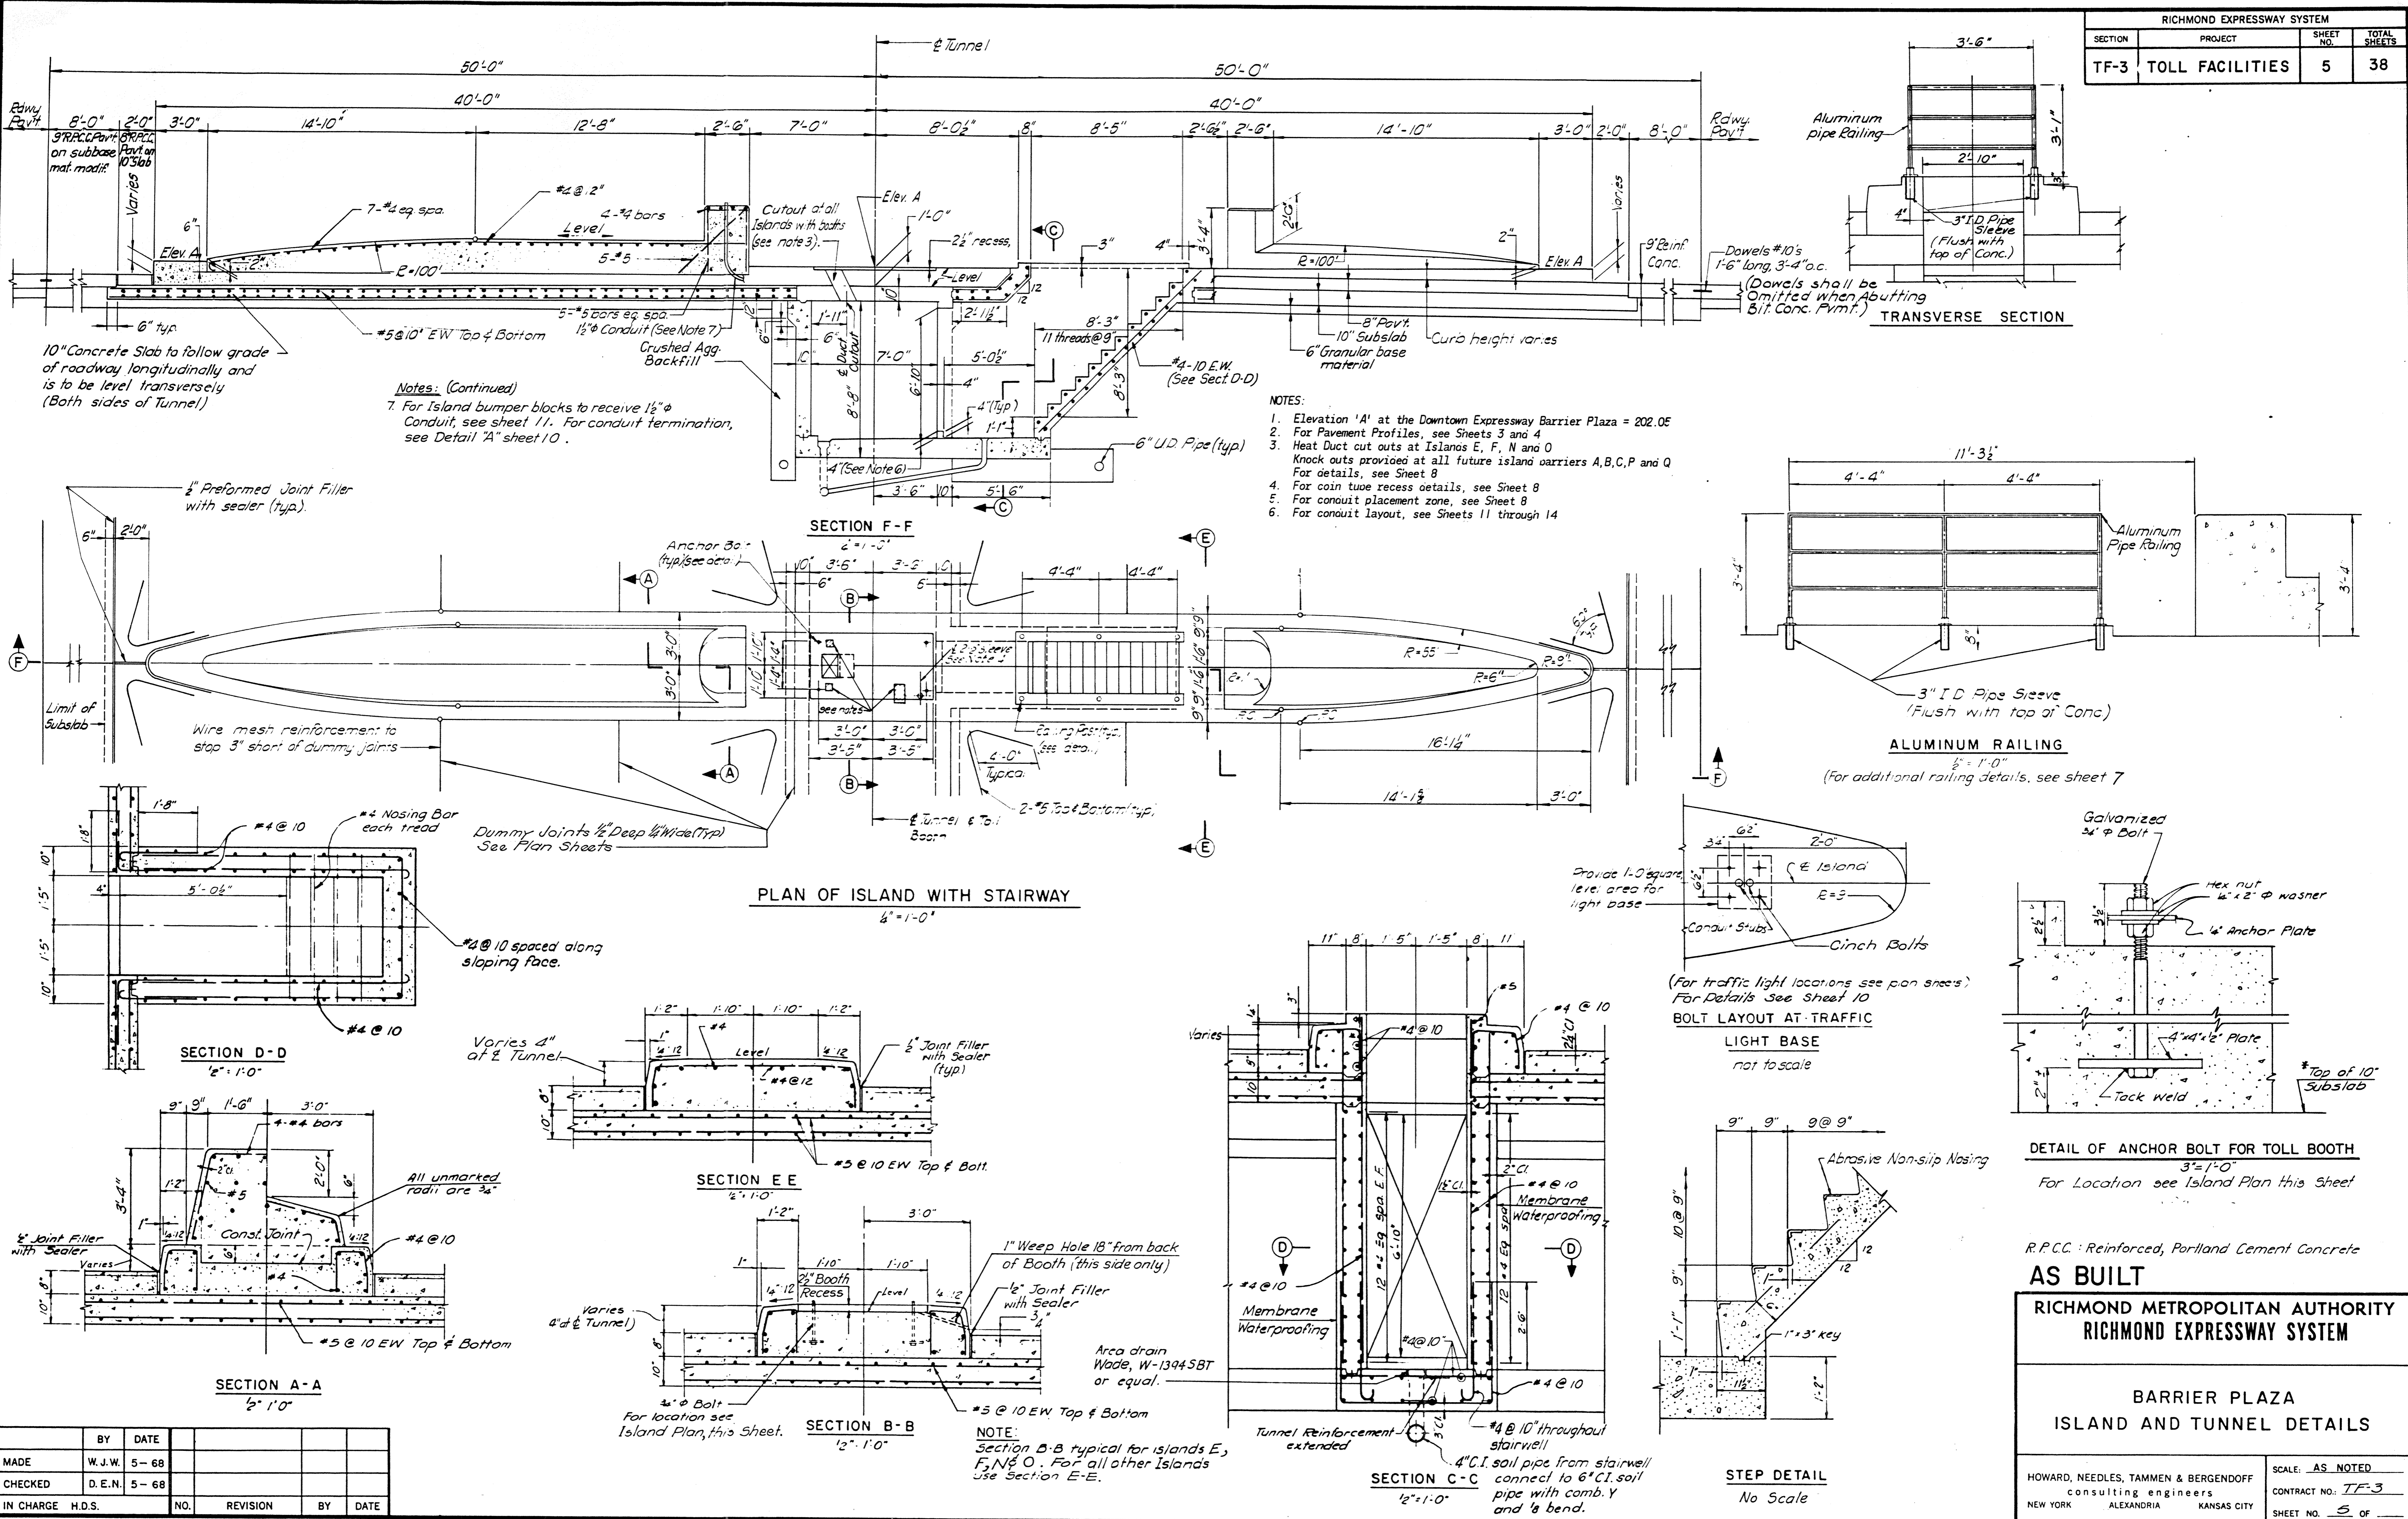

BY	DATE				
MADE	W. J. W.	5-68			
CHECKED	D. E. N.	5-68			
IN CHARGE	H. D. S.				
NO.	REVISION	BY	DATE		


R.P.C.C.: Reinforced, Portland Cement Concrete
AS BUILT
RICHMOND METROPOLITAN AUTHORITY
RICHMOND EXPRESSWAY SYSTEM

**BARRIER PLAZA
ISLAND AND TUNNEL DETAILS**


HOWARD, NEEDLES, TAMMEN & BERGENDOFF
consulting engineers
NEW YORK ALEXANDRIA KANSAS CITY

SCALE: AS NOTED
CONTRACT NO: TF-3
SHEET NO. 5 OF


RICHMOND EXPRESSWAY SYSTEM			
SECTION	PROJECT	SHEET NO.	TOTAL SHEETS
TF-3	TOLL FACILITIES	6	38

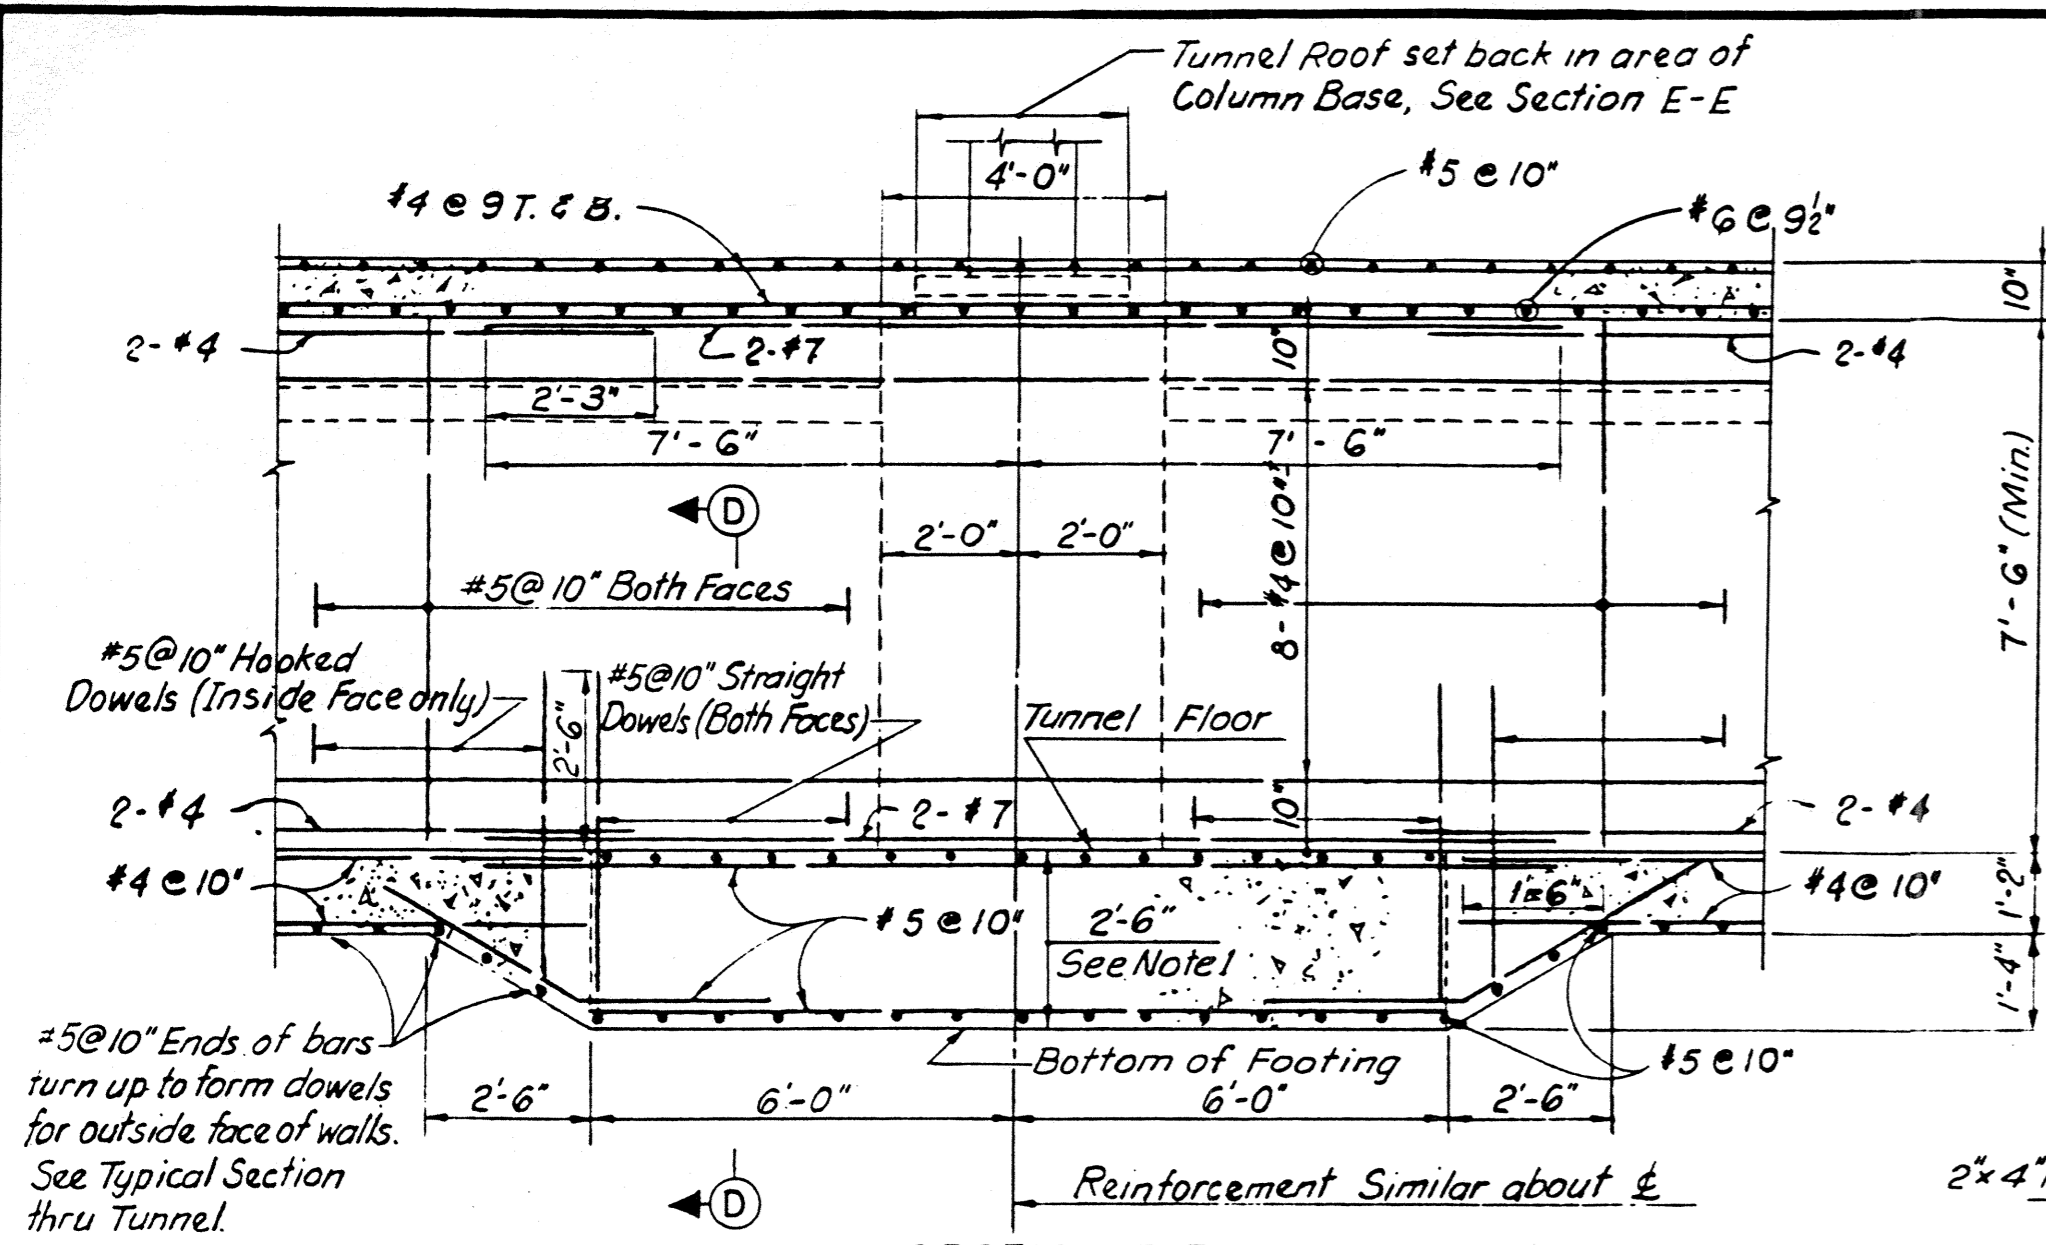


SECTION F-F
(Pedestal Reinforcement not Shown)

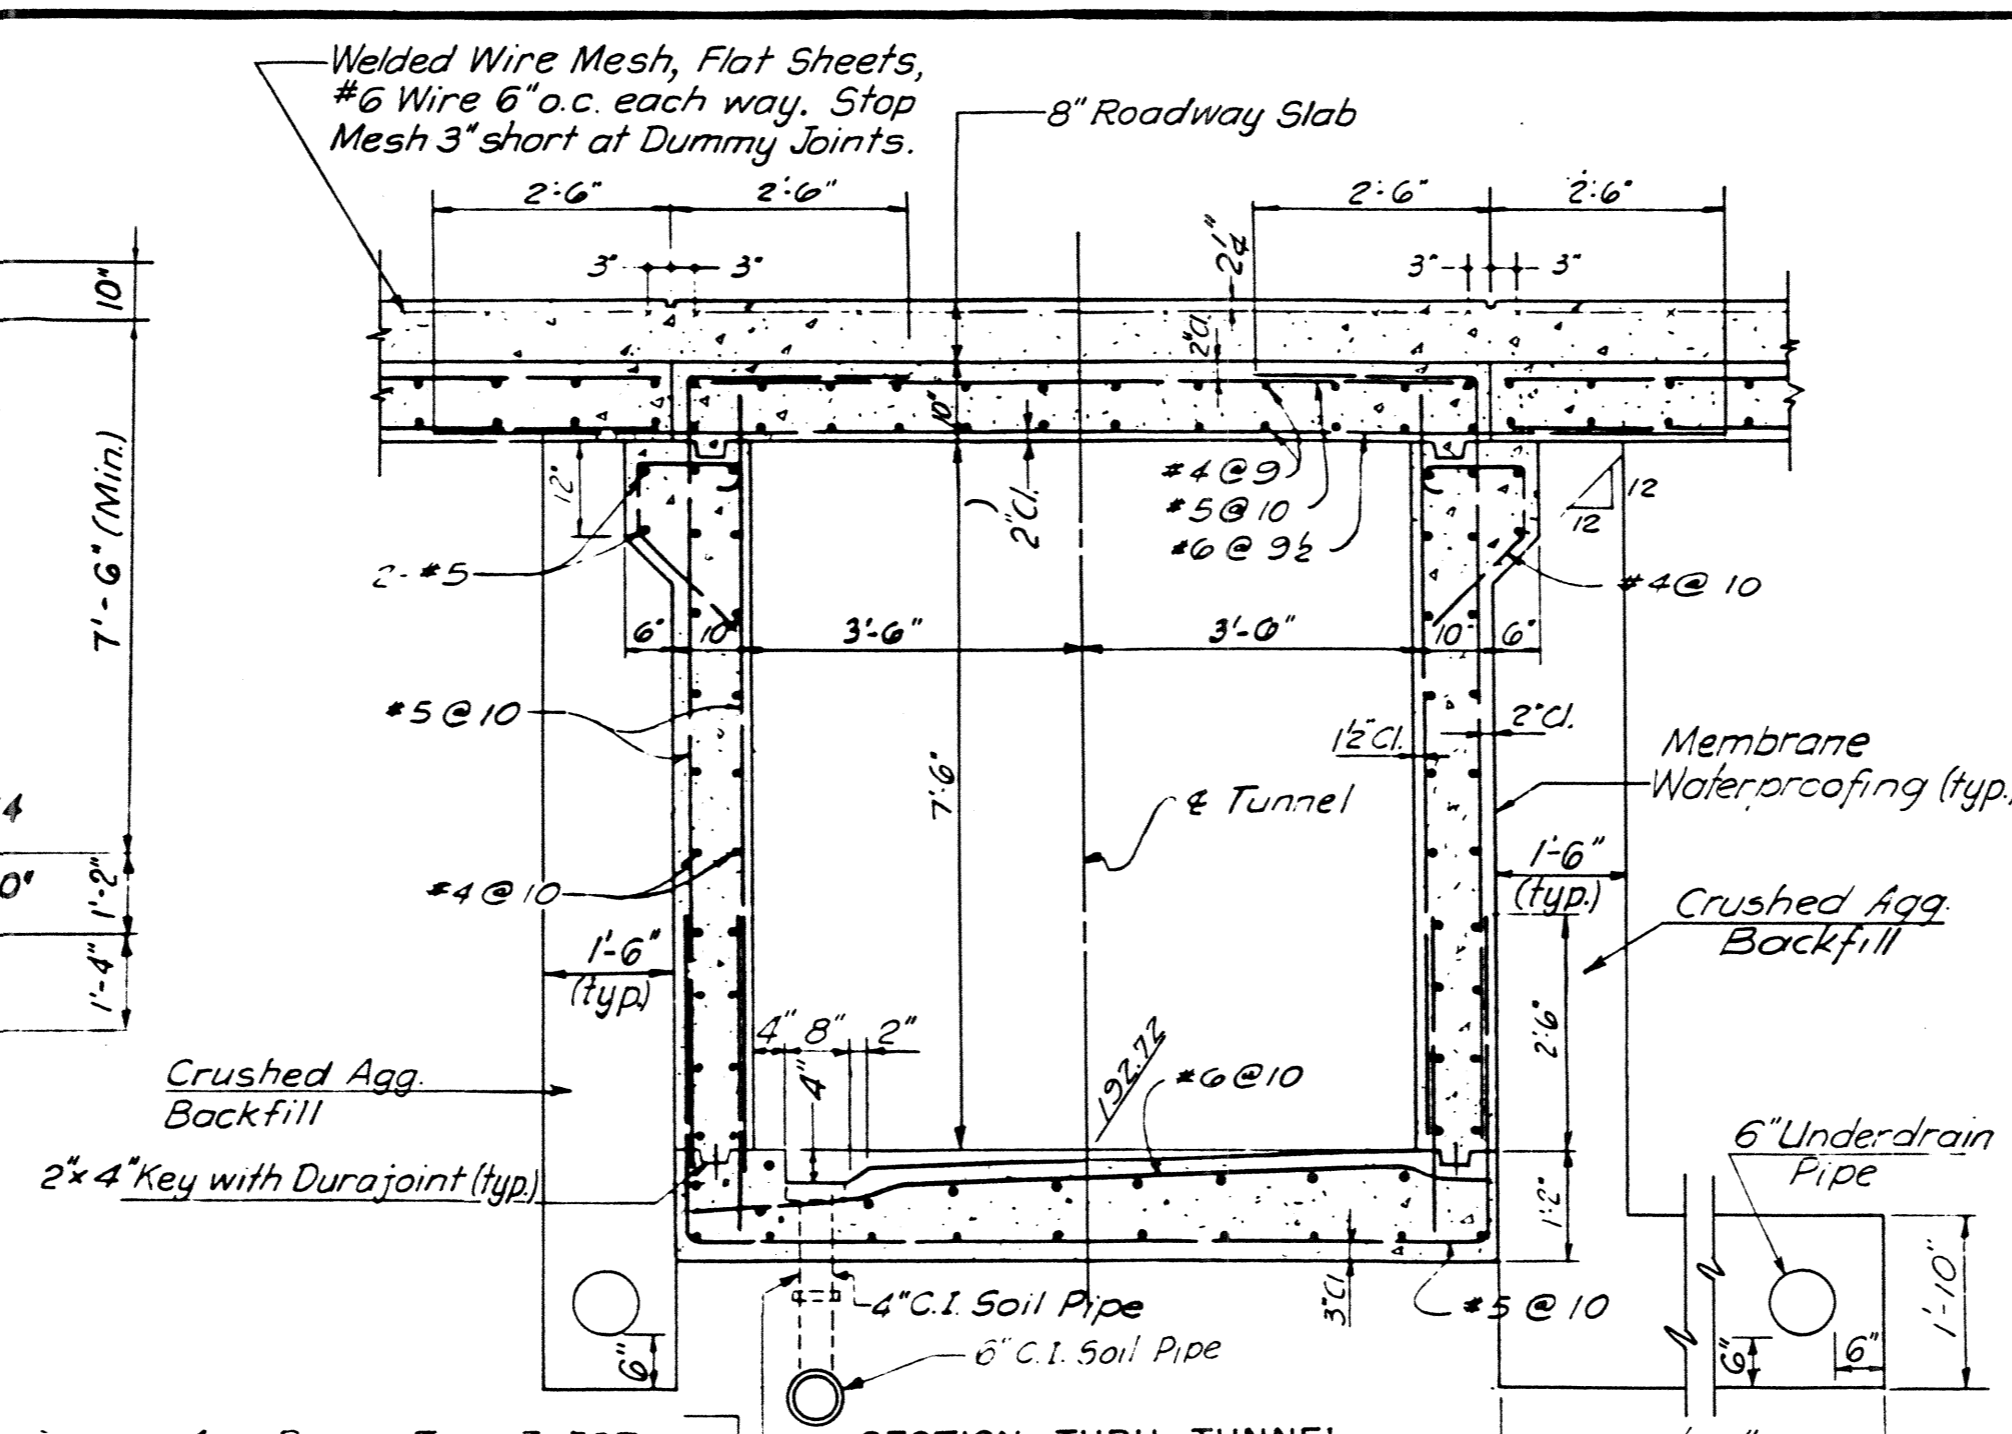


SECTION THRU TUNNEL BETWEEN ISLANDS

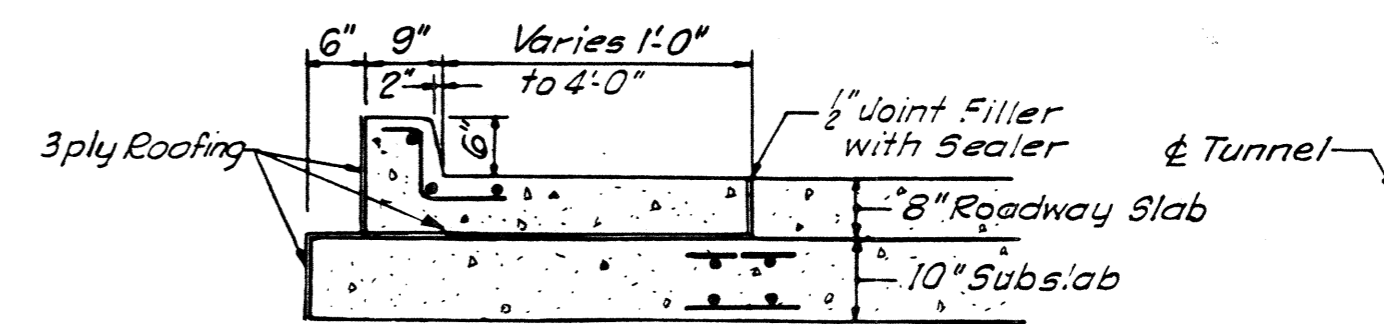


SECTION A-A
1/2" = 1'-0"
(See Sheet 3)

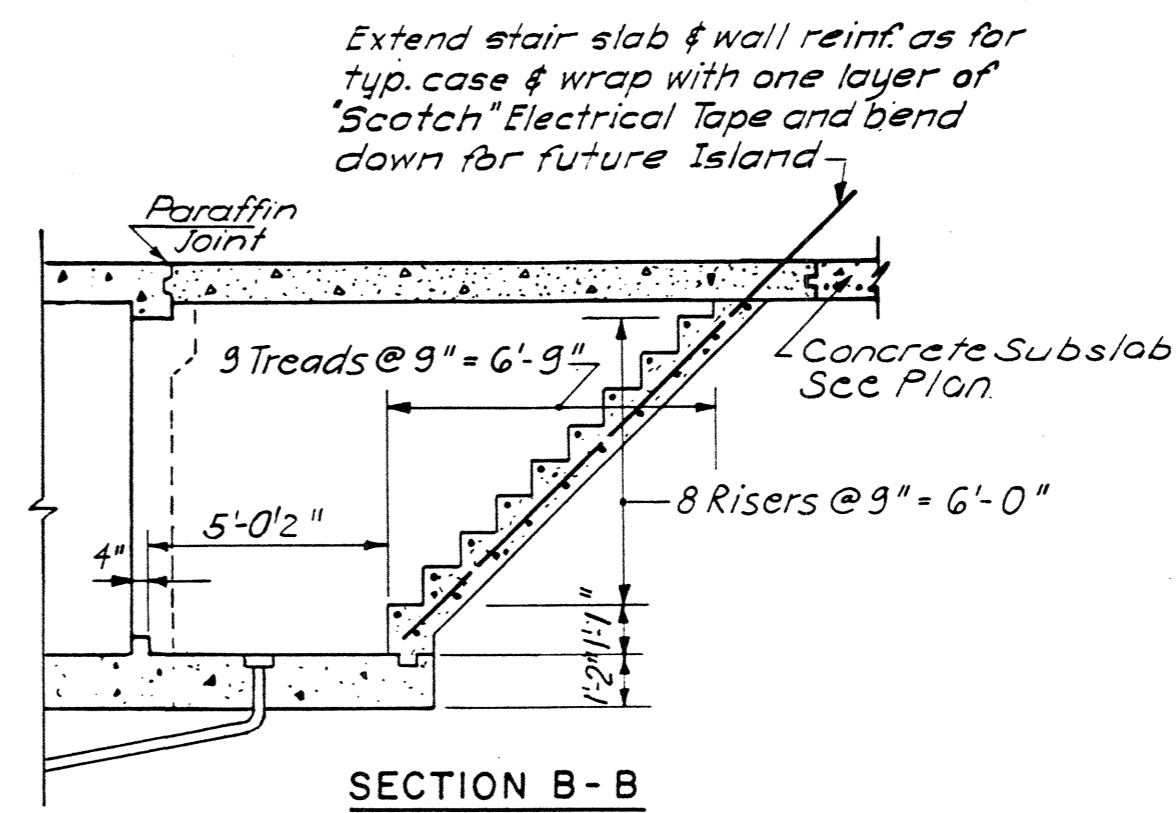


SECTION B-B
1/4" = 1'-0"
(See Sheet 3)

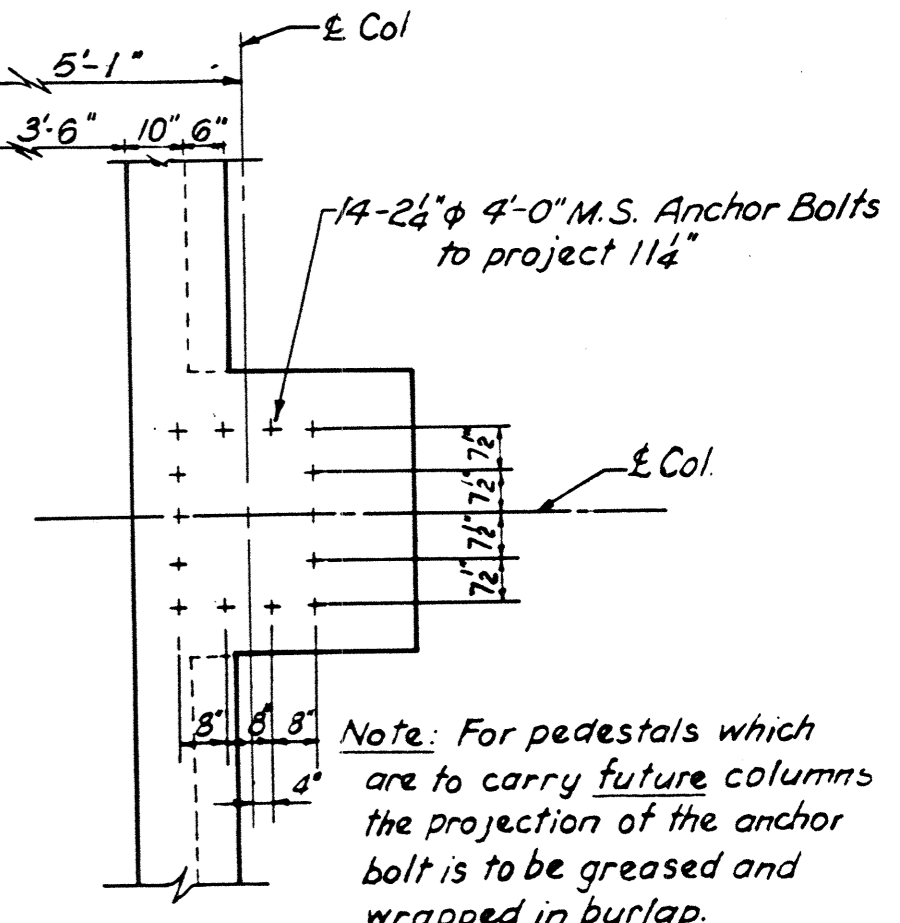


ANCHOR BOLT LAYOUT
BARRIER PLAZA CANOPY COLUMN
3/8" = 1'-0"

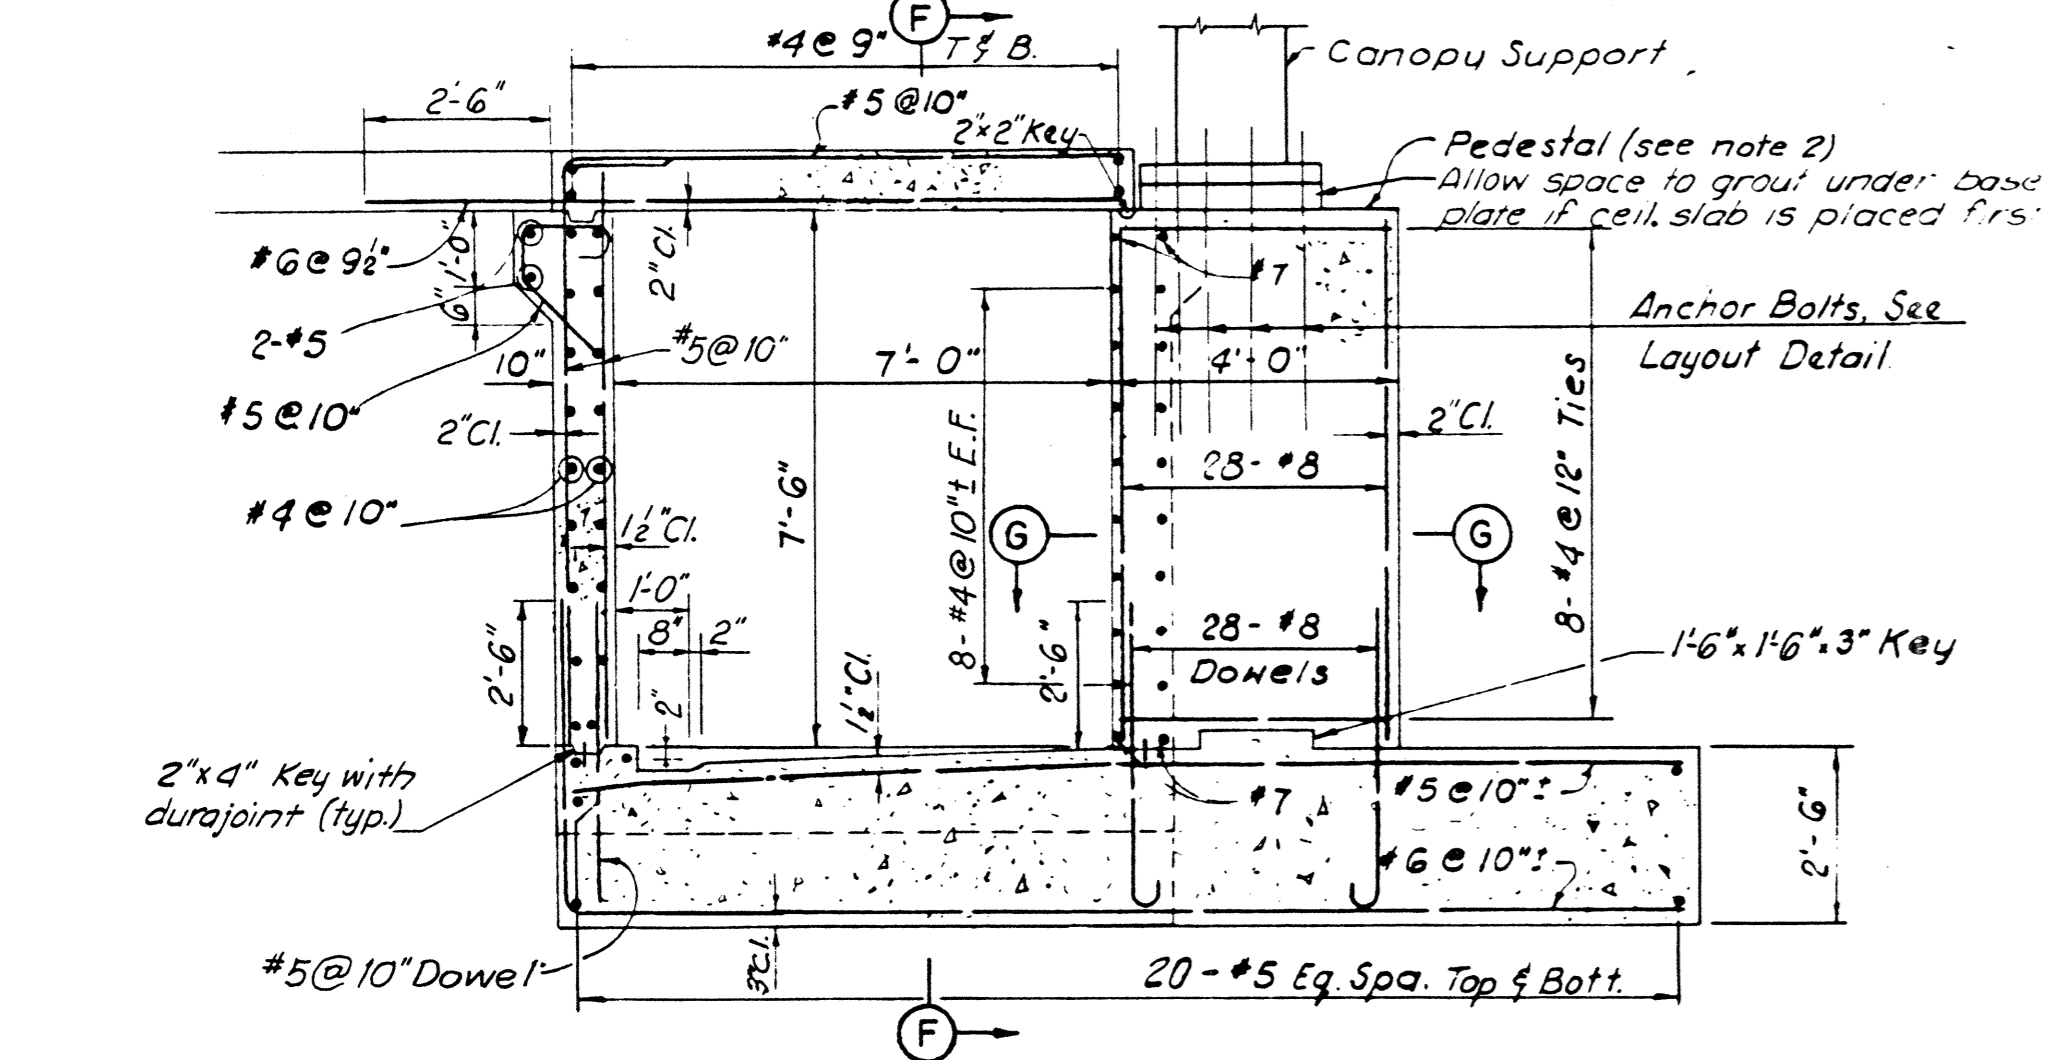


SECTION E-E
3/8" = 1'-0"

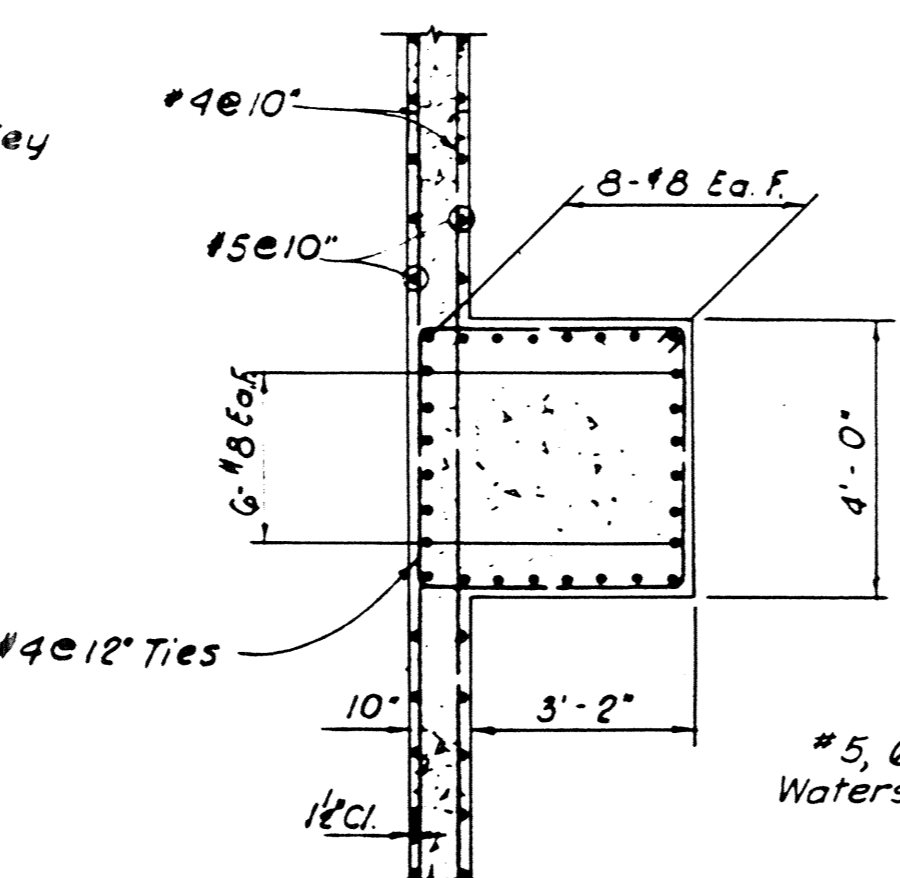


SECTION G-G
3/8" = 1'-0"

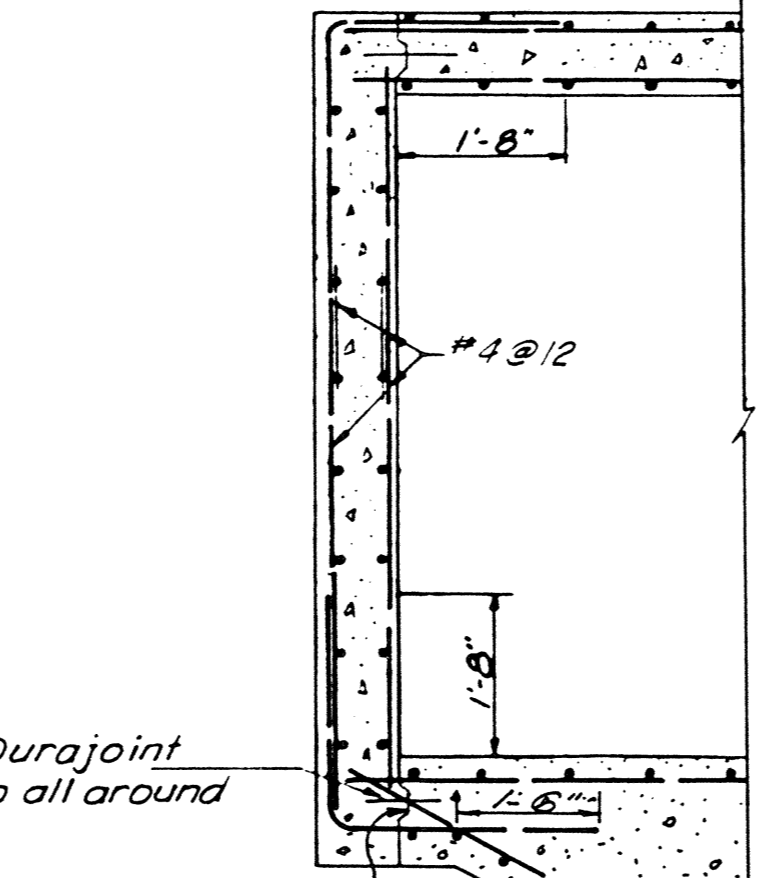

SECTION AT END OF TUNNEL
1/2" = 1'-0"

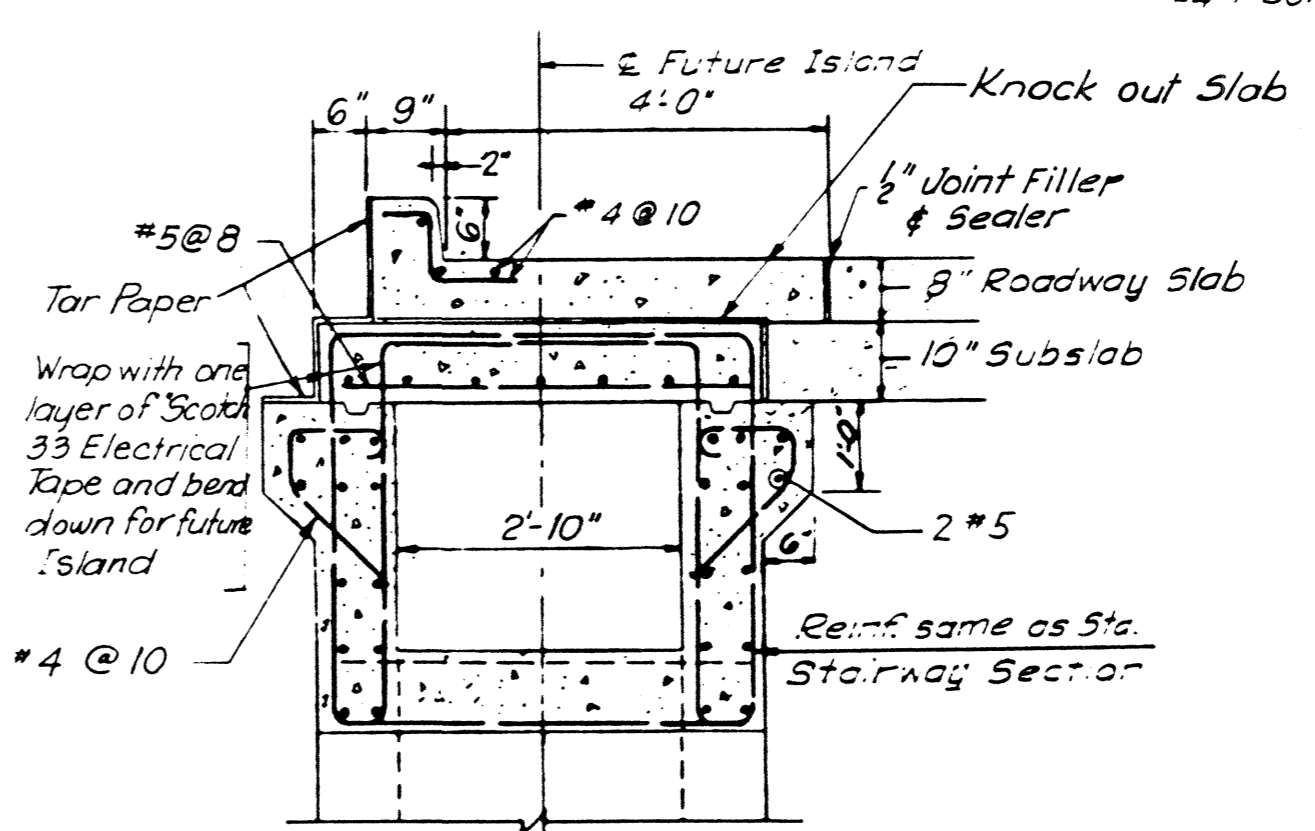


SECTION C-C
1/2" = 1'-0"
(See Sheet 3)

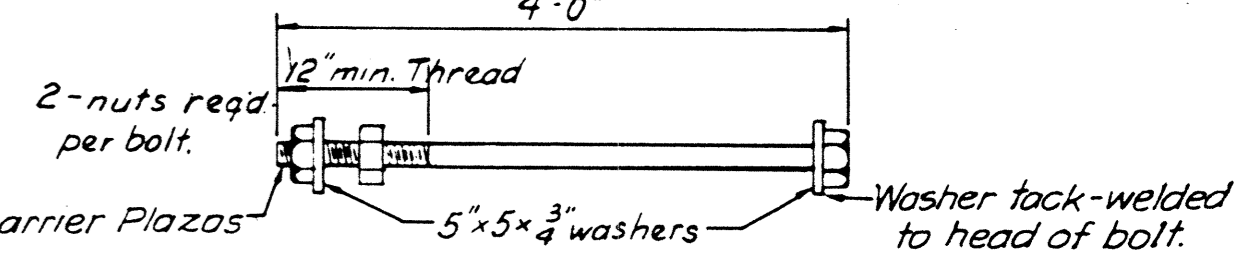


COLUMN ANCHOR BOLT DETAIL
3/4" = 1'-0"


- Notes
- 1) Top of Canopy Footing will parallel slope of Tunnel Floor.
 - 2) Canopy Pedestal shall be vertical at all times.

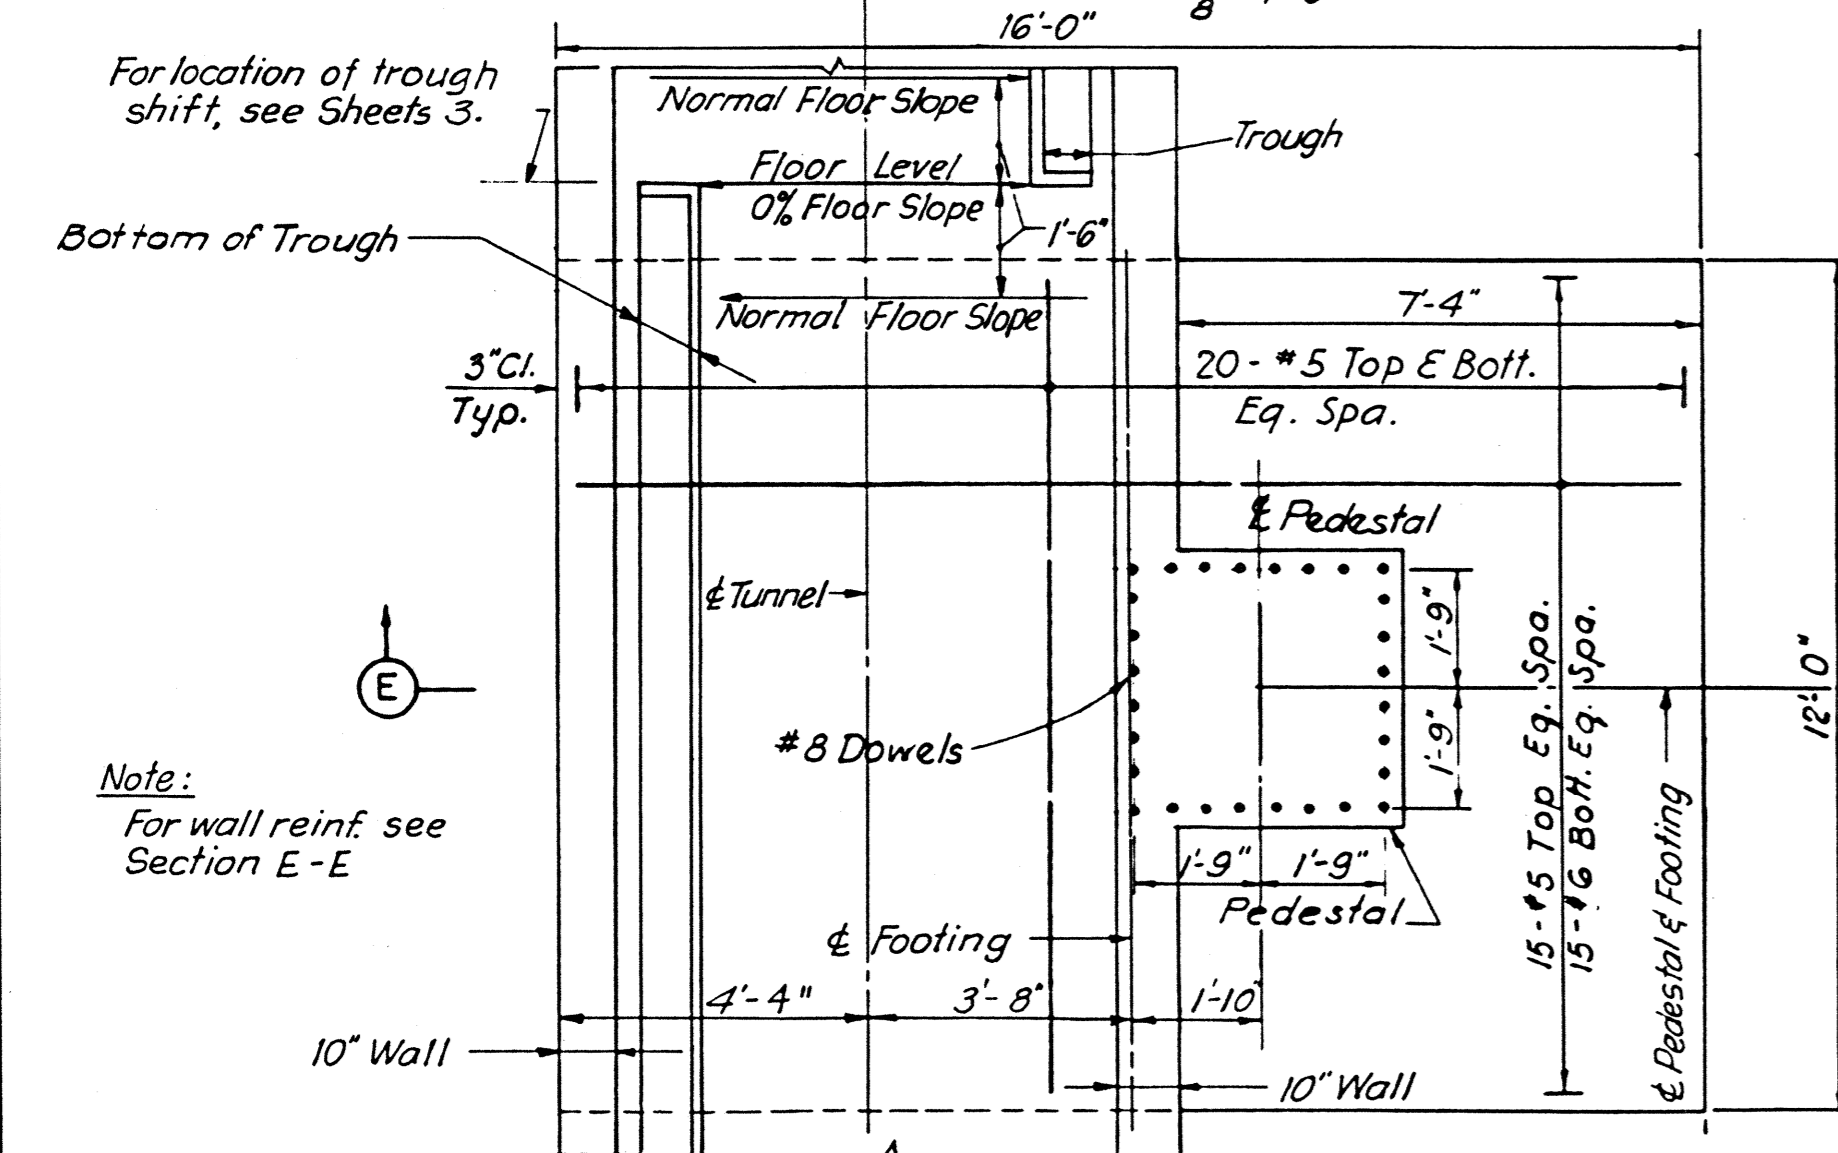


CANOPY FOOTING PLAN
3/8" = 1'-0"

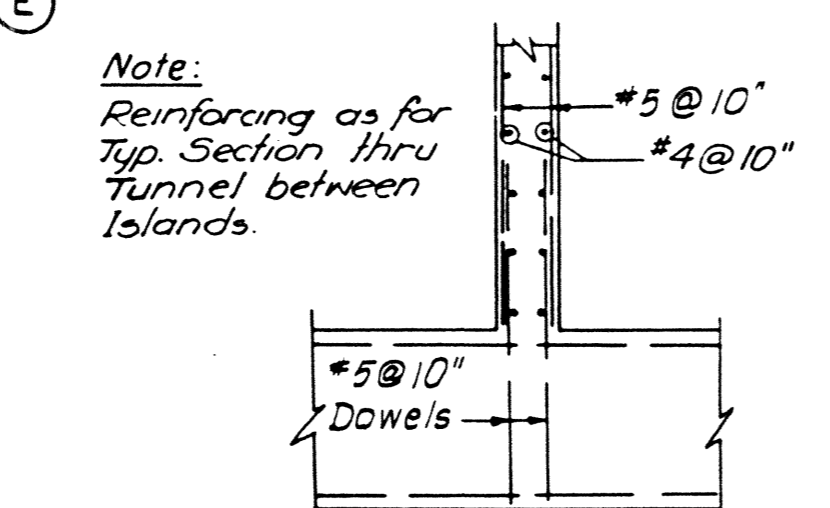

SECTION D-D
3/8" = 1'-0"

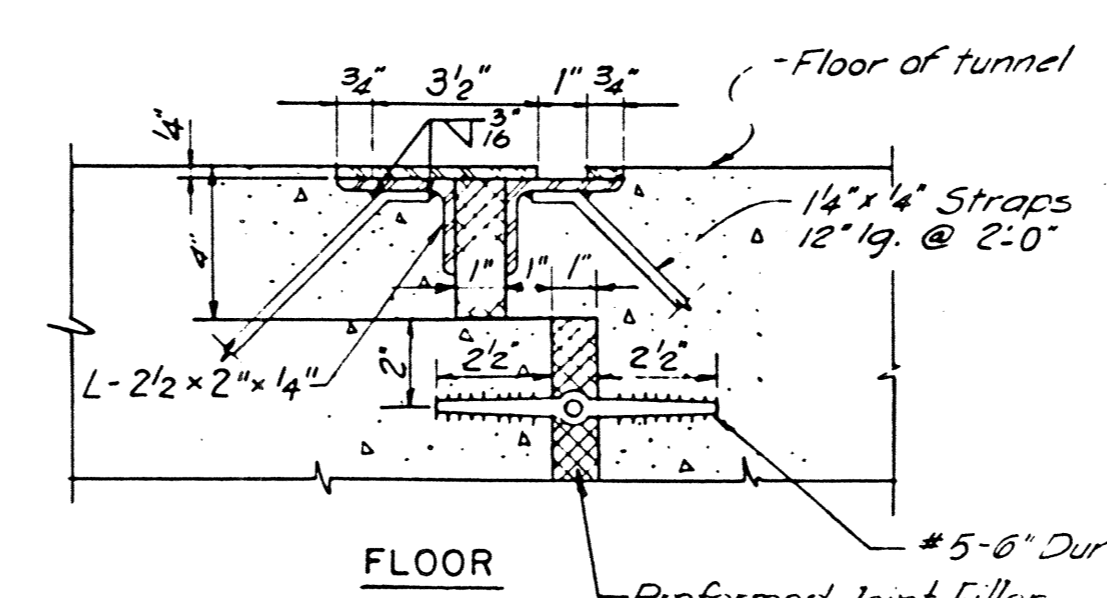

DETAILS OF TUNNEL EXPANSION JOINT
3" = 1'-0"

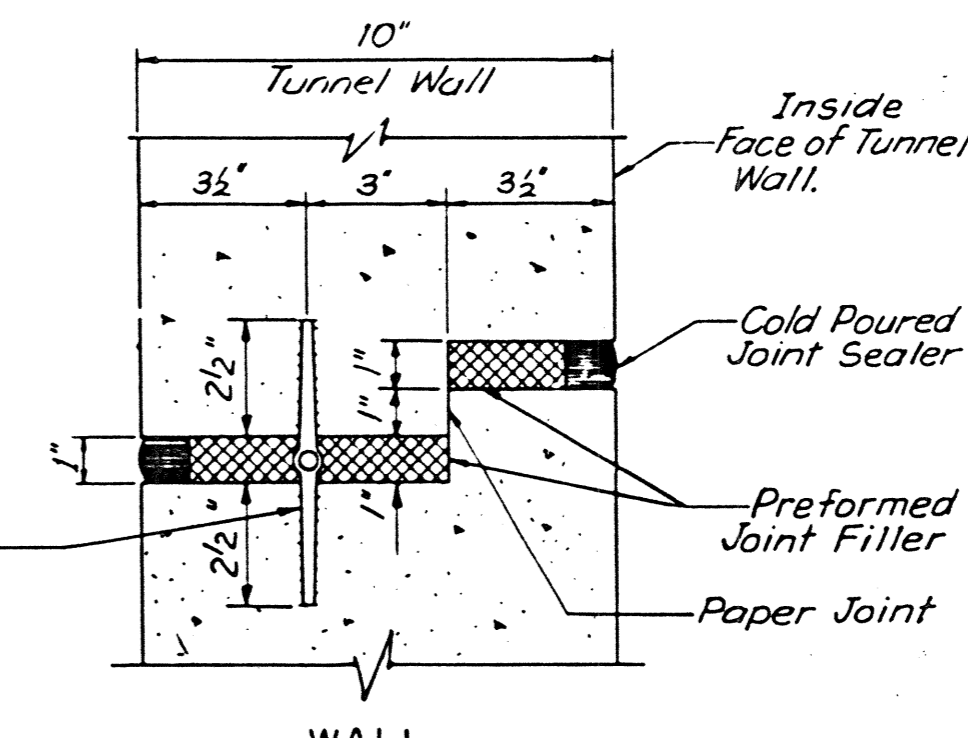

WALL







BY	DATE				
MADE	W.J.W	5-68			
CHECKED	D.E.N.	5-68	1	Final Check	D.E.N. 6-68
IN CHARGE	H.D.S.				

AS BUILT
RICHMOND METROPOLITAN AUTHORITY
RICHMOND EXPRESSWAY SYSTEM

BARRIER PLAZA
TUNNEL DETAILS

HOWARD, NEEDLES, TAMMEN & BERGENOFF
consulting engineers
NEW YORK ALEXANDRIA KANSAS CITY
SCALE: AS NOTED
CONTRACT NO. TF-3
SHEET NO. 6 OF

RICHMOND EXPRESSWAY SYSTEM			
SECTION	PROJECT	SHEET NO.	TOTAL SHEETS
TF-3	TOLL FACILITIES	8	38

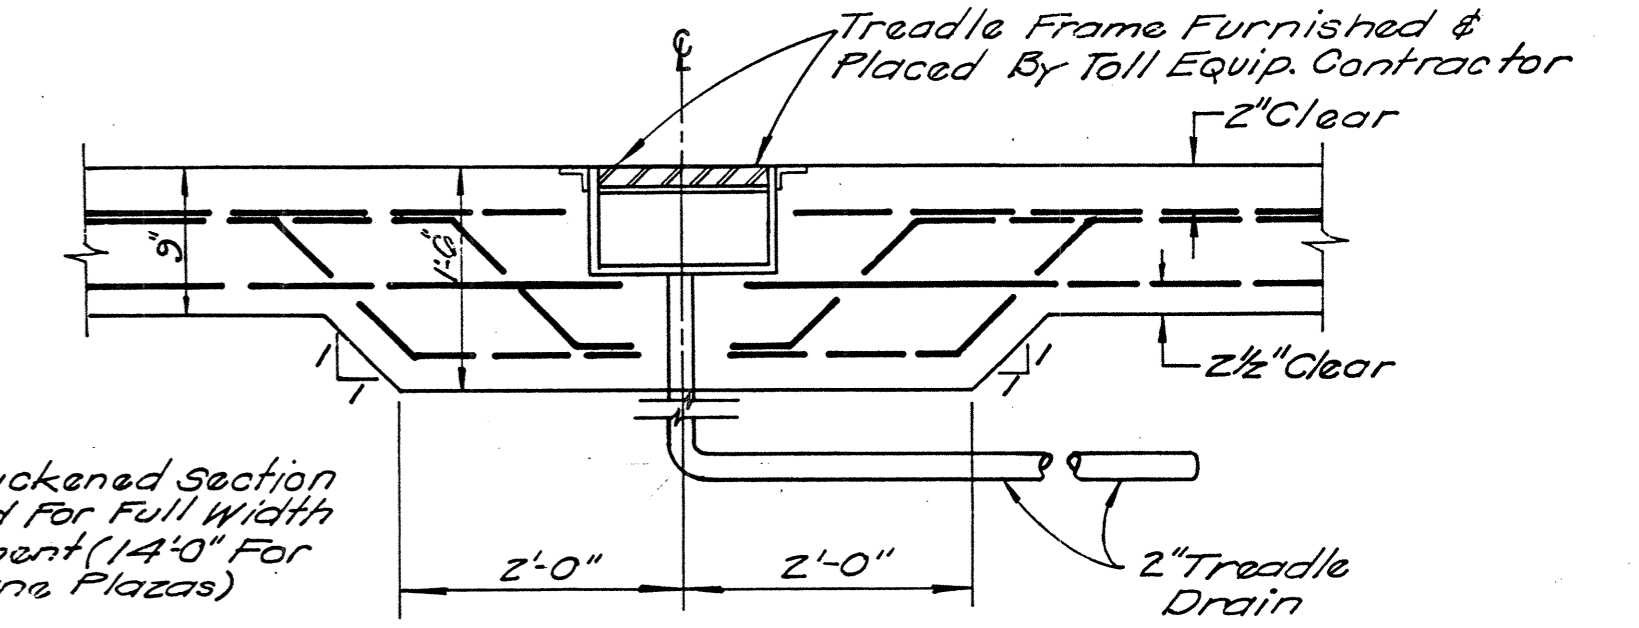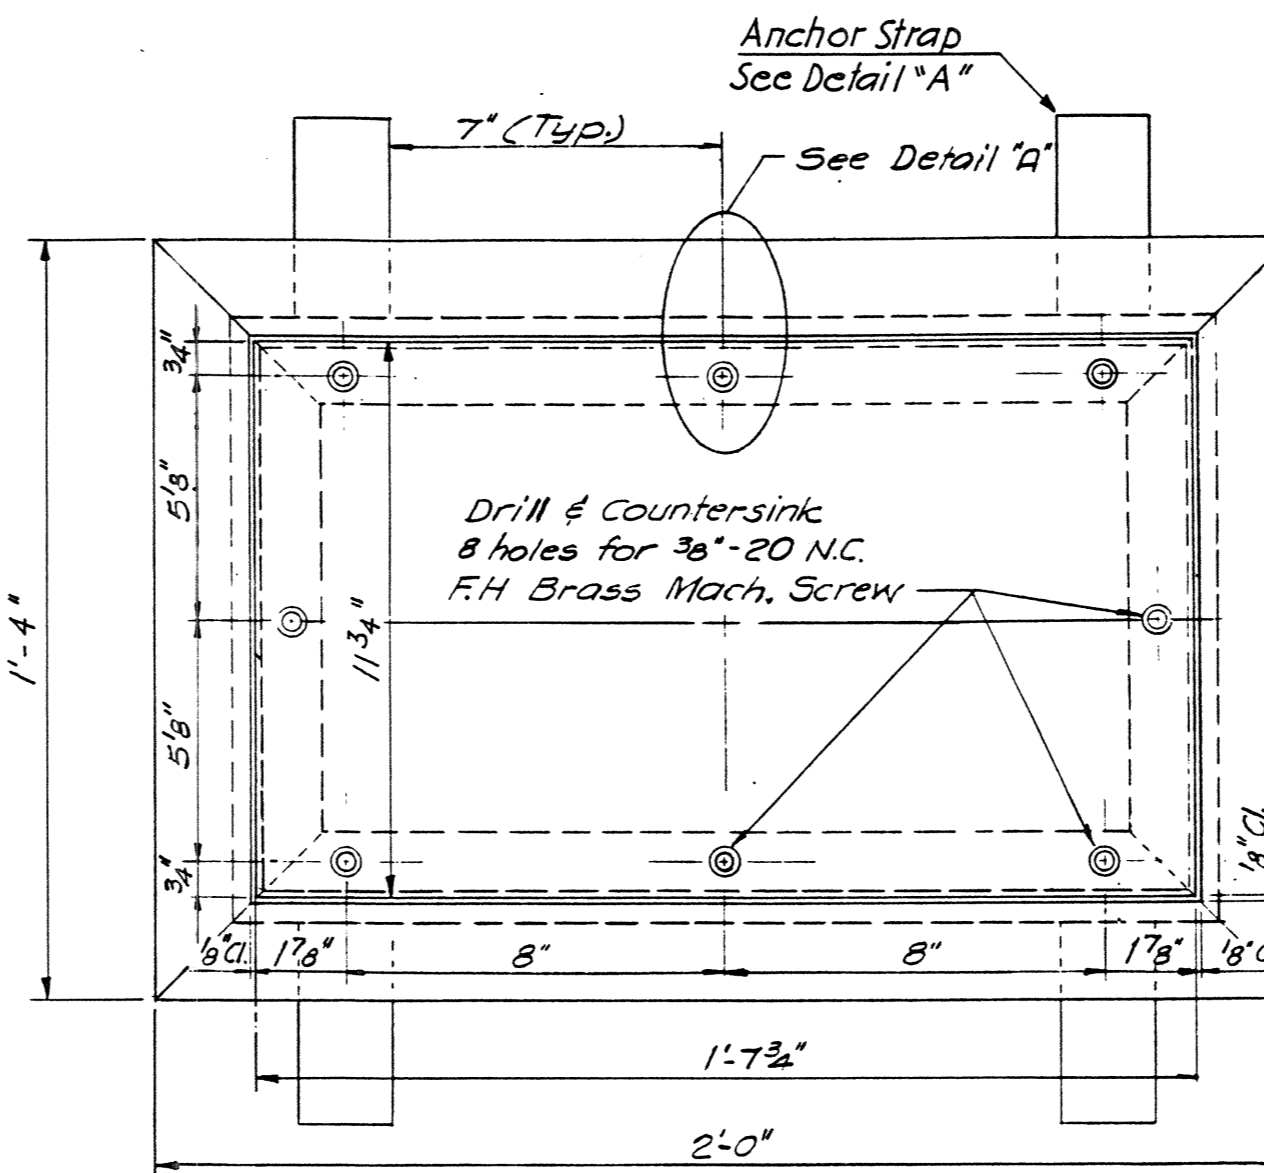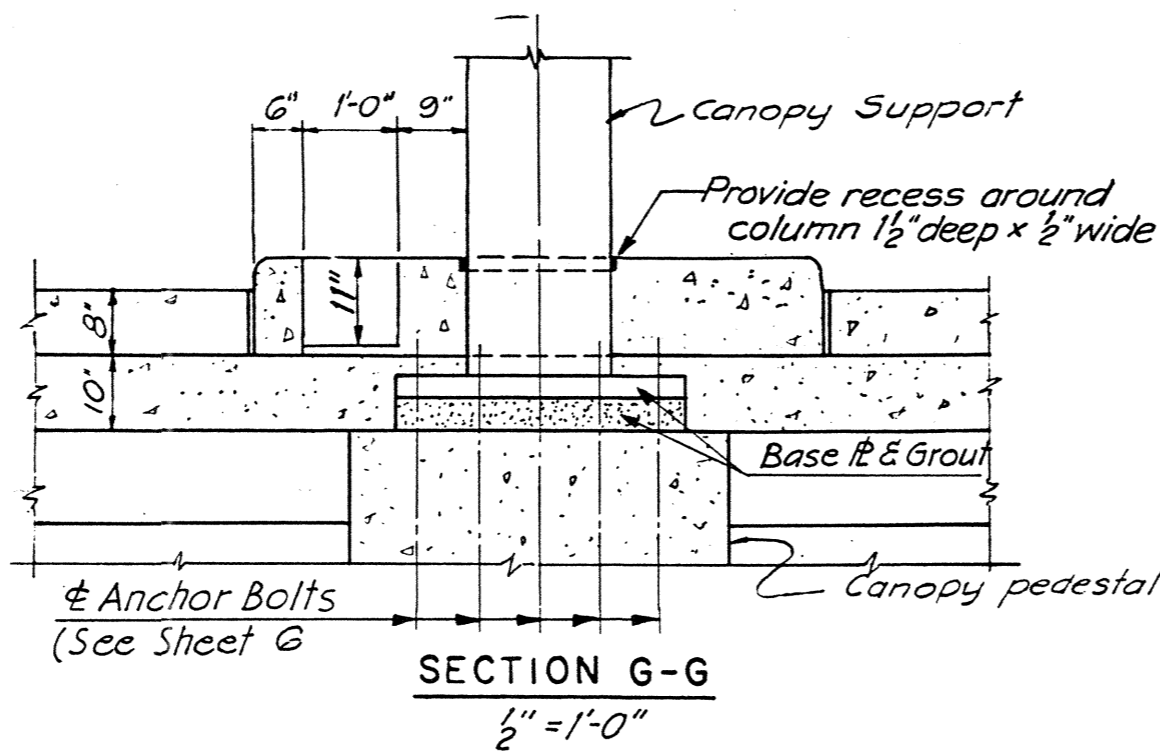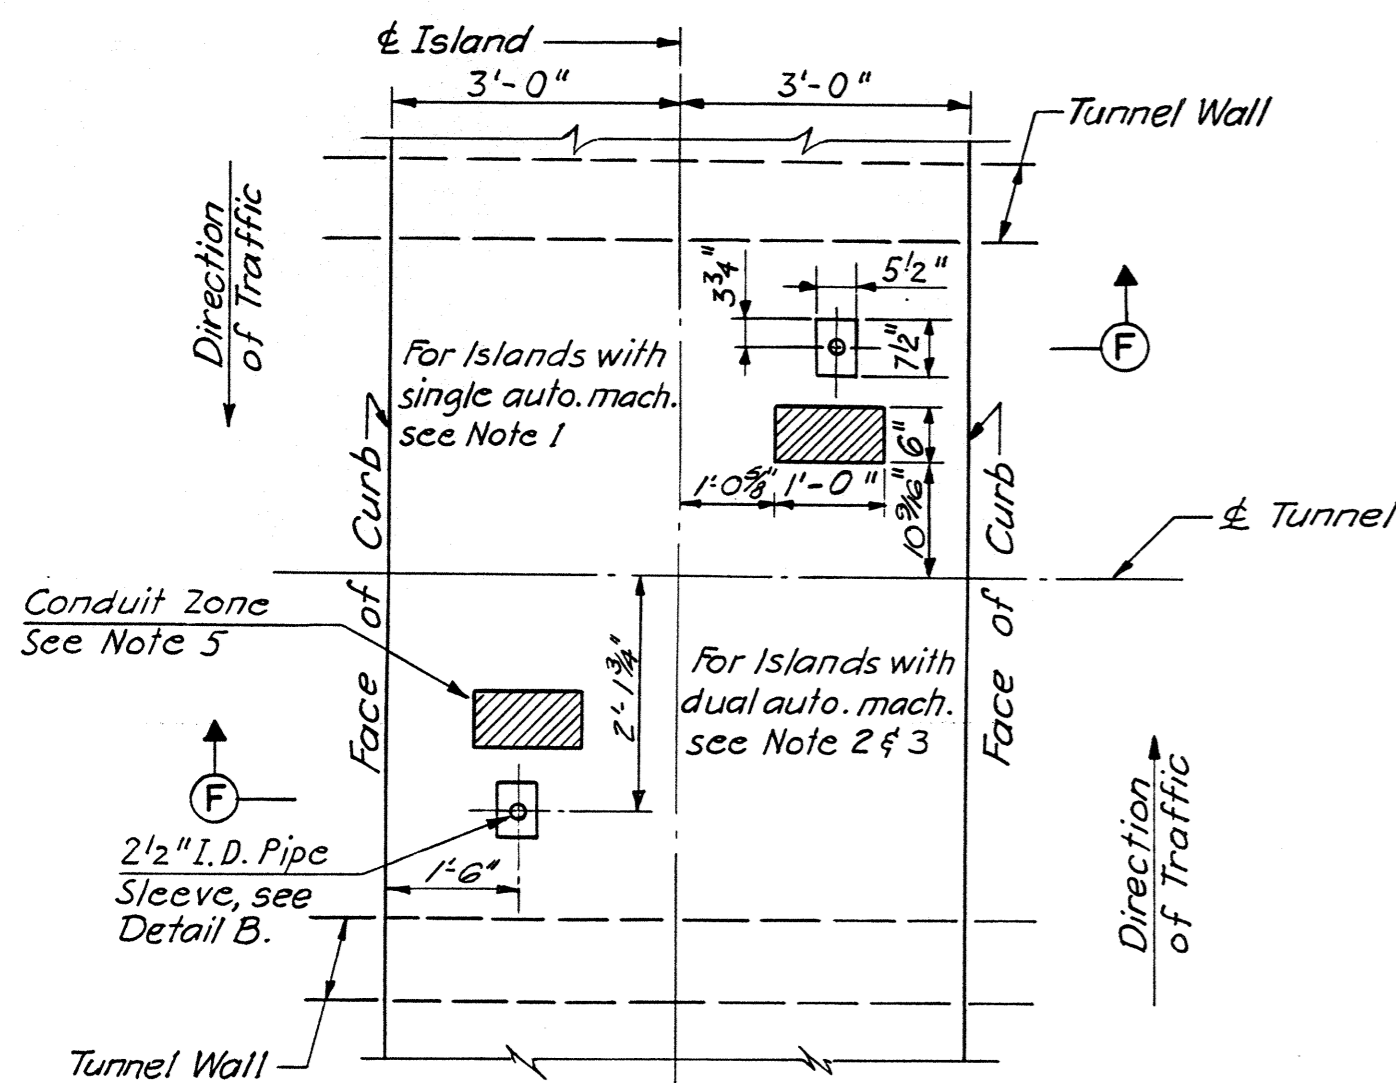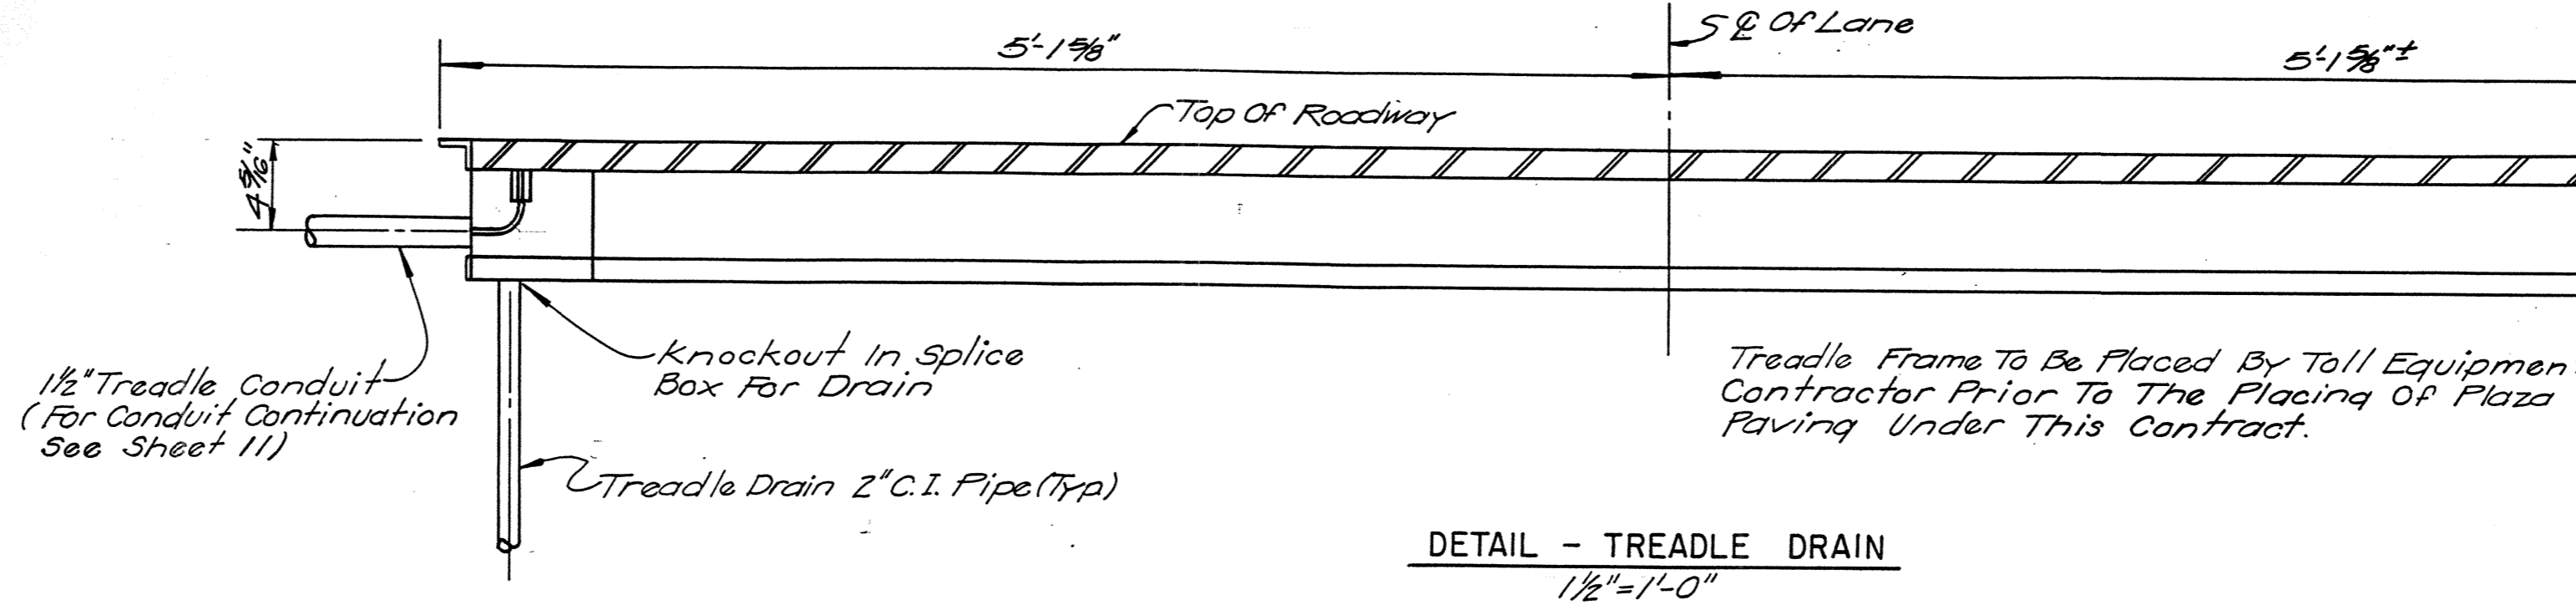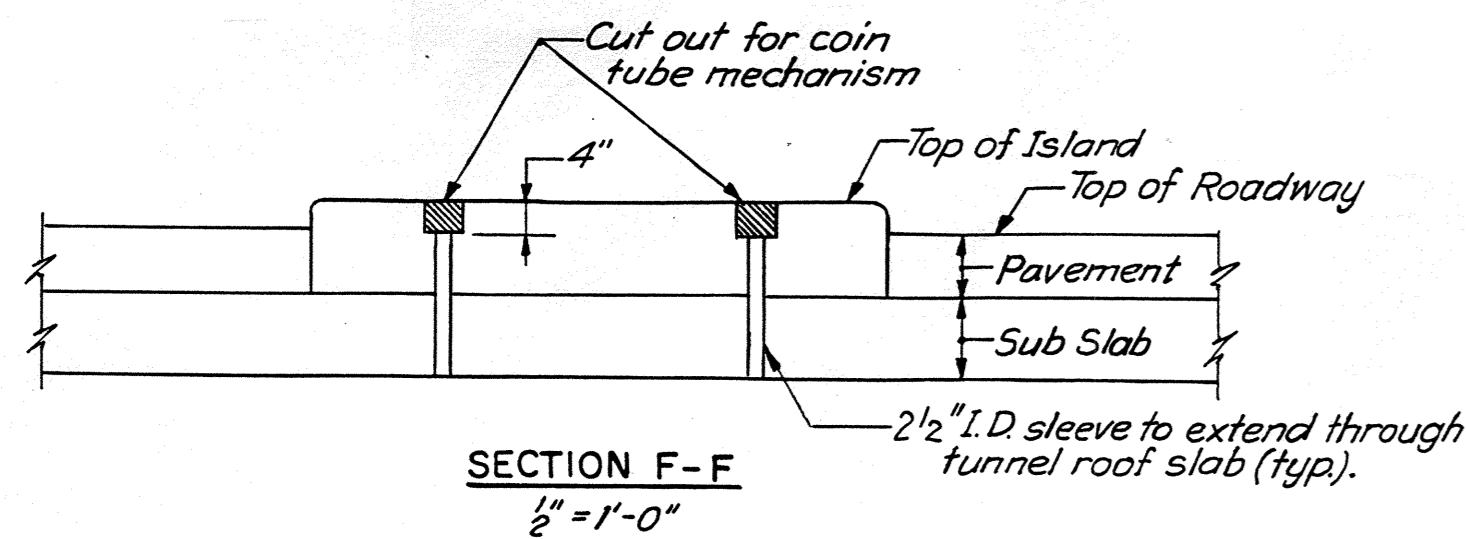


10' TREADLE FRAME INSTALLATION
3/4" = 1'-0"

NOTES





- Islands E, F, L, M, N & O will have a single coin tube and recess for automatic machine.
- Islands G, H, I & K will have dual coin tubes and tube recesses for automatic machines. One location at each island will be for future automatic machines.
- Island J will have dual coin tubes and tube recesses for future automatic machines.
- All future island locations will have a single coin tube. Sleeve to be threaded and plugged.
- Conduits to or from toll booths or automatic machines are to be placed totally within the zones shown. For conduit layouts and stubbing details, see Sheets 10, 12, 13 & 14.

CONDUIT ZONE & PIPE SLEEVE LOCATION FOR AUTOMATIC TOLL MACHINE
1/2" = 1'-0"


(Location and dimension of Conduit Zones and Pipe sleeves are similar for each Direction of Traffic.)

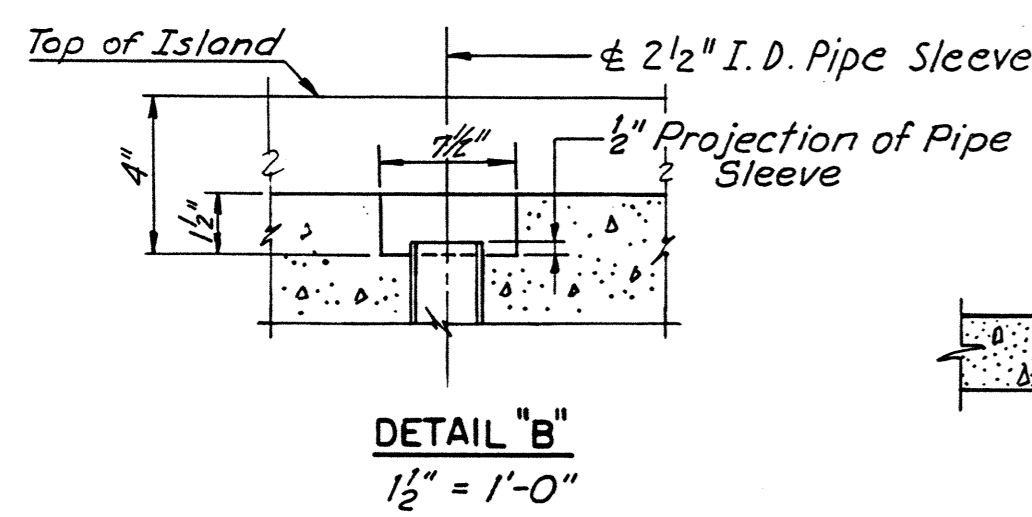

COIN TUBE DETAIL AT FUTURE ISLAND LOCATION
No Scale

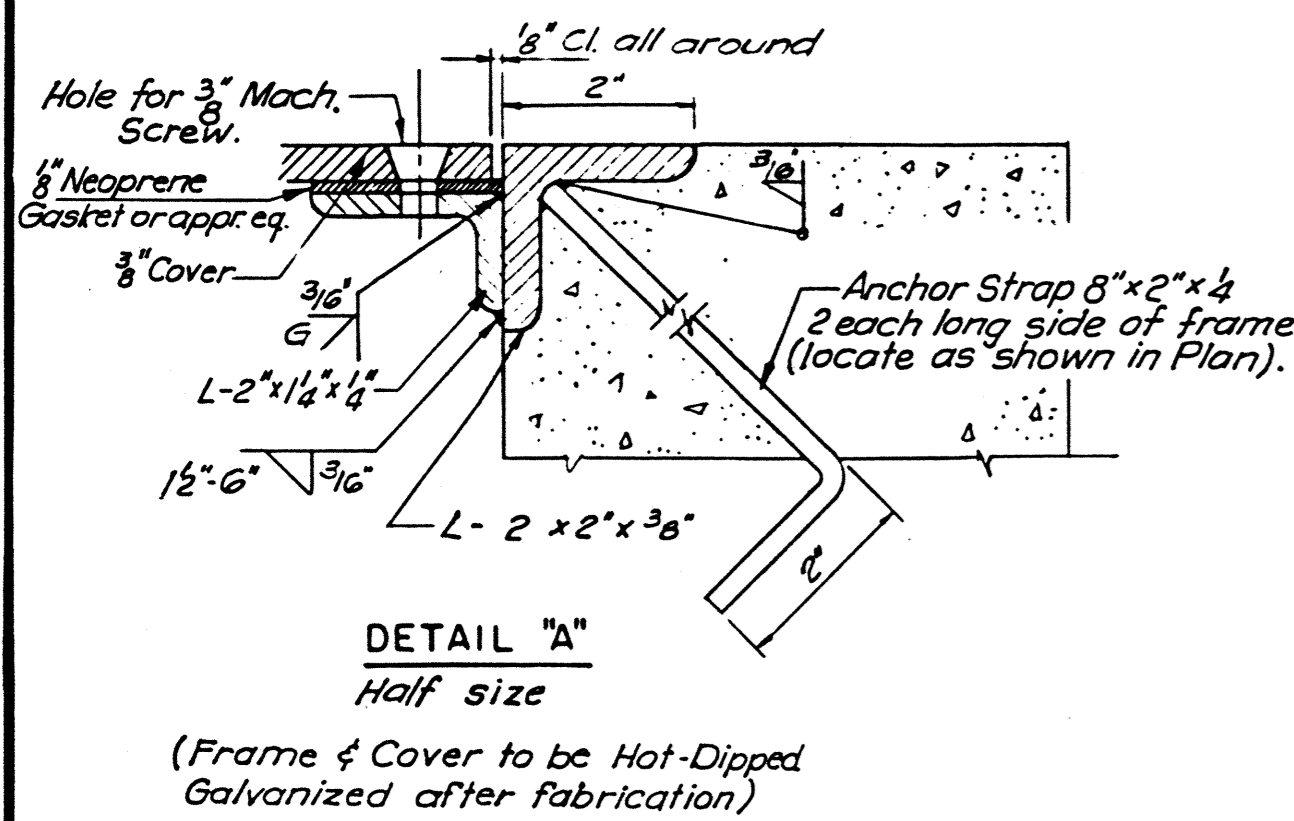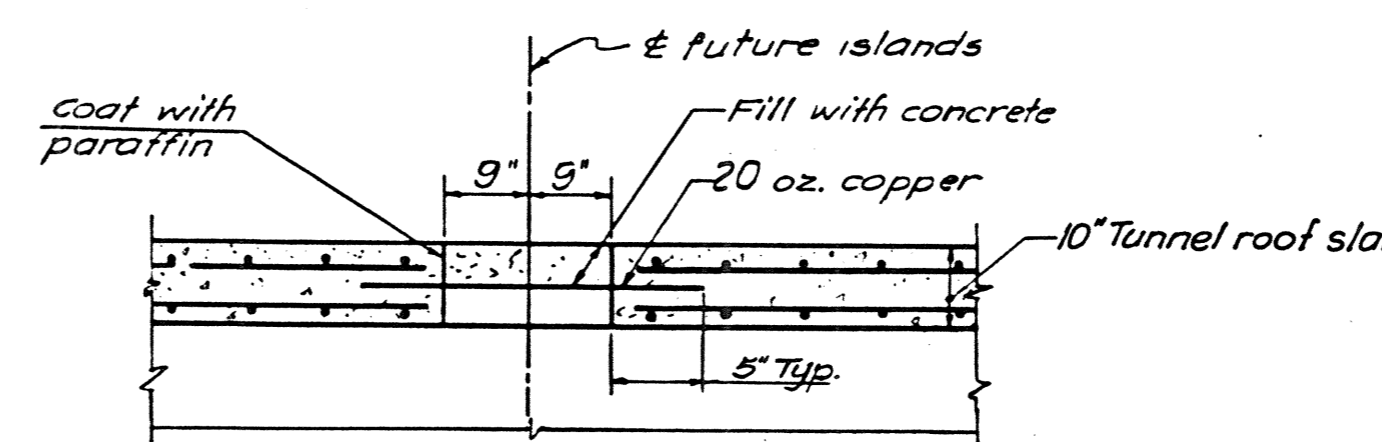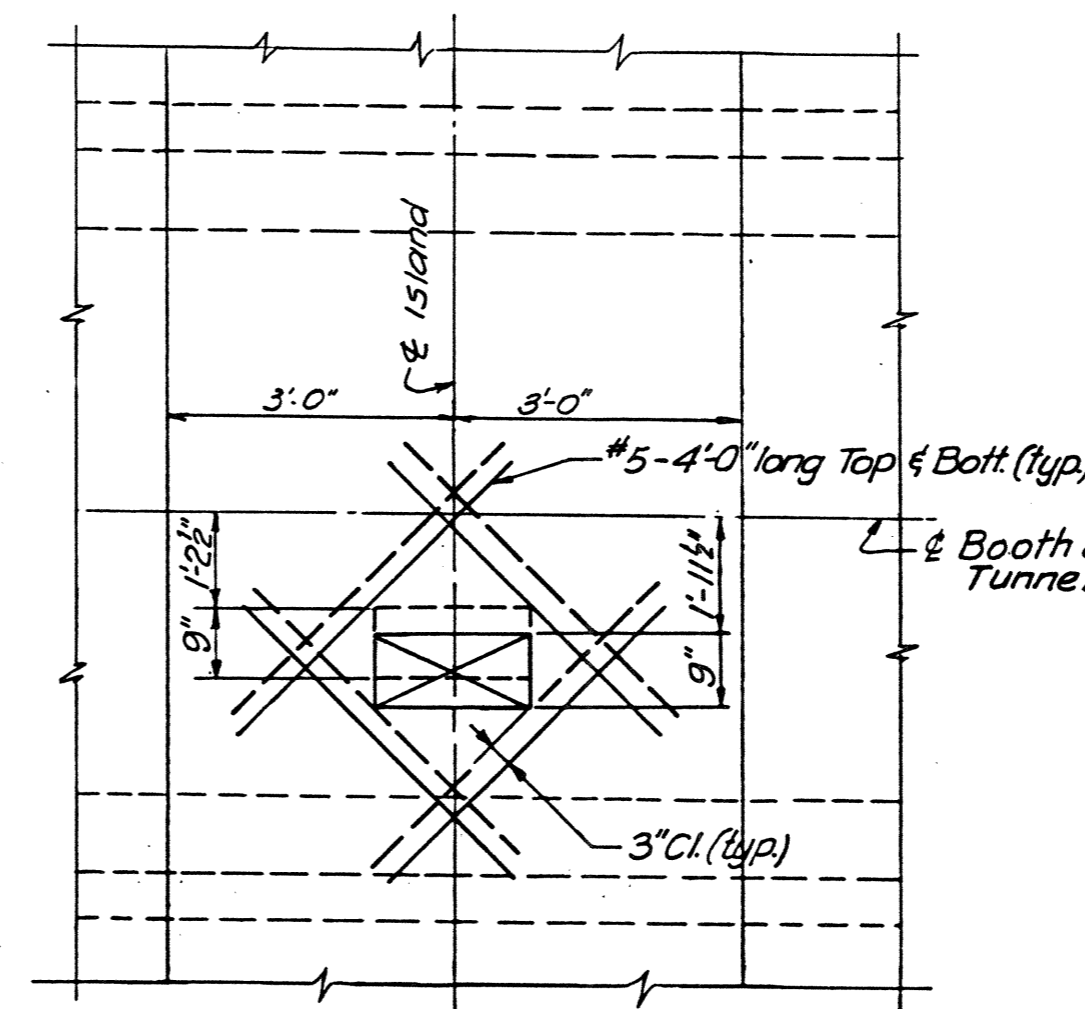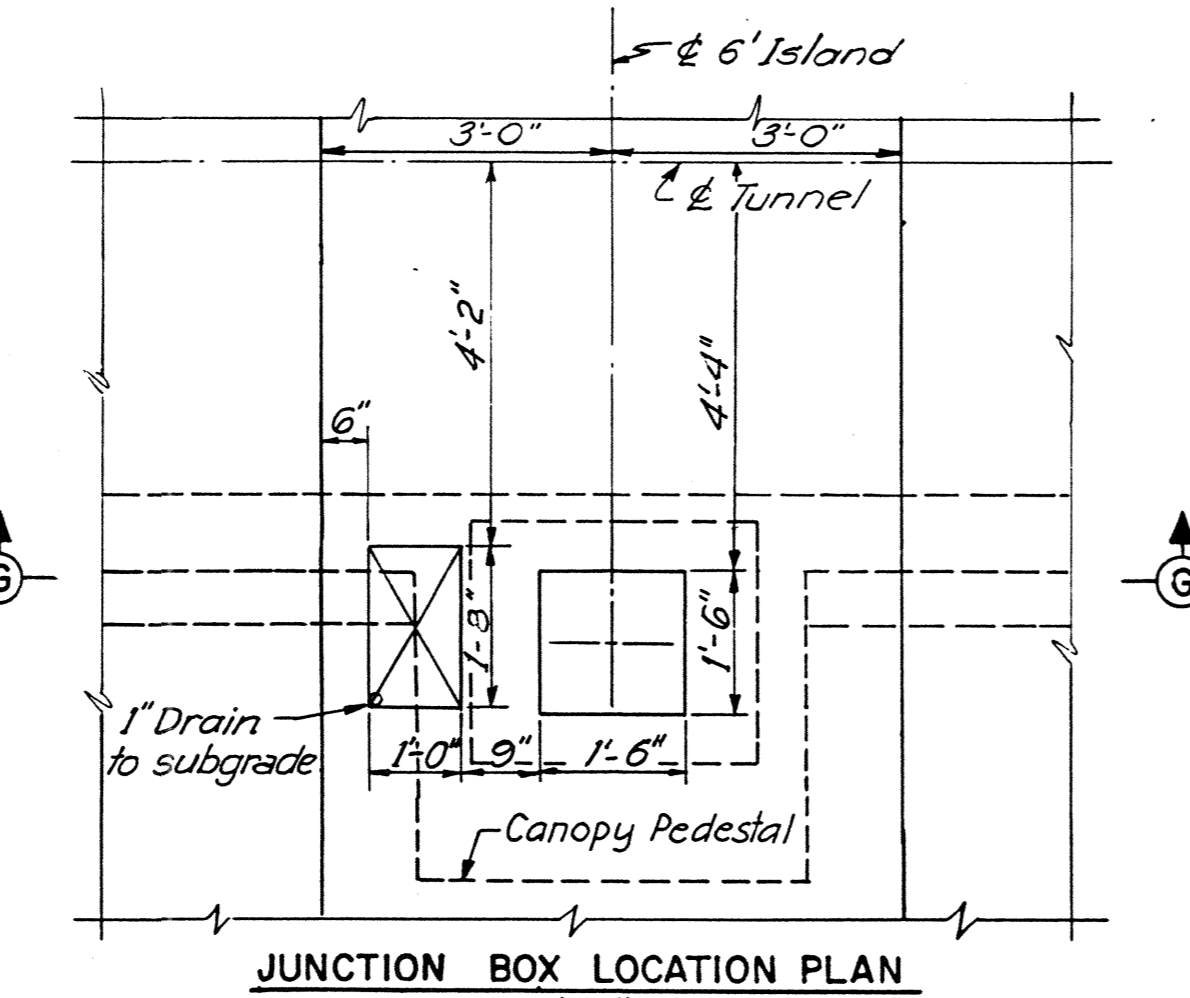

(Frame & Cover to be Hot-Dipped Galvanized after fabrication)

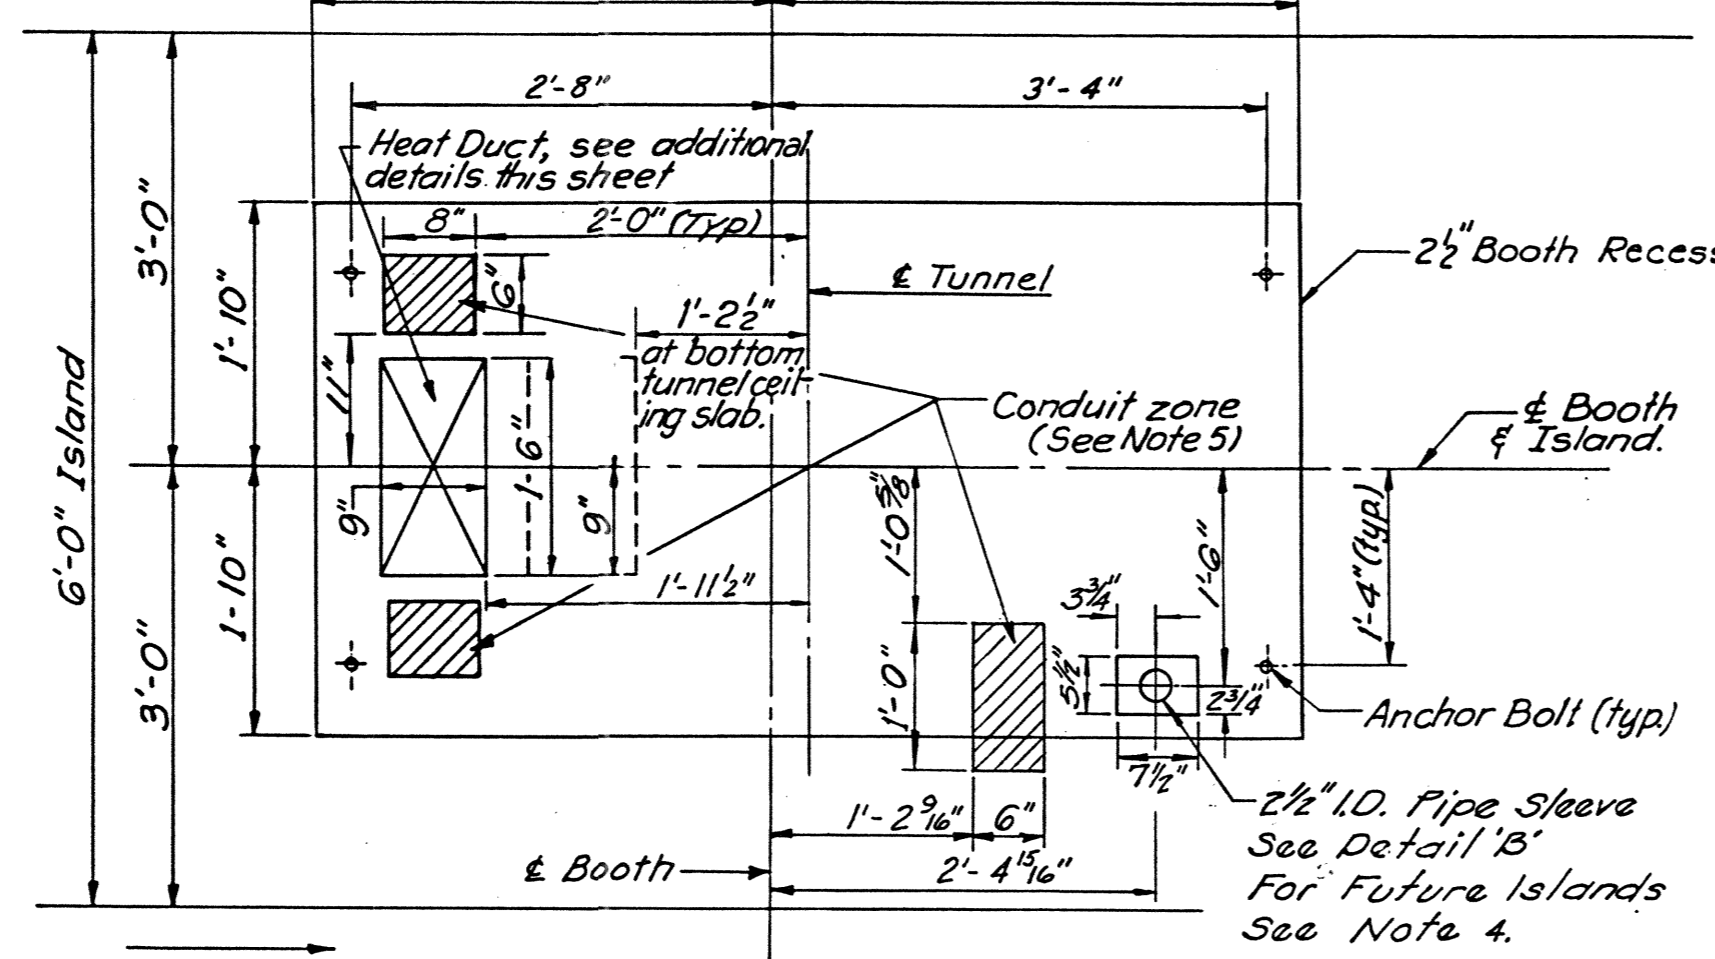

Direction of Traffic
NOTE: Utility Locations in Tunnel Ceiling Slab Future Islands A, B, C, P, & Q Similar

IN CHARGE	H.D.S.	NO.	REVISION	BY	DATE
BY	DATE	3	Utility Locations Barrier Plaza Toll Booth	E.J.M.	12-77
MADE	W. J. W.	5-68	2 New Treadle Frame & Drain	P.H.T.	2-75
CHECKED	D. E. N.	5-68	1 Final Check	D.E.N.	6-68

AS BUILT

RICHMOND METROPOLITAN AUTHORITY
RICHMOND EXPRESSWAY SYSTEM

MISCELLANEOUS DETAILS





HOWARD, NEEDLES, TAMMEN & BERGENDOFF
consulting engineers
NEW YORK ALEXANDRIA KANSAS CITY

SCALE: AS NOTED
CONTRACT NO: TF-3
SHEET NO. 8 OF


RICHMOND EXPRESSWAY SYSTEM		
SECTION	SHEET NO.	TOTAL SHEETS
TF-3	TOLL FACILITIES	16 / 38

NOTES:


- LANES 7,8,9,12,13 & 14 ARE TO RECEIVE EXACT CHANGE SIGNS, SEE DETAIL.
- LIGHT UNITS ARE TO BE PLACED IN FRONT OF EXACT CHANGE SIGNS. THE LIGHT UNITS ARE TO BE FOCUSED ON THE HORIZONTAL ϕ OF THE PANEL. LIGHT UNIT BALLASTS WILL BE EXPOSED.
- A 3'-0" WIDE SECTION OF ISLAND WHOSE CENTER REPRESENTS THE COL. ϕ INCLUDING A 4'-0" WIDE AND 10" HIGH CONC. FILLER BELOW ARE INCLUDED IN THIS CONTRACT. THE JUNCTION BOX SHOWN IN SECTION B-B WILL BE OWNER SUPPLIED BUT INSTALLED UNDER THIS CONTRACT. ALL WORK SHOWN IN SECTION C-C IS PART OF THIS CONTRACT. PROPER JOINT SEAL AND CURB DIMENSIONS TO FIT WITH THE EXISTING MUST BE PROVIDED.

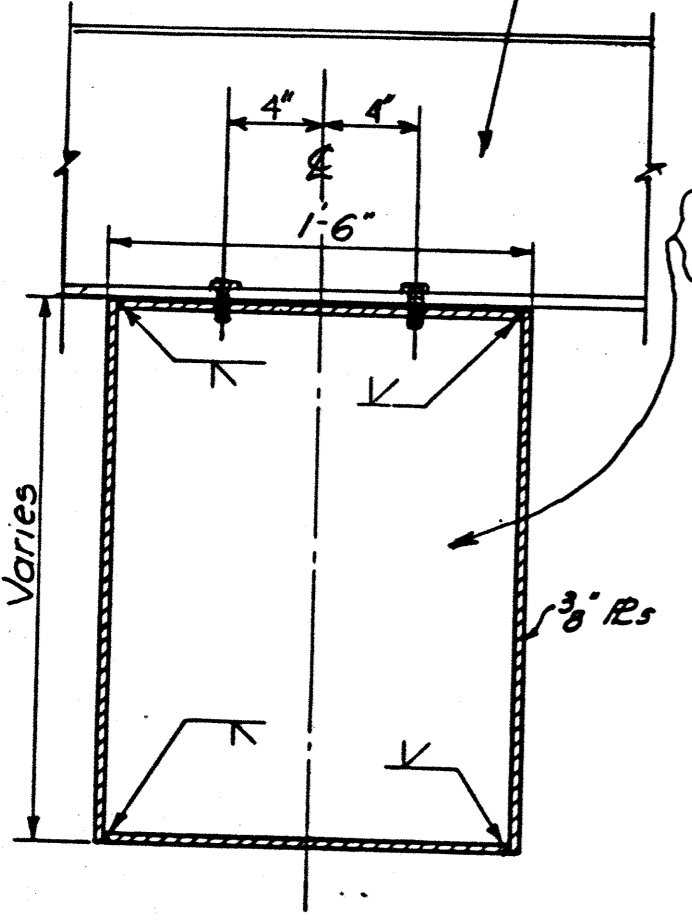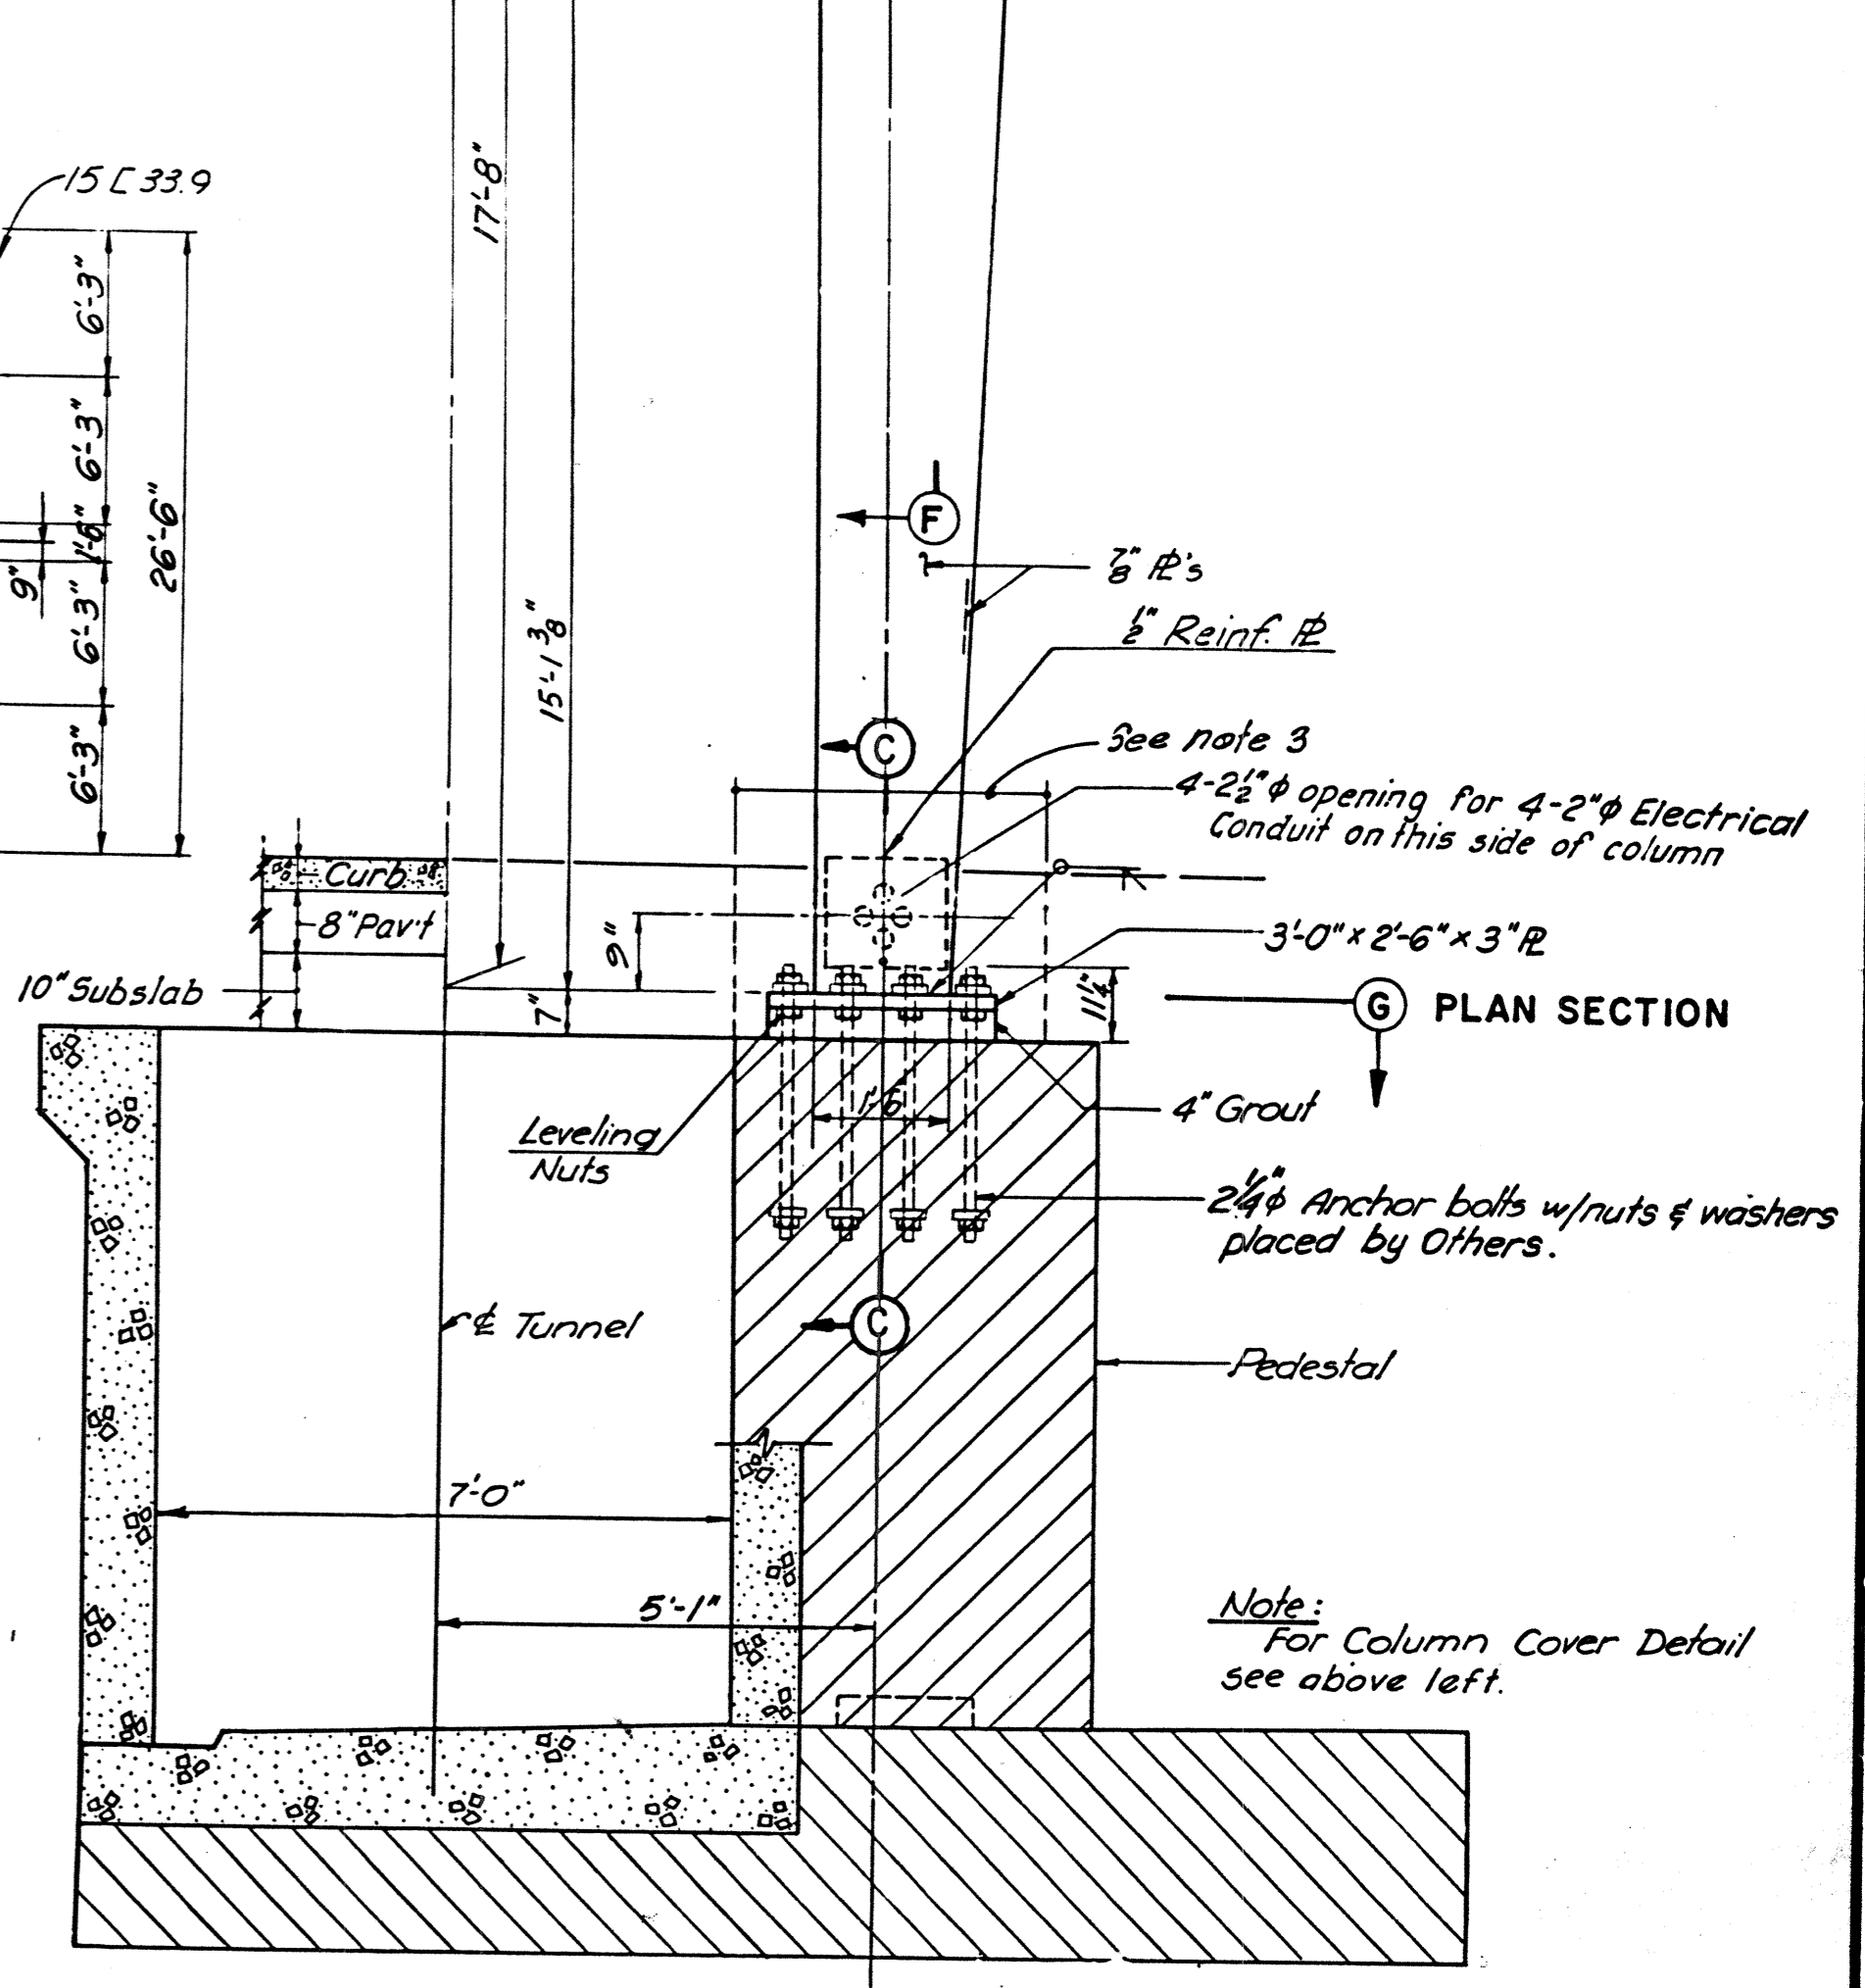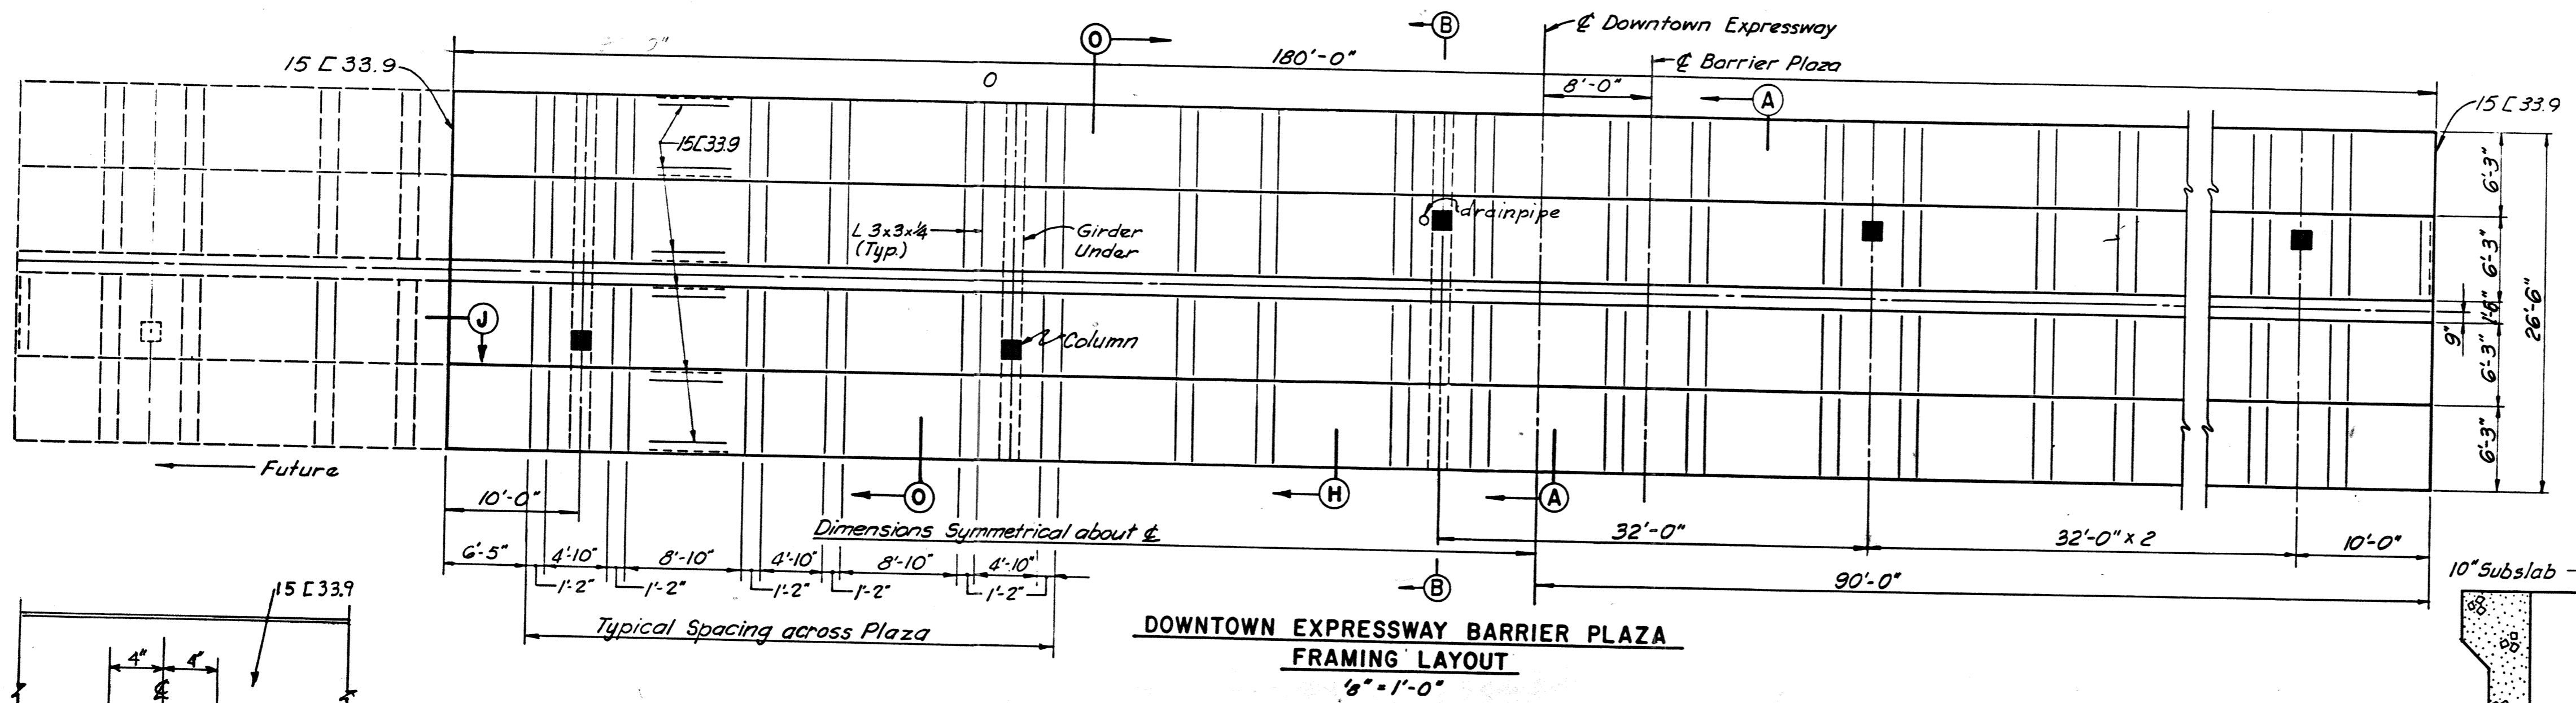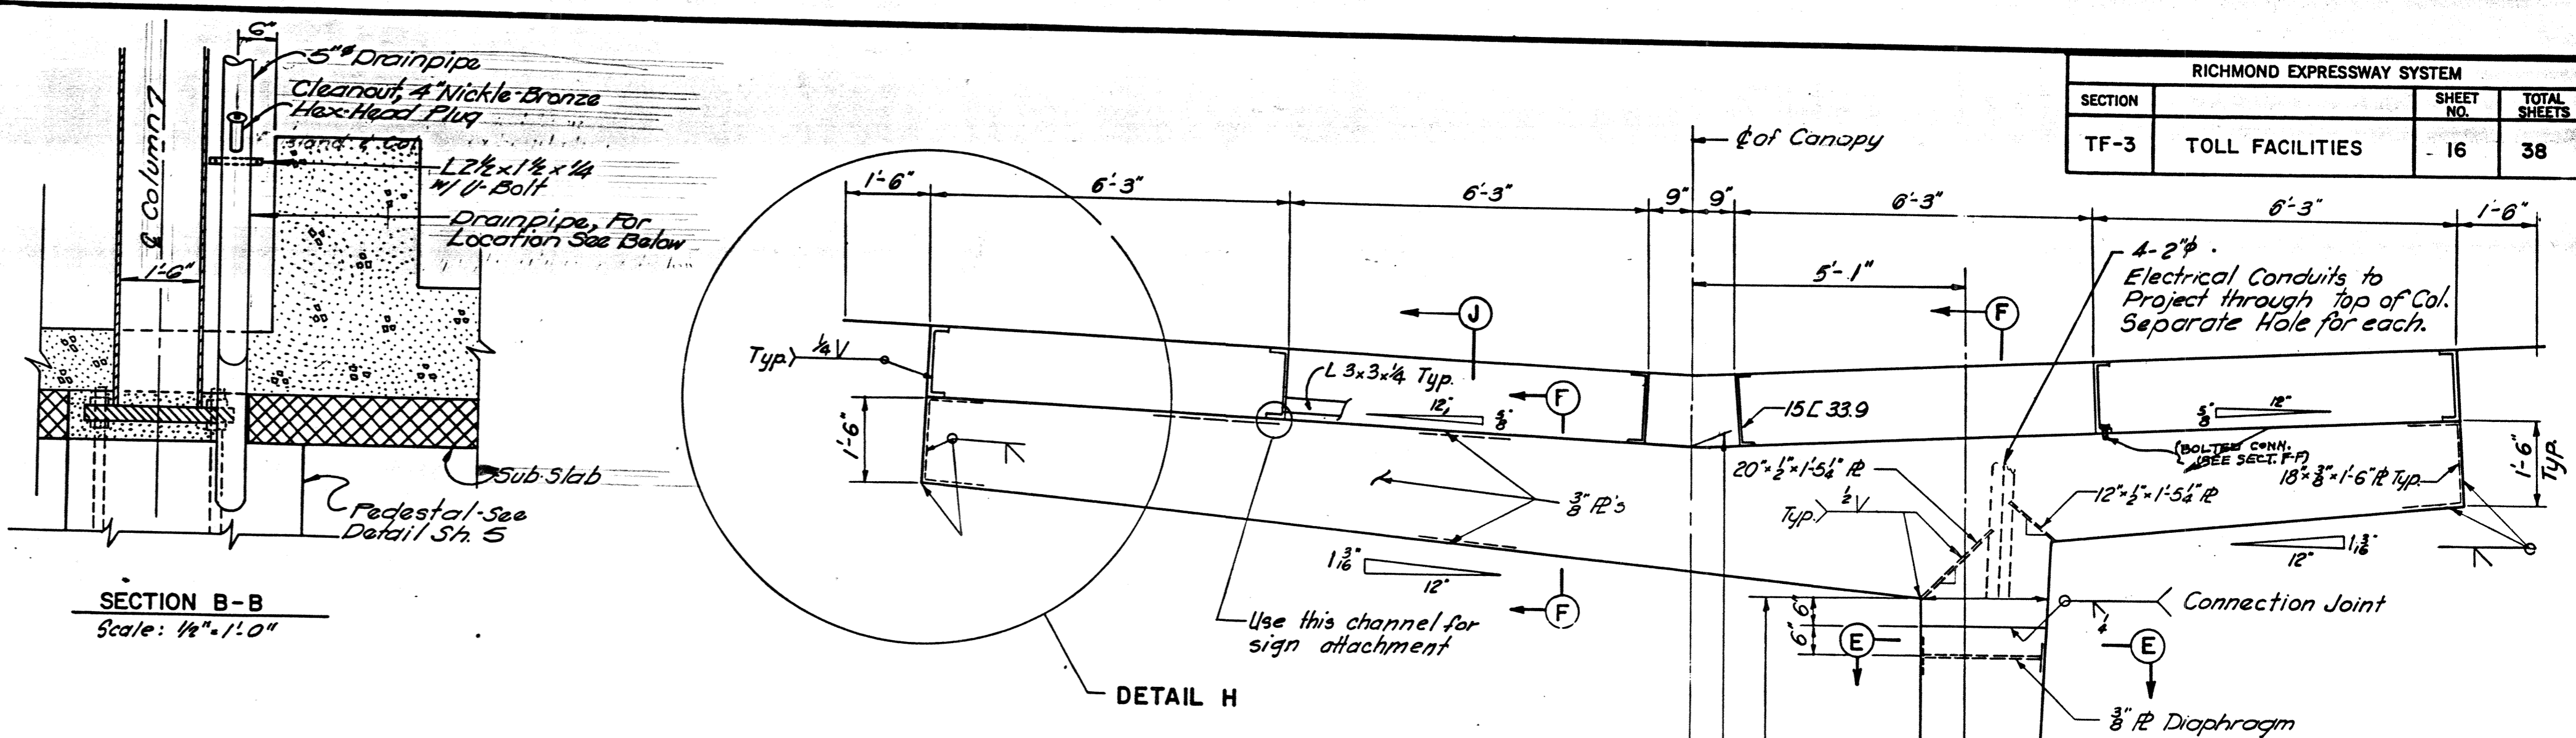

SECTION F-F
Scale: 1/2" = 1'-0"

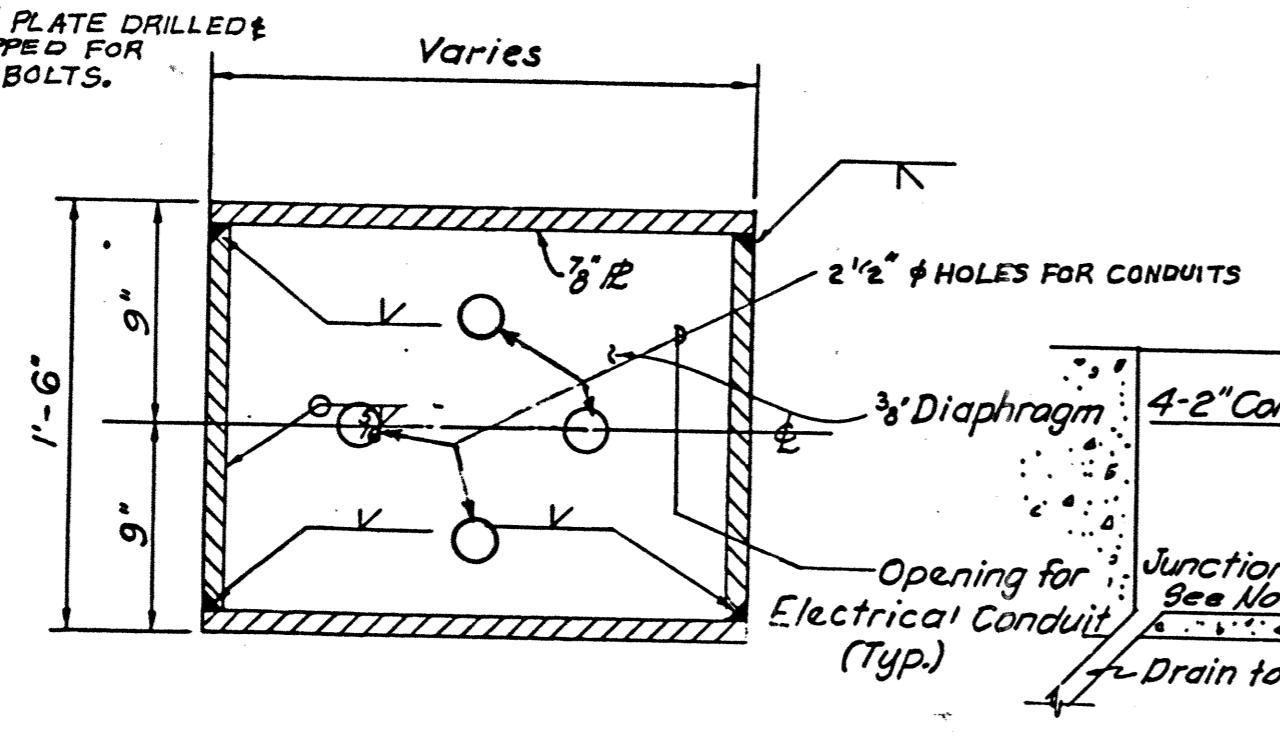

SECTION E-E
Scale: 1/2" = 1'-0"

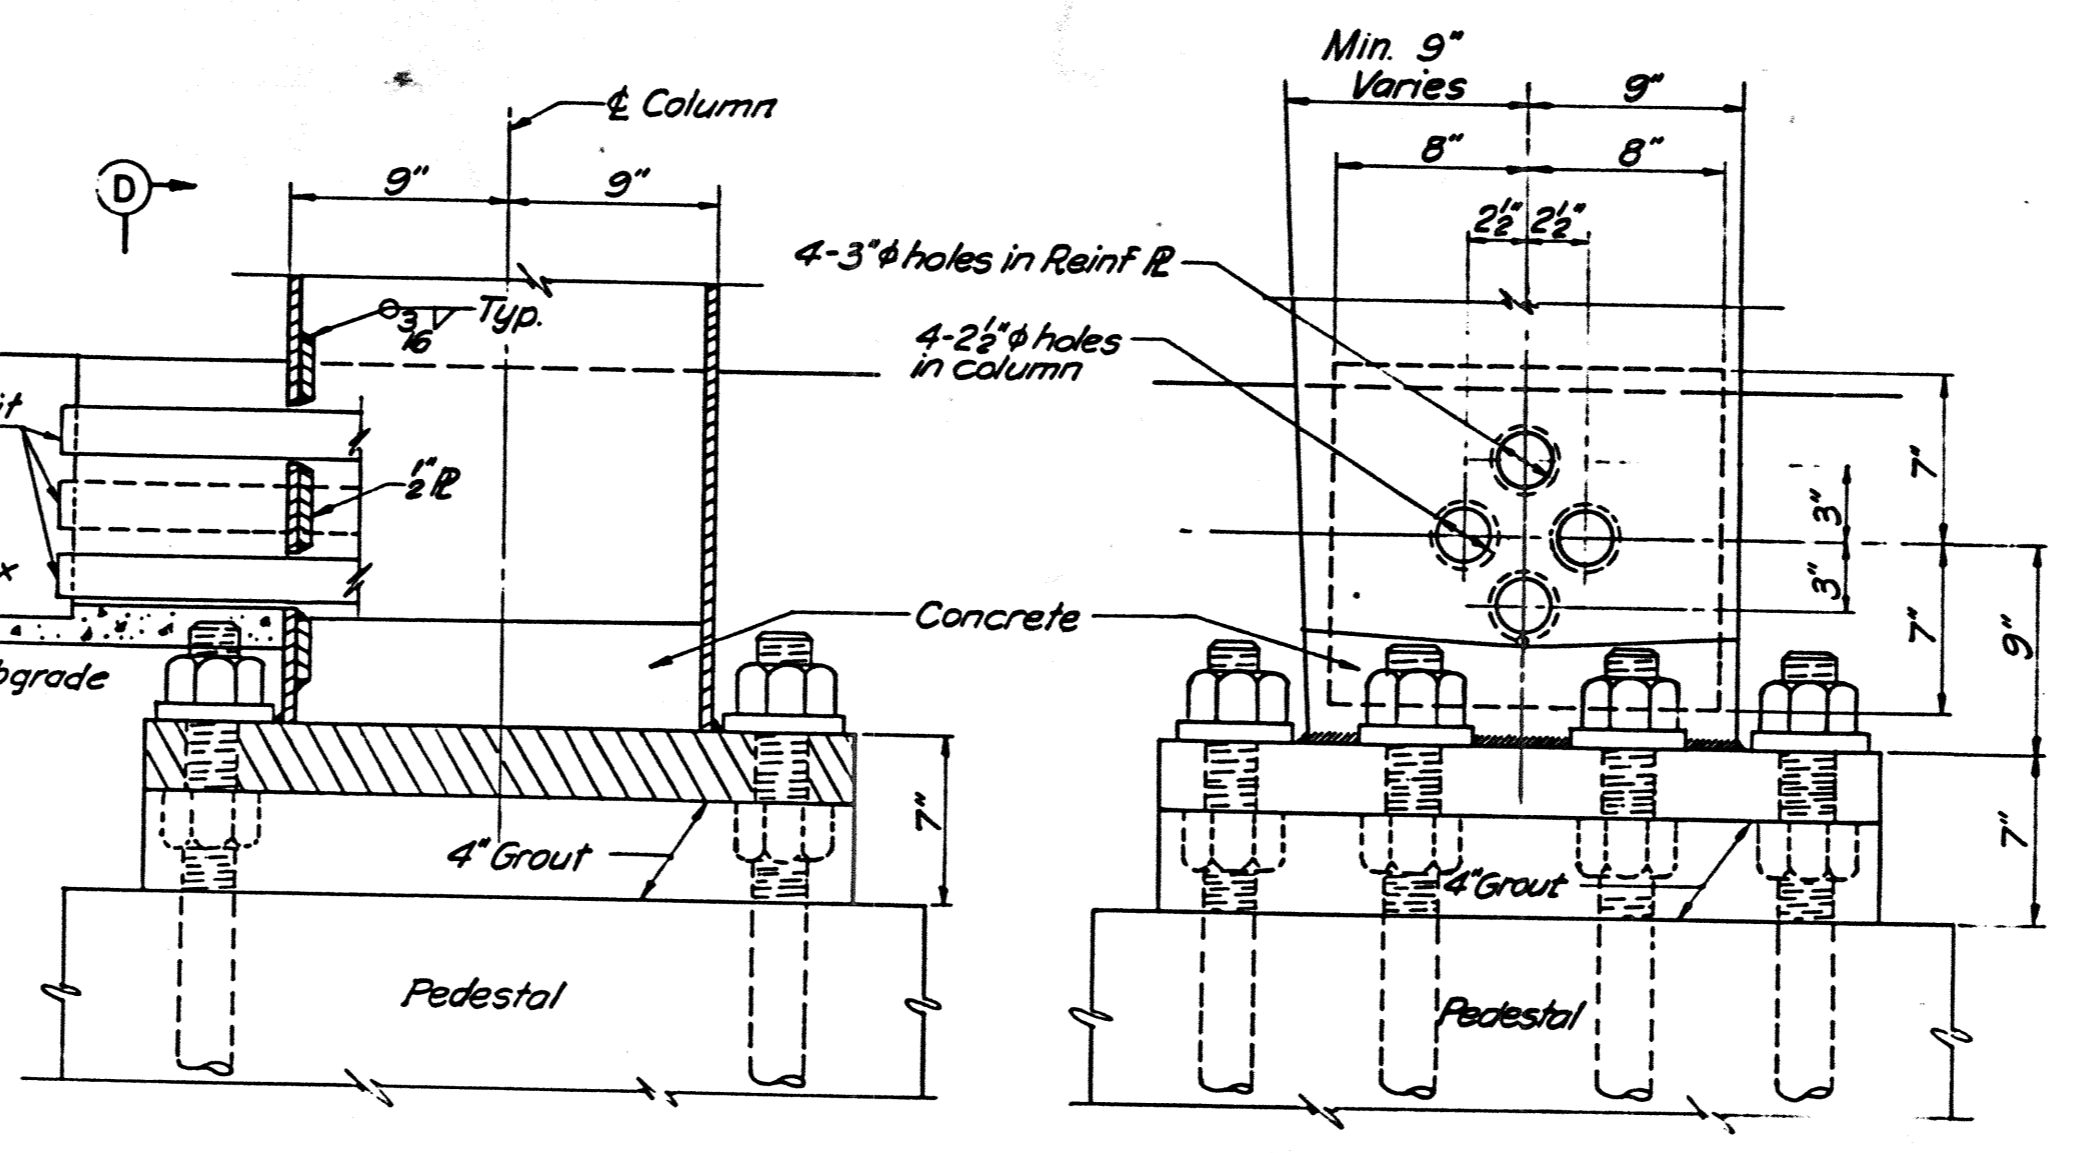

SECTION C-C
Scale: 1/2" = 1'-0"

SECTION D-D
Scale: 1/2" = 1'-0"

AS BUILT

RICHMOND METROPOLITAN AUTHORITY
RICHMOND EXPRESSWAY SYSTEM




CANOPY FRAMING & DETAILS

HOWARD, NEEDLES, TAMMEN & BERGENDOFF
consulting engineers
NEW YORK ALEXANDRIA KANSAS CITY

SCALE: As Shown
CONTRACT NO. TF-3
SHEET NO. 16 OF 38

MADE	BY	DATE	NO.	REVISION	BY	DATE
CHECKED	KL.	9-15-74	1	Rev Anchor Bolt	P.H.T.	3/75
IN CHARGE	J.P.F.					

RICHMOND EXPRESSWAY SYSTEM			
SECTION	PROJECT	SHEET NO.	TOTAL SHEETS
TF-3	UTILITY BUILDING	29	38

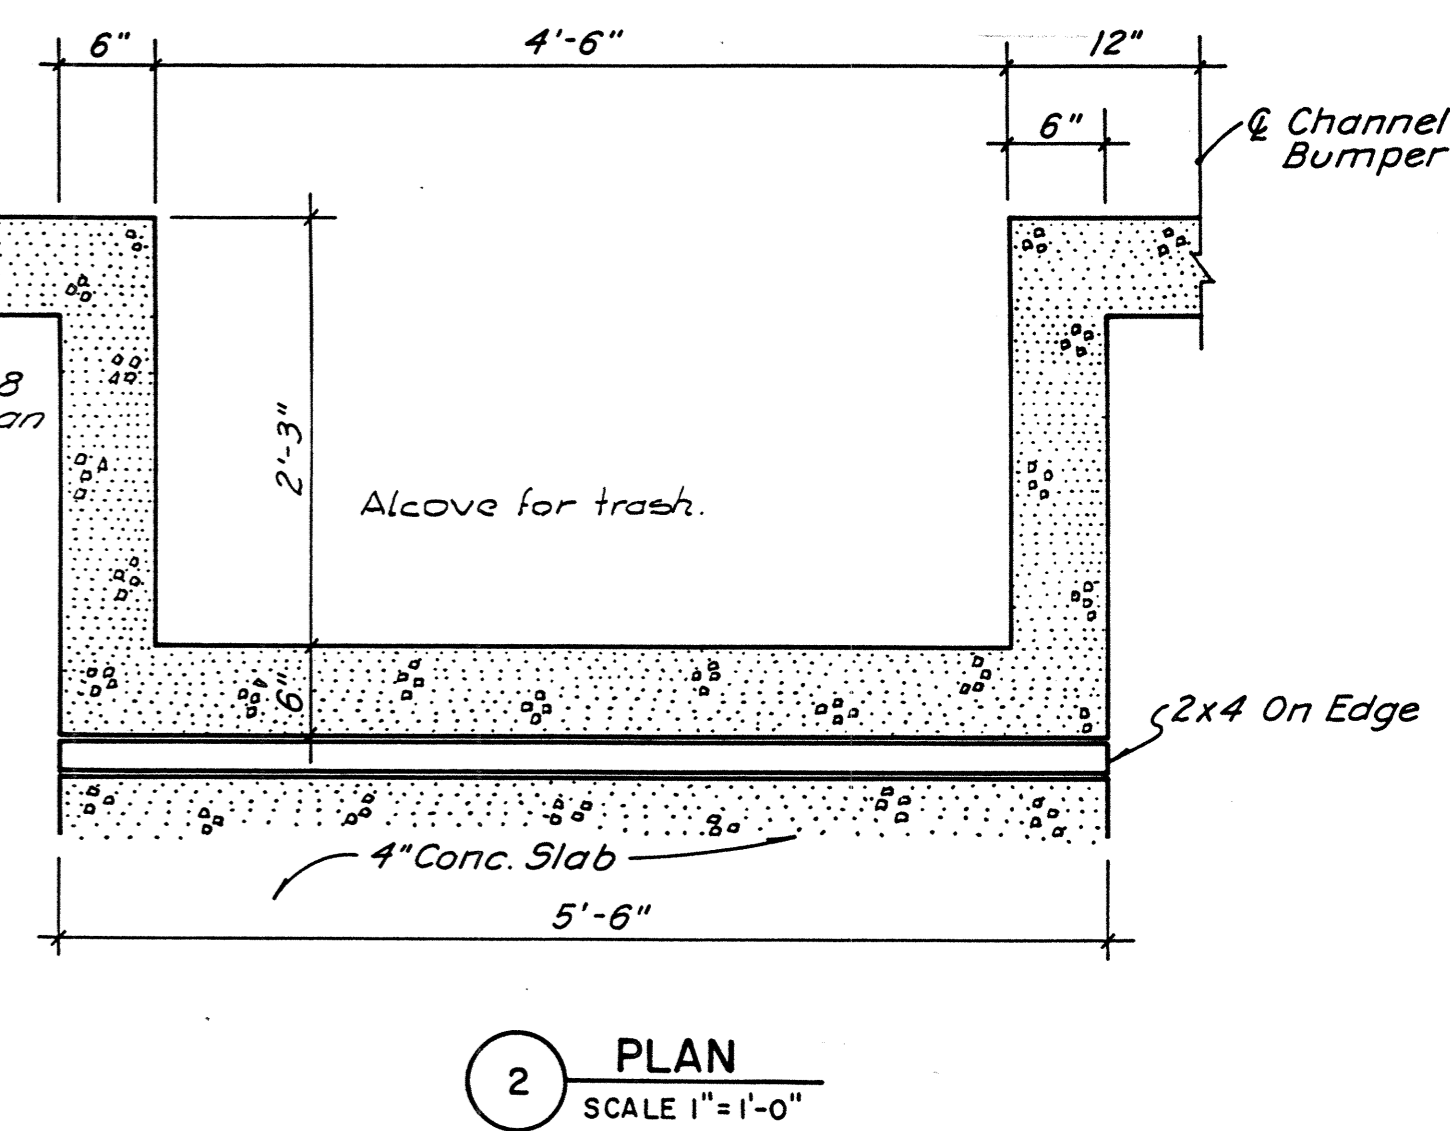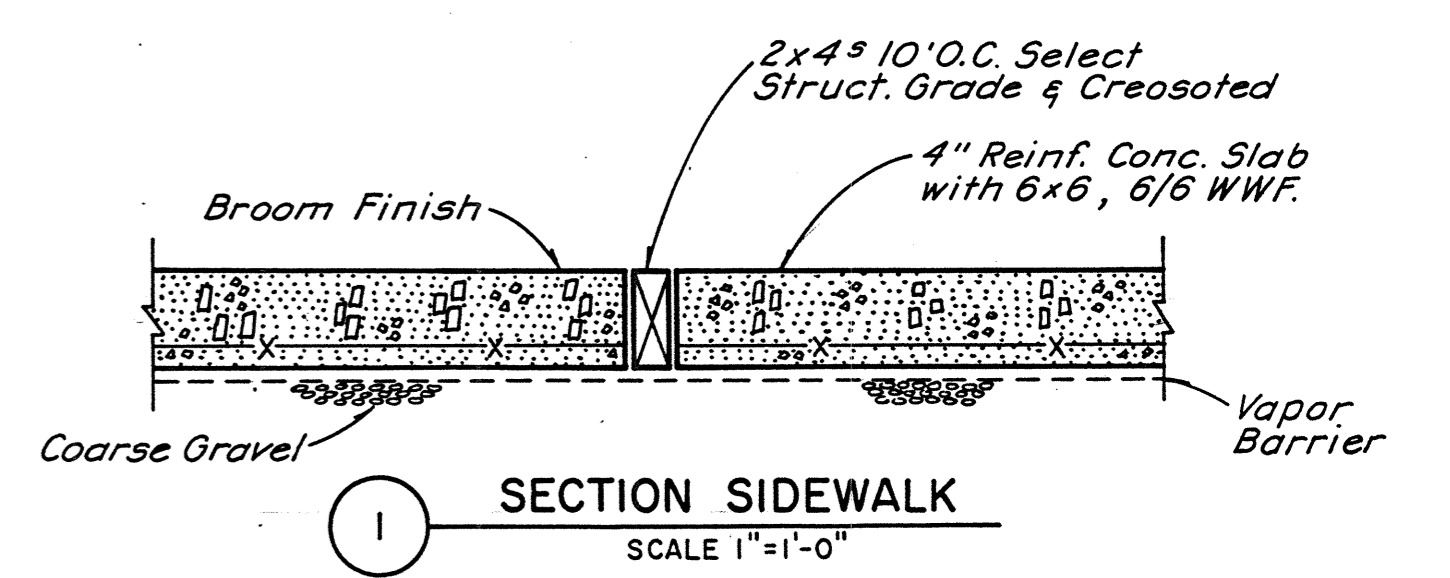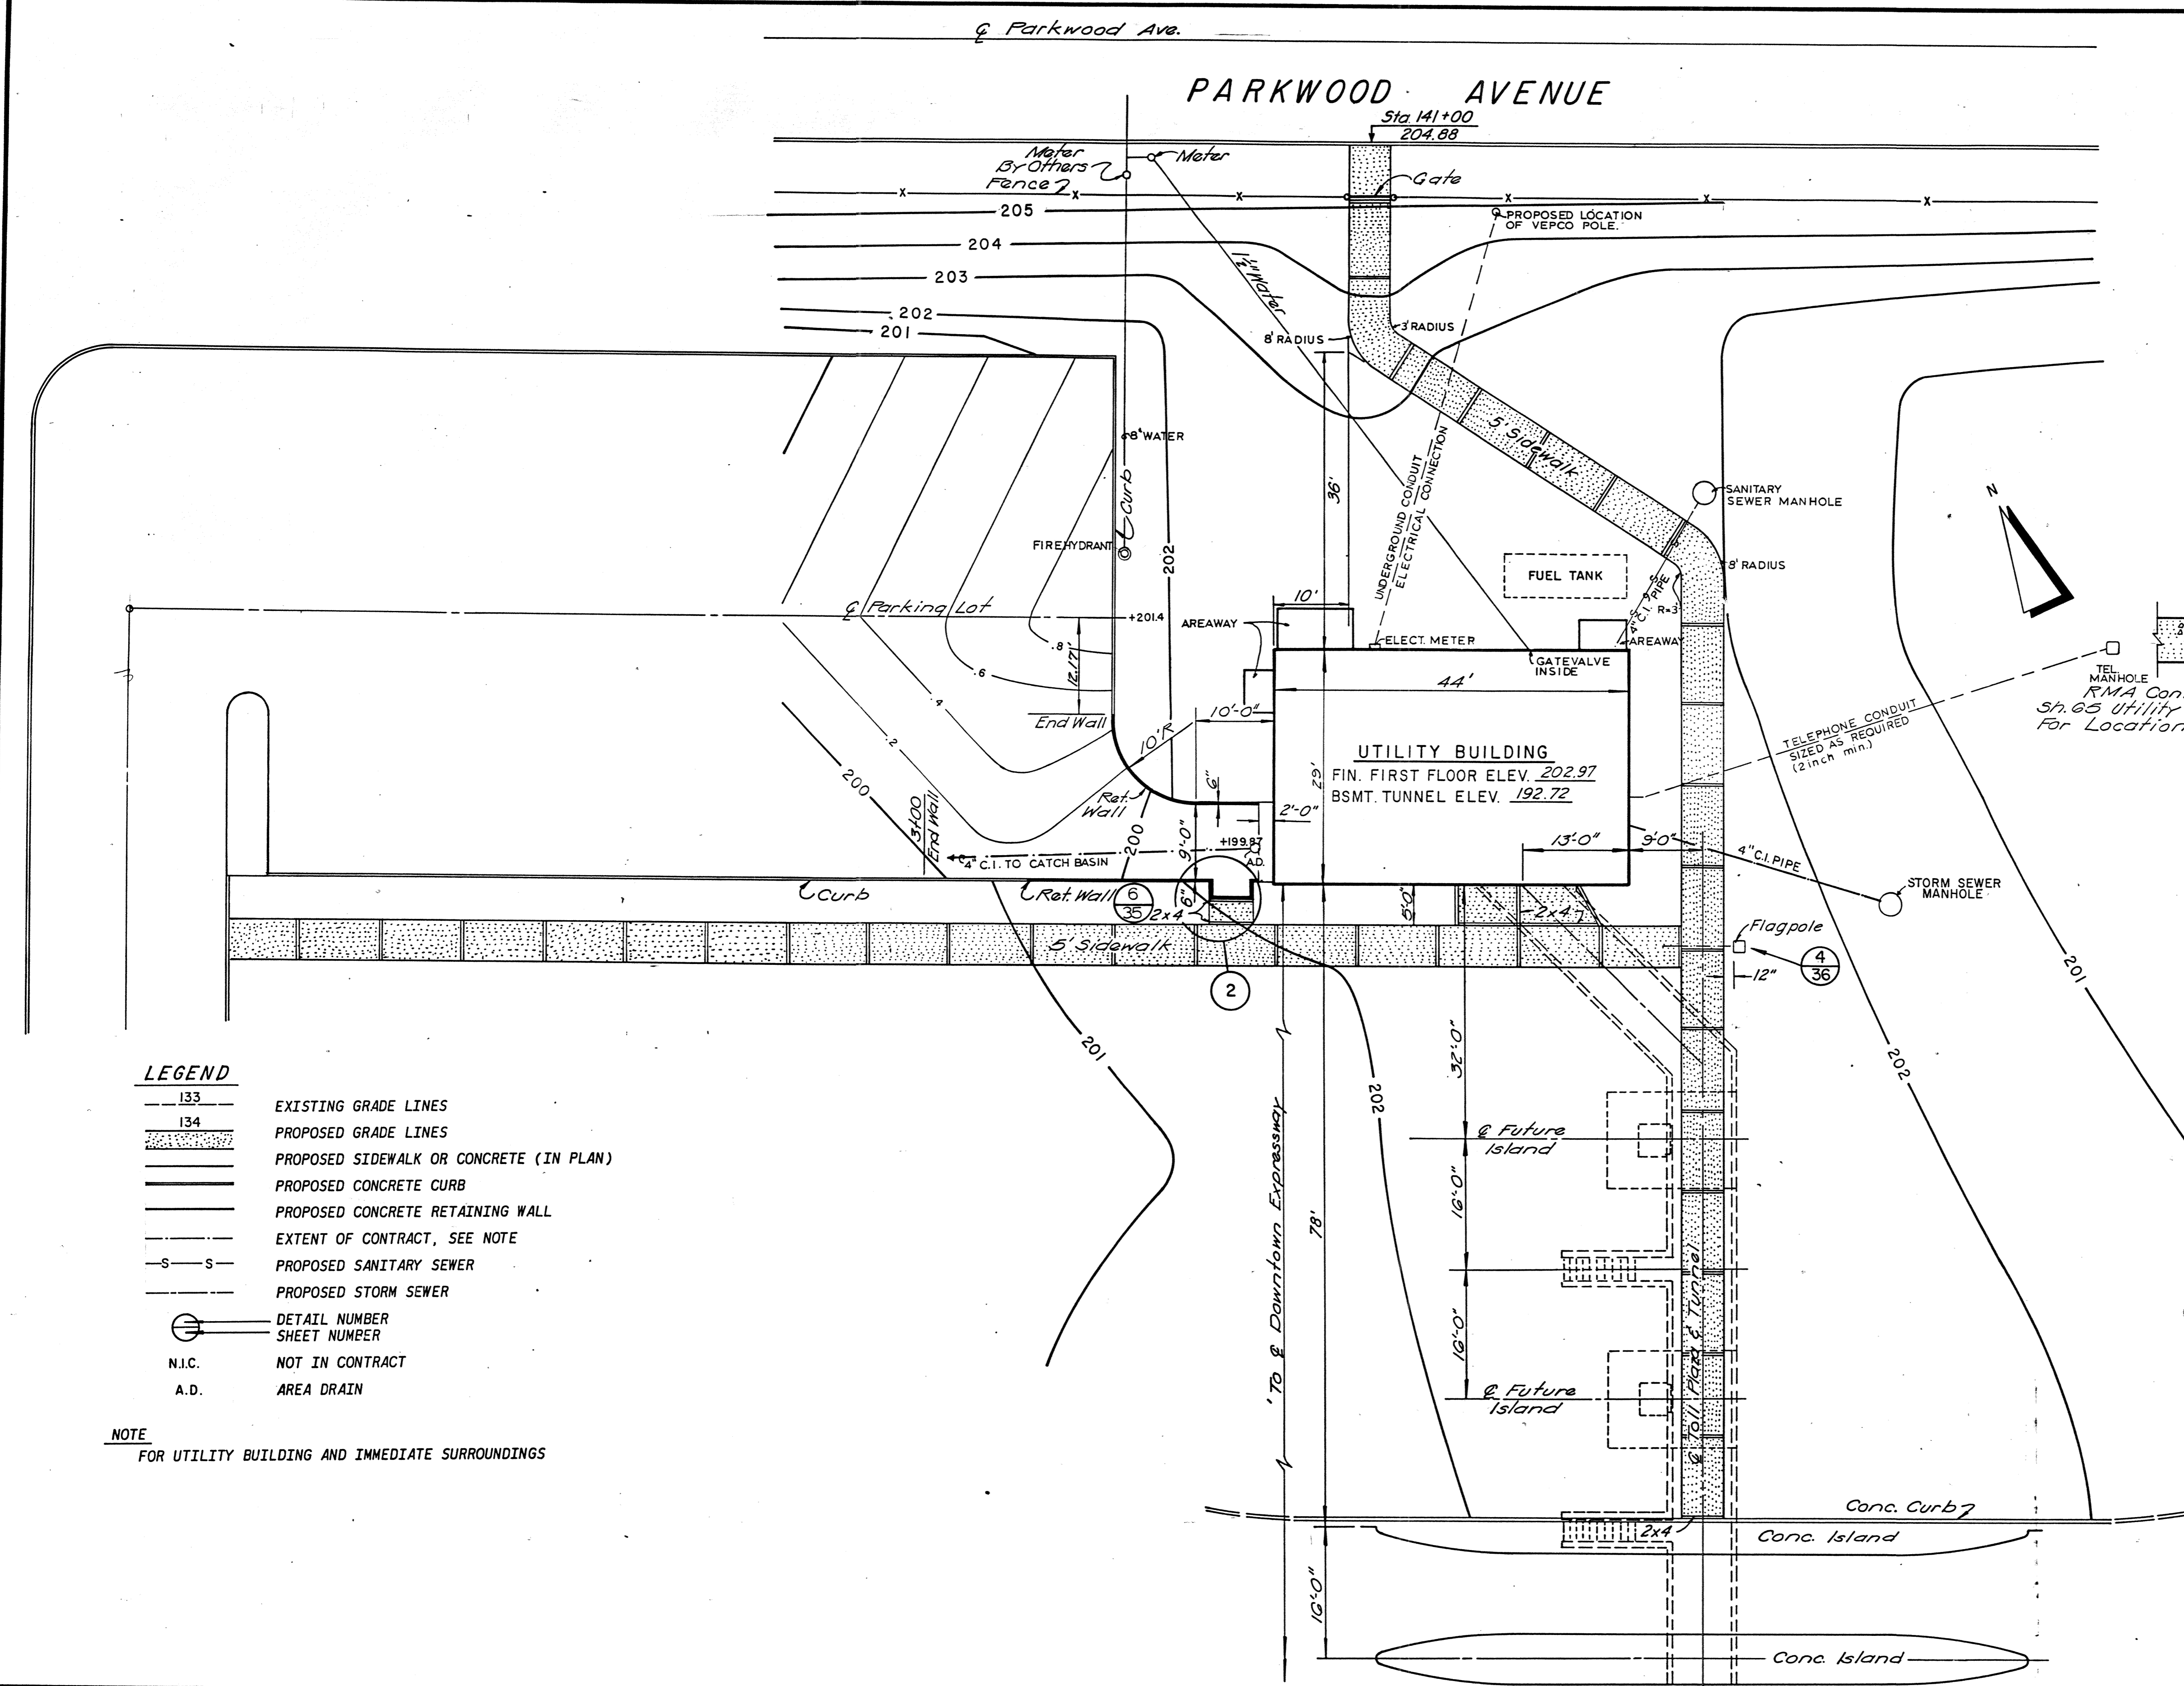

SITE PLAN
SCALE: 3/32"=1'-0"

AS BUILT

RICHMOND METROPOLITAN AUTHORITY
RICHMOND EXPRESSWAY SYSTEM

UTILITY BUILDING
SITE PLAN & DETAILS


SCALE As Shown	SHEET 29 OF 38
DATE Sept. 15, 74	

HOWARD, NEEDLES, TAMMEN & BERGENDOFF
CONSULTING ENGINEERS
Alexandria, Virginia


HNTB

DESIGNED	KL.	9-15-74			
DRAWN	D.A.S.	9-15-74			
CHECKED	KL.	9-15-74			
IN CHARGE	J.P.F.	NO.	REVISION	BY	DATE

RICHMOND EXPRESSWAY SYSTEM			
SECTION	PROJECT	SHEET NO.	TOTAL SHEETS
TF-3	UTILITY BUILDING	31	38

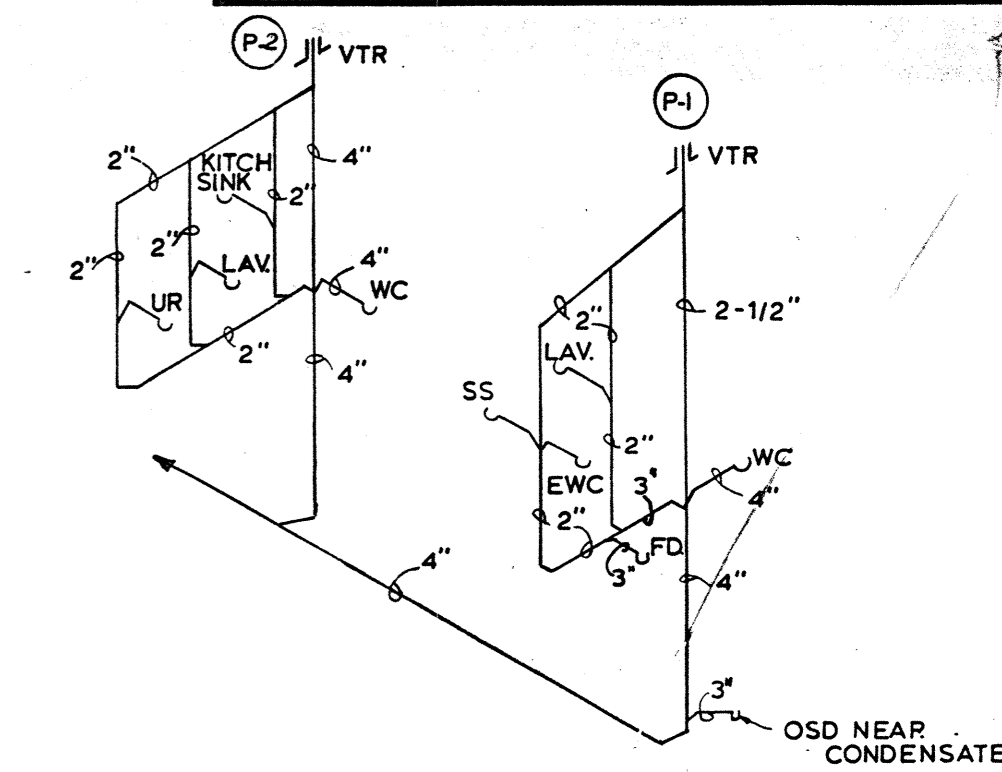

SOIL WASTE & VENT DIAGRAM

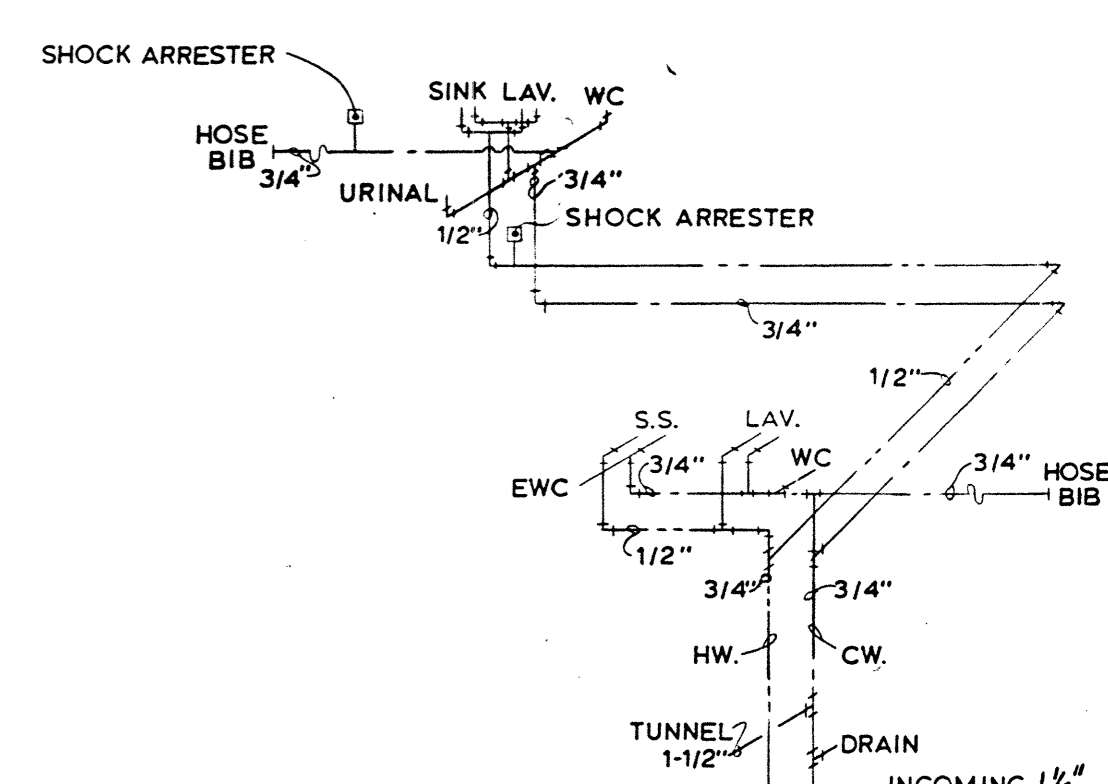

WATER PIPING DIAGRAM

LEGEND


- CONCRETE
- BRICK MASONRY
- CONCRETE MASONRY
- CONCRETE MASONRY 33% SOLID, CONCRETE FILLED
- WOOD STUD PARTITION FACED BOTH SIDES
- WINDOW
- VOID IN MASONRY
- ITEMS BY OTHERS
- A.D. AREA DRAIN
- F.D. FLOOR DRAIN
- O.S.D. OPEN SITE DRAIN

AS BUILT


RICHMOND METROPOLITAN AUTHORITY
RICHMOND EXPRESSWAY SYSTEM

UTILITY BUILDING
PLANS
ARCHITECTURAL & STRUCTURAL



SCALE 1/4"=1'-0"	SHEET 31 OF 38
DATE Sept. 15, 74	
HOWARD, NEEDLES, TAMMEN & BERGENDOFF CONSULTING ENGINEERS Alexandria, Virginia	
HNTB	

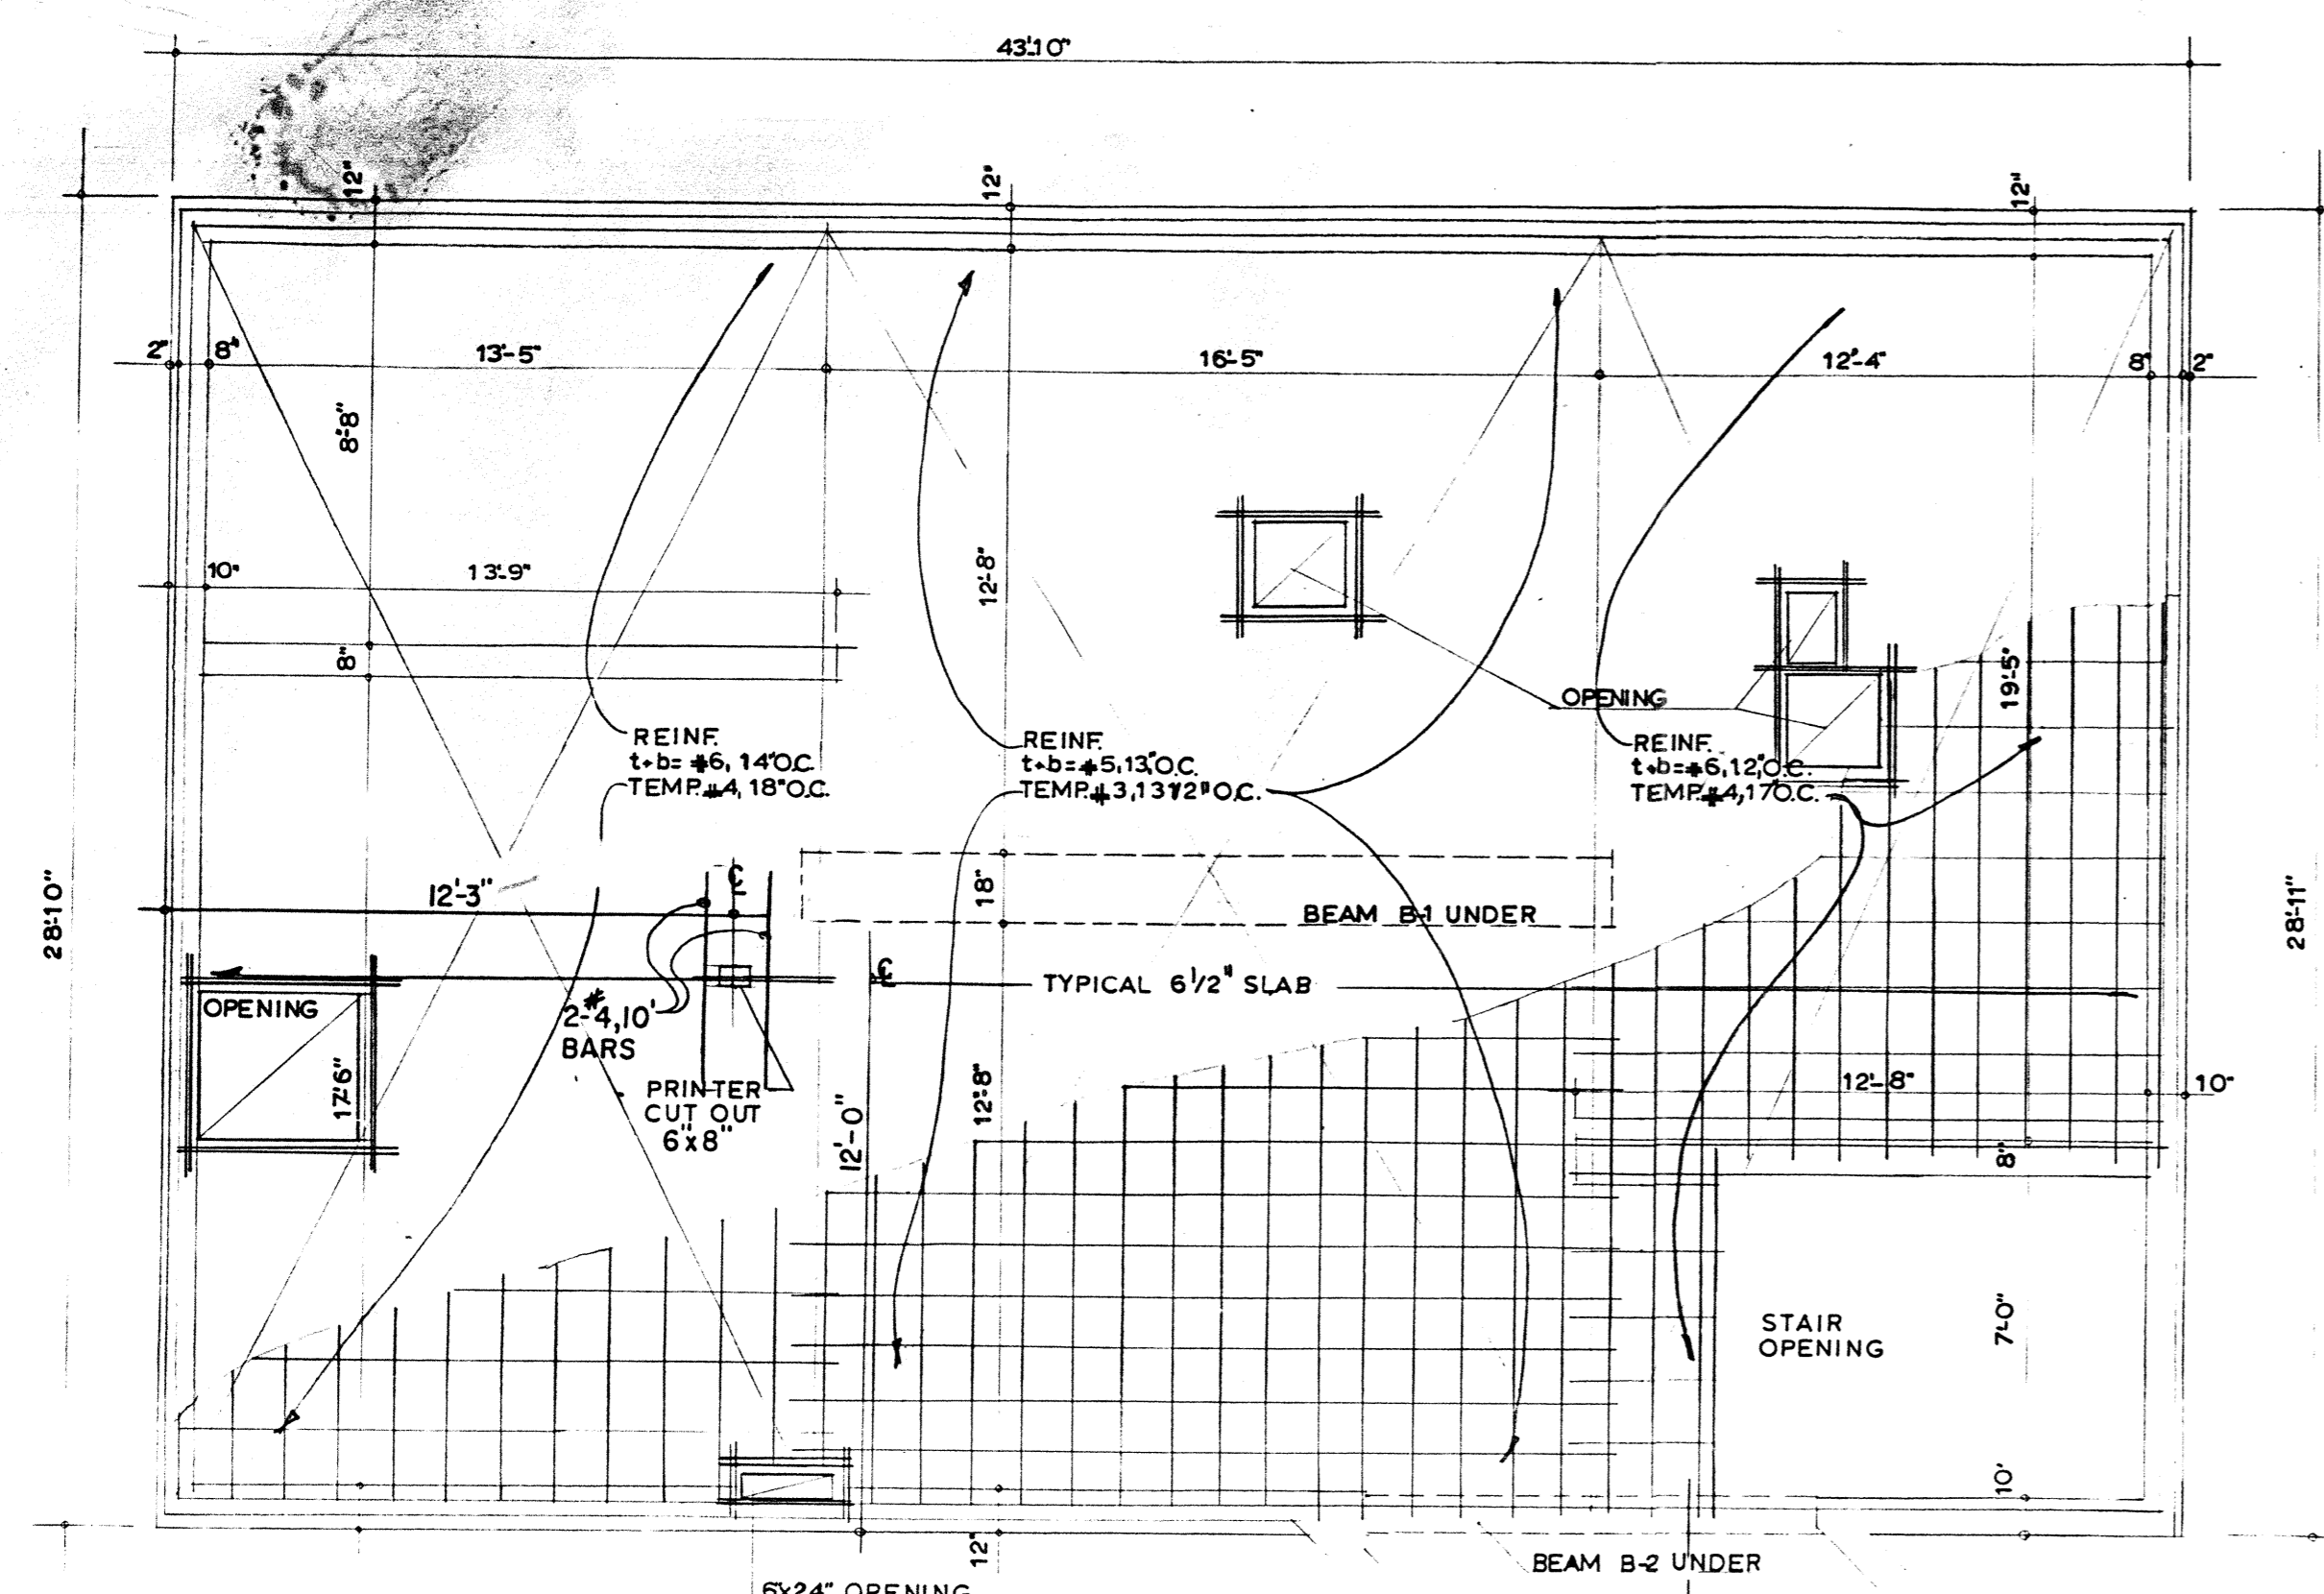

NOTE: PROVIDE #4s 1/2" LONGER THAN OPENING DIMENSION WHERE SHOWN AT OPENINGS

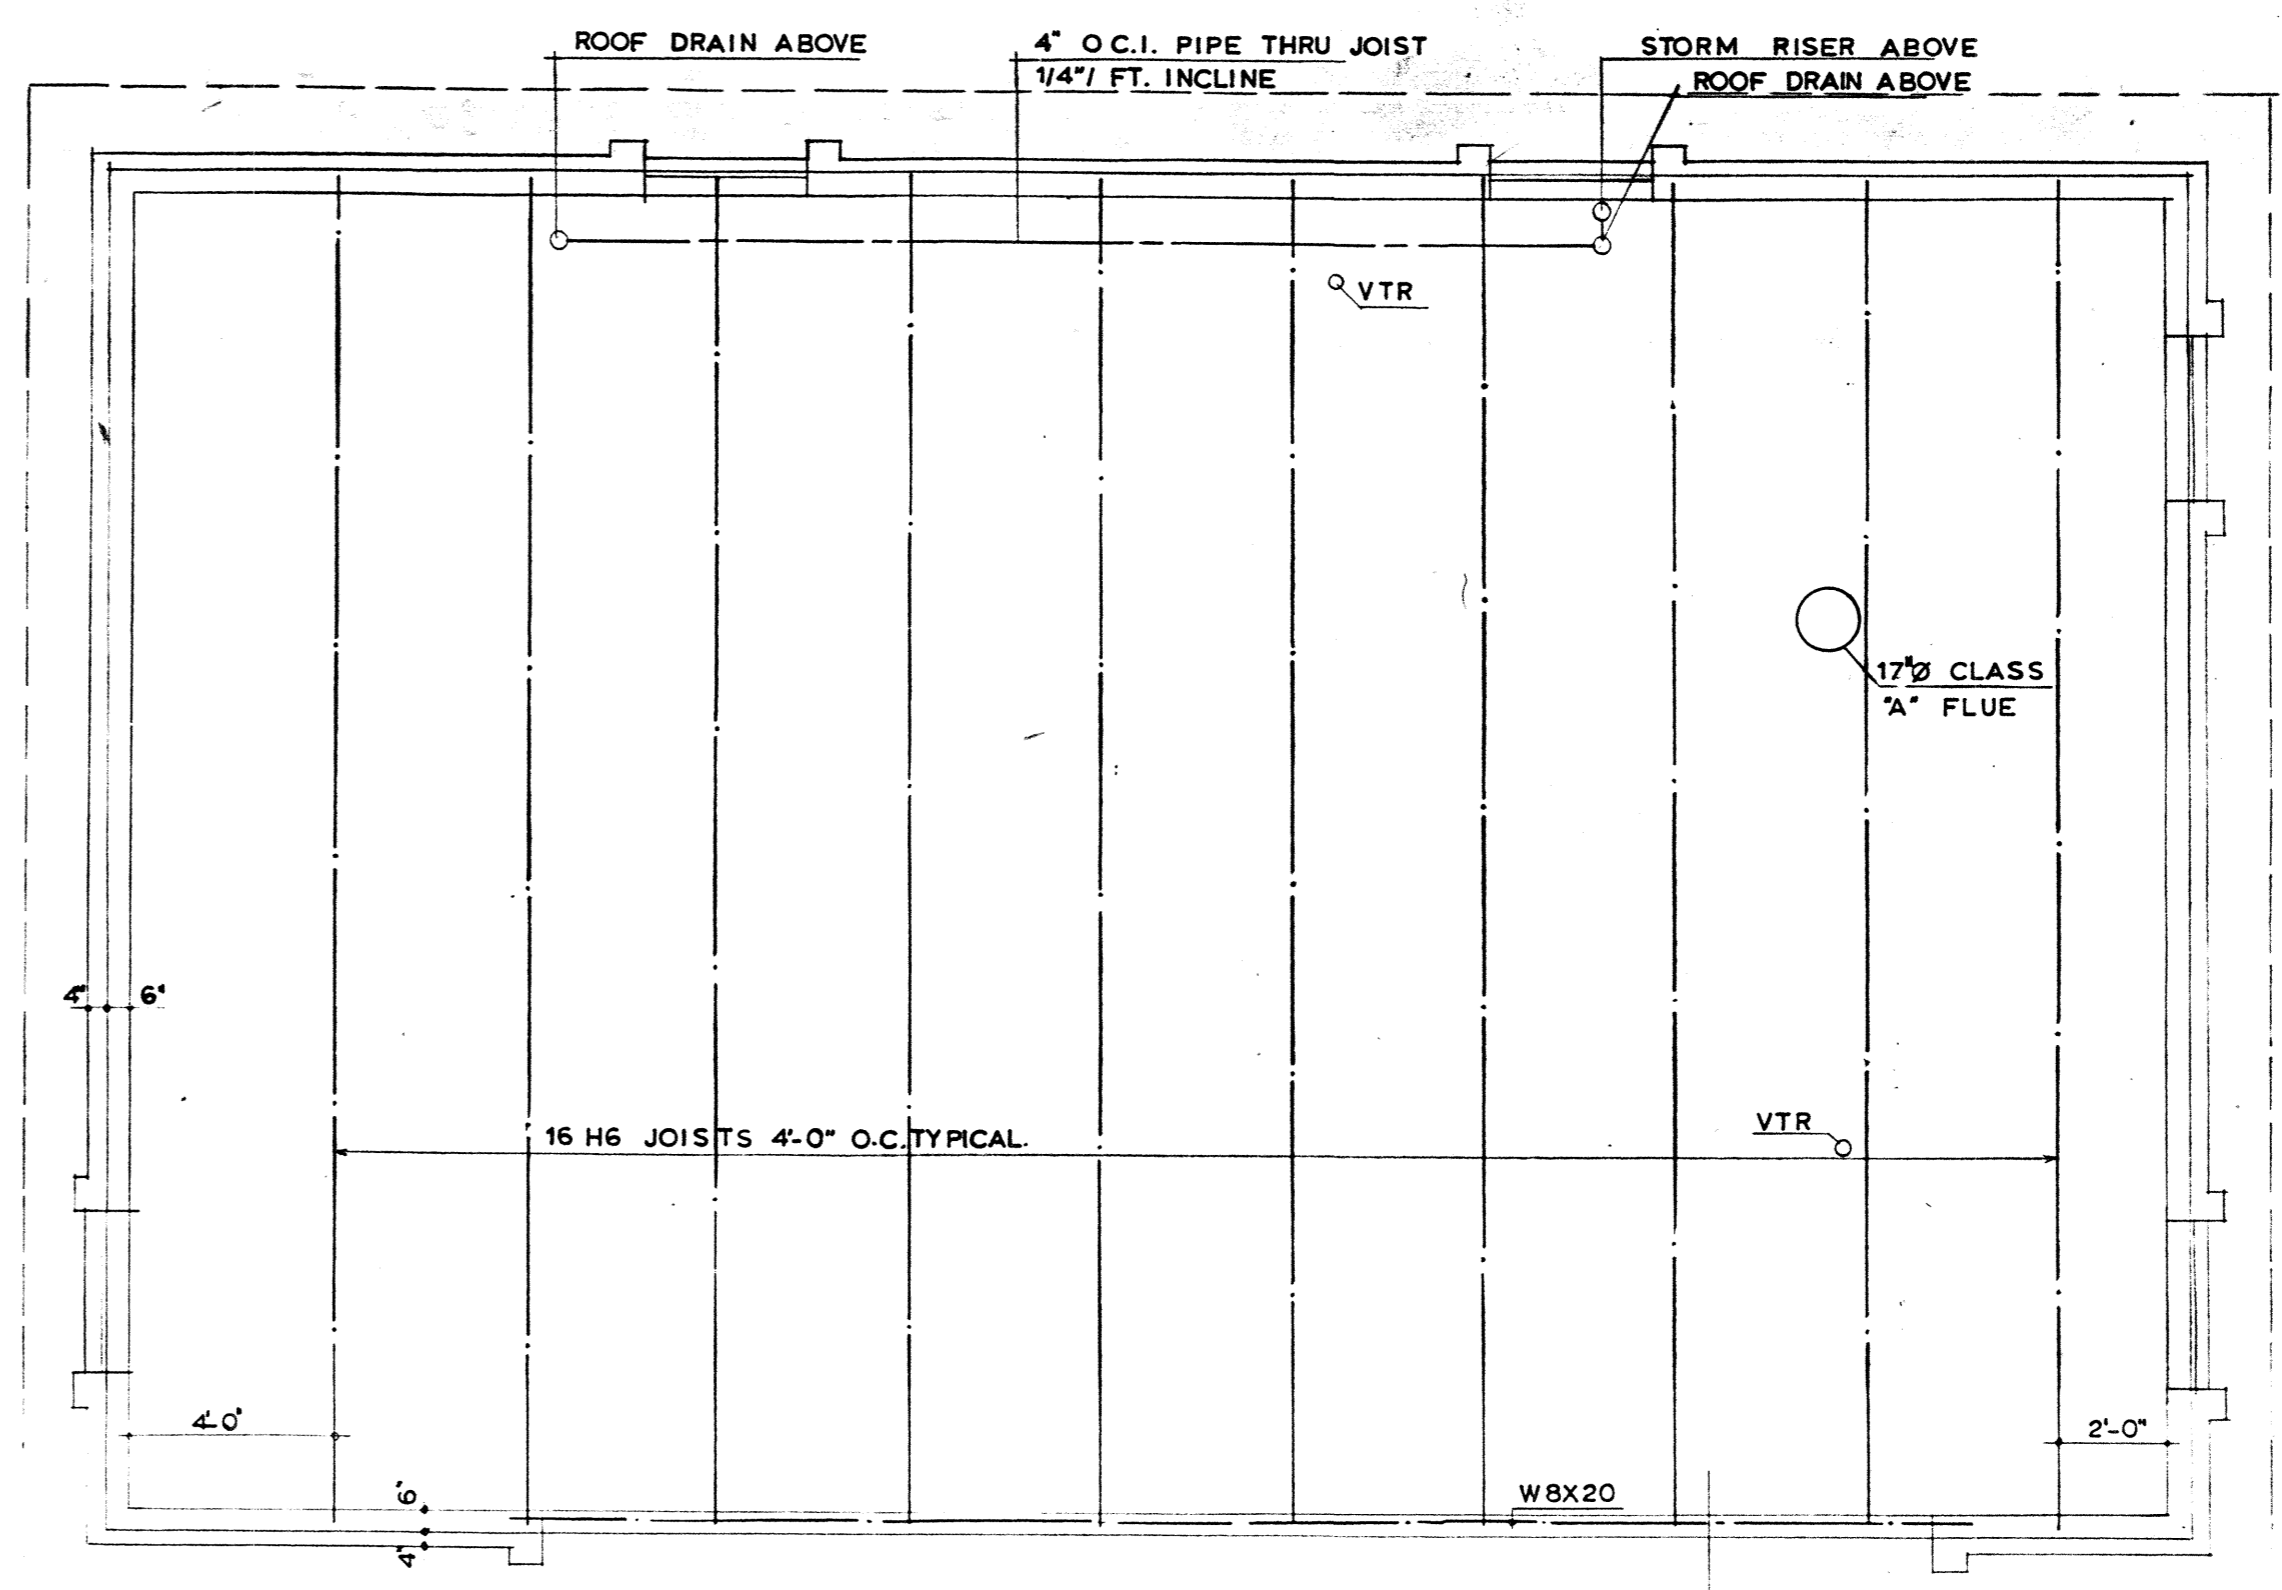







ROOF OVERHANG, EQUAL ALL SIDES

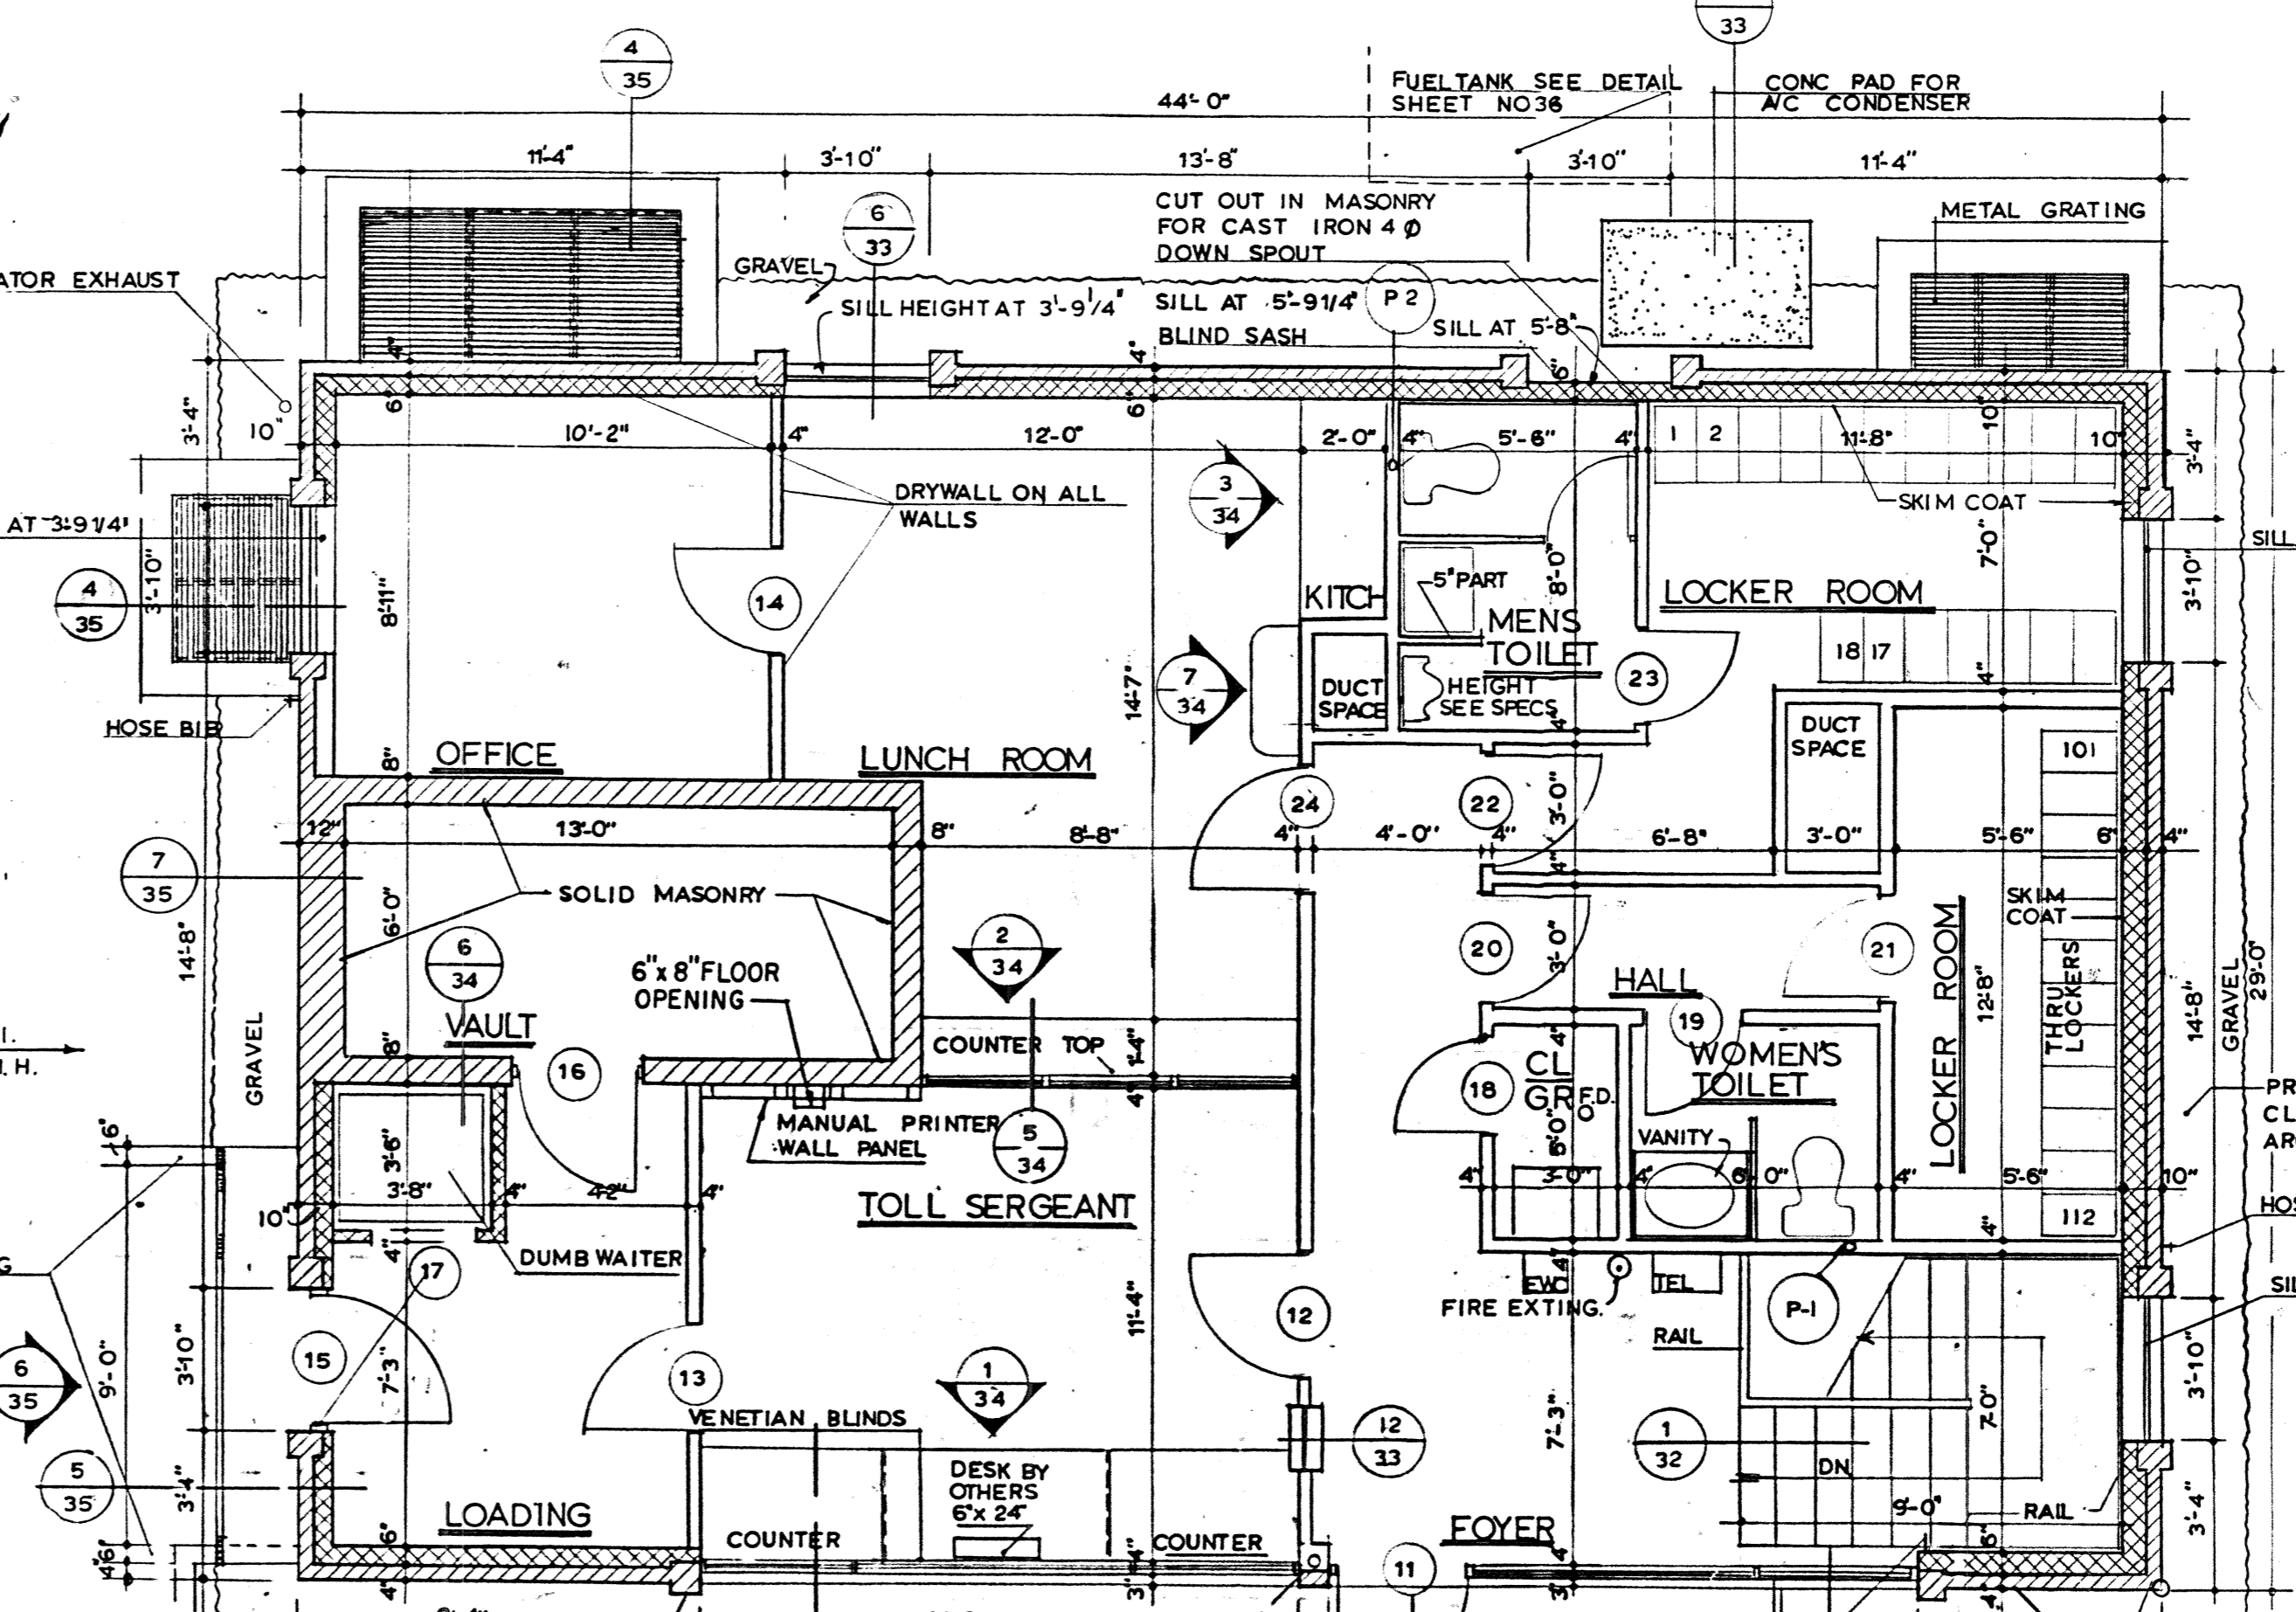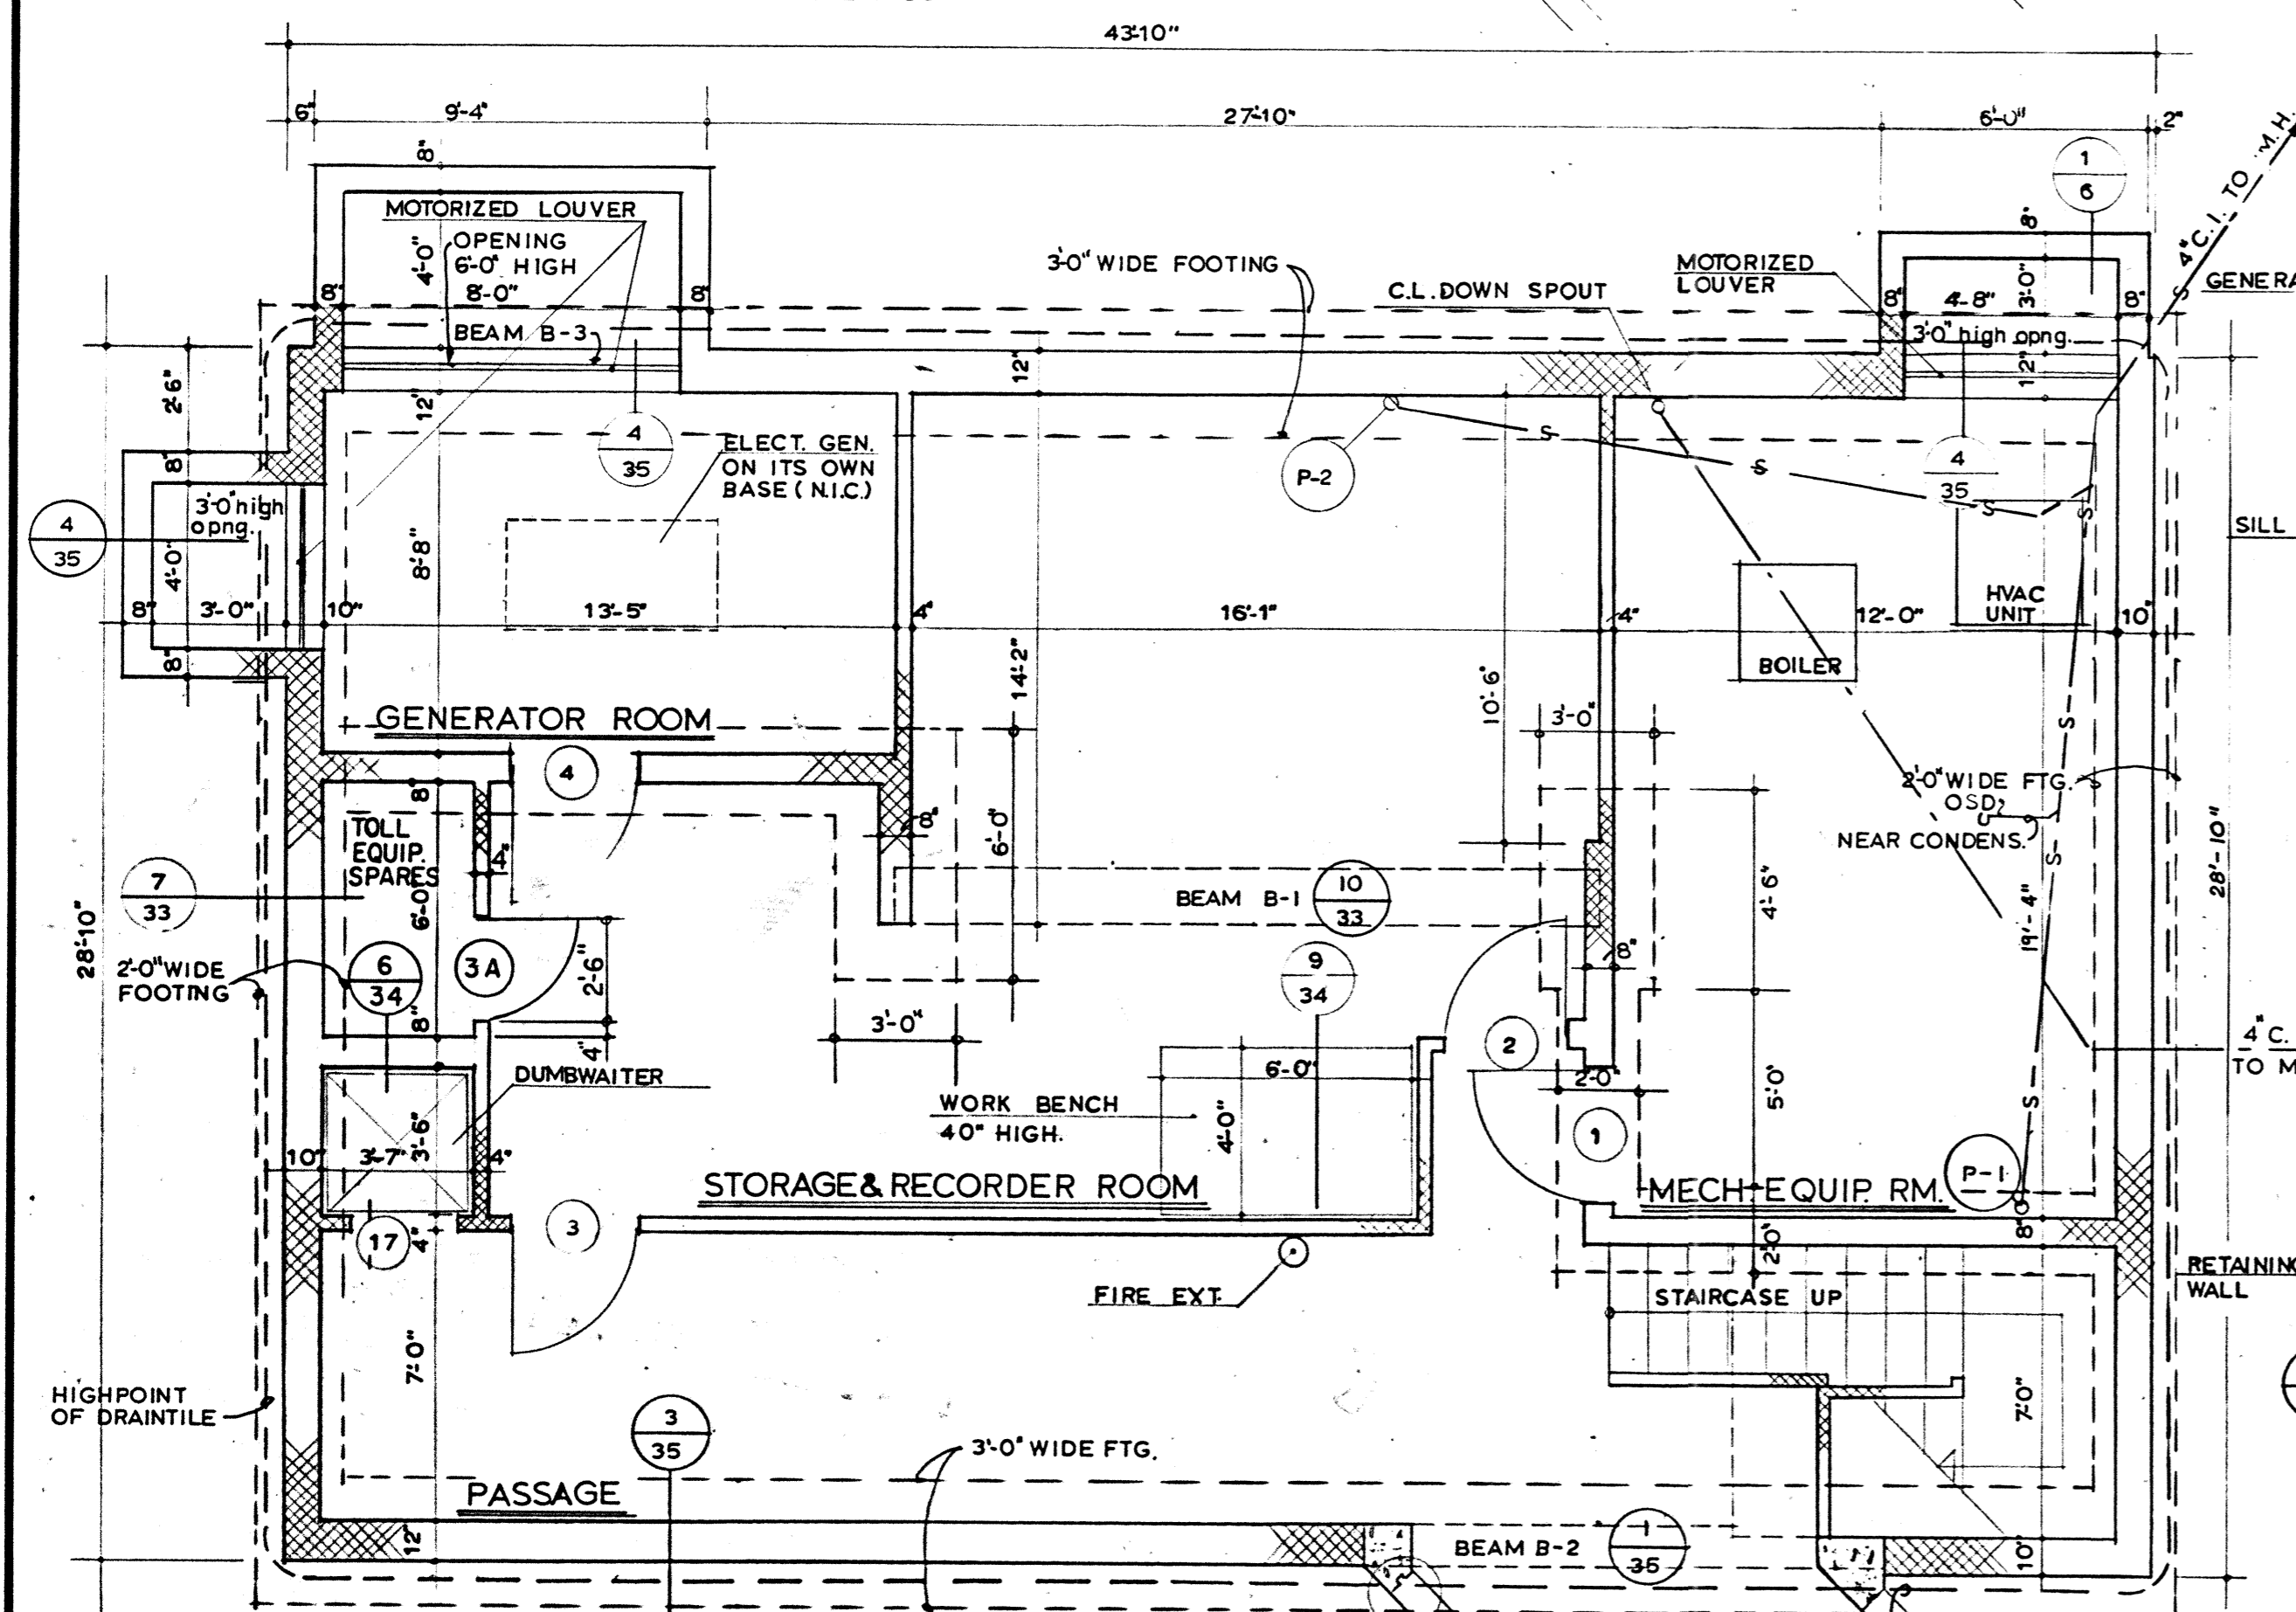

DESIGNED	DRAWN	CHECKED	IN CHARGE	NO.	REVISION	BY	DATE

FOR JOINT DETAILS SEE SHEETS FOR TUNNEL
LOW POINT OF DRAINTILE AND LEACHING BASIN UNDER 12x24x24w

RICHMOND EXPRESSWAY SYSTEM			
SECTION	PROJECT	SHEET NO.	TOTAL SHEETS
TF-3	UTILITY BUILDING	32	38

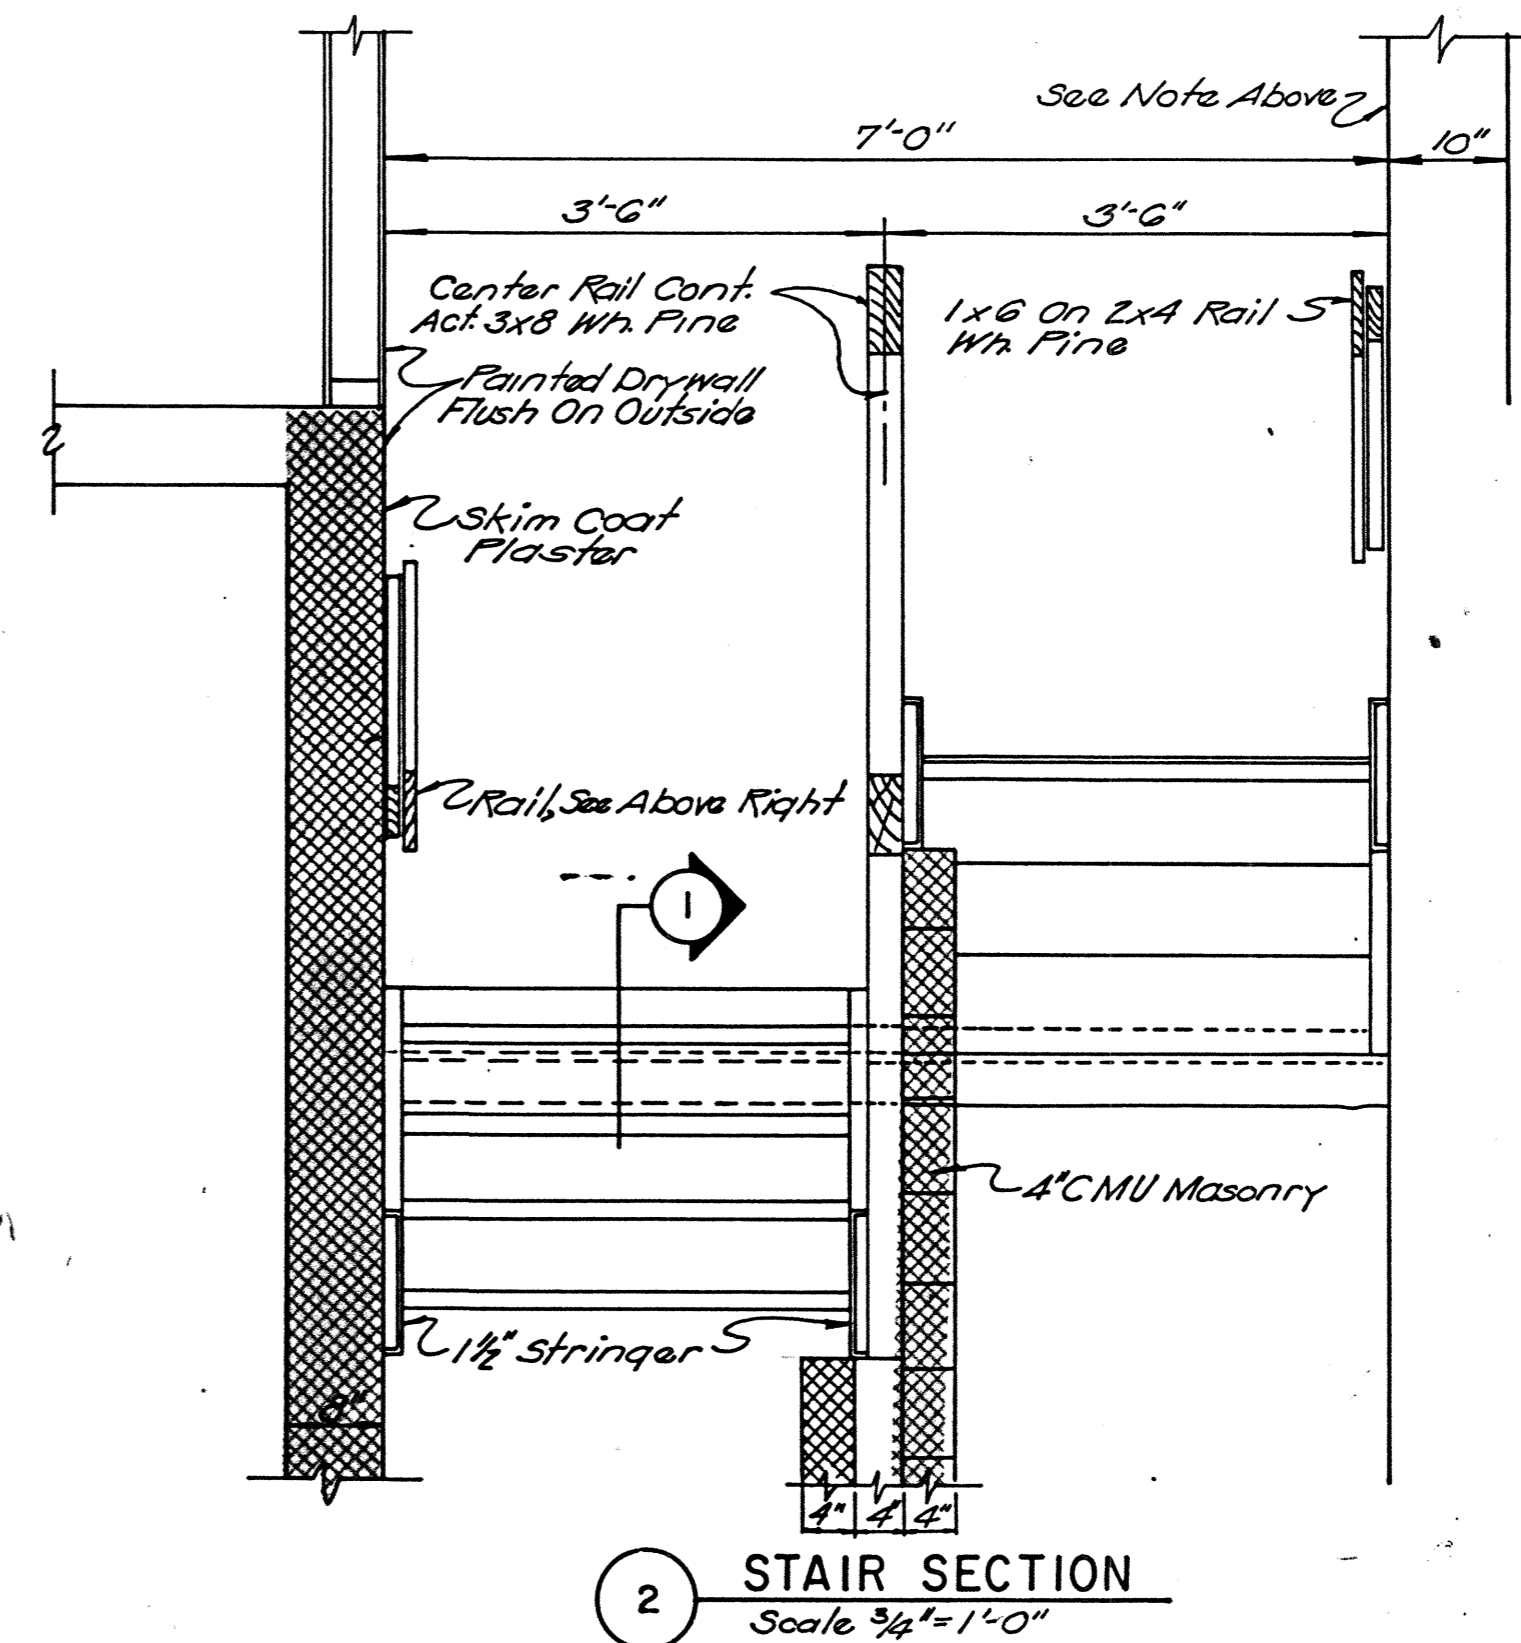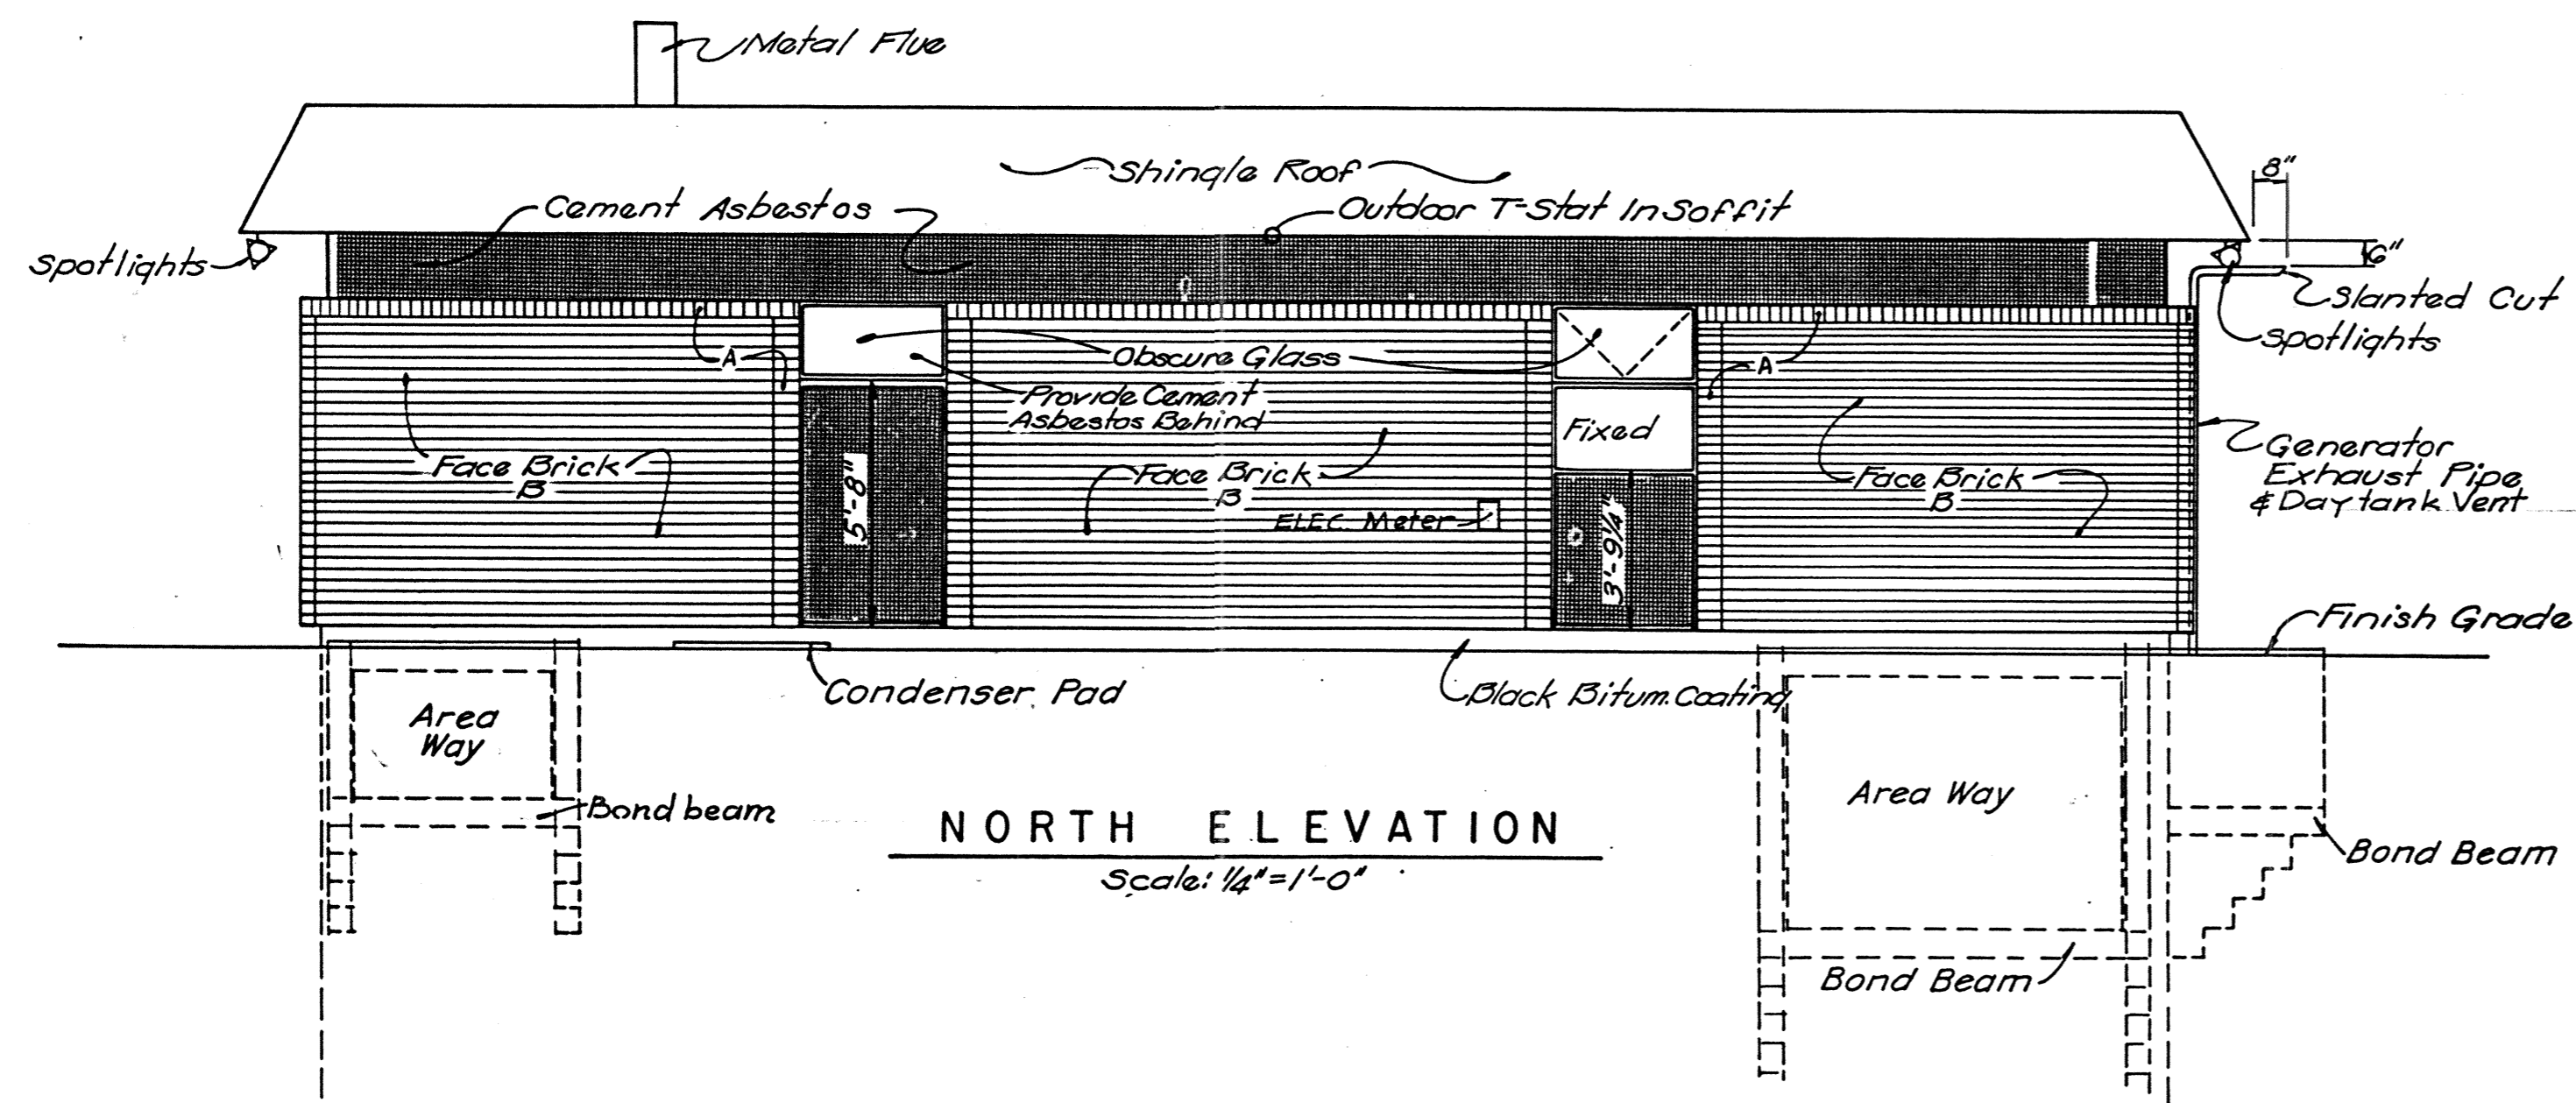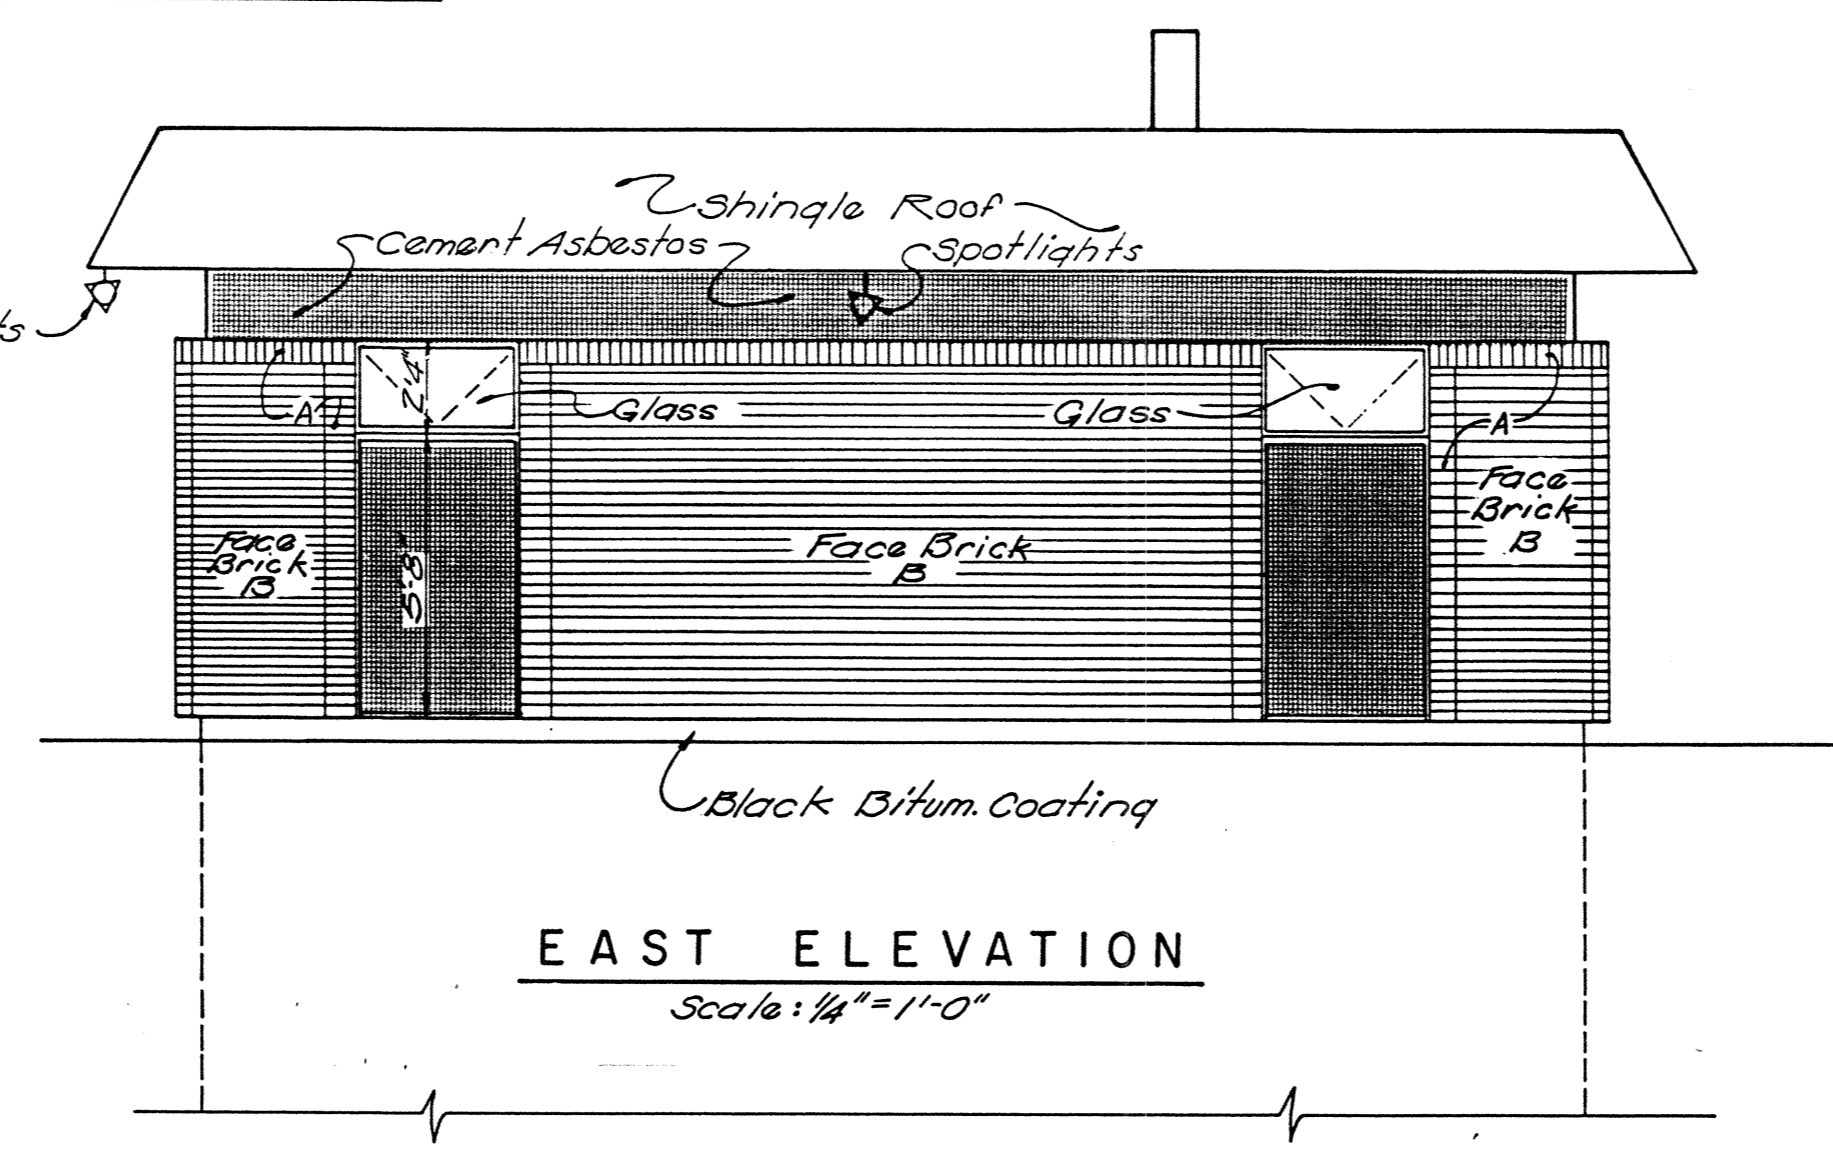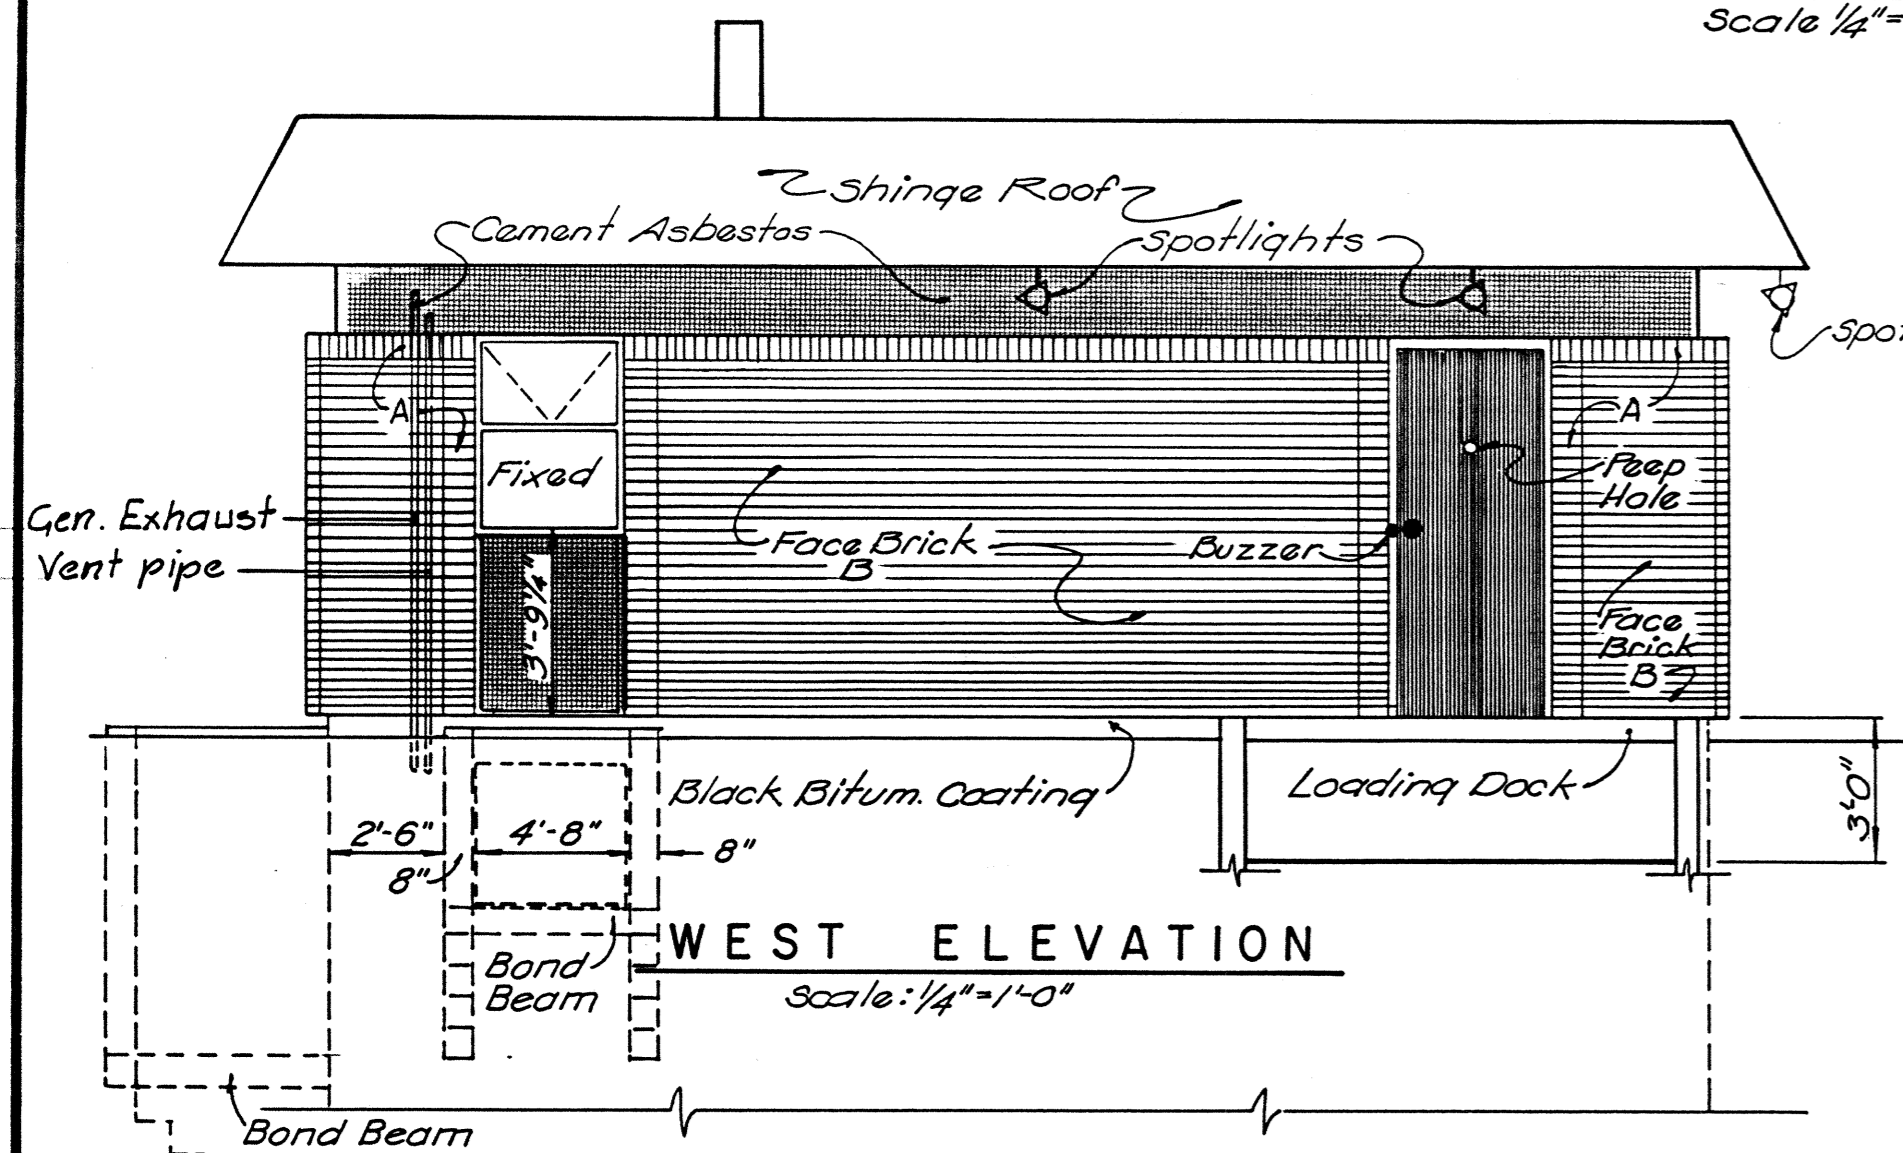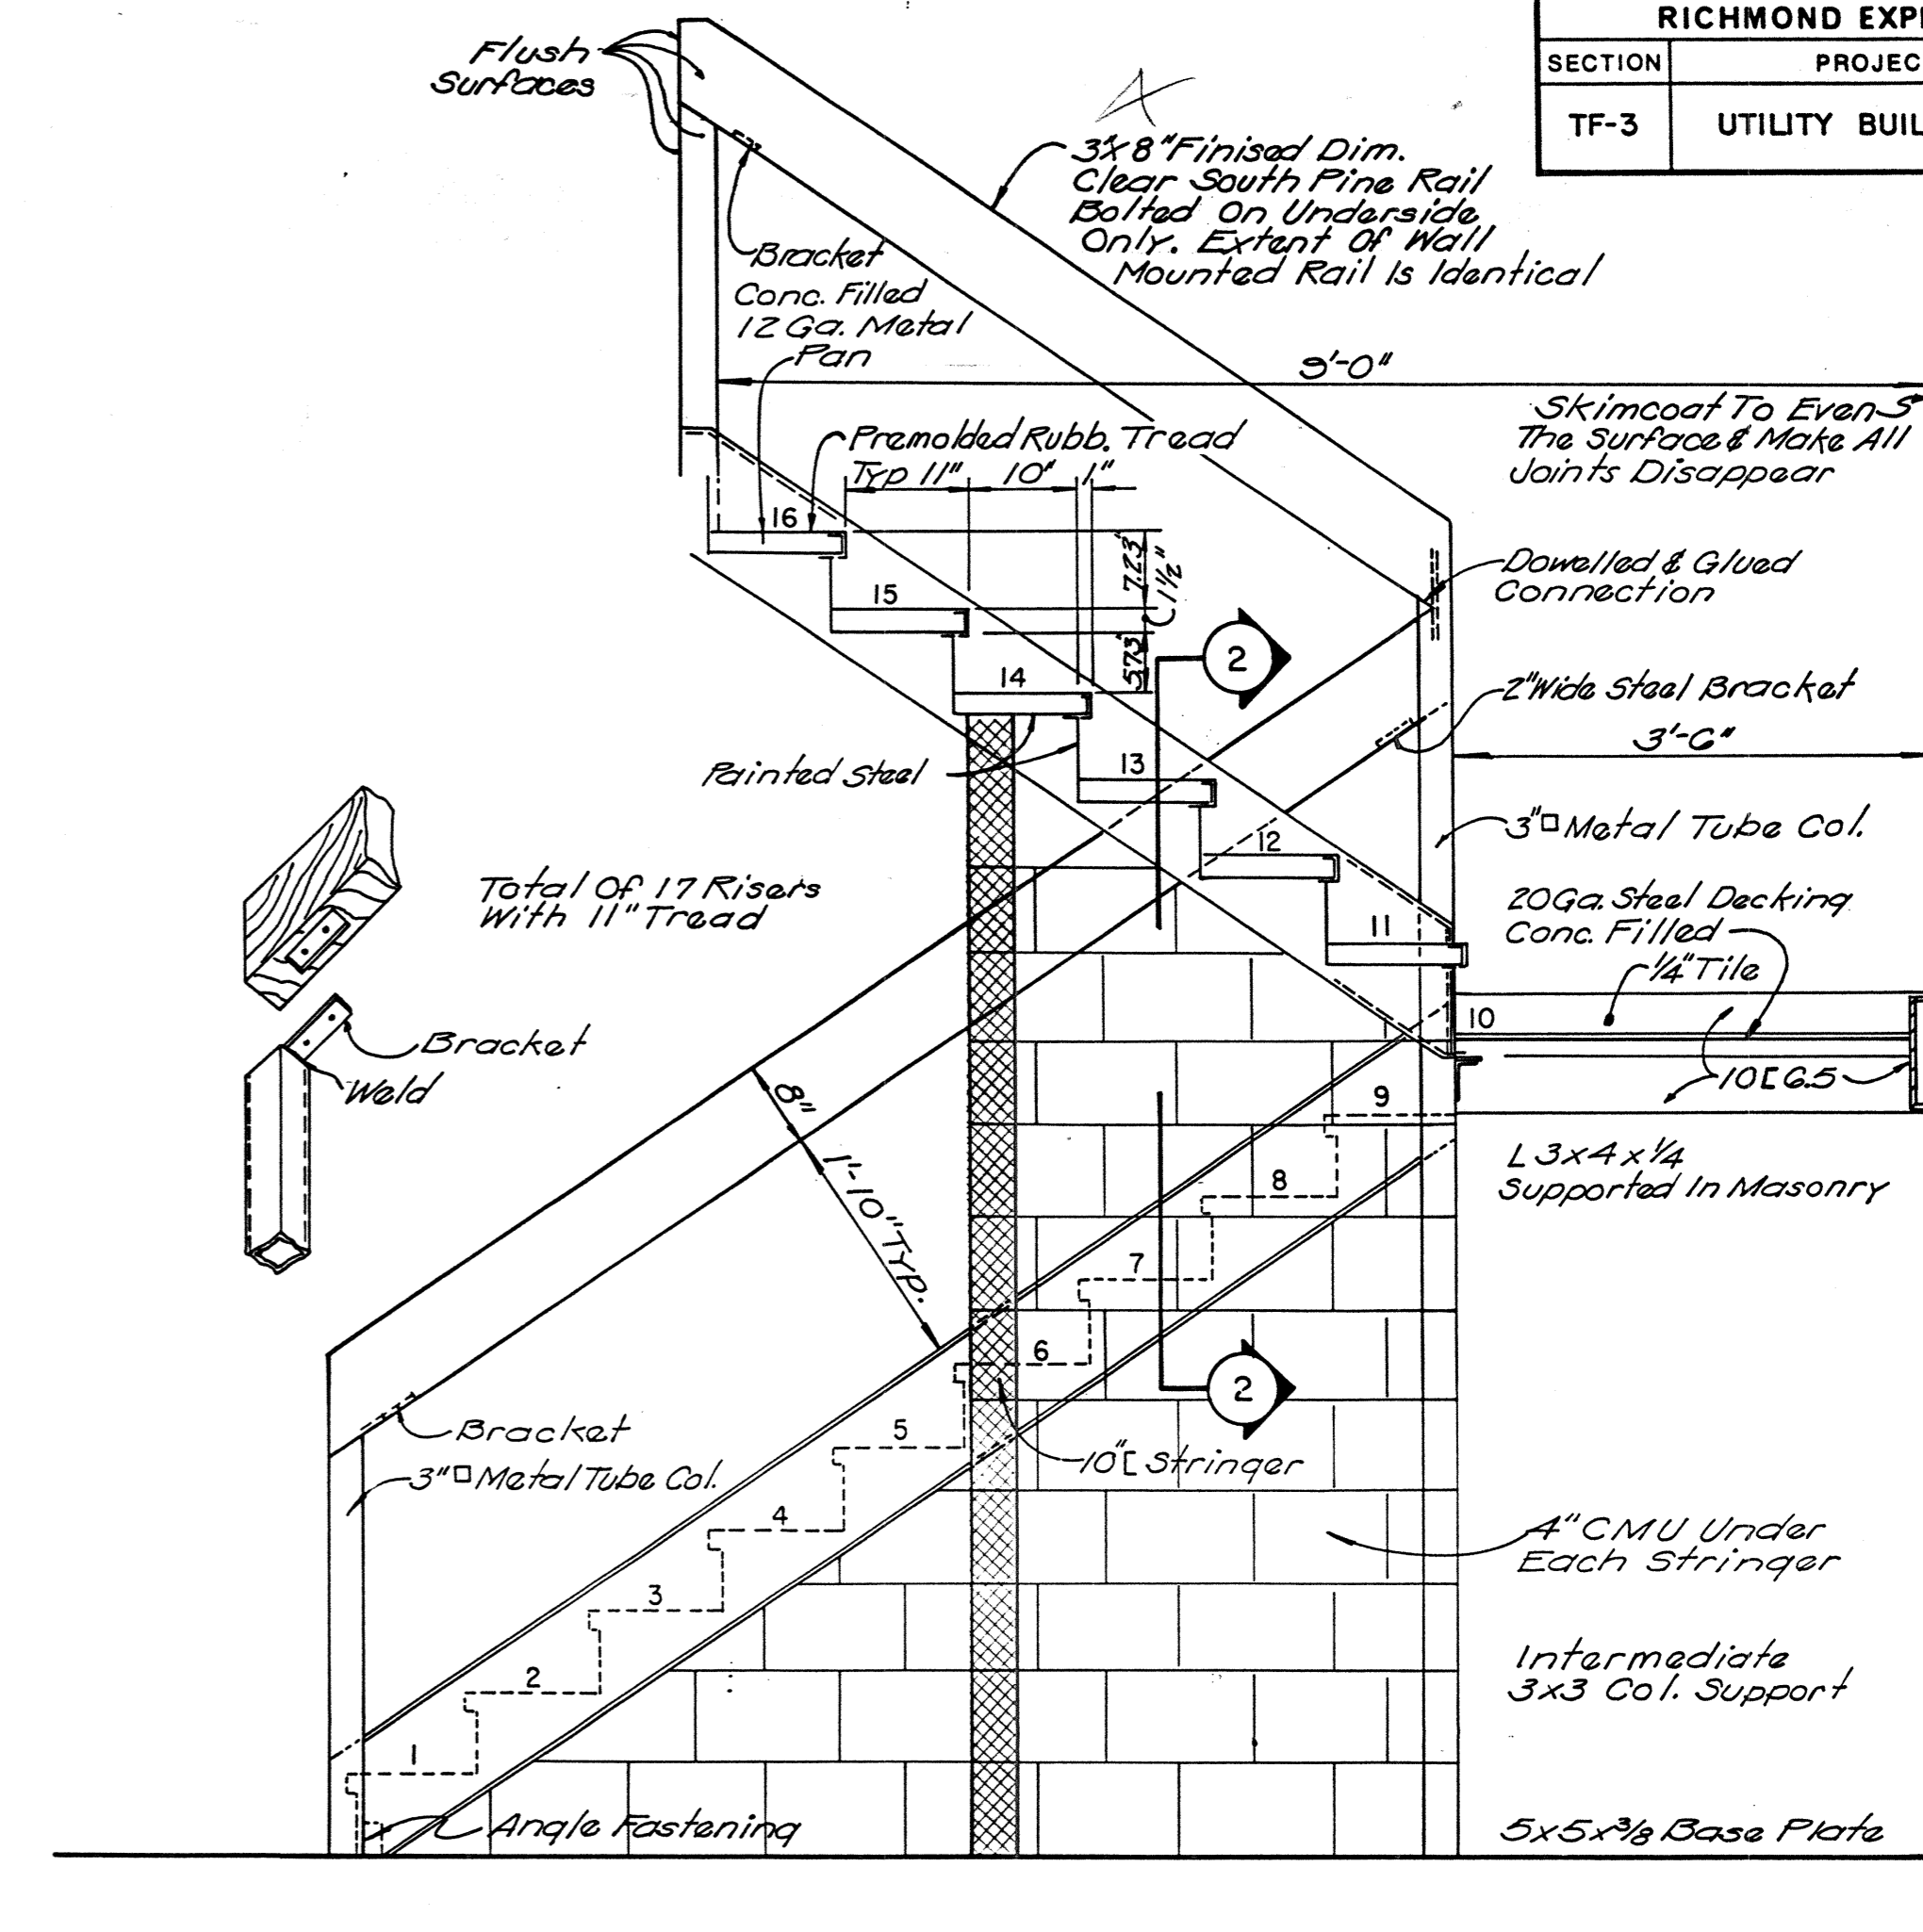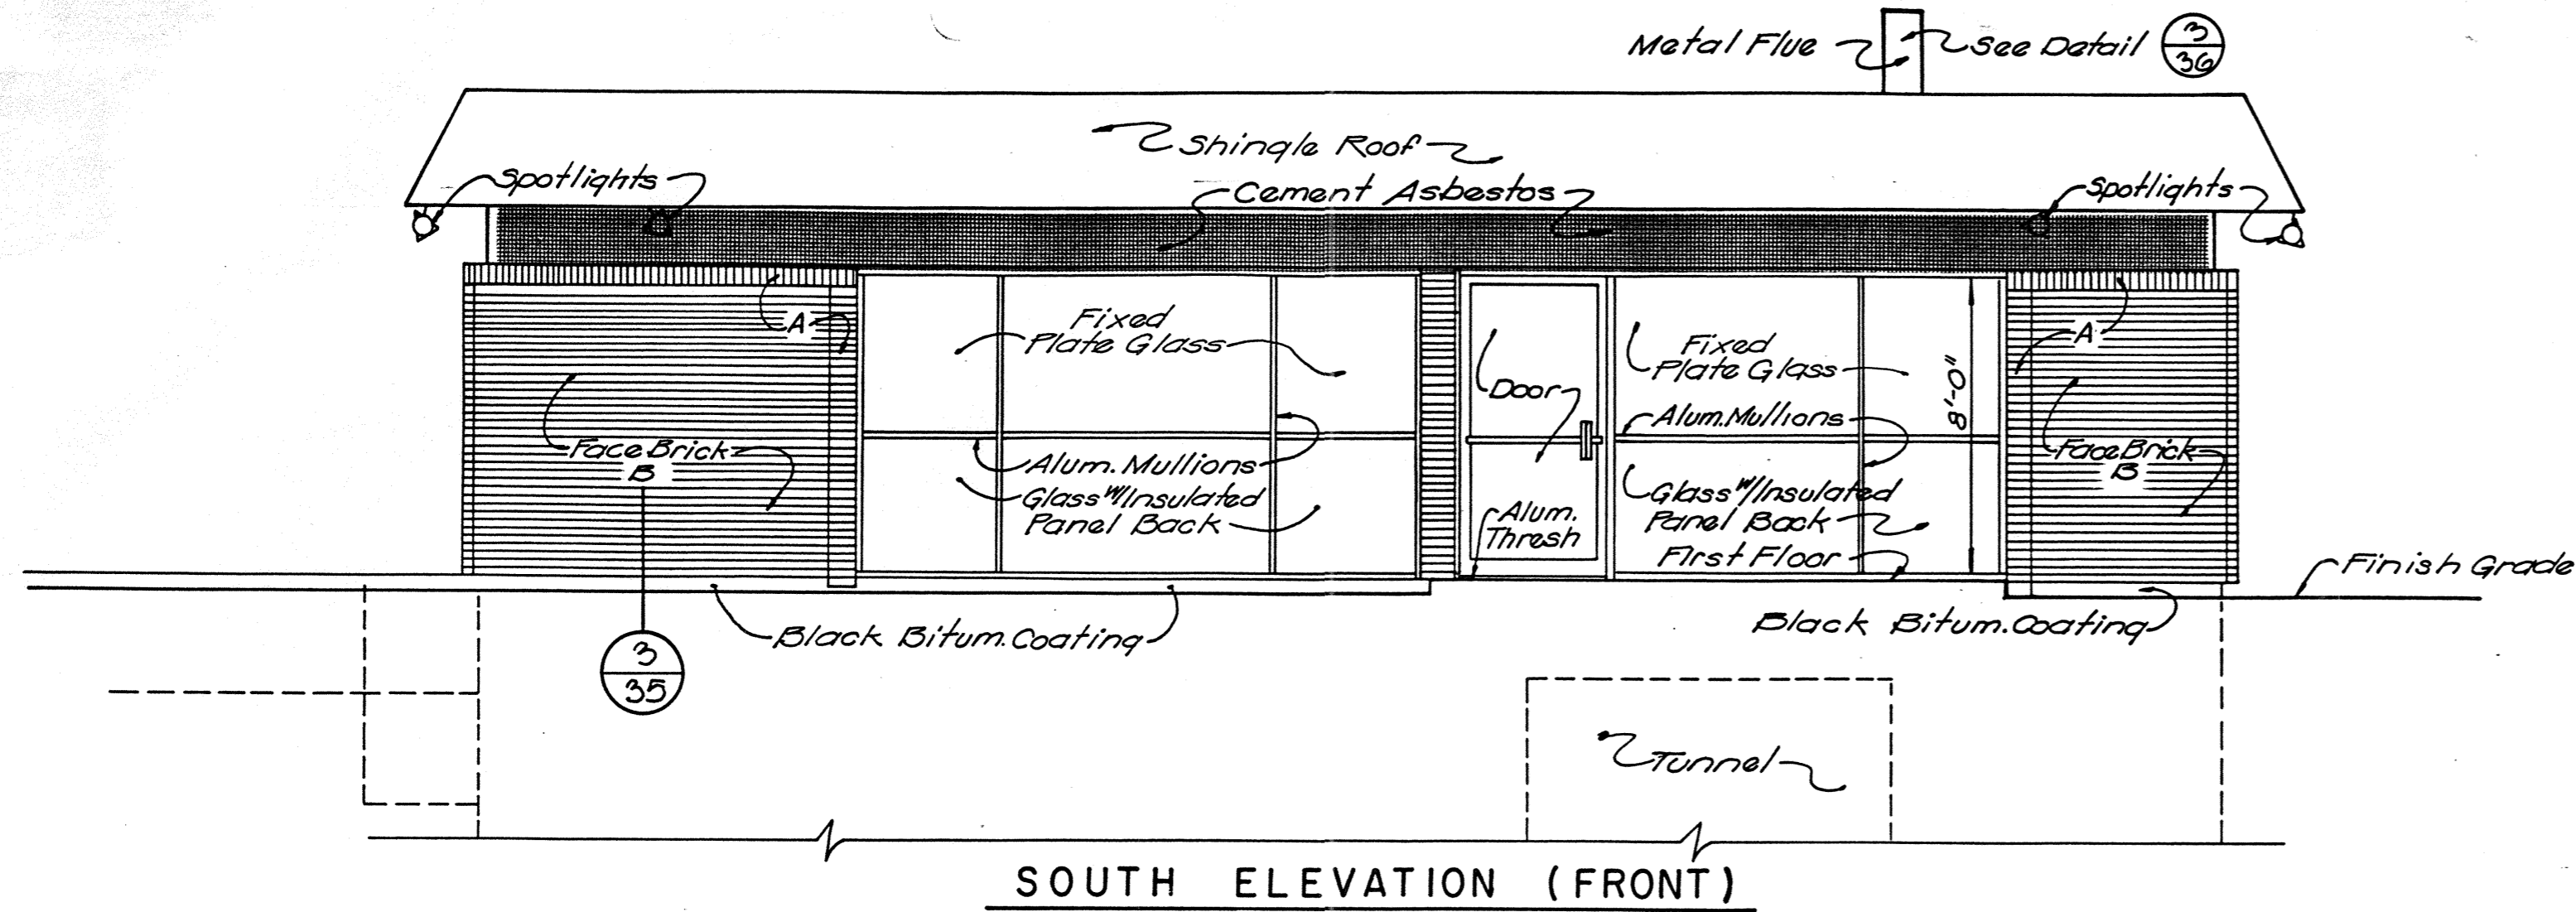

DESIGNED	KL.	9-15-74				
DRAWN	D.A.S.	9-15-74				
CHECKED	KL.	9-15-74				
IN CHARGE	J.P.F.		NO.	REVISION	BY	DATE

AS BUILT

RICHMOND METROPOLITAN AUTHORITY
RICHMOND EXPRESSWAY SYSTEM

UTILITY BUILDING
ELEVATIONS & SECTIONS



SCALE: As Shown
DATE: Sept. 15, 74

SHEET 32 OF 38

HOWARD, NEEDLES, TAMMEN & BERGENDOFF
CONSULTING ENGINEERS
Alexandria, Virginia

HNTB

RICHMOND EXPRESSWAY SYSTEM			
SECTION	PROJECT	SHEET NO.	TOTAL SHEETS
TF-3	UTILITY BUILDING	37	38

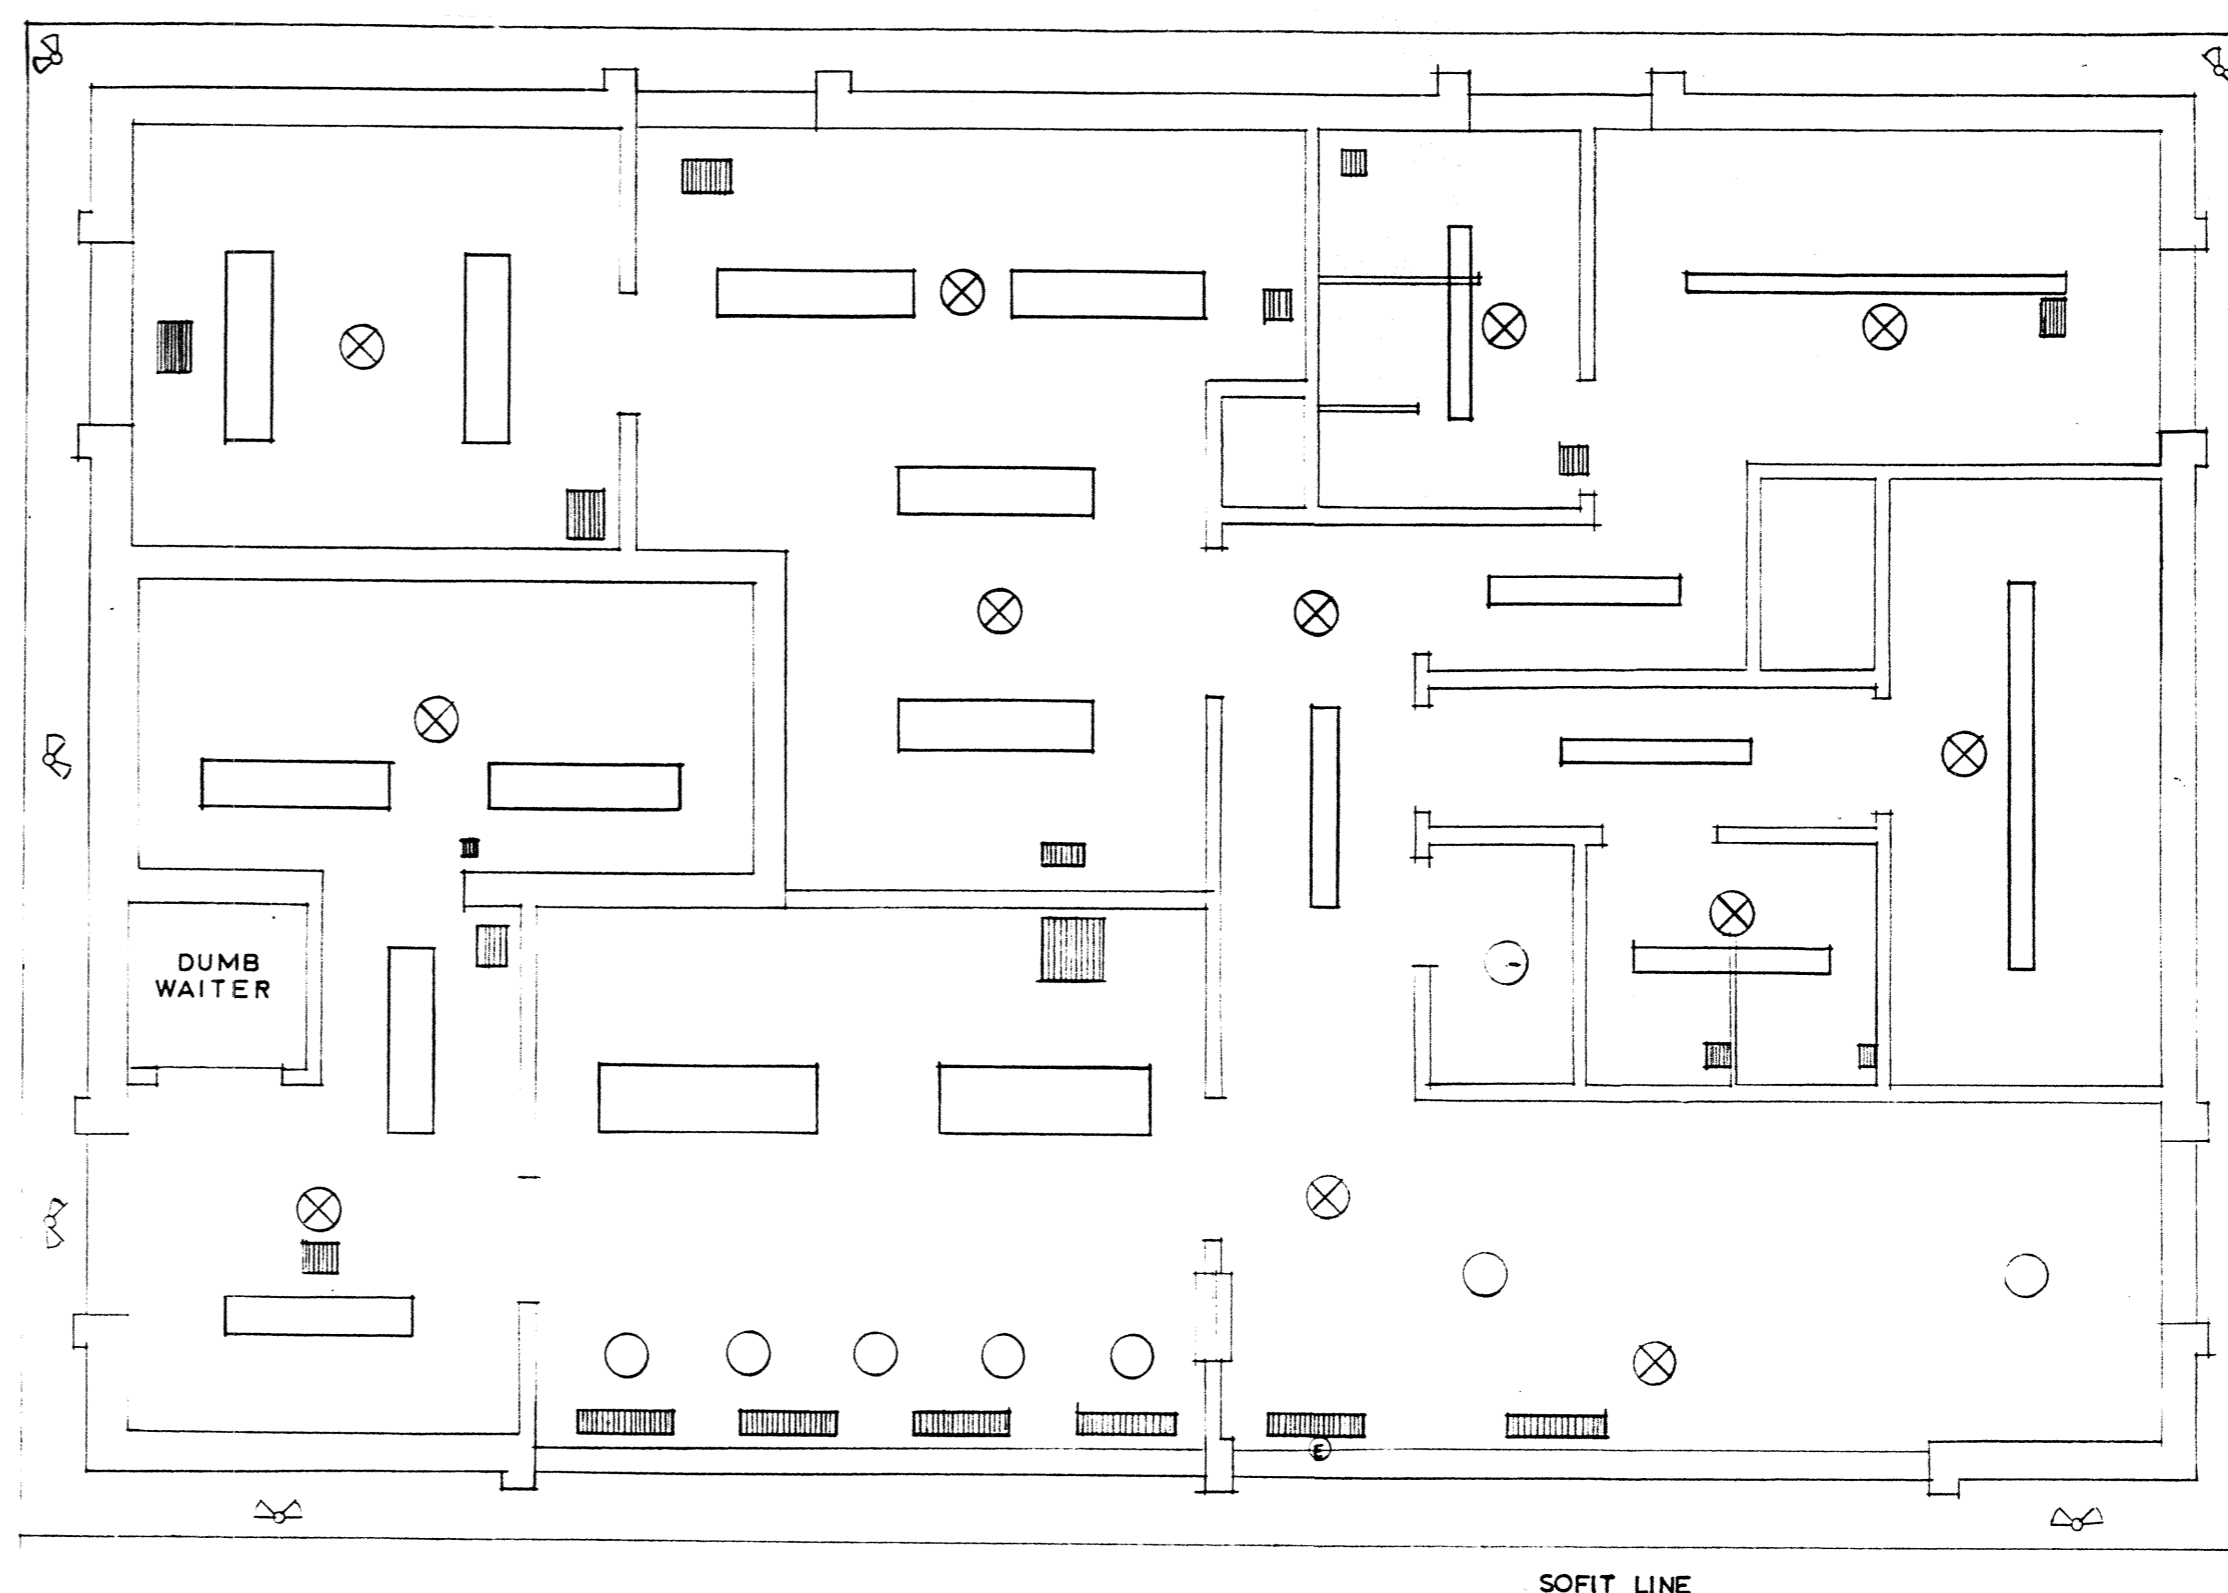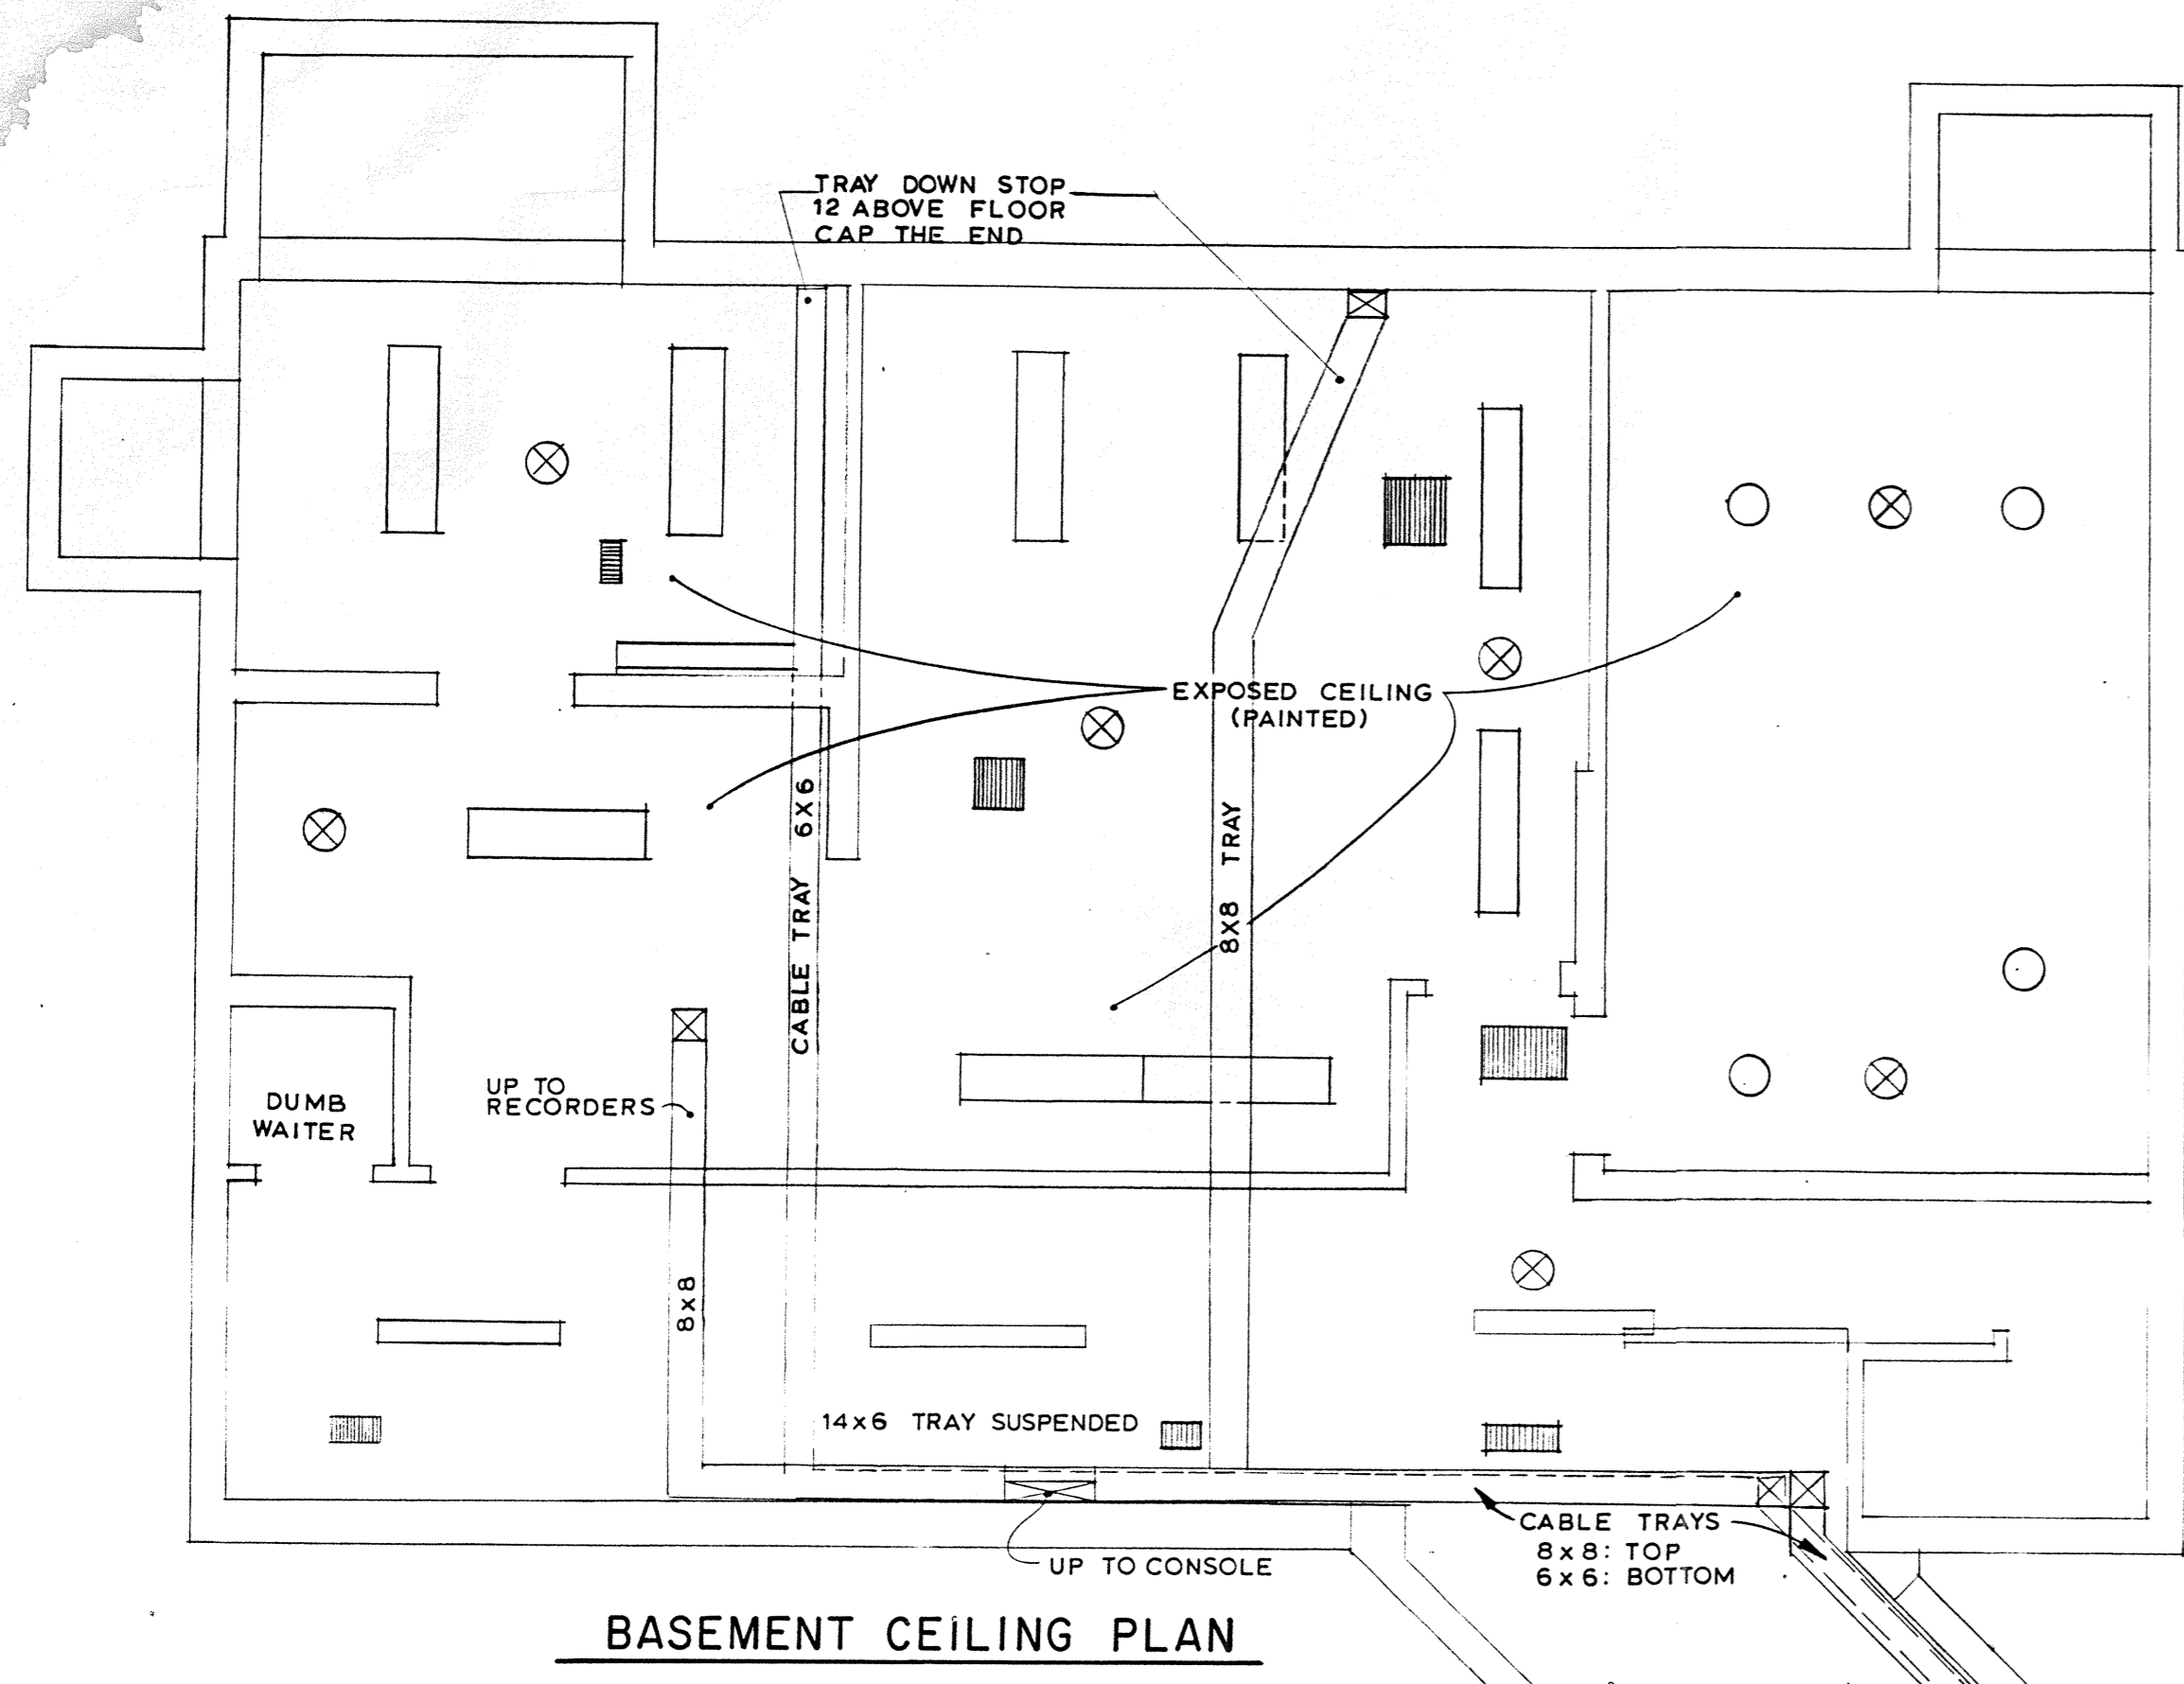

LEGEND

--- PARTITION

6x12 DUCT (SIZE)

--- FLUORESCENT FIXTURE

○ INCANDESCENT FIXTURE

⊗ EMERGENCY INCANDESCENT FIXTURE

▨ CLG. AIR REGISTER

⊖ EXHAUST FAN



ABBREVIATIONS

TR TOP REGISTER

CR CEILING REGISTER

CFM CUB. FT. / MIN.

CW COLD WATER

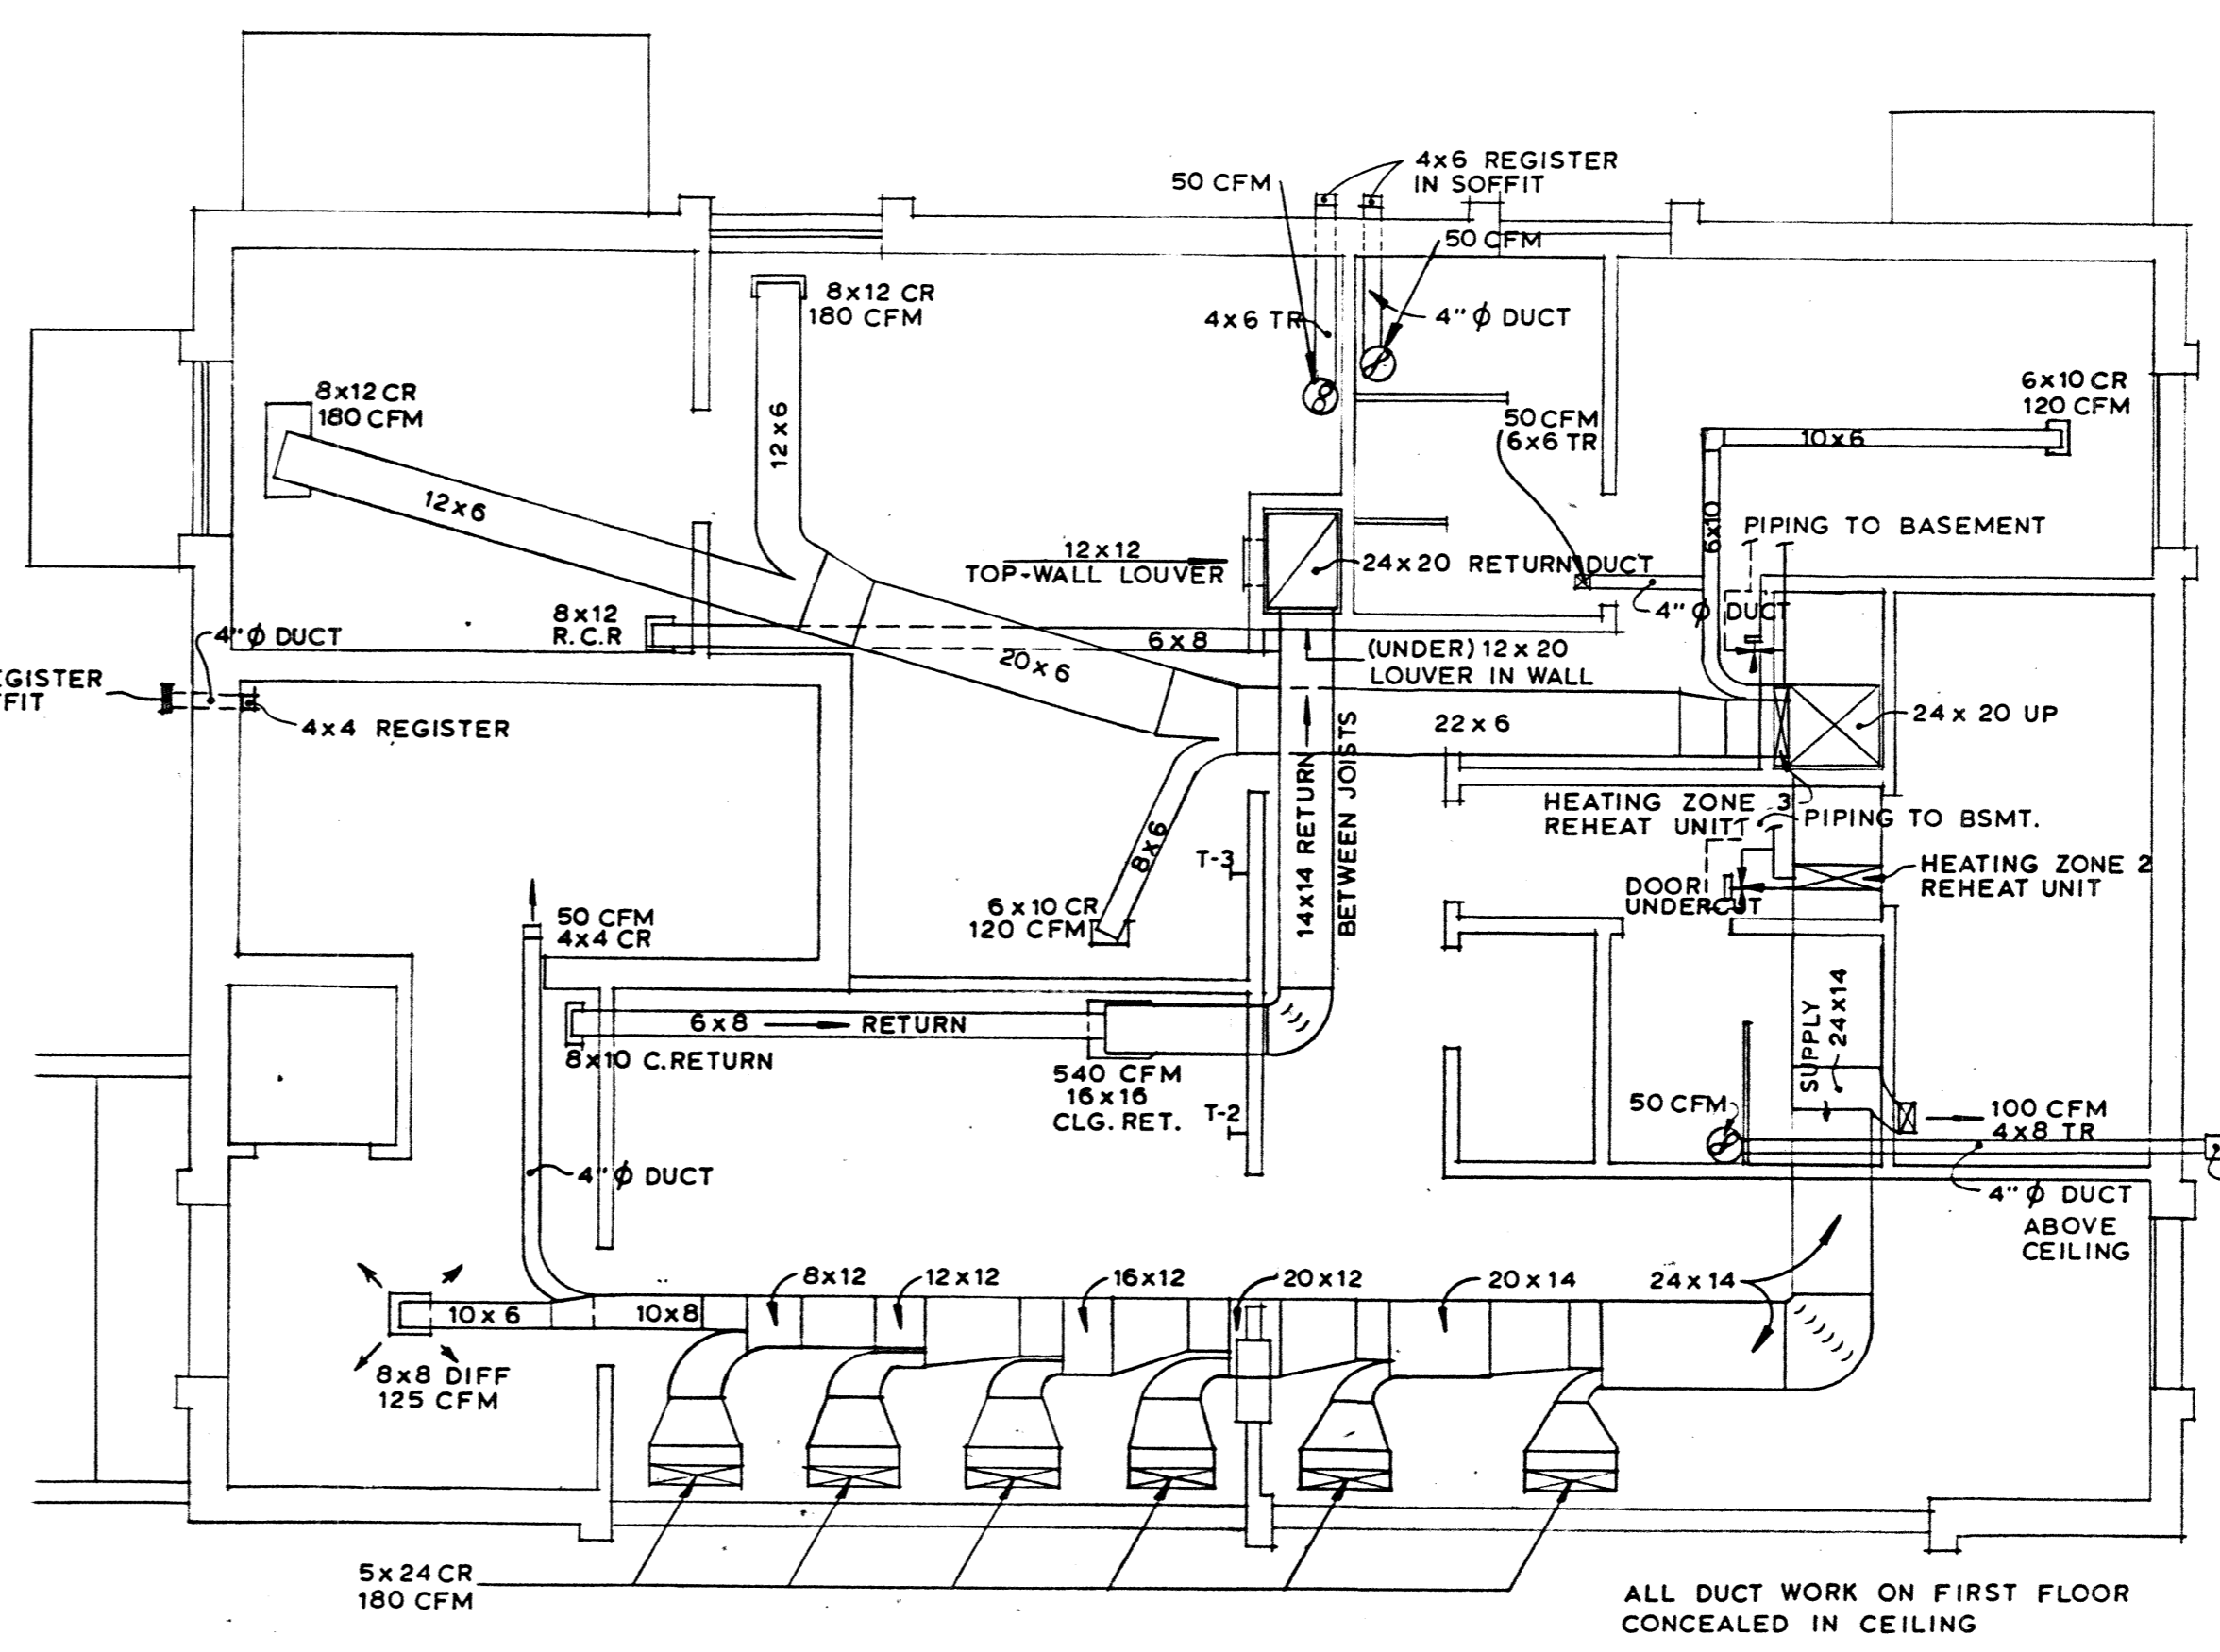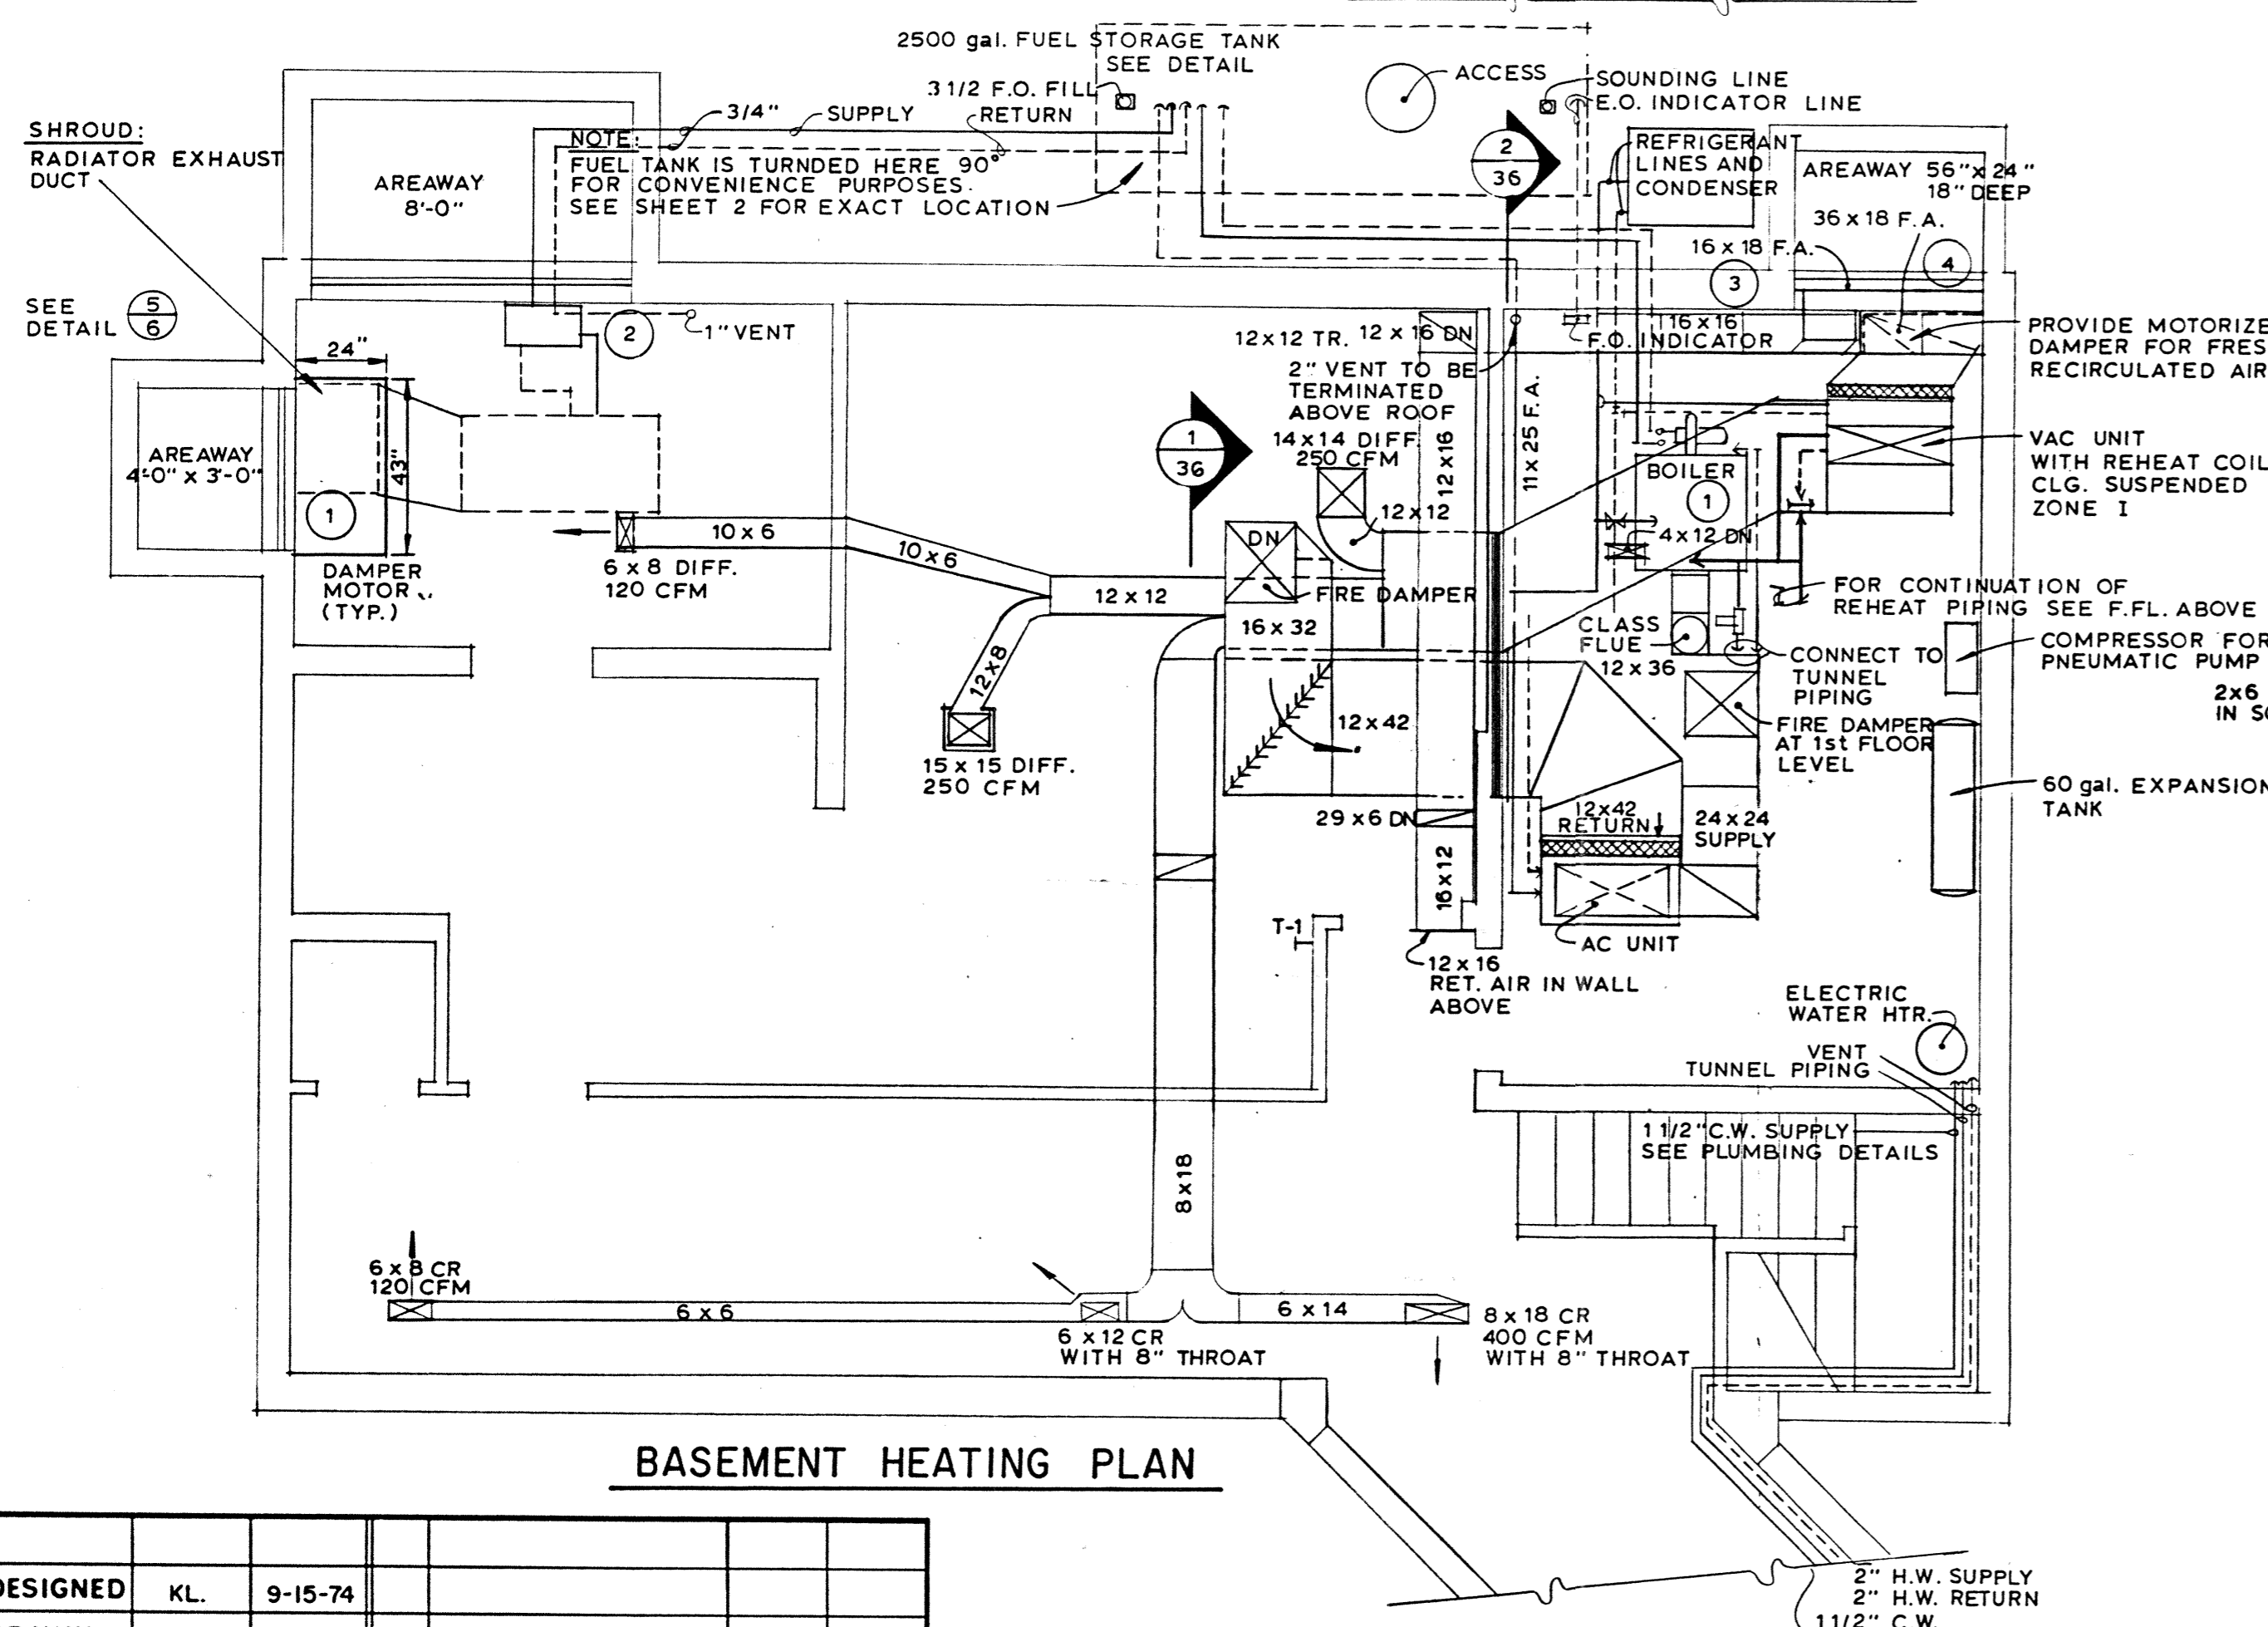

MOTOR SCHEDULE

1	INLINE PUMP TUNNELHW 3	32 GPM	42 FT. HEAD	3/4 HP	208/3/60
2	CIRCULATOR 1	12 GPM	12 FT. HEAD	1/6 HP	115/1/60
3	CIRCULATOR 2	12 GPM	12 FT. HEAD	1/6 HP	115/1/60
4	EXHAUST FAN, KITCHEN	50 CFM			115/1/60 50W
5	EXHAUST FAN, MEN TOILET	50 CFM			115/1/60 50W
6	EXHAUST FAN, FEM. TOIL.	50 CFM			115/1/60 50W
7	A/C AIRHANDL. UNIT	3000 CFM		2 HP	208/3/60
8	CONDENSING UNIT 1	3000 CFM		2 HP	208/3/60 30KW
9	CONDENSING UNIT 2	300 CFM		1 HP	208/3/60 10KW
10	H VAC UNIT	300 CFM		1 HP	208/3/60 10KW
11	OIL BURNER			1/3 HP	115/1/60
12	DAMPER MOTOR 1			1/6 HP	115/1/60
13	DAMPER MOTOR 2	SEE BASEMENT		1/6 HP	111/1/60
14	DAMPER MOTOR 3	HEATING PLAN		1/6 HP	115/1/60
15	DAMPER MOTOR 4			1/6 HP	115/1/60
16	VOID				
17	UNIT HEATER 1			1/3 HP	115/1/60
18	UNIT HEATER 2	BARRIER PLAZA BOOTHS		1/3 HP	115/1/60
19	UNIT HEATER 3			1/3 HP	115/1/60
20	UNIT HEATER 4			1/3 HP	115/1/60
21	TUNNEL HEATER 1			1/5 HP	115/1/60
22	TUNNEL HEATER 2			1/5 HP	115/1/60
23	DUMBWAITER			1 HP	208/3/60

AS BUILT

RICHMOND METROPOLITAN AUTHORITY
RICHMOND EXPRESSWAY SYSTEM

UTILITY BUILDING
MECHANICAL PLANS & SCHEDULES

SCALE 1/4"=1'-0"
DATE Sept. 15, 74


SHEET 37 OF 38

HOWARD, NEEDLES, TAMMEN & BERGENDOFF
CONSULTING ENGINEERS
Alexandria, Virginia


HNTB

DESIGNED	KL.	9-15-74			
DRAWN	KL.	9-15-74			
CHECKED	KL.	9-15-74			
IN CHARGE	J.P.F.		NO.	REVISION	BY DATE

RICHMOND EXPRESSWAY SYSTEM			
SECTION	PROJECT	SHEET NO.	TOTAL SHEETS
TF-3	UTILITY BUILDING	38	38

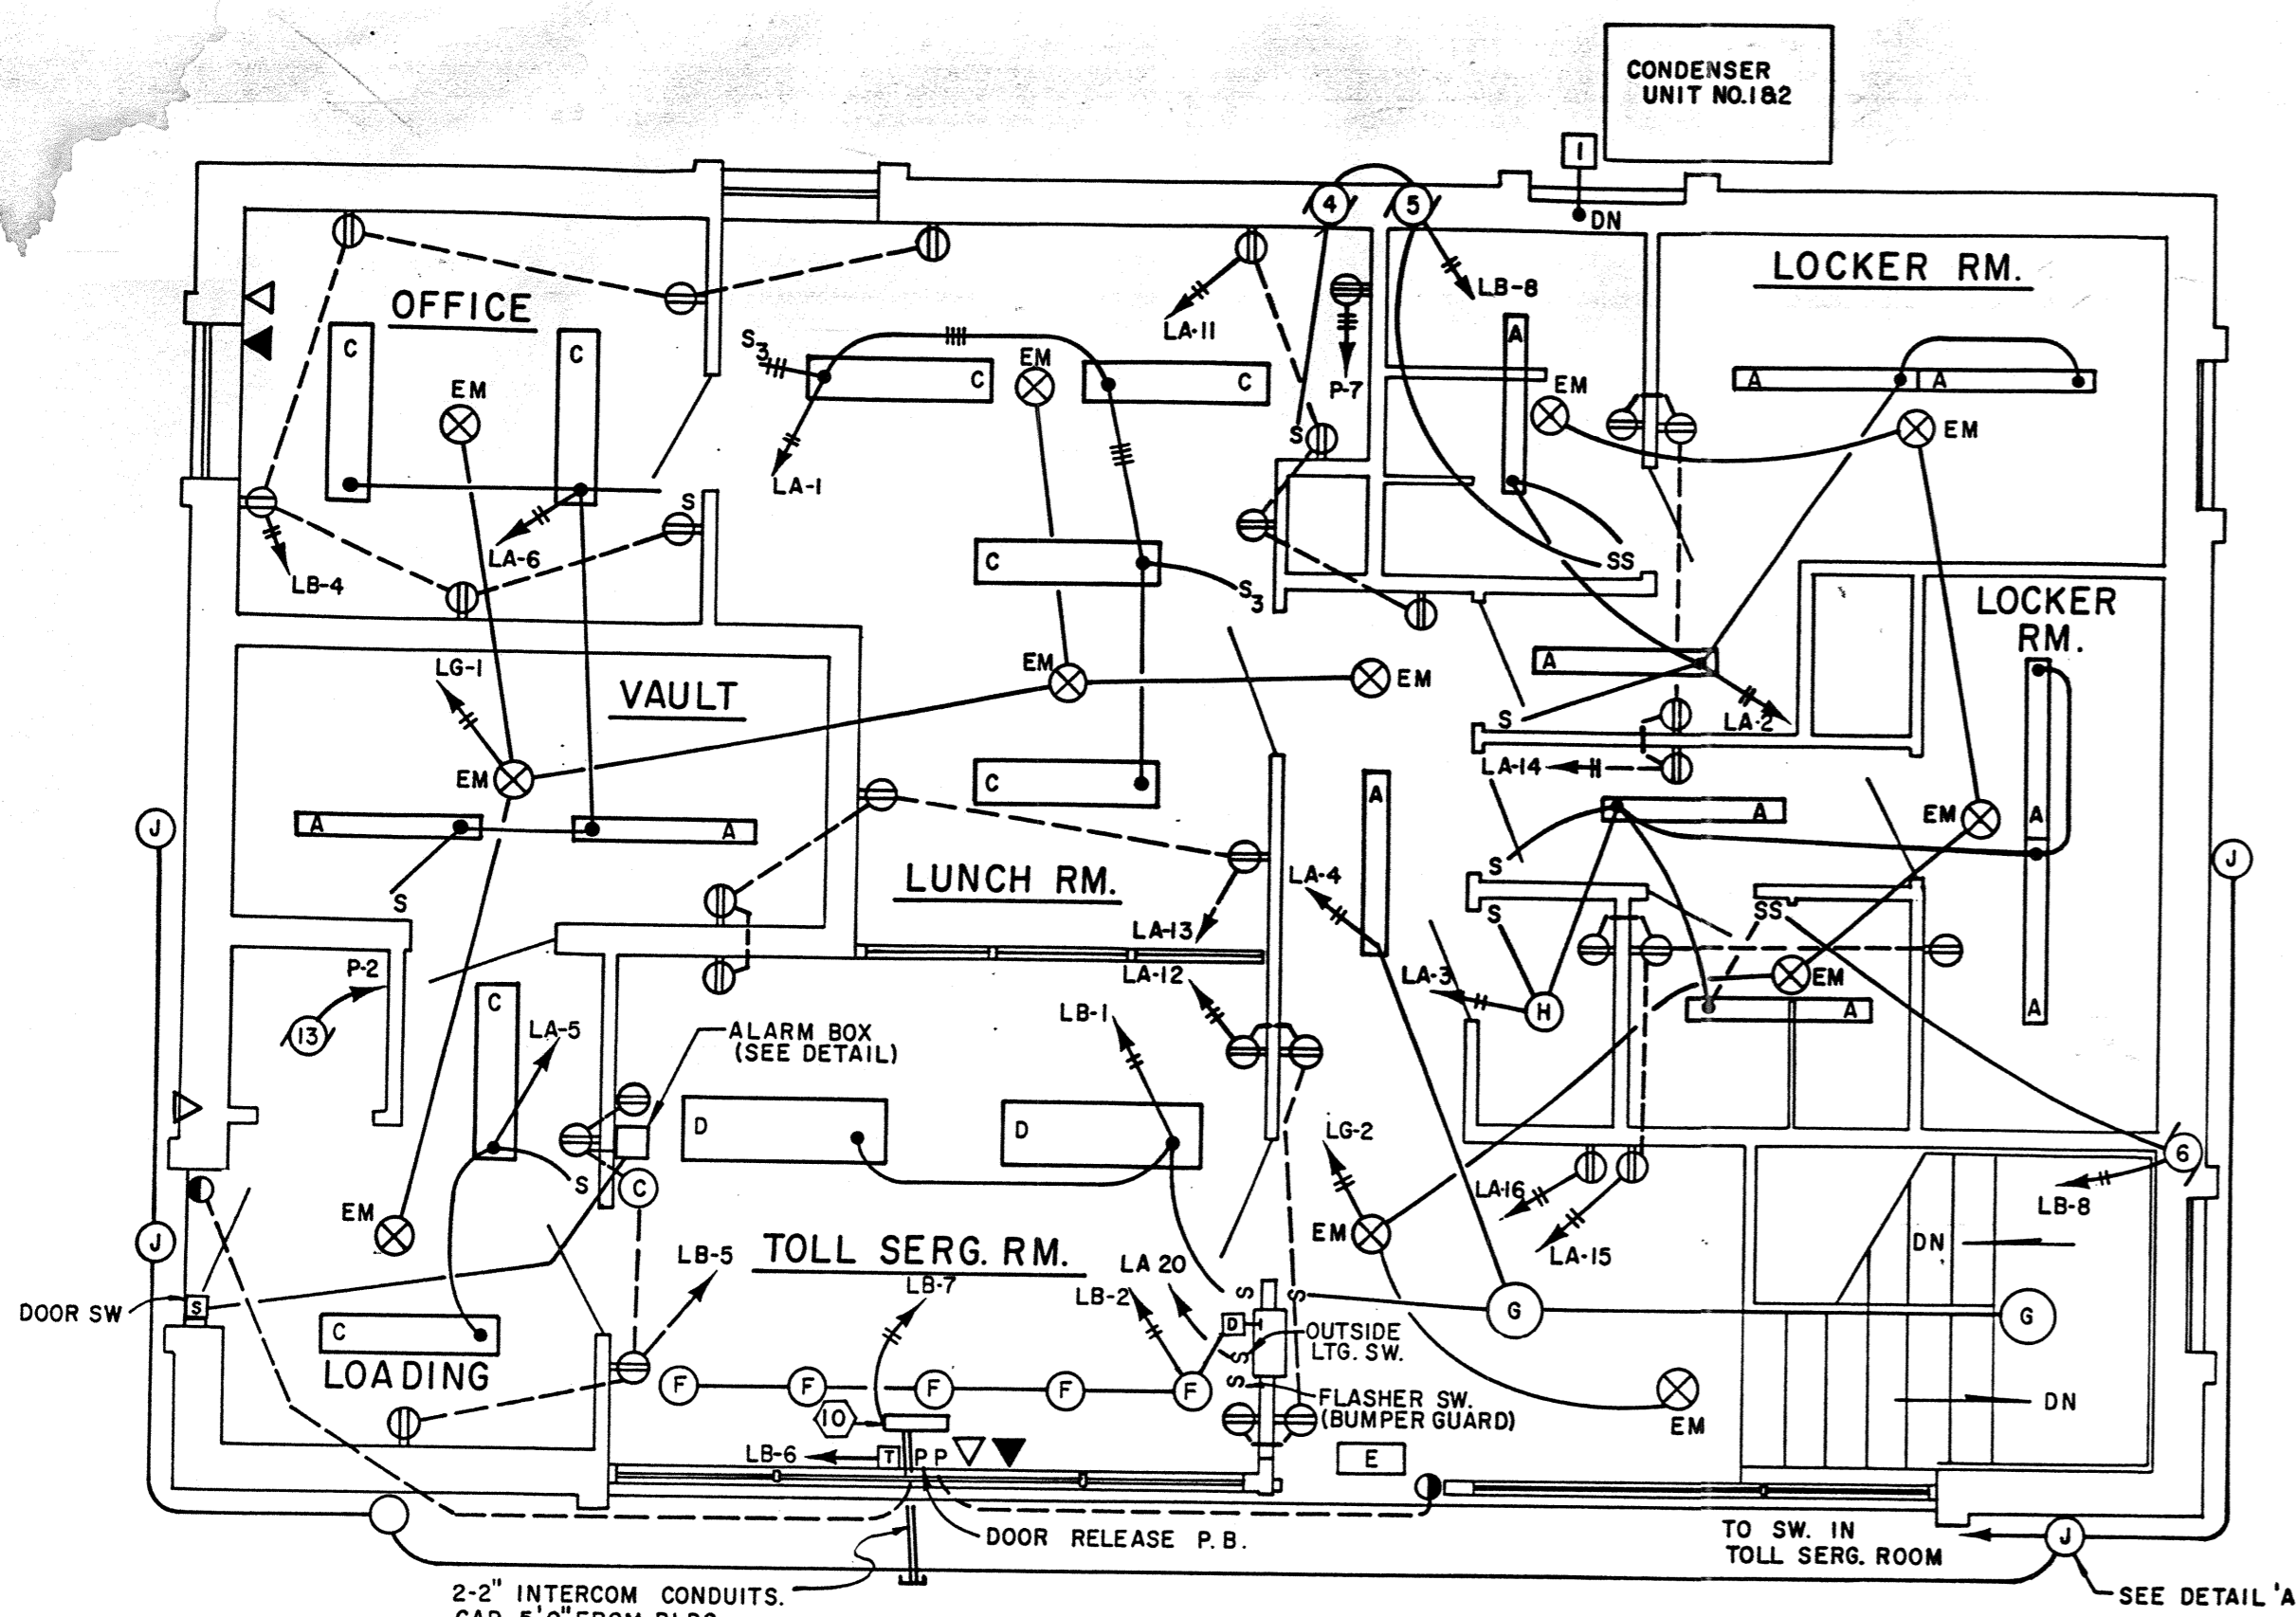


FIRST FLOOR
1/4" = 1'-0"

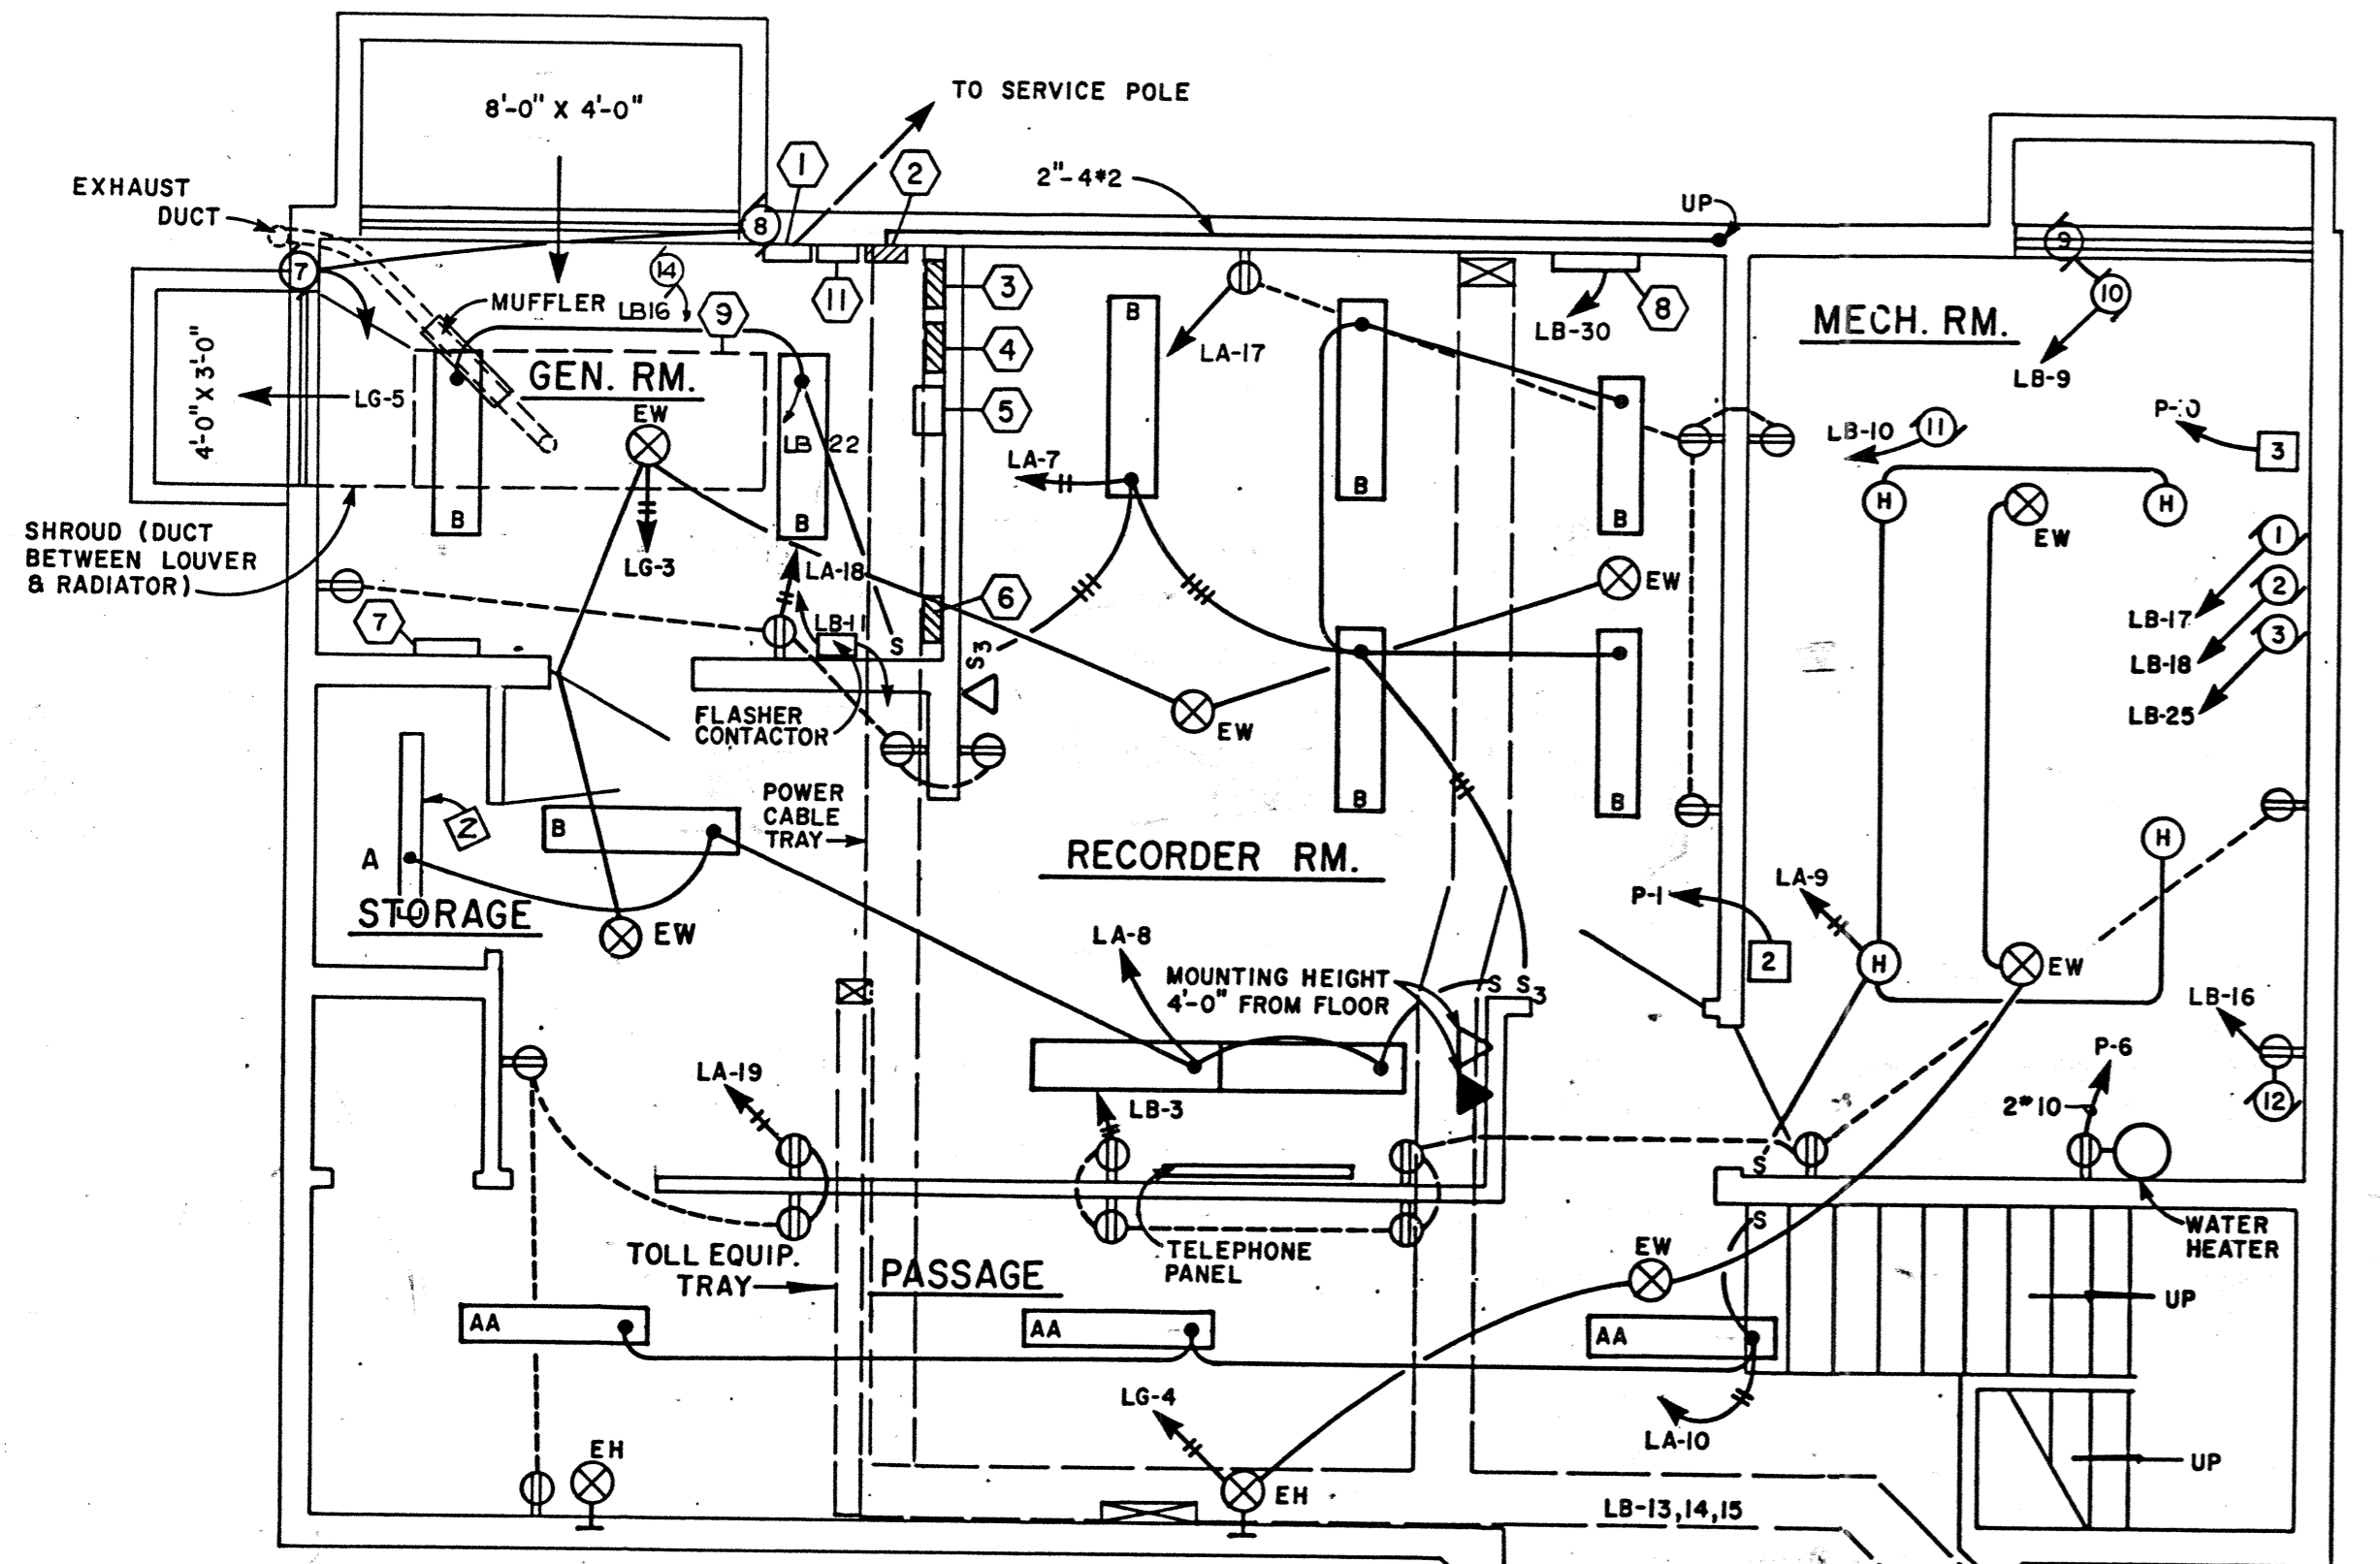


BASEMENT
1/4" = 1'-0"

- LEGEND**
- ⊖ A FLUORESCENT FIXTURE, LETTER INDICATES TYPE.
 - ⊖ B INCANDESCENT FIXTURE, LETTER INDICATES TYPE.
 - ⊖ C EMERGENCY LIGHT - IN CEILING
 - ⊖ D EMERGENCY LIGHT - WALL MOUNTED
 - ⊖ E EXIT LIGHT
 - ⊖ F DIMMER
 - ⊖ G DUPLEX WALL RECEPTACLE OUTLET
 - ⊖ H RANGE RECEPTACLE
 - ⊖ I SINGLE POLE SWITCH
 - ⊖ J THREE WAY SWITCH
 - ⊖ K DOOR RELEASE SYSTEM
 - ⊖ L TELEPHONE OUTLET
 - ⊖ M INTERCOM SYSTEM TELEPHONE OUTLET
 - ⊖ N ELECTRIC CLOCK OUTLET
 - ⊖ O TRANSFORMER FOR DOOR RELEASE SYSTEM
 - ⊖ P PANEL BOARD
 - ⊖ Q WIRING CONCEALED IN WALLS OR CEILING
 - ⊖ R WIRING CONCEALED IN FLOOR
 - ⊖ S HOME RUN WITH PANEL & CIRC. DESIGNATION
- ① CURRENT TRANSFORMER & METERING EQUIPMENT
- ② MAIN DISTRIBUTION PANELBOARD - P
- ③ PANEL BOARD - LA
- ④ PANEL BOARD - LB
- ⑤ AUTO TRANSFER SWITCH
- ⑥ EMERGENCY GENERATOR PANEL - LG
- ⑦ GENERATOR CONTROL PANEL
- ⑧ RECORDER ROOM PANEL BOARD - R
- ⑨ GENERATOR SET (45 KW CONTINUOUS)
- ⑩ INTER-COM PANEL
- ⑪ DISCONNECT SWITCH (400 A) & FUSES (225 A)
- ⑫ CIRC. PUMP #1 (ZONE-1) 1/2 HP, 115 V, 1ϕ, 60~2*12
- ⑬ CIRC. PUMP #2 (ZONE-2) 1/2 HP, 115 V, 1ϕ, 60~2*12
- ⑭ CIRC. PUMP #3 (TUNNEL) 3/4 HP, 208 V, 3ϕ, 60~4*12
- ⑮ EXHAUST FAN (KITCHEN)
- ⑯ EXHAUST FAN (MEN TOILET)
- ⑰ EXHAUST FAN (WOMEN TOILET)
- ⑱ DAMPER MOTOR #1
- ⑲ DAMPER MOTOR #2
- ⑳ DAMPER MOTOR #3
- ㉑ DAMPER MOTOR #4
- ㉒ OIL BURNER, 1/3 HP, 115 V, 1ϕ, 60~2*12
- ㉓ SPARE 2*12
- ㉔ DUMBWAITER 1 HP, 208 V, 3ϕ, 60~4*12
- ㉕ CONDENSER UNIT #1 (2 HP & 30 KW) & CONDENSER UNIT #2 (2 HP & 10 KW)
- ㉖ A/C AIR HANDLING UNIT (2 HP)
- ㉗ HVAC UNIT (1 HP)
- ㉘ GENERATOR DAY TANK PUMP

GENERAL NOTES:
FOR LIGHTING FIXTURE SCHEDULE SEE SPEC'S
TOLL ISLAND 'J' BETWEEN LANES 10 & 11 REQUIRES NO INDIVIDUAL CT.

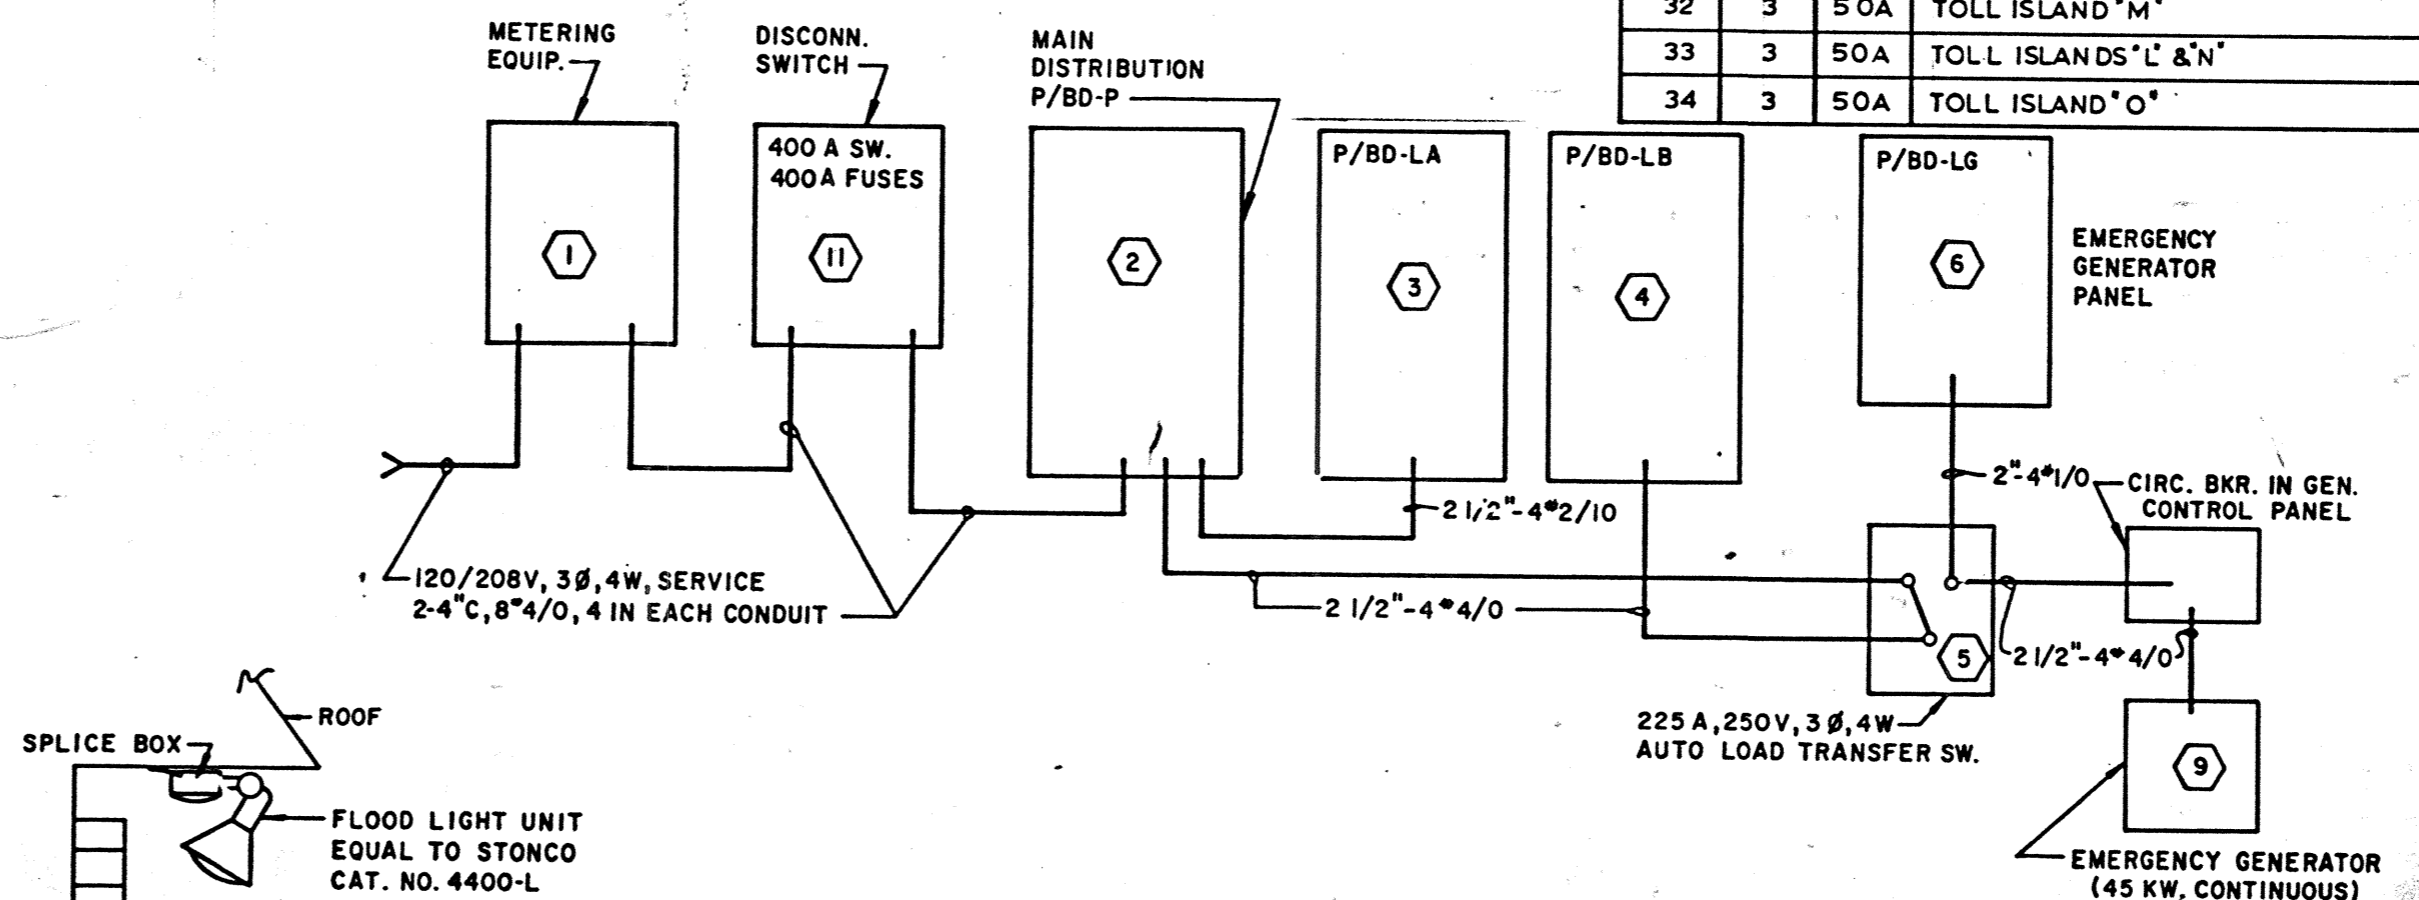

POWER RISER DIAGRAM
NO SCALE

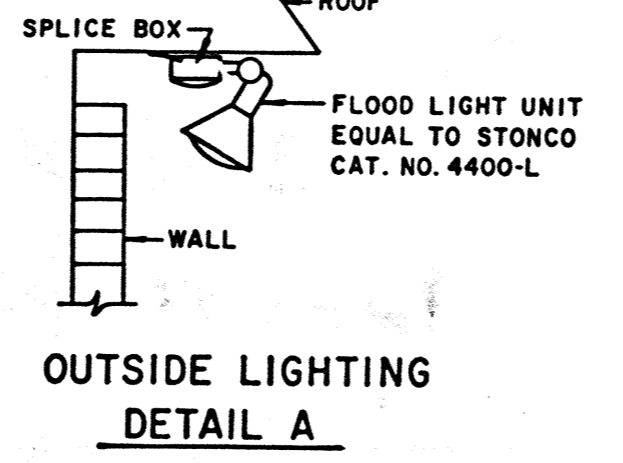

OUTSIDE LIGHTING
DETAIL A


MAIN DISTRIBUTION PANEL-P			
120/208 V, 3ϕ, 4W, SN, 42 POLES, WESTINGHOUSE 600 A BUS TYPE CDP			
CIRC. NO.	POLE	TRIP	DESCRIPTION
1	2	20 A	AC UNIT #3 (2HP)
2	2	20 A	SPARE
3	2	20 A	SPARE
4	3	20 A	SPARE
5	3	50 A	KITCHEN UNIT 8.5 KW
6	2	30 A	ELECT. W.H. UTILITY (4 KW)
7	2	20 A	DUMB WAITER
8	2	20 A	A/C UNIT
9	3	30 A	SPARE
10	3	50 A	HVAC UNIT (1HP & 10 KW)
11	3	50 A	SPARE
12	3	150 A	CONDENSERS, #1 & #2 (@ 43.0 KW)
13	3	150 A	PANEL BOARD LA
14	3	150 A	PANEL BOARD LB
15	3		SPACE
16	3		SPACE

PANEL BOARD - LB			
120/208 V, 3ϕ, 4W, SN, 42 POLES, WESTINGHOUSE 225 A BUS TYPE WBA			
CIRC. NO.	POLE	TRIP	DESCRIPTION
1,2	1	20A	LTG. 1st. FLOOR
3,4,5	1	20A	RECEPT. 1st. FLOOR & BASEMENT DR. ALARM
6	1	20A	DOOR RELEASE SYSTEM
7	1	20A	INTER-COM PANEL
8	1	20A	EXHAUST FANS (THREE)
9	1	20A	DAMPER MOTORS *3 & *4
10	1	20A	OIL BURNER
11	1	20A	FLASHER, CONTACTOR (BUMPER GUARD)
12	1	20A	TUNNEL HEATER FANS (THREE)
13,4,5	1	20A	LIGHTING TUNNEL (A-B' LIGHTS)
16	1	20A	LIGHTING TUNNEL
17	1	20A	CIRCULATOR PUMP #1
18	1	20A	CIRCULATOR PUMP #2
19	1	20A	STAIRCASE LTG (TUNNEL)
20	3	50A	AIR COMPRESSOR (CONTROLS)
21	1	20A	SPARE
22	1	20A	LIGHTS GENERATOR RM.
23	1	20A	LIGHTING TUNNEL ('C' LIGHTS)
24	1	20A	SPARE
25	3	20A	CIRCULATOR PUMP #3 (TUNNEL)
26	3	50A	TOLL ISLAND 'E'
27	3	50A	P/BD - R (RECORDER RM.)
28	3	50A	TOLL ISLANDS 'F' & 'H'
29	3	50A	TOLL ISLAND 'G'
30	3	50A	TOLL ISLAND 'I'
31	3	50A	TOLL ISLAND 'K'
32	3	50A	TOLL ISLAND 'M'
33	3	50A	TOLL ISLANDS 'L' & 'N'
34	3	50A	TOLL ISLAND 'O'

PANEL BOARD - LA			
120/208 V, 3ϕ, 4W, SN, 32 POLES, WESTINGHOUSE 225 A BUS TYPE WBA			
CIRC. NO.	POLE	TRIP	DESCRIPTION
1,2,3	1	20A	LTG. 1st FLOOR
4,5,6	1	20A	LTG. BASEMENT
7,8,9,10	1	20A	RECEPTACLES 1st FLOOR
11,12,13,14,15	1	20A	ELECT. WATER COOLER
16	1	20A	RECEPTACLES BASEMENT
17,18,19	1	20A	OUTSIDE FLOOD LIGHTING
20	1	20A	SPARE
21	1	20A	SPARE
22	1	20A	SPARE
23	1	20A	SPARE
24	1	20A	SPARE
25	1	20A	SPARE
26	1	20A	SPARE
27	1	20A	SPARE
28	1	20A	SPARE
29,30	1		SPACE
31,32	1		SPACE

PANEL BOARD - R			
120/208 V, 3ϕ, 4W, SN, 10 POLES, WESTINGHOUSE 100 A BUS TYPE WBA			
CIRC. NO.	POLE	TRIP	DESCRIPTION
1 to 16	1	20A	RECORDER ROOM CIRC.
17 to 20	1		SPACES

PANEL BOARD - LG			
120/208 V, 3ϕ, 4W, 10 POLES, WESTINGHOUSE 100 A BUS TYPE WBA			
CIRC. NO.	POLE	TRIP	DESCRIPTION
1	1	20A	LTG. 1st. FLOOR (EMG.)
2	1	20A	LTG. 1st. FLOOR (EMG.)
3	1	20A	LTG. BASEMENT (EMG.)
4	1	20A	LTG. BASEMENT (EMG.)
5	1	20A	DAMPER MOTORS #1 & #2
6	1	20A	SPARE
7	1	20A	SPARE
8	1		SPACE
9	1		SPACE
10	1		SPACE

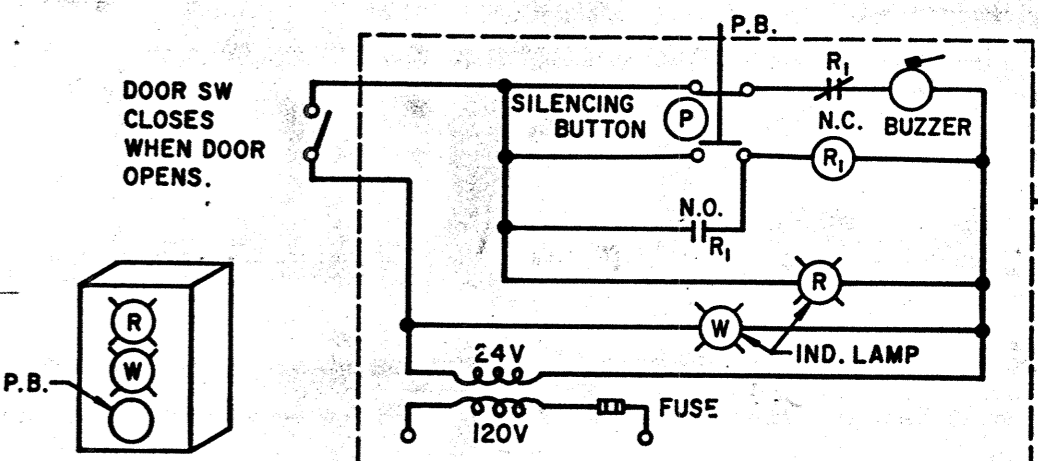

ALARM SYSTEM
NO SCALE

AS BUILT
RICHMOND METROPOLITAN AUTHORITY
RICHMOND EXPRESSWAY SYSTEM

UTILITY BUILDING
ELECTRICAL

SCALE AS NOTED
DATE _____ SHEET 38 OF 38


HOWARD, NEEDLES, TAMMEN & BERGENDOFF
CONSULTING ENGINEERS
Alexandria, Virginia HNTB

DESIGNED	NO.	REVISION	BY	DATE
DRAWN				
CHECKED				
IN CHARGE				


Added New Rooms, Adjust
Panel Change CTS.
2, 26, 29, 30, 31, ADD 32, 33, 34
PNT: 2/75
KL 10/7-74

DOWNTOWN EXPRESSWAY (DTE) OPEN ROAD TOLLING


ORIGINAL PLANS

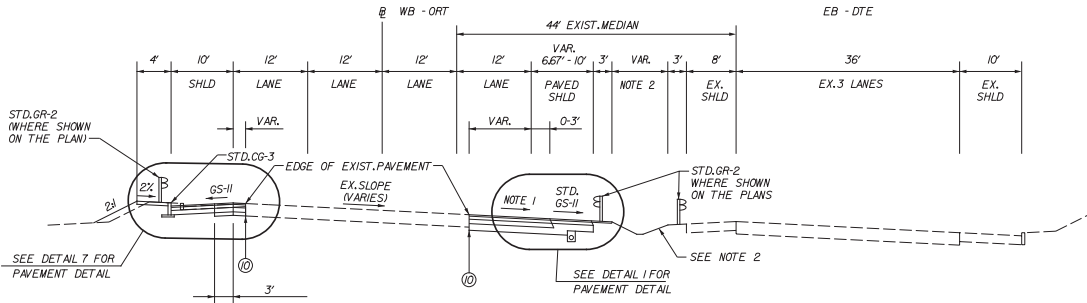

WB-ORT (RTE. 195)
 STA. 103+25 TO 104+95 ONLY
 Sta. 100+00.00 to Sta. 113+86.26 RT.
 Sta. 114+69.23 to Sta. 115+00.00 RT.
 Sta. 103+25.00 to Sta. 104+95.00 LT.

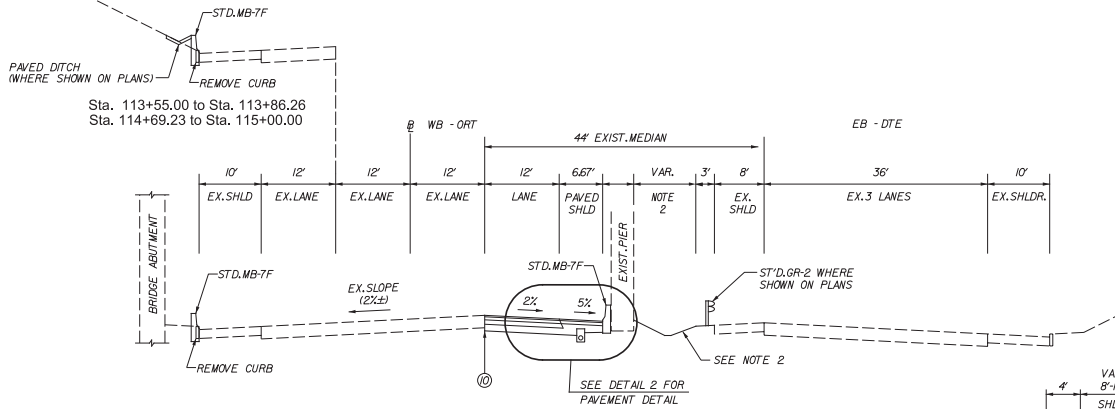

WB-ORT AT MEADOW STREET BRIDGE
 Sta. 113+86.26 to Sta. 114+69.23 RT.
 Sta. 113+55.00 to Sta. 115+00.00 LT.

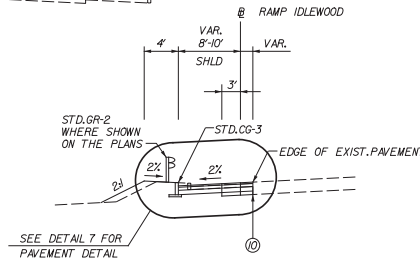


RAMP IDLEWOOD
 Sta. 10+00.00 to Sta. 15+32.07

LEGEND

- ① SURFACE COURSE, 1 1/2 IN. ASPHALT CONCRETE TYPE SMA-9.5 @ 165 LBS./SY.
- ② INTERMEDIATE COURSE, 2.0 IN. ASPHALT CONCRETE TYPE IM-19.0A
- ③ INTERMEDIATE COURSE, 3.0 IN. ASPHALT CONCRETE TYPE SMA-19.0
- ④ BASE COURSE, 4.0 IN. ASPHALT CONCRETE TYPE BM-25.0A
- ⑤ SUBBASE, 6.0 IN. UNTREATED AGGREGATE MATERIAL TYPE I, SIZE NO. 21-B
- ⑥ MILL EXISTING PAVEMENT TO A DEPTH OF 1.5 IN. AND OVERLAY WITH ASPHALT CONCRETE TYPE SMA-9.5 @ 165 LBS./SY.
- ⑦ STD.UID-4 UNDERDRAIN REQ'D.
- ⑧ SUBBASE, VAR. THICKNESS, UNTREATED AGGREGATE MATERIAL TYPE I, SIZE NO. 21-B
- ⑨ SUBBASE, 4.0 IN. UNTREATED AGGREGATE MATERIAL TYPE I, SIZE NO. 21-B
- ⑩ SAWCUT
- ⑪ 1 1/2 IN. ASPHALT CONCRETE TYPE SMA-9.5A @ 165 LBS./SY.
- ⑫ 3 IN. ASPHALT CONCRETE TYPE IM-19.0A
- ⑬ LEVELING COURSE, VAR. DEPTH ASPHALT CONCRETE TYPE SMA-19.0, 2" MIN.
- ⑭ REMOVE AND REPLACE EXISTING PAVEMENT ALONG THE EDGE AS SHOWN IN YDOT STD.WP-2. SEE DETAIL 9 SHIT 2(3) FOR REPLACED PAVEMENT
- ⑮ VAR. DEPTH, ASPHALT CONCRETE TYPE BM-25.0, 3" MIN.
- ⑯ NOT USED
- ⑰ HYDRAULIC CEMENT CONCRETE SIDEWALK, #
- ⑱ NOT USED
- ⑲ SURFACE COURSE, VAR. DEPTH ASPHALT CONCRETE TYPE SMA-9.5, 1.5" MIN.


NOTES

1. SEE PROFILES FOR CROSS SLOPES.
2. SEE CROSS SECTIONS FOR DITCH LOCATIONS AND INVERTS.
3. SEE SHEET 21(3) FOR DITCH TYPICAL SECTION.

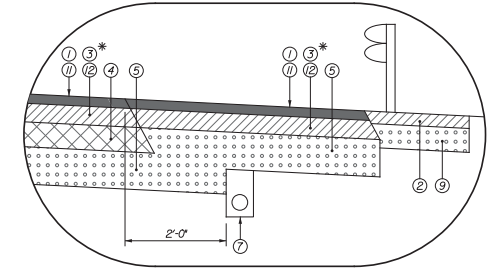


* USE ① & ⑫ WB ORT STA. 100+00 TO 115+00
 USE ① & ③ WB ORT STA. 115+00 TO END OF PROJECT

DETAIL 1
 NTS

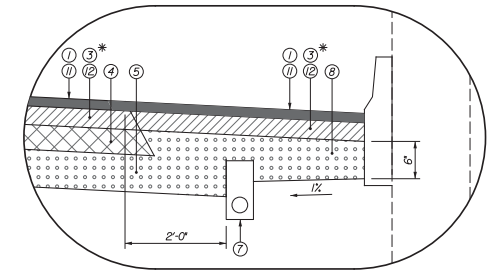

DETAIL 2
 NTS

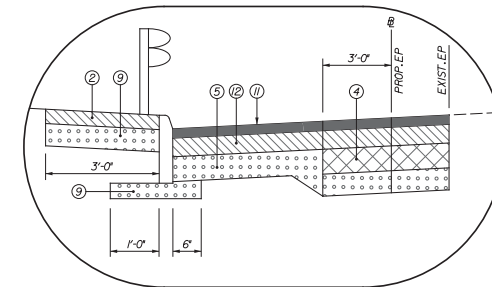

DETAIL 7
 NTS

DATE PLOTTED: 05/11/2017 10:53:00 AM

REVISIONS




		2900 S. QUINCY STREET, SUITE 200 ARLINGTON, VIRGINIA (703) 824-5100	
		Scale: 1"=10'-0"	Date: FEB. 25, 2011


richmond metropolitan authority
 RICHMOND DOWNTOWN EXPRESSWAY

DOWNTOWN EXPRESSWAY OPEN ROAD TOLLING
TYPICAL SECTIONS

Level: Check, Print, Stamp, Name, Title, Originator, Checker, Designer, Date

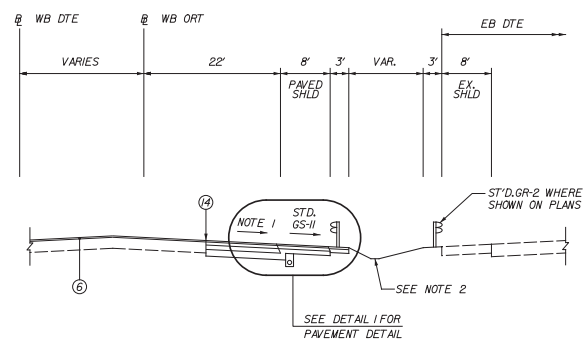


STA. 139+58.61 TO STA. 145+47.05

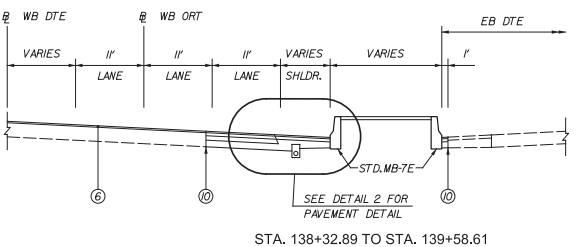


STA. 138+32.89 TO STA. 139+58.61


WESTBOUND DOWNTOWN EXPRESSWAY (DTE)

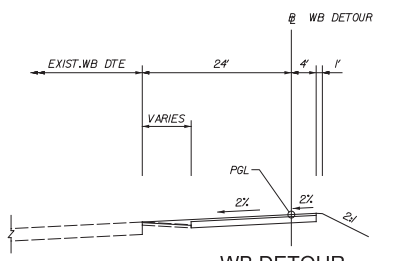

WB DETOUR
STA. 22+00.00 TO STA. 26+00.00

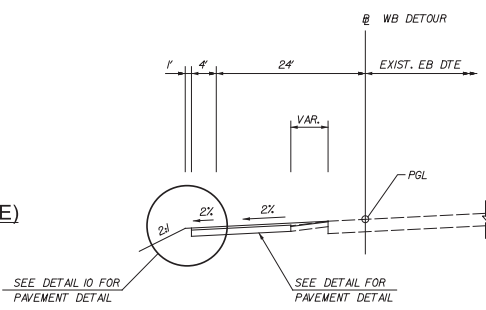


WB DETOUR
STA. 17+00.00 TO STA. 22+00.00

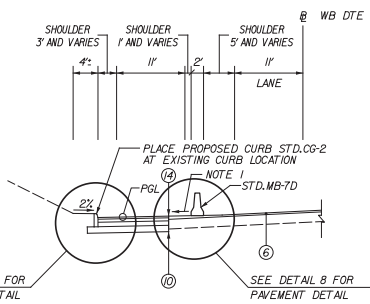


RAMP LINDEN
STA. 9+80.00 TO STA. 19+44.11

LEGEND


- ① SURFACE COURSE, 1 1/2 IN. ASPHALT CONCRETE TYPE SMA-9.5 @ 165 LBS./SY.
- ② INTERMEDIATE COURSE, 2.0 IN. ASPHALT CONCRETE TYPE IM-19.0A
- ③ INTERMEDIATE COURSE, 3.0 IN. ASPHALT CONCRETE TYPE SMA-19.0
- ④ BASE COURSE, 4.0 IN. ASPHALT CONCRETE TYPE BM-25.0A
- ⑤ SUBBASE, 6.0 IN. UNTREATED AGGREGATE MATERIAL TYPE I, SIZE NO. 21-B
- ⑥ MILL EXISTING PAVEMENT TO A DEPTH OF 15" AND OVERLAY WITH ASPHALT CONCRETE TYPE SMA-9.5 @ 165 LBS./SY.
- ⑦ STD. UD-4 UNDERDRAIN REQ'D.
- ⑧ SUBBASE, VAR. THICKNESS, UNTREATED AGGREGATE MATERIAL TYPE I, SIZE NO. 21-B
- ⑨ SUBBASE, 4.0 IN. UNTREATED AGGREGATE MATERIAL TYPE I, SIZE NO. 21-B
- ⑩ SAWCUT
- ⑪ 1 1/2 IN. ASPHALT CONCRETE TYPE SMA-9.5A @ 165 LBS./SY.
- ⑫ 3 IN. ASPHALT CONCRETE TYPE IM-19.0A
- ⑬ LEVELING COURSE, VAR. DEPTH ASPHALT CONCRETE TYPE SMA-19.0, 2" MIN.
- ⑭ REMOVE AND REPLACE EXISTING PAVEMENT ALONG THE EDGE AS SHOWN IN VDOT STD. WP-2. SEE DETAIL 9 SHIT 2(3) FOR REPLACED PAVEMENT
- ⑮ VAR. DEPTH, ASPHALT CONCRETE TYPE BM-25.0, 3" MIN.
- ⑯ NOT USED
- ⑰ HYDRAULIC CEMENT CONCRETE SIDEWALK, 4"
- ⑱ NOT USED
- ⑳ SURFACE COURSE, VAR. DEPTH ASPHALT CONCRETE TYPE SMA-9.5, 15" MIN.

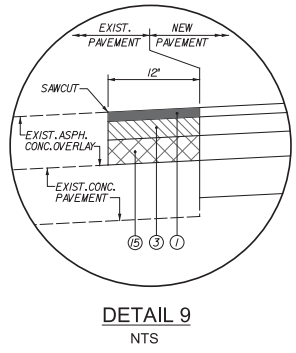


DETAIL 9
NTS

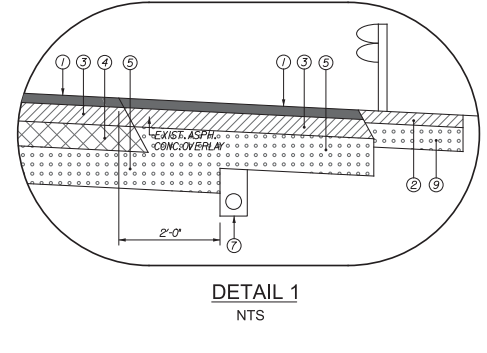


DETAIL 1
NTS

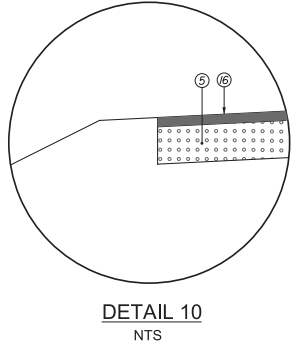


DETAIL 10
NTS

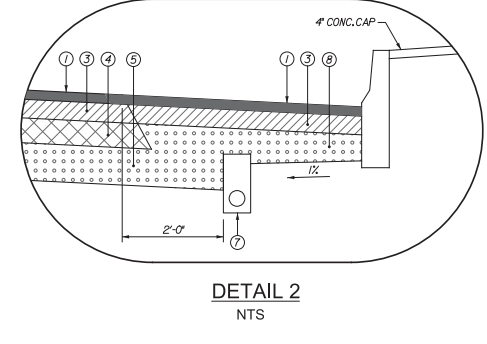

DETAIL 2
NTS

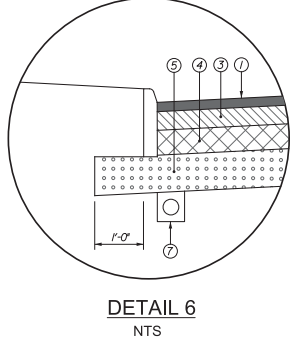

DETAIL 6
NTS

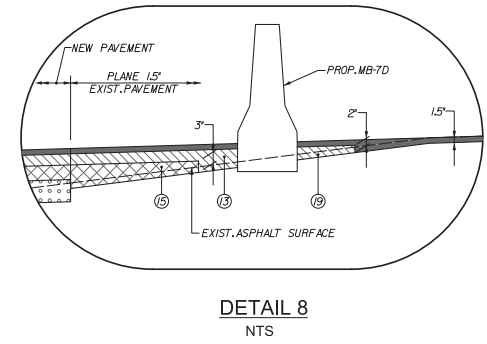

DETAIL 8
NTS

NOTES


1. SEE PROFILES FOR CROSS SLOPES.
2. SEE CROSS SECTIONS FOR DITCH LOCATIONS AND INVERTS.
3. SEE SHEET 2(3) FOR DITCH TYPICAL SECTION.



<p>2900 S. QUINCY STREET, SUITE 200 ARLINGTON, VIRGINIA (703) 824-5100</p>	RICHMOND METROPOLITAN AUTHORITY RICHMOND DOWNTOWN EXPRESSWAY DOWNTOWN EXPRESSWAY OPEN ROAD TOLLING TYPICAL SECTIONS	
	Scale: 1" = 10'-0"	Date: FEB. 25, 2011

P:\87502\10-141
 10-8-12 REVISED RAMP LINDEN TYP. LANE WIDTHS
 10/3/2012

NO.	DESCRIPTION	DATE
1	10-8-12 REVISED RAMP LINDEN TYP. LANE WIDTHS	10/3/2012

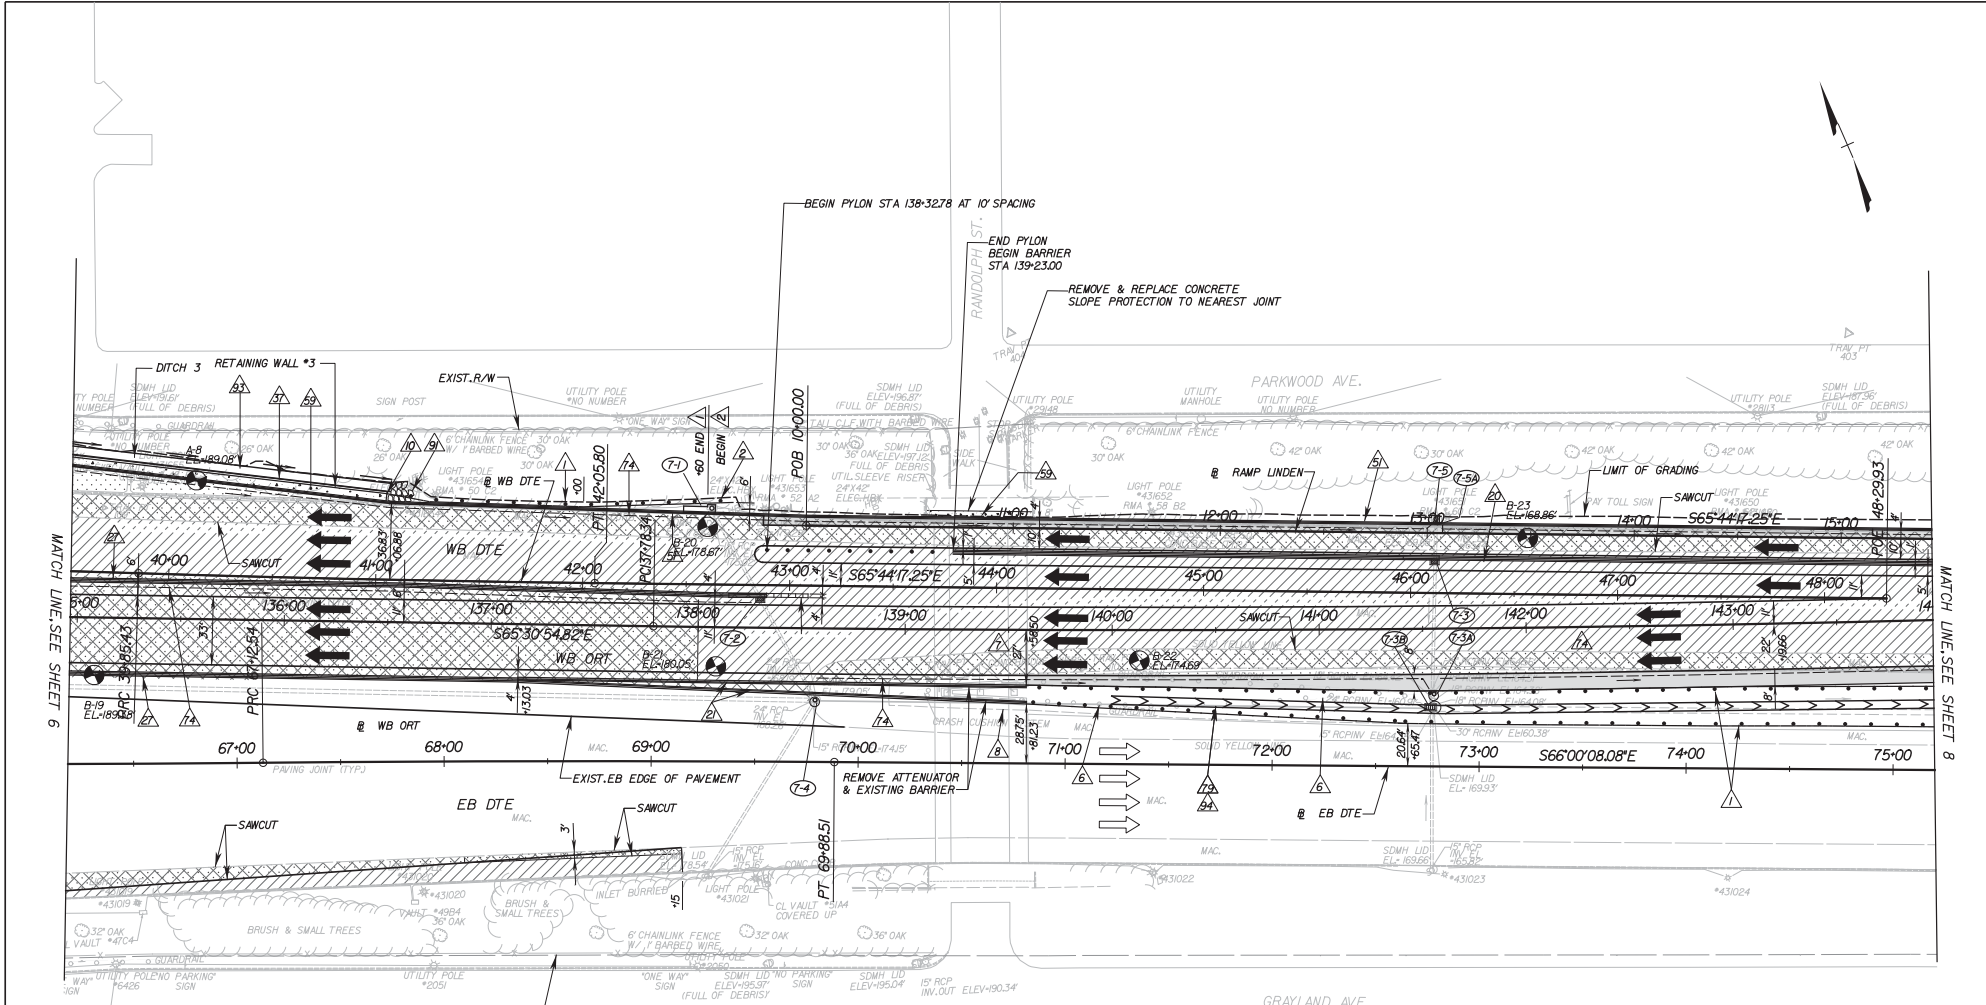

REFERENCES	
(PROFILES DETAIL & DRAINAGE DESCRIPTION SHEETS, ETC.)	
LEGEND	
IF	GEOMETRIC LAYOUT PLAN
18(1)	TYPICAL SECTIONS
2(3)	E&S PLAN - PHASE I
7(1)	E&S PLAN - PHASE II
7(2)	PROFILE WB-ORT
7A	PROFILE EB-DTE
7B	PROFILE WB-DTE
7C	PROFILE RAMP LINDEN
7D	DRAINAGE TABULATIONS
1K	RETAINING WALL *3
13(2)	MEDIAN BARRIER PROFILES
20	MEDIAN BARRIER DETAILS
20(2P)	IMPACT ATTENUATOR
20(1)	
10-8-12 REVISED BARRIER ON RAMP, ADDED PYLONS 13 REVISED BARRIER RIGHT OF WB-ORT BASELINE	
REVISIONS	

CONSTRUCTION NOTE LEGEND	
△	ST'D.GR-2 GUARDRAIL
△	ST'D.GR-6 GUARDRAIL
△	REMOVAL OF EXISTING GUARDRAIL
△	ST'D.FOA-2 FIXED OBJECT ATTACHMENT TYPE I
△	ST'D.FOA-2 FIXED OBJECT ATTACHMENT TYPE II
△	ST'D.FOA-1 FIXED OBJECT ATTACHMENT TYPE I
△	ST'D.MB-7D - 32" CONCRETE MEDIAN BARRIER
△	ST'D.MB-7E - 32" CONCRETE MEDIAN BARRIER
△	ST'D.MB-8A - 32" CONCRETE BIFURCATED MEDIAN BARRIER (10 TO 4" BIFURCATED)
△	CONCRETE GRAVITY WALL (RW-3)
△	IMPACT ATTENUATOR (TL-3) 45mph DESIGN SPEED
△	ST'D.CG-2 CURB
△	HYDRAULIC CEMENT CONCRETE SIDEWALK, 4"
△	ST'D.UD-4 UNDERDRAIN
△	ST'D.EC-2 PROTECTIVE COVERING
△	CLASS I DRY RIPRAP
△	PAVED DITCH PG-2A, TYPE E
△	GRADED FLAT BOTTOM DITCH

PAVEMENT LEGEND	
[Pattern]	PROPOSED ASPHALT SHOULDER
[Pattern]	PROPOSED ASPHALT PAVEMENT
[Pattern]	PROPOSED CONCRETE PAVEMENT
[Pattern]	PROPOSED ASPHALT PAVING & OVERLAY
[Pattern]	DEMOLITION OF PAVEMENT

2900 S. QUINCY STREET, SUITE 200
ARLINGTON, VIRGINIA
(703) 824-5100

RICHMOND METROPOLITAN AUTHORITY
RICHMOND DOWNTOWN EXPRESSWAY

DOWNTOWN EXPRESSWAY OPEN ROAD TOLLING

ROADWAY PLAN
STA. 135+00.00 TO STA. 144+00.00 WB ORT


Scale: 1" = 30'-0"

Date: FEB. 25, 2011

Contract No.: DTEOR-2011

Sheet: 7

Level: Check, Print Stamp, Originator, Checker, Rechecked, Validator, Date

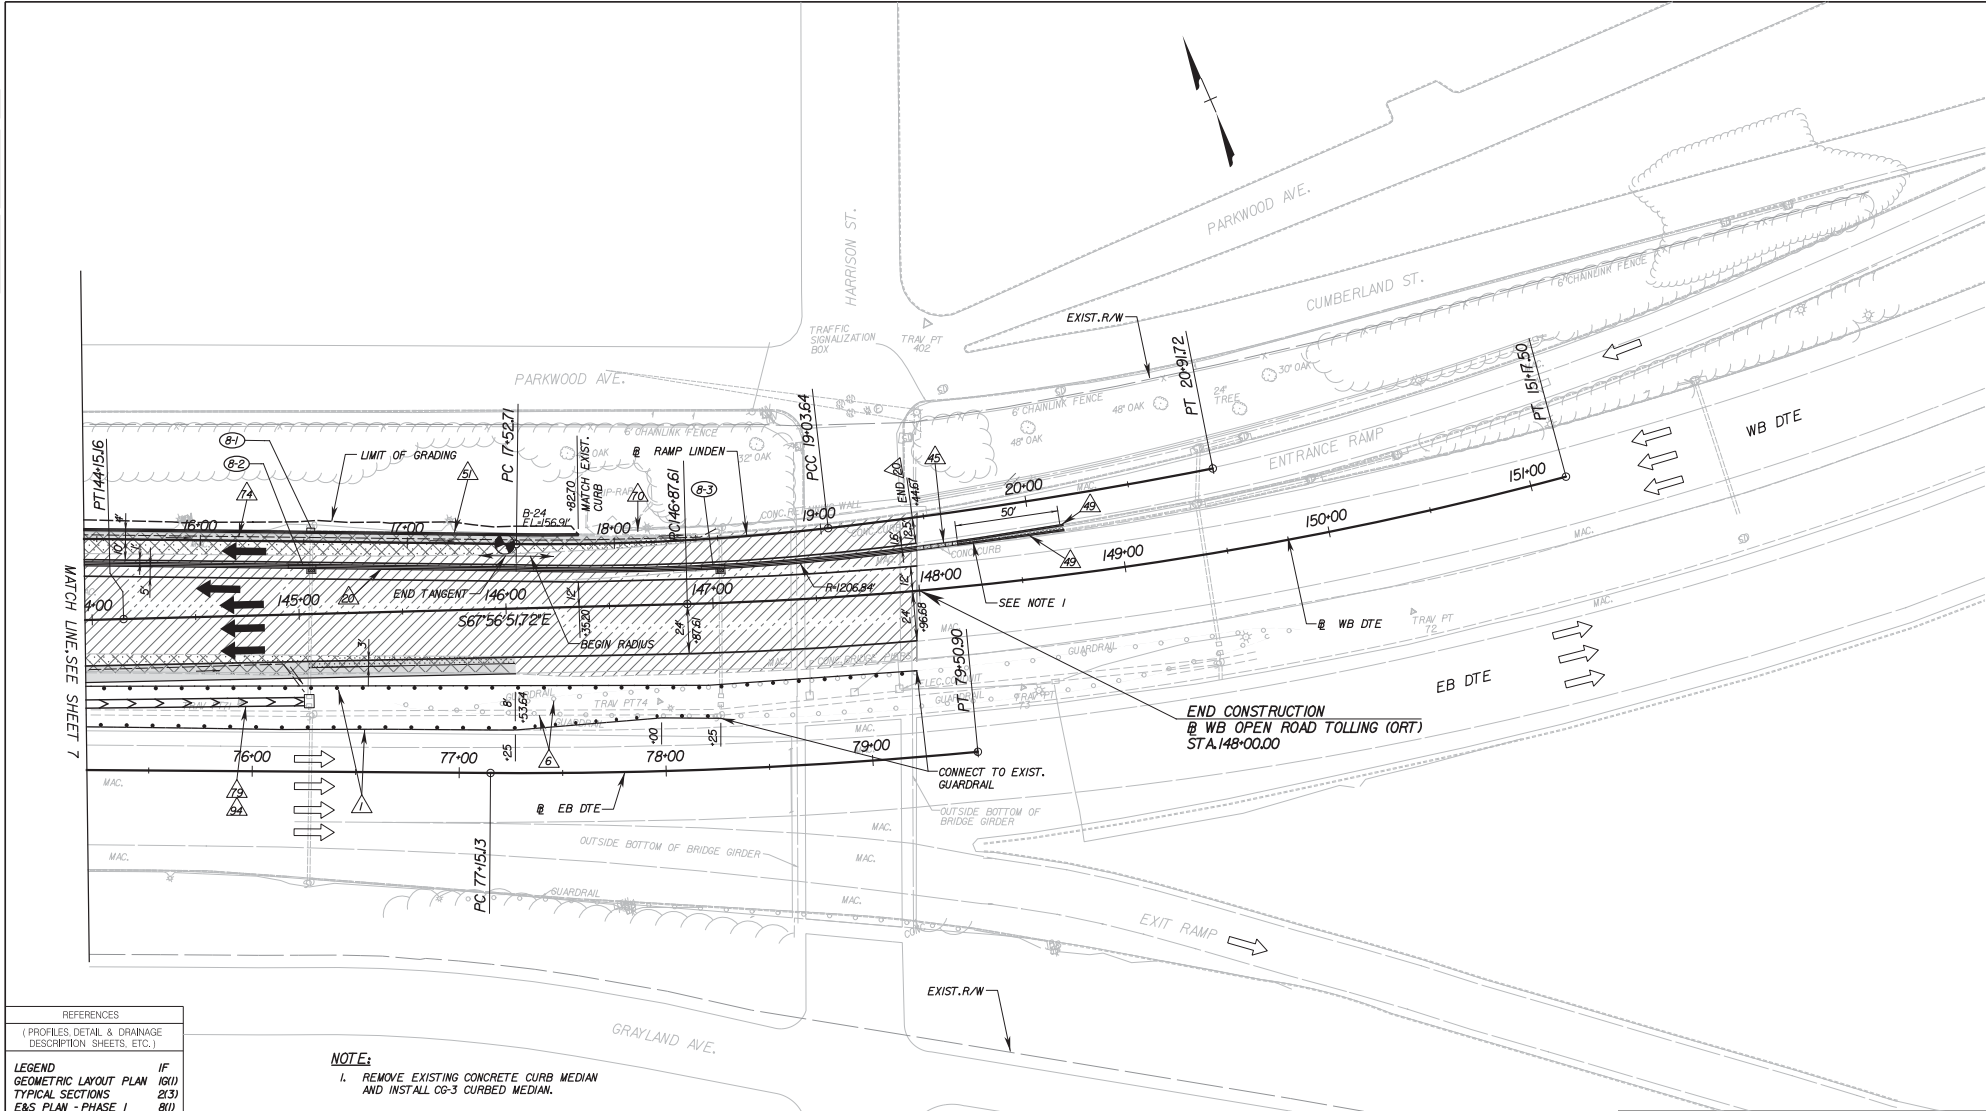

REFERENCES	
(PROFILES DETAIL & DRAINAGE DESCRIPTION SHEETS, ETC.)	
LEGEND	IF
GEOMETRIC LAYOUT PLAN	16(1)
TYPICAL SECTIONS	2(3)
E&S PLAN - PHASE I	8(1)
E&S PLAN - PHASE II	8(2)
PROFILE WB-ORT	8A
PROFILE RAMP LINDEN	8B
DRAINAGE TABULATIONS	1K
IMPACT ATTENUATOR	20(1)

REVISIONS	
10-8-12	REVISED BARRIER LOCATION, ADDED CURB AHEAD OF ATTENUATOR

NOTE:
 1. REMOVE EXISTING CONCRETE CURB MEDIAN AND INSTALL CG-3 CURBED MEDIAN.

CONSTRUCTION NOTE LEGEND

- ▲ ST'D. GR-2 GUARDRAIL
- ▲ REMOVAL OF EXISTING GUARDRAIL
- ▲ ST'D. MB-7D - 32" CONCRETE MEDIAN BARRIER
- ▲ IMPACT ATTENUATOR (TL-3>45mph DESIGN SPEED)
- ▲ ST'D. CG-3 CURB
- ▲ ST'D. CG-2 CURB
- ▲ NON-PERFORATED OUTLET PIPE
- ▲ ST'D. EW-12 ENDWALL
- ▲ ST'D. UD-4 UNDERDRAIN
- ▲ ST'D. EC-2 PROTECTIVE COVERING
- ▲ PAVED DITCH PG-2A TYPE E
- ▲ GRADED FLAT BOTTOM DITCH

PAVEMENT LEGEND

- PROPOSED ASPHALT SHOULDER
- PROPOSED ASPHALT PAVEMENT
- PROPOSED CONCRETE PAVEMENT
- PROPOSED ASPHALT PLANING & OVERLAY
- DEMOLITION OF PAVEMENT



irma RICHMOND METROPOLITAN AUTHORITY
 RICHMOND DOWNTOWN EXPRESSWAY

DOWNTOWN EXPRESSWAY OPEN ROAD TOLLING


ROADWAY PLAN
STA. 144+00.00 TO STA. 148+00.00 WB ORT

HNTB

2900 S. QUINCY STREET, SUITE 200
 ARLINGTON, VIRGINIA
 (703) 824-5100

Scale: 1"=30'-0"	Date: FEB. 25, 2011	Contract No.: DTEOR1-2011	Sheet: 8
------------------	---------------------	---------------------------	----------

04/27/2015 04:11
 Tuesday, October 02, 2012

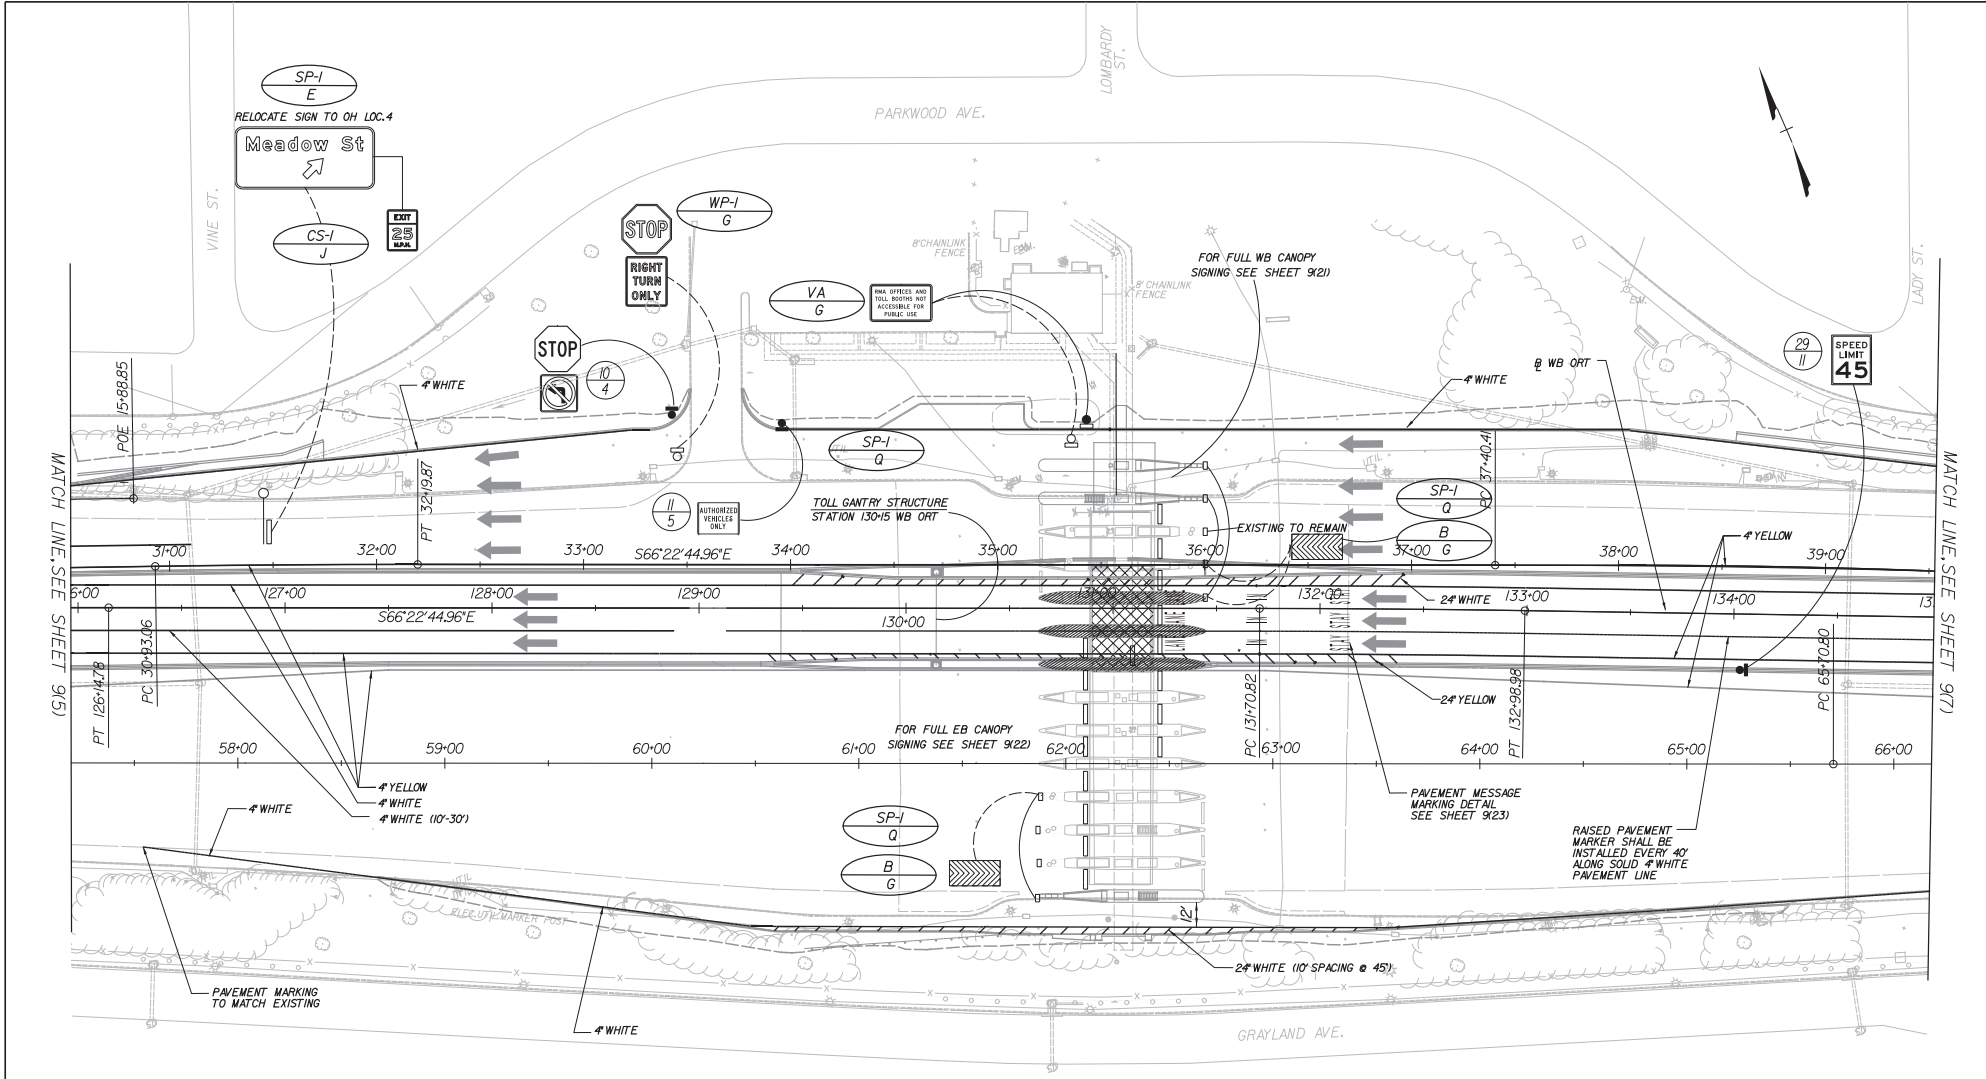


T:\2010\03\05\101 -
 Wmnsrpb\03 - October 03, 2012

REVISIONS
10-8-12 REMOVED "MAINTAIN SPEED THROUGH TOLL" SIGNS MOUNTED TO GANTRY
11-30-11 REVISED LANE ST STRIPING



 2900 S. QUINCY STREET, SUITE 200 ARLINGTON, VIRGINIA (703) 824-5100	richmond metropolitan authority RICHMOND DOWNTOWN EXPRESSWAY DOWNTOWN EXPRESSWAY OPEN ROAD TOLLING SIGNING & PAVEMENT MARKING PLAN STA. 126+00.00 TO STA. 135+00.00 WB ORT	
	Scale: 1" = 30'-0" Date: FEB. 25, 2011 Contract No.: DTEOR-2011 Sheet: 9/6	

Level: Check, Print, Stamp, Signatures, Date, Original, Checker, Recheck, Validator

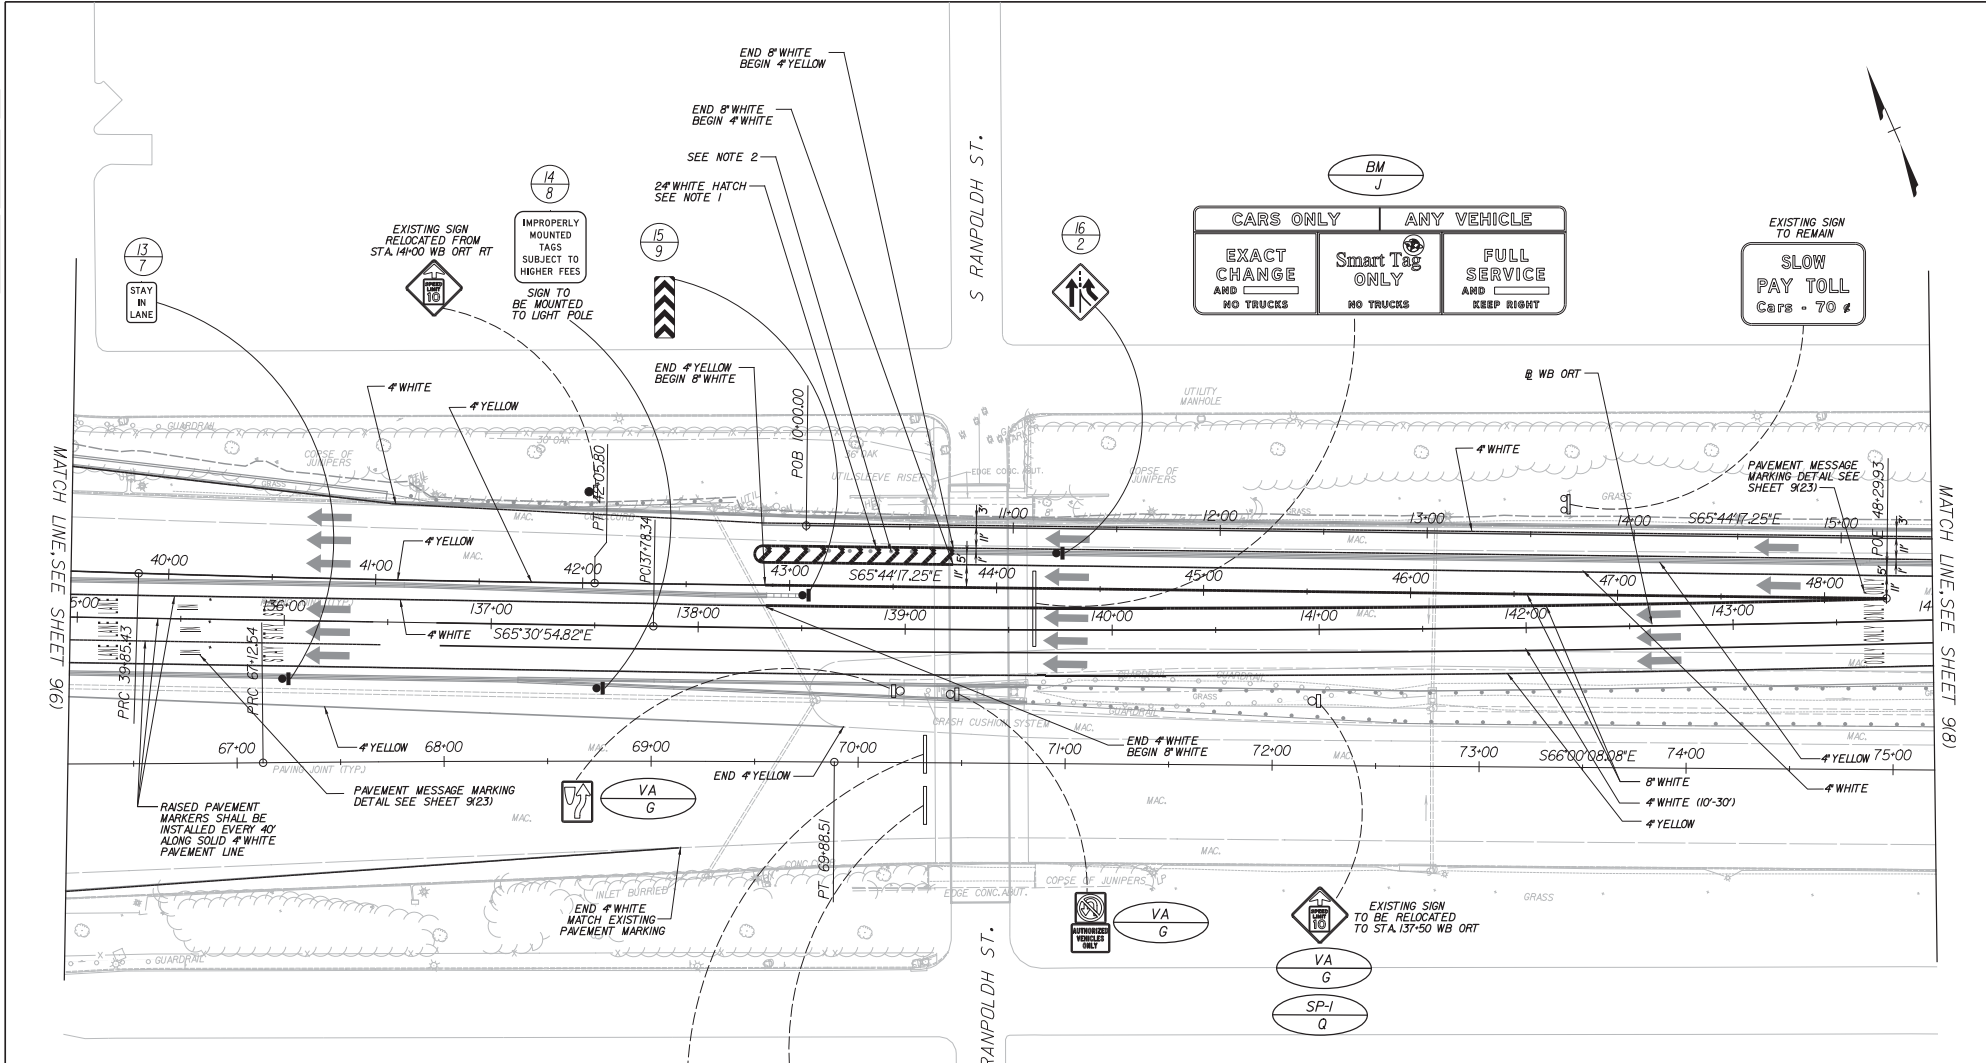


MATCH LINE: SEE SHEET 9(6)

MATCH LINE: SEE SHEET 9(8)

Bryd St - 2nd St	1/2	VA	VA
60 7th St - 9th St	1	VA	G
95 NORTH - SOUTH	2	VA	G
		SP-1	Q

EXISTING SIGN TO REMAIN

NOTES:
 1) CONTRACTOR SHALL REFER TO PAGE 3-61 OF THE VIRGINIA SUPPLEMENT TO THE MANUAL ON UNIFORM TRAFFIC CONTROL DEVICES 2011 EDITION.
 2) CONTRACTOR SHALL INSTALL (9) PYLONS AT 40' SPACING STARTING AT THE BEGINNING OF THE CONCRETE MEDIAN BARRIER.

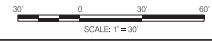

HNTB
 2900 S. QUINCY STREET, SUITE 200
 ARLINGTON, VIRGINIA
 (703) 824-5100


richmond metropolitan authority
 RICHMOND DOWNTOWN EXPRESSWAY

DOWNTOWN EXPRESSWAY OPEN ROAD TOLLING
SIGNING & PAVEMENT MARKING PLAN
STA. 135+00.00 TO STA. 144+00.00 WB ORT

Scale: 1"=30'-0"
 Date: FEB. 25, 2011
 Contract No.: DTEOR-2011
 Sheet: 9(7)

10-8-12	REVISED BARRIER RAMP LONDON
	ADDED HATCH
REVISIONS	

(A) 2'-4 #6 CIRCUITS 2A2B2C 4 #6 CIRCUITS 4A4B4C 1#6 EGC 2'-SPARE	(B) PROPOSED BORE 4'-4 #6 CIRCUITS 4A4B4C 1#6 EGC	(C) 2'-4 #6 CIRCUITS 4A4B4C 1#2 EGC	(D) EXISTING CONDUIT 4 #6 CIRCUITS 4A4B4C
--	--	--	---

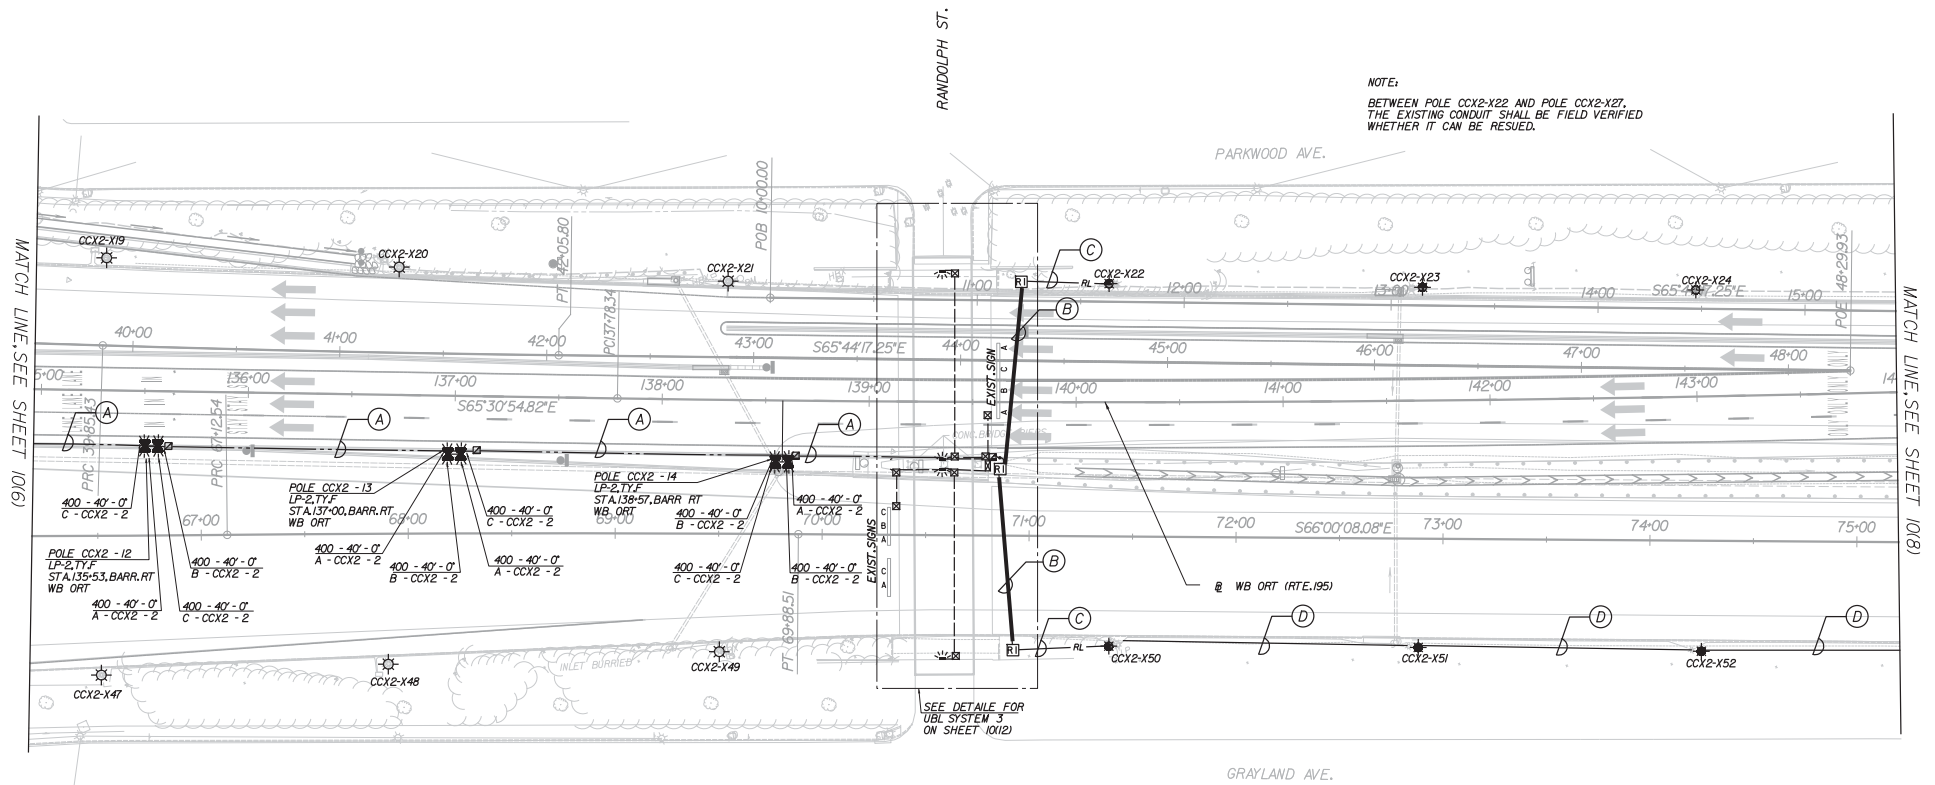

MATCH LINE-SEE SHEET 1061

MATCH LINE-SEE SHEET 1068

T:\031010\031010.dwg
Tuesday, March 5, 2011

REVISIONS


rma RICHMOND METROPOLITAN AUTHORITY
RICHMOND DOWNTOWN EXPRESSWAY

DOWNTOWN EXPRESSWAY OPEN ROAD TOLLING
HNTB LIGHTING & ELECTRICAL DISTRIBUTION PLANS
STA. 135+00.00 TO STA. 144+00.00 WB ORT

HNTB
2900 S. QUINCY STREET, SUITE 200
ARLINGTON, VIRGINIA
(703) 824-5100




Scale: 1"=30'-0"	Date: FEB. 25, 2011	Contract No.: DTEORH-2011	Sheet: 10(7)
------------------	---------------------	---------------------------	--------------

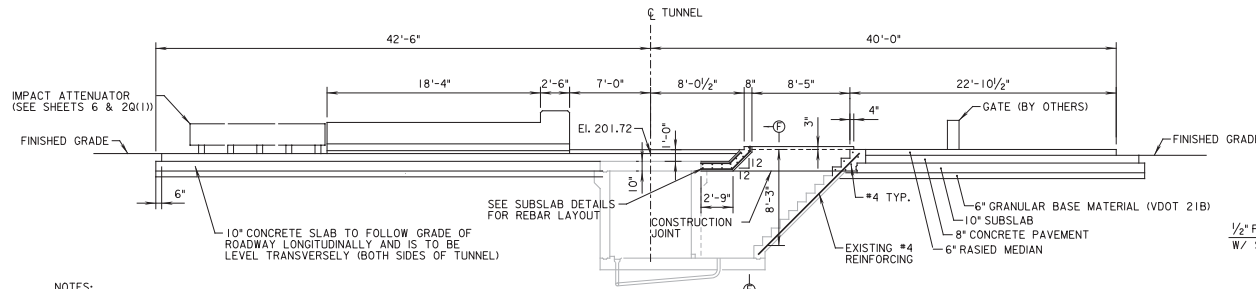


NOTES:
 FOR 8" PAVEMENT AND 10" SUBSLAB DETAILS, SEE SHEET 12(4).
 FOR DETAILS OF THE CONDUIT AND JUNCTION BOXES EMBEDDED IN THE ISLANDS, SEE TOLL PLAZA ELECTRICAL PLANS.
 THE PROVISIONS OF SECTIONS 412 AND 413 OF THE SPECIFICATIONS SHALL BE ADHERED TO IN PERFORMING THIS WORK.


SECTION A-A
 SCALE: 3/8" = 1'-0"

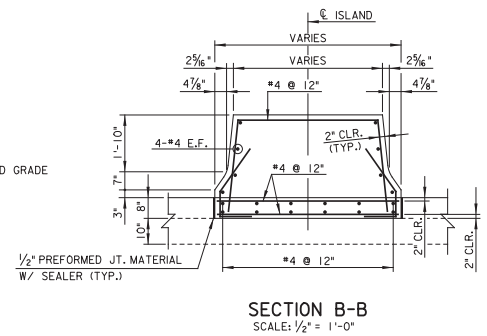


SECTION B-B
 SCALE: 1/2" = 1'-0"

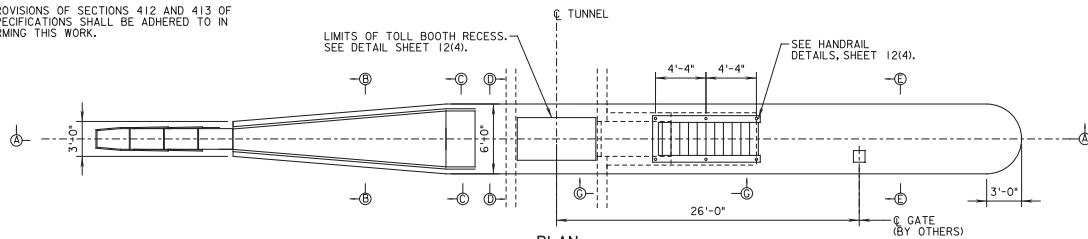


PLAN
 SCALE: 3/8" = 1'-0"

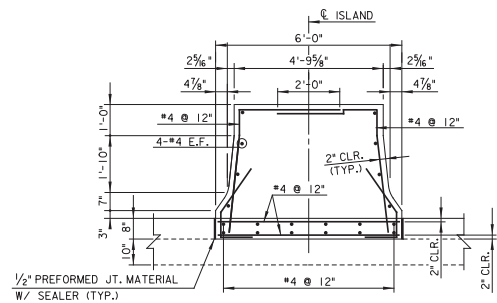


SECTION C-C
 SCALE: 1/2" = 1'-0"

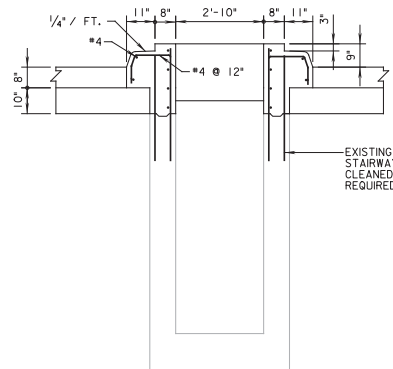

SECTION F-F
 SCALE: 1/2" = 1'-0"

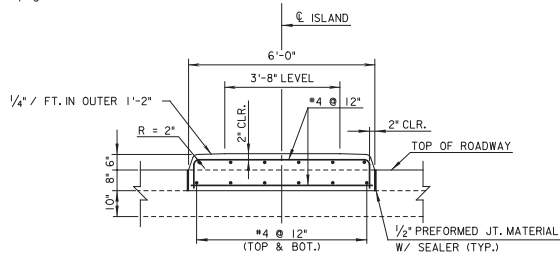


SECTION E-E
 SCALE: 1/2" = 1'-0"

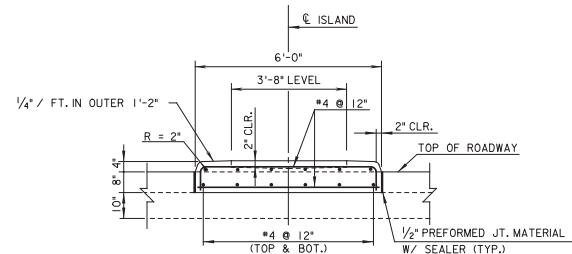


SECTION D-D
 SCALE: 1/2" = 1'-0"

NOTE: FOR SECTION BELOW TOLL BOOTH, SEE TOLL BOOTH RECESS DETAIL, SHEET 12(4).

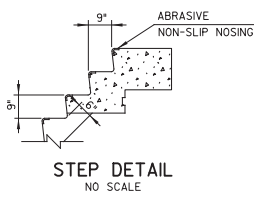

STEP DETAIL
 NO SCALE

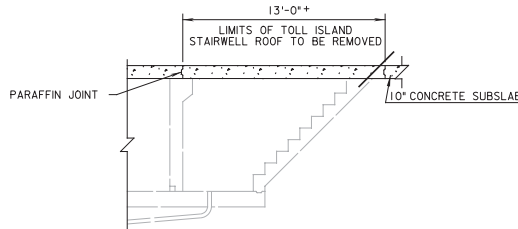

SECTION G-G (EXISTING)
 SCALE: 1/4" = 1'-0"


NO.	REVISIONS

ma RICHMOND METROPOLITAN AUTHORITY
 RICHMOND DOWNTOWN EXPRESSWAY


HNTB
 2900 S. QUINCY STREET, SUITE 200
 ARLINGTON, VIRGINIA
 (703) 824-5100

DOWNTOWN EXPRESSWAY OPEN ROAD TOLLING
**TOLL PLAZA
 ISLAND D AND P DETAILS**

Scale: AS NOTED	Date: FEB. 25, 2011	Contract No.: DTEOH-2011	Sheet: 12(2)
--------------------	------------------------	-----------------------------	-----------------

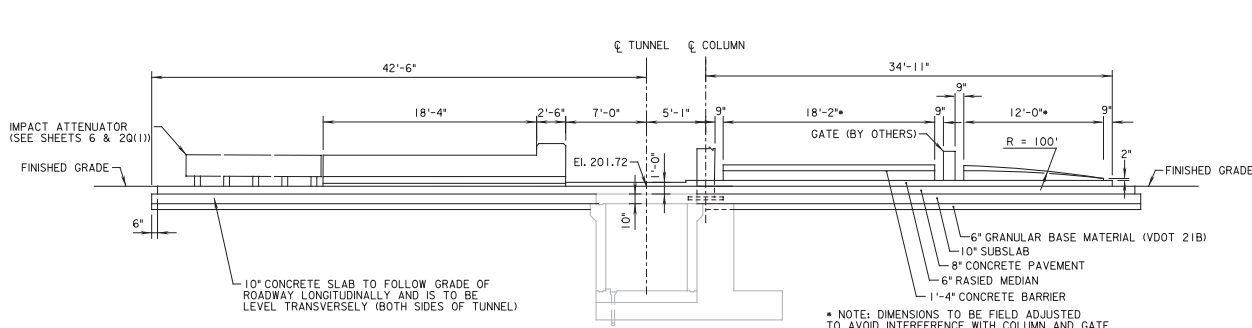


SECTION A-A
SCALE: 3/8" = 1'-0"

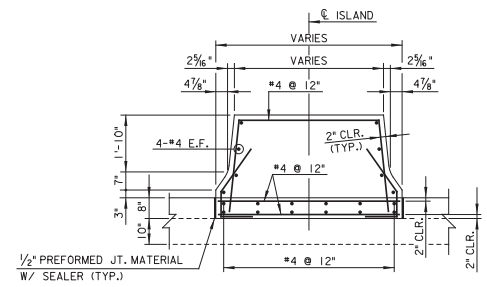


SECTION B-B
SCALE: 1/2" = 1'-0"


NOTES:
FOR 8" PAVEMENT AND 10" SUBSLAB DETAILS, SEE SHEET 12(4).
FOR DETAILS OF THE CONDUIT AND JUNCTION BOXES EMBEDDED IN THE ISLANDS, SEE TOLL PLAZA ELECTRICAL PLANS.
THE PROVISIONS OF SECTIONS 412 AND 413 OF THE SPECIFICATIONS SHALL BE ADHERED TO IN PERFORMING THIS WORK.

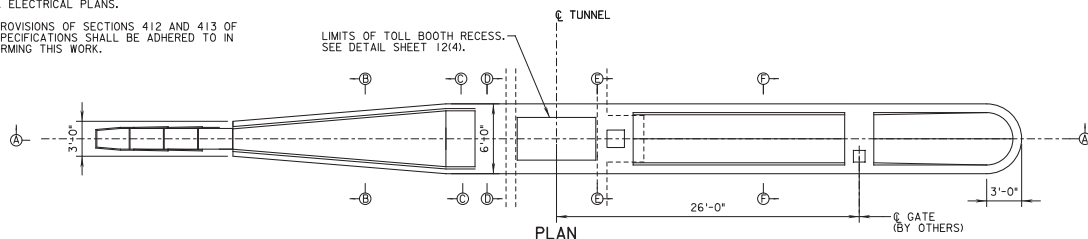


PLAN
SCALE: 3/8" = 1'-0"

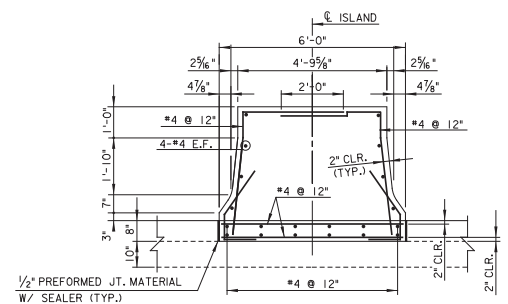

SECTION C-C
SCALE: 1/2" = 1'-0"

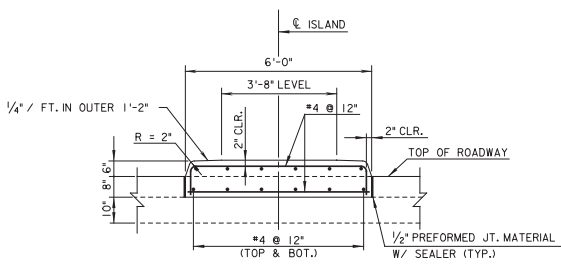


SECTION E-E
SCALE: 1/2" = 1'-0"

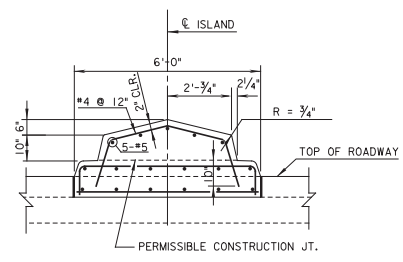

SECTION F-F
SCALE: 1/2" = 1'-0"

NOTE: FOR MEDIAN DIMENSIONS NOT LABELED SEE SECTION E-E

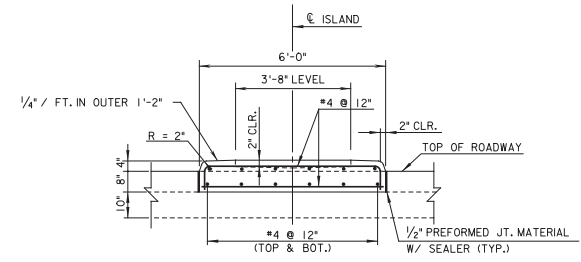

SECTION D-D
SCALE: 1/2" = 1'-0"

NOTE: FOR SECTION BELOW TOLL BOOTH, SEE TOLL BOOTH RECESS DETAIL SHEET 12(4).

NO.	DATE	DESCRIPTION
A	10-25-11	ADDED CONCRETE BARRIER ON TOP OF MEDIAN ADDED SECTION F-F
REVISIONS		


richmond metropolitan authority
RICHMOND DOWNTOWN EXPRESSWAY

HNTB
2900 S. QUINCY STREET, SUITE 200
ARLINGTON, VIRGINIA
(703) 824-5100

DOWNTOWN EXPRESSWAY OPEN ROAD TOLLING

TOLL PLAZA ISLAND C DETAILS


Scale:	Date:	Contract No.:	Sheet:
AS NOTED	FEB. 25, 2011	DTEOR-2011	12(3)

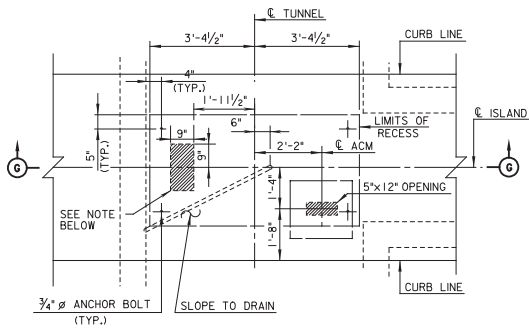

PLAN OF TOLL BOOTH RECESS


SCALE: 1/2" = 1'-0"

NOTE: 18" X 9" OPENING IN TUNNEL CEILING IS EXISTING. TOP 5" OF OPENING IS CAPPED WITH UNREINFORCED CONCRETE. CONTRACTOR SHALL REMOVE CAP AND MAINTAIN OPENING THROUGH ISLAND.

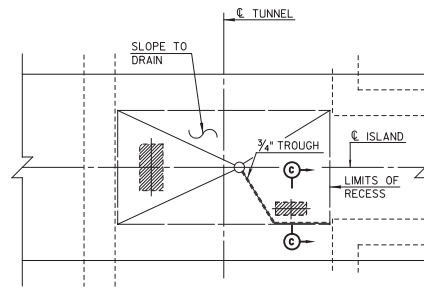


PLAN OF TOLL BOOTH DRAINAGE

SCALE: 1/2" = 1'-0"

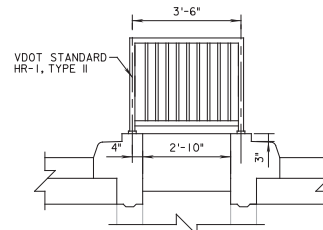

ALUMINUM RAILING TRANSVERSE SECTION ISLANDS D & P


SCALE: 1/2" = 1'-0"

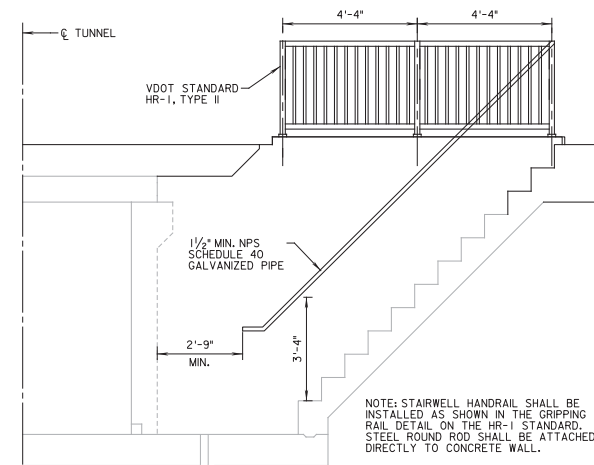

ALUMINUM RAILING LONGITUDINAL SECTION ISLANDS D & P


SCALE: 1/2" = 1'-0"

NOTE: STAIRWELL HANDRAIL SHALL BE INSTALLED AS SHOWN IN THE GRIPPING RAIL DETAIL ON THE HR-1 STANDARD. STEEL ROUND ROD SHALL BE ATTACHED DIRECTLY TO CONCRETE WALL.

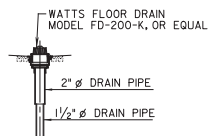


FLOOR DRAIN DETAIL
N.T.S.

NOTE: FLOOR DRAIN, PVC DRAIN PIPE AND CLEAN OUT SHALL BE INCIDENTAL TO OTHER ITEMS.

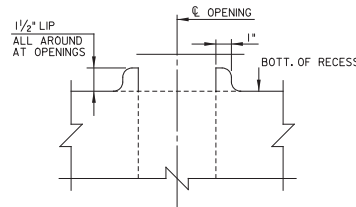


SECTION C-C

SCALE: 3" = 1'-0"

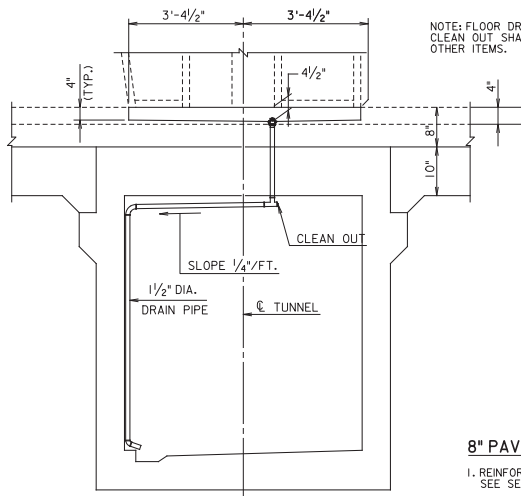

SECTION G-G

N.T.S.

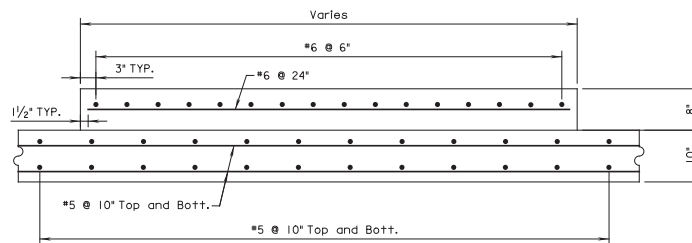

8" PAVEMENT SLAB AND 10" SUBSLAB DETAILS


SCALE: 1" = 1'-0"

8" PAVEMENT SLAB NOTES

1. REINFORCING BARS SHALL BE GLASSFIBER REINFORCED POLYMER (GFRP). SEE SECTION 316 FOR GFRP DETAILS.
2. REINFORCING BARS SHALL BE SECURED USING PLASTIC TIES, NYLON TIES, OR PLASTIC SNAP TIES. NO METAL TIES SHALL BE USED.
3. PLASTIC OR NON-METALLIC CHAIRS SHALL BE USED TO ELEVATE REBAR AT LOCATIONS SHOWN. CHAIRS SHALL BE SECURED TO 10" SLAB BY METHOD(S) APPROVED BY THE ENGINEER.
4. CONTRACTOR TO COORDINATE PLACEMENT OF LOOPS WITH TOLL INTEGRATOR AND ENGINEER PRIOR TO POURING CONCRETE.
5. CONCRETE SHALL BE CLASS A4.
6. SEE VDOT STANDARD PR-3 FOR DETAILS NOT SHOWN ON THIS SHEET.

10" SUBSLAB NOTES

1. REINFORCING BARS SHALL BE ASTM A615, GRADE 60.
2. CONCRETE SHALL BE CLASS A3.
3. DOWELS CONNECTING PROPOSED AND EXISTING SUB-SLABS SHALL BE #6 BARS SPACED AT 18" O.C. DOWELS SHALL PROJECT A MINIMUM OF 9" INTO NEW AND EXISTING CONCRETE.

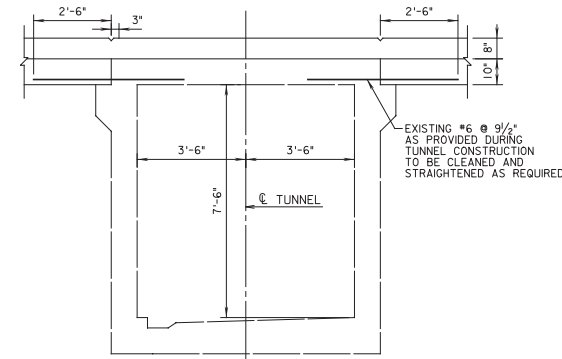

SECTION THRU TUNNEL BETWEEN ISLANDS

SCALE: 1/2" = 1'-0"

EXISTING #6 @ 9 1/2" AS PROVIDED DURING TUNNEL CONSTRUCTION TO BE CLEANED AND STRAIGHTENED AS REQUIRED

RASTRUP/SLA, Inc.
 Tuesday, October 25, 2011

NO.	DATE	DESCRIPTION
1	10-25-11	MODIFIED DIMENSIONS ON SECTION G-G
REVISIONS		

 RICHMOND METROPOLITAN AUTHORITY
 RICHMOND DOWNTOWN EXPRESSWAY


DOWNTOWN EXPRESSWAY OPEN ROAD TOLLING

HNTB

**TOLL PLAZA
TOLL ISLAND DETAILS**

2800 S. QUINCY STREET, SUITE 200
 ARLINGTON, VIRGINIA
 (703) 824-5100

Scale: AS NOTED	Date: FEB. 25, 2011	Contract No.: DTEOR1-2011	Sheet: 12(4)
--------------------	------------------------	------------------------------	-----------------

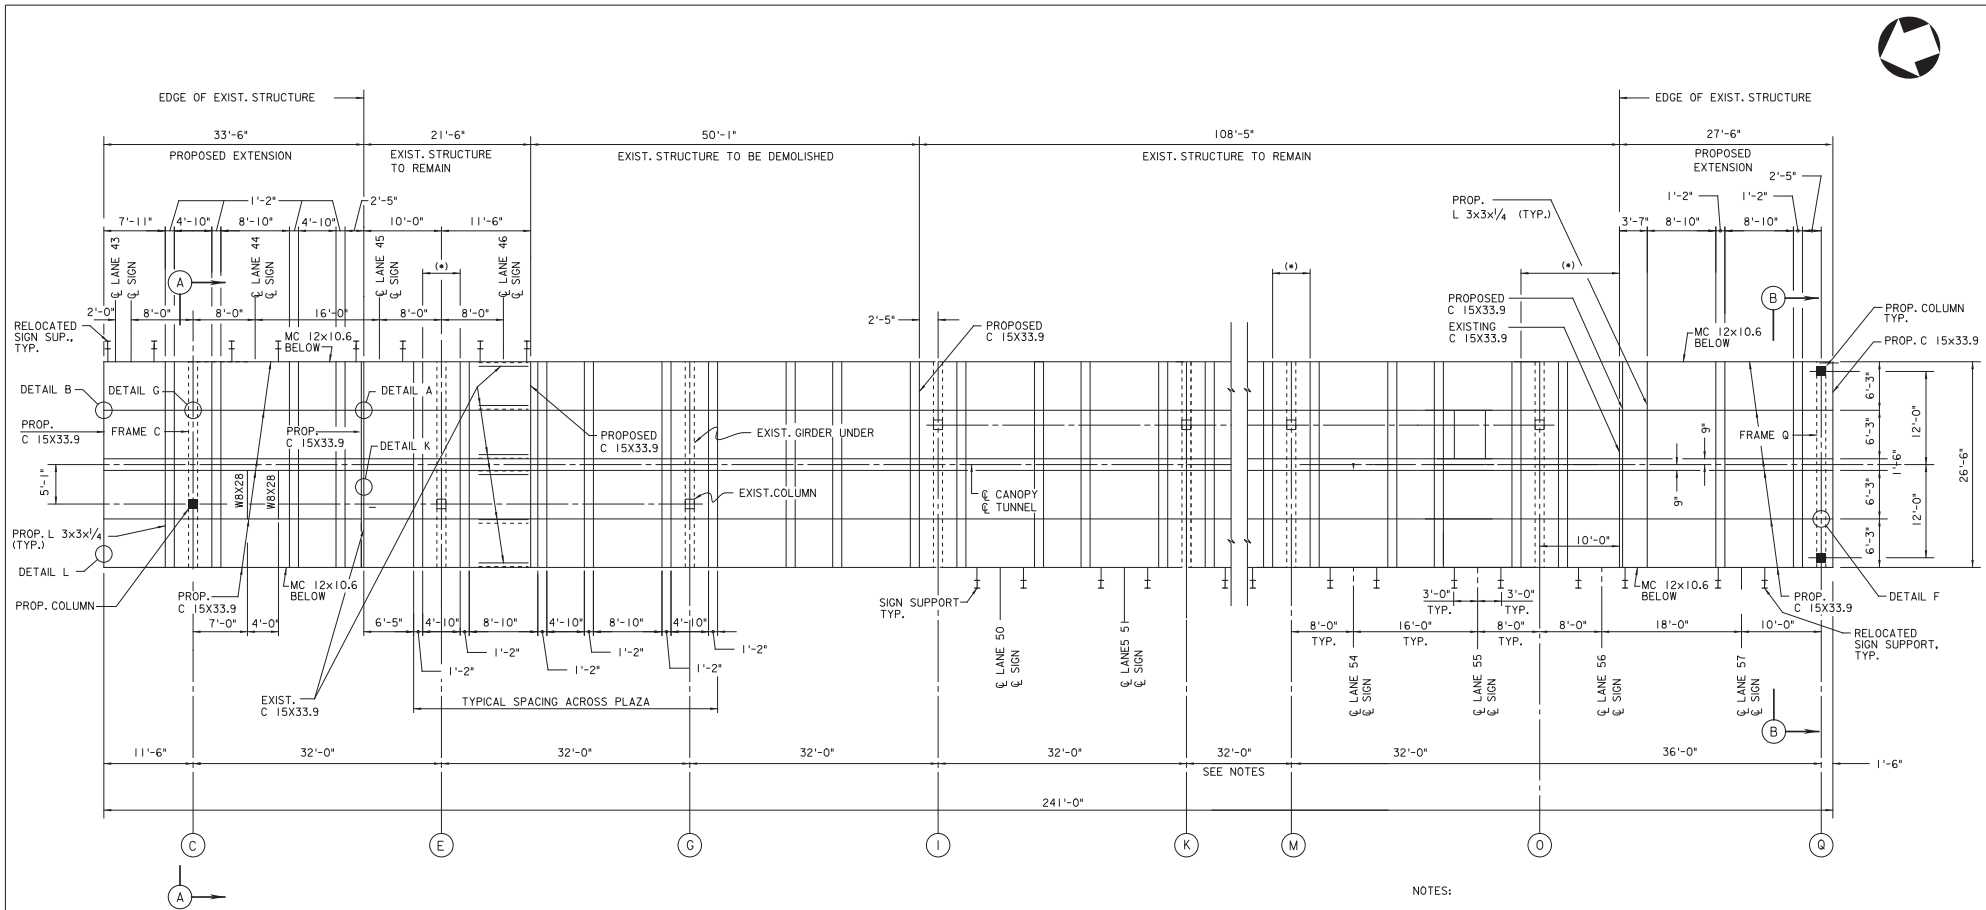

FRAMING PLAN

SCALE: 1/8" = 1'-0"

(*) ALL 6 EXISTING C 15X33.9 IN THIS AREA SHALL BE REINFORCED WITH #5X16, SEE DETAIL I ON SHEET 12(10). THIS SHALL BE COMPLETED PRIOR TO ANY CANOPY REMOVAL OR EXTENSION WORK.

NOTES:

- LOCATION OF SIGN SUPPORTS FOR LANES 52 AND 53 BETWEEN AXIS K AND M ARE THE SAME AS BETWEEN AXIS M AND O.
- FOR SECTIONS A-A AND B-B, SEE SHEETS 12(8) AND 12(9).
- FOR CANOPY EXTENSION DETAILS AND SIGN SUPPORT DETAILS, SEE SHEETS 12(10) AND 12(11).
- RELOCATED X-ARROW LED SIGN SUPPORTS ARE NOT SHOWN FOR CLARITY. SEE SHEET 12(11) FOR DETAILS.

8/8/2010 10:57 AM Tuesday, March 5, 2011

REVISIONS


ma RICHMOND METROPOLITAN AUTHORITY
RICHMOND DOWNTOWN EXPRESSWAY

HNTB
2900 S. QUINCY STREET, SUITE 200
ARLINGTON, VIRGINIA
(703) 824-5100

DOWNTOWN EXPRESSWAY OPEN ROAD TOLLING


**TOLL PLAZA
CANOPY FRAMING PLAN**

Scale: 1/8" = 1'-0"	Date: FEB. 25, 2011	Contract No.: DTEOH-2011	Sheet: 12(7)
------------------------	------------------------	-----------------------------	-----------------

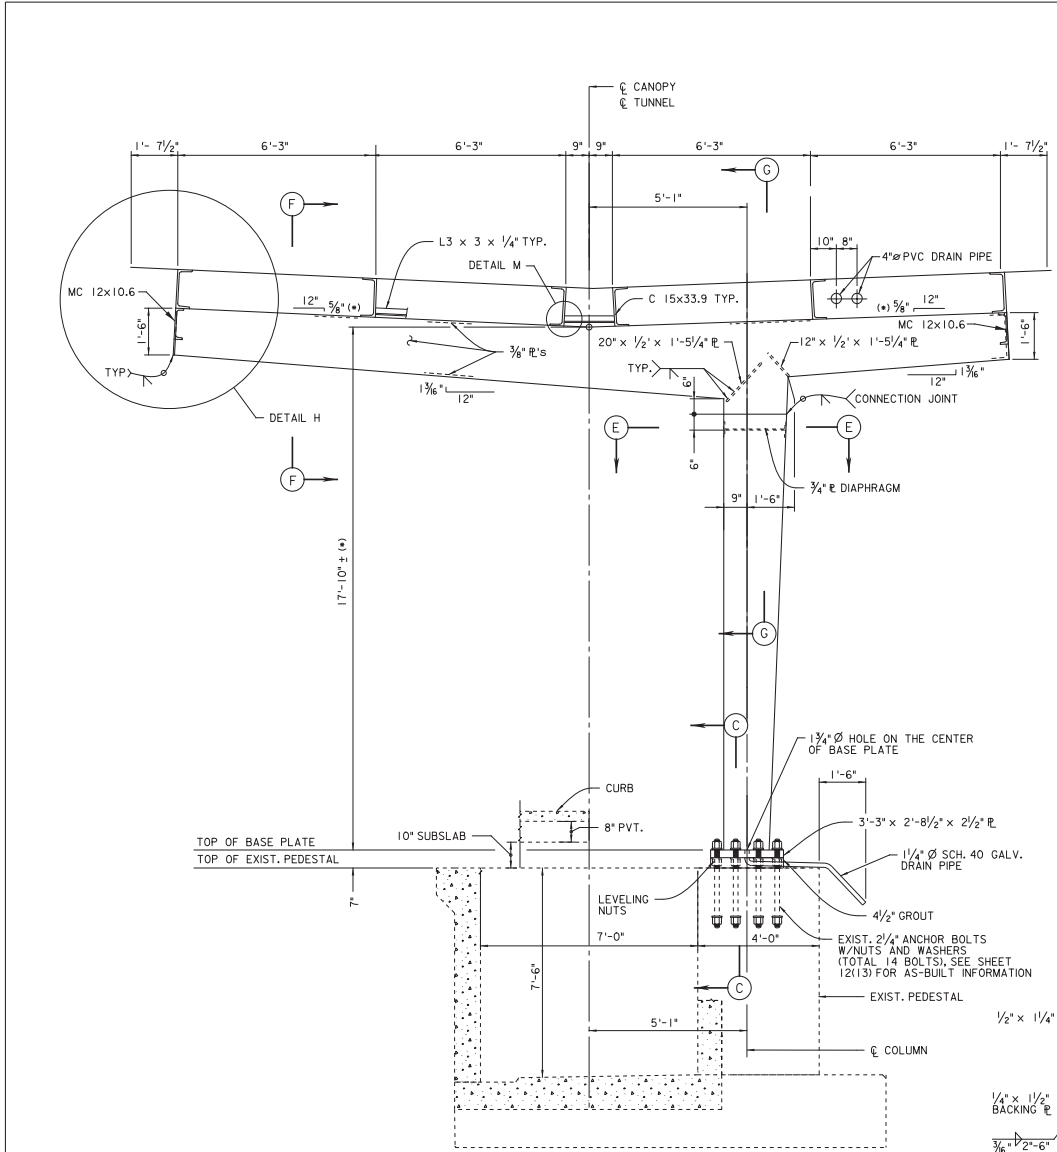


SECTION A-A
SCALE: 1/2" = 1'-0"

(*) 17'-10" IS BASED ON 17'-8" DIMENSION PER ORIGINAL DESIGN PLANS PLUS 2" ADJUSTMENT AT C OF CANOPY FOR THE ROOF SLOPE. ELEVATIONS OF THE TOP OF THE PROPOSED FRAME "C" AT ALL C15X33.9 LOCATIONS SHALL BE 2" HIGHER THAN ELEVATIONS OF THE TOP OF EXIST. FRAME "E" AT THE SAME LOCATIONS. CONTRACTOR IS RESPONSIBLE FOR SURVEYING OF EXIST. FRAME "E" BEFORE FABRICATION OF PROPOSED FRAME "C". IF REQUIRED, FRAME HEIGHT AND SLOPES OF THE FRAME TOP SHALL BE ADJUSTED.

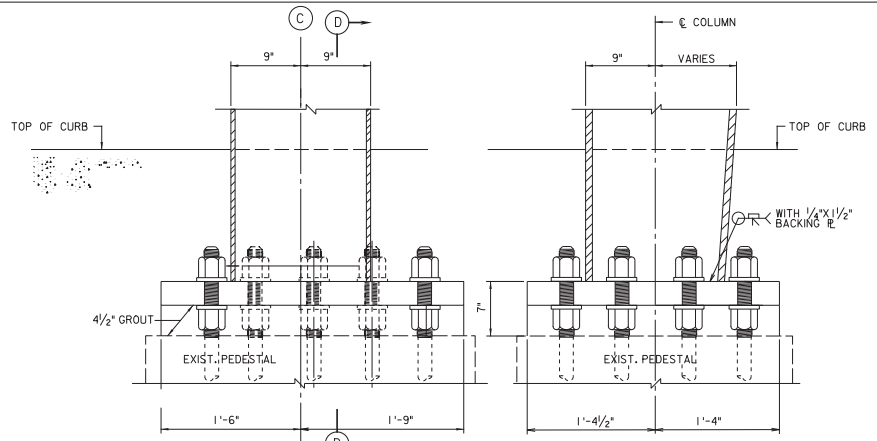


SECTION C-C
SCALE: 1/2" = 1'-0"
FOR EXIST. ANCHOR BOLT LOCATION, SEE SHEET 12(13).


SECTION D-D
SCALE: 1/2" = 1'-0"

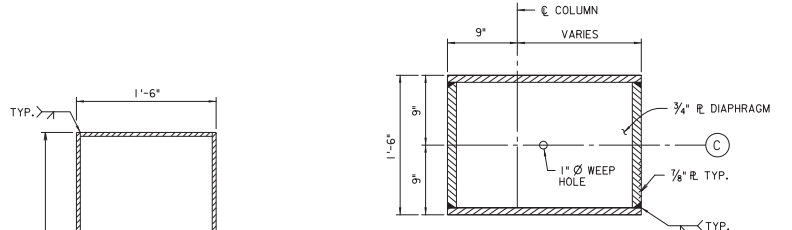


SECTION E-E
SCALE: 1/2" = 1'-0"

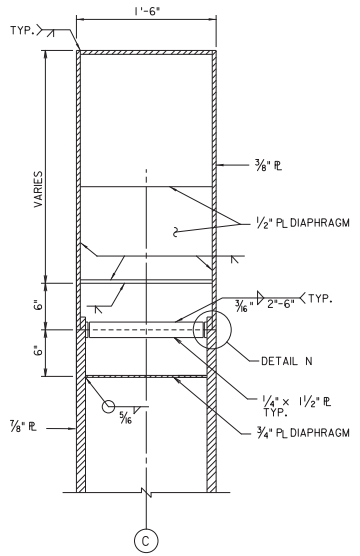

SECTION G-G
SCALE: 1/2" = 1'-0"

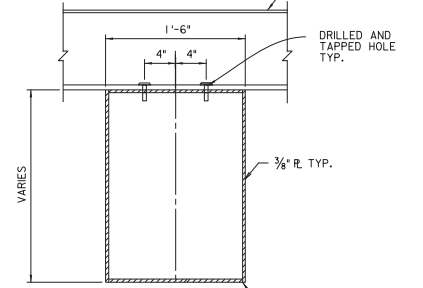

SECTION F-F
SCALE: 1/2" = 1'-0"

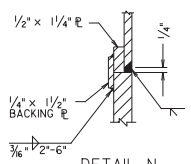

DETAIL N
SCALE: 3" = 1'-0"

NOTES:
FOR LOCATION OF SECTION A-A, SEE SHEET 12(7).
FOR DETAILS M AND H, SEE SHEET 12(11).
LOCATION OF EXISTING ANCHOR BOLTS SHALL BE FIELD VERIFIED BY CONTRACTOR.
GROUT BELOW BASE PLATE AND 1/4" Ø DRAIN PIPE SHALL BE INCIDENTAL.

DATE: 05/11/2011	REVISIONS


richmond metropolitan authority
RICHMOND DOWNTOWN EXPRESSWAY

DOWNTOWN EXPRESSWAY OPEN ROAD TOLLING

**TOLL PLAZA
CANOPY FRAME C DETAILS**


HNTB
2800 S. QUINCY STREET, SUITE 200
ARLINGTON, VIRGINIA
(703) 824-5100

Scale: AS NOTED	Date: FEB. 25, 2011	Contract No.: DTEOH-2011	Sheet: 12(8)
-----------------	---------------------	--------------------------	--------------

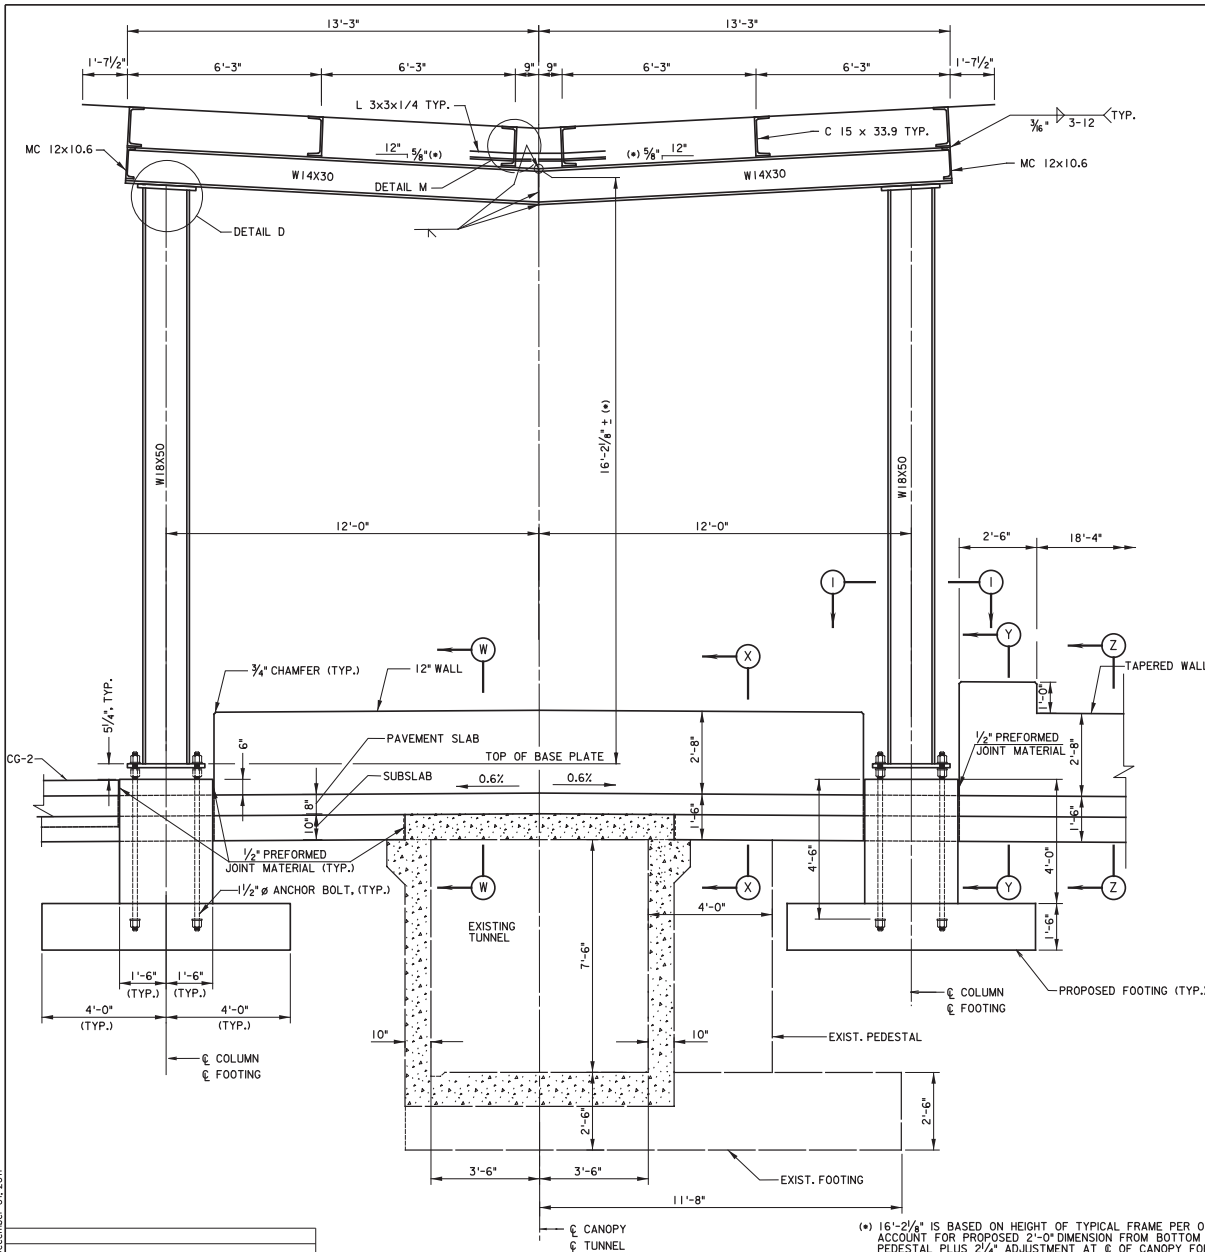


SECTION B-B
SCALE: 1/2" = 1'-0"

(*) 16'-2 1/8" IS BASED ON HEIGHT OF TYPICAL FRAME PER ORIGINAL DESIGN PLANS MODIFIED TO ACCOUNT FOR PROPOSED 2'-0" DIMENSION FROM BOTTOM OF SUBSLAB TO TOP OF FOOTING PEDESTAL PLUS 2/4" ADJUSTMENT AT ϵ OF CANOPY FOR THE ROOF SLOPE. ELEVATION OF THE PROPOSED FRAME "Q" AT ALL C15X33.9 LOCATIONS SHALL BE 2/4" HIGHER THAN ELEVATIONS OF THE TOP OF EXIST. FRAME "Q" AT THE SAME LOCATIONS. CONTRACTOR IS RESPONSIBLE FOR SURVEYING THE EXIST. FRAME "Q" PRIOR TO FABRICATION OF PROPOSED FRAME "Q". IF REQUIRED, FRAME HEIGHT AND SLOPES OF THE FRAME TOP SHALL BE ADJUSTED.

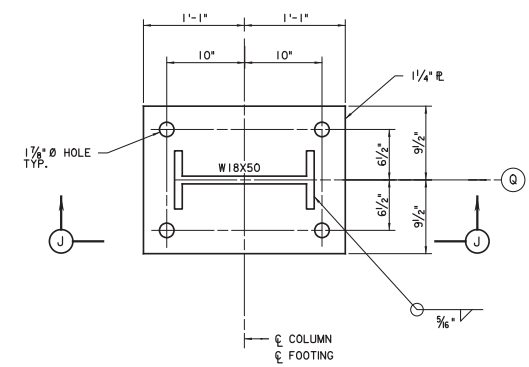

SECTION I-I
SCALE: 1 1/2" = 1'-0"

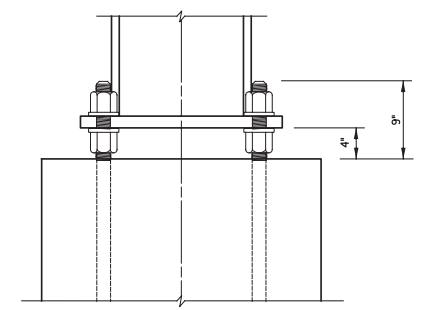


SECTION J-J
SCALE: 1 1/2" = 1'-0"

- NOTES:
 FOR LOCATION OF SECTION B-B, SEE SHEET 12(7).
 FOR DETAIL D, SEE SHEET 12(10).
 FOR DETAIL M, SEE SHEET 12(11).
 FOR FOOTING, SEE SHEET 12(13).
 FOR 8" PAVEMENT AND 10" SUBSLAB DETAILS, SEE SHEET 12(4).
 FOR SECTIONS W-W, X-X, Y-Y AND Z-Z, SEE SHEET 12(5A).


848715(0) - Rev. 01
 Thursday, December 01, 2011

NO.	REVISIONS
1	#-30# ADDED CONCRETE WALLS AND CC-2


HNTB	RICHMOND METROPOLITAN AUTHORITY RICHMOND DOWNTOWN EXPRESSWAY DOWNTOWN EXPRESSWAY OPEN ROAD TOLLING		
	TOLL PLAZA CANOPY FRAME Q DETAILS		
2800 S. QUINCY STREET, SUITE 200 ARLINGTON, VIRGINIA (703) 824-5100	Scale: AS NOTED	Date: FEB. 25, 2011	Contract No.: DTEOR1-2011
			Sheet: 12(9)

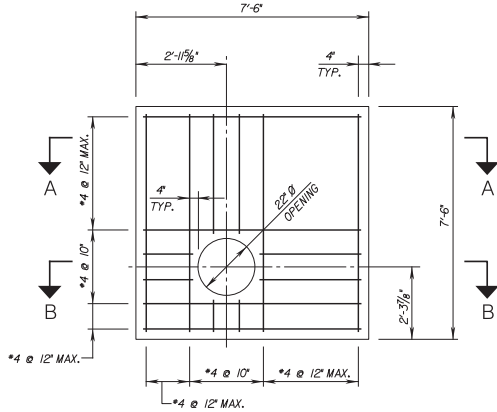

PLAN

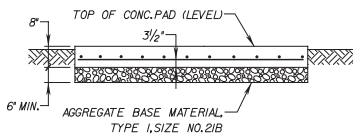

SECTION A-A

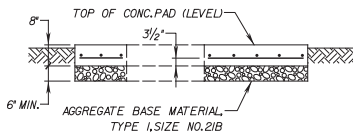


SECTION B-B

NOTES

1. CONCRETE SHALL BE CLASS A3. DEFORMED REINFORCING BARS SHALL CONFORM TO ASTM A615 GRADE 60.
2. PAD DIMENSIONS AND LAYOUT SHOWN SHALL BE USED FOR THE CONTRACT SPECIFIED TRANE QU UNIT. IF A DIFFERENT UNIT IS APPROVED, CONTRACTOR IS REQUIRED TO SUBMIT PAD LAYOUT TO THE ENGINEER FOR REVIEW AND APPROVAL.
3. CONTRACTOR SHALL INSTALL THE BURIED DUCT ABOVE THE TOP OF PAD ELEVATION PRIOR TO POURING PAD CONCRETE.
4. CONTRACTOR SHALL VERIFY DIMENSIONS OF ACTUAL CURB AND UNIT SUPPLIED AND SUBMIT ANY DISCREPANCIES BETWEEN THE PAD LAYOUT AND UNIT TO THE ENGINEER.

PAD LAYOUT
NTS

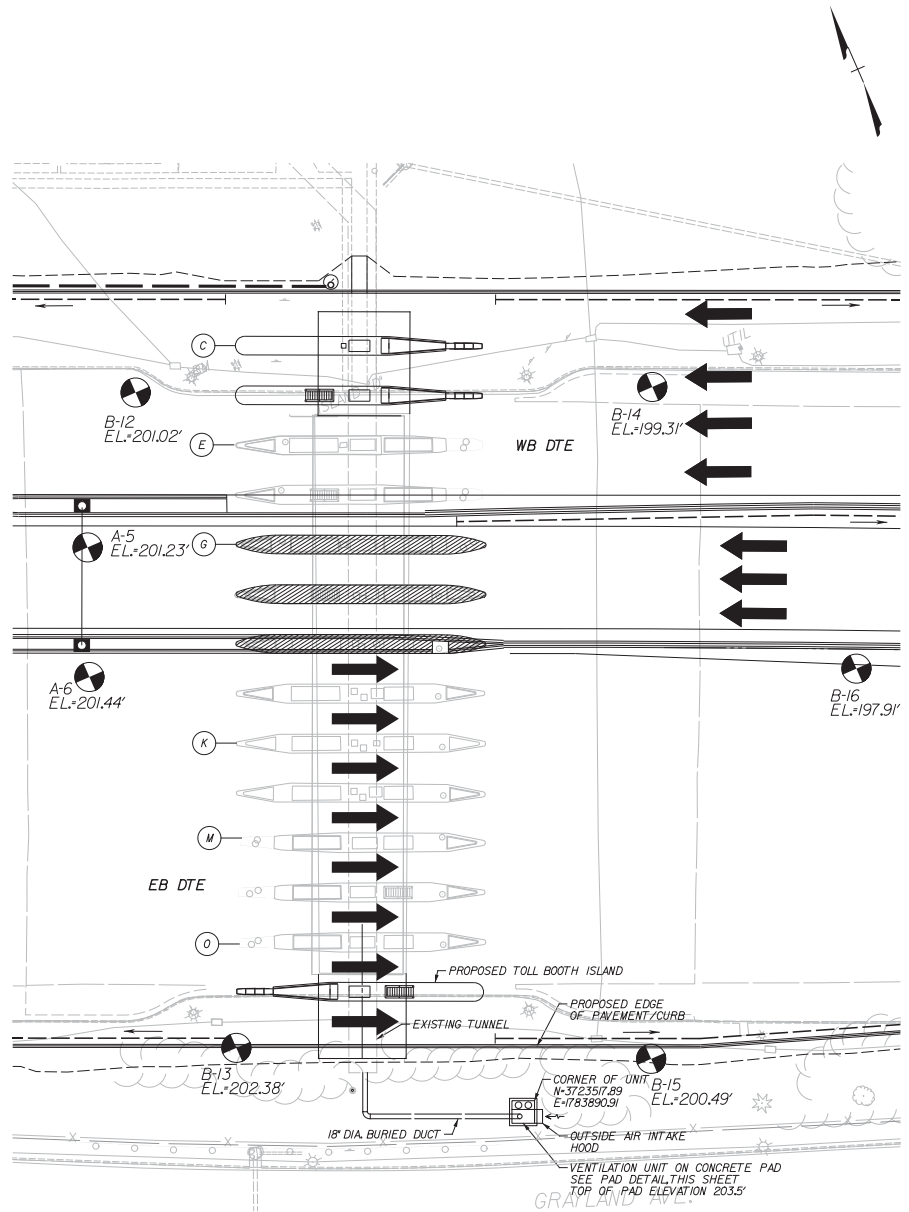

PLAN

GENERAL MECHANICAL NOTES:

1. ALL WORK SHALL CONFORM TO THE REQUIREMENTS OF VIRGINIA MECHANICAL CODE
2. VISIT SITE AND NOTE EXISTING CONDITION AFFECTING THE WORK PRIOR TO BIDDING. RELOCATION OF EXISTING SYSTEMS FOR THE INSTALLATION OF NEW WORK SHALL BE INCLUDED IN THE SCOPE OF THIS PROJECT.
3. COORDINATE ALL MECHANICAL WORK WITH THAT OF OTHER TRADES TO ENSURE PROPER AND ADEQUATE INTERFACE OF THEIR WORK WITH THE WORK OF THIS CONTRACTOR.
4. DEMOLITION: REMOVE ALL WORK AS INDICATED. REMOVE OR REROUTE EXISTING WORK TO SUIT NEW WORK. DO ALL CORE DRILLING, CUTTING AND PATCHING FOR INSTALLATION OF NEW WORK. EXISTING EQUIPMENT AND DEVICE SHALL BE REMOVED FROM SITE AT THE DIRECTION OF THE ENGINEER.
5. DAMAGES: CORRECT ALL DAMAGE TO EXISTING FINISHES, TUNNEL WALLS, FLOOR AND CEILING, OR SYSTEMS ASSOCIATED WITH THE INSTALLATION OF NEW WORK.
6. DRAWINGS ARE SCHEMATIC REPRESENTATION OF THE WORK TO BE PERFORMED AND ARE NOT INTENDED TO SHOW ALL DETAIL OF THE WORK. VERIFY LOCATIONS AND MEASUREMENTS OF ALL ITEMS AT PROJECT SITE PRIOR TO FABRICATION AND INSTALLATION.
7. PROVIDE NEC MINIMUM CODE CLEARANCE IN FRONT OF ANY ELECTRICAL EQUIPMENT (FRONT, BELOW, ABOVE, ETC.). ARRANGE EQUIPMENT SO THAT EQUIPMENT ACCESS CLEARANCE INDICATED ON DRAWINGS OR AS RECOMMENDED BY MANUFACTURER ARE PROVIDED.
8. PROVIDE ALL OFFSETS, FITTINGS AND TRANSITIONS REQUIRED TO CONNECT TO MECHANICAL EQUIPMENT.
9. ITEMS NOTED 'TYPICAL' ON ANY DRAWING SHEET APPLY TO THE ENTIRE DRAWING SET.
10. REFER TO ELECTRICAL DRAWINGS FOR POWER CONNECTIONS TO MECHANICAL EQUIPMENT.

ABBREVIATIONS

FRP FIBER REINFORCED PLASTIC
OSA OUTSIDE AIR

rma RICHMOND METROPOLITAN AUTHORITY
RICHMOND DOWNTOWN EXPRESSWAY

DOWNTOWN EXPRESSWAY OPEN ROAD TOLLING
MECHANICAL PLAN

HNTB

2800 S. QUINCY STREET, SUITE 200
ARLINGTON, VIRGINIA
(703) 824-5100

Scale: 1" = 20'-0" Date: FEB. 25, 2011 Contract No.: DTEORH-2011 Sheet: 14(1)

M&E 2/14/11 4:47 PM Tuesday, March 15, 2011

REVISIONS




DOWNTOWN EXPRESSWAY (DTE) OPEN ROAD TOLLING

**TOLL GANTRY SHOP DRAWINGS
AND STRUCTURAL CALCULATIONS**


SHOP DRAWING REVIEW

Review is for general compliance with contract documents. Reviewer is responsible for correctness of dimensions, details, materials, and safety during fabrication and erection shall remain with the contractor.


HNTB Corporation
 HNTB Corporation
 No Exceptions Taken
 Make Corrections Noted
 Amend and Resubmit
 Rejected - See Remarks By **AN** Date **12/15/11**

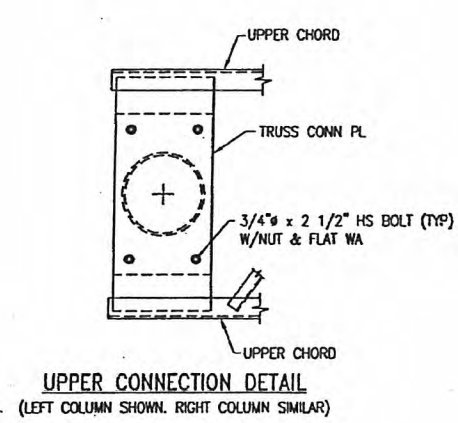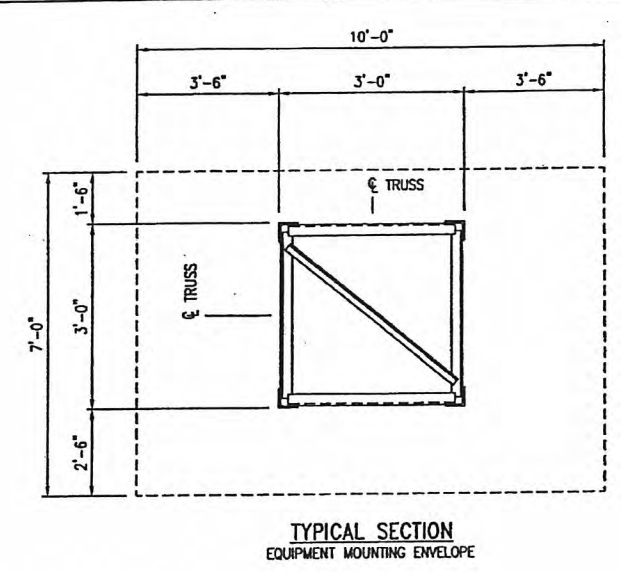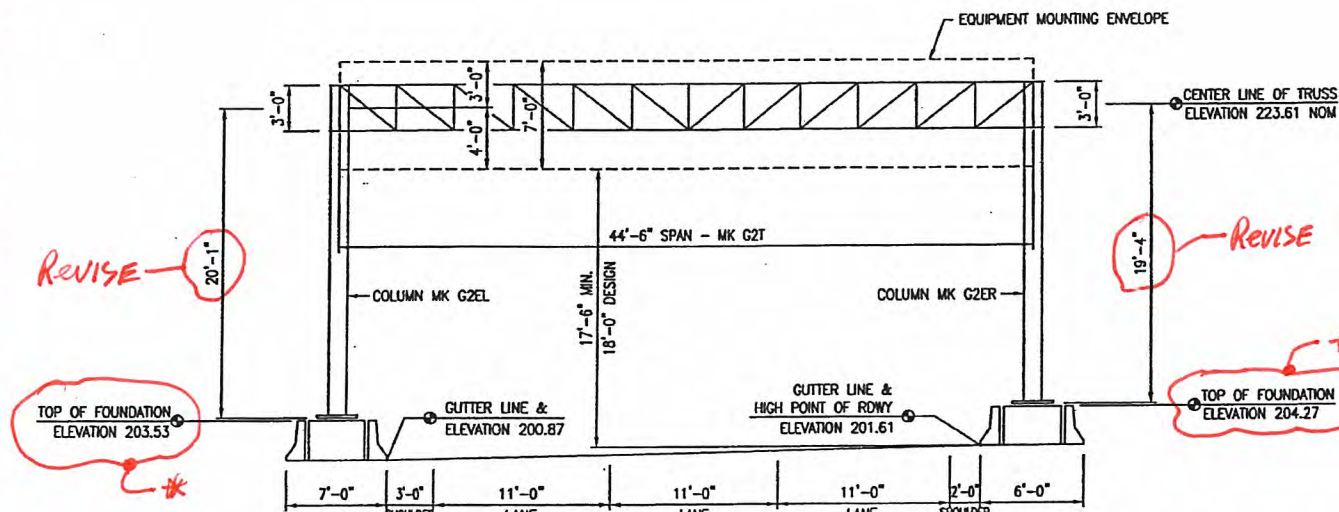


UPPER CONNECTION DETAIL
 (LEFT COLUMN SHOWN, RIGHT COLUMN SIMILAR)

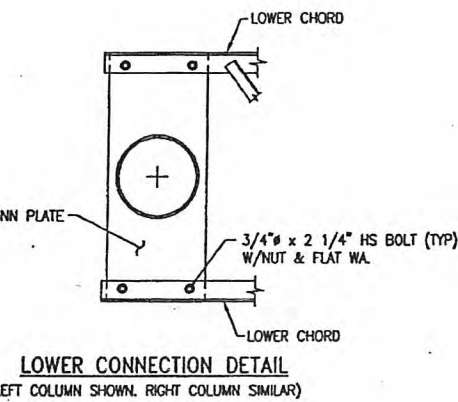

LOWER CONNECTION DETAIL
 (LEFT COLUMN SHOWN, RIGHT COLUMN SIMILAR)

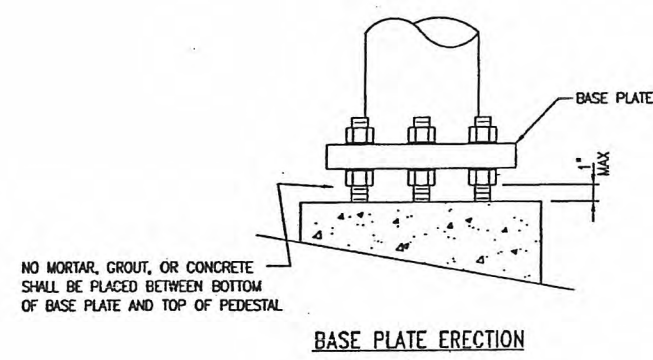


BASE PLATE ERECTION

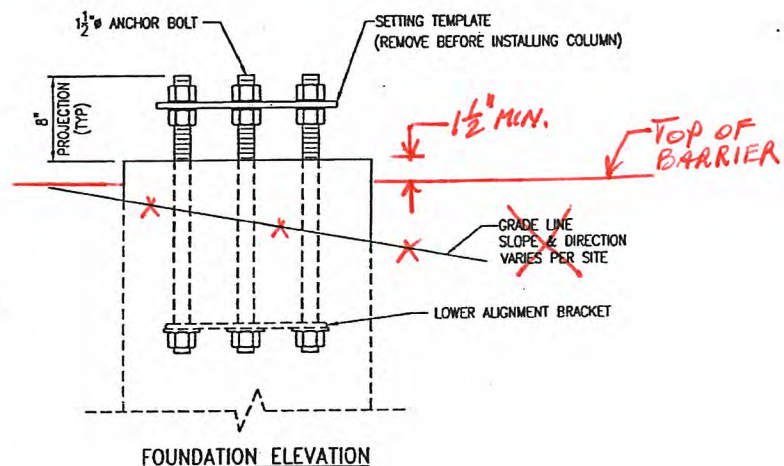

FOUNDATION ELEVATION

ANCHOR NOTE:
 USE STEEL SETTING & LOWER ALIGNMENT BRACKET TO ASSURE PROPER ANCHOR BOLT LAYOUT & ALIGNMENT.
 REUSE SETTING TEMPLATE AT SIMILAR LOCATIONS.

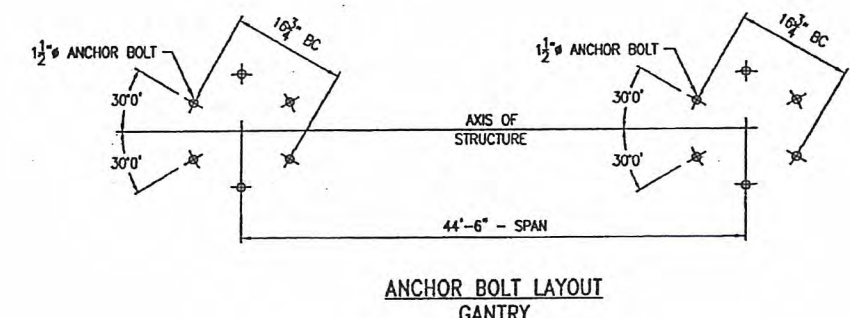

ANCHOR BOLT LAYOUT
 GANTRY

GENERAL NOTES:
 STRUCTURE DESIGN PER AASHTO STANDARD SPECS. FOR STRUCTURAL SUPPORTS FOR HIGHWAY SIGNS, LUMINAIRES AND TRAFFIC SIGNALS, 2009 5th EDITION.
 DESIGN WIND SPEED 90 MPH.
 ALL WELDING PER AWS D1.1 (LATEST EDITION).
 STRUCTURE DESIGN, ANCHOR BOLT & FOUNDATION DESIGN BY HURTT FABRICATING CORP.
 EQUIPMENT MOUNTING BRACKETS & HARDWARE BY OTHERS.
 FOUNDATION & ROADWAY ELEVATIONS PROVIDED BY VENTURE ELECTRIC CO. ON 8-27-11.
 THE ELEVATIONS SHOWN ARE FOR REFERENCE AND RELATIONSHIP ONLY AND MAY NOT BE THE ACTUAL SITE ELEVATIONS.
 17'-6" MINIMUM (18'-0" DESIGN) CLEARANCE FROM THE HIGH POINT OF THE ROADWAY TO THE BOTTOM OF THE EQUIPMENT MOUNTING ENVELOPE.
 THE TRUSS TO COLUMN HIGH STRENGTH BOLT CONNECTIONS SHALL BE INSTALLED USING THE "TURN-OF-NUT" METHOD PER SECTION 407.06(b)3 OF THE VDOT ROAD AND BRIDGE SPECIFICATIONS 2002.

REV:

PRINTS ISSUED								
FOR	#	DATE	FOR	#	DATE	FOR	#	DATE
PE	E	10-18-11	APP	E	12-13-11			
PE	E	12-13-11						
H-DIST	G	12-13-11						
INSP	1	12-13-11						

David L. Cowell
 Lic. No. 030335
 PROFESSIONAL ENGINEER

HURTT FABRICATING CORP.
 P.O. BOX 128
 MARCELINE, MO 64658


CUSTOMER: VENTURE ELECTRIC CO.
 PROJECT: CONTRACT NO. DTEORT-2011
 DOWNTOWN EXPRESSWAY OPEN ROAD TOLLING PROJECT
 RICHMOND METROPOLITAN AUTHORITY
 SUBJECT: ERECTION DIAGRAM FOR TOLL GANTRY

FILE:	5953 OH EIB	DATE:	10-13-11	PKG:	A
PRINTED FOR:	RICHMOND METRO AUTHORITY	DR BY:	TAP	CH BY:	CLH
		JOB NO:	HF-5953	SHEET	E1



SHOP DRAWING REVIEW

Review is for general compliance with contract documents. Sole responsibility for correctness of dimensions, details, quantities, and safety during fabrication and erection shall remain with the contractor.


HNTB Corporation
 No Exceptions Taken
 Make Corrections Noted
 Amend and Resubmit
 Rejected - See Remarks By AN Date 12/15/11

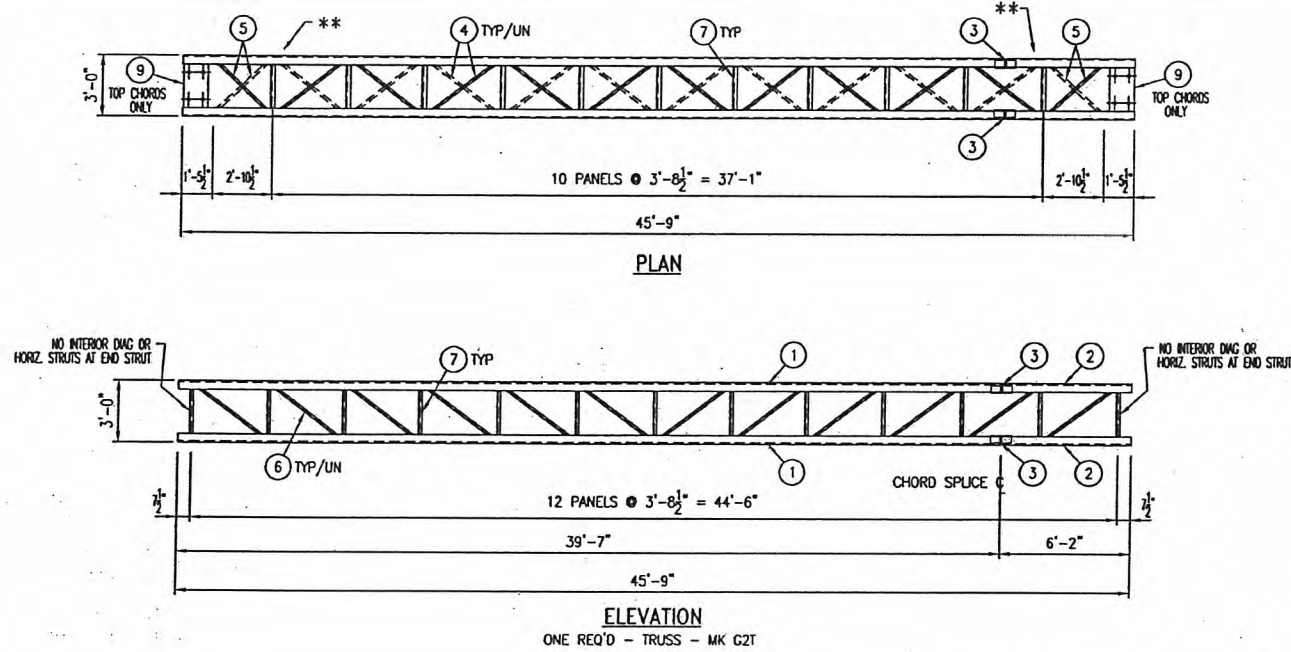


BILL OF MATERIAL				
QTY	MK	DESCRIPTION	LENGTH	REMARKS
4	1	L 4 x 4 x 3/8	39'-6 1/2"	
4	2	L 4 x 4 x 3/8	6'-1 1/2"	
4	3	L 4 x 4 x 3/8	1'-0"	
20	4	L 2 1/2 x 2 1/2 x 1/4	4'-0 1/2"	
4	5	L 2 1/2 x 2 1/2 x 1/4	3'-7 1/8"	
24	6	L 2 x 2 x 3/16	4'-0 1/2"	
48	7	L 2 x 2 x 3/16	2'-7"	
13	8	L 2 x 2 x 3/16	3'-7"	
2	9	PL 1/2 X 14	2'-8"	
8		3/4" HSB	2 1/4"	W/NUT & FLAT WASHER
8	END COLUMN	3/4" HSB	2 1/2"	W/NUT & FLAT WASHER

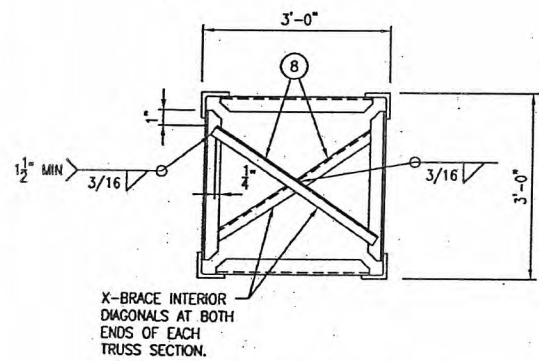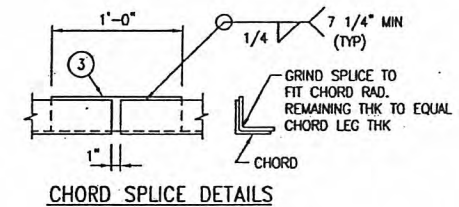


TYPICAL TRUSS SECTION END

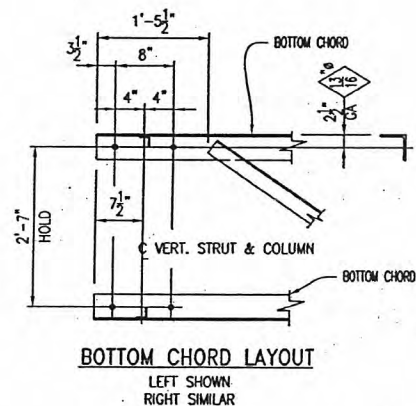


BOTTOM CHORD LAYOUT
 LEFT SHOWN
 RIGHT SIMILAR

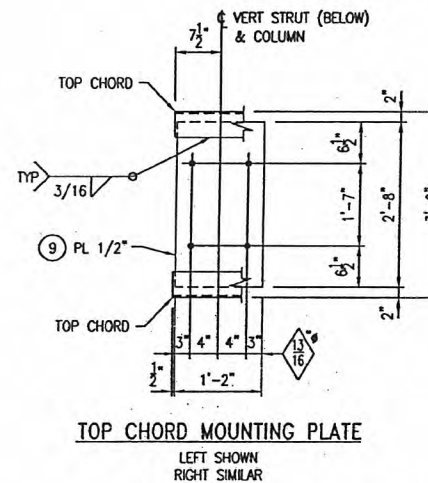


TOP CHORD MOUNTING PLATE
 LEFT SHOWN
 RIGHT SIMILAR

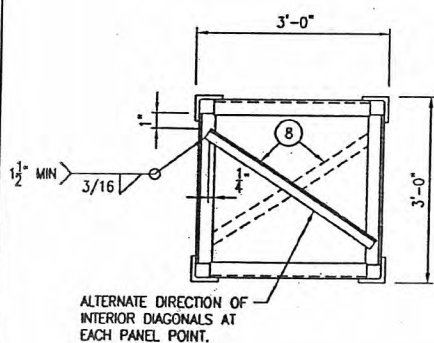

TYPICAL TRUSS SECTION

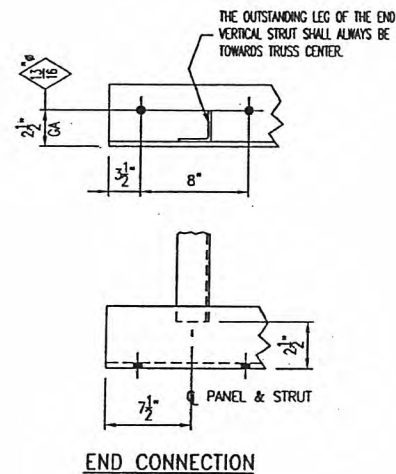

END CONNECTION

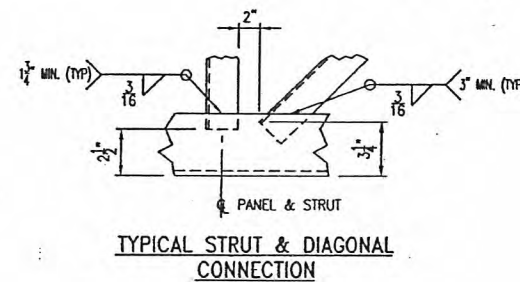


TYPICAL STRUT & DIAGONAL CONNECTION

CAMBER NOTES:
 PROVIDE 1" OF CAMBER AT CENTERLINE OF TRUSS

MATERIAL SPECIFICATIONS:
 STEEL CHORDS - ASTM A572 GR 50, A529 GR 50 or A709 GR 50 (50 KSI MIN YIELD)
 OTHER STEEL SHAPES, PLATES AND BARS - ASTM A709 GR 36 or A36
 GALVANIZE AFTER FAB PER ASTM A123
 HS BOLTS - ASTM A325 TYPE 1
 NUTS - ASTM A563 DH
 WASHERS - ASTM F436
 GALVANIZE HARDWARE PER ASTM A153


REV:					
PRINTS ISSUED					
FOR	#	DATE	FOR	#	DATE
PE	E	10-18-11			
APP	E	10-12-11			
APP	E	11-17-11			
APP	E	12-13-11			

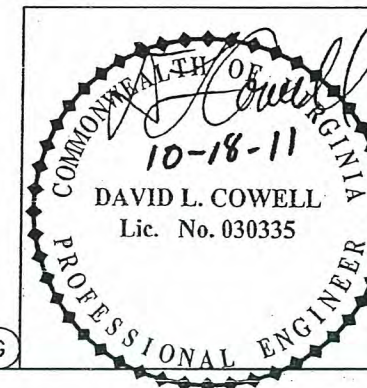


HURTT FABRICATING CORP.
 P.O. BOX 128
 MARCELINE, MO 64658

CUSTOMER: VENTURE ELECTRIC CO.
PROJECT: CONTRACT NO. DTEORT-2011
 DOWNTOWN EXPRESSWAY OPEN ROAD TOLLING PROJECT
 RICHMOND METROPOLITAN AUTHORITY
SUBJECT: FABRICATION DETAILS FOR TOLL GANTRY TRUSS


FILE: 5953 OH GANTRY TRUSS	DATE: 10-13-11	PKG: A
PRINTED FOR: RICHMOND METRO AUTHORITY	DR BY: TAP	CH BY: CLH
	JOB NO: HF-5953	SHEET 1 OF 2

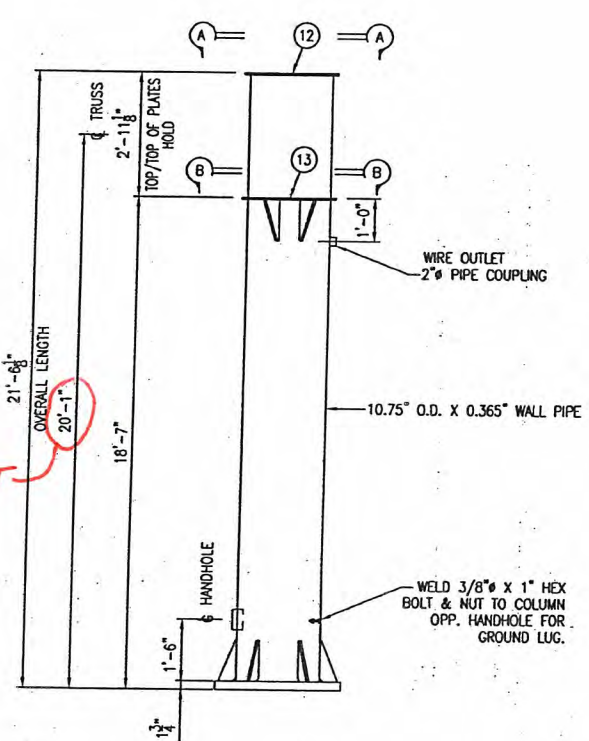


LEFT END COLUMN DETAIL
ONE REQ'D - MK G2EL

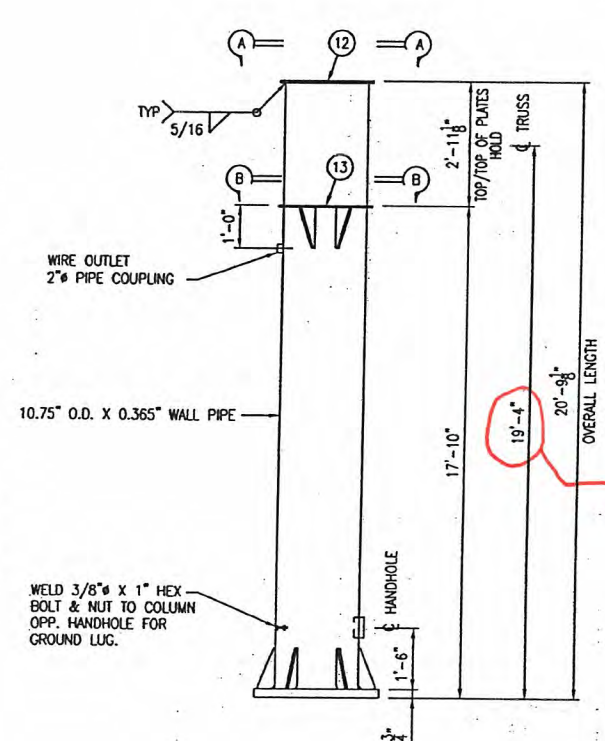

RIGHT END COLUMN DETAIL
ONE REQ'D - MK G2ER

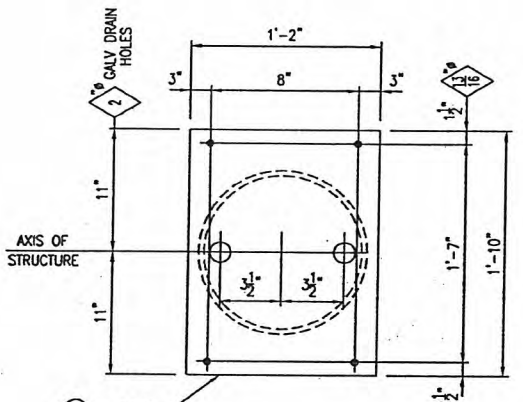


VIEW A-A
UPPER MOUNTING PLATE

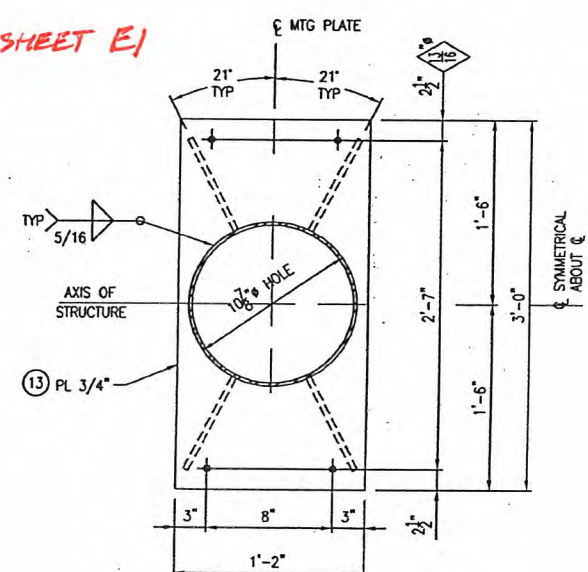

SECTION B-B
LOWER MOUNTING PLATE

BILL OF MATERIAL				
QTY	MK	DESCRIPTION	LENGTH	REMARKS
1	G2EL	10.75\"/>		
1	G2ER	10.75\"/>		
2	10	PL 1 3/4 x 22 3/4\"/>		
12	11	PL 3/4 x 5	1'-0\"/>	
2	12	PL 3/4 x 14	1'-10\"/>	
2	13	PL 3/4 x 14	3'-0\"/>	
8	14	PL 1/2 x 12	1'-0\"/>	
2	HF	PL 2 x 5 1/2	0'-8\"/>	
2	HC	PL 1/8 x 5 1/2	0'-8\"/>	
2	HG	GASKET 1/16 x 5 1/2	0'-8\"/>	
8	HARDWARE	3/8\"/>		
2	GROUND LUG	3/8\"/>		
2		2\"/>		

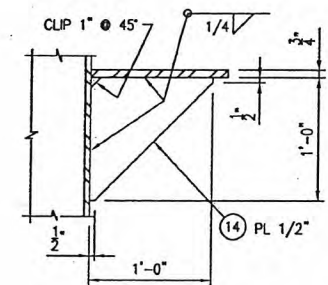


TRUSS CONNECTION
GUSSET
REQUIRED @ BOTTOM CONNECTION ONLY

SHOP DRAWING REVIEW


Review is for general compliance with contract documents. Sole responsibility for correctness of dimensions, details, quantities, and safety during fabrication and erection shall remain with the contractor.

- No Exceptions Taken
- Make Corrections Noted
- Amend and Resubmit
- Rejected - See Remarks


HNTB Corporation
AN
12/15/11

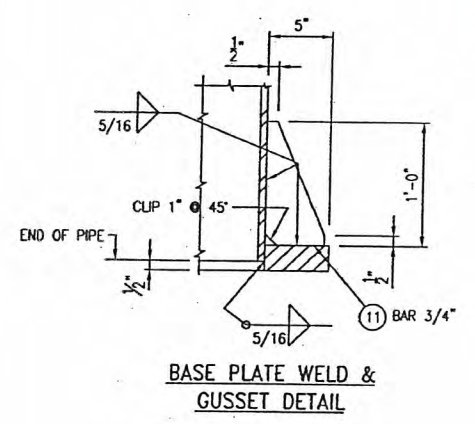

BASE PLATE WELD &
GUSSET DETAIL

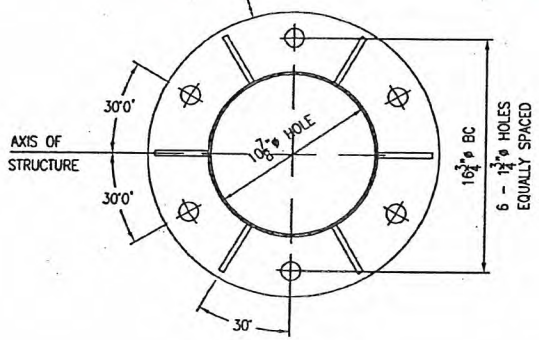

BASE PLATE DETAIL

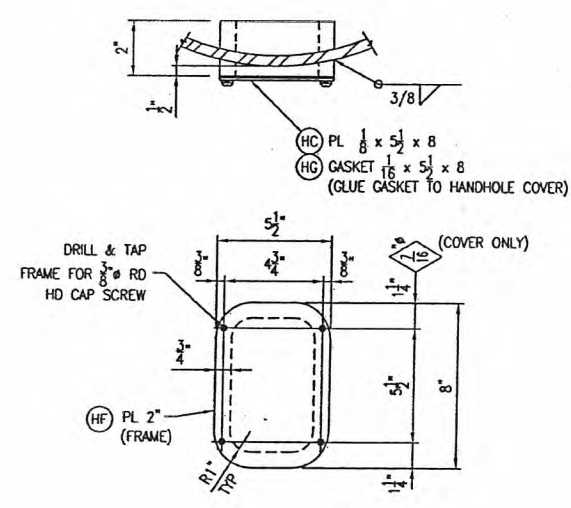

HANDHOLE DETAIL

MATERIAL SPECIFICATIONS:


COLUMN PIPE - A500 GR B or API 5L X42, X52, or X60 (42 KSI MIN. YIELD)
STEEL BARS & PLATES - ASTM A709 GR 36 or A36
GALV. STEEL AFTER FAB PER ASTM A123
STD BOLTS, NUTS, & WASHERS - ASTM A307
GALV. HARDWARE PER ASTM A153

REV:					
PRINTS ISSUED					
FOR	#	DATE	FOR	#	DATE
PE	E	10-18-11			
HD	S	10-12-11			
INS	P	1-12-11			
APP	E	12-13-11			

HURTT FABRICATING CORP.
P.O. BOX 128
MARCELINE, MO 64658

CUSTOMER: VENTURE ELECTRIC CO.
PROJECT: CONTRACT NO. DTEORT-2011
DOWNTOWN EXPRESSWAY OPEN ROAD TOLLING PROJECT
RICHMOND METROPOLITAN AUTHORITY
SUBJECT: FABRICATION DETAILS FOR TOLL GANTRY END COLUMNS

FILE: 5953 GANTRY END COLUMN DATE: 10-13-11 PKG: A
PRINTED FOR: DR BY: CH BY: JOB NO: SHEET
RICHMOND METRO AUTHORITY TAP CLH HF-5953 2 OF 2

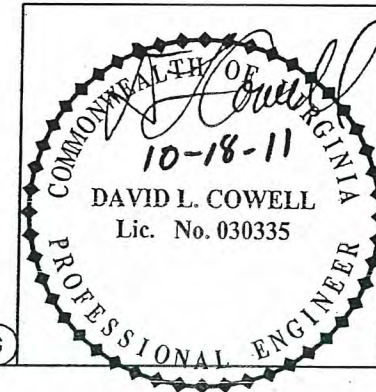


SEE SHEET E1


SEE SHEET E1

BILL OF MATERIAL

QTY	MK	DESCRIPTION	LENGTH	REMARKS
2		1/2" ROD	5'-2 1/2"	BLACK
4	HOOP	1/2" ROD	1'-8 3/4"	BLACK
12		1 1/2" FLAT WASHER		LOW CARBON
2	TEMP	PL 3/8 x 22 3/4"		BLACK
12	AB11H	1 1/2" NOM ROD DIA	3'-4"	
36		1 1/2" HEAVY HEX NUT		GALV
24		1 1/2" FLAT WASHER		GALV

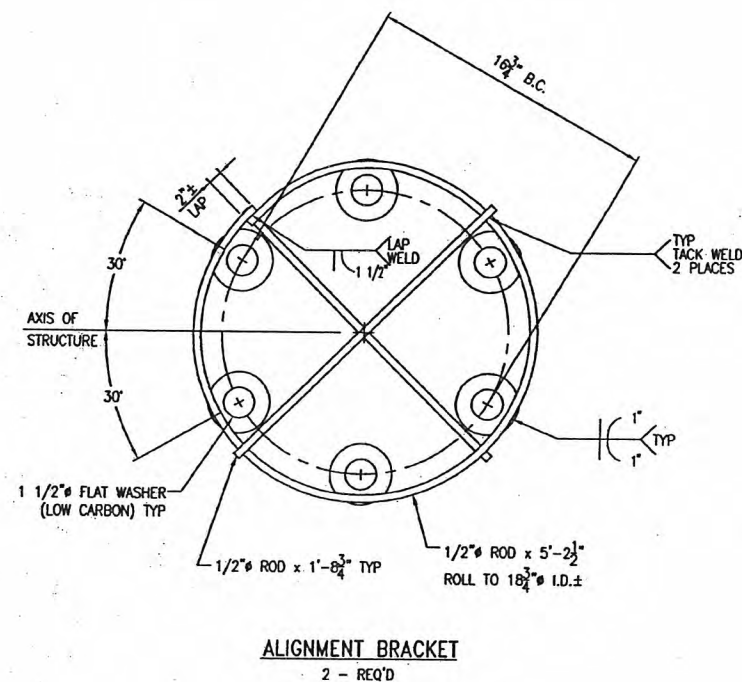

ALIGNMENT BRACKET
2 - REQ'D

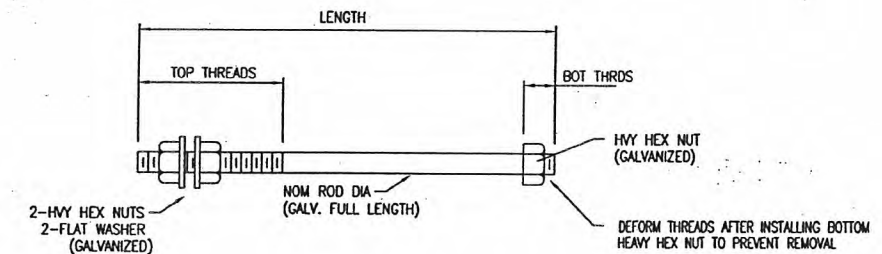

ANCHOR BOLT DETAIL


QTY	MK	ROD SIZE NOM DIA	LENGTH	TOP THRDS	BOT THRDS
12	AB11H	1 1/2"	3'-4"	8"	2"

SHOP DRAWING REVIEW

Review is for general compliance with contract documents. Sole responsibility for correctness of dimensions, details, quantities, and safety during fabrication and erection shall remain with the contractor.

- No Exceptions Taken
 - Make Corrections Noted
 - Amend and Resubmit
 - Rejected - See Remarks
- By AN Date 12/15/11

HNTB Corporation

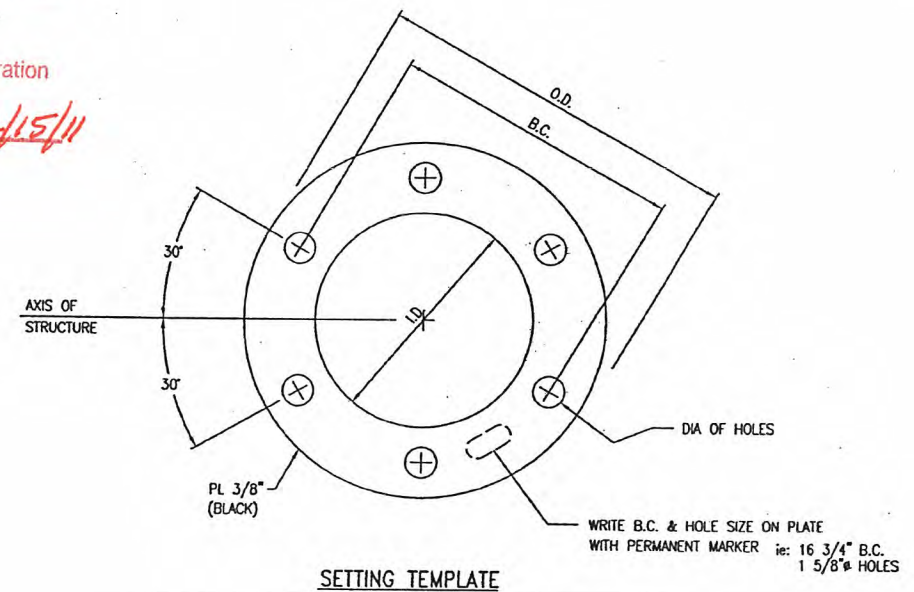

SETTING TEMPLATE


QTY	O.D.	B.C.	I.D.	DIA OF HOLES
2	22 3/4"	16 3/4"	10 3/4"	1 5/8"

MATERIAL SPECIFICATIONS:

STEEL PLATES, BARS & RODS - ASTM A709 GR 36 or A36
 BRACKET WASHERS - LOW CARBON STANDARD PATTERN
 SHIP ALIGNMENT BRACKETS & SETTING TEMPLATE BLACK
 ANCHOR BOLT ROD - ASTM F1554 GR 55 (55 KSI MIN YIELD)
 NUTS - ASTM A194 GR 2H OR A563 DH
 WASHERS - ASTM F436
 GALV ENTIRE ROD, NUTS, AND WASHERS PER ASTM A153 CL C

REV:


PRINTS ISSUED					
FOR	#	DATE	FOR	#	DATE
PE	E	10-18-11			
		10-20-11			
		12-13-11			

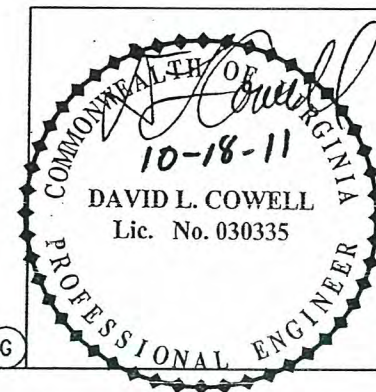

HURTT FABRICATING CORP.
 P.O. BOX 128
 MARCELINE, MO 64658

CUSTOMER: VENTURE ELECTRIC CO.
 PROJECT: CONTRACT NO. DTEORT-2011
 DOWNTOWN EXPRESSWAY OPEN ROAD TOLLING PROJECT
 RICHMOND METROPOLITAN AUTHORITY
 SUBJECT: ANCHOR BOLT FABRICATION DETAILS FOR
 TOLL GANTRY STRUCTURE

FILE: 5953 ANCHOR BOLT DATE: 10-13-11 PKG: A
 PRINTED FOR: DR BY: CH BY: JOB NO: SHEET
 RICHMOND METRO AUTHORITY TAP CLH HF-5953 ABI

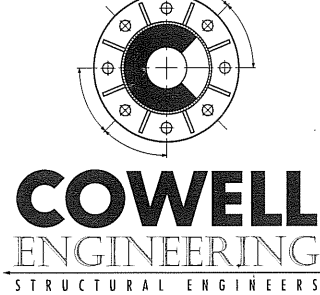

October 18, 2011

Craig Hengstenberg
Hurt Fabricating
P.O. Box 128
Marceline, MO 64658

RE: Independent Review
Sign Structures and Foundations
Project: HF - 5953 Toll Gantry Structure
Richmond, VA

Dear Craig:


This office has reviewed the drawings provided for the above referenced project to determine compliance with the AASHTO standards entitled: Standard Specifications for Structural Supports for Highway Signs, Luminaires and Traffic Signals (2003) and AASHTO Standard Specifications for Highway Bridges (2002), and the VDOT Road and Bridge Standards.


The review consisted of verifying the input values from the supplied drawings, comparing the drawing against the referenced standard/specification and performing computations to verify some of the computer generated numbers when needed.

Cowell Engineering, LLC has the required independent status necessary for review. Neither the company nor any of its employees have any affiliations (past or present) with any manufacturer, supplier, or contractor associated with traffic structures.

Based upon this review and to the best of my knowledge and belief, the submitted drawings are in compliance with the pertinent passages of the above referenced AASHTO specifications.

Yours very truly,
COWELL ENGINEERING


David L. Cowell, P.E.
W.O. # 11040

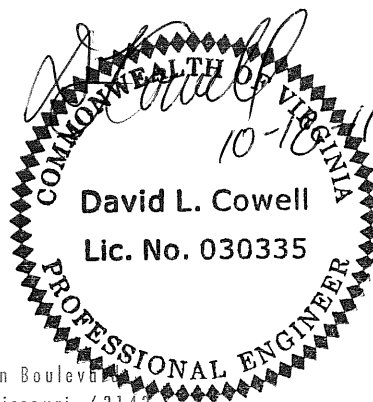


HURTT FABRICATING CORP., MARCELINE, MO.
OVERHEAD ANGLE SIGN SUPPORT DESIGN, version K 06-10-08
16th Ed. AASHTO (2002), 4th Ed. Luminaires (2003)

Structure Name : GANTRY
Job Description : HF 5953
Engineer : CLH
Run Date & Time : 10/13/2011 at 11:50

Truss # = GN
Hurttt Job # = HF 5953
Item # =
State Job # =
State Project = DTEORT-2011
DOWNTOWN EXPY
File Name: 5953GNTY.DAT

County = RICHMOND, VA
VMS (Y/N) = N

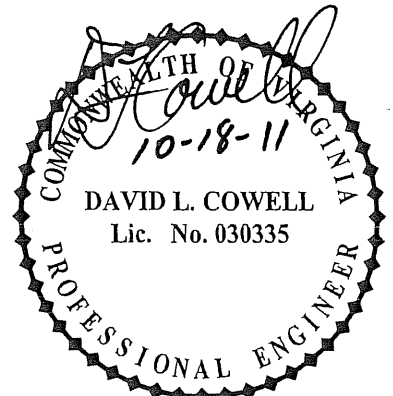

HURTT FABRICATING CORP., MARCELINE, MO.
 OVERHEAD ANGLE SIGN SUPPORT DESIGN, version K 06-10-08
 16th Ed. AASHTO (2002), 4th Ed. Luminaires (2003)


Structure Name : GANTRY
 Job Description : HF 5953
 Engineer : CLH
 Run Date & Time : 10/13/2011 at 11:50

* * * * * TRUSS DESIGN * * * * *

TRUSS DIMENSIONS (FT)

PANEL LENGTH (FT)

LENGTH	DEPTH	WIDTH	WALK DESIGN		NUMBER OF PANELS	
			CENTER	END	CENTER	END
44.50	3.00	3.00	3.71			1.85
WIND VELOCITY MPH	NUMBER OF SIGNS	DIST L	LENGTH	WGT/FT	CENTER	END
90.00	2	0.00	0.00	0.00	10	4

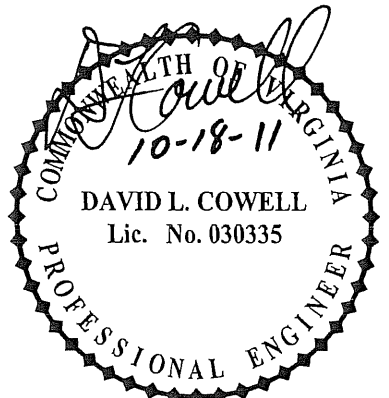


HURTT FABRICATING CORP., MARCELINE, MO.
 OVERHEAD ANGLE SIGN SUPPORT DESIGN, version K 06-10-08
 16th Ed. AASHTO (2002), 4th Ed. Luminaires (2003)

Structure Name : GANTRY
 Job Description : HF 5953
 Engineer : CLH
 Run Date & Time : 10/13/2011 at 11:50

* * * * * TRUSS DESIGN * * * * *

S I G N D A T A

SIGN NO.	SIGN LENGTH	nids	SIGN HEIGHT	CD	Kz	DISTANCE FROM LS	DISTANCE CENTER	ECCN	WGT
1	33.00	6	1.50	1.30	1.00	5.75	22.25	-2.25	1816.00
2	44.00	8	0.25	1.30	1.00	-38.50	22.25	1.50	6044.00

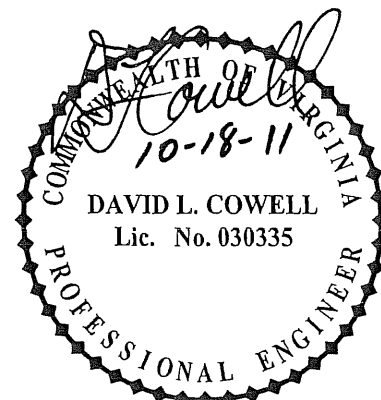


HURTT FABRICATING CORP., MARCELINE, MO.
 OVERHEAD ANGLE SIGN SUPPORT DESIGN, version K 06-10-08
 16th Ed. AASHTO (2002), 4th Ed. Luminaires (2003)

Structure Name : GANTRY
 Job Description : HF 5953
 Engineer : CLH
 Run Date & Time : 10/13/2011 at 11:50

* * * * * TRUSS DESIGN * * * * *

TRUSS DEPTH = 3.00 FEET
 TRUSS WIDTH = 3.00 FEET
 DEFLECTION = 0.372 IN.
 CAMBER REQUIRED = 0.906 IN.

	L-WIND FORCE (LBS.)	L-DEAD WEIGHT (LBS.)	R-WIND FORCE (LBS.)	R-DEAD LOAD (LBS.)
CASE 1	0.0	5440.4	0.00	5440.4
CASE 2	1979.2	5440.4	1979.20	5440.4
CASE 3	989.6	6364.0	989.60	6364.0

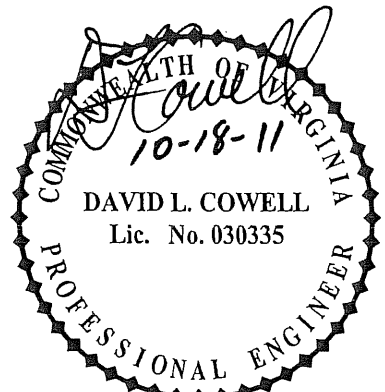

HURTT FABRICATING CORP., MARCELINE, MO.
 OVERHEAD ANGLE SIGN SUPPORT DESIGN, version K 06-10-08
 16th Ed. AASHTO (2002), 4th Ed. Luminaires (2003)


Structure Name : GANTRY
 Job Description : HF 5953
 Engineer : CLH
 Run Date & Time : 10/13/2011 at 11:50

* * * * * TRUSS CHORDS * * * * *

LENGTH FT	NUMBER REQUIRED	NUMBER OF 0.625" BOLTS (A325)	NUMBER OF 0.75" BOLTS (A325)	NUMBER OF 0.875" BOLTS (A325)
45.00	4	4.00	3.00	2.00

MEMBER AND SHAPE CONFIGURATION	YIELD KSI	GROSS AREA	NET AREA	LEAST ROG	WEIGHT (LBS)
4x4x.375	50.00	2.86	2.10	0.79	1764.00

	FORCE (LBS)	FA (PSI)	ALLOWABLE (PSI)	LENGTH OF 0.19" FILLET WELD
CASE 1	18620.4	6510.6	23269.4	6.69
CASE 2	26535.4	9278.1	30948.3	7.17
CASE 3	25127.1	8785.7	30948.3	6.79

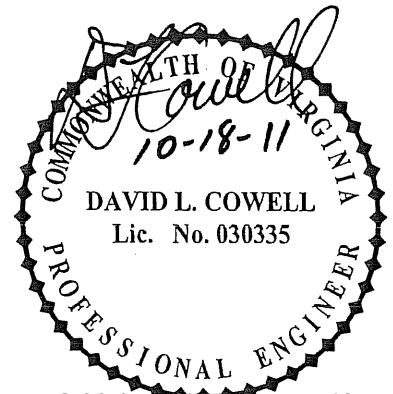

HURTT FABRICATING CORP., MARCELINE, MO.
 OVERHEAD ANGLE SIGN SUPPORT DESIGN, version K 06-10-08
 16th Ed. AASHTO (2002), 4th Ed. Luminaires (2003)


Structure Name : GANTRY
 Job Description : HF 5953
 Engineer : CLH
 Run Date & Time : 10/13/2011 at 11:50

* * * * * WIND DIAGONAL * * * * *

LENGTH FT	NUMBER REQUIRED	MINIMUM BOLTS NO. & SIZE (A325)
4.62	20	2 - 0.625

MEMBER AND SHAPE CONFIGURATION	YIELD KSI	GROSS AREA	NET AREA	LEAST ROG	WEIGHT (LBS)
2.5x2.5x.25	36.00	1.19	0.71	0.49	378.55

	FORCE (LBS)	FA (PSI)	ALLOWABLE (PSI)	LENGTH OF 0.19" FILLET WELD
CASE 1	0.0	0.0	11268.4	0.00
CASE 2	1661.3	1396.0	14986.9	0.45
CASE 3	830.6	698.0	14986.9	0.22

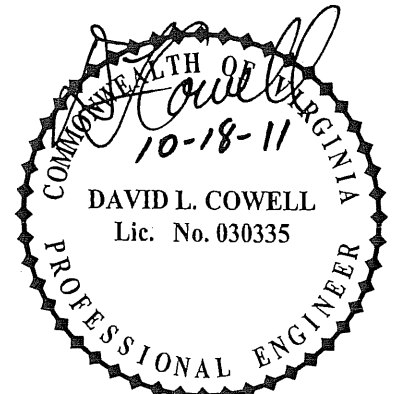

HURTT FABRICATING CORP., MARCELINE, MO.
 OVERHEAD ANGLE SIGN SUPPORT DESIGN, version K 06-10-08
 16th Ed. AASHTO (2002), 4th Ed. Luminaires (2003)


Structure Name : GANTRY
 Job Description : HF 5953
 Engineer : CLH
 Run Date & Time : 10/13/2011 at 11:50

* * * * * WIND DIAGONAL END PANEL * * * * *

LENGTH FT	NUMBER REQUIRED	MINIMUM BOLTS NO. & SIZE (A325)
3.32	8	2 - 0.625

MEMBER AND SHAPE CONFIGURATION	YIELD KSI	GROSS AREA	NET AREA	LEAST ROG	WEIGHT (LBS)
2.5x2.5x.25	36.00	1.19	0.71	0.49	108.80

	FORCE (LBS)	FA (PSI)	ALLOWABLE (PSI)	LENGTH OF 0.19" FILLET WELD
CASE 1	0.0	0.0	11268.4	0.00
CASE 2	1193.7	1003.1	14986.9	0.32
CASE 3	596.8	501.6	14986.9	0.16

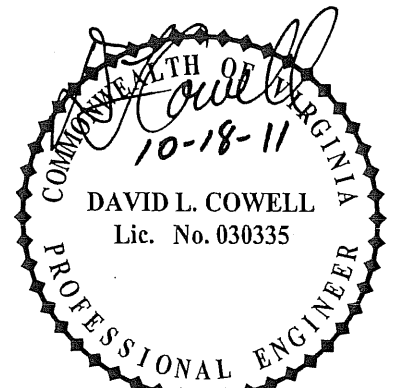

HURTT FABRICATING CORP., MARCELINE, MO.
 OVERHEAD ANGLE SIGN SUPPORT DESIGN, version K 06-10-08
 16th Ed. AASHTO (2002), 4th Ed. Luminaires (2003)


Structure Name : GANTRY
 Job Description : HF 5953
 Engineer : CLH
 Run Date & Time : 10/13/2011 at 11:50

* * * * * WIND STRUT * * * * *

LENGTH FT	NUMBER REQUIRED	MINIMUM BOLT SIZE (A325)
2.75	30	0.625

MEMBER AND SHAPE CONFIGURATION	YIELD KSI	GROSS AREA	NET AREA	LEAST ROG	WEIGHT (LBS)
2x2x.19	36.00	0.72	0.39	0.39	201.30

	FORCE (LBS)	FA (PSI)	ALLOWABLE (PSI)	LENGTH OF 0.19" FILLET WELD
CASE 1	0.0	0.0	14905.6	0.00
CASE 2	989.6	1384.1	19824.4	0.27
CASE 3	494.8	692.0	19824.4	0.13

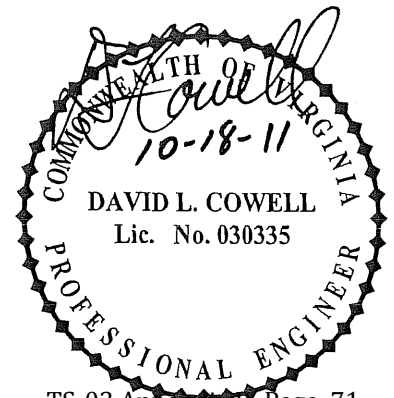

HURTT FABRICATING CORP., MARCELINE, MO.
 OVERHEAD ANGLE SIGN SUPPORT DESIGN, version K 06-10-08
 16th Ed. AASHTO (2002), 4th Ed. Luminaires (2003)


Structure Name : GANTRY
 Job Description : HF 5953
 Engineer : CLH
 Run Date & Time : 10/13/2011 at 11:50

* * * * * DEAD LOAD DIAGONAL * * * * *

LENGTH FT	NUMBER REQUIRED	MINIMUM BOLTS NO. & SIZE (A325)
4.62	20	2 - 0.625

MEMBER AND SHAPE CONFIGURATION	YIELD KSI	GROSS AREA	NET AREA	LEAST ROG	WEIGHT (LBS)
2x2x.19	36.00	0.72	0.39	0.39	225.28

	FORCE (LBS)	FA (PSI)	ALLOWABLE (PSI)	LENGTH OF 0.19" FILLET WELD
CASE 1	7865.1	11000.1	19800.0	2.83
CASE 2	7865.1	11000.1	26334.0	2.12
CASE 3	8716.5	12190.9	26334.0	2.35

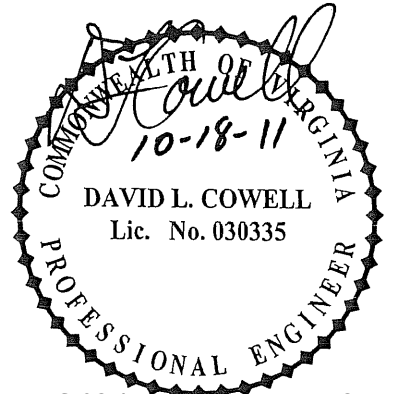

HURTT FABRICATING CORP., MARCELINE, MO.
 OVERHEAD ANGLE SIGN SUPPORT DESIGN, version K 06-10-08
 16th Ed. AASHTO (2002), 4th Ed. Luminaires (2003)


Structure Name : GANTRY
 Job Description : HF 5953
 Engineer : CLH
 Run Date & Time : 10/13/2011 at 11:50

* * * * * DEAD LOAD DIAGONAL END PANEL * * * * *

LENGTH FT	NUMBER REQUIRED	MINIMUM BOLTS NO. & SIZE (A325)
3.32	8	2 - 0.625

MEMBER AND SHAPE CONFIGURATION	YIELD KSI	GROSS AREA	NET AREA	LEAST ROG	WEIGHT (LBS)
2x2x.19	36.00	0.72	0.39	0.39	64.75

	FORCE (LBS)	FA (PSI)	ALLOWABLE (PSI)	LENGTH OF 0.19" FILLET WELD
CASE 1	5651.4	7904.1	19800.0	2.03
CASE 2	5651.4	7904.1	26334.0	1.53
CASE 3	6263.2	8759.8	26334.0	1.69

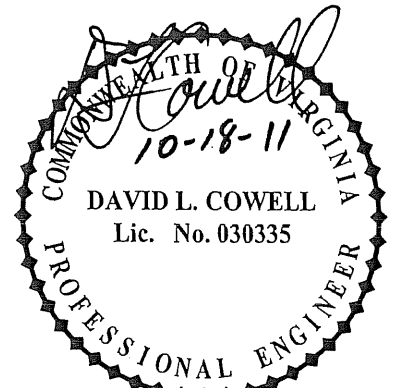

HURTT FABRICATING CORP., MARCELINE, MO.
 OVERHEAD ANGLE SIGN SUPPORT DESIGN, version K 06-10-08
 16th Ed. AASHTO (2002), 4th Ed. Luminaires (2003)


Structure Name : GANTRY
 Job Description : HF 5953
 Engineer : CLH
 Run Date & Time : 10/13/2011 at 11:50

* * * * * DEAD LOAD VERTICAL * * * * *

LENGTH FT	NUMBER REQUIRED	MINIMUM BOLT SIZE (A325)
2.75	30	0.625

MEMBER AND SHAPE CONFIGURATION	YIELD KSI	GROSS AREA	NET AREA	LEAST ROG	WEIGHT (LBS)
2x2x.19	36.00	0.72	0.39	0.39	201.30

	FORCE (LBS)	FA (PSI)	ALLOWABLE (PSI)	LENGTH OF 0.19" FILLET WELD
CASE 1	4685.2	6552.7	14905.6	1.68
CASE 2	4685.2	6552.7	19824.4	1.27
CASE 3	5192.4	7262.1	19824.4	1.40

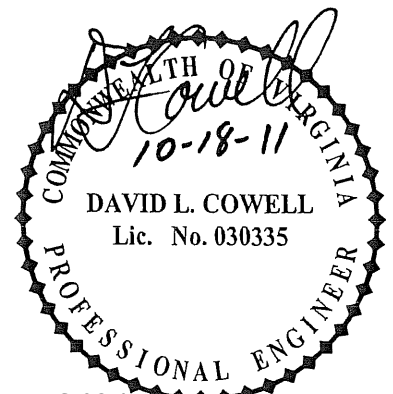

HURTT FABRICATING CORP., MARCELINE, MO.
 OVERHEAD ANGLE SIGN SUPPORT DESIGN, version K 06-10-08
 16th Ed. AASHTO (2002), 4th Ed. Luminaires (2003)

Structure Name : GANTRY
 Job Description : HF 5953
 Engineer : CLH
 Run Date & Time : 10/13/2011 at 11:50

* * * * * INTERIOR DIAGONAL * * * * *

LENGTH = 3.55 NUMBER REQUIRED = 15

MEMBER AND SHAPE CONFIGURATION	YIELD KSI	GROSS AREA	LENGTH OF 0.19" FILLET WELD	LEAST ROG	WEIGHT
1.75x1.75x0.13	36.00	0.42	1.50	0.35	76.75

	FORCE (LBS)	FA (PSI)	ALLOWABLE (PSI)	LENGTH OF 0.19" FILLET WELD
CASE 1	0.0	0.0	9849.5	1.50
CASE 2	27.3	13.6	13099.8	0.01
CASE 3	0.0	0.0	13099.8	0.00




HURTT FABRICATING CORP., MARCELINE, MO.
 CANTILEVER ANGLE SIGN SUPPORT DESIGN
 Version K 06-10-08
 16th Ed. AASHTO (2002), 4th Ed. Luminaires (2003)

Structure Name : GANTRY
 Job Description : HF 5953
 Engineer : CLH
 Run Date & Time : 10/13/2011 at 11:49

* * * * * COLUMN DESIGN * * * * *

HEIGHT (FT) TOTAL	TRUSS	DIAMETER (IN)	THICKNESS (IN)	YIELD STRENGTH (KSI)	WEIGHT (LB)
21.83	20.08	10.75	0.3650	42	885

	AXIAL (LBS)	MOMENT (FT-LB)	TORQUE (FT-LB)	SHEAR (LBS)	FA ALLOW	FB ALLOW	FV ALLOW	CSR
CASE 1 COMBINATION 1	6271	60672	0	0	8637	27720	13860	0.940
CASE 2 COMBINATION 1	6271	80056	24395	2246	11487	36868	18434	0.995
CASE 2 COMBINATION 2	6271	76940	14637	1477	11487	36868	18434	0.912
CASE 3 COMBINATION 1	7152	78220	12197	1266	11487	36868	18434	0.927
CASE 3 COMBINATION 2	7152	78385	7318	833	11487	36868	18434	0.918

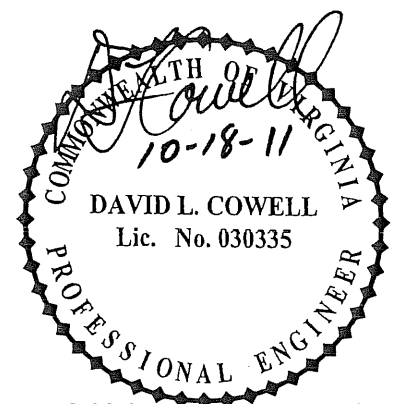

HURTT FABRICATING CORP., MARCELINE, MO.
 CANTILEVER ANGLE SIGN SUPPORT DESIGN
 Version K 06-10-08
 16th Ed. AASHTO (2002), 4th Ed. Luminaires (2003)

Structure Name : GANTRY
 Job Description : HF 5953
 Engineer : CLH
 Run Date & Time : 10/13/2011 at 11:49

* * * * * TRUSS MOUNTING PLATE * * * * *

WIDTH A [IN]	WIDTH B [IN]	THICKNESS C [IN]	GUSSET DEPTH D [IN]	THICKNESS E [IN]	WEIGHT [LBS]
--------------------	--------------------	------------------------	---------------------------	------------------------	-----------------


36.00	13.75	0.750	12.00	0.500	177
-------	-------	-------	-------	-------	-----

WELD SIZE-W2 (1/16")

WELD SIZE-W3 (1/16")

5

4

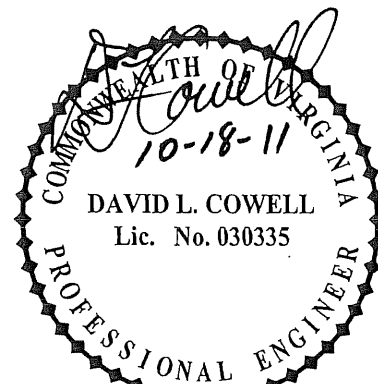

HURTT FABRICATING CORP., MARCELINE, MO.
 CANTILEVER ANGLE SIGN SUPPORT DESIGN
 Version K 06-10-08
 16th Ed. AASHTO (2002), 4th Ed. Luminaires (2003)

Structure Name : GANTRY
 Job Description : HF 5953
 Engineer : CLH
 Run Date & Time : 10/13/2011 at 11:49

* * * * * ANCHOR BOLT DESIGN * * * * *


DIAMETER [IN]	EMBEDMENT LENGTH [IN]	YIELD STRENGTH (KSI)	MAXIMUM TENSION [LBS]	WEIGHT [LBS]
2.50	50.00	55.00	61229	323

DIMENSIONS [IN]	BASE PLATE BOLT SPACING [IN] X Y	EDGE DISTANCE [IN]	WEIGHT [LBS]
18.25 x 18.25 x 2.00	10.75 10.75	3.75	188.89

WELD SIZE-W4 (1/16")

5.00

Total Weight of Column Plates & Anchor Bolts = 1573.64 LBS.
 Total Weight of Truss, Column, Plates & Anchor Bolts = 2972.28 LBS.

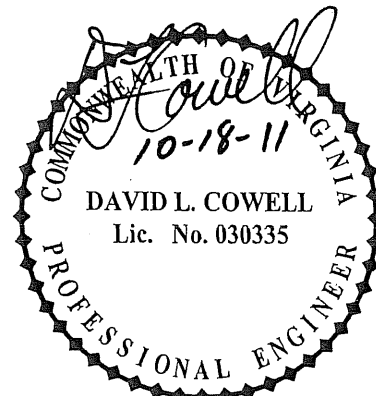

HURTT FABRICATING CORP.
MARCELINE, MO.

Vertical (Single Pole) Pipe Support for Cantilever
Using More Than 4 Anchor Bolts

TRUSS NUMBER Gantry
OUR JOB NUMBER HF-5953
RUN DATE 10-17-2011

The end column will be attached to a concrete footing using
6 - 1.5 in. anchor bolts with a Fy= 55 KSI,
with a bolt circle of 16.75 inches having a S = 35.4 cu-in

Check Bolt 1.5 inch diameter, Tensile Area = 1.41 Sq in
Root Area = 1.29 Sq in

Bolt Tension = 38.23 Kips/bolt
Bolt Shear = 0.37 Kips/bolt
Bolt Torsion = 5.83 Kips/bolt

Increase allowable by 1.33 because of wind loads.
Ft = .5(Fy)1.33 = 36.67 Ksi Fv = .3(Fy)1.33 = 21.95 Ksi

fv = (0.37 + 5.83)K / 1.29 Sq in = 4.81 Ksi
fv < Fv or 4.81 ksi < 21.945 ksi OK

ft = 38.23 K / 1.41 Sq in = 27.12 Ksi
ft < Ft or 27.12 ksi < 36.67 ksi OK

k= Fv/Ft= 0.60 (fv) + (k*ft) < Fv
23.10 + 263.36 = 286.5 < 482 OK


Use the 1.5 inch anchor bolts.
and minimum edge distance of 2.25 in < 3 in OK

Weld base plate to pipe with 5/16" fillet welds & 6 - 3/4" thick
stiffener plates located 30 degrees off the centerline of the
hole with 5/16" fillet welds. Capacity of the 5/16" weld and the
the stiffner plates will exceed the strength of the pipe column.

Plate Fy = 36 KSI, Fb = .66(Fy) = 24.00 Ksi

Check Base Plate Thickness of Dia. = 22.75 inch & 1.75 inch thickness


Distance between gussets = 9.67 in Moment = 9 in-lbs
width of resistance = 6.00 in
plate thickness required = 1.70 < 1.75 in

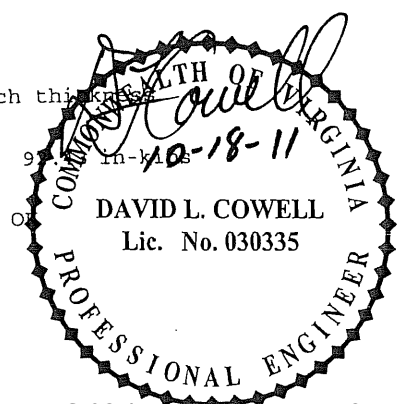


DTE RAMP TOLL PLAZAS

ORIGINAL PLANS


RICHMOND EXPRESSWAY SYSTEM		
	SHEET NO.	TOTAL SHEETS
TOLL FACILITIES	4	38

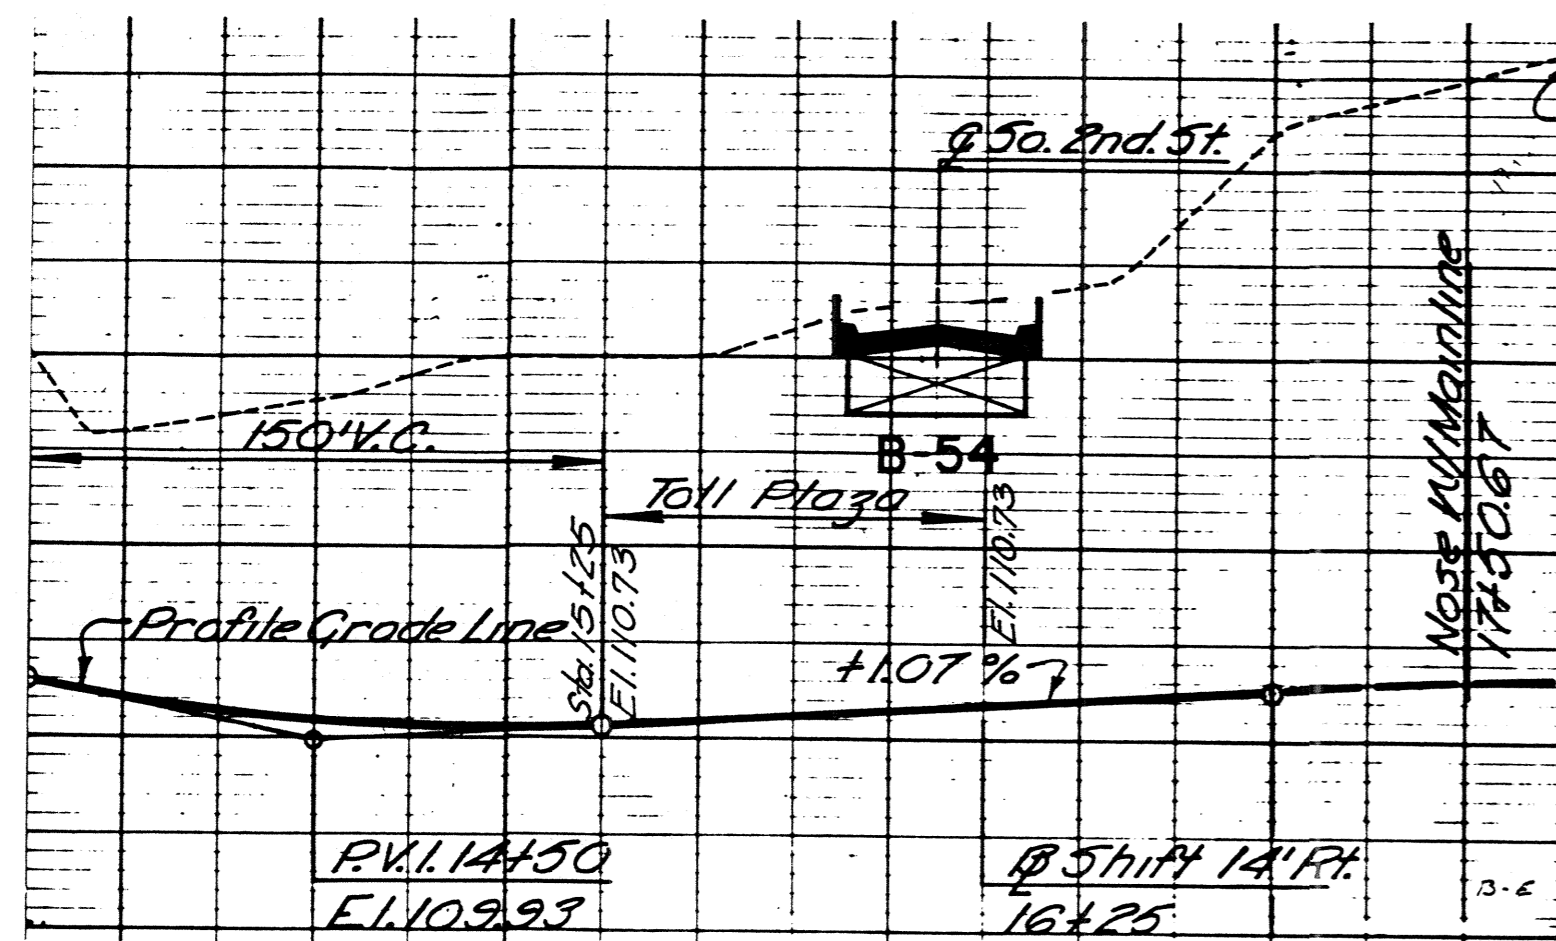


RAMP BYRD-E
Scale: 1"=10' Vert.
1"=50' Horiz.

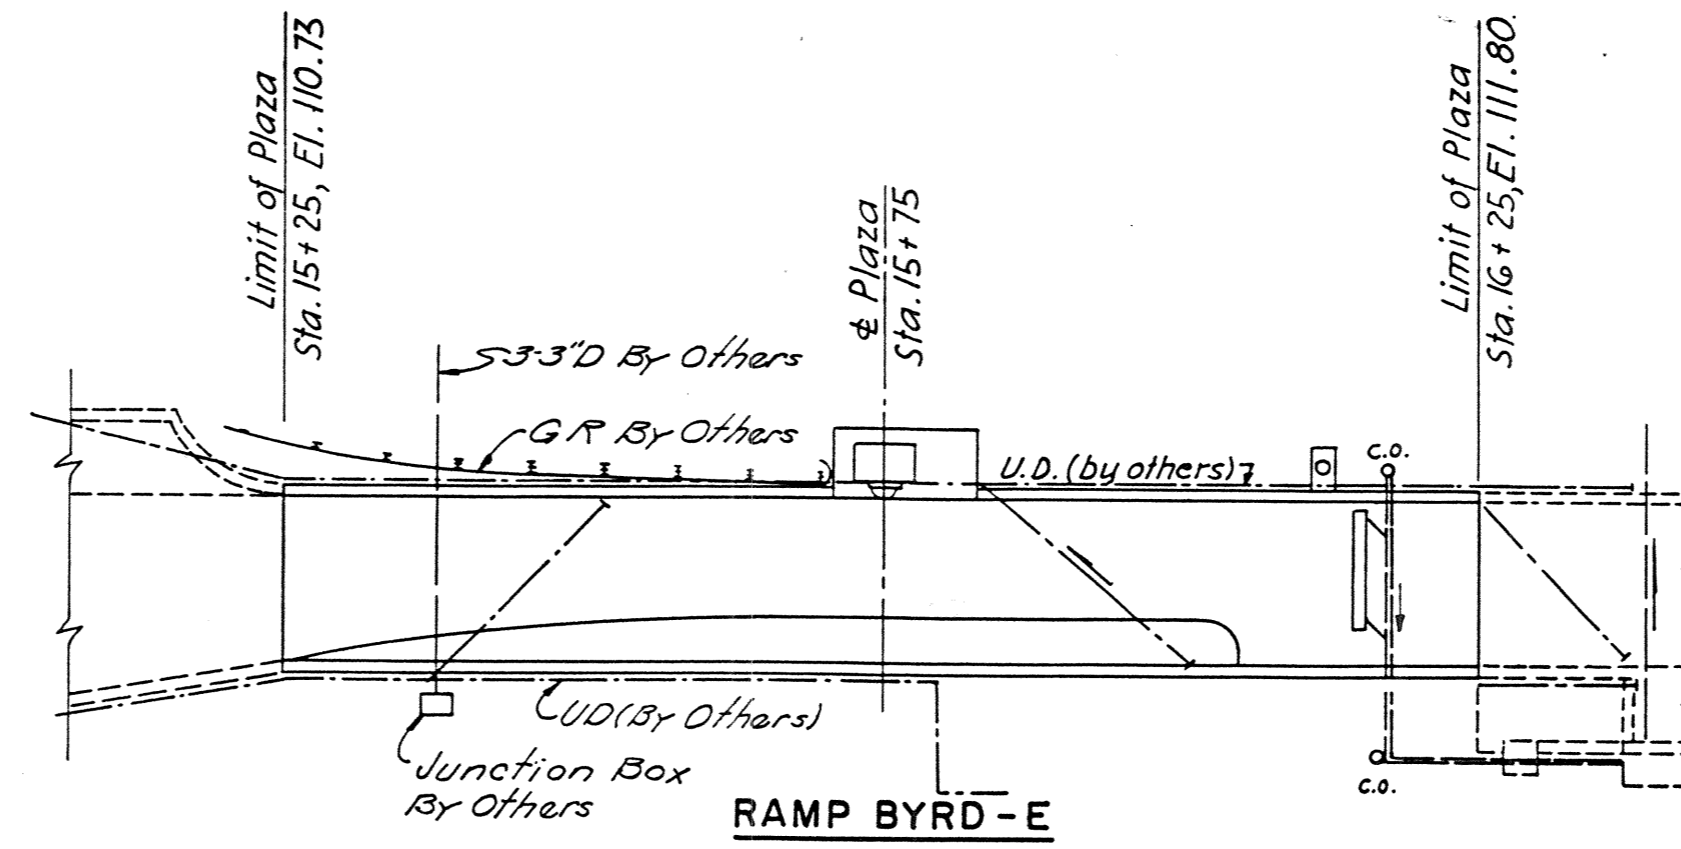


RAMP BYRD-E

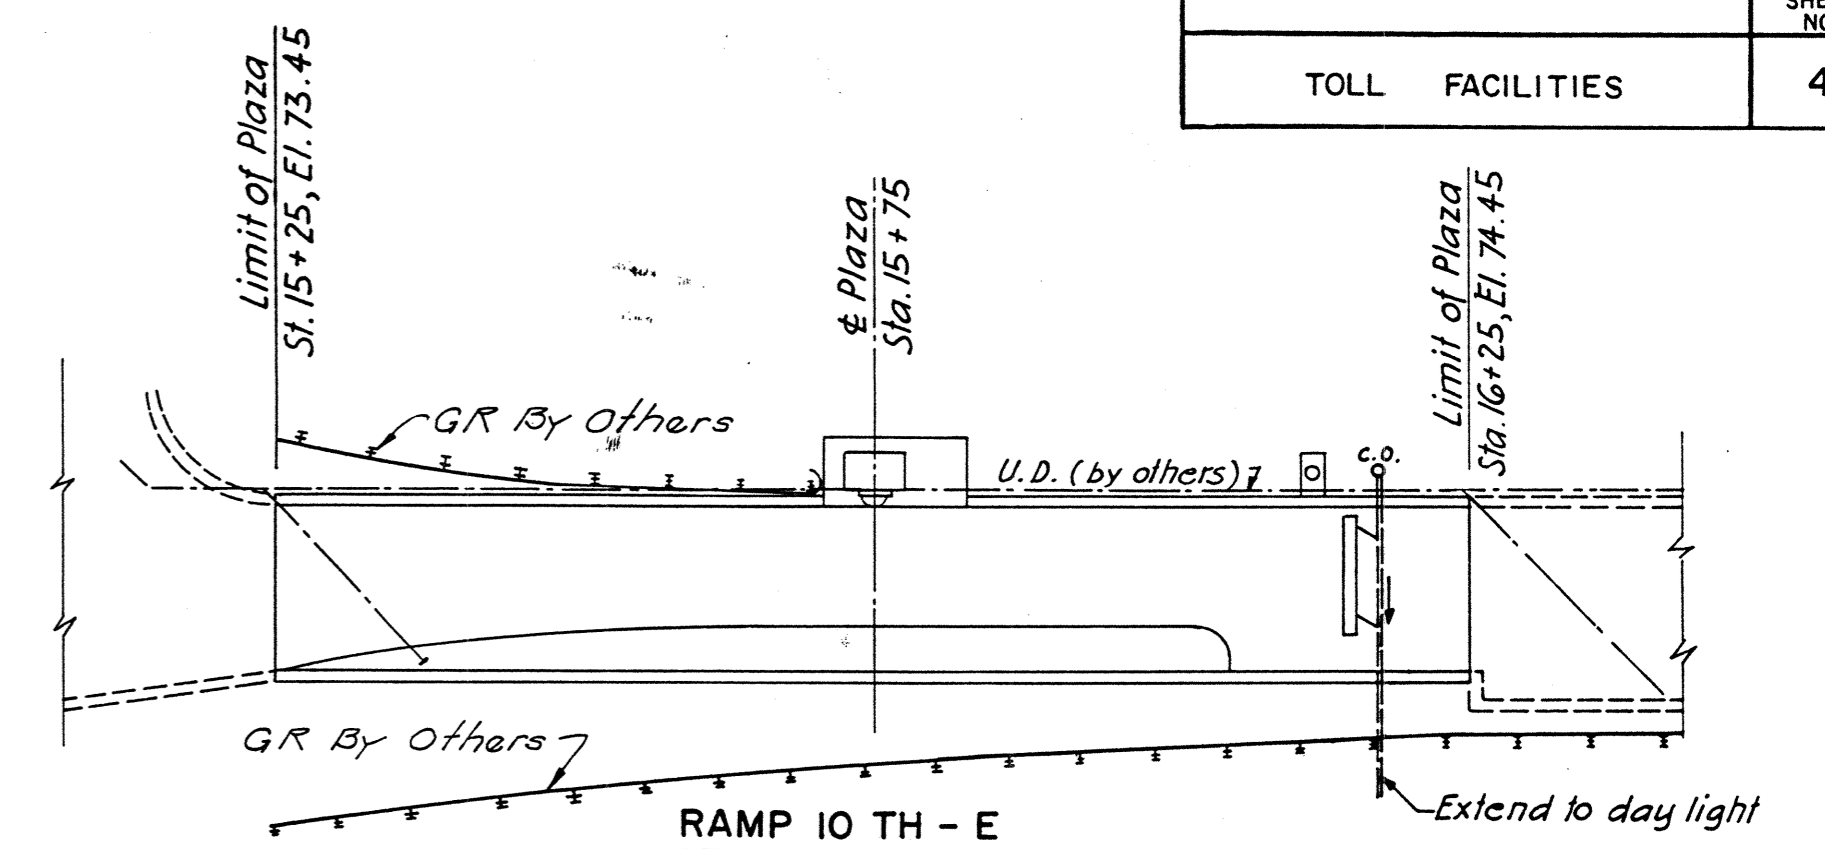


RAMP 10TH-E

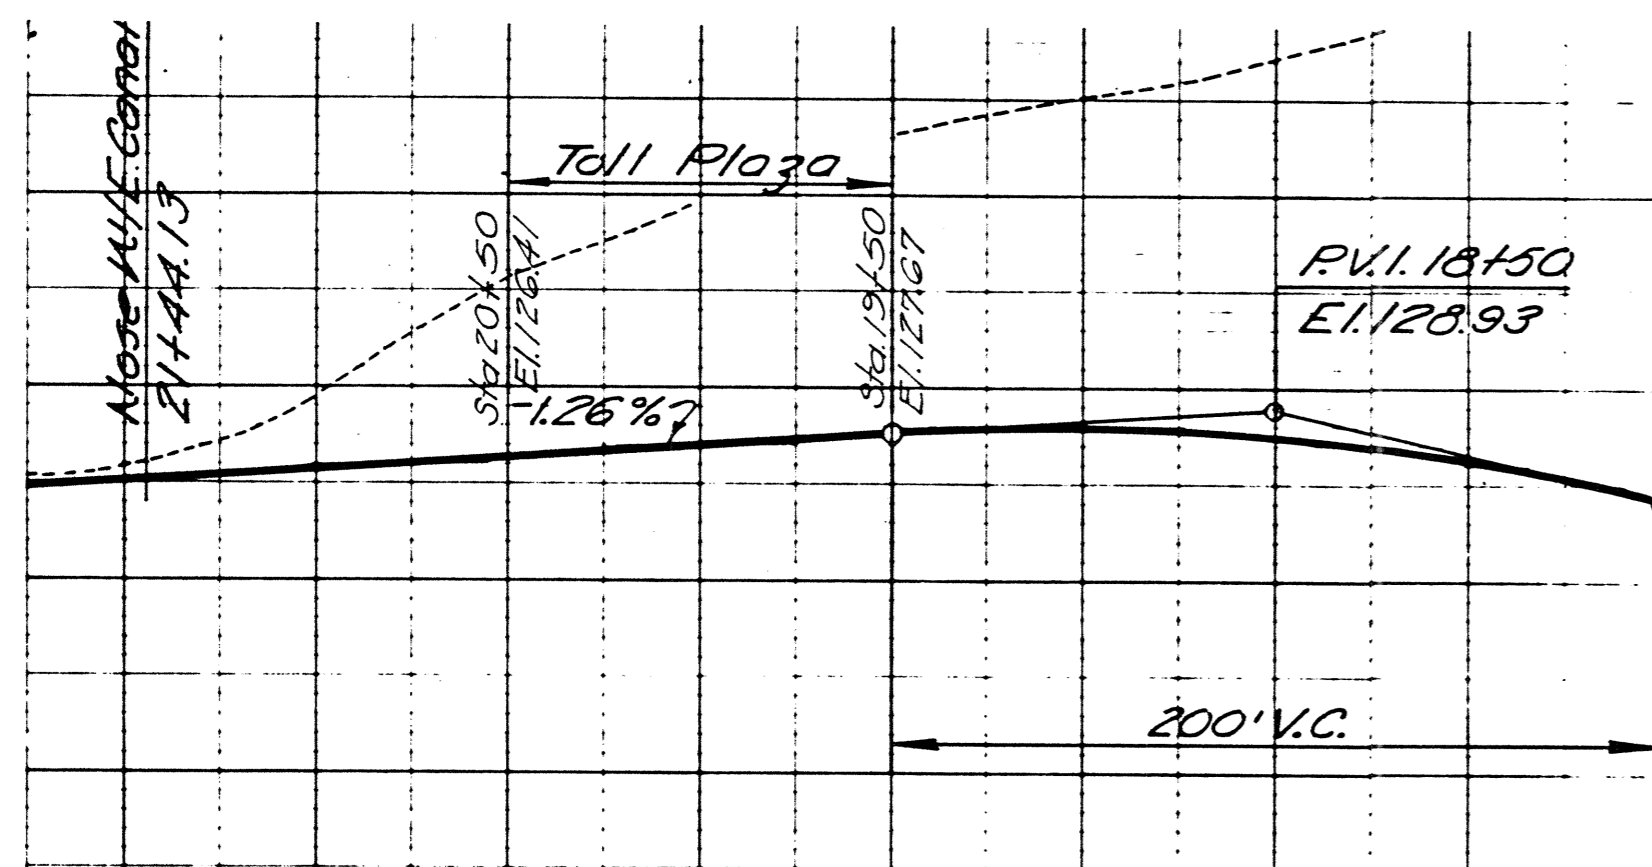


RAMP E-CANAL
Scale: 1"=10' Vert.
1"=50' Horiz.

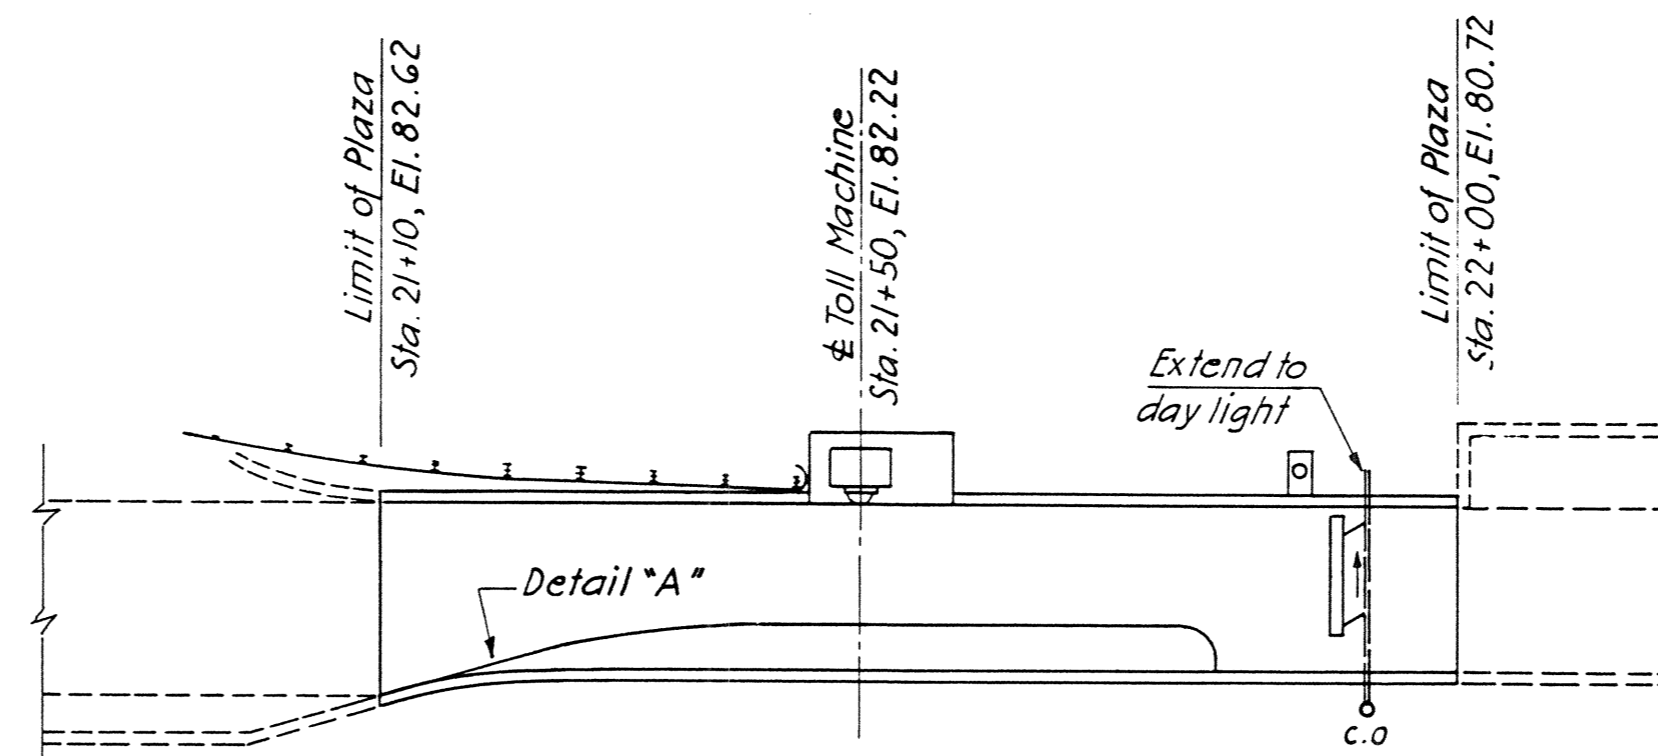


RAMP E-11TH

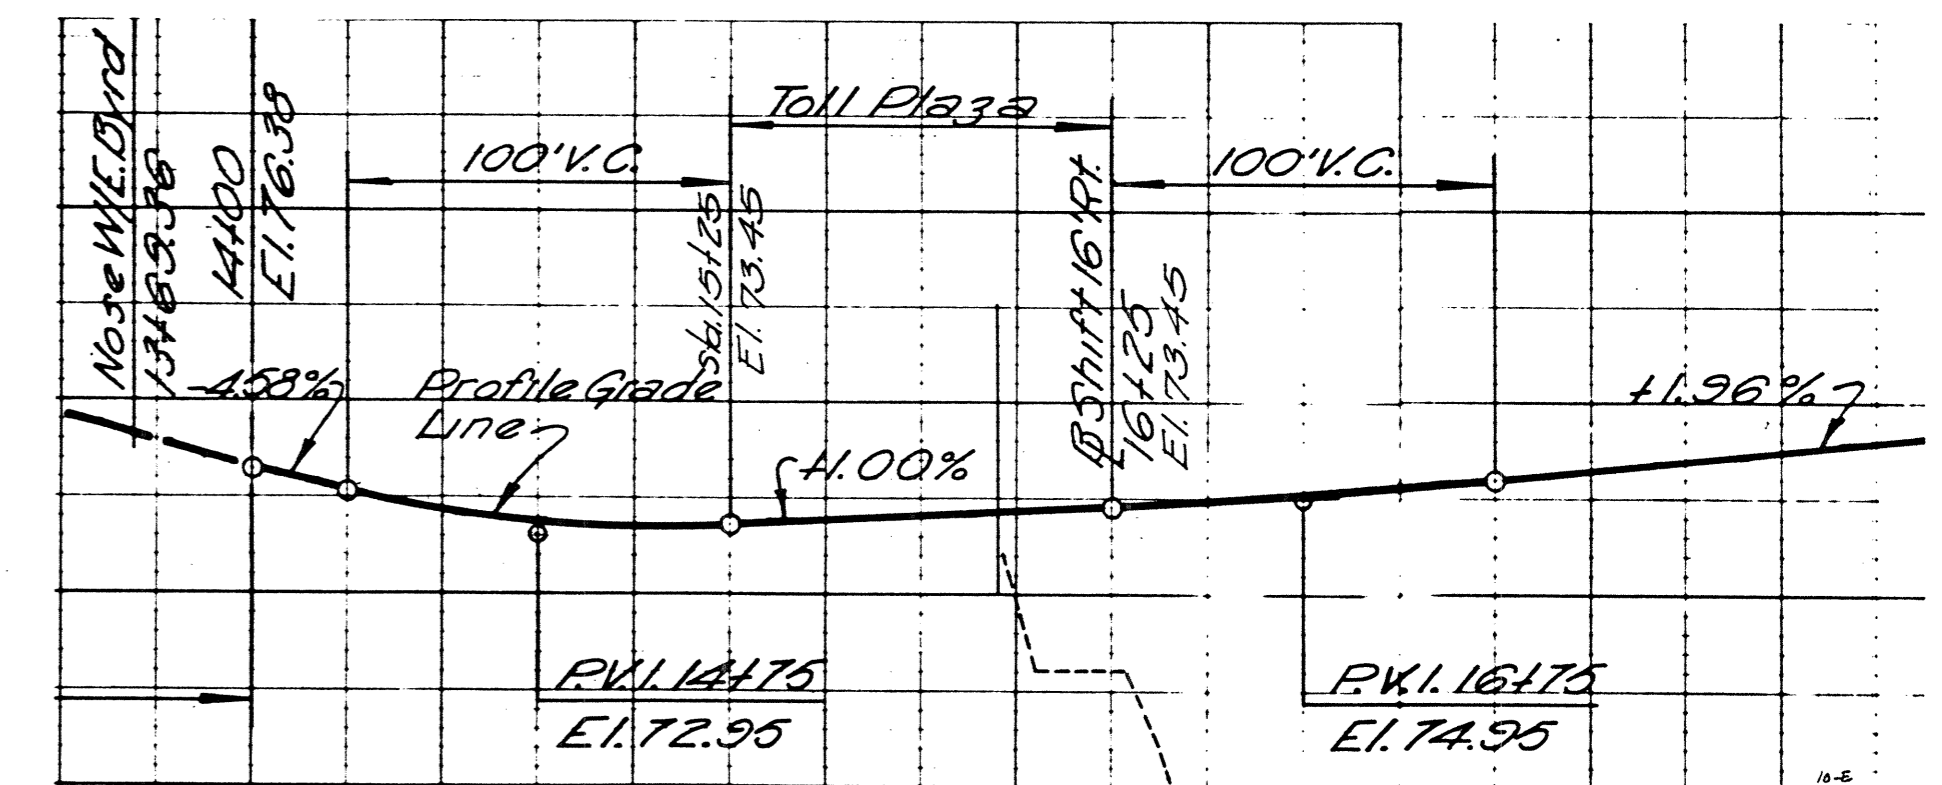


RAMP 10TH-E
Scale: 1"=10' Vert.
1"=50' Horiz.

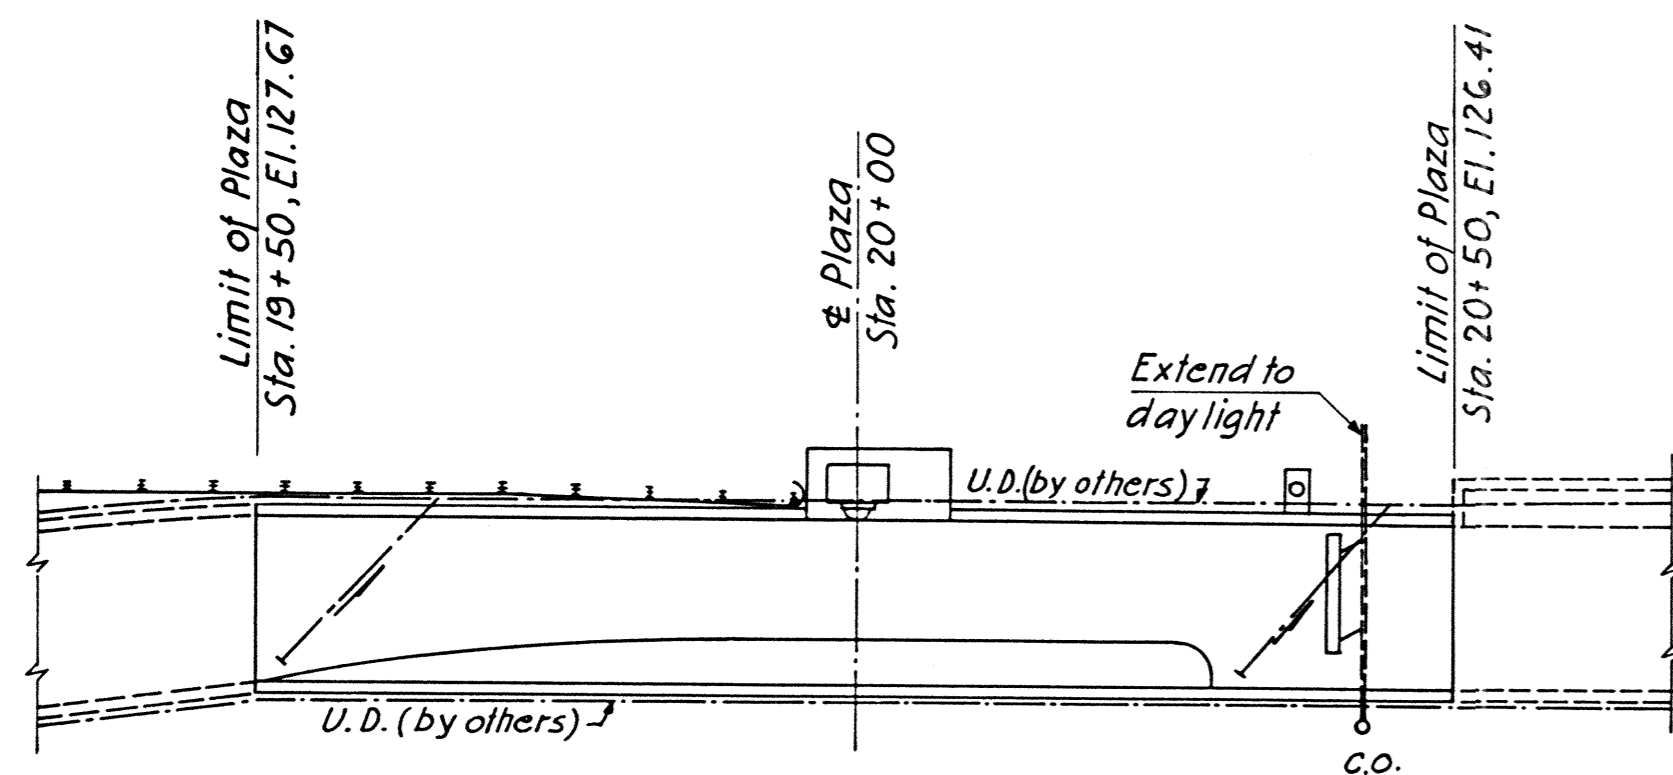

RAMP E-CANAL

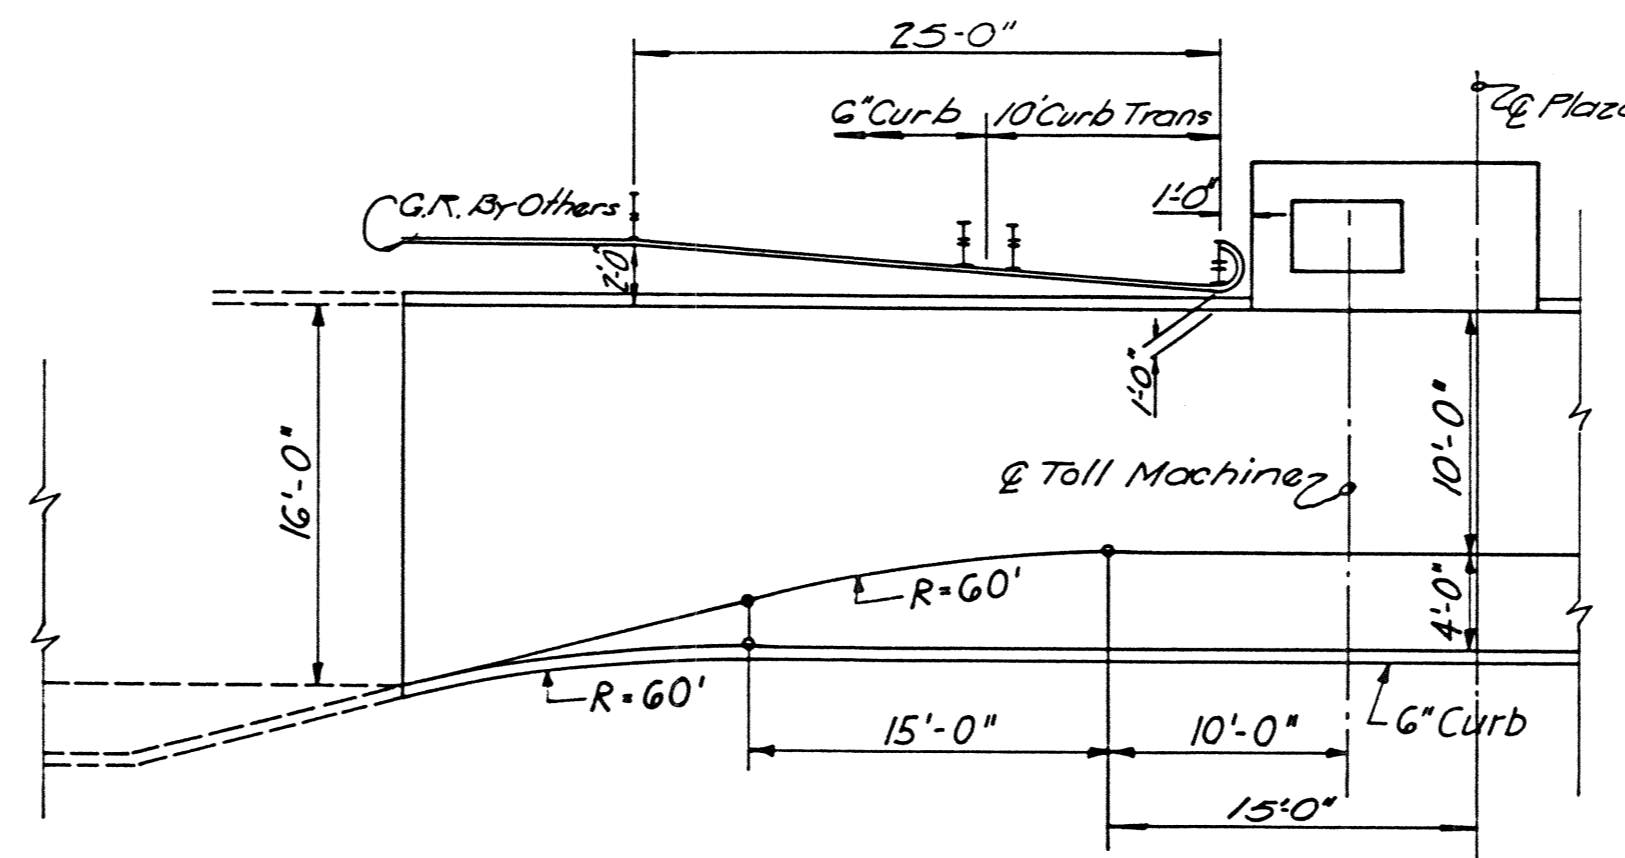

DETAIL "A"
RAMP E-11TH
1/8" = 1'-0"

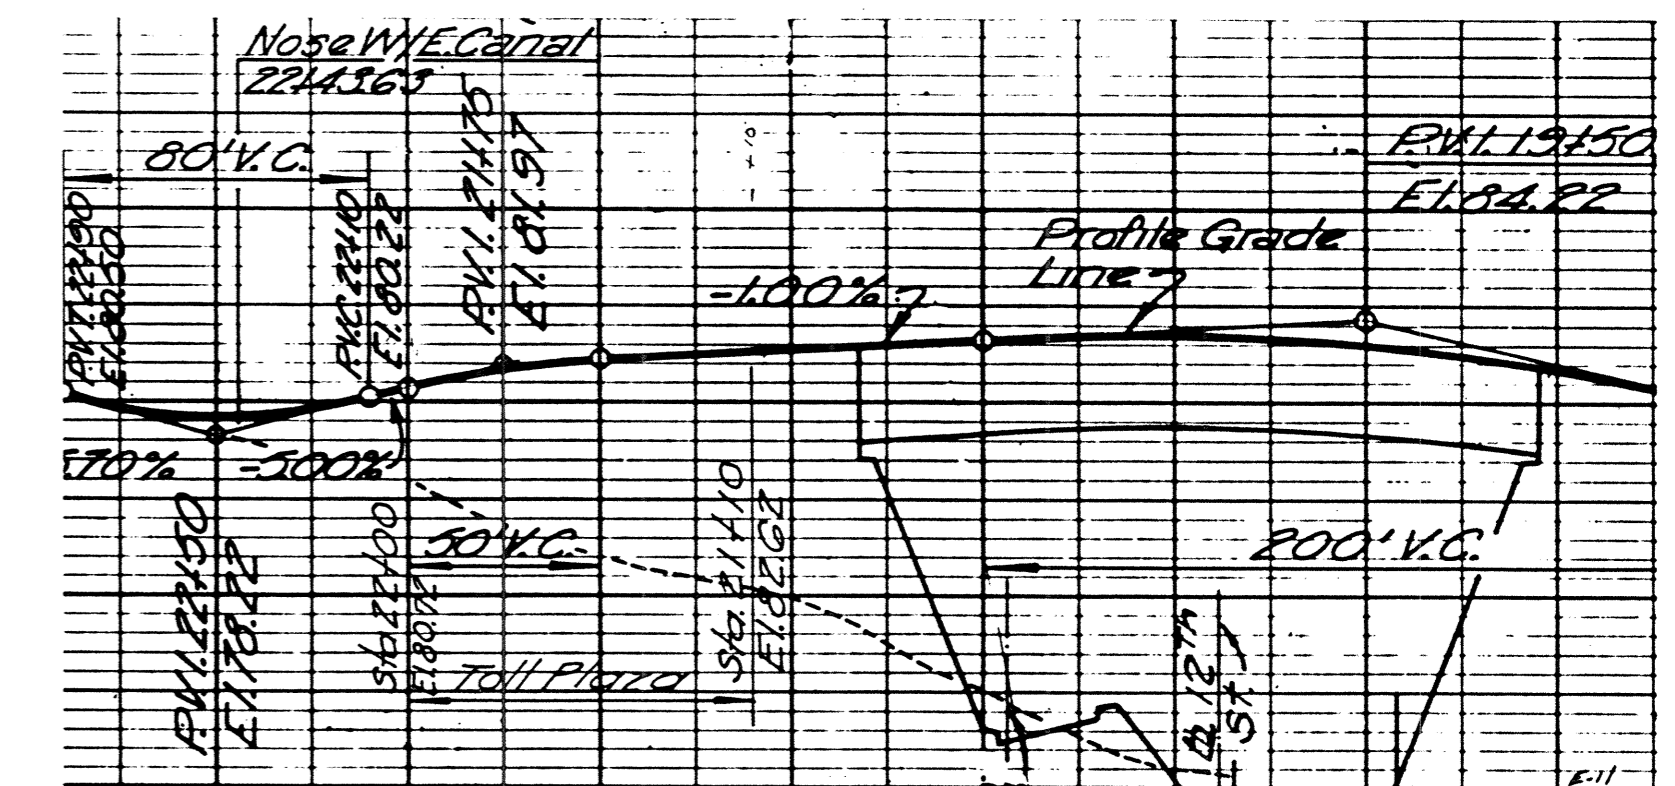

RAMP E-11TH
Scale: 1"=10' Vert.
1"=50' Horiz.

AS BUILT

RICHMOND METROPOLITAN AUTHORITY
RICHMOND EXPRESSWAY SYSTEM


RAMP PLAZA LAYOUTS

HOWARD, NEEDLES, TAMMEN & BERGENDOFF
consulting engineers
NEW YORK ALEXANDRIA KANSAS CITY

SCALE: 1/16" = 1'-0"
(Unless noted)
CONTRACT NO. 77-3
SHEET NO. 4 OF

BY	DATE			
MADE	D.E.N.	5-68		
CHECKED	W.J.W.	5-68	1	Final Check W.J.W. 6-68
IN CHARGE	H.D.S.			
	NO.	REVISION	BY	DATE

RICHMOND EXPRESSWAY SYSTEM			
SECTION	PROJECT	SHEET NO.	TOTAL SHEETS
9	DOWNTOWN EXPRESSWAY	58	

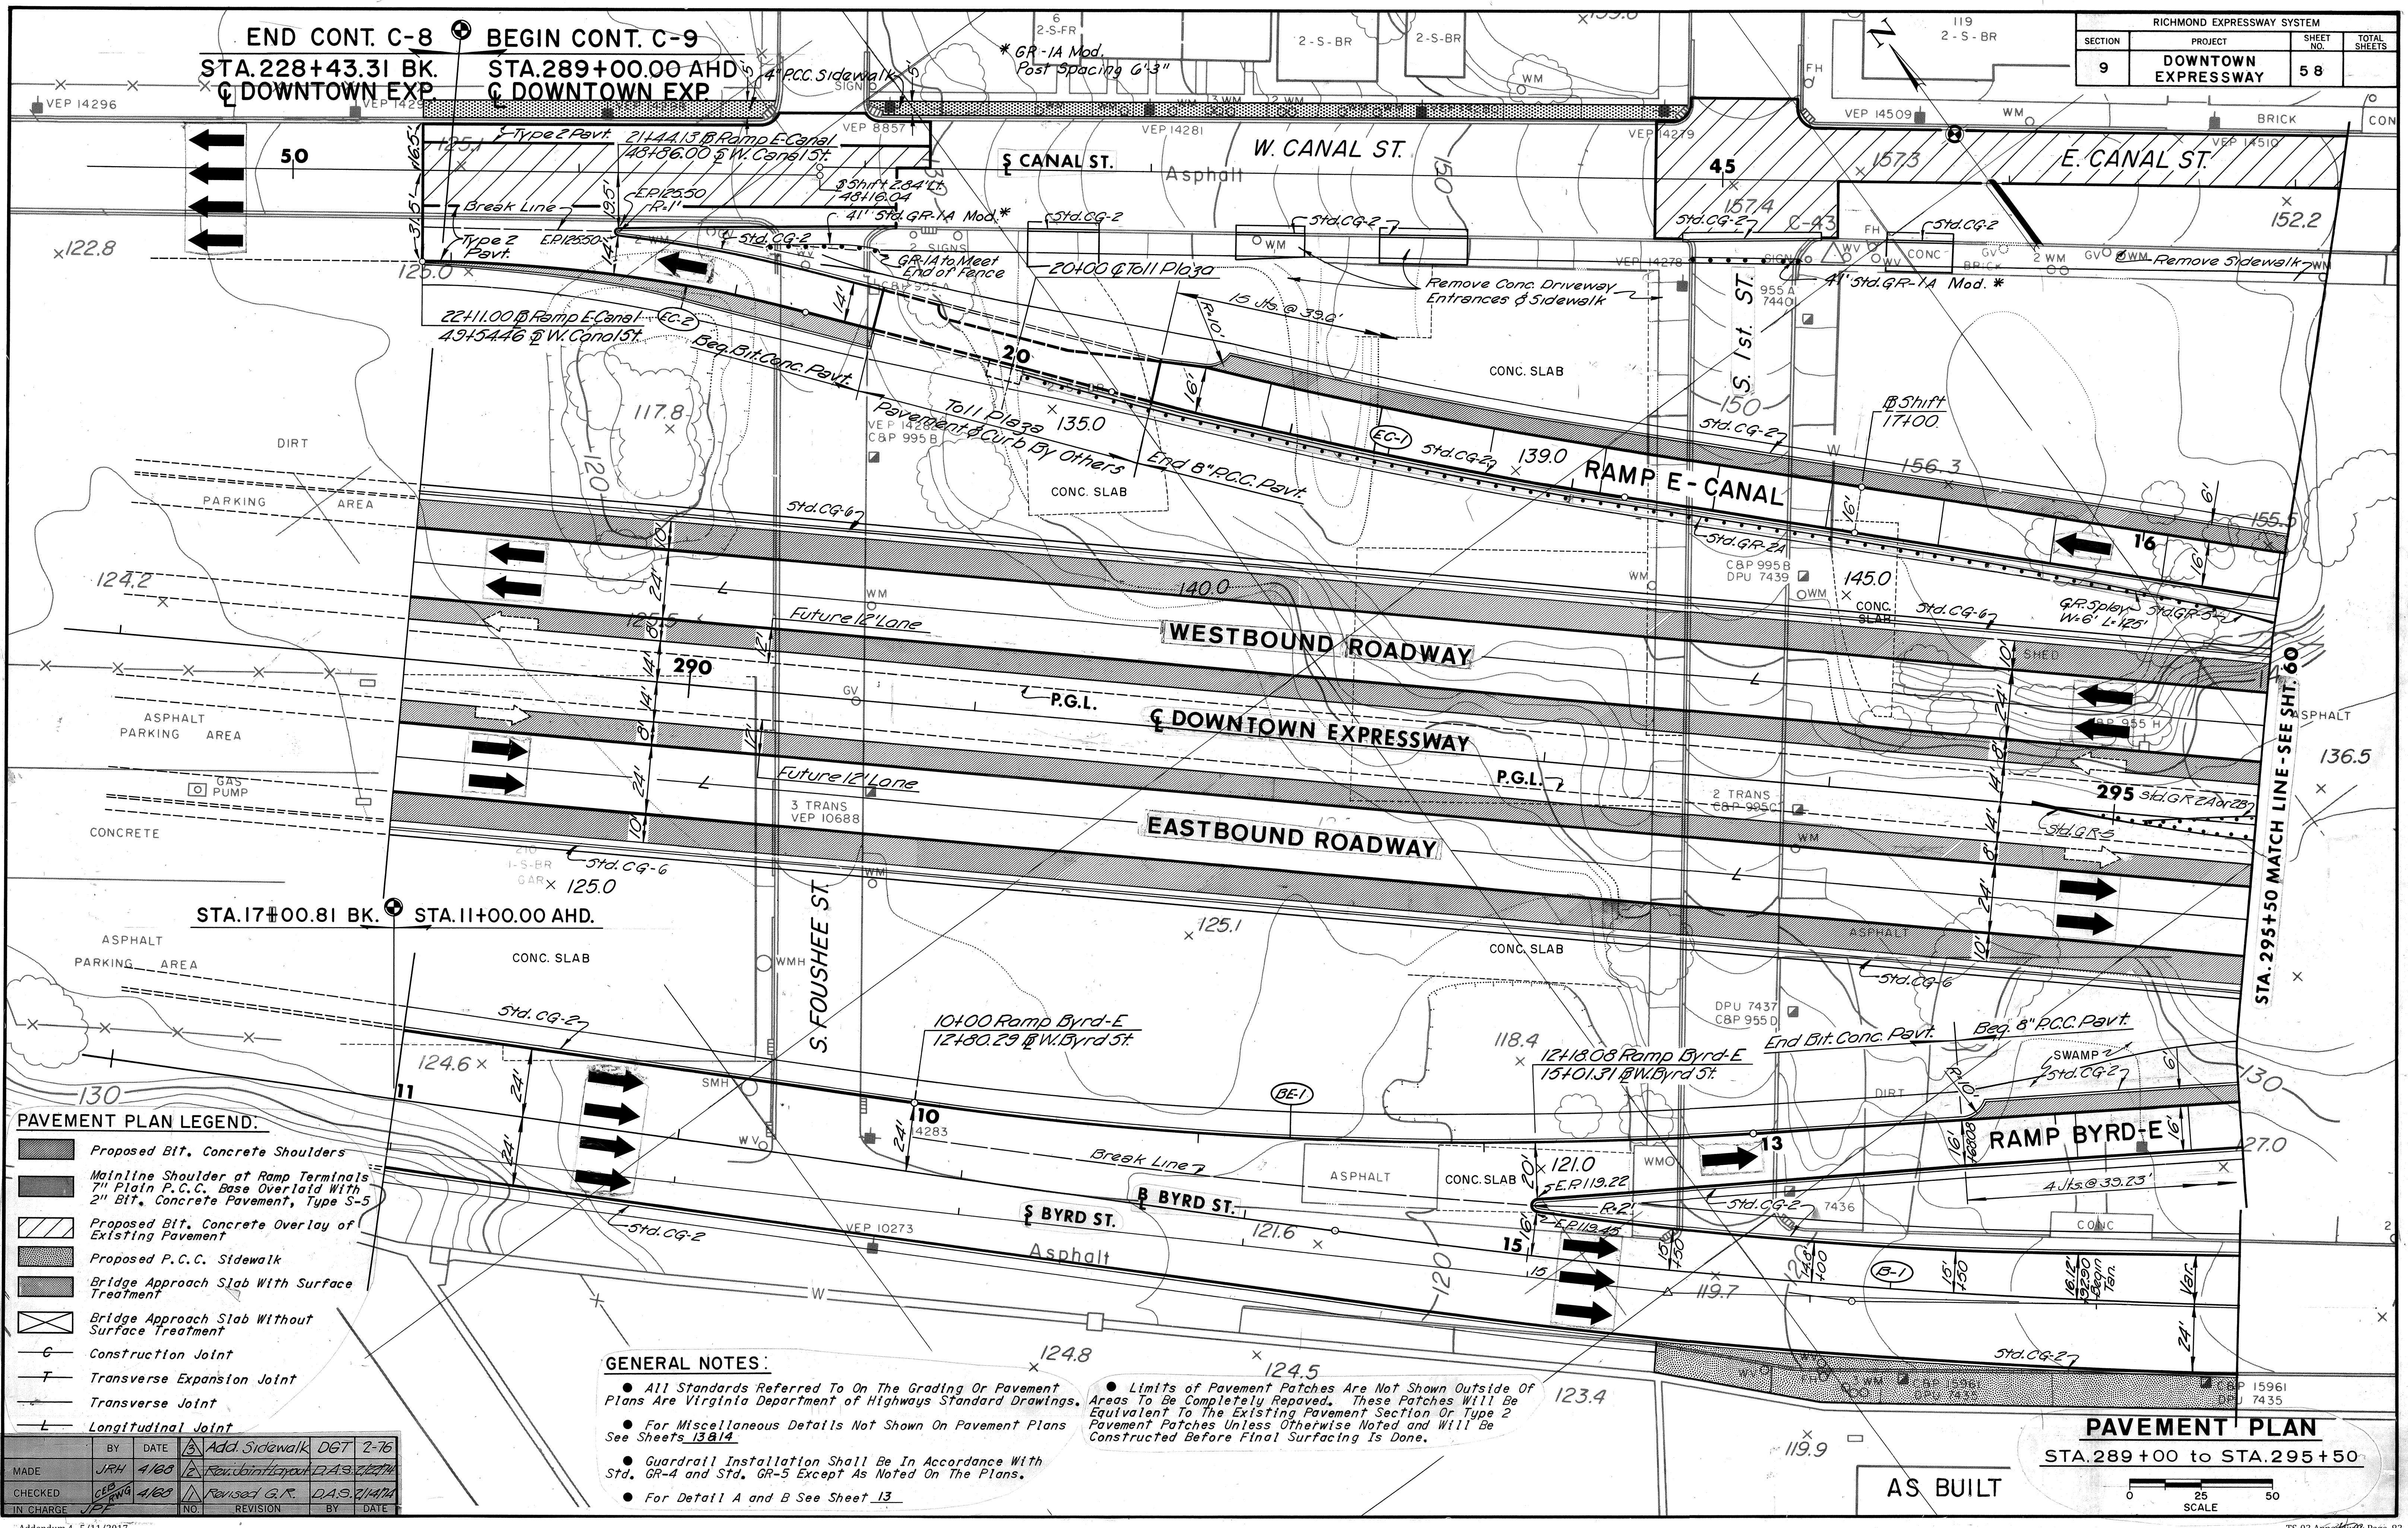

PAVEMENT PLAN LEGEND:

- Proposed Bit. Concrete Shoulders
- Mainline Shoulder at Ramp Terminals
7" Plain P.C.C. Base Overlaid With
2" Bit. Concrete Pavement, Type S-5
- Proposed Bit. Concrete Overlay of Existing Pavement
- Proposed P.C.C. Sidewalk
- Bridge Approach Slab With Surface Treatment
- Bridge Approach Slab Without Surface Treatment
- Construction Joint
- Transverse Expansion Joint
- Transverse Joint
- Longitudinal Joint

GENERAL NOTES:

- All Standards Referred To On The Grading Or Pavement Plans Are Virginia Department of Highways Standard Drawings.
- For Miscellaneous Details Not Shown On Pavement Plans See Sheets 13 & 14.
- Guardrail Installation Shall Be In Accordance With Std. GR-4 and Std. GR-5 Except As Noted On The Plans.
- For Detail A and B See Sheet 13.
- Limits of Pavement Patches Are Not Shown Outside Of Areas To Be Completely Repaved. These Patches Will Be Equivalent To The Existing Pavement Section Or Type 2 Pavement Patches Unless Otherwise Noted and Will Be Constructed Before Final Surfacing Is Done.


BY	DATE	ADD. SIDEWALK	DGT	2-76
MADE	JRH	4/68	Revised layout	D.A.S. 2/27/74
CHECKED	C.B.W.	4/68	Revised G.R.	D.A.S. 2/14/74
IN CHARGE	J.P.F.			
NO.	REVISION	BY	DATE	

PAVEMENT PLAN
STA. 289+00 to STA. 295+50

AS BUILT

0 25 50
SCALE

RICHMOND EXPRESSWAY SYSTEM			
SECTION	PROJECT	SHEET NO.	TOTAL SHEETS
9	DOWNTOWN EXPRESSWAY	60	

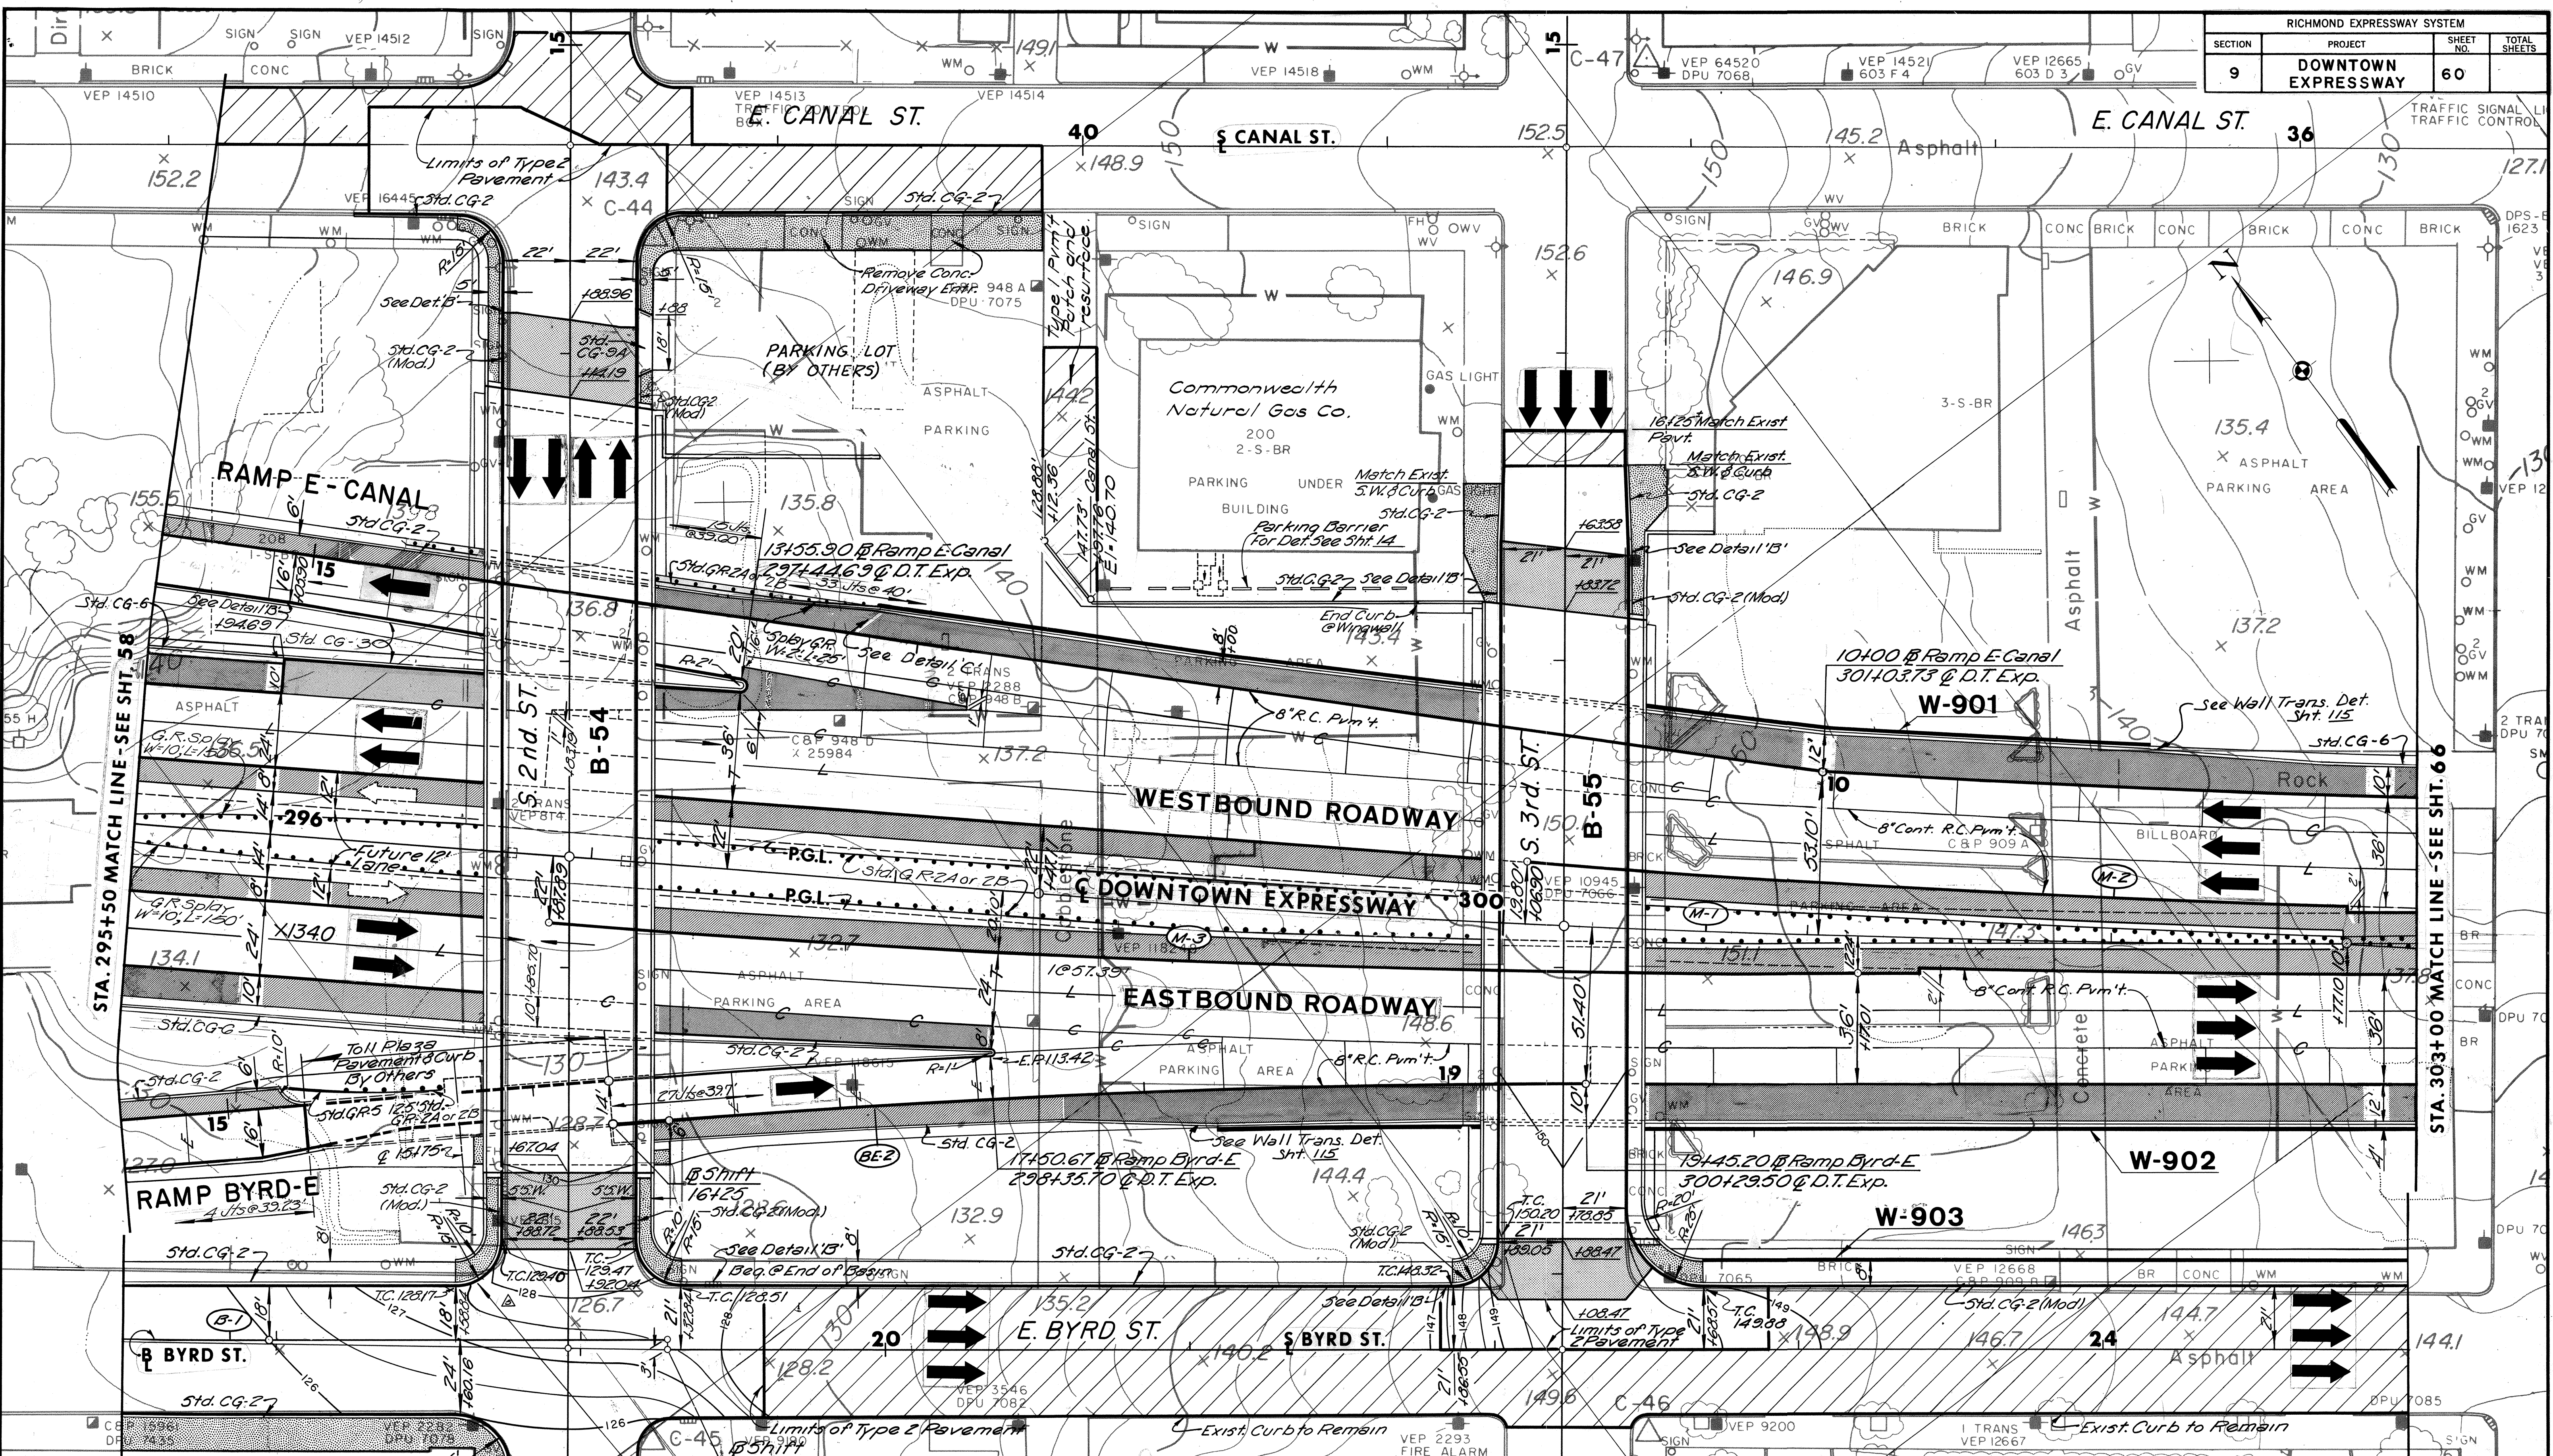

BY	DATE	REVISION	BY	DATE
MADE	JRH	1/68	Rev. Wall Trans	DAS 2/27/74
CHECKED	CEP	4/68	Rev. Curb Trans	OAS 2/15/74
IN CHARGE	JRF		Revised G.R.	OAS 2/14/74

NO.	REVISION	BY	DATE
1	Rev. Pav/Contour	RTS	2/25/74
2	Rev. Joint Seal	DAS	2/22/74

GENERAL NOTES:

- For Legend See Sheet 58
- For Details of Raised Concrete Median Barrier Transition At Bridge Piers See Sheet 19
- Cross Street Bridge Approach Slab Surface Treatment: Tack Coat With 0.1 Gal./Sq. Yd., RC-70 Bituminous Material Surface With 1" Bituminous Concrete, Type 1-2 and 1" Bituminous Concrete, Type S-5.

• Curb or Curb and Gutter Shall Be Tied To Concrete Pavement Or Base By Means of Dowels as Shown on Sheet 13

• For Mainline Shoulder Details At Ramp Terminals See Sheet 14

PAVEMENT PLAN
 STA. 295+50 to STA. 303+00

AS BUILT

E. CANAL ST.

STA. 19+25 MATCH LINE - SEE SHT. 79

STA. 91+25 MATCH LINE - SEE SHT. 79

1 TRANS
VEP 12736
CBP 807 D
CBP 1777

VEP 10674
CBP 807 E

TRAFFIC LIGHT
VEP 10673
DPS E 1638

15344

BILLBOARD

WMU METAL C VER WM GV

S. 10th. ST.
20
Type 2 Pavement

Exist. Curb to Remain

Std. CG-9A

Match. Exist. Loading Dock
Pavt. & End Std. CG-2

WOOD DOCK

Std. CG-2

25' Taper

Std. CG-2 (Mod)

Add Posts

Std. GR-2A

Splay G.R.
W: 2' L: 50'

Std. GR-5

15

325

RAISED CONCRETE
MEDIAN BARRIER, STD. MB-6A

CANAL RUNS UNDER

CANAL

15

Std. GR-5

Std. CG-2

Byrd St.

13+69.36 Ramp 10th-E
45+71.00 E. Byrd St.

Exist. Curb to Remain

Limits of Type 2 Pavement

GENERAL NOTES:

● For Legend See Sheet 58

● For Details Of Raised Concrete Median Barrier Transition At Bridge Piers See Sheet 19

● Cross Street Bridge Approach Slab Surface Treatment: Tack Coat With 0.1 Gal./Sq. Yd. RC-70 Bituminous Material, Surface With 1 1/2" Bituminous Concrete, Type I-2 and 1" Bituminous Concrete, Type S-5.

AS BUILT

SCALE 0 25 50

Std. CG-6

ASPHALT

26'

27'

5'

36'

90

90

20

24

320

36'

26'

88

40

26'

27'

26'

27'

26'

27'

26'

27'

26'

std. CG-6

Asphalt

S. 9th. ST.

86.5

88.8

Std. CG-2 Mod.

8" Cont. R.C. Pymt.

20

24

320

36'

26'

88

40

26'

27'

26'

27'

26'

27'

26'

27'

86.5

88.8

86.3

85.6

84.9

84.7

84.7

50' Taper

27' x 40'

8" R.C. Pymt.

40'

100

10

10

Meet Exist. Curb & S.W. 19+53.4

Replace Exist. Conc. Apron With Std. CG-9A

See Detail 'B'

Std. CG-2 (Mod)

130.72

180.72

21'

21'

See Detail 'C'

84.8

84.8

Std. CG-2

25' Taper

See Detail 'B'

Std. CG-2 (Mod)

130.72

180.72

21'

21'

See Detail 'C'

84.8

84.8

Std. CG-9A

CANOPY

Match. Exist. Loading Dock Pavt. & End Std. CG-2

Std. CG-2

25' Taper

See Detail 'B'

Std. CG-2 (Mod)

130.72

180.72

21'

21'

See Detail 'C'

84.8

84.8

Std. CG-2

25' Taper

See Detail 'B'

Std. CG-2 (Mod)

130.72

180.72

21'

21'

See Detail 'C'

84.8

84.8

Std. CG-2

25' Taper

See Detail 'B'

Std. CG-2 (Mod)

130.72

180.72

21'

21'

See Detail 'C'

84.8

84.8

BY	DATE	REVISION	BY	DATE
BY	DATE	Added Berm	F.H.T.	1/22/75
MADE	JRH	Rev. Joint Layout	D.A.S.	2/22/74
CHECKED	CEP	Added Std. H.R. Mod.	D.A.S.	2/21/74
IN CHARGE	JPF			

MATCH LINE - SEE SHEET 73A

As Built TEAM 6-77


PAVEMENT PLAN
STA. 318+00 to STA. 325+50

AS BUILT

SCALE 0 25 50

DTE RAMP TOLL PLAZAS


11TH ST RAMP WIDENING PLANS

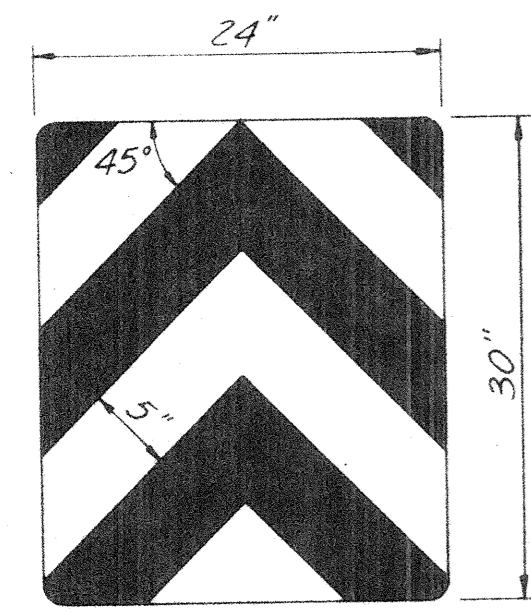

Colors
Alternating black and
reflectorized yellow stripes


OM-3 Modified
1" = 1'-0"

Note:
Signs are to be as specified in
the current manual on Uniform
Traffic Control Devices for Highways
& Street, by the Federal Highway
Administration.

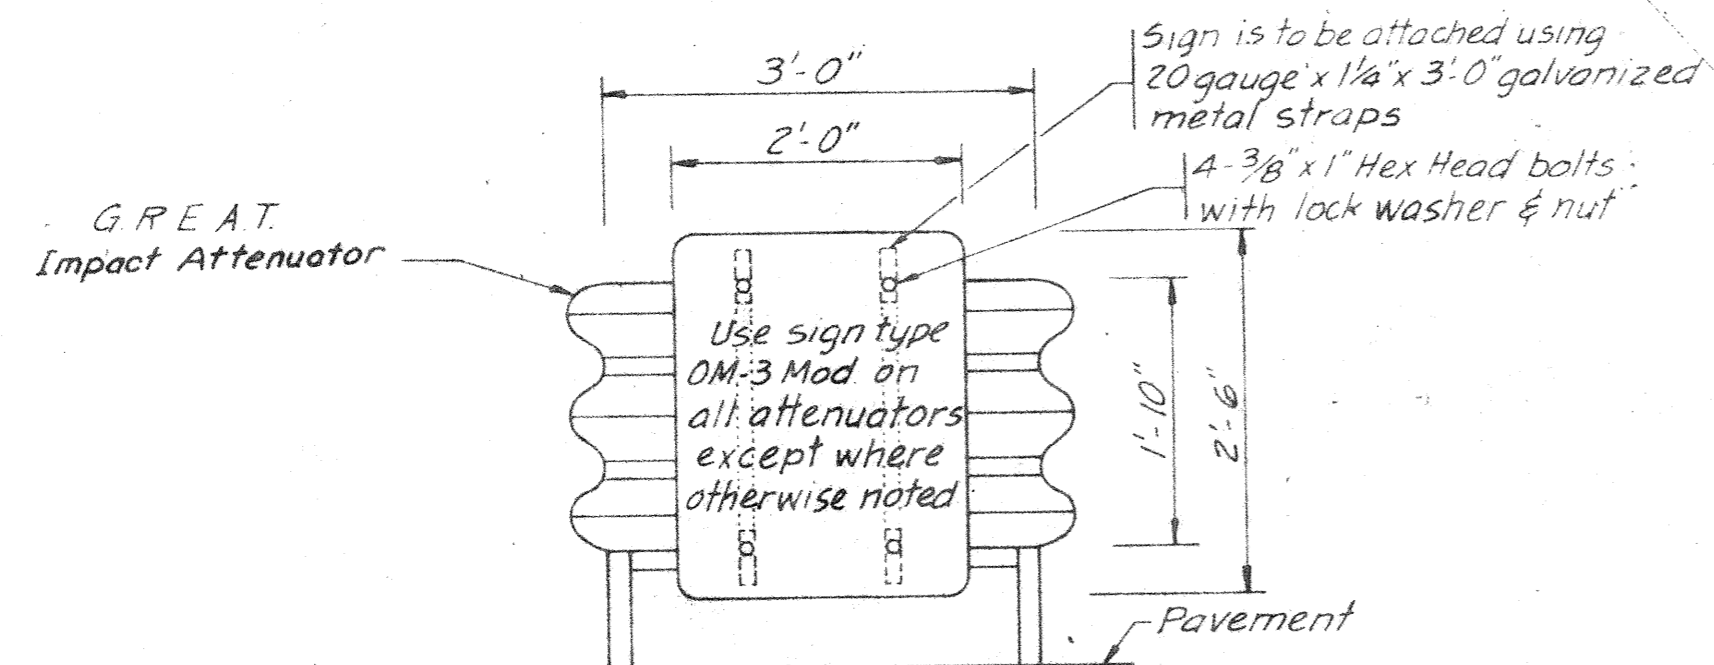

**SIGN ATTACHMENT
DETAIL**
3/4" = 1'-0"


ATTENUATOR SIGNING DETAILS

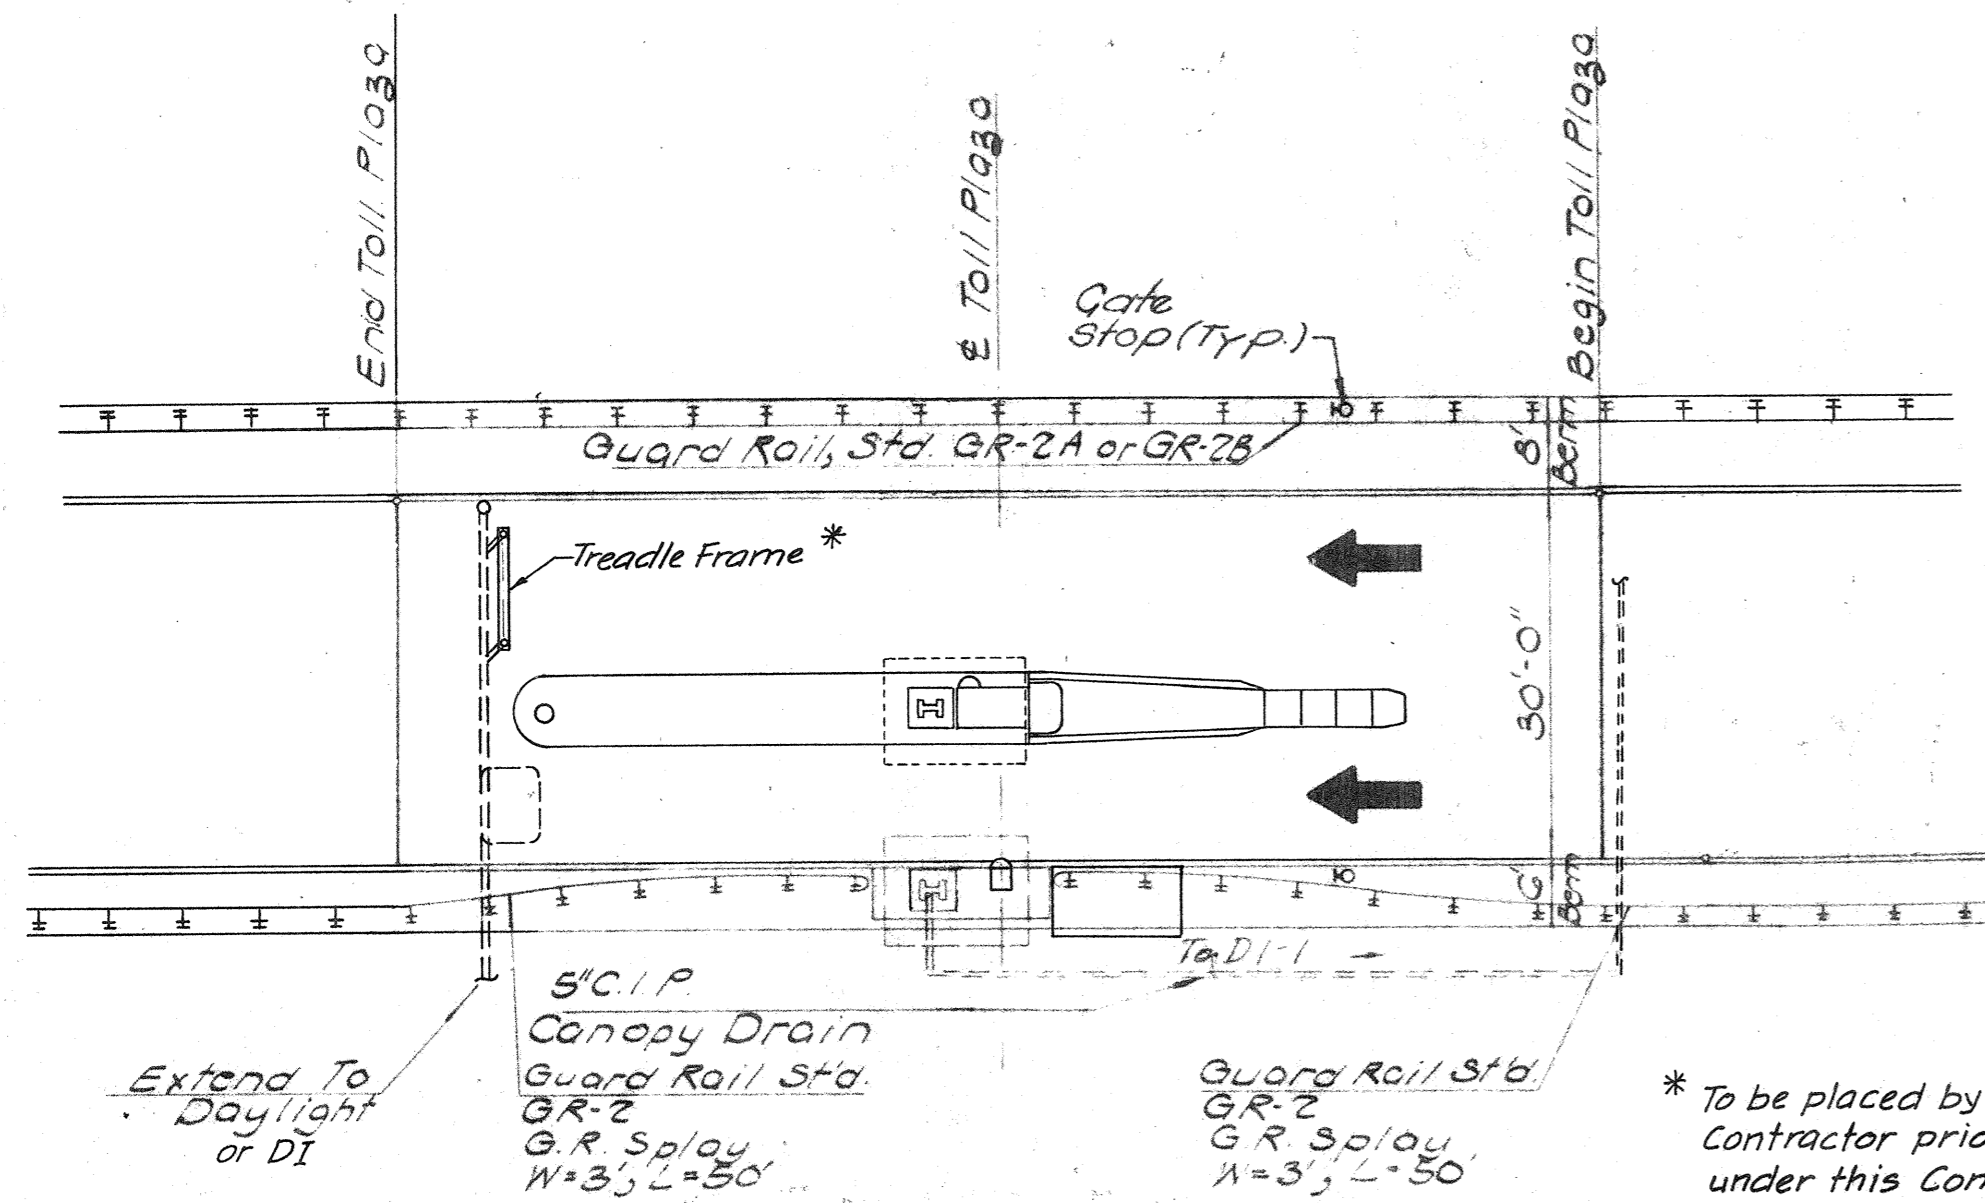


1/16" = 1'-0"

LEGEND:


- Traffic Signal (N.I.C.)
- * Automatic Toll Machine
- Toll Booth (N.I.C.)

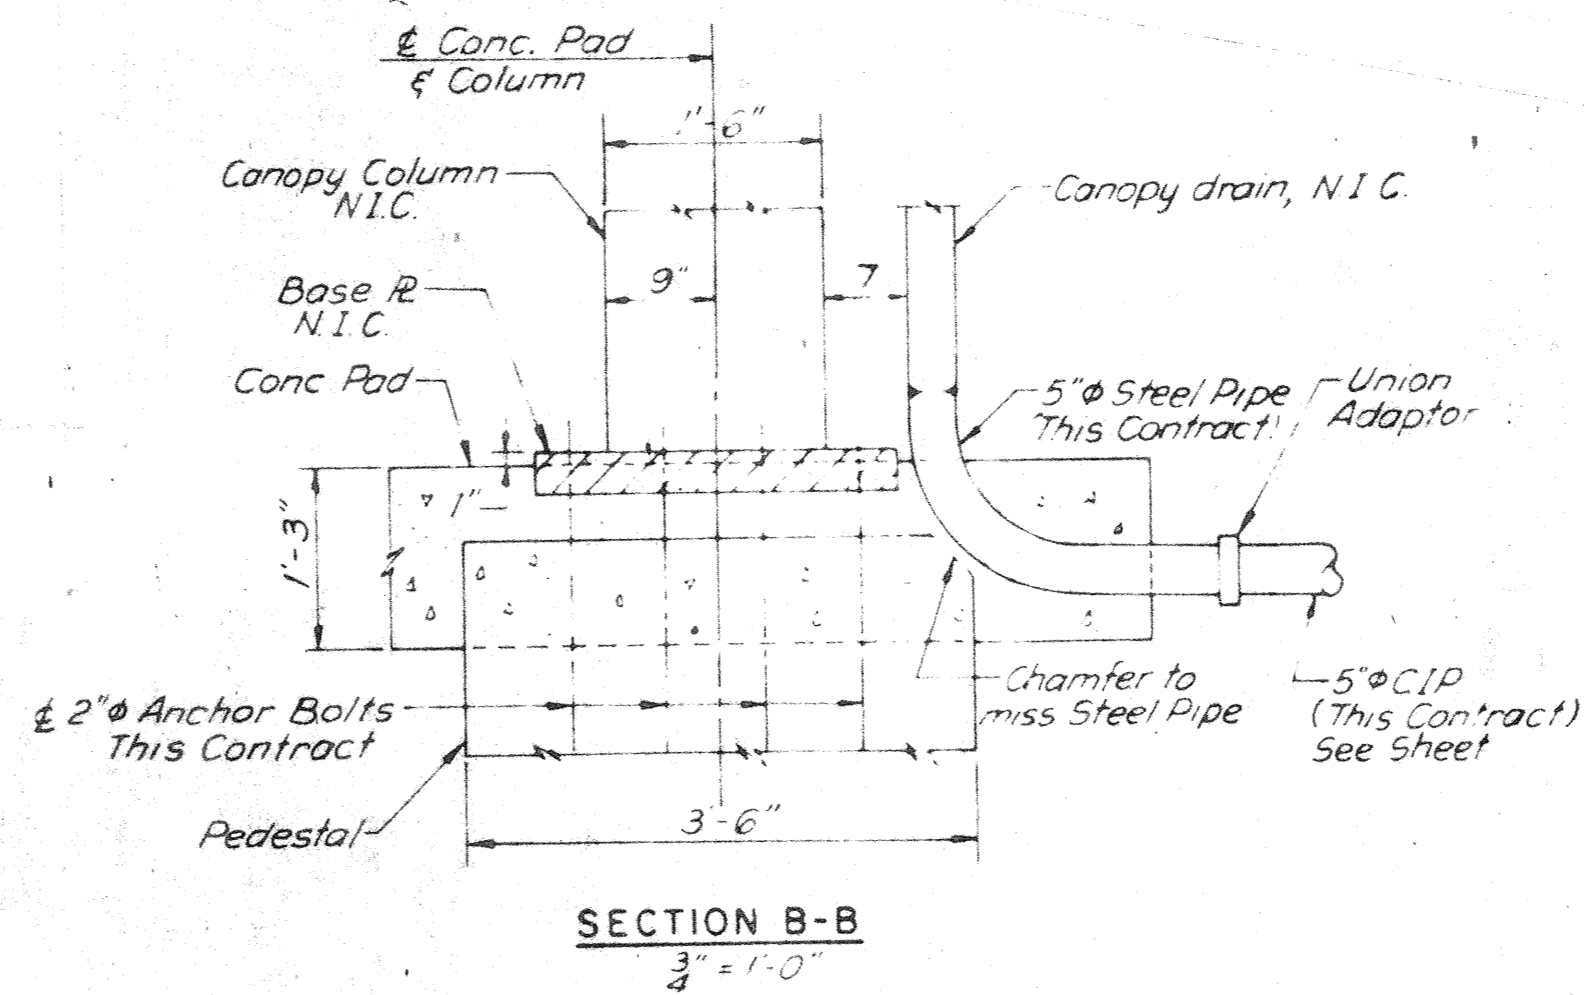

SECTION B-B
3/4" = 1'-0"

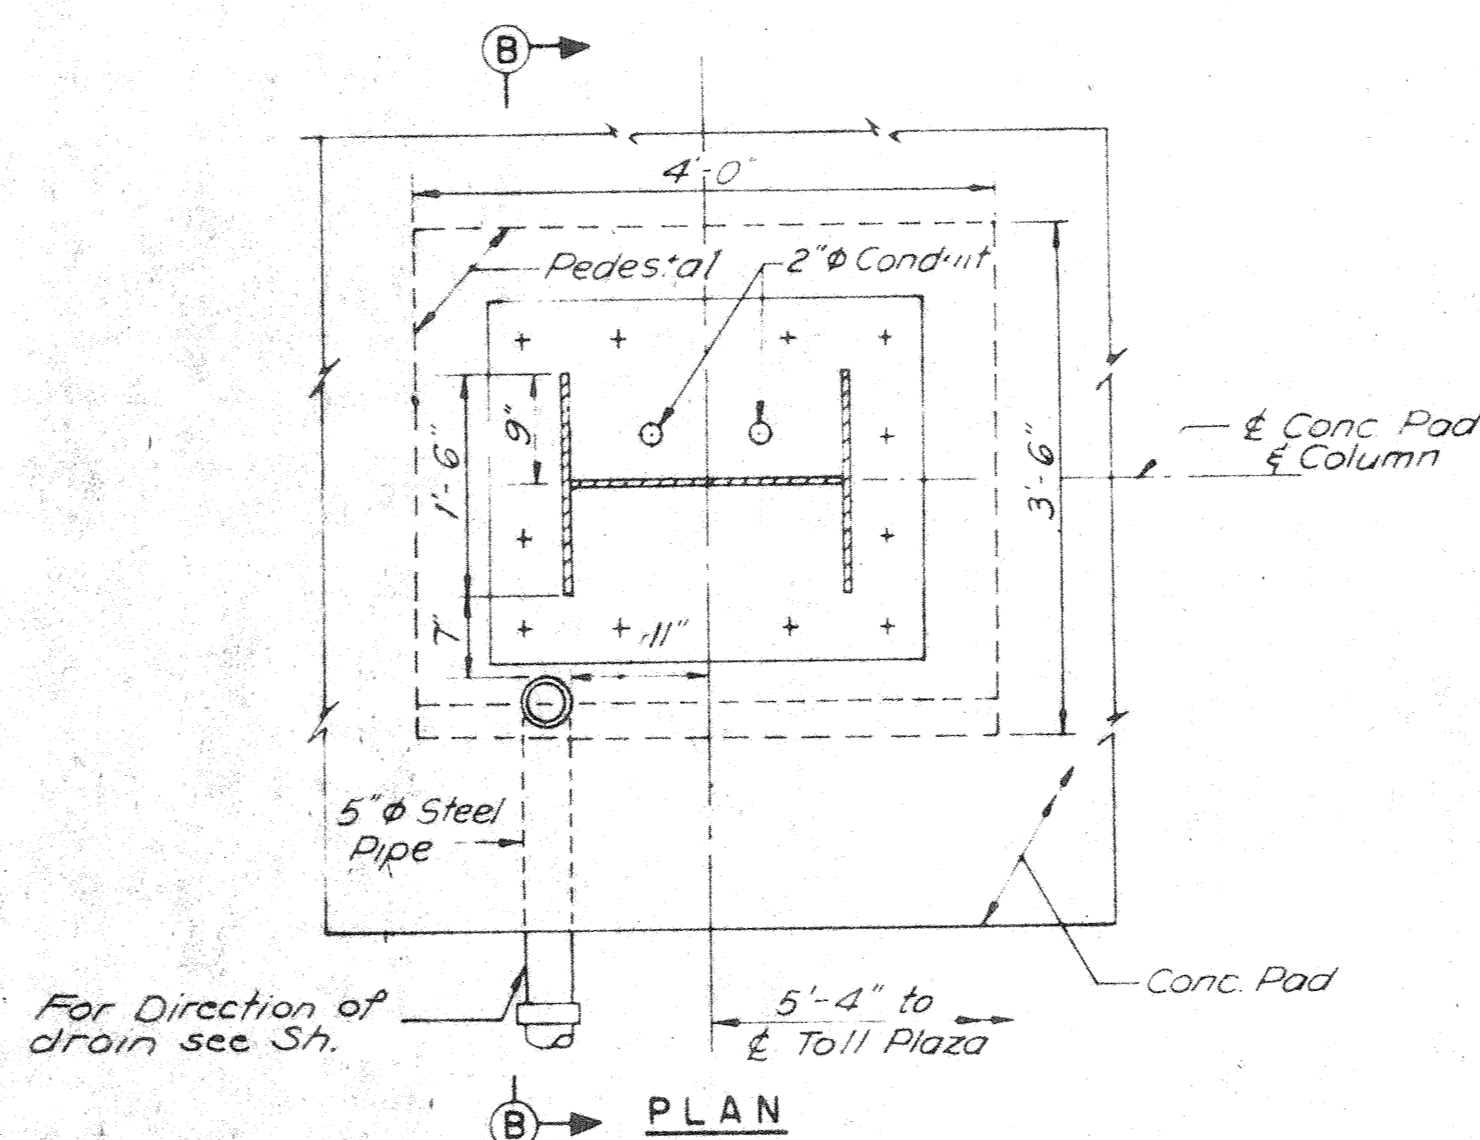

RAMP CANOPY DRAIN
3/4" = 1'-0"

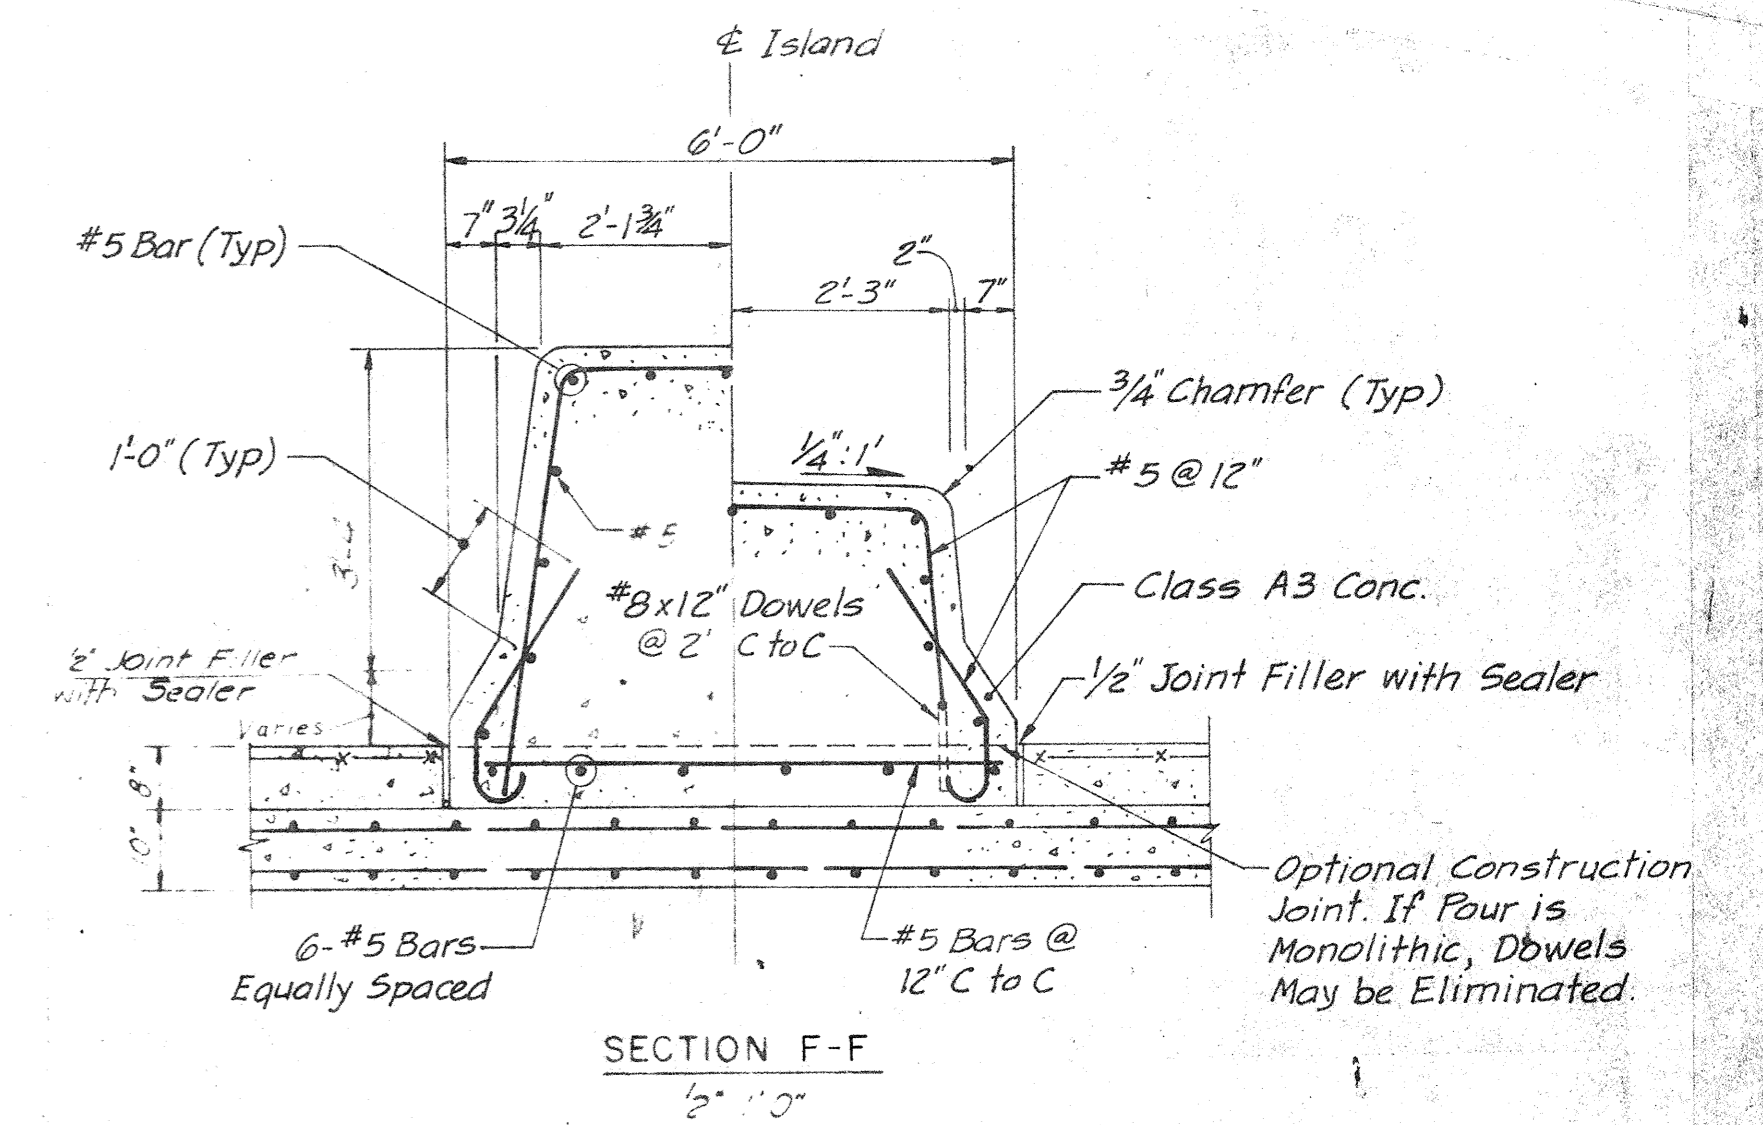


SECTION F-F
2" = 1'-0"


Note:
For Conduit Schedule, see sheet 2D(5)

	By	Date	No.	Revision	By	Date
Designed	PHT	1-91				
Drawn	CN	1-91				
Checked	ICM	1-91				
Approved	RBN	1-91				

ma RICHMOND METROPOLITAN AUTHORITY			
RICHMOND EXPRESSWAY SYSTEM			
TWO LANE RAMP TOLL PLAZA			
DETAILS			
HOWARD NEEDLES TAMMEN & BERGENDOFF Architects ALEXANDRIA, VA.		Engineers PLANNERS HNTB	
Scale:	Date:	Contract No.:	Sheet:
AS NOTED	JAN. 1991	C-15	2D(2) of

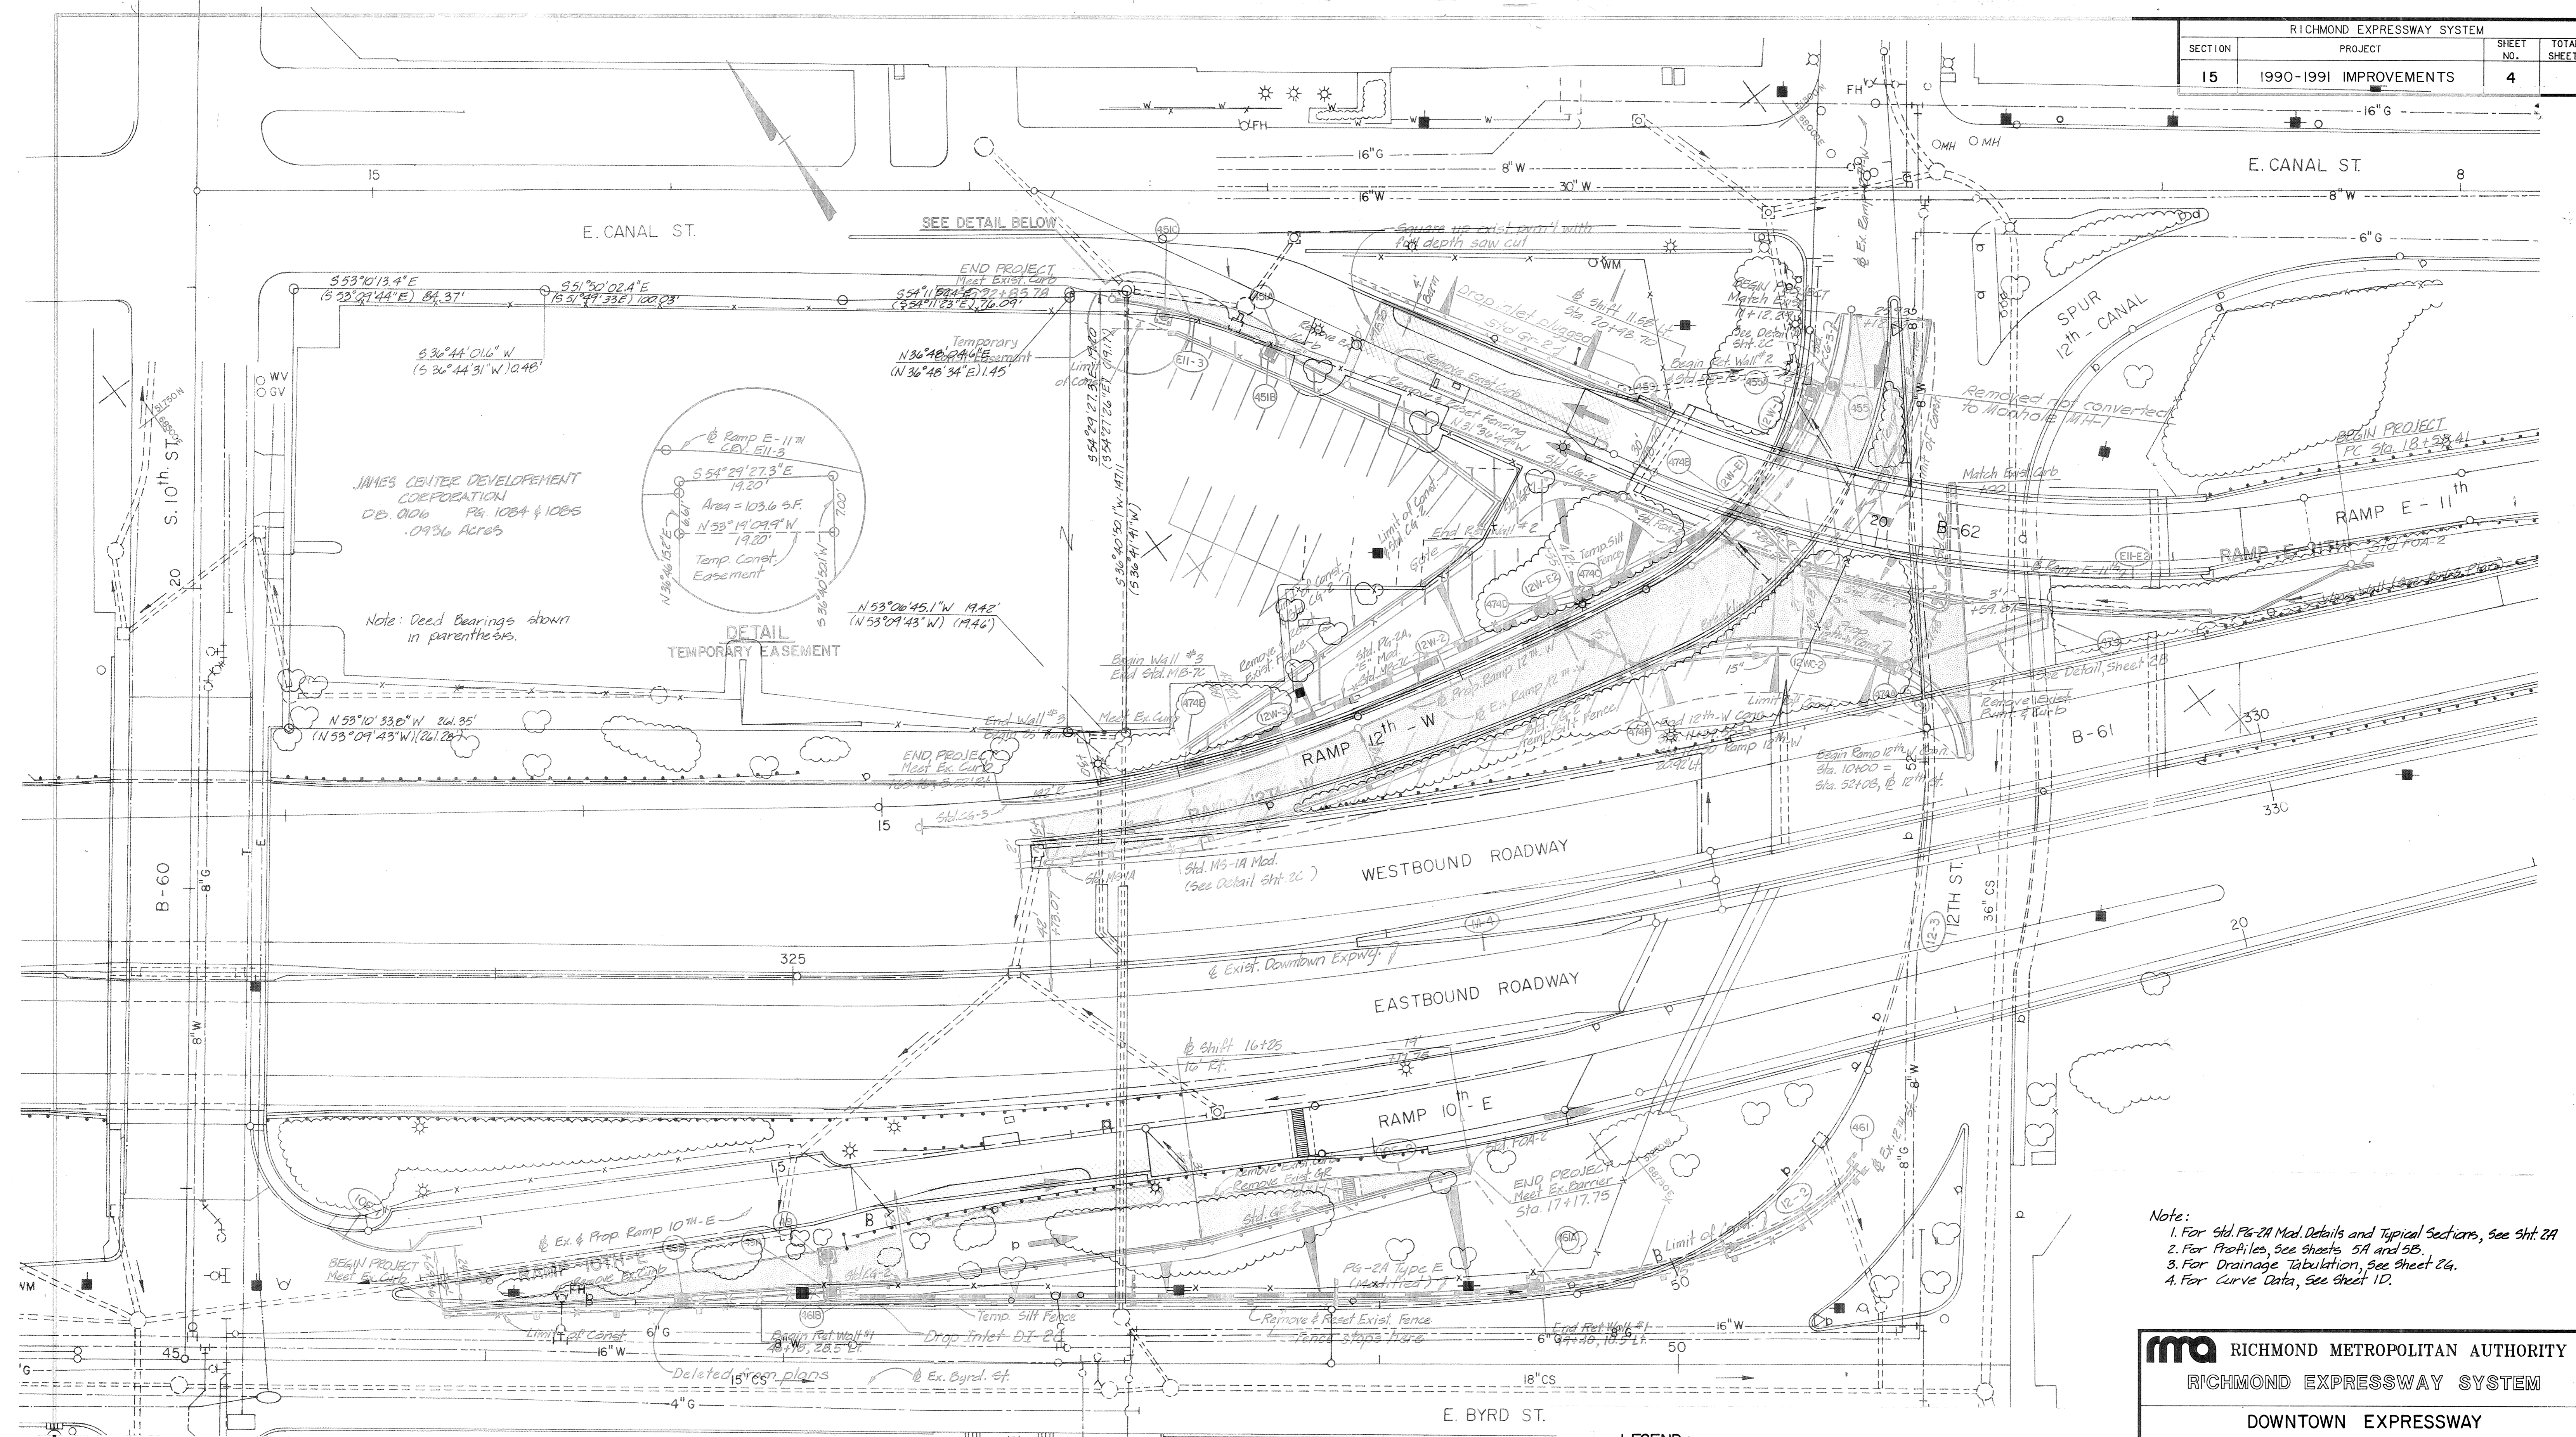


JAMES CENTER DEVELOPMENT CORPORATION
DB. 0106 PG. 1084 & 1086
.0936 Acres

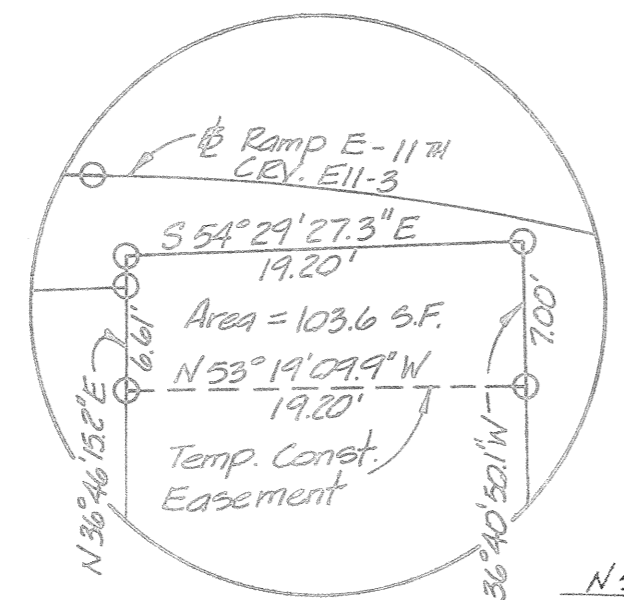

Note: Dead Bearings shown in parentheses.

- Note:
1. For Std. PG-2A Mod. Details and Typical Sections, see Sht. 2A
 2. For Profiles, see Sheets 5A and 5B.
 3. For Drainage Tabulation, see Sheet 24.
 4. For Curve Data, see Sheet 1D.

Designed	By	Date			
Drawn					
Checked					
Approved	No.	Revision	By	Date	

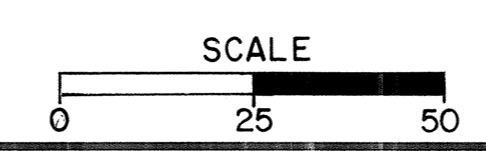

- LEGEND:
- FULL STRENGTH PVMT.
 - PAVED SHOULDER
 - DEMOLITION OF PAVEMENT
 - DEMOLITION OF TOLL PLAZA

AS BUILT

ma RICHMOND METROPOLITAN AUTHORITY
RICHMOND EXPRESSWAY SYSTEM

**DOWNTOWN EXPRESSWAY
GRADING, DRAINAGE &
PAVEMENT PLAN**

HOWARD NEEDLES TAMMEN & BERGENDOFF
Architects Engineers Planners
ALEXANDRIA, VA.


HNTB

Scale: 1" = 25'
Date: JAN. 1991
Contract No. C-15
Sheet: 4 of 4

DOUGLASDALE RAMP TOLL PLAZA

ORIGINAL PLANS

RICHMOND EXPRESSWAY SYSTEM			
SECTION	PROJECT	SHEET NO.	TOTAL SHEETS
4	BELTLINE EXPRESSWAY	75	155

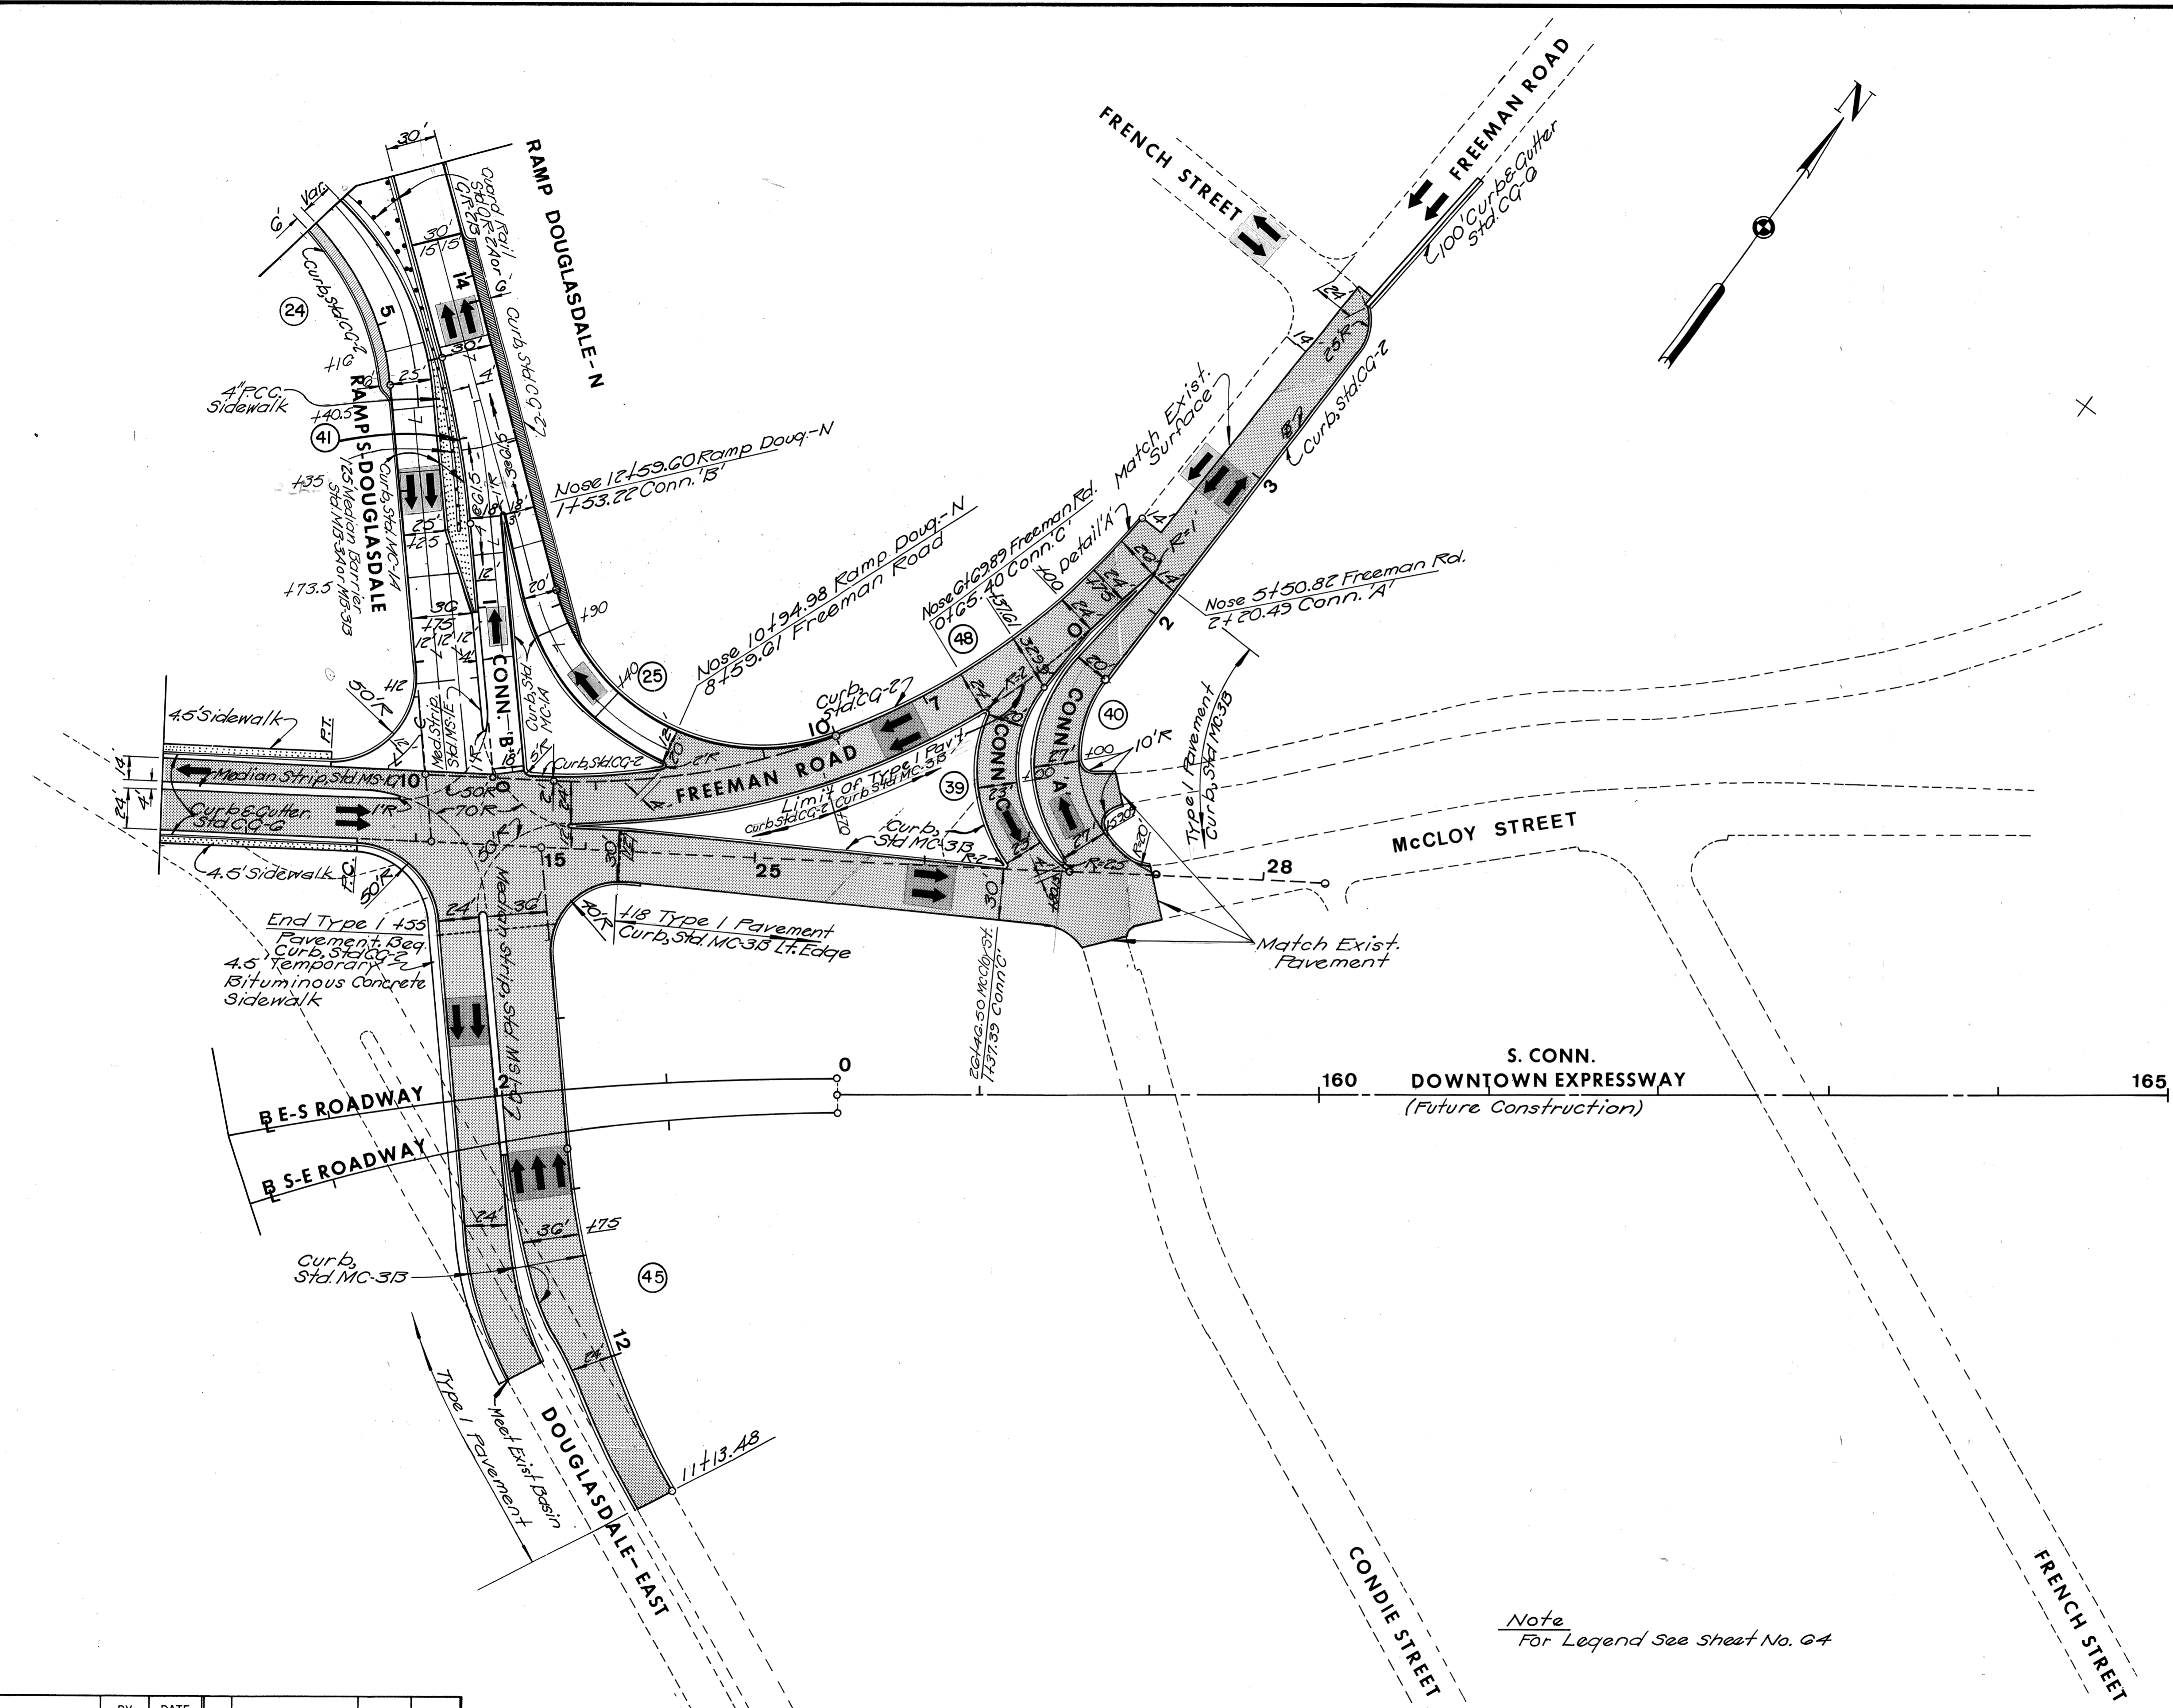

Note
For Legend See sheet No. 64

AS BUILT

RICHMOND METROPOLITAN AUTHORITY
RICHMOND EXPRESSWAY SYSTEM
BELTLINE EXPRESSWAY


PAVEMENT PLAN
STA. 10 +50 TO STA. 165+00

HOWARD, NEEDLES, TAMMEN & BERGENDOFF
consulting engineers
NEW YORK ALEXANDRIA KANSAS CITY

SCALE: 1"=50'
CONTRACT NO.: 4
SHEET NO. 75 OF 155

BY	DATE				
MADE	DAS	7-70			
CHECKED	C.E.B.		AS BUILT	R.W.R.	9-73
IN CHARGE	J.P.F.				
NO.	REVISION	BY	DATE		

RICHMOND EXPRESSWAY SYSTEM			
SECTION	PROJECT	SHEET NO.	TOTAL SHEETS
4	BELTLINE EXPRESSWAY	81	155

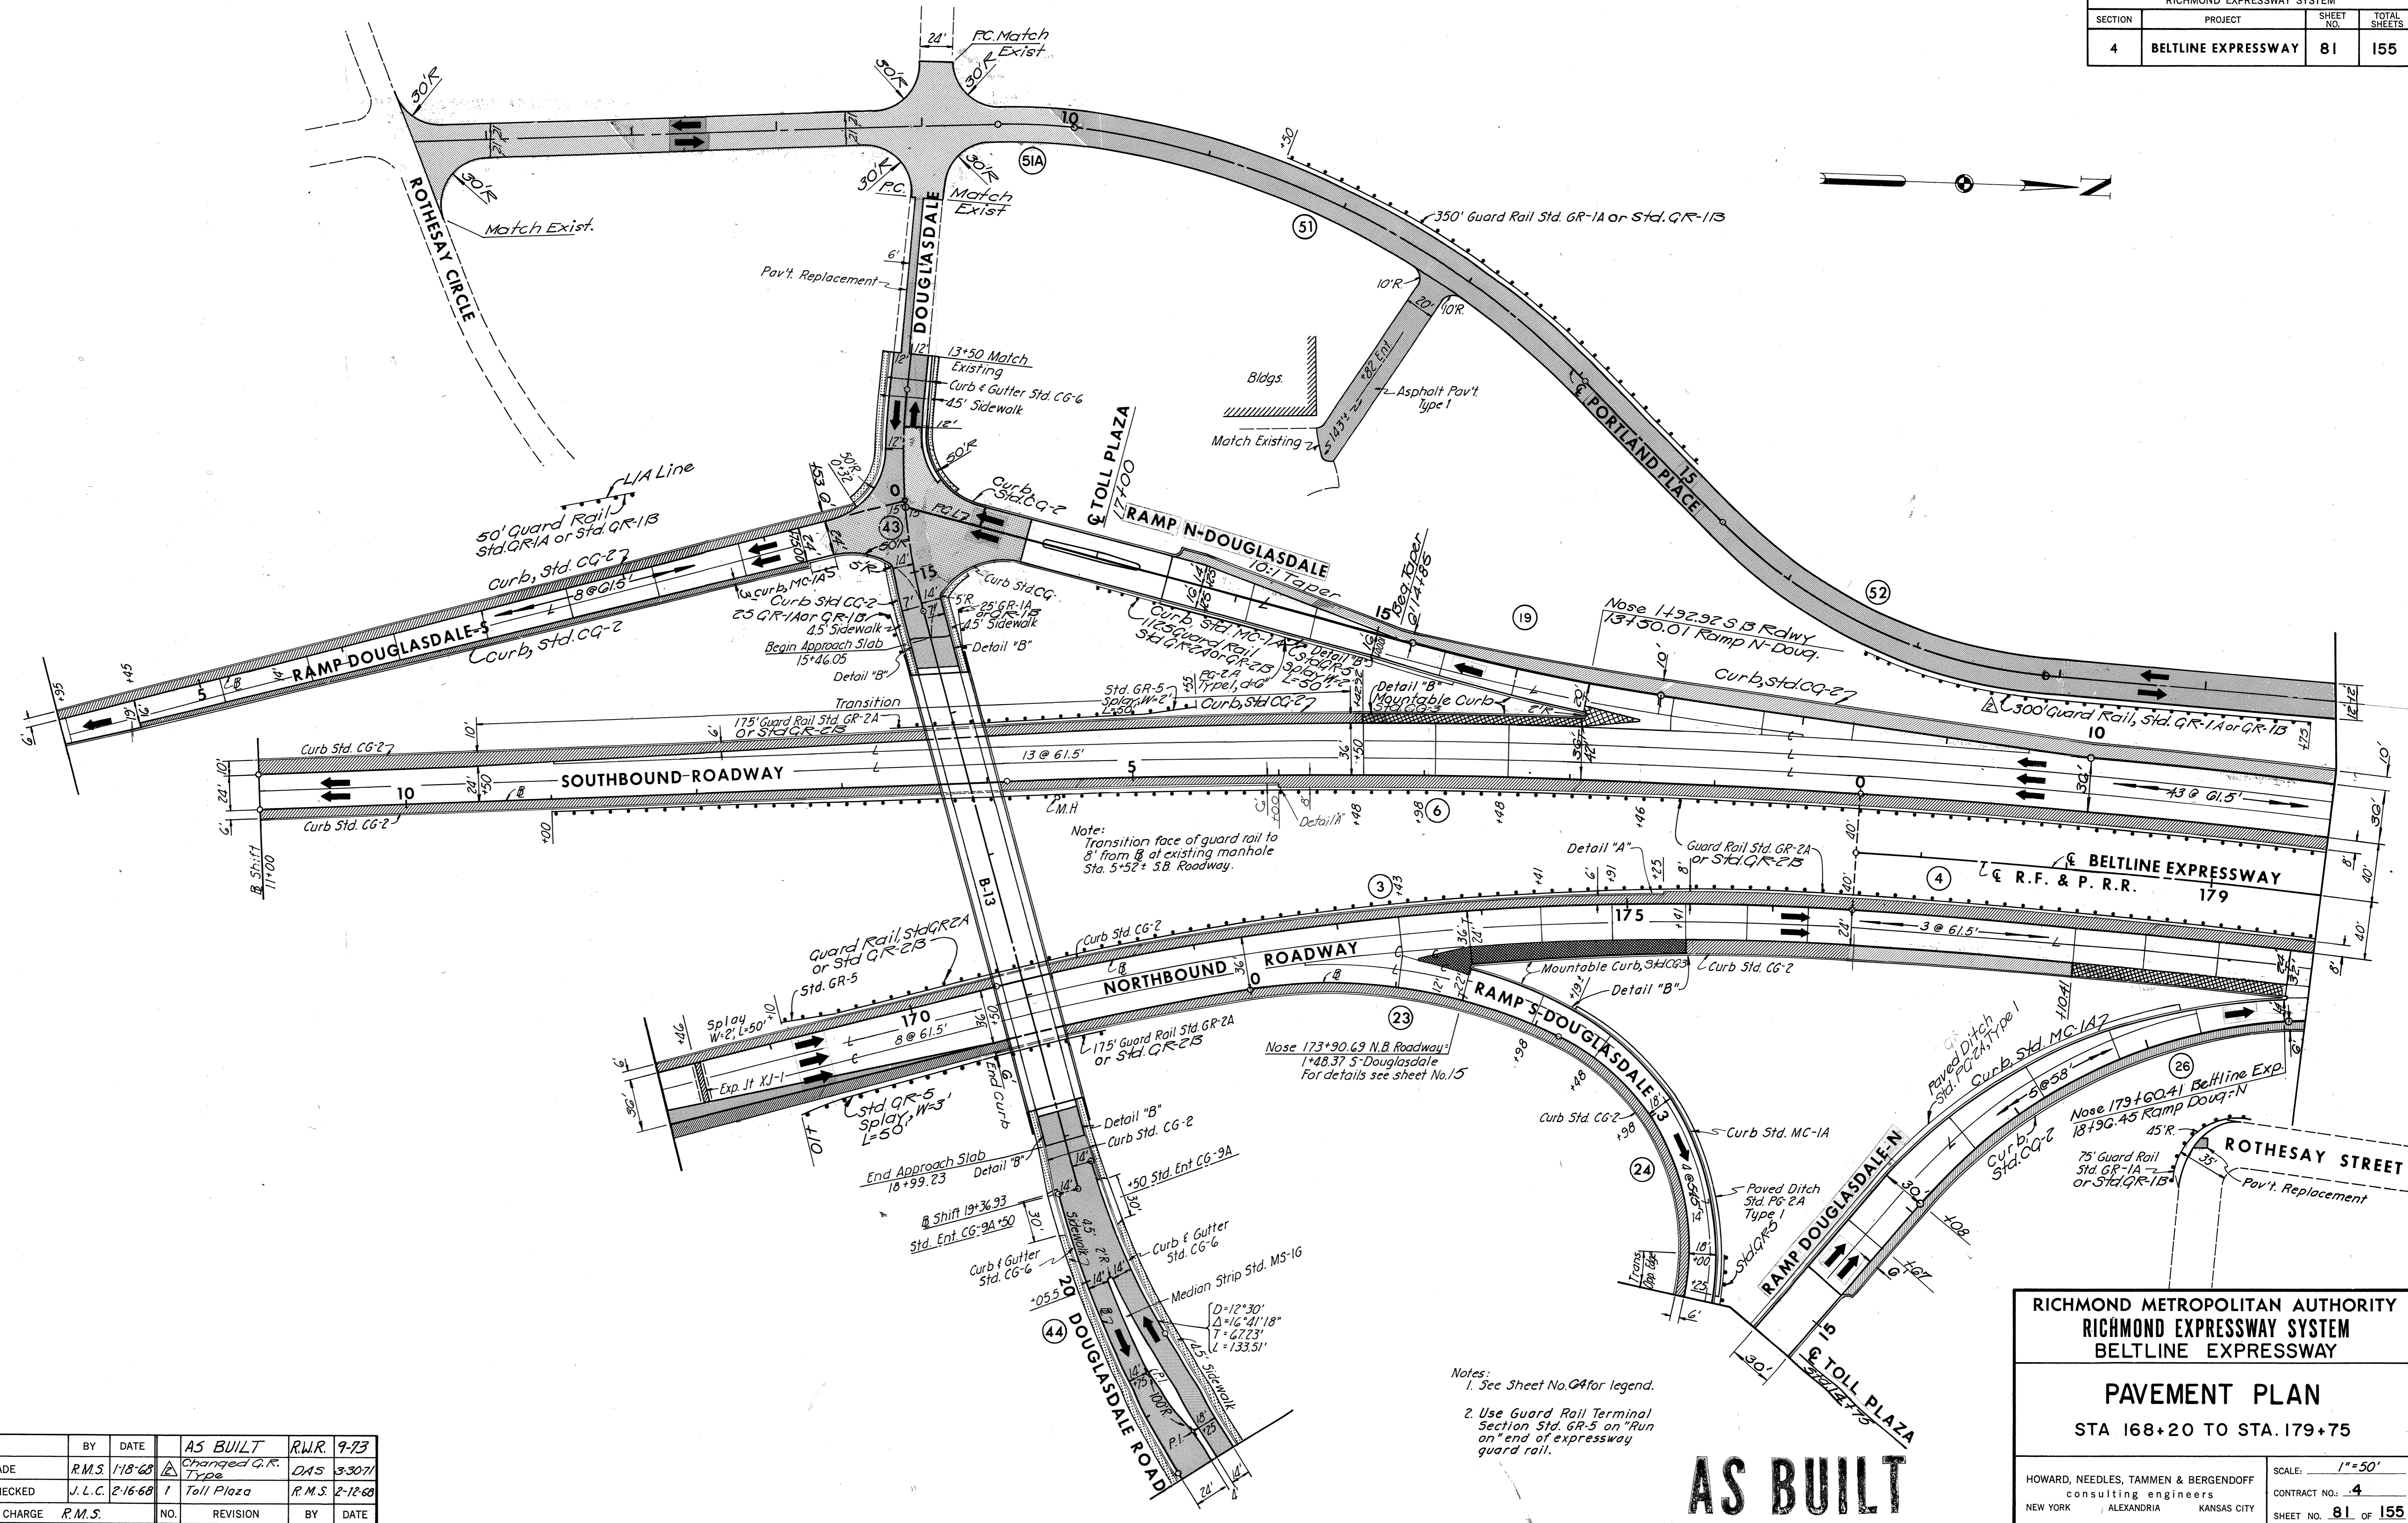

Note: Transition face of guard rail to 8' from @ at existing manhole Sta. 5+52+3.8 Roadway.

Nose 173+90.69 N.B. Roadway = 1+48.37 5-Douglasdale For details see sheet No.15

Nose 179+60.41 Beltline Exp. 18+96.45 Ramp Douq-N

- Notes:
1. See Sheet No. 84 for legend.
 2. Use Guard Rail Terminal Section Std. GR-5 on "Run on" end of expressway guard rail.

AS BUILT


BY	DATE	AS BUILT	R.W.R.	9-73
MADE	R.M.S. 1-18-68	Changed G.R. Type	DAS	3-30-71
CHECKED	J.L.C. 2-16-68	Toll Plaza	R.M.S.	2-12-68
IN CHARGE	R.M.S.			

RICHMOND METROPOLITAN AUTHORITY
RICHMOND EXPRESSWAY SYSTEM
BELTLINE EXPRESSWAY

PAVEMENT PLAN
STA 168+20 TO STA. 179+75

HOWARD, NEEDLES, TAMMEN & BERGENDOFF consulting engineers NEW YORK ALEXANDRIA KANSAS CITY	SCALE: 1" = 50' CONTRACT NO.: 4 SHEET NO. 81 OF 155
---	---


RICHMOND EXPRESSWAY SYSTEM			
SECTION	PROJECT	SHEET NO.	TOTAL SHEETS
4	BELTLINE EXPRESSWAY	56	155

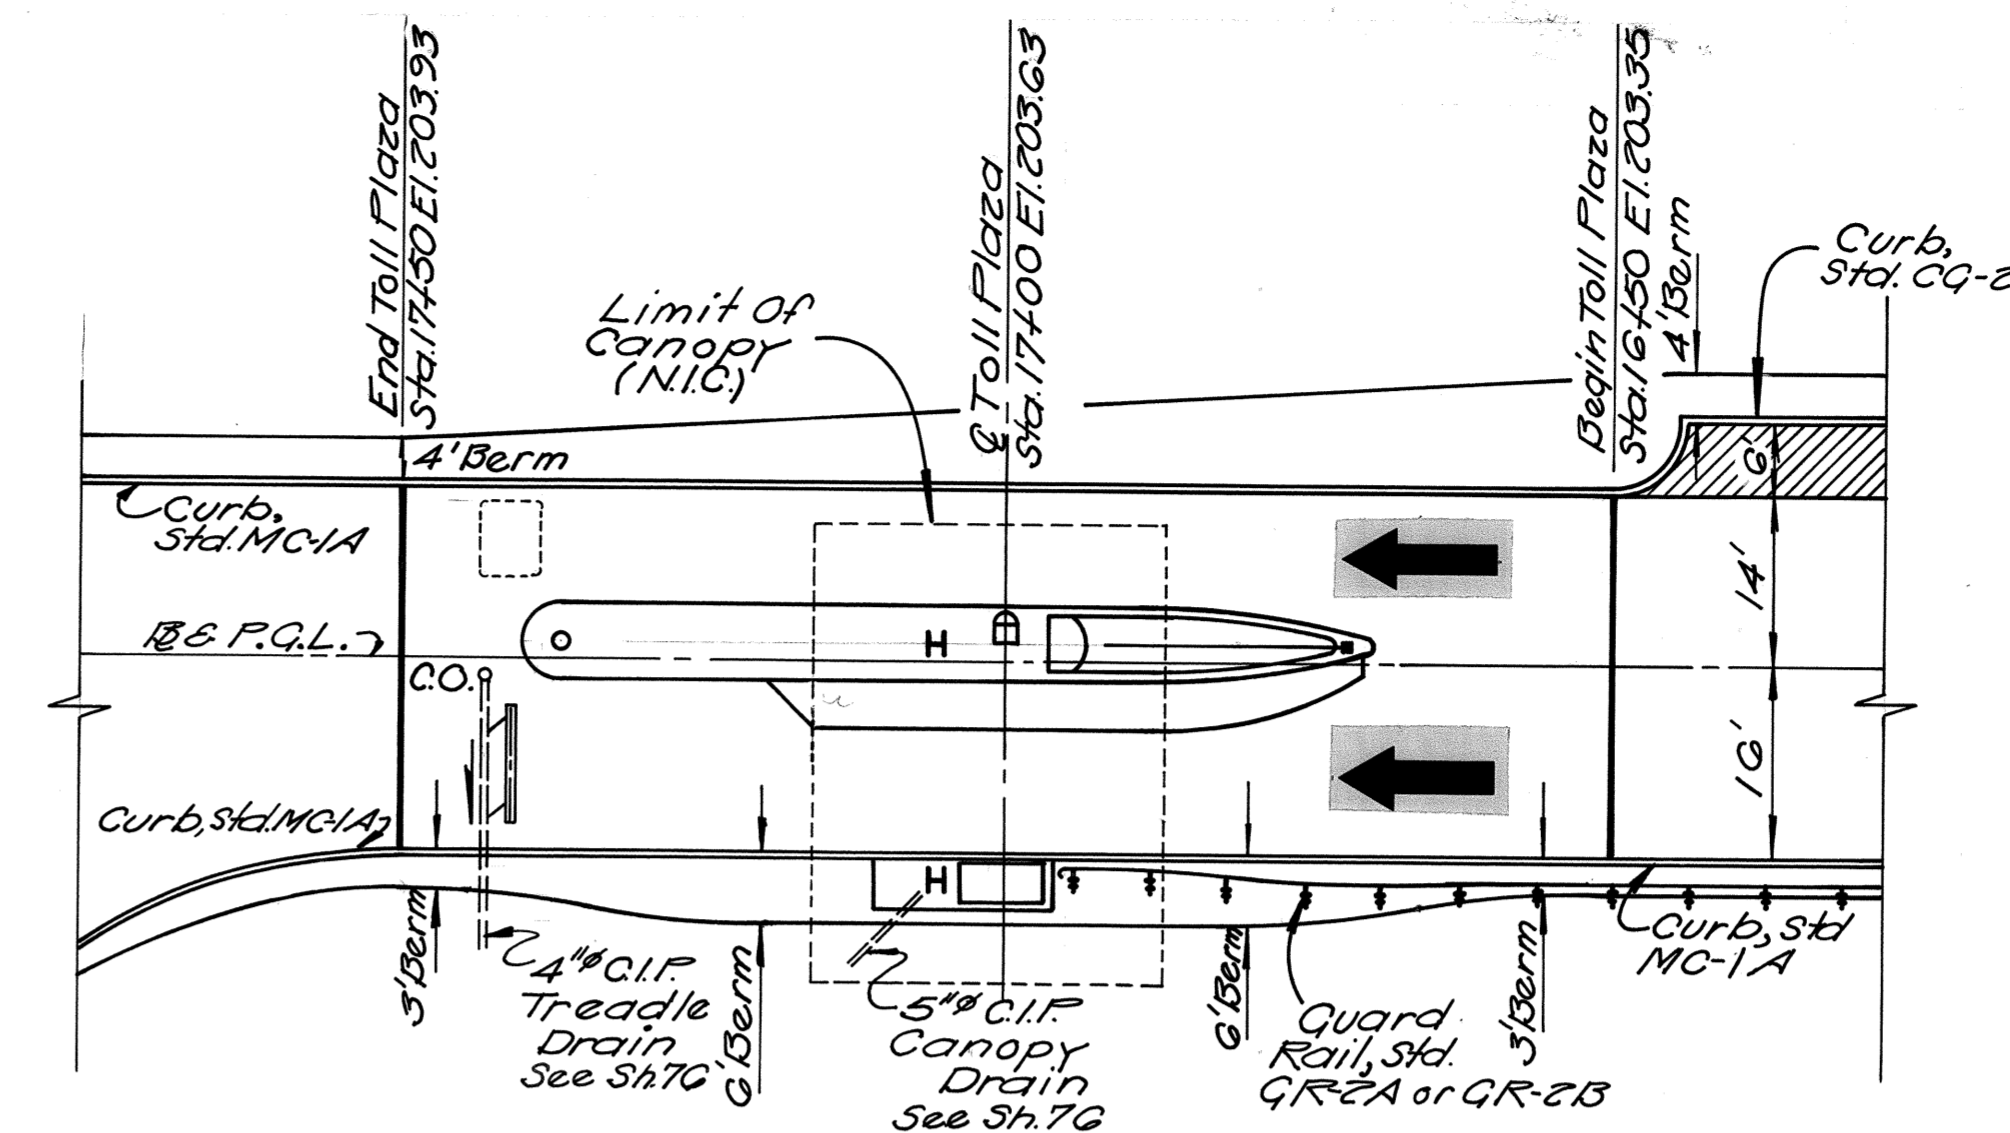

RAMP N-DOUGLASDALE
Scale 1/16" = 1'-0"

NOTES

- For Profiles See Sh. No. 33 & 42
- C.O. in Pavement - 5" C.I. 90° Elbow & 5" x 1/2" - 10' Supreme Floor Level Cleanout

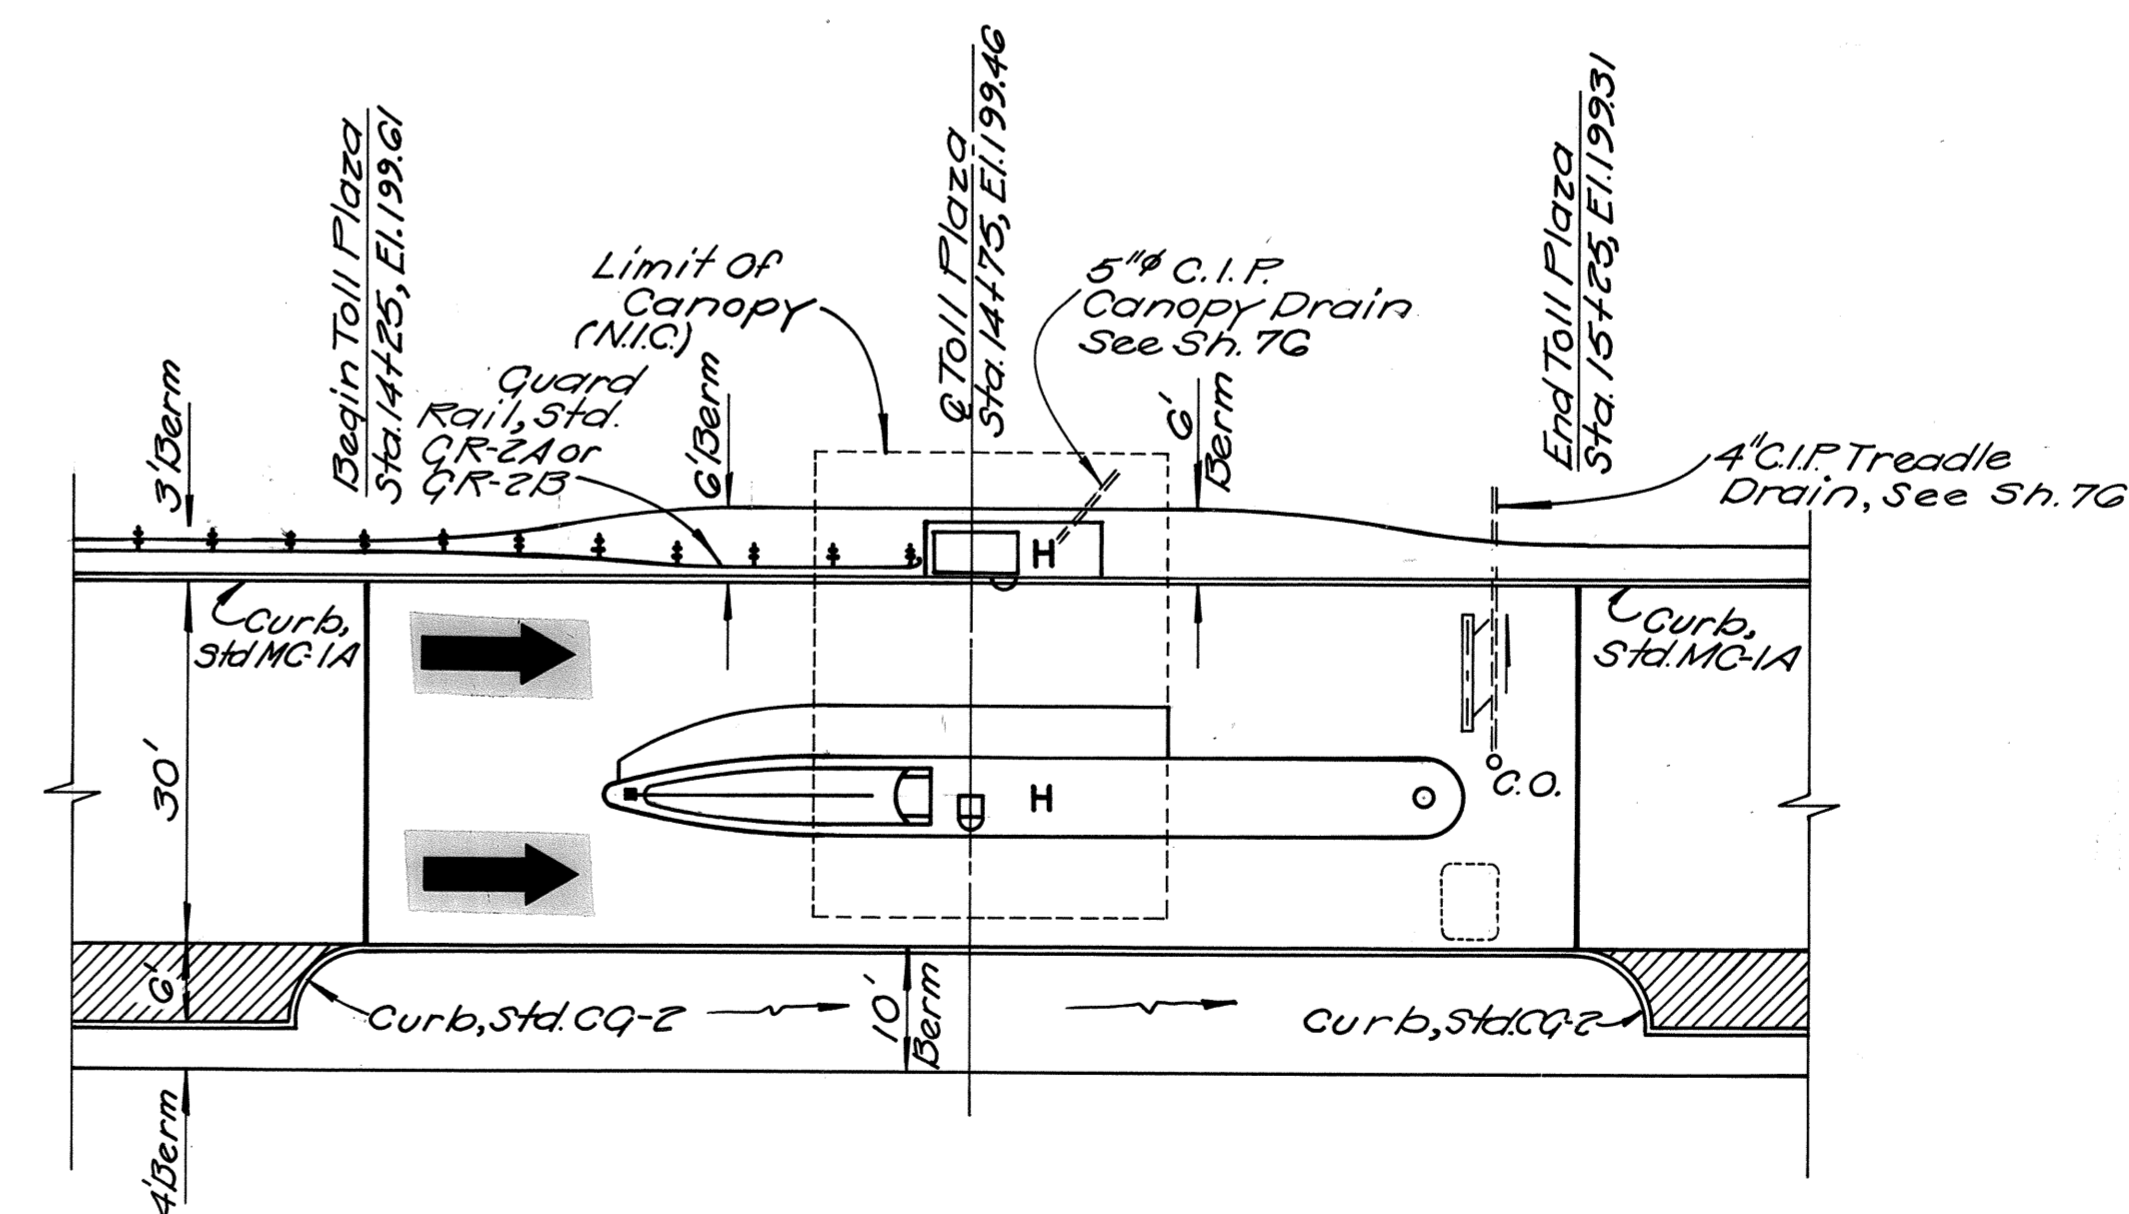

RAMP DOUGLASDALE-N
Scale 1/16" = 1'-0"

AS BUILT

**RICHMOND METROPOLITAN AUTHORITY
RICHMOND EXPRESSWAY SYSTEM
BELTLINE EXPRESSWAY**

**MISCELLANEOUS
TOLL PLAZA DETAILS**

HOWARD, NEEDLES, TAMMEN & BERGENDOFF
consulting engineers
NEW YORK ALEXANDRIA KANSAS CITY







SCALE: *As Noted*
CONTRACT NO.: 4
SHEET NO. 56 OF 155

	BY	DATE			
MADE	D.A.S.	8-70			
CHECKED	R.M.G.	8-70	AS BUILT	LWC	8-73
IN CHARGE	J.F.F.		NO.	REVISION	BY DATE

NORTHBOUND POWHITE PARKWAY TOLL PLAZA

ORIGINAL PLANS - ADMINISTRATION BUILDING & TOLL PLAZA

RICHMOND EXPRESSWAY SYSTEM			
SECTION	PROJECT	SHEET NO.	TOTAL SHEETS
2	POWHITE PARKWAY	43	188

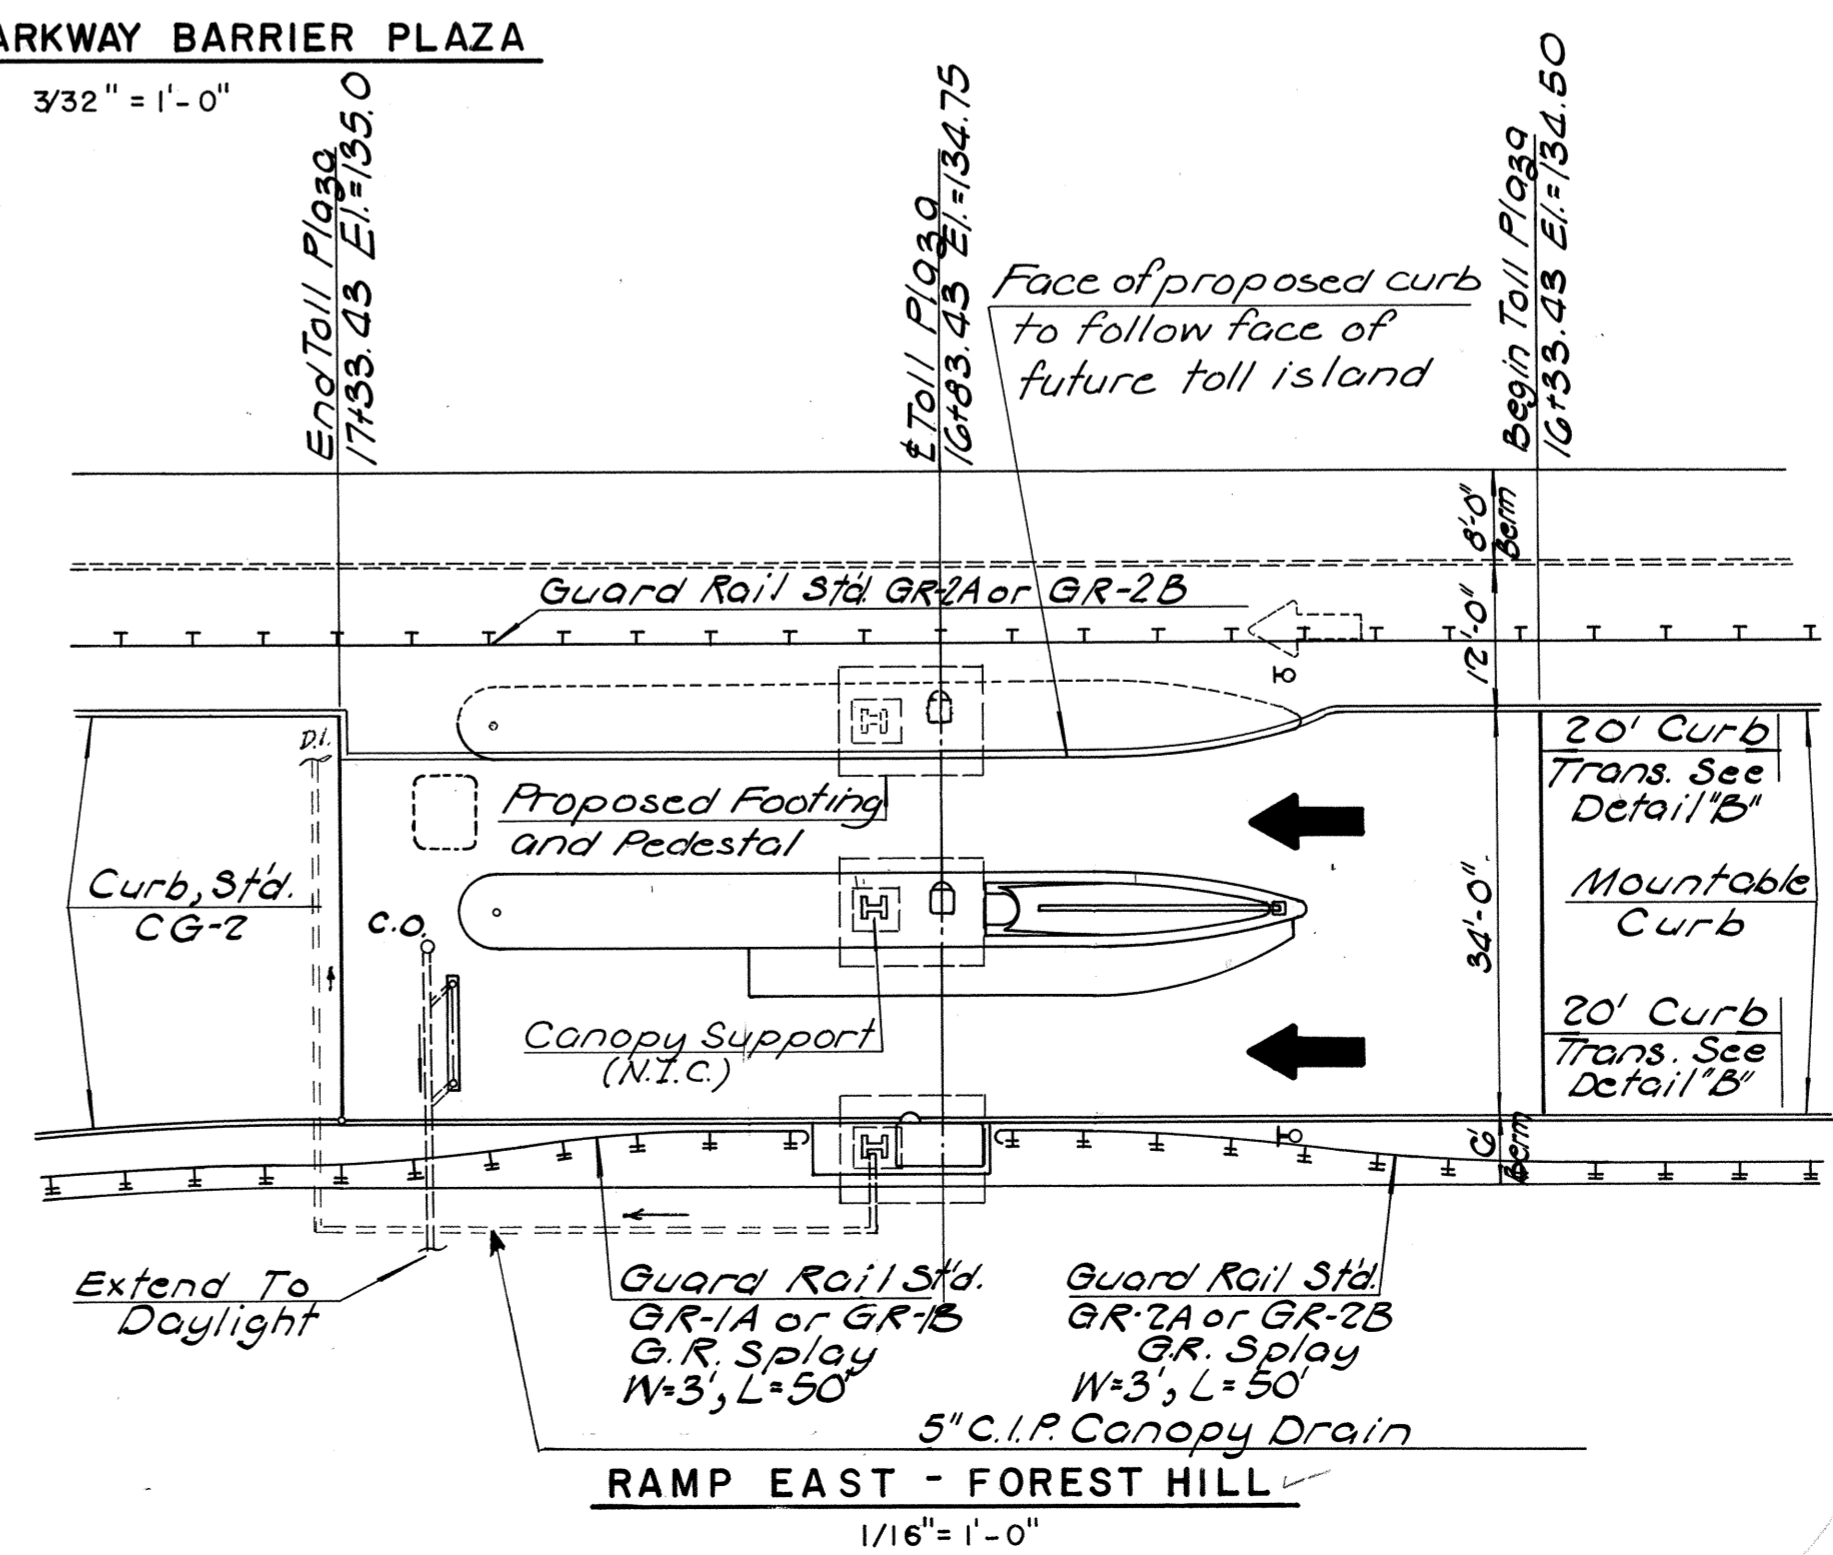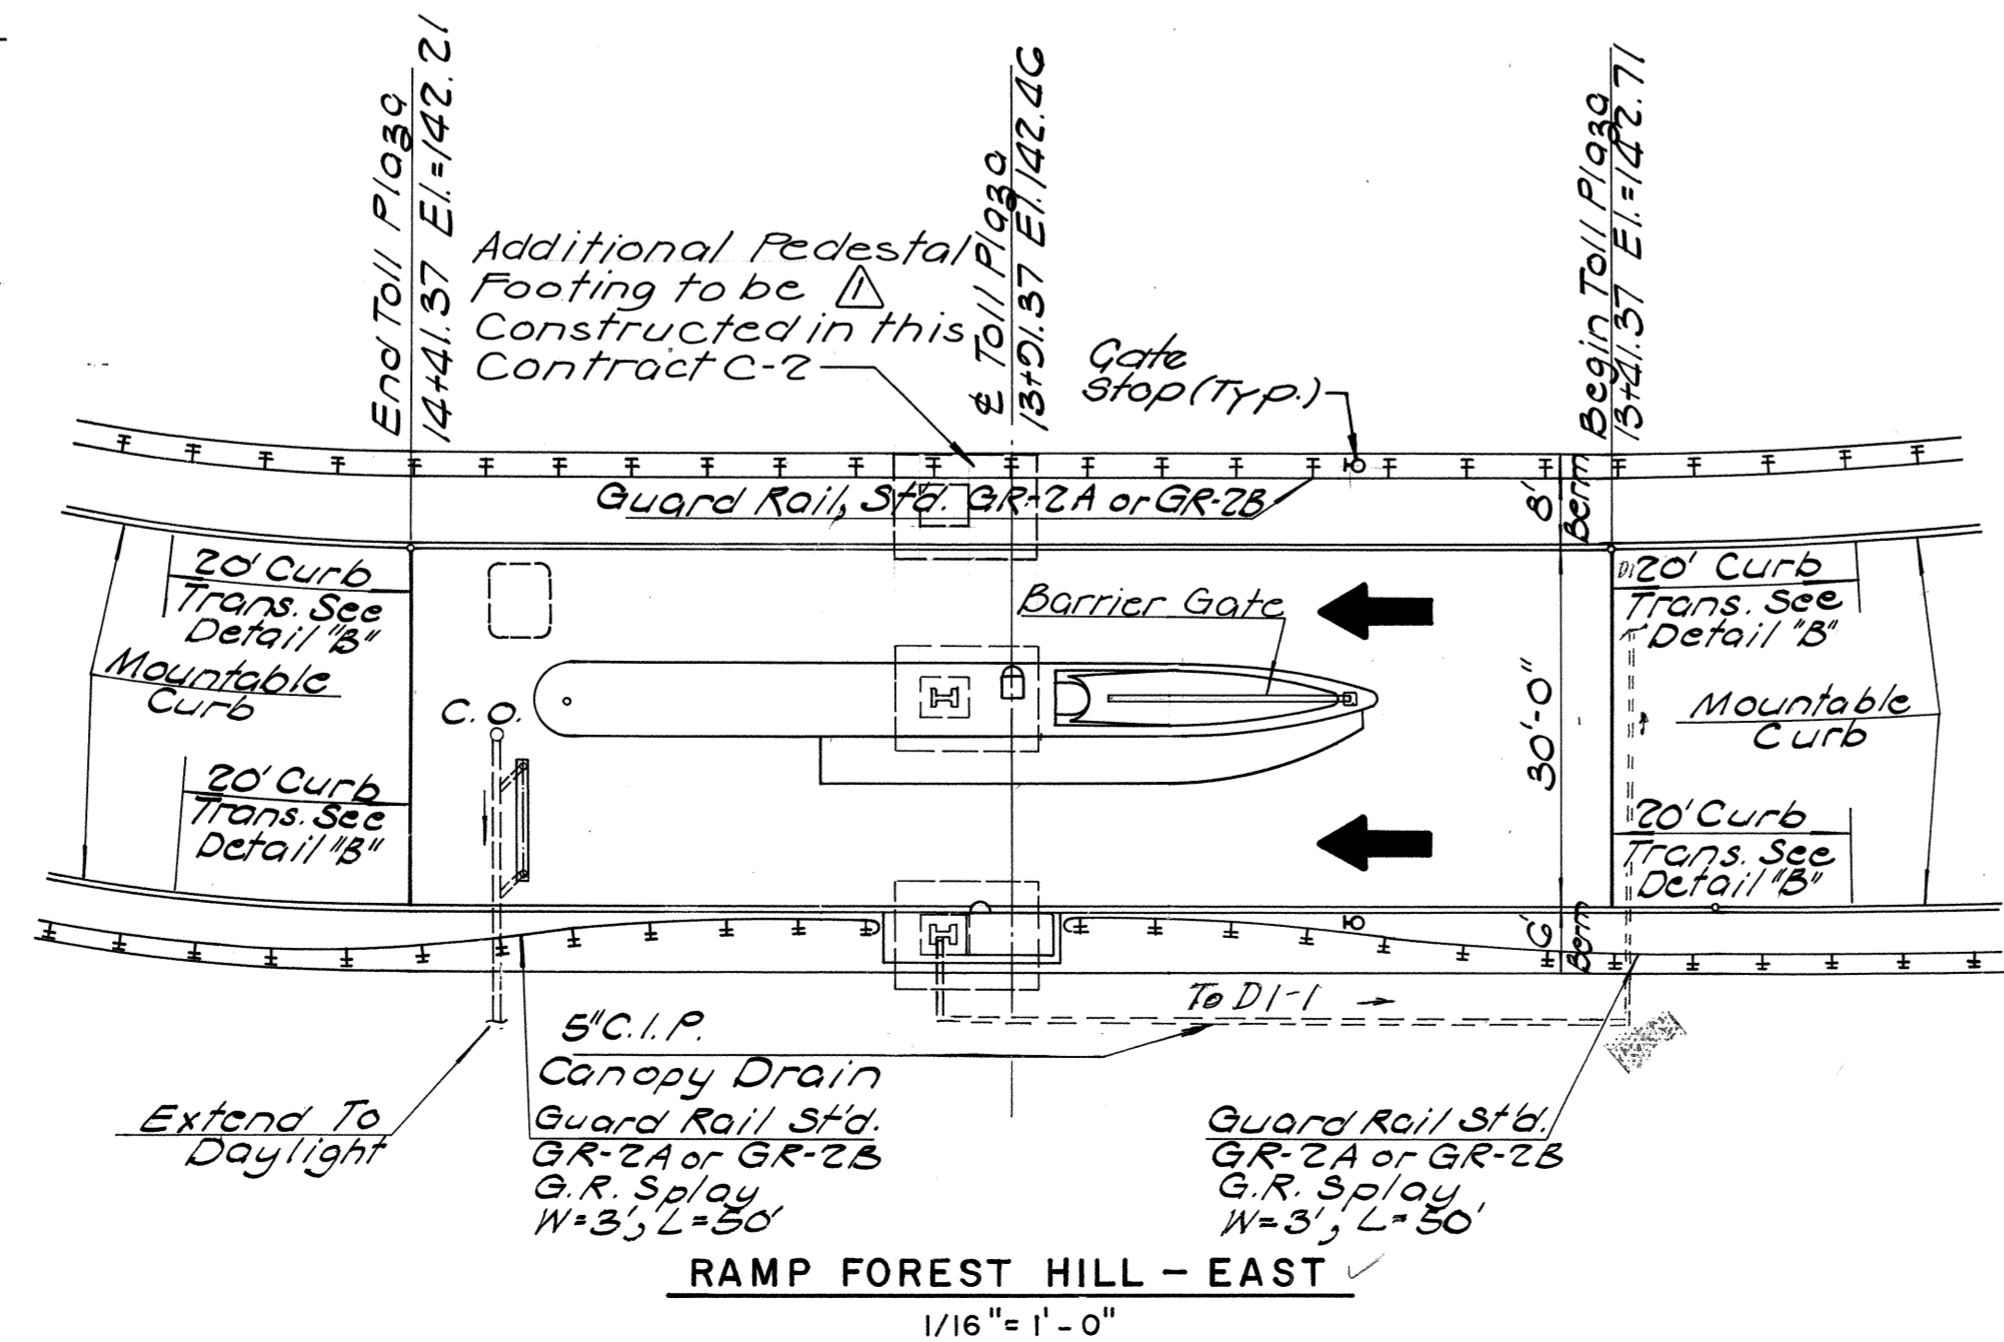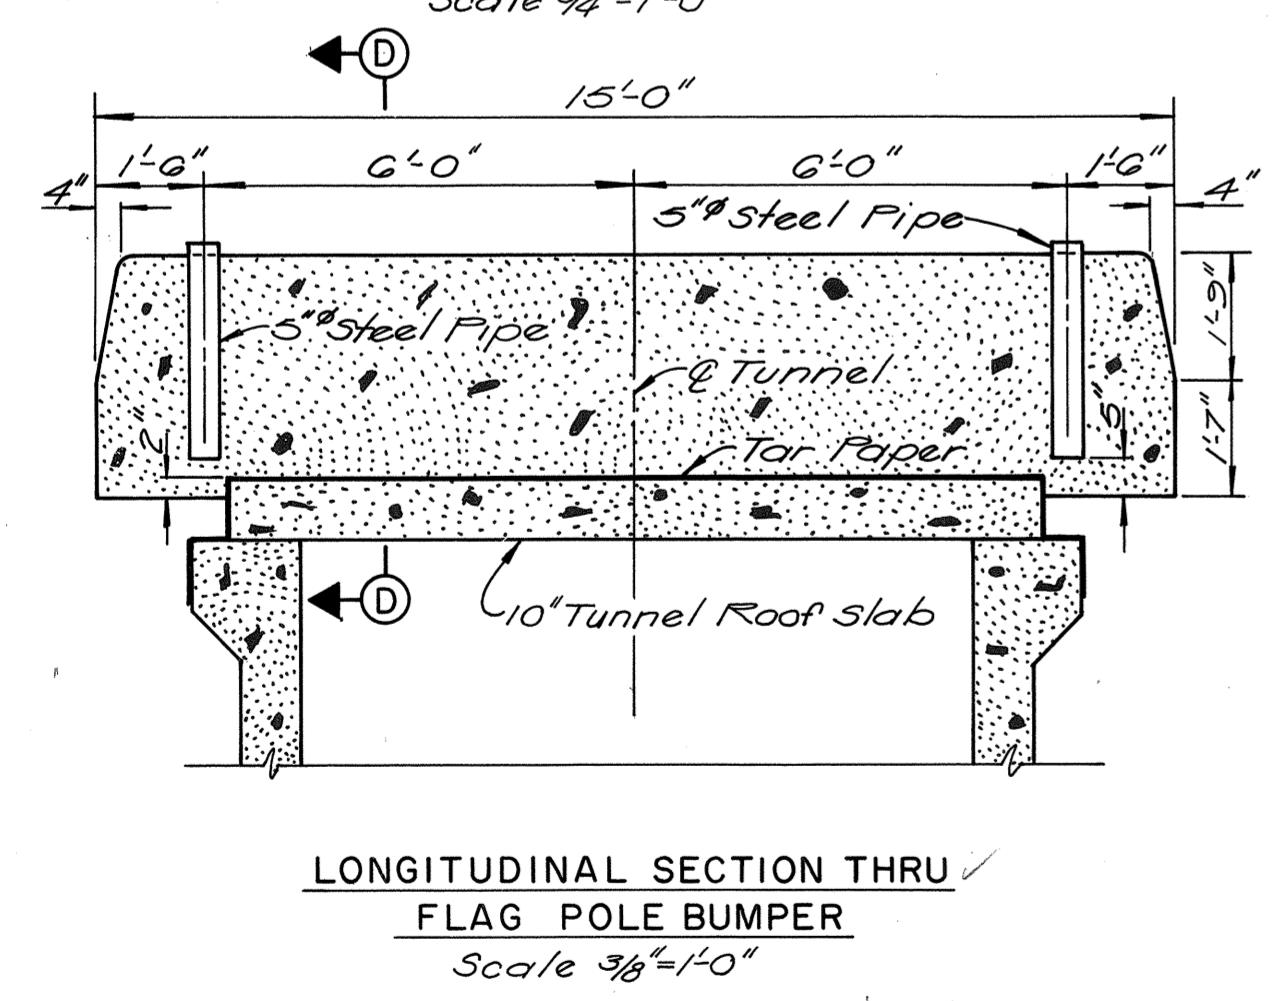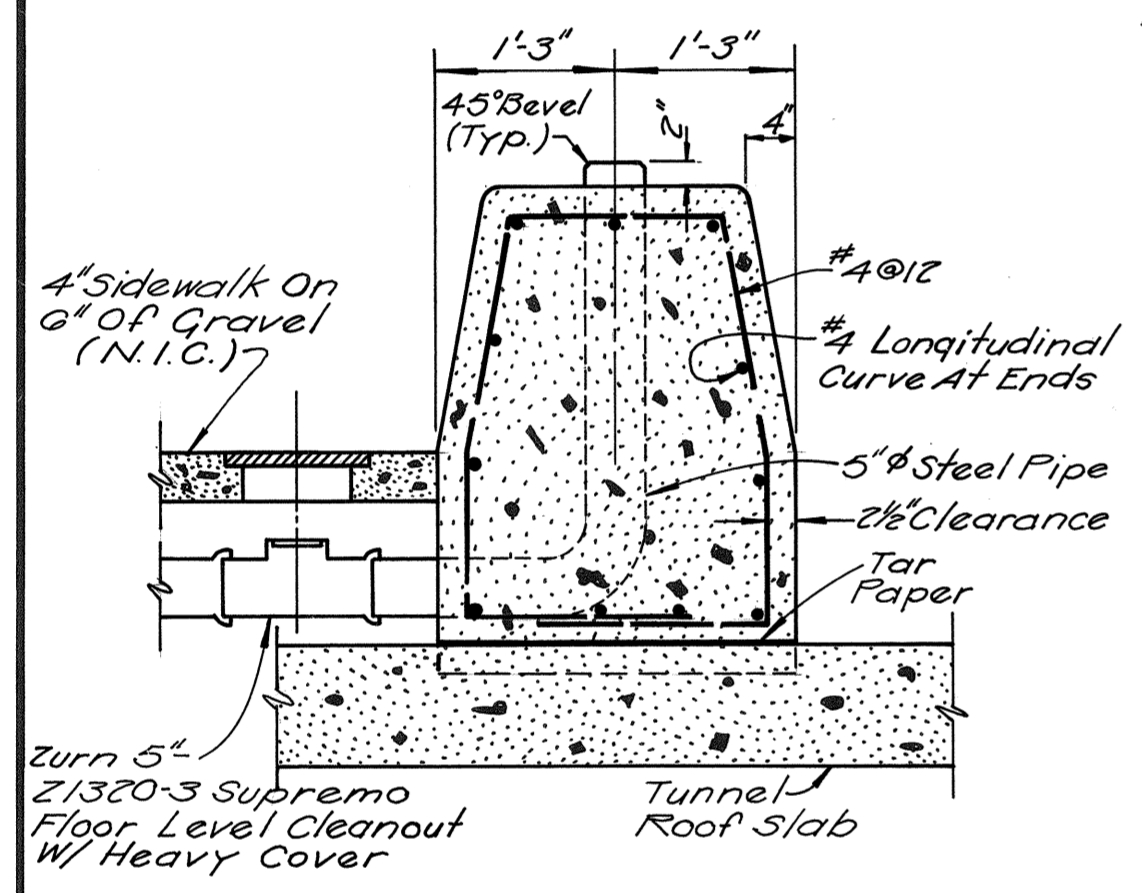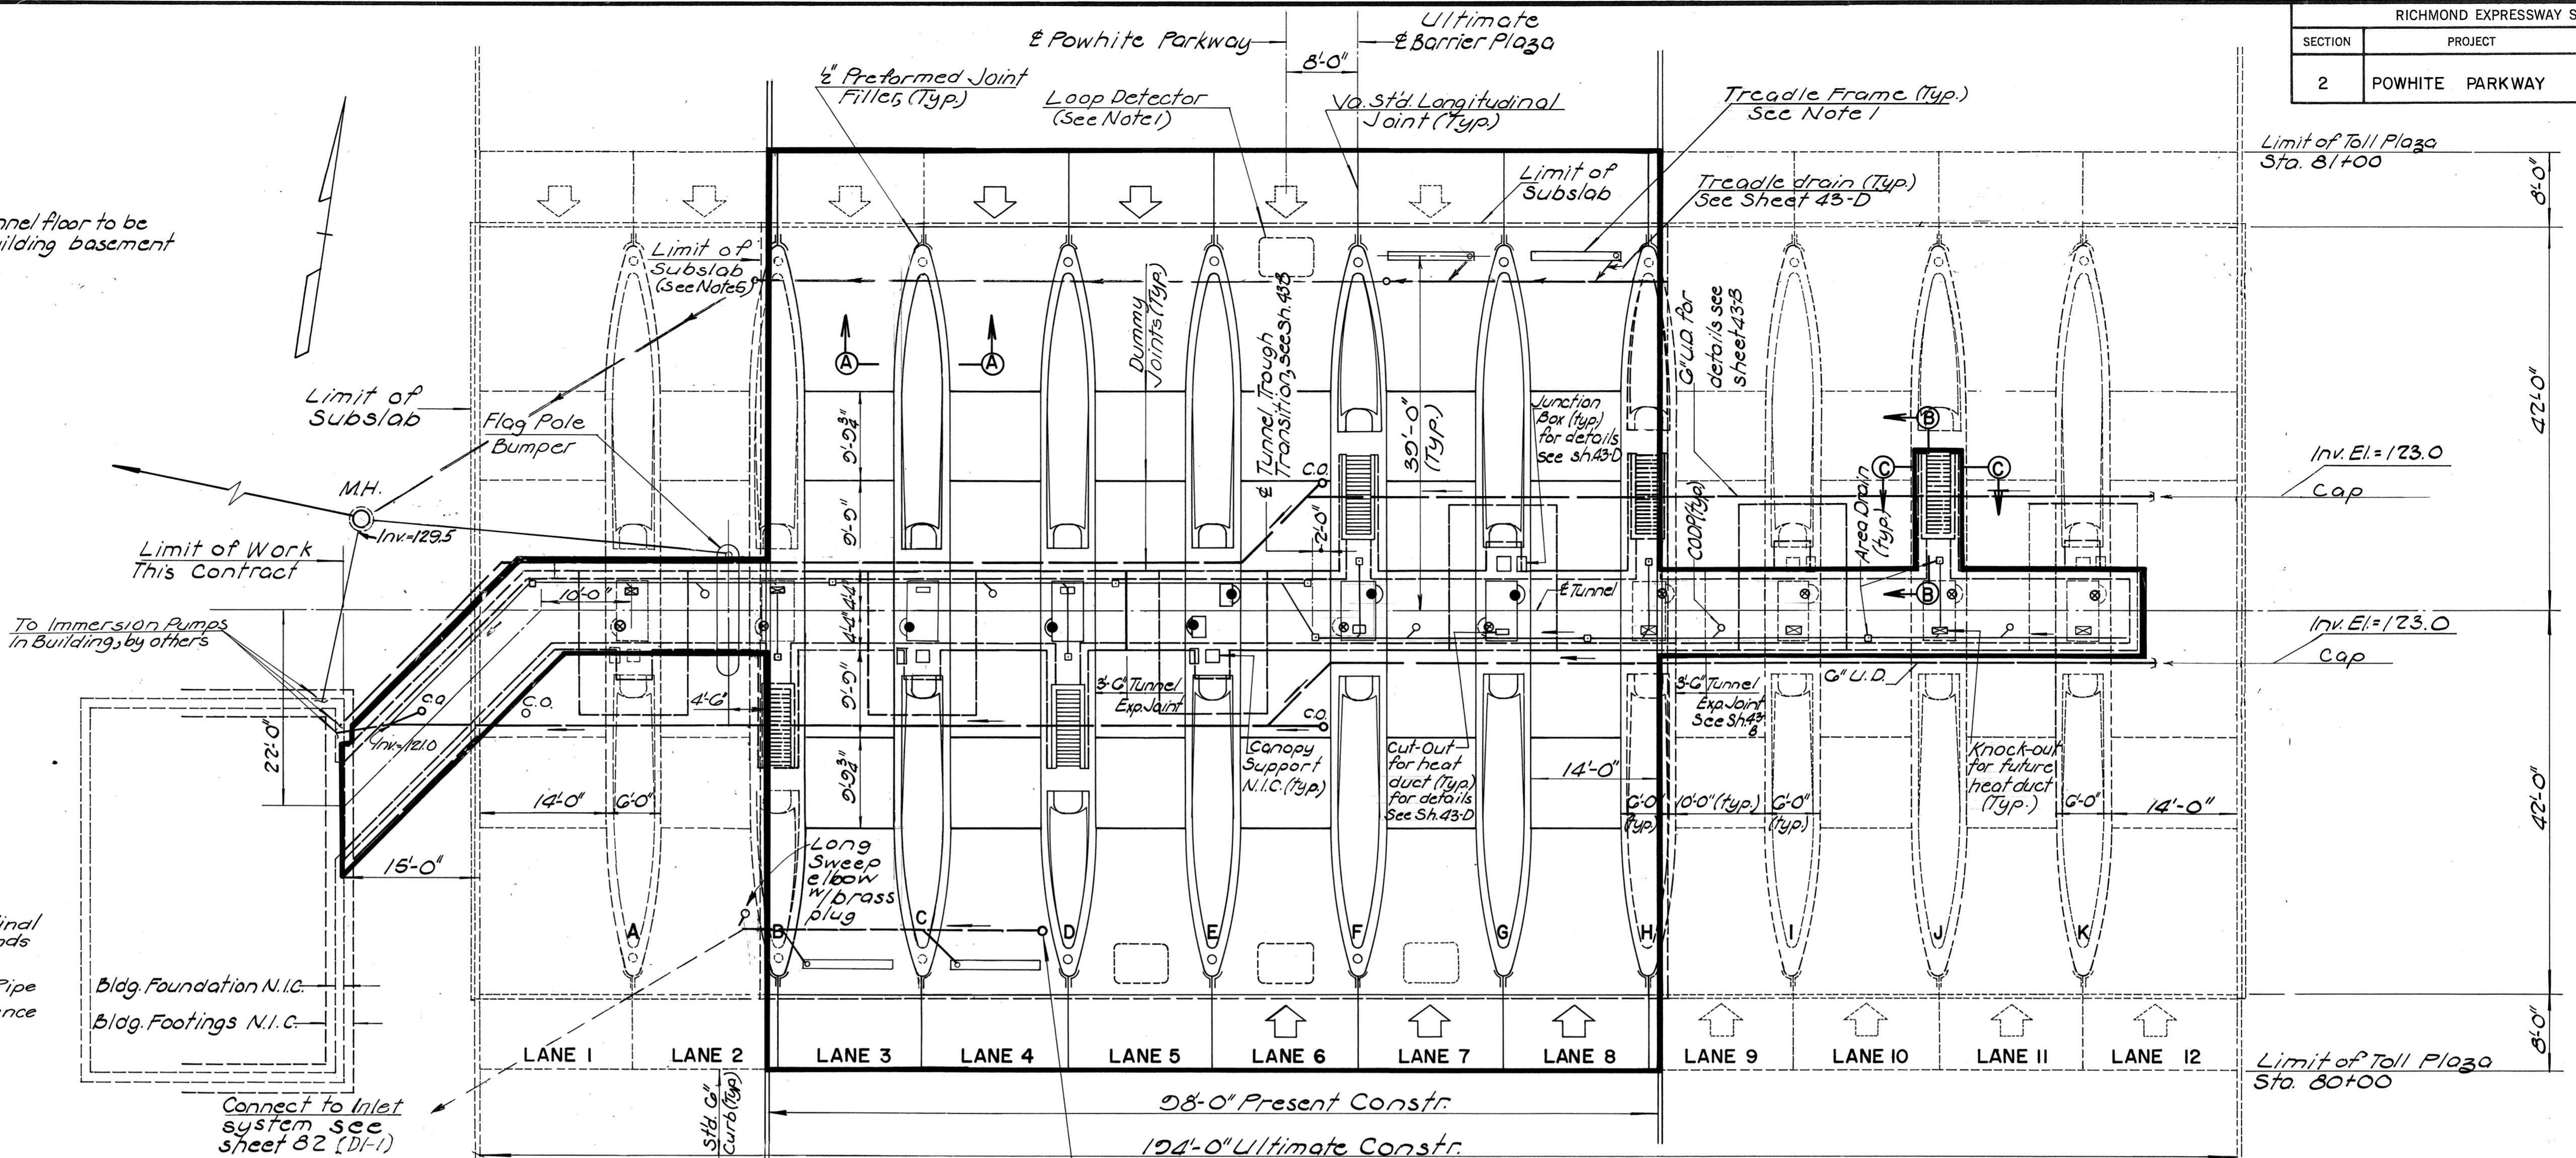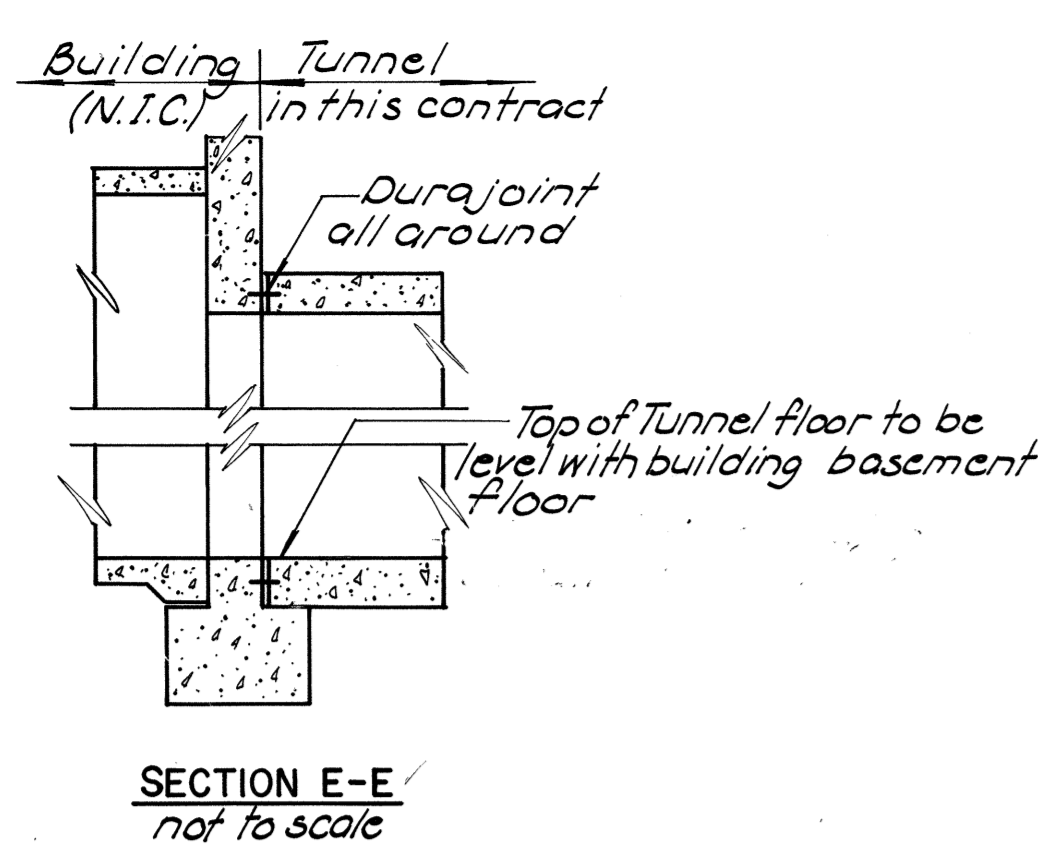

- NOTES:**
- To be placed by Toll Equipment Contractor prior to the paving, under this Contract.
 - Tunnel drainage trough to begin at the building foundation.
 - C.O.D.P. = Clean out Drain Pipe.
 - Sections A-A, B-B and C-C appear on sheet 42-B.
 - Place #8 Longitudinal hook bolts for future widening.

- LEGEND:**
- Location of future traffic signal.
 - Traffic signal, (N.I.C.)
 - ⊞ Automatic Toll Machine, (N.I.C.)
 - ⊞ Future Automatic Toll Machine
 - ⊞ Toll Booth, (N.I.C.)
 - Prop. Coin Tubes
 - Future Coin Tubes











AS BUILT

**RICHMOND METROPOLITAN AUTHORITY
RICHMOND EXPRESSWAY SYSTEM
POWHITE PARKWAY**




**MAINLINE & RAMP
TOLL PLAZA PLANS**

MADE	BY	DATE	NO.	REVISION	BY	DATE
8/17/02	CP	8/17/02	2	As Built	JRC	6/73
	RWG			Rev per Addendum B Amendment A, Addendum C	PHI	2/22/01
	JPF					

HOWARD, NEEDLES, TAMMEN & BERGENDOFF consulting engineers
NEW YORK ALEXANDRIA KANSAS CITY
SCALE: As Noted
CONTRACT NO. C-2
SHEET NO. 43 OF 188

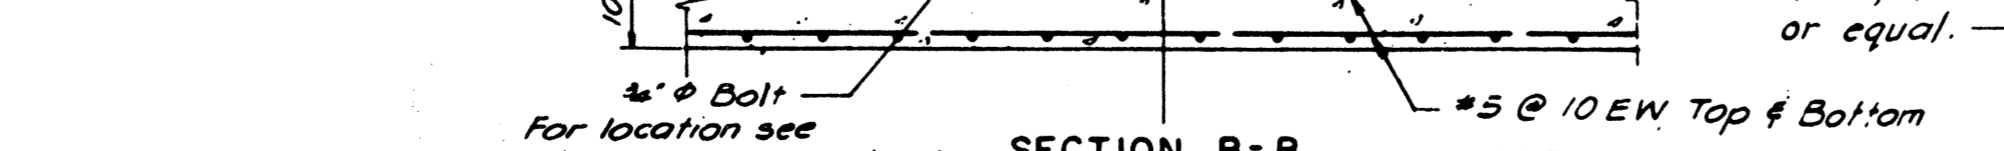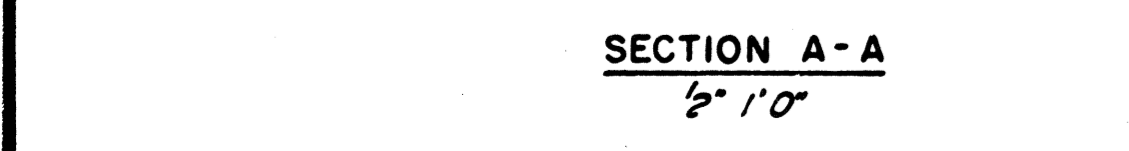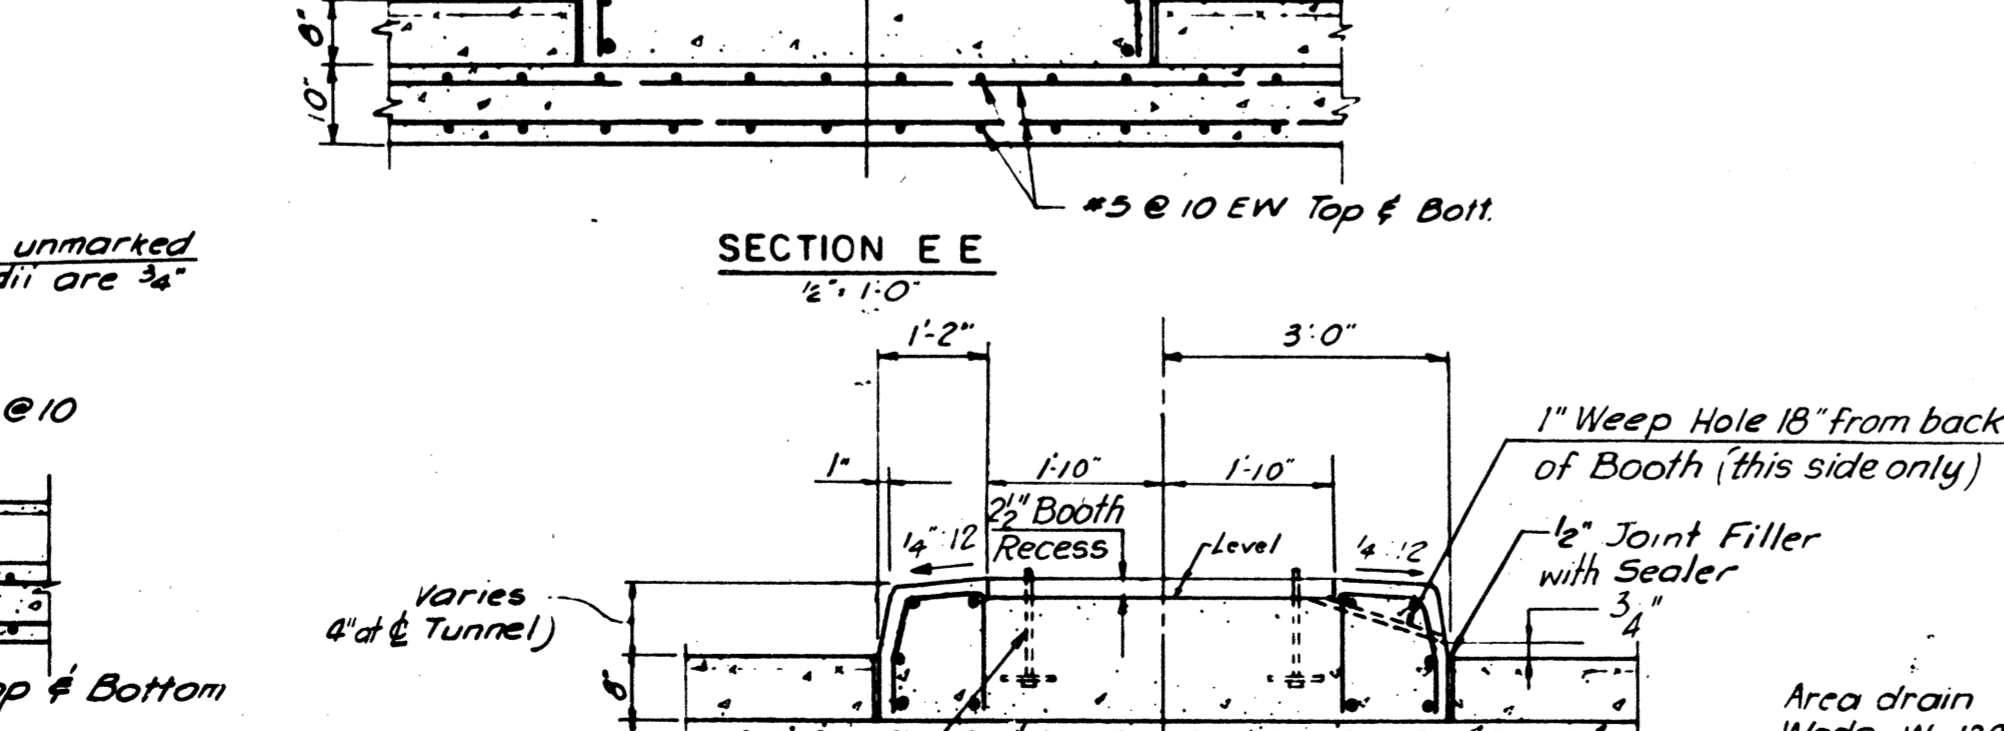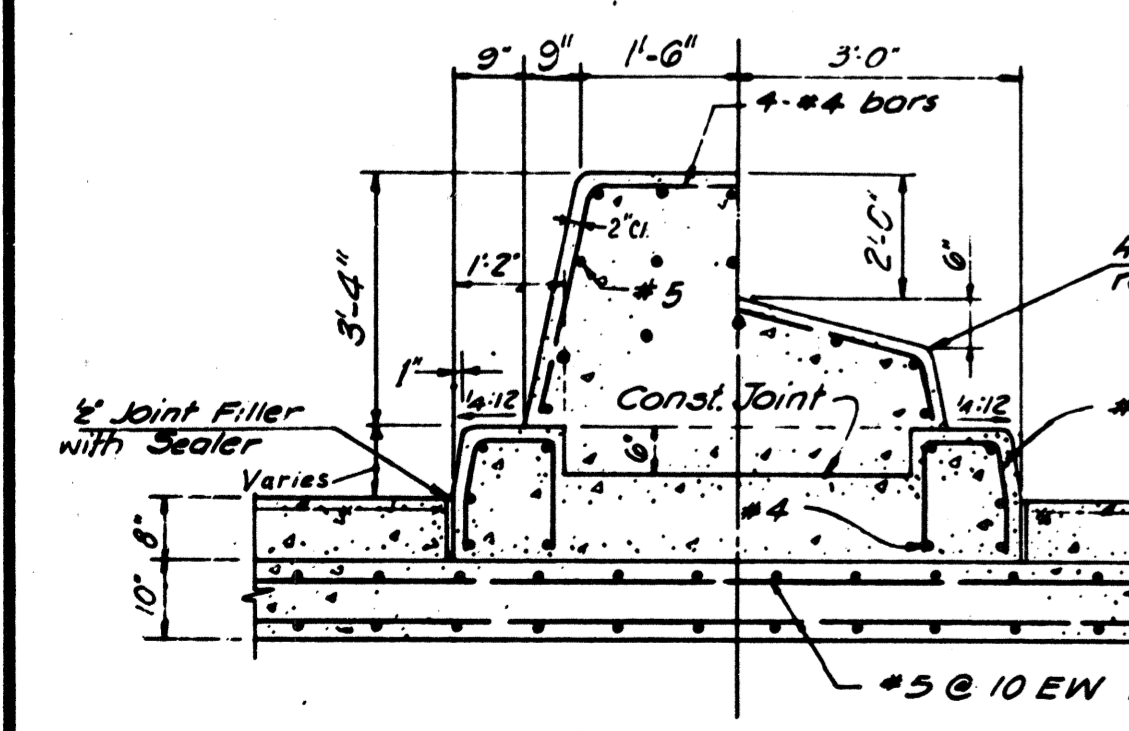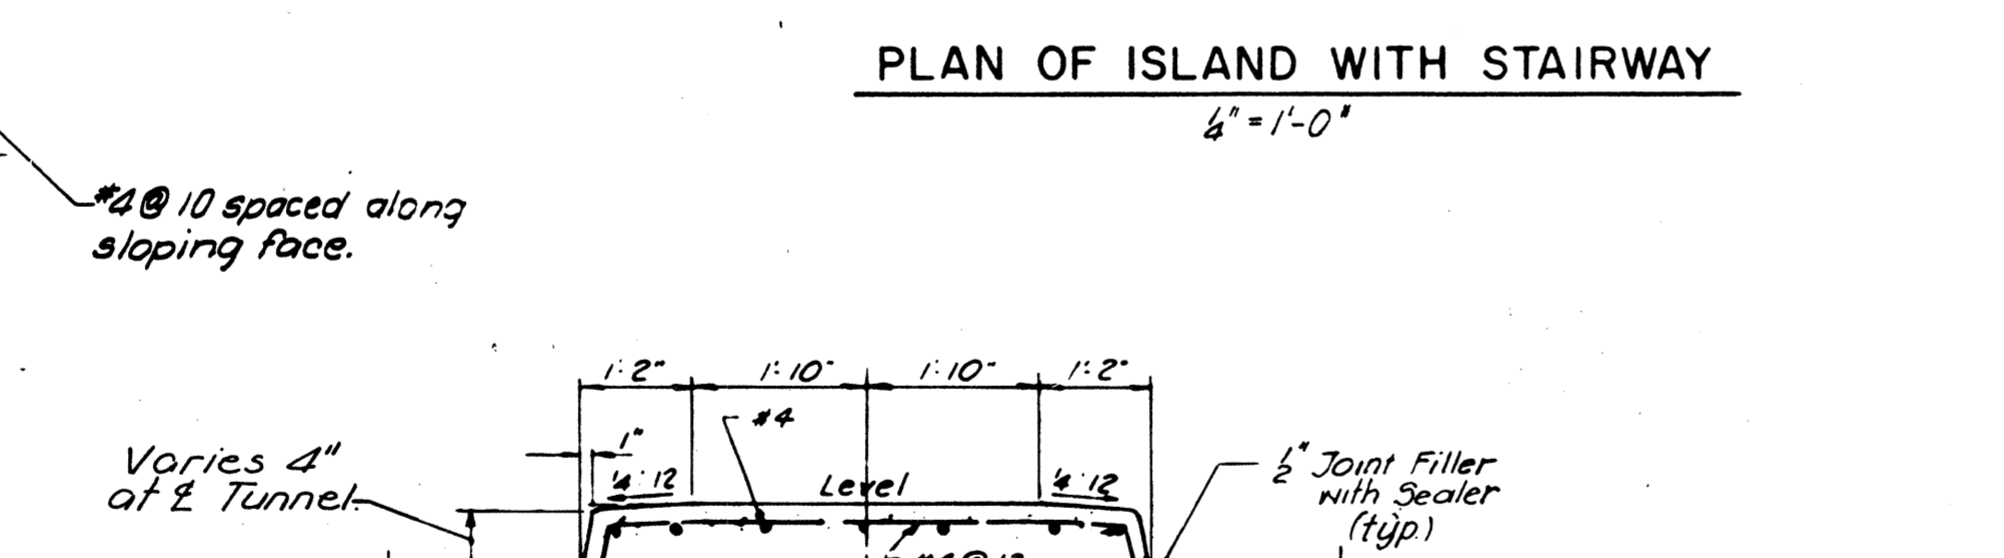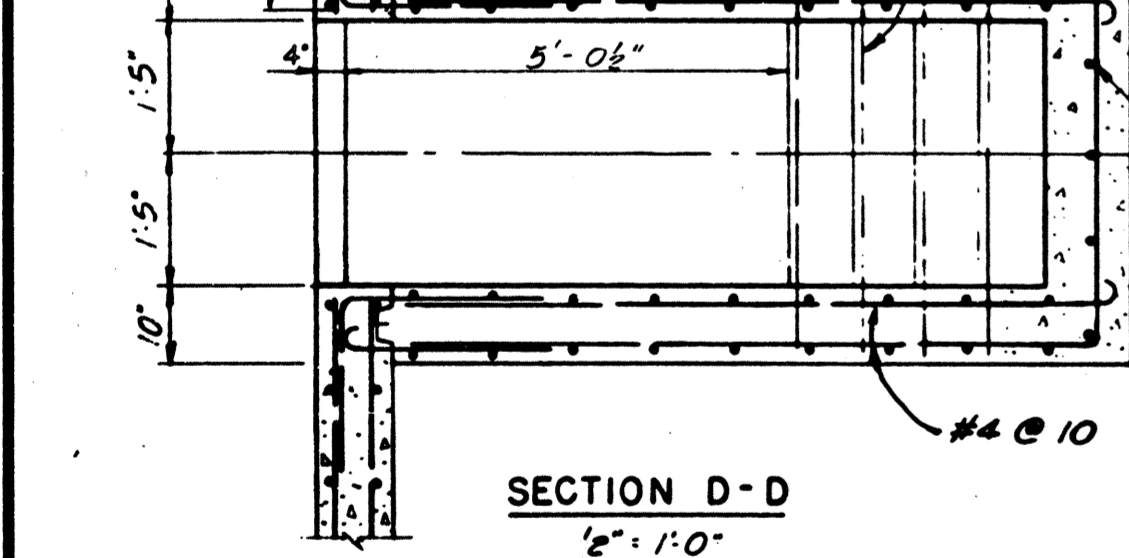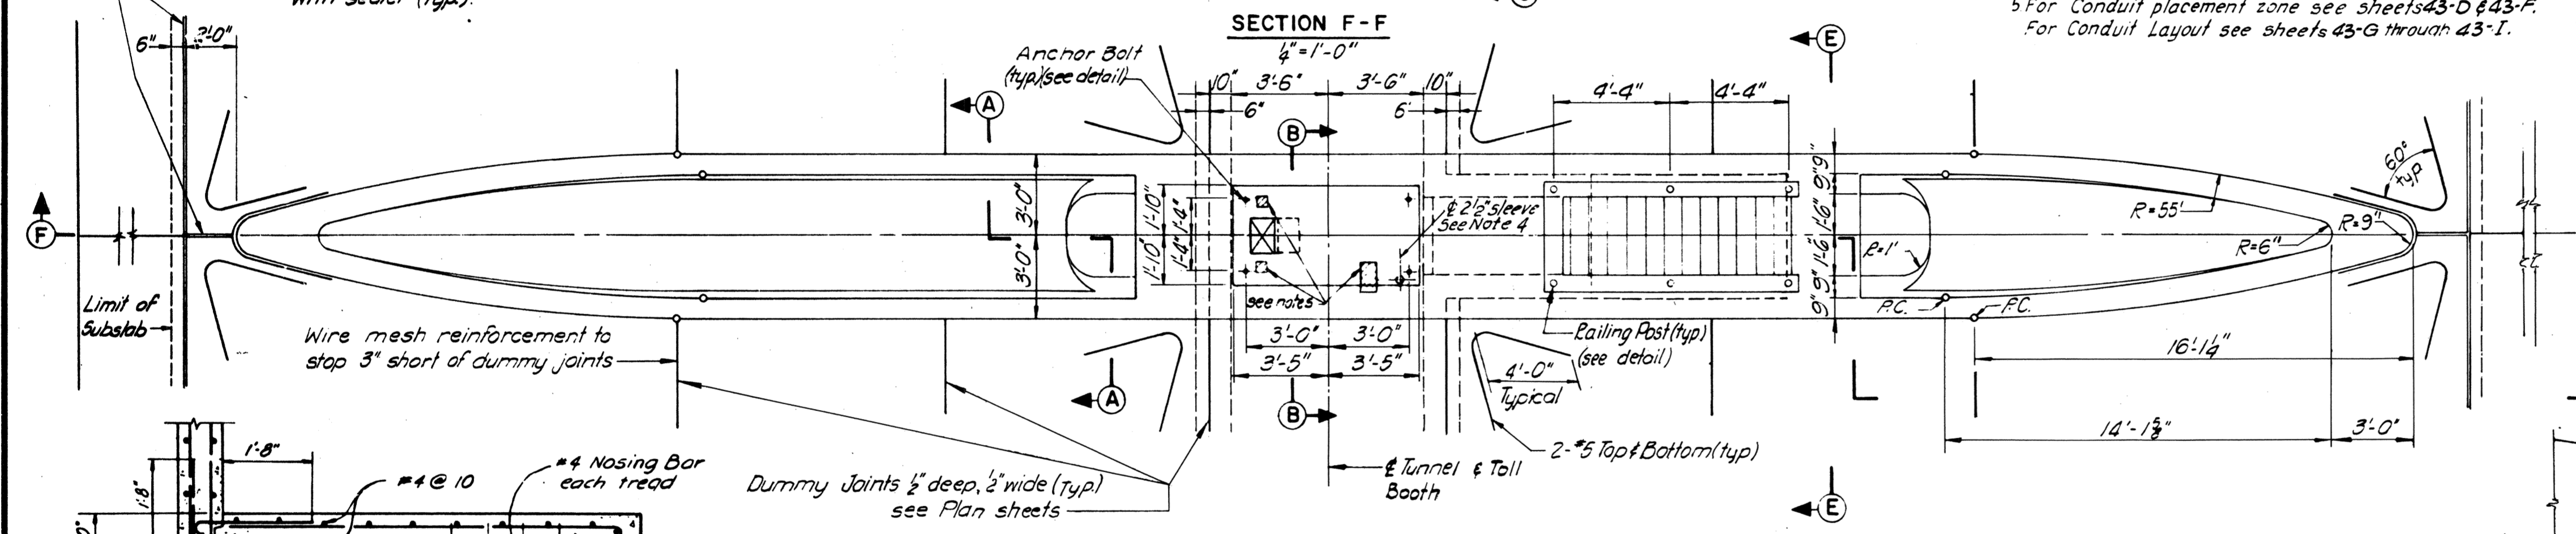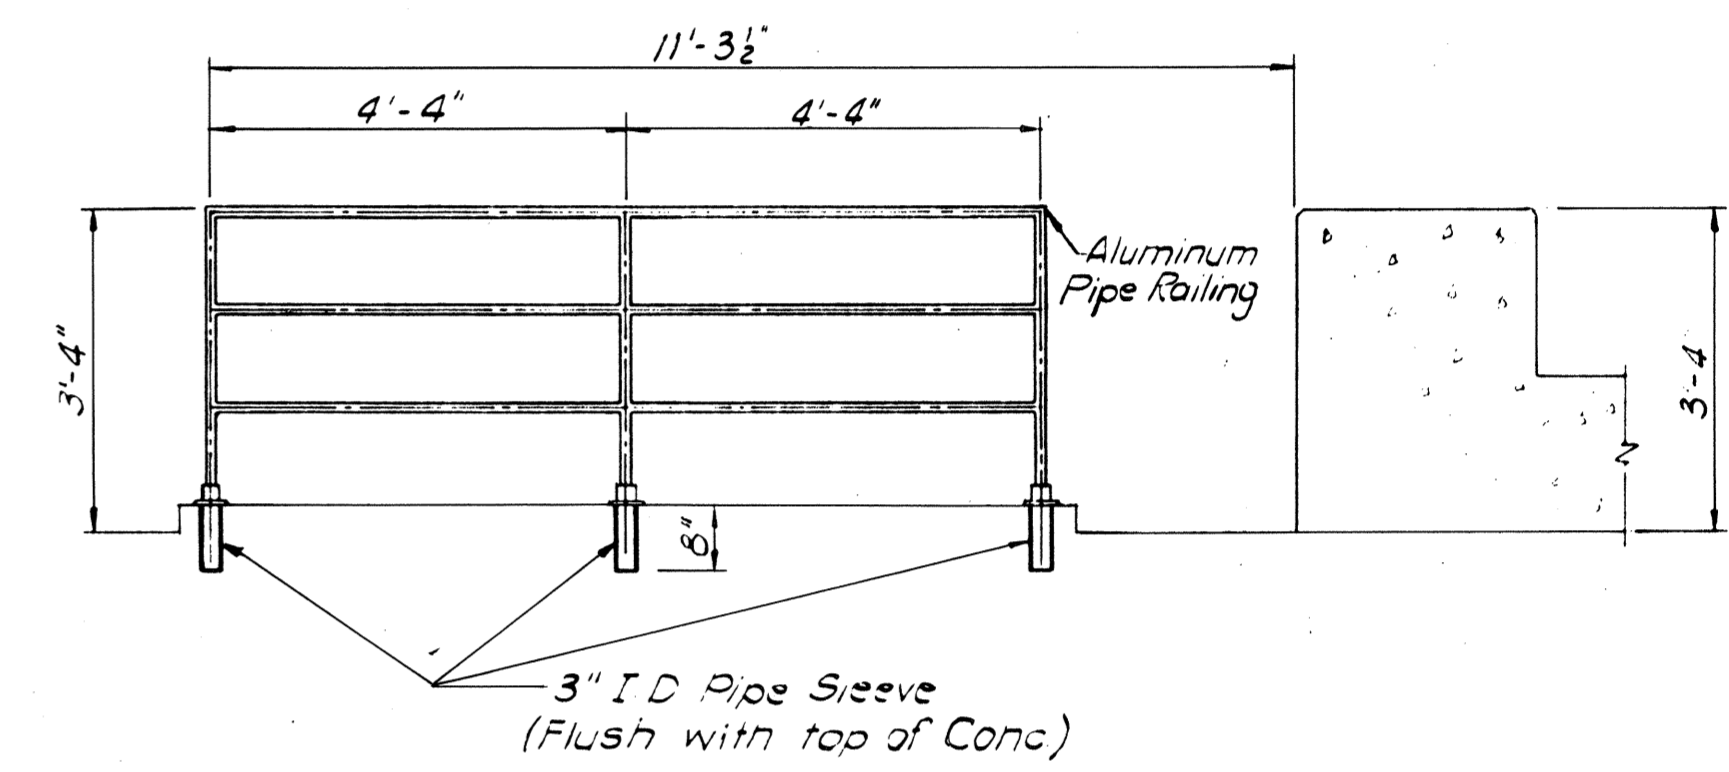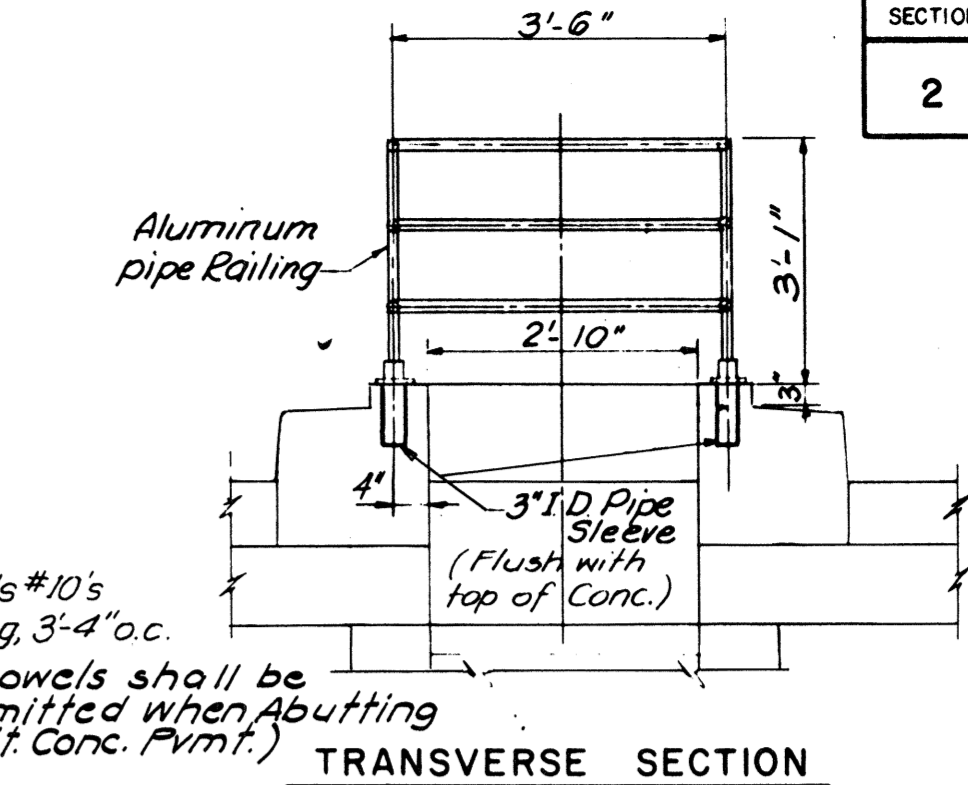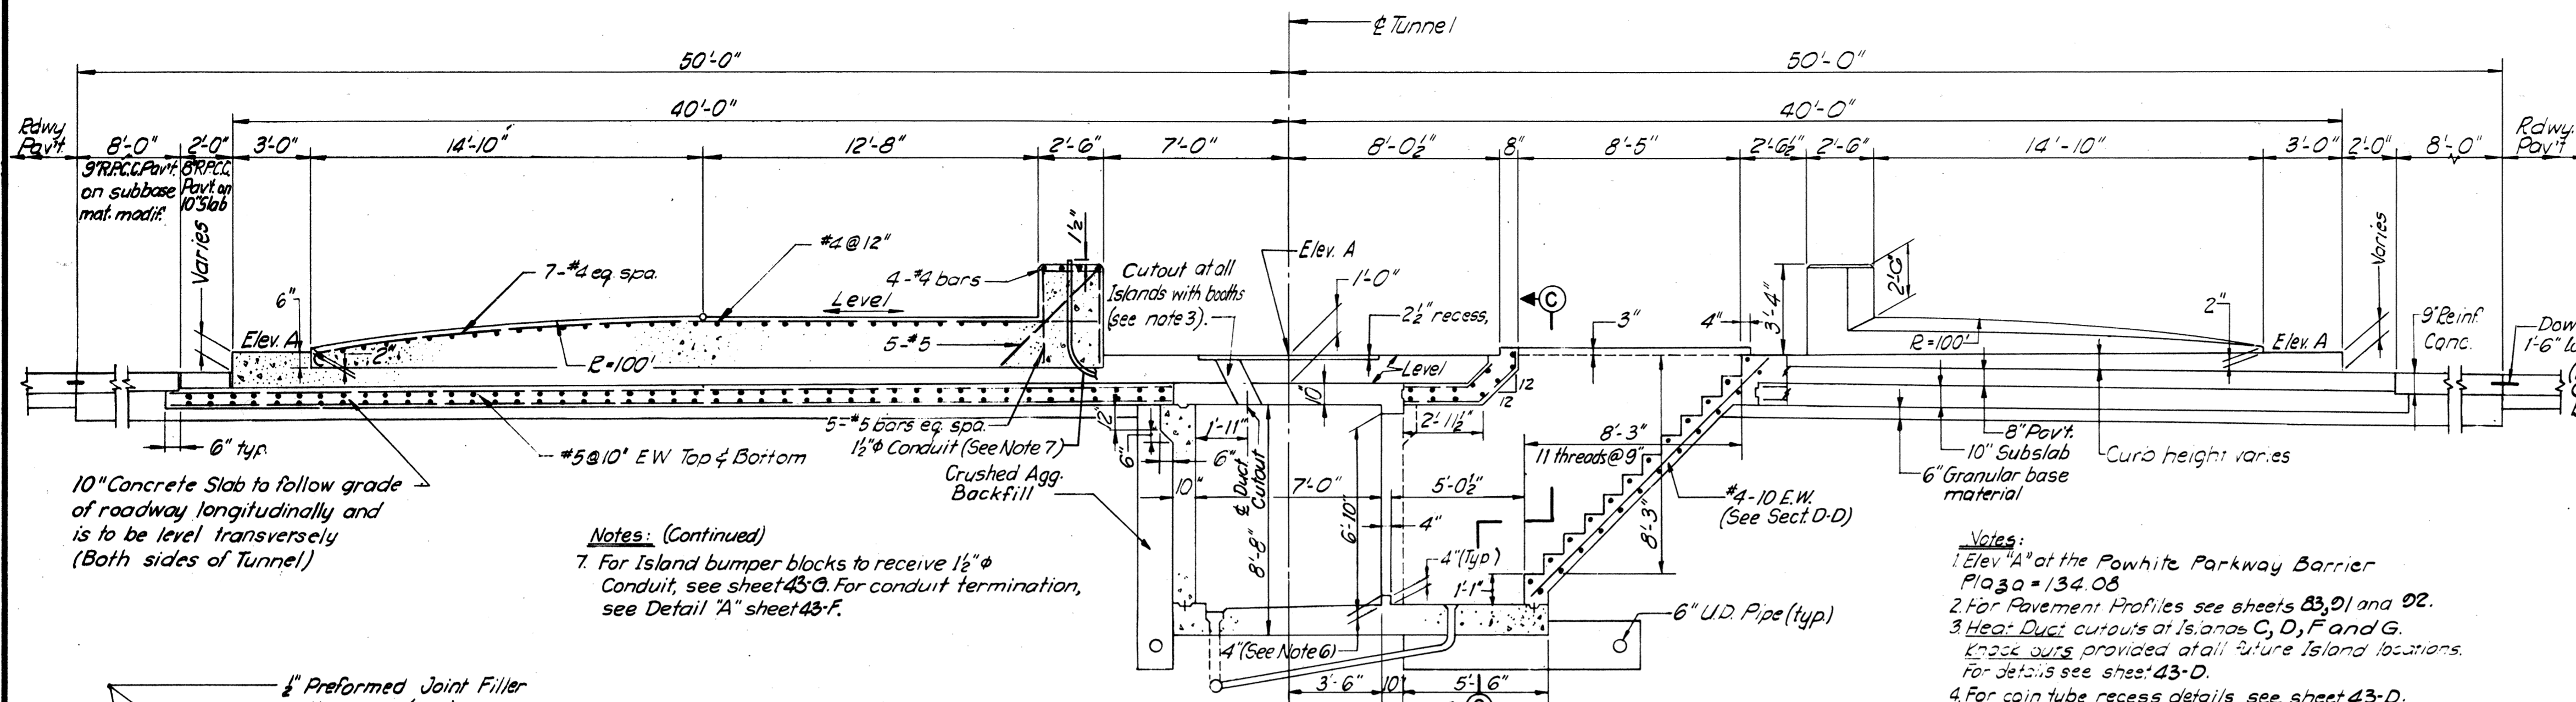

BY	DATE				
MADE	W.J.W.	5-68			
CHECKED	D.E.N.	5-68	1	As Built	JRC 6-73
IN CHARGE	H.D.S.				

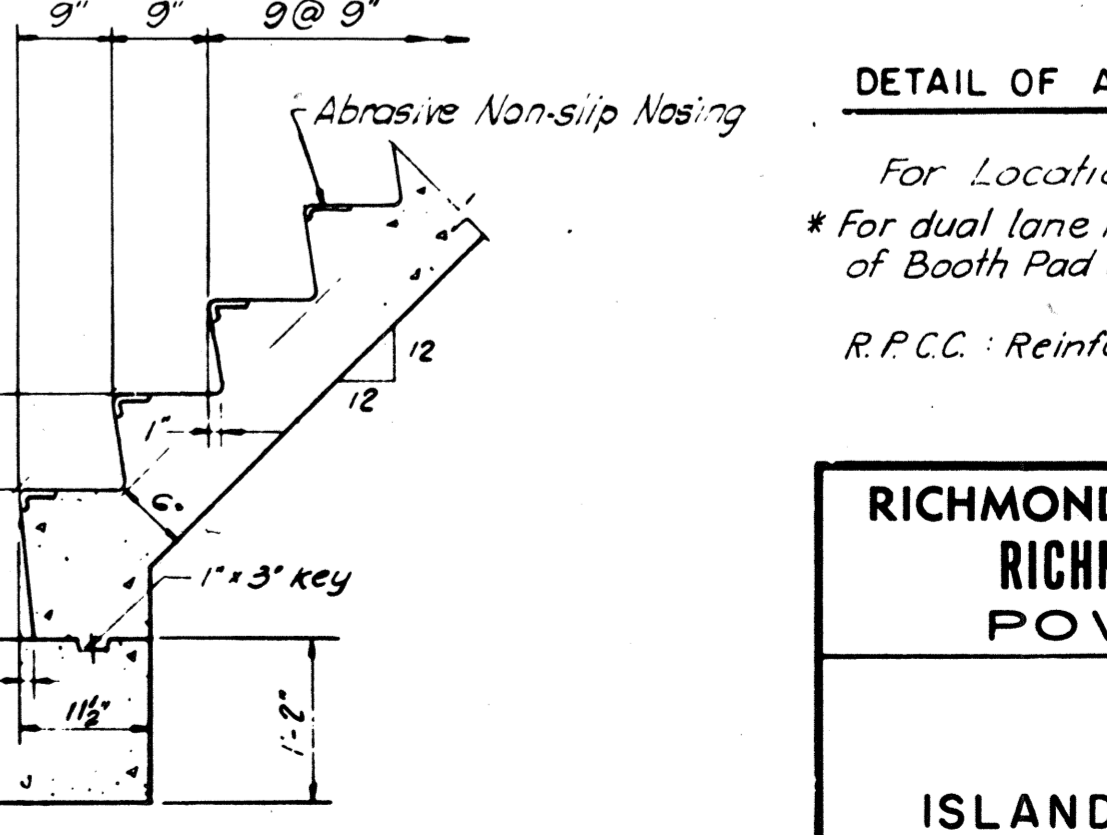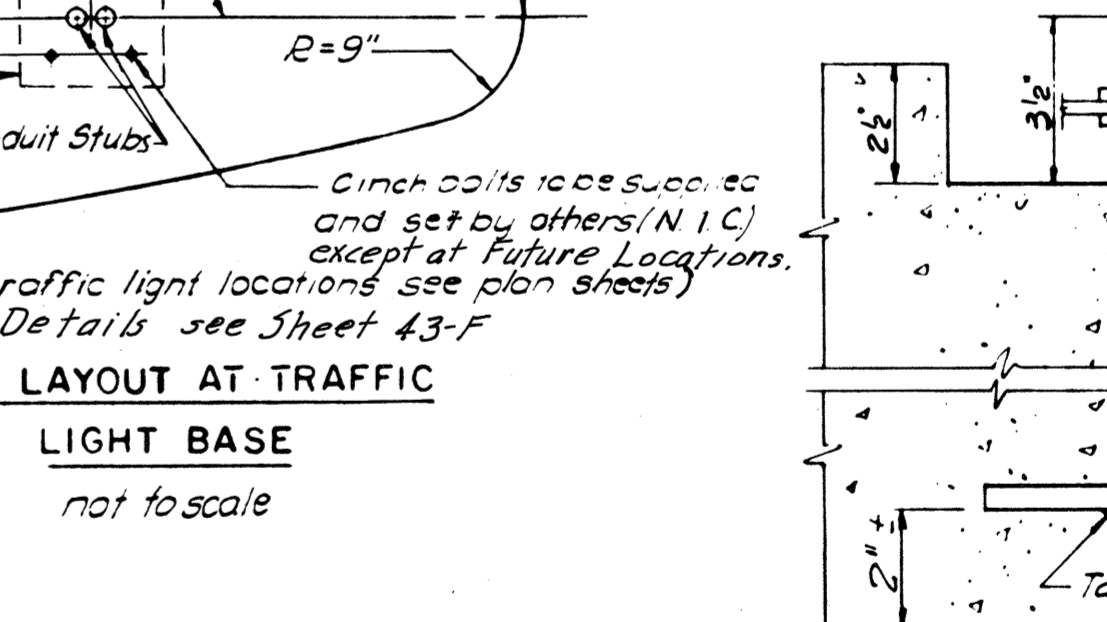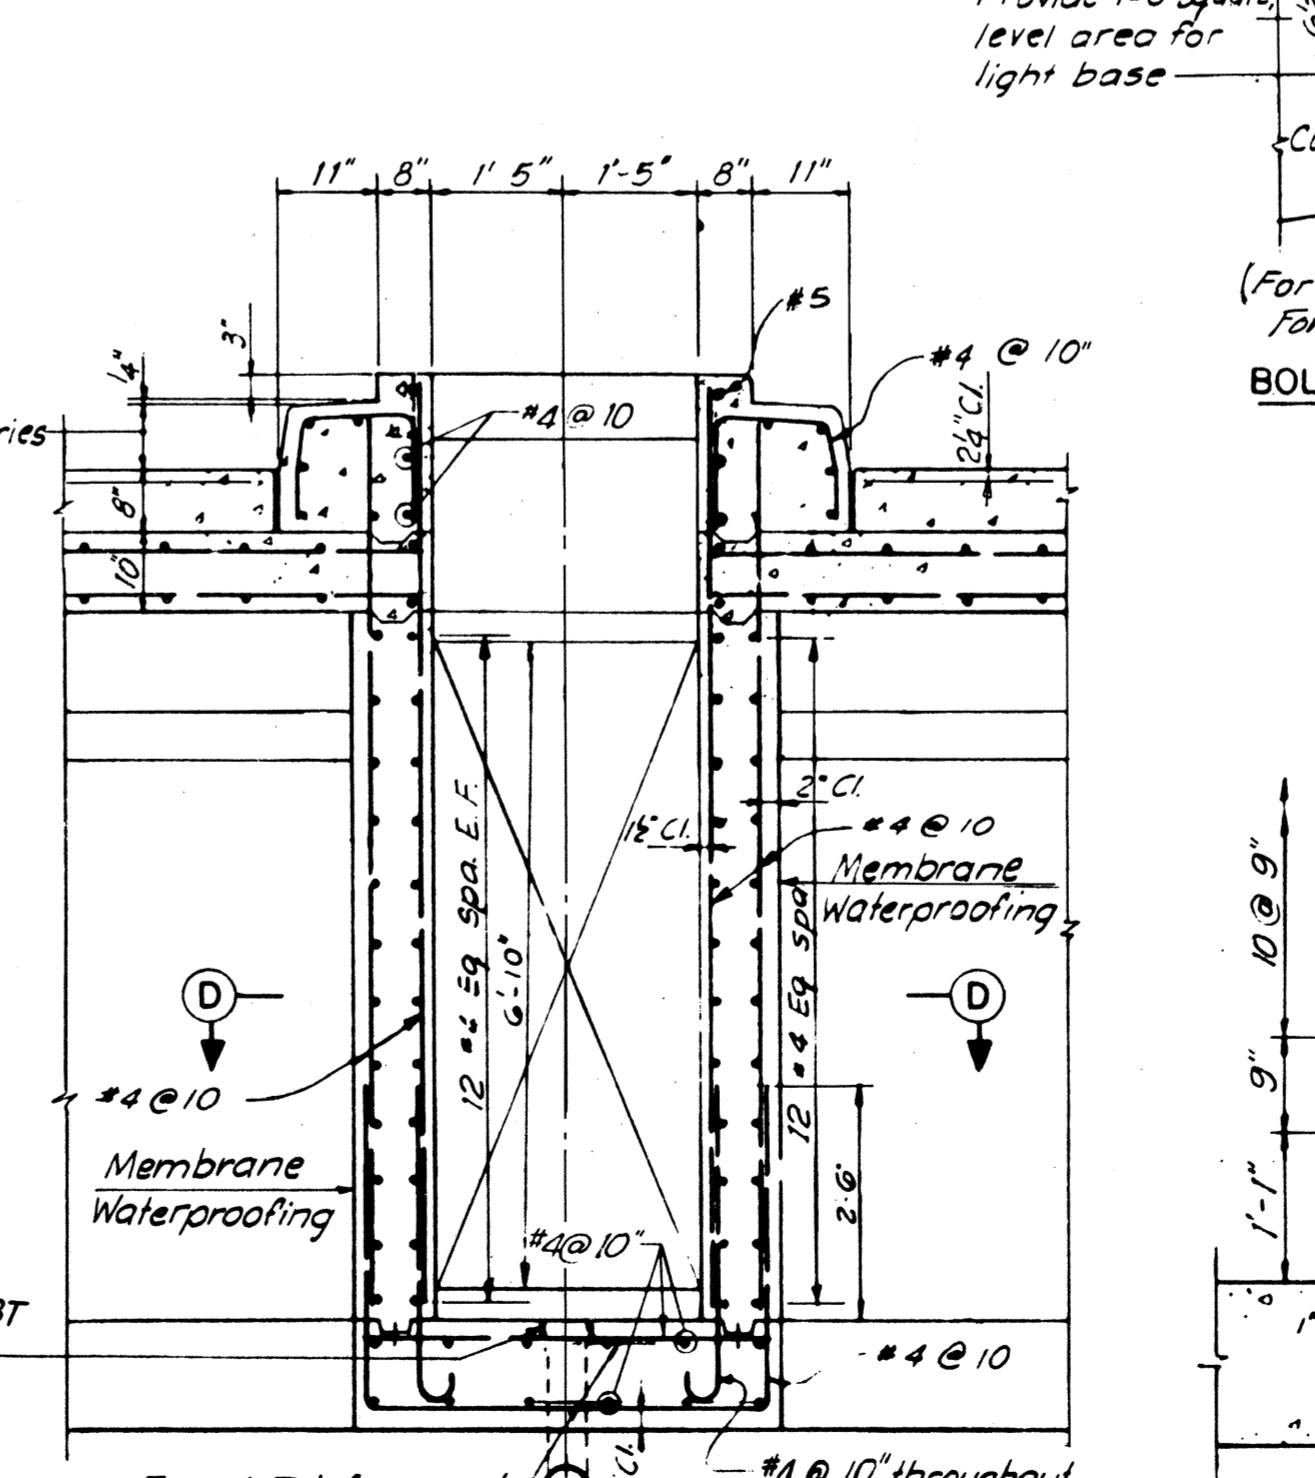

DETAIL OF ANCHOR BOLT FOR TOLL BOOTH
 3" = 1'-0"
 For Location see Island Plan this Sheet
 * For dual lane Ramp Plaza this line is the bottom of Booth Pad and Roadway Pav't.
 R.P.C.C.: Reinforced, Portland Cement Concrete












AS BUILT

RICHMOND METROPOLITAN AUTHORITY
RICHMOND EXPRESSWAY SYSTEM
POWHITE PARKWAY

BARRIER PLAZA
ISLAND AND TUNNEL DETAILS

HOWARD, NEEDLES, TAMMEN & BERGENDOFF consulting engineers NEW YORK ALEXANDRIA KANSAS CITY	SCALE: AS NOTED CONTRACT NO.: C-2 SHEET NO. 43-A OF 188
---	---

RICHMOND EXPRESSWAY SYSTEM			
SECTION	PROJECT	SHEET NO.	TOTAL SHEETS
2	POWHITE PARKWAY	43-B	188

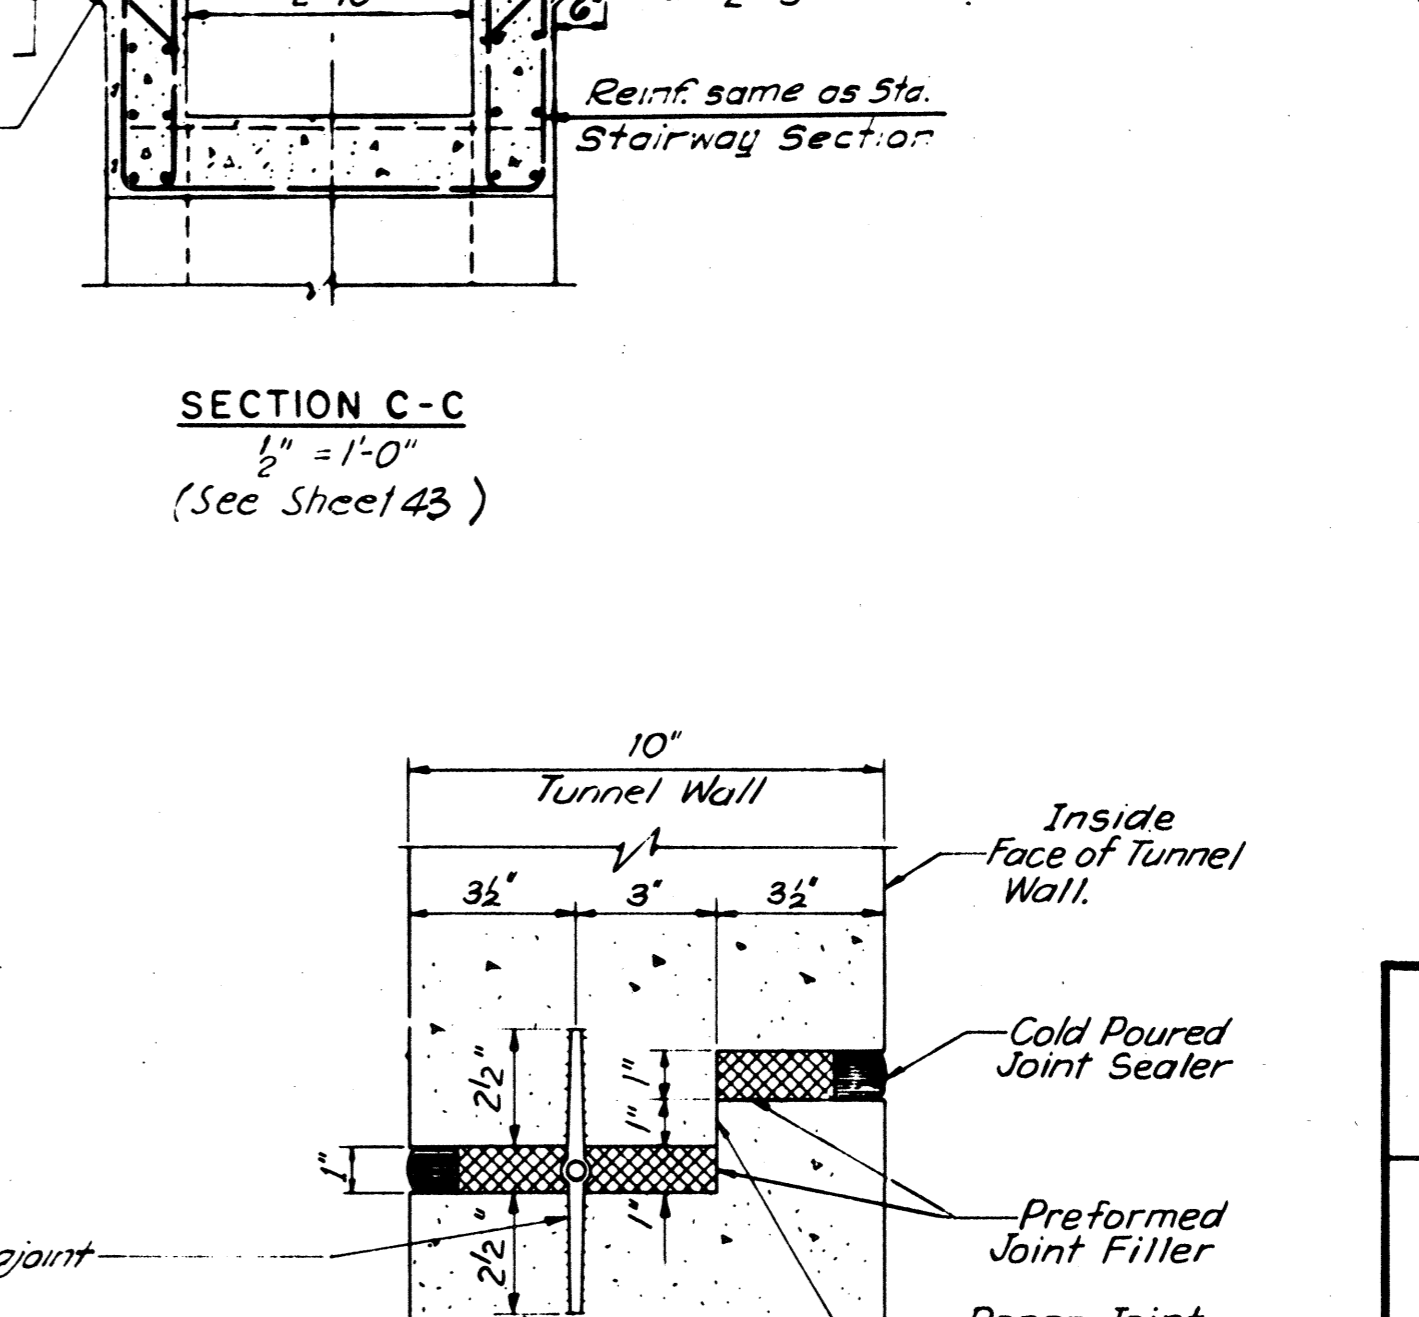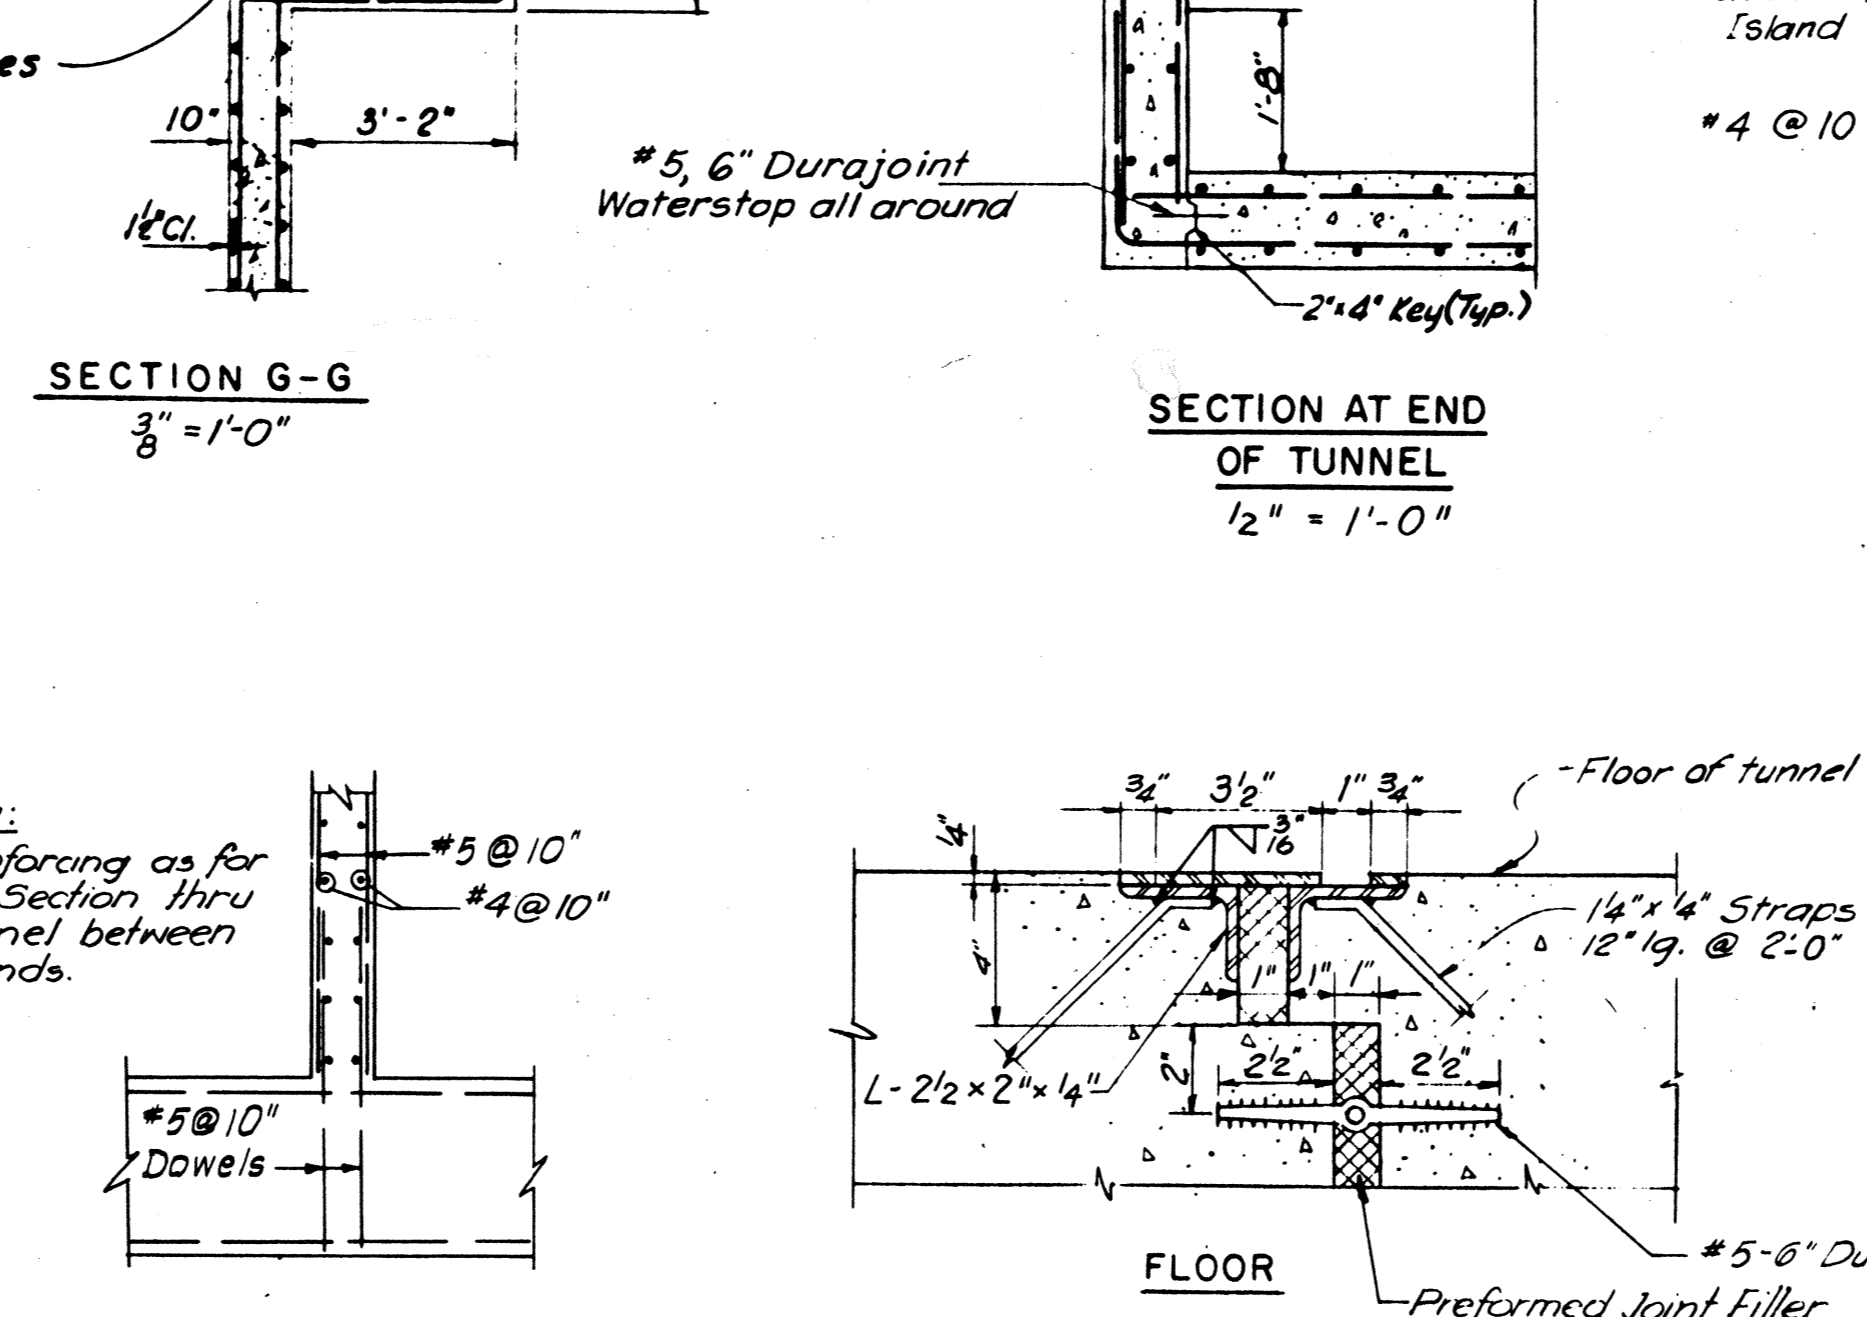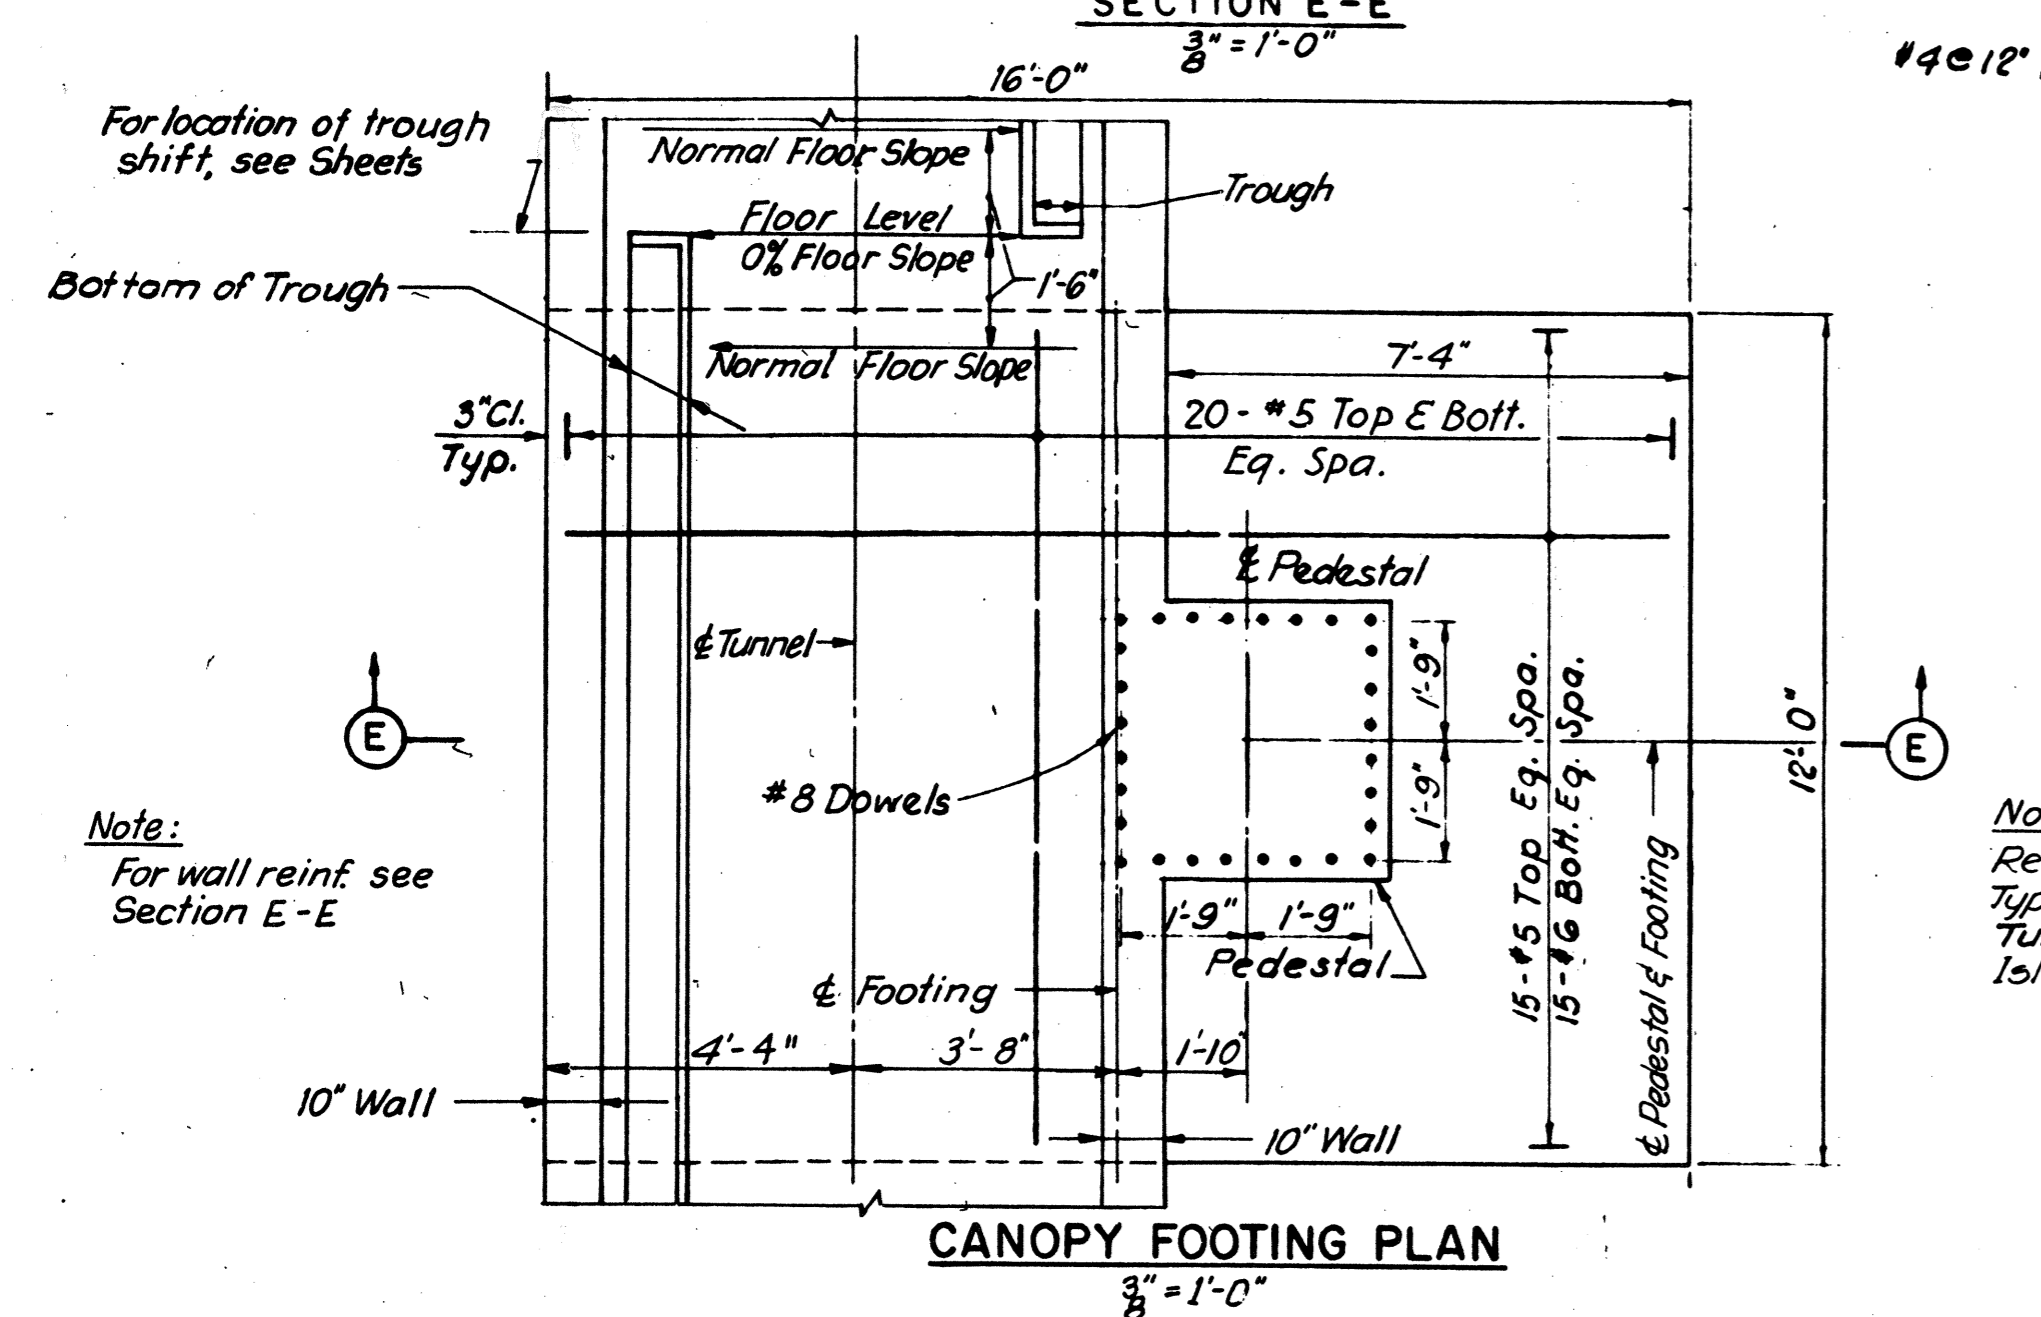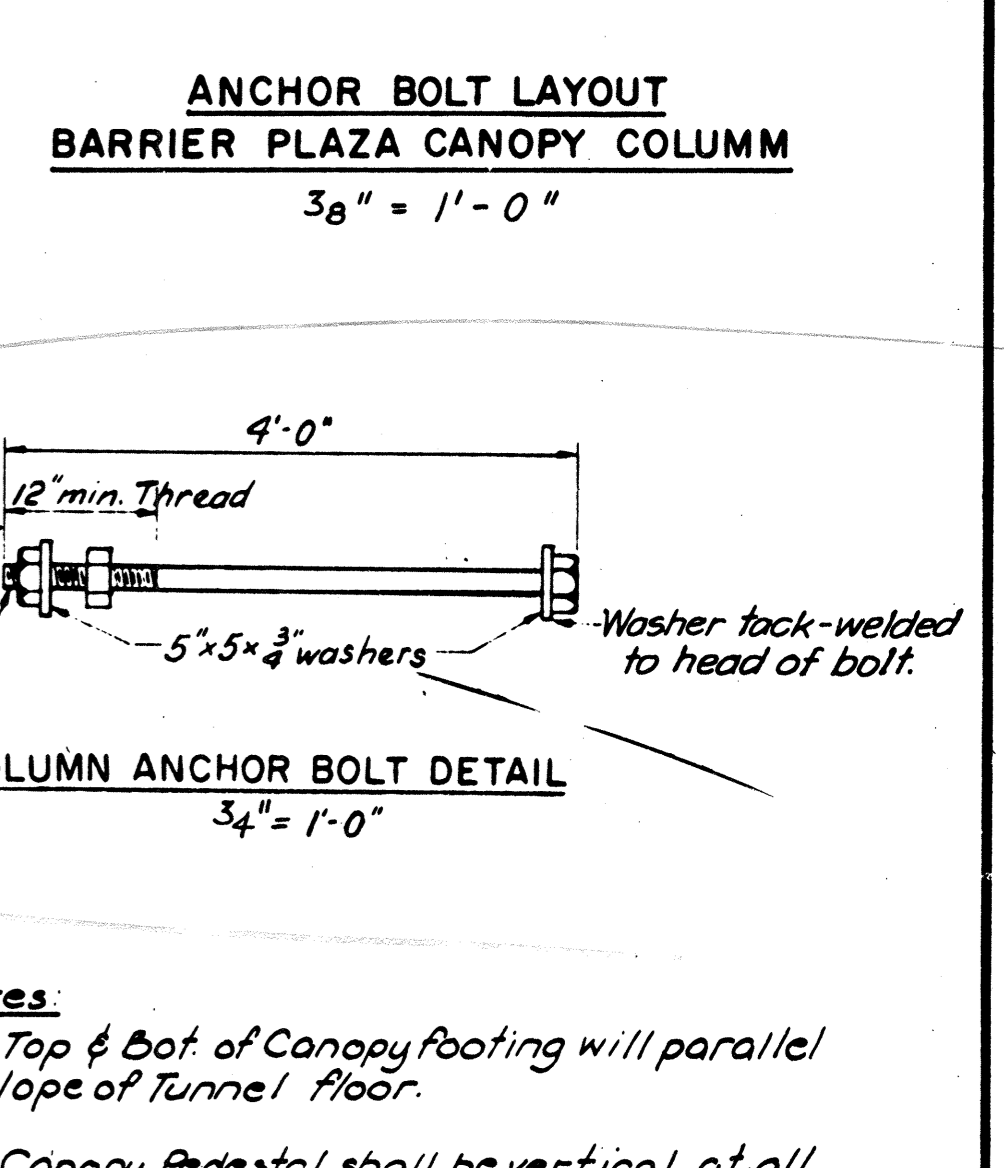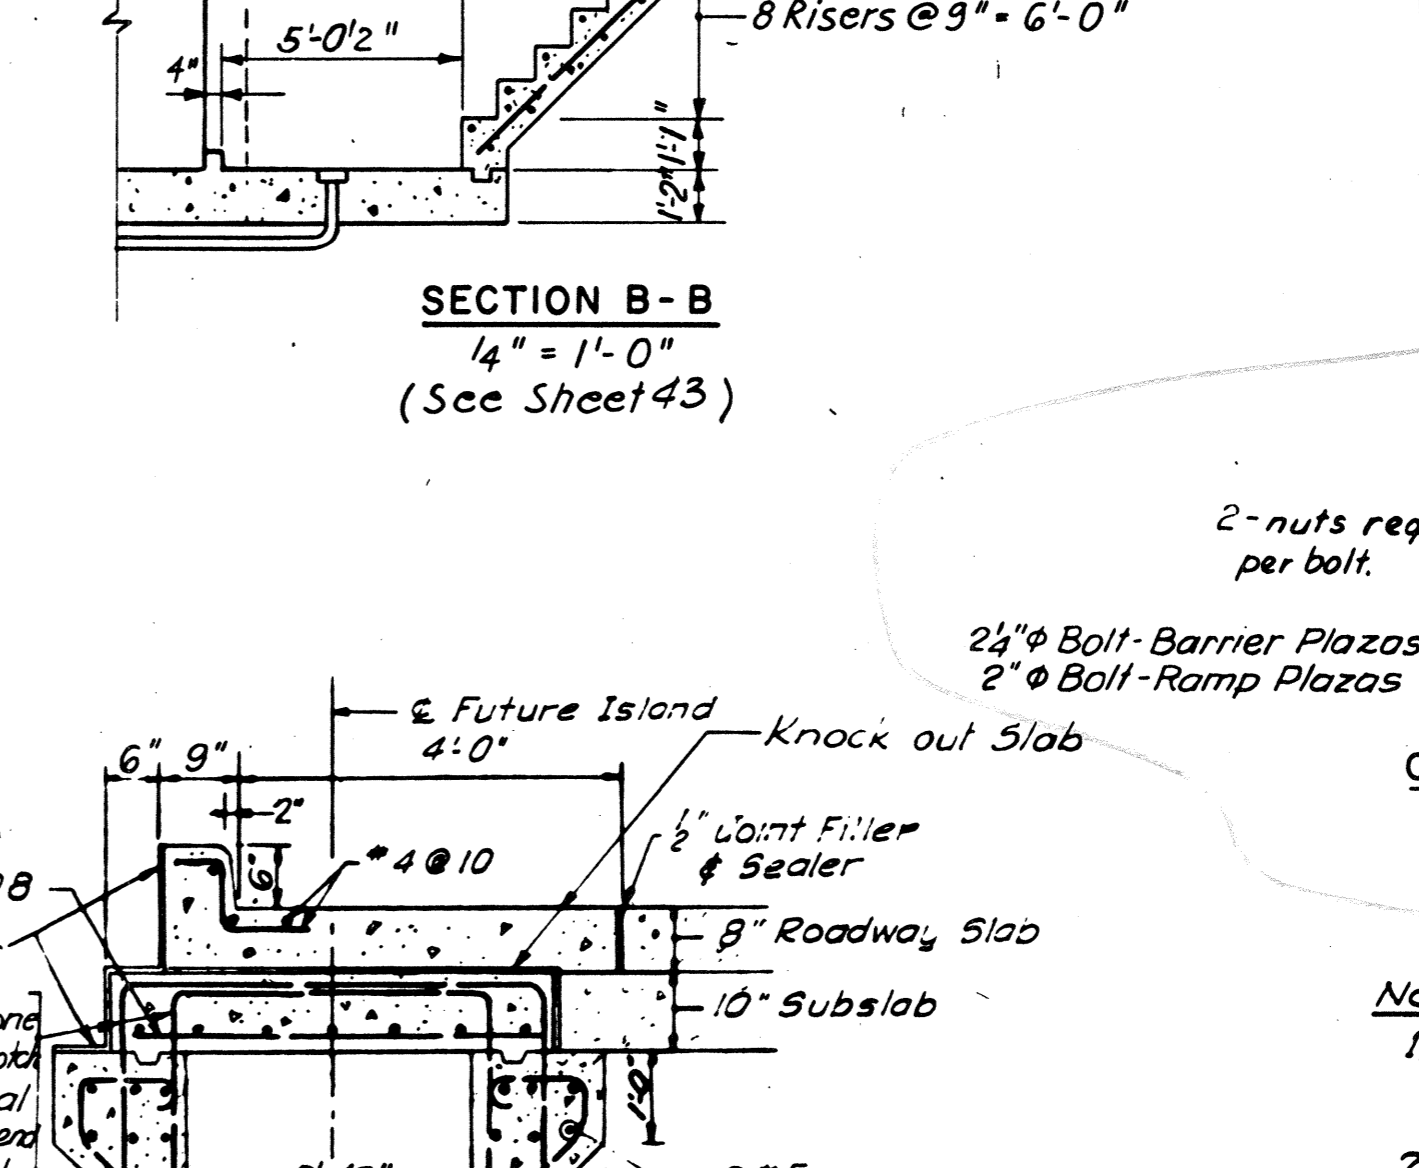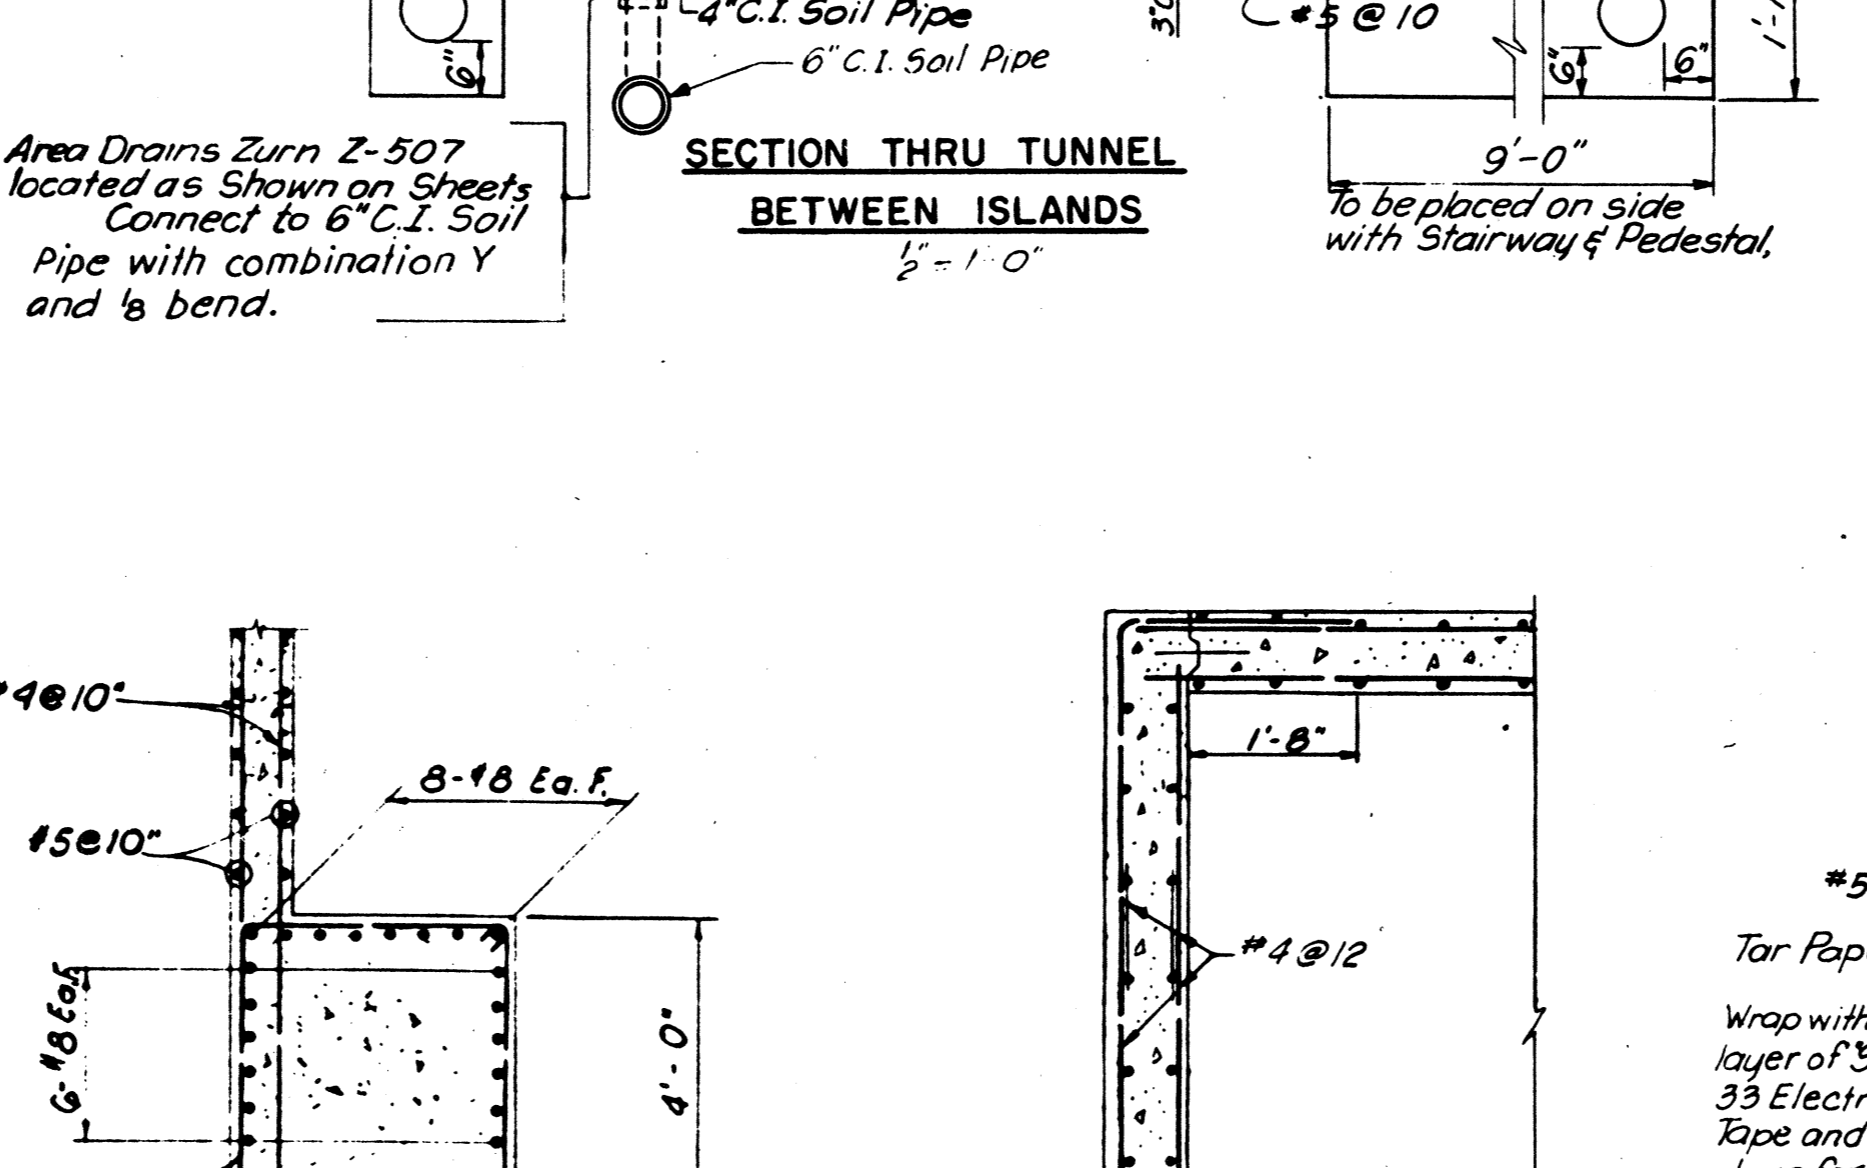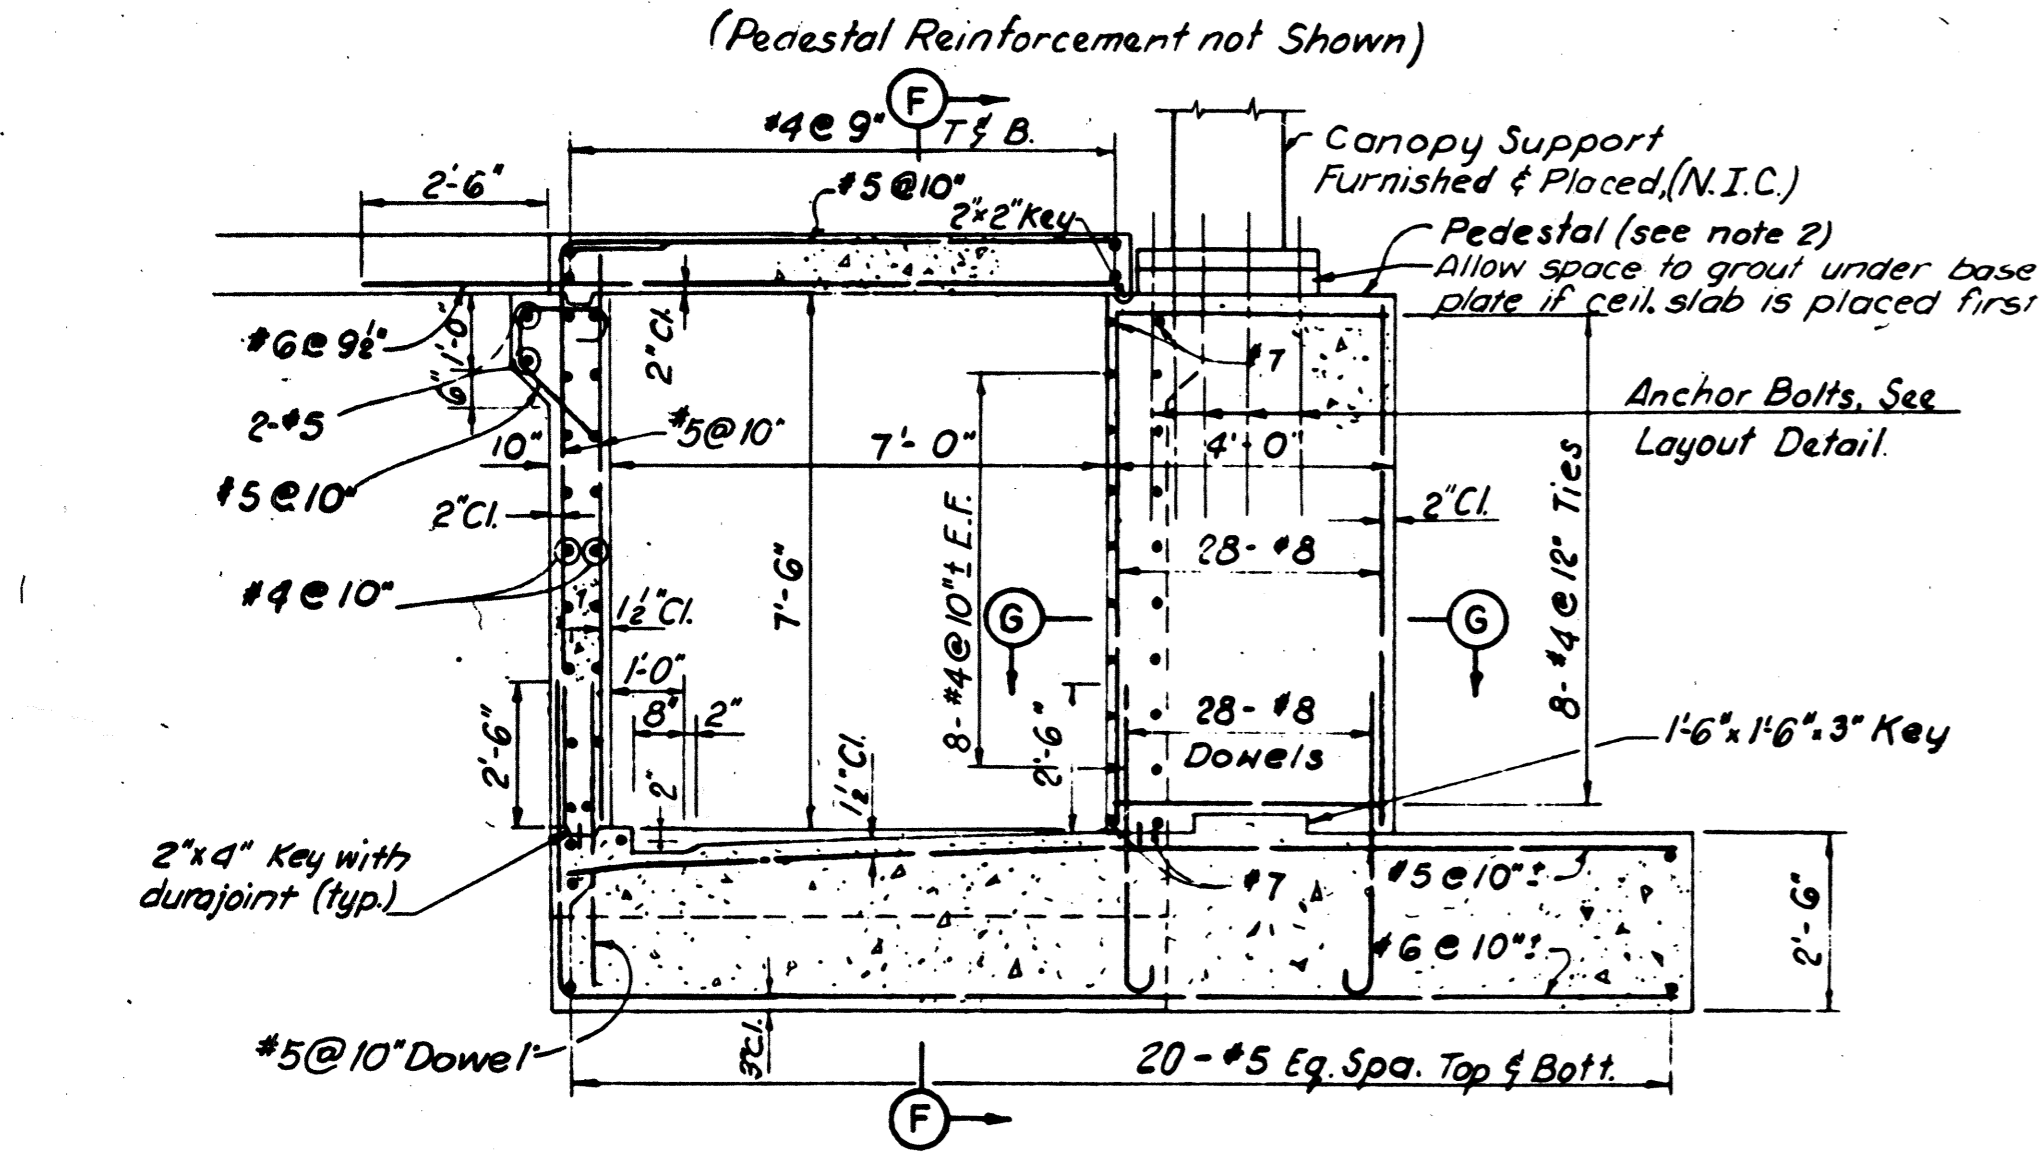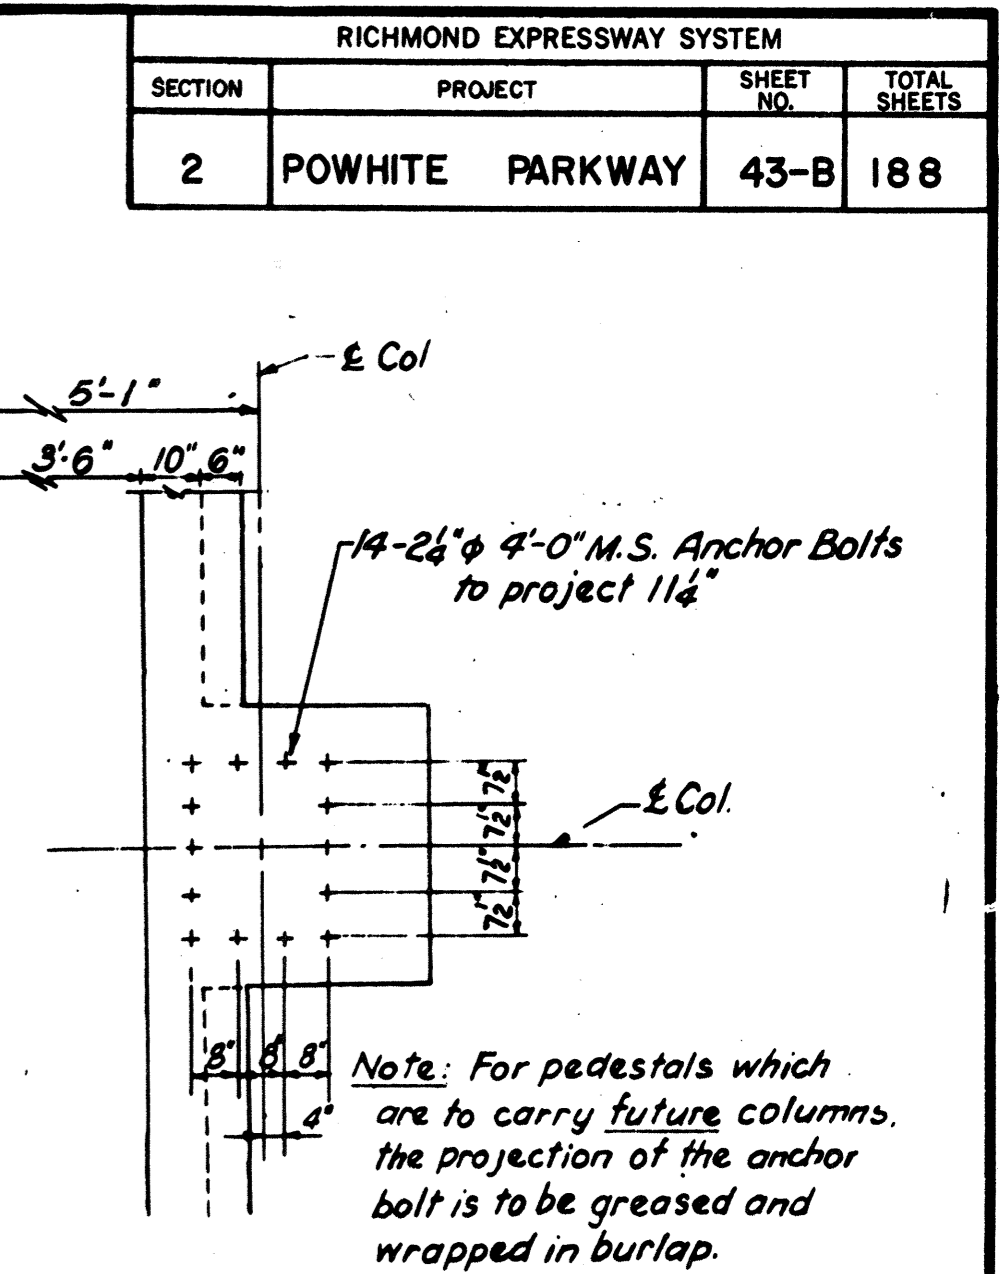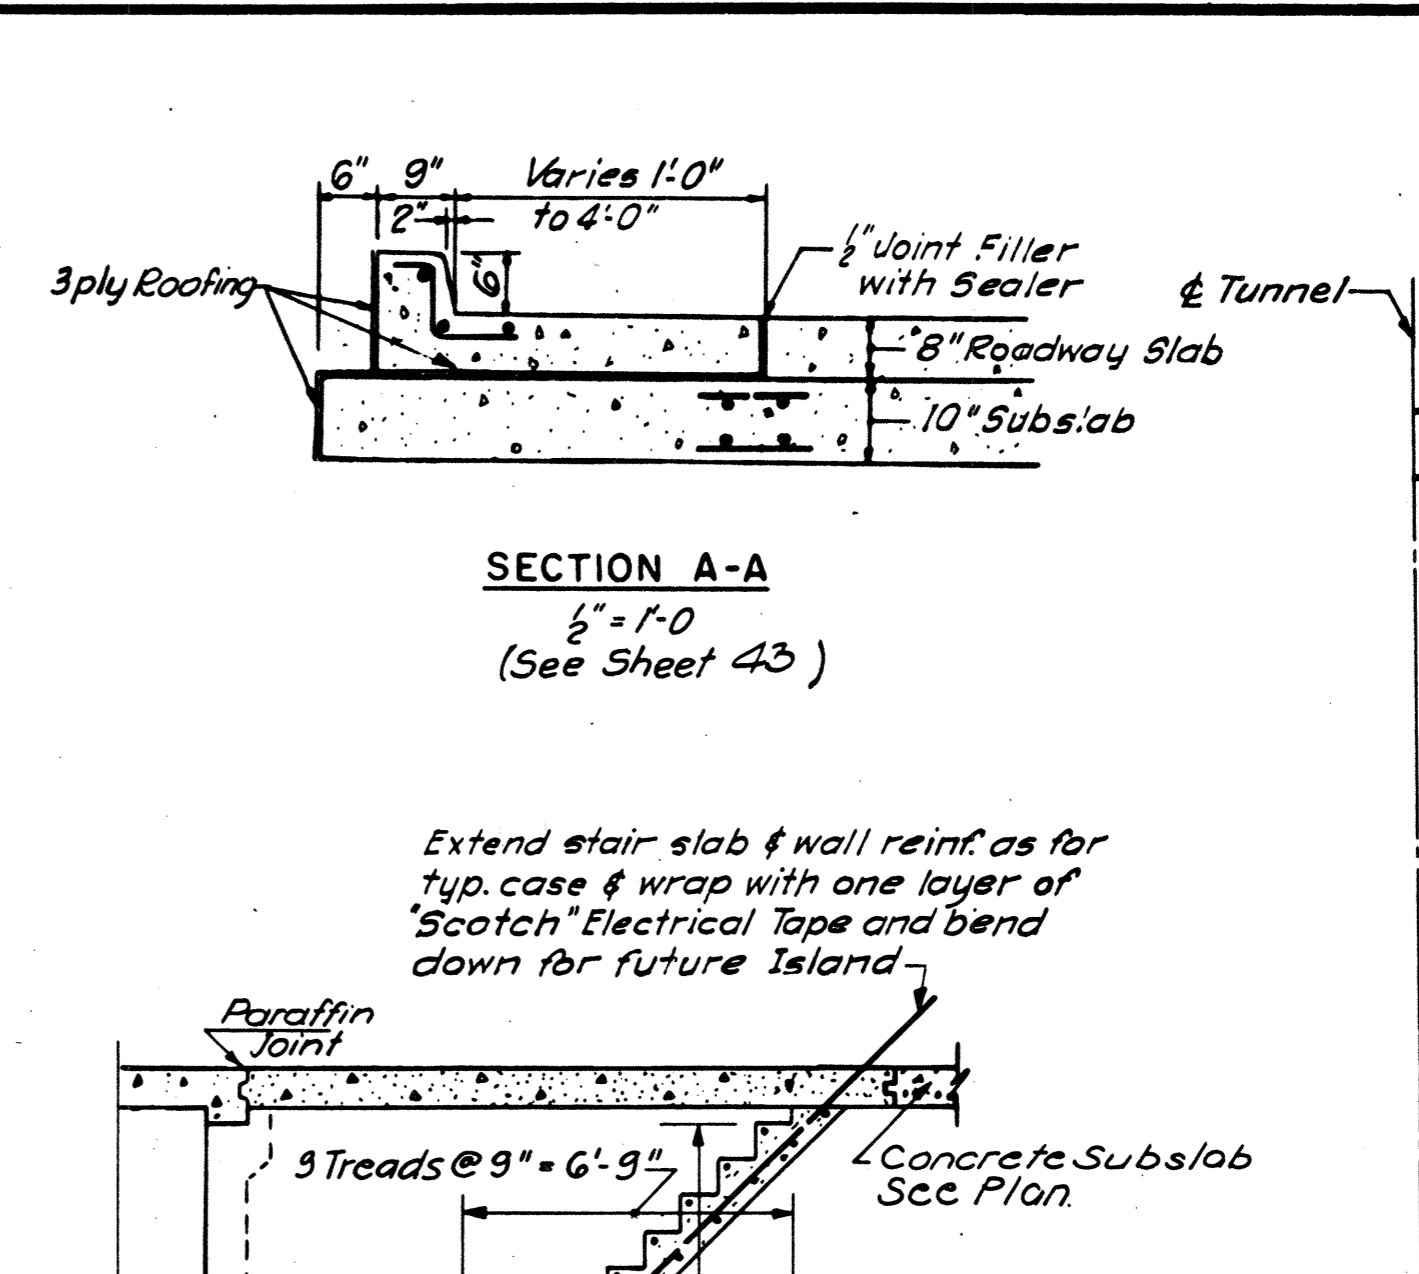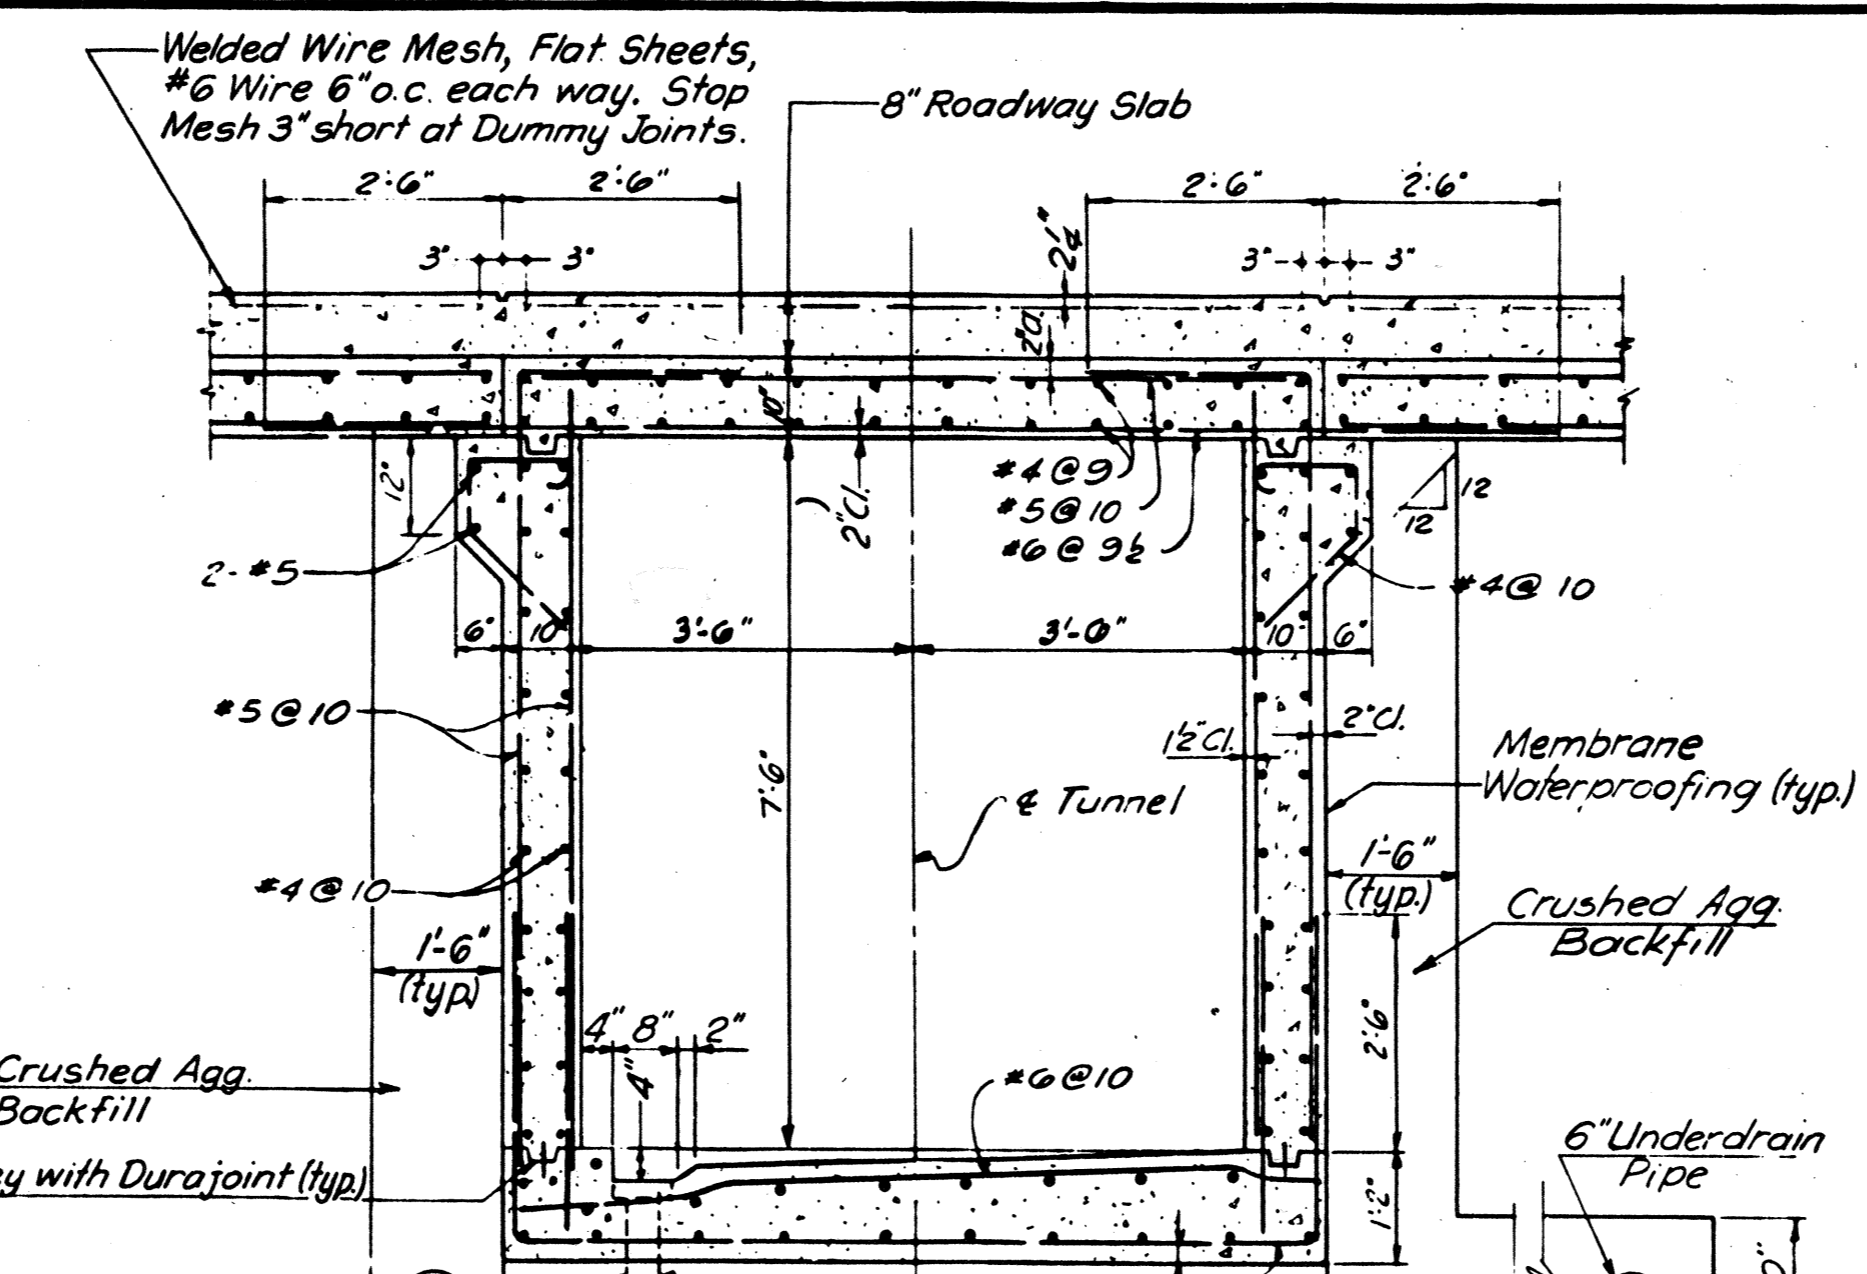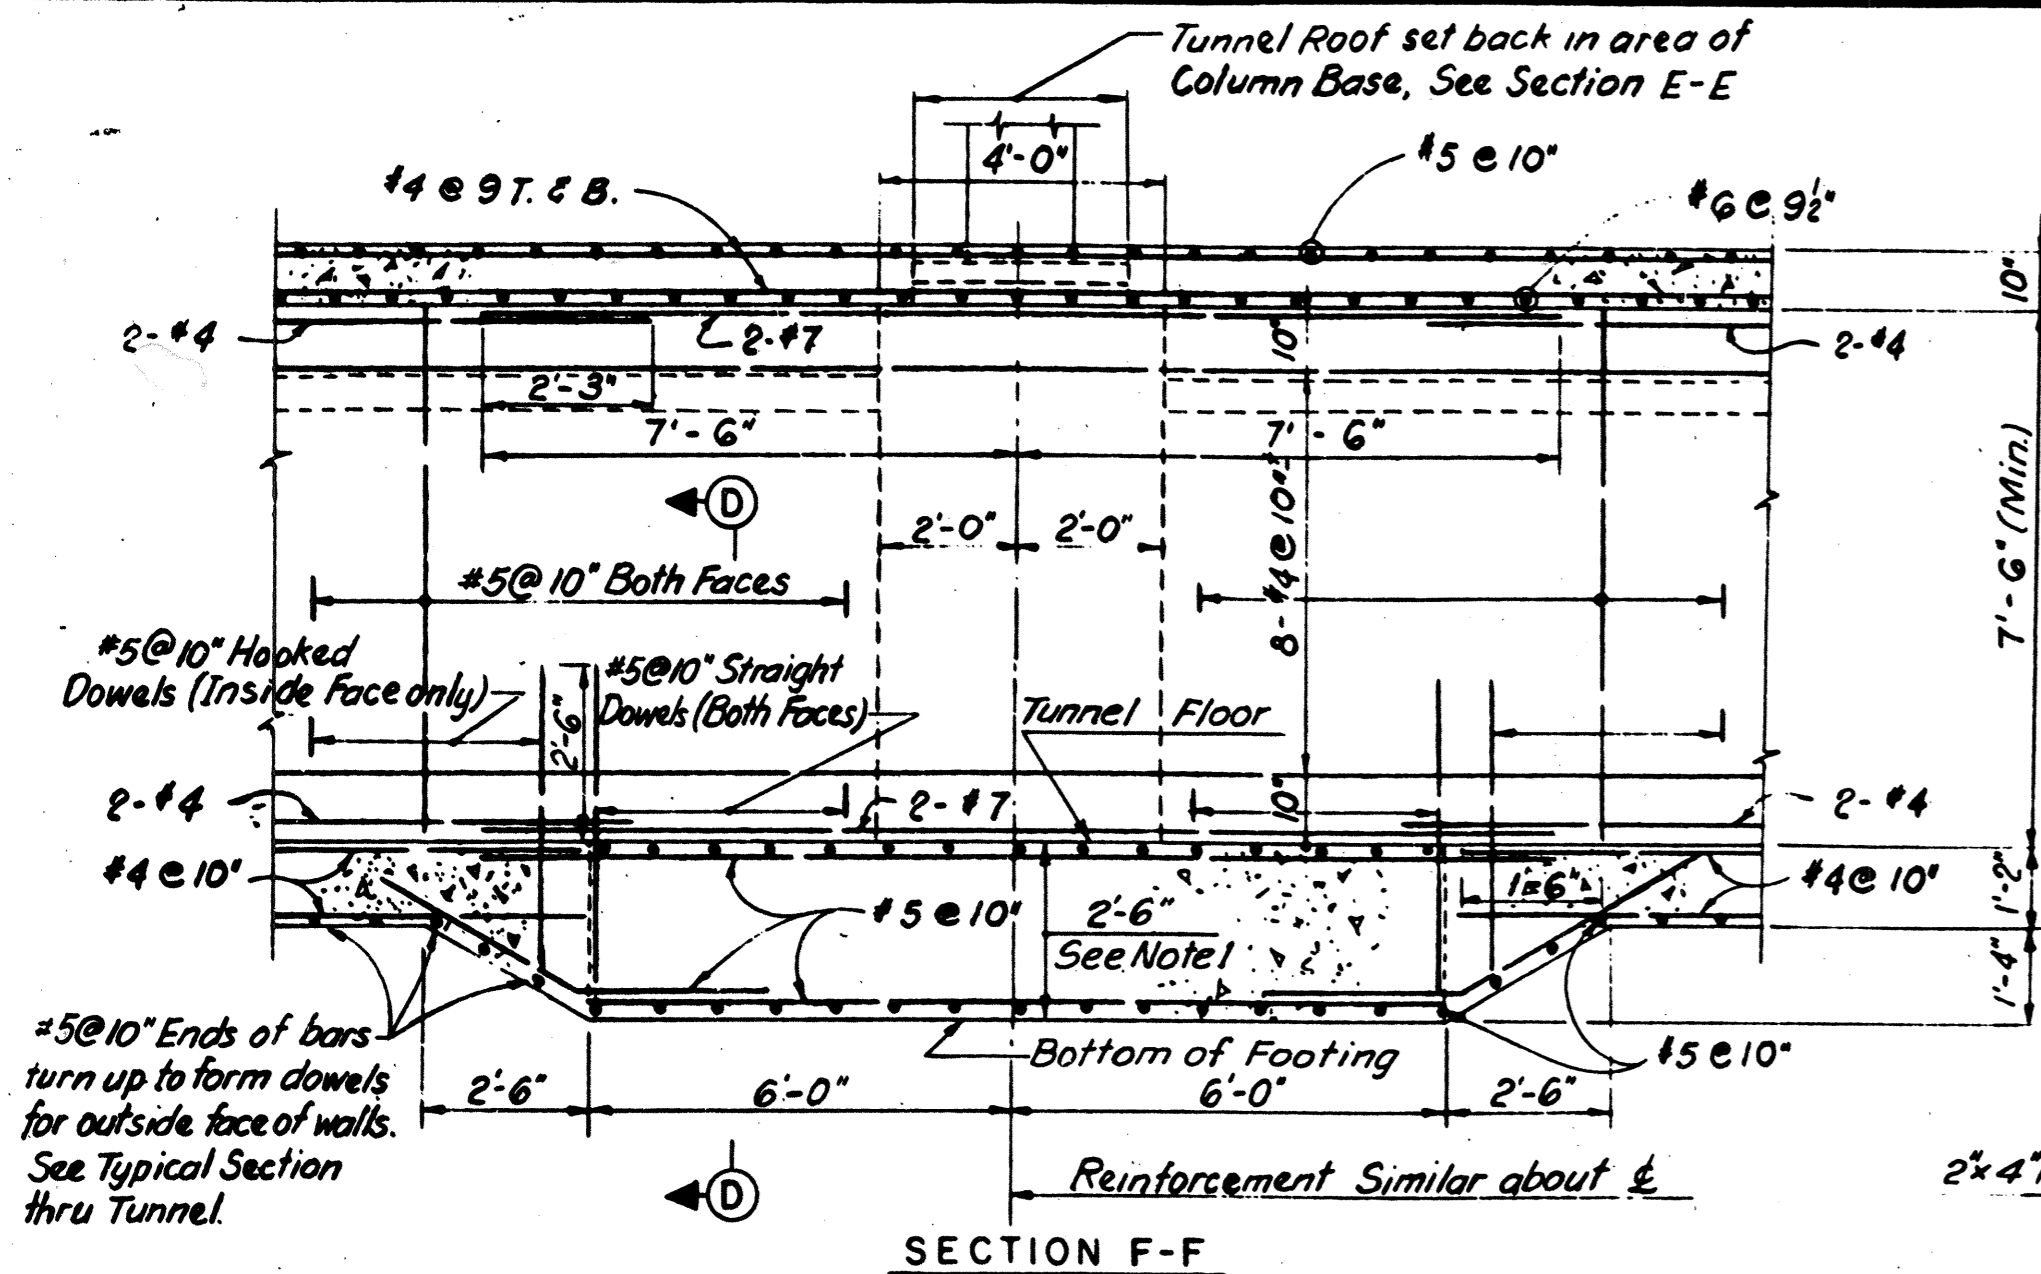

Notes:
 1) Top & Bot. of Canopy footing will parallel slope of Tunnel floor.
 2) Canopy Pedestal shall be vertical at all times.

AS BUILT

RICHMOND METROPOLITAN AUTHORITY
 RICHMOND EXPRESSWAY SYSTEM
 POWHITE PARKWAY




BARRIER PLAZA
 TUNNEL DETAILS

HOWARD, NEEDLES, TAMMEN & BERGENDOFF
 consulting engineers
 NEW YORK ALEXANDRIA KANSAS CITY




SCALE: AS NOTED
 CONTRACT NO.: C-2
 SHEET NO. 43-B OF 188

BY	DATE	NO.	REVISION	BY	DATE
MADE	W.J.W. 5-68	2	As Built	J.R.C.	6-73
CHECKED	D.E.N. 5-68	1	Final Check	D.E.N.	6-68
IN CHARGE	H.O.S.				

RICHMOND EXPRESSWAY SYSTEM			
SECTION	PROJECT	SHEET NO.	TOTAL SHEETS
2	POWHITE PARKWAY	43-D	186

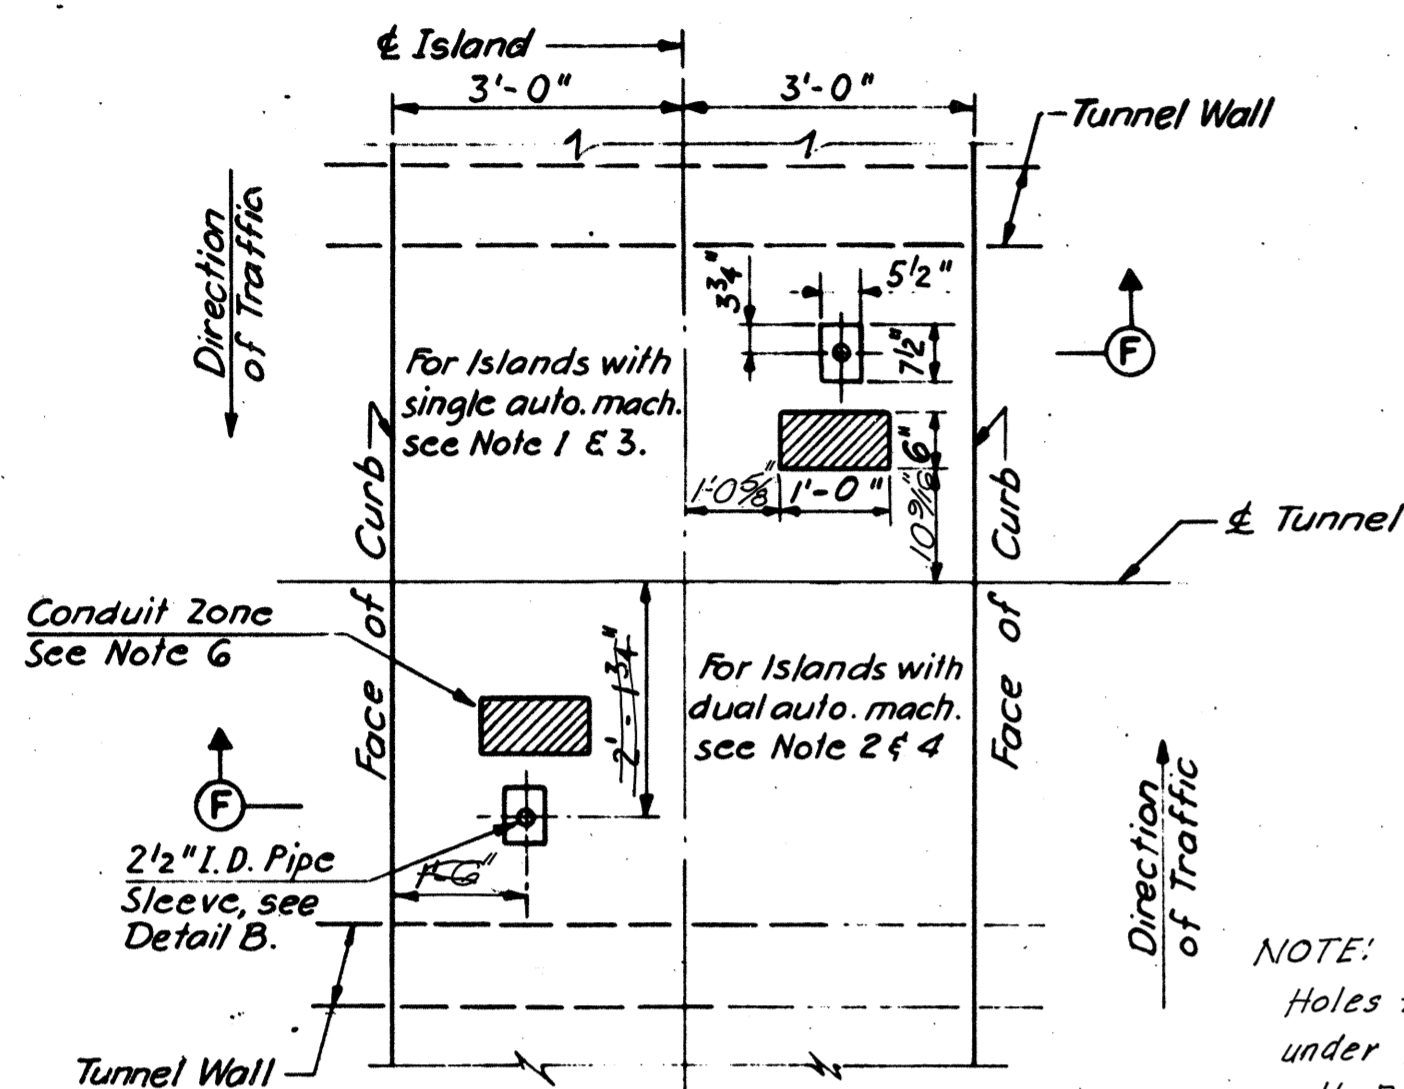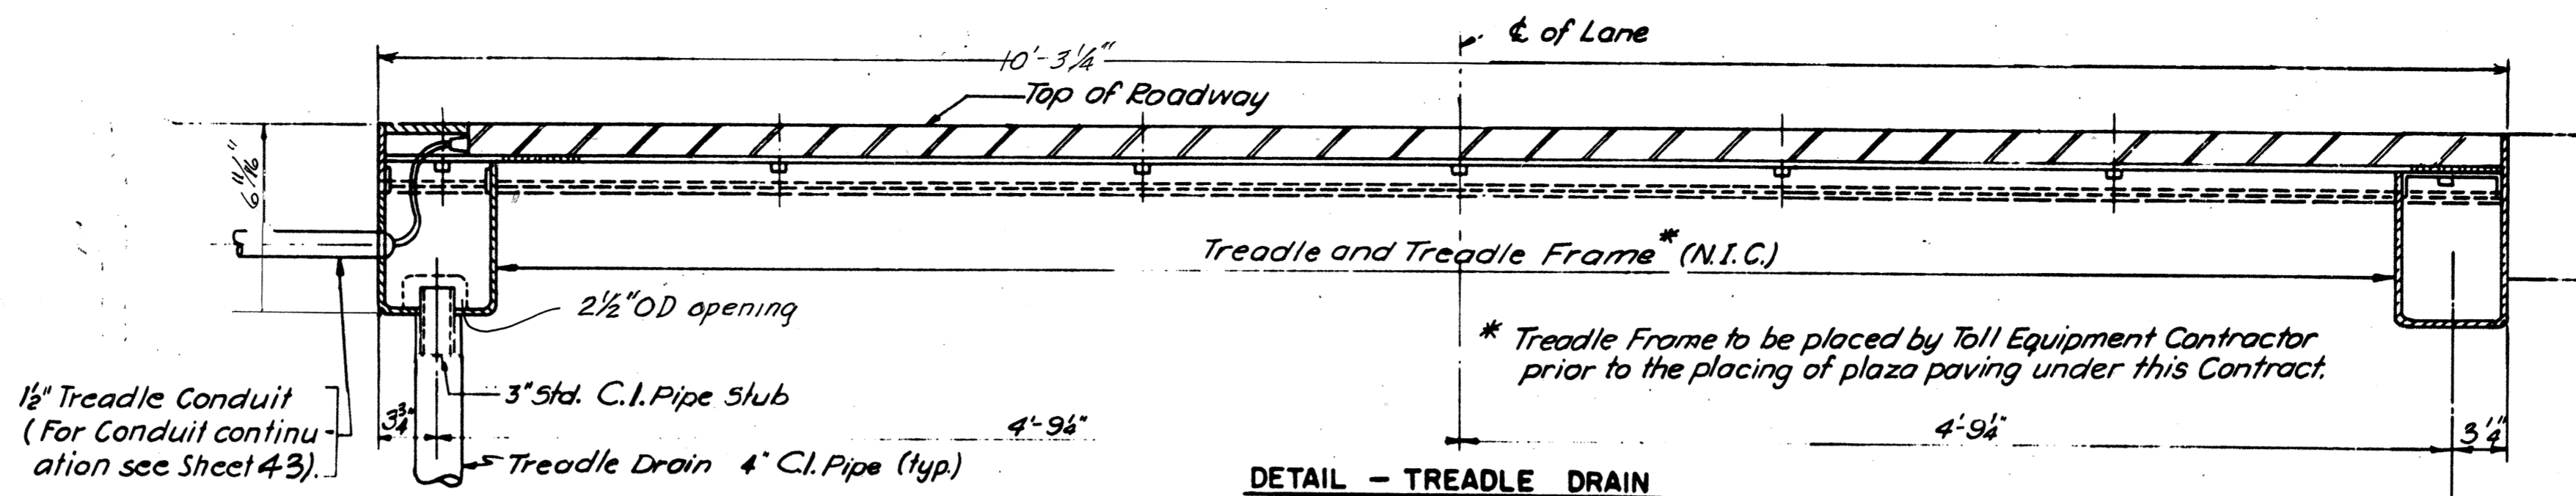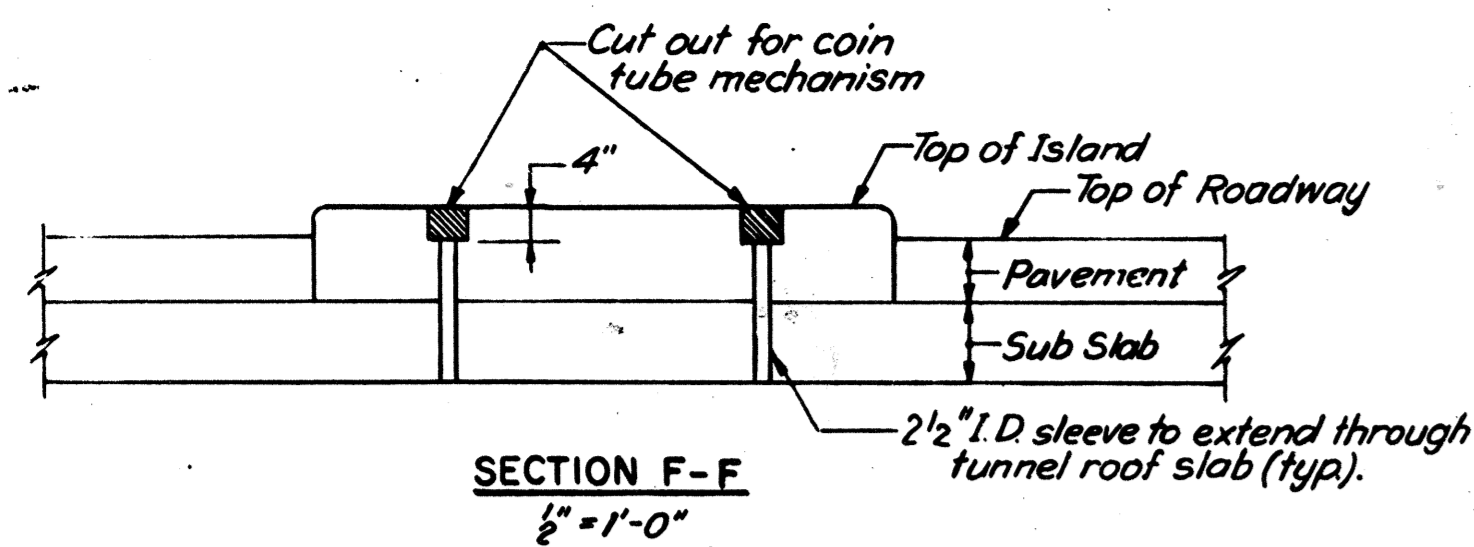

NOTE:
Holes for Coin Tubes as installed under this Contract did not fit with Booths & Coin Machines as supplied. New holes were drilled for machines, etc.




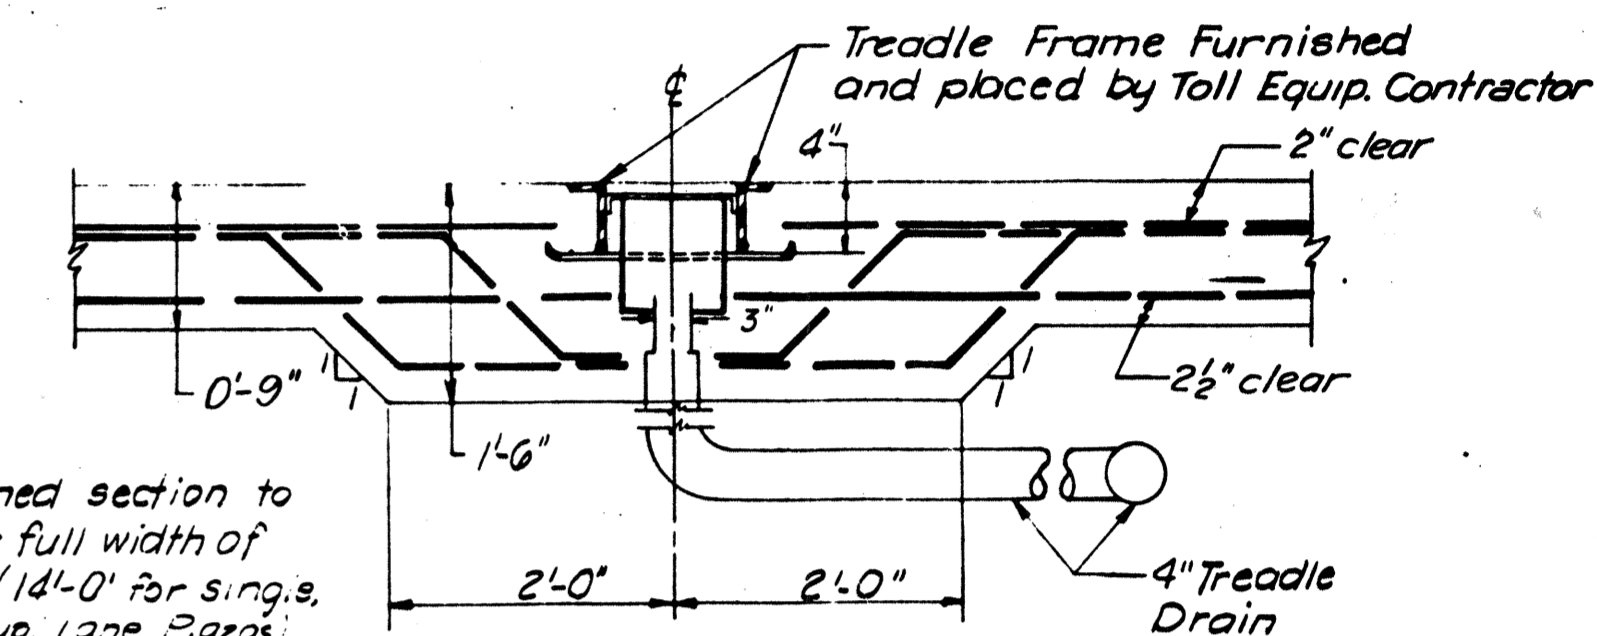
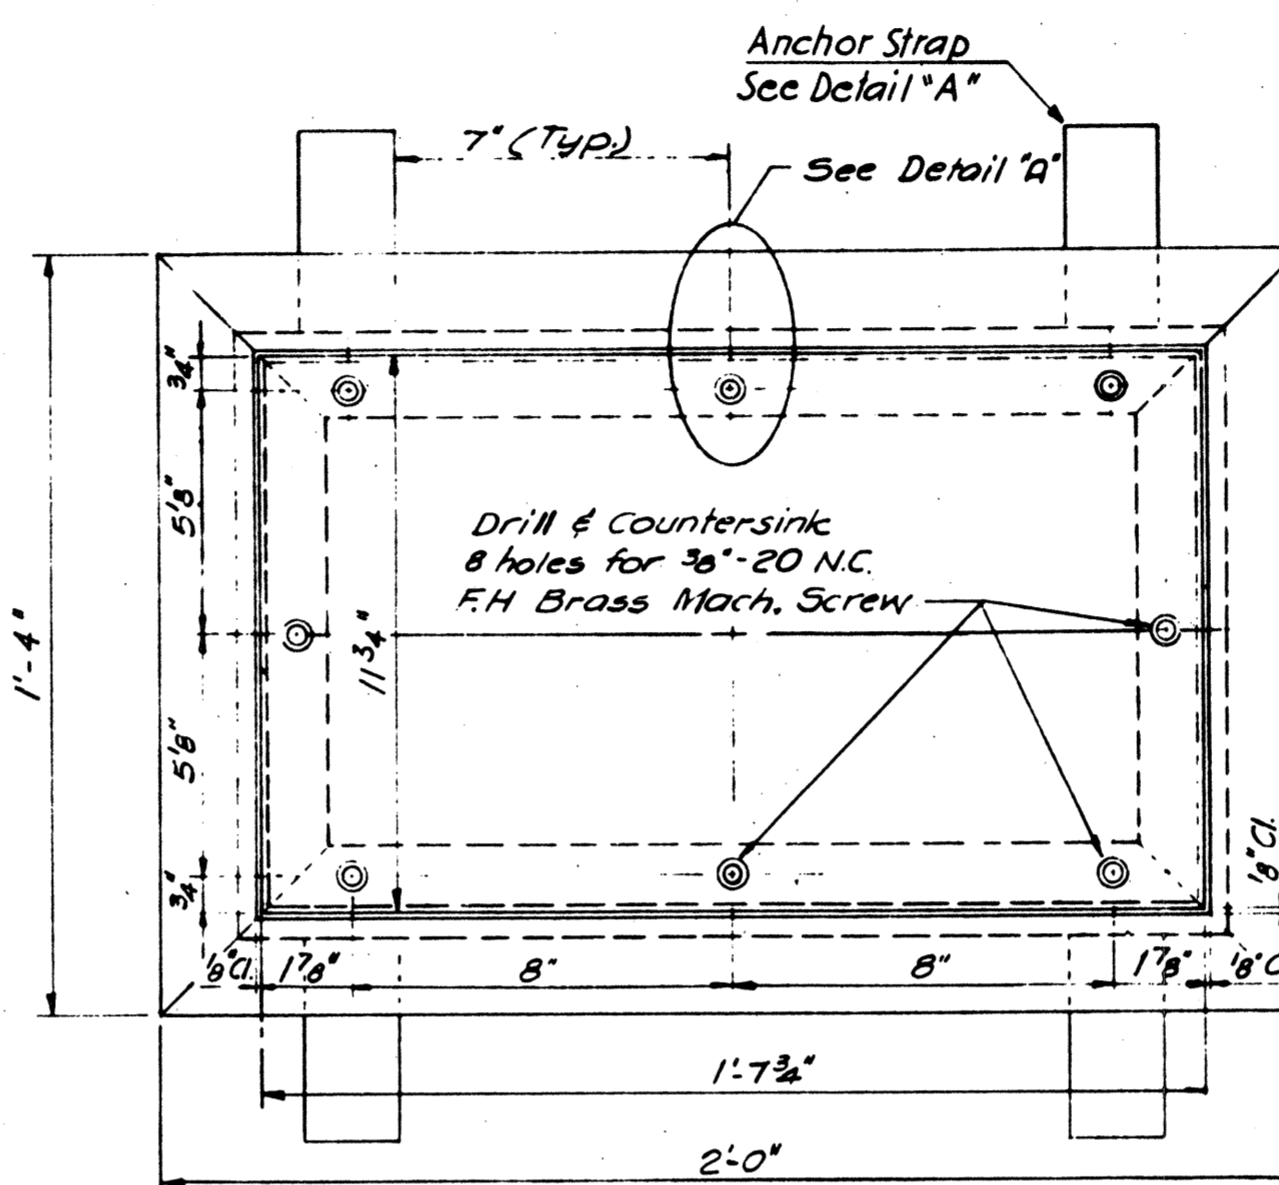
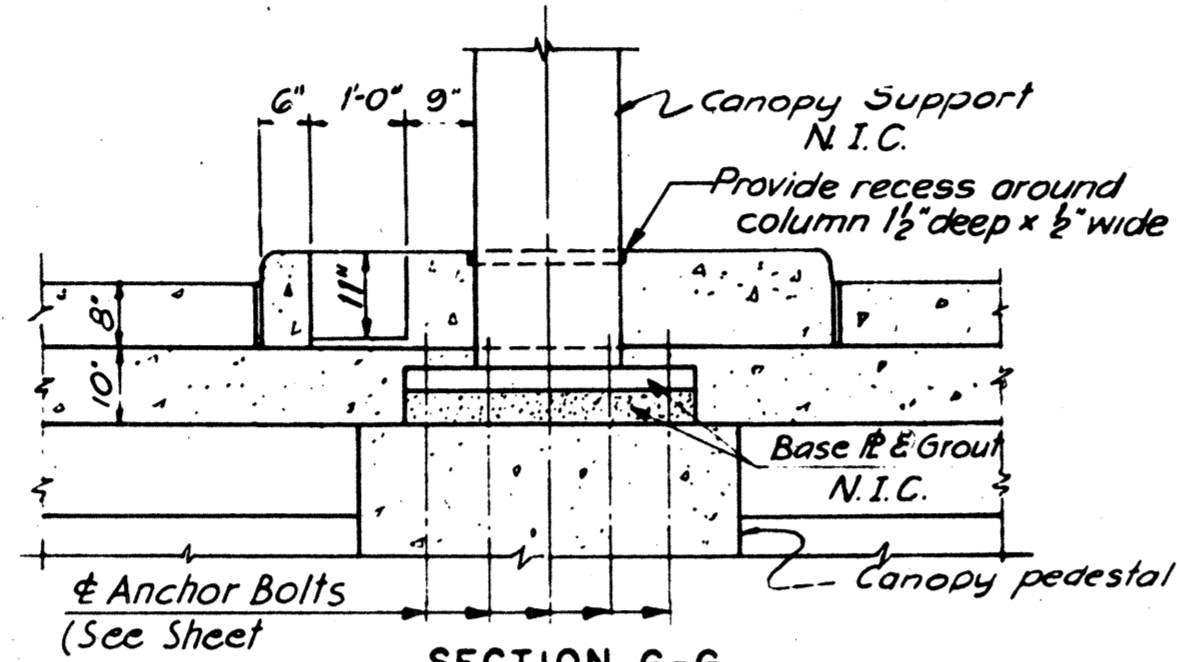


1-6\"/>


SECTION "C-C"
10' TREADLE FRAME INSTALLATION
3\"/>

NOTES:

- Islands C & D will have a single coin tube and tube recess for automatic machine.
- Islands E, F & G will have dual coin tubes and tube recesses for automatic machines. One location of each island will be for future automatic machines. See conduit layouts and Note 5.
- All future island locations will have a single coin tube. Sleeve to be threaded and plugged.
- For coin tube recesses at future automatic machine locations, plug 2 1/2\"/>

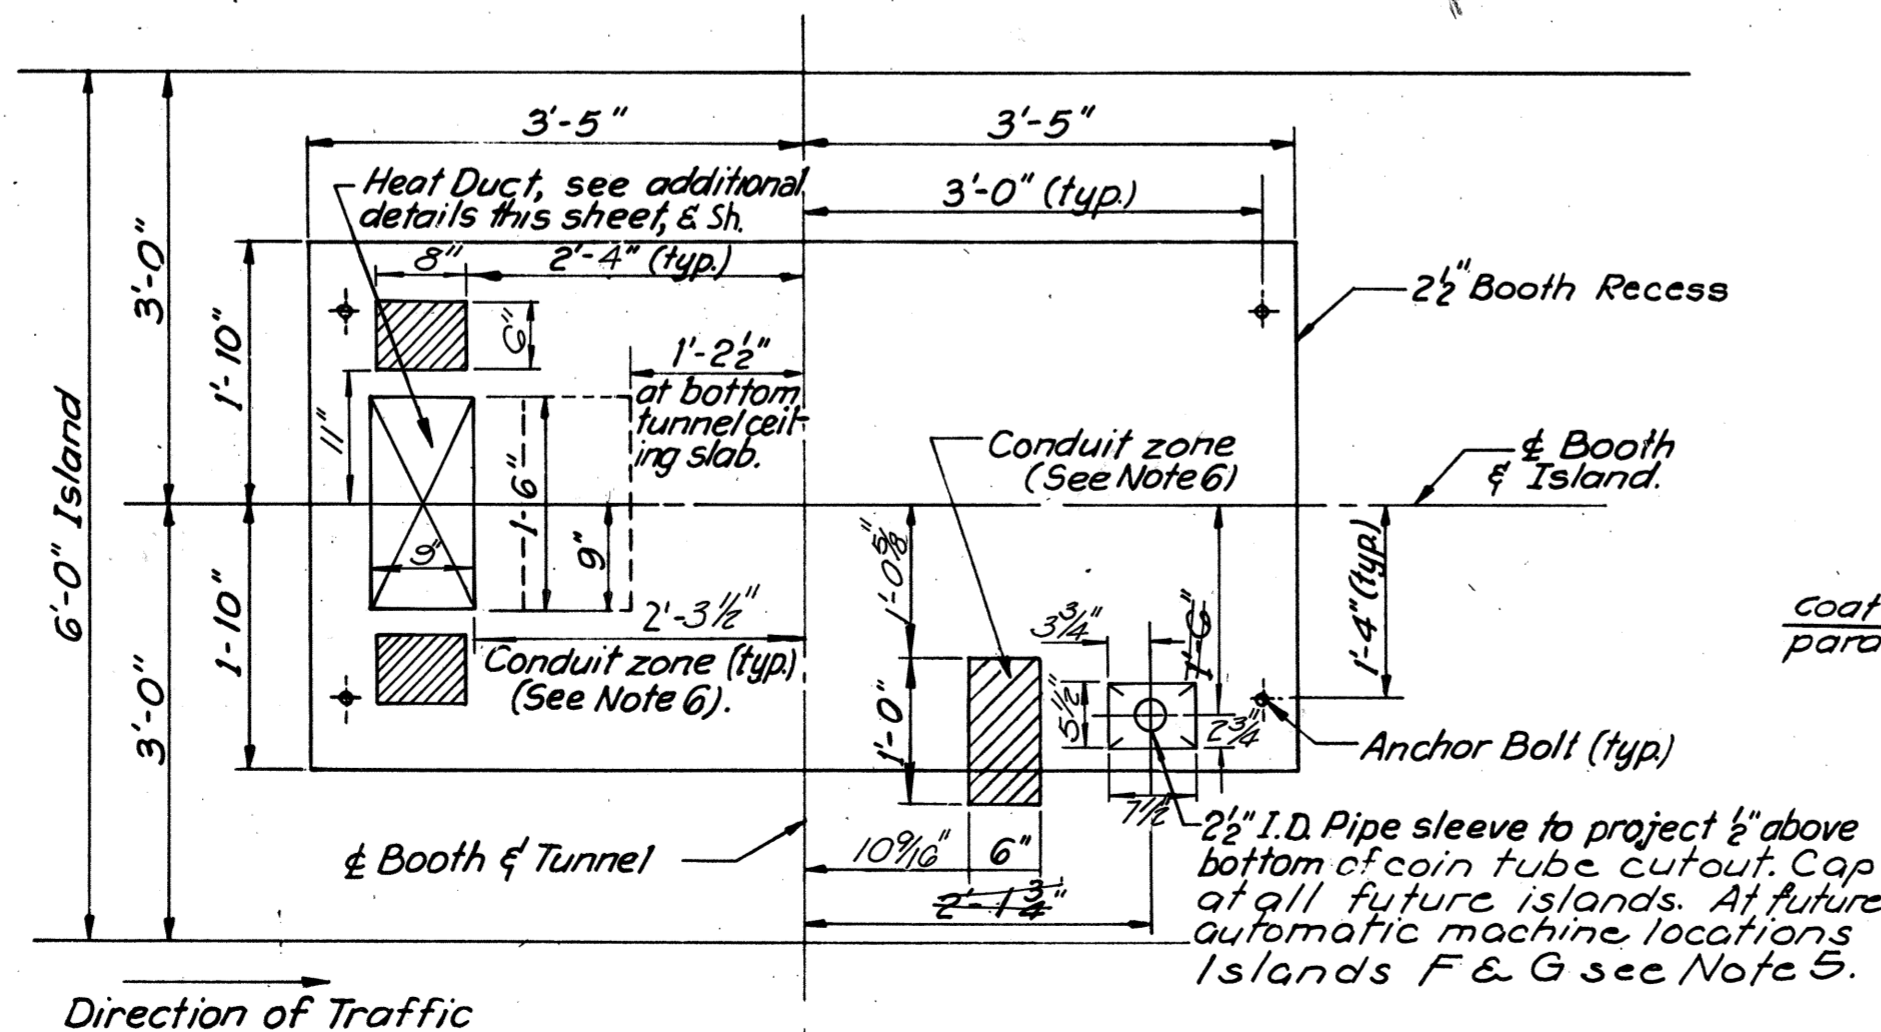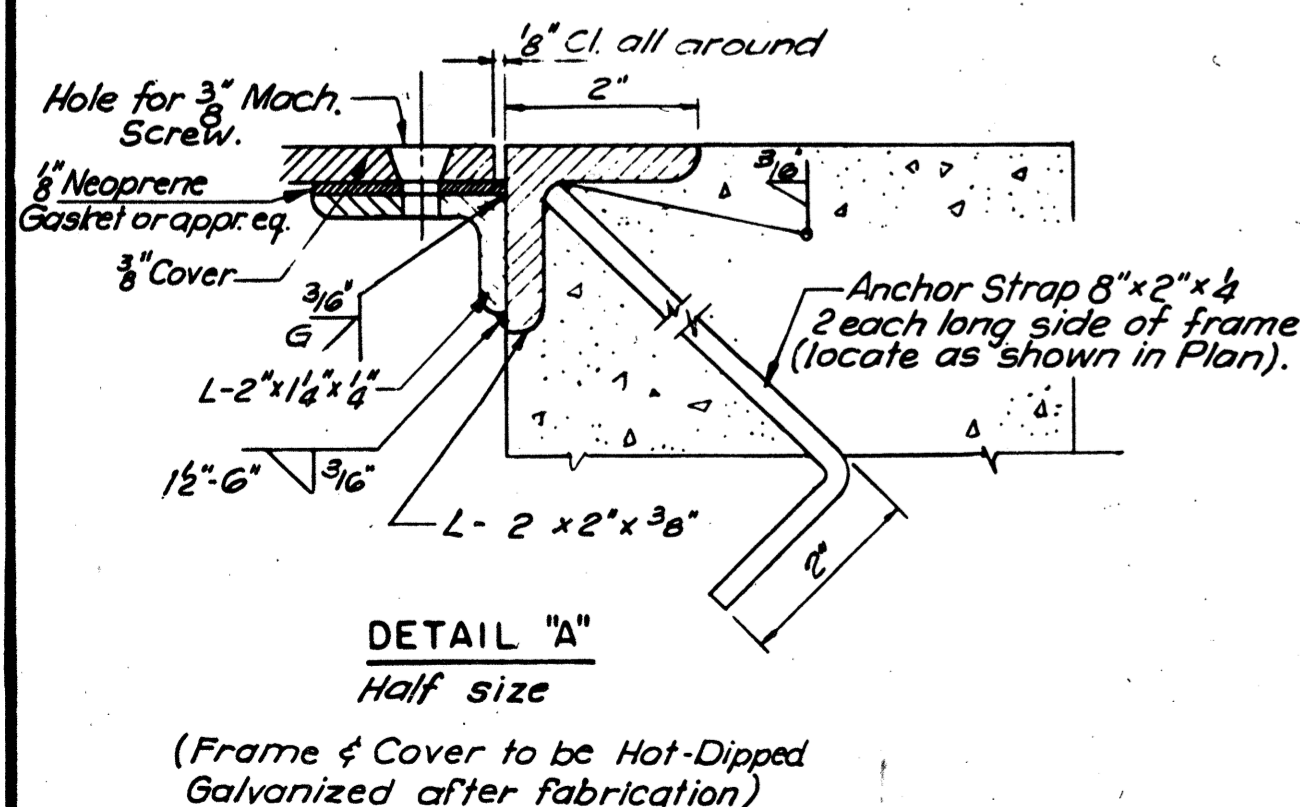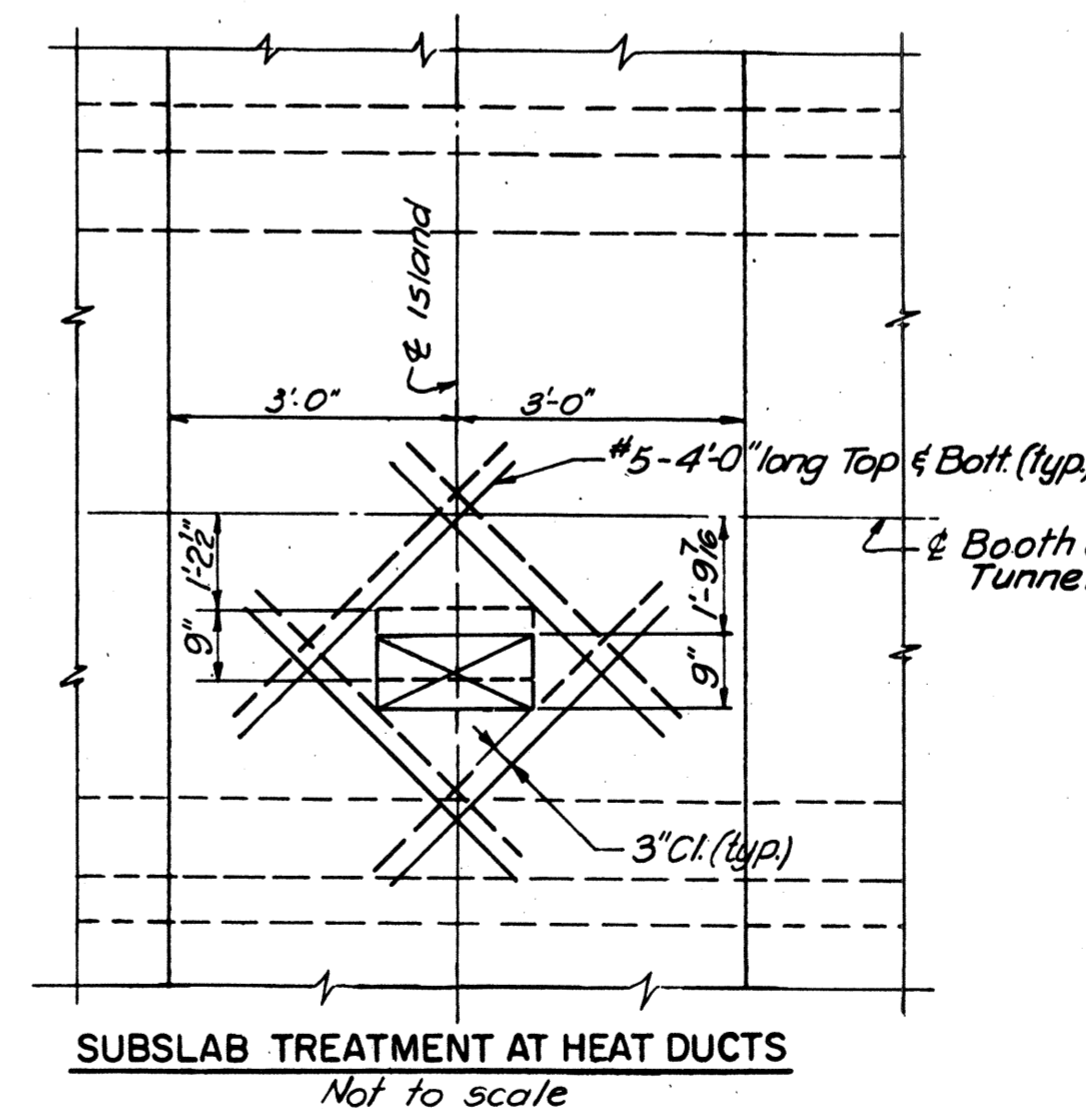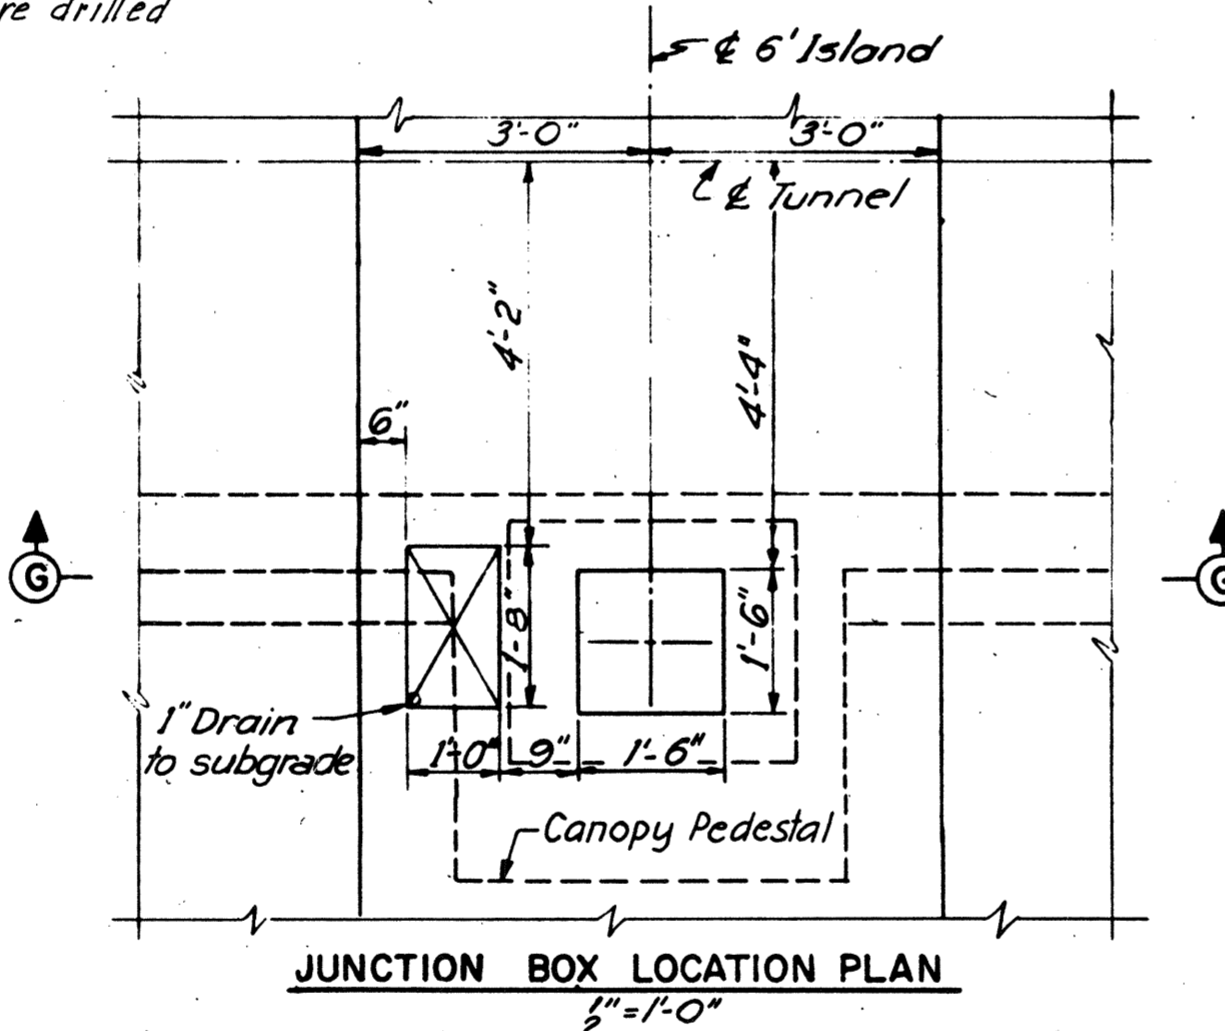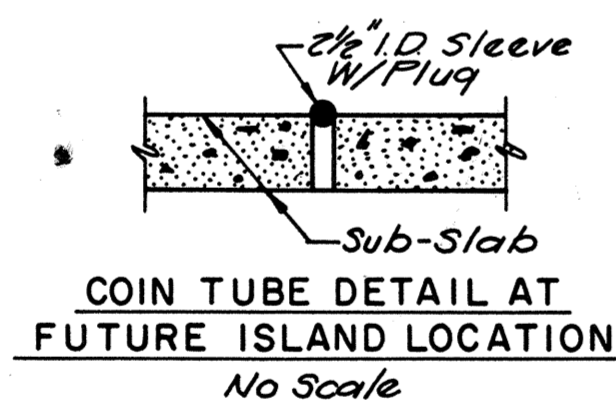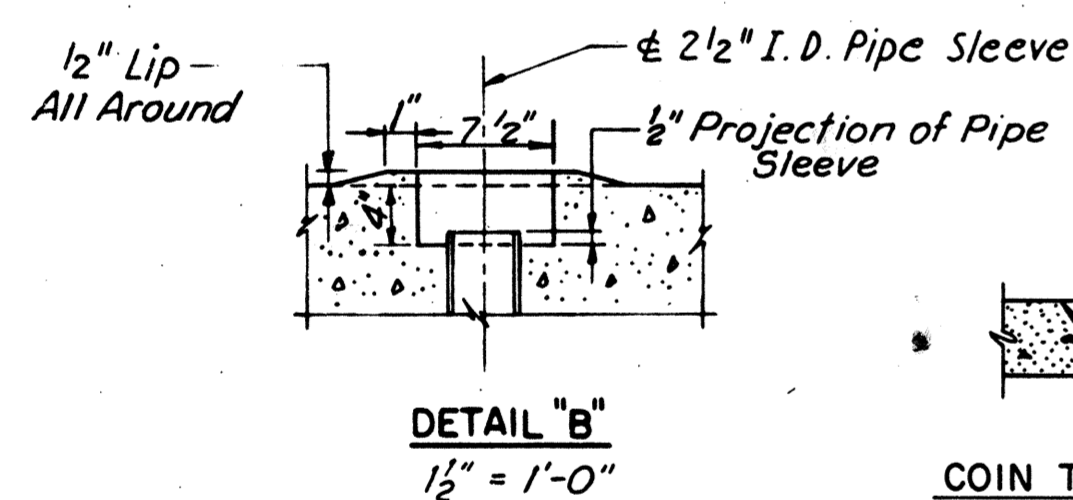

NOTE
Utility Locations in Tunnel Ceiling Slab Future Island A, B, H, I, J & K Similar

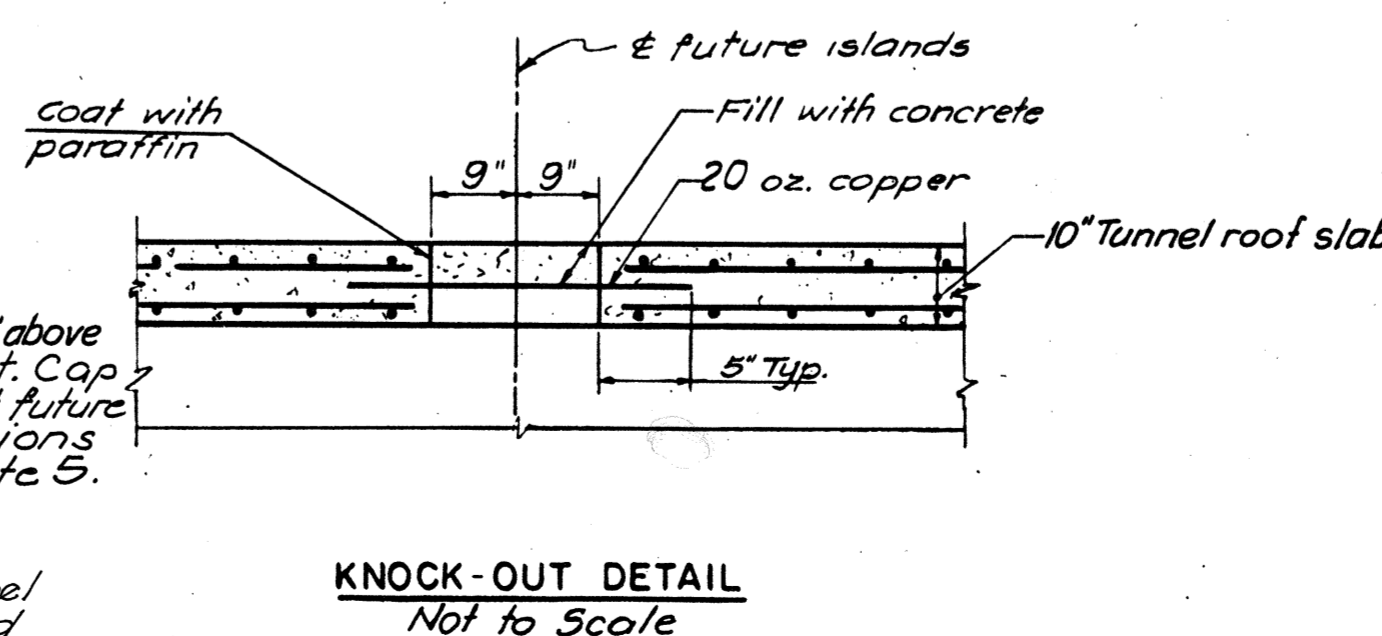

AS BUILT

RICHMOND METROPOLITAN AUTHORITY
RICHMOND EXPRESSWAY SYSTEM
POWHITE PARKWAY



MISCELLANEOUS DETAILS

HOWARD, NEEDLES, TAMMEN & BERGENDOFF
consulting engineers
NEW YORK ALEXANDRIA KANSAS CITY


SCALE: AS NOTED
CONTRACT NO.: C-2
SHEET NO. 43-D OF 186

BY	DATE	3	As Built	JRC	6-73
MADE	W. J. W.	5-68	Rev For ATIS Mach. F.H.T.	7/67	
CHECKED	D. E. N.	5-68	Final Check	D.E.N.	6-68
IN CHARGE	H.D.S.				
		NO.	REVISION	BY	DATE


RICHMOND EXPRESSWAY SYSTEM			
SECTION	PROJECT	SHEET NO.	TOTAL SHEETS
TF-2	TOLL FACILITIES	12	26

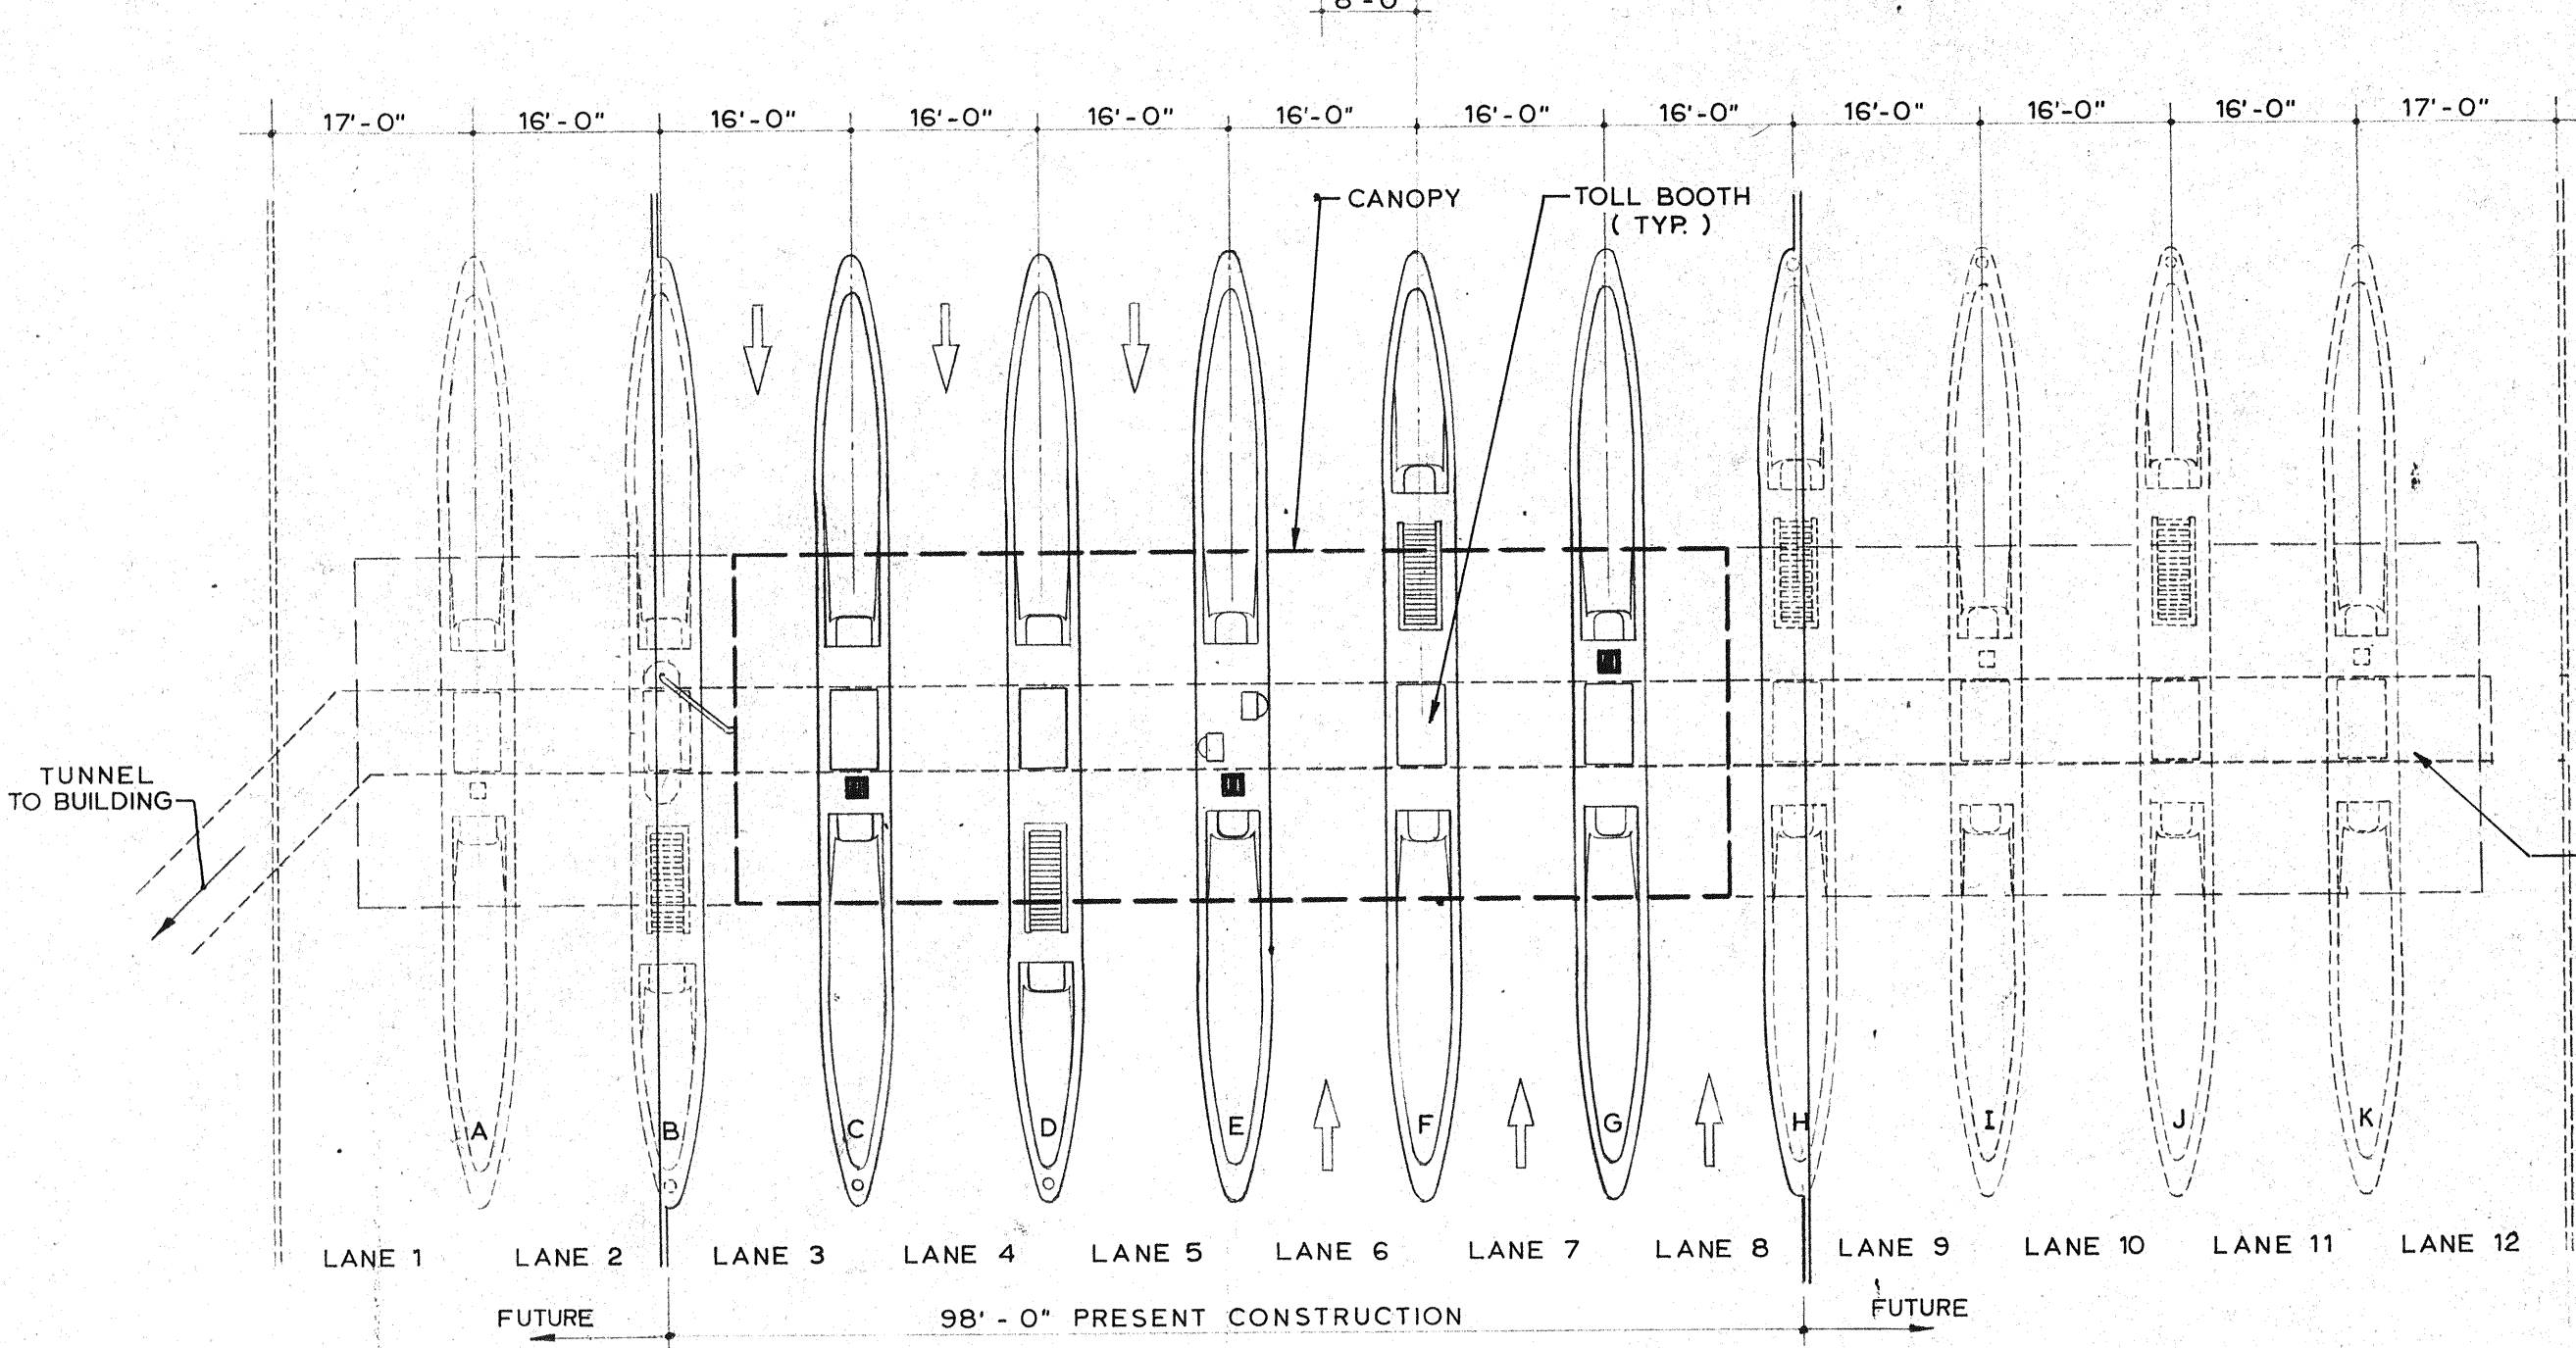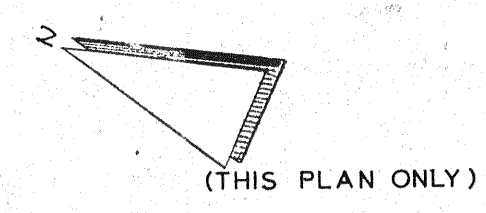


PLAN

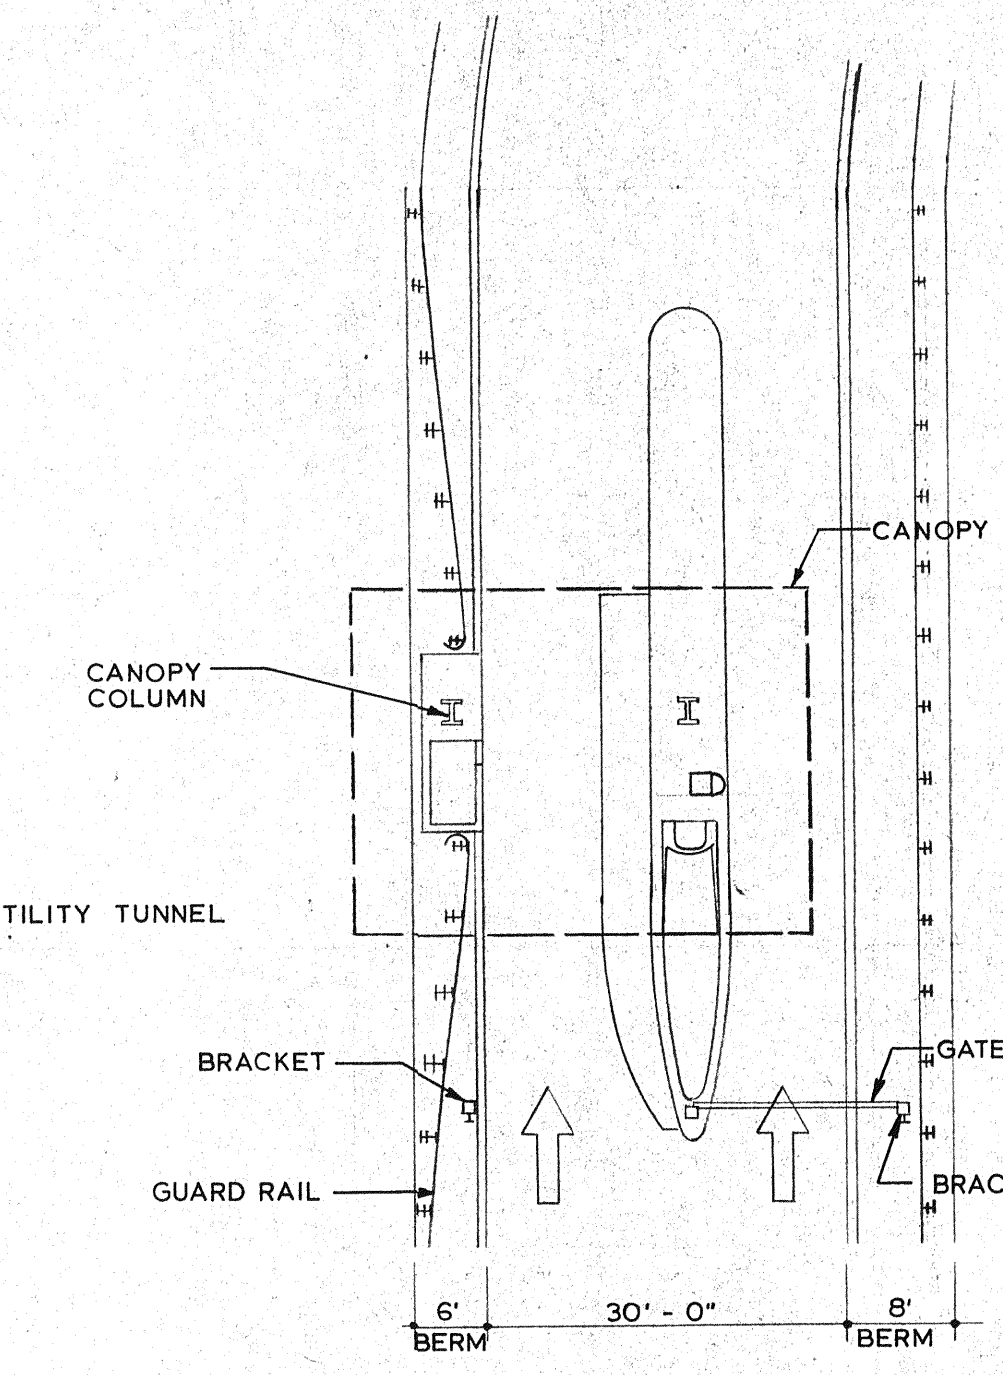


PLAN
RAMP FOREST HILL - EAST

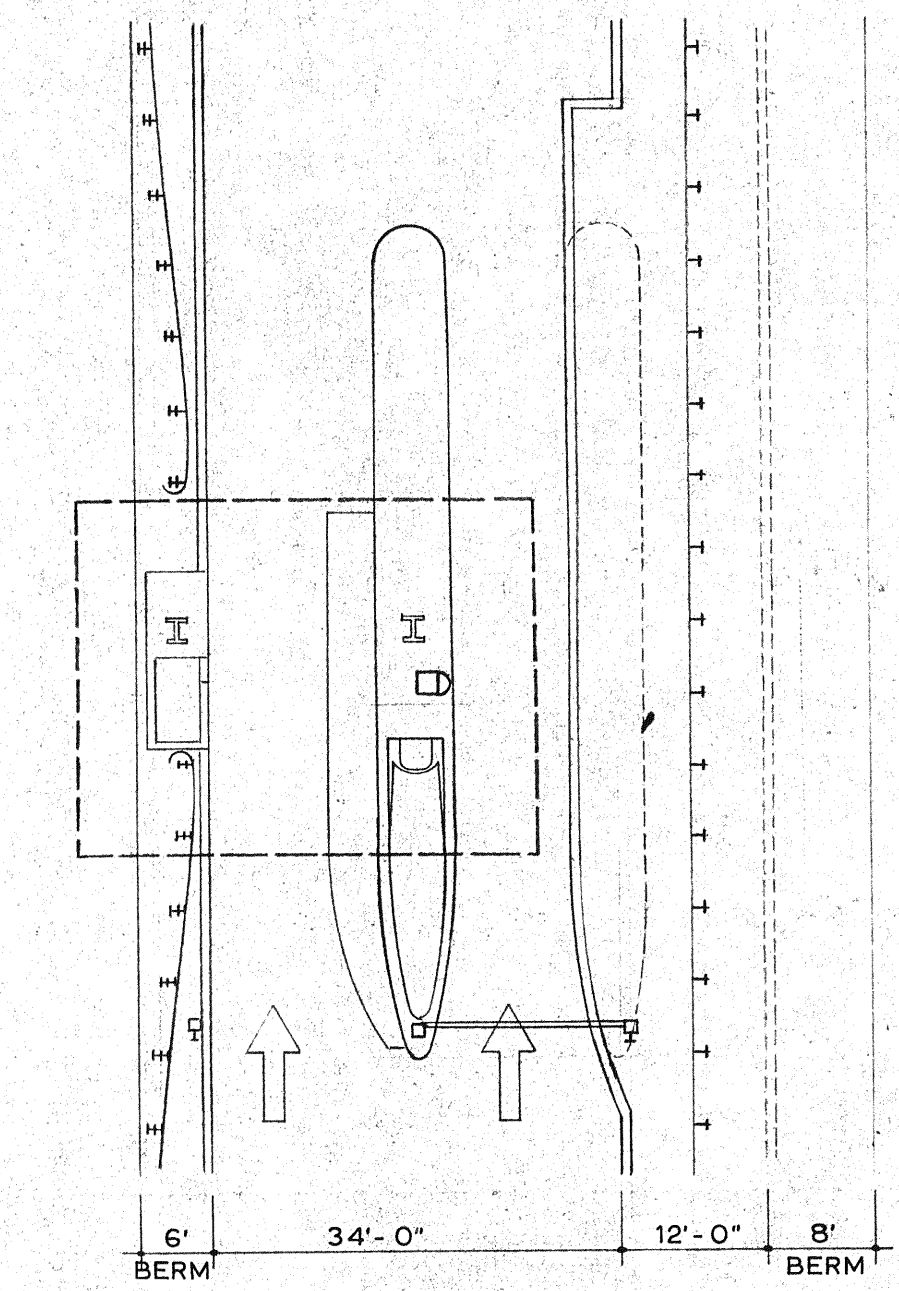


PLAN
RAMP EAST - FOREST HILL

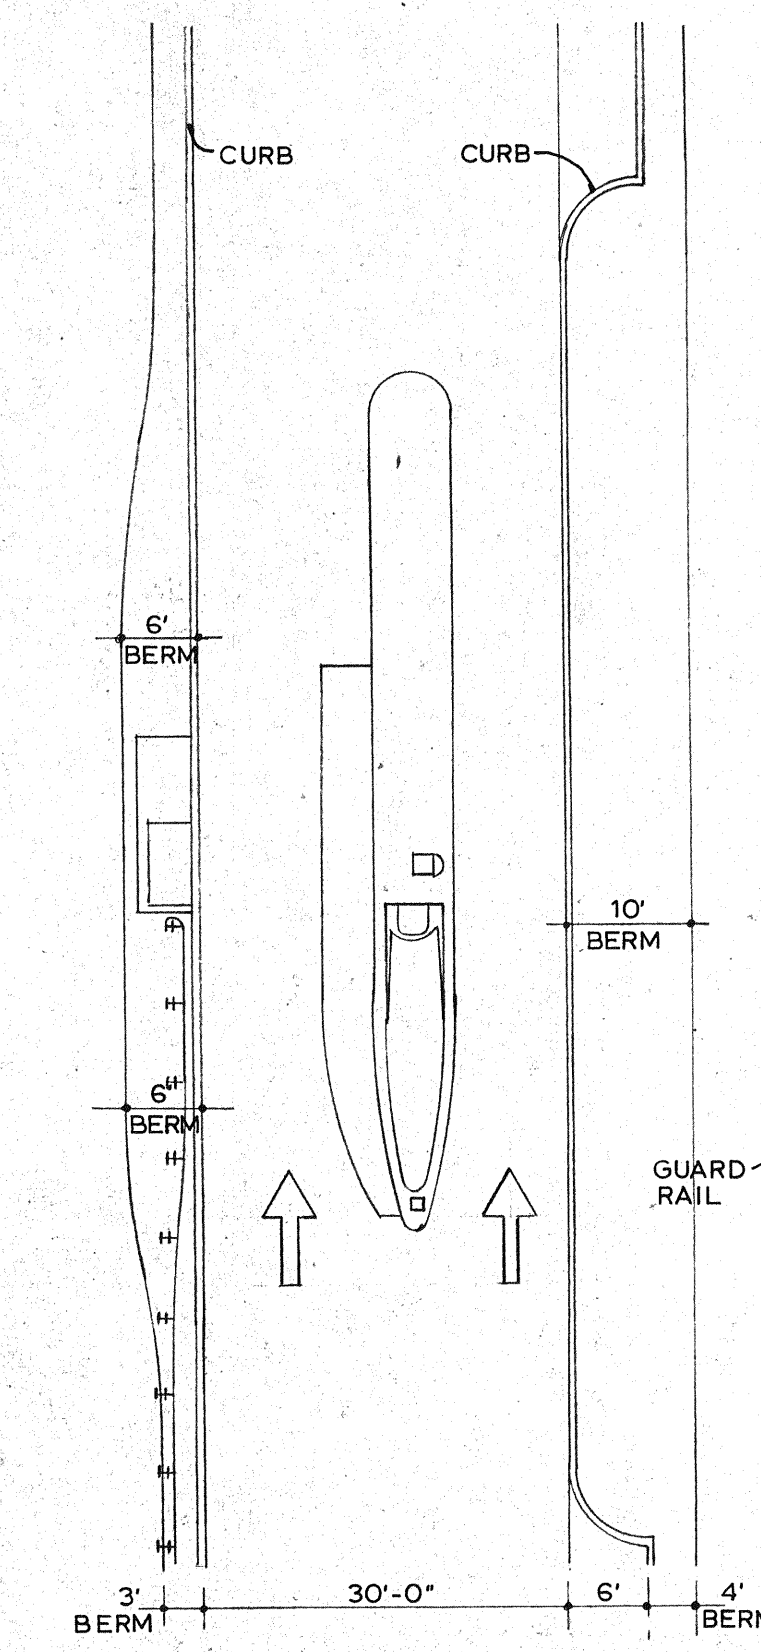


PLAN
RAMP DOUGLASDALE - NORTH

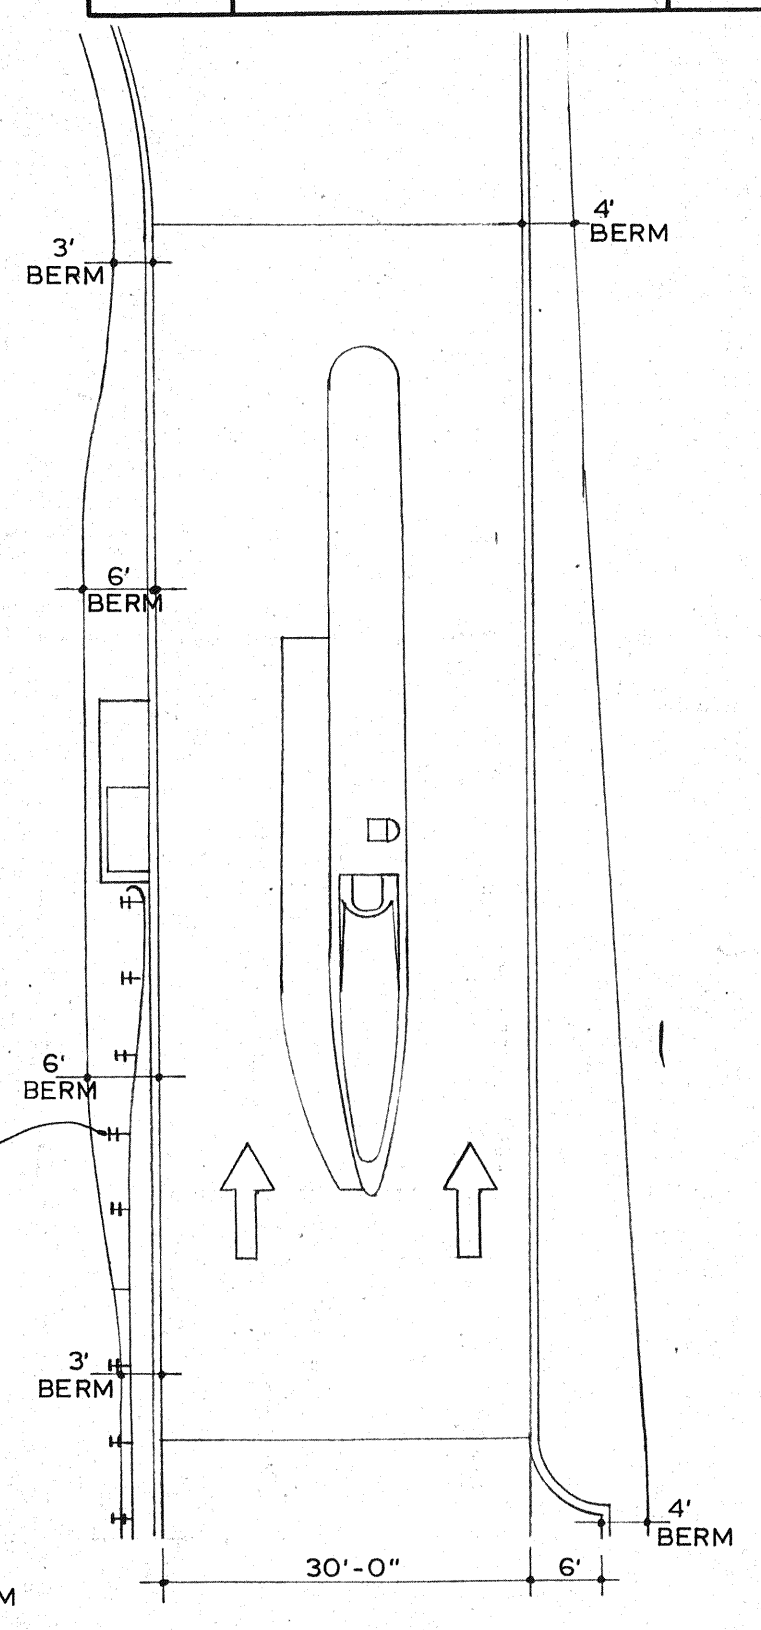


PLAN
RAMP NORTH - DOUGLASDALE

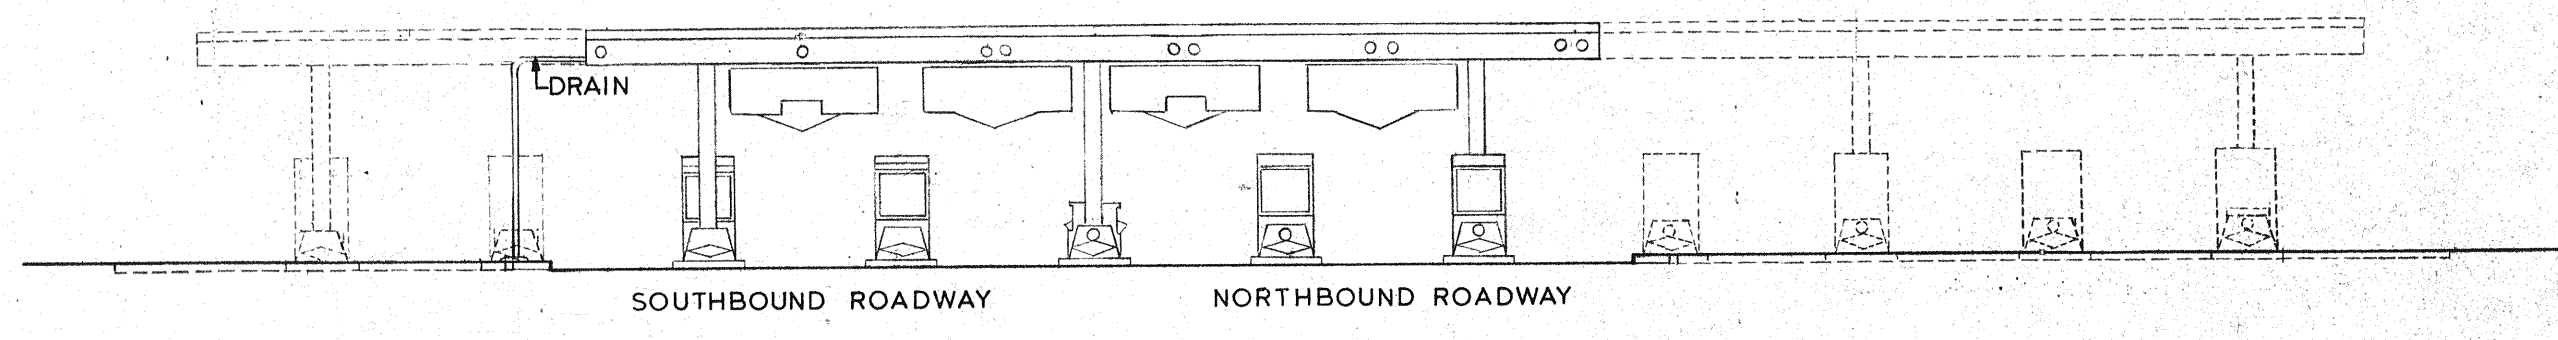


EAST ELEVATION

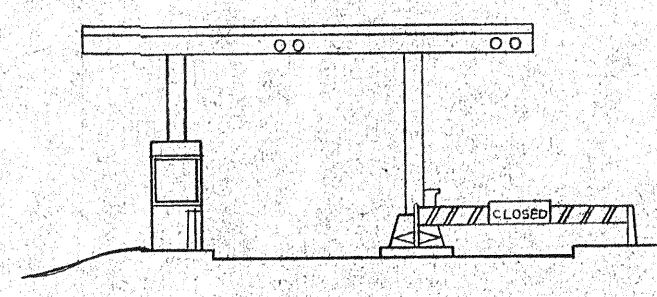


ELEVATION
RAMP FOREST HILL - EAST

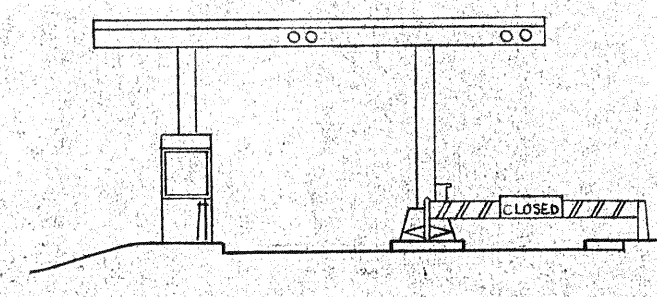


ELEVATION
RAMP EAST - FOREST HILL

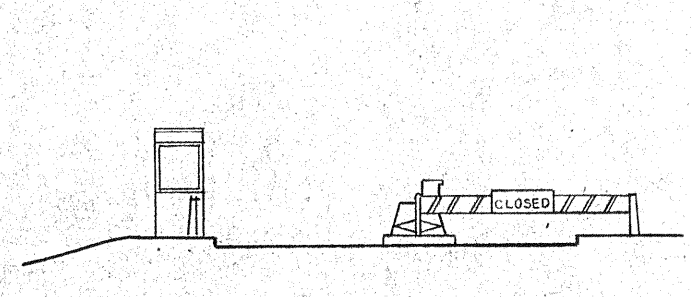

ELEVATION
RAMP DOUGLASDALE - NORTH

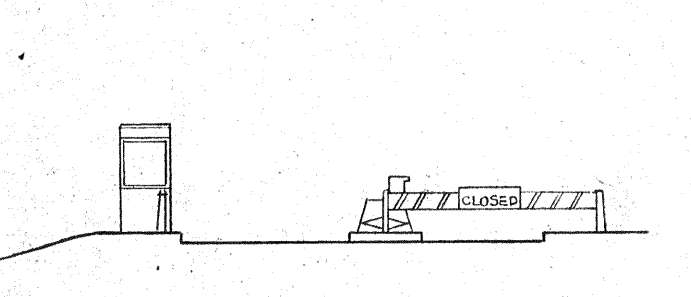

ELEVATION
RAMP NORTH - DOUGLASDALE

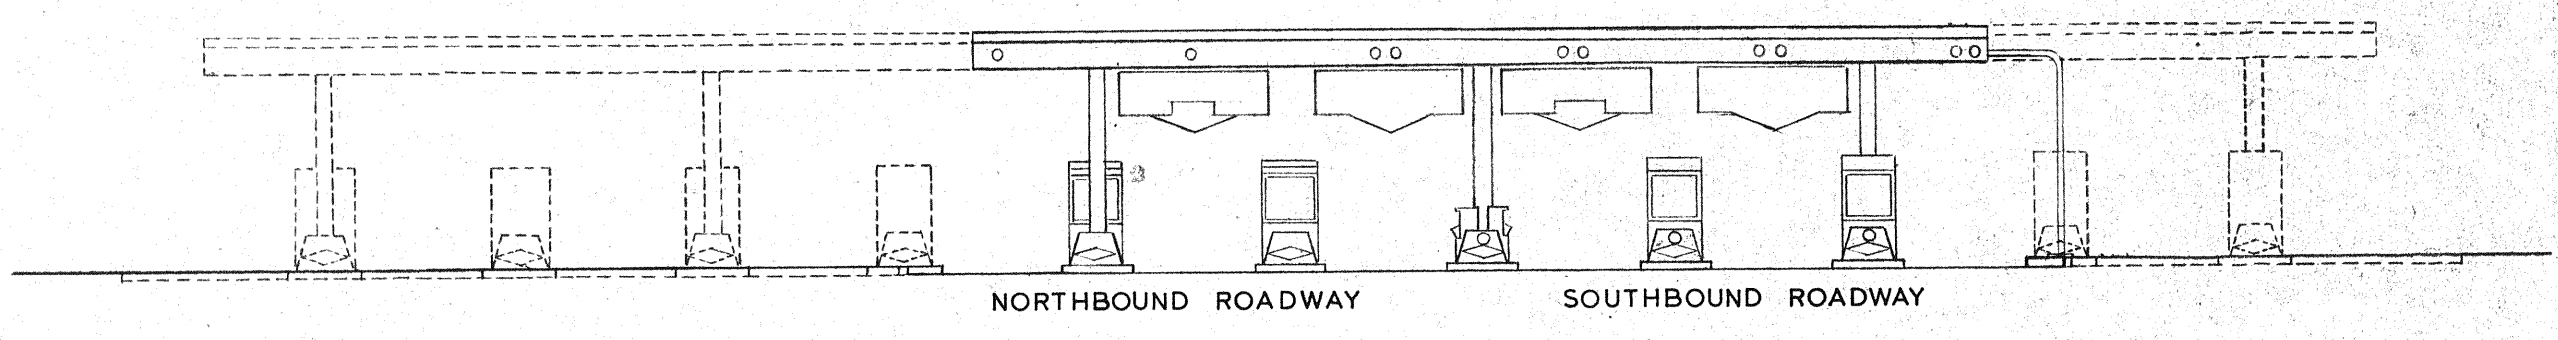

WEST ELEVATION

NOTE:
THIS SHEET IS INTENDED FOR ORIENTATION ONLY.
PARTS OF THE WORK SHOWN HERE ARE
INCLUDED IN THIS CONTRACT.

**RICHMOND METROPOLITAN AUTHORITY
RICHMOND EXPRESSWAY SYSTEM
POWHITE PARKWAY**

**TOLL FACILITIES
PLANS & ELEVATIONS**

	BY	DATE			
MADE	R.M.	7-31-71			
CHECKED	KL.	2-20-72			
IN CHARGE	J.P.F.		NO.	REVISION	BY DATE

HOWARD, NEEDLES, TAMMEN & BERGENDOFF
consulting engineers
NEW YORK ALEXANDRIA KANSAS CITY

SCALE: 1/16" = 1'-0"
CONTRACT NO. TF-2
SHEET NO. 12 OF 15

RICHMOND EXPRESSWAY SYSTEM			
SECTION	PROJECT	SHEET NO.	TOTAL SHEETS
TF-2	UTILITY BUILDING	2	26

INDEX OF SHEETS


UTILITY BUILDING

- 2 of 11 Site Plans
- 3 of 11 Plans & Misc.
- 4 of 11 Elevations & Sections
- 5 of 11 Sections & Details
- 6 of 11 Details & Schedules
- 7 of 11 Details
- 8 of 11 Htg. / AC & Refl. Clg. Plan
- 9 of 11 Mechanical & Controls
- 10 of 11 Electrical
- 11 of 11 Tunnel Electrical

LEGEND


- 133 --- EXISTING GRADE LINES
- 134 --- PROPOSED GRADE LINES
- PROPOSED SIDEWALK OR CONCRETE (IN PLAN)
- PROPOSED CONC. CURB N.I.C.
- PROPOSED CONC. RETAINING WALL
- EXTENT OF CONTRACT, SEE NOTE
- PROPOSED SANITARY SEWER
- PROPOSED STORM SEWER
- DETAIL NUMBER
- SHEET NUMBER
- N.I.C. --- NOT IN CONTRACT
- A.D. --- AREA DRAIN

NOTE:
FOR UTILITY BLDG. AND IMMEDIATE
SURROUNDINGS.

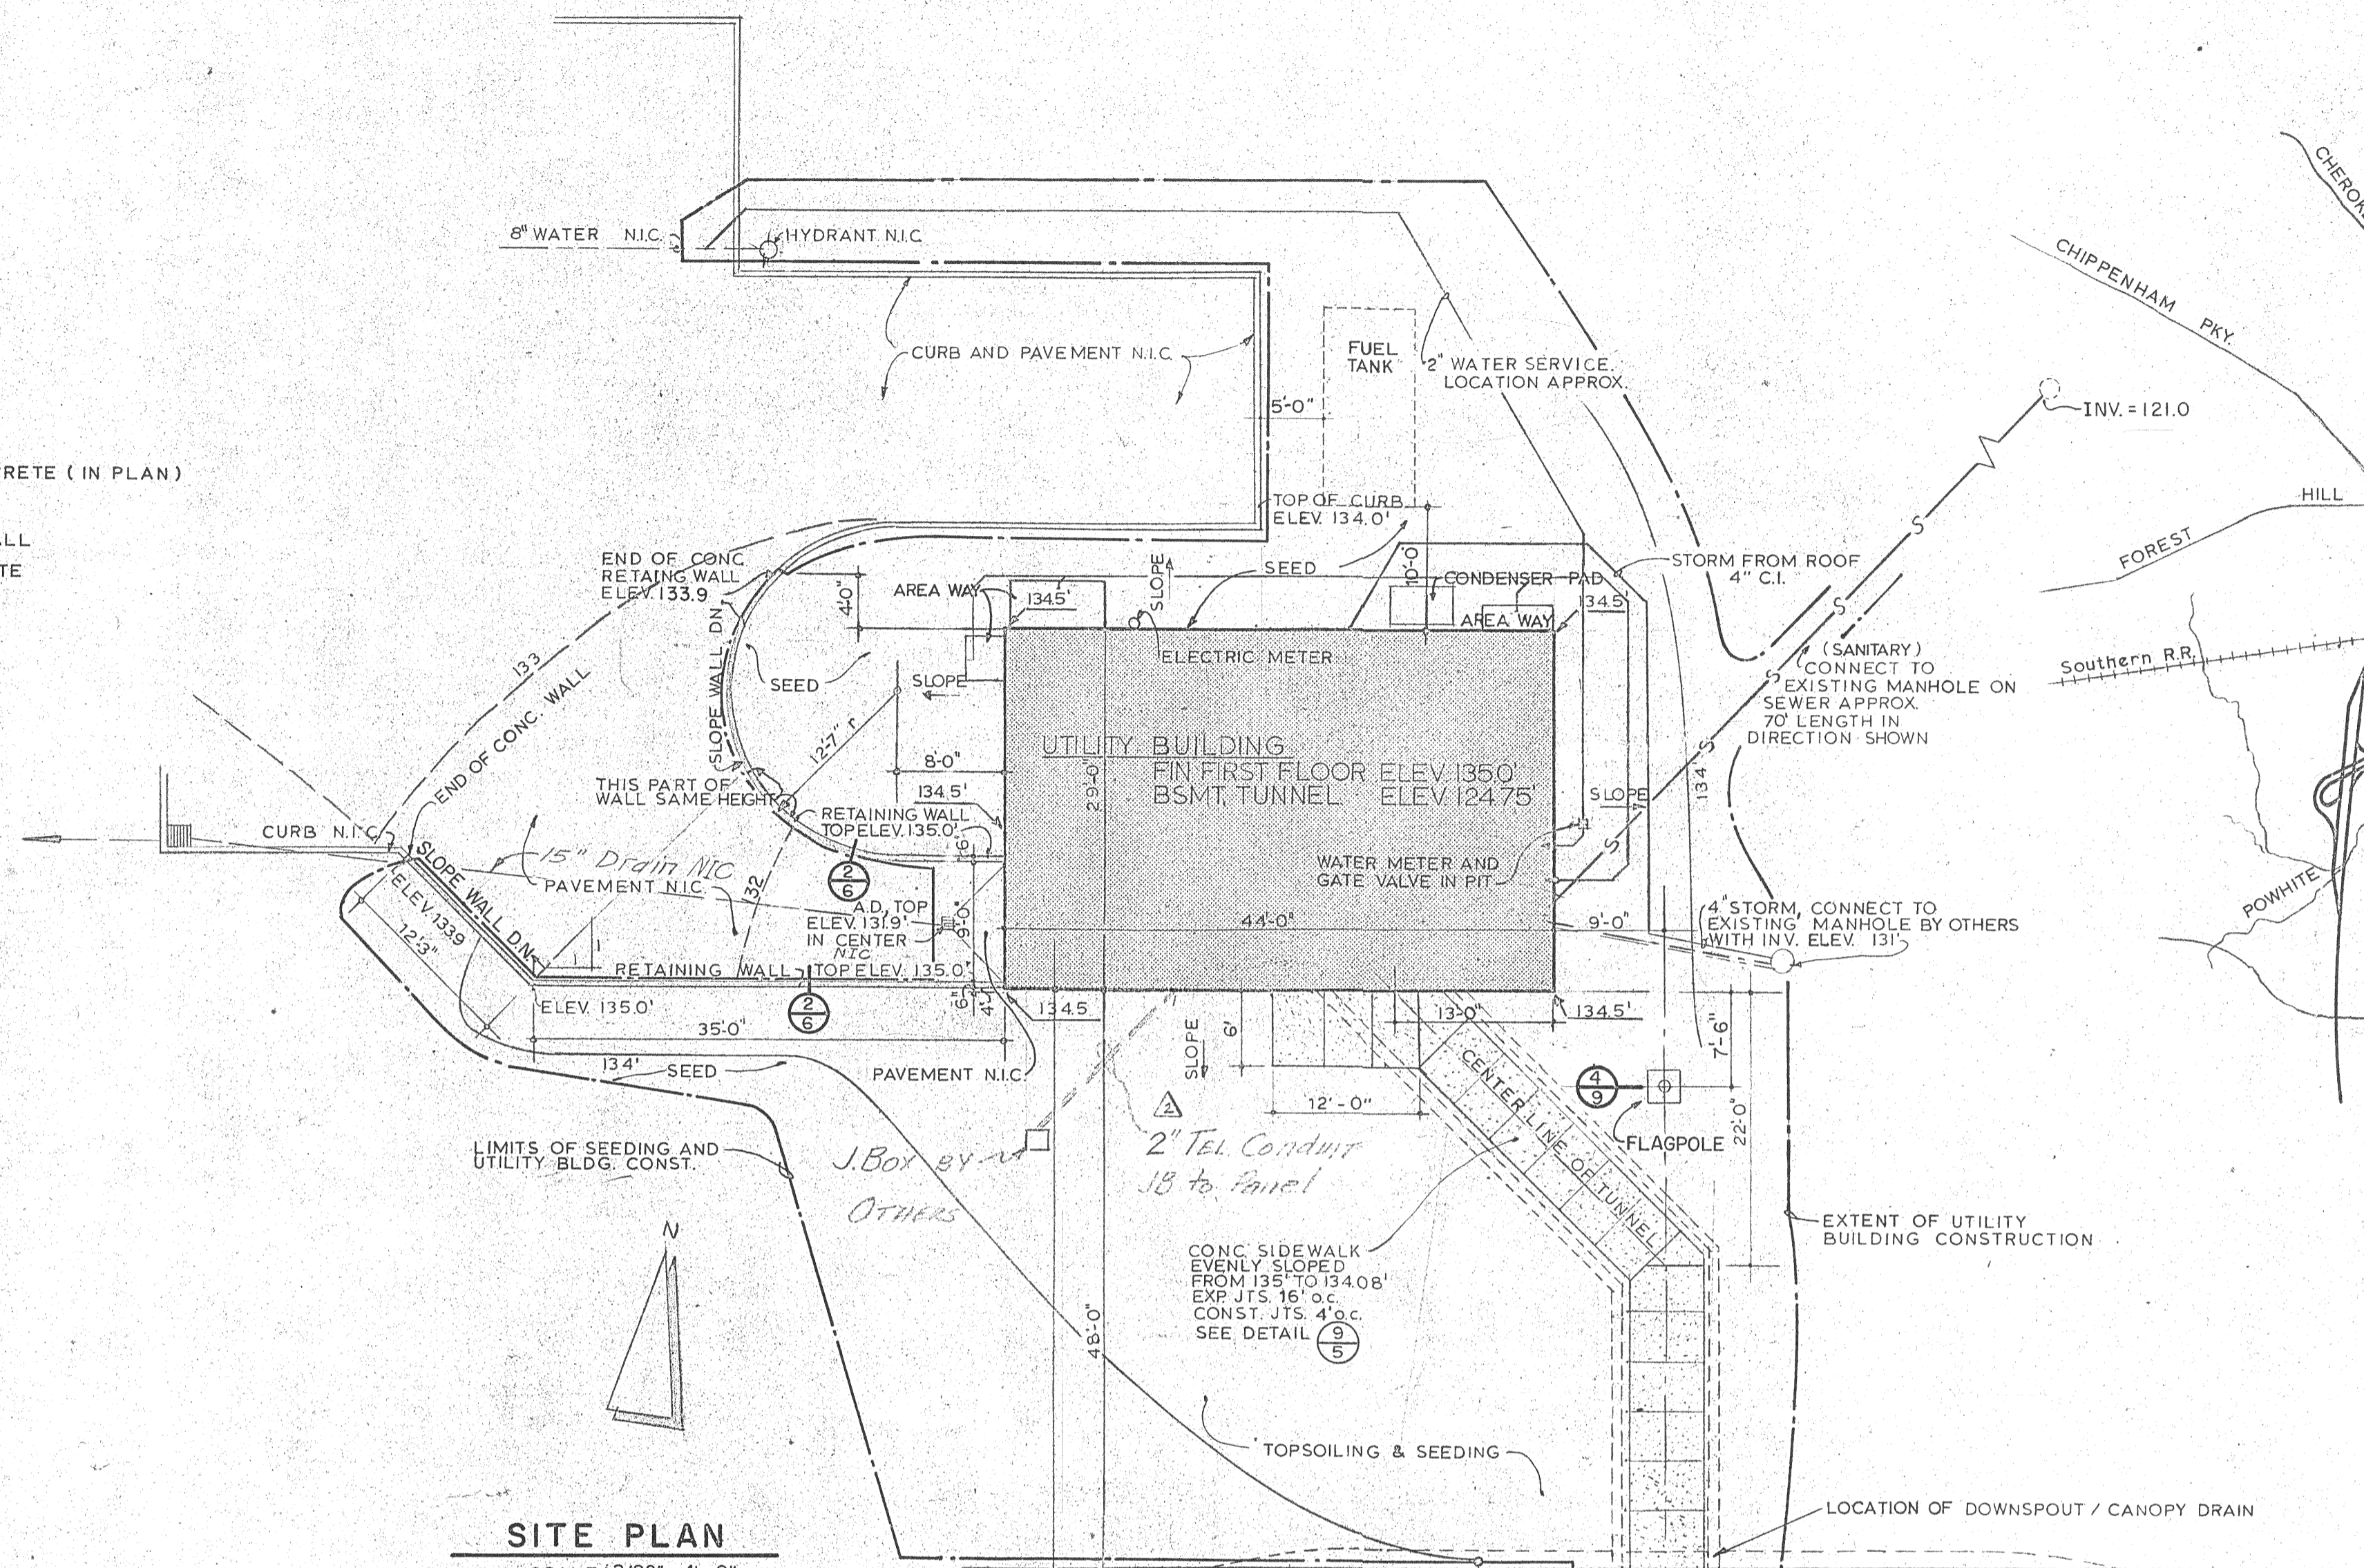


SITE PLAN

SCALE: 1/32" = 1'-0"

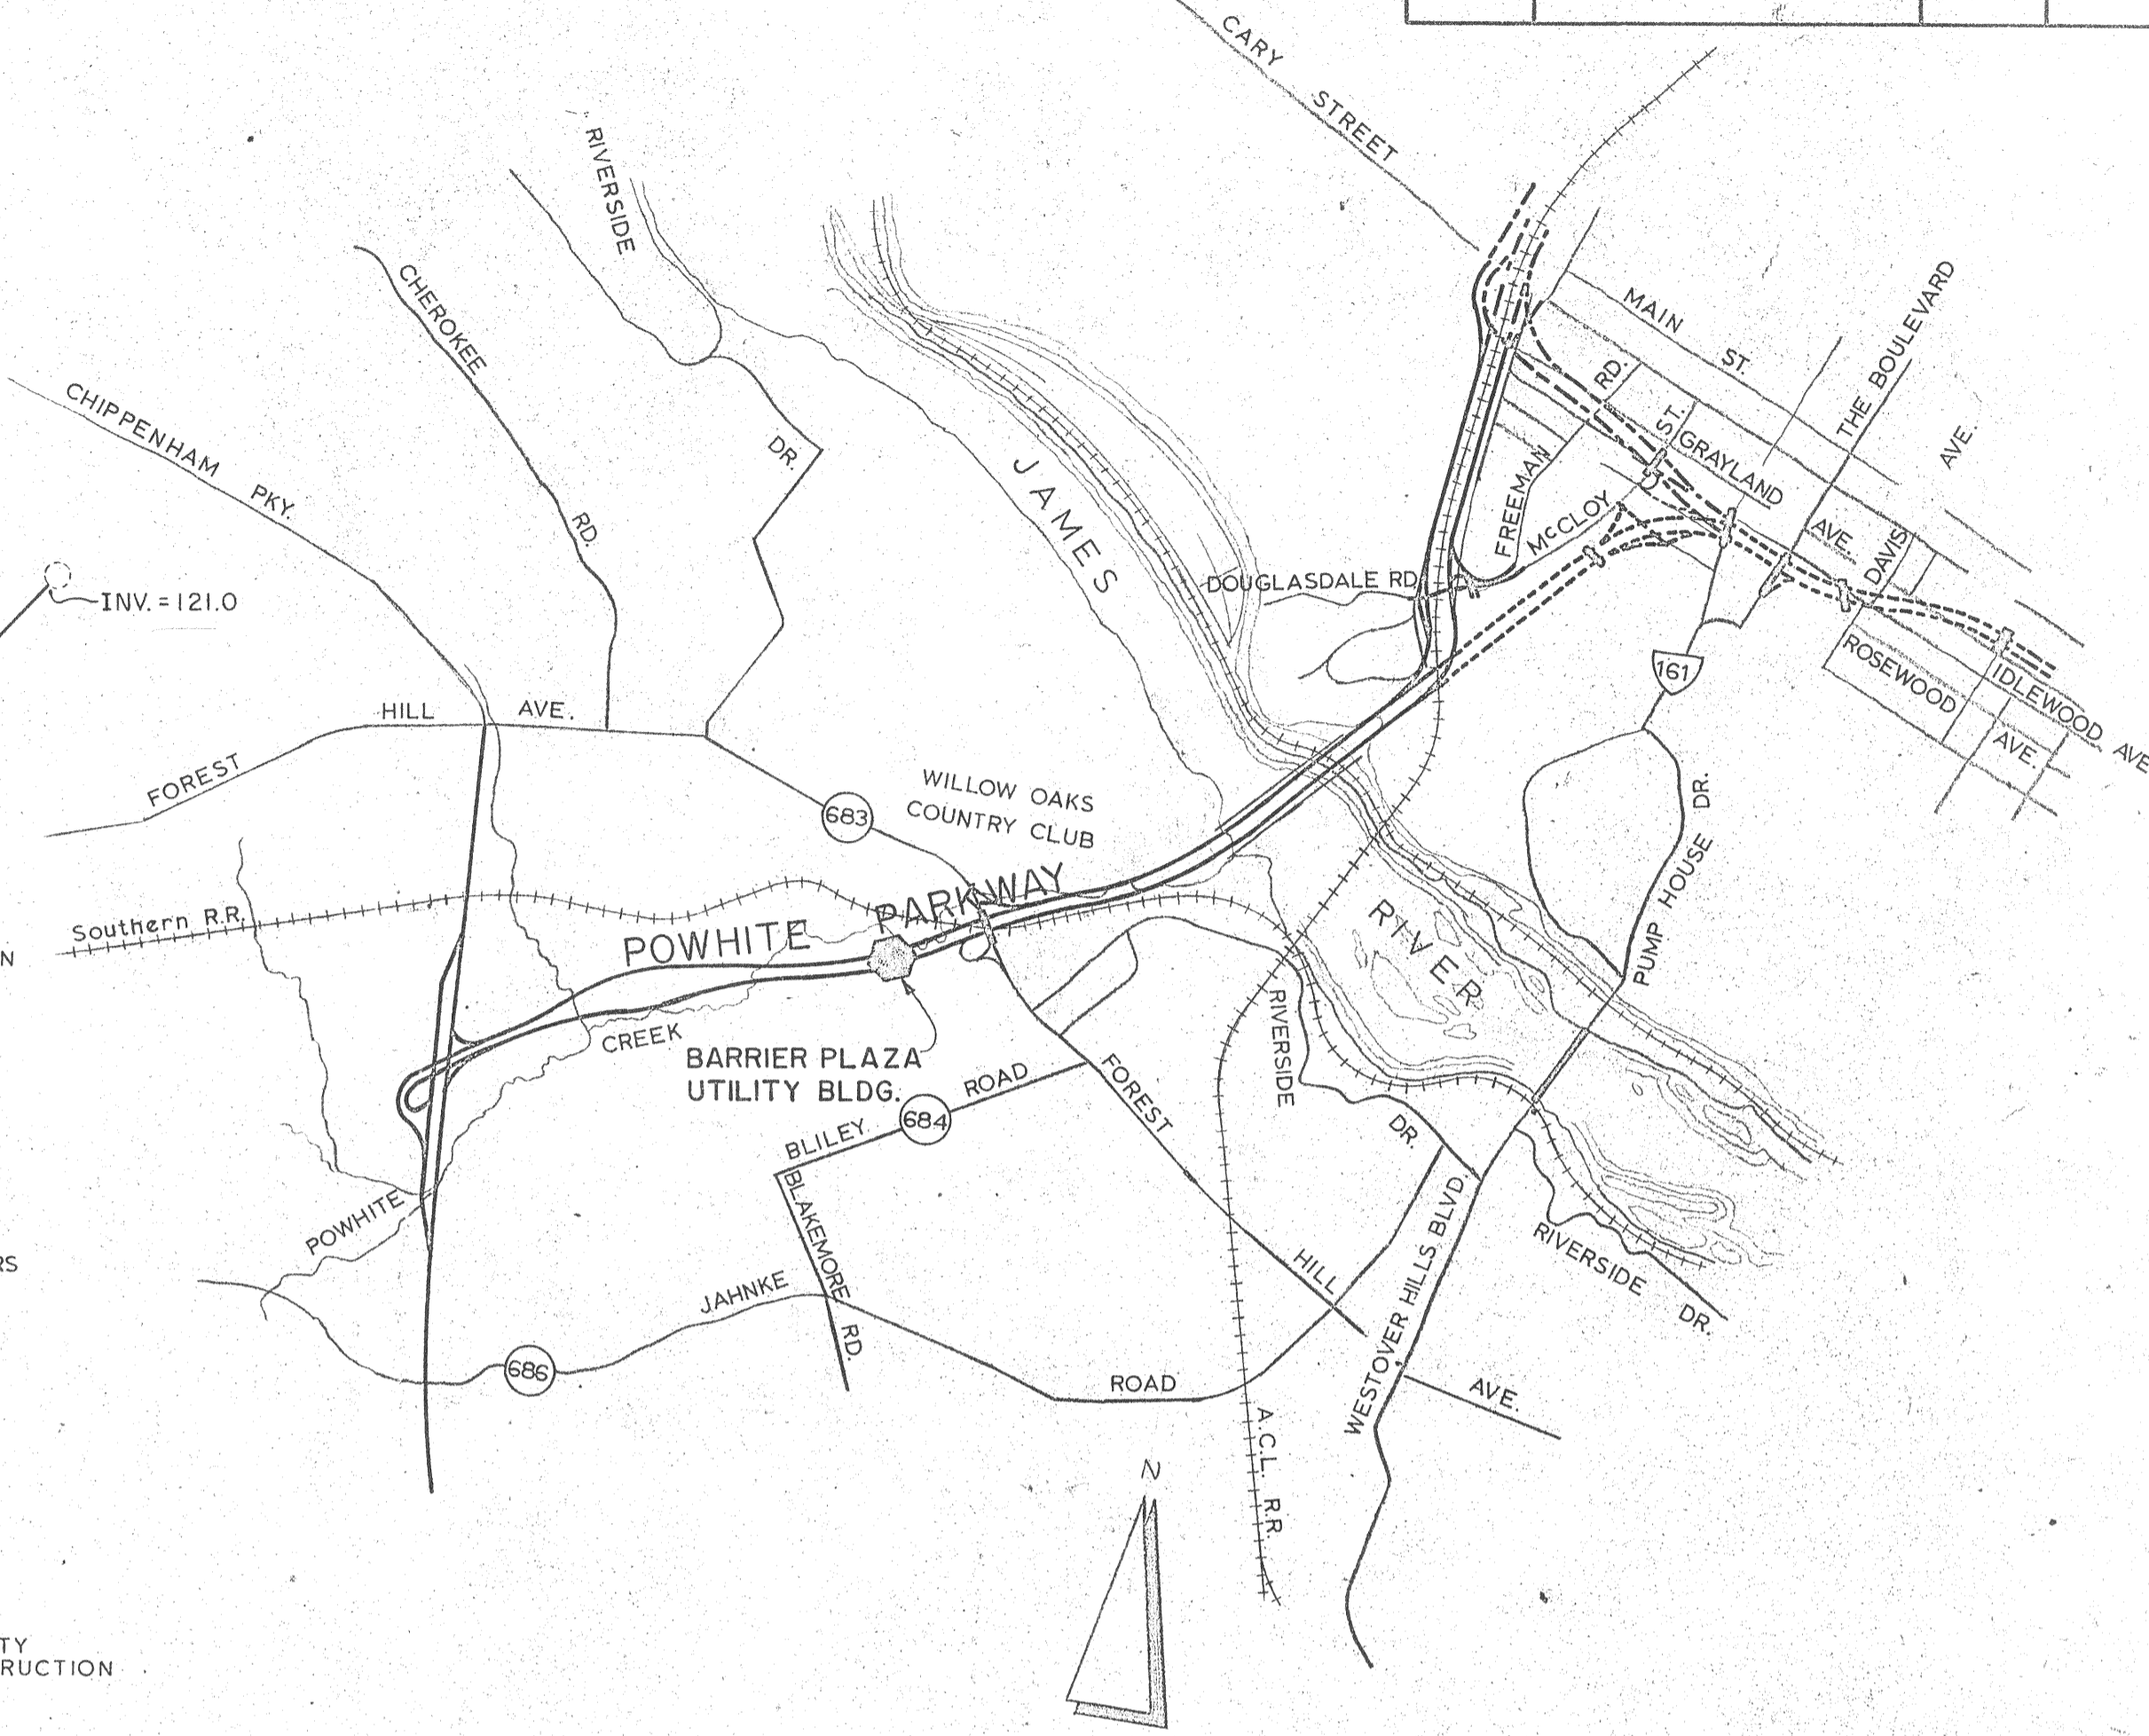

VICINITY MAP
NO SCALE

SUMMARY OF PAY ITEMS			
ITEM DESCRIPTION	UNIT	QUANTITY	
Utility Building - General Construction	-	L.S.	
Utility Building and Tunnel - Plumbing	-	L.S.	
Utility Building and Tunnel - HVAC	-	L.S.	
Utility Building and Tunnel - Electrical	-	L.S.	
Canopy at Barrier Plaza	-	L.S.	
Ramp Plaza With Canopy	EACH	2	
Ramp Plaza Without Canopy	EACH	2	
Installation of Toll Booth at Barrier Toll Plaza	EACH	4	
Mobilization	-	L.S.	

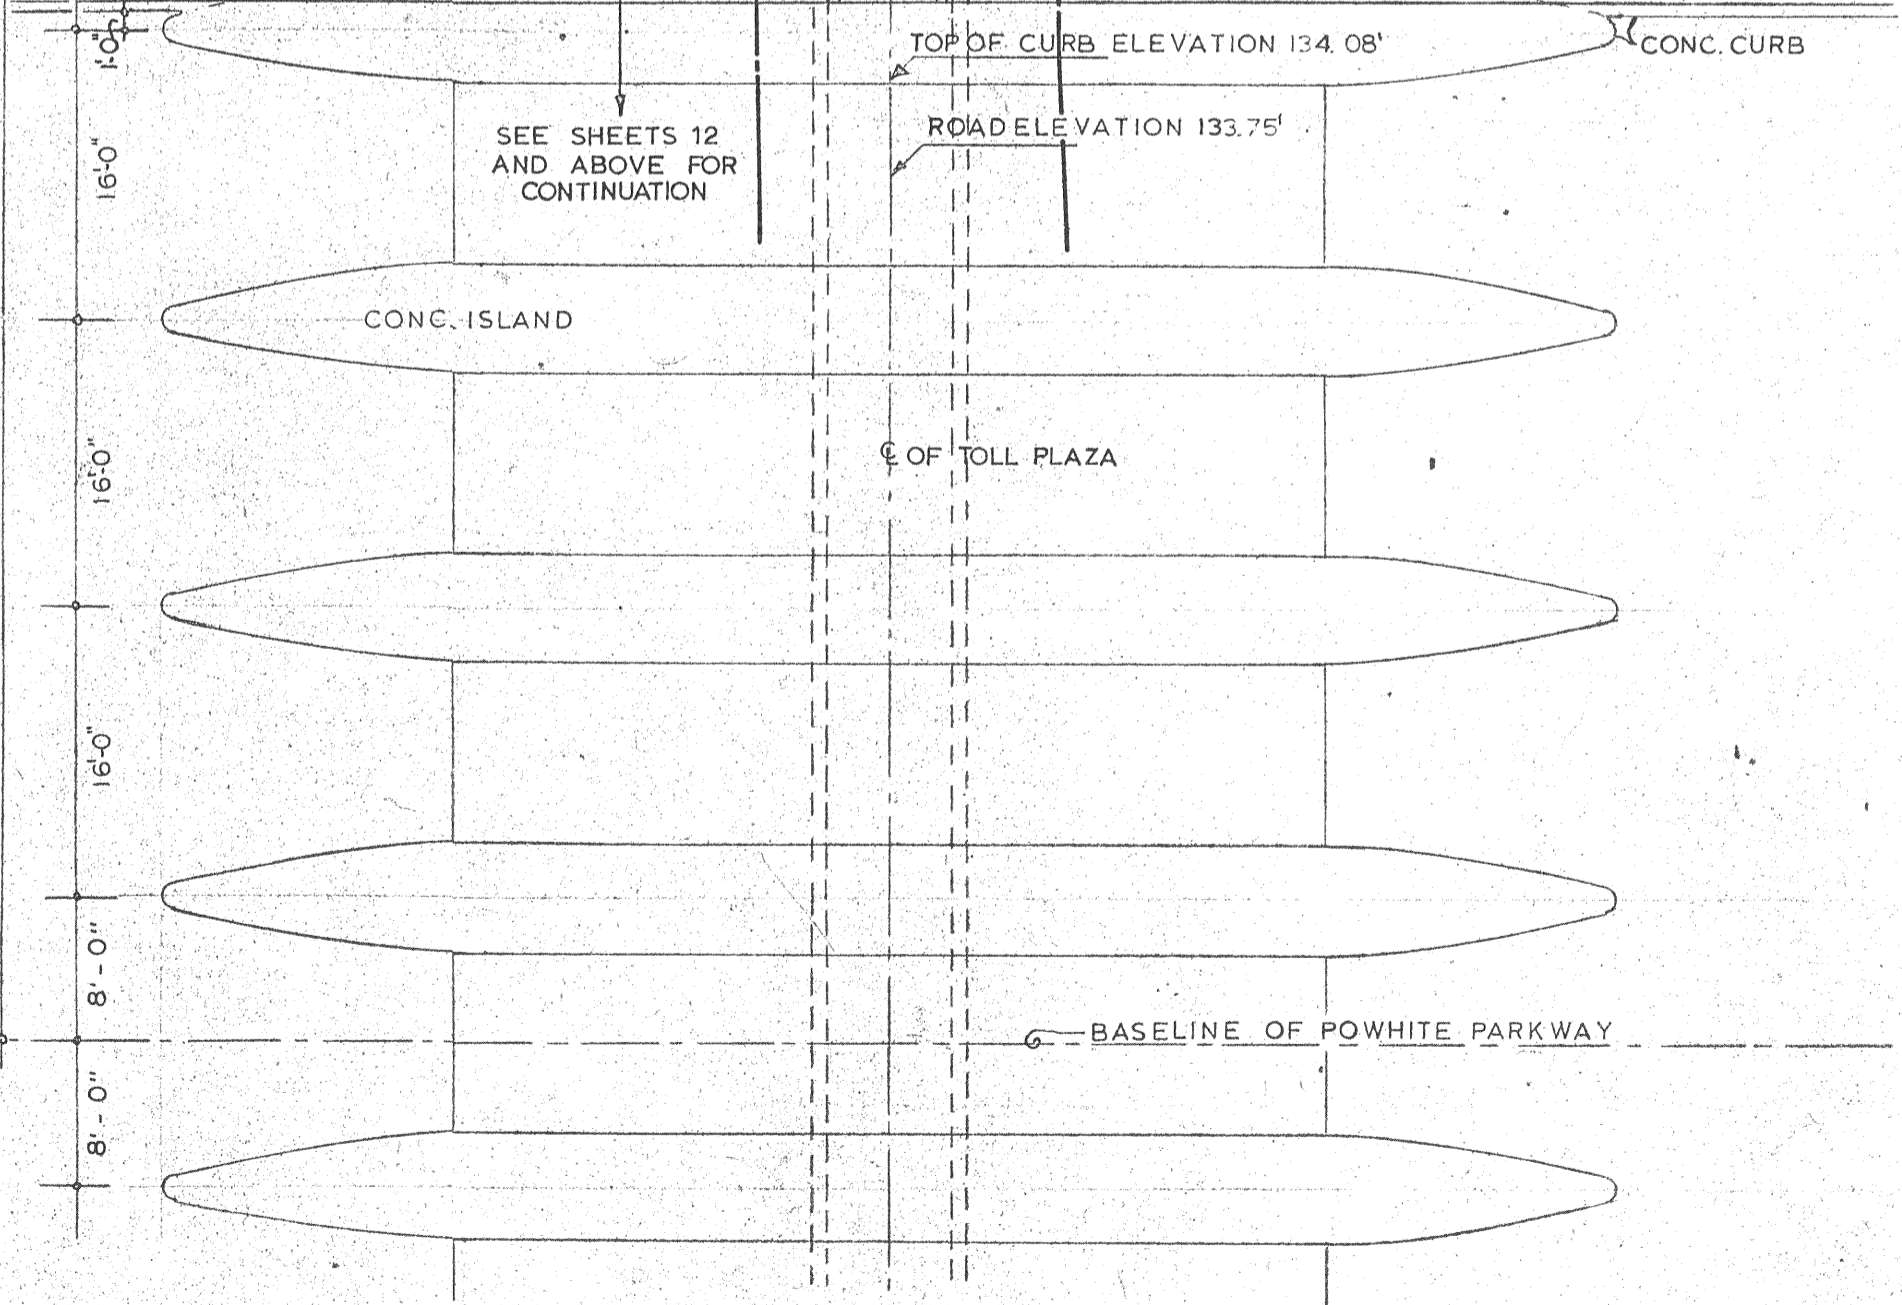

NO.	REVISION	BY	DATE
1	TEL CONDUIT	JRL	7/12
2	4" Storm Pipe	RTC	6/72


RICHMOND METROPOLITAN AUTHORITY
RICHMOND EXPRESSWAY SYSTEM
POWHITE PARKWAY

UTILITY BUILDING SITE PLANS


HOWARD, NEEDLES, TAMMEN & BERGENDOFF
consulting engineers
NEW YORK ALEXANDRIA KANSAS CITY

SCALE: AS SHOWN
CONTRACT NO. TF-2
SHEET NO. 2 OF 11


RICHMOND EXPRESSWAY SYSTEM			
SECTION	PROJECT	SHEET NO.	TOTAL SHEETS
TF-2	UTILITY BUILDING	3	26

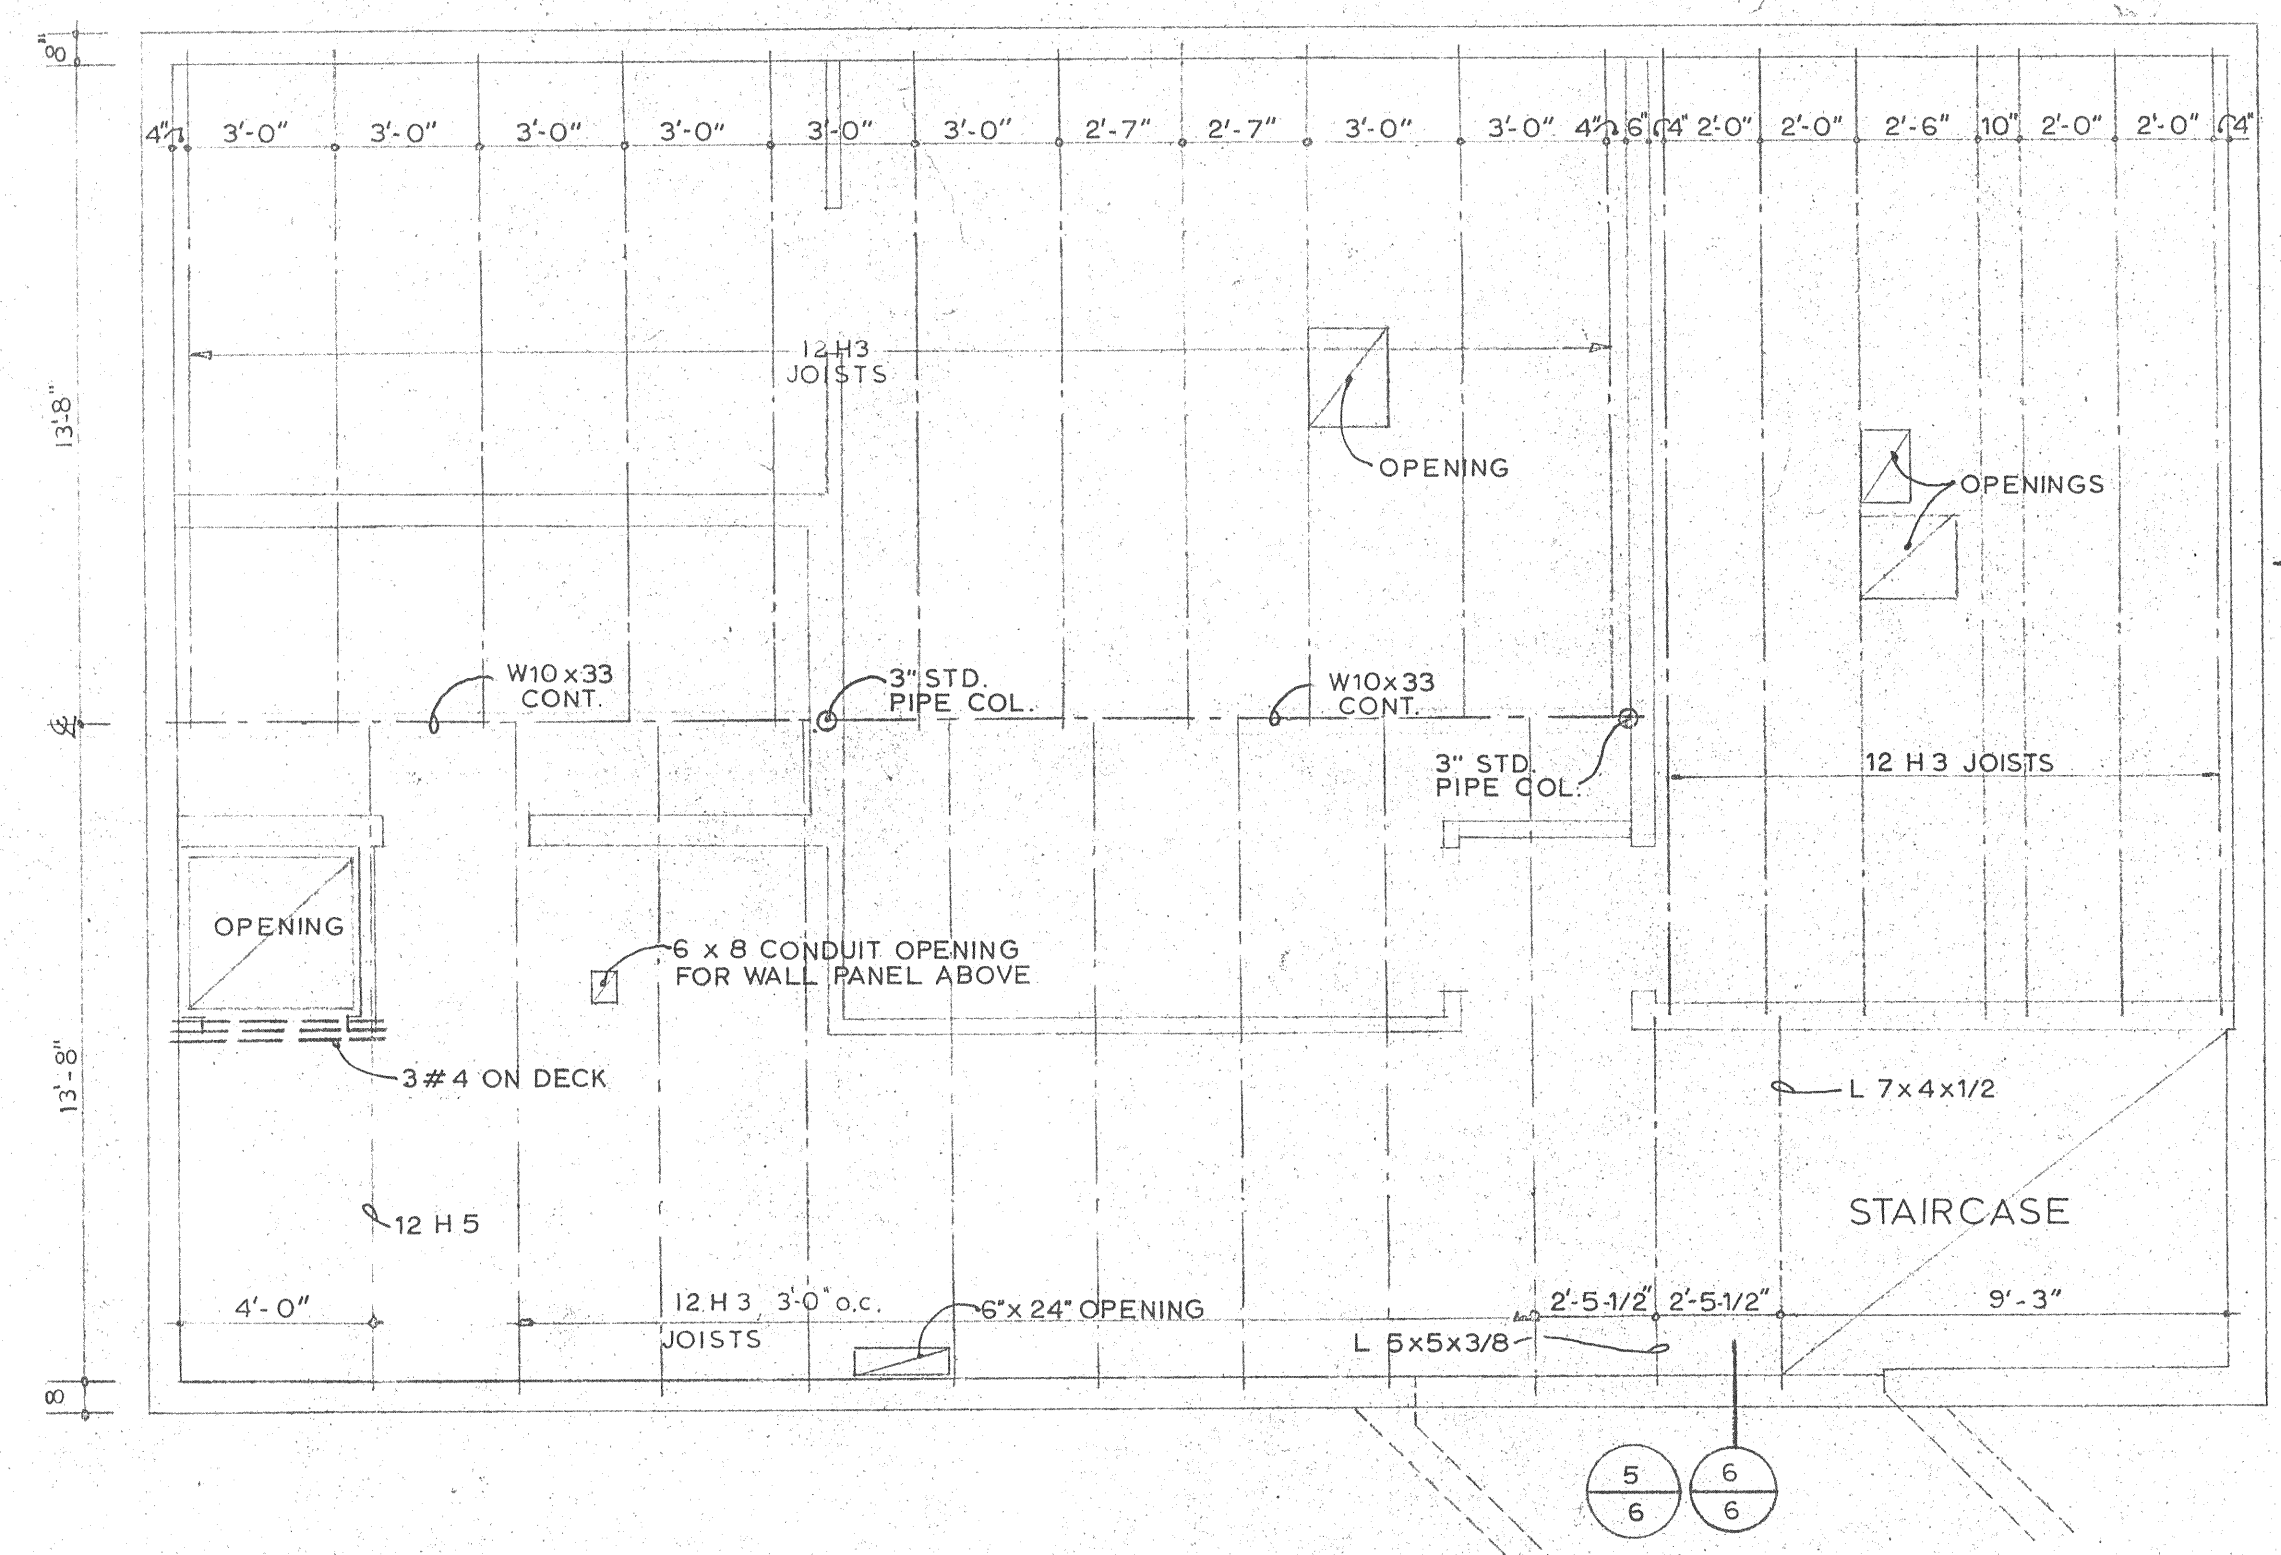


BASEMENT DECK PLAN
SCALE: 1/4" = 1'-0"

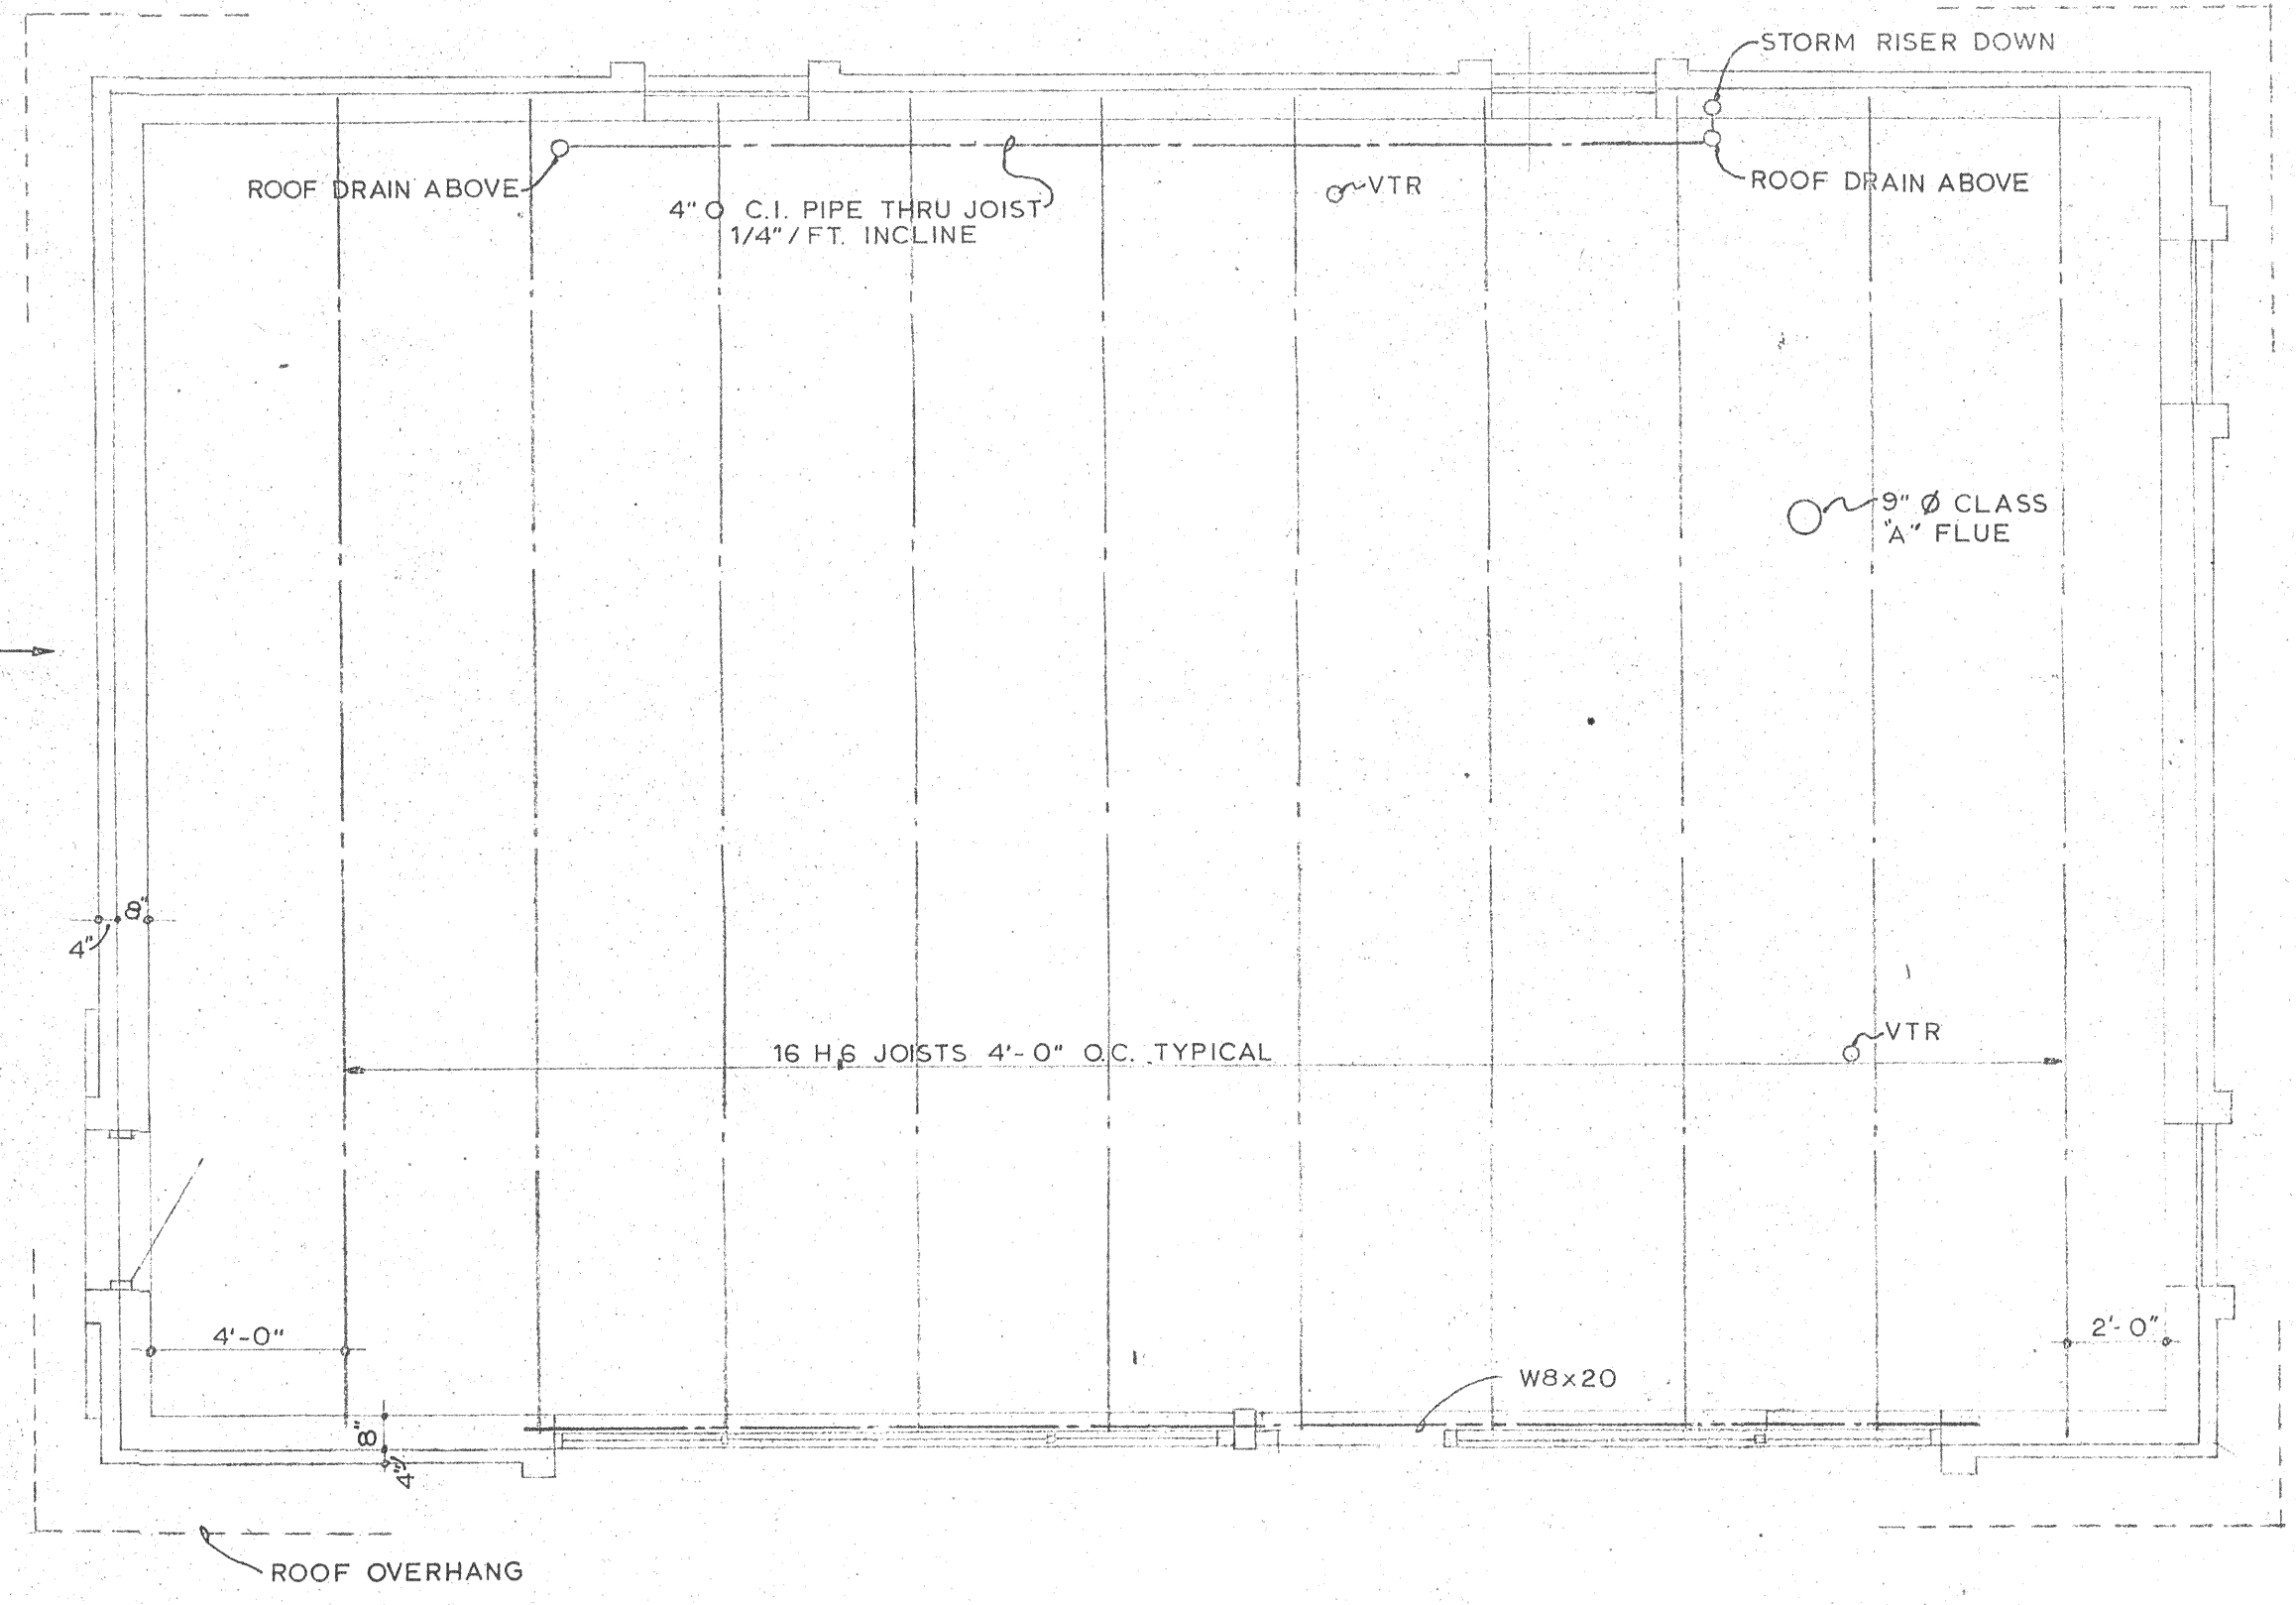

ROOF DECK PLAN
SCALE: 1/4" = 1'-0"

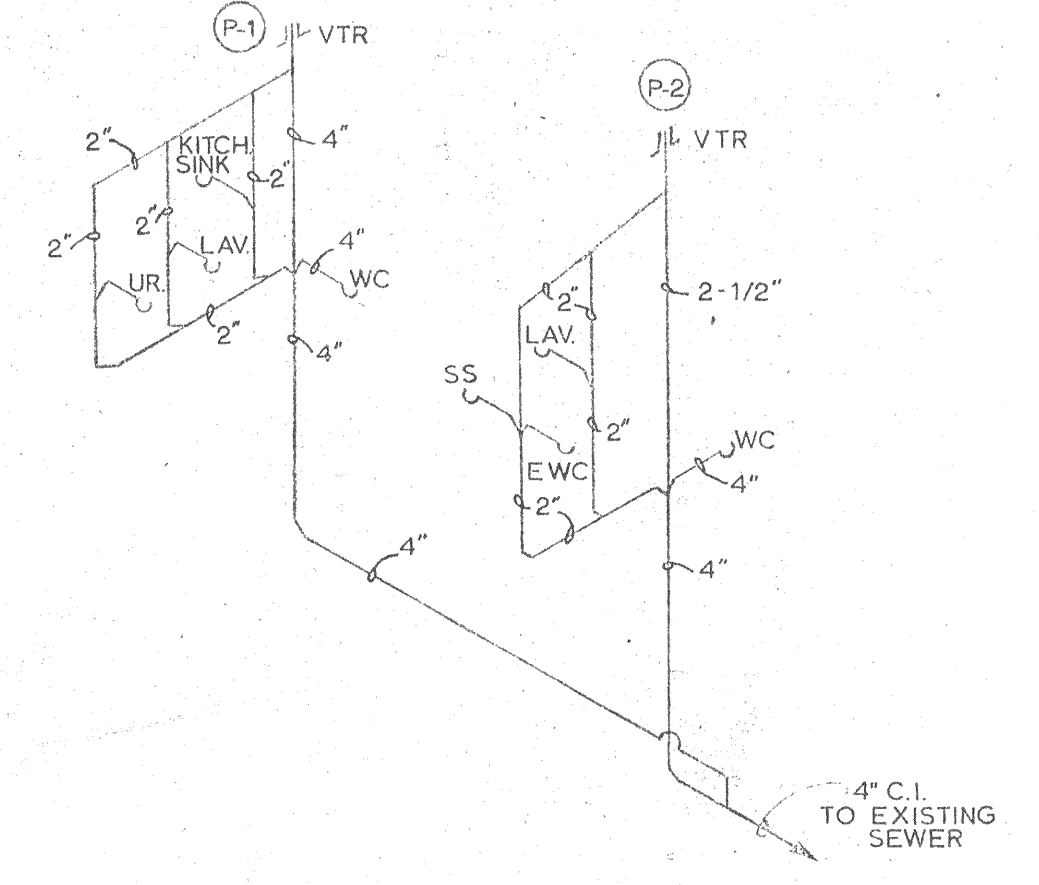


SOIL WASTE & VENT DIAGRAM

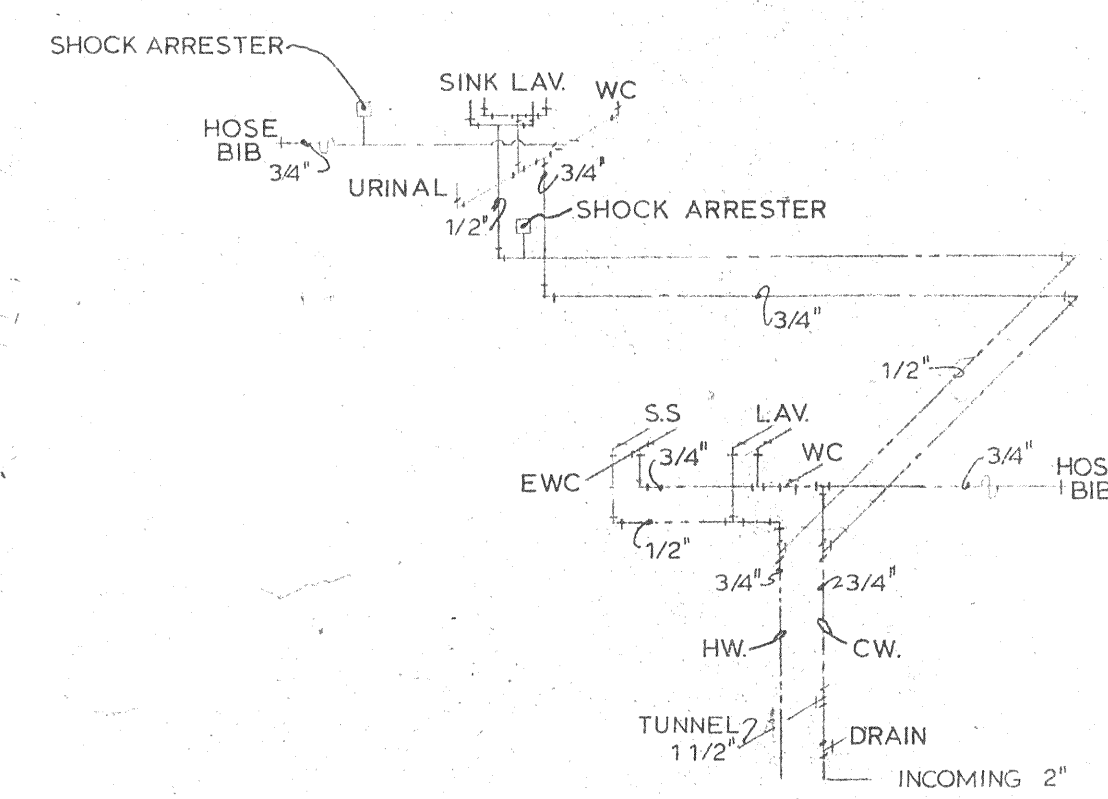


WATER PIPING DIAGRAM

LEGEND

- CONCRETE
- BRICK MASONRY
- CONCRETE MASONRY
- WOOD STUD PARTITION
- WINDOW
- VOID IN MASONRY
- ITEMS BY OTHERS
- A.D. AREA DRAIN
- F.D. FLOOR DRAIN

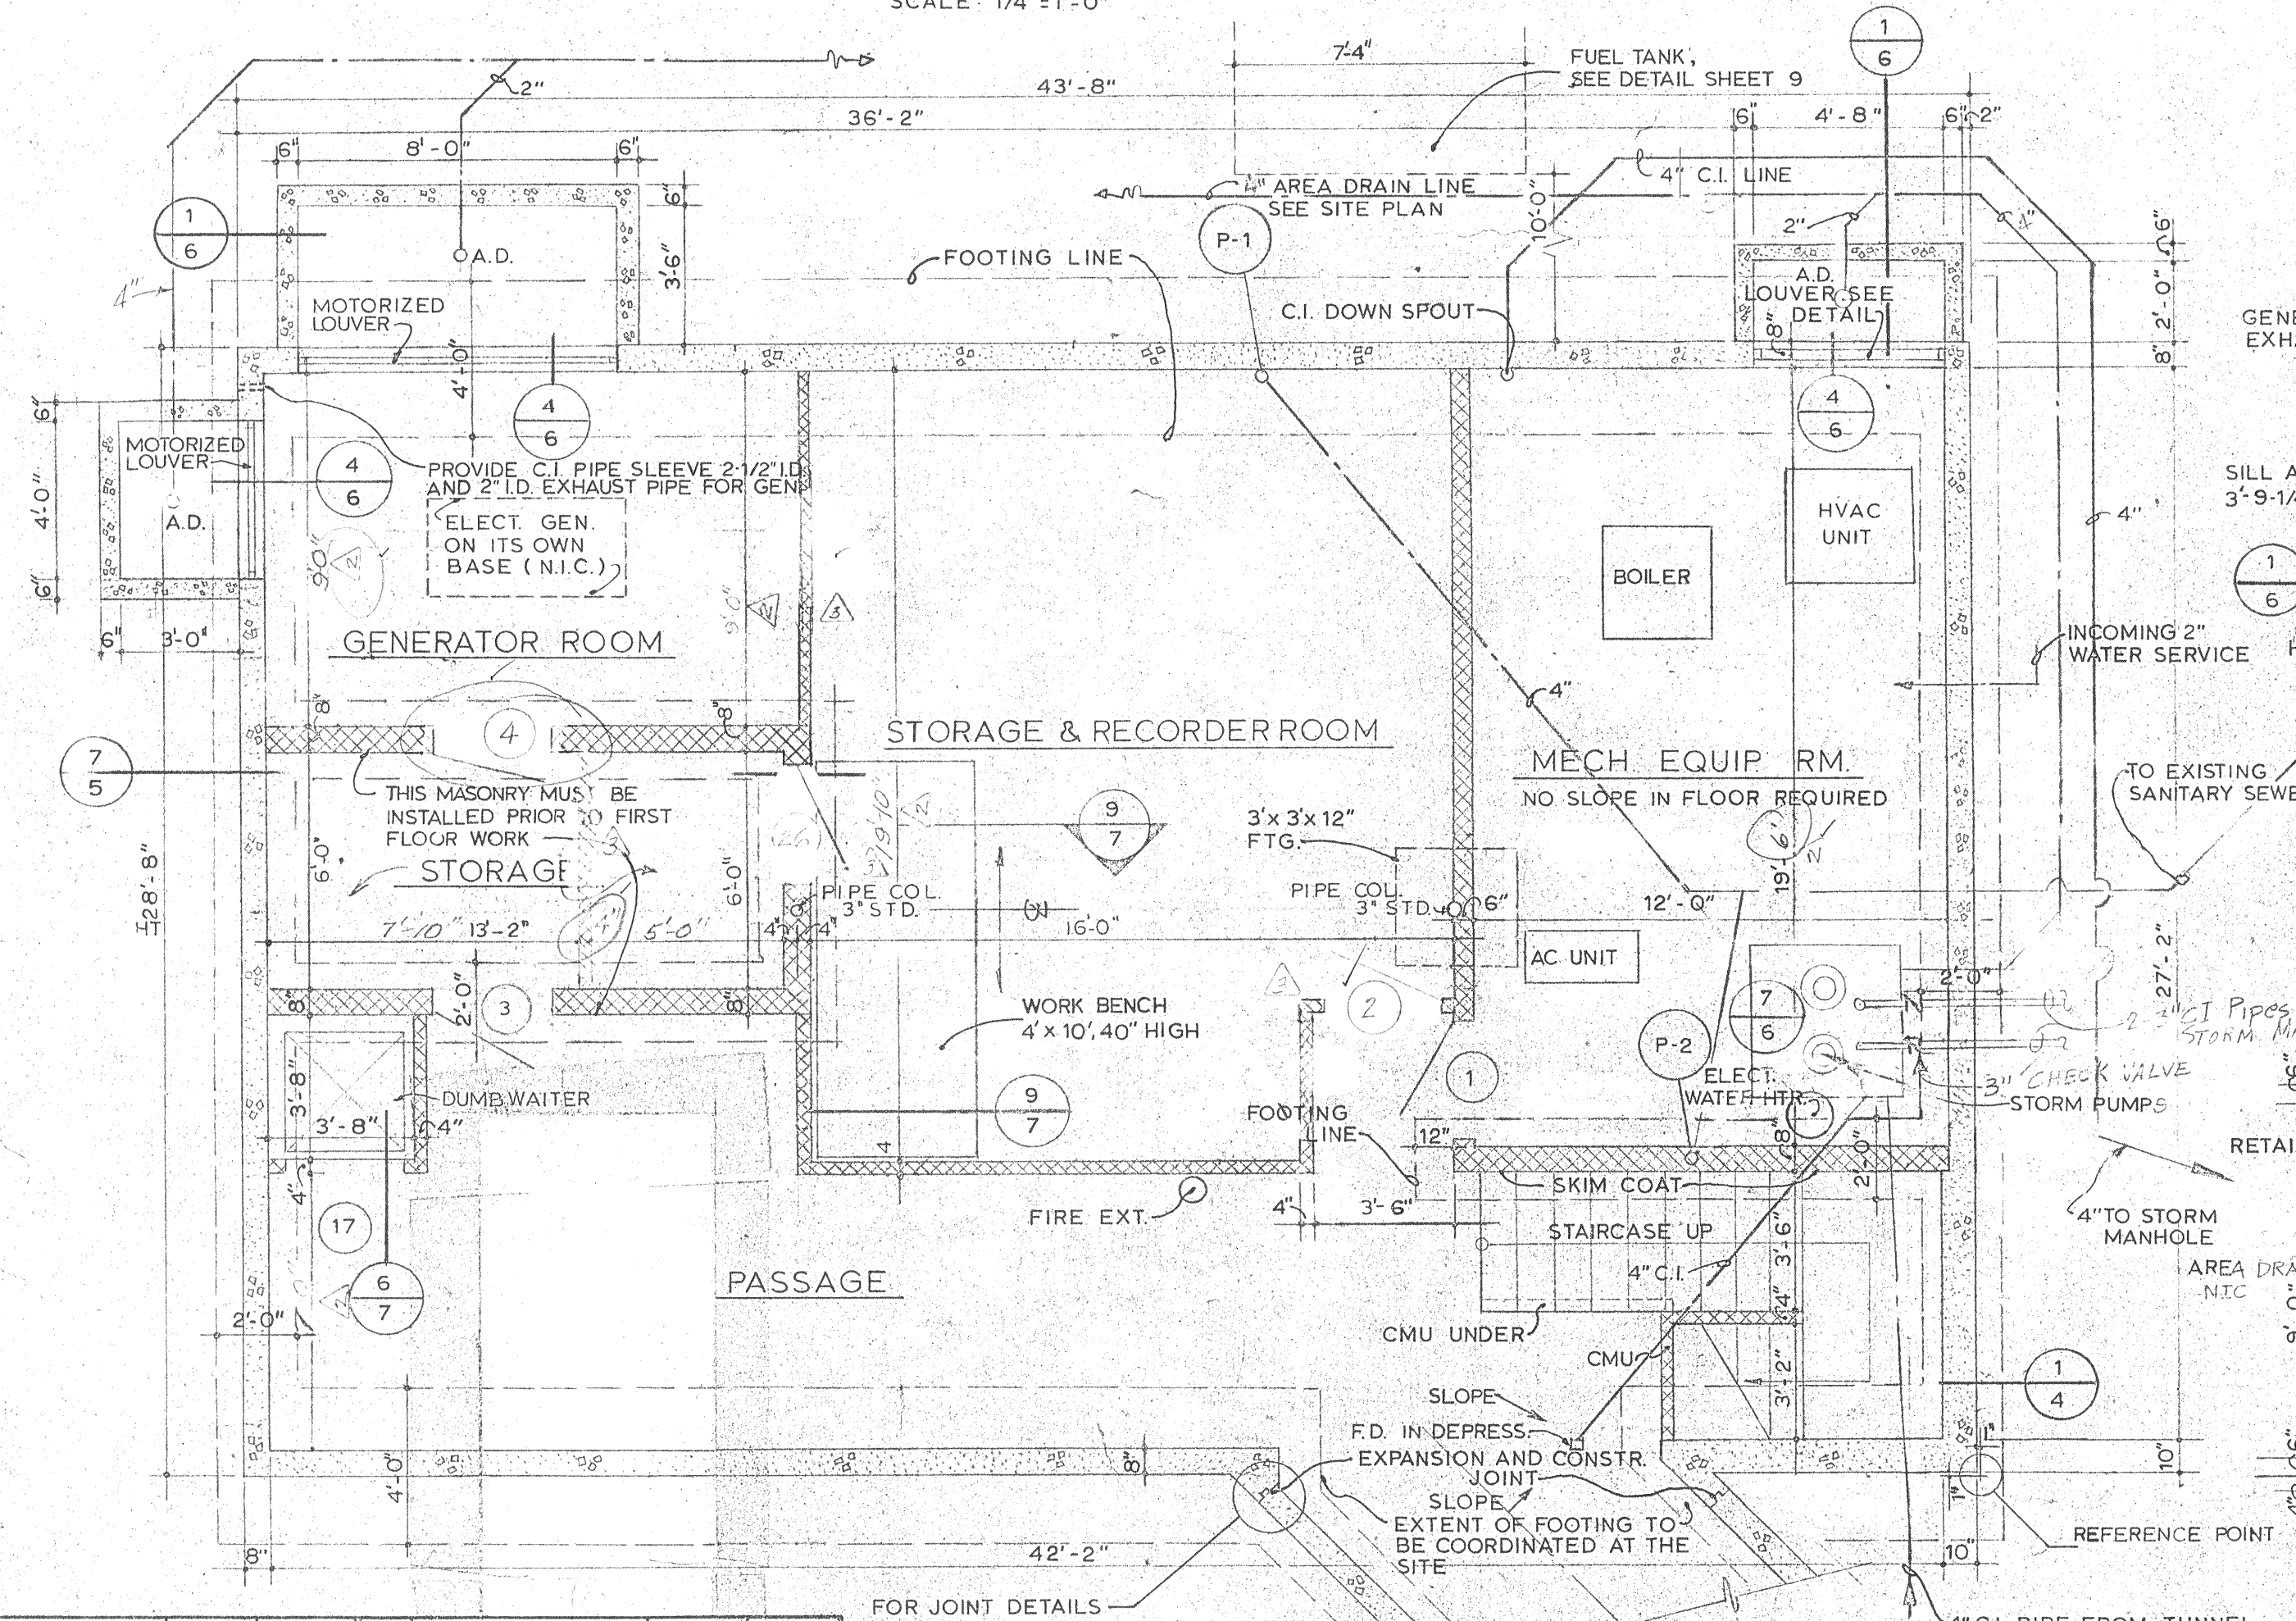

BASEMENT FLOOR PLAN
SCALE: 1/4" = 1'-0"

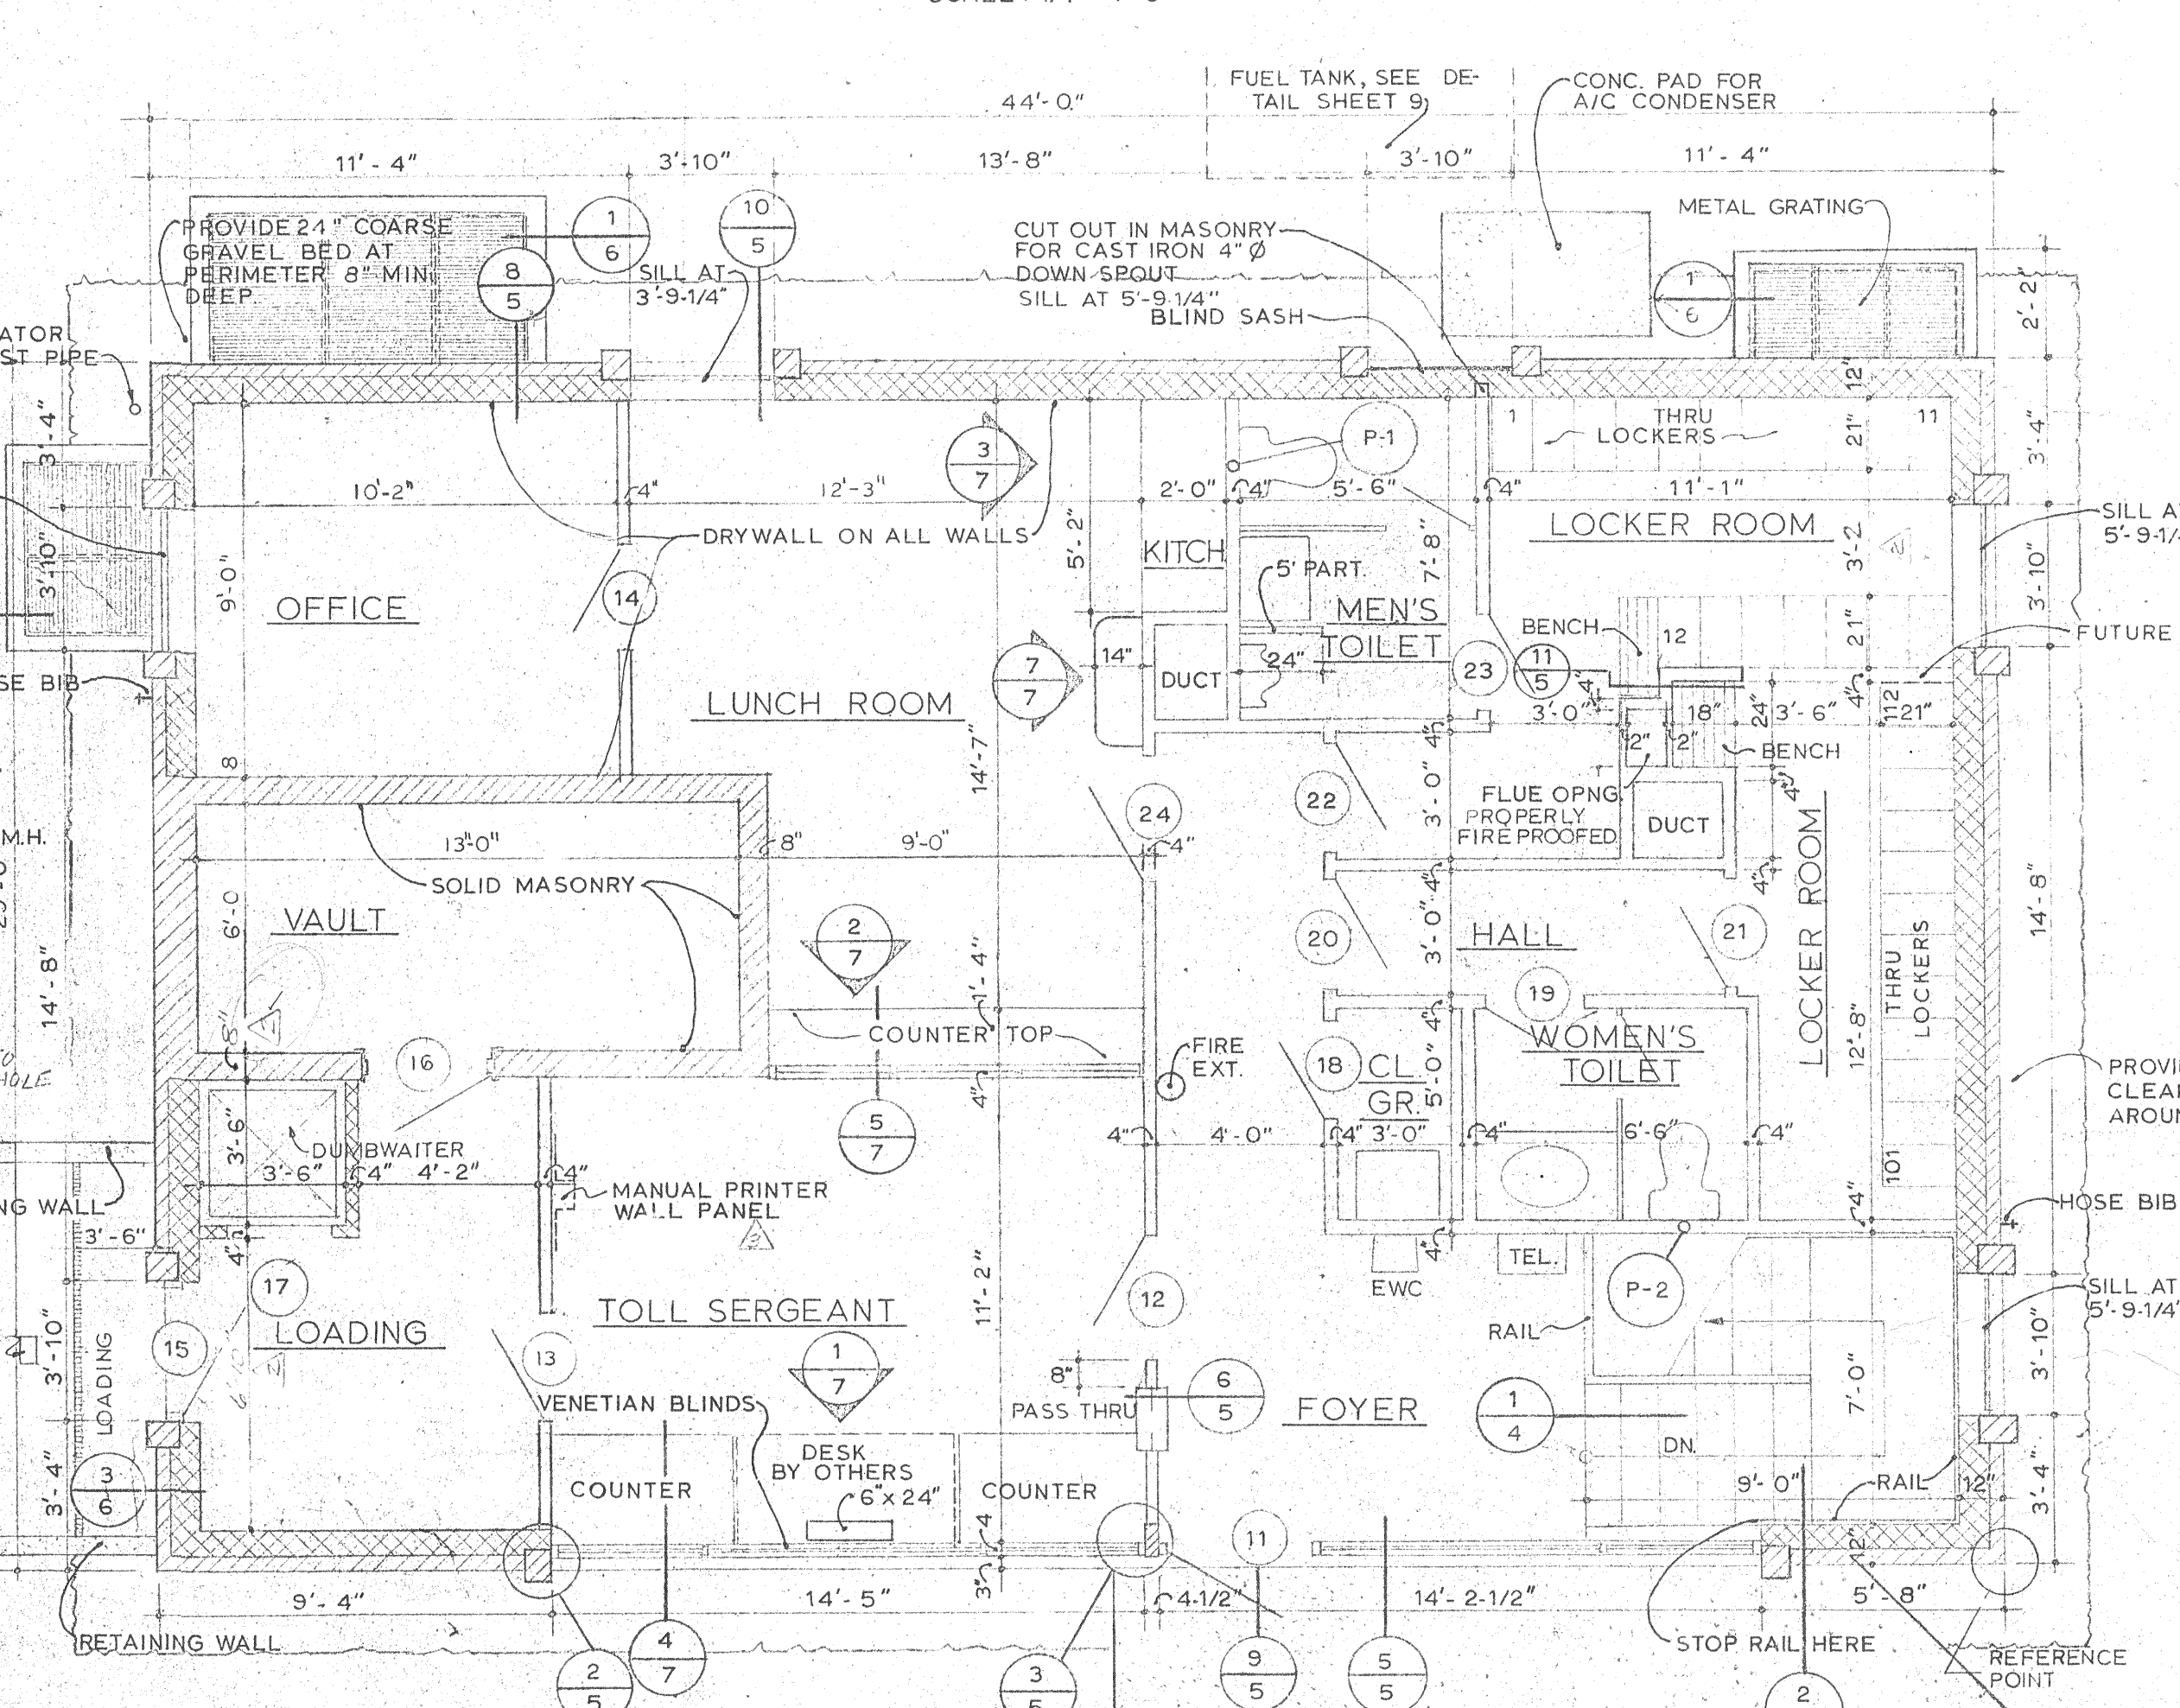

FIRST FLOOR PLAN
SCALE: 1/4" = 1'-0"

BY	DATE	REVISION	BY	DATE
ADDENDUM NO. 42	JRC	8/72		
MADE	R.B.M.	7-31-71	REVISE DRAWINGS	JRC
CHECKED	KL	7-31-71	STORM PUMPS	RTC
IN CHARGE	J.P.F.			

FOR JOINT DETAILS SEE SHEET 43-B, CONTR. C-2
4" C.I. PIPE FROM TUNNEL FLOOR DRAINS BY OTHERS, CONNECTION PART OF THIS CONTRACT







RICHMOND METROPOLITAN AUTHORITY
RICHMOND EXPRESSWAY SYSTEM
POWHITE PARKWAY

UTILITY BUILDING PLANS & MISC.

HOWARD, NEEDLES, TAMMEN & BERGENDOFF
consulting engineers
NEW YORK ALEXANDRIA KANSAS CITY

SCALE: 1/4" = 1'-0"
CONTRACT NO. TF-2
SHEET NO. 3 OF 11

RICHMOND EXPRESSWAY SYSTEM			
SECTION	PROJECT	SHEET NO.	TOTAL SHEETS
TF-2	UTILITY BUILDING	4	26

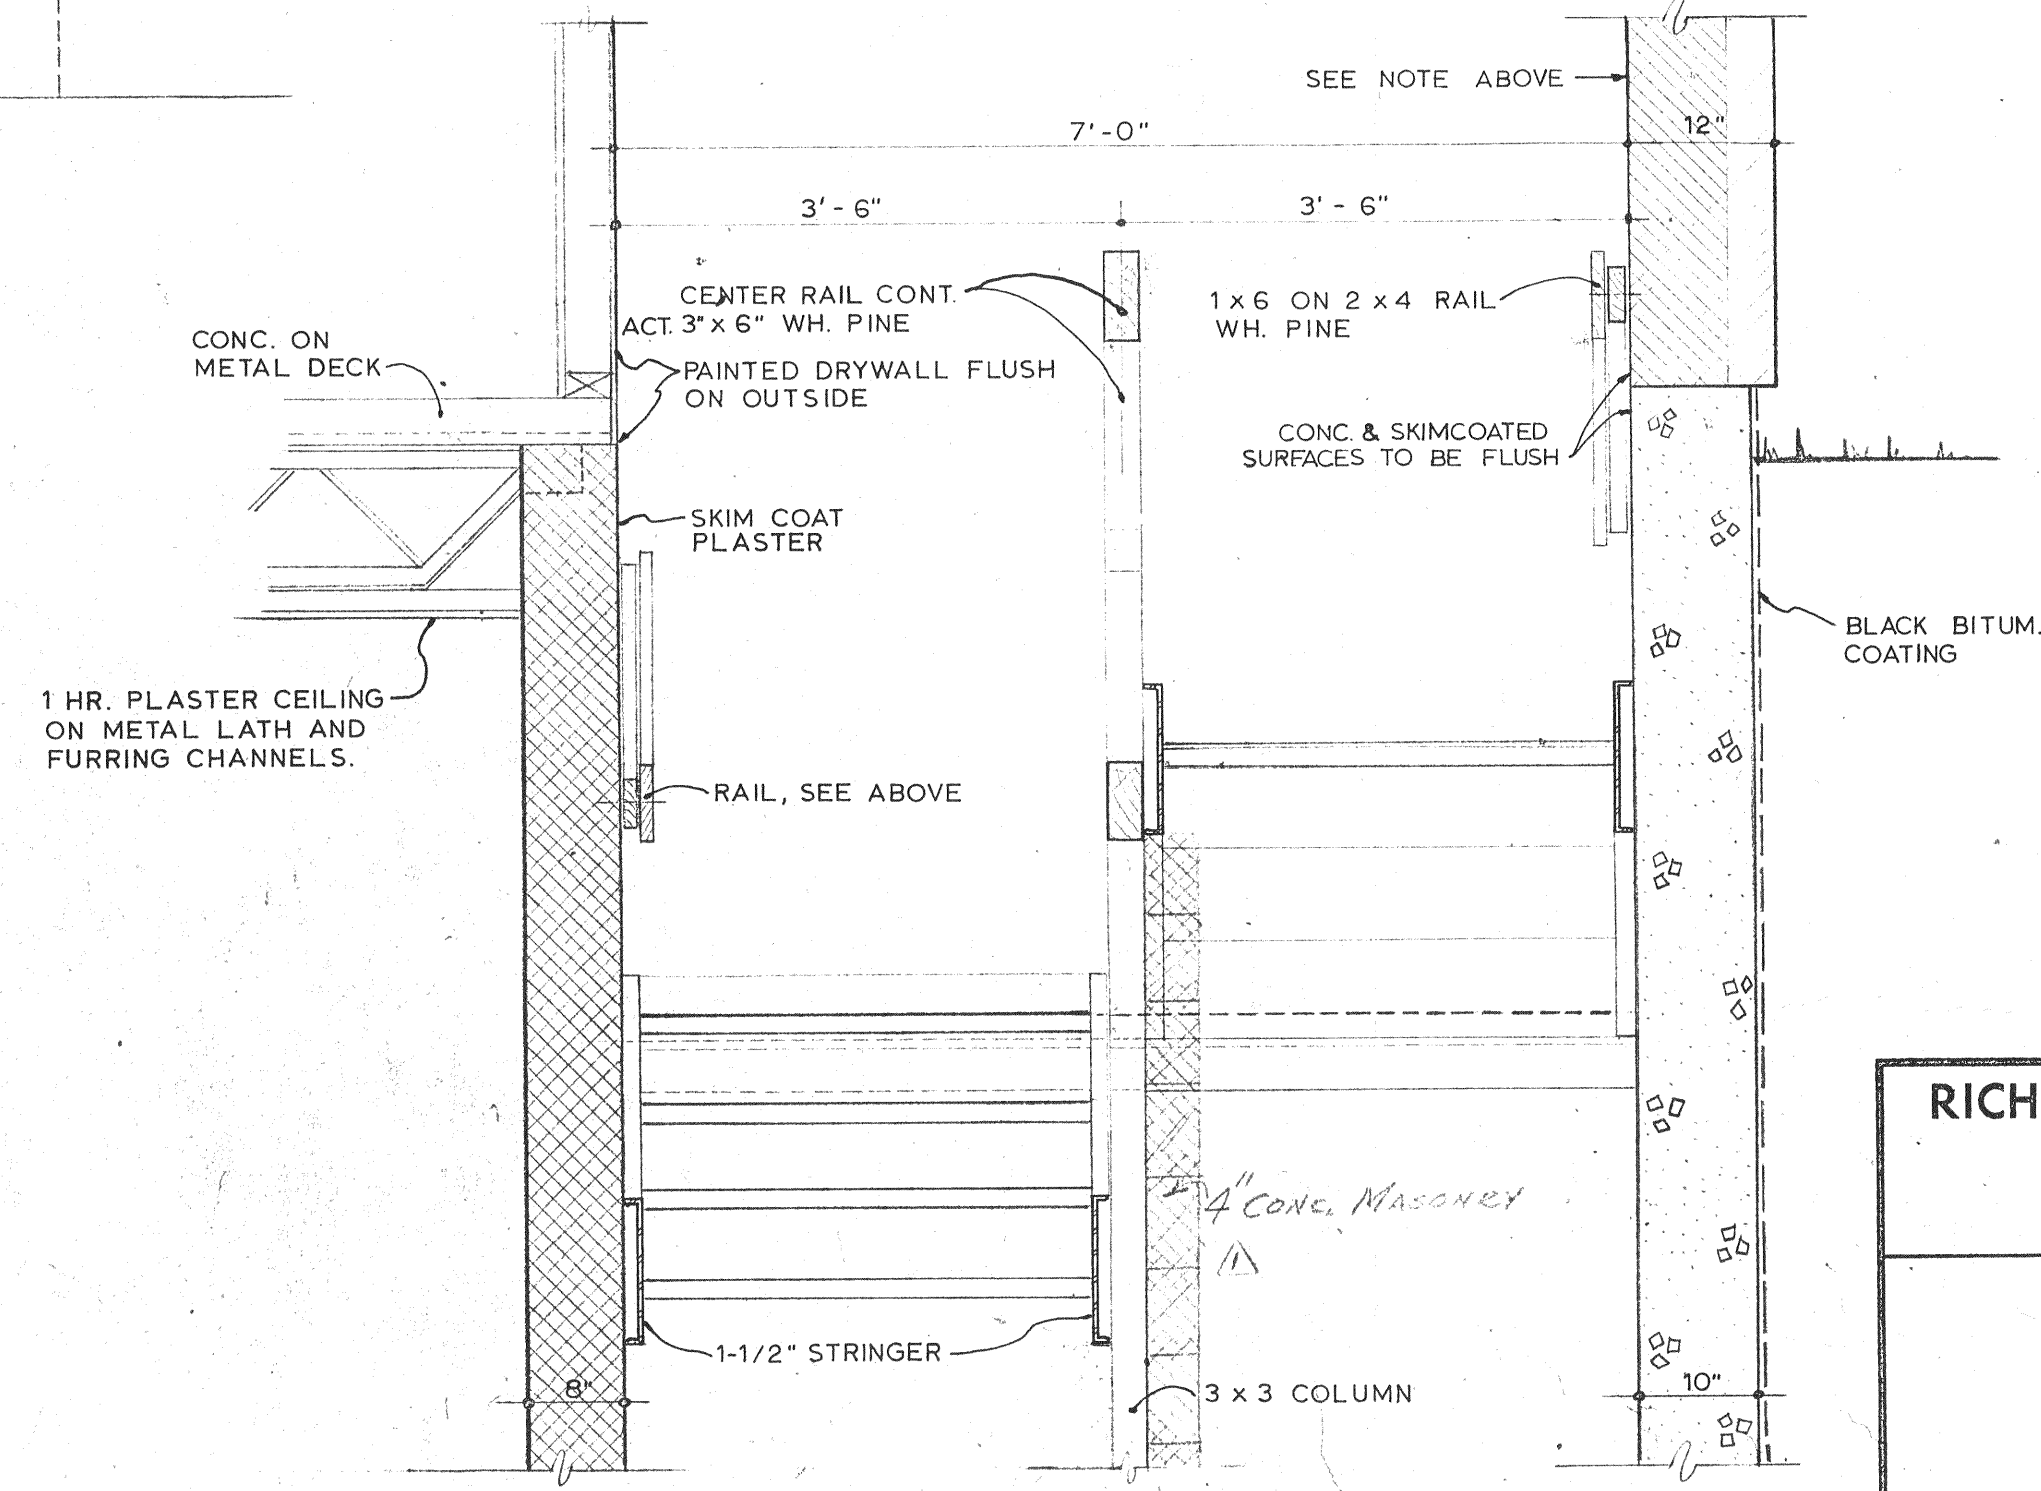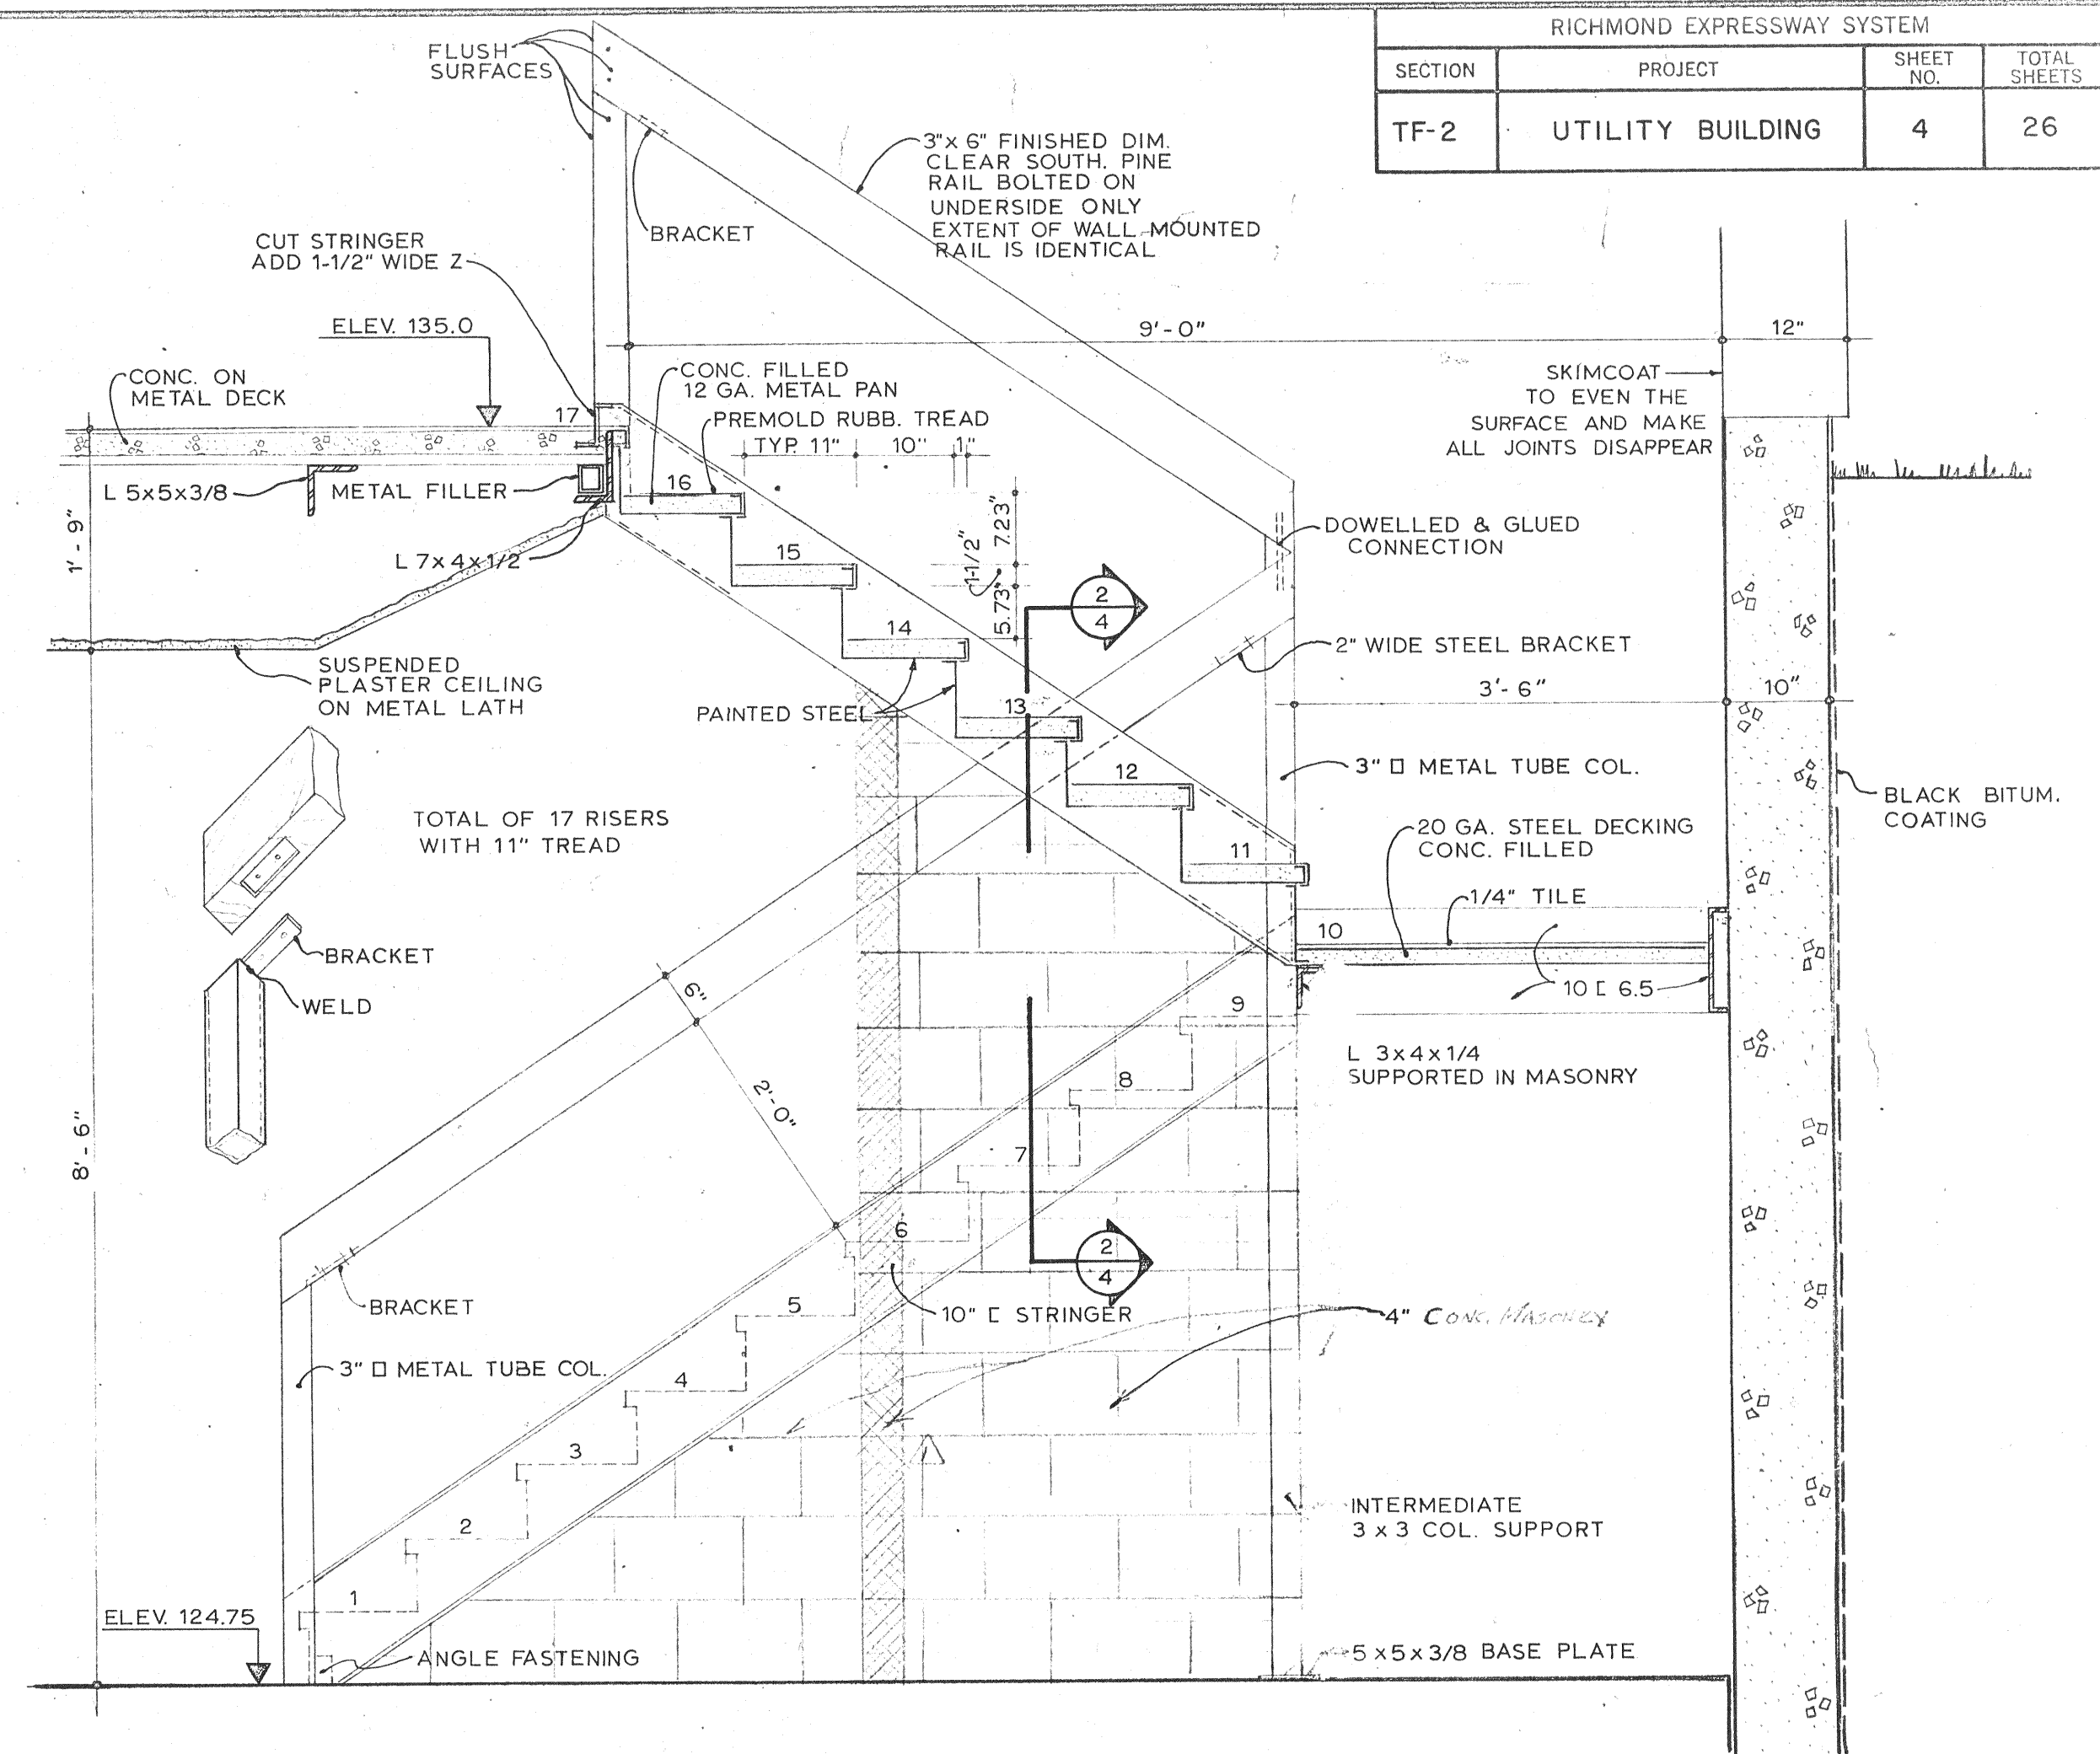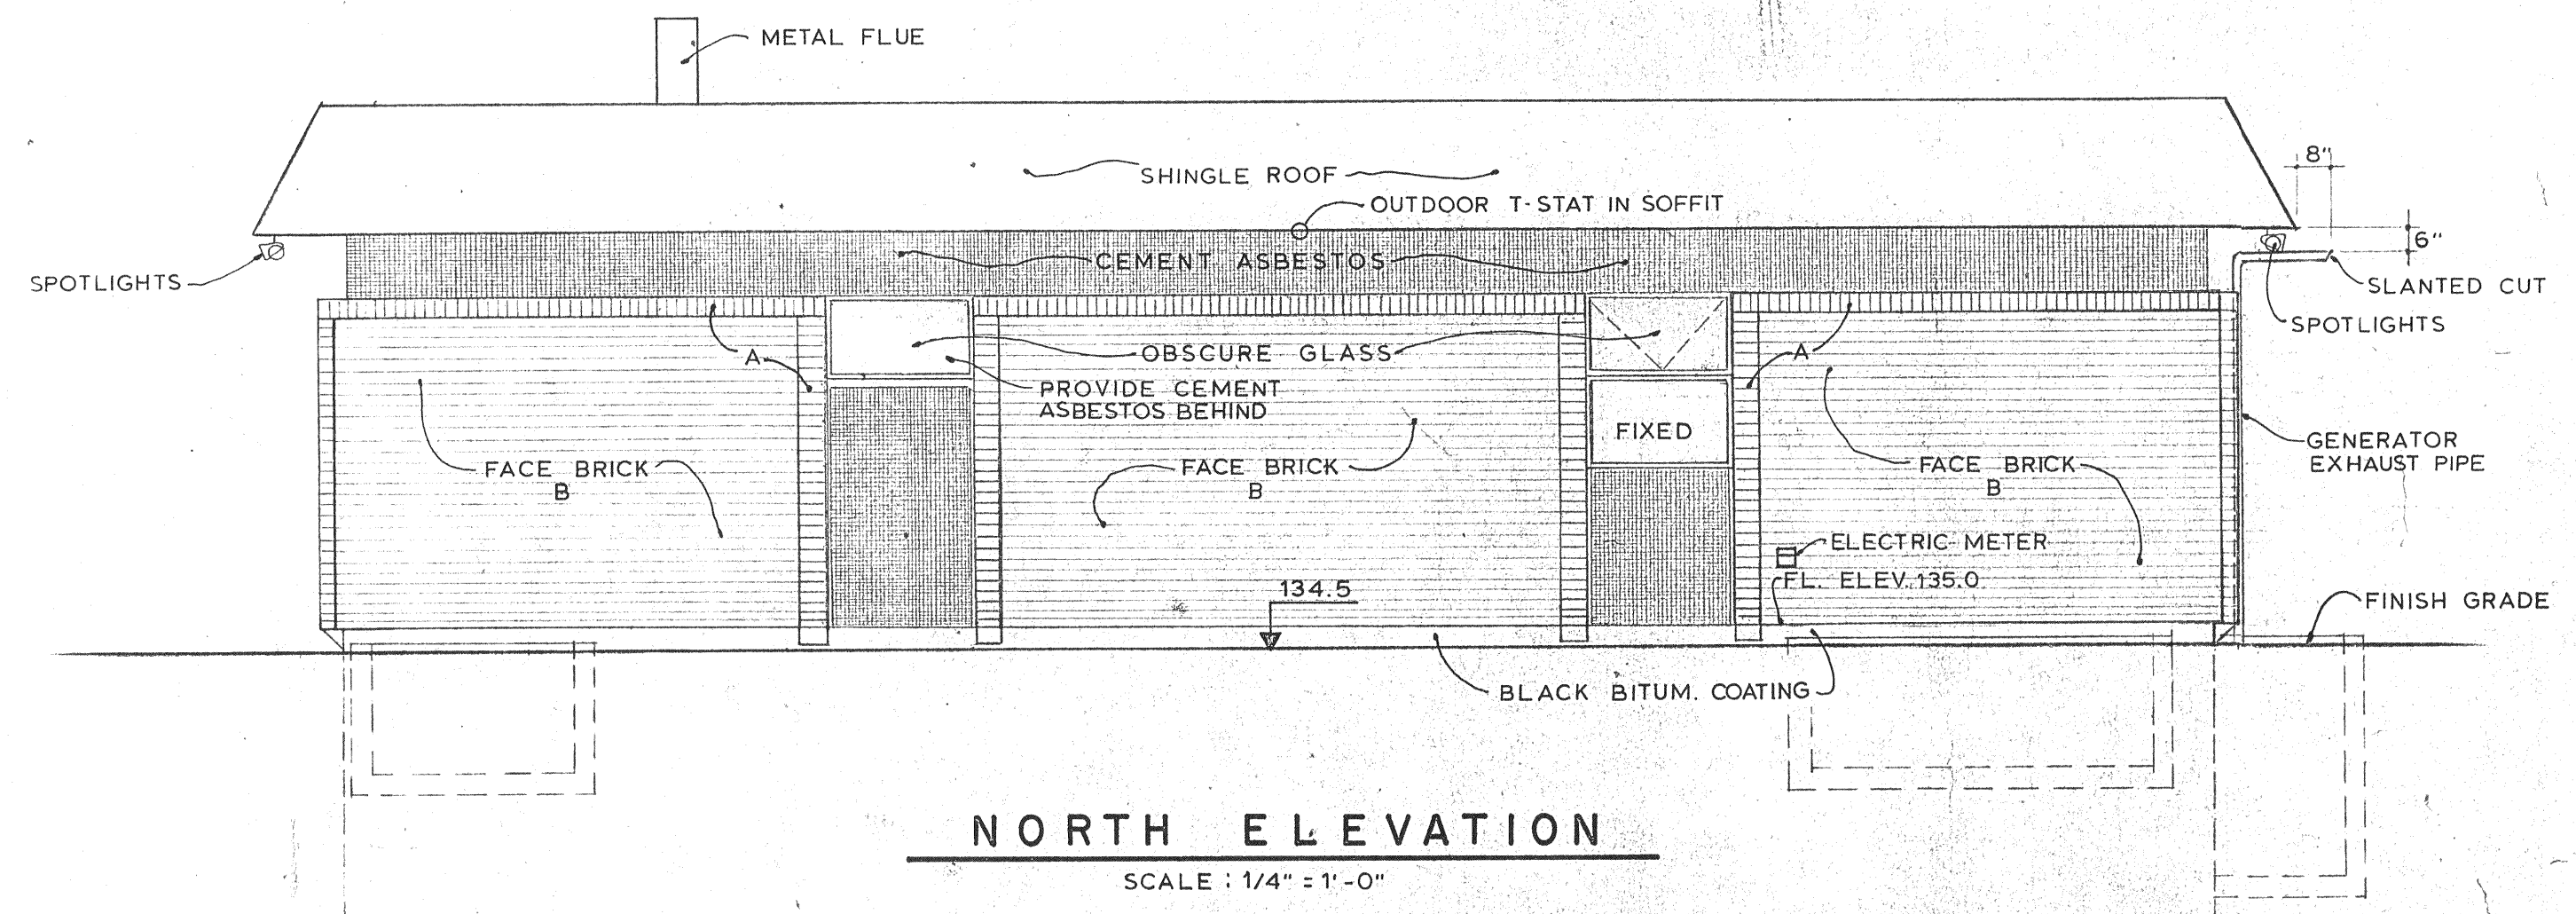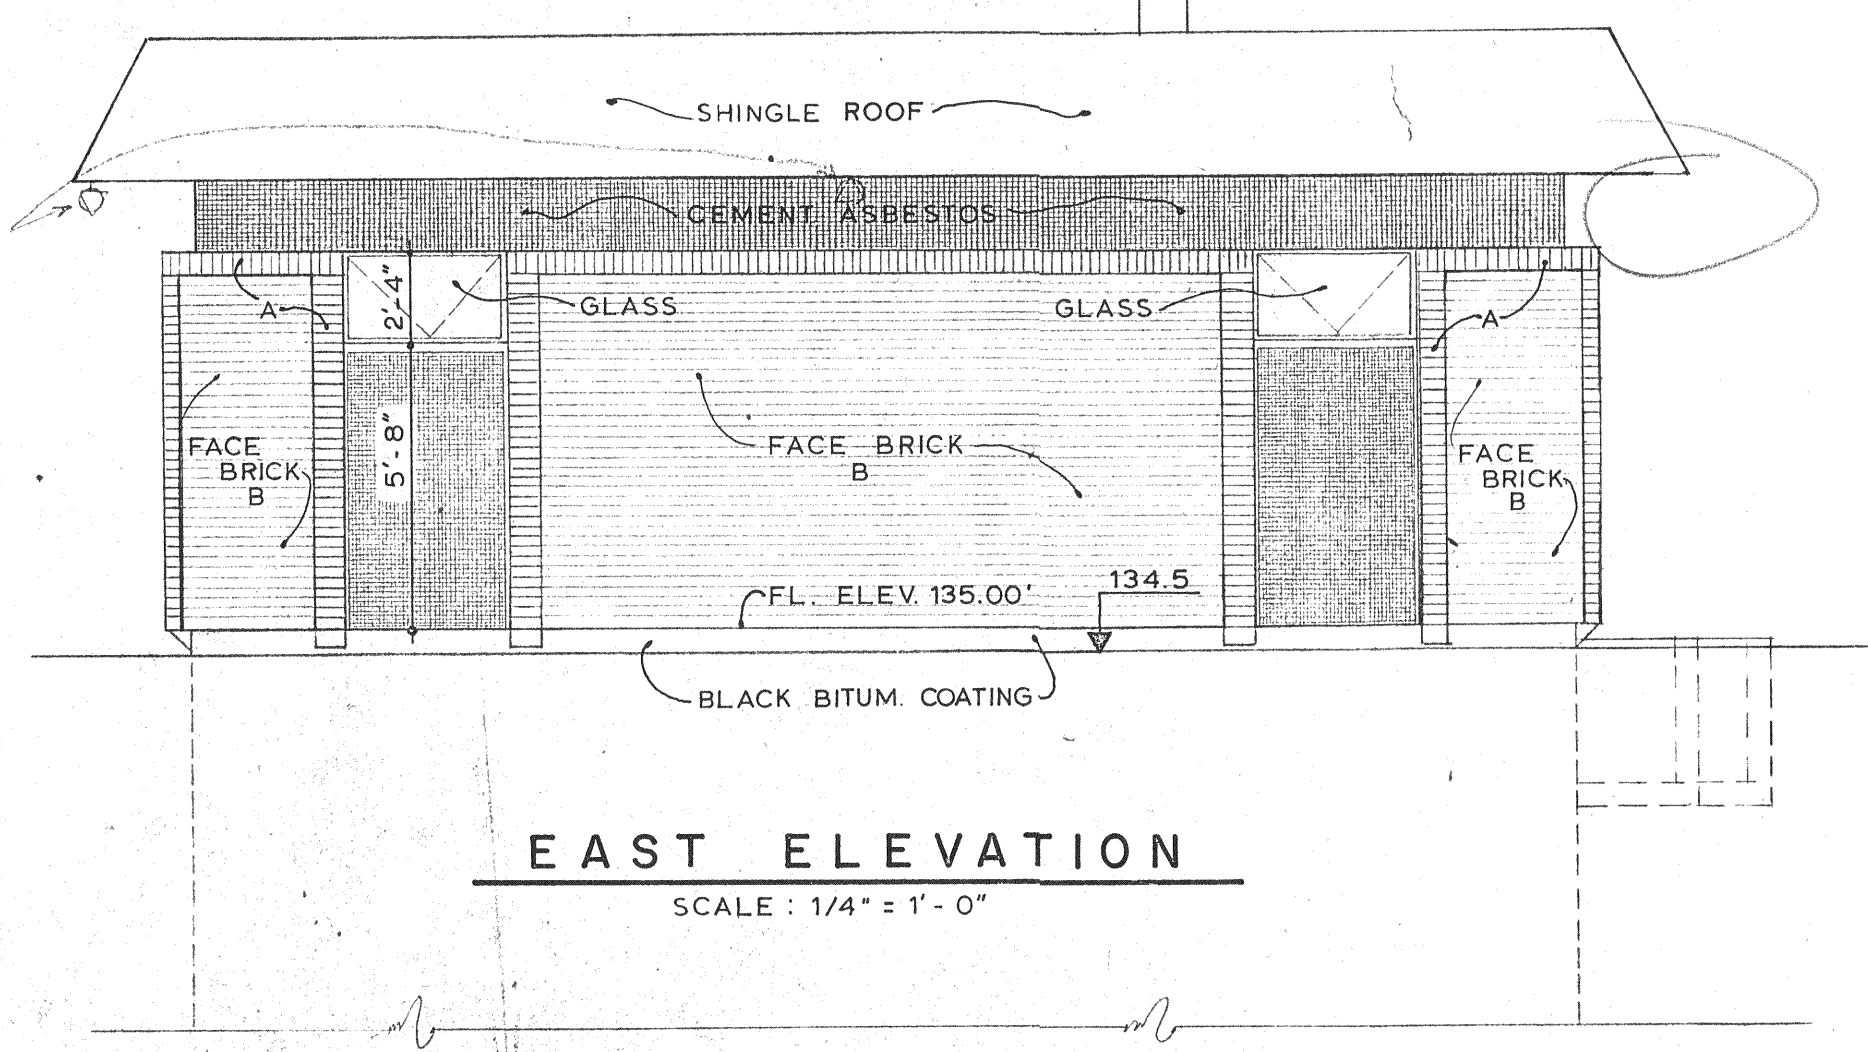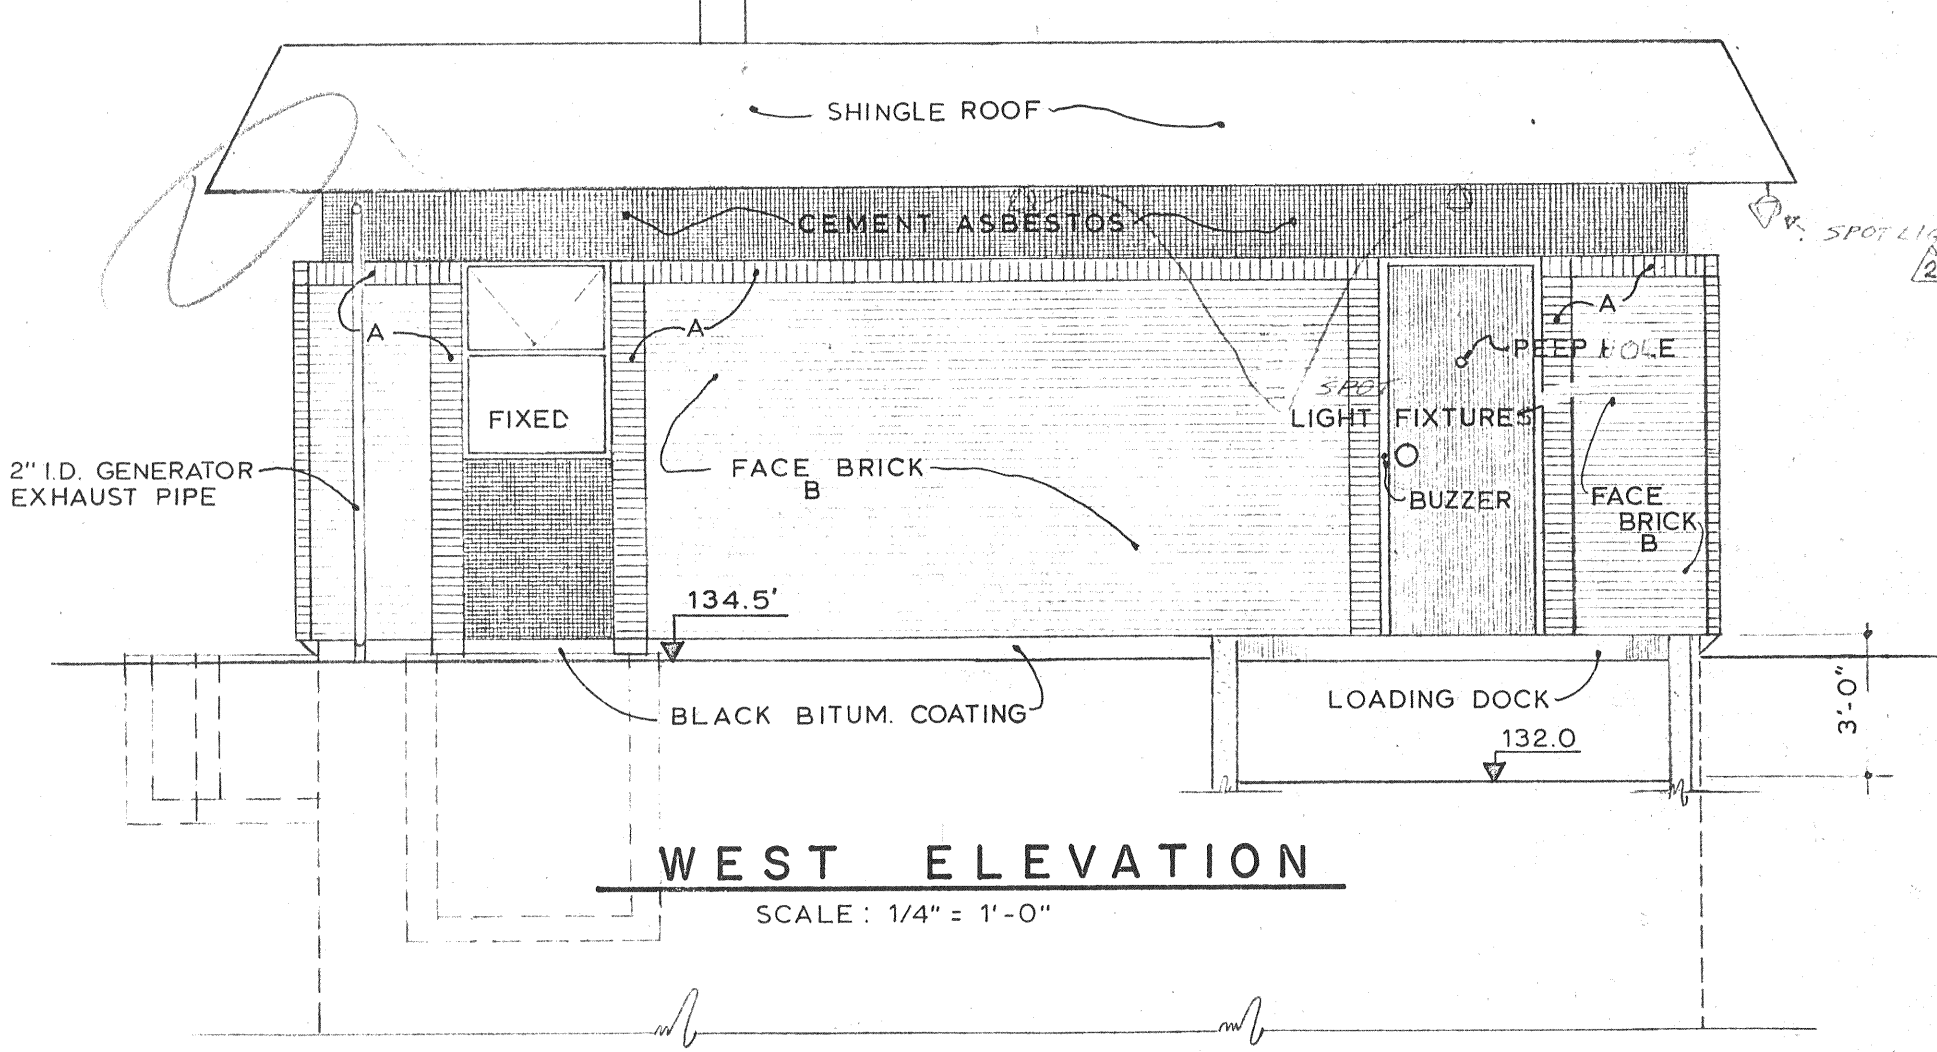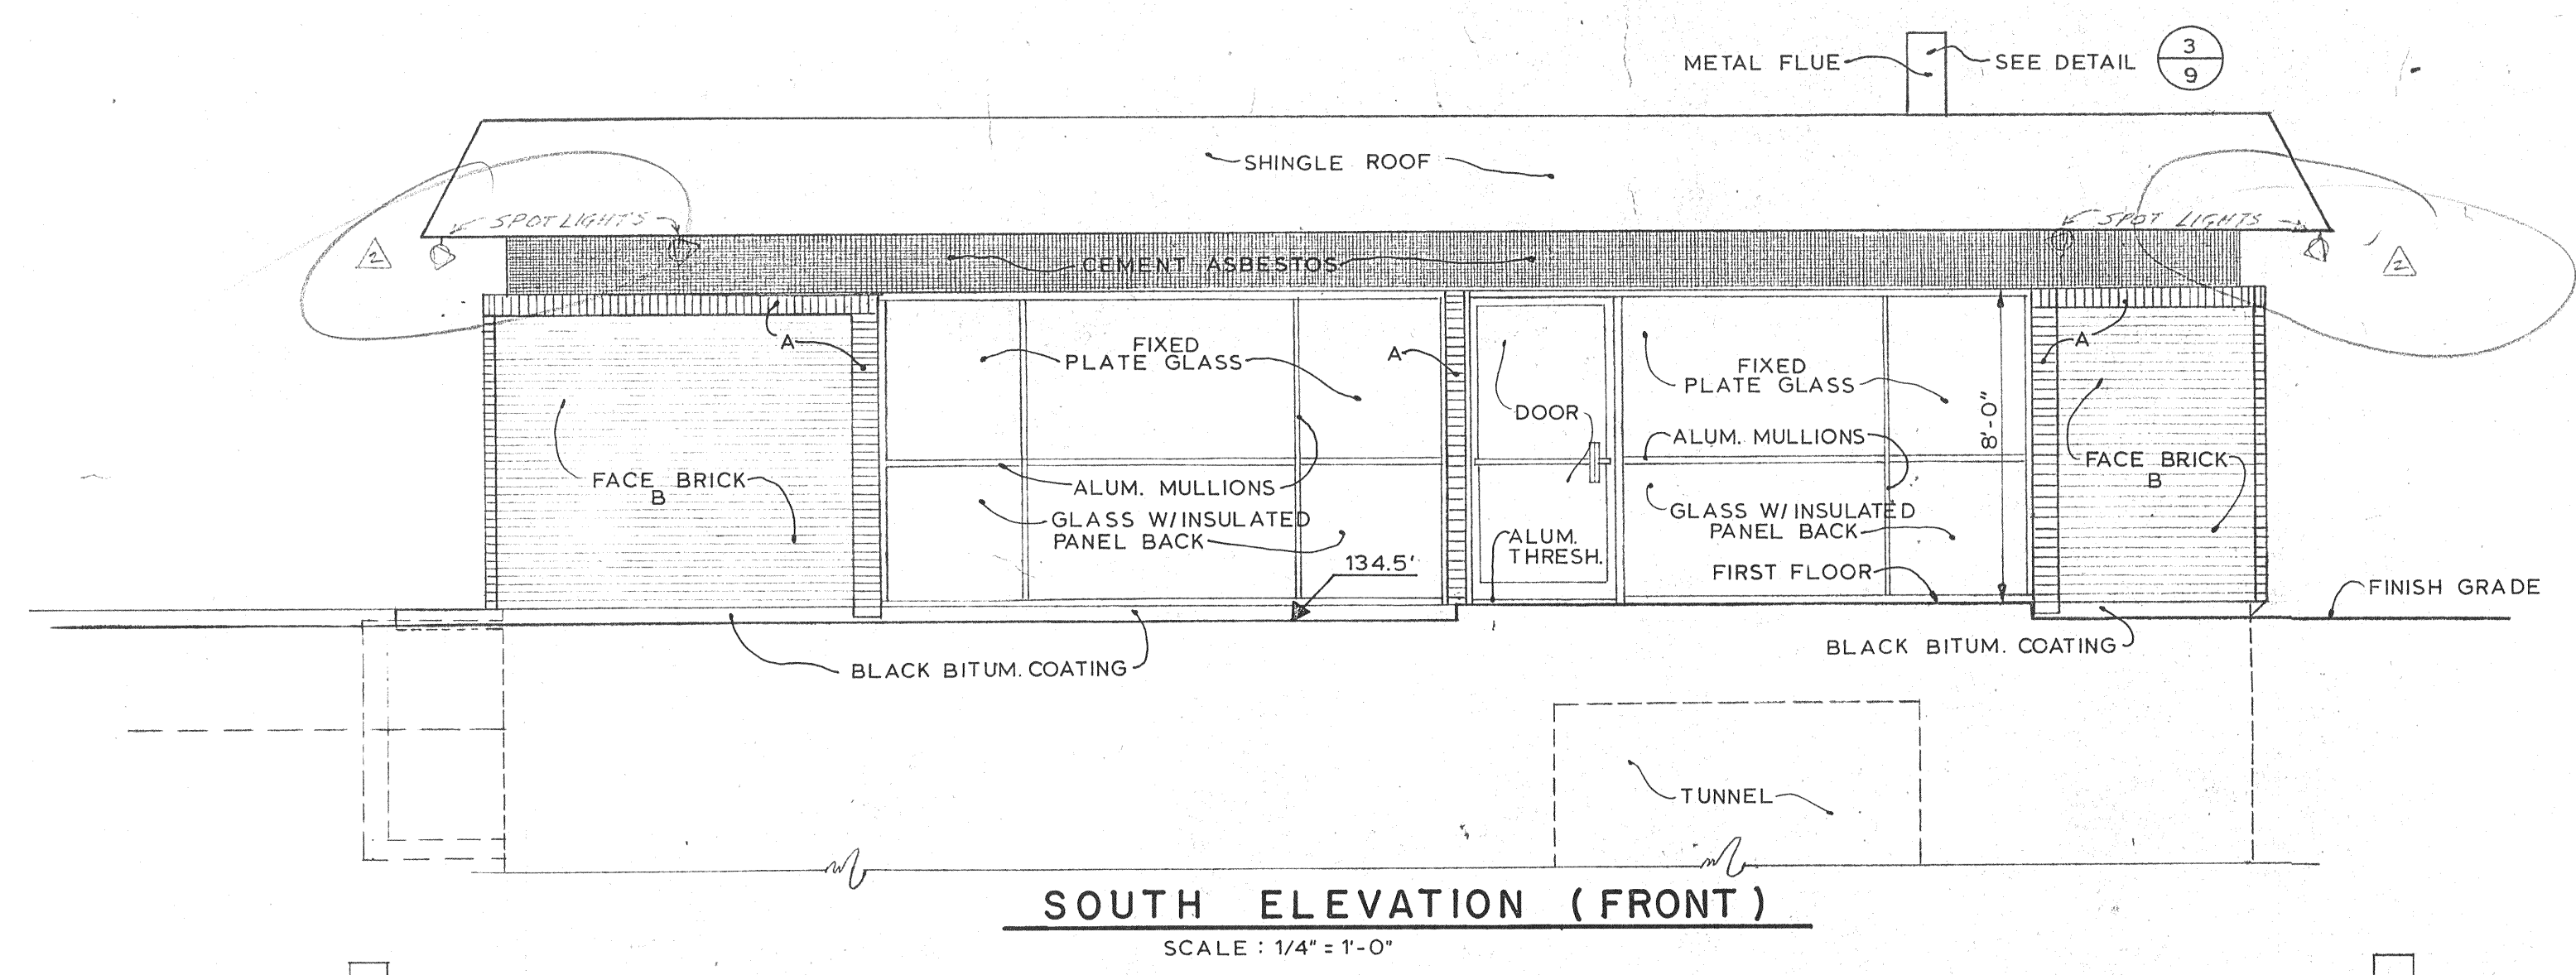


MADE	BY	DATE	NO.	REVISION	BY	DATE
	R.B.M.	7-31-71			J.P.F.	8/2
CHECKED	KL.	7-31-71			J.P.F.	7/22
IN CHARGE	J.P.F.					

RICHMOND METROPOLITAN AUTHORITY
RICHMOND EXPRESSWAY SYSTEM
POWHITE PARKWAY


UTILITY BUILDING
ELEVATIONS & SECTIONS

HOWARD, NEEDLES, TAMMEN & BERGENDOFF
consulting engineers
NEW YORK ALEXANDRIA KANSAS CITY

SCALE: AS SHOWN
CONTRACT NO.: TF-2
SHEET NO. 4 OF 11

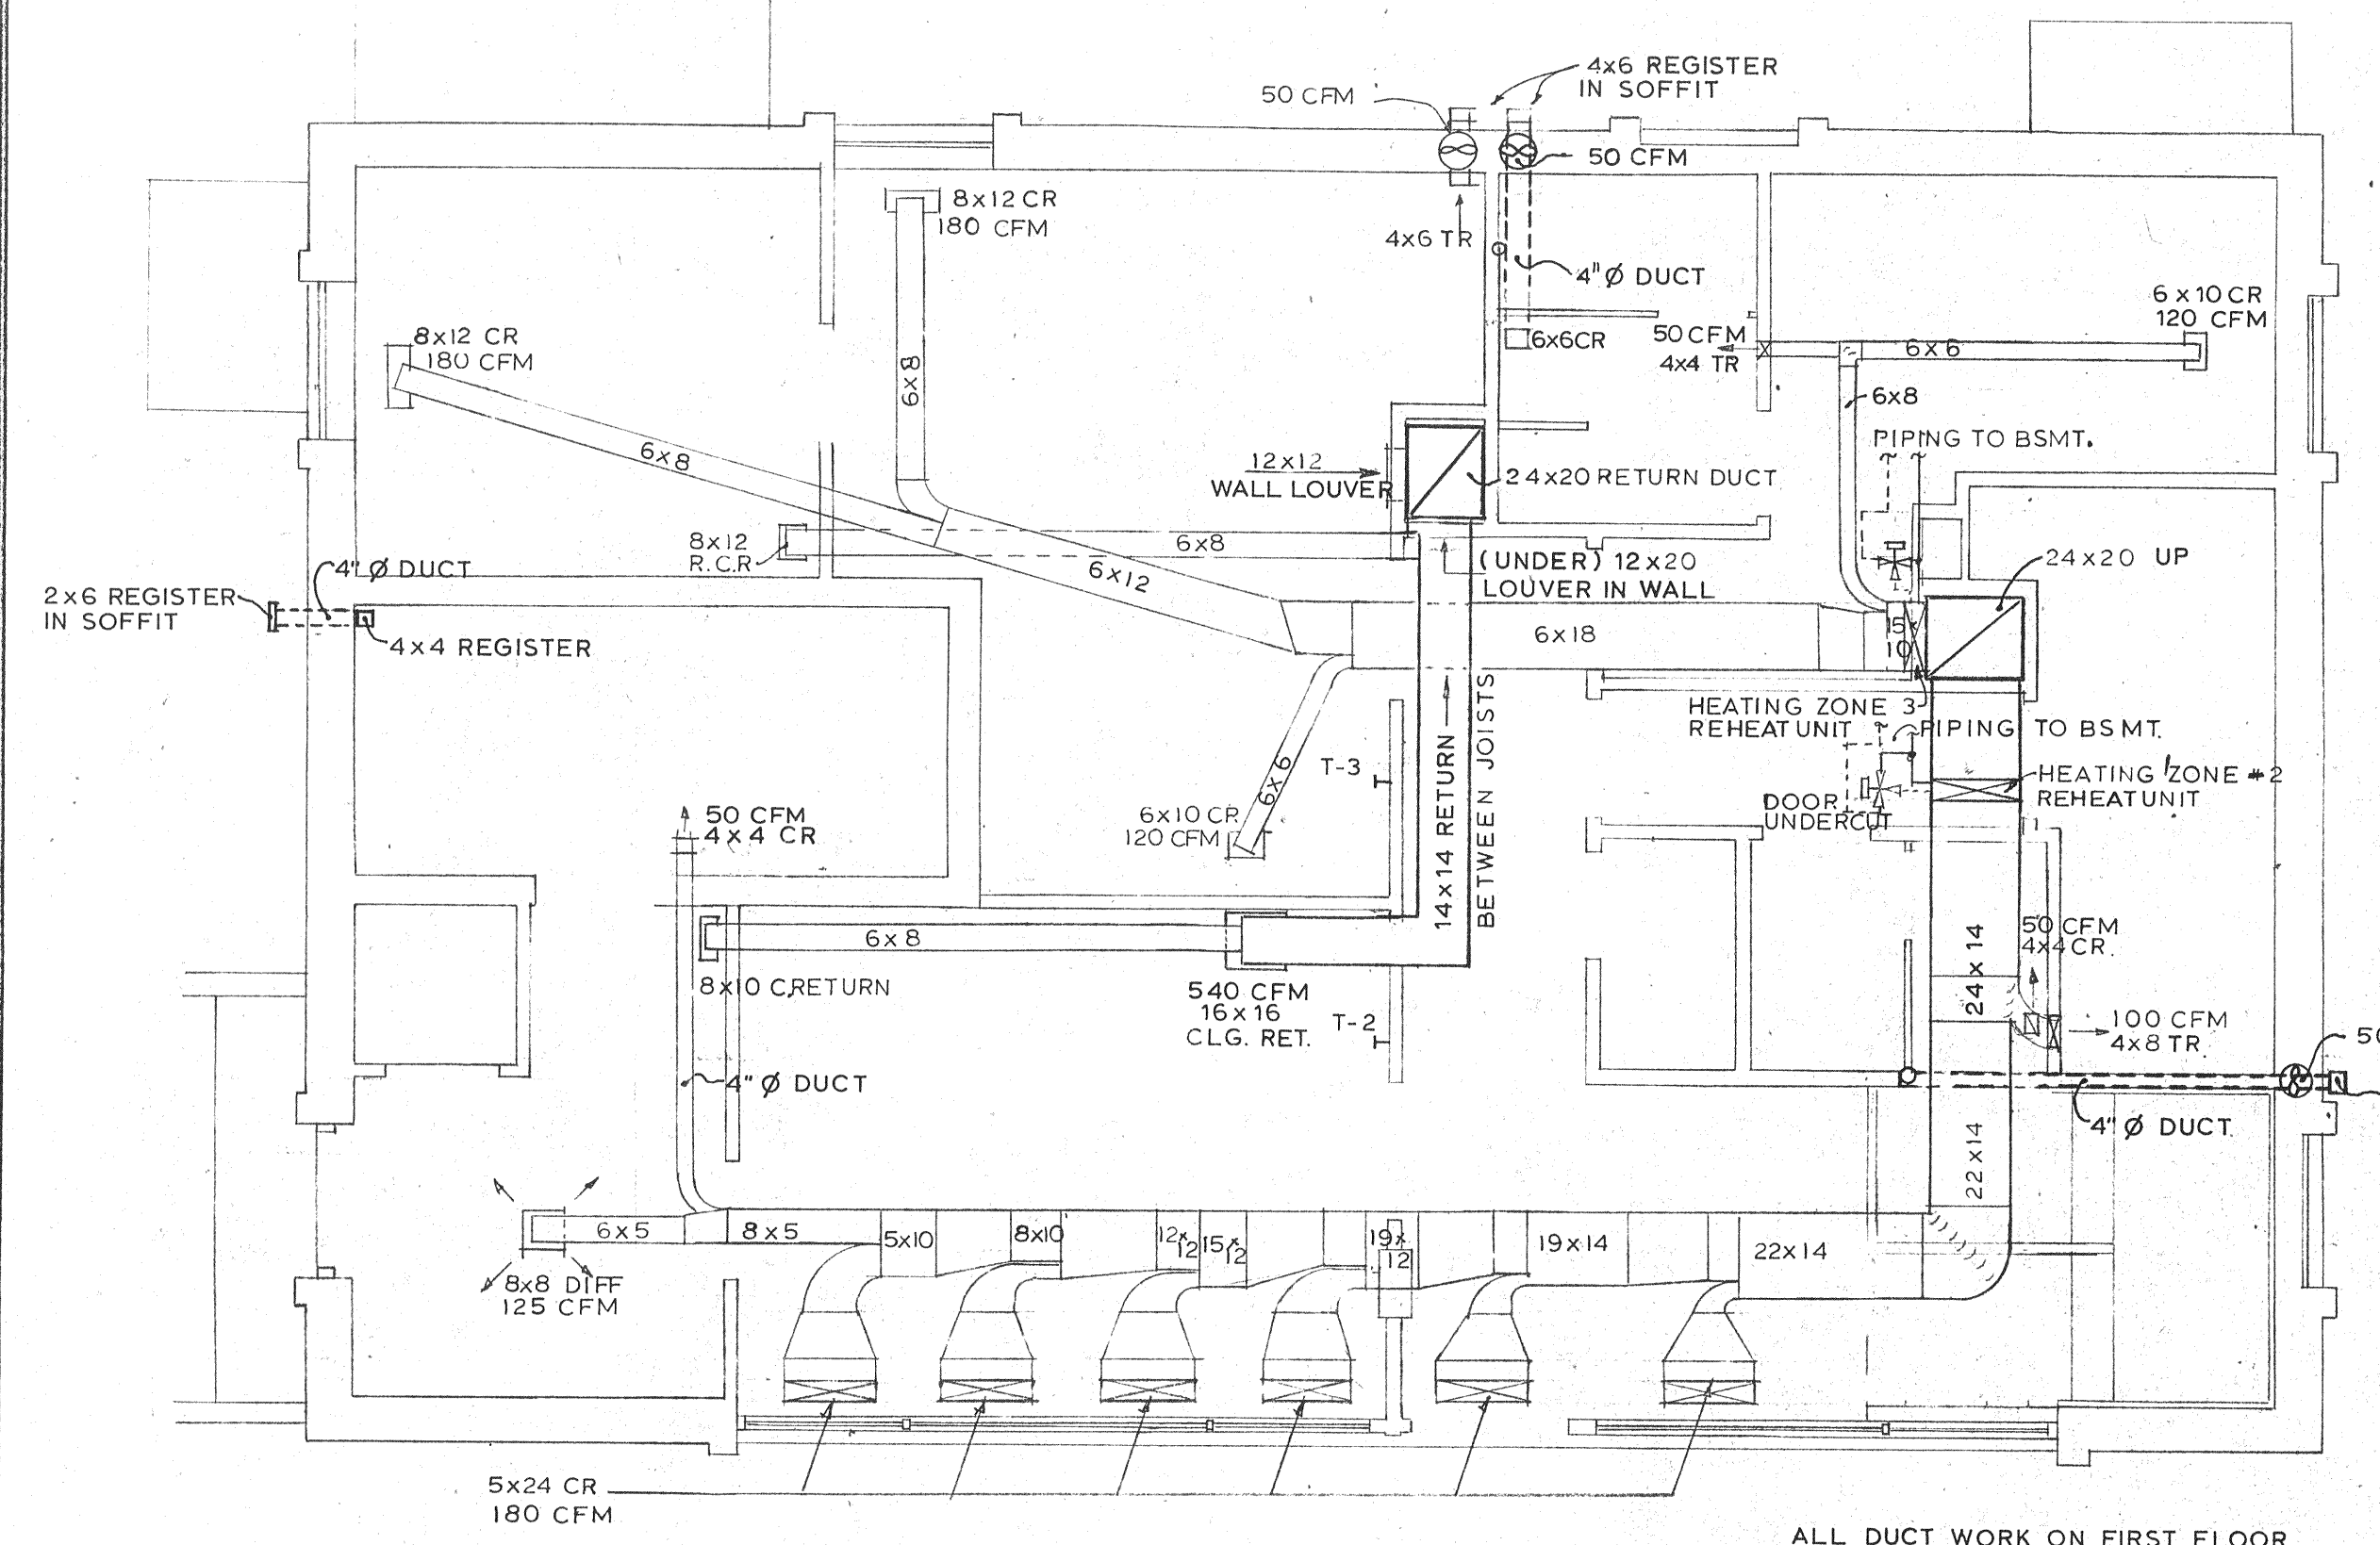

FIRST FLOOR HEATING PLAN

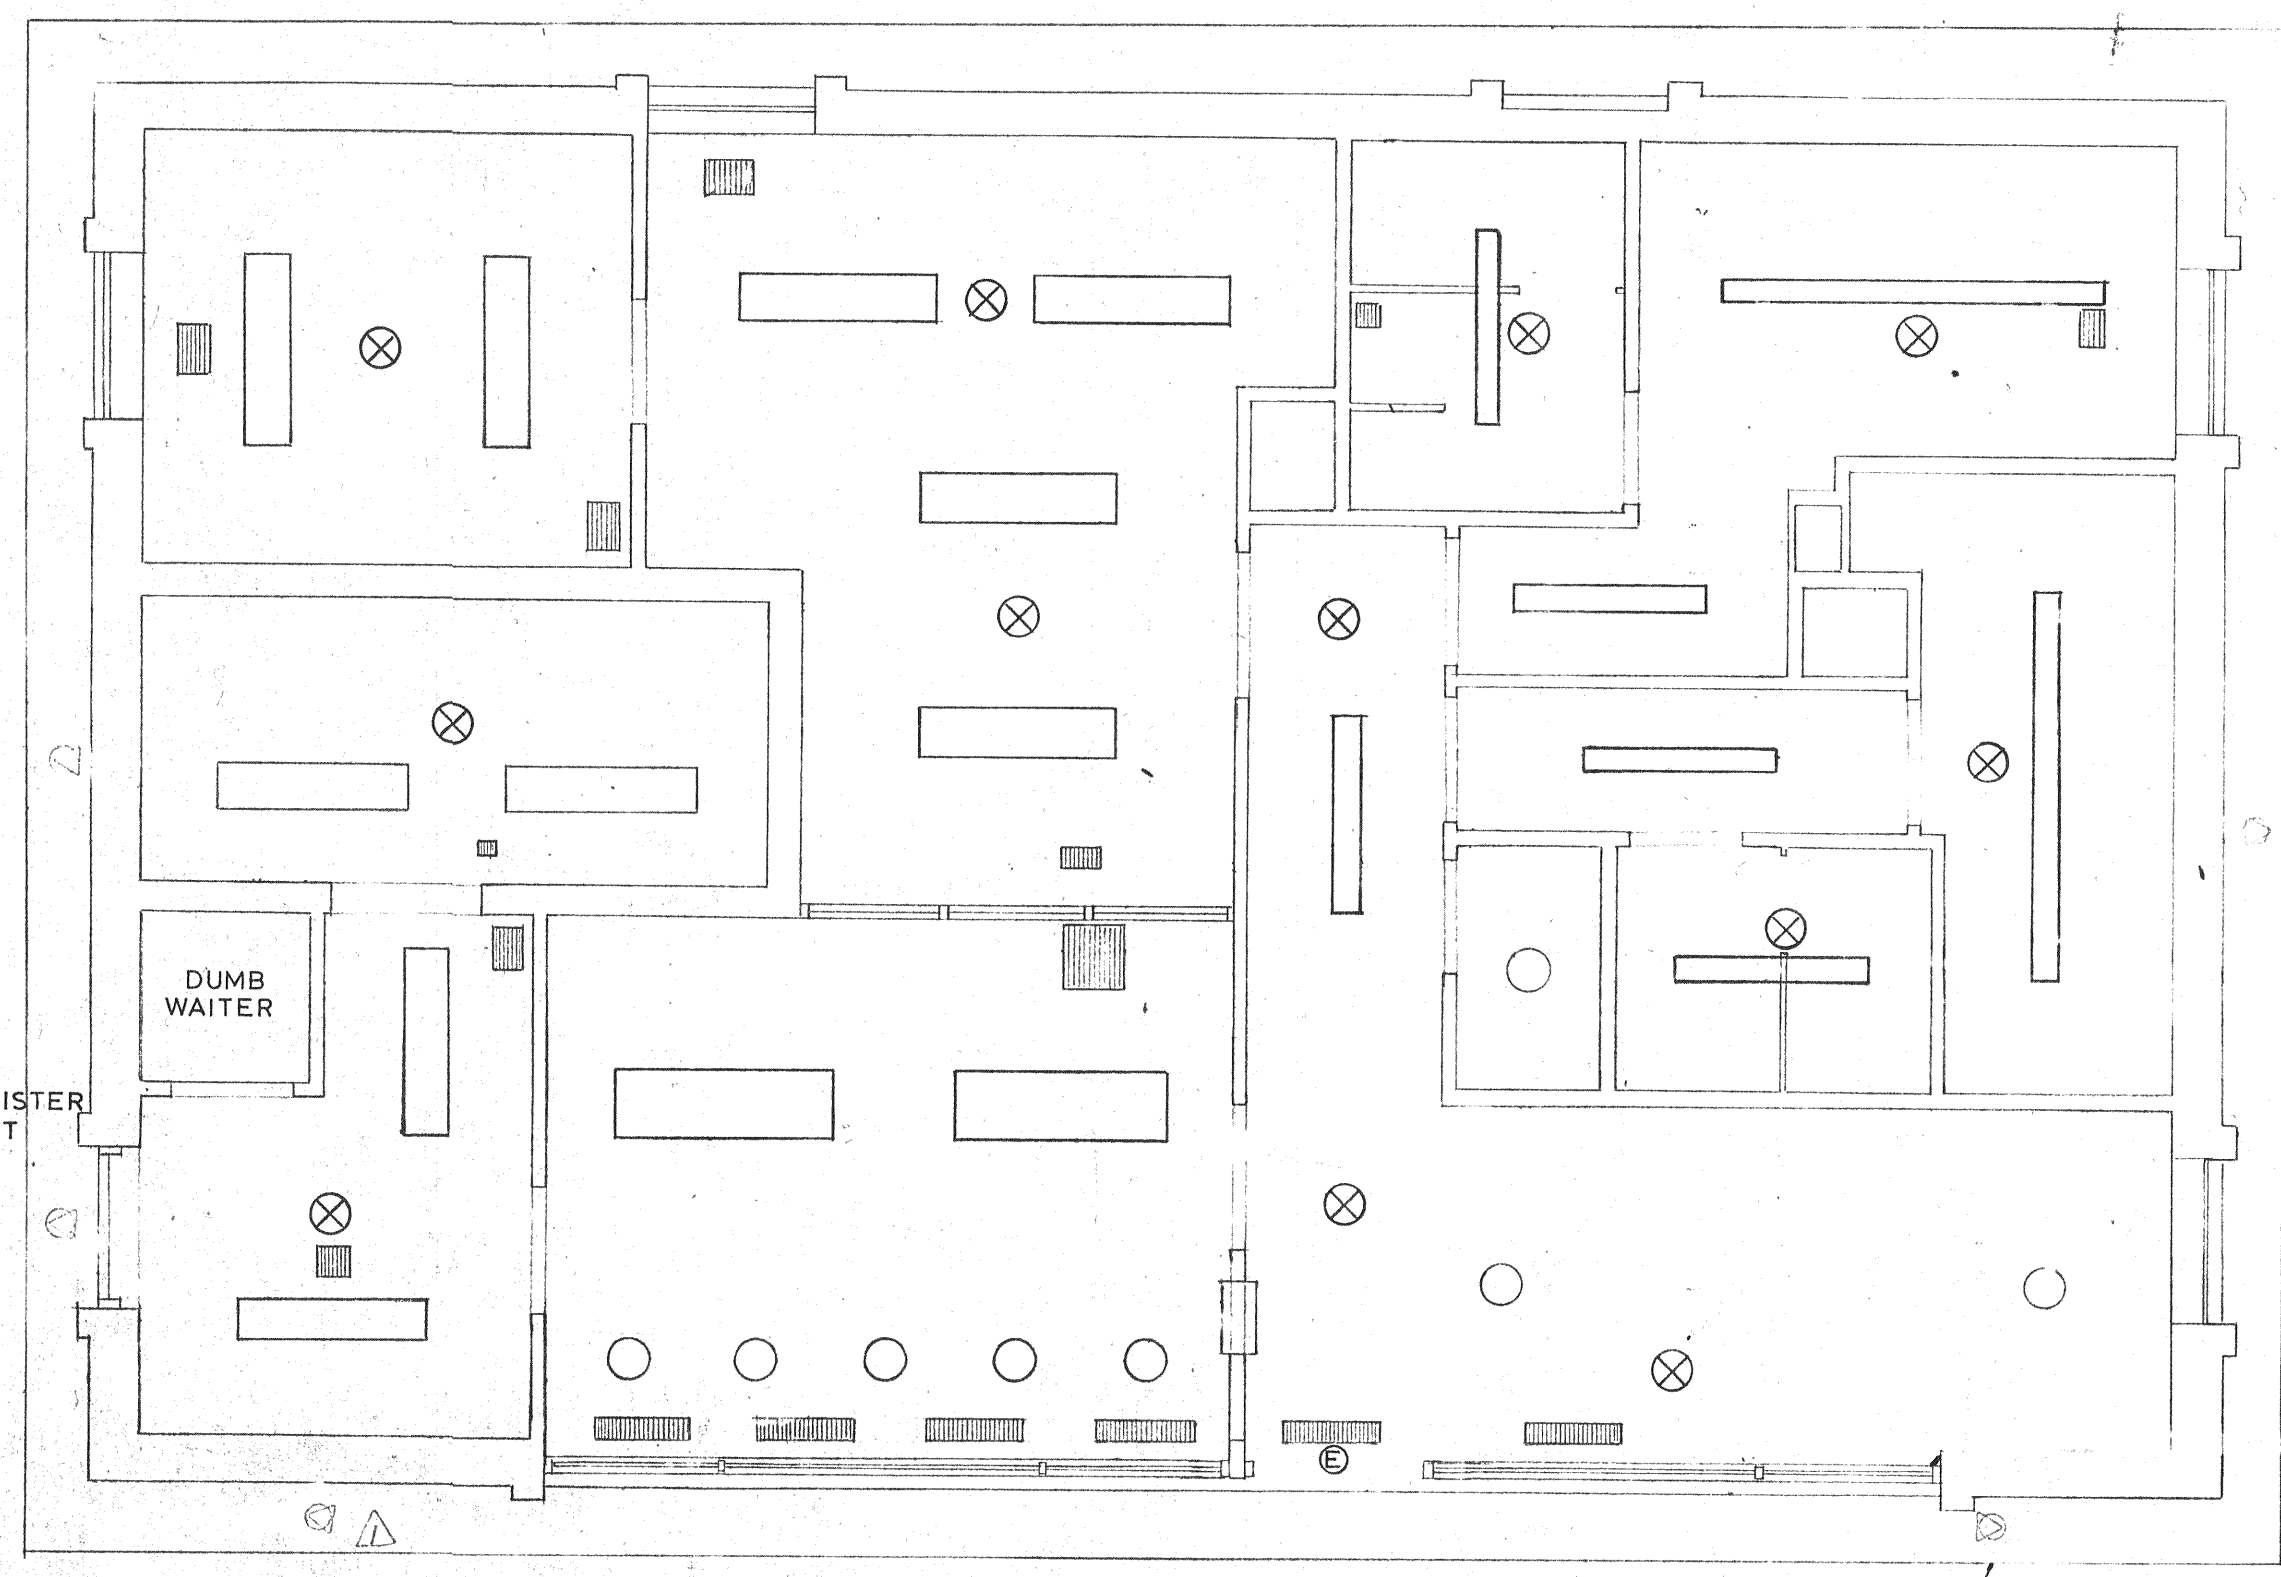


FIRST FLOOR CEILING PLAN


- LEGEND**
- PARTITION
 - 6x12 DUCT (SIZE)
 - FLUORESCENT FIXTURE
 - INCANDESCENT FIXTURE
 - EMERGENCY INCAND. FIXTURE
 - CLG. AIR REGISTER
 - EXHAUST FAN
- ABBREVIATIONS**
- TR TOP REGISTER
 - CR CEILING REGISTER
 - CFM CUB. FT. / MIN.
 - CW COLD WATER

MOTOR SCHEDULE

1. INLINE PUMP, TUNNEL HW. #3	32 GPM. 42 FT HEAD	3/4 HP	208/3/60
2. CIRCULATOR 1	12 GPM. 12 FT HEAD	1/6 HP	115/1/60
3. CIRCULATOR 2	12 GPM. 12 FT HEAD	1/6 HP	115/1/60
4. EXHAUST FAN, KITCHEN	50 CFM.		115/1/60 50 W
5. EXHAUST FAN, MEN TOILET	50 CFM.		115/1/60 50 W
6. EXHAUST FAN, FEMALE TOILET	50 CFM.		115/1/60 50 W
7. A/C AIRHANDL. UNIT	3000 CFM	2 HP	208/3/60
8. CONDENSING UNIT 1	3000 CFM	2 HP	208/3/60 30 KW
9. CONDENSING UNIT 2	1300 CFM	1 HP	208/3/60 10 KW
10. HVAC UNIT	1300 CFM	1 HP	208/3/60 10 KW
11. OIL BURNER		1/3 HP	115/1/60
12. DAMPER MOTOR 1		1/6 HP	115/1/60
13. DAMPER MOTOR 2	SEE BASEMENT HEATING PLAN	1/6 HP	115/1/60
14. DAMPER MOTOR 3		1/6 HP	115/1/60
15. DAMPER MOTOR 4		1/6 HP	115/1/60
16. SEWAGE EJECTOR		1/5 HP	115/1/60
17. UNIT HEATER 1		1/3 HP	115/1/60
18. UNIT HEATER 2	BARRIER PL. BOOTHS	1/3 HP	115/1/60
19. UNIT HEATER 3		1/3 HP	115/1/60
20. UNIT HEATER 4		1/3 HP	115/1/60
21. TUNNEL HEATER 1		1/5 HP	115/1/60
22. TUNNEL HEATER 2		1/5 HP	115/1/60
23. DUMBWAITER		1 HP	208/3/60
FOR RAMPS. (TOTAL 4) ELECTROMODE ELECT HEATER			240 V 1/60 3 KW

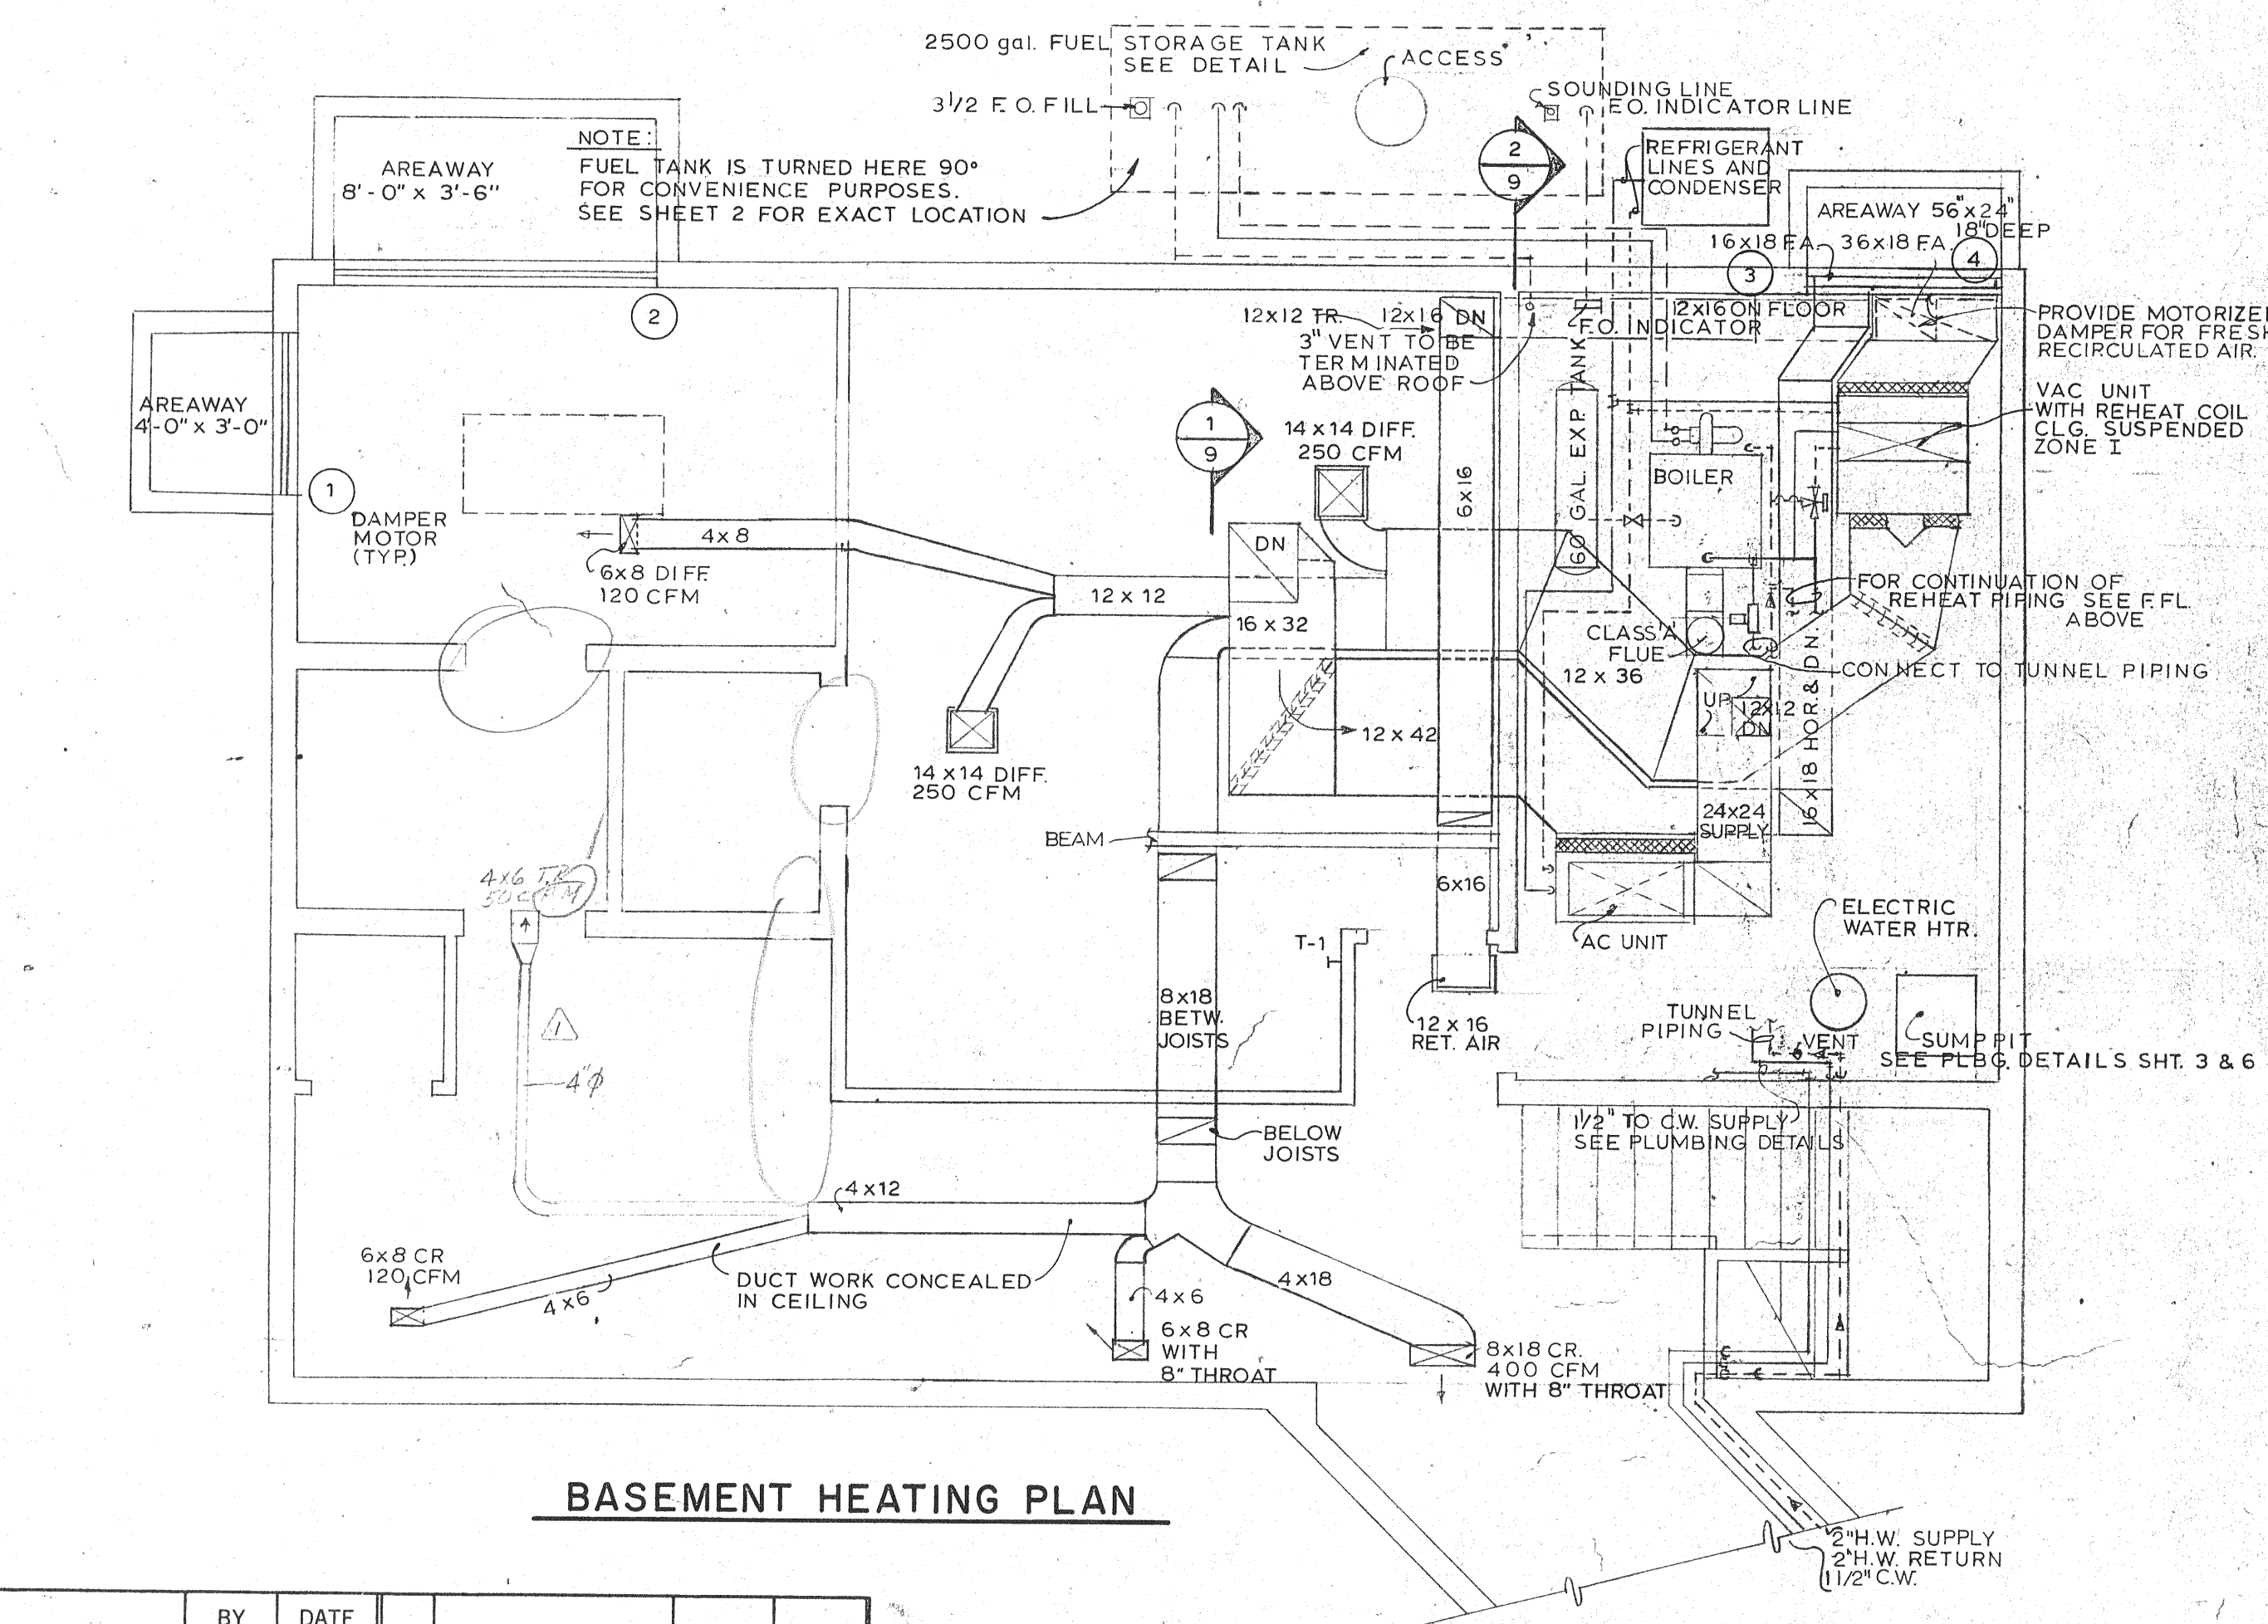

BASEMENT HEATING PLAN

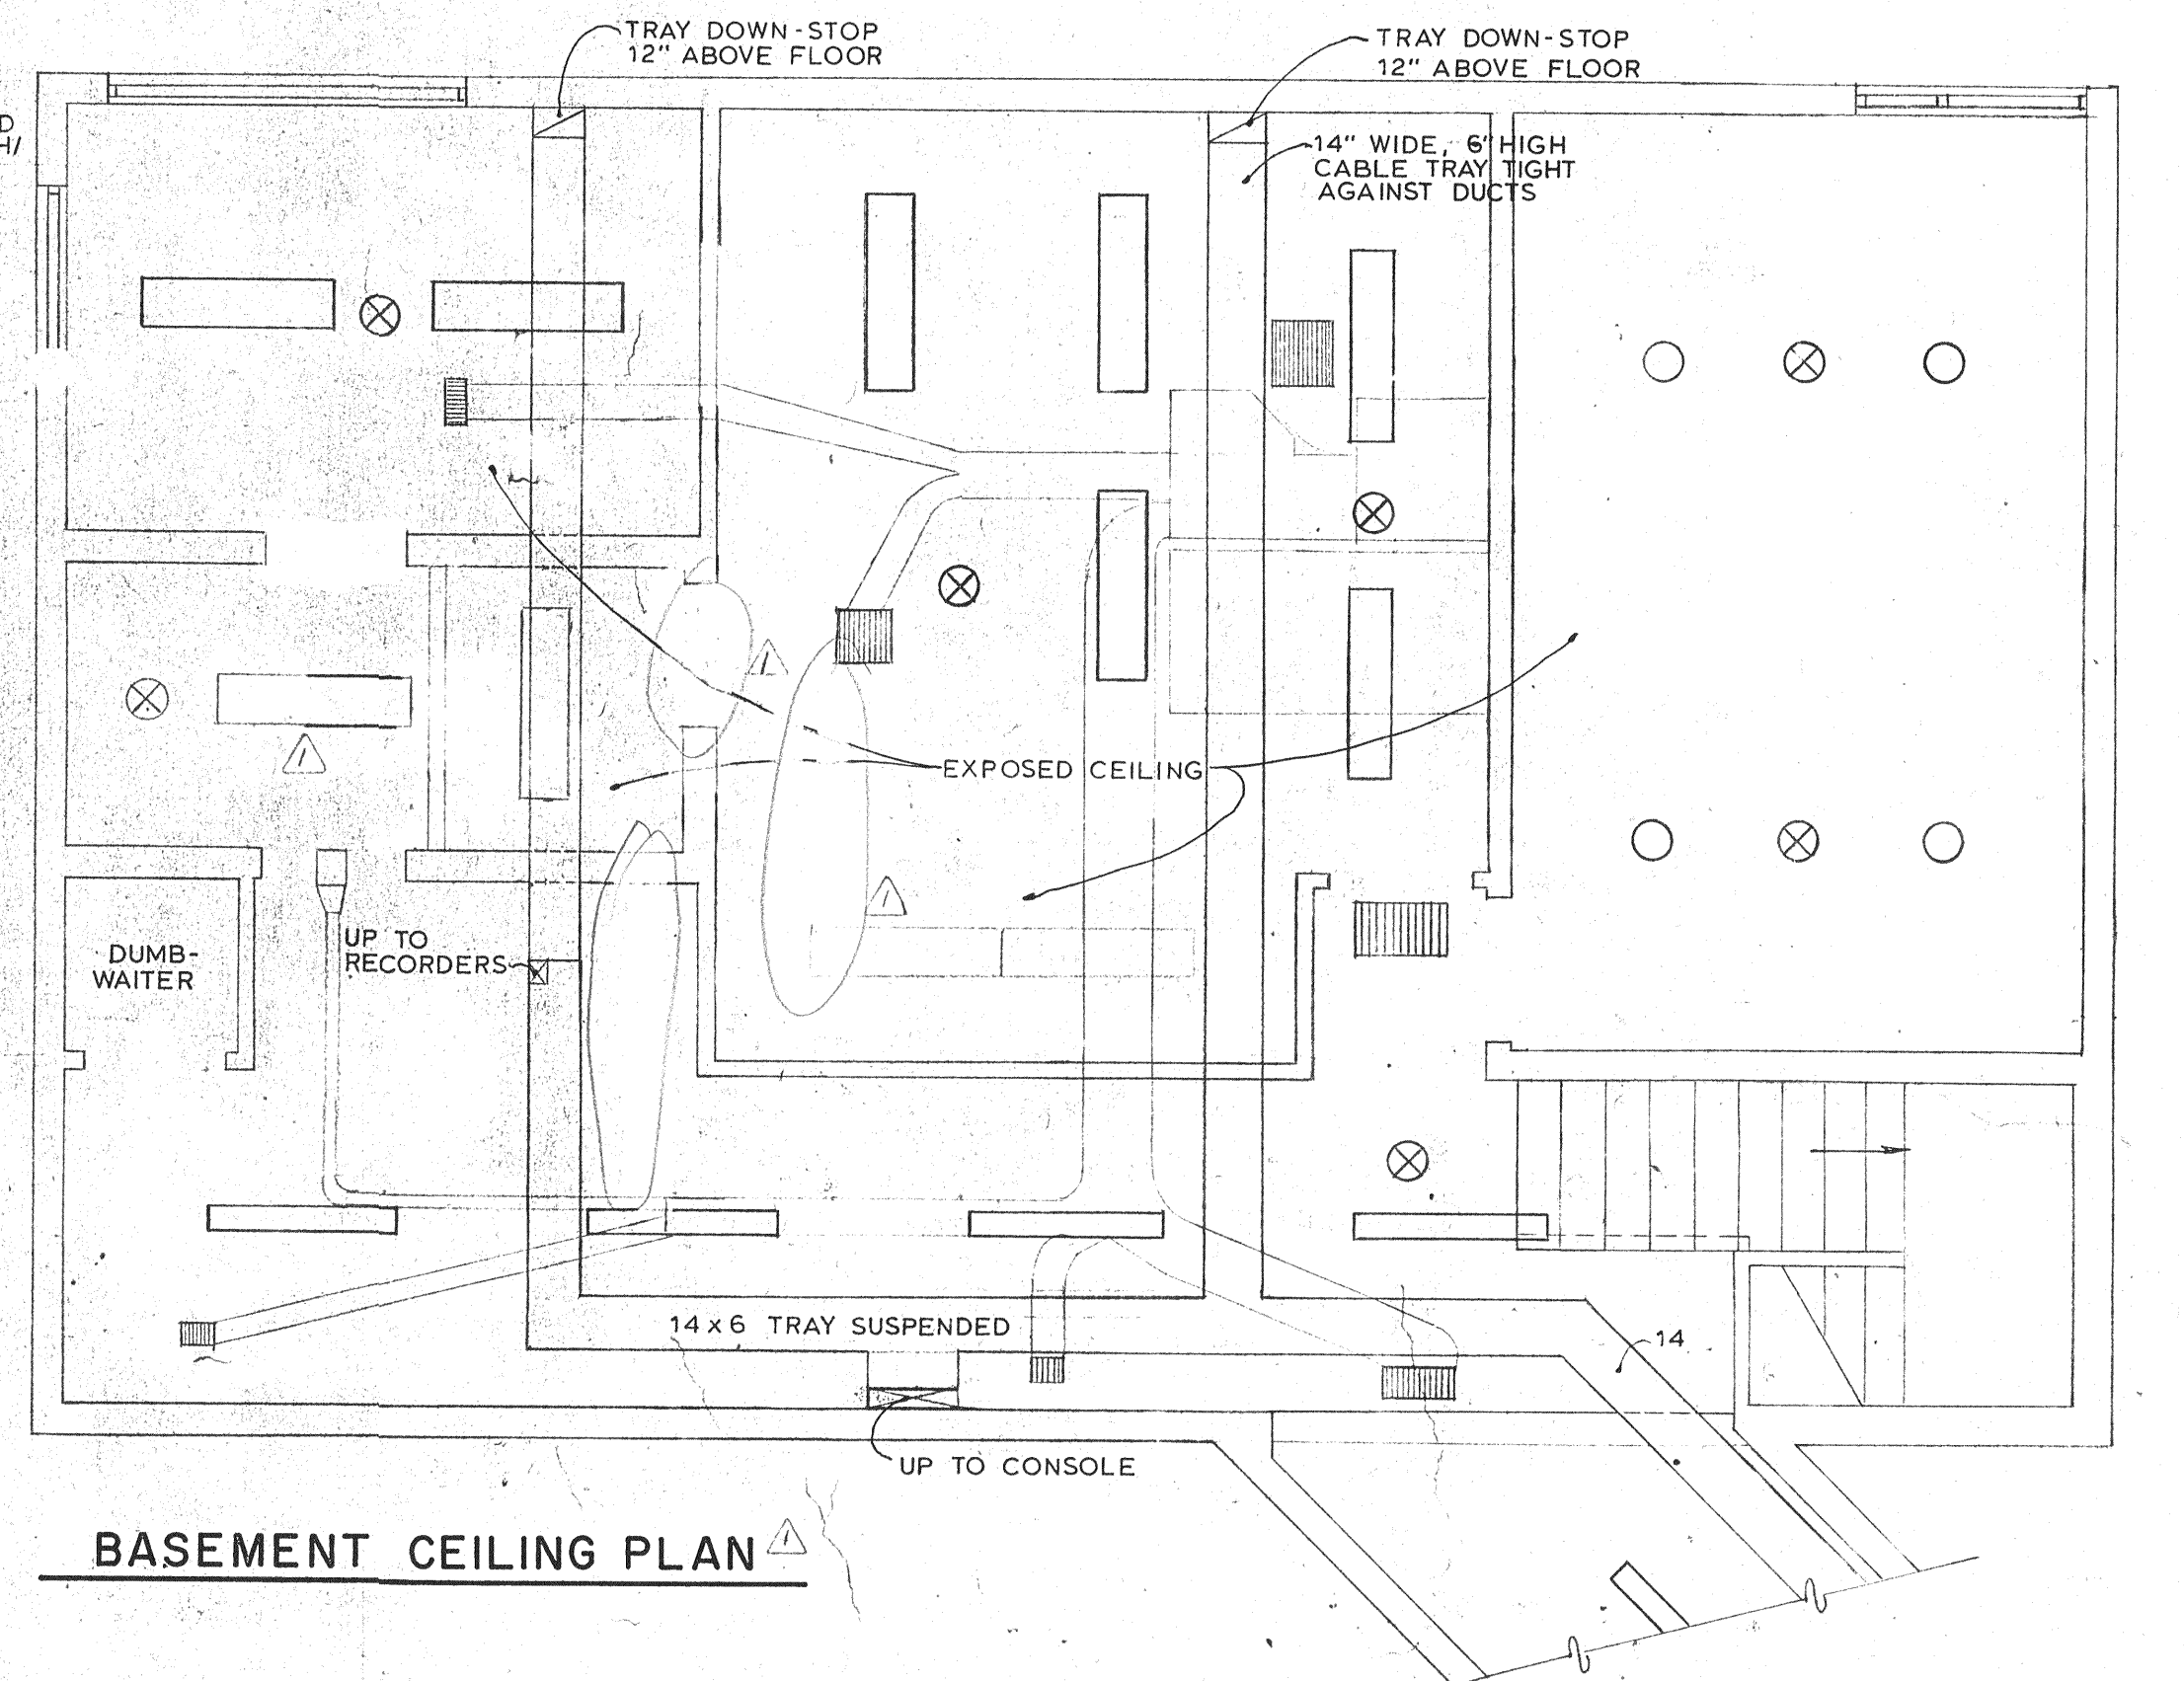

BASEMENT CEILING PLAN

BY	DATE				
MADE	R.B.M.	7-31-71			
CHECKED	KL.	7-31-71	REV# 1	JRC	8-72
IN CHARGE	J.P.F.		NO.	REVISION	BY DATE


NOTE: PROVIDE CLEANOUTS AND ACCESS PANELS WHERE CODE AND CONVENIENCE REQUIRES.

RICHMOND METROPOLITAN AUTHORITY
RICHMOND EXPRESSWAY SYSTEM
POWHITE PARKWAY

UTILITY BUILDING
HTG/AC AND REFL. CLG. PLAN

HOWARD, NEEDLES, TAMMEN & BERGENDOFF
 consulting engineers
 NEW YORK ALEXANDRIA KANSAS CITY

SCALE: NOT TO SCALE
 CONTRACT NO.: TF-2
 SHEET NO. 8 OF 11

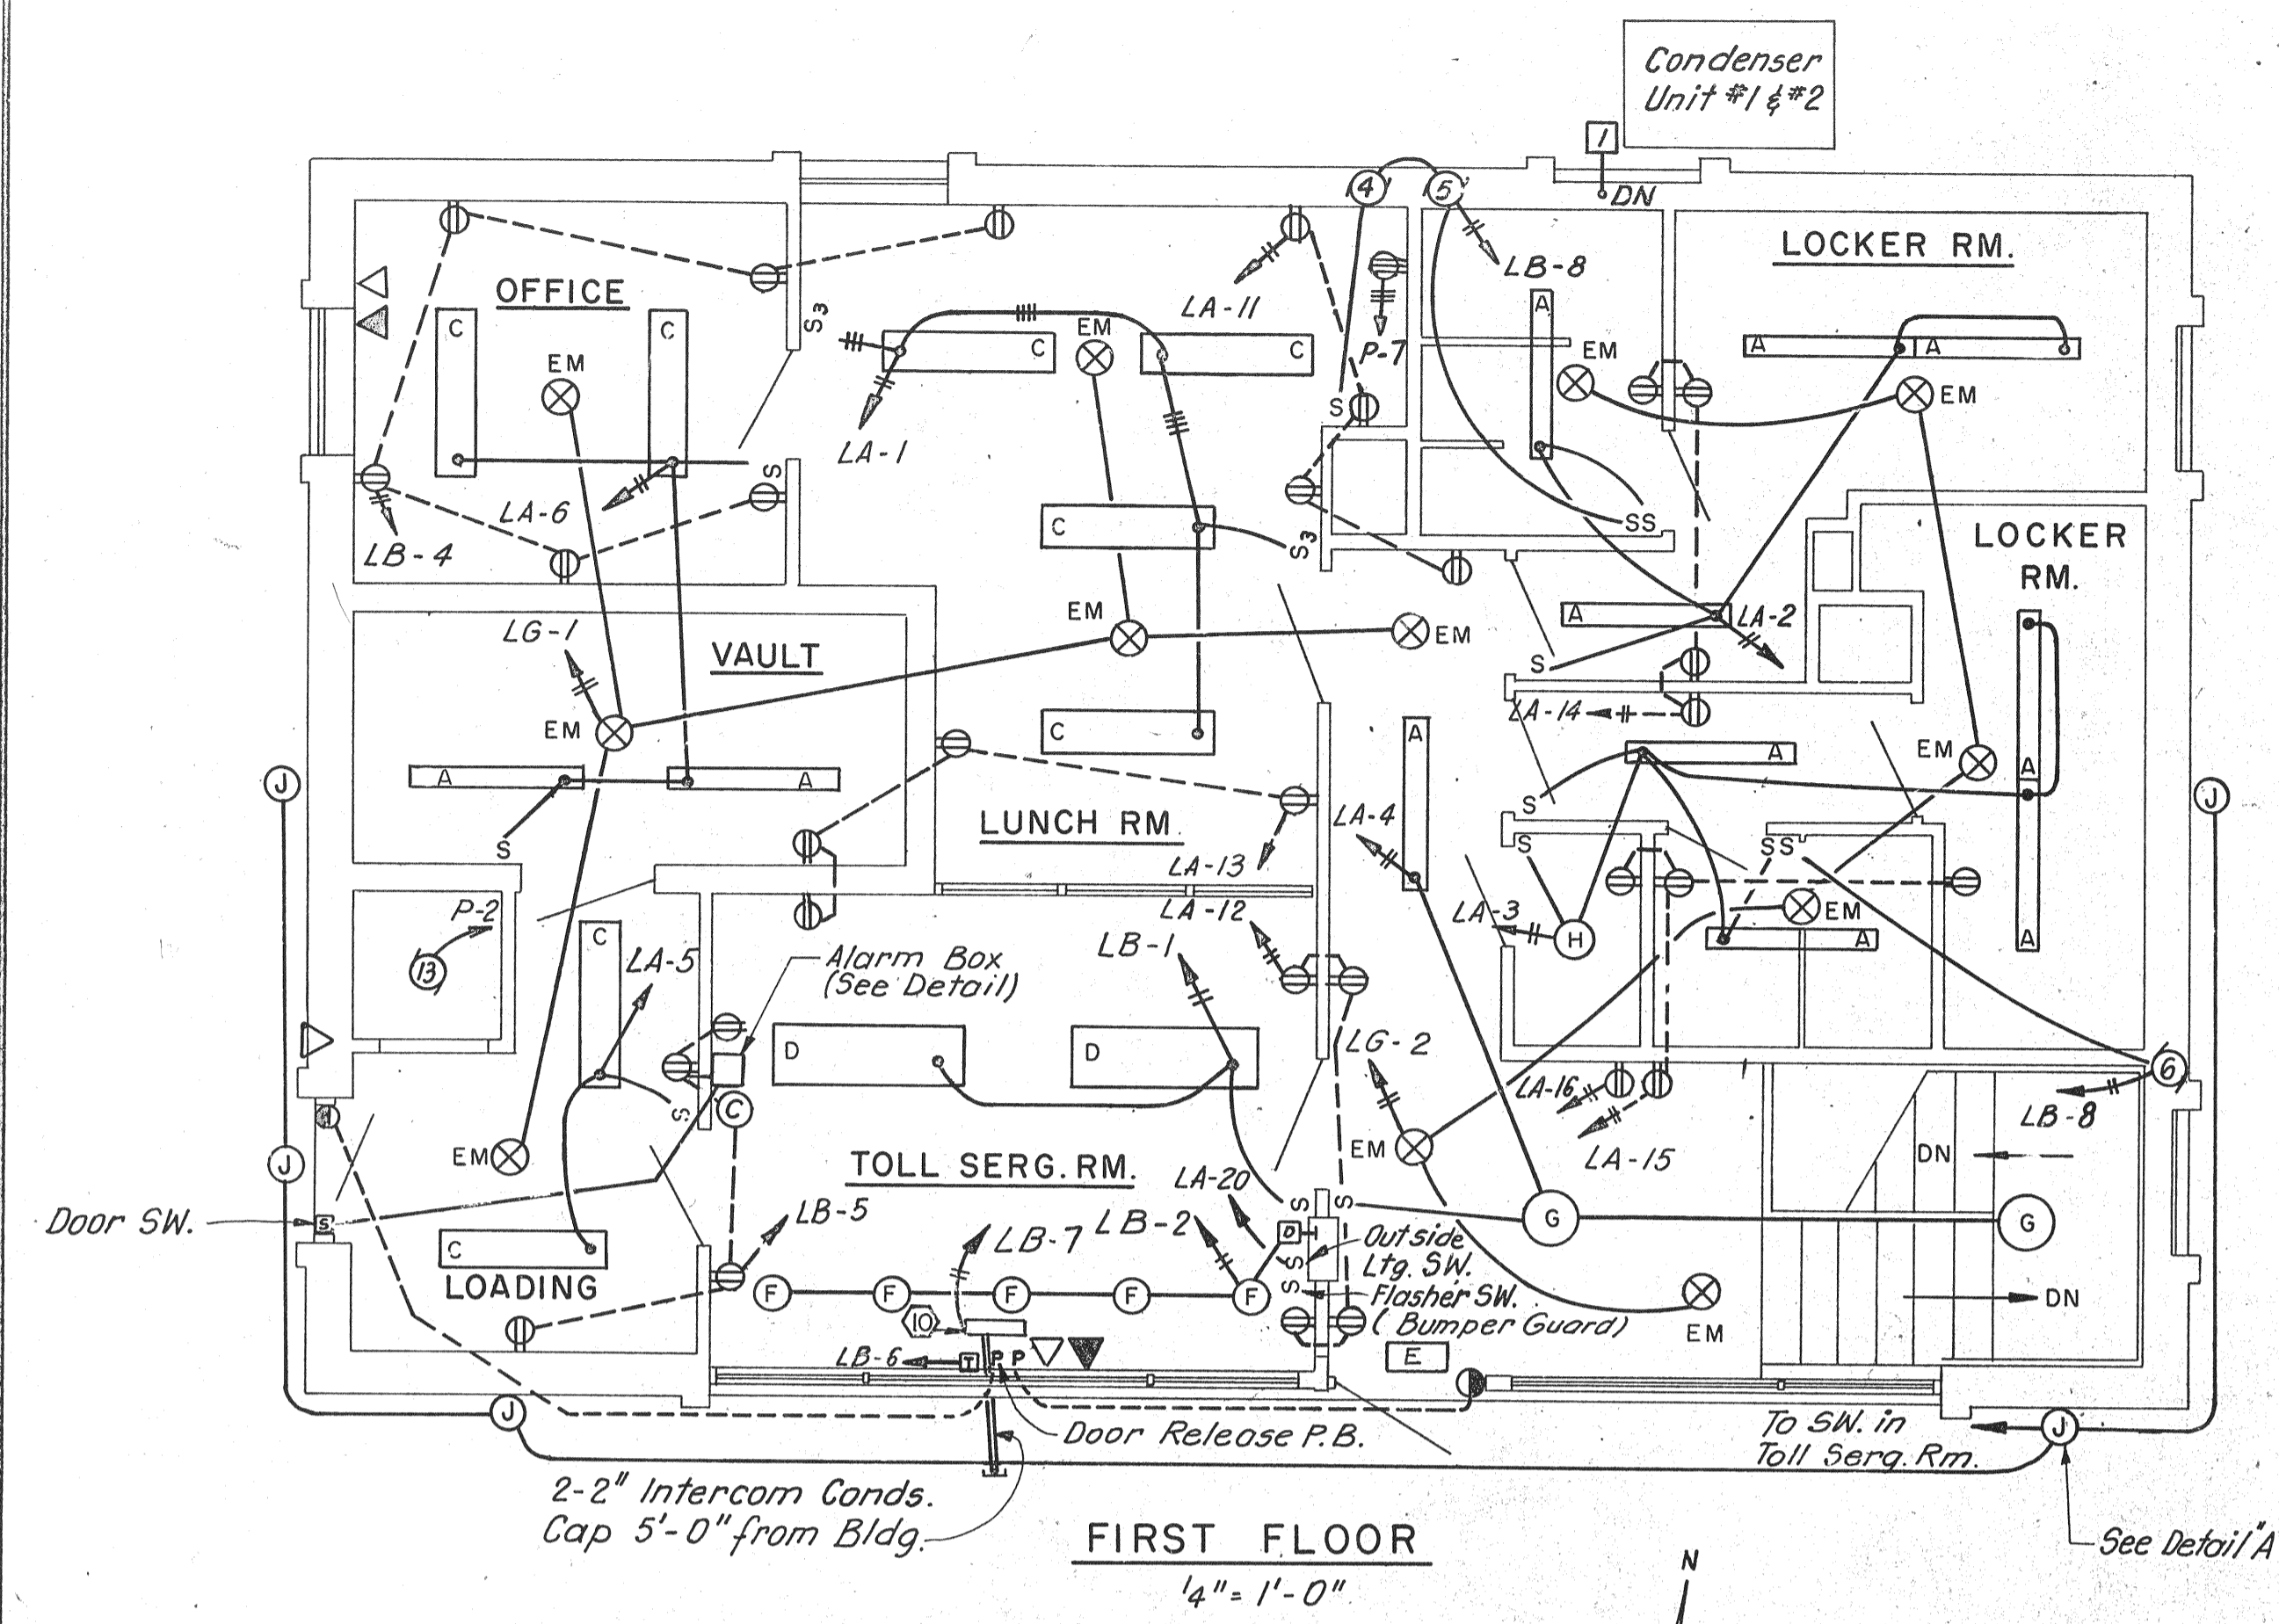


LEGEND

- ⊗ Fluorescent Fixture, Letter indicates type.
- ⊙ Incandescent Fixture, Letter indicates type.
- ⊕ Emergency Light - in ceiling
- ⊖ Emergency Light - Wall Mounted
- ⊘ Exit Light
- ⊙ Dimmer
- ⊕ Duplex Wall Receptacle Outlet
- ⊖ Range Receptacle
- ⊙ Single Pole Switch
- ⊖ Threeway Switch
- ⊕ -P Door Release system
- ⊙ Telephone Outlet
- ⊖ Intercom System telephone Outlet
- ⊙ Electric clock outlet
- ⊖ Transformer for Door Release system
- ⊕ Panel Board
- Wiring Concealed in Walls or Ceiling
- Wiring Concealed in Floor.
- LA-3 Home run with Panel & Circ. Designation

- ① Circu. Pump #1 (Zone-1), 1/2 HP, 115V, 1φ, 60 co, 2#12
- ② Circu. Pump #2 (Zone-2), 1/2 HP, 115V, 1φ, 60 co, 2#12
- ③ Circu. Pump #3 (Tunnel), 3/4 HP, 208V, 3φ, 60 co, 4#12
- ④ Exhaust Fan (Kitchen)
- ⑤ Exhaust Fan (Men toilet)
- ⑥ Exhaust Fan (Women toilet)
- ⑦ Damper Motor #1
- ⑧ Damper Motor #2
- ⑨ Damper Motor #3
- ⑩ Damper Motor #4
- ⑪ Oil Burner, 1/2 HP, 115V, 1φ, 60 co, 2#12
- ⑫ Storm Sewage Ejector, 1/2 HP, 115V, 1φ, 60 co, 2#12
- ⑬ Dumb Waiter 1 HP, 208V, 3φ, 60 co, 4#12
- ⑭ Condenser Unit #1 (2HP & 30 KW) & Condenser Unit #2 (1HP & 10 KW)
- ⑮ A/C Air handling Unit (2HP)
- ⑯ HVAC Unit (1HP)

General Notes:
1- For Lighting Fixture Schedule see Spec's.

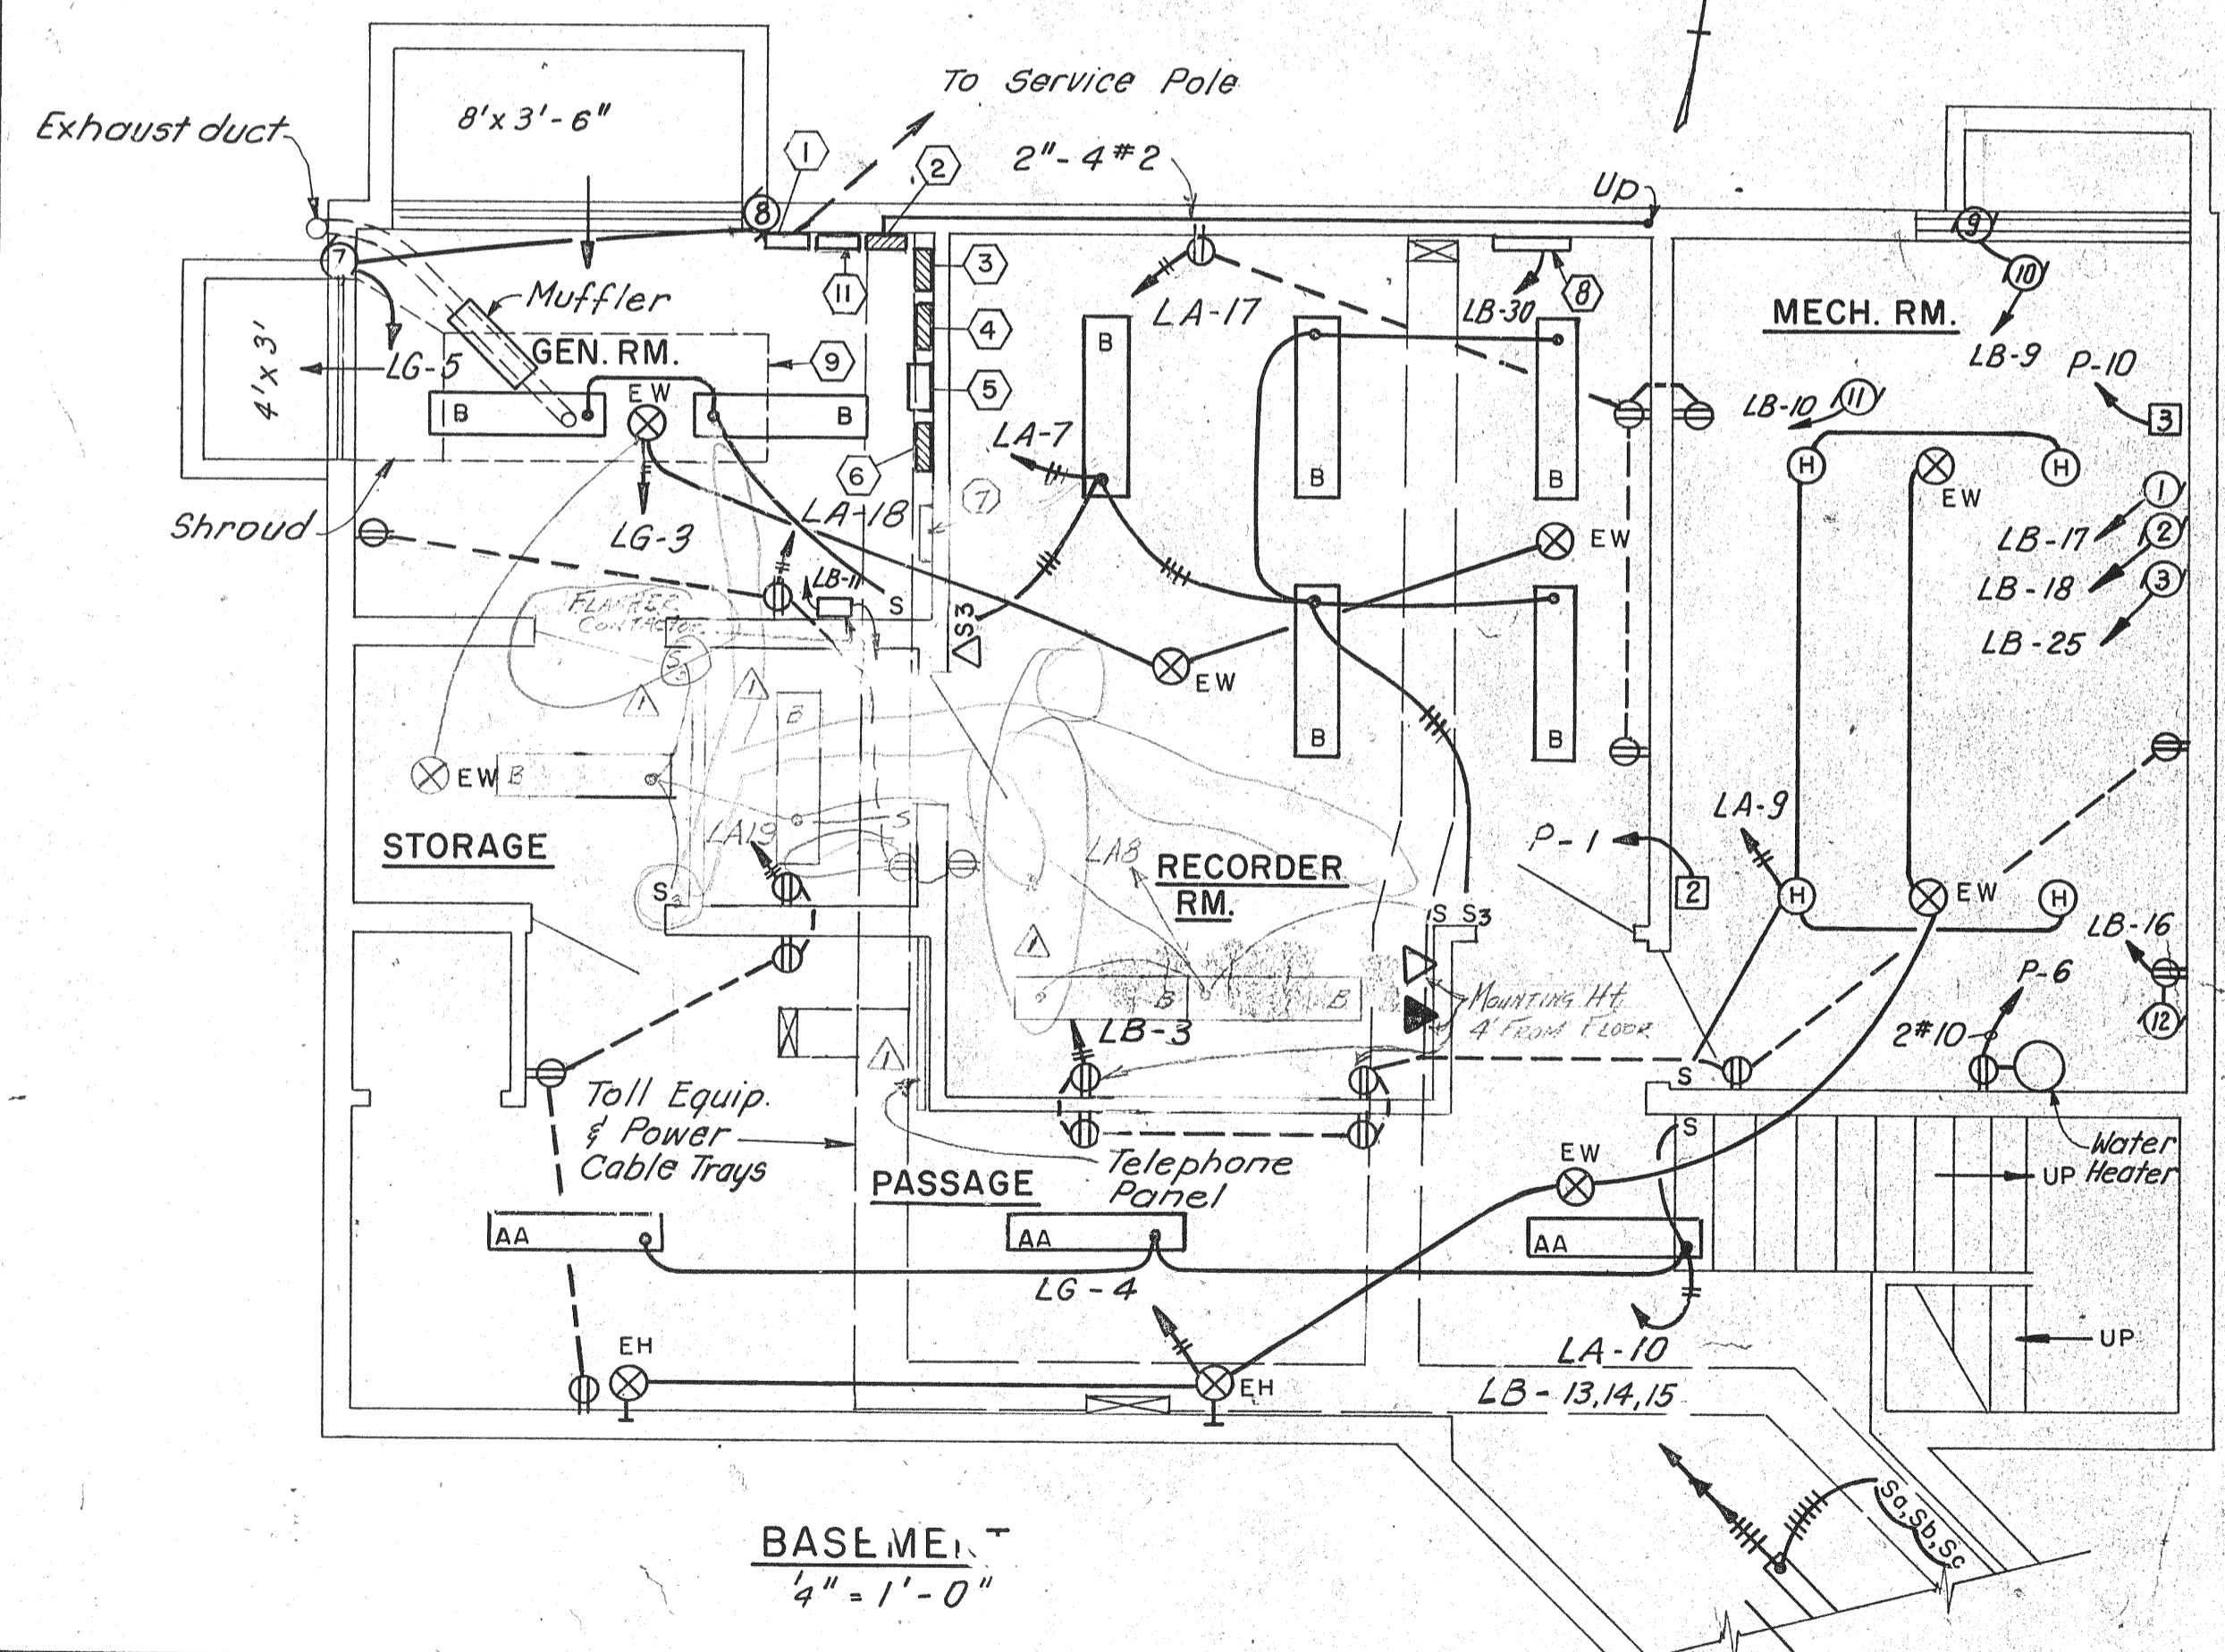



MAIN DISTRIBUTION PANEL-P			
120/208V, 3φ, 4W, 5N, 42 Poles, Westinghouse 600A BUS Type CDP			
Circ. No.	Pole	Trip	Description
1	2	20A	AC Air handling Unit (2HP)
2	2	20A	Dumb Waiter (1HP)
3	2	20A	Spare
4	3	20A	Spare
5	3	20A	Spare
6	2	30A	Elect. W.H. Utility (4KW)
7	2	50A	Kitchen Unit (8.5 KW)
8	2	30A	Spare
9	3	30A	Spare
10	3	50A	HVAC Unit (1HP & 10KW)
11	3	50A	Spare
12	3	150A	Condensers #1 & #2 (@ 43.0 KW)
13	3	150A	Panel Board - LA
14	3	150A	Panel Board - LB
15	3		Space
16	3		Space

PANEL BOARD - LA			
120/208V, 3φ, 4W, 5N, 32 Poles, Westinghouse 225A BUS Type WBA			
Circ. No.	Pole	Trip	Description
1,2,3,4,5,6,7,8,9,10,11,12,13,14,15	1	20A	Ltg. 1st Floor
16	1	20A	Ltg. Basement
17,18,19	1	20A	Receptacles 1st Floor
20	1	20A	Elect. Water Cooler
21	1	20A	Receptacles Basement
22	1	20A	Out side flood Ltg.
23	1	20A	Spare
24	1	20A	Spare
25	1	20A	Spare
26	1	20A	Spare
27	1	20A	Spare
28	1	20A	Spare
29,30	1		Space
31,32	1		Space

PANEL BOARD - LB			
120/208V, 3φ, 4W, 5N, 42 Poles, Westinghouse 225A BUS Type WBA			
Circ. No.	Pole	Trip	Description
1,2	1	20A	Ltg. 1st Floor
3,4,5	1	20A	Recept. 1st Fl. & Basement
6	1	20A	Door Release system
7	1	20A	Intercom Panel
8	1	20A	Exhaust Fans (three)
9	1	20A	Damper Motors #3 & #4
10	1	20A	Oil Burner
11	1	20A	Flasher, Contactor (Bumper Guard)
12	1	20A	Tunnel Heater Fans (two)
13,14,15	1	20A	Ltg. Tunnel
16	1	20A	Storm Sewage Ejector
17	1	20A	Circulator Pump #1
18	1	20A	Circulator Pump #2
19	1	20A	Stair Case Ltg. (Tunnel)
20,21	1	20A	Spare
22,23,24	1	20A	Spare
25	3	20A	Circulator Pump #3 (Tunnel)
26	3	50A	Toll Isl. "C" C.B. Panel -1
27	3	50A	Toll Isls. "D, E & F" C.B. Panel -2
28	3	50A	Toll Isls. "G, H & I" C.B. Panel -3
29	3	50A	Future Isls. "J & K" C.B. Panel -4
30	3	50A	P/BD-R (Record Rm)

PANEL BOARD - R			
120/208V, 3φ, 4W, 5N, 20 Poles, Westinghouse 100A BUS Type WBA			
Circ. No.	Pole	Trip	Description
1 to 16	1	20A	Recorder Room Circs.
17 to 20	1		Spaces

PANEL BOARD - LG			
120/208V, 3φ, 4W, 5N, 10 Poles, Westinghouse 100A BUS Type WBA			
Circ. No.	Pole	Trip	Description
1	1	20A	Ltg. 1st Floor (Emg.)
2	1	20A	Ltg. 1st Floor (Emg.)
3	1	20A	Ltg. Basement (Emg.)
4	1	20A	Ltg. Basement (Emg.)
5	1	20A	Damper Motors #1 & #2
6	1	20A	Spare
7	1	20A	Spare
8	1		Space
9	1		Space
10	1		Space

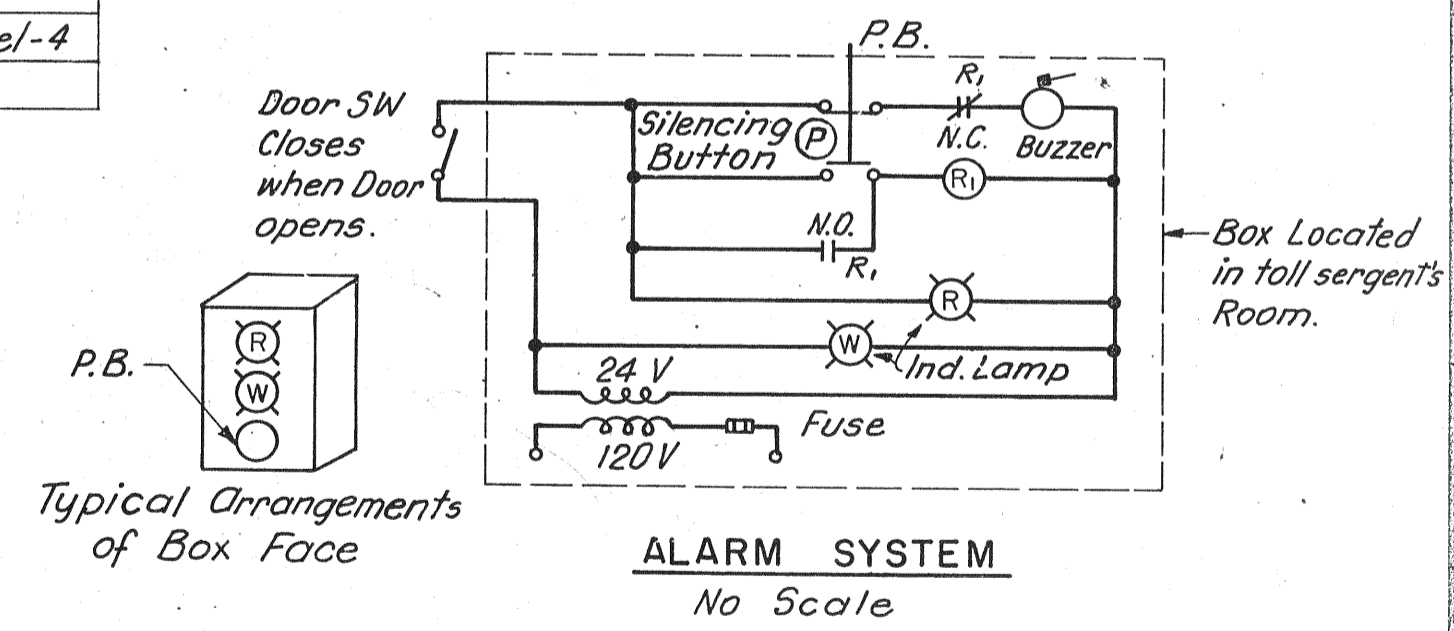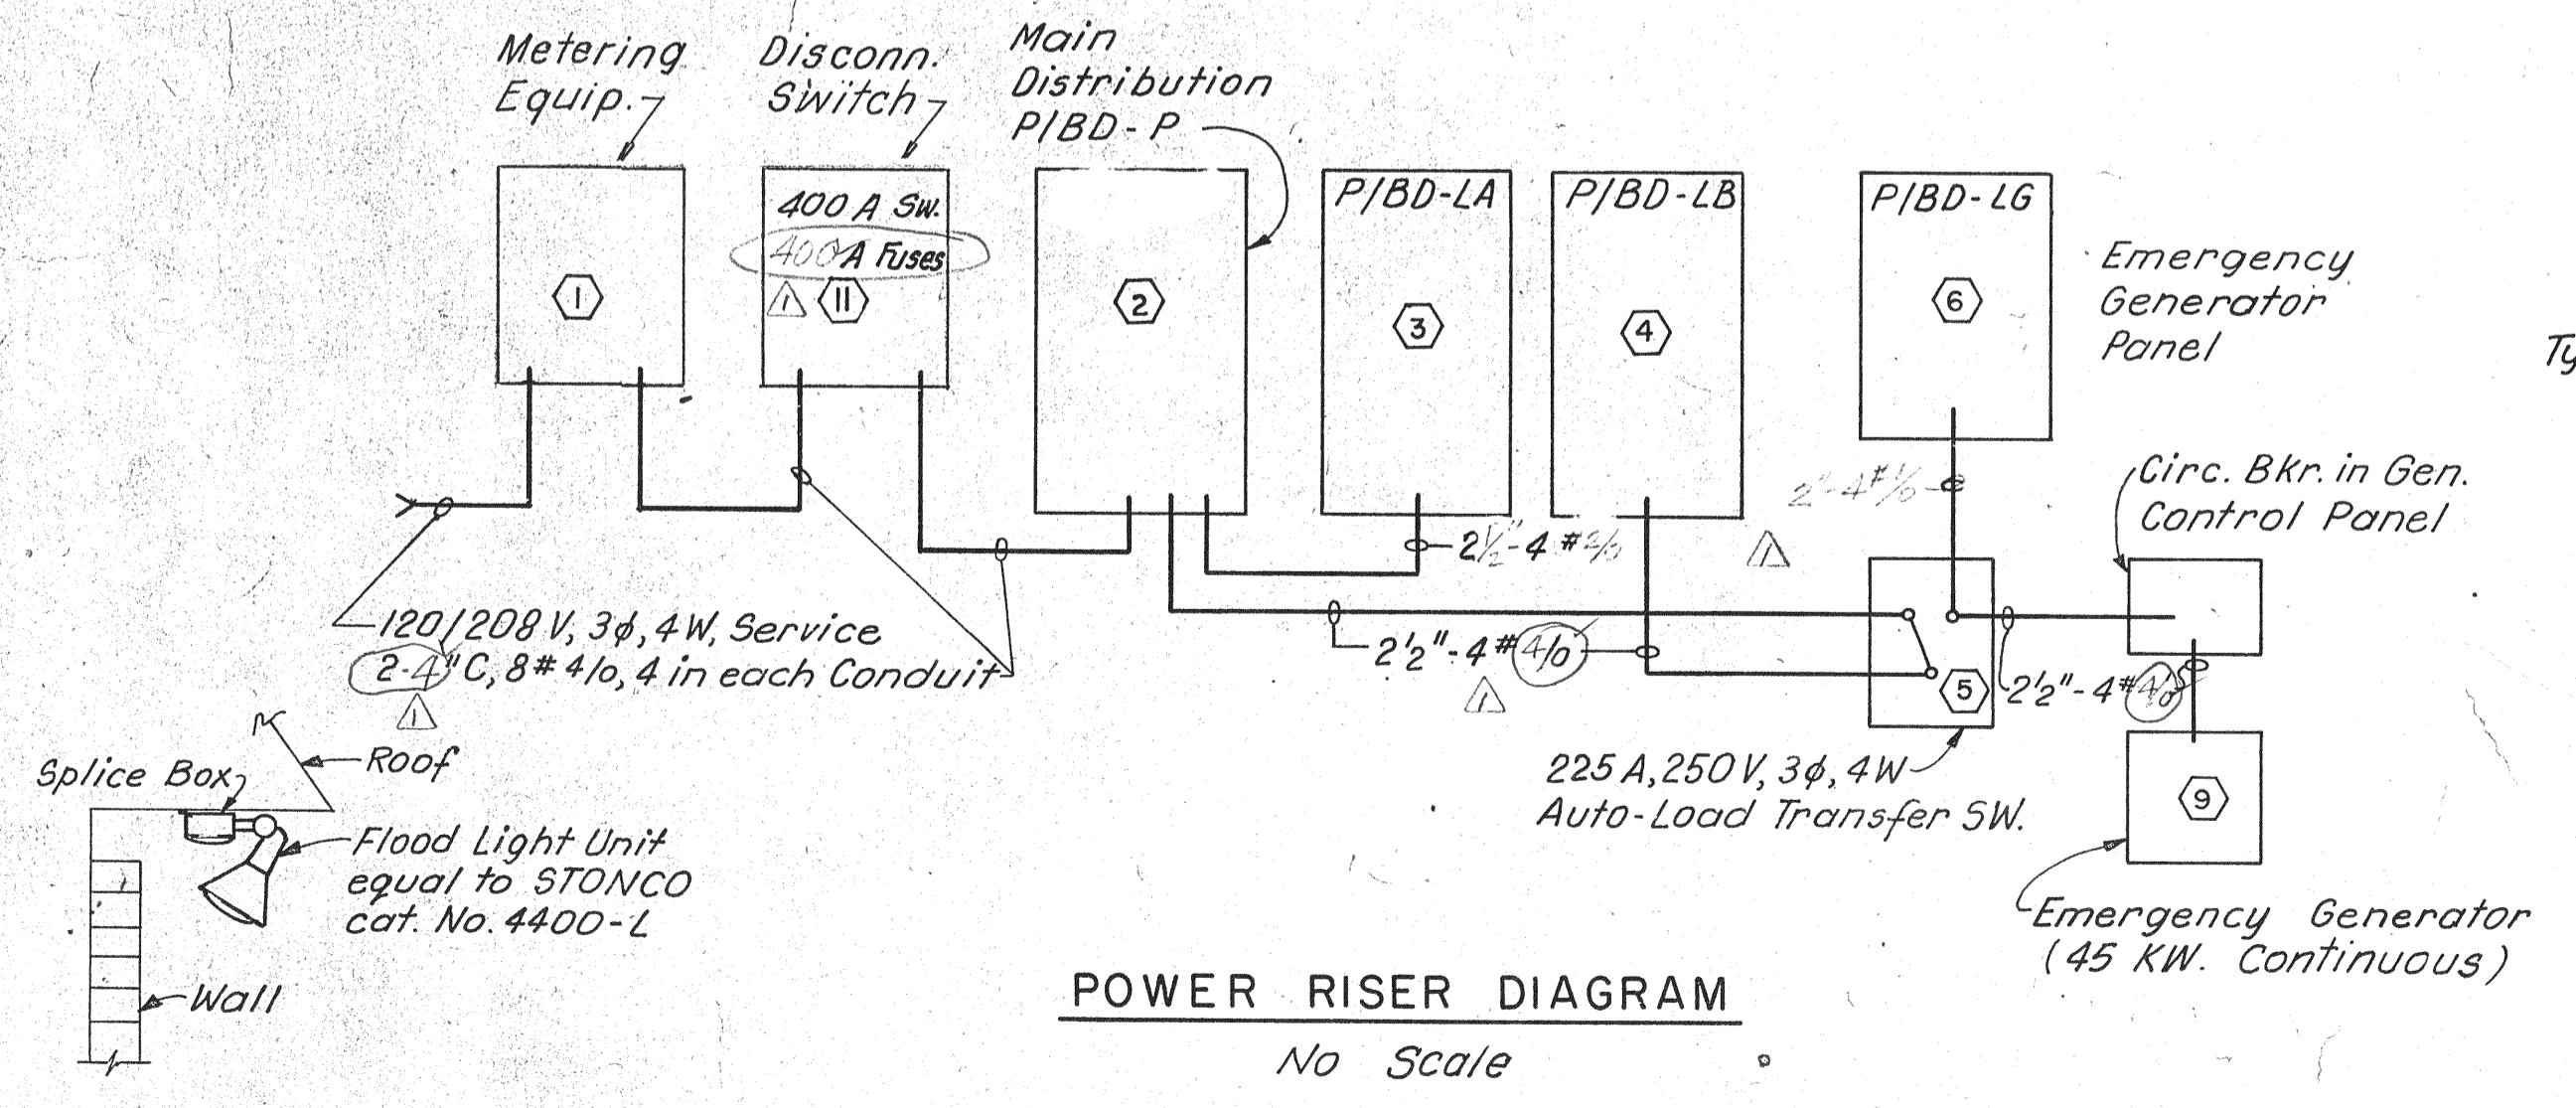

BY	DATE				
MADE	L.S.	3-2-72			
CHECKED	H.C.A.	3-2-72	Rev. for	J.K.C.	8-72
IN CHARGE	P.G.P.		NO.	REVISION	BY

RICHMOND METROPOLITAN AUTHORITY
RICHMOND EXPRESSWAY SYSTEM

UTILITY BUILDING
ELECTRICAL


HOWARD, NEEDLES, TAMMEN & BERGENDOFF
consulting engineers
NEW YORK ALEXANDRIA KANSAS CITY

SCALE: AS NOTED
CONTRACT NO. TF-2
SHEET NO. 10 OF 27

NORTHBOUND POWHITE PARKWAY TOLL PLAZA

1978 WIDENING

RICHMOND EXPRESSWAY SYSTEM			
SECTION	PROJECT	SHEET NO.	TOTAL SHEETS
TF-4	POWHITE PARKWAY	I	

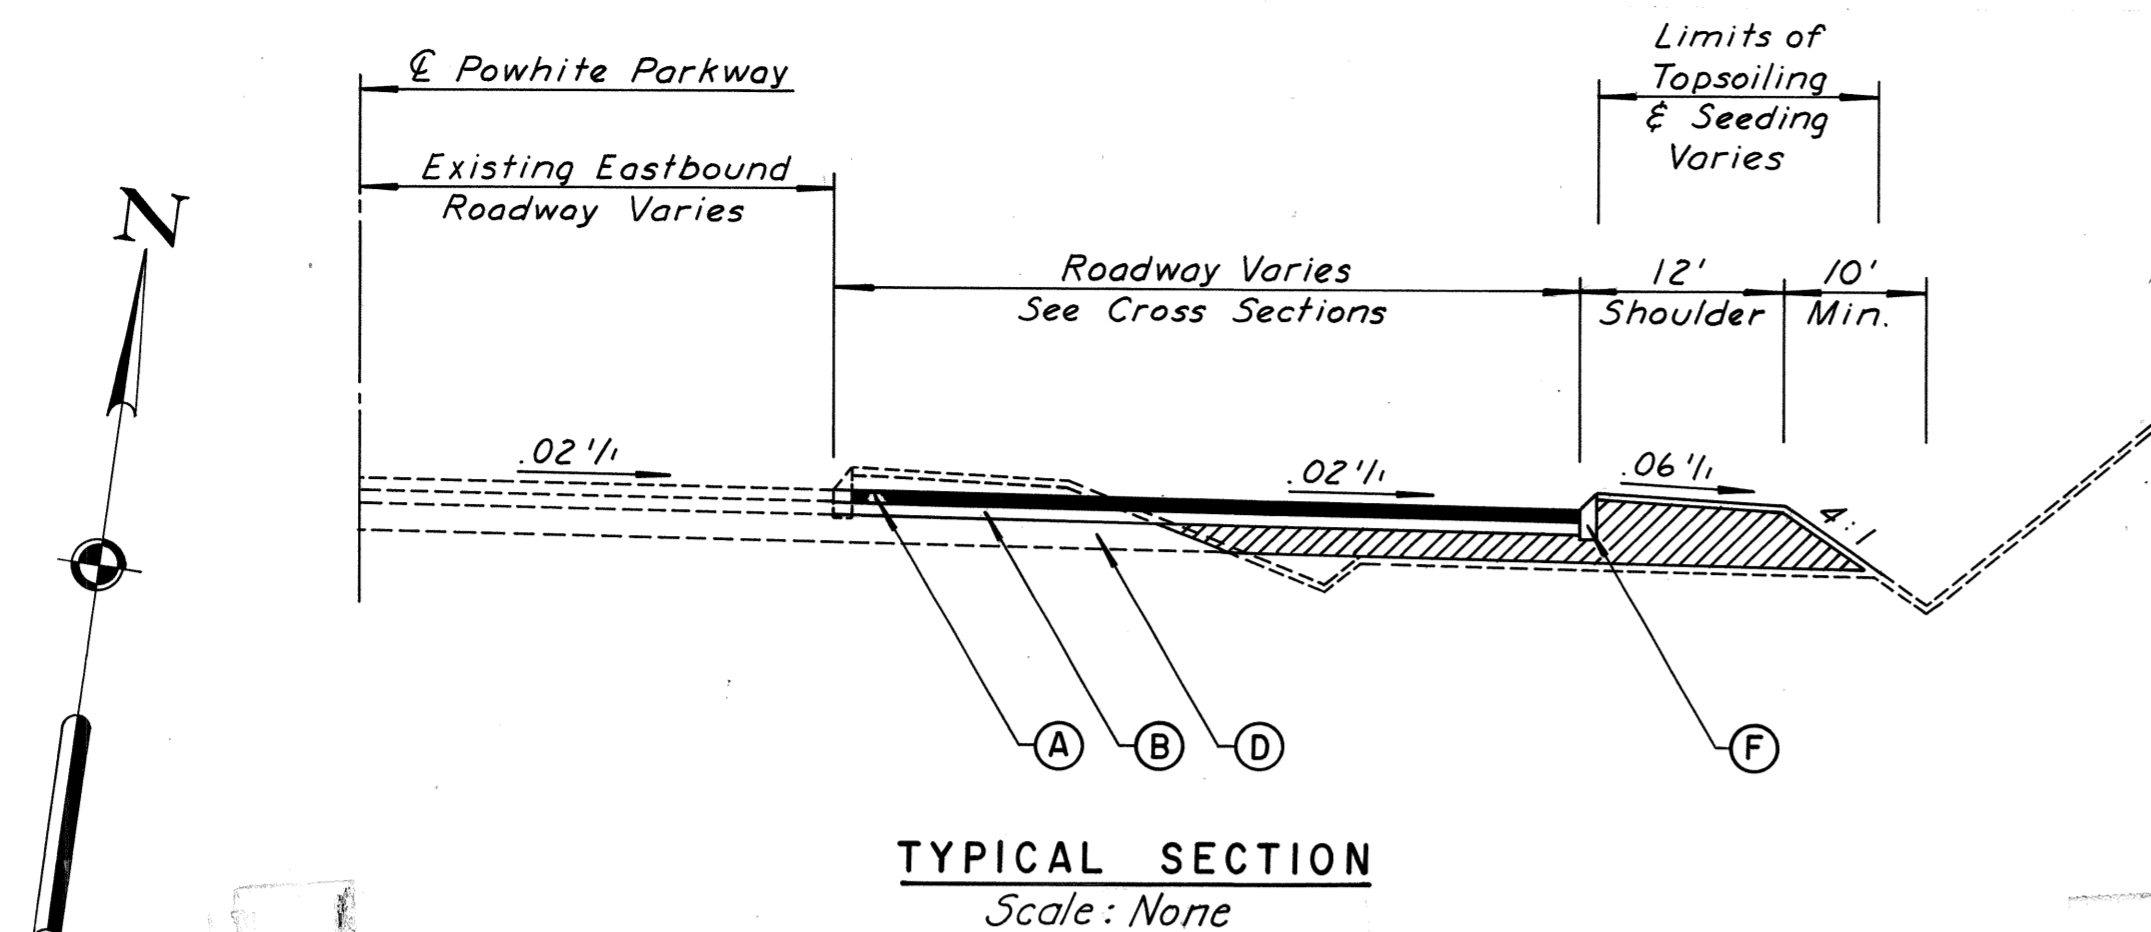


LEGEND:

- (A) - 1/2" Bituminous Concrete Surface Course Type S-5.
- (B) - 5 1/2" Bituminous Concrete Base Course Type B-3.
- (D) - 12" Aggregate Subbase Course, Size 21A. Prime Width of Pavement with 0.4 Gal./Sq. Yd. AE-2 or RC-250.
- (F) - Mountable Curb, CG-3.

CONSTRUCTION SEQUENCE:

1. Preparation for placement of concrete slab for Toll Plaza expansion to include all necessary conduit, installing or connecting subsurface drainage where required, removing existing caps to stairways to tunnel, etc.
2. Installing and extending necessary conduit for lighting & communication to include light pole foundations and junction boxes.
3. Island construction with emphasis on Lanes 9 & 10 for automatic coin collection to relieve peak traffic back-up.
4. Continuation of grading and pavement construction to provide access to expanded toll facilities. Put into operation new lighting and communications.
5. Completion of toll plaza island and equipment.
6. Final completion of pavement and toll plaza construction, including guard rail, sign relocation, pavement striping, etc.

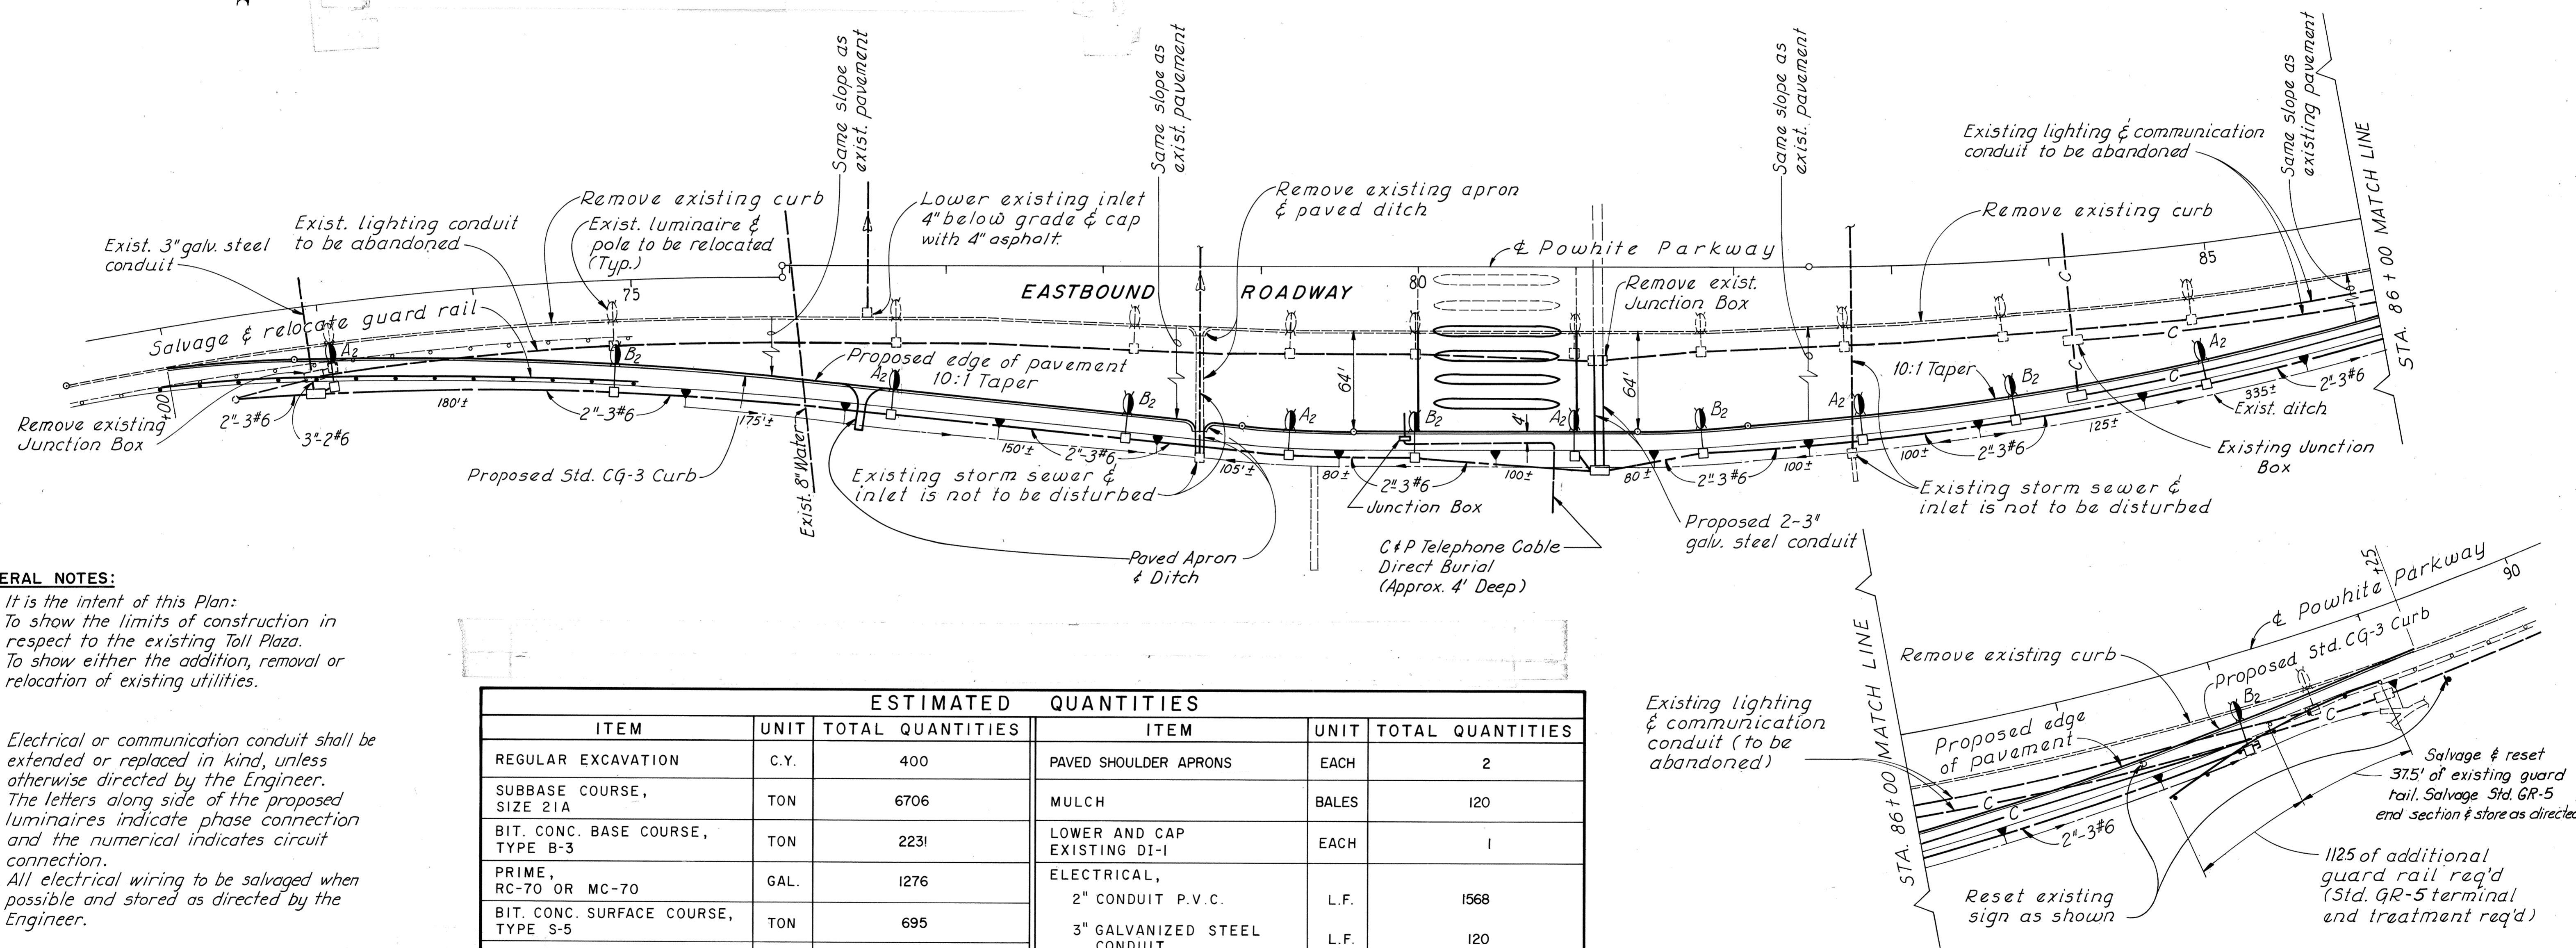

GENERAL NOTES:

1. It is the intent of this Plan:
 - a. To show the limits of construction in respect to the existing Toll Plaza.
 - b. To show either the addition, removal or relocation of existing utilities.
2. a. Electrical or communication conduit shall be extended or replaced in kind, unless otherwise directed by the Engineer.
 b. The letters along side of the proposed luminaires indicate phase connection and the numerical indicates circuit connection.
 c. All electrical wiring to be salvaged when possible and stored as directed by the Engineer.
3. Pavement striping shall be expanded to include expanded facility.
4. Rates of taper refer to offsets from centerline.

ESTIMATED QUANTITIES					
ITEM	UNIT	TOTAL QUANTITIES	ITEM	UNIT	TOTAL QUANTITIES
REGULAR EXCAVATION	C.Y.	400	PAVED SHOULDER APRONS	EACH	2
SUBBASE COURSE, SIZE 21A	TON	6706	MULCH	BALES	120
BIT. CONC. BASE COURSE, TYPE B-3	TON	2231	LOWER AND CAP EXISTING DI-1	EACH	1
PRIME, RC-70 OR MC-70	GAL.	1276	ELECTRICAL,		
BIT. CONC. SURFACE COURSE, TYPE S-5	TON	695	2" CONDUIT P.V.C.	L.F.	1568
CG-3	L.F.	1696	3" GALVANIZED STEEL CONDUIT	L.F.	120
REMOVAL, CG-3	L.F.	1740	# 6 ELECTRICAL CONDUCTOR	L.F.	5970
REMOVE AND RELOCATE, STD. GR-2A OR GR-2B	L.F.	402	CONCRETE JUNCTION BOX	EACH	2
STD. GR-2A OR GR-2B	L.F.	213	RESET LIGHT POLES	EACH	12
TOPSOIL, CLASS B	C.Y.	217	COMMUNICATIONS,		
SEED	LB.	200	2" METAL CONDUIT	L.F.	455
TACK COAT	GAL.	175	JUNCTION BOX	EACH	1
			SIGNING,		
			RESET SPEED SIGN	EACH	1

BY	DATE	REVISION	BY	DATE
MADE	D.B.P. 9-75			
CHECKED	C.C.J. 9-75	Misc. Rev	P.H.T.	9-75
IN CHARGE	J.P.F.			

**RICHMOND METROPOLITAN AUTHORITY
RICHMOND EXPRESSWAY SYSTEM
POWHITE PARKWAY**

**EXPANSION OF POWHITE TOLL PLAZA
GRADING, PAVEMENT AND UTILITY
PLAN**

STA. 72+00 TO STA. 89+25 E.B.L.







HOWARD, NEEDLES, TAMMEN & BERGENDOFF
consulting engineers
NEW YORK ALEXANDRIA KANSAS CITY

SCALE: 1" = 50'
CONTRACT NO.:
SHEET NO. 1 OF 18

AS BUILT

RICHMOND EXPRESSWAY SYSTEM			
SECTION	PROJECT	SHEET NO.	TOTAL SHEETS
TF-4	POWHITE PARKWAY	2	

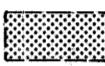


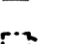
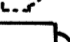



SEQUENCE


-  EXISTING EQUIPMENT TO REMAIN IN SERVICE.
-  NEW COLLECTION EQUIPMENT TO BE INSTALLED ON ISLANDS H AND I AS THEY ARE COMPLETED.
-  TOLL BOOTH AND EQUIPMENT TO SHIFT FROM ISLANDS F & G TO ISLANDS J & K IN SINGLE UNIT STAGES.
-  EQUIPMENT TO BE SHIFTED FROM ISLAND E TO ISLAND F. CAP CONDUIT ZONES ON ISLAND E TO ALLOW EASY FUTURE INSTALLATION OF UA MACHINE.
-  NEXT LEVEL OF EXPANSION TO INCREASE PEAK NUMBER OF LANES TO FIVE EACH WAY.
-  ULTIMATE LEVEL OF EXPANSION WOULD PROVIDE SIX LANES IN PEAK DIRECTION BY REVERSING LANES 7 AND 8.

NOTES:



- 1) To be placed by Toll Equipment Contractor prior to the paving, under this Contract.
- 2) Section B-B appears on sheet 4.

LEGEND:


-  Location of future traffic signal
-  Traffic signal
-  Automatic Toll Machine
-  Future Automatic Toll Machine
-  Toll Booth
-  Construct Coin Tube & Plug
-  Existing Coin Tubes knock-out to be opened
-  Existing plugged coin tube for future expansion.

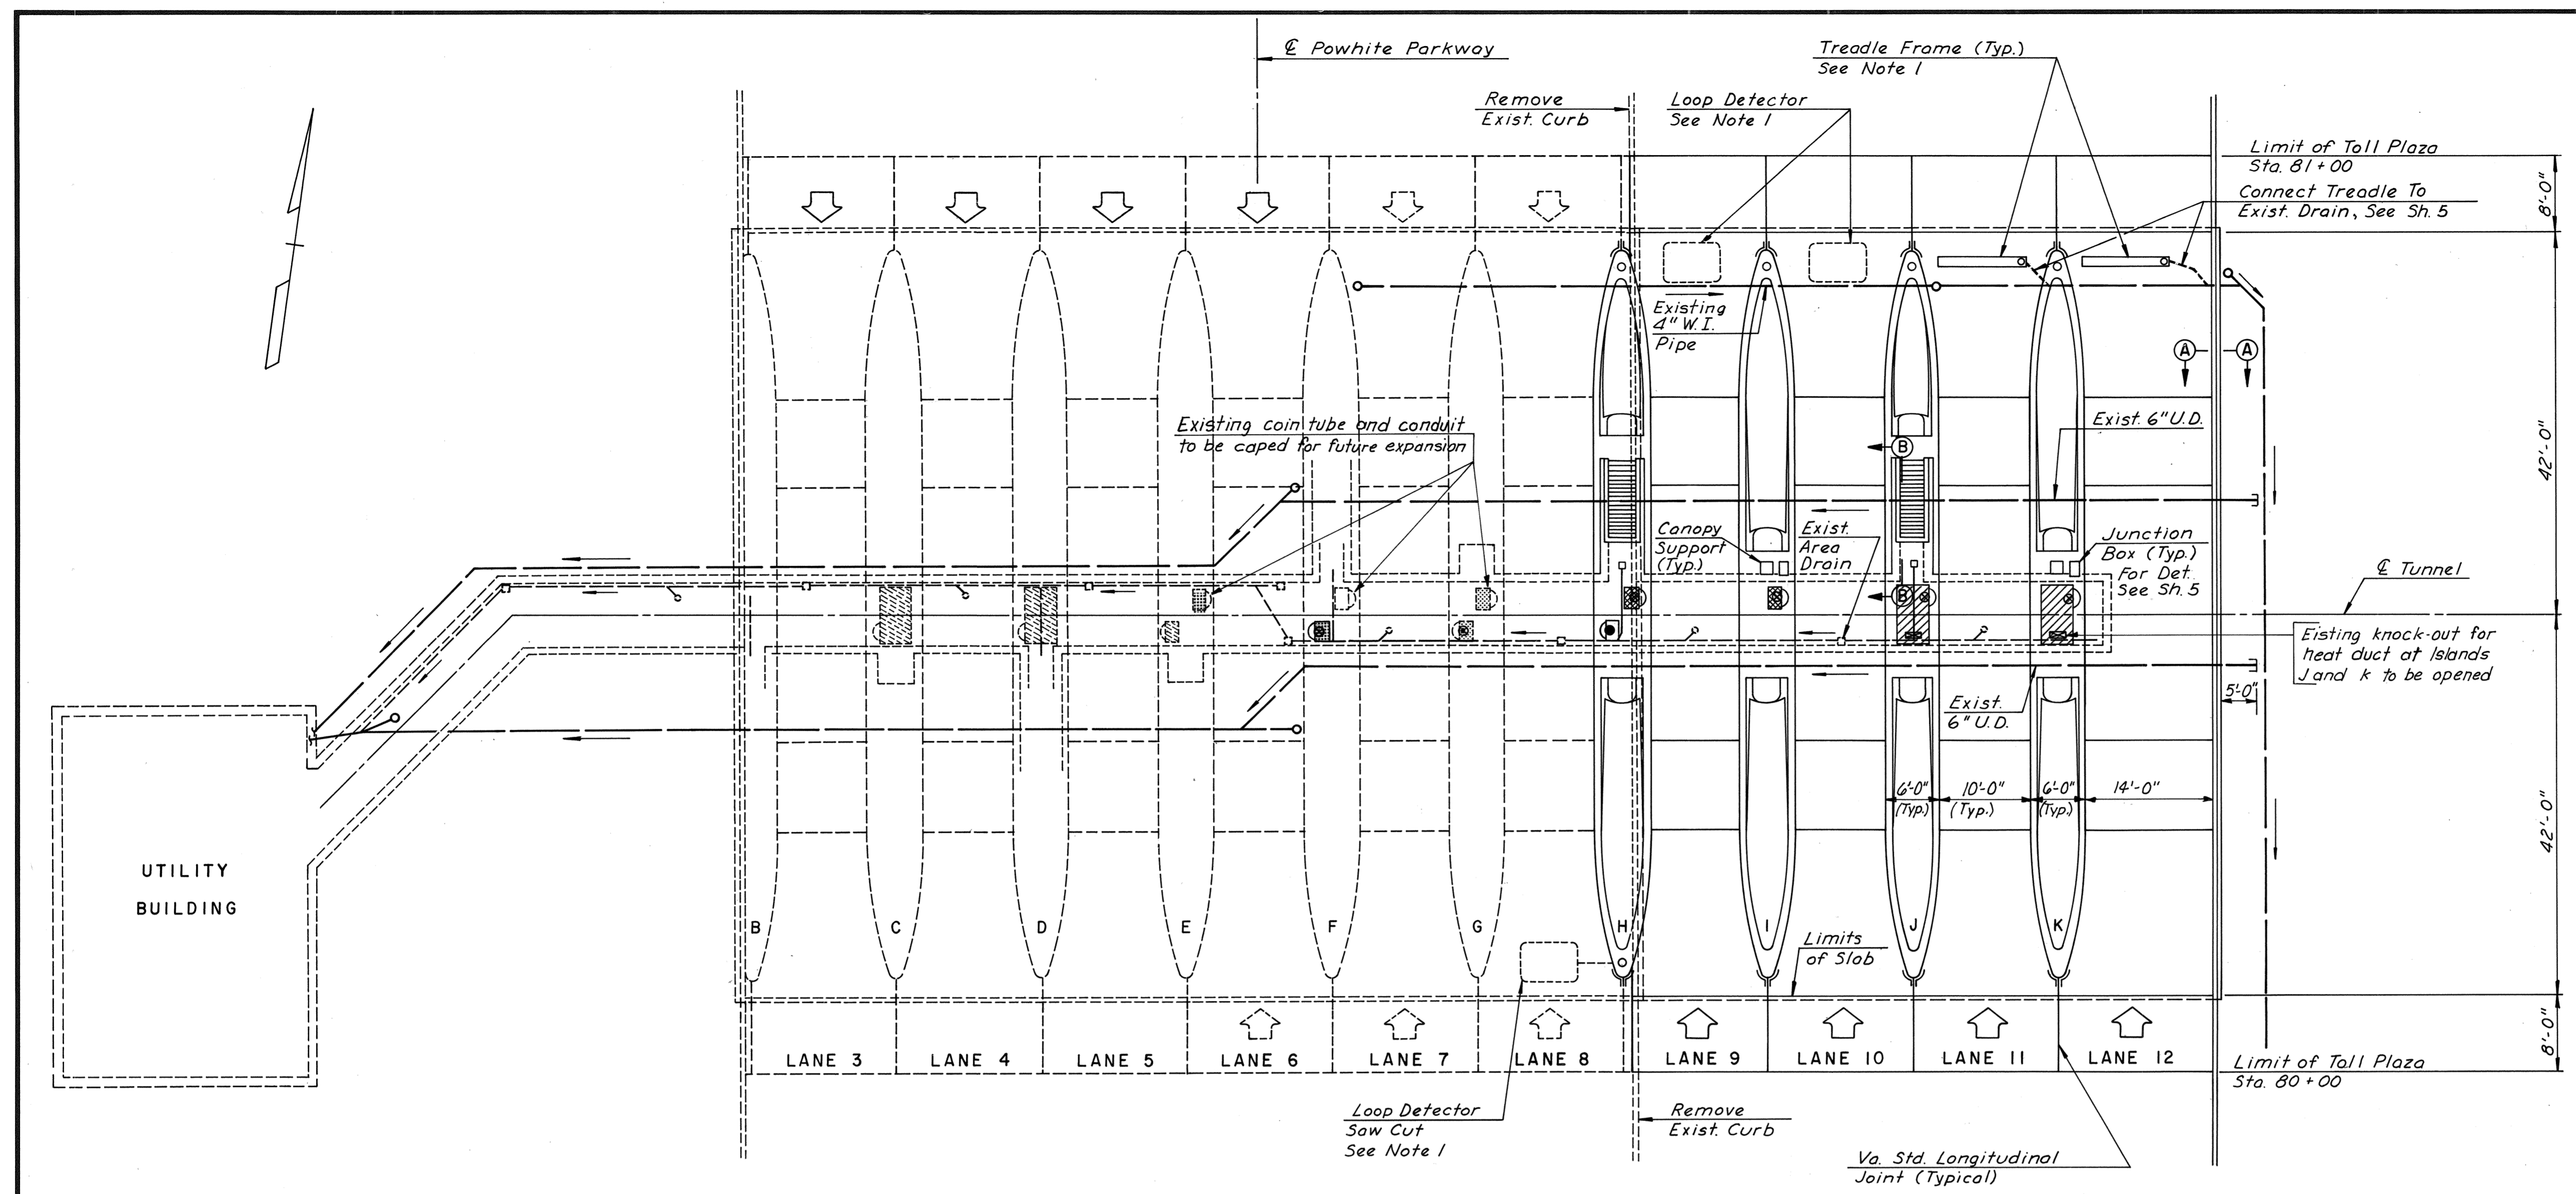


PLAN
Scale: 3/32" = 1'-0"

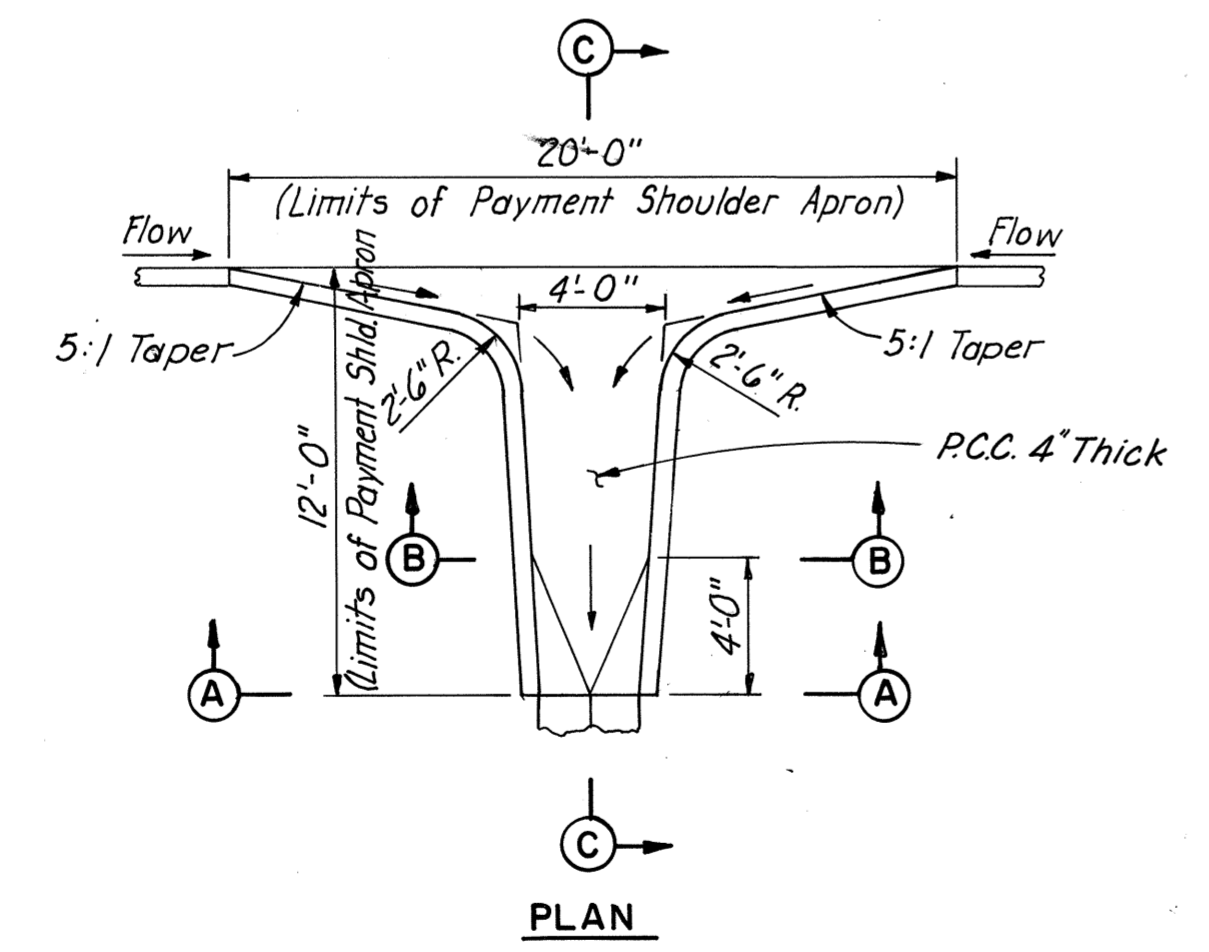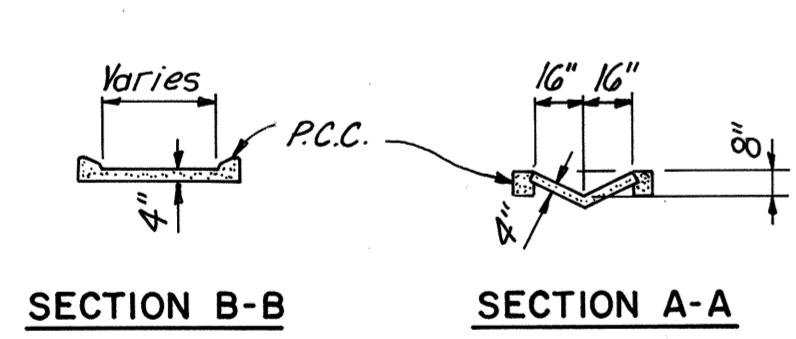

SPECIAL DESIGN SHOULDER APRON

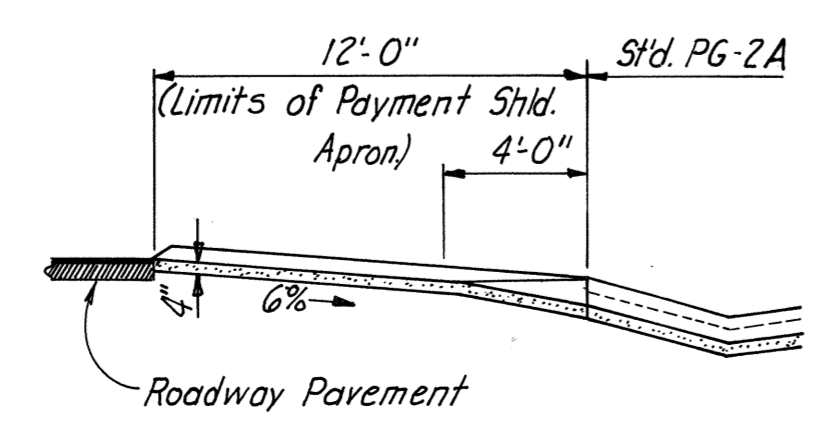

SECTION C-C

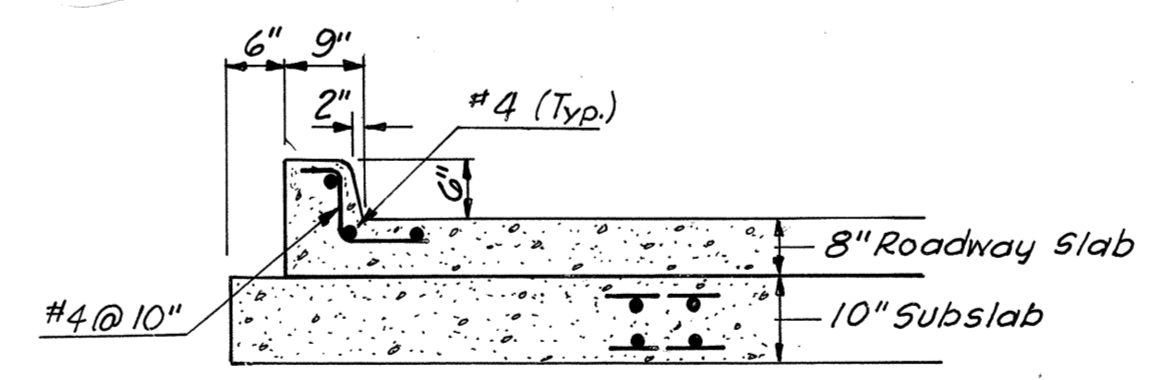

SECTION A-A
Scale: 1/2" = 1'-0"

DESIGNED	T.E.M.	9-19-75				
DRAWN	TEM	9-19-75				
CHECKED	PHT	9-75	1	New Sheet	PHT	9-75
IN CHARGE	J.P.F.		NO.	REVISION	BY	DATE

RICHMOND METROPOLITAN AUTHORITY
RICHMOND EXPRESSWAY SYSTEM
POWHITE PARKWAY

EXPANSION OF POWHITE TOLL PLAZA
TOLL PLAZA PLAN
AND NOTES

SCALE: As noted
DATE: 9-75





SHEET 2 OF 18

HOWARD, NEEDLES, TAMMEN & BERGENDOFF
CONSULTING ENGINEERS
Alexandria, Virginia







HNTB

AS BUILT

RICHMOND EXPRESSWAY SYSTEM			
SECTION	PROJECT	SHEET NO.	TOTAL SHEETS
TF-4	POWHITE PARKWAY	3	

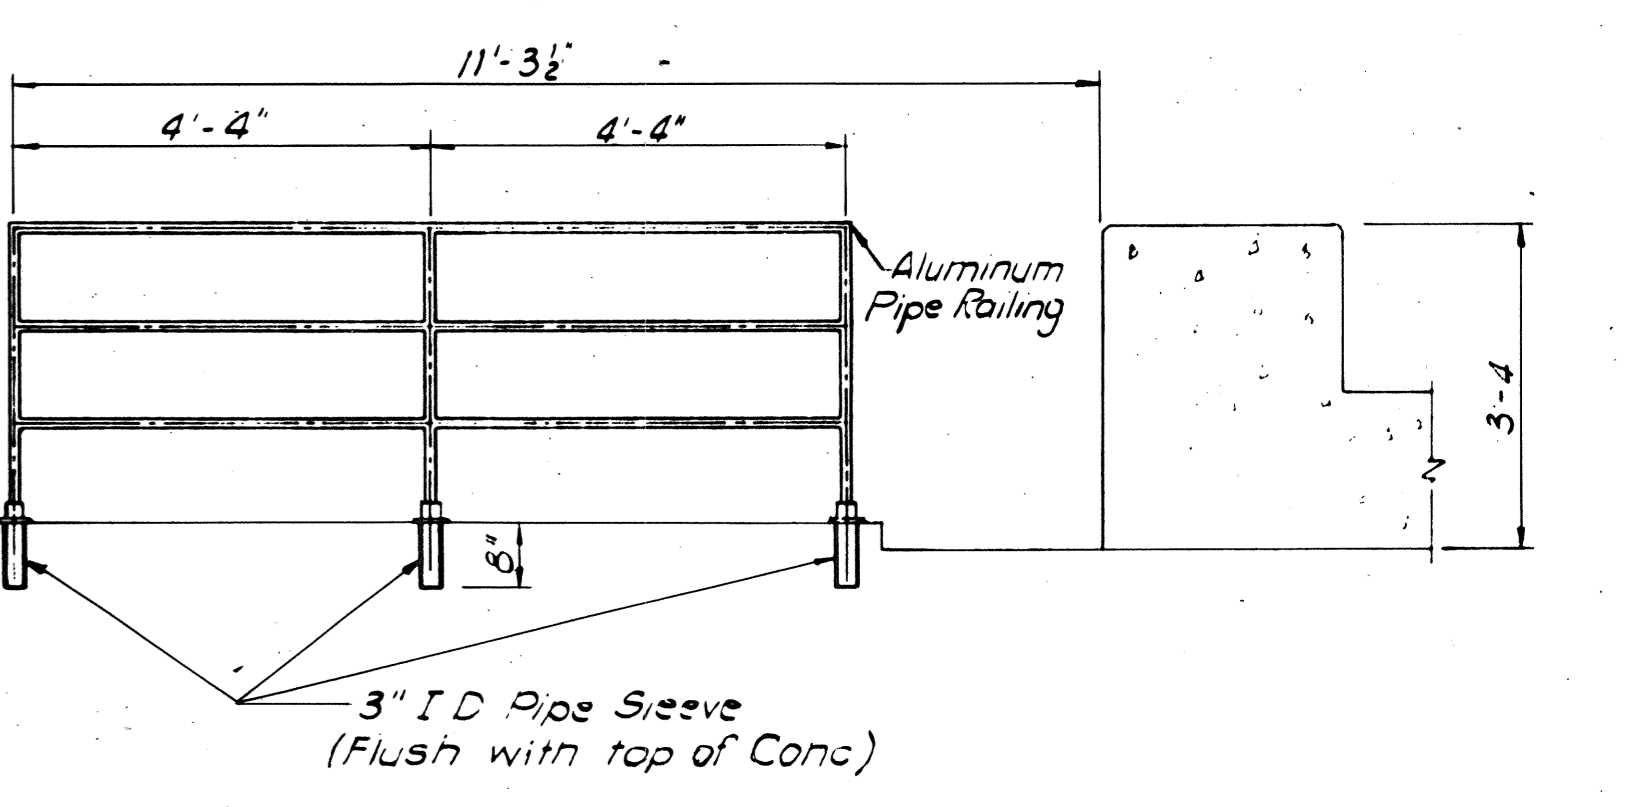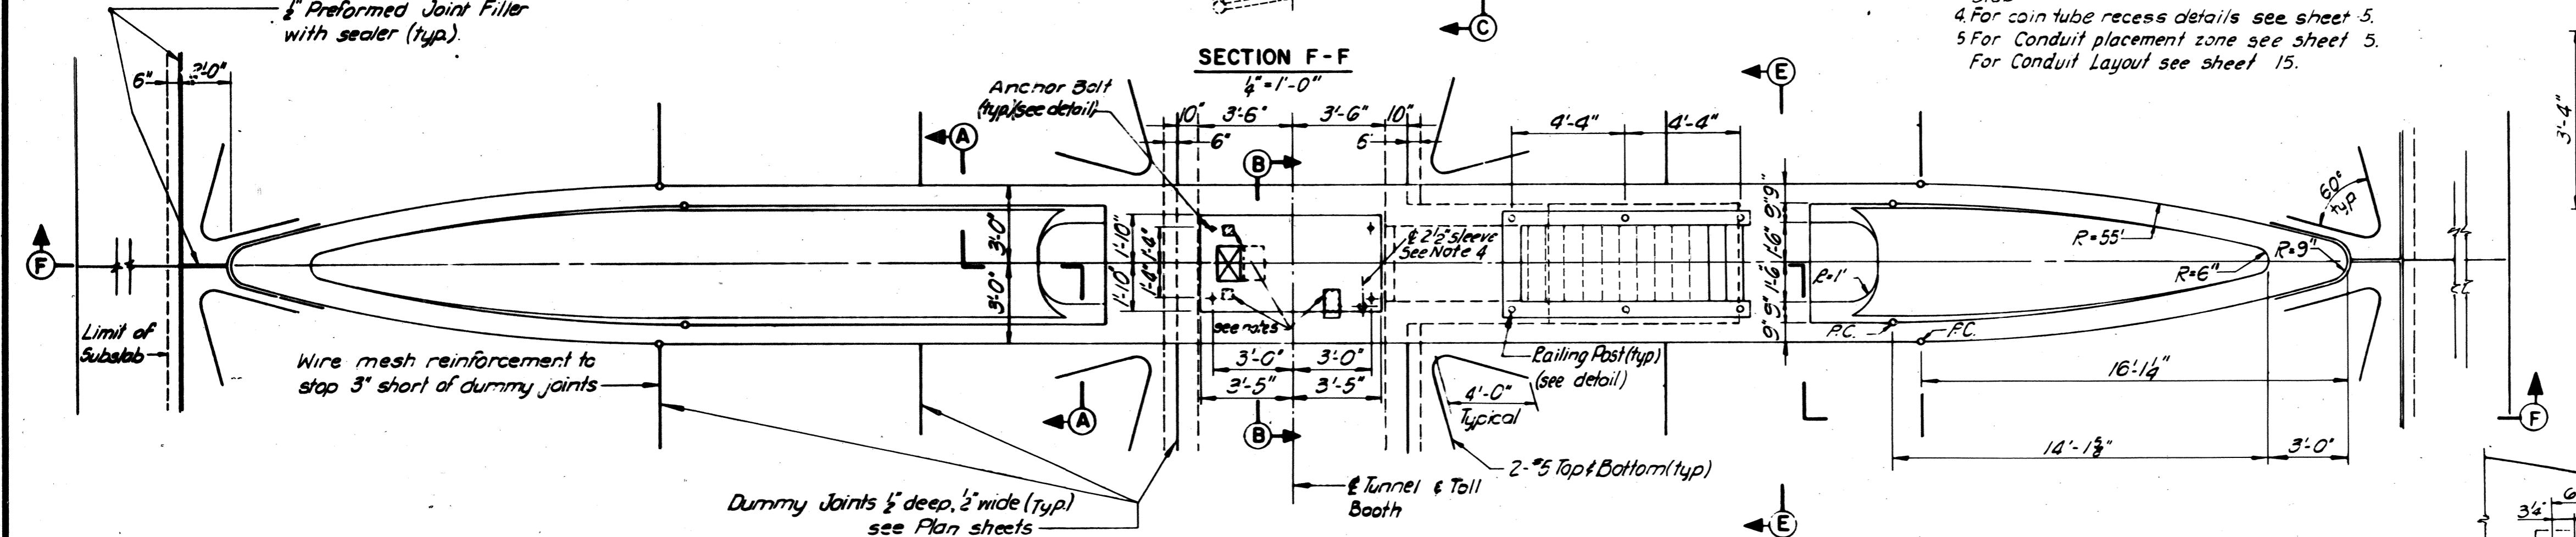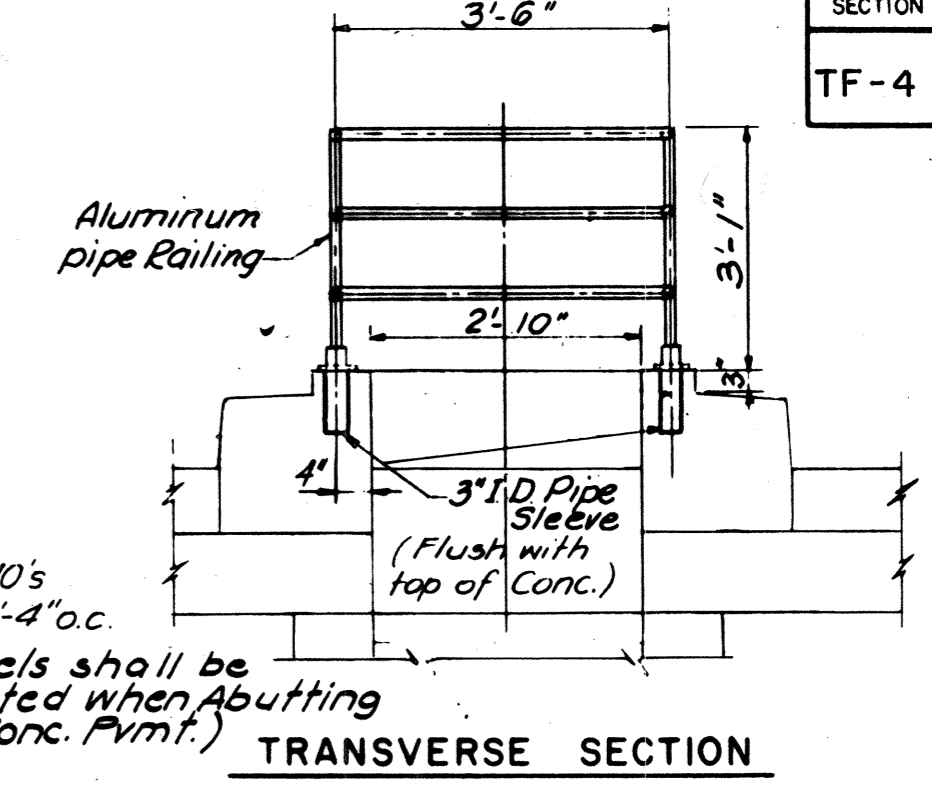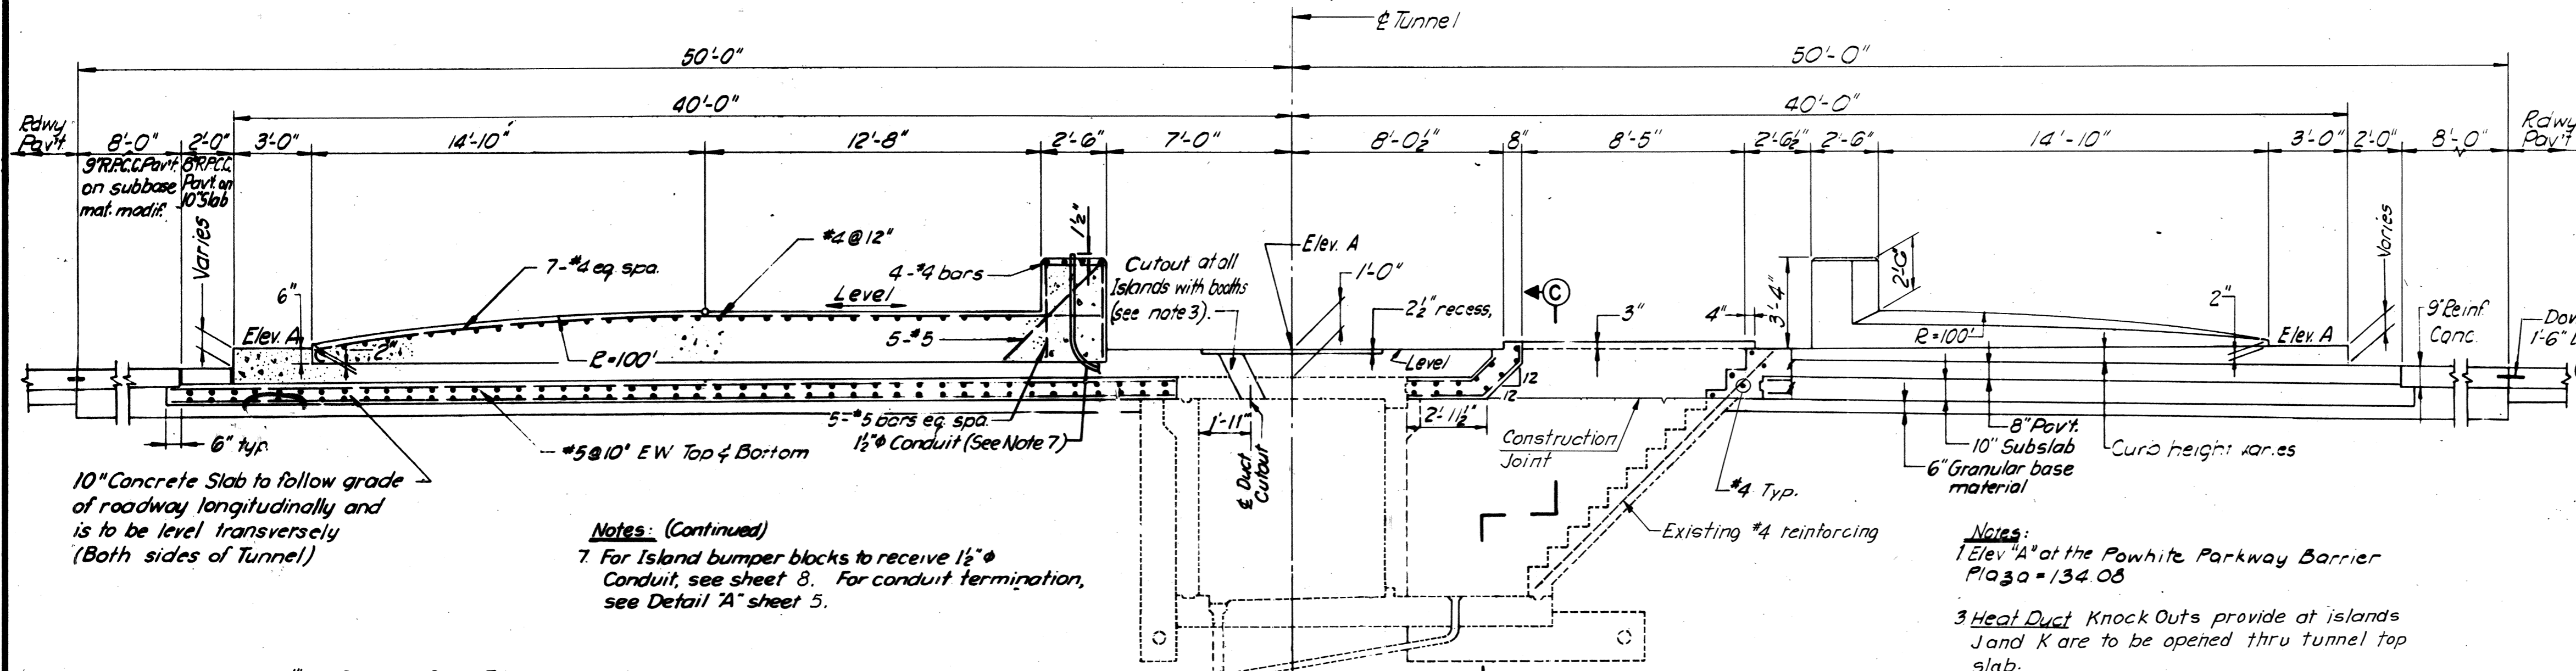

PLAN OF ISLAND WITH STAIRWAY
1/2" = 1'-0"

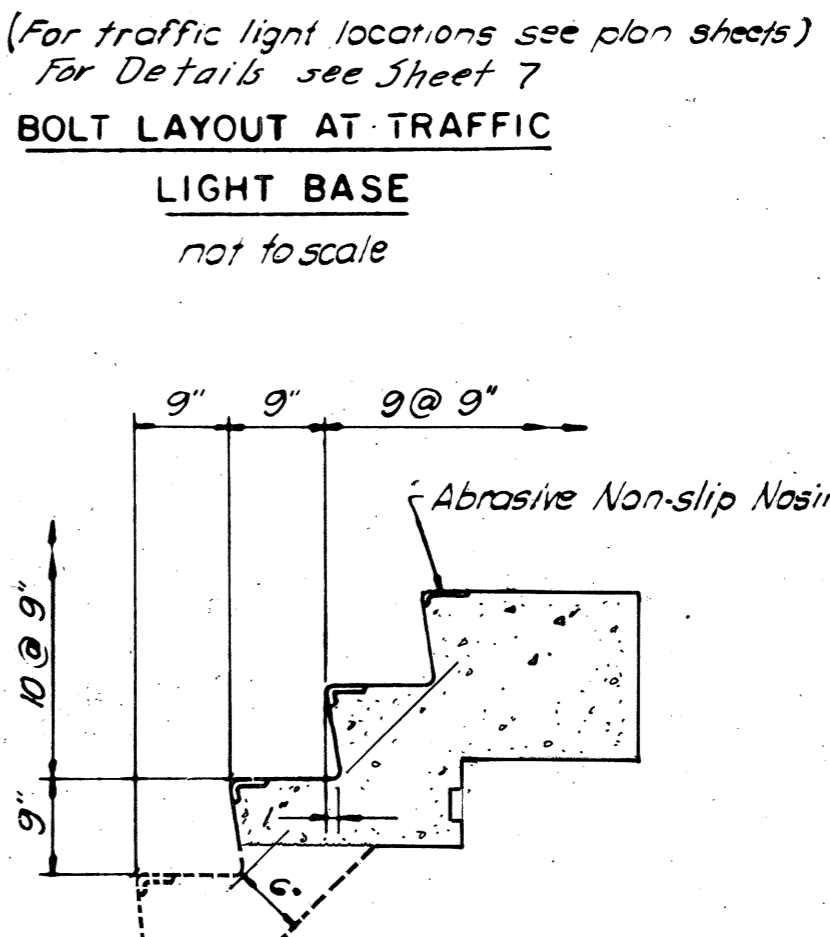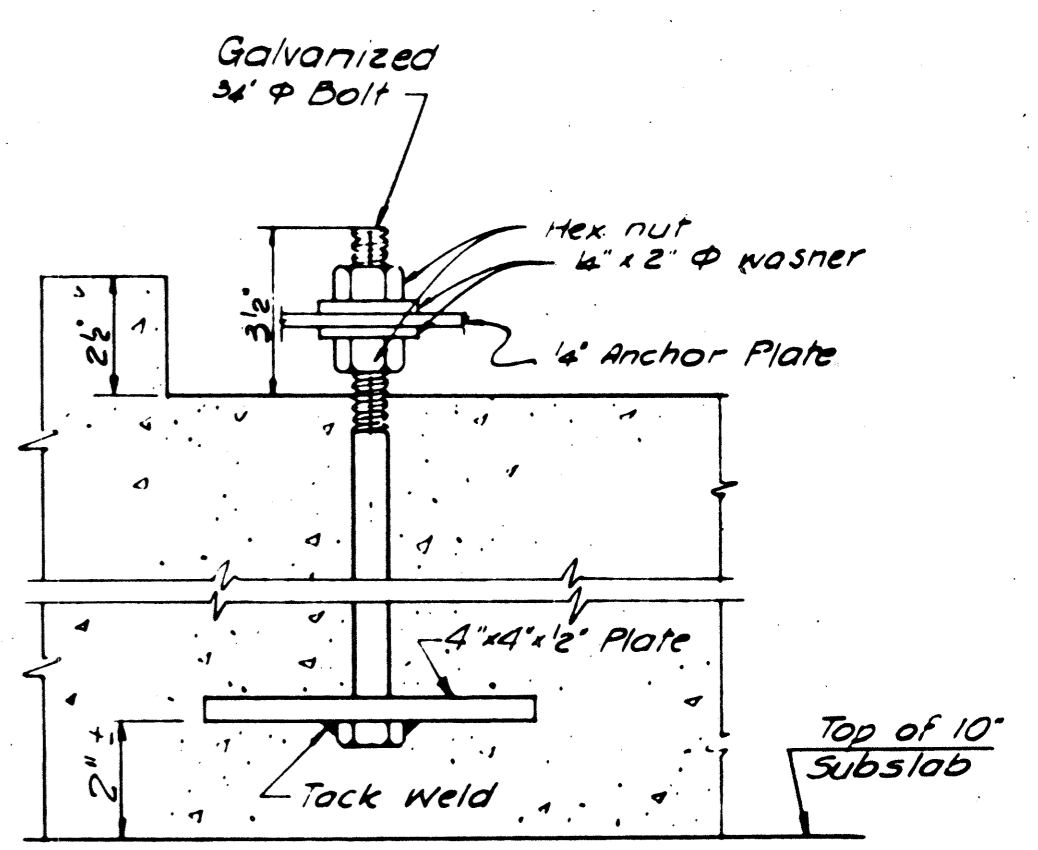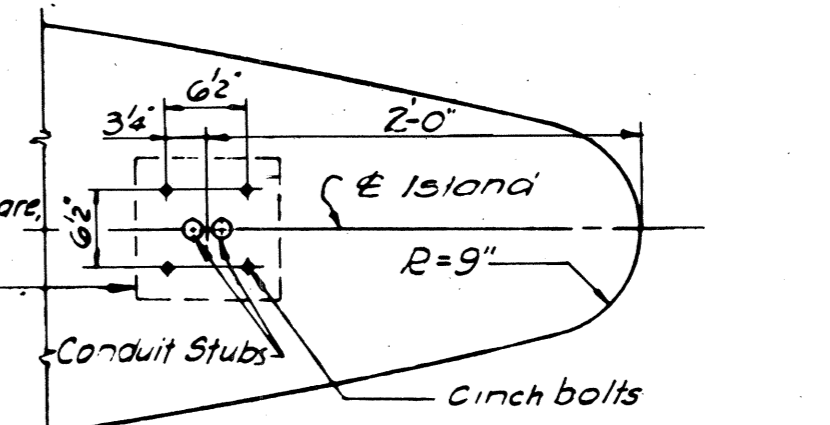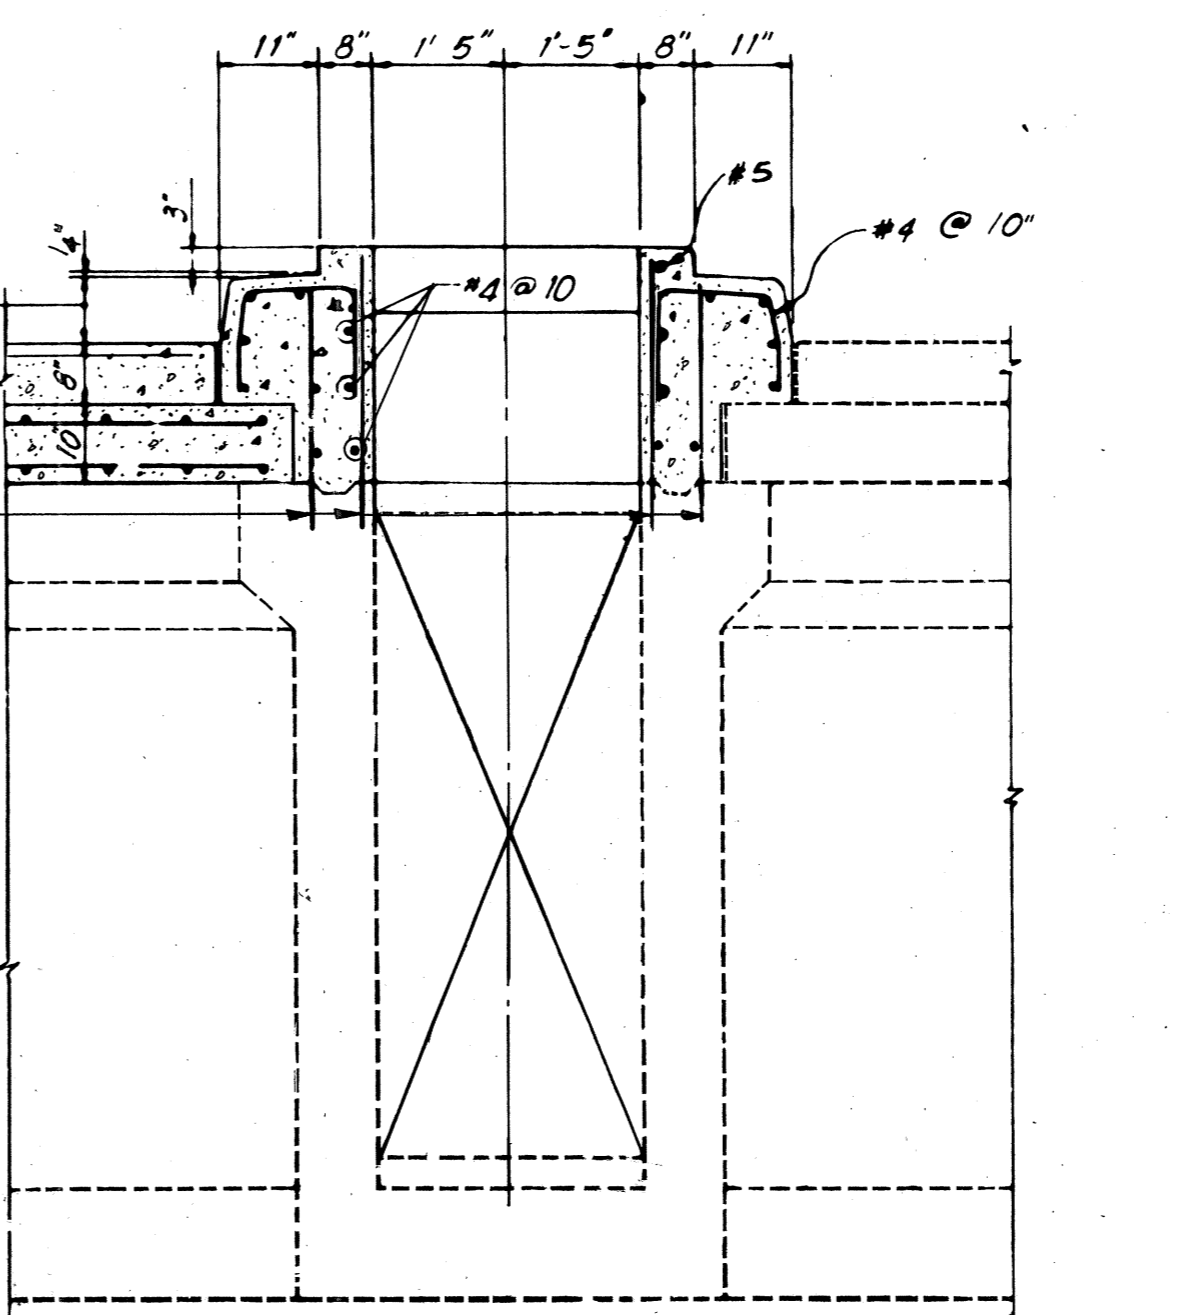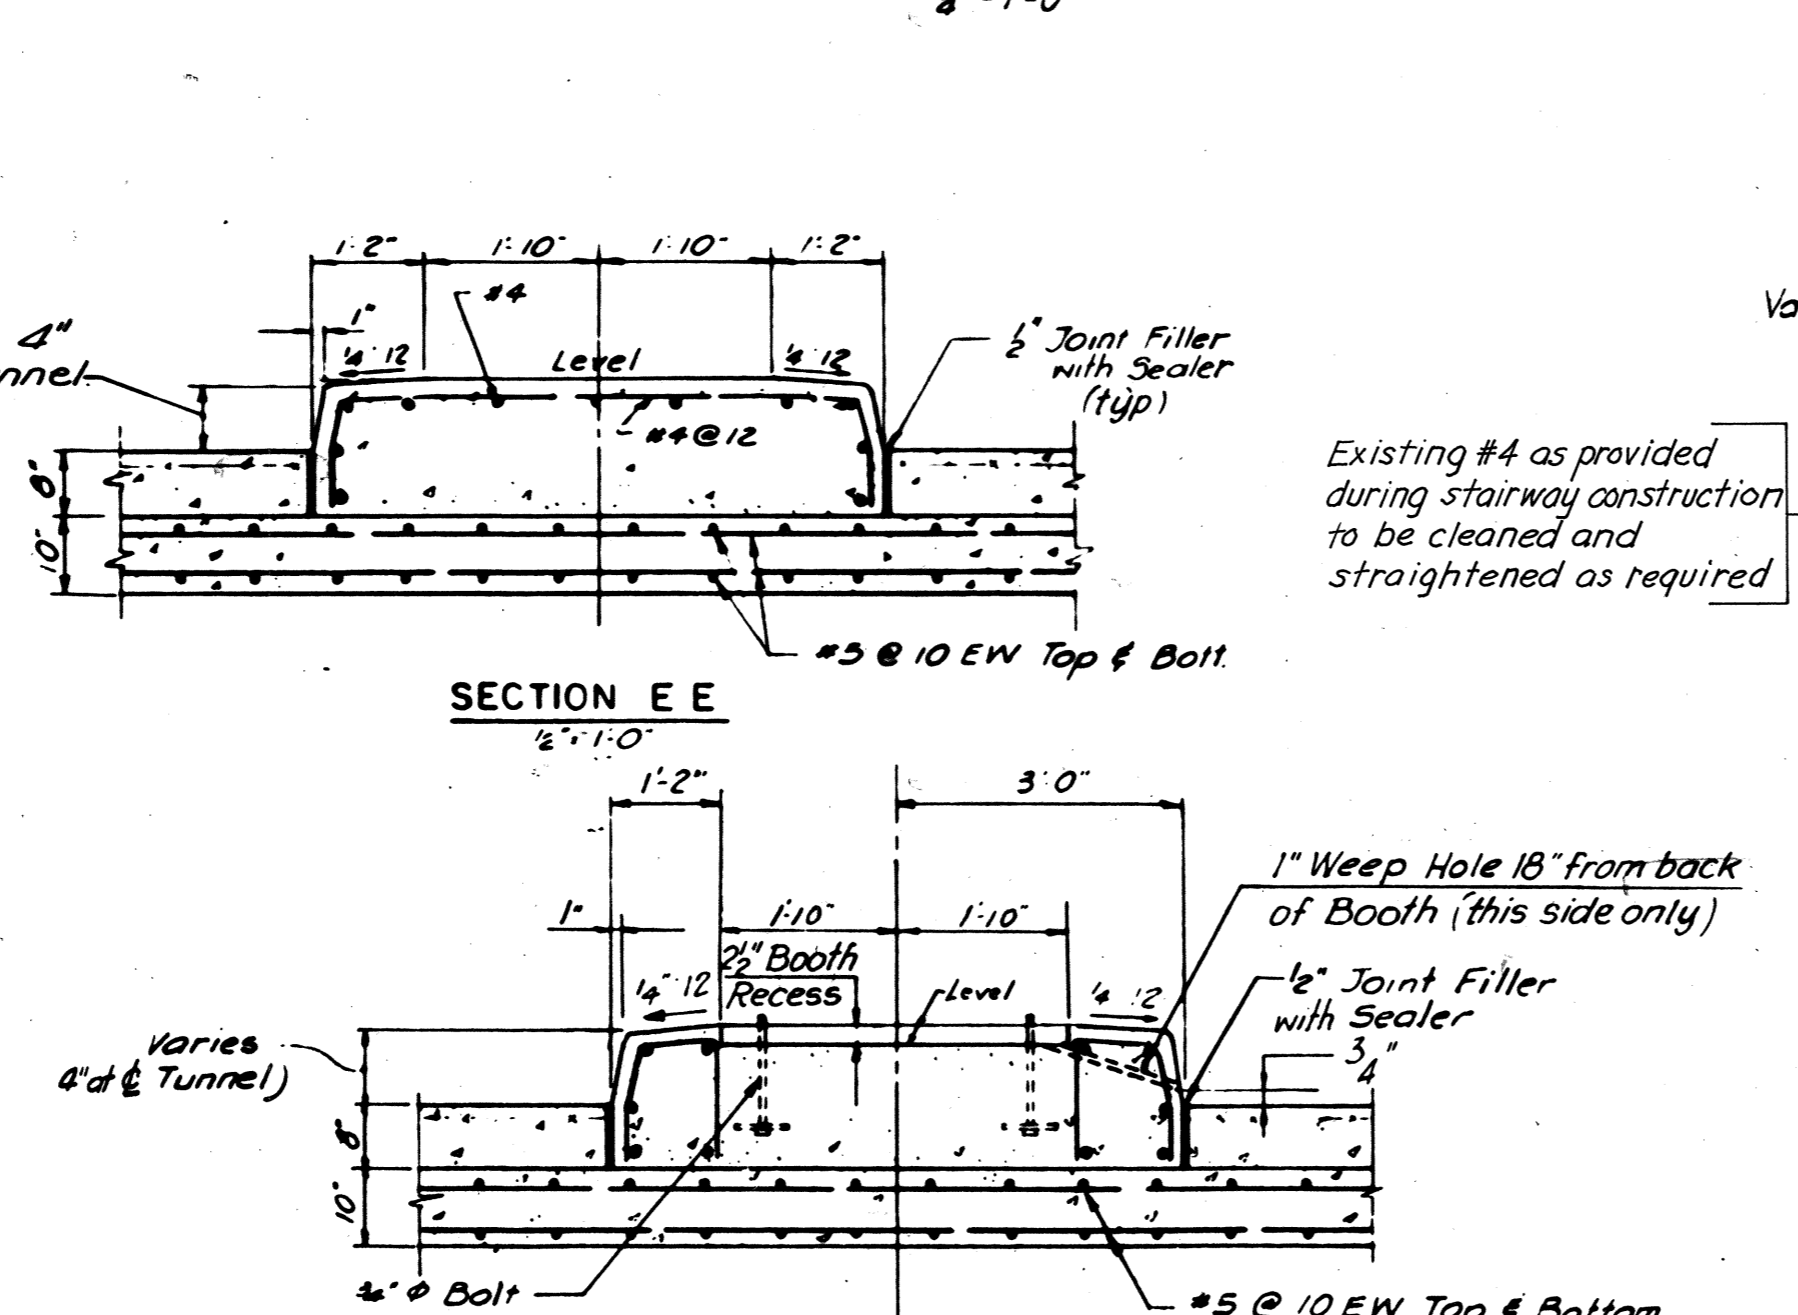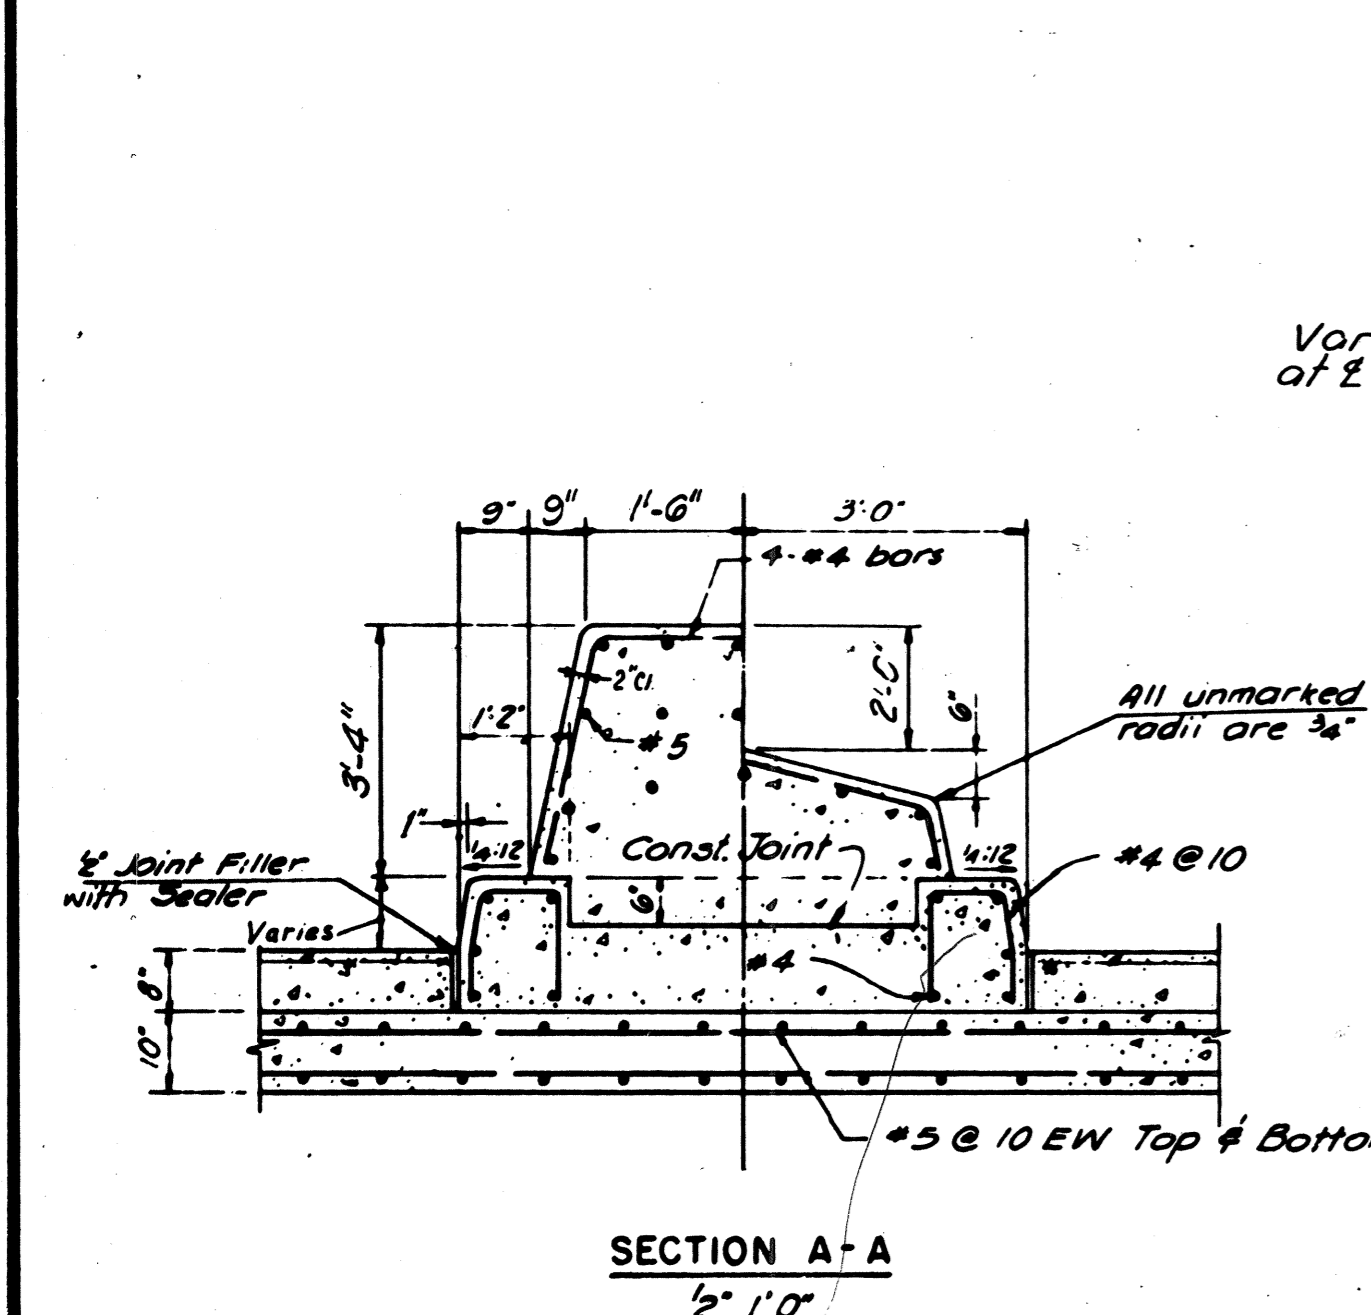

DETAIL OF ANCHOR BOLT FOR TOLL BOOTH
3'-1'-0"
For Location see Island Plan this Sheet

R.P.C.C.: Reinforced, Portland Cement Concrete

AS BUILT
RICHMOND METROPOLITAN AUTHORITY
RICHMOND EXPRESSWAY SYSTEM
POWHITE PARKWAY


BARRIER PLAZA
ISLAND AND TUNNEL DETAILS

BY	DATE	NO.	REVISION	BY	DATE
MADE	W.J.W.	5-68			
CHECKED	D.E.M.	5-68	Add Sh. No's to Notes Rev. Proj. Block	P.H.T.	9-75
IN CHARGE	M.D.S.				


NOTE: Section B-B typical for islands J & K. For all other Islands use Section E-E.

HOWARD, NEEDLES, TAMMEN & BERGENDOFF consulting engineers NEW YORK ALEXANDRIA KANSAS CITY	SCALE: AS NOTED CONTRACT NO.: SHEET NO. 3 OF 18
---	---


RICHMOND EXPRESSWAY SYSTEM			
SECTION	PROJECT	SHEET NO.	TOTAL SHEETS
TF-4	POWHITE PARKWAY	4	

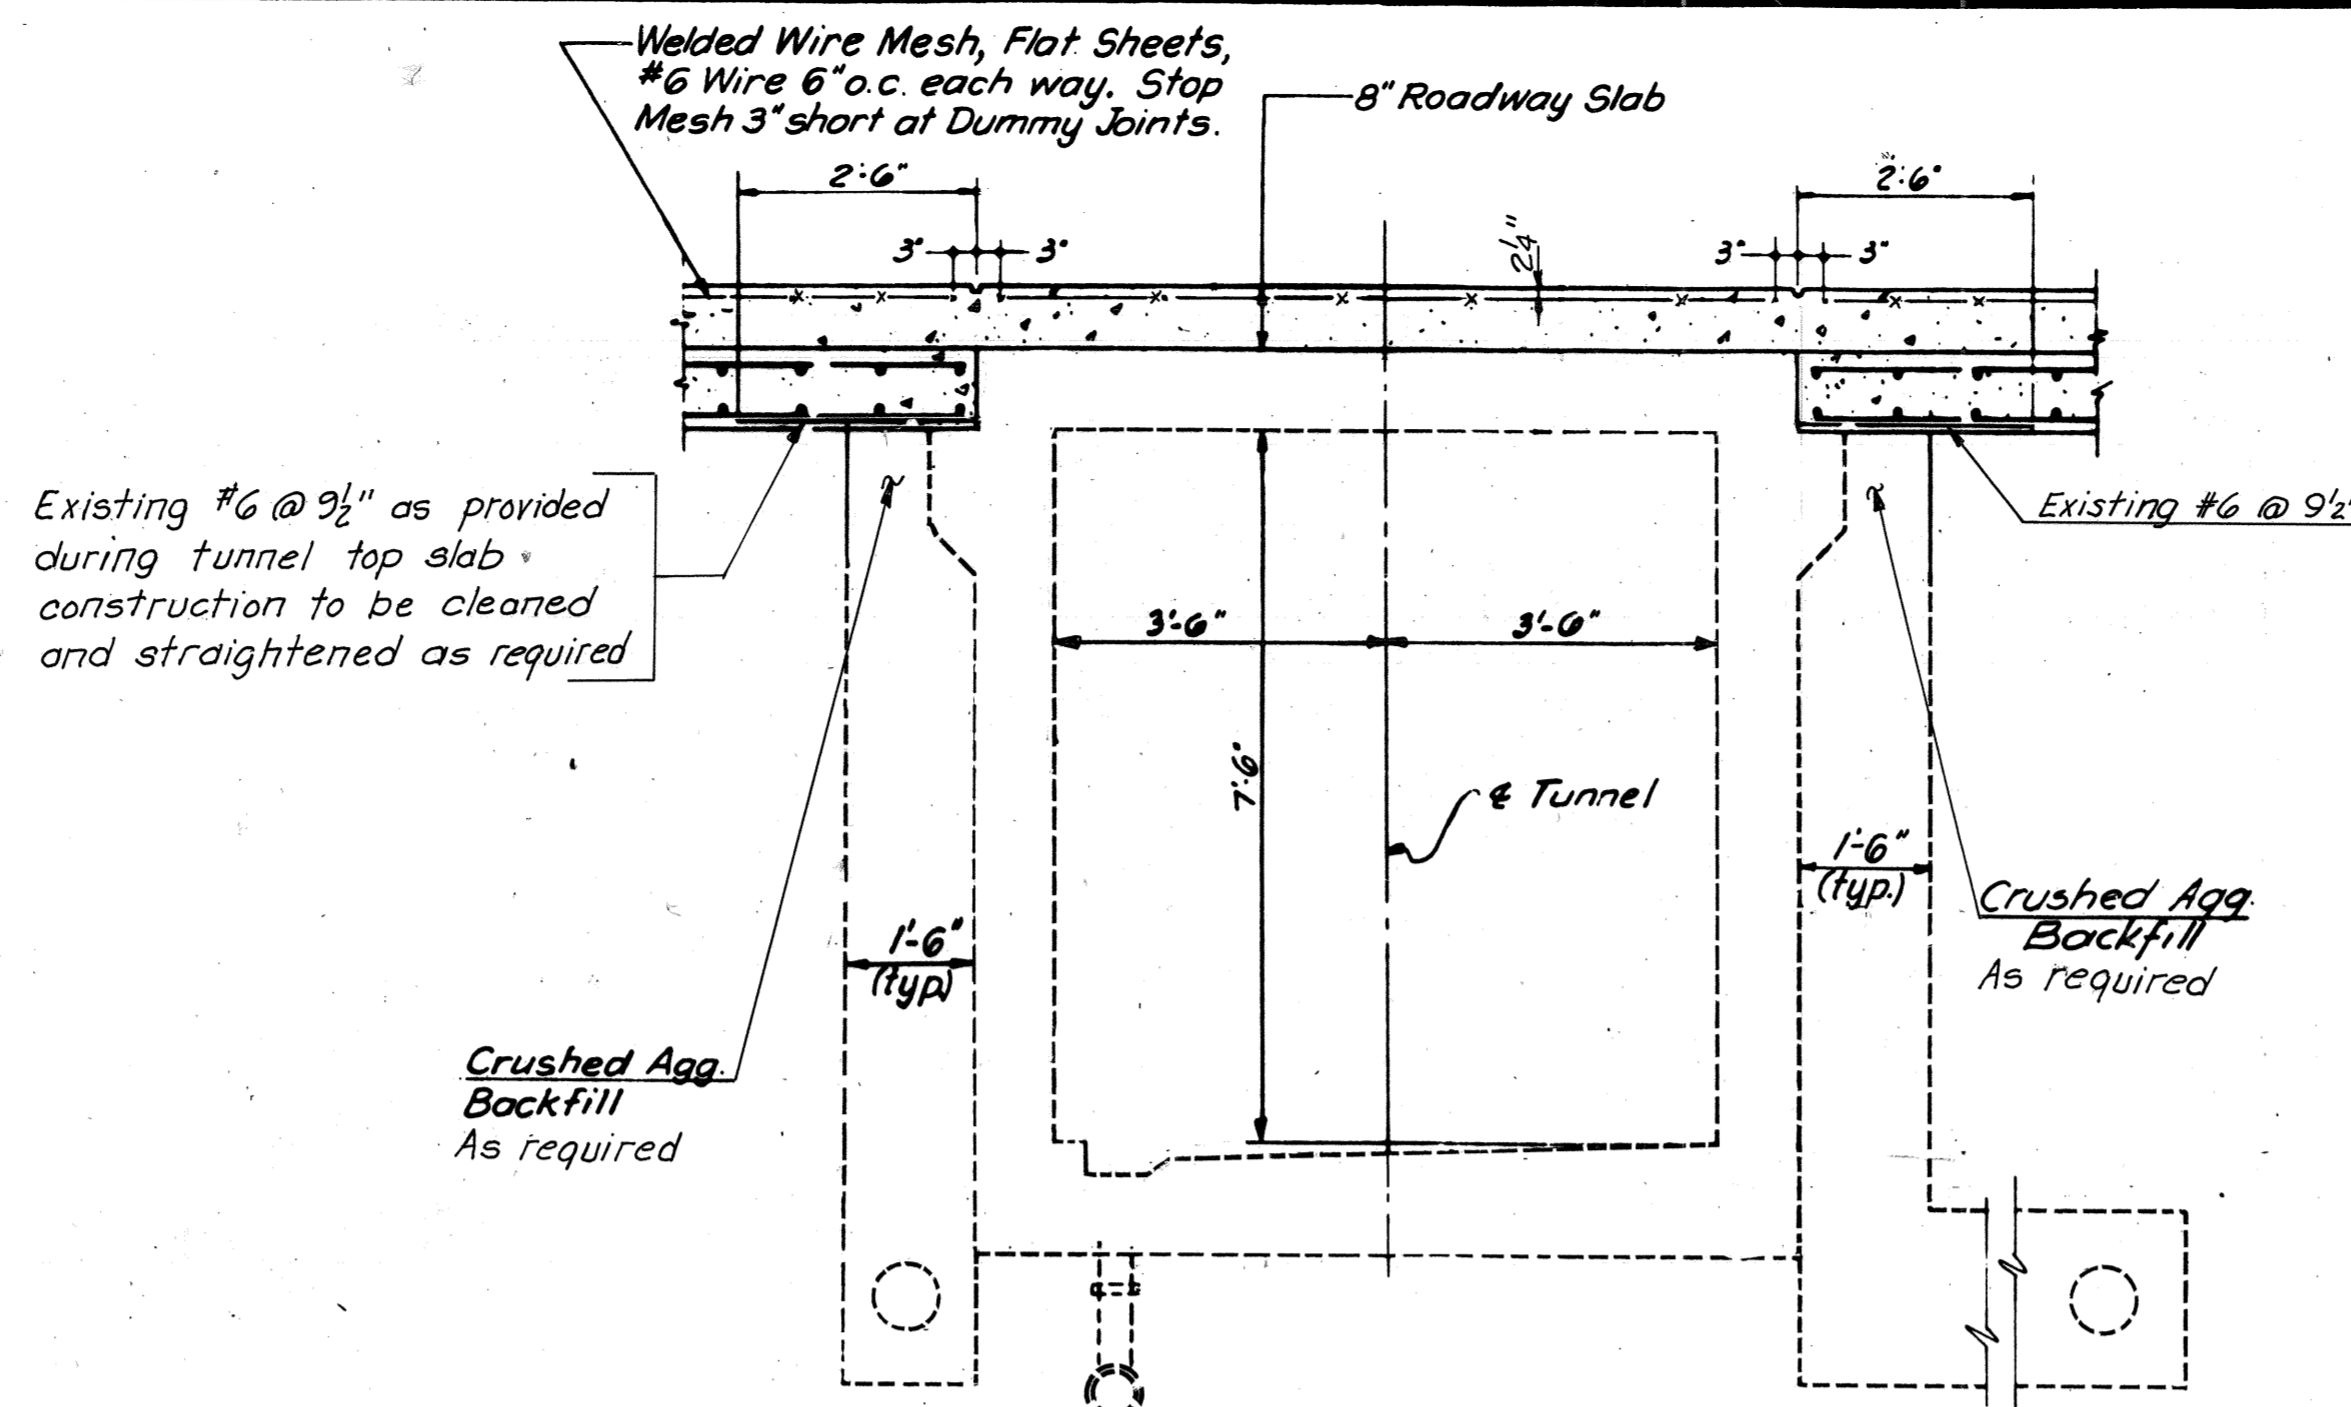


SECTION THRU TUNNEL BETWEEN ISLANDS
1/2" = 1'-0"

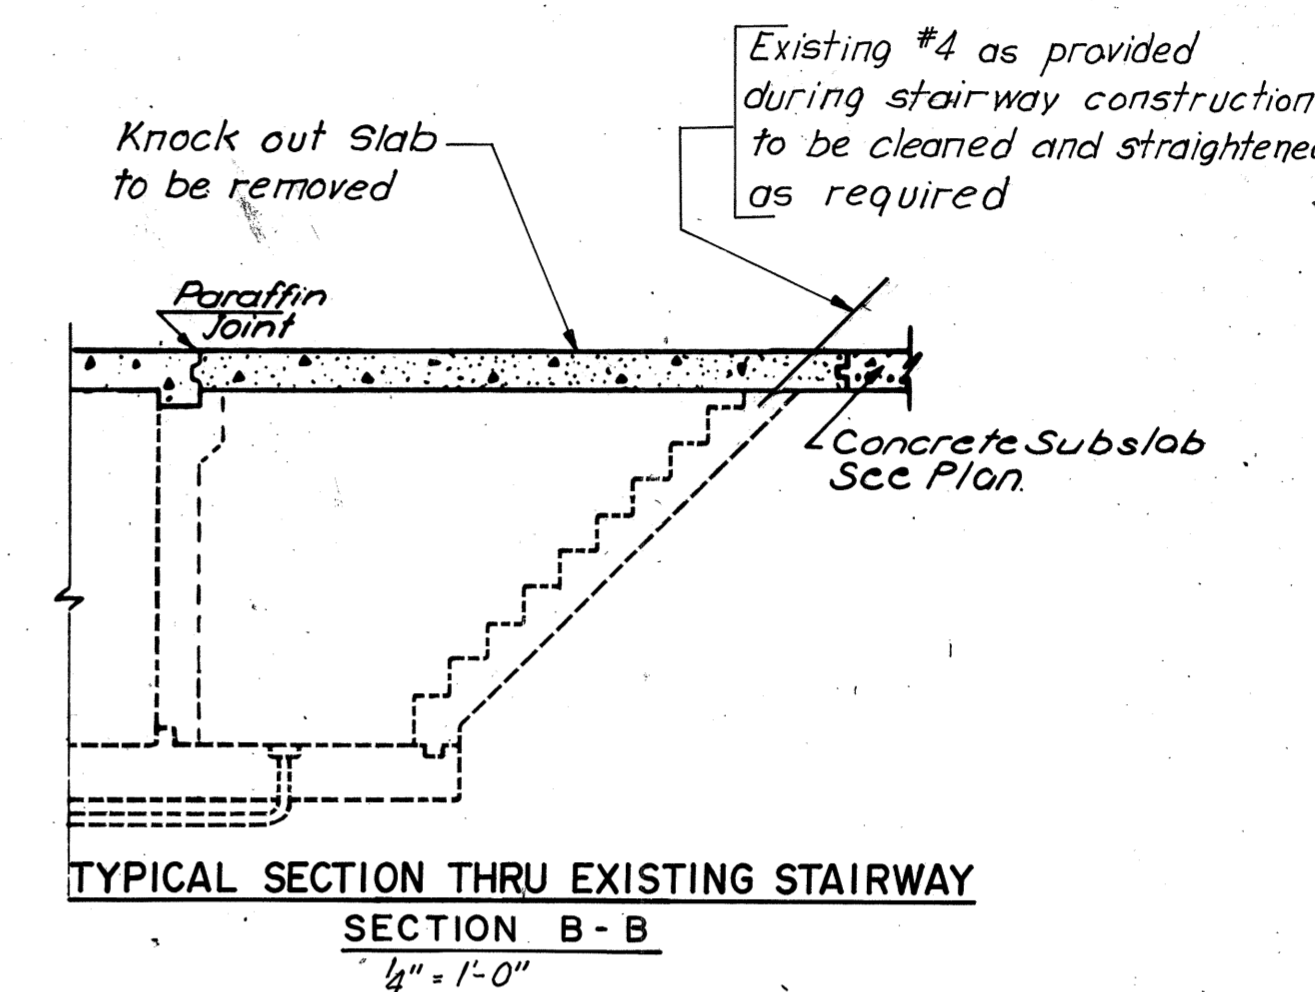


TYPICAL SECTION THRU EXISTING STAIRWAY
SECTION B-B
1/4" = 1'-0"

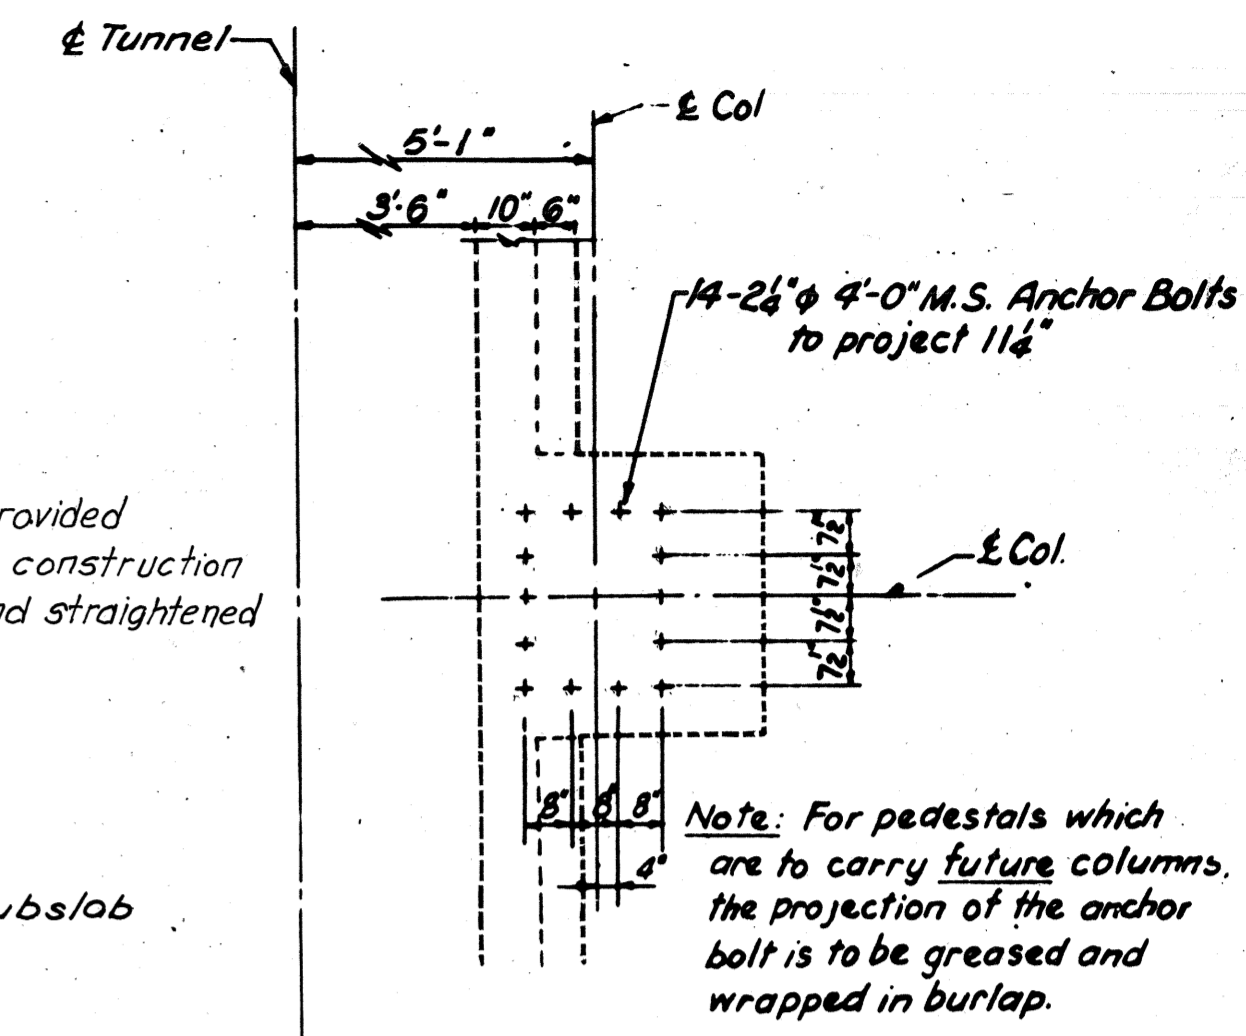

ANCHOR BOLT LAYOUT BARRIER PLAZA CANOPY COLUMN
3/8" = 1'-0"

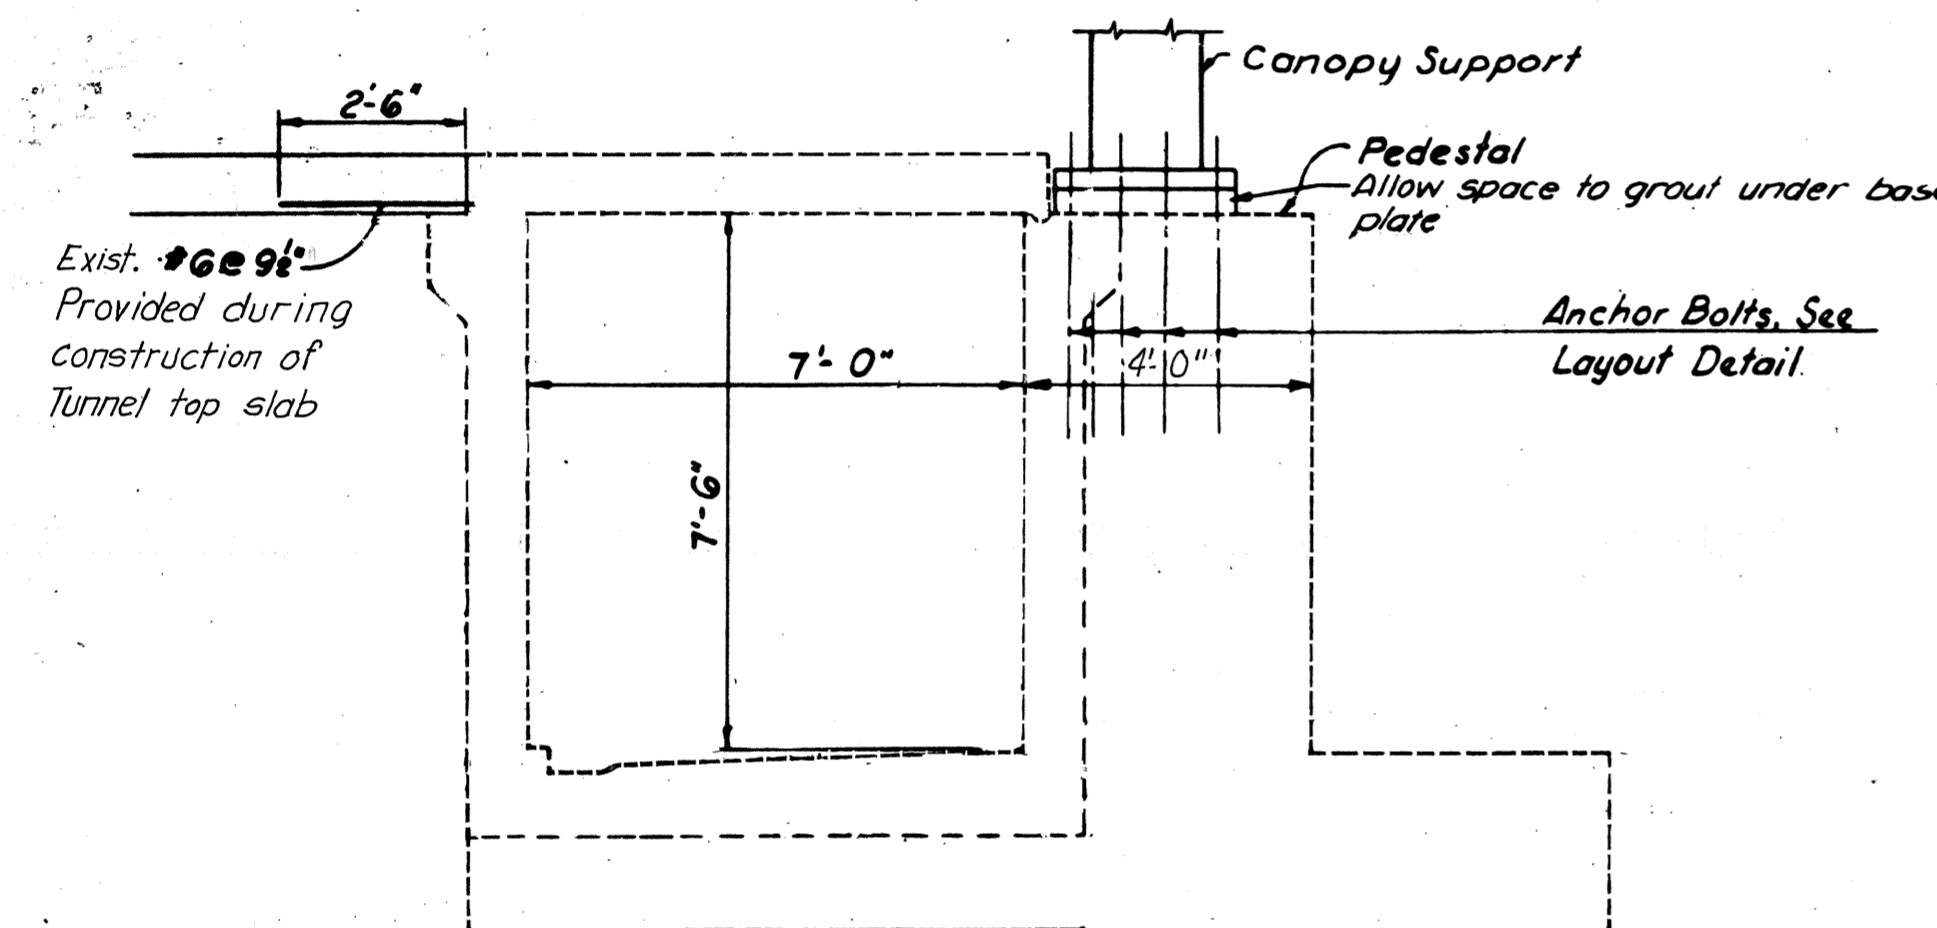


SECTION THRU TUNNEL AT CANOPY SUPPORT PEDESTAL

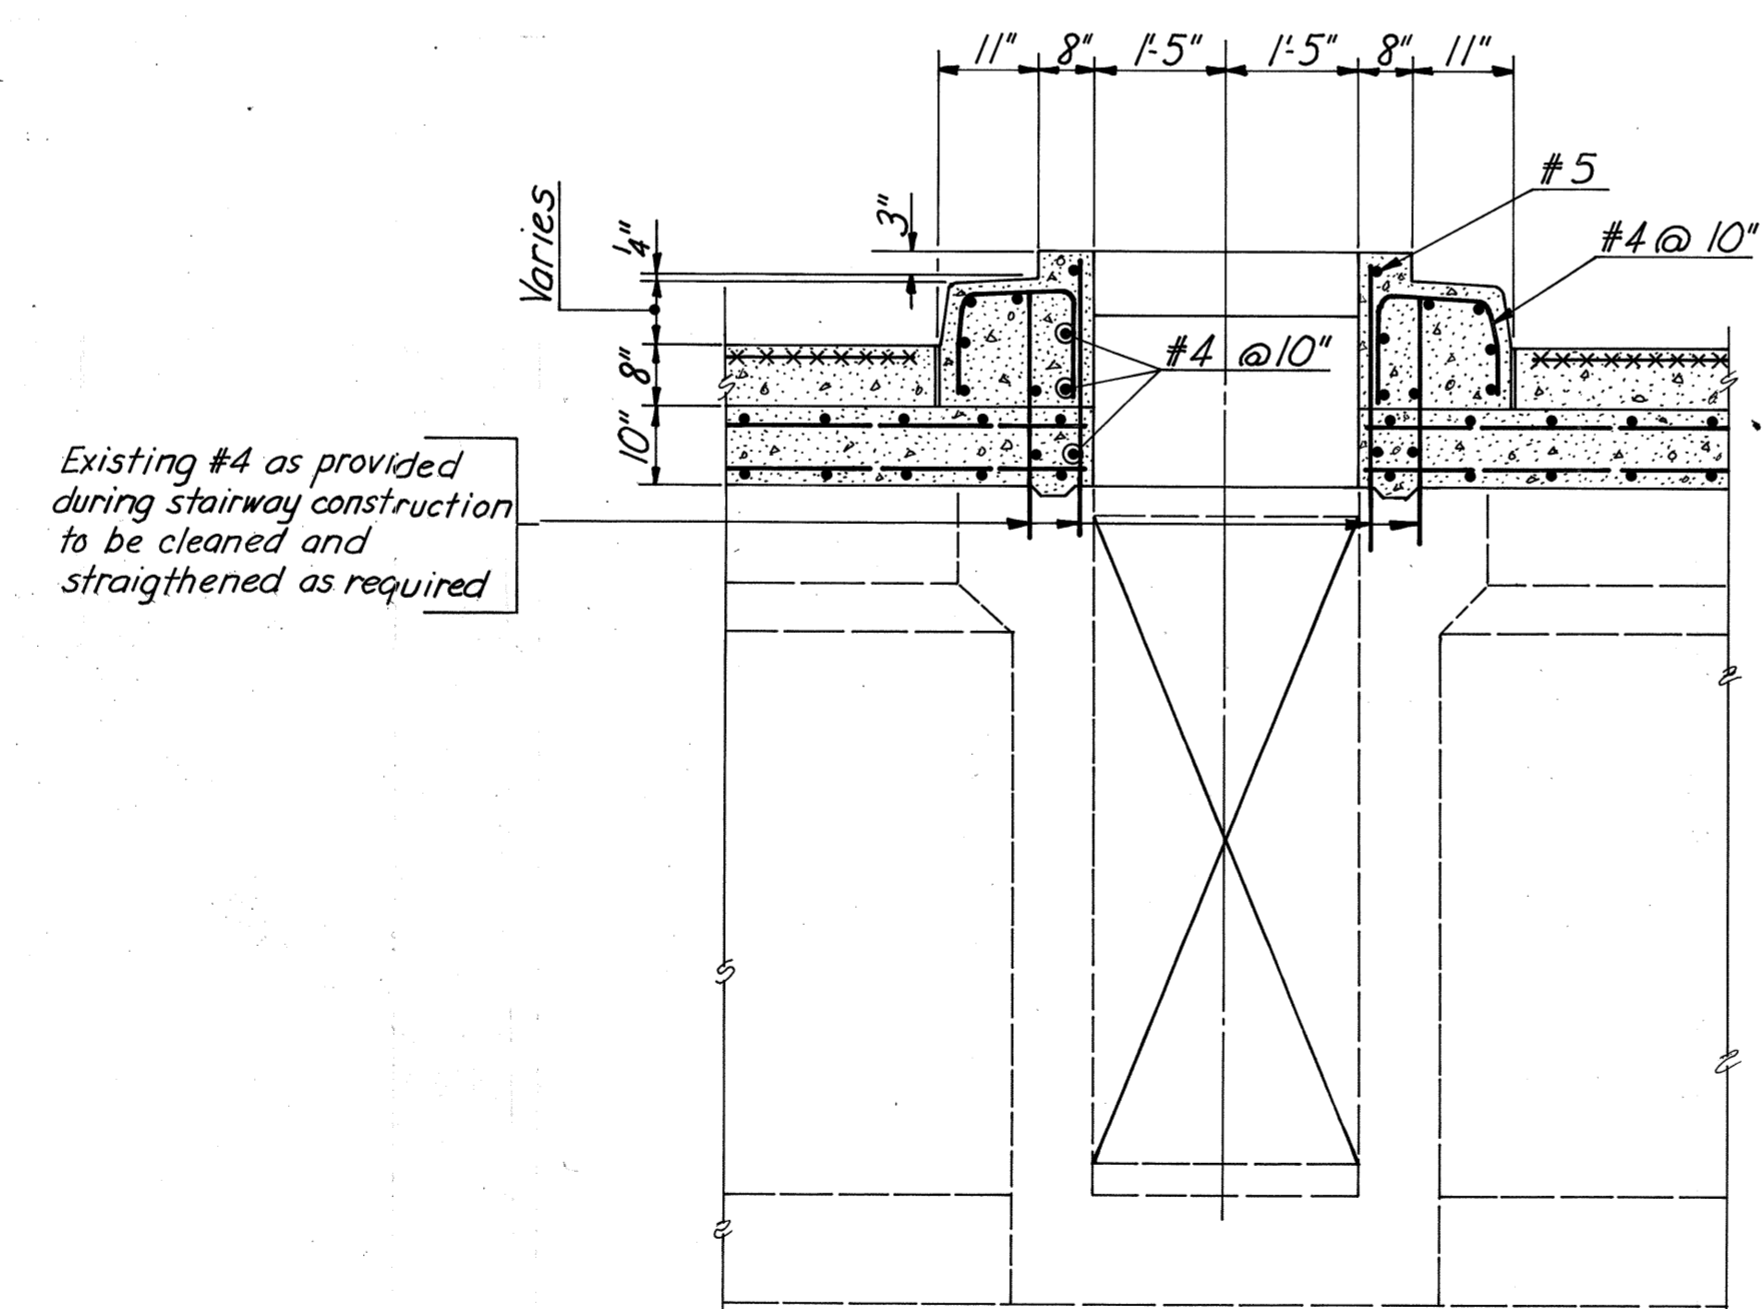


Shown at island J for Section C-C thru island H see Sheet

SECTION C-C
Scale: 1/2" = 1'-0"

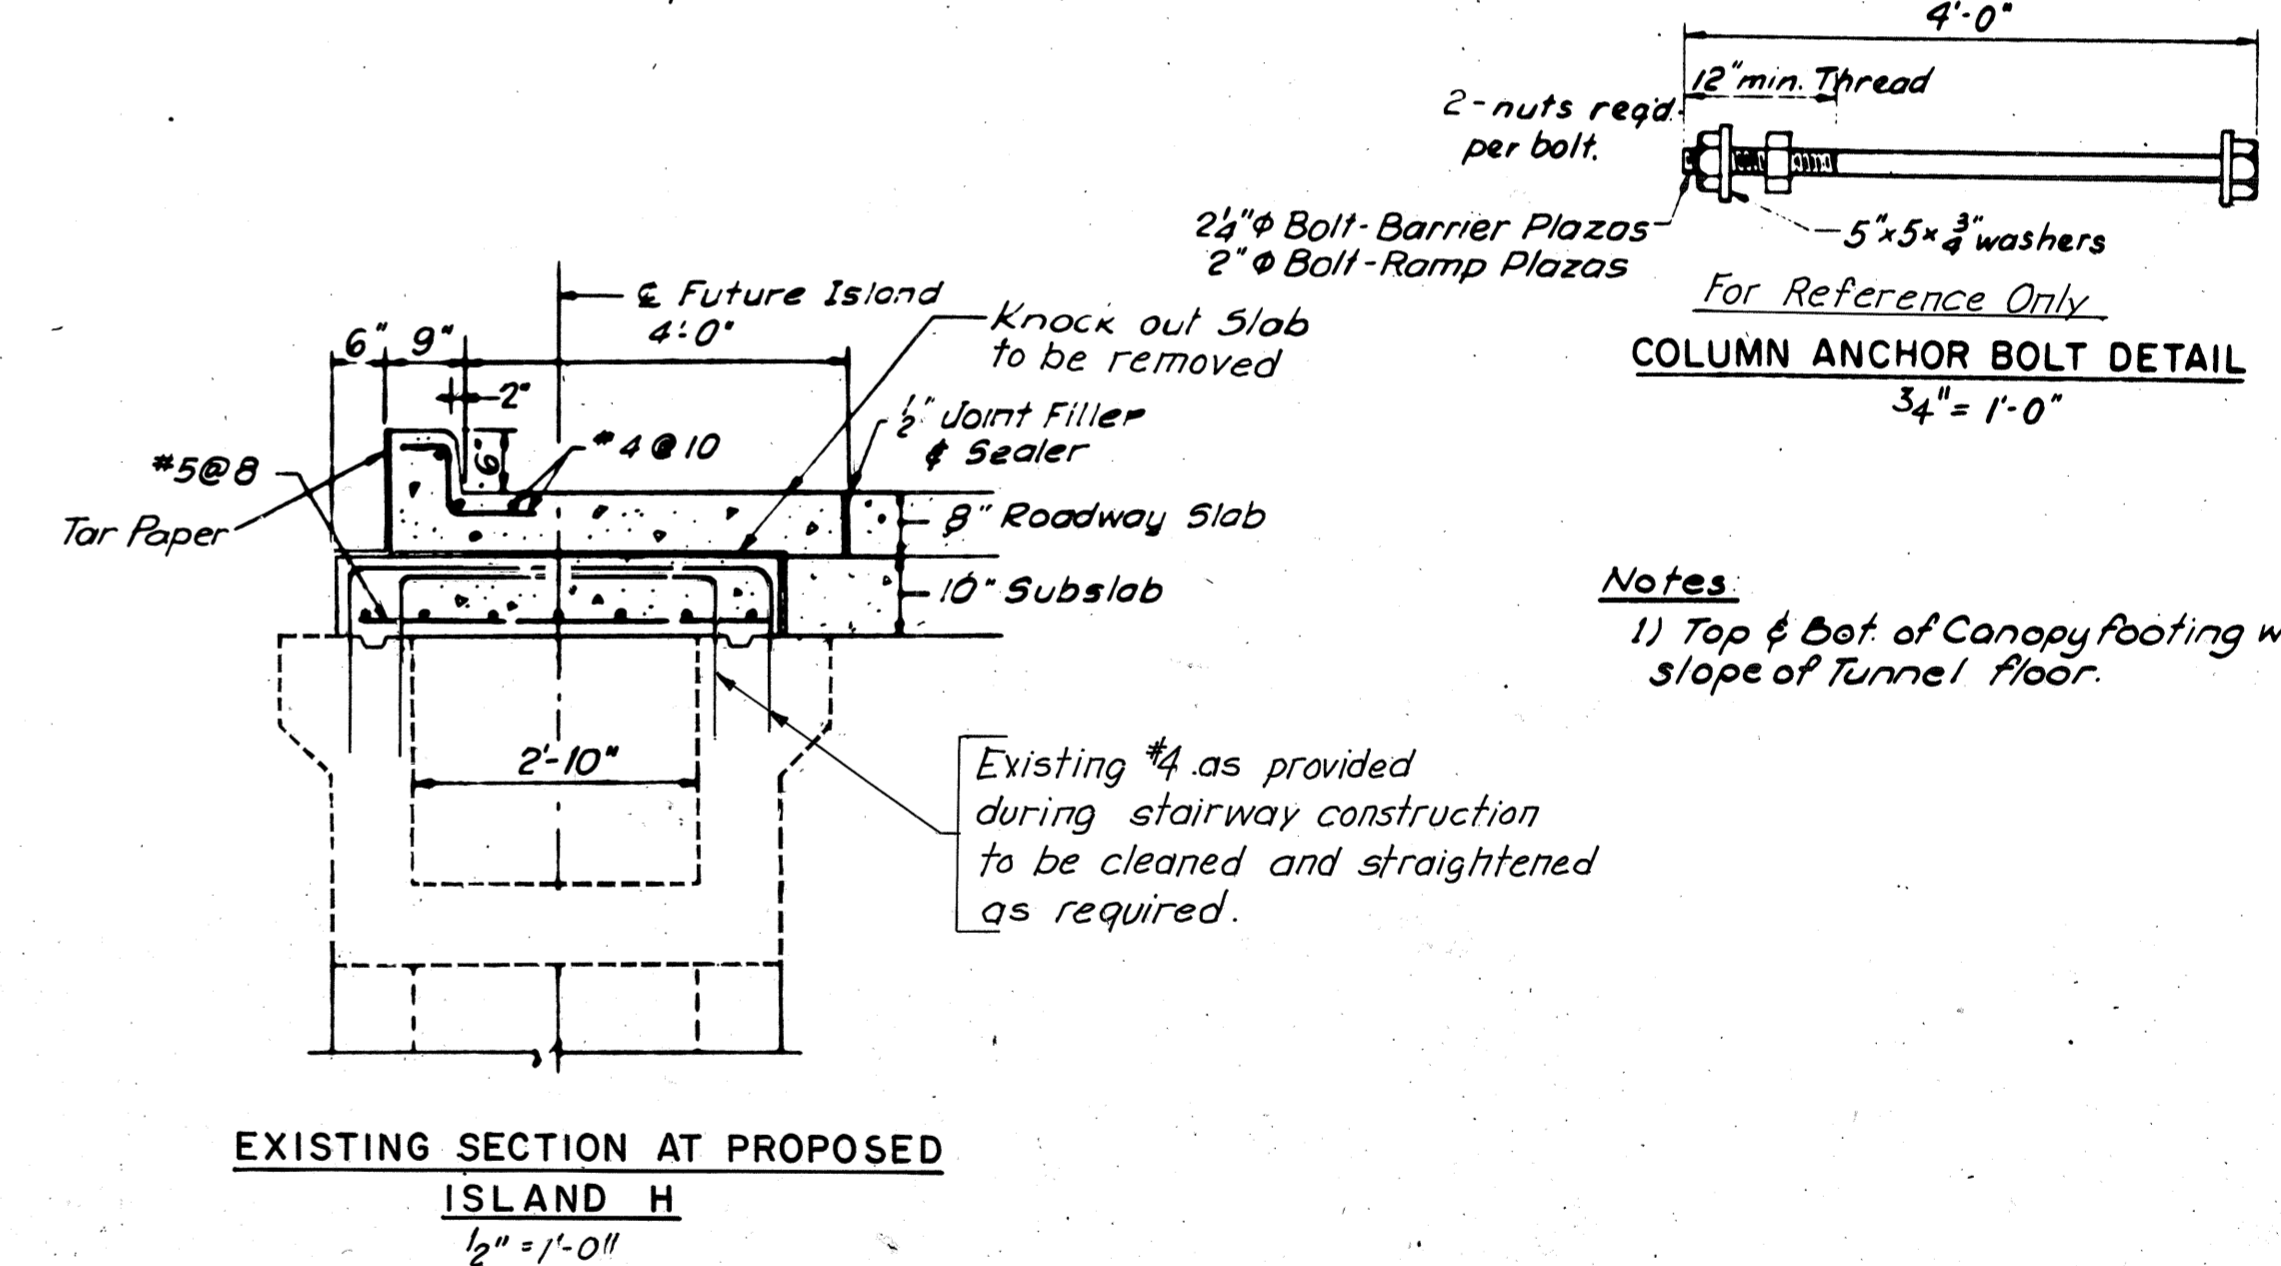

EXISTING SECTION AT PROPOSED ISLAND H
1/2" = 1'-0"

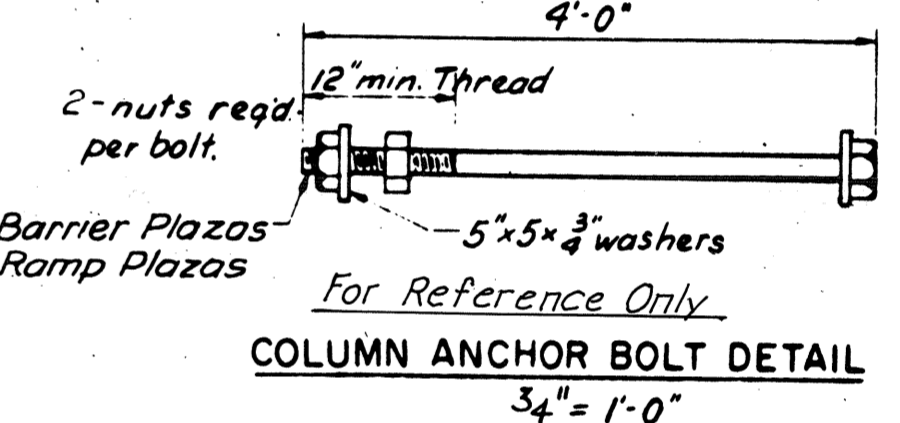

COLUMN ANCHOR BOLT DETAIL
3/4" = 1'-0"

Notes:
1) Top & Bot. of Canopy footing will parallel slope of Tunnel floor.

BY	DATE				
MADE	W.J.W.	5-68			
CHECKED	D.E.N.	5-68	Rev. Sect. A-A	P.H.T.	9-75
IN CHARGE	H.D.S.		Rev. Proj. Block		

AS BUILT



RICHMOND METROPOLITAN AUTHORITY
RICHMOND EXPRESSWAY SYSTEM
POWHITE PARKWAY

BARRIER PLAZA
TUNNEL DETAILS


HOWARD, NEEDLES, TAMMEN & BERGENDOFF
consulting engineers
NEW YORK ALEXANDRIA KANSAS CITY

SCALE: AS NOTED
CONTRACT NO.:
SHEET NO. 4 OF 18

RICHMOND EXPRESSWAY SYSTEM			
SECTION	PROJECT	SHEET NO.	TOTAL SHEETS
TF-4	POWHITE PARKWAY	5	

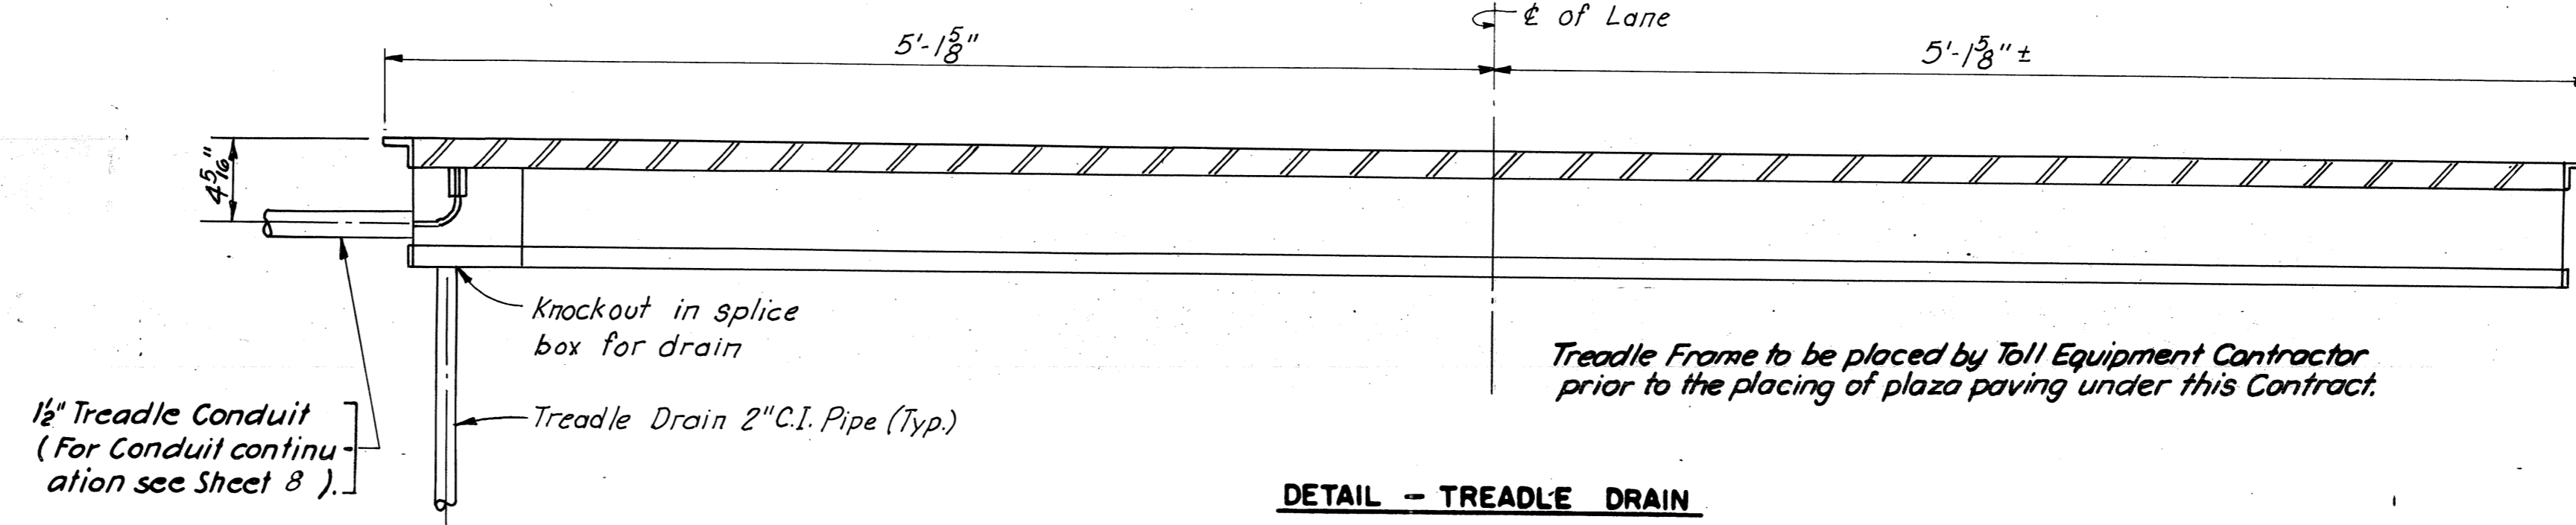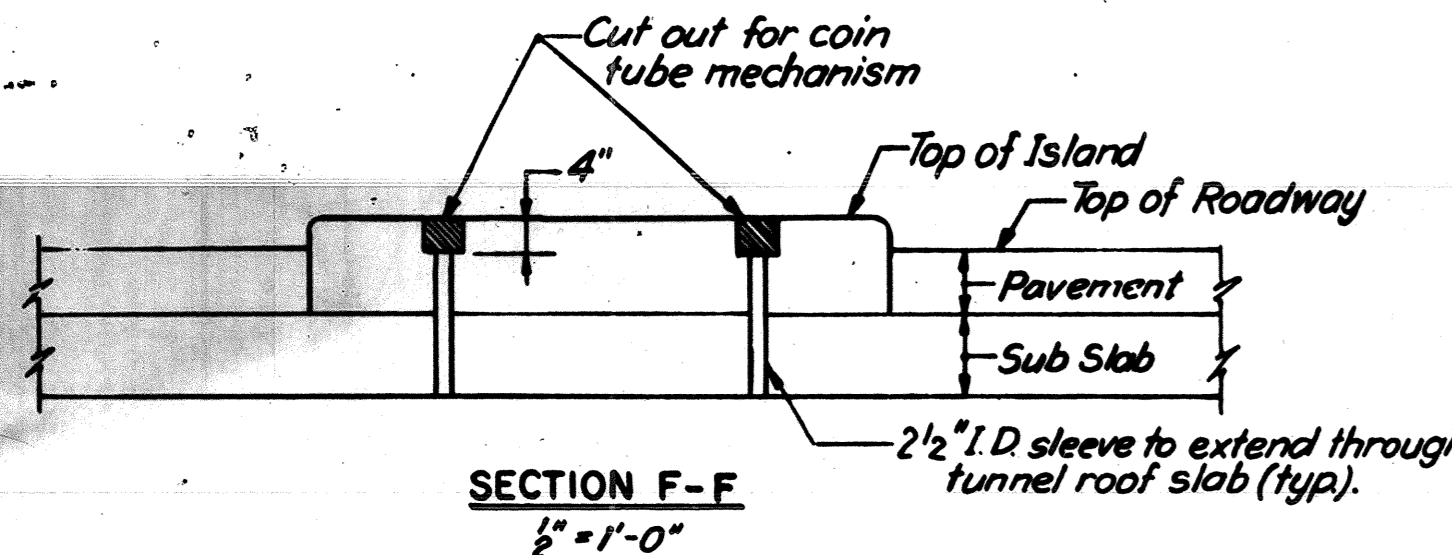


Treadle Frame to be placed by Toll Equipment Contractor prior to the placing of plaza paving under this Contract.

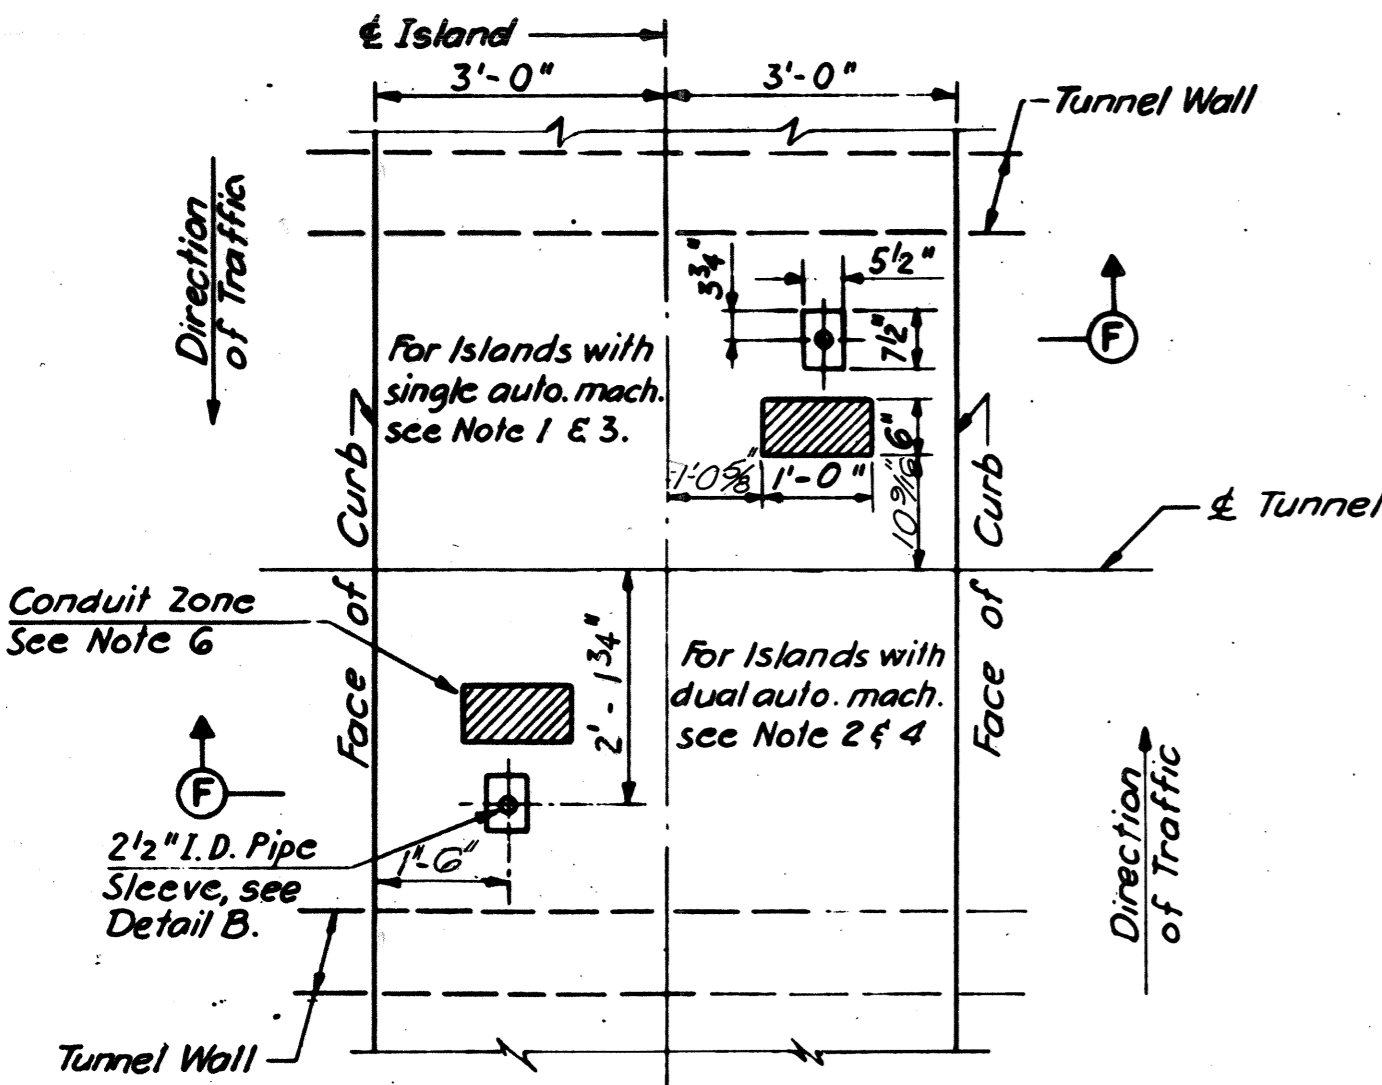


CONDUIT ZONE & PIPE SLEEVE LOCATION FOR AUTOMATIC TOLL MACHINE
1/2" = 1'-0"


(Location and dimension of Conduit Zones and Pipe sleeves are similar for each Direction of Traffic.)

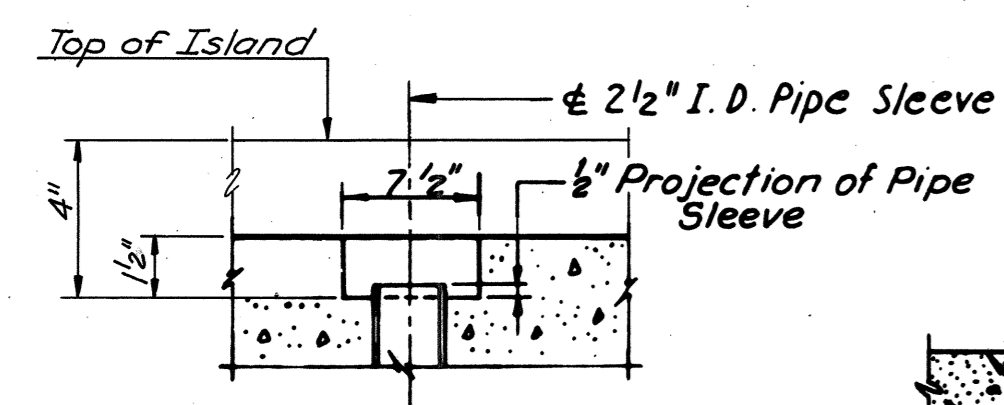


DETAIL "B"
1/2" = 1'-0"

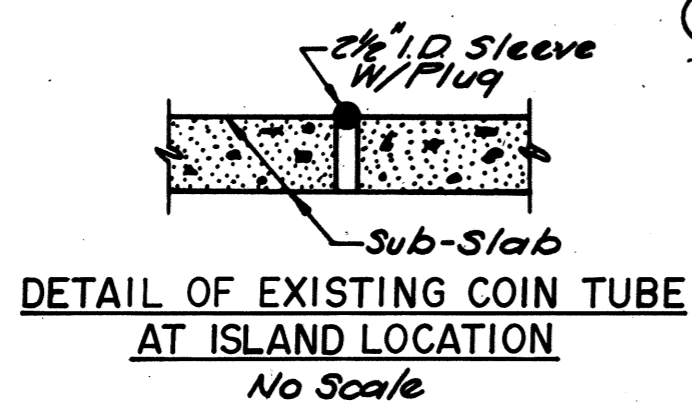


DETAIL OF EXISTING COIN TUBE AT ISLAND LOCATION
No Scale

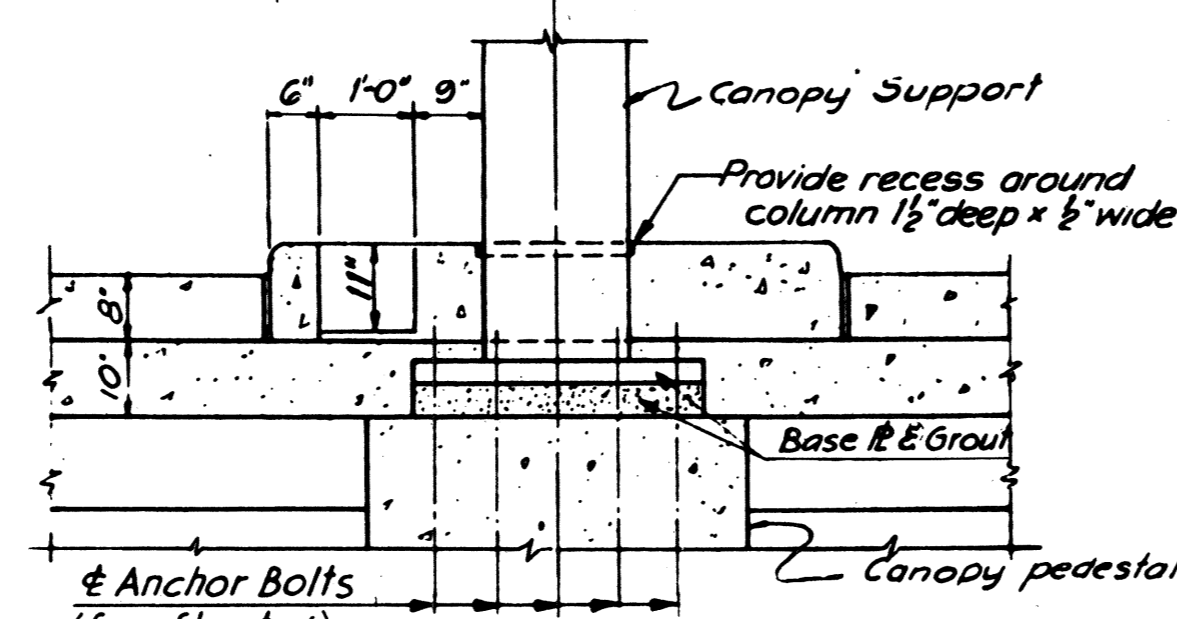


SECTION G-G
1/2" = 1'-0"

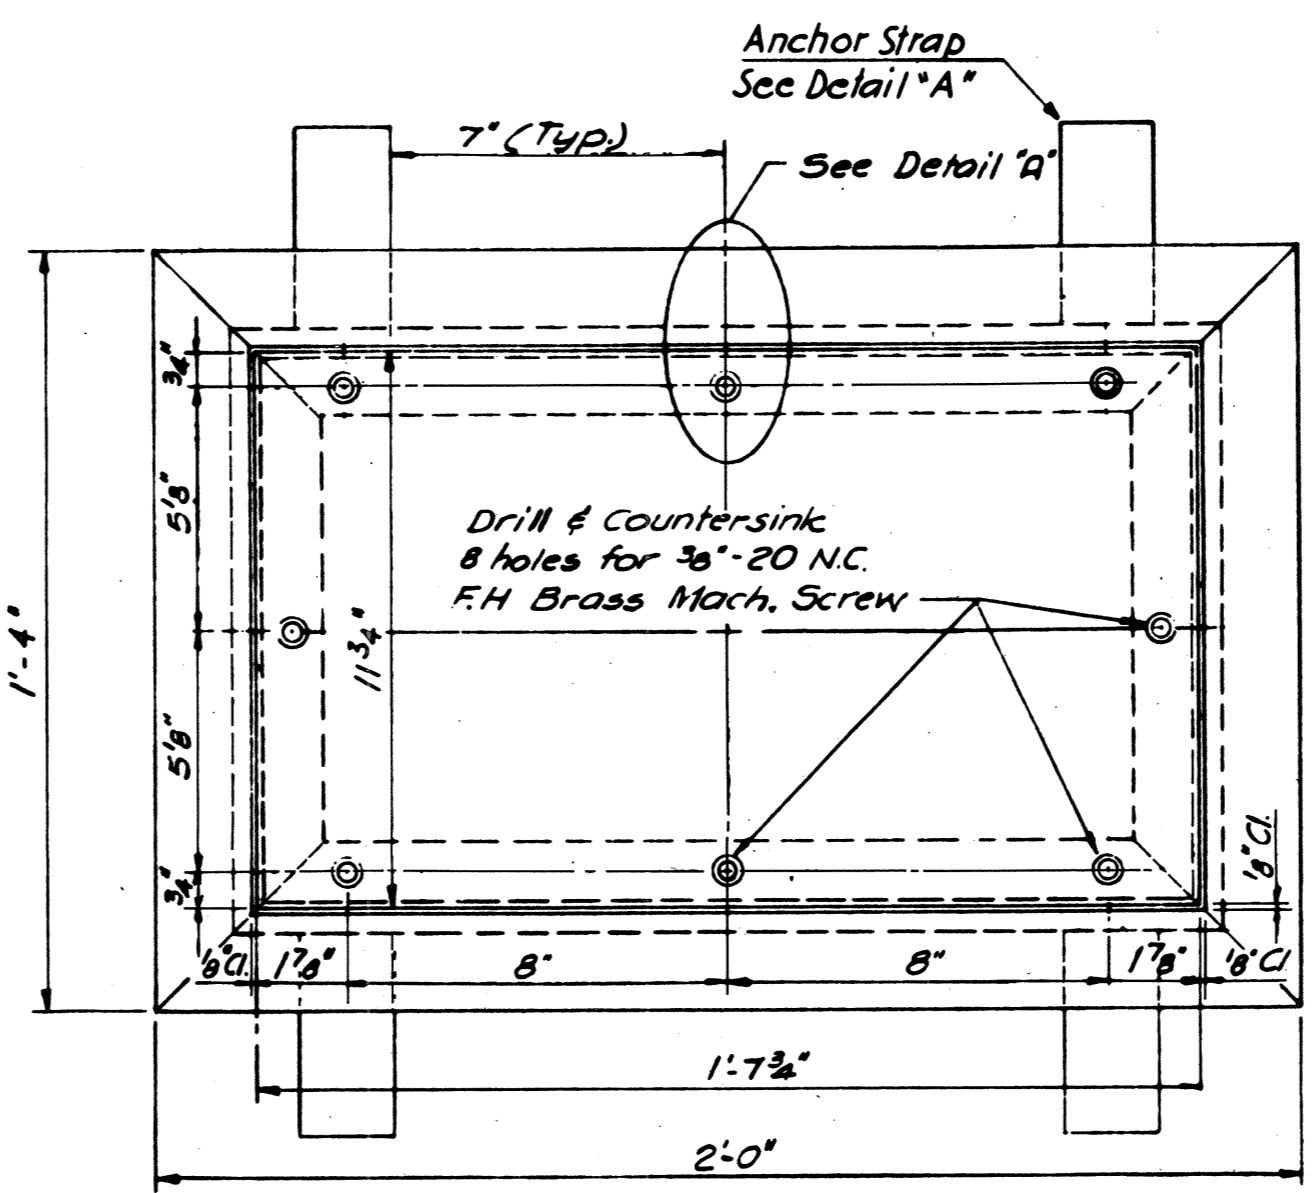


JUNCTION BOX
3" = 1'-0"

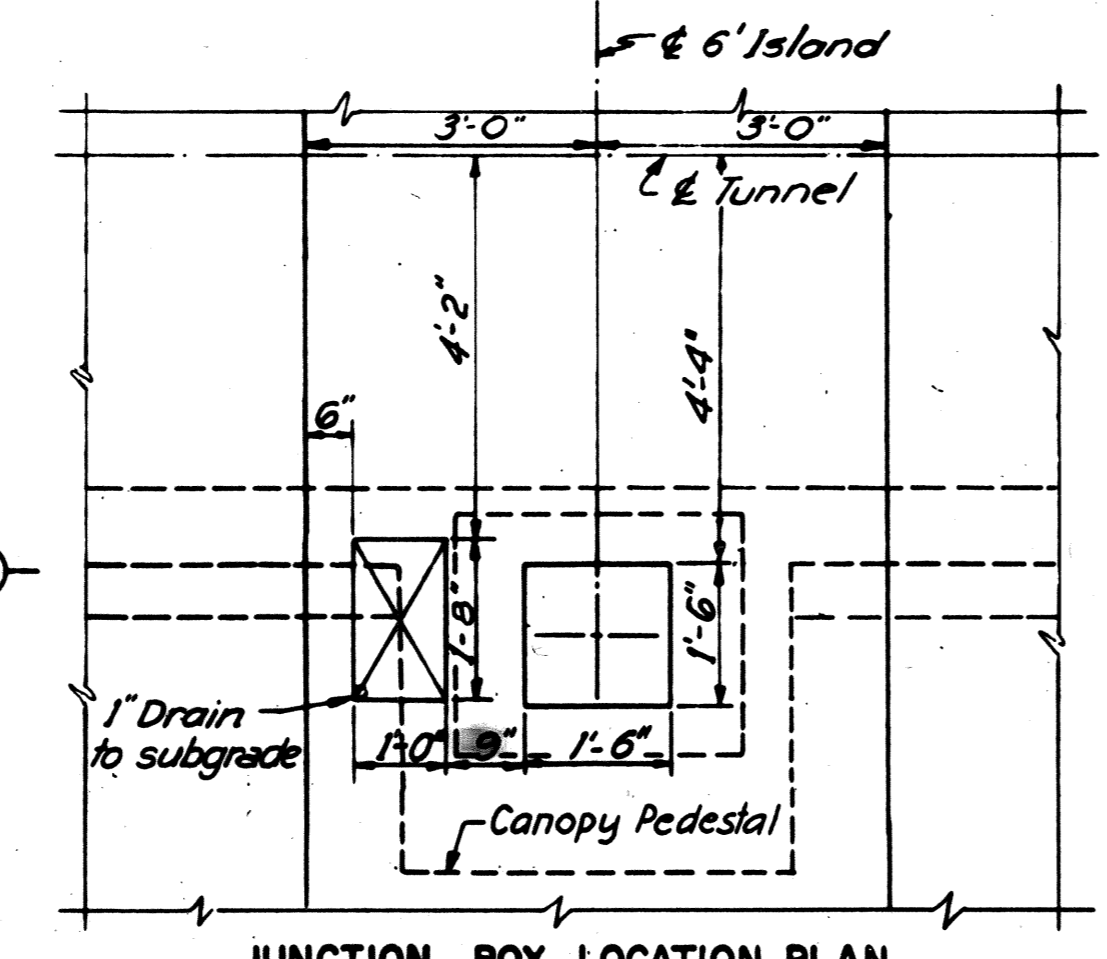

JUNCTION BOX LOCATION PLAN
1/2" = 1'-0"

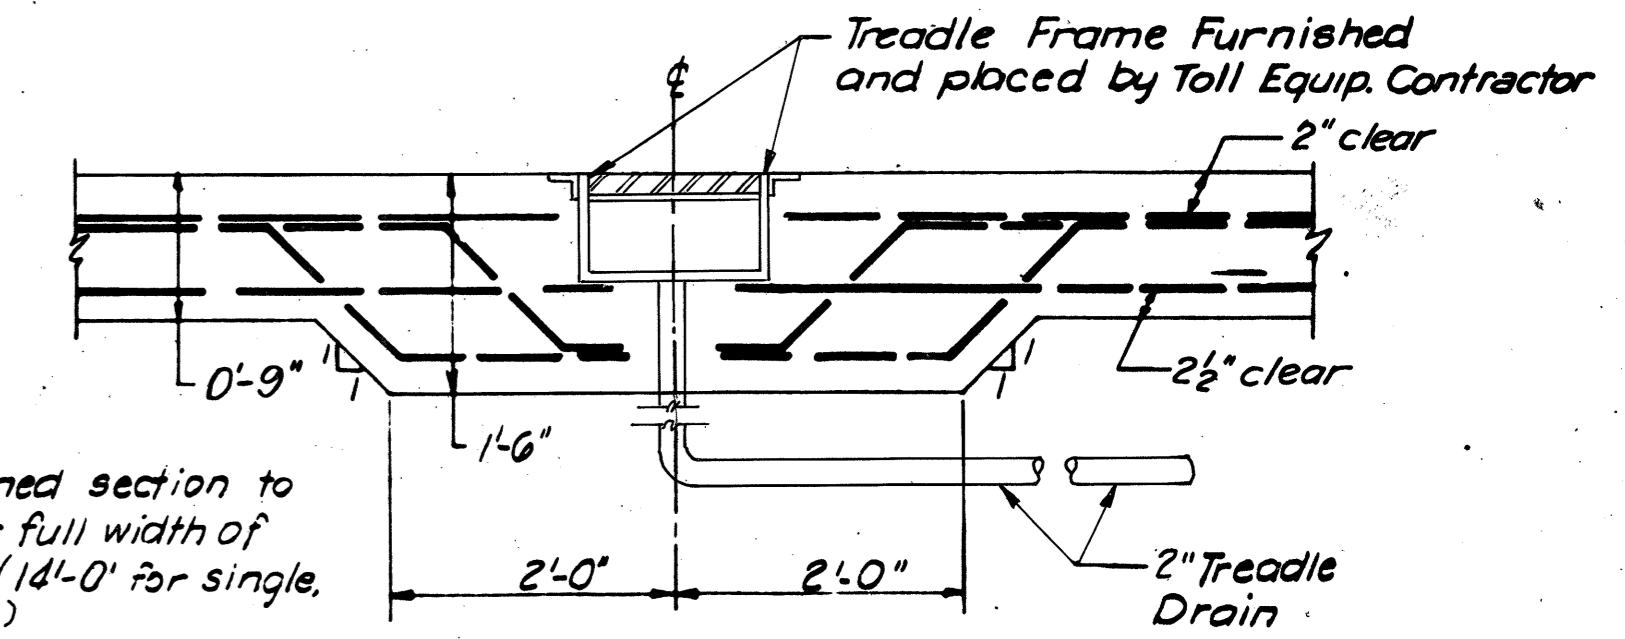


SECTION "C-C"
10' TREADLE FRAME INSTALLATION
3/4" = 1'-0"

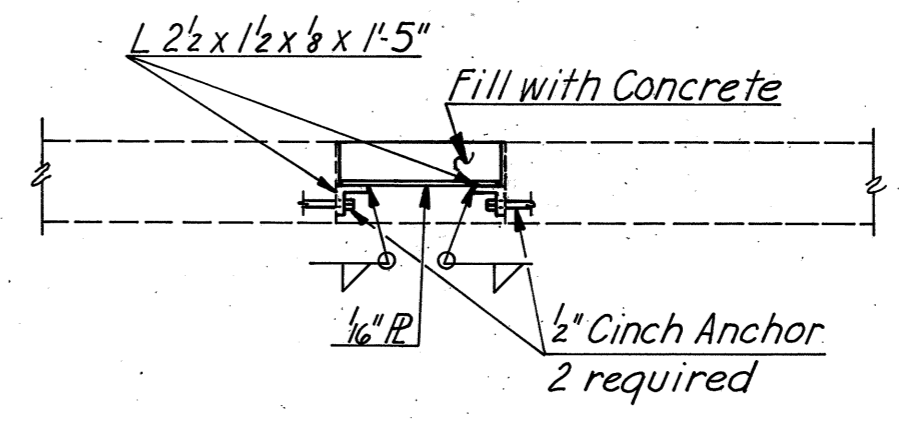


DETAIL OF HEAT DUCT PLUG AT ISLANDS F AND G


- NOTES:**
- Islands I, J and K will have a single coin tube and tube recess for automatic machine.
 - Island H will have dual coin tubes and tube recesses for automatic machines. One coin tube will be for a future automatic machine. See Conduit Layout & Note 5.
 - For coin tube recesses at future automatic machine locations, plug 2 1/2" I.D. sleeve at bottom of recess; then coat bottom and sides of recess with paraffin and fill with concrete.
 - Conduits to or from toll booths or automatic machines are to be placed totally within the zones shown. For Conduit Layouts and details see Sheets 8 and 15.

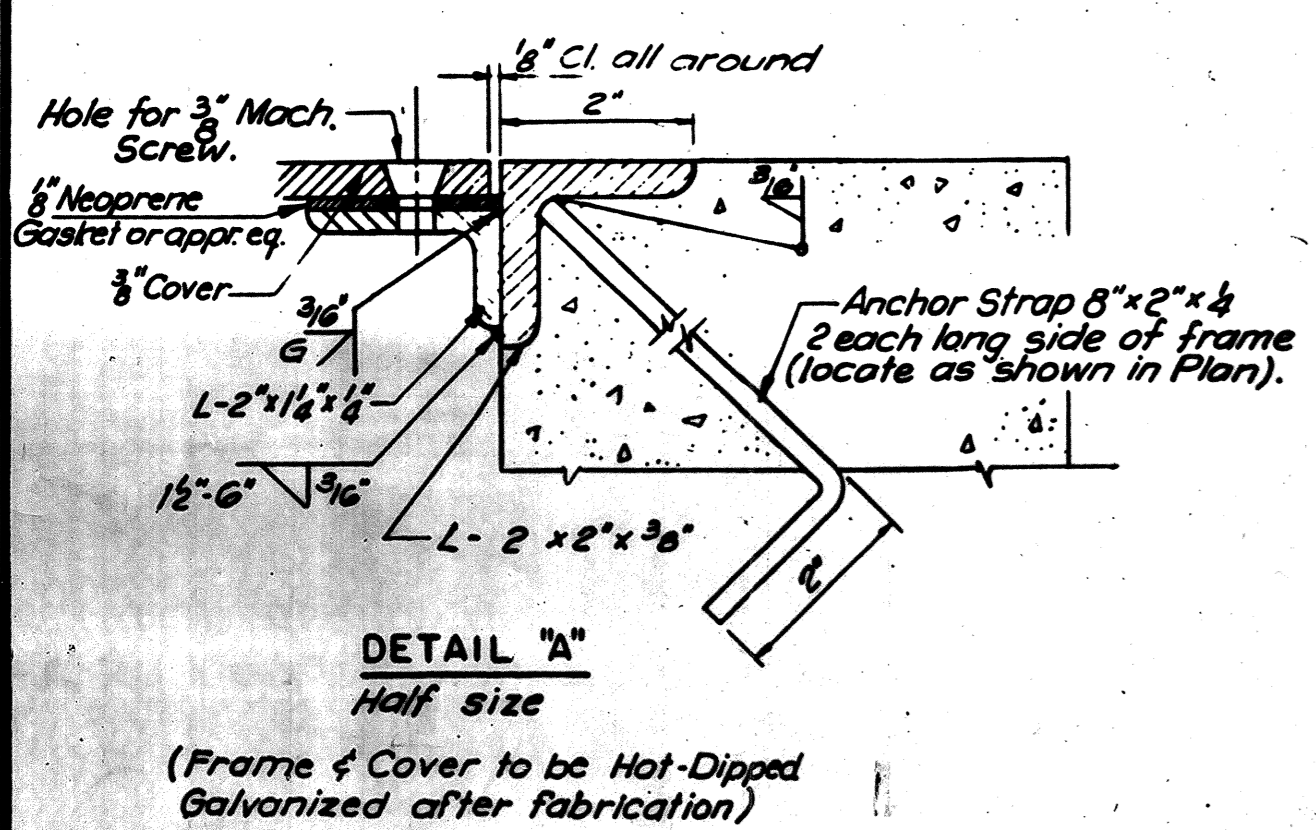


DETAIL "A"
Half size
(Frame & Cover to be Hot-Dipped Galvanized after fabrication)

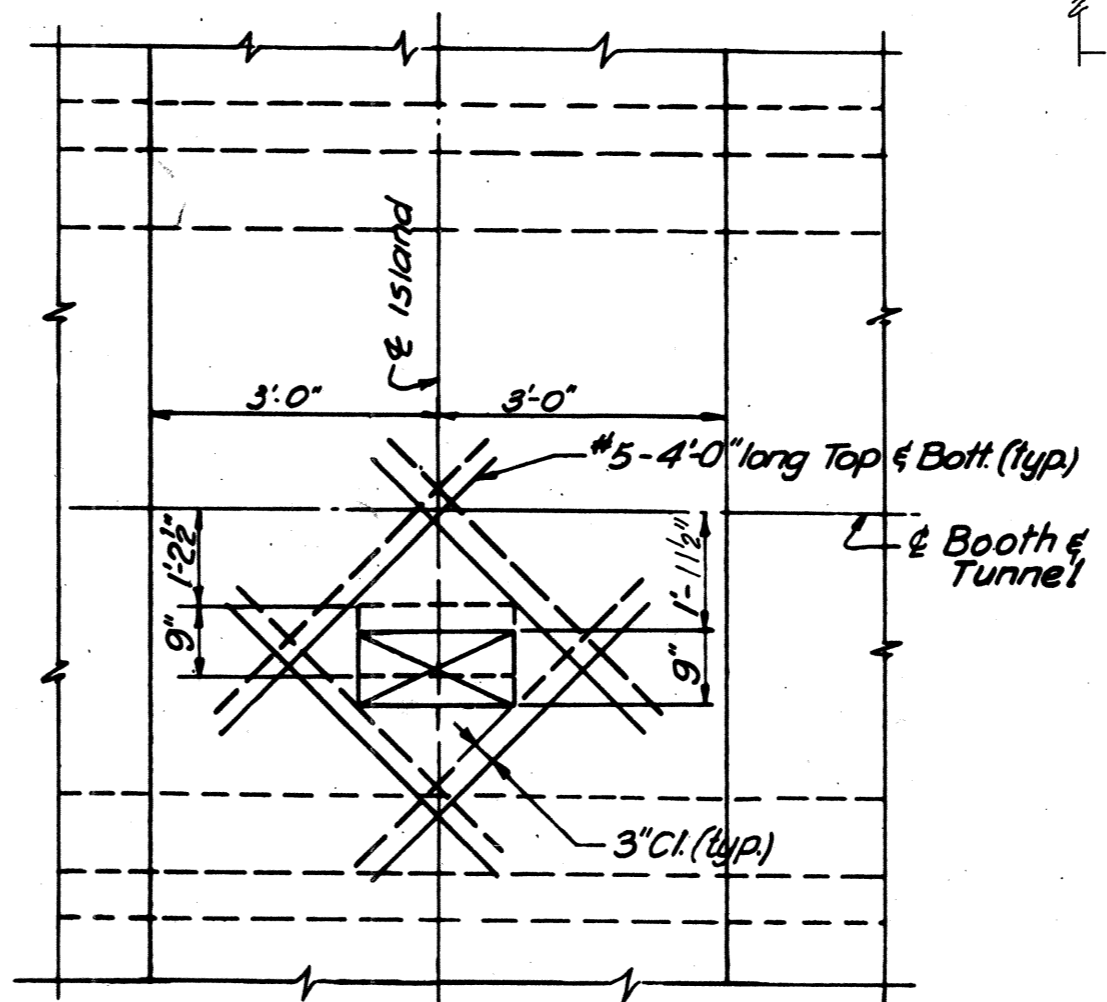

SUBSLAB TREATMENT AT HEAT DUCTS
Not to scale

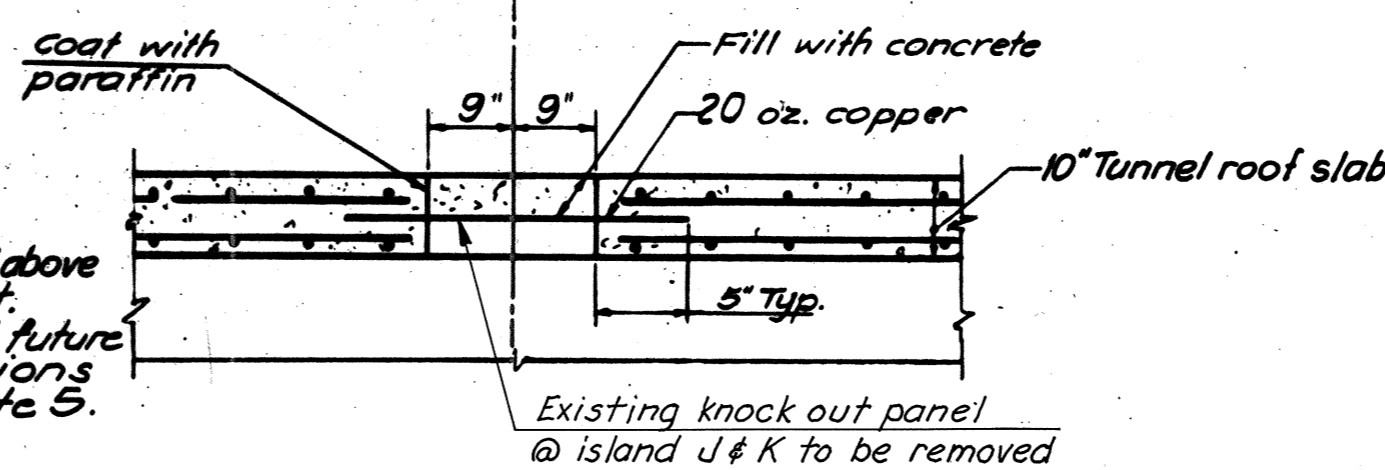

KNOCK-OUT DETAIL
Not to scale

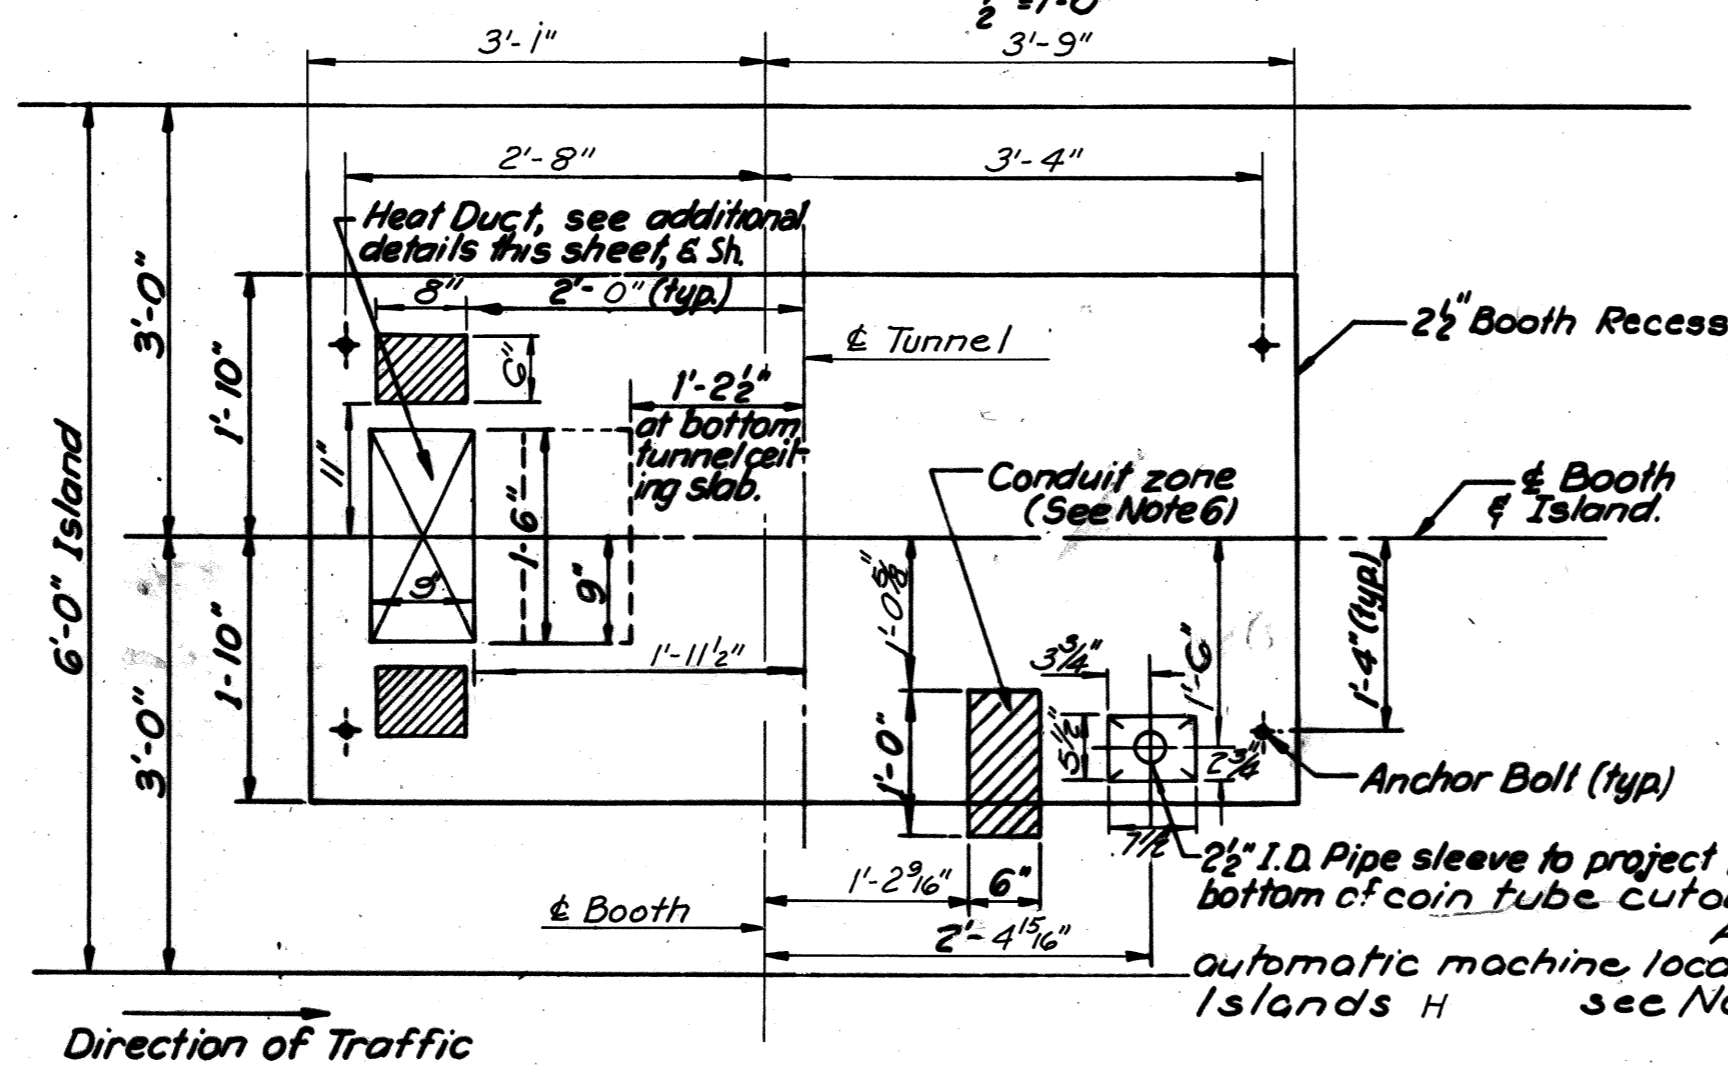

UTILITY LOCATIONS BARRIER PLAZA TOLL BOOTHS
Islands J & K
3" = 1'-0"

BY	DATE	NO.	REVISION	BY	DATE
MADE	W. J. W.	5-68			
CHECKED	D. E. N.	5-68	New Treadle Drain Misc. Rev.	P.H.T.	9-75
IN CHARGE	H.D.S.				

AS BUILT

RICHMOND METROPOLITAN AUTHORITY
RICHMOND EXPRESSWAY SYSTEM
POWHITE PARKWAY


MISCELLANEOUS DETAILS

HOWARD, NEEDLES, TAMMEN & BERGENDOFF consulting engineers NEW YORK ALEXANDRIA KANSAS CITY	SCALE: AS NOTED CONTRACT NO. SHEET NO. 5 OF 18
---	--


NORTHBOUND POWHITE PARKWAY TOLL PLAZA

1989 WIDENING

RICHMOND EXPRESSWAY SYSTEM			
SECTION	PROJECT	SHEET NO.	TOTAL SHEETS
12	POWHITE PARKWAY	7	101

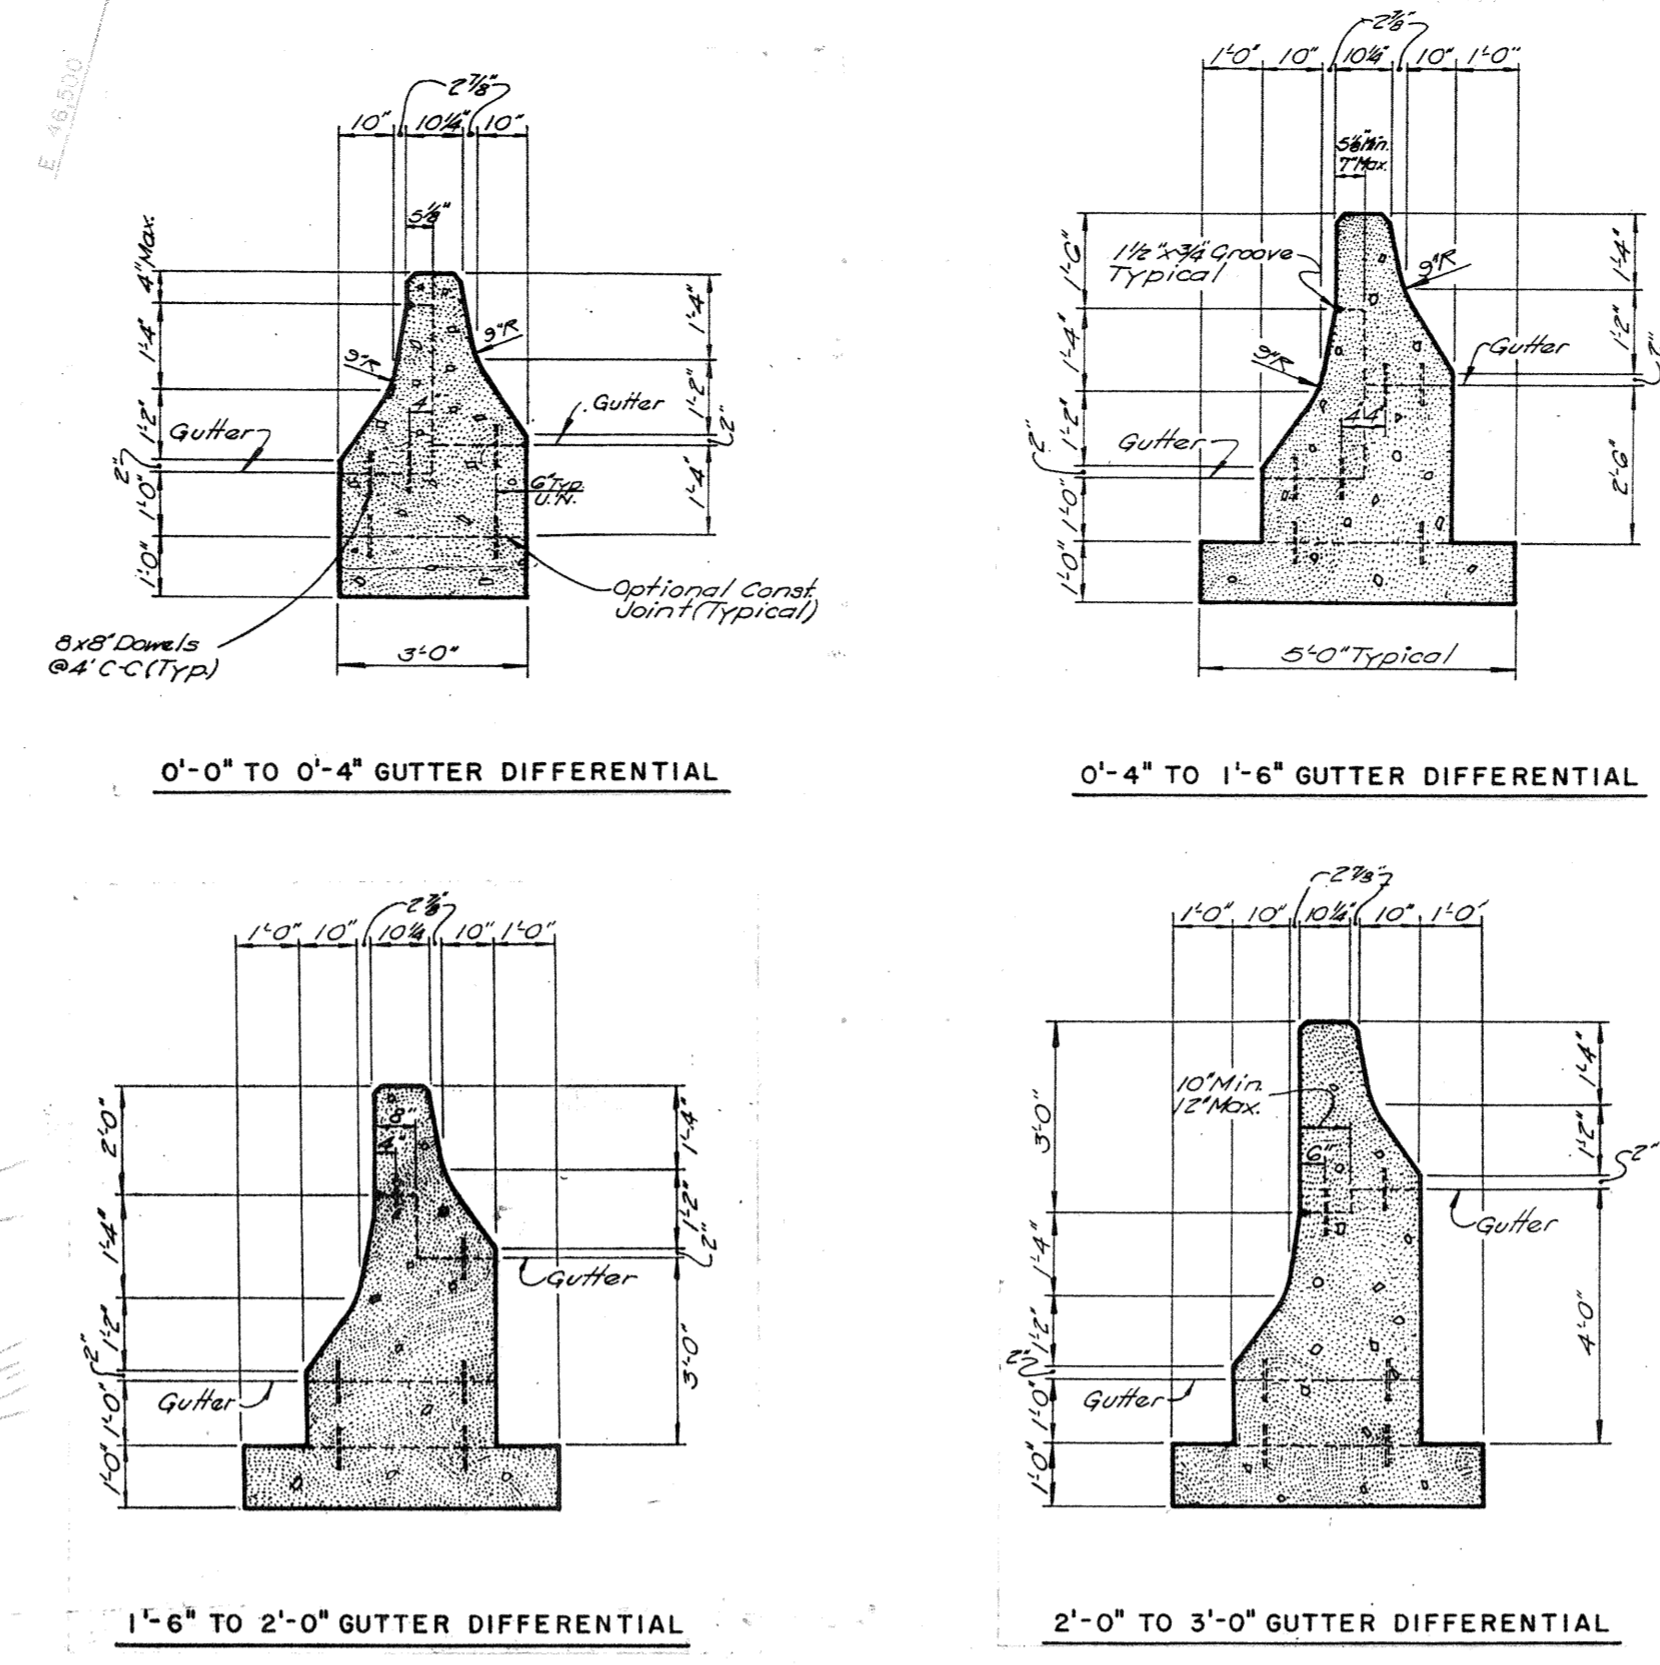

SPECIAL MEDIAN WALL

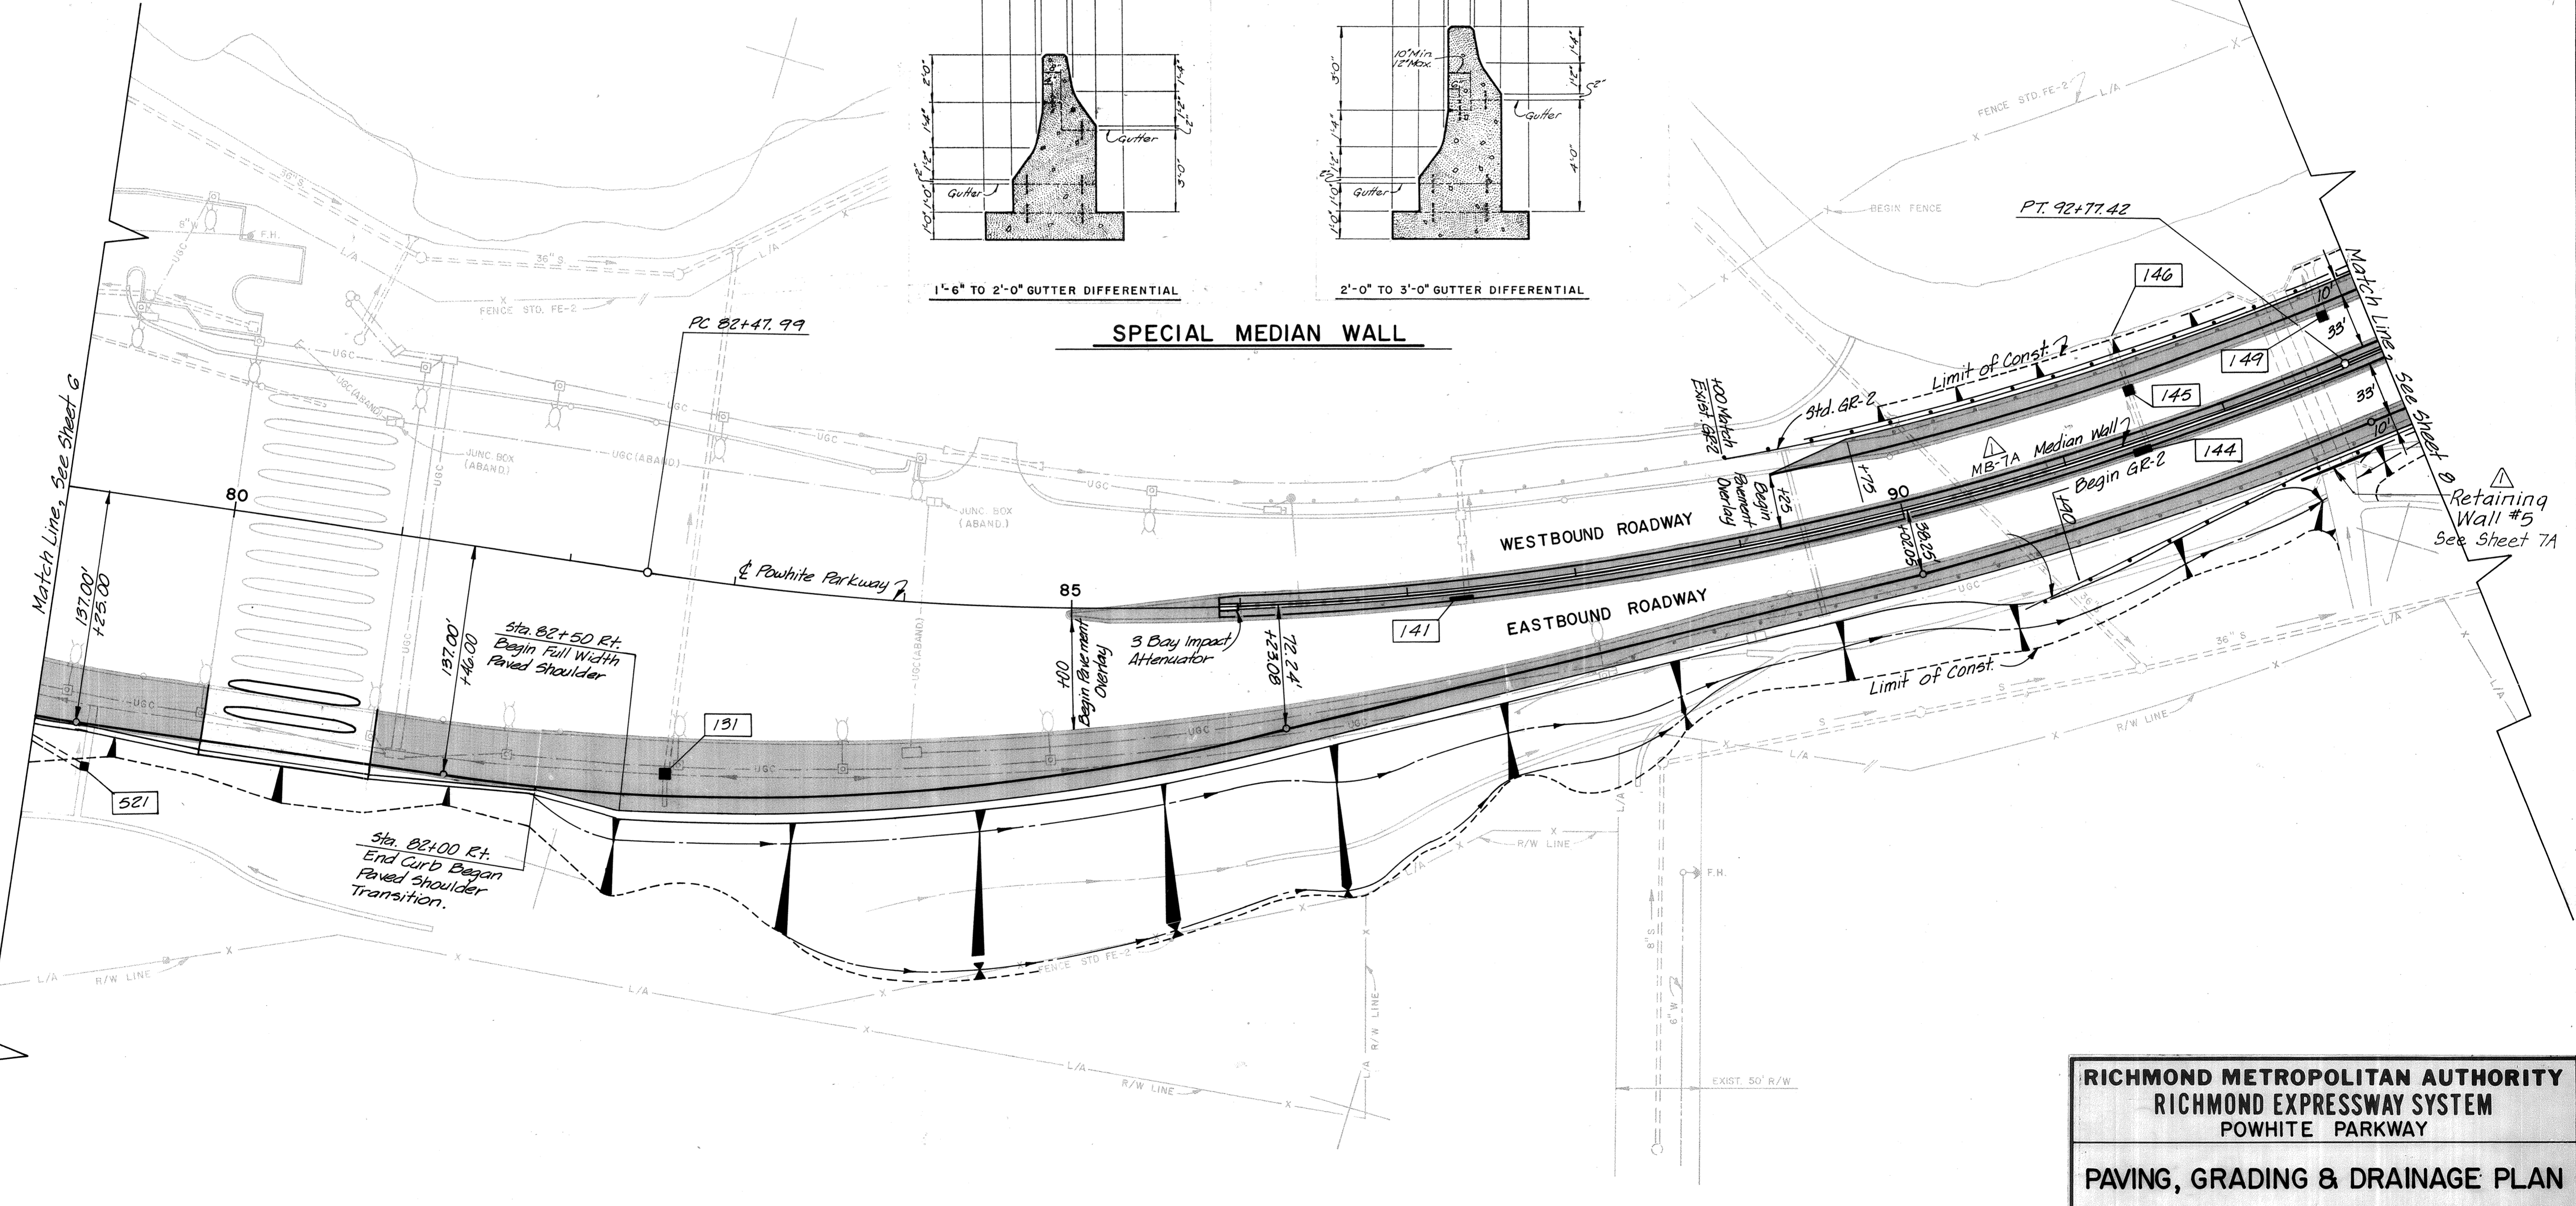

By	Date				
Designed	TJC	3/87			
Drawn	JLT	3/87			
Checked	RLV	3/87	As Built	TEM	3-89
Approved	DJA	3/87	No.	Revision	By Date

RICHMOND METROPOLITAN AUTHORITY
RICHMOND EXPRESSWAY SYSTEM
POWHITE PARKWAY

PAVING, GRADING & DRAINAGE PLAN
 Sta. 79+00 to Sta 93+00

HOWARD NEEDLES TAMMEN & BERGENDOFF
 Architects Engineers Planners
 ALEXANDRIA, VA


HNTB

Scale: 1" = 50' Date: MARCH 1987 Contract No. C-12 Sheet 7 of 101


AS BUILT

NORTHBOUND POWHITE PARKWAY TOLL PLAZA

2006 PLANS FOR DEMOLITION OF PORTION OF TOLL PLAZA

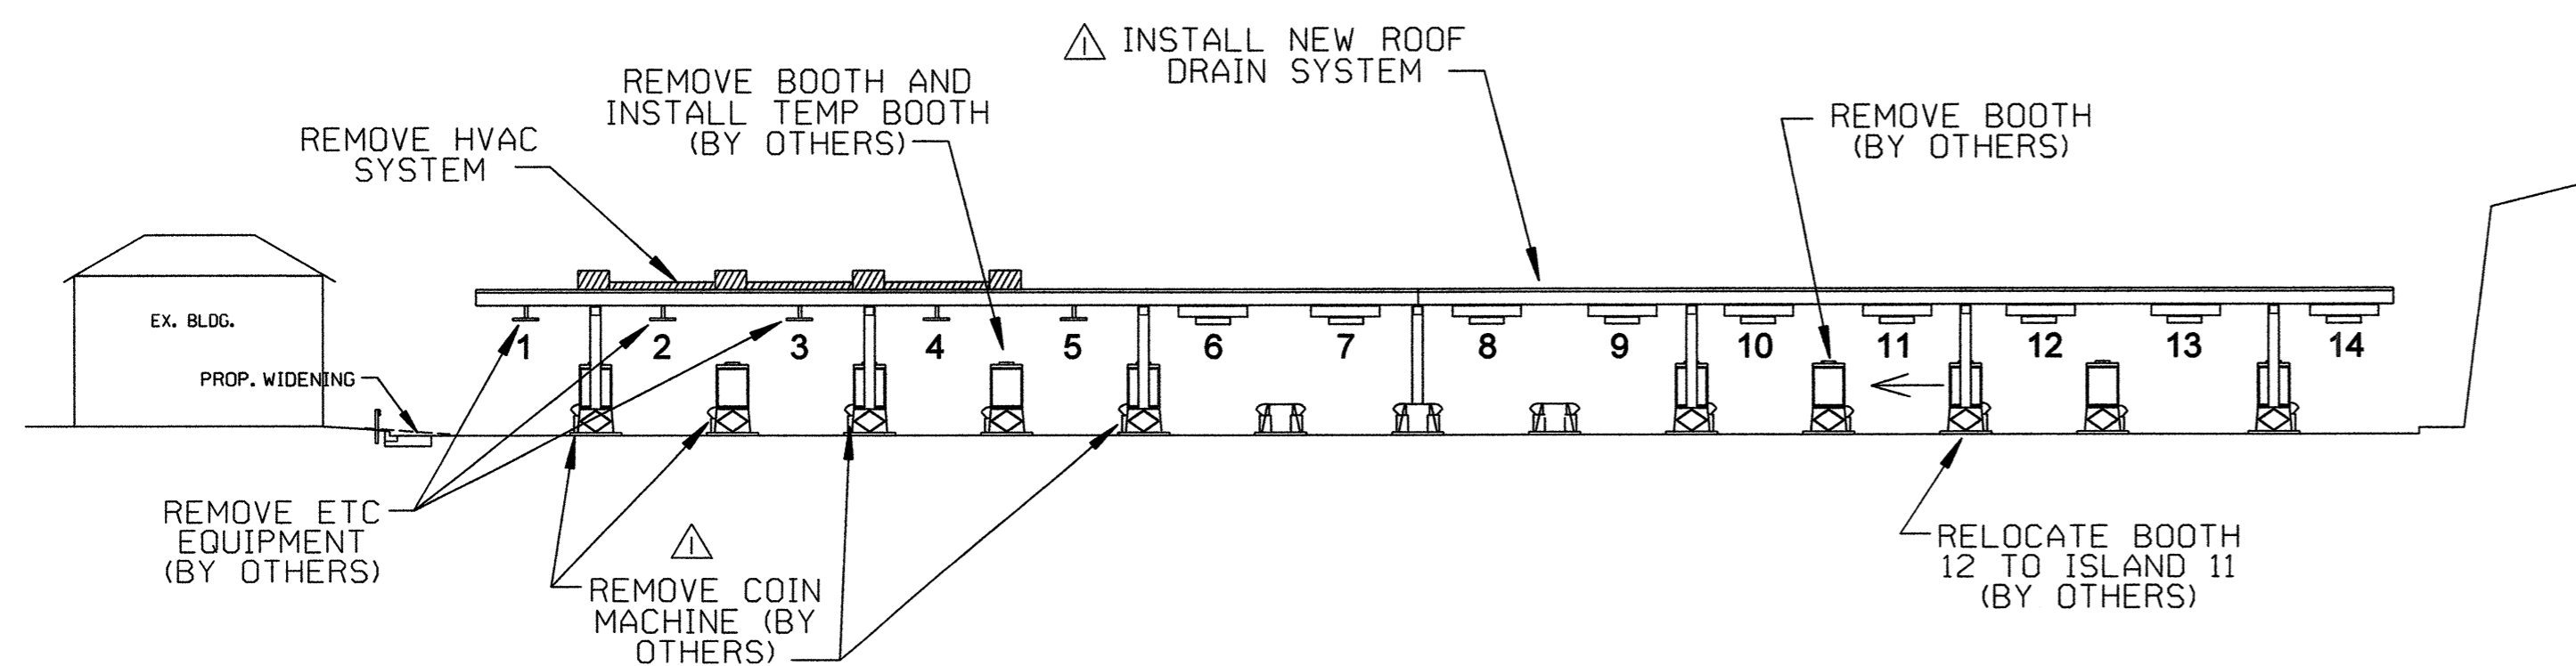

STAGE IIB ELEVATION

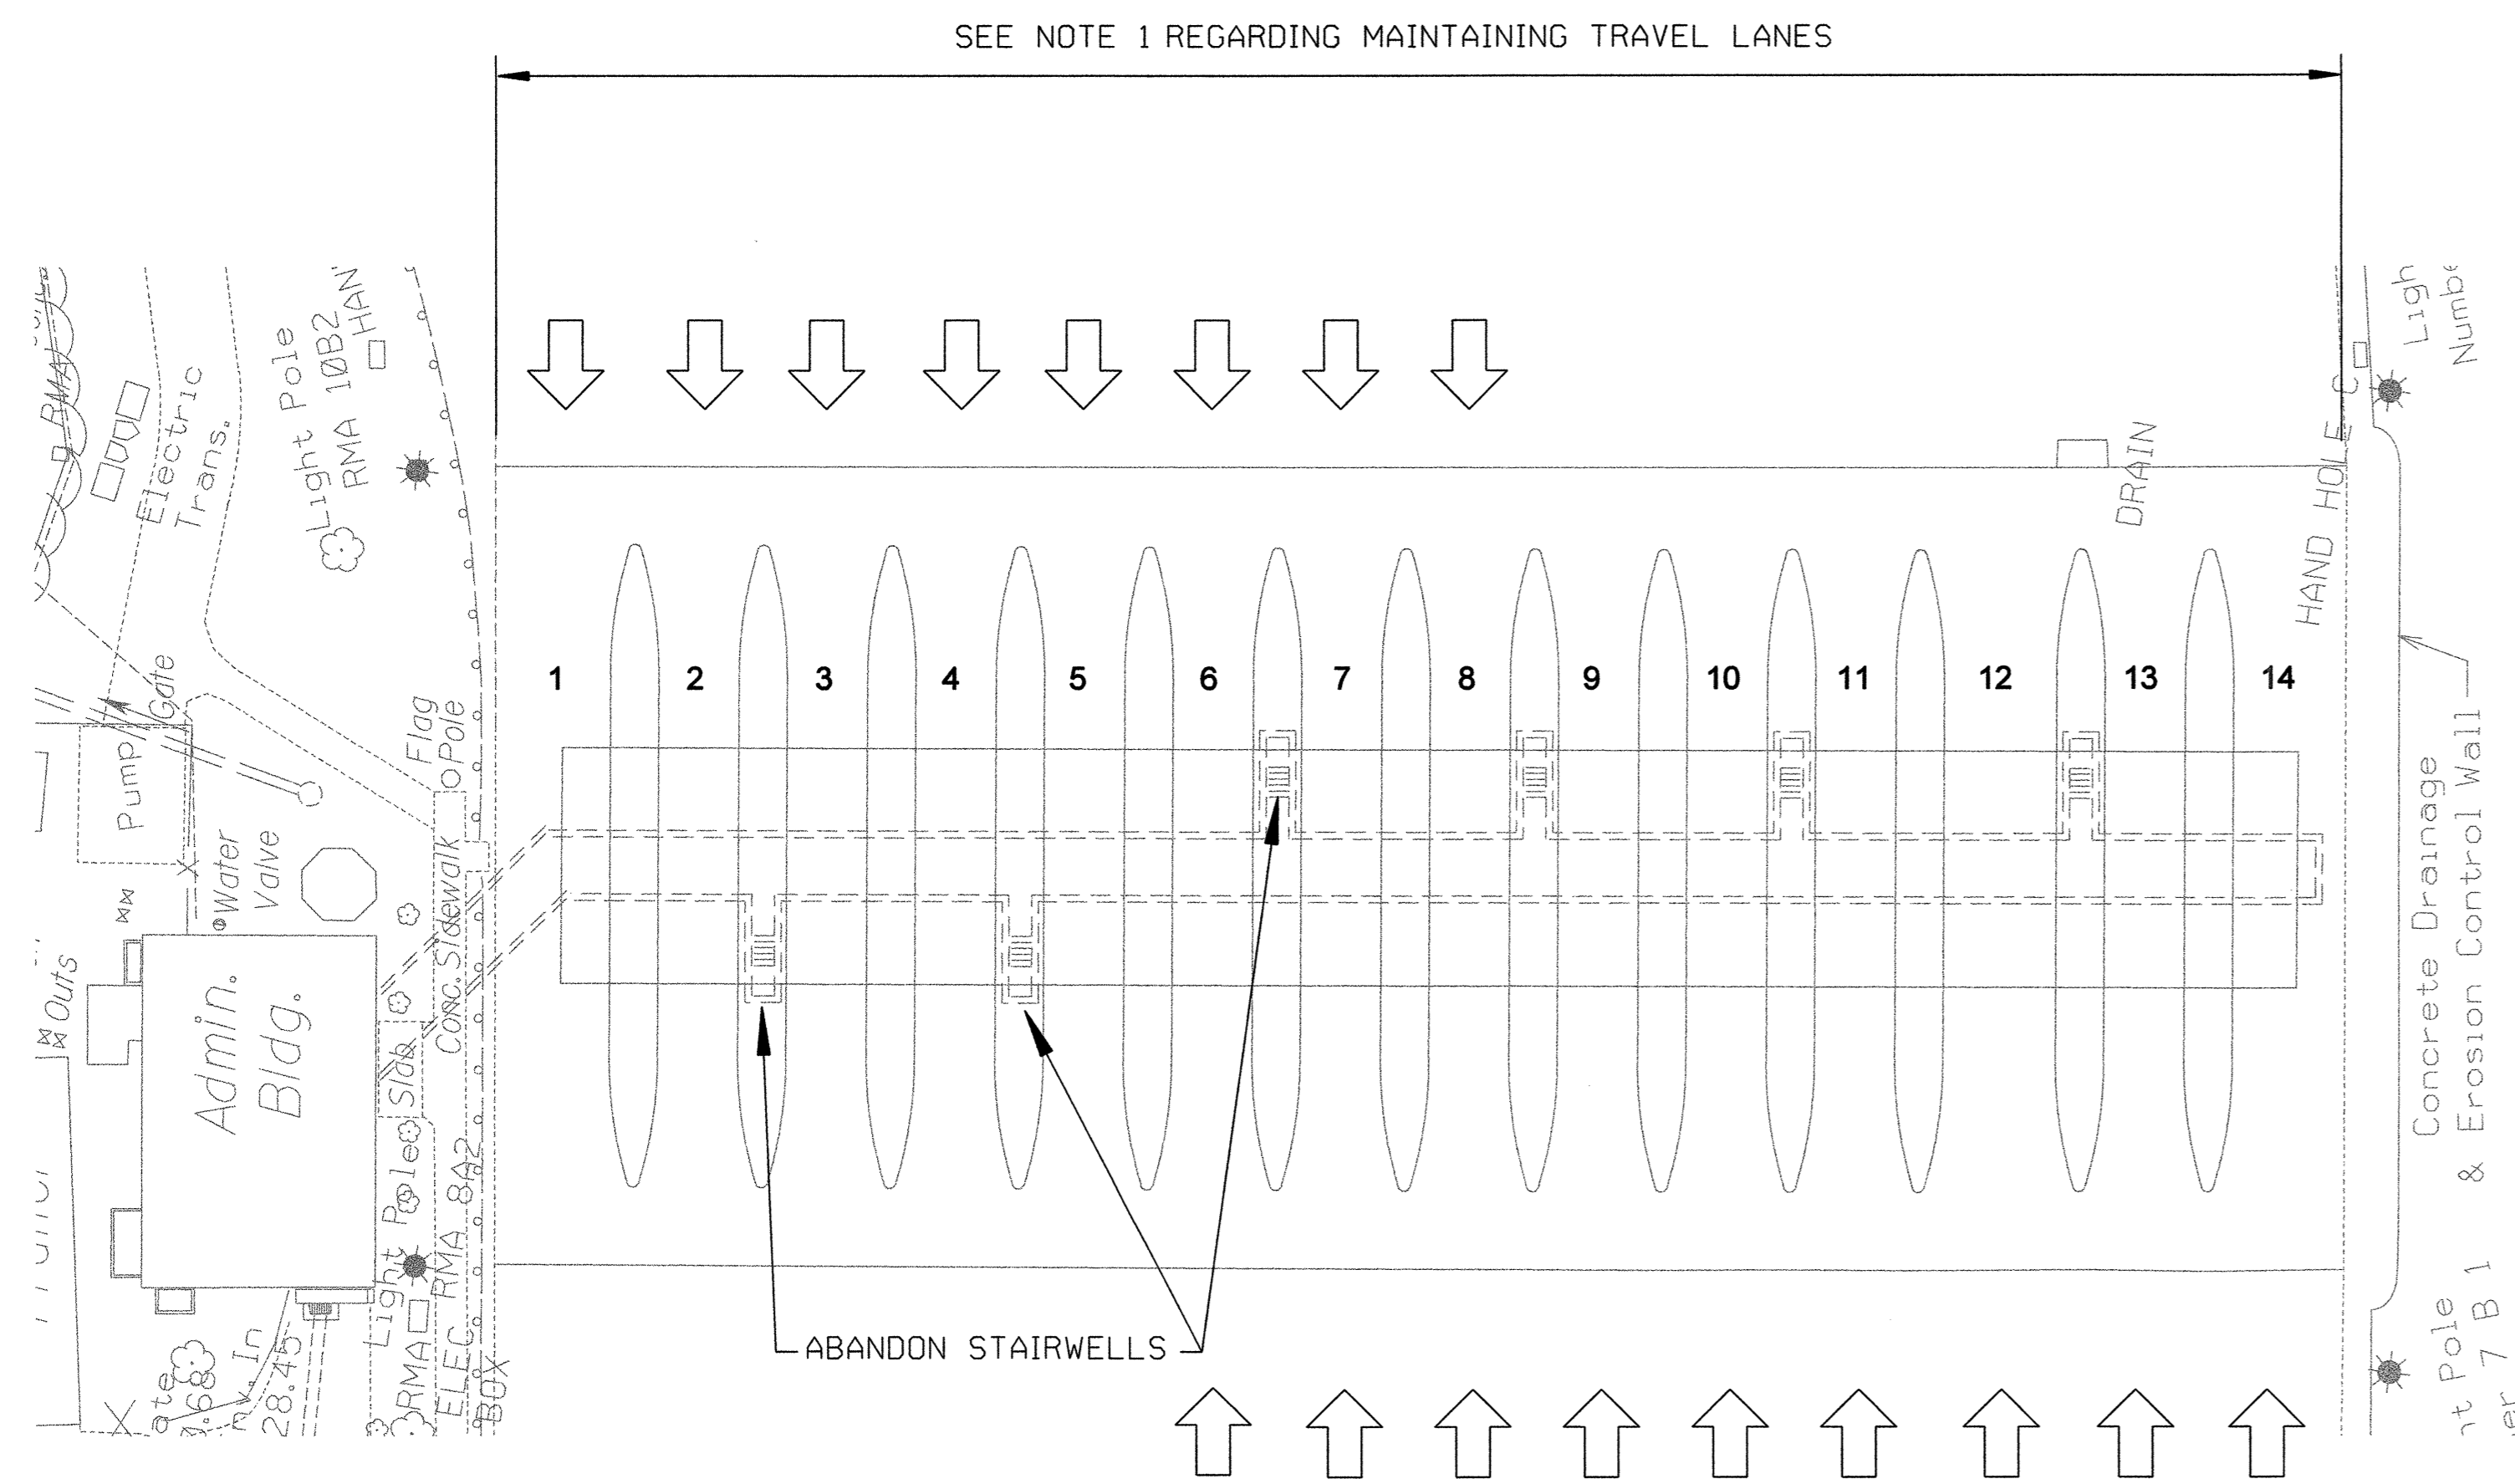


STAGE IIB PLAN


- NOTES:
1. CONTRACTOR SHALL COORDINATE WITH ENGINEER WHO WILL PROVIDE SINGLE AND/OR LANE CLOSURES FOR PERIODS LESS THAN 24 HOURS, OR FOR WEEKENDS, TO CREATE WORK ZONE, AS DESCRIBED IN CONTRACT DOCUMENTS.
 2. CONTRACTOR SHALL COORDINATE WITH ENGINEER TO ALLOW APPROPRIATE SCHEDULING OF TOLL PLAZA MODIFICATION WORK TO BE PERFORMED BY OTHERS.
 3. NO WORK IMPACTING SB TRAVEL LANES SHALL BE ALLOWED BETWEEN 3:00 PM AND 7:00 PM, MONDAY THROUGH FRIDAY.
 4. NO WORK IMPACTING NB TRAVEL LANES SHALL BE ALLOWED BETWEEN 6:00 AM AND 10:00 AM, MONDAY THROUGH FRIDAY.
 5. FOR ADDITIONAL SEQUENCE NOTES, SEE MAINTENANCE OF TRAFFIC SHEET OF APPROPRIATE STAGE.
 6. CONTRACTOR SHALL MAKE EVERY EFFORT TO SALVAGE EXISTING HVAC UNITS. SEE SPECIAL PROVISIONS.

ADDENDUM NO. 2:	5/17/06
ADDENDUM NO. 1:	5/10/06


REVISIONS

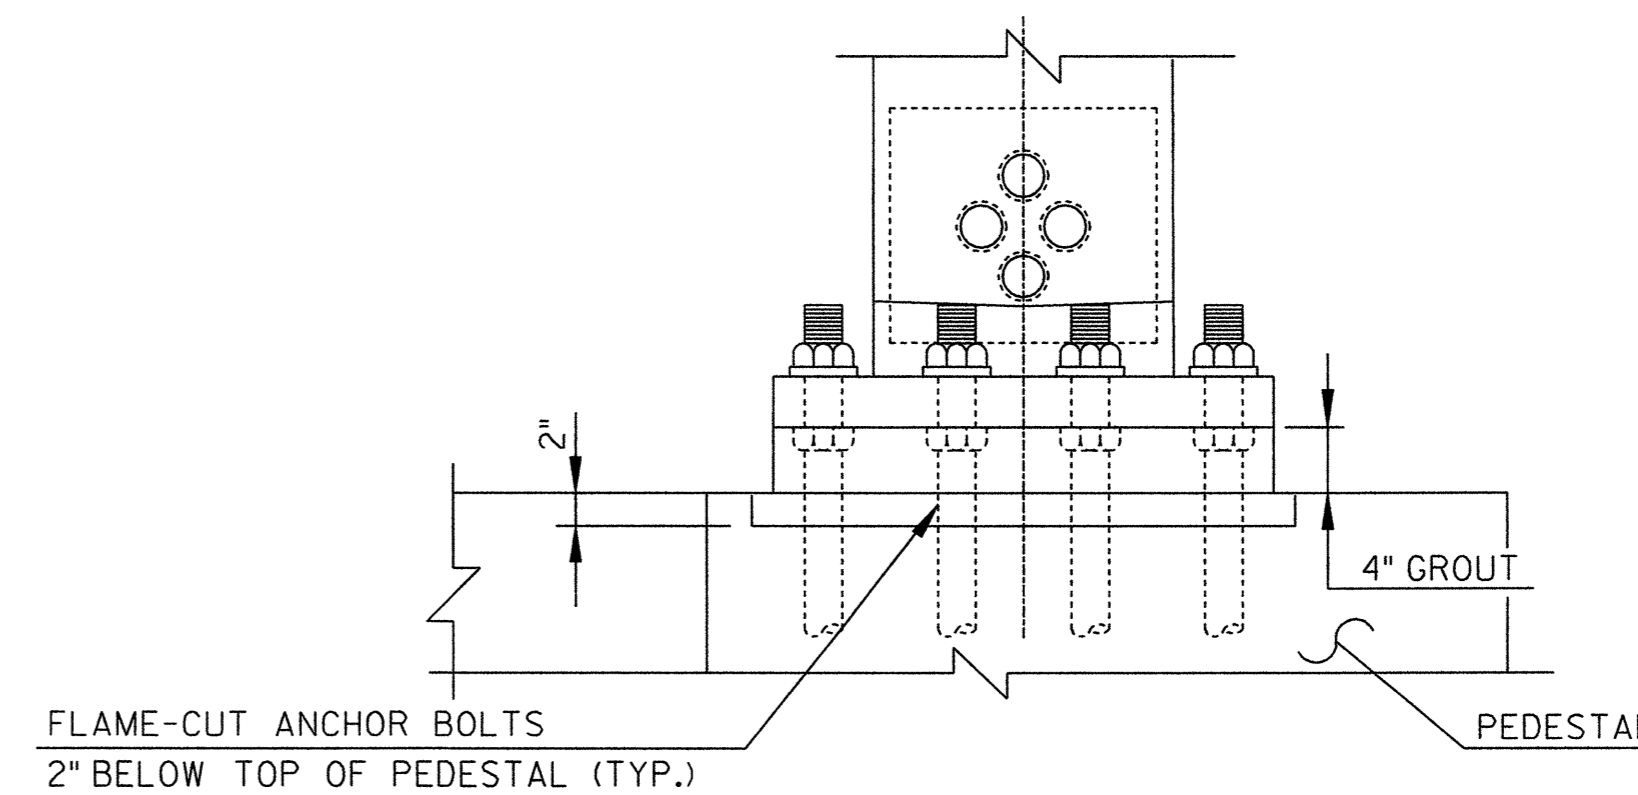


CANOPY SUPPORT REMOVAL
NOT TO SCALE

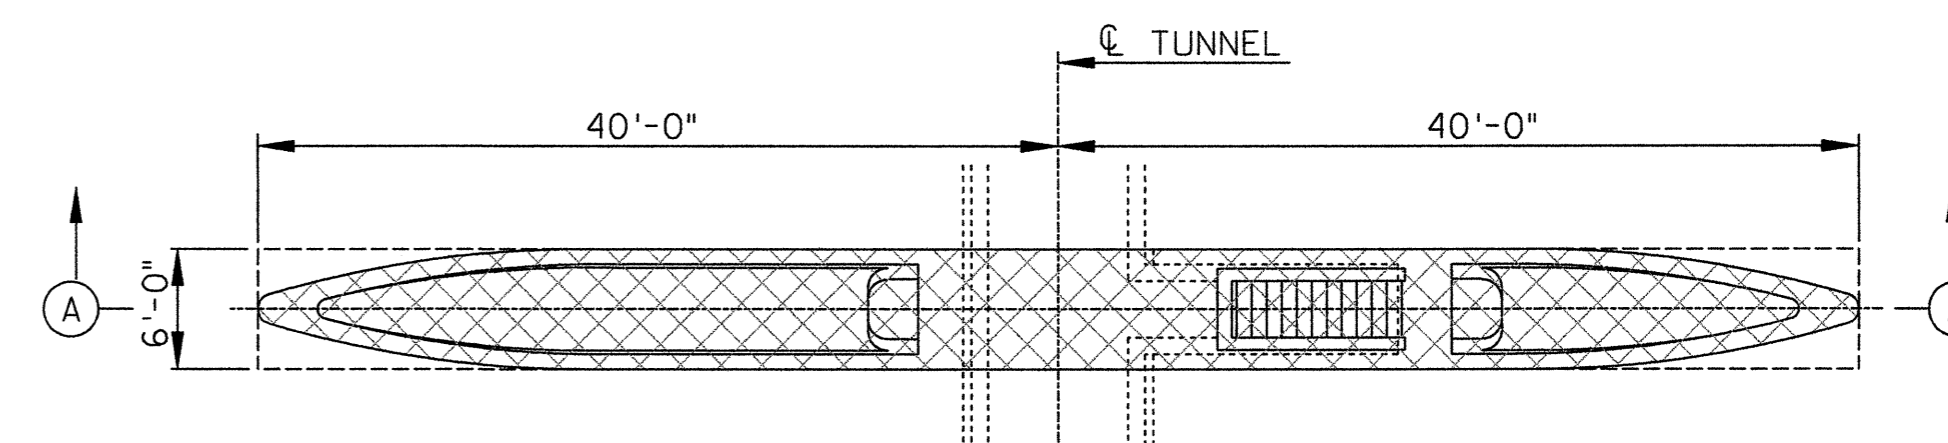


ISLAND DEMOLITION PLAN - ISLAND WITH STAIRS
NOT TO SCALE

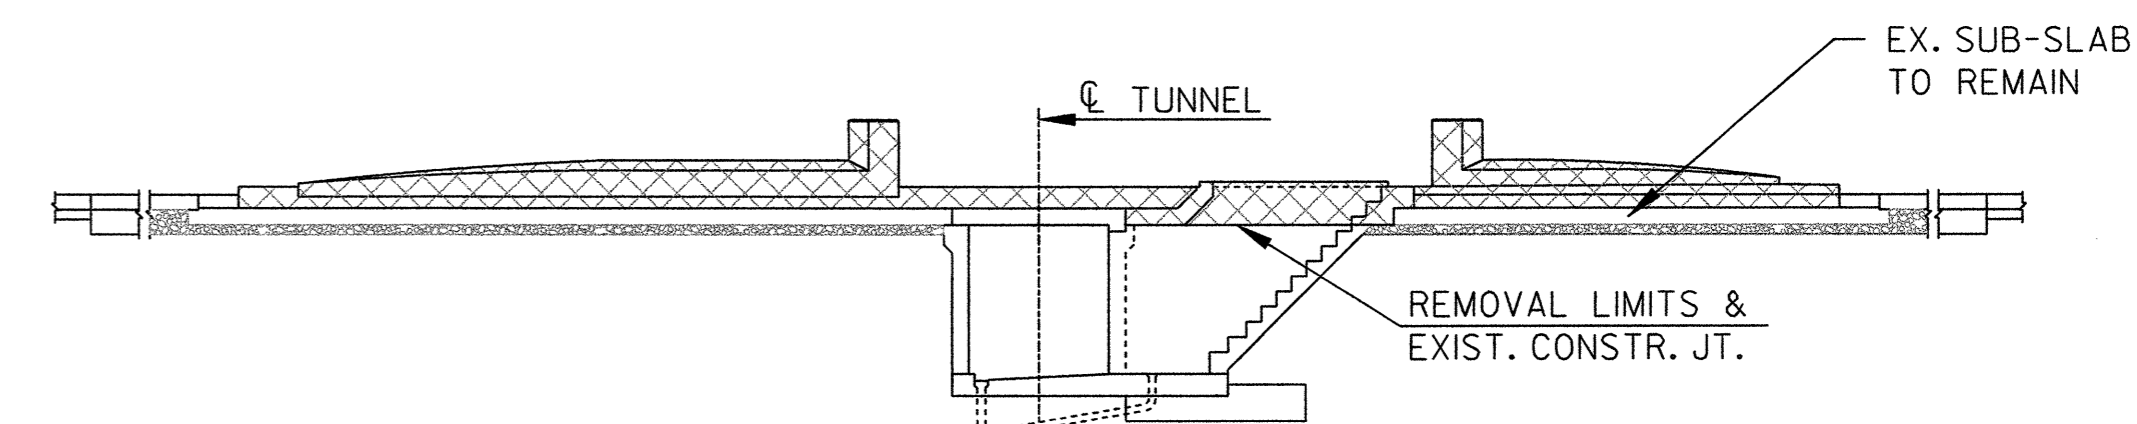

SECTION A-A
NOT TO SCALE

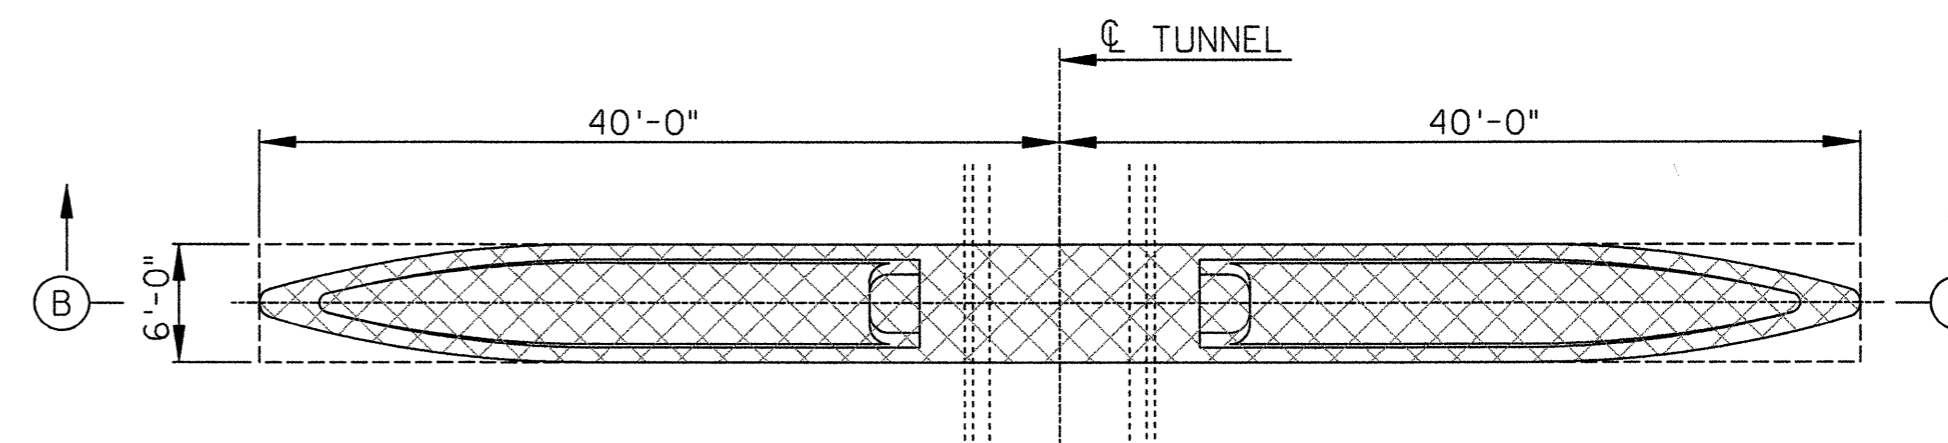

ISLAND DEMOLITION PLAN - ISLAND WITHOUT STAIRS
NOT TO SCALE

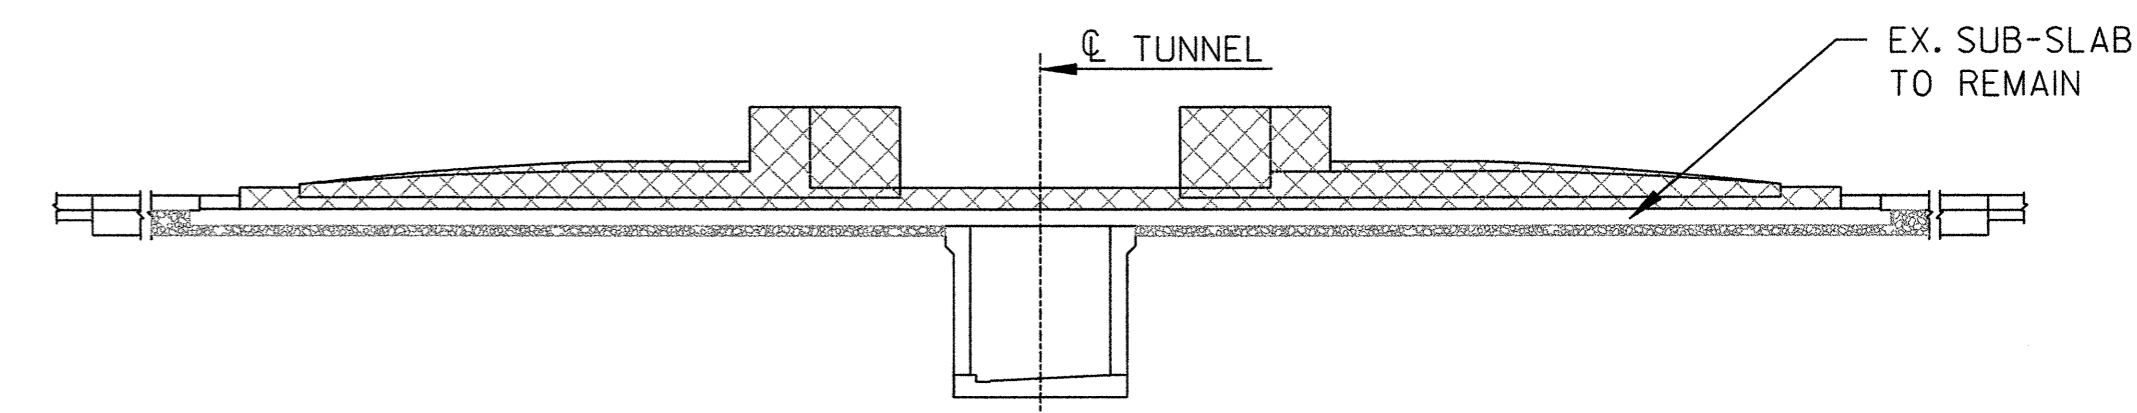

SECTION B-B
NOT TO SCALE

HNTB


9175 GUILFORD ROAD, SUITE 100
COLUMBIA, MARYLAND 21046
(301) 543-1000

RICHMOND METROPOLITAN AUTHORITY
RICHMOND EXPRESSWAY SYSTEM


POWHITE PARKWAY EXPRESS
TOLL LANES PROJECT
EX. TOLL PLAZA MODIFICATIONS
STAGE IIB

Scale:	Date:	Contract No.:	Sheet:
1" = 20'	07/20/06	PEL-2006	30 of 161


NOTE: THIS STAGE SHALL OCCUR WITHIN 1 WEEKEND

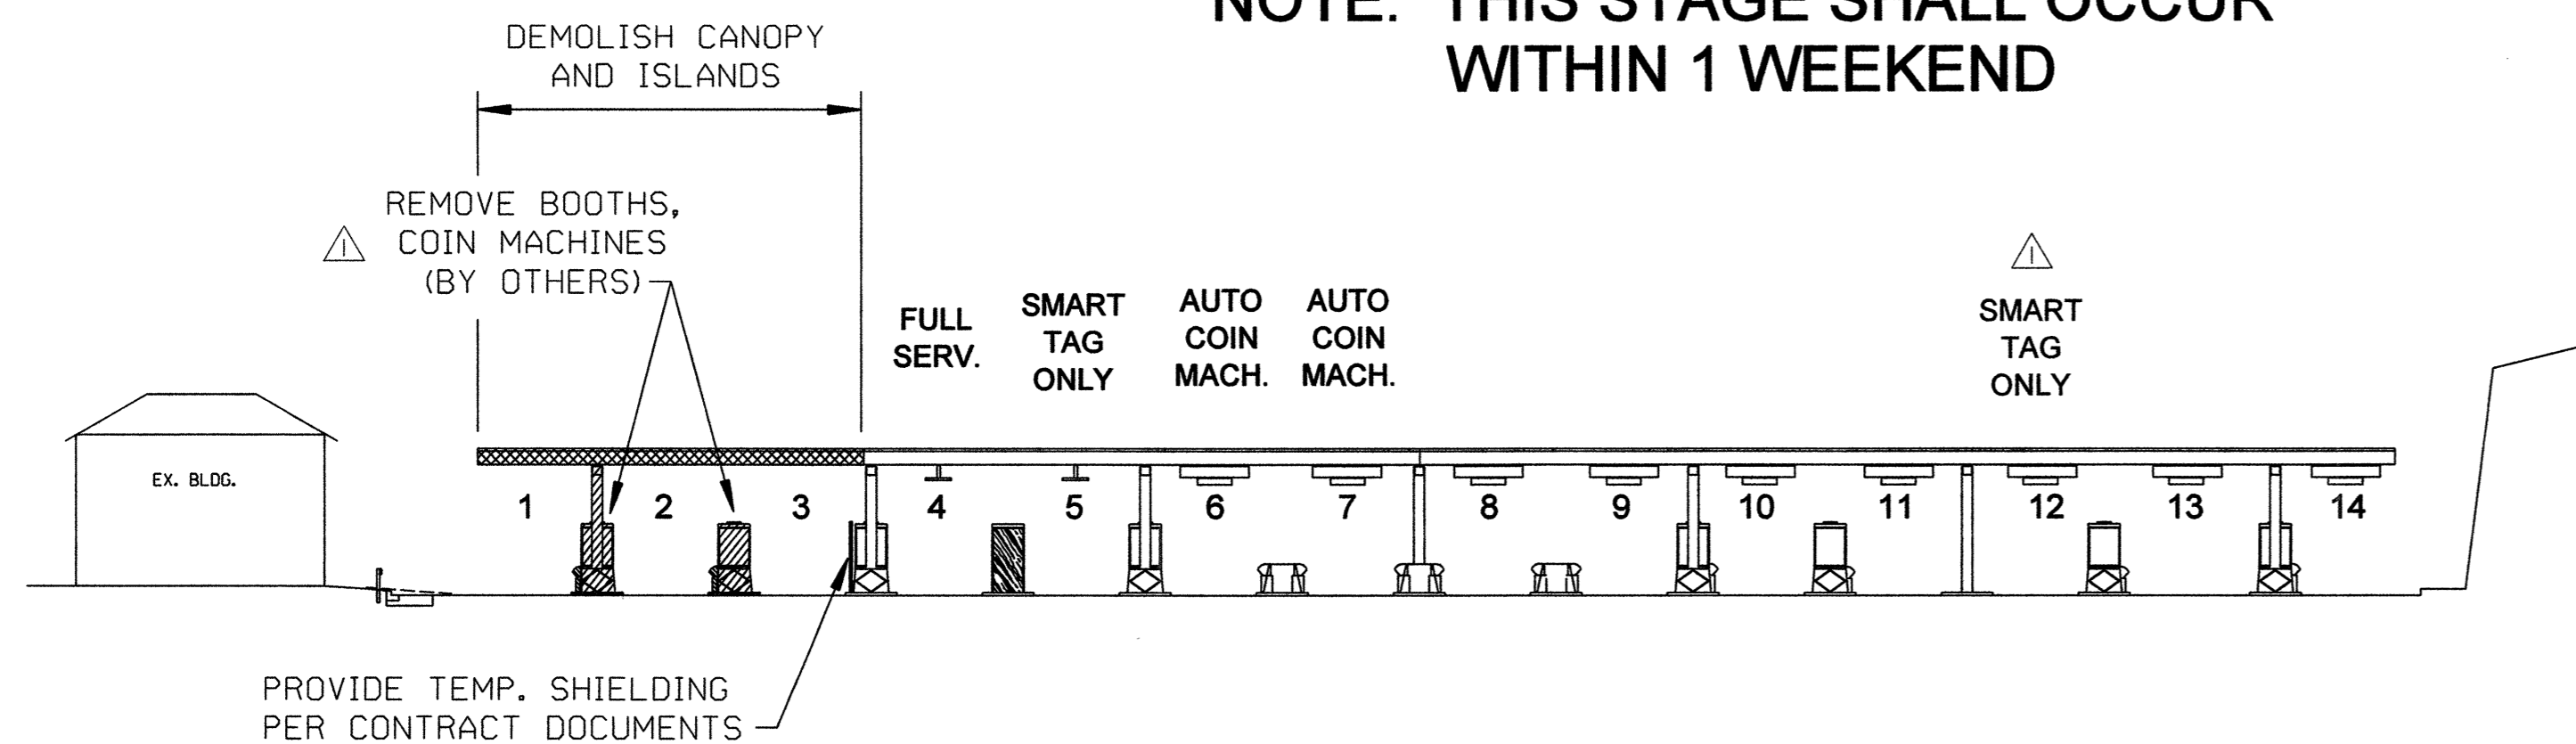


STAGE IIIA ELEVATION

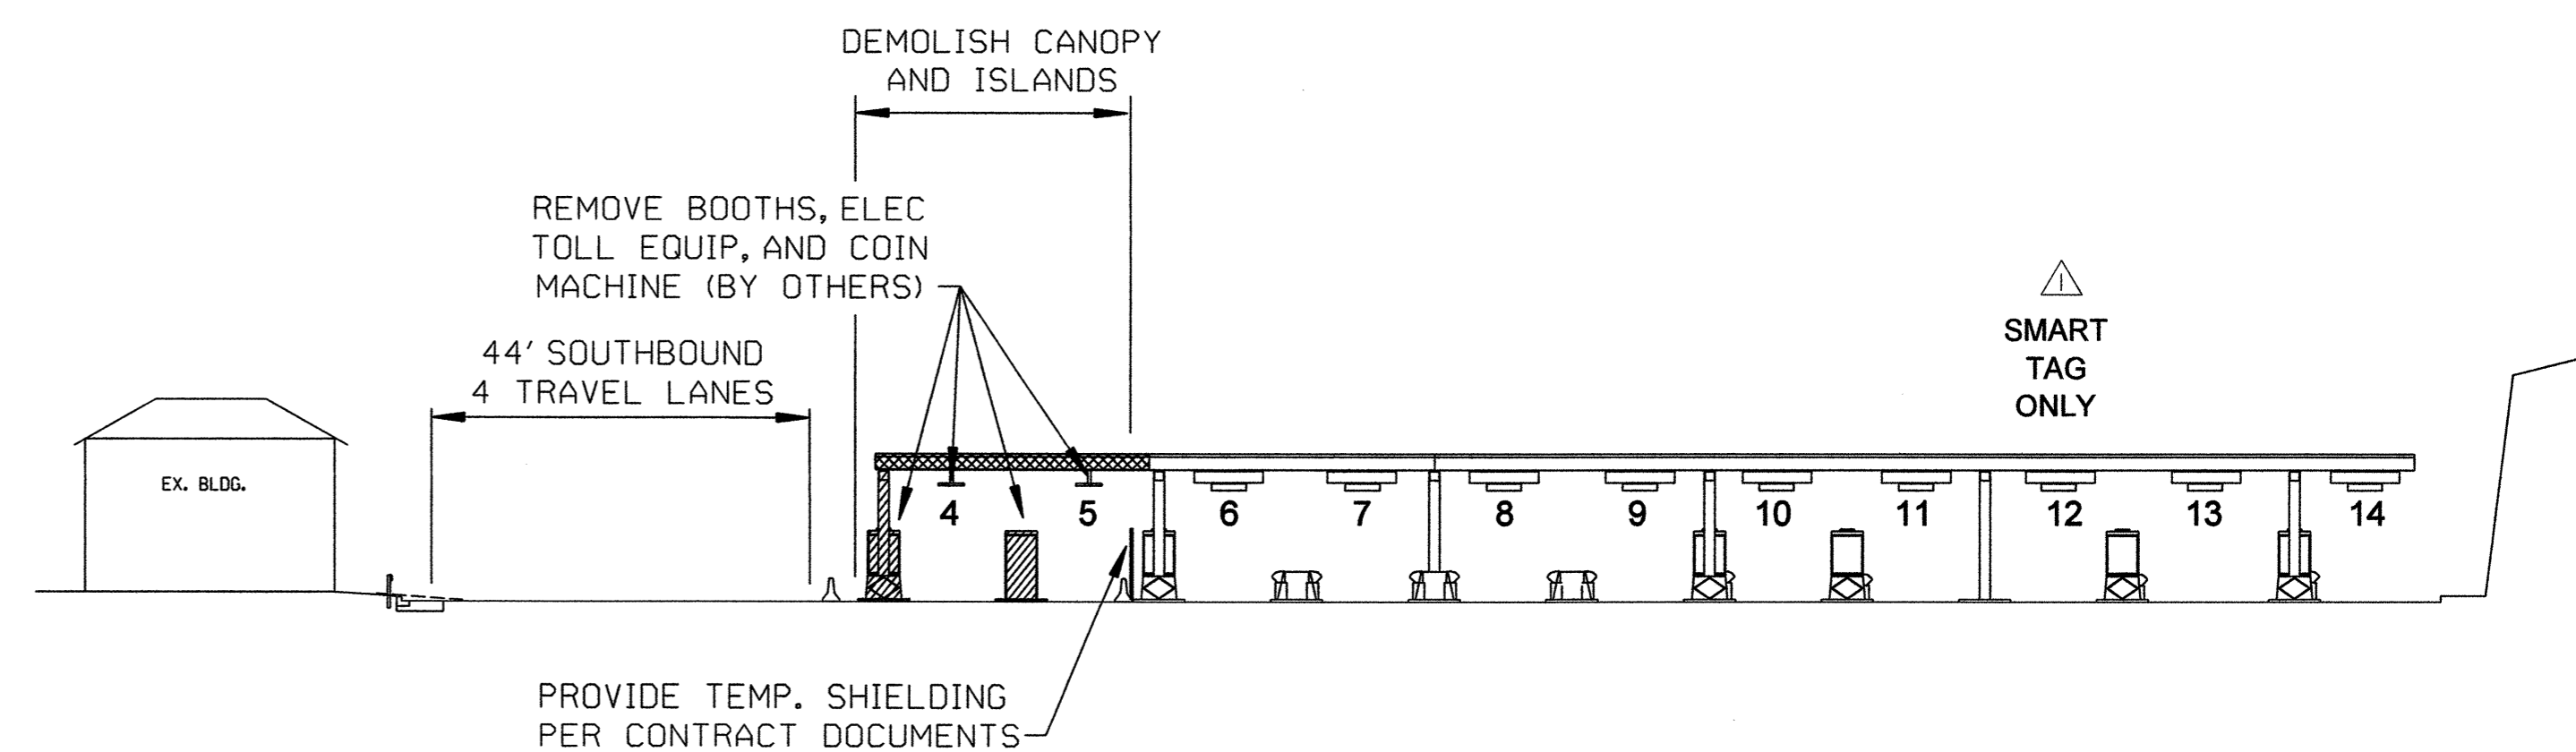

STAGE IIIB ELEVATION

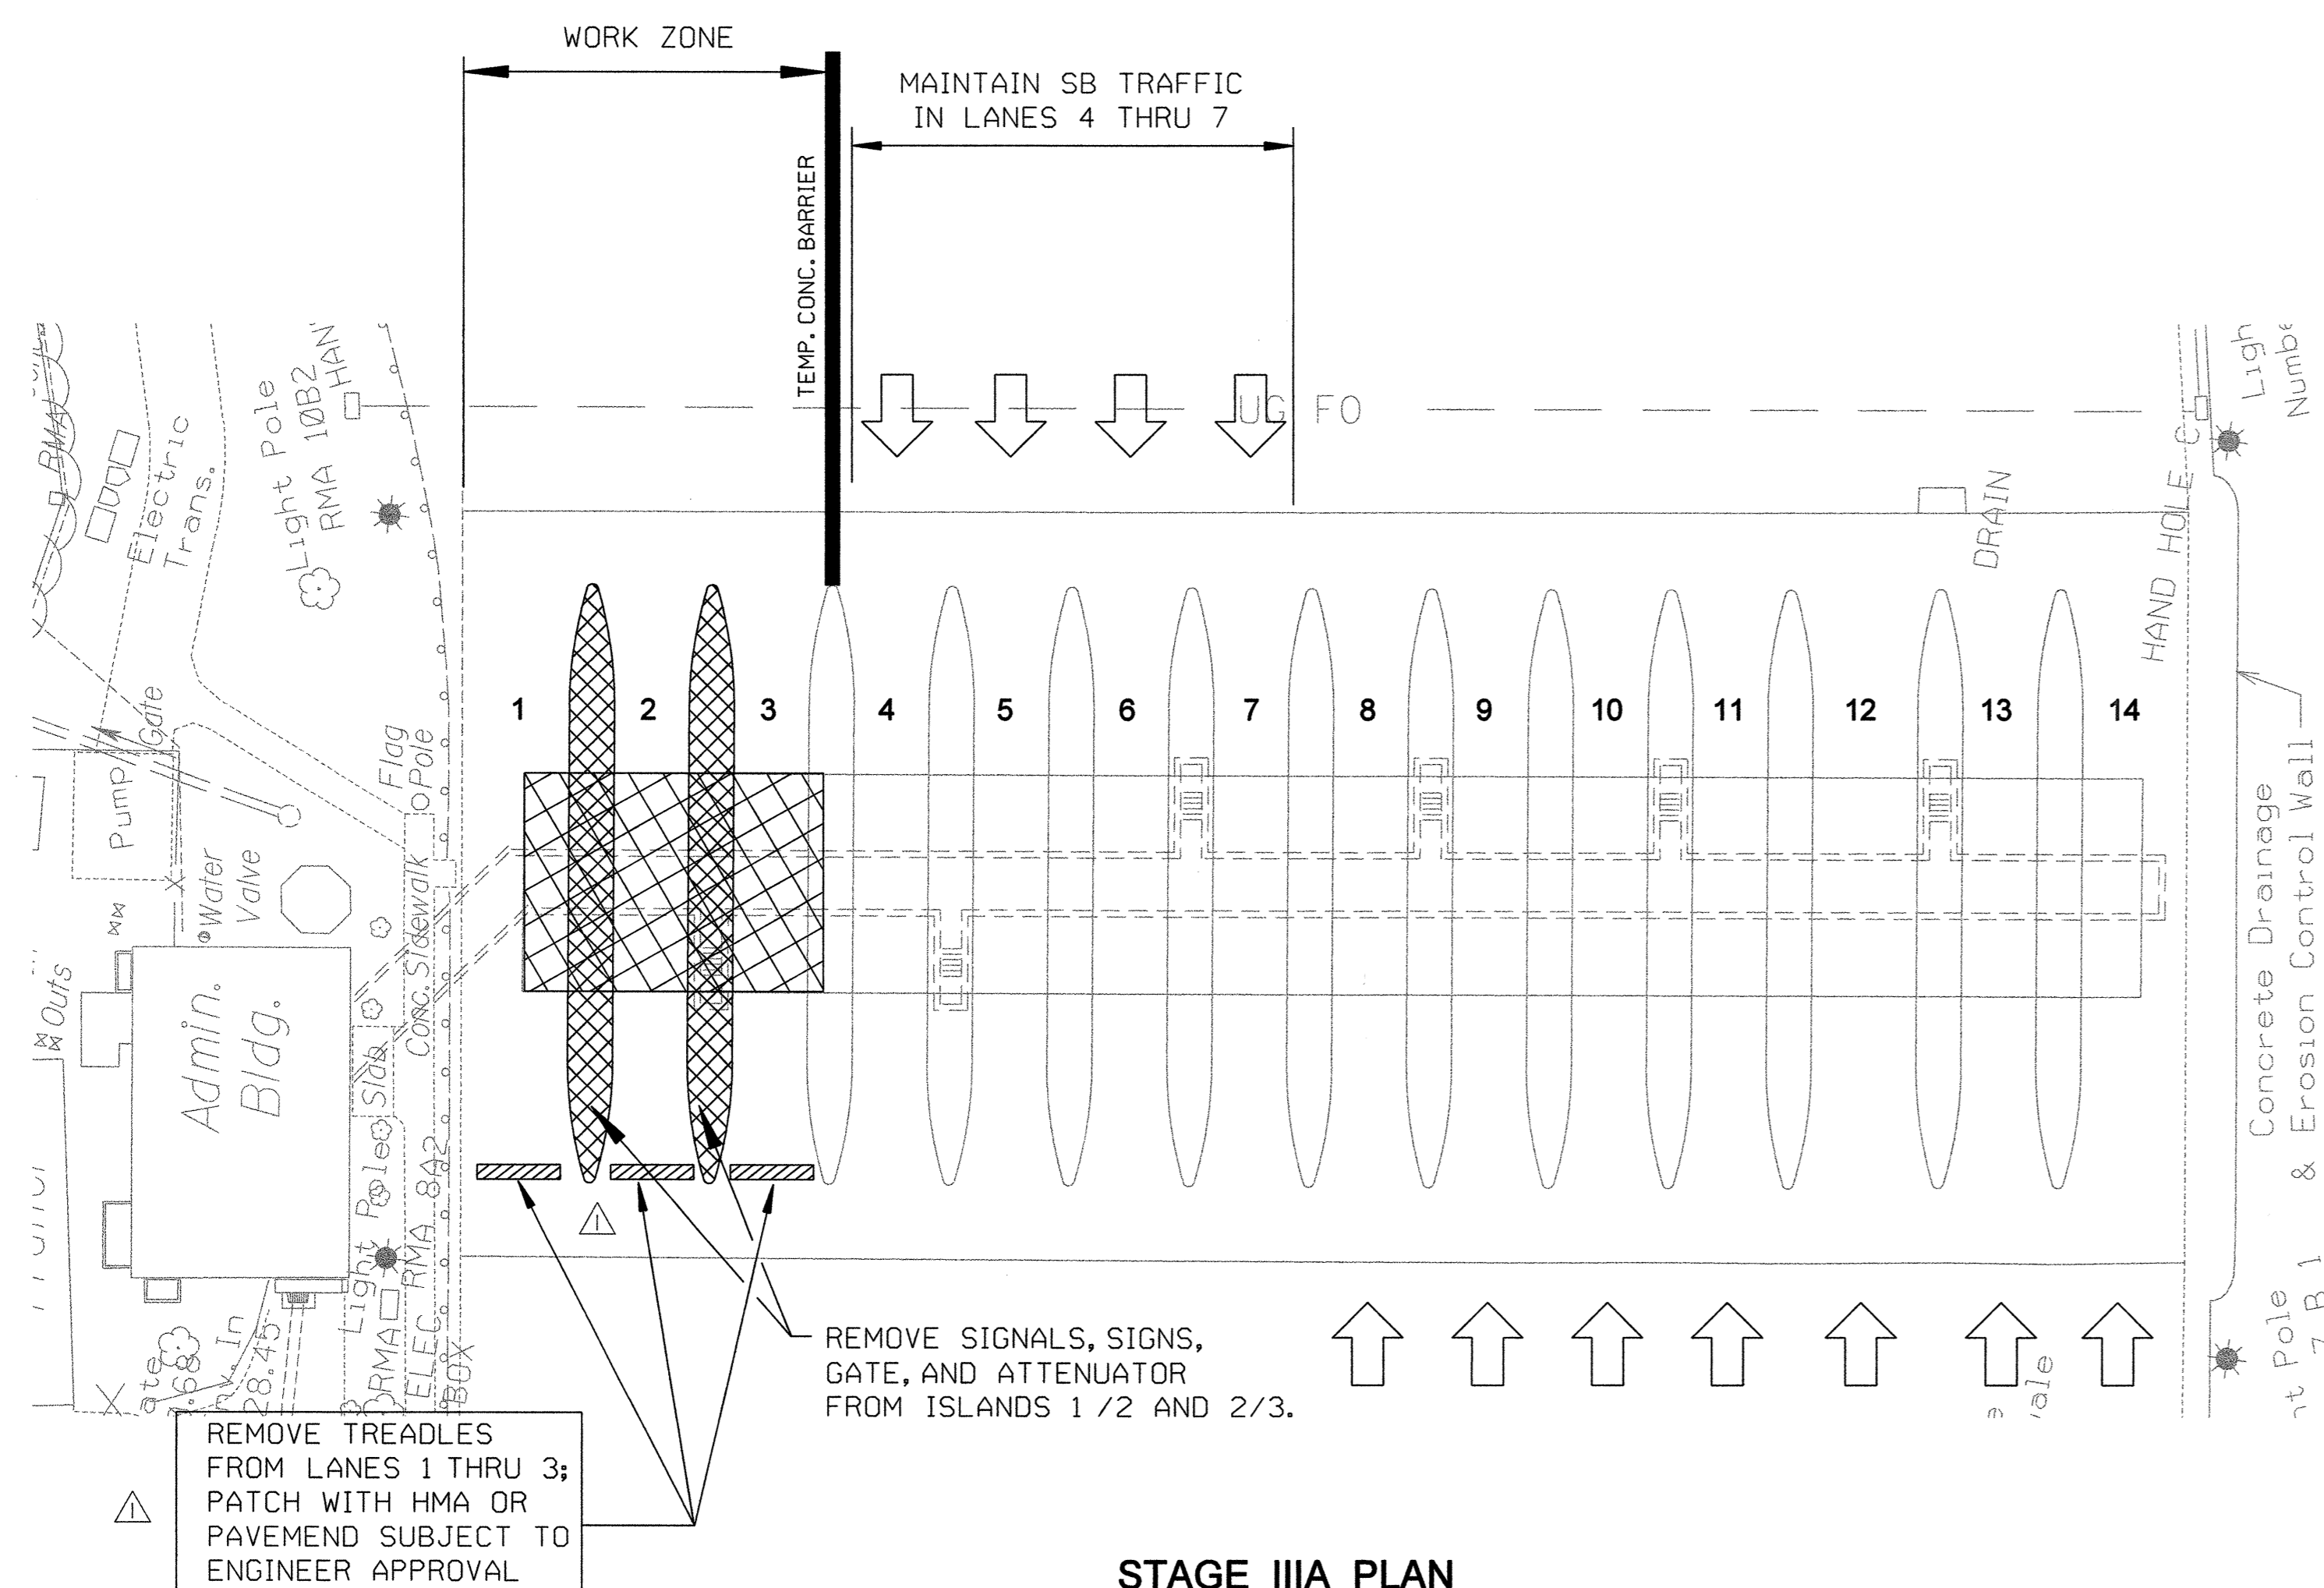

STAGE IIIA PLAN

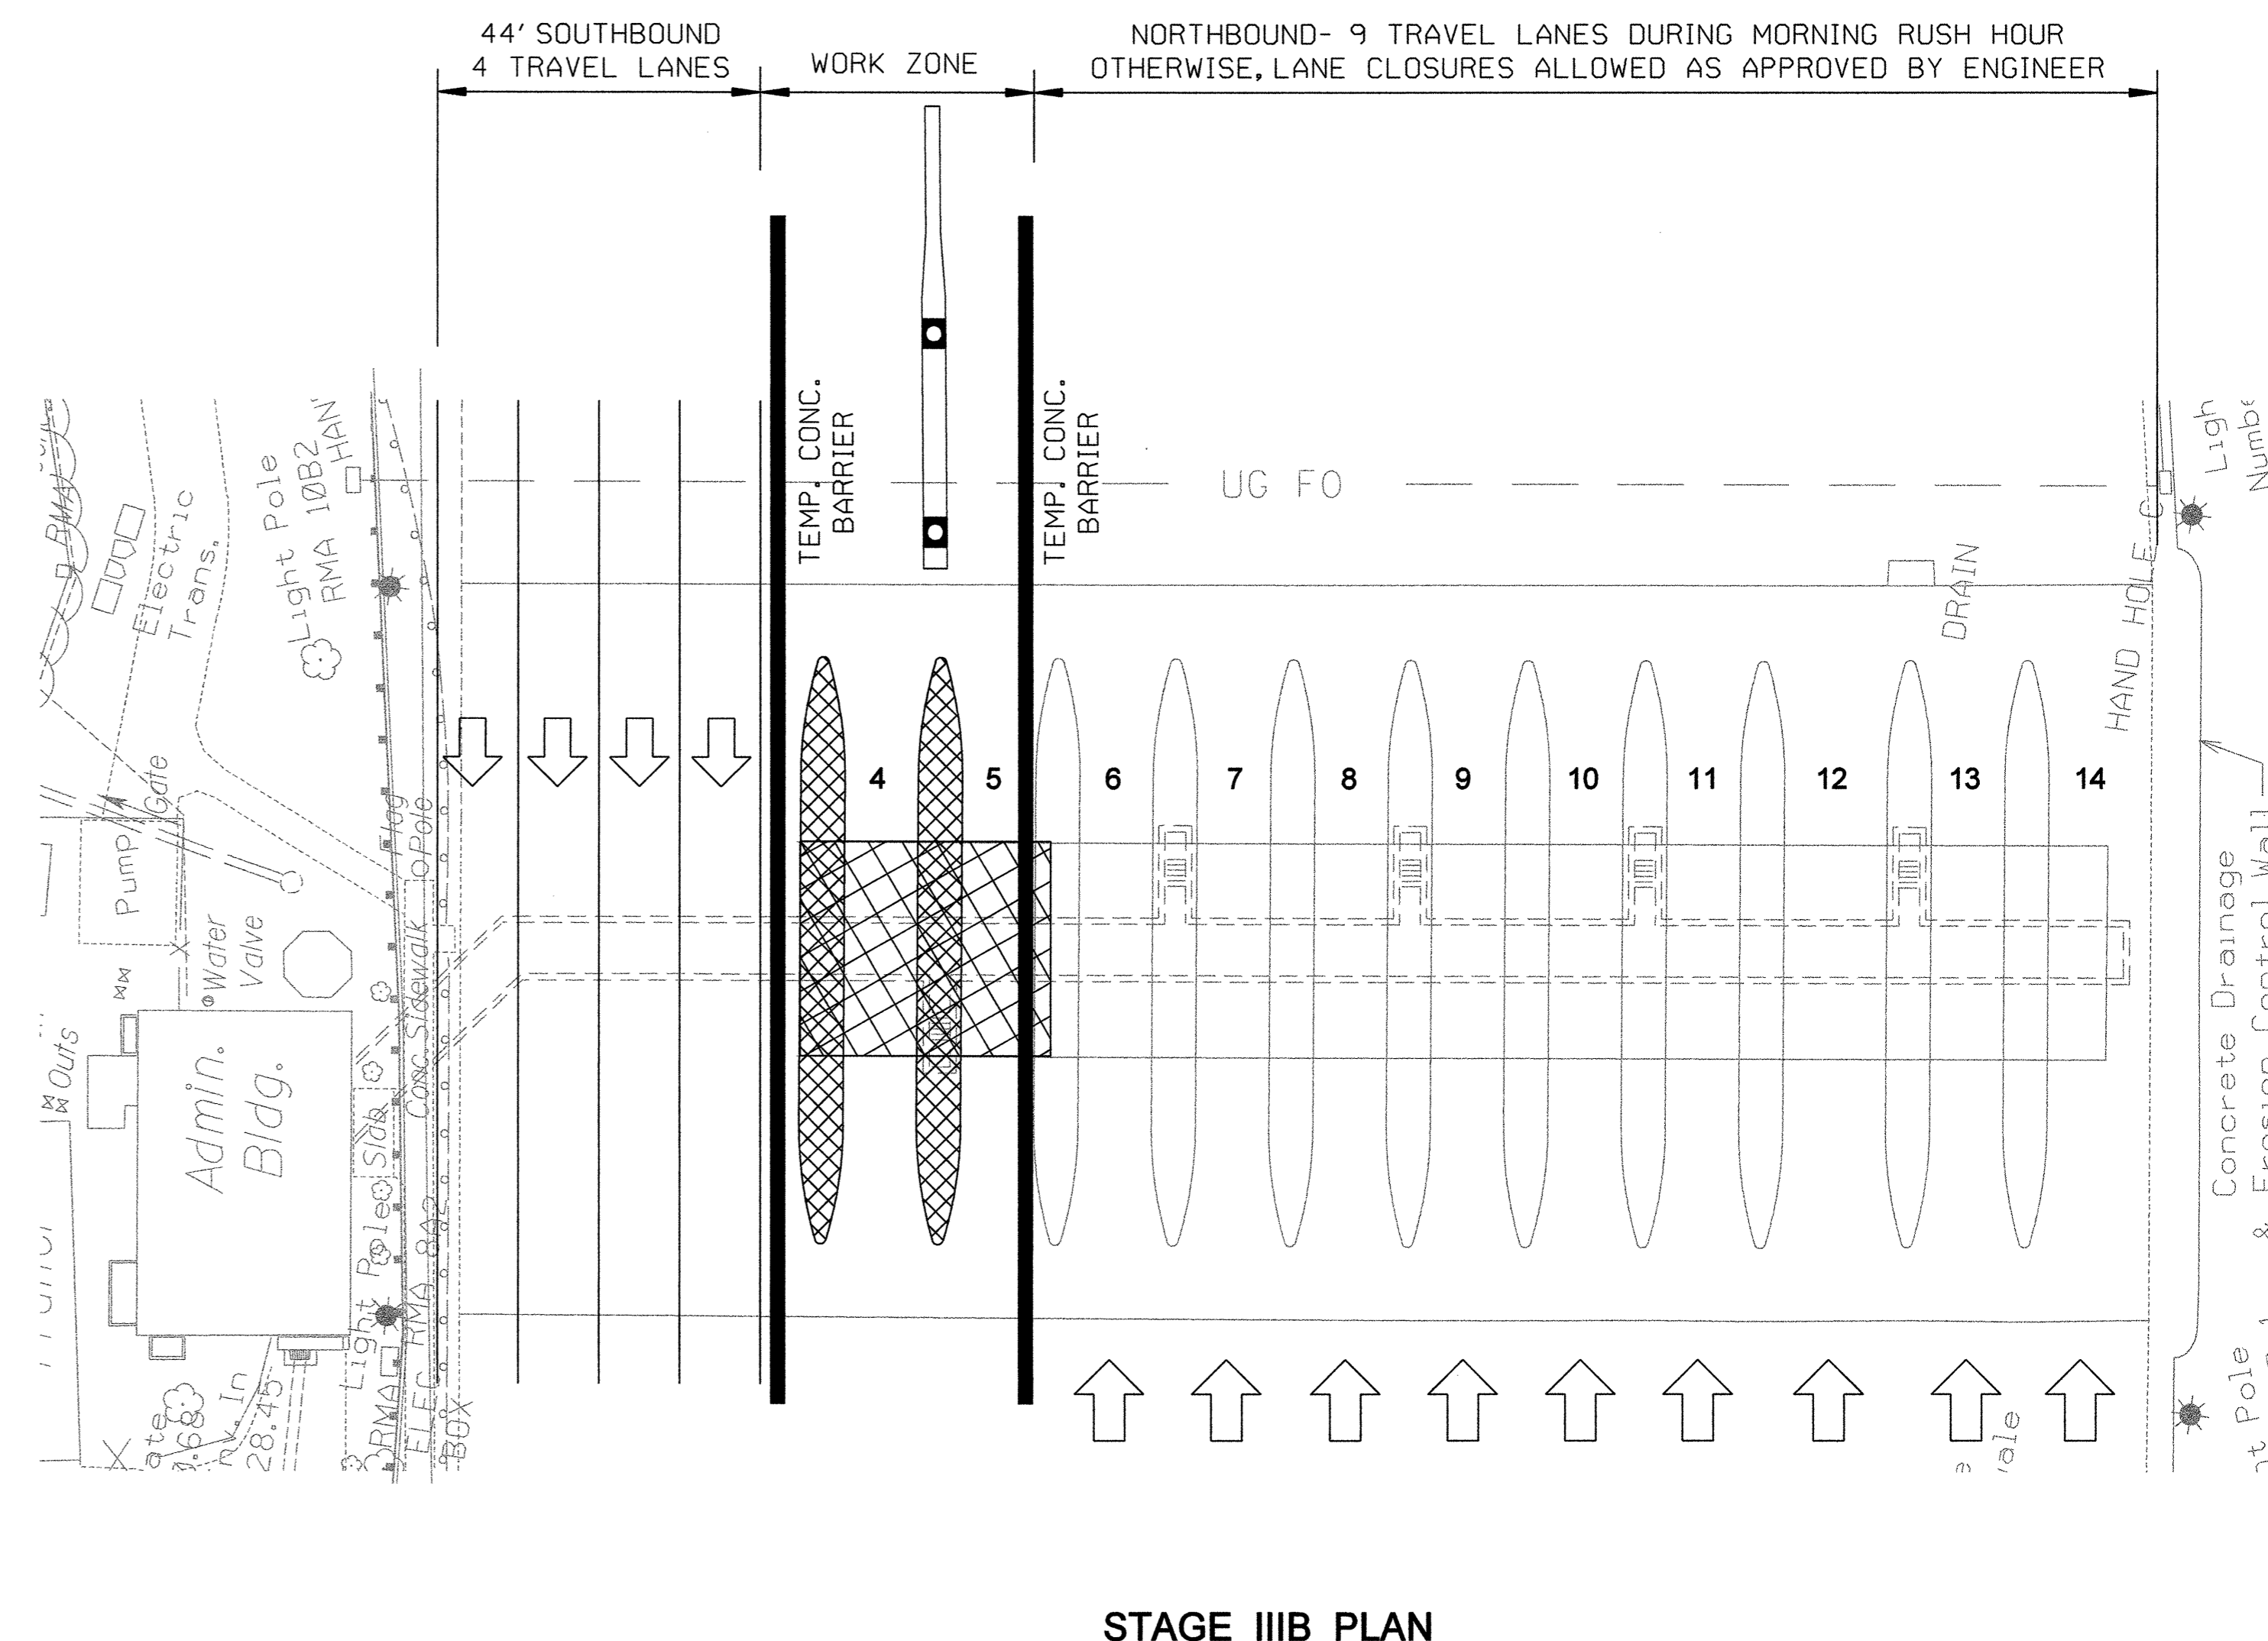

STAGE IIIB PLAN

NOTES:

1. CONTRACTOR SHALL COORDINATE WITH ENGINEER WHO WILL PROVIDE SINGLE AND/OR MULTIPLE LANE CLOSURES FOR PERIODS LESS THAN 24 HOURS, OR FOR WEEKENDS, TO CREATE WORK ZONE, AS DESCRIBED IN CONTRACT DOCUMENTS.
2. CONTRACTOR SHALL COORDINATE WITH ENGINEER TO ALLOW APPROPRIATE SCHEDULING OF TOLL PLAZA MODIFICATION WORK TO BE PERFORMED BY OTHERS.
3. NO WORK IMPACTING SB TRAVEL LANES SHALL BE ALLOWED BETWEEN 3:00 PM AND 7:00 PM, MONDAY THROUGH FRIDAY.
4. NO WORK IMPACTING NB TRAVEL LANES SHALL BE ALLOWED BETWEEN 6:00 AM AND 10:00 AM, MONDAY THROUGH FRIDAY.
5. FOR ADDITIONAL SEQUENCE NOTES, SEE MAINTENANCE OF TRAFFIC SHEET OF APPROPRIATE STAGE.

ADDENDUM NO. 1: 5/10/06
REVISIONS


RICHMOND METROPOLITAN AUTHORITY
RICHMOND EXPRESSWAY SYSTEM

POWHITE PARKWAY EXPRESS
TOLL LANES PROJECT
EX. TOLL PLAZA MODIFICATIONS
STAGES IIIA & IIIB


HNTB

9175 GUILFORD ROAD, SUITE 100
 COLUMBIA, MARYLAND 21046
 (301) 543-1000


Scale: 1" = 20'	Date: 07/20/06	Contract No.: PEL-2006	Sheet: 31 of 161
-----------------	----------------	------------------------	------------------

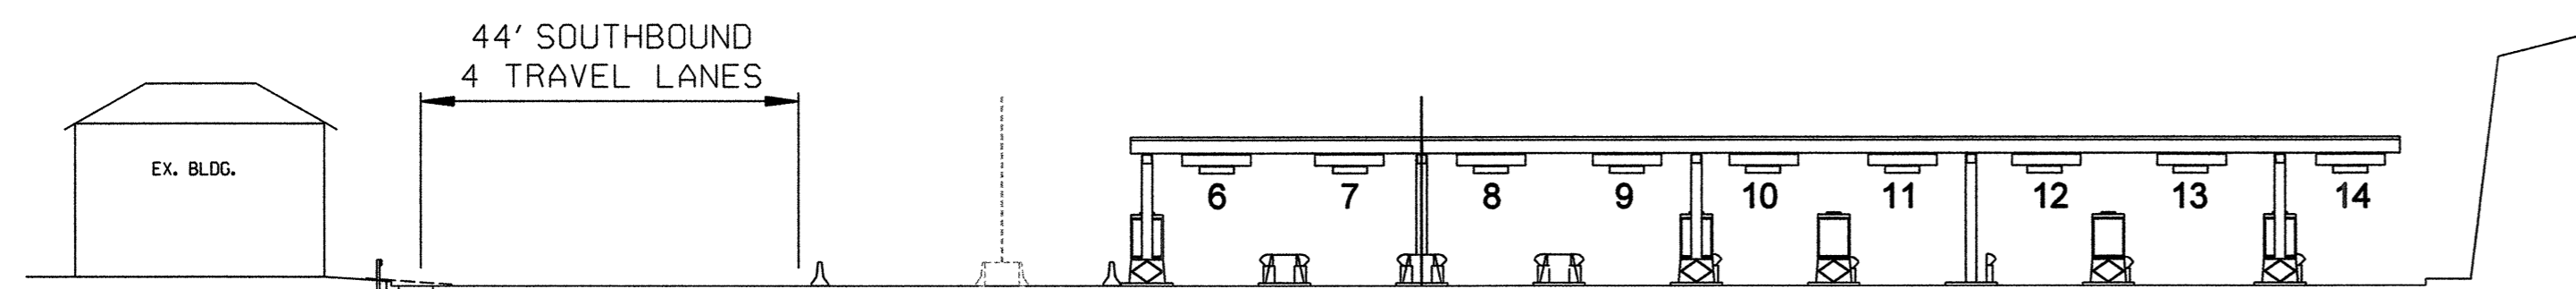


STAGE IIIC ELEVATION

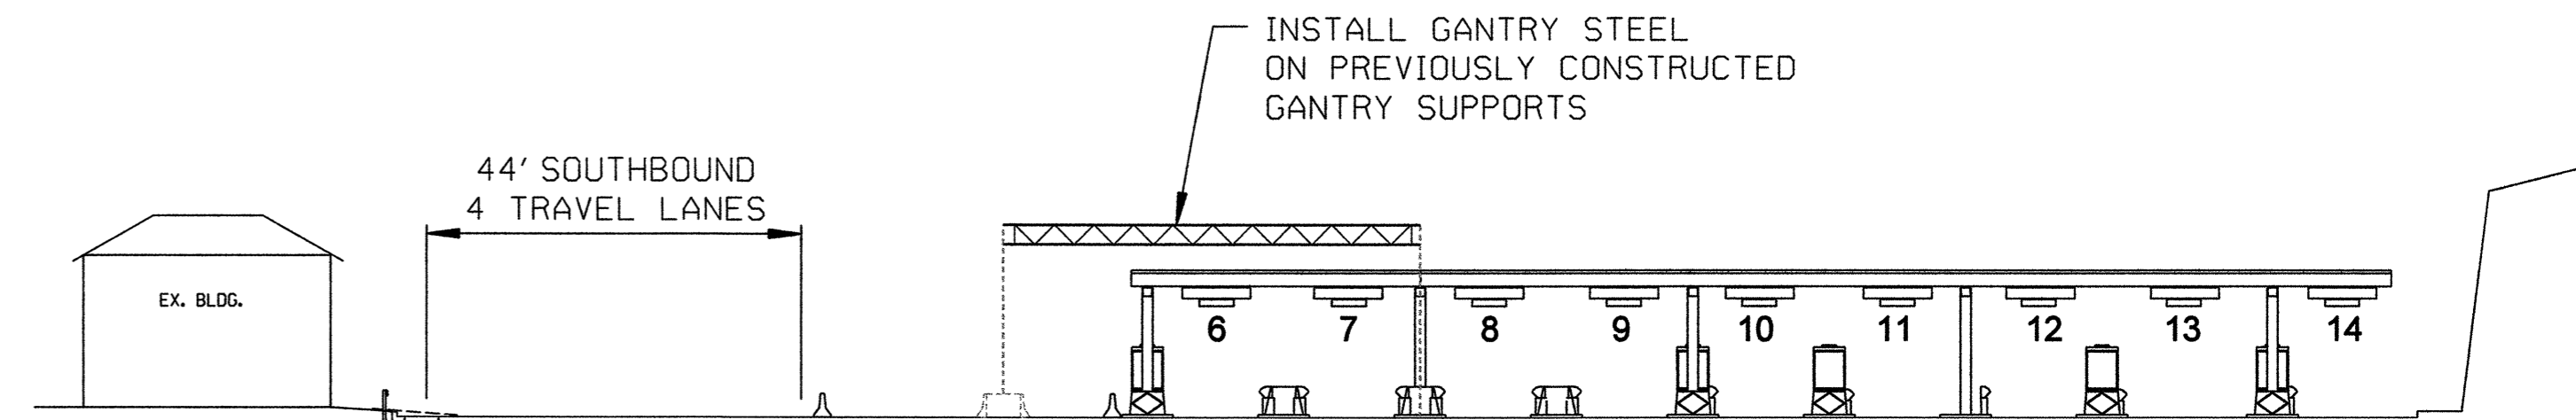

STAGE IIID ELEVATION

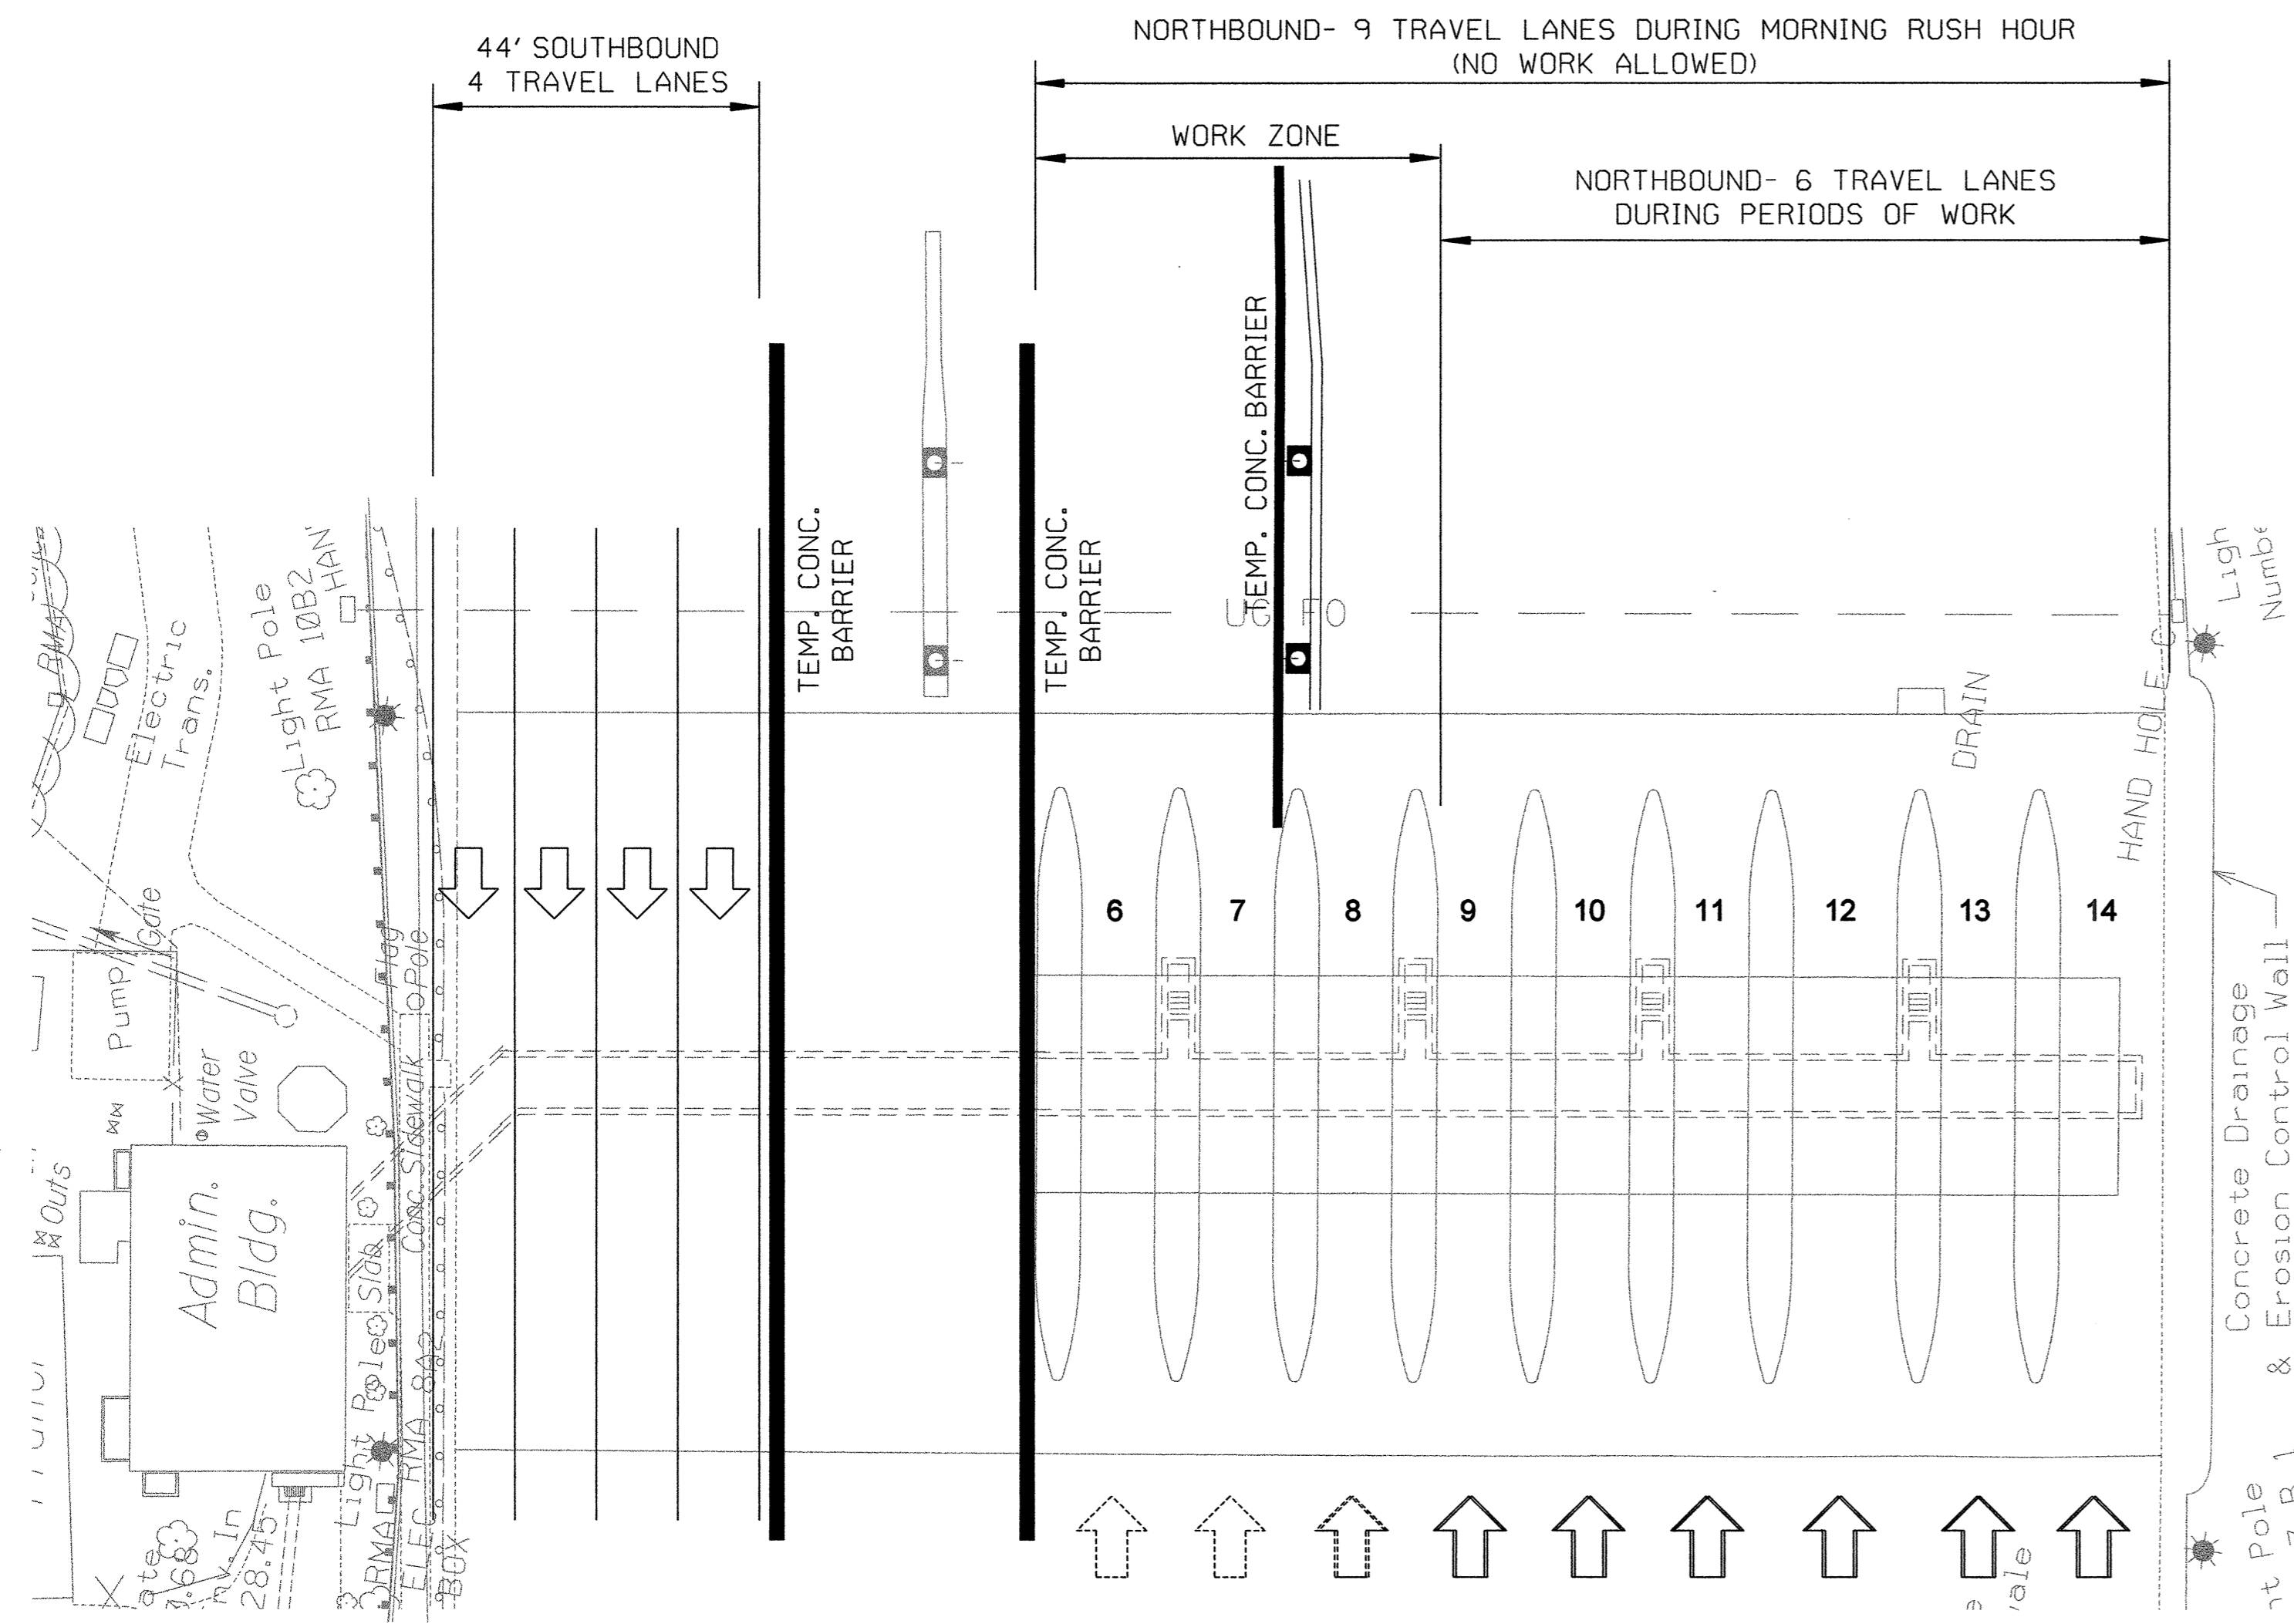

STAGE IIIC PLAN

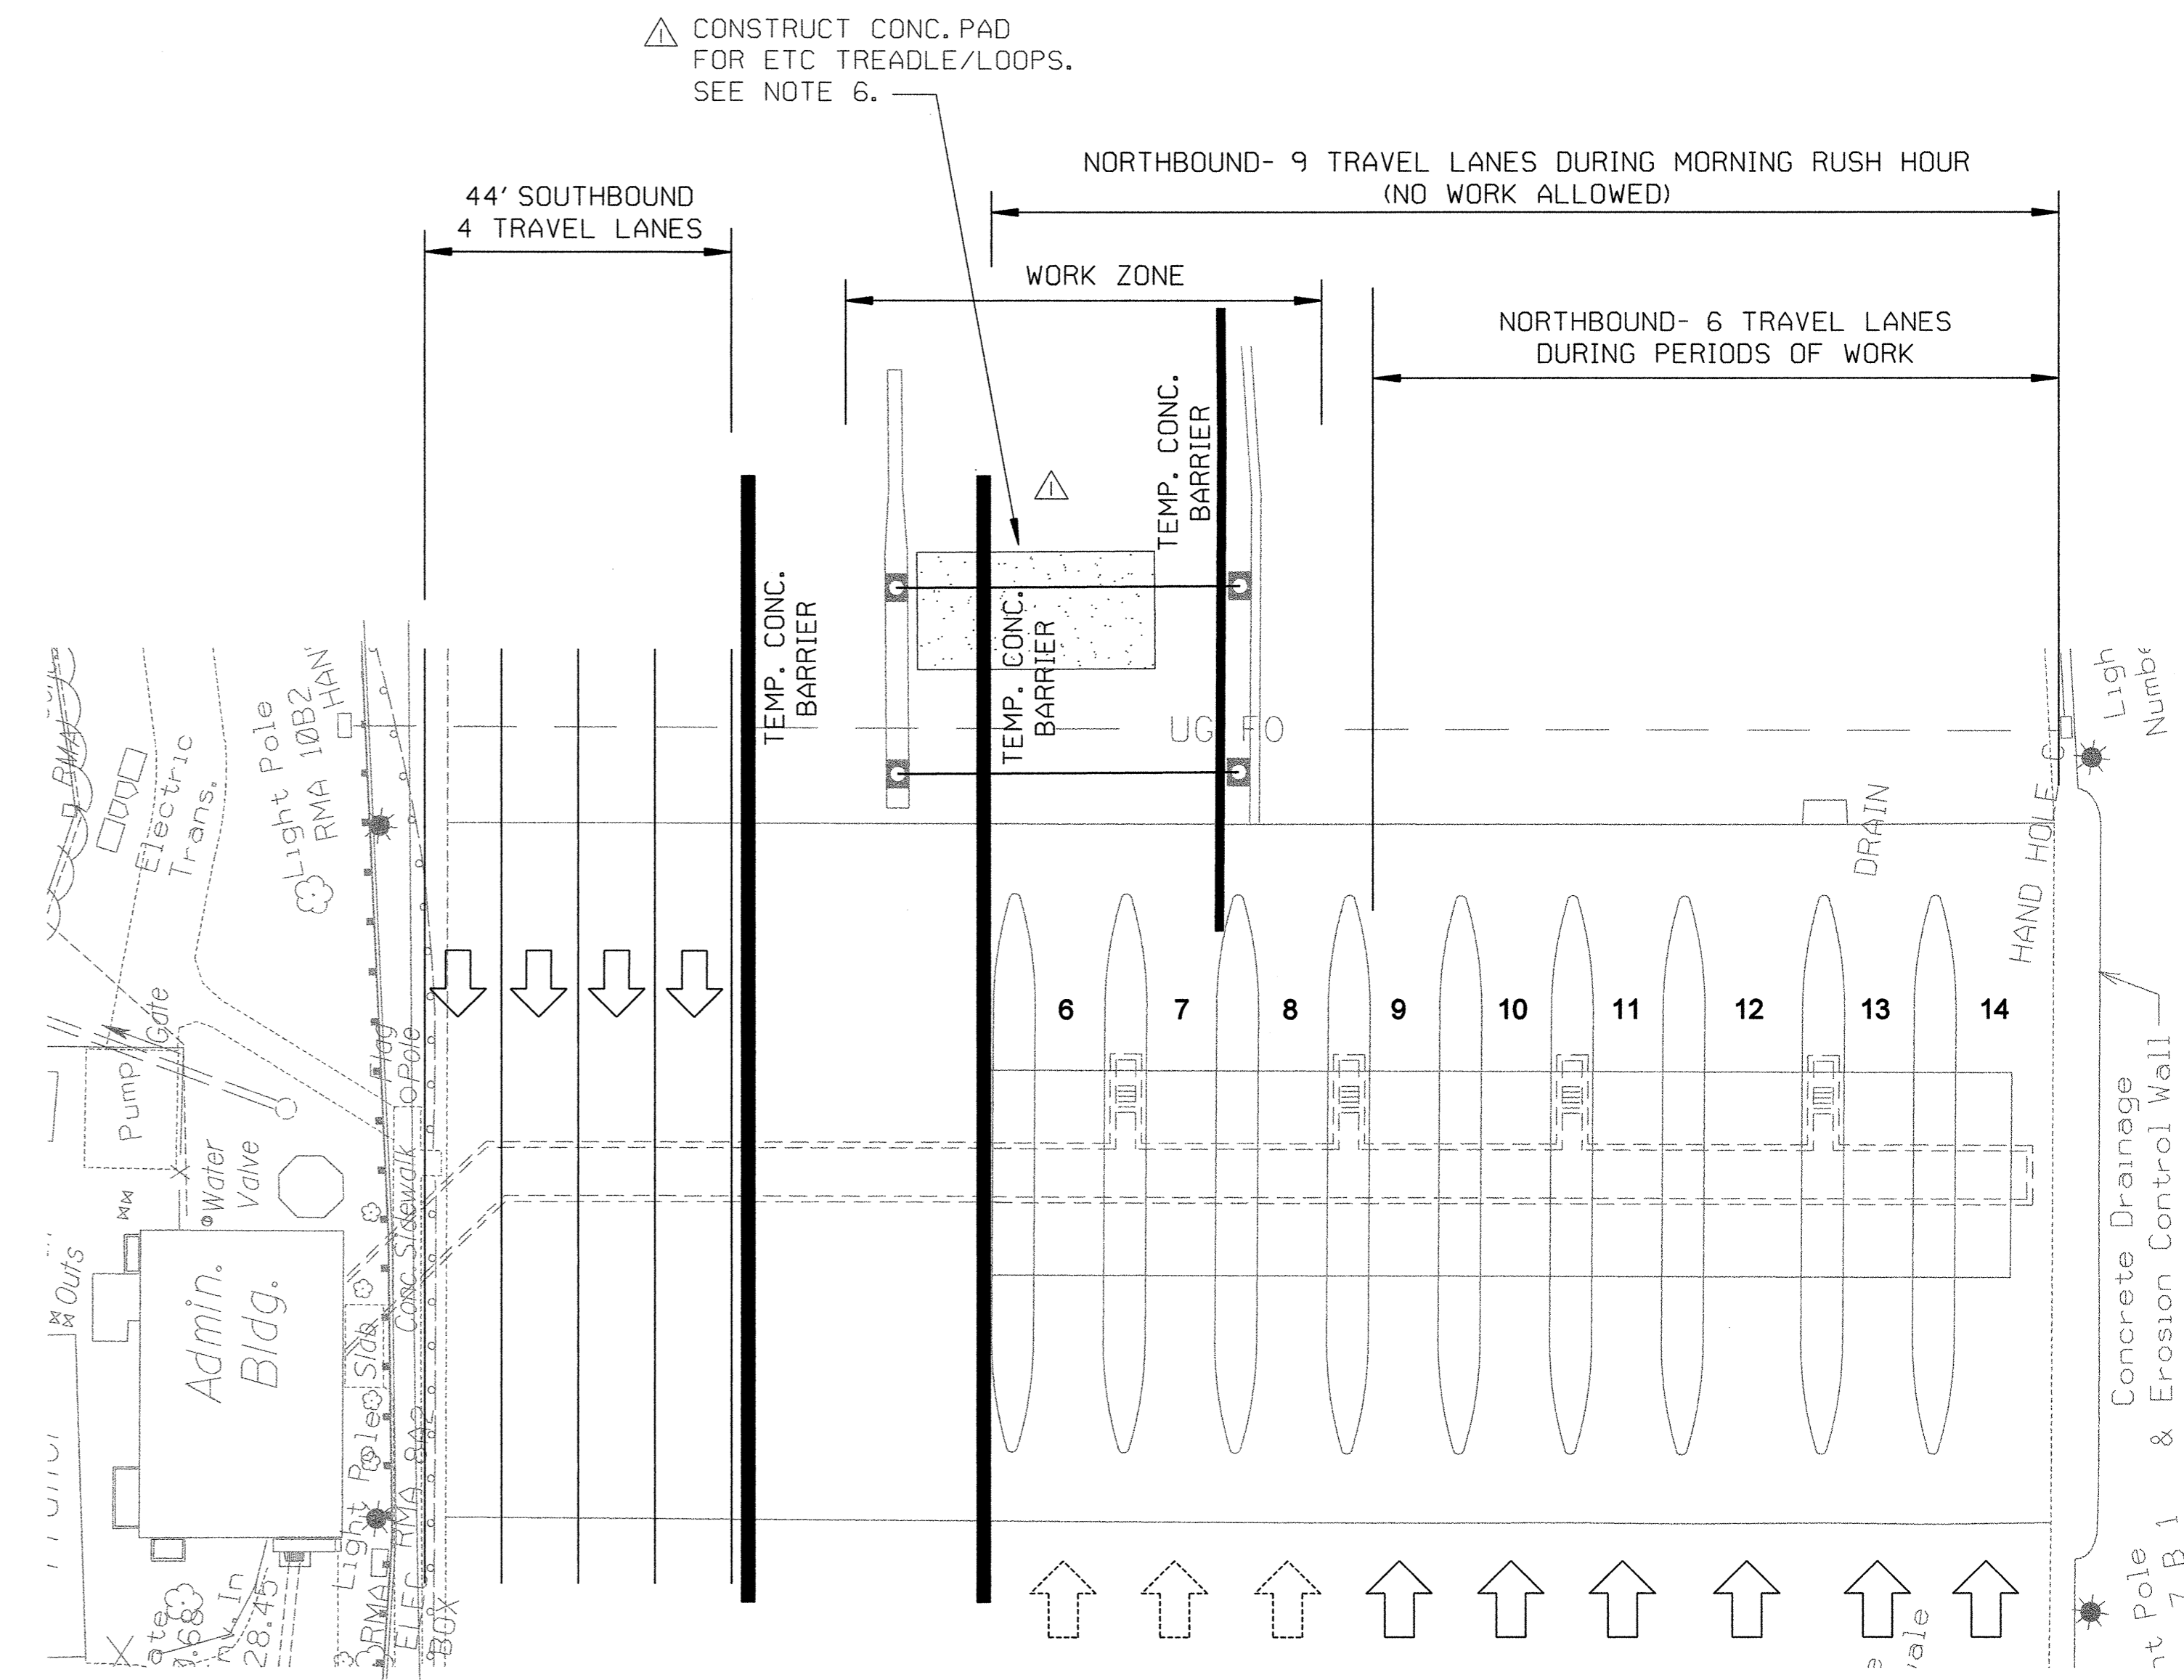


STAGE IIID PLAN

NOTES:

1. CONTRACTOR SHALL COORDINATE WITH ENGINEER WHO WILL PROVIDE SINGLE AND/OR MULTIPLE LANE CLOSURES FOR PERIODS LESS THAN 24 HOURS, OR FOR WEEKENDS, TO CREATE WORK ZONE, AS DESCRIBED IN CONTRACT DOCUMENTS.
2. CONTRACTOR SHALL COORDINATE WITH ENGINEER TO ALLOW APPROPRIATE SCHEDULING OF TOLL PLAZA MODIFICATION WORK TO BE PERFORMED BY OTHERS.
3. NO WORK IMPACTING SB TRAVEL LANES SHALL BE ALLOWED BETWEEN 3:00 PM AND 7:00 PM, MONDAY THROUGH FRIDAY.
4. NO WORK IMPACTING NB TRAVEL LANES SHALL BE ALLOWED BETWEEN 6:00 AM AND 10:00 AM, MONDAY THROUGH FRIDAY.
5. FOR ADDITIONAL SEQUENCE NOTES, SEE MAINTENANCE OF TRAFFIC SHEET OF APPROPRIATE STAGE.
6. CONC. PAD FOR TREADLE SHALL BE CONSTRUCTED OVER A ONE WEEKEND PERIOD, BETWEEN FRI. 10:00 A.M. AND MON. 6:00 A.M. HIGH-EARLY STRENGTH CONCRETE SHALL BE USED.

ADDENDUM NO. 1:	5/10/06
REVISIONS	

HNTB		RICHMOND METROPOLITAN AUTHORITY RICHMOND EXPRESSWAY SYSTEM	
9175 GUILFORD ROAD, SUITE 100 COLUMBIA, MARYLAND 21046 (301) 543-1000		POWHITE PARKWAY EXPRESS TOLL LANES PROJECT EX. TOLL PLAZA MODIFICATIONS STAGES IIIC & IIID	
Scale: 1" = 20'	Date: 07/20/06	Contract No.: PEL-2006	Sheet: 32 of 161

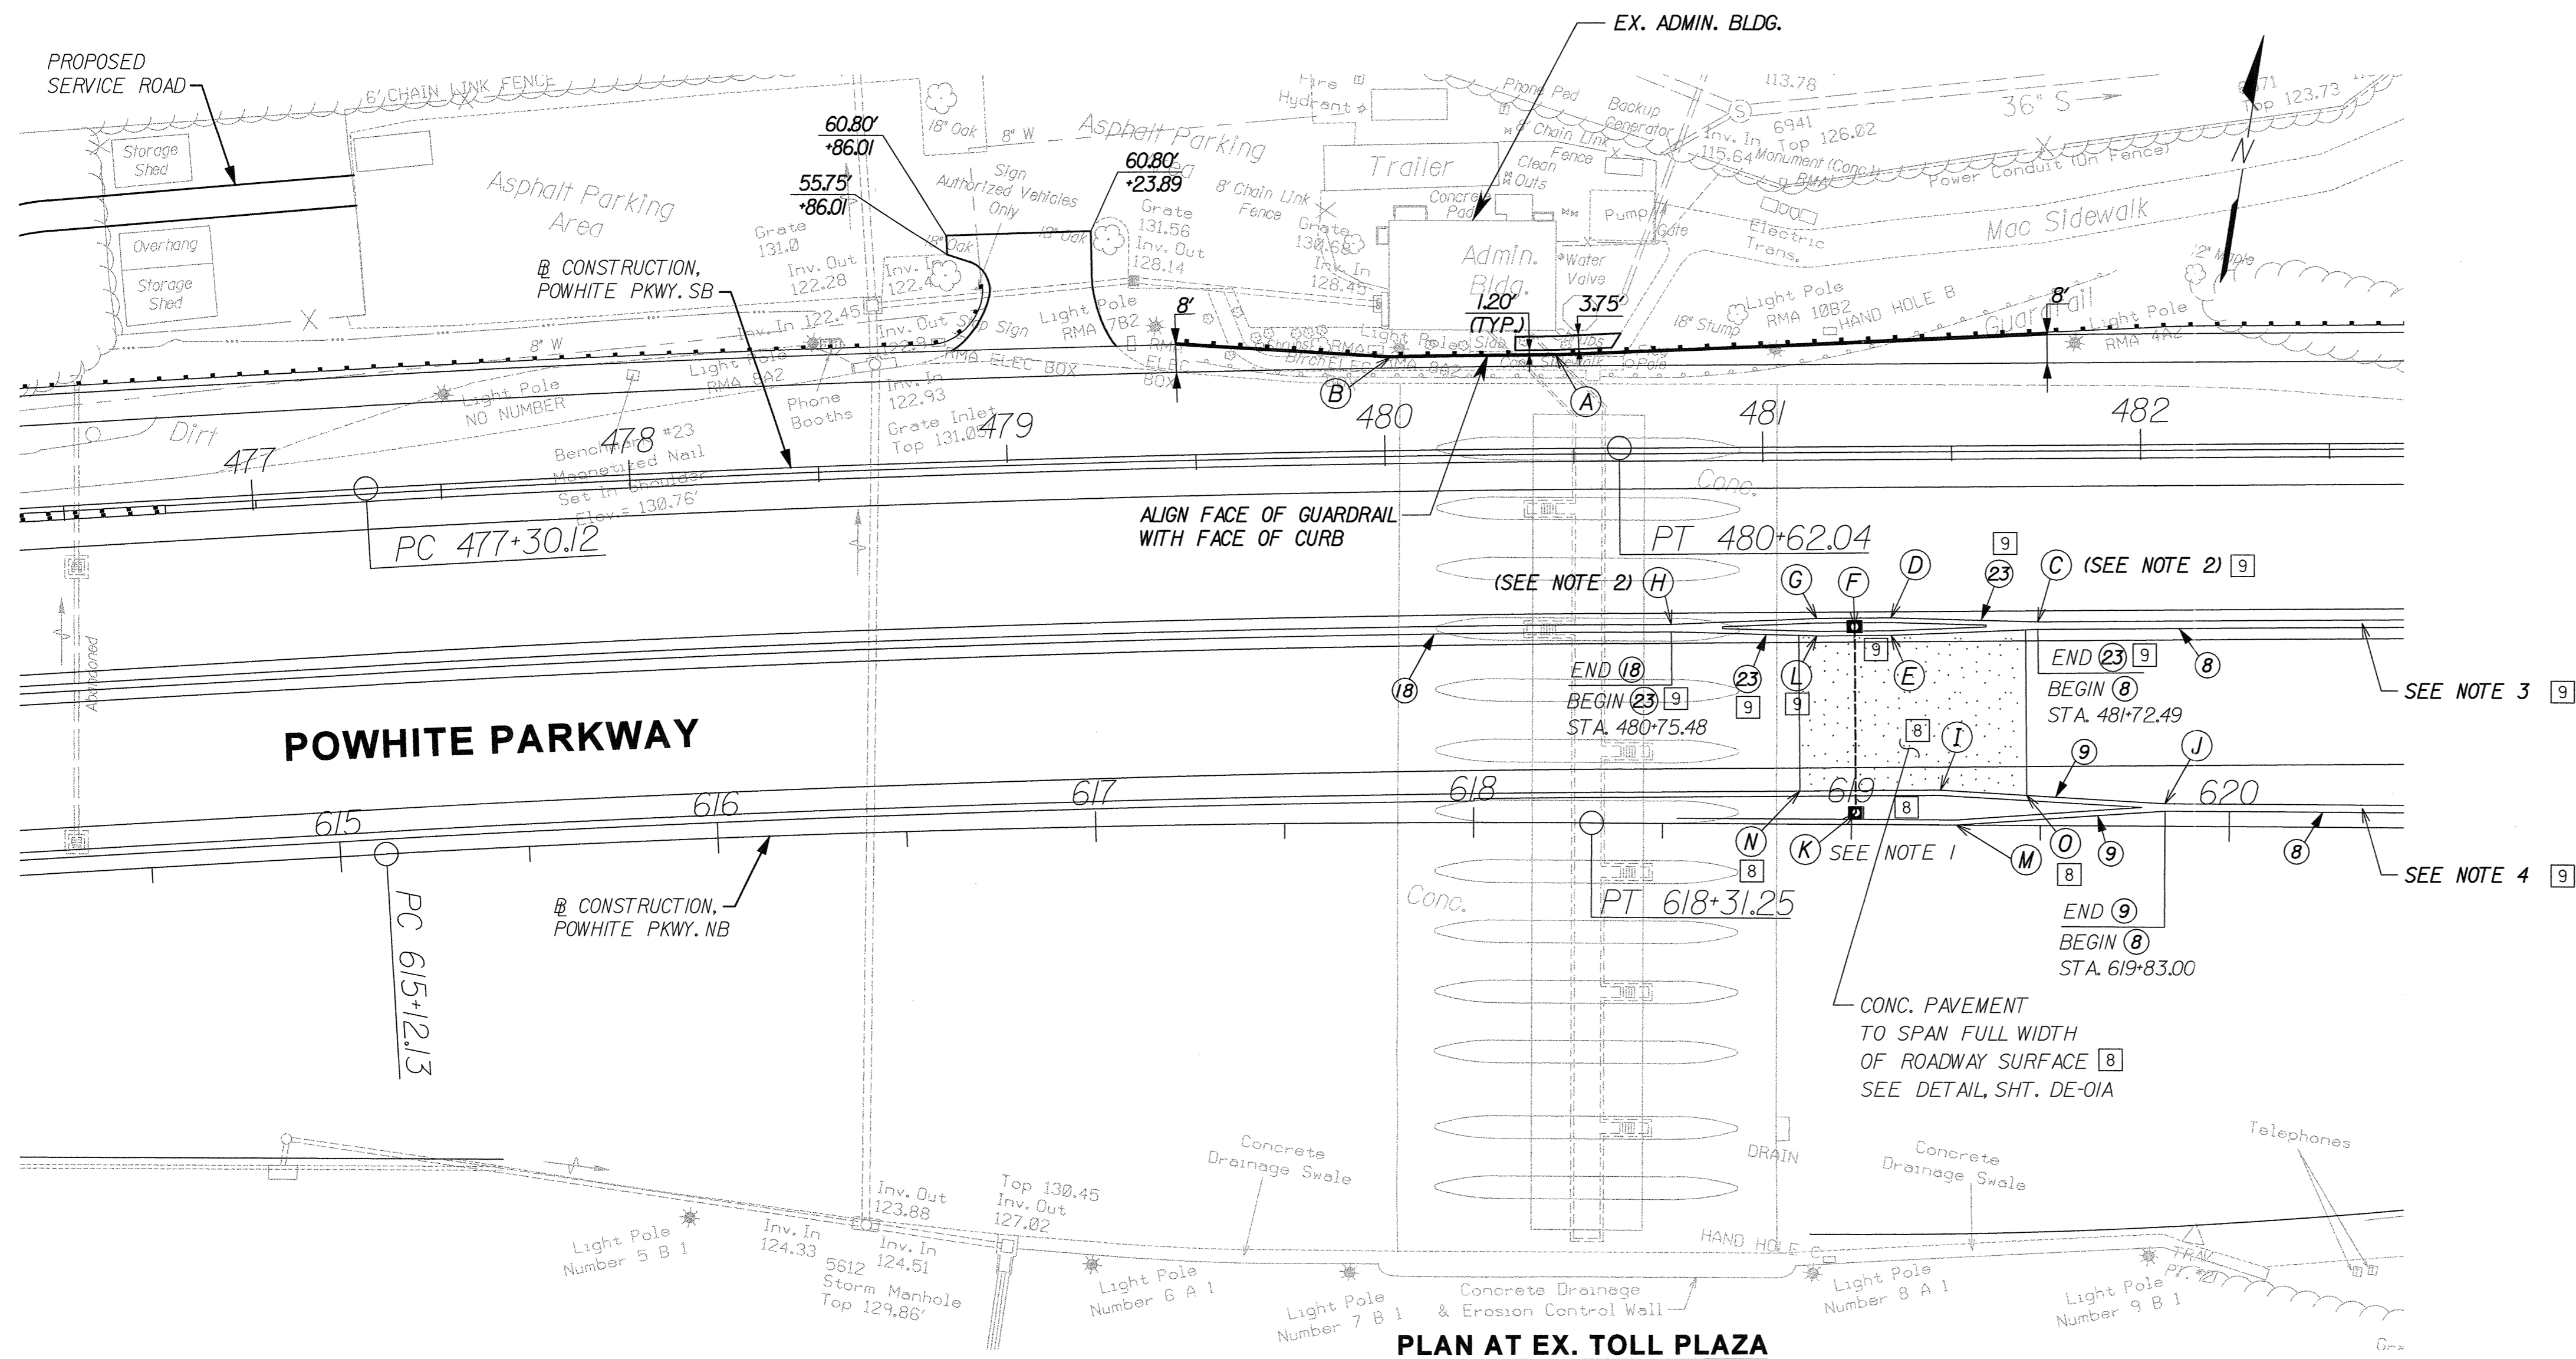


PLAN AT EX. TOLL PLAZA

HORIZONTAL CONTROL POINT SCHEDULE

POINT NO.	LOCATION	DESCRIPTION
(A)	STA. 480+45.49, 25.00' LT., POWHITE PKWY. SB	FACE OF CURB
(B)	STA. 480+01.69, 25.00' LT., POWHITE PKWY. SB	FACE OF CURB
(C)	STA. 481+72.49, 47.02' RT., POWHITE PKWY. SB	END BARRIER HORIZONTAL TRANSITION; END 50' BARRIER HEIGHT
(D)	STA. 481+33.63, 45.67' RT., POWHITE PKWY. SB	BEGIN BARRIER TRANSITION
(E)	STA. 481+33.63, 50.33' RT., POWHITE PKWY. SB	BEGIN BARRIER TRANSITION
(F)	STA. 481+23.98, 48.00' RT., POWHITE PKWY. SB	CENTER GANTRY FOUNDATION TY. 2A
(G)	STA. 481+3.96, 45.67' RT., POWHITE PKWY. SB	END BARRIER TRANSITION
(H)	STA. 480+75.48, 47.02' RT., POWHITE PKWY. SB	BEGIN BARRIER HORIZONTAL TRANSITION; BEGIN 50' BARRIER HEIGHT
(I)	STA. 619+23.59, 9.33' LT., POWHITE PKWY. NB	BEGIN BARRIER TRANSITION
(J)	STA. 619+83.00, 5.97' LT., POWHITE PKWY. NB	END BARRIER TRANSITION
(K)	STA. 619+1.21, 2.95' LT., POWHITE PKWY. NB	CENTER GANTRY FOUNDATION TY. 2B
(L)	STA. 481+3.96, 50.33' RT., POWHITE PKWY. SB	END BARRIER TRANSITION
(M)	STA. 619+27.81, 0.00', POWHITE PKWY. NB	BEGIN BARRIER TRANSITION
(N)	STA. 618+86.36, POWHITE PKWY. NB	LIMIT OF 9' CONC. PAVEMENT
(O)	STA. 619+46.36, POWHITE PKWY. NB	LIMIT OF 9' CONC. PAVEMENT

- LEGEND**
- (8) Modified MB-7D, Concrete Median Barrier
 - (9) Modified MB-7E, Concrete Median Barrier
 - (18) Modified MB-8A, Type I Conc. Med. Barrier, See Sht. DE-02
 - (9) (23) Std MB-12B, Conc. Med. Barrier

NO.	REVISIONS
10	4/10/08: REVISED SHEET - SEE SHEET 1C
9	3/5/08: REVISED SHEET - SEE SHEET 1C
8	10/03/07: REVISED GANTRY AREA - SEE SHEET 1C
2	7/20/06: ADDED SHEET

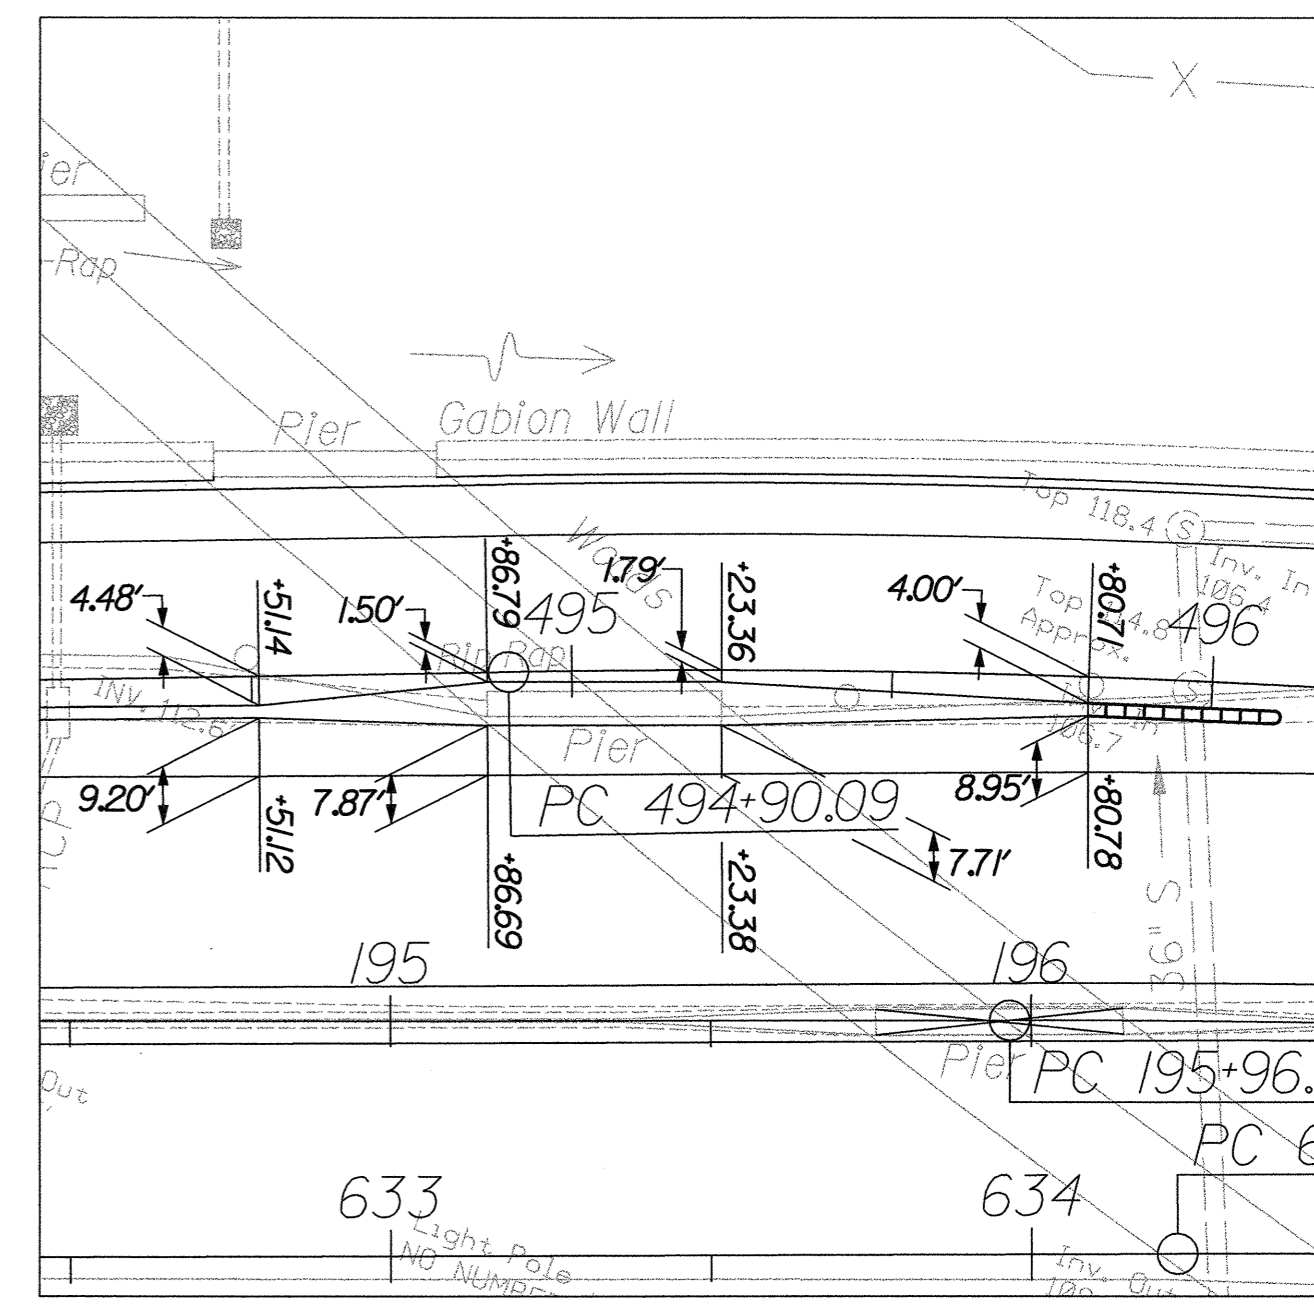

BARRIER TRANSITION PLAN AT POWHITE PARKWAY SB RAILROAD BRIDGE PIER

- NOTES:**
1. SEE SHEETS SM-40 AND SM-41 FOR GANTRY FOUNDATION DETAILS.
 - (9) 2. TRANSITION FROM THE 32" BARRIER HEIGHT TO A 50" BARRIER HEIGHT OVER A DISTANCE OF 6 FEET. SEE THE VDOT STANDARDS PAGE 501.55 FOR ADDITIONAL BARRIER TRANSITION DETAILS.
 - (9) 3. 2" CONDUITS TO BE INSTALLED IN CONCRETE MEDIAN BARRIER FROM GANTRY LOCATION TO DVAS POLE AT APPROXIMATE STA. 184+12. SEE SHEET L-07 FOR MORE DETAILS.
 - (9) 4. 2" CONDUITS TO BE INSTALLED IN CONCRETE MEDIAN BARRIER FROM GANTRY LOCATION TO DVAS CAMERA MOUNTED ON LIGHT POLE LP-15. SEE SHEET L-07 FOR MORE DETAILS.

DE-06 OF 06

RMA RICHMOND METROPOLITAN AUTHORITY
RICHMOND EXPRESSWAY SYSTEM

HNTB





9175 GUILFORD ROAD, SUITE 100
COLUMBIA, MARYLAND 21046
(301) 543-1000


**POWHITE PARKWAY EXPRESS
TOLL LANES PROJECT**

MISCELLANEOUS DETAILS

Scale: 1" = 30'	Date: 3/06/08	Contract No.: PEL-2006	Sheet: 47 of 161
--------------------	------------------	---------------------------	---------------------

PAVEMENT LEGEND

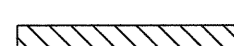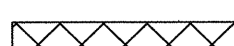-  PROPOSED FULL DEPTH PAVING
-  PROPOSED RESURFACING
-  FLEXIBLE PAVEMENT PLANING AREA
-  PAVEMENT / CONCRETE REMOVAL

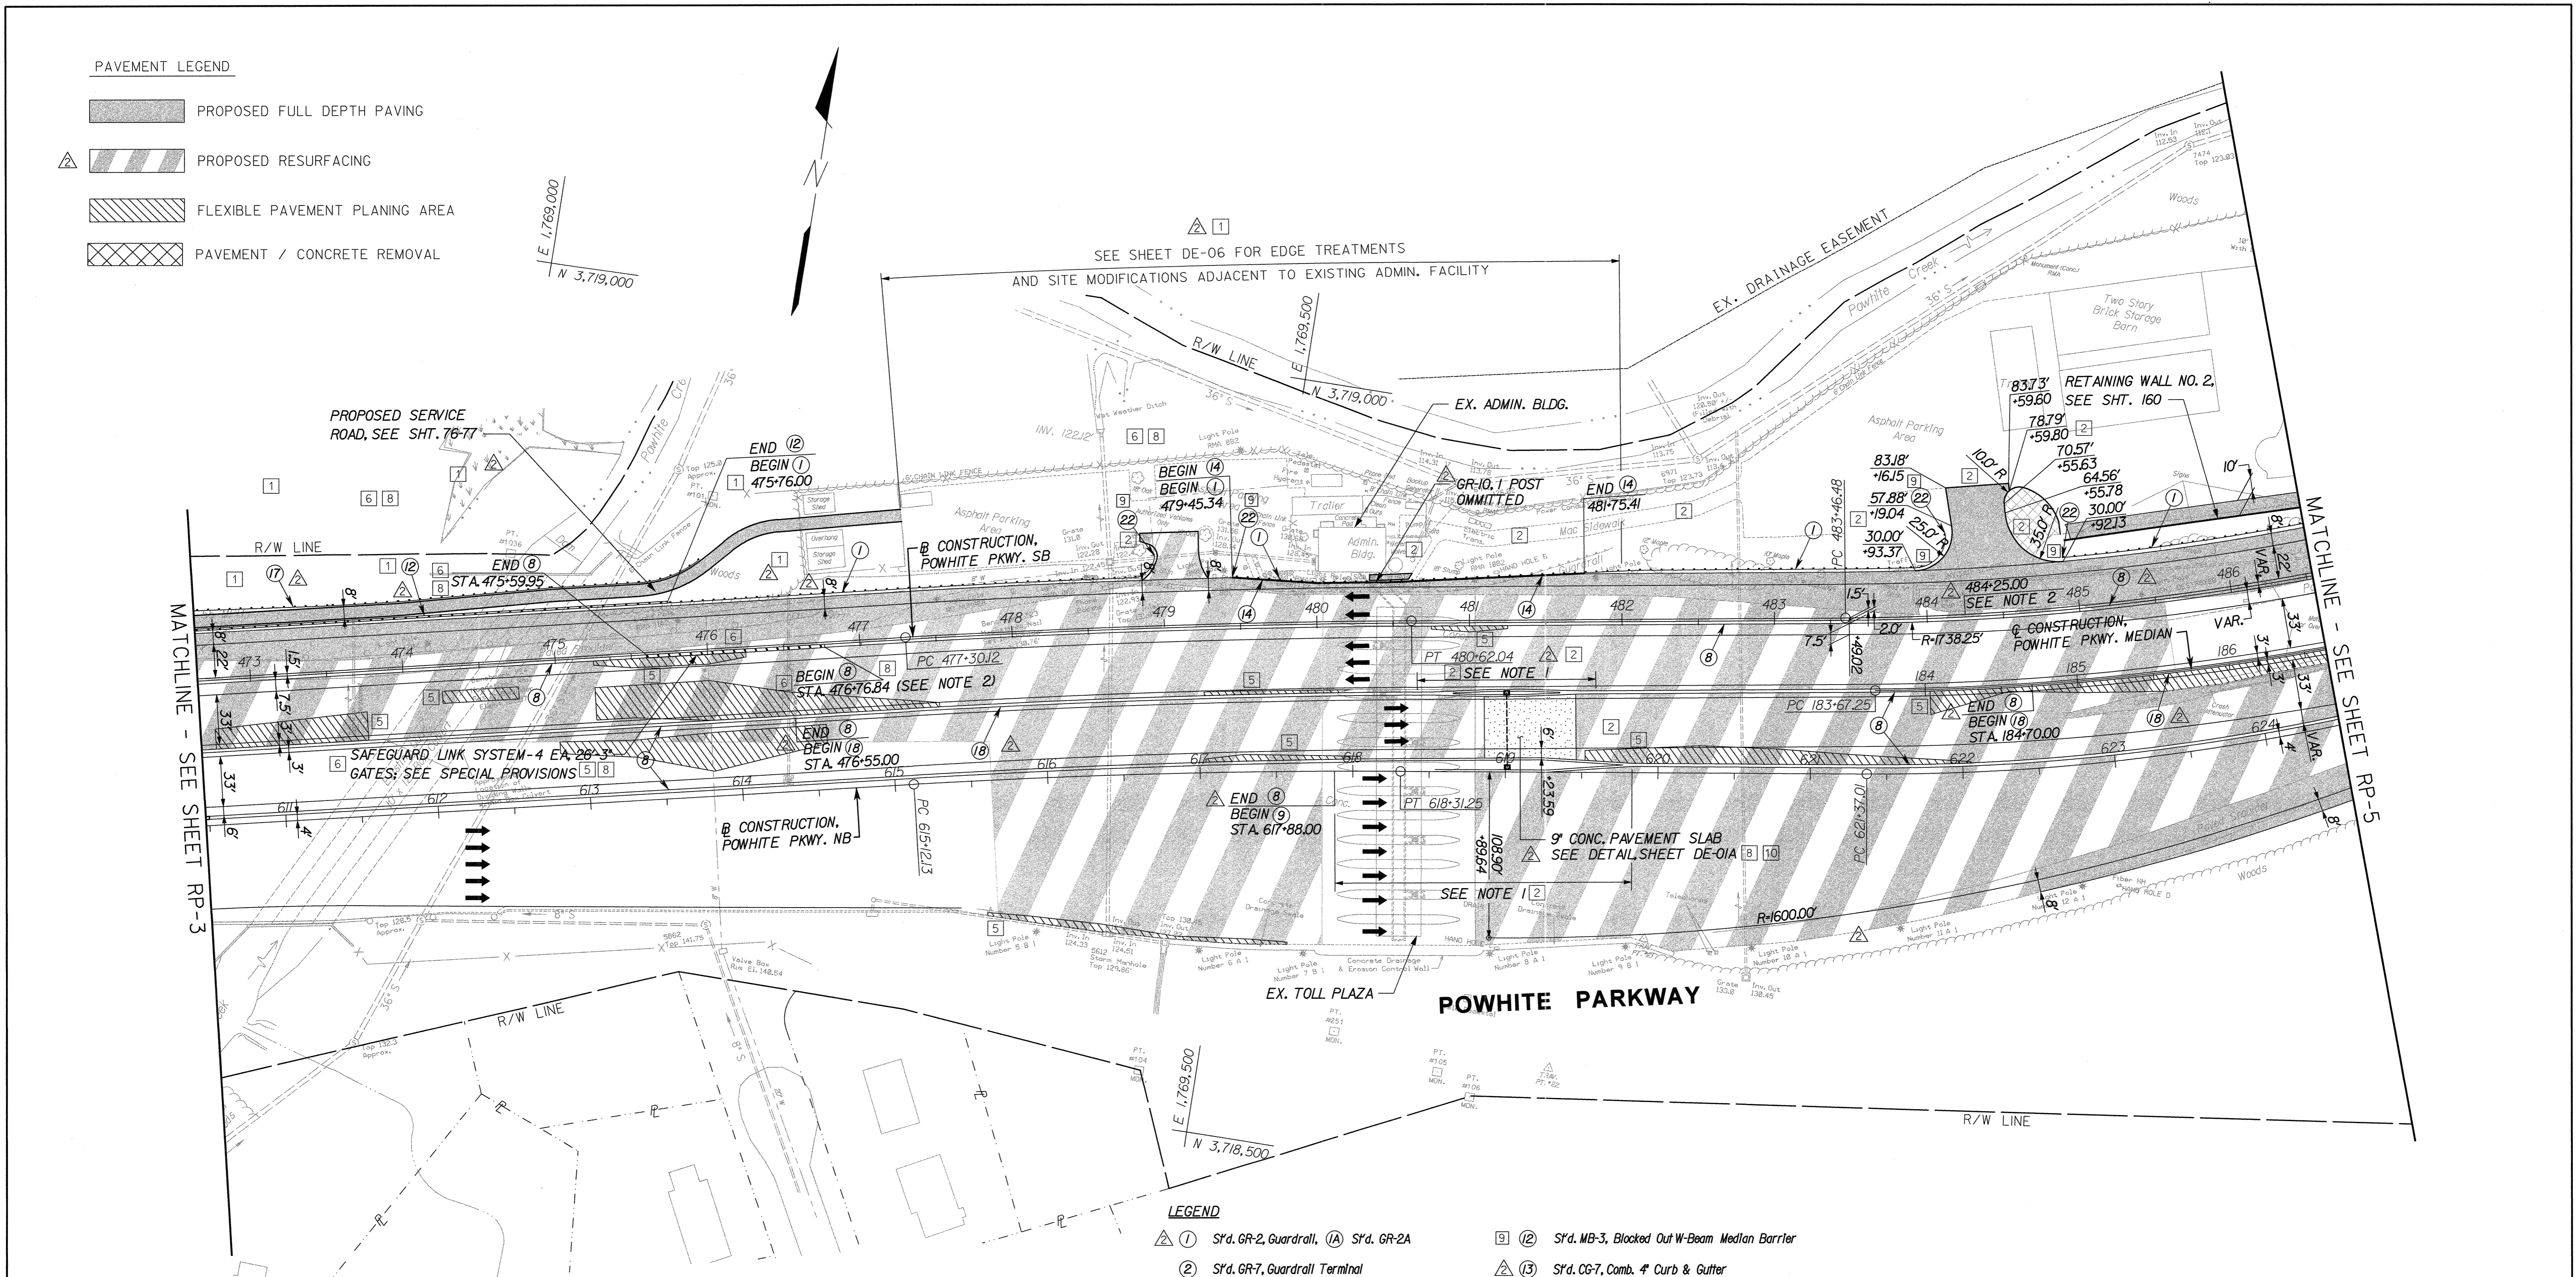

NOTES:

- 2 1 1. SEE SHEET DE-06 FOR BARRIER TYPES AND TRANSITIONS AT NB GANTRY STRUCTURE.
- 8 6 △ 2. CONCRETE MEDIAN BARRIER, MODIFIED TYPE 7D, FROM STA. 476+76.84 TO STA. 484+25 SHALL MATCH 2'-9" HEIGHT STANDARD AS SHOWN ON SHT. DE-02.

10	4/10/08: REVISED SHEET - SEE SHEET 1C
9	3/5/08: REVISED SHEET - SEE SHEET 1C
8	10/03/07: REVISED SHEET - SEE SHEET 1C
6	5/2/07: REVISED SHEET - SEE SHEET 1B
5	3/27/07: REVISED SHEET - SEE SHEET 1B
2	7/20/06: REVISED SHEET - SEE SHEET 1B
1	6/23/06: SEE SHEET 1A
△	ADDENDUM NO. 2: 5/17/06
REVISIONS	

LEGEND

- | | |
|--|--|
| △ 1 S'd. GR-2, Guardrail, (A) S'd. GR-2A | 9 12 S'd. MB-3, Blocked Out W-Beam Median Barrier |
| 2 S'd. GR-7, Guardrail Terminal | △ 13 S'd. CG-7, Comb. 4' Curb & Gutter |
| 3 S'd. GR-9, Guardrail Terminal | △ 14 S'd. CG-3, Standard 4' Curb |
| 9 4 Impact Attenuator (TL-3, > 55 MPH) (A) (TL-2, > 40 MPH) | 15 Constant Slope Concrete Median Barrier, See Sheet DE-04 |
| 5 S'd. GR-FOA-2, Fixed Object Attachment, Type I | 16 4' Concrete Sidewalk Per Section 504 Of Standard Specifications |
| 6 S'd. GR-FOA-2, Fixed Object Attachment, Type II | △ 17 S'd. GR-8, Guardrail (Weak Post) |
| 7 S'd. MB-5, W-Beam Median Barrier, Weak Post | △ 17A S'd. GR-8A, Guardrail (Weak Post) |
| △ 8 Modified MB-7D, Concrete Median Barrier | △ 18 Modified MB-8A, Type I Conc. Med. Barrier, See Sht. DE-02 |
| △ 9 Modified MB-7E, Concrete Median Barrier | △ 19 S'd. MB-8A, Type II Conc. Med. Barrier |
| △ 10 Modified MB-7F, Concrete Median Barrier | △ 20 S'd. MB-8A, Type III Conc. Med. Barrier |
| △ 11 Modified MB-8A Conc. Median Barrier, Ty. III, See Sheet DE-02 | 9 21 S'd. CG-6, Comb. 6' Curb & Gutter |
| | 9 22 S'd. GR-II, Guardrail Terminal |

RP-4 OF 7

richmond metropolitan authority
RICHMOND EXPRESSWAY SYSTEM

HNTB

9175 GUILFORD ROAD, SUITE 100
COLUMBIA, MARYLAND 21046
(301) 543-1000

**POWHITE PARKWAY EXPRESS
TOLL LANES PROJECT**
ROADWAY PAVEMENT PLAN
STA. 472+65 TO STA. 486+50
B CONSTR. POWHITE PARKWAY SB

Scale: 1" = 50'	Date: 3/06/08	Contract No.: PEL-2006	Sheet: 61 of 161
--------------------	------------------	---------------------------	---------------------



POWHITE PARKWAY TOLL PLAZA

**TOLL GANTRY SHOP DRAWINGS
AND STRUCTURAL CALCULATIONS**


SHOP DRAWING REVIEW
HNTB Corporation

Review is for general compliance with contract documents. Sole responsibility for correctness of dimensions, details, quantities and safety during fabrication and erection shall remain with the Contractor.


- No Exceptions Taken
- Make Correction Noted By AN
- Amend and Resubmit
- Rejected - See Remarks Date 3/22/08

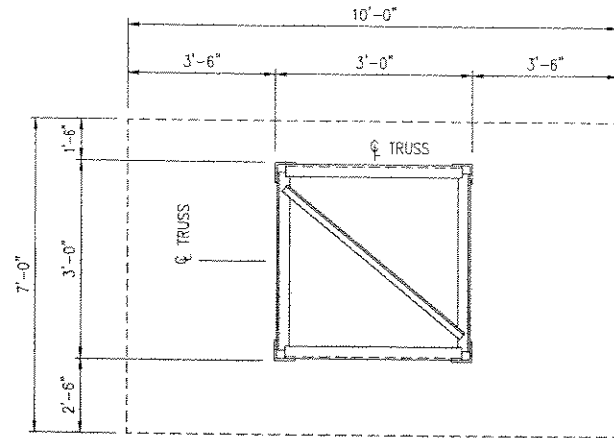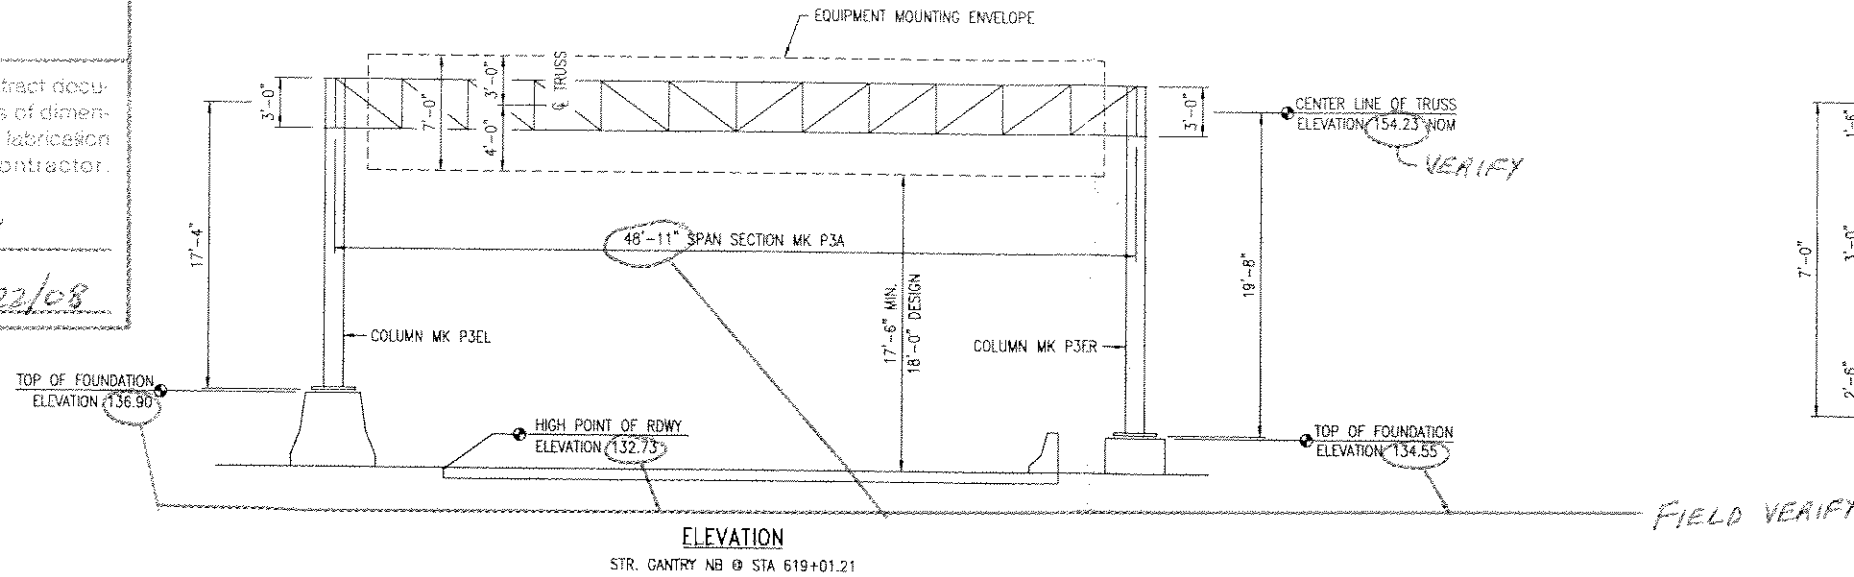

TYPICAL SECTION
EQUIPMENT MOUNTING ENVELOPE

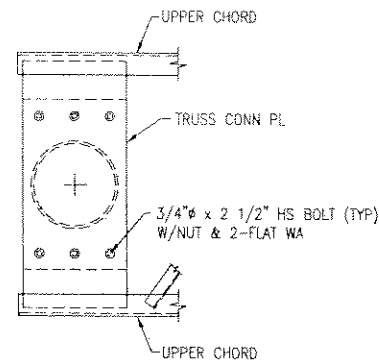


UPPER CONNECTION DETAIL
(LEFT COLUMN SHOWN, RIGHT COLUMN SIMILAR)

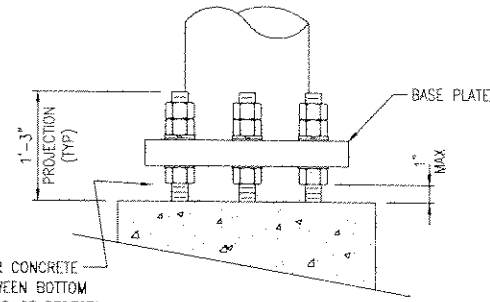

BASE PLATE ERECTION

NO MORTAR, GROUT, OR CONCRETE SHALL BE PLACED BETWEEN BOTTOM OF BASE PLATE AND TOP OF PEDESTAL

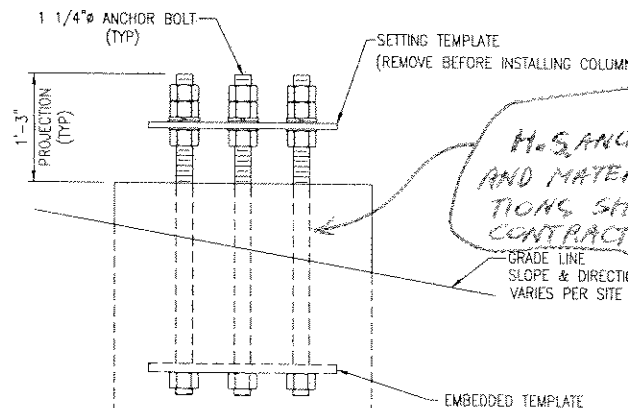

TYPICAL FOUNDATION ELEVATION

H.S. ANCHOR BOLT AND MATERIAL SPECIFICATIONS SHALL COMPLY WITH CONTRACT DRAWING SM-40 OF 41

FIELD VERIFY

GENERAL NOTES:

STRUCTURE DESIGN PER ASHTO STANDARD SPECS. FOR STRUCTURAL SUPPORTS FOR HIGHWAY SIGNS, LUMINAIRES AND TRAFFIC SIGNALS, 1994 EDITION.

DESIGN WIND SPEED 80 MPH.

ALL WELDING PER AWS D1.1 (LATEST EDITION).

STRUCTURE DESIGN BY HURTT FABRICATING CORP.

ANCHOR BOLT & FOUNDATION DESIGN BY HNTB.

EQUIPMENT MOUNTING BRACKETS & HARDWARE BY OTHERS.

FOUNDATION & ROADWAY ELEVATIONS PROVIDED BY VENTURE ELECTRIC CO. ON 2-5-08.

THE ELEVATIONS SHOWN ARE FOR REFERENCE AND RELATIONSHIP ONLY AND ARE NOT THE ACTUAL SITE ELEVATIONS.


17'-6" MINIMUM (18'-0" DESIGN) CLEARANCE FROM THE HIGH POINT OF THE ROADWAY TO THE BOTTOM OF THE EQUIPMENT MOUNTING ENVELOPE.

THE TRUSS TO COLUMN HIGH STRENGTH BOLT CONNECTIONS SHALL BE INSTALLED USING THE "TURN-OF-NUT" METHOD PER SECTION 407.06(b)3 OF THE VDOT ROAD AND BRIDGE SPECIFICATIONS 2002.


ANCHOR NOTE:

USE STEEL SETTING & EMBEDDED TEMPLATES TO ASSURE PROPER ANCHOR BOLT LAYOUT & ALIGNMENT.

REUSE SETTING TEMPLATE AT SIMILAR LOCATIONS.

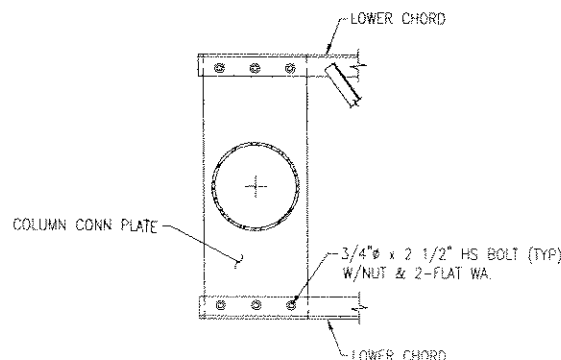


LOWER CONNECTION DETAIL
(LEFT COLUMN SHOWN, RIGHT COLUMN SIMILAR)

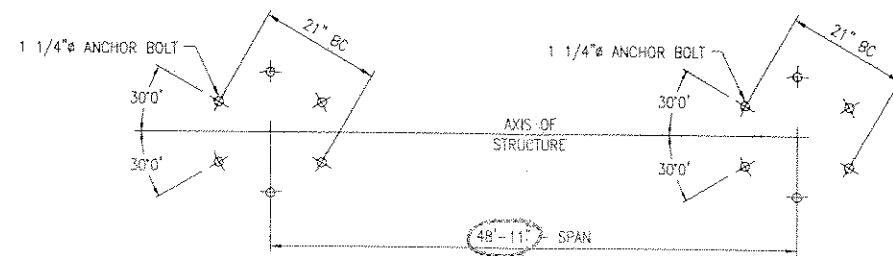

ANCHOR BOLT LAYOUT
LOC. GANTRY NB

FIELD VERIFY

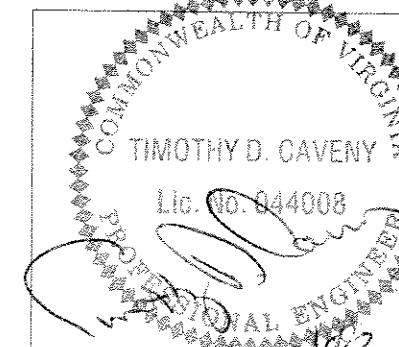

REV:					
PRINTS ISSUED					
FOR	#	DATE	FOR	#	DATE


HURTT FABRICATING CORP.
P.O. BOX 128
MARCELINE, MO 64658

CUSTOMER: VENTURE ELECTRIC CO.


PROJECT: CONTRACT NO. PEL-2006
POWHITE PARKWAY EXPRESS LANES PROJECT
RICHMOND METROPOLITAN AUTHORITY

SUBJECT: ERECTION DIAGRAM FOR LOC. NORTH BOUND
GANTRY @ STA 619+01.21

FILE: 4871 OH E1 PKG F DATE: 2-13-08 PKG: F
PRINTED FOR: DR BY: CH BY: JOB NO: SHEET
RICHMOND METRO AUTHORITY JBS

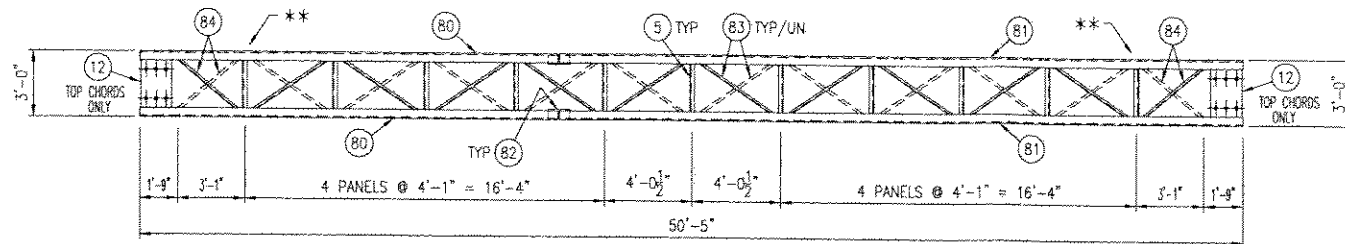


PLAN

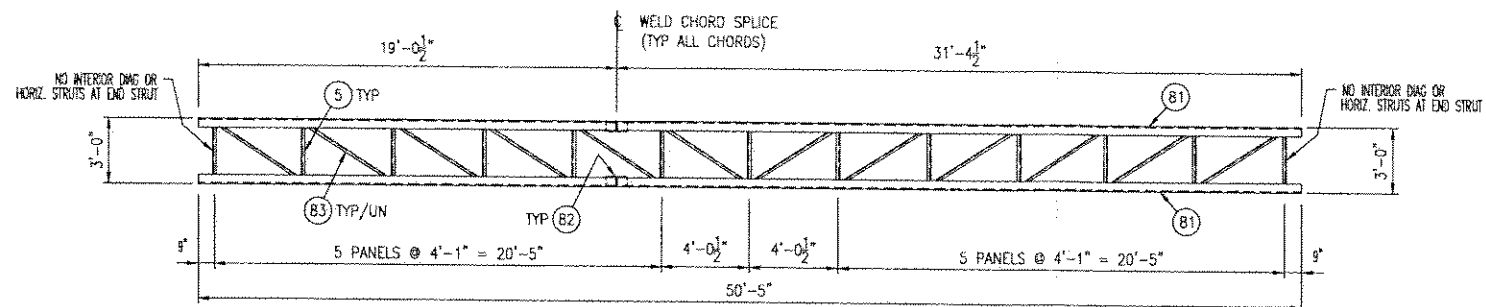


ELEVATION

ONE REQ'D - SPAN SECTION - MK P3A

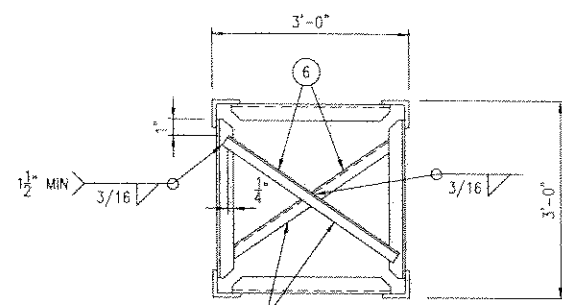


X-BRACE INTERIOR DIAGONALS AT BOTH ENDS OF EACH TRUSS SECTION.

TYPICAL TRUSS SECTION END

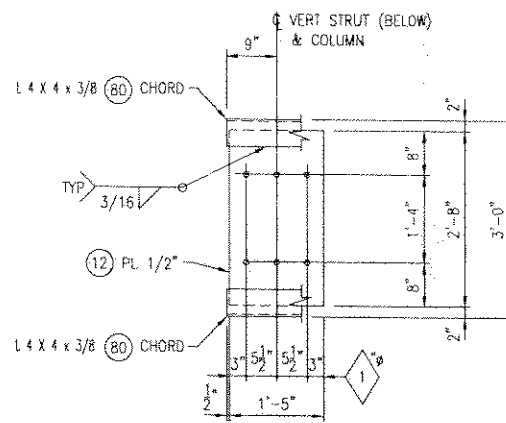


TOP CHORD MOUNTING PLATE


LEFT SECTION SHOWN
RIGHT SECTION SIMILAR

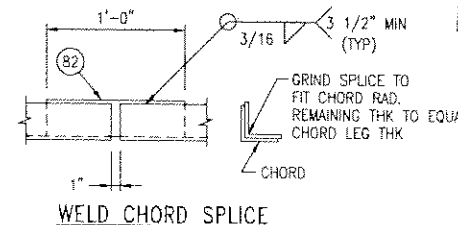

WELD CHORD SPLICE

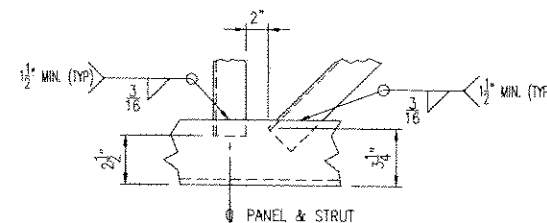


TYPICAL STRUT & DIAGONAL CONNECTION

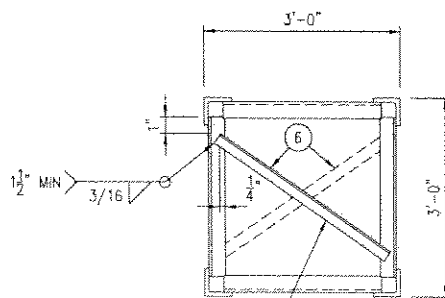

ALTERNATE DIRECTION OF INTERIOR DIAGONALS AT EACH PANEL POINT.

TYPICAL TRUSS SECTION

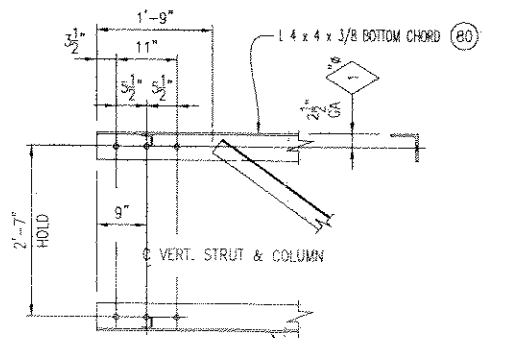

BOTTOM CHORD LAYOUT

LEFT SECTION SHOWN
RIGHT SECTION SIMILAR

BILL OF MATERIAL				
QTY	MK	DESCRIPTION	LENGTH	REMARKS
4	80	L 4 x 4 x 3/8	19'-0"	
4	81	L 4 x 4 x 3/8	31'-4"	
4	82	L 4 x 4 x 3/8	1'-0"	
44	83	L 2 x 2 x 3/16	4'-4 1/8"	
4	84	L 2 x 2 x 3/16	3'-9"	
48	5	L 2 x 2 x 3/16	2'-7"	
13	6	L 2 x 2 x 3/16	3'-7"	
2	12	PL 1/2 X 17	2'-8"	
24	END COLUMN	3/4" HSB	2 1/2"	W/NUT & 2-FLAT WASHER

SHOP DRAWING REVIEW
HNTB Corporation

Review is for general compliance with contract documents. Sole responsibility for correctness of dimensions, details, quantities and safety during fabrication and erection shall remain with the Contractor.

No Exceptions Taken
 Make Correction Noted By AN
 Amend and Resubmit
 Rejected - See Remarks Date 3/22/08


CAMBER NOTES:

PROVIDE 3/4" OF CAMBER AT CENTERLINE OF TRUSS

MATERIAL SPECIFICATIONS:


STEEL SHAPES & PLATE - ASTM A36
 GALVANIZE AFTER FAB PER ASTM A123
 HS BOLTS - ASTM A325 TYPE 1
 NUTS - ASTM A563 DH
 WASHERS - ASTM F436
 GALVANIZE HARDWARE PER ASTM A153

REV:								
PRINTS ISSUED								
FOR	#	DATE	FOR	#	DATE	FOR	#	DATE

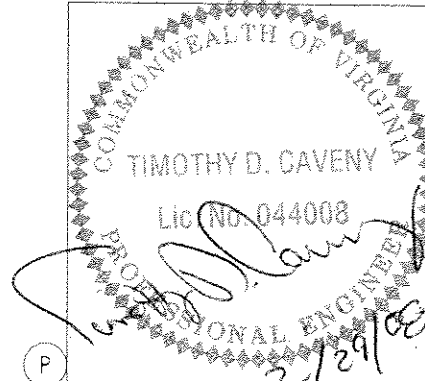

HURTT FABRICATING CORP.
 P.O. BOX 128
 MARCELINE, MO 64658

CUSTOMER: VENTURE ELECTRIC CO.
 PROJECT: CONTRACT NO. PEL-2006
 POWHITE PARKWAY EXPRESS LANES PROJECT
 RICHMOND METROPOLITAN AUTHORITY
 SUBJECT: FABRICATION DETAILS FOR GANTRY TRUSS
 LOC. NORTH BOUND GANTRY
 FILE: 4871 OH GANTRY TRUSS PKG P | DATE: 2-13-08 | PKG: P
 PRINTED FOR: DR BY: CH BY: JOB NO: SHEET
 RICHMOND METRO AUTHORITY | JBS | TAP | HF-4871 | 1 OF 2

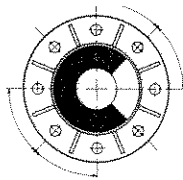

COWELL
ENGINEERING
STRUCTURAL ENGINEERS

February 29, 2008

Craig Hengstenberg
Hurtt Fabricating
P.O. 128
Marceline, MO 64658

RE: Independent Review
Sign Structures and Foundations
Project: HF - 4871
Gantry Sign Location:

Dear Craig:

This office has reviewed the drawings provided for the above referenced project to determine compliance with the AASHTO standards entitled: Standard Specifications for Structural Supports for Highway Signs, Luminaries and Traffic Signals (1994) and AASHTO Standard Specifications for Highway Bridges (1996), and the VDOT Road and Bridge Standards.

The review consisted of verifying the input values from the supplied drawings, comparing the drawing against the referenced standard/specification and performing computations to verify some of the computer generated numbers when needed.

Cowell Engineering, LLC has the required independent status necessary for review. Neither the company nor any of its employees have any affiliations (past or present) with any manufacturer, supplier, or contractor associated with traffic structures.

Based upon this review and to the best of my knowledge and belief, the submitted drawings are in compliance with the pertinent passages of the above referenced AASHTO specifications.

Yours very truly,
COWELL ENGINEERING

Timothy D. Caveny, P.E., S.E.
W.O. #07087



3008 Suite B Boulevard
Saint Louis, Missouri 63143
314.644.4002 office
314.644.1988 fax
www.cowelleng.com

HURTT FABRICATING CORP., MARCELINE, MO.
OVERHEAD ANGLE SIGN SUPPORT DESIGN version 2 8-23-07
15th Ed. AASHTO, 3rd Ed. Luminaires

Structure Name : GANT N
Job Description : HF 4871
Engineer : CLH
Run Date & Time : 2/12/2008 at 15:40


Truss # = GNB
Hurttt Job # = HF 4871
Item # =
State Job # = RICH EXPY
State Project = PEL 2006
File Name: 4871GANB.DAT

County = RMA

Although extensive measures have been taken to insure the correctness of this program, the presence of undetected errors in the program or material is possible. Therefore, the application of judgement is required on the correctness of the output and its proper application to the intended use. The program material contained herein is supplied without representation or warranty of any kind. Cowell Engineering LLC and San4dSoft therefore assume no responsibility and shall have no liability, consequential or otherwise, of any kind arising from the use of the program or any part thereof.

SHEETS 1-12 FOR TRUSS DESIGN ONLY

SHOP DRAWING REVIEW HNTB Corporation	
Review is for general compliance with contract documents. Sole responsibility for correctness of dimensions, details, quantities and safety during fabrication and erection shall remain with the Contractor.	
<input checked="" type="checkbox"/> No Exceptions Taken	
<input type="checkbox"/> Make Correction Noted By	<u>AN</u>
<input type="checkbox"/> Amend and Resubmit	
<input type="checkbox"/> Rejected - See Remarks Date	<u>3/22/08</u>

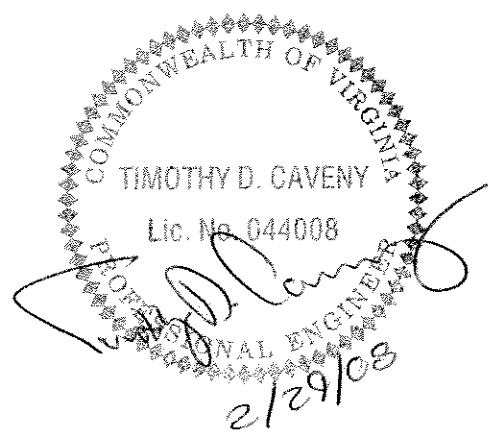

HURTT FABRICATING CORP., MARCELINE, MO.
 OVERHEAD ANGLE SIGN SUPPORT DESIGN version 2 8-23-07
 15th Ed. AASHTO, 3rd Ed. Luminaires

Structure Name : GANT N
 Job Description : HF 4871
 Engineer : CLH
 Run Date & Time : 2/12/2008 at 15:40

* * * * * TRUSS DESIGN * * * * *

TRUSS DIMENSIONS (FT)			PANEL LENGTH (FT)				
LENGTH	DEPTH	WIDTH	WALK DESIGN		NUMBER OF PANELS		
			CENTER	END	CENTER	END	
48.92	3.00	3.00	4.08	4.06			
WIND VELOCITY MPH	NUMBER OF SIGNS	DIST L	LENGTH	WGT/FT	CENTER	END	
80.00	1	0.00	0.00	0.00	10	2	



HURTT FABRICATING CORP., MARCELINE, MO.
OVERHEAD ANGLE SIGN SUPPORT DESIGN version 2 8-23-07
15th Ed. AASHTO, 3rd Ed. Luminaires

Structure Name : GANT N
Job Description : HF 4871
Engineer : CLH
Run Date & Time : 2/12/2008 at 15:40

* * * * * TRUSS DESIGN * * * * *

S I G N D A T A

SIGN NO.	SIGN LENGTH	SIGN HEIGHT	CD	CH	DISTANCE FROM LS	DISTANCE CENTER	ECCN	WGT
1	46.92	1.00	1.30	1.00	1.00	24.46	-3.50	0.00




HURTT FABRICATING CORP., MARCELINE, MO.
 OVERHEAD ANGLE SIGN SUPPORT DESIGN version 2 8-23-07
 15th Ed. AASHTO, 3rd Ed. Luminaires

Structure Name : GANT N
 Job Description : HF 4871
 Engineer : CLH
 Run Date & Time : 2/12/2008 at 15:40

* * * * * TRUSS DESIGN * * * * *

TRUSS DEPTH = 3.00 FEET
 TRUSS WIDTH = 3.00 FEET
 DEFLECTION = 0.101 IN.
 CAMBER REQUIRED = 0.688 IN.

	L-WIND FORCE (LBS.)	L-DEAD WEIGHT (LBS.)	R-WIND FORCE (LBS.)	R-DEAD LOAD (LBS.)
CASE 1	0.0	1464.3	0.00	1464.3
CASE 2	2171.9	1464.3	2171.90	1464.3
CASE 3	1086.0	2343.3	1085.95	2343.3

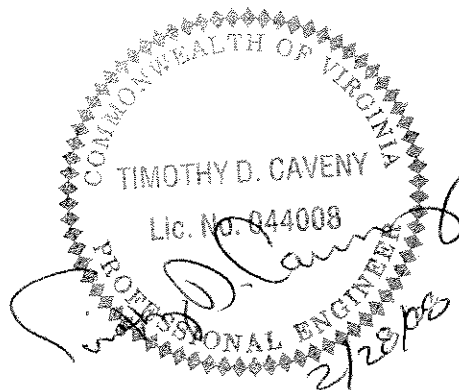

HURTT FABRICATING CORP., MARCELINE, MO.
 OVERHEAD ANGLE SIGN SUPPORT DESIGN version 2 8-23-07
 15th Ed. AASHTO, 3rd Ed. Luminaires

Structure Name : GANT N
 Job Description : HF 4871
 Engineer : CLH
 Run Date & Time : 2/12/2008 at 15:40

* * * * * TRUSS CHORDS * * * * *

LENGTH FT	NUMBER REQUIRED	NUMBER OF 0.625" BOLTS (A325)	NUMBER OF 0.75" BOLTS (A325)	NUMBER OF 0.875" BOLTS (A325)
49.42	4	2.00	2.00	1.00

MEMBER AND SHAPE CONFIGURATION	YIELD KSI	GROSS AREA	NET AREA	LEAST ROG	WEIGHT (LBS)
4x4x.375	36.00	2.86	2.10	0.79	1937.26

	FORCE (LBS)	FA (PSI)	ALLOWABLE (PSI)	LENGTH OF 0.19" FILLET WELD
CASE 1	3715.5	1299.1	16447.6	1.33
CASE 2	13519.0	4726.9	23026.7	3.47
CASE 3	10975.3	3837.5	23026.7	2.82



HURTT FABRICATING CORP., MARCELINE, MO.
 OVERHEAD ANGLE SIGN SUPPORT DESIGN version 2 8-23-07
 15th Ed. AASHTO, 3rd Ed. Luminaires

Structure Name : GANT N
 Job Description : HF 4871
 Engineer : CLH
 Run Date & Time : 2/12/2008 at 15:40

* * * * * WIND DIAGONAL * * * * *

LENGTH FT	NUMBER REQUIRED	MINIMUM BOLTS NO. & SIZE (A325)
4.92	20	2 - 0.625

MEMBER AND SHAPE CONFIGURATION	YIELD KSI	GROSS AREA	NET AREA	LEAST ROG	WEIGHT (LBS)
2x2x.19	36.00	0.72	0.39	0.39	240.11

	FORCE (LBS)	FA (PSI)	ALLOWABLE (PSI)	LENGTH OF 0.19" FILLET WELD
CASE 1	0.0	0.0	6627.6	0.00
CASE 2	1943.0	2717.4	9278.6	0.50
CASE 3	971.5	1358.7	9278.6	0.25



HURTT FABRICATING CORP., MARCELINE, MO.
 OVERHEAD ANGLE SIGN SUPPORT DESIGN version 2 8-23-07
 15th Ed. AASHTO, 3rd Ed. Luminaires


Structure Name : GANT N
 Job Description : HF 4871
 Engineer : CLH
 Run Date & Time : 2/12/2008 at 15:40

* * * * * WIND DIAGONAL END PANEL * * * * *

LENGTH FT	NUMBER REQUIRED	MINIMUM BOLTS NO. & SIZE (A325)
4.90	4	2 - 0.625

MEMBER AND SHAPE CONFIGURATION	YIELD KSI	GROSS AREA	NET AREA	LEAST ROG	WEIGHT (LBS)
2x2x.19	36.00	0.72	0.39	0.39	47.86

	FORCE (LBS)	FA (PSI)	ALLOWABLE (PSI)	LENGTH OF 0.19" FILLET WELD
CASE 1	0.0	0.0	6672.5	0.00
CASE 2	1936.4	2708.3	9341.5	0.50
CASE 3	968.2	1354.1	9341.5	0.25

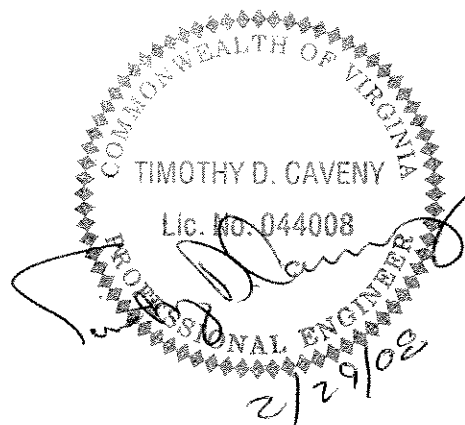

HURTT FABRICATING CORP., MARCELINE, MO.
 OVERHEAD ANGLE SIGN SUPPORT DESIGN version 2 8-23-07
 15th Ed. AASHTO, 3rd Ed. Luminaires


Structure Name : GANT N
 Job Description : HF 4871
 Engineer : CLH
 Run Date & Time : 2/12/2008 at 15:40

* * * * * WIND STRUT * * * * *

LENGTH FT	NUMBER REQUIRED	MINIMUM BOLT SIZE (A325)
2.75	26	0.625

MEMBER AND SHAPE CONFIGURATION	YIELD KSI	GROSS AREA	NET AREA	LEAST ROG	WEIGHT (LBS)
2x2x.19	36.00	0.72	0.39	0.39	174.46

	FORCE (LBS)	FA (PSI)	ALLOWABLE (PSI)	LENGTH OF 0.19" FILLET WELD
CASE 1	0.0	0.0	14590.6	0.00
CASE 2	1086.0	1518.8	20426.9	0.28
CASE 3	543.0	759.4	20426.9	0.14

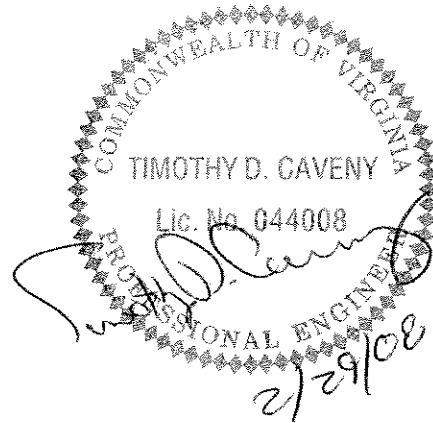

HURTT FABRICATING CORP., MARCELINE, MO.
 OVERHEAD ANGLE SIGN SUPPORT DESIGN version 2 8-23-07
 15th Ed. AASHTO, 3rd Ed. Luminaires

Structure Name : GANT N
 Job Description : HF 4871
 Engineer : CLH
 Run Date & Time : 2/12/2008 at 15:40

* * * * * DEAD LOAD DIAGONAL * * * * *

LENGTH FT	NUMBER REQUIRED	MINIMUM BOLTS NO. & SIZE (A325)
4.92	20	2 - 0.625

MEMBER AND SHAPE CONFIGURATION	YIELD KSI	GROSS AREA	NET AREA	LEAST ROG	WEIGHT (LBS)
2x2x.19	36.00	0.72	0.39	0.39	240.11

	FORCE (LBS)	FA (PSI)	ALLOWABLE (PSI)	LENGTH OF 0.19" FILLET WELD
CASE 1	1310.0	1832.1	19800.0	0.47
CASE 2	1310.0	1832.1	27720.0	0.34
CASE 3	2159.3	3019.9	27720.0	0.55



HURTT FABRICATING CORP., MARCELINE, MO.
 OVERHEAD ANGLE SIGN SUPPORT DESIGN version 2 8-23-07
 15th Ed. AASHTO, 3rd Ed. Luminaires


Structure Name : GANT N
 Job Description : HF 4871
 Engineer : CLH
 Run Date & Time : 2/12/2008 at 15:40

* * * * * DEAD LOAD DIAGONAL END PANEL * * * * *

LENGTH FT	NUMBER REQUIRED	MINIMUM BOLTS NO. & SIZE (A325)
4.90	4	2 - 0.625

MEMBER AND SHAPE CONFIGURATION	YIELD KSI	GROSS AREA	NET AREA	LEAST ROG	WEIGHT (LBS)
2x2x.19	36.00	0.72	0.39	0.39	47.86

	FORCE (LBS)	FA (PSI)	ALLOWABLE (PSI)	LENGTH OF 0.19" FILLET WELD
CASE 1	1305.6	1826.0	19800.0	0.47
CASE 2	1305.6	1826.0	27720.0	0.33
CASE 3	2152.0	3009.8	27720.0	0.55

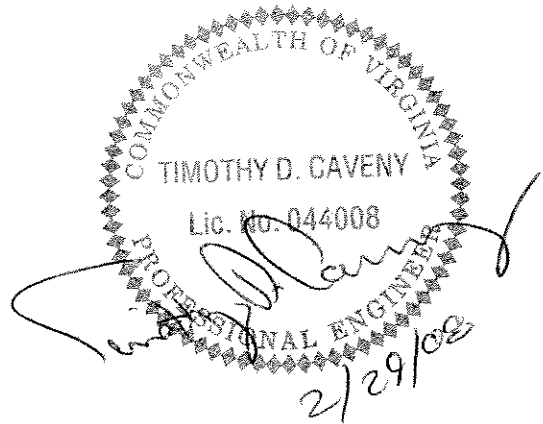

HURTT FABRICATING CORP., MARCELINE, MO.
 OVERHEAD ANGLE SIGN SUPPORT DESIGN version 2 8-23-07
 15th Ed. AASHTO, 3rd Ed. Luminaires


Structure Name : GANT N
 Job Description : HF 4871
 Engineer : CLH
 Run Date & Time : 2/12/2008 at 15:40

* * * * * DEAD LOAD VERTICAL * * * * *

LENGTH FT	NUMBER REQUIRED	MINIMUM BOLT SIZE (A325)
2.75	26	0.625

MEMBER AND SHAPE CONFIGURATION	YIELD KSI	GROSS AREA	NET AREA	LEAST ROG	WEIGHT (LBS)
2x2x.19	36.00	0.72	0.39	0.39	174.46

	FORCE (LBS)	FA (PSI)	ALLOWABLE (PSI)	LENGTH OF 0.19" FILLET WELD
CASE 1	732.2	1024.0	14590.6	0.26
CASE 2	732.2	1024.0	20426.9	0.19
CASE 3	1206.8	1687.9	20426.9	0.31

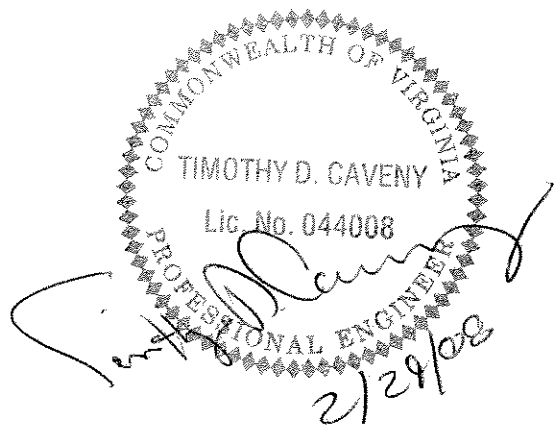


HURTT FABRICATING CORP., MARCELINE, MO.
OVERHEAD ANGLE SIGN SUPPORT DESIGN version 2 8-23-07
15th Ed. AASHTO, 3rd Ed. Luminaires

Structure Name : GANT N
Job Description : HF 4871
Engineer : CLH
Run Date & Time : 2/12/2008 at 15:40

* * * * * INTERIOR DIAGONAL * * * * *

LENGTH = 3.55 NUMBER REQUIRED = 13

MEMBER AND SHAPE CONFIGURATION	YIELD KSI	GROSS AREA	LENGTH OF 0.19" FILLET WELD	LEAST ROG	WEIGHT
1.75x1.75x0.13	36.00	0.42	1.50	0.35	66.52

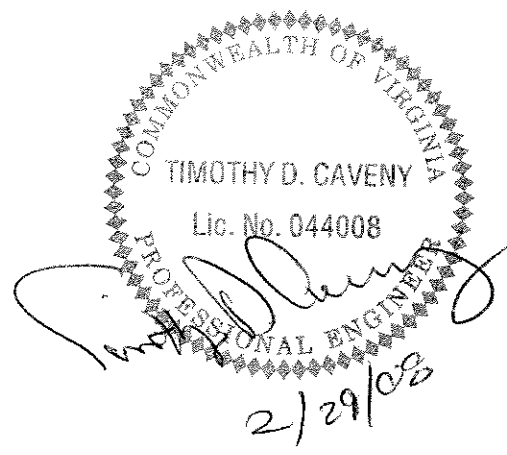

HURTT FABRICATING CORP. MARCELINE, MO.
CANTILEVER ANGLE SIGN SUPPORT DESIGN version 2 8-23-07
15th Ed. AASHTO, 3rd Ed. Luminaires


Structure Name : GTY NB
Job Description : HF 4871
Engineer : CLH
Run Date & Time : 2/12/2008 at 15:49

Truss # = GANi File Name: 4871GTNB.DTA
Hurtt Job # = HF 4871
Item # =
State Job # = RICH EXPY
State Project = PEL 2006

County = RMA

Although extensive measures have been taken to insure the correctness of this program, the presence of undetected errors in the program or material is possible. Therefore, the application of judgement is required on the correctness of the output and its proper application to the intended use. The program material contained herein is supplied without representation or warranty of any kind. Cowell Engineering LLC and San4dSoft therefore assume no responsibility and shall have no liability, consequential or otherwise, of any kind arising from the use of the program or any part thereof.

*SHEETS 1-10 # EXTRA CHECKS FOR
COLUMN DESIGN ONLY*

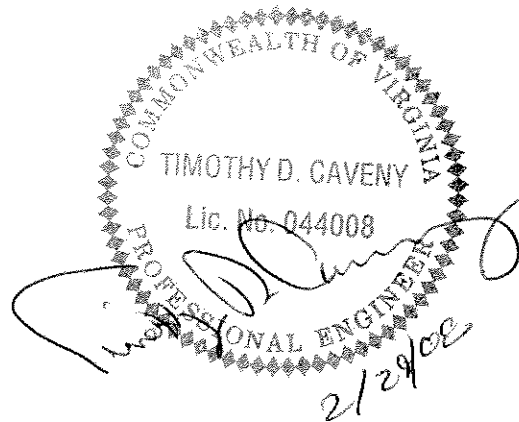

HURTT FABRICATING CORP. MARCELINE, MO.
 CANTILEVER ANGLE SIGN SUPPORT DESIGN version 2 8-23-07
 15th Ed. AASHTO, 3rd Ed. Luminaires

Structure Name : GTY NB
 Job Description : HF 4871
 Engineer : CLH
 Run Date & Time : 2/12/2008 at 15:49

* * * * * TRUSS DESIGN * * * * *

TRUSS DIMENSIONS (FT)

LENGTH	DEPTH	WIDTH	PANEL LENGTH (FT)	NUMBER OF PANELS
24.46	3.00	3.00	4.08	6

WALK DESIGN

WIND VELOCITY MPH	NUMBER OF SIGNS	DIST L	LENGTH	WGT/FT
80.00	1	0.00	0.00	0.00

S I G N D A T A

SIGN NO.	SIGN LENGTH	SIGN HEIGHT	CD	CH	DISTANCE FROM LS	DISTANCE CENTER	ECCN	WGT
1	23.46	1.00	1.30	1.00	1.00	12.73	-3.50	352.00



HURTT FABRICATING CORP. MARCELINE, MO.
 CANTILEVER ANGLE SIGN SUPPORT DESIGN version 2 8-23-07
 15th Ed. AASHTO, 3rd Ed. Luminaires

Structure Name : GTY NB
 Job Description : HF 4871
 Engineer : CLH
 Run Date & Time : 2/12/2008 at 15:49

* * * * * TRUSS DESIGN * * * * *

TRUSS DEPTH = 3.00 FEET
 TRUSS WIDTH = 3.00 FEET
 DEFLECTION = 0.118 IN.
 CAMBER REQUIRED = 0.412 IN.


	WIND SHEAR (LBS.)	DEAD WEIGHT (LBS.)	WIND MOMENT (FT.-LBS.)	DEAD-W MOMENT (FT.-LBS.)
CASE 1	0.0	1806.8	0.00	22273.4
CASE 2	2149.6	1806.8	26712.11	22273.4
CASE 3	1074.8	2675.2	13356.06	32928.4

* * * * * TRUSS CHORDS * * * * *

LENGTH FT	NUMBER REQUIRED	NUMBER OF 0.625" BOLTS (A325)	NUMBER OF 0.75" BOLTS (A325)	NUMBER OF 0.875" BOLTS (A325)
25.21	4	2.00	2.00	1.00

MEMBER AND SHAPE CONFIGURATION	YIELD KSI	GROSS AREA	NET AREA	LEAST ROG	WEIGHT (LBS)
4x4x.38	36.00	2.86	2.10	0.79	988.23

	FORCE (PSI)	FA (PSI)	ALLOWABLE (PSI)	LENGTH OF 0.19" FILLET WELD
CASE 1	4760.6	1664.5	16451.3	1.71
CASE 2	13976.8	4887.0	23031.9	3.59
CASE 3	11424.0	3994.4	23031.9	2.93

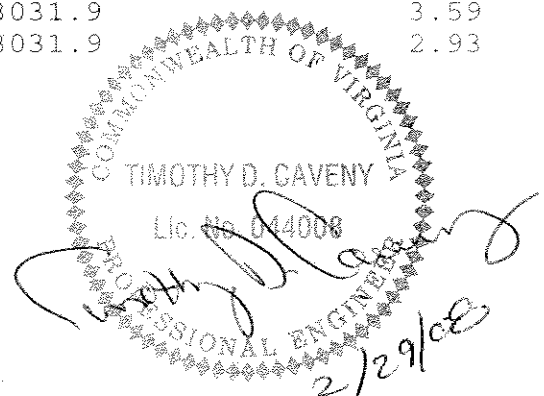

HURTT FABRICATING CORP. MARCELINE, MO.
 CANTILEVER ANGLE SIGN SUPPORT DESIGN version 2 8-23-07
 15th Ed. AASHTO, 3rd Ed. Luminaires

Structure Name : GTY NB
 Job Description : HF 4871
 Engineer : CLH
 Run Date & Time : 2/12/2008 at 15:49

* * * * * COLUMN DESIGN * * * * *


HEIGHT (FT) TOTAL	TRUSS	DIAMETER (IN)	THICKNESS (IN)	YIELD STRENGTH (KSI)	WEIGHT (LB)
21.43	19.68	14.00	0.2500	42	787

	AXIAL (LBS)	MOMENT (FT-LB)	TORQUE (FT-LB)	SHEAR (LBS)	FA ALLOW	FB ALLOW	FV ALLOW	CSR
CASE 1 COMBINATION 1	2794	22273	0	0	14275	27720	13860	0.283
CASE 2 COMBINATION 1	2794	52645	26712	2510	19984	38808	19404	0.518
CASE 2 COMBINATION 2	2794	43434	16027	1651	19984	38808	19404	0.402
CASE 3 COMBINATION 1	3663	44032	13356	1415	19984	38808	19404	0.405
CASE 3 COMBINATION 2	3663	42162	8014	931	19984	38808	19404	0.380

→ ϕ for overhead span

max mom @ BASE = $2172(19.67) = 42,723$

Mesign = $\sqrt{42,723^2 + (1.2)(42,723)^2} = 43,569$

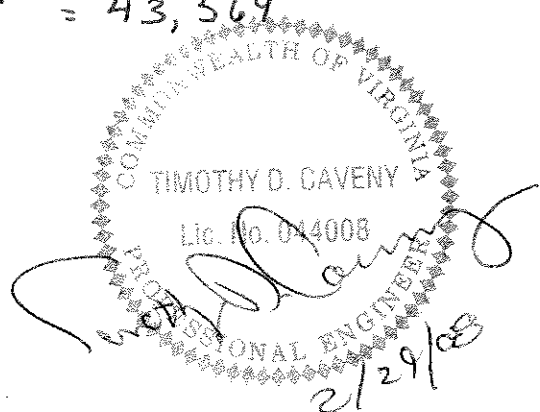

HURTT FABRICATING CORP. MARCELINE, MO.
CANTILEVER ANGLE SIGN SUPPORT DESIGN version 2 8-23-07
15th Ed. AASHTO, 3rd Ed. Luminaires

Structure Name : GTY NB
Job Description : HF 4871
Engineer : CLH
Run Date & Time : 2/12/2008 at 15:49

* * * * * TRUSS MOUNTING PLATE * * * * *

WIDTH A [IN]	WIDTH B [IN]	THICKNESS C [IN]	GUSSET DEPTH D [IN]	THICKNESS E [IN]	WEIGHT [LBS]
--------------------	--------------------	------------------------	---------------------------	------------------------	-----------------


36.00	17.00	0.500	12.00	0.500	149
-------	-------	-------	-------	-------	-----

WELD SIZE-W2 (1/16")

WELD SIZE-W3 (1/16")

5

4

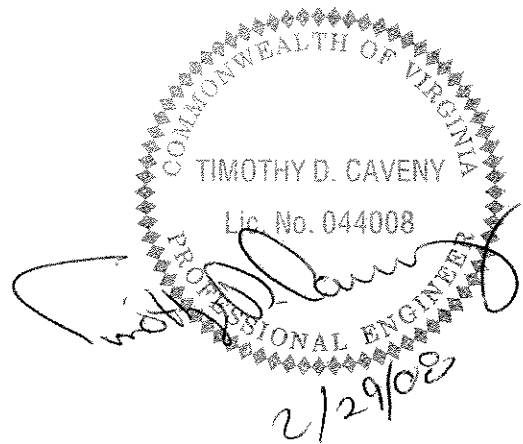

HURTT FABRICATING CORP. MARCELINE, MO.
 CANTILEVER ANGLE SIGN SUPPORT DESIGN version 2 8-23-07
 15th Ed. AASHTO, 3rd Ed. Luminaires

Structure Name : GTY NB
 Job Description : HF 4871
 Engineer : CLH
 Run Date & Time : 2/12/2008 at 15:49

* * * * * ANCHOR BOLT DESIGN * * * * *


DIAMETER [IN]	EMBEDMENT LENGTH [IN]	YIELD STRENGTH (KSI)	MAXIMUM TENSION [LBS]	WEIGHT [LBS]
2.00	40.00	55.00	31499	171


DIMENSIONS [IN]	BASE PLATE BOLT SPACING [IN] X Y	EDGE DISTANCE [IN]	WEIGHT [LBS]
21.50 x 21.50 x 2.00	14.00 14.00	3.75	262.16

WELD SIZE-W4 (1/16")

5.00

Total Weight of Column Plates & Anchor Bolts = 1369.44 LBS.
 Total Weight of Truss, Column, Plates & Anchor Bolts = 2824.26 LBS.

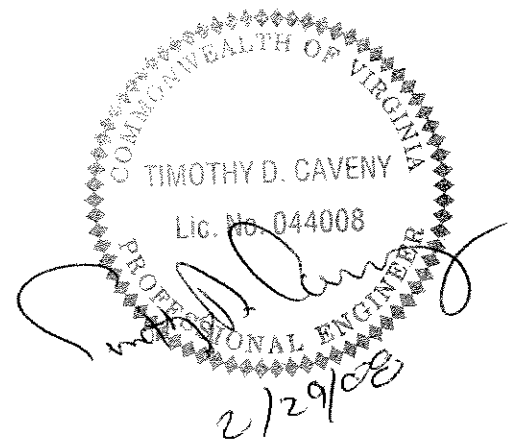

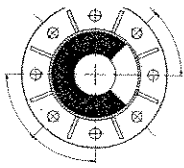

COWELL
ENGINEERING
STRUCTURAL ENGINEERS

PROJECT HF-4871
LOCATION Richmond Virginia
CLIENT Wacht Fns
BY TOC DATE 6/27/07 W.O.# _____
CHECK _____ DATE _____ SHEET _____ OF _____

CHECK BASE RATE

$M_{actual} = 43,569 \therefore \text{OK}$

$M_{max @ BASE} = 2860(20) = 57,200 \text{ ft-Lbs}$

$M_{design} = \sqrt{57,200^2 + [(2)(57,200)]^2} = 58,333$

$T = \frac{4(58,333 \text{ ft-Lbs})}{6(1.75')} - \left(\frac{1914.8 + 799}{6} \right) = 21,770 \#$

$V = \sqrt{2859^2 + .2(2859)^2} = 2916 \#$

using $1\frac{1}{4}" \phi$ A.B. $A_t = .969 \text{ in}^2$ Assum 55 ksi

$F_v = 0.3(55) = 16.5 \text{ ksi}$ $F_t = 0.5(55) = 27.5 \text{ ksi}$

$f_v = \frac{2916}{.969} = 3009.3$ $f_t = \frac{21,770}{.969} = 22,466.4$

$CSR = \left(\frac{3009.3}{16.5(\frac{1}{3})} \right)^2 + \left(\frac{22.5}{27.5(\frac{1}{3})} \right)^2 = 0.395 < 1.0$

.376


BENDING of IR Between Bolts.


$L = 20"(11)/6 = 10.47"$ $M_{IR} = \frac{Pl}{8} = \frac{21.8(10.47)}{8} = 28.5 \text{ in-k}$

$f_{bIR} = \frac{28.5 \text{ k-in}(6)}{6(1.5)^3} = 12.7 \text{ ksi}$

Weld to BASE IR

$f_t = \frac{21.7 \text{ k}}{4.5 \times 2 \times .375} = 6.4 \text{ ksi} < .3(70) = 21 \text{ ksi}$

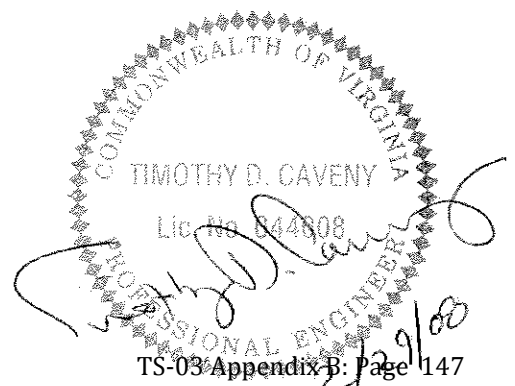

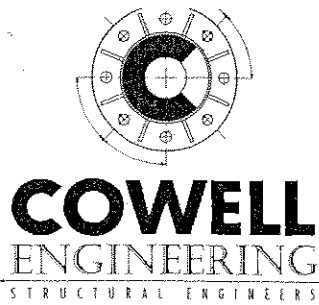


PROJECT HF-4871
LOCATION Richmond Va
CLIENT HvrH Fab
BY JAC DATE 6/27/07 W.O.# _____
CHECK _____ DATE _____ SHEET _____ OF _____

Weld of Gusset to Col.



$$f_v = \frac{21.7k}{115 \times 2 \times .375} = 2.5 \text{ ksi} \quad \begin{matrix} \text{ok} \\ \text{S} \end{matrix}$$

STRESS ON Gusset

$$f_t = \frac{21.7k}{45 \times .75} = 6.5 \text{ ksi} \quad \begin{matrix} \text{ok} \\ \text{S} \end{matrix}$$

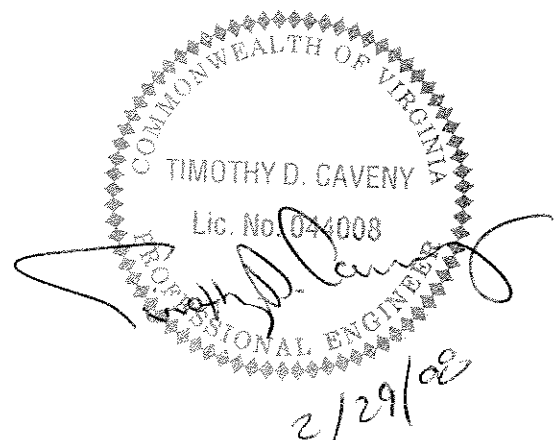


SB GANTRY

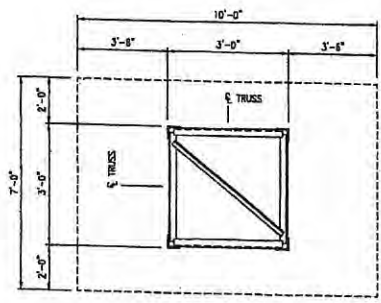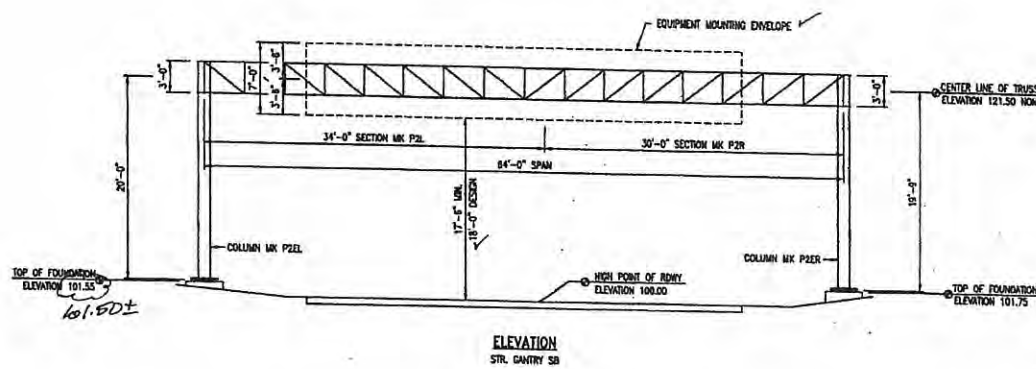


ELEVATION
STR. GANTRY SB


TYPICAL SECTION
EQUIPMENT MOUNTING ENVELOPE

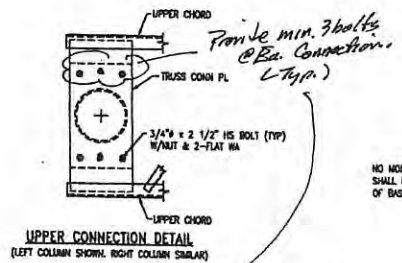

UPPER CONNECTION DETAIL
(LEFT COLUMN SHOWN, RIGHT COLUMN SIMILAR)

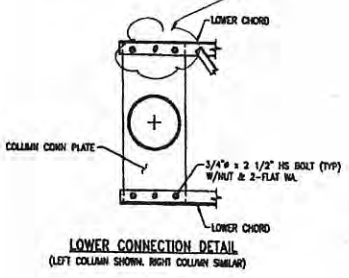


LOWER CONNECTION DETAIL
(LEFT COLUMN SHOWN, RIGHT COLUMN SIMILAR)

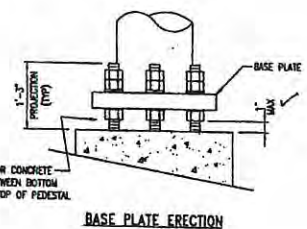

BASE PLATE ERECTION

NO MORTAR, GROUT, OR CONCRETE SHALL BE PLACED BETWEEN BOTTOM OF BASE PLATE AND TOP OF PEDIESTAL.

ANCHOR NOTE:
USE STEEL SETTING & EMBEDDED TEMPLATES TO ASSURE PROPER ANCHOR BOLT LAYOUT & ALIGNMENT.
REUSE SETTING TEMPLATE AT SIMILAR LOCATIONS.

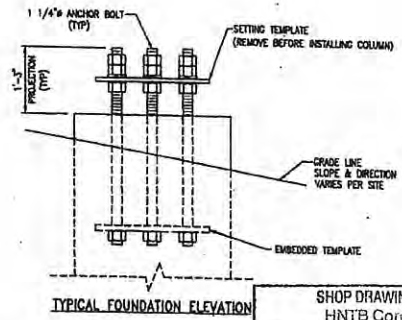

TYPICAL FOUNDATION ELEVATION

SHOP DRAWING REVIEW
HNTB Corporation

Review is for general compliance with contract documents. Sole responsibility for correctness of dimensions, details, quantities and safety during fabrication and erection shall remain with the Contractor.


No Exceptions Taken
 Make Correction Noted By *BS*
 Amend and Resubmit
 Rejected - See Remarks Date *6/29/07*

GENERAL NOTES:
STRUCTURE DESIGN PER AASHTO STANDARD SPECS. FOR STRUCTURAL SUPPORTS FOR HIGHWAY SIGNS, LUMINAIRES AND TRAFFIC SIGNALS, 1994 EDITION.
DESIGN WIND SPEED 80 MPH.
ALL WELDING PER AWS D1.1 (LATEST EDITION).
STRUCTURE DESIGN BY HURTT FABRICATING CORP.
ANCHOR BOLT & FOUNDATION DESIGN BY HNTB.
EQUIPMENT MOUNTING BRACKETS & HARDWARE BY OTHERS.
FOUNDATION & ROADWAY ELEVATIONS PROVIDED BY VENTURE ELECTRIC CO. ON 6-12-07.


THE ELEVATIONS SHOWN ARE FOR REFERENCE AND RELATIONSHIP ONLY AND ARE NOT THE ACTUAL SITE ELEVATIONS.

17'-6" MINIMUM (18'-0" DESIGN) CLEARANCE FROM THE HIGH POINT OF THE ROADWAY TO THE BOTTOM OF THE EQUIPMENT MOUNTING ENVELOPE.

THE TRUSS SPlice CONNECTION SHALL BE MADE USING HIGH STRENGTH BOLTS & DTI WASHERS. TIGHTENING SHALL CONFORM TO SECTION 407.06(3) OF THE VDOT ROAD AND BRIDGE SPECIFICATIONS 2002 AND THE DTI MANUFACTURER'S INSTRUCTIONS. THE TRUSS TO COLUMN HIGH STRENGTH BOLT CONNECTIONS SHALL BE INSTALLED USING THE "TURN-OF-NUT" METHOD PER SECTION 407.06(6) OF THE VDOT ROAD AND BRIDGE SPECIFICATIONS 2002.

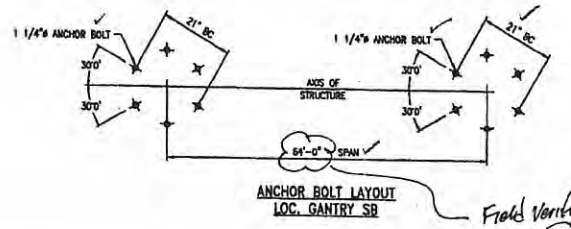

ANCHOR BOLT LAYOUT
LOC. GANTRY SB

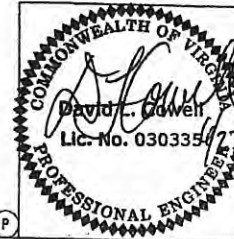

REV:					
PRINTS ISSUED					
FOR	#	DATE	FOR	#	DATE


HURTT FABRICATING CORP.
P.O. BOX 128
MARCELINE, MO 64658

CUSTOMER: VENTURE ELECTRIC CO.


PROJECT: CONTRACT NO. PES-8008
POPPATE PARKWAY EXPRESS LANES PROJECT
RETURNED METROPOLITAN AUTHORITY

SUBJECT: ERECTION DIAGRAM FOR LOC. SOUTH BOUND GANTRY


FILE:	4871 OF EIB	DATE:	6-22-07	PKG:	8
PRINTED FOR:	DR BY: TAP	CH BY:	JBS	JOB NO:	HP-4371
REVISION	REVISION	REVISION	REVISION	REVISION	REVISION

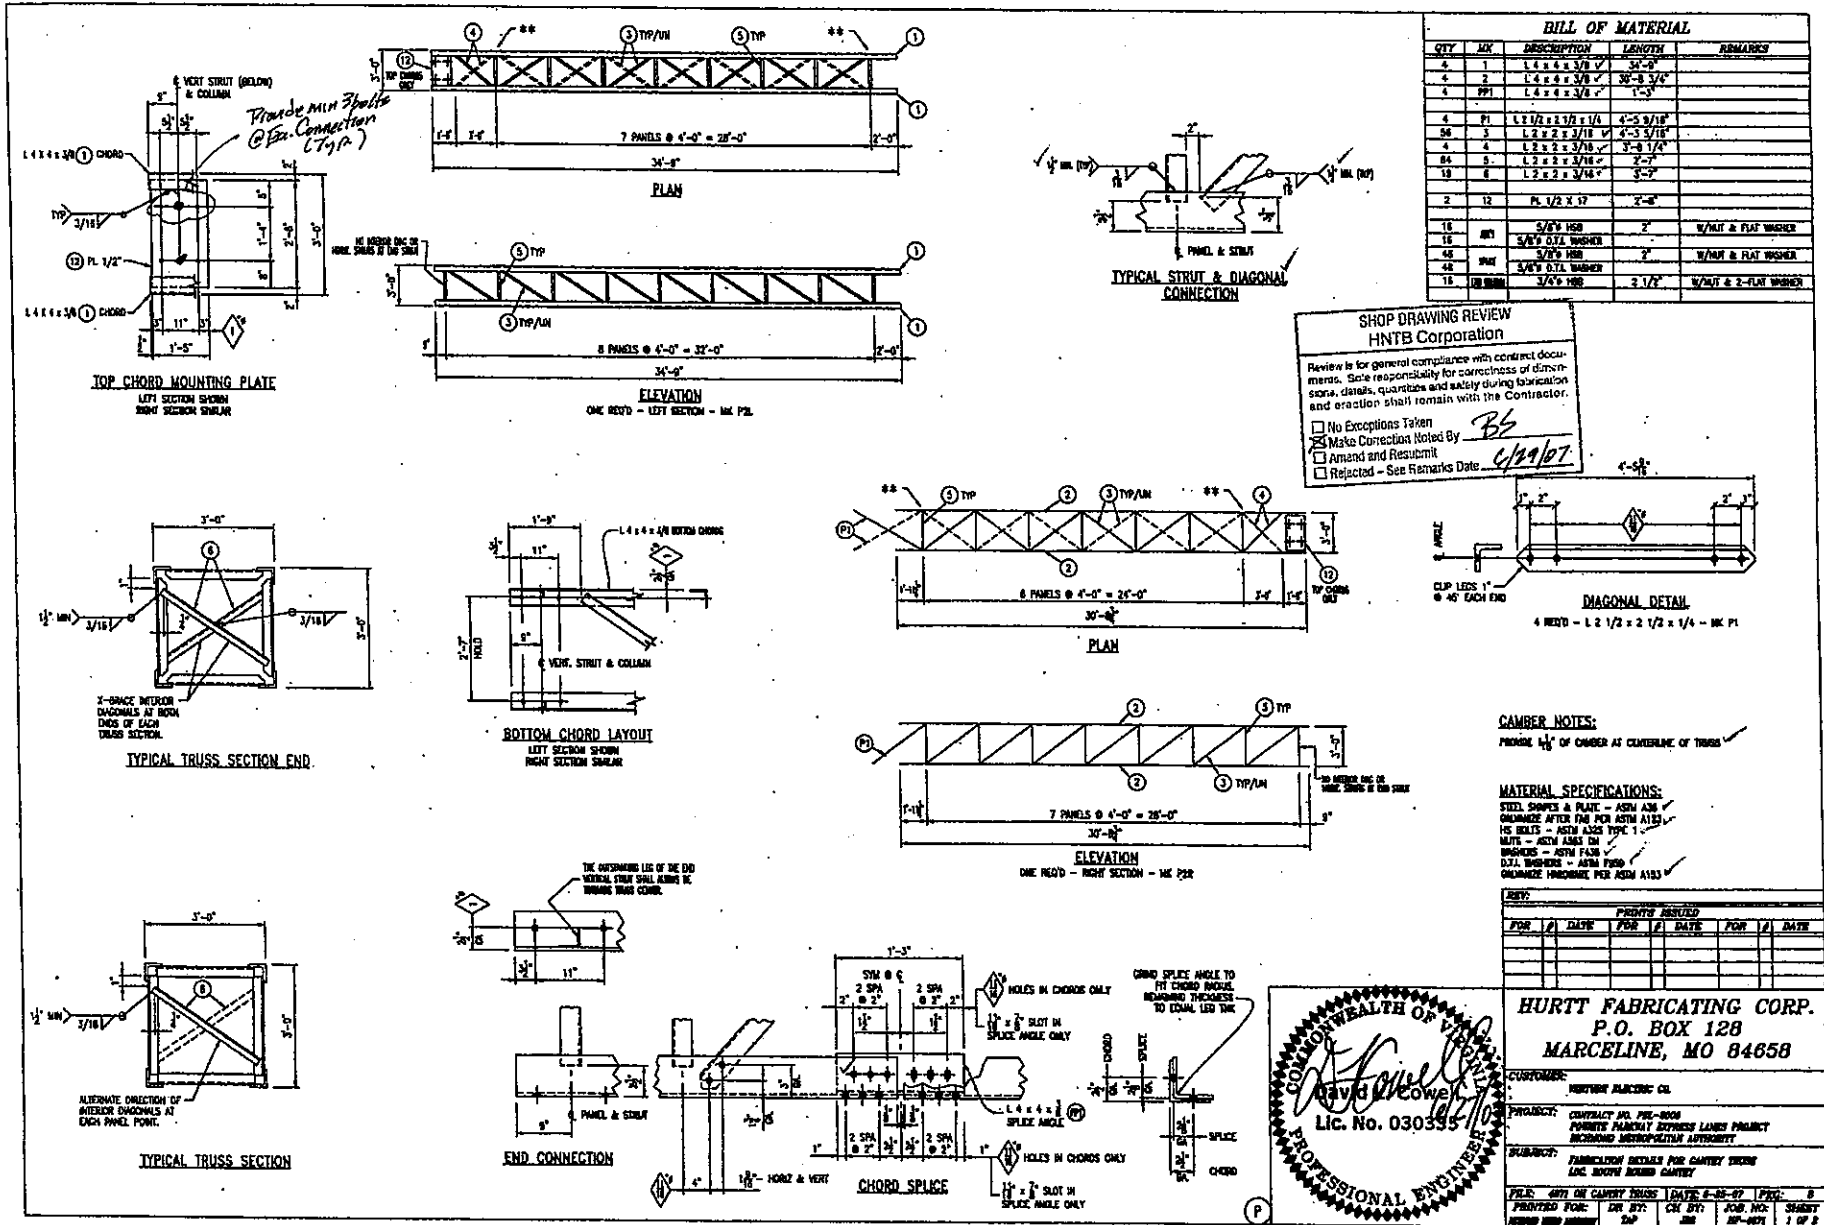


Provide min 3 bolts @ End Connections (Typ.)

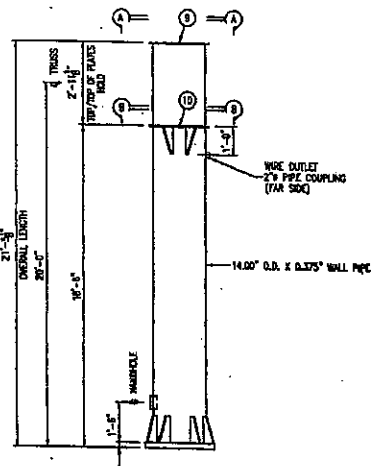


LEFT END COLUMN DETAIL
ONE REND - MK PZEL

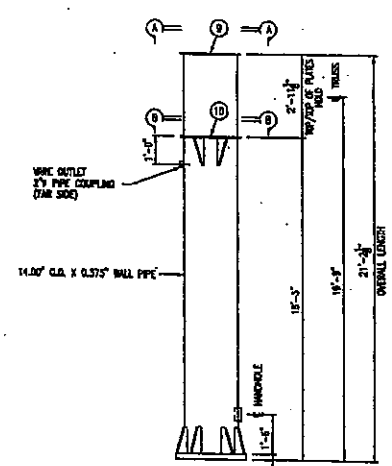

RIGHT END COLUMN DETAIL
ONE REND - MK PZEL

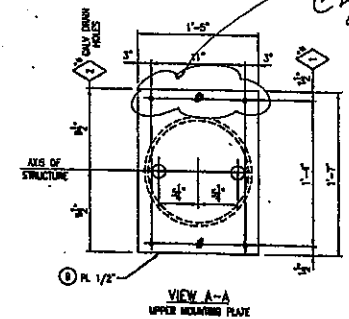


VIEW A-A
UPPER INSULATING PLATE

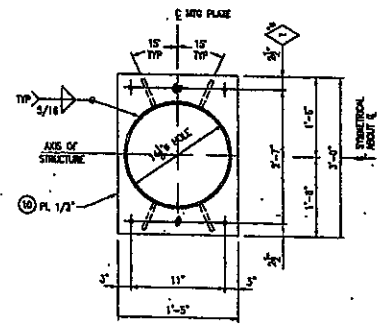


SECTION B-B
LOWER INSULATING PLATE


BILL OF MATERIAL				
QTY	MR	DESCRIPTION	LENGTH	REMARKS
1	PZEL	14.00\"/>		
1	PZEL	14.00\"/>		
2	7	PL 1 1/2\"/>		
12	8	PL 3/4\"/>		
2	9	PL 1/2\"/>		
2	10	PL 1/2\"/>		
8	11	PL 1/2\"/>		
2	HF	PL 2\"/>		
2	HC	BAR 3 1/2\"/>		
2	HK	BAR 1 1/2\"/>		
2	HW	3/8\"/>		
2	HW	3/8\"/>		
2		3\"/>		
2		3\"/>		

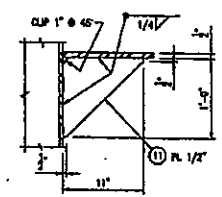

TRUSS CONNECTION
GUSSET
REQUIRED @ BOTTOM
CONNECTION ONLY

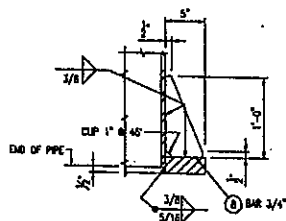


BASE PLATE WELD &
GUSSET DETAIL

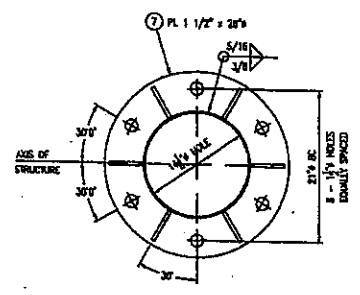


BASE PLATE DETAIL

*See Attachment
for Hand hole detail*

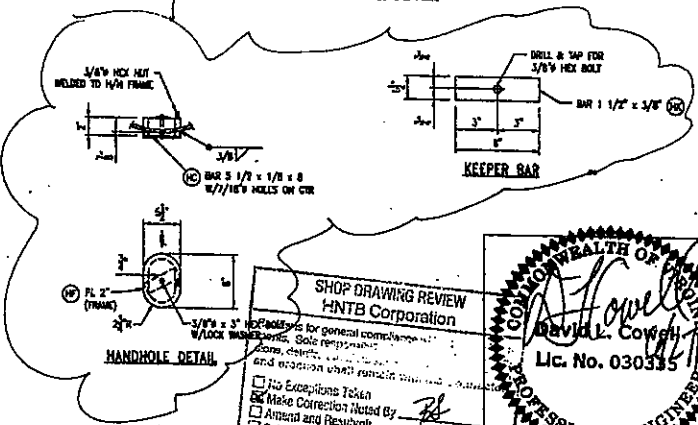

HANDHOLE DETAIL

SHOP DRAWING REVIEW
HNTB Corporation
No Exceptions Taken
Make Correction Noted By
Amend and Resubmit
Rejected - See Remarks Date

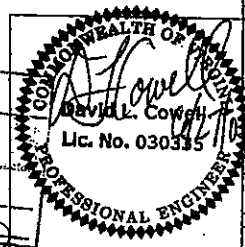

MATERIAL SPECIFICATIONS:

COLUMN PIPE - A500 GR B or A514, 242, 250, or 260
(20 MIN. YIELD)
STEEL BOLTS & PLATES - ASTM A36
CALC. STEEL AFTER FAB PER ASTM A133
STD BOLTS, NUTS & WASHERS - ASTM A307
CALC. HARDWARE PER ASTM A133

ANY:

PRINTS DESIRED					
FOR	DATE	FOR	DATE	FOR	DATE

HURT FABRICATING CORP.
P.O. BOX 128
MARCELINE, MO 64658

CUSTOMER: **WYNNE ELECTRIC CO.**

PROJECT: **CONTRACT NO. PZL-2008
POWERS FAMILY EXPRESS LAKES PROJECT
REINFORCED ASTROPHYSICAL AUTHORITY**

SUBJECT: **FOUNDATION DETAILS FOR GALLERY END COLUMN
LOC. SOUTH AVENUE GALLERY**

FILE: **4071 GALLERY END COLUMN DATE: 6-26-07** PZEL: **8**


PRINTED FOR: **DR: BJT** JOB NO: SHEET: **3 OF 2**

SHOP DRAWING REVIEW
HNTB Corporation

Review is for general compliance with contract documents. Sole responsibility for correctness of dimensions, details, quantities and safety during fabrication and erection shall remain with the Contractor.

- No Exceptions Taken
- Make Correction Noted By
- Amend and Resubmit
- Rejected - See Remarks Date

nc = National Coarse

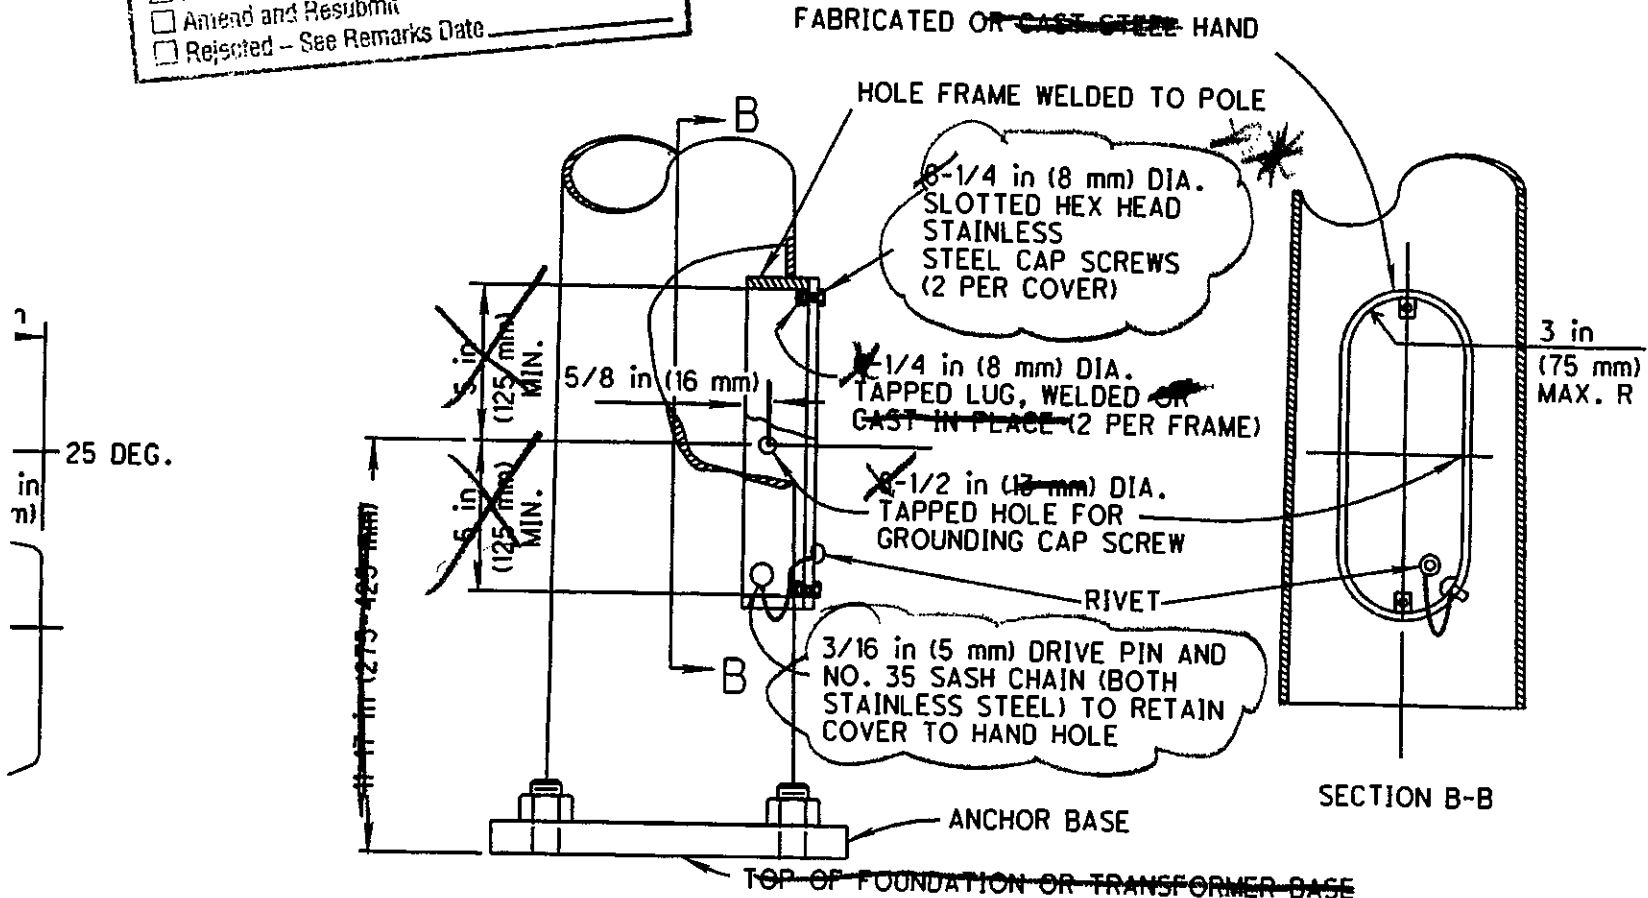

HAND HOLE WITH COVER

(SEE NOTES 1 & 2)

HURTT FABRICATING CORP. MARCELINE, MO.
OVERHEAD ANGLE SIGN SUPPORT DESIGN
15th Ed. AASHTO, 3rd Ed. Luminaires


Structure Name : GANTRY
Job Description : HF 4871
Engineer : CLH
Run Date & Time : 6/27/2007 at 13:21

Truss # = GT
Hurtt Job # = HF 4871
Item # =
State Job # = RICH EXPY
State Project = PEL 2006

County = RMA

FOR TRUSS DESIGN

SHOP DRAWING REVIEW HNTB Corporation	
Review is for general compliance with contract documents. Sole responsibility for correctness of dimensions, details, quantities and safety during fabrication and erection shall remain with the Contractor.	
<input checked="" type="checkbox"/> No Exceptions Taken	<i>BS</i>
<input type="checkbox"/> Make Correction Noted By	
<input type="checkbox"/> Amend and Resubmit	
<input type="checkbox"/> Rejected - See Remarks Date	<i>6/29/07</i>

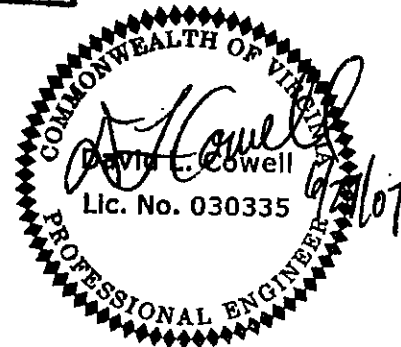

HURTT FABRICATING CORP. MARCELINE, MO.
 OVERHEAD ANGLE SIGN SUPPORT DESIGN
 15th Ed. AASHTO, 3rd Ed. Luminaires

Structure Name : GANTRY
 Job Description : HF 4871
 Engineer : CLH
 Run Date & Time : 6/27/2007 at 13:21

* * * * * TRUSS DESIGN * * * * * DLC:03.24.2007 - A15L3*

TRUSS DIMENSIONS (FT)			PANEL LENGTH (FT)				
LENGTH	DEPTH	WIDTH	WALK DESIGN		NUMBER OF PANELS		
			LENGTH	WGT/FT	CENTER	END	
64.00 ✓	3.00 ✓	3.00 ✓	4.00 ✓	0.00	14	4.00 ✓	
WIND VELOCITY MPH	NUMBER OF SIGNS	DIST L	LENGTH	WGT/FT	CENTER	END	
80.00 ✓	1	0.00	0.00	0.00	14	2	




HURTT FABRICATING CORP. MARCELINE, MO.
OVERHEAD ANGLE SIGN SUPPORT DESIGN
15th Ed. AASHTO, 3rd Ed. Luminaires

Structure Name : GANTRY
Job Description : HF 4871
Engineer : CLH
Run Date & Time : 6/27/2007 at 13:21

* * * * * TRUSS DESIGN * * * * * DLC:03.24.2007 - A15L3*

S I G N D A T A

SIGN NO.	SIGN LENGTH	SIGN HEIGHT	CD	CH	DISTANCE FROM LS	DISTANCE CENTER	ECCN	WGT
1	62.00	1.00	1.30	1.00	1.00	32.00	-3.00	0.00

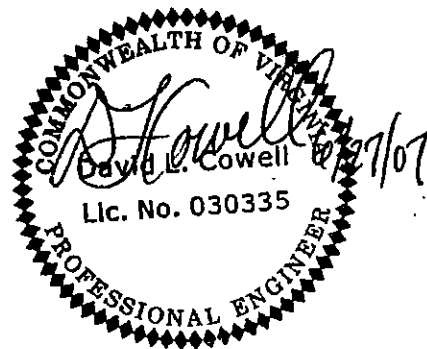

HURTT FABRICATING CORP. MARCELINE, MO.
OVERHEAD ANGLE SIGN SUPPORT DESIGN
15th Ed. AASHTO, 3rd Ed. Luminaires

Structure Name : GANTRY
Job Description : HF 4871
Engineer : CLH
Run Date & Time : 6/27/2007 at 13:21

* * * * * TRUSS DESIGN * * * * * DLC:03.24.2007 - A15L3*

TRUSS DEPTH = 3.00 FEET ✓
TRUSS WIDTH = 3.00 FEET ✓
DEFLECTION = 0.295 IN. ✓
CAMBER REQUIRED = 1.063 IN. ✓

	L-WIND FORCE (LBS.)	L-DEAD WEIGHT (LBS.)	R-WIND FORCE (LBS.)	R-DEAD LOAD (LBS.)
CASE 1	0.0	1914.8	0.00	1914.8
CASE 2	2858.7	1914.8	2858.73	1914.8
CASE 3	1429.4	3068.1	1429.36	3068.1



HURTT FABRICATING CORP. MARCELINE, MO.
 OVERHEAD ANGLE SIGN SUPPORT DESIGN
 15th Ed. AASHTO, 3rd Ed. Luminaires

Structure Name : GANTRY
 Job Description : HF 4871
 Engineer : CLH
 Run Date & Time : 6/27/2007 at 13:21

* * * * * TRUSS CHORDS * * * * * DLC:03.24.2007 - A15L3*

LENGTH FT	NUMBER REQUIRED	NUMBER OF 0.625" BOLTS (A325)	NUMBER OF 0.75" BOLTS (A325)	NUMBER OF 0.875" BOLTS (A325)
64.50	4	3.00 ✓	2.00	2.00

MEMBER AND SHAPE CONFIGURATION	YIELD KSI	GROSS AREA	NET AREA	LEAST ROG	WEIGHT (LBS)
4x4x.375 ✓	36.00	2.86	2.10	0.79	2528.40

	FORCE (LBS)	FA (PSI)	ALLOWABLE (PSI)	LENGTH OF 0.19" FILLET WELD
CASE 1	6132.9	2144.4	16535.9	2.20
CASE 2	22856.7	7991.8	23150.2	5.86
CASE 3	18420.3	6440.7	23150.2	4.73



HURTT FABRICATING CORP. MARCELINE, MO.
 OVERHEAD ANGLE SIGN SUPPORT DESIGN
 15th Ed. AASHTO, 3rd Ed. Luminaires

Structure Name : GANTRY
 Job Description : HF 4871
 Engineer : CLH
 Run Date & Time : 6/27/2007 at 13:21

* * * * * WIND DIAGONAL * * * * * DLC:03.24.2007 - A15L3*

LENGTH FT	NUMBER REQUIRED	MINIMUM BOLTS NO. & SIZE (A325)
4.85	28	2 - 0.625 ✓

MEMBER AND SHAPE CONFIGURATION	YIELD KSI	GROSS AREA	NET AREA	LEAST ROG	WEIGHT (LBS)
2x2x.19 ✓	36.00	0.72	0.39	0.39	331.63

	FORCE (LBS)	FA (PSI)	ALLOWABLE (PSI)	LENGTH OF 0.19" FILLET WELD
CASE 1	0.0	0.0	6809.4	0.00
CASE 2	2523.0	3528.7	9533.2	0.65 ✓
CASE 3	1261.5	1764.4	9533.2	0.32



HURTT FABRICATING CORP. MARCELINE, MO.
 OVERHEAD ANGLE SIGN SUPPORT DESIGN
 15th Ed. AASHTO, 3rd Ed. Luminaires


Structure Name : GANTRY
 Job Description : HF 4871
 Engineer : CLH
 Run Date & Time : 6/27/2007 at 13:21

* * * * * WIND DIAGONAL END PANEL * * * * * DLC:03.24.2007- A15L

LENGTH FT	NUMBER REQUIRED	MINIMUM BOLTS NO. & SIZE (A325)
4.85	4	2 - 0.625✓

MEMBER AND SHAPE CONFIGURATION	YIELD KSI	GROSS AREA	NET AREA	LEAST ROG	WEIGHT (LBS)
2x2x.19✓	36.00	0.72	0.39	0.39	47.38

	FORCE (LBS)	FA (PSI)	ALLOWABLE (PSI)	LENGTH OF 0.19" FILLET WELD
CASE 1	0.0	0.0	6809.4	0.00
CASE 2	2523.0	3528.7	9533.2	0.65✓
CASE 3	1261.5	1764.4	9533.2	0.32

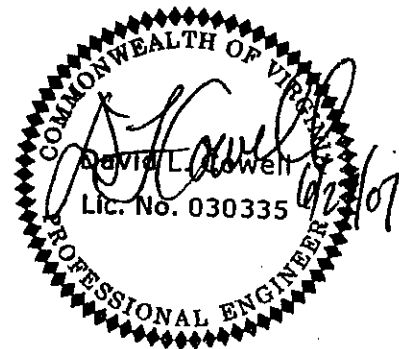

HURTT FABRICATING CORP. MARCELINE, MO.
 OVERHEAD ANGLE SIGN SUPPORT DESIGN
 15th Ed. AASHTO, 3rd Ed. Luminaires


Structure Name : GANTRY
 Job Description : HF 4871
 Engineer : CLH
 Run Date & Time : 6/27/2007 at 13:21

* * * * * WIND STRUT * * * * * DLC:03.24.2007 - A15L3*

LENGTH FT	NUMBER REQUIRED	MINIMUM BOLT SIZE (A325)
2.75	34	0.625

MEMBER AND SHAPE CONFIGURATION	YIELD KSI	GROSS AREA	NET AREA	LEAST ROG	WEIGHT (LBS)
2x2x.19	36.00	0.72	0.39	0.39	228.14

	FORCE (LBS)	FA (PSI)	ALLOWABLE (PSI)	LENGTH OF 0.19" FILLET WELD
CASE 1	0.0	0.0	14590.6	0.00
CASE 2	1429.4	1999.1	20426.9	0.37
CASE 3	714.7	999.6	20426.9	0.18

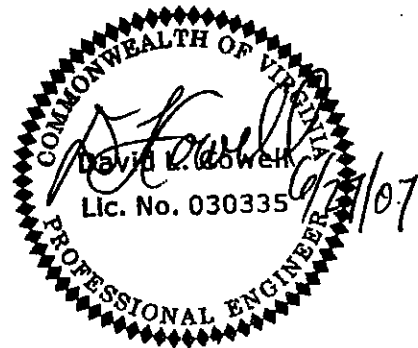

HURTT FABRICATING CORP. MARCELINE, MO.
 OVERHEAD ANGLE SIGN SUPPORT DESIGN
 15th Ed. AASHTO, 3rd Ed. Luminaires

Structure Name : GANTRY
 Job Description : HF 4871
 Engineer : CLH
 Run Date & Time : 6/27/2007 at 13:21


* * * * * DEAD LOAD DIAGONAL * * * * * DLC:03.24.2007 - A15L3*

LENGTH FT NUMBER REQUIRED MINIMUM BOLTS NO. & SIZE (A325)

4.85 28 2 - 0.625 *Accepted*

MEMBER AND SHAPE CONFIGURATION	YIELD KSI	GROSS AREA	NET AREA	LEAST ROG	WEIGHT (LBS)
2x2x.19 ✓	36.00	0.72	0.39	0.39	331.63

	FORCE (LBS)	FA (PSI)	ALLOWABLE (PSI)	LENGTH OF 0.19" FILLET WELD
CASE 1	1690.0	2363.6	19800.0	0.61
CASE 2	1690.0	2363.6	27720.0	0.43
CASE 3	2789.9	3902.0	27720.0	0.72 ✓

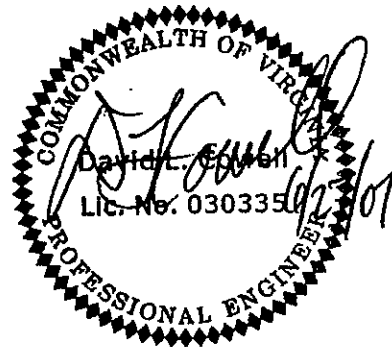

HURTT FABRICATING CORP. MARCELINE, MO.
 OVERHEAD ANGLE SIGN SUPPORT DESIGN
 15th Ed. AASHTO, 3rd Ed. Luminaires


Structure Name : GANTRY
 Job Description : HF 4871
 Engineer : CLH
 Run Date & Time : 6/27/2007 at 13:21

* * * * * DEAD LOAD DIAGONAL END PANEL * * * DLC:03.24.2007 - A15

LENGTH FT	NUMBER REQUIRED	MINIMUM BOLTS NO. & SIZE (A325)
4.85	4	2 - 0.625 ✓

MEMBER AND SHAPE CONFIGURATION	YIELD KSI	GROSS AREA	NET AREA	LEAST ROG	WEIGHT (LBS)
2x2x.19 ✓	36.00	0.72	0.39	0.39	47.38

	FORCE (LBS)	FA (PSI)	ALLOWABLE (PSI)	LENGTH OF 0.19" FILLET WELD
CASE 1	1690.0	2363.6	19800.0	0.61
CASE 2	1690.0	2363.6	27720.0	0.43
CASE 3	2789.9	3902.0	27720.0	0.72

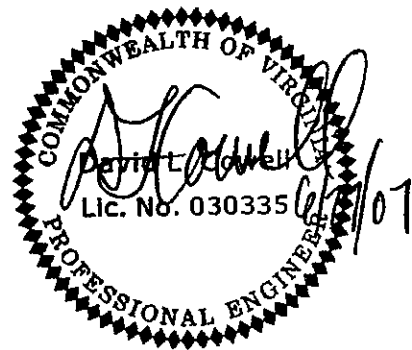

HURTT FABRICATING CORP. MARCELINE, MO.
 OVERHEAD ANGLE SIGN SUPPORT DESIGN
 15th Ed. AASHTO, 3rd Ed. Luminaires


Structure Name : GANTRY
 Job Description : HF 4871
 Engineer : CLH
 Run Date & Time : 6/27/2007 at 13:21

* * * * * DEAD LOAD VERTICAL * * * * * DLC:03.24.2007 - A15L3

LENGTH FT	NUMBER REQUIRED	MINIMUM BOLT SIZE (A325)
2.75	34	0.625

MEMBER AND SHAPE CONFIGURATION	YIELD KSI	GROSS AREA	NET AREA	LEAST ROG	WEIGHT (LBS)
2x2x.19	36.00	0.72	0.39	0.39	228.14

	FORCE (LBS)	FA (PSI)	ALLOWABLE (PSI)	LENGTH OF 0.19" FILLET WELD
CASE 1	957.4	1339.0	14590.6	0.34
CASE 2	957.4	1339.0	20426.9	0.25
CASE 3	1580.6	2210.6	20426.9	0.41

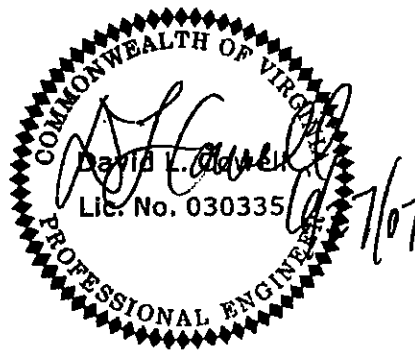


HURTT FABRICATING CORP. MARCELINE, MO.
OVERHEAD ANGLE SIGN SUPPORT DESIGN
15th Ed. AASHTO, 3rd Ed. Luminaires

Structure Name : GANTRY
Job Description : HF 4871
Engineer : CLH
Run Date & Time : 6/27/2007 at 13:21

* * * * * INTERIOR DIAGONAL * * * * * DLC:03.24.2007 - A15L3

LENGTH = 3.55 NUMBER REQUIRED = 17

MEMBER AND SHAPE CONFIGURATION	YIELD KSI	GROSS AREA	LENGTH OF 0.19" FILLET WELD	LEAST ROG	WEIGHT
1.75x1.75x0.13 ✓ <i>2.6x2.75</i>	36.00	0.42	1.50	0.35	86.98

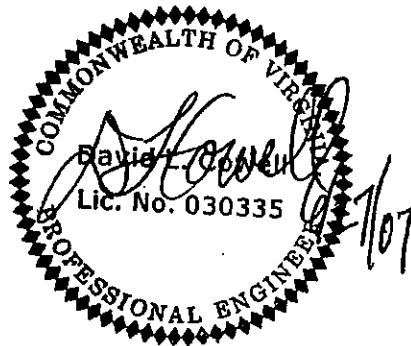

HURTT FABRICATING CORP. MARCELINE, MO.
 CANTILEVER ANGLE SIGN SUPPORT DESIGN
 15th Ed. AASHTO, 3rd Ed. Luminaires

Structure Name : GTY SB
 Job Description : HF 4871
 Engineer : CLH
 Run Date & Time : 6/27/2007 at 13:17

Truss # = GA
 Hurtt Job # = HF 4871
 Item # =
 State Job # = RICH EXPY
 State Project = PEL 2006

County = RMA

** FOR END COLUMN DESIGN ONLY **

***** TRUSS DESIGN *****

TRUSS DIMENSIONS (FT)

LENGTH	DEPTH	WIDTH	PANEL LENGTH (FT)	NUMBER OF PANELS
32.00 ✓	3.00	3.00	4.00	8

WIND VELOCITY MPH	NUMBER OF SIGNS	WALK DESIGN		
		DIST L	LENGTH	WGT/FT
80.00 ✓	1	0.00	0.00	0.00

S I G N D A T A

SIGN NO.	SIGN LENGTH	SIGN HEIGHT	CD	CH	DISTANCE FROM LS	DISTANCE CENTER	ECCN	WGT
1	31.00 ✓	1.00	1.30	1.00	1.00	16.50	-3.00	0.00

SHOP DRAWING REVIEW
 HNTB Corporation

Review is for general compliance with contract documents. Sole responsibility for correctness of dimensions, details, quantities and safety during fabrication and erection shall remain with the Contractor.

No Exceptions Taken
 Make Correction Noted By BS
 Amend and Resubmit
 Rejected - See Remarks Date 4/29/07



HURTT FABRICATING CORP. MARCELINE, MO.
 CANTILEVER ANGLE SIGN SUPPORT DESIGN
 15th Ed. AASHTO, 3rd Ed. Luminaires

Structure Name : GTY SB
 Job Description : HF 4871
 Engineer : CLH
 Run Date & Time : 6/27/2007 at 13:17

* * * * * TRUSS DESIGN * * * * * DLC:03.24.20

TRUSS DEPTH = 3.00 FEET ✓
 TRUSS WIDTH = 3.00 FEET ✓
 DEFLECTION = 0.185 IN.
 CAMBER REQUIRED = 0.569 IN.


	WIND SHEAR (LBS.)	DEAD WEIGHT (LBS.)	WIND MOMENT (FT.-LBS.)	DEAD-W MOMENT (FT.-LBS.)
CASE 1	0.0	1897.7	0.00	30362.8
CASE 2	2829.0	1897.7	45821.48	30362.8
CASE 3	1414.5	3034.0	22910.74	48591.2

* * * * * TRUSS CHORDS * * * * *

LENGTH FT	NUMBER REQUIRED	NUMBER OF 0.625" BOLTS (A325)	NUMBER OF 0.75" BOLTS (A325)	NUMBER OF 0.875" BOLTS (A325)
32.75	4	3.00	2.00	2.00

MEMBER AND SHAPE CONFIGURATION	YIELD KSI	GROSS AREA	NET AREA	LEAST ROG	WEIGHT (LBS)
4x4x.38 ✓	36.00	2.86	2.10	0.79	1283.80

	FORCE (PSI)	FA (PSI)	ALLOWABLE (PSI)	LENGTH OF 0.19" FILLET WELD
CASE 1	5402.6	1889.0	16535.9	1.94
CASE 2	20108.2	7030.8	23150.2	5.16
CASE 3	16271.9	5689.5	23150.2	4.17

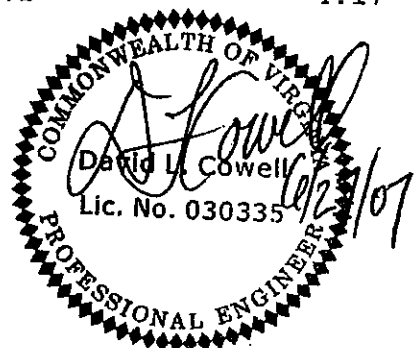

HURTT FABRICATING CORP. MARCELINE, MO.
 CANTILEVER ANGLE SIGN SUPPORT DESIGN
 15th Ed. AASHTO, 3rd Ed. Luminaires

Structure Name : GTY SB
 Job Description : HF 4871
 Engineer : CLH
 Run Date & Time : 6/27/2007 at 13:17

* * * * * WIND DIAGONAL * * * * * DLC:03.24.2

LENGTH FT	NUMBER REQUIRED	MINIMUM BOLT SIZE (A325)
4.45	14	0.625

MEMBER AND SHAPE CONFIGURATION	YIELD KSI	GROSS AREA	NET AREA	LEAST ROG	WEIGHT (LBS)
2x2x.19	36.00	0.72	0.39	0.39	152.05


	FORCE (PSI)	FA (PSI)	ALLOWABLE (PSI)	LENGTH OF 0.19" FILLET WELD
CASE 1	0.0	0.0	8098.3	0.00
CASE 2	4095.6	5728.1	11337.6	1.05
CASE 3	2047.8	2864.1	11337.6	0.53

* * * * * WIND DIAGONAL END PANEL * * * * * DLC:03.24.2

LENGTH FT	NUMBER REQUIRED	MINIMUM BOLT SIZE (A325)
3.89	2	0.625

MEMBER AND SHAPE CONFIGURATION	YIELD KSI	GROSS AREA	NET AREA	LEAST ROG	WEIGHT (LBS)
2x2x.19	36.00	0.72	0.39	0.39	18.98

	FORCE (PSI)	FA (PSI)	ALLOWABLE (PSI)	LENGTH OF 0.19" FILLET WELD
CASE 1	0.0	0.0	10461.2	0.00
CASE 2	3578.5	5004.8	14645.7	0.90
CASE 3	1789.2	2502.4	14645.7	0.45

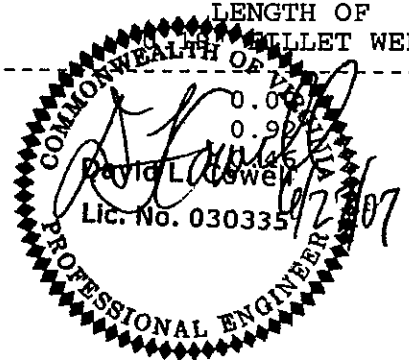

HURTT FABRICATING CORP. MARCELINE, MO.
 CANTILEVER ANGLE SIGN SUPPORT DESIGN
 15th Ed. AASHTO, 3rd Ed. Luminaires


Structure Name : GTY SB
 Job Description : HF 4871
 Engineer : CLH
 Run Date & Time : 6/27/2007 at 13:17

* * * * * WIND STRUT * * * * * DLC:03.24.2

LENGTH FT	NUMBER REQUIRED	MINIMUM BOLT SIZE (A325)
2.75	16	0.625

MEMBER AND SHAPE CONFIGURATION	YIELD KSI	GROSS AREA	NET AREA	LEAST ROG	WEIGHT (LBS)
2x2x.19✓	36.00	0.72	0.39	0.39	107.36

	FORCE (PSI)	FA (PSI)	ALLOWABLE (PSI)	LENGTH OF 0.19" FILLET WELD
CASE 1	0.0	0.0	14590.6	0.00
CASE 2	2530.4	3539.0	20426.9	0.65
CASE 3	1265.2	1769.5	20426.9	0.32

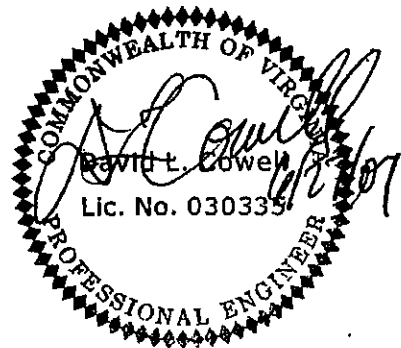

HURTT FABRICATING CORP. MARCELINE, MO.
 CANTILEVER ANGLE SIGN SUPPORT DESIGN
 15th Ed. AASHTO, 3rd Ed. Luminaires


Structure Name : GTY SB
 Job Description : HF 4871
 Engineer : CLH
 Run Date & Time : 6/27/2007 at 13:17

* * * * * DEAD LOAD DIAGONAL * * * * * DLC:03.24.2

LENGTH FT	NUMBER REQUIRED	MINIMUM BOLT SIZE (A325)
4.45	16	0.625

MEMBER AND SHAPE CONFIGURATION	YIELD KSI	GROSS AREA	NET AREA	LEAST ROG	WEIGHT (LBS)
2x2x.19	36.00	0.72	0.39	0.39	173.77

	FORCE (PSI)	FA (PSI)	ALLOWABLE (PSI)	LENGTH OF 0.19" FILLET WELD
CASE 1	1535.8	2147.9	19800.0	0.55
CASE 2	1535.8	2147.9	27720.0	0.39
CASE 3	2530.7	3539.4	27720.0	0.65

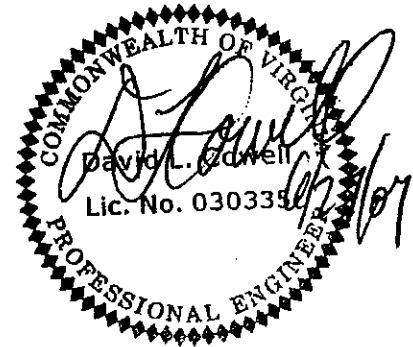

HURTT FABRICATING CORP. MARCELINE, MO.
 CANTILEVER ANGLE SIGN SUPPORT DESIGN
 15th Ed. AASHTO, 3rd Ed. Luminaires

Structure Name : GTY SB
 Job Description : HF 4871
 Engineer : CLH
 Run Date & Time : 6/27/2007 at 13:17

* * * * * DEAD LOAD VERTICAL * * * * * DLC:03.24.2

LENGTH FT	NUMBER REQUIRED	MINIMUM BOLT SIZE (A325)
2.75	18	0.625


MEMBER AND SHAPE CONFIGURATION	YIELD KSI	GROSS AREA	NET AREA	LEAST ROG	WEIGHT (LBS)
2x2x.19	36.00	0.72	0.39	0.39	120.78

	FORCE (PSI)	FA (PSI)	ALLOWABLE (PSI)	LENGTH OF 0.19" FILLET WELD
CASE 1	948.8	1327.0	14590.6	0.34
CASE 2	948.8	1327.0	20426.9	0.24
CASE 3	1563.5	2186.7	20426.9	0.40

* * * * * INTERIOR DIAGONAL * * * * * DLC:03.24.2

LENGTH = 3.55 NUMBER REQUIRED = 8

MEMBER AND SHAPE CONFIGURATION	YIELD KSI	GROSS AREA	LEAST ROG	WEIGHT
1.75x1.75x0.13	36.00	0.42	0.35	40.93

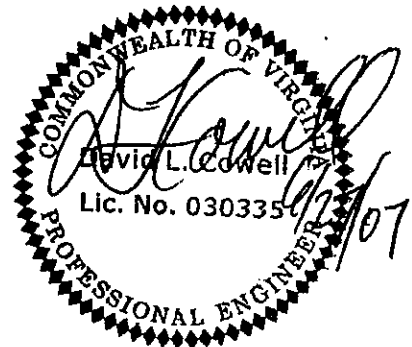

HURTT FABRICATING CORP. MARCELINE, MO.
 CANTILEVER ANGLE SIGN SUPPORT DESIGN
 15th Ed. AASHTO, 3rd Ed. Luminaires

Structure Name : GTY SB
 Job Description : HF 4871
 Engineer : CLH
 Run Date & Time : 6/27/2007 at 13:17


* * * * * TRUSS MOUNTING PLATE * * * * * DLC:03.24.20

WIDTH A [IN]	WIDTH B [IN]	THICKNESS C [IN]	GUSSET DEPTH D [IN]	THICKNESS E [IN]	WEIGHT [LBS]
36.00	17.00	0.500	12.00	0.500	149

WELD SIZE-W2 (1/16")


5

WELD SIZE-W3 (1/16")

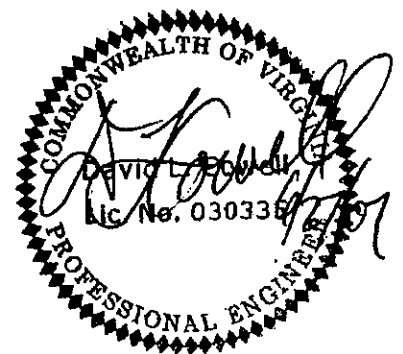


HURTT FABRICATING CORP. MARCELINE, MO.
 CANTILEVER ANGLE SIGN SUPPORT DESIGN
 15th Ed. AASHTO; 3rd Ed. Luminaires

Structure Name : GTY SB
 Job Description : HF 4871
 Engineer : CLH
 Run Date & Time : 6/27/2007 at 13:17

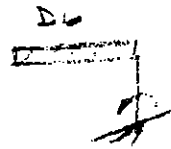

* * * * * COLUMN DESIGN * * * * * DLC:03.24.2

	HEIGHT (FT) TOTAL	(FT) TRUSS	DIAMETER (IN)	THICKNESS (IN)	YIELD STRENGTH (KSI)	WEIGHT (LB)		
	21.75	20.00	14.00 ✓	0.2500 ✓	42	799		
	AXIAL (LBS)	MOMENT (FT-LB)	TORQUE (FT-LB)	SHEAR (LBS)	FA ALLOW	FB ALLOW	FV ALLOW	CSR
CASE 1	2897	30363	0.0 ✓	0.0	14027	27720	13860	0.380
COMBINATION 1								
CASE 2	2897	70357	45821	3207	19637	38808	19404	0.778
COMBINATION 1								
CASE 2	2897	58305	27493	2110	19637	38808	19404	0.568
COMBINATION 2								
CASE 3	4033	62334	22911	1766	19637	38808	19404	0.589
COMBINATION 1								
CASE 3	4033	60369	13746	1162	19637	38808	19404	0.548
COMBINATION 2								

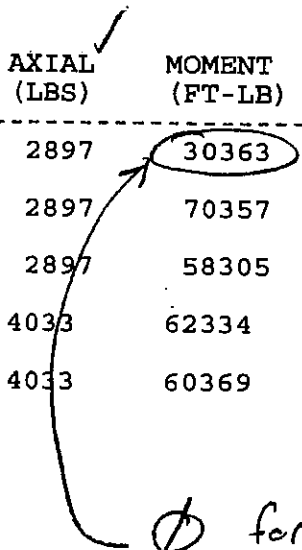



φ for OVERHEAD SPAN

Max Mom @ BASE = 2860 (20') = 57,200 ft-Lbs

$M_{DESIGN} = \sqrt{(57,200^2) + [(2)(57,200)]^2} = 58,333 \text{ ft-Lbs}$

∴ DESIGN IS Conservative ✓

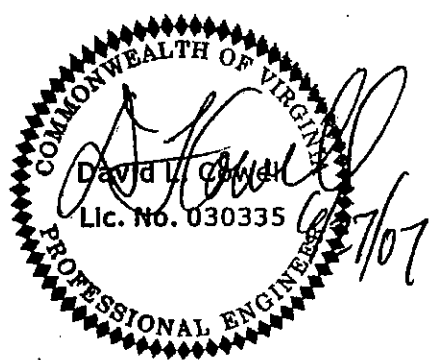

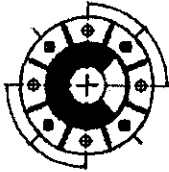

COWELL
ENGINEERING
STRUCTURAL ENGINEERS

PROJECT Hf-4871
LOCATION Richmond Virginia
CLIENT Hurt Fab
BY TDC DATE 6/27/07 W.O.# _____
CHECK _____ DATE _____ SHEET 1 OF 2

CHECK BASE PLATE

$$M_{max} @ \text{BASE} = 2860(20) = 57,200 \text{ ft-Lbs}$$

$$M_{design} = \sqrt{57,200^2 + [(2)(57,200)]^2} = 58,333$$

$$T = \frac{4(58,333 \text{ ft-Lbs})}{6(1.75')} - \left(\frac{1914.8 + 799}{6} \right) = 21,770 \#$$

$$V = \sqrt{2859^2 + .2(2859)^2} = 2916 \#$$

using $1\frac{1}{4}" \phi$ A.B. $A_t = .969 \text{ in}^2$ Assum 55 ksi (Not by Hurt fab)

$$F_r = 0.3(55) = 16.5 \text{ ksi} \quad F_t = 0.5(55) = 27.5 \text{ ksi}$$

$$f_v = \frac{2916}{.969} = 3009.3 \quad f_t = \frac{21,770}{.969} = 22,466.4$$

$$CSR = \left(\frac{300}{16.5(1\frac{1}{3})} \right)^2 + \left(\frac{22.5}{27.5(1\frac{1}{3})} \right)^2 = 0.395 < 1.0 \quad (\text{Anchor Bolt Size Seems Reasonable})$$

.376


BENDING of IR Between Bolts


$$L = 20"(\pi)/6 = 10.47" \quad M_{IR} = \frac{Pl}{8} = \frac{21.8(10.47)}{8} = 28.5 \text{ k-in}$$

$$f_{be} = \frac{28.5 \text{ k-in}(6)}{6(1.5)^2} = 12.7 \text{ ksi}$$

Weld to BASE IR

$$f_t = \frac{21.7 \text{ k}}{4.5 \times 2 \times .375} = 6.4 \text{ ksi} < .3(70) = 21 \text{ ksi}$$

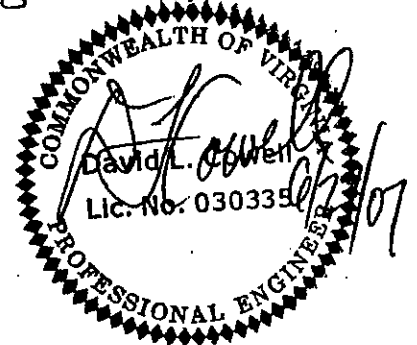

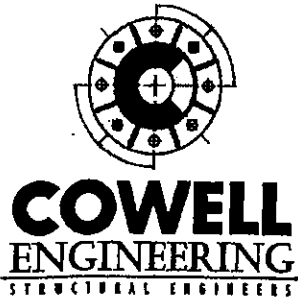

PROJECT HF-4871
 LOCATION Richmond Va
 CLIENT Huch Fab
 BY TAC DATE 6/27/07 W.O.# _____
 CHECK _____ DATE _____ SHEET 2 OF 2


Weld of Gusset to Col.

$$f_v = \frac{21.7k}{115 \times 2 \times .375} = 2.5 \text{ ksi} \quad \begin{matrix} \text{ok} \\ \text{S} \end{matrix}$$

STRESS ON Gusset


$$f_t = \frac{21.7k}{45 \times .75} = 6.5 \text{ ksi} \quad \begin{matrix} \text{ok} \\ \text{S} \end{matrix}$$

SHOP DRAWING REVIEW HNTB Corporation	
Review is for general compliance with contract documents. Sole responsibility for correctness of dimensions, details, quantities and safety during fabrication and erection shall remain with the Contractor.	
<input checked="" type="checkbox"/> No Exceptions Taken	 _____ Date: <u>6/29/07</u>
<input type="checkbox"/> Make Correction; Noted By _____	
<input type="checkbox"/> Amend and Resubmit	
<input type="checkbox"/> Rejected - See Remarks Date _____	

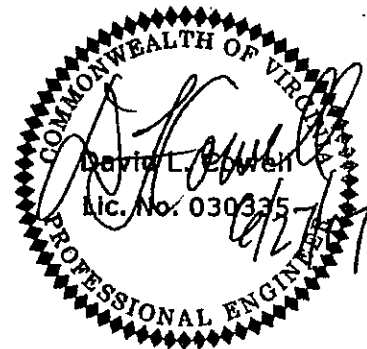


SOUTHBOUND POWHITE PARKWAY TOLL PLAZA

ORIGINAL PLANS - ADMINISTRATION BUILDING & TOLL PLAZA

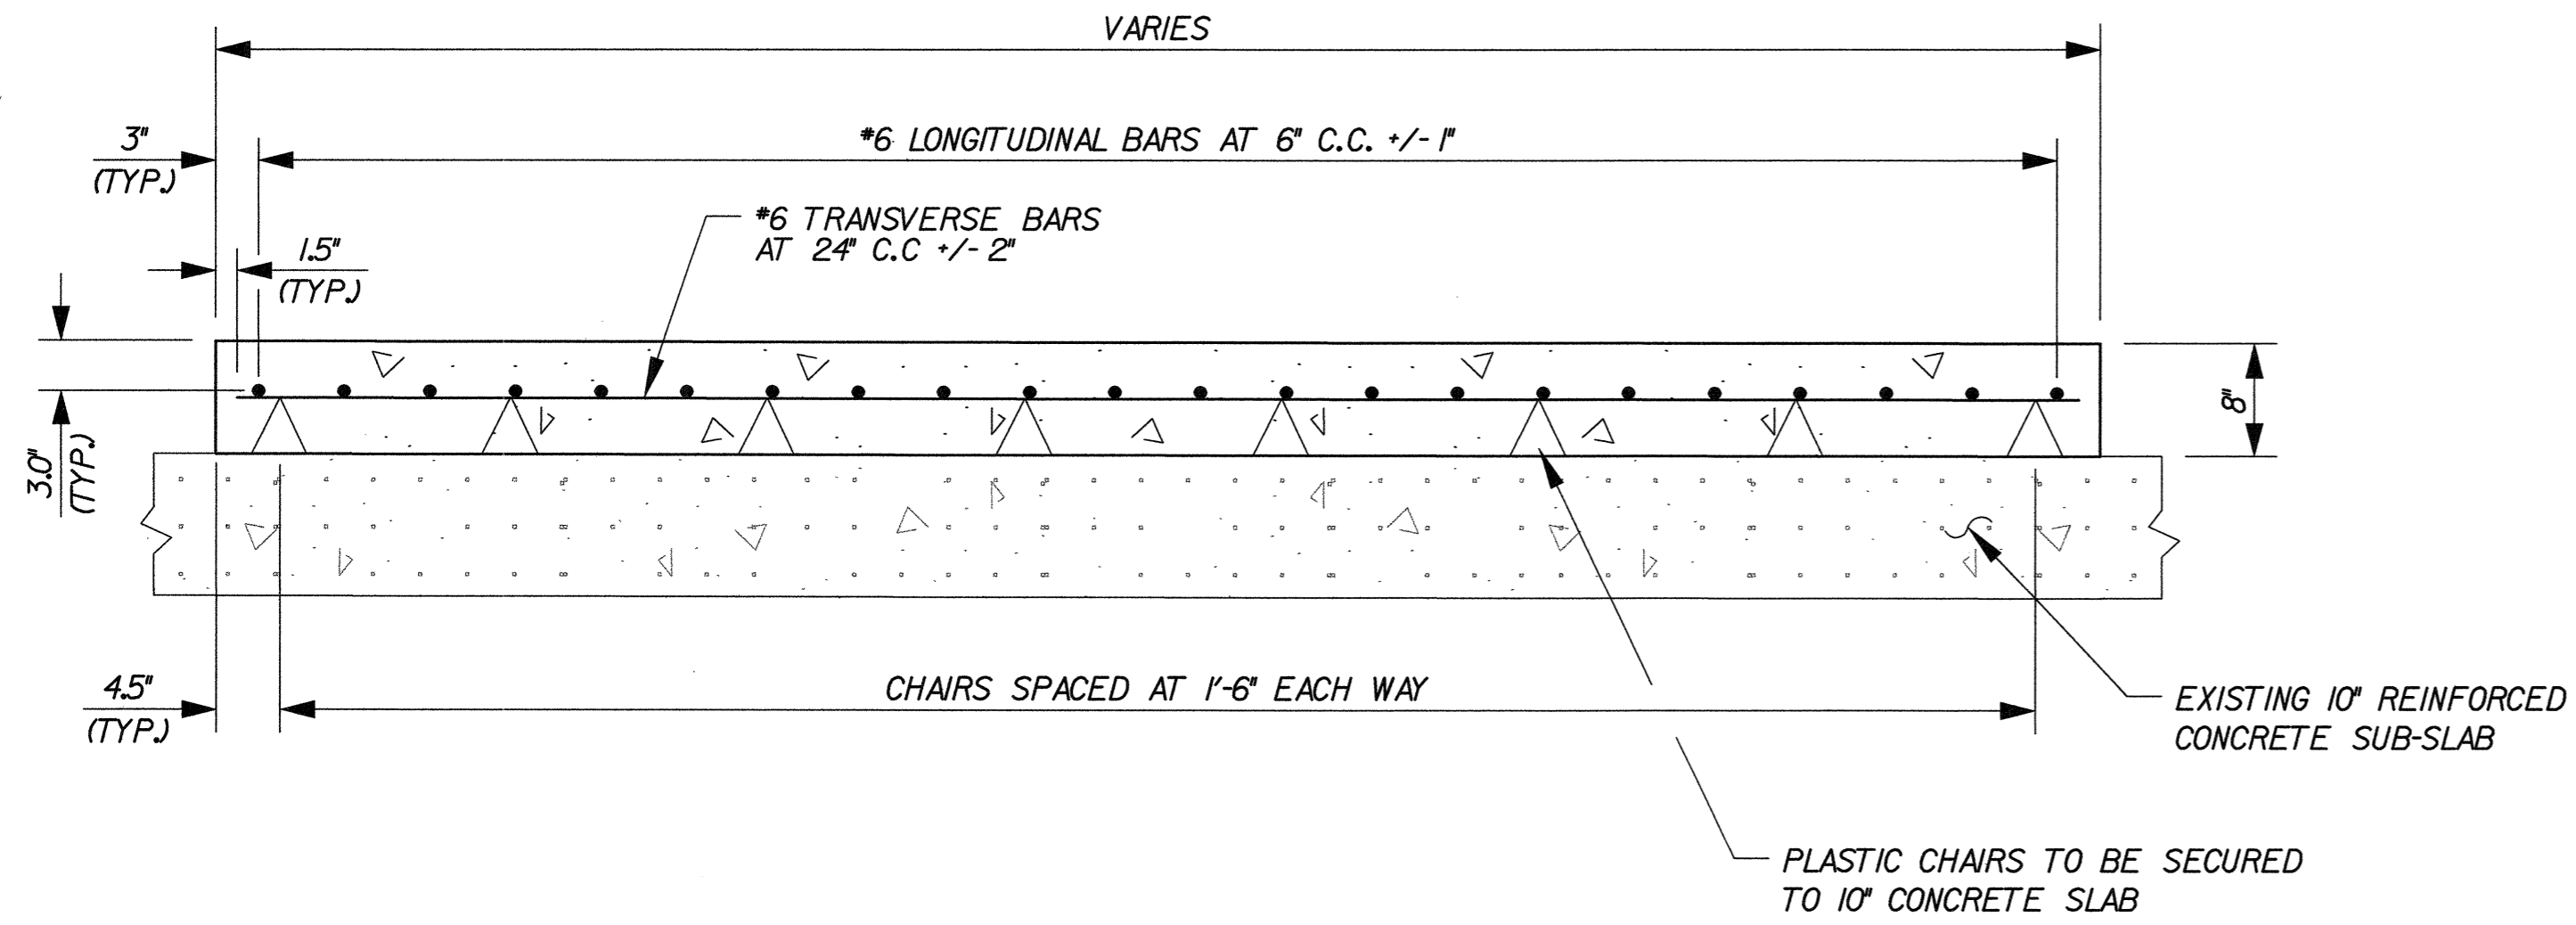

PROPOSED TOLL PLAZA 8" PAVEMENT SLAB SECTION
NTS

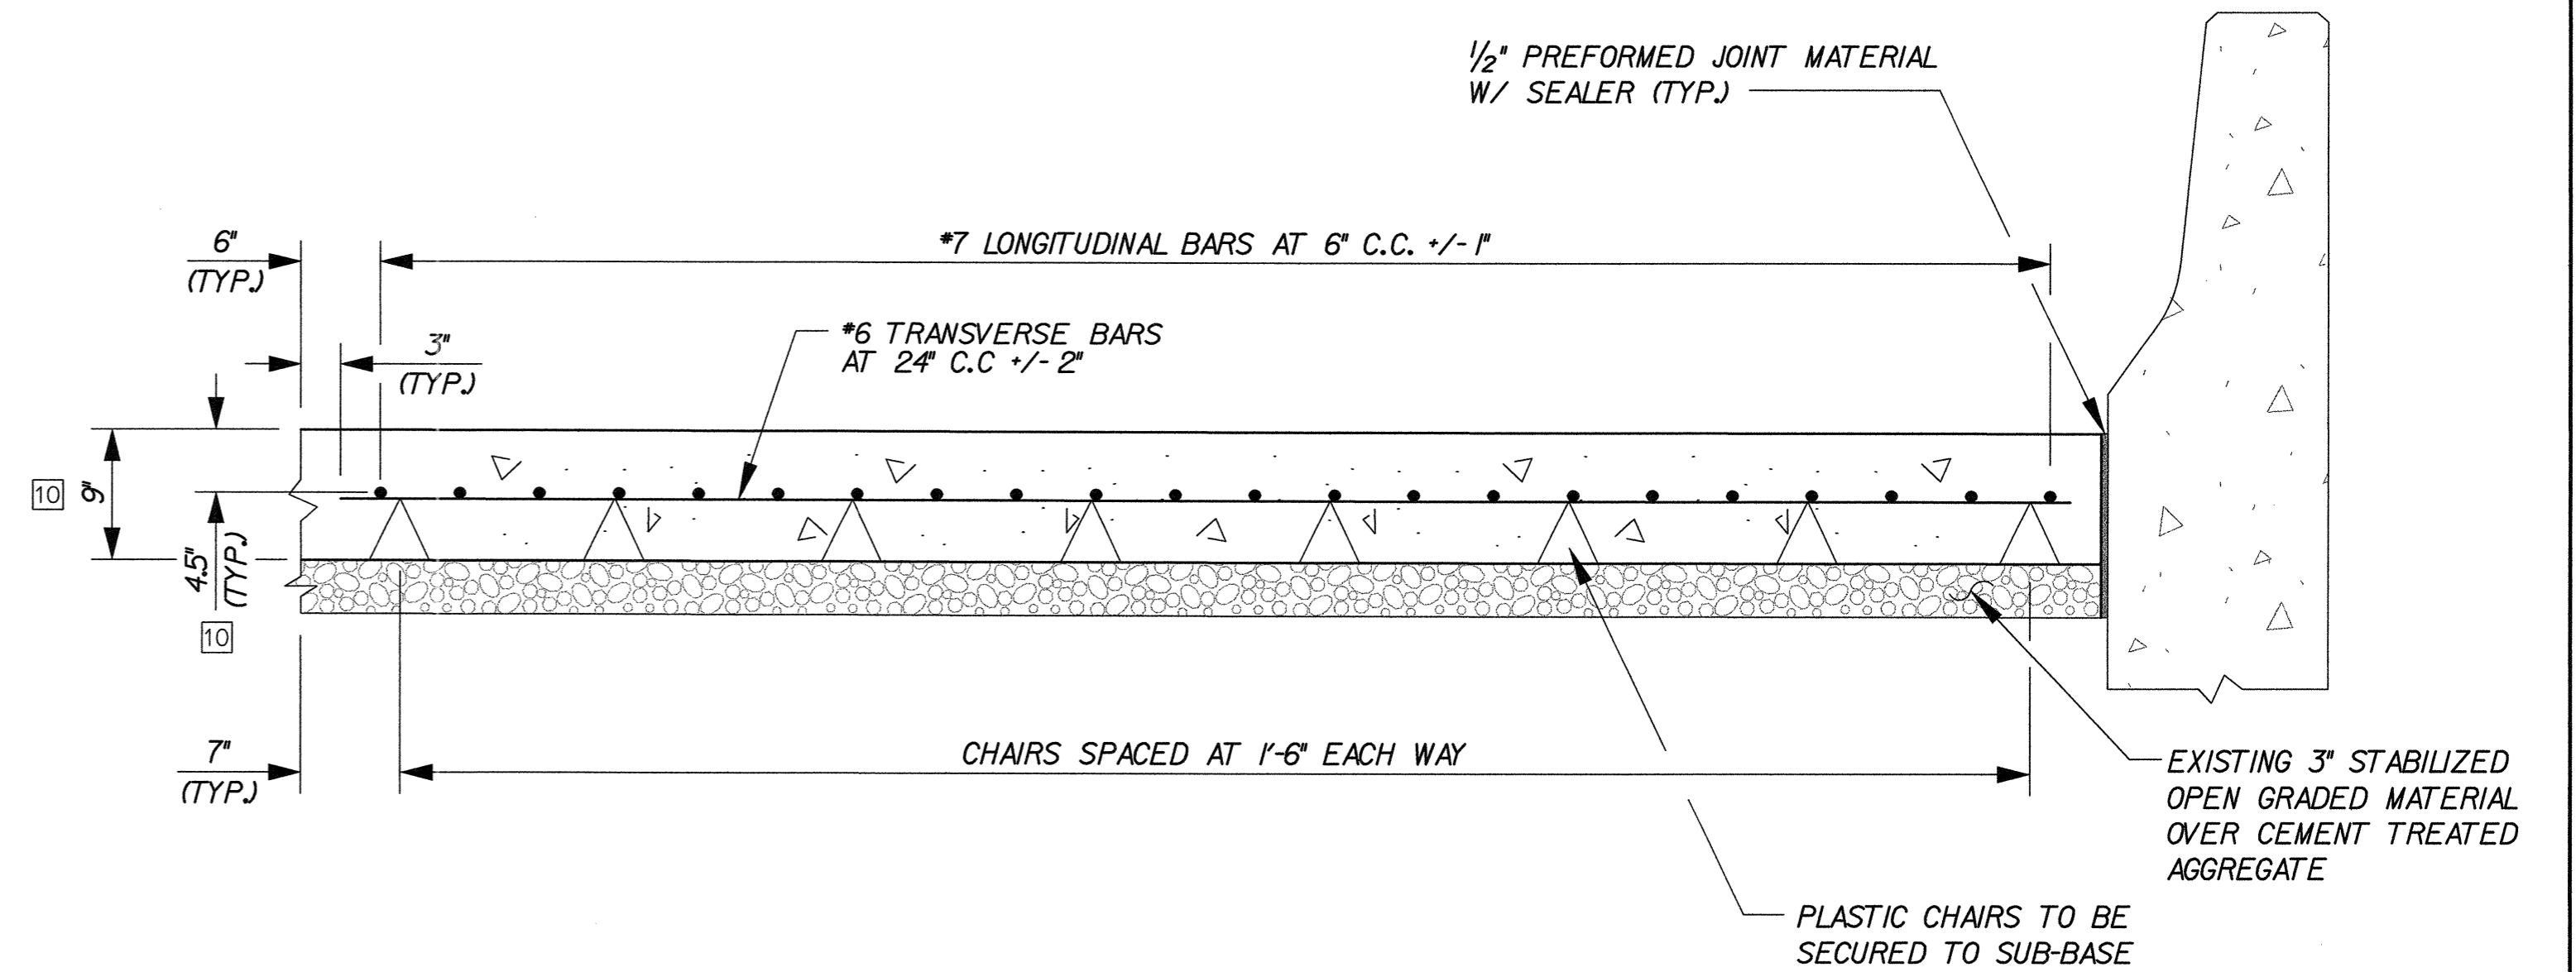

PROPOSED EXPRESS LANE 9" PAVEMENT SLAB SECTION
NTS

NOTES:

1. CONTRACTOR TO SUBMIT POUR SEQUENCE PRIOR TO POUR FOR APPROVAL BY THE ENGINEER.
2. SEE VDOT SPECIFICATION PR-3 AND PR-6 FOR DETAILS NOT SHOWN ON THIS SHEET.
3. SLAB CONCRETE SHALL BE TYPE A4, HIGH EARLY CONCRETE WITH NON-METALLIC FIBERGLASS ADDITIVE.
4. REINFORCING BARS SHALL BE V-ROD REINFORCING BARS MANUFACTURED BY CONCRETE PROTECTION SYSTEMS INC. OR ENGINEER APPROVED EQUAL.
5. REINFORCING BARS SHALL BE SECURED USING PLASTIC TIES, NYLON TIES, OR PLASTIC SNAP TIES. NO METAL TIES OR TIES CONTAINING METAL SHALL BE USED.
6. ALL WORK SHALL BE IN ACCORDANCE WITH MANUFACTURER'S SPECIFICATIONS AND AS DIRECTED BY THE ENGINEER.
7. PLASTIC OR NON-METALLIC (NON CORROSIVE) CHAIRS SHALL BE USED TO ELEVATE REBAR AT LOCATIONS SHOWN.
8. REBAR SHALL BE SECURED TO CHAIRS.
9. CHAIRS SHALL BE SECURED TO 10" SLAB OR 3" SUB-BASE BY METHOD(S) APPROVED BY ENGINEER.
10. CONTRACTOR TO COORDINATE PLACEMENT OF LOOPS WITH ORT CONTRACTOR PRIOR TO POURING CONCRETE AND PRIOR TO SAW-CUTTING JOINTS.

10	4/10/08: REVISED SHEET - SEE SHEET 1C
9	3/5/08: REVISED SHEET - SEE SHEET 1C
8	10/03/07: ADDED SHEET.
REVISIONS	

HNTB
9175 GUILFORD ROAD, SUITE 100
COLUMBIA, MARYLAND 21046
(301) 543-1000


DE-01A

ma RICHMOND METROPOLITAN AUTHORITY
RICHMOND EXPRESSWAY SYSTEM


**POWHITE PARKWAY EXPRESS
TOLL LANES PROJECT**

MISCELLANEOUS ROADWAY DETAILS


Scale: NONE	Date: 3/06/08	Contract No.: PEL-2006	Sheet: 42A of 161
----------------	------------------	---------------------------	----------------------

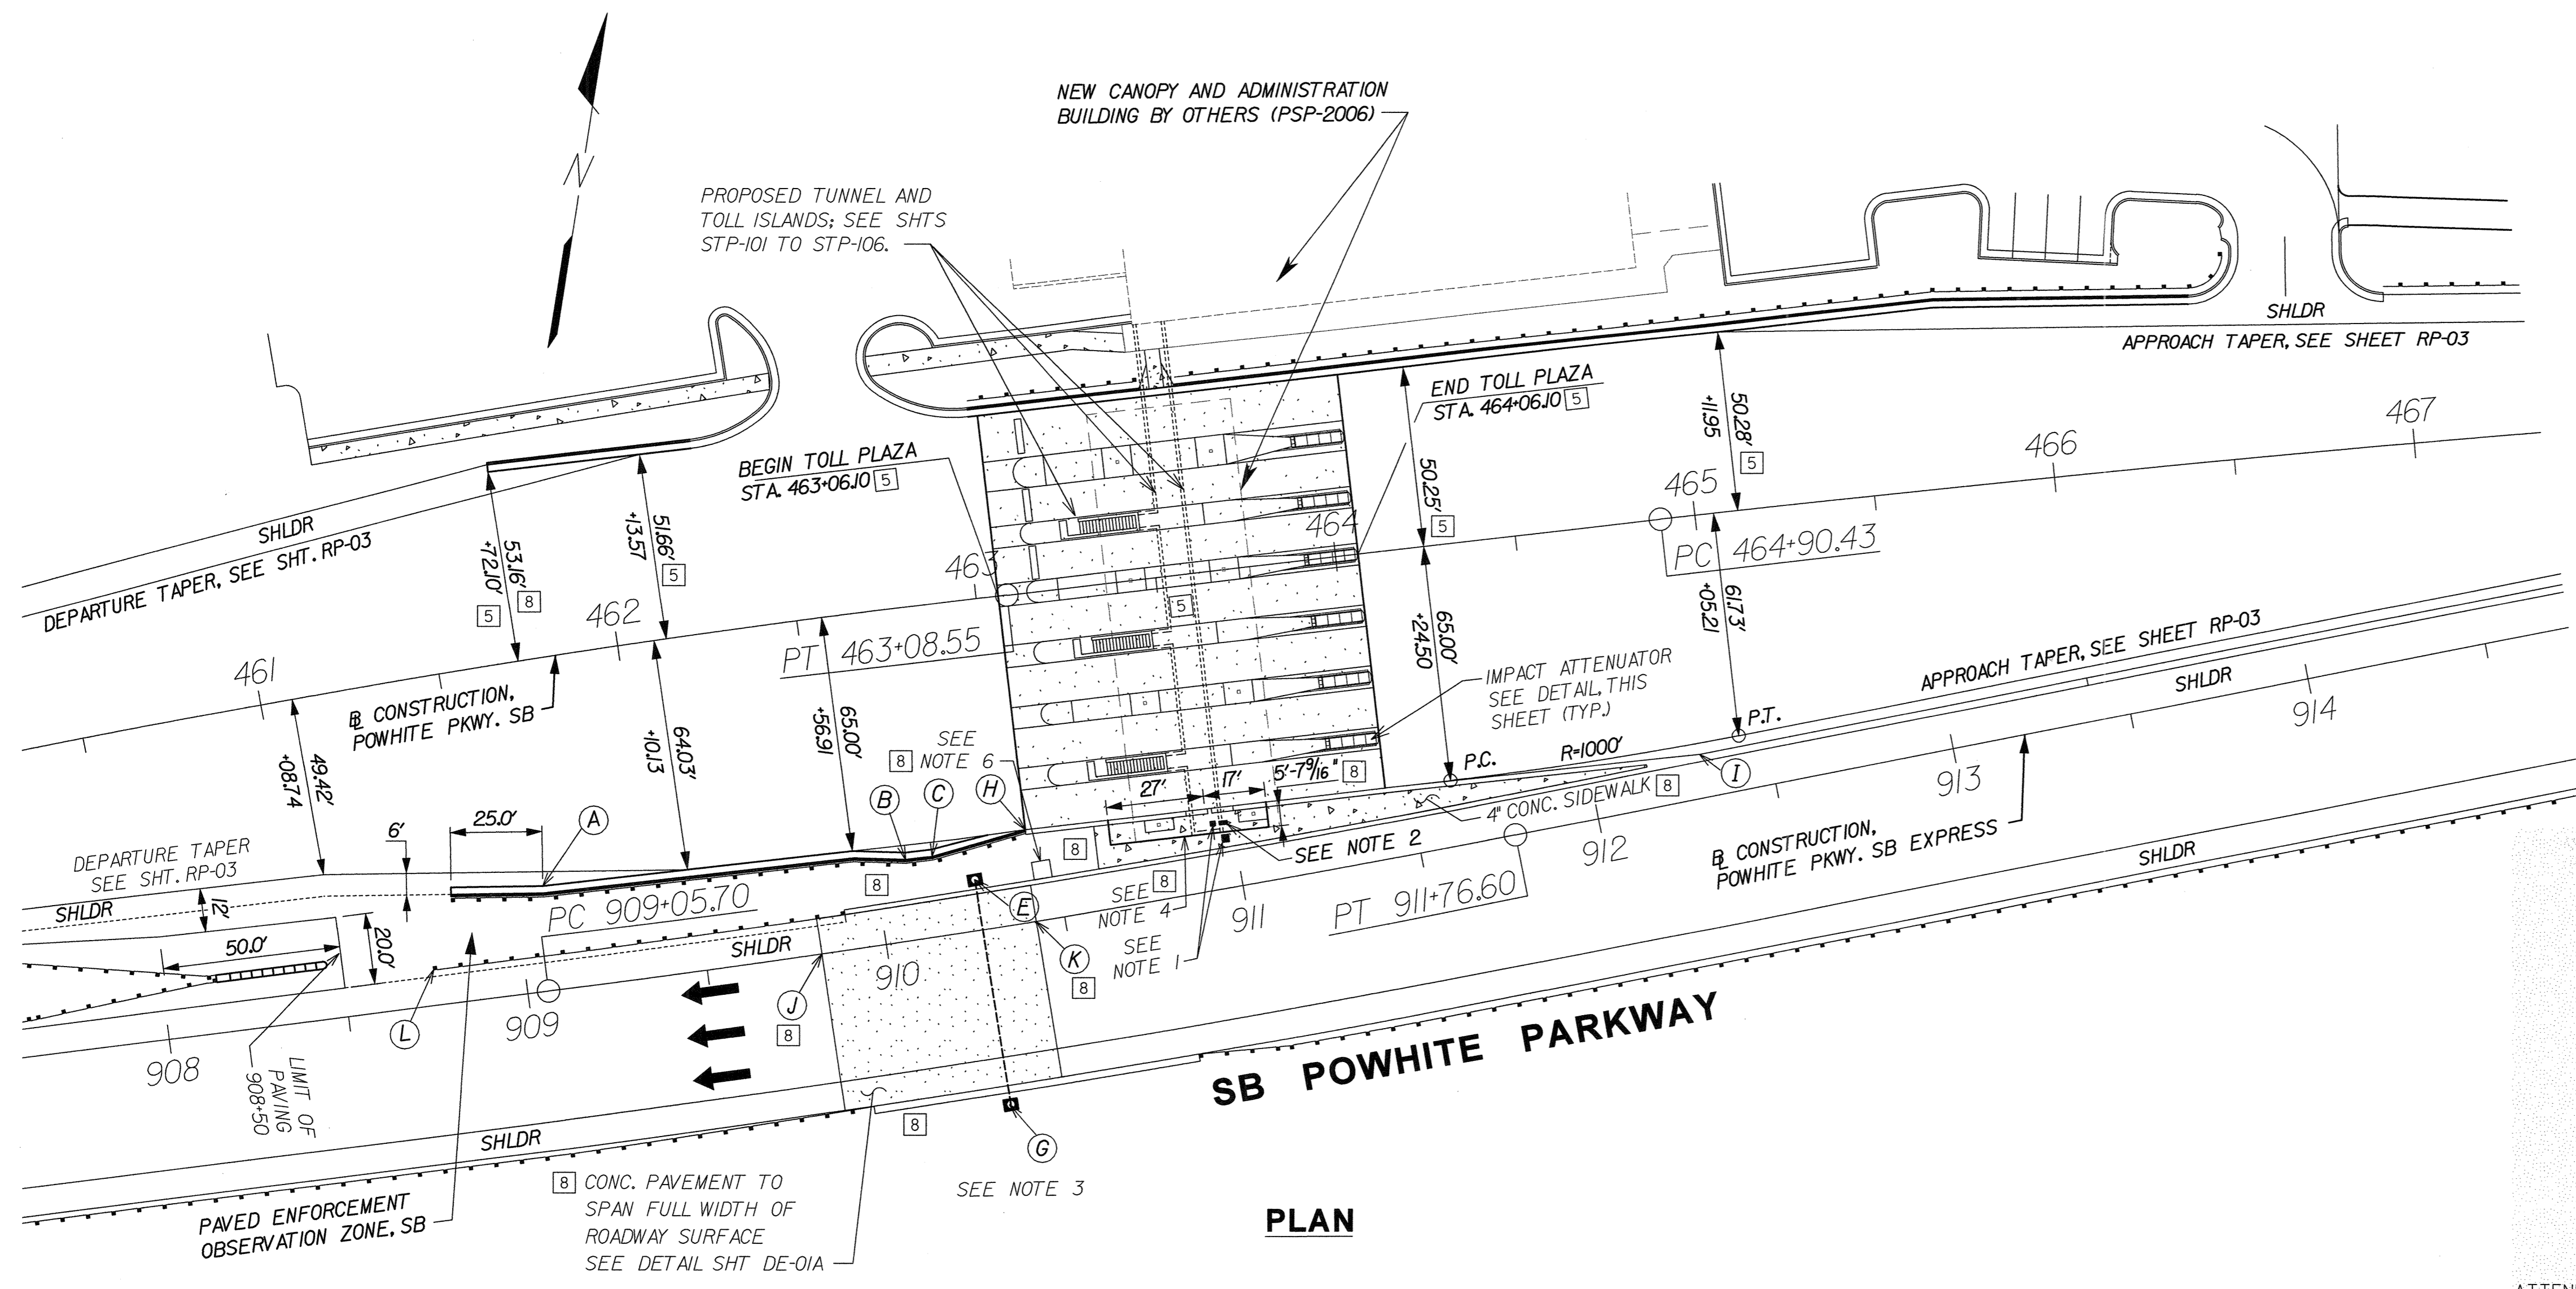

PLAN

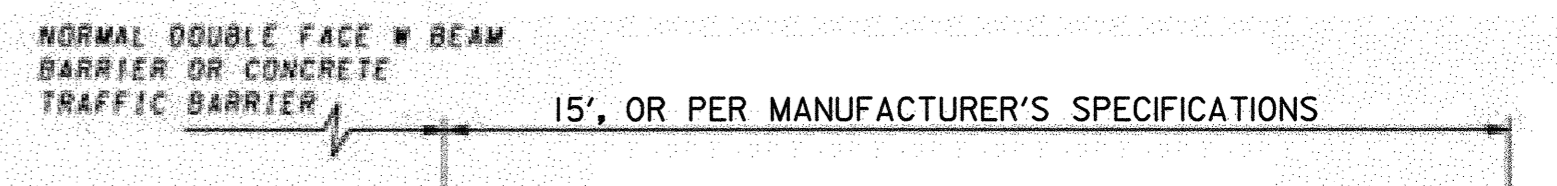

ATTENUATOR SHALL BE TRINITY TRACC "SHORTTRACC", OR ENERGY ABSORPTION SYSTEMS "QUAD GUARD - 30-03-Y", OR APPROVED EQUAL, AND SHALL BE INSTALLED PER MANUFACTURER'S SPECIFICATIONS AND RECOMMENDATIONS

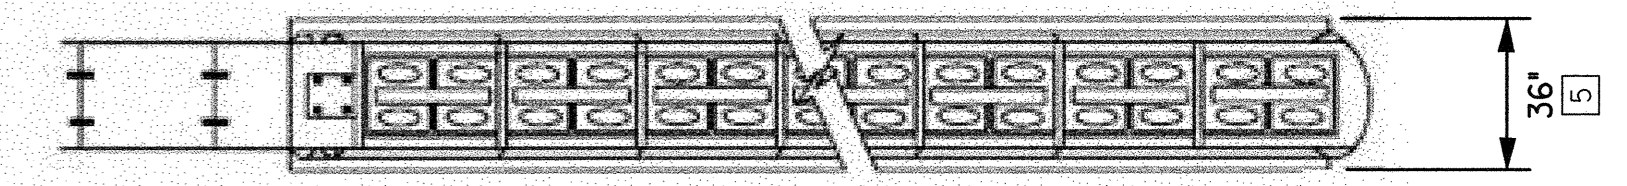

PLAN


HORIZONTAL CONTROL POINT SCHEDULE

POINT NO.	LOCATION	DESCRIPTION
(A)	STA. 461+69.06, 62.55' RT., POWHITE PKWY. SB	EDGE OF GUTTER PAN
(B)	STA. 462+71.5, 69.35' RT., POWHITE PKWY. SB	FACE OF CURB (SET BACK FOR INLET)
(C)	STA. 462+79.00, 69.35' RT., POWHITE PKWY. SB	FACE OF CURB (SET BACK FOR INLET)
(E)	STA. 910+27, 14.00' LT., POWHITE PKWY. SB EXPRESS	CENTER GANTRY FOUNDATION TY. 1
(G)	STA. 910+27, 50.00' RT., POWHITE PKWY. SB EXPRESS	CENTER GANTRY FOUNDATION TY. 1
(H)	STA. 463+06.05, 65.00' RT., POWHITE PKWY. SB	FACE OF CURB/END OF BARRIER
(I)	STA. 464+93.82, 65.67' RT., POWHITE PKWY. SB	BEGIN MEDIAN BARRIER TRANSITION
(J)	STA. 909+82, 0.00' RT., POWHITE PKWY. SB EXPRESS	LIMIT OF 9' CONC. PAVEMENT
(K)	STA. 910+42, 0.00' RT., POWHITE PKWY. SB EXPRESS	LIMIT OF 9' CONC. PAVEMENT
(L)	STA. 908+75, 10.00' LT., POWHITE PKWY. SB EXPRESS	BEGIN GUARD RAIL

- NOTES:
- ELECTRICAL EQUIPMENT TO BE INSTALLED BY OTHERS.
 - MECHANICAL EQUIPMENT TO BE INSTALLED BY OTHERS.
 - SEE SHEET SM-40 FOR GANTRY FOUNDATION DETAILS.
 - LIMITS OF 10' BASE SLAB WITH 8" (MAX) SURFACE SLAB PER SHEET STP-105 SECTION A-A.
 - SEE SHEET DE-05A FOR SPOT ELEVATIONS BETWEEN EXPRESS LANE AND TOLL PLAZA.
 - SEE SHEET DE-05A FOR CONCRETE PAD FOR ORT EQUIPMENT ENCLOSURE.

NO.	DATE	DESCRIPTION
10	4/10/08	REVISED SHEET - SEE SHEET 1C
8	10/03/07	REVISED SHEET - SEE SHEET 1C
5	3/27/07	REVISED DIMENSION - SEE SHEET 1B
1	6/23/06	ADDED SHEET

REVISIONS

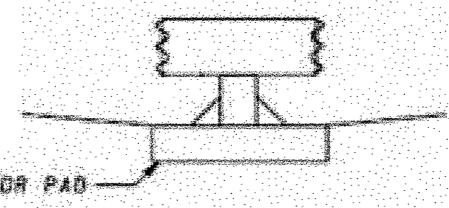

SECTION A-A

TOLL ISLAND ATTENUATOR DETAIL

NOT TO SCALE

DE-05 OF 06

richmond metropolitan authority
RICHMOND EXPRESSWAY SYSTEM

POWHITE PARKWAY EXPRESS
TOLL LANES PROJECT

MISCELLANEOUS DETAILS
 NEW TOLL PLAZA

HNTB

9175 GUILFORD ROAD, SUITE 100
 COLUMBIA, MARYLAND 21046
 (301) 543-1000


Scale: 1" = 30'	Date: 3/06/08	Contract No.: PEL-2006	Sheet: 46 of 161
--------------------	------------------	---------------------------	---------------------

NOTES:

1. FOR TUNNEL AND TOLL PLAZA DETAILS, SEE SHTS DE-05 AND STP-101 THRU STP-106

NEW CANOPY AND ADMINISTRATION BUILDING BY OTHERS (PSP-2006)

W-BEAM ALIGNMENT SHALL BE SET TO CLEAR PROPOSED UTILITIES. EMBANKMENT SHALL BE CONSTRUCTED TO SUPPORT W-BEAM. SEE UTILITY PLANS AND CROSS SECTIONS.

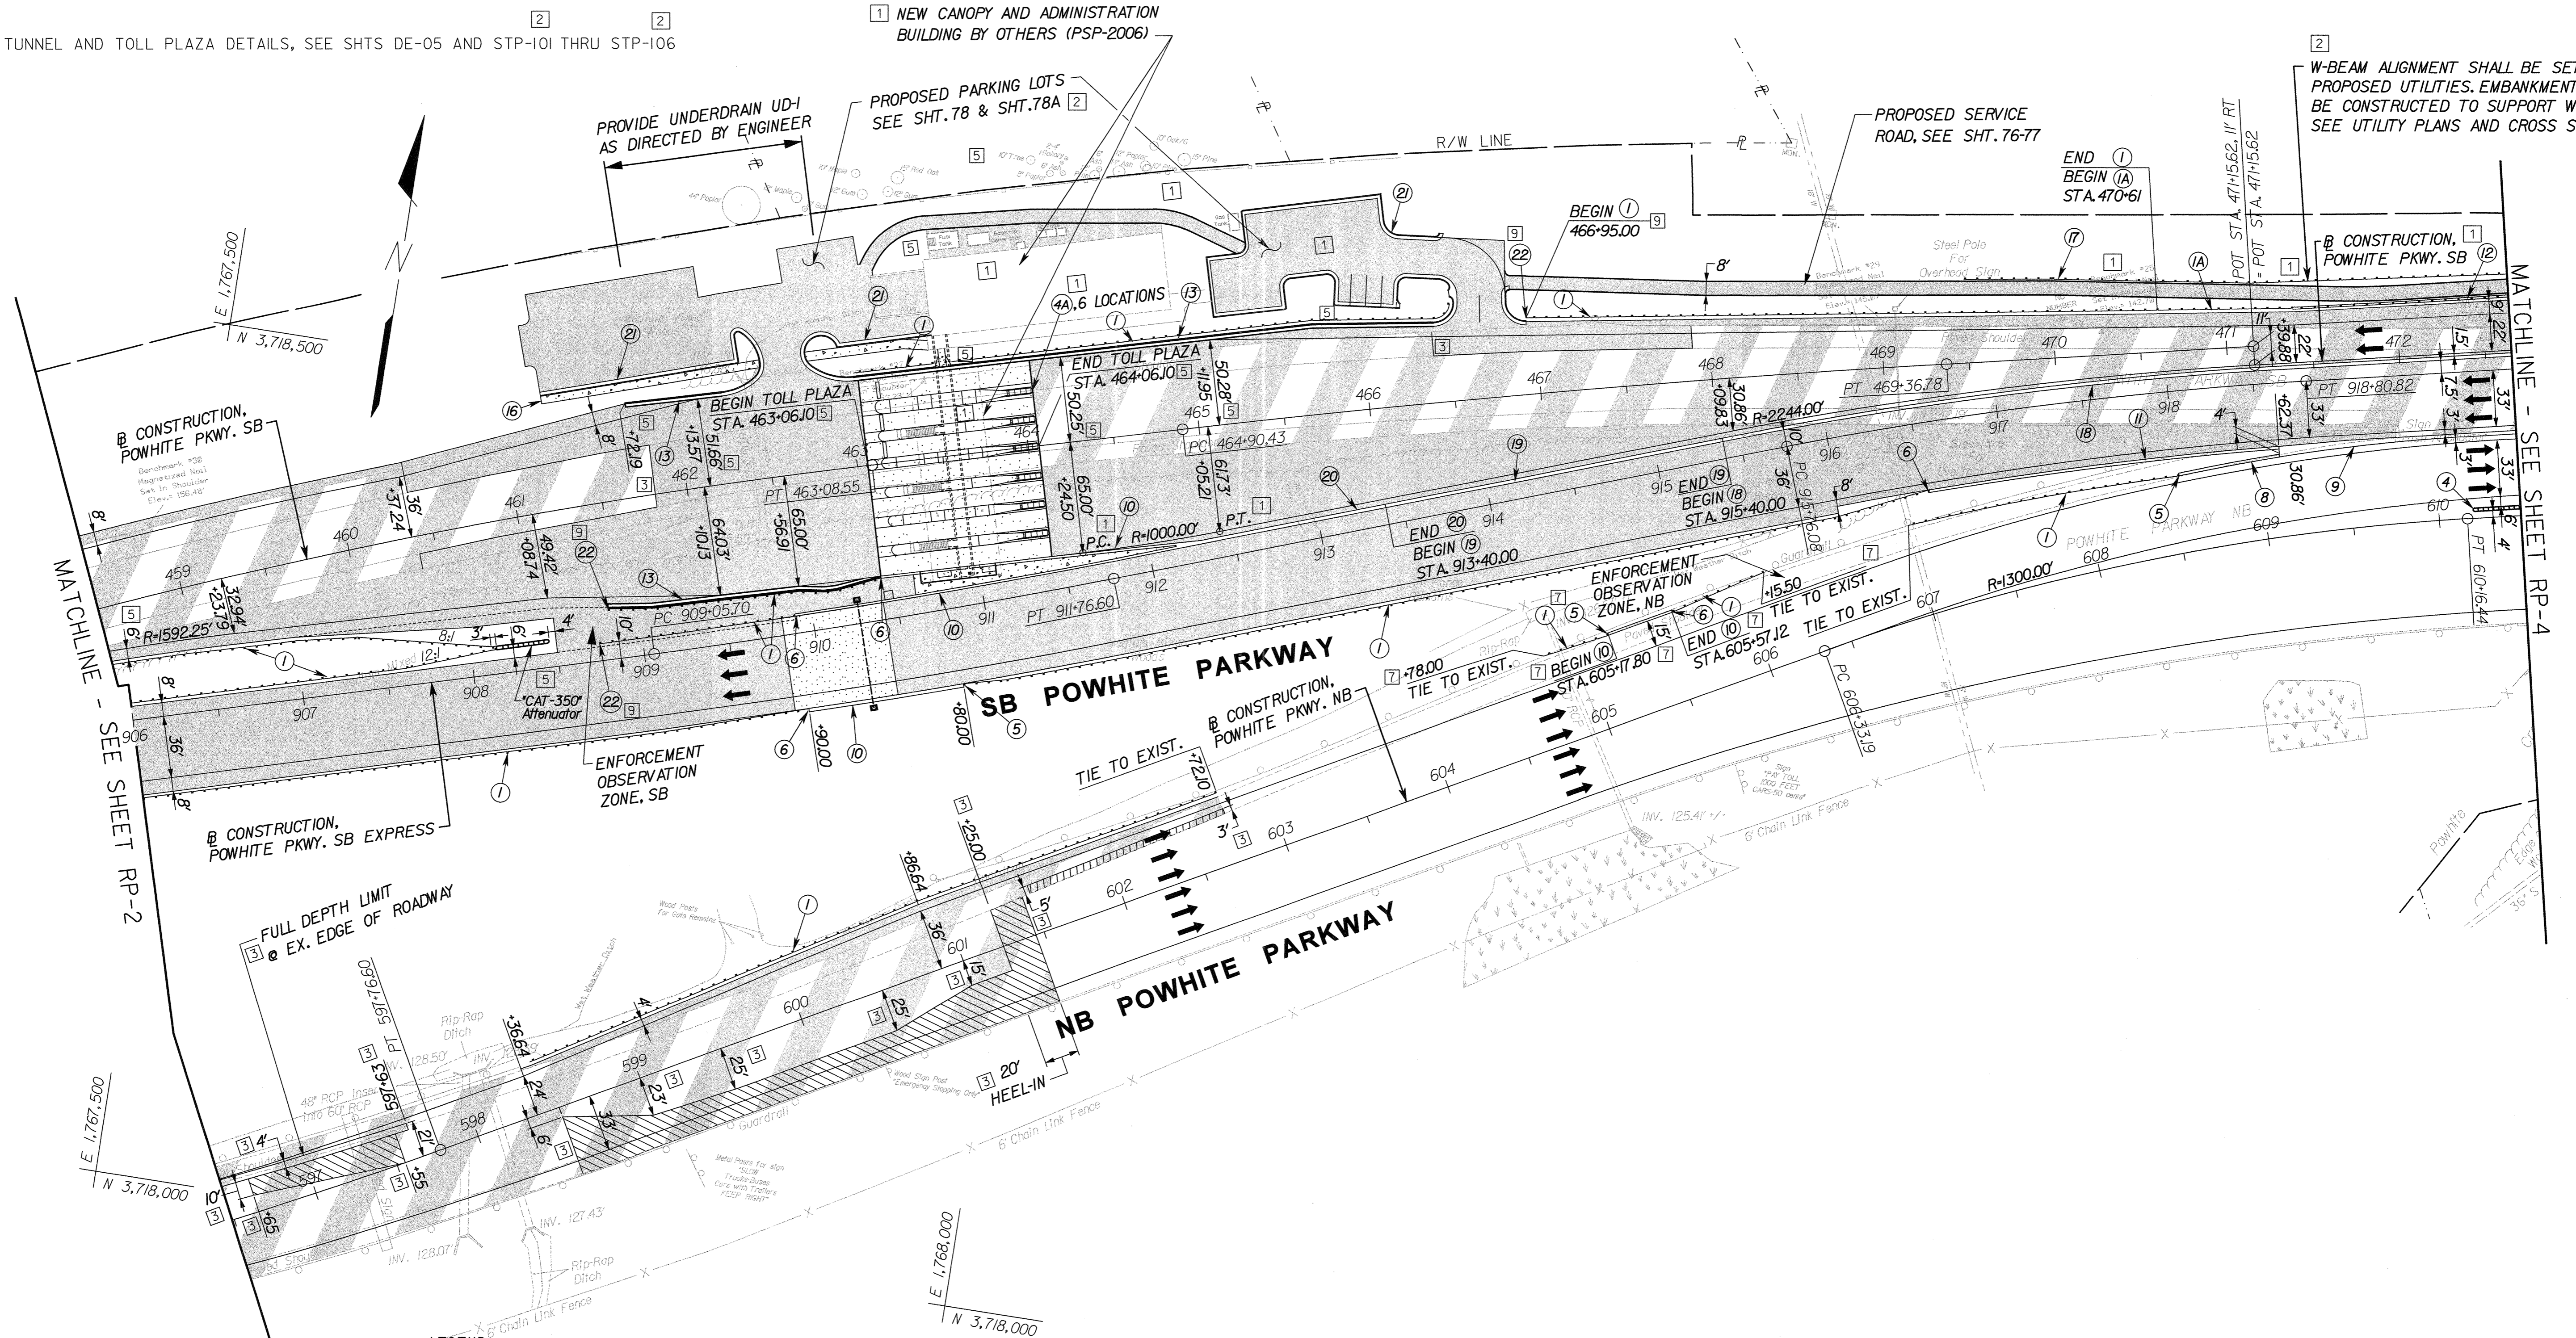

MATCHLINE - SEE SHEET RP-2

MATCHLINE - SEE SHEET RP-4

LEGEND

- | | | | | |
|----|---|-----|-----|--|
| 1 | S'd. GR-2, Guardrail, (IA) S'd. GR-2A | 9 | 12 | S'd. MB-3, Blocked Out W-Beam Median Barrier |
| 2 | S'd. GR-7, Guardrail Terminal | 13 | 13 | S'd. CG-7, Comb. 4" Curb & Gutter |
| 3 | S'd. GR-9, Guardrail Terminal | 14 | 14 | S'd. CG-3, Standard 4" Curb |
| 4 | Impact Attenuator (TL-3, > 55 MPH) (IA) (TL-2, > 40 MPH) | 15 | 15 | Constant Slope Concrete Median Barrier, See Sheet DE-04 |
| 5 | S'd. GR-FOA-2, Fixed Object Attachment, Type I | 16 | 16 | 4" Concrete Slidewalk Per Section 504 Of Standard Specifications |
| 6 | S'd. GR-FOA-2, Fixed Object Attachment, Type II | 17 | 17 | S'd. GR-8, Guardrail (Weak Post) |
| 7 | S'd. MB-5, W-Beam Median Barrier, Weak Post | 17A | 17A | S'd. GR-8A, Guardrail (Weak Post) |
| 8 | Modified MB-7D, Concrete Median Barrier | 18 | 18 | Modified MB-8A, Type I Conc. Med. Barrier, See Sht. DE-02 |
| 9 | Modified MB-7E, Concrete Median Barrier | 19 | 19 | S'd. MB-8A, Type II Conc. Med. Barrier |
| 10 | Modified MB-7F, Concrete Median Barrier | 20 | 20 | S'd. MB-8A, Type III Conc. Med. Barrier |
| 11 | Modified MB-8A Conc. Median Barrier, Ty. III, See Sheet DE-02 | 21 | 21 | S'd. CG-6, Comb. 6" Curb & Gutter |
| | | 22 | 22 | S'd. GR-11, Guardrail Terminal |

PAVEMENT LEGEND

- | | |
|--|--------------------------------|
| | PROPOSED FULL DEPTH PAVING |
| | PROPOSED RESURFACING |
| | FLEXIBLE PAVEMENT PLANING AREA |
| | PAVEMENT REMOVAL |


REVISIONS
9/3/5/08: REVISED SHEET - SEE SHEET 1C
7/5/22/07: REVISED SHEET - SEE SHEET 1C
5/3/27/07: REVISED SHEET - SEE SHEET 1B
3/10/17/06: REVISED SHEET - SEE SHEET 1B
2/7/20/06: SEE SHEET 1B
1/6/23/06: SEE SHEET 1A
ADDENDUM NO. 2: 5/17/06: REPLACED SHEET

RM RICHMOND METROPOLITAN AUTHORITY
RICHMOND EXPRESSWAY SYSTEM


HNTB
9175 GUILFORD ROAD, SUITE 100
COLUMBIA, MARYLAND 21046
(301) 543-1000

**POWHITE PARKWAY EXPRESS
TOLL LANES PROJECT**
ROADWAY PAVEMENT PLAN
STA. 458+50 TO STA. 472+65
CONSTR. POWHITE PARKWAY SB

Scale: 1" = 50'	Date: 3/06/08	Contract No.: PEL-2006	Sheet: 60 of 161
--------------------	------------------	---------------------------	---------------------

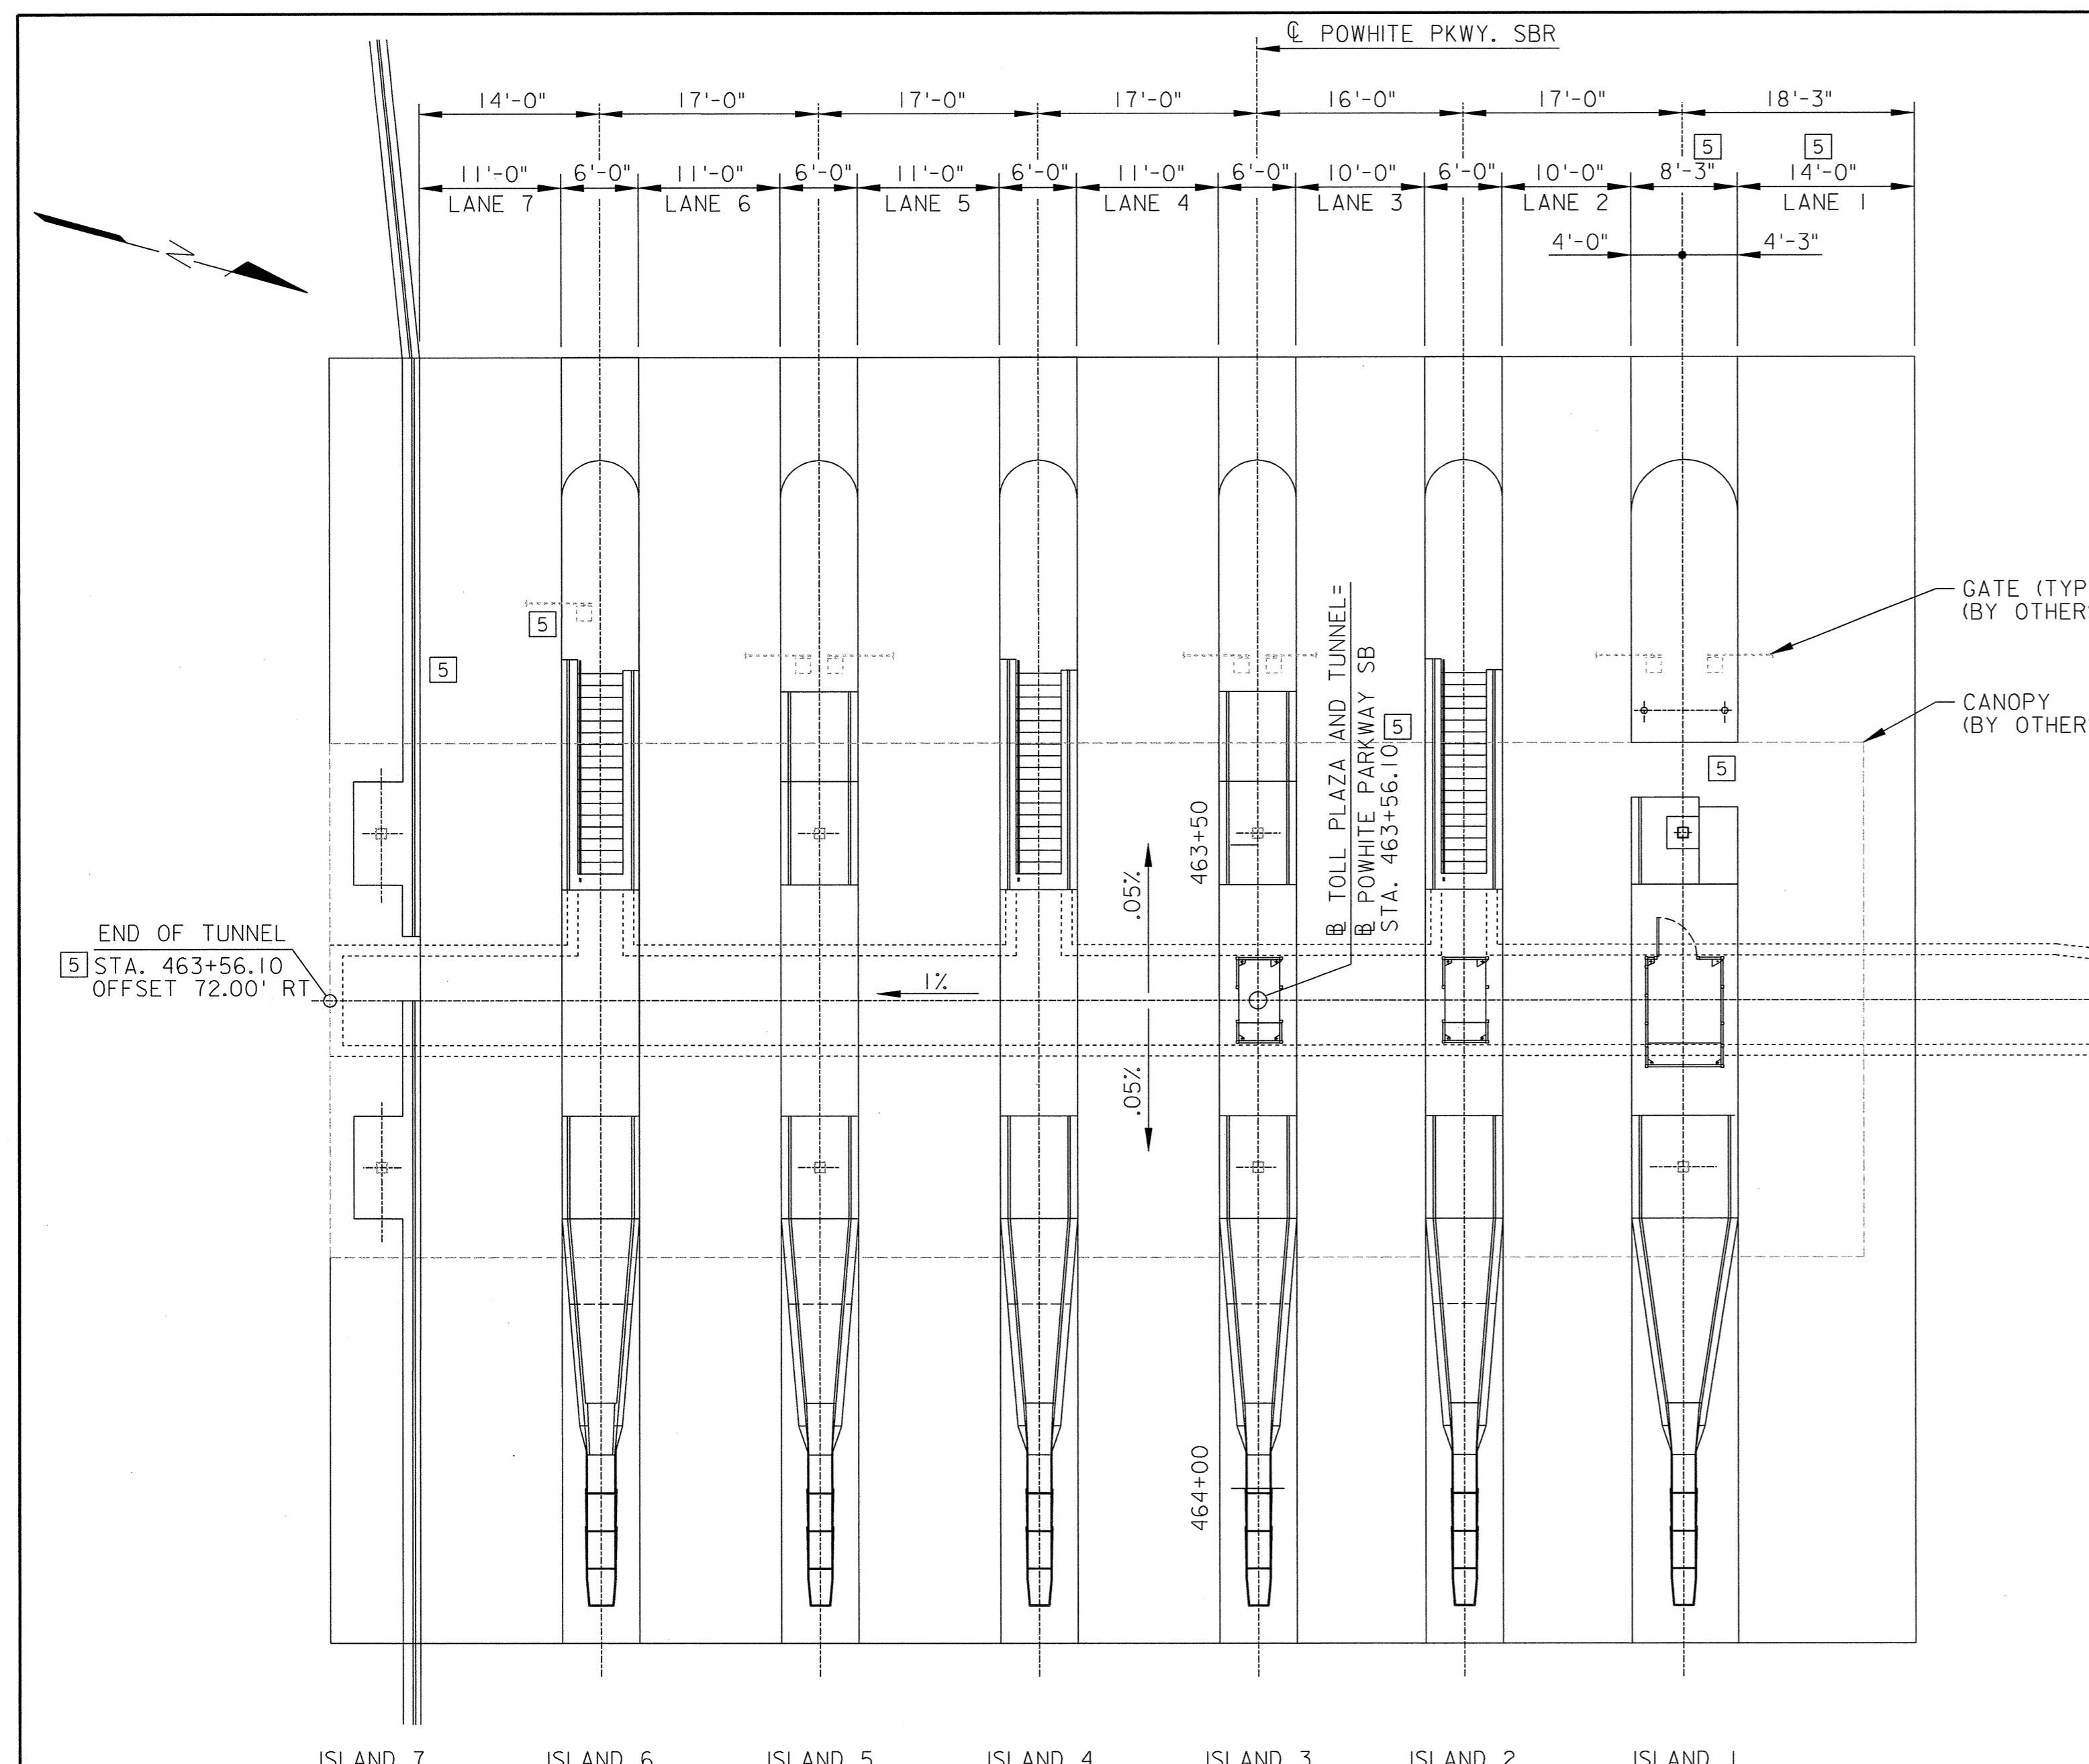

PLAN OF TOLL PLAZA
SCALE: 1" = 10'-0"

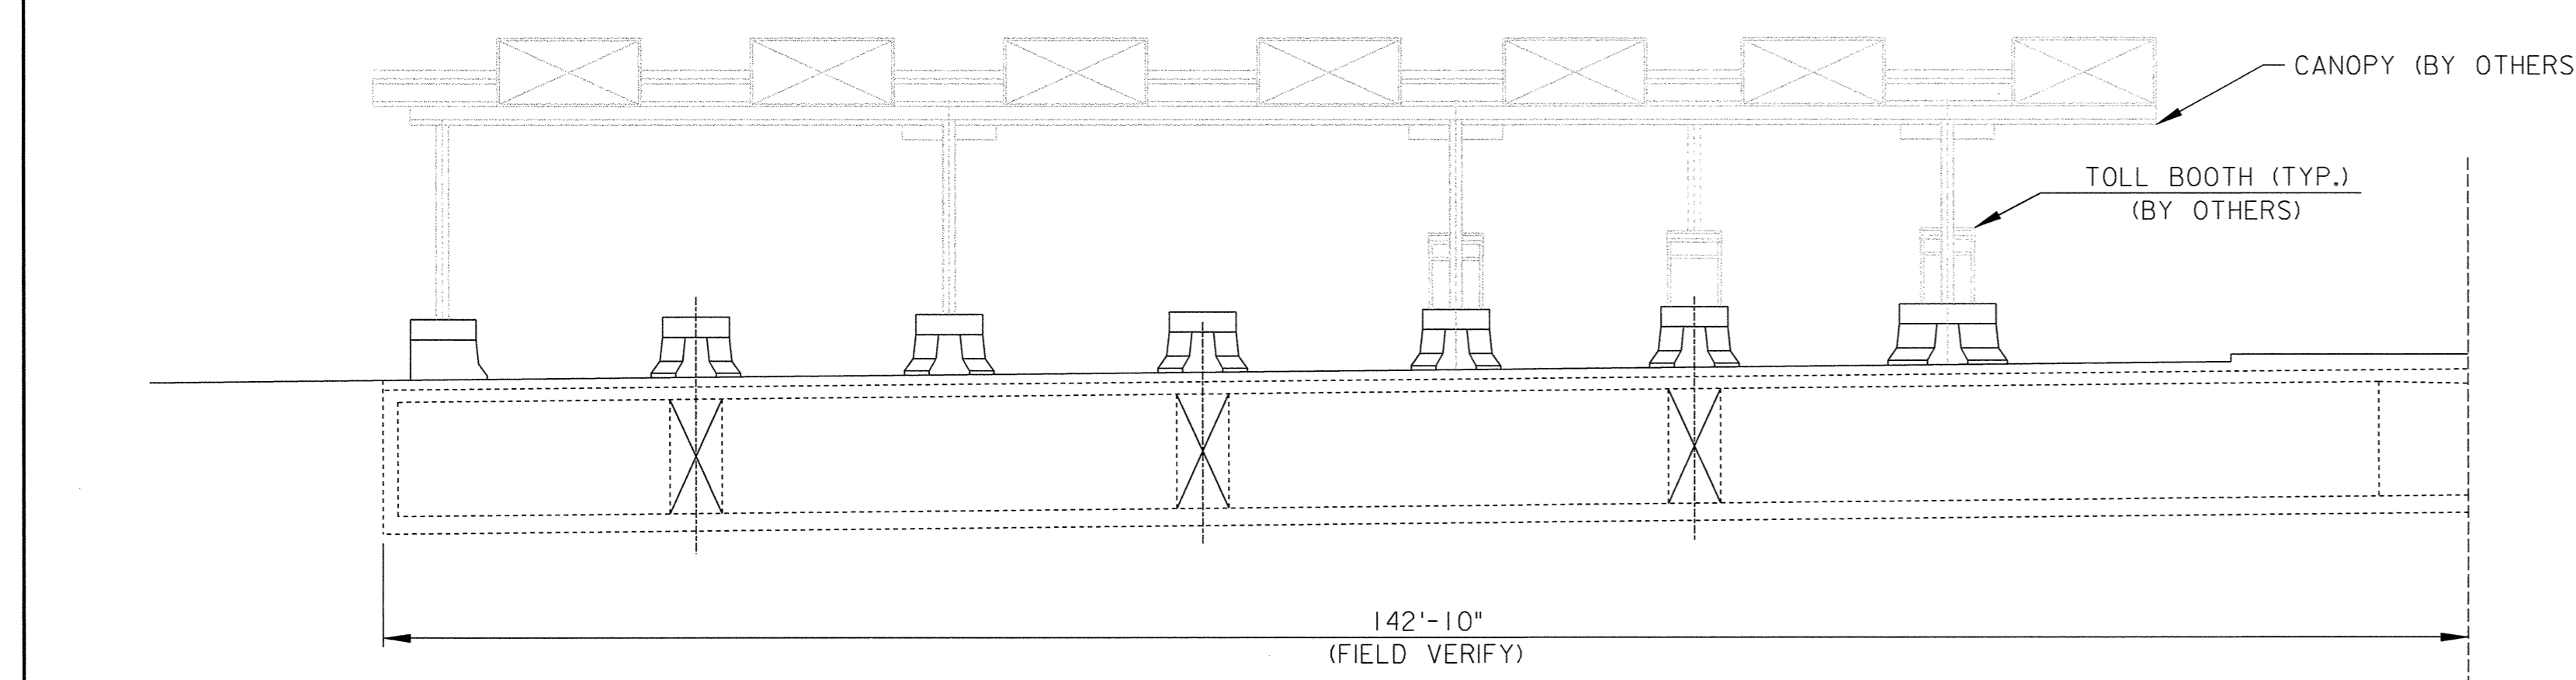

ELEVATION OF TOLL PLAZA
SCALE: 1" = 10'-0"

REVISIONS	
5	3/27/07: REVISED ISLANDS 1, 6 & 7
2	7/20/06: REVISED SHEET SIZE AND TITLE BLOCK
1	6/23/06: ADDED SHEET

SPECIFICATIONS:
 CONSTRUCTION - VIRGINIA DEPARTMENT OF TRANSPORTATION, ROAD AND BRIDGE SPECIFICATIONS, 2002
 DESIGN - 2002 (17TH EDITION) AASHTO STANDARD SPECIFICATIONS FOR HIGHWAY BRIDGES, WITH INTERIMS THROUGH 2004

DESIGN LOADS:
 ROOF LIVE LOAD 20 PSF
 WIND 40 PSF
 FLAT ROOF SNOW LOAD 20 PSF

DESIGN STRENGTHS:
 CONCRETE FC= 3000 PSI
 REINF. STEEL FY= 60 KSI

STRUCTURAL STEEL MATERIAL SPECIFICATIONS:
 WIDE FLANGE SHAPES, ASTM A992
 CHANNELS, ANGLES AND PLATES ASTM A36
 STRUCTURAL TUBING AND PIPE ASTM A500, GRADE C
 HIGH STRENGTH BOLTS ASTM A325X
 ANCHOR BOLTS ASTM F1554, GRADE 55
 HARDENED STEEL WASHERS ASTM F436

GENERAL NOTES:

ALL SHOP CONNECTIONS SHALL BE WELDED AND ALL FIELD CONNECTIONS SHALL BE BOLTED.

ALL STRUCTURAL STEEL SHALL BE HOT-DIP GALVANIZED PER ASTM A123, UNLESS OTHERWISE NOTED. ALL BOLTS, ANCHOR BOLTS, WASHERS AND NUTS SHALL BE HOT-DIP GALVANIZED PER ASTM A153. THE LOWER CANOPY FRAMING STEEL SHALL BE PAINTED. SEE SPECIAL PROVISIONS.

ALL METAL ROOF DECK SHALL BE 3", 22 GAGE, WIDE RIB TYPE B, GALVANIZED, WITH THE MINIMUM PROPERTIES DEFINED BY THE STEEL DECK INSTITUTE (SDI).

7/8" DIAMETER BOLTS SHALL BE USED FOR THE CANOPY STRUCTURE AND 3/4" DIAMETER BOLTS FOR ROOF SCREEN STRUCTURES.

ALL SHOP AND FIELD WELDING SHALL BE PERFORMED BY QUALIFIED WELDERS IN ACCORDANCE WITH AWS D1.1-2002 USING E70XX ELECTRODES.

ALL HOLES REQUIRED IN STRUCTURAL STEEL MEMBERS FOR PIPING AND DUCTWORK SHALL BE SHOWN ON THE SHOP DRAWINGS AND BE MADE IN THE SHOP. NO HOLES SHALL BE CUT IN THE FIELD WITHOUT APPROVAL OF THE ARCHITECT/ENGINEER.

ALL BOLTED CONNECTIONS SHALL BE BEARING TYPE, NON SLIP-CRITICAL, TIGHTENED TO A "SNUG-TIGHT CONDITION" AS DEFINED BY AISC.

THE FRAME OF THE STEEL SKELETON SHALL BE CARRIED UP TRUE AND PLUMB AND TEMPORARY BOLTING AND BRACING SHALL BE INTRODUCED TO SAFELY CARRY ALL LOADS TO WHICH THE STRUCTURE MAY BE SUBJECTED, INCLUDING EQUIPMENT AND OPERATION OF SAME. INDIVIDUAL COLUMNS MUST BE BRACED BEFORE BEAM CONNECTIONS ARE MADE AND BRACING SHALL BE LEFT IN PLACE AS LONG AS MAY BE REQUIRED FOR SAFETY.

AFTER COMPLETION OF ERECTION, THE OWNER SHALL ENGAGE AN INDEPENDENT TESTING AGENCY TO INSPECT HIGH STRENGTH BOLTED CONNECTIONS, TO PERFORM TESTS, AND TO PREPARE TEST REPORTS. THE TESTING AGENCY SHALL CONDUCT AND INTERPRET TESTS AND STATE IN EACH REPORT WHETHER THE TEST RESULTS COMPLY WITH THE REQUIREMENTS AND SPECIFICALLY STATE ANY DEVIATIONS THERE FROM. THE TESTING SHALL CONFORM TO THE REQUIREMENTS FOUND IN THE AISC "SPECIFICATION FOR STRUCTURAL JOINTS USING ASTM A325 AND A490 BOLTS", DATED JUNE 2000, WITH SUPPLEMENTS. BOLTS THAT ARE NEITHER NON SLIP CRITICAL NOR SUBJECT TO DIRECT TENSION NEED NOT BE INSPECTED FOR BOLT TENSION OTHER THAN TO INSURE THAT THE PLIES OF THE CONNECTED ELEMENT HAVE BEEN BROUGHT INTO SNUG CONTACT. THE INDEPENDENT TESTING AGENCY SHALL SUBMIT THE INTENDED TEST PROCEDURES TO THE STRUCTURAL ENGINEER FOR REVIEW PRIOR TO BEGINNING TESTING.

FOUNDATIONS
 FOUNDATIONS FOR THIS STRUCTURE AND SPREAD FOOTINGS BEARING ON EITHER FIRM VIRGIN SOIL OR COMPACTED STRUCTURAL FILL WITH AN ALLOWABLE BEARING CAPACITY OF 3000 PSF IN ACCORDANCE WITH THE OWNER'S GEOTECHNICAL ENGINEER'S REPORT BY FROEHLING & ROBERTSON, INC. DATED OCTOBER, 2005. THE OWNER'S GEOTECHNICAL ENGINEER SHALL VERIFY, PRIOR TO POURING, THAT THE SOIL IS CAPABLE OF SUSTAINING SUCH A LOAD.

PREPARATION OF SOIL AND SUBGRADE BENEATH FOOTINGS AND SLABS ON GRADE SHALL BE IN ACCORDANCE WITH THE RECOMMENDATIONS OF THE OWNER'S GEOTECHNICAL ENGINEER'S REPORT AND THE PROJECT SPECIFICATIONS.

ALL BACKFILL BEHIND TUNNEL WALLS SHALL BE IN ACCORDANCE WITH THE RECOMMENDATIONS OF THE OWNER'S GEOTECHNICAL ENGINEER'S REPORT AND THE PROJECT SPECIFICATIONS.

ALL WALLS SUBJECT TO LATERAL LOAD DUE TO UNBALANCED FILL SHALL BE BRACED PLUMB UNTIL BACKFILL HAS BEEN PLACED AND COMPACTED AND SHALL REMAIN BRACED UNTIL THE PERMANENT STRUCTURE ABOVE AND BELOW IS IN PLACE AND CAPABLE OF RESISTING ALL LOADS.

THE CONTRACTOR SHALL VERIFY ALL FIELD MEASUREMENTS, EXISTING DIMENSION, ELEVATIONS, AND THE SHAPES OF SIZES OF EXISTING STRUCTURAL MEMBERS SHOWN ON THE CONTRACT DRAWINGS PRIOR TO BEGINNING WORK. THE ARCHITECT/ENGINEER SHALL BE NOTIFIED IN WRITING OF ALL DISCREPANCIES THAT WOULD RESULT IN REVISIONS TO THE CONTRACT DRAWINGS.

THE CONTRACTOR SHALL VERIFY ALL DRAWINGS FOR COORDINATION BETWEEN TRADES. HE SHALL LOCATE SLOTS, SLEEVES AND TRENCHES AS REQUIRED FOR MECHANICAL TRADES AND PROVIDE AND INSTALL ANCHORS, INSERTS, HANGERS, ETC. AS REQUIRED FOR VARIOUS OTHER TRADES.

THE CONTRACTOR SHALL BE RESPONSIBLE FOR THE DESIGN AND ERECTION OF ALL TEMPORARY BRACING, FORMWORK, SHEETING, SHORING AND UNDERPINNING NECESSARY TO PERFORM THE WORK.


THE CONTRACTOR SHALL BE RESPONSIBLE FOR ALL CONSTRUCTION MEANS, METHODS, TECHNIQUES, SEQUENCES AND PROCEDURES AND FOR SAFETY PRECAUTIONS AND PROGRAMS AS THEY RELATE TO THE WORK OF THIS PROJECT.

THE CONTRACTOR SHALL SUBMIT THE REQUIRED SHOP DRAWINGS FOR REVIEW PRIOR TO BEGINNING WORK. THE CONTRACTOR SHALL CHECK ALL DIMENSIONS AND ACCEPT FULL RESPONSIBILITY FOR DIMENSIONAL CORRECTNESS. UNDER NO CIRCUMSTANCES SHALL REPRODUCTIONS OF CONTRACT DRAWINGS BE USED AS SHOP DRAWINGS.


ALL STRUCTURAL STEEL SHOP DRAWINGS SHALL BE PREPARED UNDER THE DIRECT SUPERVISION OF PROFESSIONAL ENGINEER REGISTERED IN THE COMMONWEALTH OF VIRGINIA.

STP-101


RICHMOND METROPOLITAN AUTHORITY RICHMOND EXPRESSWAY SYSTEM			
POWHITE PARKWAY EXPRESS TOLL LANES PROJECT			
TOLL PLAZA PLAN AND ELEVATION			
	Scale: 1" = 10'	Date: 3/27/07	Contract No.: PEL-2006
	9175 GUILFORD ROAD, SUITE 100 COLUMBIA, MARYLAND 21046 (301) 543-1000	Sheets: 158B of 161	

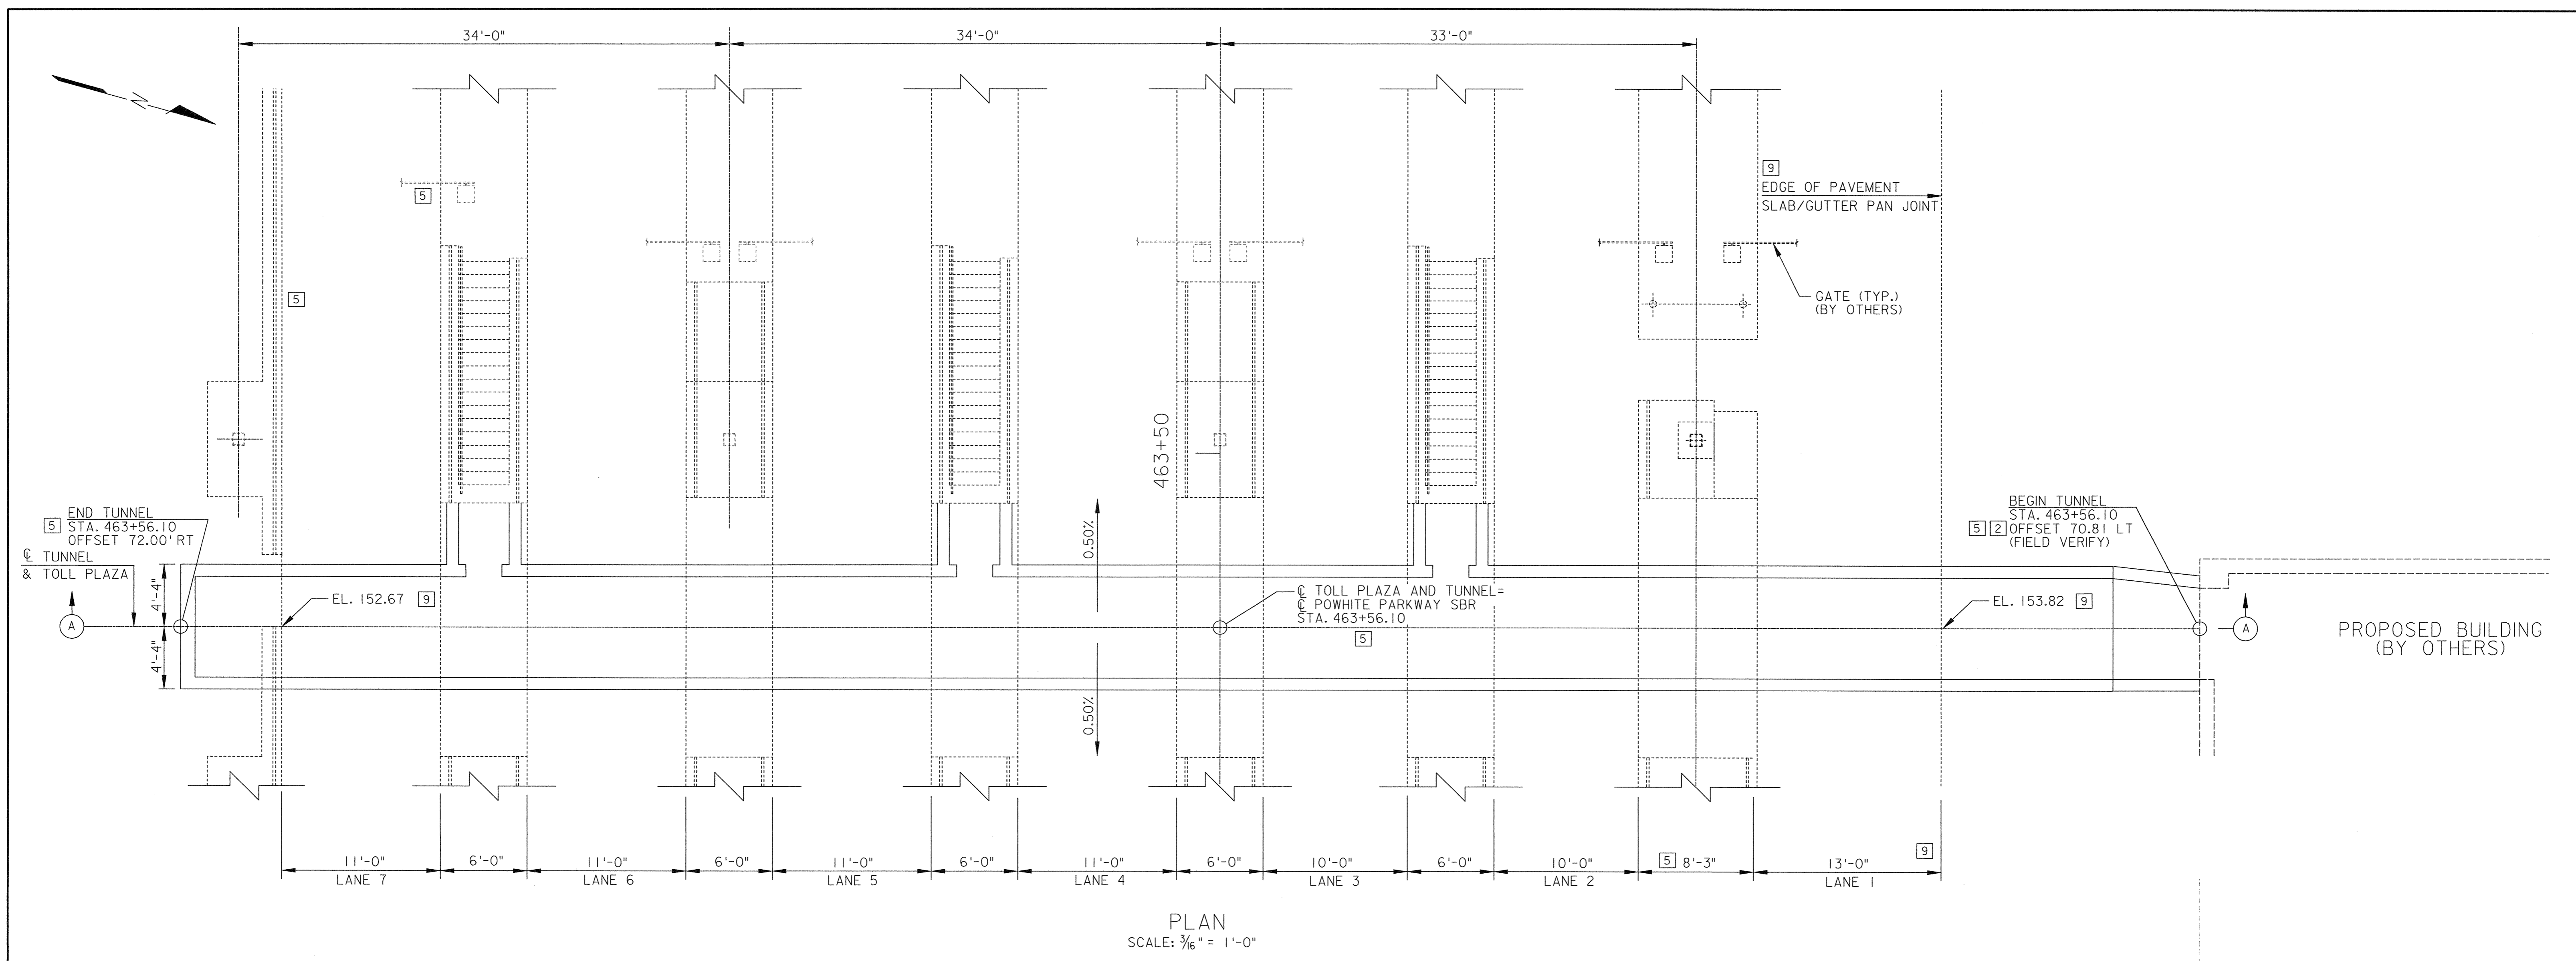


PLAN
SCALE: 3/16" = 1'-0"

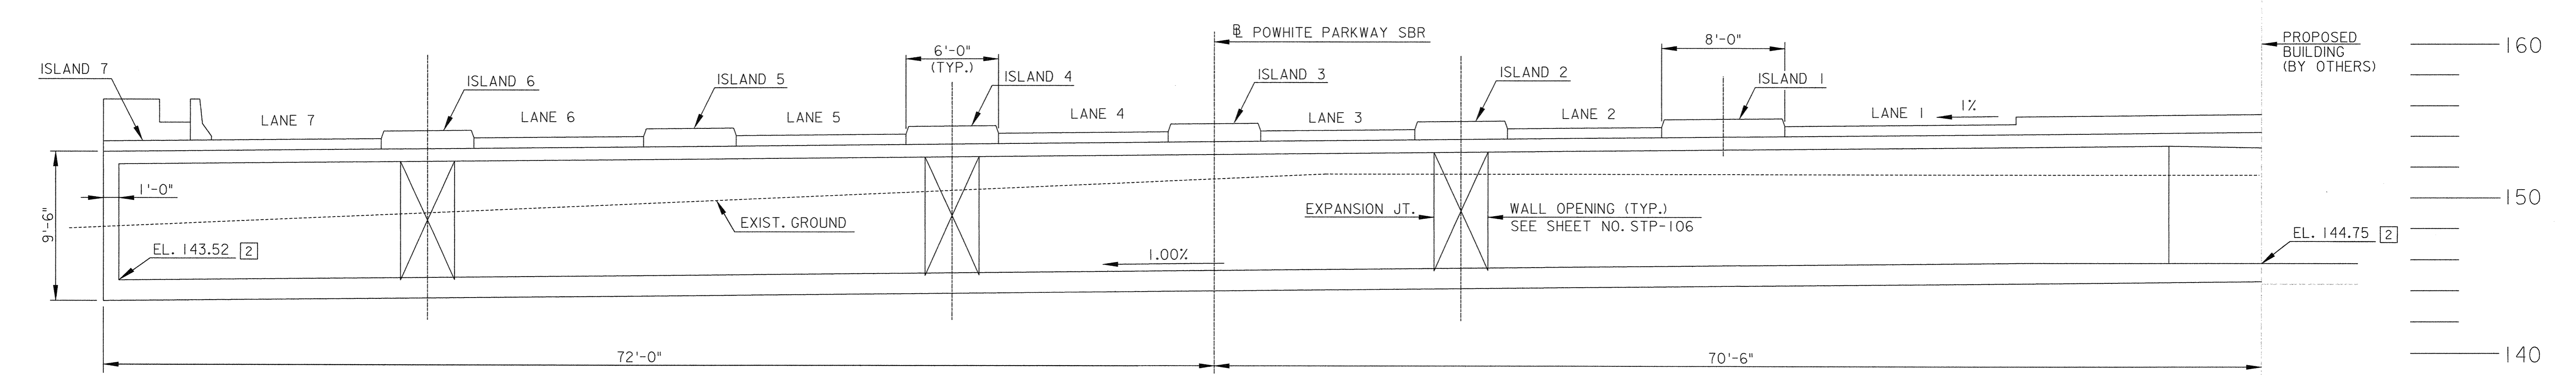

SECTION A-A
SCALE: 3/16" = 1'-0"

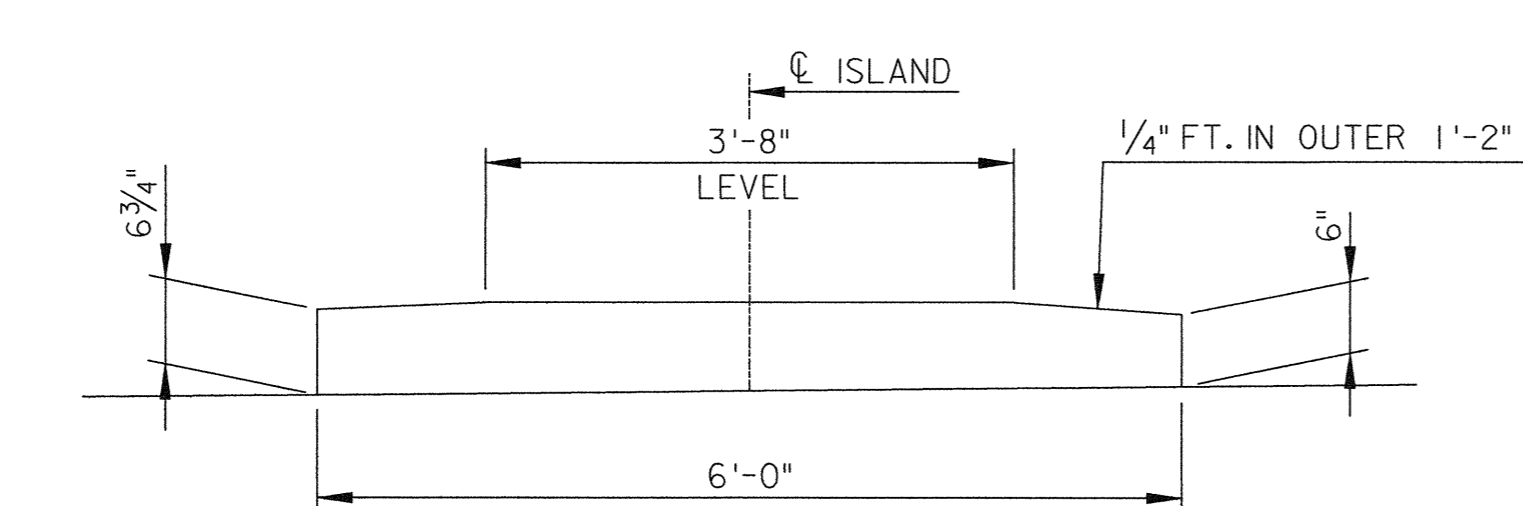

6" RAISED MEDIAN DETAILS
5 (ISLANDS 2 THRU 6)
SCALE: 3/4" = 1'-0"

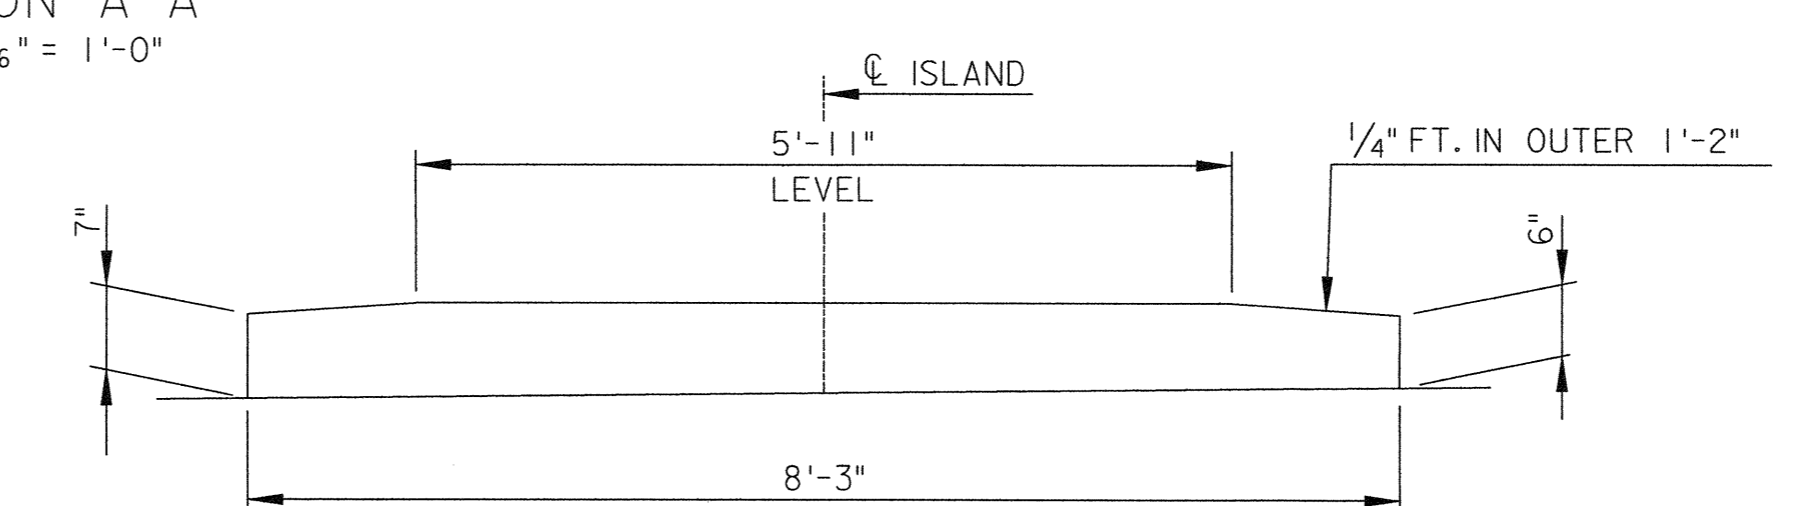

6" RAISED MEDIAN DETAILS
5 (ISLAND 1 ONLY)
SCALE: 3/4" = 1'-0"

REVISIONS	
9	3/5/08: REVISED SHEET - SEE SHEET 1C
5	3/27/07: REVISED TUNNEL LOCATION AND DETAILS
2	7/20/06: REVISED SHEET SIZE AND TITLE BLOCK
1	6/23/06: ADDED SHEET

STP-102


9175 GUILFORD ROAD, SUITE 100
COLUMBIA, MARYLAND 21046
(301) 543-1000

RICHMOND METROPOLITAN AUTHORITY
RICHMOND EXPRESSWAY SYSTEM


POWHITE PARKWAY EXPRESS
TOLL LANES PROJECT

TOLL PLAZA
TUNNEL PLAN & ELEVATION


Scale: AS SHOWN
Date: 3/06/08
Contract No.: PEL-2006
Sheet: 158C of 161

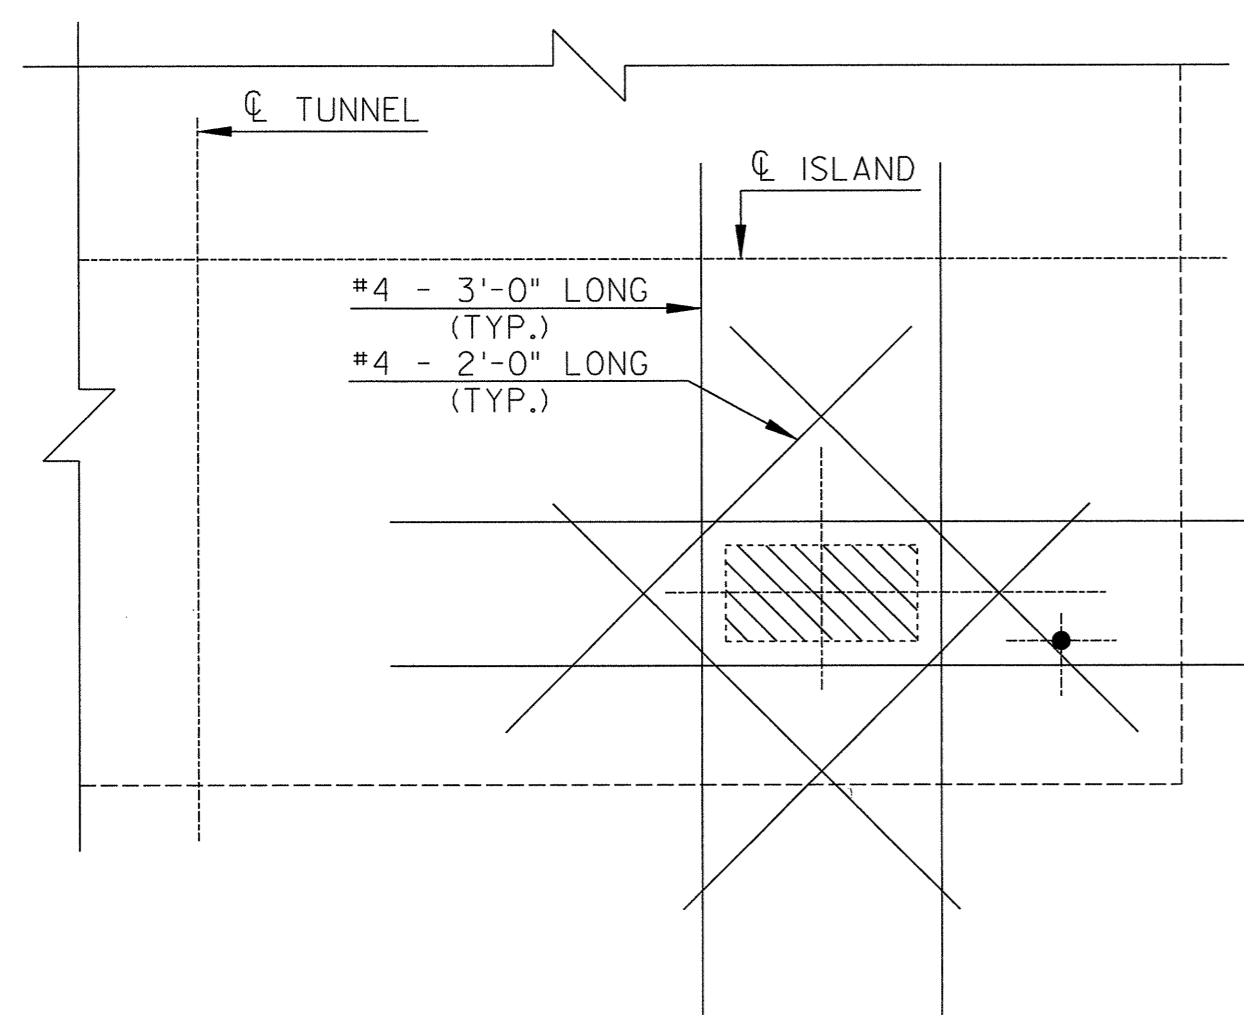


5 TYPICAL CUT OUT REINFORCEMENT DETAIL
(AT TUNNEL ROOF SLAB)
SCALE: 1/2" = 1'-0"

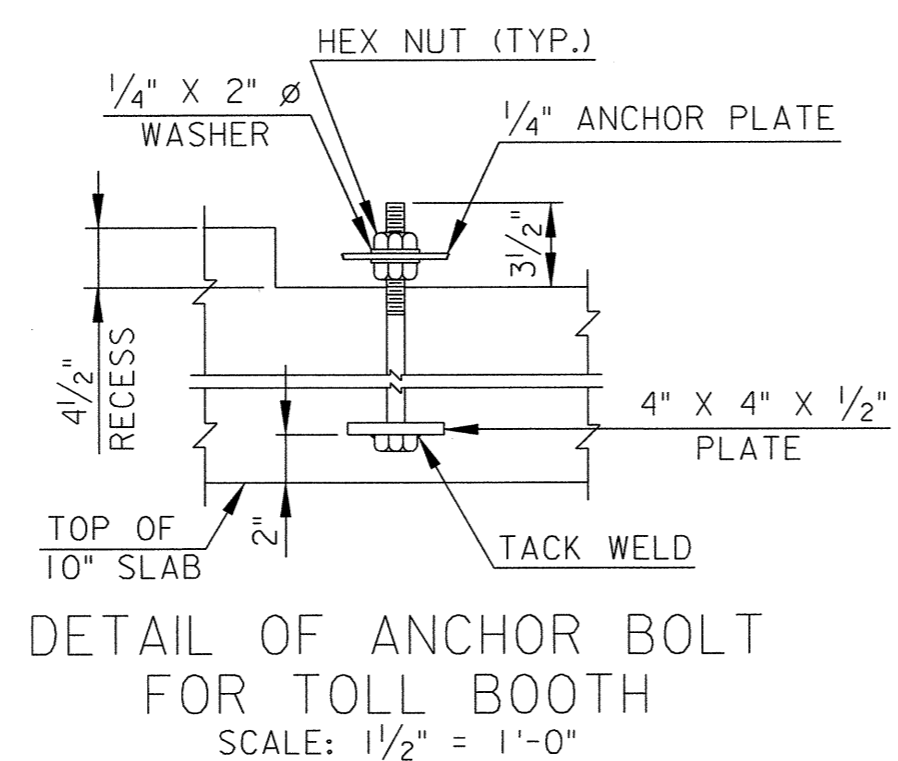


DETAIL OF ANCHOR BOLT FOR TOLL BOOTH
SCALE: 1/2" = 1'-0"

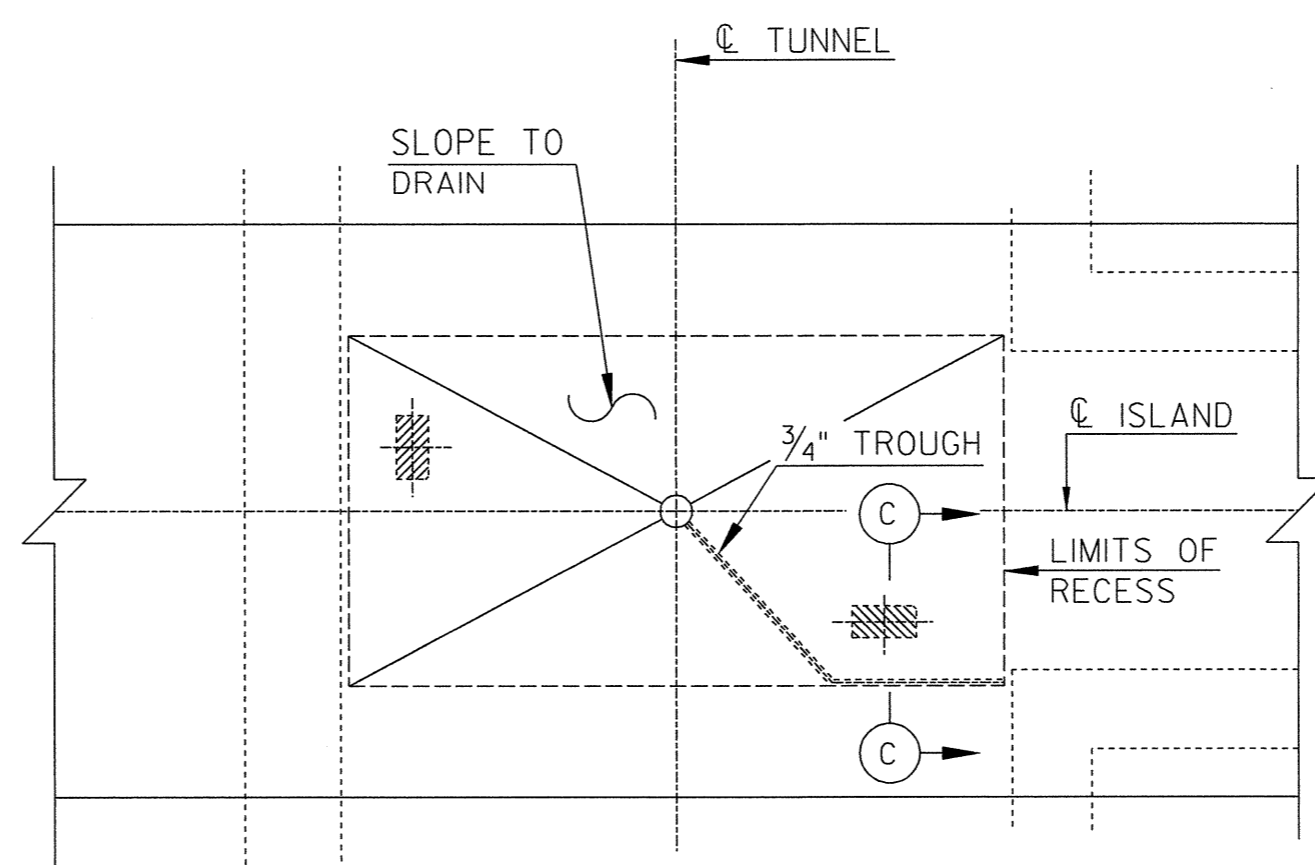


PLAN OF TOLL BOOTH DRAINAGE
SCALE: 1/2" = 1'-0"

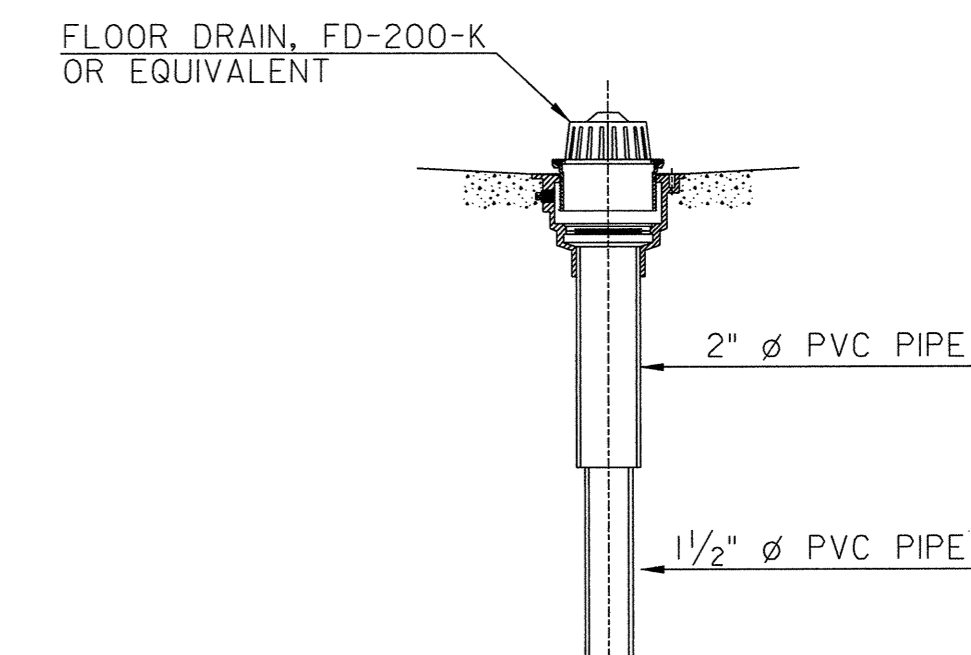


FLOOR DRAIN DETAIL
NO SCALE

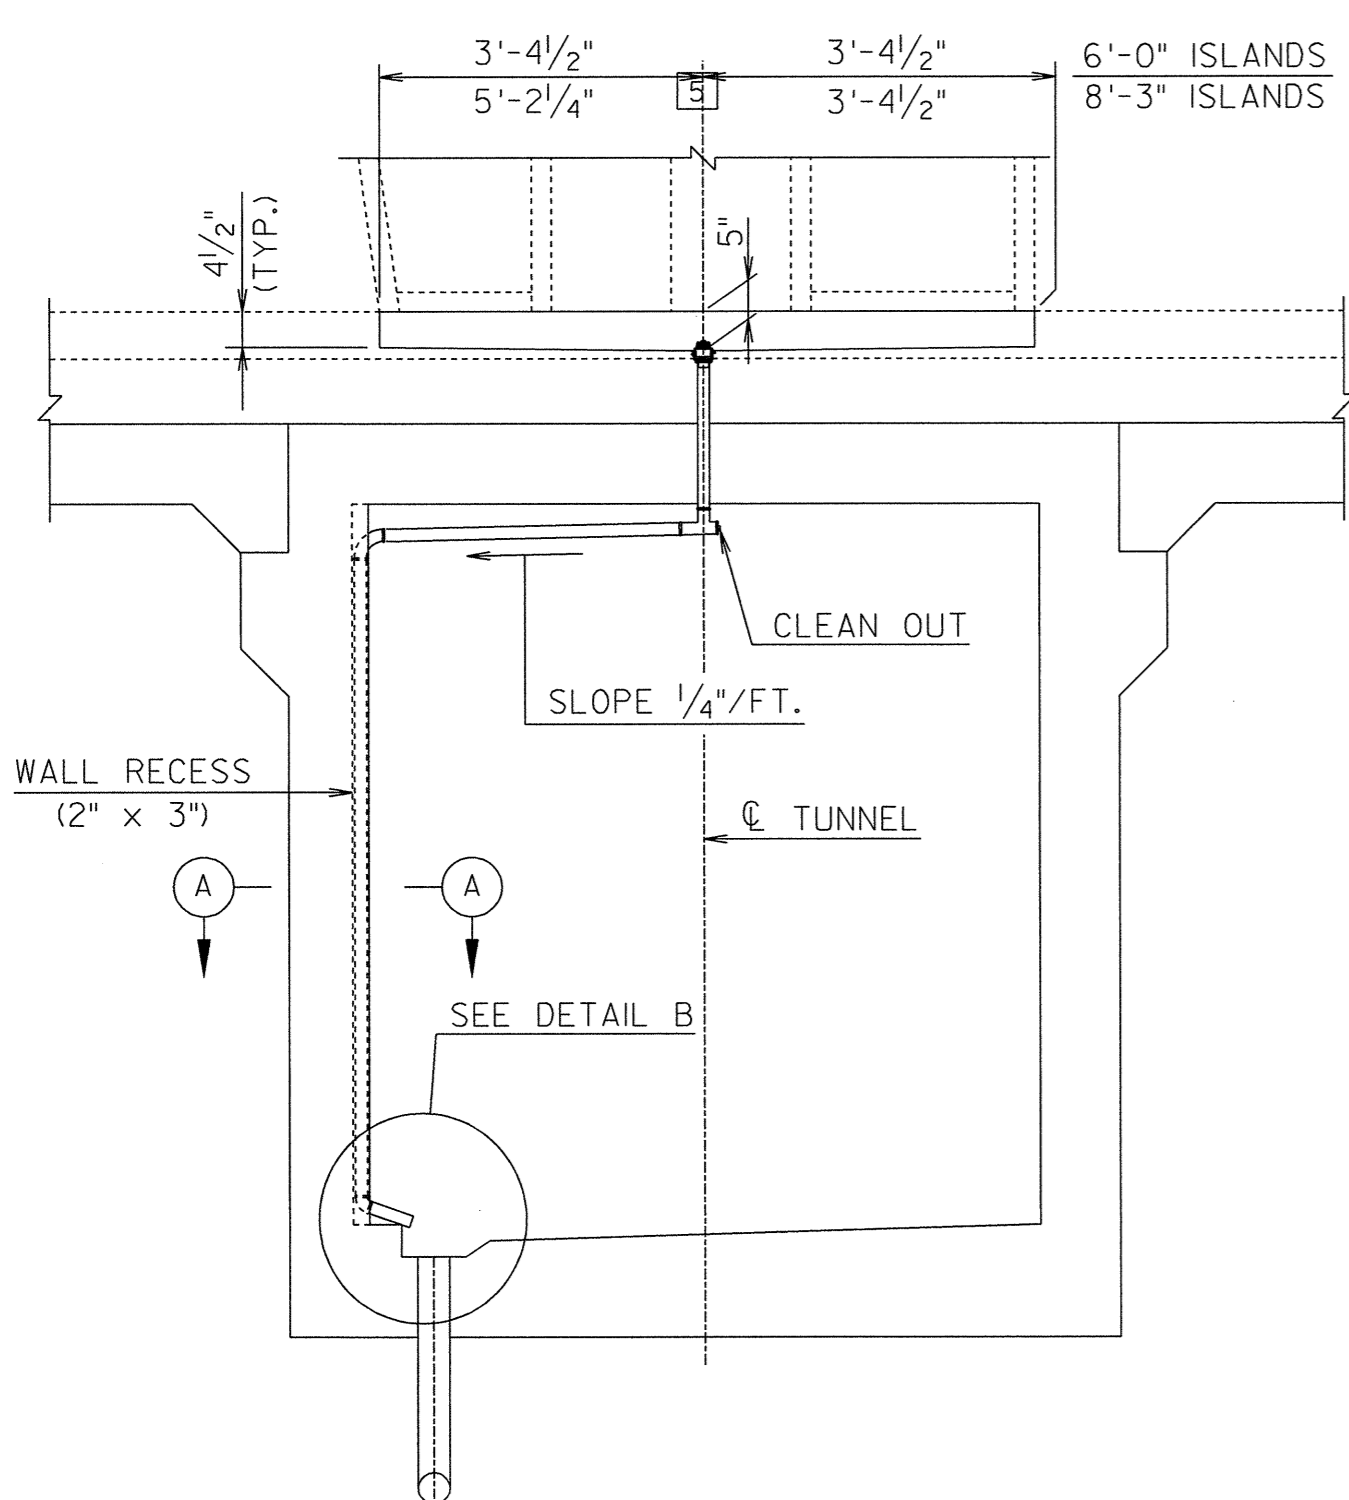


SECTION G-G
SCALE: 1/2" = 1'-0"

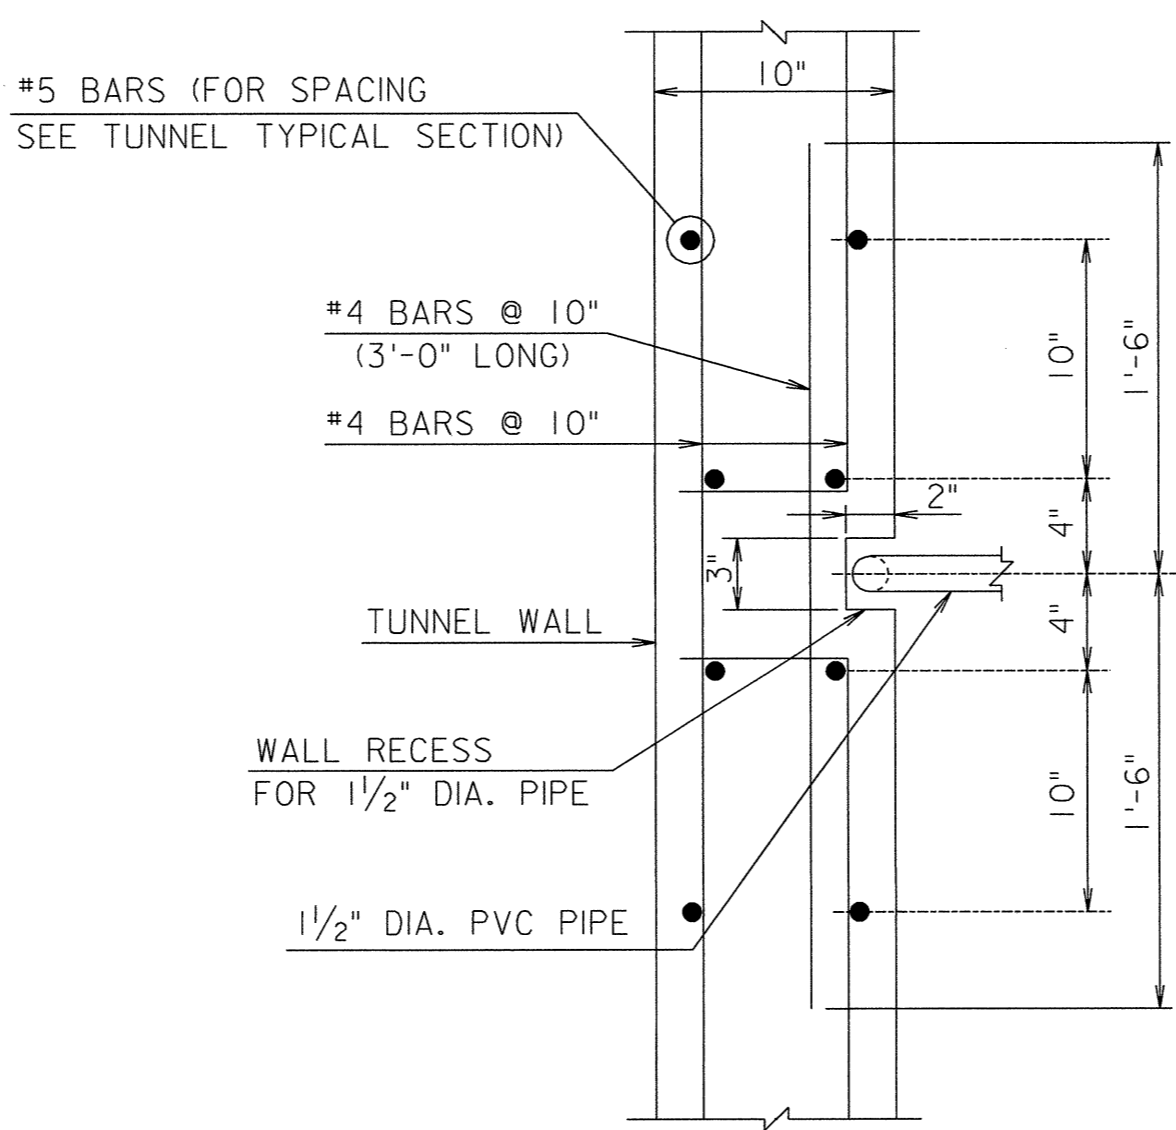

SECTION A-A
SCALE: 1/2" = 1'-0"

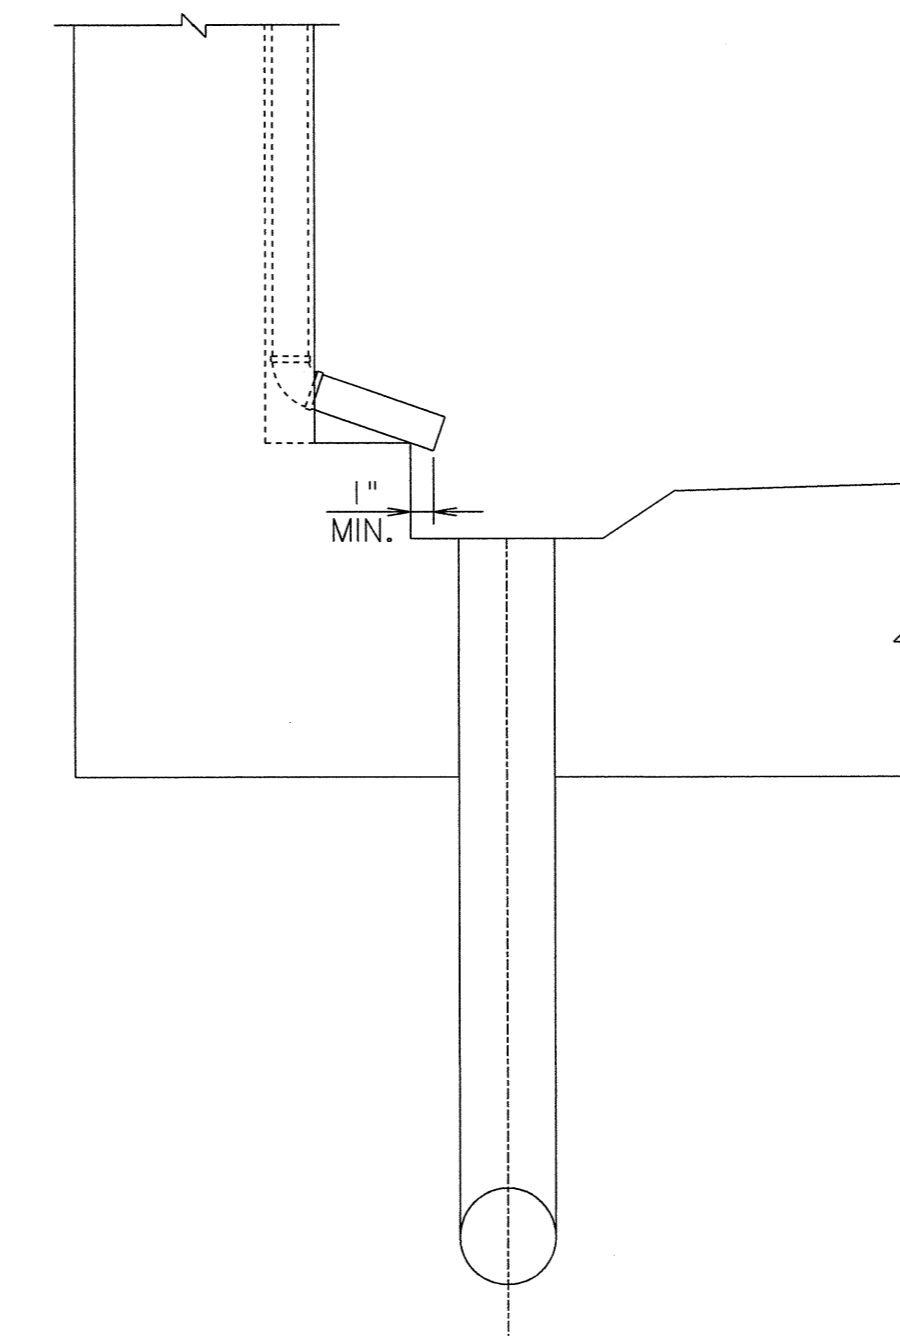

DETAIL B
SCALE: 1/2" = 1'-0"

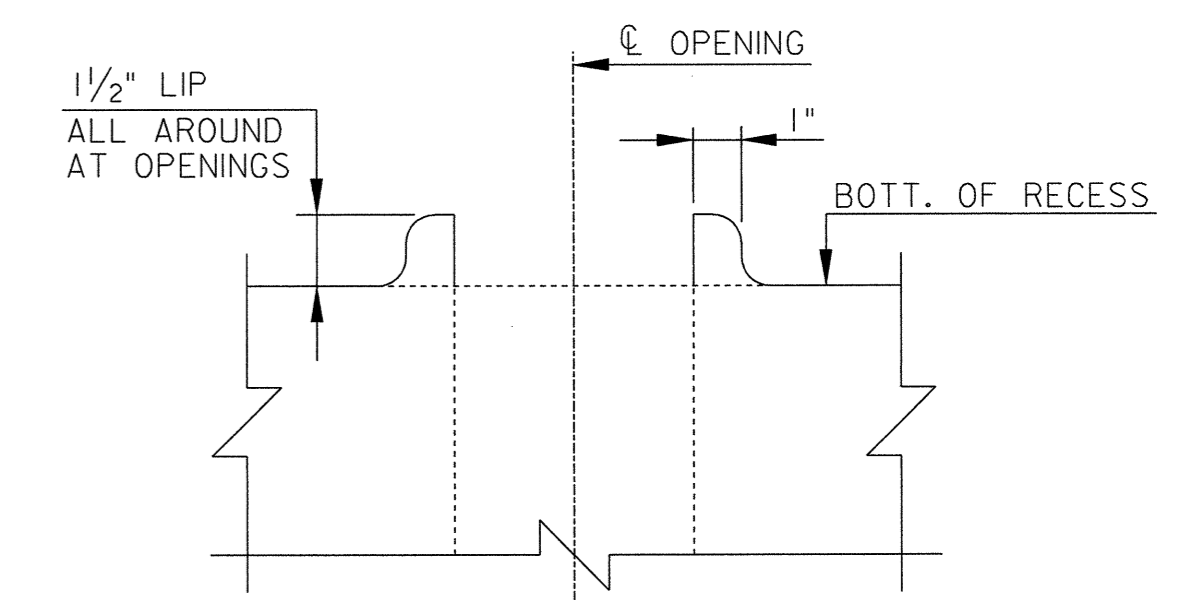

SECTION C-C
SCALE: 3" = 1'-0"

NOTE:
FOR LOCATION OF SECTION G-G,
SEE SHEET STP-103C OR STP-104A.

NO.	REVISIONS
5	3/27/07: REVISED CUT OUT DETAIL & SECT. F-F
3	10/17/06: ADDED A-A & DETAIL B; REVISED G-G
2	7/20/06: ADDED SHEET FOR DETAILS PREVIOUSLY SHOWN ON SHEET STP-103

STP-103B

RM RICHMOND METROPOLITAN AUTHORITY
RICHMOND EXPRESSWAY SYSTEM


HNTB

**POWHITE PARKWAY EXPRESS
TOLL LANES PROJECT**

TOLL PLAZA
TYPICAL DETAILS - I


9175 GUILFORD ROAD, SUITE 100
COLUMBIA, MARYLAND 21046
(301) 543-1000

Scale: AS SHOWN	Date: 3/27/07	Contract No.: PEL-2006	Sheet: 158D2 of 161
--------------------	------------------	---------------------------	------------------------

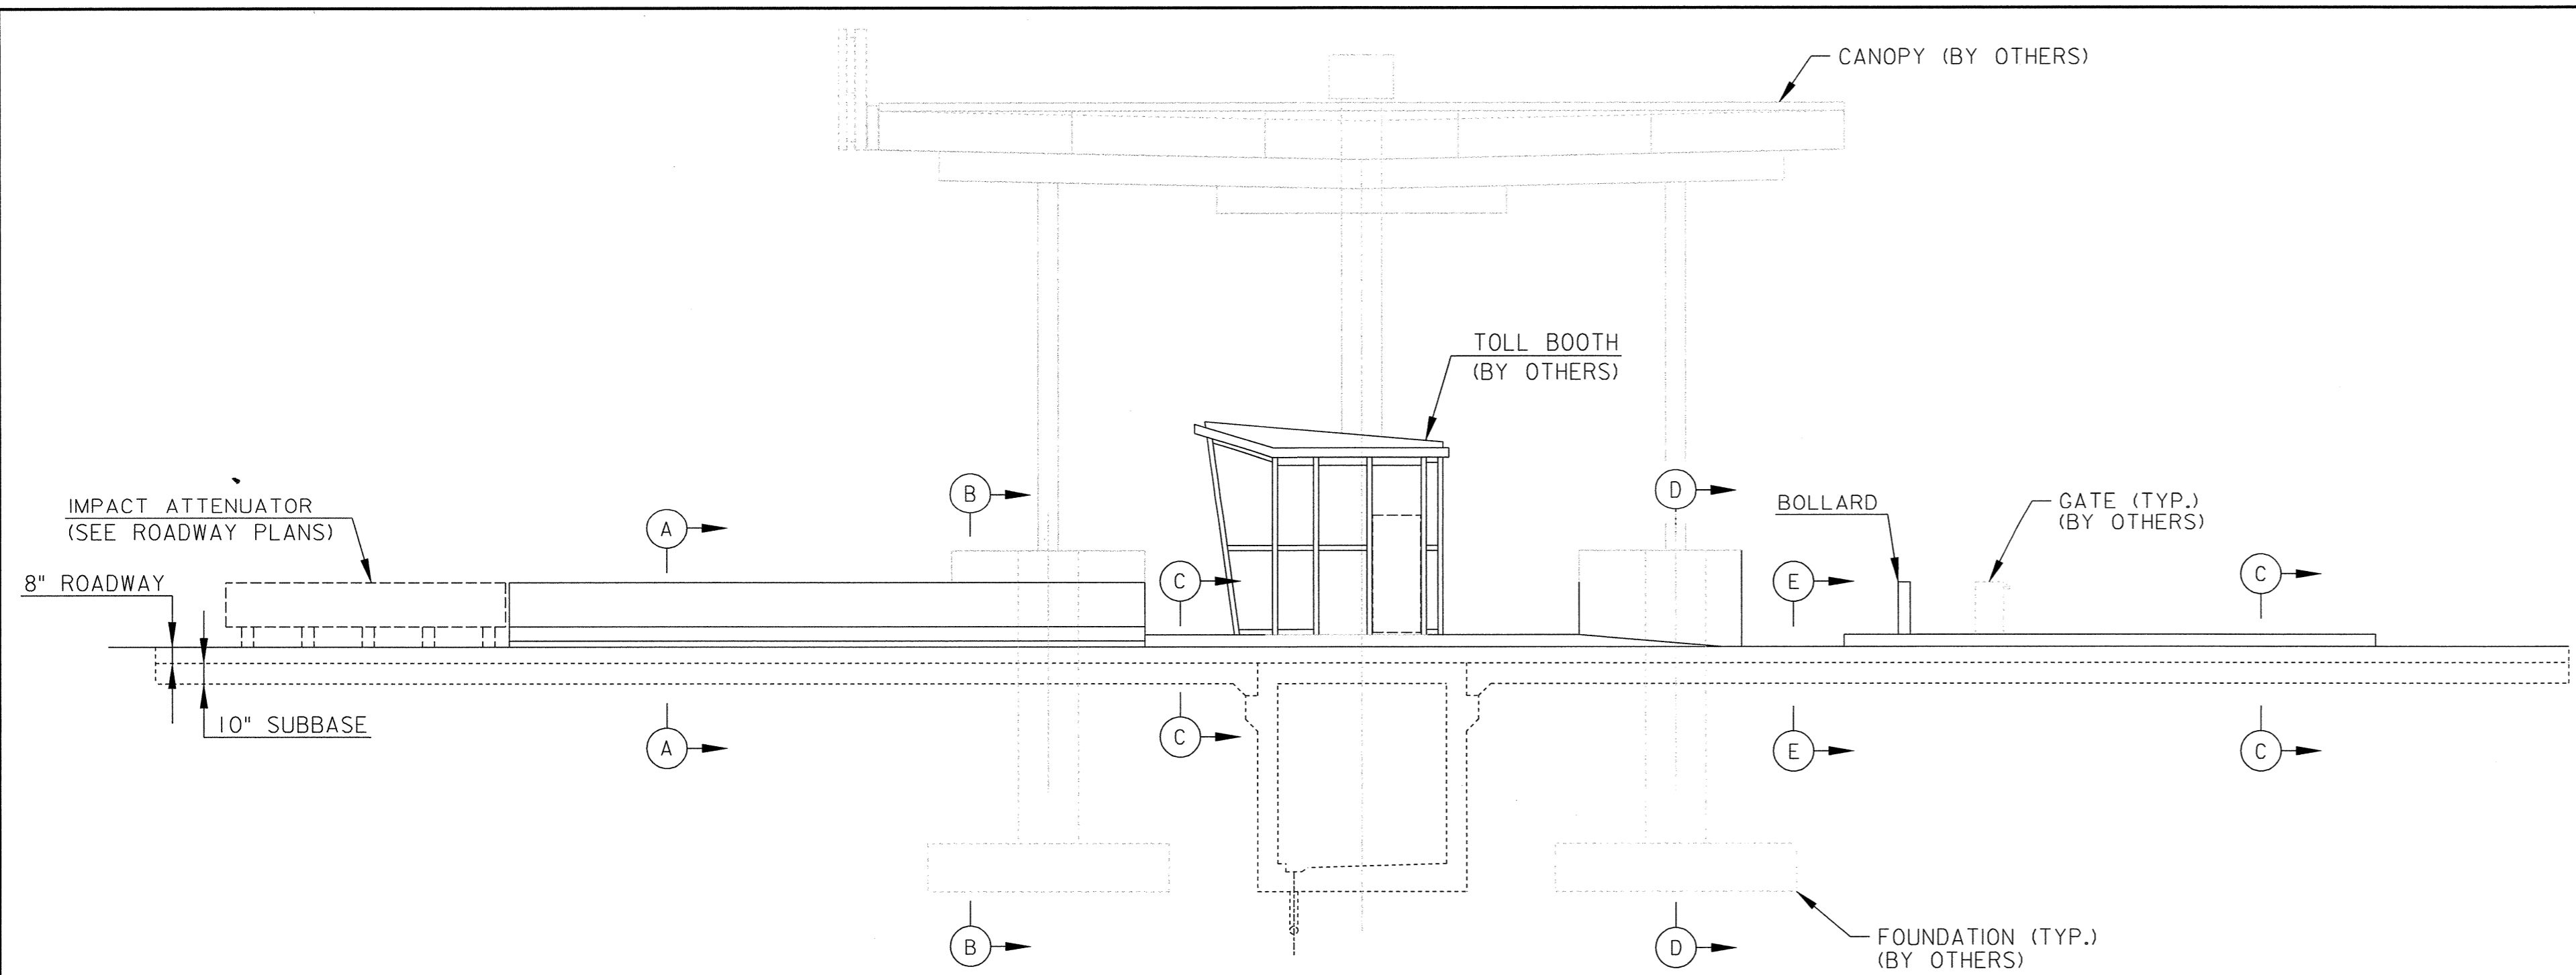


ELEVATION OF 8'-3" ISLAND
(ISLAND 1)
SCALE: 3/16" = 1'-0"


NOTE:
A TEMPLATE SHALL BE DEVELOPED BY THE CONTRACTOR
TO BE USED FOR THE ANCHOR BOLT SETTING OF BOTH
TOLL BOOTH ASSEMBLIES AND THE ACM.

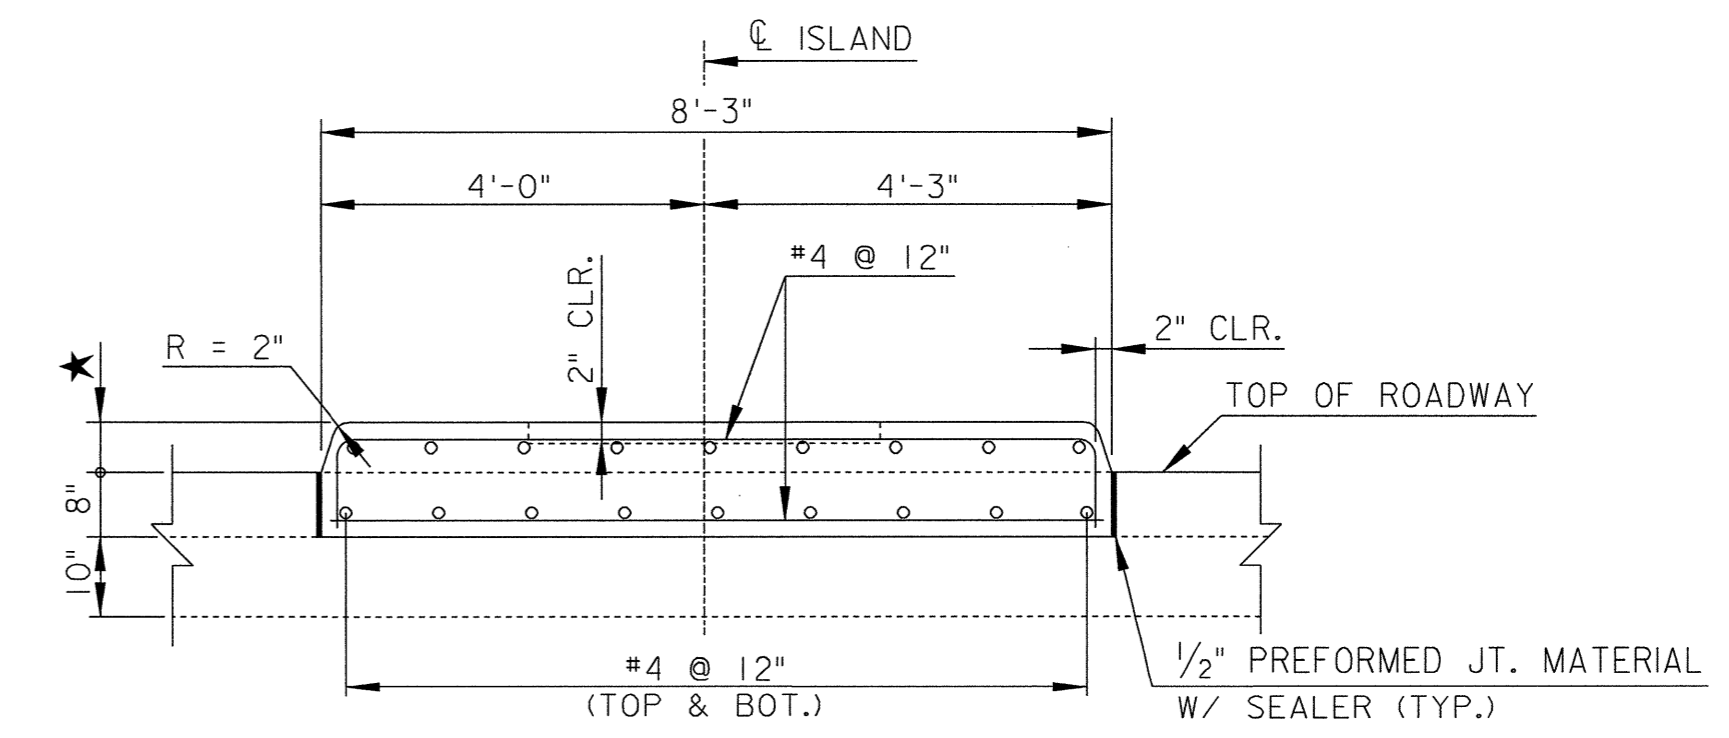


SECTION C-C
SCALE: 1/2" = 1'-0"

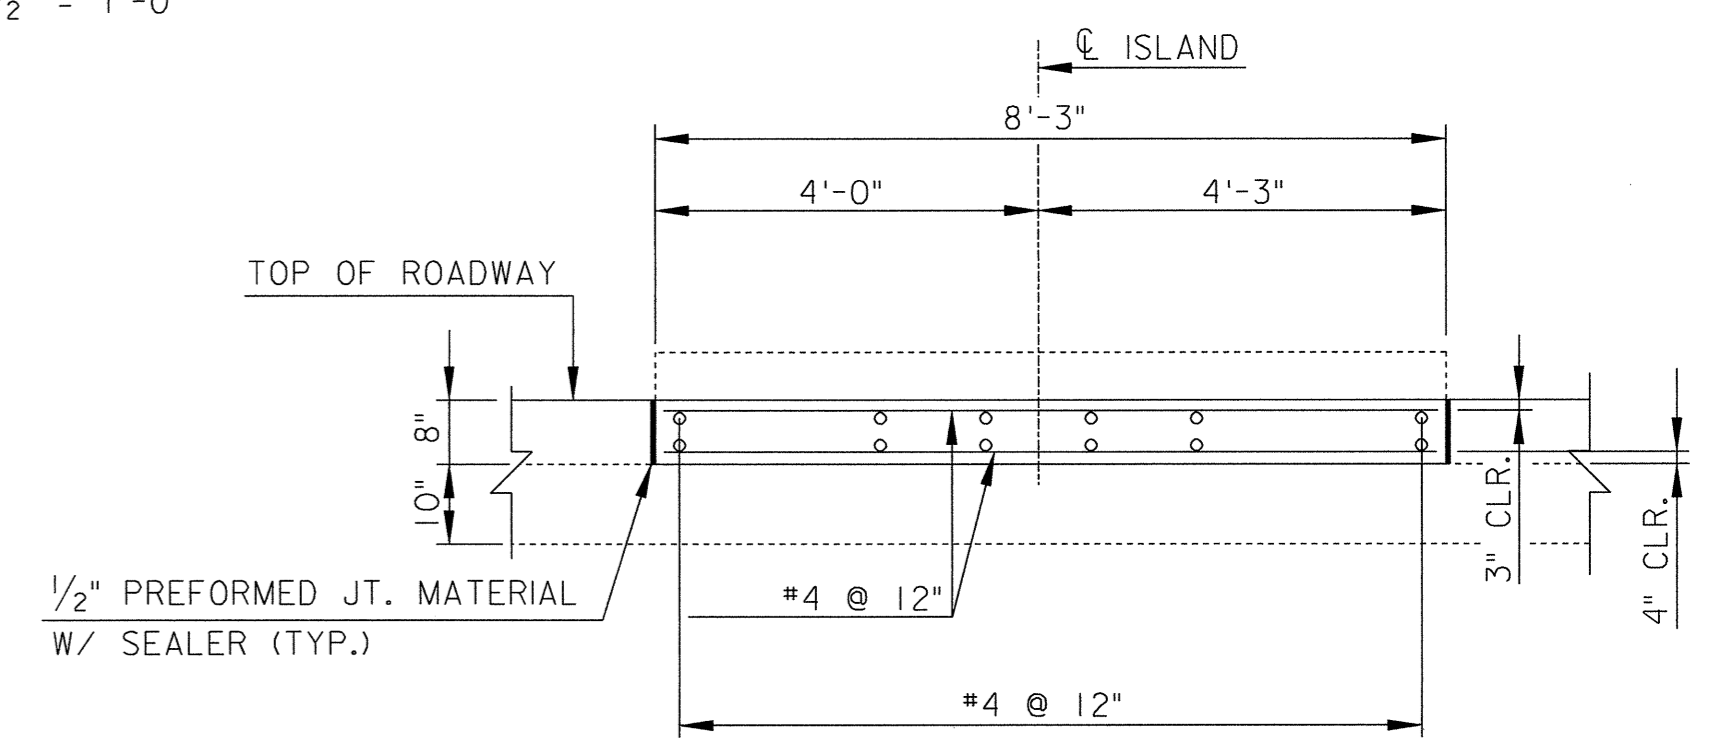


SECTION E-E
SCALE: 1/2" = 1'-0"

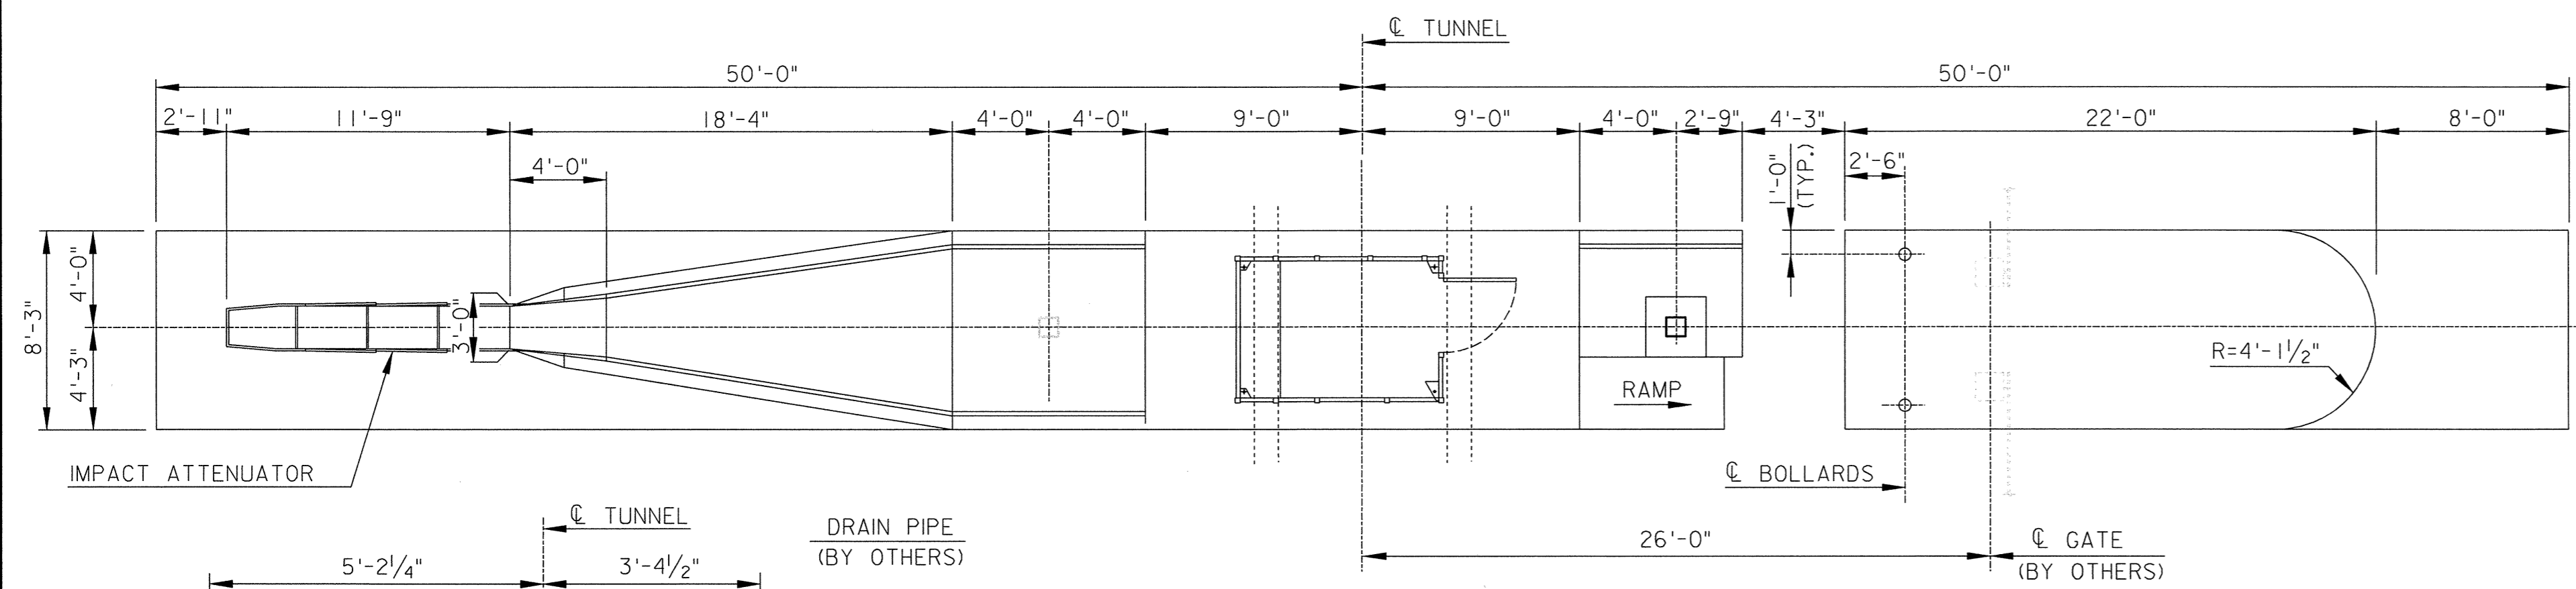


PLAN OF 8'-3" ISLAND
SCALE: 3/16" = 1'-0"

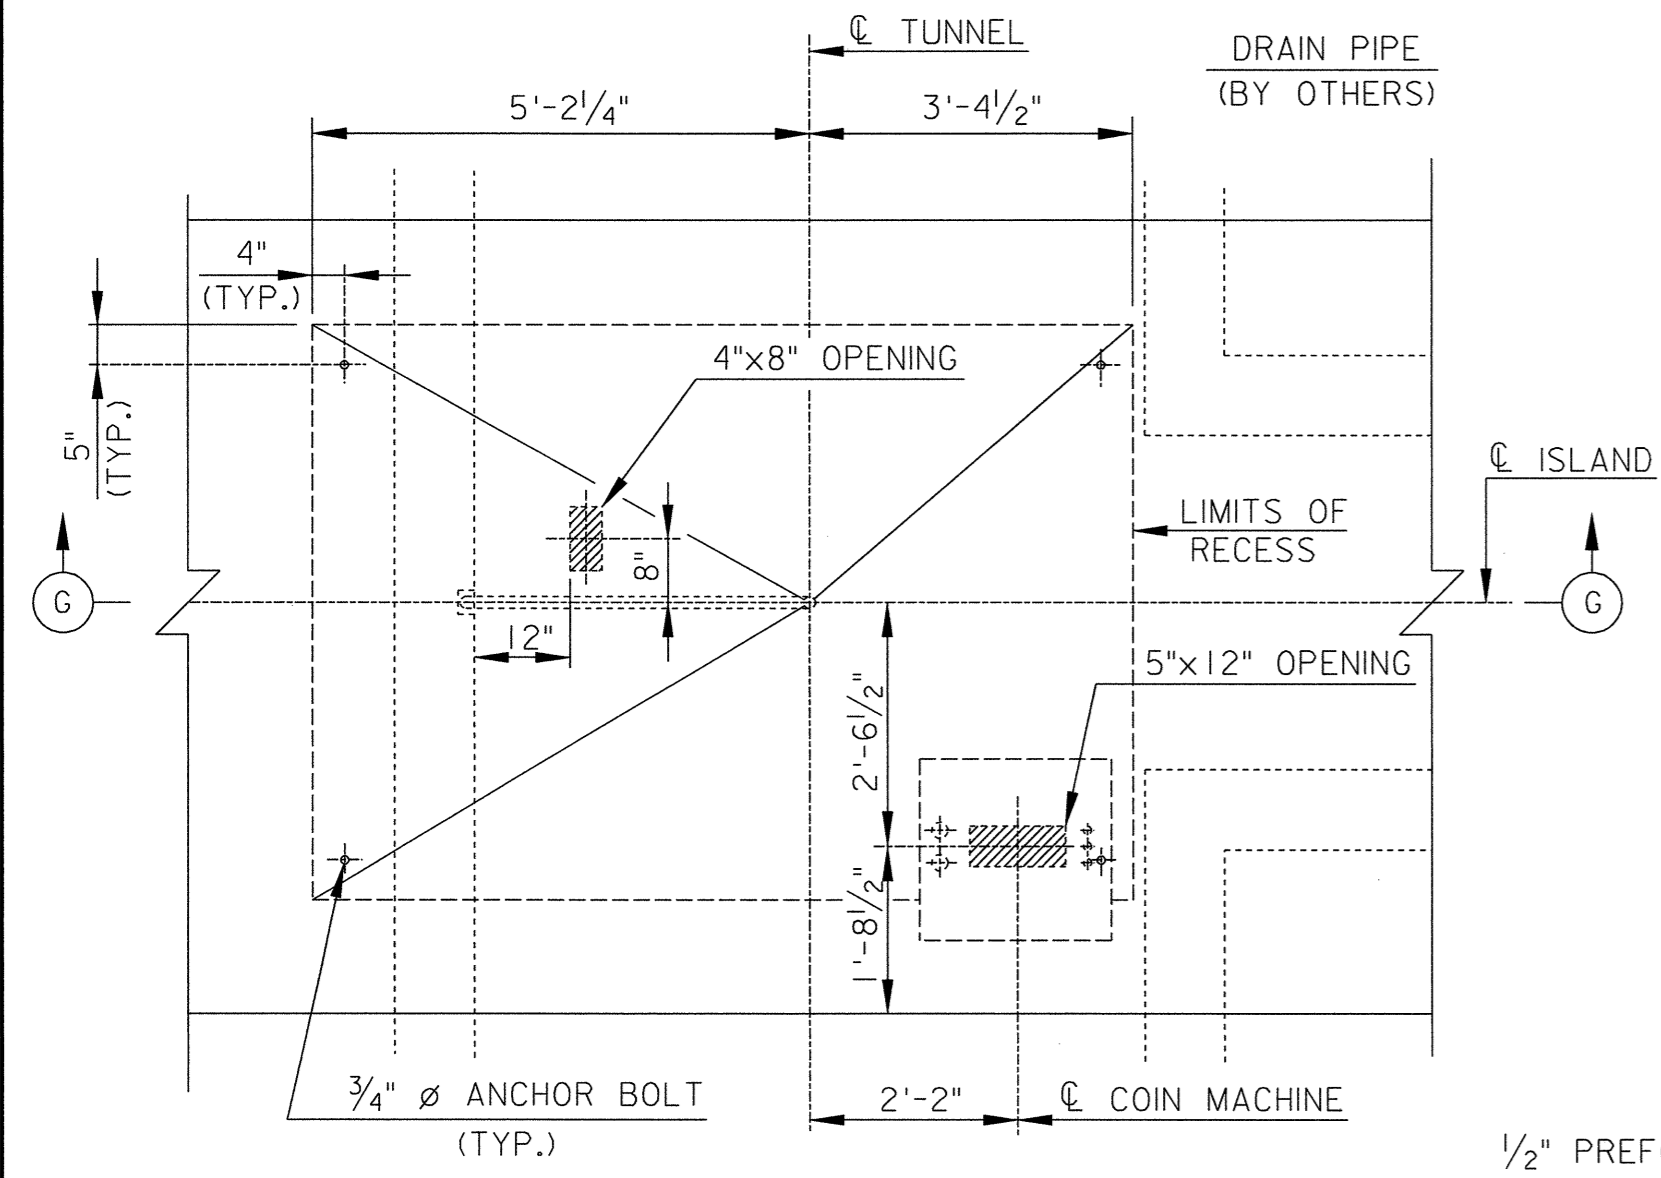


PLAN OF TOLL BOOTH RECESS
SCALE: 1/2" = 1'-0"

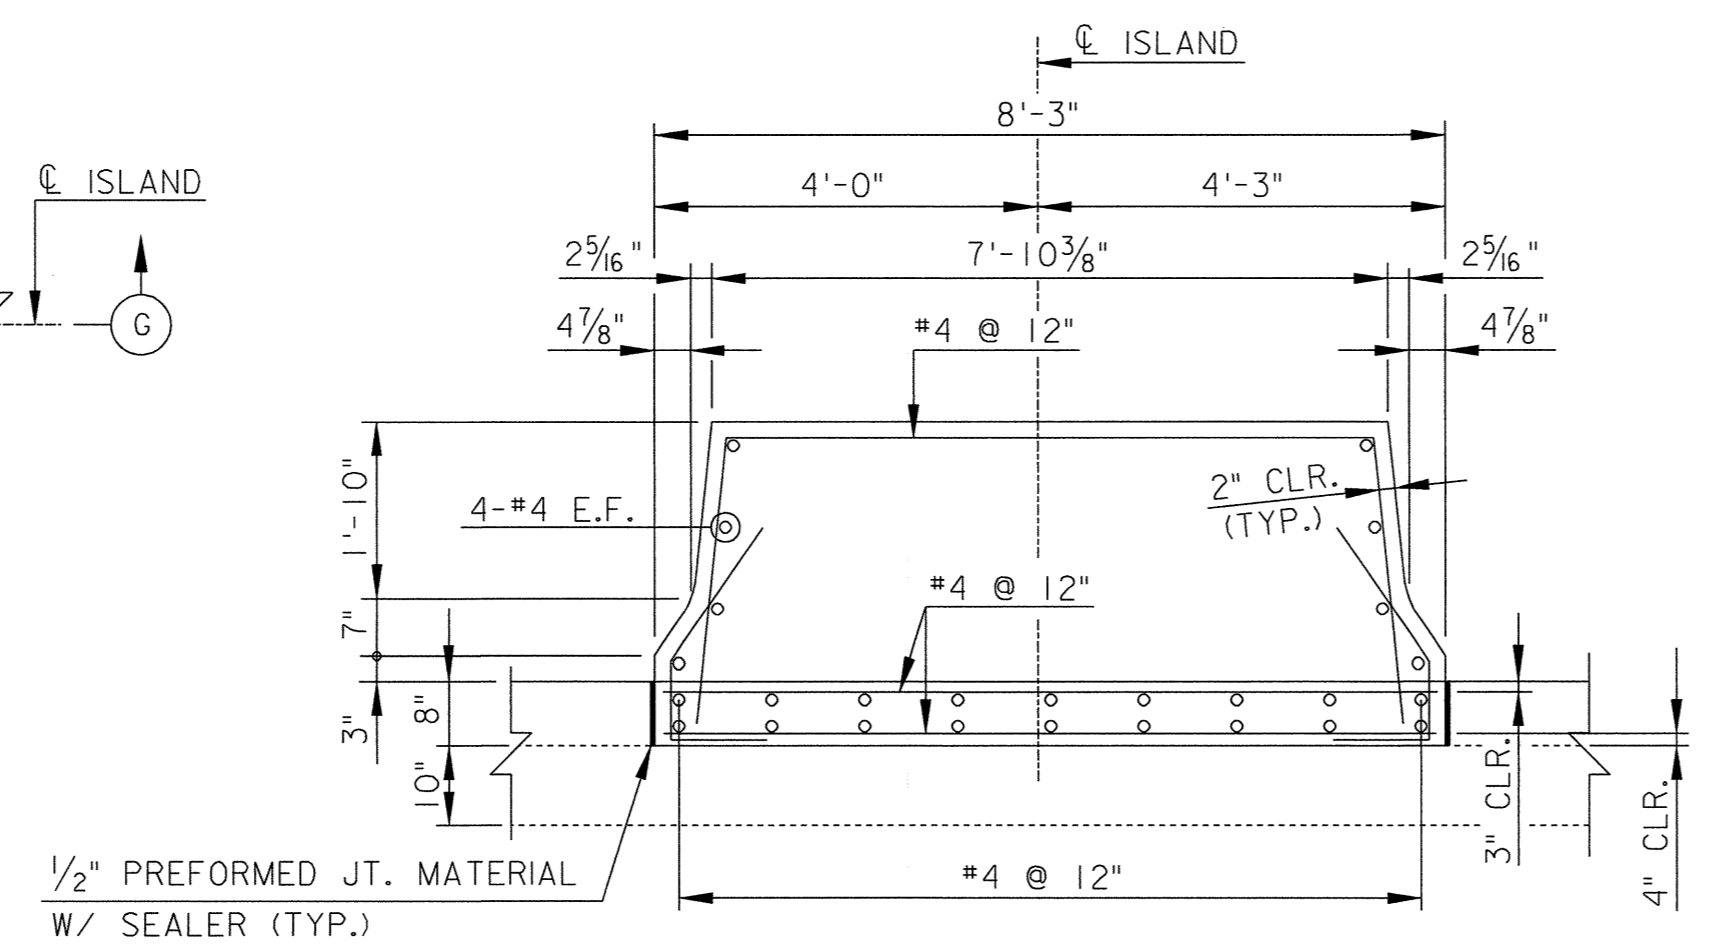

SECTION A-A
SCALE: 1/2" = 1'-0"

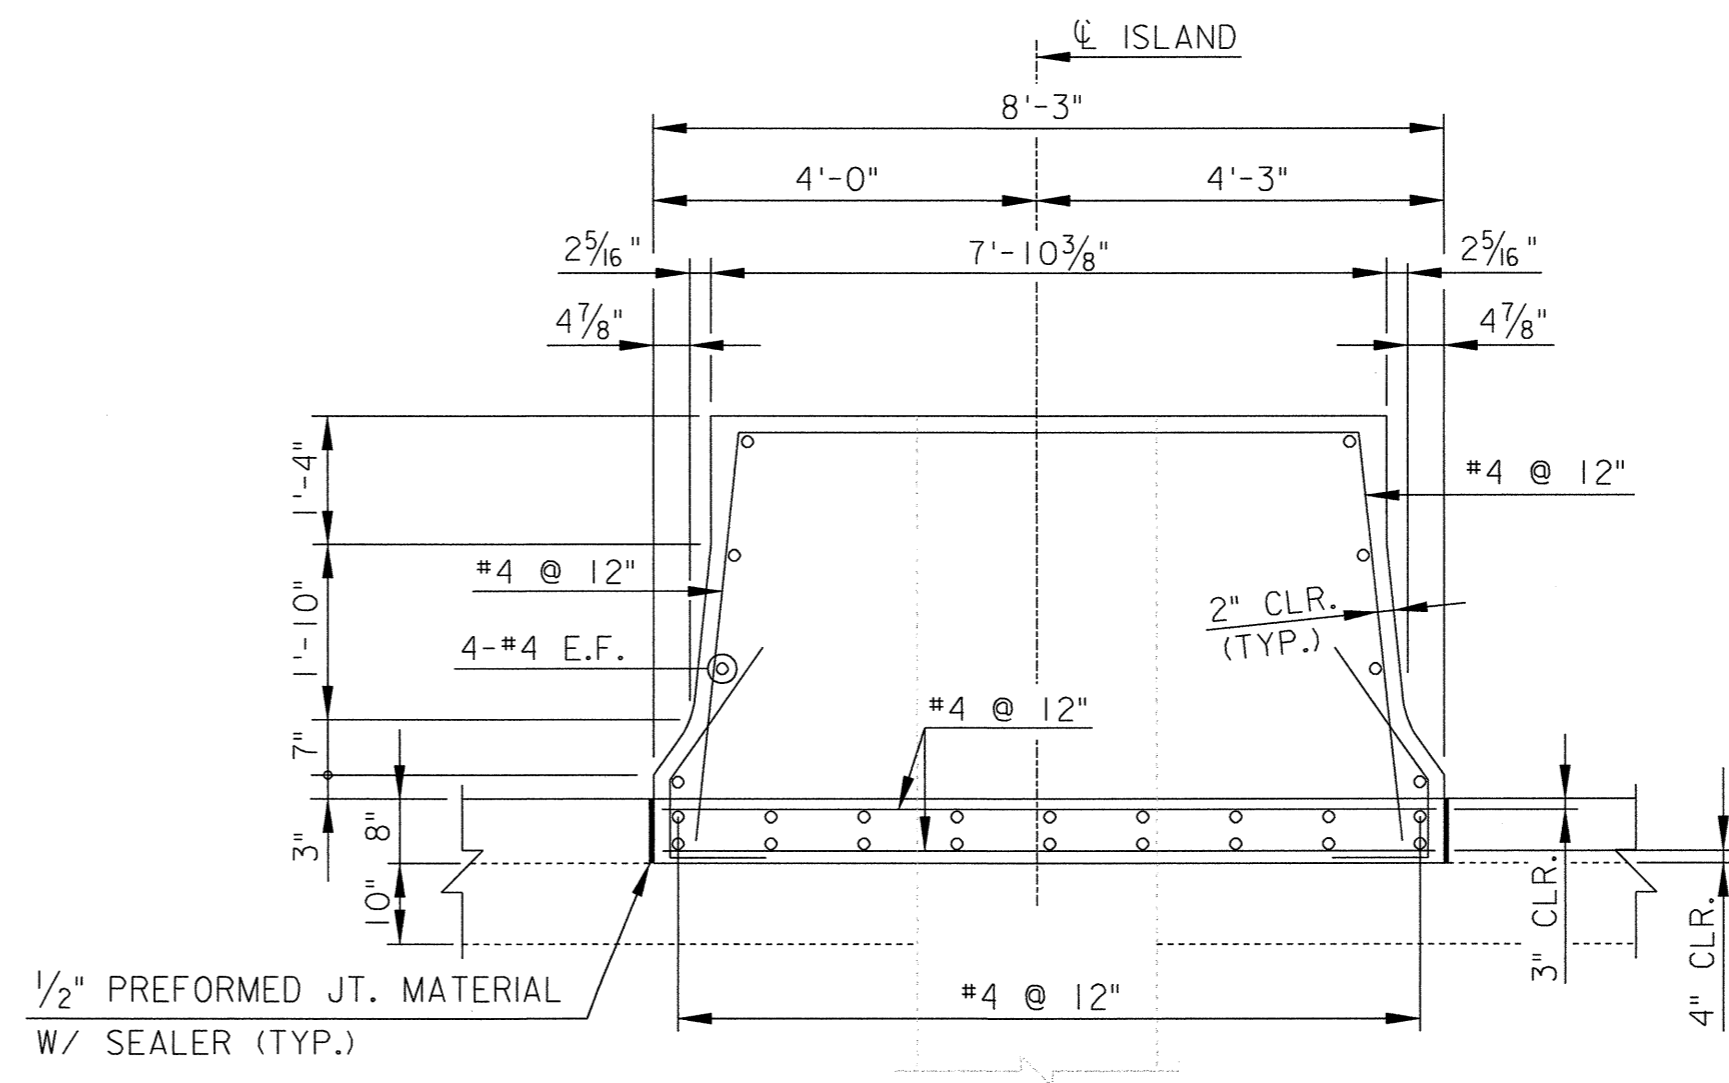

SECTION B-B
SCALE: 1/2" = 1'-0"

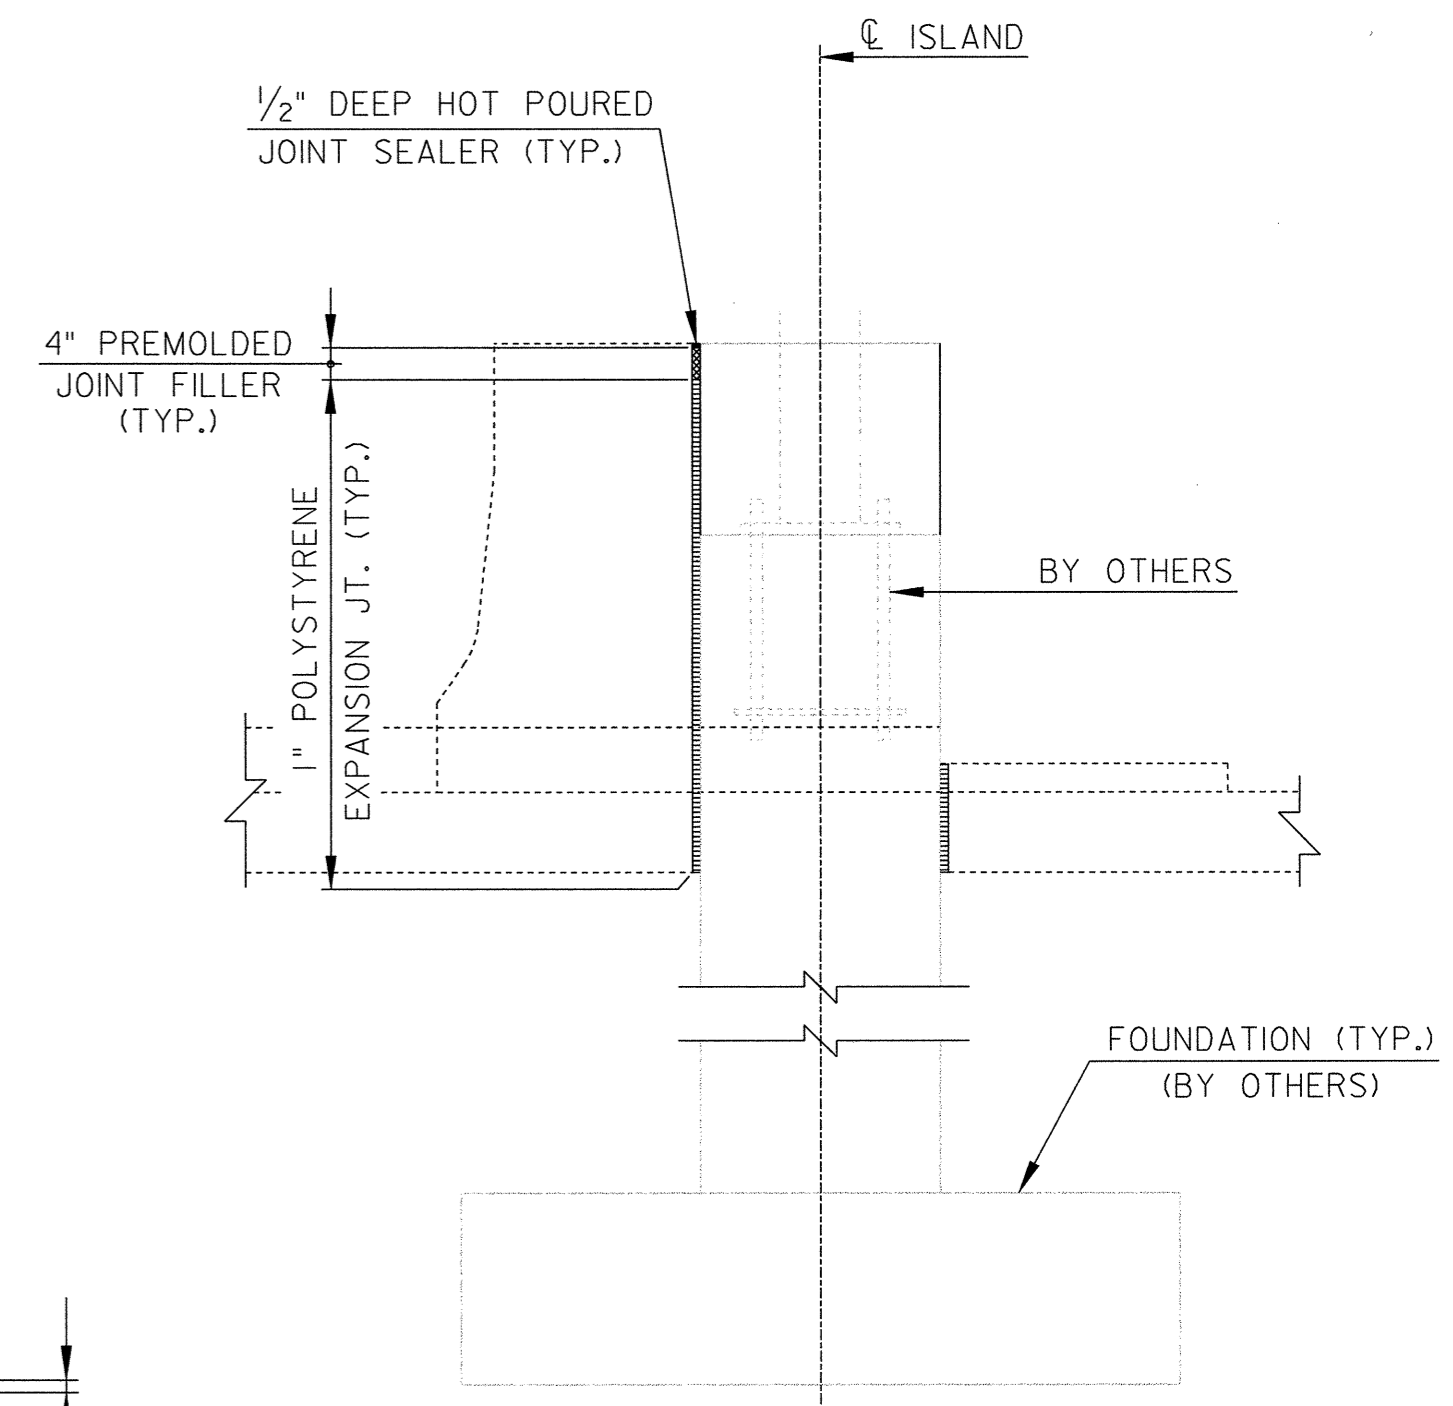

SECTION D-D
SCALE: 1/2" = 1'-0"

NO.	DATE	REVISIONS
5	3/27/07	ADDED SHEET

NOTE: FOR SECTION G-G, SEE SHEET STP-103B.


★ FOR RAISED MEDIAN DETAILS,
SEE SHEET NO. STP-102

HNTB
9175 GUILFORD ROAD, SUITE 100
COLUMBIA, MARYLAND 21046
(301) 543-1000

RM RICHMOND METROPOLITAN AUTHORITY
RICHMOND EXPRESSWAY SYSTEM
**POWHITE PARKWAY EXPRESS
TOLL LANES PROJECT**
TOLL PLAZA
ISLAND I DETAILS


Scale: AS SHOWN	Date: 3/27/07	Contract No.: PEL-2006	Sheet: 15803 of 161
--------------------	------------------	---------------------------	------------------------

STP-103C

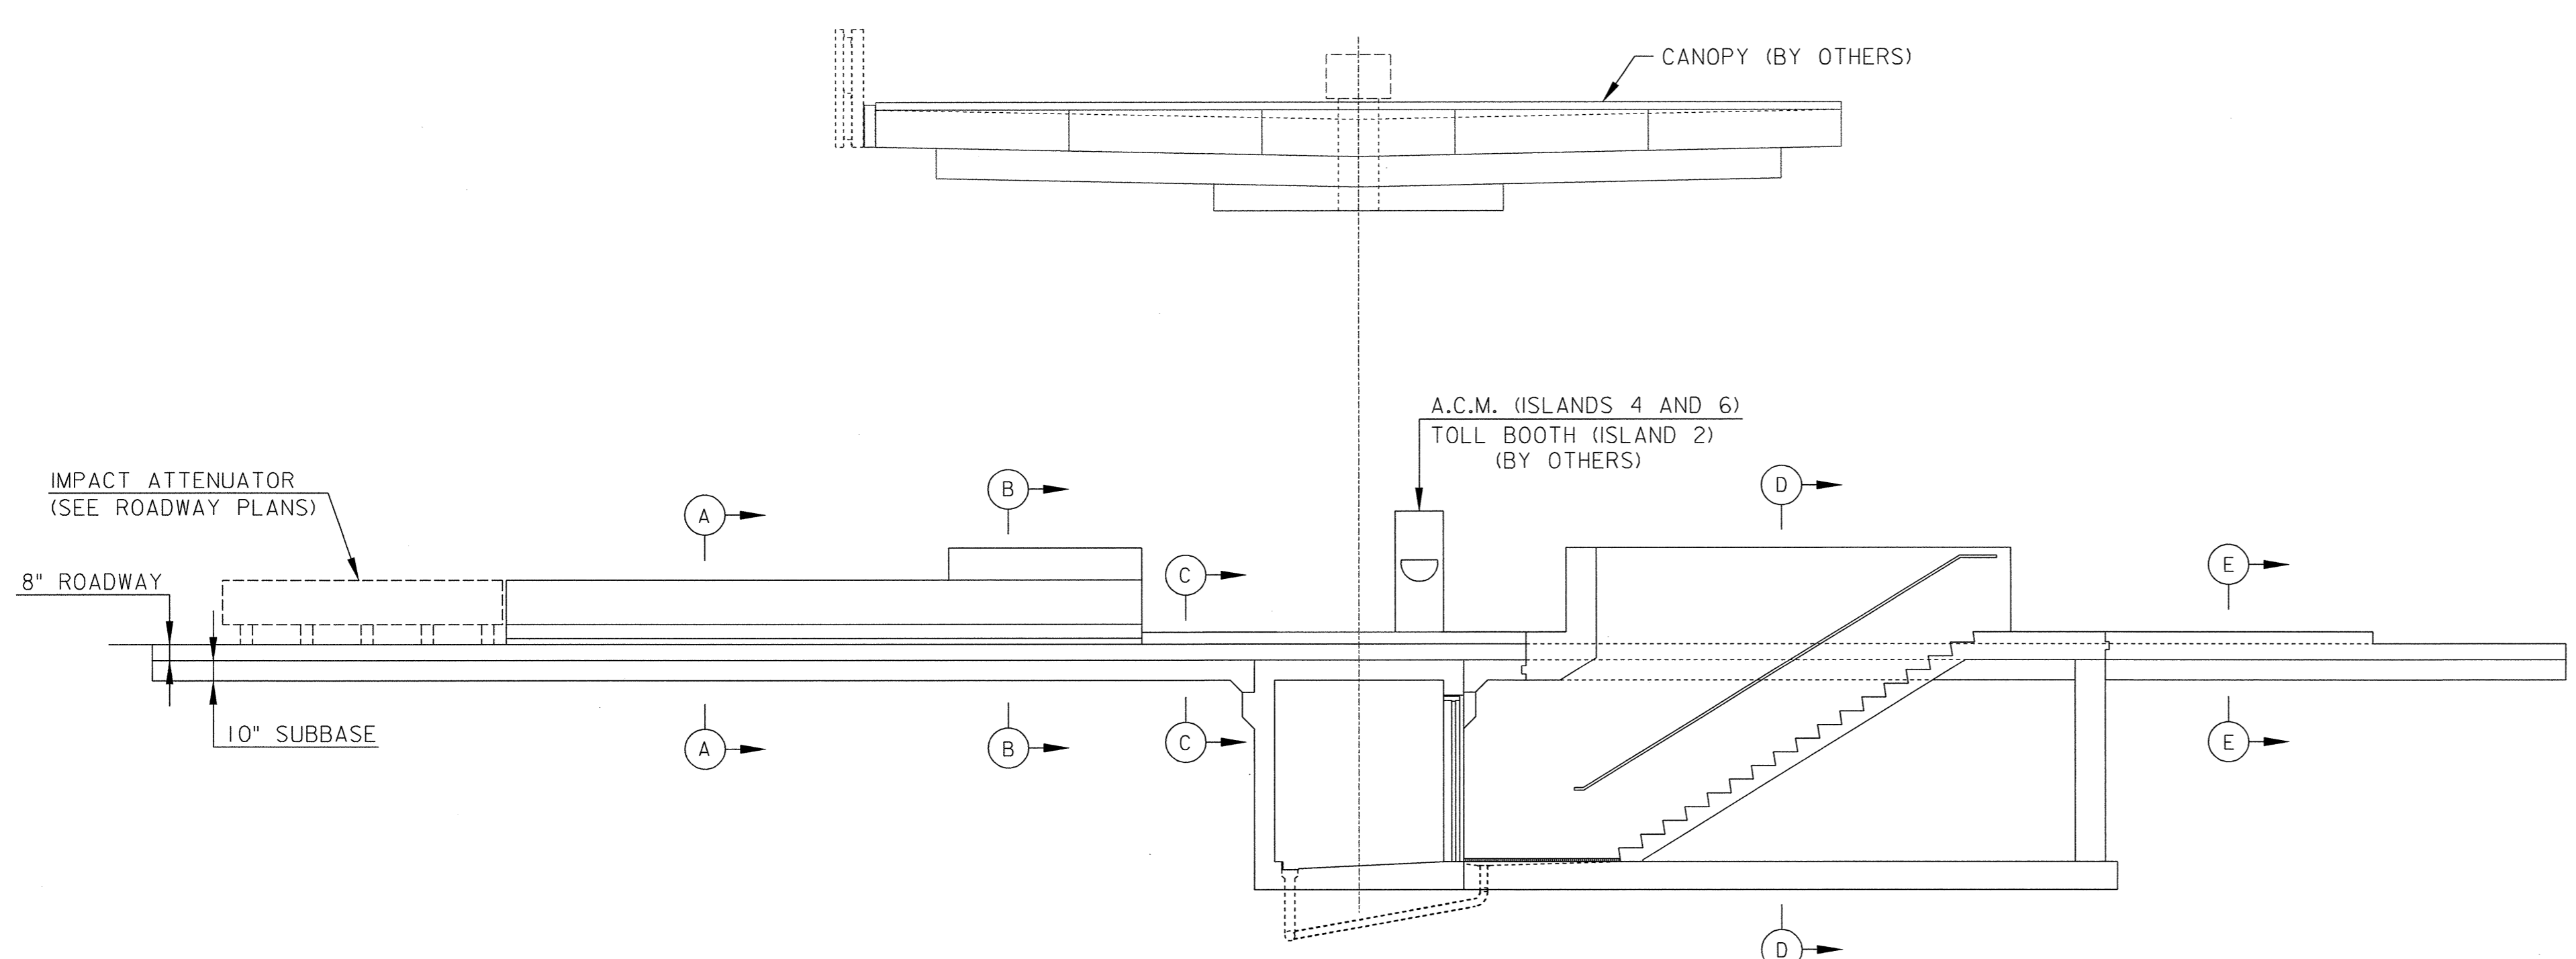


ELEVATION OF 6'-0" ISLAND W/STAIRWAY
SCALE: 3/16" = 1'-0"


NOTE:
A TEMPLATE SHALL BE DEVELOPED BY THE CONTRACTOR
TO BE USED FOR THE ANCHOR BOLT SETTING OF BOTH
TOLL BOOTH ASSEMBLIES AND THE ACM.

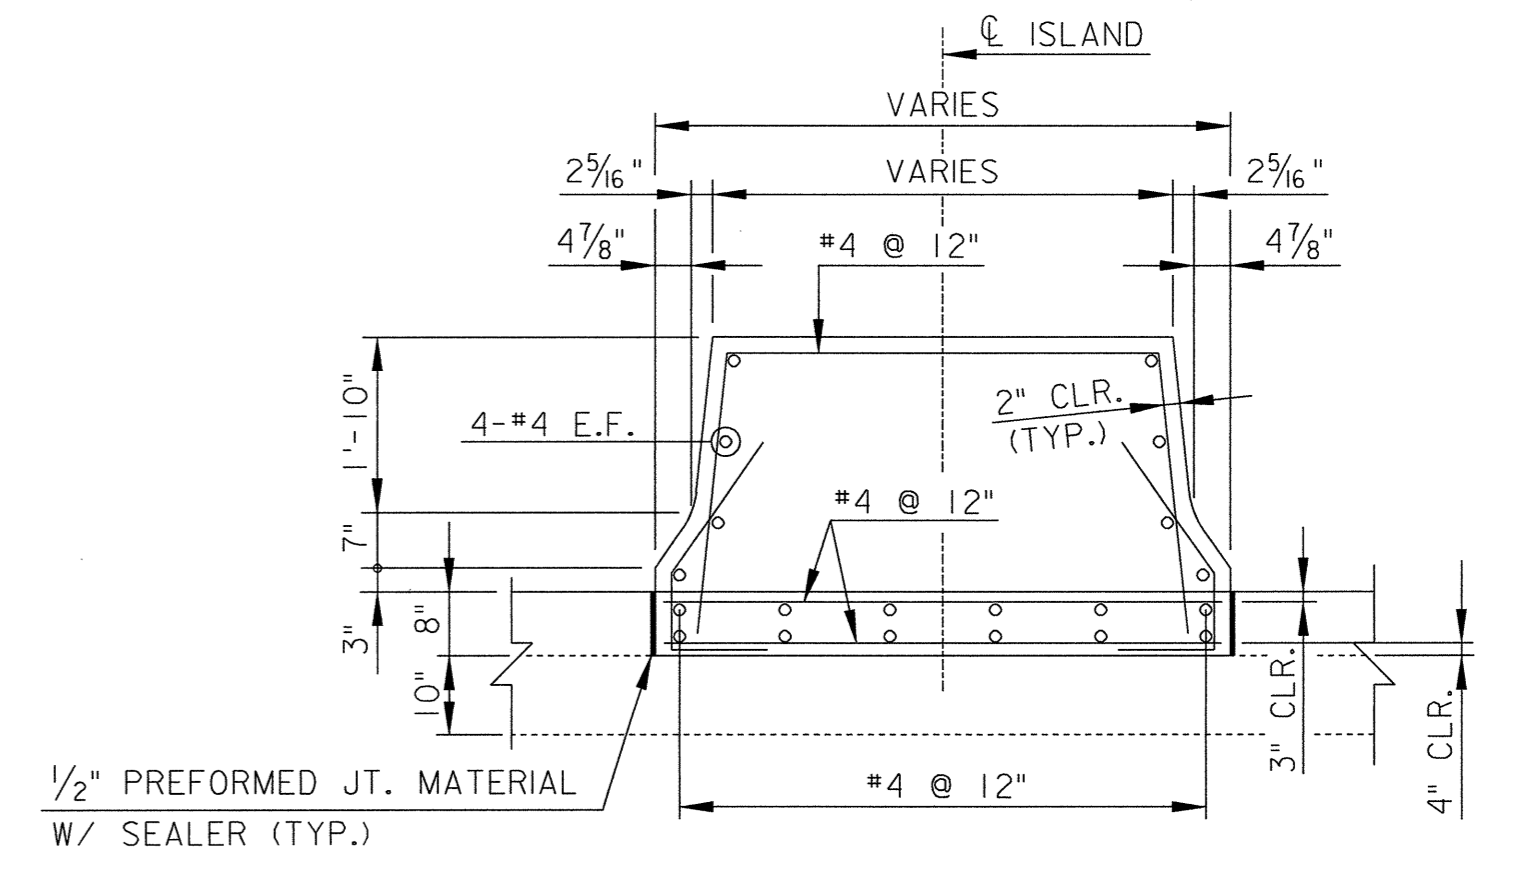

SECTION A-A
SCALE: 1/2" = 1'-0"

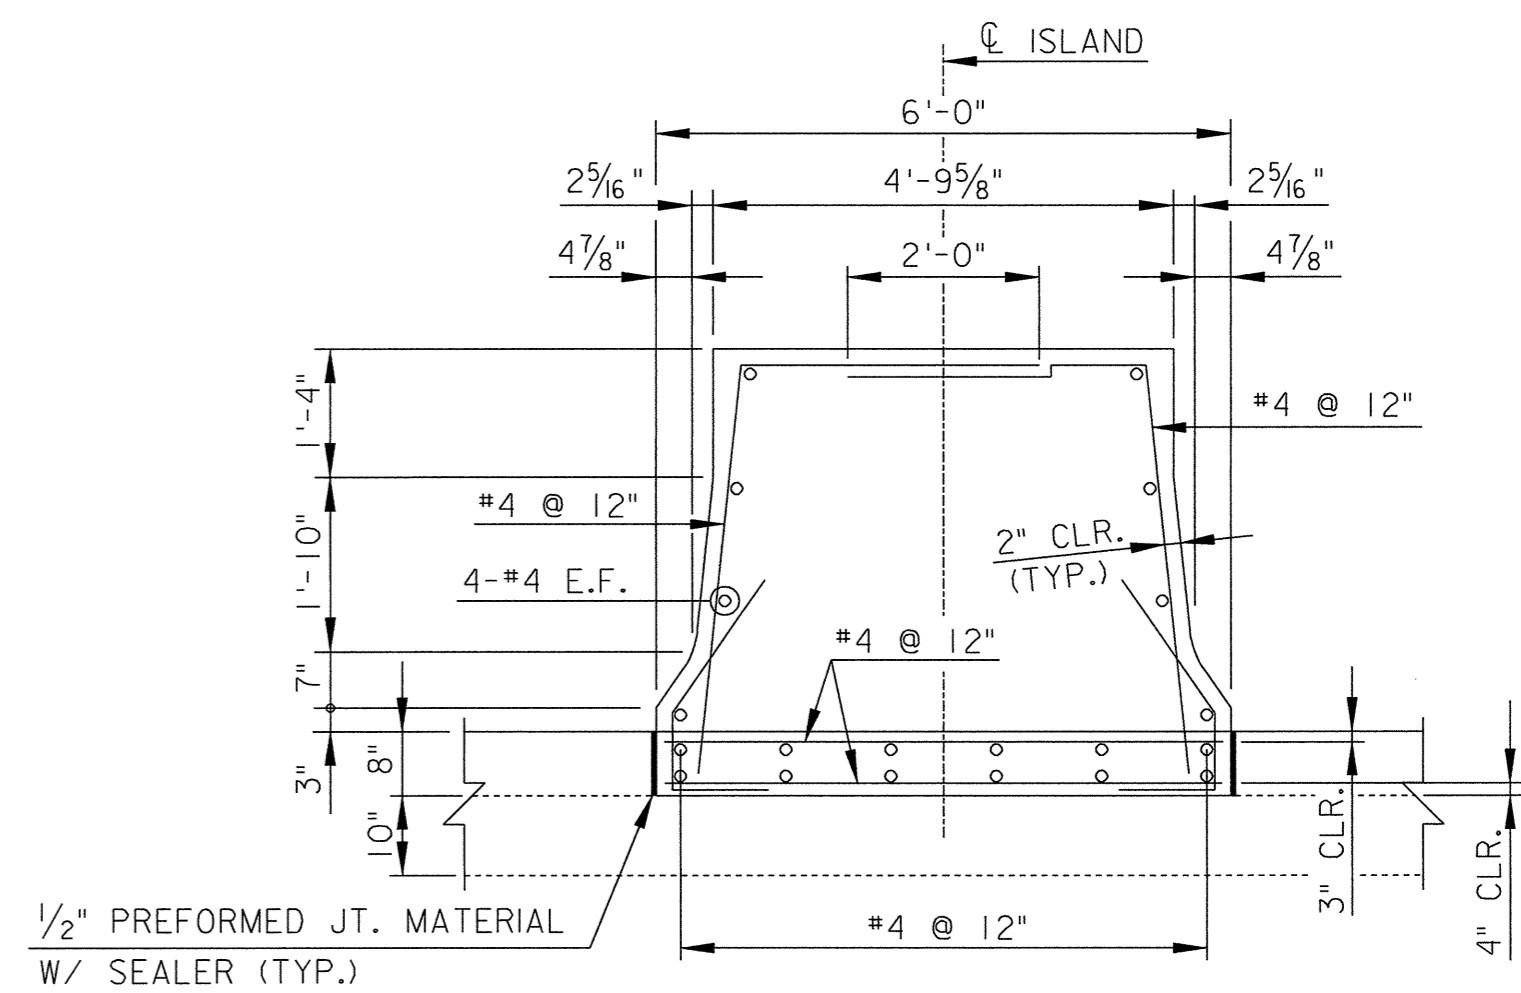


SECTION B-B
SCALE: 1/2" = 1'-0"

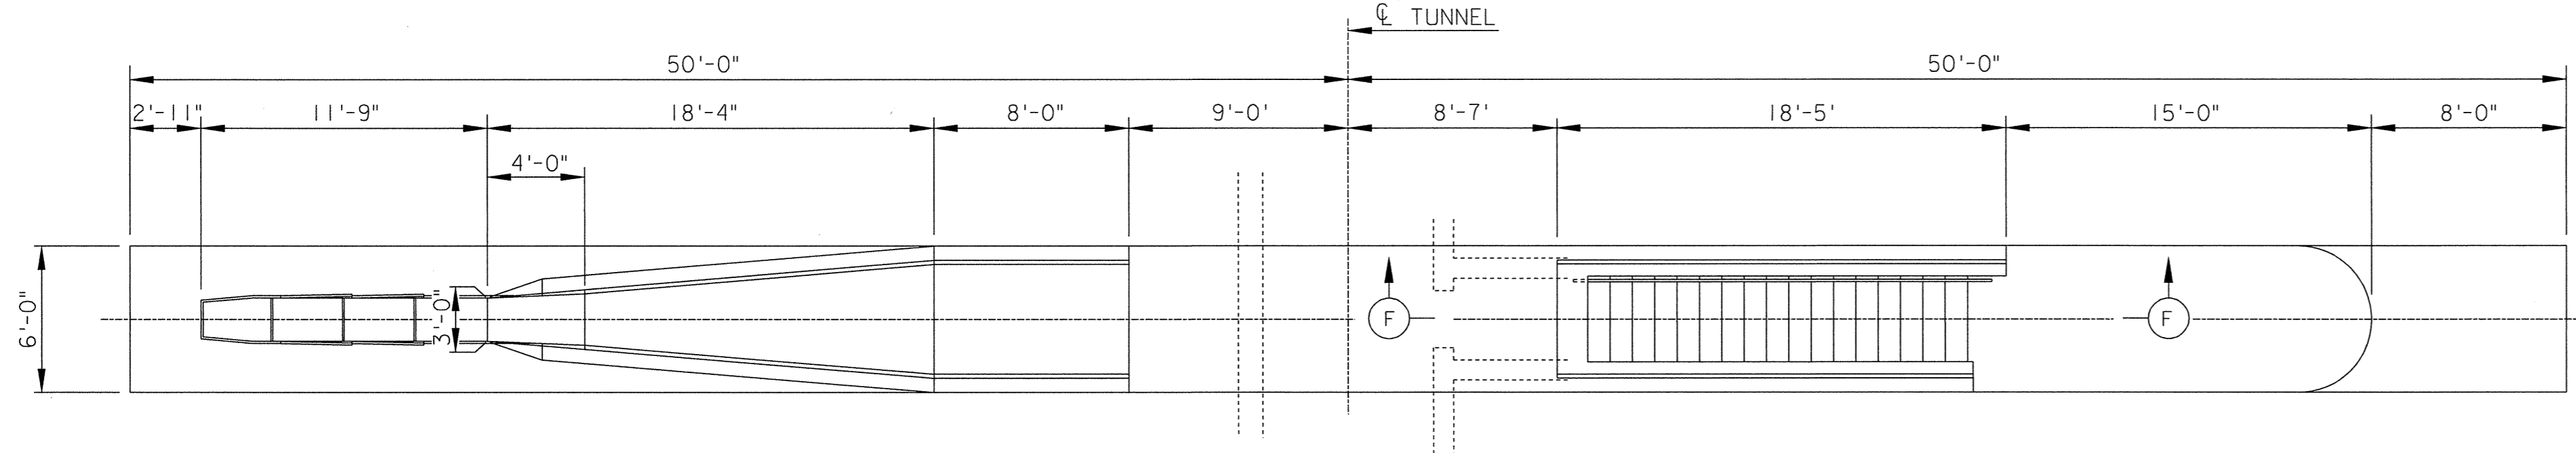


PLAN OF 6'-0" ISLAND W/STAIRWAY
SCALE: 3/16" = 1'-0"


NOTE:
FOR SECTIONS D-D, E-E & F-F,
SEE SHEET STP-104B.

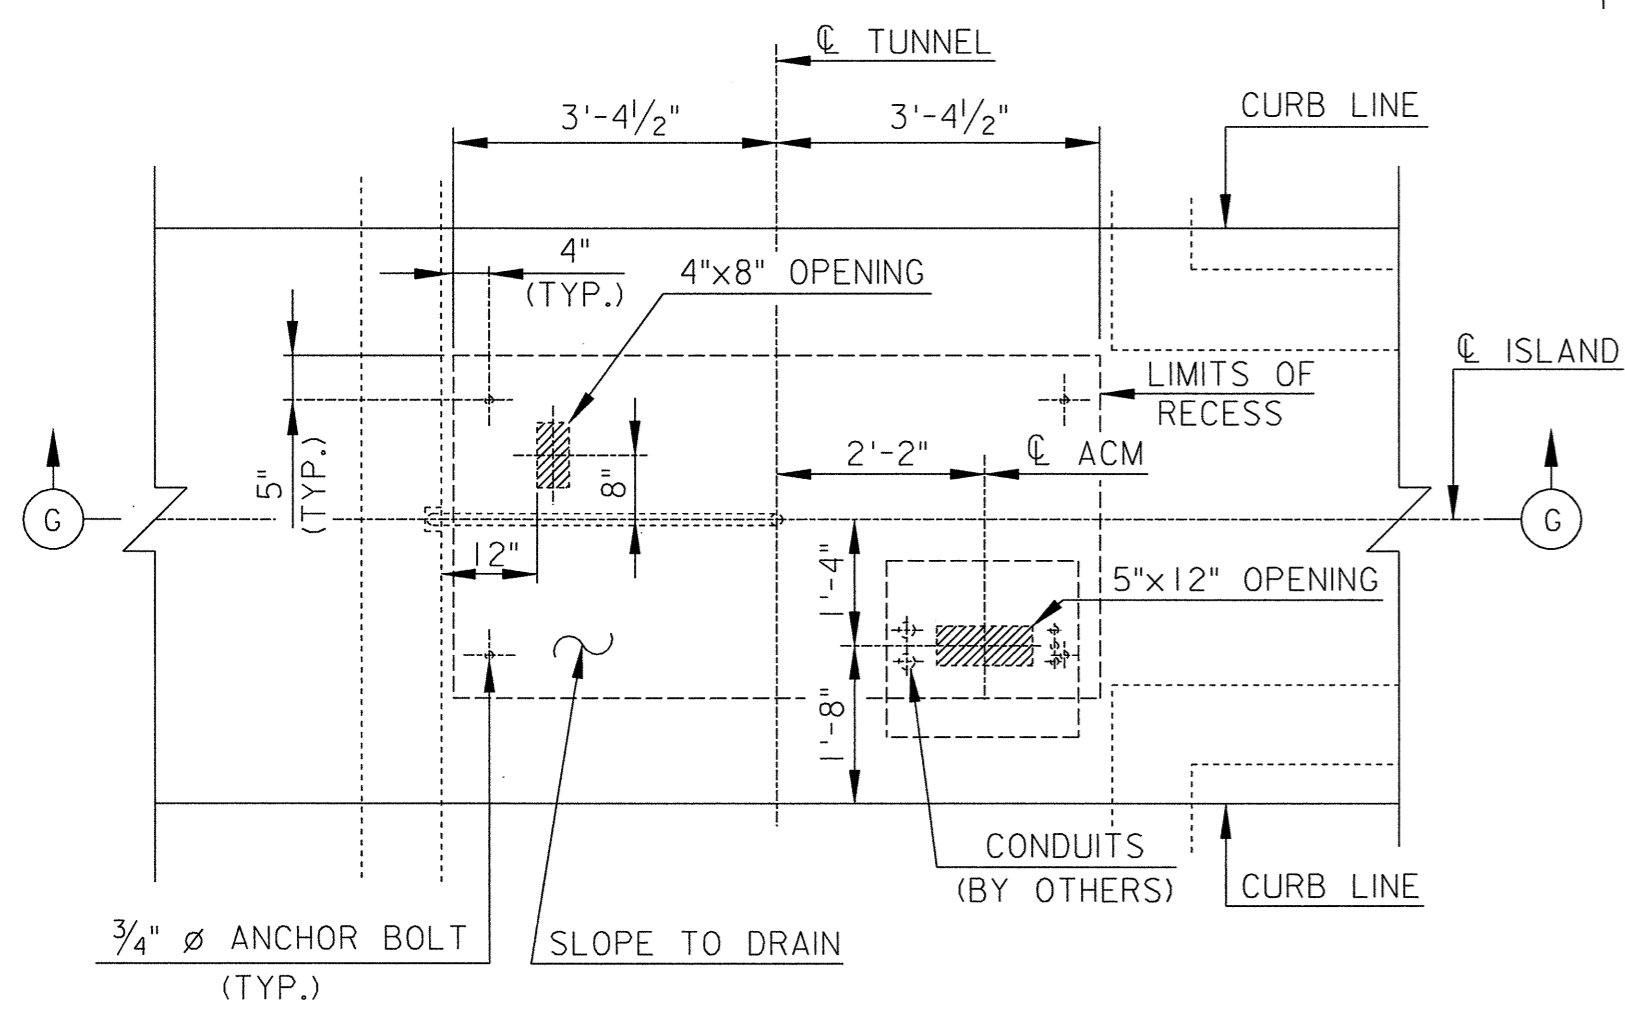


PLAN OF TOLL BOOTH RECESS
(ISLAND 2 ONLY)
SCALE: 1/2" = 1'-0"

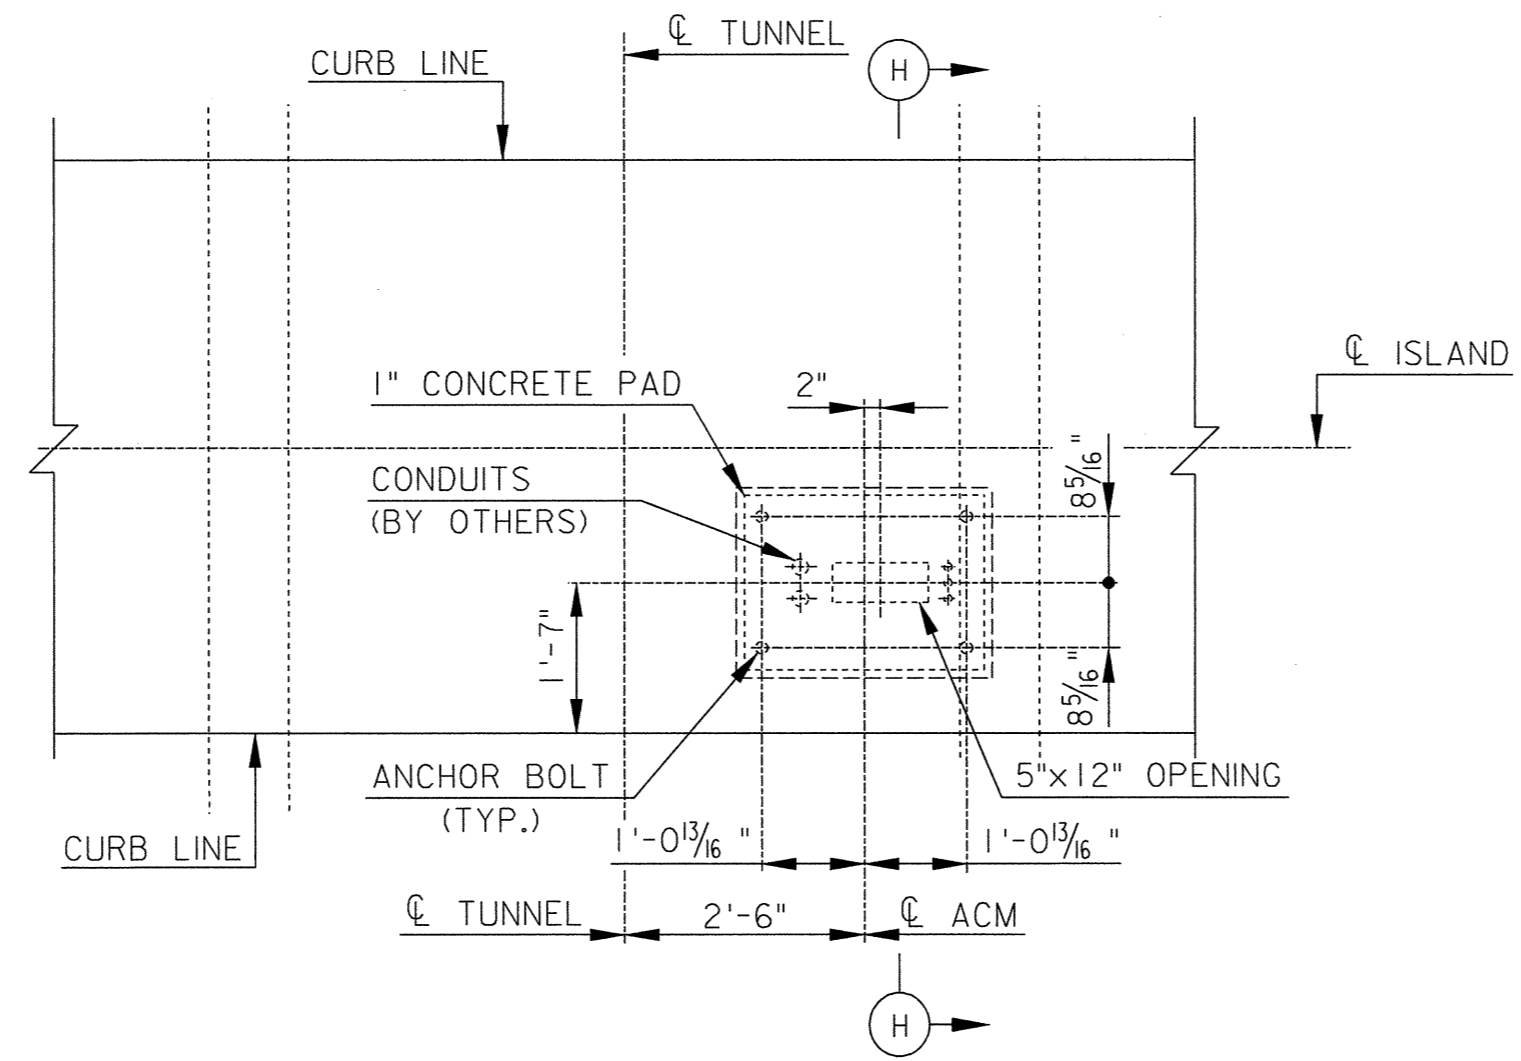

PLAN AT ACM MACHINE
(ISLANDS 4 & 6 ONLY)
SCALE: 1/2" = 1'-0"

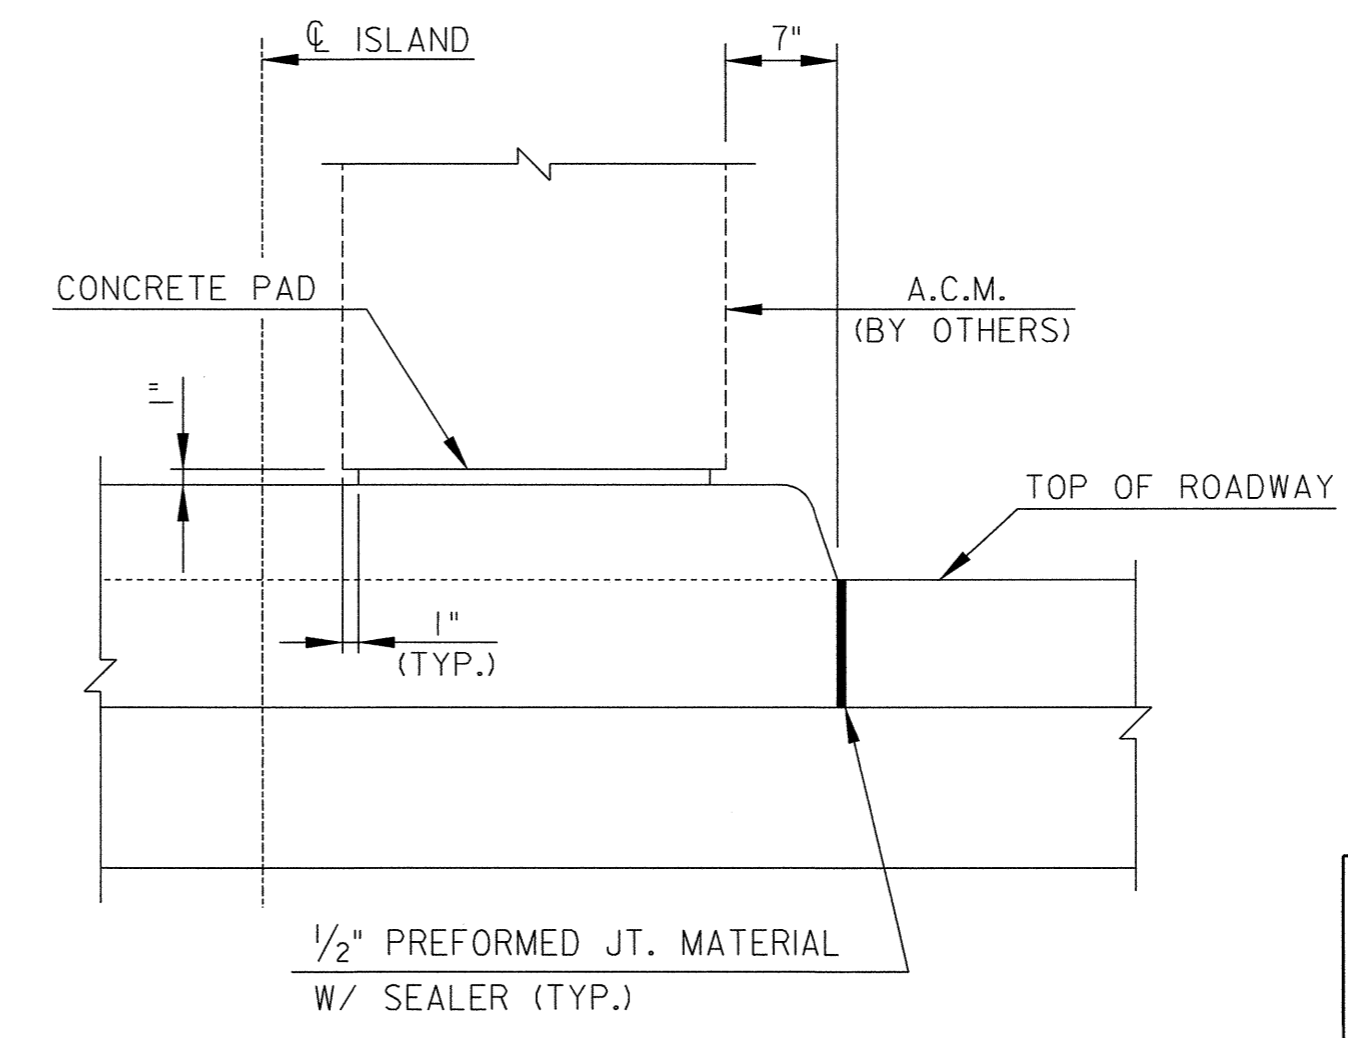

SECTION H-H
SCALE: 1" = 1'-0"

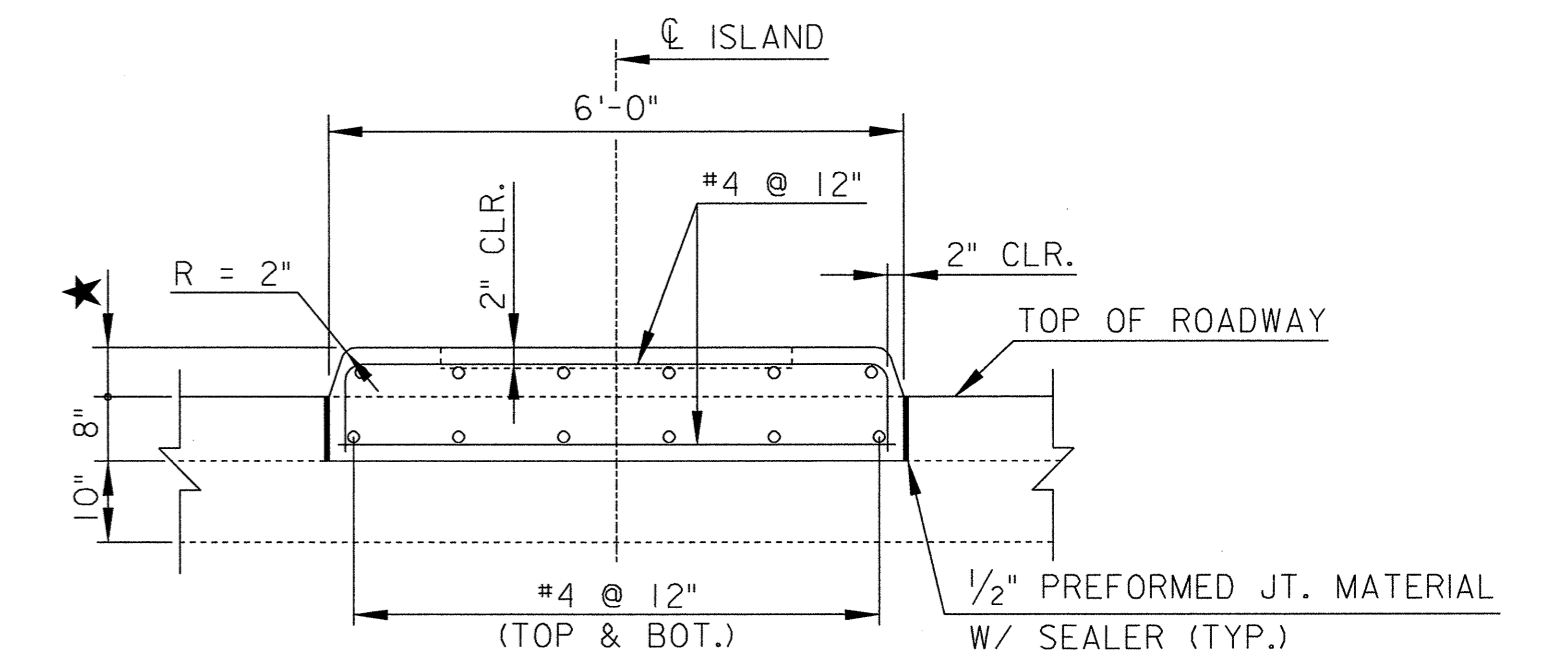

SECTION C-C
SCALE: 1/2" = 1'-0"

★ FOR RAISED MEDIAN DETAILS, SEE SHEET NO. STP-102.

STP-104A

5	3/27/07:	REVISED SHEET - SEE SHEET 1B
2	7/20/06:	REVISED SHEET - SEE SHEET 1B
1	6/23/06:	ADDED SHEET
REVISIONS		

NOTE:
FOR SECTION G-G AND TOLL BOOTH RECESS
DRAINAGE DETAIL, SEE SHEET STP-103B.


RM RICHMOND METROPOLITAN AUTHORITY
RICHMOND EXPRESSWAY SYSTEM

**POWHITE PARKWAY EXPRESS
TOLL LANES PROJECT**

TOLL PLAZA
TOLL ISLANDS 2, 4 AND 6 DETAILS - I


HNTB
9175 GUILFORD ROAD, SUITE 100
COLUMBIA, MARYLAND 21046
(301) 543-1000

Scale:	Date:	Contract No.:	Sheet:
AS SHOWN	3/27/07	PEL-2006	158E1 of 161

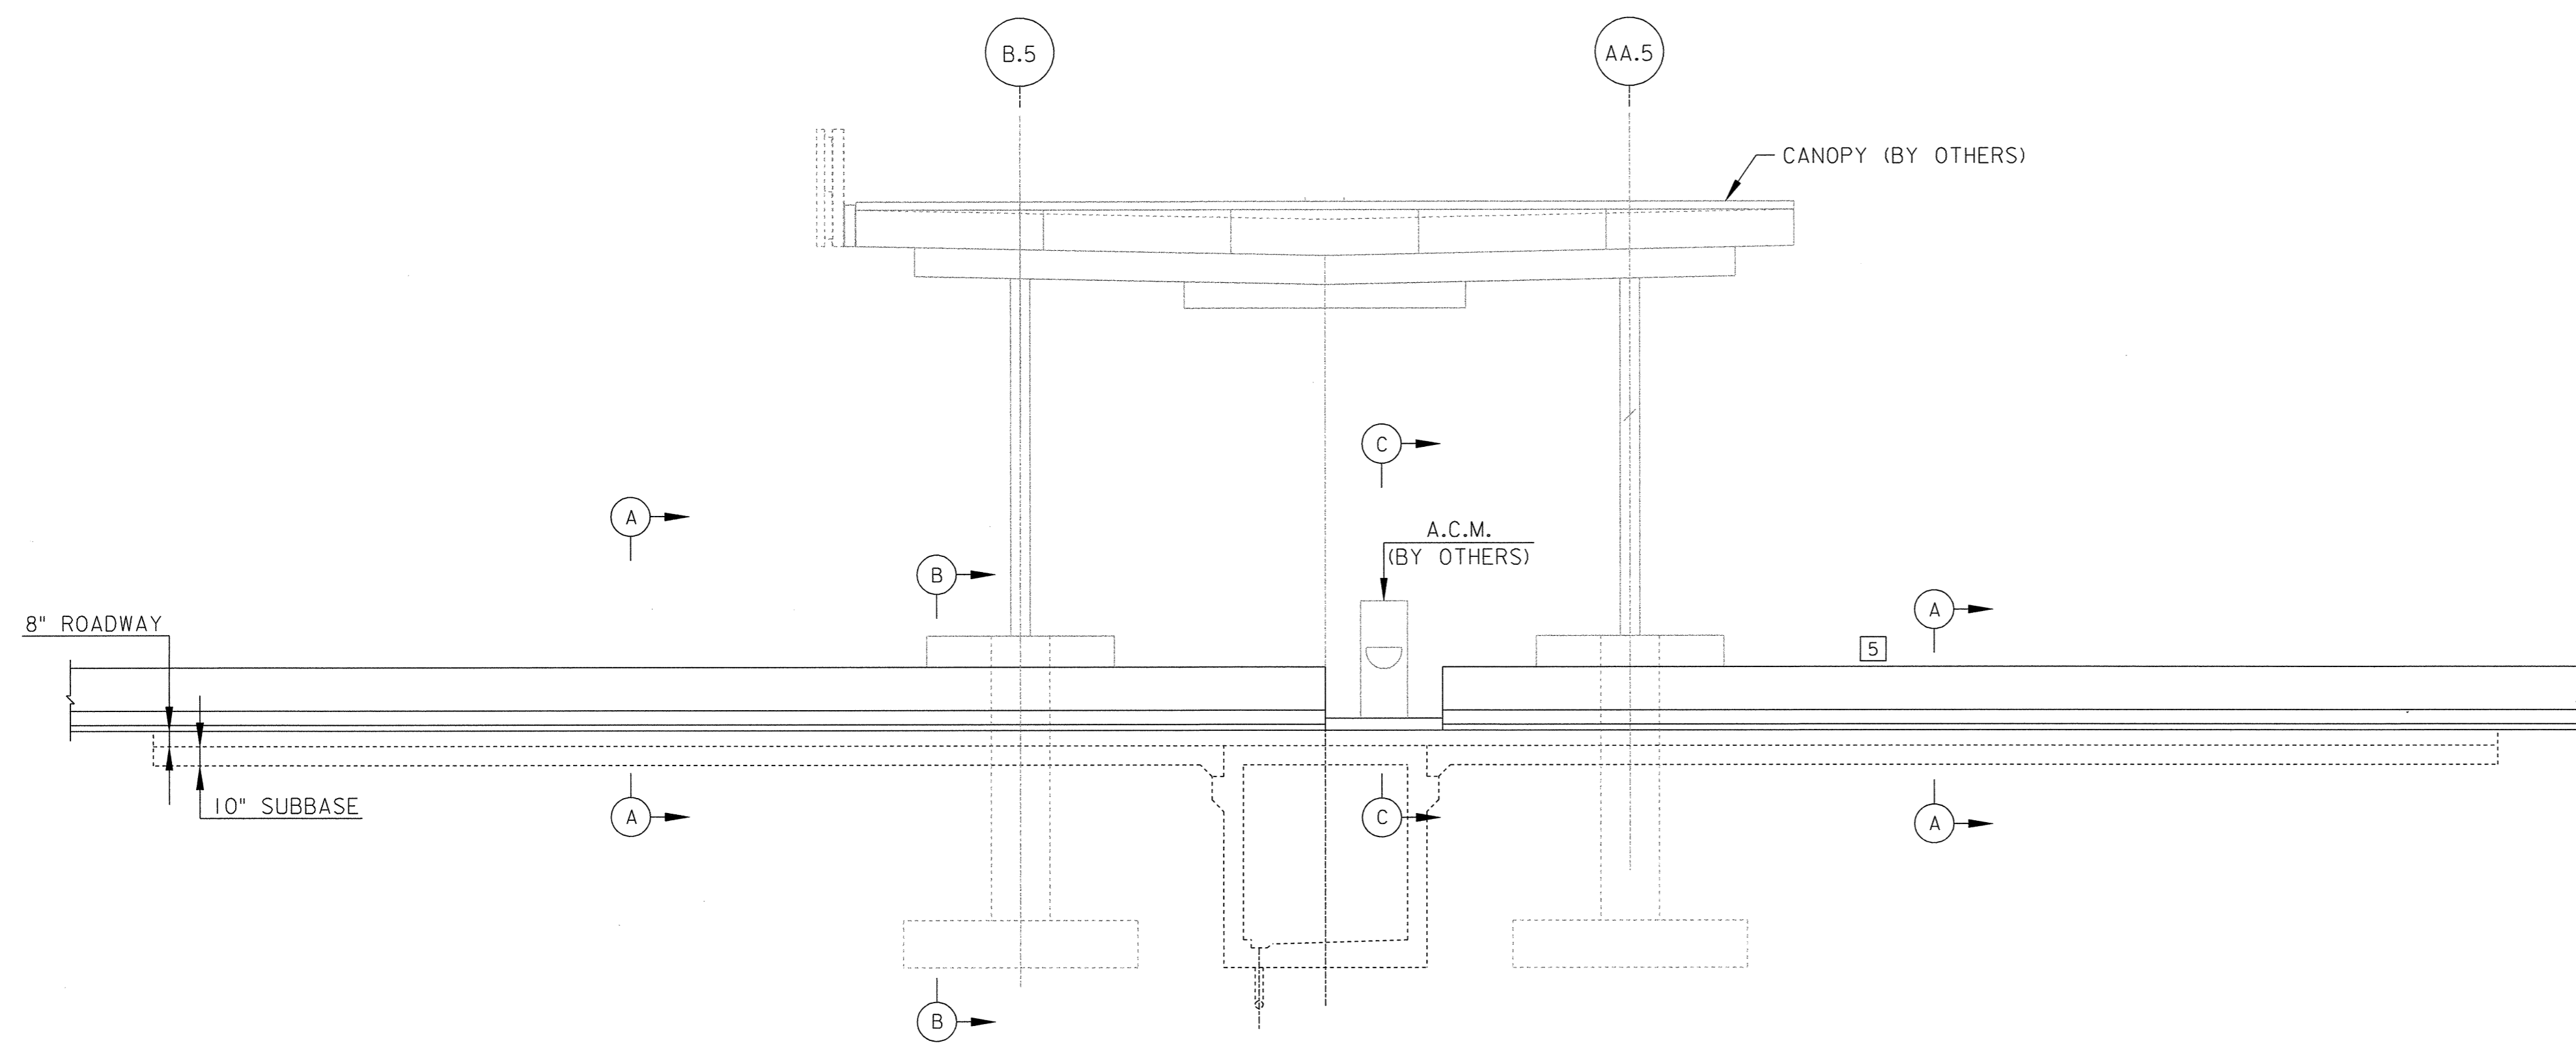


ELEVATION OF ISLAND 7
SCALE: 3/16" = 1'-0"

NOTE:
A TEMPLATE SHALL BE DEVELOPED BY THE CONTRACTOR TO BE USED FOR THE ANCHOR BOLT SETTING OF BOTH TOLL BOOTH ASSEMBLIES AND THE ACM.

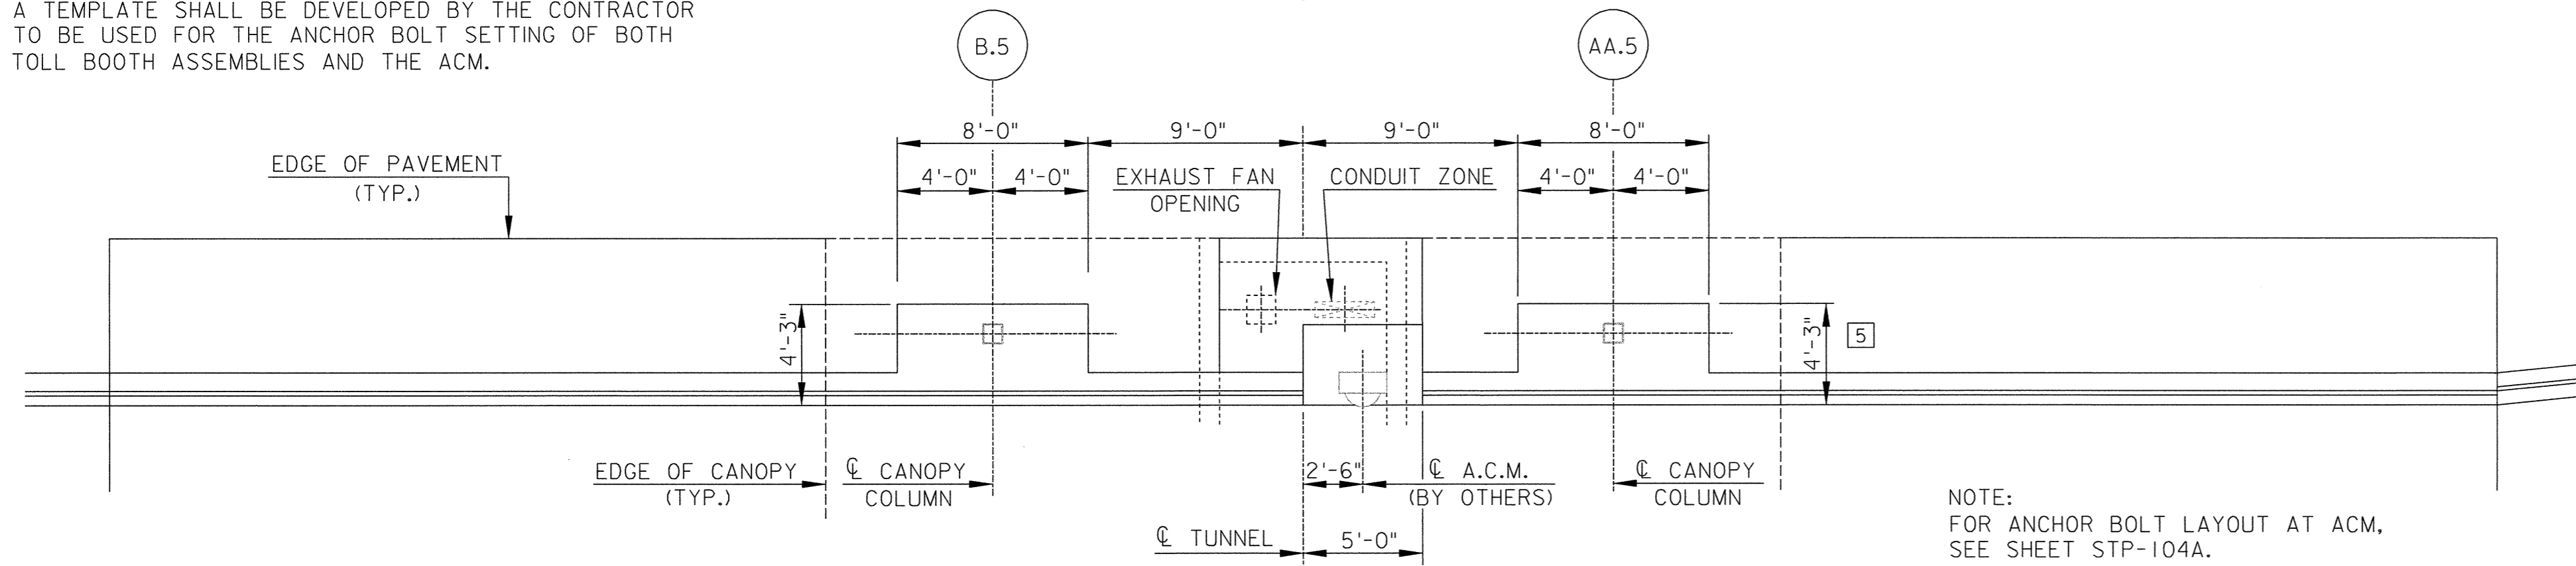


PLAN OF ISLAND 7
SCALE: 3/16" = 1'-0"


NOTE:
FOR ANCHOR BOLT LAYOUT AT ACM, SEE SHEET STP-104A.

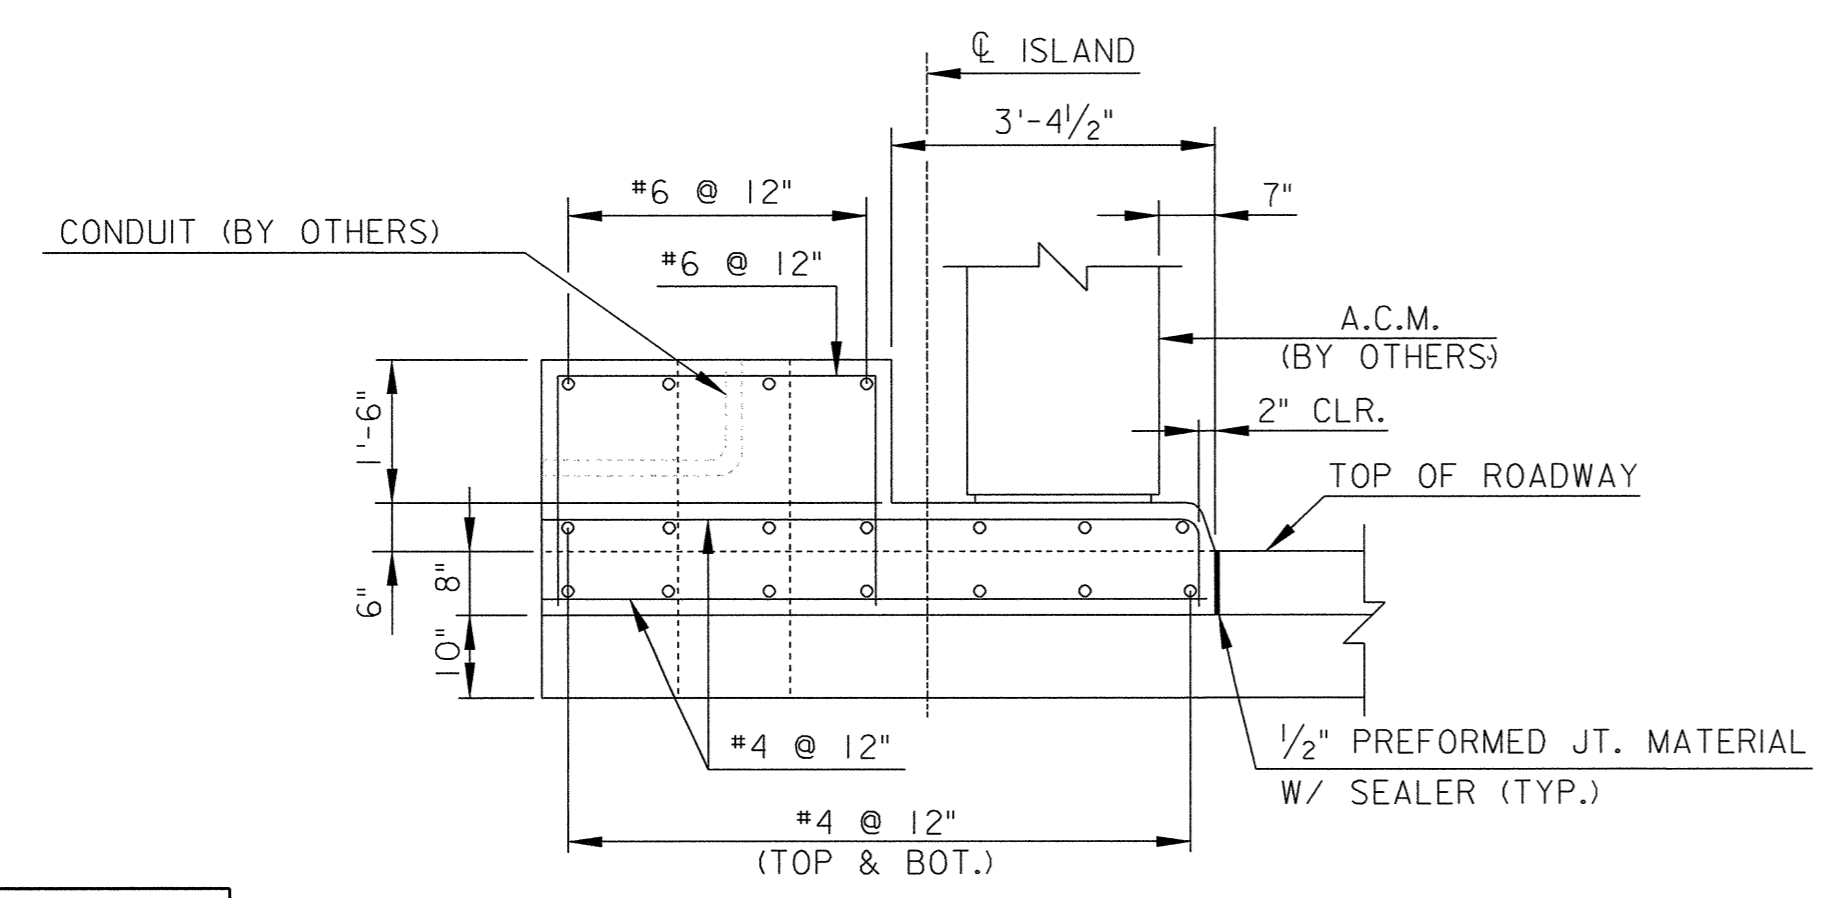

SECTION C-C
SCALE: 1/2" = 1'-0"

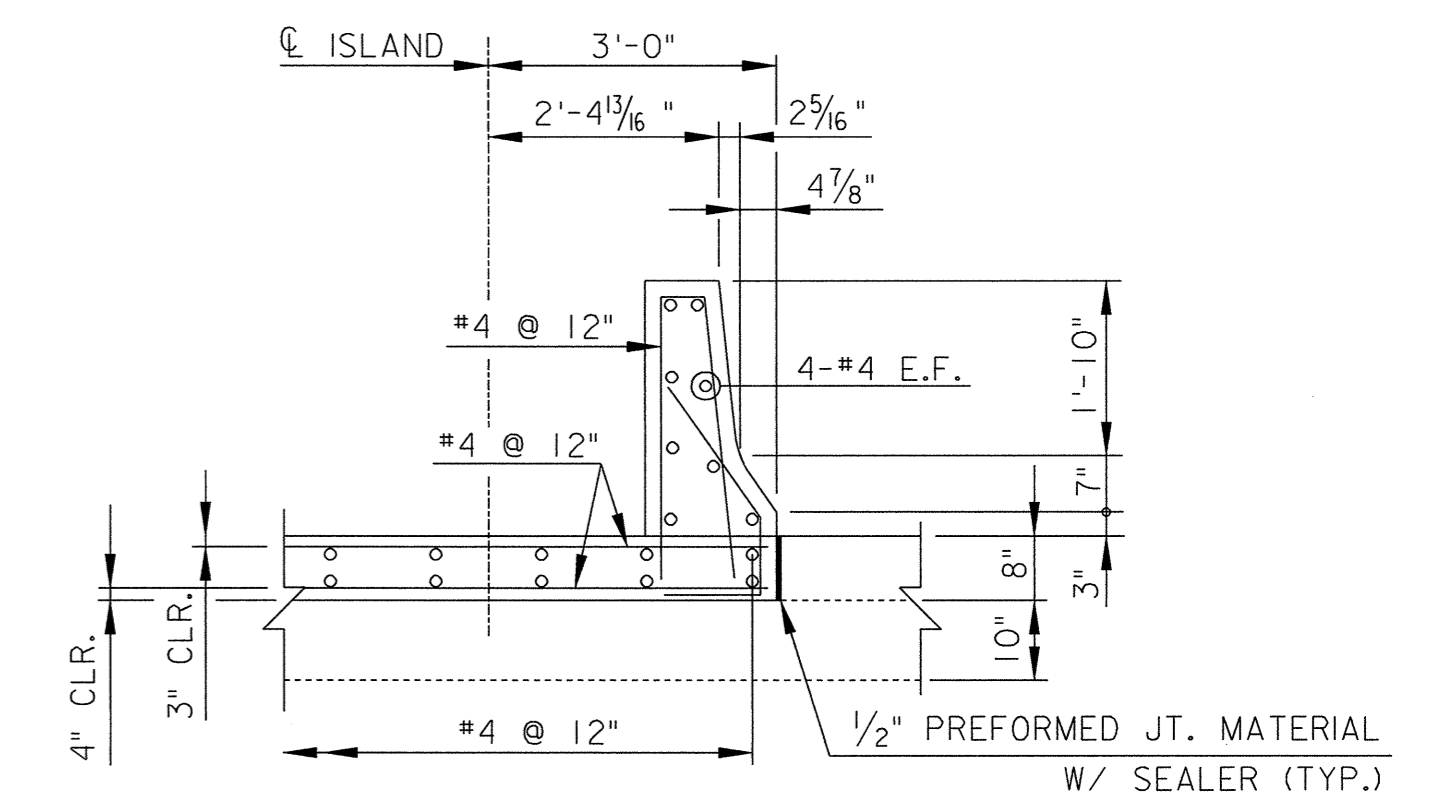

SECTION A-A
SCALE: 1/2" = 1'-0"

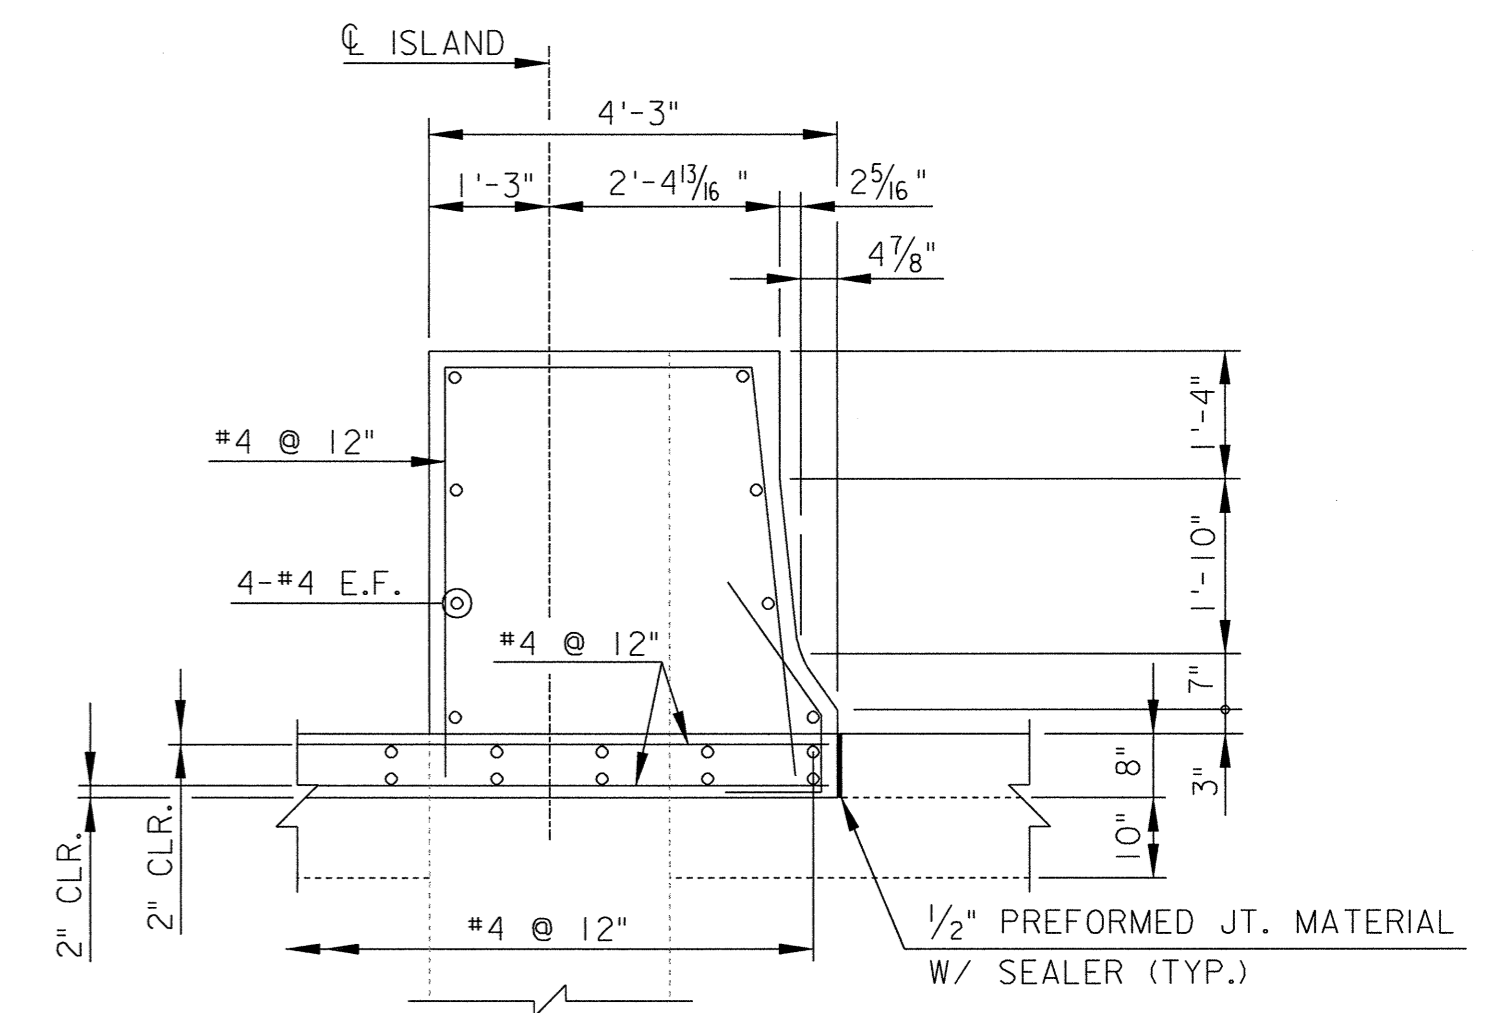

SECTION B-B
SCALE: 1/2" = 1'-0"

REVISIONS	
5	3/27/07: REMOVED GATE
2	7/20/06: REVISED SHEET SIZE AND TITLE BLOCK
1	6/23/06: ADDED SHEET

STP-105

RM RICHMOND METROPOLITAN AUTHORITY
RICHMOND EXPRESSWAY SYSTEM


**POWHITE PARKWAY EXPRESS
TOLL LANES PROJECT**

TOLL PLAZA
ISLAND 7 DETAILS

HNTB


9175 GUILFORD ROAD, SUITE 100
COLUMBIA, MARYLAND 21046
(301) 543-1000

Scale: AS SHOWN	Date: 3/27/07	Contract No.: _PEL-2006	Sheet: 158F of 161
--------------------	------------------	----------------------------	-----------------------

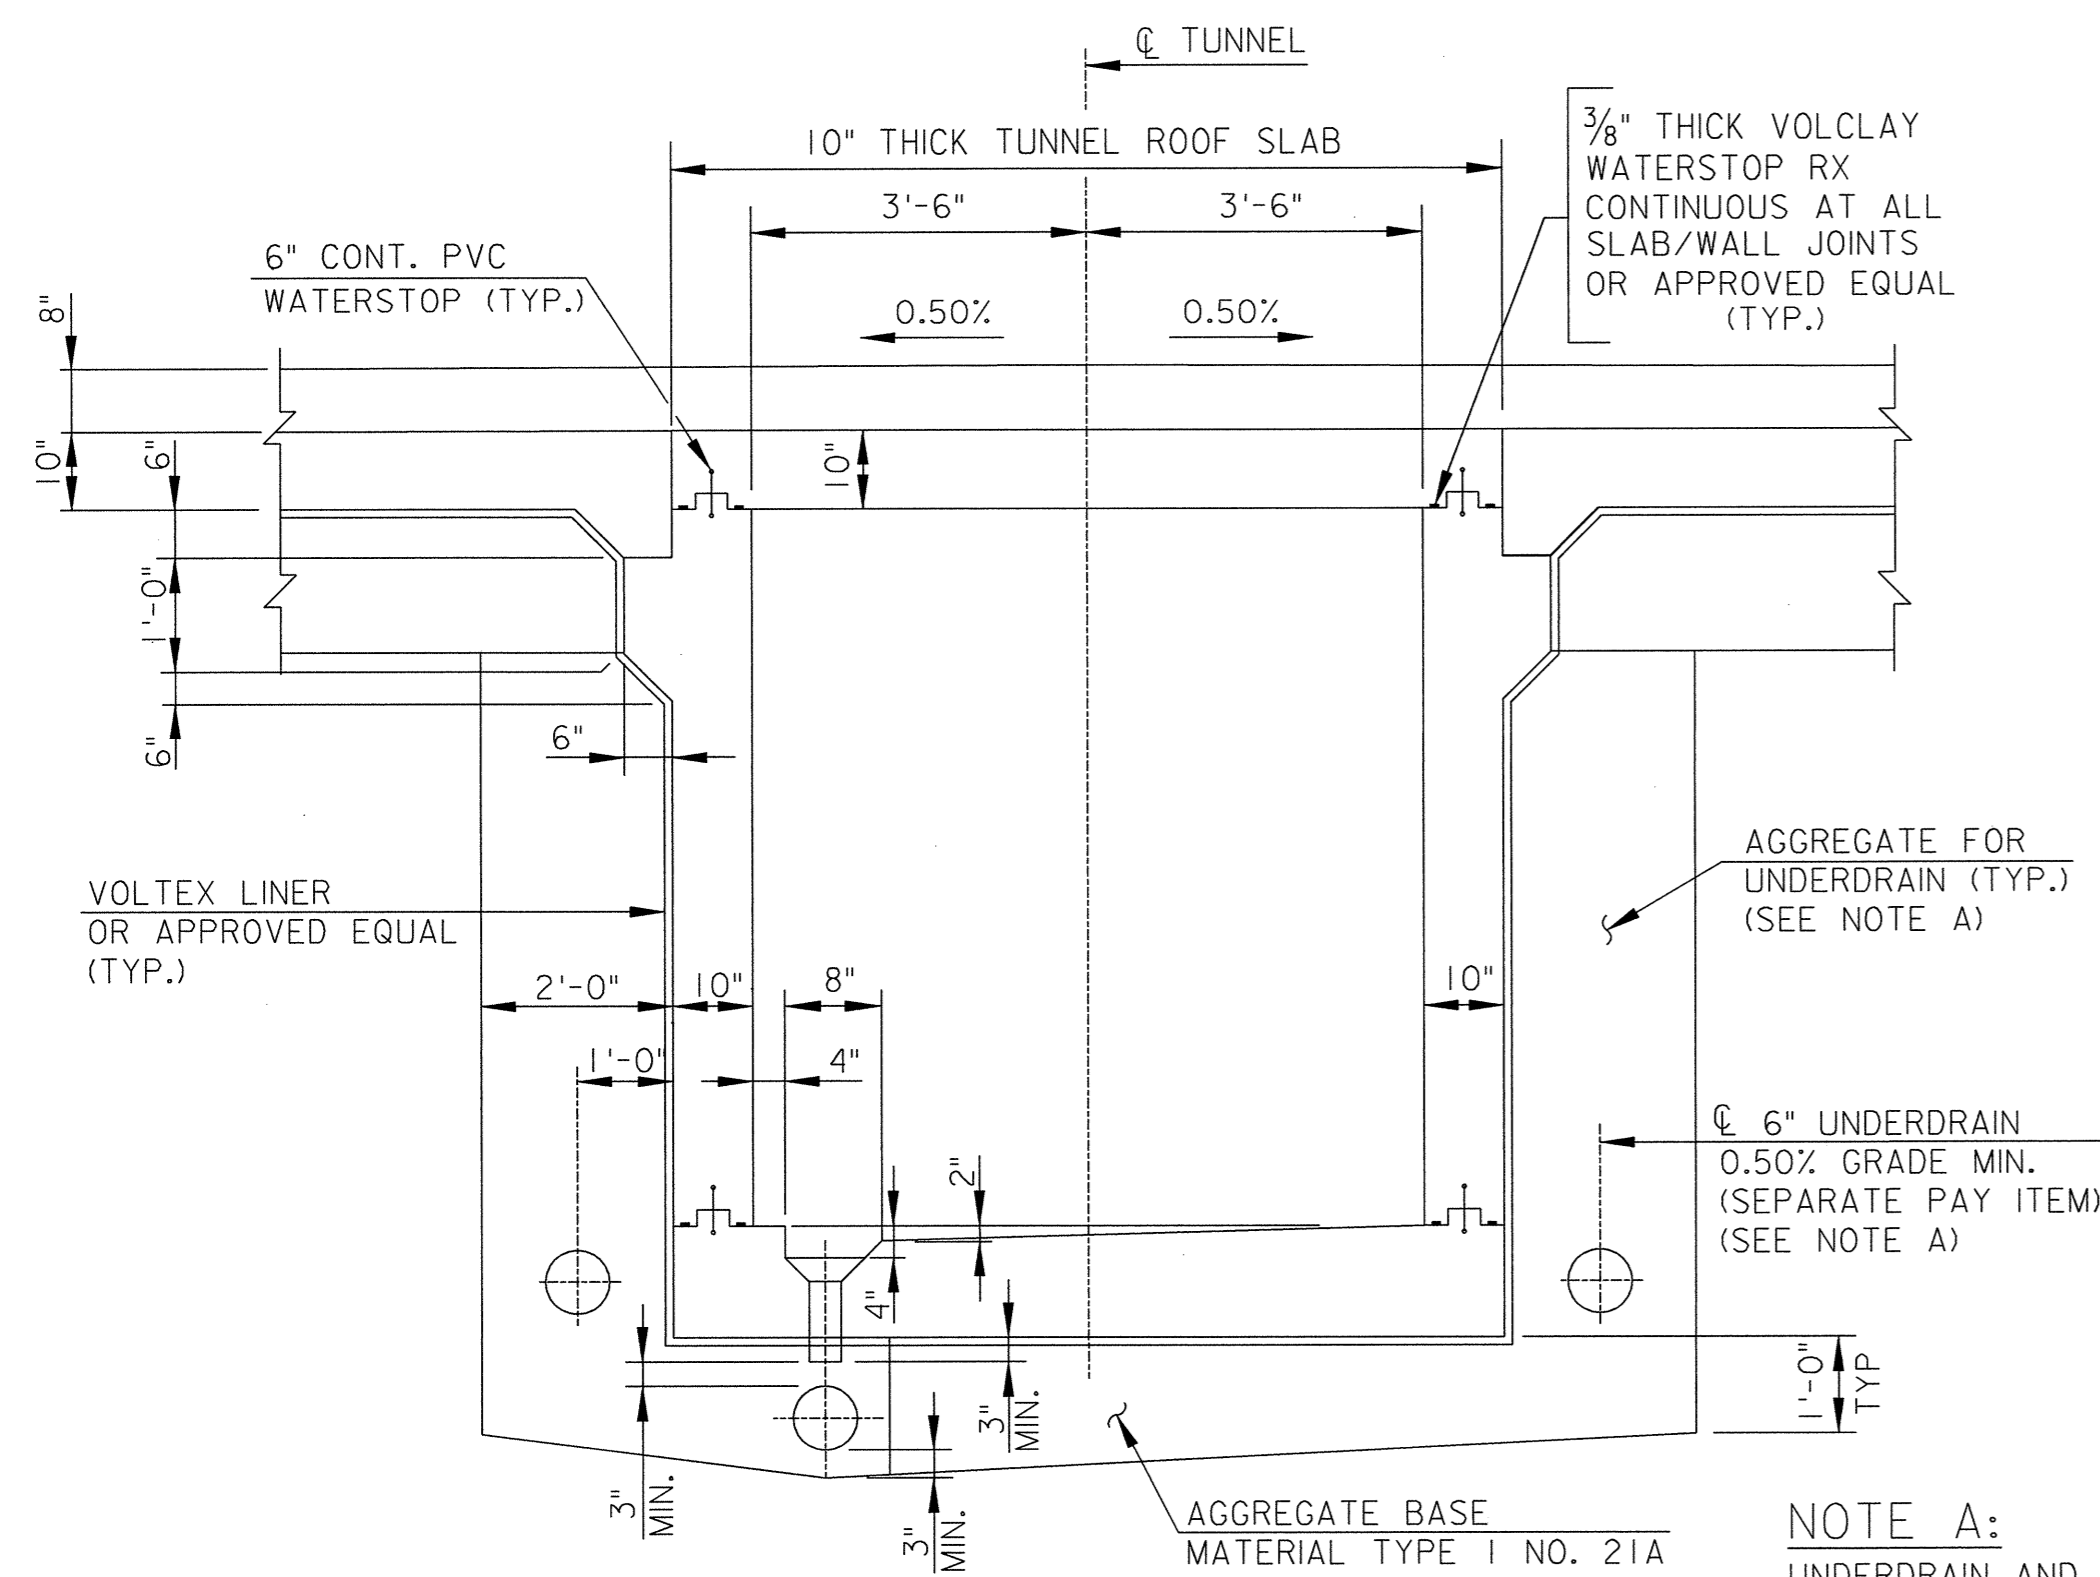


TYPICAL SECTION - BETWEEN ISLANDS
SCALE: 1/2" = 1'-0"

NOTE A:
UNDERDRAIN AND AGGREGATE FOR UNDERDRAIN SHALL BE PLACED AROUND THE OUTLINE OF THE STAIR WELLS. UNDERDRAIN SHALL BE SLOPED TO DRAIN.

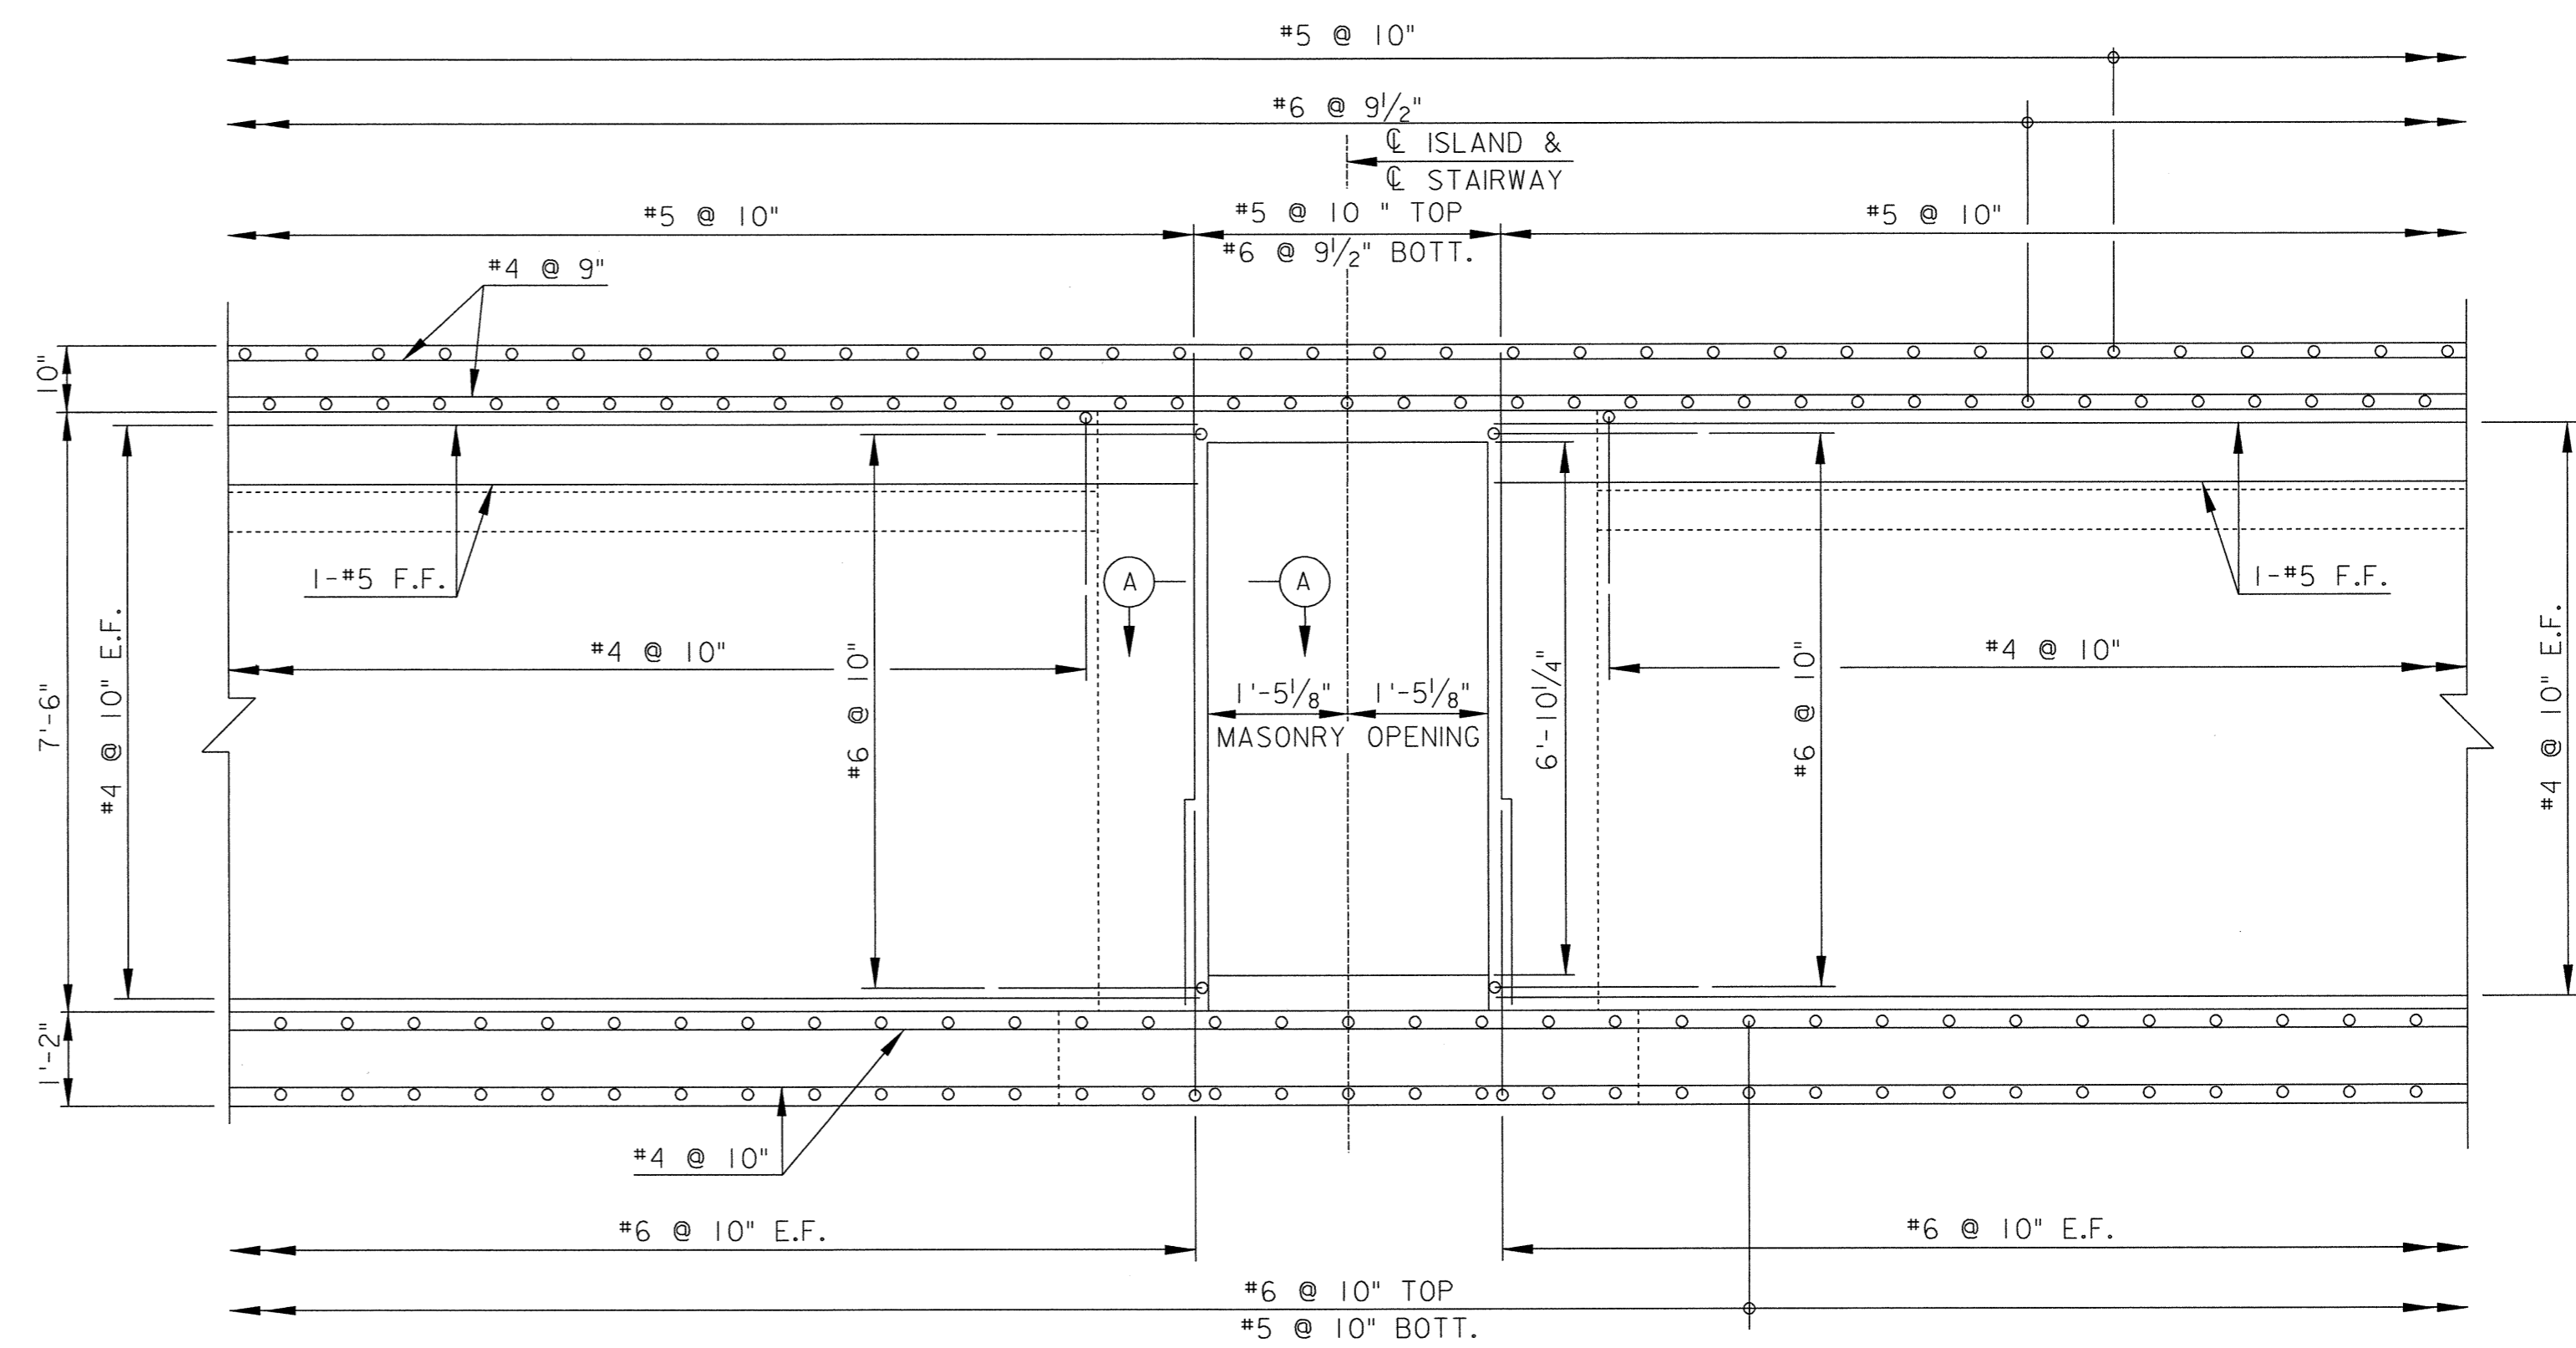


TUNNEL LONGITUDINAL SECTION
AT STAIRWAY ENTRANCE
SCALE: 1/2" = 1'-0"


NOTE A:
MASONRY OPENING SHALL BE FIELD VERIFIED AT EXISTING POWHITE TOLL PLAZA WITH ENGINEER.

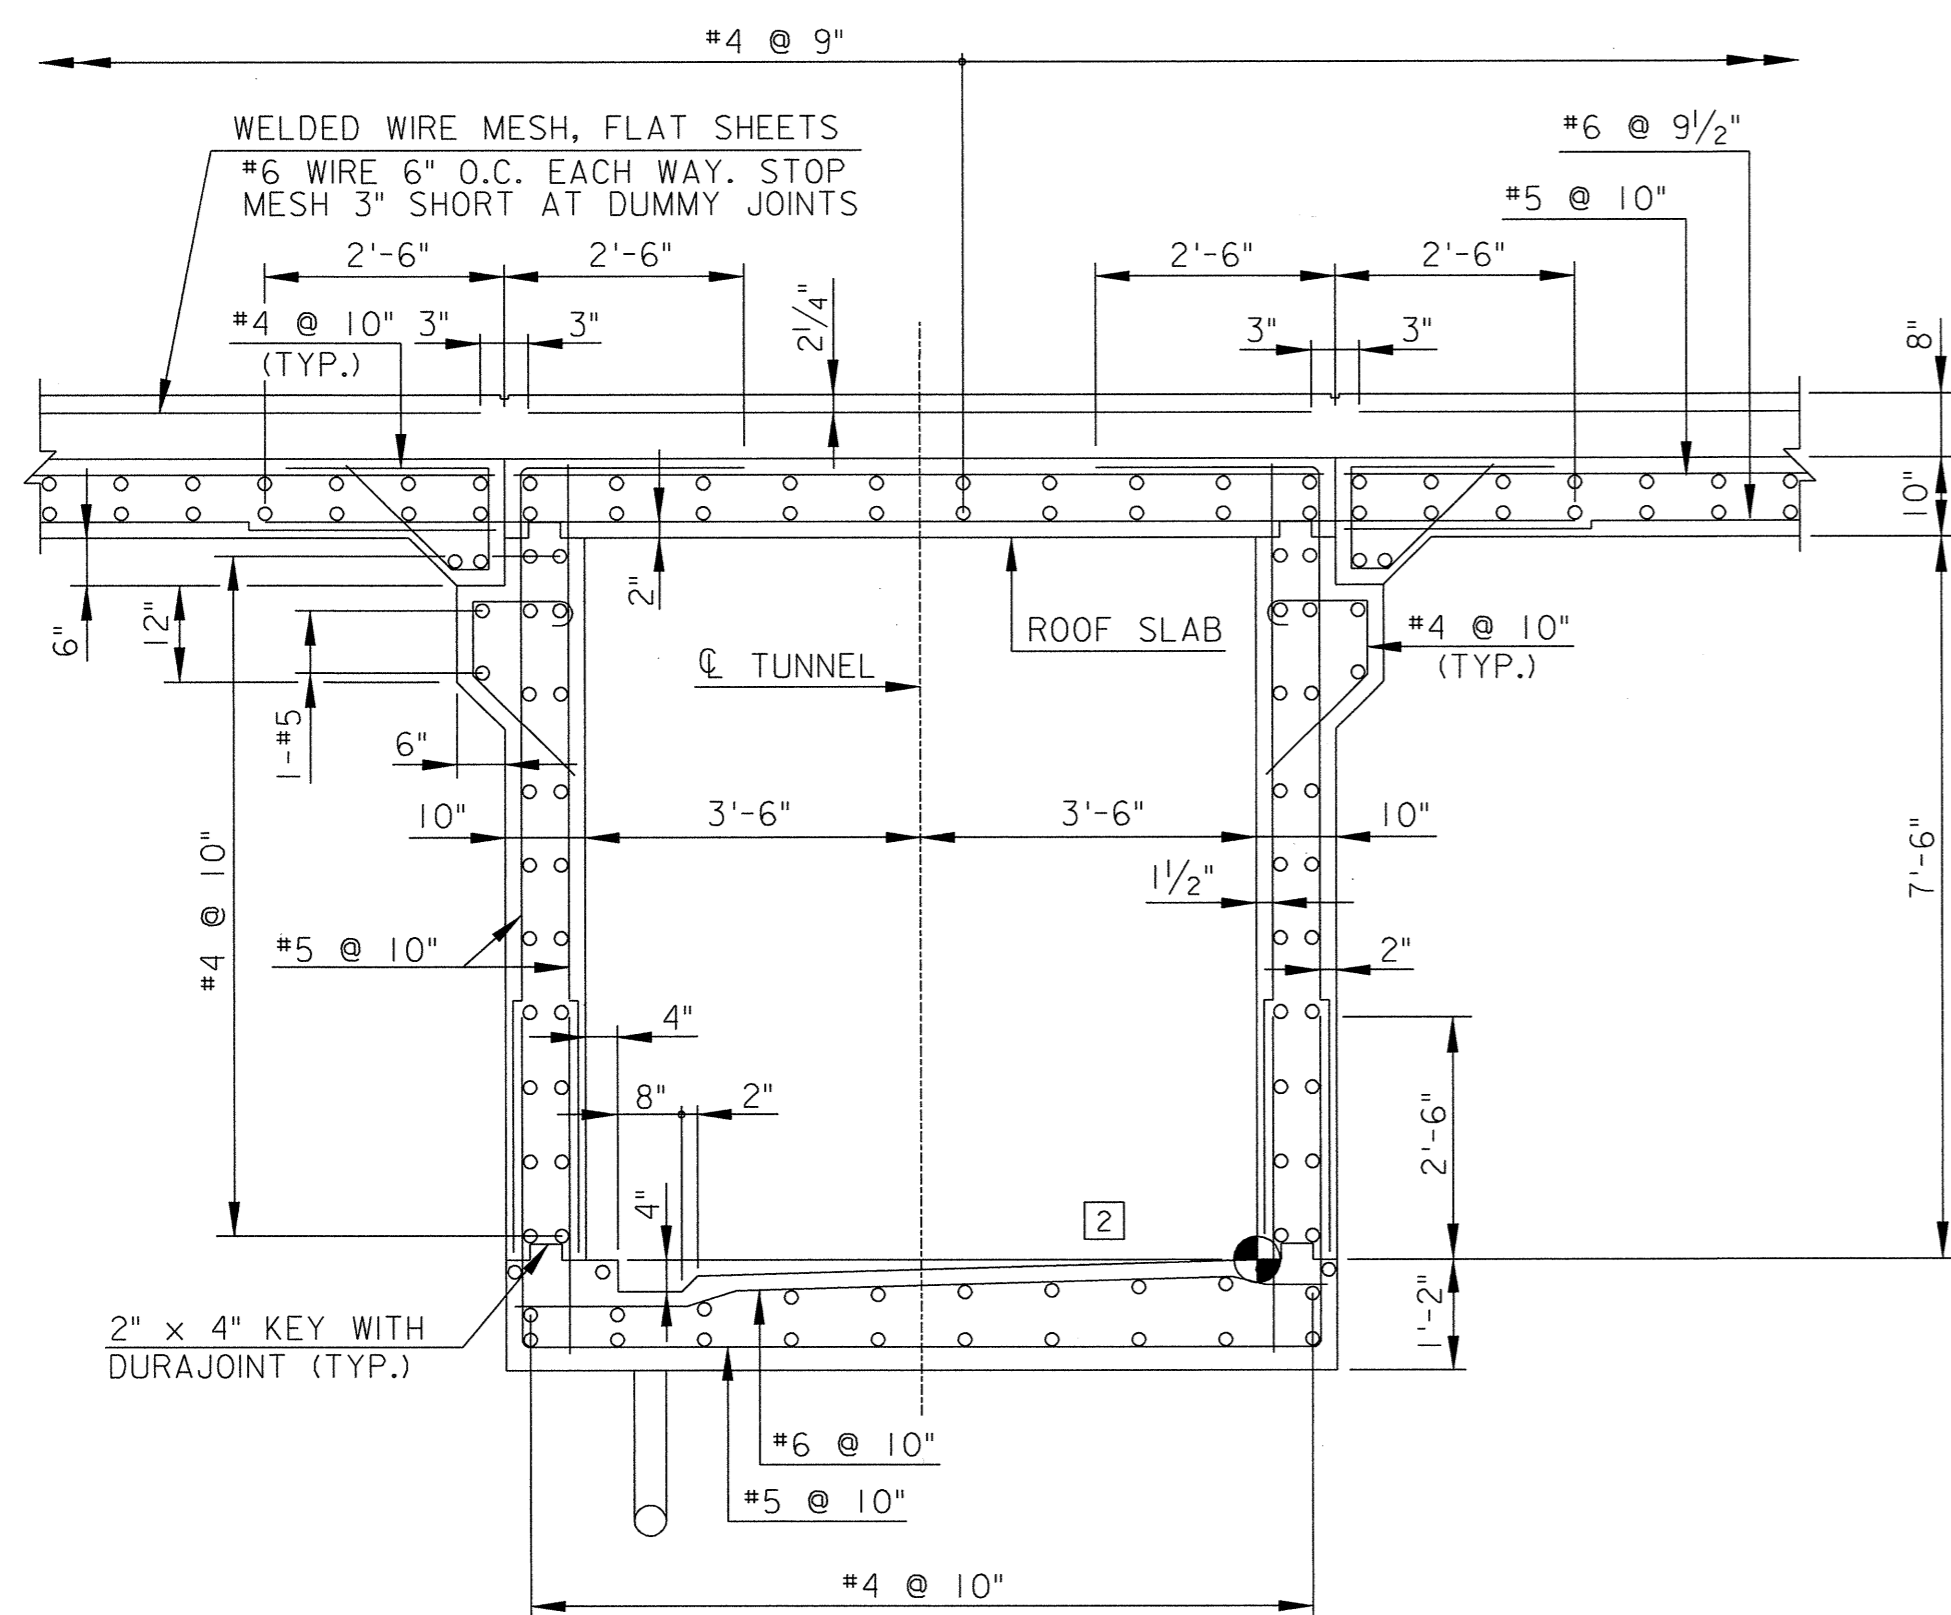

TUNNEL TYPICAL SECTION
SCALE: 1/2" = 1'-0"

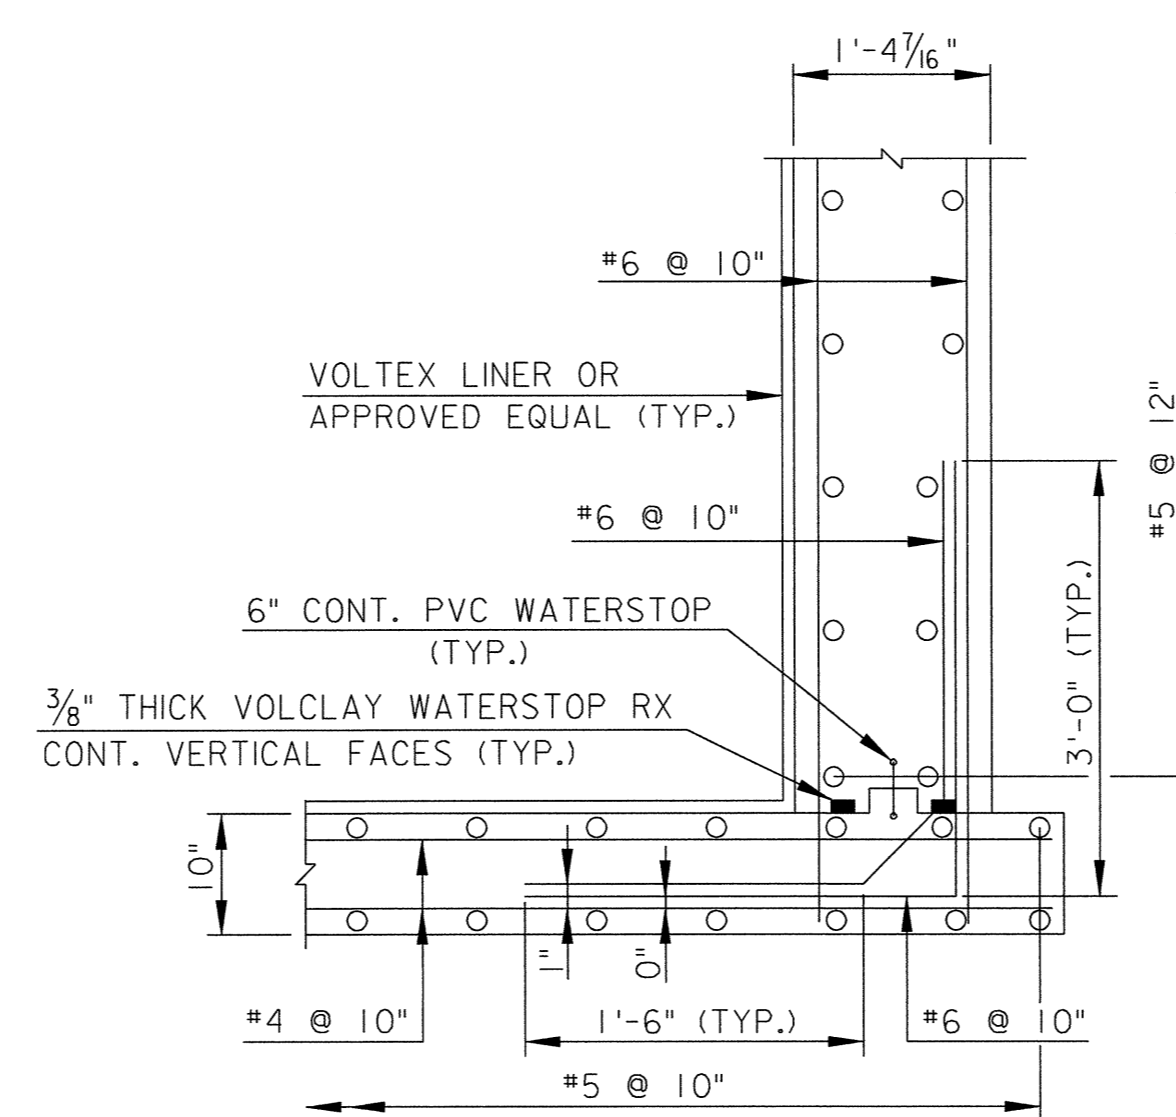

SECTION A-A
SCALE: 3/4" = 1'-0"

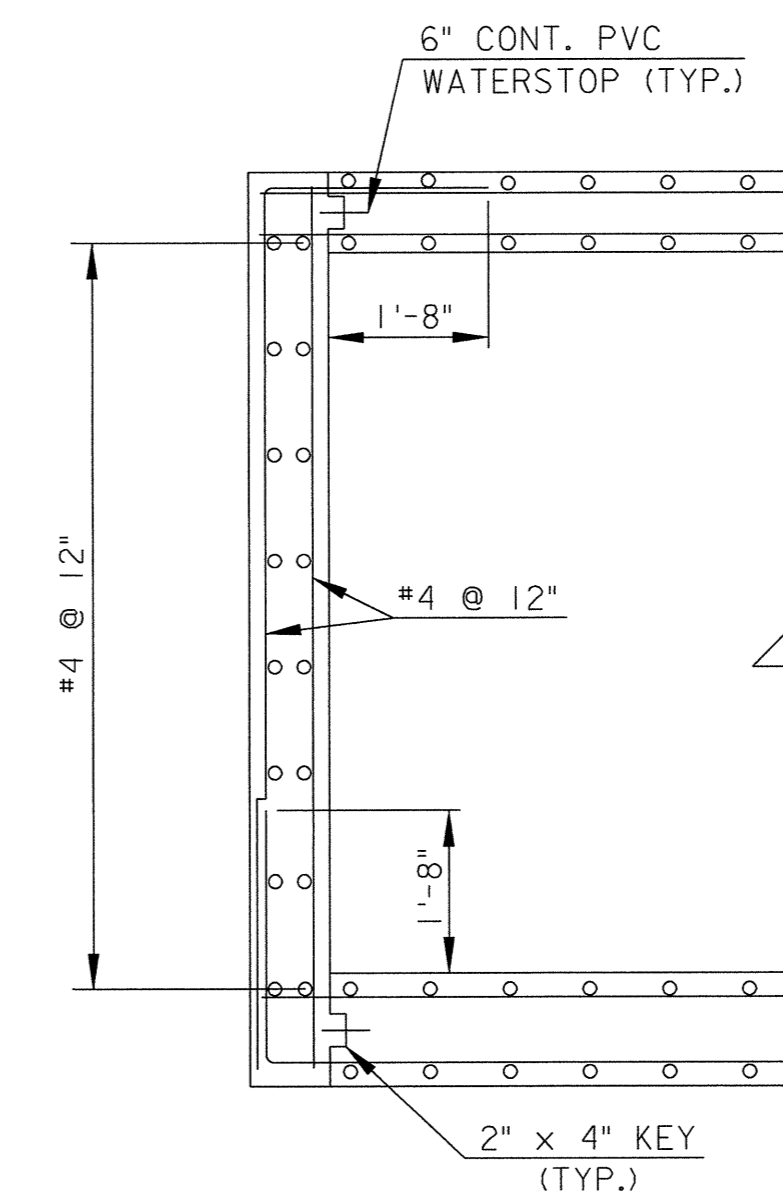

SECTION AT END OF TUNNEL
SCALE: 1/2" = 1'-0"

NO.	DATE	REVISIONS
5	3/27/07	REMOVED AND UPDATED DETAILS
2	7/20/06	REVISED SHEET - SEE SHEET 1B
1	6/23/06	ADDED SHEET

HNTB
9175 GUILFORD ROAD, SUITE 100
COLUMBIA, MARYLAND 21046
(301) 543-1000

STP-106A

RM RICHMOND METROPOLITAN AUTHORITY
RICHMOND EXPRESSWAY SYSTEM

**POWHITE PARKWAY EXPRESS
TOLL LANES PROJECT**

TOLL PLAZA
MISCELLANEOUS TUNNEL DETAILS-1

Scale: AS SHOWN	Date: 3/27/07	Contract No.: PEL-2006	Sheet: 158GI of 161
--------------------	------------------	---------------------------	------------------------

OWNER:
RICHMOND METROPOLITAN AUTHORITY
 919 EAST MAIN STREET
 SUITE 600
 RICHMOND, VA 23219
 TEL: 804.523.3300
 FAX: 804.523.3330












ARCHITECT:

HNTB

HNTB ARCHITECTURE
 The HNTB Companies
 ARCHITECTS
 ENGINEERS
 PLANNERS

MEP / STRUCTURAL:
HANKINS & ANDERSON
 4880 SADLER ROAD
 SUITE 300
 GLEN ALLEN, VA 23060
 TEL: 804.285.4171
 FAX: 804.217.8520

CIVIL / LANDSCAPE:
HNTB CORPORATION
 9175 GUILFORD ROAD
 COLUMBIA, MD 21046
 TEL: 301.543.1000
 FAX: 301.498.5070

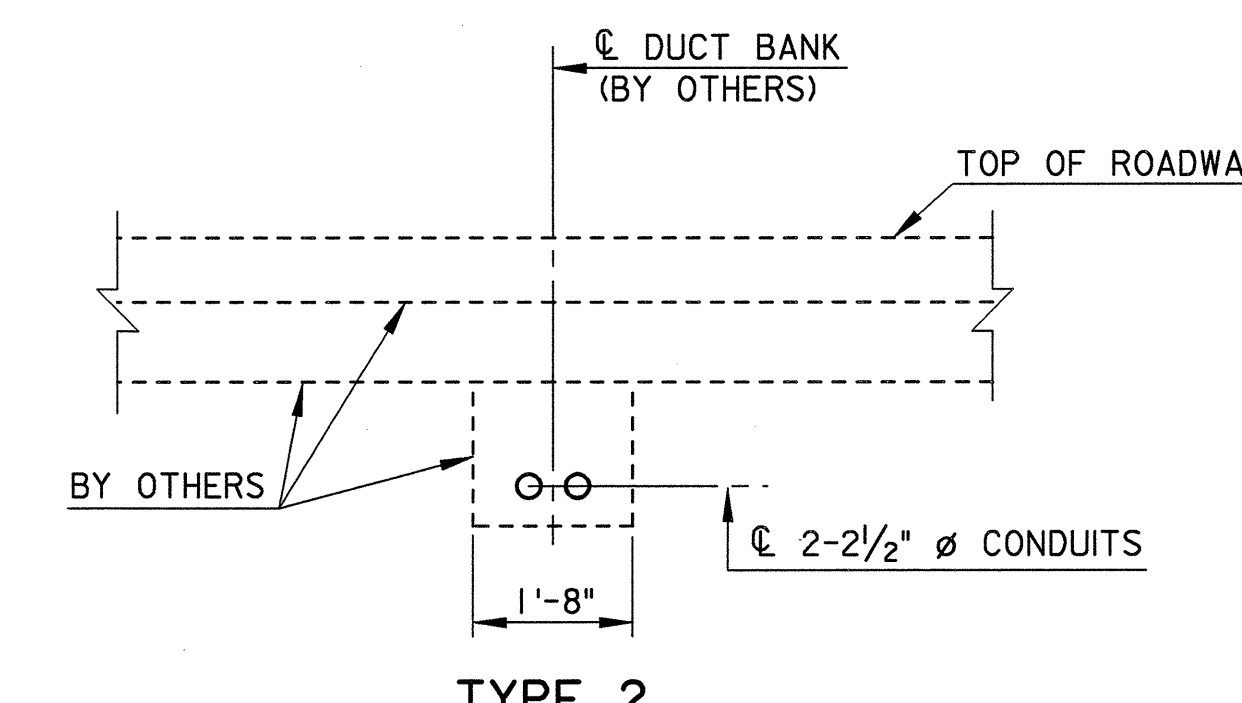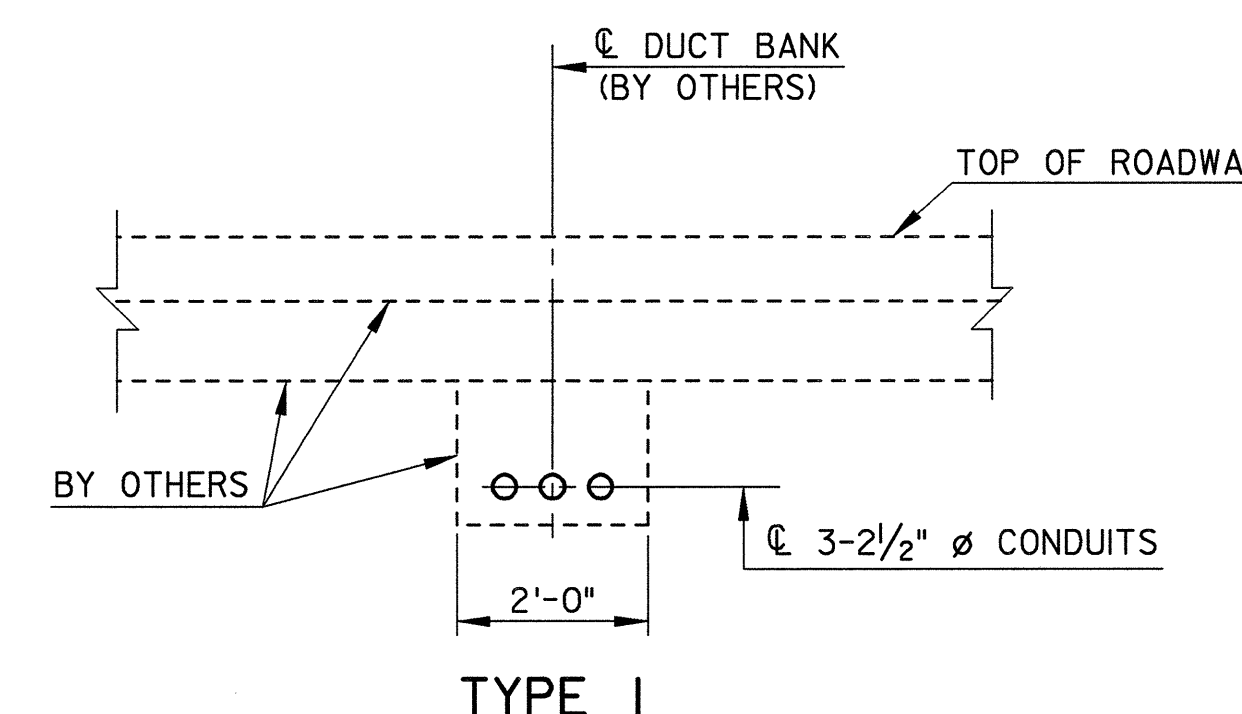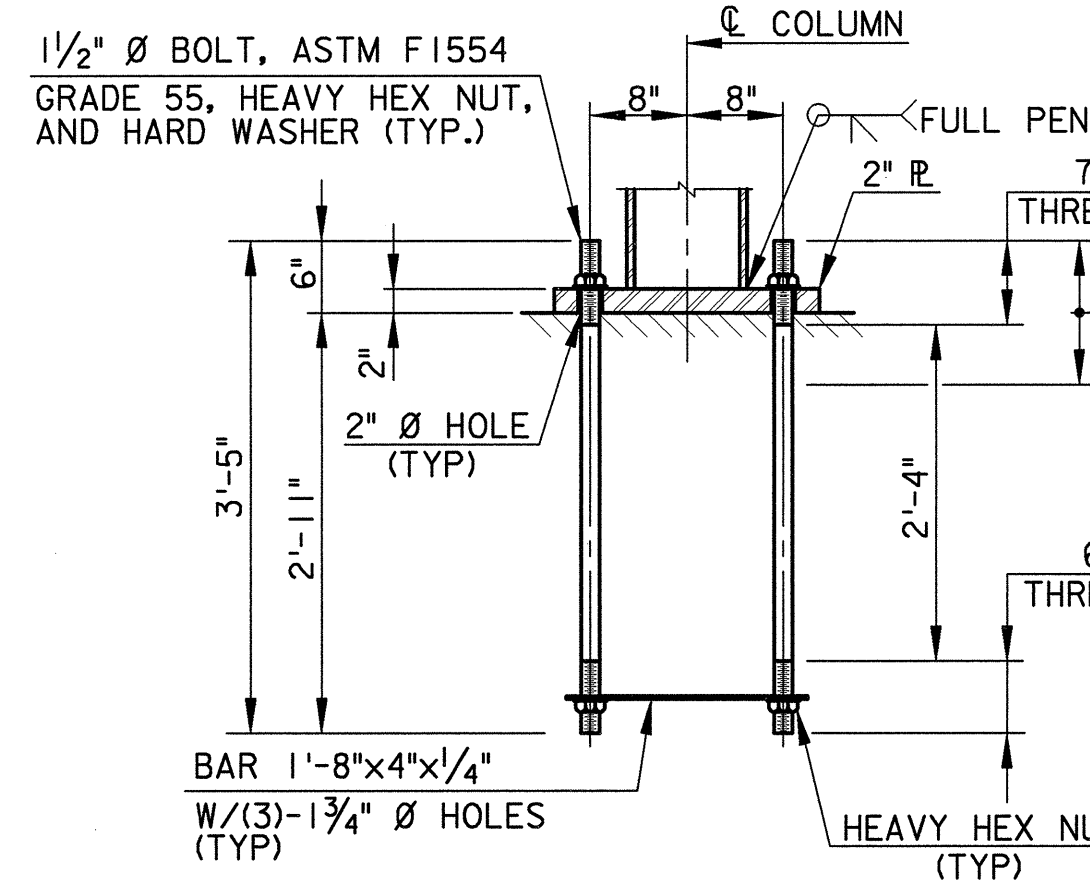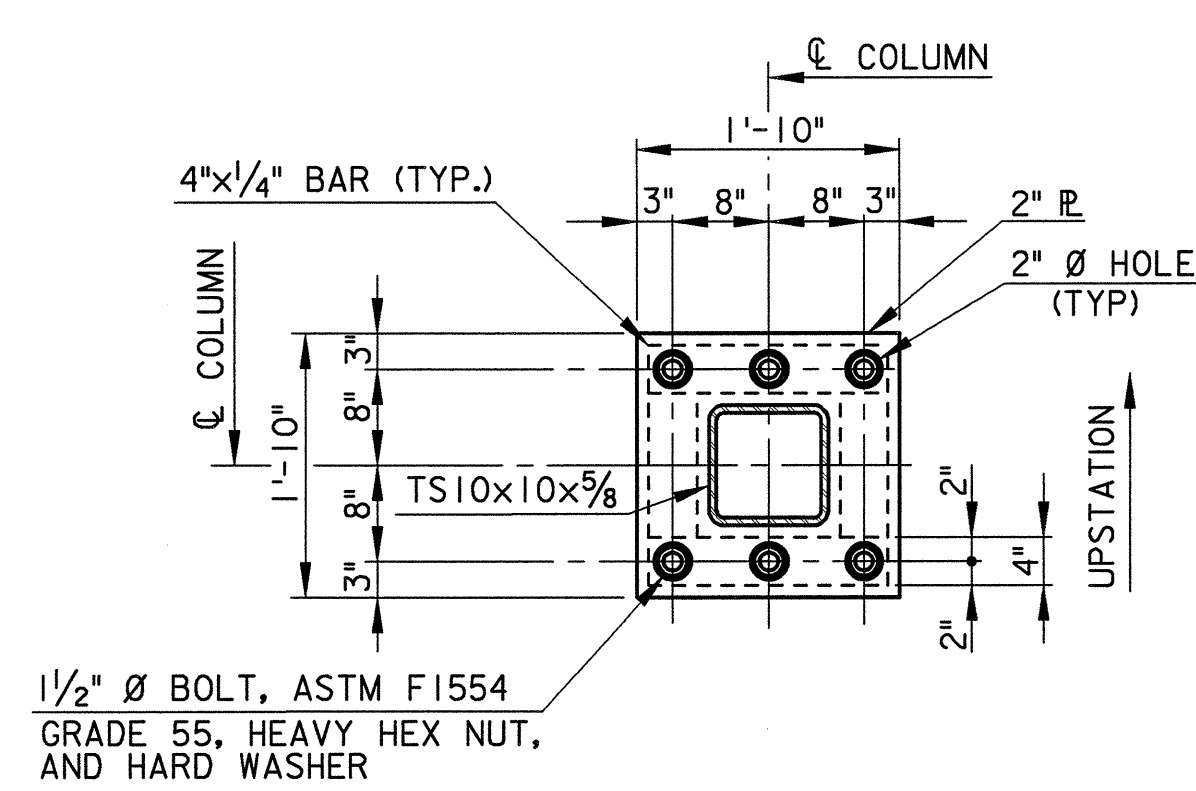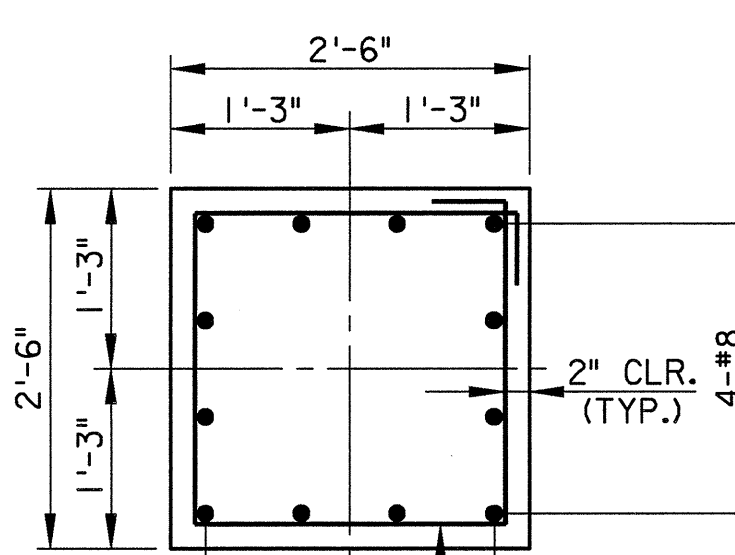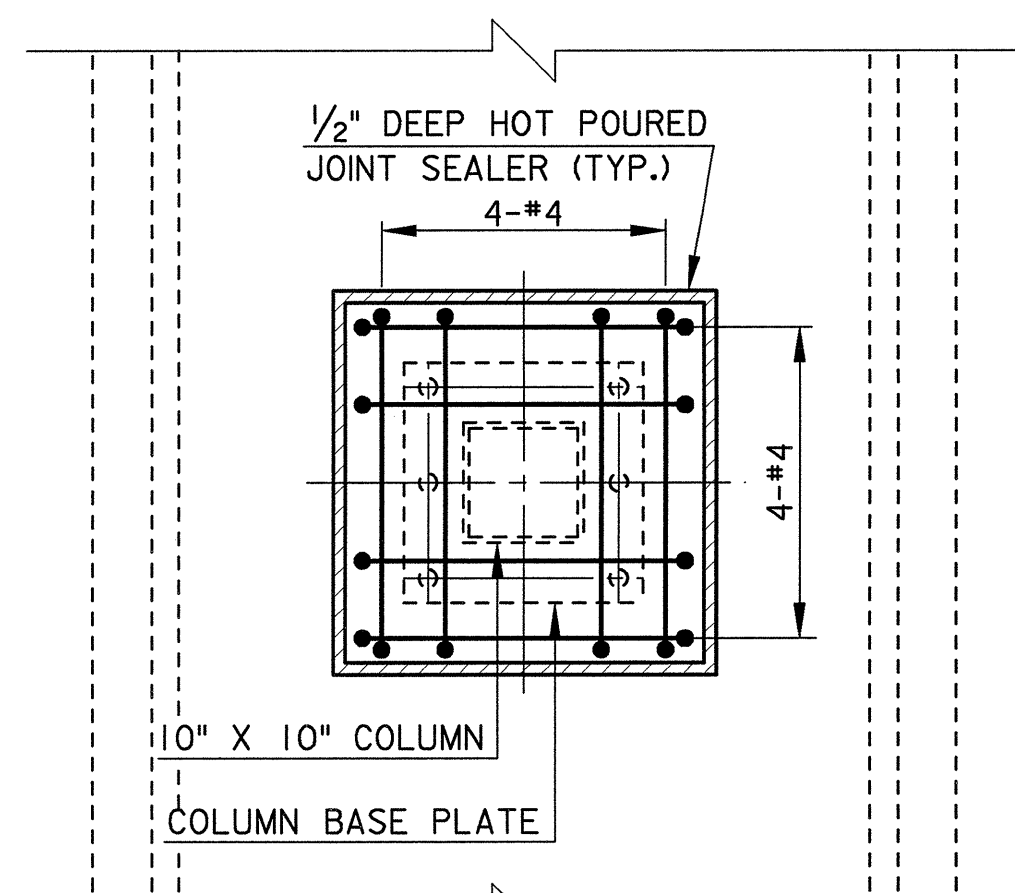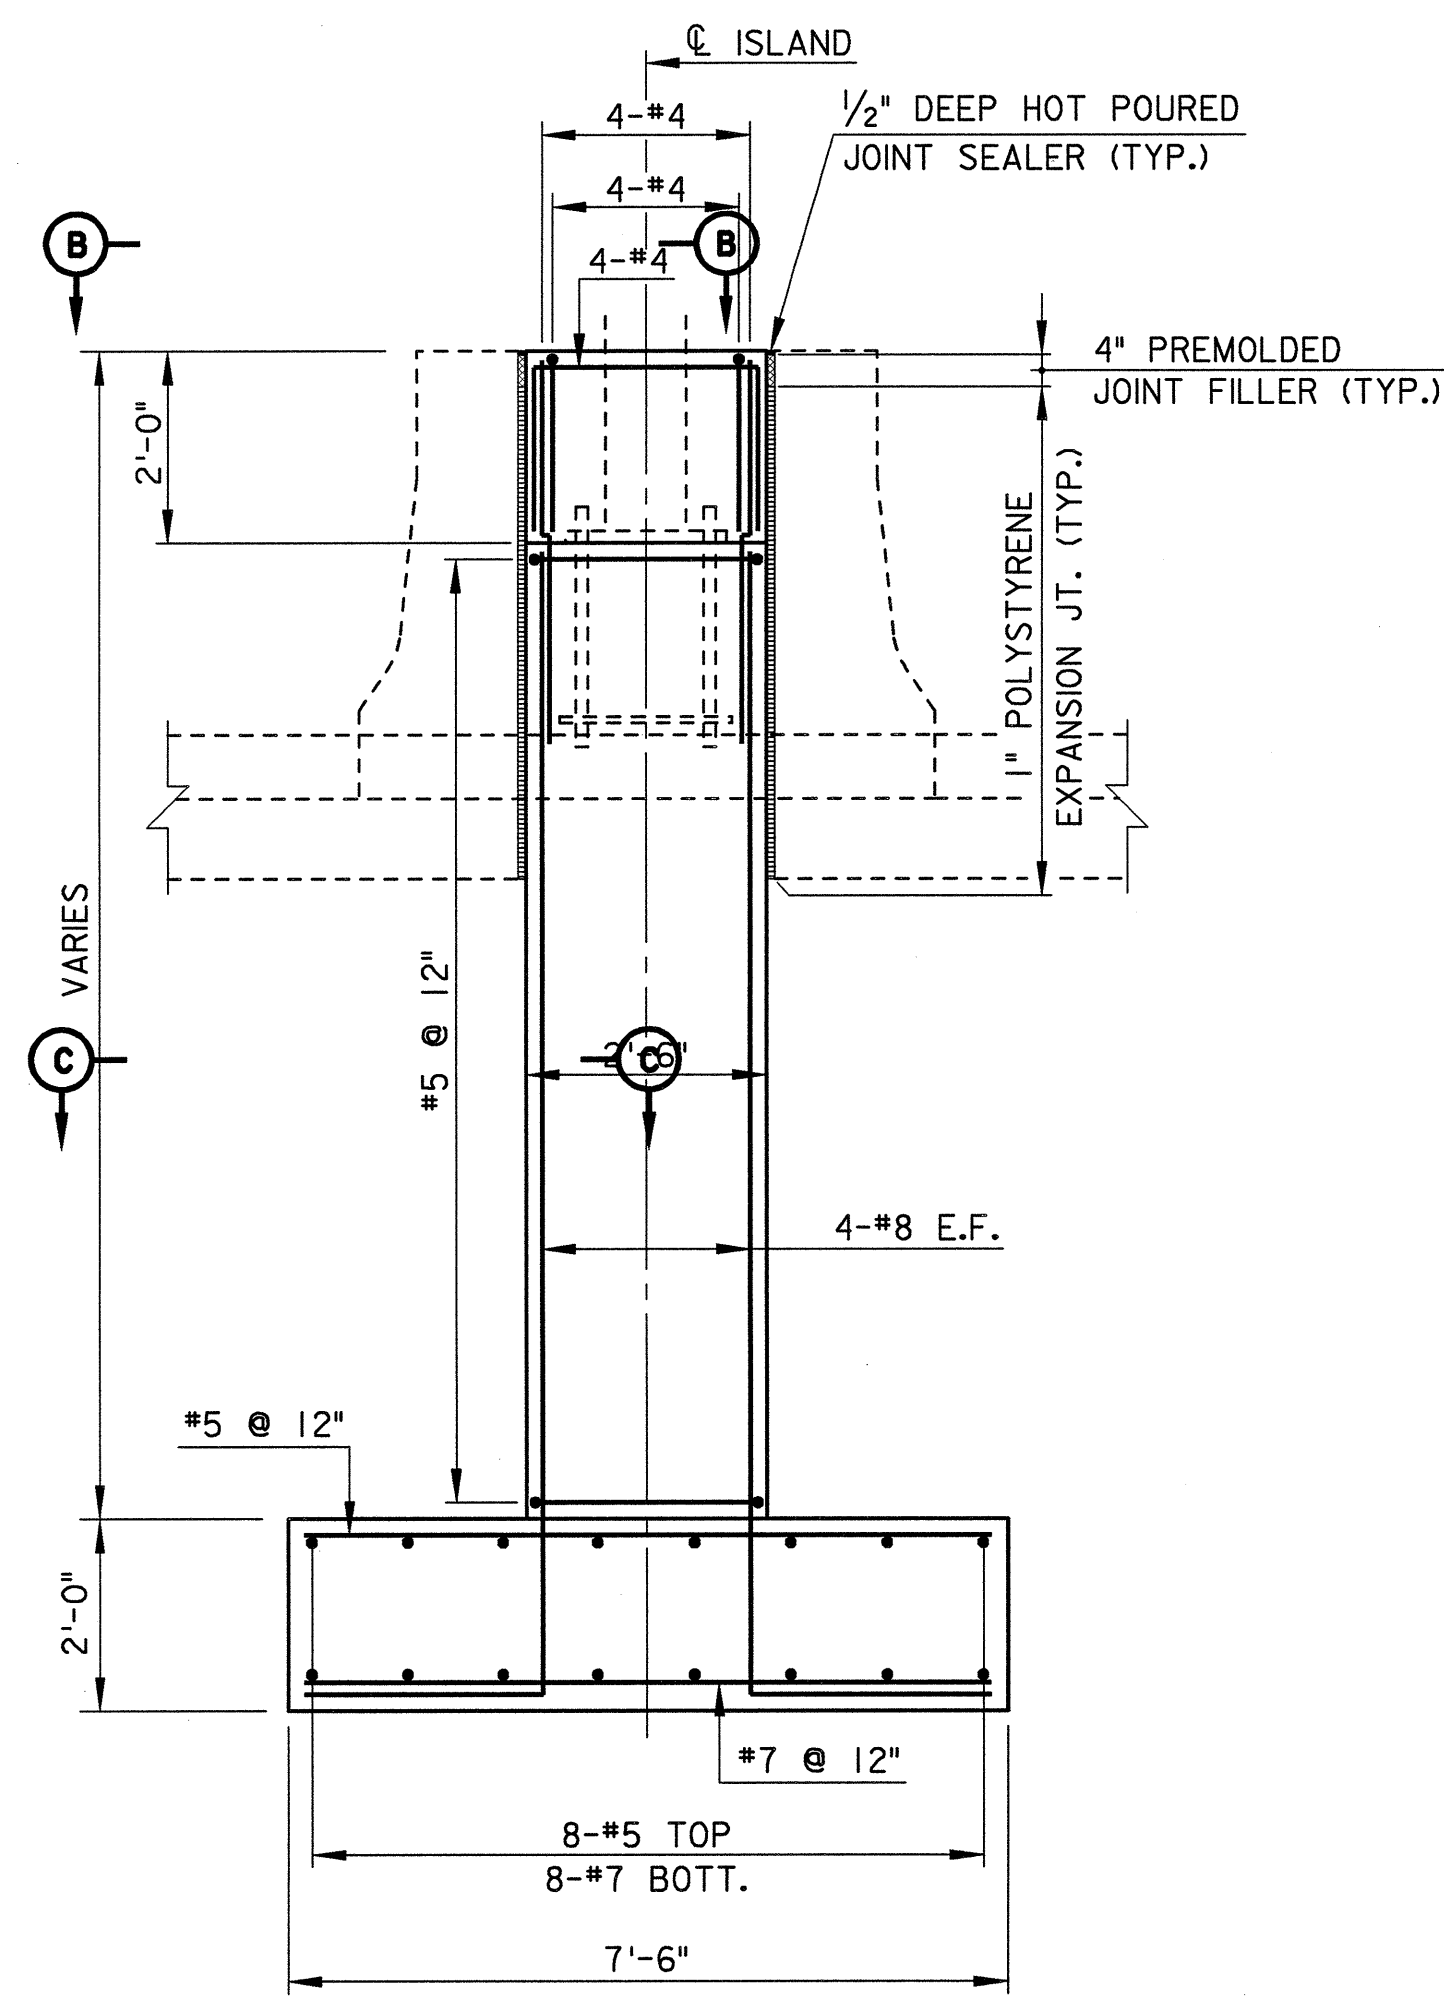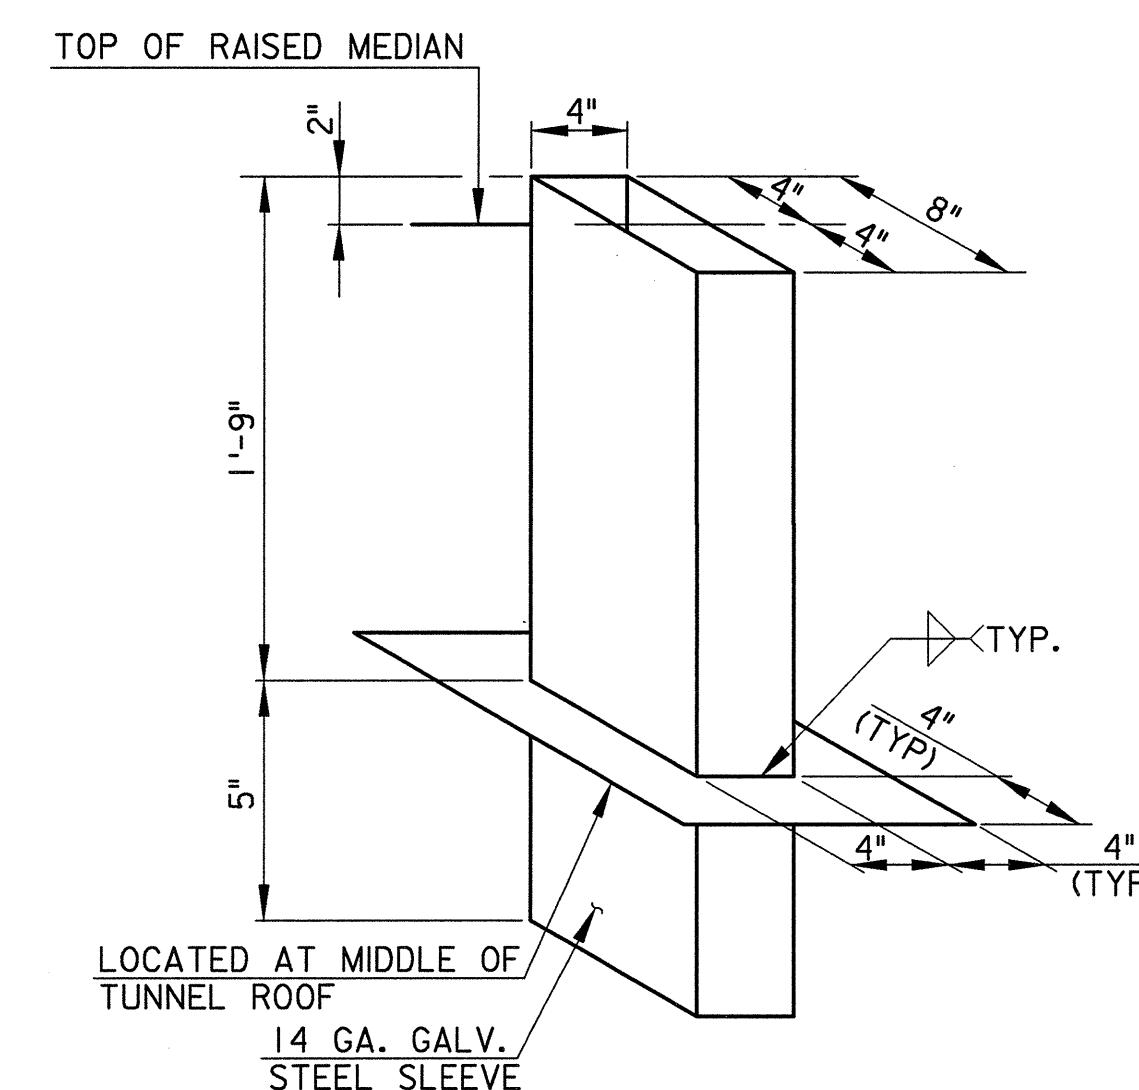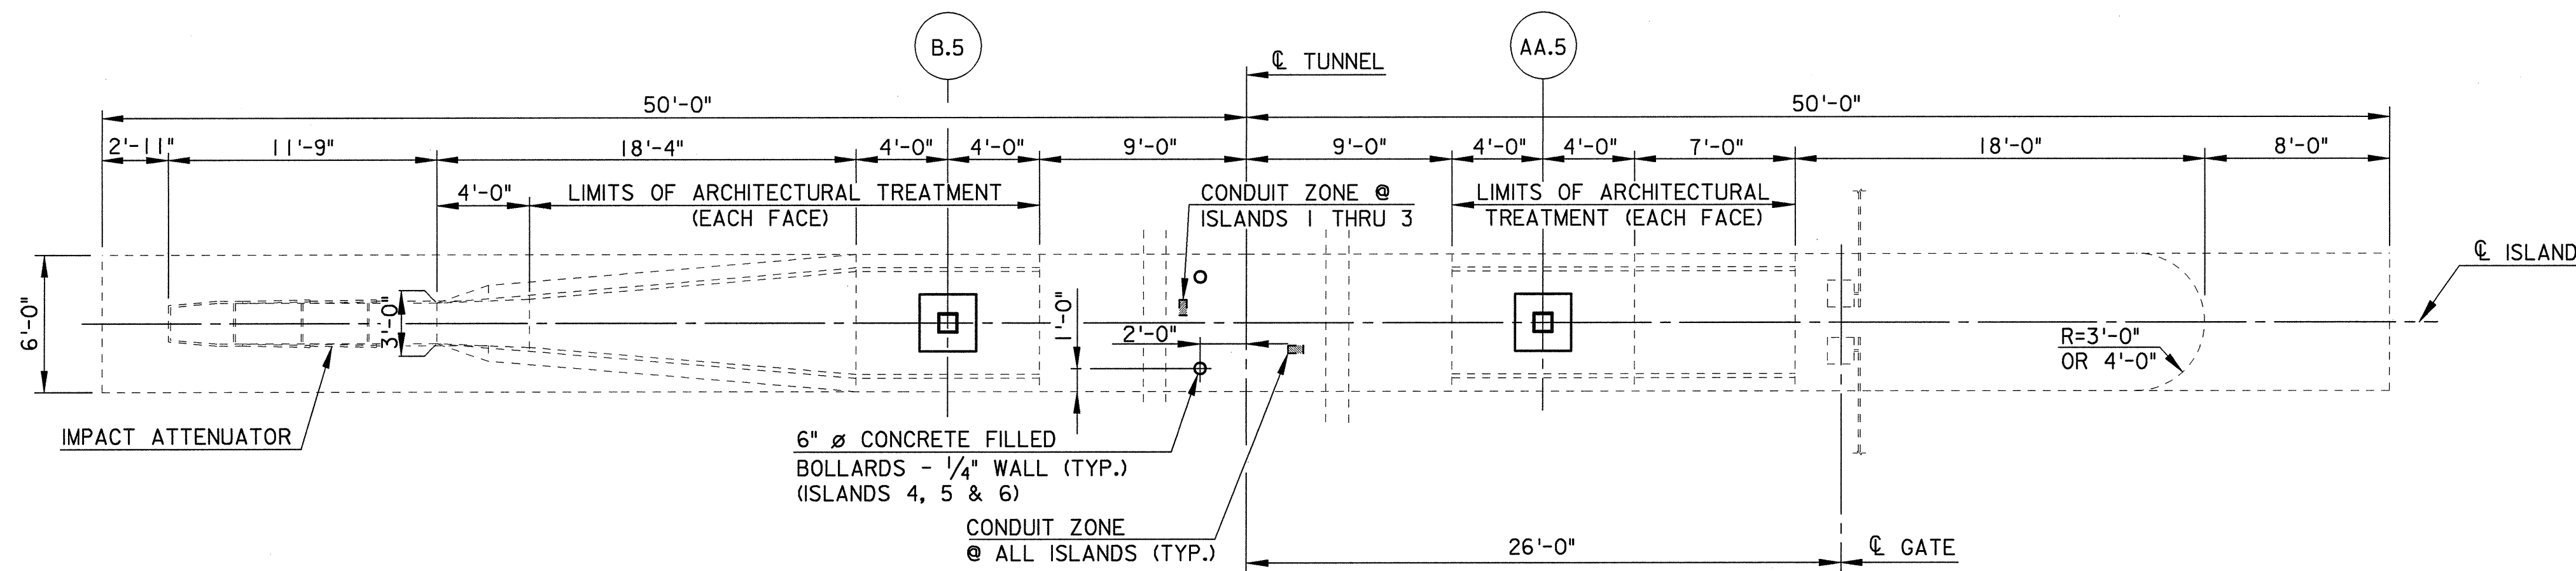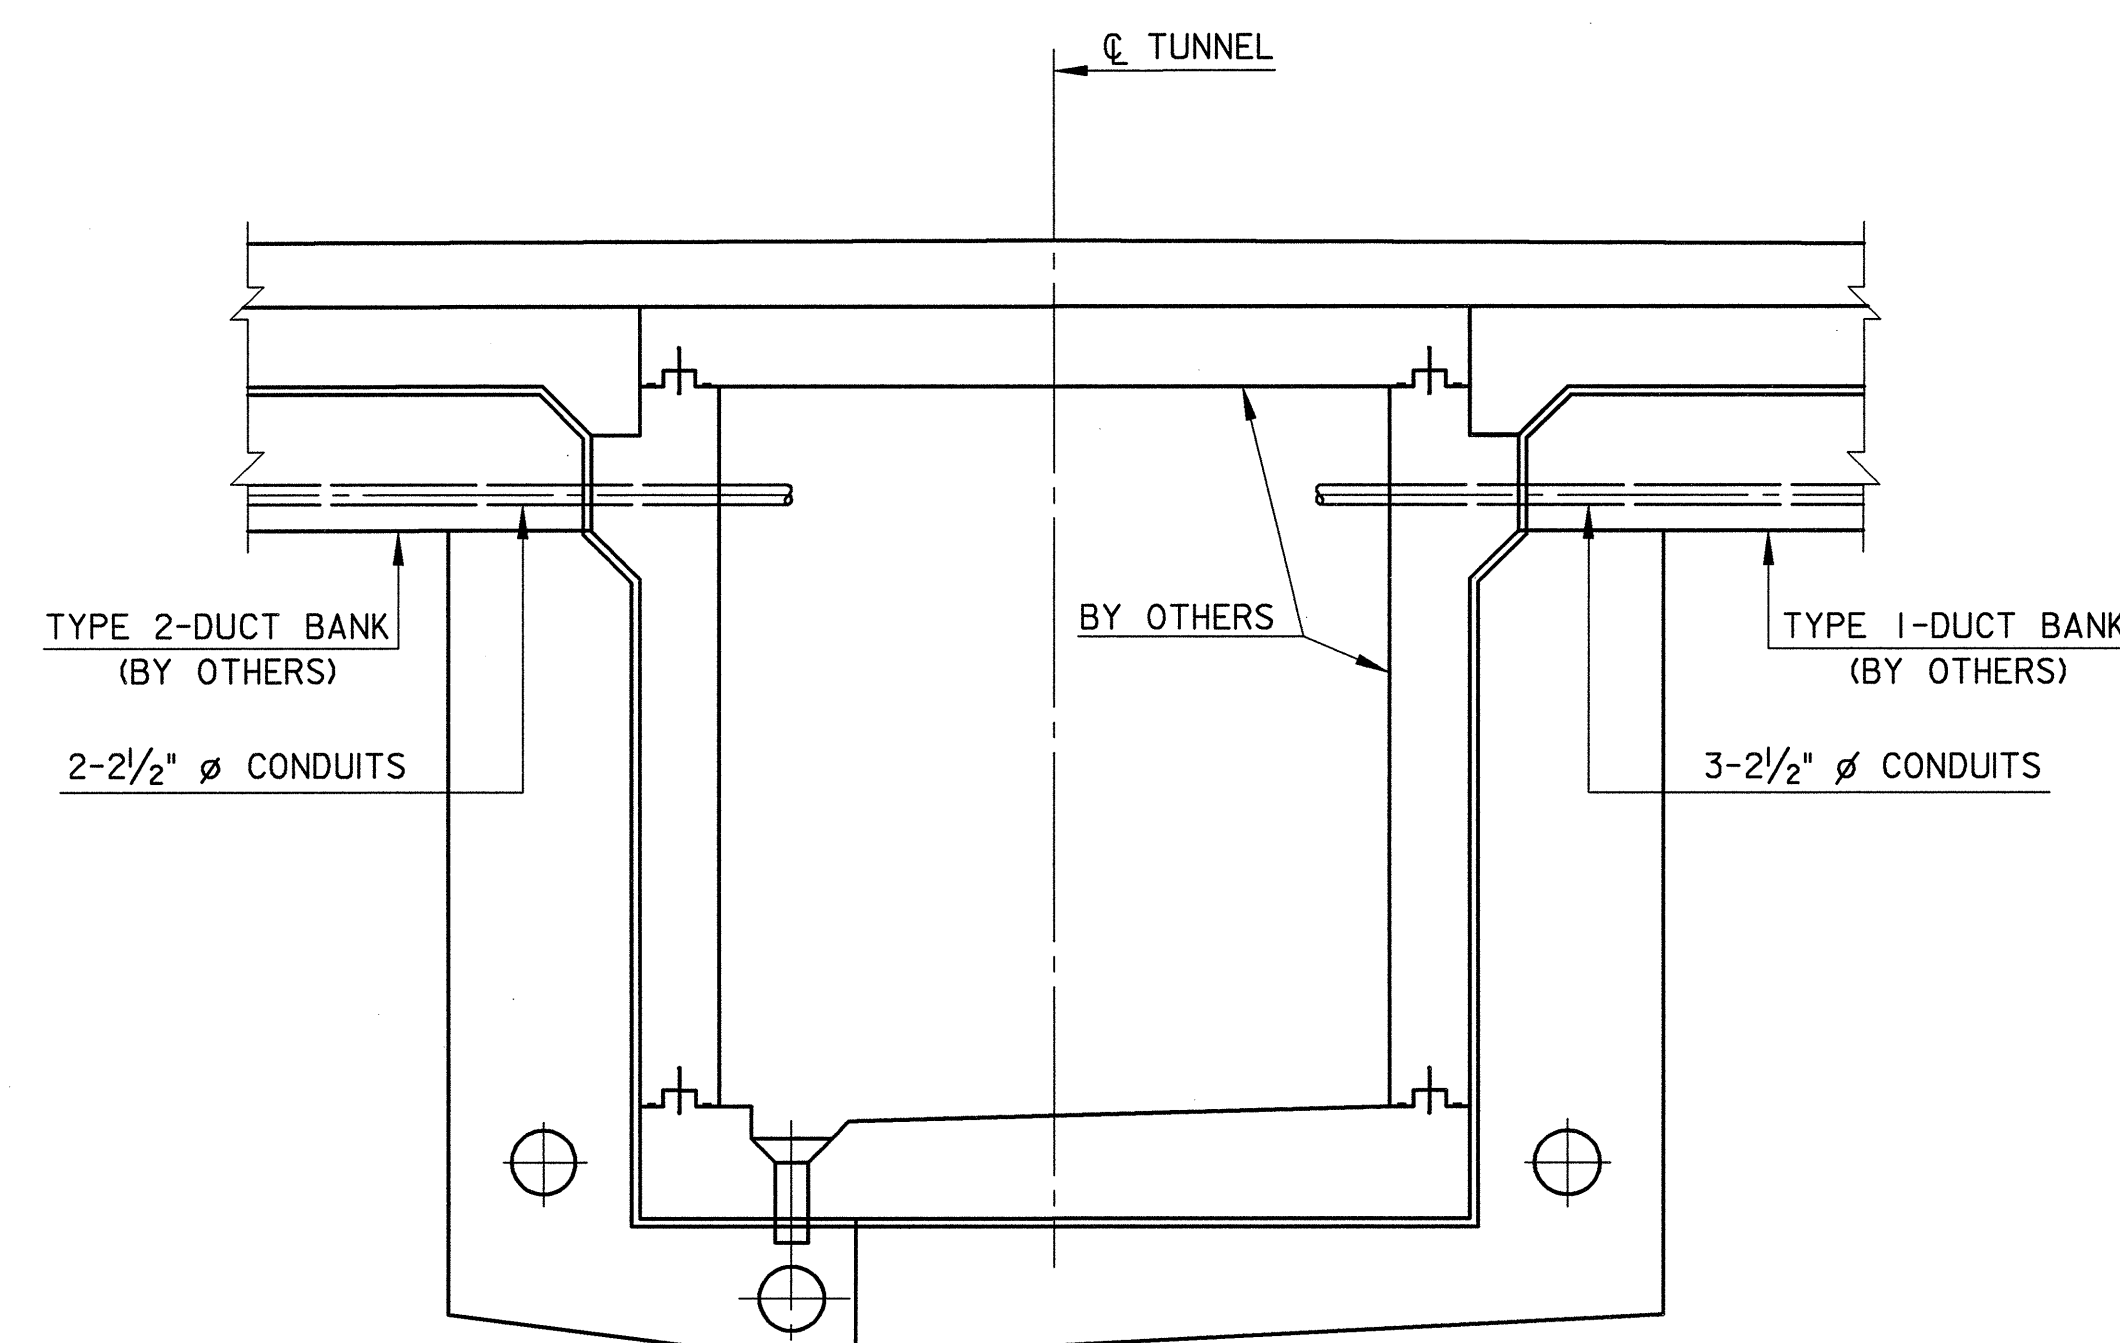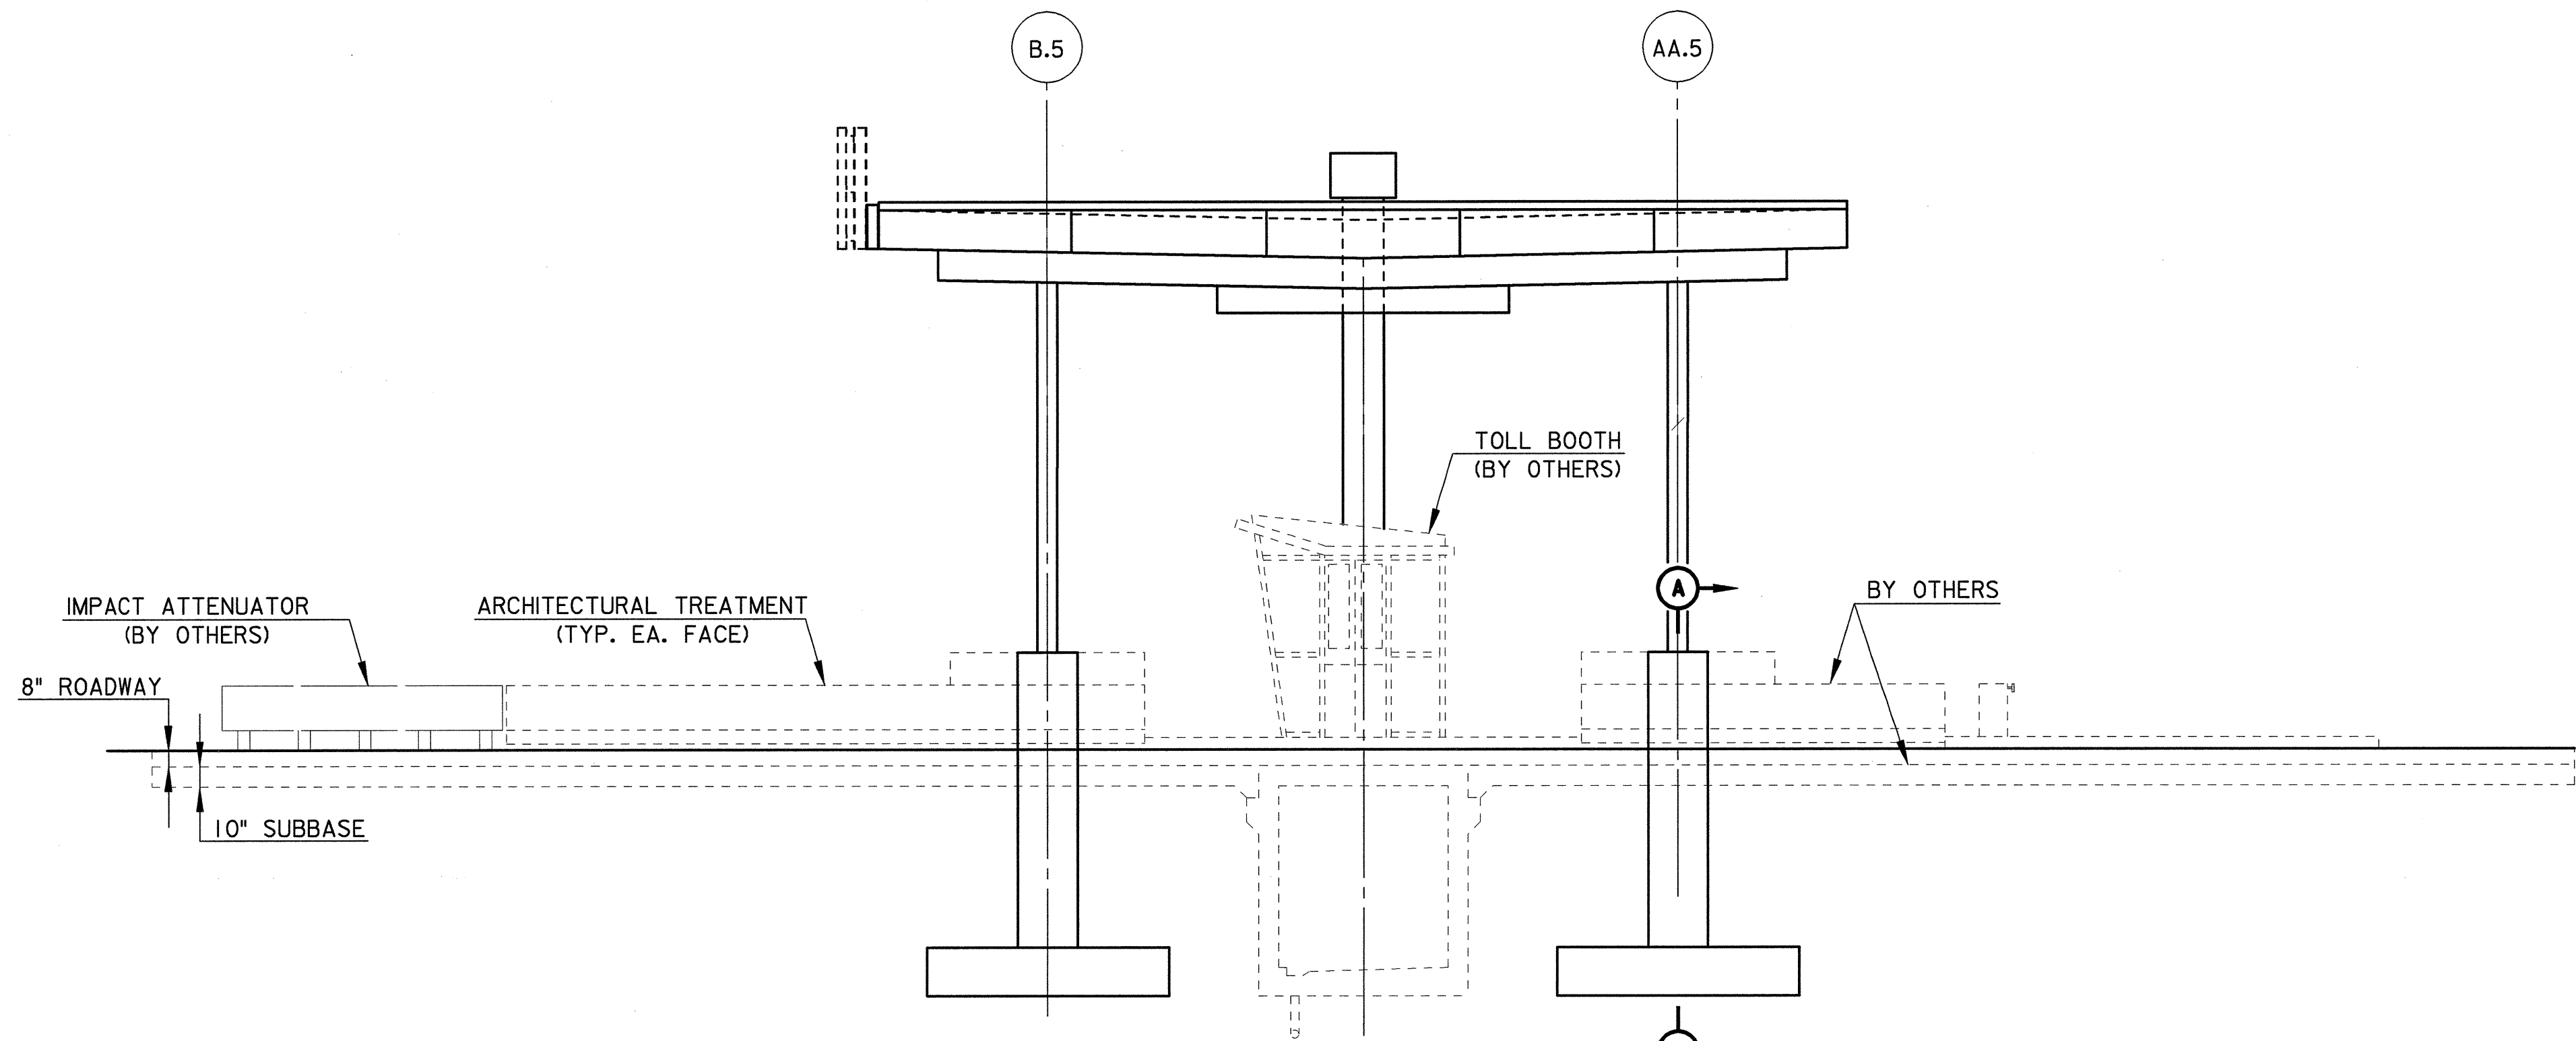

RICHMOND METROPOLITAN AUTHORITY
 POWHITE PARKWAY SPLIT PLAZA TOLL FACILITY
 RICHMOND, VIRGINIA













DATE ISSUED FOR CONSTRUCTION: 7/20/2006

PROJECT NO.: PSP-2006
 DRAWN BY: EJM
 CHECKED BY: BS
 APPROVED BY: BCC

REVISION	DATE	DESCRIPTION

STRUCTURAL TOLL PLAZA
 TYPICAL TOLL ISLAND
 DETAILS - 1
 STP-103

RICHMOND METROPOLITAN AUTHORITY
 POWHITE PARKWAY SPLIT PLAZA TOLL FACILITY
 RICHMOND, VIRGINIA

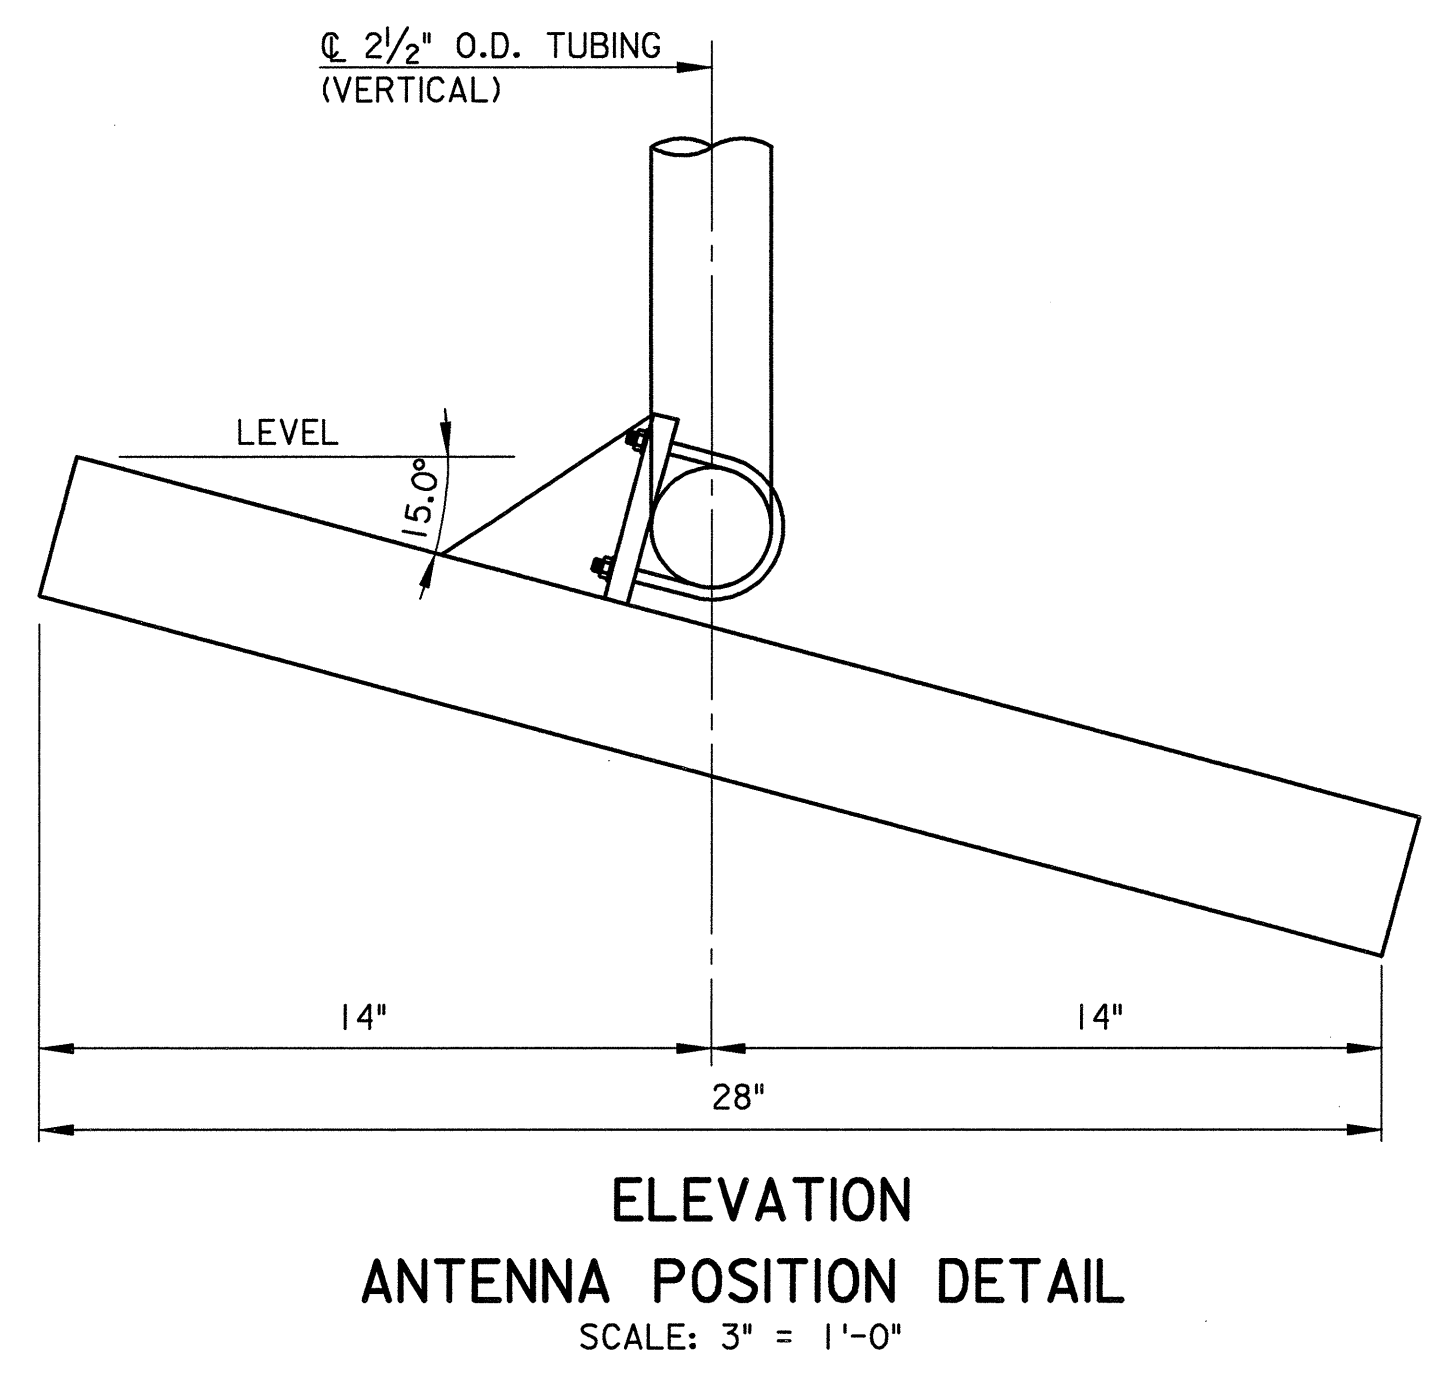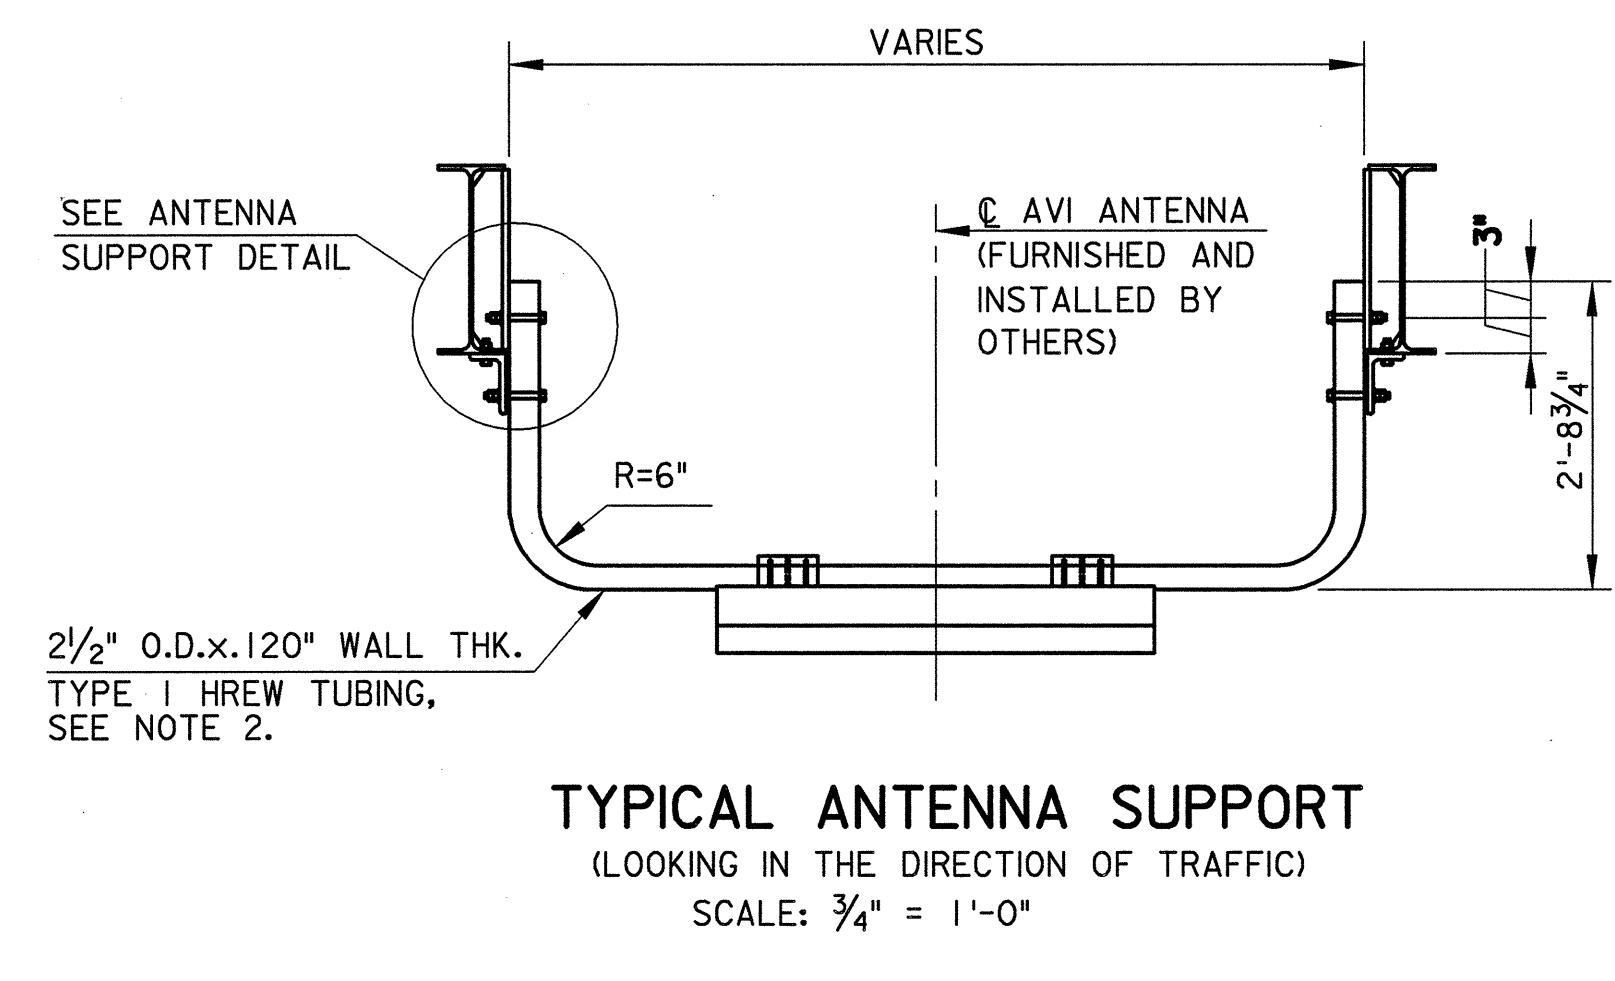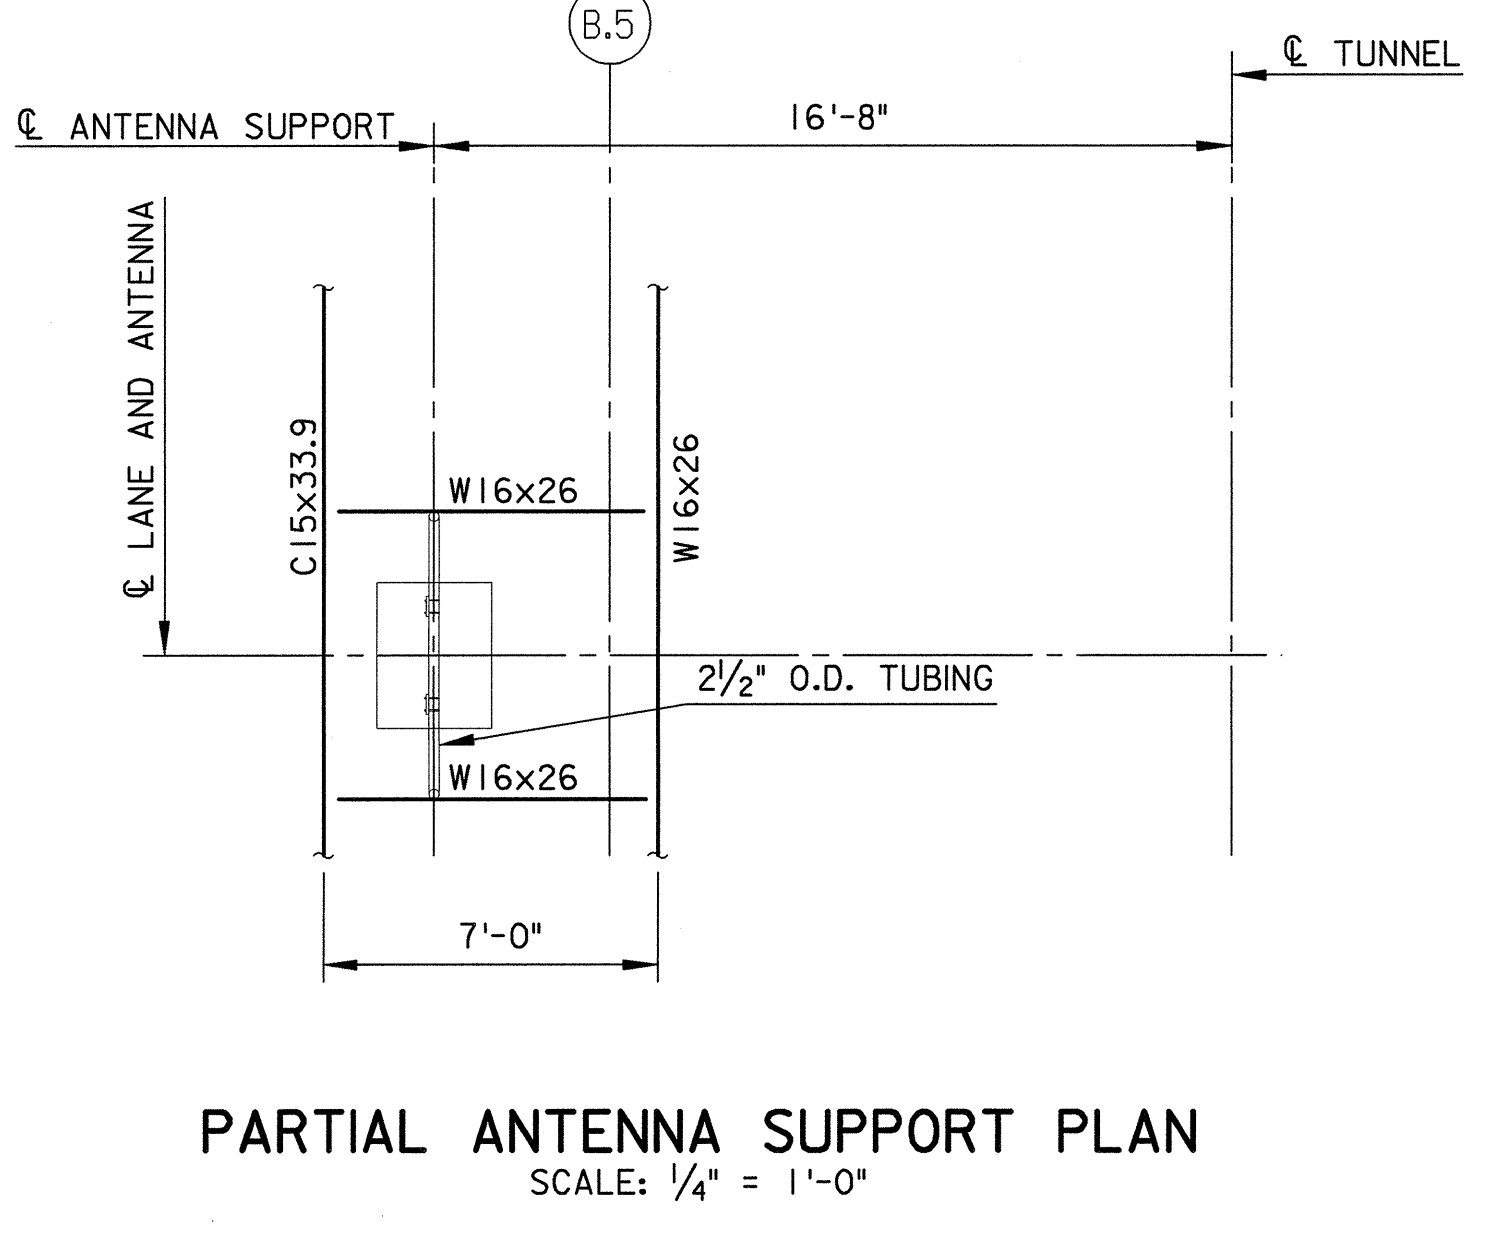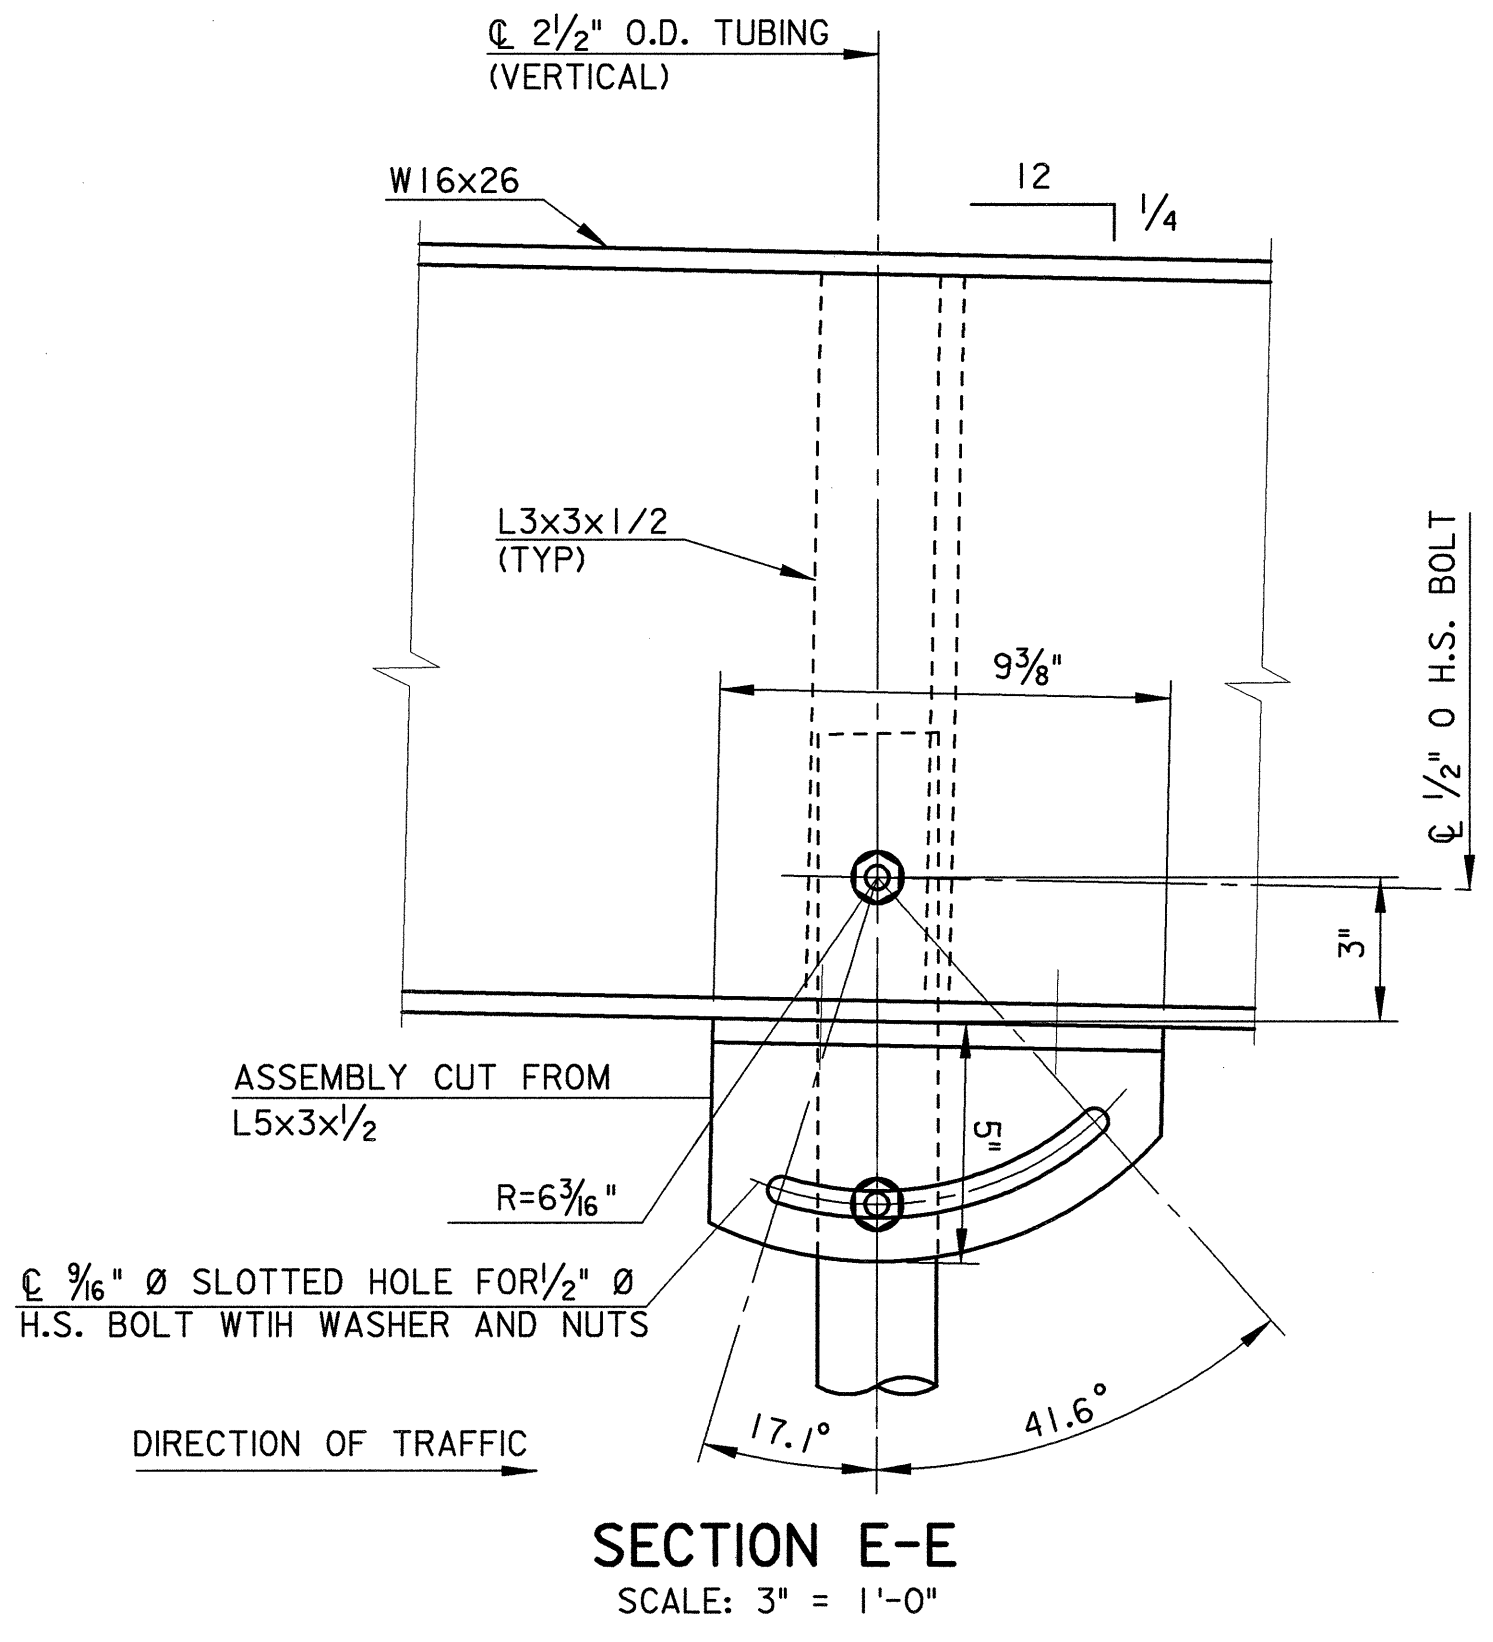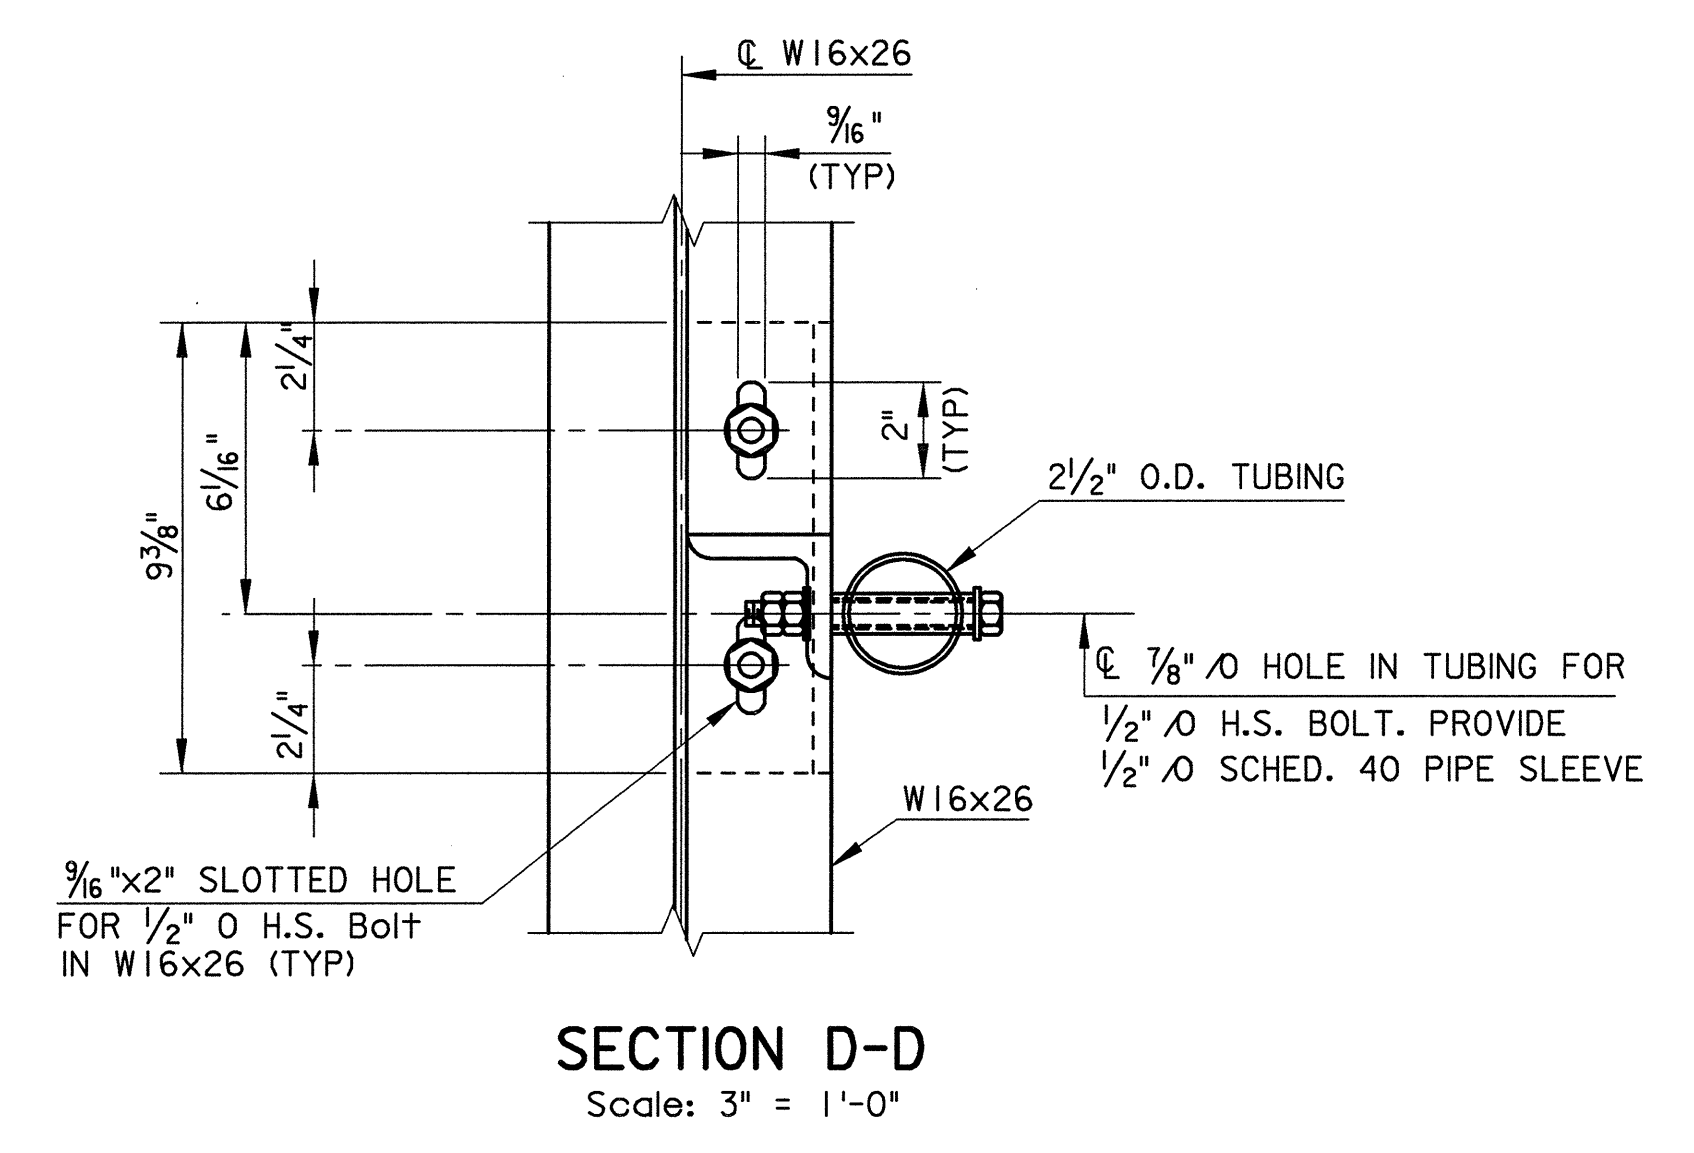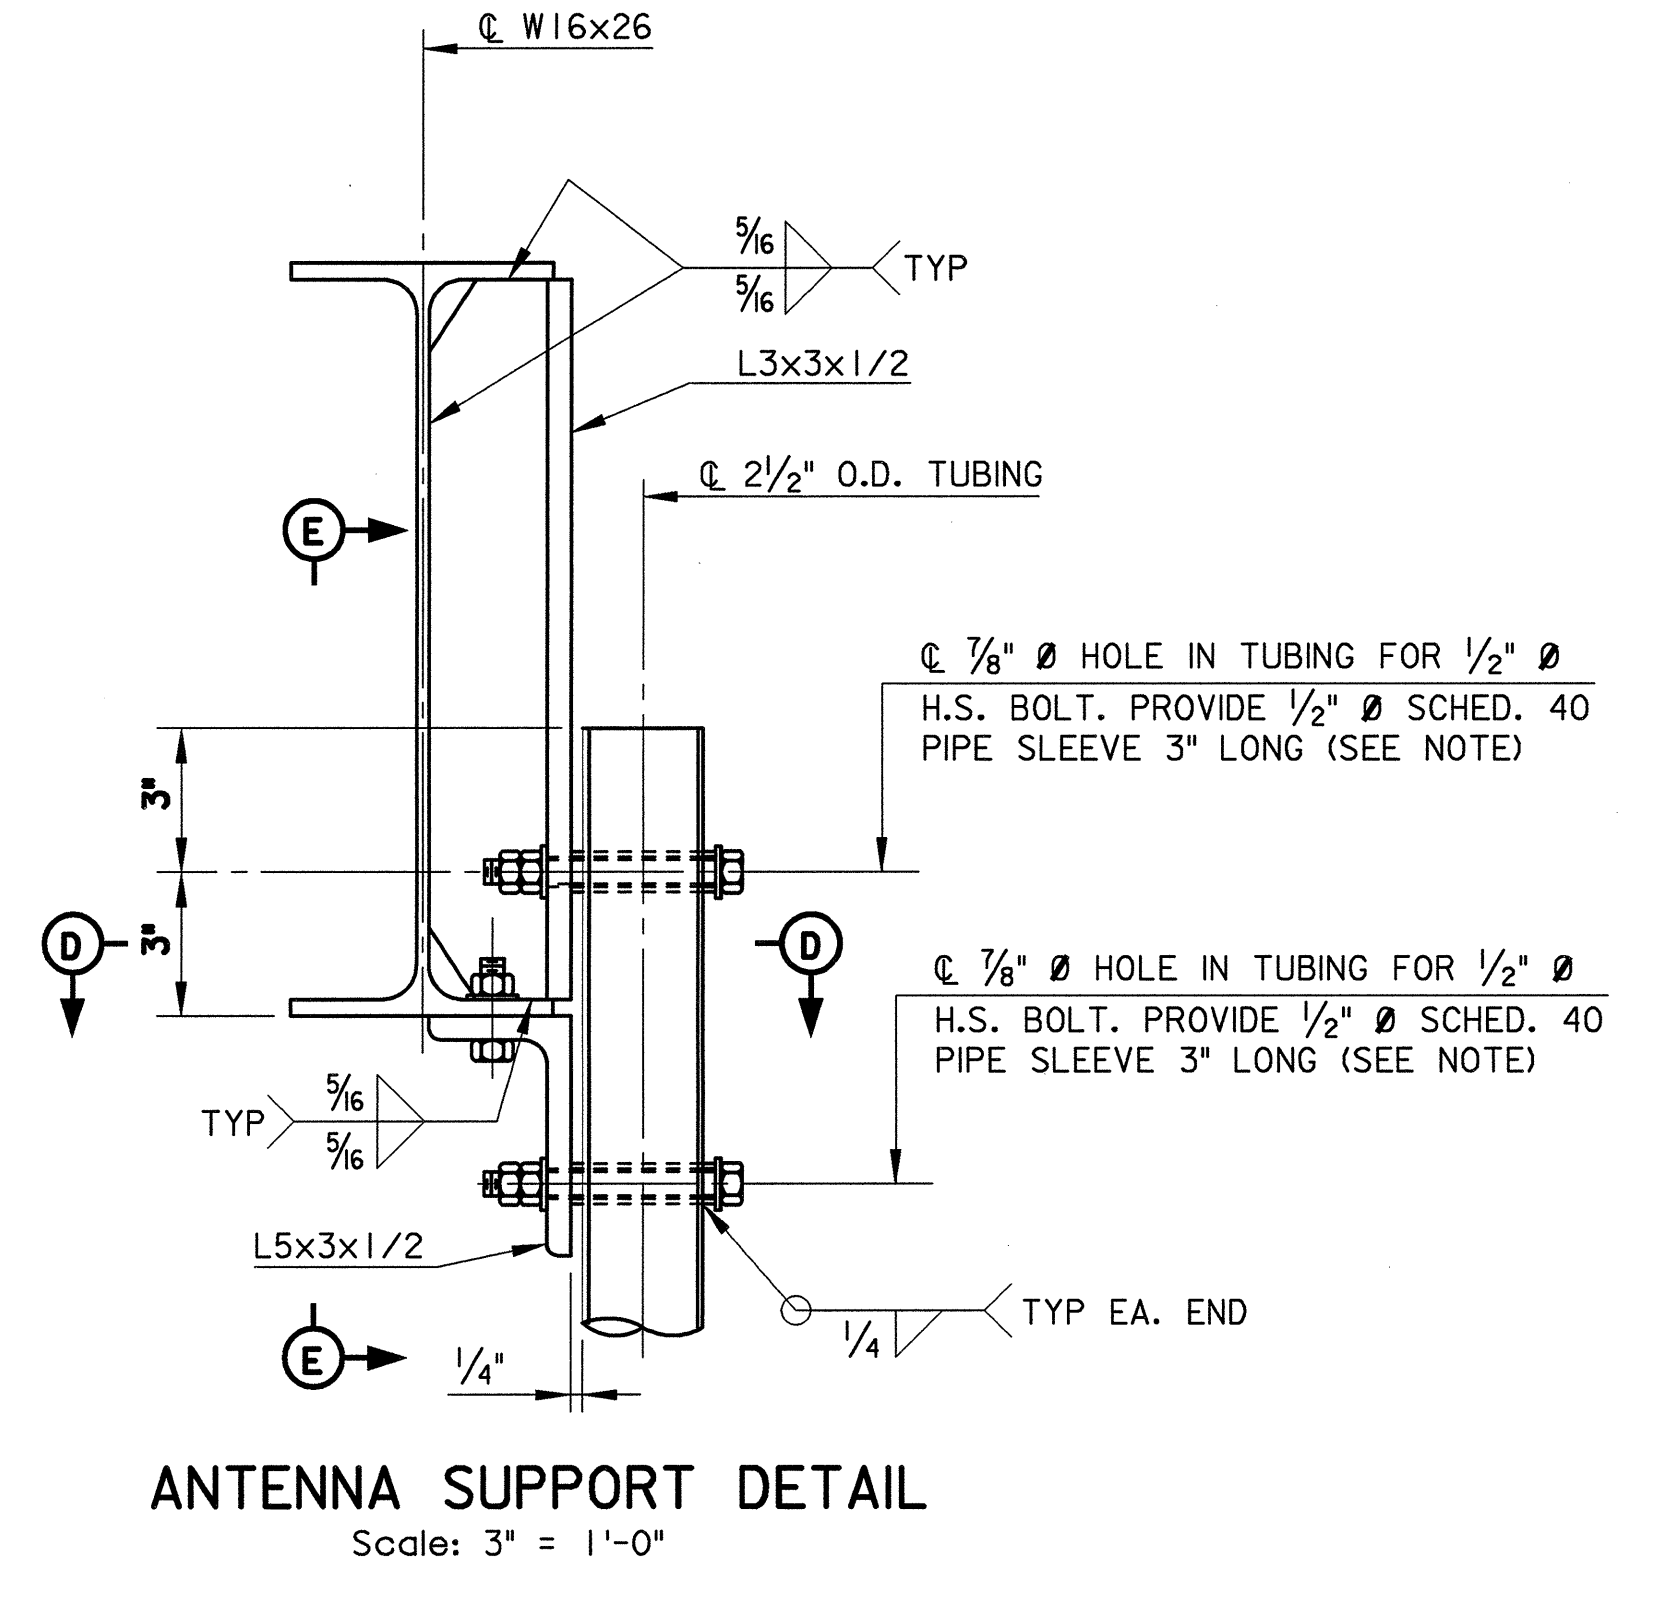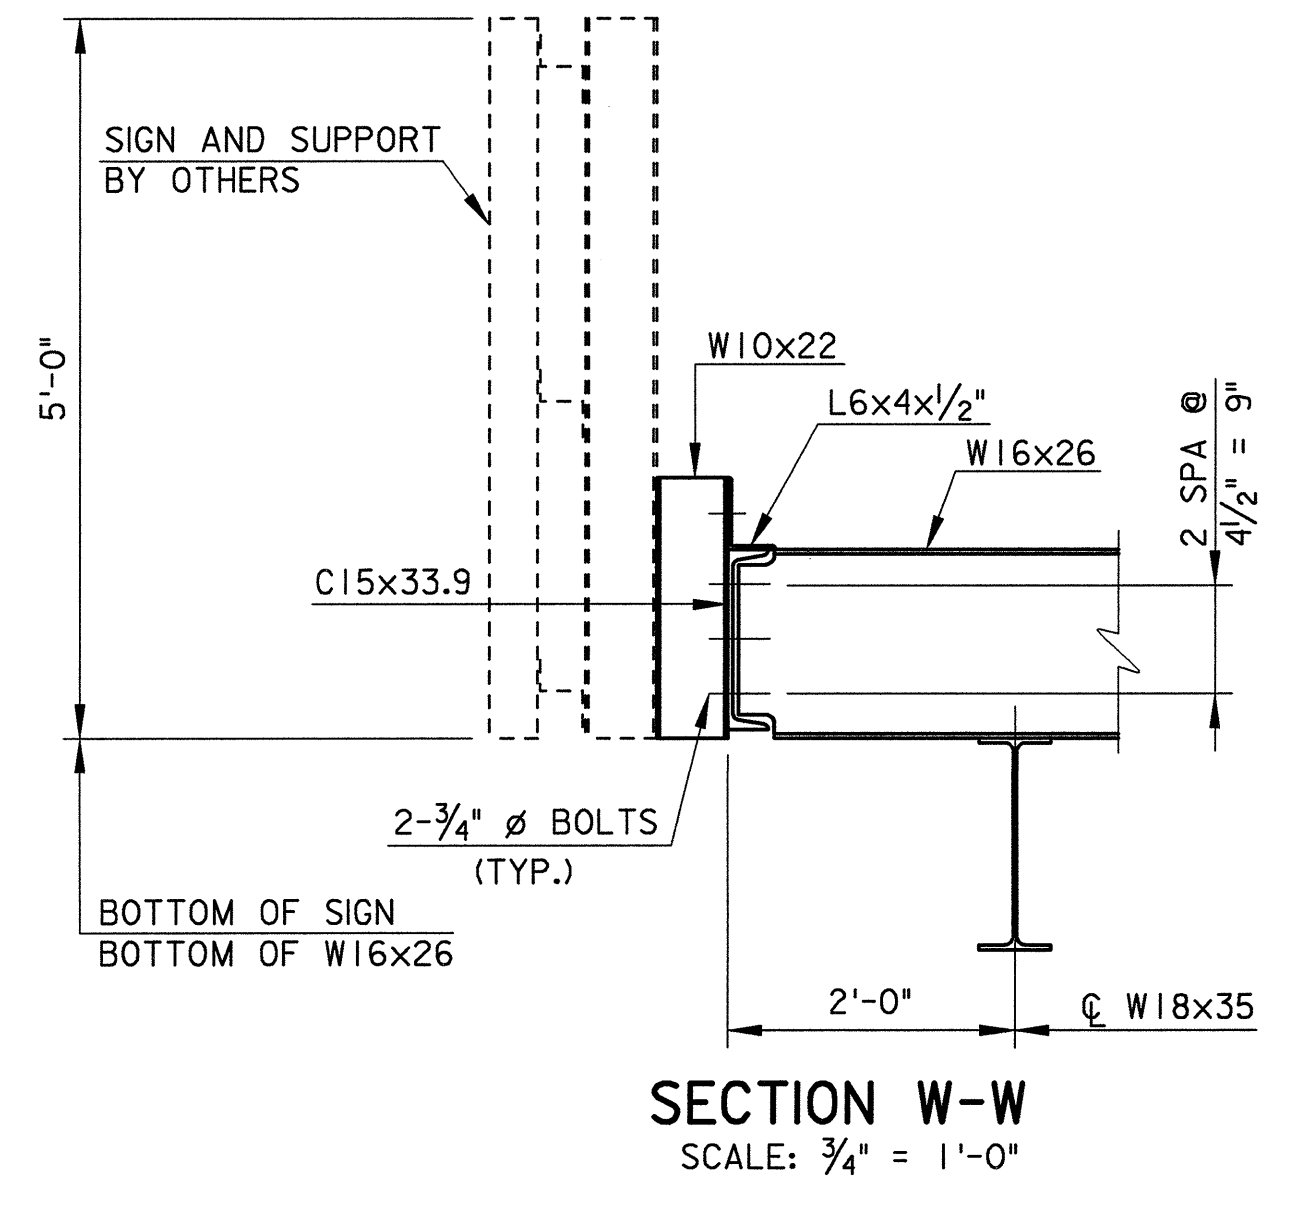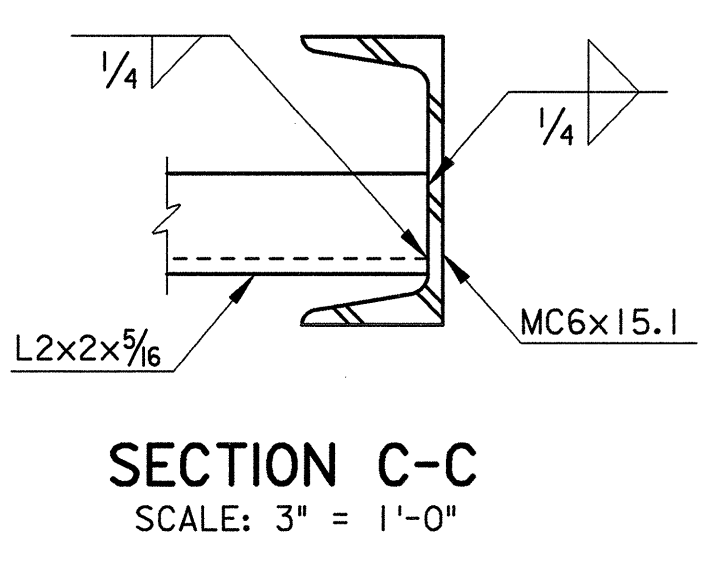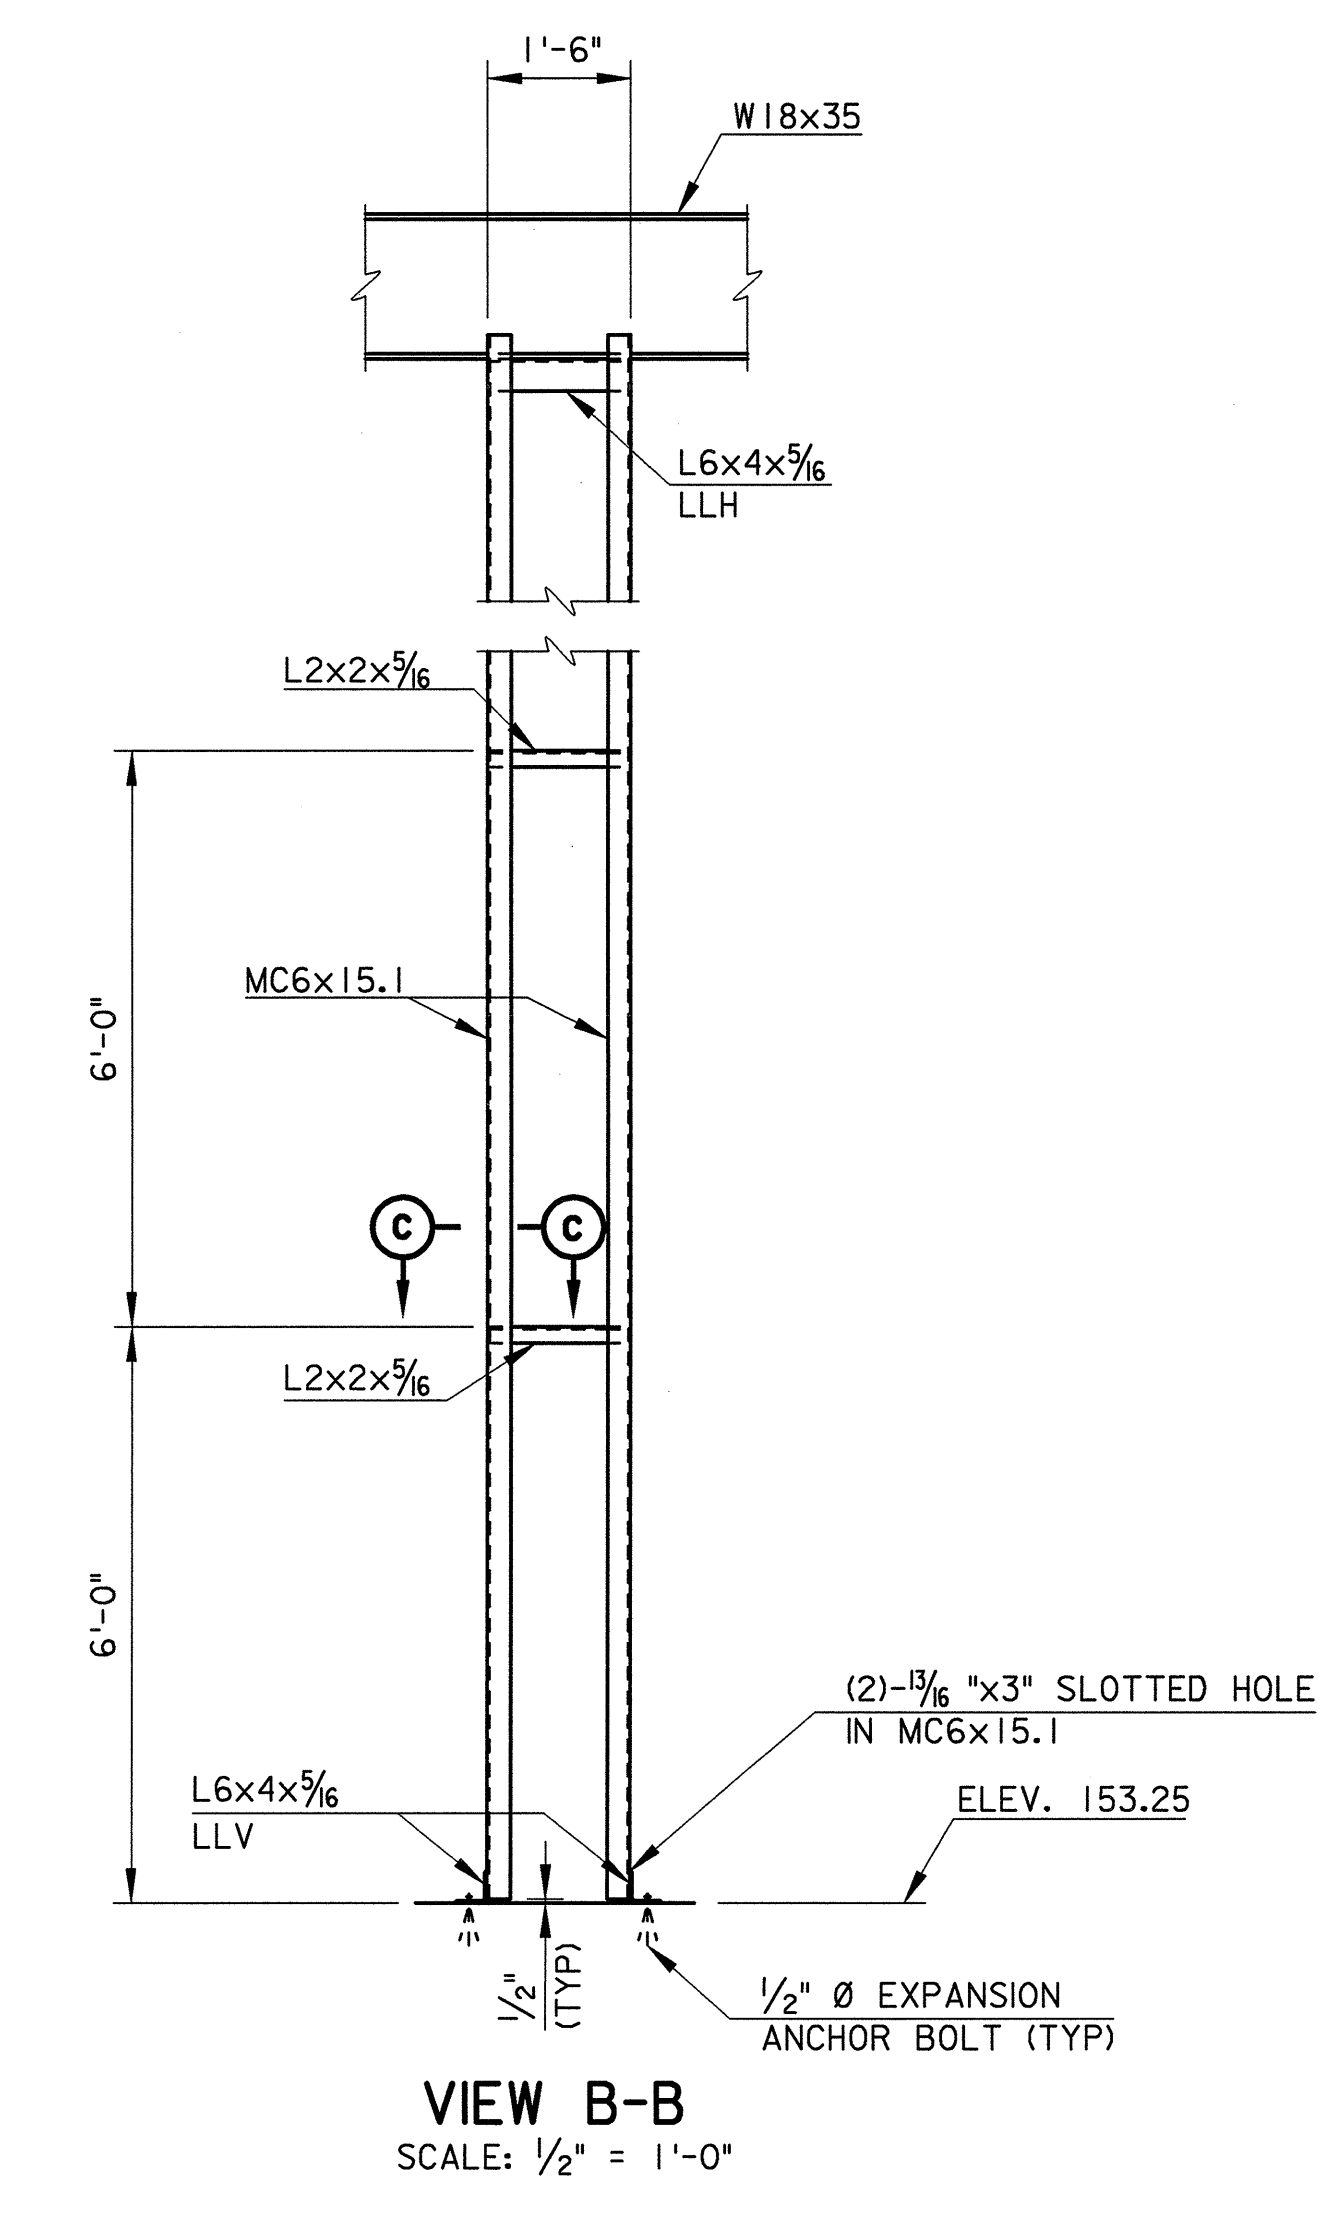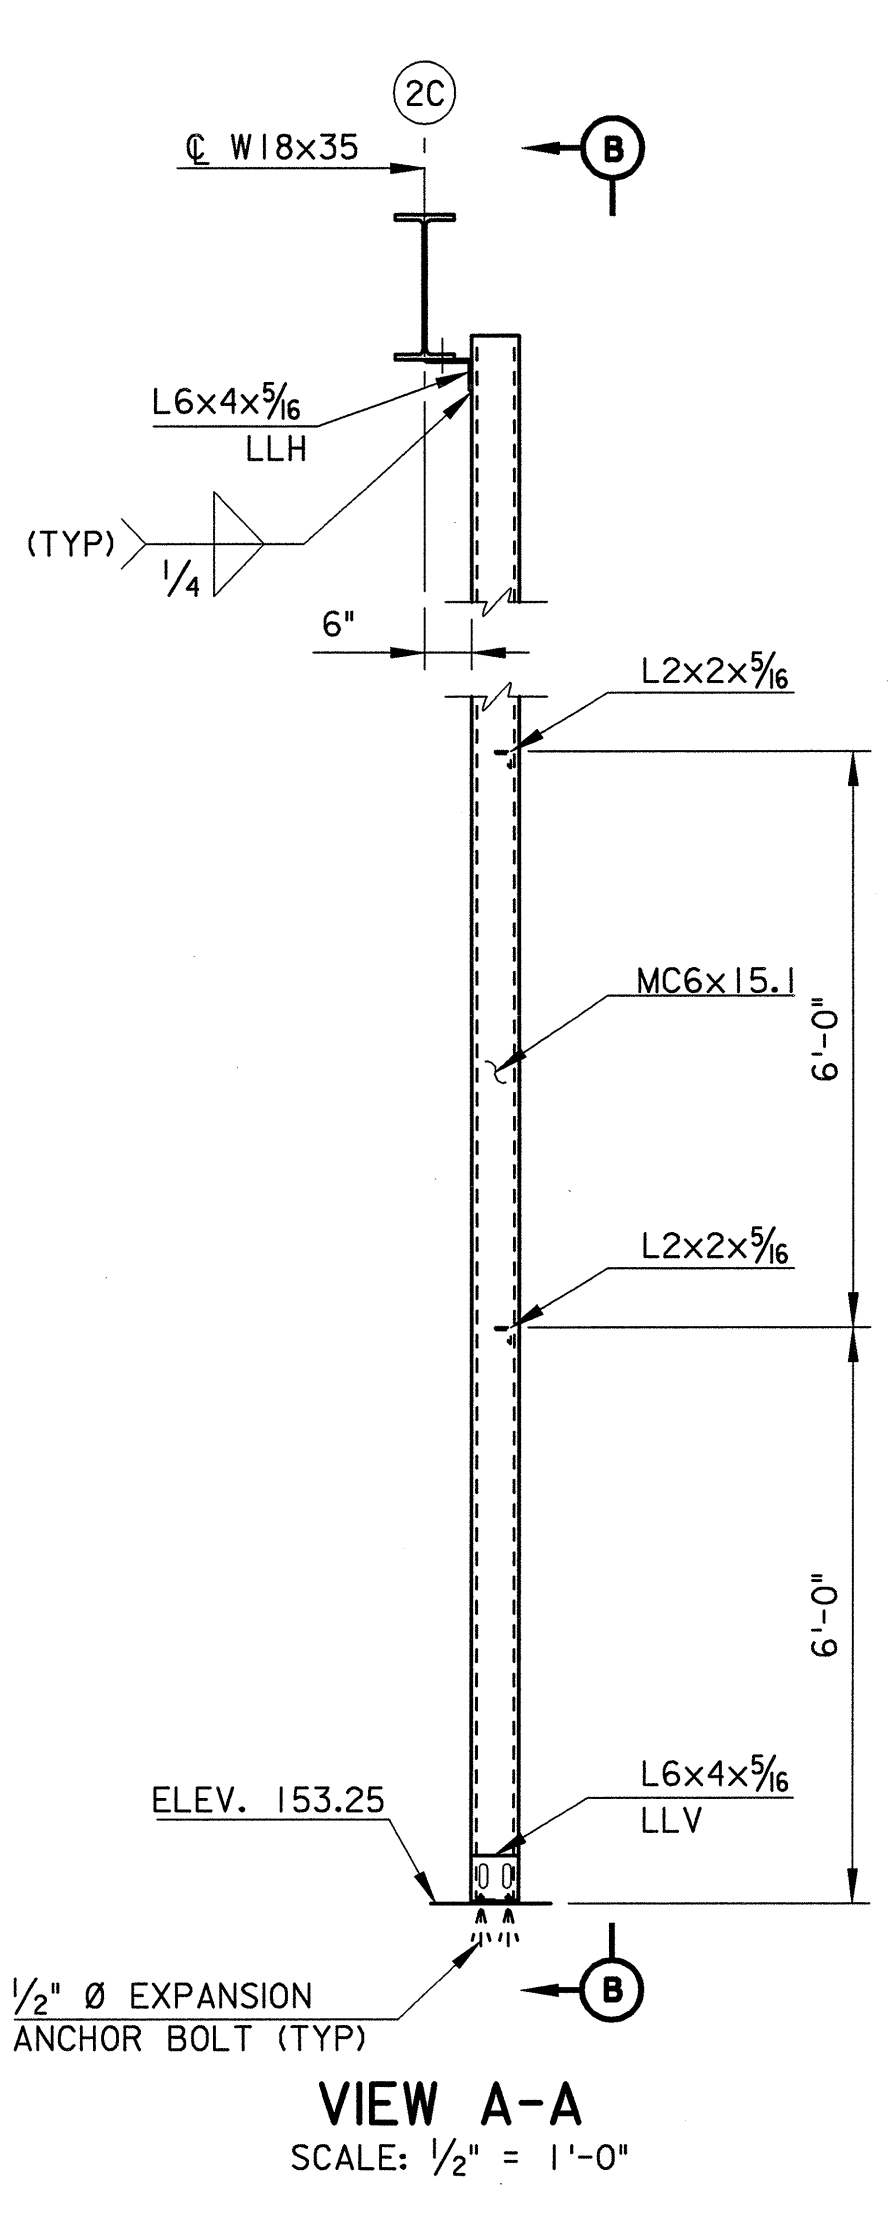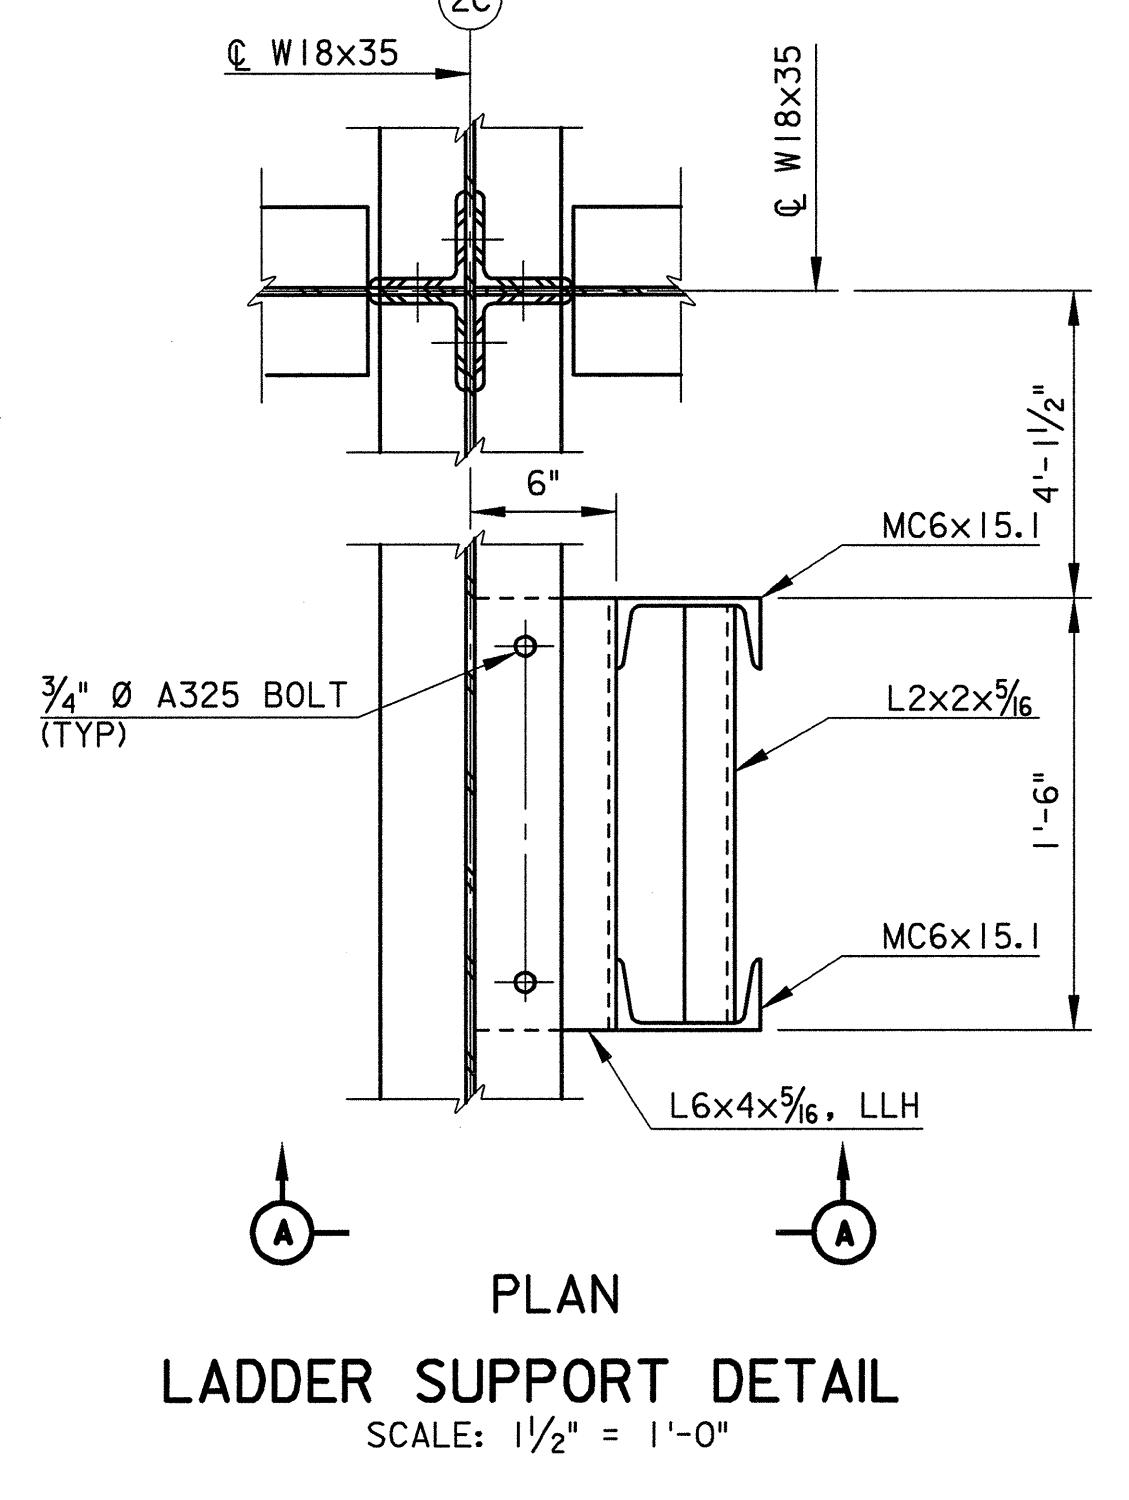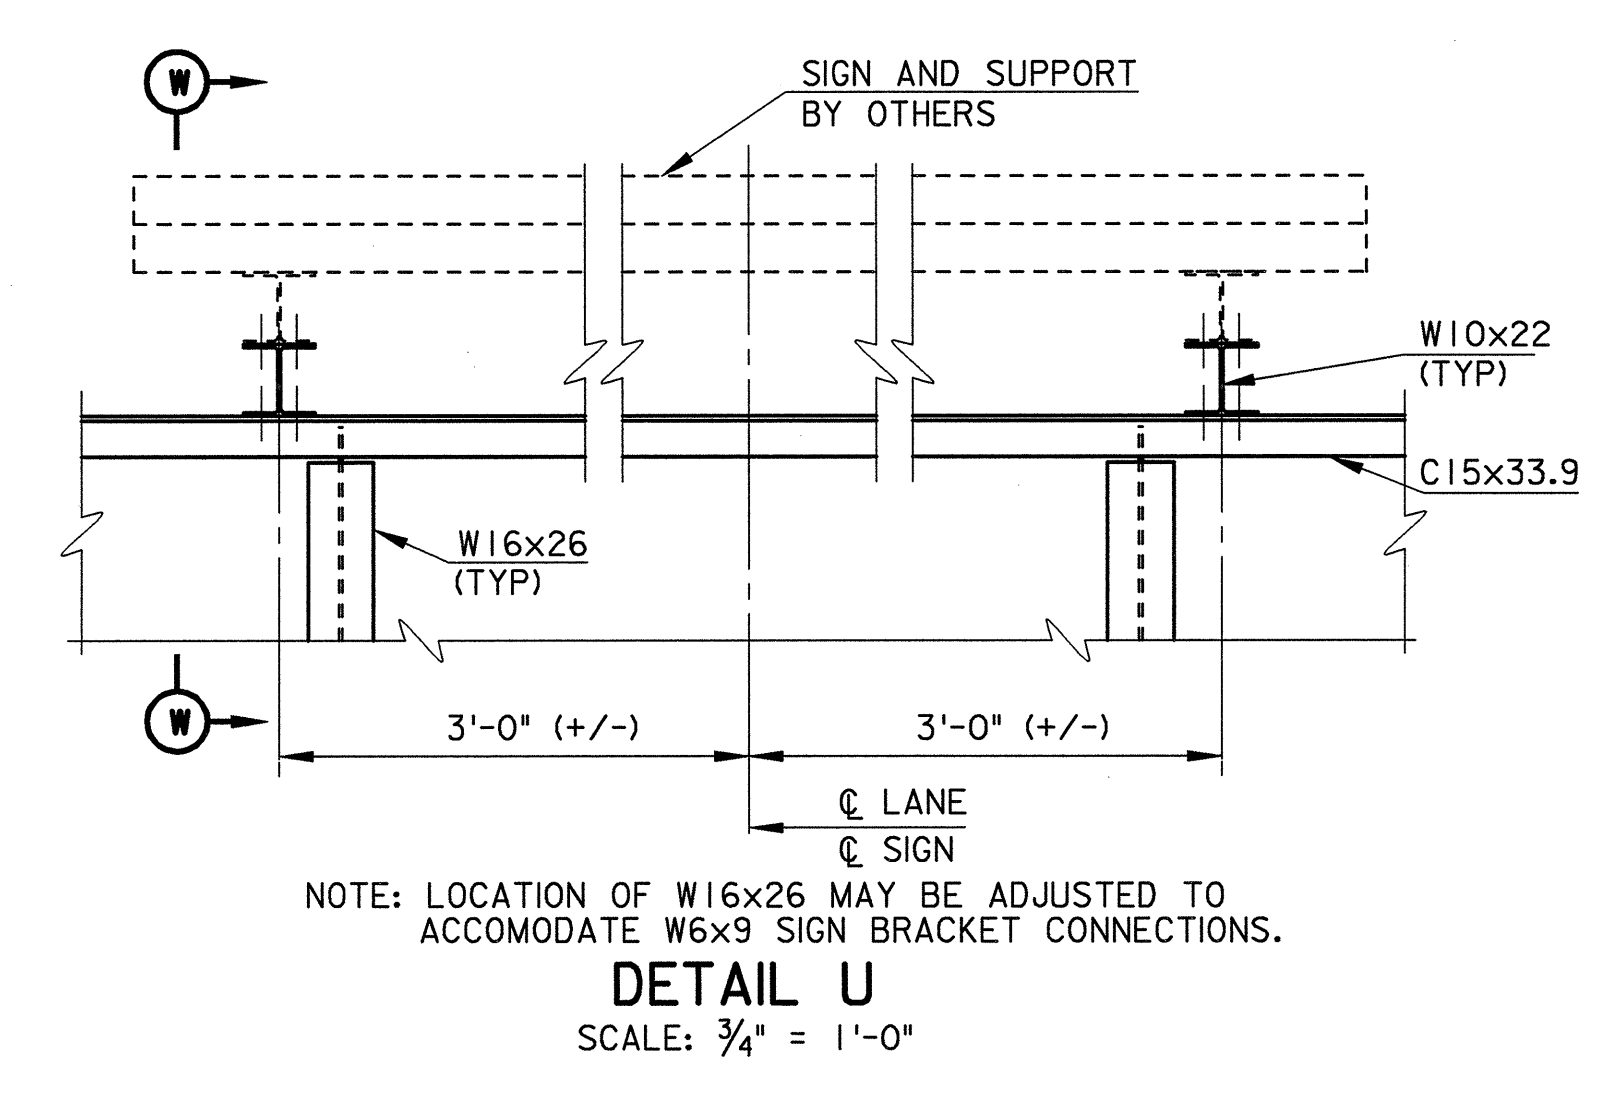


- NOTES:**
- FOR INSTALLATION OF ELECTRICAL INFRASTRUCTURE AND EQUIPMENT SEE ELECTRICAL DRAWINGS.
 - ANTENNA SUPPORT BRACKETS SHALL BE FABRICATED FROM ASTM 513 TYPE 1 HOT-ROLLED ELECTRICWELDED (HREW) MECHANICAL TUBING.
 - STEEL MEMBERS AND PLATES FOR ANTENNA SUPPORT SHALL BE ASTM A709, GRADE 36 GALVANIZED TO ASTM-123.
 - THE C15X33.9 AND W16X26 MEMBERS ARE CANOPY STEEL.

DATE	7/20/2006	
ISSUED FOR CONSTRUCTION		
PROJECT NO.	PSP-2006	
DRAWN BY	CR	
CHECKED BY	BS	
APPROVED BY	BCC	
REVISION	DATE	DESCRIPTION
△	6/23/06	REVISED SHEET

STRUCTURAL TOLL PLAZA
 CANOPY DETAILS
 STP-110

STRUCTURAL NOTES:


- CONCRETE: $f'_c = 3500\text{psi}$ SLABS, $f'_c = 3000\text{psi}$ FOOTINGS AND WALLS.
- RE-STEEL: $f'_u = 60\text{ KSI}$.
- ANCHOR BOLTS SHALL BE ASTM A36 STEEL.
- ALL RE-STEEL SHALL BE LAPPED A MIN. OF 36 BAR DIA'S (UNLESS NOTED OTHERWISE).
- ALL REINFORCING STEEL UTILIZED IN THE MASONRY WALLS SHALL BE #4 RODS FURNISHED IN 5'-2" LENGTHS FOR THE FULL HEIGHT OF THE WALLS. RODS EMBEDDED IN FOOTINGS SHALL BE HOOKED.
- ACCURATELY POSITION, SUPPORT, & SECURE IN PLACE ALL STEEL REINFORCING & WIRE FABRIC USING CHAIRS, BOLSTERS, BAR SUPPORTS, & SPACERS SIZED AND SHAPED FOR ADEQUATE SUPPORT OF REINFORCING DURING CONCRETE PLACEMENT.
 MIN COVERAGE @ FOOTINGS: 3"
 MIN COVERAGE @ SLABS / WALLS: 1 1/2"
- SOIL BEARING CAPACITY: 2000 PSF NET (ASSUMED).
- CURING COMPOUND AND SEALER SHALL BE (BASE BUILDING PRODUCTS) SONNENBORN KURE-N-SEAL. CURING COMPOUND SHALL BE APPLIED IMMEDIATELY FOLLOWING CONCRETE FINISHING, AND IN ACCORDANCE WITH THE MANUFACTURER'S WRITTEN SPECIFICATIONS.
- GRANULAR FILL: #57 OR #5 (AS NOTED) STONE THICKNESS: 4"
- VAPOR BARRIER: 1 LAYER 6 MIL POLY.
- SLAB REINFORCING: 6 x 6 x 10/10 W/MF & FIBERMESH (BASEMENT), FIBERMESH (1st FLOOR)
- ALL CONCRETE JOINTS SHALL BE FILLED WITH A NO-TRACK FILLER.
- * REFER TO THE METAL BUILDING MANUFACTURERS ANCHOR BOLT PLAN FOR QUANTITY, SIZE, AND LOCATION OF ALL ANCHOR BOLTS. ***VERY IMPORTANT***
- ALL MASONRY PIERS SHALL BE FULLY BONDED.
- ALL MASONRY WALLS SHALL BE FULLY BONDED AT INTERSECTIONS.
- ALL MASONRY CORES WITH RODS SHALL BE FILLED WITH CONCRETE.
- ALL MASONRY WALLS SHALL HAVE DUR-O-WAL HORZ TRUSS REINFORCING @ 24" ABOVE GRADE & 16" BELOW GRADE.
- ALL MASONRY BELOW GRADE & OTHER INTERIOR MASONRY SHALL BE STANDARD UNITS, ASTM C 90, TYPE I, NORMAL WEIGHT, NOMINAL 8"x16"x8" UNLESS NOTED OTHERWISE ON THE DRAWINGS.
- MORTAR SHALL BE IN ACCORDANCE WITH ASTM C 270, TYPE M FOR BELOW GRADE APPLICATIONS, AND TYPE S FOR ALL OTHER MASONRY.
- STRIKE EXPOSED JOINTS FOR MASONRY CONCAVE. STRIKE ALL UNEXPOSED JOINTS FLUSH.
- ALL MASONRY WALLS SHALL HAVE EXPANSION JOINTS AT A MAXIMUM 25' (21' FROM "MASONRY" BUILDING CORNERS) OR CLOSER IF SO INDICATED ON THE DRAWINGS. ALL JOINTS SHALL CONTAIN A FIBER EXPANSION MATERIAL AND SHALL BE CAULKED WITH A TWO PART POLYSULFIDE CAULKING. ALL JOINTS IN FIRE WALLS SHALL BE CAULKED WITH A FIRE CAULKING. SEE EXTERIOR ELEVATIONS FOR LOCATIONS OF MASONRY EXPANSION JOINTS (MCJ'S). MCJ SHALL EXTEND FULL HEIGHT OF MASONRY.
- ALL EXPOSED EXTERIOR PRE-COLORED OR UNFINISHED MASONRY SHALL BE SEALED WITH TWO COATS OF ENVIROSEAL DOUBLE 7 BLOCK SEALANT AS MANUFACTURED BY HARRIS SPECIALTY CHEMICALS, INC., OR AN APPROVED EQUAL.
- ALL WALLS PENETRATING THE FLOOR SLAB SHALL HAVE A 1/2" EXPANSION JOINT (E.J.) AT THE FLOOR LINE.
- EXPANSION JOINT MATERIAL AT WALLS TO SLAB SHALL BE 1/2" ASPHALT IMPREGNATED FIBERBOARD.
- ALL CONCRETE WALLS ABOVE GRADE SHALL BE PLUGGED AND RUBBED.
- PROVIDE SHORING ADEQUATE TO PREVENT DAMAGE OR MOVEMENT OF THE RETAINING WALLS PRIOR TO BACK FILLING. RETAINING WALLS SHALL BE EVENLY BACK FILLED ON BOTH SIDES OF THE WALL TO THE LOW SIDE GRADE LINE BEFORE BACK FILLING ABOVE THE LOW GRADE LINE. ALL BACK FILL SHALL BE COMPACTED WHEN PLACED AND PRIOR TO PLACING ANOTHER LIFT, TO 95% OPTIMUM DENSITY BASED ON STANDARD PROCTOR.
- ALL BASEMENT WALLS SHALL BE BACKFILLED ENTIRELY W/ #5 STONE.
- PROVIDE PERIMETER INSULATION ALONG ALL EXTERIOR WALLS (1" RIGID).
- THE BOTTOM OF ALL FOOTINGS SHALL BE A MINIMUM OF 18" BELOW FINISHED GRADE.
- ALL CONCRETE WORK SHALL BE PERFORMED IN ACCORDANCE WITH ACI 318, LATEST EDITION.
- ALL FOOTINGS SHALL BEAR ON ORIGINAL EARTH. FILL COMPACTED TO 95% PROCTOR OR FLOWABLE FILL.

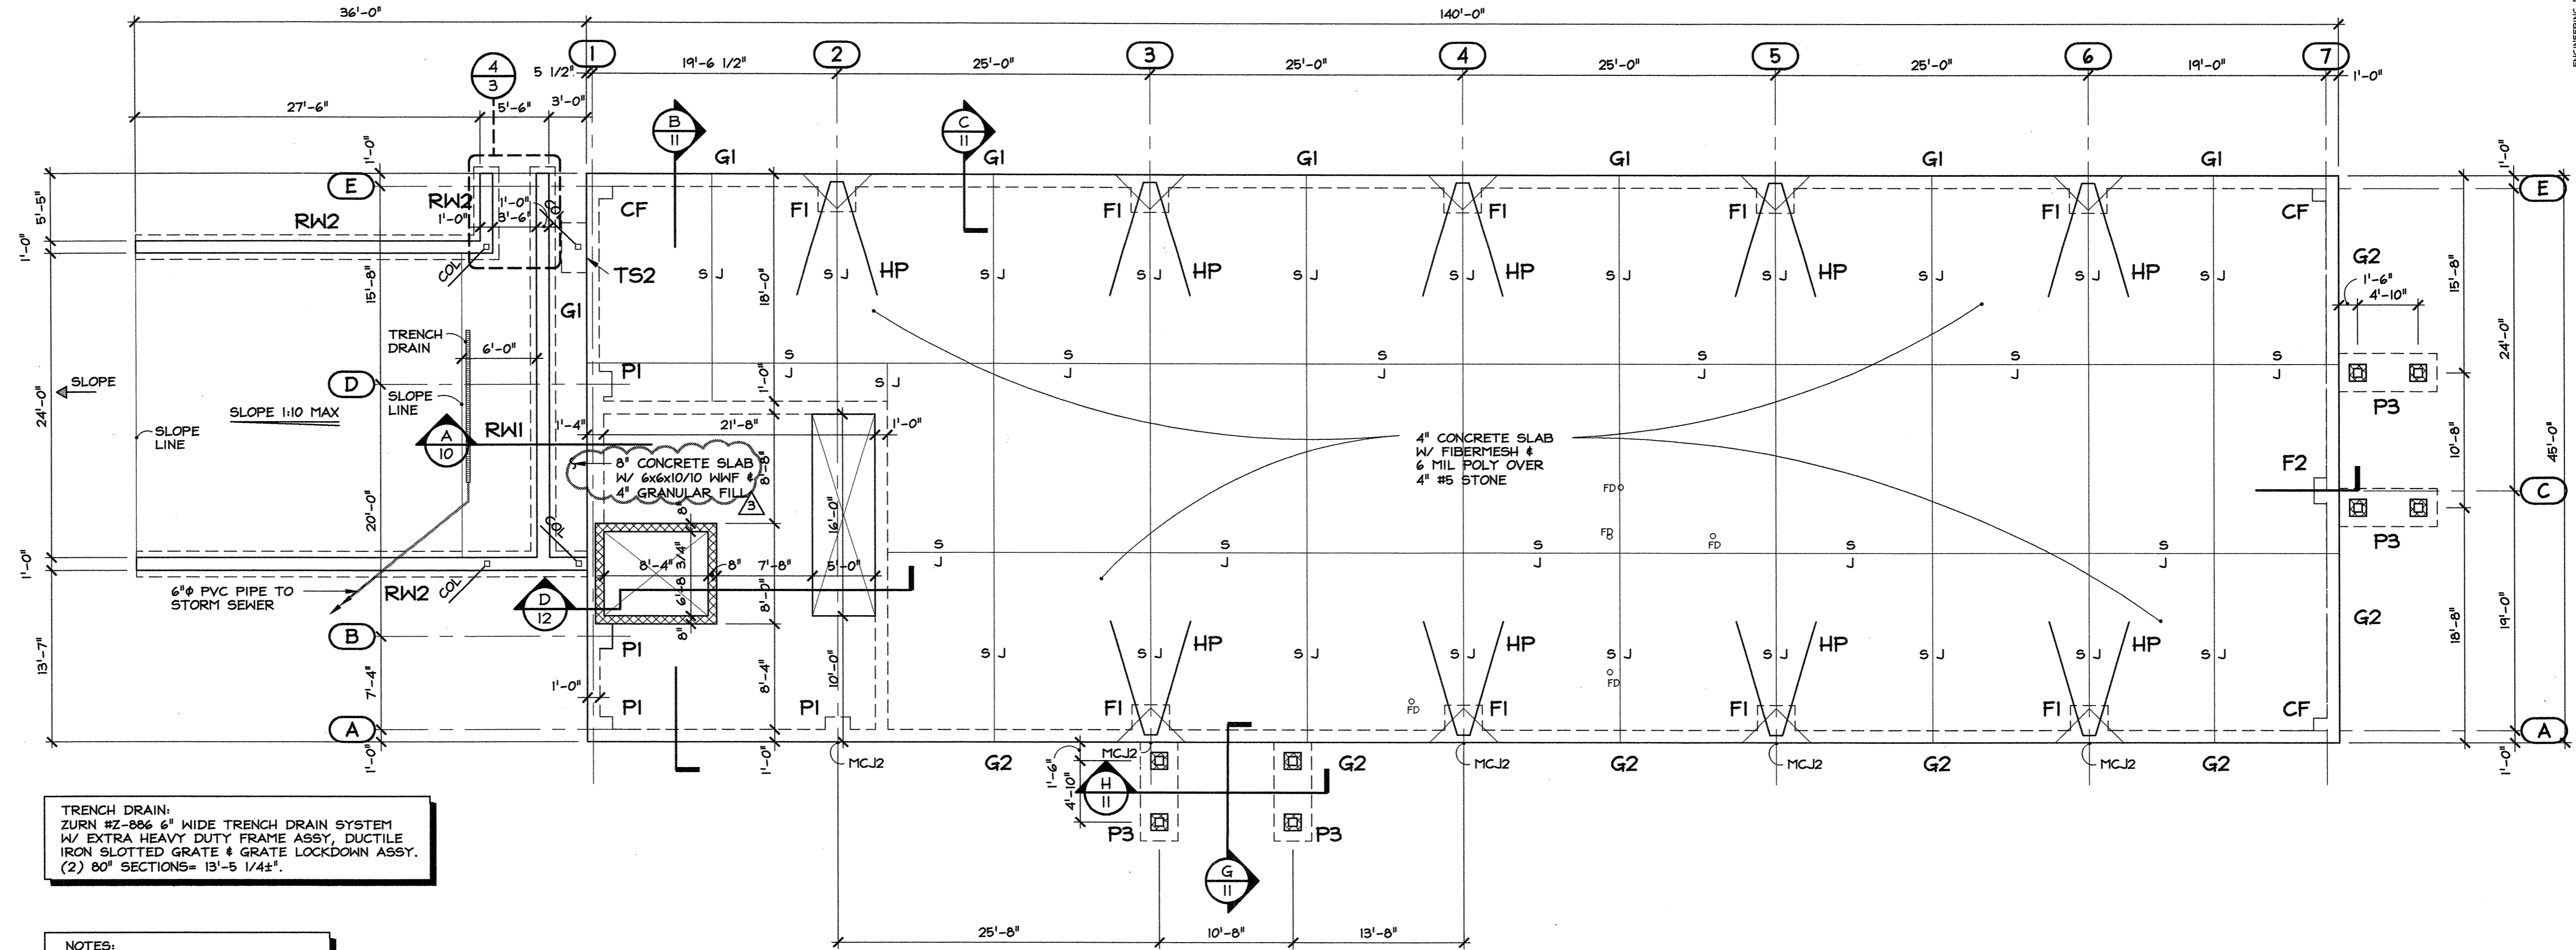

TRENCH DRAIN:
 ZURN #2-886 6" WIDE TRENCH DRAIN SYSTEM
 W/ EXTRA HEAVY DUTY FRAME ASSY, DUCTILE
 IRON SLOTTED GRATE & GRATE LOCKDOWN ASSY.
 (2) 80° SECTIONS= 13'-5 1/4±"

NOTES:
 FOR RODS @ MASONRY JAMBS,
 SEE FLOOR PLAN FOR DOOR
 LOCATIONS.
 MASONRY FINISH AS CALLED FOR
 ON THE ELEVATIONS SHALL
 EXTEND 1 COURSE BELOW GRADE.
 PROVIDE POSITIVE SLOPE FOR
 DRAINAGE @ ALL EXTERIOR
 CONCRETE SLABS. SEE ALSO SITE
 PLANS.
 FOR CONCRETE SLAB ELEV'S, SEE
 FLOOR PLAN.

FOUNDATION PLAN
 SCALE: 1/8" = 1'-0"

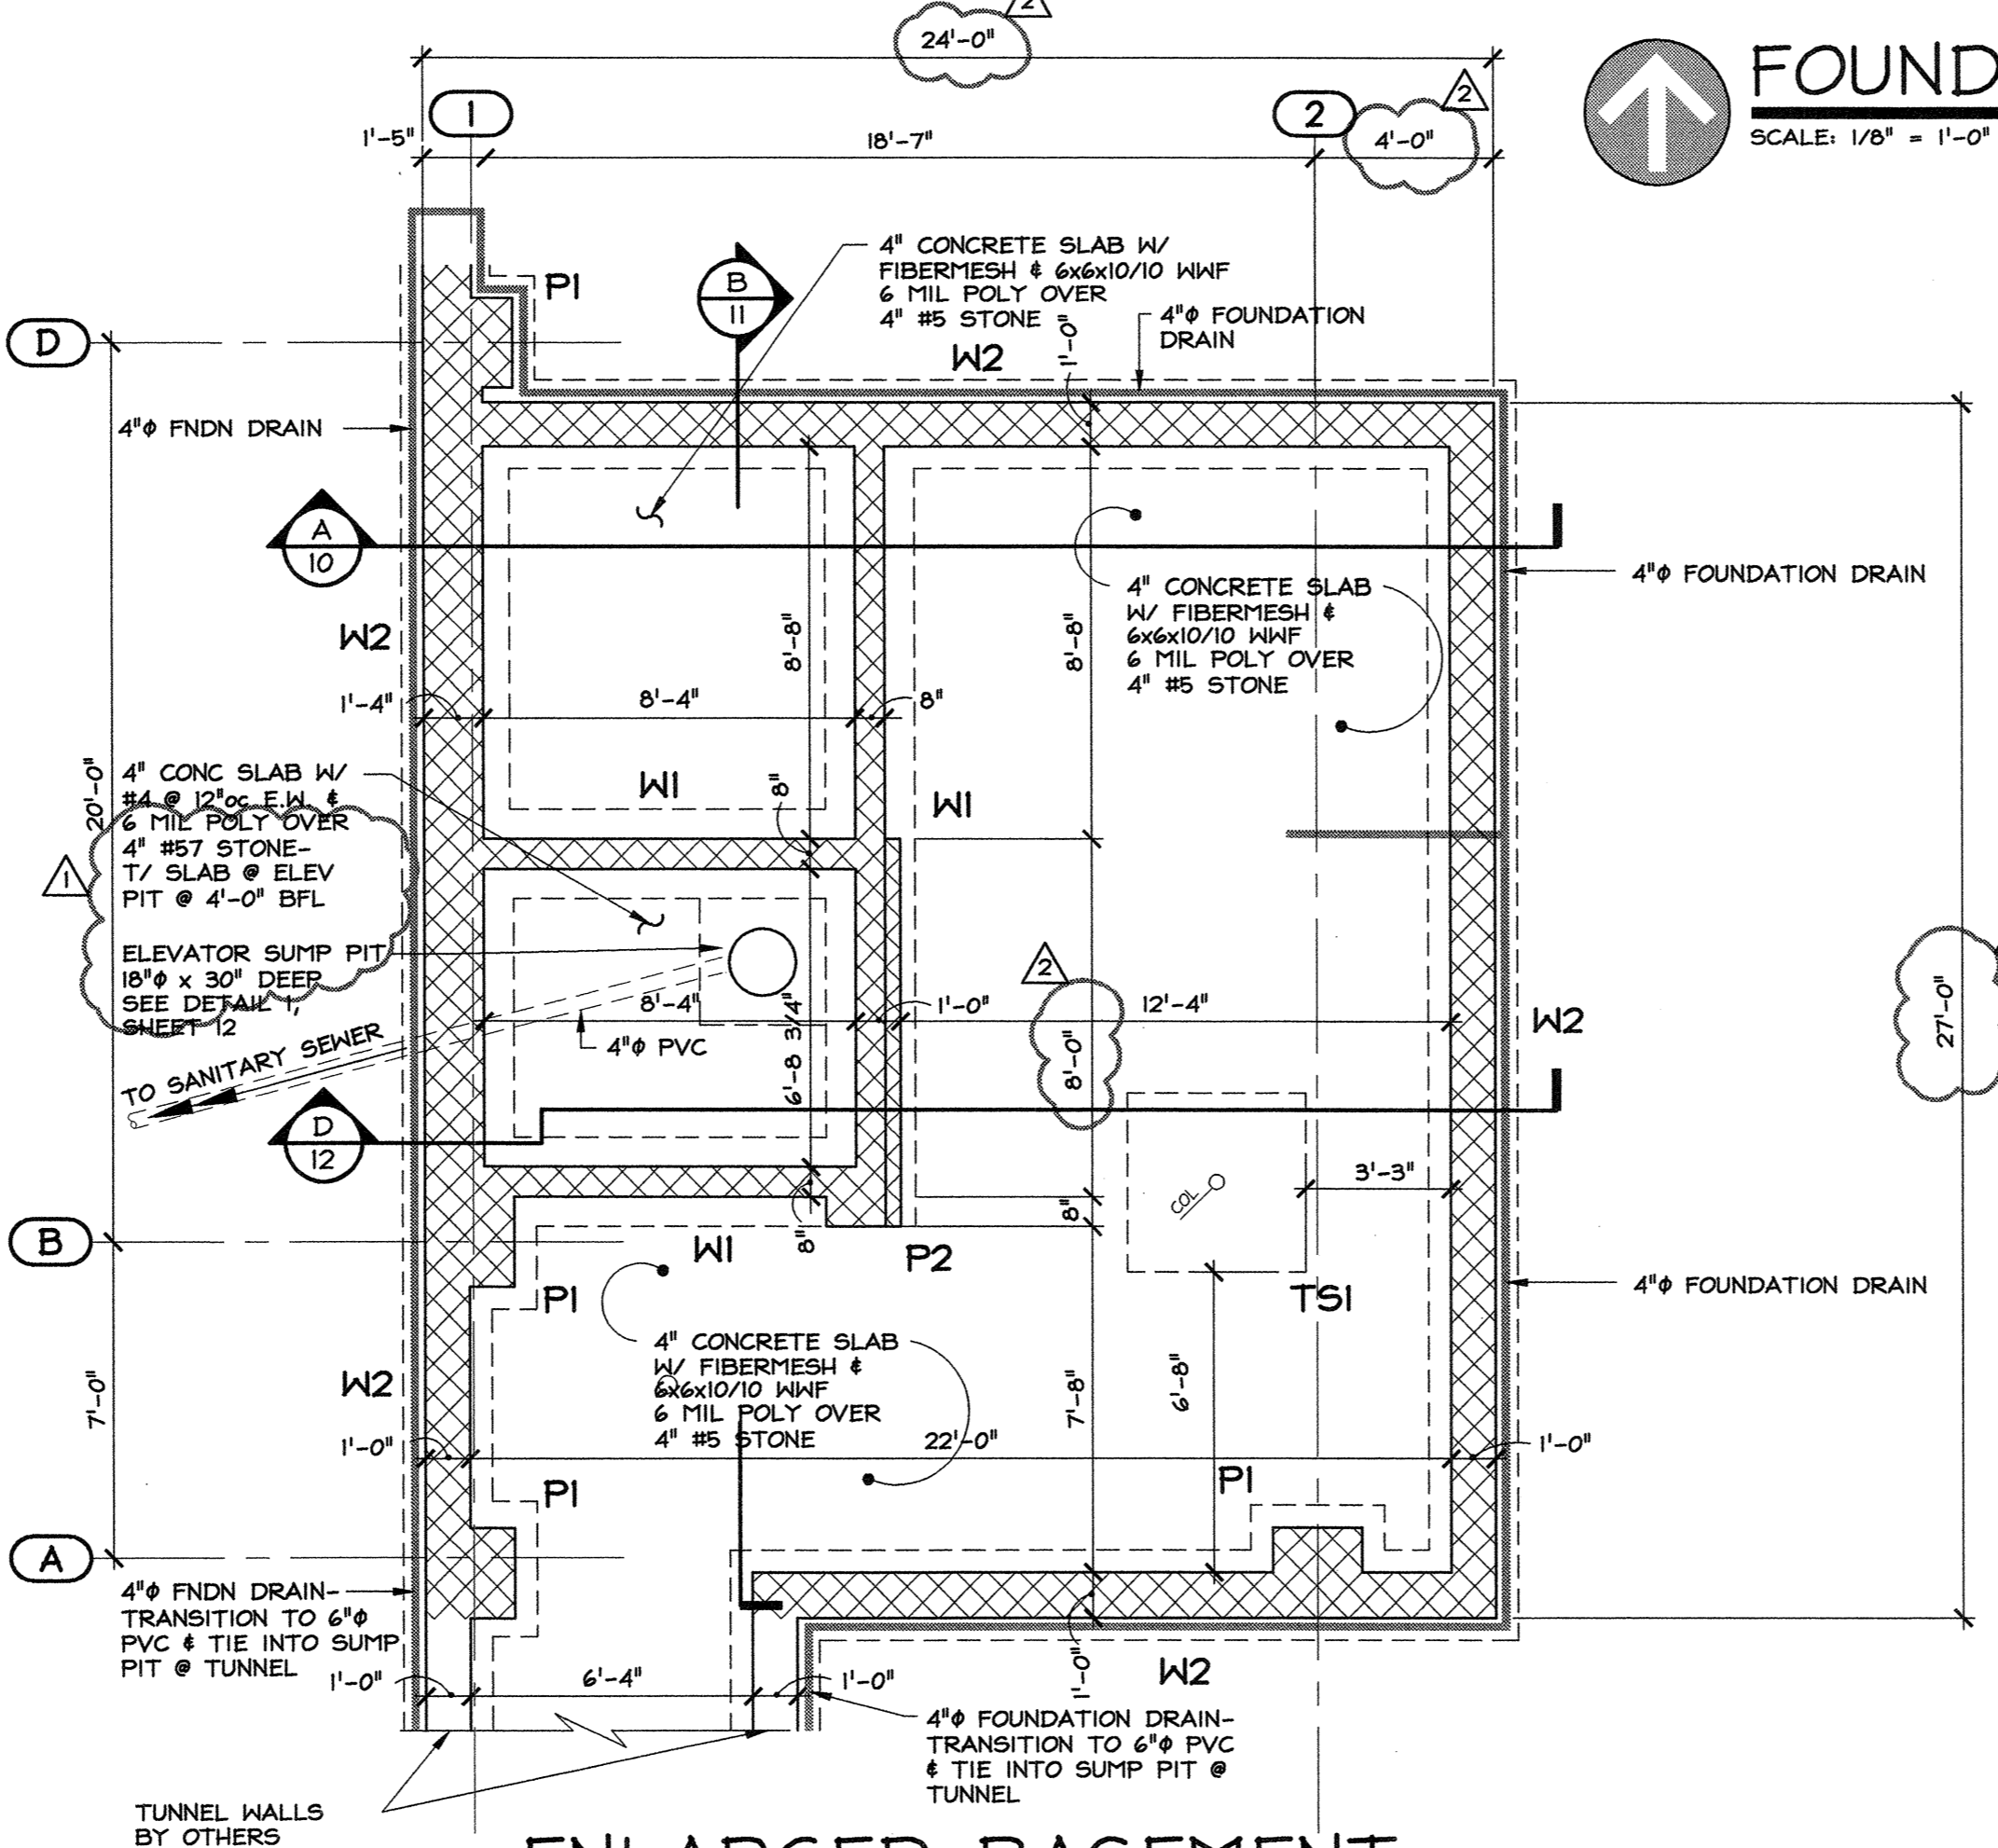

ENLARGED BASEMENT FOUNDATION PLAN
 SCALE: 1/4" = 1'-0"

MARK	DIMENSION		PIER	STEEL								HAIRPIN (HP)	ANCHOR BOLT (AB)		
	SIZE			X	Y	M	N	O	P	#	Q			R	
	L	W													D
CF	2-0	2-0	2-0			3 #4	3 #4								SEE NOTE #13
F1	3-0	3-0	2-0			4 #4	4 #4				4	1-0	9-0		SEE NOTE #13
F2	2-0	2-0	2-0			3 #4	3 #4								SEE NOTE #13
G1	1-0	2-0	2-0				2 #4								SEE NOTE #13
G2	1-0	2-0	2-0				2 #4	#4 @ 8"							SEE NOTE #13
P1	3-0	3-0	1-0	VAR.	VAR.	2-0	2-0	4 #4	4 #4	4 #4					SEE NOTE #13
P2	2-0	2-0	1-0	13-0	4-0	1-4	1-4	4 #4	4 #4	4 #4					2 1/2" 1-4
P3	3-0	8-0	1-0	5-4	1-4	1-4	1-4	#4 @ 8"	#4 @ 8"	#4 @ 8"					4 3/4" 1-0
RW1	SEE DETAIL														
RW2	SEE DETAIL														
TS1	4-0	4-0	1-0			4"		5 #4	5 #4						4 3/4" 1-0
TS2	4-0	2-0	1-6			4"		#4 @ 8"	#4 @ 8"						4 3/4" 1-6
W1	2-0	1-0						2 #4	#4 @ 8"						
W2	2-0	1-0						2 #4	#4 @ 8"						

NOTE: G2, P1, P2, RW1; EXTEND RE-STEEL THRU COLUMN FOOTINGS.

DO NOT SCALE DRAWING FOR DIMENSIONS

PROPOSED BUILDING FOR:
 RICHMOND METROPOLITAN AUTHORITY
 6234 FOWHITE PARKWAY · CITY OF RICHMOND · VIRGINIA
 FOUNDATION PLAN
 DRAWN BY: KANDY HOOKER
 CHECKED BY: RFN
 SCALE: 1/8" = 1'-0"
 DATE: OCTOBER 11, 2006
 PROJECT NO. 06357

REVISION:	NO.	DATE:	DESCRIPTION:
	1	10.11.06	ISSUED FOR CONSTRUCTION
	2	11.07.06	ELEVATOR SUMP REVISED/ADDED DIMENSIONS
	3	12.05.06	REV. DOCK SLAB THICKNESS

5625 LABURNUM AVENUE
 RICHMOND, VIRGINIA 23231
 PHONE: 804-236-0190
 FAX: 804-236-0194


PO BOX 615
 WICOMICO CHURCH 22579
 PHONE: 804-580-2227
 FAX: 804-580-3334

REVISION:	NO.	DATE:	DESCRIPTION:
	1	10.10.06	ISSUED FOR CONSTRUCTION
	2	11.07.06	REVISED/ADDED DIMENSIONS
	3	11.27.06	MOVED WALLS & WINDOWS

PROPOSED BUILDING FOR:
RICHMOND METROPOLITAN AUTHORITY
 6234 POWHITE PARKWAY • CITY OF RICHMOND • VIRGINIA

FLOOR PLAN

DRAWN BY: RANDY HOOKER
 CHECKED BY: LTC
 DATE: OCTOBER 11, 2006
 PROJECT NO. 06587
 SCALE: 1/8" = 1'-0"

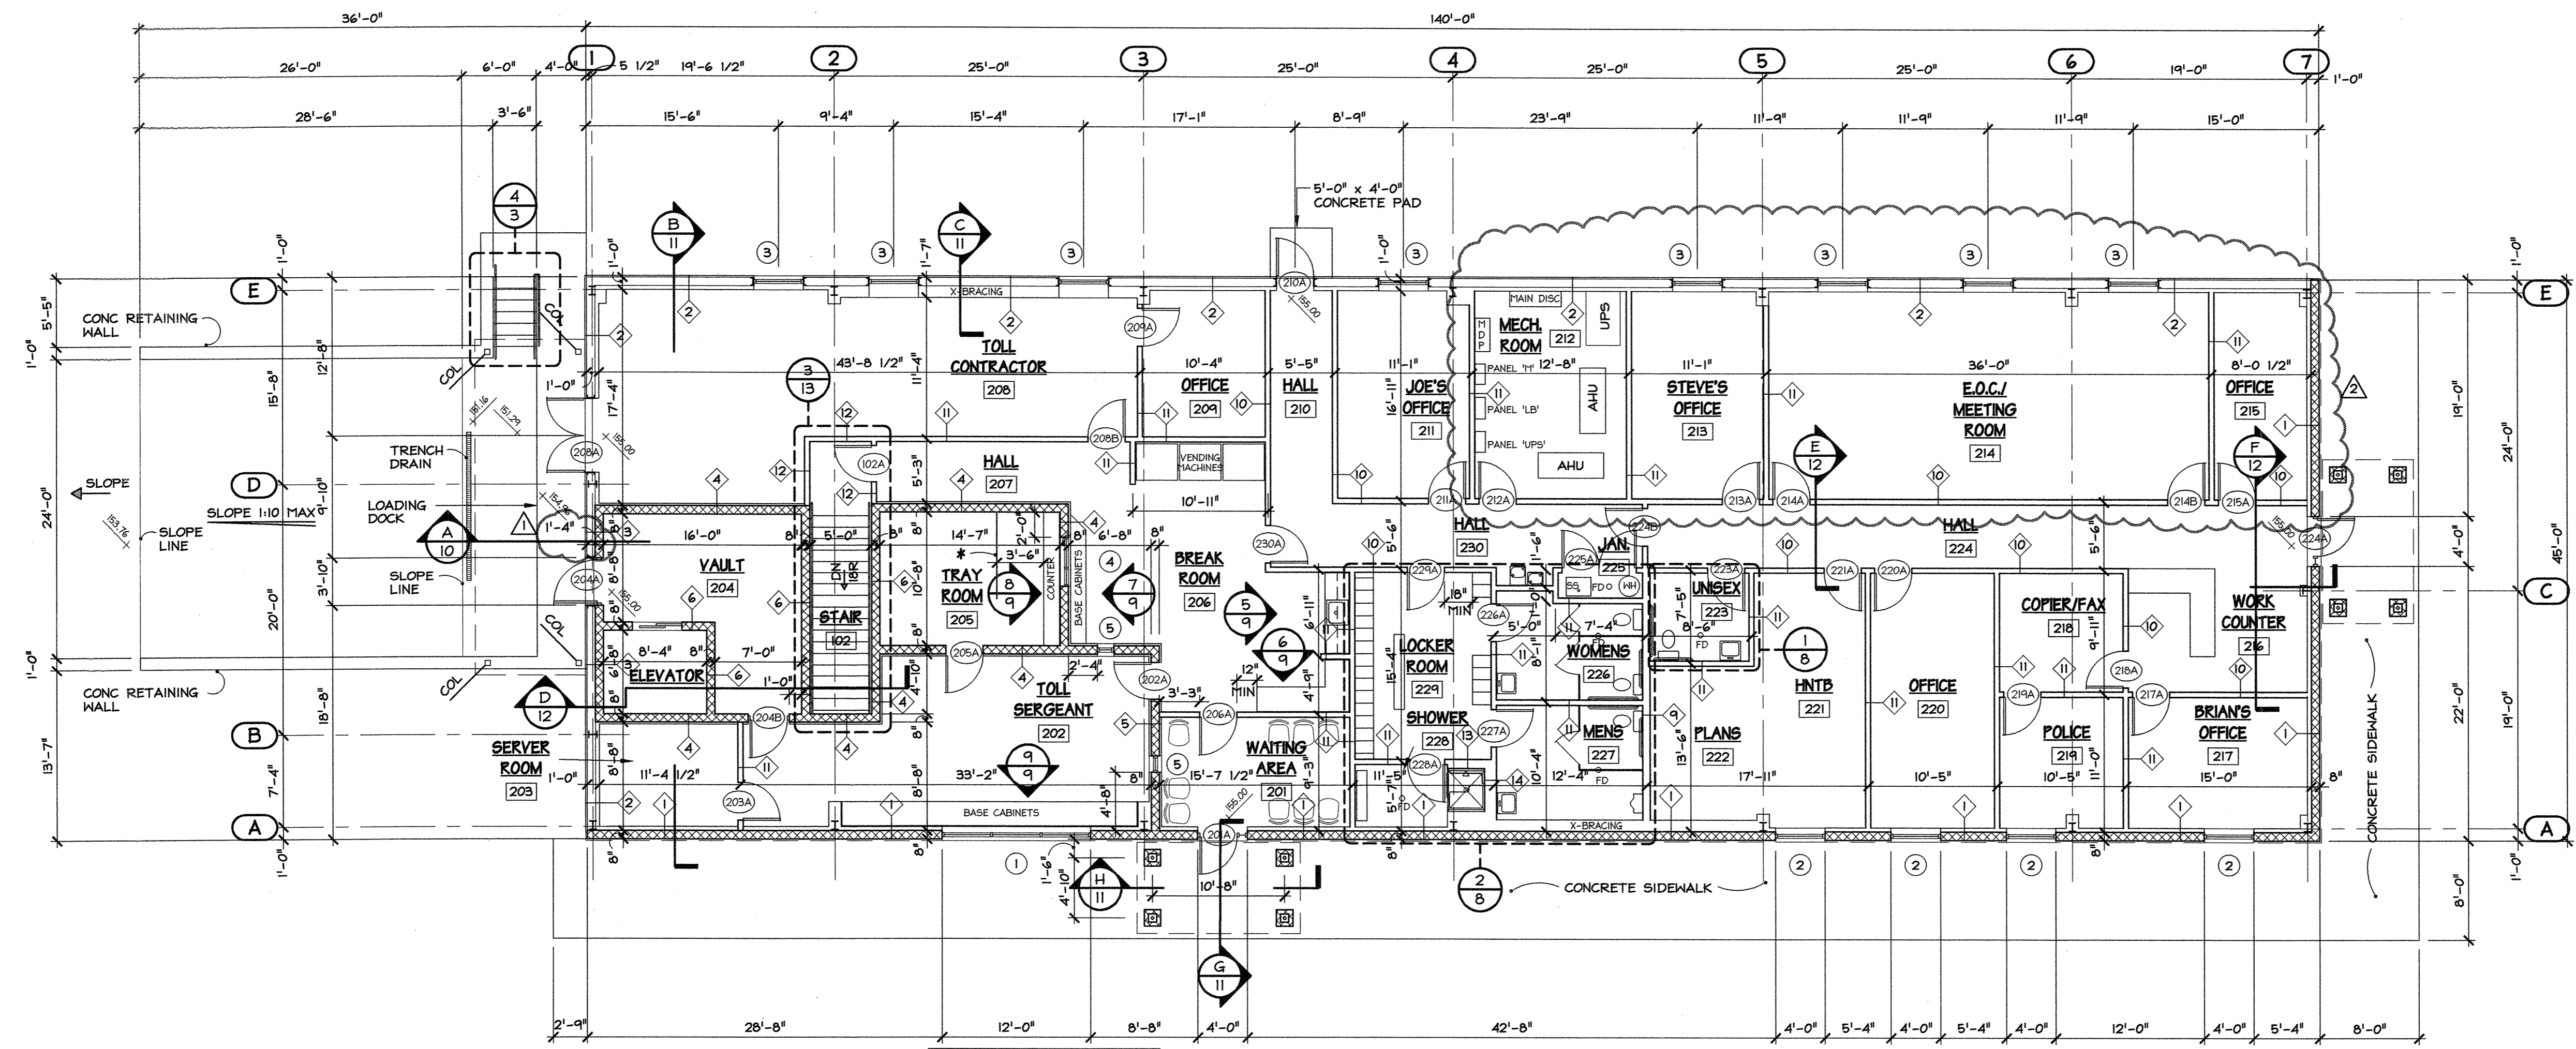


* NOTE:
 PROVIDE FLOOR / WALL MOUNTED TOILET PARTITION IN TRAY ROOM OR METAL STUD & GYPSUM BOARD PARTITION- LENGTH= 7'

FLOOR PLAN
 SCALE: 1/8" = 1'-0"







WALL LEGEND

- ① 8" SPLIT FACE CMU WALL TO 3'-4" AFF- METAL BUILDING WALL BEGINS AT 3'-4" AFF- W/ INTERIOR 4" x 20ga STEEL STUD WALL W/ 3 1/2" R-II FG BATT INSUL W/ VAPOR BARRIER & 5/8" GYPSUM BOARD, PROVIDE VINYL BACKED R-19 FG INSULATION FROM TOP OF STUD WALL TO TOP OF METAL BUILDING WALL.
- ② METAL BUILDING WALL W/ INTERIOR 4" x 20ga STEEL STUD WALL W/ 3 1/2" R-II FG BATT INSUL W/ VAPOR BARRIER & 5/8" GYPSUM BOARD, PROVIDE VINYL BACKED R-19 FG INSULATION FROM TOP OF STUD WALL TO TOP OF METAL BUILDING WALL.
- ③ METAL BUILDING WALL W/ INTERIOR 8" CMU WALL.
- ④ 8" CMU WALL W/ 1 1/2" x 20ga HAT CHANNELS & 5/8" GYPSUM BOARD.
- ⑤ 8" CMU WALL W/ 1 1/2" x 20ga HAT CHANNELS & 5/8" GYPSUM BOARD EACH FACE.
- ⑥ 8" CMU WALL.
- ⑦ 12" CMU WALL.
- ⑧ 16" CMU WALL.
- ⑨ 6" x 20ga METAL STUDS @ 24oc W/ 5/8" GYPSUM BOARD EACH FACE.
- ⑩ 1 HOUR RATED WALL ASSEMBLY - UL DESIGN #J419 4" x 20ga METAL STUDS @ 24oc W/ 3 1/2" FG SOUND BATT & 5/8" FIRE RATED GYPSUM BOARD EACH FACE.
- ⑪ 4" x 20ga METAL STUDS @ 24oc W/ 3 1/2" FG SOUND BATT & 5/8" GYPSUM BOARD EACH FACE.
- ⑫ 4" x 20ga METAL STUDS @ 24oc W/ 3 1/2" R-13 FG BATT INSULATION W/ VAPOR BARRIER & 5/8" EXTERIOR GRADE GYPSUM BOARD ON INTERIOR FACE OF STAIRWELL & 5/8" GYPSUM BOARD ON TOLL CONTRACTOR & HALL FACE OF WALL.
- ⑬ 8" x 20ga METAL STUDS @ 24oc W/ 3 1/2" FG SOUND BATT & 5/8" GYPSUM BOARD EACH FACE.
- ⑭ 1 1/2" CHASE WALL- 2 1/4" AIR SPACE BETWEEN 4" x 20ga STEEL STUD WALLS W/ 5/8" GYPSUM BOARD.

NOTE: PROVIDE MOISTURE RESISTANT GYPSUM BOARD IN ALL TOILET ROOMS, SHOWER & STAIR.

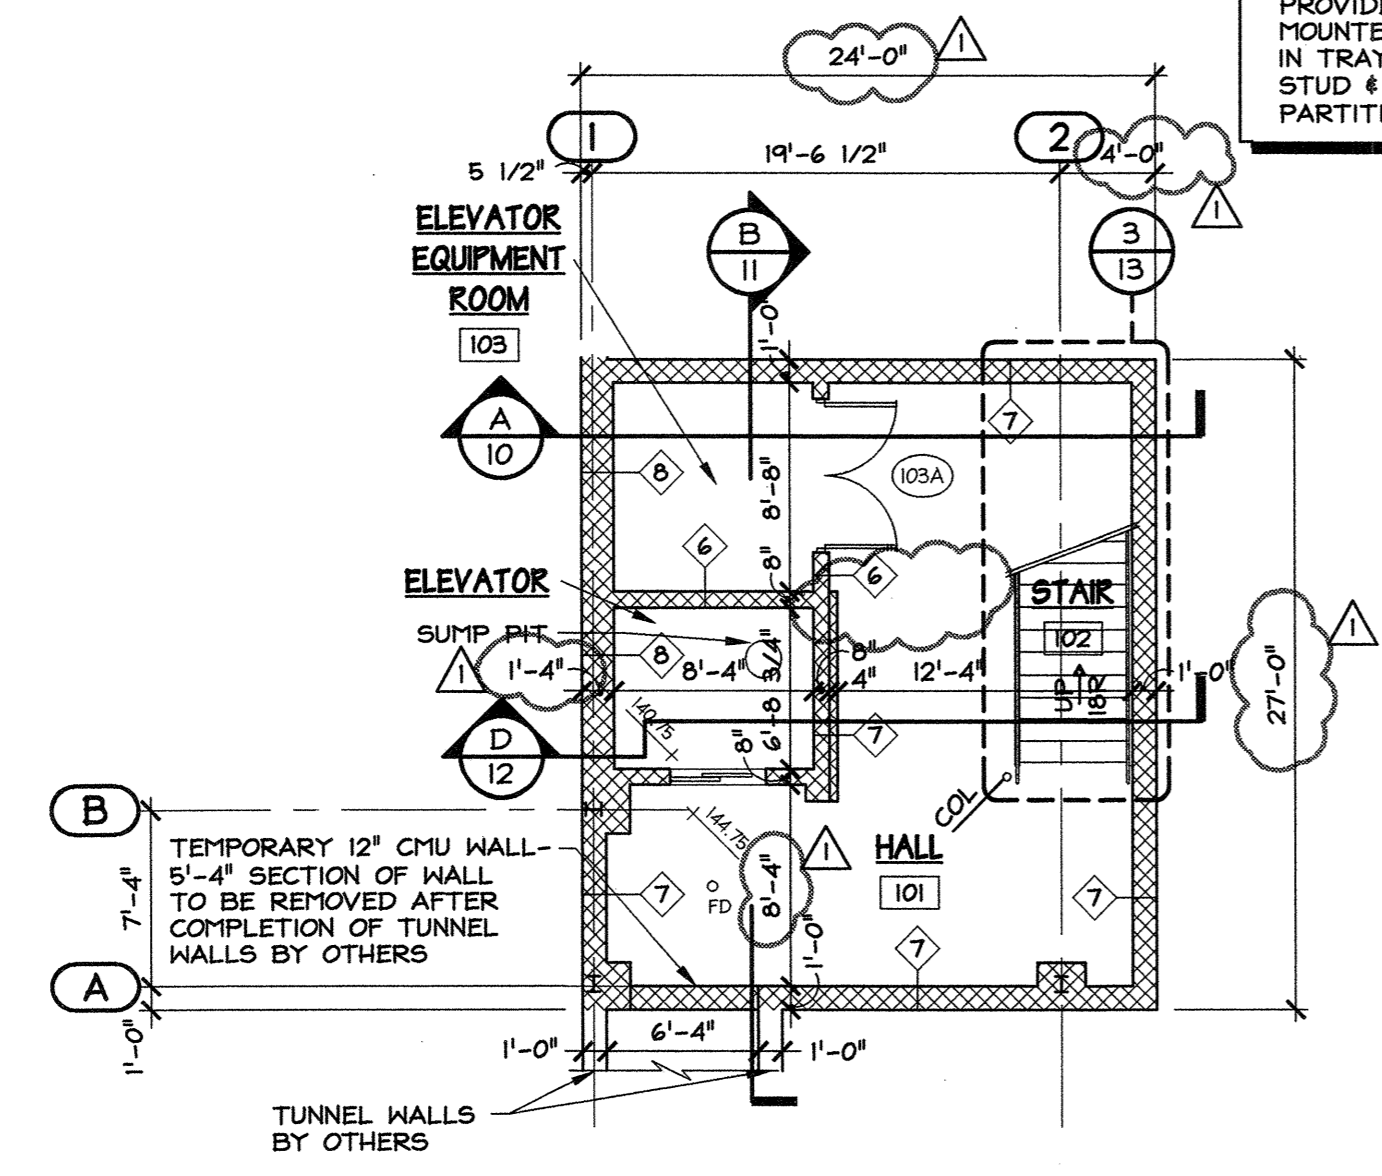

BASEMENT FLOOR PLAN
 SCALE: 1/8" = 1'-0"

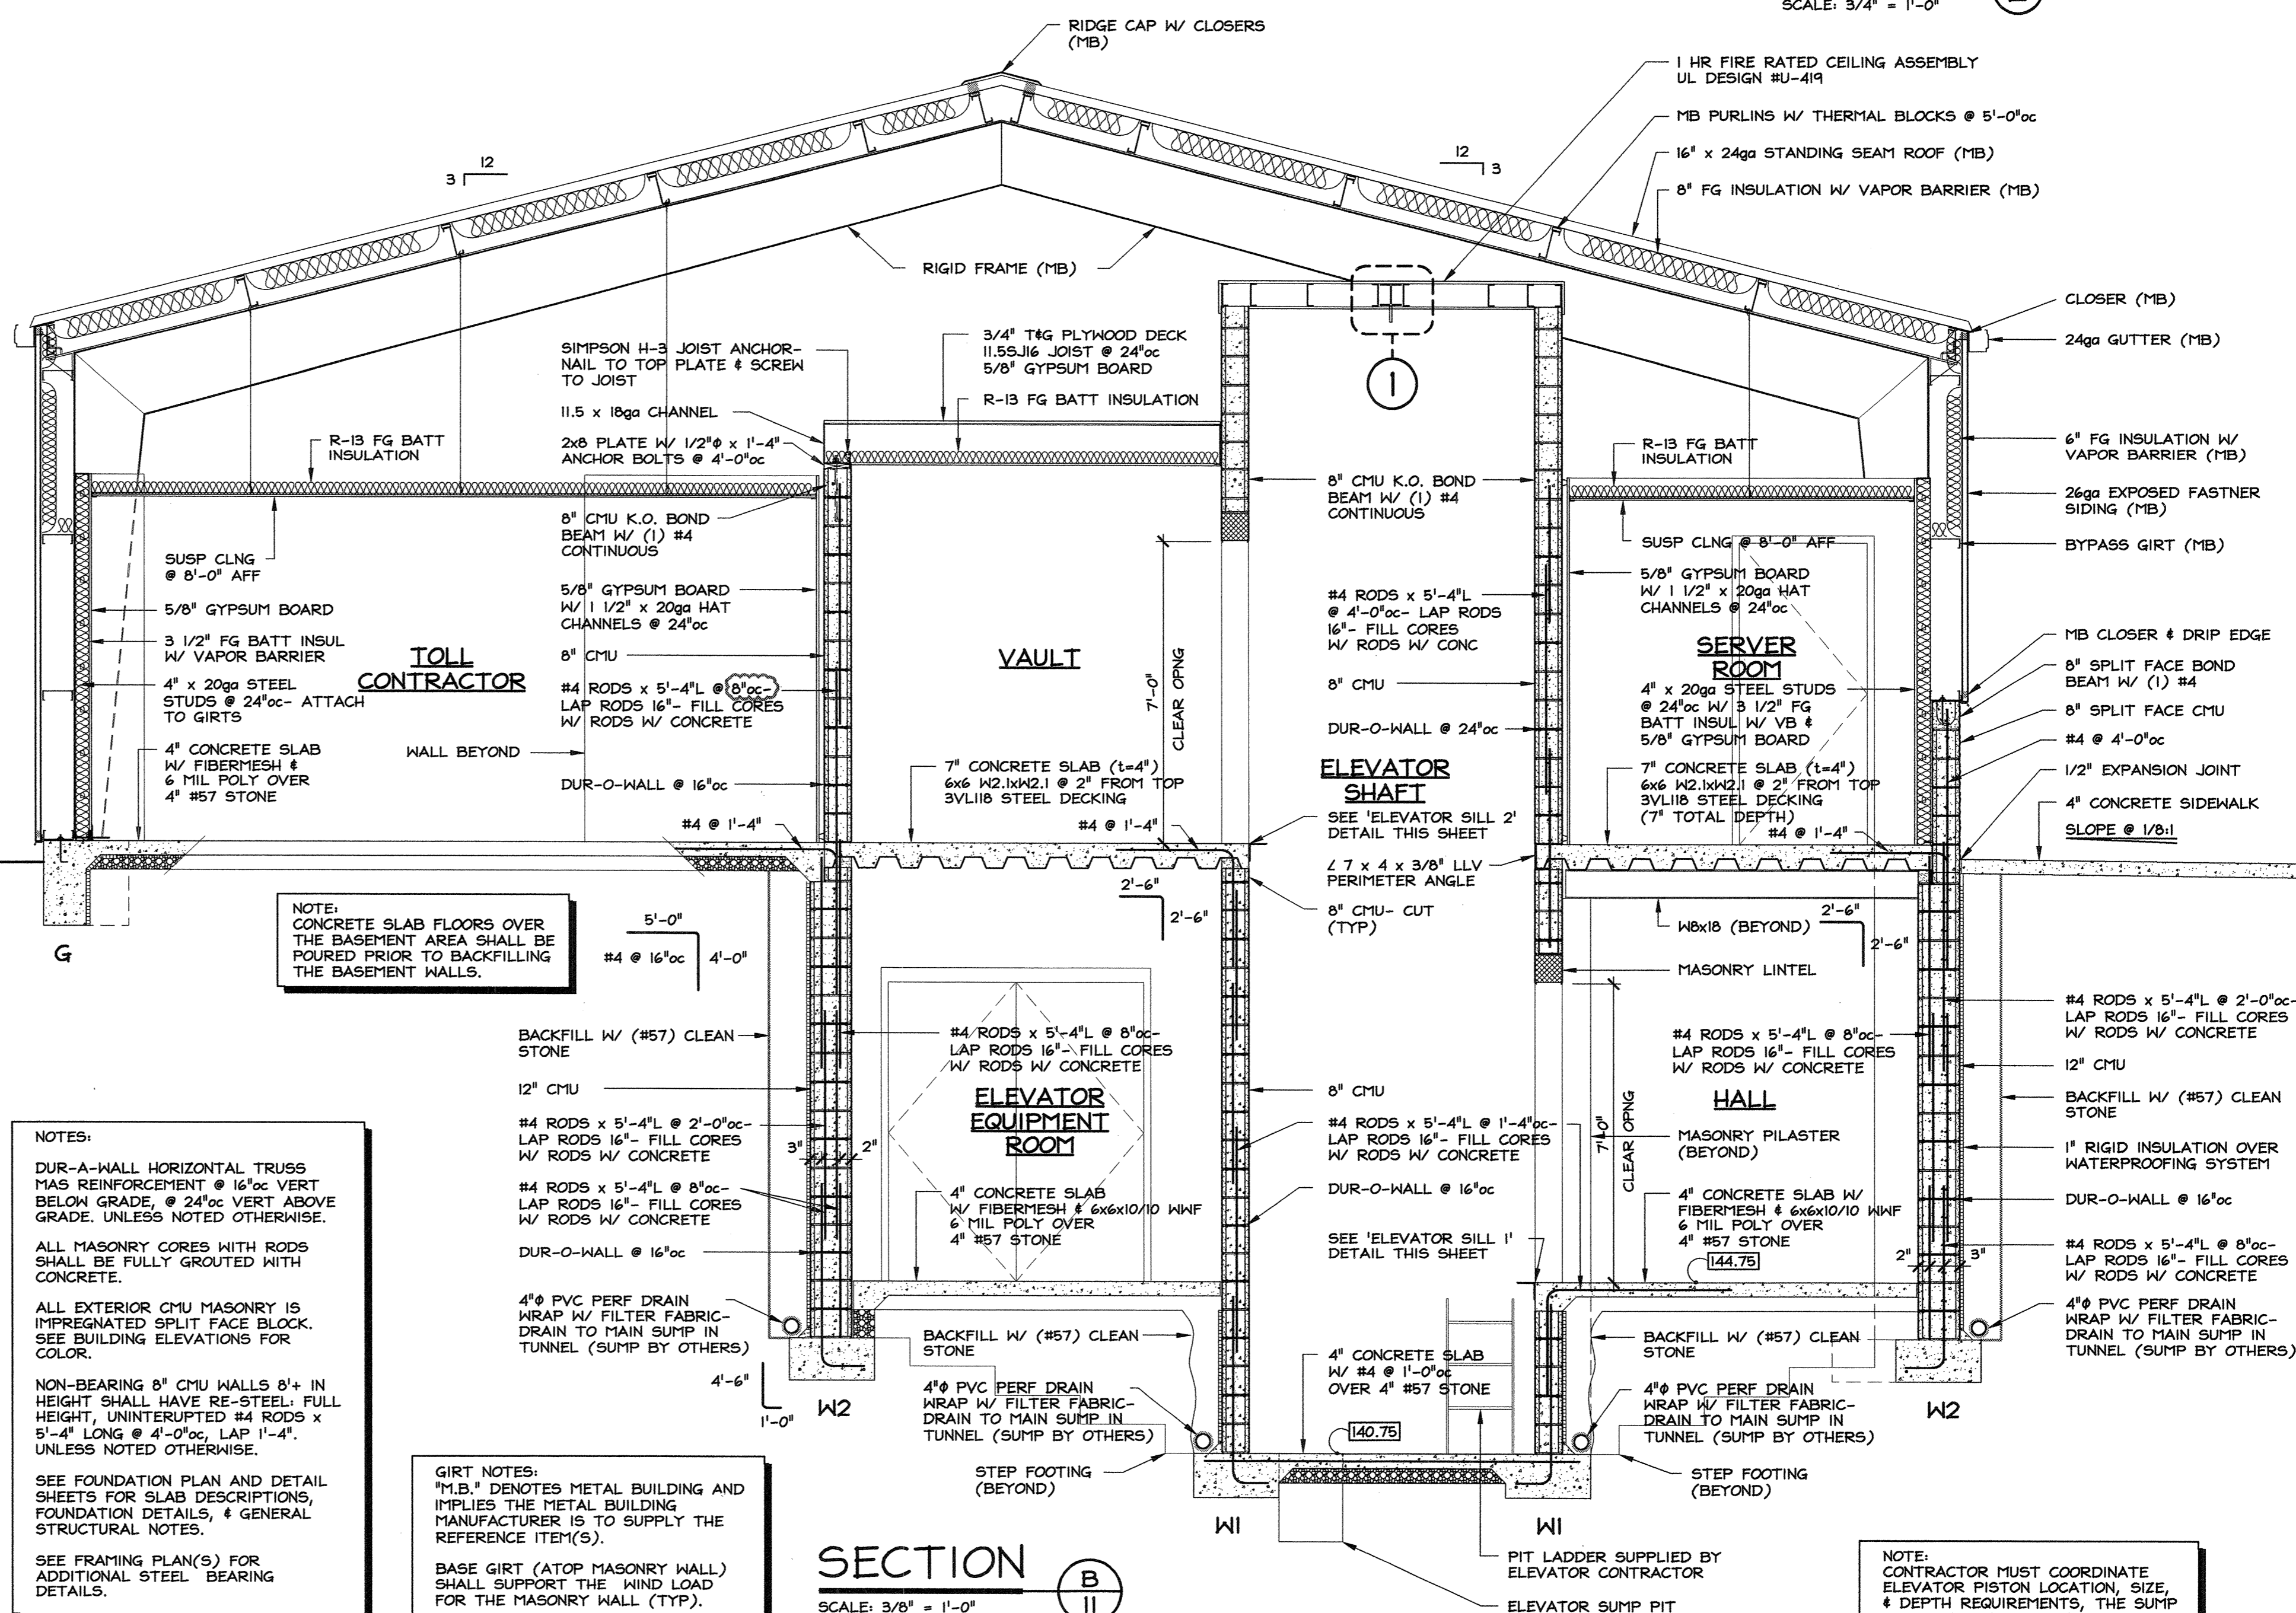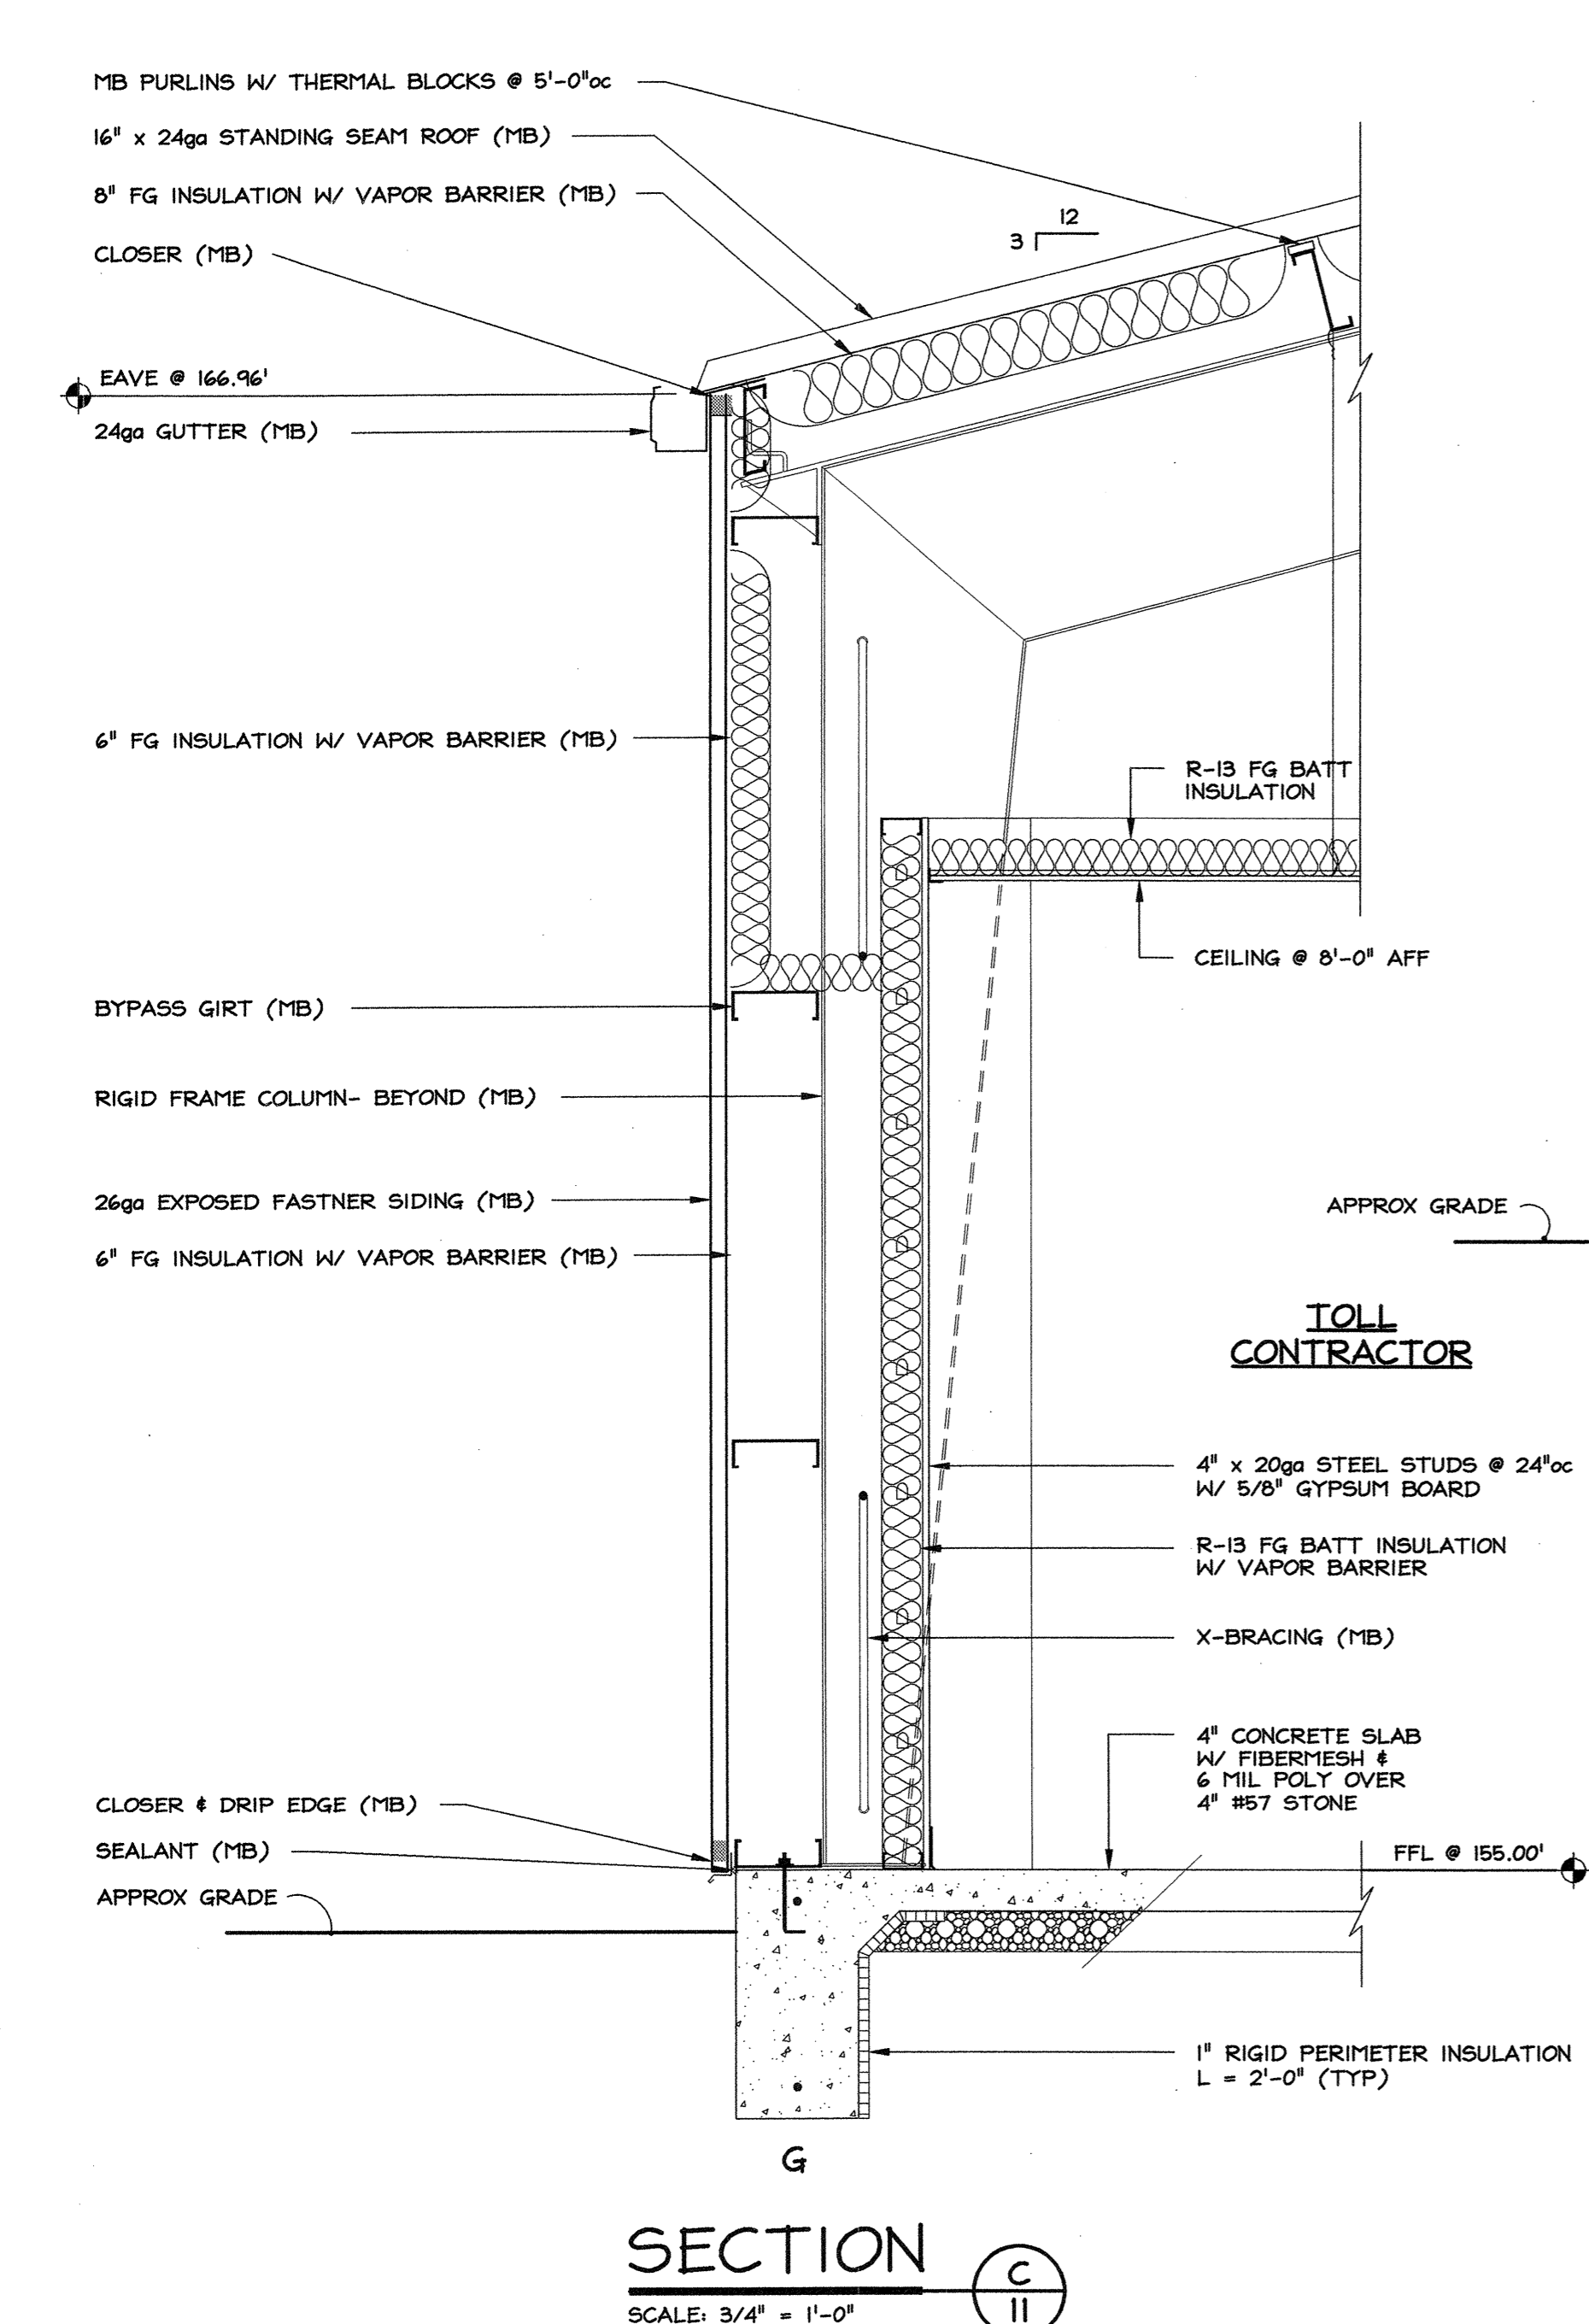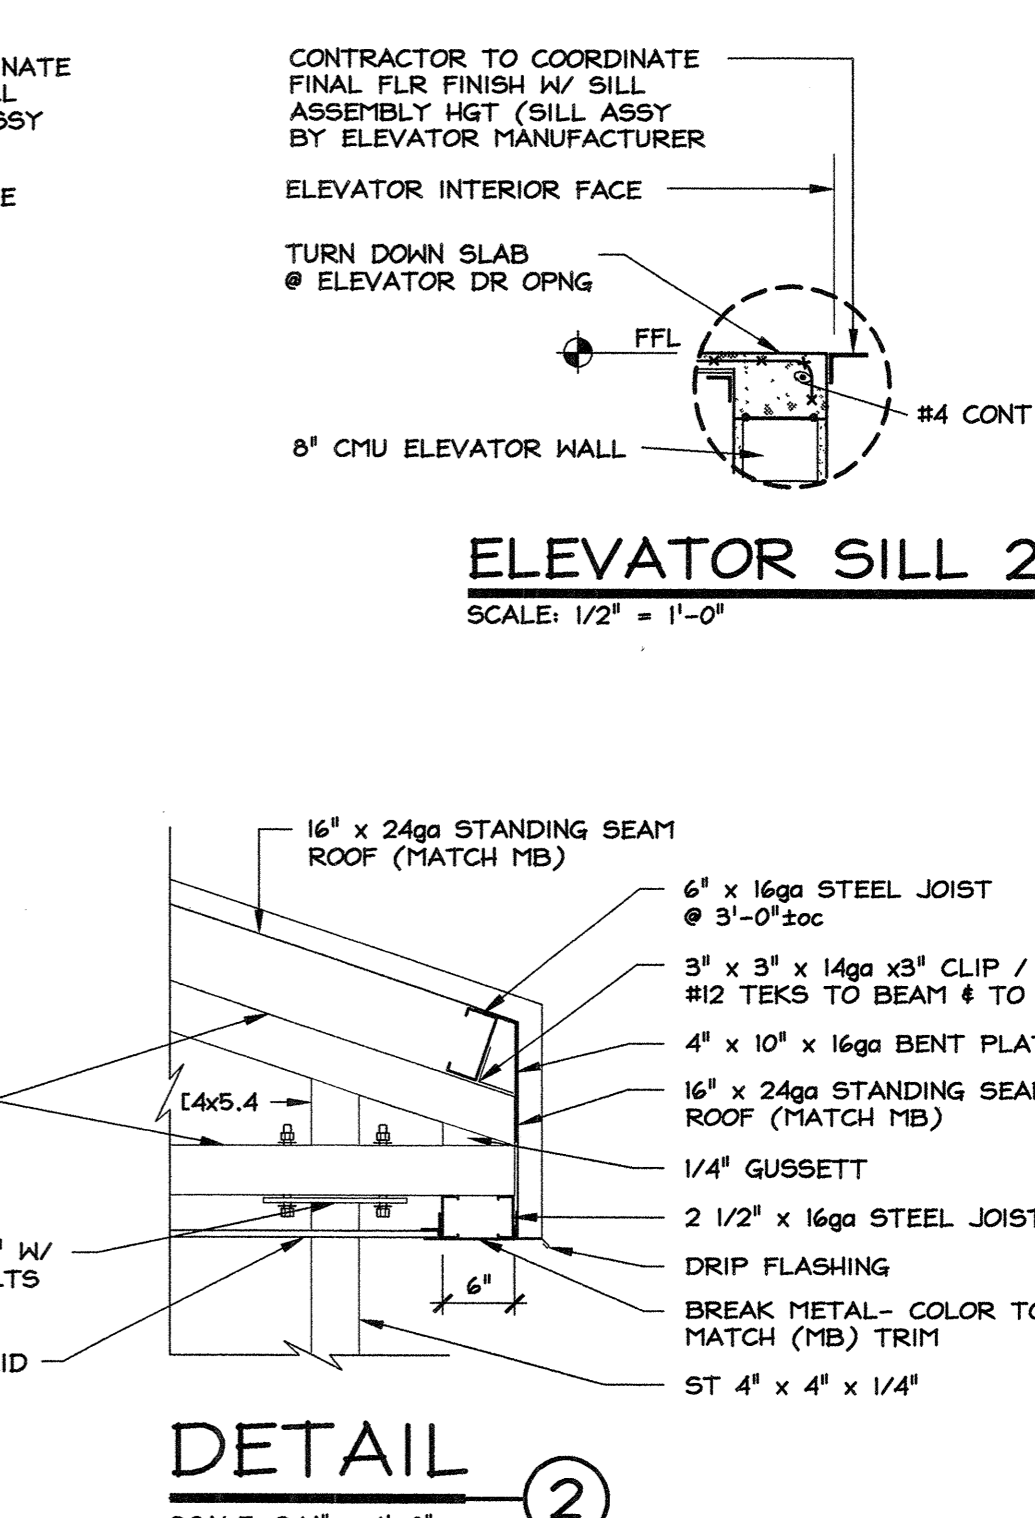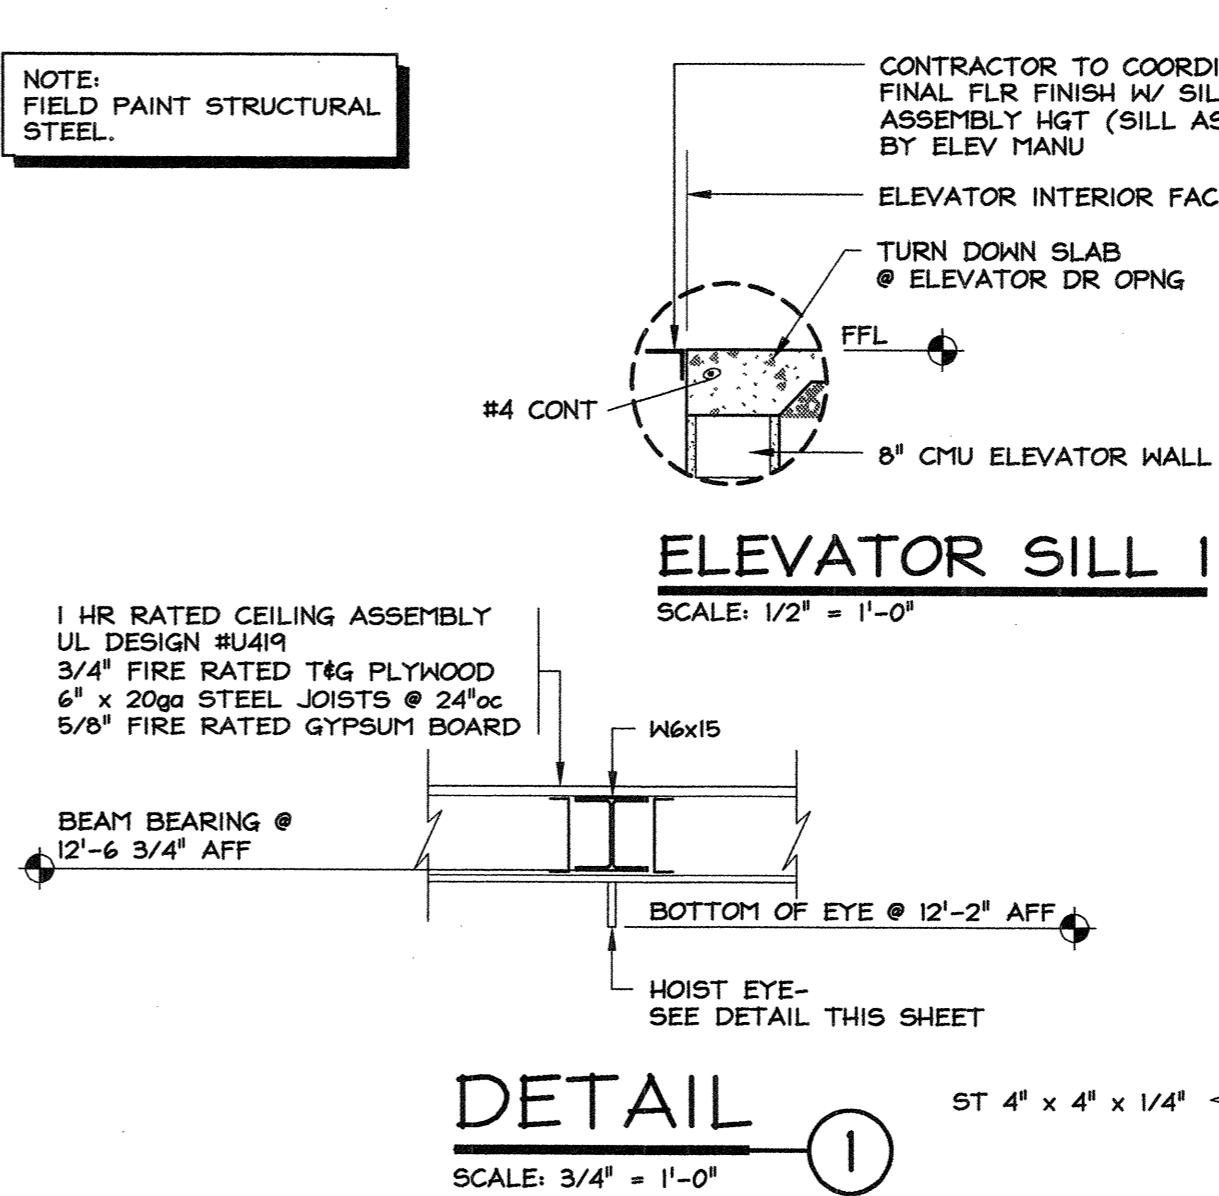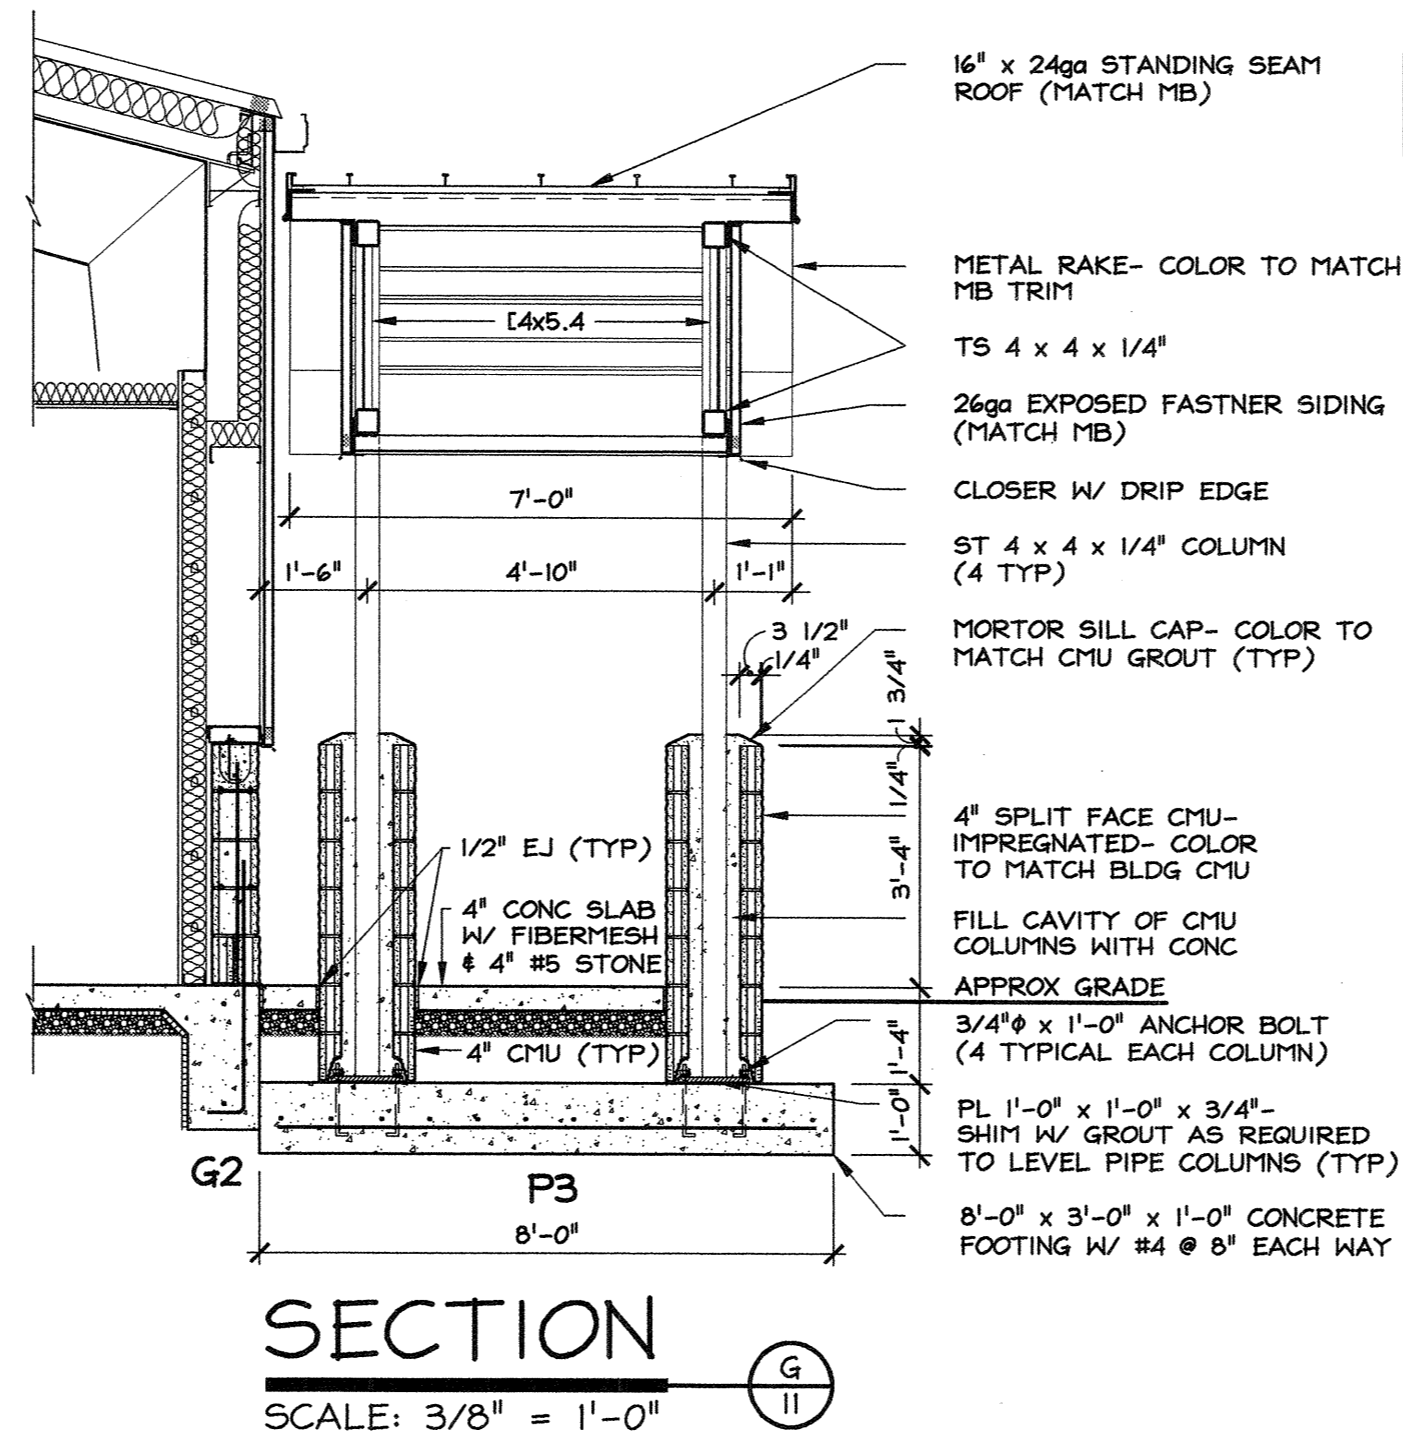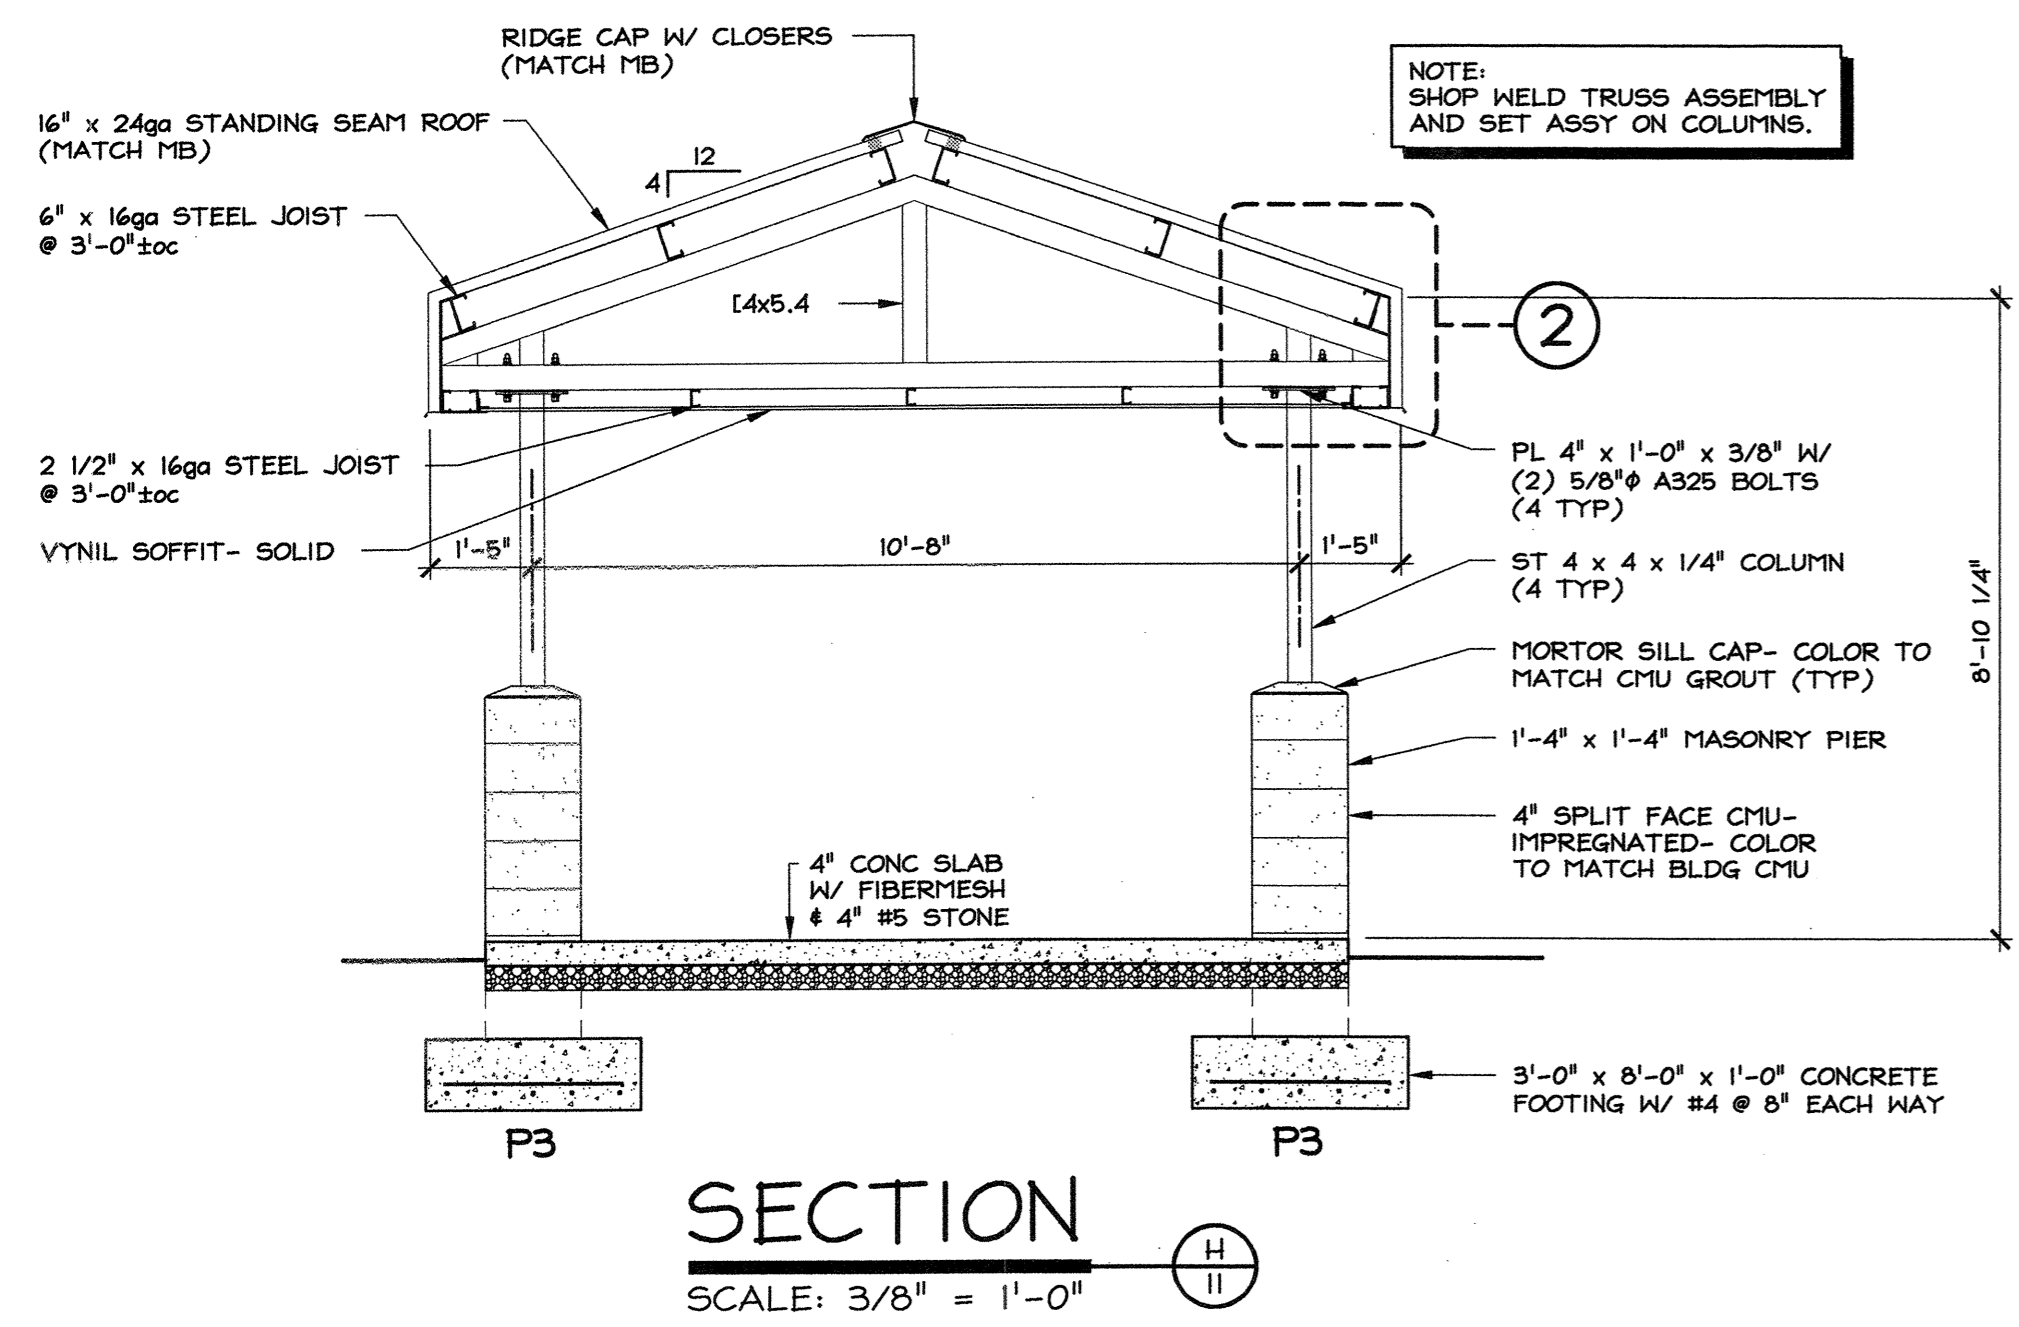

NOTES:
DUR-A-WALL HORIZONTAL TRUSS MAS REINFORCEMENT @ 16oc VERT BELOW GRADE, @ 24oc VERT ABOVE GRADE, UNLESS NOTED OTHERWISE.
ALL MASONRY CORES WITH RODS SHALL BE FULLY GROUTED WITH CONCRETE.
ALL EXTERIOR CMU MASONRY IS IMPREGNATED SPLIT FACE BLOCK. SEE BUILDING ELEVATIONS FOR COLOR.
NON-BEARING 8" CMU WALLS 8'+ IN HEIGHT SHALL HAVE RE-STEEL FULL HEIGHT, UNINTERRUPTED #4 RODS X 5'-4" LONG @ 4'-0" LAP 1'-4". UNLESS NOTED OTHERWISE.
SEE FOUNDATION PLAN AND DETAIL SHEETS FOR SLAB DESCRIPTIONS, FOUNDATION DETAILS, & GENERAL STRUCTURAL NOTES.
SEE FRAMING PLAN(S) FOR ADDITIONAL STEEL BEARING DETAILS.

GIRT NOTES:
"M.B." DENOTES METAL BUILDING AND IMPLIES THE METAL BUILDING MANUFACTURER IS TO SUPPLY THE REFERENCE ITEM(S).
BASE GIRTS (ATOP MASONRY WALL) SHALL SUPPORT THE WIND LOAD FOR THE MASONRY WALL (TYP).

NOTE:
CONTRACTOR MUST COORDINATE ELEVATOR PISTON LOCATION, SIZE, & DEPTH REQUIREMENTS, THE SUMP PIT LOCATION, AND THE ELEVATOR DOOR OPNG REQUIREMENTS W/ ELEVATOR CONTRACTOR.

EDDA
ENGINEERING DESIGN ASSOCIATES
ARCHITECTS • ENGINEERS • CONSTRUCTION MANAGERS
SURVEYORS • ENVIRONMENTAL SCIENTISTS

5625 LABURNUM AVENUE
RICHMOND, VIRGINIA 23231
PHONE: 804-236-0190
FAX: 804-236-0194

PO BOX 515
WICOMICO CHURCH 22579
PHONE: 804-580-2227
FAX: 804-580-3334

REVISION:	NO.	DATE:	DESCRIPTION:
	12/11/06	12/11/06	ISSUED FOR CONSTRUCTION

PROPOSED BUILDING FOR:
RICHMOND METROPOLITAN AUTHORITY

6224 POWHITE PARKWAY • CITY OF RICHMOND • VIRGINIA

BUILDING SECTIONS

DRAWN BY: RANDY HOOKER
CHECKED BY: RFN
DATE: December 11, 2006
PROJECT NO: 060587
SCALE: 3/4" = 1'-0"

DRAWING NO: 11 of 16


DO NOT SCALE DRAWING FOR DIMENSIONS

ELECTRICAL SCHEDULE

MARK	DESCRIPTION
⊕	EXIT LIGHT W/ DIRECTIONAL ARROW OPTION & BATTERY PACK
⊕	EMERGENCY EGRESS LIGHT W/ BATTERY PACK
□	2x4 LAY-IN FLUORESCENT 120V, W/ (4) 40 WATT TUBES W/ PRISMATIC LENS
□	2x4 SURFACE MTD FLUORESCENT 120V, W/ (4) 40 WATT TUBES W/ PRISMATIC LENS
⊕	SINGLE POLE SWITCH
⊕ ³	THREE-WAY SWITCH
⊕	DUPLEX OUTLET, 120 VOLT
⊕ ^{GFI}	DUPLEX OUTLET, 120 VOLT W/ GROUND FAULT INTERRUPT (GFI)
▽	TELE OUTLET, PROVIDE BOX AND PULL STRING
▽	DATA LINK OUTLET, PROVIDE BOX AND PULL STRING
▽	TELE / DATA LINK OUTLET, PROVIDE BOX AND PULL STRING
⊕ ^{WH}	ELECTRICAL WATER HEATER, 120V / 2000W ENERGY EFFICIENT TYPE
⊕	WATER COOLER, ADA COMPLIANT, BI-LEVEL, 120 VOLT

ELECTRICAL NOTES


- THE ELECTRICAL WORK SHALL BE PER THE NATIONAL ELECTRICAL CODE AND ALSO CONFORM TO THE REQUIREMENTS OF THE LOCAL POWER COMPANY AND THE CITY OF RICHMOND, VIRGINIA.
- THE ELECTRICAL CONTRACTOR SHALL DETERMINE THE ELECTRICAL SERVICE REQUIREMENTS AND VERIFY THE VOLTAGE AVAILABLE FOR THE ELECTRICAL SERVICE.
- ALL MECHANICAL AND ELECTRICAL EQUIPMENT SHALL BE U.L. APPROVED.
- THE ELECTRICAL CONTRACTOR SHALL FURNISH ANY AND ALL ACCESSORY MATERIAL AND LABOR AS REQUIRED TO INSURE THE PROPER OPERATION AND CODE COMPLIANCE OF ALL MECHANICAL AND ELECTRICAL EQUIPMENT.
- THE CONTRACTOR SHALL SUPPLY AND INSTALL ALL POWER WIRING AND ASSOCIATED ITEMS (SWITCHES, STARTERS, FUSES, BREAKERS, PANEL BOXES, CUT-OFFS FOR THE PROPOSED MECHANICAL EQUIPMENT, I.E., HEATING, AIR CONDITIONING, FANS, LOUVERS, ETC. WHICH WILL BE SUPPLIED BY THE MECHANICAL CONTRACTOR. THE MECHANICAL CONTRACTOR SHALL PROVIDE AND INSTALL ALL LOW VOLTAGE CONTROL WIRING.
- CONTRACTOR SHALL VERIFY EXACT LOCATION AND RATING OF EQUIPMENT TO BE INSTALLED AND ACCOMMODATE ELECTRICAL INTERFACES AS RECOMMENDED BY THE MANUFACTURER.
- ALL WIRING SHALL HAVE COPPER CONDUCTORS. WIRE INSULATION RATING SHALL MATCH OR EXCEED EQUIPMENT RATING.
- WHERE PERMITTED BY CODE AND AUTHORITY HAVING JURISDICTION, TYPE MC CABLE MAY BE USED.
- DO NOT MIX RECEPTACLE CIRCUITS WITH LIGHTING CIRCUITS.
- LABEL CIRCUITS ON PANELS AND JUNCTION BOX COVERS USING EMBOSSED OR PRINTED SELF-ADHESIVE TAPE.
- PROVIDE FOR ANY ADDITIONAL EGRESS / EXIT LIGHTING AS REQUIRED BY THE FIRE MARSHALL'S OFFICE.
- THE ELECTRICAL CONTRACTOR SHALL ROUGH-IN TELEPHONE / DATA COMMUNICATION BOXES WITH 3/4" CONDUIT AND SHALL EXTEND EMPTY CONDUIT 4" ABOVE THE CEILING. THE OWNER SHALL BE RESPONSIBLE FOR THE INSTALLATION OF THE PHONE / DATA COMMUNICATIONS SYSTEMS.
- ALL EGRESS LIGHTING (INCLUDING BATTERY PACKS) & EXTERIOR WALL PACK FIXTURES SHALL HAVE A 5-YR. (MIN.) WARRANTY.
- PANEL BOXES, DISCONNECTS, ETC. SHALL BE SQUARE D OR G.E. BRAND OR EQUAL AS APPROVED BY ENGINEER.
- ALL WIRING SHALL BE CONCEALED WHERE POSSIBLE.
- ELECTRICAL OUTLETS IN THE TOILETS AND @ BREAK RM SINK COUNTER SHALL BE GFI DUPLEX OUTLETS. MOUNT OUTLETS ABOVE THE LAVATORIES / COUNTERS.
- OWNER SHALL PAY ANY POWER COMPANY CHARGES FOR PERMANENT POWER.
- CONTRACTOR TO MAKE ALL ARRANGEMENTS FOR ELECTRICAL SERVICE TO INCLUDE LOAD LETTER.
- COORDINATE ALL WORK WITH THE MECHANICAL CONTRACTOR AND OTHER TRADES AS APPROPRIATE.

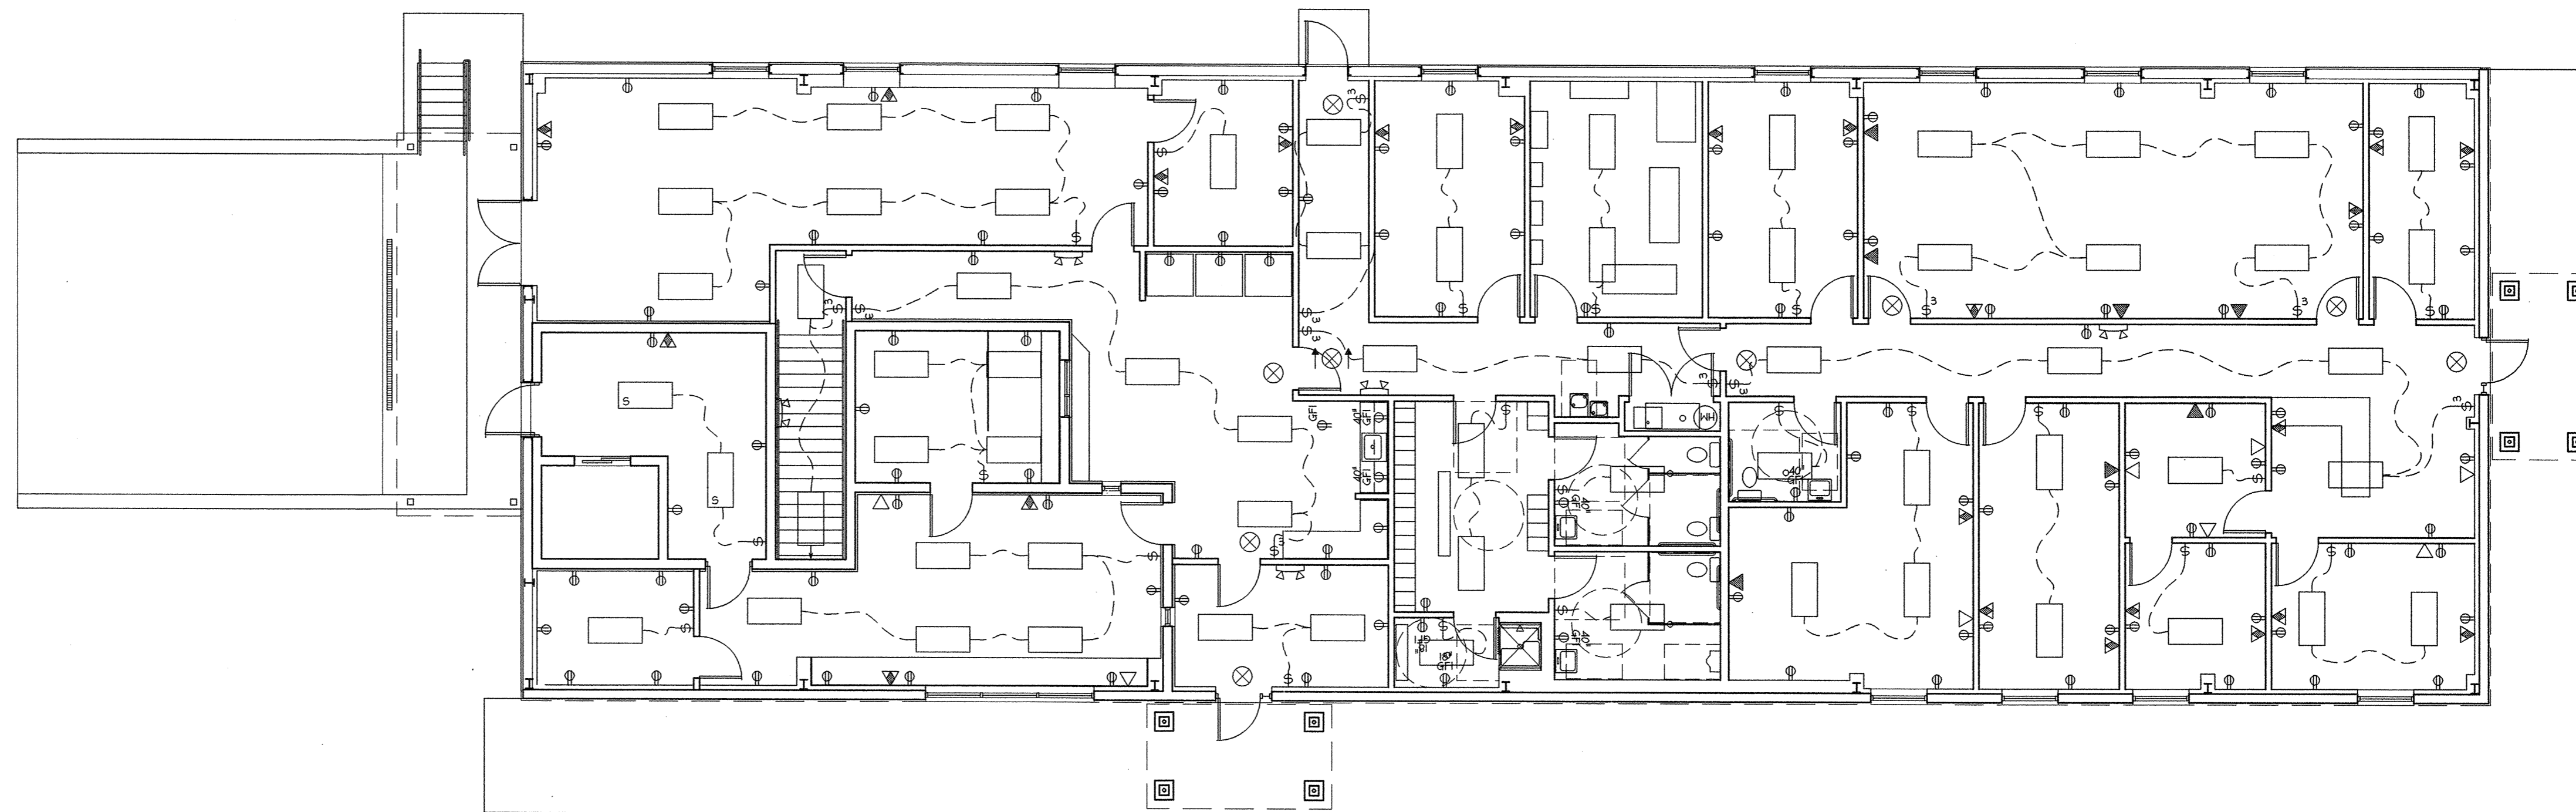

FIRST FLOOR
ELECTRICAL LAYOUT PLAN



SCALE: 1/8" = 1'-0"

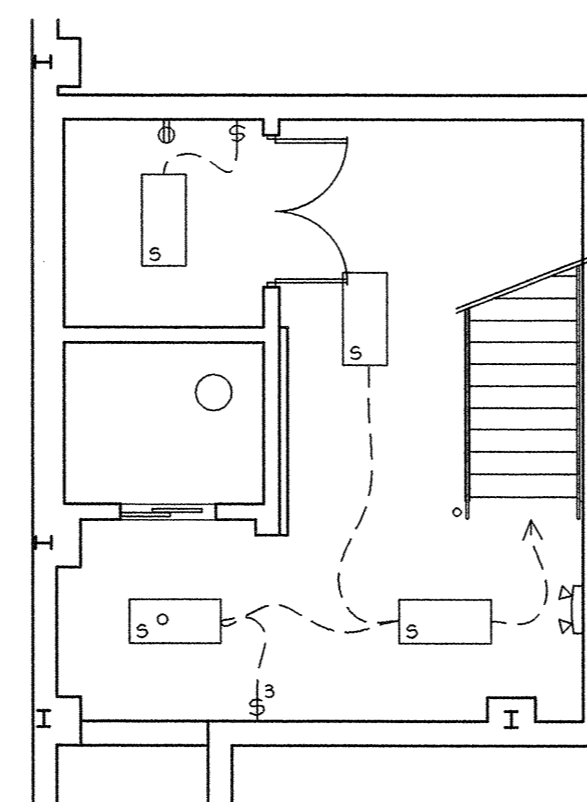

BASEMENT
ELECTRICAL LAYOUT PLAN



SCALE: 1/8" = 1'-0"

EDA

ENGINEERING DESIGN ASSOCIATES

ARCHITECTS • ENGINEERS • CONSTRUCTION MANAGERS
SURVEYORS • ENVIRONMENTAL SCIENTISTS

5625 LABURNUM AVENUE
RICHMOND, VIRGINIA 23231
PHONE: 804-236-0190
FAX: 804-236-0194


PO BOX 515
WICOMICO CHURCH 22579
PHONE: 804-580-2227
FAX: 804-580-3334

REVISION:	NO.	DATE:	DESCRIPTION:
		12/11/06	ISSUED FOR CONSTRUCTION

PROPOSED BUILDING FOR:
RICHMOND METROPOLITAN AUTHORITY
6234 POWHITE PARKWAY . . . CITY OF RICHMOND . . . VIRGINIA


ELECTRICAL LAYOUT PLAN
DRAWN BY: RANDY HOOKER . . . CHECKED BY: LTC
SCALE: 1/8" = 1'-0" . . . DATE: December 11, 2006 . . . PROJECT NO: 06357

DRAWING NO:
15 of 16

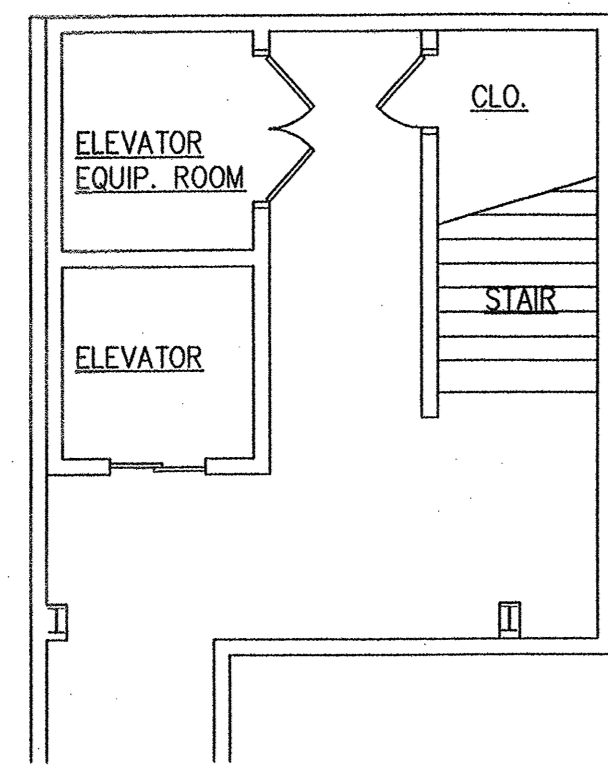

BASEMENT FLOOR PLAN - MECHANICAL

SCALE: 1/8" = 1'-0"

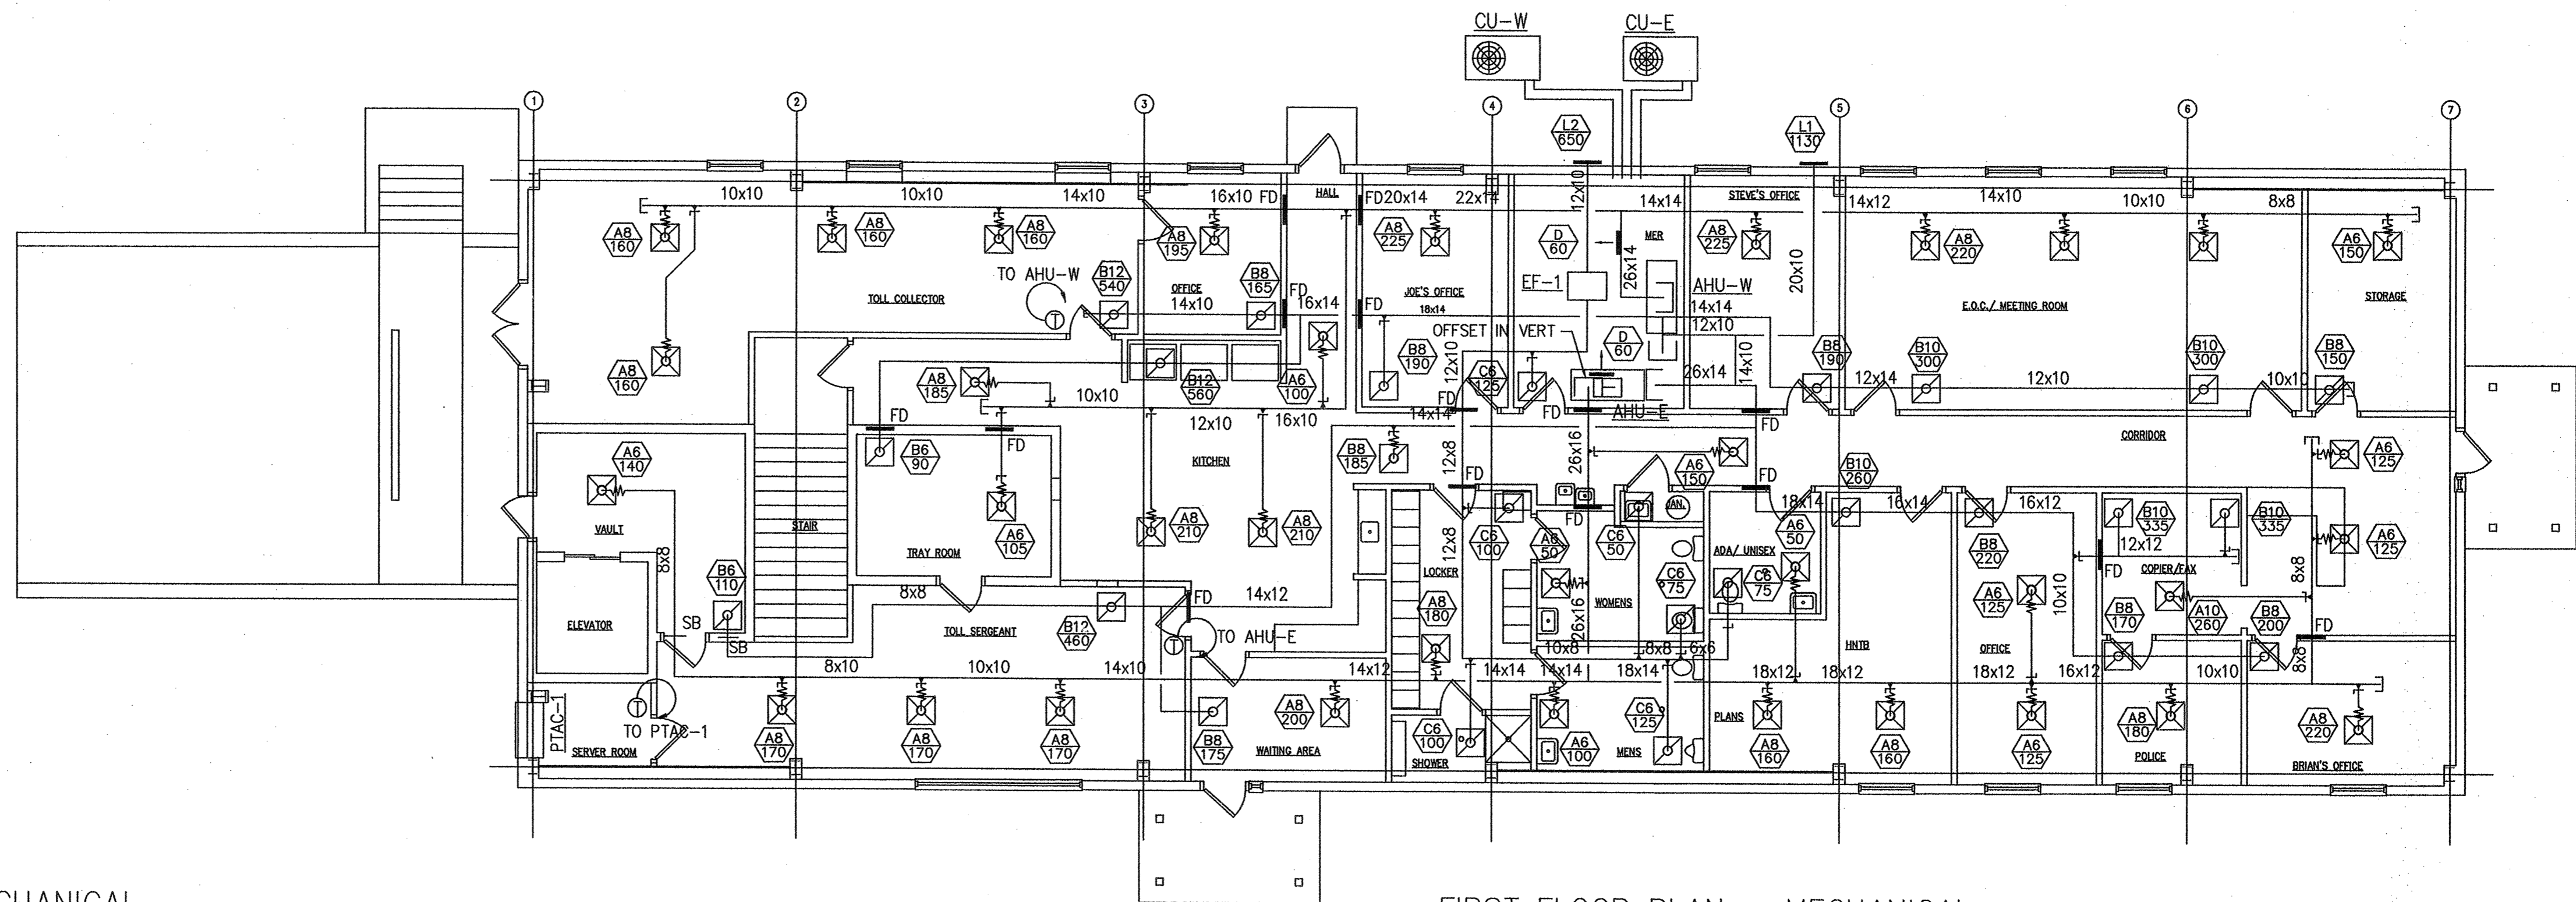

FIRST FLOOR PLAN - MECHANICAL

SCALE: 1/8" = 1'-0"

SPLIT SYSTEM AIR COOLED HEAT PUMP SCHEDULE

UNIT NUMBER	LOCATION AND AREAS SERVED	INDOOR UNIT																		OUTDOOR CONDENSING UNIT								REMARKS													
		FAN DATA				DX COOLING COIL DATA								HEATING COIL DATA						SELECTION BASED ON				COMPRESSOR DATA					CONDENSER FAN DATA				SELECTION BASED ON								
		CFM	OA	EXTERNAL S.P. IN. H ₂ O	TOTAL S.P. IN. H ₂ O	HP	RPM	V	PH	HZ	NO. ROWS	FPI	NO. CKTS.	FACE AREA S. F.	EAT °F DB	EAT °F LAT °F WB	SENS. MBH	TOTAL MBH	CFM	EAT °F DB	EAT °F LAT °F WB	CAPACITY MBH	ELECTRIC COIL DATA				MANUFACTURER		MODEL NUMBER	UNIT NUMBER	NO.	INPUT KW EA.	V	PH	HZ	HP	CFM	V	PH	HZ	MANUFACTURER
AHU-E	EAST OFFICES	2915	650	0.75	2.00	2	1725	230	3	60	4	12	1	11.2	81	67	75.8	99.2	2915	59	78	61.5	230	3	60	35	AM STD	TWE120A3	CU-E	1	9.84	230	3	60	1	8200	230	1	60	AM STD	TWA120A3
AHU-W	WEST OFFICES	2965	480	0.75	2.00	2	1725	230	3	60	4	12	1	11.2	80	60	76.7	95.9	2965	62	78	50.9	230	3	60	35	AM STD	TWE120A3	CU-W	1	9.84	230	3	60	1	8200	230	1	60	AM STD	TWA120A3

PACKAGED AIR CONDITIONING UNIT SCHEDULE

UNIT NUMBER	LOCATION AND AREAS SERVED	COOLING COIL DATA			HEATING COIL DATA			FAN DATA				SELECTION BASED ON		REMARKS				
		CFM	OA	COOLING TOTAL BTU/HR	CFM	OA	HEATING CAPACITY BTU/HR	CFM	WATTS	V	PH	HZ	MANUFACTURER		MODEL NUMBER			
PTAC-1	SERVER ROOM	300	50	11,700	310	50	10,600	230	1	60	2.0	310	1114	230	1	60	MCQUAY	PSHA1012EZ

AIR DISTRIBUTION DEVICE SCHEDULE

UNIT NUMBER	SERVICE	SHAPE	MATERIAL	FRAME	FINISH	ACCESSORIES	SELECTION BASED ON		REMARKS
							MANUFACTURER	MODEL NUMBER	
A	SUPPLY	SQUARE	ALUMINUM	LAY IN	WHITE	OBD	TITUS	RAS	
B	RETURN	SQUARE	ALUMINUM	LAY IN	WHITE	OBD	TITUS	PAR	
C	EXHAUST	SQUARE	ALUMINUM	LAY IN	WHITE	OBD	TITUS	PAR	
D	SUPPLY	RECT	ALUMINUM	SURFACE	WHITE	OBD	TITUS	3FL	8x6
L1	O A INTAKE	RECT	ALUMINUM	SURFACE	WHITE	SB,BD,BS	RUSKIN	ELF211D	30x24
L2	EXHAUST	SQUARE	ALUMINUM	SURFACE	WHITE	SB,BD,BS	RUSKIN	ELF211D	18x18

GENERAL FAN SCHEDULE

UNIT NUMBER	LOCATION AND AREAS SERVED	TYPE	CFM	TOTAL S.P. IN. H ₂ O	FAN RPM	MOTOR DATA				SELECTION BASED ON		REMARKS
						HP	RPM	V	PH	HZ	MANUFACTURER	
EF-1	GENERAL EXHAUST	INLINE	650	1.00	UNIT	1/2	1330	115	1	60	PENNBARRY	Z102H

MECHANICAL GENERAL NOTES

- ALL WORK SHALL BE PERFORMED IN ACCORDANCE WITH THE APPLICABLE STATE AND LOCAL CODES.
- THE ROUTING OF ALL DUCTWORK AND PIPING AS SHOWN ON THE DRAWING ARE DIAGRAMMATIC ONLY, INTENDING TO SHOW GENERAL RUNS AND LOCATIONS OF EQUIPMENT, DUCTWORK PIPING AND SPECIALTIES. THE CONTRACTOR SHALL COORDINATE WORK WITH ALL OTHER TRADES.
- NO DUCTWORK OR PIPING SHALL BE ROUTED OVER ELECTRICAL EQUIPMENT.
- ALL DUCTWORK AND PIPING SHALL BE ROUTED CONCEALED IN WALLS OR ABOVE CEILING EXCEPT IN MECHANICAL EQUIPMENT ROOM WHERE EXPOSED WORK IS ACCEPTABLE.
- ALL DUCTWORK SHALL BE CONSTRUCTED AND INSTALLED PER SMACNA.
- SUPPLY DUCTWORK SHALL BE LINED, GALVANIZED SHEET METAL WITH INSULATED FLEXIBLE BRANCH DUCTWORK NOT TO EXCEED 10'-0" IN LENGTH.
- RETURN AIR AND OUTSIDE AIR DUCTWORK SHALL BE LINED, GALVANIZED SHEET METAL.
- EXHAUST DUCTWORK SHALL BE GALVANIZED SHEET METAL. EXHAUST DUCTWORK FROM THE SHOWER ROOM SHALL BE ALUMINUM UNTIL IT CONNECTS TO THE MAIN DUCT.
- PROVIDE FIRE DAMPERS AND ACCESS DOORS AS SHOWN.
- PROVIDE SECURITY BARS AT ALL VAULT WALL PENETRATIONS.
- PROVIDE ELECTRICAL DISCONNECTS FOR ALL MECHANICAL EQUIPMENT.
- PROVIDE TYPE L COPPER REFRIGERANT LINES AS SIZED BY THE EQUIPMENT MANUFACTURER.
- PROVIDE CONDENSATE TRAPS AND DRAINS TO NEAREST FLOOR DRAIN AND TERMINATE WITH AN AIR GAP.

MECHANICAL SYMBOLS

SYMBOL	DESCRIPTION
	NEW DIFFUSER DESIGNATION (TOP - TYPE/NECK DIAMETER, BOTTOM - CFM)
	NEW EQUIPMENT
	NEW DUCT
	NEW SUPPLY DIFFUSER
	NEW R/A OR EXHAUST GRILLE
	FLEXIBLE DUCT
	THERMOSTAT
	SPIN-IN TAP WITH VOLUME DAMPER
	SPIN-IN TAP W/O VOLUME DAMPER
	MANUAL VOLUME DAMPER
	REFRIGERANT LIQUID PIPE
	REFRIGERANT GAS PIPE

MECHANICAL ABBREVIATIONS

AFF	ABOVE FINISHED FLOOR
BD	BACKDRAFT DAMPER
BS	BIRD SCREEN
CU	CONDENSING UNIT
EF	EXHAUST FAN
OBD	OPPOSED BLADE DAMPER
RA	RETURN AIR
SA	SUPPLY AIR
SB	SECURITY BARS
FD	FIRE DAMPER WITH ACCESS DOOR

PROJ. NO.: C-60007F
 PROJ. MGR.: CS
 DESIGNED BY: CLM
 DRAWN BY: EFM
 CHECKED BY: CS
 DATE: 11-30-06

REVISIONS

DRAWING TITLE
 FLOOR PLANS, LEGEND, NOTES
 AND SCHEDULES - MECHANICAL

PROJECT
 PROPOSED BUILDING FOR:
 RICHMOND METROPOLITAN AUTHORITY

2008 Southworth Mechanical Corporation
 222 - 222 - 806
 2222 Richmond, Virginia 23223

SHEET NO.




M-1

1 OF 1

FOREST HILL AVENUE RAMPS

TOLL PLAZA ORIGINAL PLANS

RICHMOND EXPRESSWAY SYSTEM			
SECTION	PROJECT	SHEET NO.	TOTAL SHEETS
2	POWHITE PARKWAY	86	188

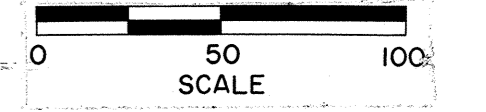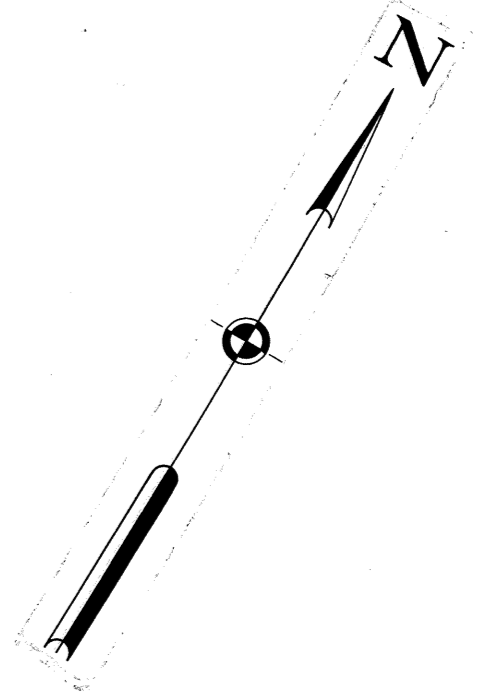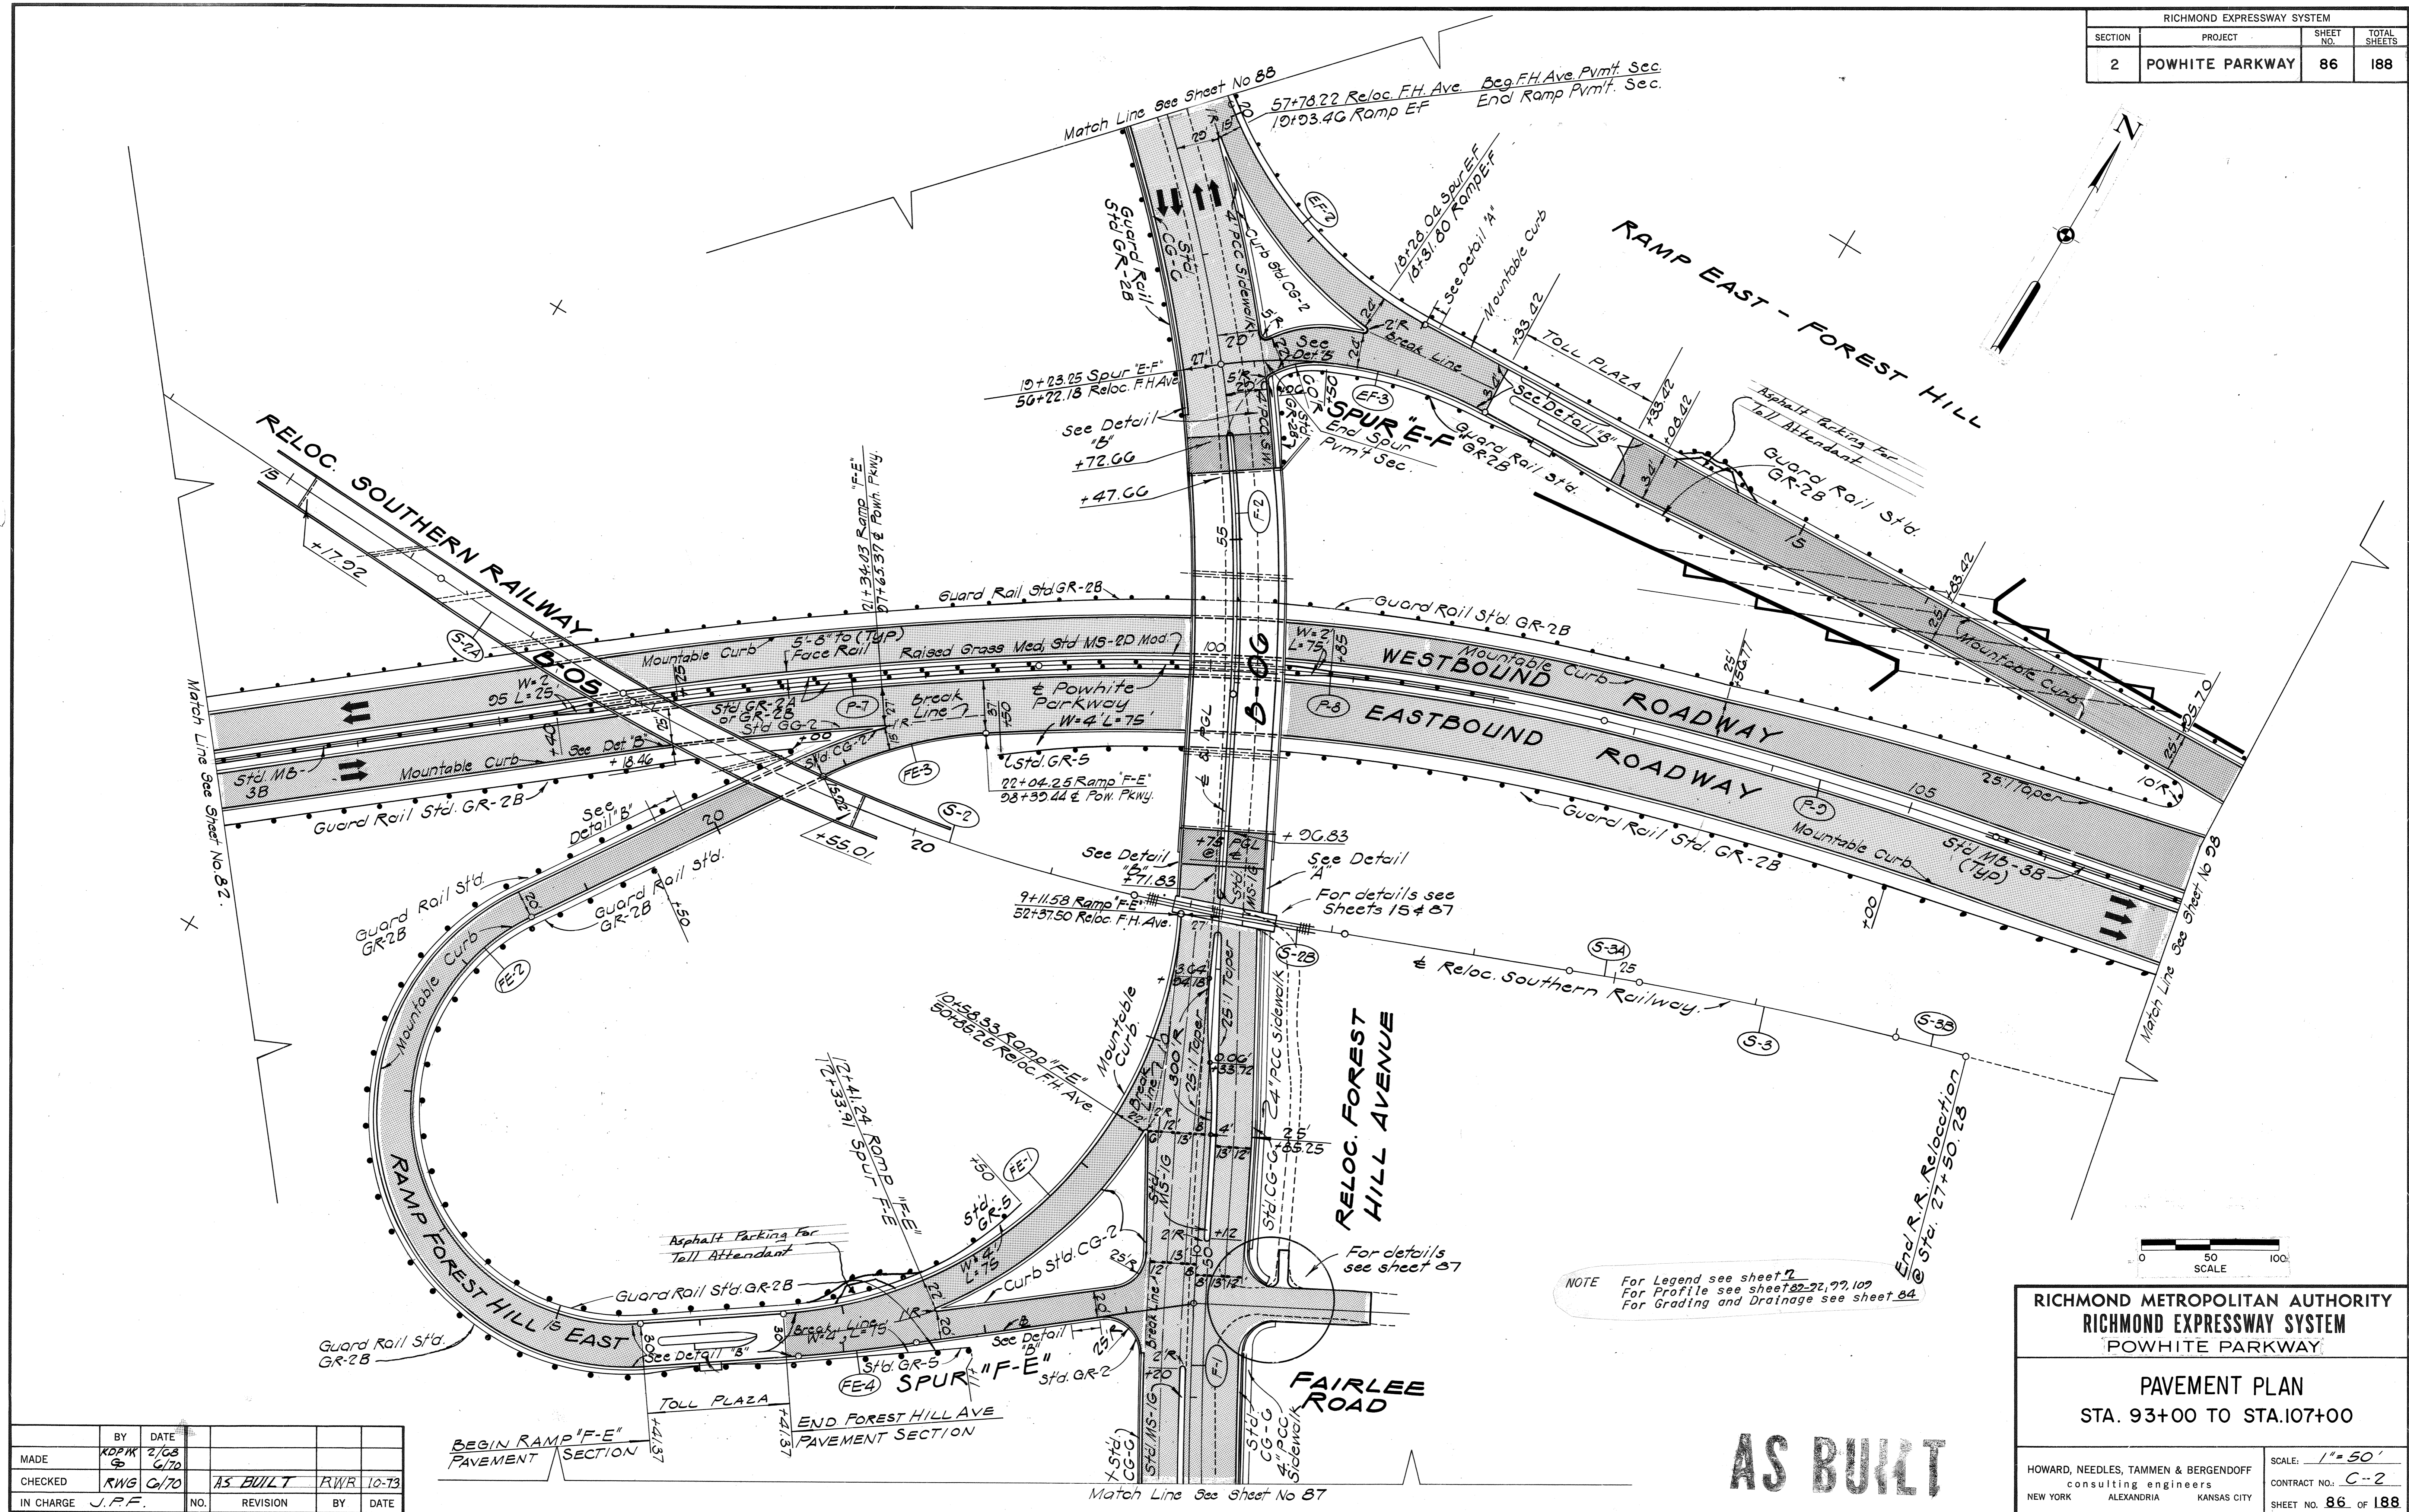

NOTE For Legend see sheet 7
 For Profile see sheets 22, 27, 107
 For Grading and Drainage see sheet 84

RICHMOND METROPOLITAN AUTHORITY
 RICHMOND EXPRESSWAY SYSTEM
 POWHITE PARKWAY

PAVEMENT PLAN
 STA. 93+00 TO STA. 107+00

HOWARD, NEEDLES, TAMMEN & BERGENDOFF
 consulting engineers
 NEW YORK ALEXANDRIA KANSAS CITY







SCALE: 1" = 50'
 CONTRACT NO.: C-2
 SHEET NO. 86 OF 188

AS BUILT

MADE	BY	DATE	NO.	REVISION	BY	DATE
	KDP/K	2/08				
	G	6/10				
CHECKED	RWG	6/10		AS BUILT	RWR	10-13
IN CHARGE	J.P.F.					

BEGIN RAMP "F-E" PAVEMENT SECTION
 END FOREST HILL AVE PAVEMENT SECTION

RICHMOND EXPRESSWAY SYSTEM			
SECTION	PROJECT	SHEET NO.	TOTAL SHEETS
2	POWHITE PARKWAY	43	188

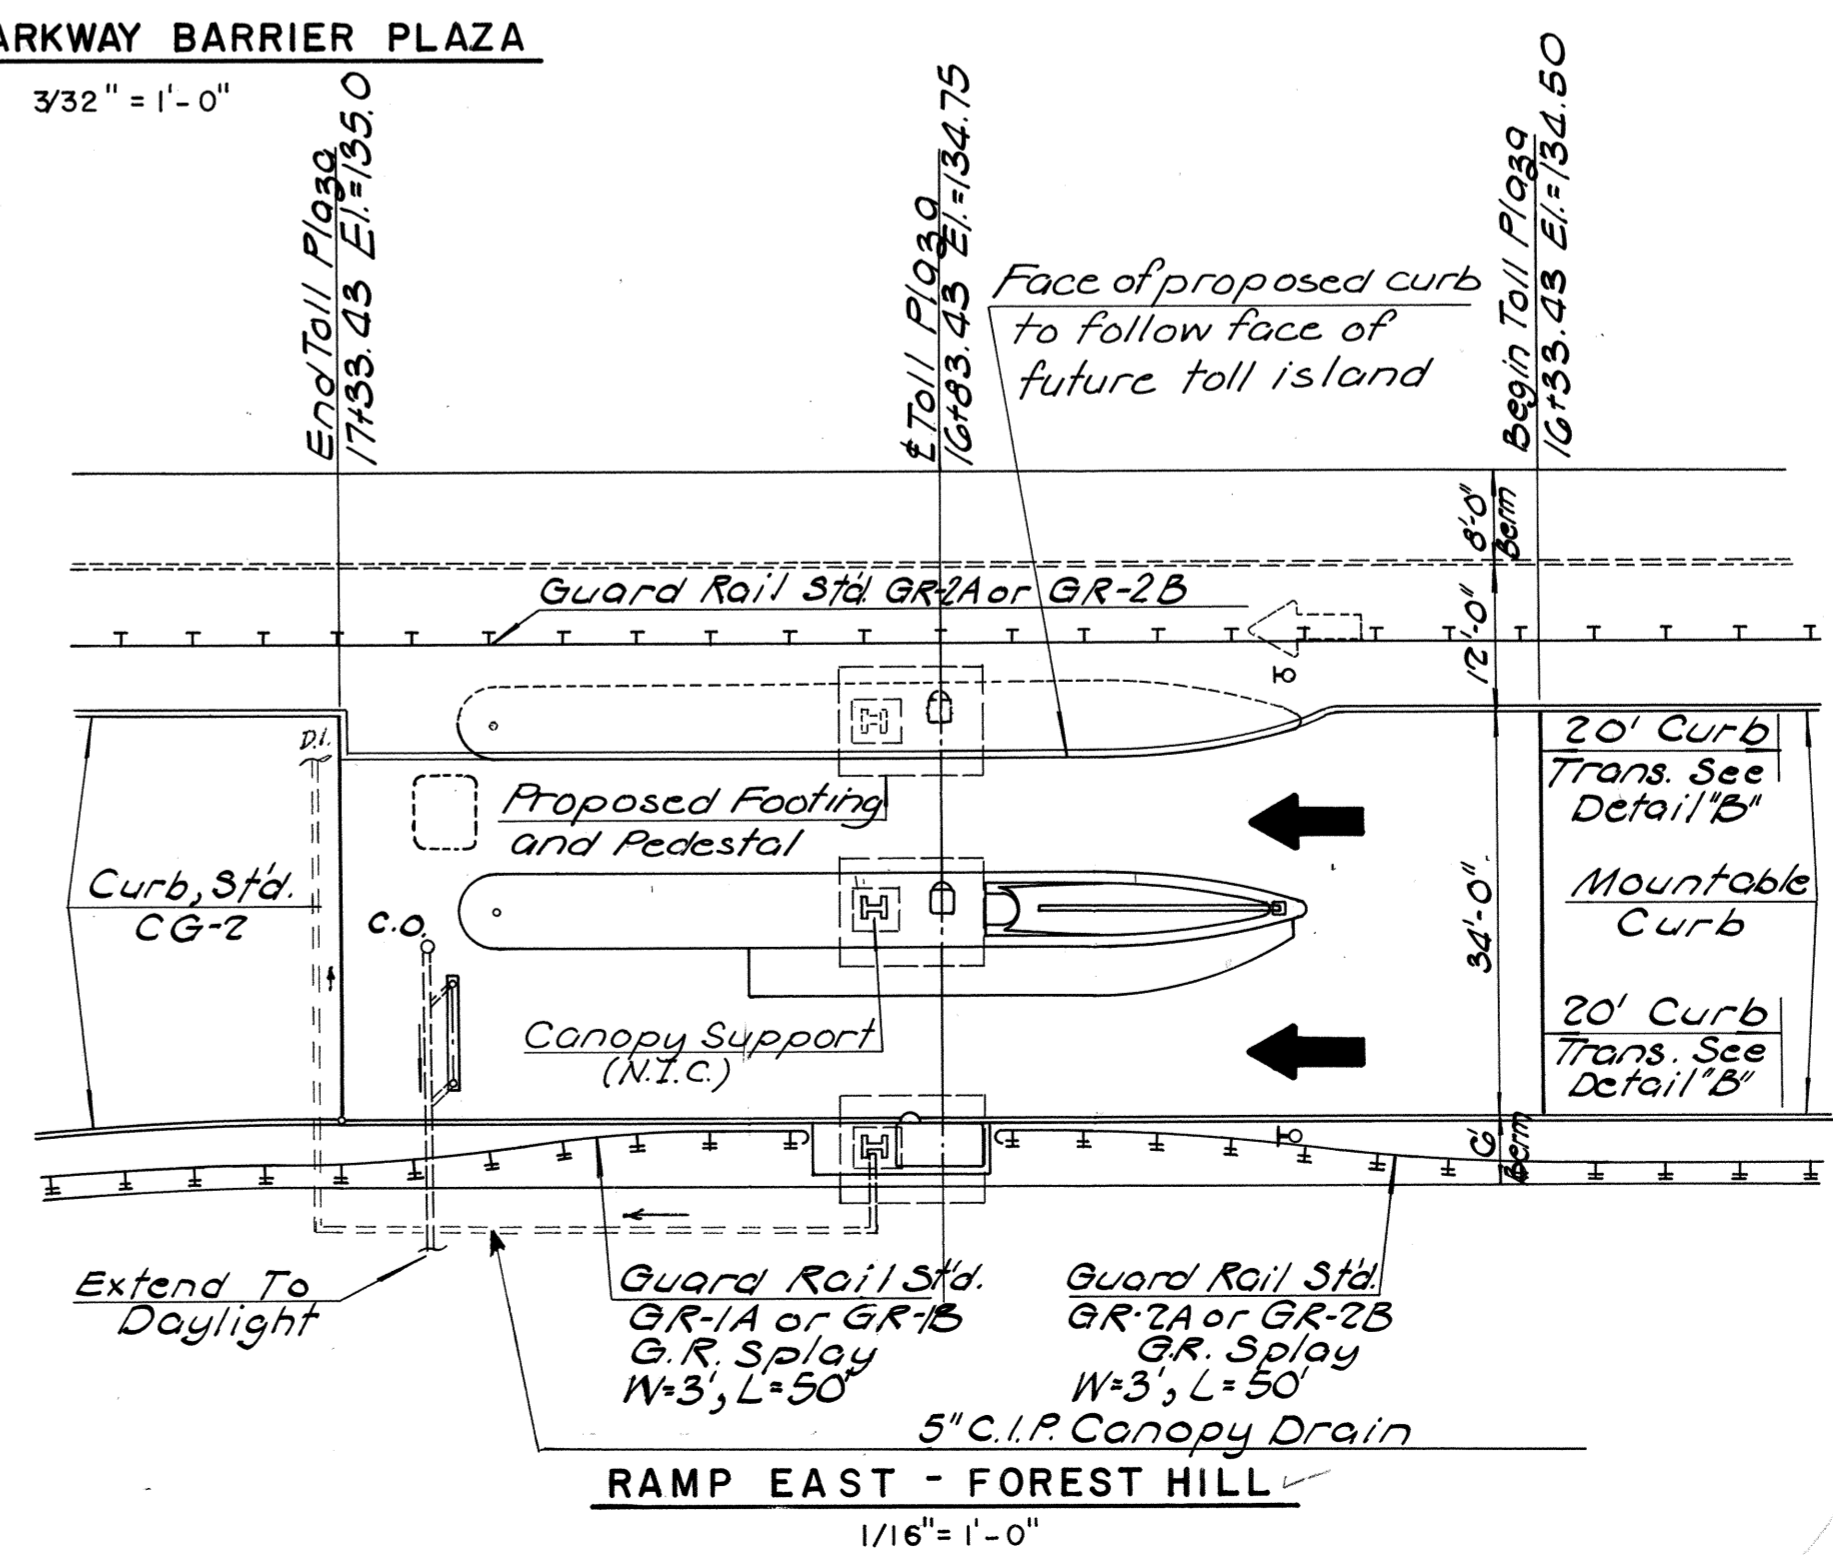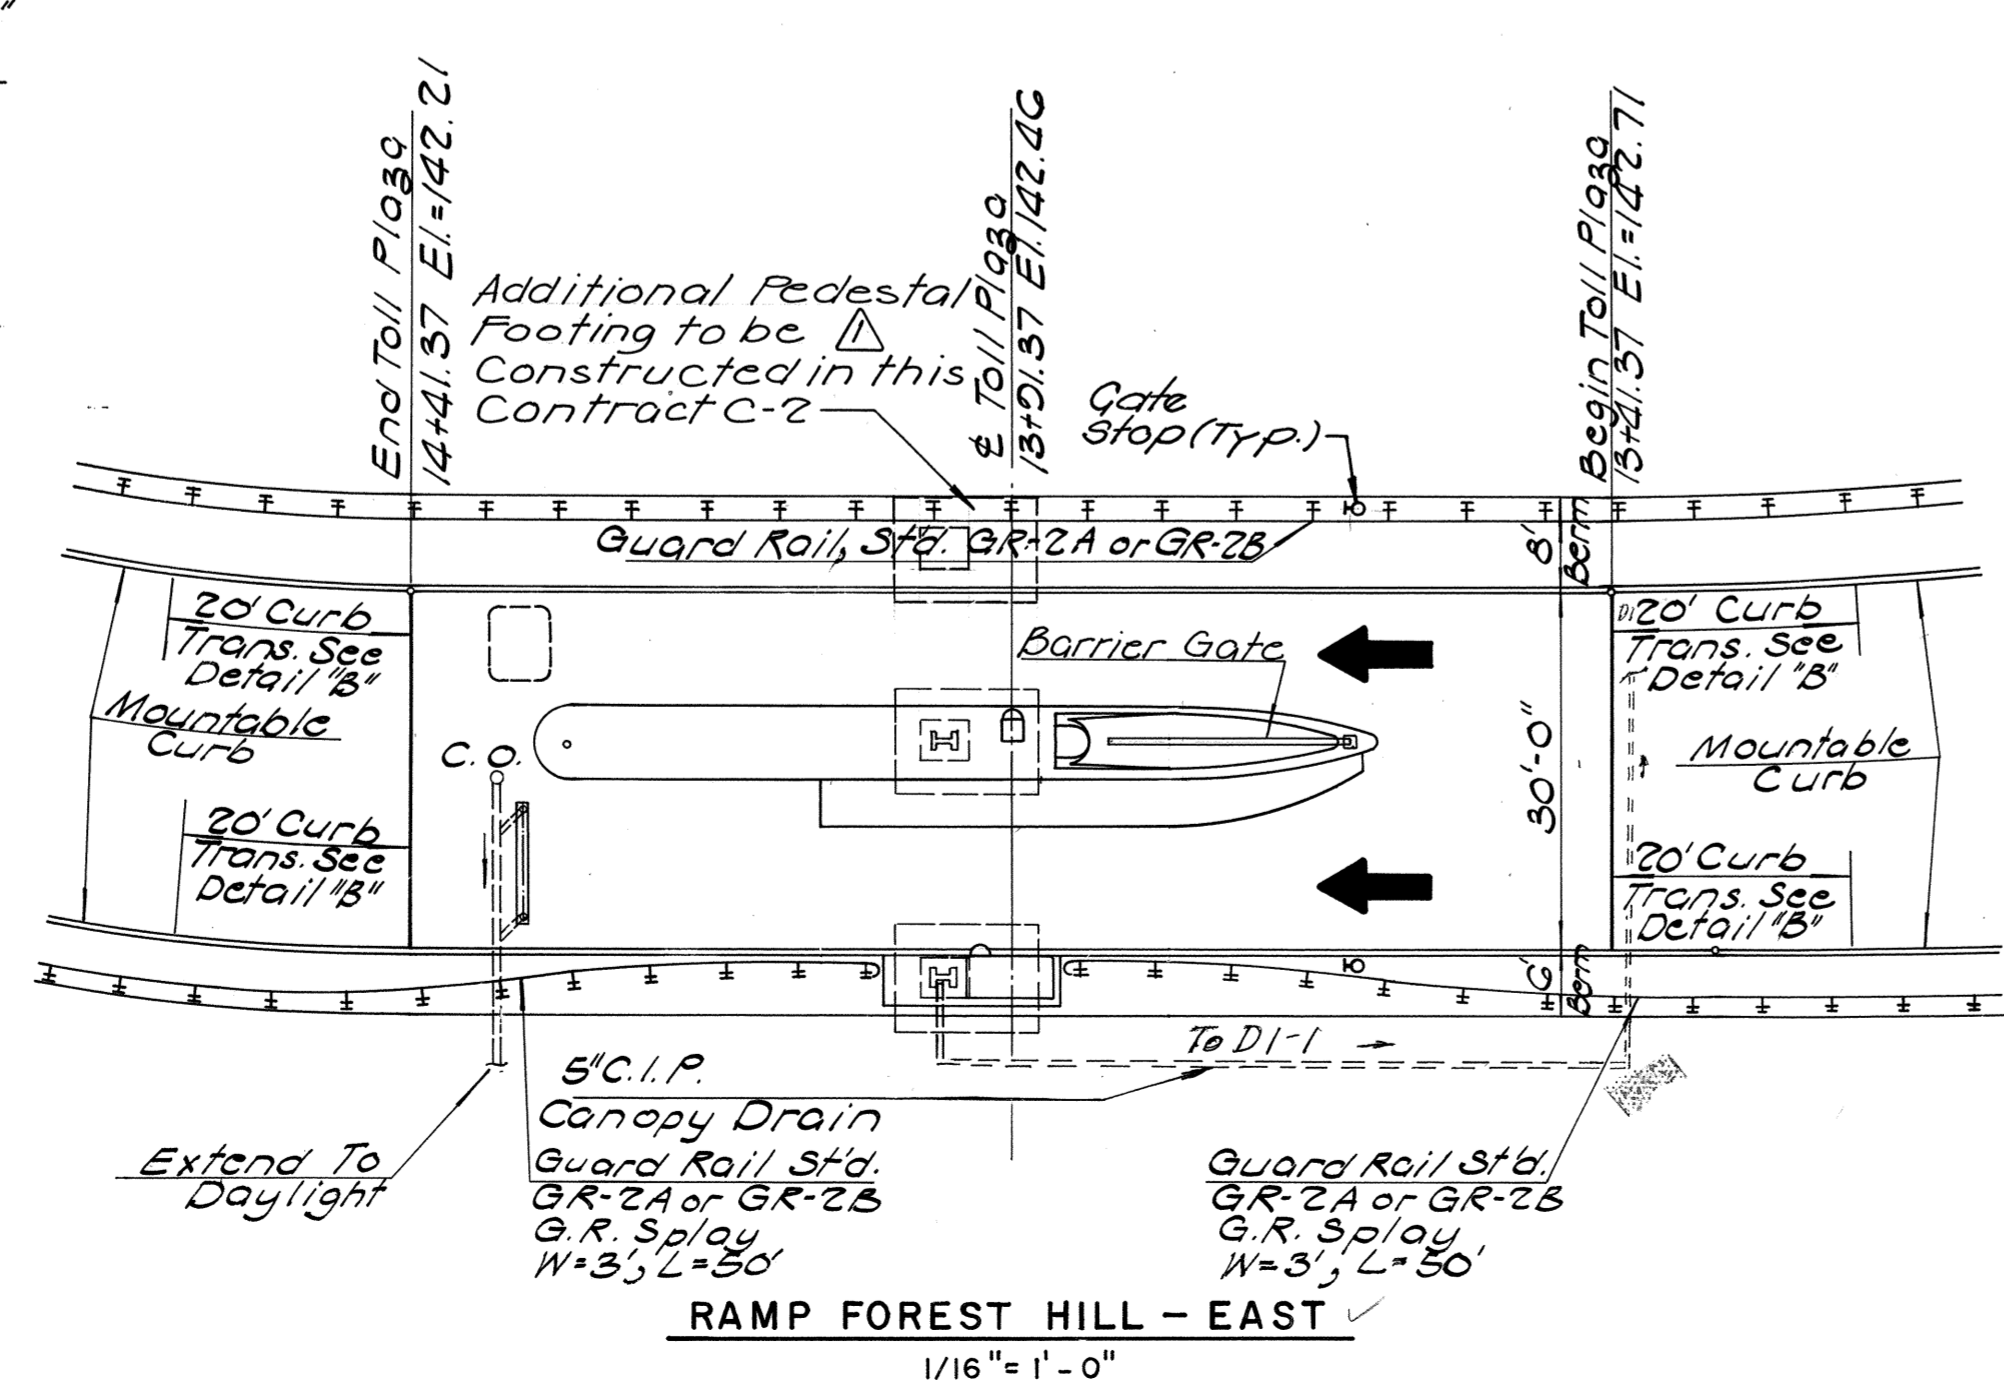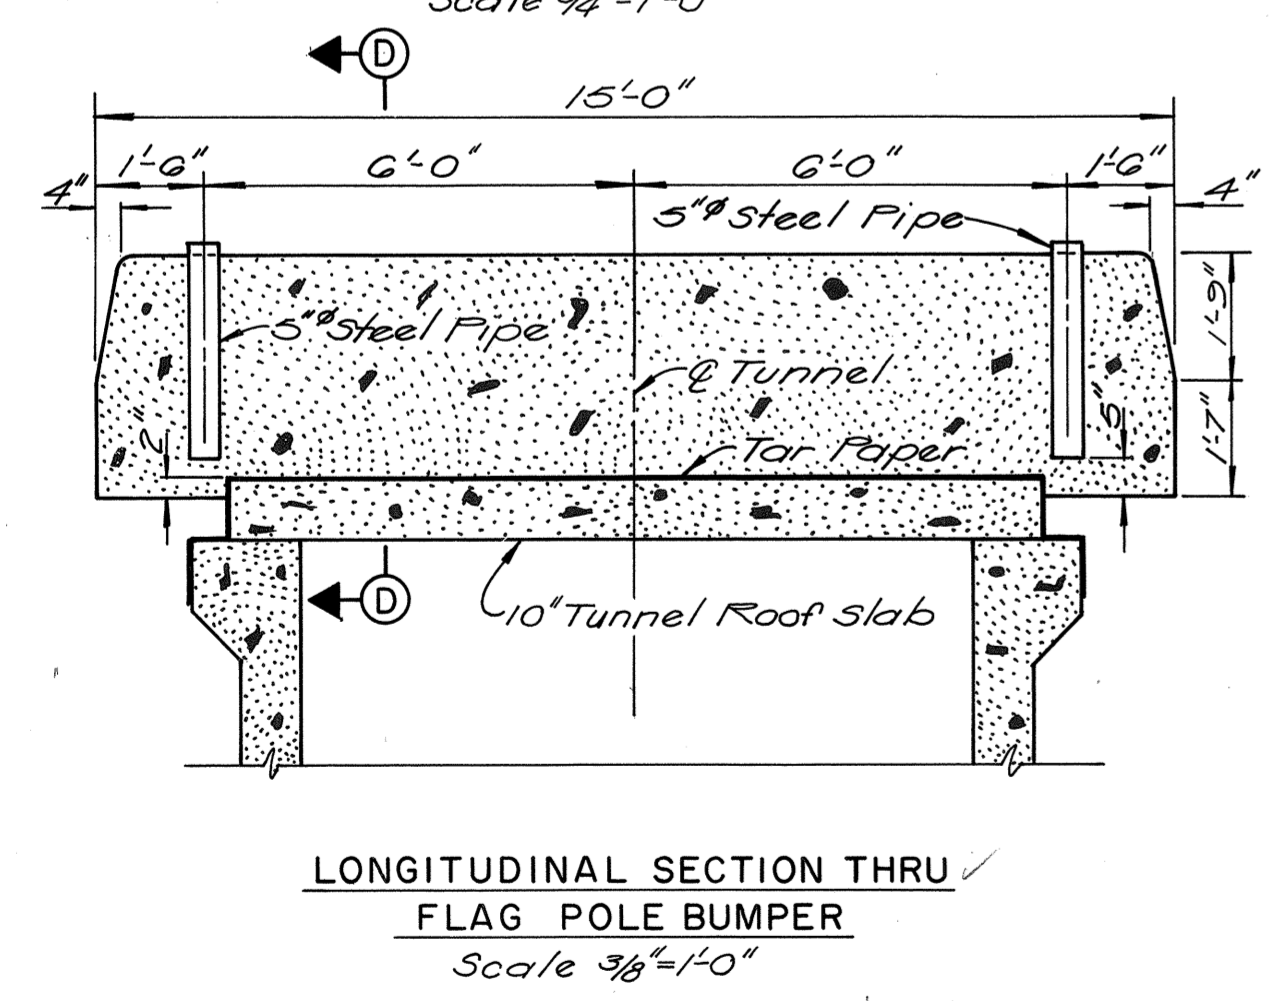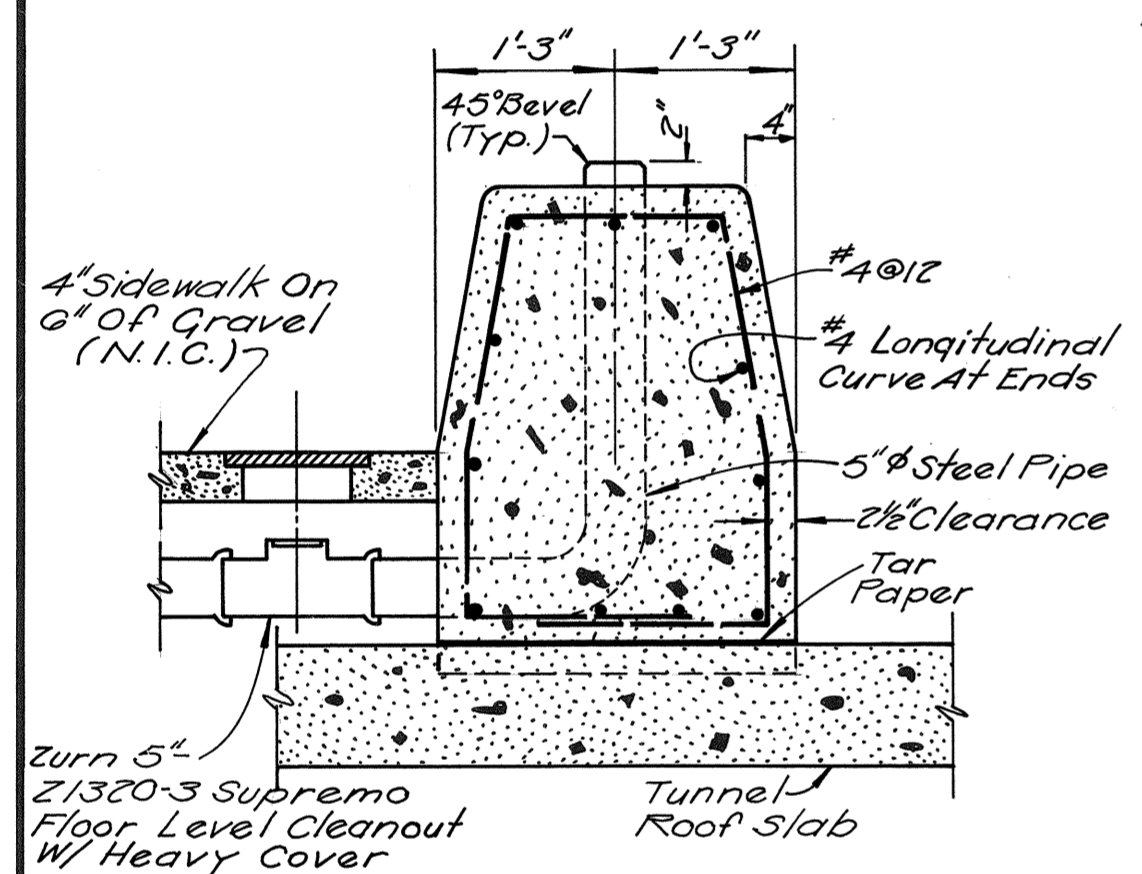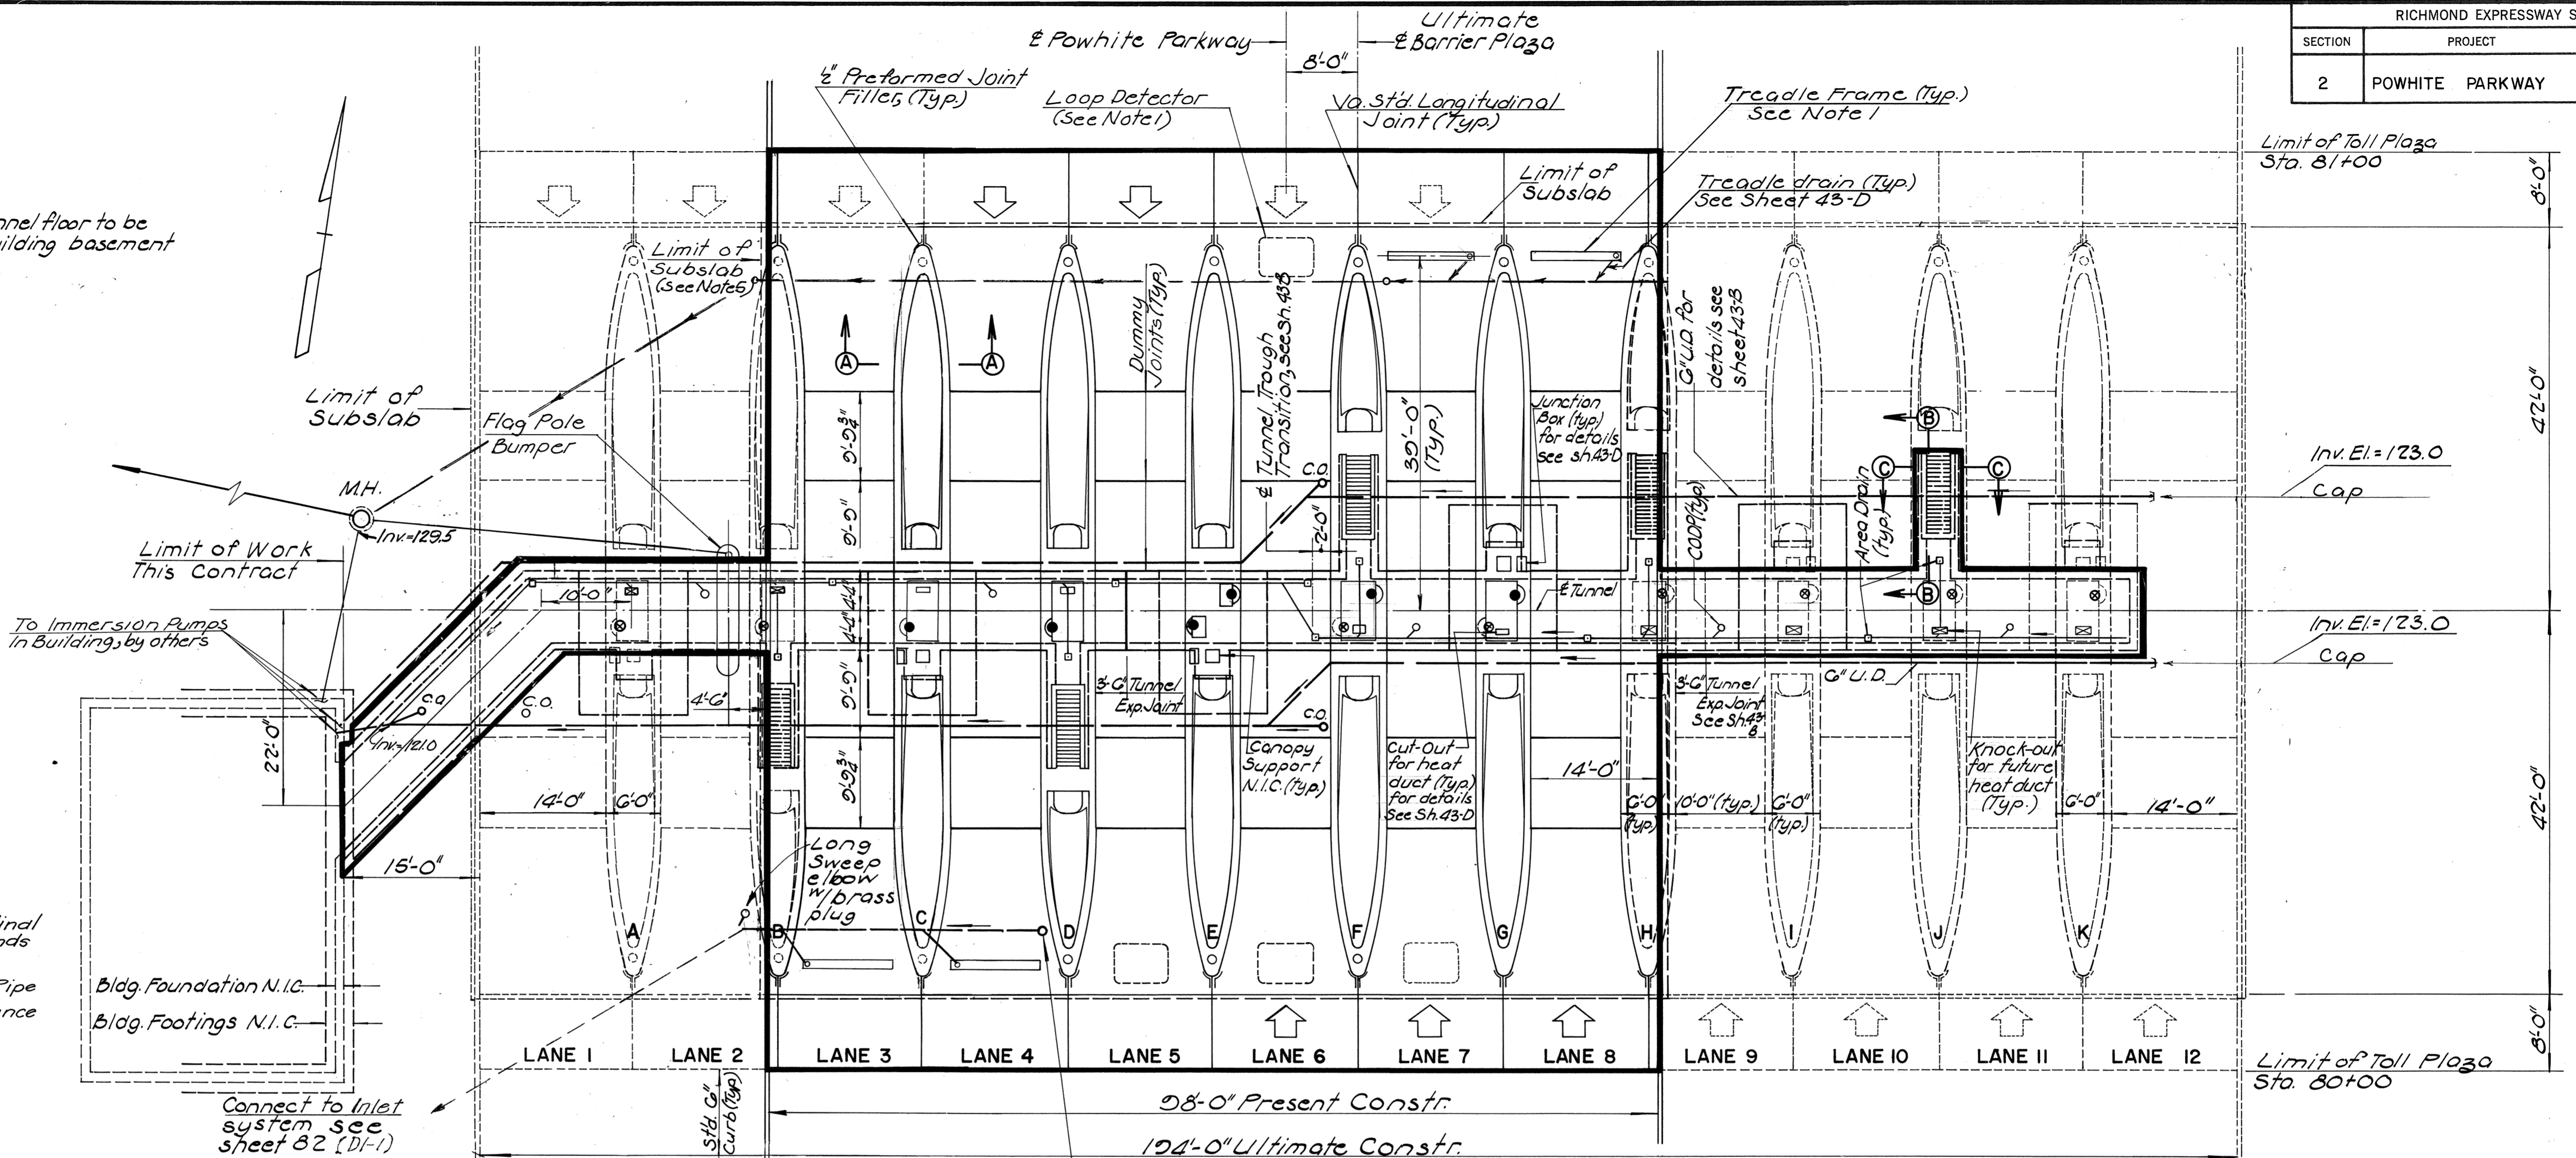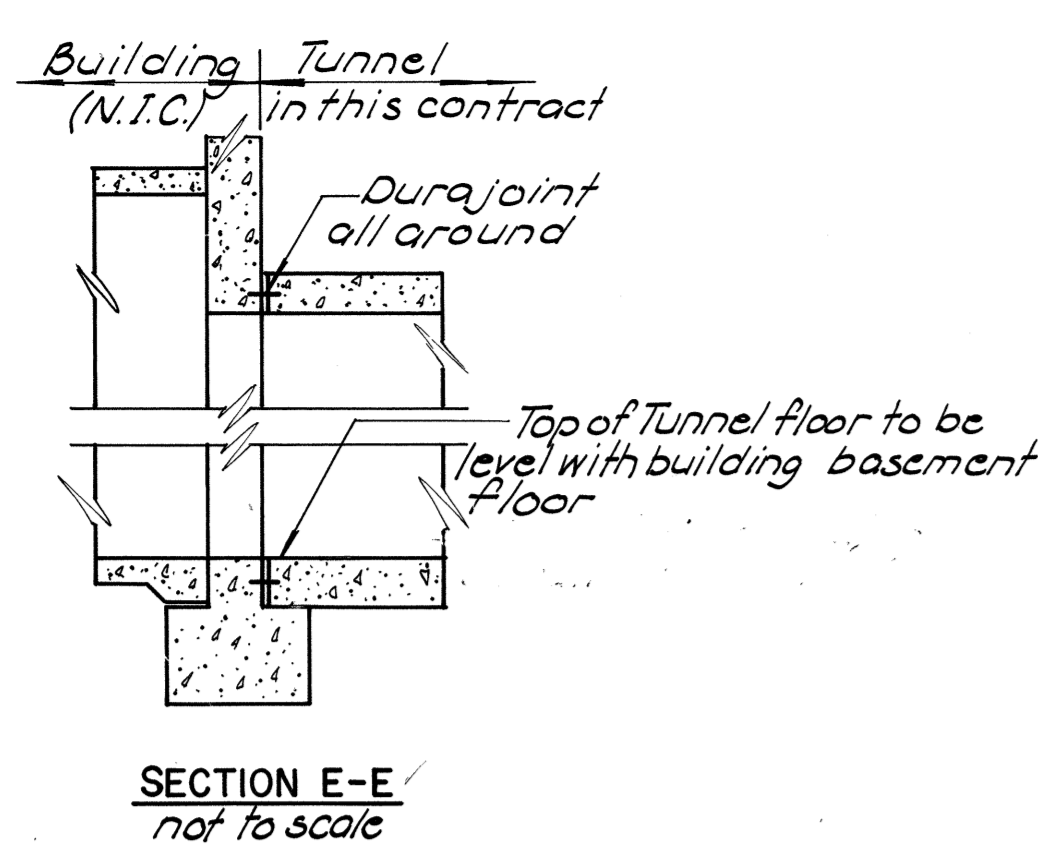

- NOTES:**
- 1) To be placed by Toll Equipment Contractor prior to the paving, under this Contract.
 - 2) Tunnel drainage trough to begin at the building foundation.
 - 3) C.O.D.P. = Clean out Drain Pipe.
 - 4) Sections A-A, B-B and C-C appear on sheet 42-B.
 - 5) Place #8 Longitudinal hook bolts for future widening.

- LEGEND:**
- Location of future traffic signal.
 - Traffic signal, (N.I.C.)
 - ⊞ Automatic Toll Machine, (N.I.C.)
 - ⊞ Future Automatic Toll Machine
 - ⊞ Toll Booth, (N.I.C.)
 - Prop. Coin Tubes
 - Future Coin Tubes

AS BUILT

RICHMOND METROPOLITAN AUTHORITY
RICHMOND EXPRESSWAY SYSTEM
POWHITE PARKWAY

MAINLINE & RAMP
TOLL PLAZA PLANS

MADE	BY	DATE	NO.	REVISION	BY	DATE
8/17/02	CP	8/17/02	2	As Built	JRC	6/73
	RWG			Rev per Addendum B Amendment A, Addendum C, Addendum D	PHI	2/22/01
	JPF					


HOWARD, NEEDLES, TAMMEN & BERGENDOFF consulting engineers
NEW YORK ALEXANDRIA KANSAS CITY
SCALE: As Noted
CONTRACT NO. C-2
SHEET NO. 43 OF 188

FOREST HILL AVENUE RAMPS

WIDENING OF RAMP FROM S.B. POWHITE PARKWAY TO FOREST HILL
AVENUE

ORIGINAL PLANS FOR CONSTRUCTION OF RAMP FROM E.B. FOREST
HILL AVENUE TO N.B. POWHITE PARKWAY




GEOMETRIC TABLE					
NO.	STATION	OFFSET	NO.	STATION	OFFSET
1	PC 95+94.13		13	PCC 13+38.87	30.01' Lt.
2	Nose 97+13.74	46.25' Rt.	14	PT 15+15.78	
3	PCC 98+79.09		15	POT 15+65.78	4.00' Lt.
4	PCC 98+27.43	38.25' Rt.	16	POT 16+65.78	4.00' Lt.
5	PCC 98+79.09	57.25' Rt.	17	PC 17+00.78	
6	P.I., N.C. 19+83.00	20.00' Lt.	18	PT 17+44.45	
7	PC 20+42.99	18.78' Lt.	19	PC 18+22.58	25.06' Lt.
8	Nose 20+83.01	19.34' Lt.	20	PCC 102+77.91	
9	PCC 21+52.34		21	103+97.88	59.12' Rt.
10	PC 11+95.07	40.40' Rt.	22	105+00.00	62.57' Rt.
11	PCC 12+52.95	22.00' Lt.	23	PT 105+62.94	
12	PCC 13+40.22				

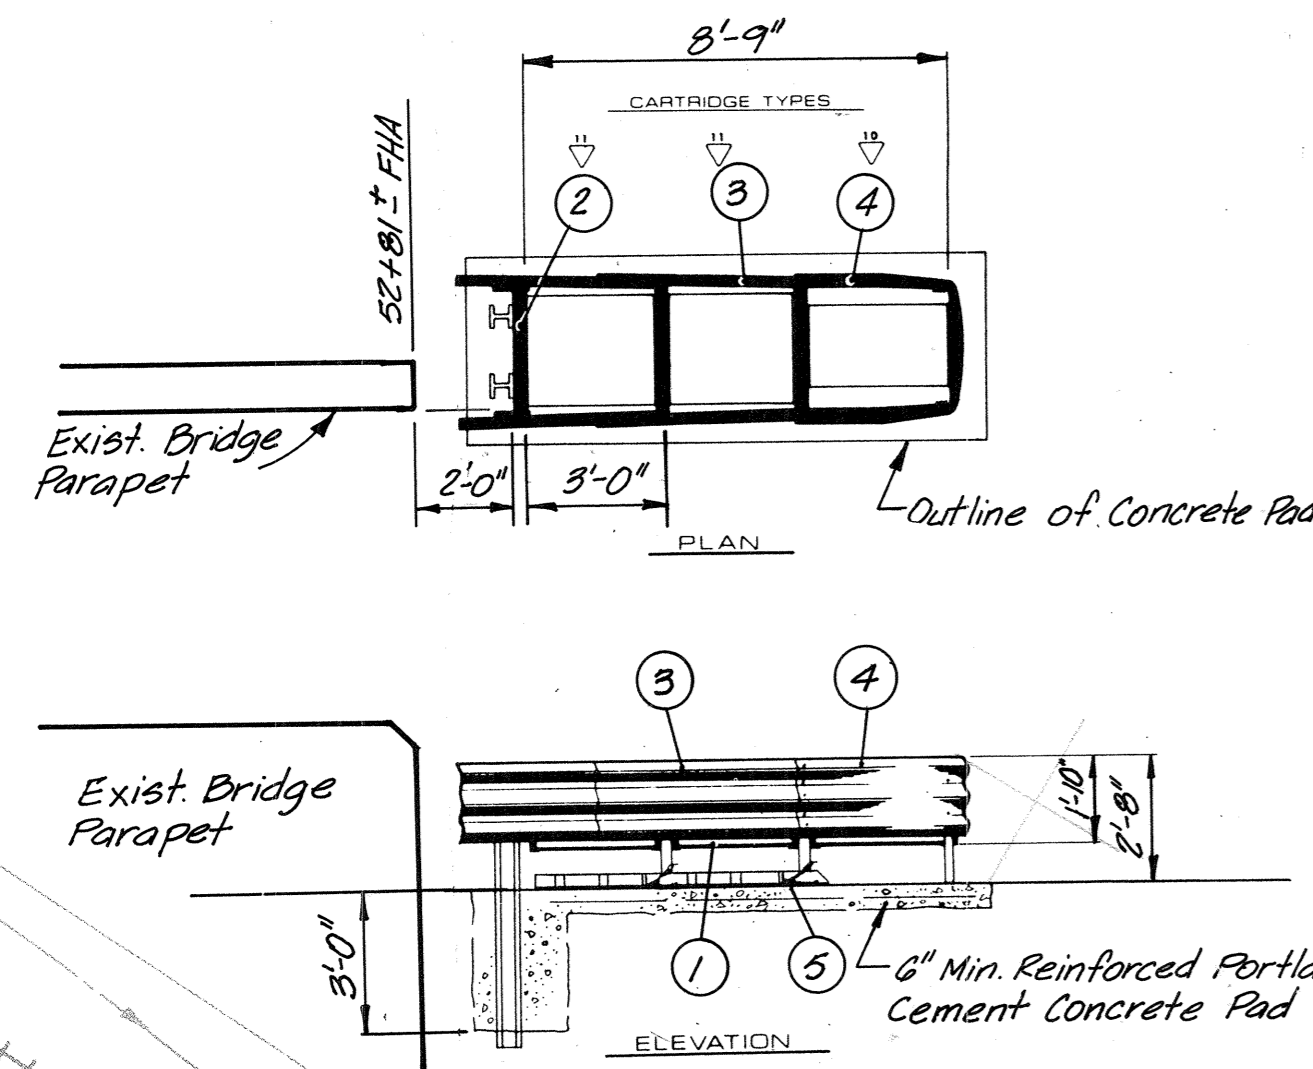

Energy Absorption System, Inc.
Model No. 20620652 Great or Equal

Legend:
 ① Hi-Dri Cartridge
 ② Diaphragm
 ③ Thrive Beam Fender Panel
 ④ Nose Cover
 ⑤ Stabilizing Chain

Cold Plane Existing Pavement
1/2" Avg. Depth, Taper From
0" to 1/2" Depth in 50' At
Each End.

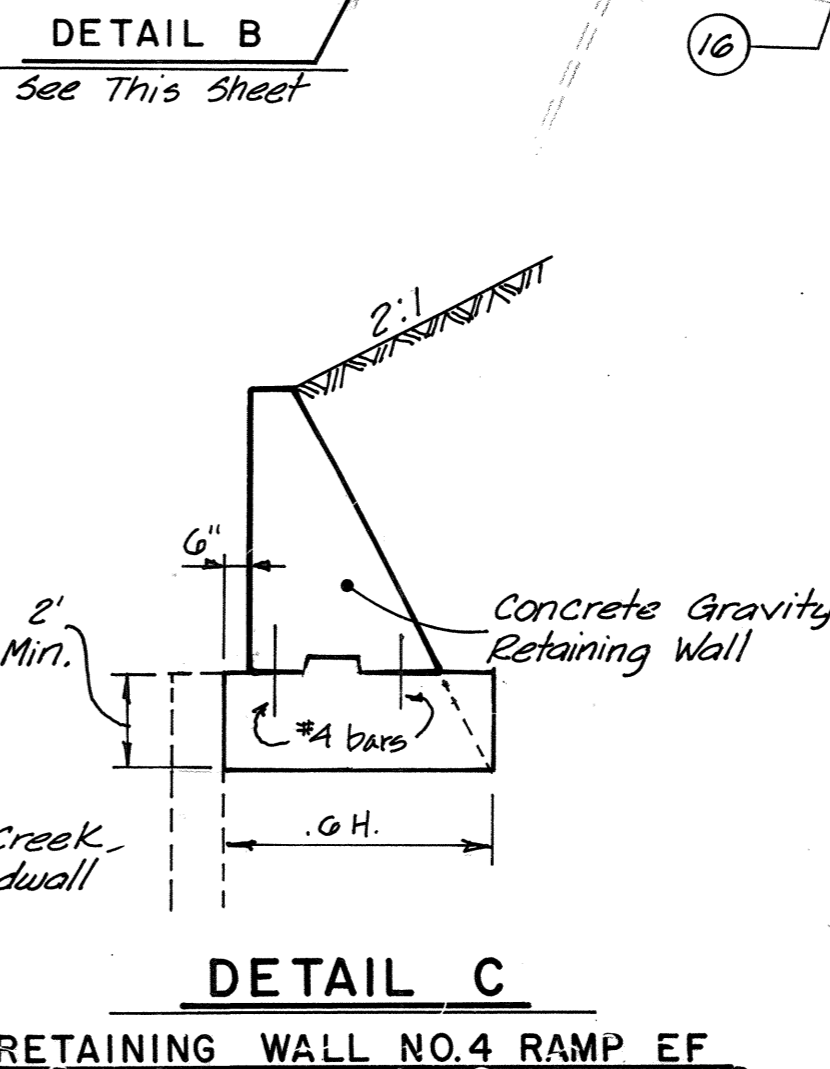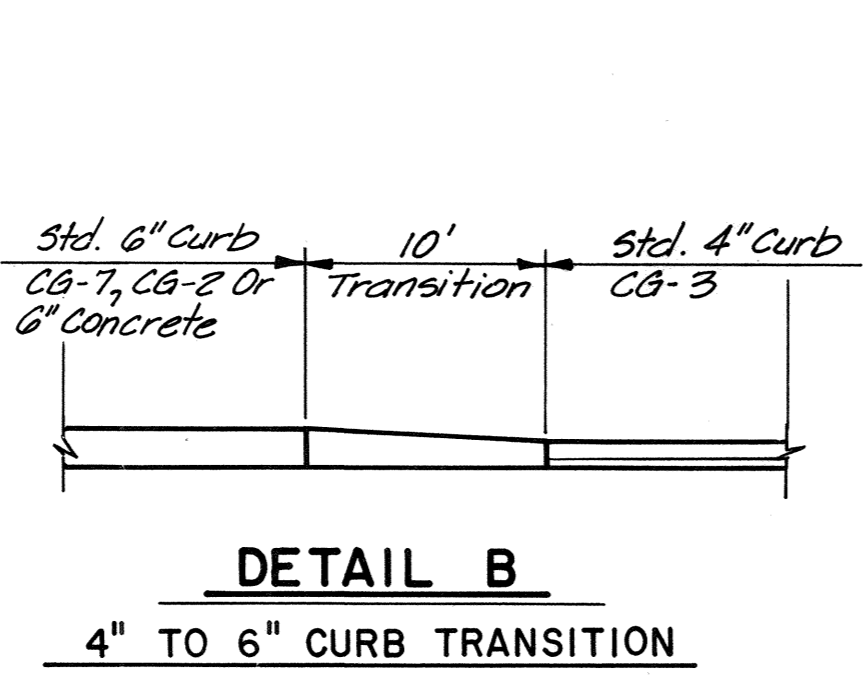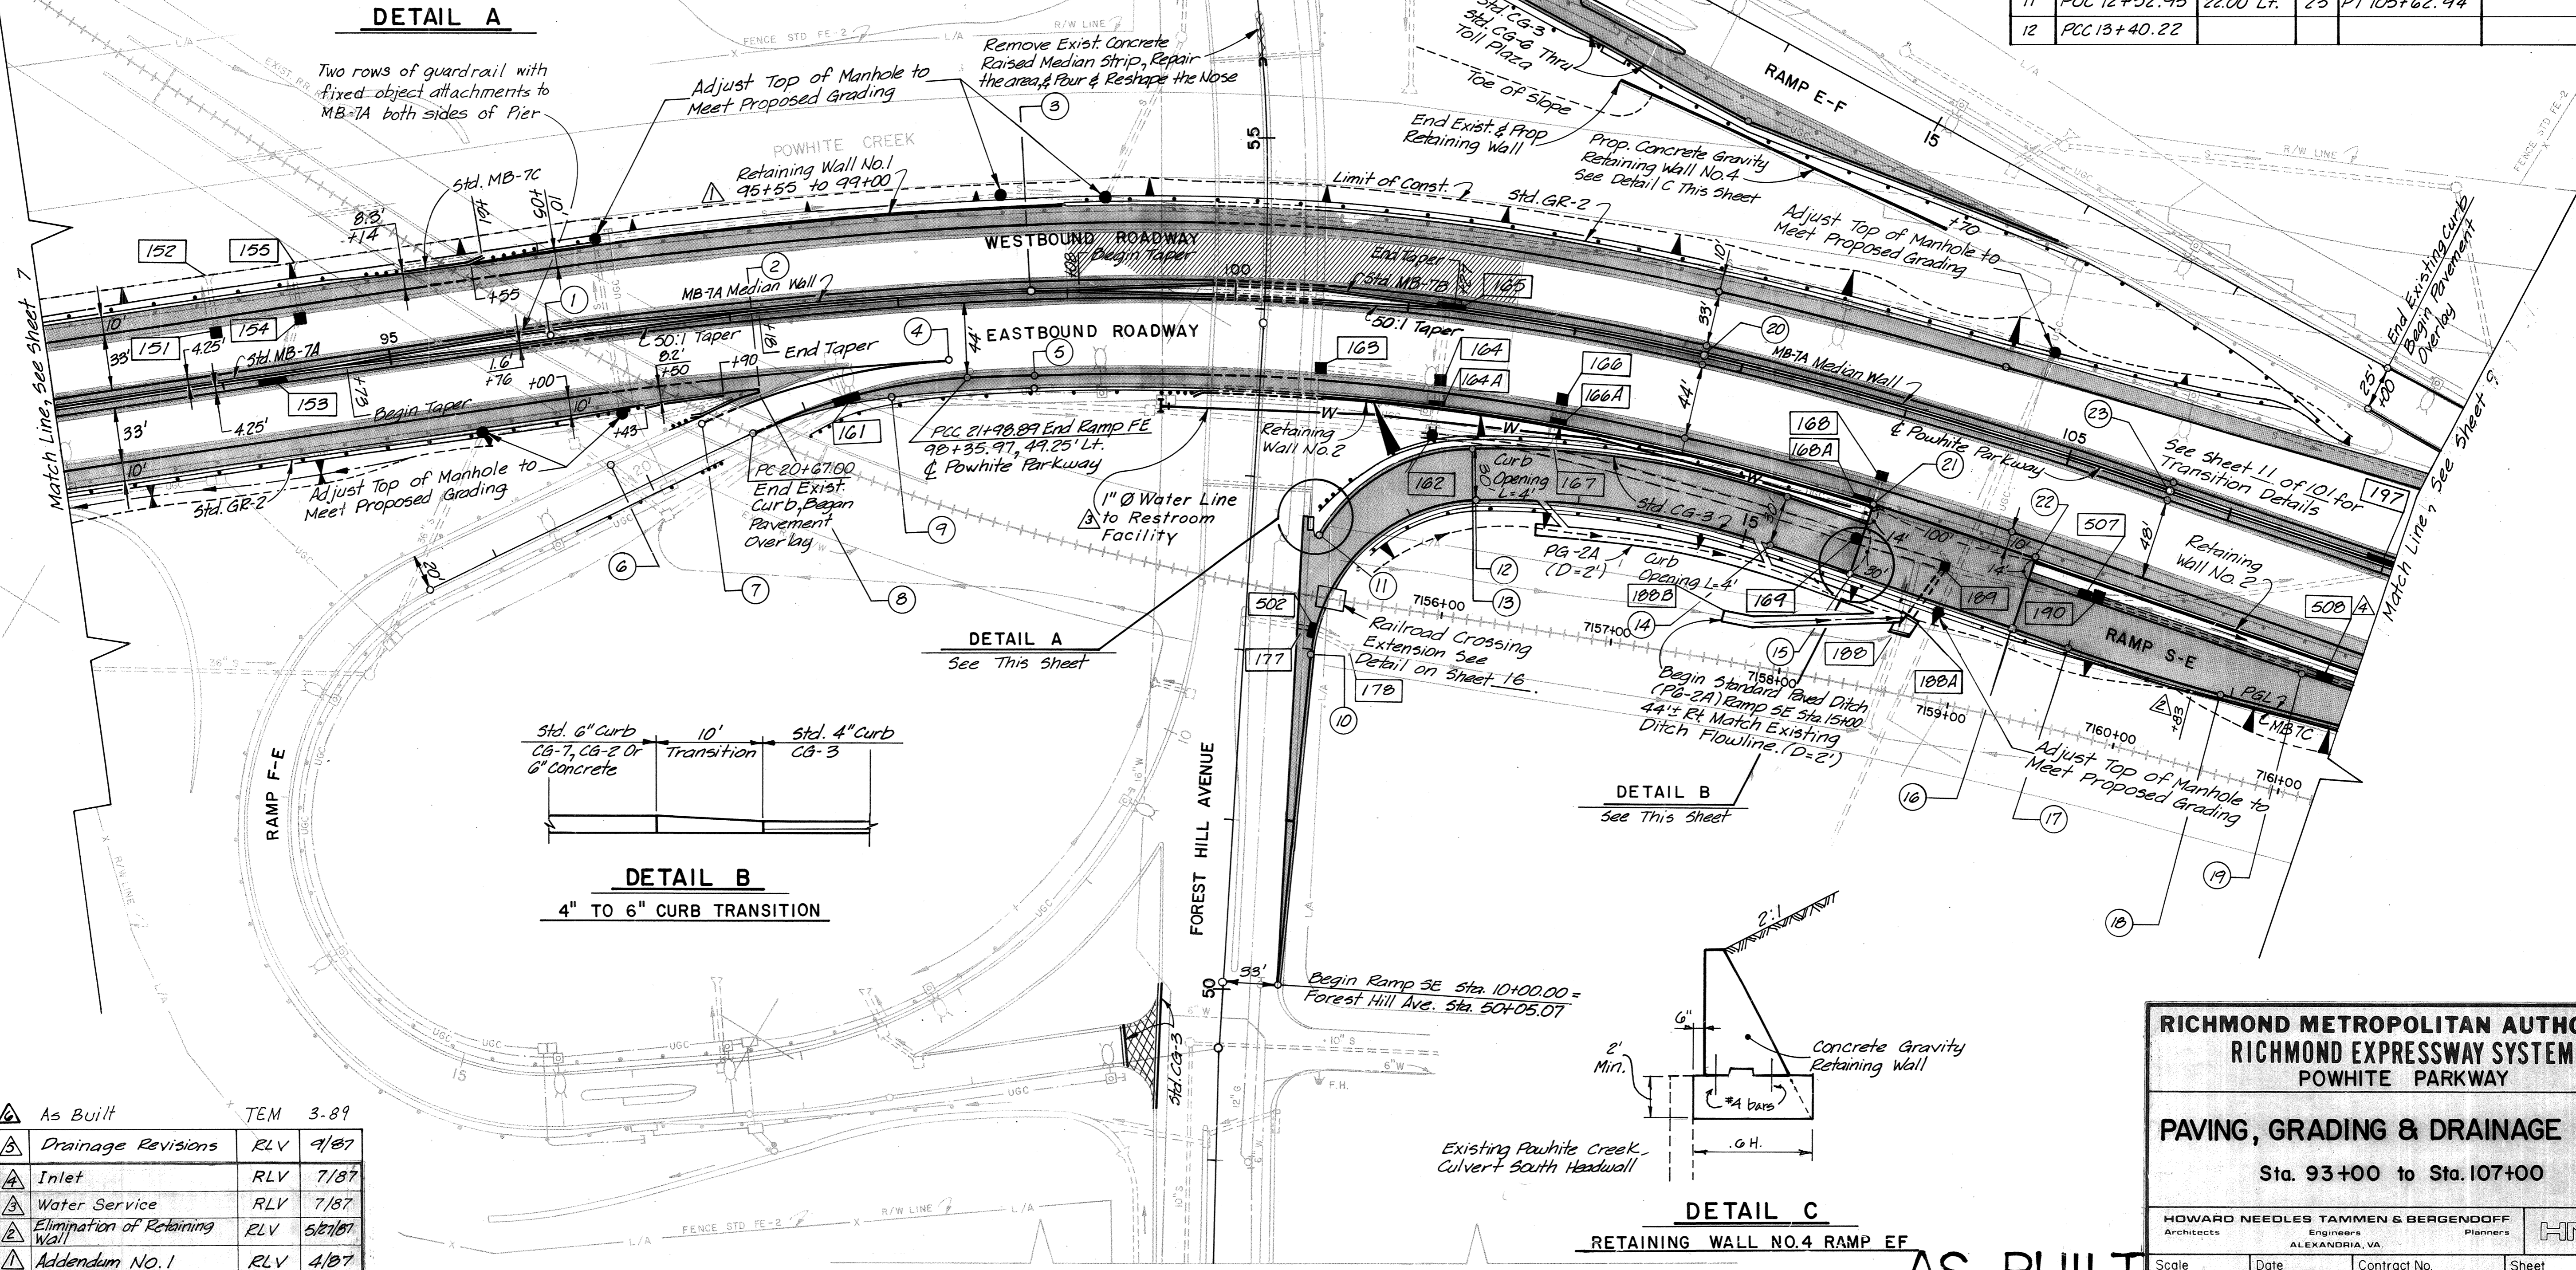

As Built	TEM	3-89
Drainage Revisions	RLV	4/87
Inlet	RLV	7/87
Water Service	RLV	7/87
Elimination of Retaining Wall	RLV	5/21/87
Addendum No. 1	RLV	4/87
Revision	By	Date
Designed	TJC	3/87
Drawn	JLT	3/87
Checked	RLV	3/87
Approved	DJA	3/87

RICHMOND METROPOLITAN AUTHORITY
RICHMOND EXPRESSWAY SYSTEM
POWHITE PARKWAY

PAVING, GRADING & DRAINAGE PLAN
 Sta. 93+00 to Sta. 107+00

HOWARD NEEDLES TAMMEN & BERGENDOFF
 Architects
 ALEXANDRIA, VA.

HNTB
 Planners

Scale: 1" = 50'
 Date: MARCH 1987
 Contract No.: C-12
 Sheet: 8 of