

**APPENDIX
PC-2018**

RECORD DRAWINGS


RM TA BRIDGES 63, 64, 65, 66, 67, 68

RMTA System Map

RICHMOND EXPRESSWAY SYSTEM

Scale: 0 1000 2000 3000ft.

63 - Bridge Numbers and RMTA Facilities Shown in Red

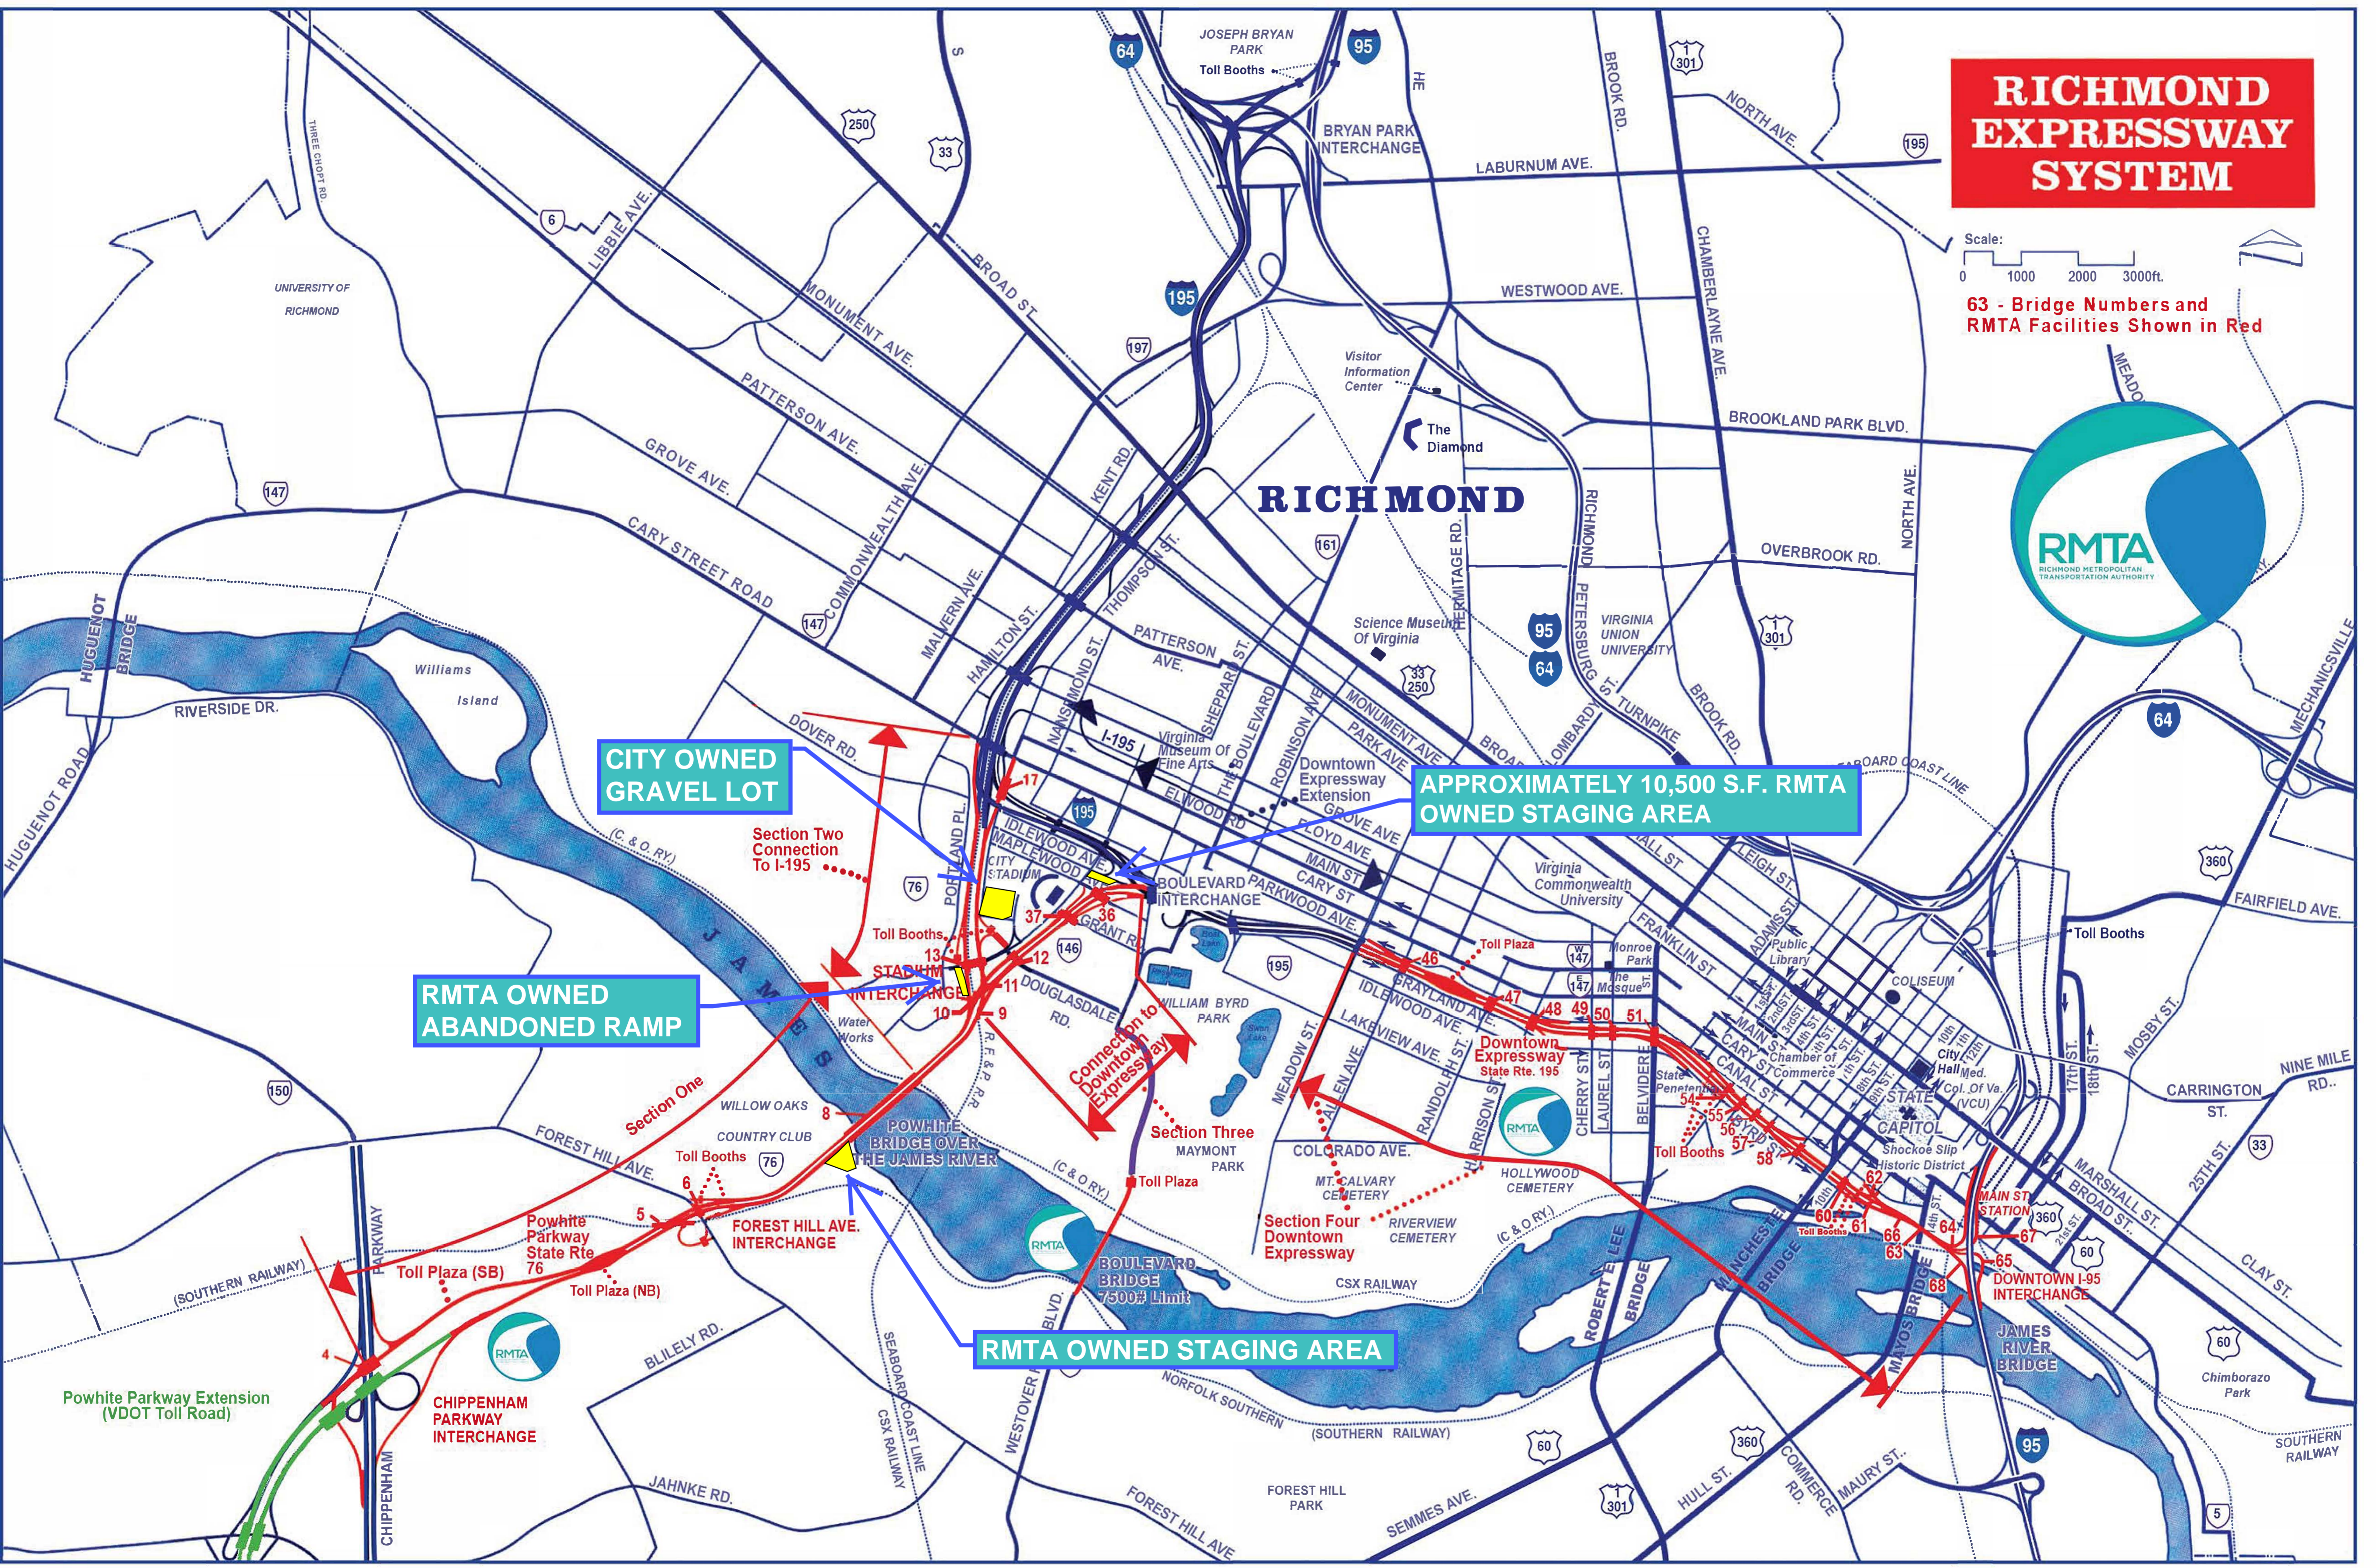



RICHMOND METROPOLITAN TRANSPORTATION
AUTHORITY

RICHMOND EXPRESSWAY SYSTEM
CONTRACT NO. PC – 2018
PROTECTIVE COATING OF STRUCTURES




Bridge 63

Downtown Expressway

12th St. - R.R. Tracks and 16th St.

RECORD SET PLANS (Next 25)

RICHMOND EXPRESSWAY SYSTEM			
SECTION	PROJECT	SHEET NO.	TOTAL SHEETS
10	DOWNTOWN EXPRESSWAY	70	265

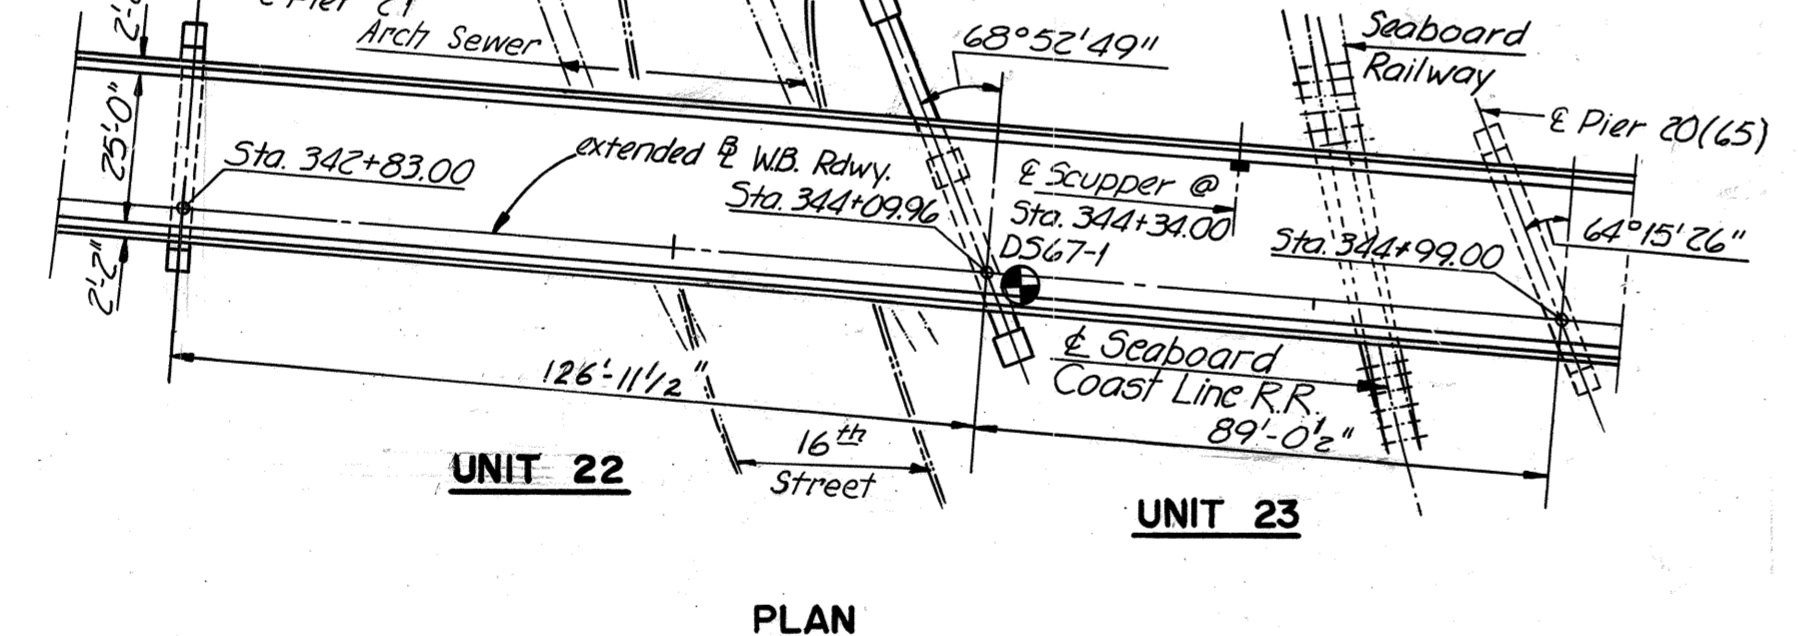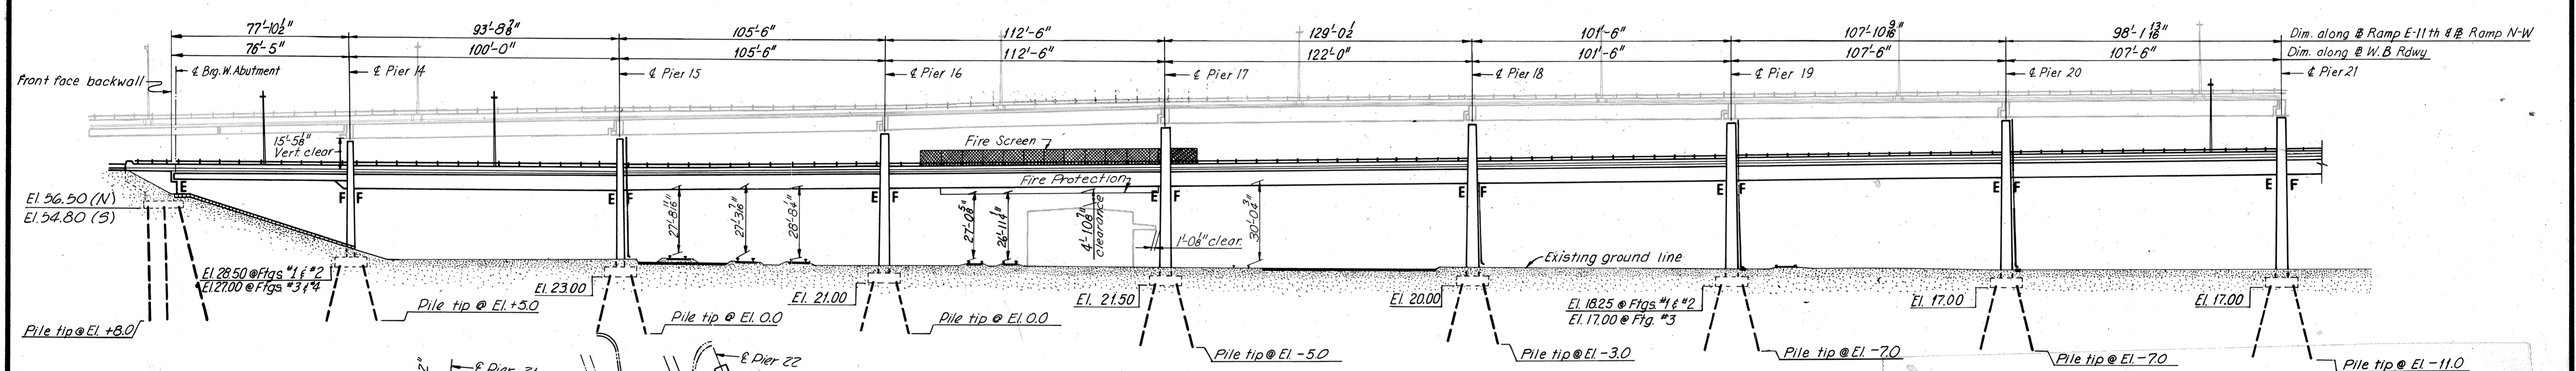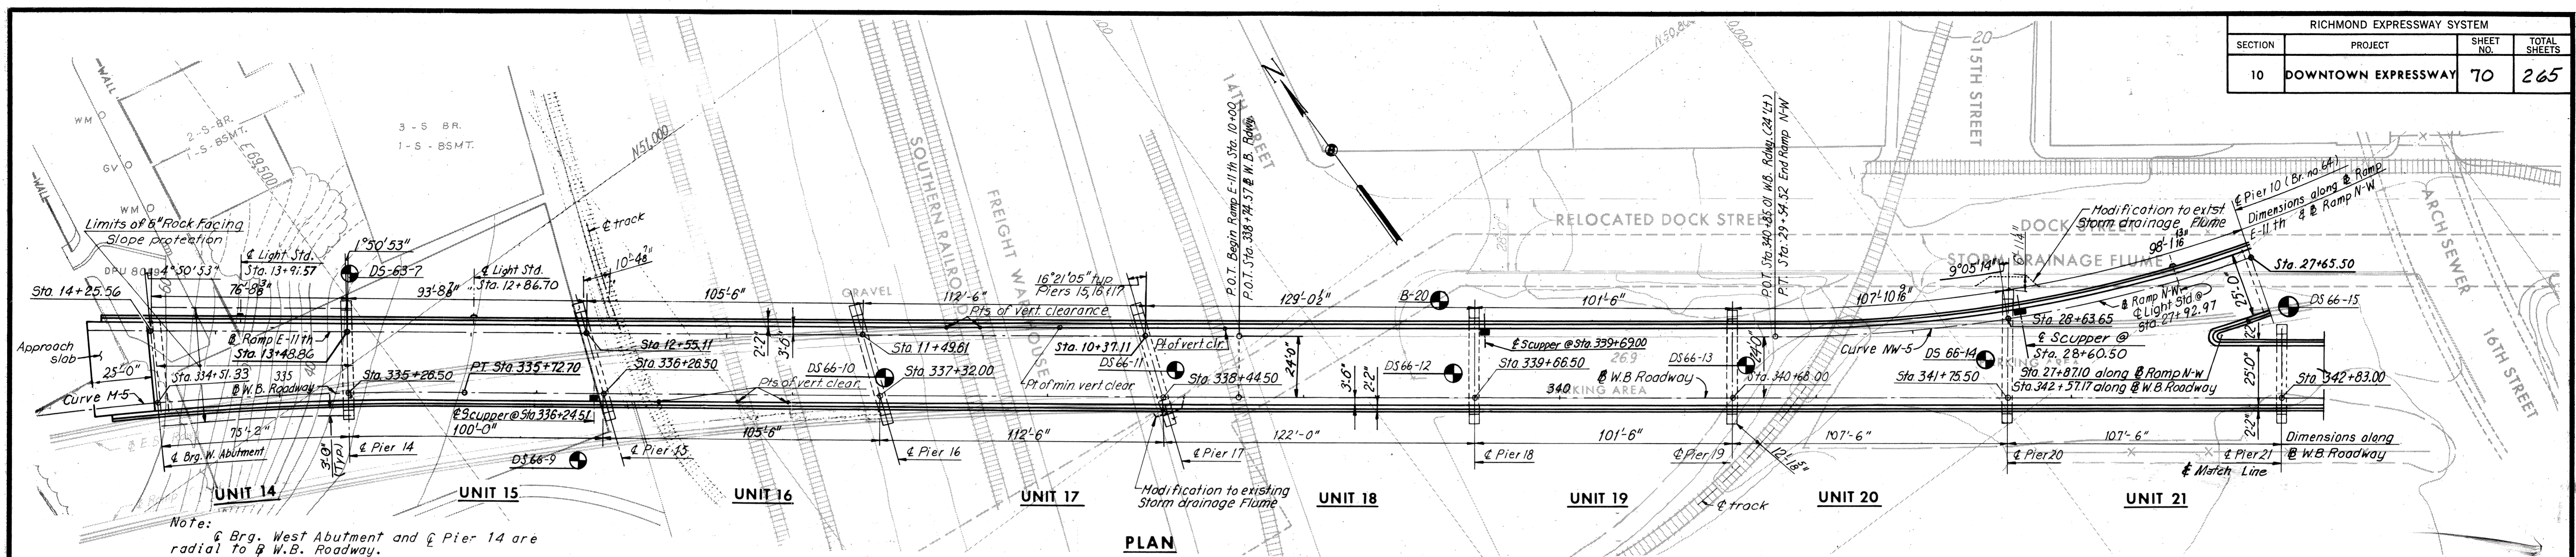


HORIZONTAL CURVE DATA

Curve	P.I.	Δ	D	T	L	R
W.B. Roadway						
Curve M-5	Sta. 334+26.15	11°45'56"	4°00'	147.59'	294.14'	1432.40'
Ramp N-W	Sta. 28+25.38	26°18'00"	10°00'	133.86'	263.00'	572.96'
Curve NW-5						

INDEX

GENERAL PLAN AND ELEVATION.	SHEET
QUANTITIES	1
WEST ABUTMENT	2
WEST ABUTMENT DETAILS	3
PIER 14	4
PIER 15	5
PIER 16	6
PIER 17	7
PIER 18 AND 19	8
PIER 20	9
PIER 21	10
PIER 22	11
FRAMING PLAN UNITS 14, 15 AND 16	12
FRAMING PLAN UNITS 17 AND 18	13
FRAMING PLAN UNITS 19, 20 AND 21	14
FRAMING DETAILS UNITS 20 AND 21	15
FRAMING PLAN UNITS 22 AND 23	16
DECK PLAN UNITS 14, 15 AND 16	17
DECK PLAN UNITS 17, 18 AND 19	18
DECK PLAN UNITS 19, 20 AND 21	19
DECK PLAN UNITS 22 AND 23	20
STRUCTURE DETAILS	21
FIRE PROTECTION DETAILS	22
JOINT DETAILS	23
APPROACH SLAB AND SLOPE PROTECTION DETAILS	24
BORING LOGS	25
STANDARD SHEETS	26 THRU 29

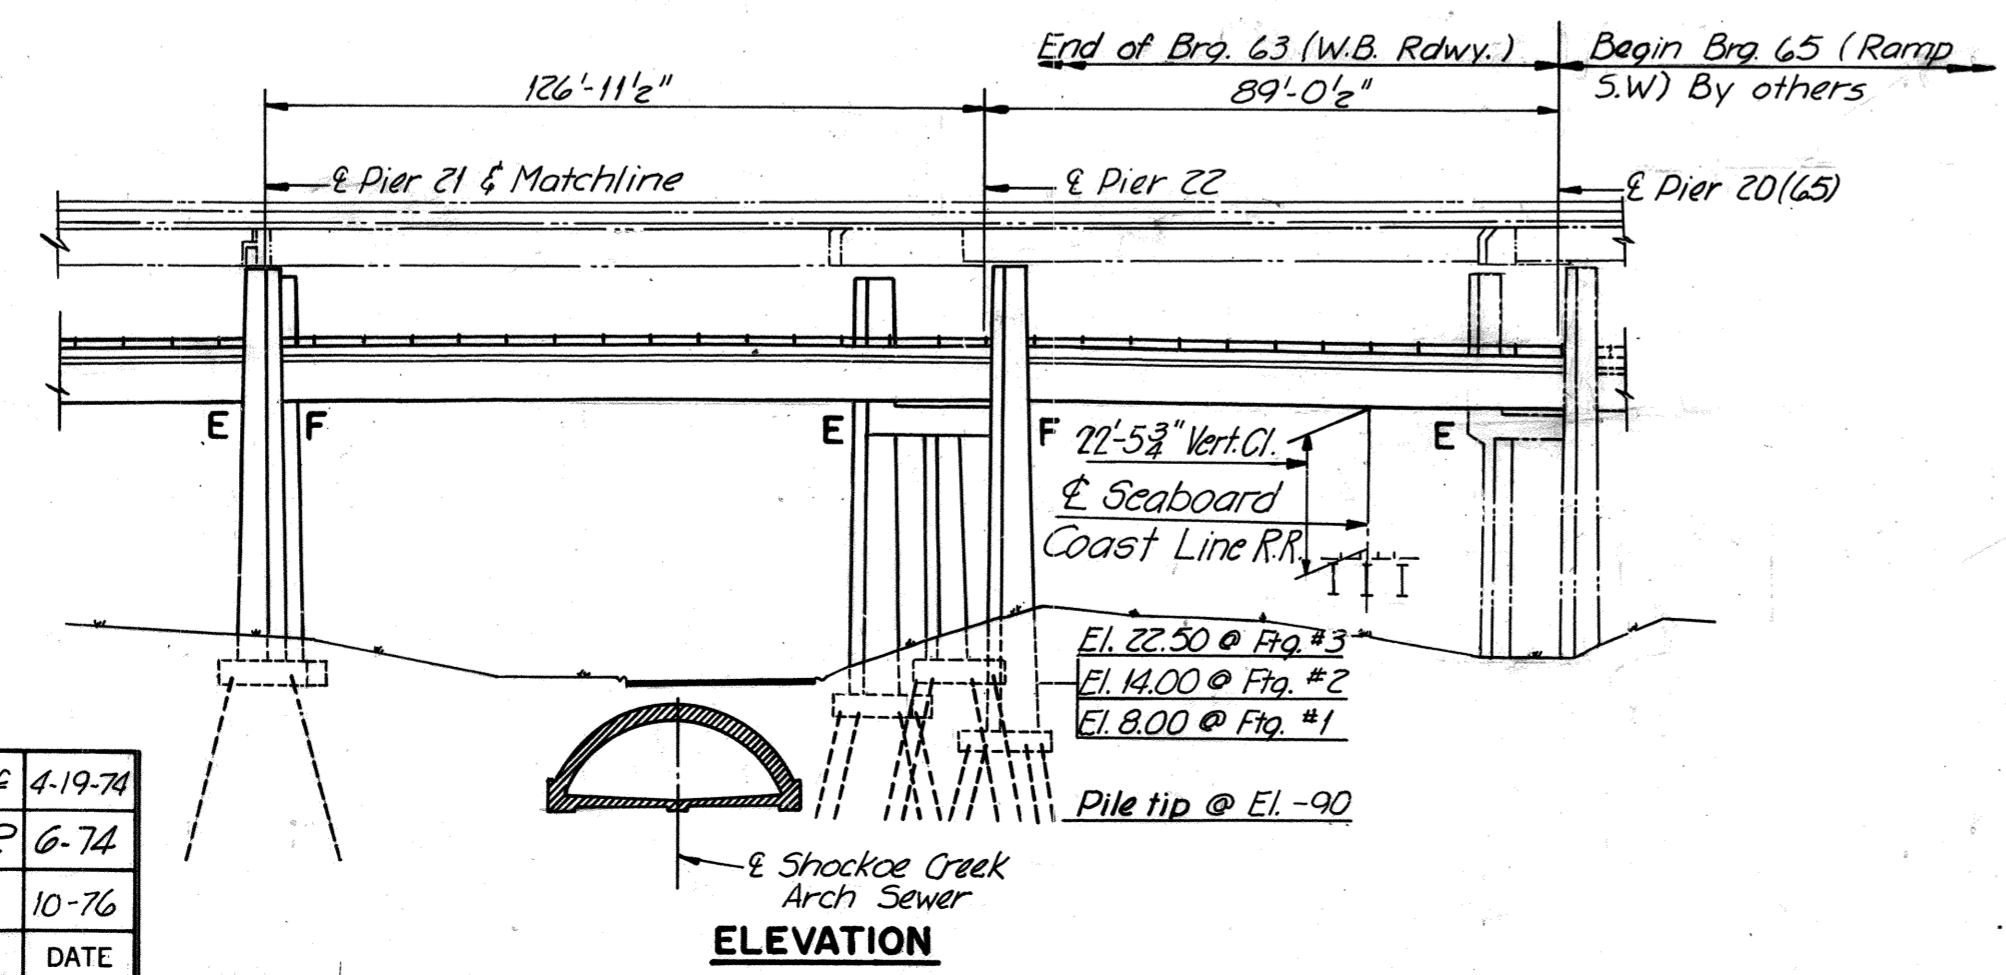

Notes:

- For Estimated quantities and General Notes see Sheet 2.
- For Boring Logs see Sheets 26 Thru 29.
- For Layout of Pier 10(64) see Bridge No. 64 (Ramp N-W) Sheet 3.
- ⊙ Indicates boring location.
- Footings numbers (1,2, etc.) on each pier go from North to South.
- For Profile Grade Data see Sheet 2.

BY	DATE	Joint Type & Rail-Road Name Added	PRMS	4-19-74
MADE	Y.C.P.	1-9-69	K.D.P.	6-74
CHECKED	J.D.	3-13-69	TEM	10-76
IN CHARGE	FKD			

RICHMOND METROPOLITAN AUTHORITY
RICHMOND EXPRESSWAY SYSTEM
DOWNTOWN EXPRESSWAY

BRIDGE NO. 63
WESTBOUND ROADWAY OVER
12TH ST. - R.R. TRACKS AND 16TH ST.
GENERAL PLAN AND ELEVATION

HOWARD, NEEDLES, TAMMEN & BERGENDOFF
 consulting engineers
 NEW YORK ALEXANDRIA KANSAS CITY

SCALE: 1" = 30'
 CONTRACT NO.: 10
 SHEET NO. 1 OF 29

AS BUILT


RICHMOND EXPRESSWAY SYSTEM			
SECTION	PROJECT	SHEET NO.	TOTAL SHEETS
10	DOWNTOWN EXPRESSWAY	71	265

ESTIMATED QUANTITIES


	Structure Excavation Cu. Yds.	Concrete (†) Cu. Yds.	Reinforcing Steel Lbs.	Str. Steel Mild Carbon Lbs.	Str. Steel High Strength Lbs.	Aluminum Railing (1-Rail) Lin. Ft.	Porous Backfill Cu. Yds.	Underdrain 6" Dia. Pipe Lin. Ft.	Steel Piles 106P42 Lin. Ft.	Asphalt Damp proofing Sq. Yds.
Superstructure	---	1,246.9	277,890	964,800	349,300	2,157	---	---	---	---
Substructure	2,043	1,881.7	351,080	---	---	---	8	54	9,630	27
Total	2,043	3,128.6†	628,970	964,800	349,300	2,157	8	54	9,630	27

	Approach Slab Concrete (‡) Cu. Yds.	Fire Protection Insulation Lump Sum	Fire Screen Lin. Ft.	Approach Slab Reinforcing Steel Lbs.	Metal Conduit Lin. Ft.		Bridge Drainage Metal Work Lbs.	Rock Facing Slope Prot. Sq. Yds.	Modifications To Storm Drain. Flume Cu. Yds.
Superstructure	---	1	209	---	464		9,210	---	---
Substructure	51.8	-	---	11,120	---		---	352	123
Total	51.8 ‡	1	209	11,120	464		9,210	352	123

† All Concrete for Superstructure shall be Class A4 and for Substructure Class A3.

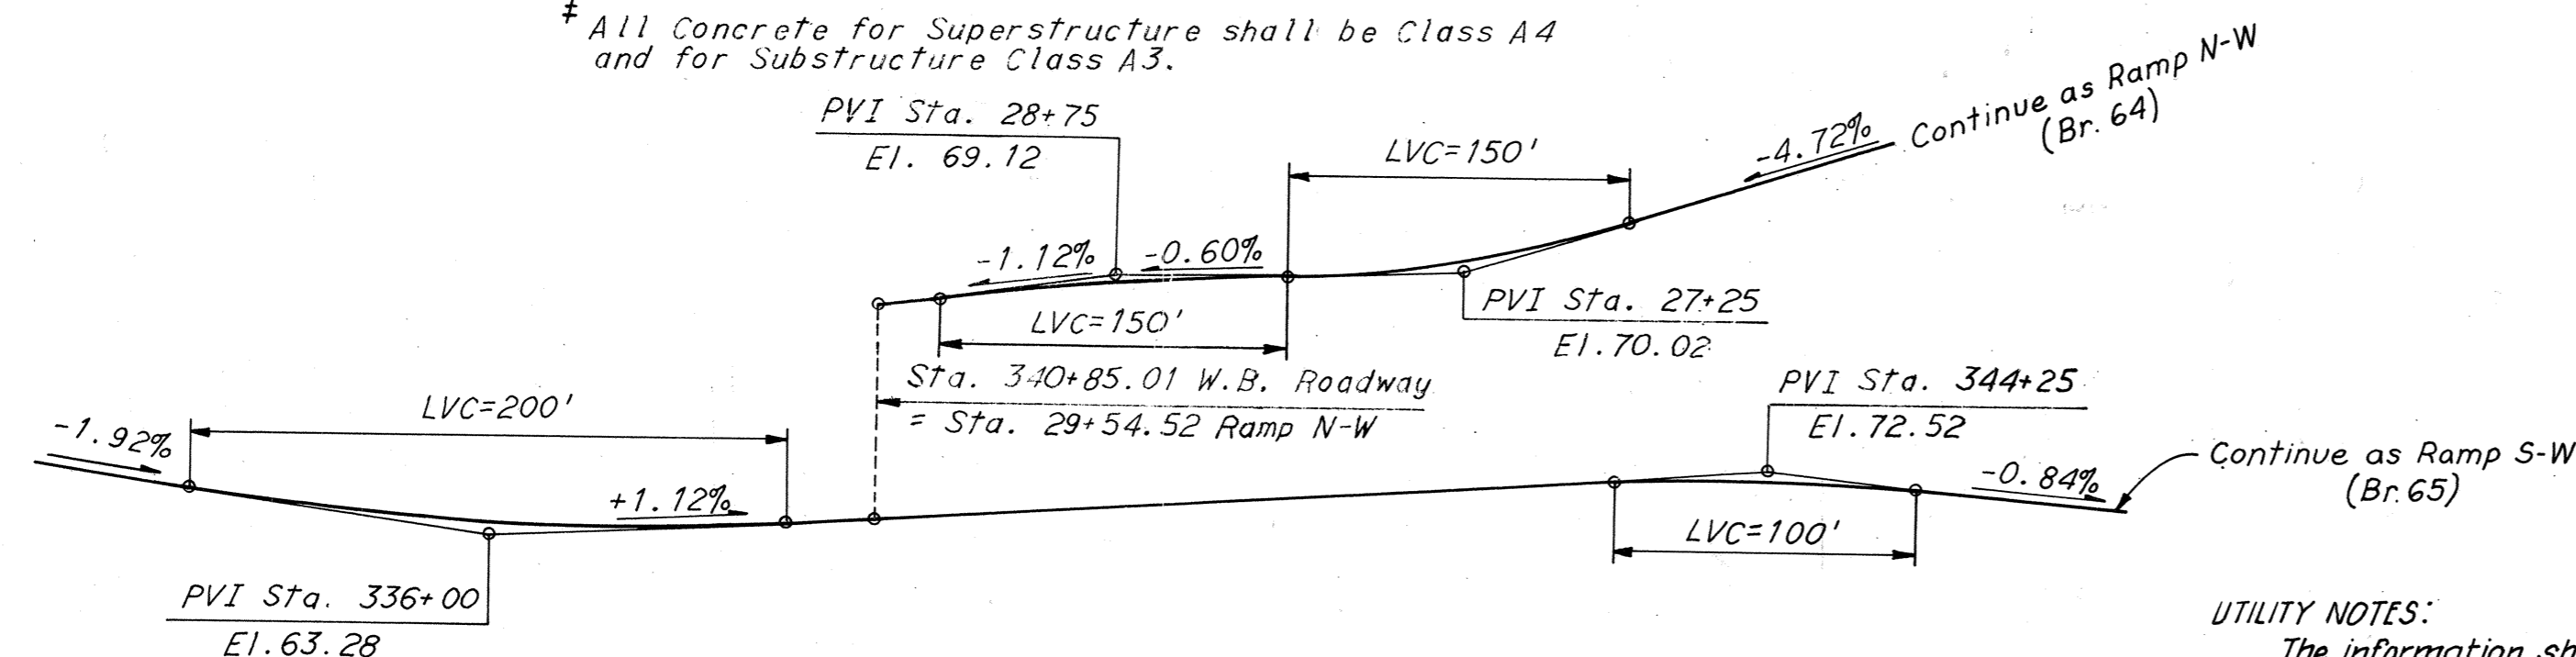

**W.B. ROADWAY, RAMPS N-W AND S-W
PROFILE GRADE DATA**

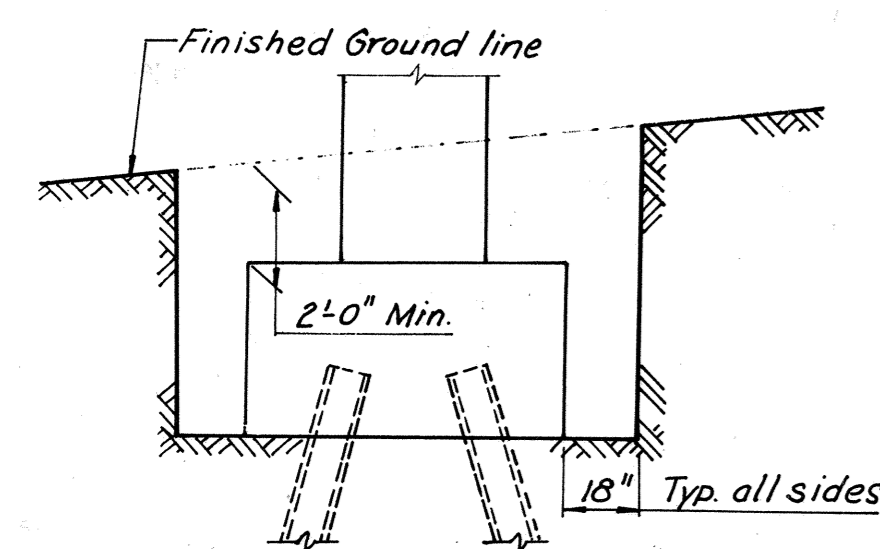

LIMITS OF STRUCTURE EXCAVATION

GENERAL NOTES:

- Roadway:** One variable width roadway transitioning from Ramps N-W and S-W (Bridges No. 64 and 65) into W.B. Roadway and Ramp E-11th.
- Capacity:** Dead load includes 15 lbs. per sq. ft. for future wearing surface. Live load HS 20-44 loading and alternate military loading.
- Specifications:** GENERAL: Virginia Department of Highway Road and Bridge Specifications 1970.
DESIGN: A.A.S.H.O. Standard Specifications for Highway Bridges 1973, modified by Special Design provisions.
WELDING: 1972 Structural Welding Code of the American Welding Society

CONTRACT SPECIAL PROVISIONS
Specifications and Contract Special Provisions referred to above are necessary to make these plans complete.

- Datum:** City of Richmond
- Temperature:** The normal temperature referred to in the plans is 60° F. The temperature range for movement is 0° F to 120° F.
- Dimensions:** All dimensions are measured horizontally and vertically unless otherwise noted.
- Excavation:** Excavation below subgrade and cut slope template shall be classified as Structure Excavation. All excavation above these limits shall be classified as Regular Excavation and is not included in the Structural Quantities.
- Foundations:** Footings shall rest on firm material. Foundation material shall be dry and special attention is called to Section 401.05 of General Specifications and to the Contract Special Provisions, concerning preparation of foundations for footings.

Concrete Notes: Concrete in superstructure shall be Class A-4. All other concrete shall be Class A-3. All exposed edges and corners shall have a 1/4" chamfer or fillet unless otherwise noted. Care in the method of vibration, the use of low-slump concrete, and/or other means shall be employed to prevent downward movement of newly placed slab concrete. Finishing concrete surfaces: See Standard Architectural Detail Sheets and the Contract Special Provisions for types and details. All reinforcing bar dimensions on the detailed drawings are to centers of bars unless otherwise noted. Clear distance between reinforcing steel and face of concrete shall be as noted on the plans. All bar laps shall be 30 diameters of the smaller diameter bar unless otherwise noted. All reinforcing steel shall be deformed bars conforming to ASTM Designation A615 Grade 40.

Steel Notes: Structural steel shall conform to A.S.T.M. Designations A36, A572 - Grade 50 and A588 a noted. See Special Provisions. All field connections shall be made with high strength bolts. High strength bolts shall be 7/8" diameter unless otherwise noted and shall conform to A.S.T.M. Specification A-325.

UTILITY NOTES:

The information shown on these drawings concerning type and location of underground utilities is not guaranteed to be accurate or all inclusive. The Contractor is responsible for making his own determinations as to the type and location of underground utilities as may be necessary to avoid damage thereto.

SUBSURFACE NOTES:

The subsurface information shown on these drawings was obtained solely for use in establishing design controls for the project. The accuracy of this information is restricted solely to that noted at the actual boring locations. Any projection of this subsurface data either between borings or beyond the limit of the borings is purely interpretive and should not be construed as that representing the actual conditions to be encountered during construction.

BY	DATE				
MADE	JD	2-24-69			
CHECKED	ATA	4-29-69	1	As Built	TEM 10-76
IN CHARGE			NO.	REVISION	BY DATE

**RICHMOND METROPOLITAN AUTHORITY
RICHMOND EXPRESSWAY SYSTEM
DOWNTOWN EXPRESSWAY**

**BRIDGE NO. 63
WESTBOUND ROADWAY OVER
12TH ST. - R.R. TRACKS AND 16TH ST.**






QUANTITIES

HOWARD, NEEDLES, TAMMEN & BERGENDOFF
consulting engineers
NEW YORK ALEXANDRIA KANSAS CITY

SCALE: As Noted
CONTRACT NO.: 10
SHEET NO. 2 OF 29

AS BUILT

RICHMOND EXPRESSWAY SYSTEM			
SECTION	PROJECT	SHEET NO.	TOTAL SHEETS
10	DOWNTOWN EXPRESSWAY	72	265

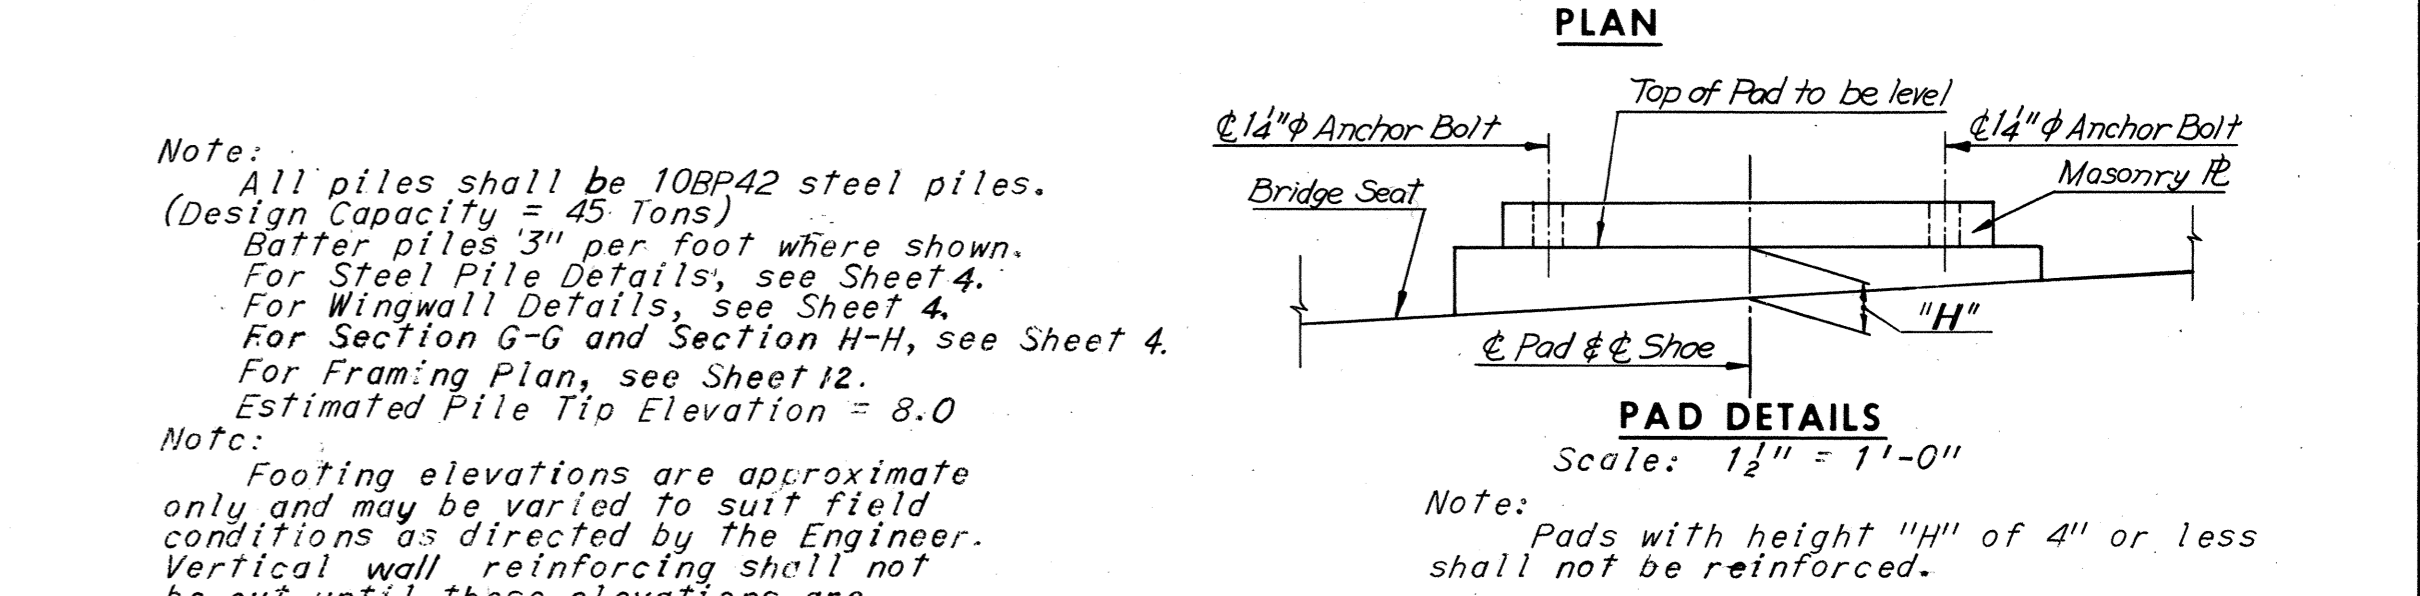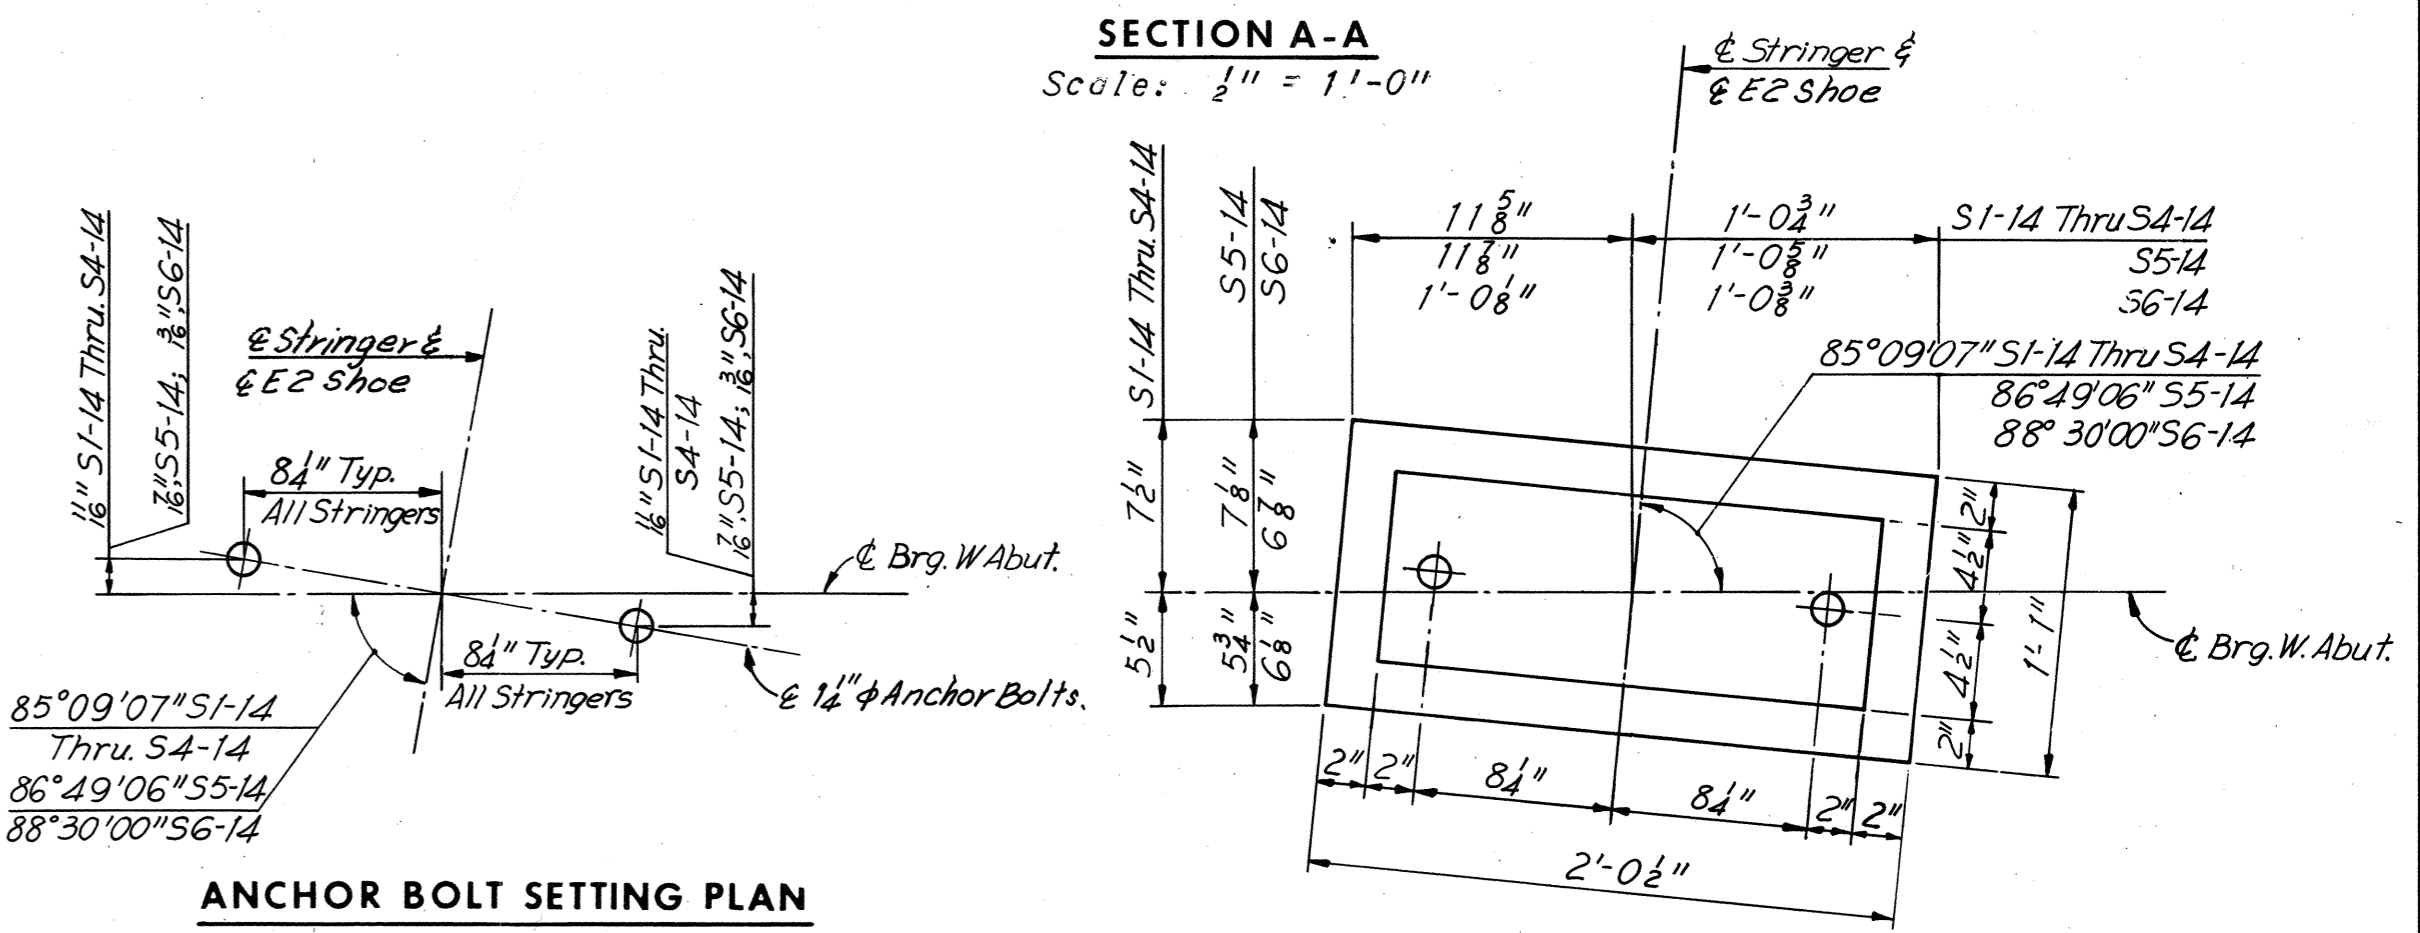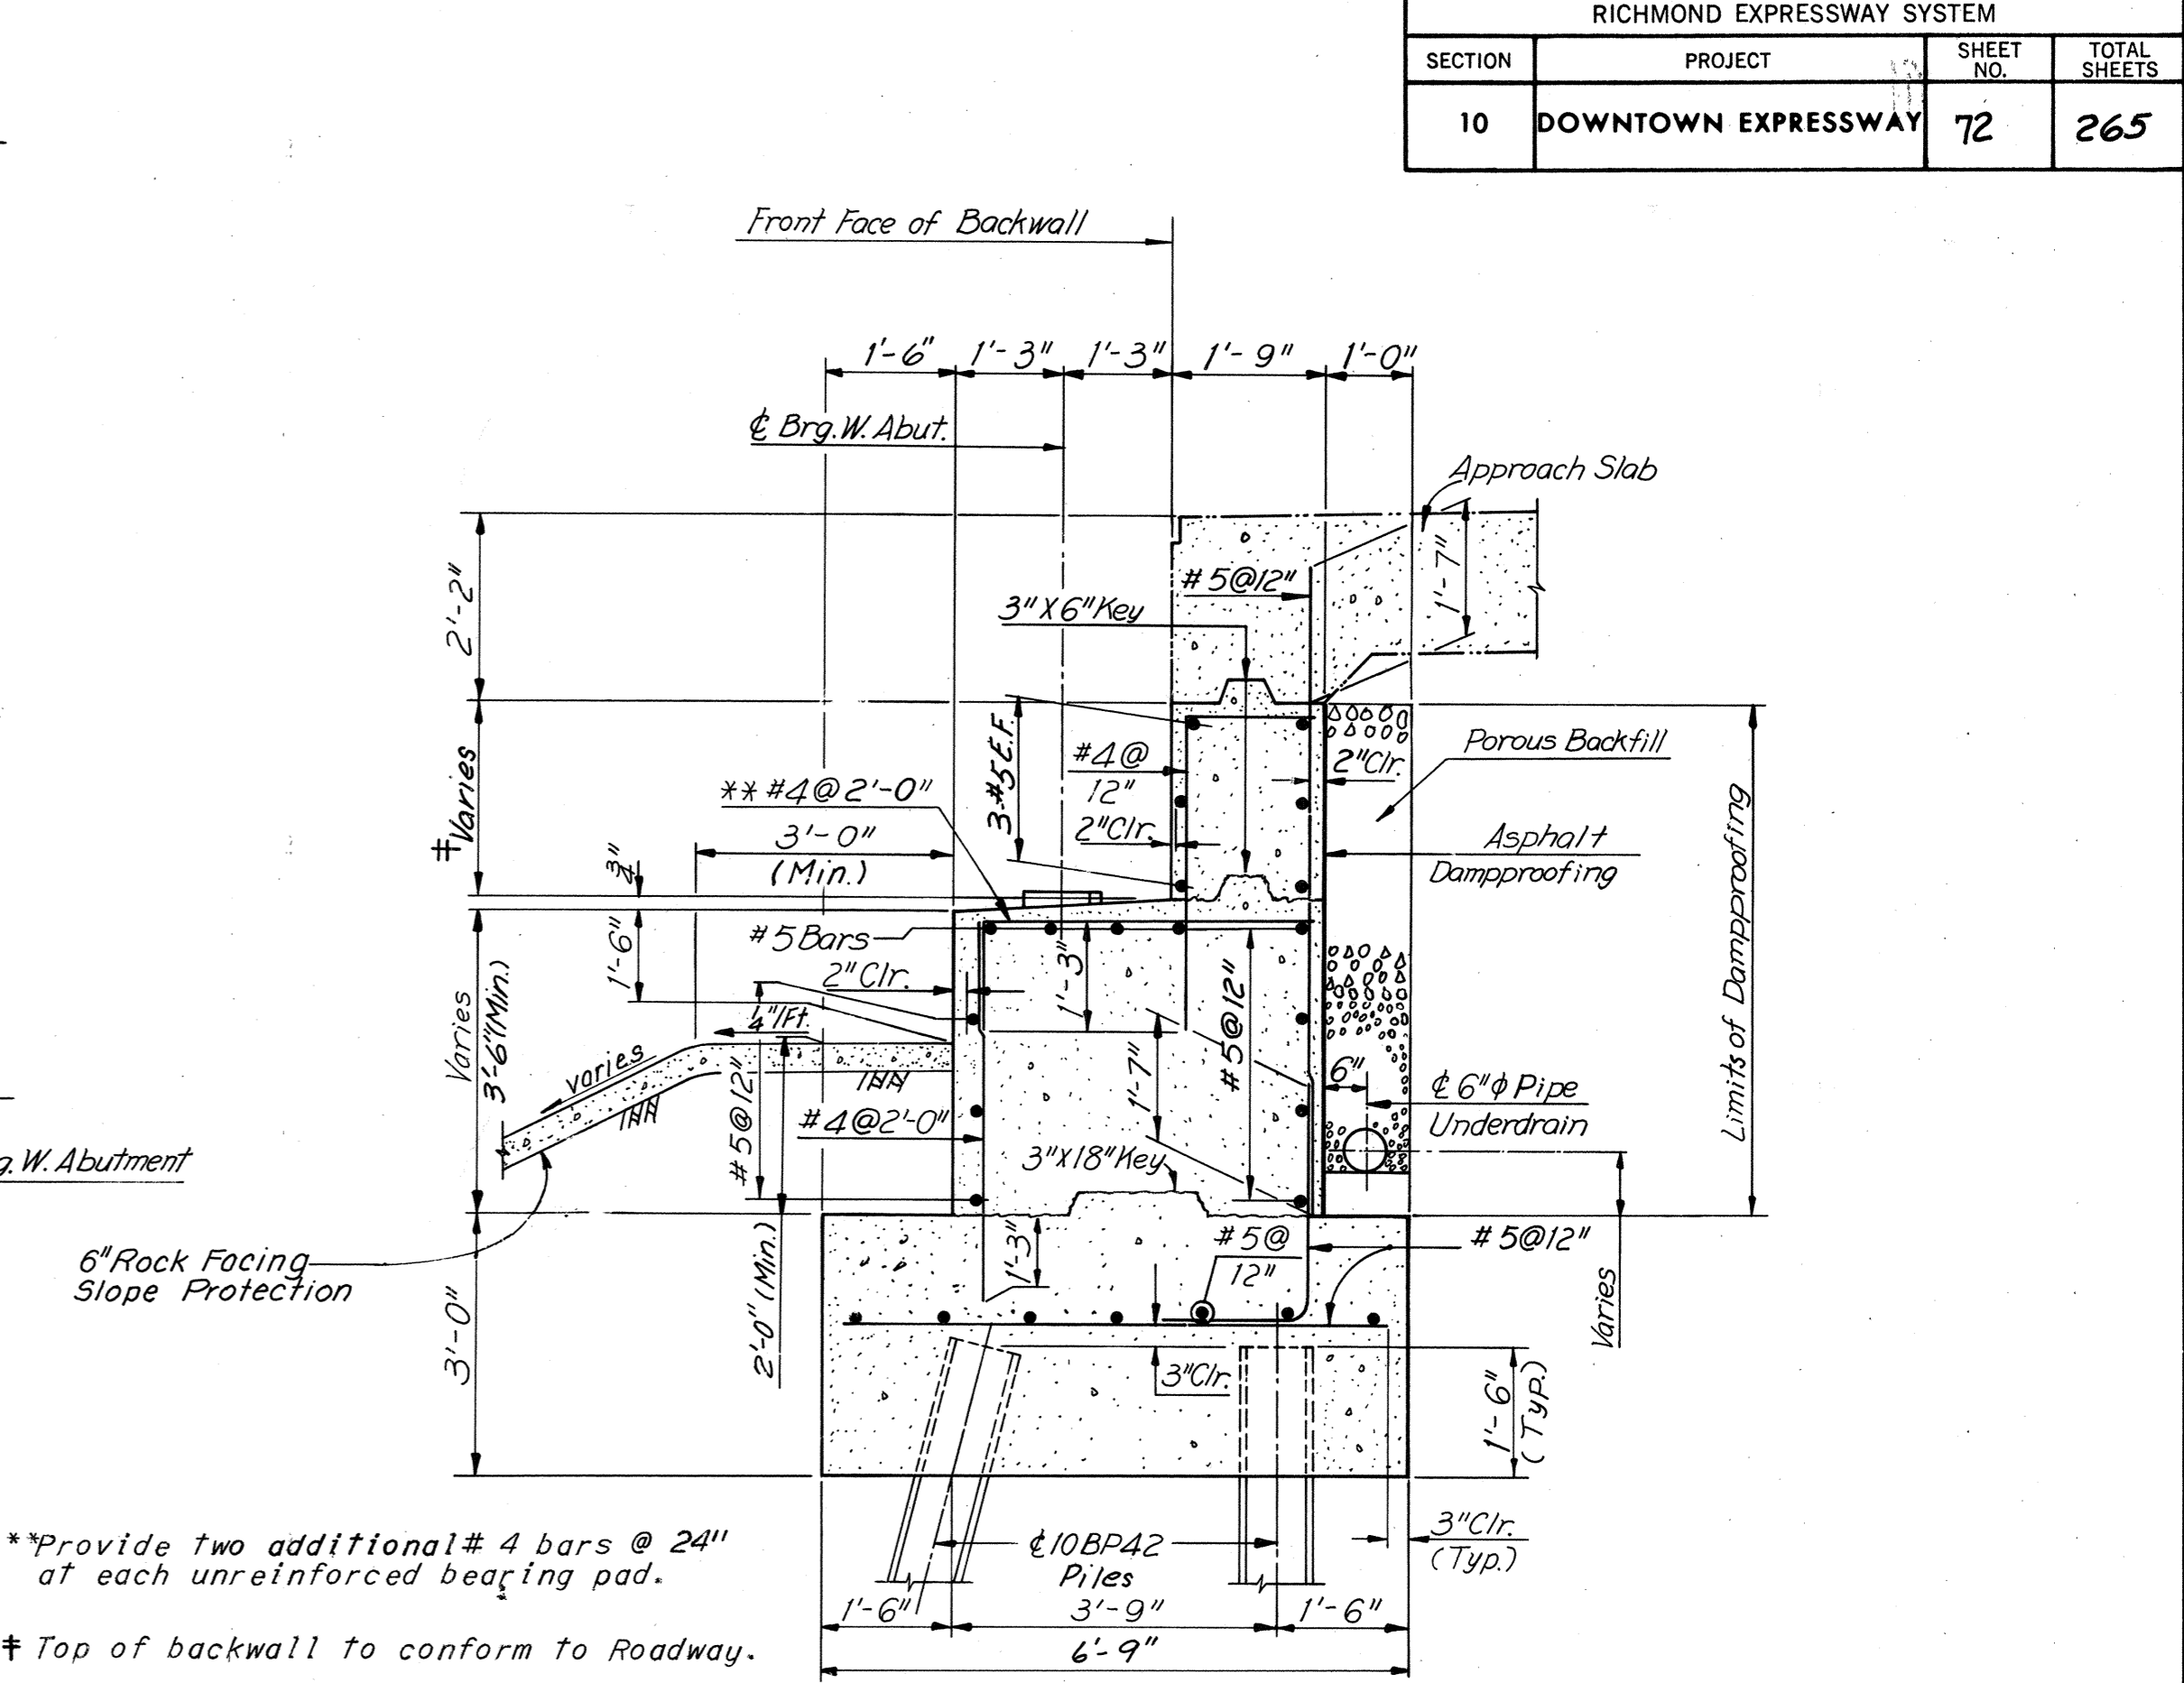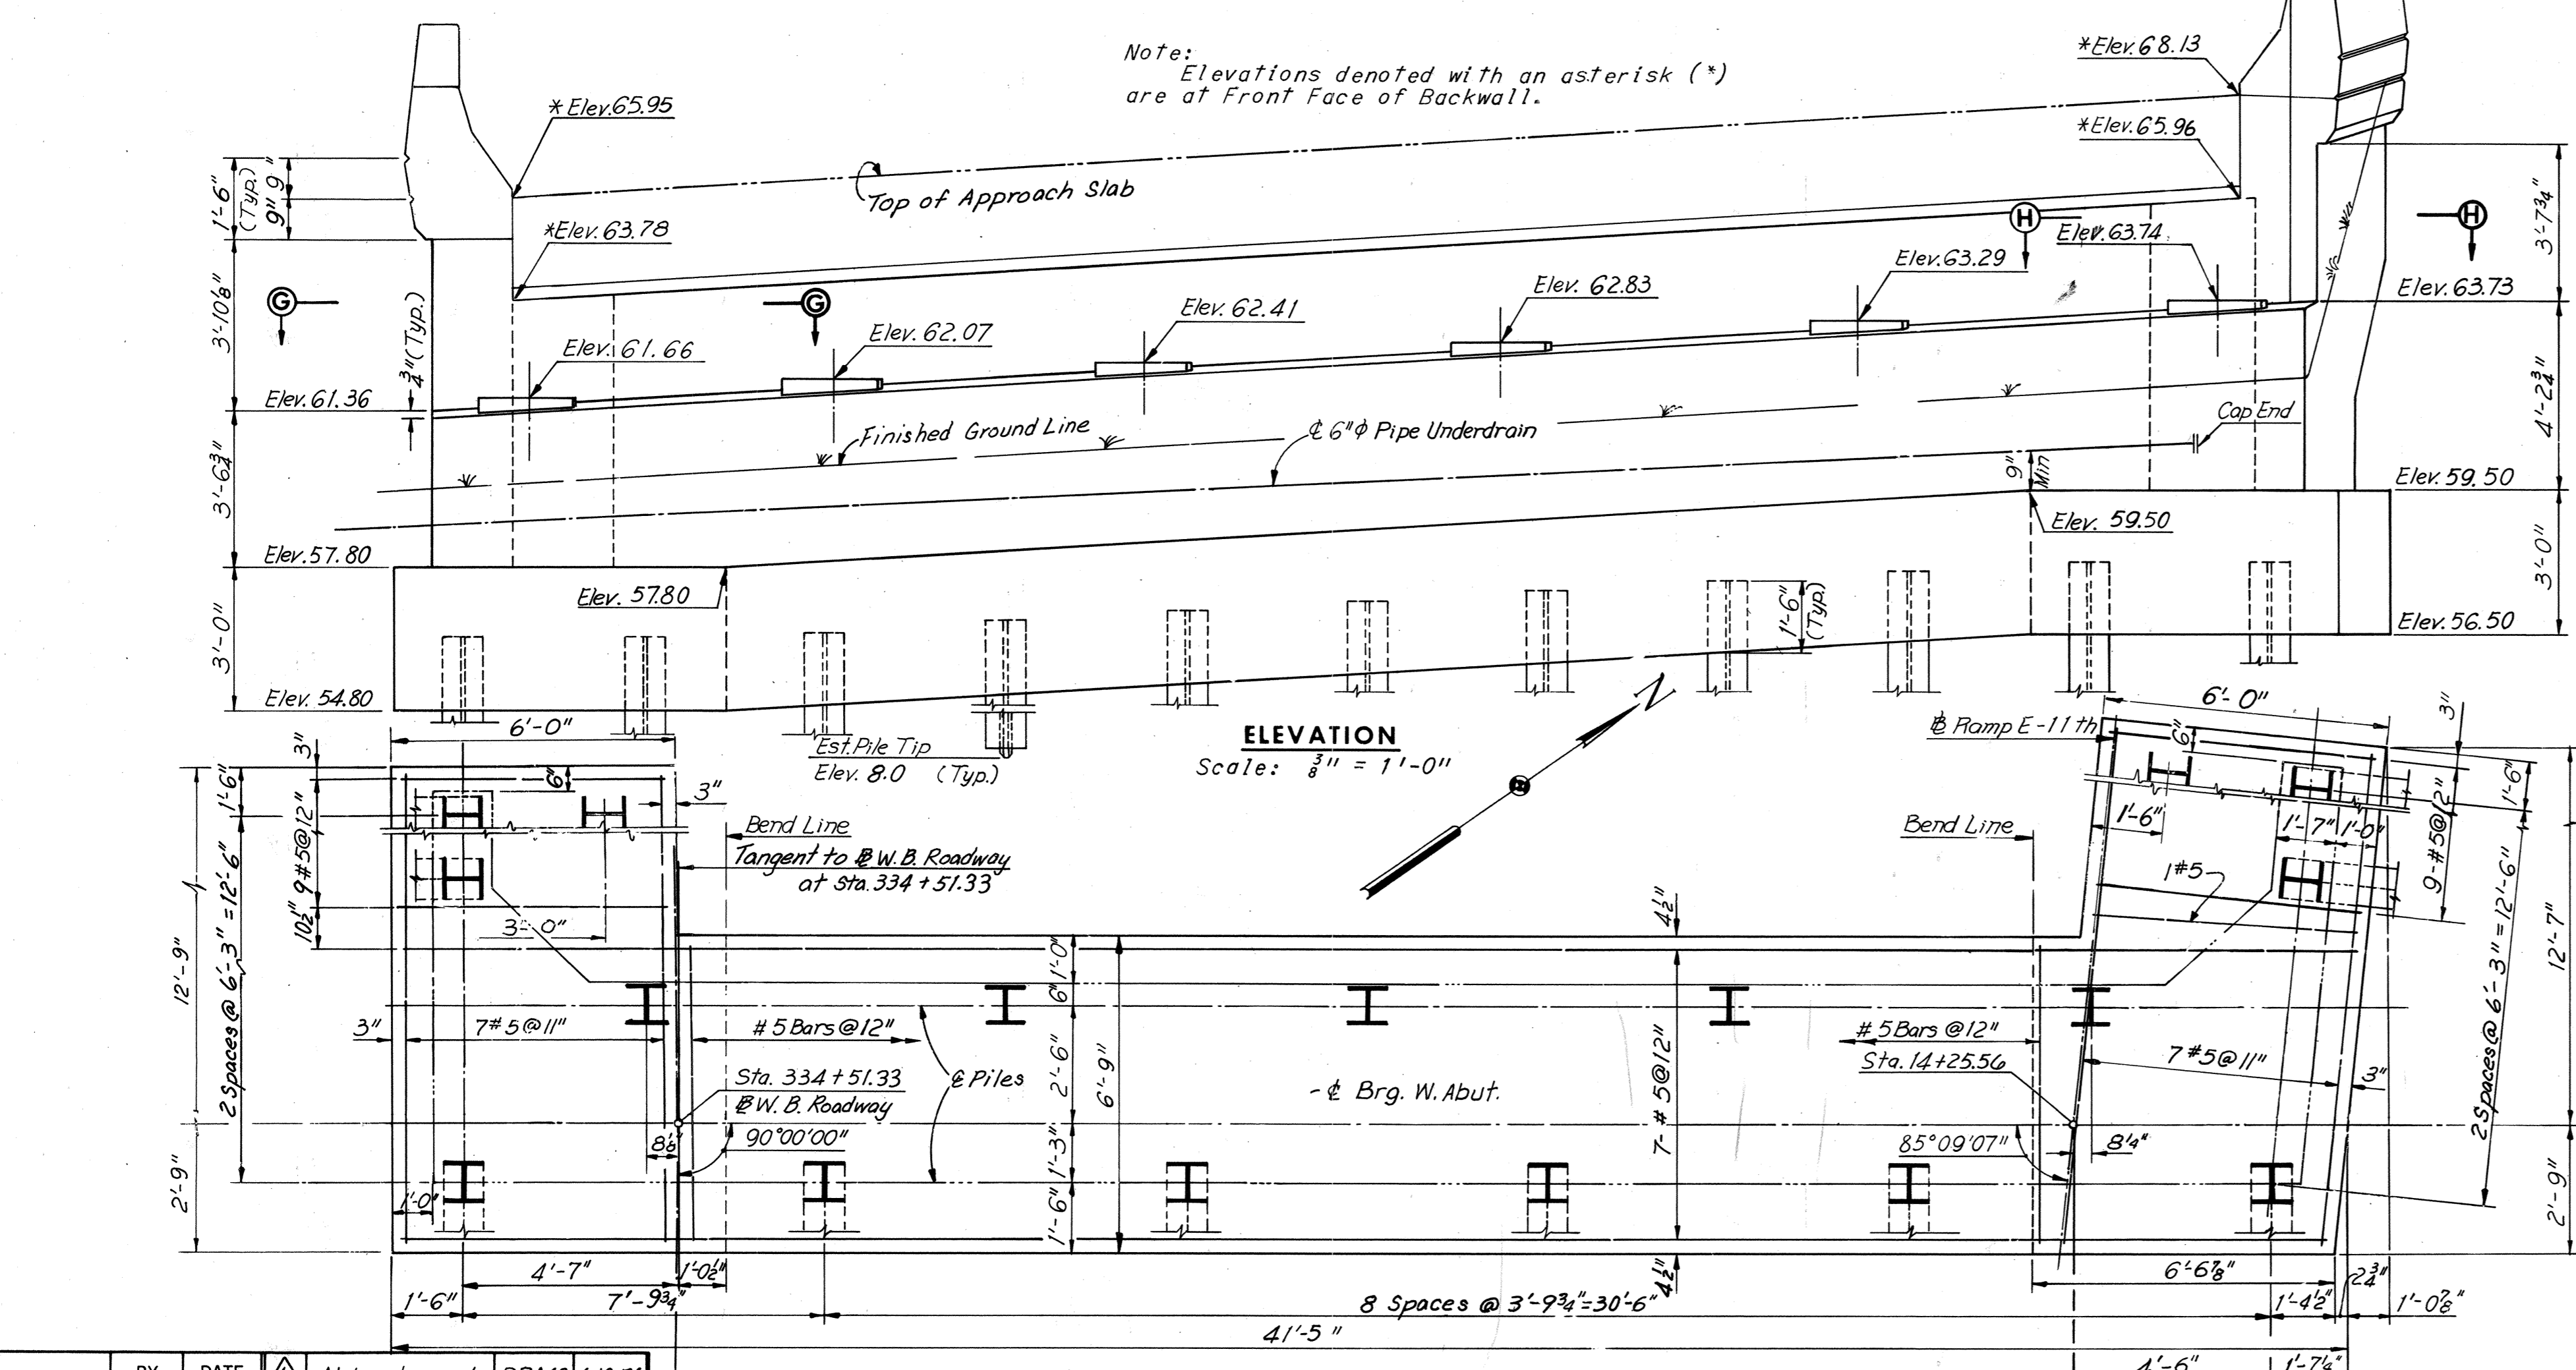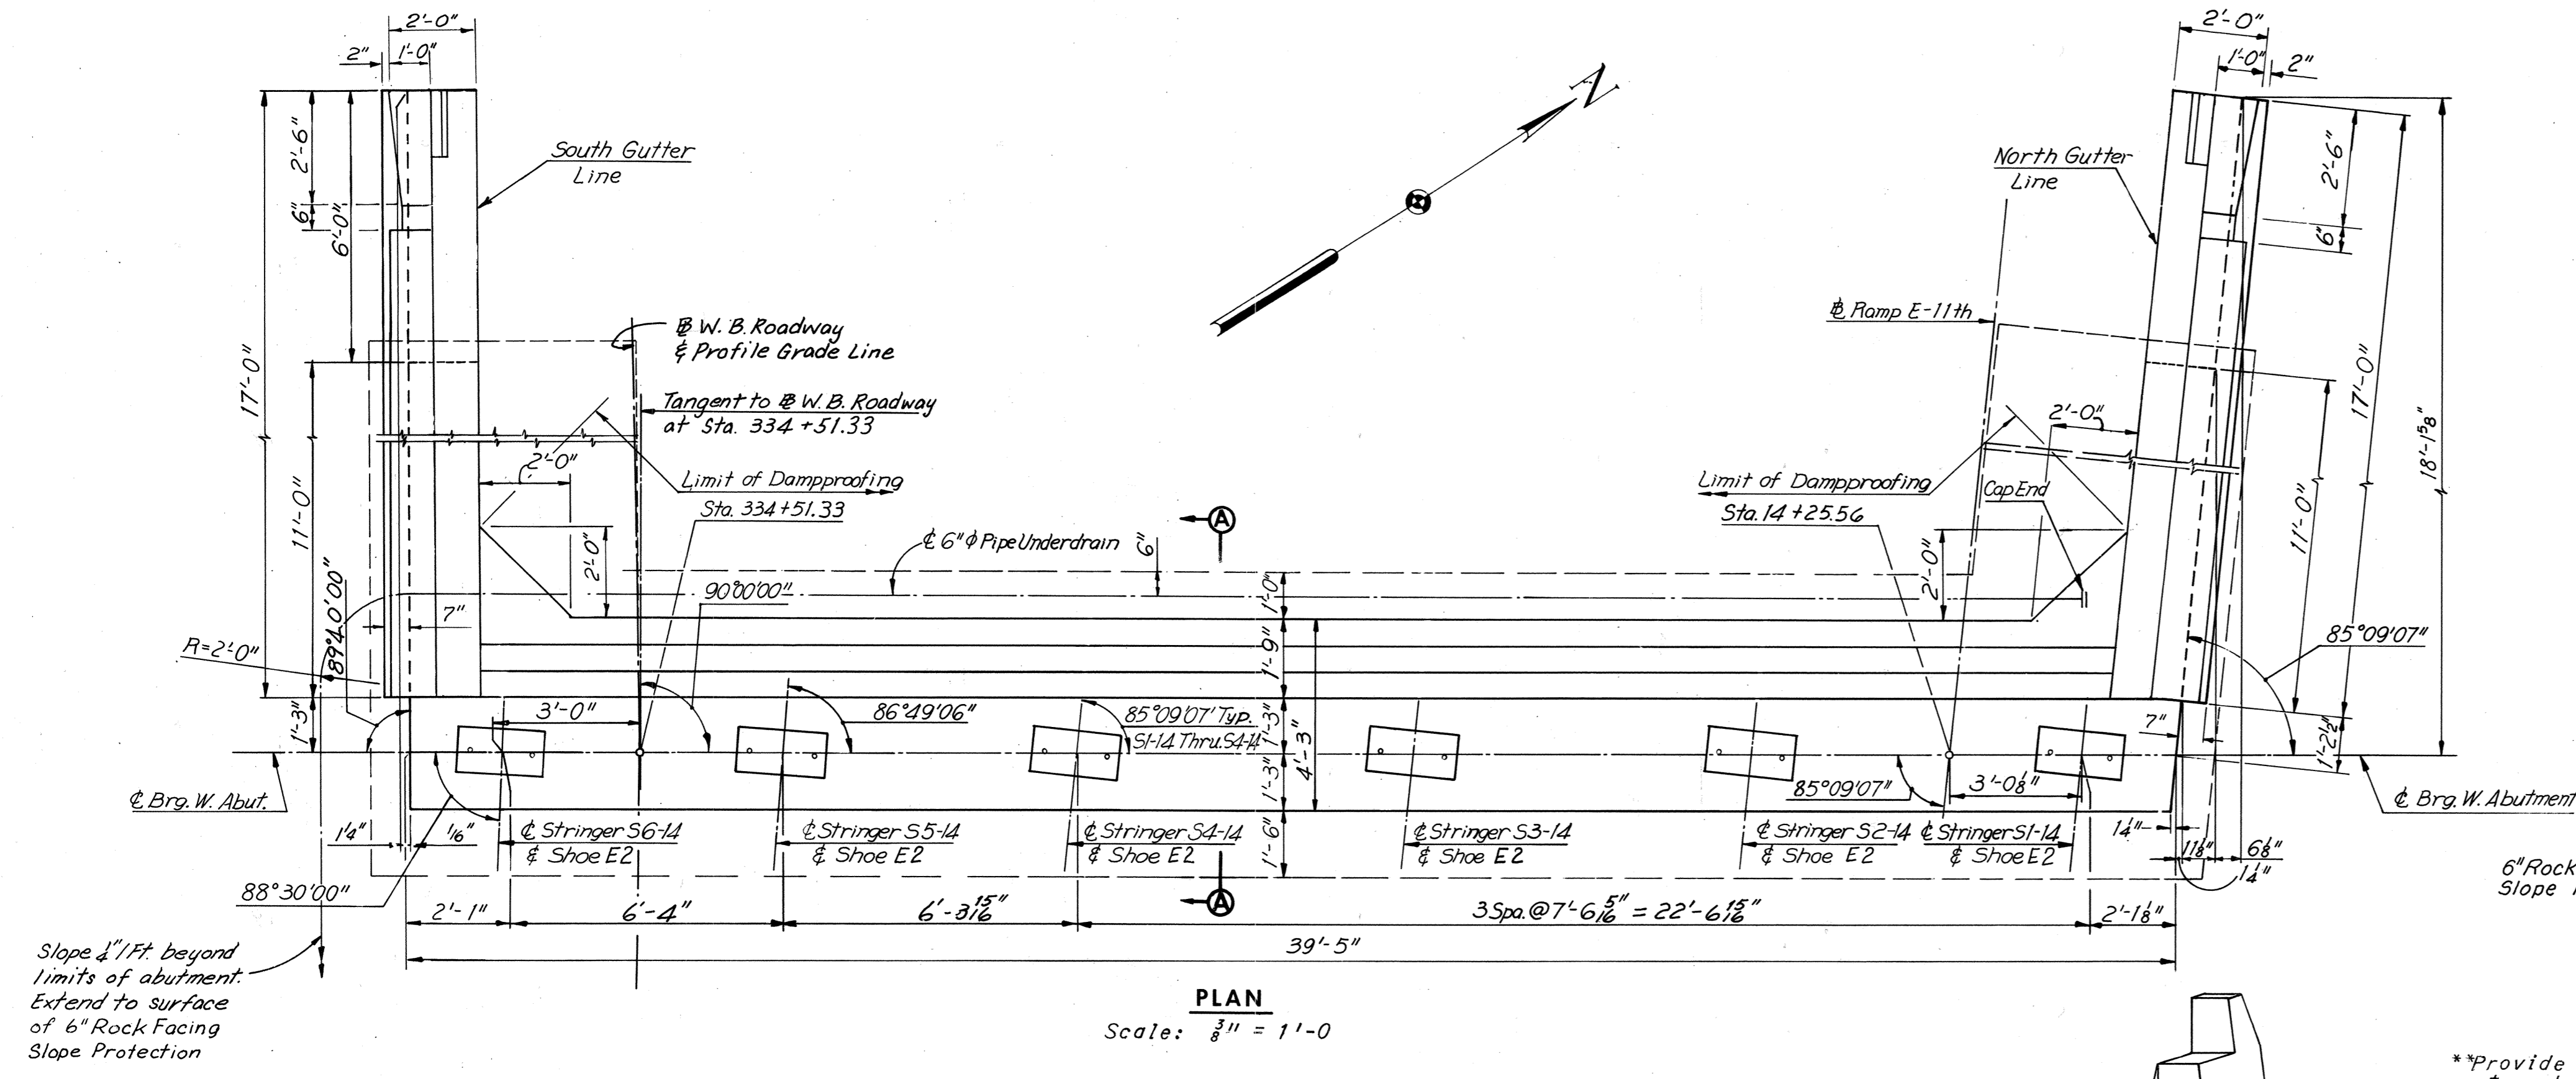

FOOTING
Scale: $\frac{3}{8}'' = 1'-0''$

Note: Abutment Footing built as dimensioned about called & Footing
Abutment built as dimensioned about & Brg.

BY	DATE	Note changed	PRMS	4-19-74
MADE	AHH	6-22-68	2	As Built
CHECKED	GCC	8-17-68		
IN CHARGE				
	NO.	REVISION	BY	DATE

AS BUILT








RICHMOND METROPOLITAN AUTHORITY
RICHMOND EXPRESSWAY SYSTEM
DOWNTOWN EXPRESSWAY

BRIDGE NO. 63
WESTBOUND ROADWAY OVER
12TH ST. - R.R. TRACKS AND 16TH ST.
WEST ABUTMENT

HOWARD, NEEDLES, TAMMEN & BERGENDOFF
consulting engineers
NEW YORK ALEXANDRIA KANSAS CITY

SCALE: As Noted
CONTRACT NO.: 10
SHEET NO. 3 OF 29

RICHMOND EXPRESSWAY SYSTEM			
SECTION	PROJECT	SHEET NO.	TOTAL SHEETS
10	DOWNTOWN EXPRESSWAY	74	265

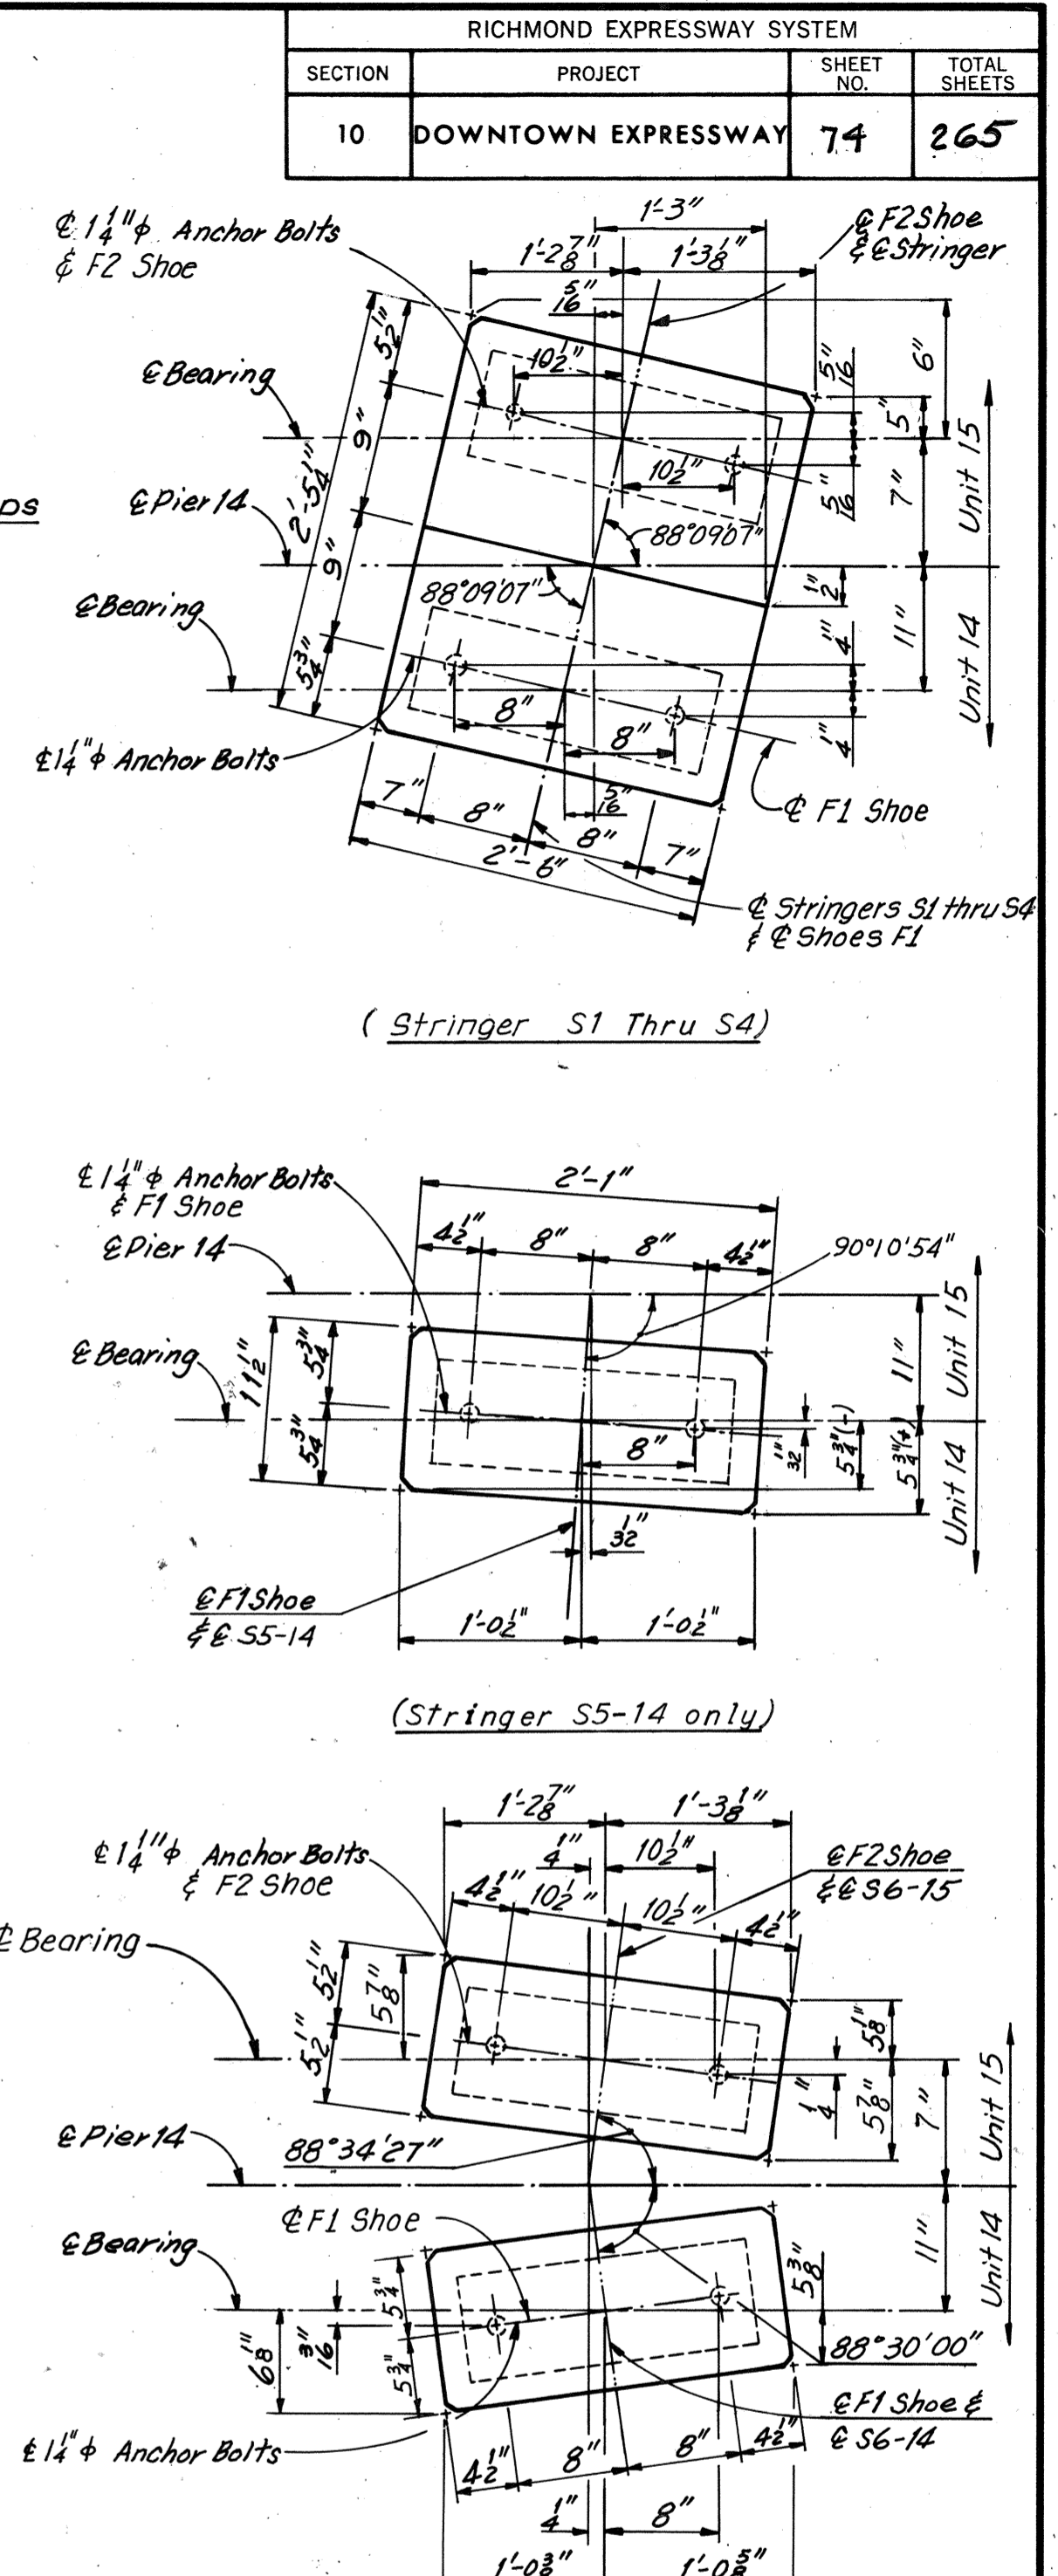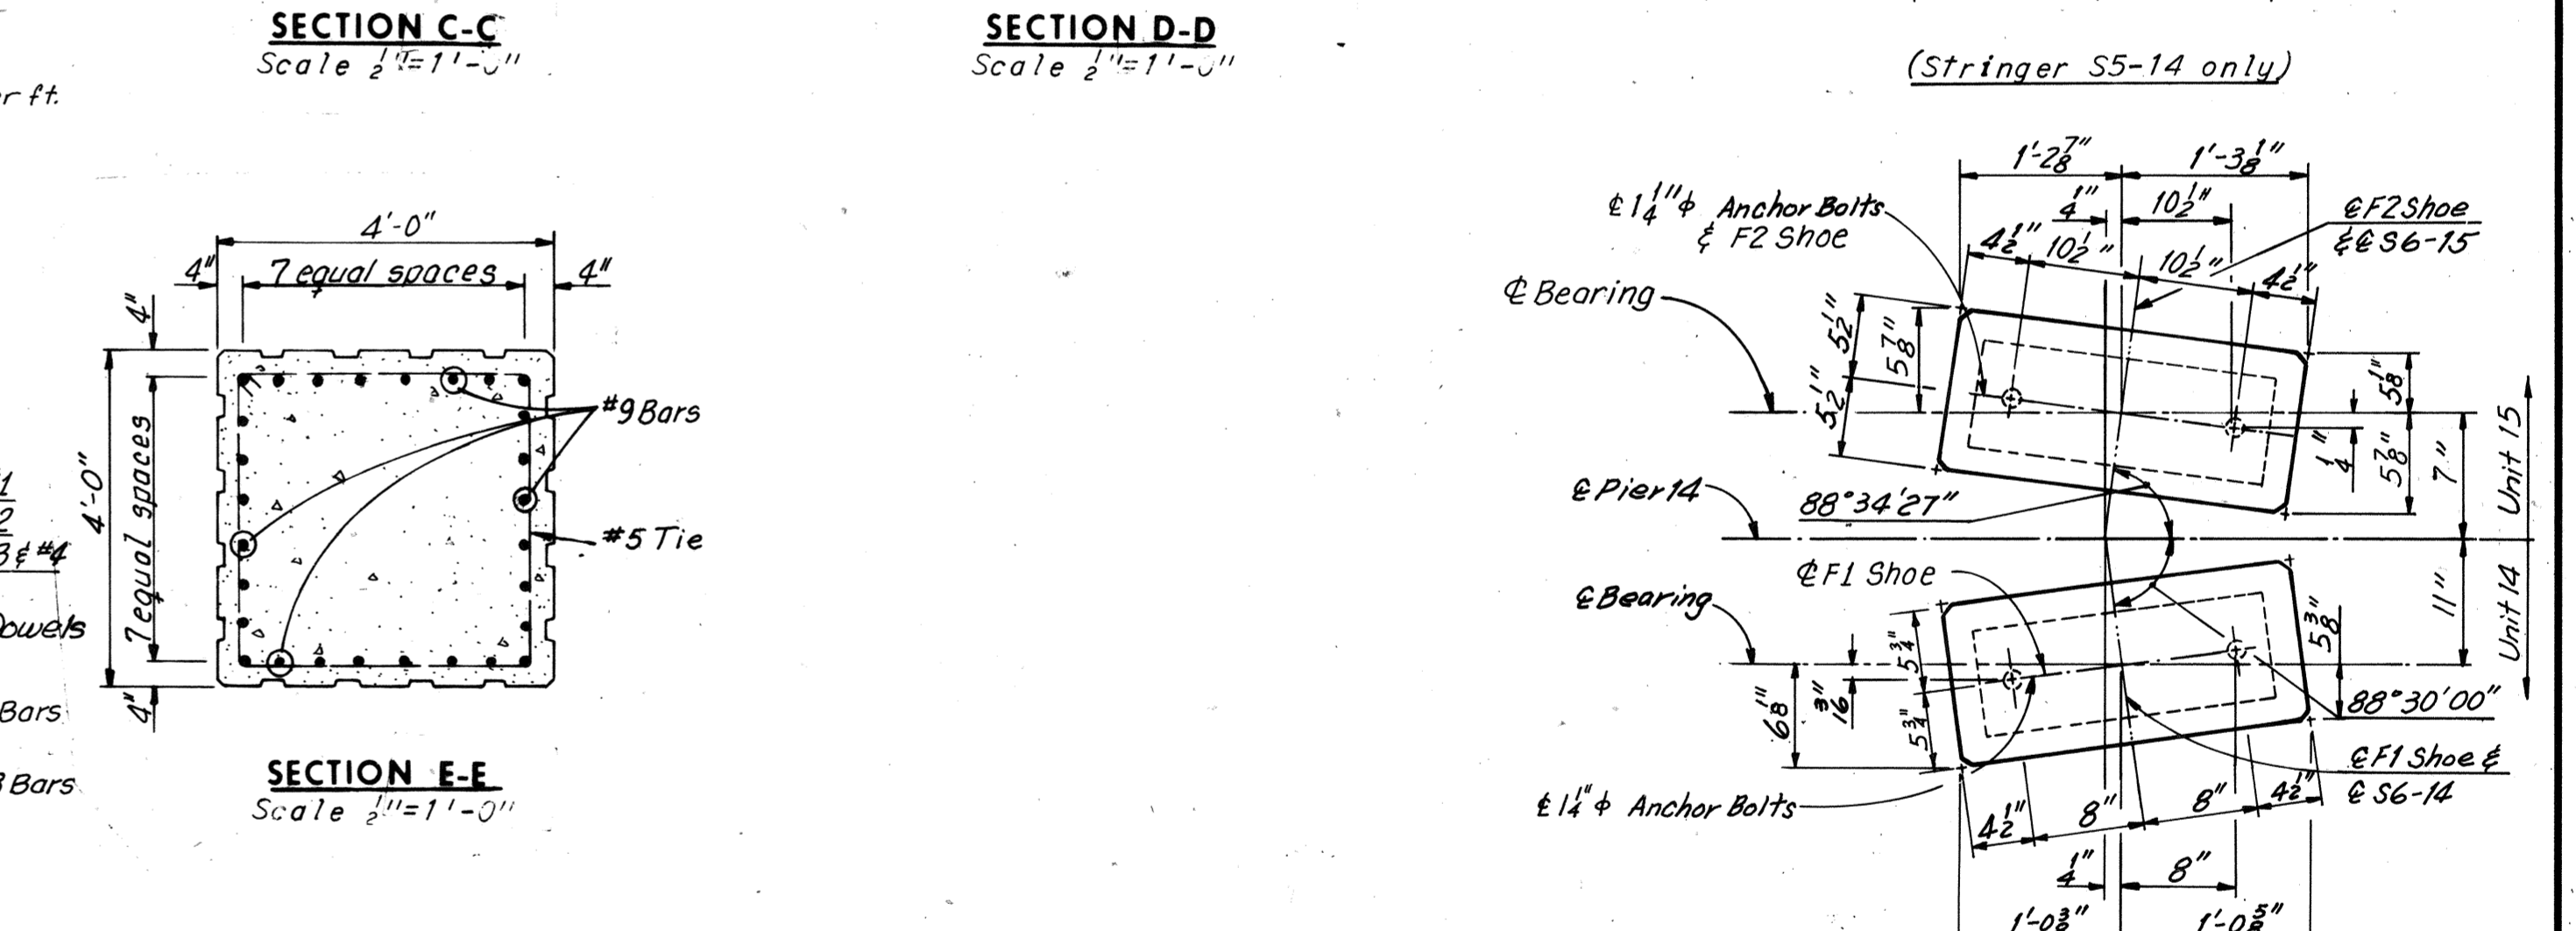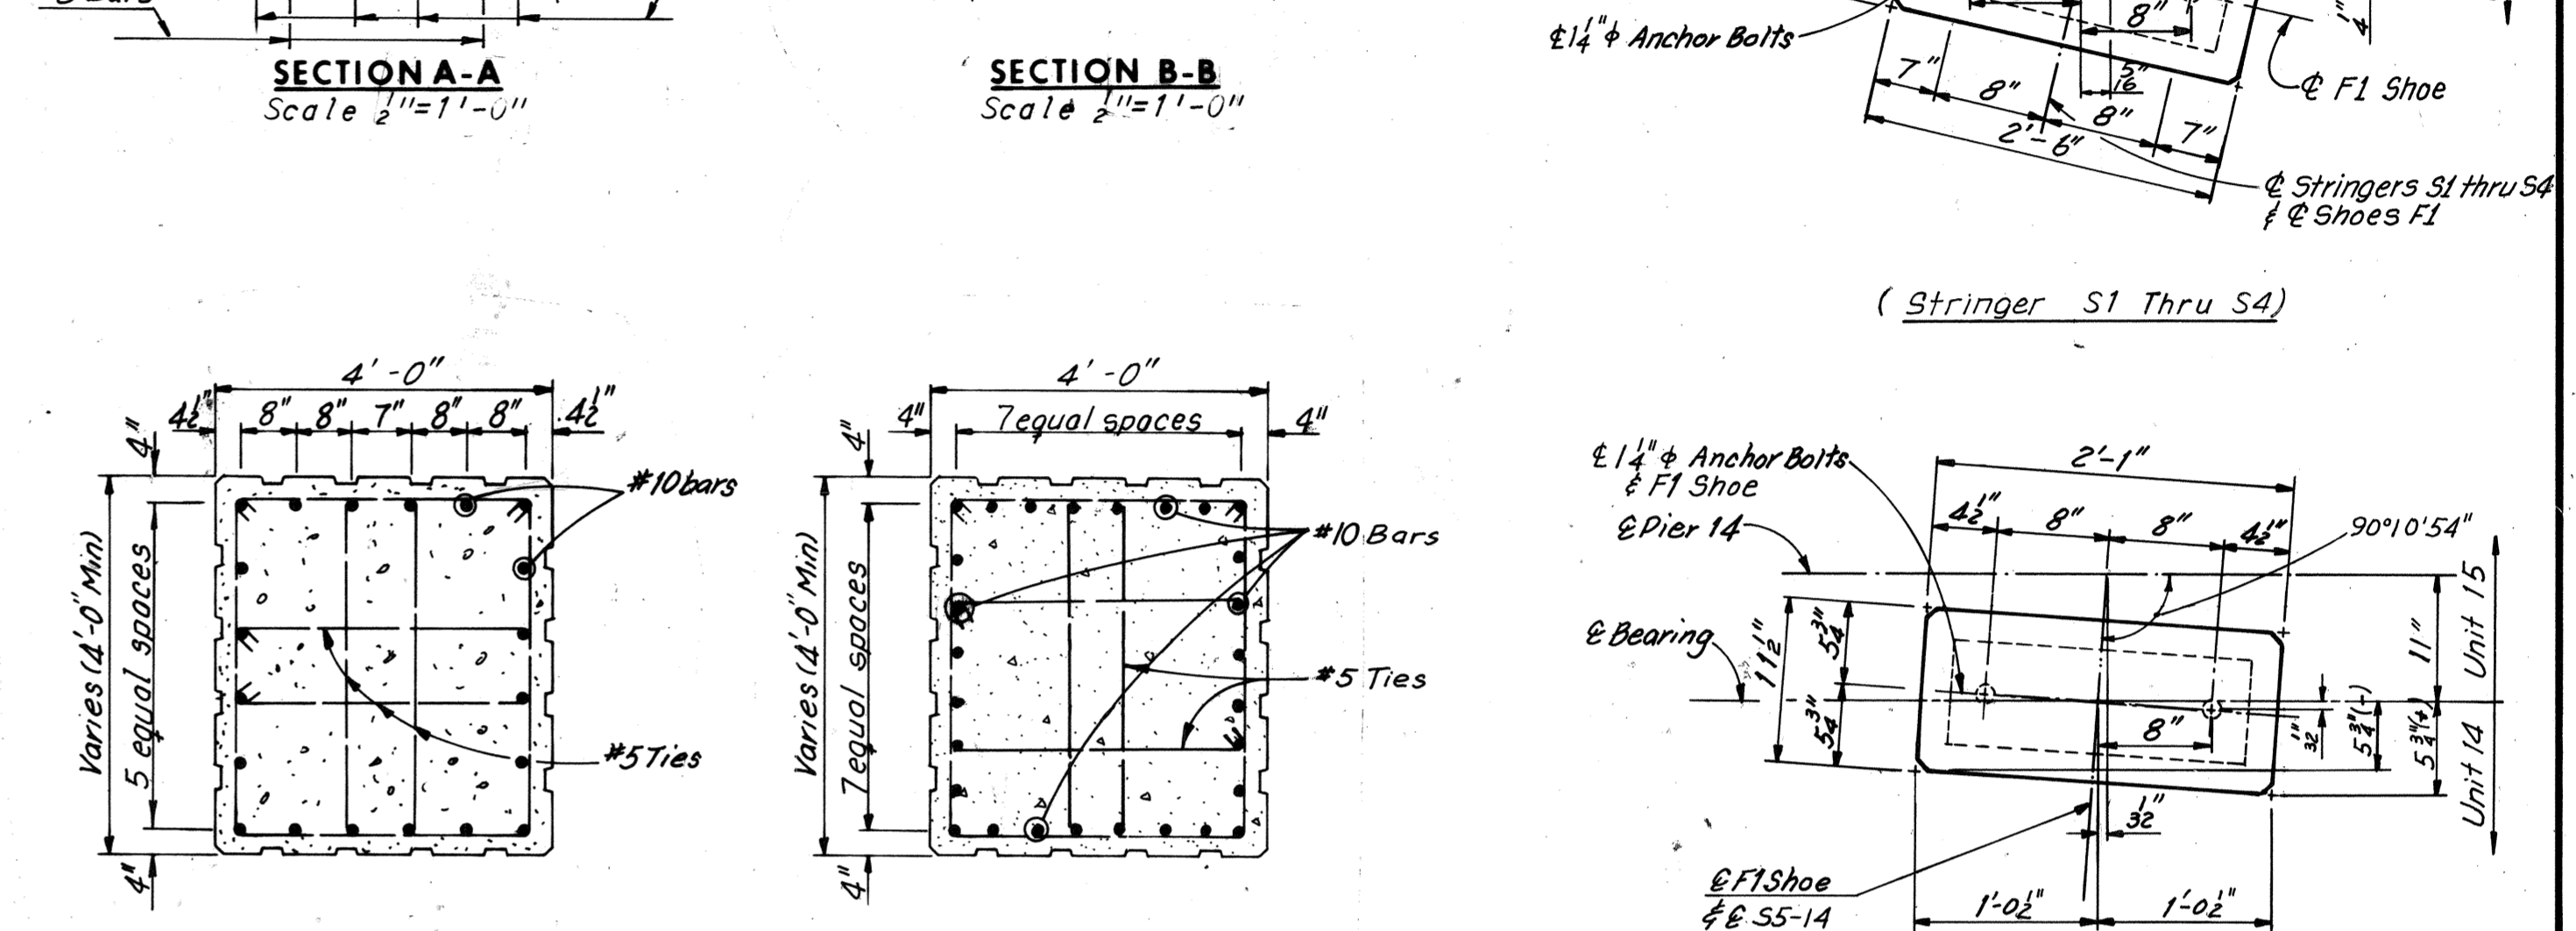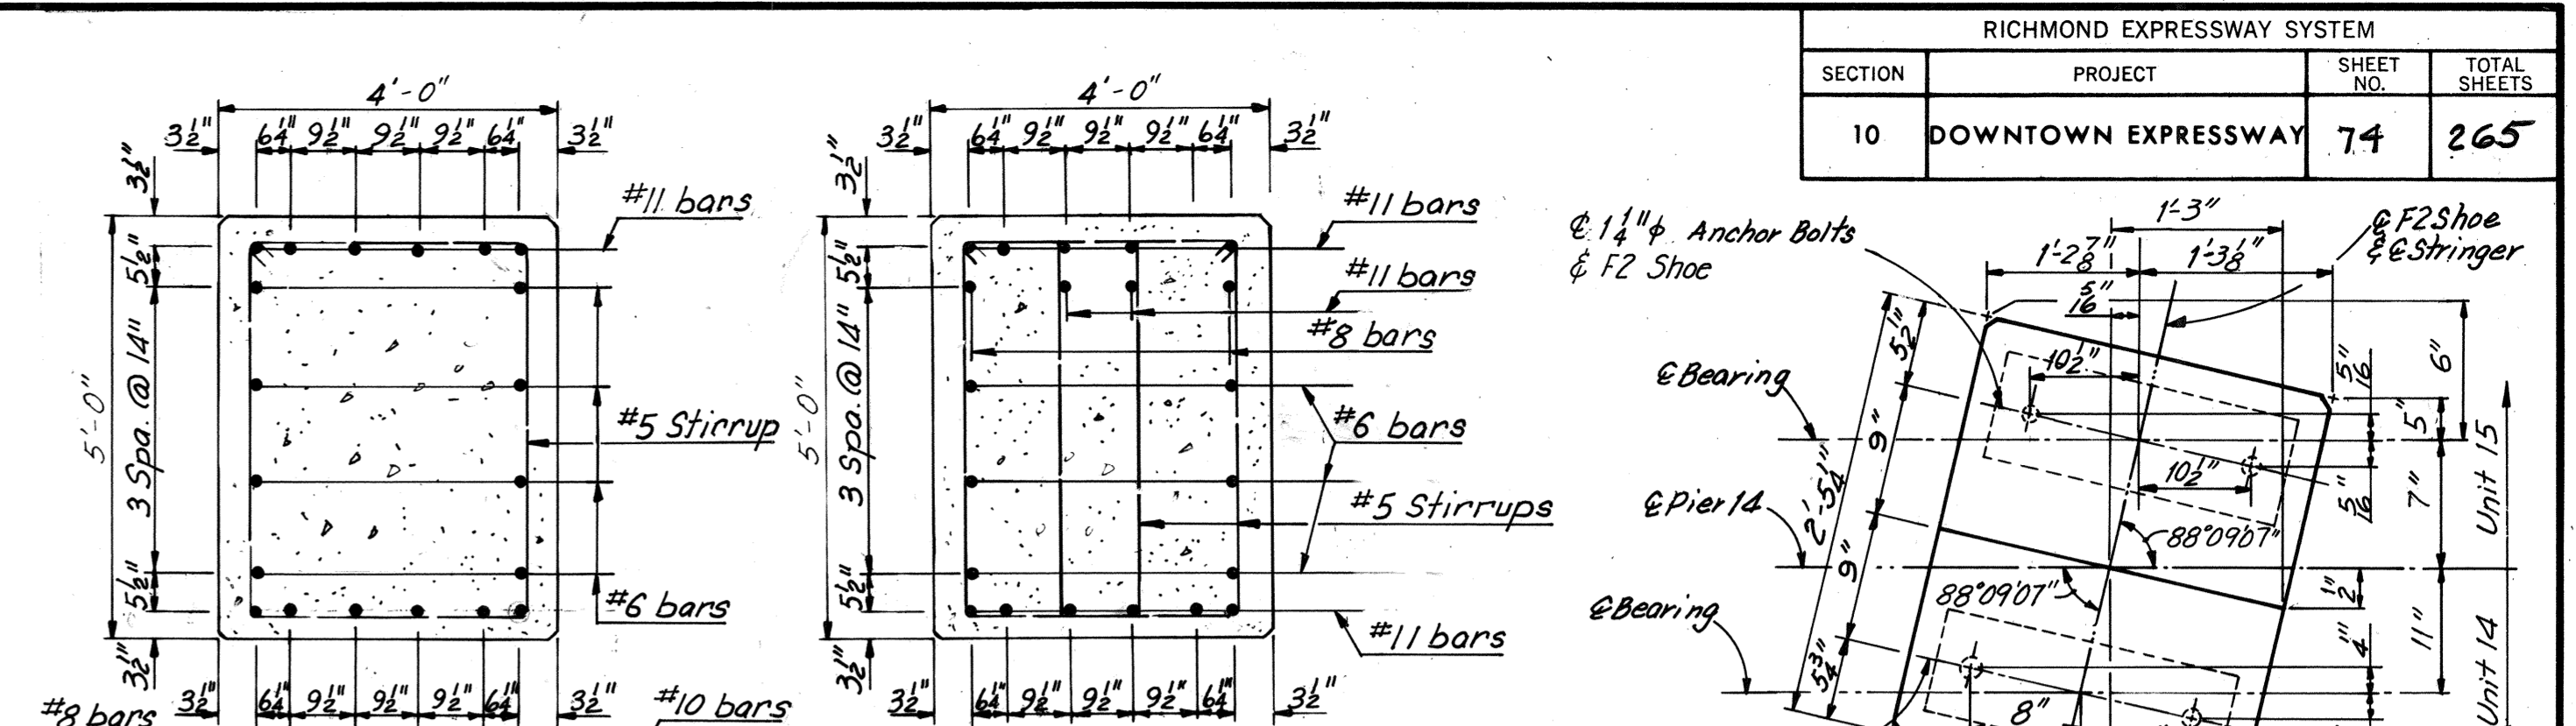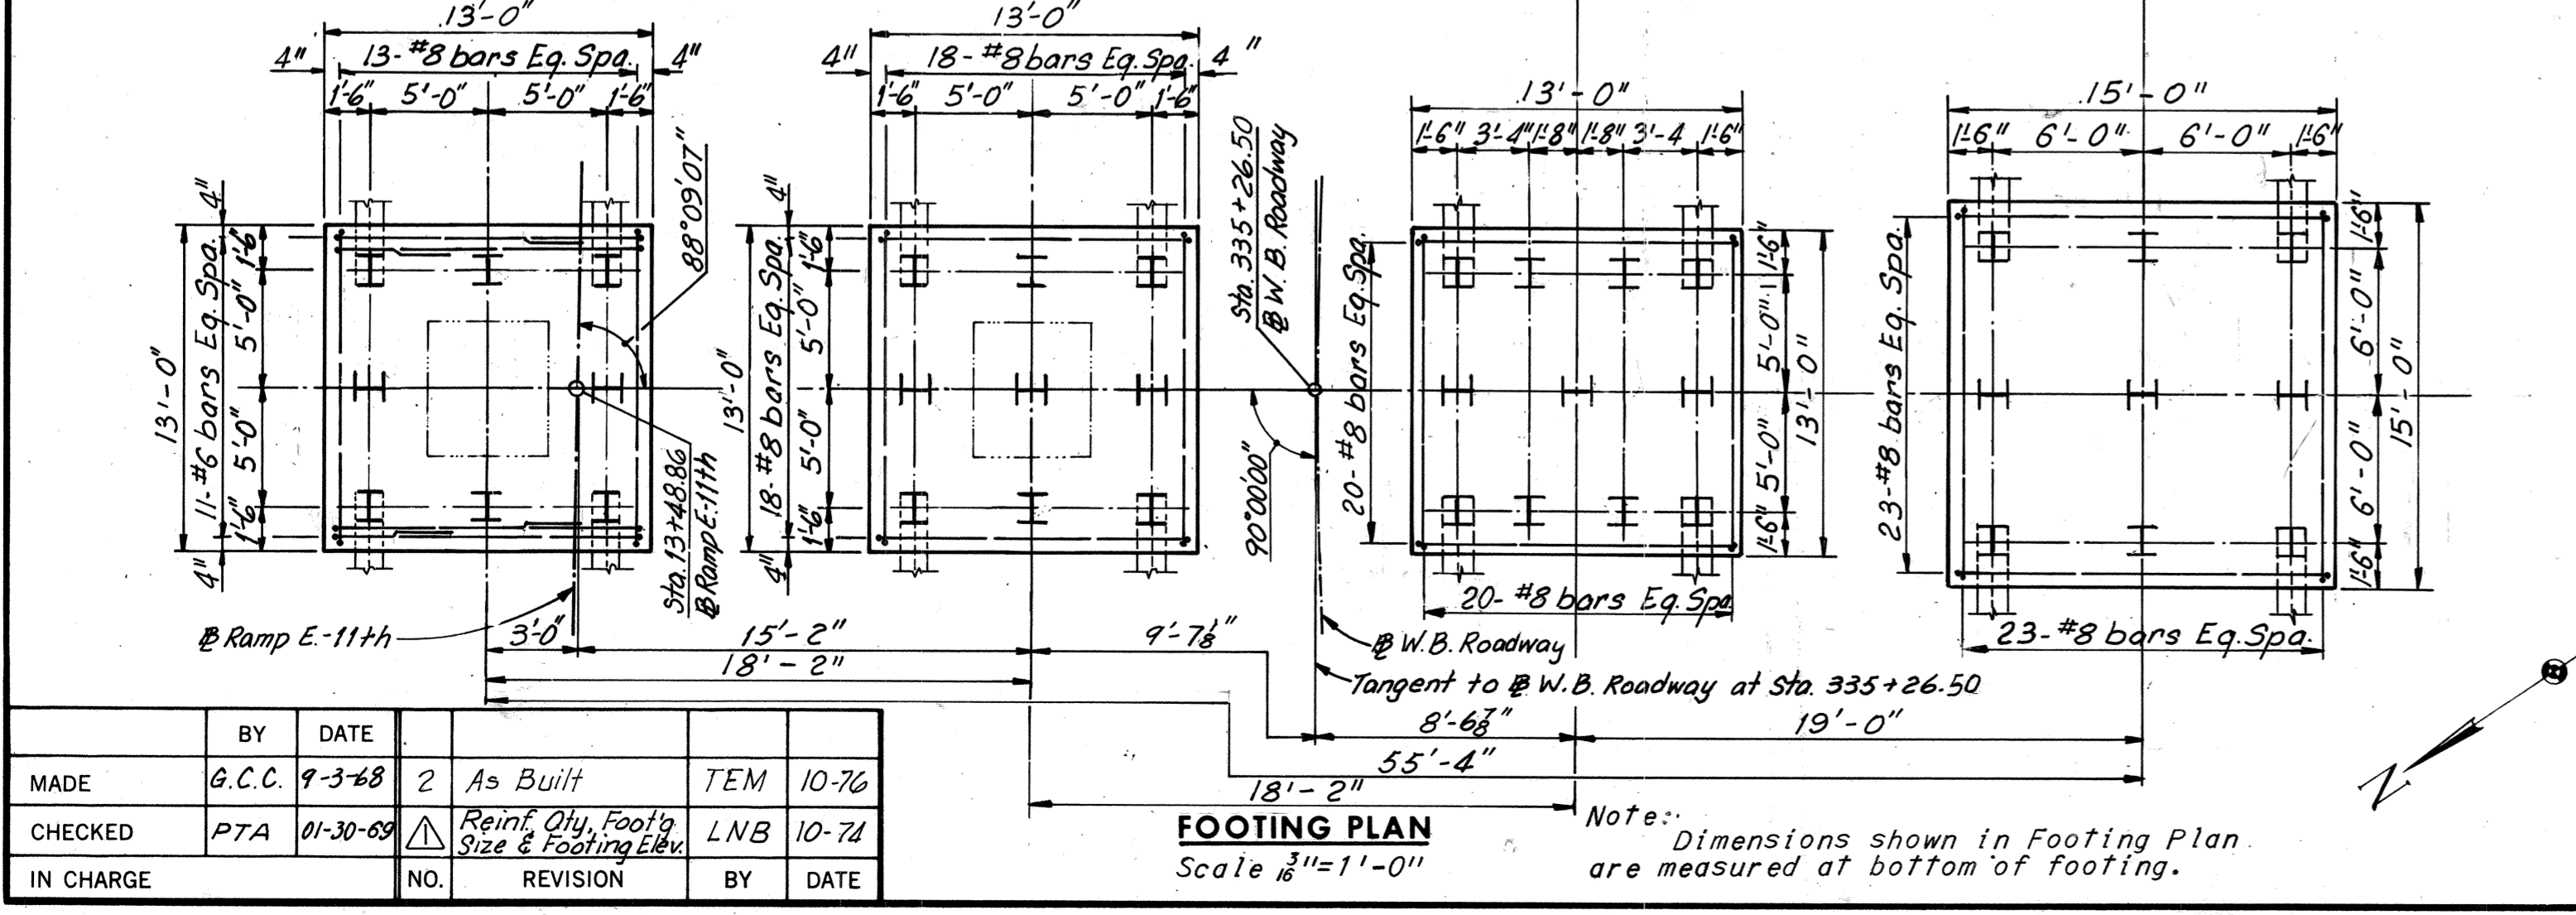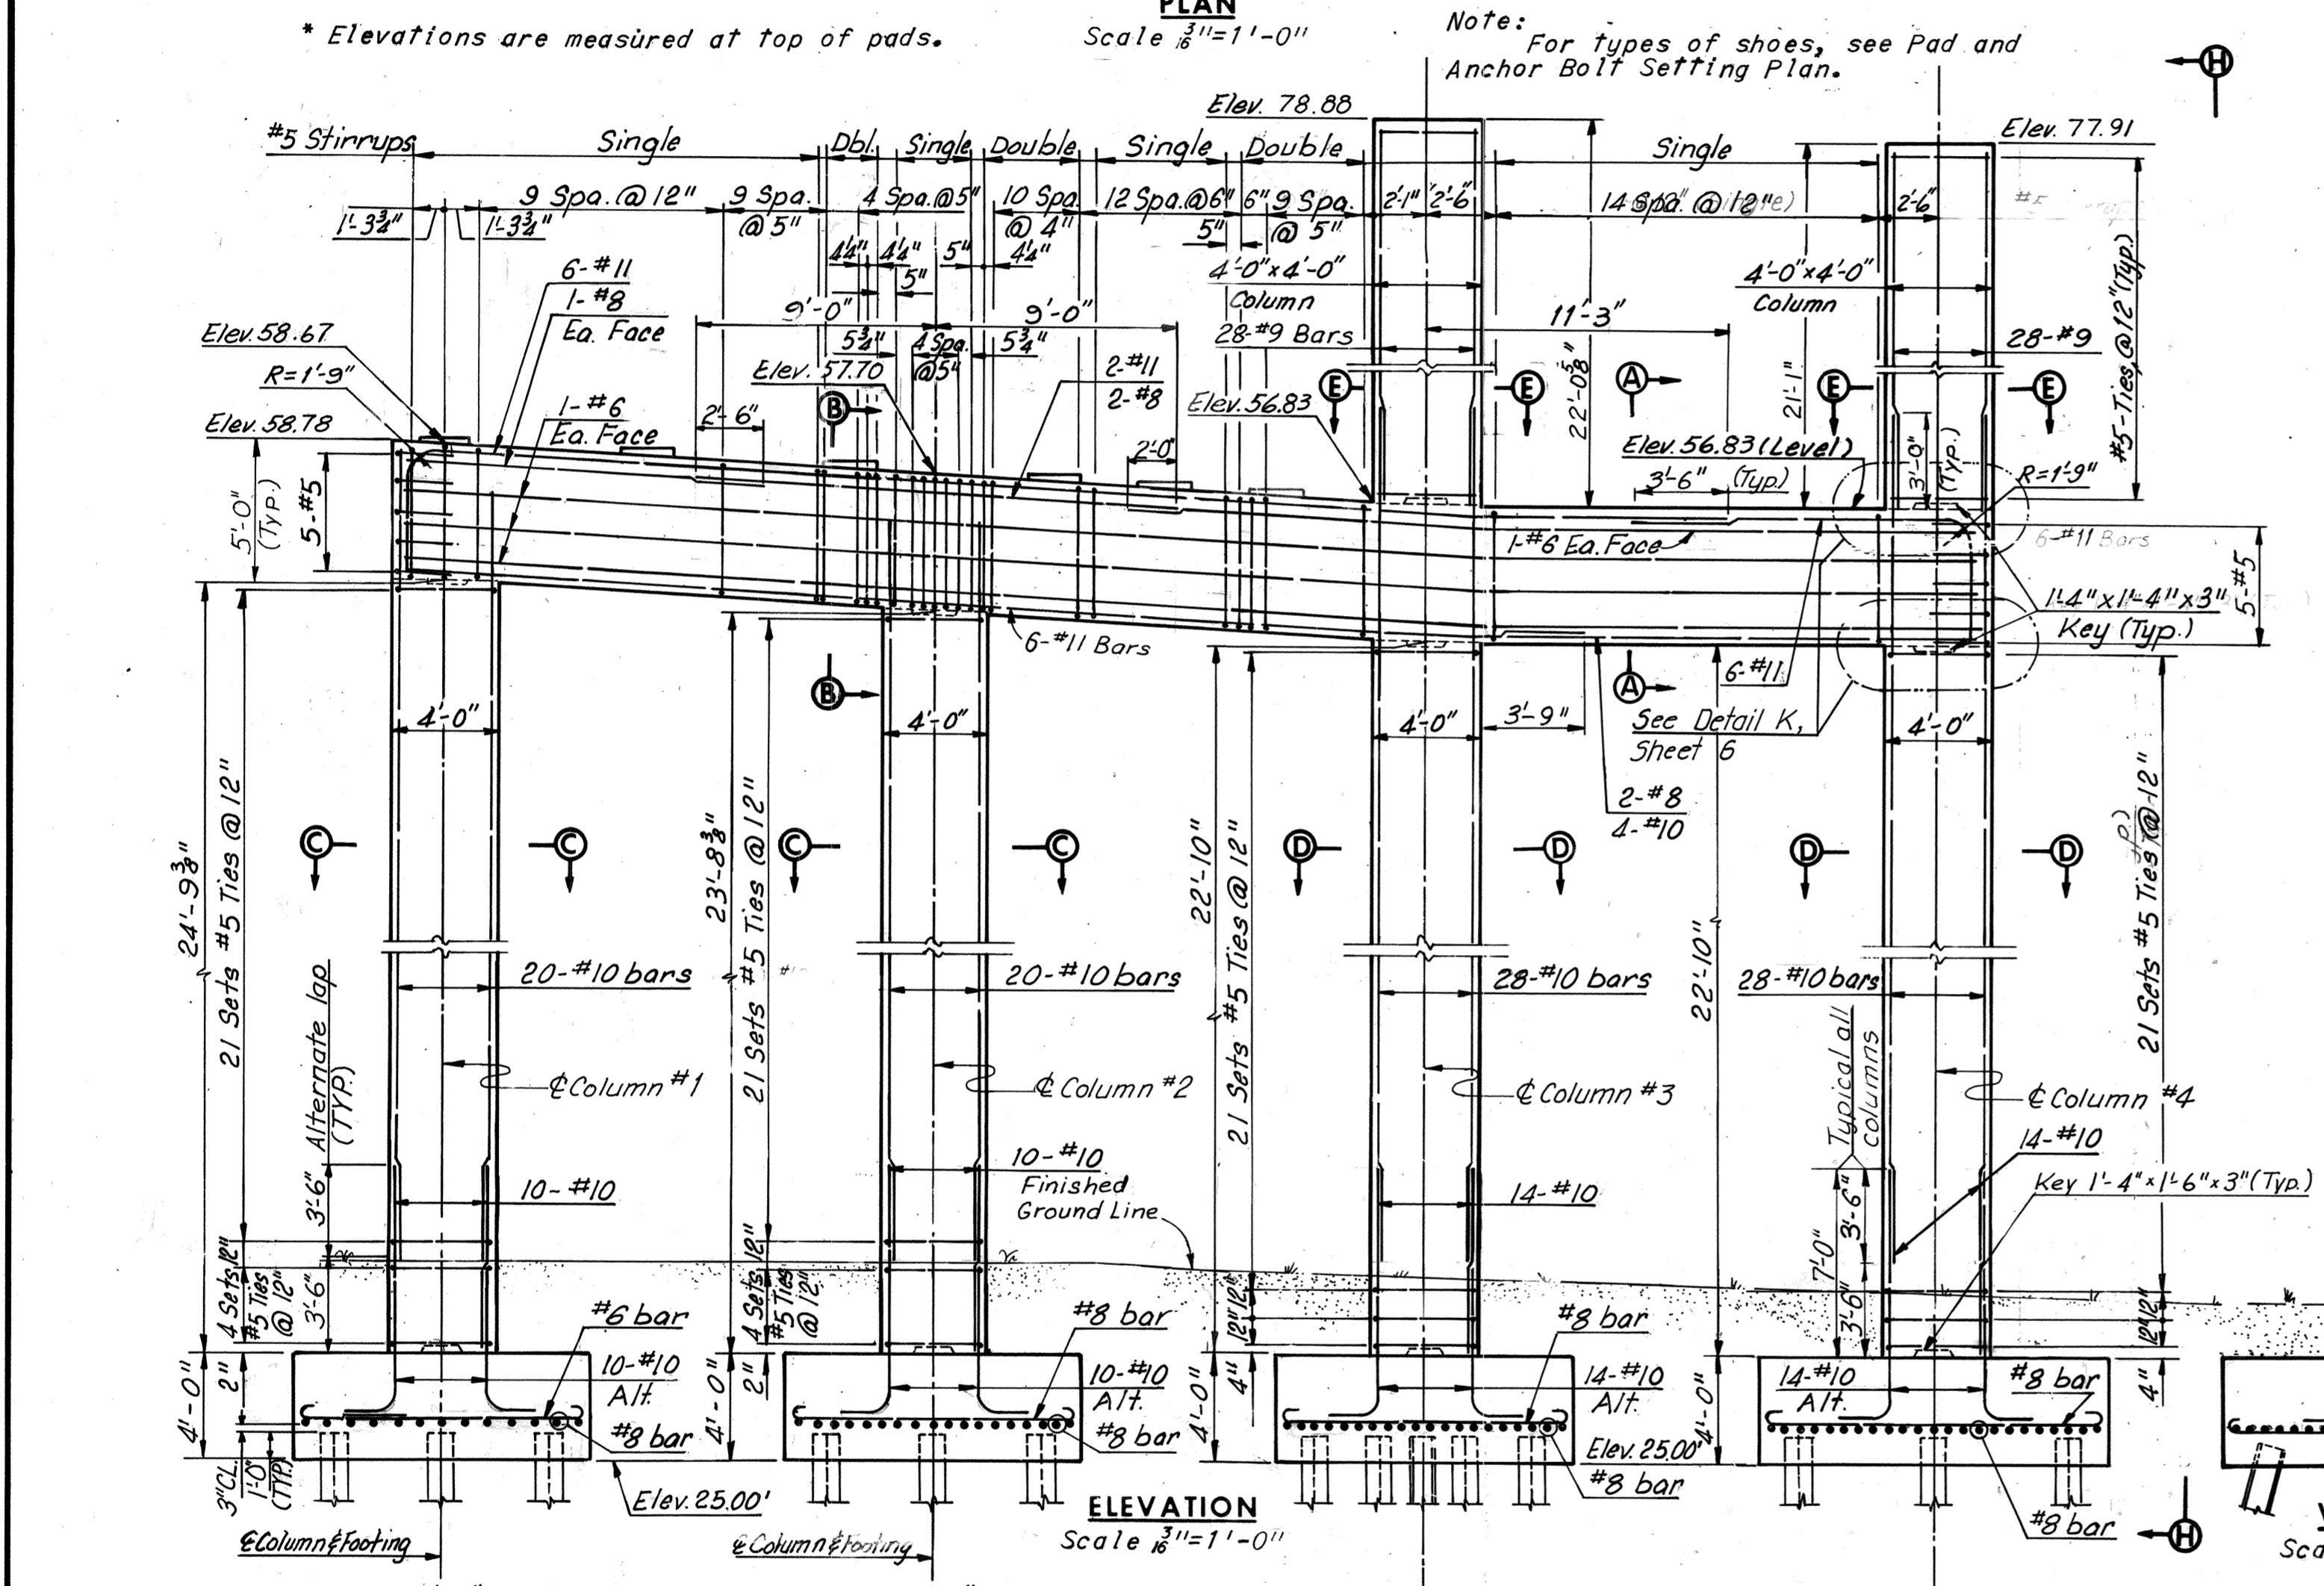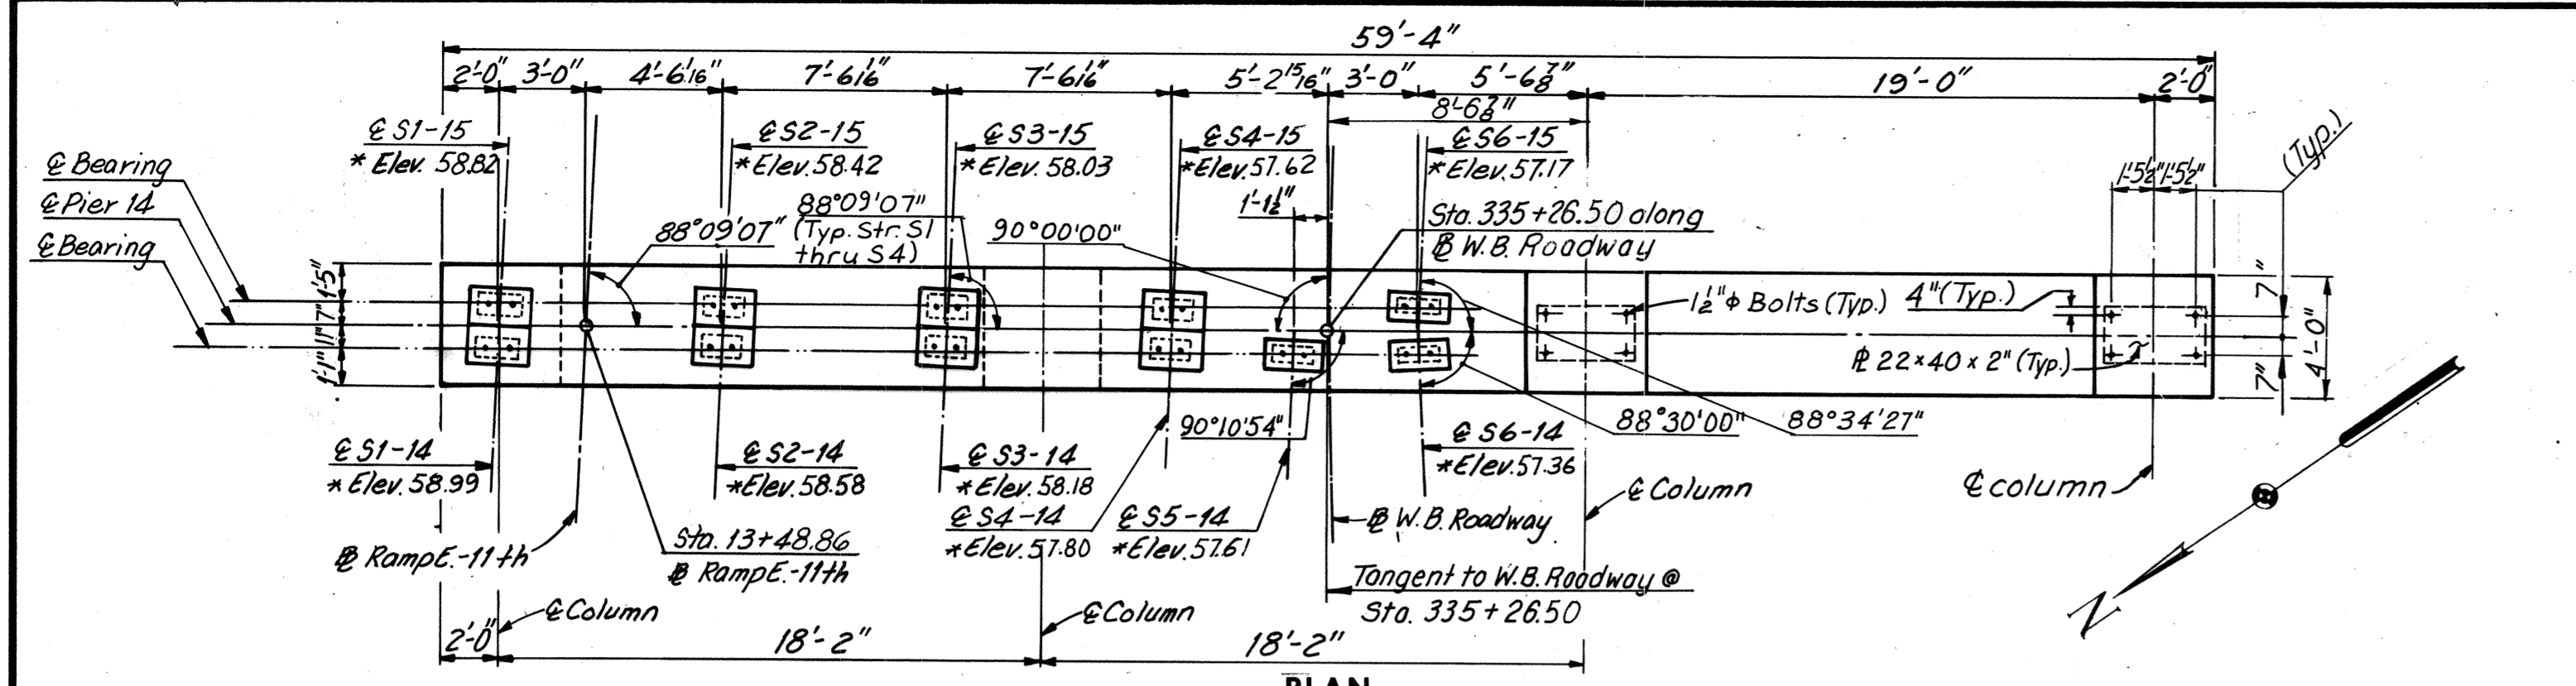

Note: All piles shall be 10BP42 Steel Piles (Design capacity = 45 tons), for Details see Sheet 6. Batter all piles 3" per foot where shown. For Shoe details, see Sheets S1S2. For Framing Plan, see Sheet 12. Estimated Pile Tip Elevation 5.0

Note: For architectural treatment of columns, see Standard Architectural Details Sheet S7

Note: Footing elevations are approximate only and may be varied to suit field conditions as directed by the Engineer. Vertical shaft reinforcing shall not be cut until these elevations are established. Where elevations change more than 2 ft., redesign will be required.

MADE	BY	DATE	NO.	REVISION	BY	DATE
G.C.C.	G.C.C.	9-3-68	2	As Built	TEM	10-76
CHECKED	PTA	01-30-69		Reinf. Qty, Footing Size & Footing Elev.	LNB	10-74
IN CHARGE						

RICHMOND METROPOLITAN AUTHORITY
RICHMOND EXPRESSWAY SYSTEM
DOWNTOWN EXPRESSWAY




BRIDGE NO. 63
WESTBOUND ROADWAY OVER
12TH ST. - R.R. TRACKS AND 16TH ST.
PIER 14

HOWARD, NEEDLES, TAMMEN & BERGENDOFF
consulting engineers
NEW YORK ALEXANDRIA KANSAS CITY

SCALE: As Noted
CONTRACT NO.: 10
SHEET NO. 5 OF 29

AS BUILT






RICHMOND EXPRESSWAY SYSTEM			
SECTION	PROJECT	SHEET NO.	TOTAL SHEETS
10	DOWNTOWN EXPRESSWAY	75	265

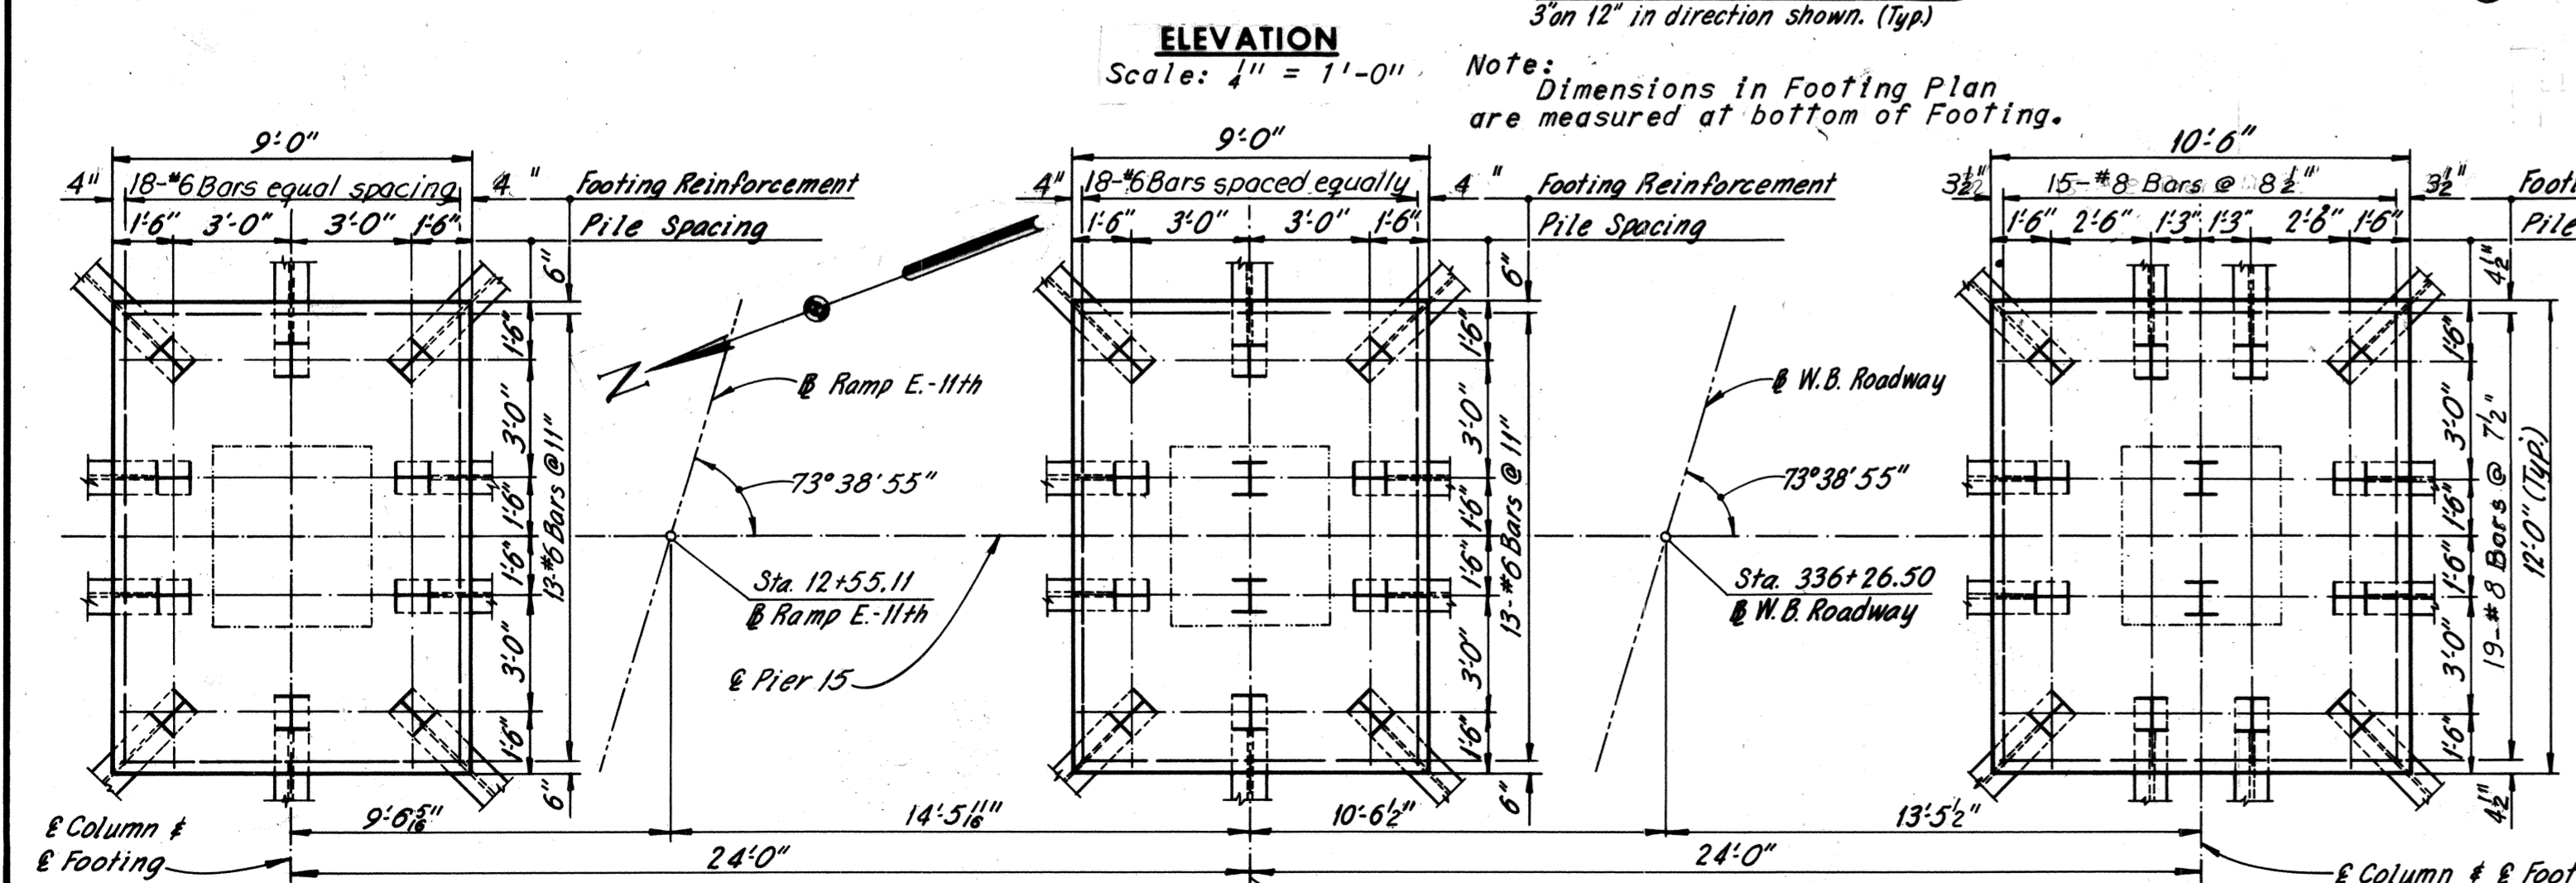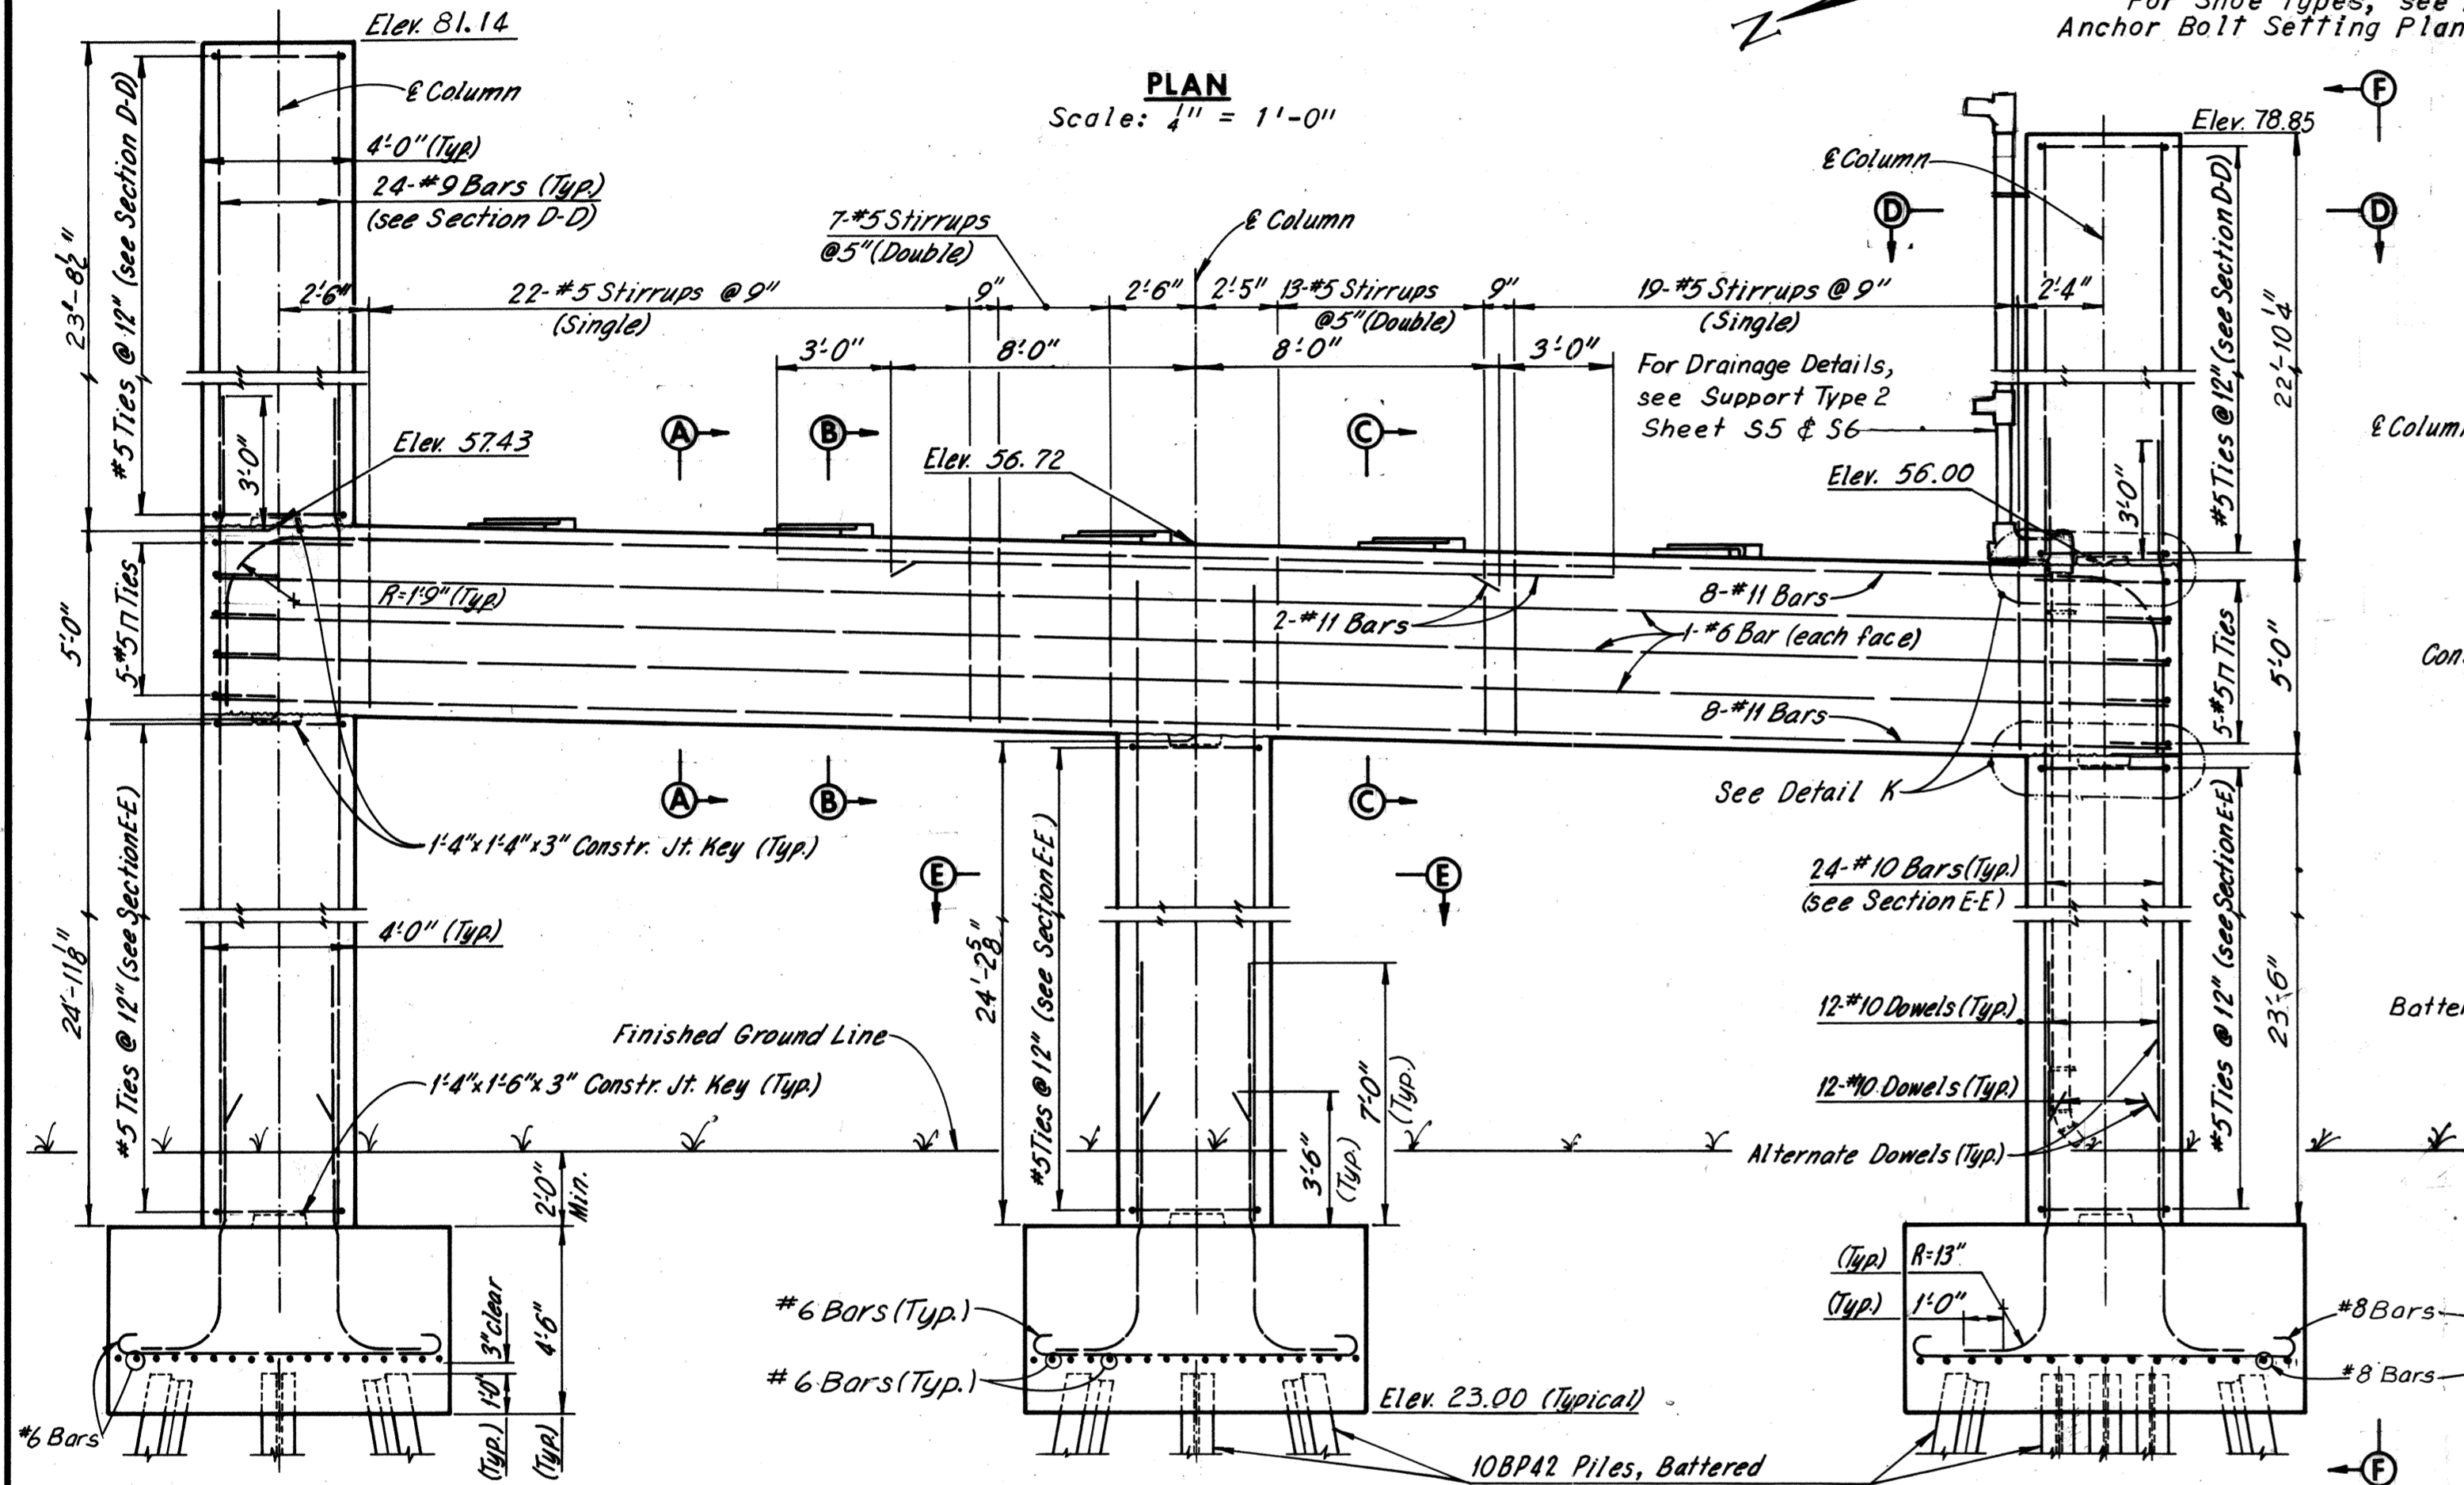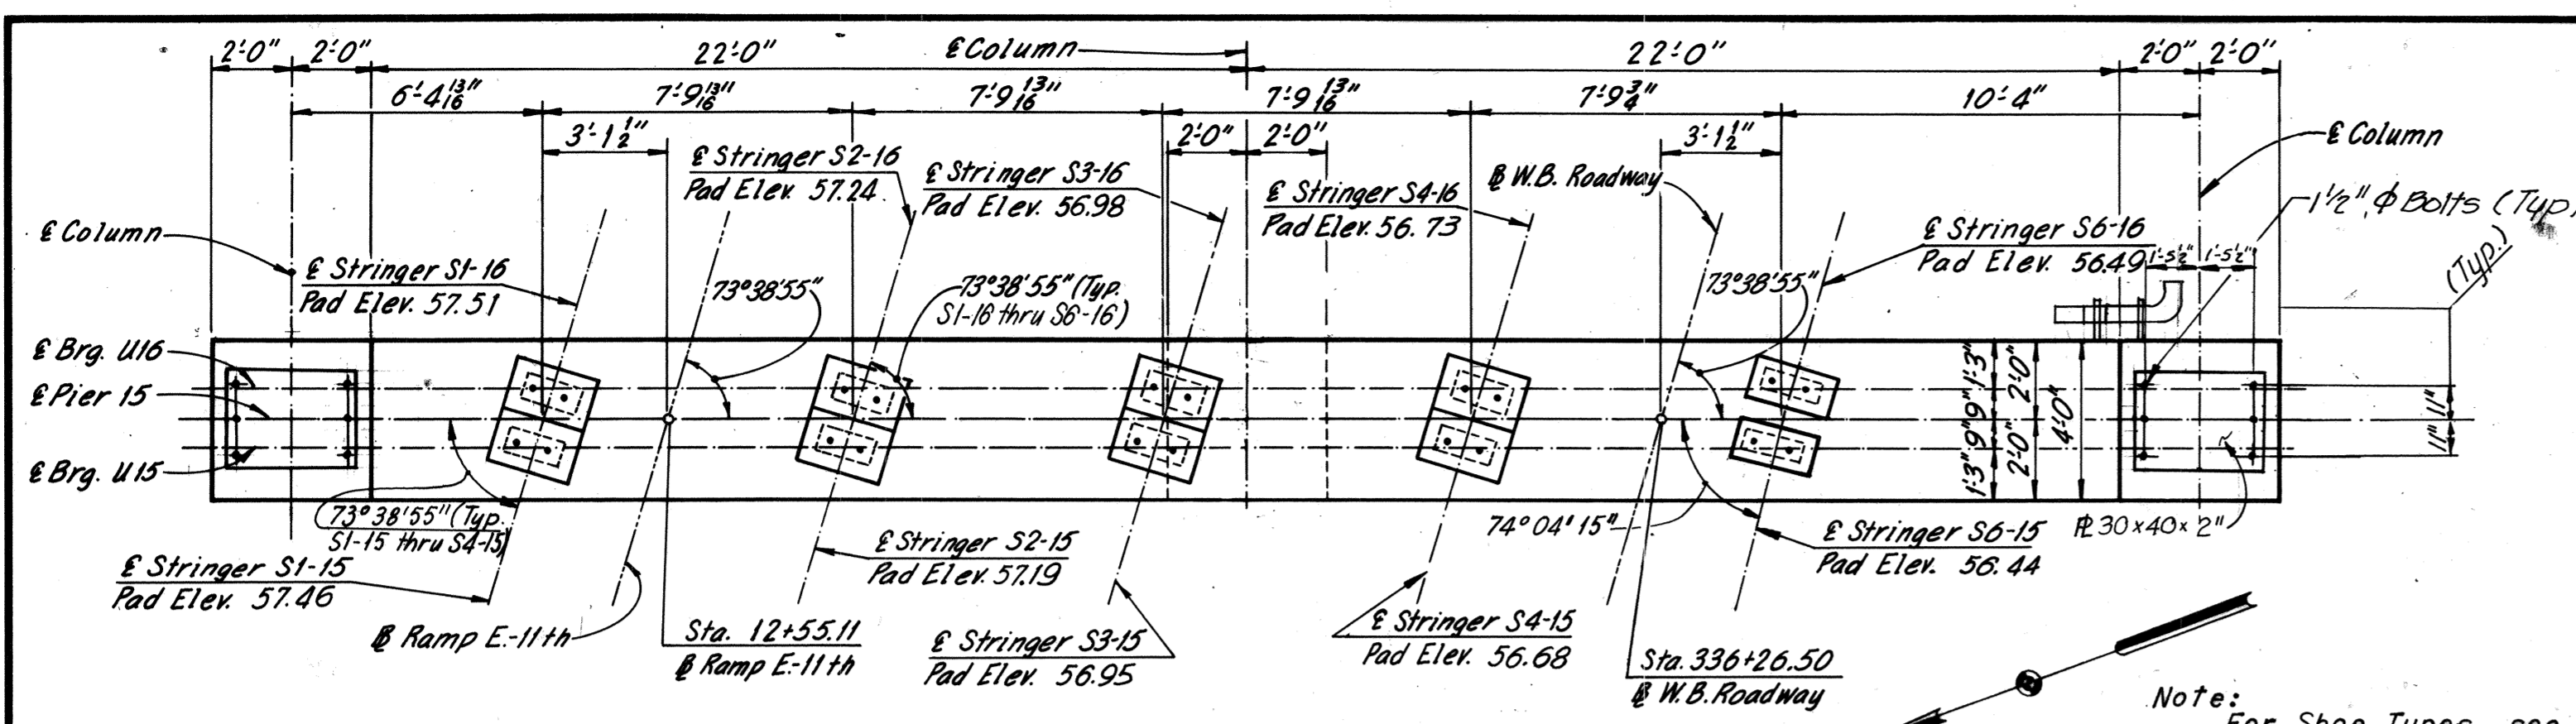

NO.	REVISION	BY	DATE
1	As Built	TEM	10-76

FOOTING PLAN
Scale: 1/4" = 1'-0"

Note: Footing elevations are approximate only and may be varied to suit field conditions as directed by the Engineer. Vertical shaft reinforcing shall not be cut until these elevations are established. Where elevations change more than 2 ft., redesign will be required.

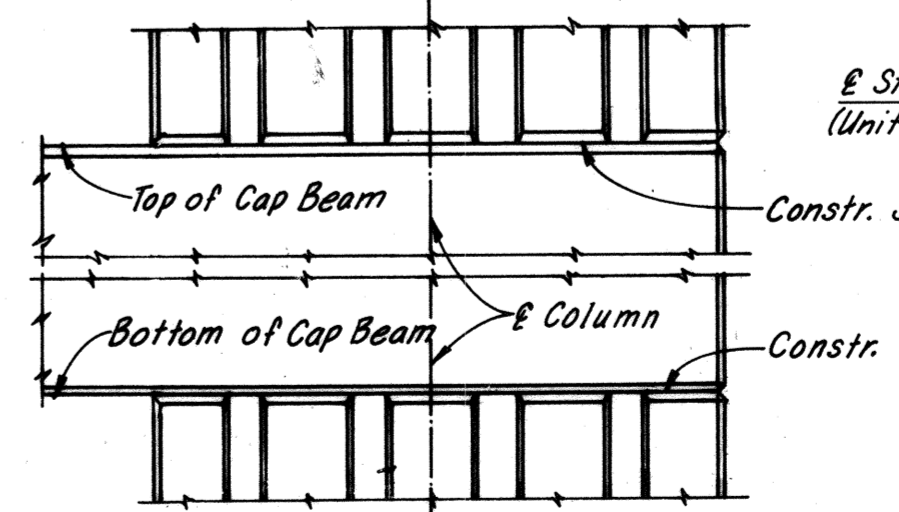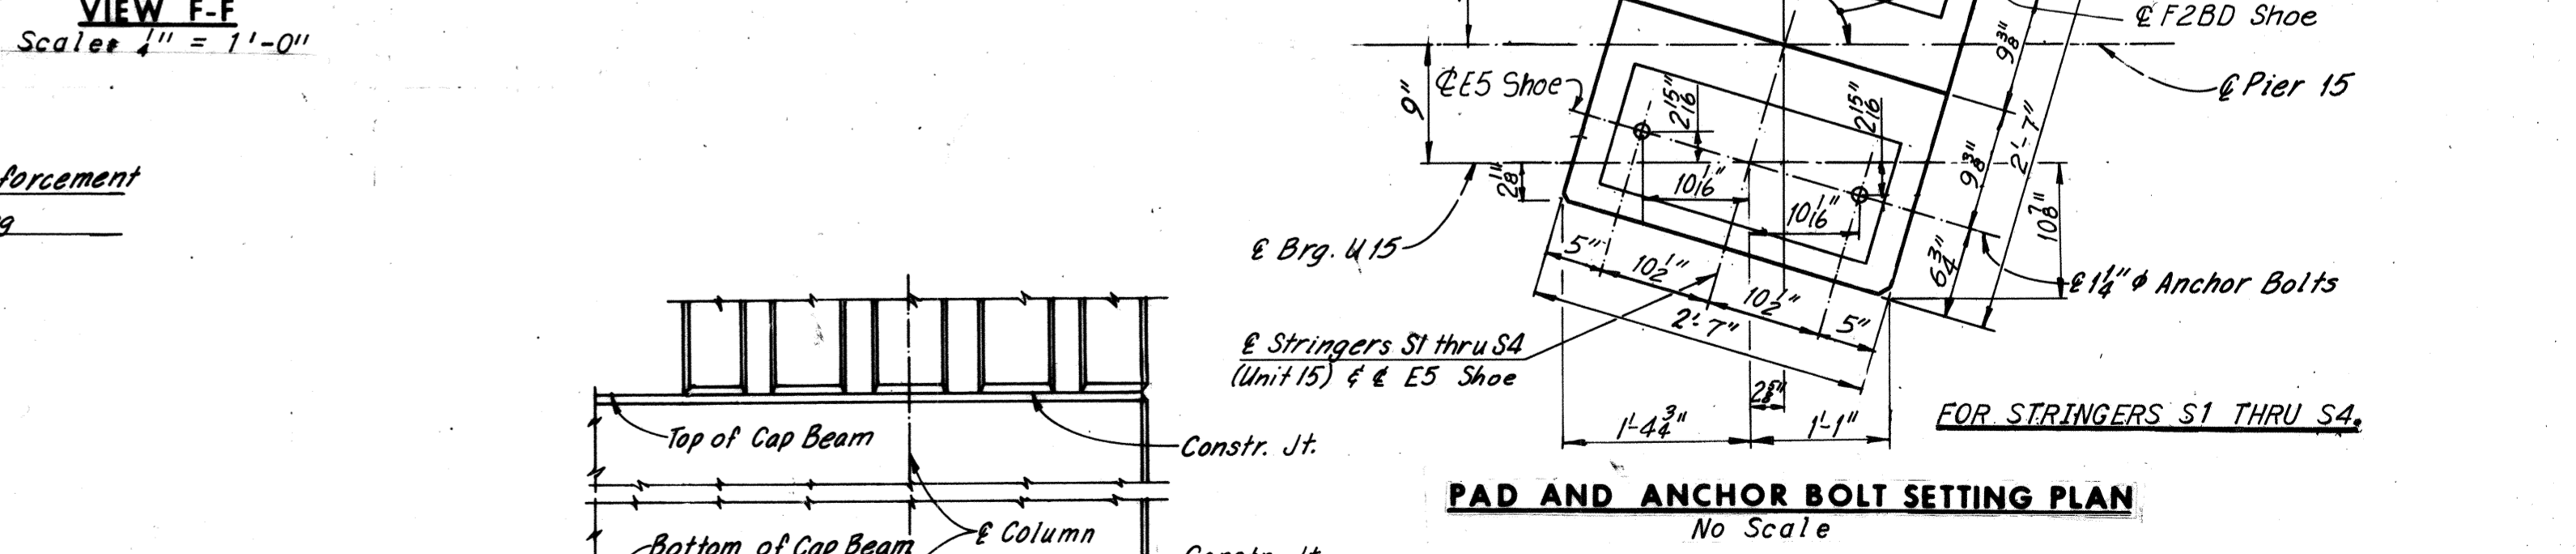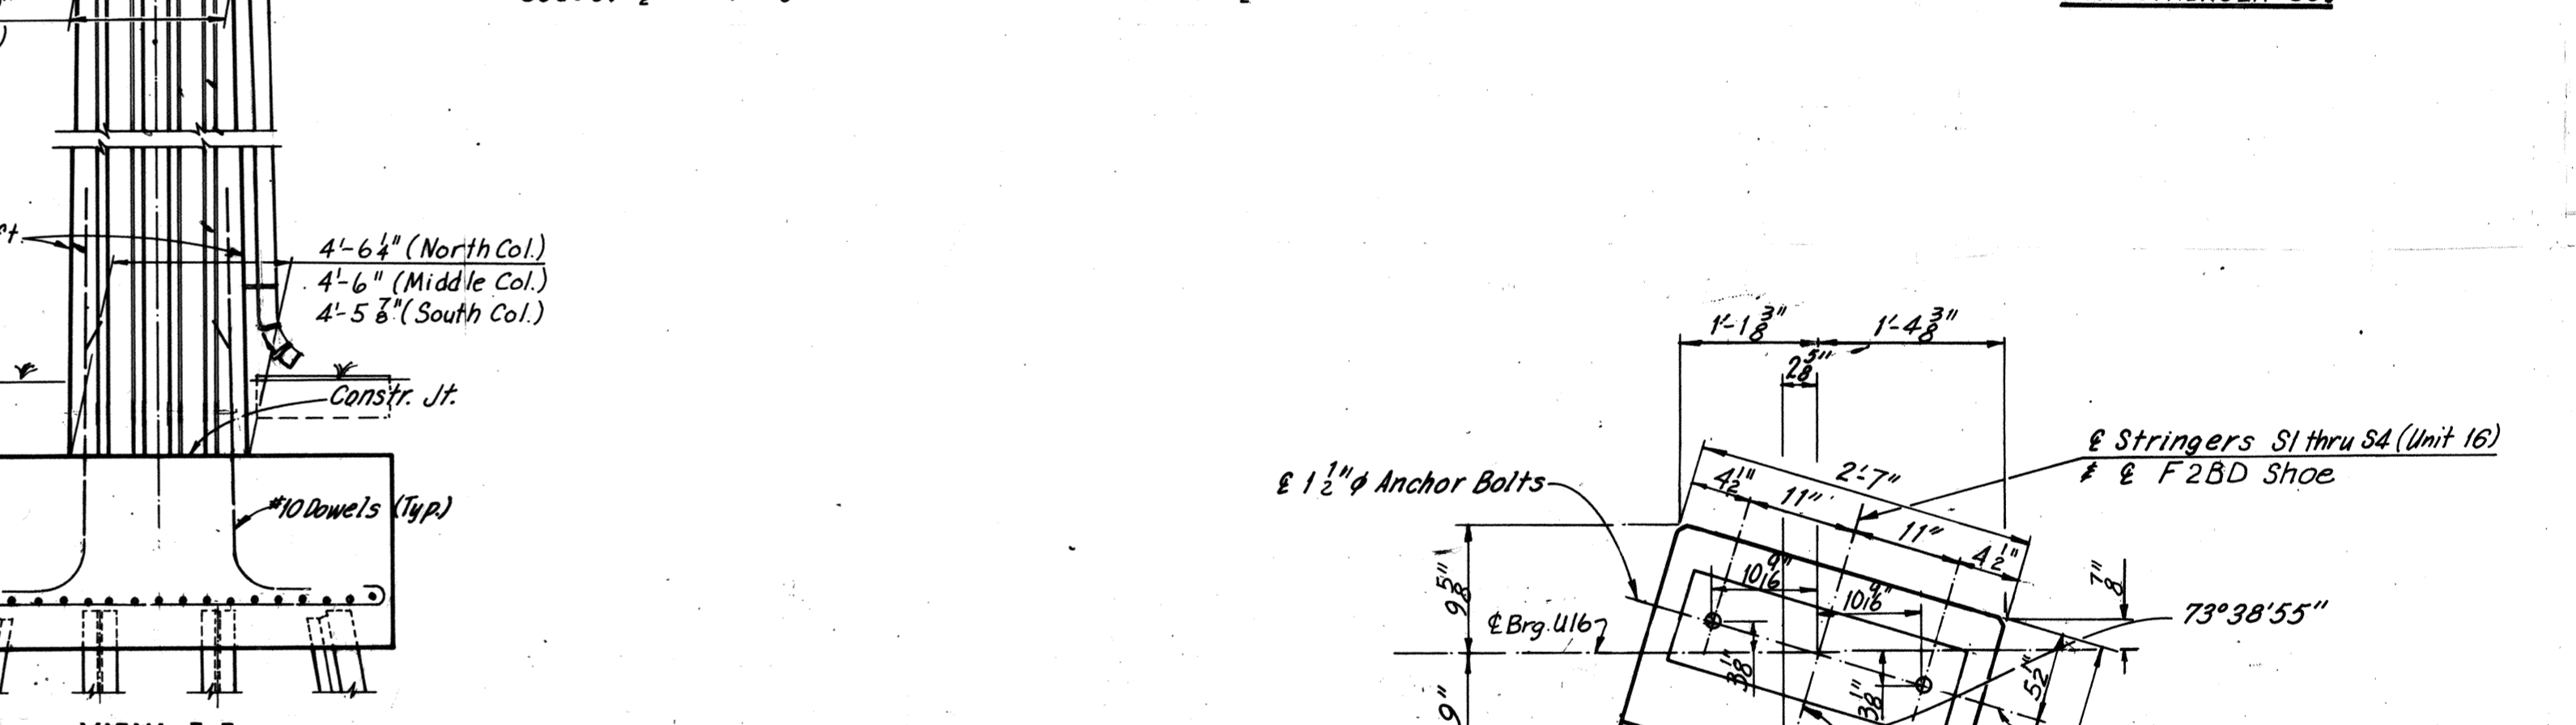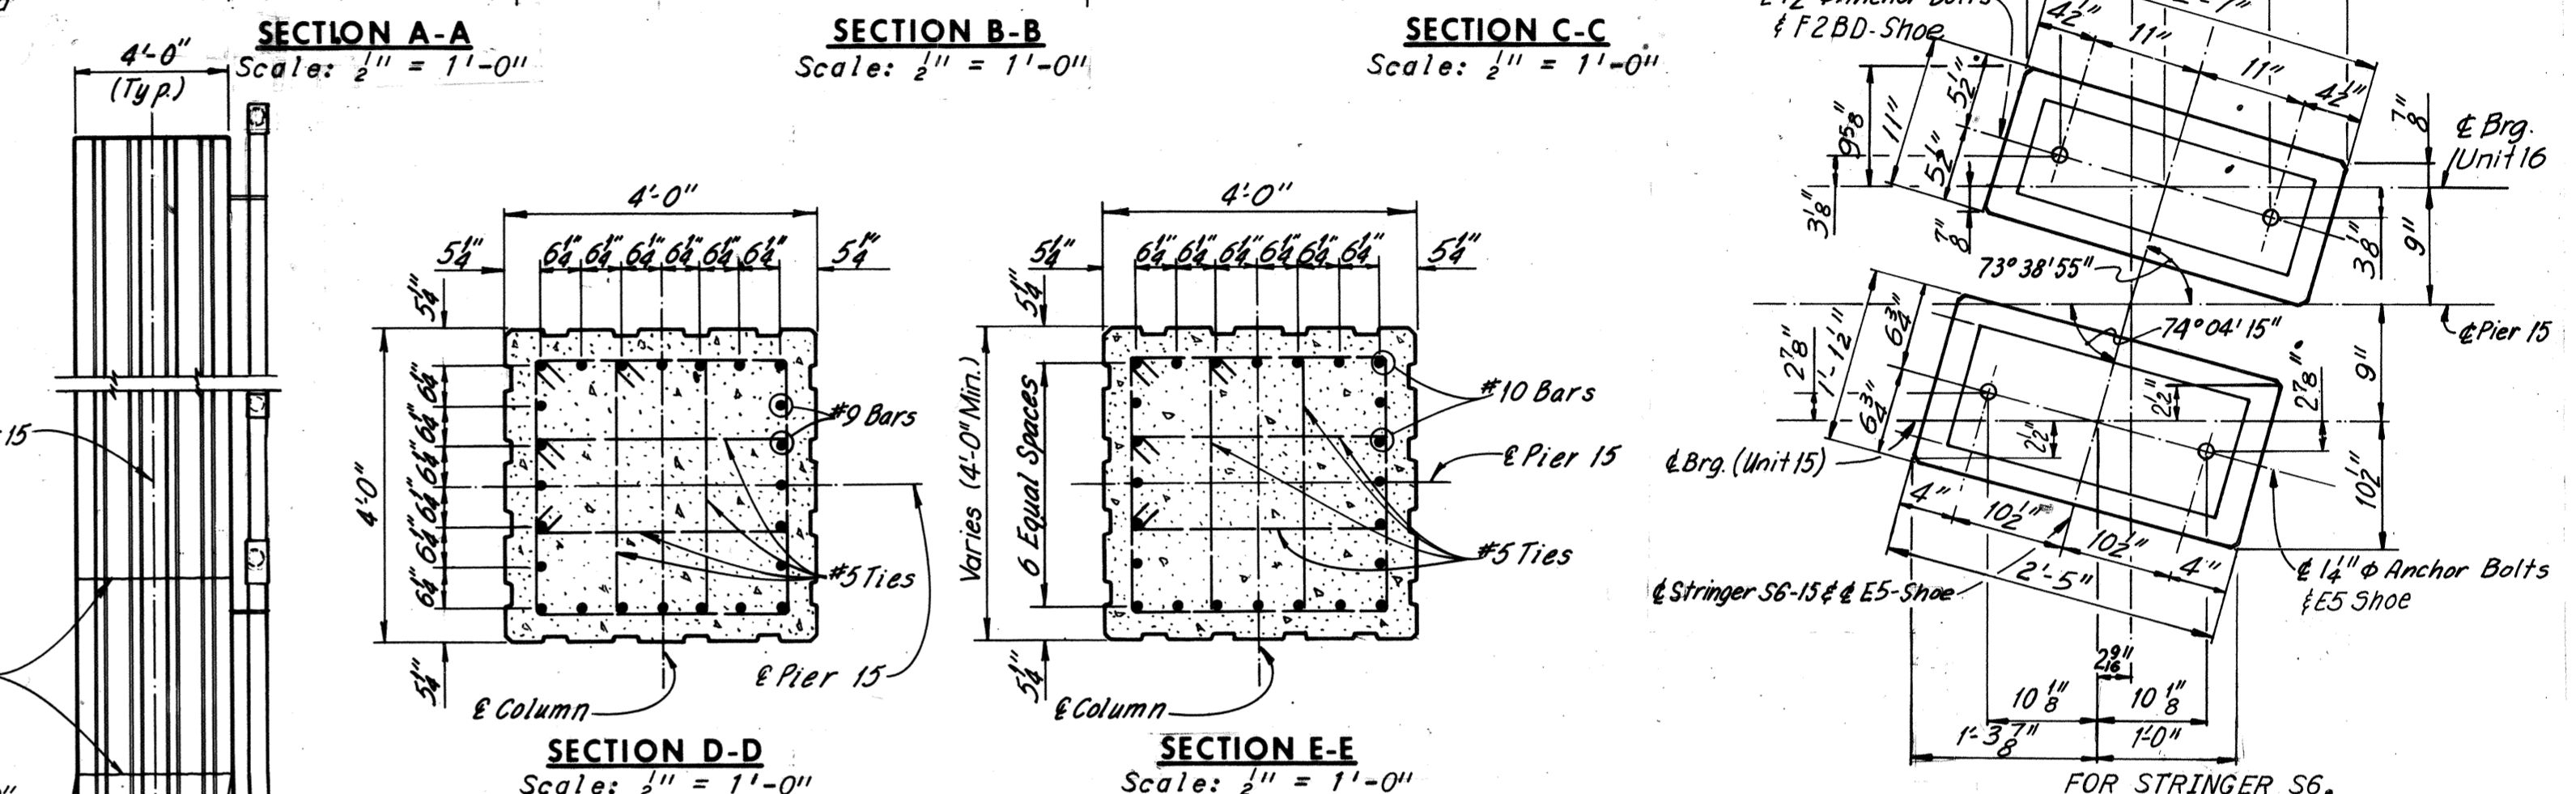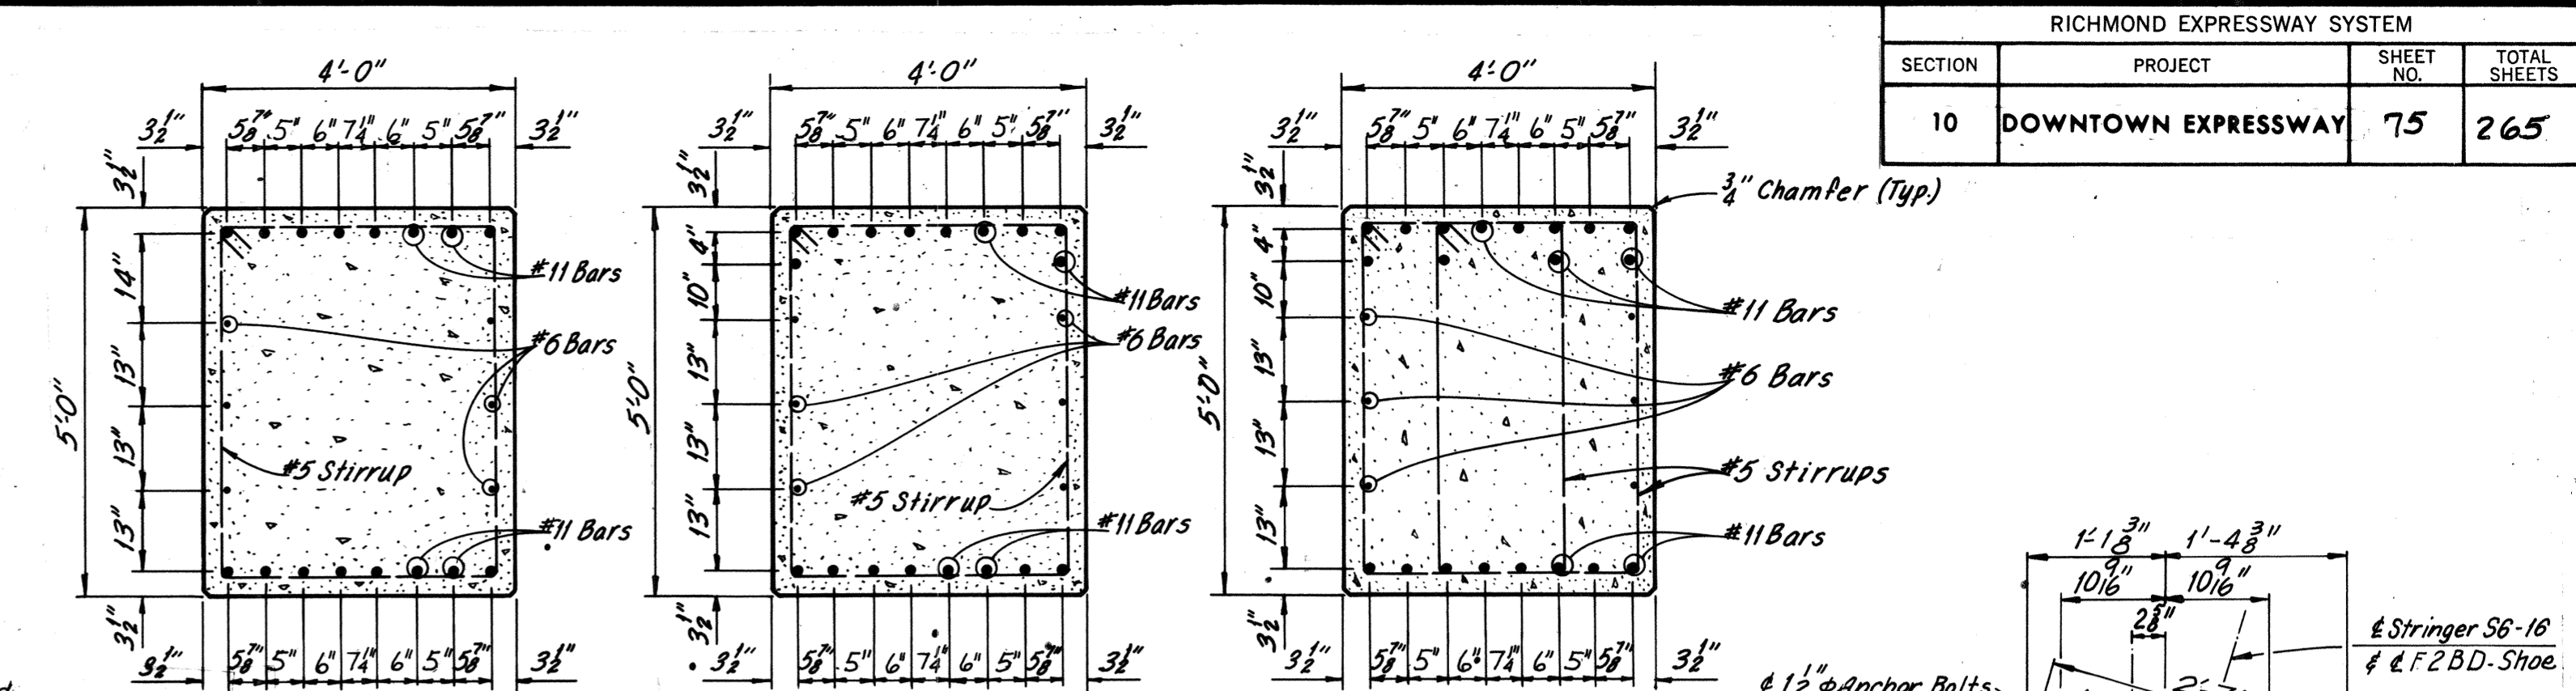

DETAIL K
No Scale

Note: All piles shall be 10BP42 Steel Piles (Design capacity = 45 tons).
Batter all piles 3" per foot where shown.
For Shoe details, see Sheet S152.
For Framing details, see Sheet 12.
Estimated Pile Tip Elevation 0.0.
For Architectural treatment of column, see Sheet S7.

AS BUILT

RICHMOND METROPOLITAN AUTHORITY
RICHMOND EXPRESSWAY SYSTEM
DOWNTOWN EXPRESSWAY

BRIDGE NO. 63
WESTBOUND ROADWAY OVER
12TH ST. - R.R. TRACKS AND 16TH ST.
PIER 15











HOWARD, NEEDLES, TAMMEN & BERGENDOFF
consulting engineers
NEW YORK ALEXANDRIA KANSAS CITY

SCALE: As Noted
CONTRACT NO.: 10
SHEET NO. 6 OF 29

1028-21-10-003-B53

RICHMOND EXPRESSWAY SYSTEM			
SECTION	PROJECT	SHEET NO.	TOTAL SHEETS
10	DOWNTOWN EXPRESSWAY	77	265

Note: All piles shall be HP12x53 Steel Piles (Design capacity = 58 tons).
 For Shoe Details, see Sheets S1-S2
 Pile Tip elevation = -5.0
 For Framing Plan see Sheet 13.
 For Steel Pile Details, see Sheet 11.
 For architectural treatment of Columns, see Sheet S7.

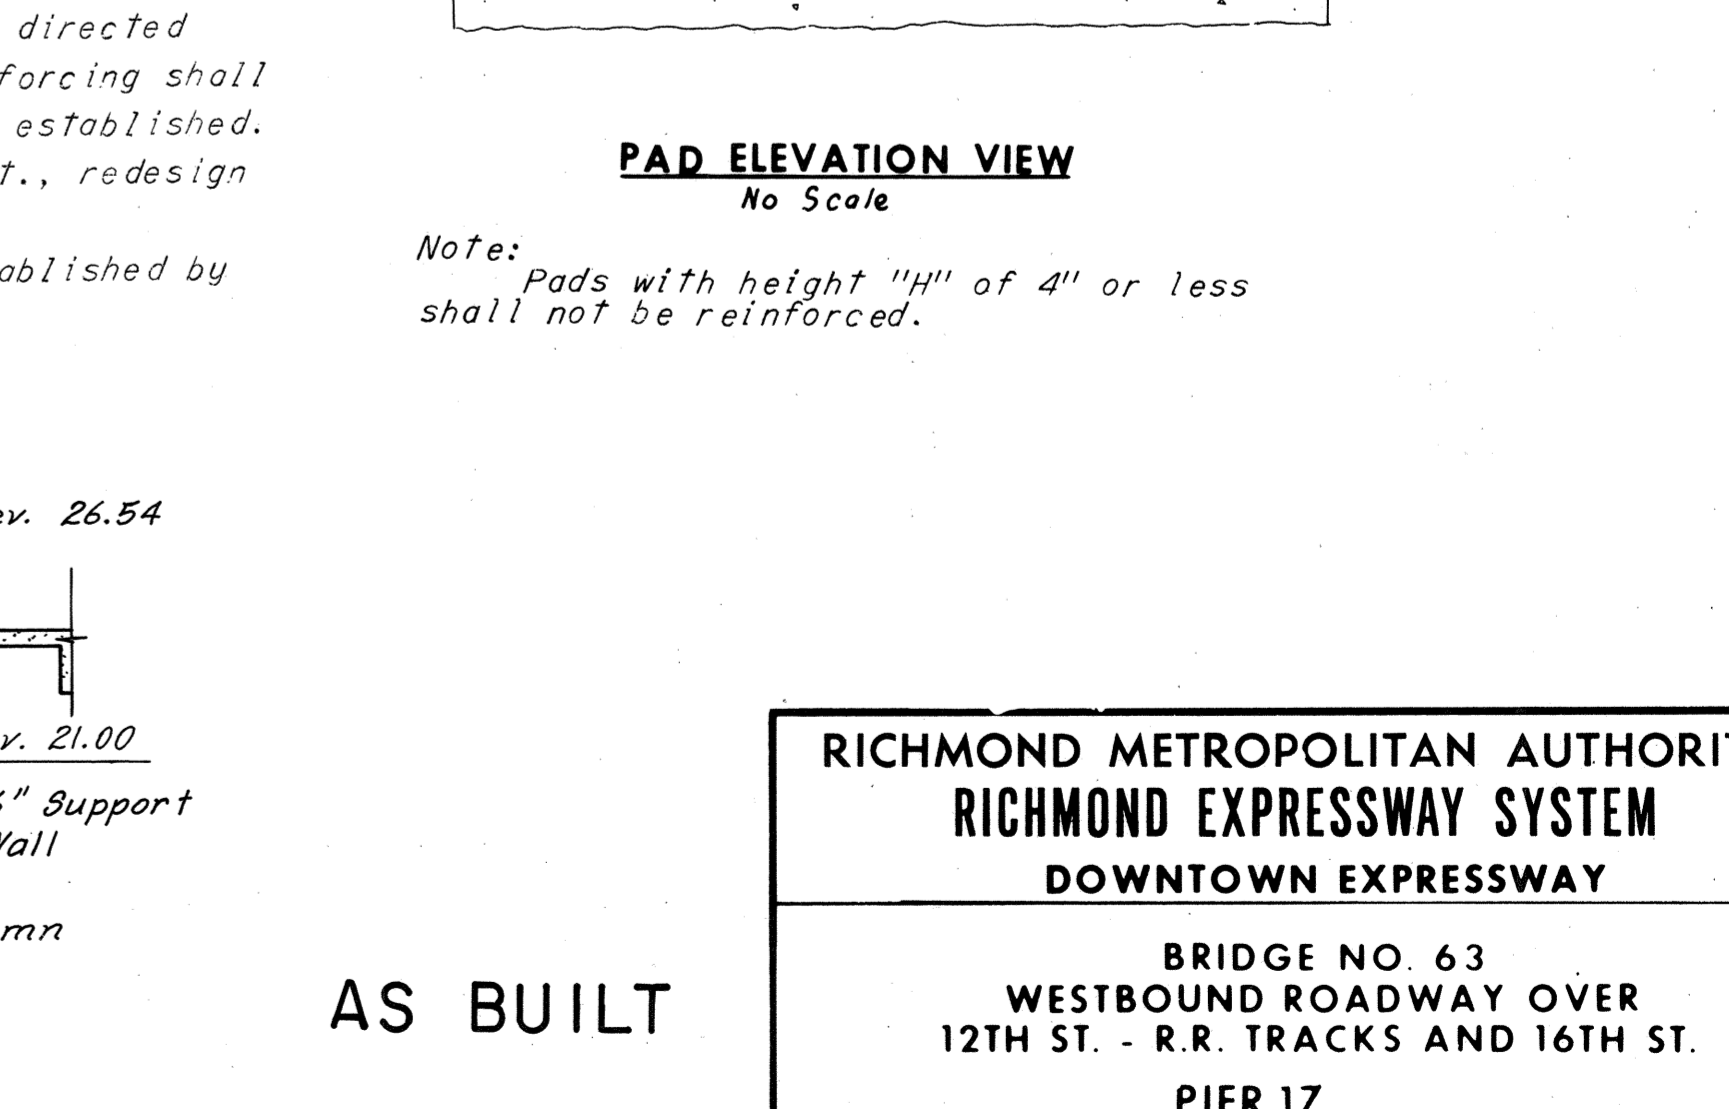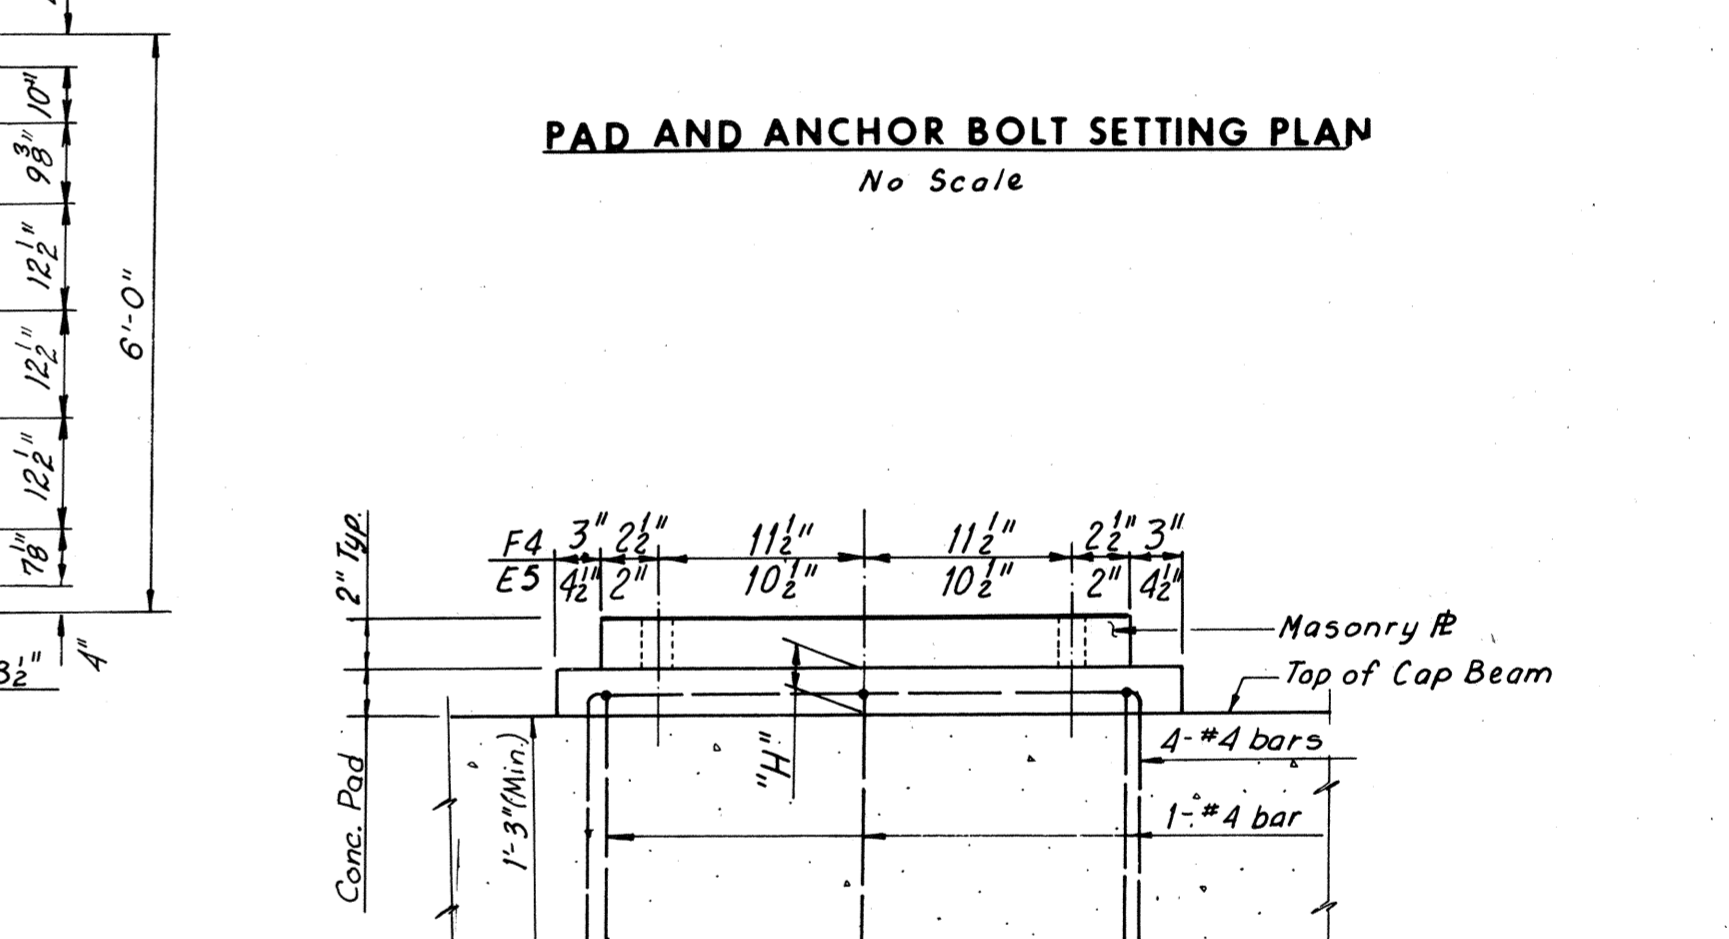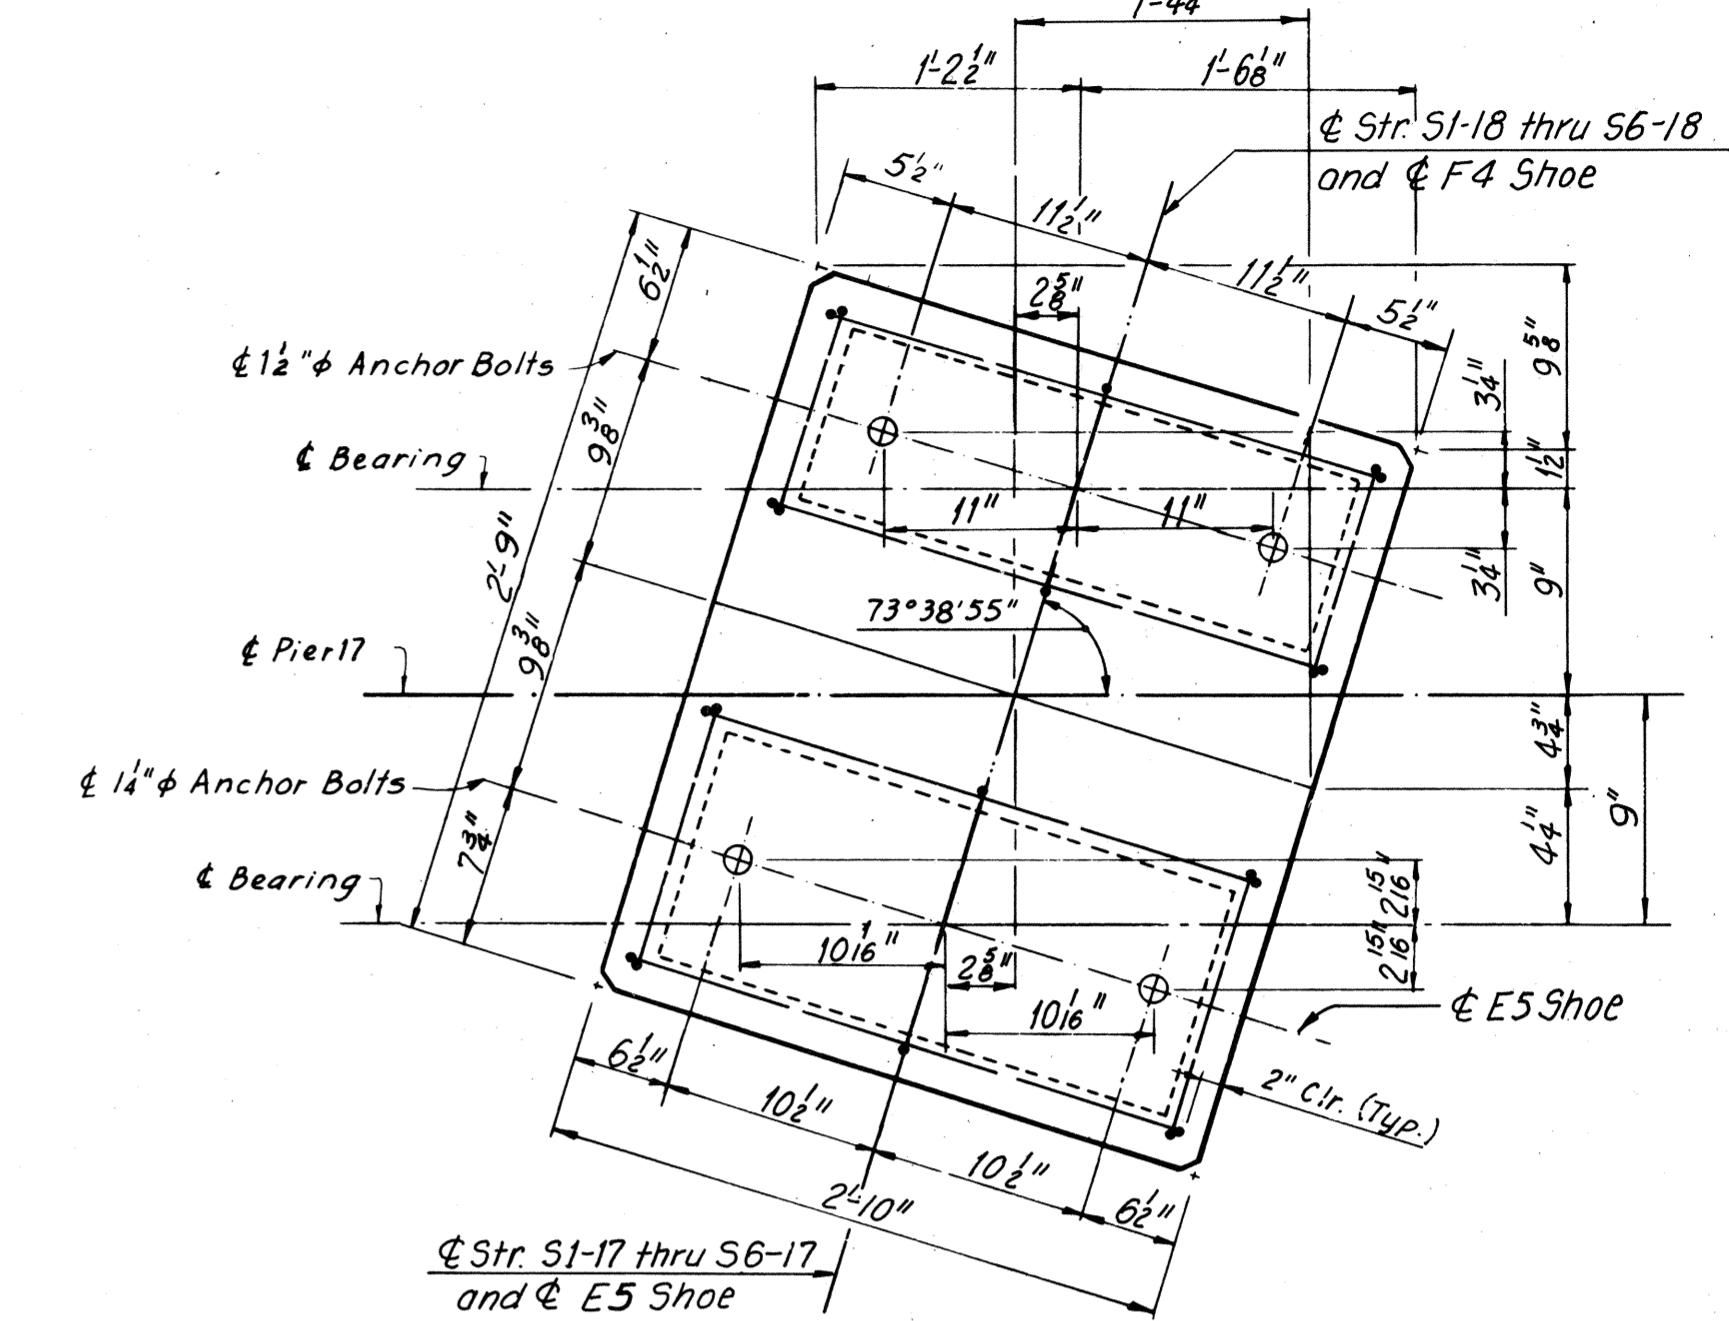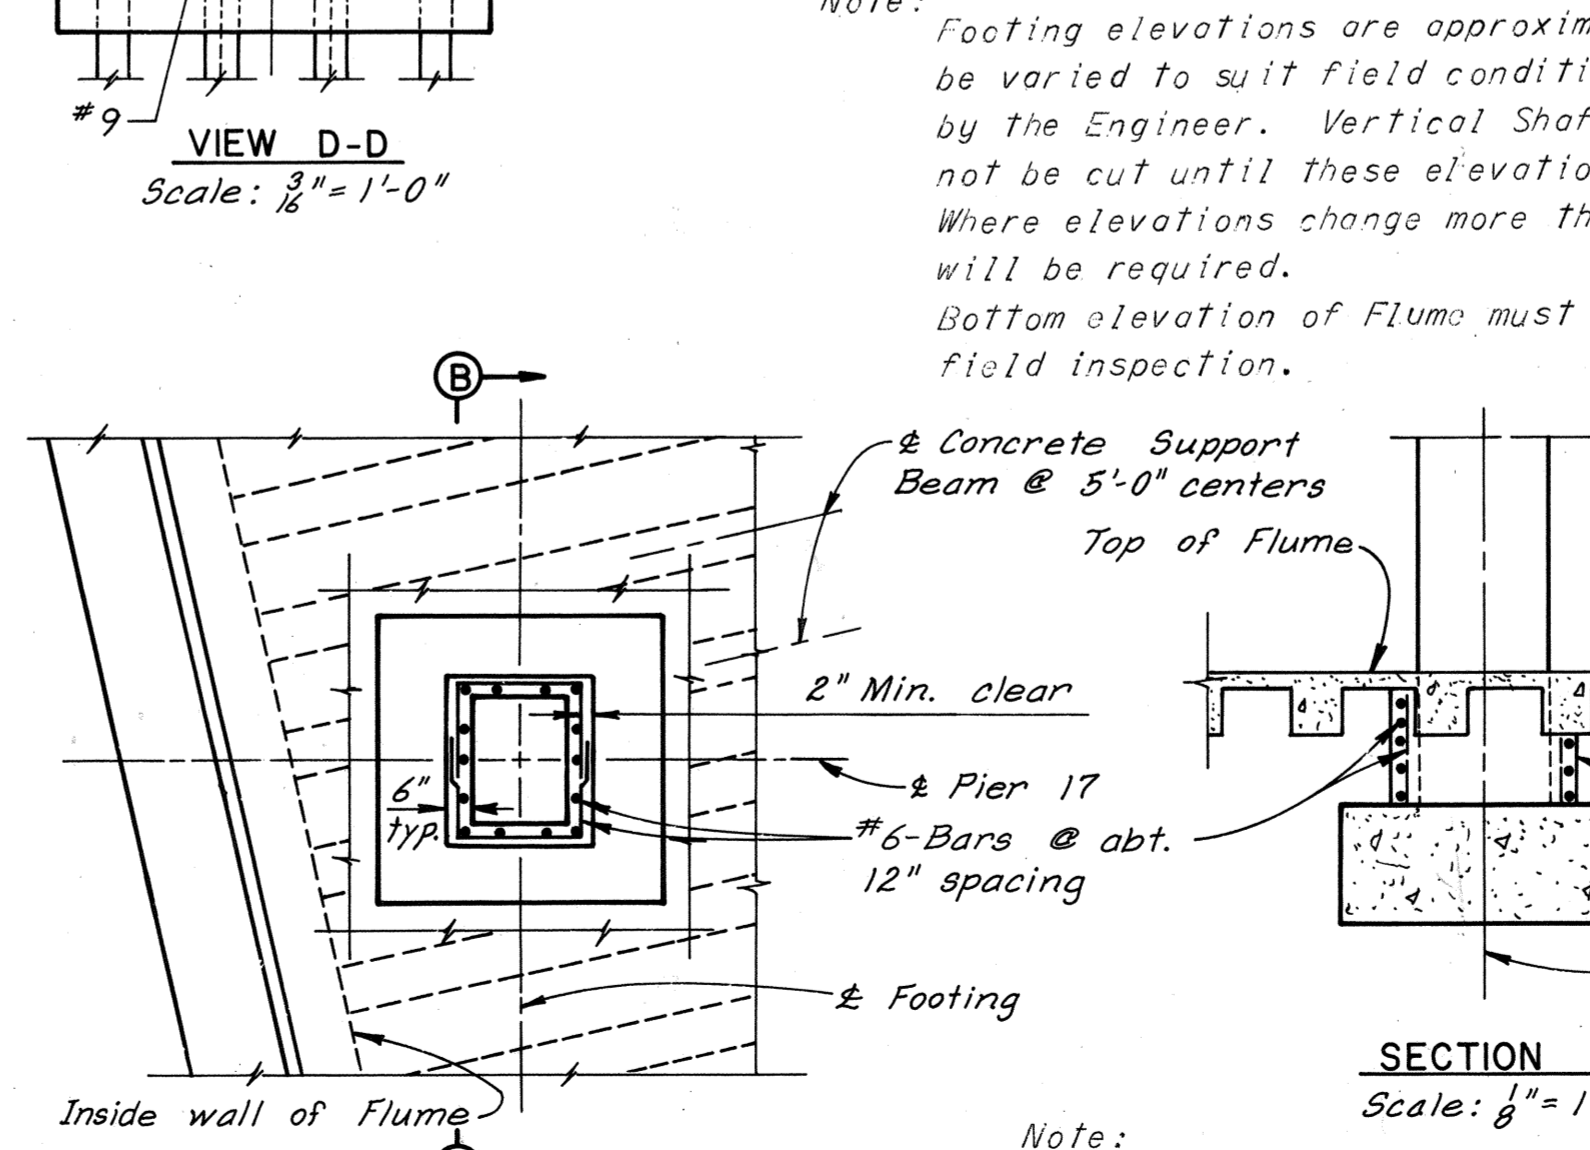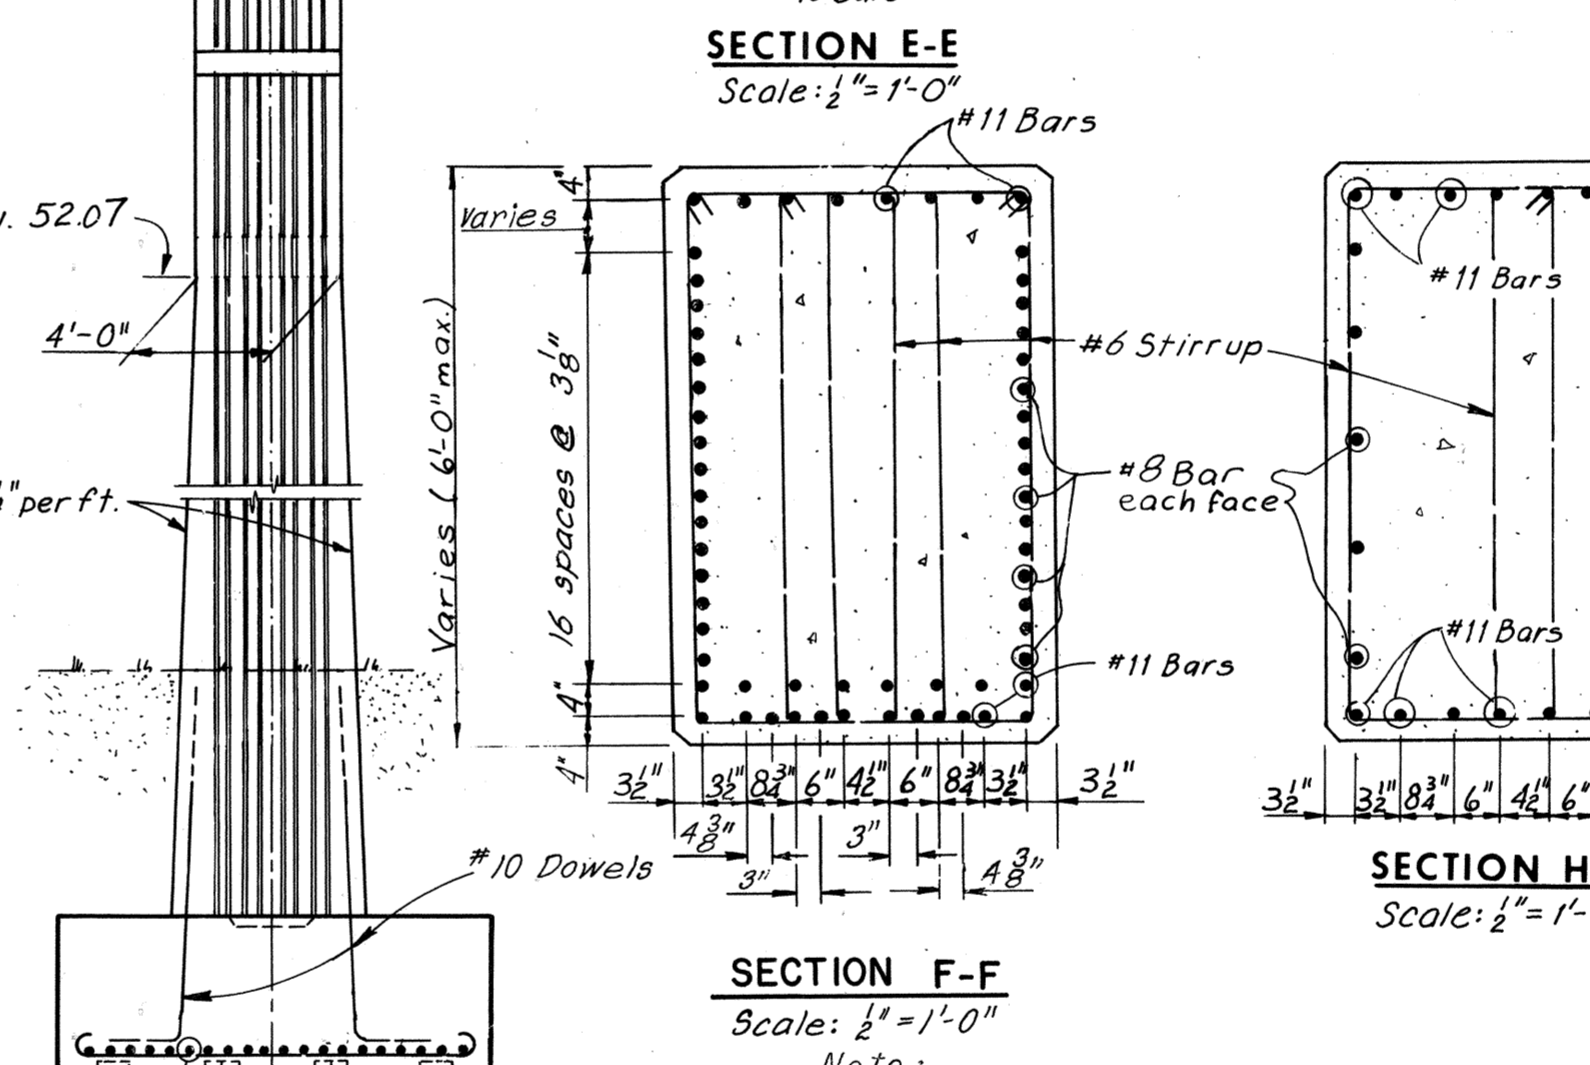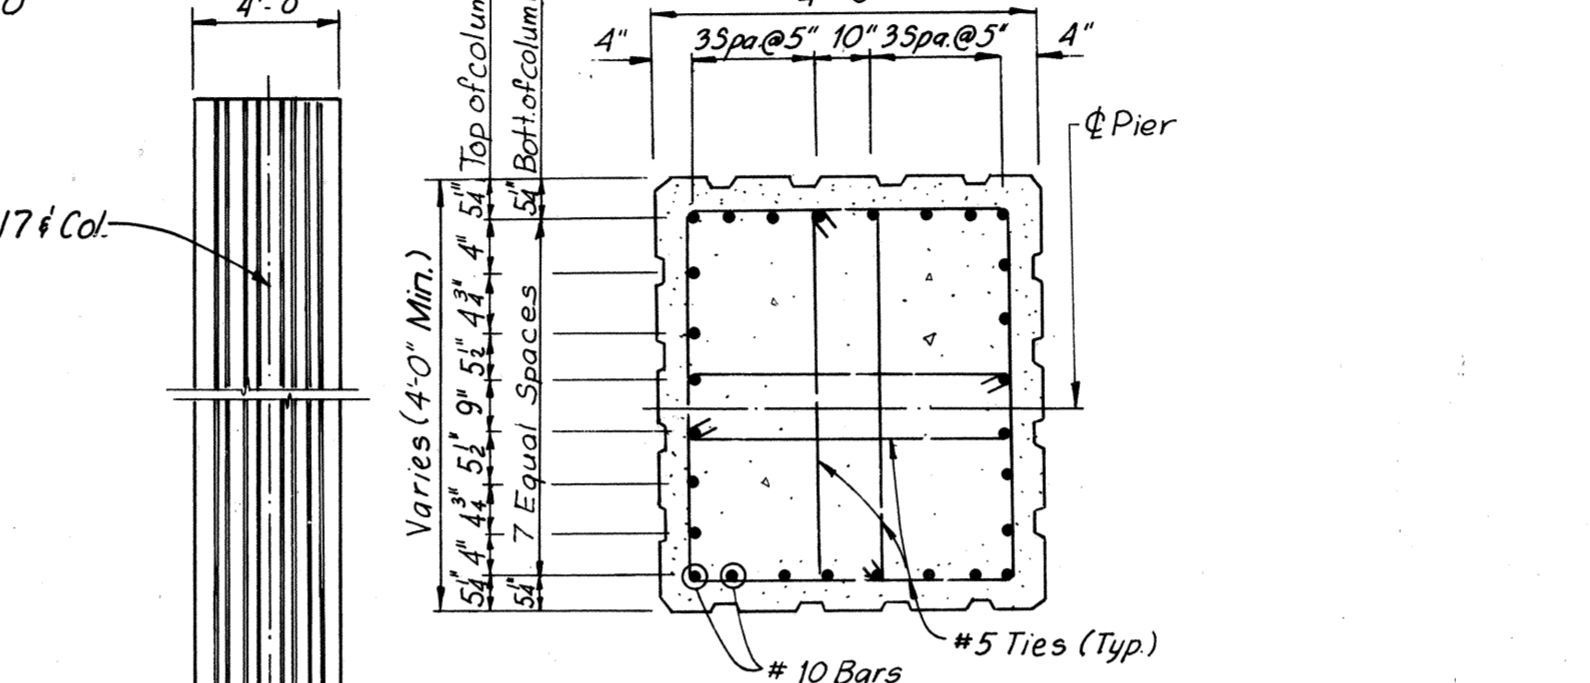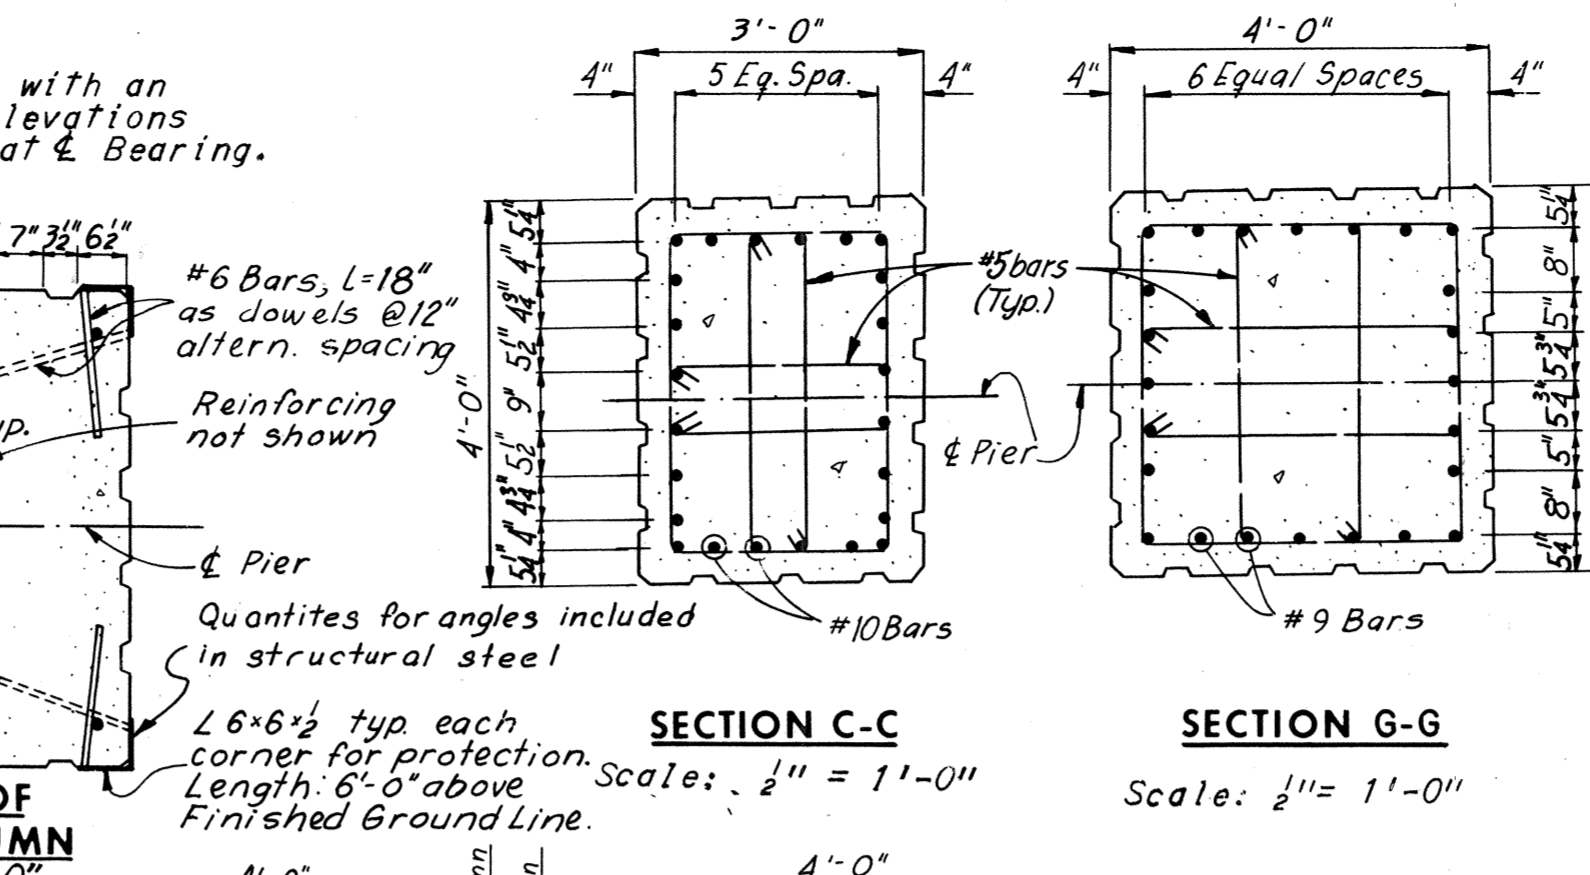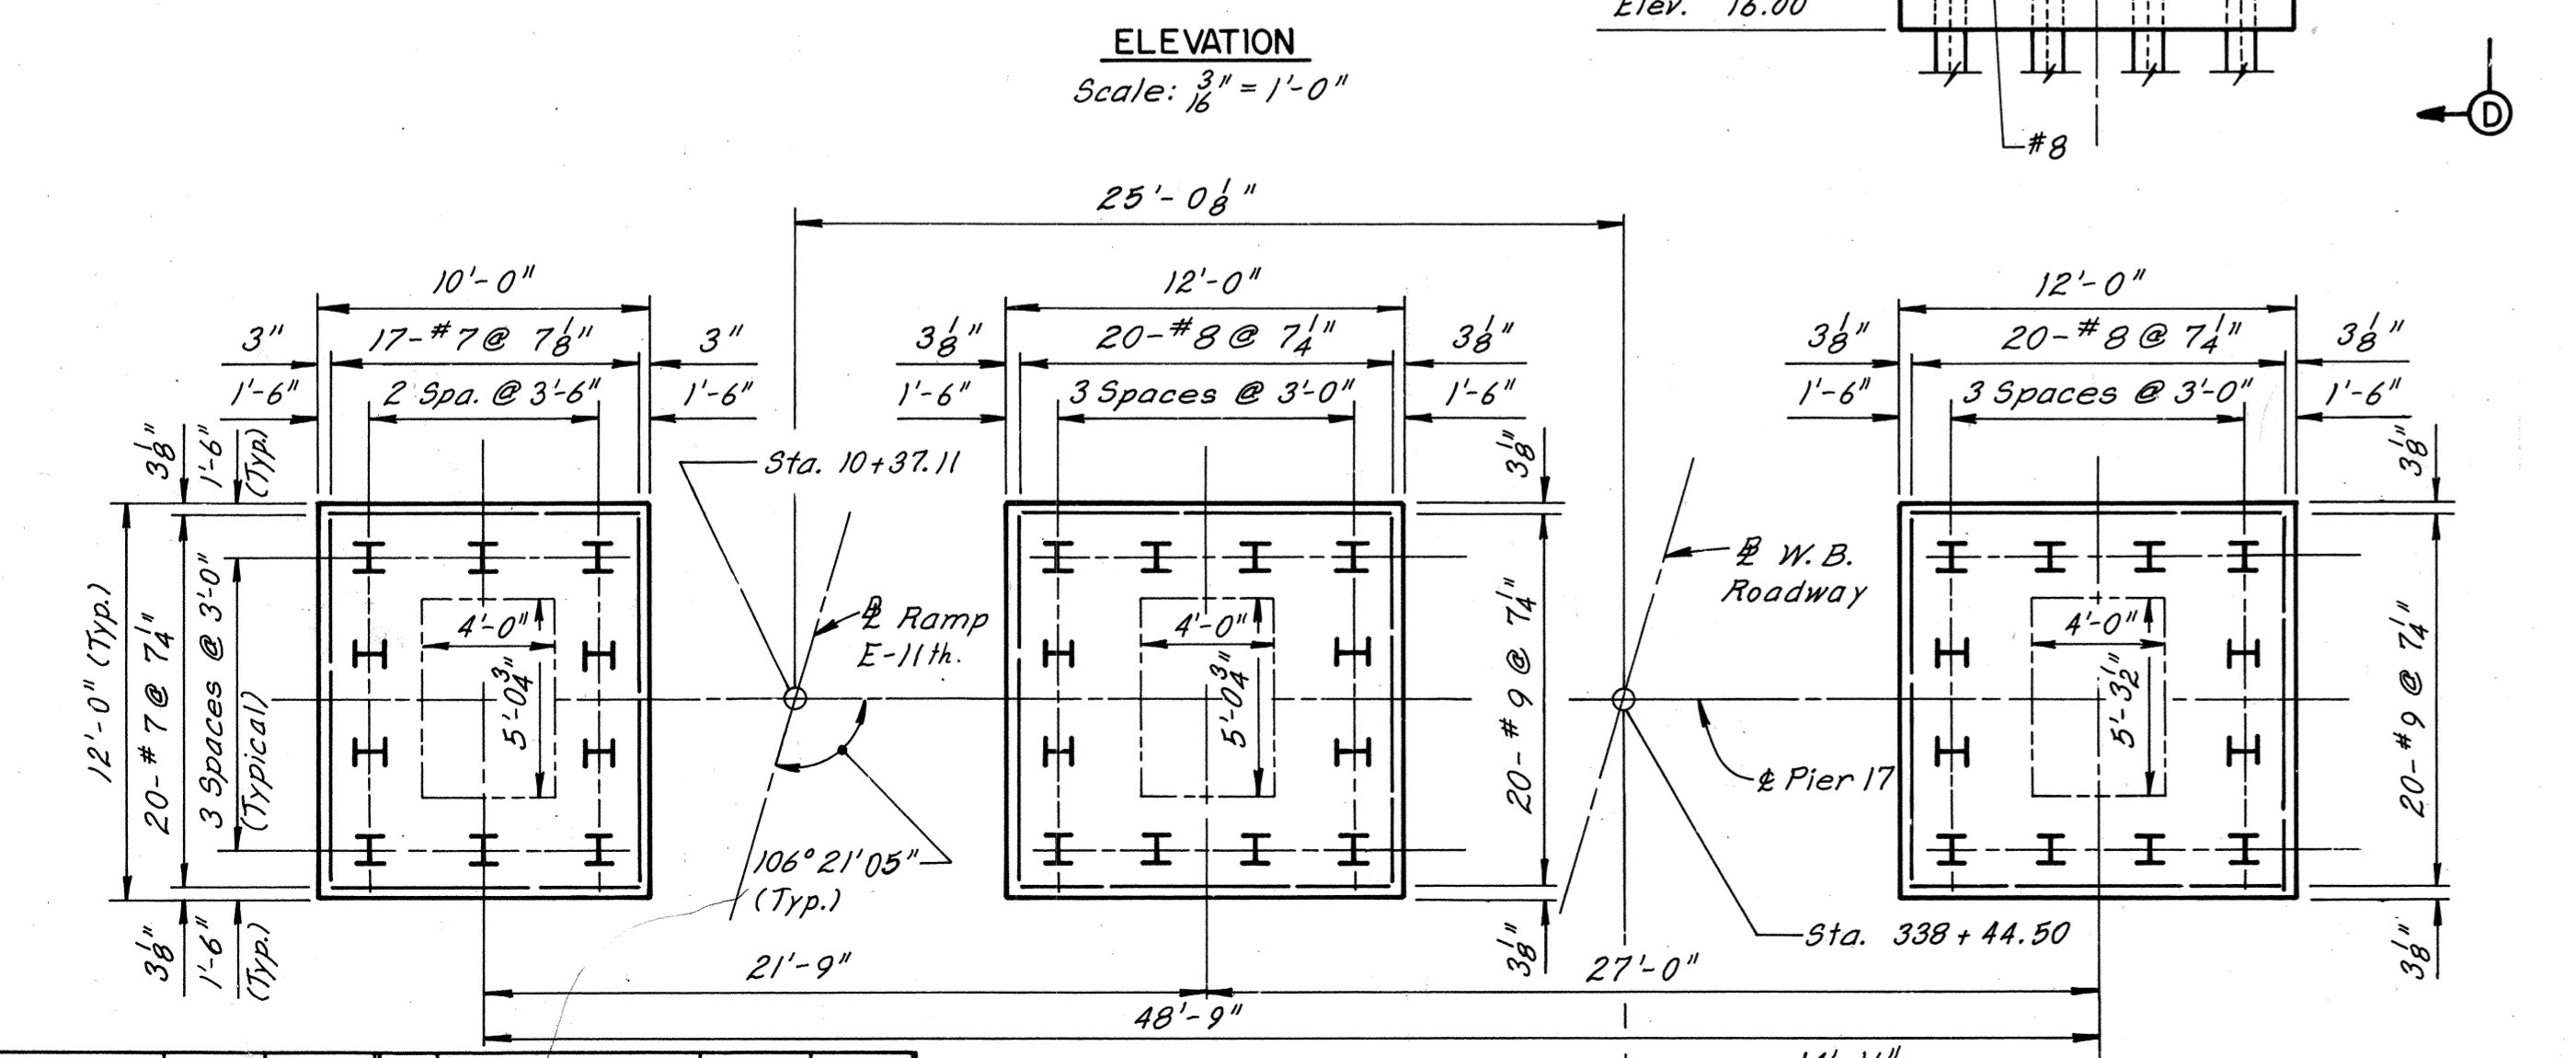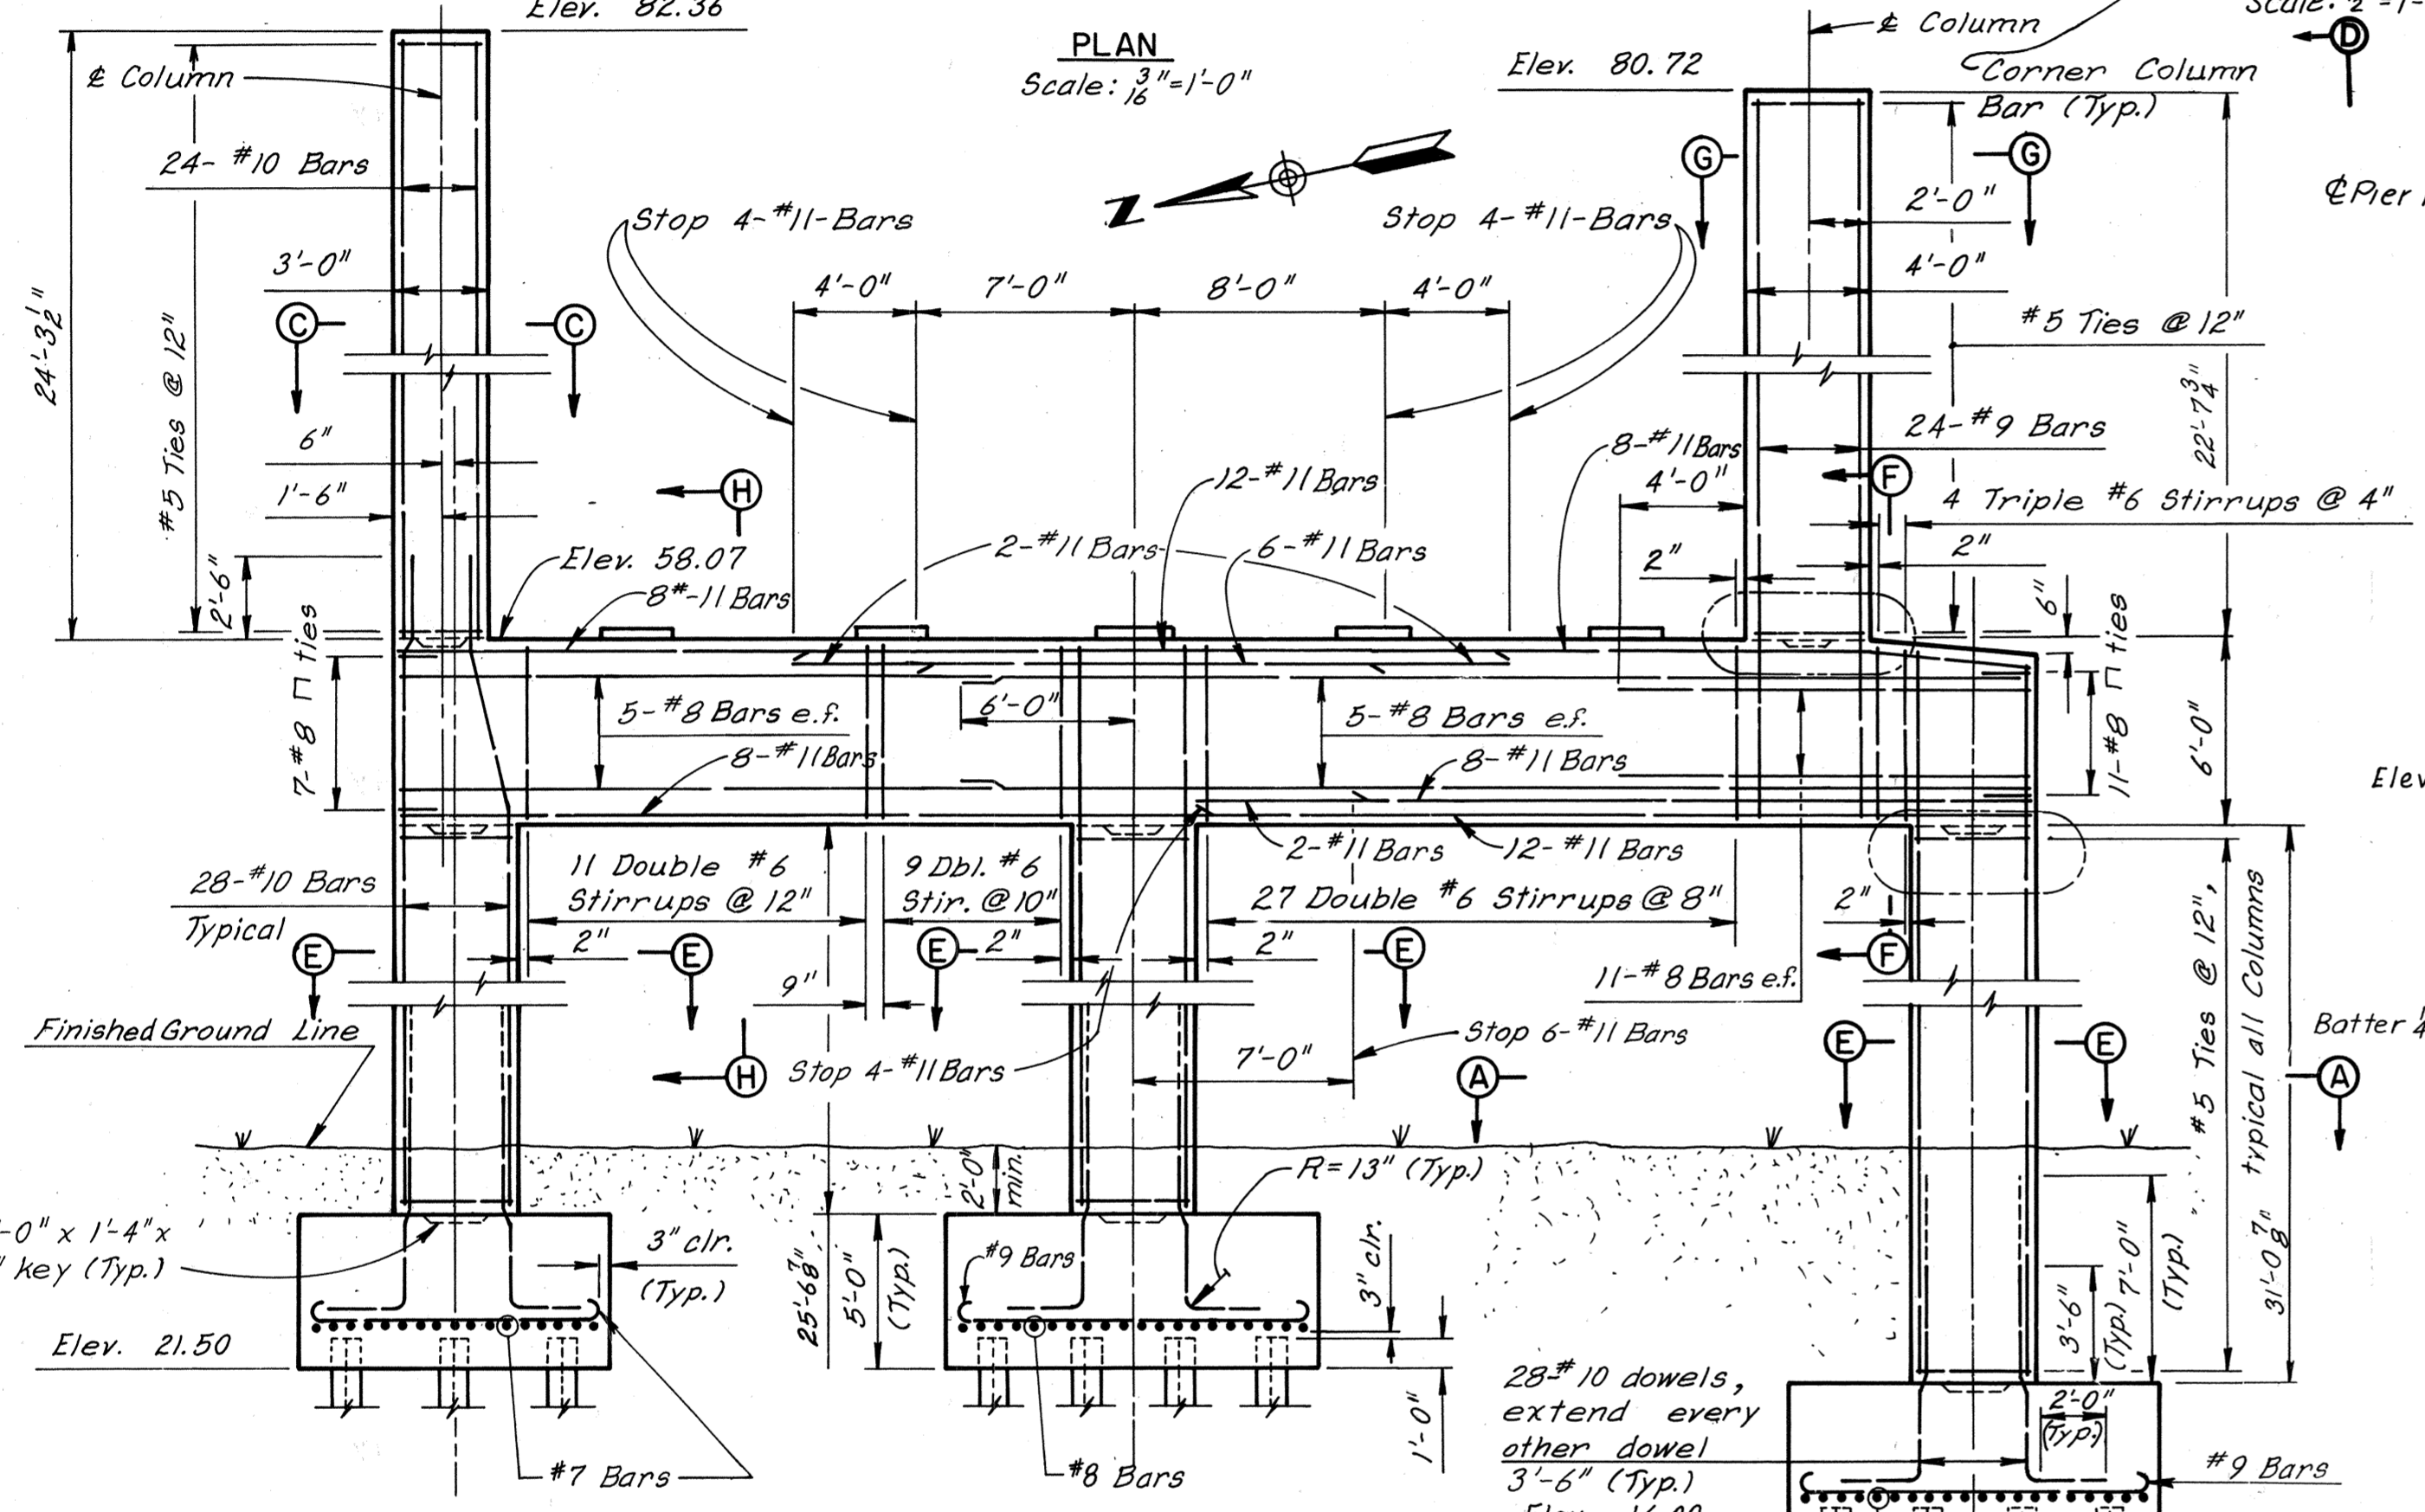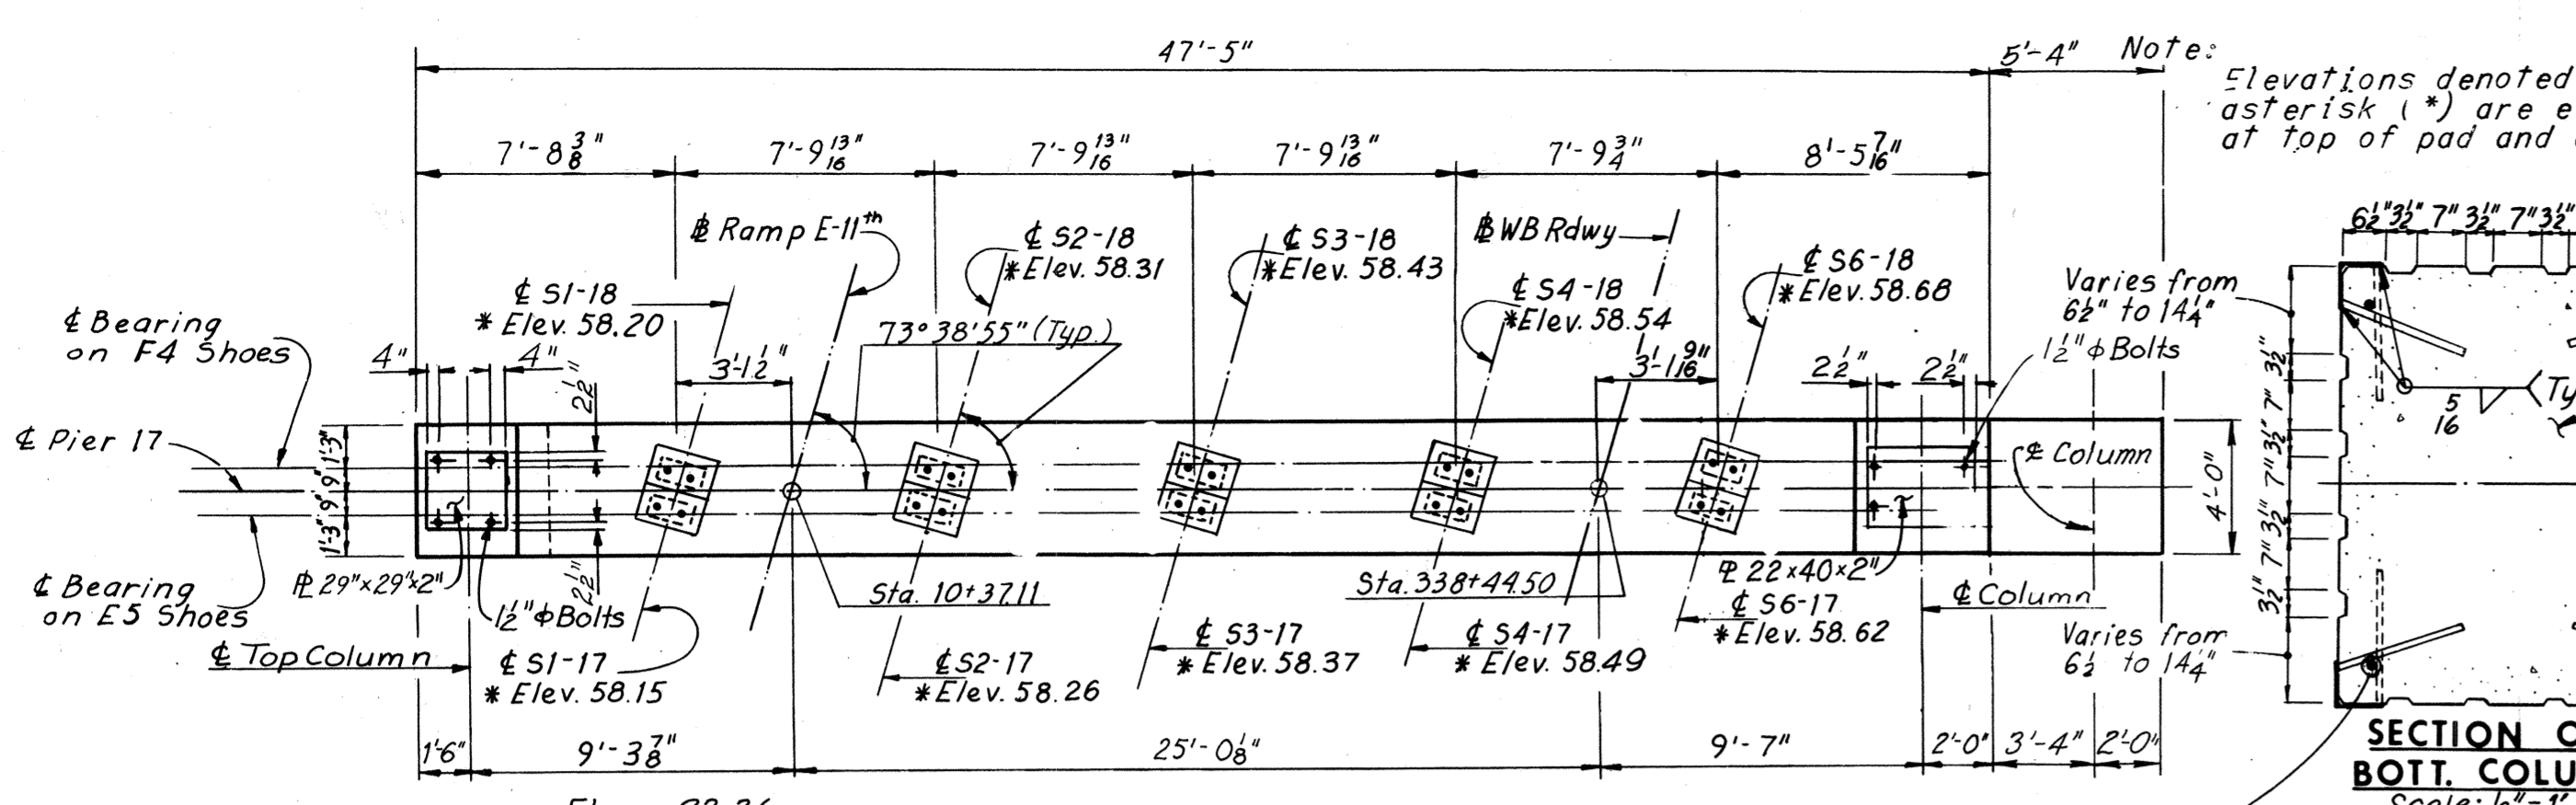

Note: Footing elevations are approximate only and may be varied to suit field conditions as directed by the Engineer. Vertical Shaft reinforcing shall not be cut until these elevations are established. Where elevations change more than 2 ft., redesign will be required. Bottom elevation of Flume must be established by field inspection.

Note: Remove portions of Flume as required to build footing and Column, then replace removed portions of Flume around Column partially supported by 6" support wall as shown in View A-A.

BY	DATE	Entire Sheet	REJ	11-14-74
MADE	REJ	11-6-74	2	As Built
CHECKED	DMG	11-14-74		
IN CHARGE				

RICHMOND METROPOLITAN AUTHORITY
RICHMOND EXPRESSWAY SYSTEM
DOWNTOWN EXPRESSWAY








BRIDGE NO. 63
 WESTBOUND ROADWAY OVER
 12TH ST. - R.R. TRACKS AND 16TH ST.
 PIER 17

AS BUILT

HOWARD, NEEDLES, TAMMEN & BERGENDOFF
 consulting engineers
 NEW YORK ALEXANDRIA KANSAS CITY

SCALE: As Noted
 CONTRACT NO. 10
 SHEET NO. 8 OF 29

RICHMOND EXPRESSWAY SYSTEM			
SECTION	PROJECT	SHEET NO.	TOTAL SHEETS
10	DOWNTOWN EXPRESSWAY	78	265

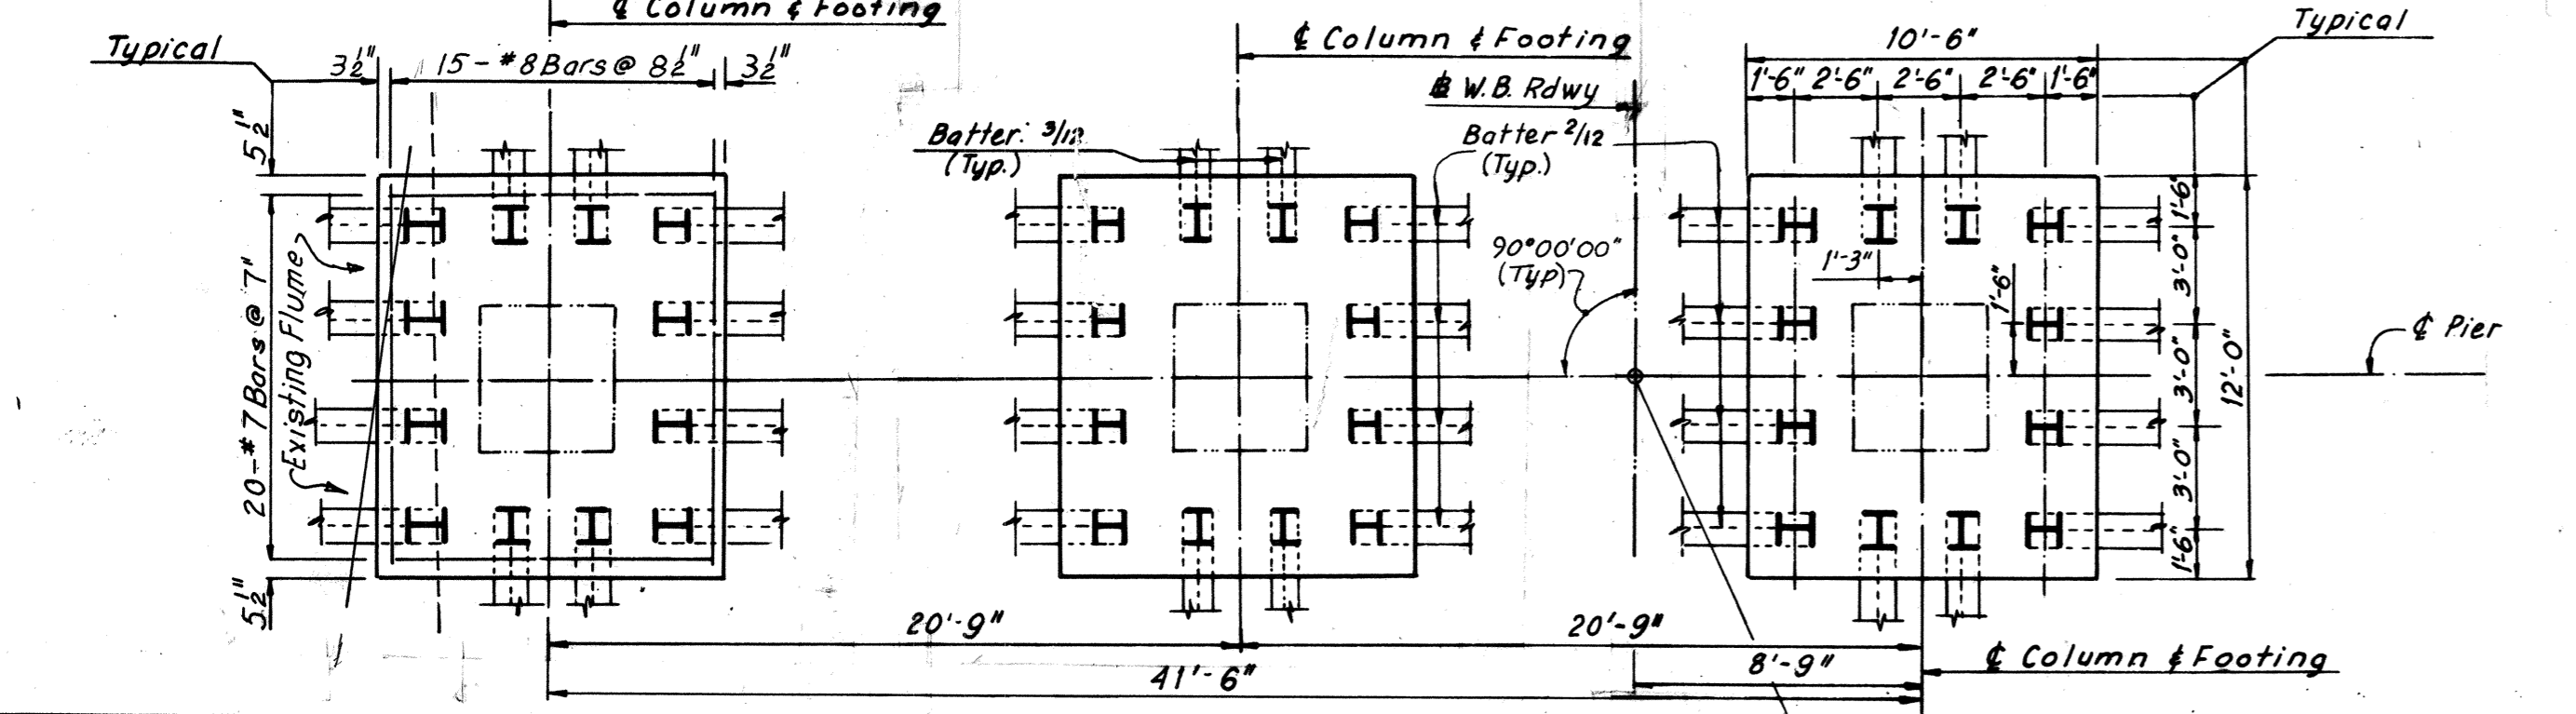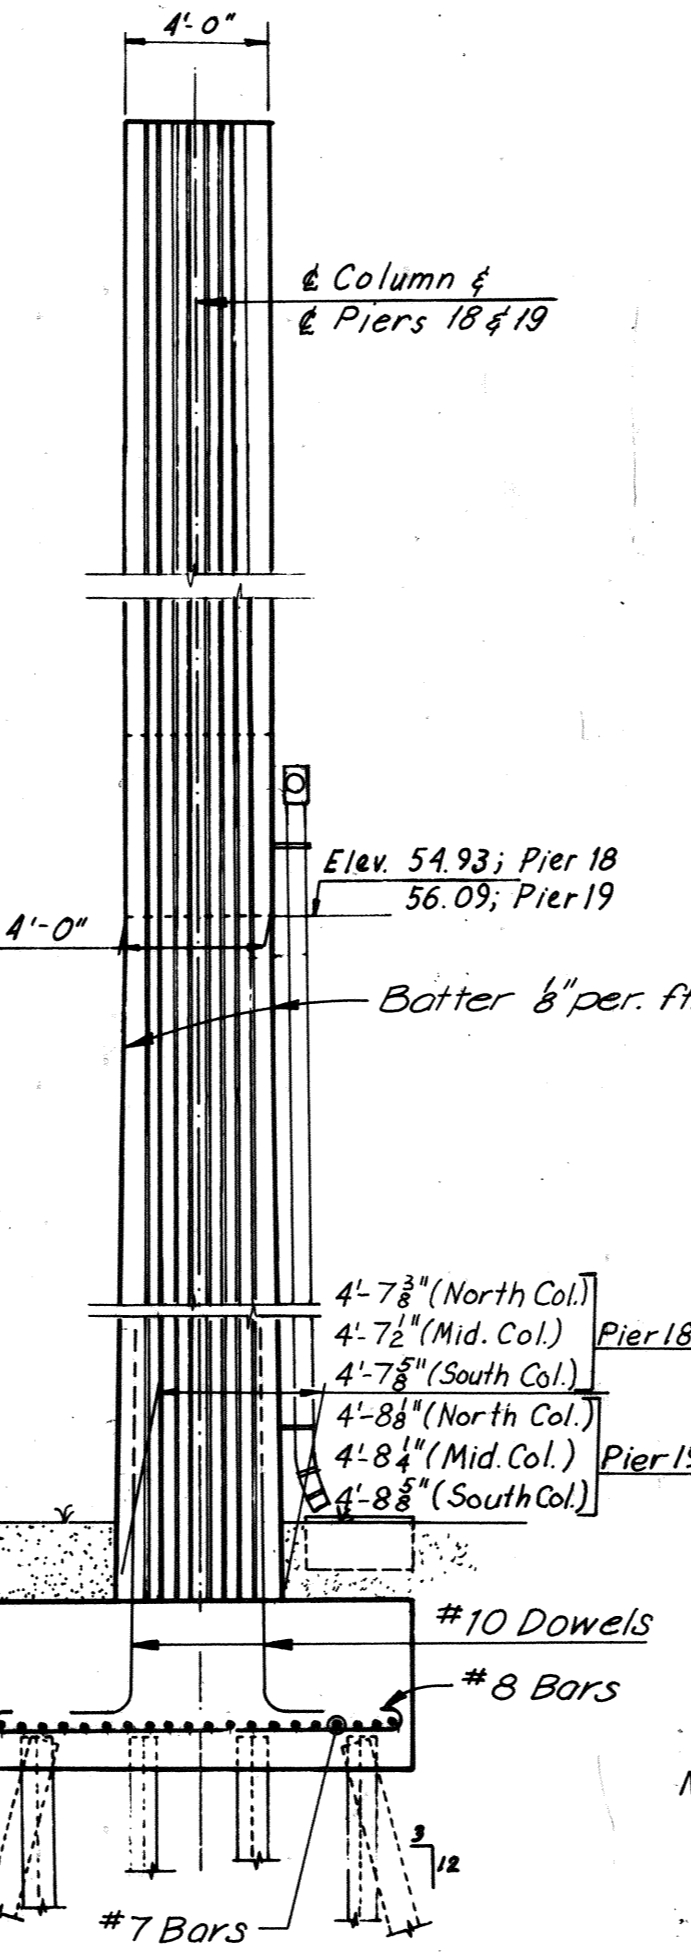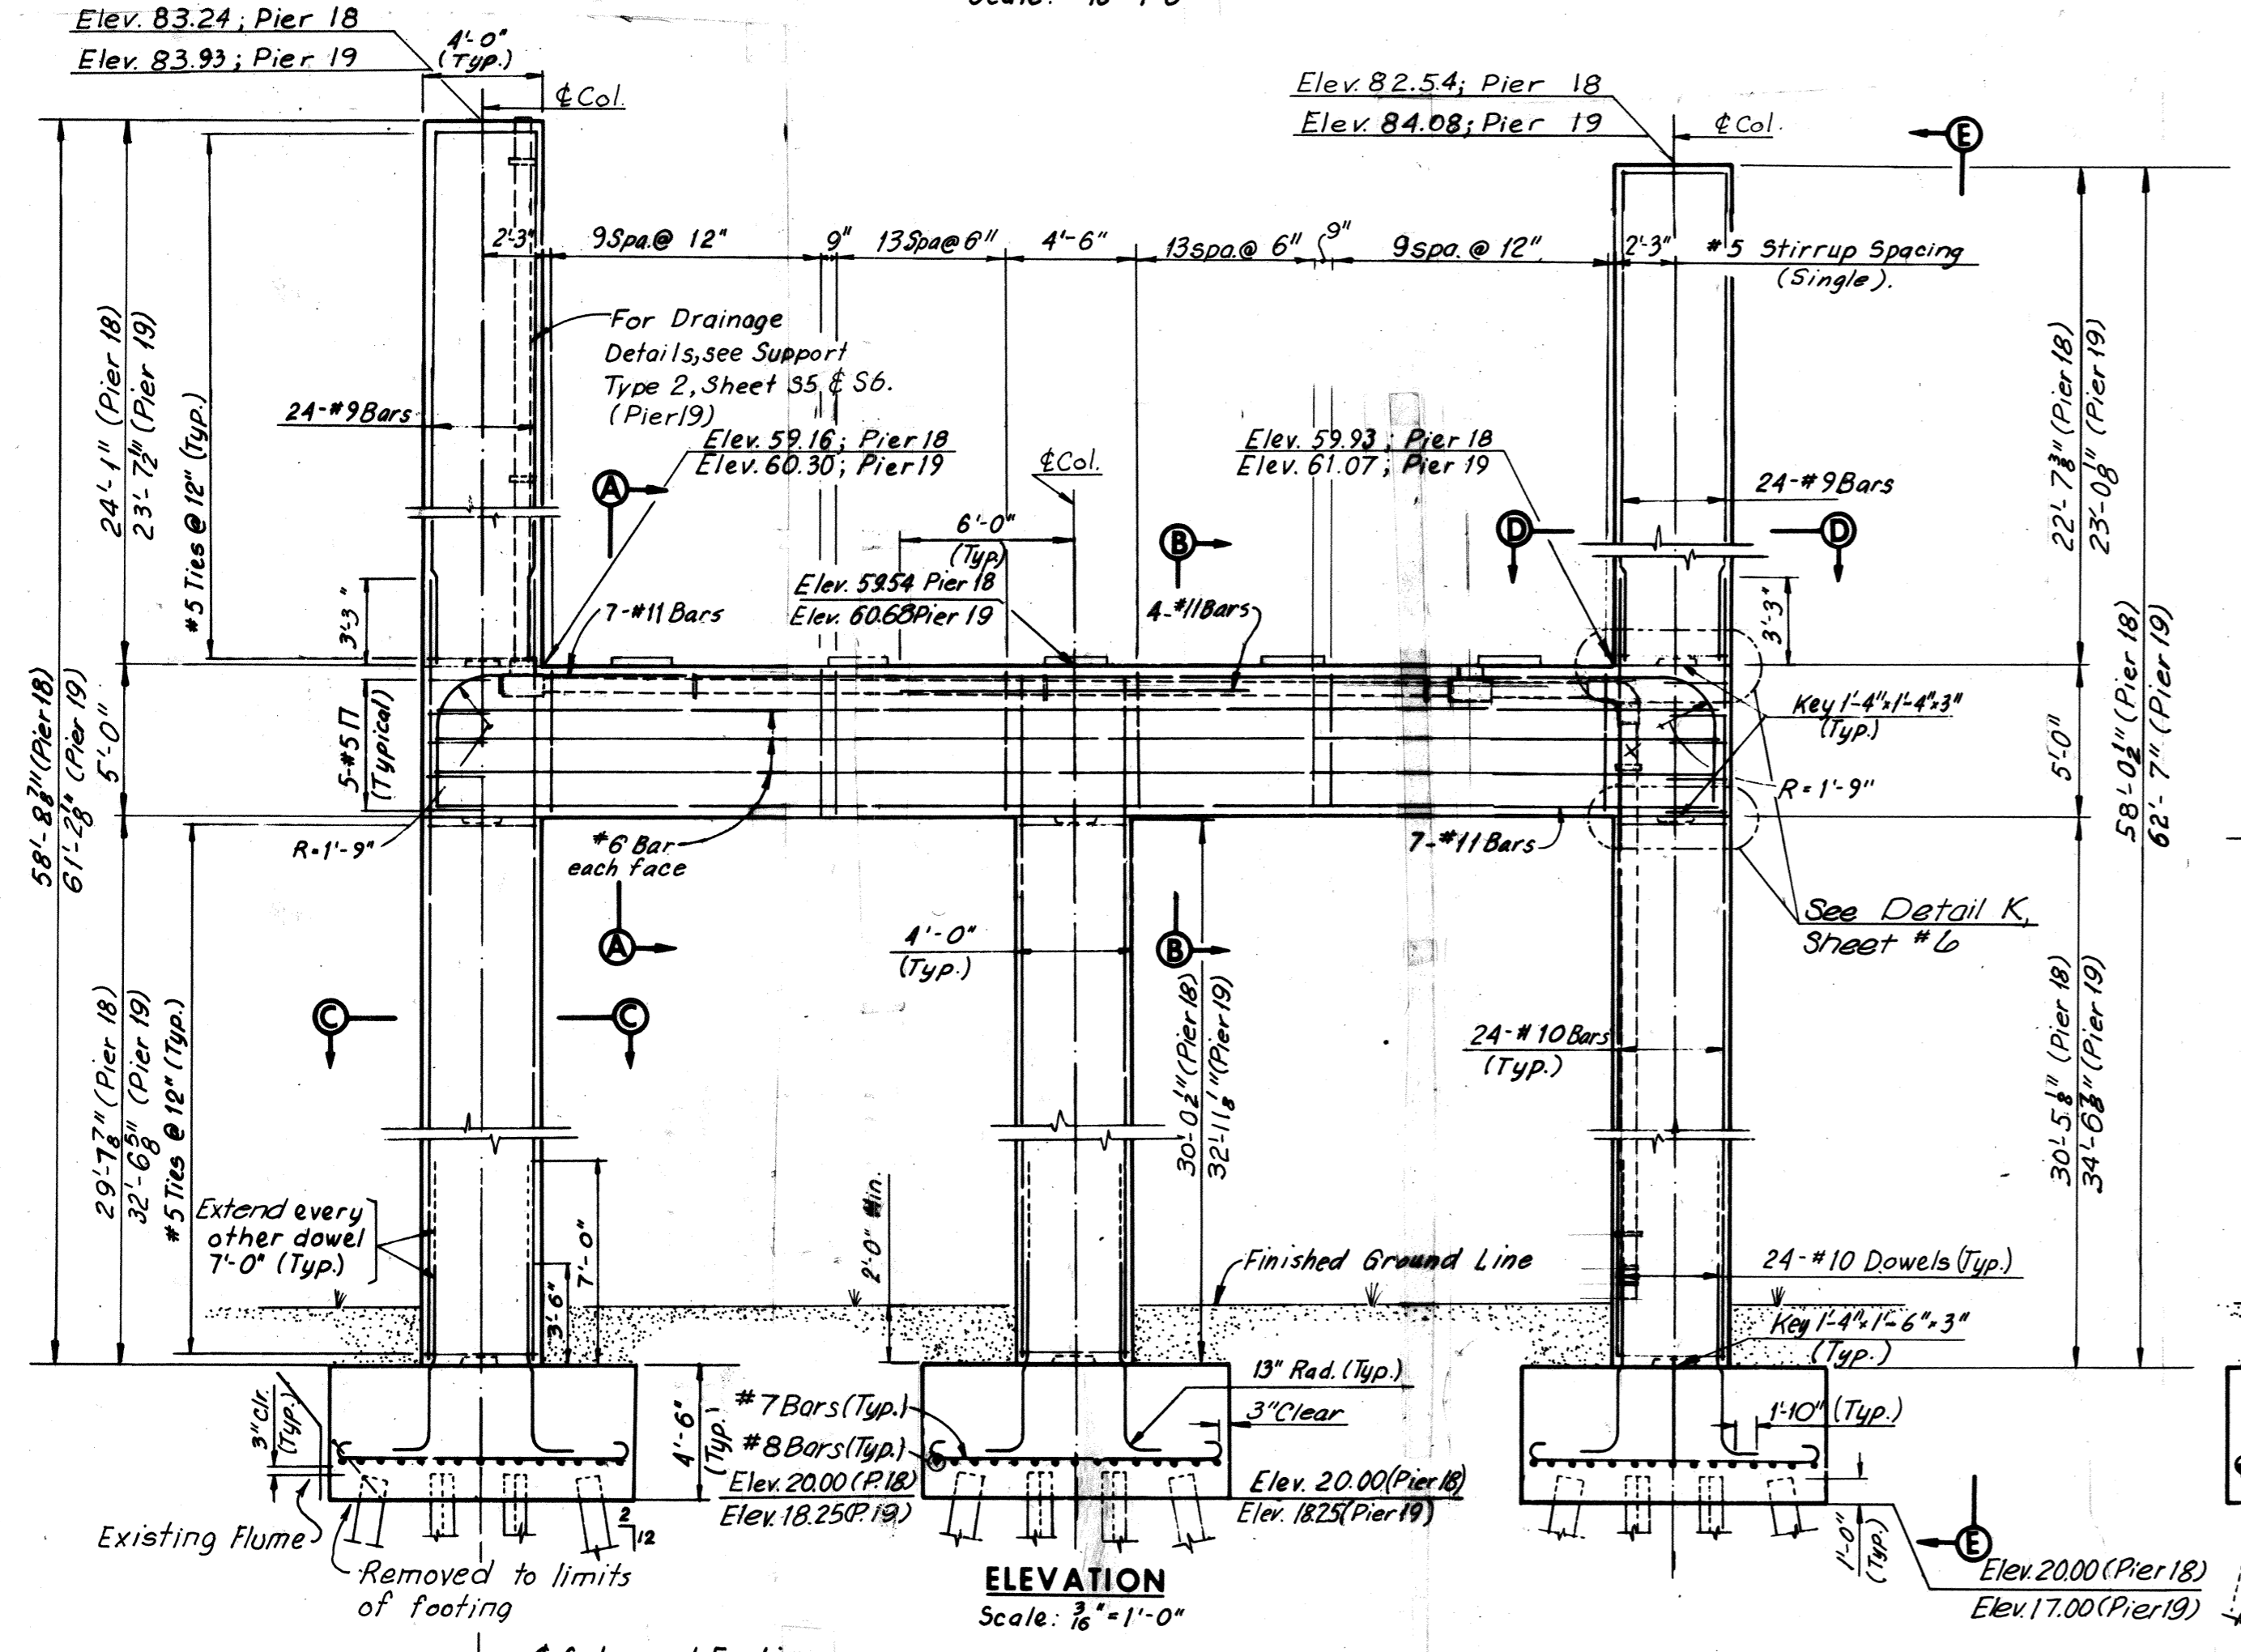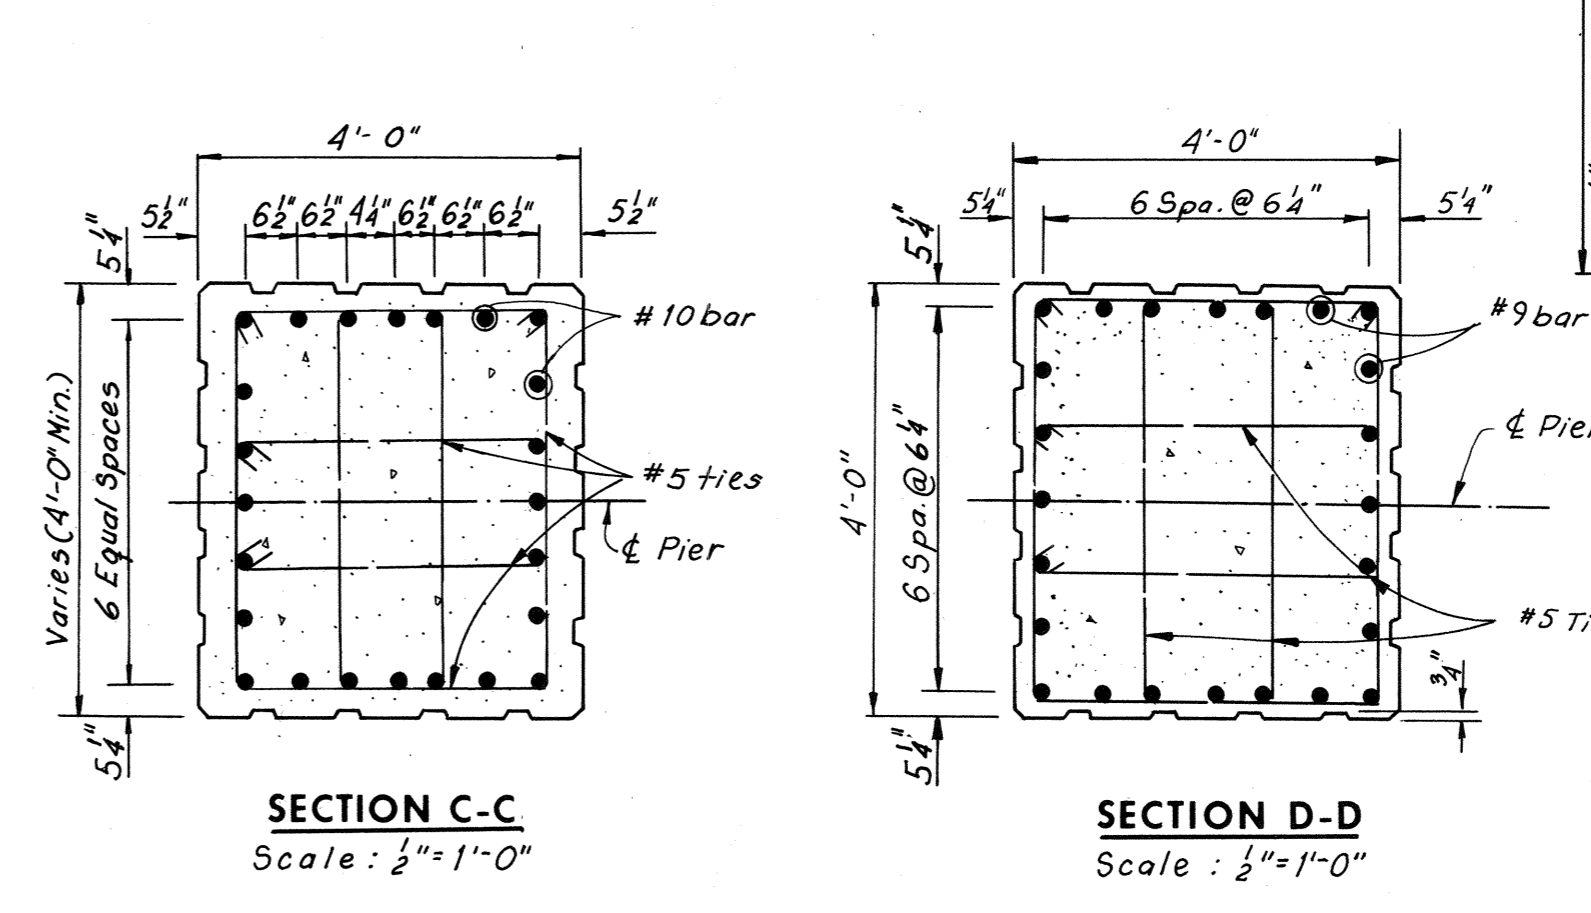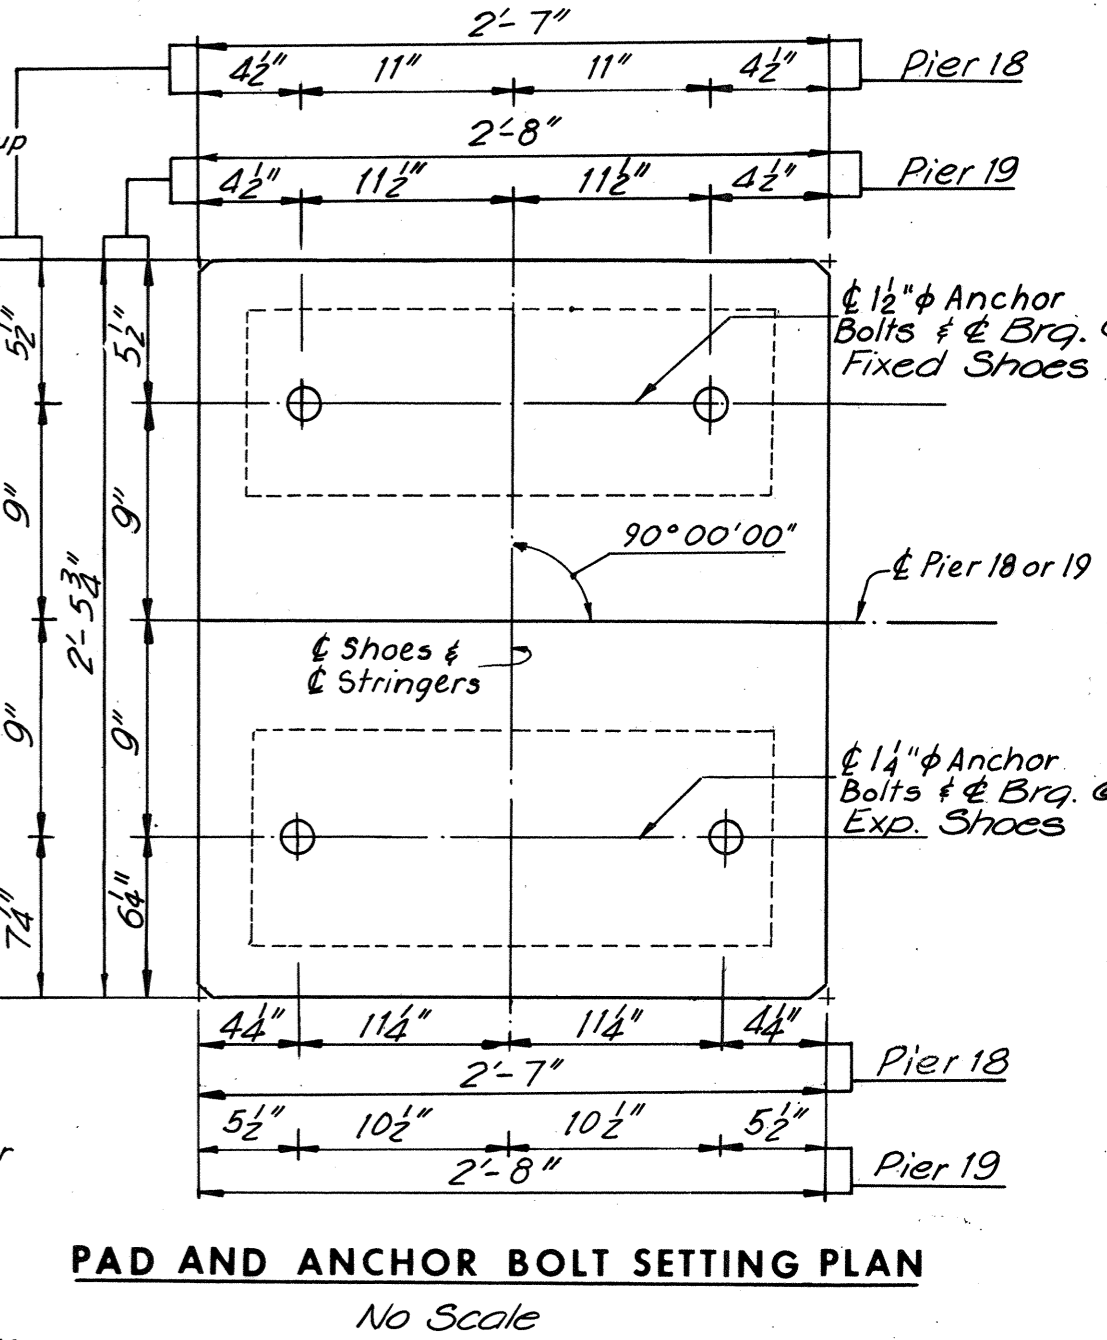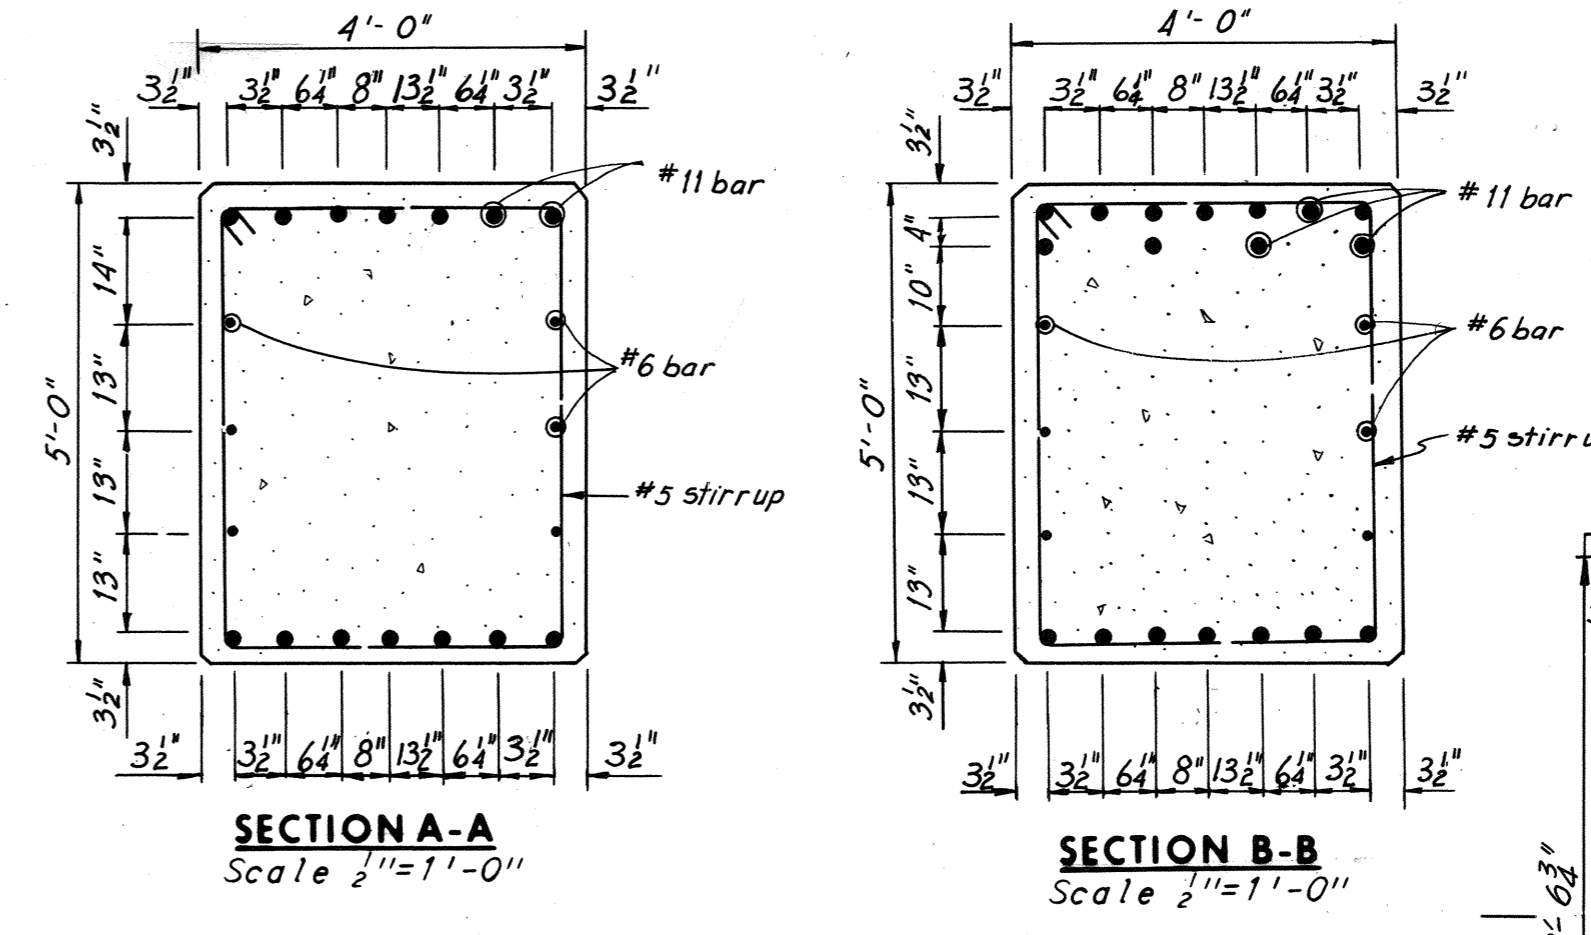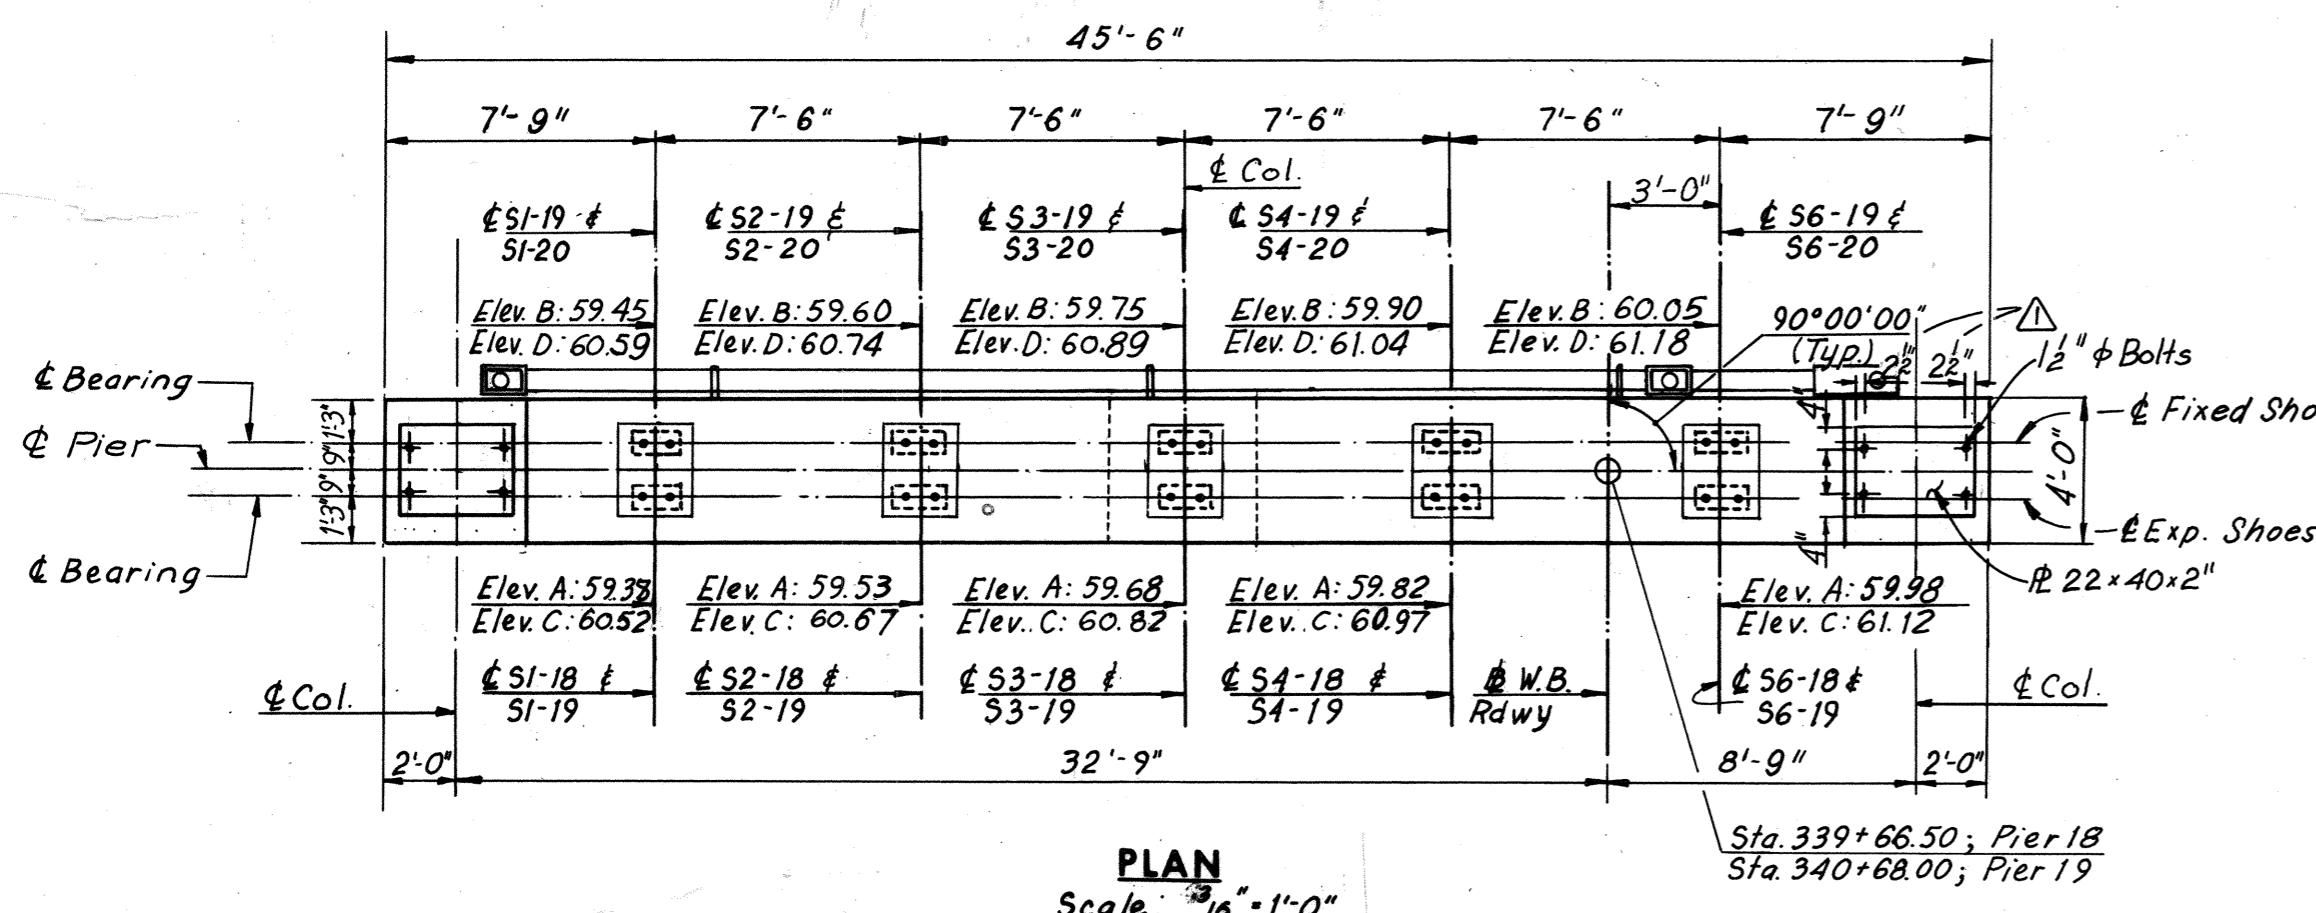

Note: All piles shall be 10BP42 Steel Piles (Design capacity = 45 tons).
Batter piles 3" or 2" per foot where shown.
For Shoe Details, see Sheets S1 and S2.
For Steel Pile Details, see Sheet 11.
Estimated Pile Tip elevations: -3.0 @ Pier 18, -7.0 @ Pier 19.
For architectural treatment of columns, see Sheet S7.

Note: 1) Footing elevations are approximate only and may be varied to suit field conditions as directed by the Engineer. Vertical shaft reinforcing shall not be cut until these elevations are established. Where elevations change more than 2 ft. redesign will be required.
2) Flume modification at Pier 18 only.

BY	DATE	Anchor Bolt Loc.	REP	11-13-74
MADE	C.E.B.	12-13-68	2 As Built	TEM 10-76
CHECKED	PTA	01-24-69		
IN CHARGE				

RICHMOND METROPOLITAN AUTHORITY
RICHMOND EXPRESSWAY SYSTEM
DOWNTOWN EXPRESSWAY










BRIDGE NO. 63
WESTBOUND ROADWAY OVER
12TH ST. - R.R. TRACKS AND 16TH ST.
PIERS 18 AND 19

HOWARD, NEEDLES, TAMMEN & BERGENDOFF
consulting engineers.
NEW YORK ALEXANDRIA KANSAS CITY

SCALE: As Noted
CONTRACT NO.: 10
SHEET NO. 9 OF 29

AS BUILT

RICHMOND EXPRESSWAY SYSTEM			
SECTION	PROJECT	SHEET NO.	TOTAL SHEETS
10	DOWNTOWN EXPRESSWAY	81	265

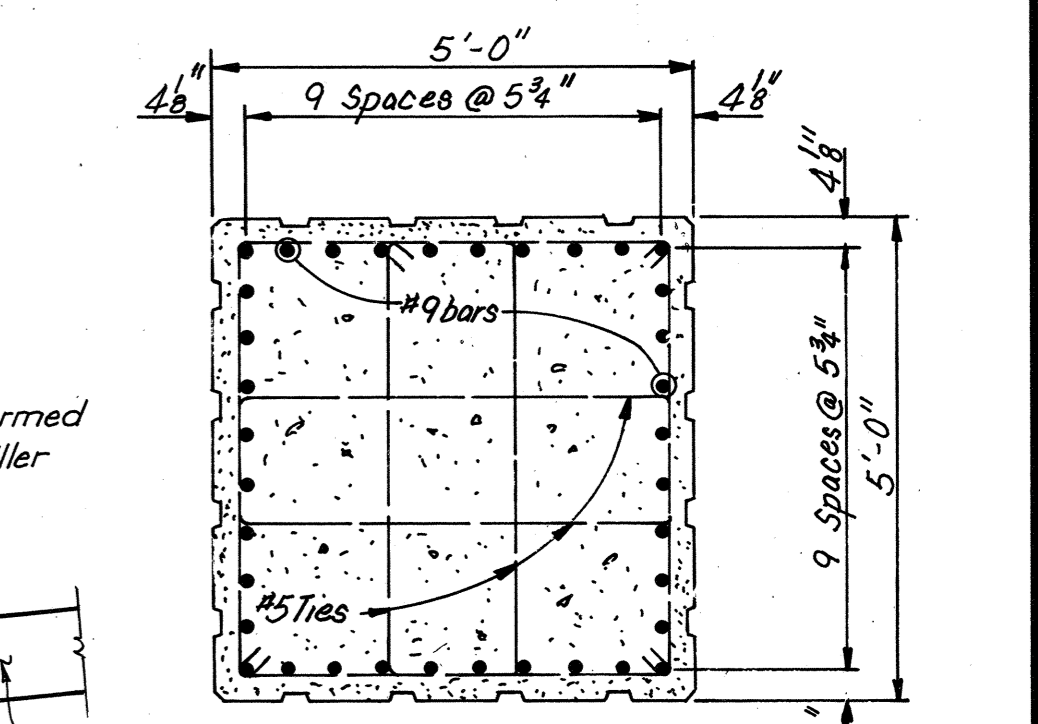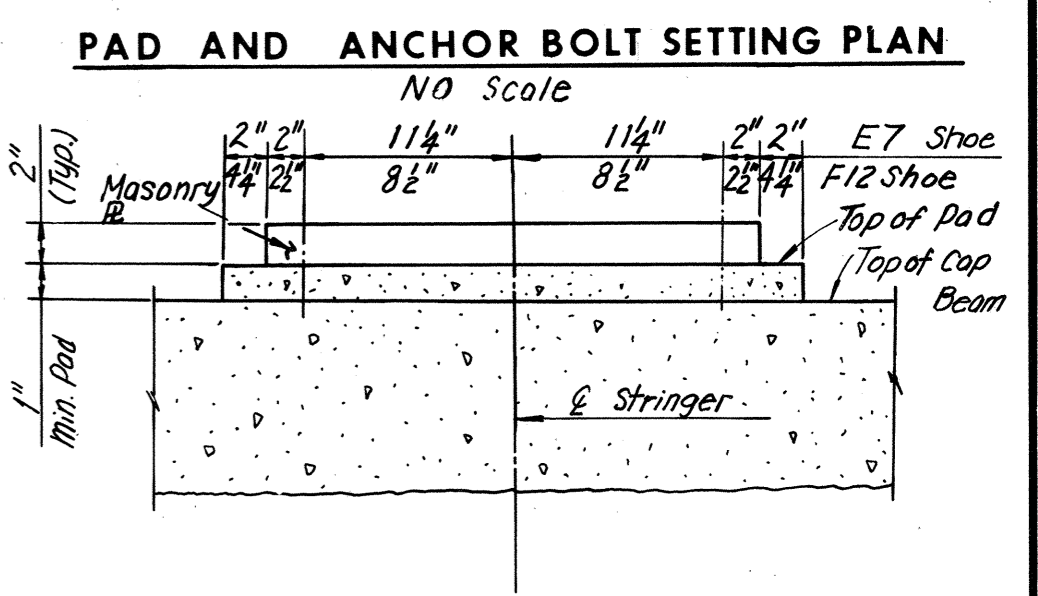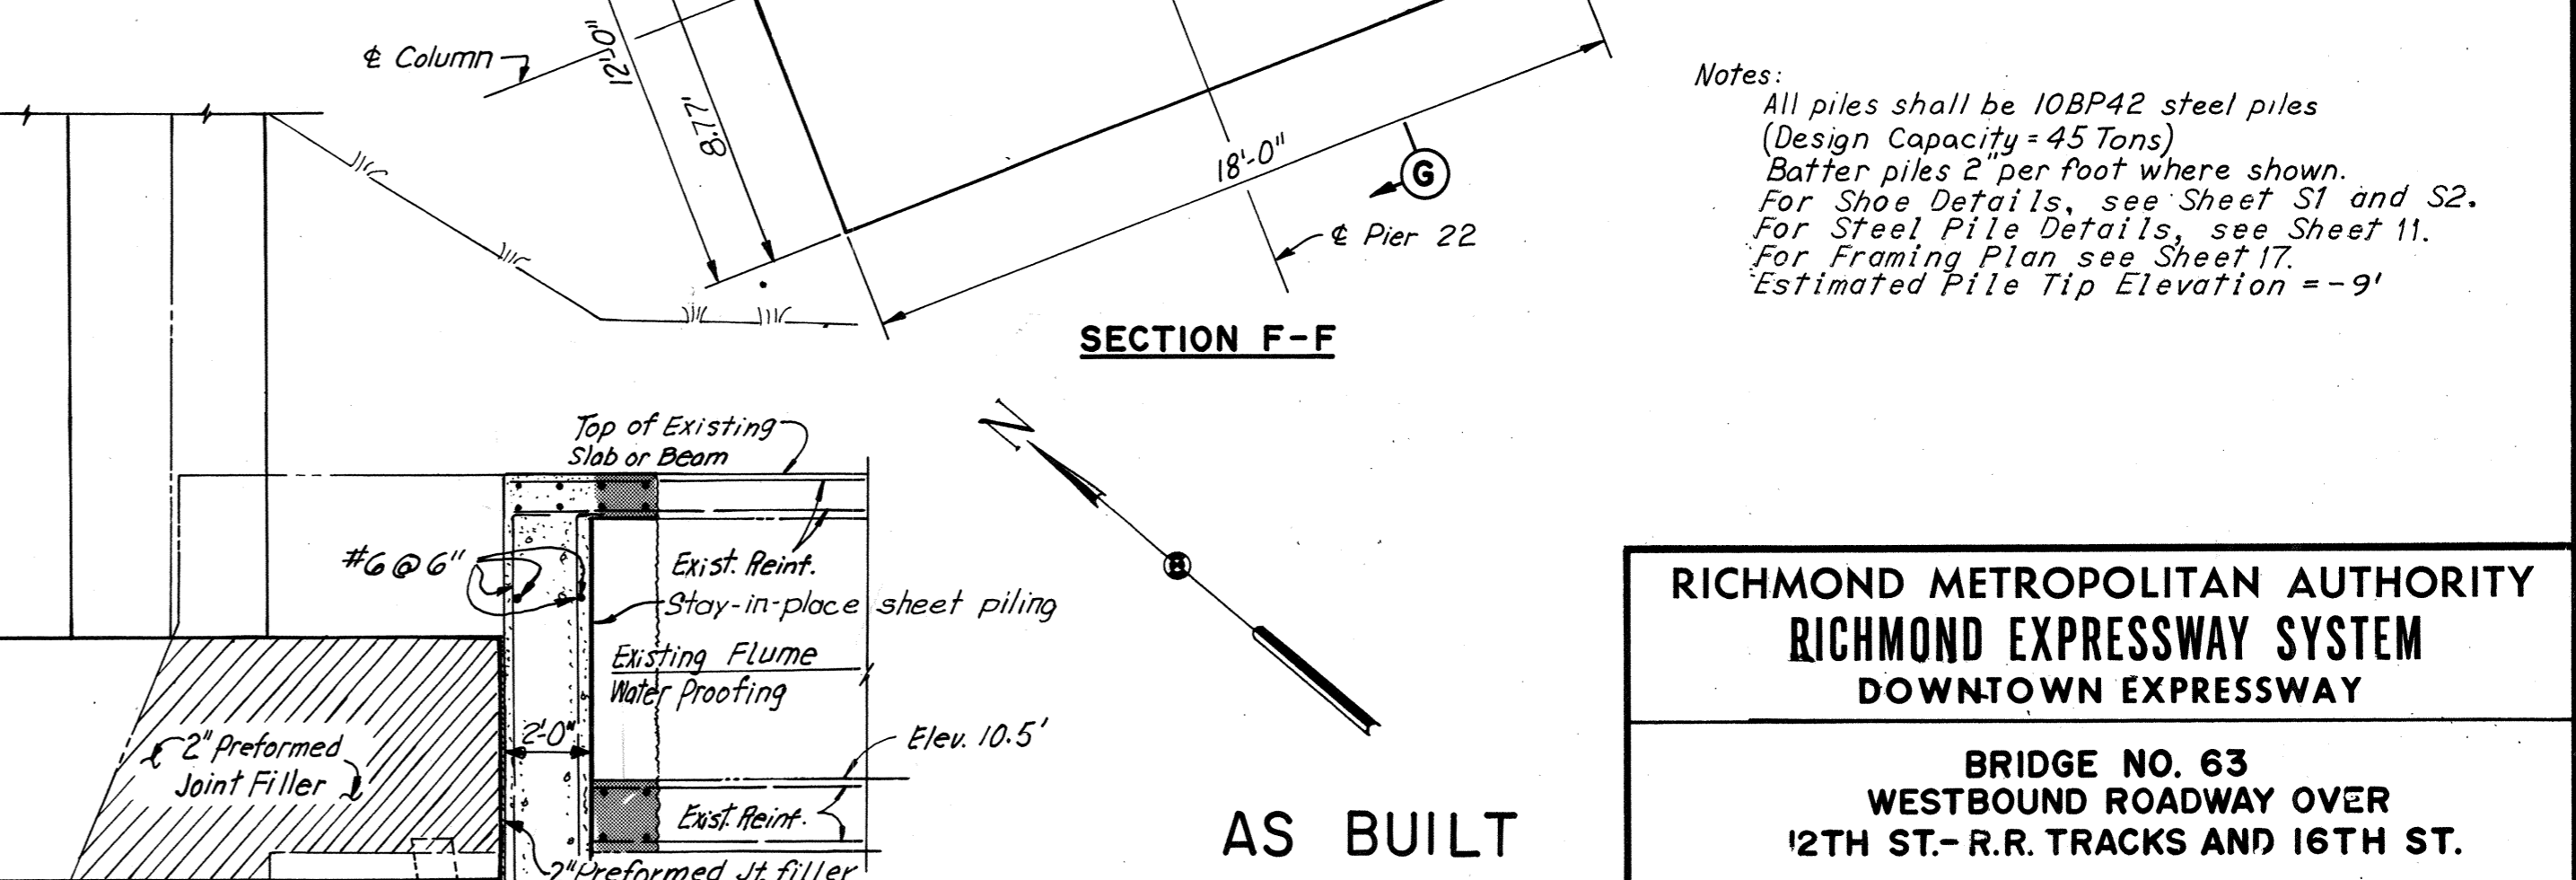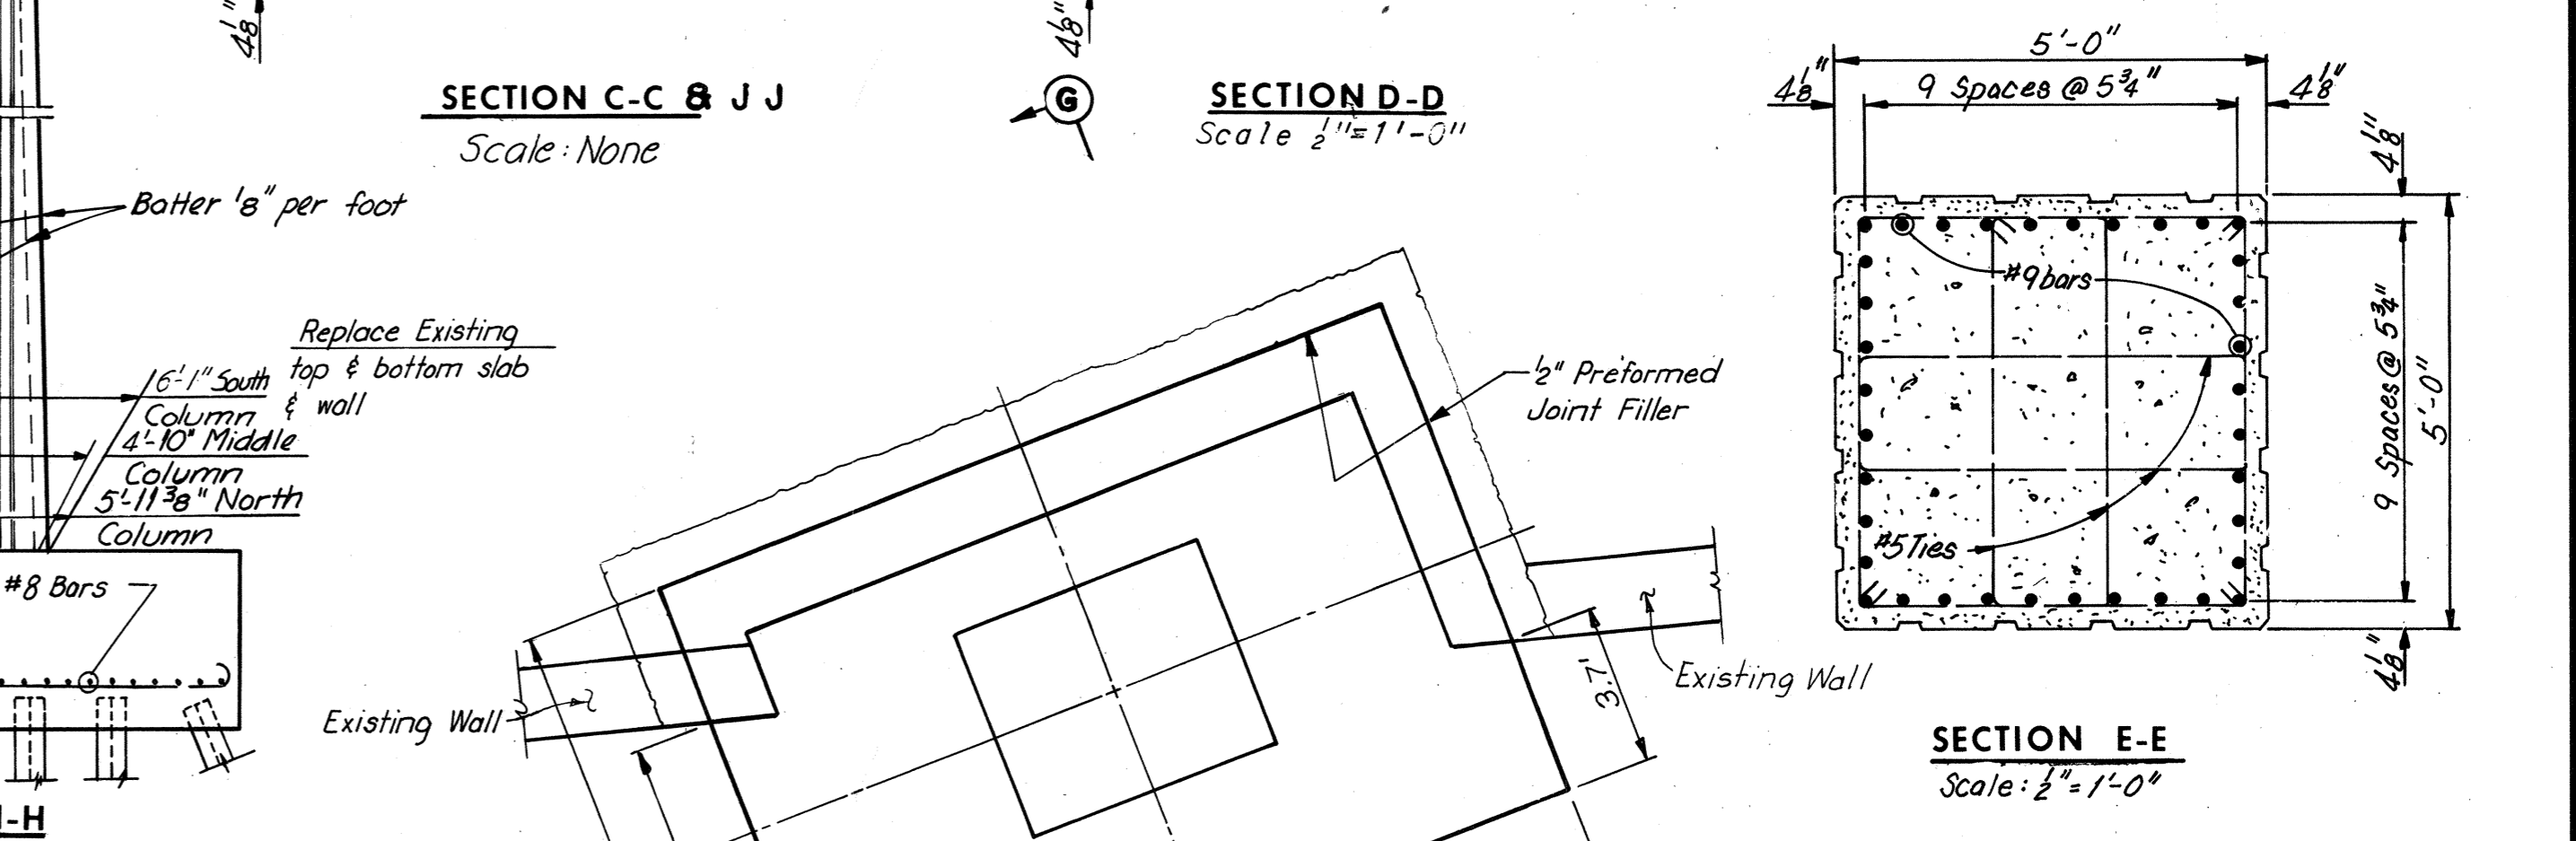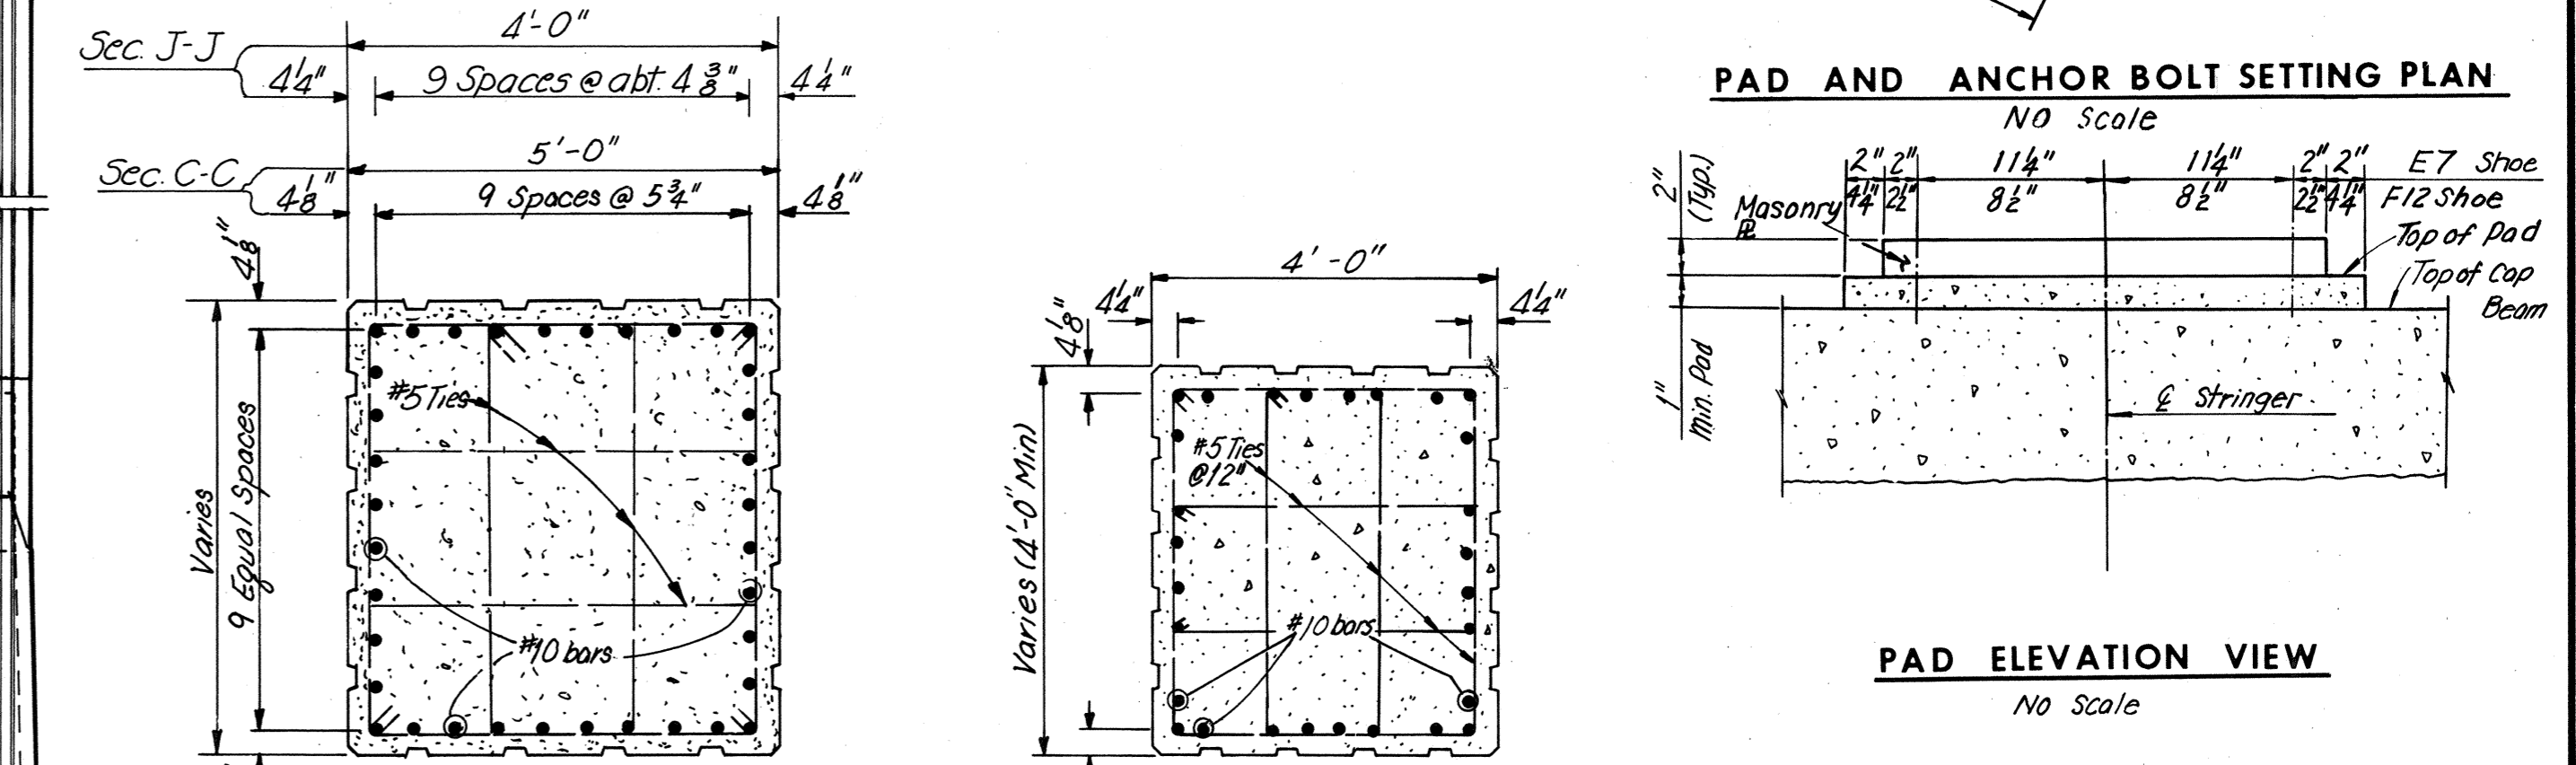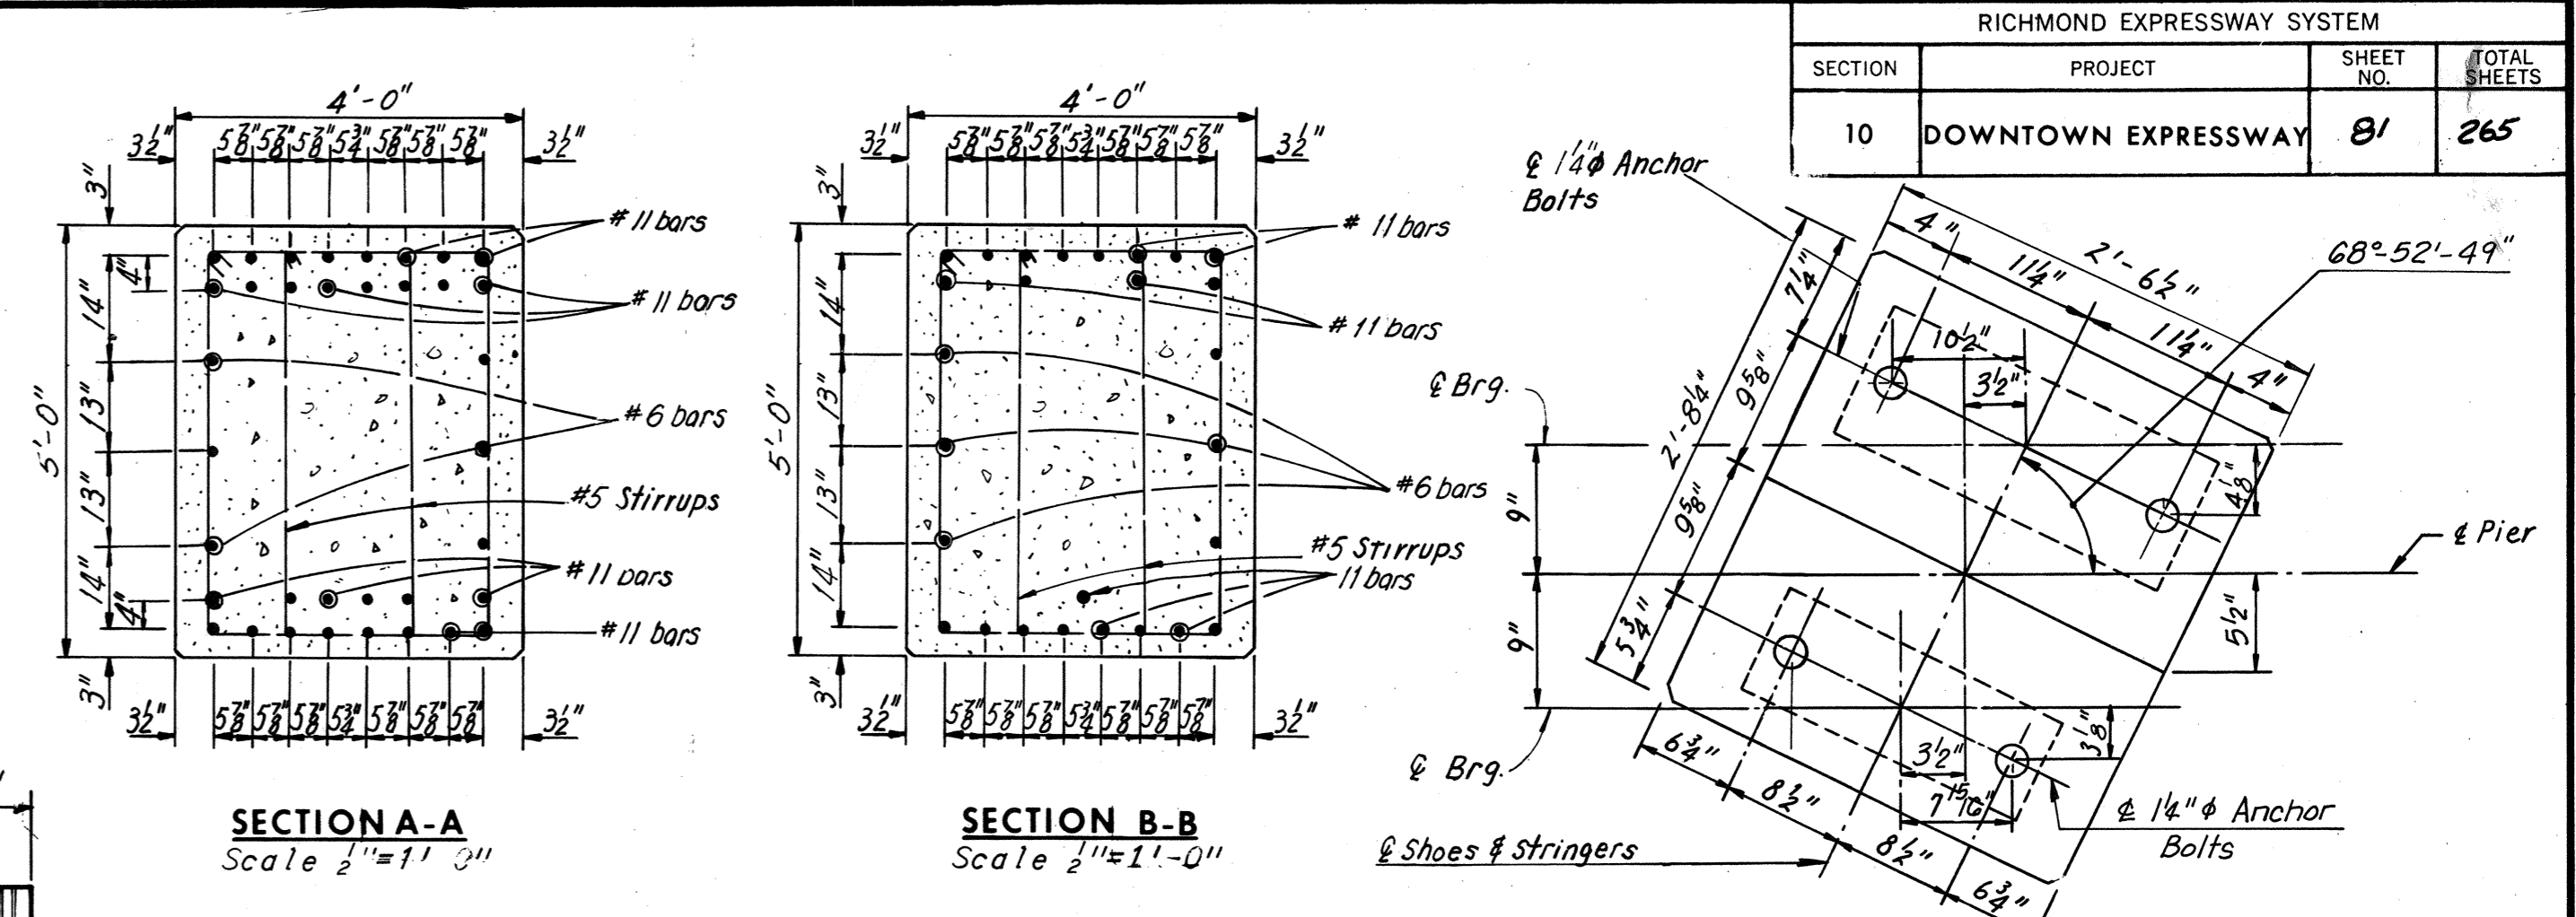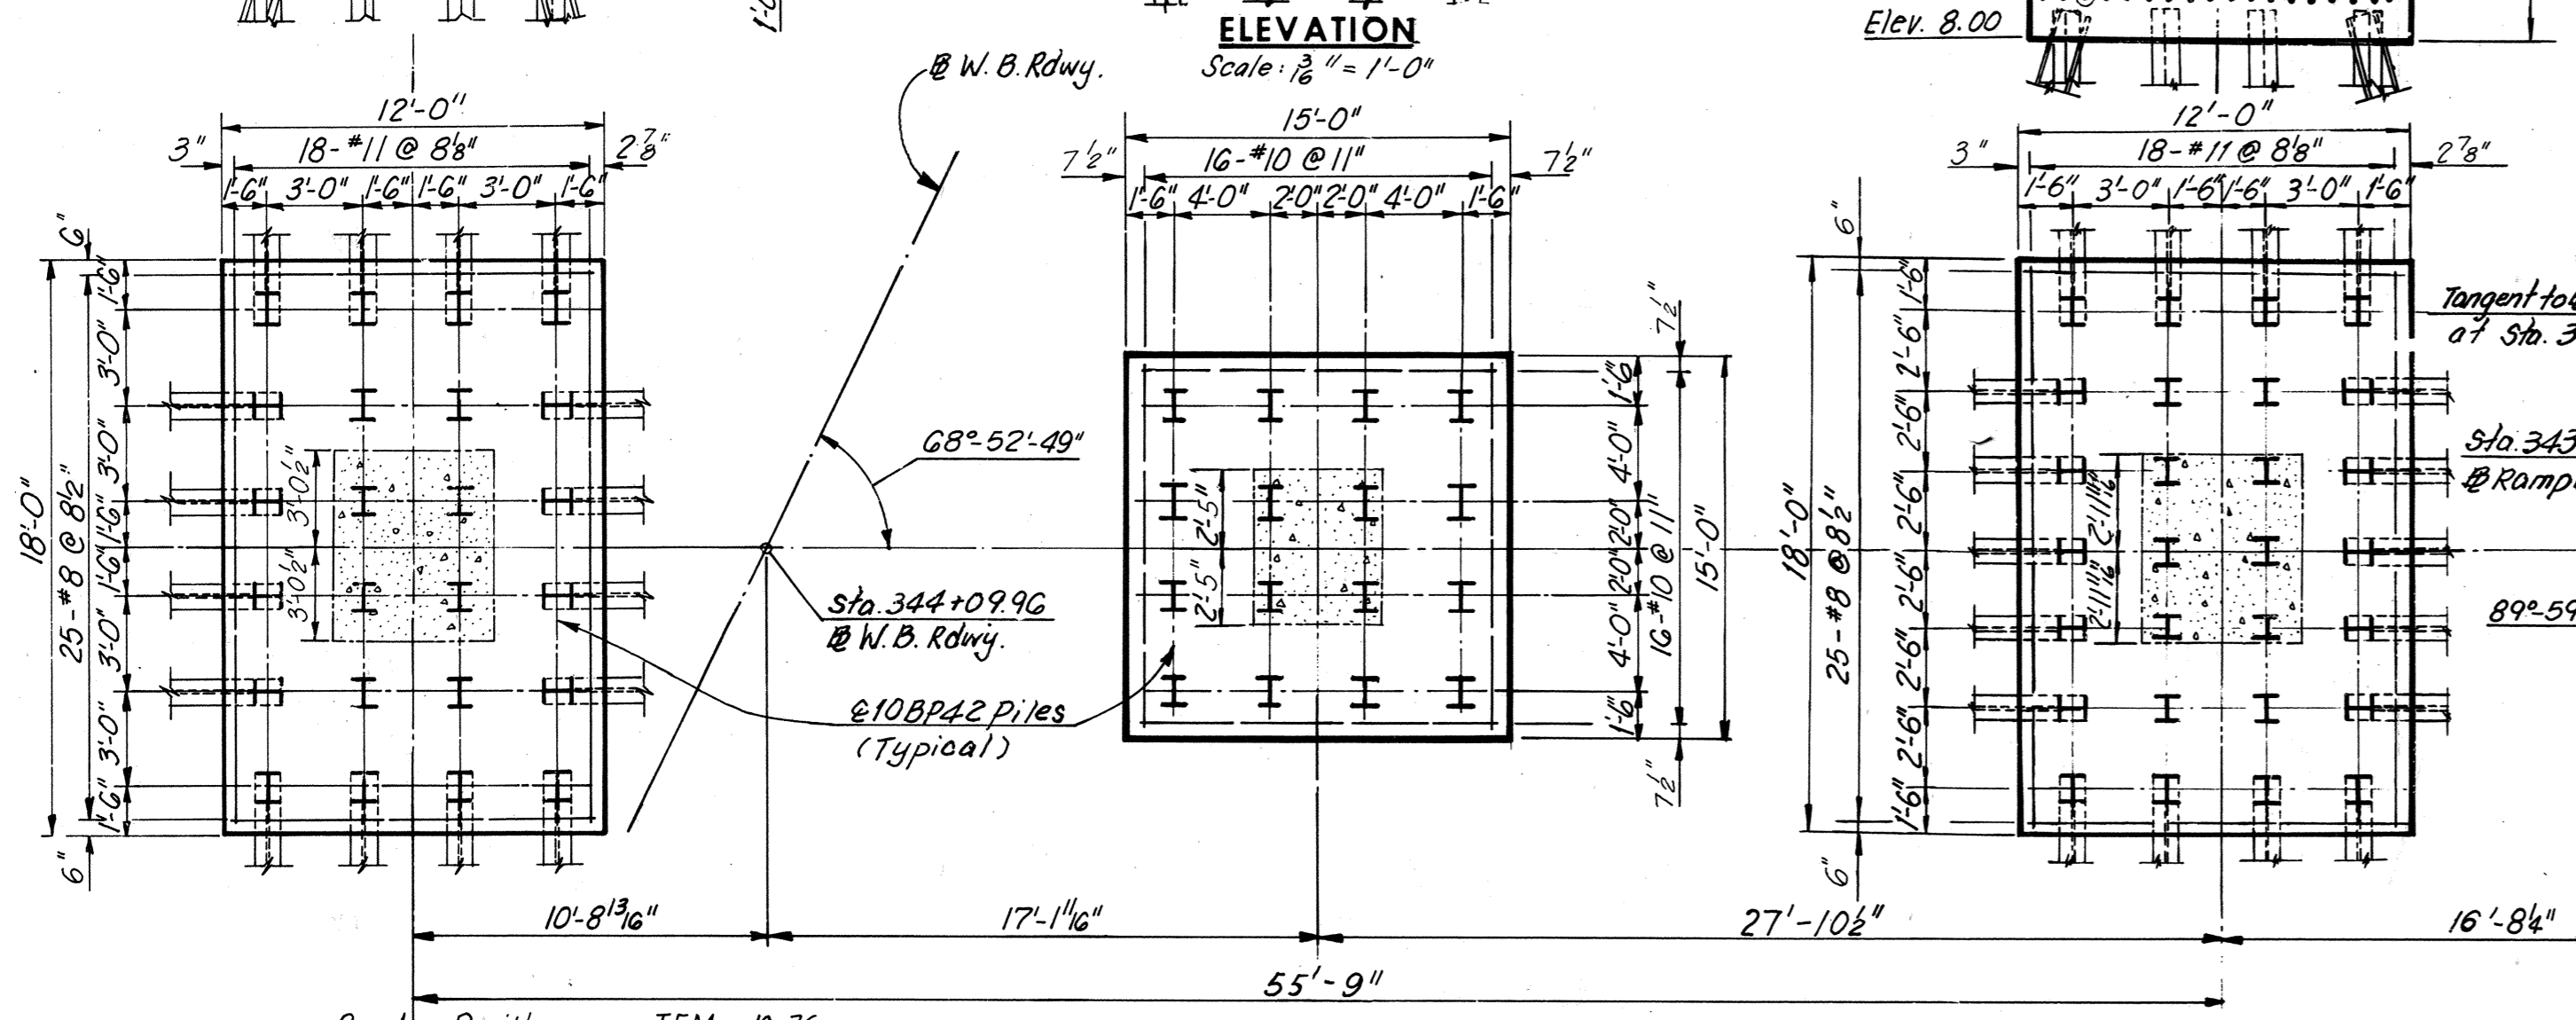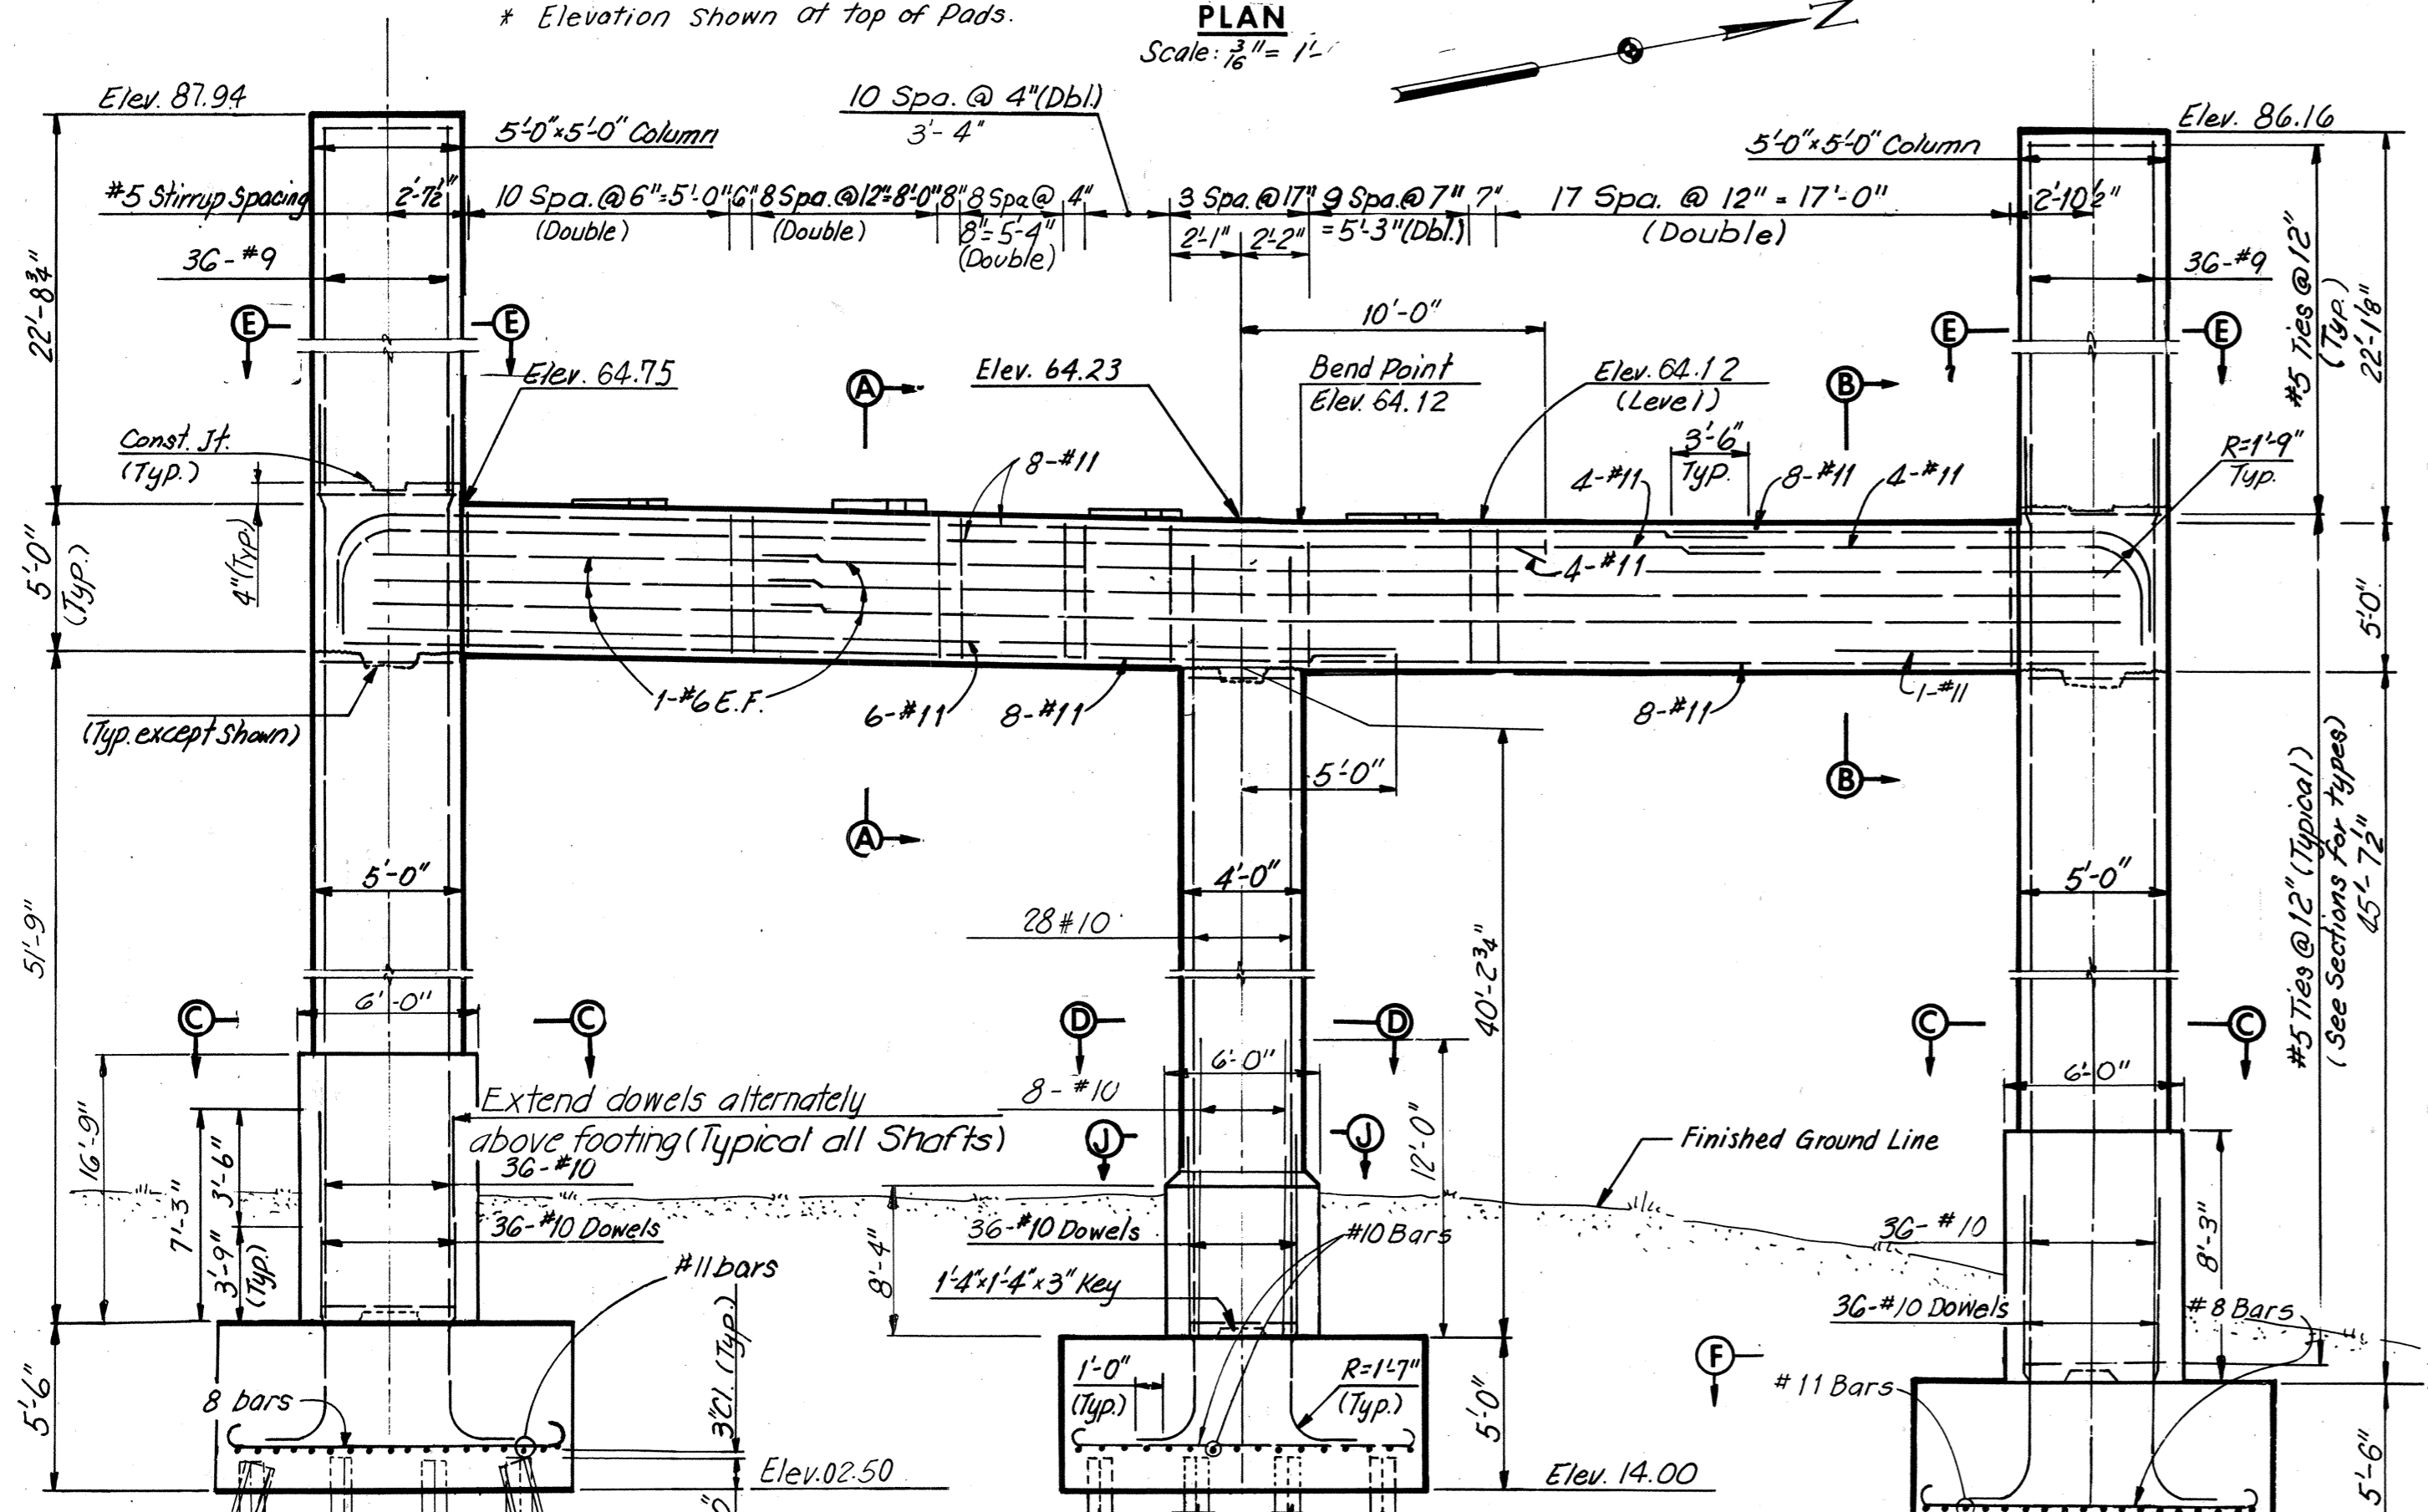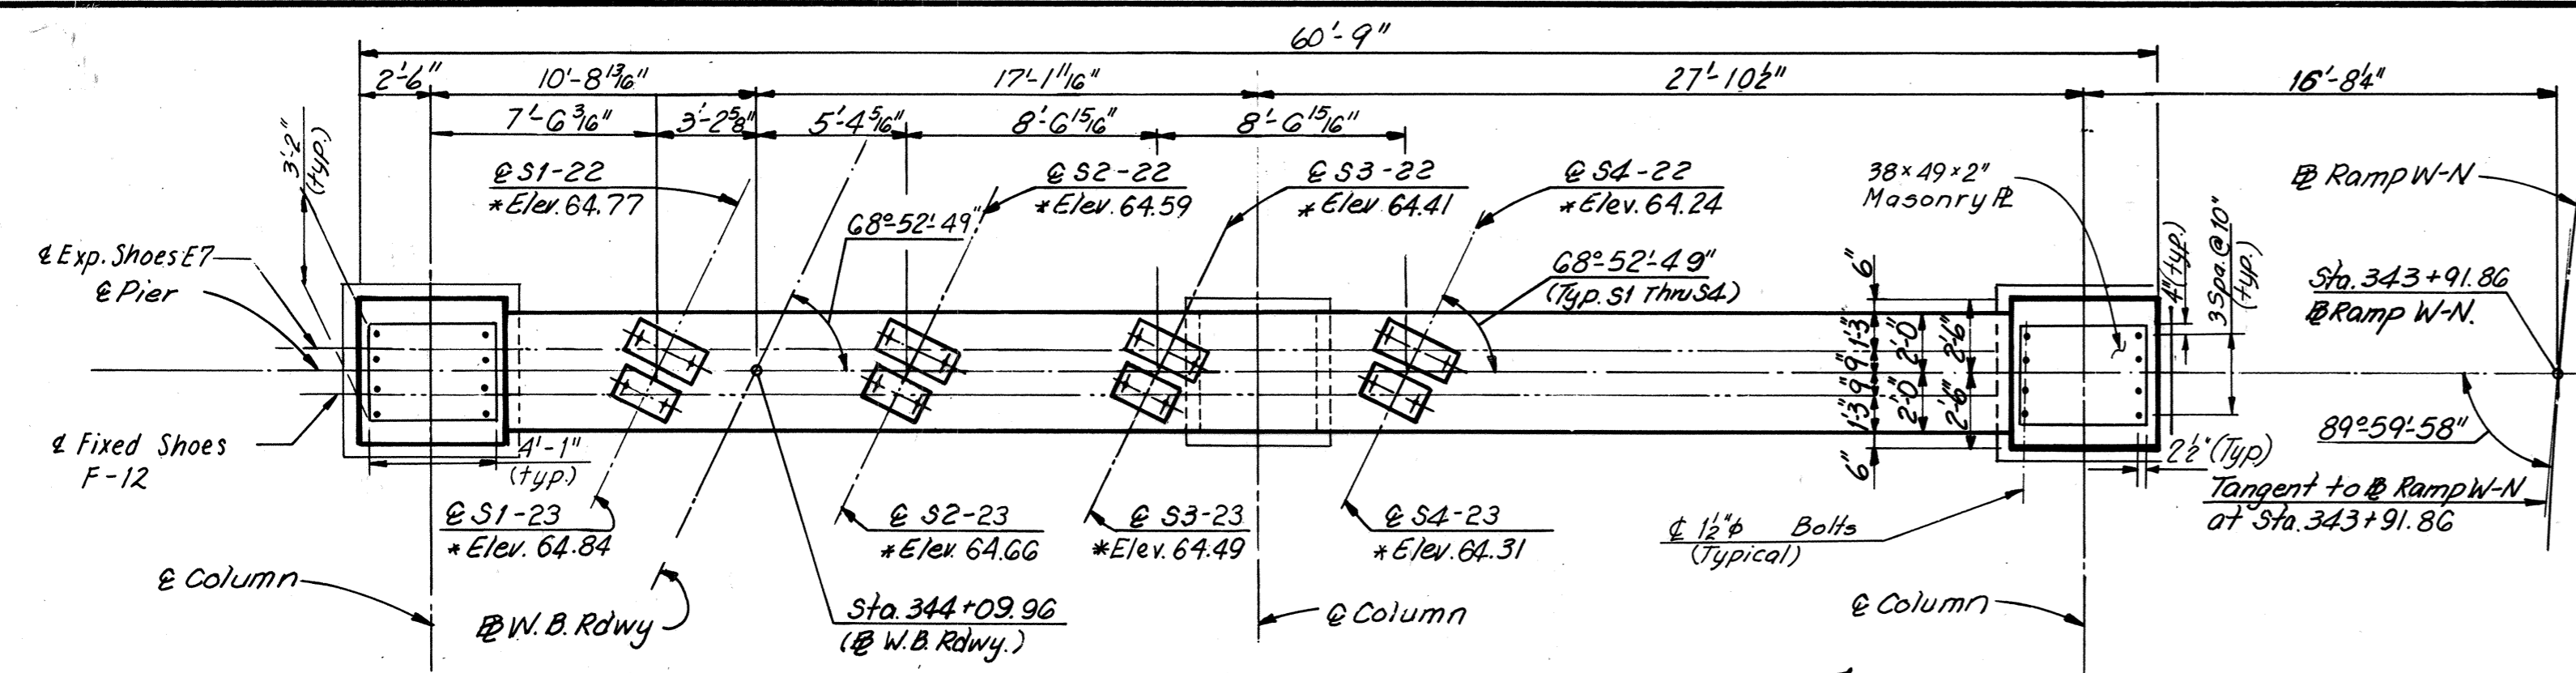

Notes:
 All piles shall be 10BP42 steel piles (Design Capacity = 45 Tons)
 Batter piles 2 per foot where shown.
 For Shoe Details, see Sheet S1 and S2.
 For Steel Pile Details, see Sheet 11.
 For Framing Plan, see Sheet 17.
 Estimated Pile Tip Elevation = -9'

RICHMOND METROPOLITAN AUTHORITY
RICHMOND EXPRESSWAY SYSTEM
DOWNTOWN EXPRESSWAY

BRIDGE NO. 63
WESTBOUND ROADWAY OVER
12TH ST.-R.R. TRACKS AND 16TH ST.
PIER 22

HOWARD, NEEDLES, TAMMEN & BERGENDOFF
 consulting engineers
 NEW YORK ALEXANDRIA KANSAS CITY


SCALE: As Noted
 CONTRACT NO.: 10
 SHEET NO. 12 OF 29

NO.	REVISION	BY	DATE
3	As Built	TEM	10-76
2	Column Dimen. & Shoe Type Changed	PRMC	4-19-74
1	Fig. Elev. Reint. Anch. Bolt, Col. Dim. Sect. J-J	R.B.H.	7-31-74


FOOTING PLAN
 Scale: 3/8" = 1'-0"

AS BUILT


Piles located within 10 ft. (horizontal distance) of Storm Drainage Flume and/or Arch sewer shall be pre-bored to an Elevation 5 ft. below bottom of Flume and/or arch sewer.

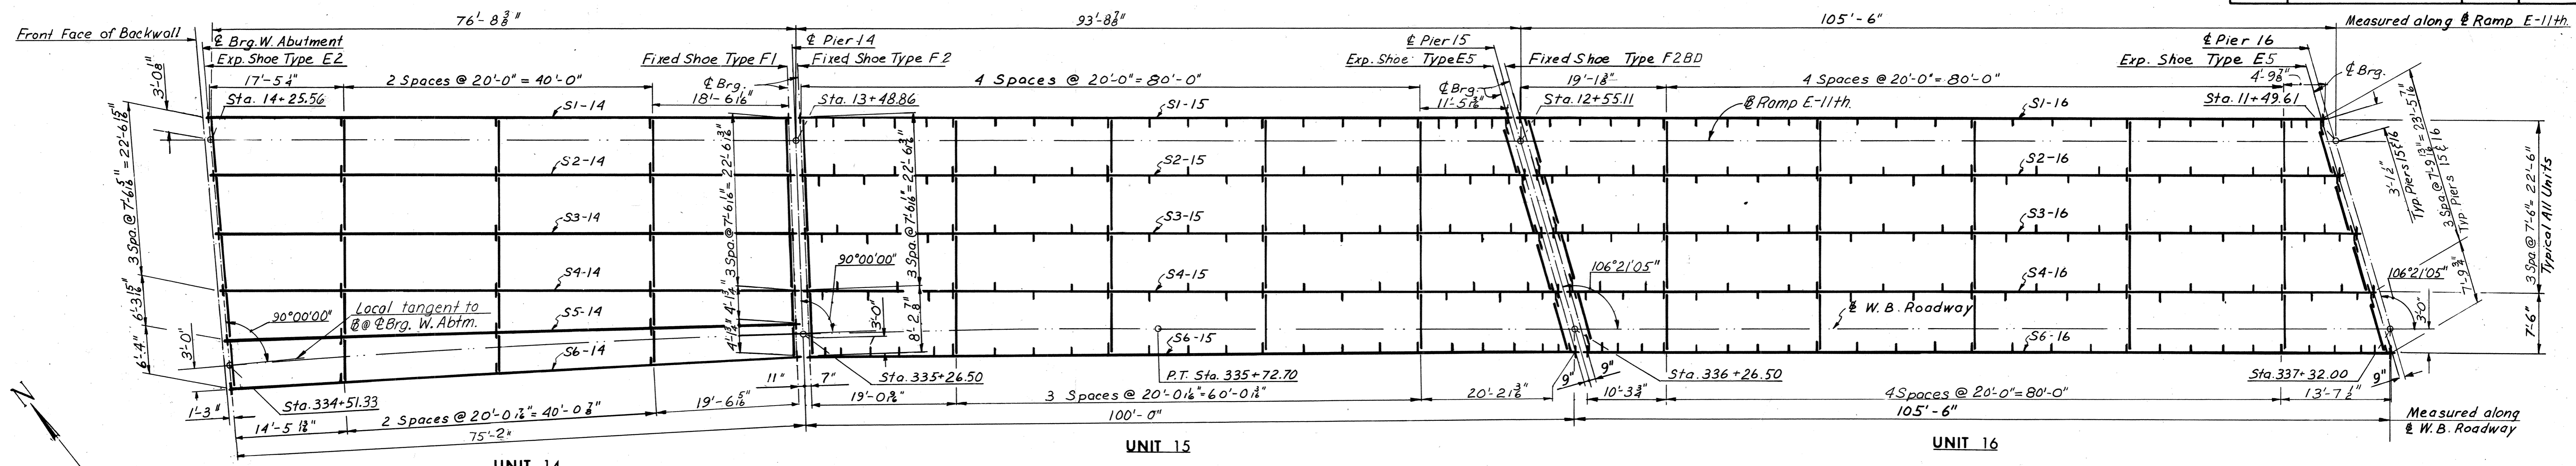

Note: Girder spacing is measured along ζ Bearing.

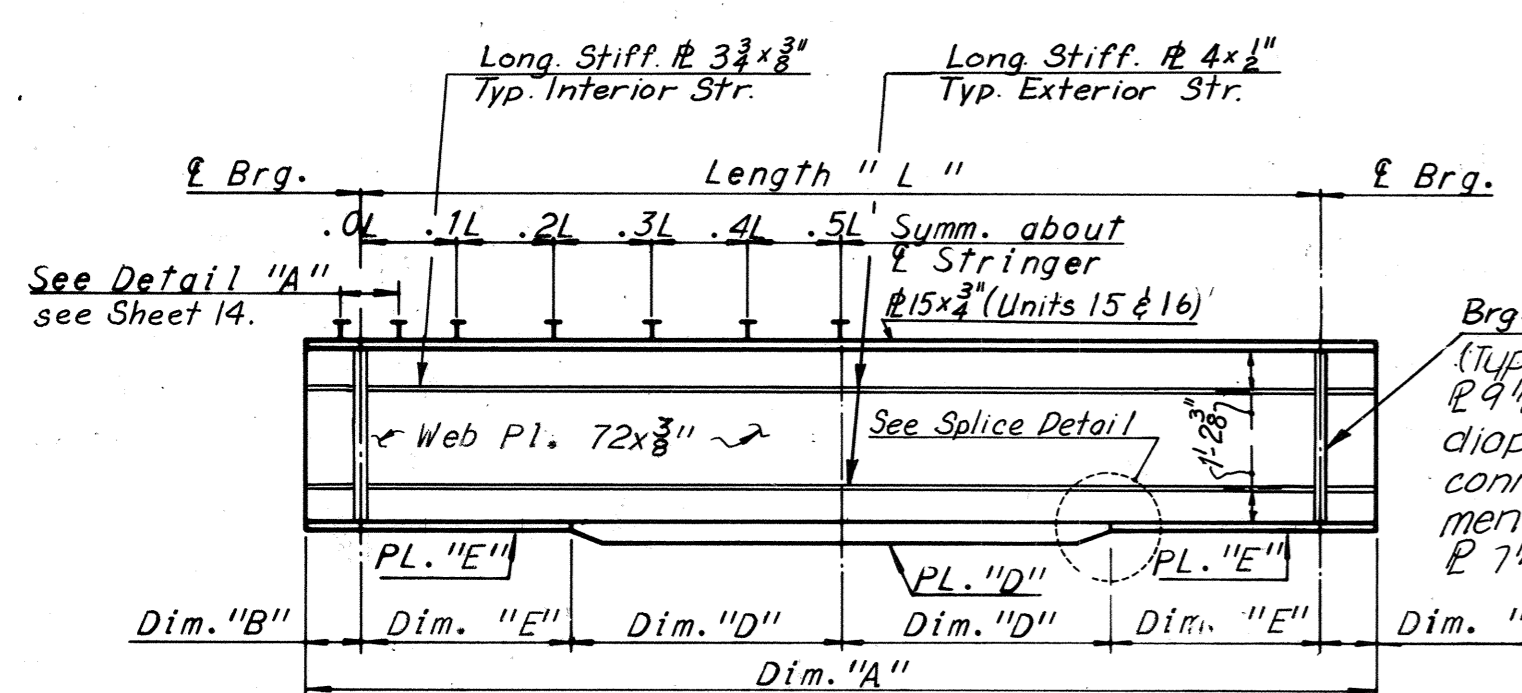

STRINGER ELEVATION UNITS 15 AND 16
No scale

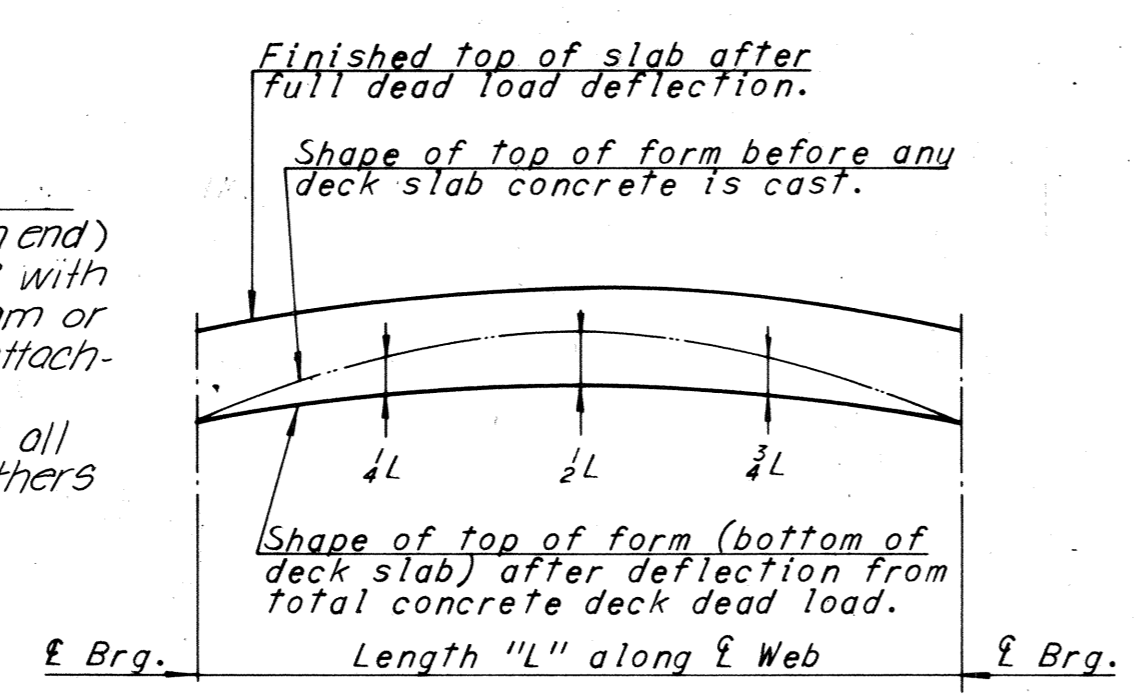


CAMBER DIAGRAM


NOTE TO FABRICATOR
The stringers shall be fabricated with an upward camber amounting to the tabulated value. This will provide approximate compensation for deflection under full dead load and for conformity with finished grade. Dimensions are in inches.

NOTE TO CONTRACTOR
Deflections given are those anticipated to occur in the stringer upon placement of the total concrete deck dead load. In practice, the stringers in place are not likely to have the exact camber to compensate for these deflections during construction. The residual amounts shall be provided by adjusting forms to vary the thickness of the concrete haunch between the bottom of the slab and the top of stringer without altering the slab thickness.


DEAD LOAD DEFLECTION DIAGRAM

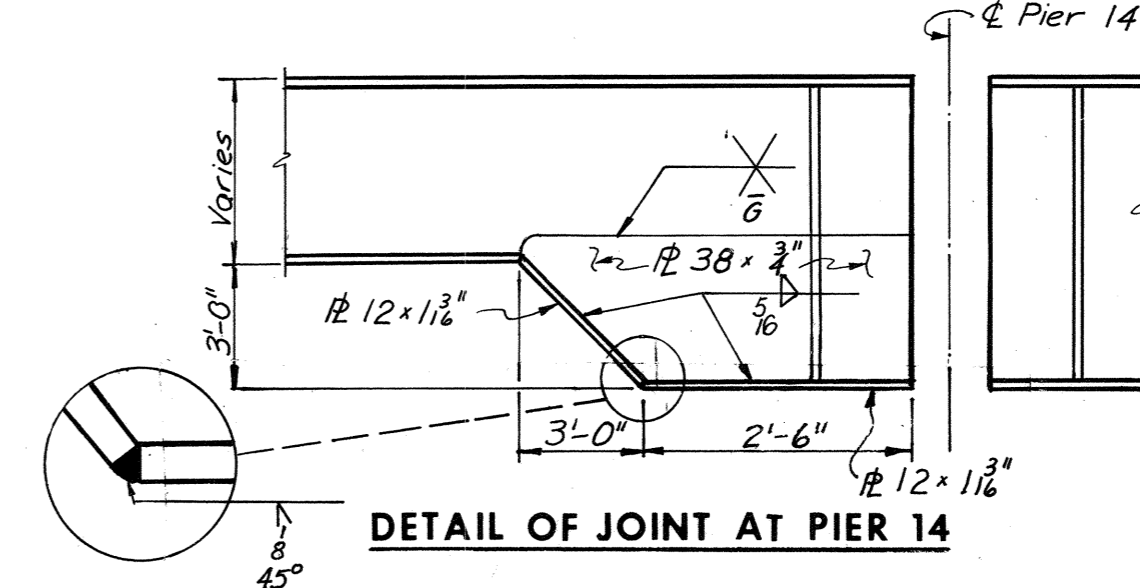

DETAIL OF JOINT AT PIER 14

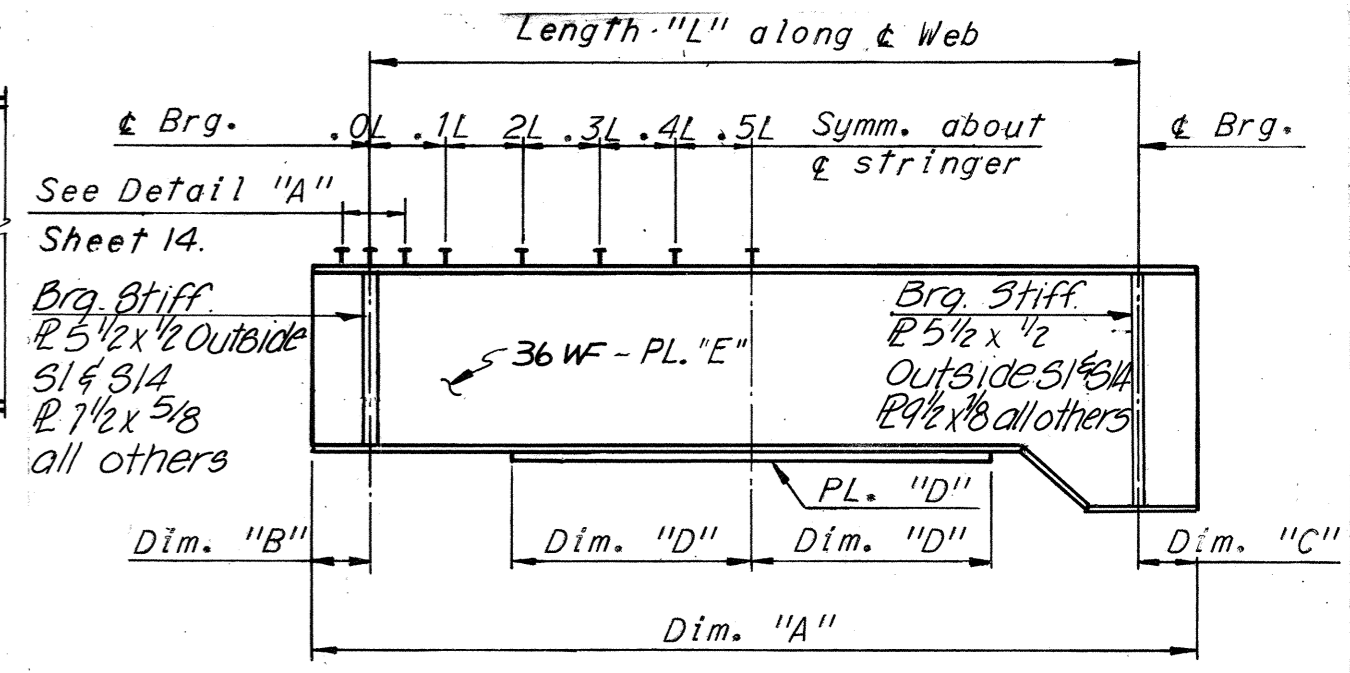

STRINGER ELEVATION - UNIT 14
No scale

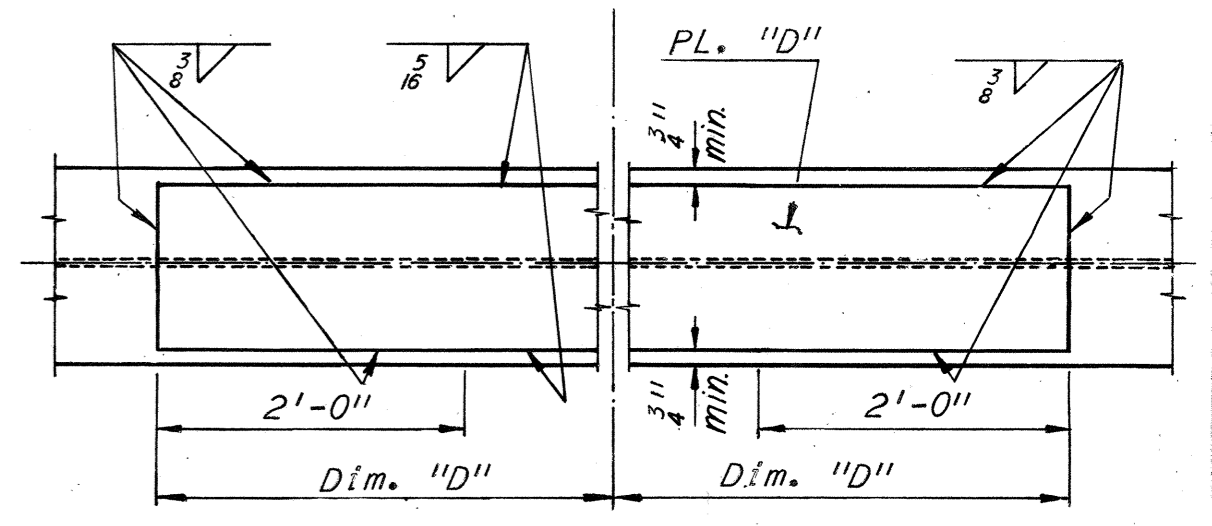

COVER PLATE DETAIL

Note: Intermediate stiffener Pls. $4\frac{1}{2} \times 3\frac{1}{2}$ shall be equally spaced between diaphragms as shown. The first two stiffener spaces at the ends of stringers shall be one-half the normal spacing within the panel.

Note: All steel shall be A-36 unless otherwise shown. Exterior stringer longitudinal stiffeners shall be located on the exterior face of the stringer. It may be necessary to increase Bearing Stiffener size to accommodate erection of end diaphragm. Note: (-) sign in camber denotes downward camber.

SHOE SCHEDULE			
EXPANSION SHOES		FIXED SHOES	
TYPE	NO. REQD.	TYPE	NO. REQD.
E2	6	F1	6
E5	10	F2	5
		F2BD	5

UNIT	STRINGER	Dim. "A"	LENGTH "L"	Dim. "B"	Dim. "C"	Dim. "D"	Dim. "E"	PL "D"	PL "E"	MAX. SHEAR STUD SPACING					DEAD LOAD DEFLECTION SCHEDULE			CAMBER SCHEDULE				
										0.0L-0.1E	0.1L-0.2L	0.2L-0.3L	0.3L-0.4L	0.4L-0.5L	1/4	1/2	3/4	1/4	1/2	3/4		
										8"	9"	12"	14 1/2"	18"	1"	1 3/8"	1"	1 3/8"	1 1/2"	1 3/8"	1 1/2"	1 3/8"
14	S1-14	77'-8 3/8"	75'-11 3/8"	1'-1 1/8"	8"	31'-6"	---	10 1/2 x 1 3/8"	36WF182	8"	9"	12"	14 1/2"	18"	1"	1 3/8"	1"	1 3/8"	1 1/2"	1 3/8"	1 1/2"	1 3/8"
	S2-14	77'-2 1/2"	75'-6 3/8"	1'-1 1/8"	7"	30'-6"	---	10 1/2 x 1 3/8"	36WF182	9"	10"	12 1/2"	15"	18"	1 1/8"	1 1/2"	1 1/8"	1 3/8"	1 1/2"	1 3/8"	1 1/2"	1 3/8"
	S3-14	76'-9 3/8"	75'-1 3/8"	1'-1 1/8"	7"	30'-6"	---	10 1/2 x 1 3/8"	36WF182	9"	10"	12 1/2"	15"	18"	1"	1 3/8"	1"	1 3/8"	1 1/2"	1 3/8"	1 1/2"	1 3/8"
	S4-14	76'-5 3/8"	74'-9 3/8"	1'-1 1/8"	7"	29'-0"	---	10 1/2 x 1"	36WF160	9 1/2"	10 1/2"	13 1/2"	16"	20"	1"	1 3/8"	1 1/8"	1 3/8"	1 1/2"	1 3/8"	1 1/2"	1 3/8"
	S5-14	76'-0 1/2"	74'-4 1/2"	1'-1"	7"	30'-0"	---	10 1/2 x 1"	36WF135	10"	11 1/2"	15"	18 1/2"	23 1/2"	1 1/8"	1 3/8"	1 1/8"	1 3/8"	1 1/2"	1 3/8"	1 1/2"	1 3/8"
	S6-14	75'-10 1/2"	74'-1"	1'-1"	8"	30'-0"	---	10 1/2 x 1 1/8"	36WF150	9"	10"	14"	17"	23"	1 1/8"	1 3/8"	1 1/8"	1 3/8"	1 1/2"	1 3/8"	1 1/2"	1 3/8"
15	S1-15	92'-9 3/8"	91'-7 3/8"	7"	7 3/8"	45'-9 3/8"	---	15x1	---	15"	17"	20"	24"	24"	2"	1 1/8"	3/4"	-1 1/8"	-3/4"	-9/16"	-3/8"	-9/16"
	S2-15	94'-7"	93'-6 1/8"	6"	6 1/8"	46'-9 3/8"	---	15x1	---	16"	18"	20 1/2"	23 1/2"	24"	1 1/8"	1 1/8"	1 1/8"	-1 1/8"	-1 1/8"	-1 1/8"	-1 1/8"	
	S3-15	96'-6 3/8"	95'-6 3/8"	6"	6 1/8"	23'-0"	21'-9 3/8"	15x1 1/2"	15x3 1/2"	16"	18"	20 1/2"	24"	24"	1 1/8"	1 1/8"	1 1/8"	-1 1/8"	-3/4"	-1 1/8"	-1 1/8"	
	S4-15	98'-6"	97'-5 1/2"	6"	6 1/8"	22'-0"	26'-8 3/8"	15x1 1/2"	15x3 1/2"	16"	18"	20 1/2"	23"	24"	1 1/8"	1 1/8"	1 1/8"	-1 1/8"	-1 1/8"	-1 1/8"	-1 1/8"	
16	S1-16	105'-3 3/8"	103'-11 1/8"	8 3/8"	8 3/8"	29'-0"	22'-11 3/8"	15x1 3/8"	15x3 1/2"	14 1/2"	16 1/2"	19 1/2"	24"	24"	1 1/8"	1 1/8"	1 1/8"	-1 1/8"	-1 1/8"	-1 1/8"	-1 1/8"	
	S2-16	105'-1 1/2"	103'-11 1/8"	7 3/8"	7 3/8"	27'-6"	24'-5 3/8"	15x1 3/8"	15x3 1/2"	16"	18"	21"	24"	24"	1 1/8"	1 1/8"	1 1/8"	-1 1/8"	-1 1/8"	-1 1/8"	0	
	S3-16	105'-1 1/8"	103'-11 1/8"	7 3/8"	7 3/8"	27'-6"	24'-5 3/8"	15x1 3/8"	15x3 1/2"	16"	18"	21"	24"	24"	1 1/8"	1 1/8"	1 1/8"	-1 1/8"	-1 1/8"	-1 1/8"	+1 1/8"	
	S4-16	105'-1 1/8"	103'-11 1/8"	7 3/8"	7 3/8"	27'-6"	24'-5 3/8"	15x1 3/8"	15x3 1/2"	16"	18"	21"	24"	24"	1 1/8"	1 1/8"	1 1/8"	-1 1/8"	-1 1/8"	-1 1/8"	+1 1/8"	
	S5-16	105'-1 1/8"	103'-11 1/8"	7 3/8"	7 3/8"	27'-6"	24'-5 3/8"	15x1 3/8"	15x3 1/2"	16"	18"	21"	24"	24"	1 1/8"	1 1/8"	1 1/8"	-1 1/8"	-1 1/8"	-1 1/8"	+1 1/8"	
	S6-16	105'-3 3/8"	103'-11 1/8"	8 3/8"	8 3/8"	29'-0"	22'-11 3/8"	15x1 3/8"	15x3 1/2"	14 1/2"	16 1/2"	19 1/2"	24"	24"	1 1/8"	1 1/8"	1 1/8"	-1 1/8"	-1 1/8"	-1 1/8"	+1 1/8"	

**Spacing begins at termination of 6 spaces @ 4'.

Notes: For Shoe details see Sheets 81/82
For Diaphragm details see Sheet 18.
For Superstructure steel quantities see Sheet 2.
For Joint details see Sheet 24.
For Shear Stud Detail see Sheet 14.

Note: For web to flange weld sizes and longitudinal stiffener plate details see Sheet 14.

RICHMOND METROPOLITAN AUTHORITY
RICHMOND EXPRESSWAY SYSTEM
DOWNTOWN EXPRESSWAY


BRIDGE NO. 63
WESTBOUND ROADWAY OVER
12TH ST. - R.R. TRACKS AND 16TH ST.
FRAMING PLAN - UNITS 14, 15 AND 16

HOWARD, NEEDLES, TAMMEN & BERGENDOFF
consulting engineers
NEW YORK ALEXANDRIA KANSAS CITY

SCALE: AS NOTED
CONTRACT NO.: 10
SHEET NO. 13 OF 29

AS BUILT

MADE	J.D.	8-8-68			
CHECKED	PTA	10-23-68	1	As-Built	TEM 10-76
IN CHARGE			NO.	REVISION	BY DATE

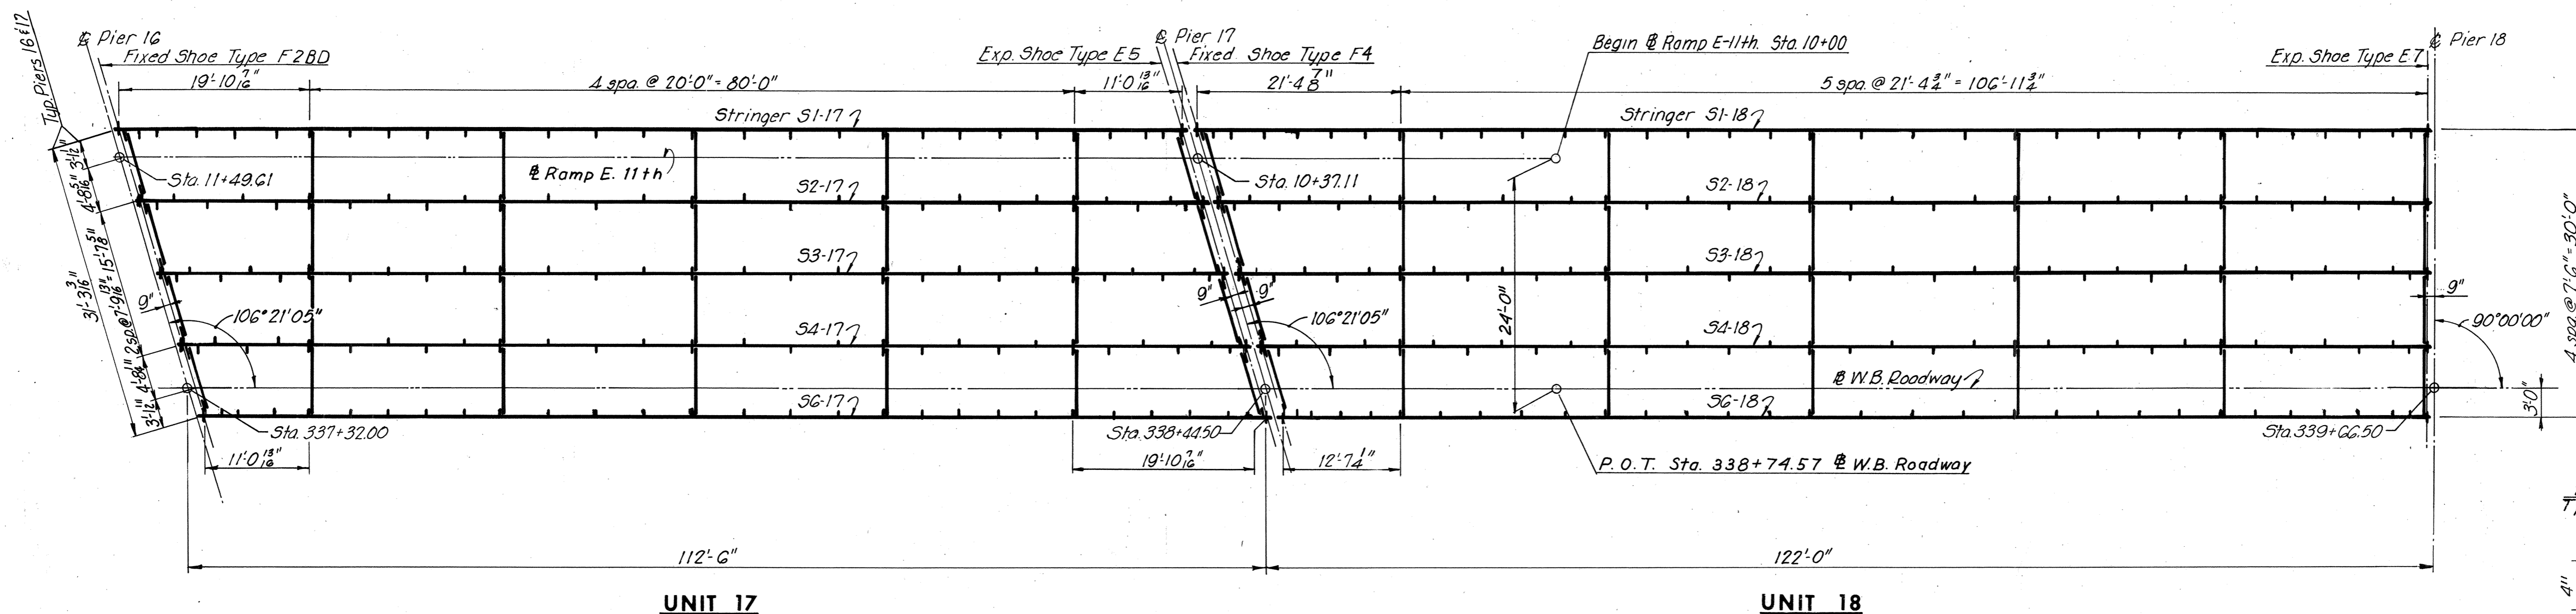


UNIT 17

UNIT 18


FRAMING PLAN

Scale: 1"=10'-0"

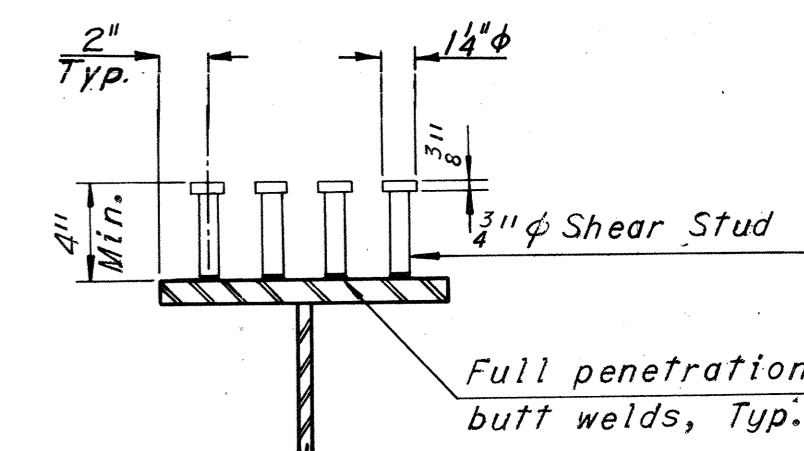

SHEAR STUD DETAIL
No Scale


SHOE SCHEDULE			
EXPANSION SHOES		FIXED SHOES	
TYPE	NO. REQD.	TYPE	NO. REQD.
E5	5	F2BD	5
E7	5	F4	5

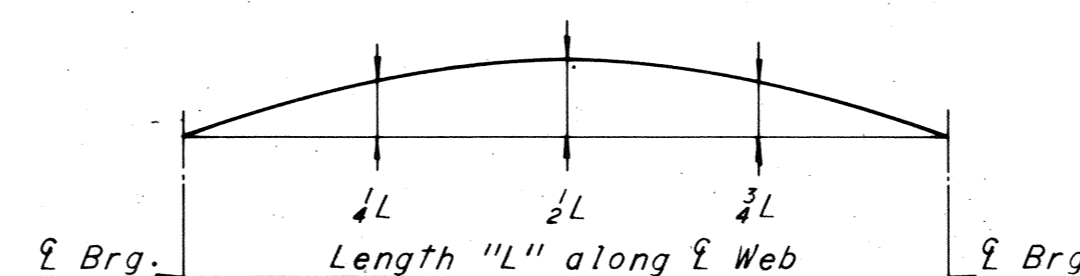

CAMBER DIAGRAM


NOTE TO FABRICATOR

The stringers shall be fabricated with an upward camber amounting to the tabulated value. This will provide approximate compensation for deflection under full dead load and for conformity with finished grade. Dimensions are in inches.

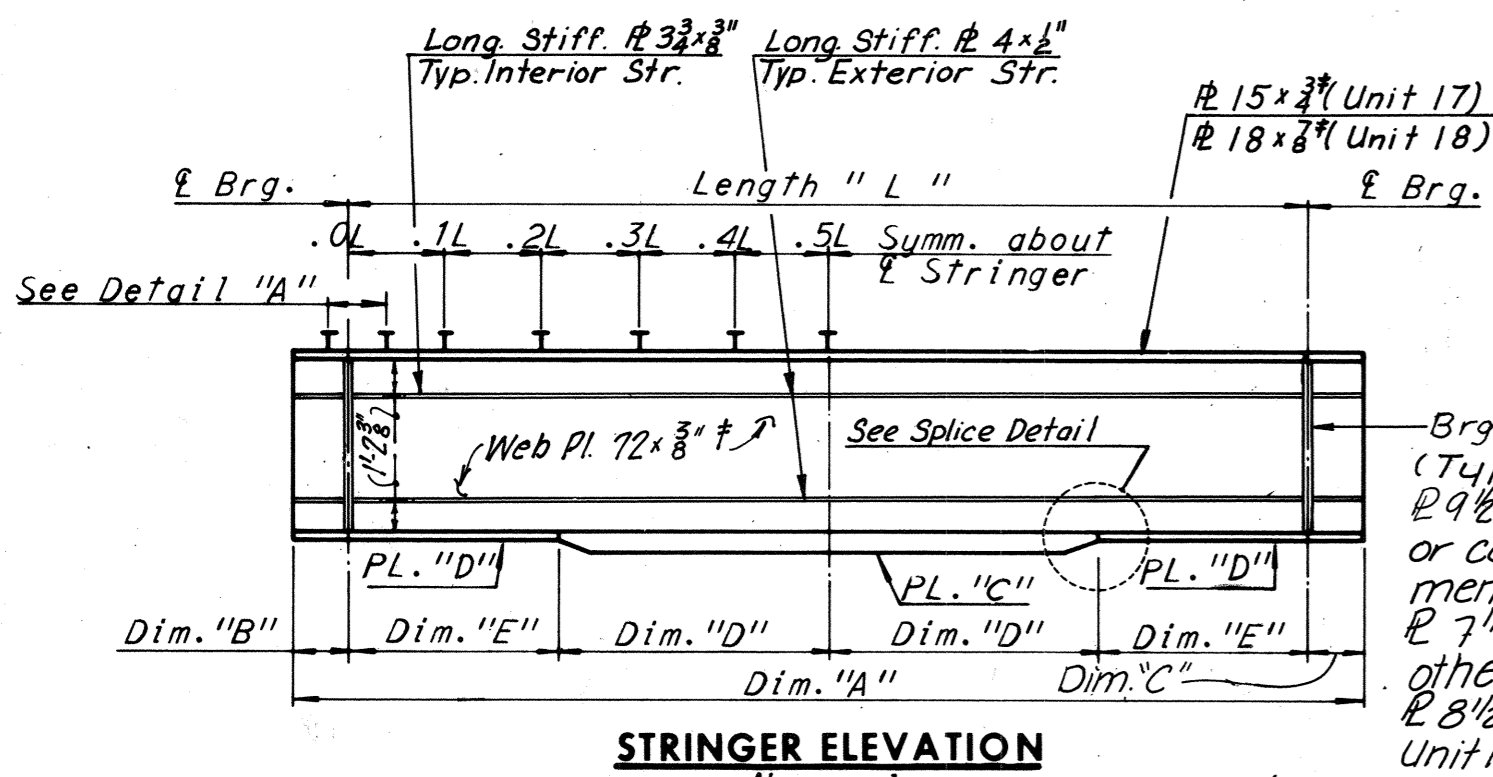

STRINGER ELEVATION

No scale

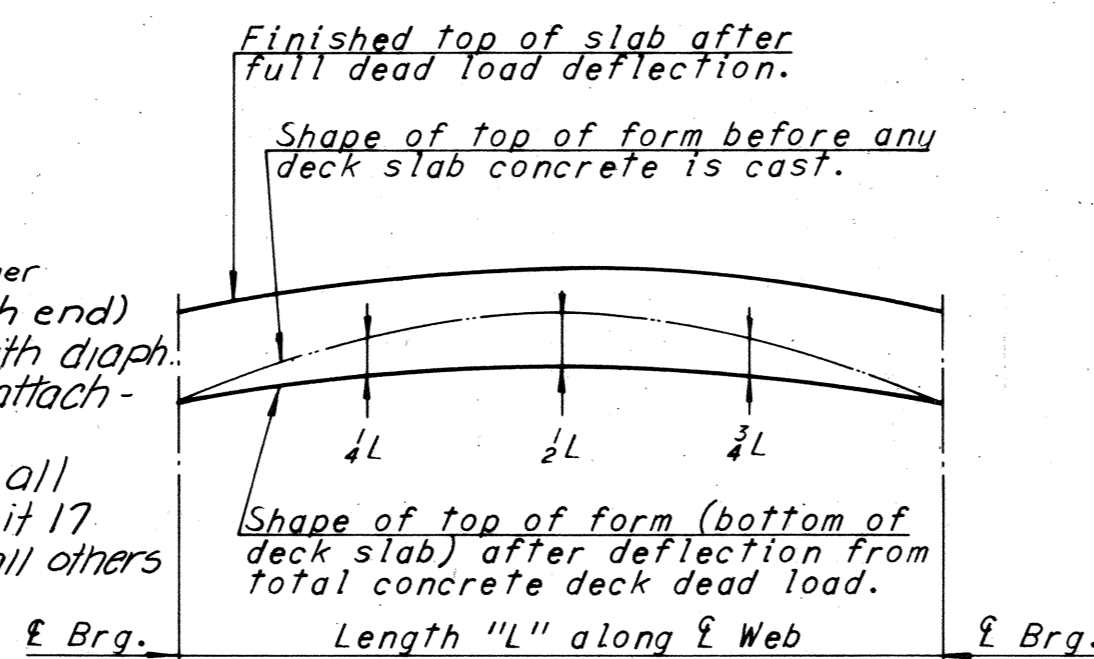

DEAD LOAD DEFLECTION DIAGRAM

NOTE TO CONTRACTOR


Deflections given are those anticipated to occur in the stringer upon placement of the total concrete deck dead load. In practice, the stringers in place are not likely to have the exact camber to compensate for these deflections during construction. The residual amounts shall be provided by adjusting forms to vary the thickness of the concrete haunch between the bottom of the slab and the top of stringer without altering the slab thickness.

Note:

It may be necessary to increase Bearing Stiffener size to accommodate erection of end diaphragms.

Notes:

For Superstructure steel quantities see Sheet 2.
For Joint details see Sheet 24.
For Shoe details see Sheets 51 & 52.
For Diaphragm details see Sheet 19.

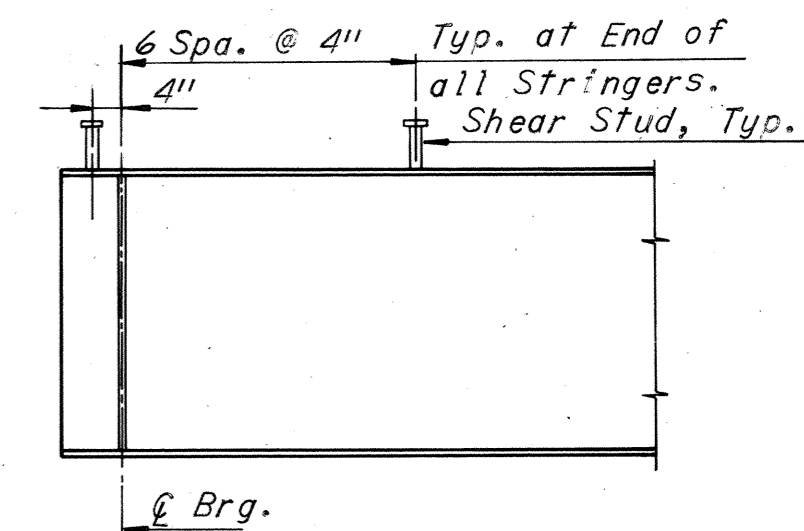


DETAIL "A"

No Scale

SHEAR STUD NOTE

Capacity = 3,400 lbs. per stud.
Contractor may, if he elects, use three 3/4" diameter studs at the same longitudinal spacing in lieu of the four 3/4" diameter studs shown.
Stud rows shall be placed parallel to the main deck reinforcement.

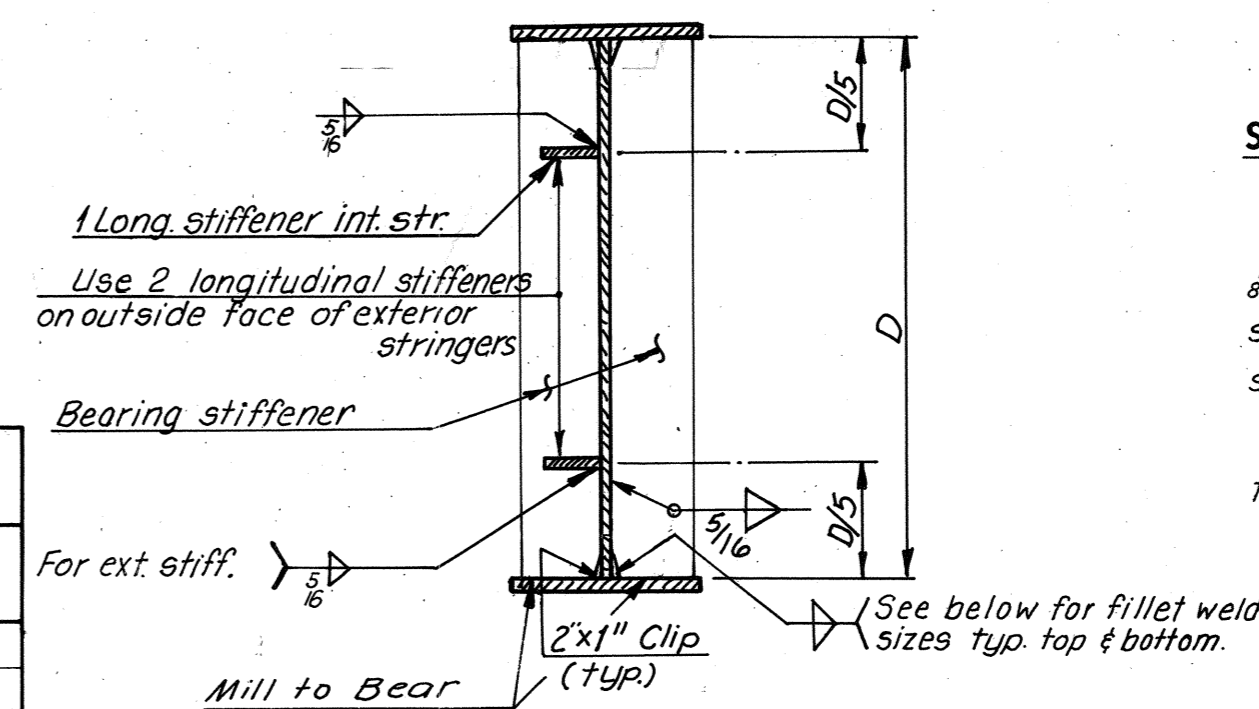

WEB TO FLANGE WELDS AND LONGITUDINAL STIFFENER WELD DETAILS

Note: Web to flange weld size shall be determined by flange thickness as follows:
To 1/2"..... 3/8" weld
To 1/2" to 2 1/4"..... 3/8" weld
over 2 1/4" to 2 3/4"..... 1/2" weld

UNIT	STRINGER	Dim. "A"	LENGTH "L"	Dim. "B"	Dim. "C"	Dim. "D"	Dim. "E"	PL. "C" †	PL. "D" †	MAX. SHEAR STUD SPACING					DEAD LOAD DEFLECTION SCHEDULE			CAMBER SCHEDULE		
										0.0L-0.1L	0.1L-0.2L	0.2L-0.3L	0.3L-0.4L	0.4L-0.5L	1/4L	1/2L	3/4L	1/4L	1/2L	3/4L
17	S1-17	112'-4"	110'-11 1/4"	8 3/8"	8 3/8"	27'-0"	28'-5 5/8"	15x1 1/2"	15x3 1/2"	13 1/2"	15 1/2"	18 1/2"	23"	24"	1 3/8"	2 1/4"	1 5/8"	2"	2 1/8"	2 1/8"
	S2-17	112'-2"	110'-11 1/4"	7 3/8"	7 3/8"	25'-0"	30'-5 5/8"	15x1"	15x3 1/2"	15"	17"	19 1/2"	22"	24"	1 3/8"	2 1/4"	1 3/8"	2"	2 1/8"	2 1/8"
	S3-17	112'-2"	110'-11 1/4"	7 3/8"	7 3/8"	25'-0"	30'-5 5/8"	15x1"	15x3 1/2"	15"	17"	19 1/2"	22"	24"	1 3/8"	2 1/4"	1 3/8"	2"	2 1/8"	2 1/8"
	S4-17	112'-2"	110'-11 1/4"	7 3/8"	7 3/8"	25'-0"	30'-5 5/8"	15x1"	15x3 1/2"	15"	17"	19 1/2"	22"	24"	1 3/8"	2 1/4"	1 3/8"	2"	2 1/8"	2 1/8"
	S6-17	112'-4"	110'-11 1/4"	8 3/8"	8 3/8"	25'-6"	29'-11 1/2"	15x1 1/2"	15x3 1/2"	14"	16"	19"	24"	24"	1 3/8"	2 1/4"	1 3/8"	2"	2 1/8"	2 1/8"
18	S1-18	129'-9"	128'-4 3/8"	8 3/8"	8"	32'-0"	32'-2 3/8"	18x1 1/2"	18x3 1/2"	14 1/2"	16 1/2"	19 1/2"	24"	24"	2 1/4"	3 1/8"	2 1/4"	1 1/8"	2 1/8"	2 5/8"
	S2-18	127'-4 1/2"	126'-2 1/4"	7 3/8"	7"	27'-0"	36'-1 1/8"	18x1 1/2"	18x3 1/2"	16 1/2"	18 1/2"	21 1/2"	24"	24"	2 1/4"	2 1/8"	2 1/4"	1 1/8"	3 1/8"	2 3/8"
	S3-18	125'-2 1/4"	123'-11 1/8"	7 3/8"	7"	24'-6"	37'-5 1/8"	18x1 1/2"	18x3 1/2"	16 1/2"	18 1/2"	21 1/2"	23 1/2"	24"	2"	2 5/8"	2"	2 1/8"	3 1/8"	2 3/8"
	S4-18	122'-11 1/8"	121'-9 1/8"	7 3/8"	7"	60'-10 1/2"	---	18x1"	---	16 1/2"	18 1/2"	21 1/2"	23 1/2"	24"	1 3/4"	2 1/8"	1 3/4"	2 1/8"	3 1/4"	2 7/8"
	S6-18	120'-11 1/8"	119'-7"	8 3/8"	8"	21'-6"	38'-3 1/2"	18x1 1/2"	18x3 1/2"	15"	17"	20"	24"	24"	1 3/4"	2 1/8"	1 3/4"	2 1/8"	3 1/8"	2 3/8"

* Spacing begins at termination of 6 spaces @ 4".

Note:

All steel shall be A36 unless otherwise shown.
† Denotes A572-Grade 50 steel for thickness of 3/4" and under and A588 steel for thickness over 3/4".
Exterior stringer, longitudinal stiffeners shall be located on the exterior face of the stringer.

Intermediate stiffener Pls. 4 1/2 x 3/8 shall be equally spaced between diaphragms as shown. The first two stiffener spaces at the ends of stringers shall be one-half the normal spacing within the panel.

MADE	BY	DATE			
CHECKED	SCC	10-18-68	1	As Built	TEM
IN CHARGE					

RICHMOND METROPOLITAN AUTHORITY
RICHMOND EXPRESSWAY SYSTEM
DOWNTOWN EXPRESSWAY



BRIDGE NO. 63
WESTBOUND ROADWAY OVER
12TH ST. - R.R. TRACKS AND 16TH ST.

FRAMING PLAN - UNITS 17 AND 18

HOWARD, NEEDLES, TAMMEN & BERGENDOFF
consulting engineers
NEW YORK ALEXANDRIA KANSAS CITY

SCALE: As Noted
CONTRACT NO.: 10
SHEET NO. 14 OF 29


AS BUILT

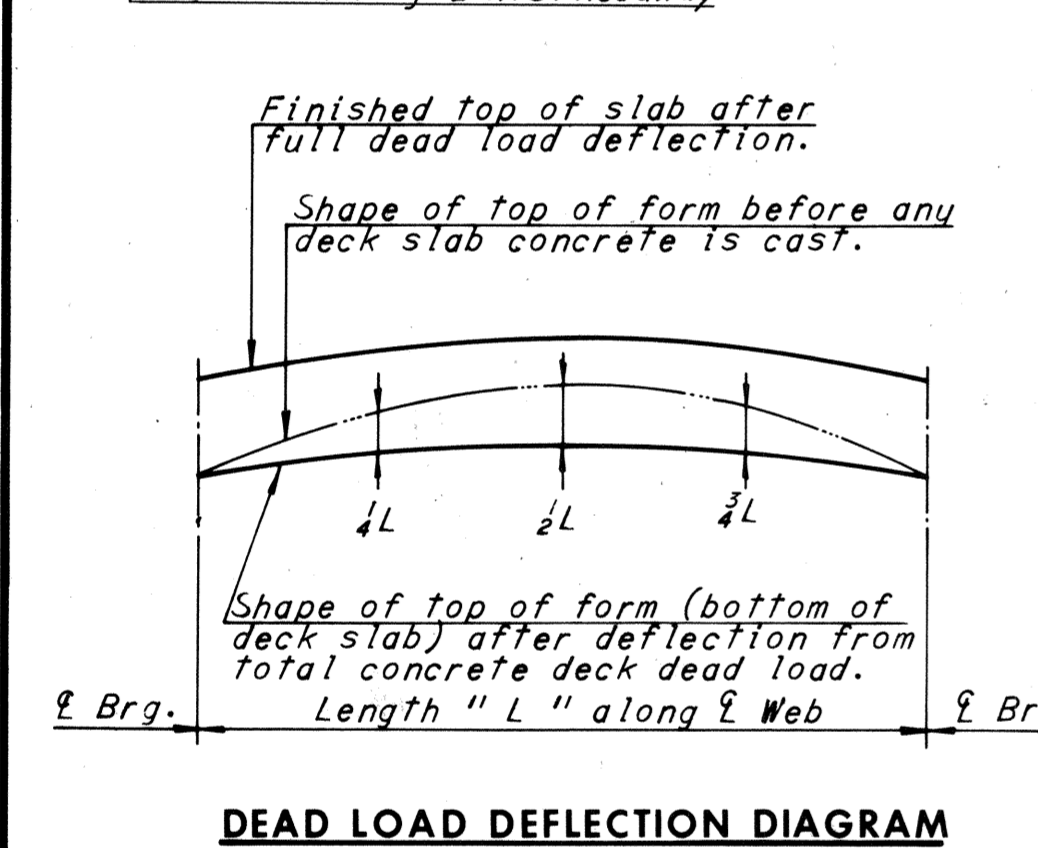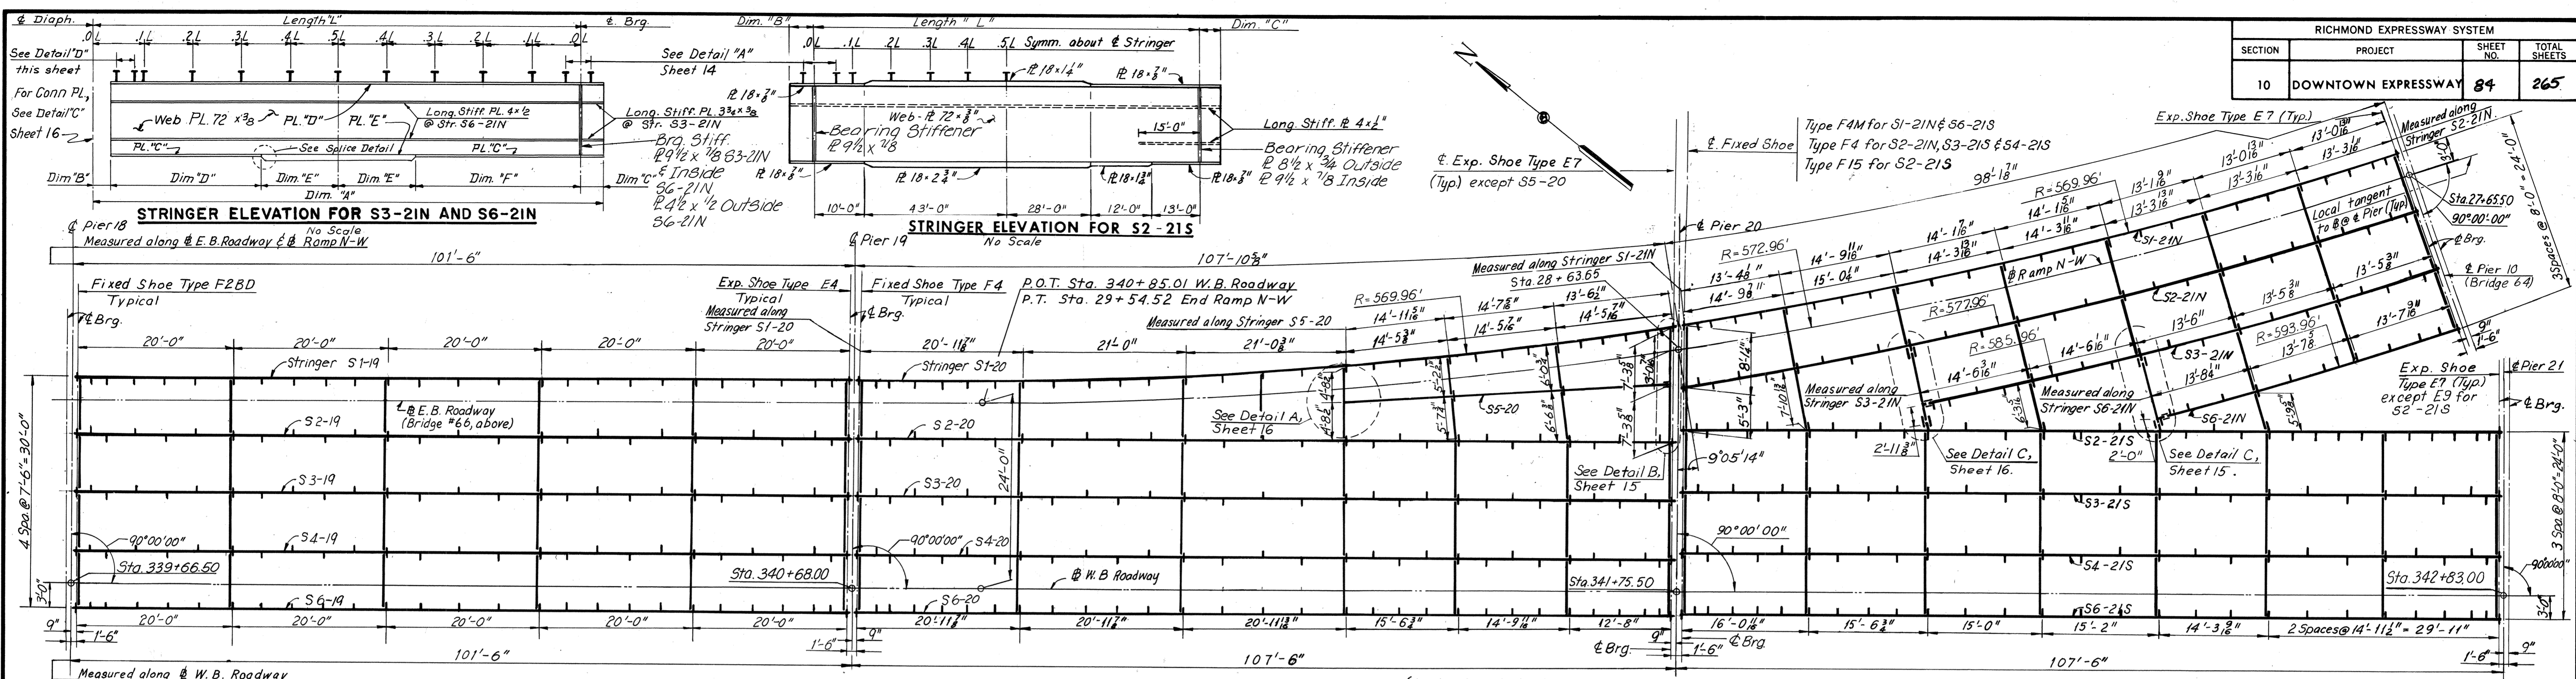

DEAD LOAD DEFLECTION DIAGRAM

NOTE TO CONTRACTOR

Deflections given are those anticipated to occur in the stringer upon placement of the total concrete deck dead load. In practice, the stringers in place are not likely to have the exact camber to compensate for these deflections during construction. The residual amounts shall be provided by adjusting forms to vary the thickness of the concrete haunch between the bottom of the slab and the top of stringer without altering the slab thickness.

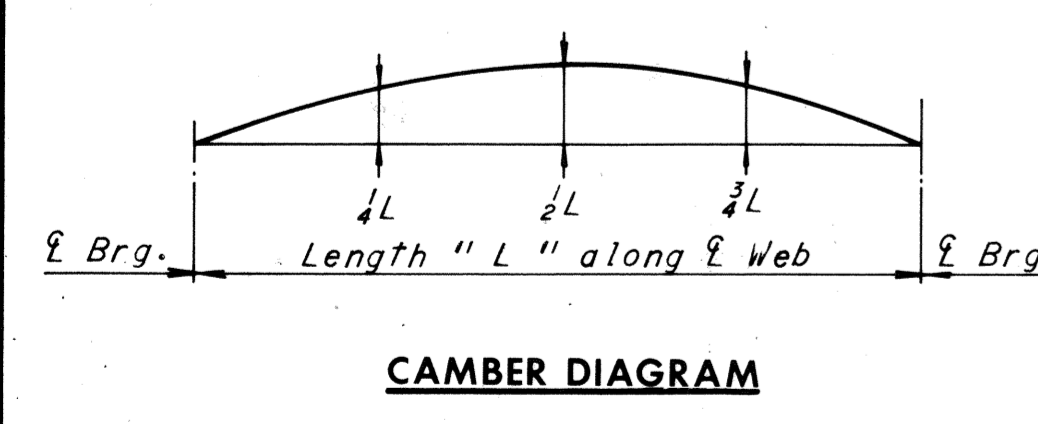


CAMBER DIAGRAM

NOTE TO FABRICATOR


The stringers shall be fabricated with an upward camber amounting to the tabulated value. This will provide approximate compensation conformity with finished grade. Dimensions are in inches. (-) Sign in camber denotes downward camber.

BY	DATE	Note Added	PRMS	4-19-74
MADE	GSH	07-31-68	2	As Built
CHECKED	PTA	10-23-68		TEM
IN CHARGE				

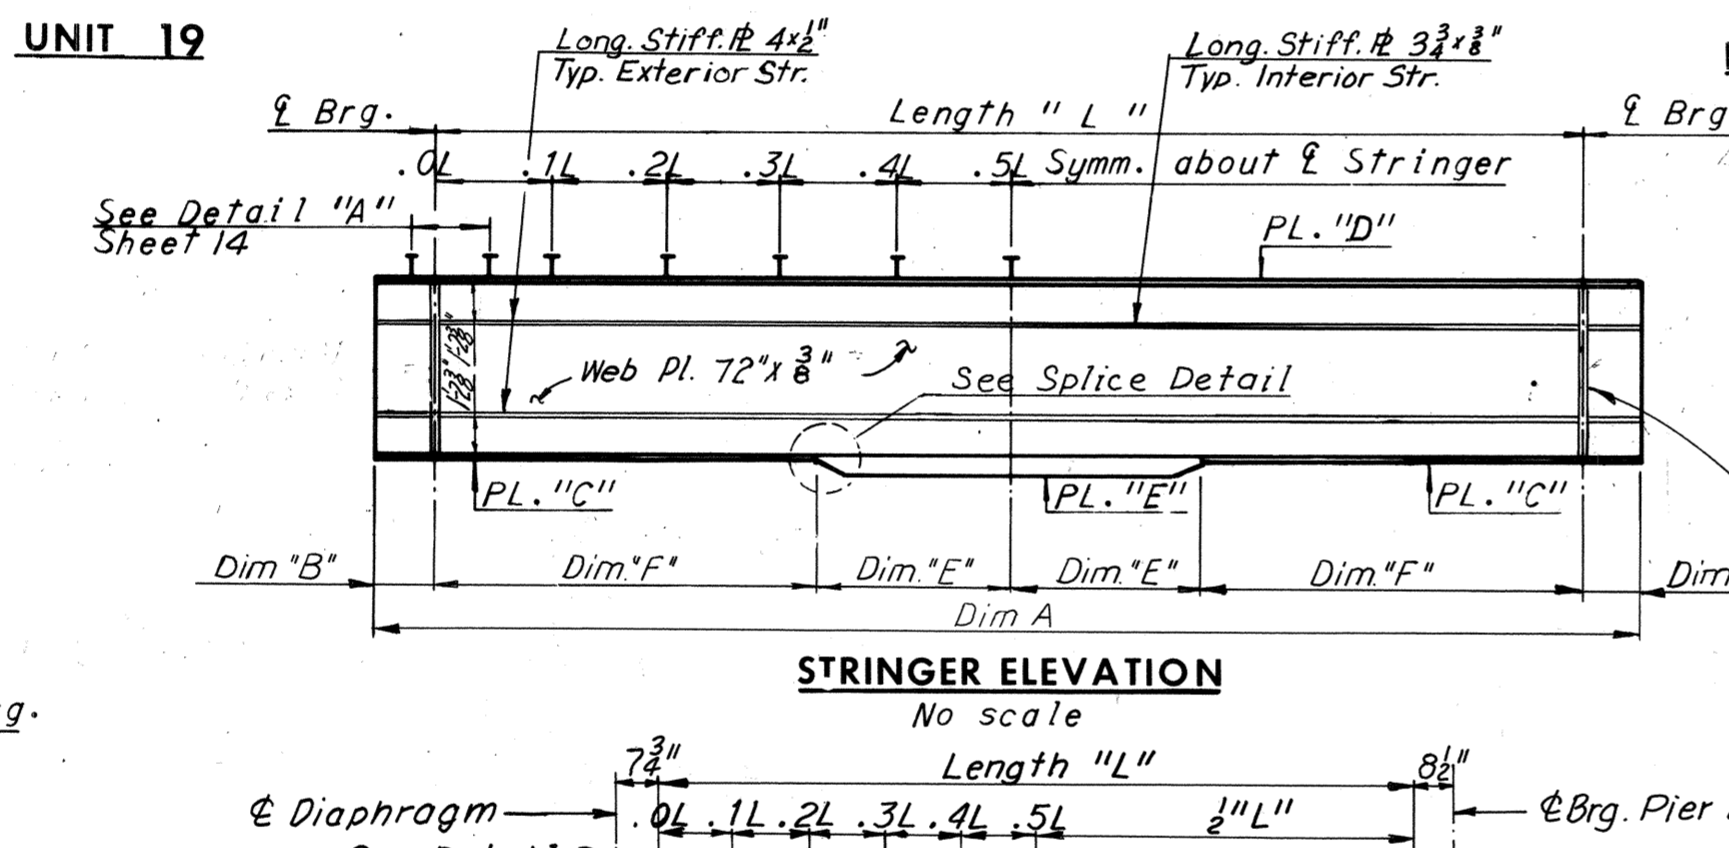


STRINGER ELEVATION FOR S5-20

Note: For web to flange weld sizes and longitudinal stiffener plate details see Sheet 14.

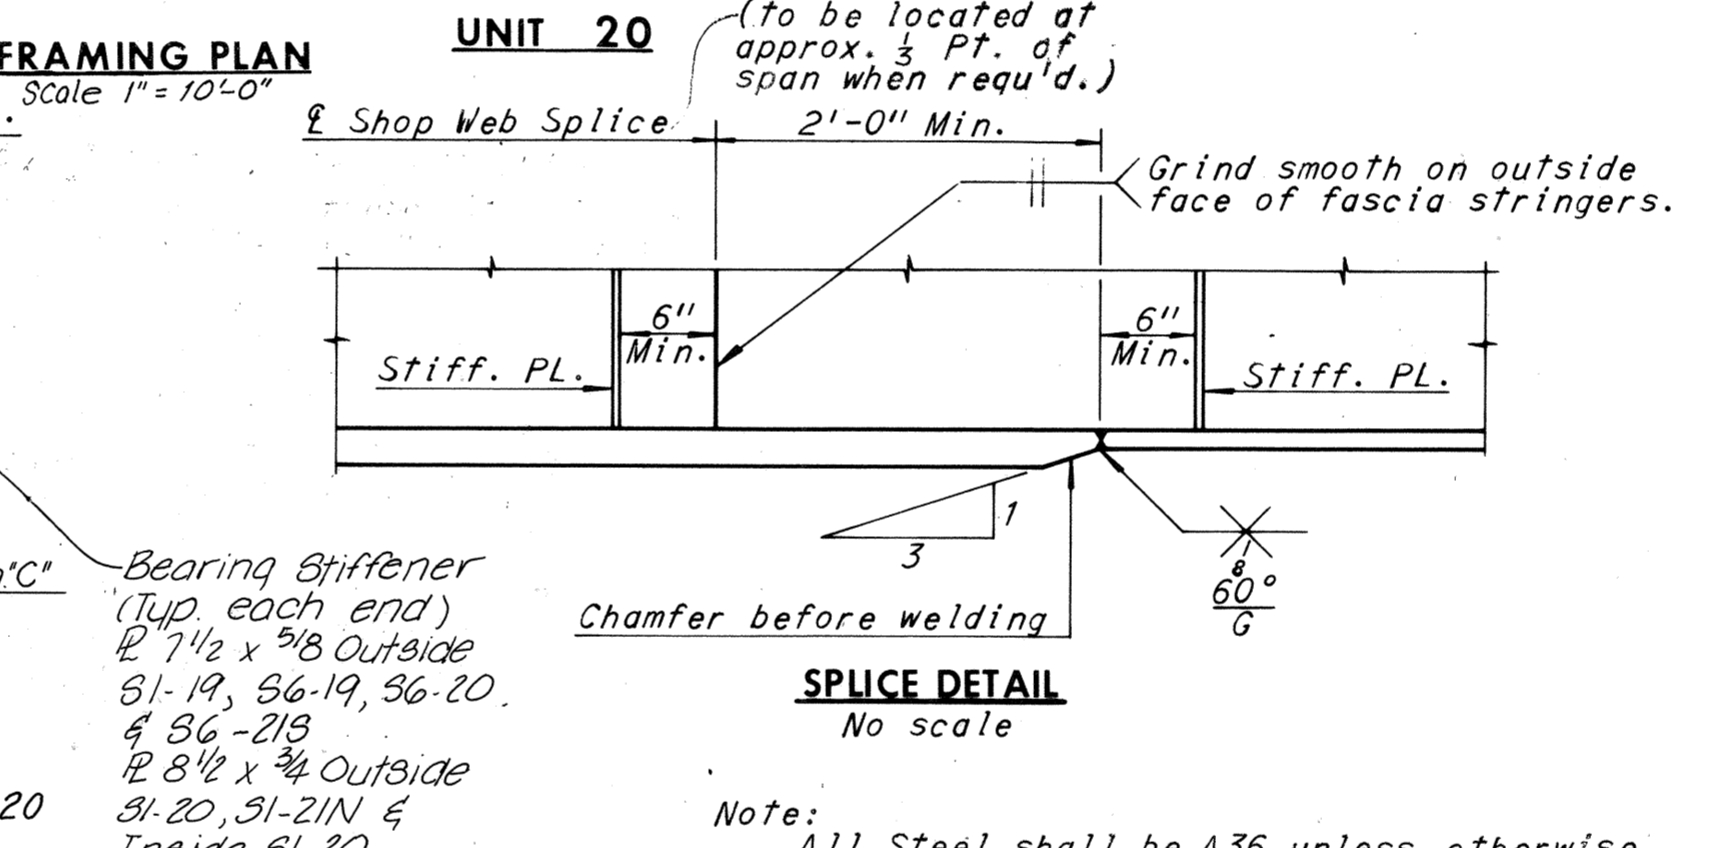

FRAMING PLAN

Note: All Steel shall be A36 unless otherwise shown. Exterior Stringer Longitudinal Stiffeners shall be located on the exterior face of the stringer. Intermediate stiffener pls. 4 1/2 x 3/8 shall be equally spaced between diaphragms as shown. The first two stiffener spaces at the ends of stringers shall be one-half the normal spacing within the panel.

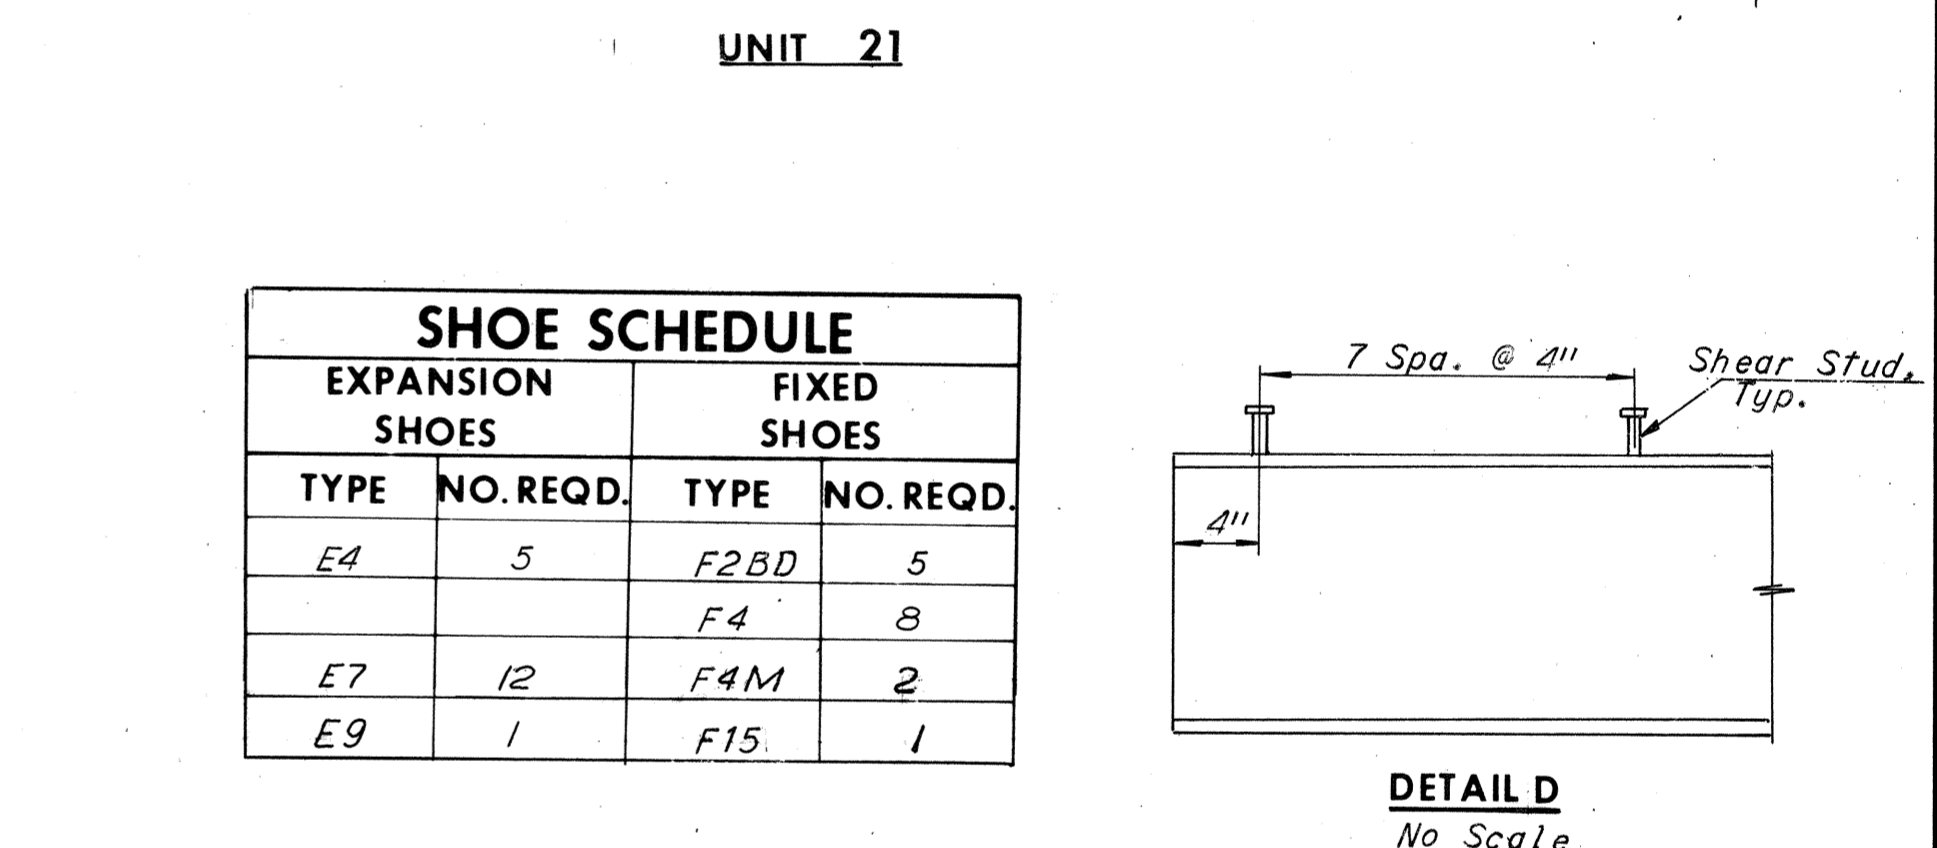

SHOE SCHEDULE

Note: It may be necessary to increase Bearing Stiffener size to accommodate erection of end diaphragms.

UNIT	STRINGER	Dim. "A"	LENGTH "L"	Dim. "B"	Dim. "C"	Dim. "D"	Dim. "E"	Dim. "F"	PL. "C"	PL. "D"	PL. "E"	DEAD LOAD DEFLECTION SCHEDULE					CAMBER SCHEDULE						
												MAX. SHEAR STUD SPACING					1/4L	1/2L	3/4L	1/4L	1/2L	3/4L	
												0.0L-0.1L	0.1L-0.2L	0.2L-0.3L	0.3L-0.4L	0.4L-0.5L							
19	S1-19	101'-4"	100'-0"	8"	8"	--	25'-0"	25'-0"	15x8"	15x4"	15x1 1/2"	14 1/2"	17"	20"	24"	24"	1"	1 3/8"	1"	1 1/4"	1 1/2"	1 1/4"	
	S2-19	101'-2"	100'-0"	7"	7"	--	24'-0"	26'-0"	15x8"	15x4"	15x1 1/2"	16"	18"	21"	24"	24"	1"	1 3/8"	1"	1 1/4"	1 1/2"	1 1/4"	
	S3-19	101'-2"	100'-0"	7"	7"	--	24'-0"	26'-0"	15x8"	15x4"	15x1 1/2"	16"	18"	21"	24"	24"	1"	1 3/8"	1"	1 1/4"	1 1/2"	1 1/4"	
	S4-19	101'-2"	100'-0"	7"	7"	--	24'-0"	26'-0"	15x8"	15x4"	15x1 1/2"	16"	18"	21"	24"	24"	1"	1 3/8"	1"	1 1/4"	1 1/2"	1 1/4"	
	S5-19	101'-4"	100'-0"	8"	8"	--	25'-0"	25'-0"	15x8"	15x4"	15x1 1/2"	14 1/2"	17"	20"	24"	24"	1"	1 3/8"	1"	1 1/4"	1 1/2"	1 1/4"	
	S6-19	101'-4"	100'-0"	8"	8"	--	25'-0"	25'-0"	15x8"	15x4"	15x1 1/2"	14 1/2"	17"	20"	24"	24"	1"	1 3/8"	1"	1 1/4"	1 1/2"	1 1/4"	
20	S1-20	107'-8 1/2"	106'-4 1/2"	8"	8 1/2"	--	34'-0"	19'-2 1/2"	18x8"	18x4"	18x1 1/2"	12"	13 1/2"	17 1/2"	21 1/2"	24"	1 1/8"	1 1/8"	1 1/8"	1 1/8"	2 3/8"	1 3/4"	
	S2-20	107'-2"	106'-0"	7"	7"	--	29'-6"	23'-6"	15x8"	15x4"	15x1 1/2"	15 1/2"	18"	21"	24"	24"	1 3/8"	1 3/8"	1 3/8"	1 3/8"	2 1/8"	1 1/2"	
	S3-20	107'-2"	106'-0"	7"	7"	--	29'-6"	23'-6"	15x8"	15x4"	15x1 1/2"	15 1/2"	18"	21"	24"	24"	1 3/8"	1 3/8"	1 3/8"	1 3/8"	2 1/8"	1 1/2"	
	S4-20	107'-2"	106'-0"	7"	7"	--	29'-6"	23'-6"	15x8"	15x4"	15x1 1/2"	15 1/2"	18"	21"	24"	24"	1 3/8"	1 3/8"	1 3/8"	1 3/8"	2 1/8"	1 1/2"	
	S5-20	--	41'-9 1/2"	--	--	--	--	--	Stringer Size 30WF99	9"	10"	11"	13"	15"	15"	15"	4"	3 3/8"	4"	5 3/8"	4 1/2"	3 3/8"	
	S6-20	107'-4"	106'-0"	8"	8"	--	28'-0"	25'-0"	15x1 1/2"	15x1 1/2"	15x1 1/2"	14 1/2"	17"	20"	24"	24"	1 1/8"	1 1/8"	1 1/8"	1 1/8"	2 1/8"	1 1/2"	
21	S1-21N	96'-11 1/2"	95'-7 1/2"	8 1/2"	8"	--	33'-0"	14'-9 3/8"	18x8"	18x4"	18x1 1/2"	15"	17"	22"	24"	24"	1 1/8"	1 1/8"	1 1/8"	1 1/8"	2 3/8"	1 3/4"	
	S2-21N	99'-5 1/2"	98'-3 3/4"	7 1/2"	7"	--	34'-0"	15'-1 1/8"	18x8"	18x4"	18x1 1/2"	12 1/2"	14"	17 1/2"	24"	24"	1 1/8"	1 1/8"	1 1/8"	1 1/8"	2 3/8"	1 3/4"	
	S3-21N	69'-4 1/2"	69'-5"	7 3/4"	7"	--	10'-0 3/4"	10'-8 3/4"	12x8"	12x4"	12x1 1/2"	11"	15"	17"	20"	20"	1 1/8"	1 1/8"	1 1/8"	1 1/8"	2 3/8"	1 3/4"	
	S6-21N	40'-11 1/2"	40'-11 7/8"	7 3/4"	8"	--	19'-10"	--	10x8"	10x8"	--	16"	18 1/2"	21"	24"	24"	1 1/8"	1 1/8"	1 1/8"	1 1/8"	2 3/8"	1 3/4"	
	S2-21S	107'-4"	106'-0"	8"	8"	--	See Stringer Elevation for S2-21S	--	--	8"	8"	11"	16"	18"	20"	24"	24"	1 1/8"	1 1/8"	1 1/8"	1 1/8"	2 3/8"	1 3/4"
	S3-21S	107'-2"	106'-0"	7"	7"	--	28'-6"	24'-6"	15x1 1/2"	15x1 1/2"	15x1 1/2"	15 1/2"	17"	20"	22 1/2"	24"	24"	1 1/8"	1 1/8"	1 1/8"	1 1/8"	2 3/8"	1 3/4"
S4-21S	107'-2"	106'-0"	7"	7"	--	28'-6"	24'-6"	15x1 1/2"	15x1 1/2"	15x1 1/2"	15 1/2"	17"	20"	22 1/2"	24"	24"	1 1/8"	1 1/8"	1 1/8"	1 1/8"	2 3/8"	1 3/4"	
S6-21S	107'-4"	106'-0"	8"	8"	--	28'-6"	24'-6"	15x1 1/2"	15x1 1/2"	15x1 1/2"	14 1/2"	16 1/2"	19 1/2"	24"	24"	1 1/8"	1 1/8"	1 1/8"	1 1/8"	2 3/8"	1 3/4"		

AS BUILT

RICHMOND METROPOLITAN AUTHORITY
RICHMOND EXPRESSWAY SYSTEM
DOWNTOWN EXPRESSWAY




BRIDGE NO. 63
 WESTBOUND ROADWAY OVER
 12TH ST. - R.R. TRACKS AND 16TH ST.
FRAMING PLAN—UNITS 19, 20 AND 21

HOWARD, NEEDLES, TAMMEN & BERGENDOFF
 consulting engineers
 ALEXANDRIA KANSAS CITY

SCALE: As Noted
 CONTRACT NO.: 10
 SHEET NO. 15 OF 29


* Spacing begins at termination of 6 spaces @ 4".

RICHMOND EXPRESSWAY SYSTEM			
SECTION	PROJECT	SHEET NO.	TOTAL SHEETS
10	DOWNTOWN EXPRESSWAY	85	265

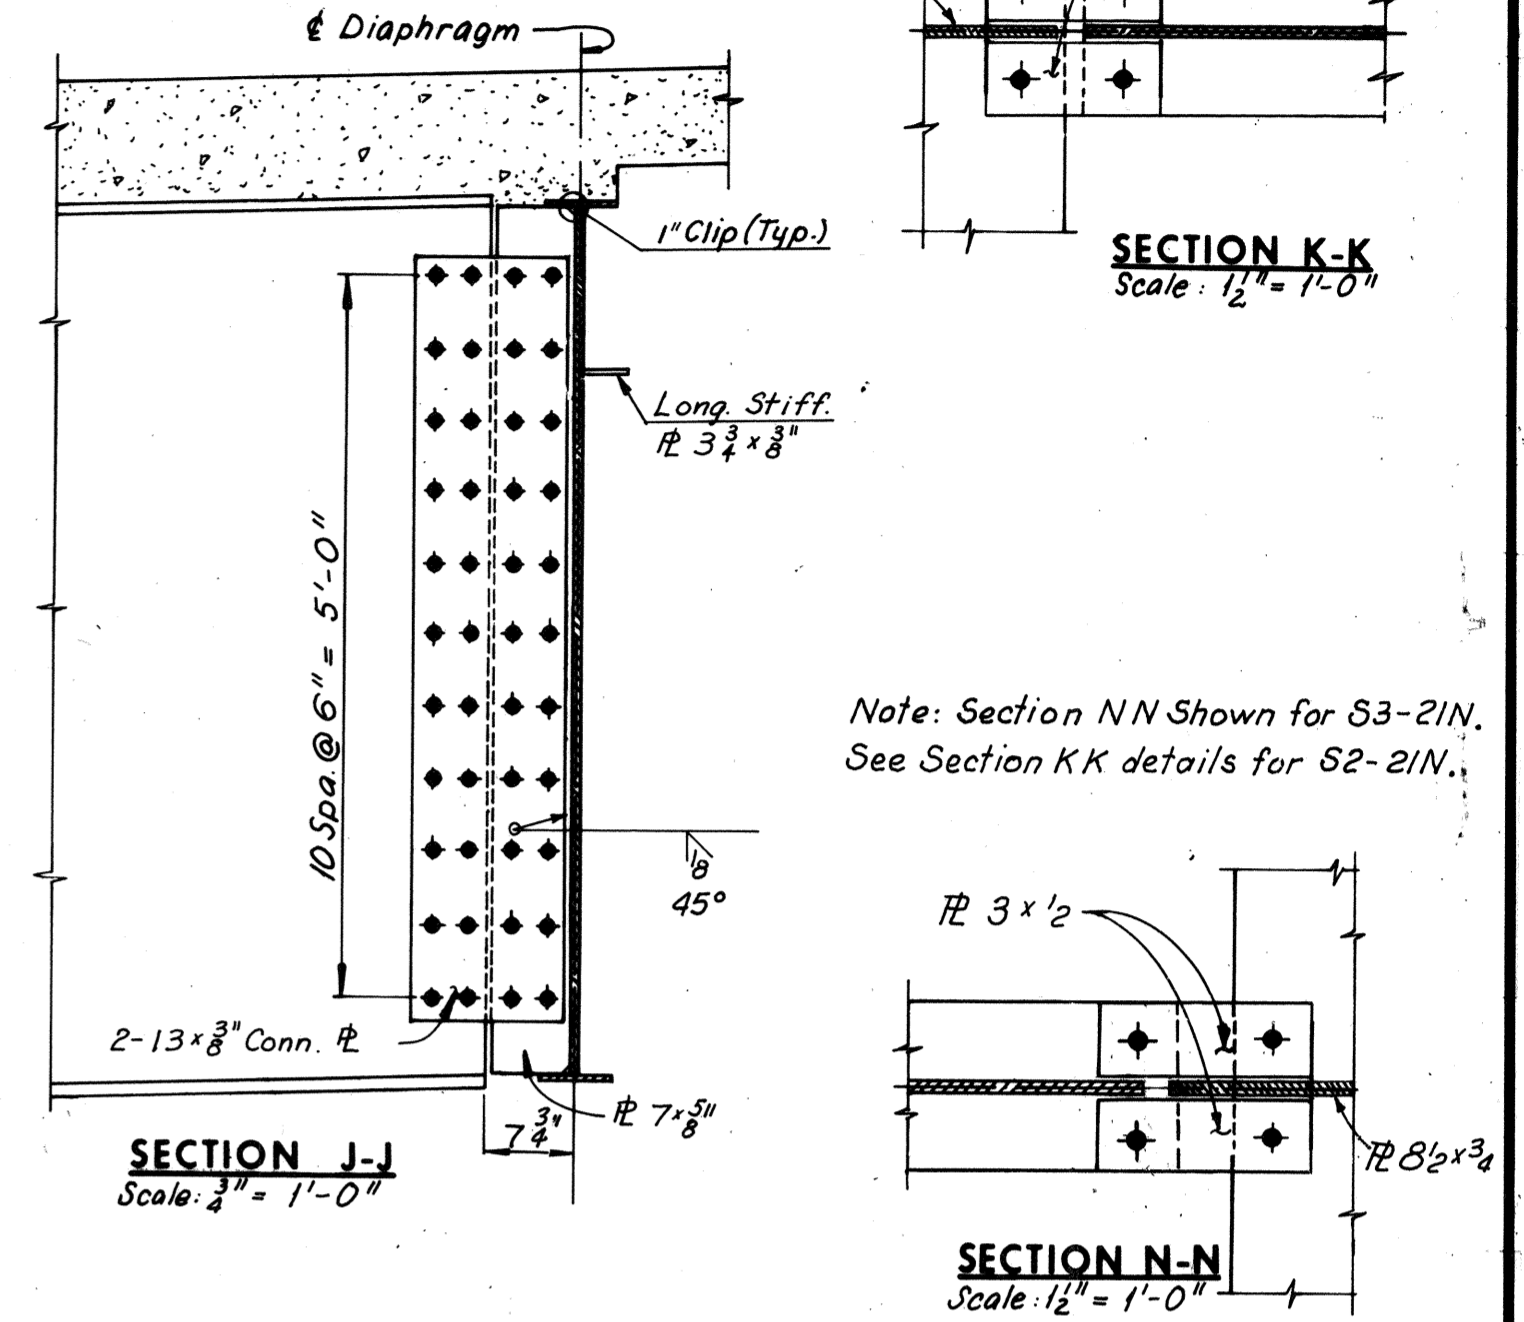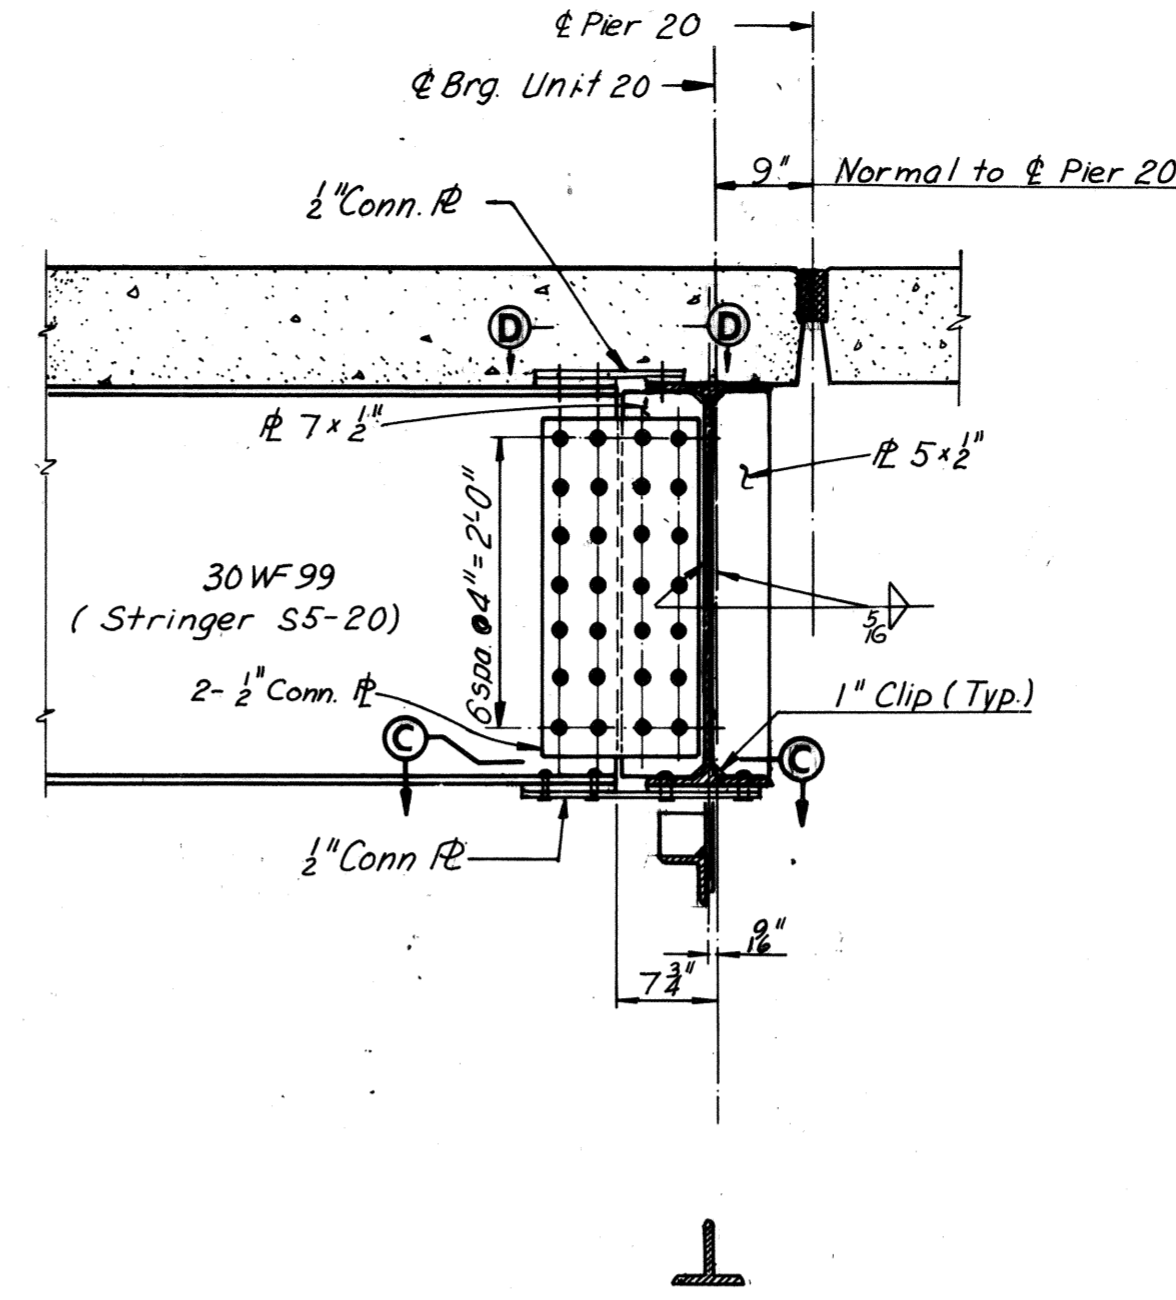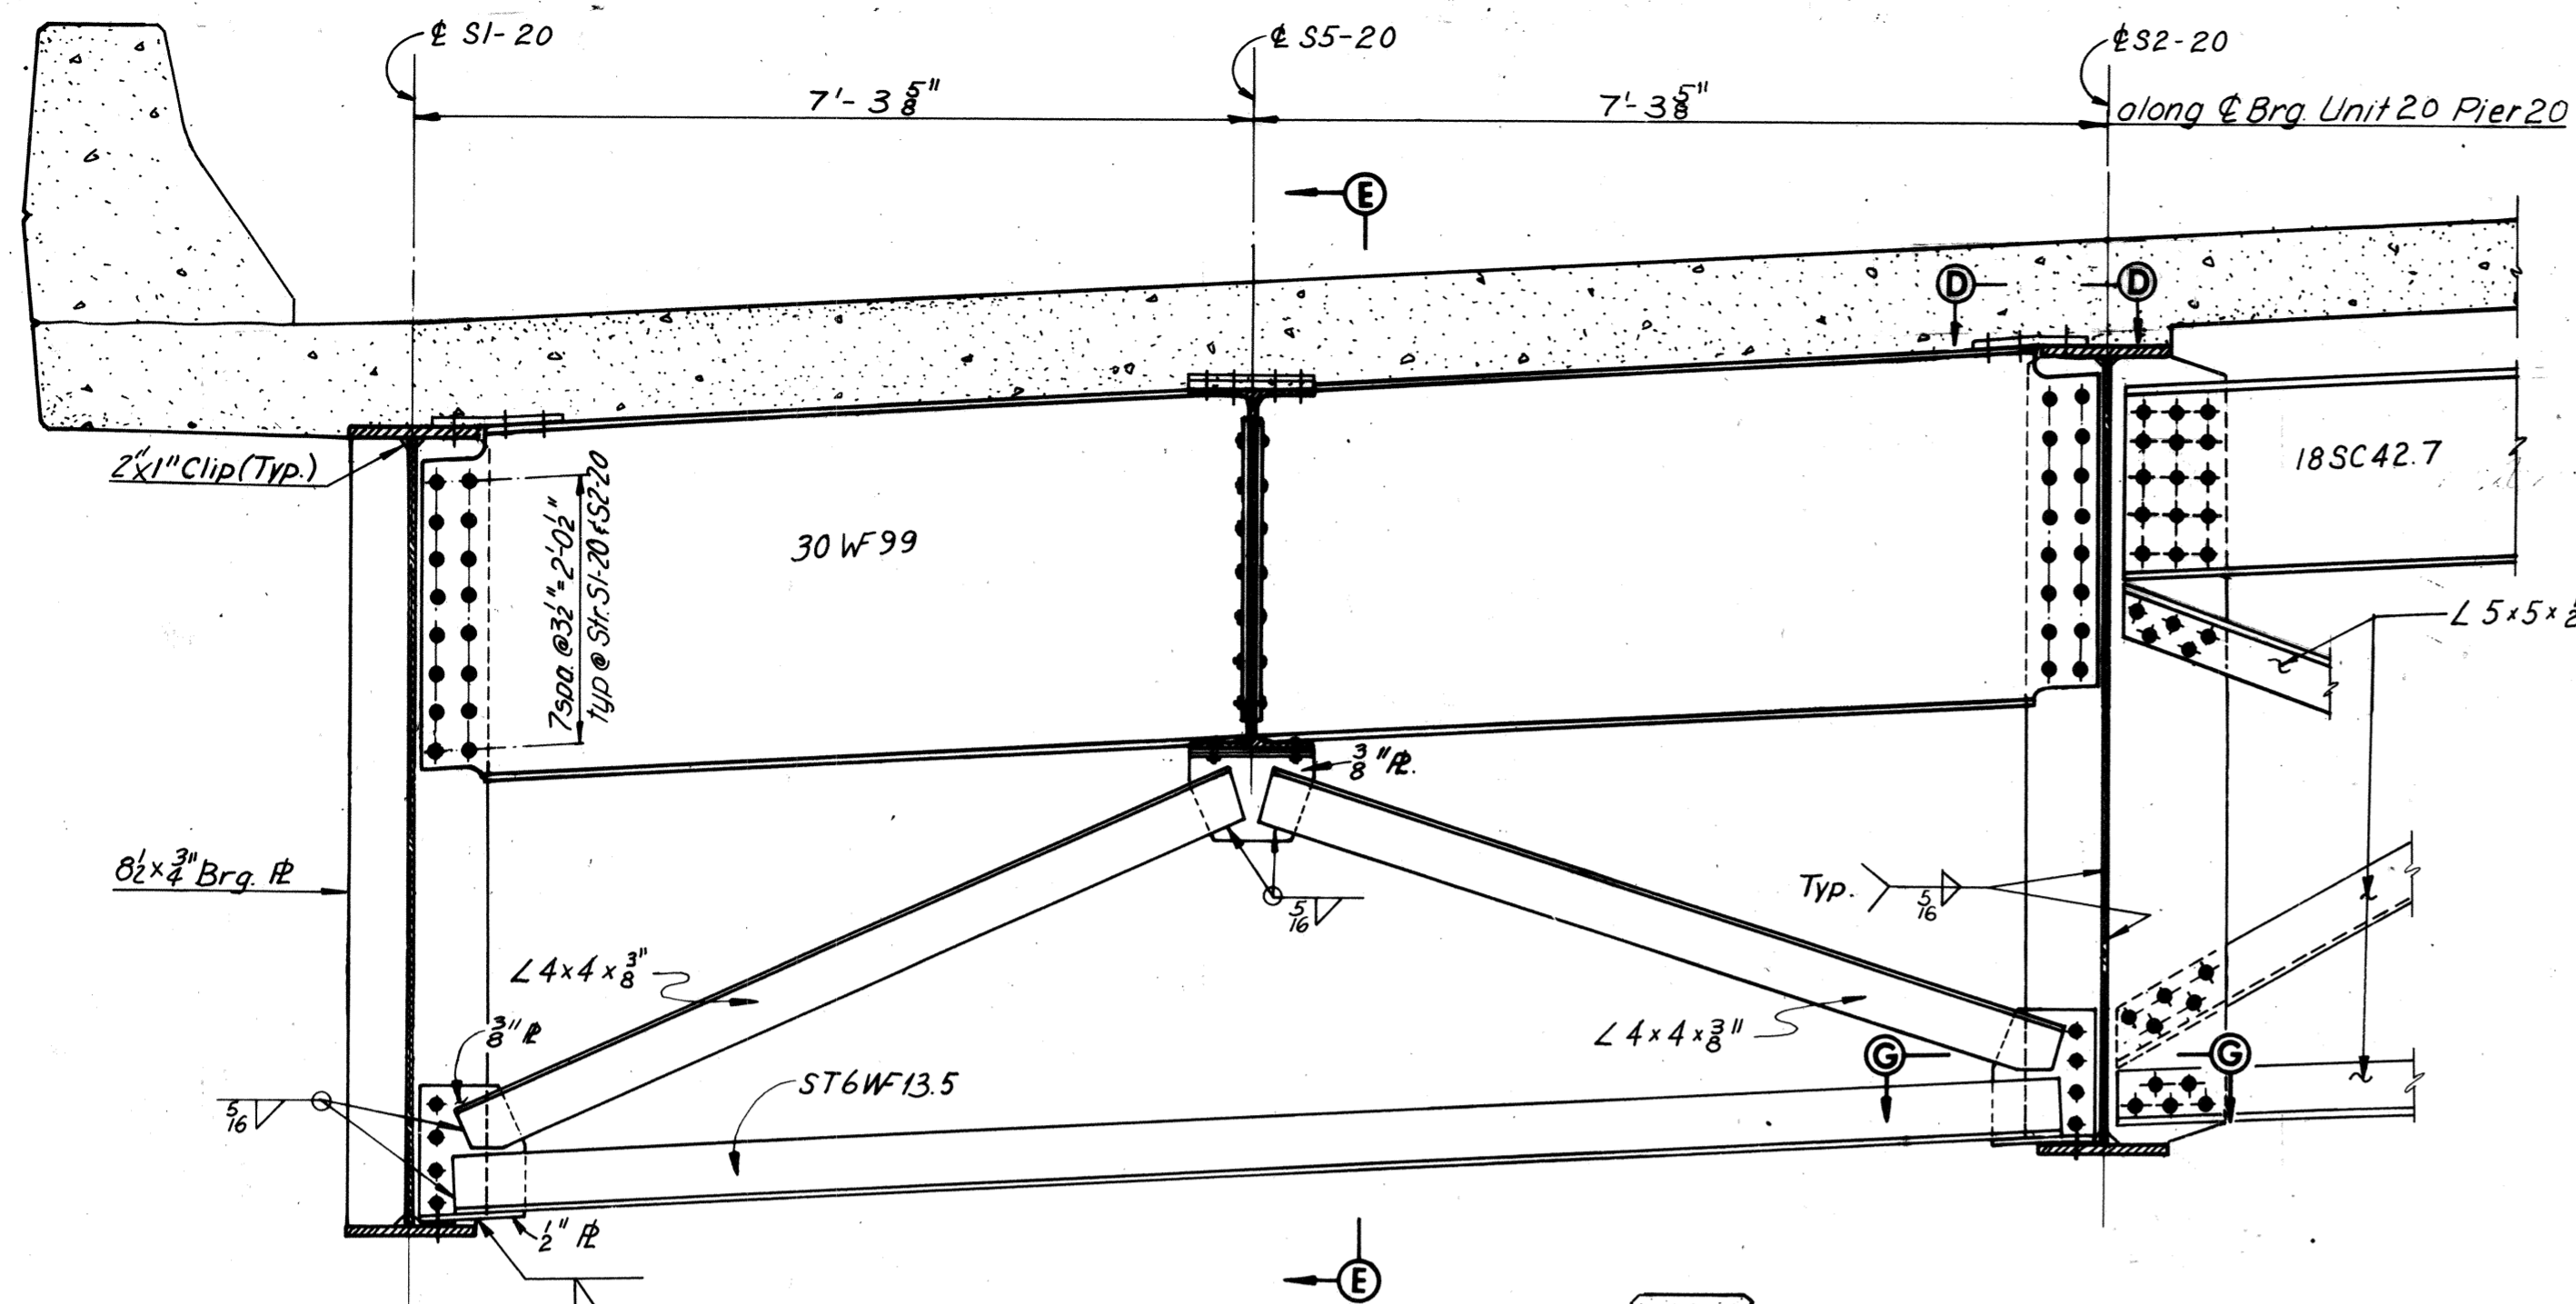


Note: Section NN Shown for S3-21N. See Section KK details for S2-21N.


DETAIL B
Scale: 3/4" = 1'-0"
Looking East

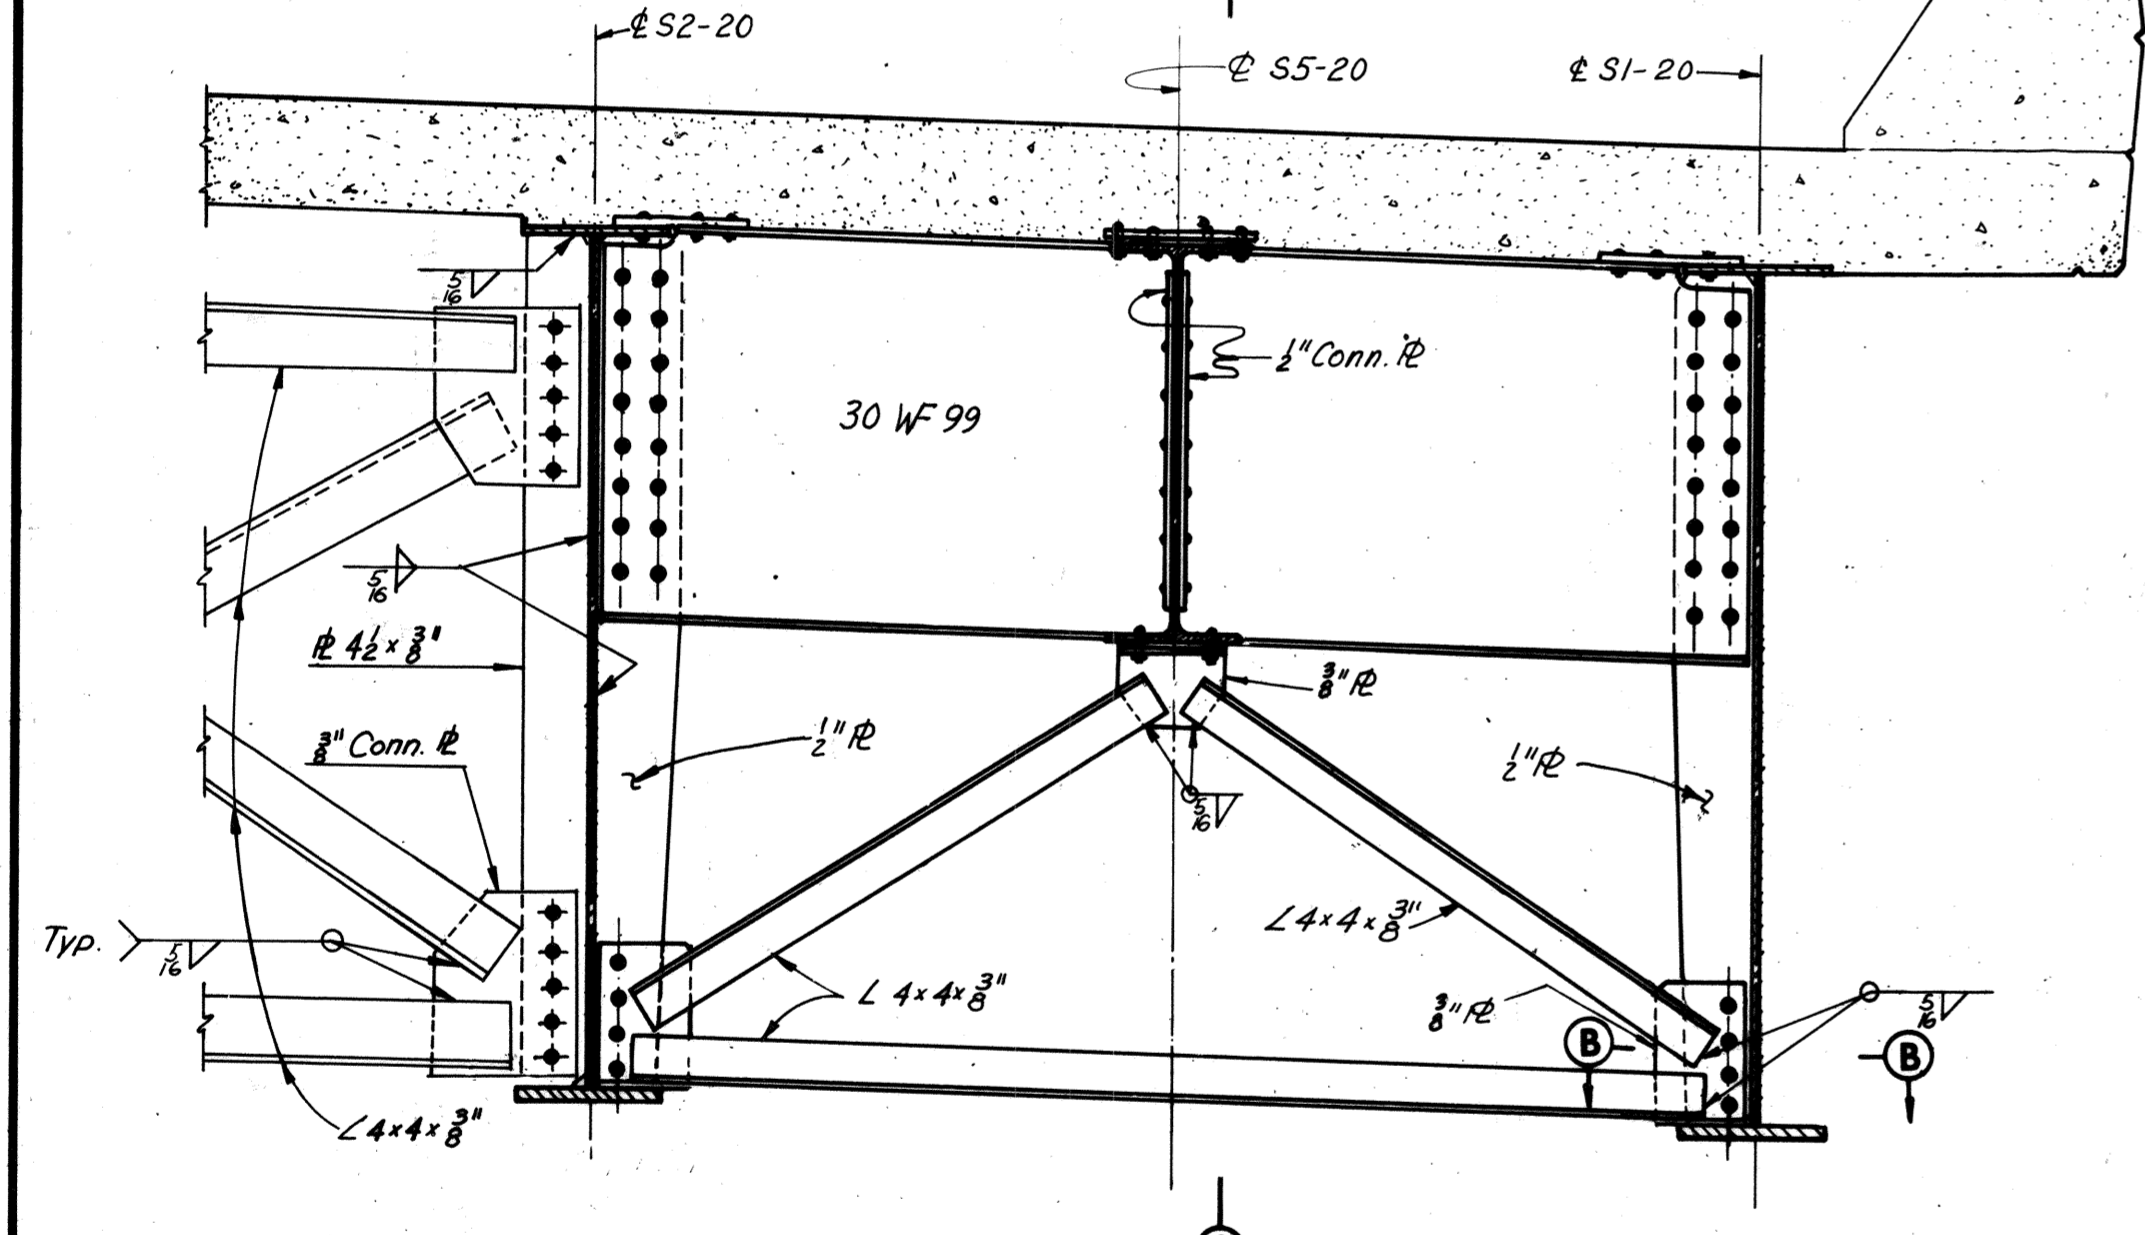

DETAIL A
Scale: 3/4" = 1'-0"
Looking West

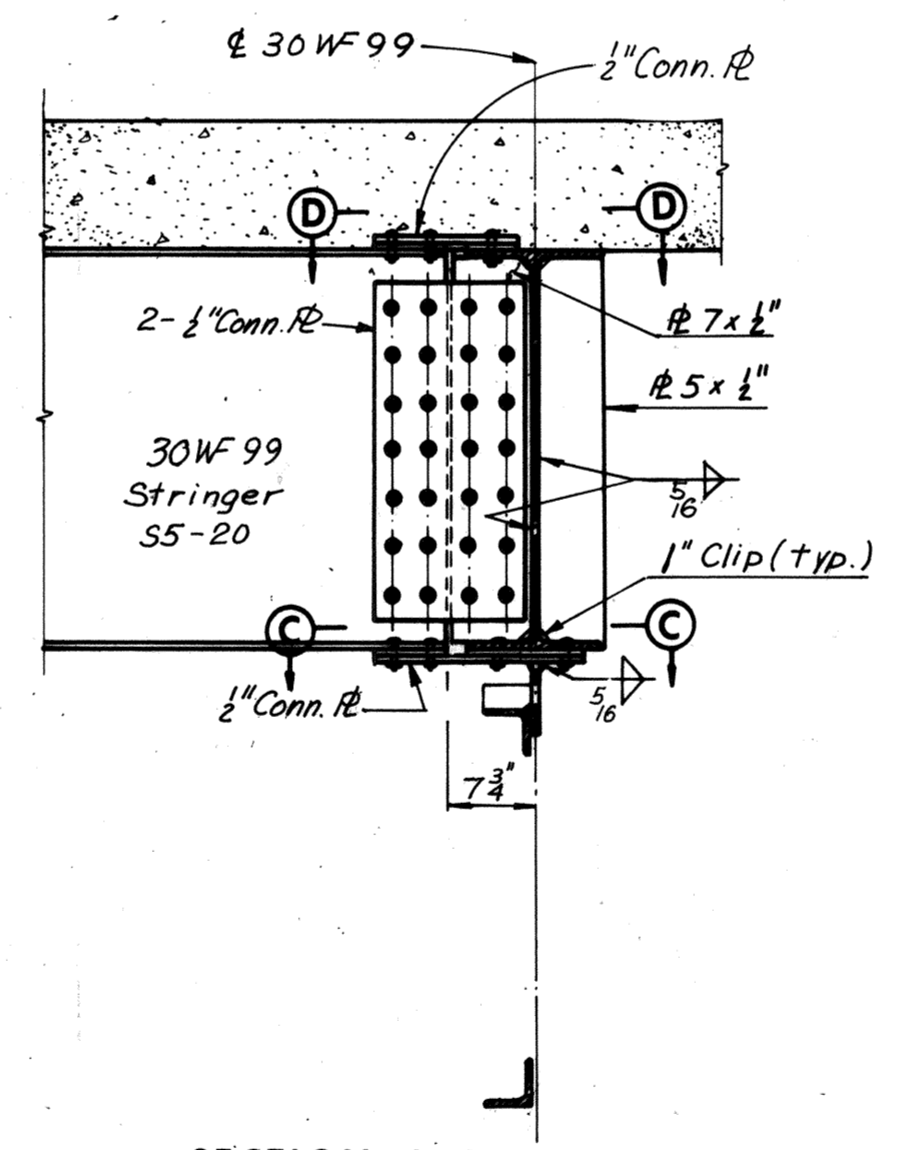


SECTION A-A
Scale: 3/4" = 1'-0"

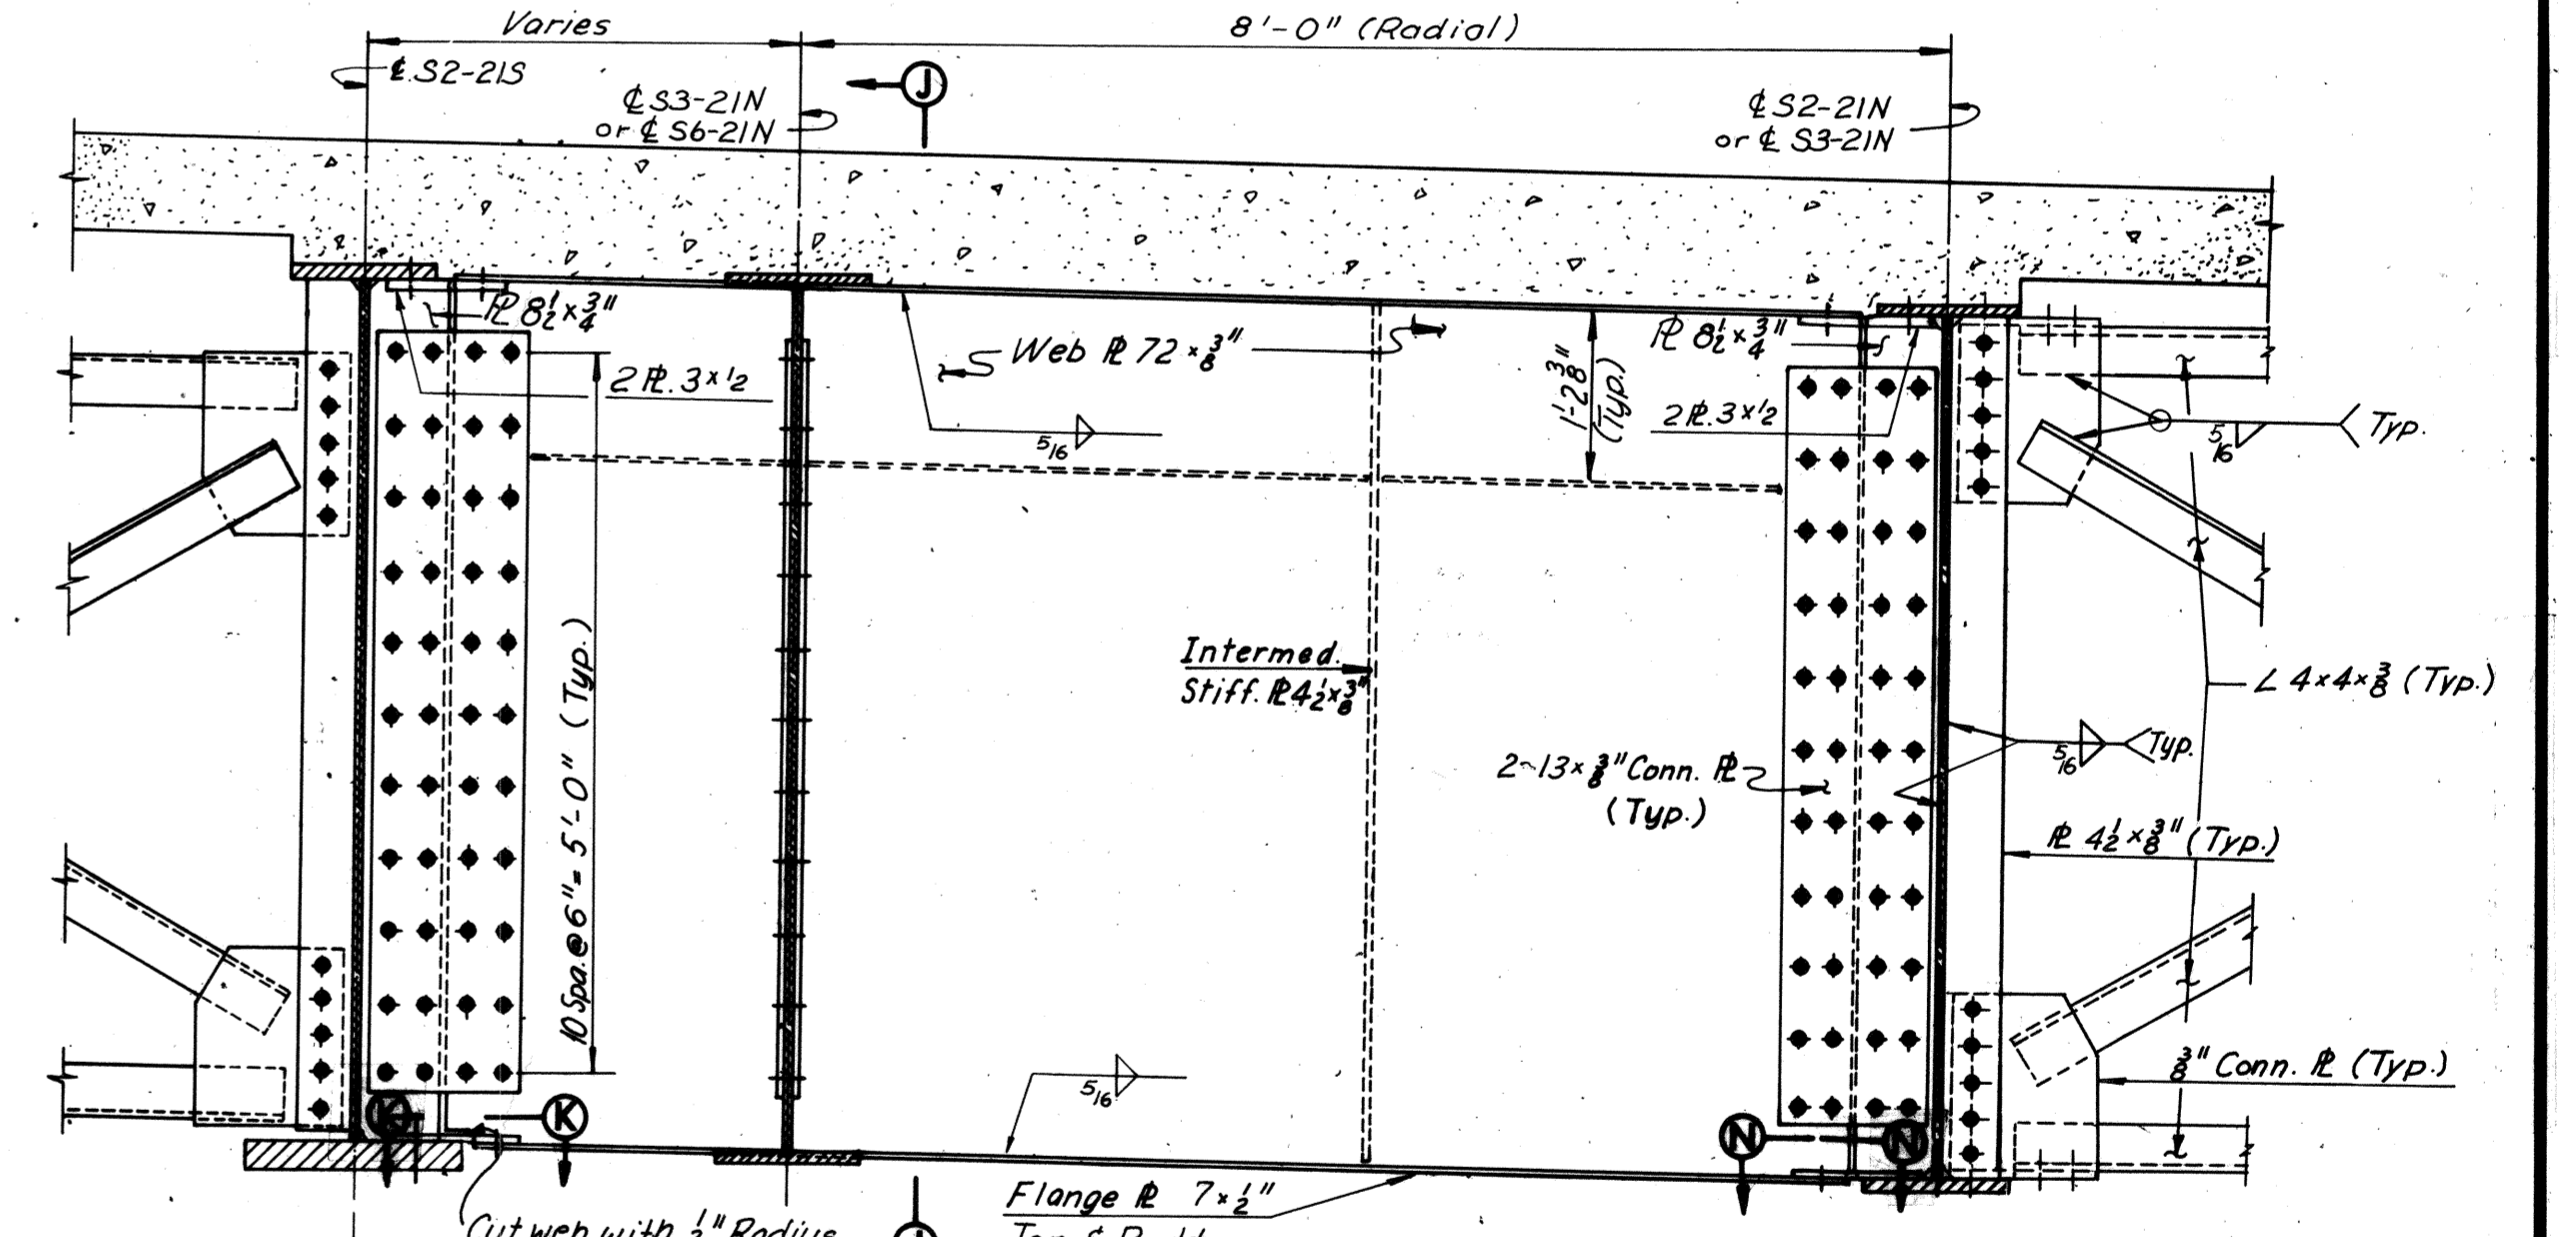


DETAIL C
Scale: 3/4" = 1'-0"
Looking West


Note: For location of Details A, B and C, see Framing Plan Units 20 and 21, Sheet 15. All steel shall be A36 unless otherwise shown.

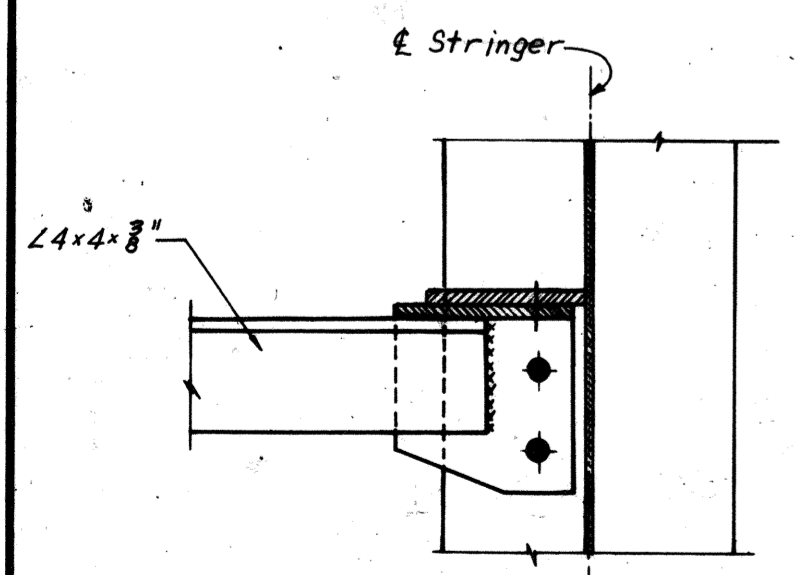

SECTION B-B
Scale: 1 1/2" = 1'-0"

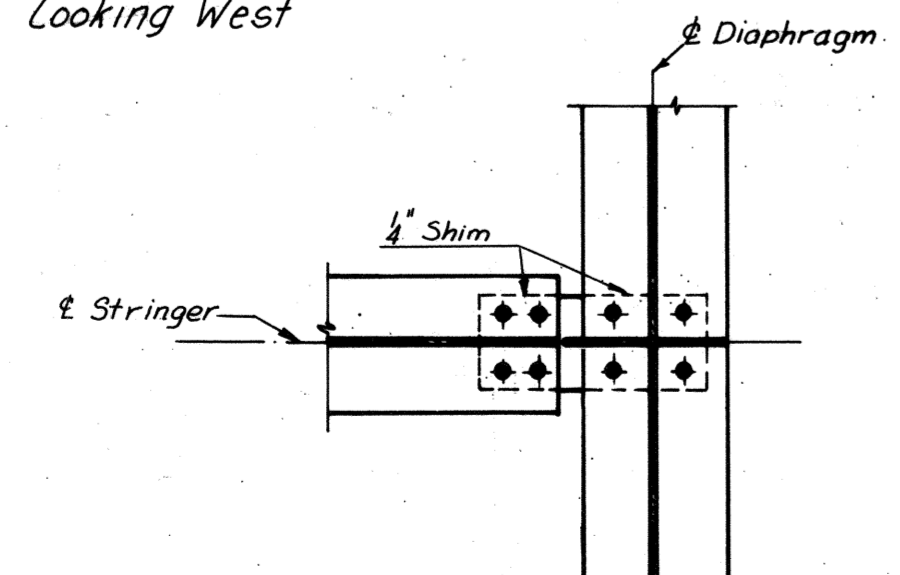

SECTION C-C
Scale: 3/4" = 1'-0"

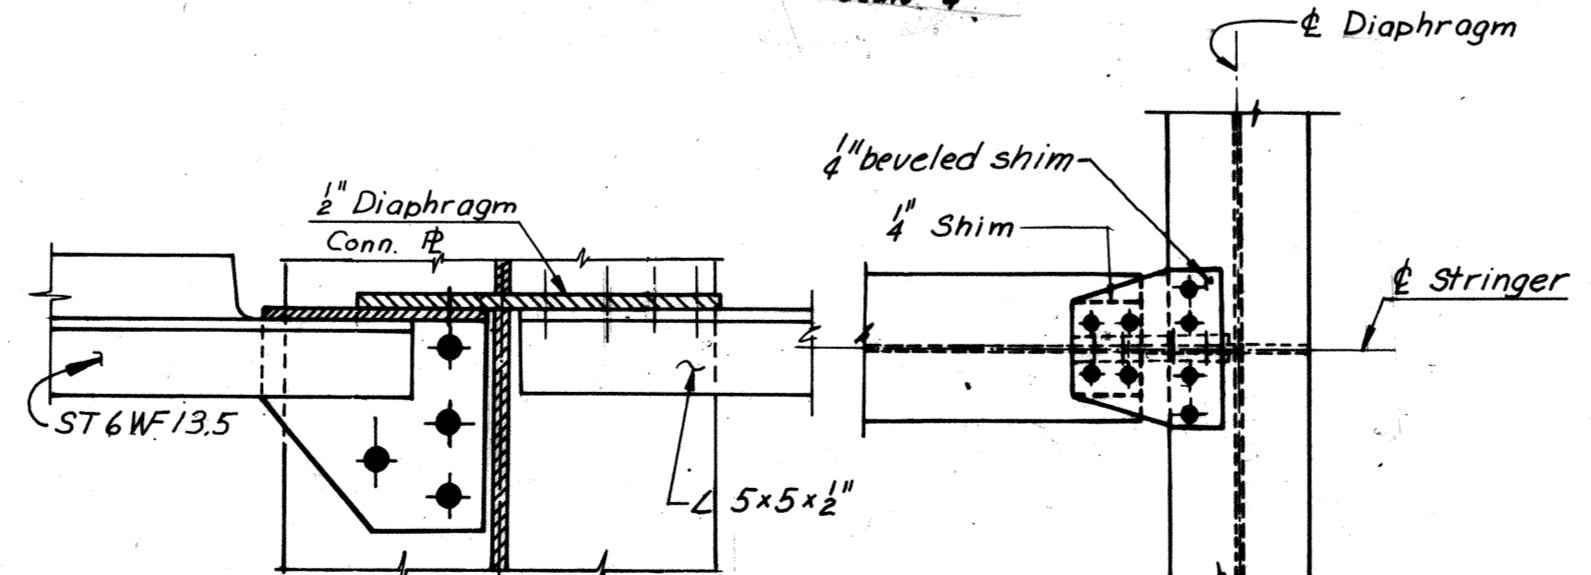

SECTION G-G
Scale: 1 1/2" = 1'-0"

SECTION D-D
Scale: 3/4" = 1'-0"

Section H-H similar

BY	DATE	NO.	REVISION	BY	DATE
MADE	J.D. 12-18-68				
CHECKED	PTA 4-29-69	1	As Built	TEM	10-76
IN CHARGE					

RICHMOND METROPOLITAN AUTHORITY
RICHMOND EXPRESSWAY SYSTEM
DOWNTOWN EXPRESSWAY


BRIDGE NO. 63
WESTBOUND ROADWAY OVER
12TH ST. - R.R. TRACKS AND 16TH ST.
FRAMING DETAILS
UNITS 20 AND 21

HOWARD, NEEDLES, TAMMEN & BERGENDOFF
consulting engineers
NEW YORK ALEXANDRIA KANSAS CITY

SCALE: As Noted
CONTRACT NO. 10
SHEET NO. 16 OF 29

AS BUILT

RICHMOND EXPRESSWAY SYSTEM			
SECTION	PROJECT	SHEET NO.	TOTAL SHEETS
10	DOWNTOWN EXPRESSWAY	86	265

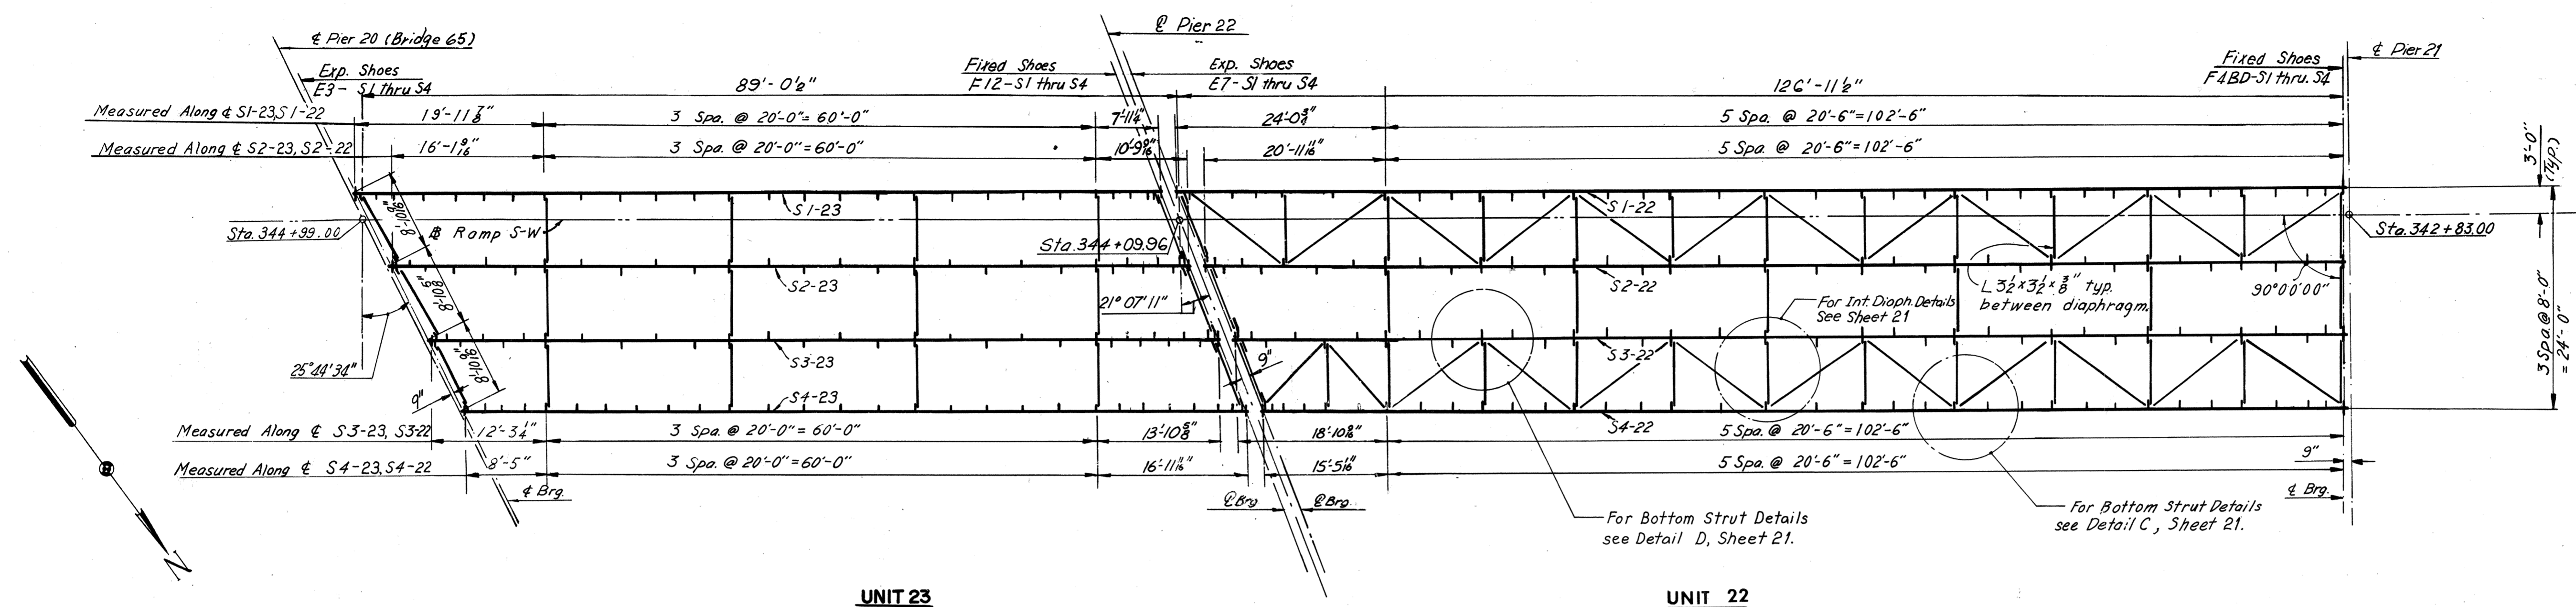


Note:
Units 22 and 23 are shown with stationing from right to left.

UNIT 23 UNIT 22


FRAMING PLAN
Scale 1" = 10'-0"

SHOE SCHEDULE			
EXPANSION SHOE		FIXED SHOES	
TYPE	NO. REQD.	TYPE	NO. REQD.
E7	4	F12	4
E3	4	F4	4

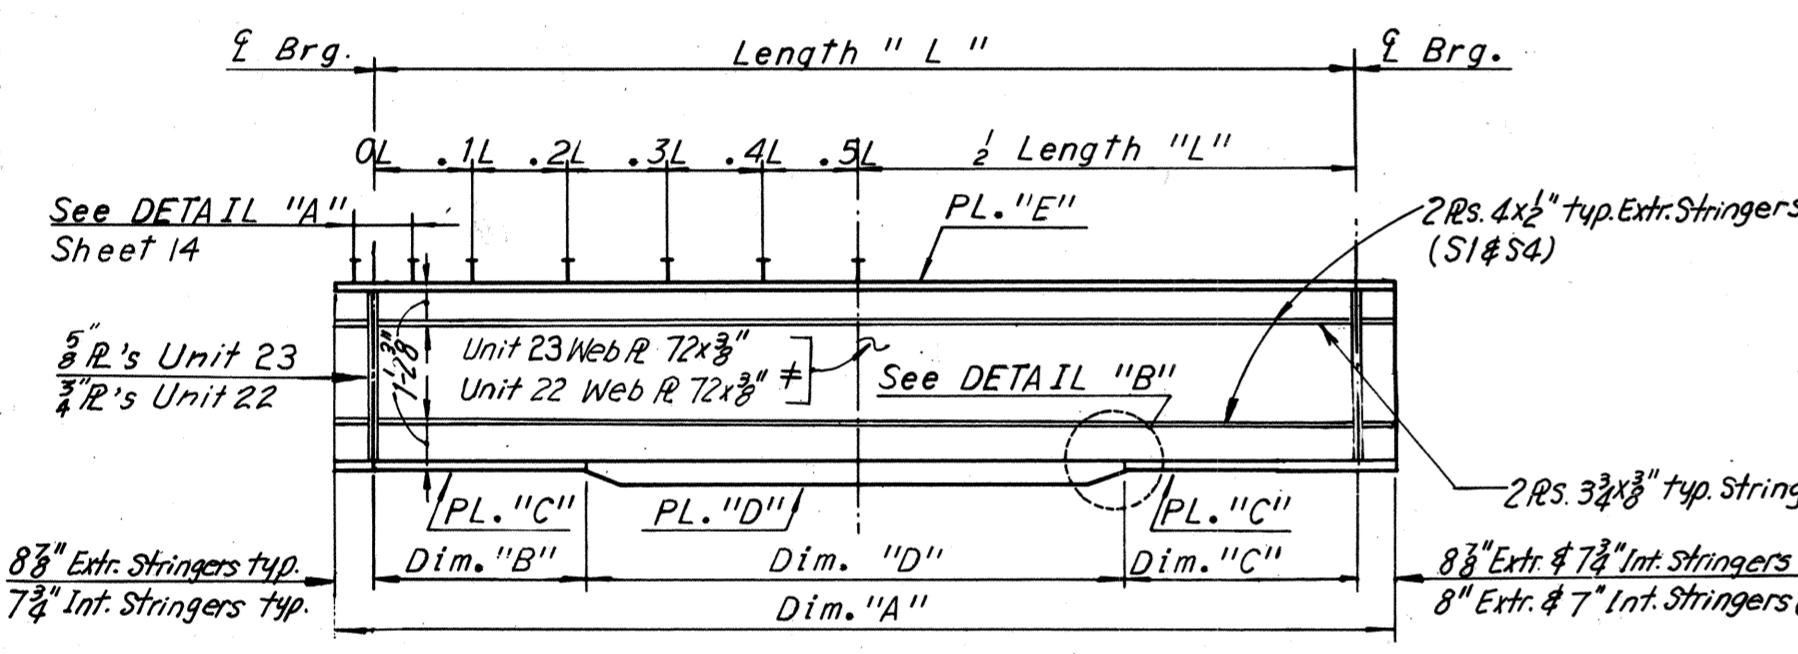


STRINGER ELEVATION
No Scale

Note: All horizontal dimensions are measured along \bar{L} Web.
Notes:
All steel shall be A36 unless otherwise shown.
Exterior stringer longitudinal stiffeners shall be located on the exterior face of stringers.
Intermediate stiffener plates shall be equally spaced between diaphragms as shown. The first two stiffener spaces at the ends of stringers shall be one-half the normal spacing within the panel.
All intermediate stiffeners shall be of Pl. 4 1/2 x 8 except where the width of top flange plate is 20" or over, Pl. 5 x 8 shall be used.

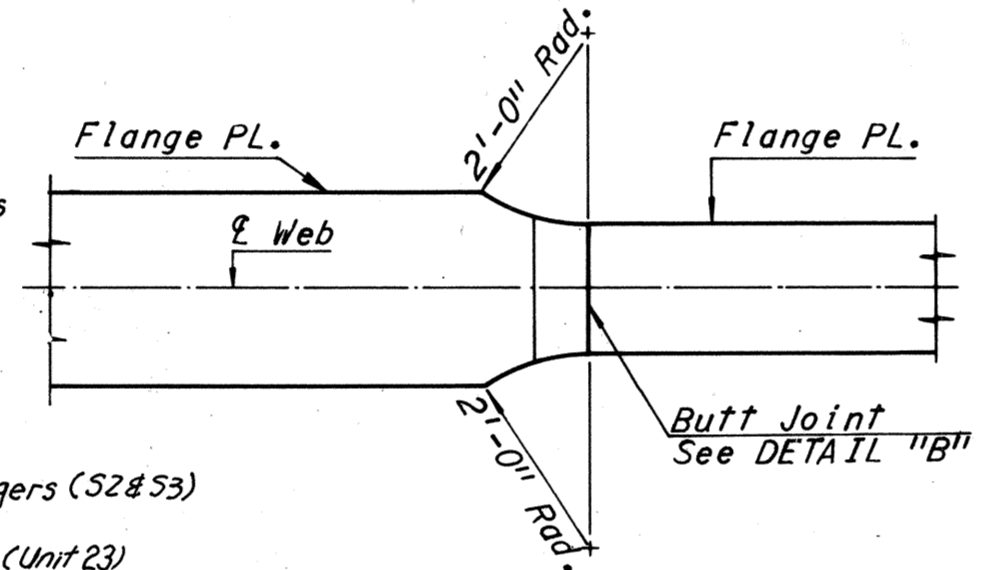


FLANGE PLATE SPlice DETAIL
No Scale

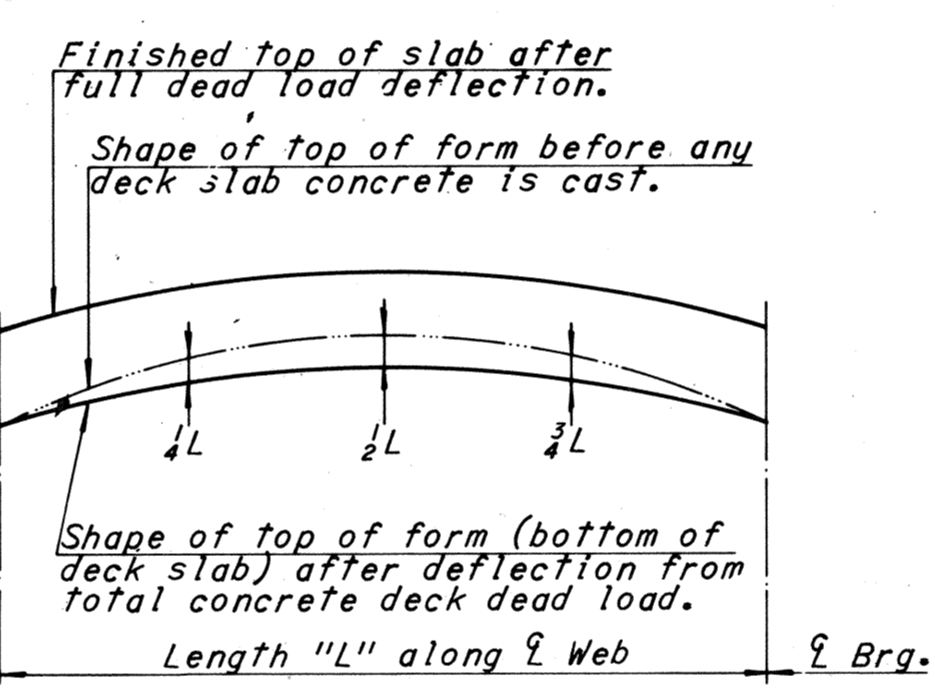


DEAD LOAD DEFLECTION DIAGRAM

NOTE TO CONTRACTOR
Deflections given are those anticipated to occur in the stringer upon placement of the total concrete deck dead load.
In practice, the stringers in place are not likely to have the exact camber to compensate for these deflections during construction. The residual amounts shall be provided by adjusting forms to vary the thickness of the concrete haunch between the bottom of the slab and the top of stringer without altering the slab thickness.

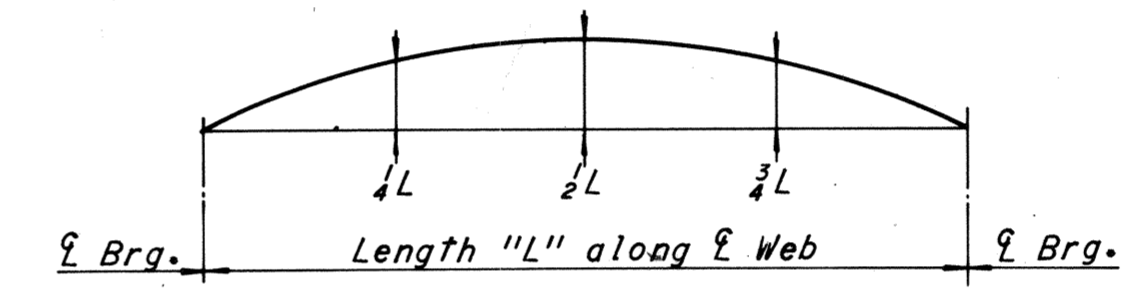


CAMBER DIAGRAM

NOTE TO FABRICATOR
The stringers shall be fabricated with an upward camber amounting to the tabulated value. This will provide approximate compensation for deflection under full dead load and for conformity with finished grade.
Note:
Stringers having a total camber of less than 1" are not required to be shop cambered, but should be turned so that any mill tolerance deviation from straightness will be in the direction shown by the Camber Diagram.
If stringers are not cambered distance top of stringers to top of slab will vary along the stringer in accordance with the offset dimensions shown in the Camber Diagram, and with minimum distance as shown in Cross-Section on Sheet 21.

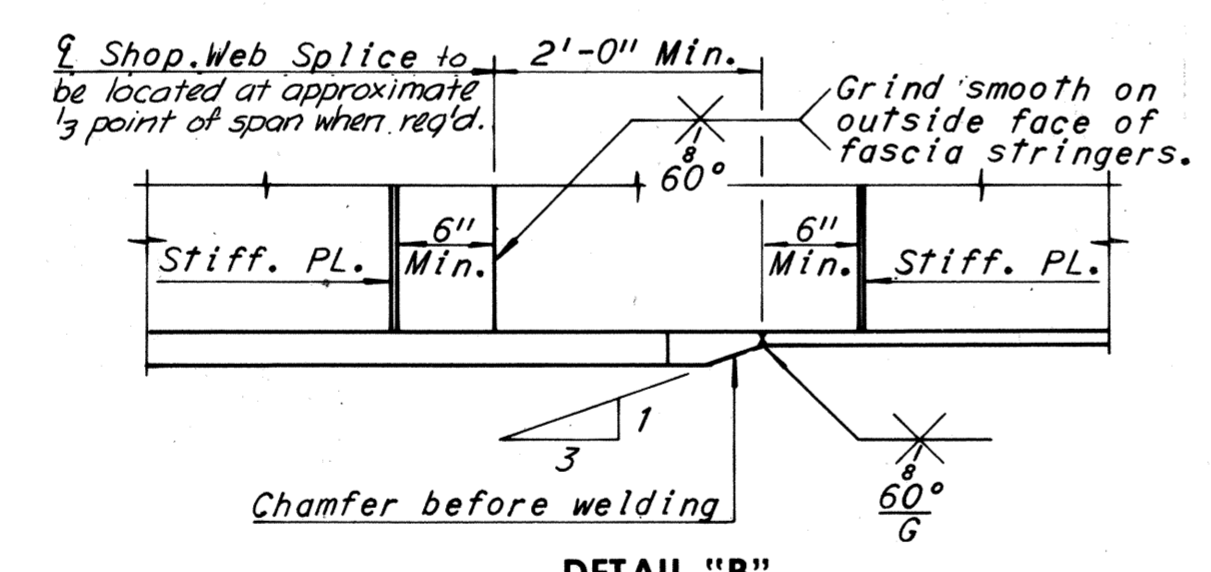

DETAIL "B"
No Scale

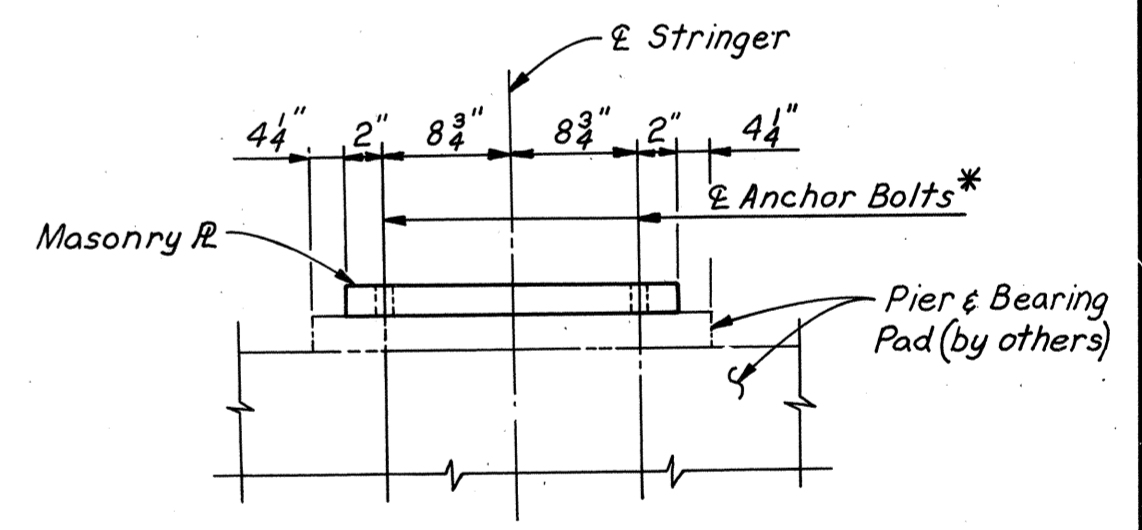

BEARING PAD ELEVATION
AT PIER 20 (BR. 65)
No Scale

Note:
Anchor Bolts for shoes for Unit 23 @ Pier 20 (65) and a setting template shall be furnished by the Contractor to the contractor constructing Pier 20 (65).

UNIT	STRINGER	Dim. "A"	LENGTH	Dim. "B"	Dim. "C"	Dim. "D"	PL. "C"	PL. "D"	PL. "E"	MAX. SHEAR STUD SPACING					DEAD LOAD DEFLECTION SCHEDULE			CAMBER SCHEDULE		
										0.0L-0.1L	0.1L-0.2L	0.2L-0.3L	0.3L-0.4L	0.4L-0.5L	1/4L	1/2L	3/4L	1/4L	1/2L	3/4L
23	S1-21	89'-2"	87'-8 1/2"	14'-4 1/2"	14'-4 1/2"	59'-0"	12 x 3/4"	16 x 1 1/2"	12 x 3/4"	15"	17"	20"	24"	24"	3/4"	1 1/8"	3/4"	2"	3"	2 5/8"
	S2-21	88'-2 3/8"	86'-11 1/8"	13'-11 1/8"	13'-11 1/8"	59'-0"	12 x 3/4"	16 x 1 1/2"	12 x 3/4"	16"	18"	20 1/2"	24"	24"	3/4"	1"	3/4"	2 7/8"	3 1/2"	2 3/4"
	S3-21	87'-5 3/8"	86'-1 1/8"	13'-7"	13'-7"	59'-0"	12 x 3/4"	16 x 1 1/2"	12 x 3/4"	16"	18"	20 1/2"	24"	24"	3/4"	1 1/8"	3/4"	2 7/8"	3 1/2"	2 3/4"
	S4-21	86'-10 1/8"	85'-4 1/8"	13'-2 3/8"	13'-2 3/8"	59'-0"	12 x 3/4"	16 x 1 1/2"	12 x 3/4"	15"	17"	20"	24"	24"	1/2"	1 1/8"	3/4"	2 7/8"	3 1/2"	2 3/4"
22	S1-22	127'-11 1/8"	126'-6 3/8"	32'-3 3/8"	32'-3 3/8"	62'-0"	18 x 7/8"	18 x 1 1/2"	18 x 7/8"	14"	16"	19"	24"	24"	2 1/2"	3 1/8"	2 1/2"	4 1/2"	5 1/2"	3 1/2"
	S2-22	124'-8 1/8"	123'-5 1/8"	36'-4 1/8"	36'-4 1/8"	51'-0"	18 x 7/8"	18 x 1 1/2"	18 x 7/8"	15 1/2"	17 1/2"	20 1/2"	23"	24"	2 3/8"	3 1/8"	2 3/8"	4 1/2"	5 1/2"	3 1/2"
	S3-22	121'-7 3/8"	120'-4 3/8"	35'-2 3/8"	35'-2 3/8"	50'-0"	18 x 7/8"	18 x 1 1/2"	18 x 7/8"	15 1/2"	17 1/2"	20 1/2"	22"	24"	2 1/2"	2 7/8"	2 1/2"	4 1/2"	5 1/2"	3 1/2"
	S4-22	118'-8 1/8"	117'-3 3/8"	33'-7 3/8"	33'-7 3/8"	50'-0"	18 x 7/8"	18 x 1 1/2"	18 x 7/8"	14 1/2"	16 1/2"	19 1/2"	24"	24"	1 3/4"	2 3/8"	1 3/4"	3"	3 3/4"	2 3/8"

*Spacing begins at termination of 7 spaces @ 4"
#Denotes A572-Grade 50 steel for thickness of 3/4" and under and A388 steel for thickness over 3/4"

BY	DATE	Notes changed added	PRMS	4-19-74
MADE	RC	11.22.68	2	As Built
CHECKED	SCC	1.10.69		
IN CHARGE				

Notes:
All Horizontal Dimensions are measured along \bar{L} Web.
For Diaphragm Details, see Sheet 21.
For Shear Stud Details, see Sheet 14.
For Structural Steel Quantities, see Sheet 2.
For Joint Details, see Sheet 24.
For Shoe Details, see Sheet S1 & S2.
For Horizontal Stiffener Details and Flange to Web Welds, see Sheet 14.

AS BUILT


RICHMOND METROPOLITAN AUTHORITY
RICHMOND EXPRESSWAY SYSTEM
DOWNTOWN EXPRESSWAY

BRIDGE NO. 63
WESTBOUND ROADWAY OVER
12TH ST. - R.R. TRACKS AND 16TH ST.
FRAMING PLAN UNITS 22 AND 23

HOWARD, NEEDLES, TAMMEN & BERGENDOFF
consulting engineers
NEW YORK ALEXANDRIA WASHINGTON CITY





SCALE: As Noted
CONTRACT NO.:
SHEET NO. 17 OF 29

RICHMOND EXPRESSWAY SYSTEM			
SECTION	PROJECT	SHEET NO.	TOTAL SHEETS
10	DOWNTOWN EXPRESSWAY	88	265

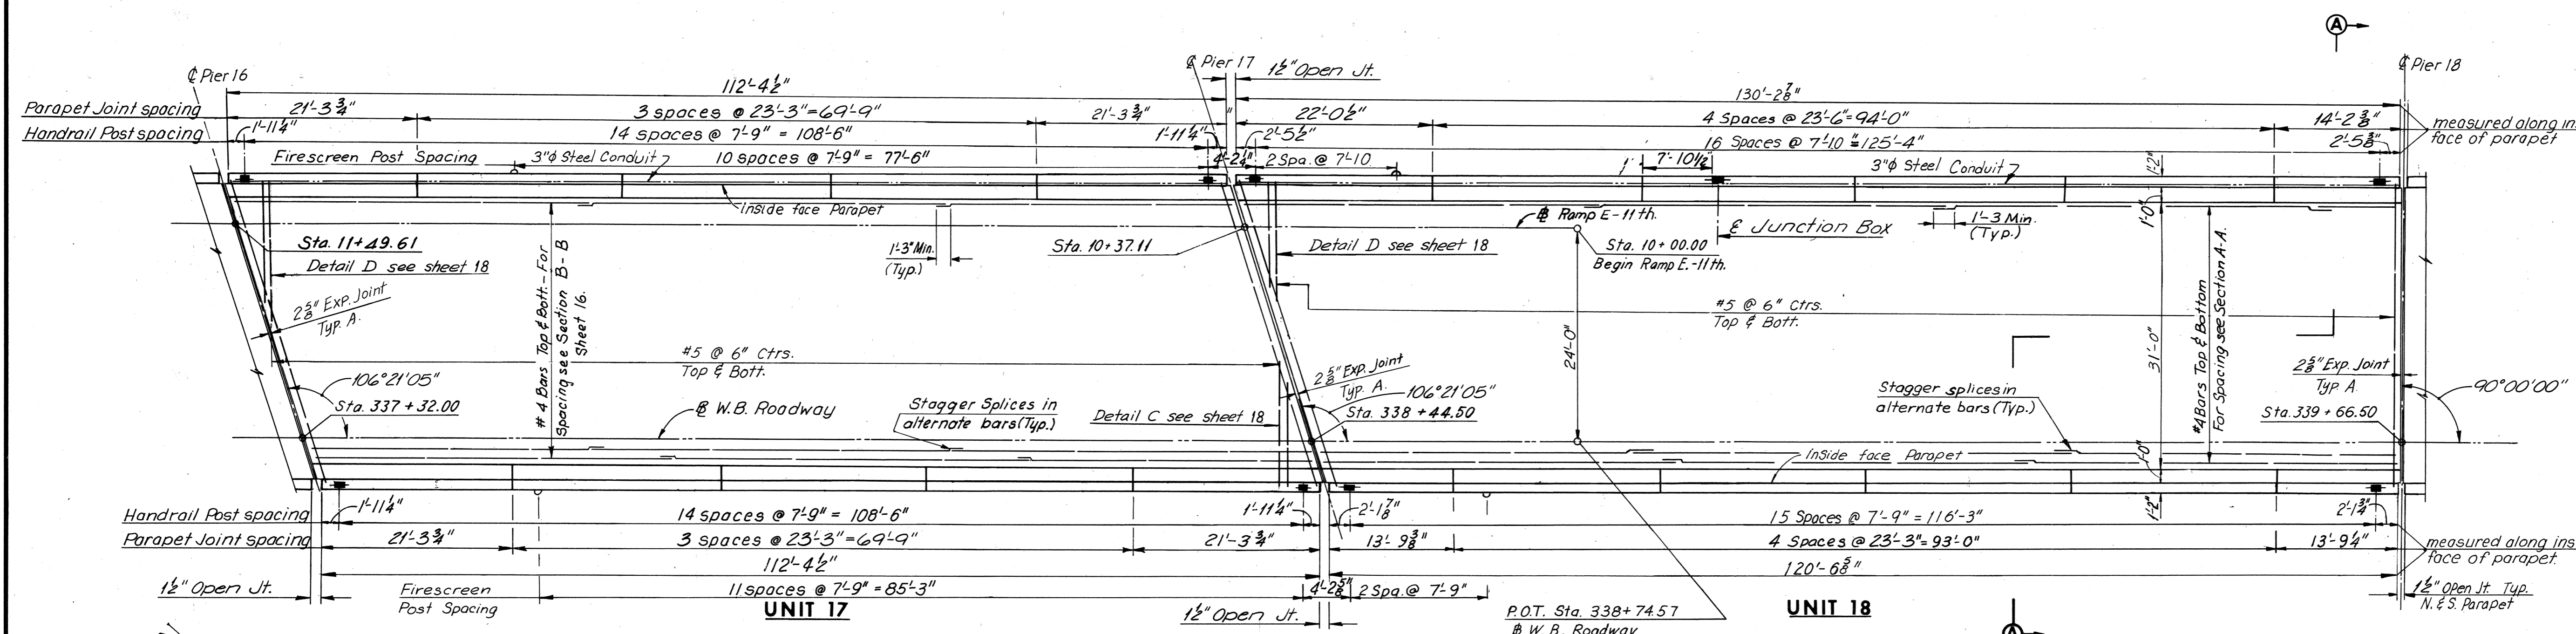


ELEVATION TABLE			
STATION	ELEV. A	ELEV. B	ELEV. C
337+24.08	64.97	—	—
+30.00	65.01	64.74	64.71
+32.00	—	64.76	—
+32.88	—	—	64.75
+40.00	65.05	64.85	64.83
+50.00	65.11	64.96	64.94
+60.00	65.16	65.07	65.06
+70.00	65.22	65.18	65.18
+80.00	65.27	65.30	65.30
+90.00	65.33	65.41	65.42
338+00.00	65.38	65.52	65.54
+10.00	65.44	65.63	65.65
+20.00	65.49	65.74	65.78
+30.00	65.55	65.86	65.90
+40.00	65.61	65.97	66.02
+44.50	—	66.02	—
+50.00	65.66	66.08	66.13
+60.00	65.73	66.19	66.25
+70.00	65.80	66.30	66.37
+80.00	65.89	66.42	66.49
+90.00	65.98	66.53	66.60
339+00.00	66.09	66.64	66.71
+10.00	66.20	66.75	66.82
+20.00	66.31	66.86	66.93
+30.00	66.43	66.98	67.05
+40.00	66.54	67.09	67.16
+50.00	66.65	67.20	67.27
+60.00	66.76	67.31	67.38
+66.50	—	67.39	—

Note: Spacing of posts for fire screen shall match handrail post spacing.

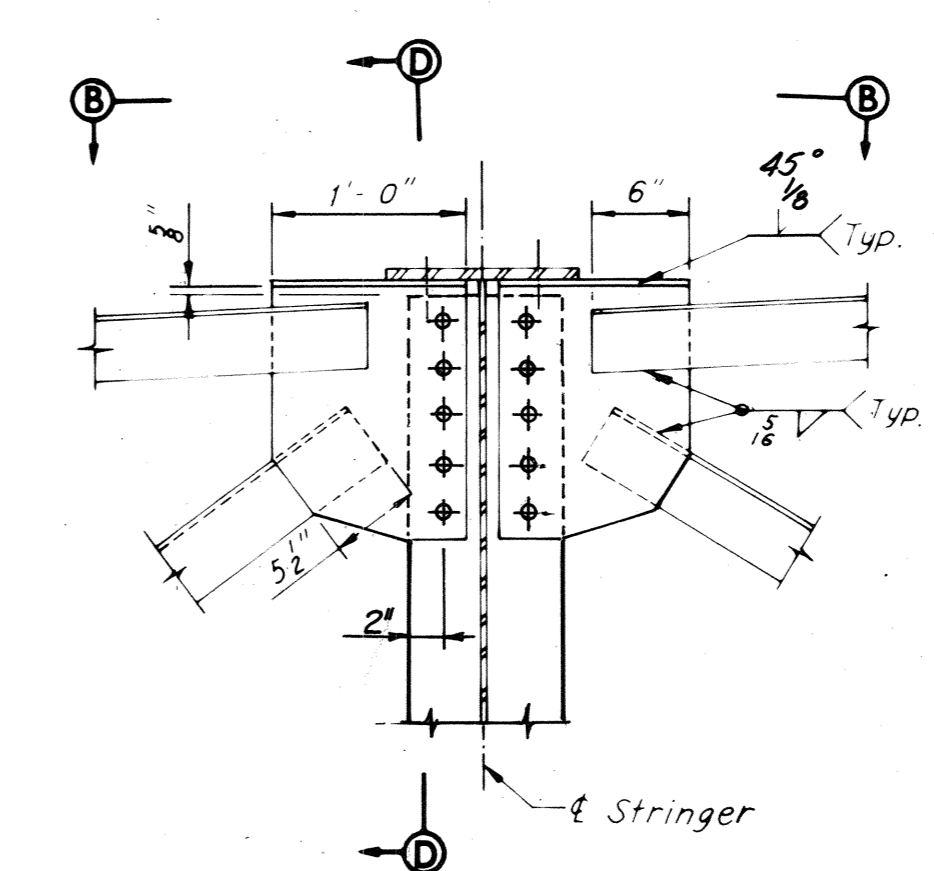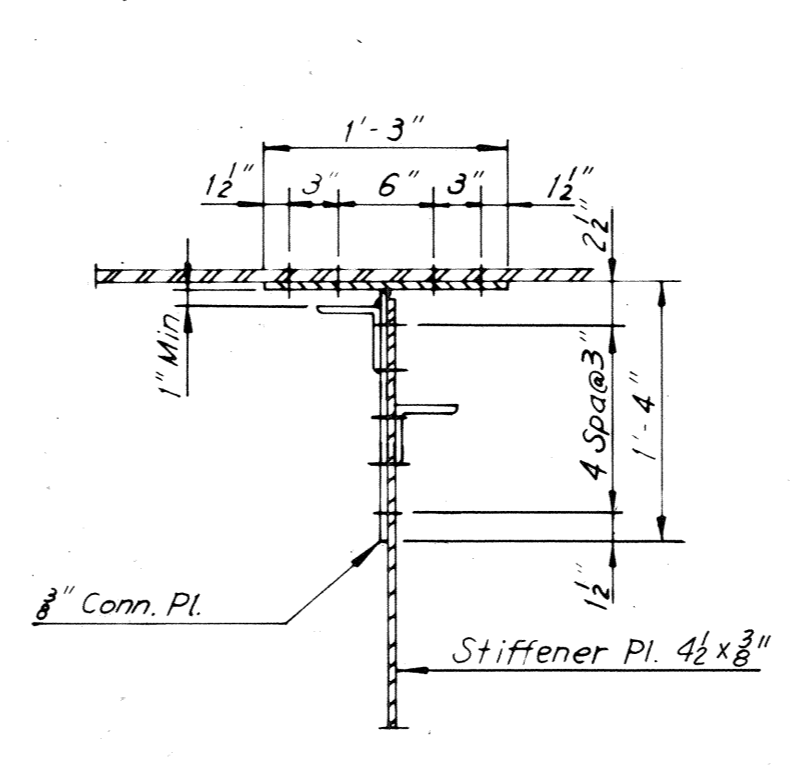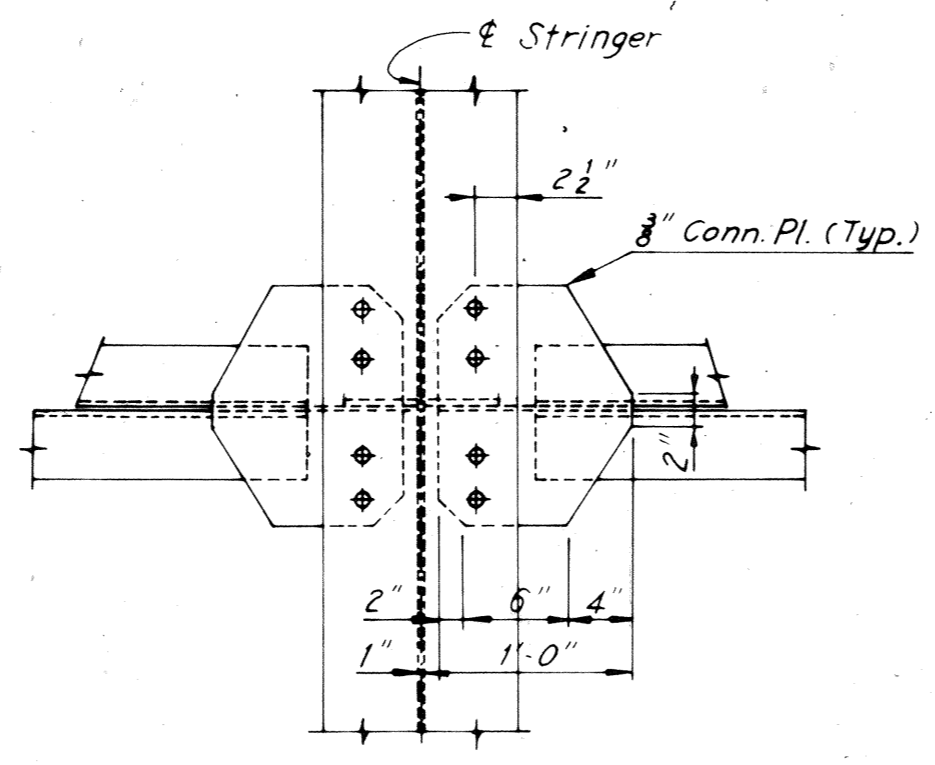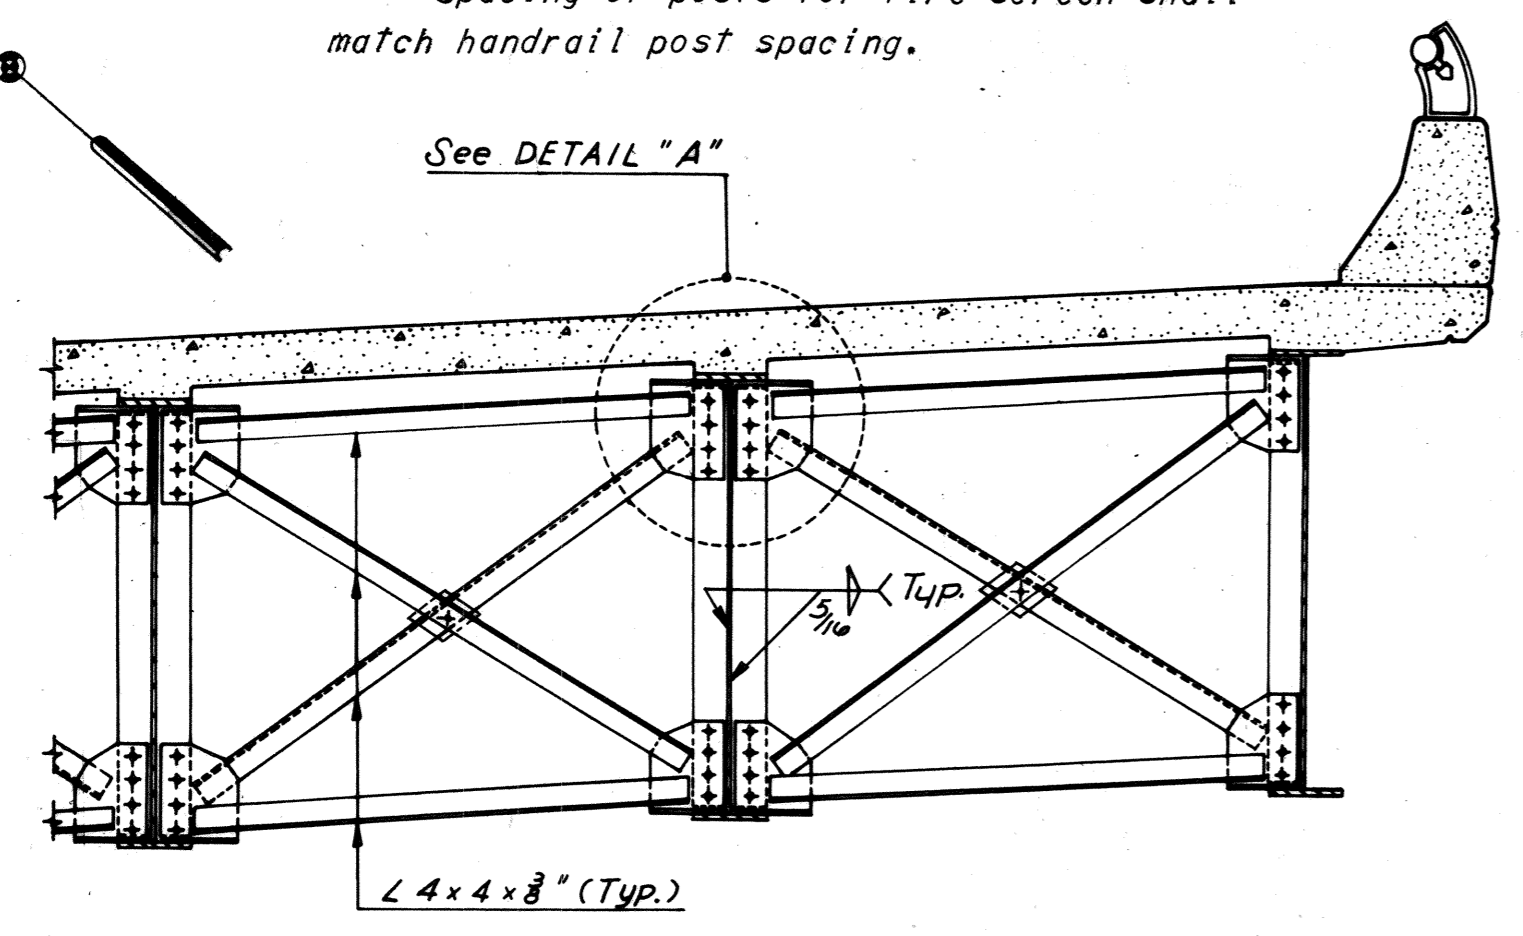

Notes:
For End Diaphragms at Pier 16, Unit 17, see Section B-B Sheet 18
For End Diaphragms at Pier 17, Units 17 & 18, see Section B-B Sheet 18
For End Diaphragms at Pier 18, Unit 18, see Section A-A, this sheet.

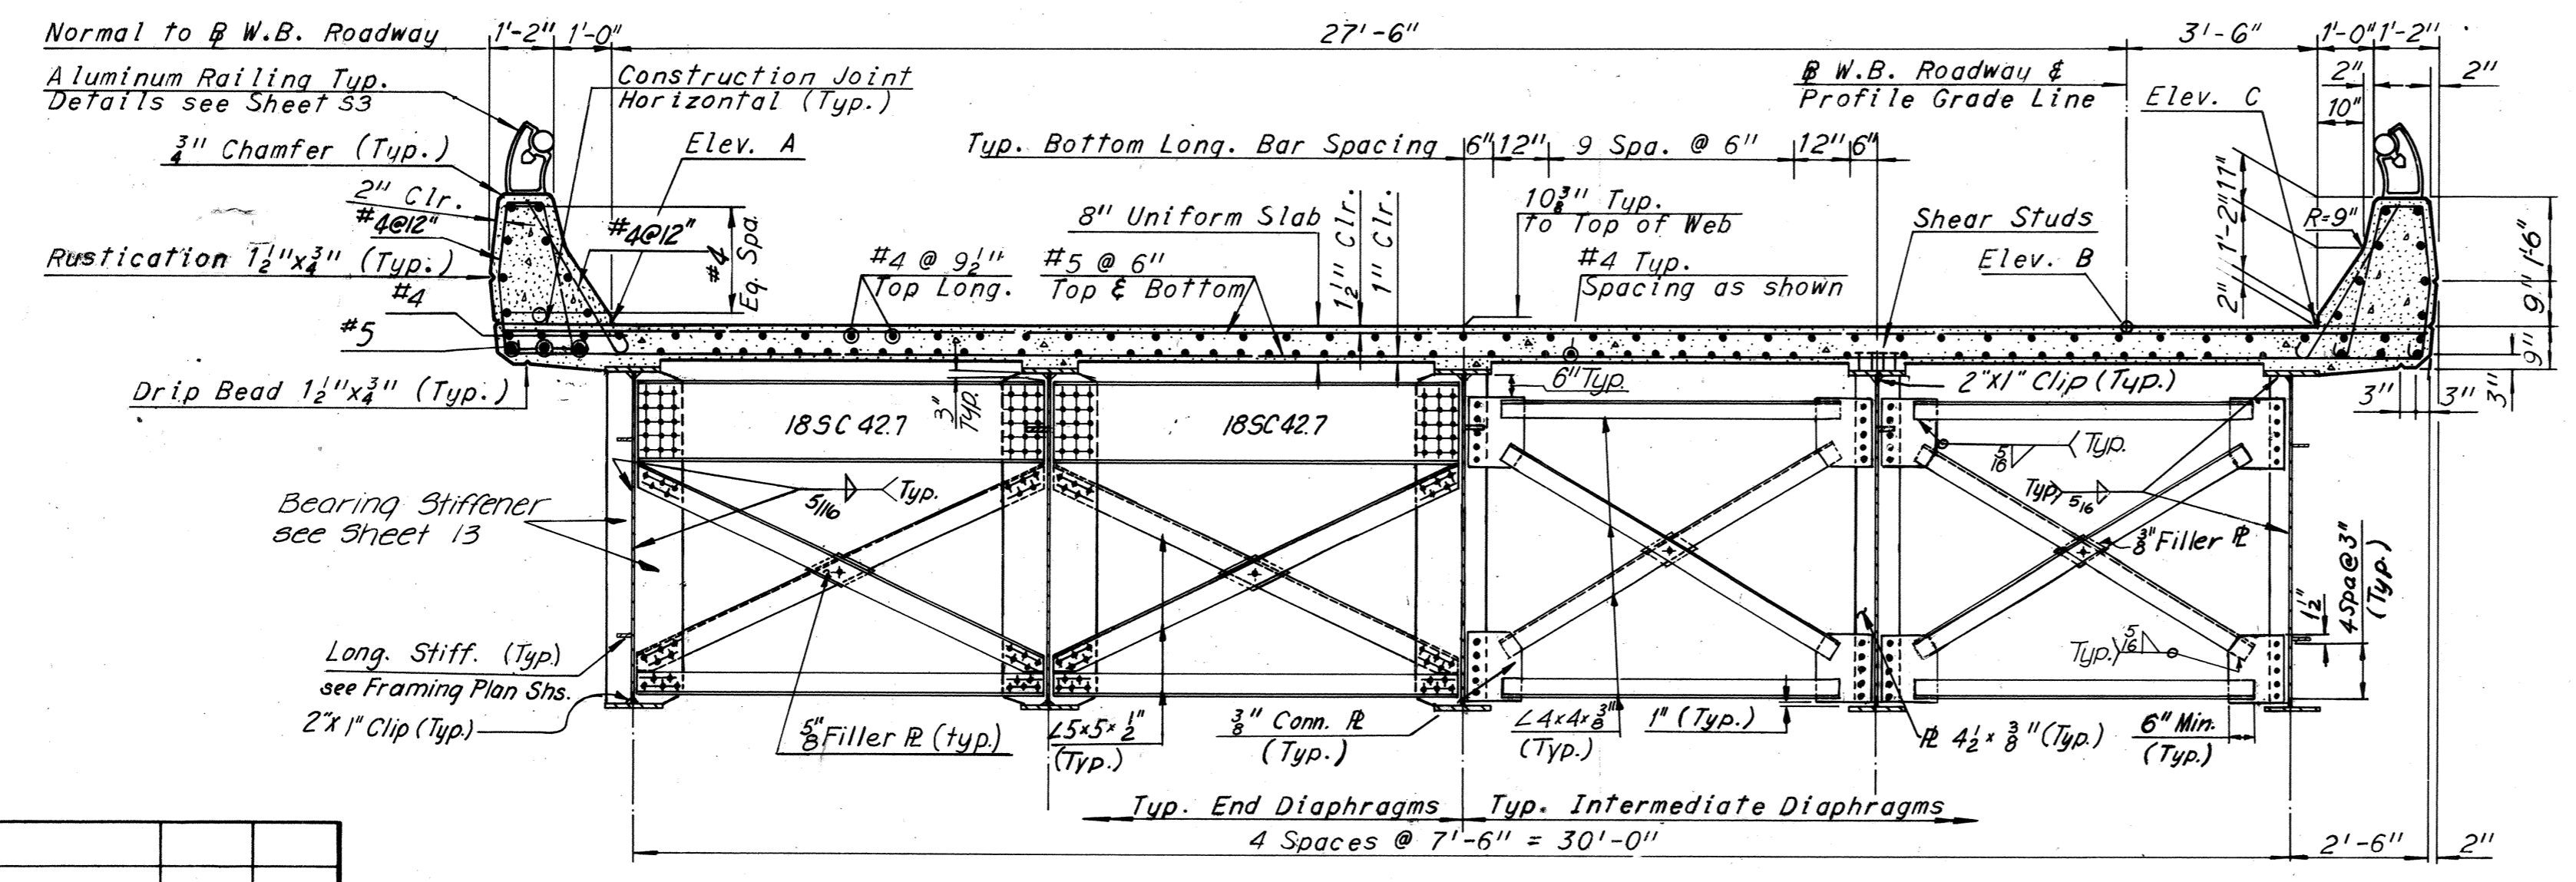

Note: Intermediate Diaphragm Details shown, are for Units 22 and 23 and curved stringers only in Units 20 and 21. Flame Conn. PL as shown above is also to be used in bays where only one of the two stringers is curved. For Units 20 and 21 see sheet 15 for Framing Plan and sheet 20 for Deck Plan. For Units 22 and 23 see Sheet 17 for Framing Plan and Sheet 21 for Deck Plan.

Notes: For Superstructure quantities, see Sheet 2. For Framing plan, see Sheet 14. For Joint details, see Sheet 24. For Railing details, see Sheet 53.

BY	DATE				
MADE	GSH	08-01-68			
CHECKED	SCC	10-21-68	1	As Built	TEM 10-76
IN CHARGE			NO.	REVISION	BY DATE

RICHMOND METROPOLITAN AUTHORITY
RICHMOND EXPRESSWAY SYSTEM
DOWNTOWN EXPRESSWAY

BRIDGE NO. 63
WESTBOUND ROADWAY OVER
12TH ST. - R.R. TRACKS AND 16TH ST.
DECK PLAN UNITS 17 AND 18

HOWARD, NEEDLES, TAMMEN & BERGENDOFF
 consulting engineers
 NEW YORK ALEXANDRIA KANSAS CITY


SCALE: As Noted
 CONTRACT NO.: 10
 SHEET NO. 19 OF 29

AS BUILT


RICHMOND EXPRESSWAY SYSTEM			
SECTION	PROJECT	SHEET NO.	TOTAL SHEETS
10	DOWNTOWN EXPRESSWAY	89	265

Notes:
 For End Diaphragms at Pier 18, Unit 19, see Section A-A, Sheet 19.
 For End Diaphragms at Pier 19, Units 19 & 20, see Section A-A, Sheet 19.
 For End Diaphragms at Pier 20, Units 20 & 21, see Section A-A, Sheet 19.
 and for Detail "C" see Sheet 16.
 For End Diaphragms at Pier 10, Unit 21N and Pier 21, Unit 21S, see Section C-C this Sheet.

Note: Transverse dotted lines in Units 20 and 21 represent interior diaphragm at left end of stringers S5-20, S3-21N and S6-21N.
 For location of diaphragms see Sheet 14.

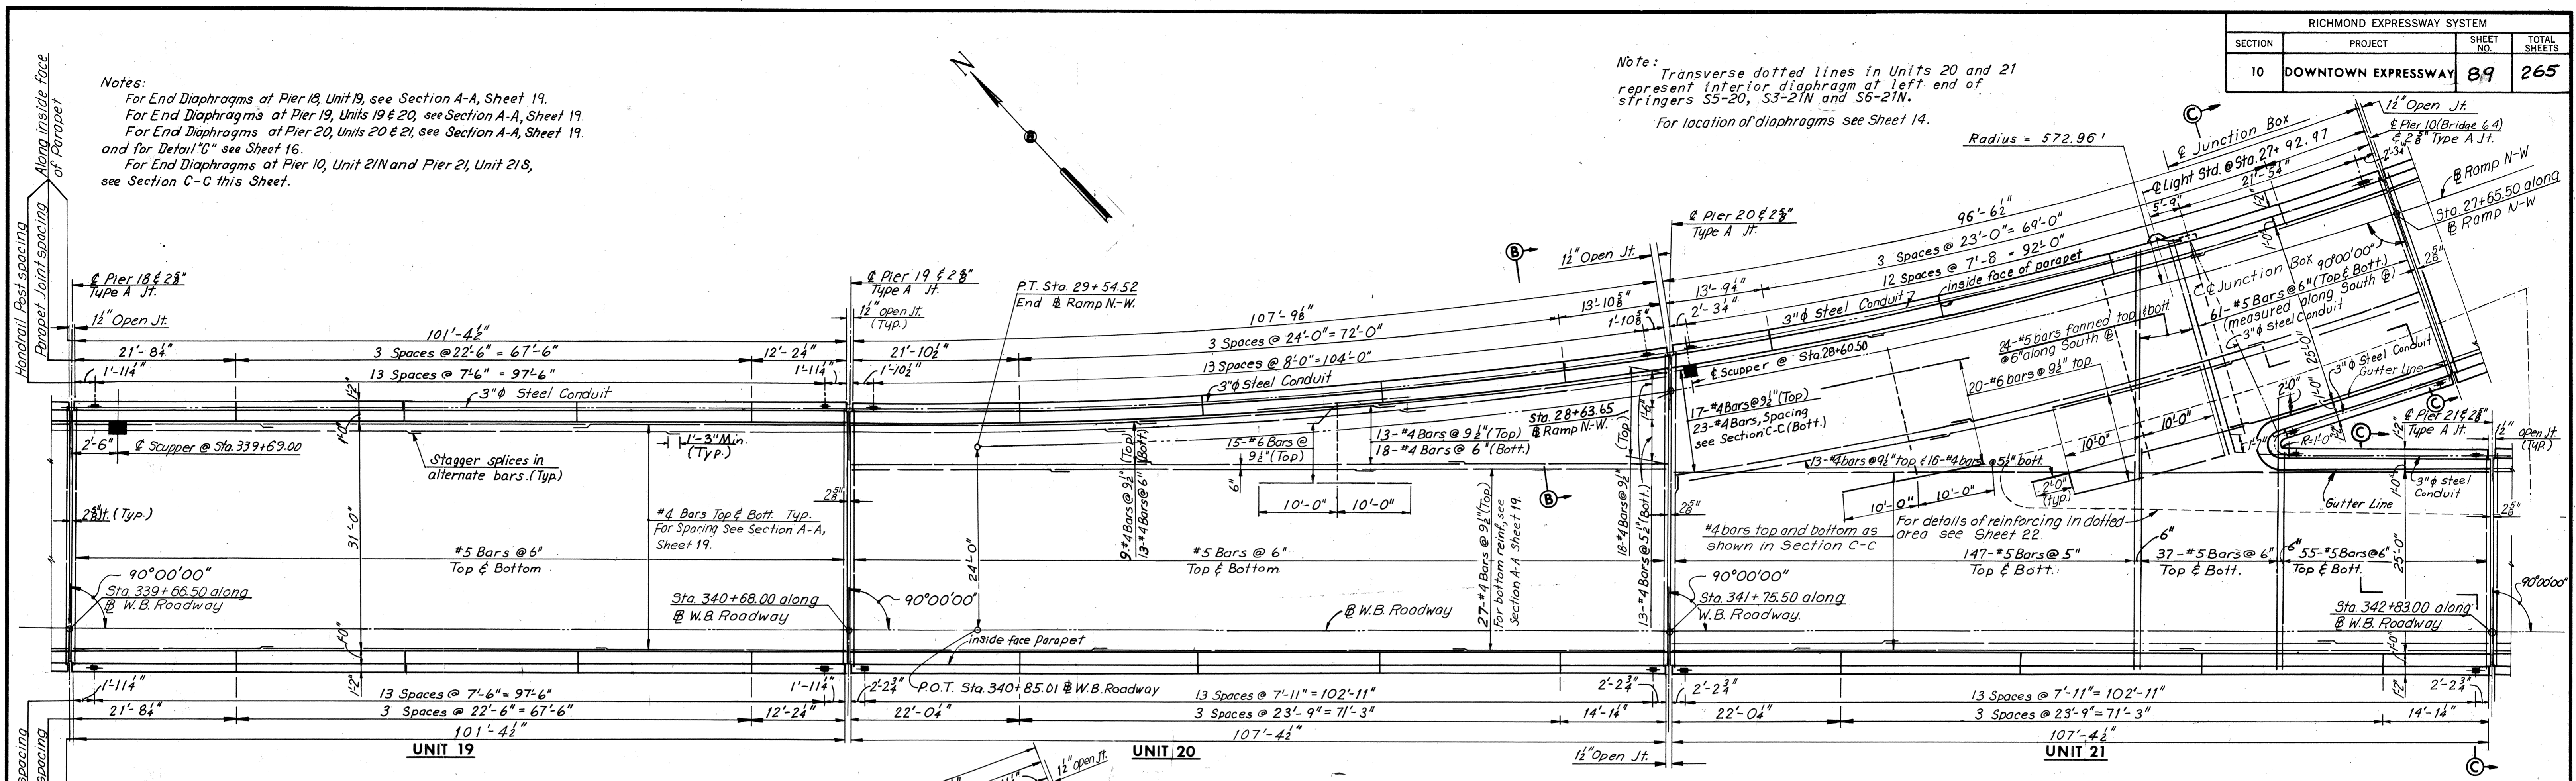

DECK PLAN
Scale 1/4" = 10'-0"

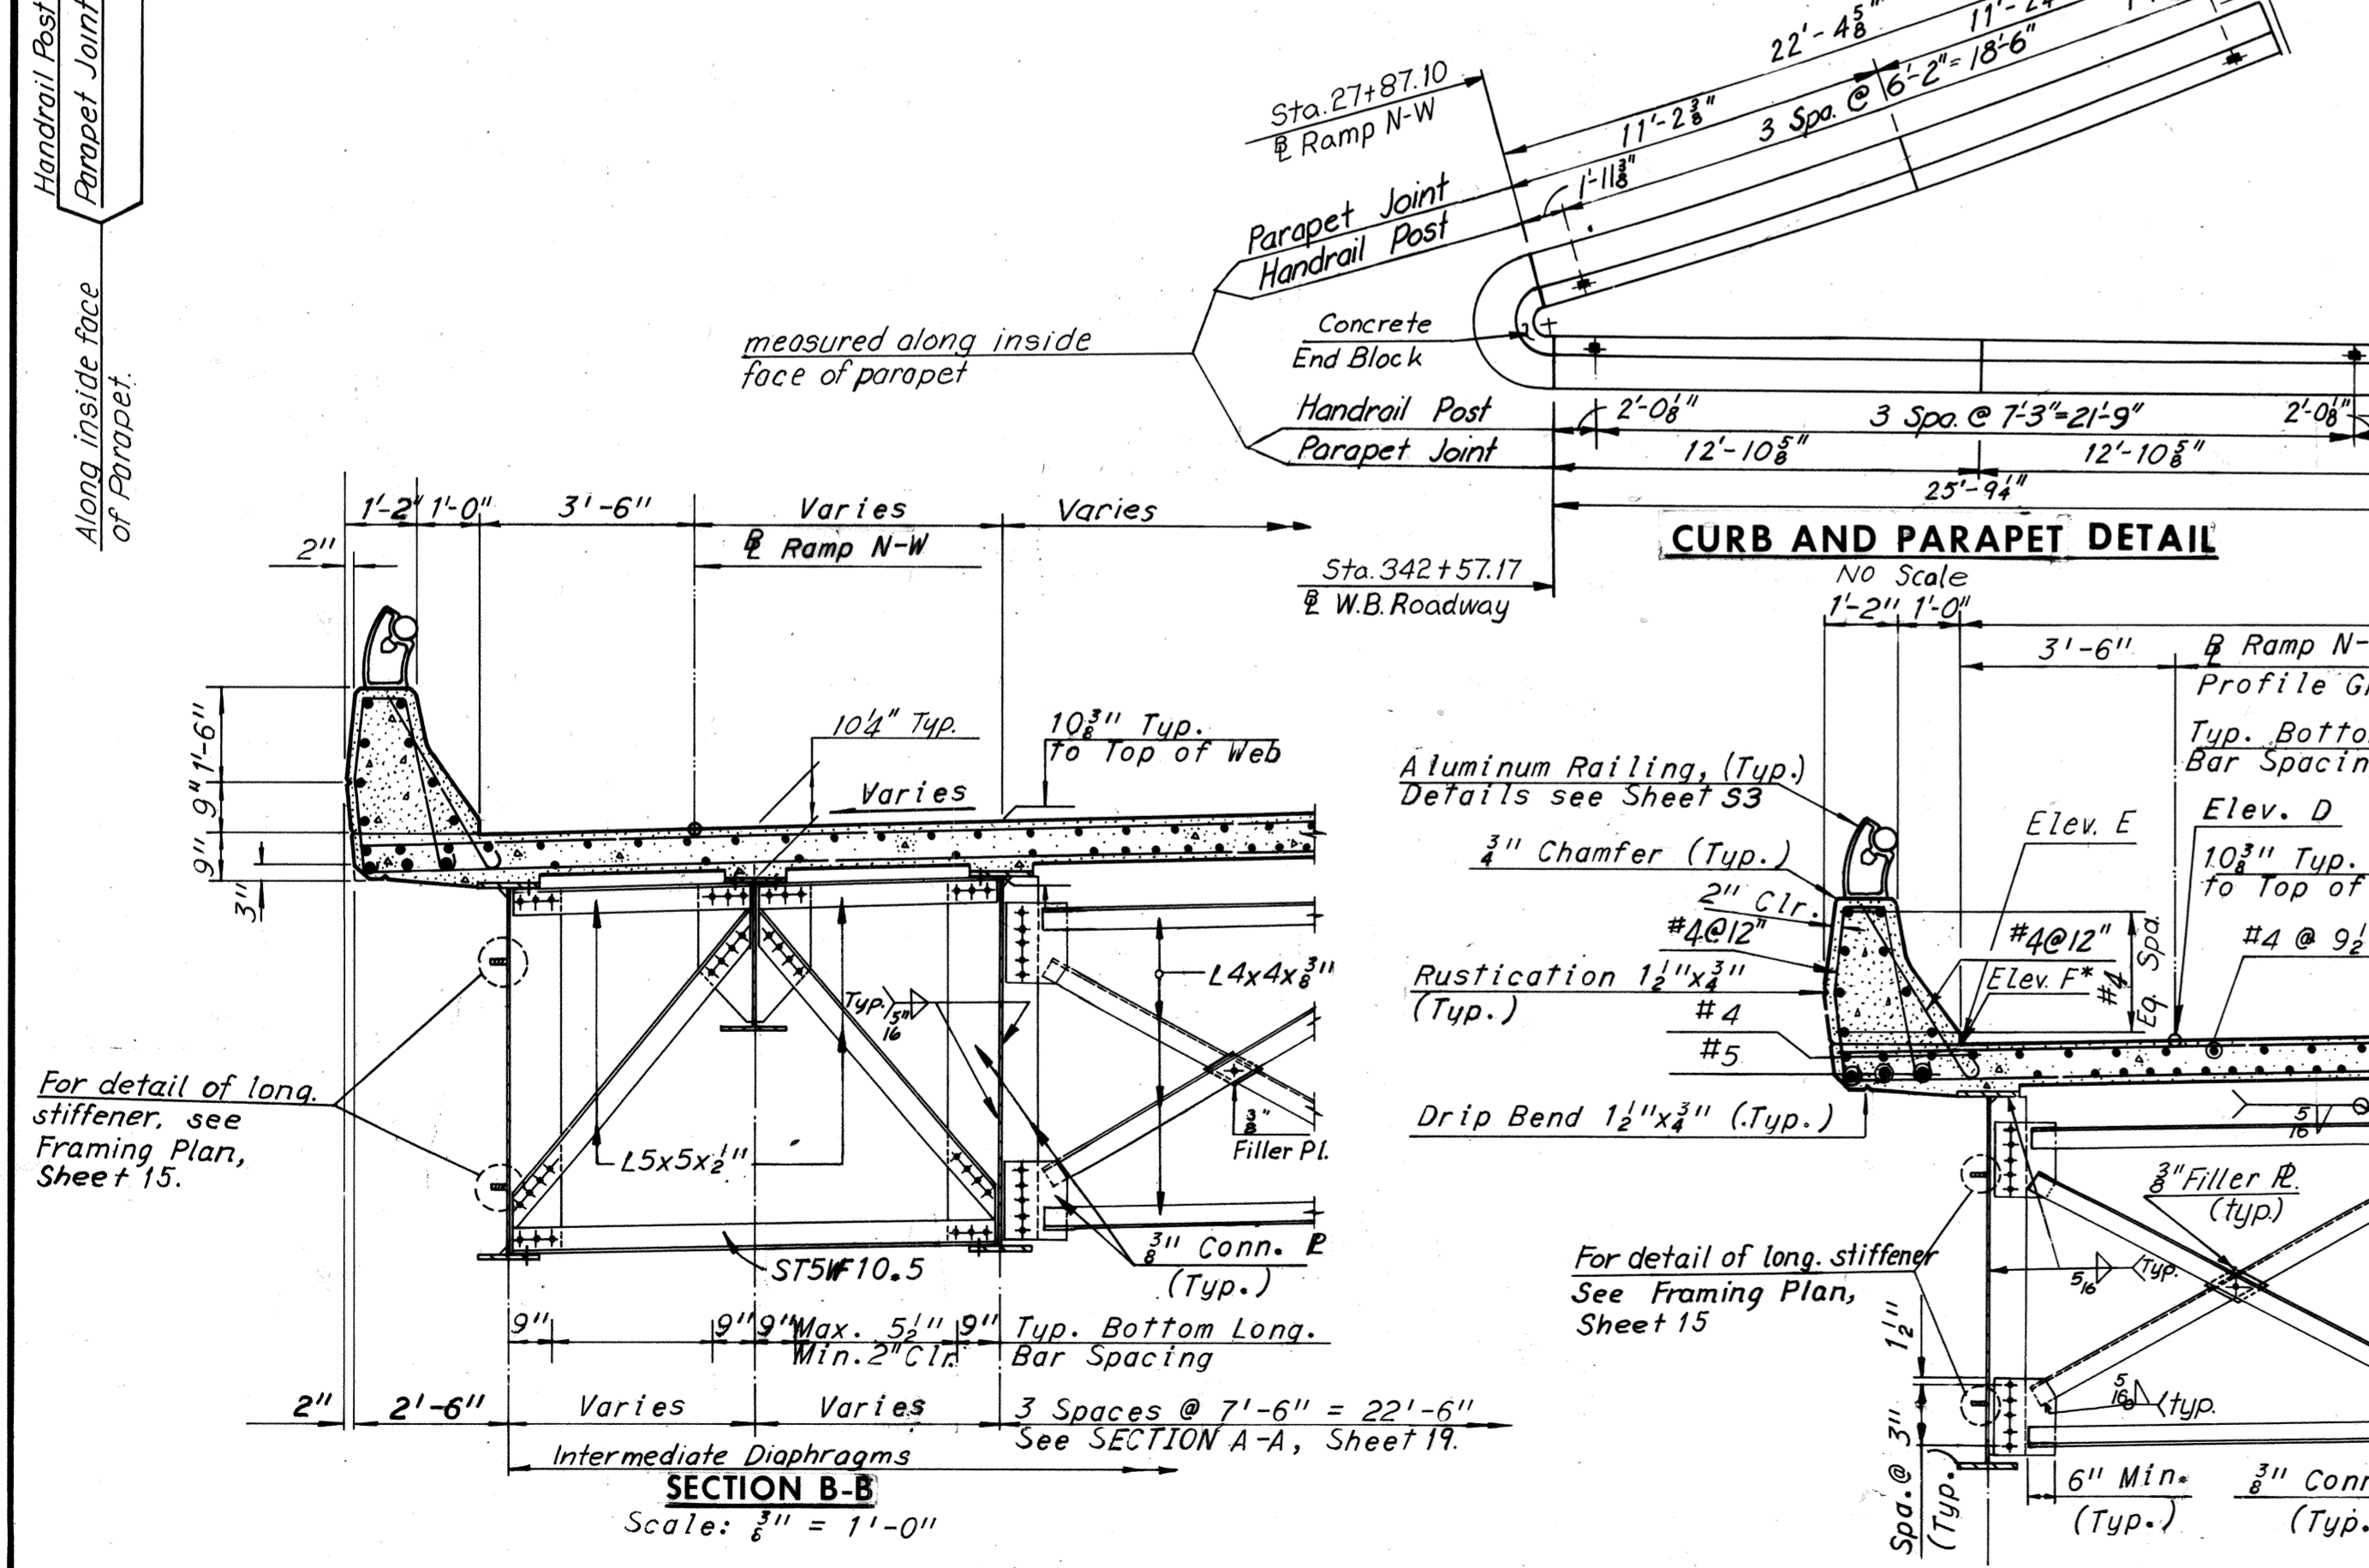


CURB AND PARAPET DETAIL
No Scale

BY	DATE	NO.	REVISION
MADE	GSH 7-29-68		
CHECKED	KCT 10-18-68	1	As Built
IN CHARGE			

Note: Elev. C* are elevations along south gutterline of Ramp N-W from Pier 10 (64) to Sta. 27+87.10 @ ctr. of Nose.
 Elev. F* are elevations along north gutterline of W.B. Roadway between Sta. 342+57.17 @ ctr. of Nose and Sta. 342+83.00 @ Pier 21.

Notes:
 For Superstructure quantities, see Sheet 2.
 For Framing plan, see Sheet 15.
 For Joint details, see Sheet 24.
 For Railing details, see Sheet 53.
 For Standard Drainage Details, see Sheet 55 & 56.
 Support Type 2 for Units 19 and 21, see Sheet 19.

Note: Intermediate Diaphragms shown in Section C-C can only be used where stringers are straight. For Intermediate Diaphragm Details for curved stringers, see Sheet 19.

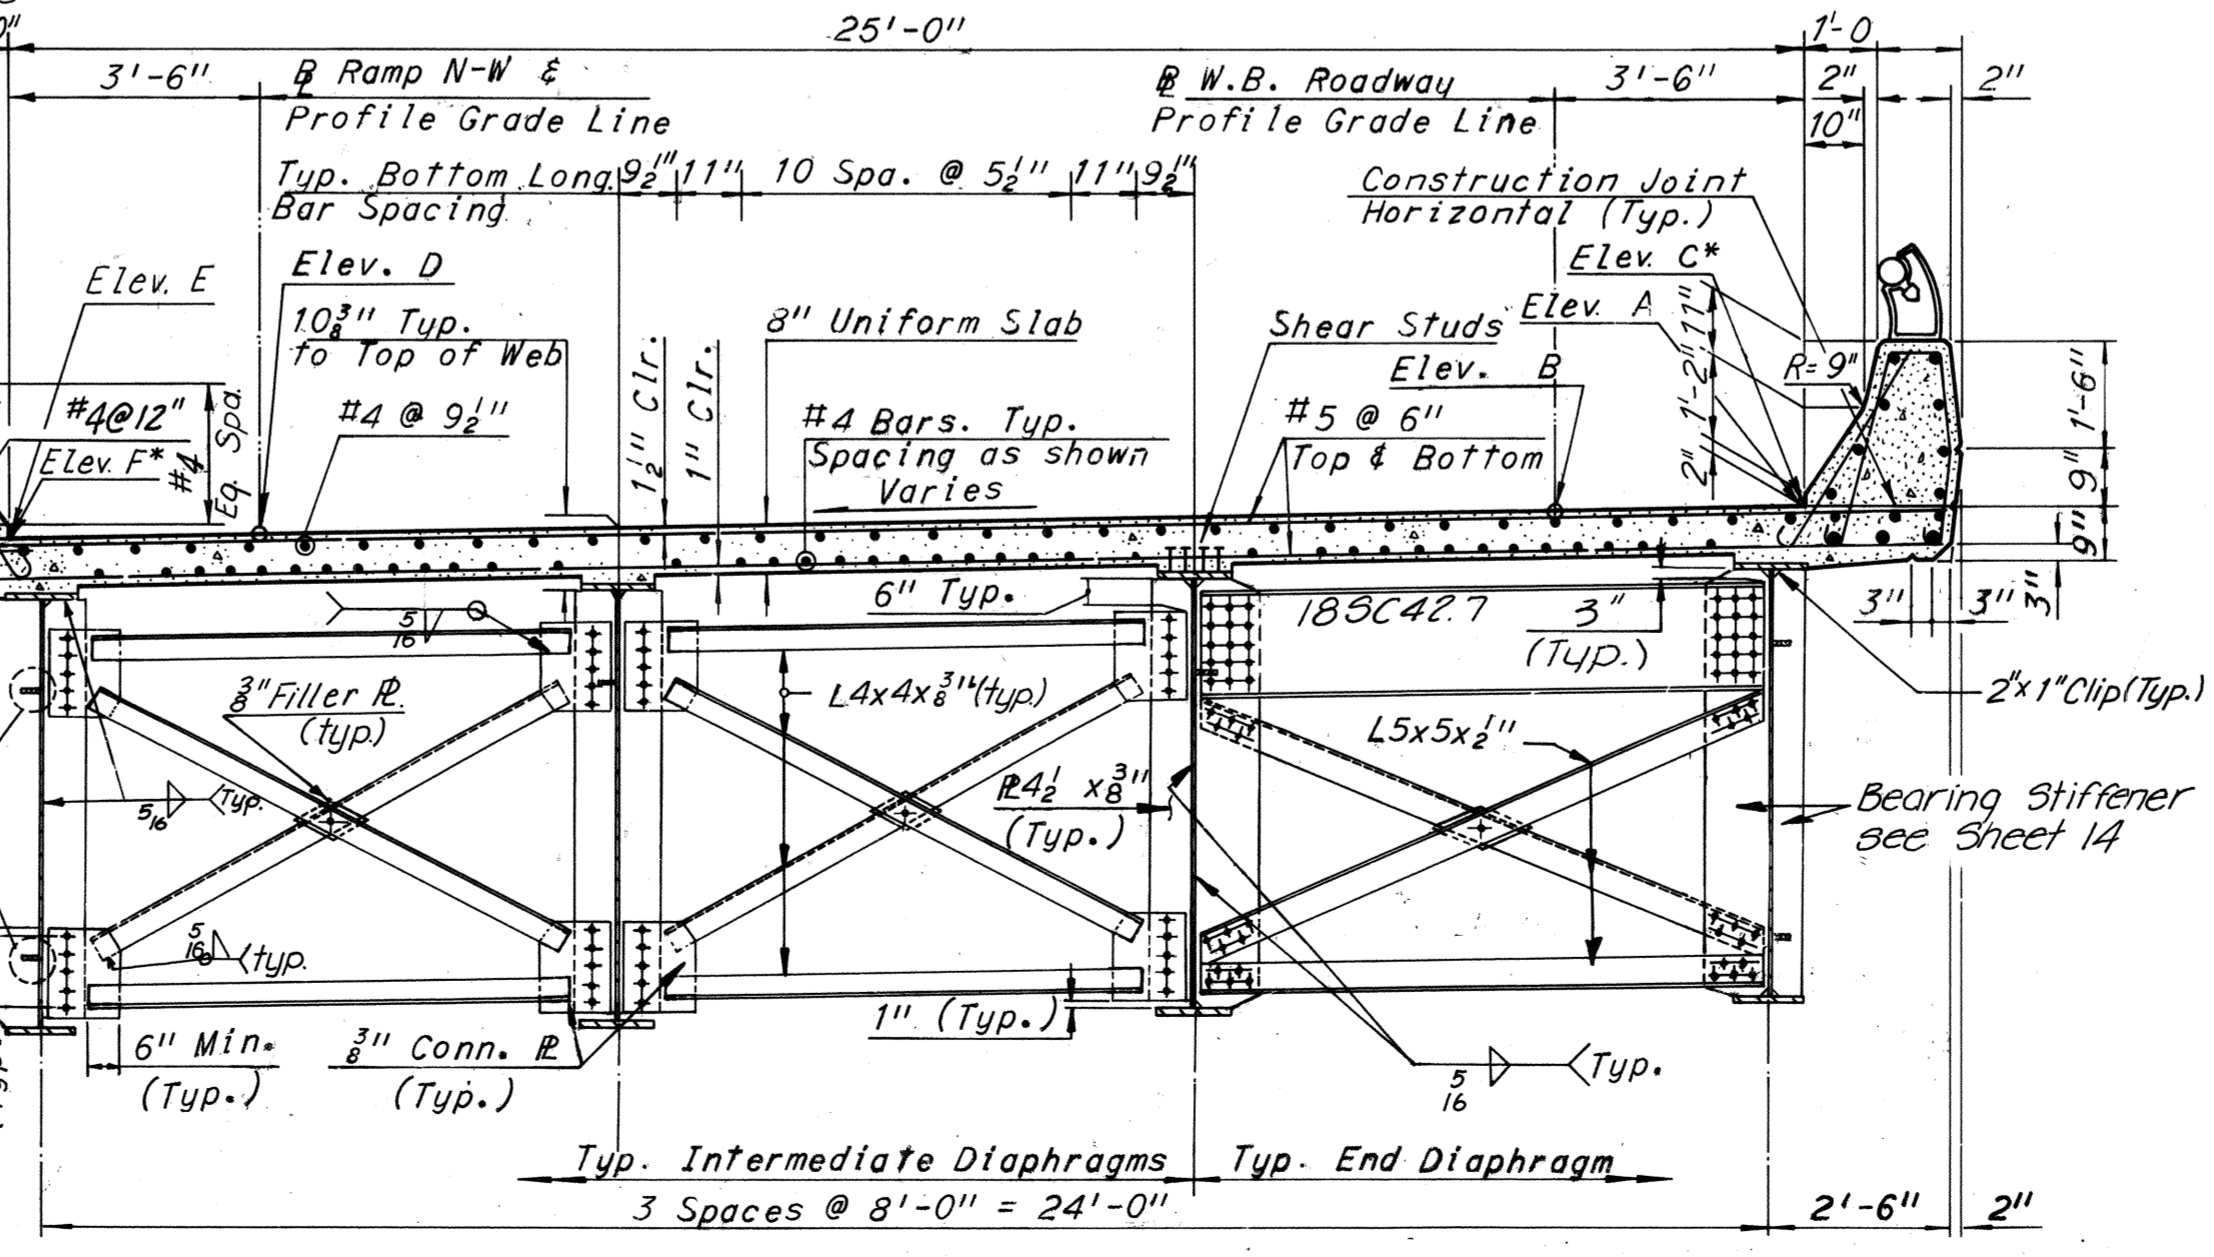

SECTION C-C
Scale: 3/8" = 1'-0"

STATION @ W.B.	ELEVATION TABLE				
	ELEV. A	ELEV. B	ELEV. F	ELEV. D	ELEV. E
339+66.50	67.46	67.39	—	66.91	66.84
+70.00	67.49	67.42	—	66.94	66.87
+80.00	67.61	67.54	—	67.06	66.99
+90.00	67.72	67.65	—	67.17	67.10
340+00.00	67.83	67.76	—	67.28	67.21
+10.00	67.94	67.87	—	67.39	67.32
+20.00	68.05	67.98	—	67.50	67.43
+30.00	68.17	68.10	—	67.62	67.55
+40.00	68.28	68.21	—	67.73	67.66
+50.00	68.39	68.32	—	67.84	67.77
+60.00	68.50	68.43	—	67.95	67.88
+68.00	68.59	68.52	—	68.04	67.97
+70.00	68.61	68.54	—	68.06	67.99
+80.00	68.73	68.66	—	68.18	68.11
+85.01	68.78	68.71	—	68.23	68.16
+90.00	68.84	68.77	—	—	—
341+00.00	68.95	68.88	—	—	—
+10.00	69.06	68.99	—	—	—
+20.00	69.18	69.11	—	—	—
+30.00	69.29	69.22	—	—	—
+40.00	69.40	69.33	—	—	—
+50.00	69.51	69.44	—	—	—
+60.00	69.62	69.55	—	—	—
+70.00	69.73	69.66	—	—	—
+75.50	69.80	69.73	—	—	—
+80.00	69.85	69.78	—	—	—
+90.00	69.96	69.89	—	—	—
342+00.00	70.07	70.00	—	—	—
+10.00	70.18	70.11	—	—	—
+20.00	70.29	70.22	—	—	—
+30.00	70.41	70.34	—	—	—
+40.00	70.52	70.45	—	—	—
+50.00	70.63	70.56	—	—	—
+57.17	70.71	70.64	70.21	—	—
+60.00	70.74	70.67	70.24	—	—
+70.00	70.85	70.78	70.35	—	—
+80.00	70.97	70.90	70.47	—	—
342+83.00	71.00	70.93	70.50	—	—

STATION @ Ramp N-W	ELEVATION TABLE		
	ELEV. D	ELEV. E	ELEV. C
29+54.52	68.23	—	—
+50.00	68.28	68.21	—
+40.00	68.39	68.32	—
+30.00	68.50	68.43	—
+20.00	68.60	68.53	—
+10.00	68.70	68.63	—
29+00.00	68.80	68.73	—
28+90.00	68.89	68.82	—
+80.00	68.98	68.91	—
+70.00	69.07	69.00	—
+63.65	69.12	—	—
+63.17	—	69.05	—
+60.00	69.15	69.08	—
+50.00	69.23	69.16	—
+40.00	69.30	69.23	—
+30.00	69.37	69.30	—
+20.00	69.44	69.37	—
+10.00	69.51	69.44	—
28+00.00	69.57	69.50	—
27+90.00	69.64	69.56	—
27+87.10	69.67	69.58	70.21
+80.00	69.74	69.64	70.34
+70.00	69.81	69.76	70.56
27+65.50	69.94	69.87	70.66


AS BUILT
 RICHMOND METROPOLITAN AUTHORITY
 RICHMOND EXPRESSWAY SYSTEM
 DOWNTOWN EXPRESSWAY

BRIDGE NO. 63
 WESTBOUND ROADWAY OVER
 12TH ST. - R.R. TRACKS AND 16TH ST.
 DECK PLAN - UNITS 19, 20 AND 21


HOWARD, NEEDLES, TAMMEN & BERGENDOFF
 consulting engineers
 NEW YORK ALEXANDRIA KANSAS CITY

SCALE: As Noted
 CONTRACT NO.: 10
 SHEET NO. 20 OF 29


RICHMOND EXPRESSWAY SYSTEM			
SECTION	PROJECT	SHEET NO.	TOTAL SHEETS
10	DOWNTOWN EXPRESSWAY	91	265

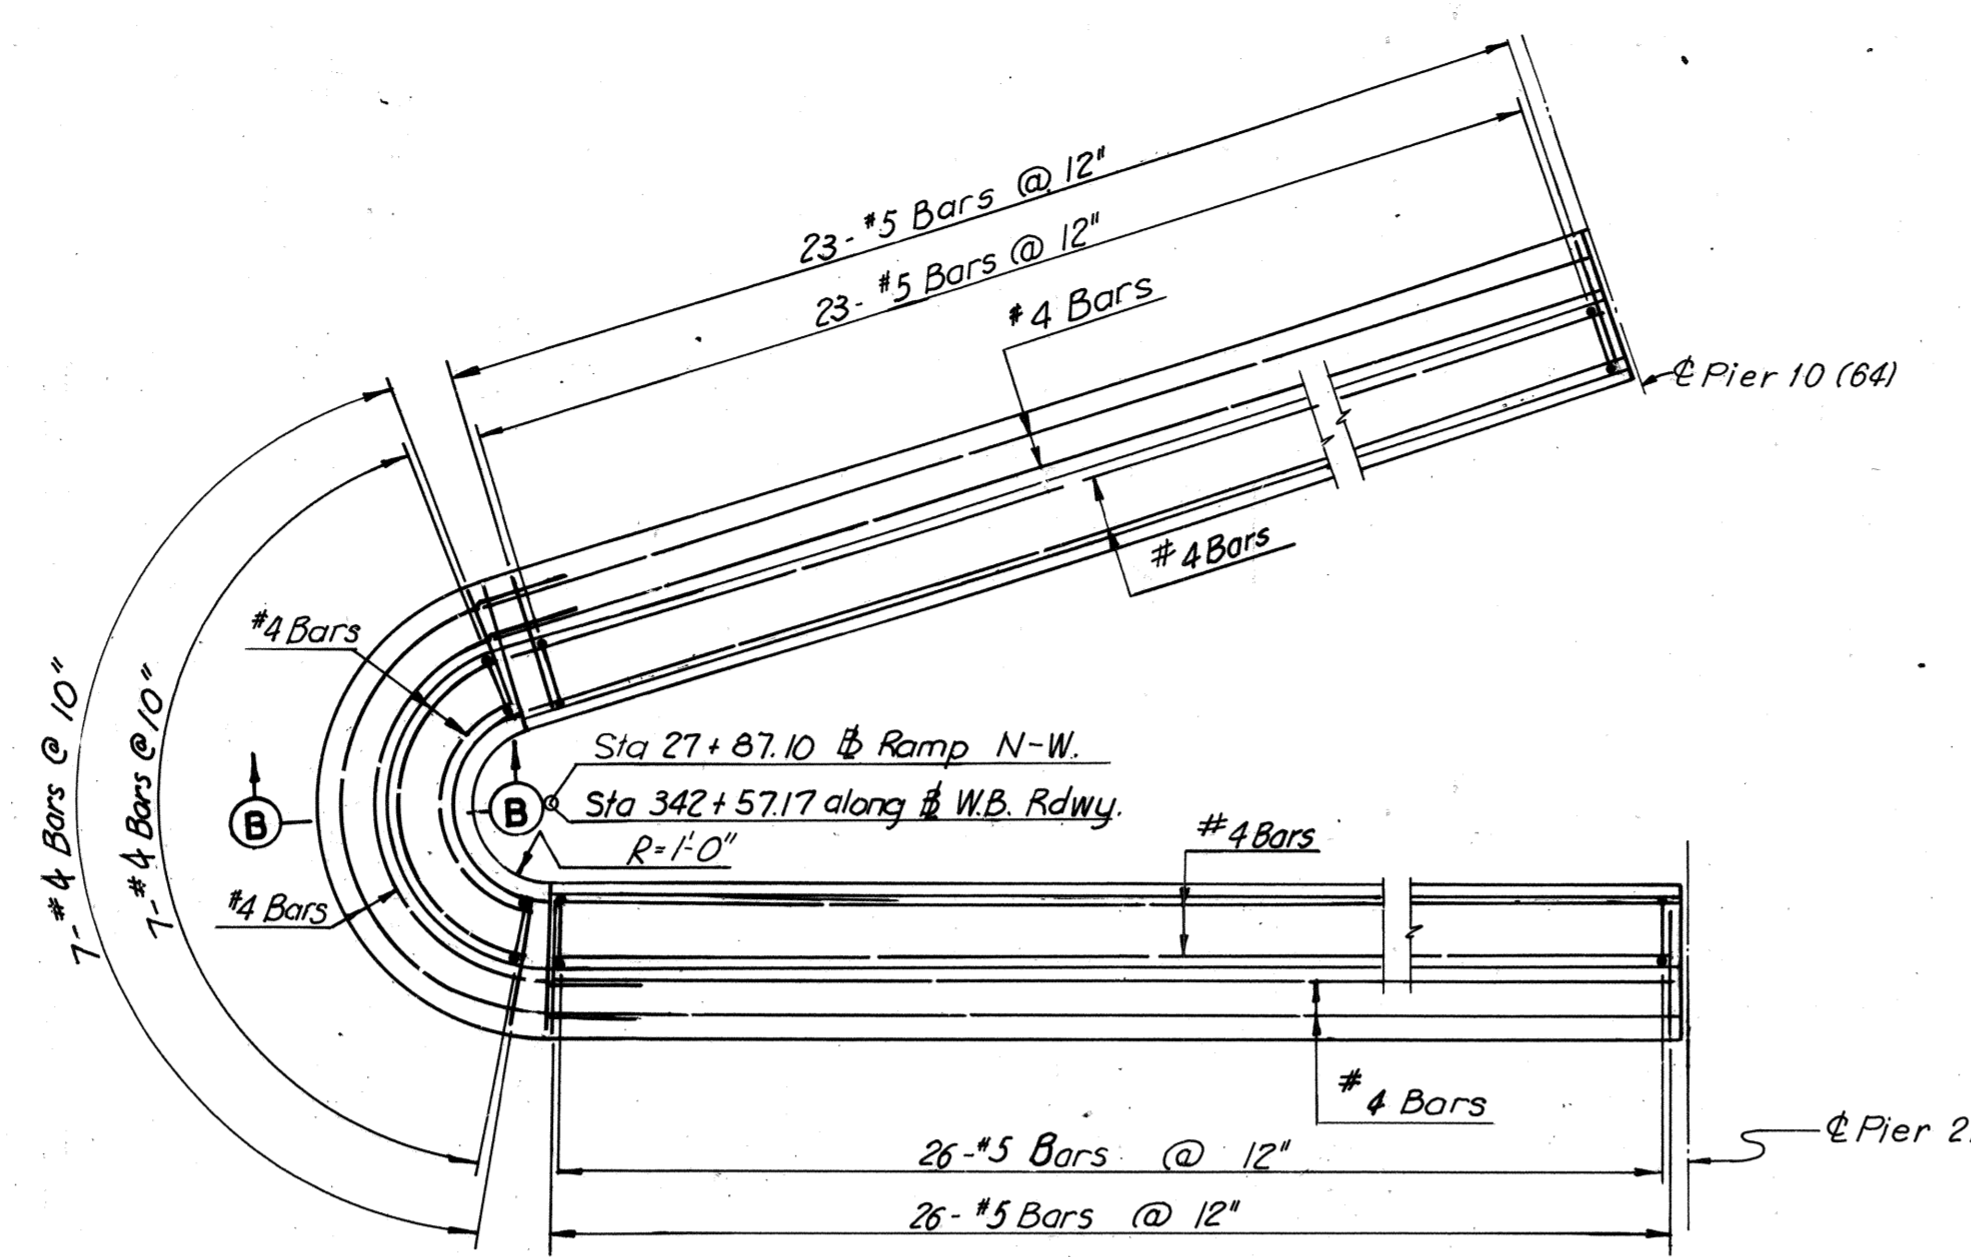


PARAPET REINFORCING STEEL DETAIL
Scale: $\frac{3}{8}'' = 1'-0''$

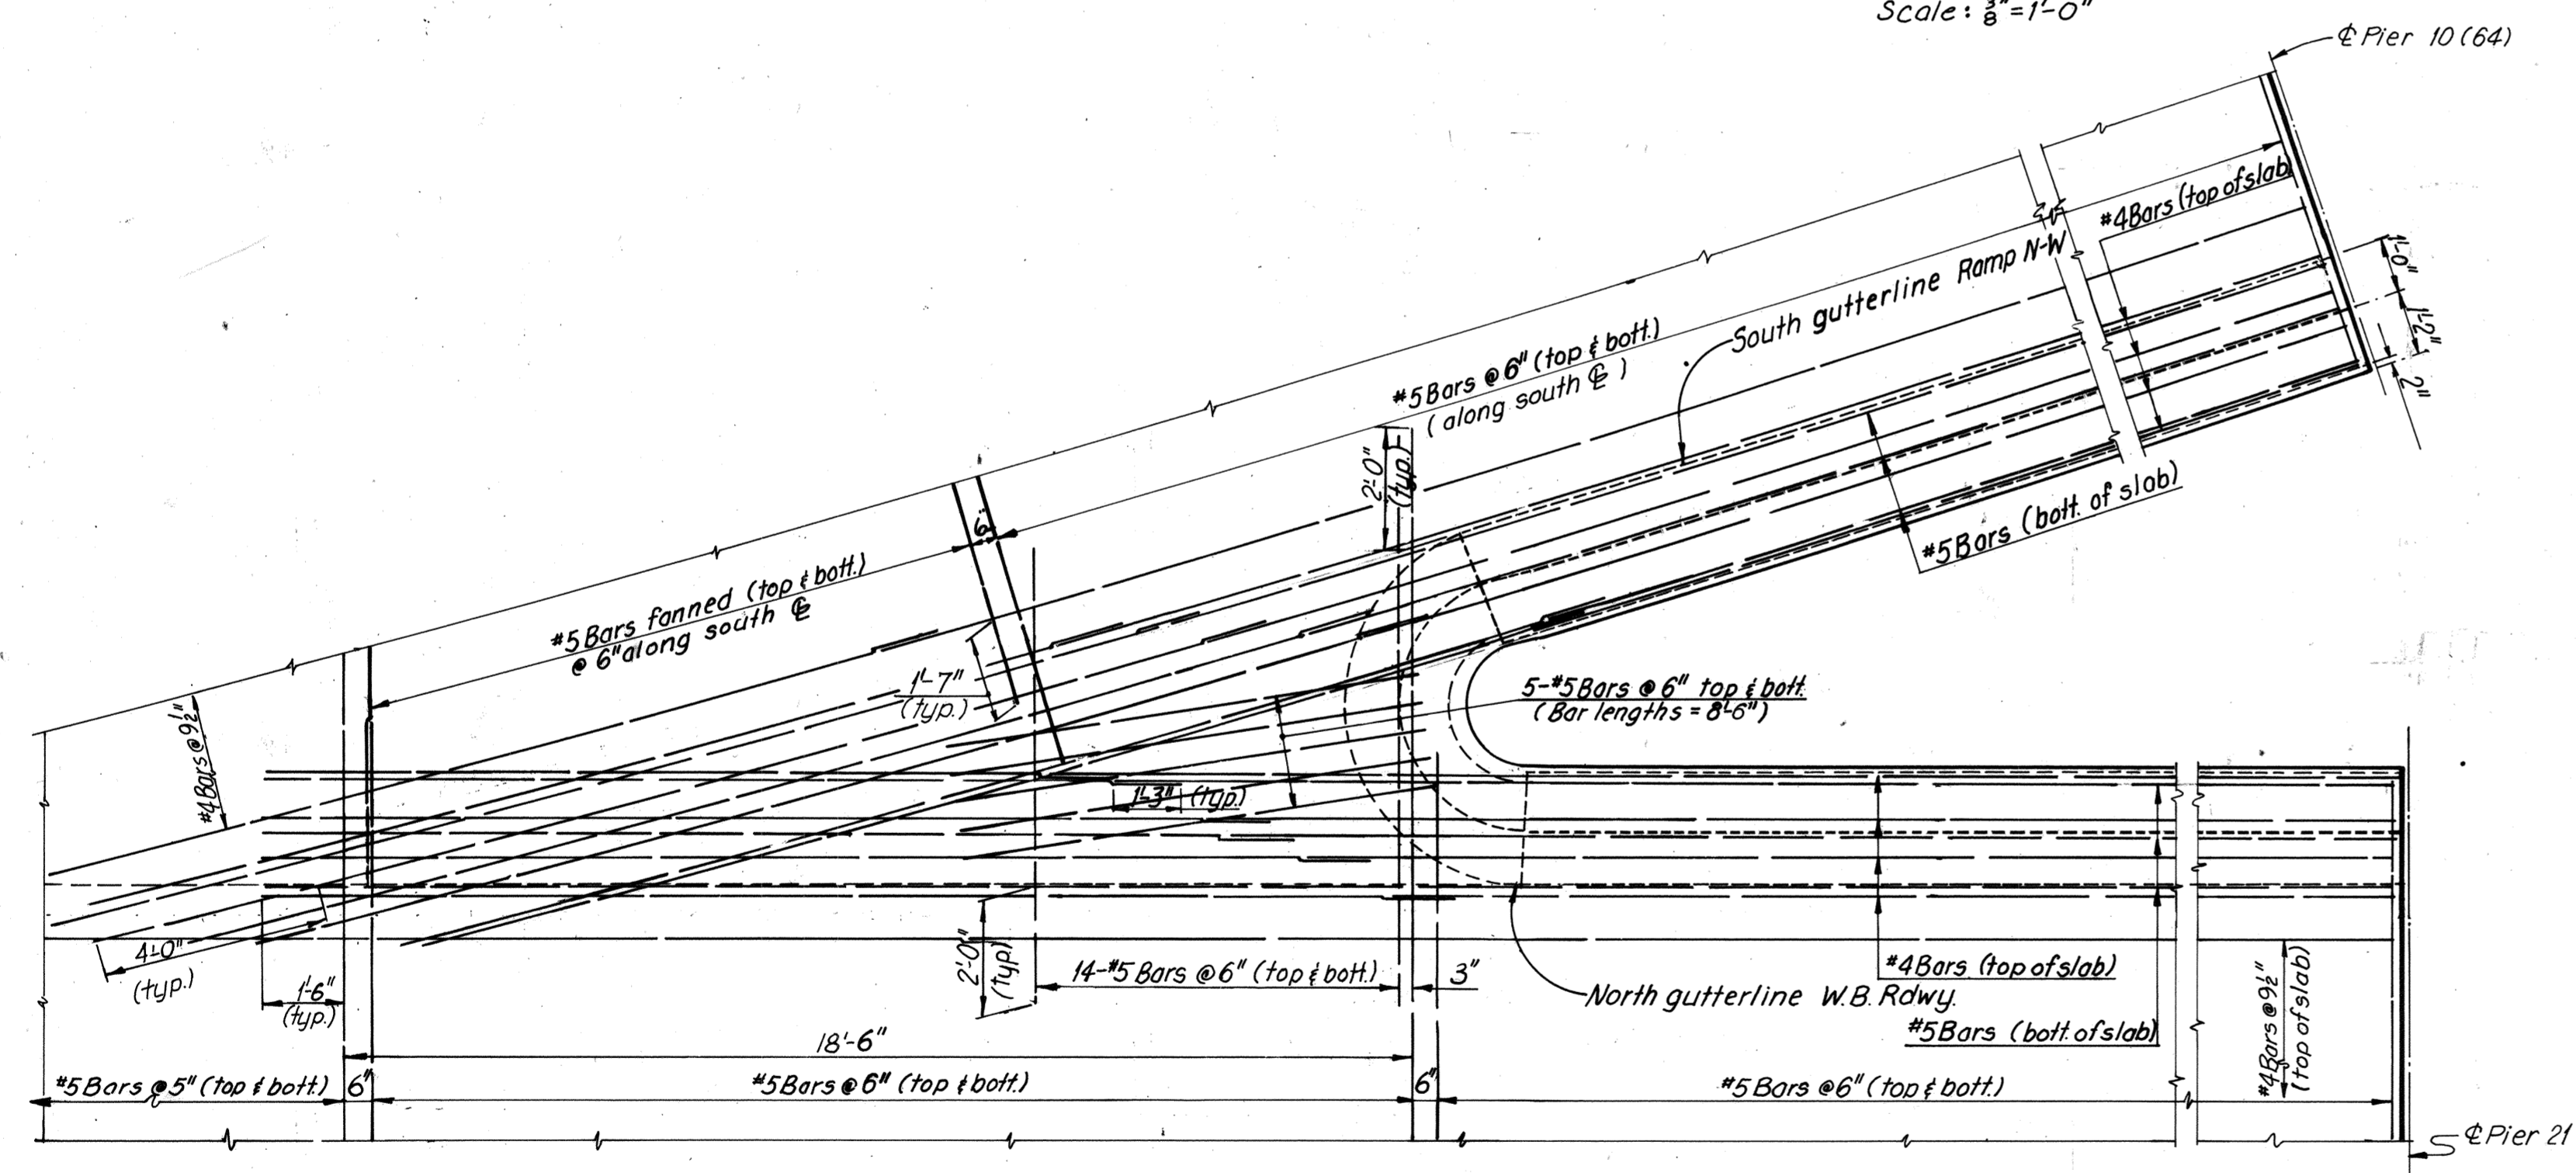


SLAB REINFORCING STEEL DETAIL
Scale: $\frac{3}{8}'' = 1'-0''$

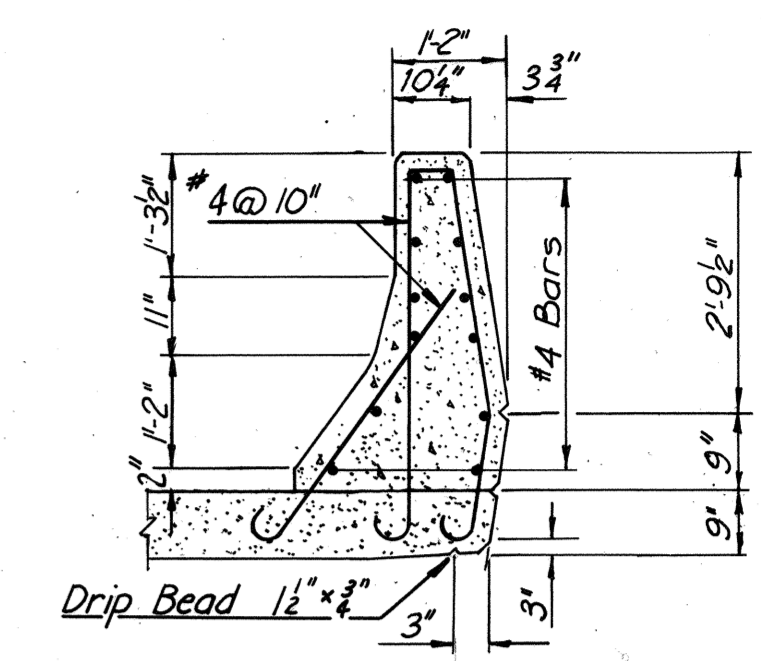


SECTION B-B
Scale: $\frac{3}{8}'' = 1'-0''$

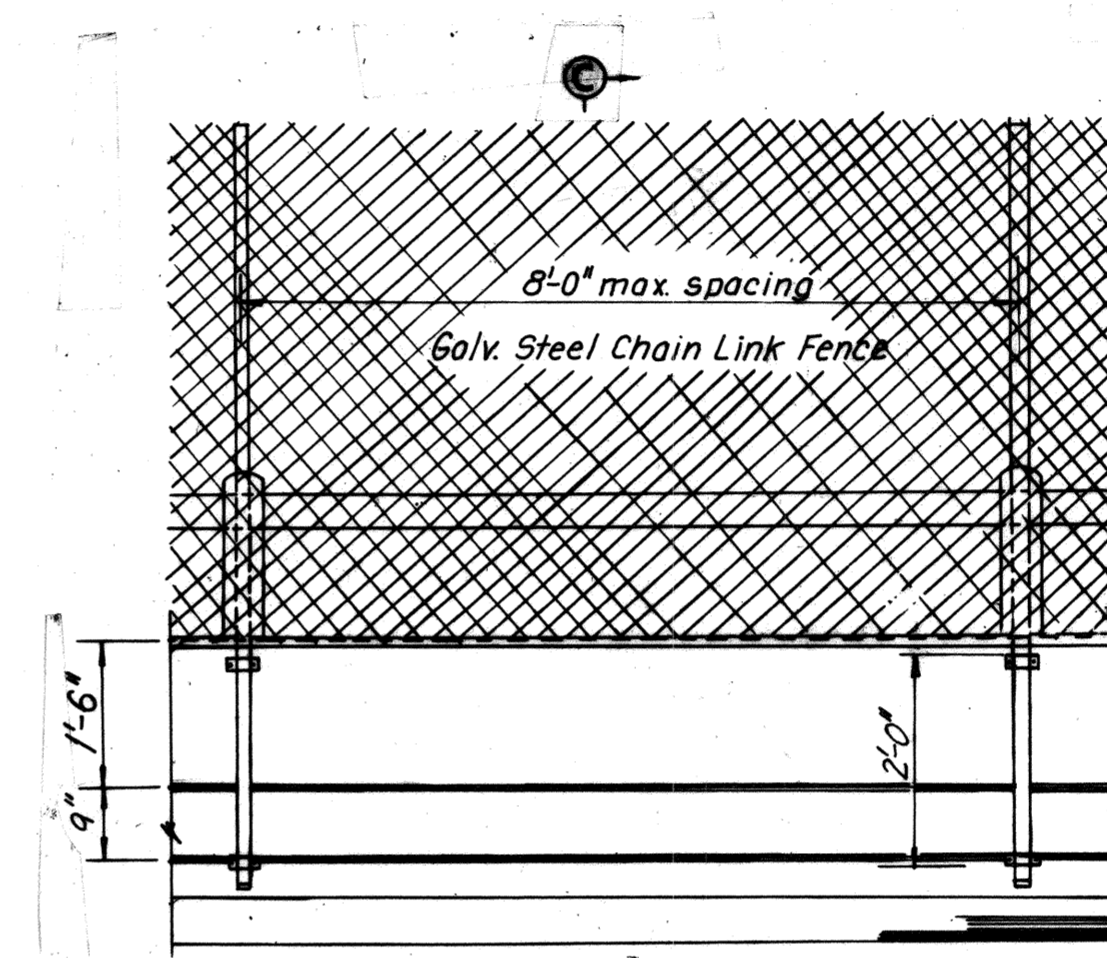


Note: Post spacing of galvanized Steel Chain Link Fence shall match handrail post spacing.

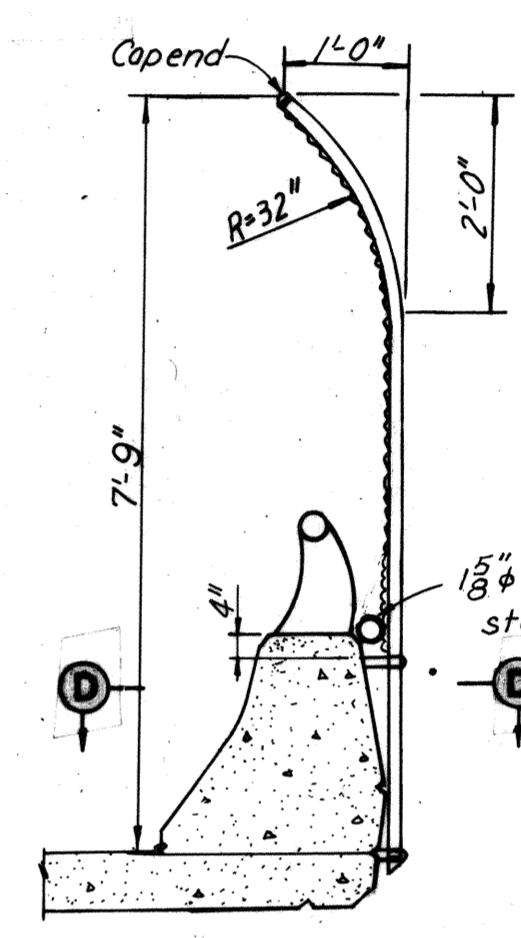

SECTION C-C

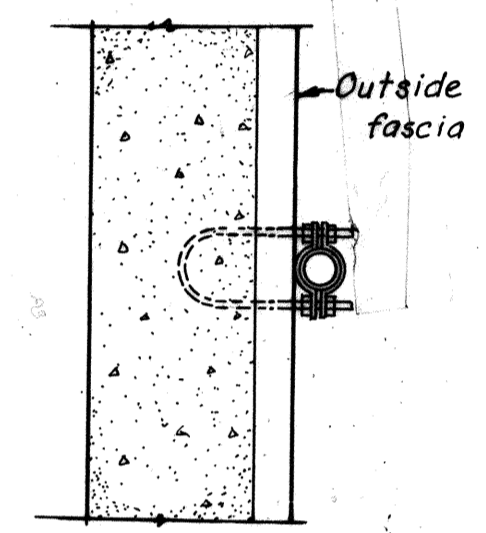

SECTION D-D

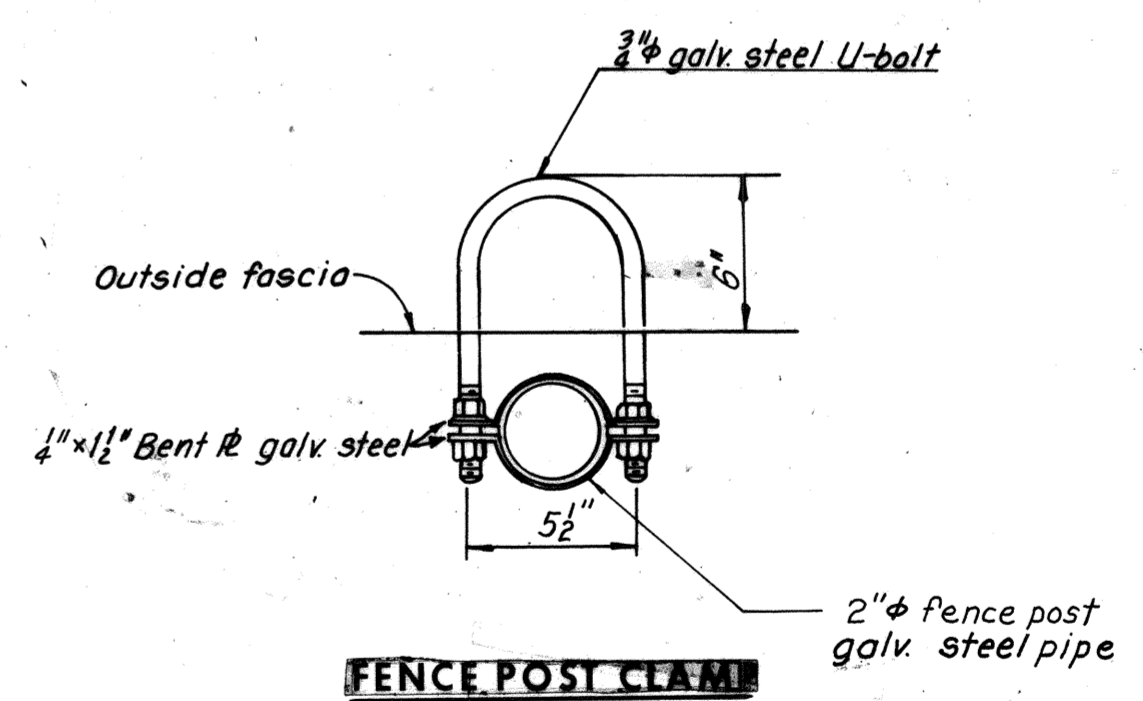

FENCE POST CLAMP

FIRE SCREEN DETAILS

No Scale

MADE	BY	DATE	NO.	REVISION	BY	DATE
	GSH/JD	12-12-68				
CHECKED	PTA	2-19-69	1	As Built	TEM	10-76
IN CHARGE						

RICHMOND METROPOLITAN AUTHORITY
RICHMOND EXPRESSWAY SYSTEM
DOWNTOWN EXPRESSWAY


BRIDGE NO. 63
WESTBOUND ROADWAY OVER
12TH ST. - R.R. TRACKS AND 16TH ST.
SUPERSTRUCTURE DETAILS

HOWARD, NEEDLES, TAMMEN & BERGENDOFF
consulting engineers
NEW YORK ALEXANDRIA KANSAS CITY


SCALE: *As Noted*
CONTRACT NO. **10**
SHEET NO. **22** OF **29**

AS BUILT




RICHMOND EXPRESSWAY SYSTEM			
SECTION	PROJECT	SHEET NO.	TOTAL SHEETS
10	DOWNTOWN EXPRESSWAY	92	265

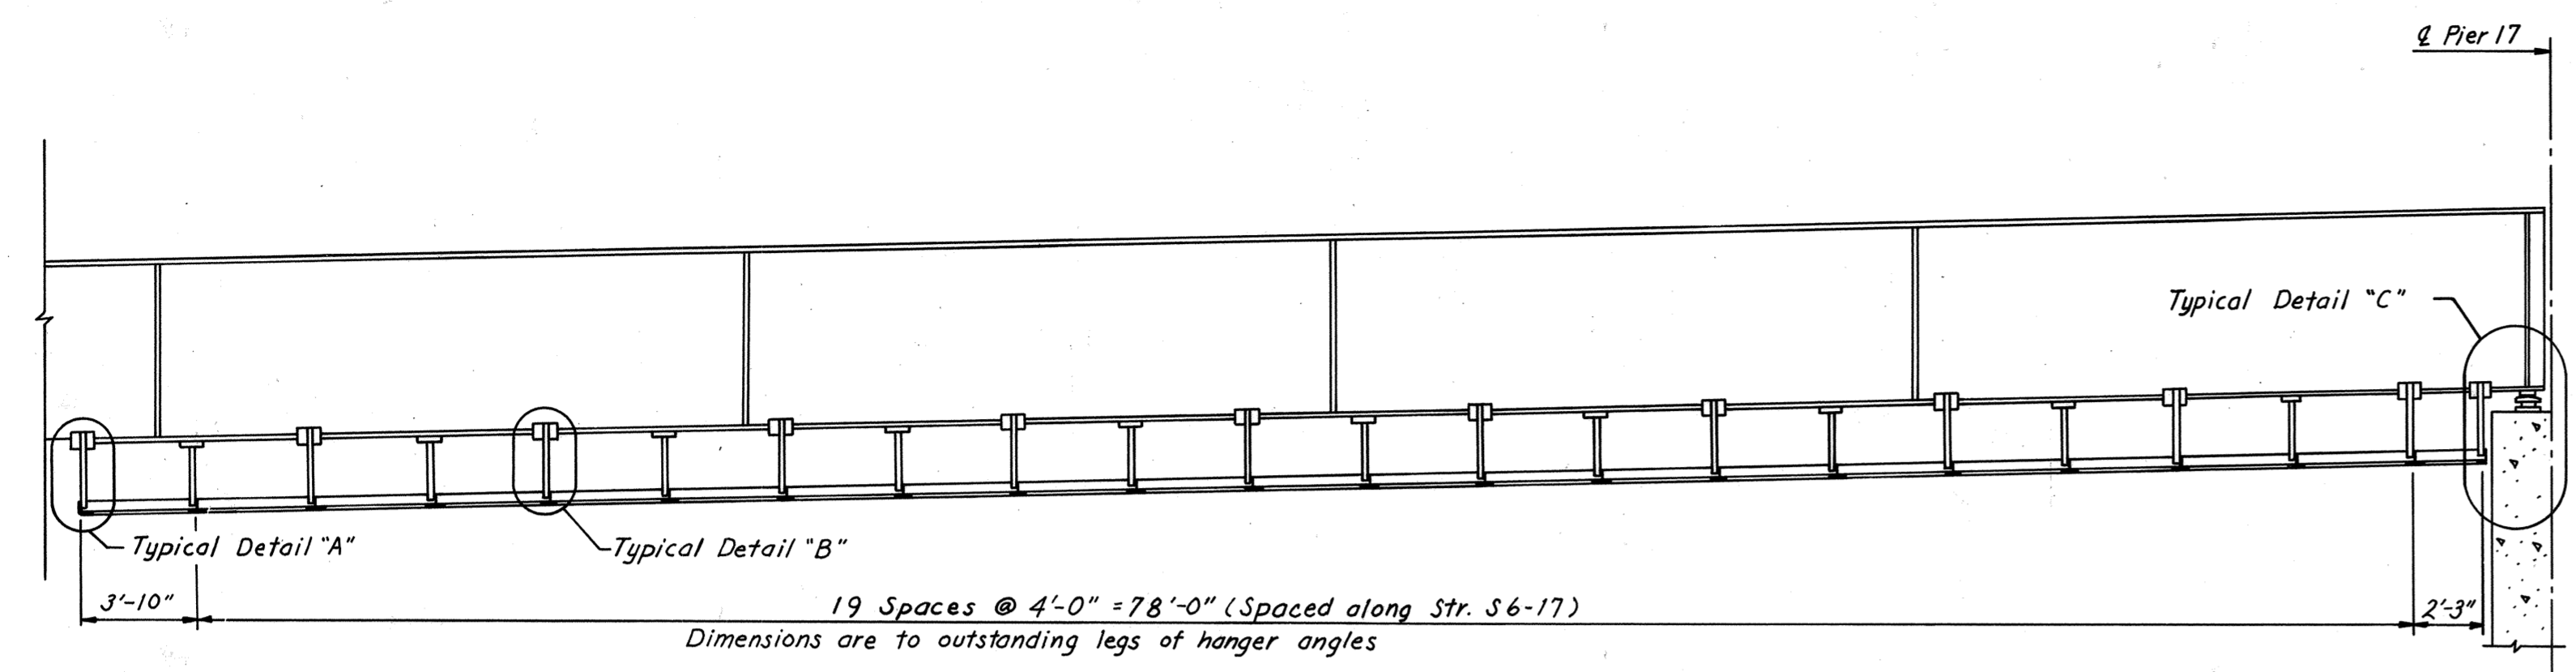

TYPICAL LONGITUDINAL SECTION OF SUPPORT FRAMING FOR FIRE PROTECTION

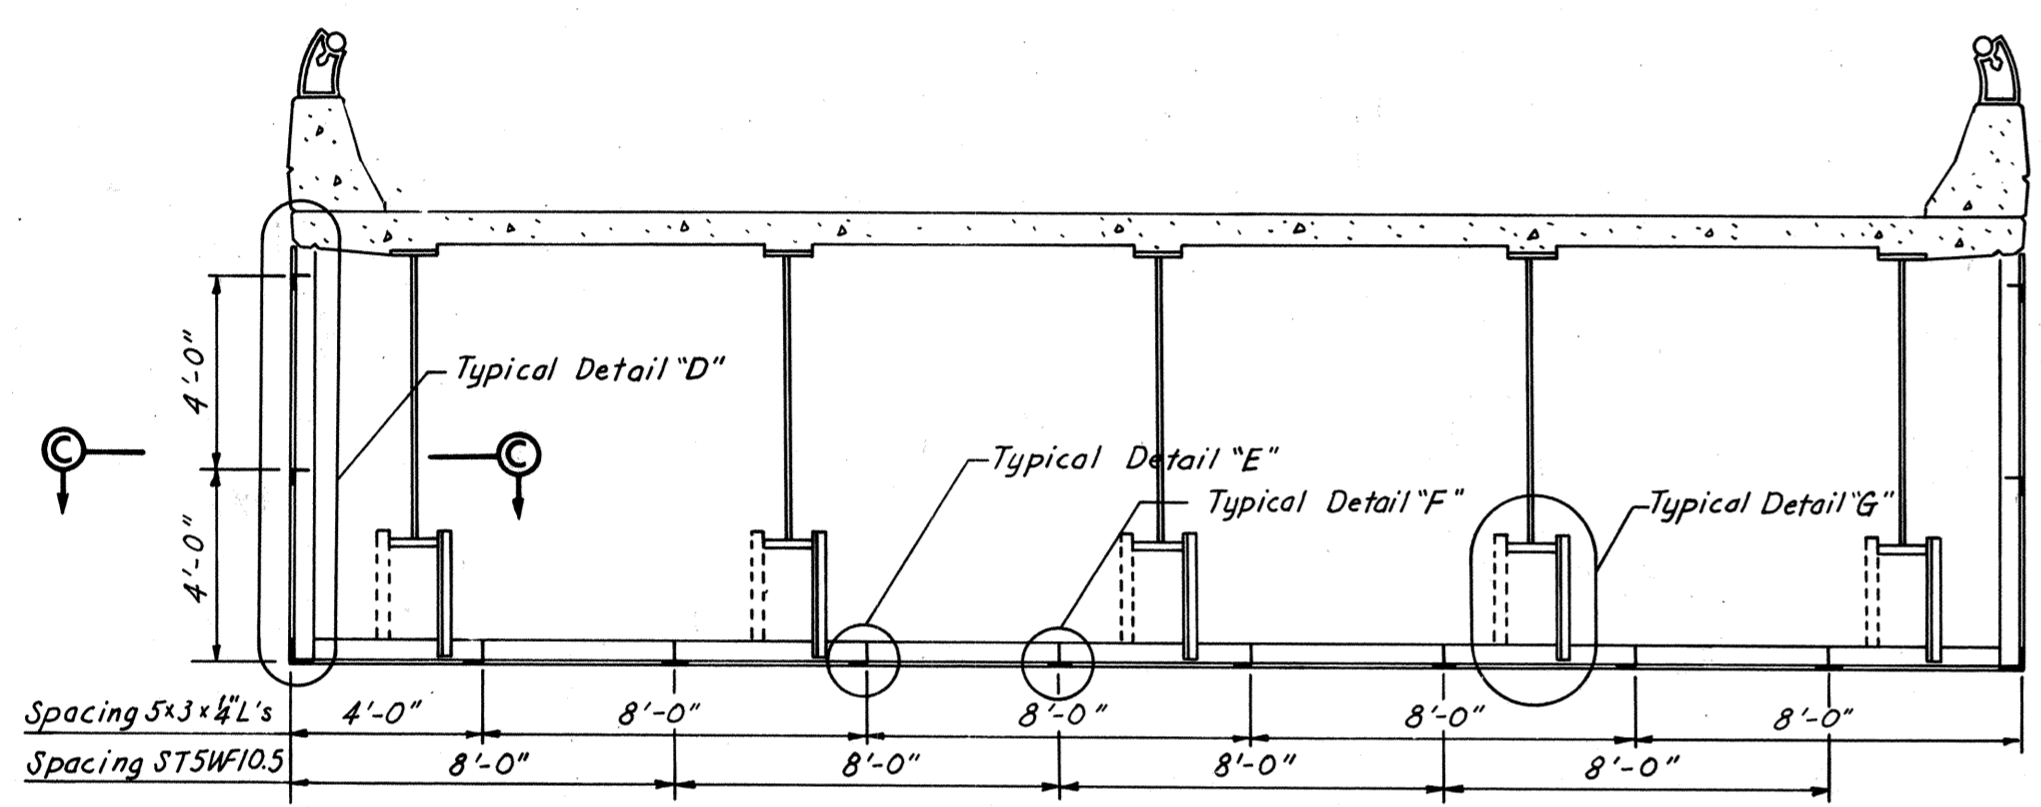


TYPICAL TRANSVERSE SECTION OF SUPPORT FRAMING

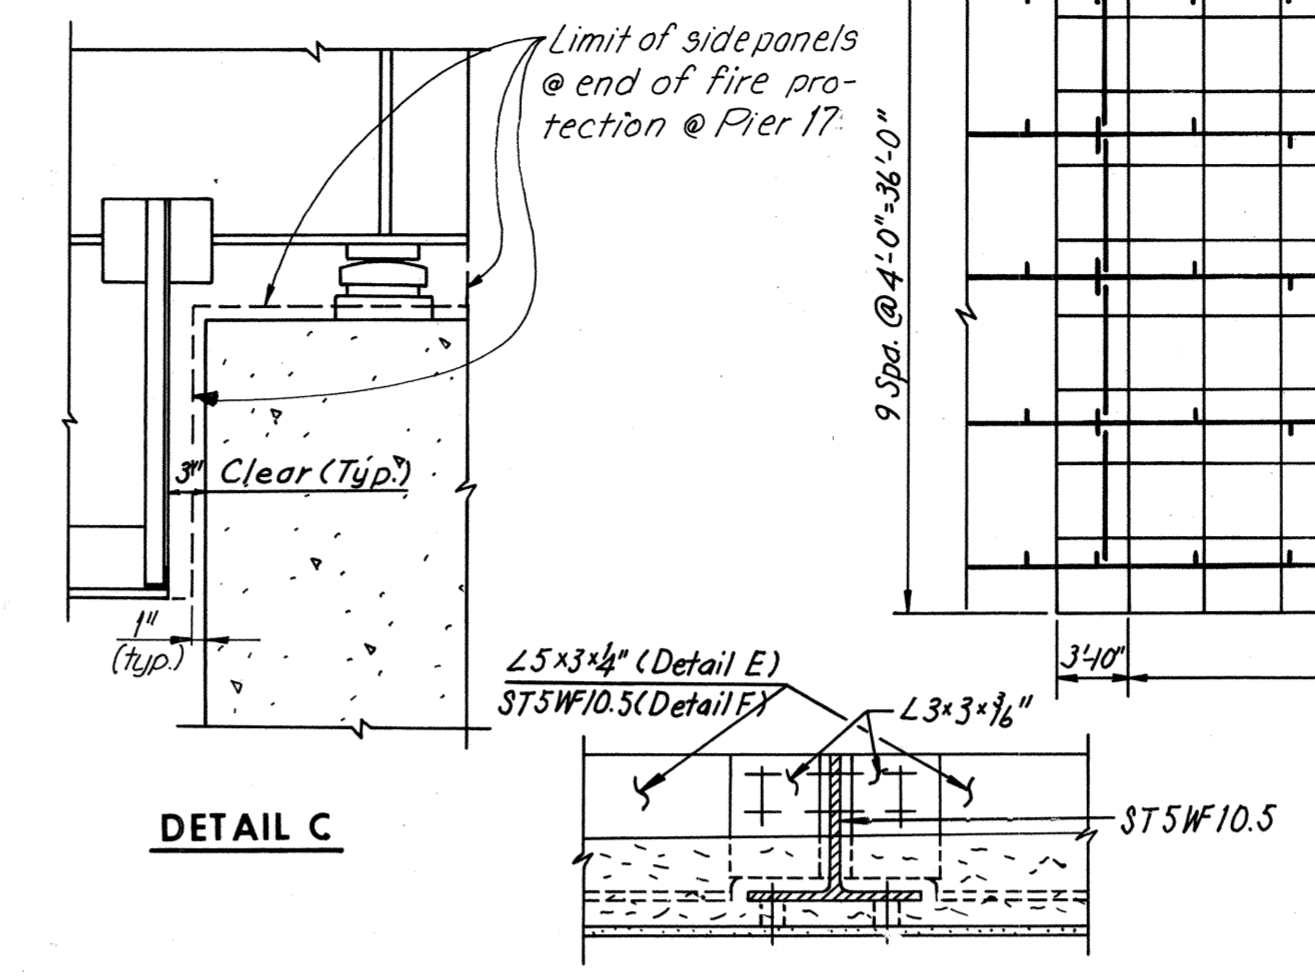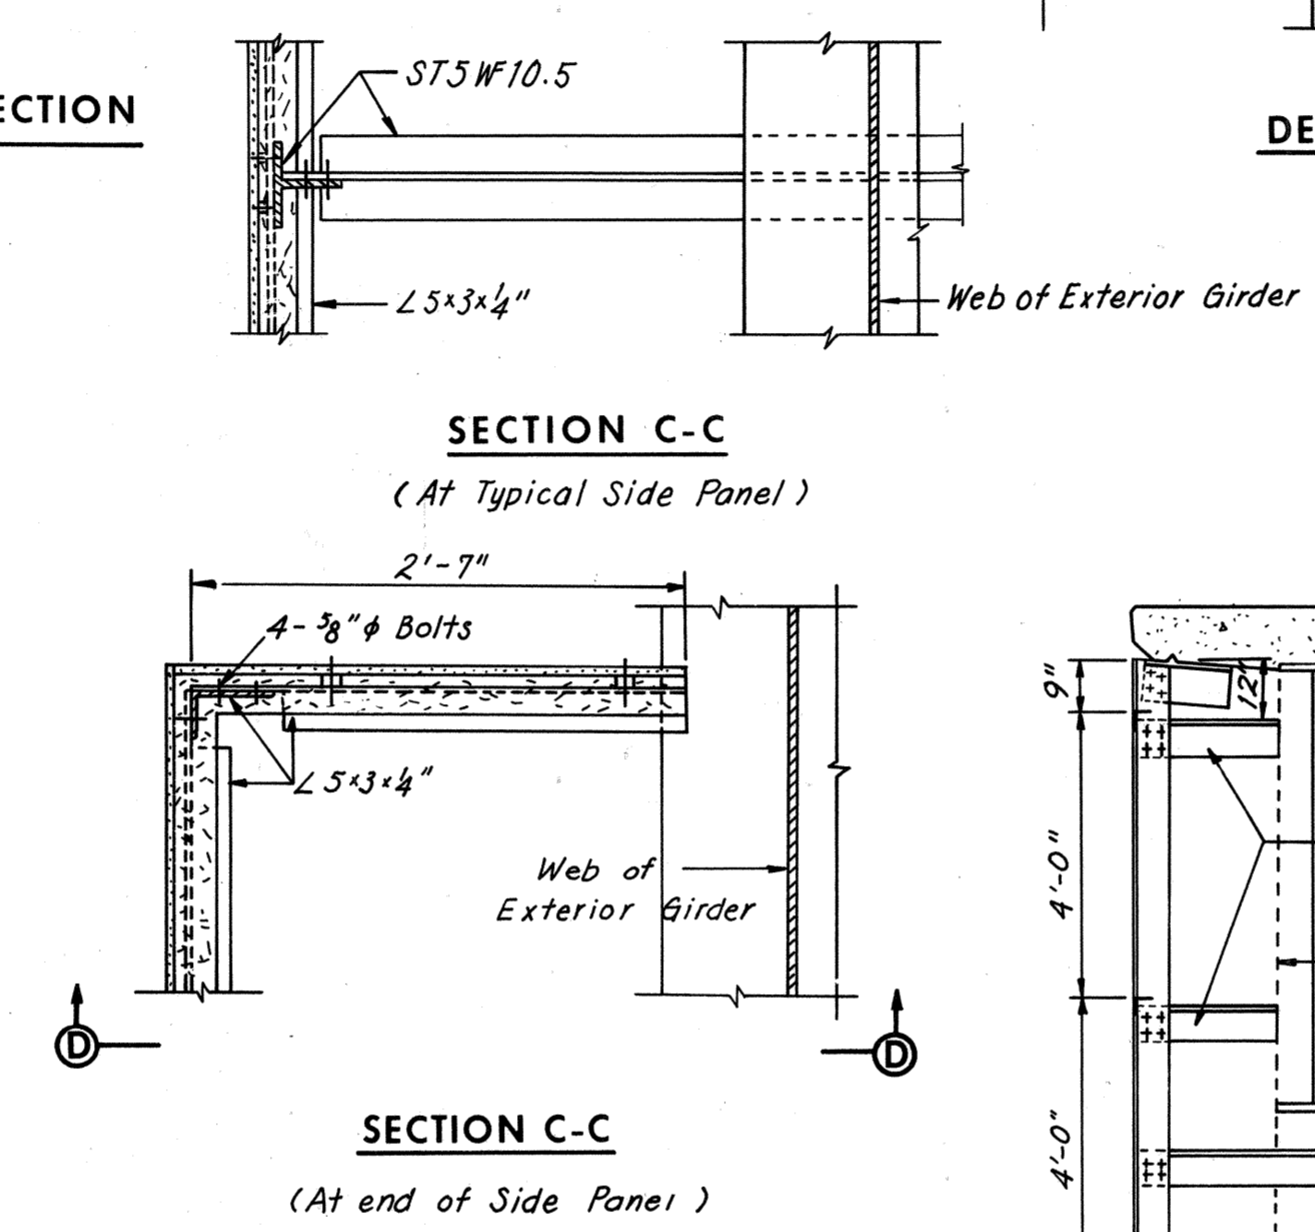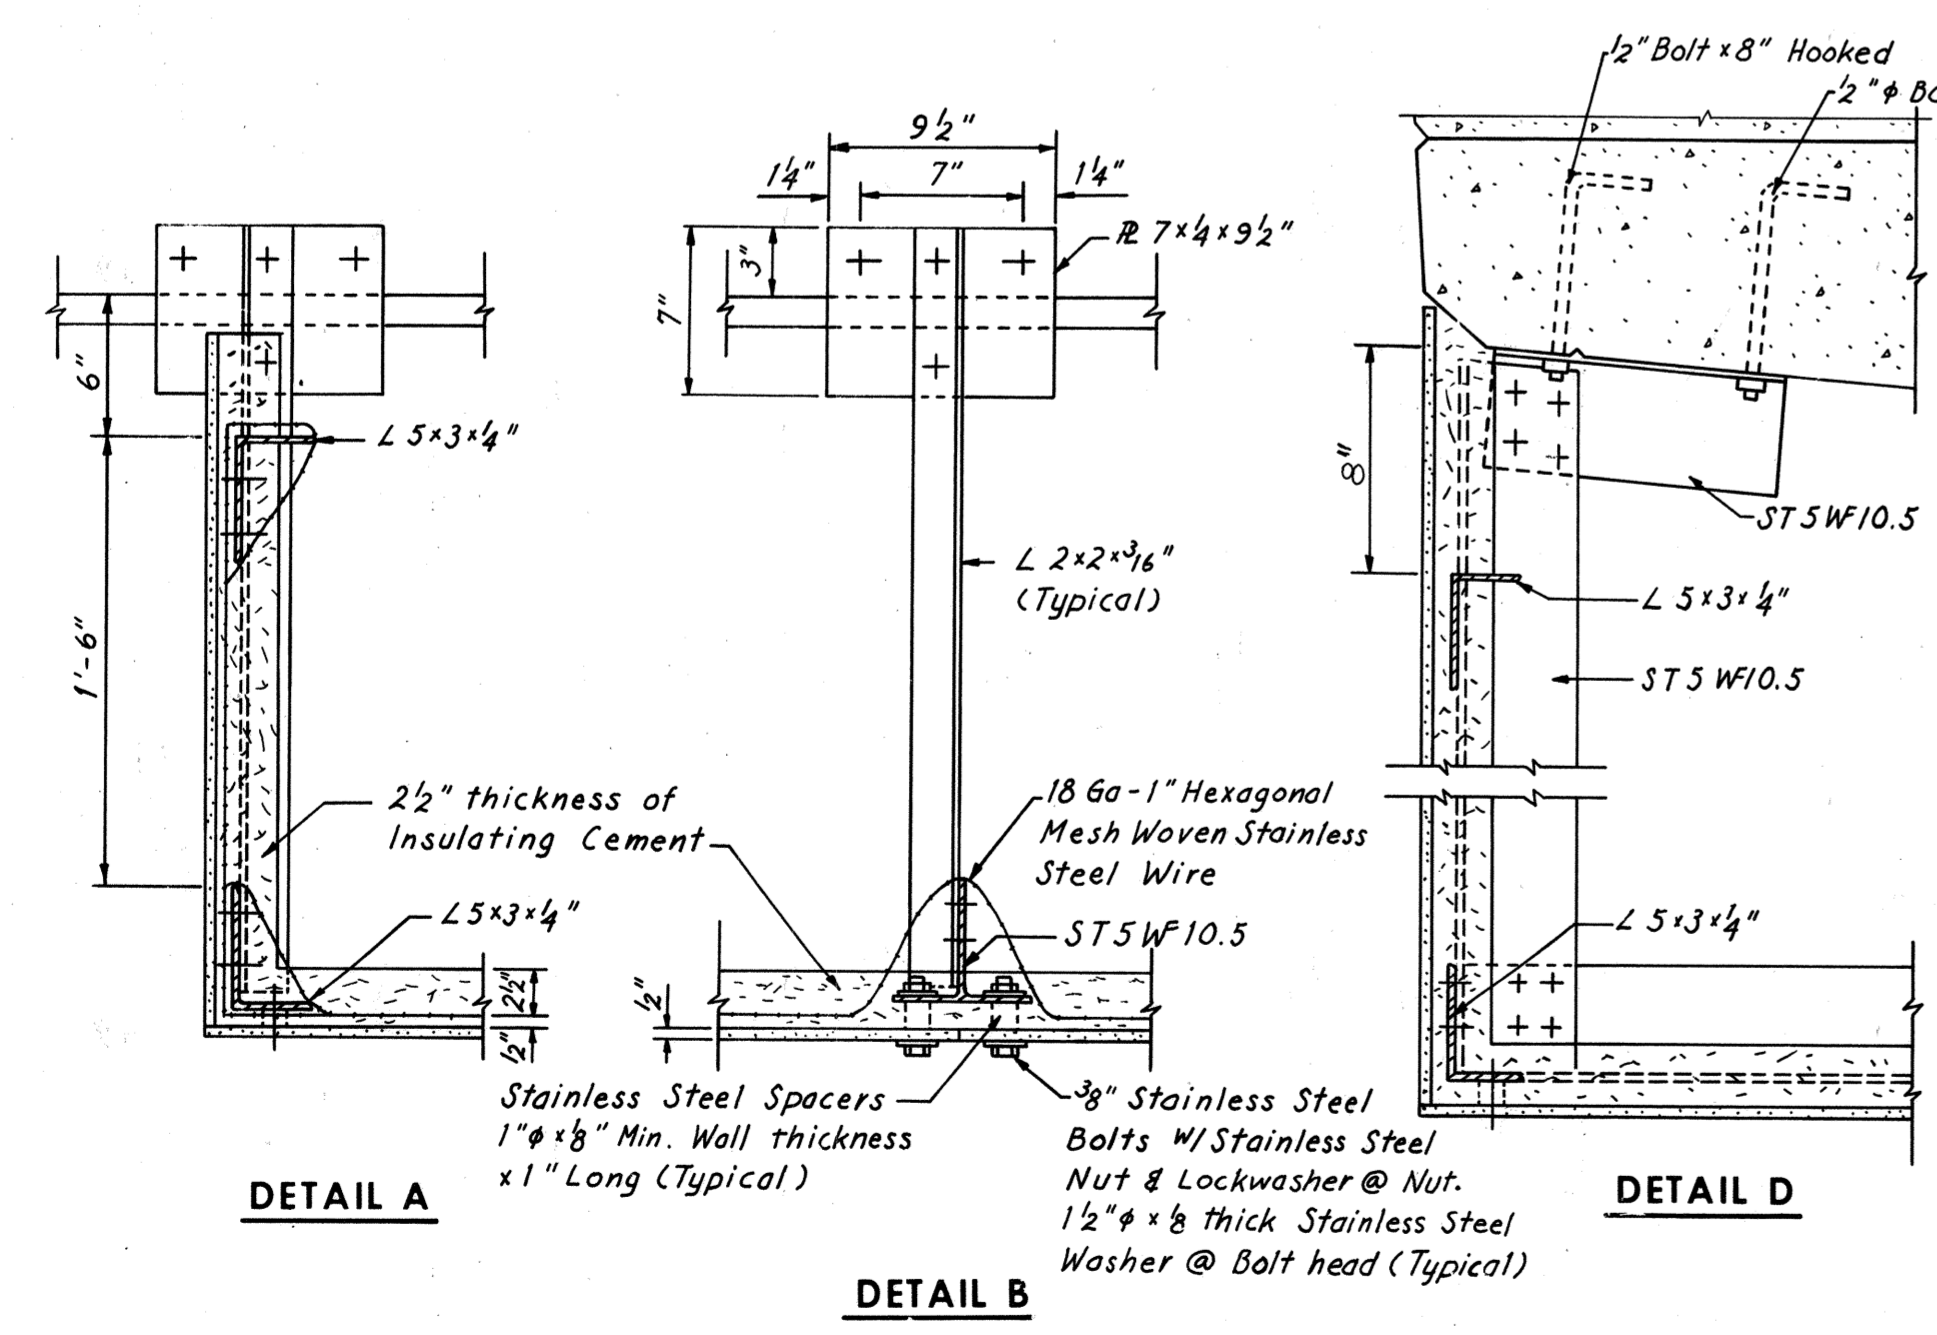


DETAIL C

SECTION A-A

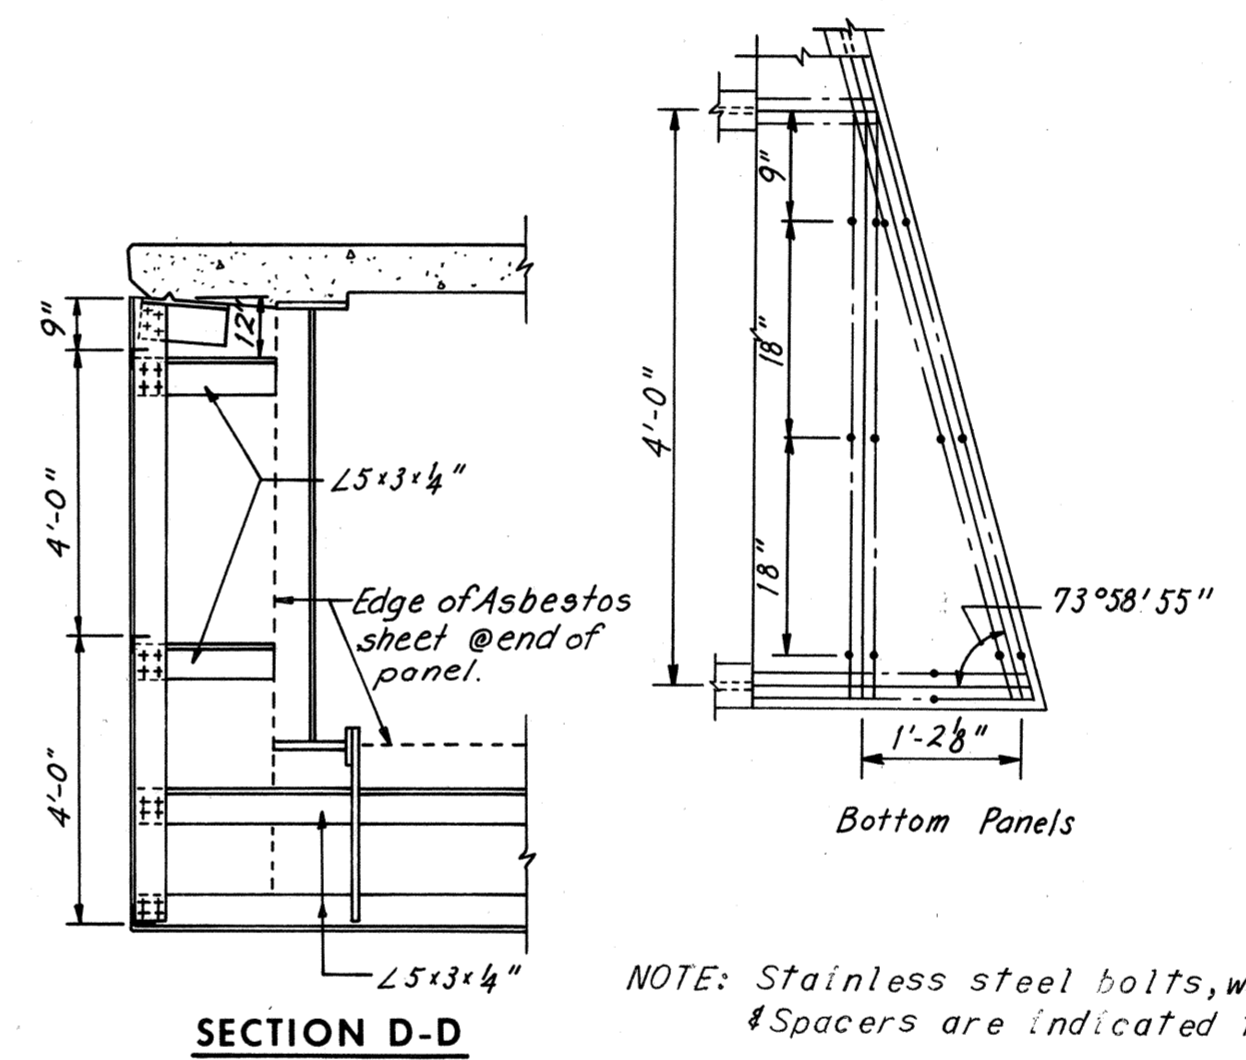


SECTION D-D

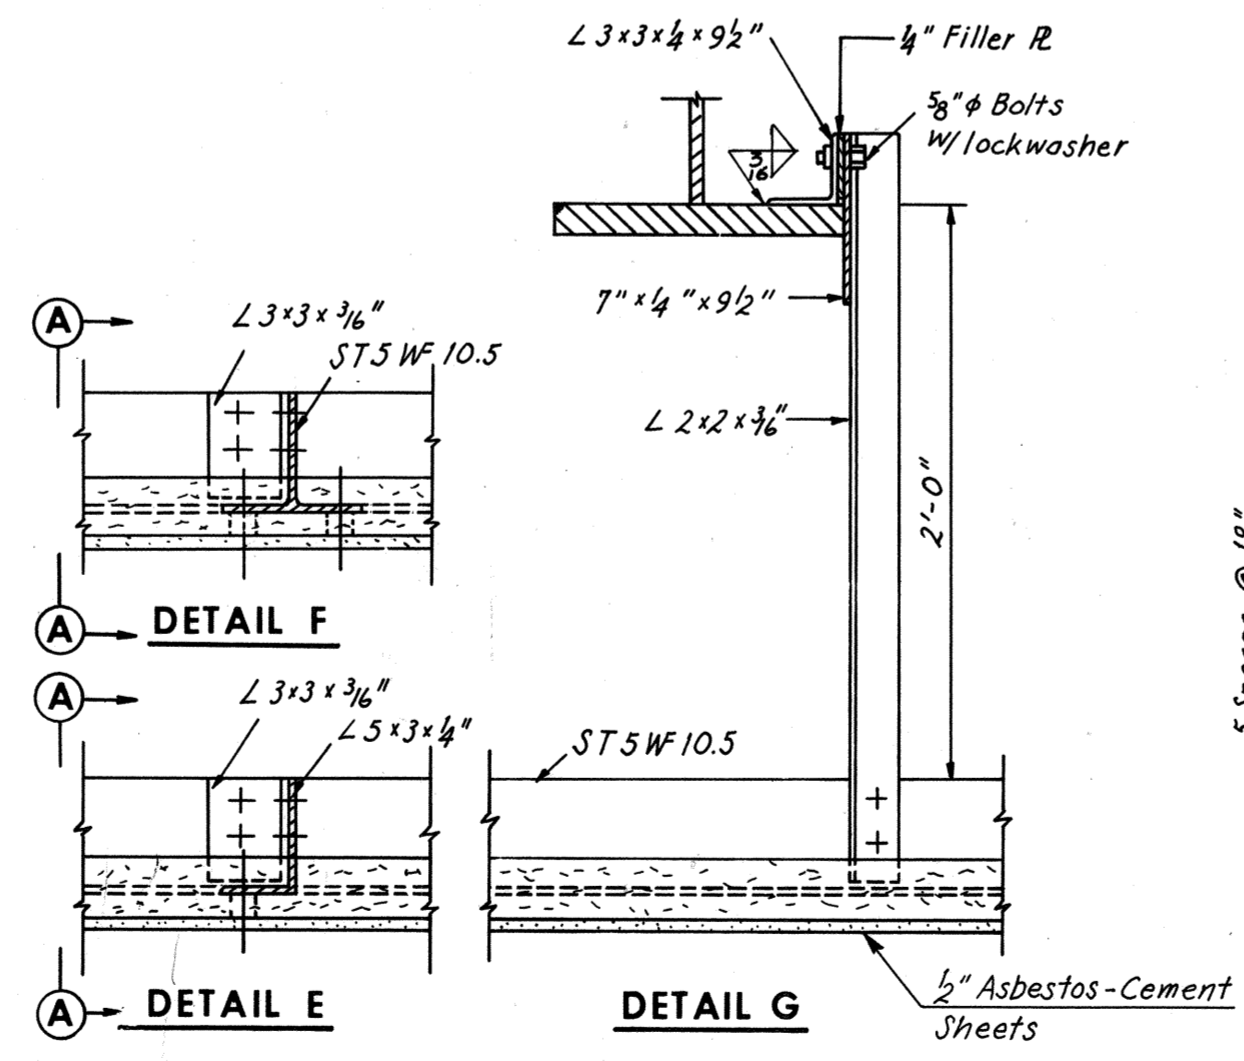


DETAIL F

DETAIL E

DETAIL G

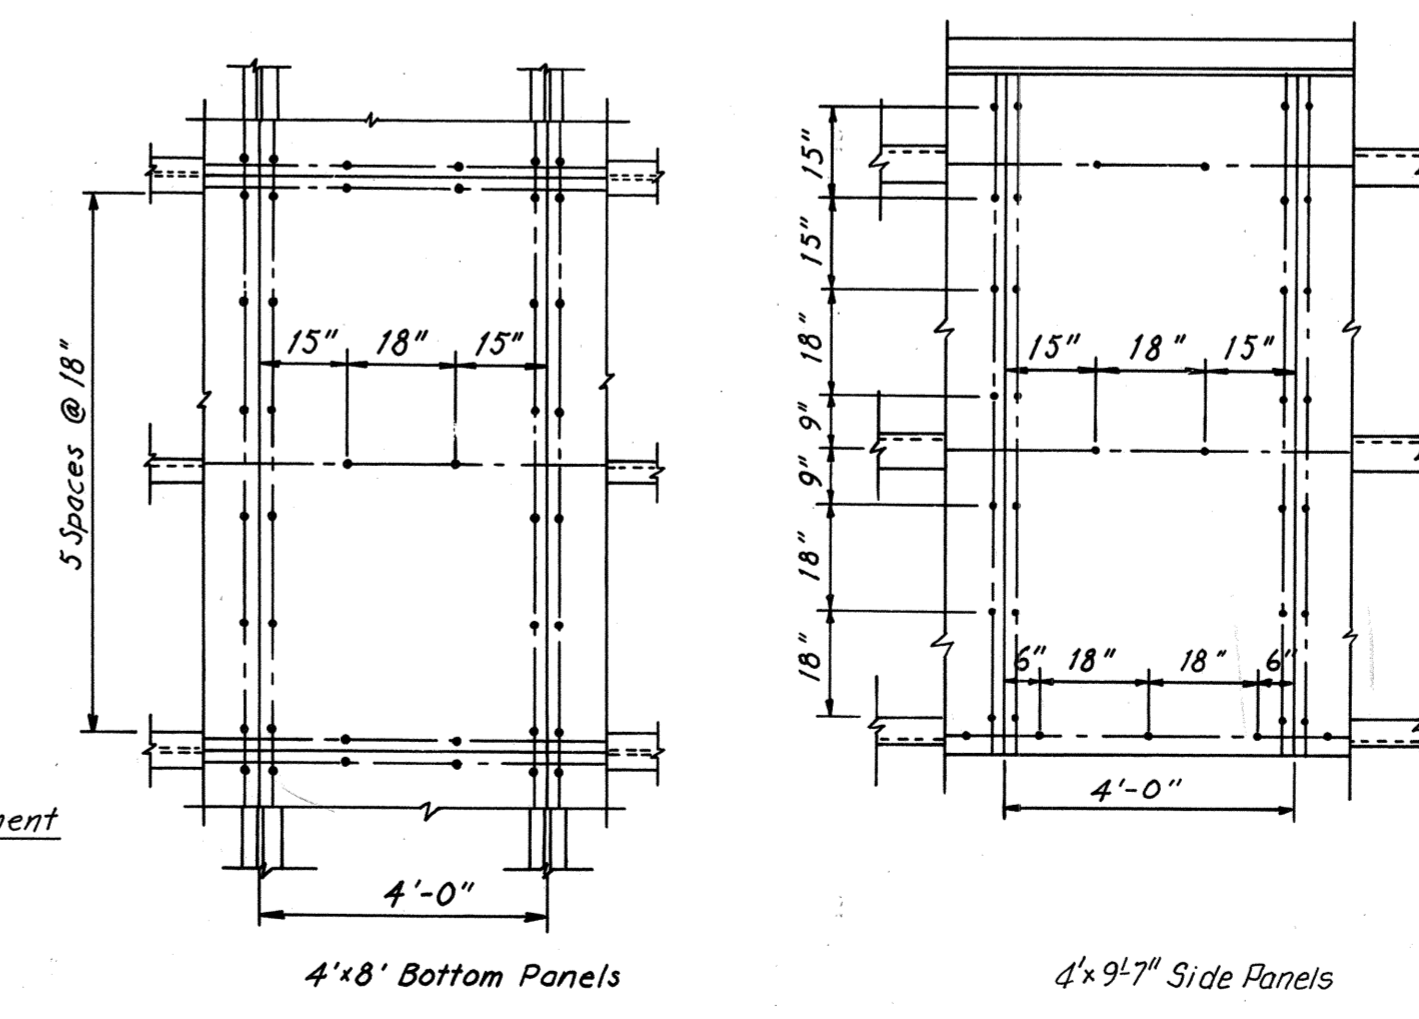

TYPICAL BOLT LAYOUTS FOR ATTACHING ASBESTOS SHEETS

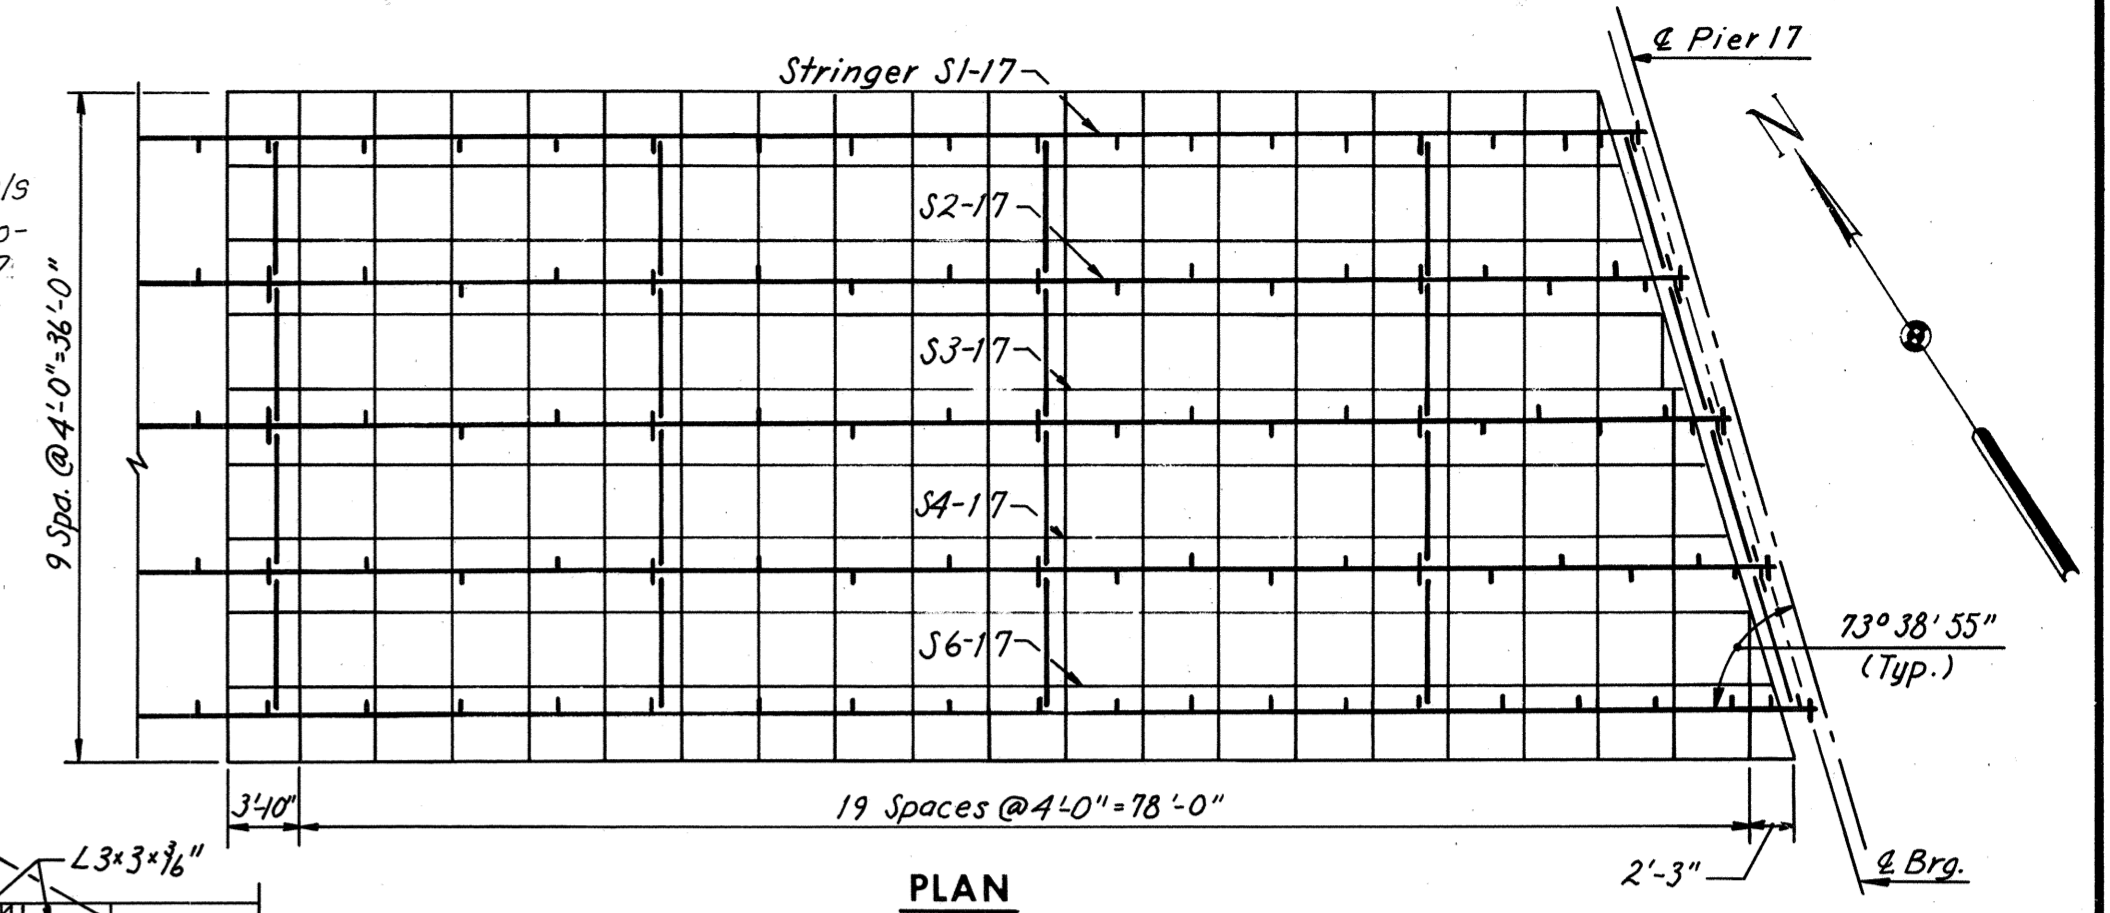

PLAN

NOTES FOR SUPPORT FRAMING

- All materials shall conform to Virginia Std. Specs. -1970
- All connections shall be made using 3/4" High strength bolts.
- All hanger connections to be field connections.
- A minimum of two bolts shall be used at all connections.
- Payment for connections shall be based on weight of bolts.
- Painting:
 - Angles welded to girders shall be painted in same manner as girders.
 - All other support framing shall receive one shop coat of red lead paint and one field coat of red lead paint.
- All support framing shall be paid for by weight as Structural Steel.

NOTES FOR INSULATION

- All exterior surfaces of support framing shall be covered by asbestos-cement sheets to the extent and in the manner indicated by the details.
- Asbestos-cement sheets shall be 1/2" thick 48" in width. Sheets shall be similar or equal to Corey Industrial A-C Board and meet the requirements of Federal Spec. SS-B-755. All sheets shall join with tight butt joint.
- 18 Ga. 1" Hexagonal Mesh Woven Stainless Steel Wire shall be placed in a continuous manner over the transverse framing members and 2" above the asbestos sheets. All ends shall be securely wired around framing members and splices at ends of rolls shall be lapped 2'-0" and be securely wired together.
- Insulating Cement shall be placed to a thickness of 2 1/2" on the inside surfaces of the asbestos sheeting as indicated by the details.
- Insulating Cement shall be similar to and equal the quality and characteristics of "Simco #55" Insulating Cement as Mfg'd. by Standard Asbestos Mfg. & Insulating Co. and shall meet requirements of Federal Spec. HH-1-523 Class 3.
- Insulating Cement shall be placed in accordance with the recommendations of the Mfg. and shall be applied to a uniform density and thickness to all surfaces of asbestos sheets.
- Basis of Payment:**
All cost of materials and labor for insulation including the woven wire and all stainless steel bolts, spacers, washers, etc., insulating cement and asbestos sheets, shall be included in the price bid per Lump Sum for Fire Protection Insulation.

**RICHMOND METROPOLITAN AUTHORITY
RICHMOND EXPRESSWAY SYSTEM
DOWNTOWN EXPRESSWAY**


**BRIDGE NO. 63
WESTBOUND ROADWAY OVER
12TH ST. - R.R. TRACKS AND 16TH ST.
FIRE PROTECTION DETAILS**

HOWARD, NEEDLES, TAMMEN & BERGENDOFF
consulting engineers
NEW YORK ALEXANDRIA KANSAS CITY









AS BUILT

BY	DATE	NO.	REVISION	BY	DATE
Y.C.P.	11-25-68				
J.D.	4-18-69	1	As Built	TEM	10-76

SCALE: *No Scale*
CONTRACT NO.: 10
SHEET NO. 23 OF 29

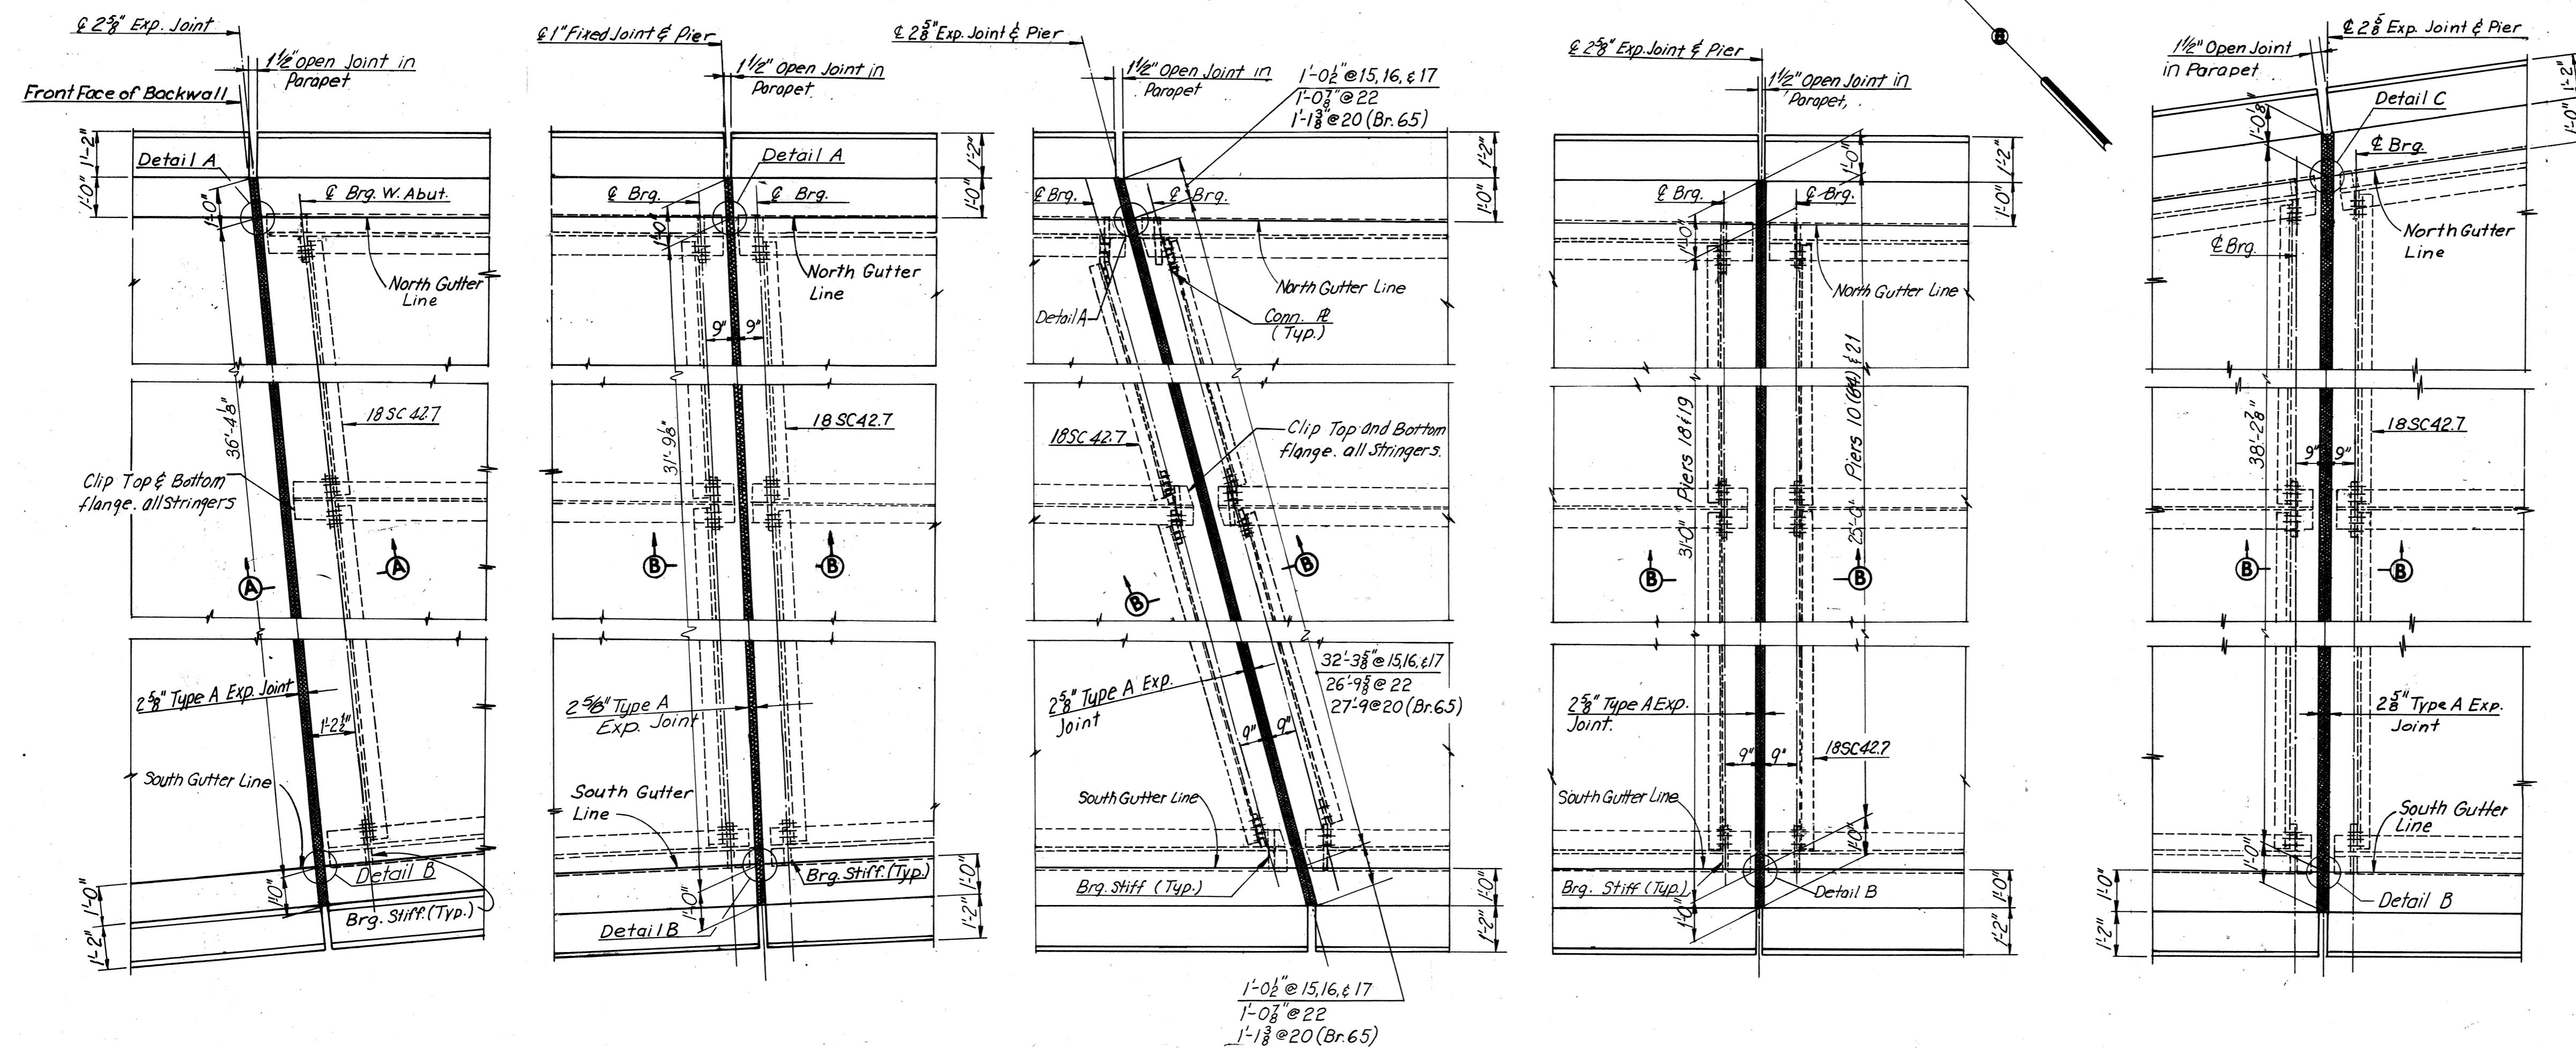

PLAN — JOINT AT WEST ABUTMENT Scale: $\frac{3}{8}'' = 1'-0''$
PLAN — JOINT AT PIER 14 Scale: $\frac{3}{8}'' = 1'-0''$
PLAN — JOINT AT PIERS 15, 16, 17, 22 AND 20 (BR. 65) Scale: $\frac{3}{8}'' = 1'-0''$
PLAN — JOINT AT PIERS 18, 19, 21 AND 10 (BR. 64) Scale: $\frac{3}{8}'' = 1'-0''$
PLAN — JOINT AT PIER 20 Scale: $\frac{3}{8}'' = 1'-0''$

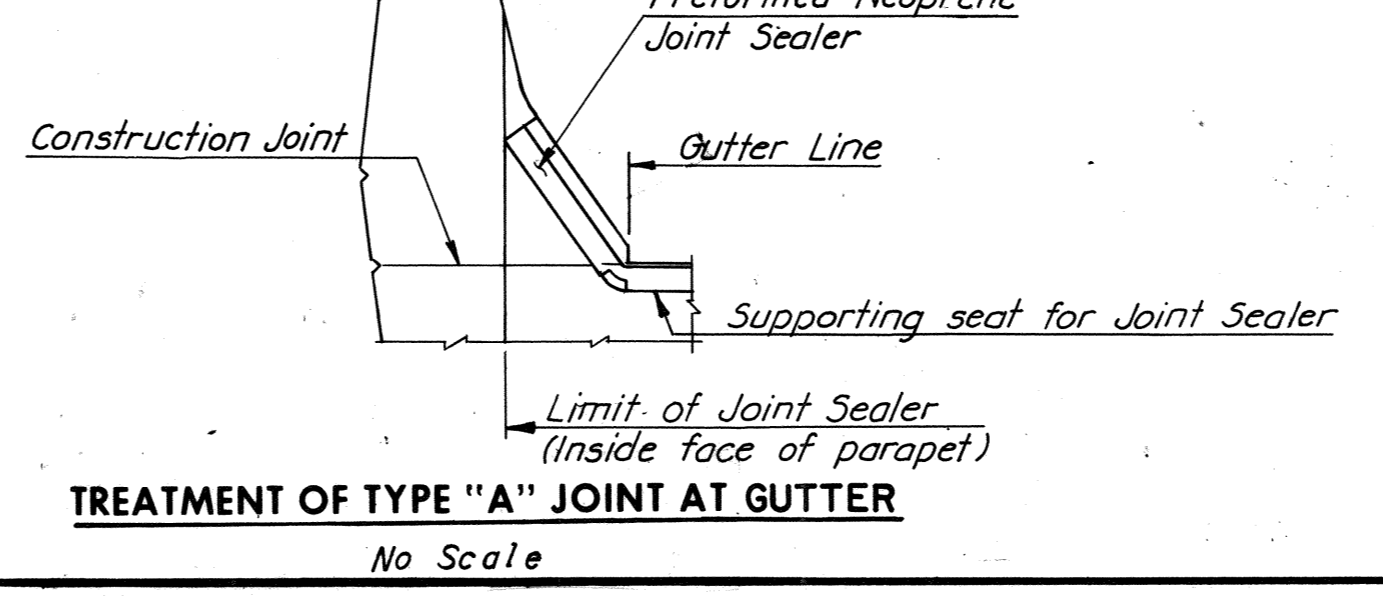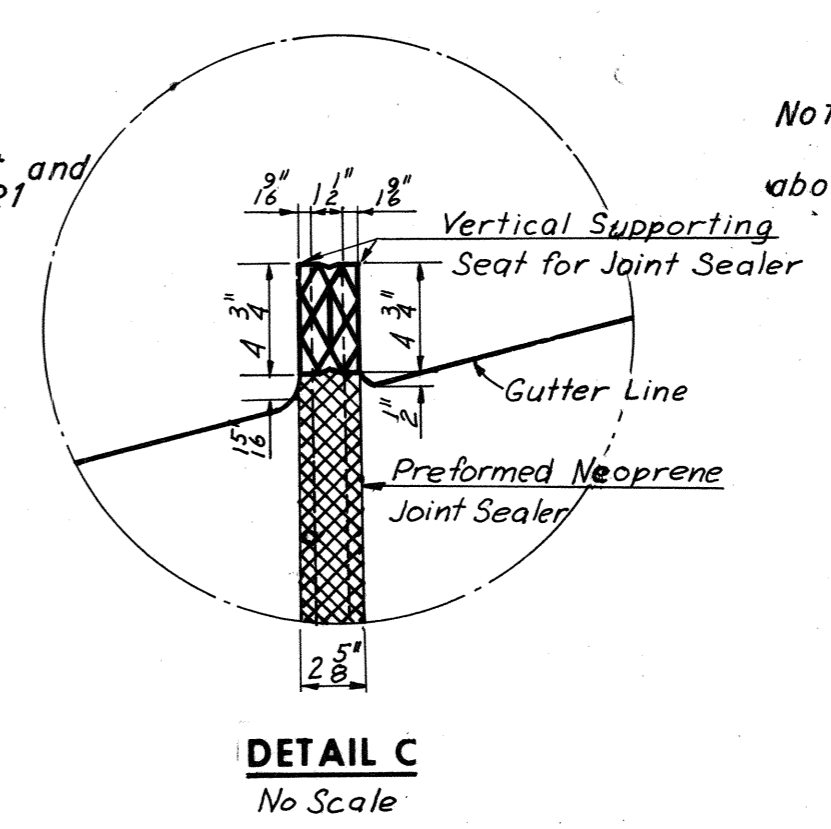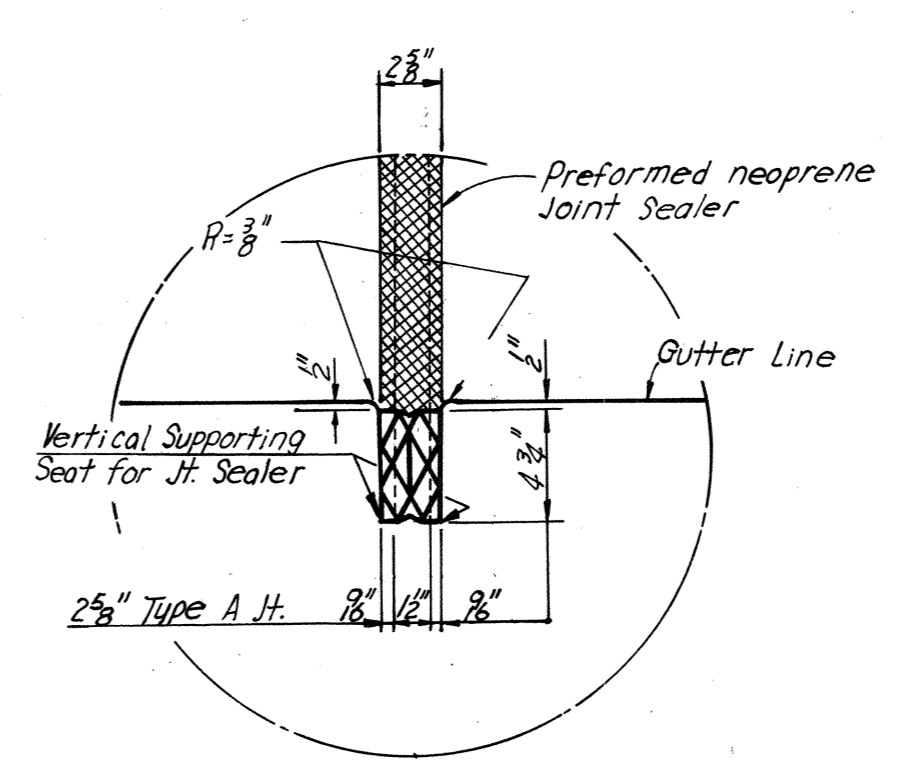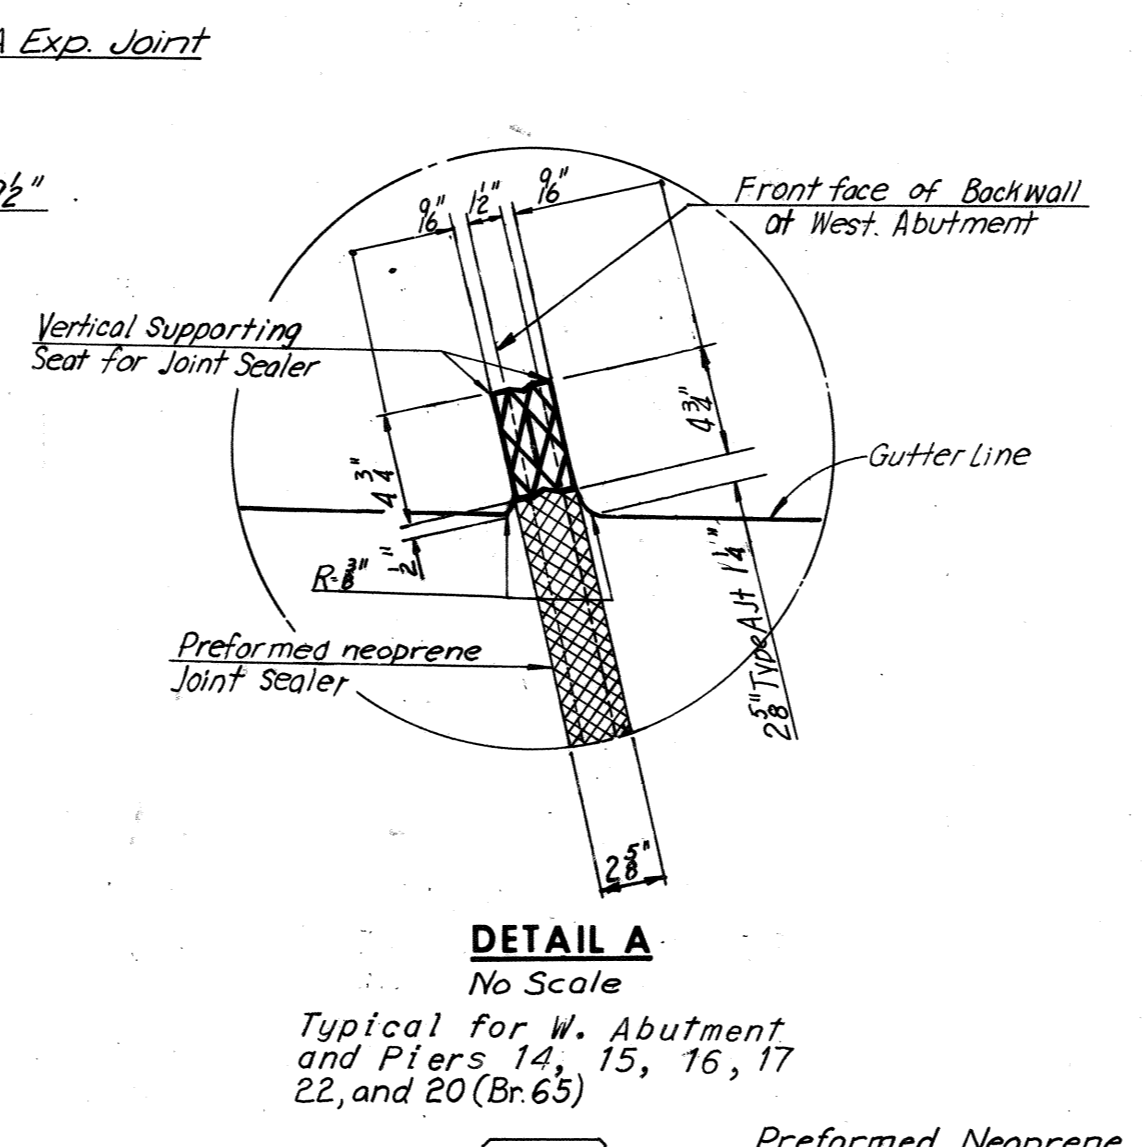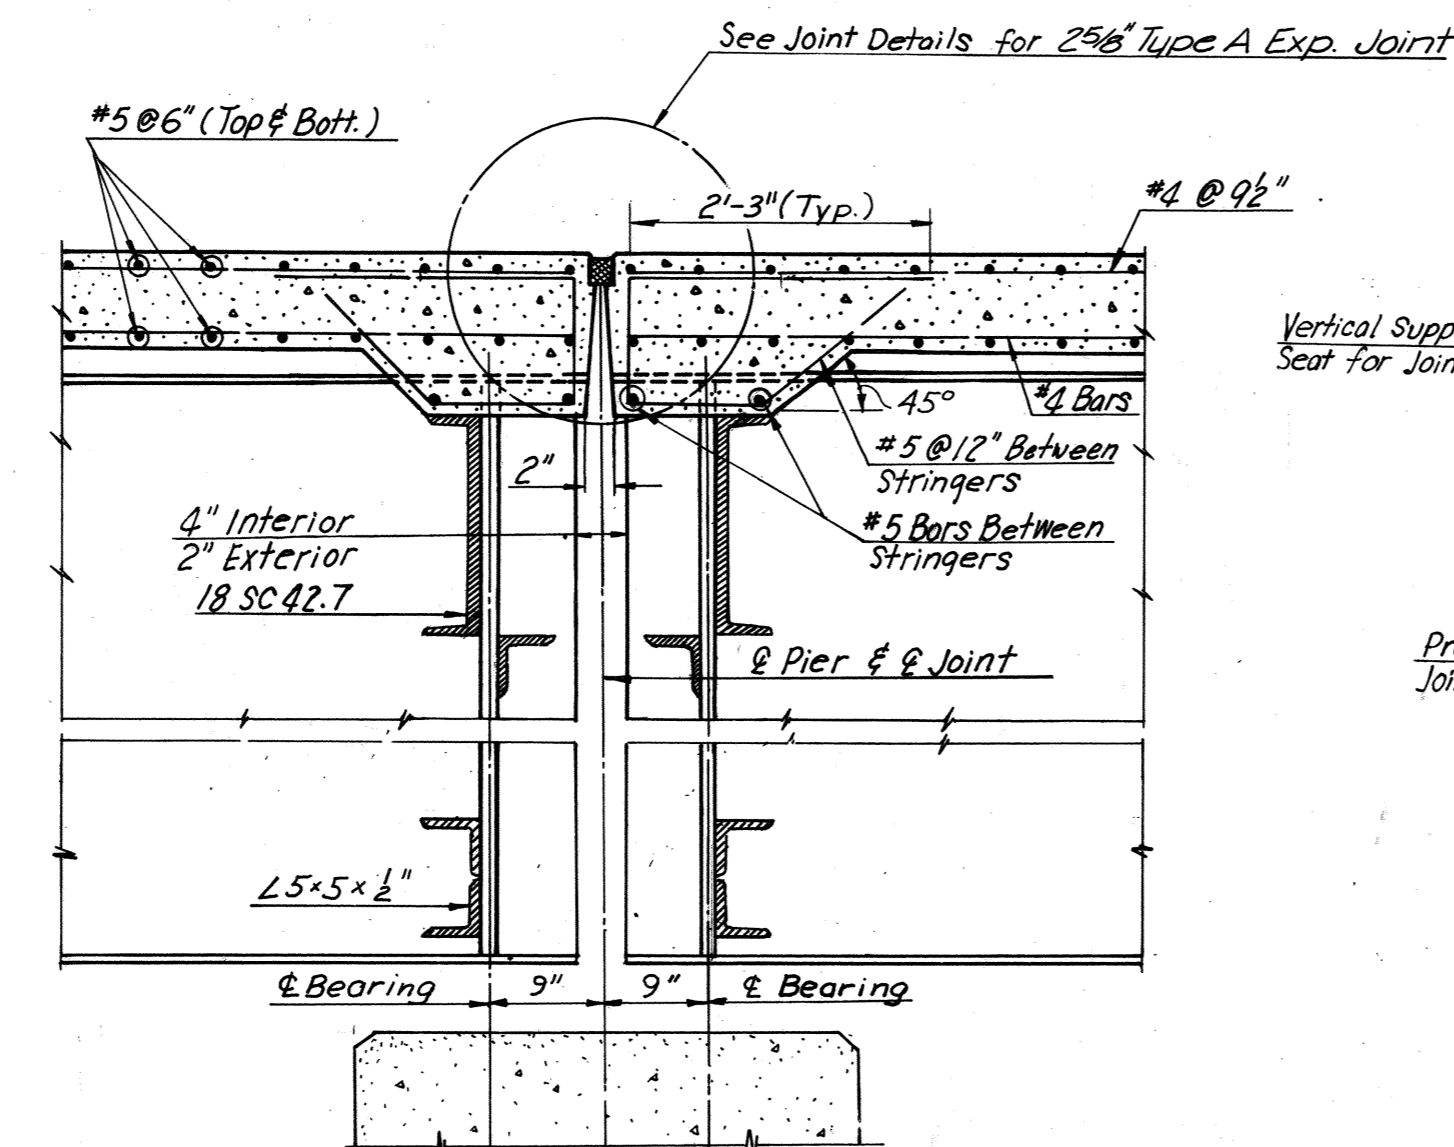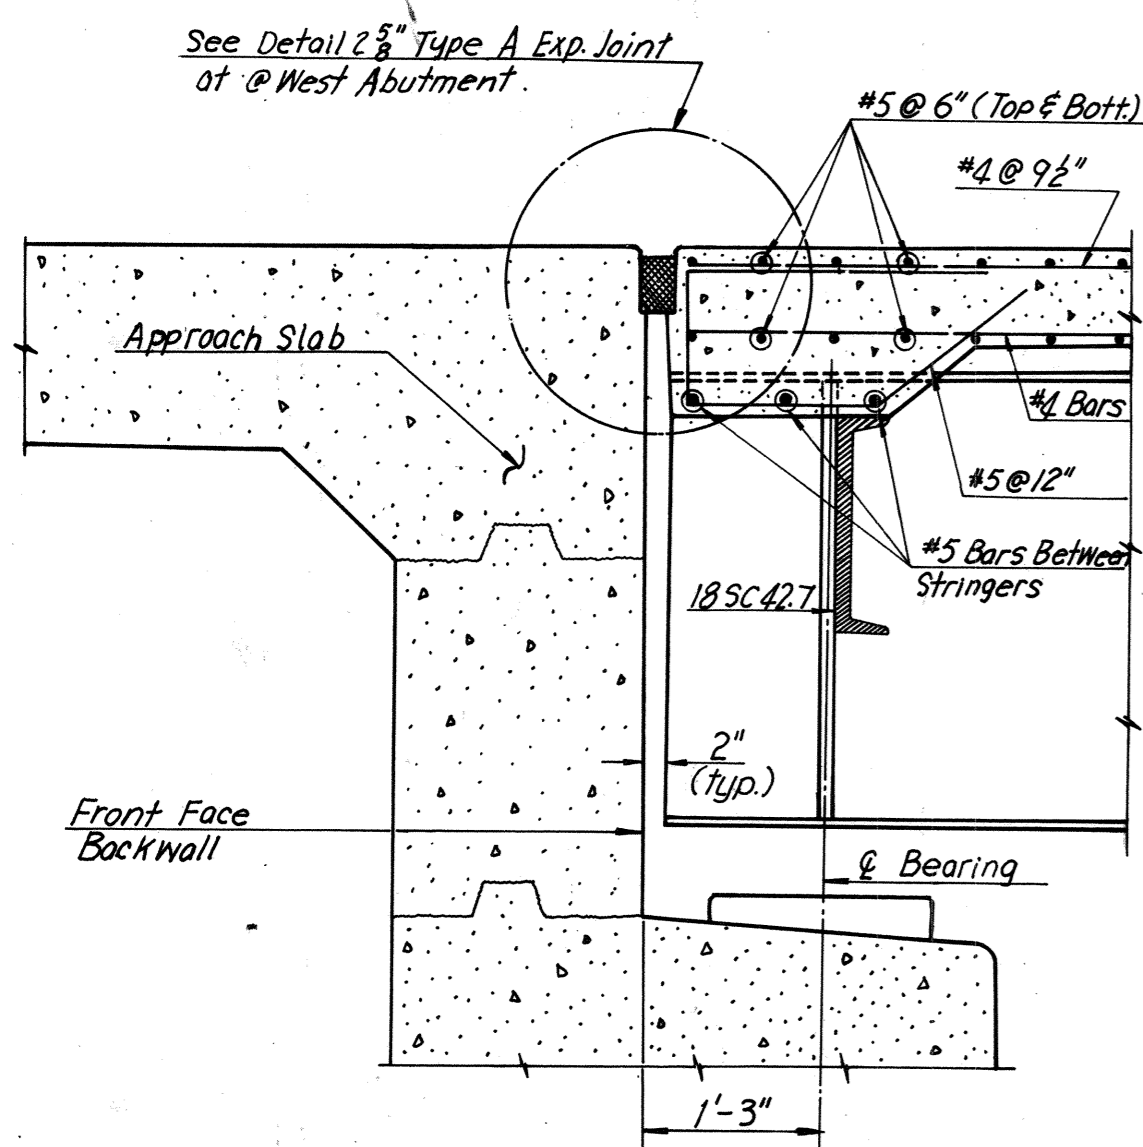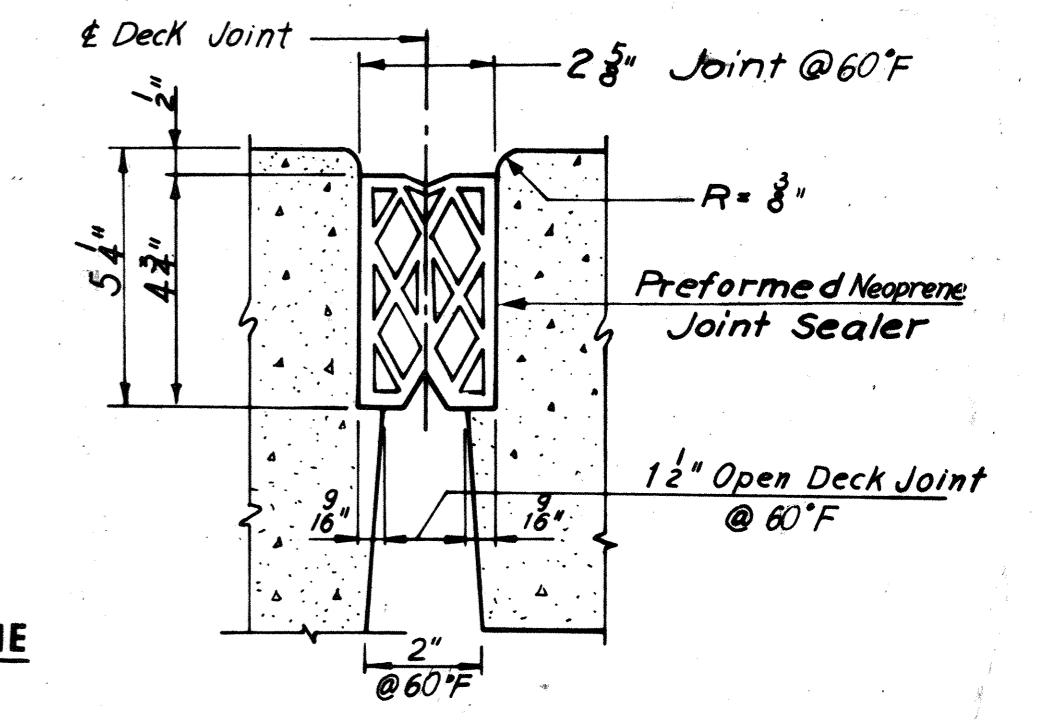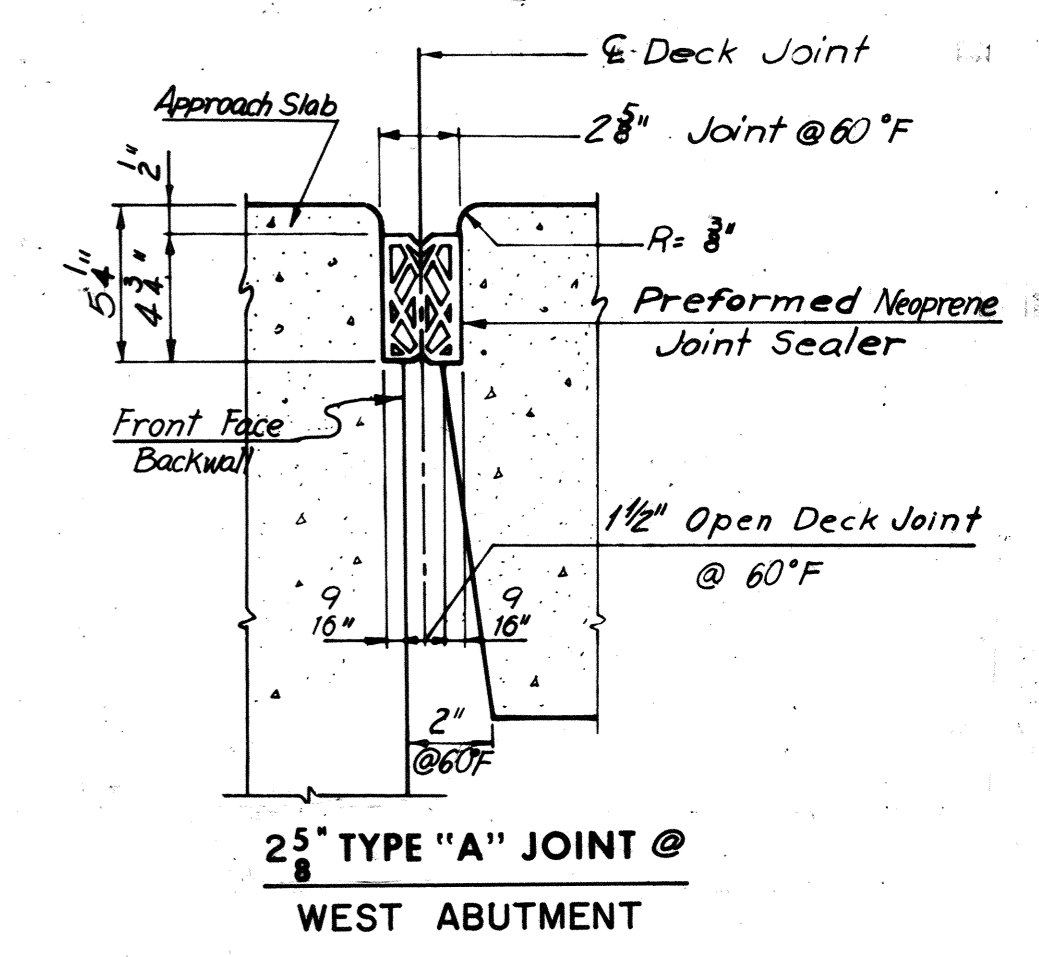

PREFORMED NEOPRENE JOINT SEALER FOR 2 1/2" TYPE "A" JOINT

EXPANSION JOINTS No Scale

Note: All horizontal dimensions shown above are normal to \bar{c} joint.

Note: All horizontal dimensions of Sections shown above are normal to \bar{c} joint.

Note: It is absolutely essential that the openings for the preformed neoprene joint sealers be accurately formed and constructed to smooth, straight lines. The size of opening shall be adjusted to allow for anticipated dead load rotation of the ends of the slab and for the temperature at the time of construction.

BY	DATE				
MADE	GSH	10-1-68			
CHECKED	J.D.	11-19-68	1	As Built	TEM 10-76
IN CHARGE			NO.	REVISION	BY DATE

RICHMOND METROPOLITAN AUTHORITY
RICHMOND EXPRESSWAY SYSTEM
DOWNTOWN EXPRESSWAY


BRIDGE NO. 63
WESTBOUND ROADWAY OVER
12TH ST. - R.R. TRACKS AND 16TH ST.

JOINT DETAILS

SCALE: As Noted
 HOWARD, NEEDLES, TAMMEN & BERGENDOFF consulting engineers
 NEW YORK ALEXANDRIA KANSAS CITY
 CONTRACT NO. 10
 SHEET NO. 24 OF 29


AS BUILT

RICHMOND EXPRESSWAY SYSTEM			
SECTION	PROJECT	SHEET NO.	TOTAL SHEETS
10	DOWNTOWN EXPRESSWAY	94	265

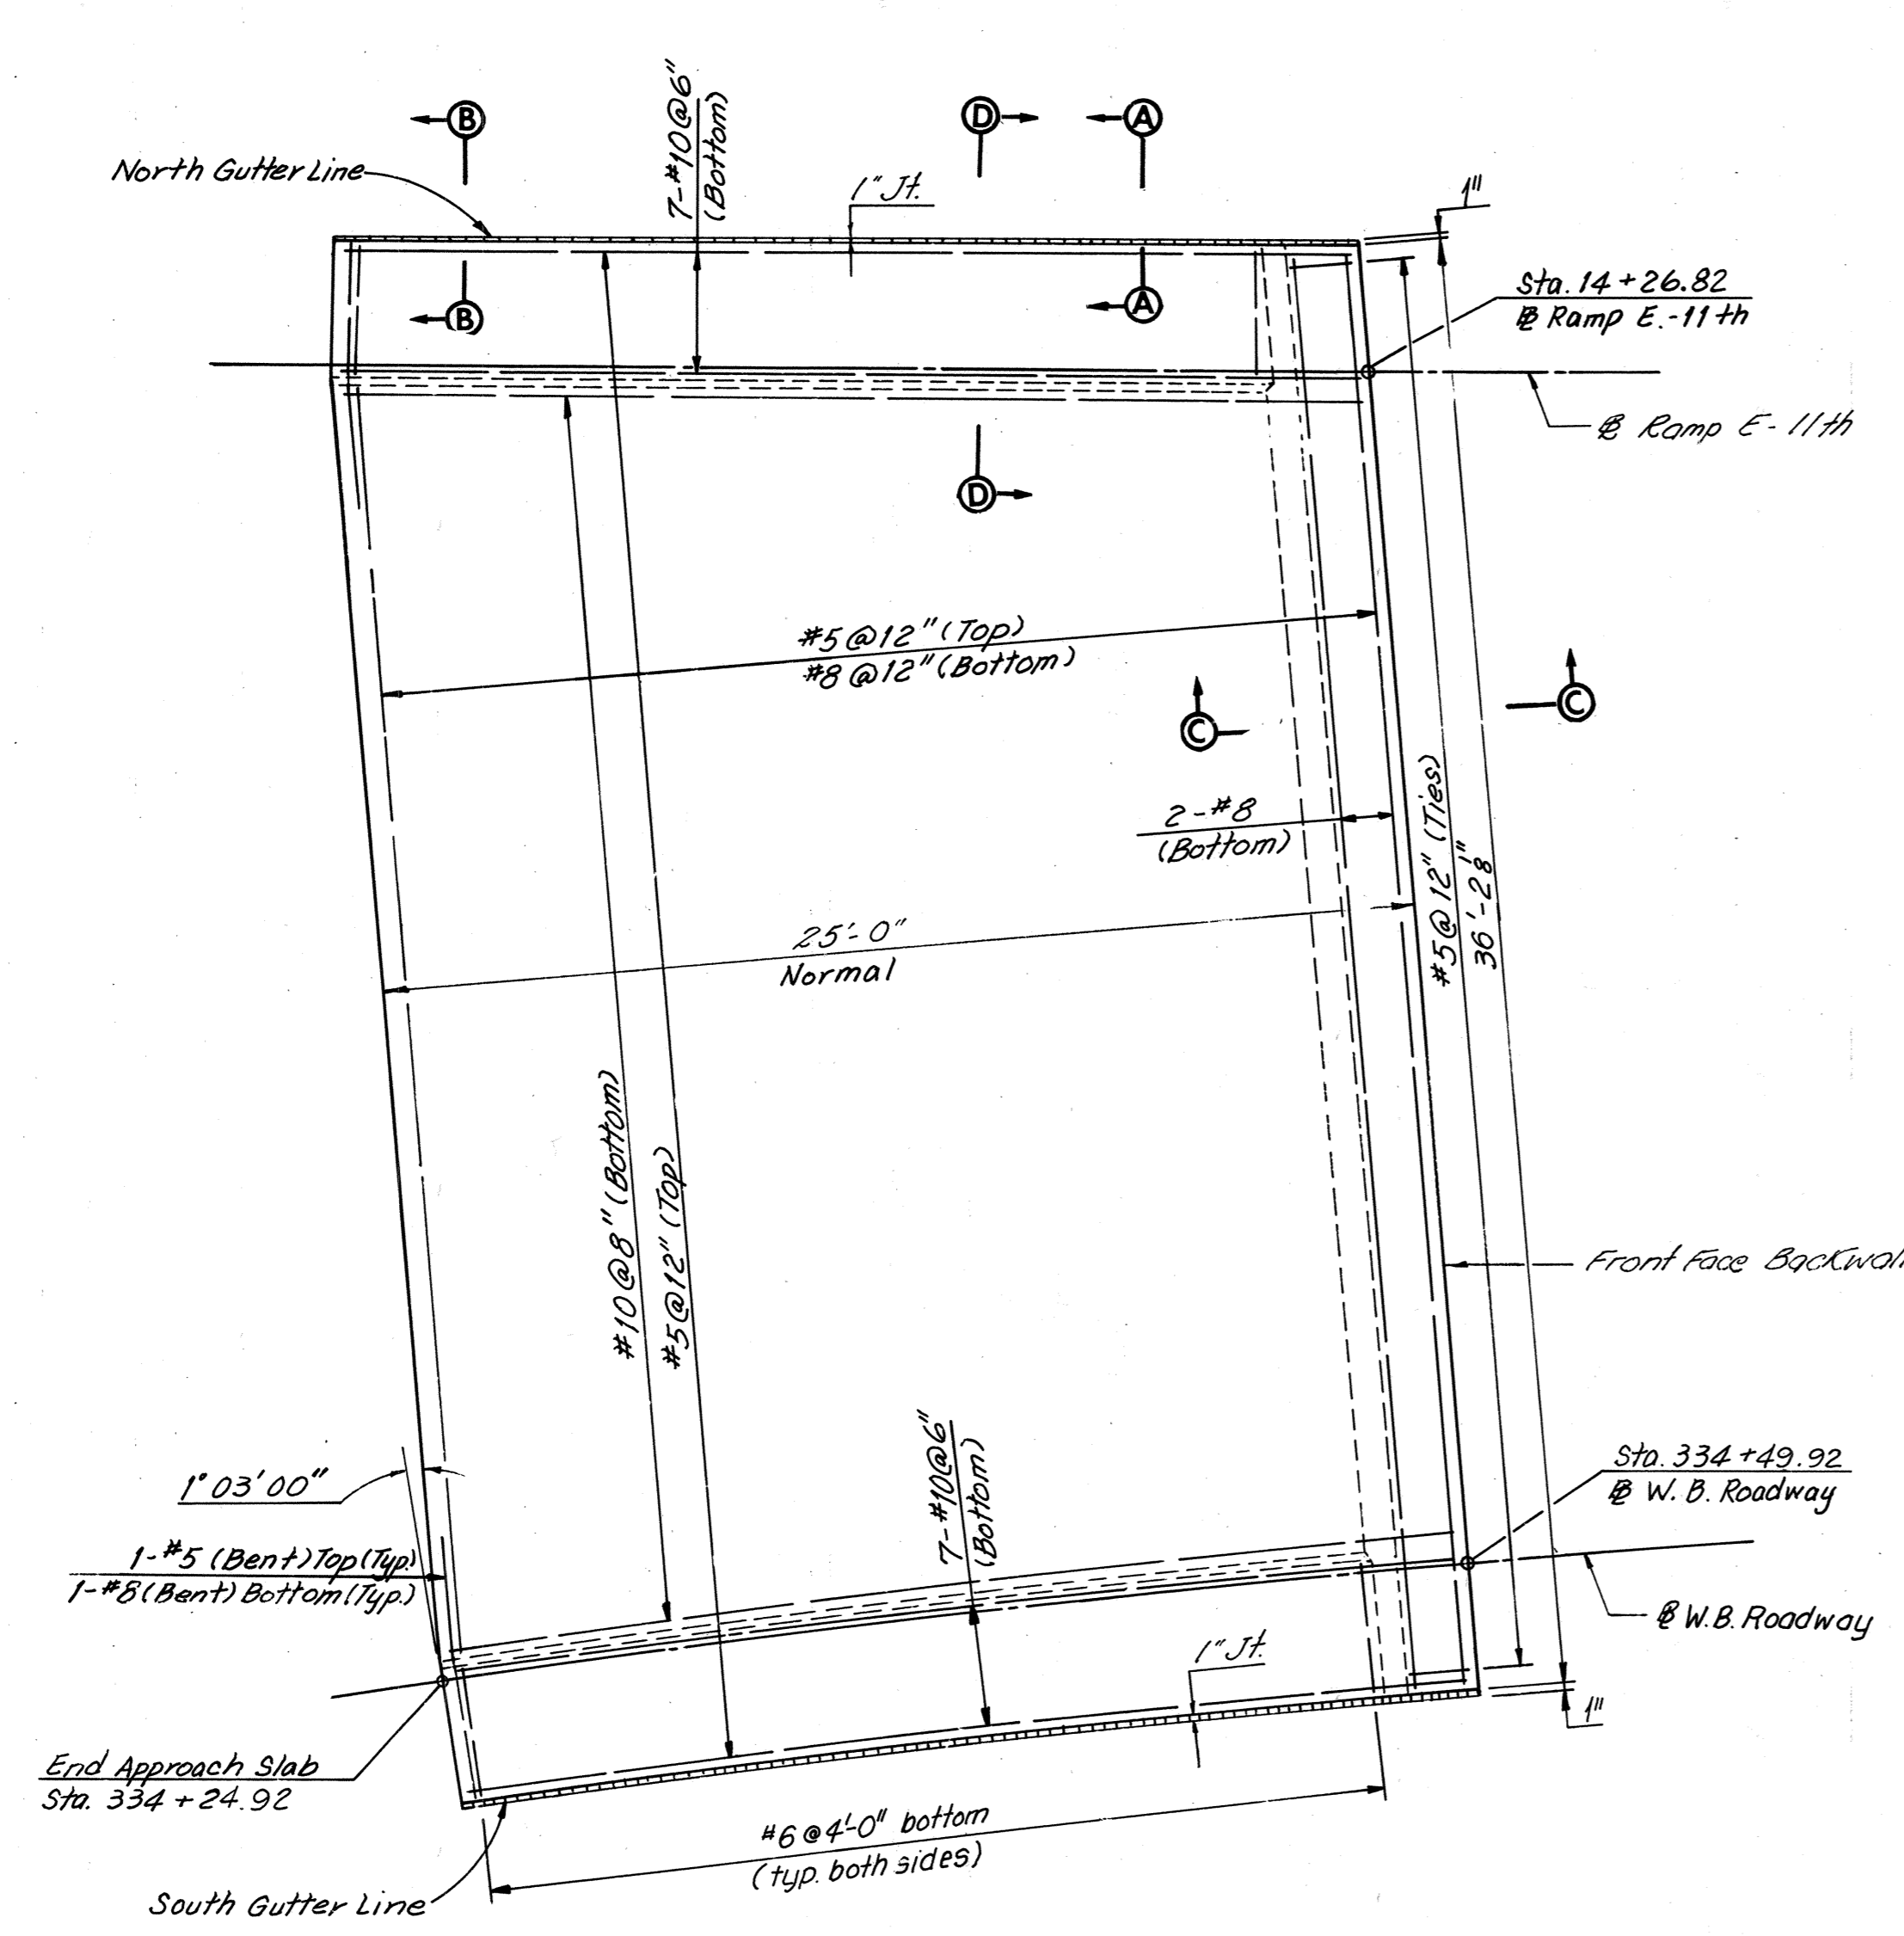


WEST ABUTMENT APPROACH SLAB
Scale: 1/4" = 1'-0"

Note: All reinforcing bars shall be minimum 2" clear at exposed face of concrete.

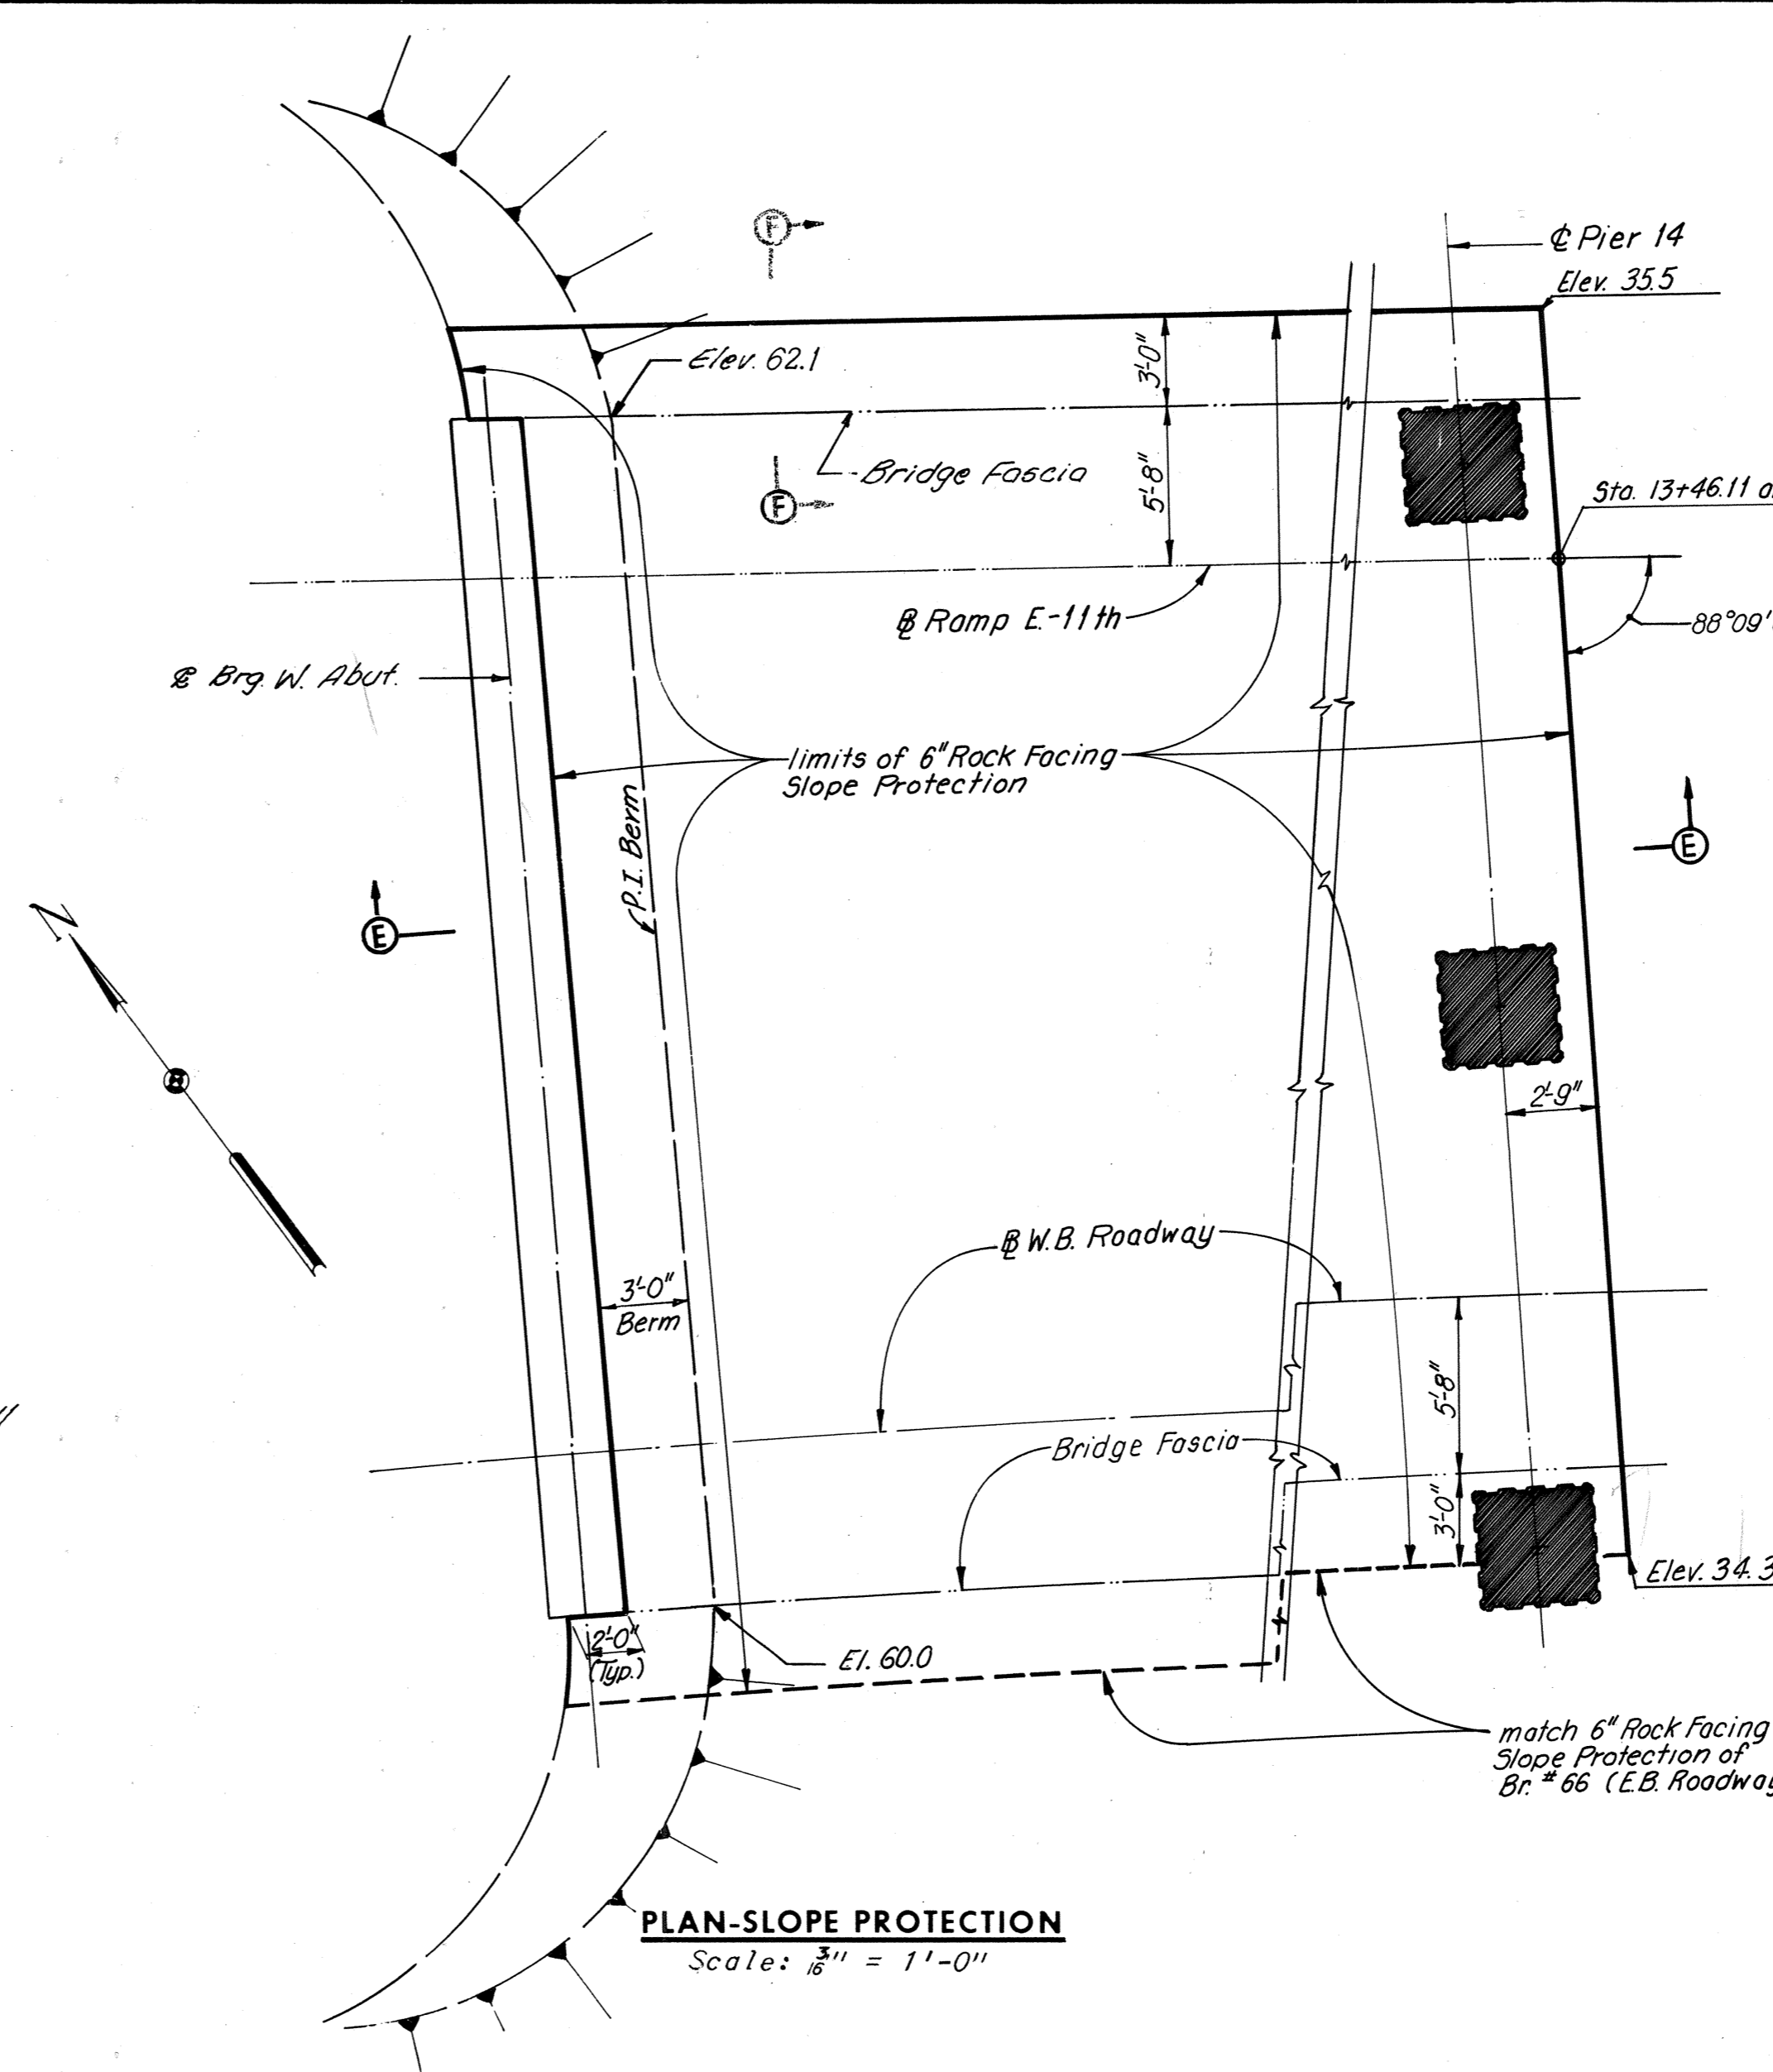


PLAN-SLOPE PROTECTION
Scale: 3/8" = 1'-0"


Note: For limits of Slope Protection, see General Plan, Sheet 1.
For West Abutment, see Sheet 3.
For Abutment Details, see Sheet 4.

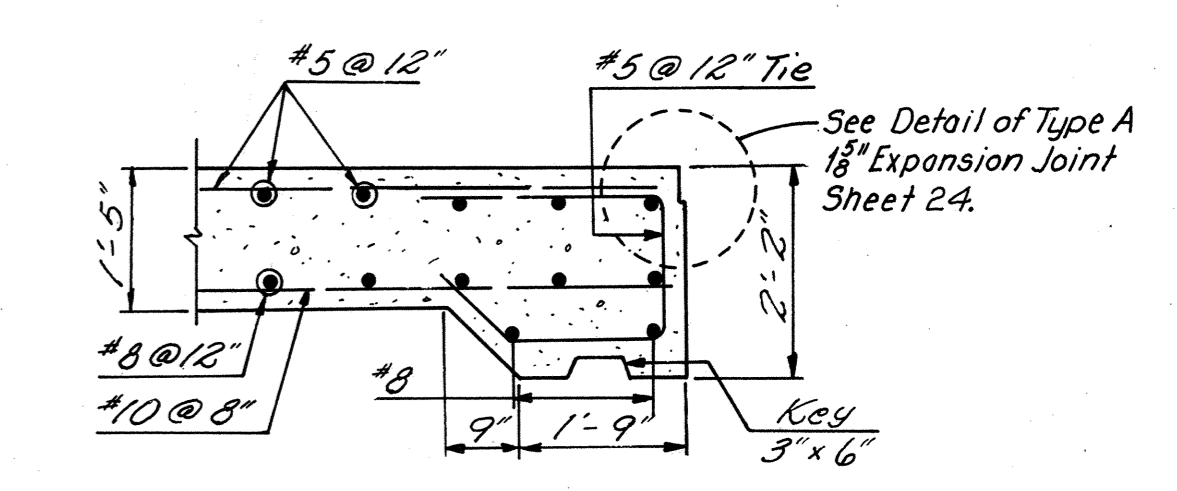


SECTION C-C
Scale: 1/2" = 1'-0"

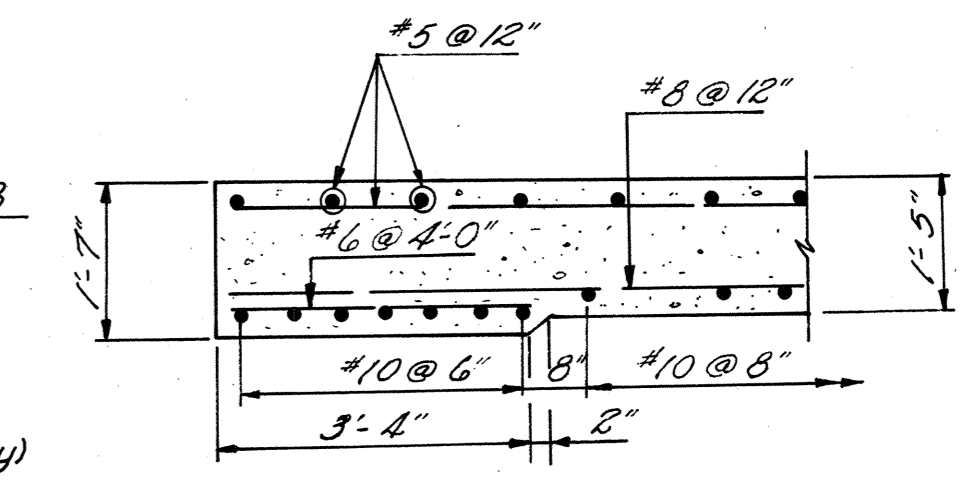


SECTION D-D
Scale: 1/2" = 1'-0"

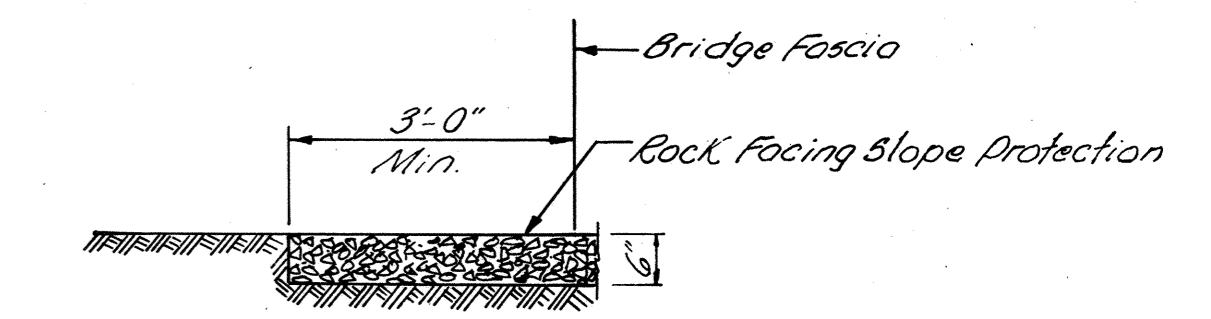


SECTION F-F
Scale: 1/2" = 1'-0"

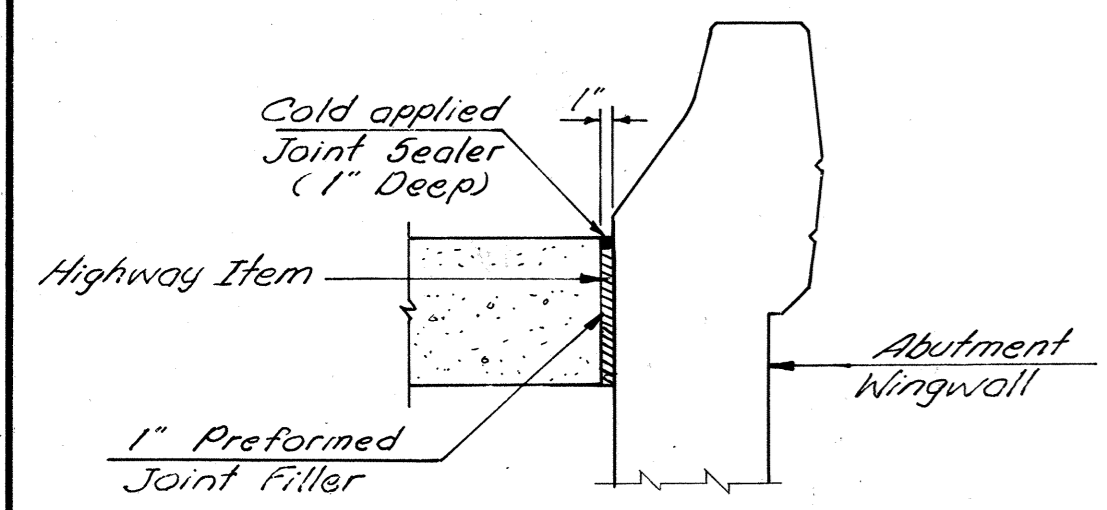

SECTION A-A
Scale: 1/2" = 1'-0"

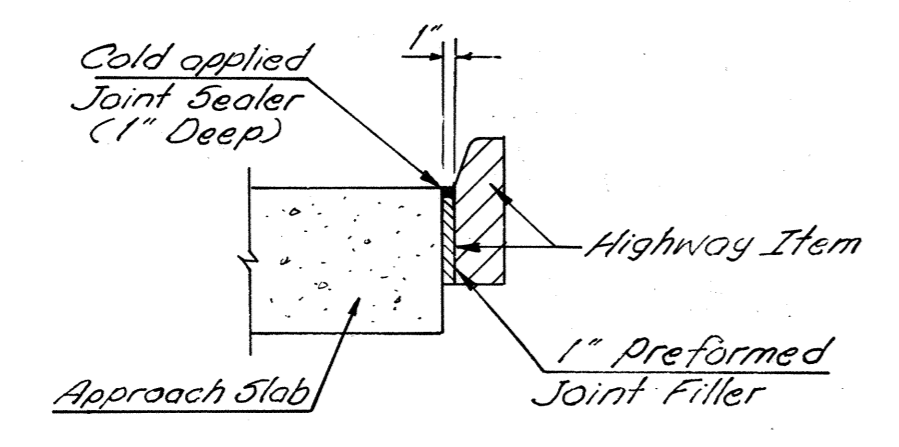

SECTION B-B
Scale: 1/2" = 1'-0"

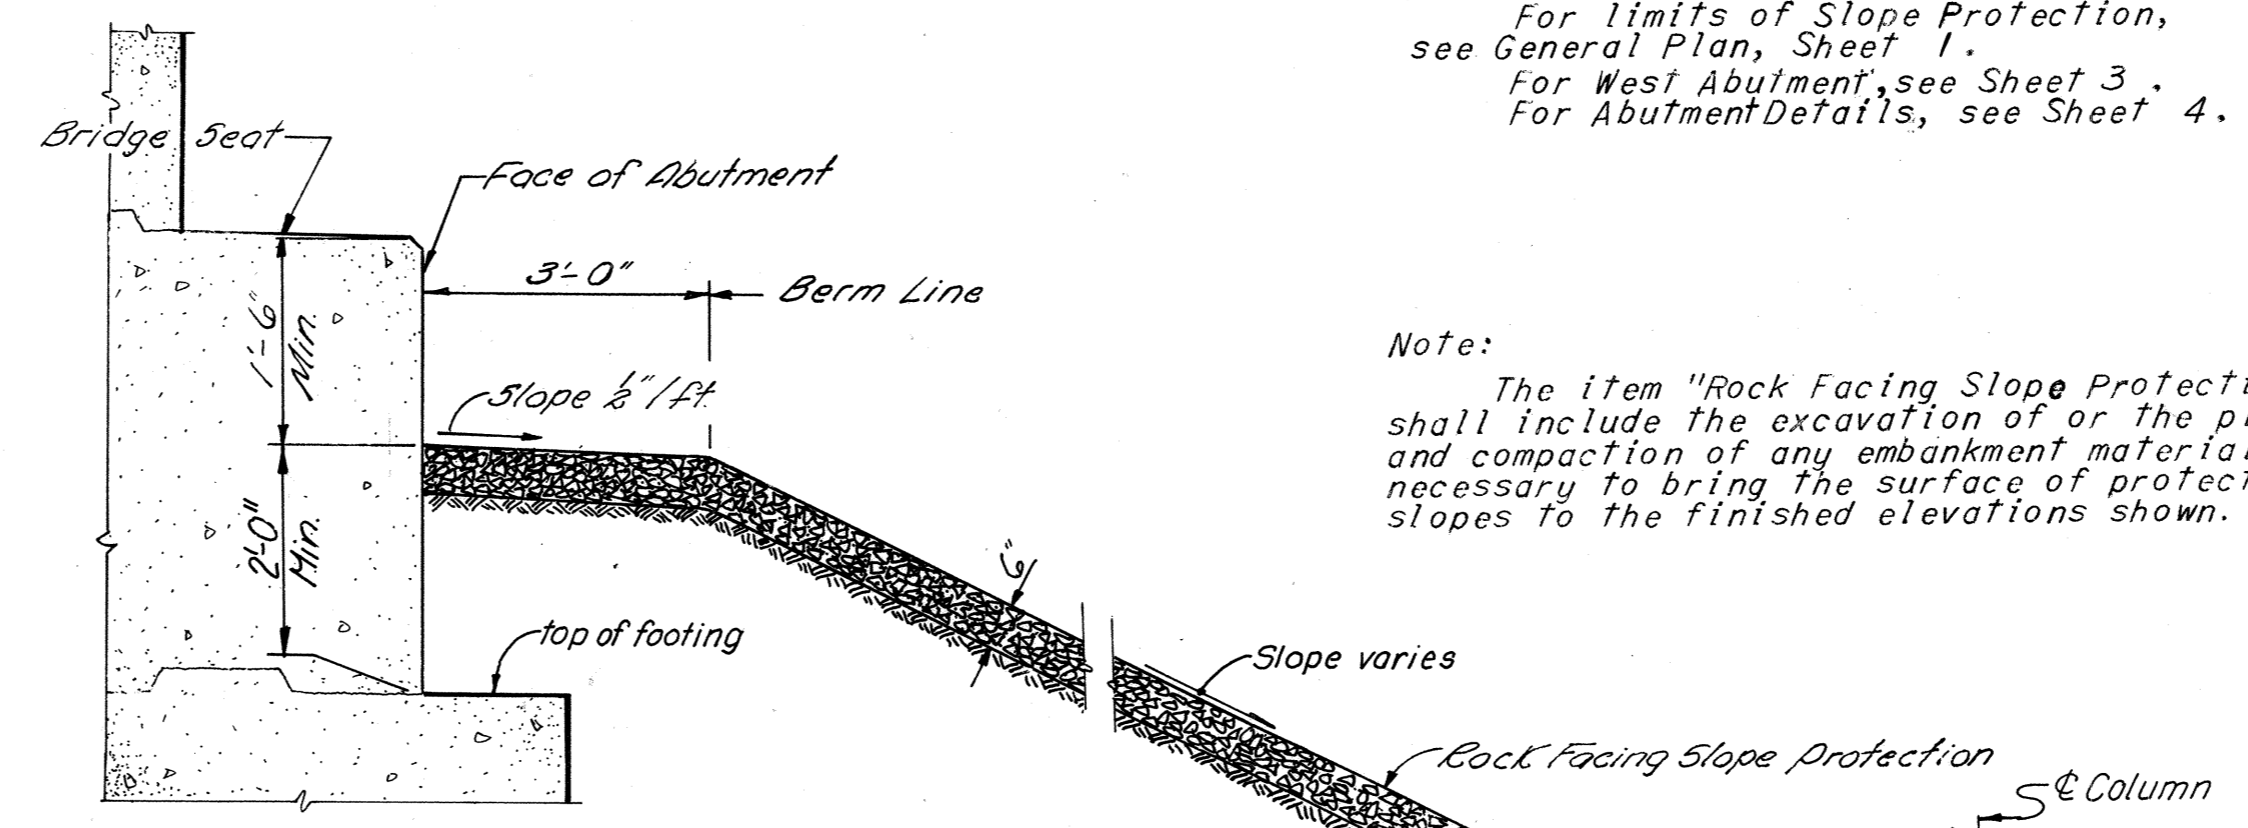

SECTION E-E
Scale: 1/2" = 1'-0"

Note: The item "Rock Facing Slope Protection" shall include the excavation of or the placing and compaction of any embankment material necessary to bring the surface of protected slopes to the finished elevations shown.

MADE	BY	DATE	NO.	REVISION	BY	DATE
	H.C.	7-8-68				
CHECKED	G.C.C.	8-22-68	1	As Built	TEM	10-76
IN CHARGE						

RICHMOND METROPOLITAN AUTHORITY
RICHMOND EXPRESSWAY SYSTEM
DOWNTOWN EXPRESSWAY

BRIDGE NO. 63
WESTBOUND ROADWAY OVER
12TH ST. - R.R. TRACKS AND 16TH ST.
APPROACH SLAB AND
SLOPE PROTECTION DETAILS

HOWARD, NEEDLES, TAMMEN & BERGENDOFF
consulting engineers
NEW YORK ALEXANDRIA KANSAS CITY

SCALE: As Noted
CONTRACT NO.: 10
SHEET NO. 25 OF 29

AS BUILT



RICHMOND METROPOLITAN TRANSPORTATION
AUTHORITY

RICHMOND EXPRESSWAY SYSTEM
CONTRACT NO. PC – 2018
PROTECTIVE COATING OF STRUCTURES


Bridge 64

Downtown Expressway

Ramp N-W Connection from
Richmond-Petersburg Turnpike

RECORD SET PLANS (Next 28)

RICHMOND EXPRESSWAY SYSTEM			
SECTION	PROJECT	SHEET NO.	TOTAL SHEETS
10	DOWNTOWN EXPRESSWAY	99	265


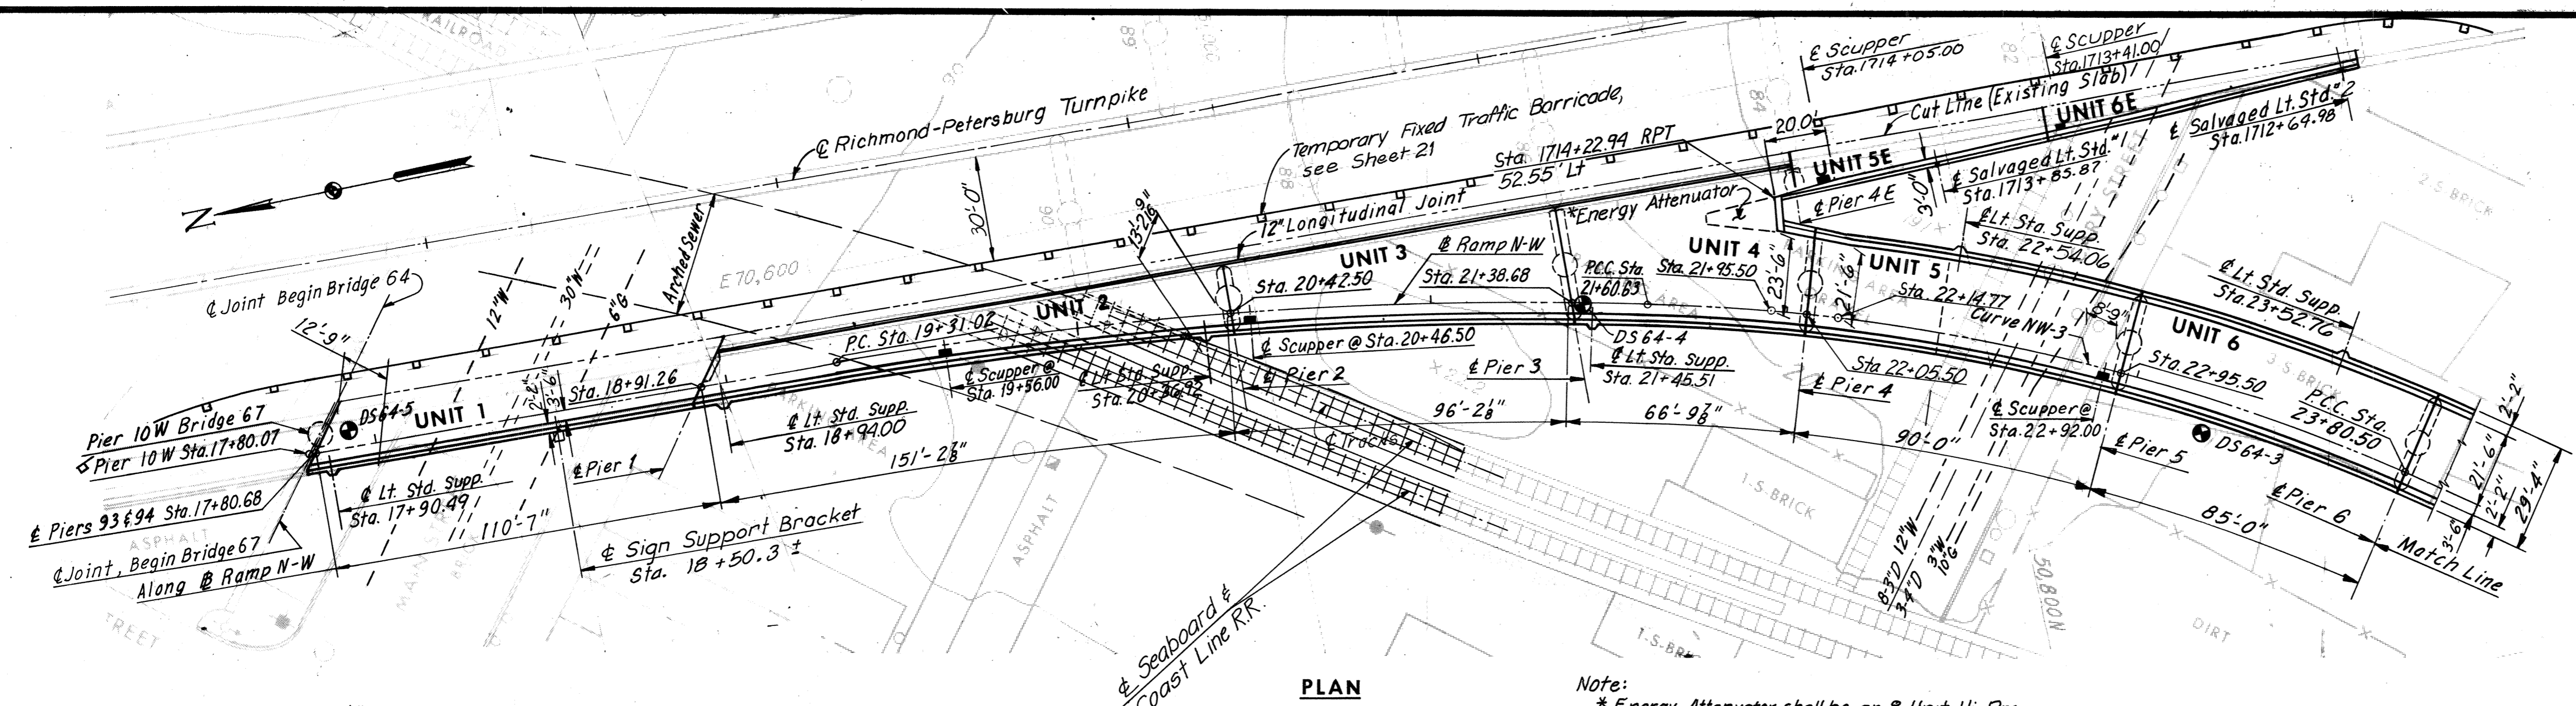


INDEX

INDEX	SHEET
GENERAL PLAN AND ELEVATION	1
GENERAL PLAN AND ELEVATION	2
LAYOUT PLAN	3
PIERS 1 AND 2	4
PIERS 3 AND 4E	5
PIER 4	6
PIER 5	7
PIERS 6 AND 7	8
PIER 8	9
PIER 9	10
PIER 10	11
FRAMING PLAN - UNITS 1 AND 2	12
FRAMING PLAN - UNITS 3 AND 4	13
FRAMING PLAN AND DECK PLAN - UNITS 5E AND 6E	14
FRAMING PLAN - UNITS 5 AND 6	15
FRAMING PLAN - UNITS 7 AND 8	16
FRAMING PLAN - UNITS 9 AND 10	17
FRAMING DETAILS	18
DECK PLAN - UNITS 1 AND 2	19
DECK PLAN - UNITS 3 AND 4	20
DECK PLAN - UNITS 5 AND 6	21
DECK PLAN - UNITS 7 AND 8	22
DECK PLAN - UNITS 9 AND 10	23
SUPERSTRUCTURE DETAILS	24
JOINT DETAILS	25
JOINT DETAILS	26
BORING LOGS	27
BORING LOGS	28
STANDARD DETAILS	S1 THRU S7


Note:
*Energy Attenuator shall be an B-Unit Hi-Dro Cell Sandwich Unit as supplied by Hydro-Cell, Ltd, 11 Lincoln Ave., New Rochelle, N.Y. 10801, or approved equal.

Note:
For General Notes, see Sheet 2.
For Quantity Table, see Sheet 2.

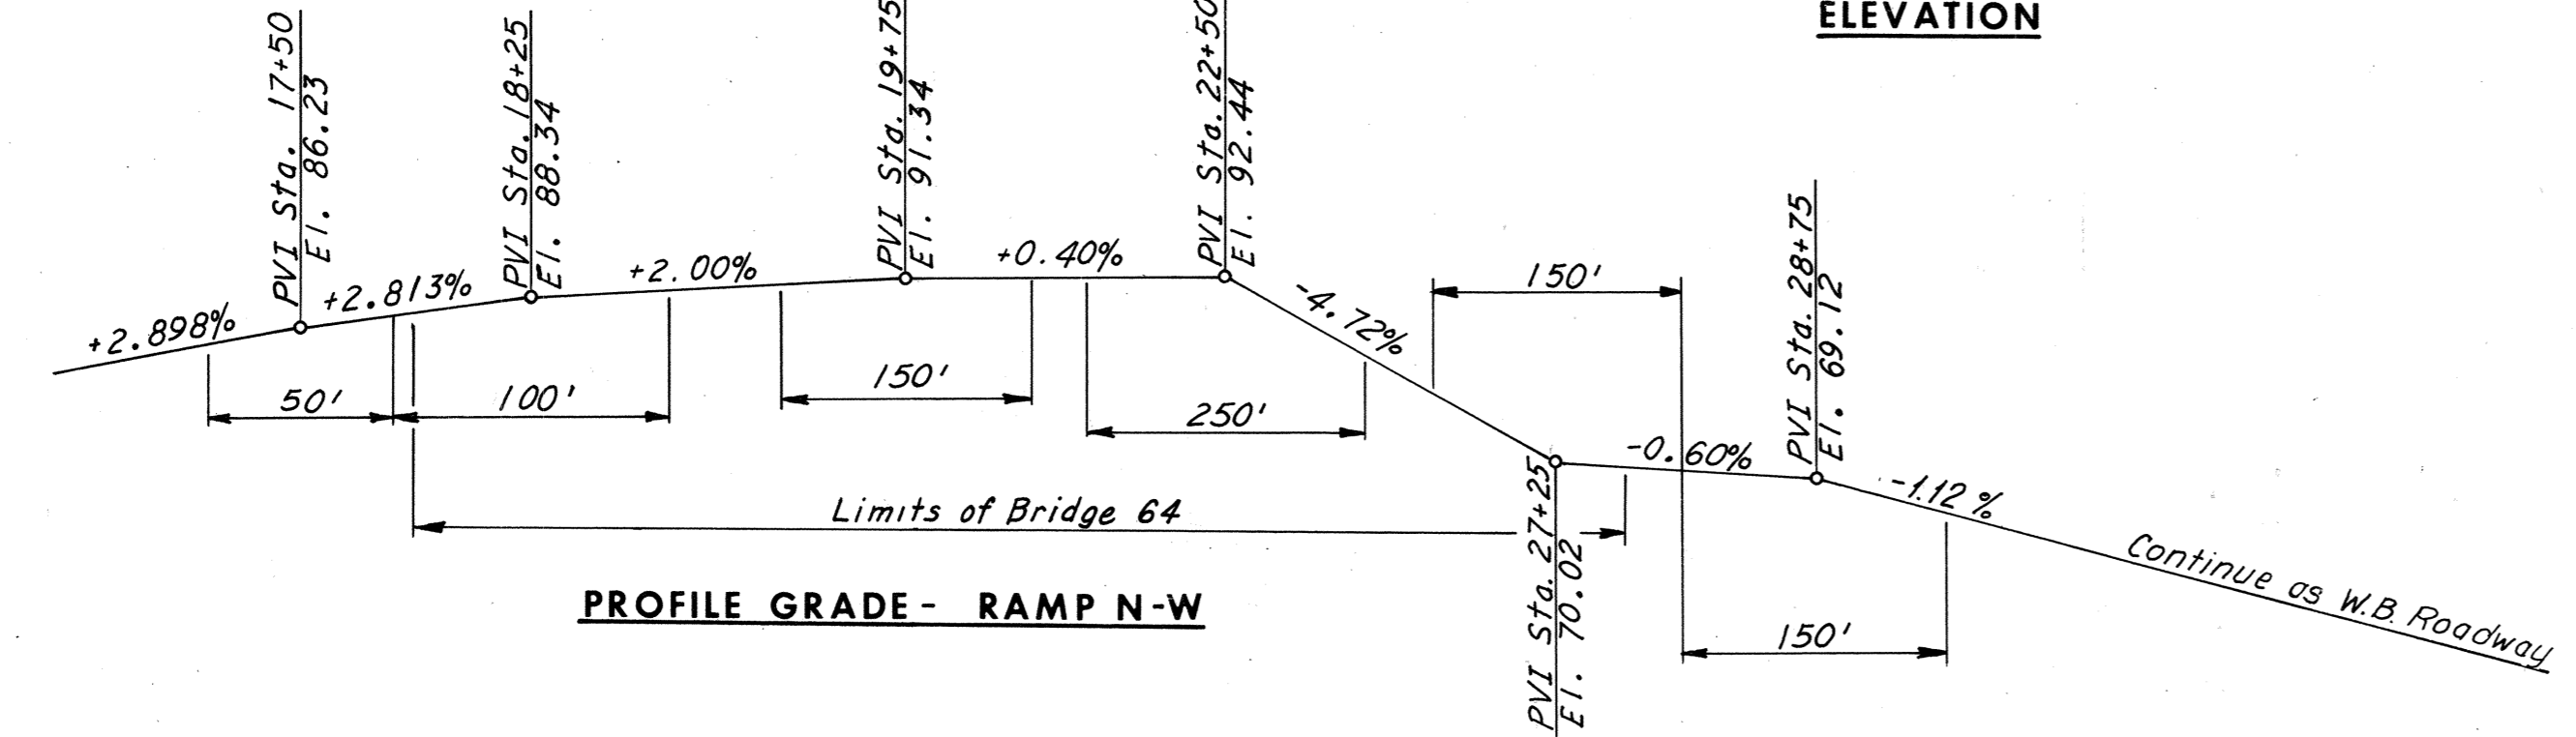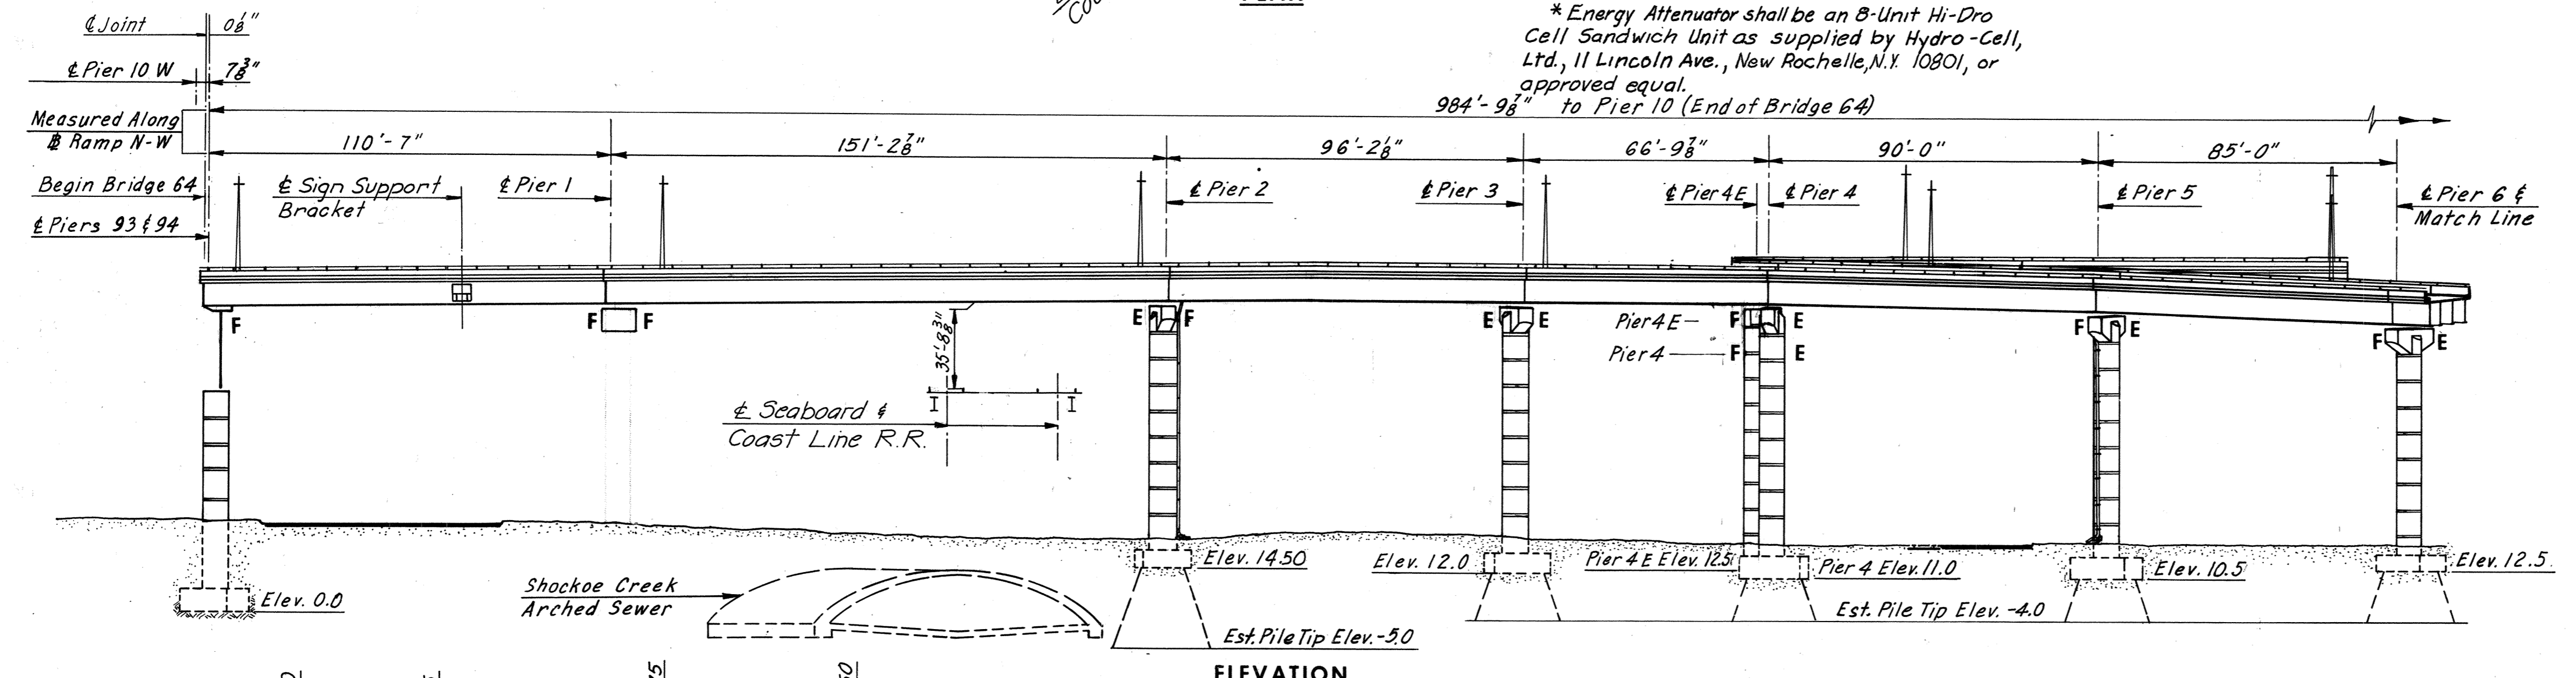

HORIZONTAL CURVE DATA

R. P. Turnpike		Ramp N-W	
Curve: R.P.T.-1	Curve: R.P.T.-2	Curve: NW-1	Curve: NW-2
P.I. = Sta. 1704+68.83	P.I. = Sta. 1723+07.01	P.I. = Sta. 13+42.50	P.I. = Sta. 20+46.21
Δ = 15° 03' 56.2"	Δ = 33° 27' 06.8"	Δ = 32° 01' 34"	Δ = 11° 28' 49.9"
D = 17° 00' 00"	D = 4° 00' 00"	D = 3° 51' 35.6"	D = 5° 00'
T = 757.65'	T = 430.45'	T = 426.01'	T = 115.19'
L = 1,506.56'	L = 836.30'	L = 829.72'	L = 229.61'
R = 3,729.58'	R = 1,432.39'	R = 1,484.39'	R = 1,145.92'
Curve: NW-3	Curve: NW-4	Curve: NW-5	
P.I. = Sta. 22+71.93	P.I. = Sta. 25+55.02	P.I. = Sta. 28+25.38	
Δ = 21° 59' 14.9"	Δ = 64° 48' 04"	Δ = 26° 18' 00"	
D = 10° 00' 00"	D = 20° 50' 05.4"	D = 10° 00' 00"	
T = 111.31'	T = 174.52'	T = 133.86'	
L = 219.88'	L = 311.02'	L = 263.00'	
R = 572.96'	R = 275.00'	R = 572.96'	

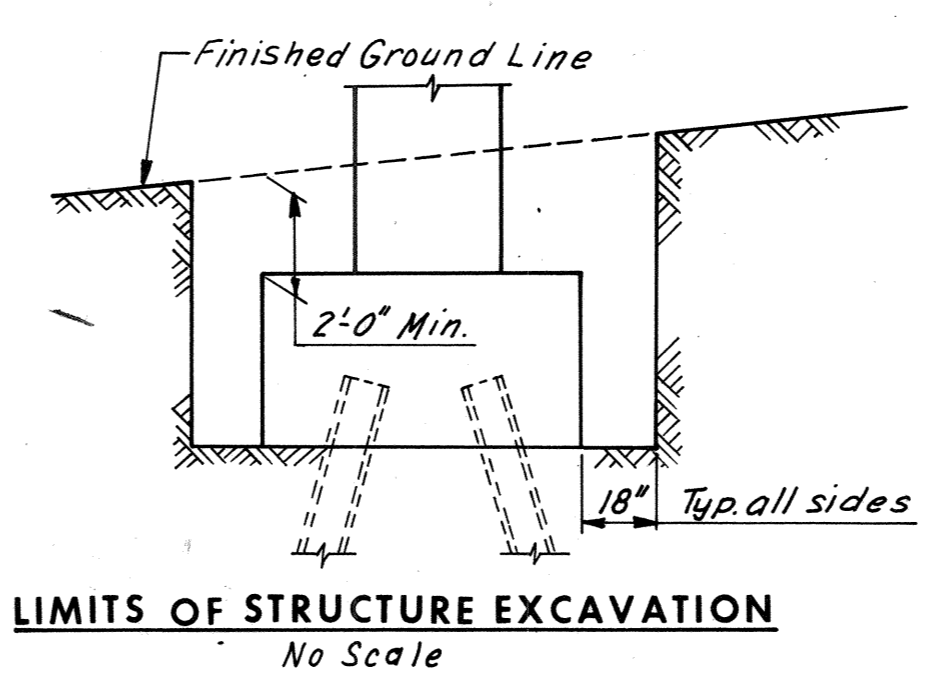

NO.	REVISION	BY	DATE
4	As Built	TEM	6-77
	Seaboard & Coast Line Add. to Plant Et.	K.D.P.	6-74
	Sign Support Bracket & Sheet 12a added	L.B.P.	8-74
	Added Sta.	REF	1-13-75

RICHMOND METROPOLITAN AUTHORITY
RICHMOND EXPRESSWAY SYSTEM
DOWNTOWN EXPRESSWAY



BRIDGE NO. 64
RAMP N-W CONNECTION FROM RICHMOND-PETERSBURG TURNPIKE
GENERAL PLAN AND ELEVATION

HOWARD, NEEDLES, TAMMEN & BERGENDOFF
consulting engineers
NEW YORK ALEXANDRIA KANSAS CITY

SCALE: 1" = 30'-0"
CONTRACT NO.: 10
SHEET NO. 1 OF 28

AS BUILT

RICHMOND EXPRESSWAY SYSTEM			
SECTION	PROJECT	SHEET NO.	TOTAL SHEETS
10	DOWNTOWN EXPRESSWAY	100	265

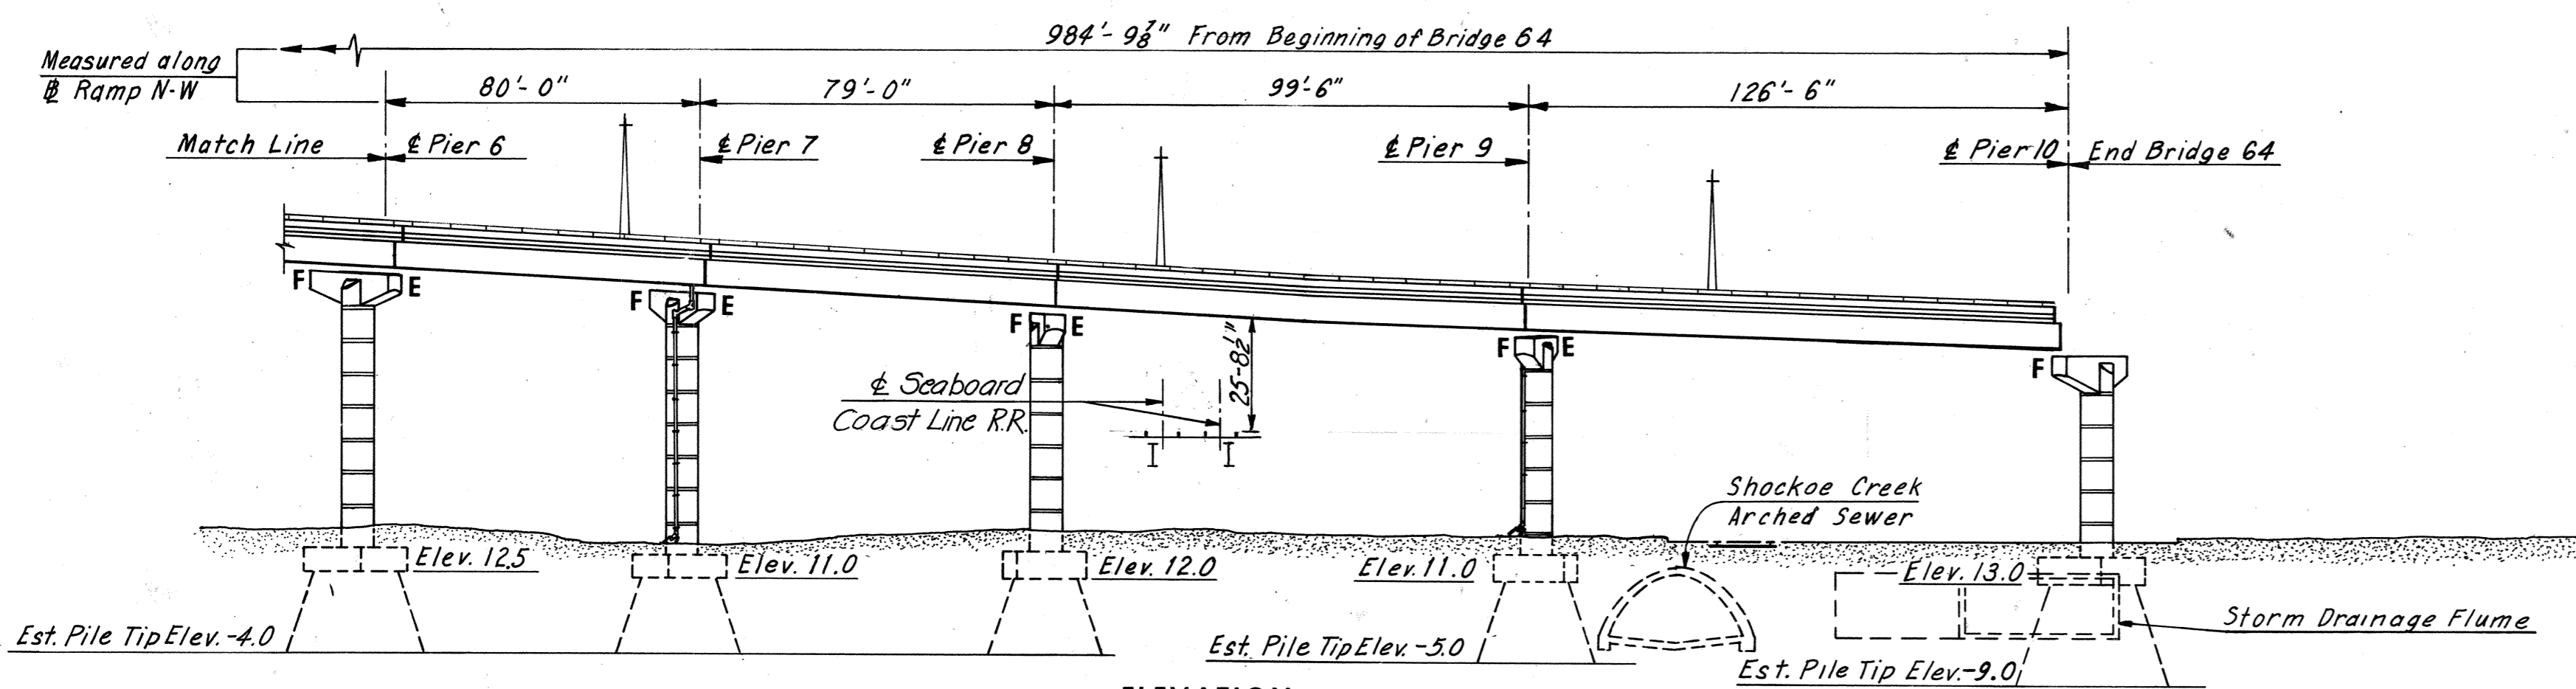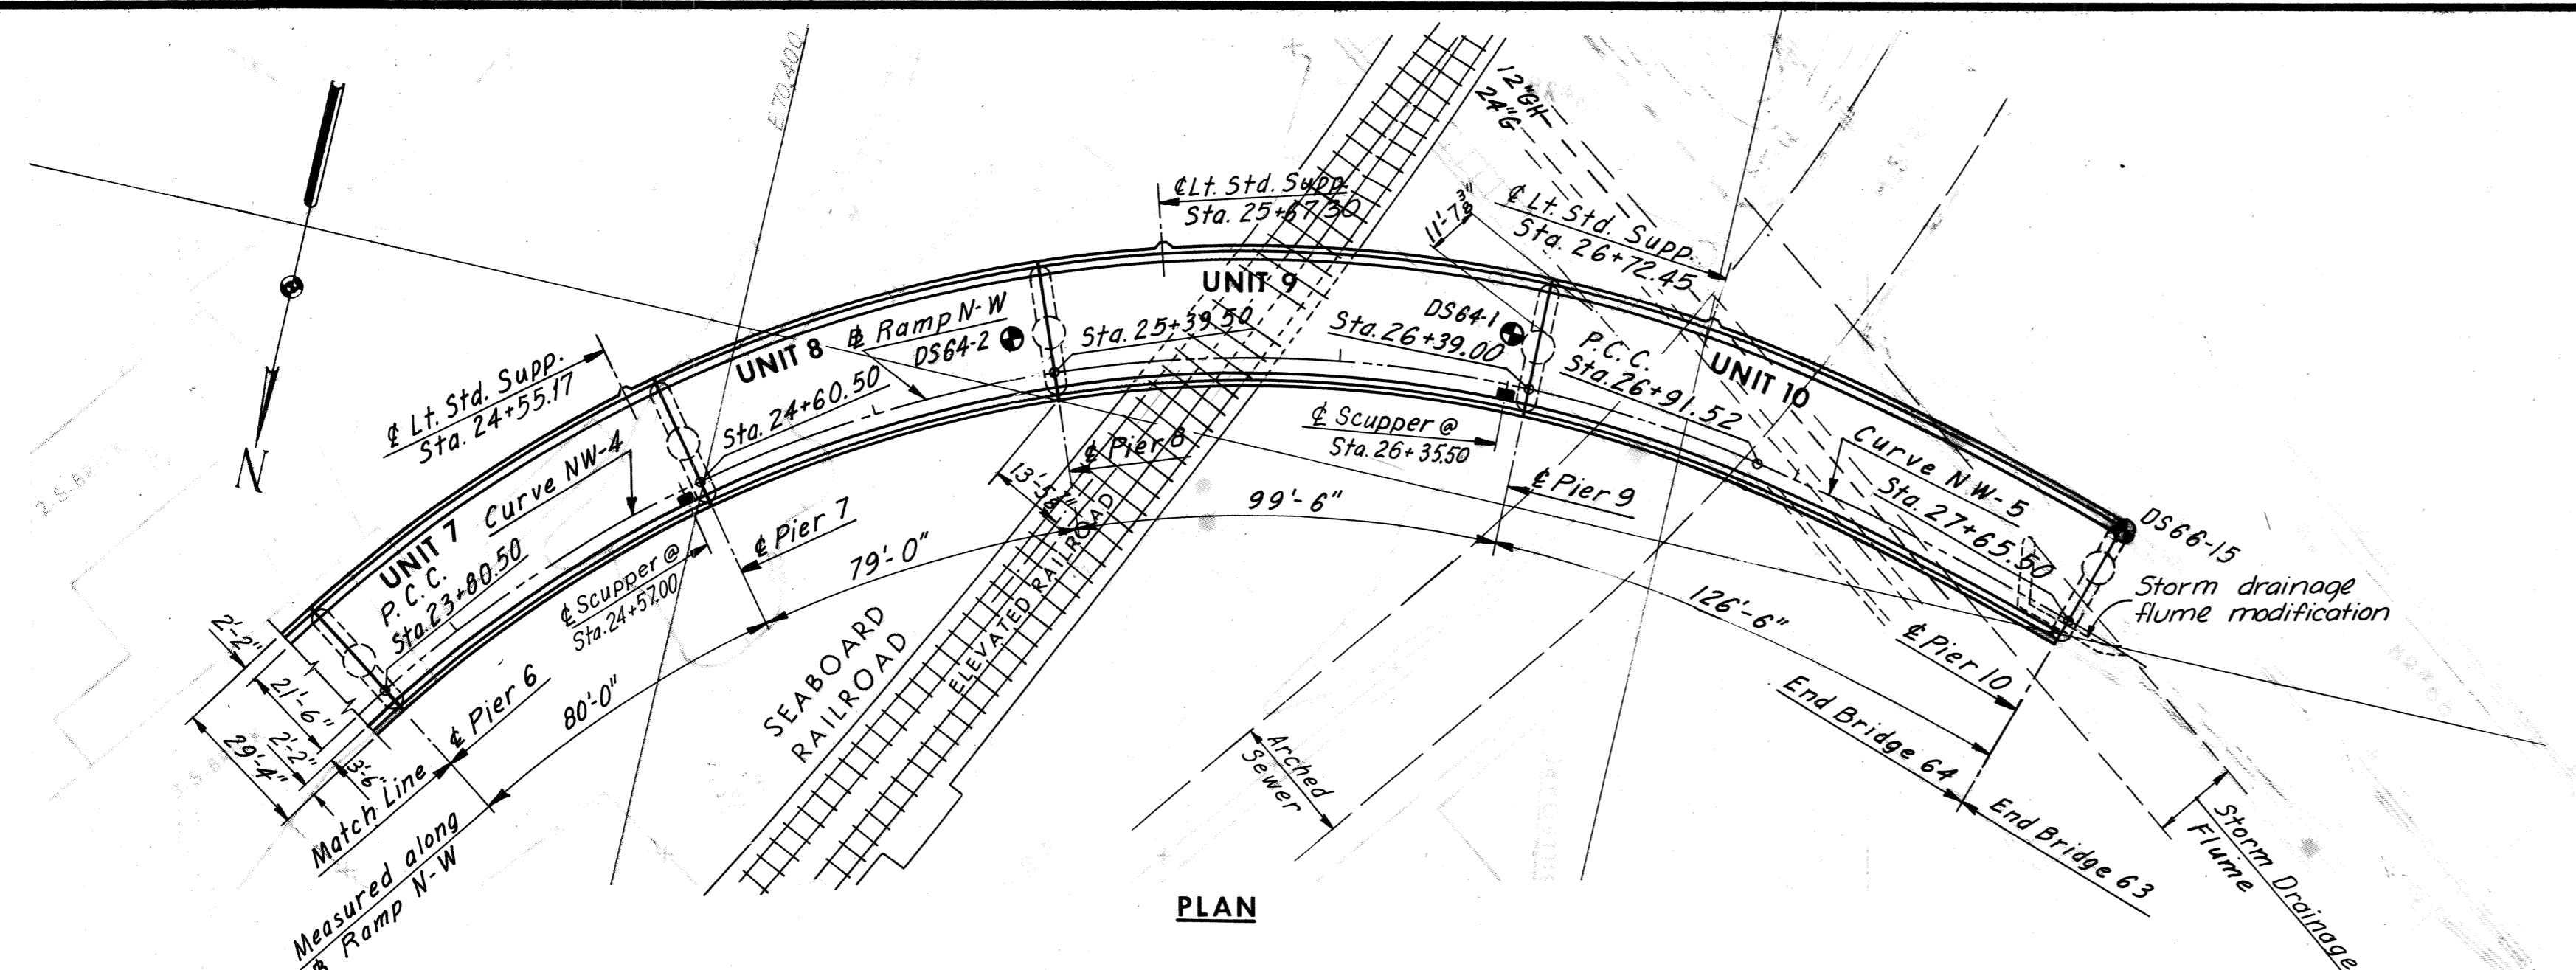

ESTIMATED QUANTITIES

	Structure Excavation Cu. Yds.	Concrete (#) Cu. Yds.	Reinforcing Steel Lbs.	Str. Steel Mild Carbon Lbs.	Str. Steel High Strength Lbs.	Aluminum Railing (1-Rail) Lin. Ft.	Steel Piles 10BP42 Lin. Ft.
Superstructure	--	1,023.8	213,790	768,100	413,900	1,600	---
Substructure	1,125	1,484.1	236,580	2,000	---	---	145
Total	1,125	2,507.9	450,370	770,100	413,900	1,600	145

	Steel Piles 12BP53 Lin. Ft.	Sheet Piling Lump Sum	Metal Conduit Lin. Ft.	Energy Attenuator 8-Unit Each	Bridge Drainage Metal Work Lbs.	Modifications to R.P. Turnpike Bridge Lump Sum	Modifications to Storm Drainage Flume Cu. Yds.
Superstructure	---	--	1,075	1	13,030	1	--
Substructure	3,035	1	--	--	--	--	116
Total	3,035	1	1,075	1	13,030	1	116

* All Concrete for Superstructure shall be Class A4 and for Substructure Class A3.

BY	DATE	Seaboard & Coast Line Add. To Plans	K.D.P.	6-74
MADE	AMH	1-13-69	Str. Steel Quantity	R.B.H.
CHECKED	GCC	4-28-69	As Built	TEM
IN CHARGE				

GENERAL NOTES:

ROADWAY: One variable width roadway transitioning from a widening of Southbound roadway of Richmond-Petersburg Turnpike to a ramp with 25'-0" clear roadway connecting with W.B. Roadway (Br. 63).

CAPACITY: Dead load includes 15 lbs. per sq. ft. for future wearing surface. Live load, HS 20-44 loading and alternate military loading.

SPECIFICATIONS: GENERAL: Virginia Department of Highway Road and Bridge Specifications 1970.
DESIGN: A.A.S.H.O. Standard Specifications for Highway Bridges 1973, modified by Special Design provisions.
WELDING: 1972 Standard Specifications for Welded Highway and Railway Bridges of The American Welding Society.
CONTRACT SPECIAL PROVISIONS: Specifications and Contract Special Provisions referred to above are necessary to make these plans complete.

DATUM: City of Richmond

TEMPERATURE: The normal temperature referred to in the plans is 60°F. The temperature range for movement is 0° F. to 120° F.

DIMENSIONS: All dimensions are measured horizontally and vertically unless otherwise noted.

EXCAVATION: Excavation below subgrade and cut slope template shall be classified as Structure Excavation. All excavation above these limits shall be classified as Regular Excavation and is not included in the Structural Quantities.

FOUNDATIONS: Footings shall rest on firm material. Foundation material shall be dry and special attention is called to Section 401.05 of Standard Specifications and to the Contract Special Provisions, concerning preparation of foundations for footings.

CONCRETE NOTES: Concrete in superstructure shall be Class A 4. All other concrete shall be Class A 3. All exposed edges and corners shall have a 3" chamfer or fillet unless otherwise noted. Care in the method of vibration, the use of low-slump concrete, and other means shall be employed to prevent downgrade movement of newly placed slab concrete. Finishing Concrete Surfaces: See Standard Architectural Detail Sheets and the Contract Special Provisions for types and details. All reinforcing bar dimensions on the detailed drawings are to centers of bars unless otherwise noted. Clear distance between reinforcing steel and face to concrete shall be as noted on the plans. All bar laps shall be 30 diameters of the smaller diameter bar unless otherwise noted. All reinforcing steel shall conform to ASTM A615 Grade 40.

STEEL NOTES: Structural steel shall conform to A.S.T.M. Designations A36, A572 - Grade 50 and A588 as noted. See Special Provisions. All field connections shall be made with high strength bolts. High strength bolts shall be 1/2" diameter unless otherwise noted and shall conform to A.S.T.M. Specification A-325.

Note: For Curve Data and Profile Grade, see Sheet 1. For Layout Plan, see Sheet 3.


AS BUILT

**RICHMOND METROPOLITAN AUTHORITY
RICHMOND EXPRESSWAY SYSTEM
DOWNTOWN EXPRESSWAY**

**BRIDGE NO. 64
RAMP N-W CONNECTION FROM
RICHMOND-PETERSBURG TURNPIKE
GENERAL PLAN AND ELEVATION**

HOWARD, NEEDLES, TAMMEN & BERGENDOFF consulting engineers NEW YORK ALEXANDRIA KANSAS CITY	SCALE: 1" = 30'-0" CONTRACT NO. 10 SHEET NO. 2 OF 28
---	--

RICHMOND EXPRESSWAY SYSTEM			
SECTION	PROJECT	SHEET NO.	TOTAL SHEETS
10	DOWNTOWN EXPRESSWAY	101	265

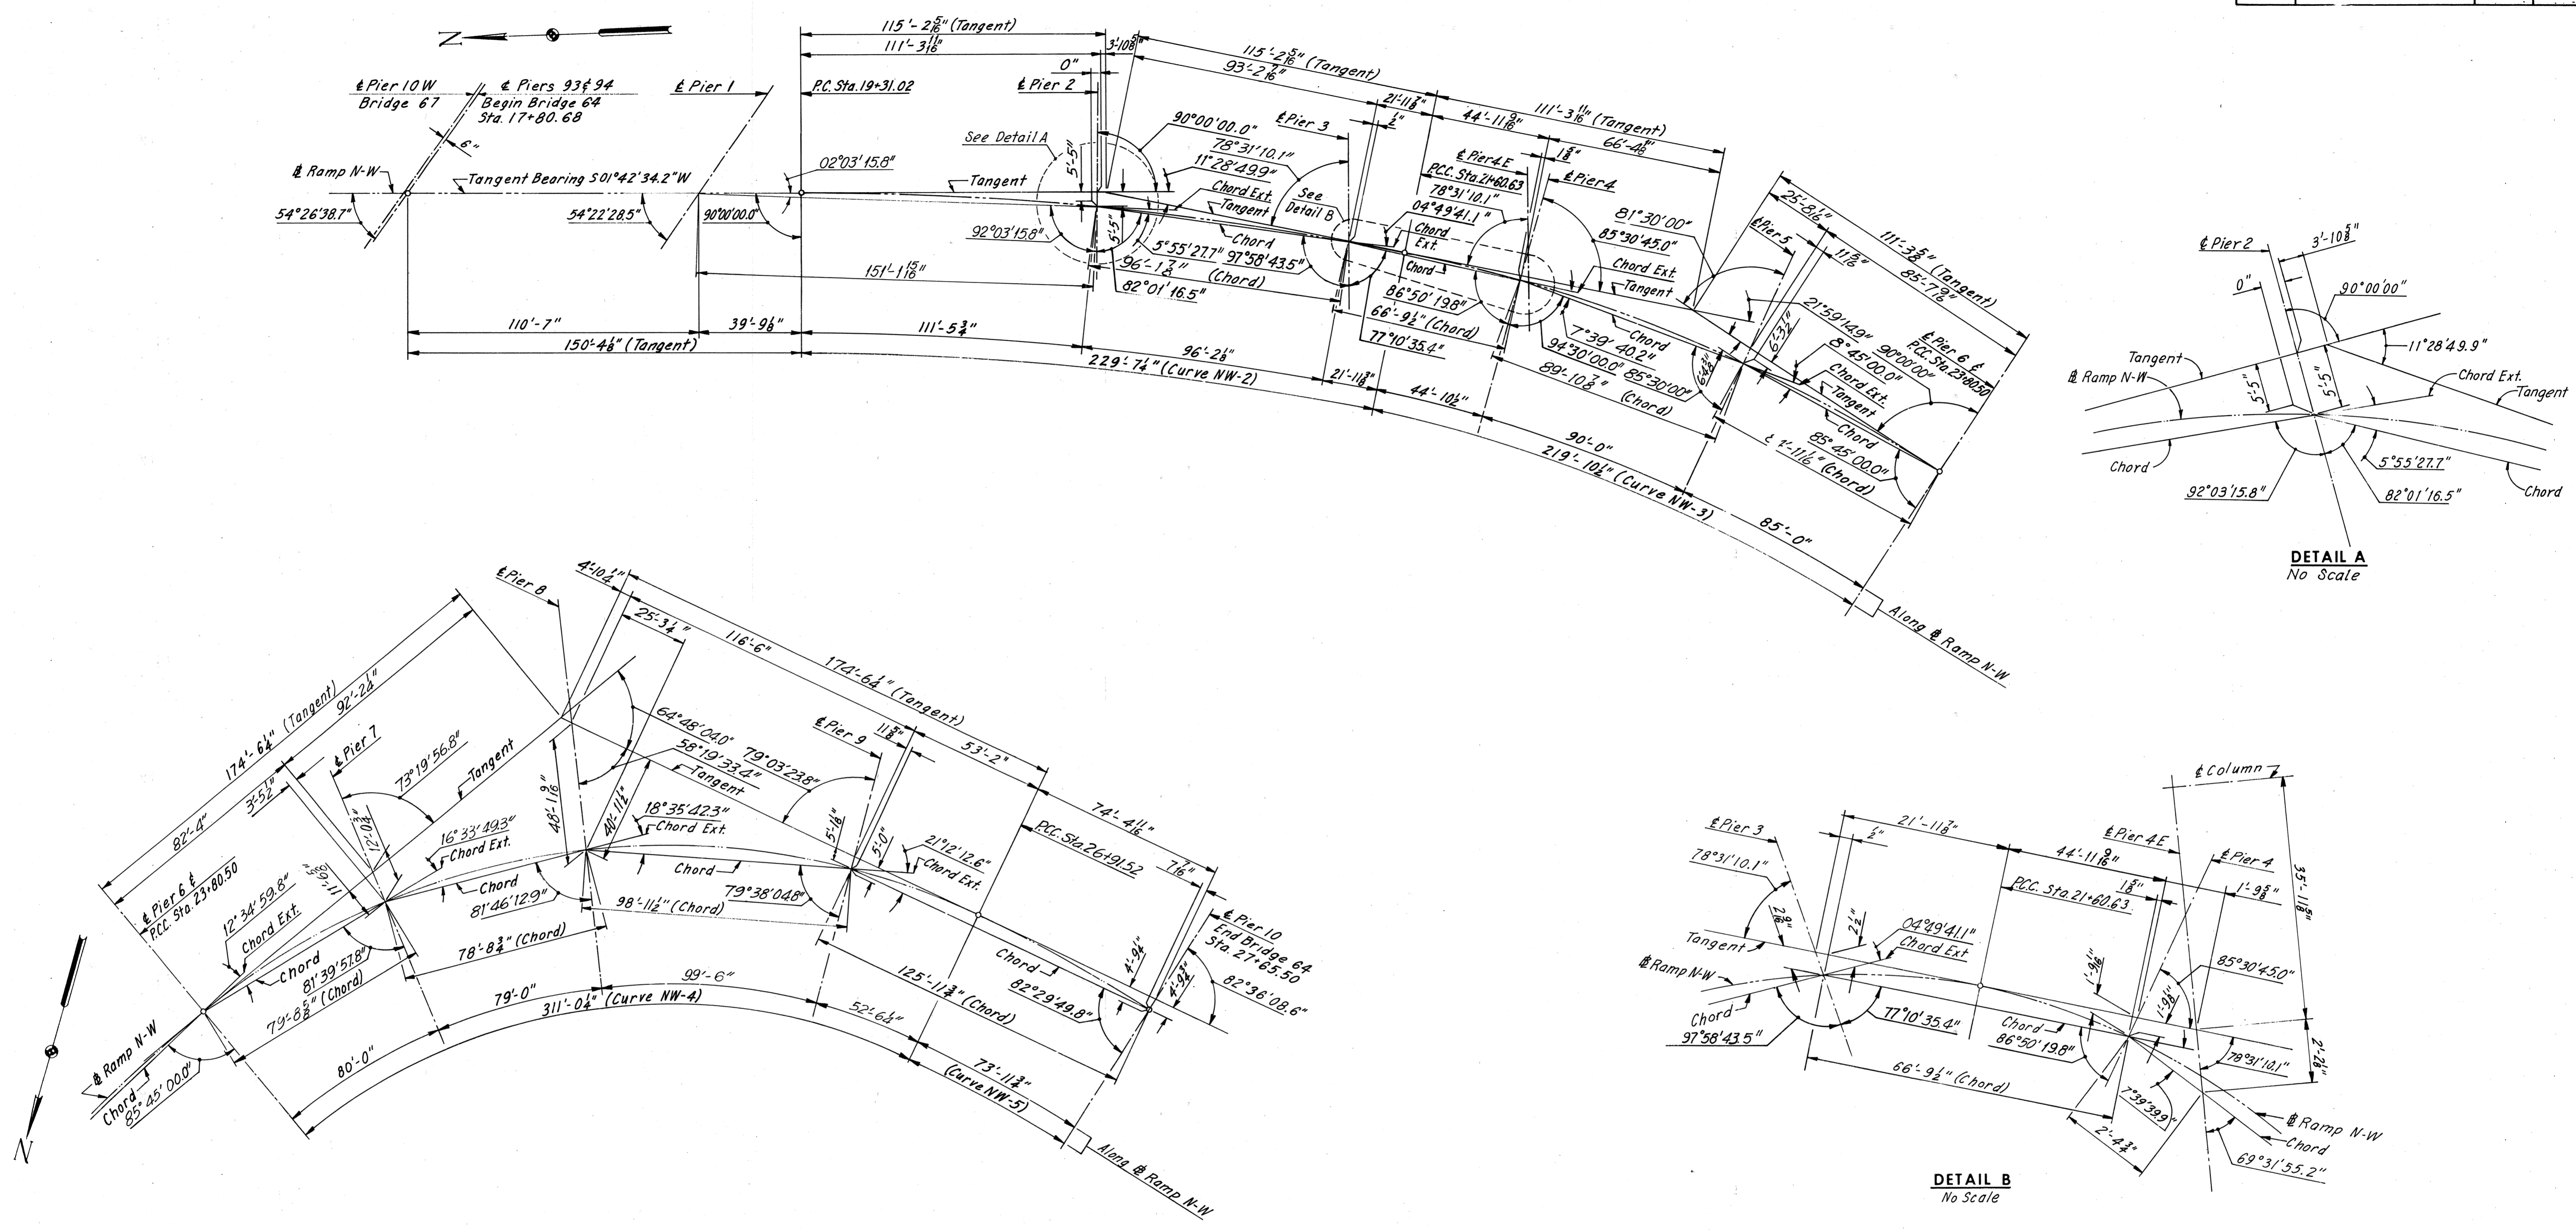

	BY	DATE		As Built	TEM	G-77
MADE	AMH	3-31-69				
CHECKED	GCC	4-21-69				
IN CHARGE			NO.	REVISION	BY	DATE














AS BUILT

RICHMOND METROPOLITAN AUTHORITY
RICHMOND EXPRESSWAY SYSTEM
DOWNTOWN EXPRESSWAY

BRIDGE NO. 64
RAMP N-W CONNECTION FROM
RICHMOND-PETERSBURG TURNPIKE
LAYOUT PLAN

HOWARD, NEEDLES, TAMMEN & BERGENDOFF
 consulting engineers
 NEW YORK ALEXANDRIA KANSAS CITY

SCALE: 1" = 30'-0"
 CONTRACT NO.: 10
 SHEET NO. 3 OF 28

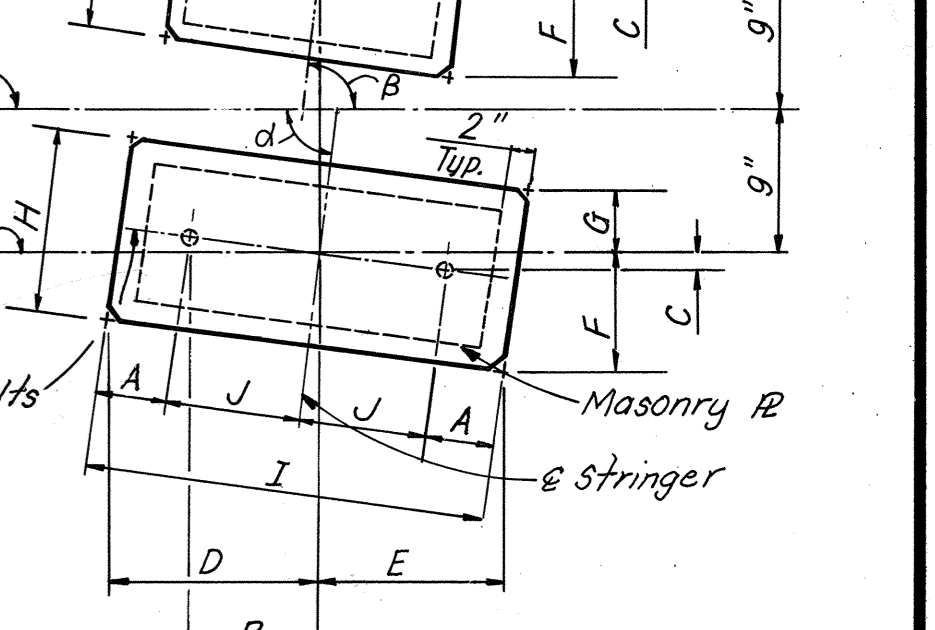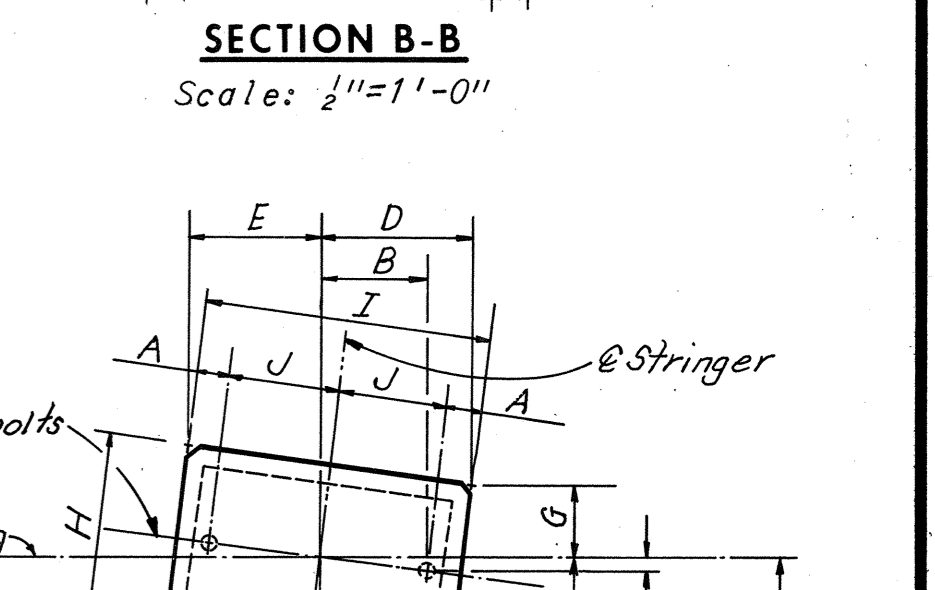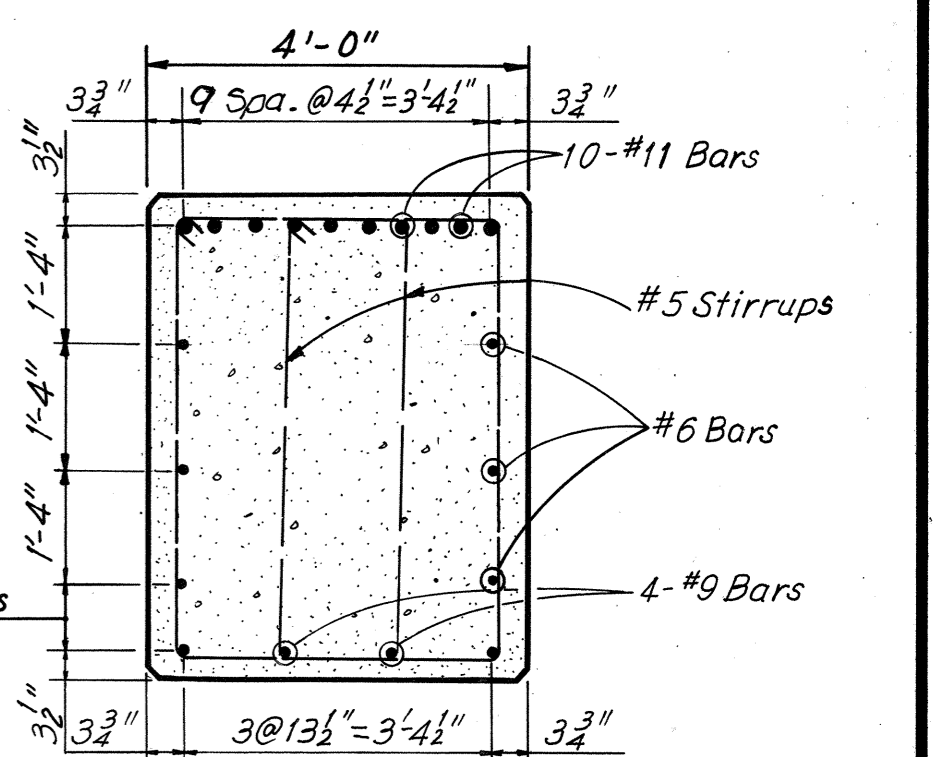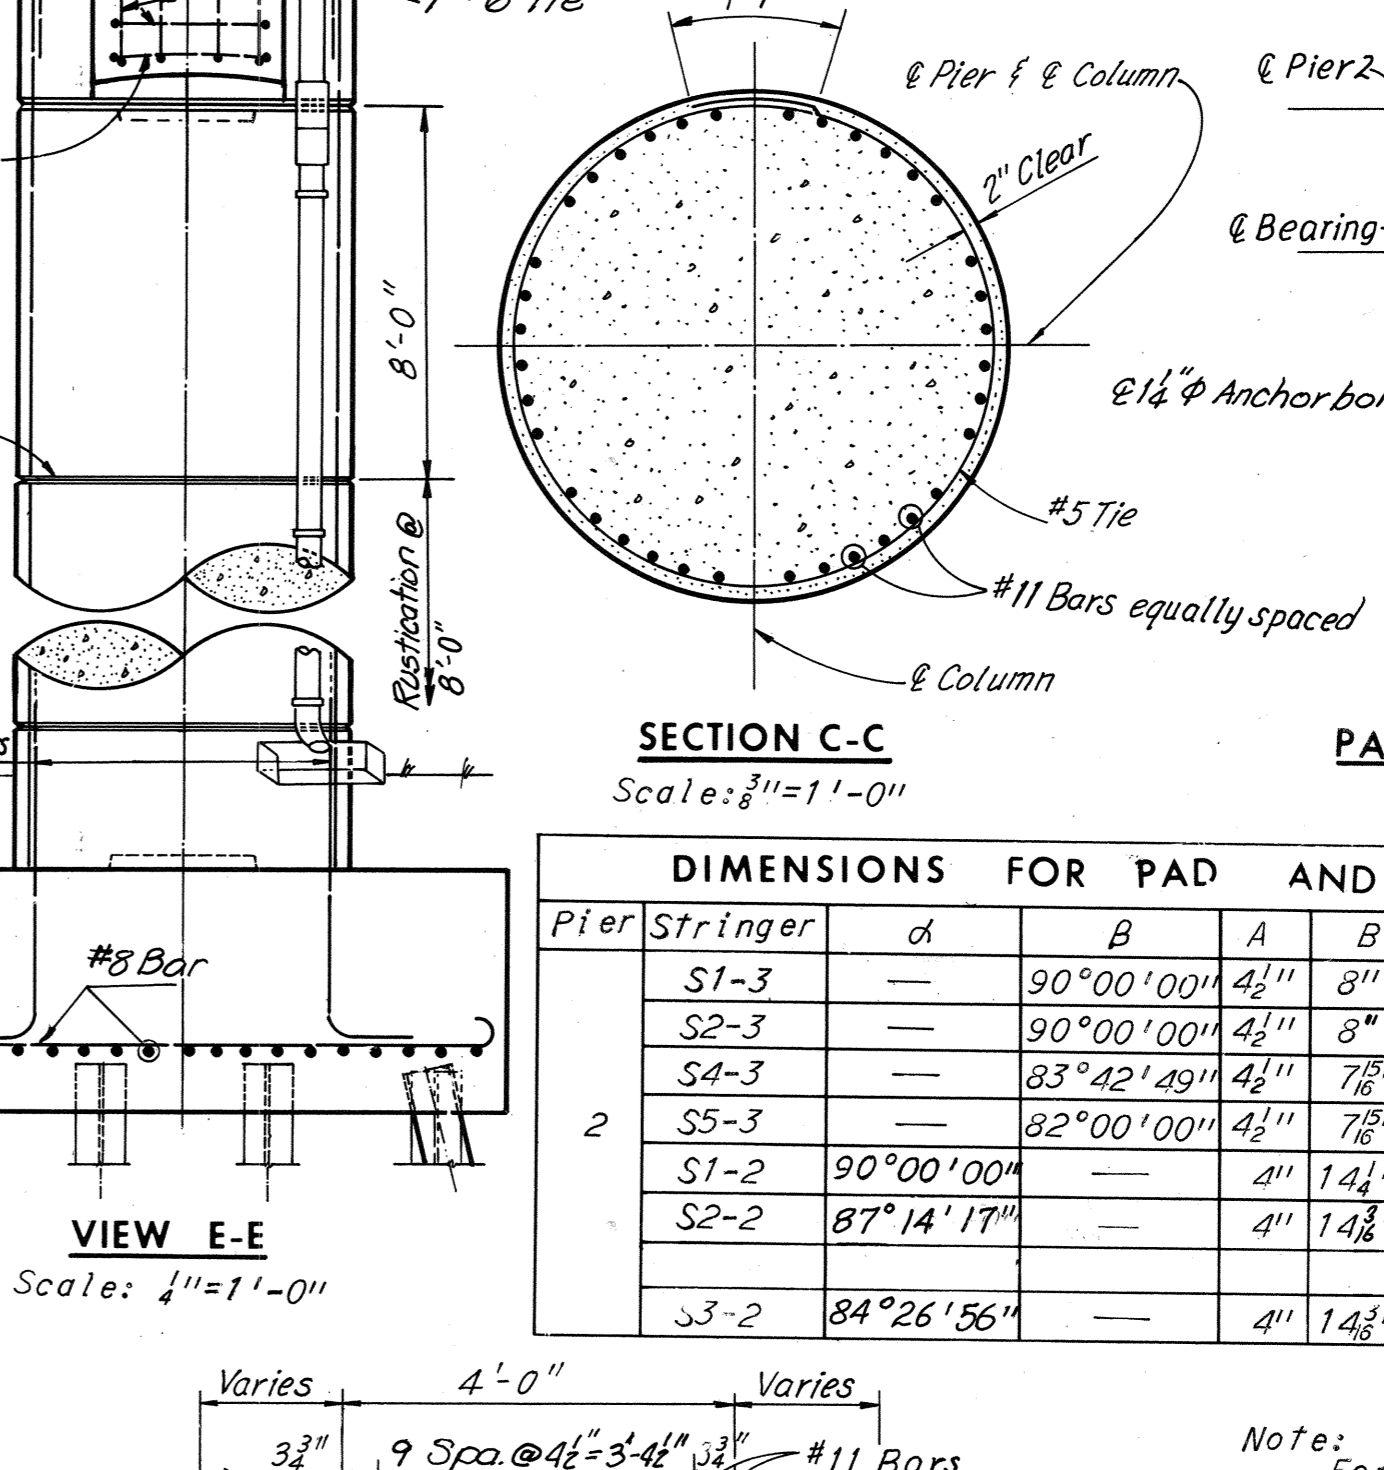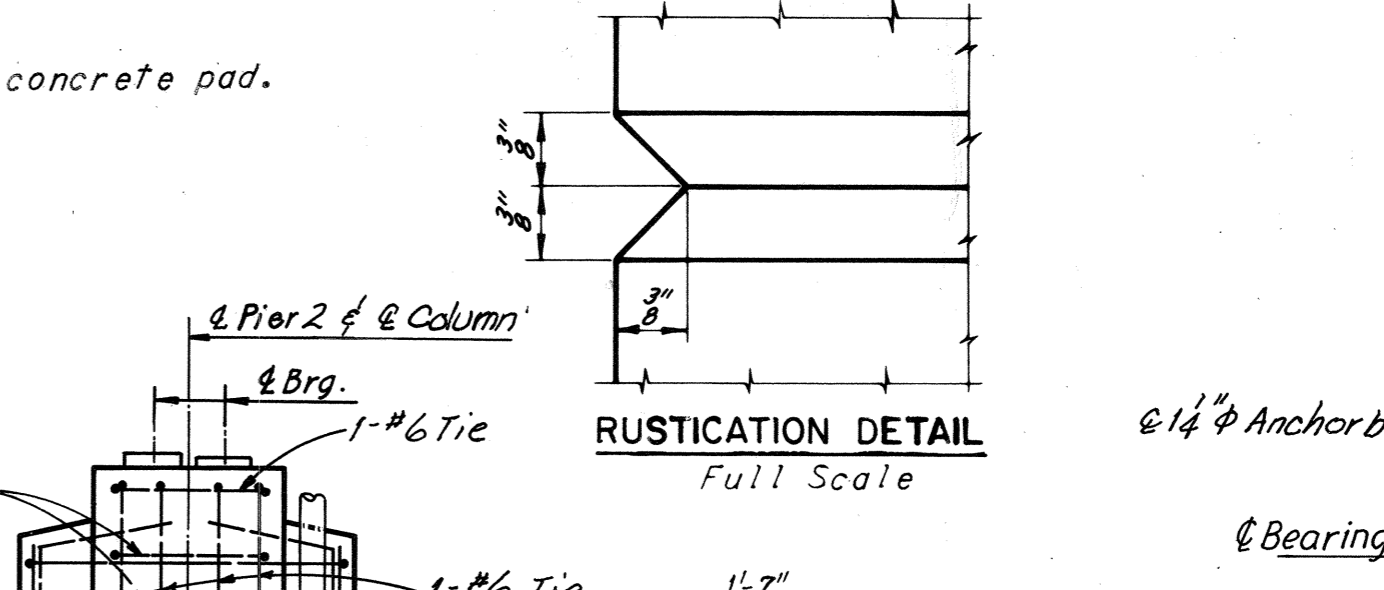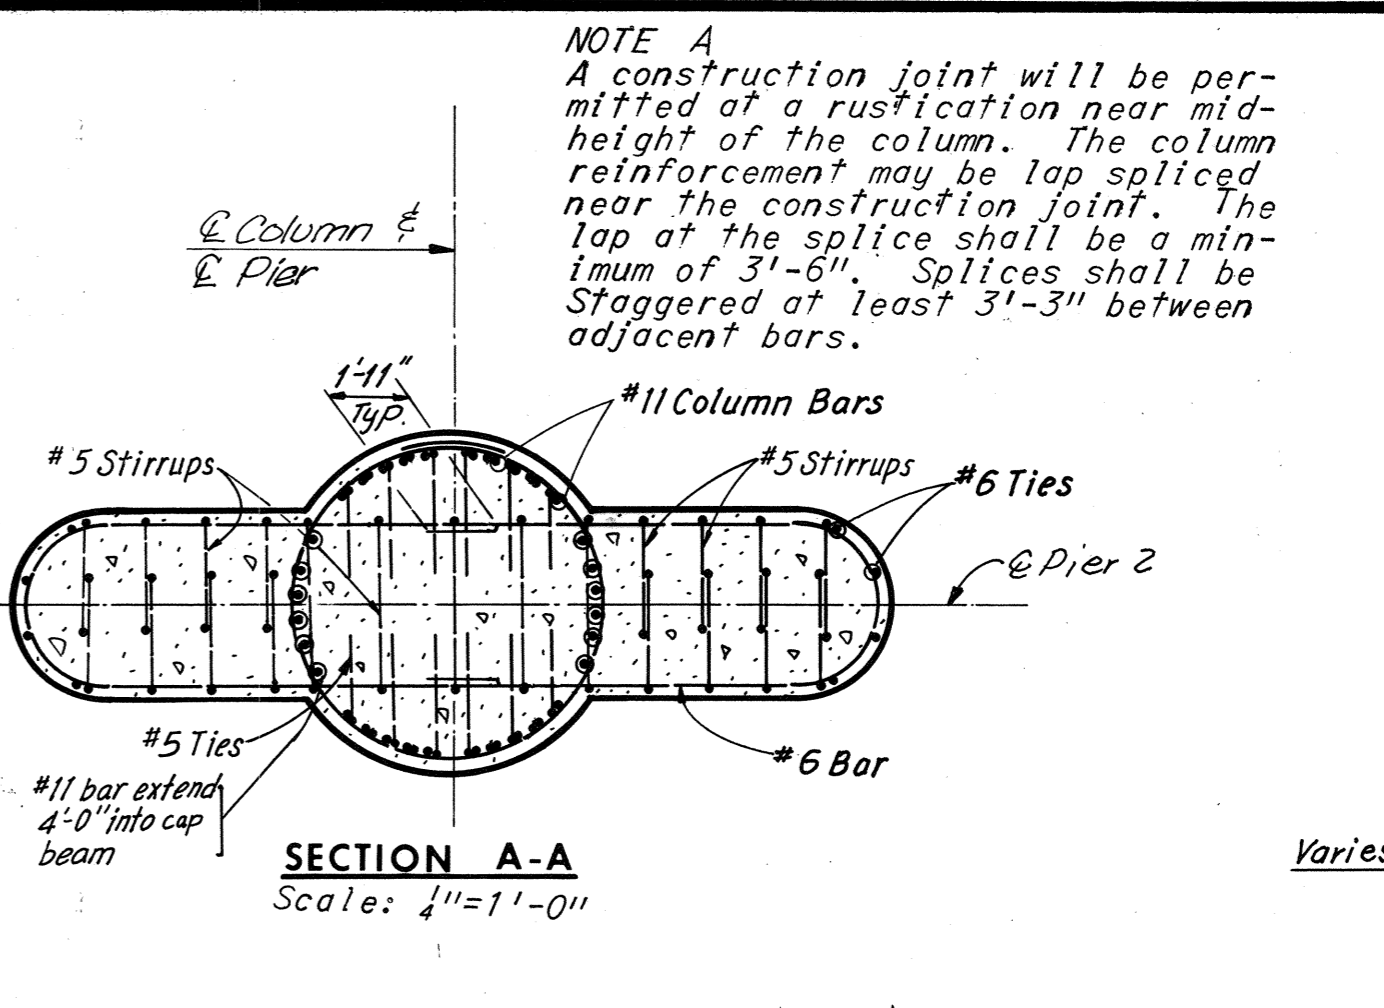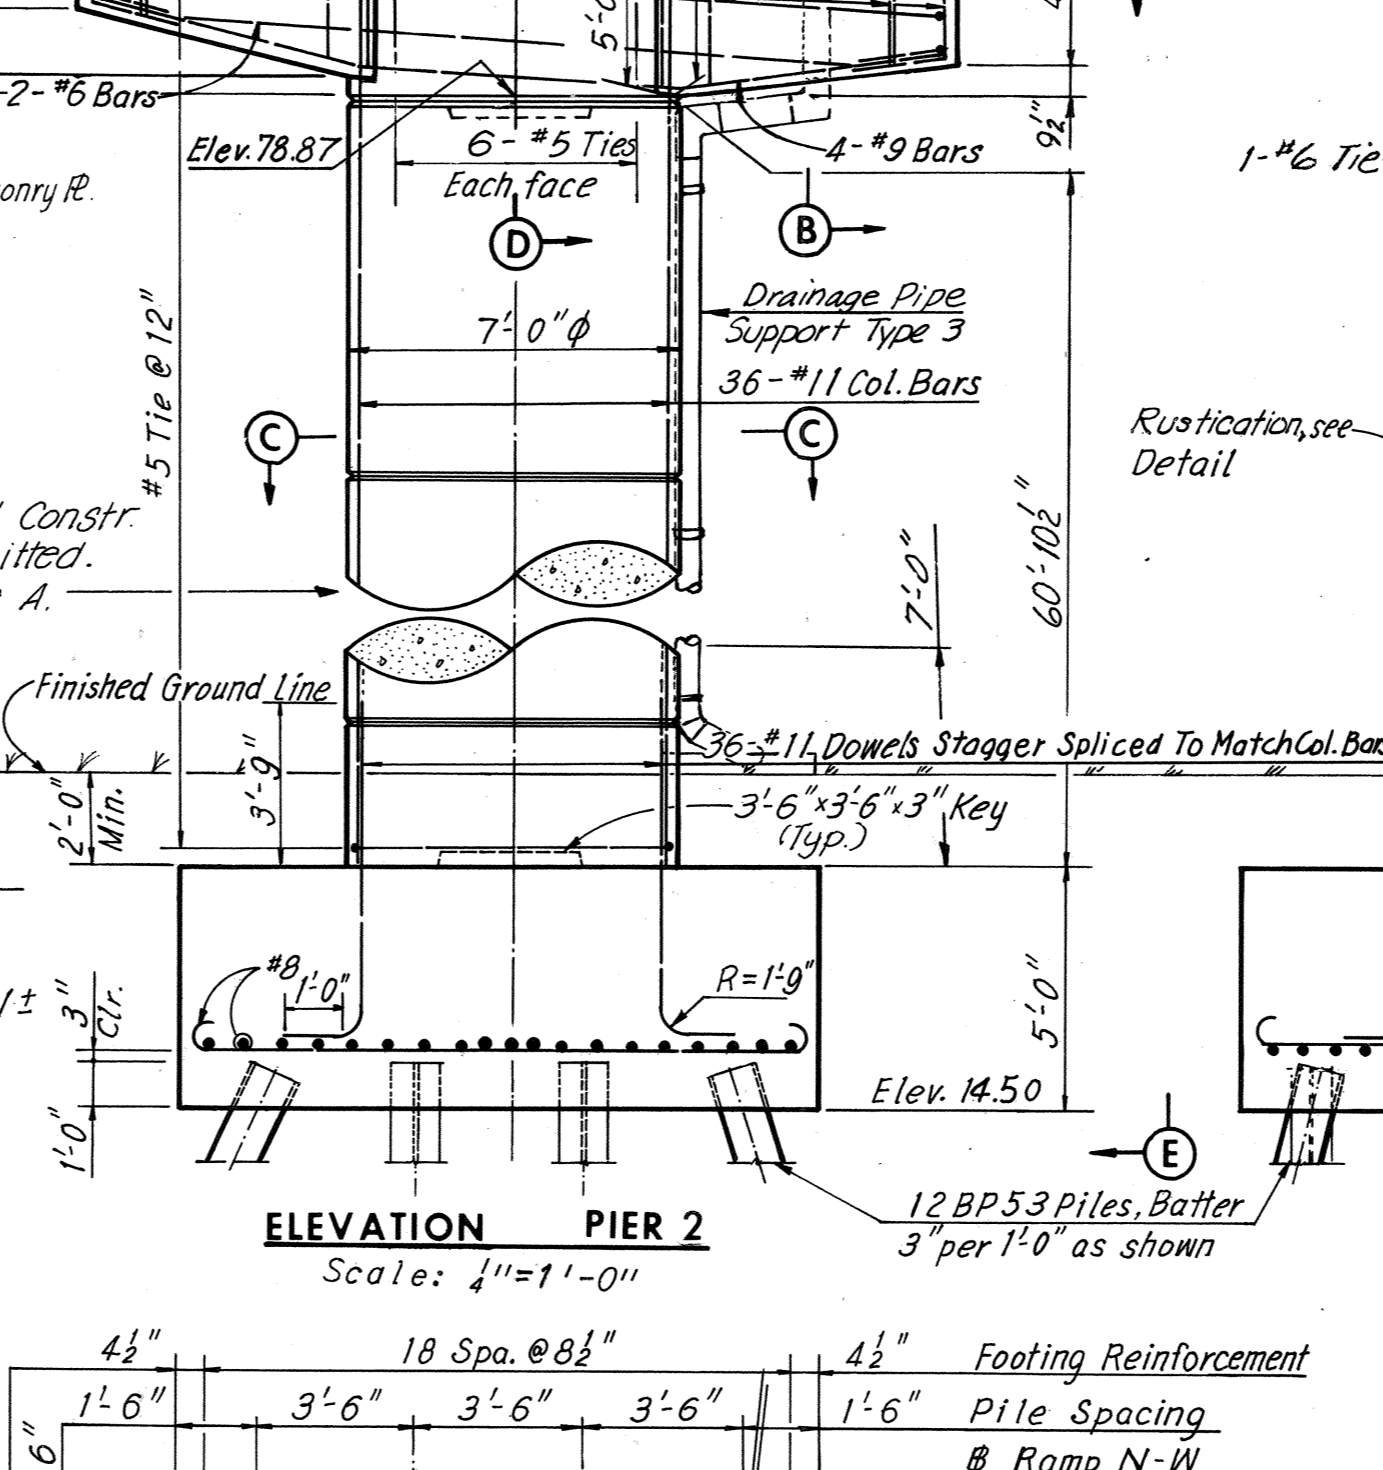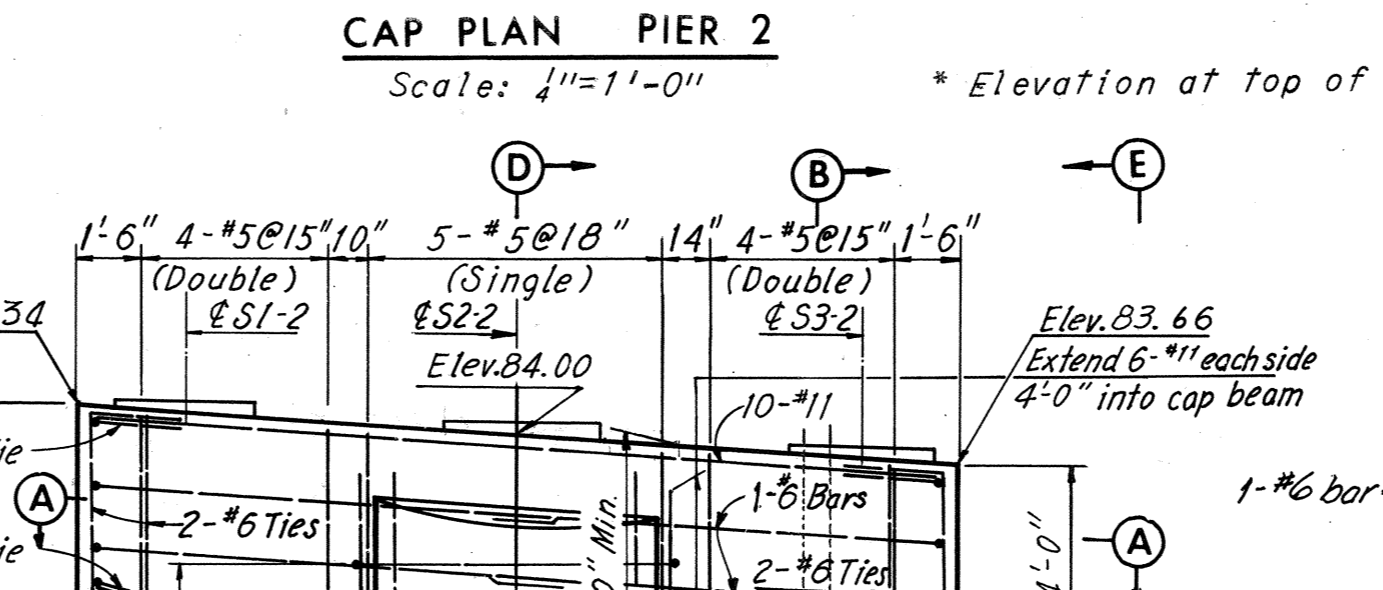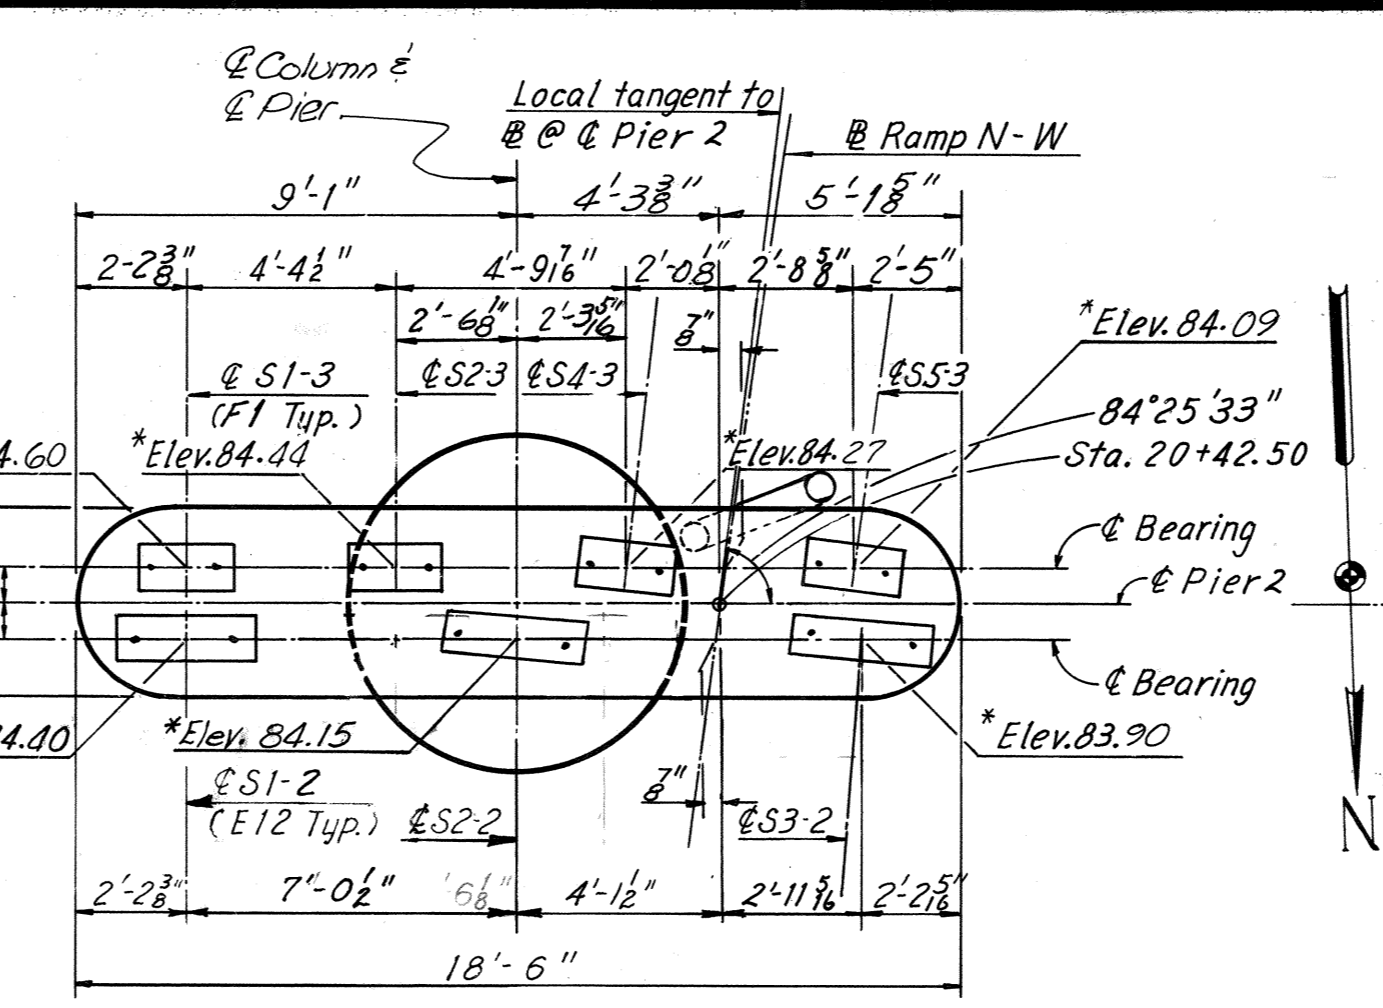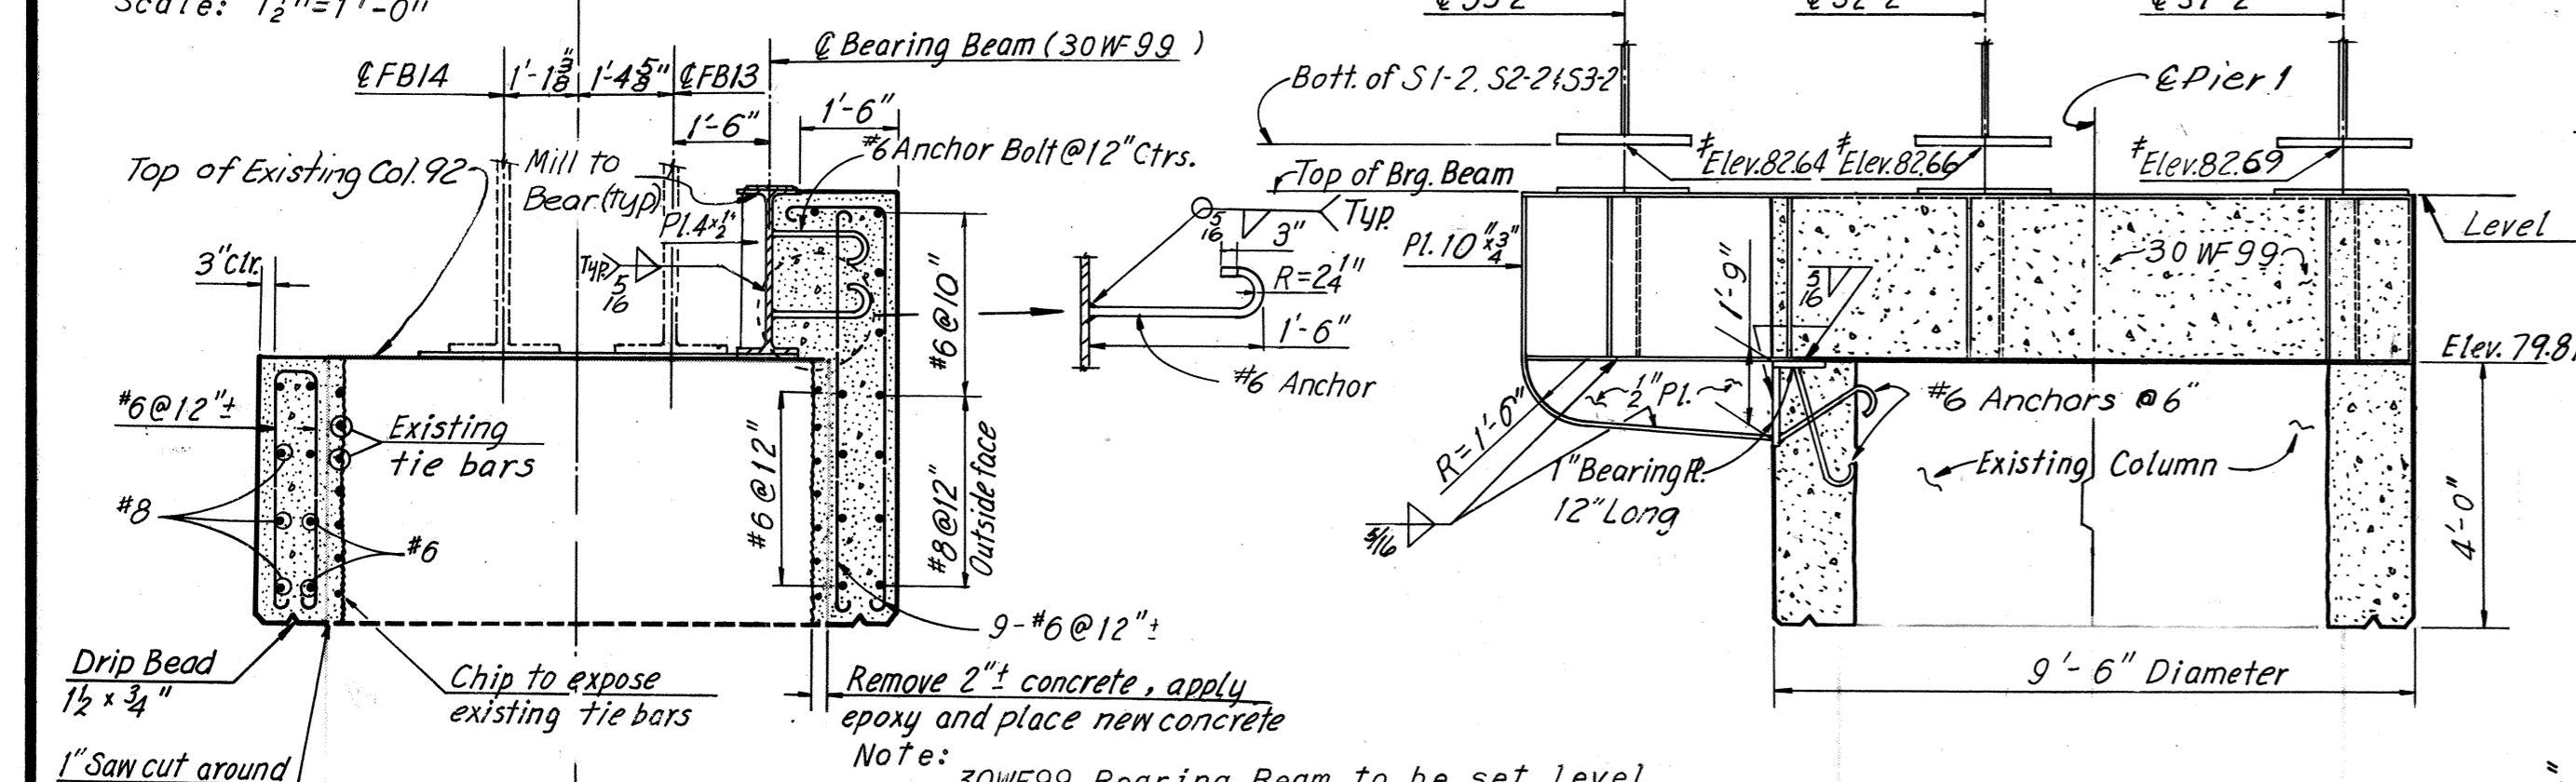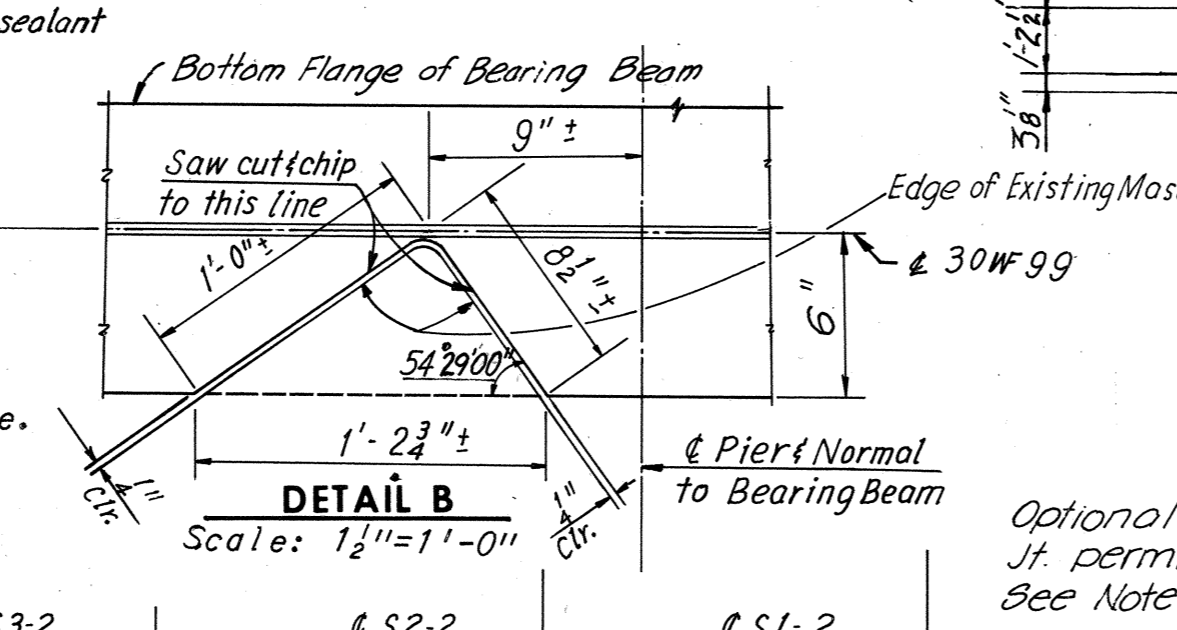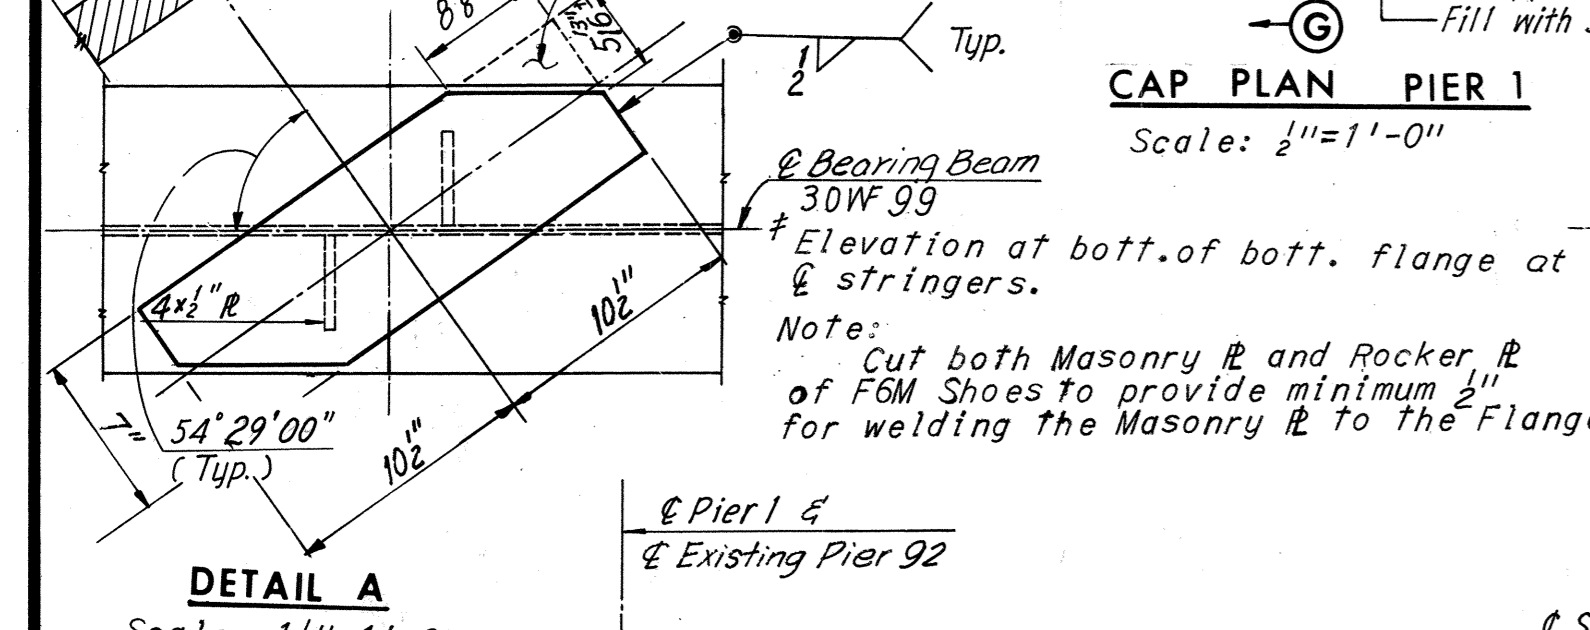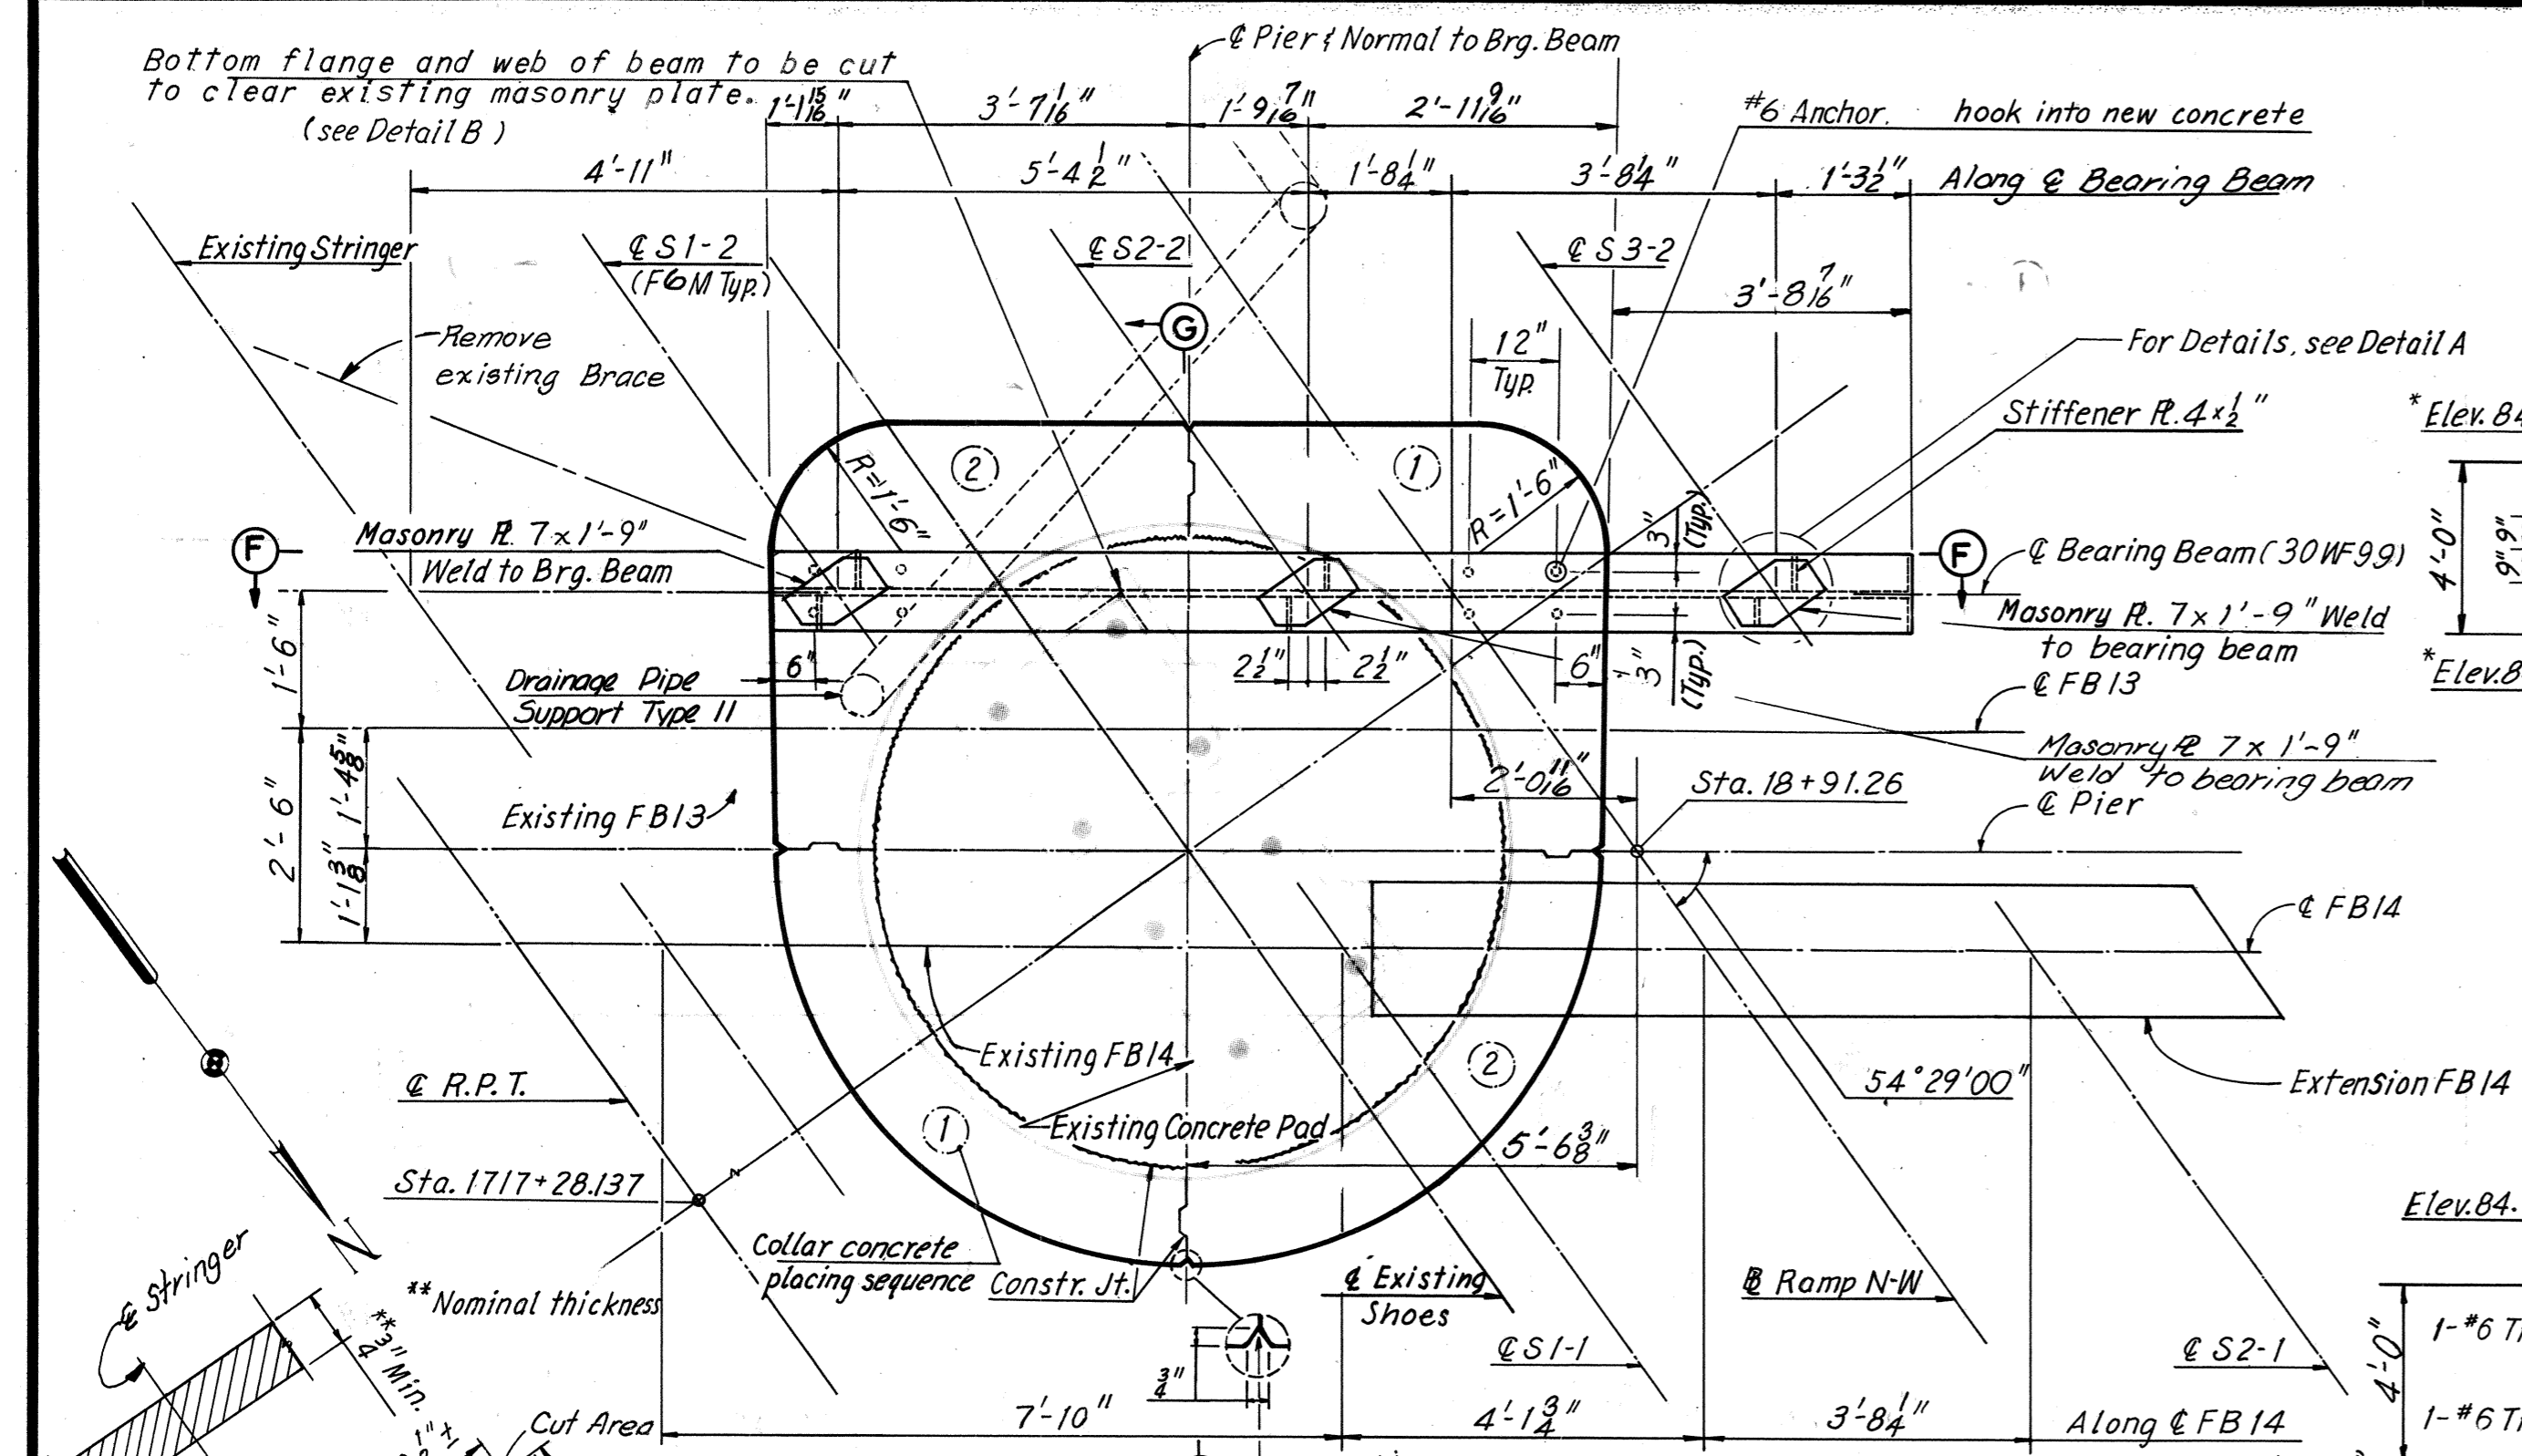

DIMENSIONS FOR PAD AND ANCHOR BOLT SETTING PLAN

Pier	Stringer	d	B	A	B	C	D	E	F	G	H	I	J
1	S1-3	—	90°00'00"	4 1/2"	8"	0	12 1/2"	12 1/2"	5 3/4"	5 3/4"	11 1/2"	25"	8"
	S2-3	—	90°00'00"	4 1/2"	8"	0	12 1/2"	12 1/2"	5 3/4"	5 3/4"	11 1/2"	25"	8"
	S4-3	—	83°42'49"	4 1/2"	7 5/8"	8"	13 3/4"	11 3/4"	7"	4"	11 1/2"	25"	8"
2	S5-3	—	82°00'00"	4 1/2"	7 5/8"	1 1/2"	13 3/4"	11 3/4"	7 3/4"	4"	11 1/2"	25"	8"
	S1-2	90°00'00"	—	4"	14 1/4"	0	18 1/2"	18 1/2"	6 3/4"	6 3/4"	13 3/4"	36 1/2"	14 1/4"
	S2-2	87°14'17"	—	4"	14 3/8"	0	18 1/2"	17 7/8"	6 1/8"	6"	13 3/4"	36 1/2"	14 1/4"
3	S3-2	84°26'56"	—	4"	14 3/8"	1 1/8"	18 3/4"	17 7/8"	8 1/8"	5 1/4"	13 3/4"	36 1/2"	14 1/4"

Note:
For Standard Shoe Details, see Sheets S1 & S2.
For Framing Plan, see Sheets 12 & 13.
For Steel and Concrete Quantities, see Sheet 2.
All piles shall be 12BP53 Steel Pile.
(Design Capacity = 57 Tons.)
Estimated pile tip elevation, Pier 2 = -5.0
For Pile Details, see Sheet 7.
For Details of Extension FB 14, see Sheet 18.
For Standard Drainage Details, see Sheet 56.

RICHMOND METROPOLITAN AUTHORITY
RICHMOND EXPRESSWAY SYSTEM
DOWNTOWN EXPRESSWAY

BRIDGE NO. 64
RAMP N-W CONNECTION FROM
RICHMOND-PETERSBURG TURNPIKE

PIERS 1 AND 2

SCALE: As Noted
HOWARD, NEEDLES, TAMMEN & BERGENDOFF
consulting engineers
CONTRACT NO. 10
NEW YORK ALEXANDRIA KANSAS CITY
SHEET NO. 4 OF 28










4 As Built TEM 4-77

BY	DATE	Angle of Beam	Ref	
MADE	K.C.T. 3-16-69	Number of Girders	R&B 12-30-74	
CHECKED	Y.C.P. 4-24-69	Note Change	TEM 5-74	
IN CHARGE	NO.	REVISION	BY	DATE

Note:
Footing elevations are approximate only and may be varied to suit field conditions as directed by the Engineer. Vertical shaft reinforcing shall not be cut until these elevations are established. Where elevations change more than 2 ft., redesign will be required.

Note to Fabricator:
All Structural Steel for Pier 1 shall be A-36.
Fabricate top of cap beam flat.

AS BUILT

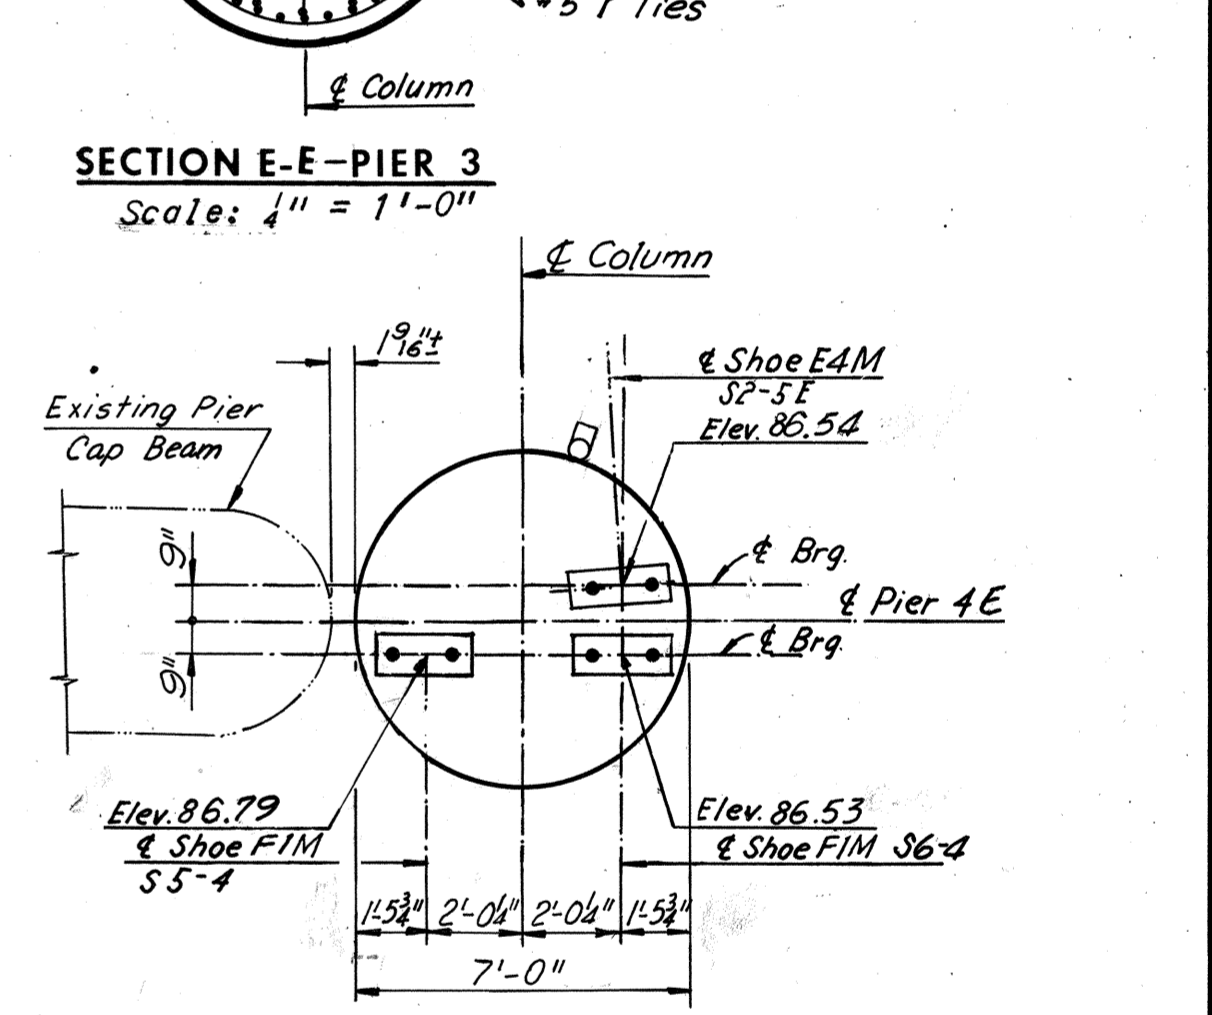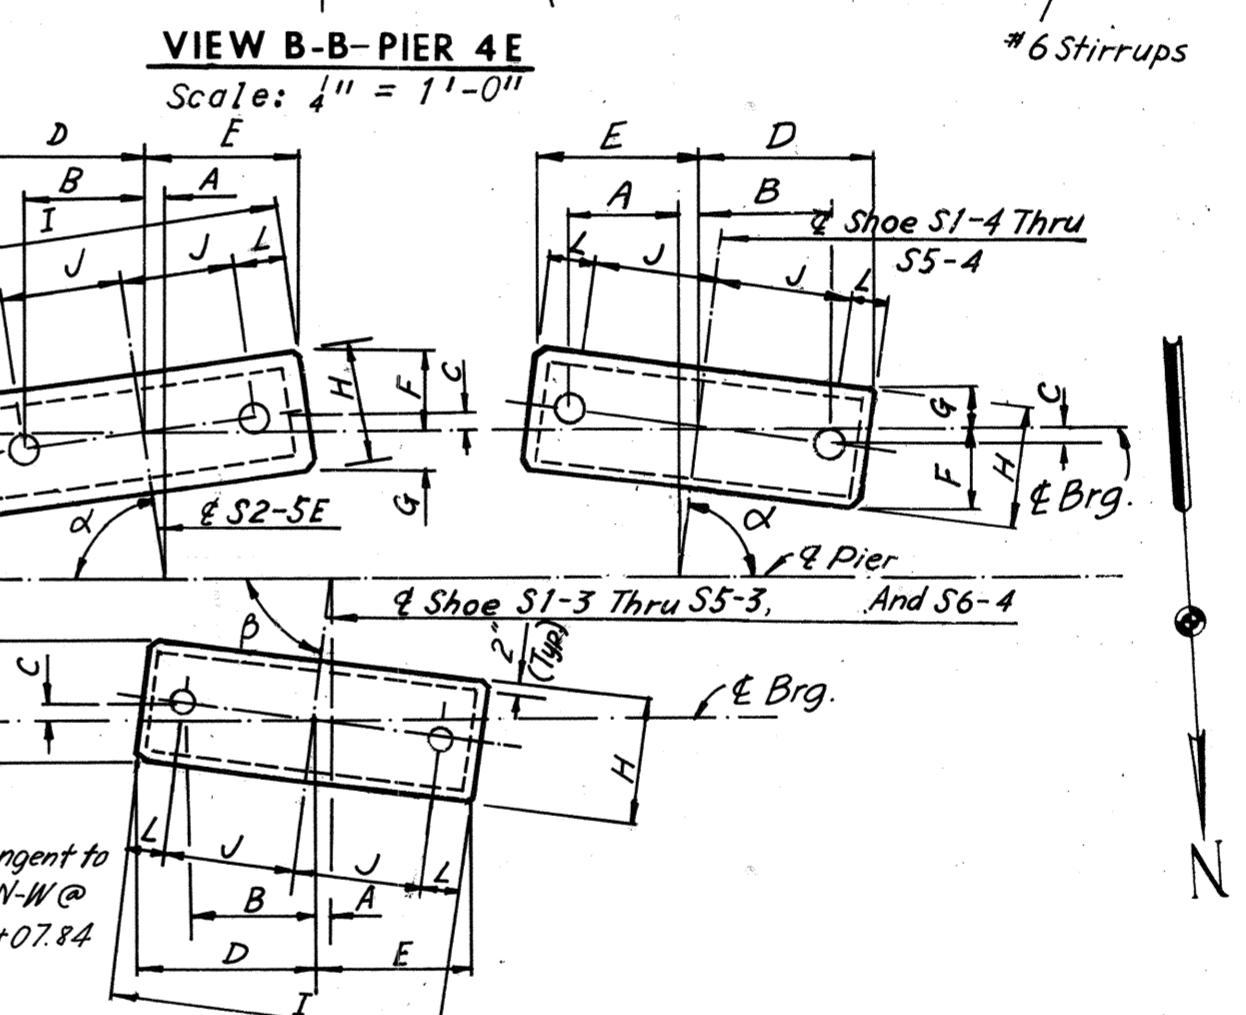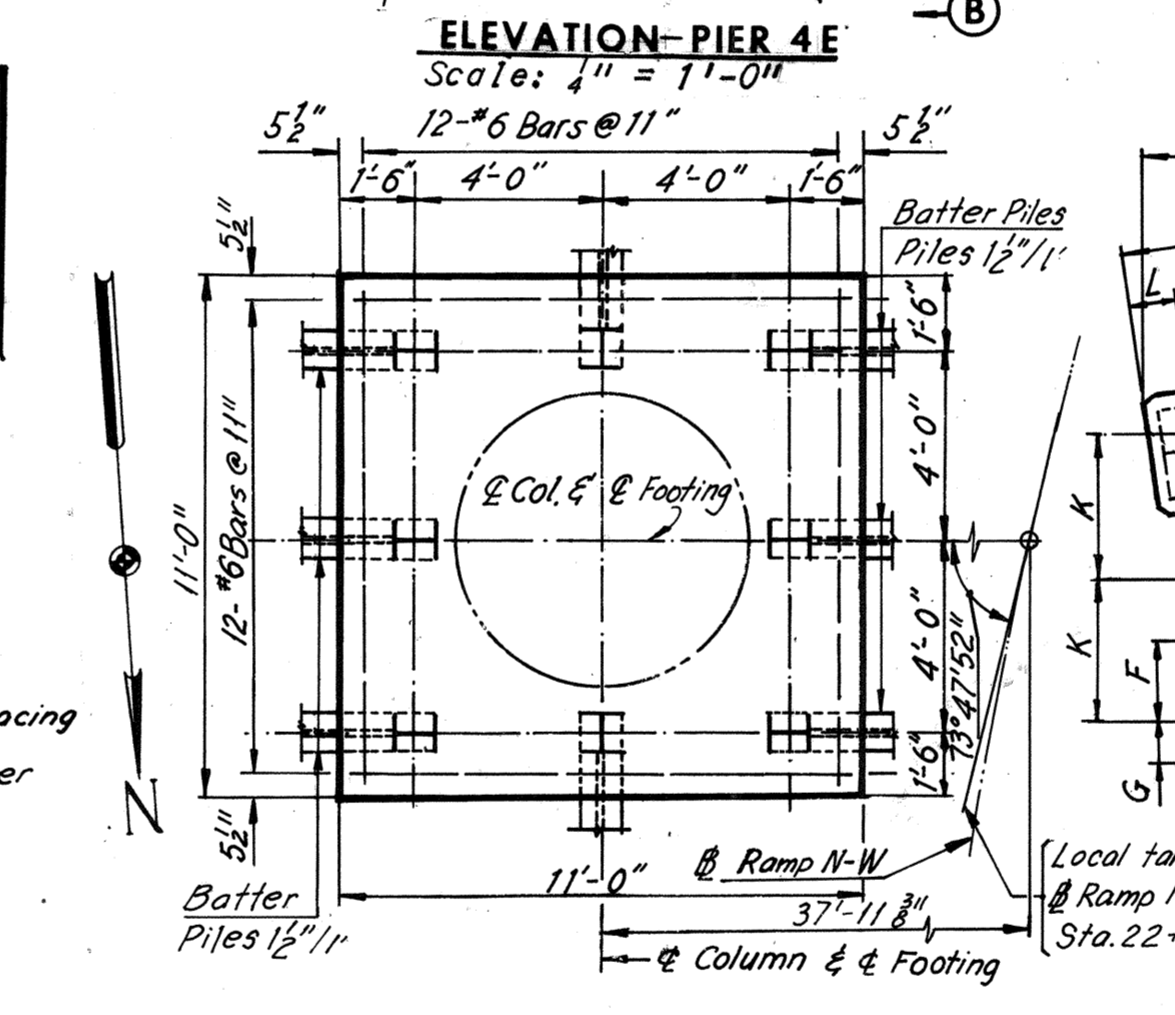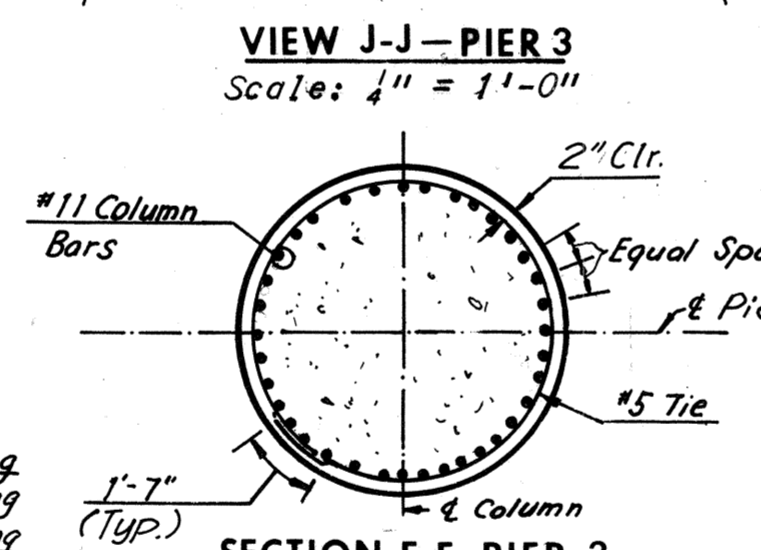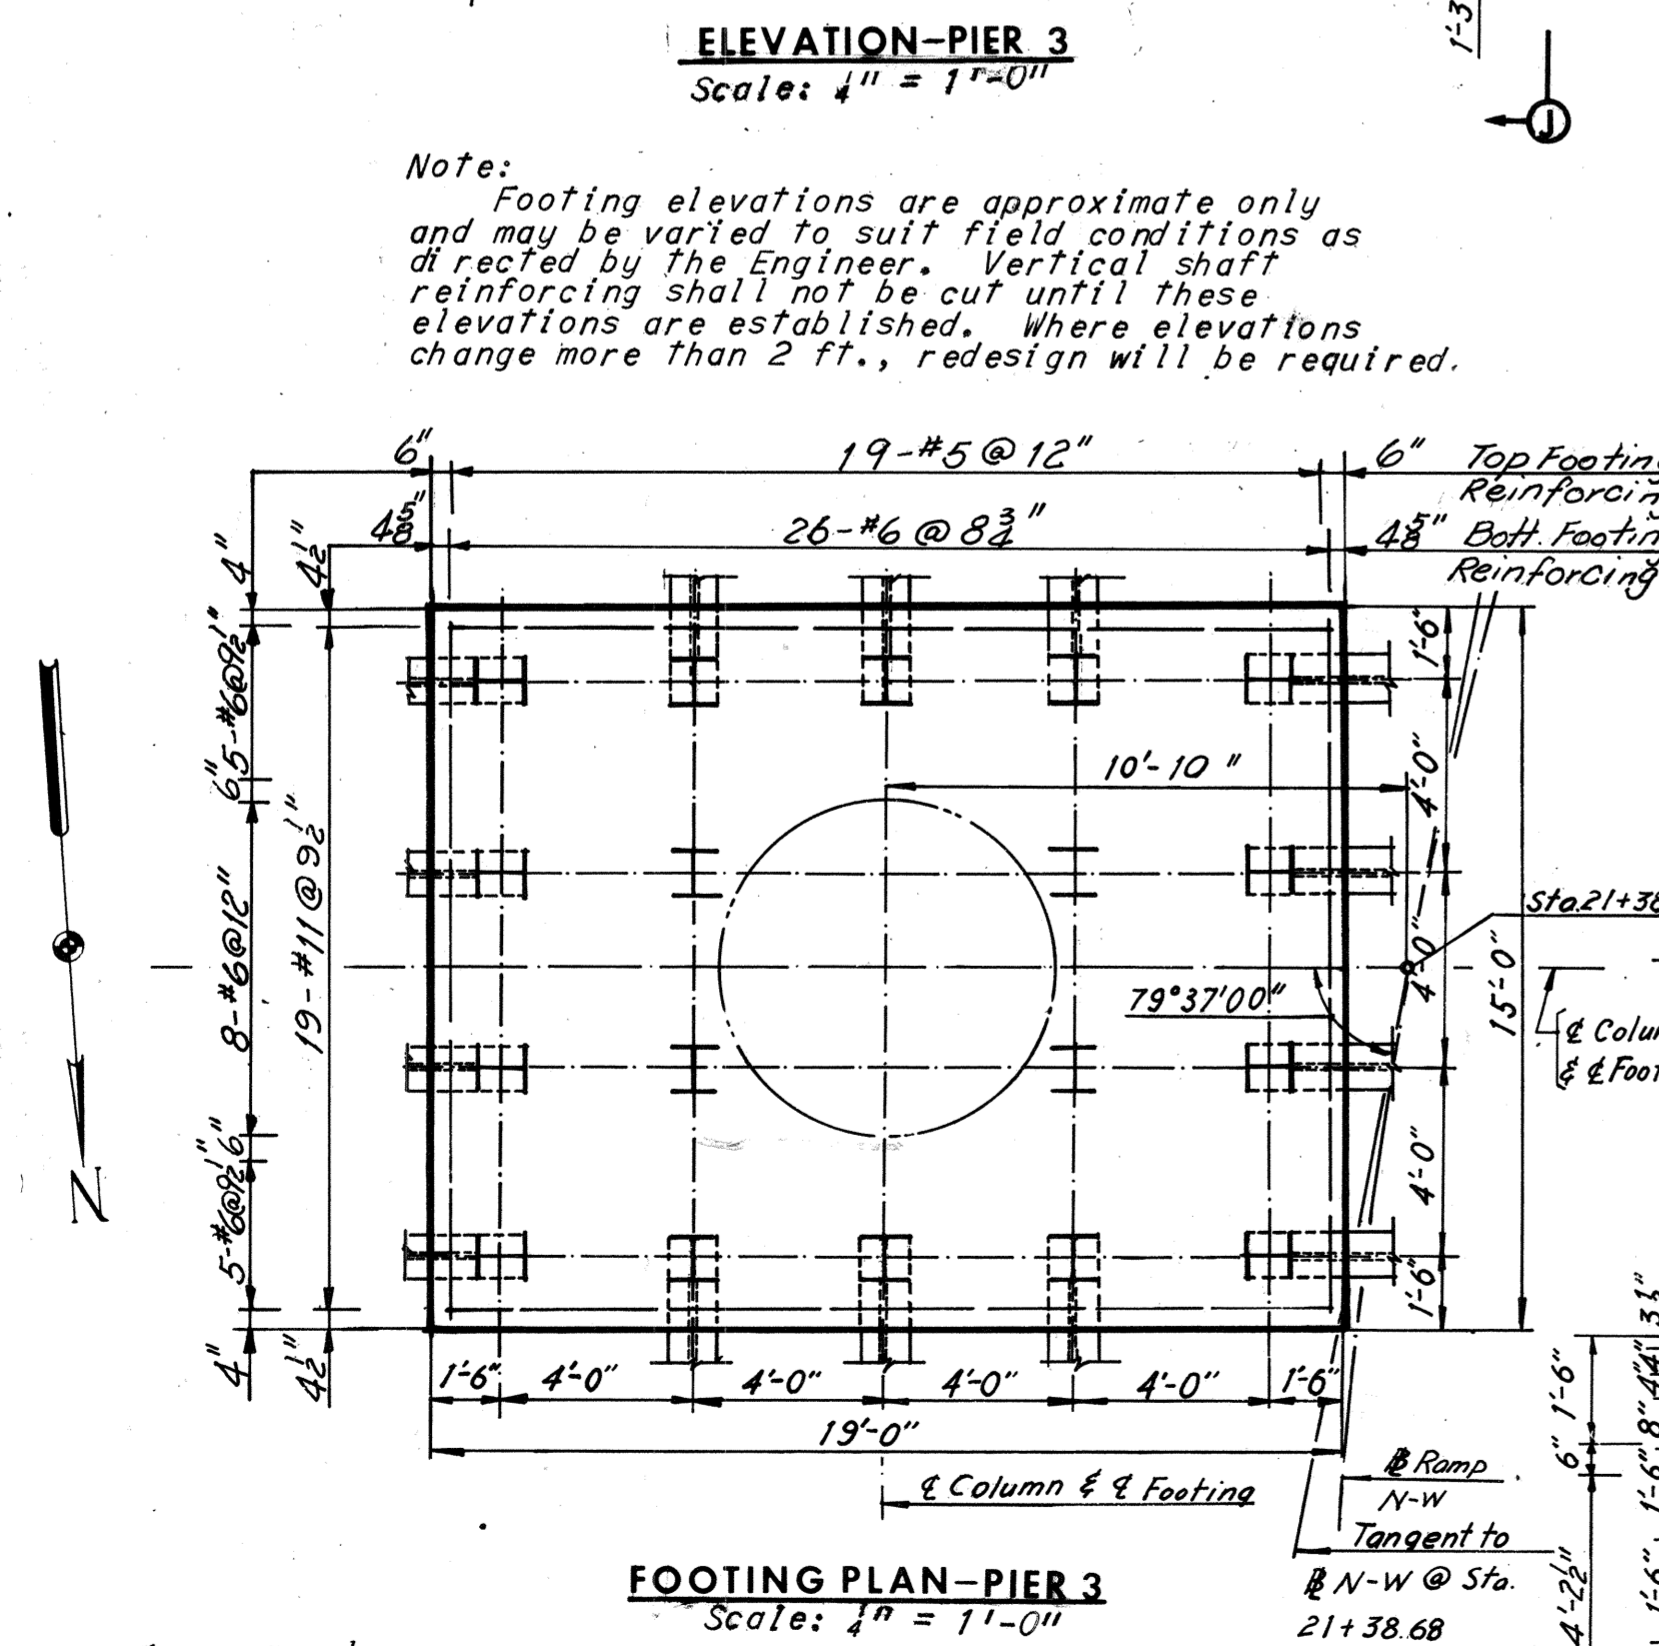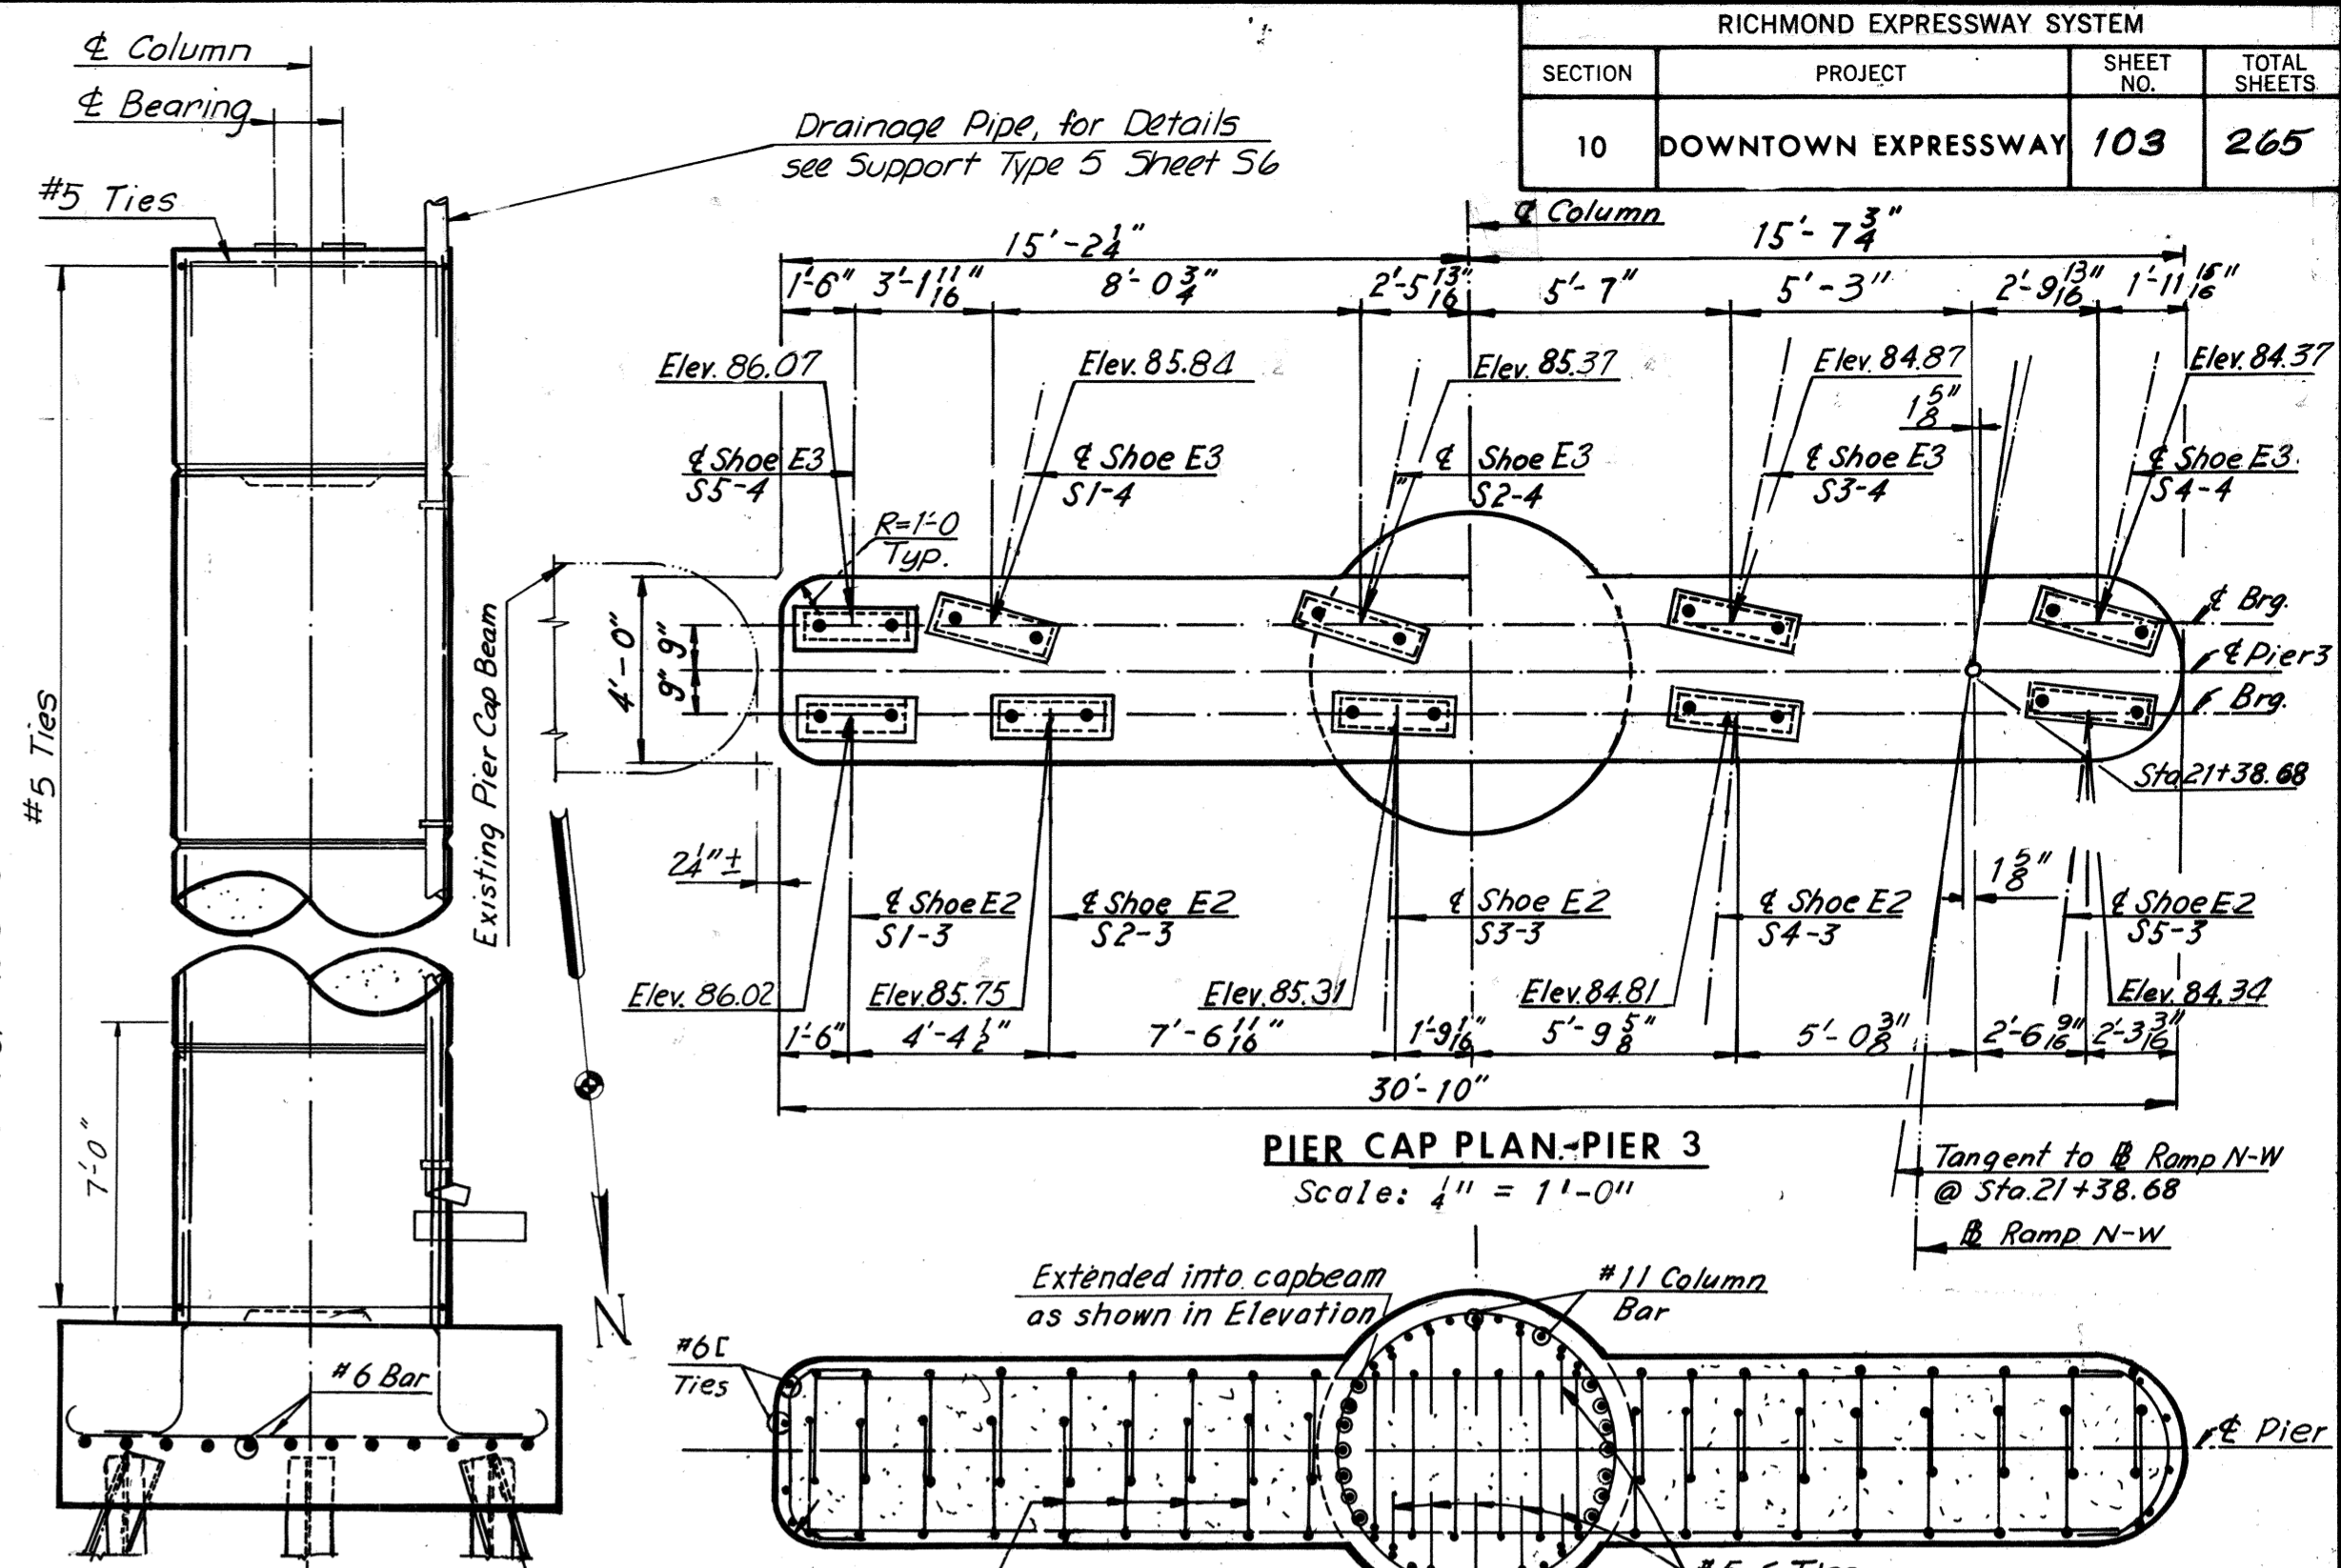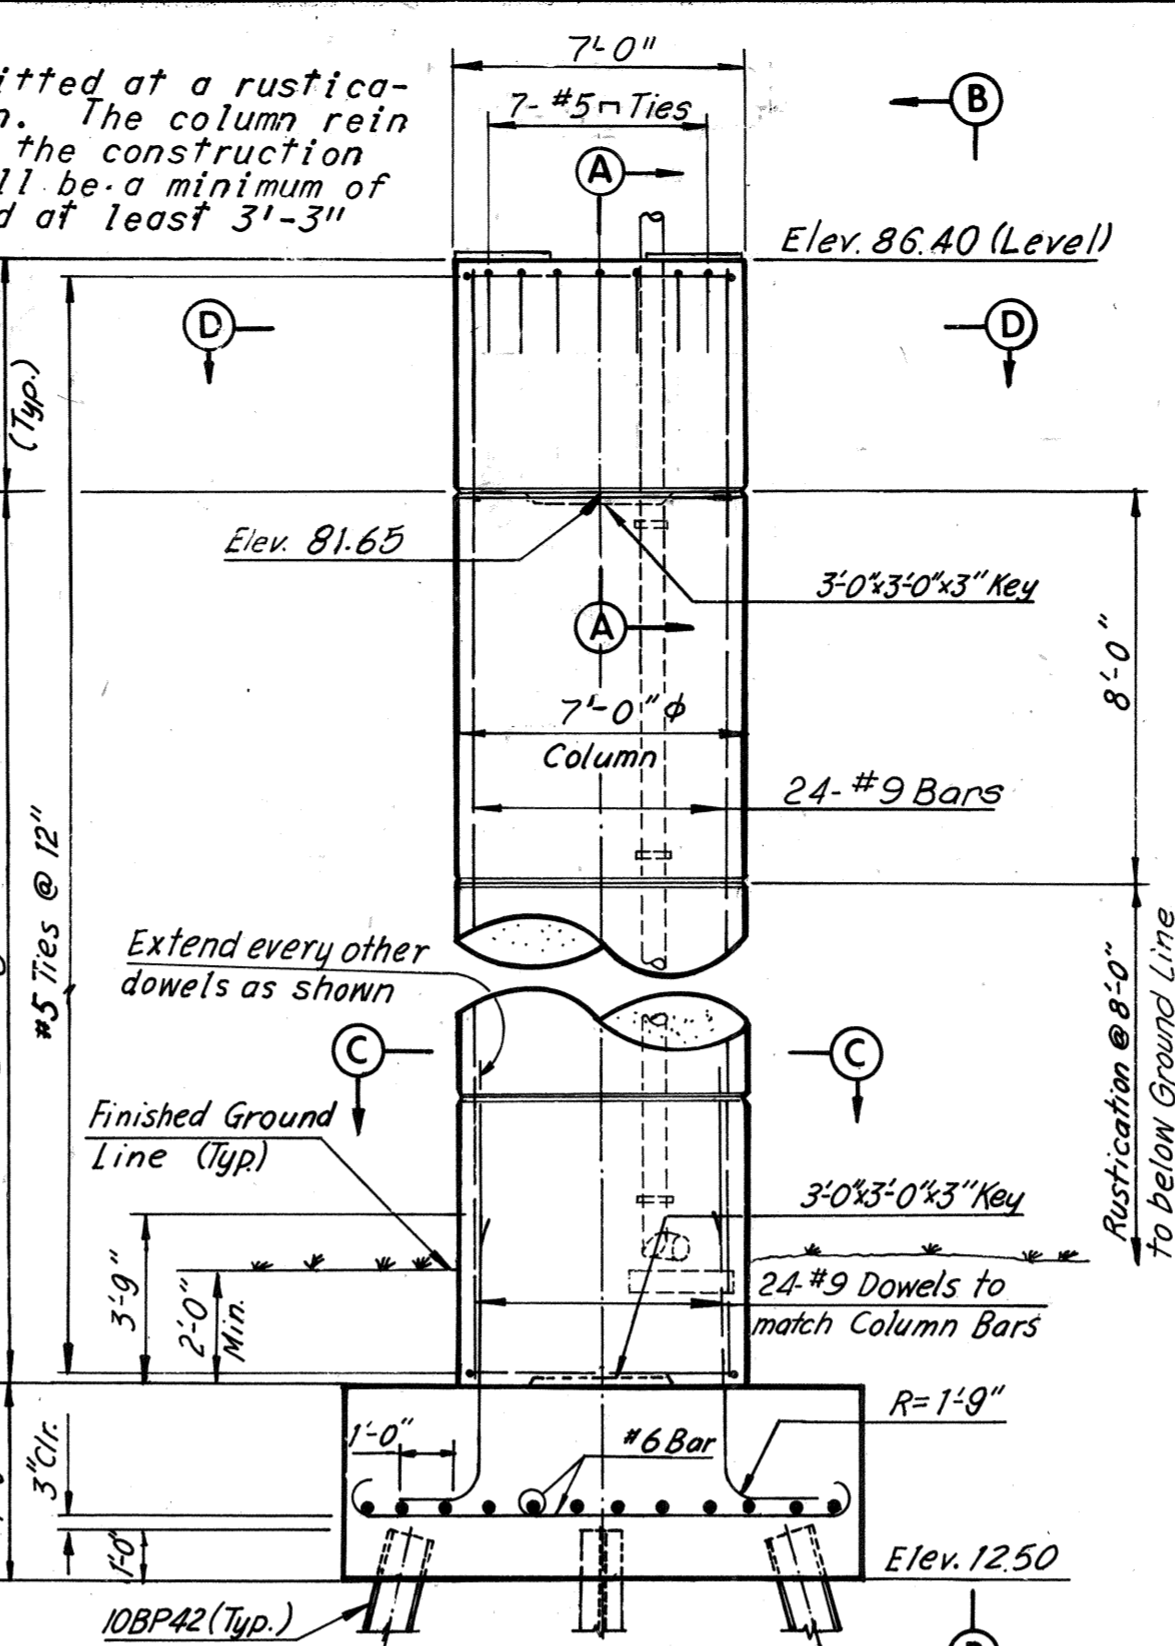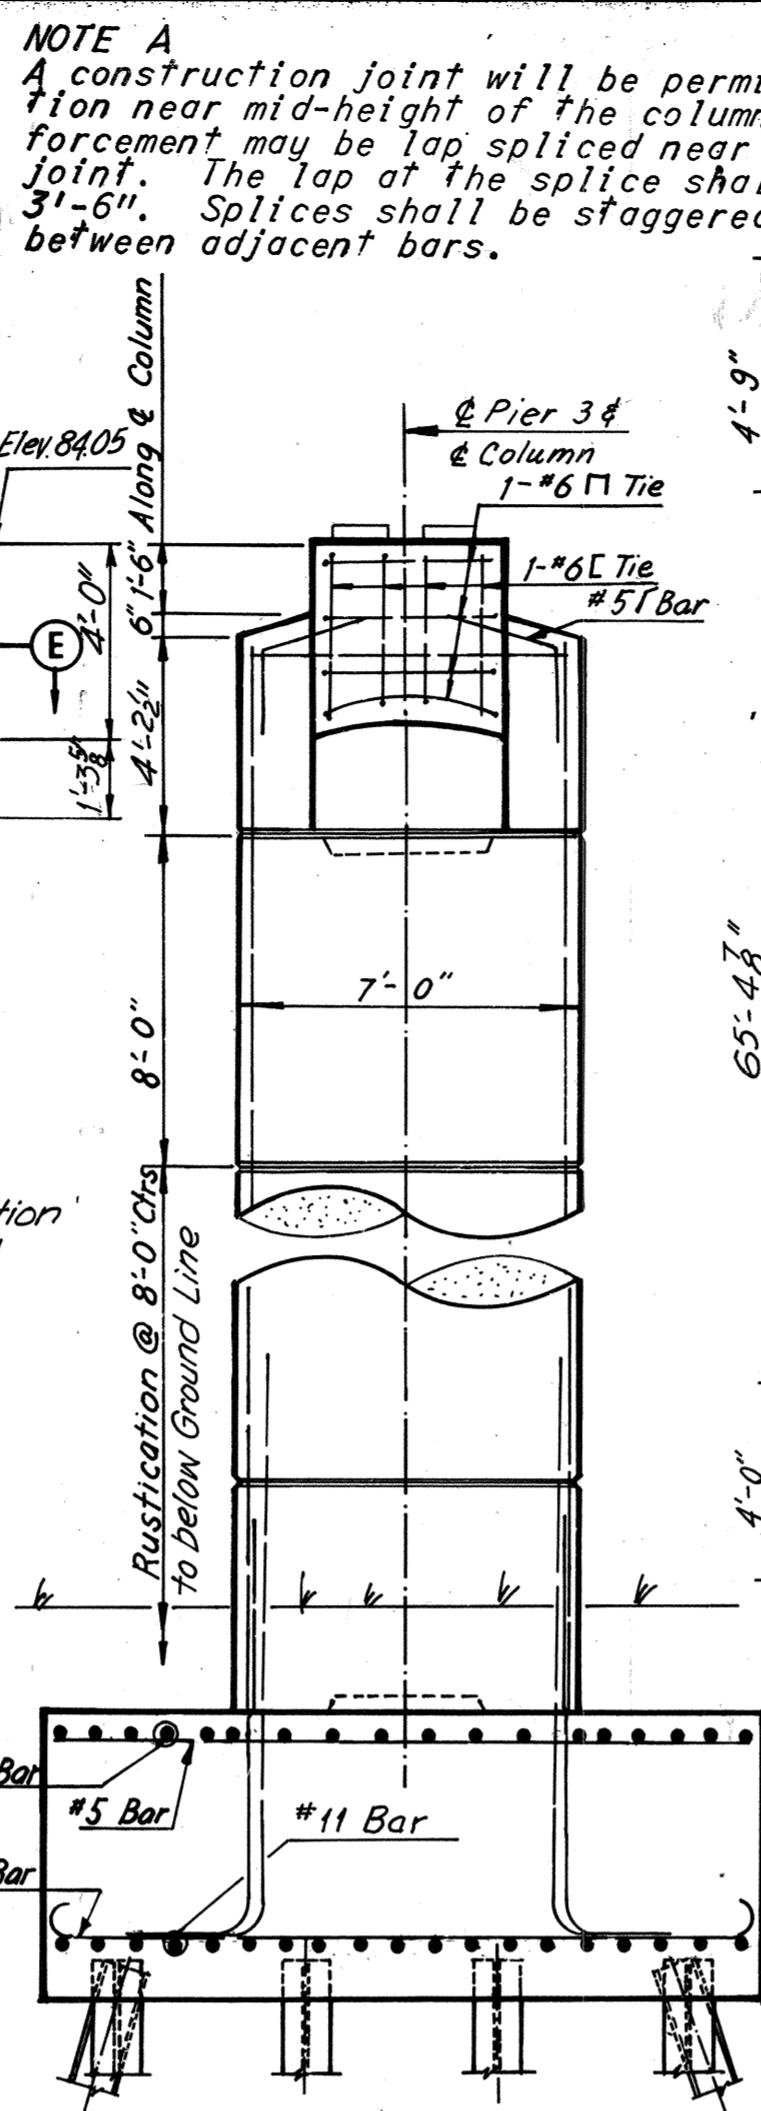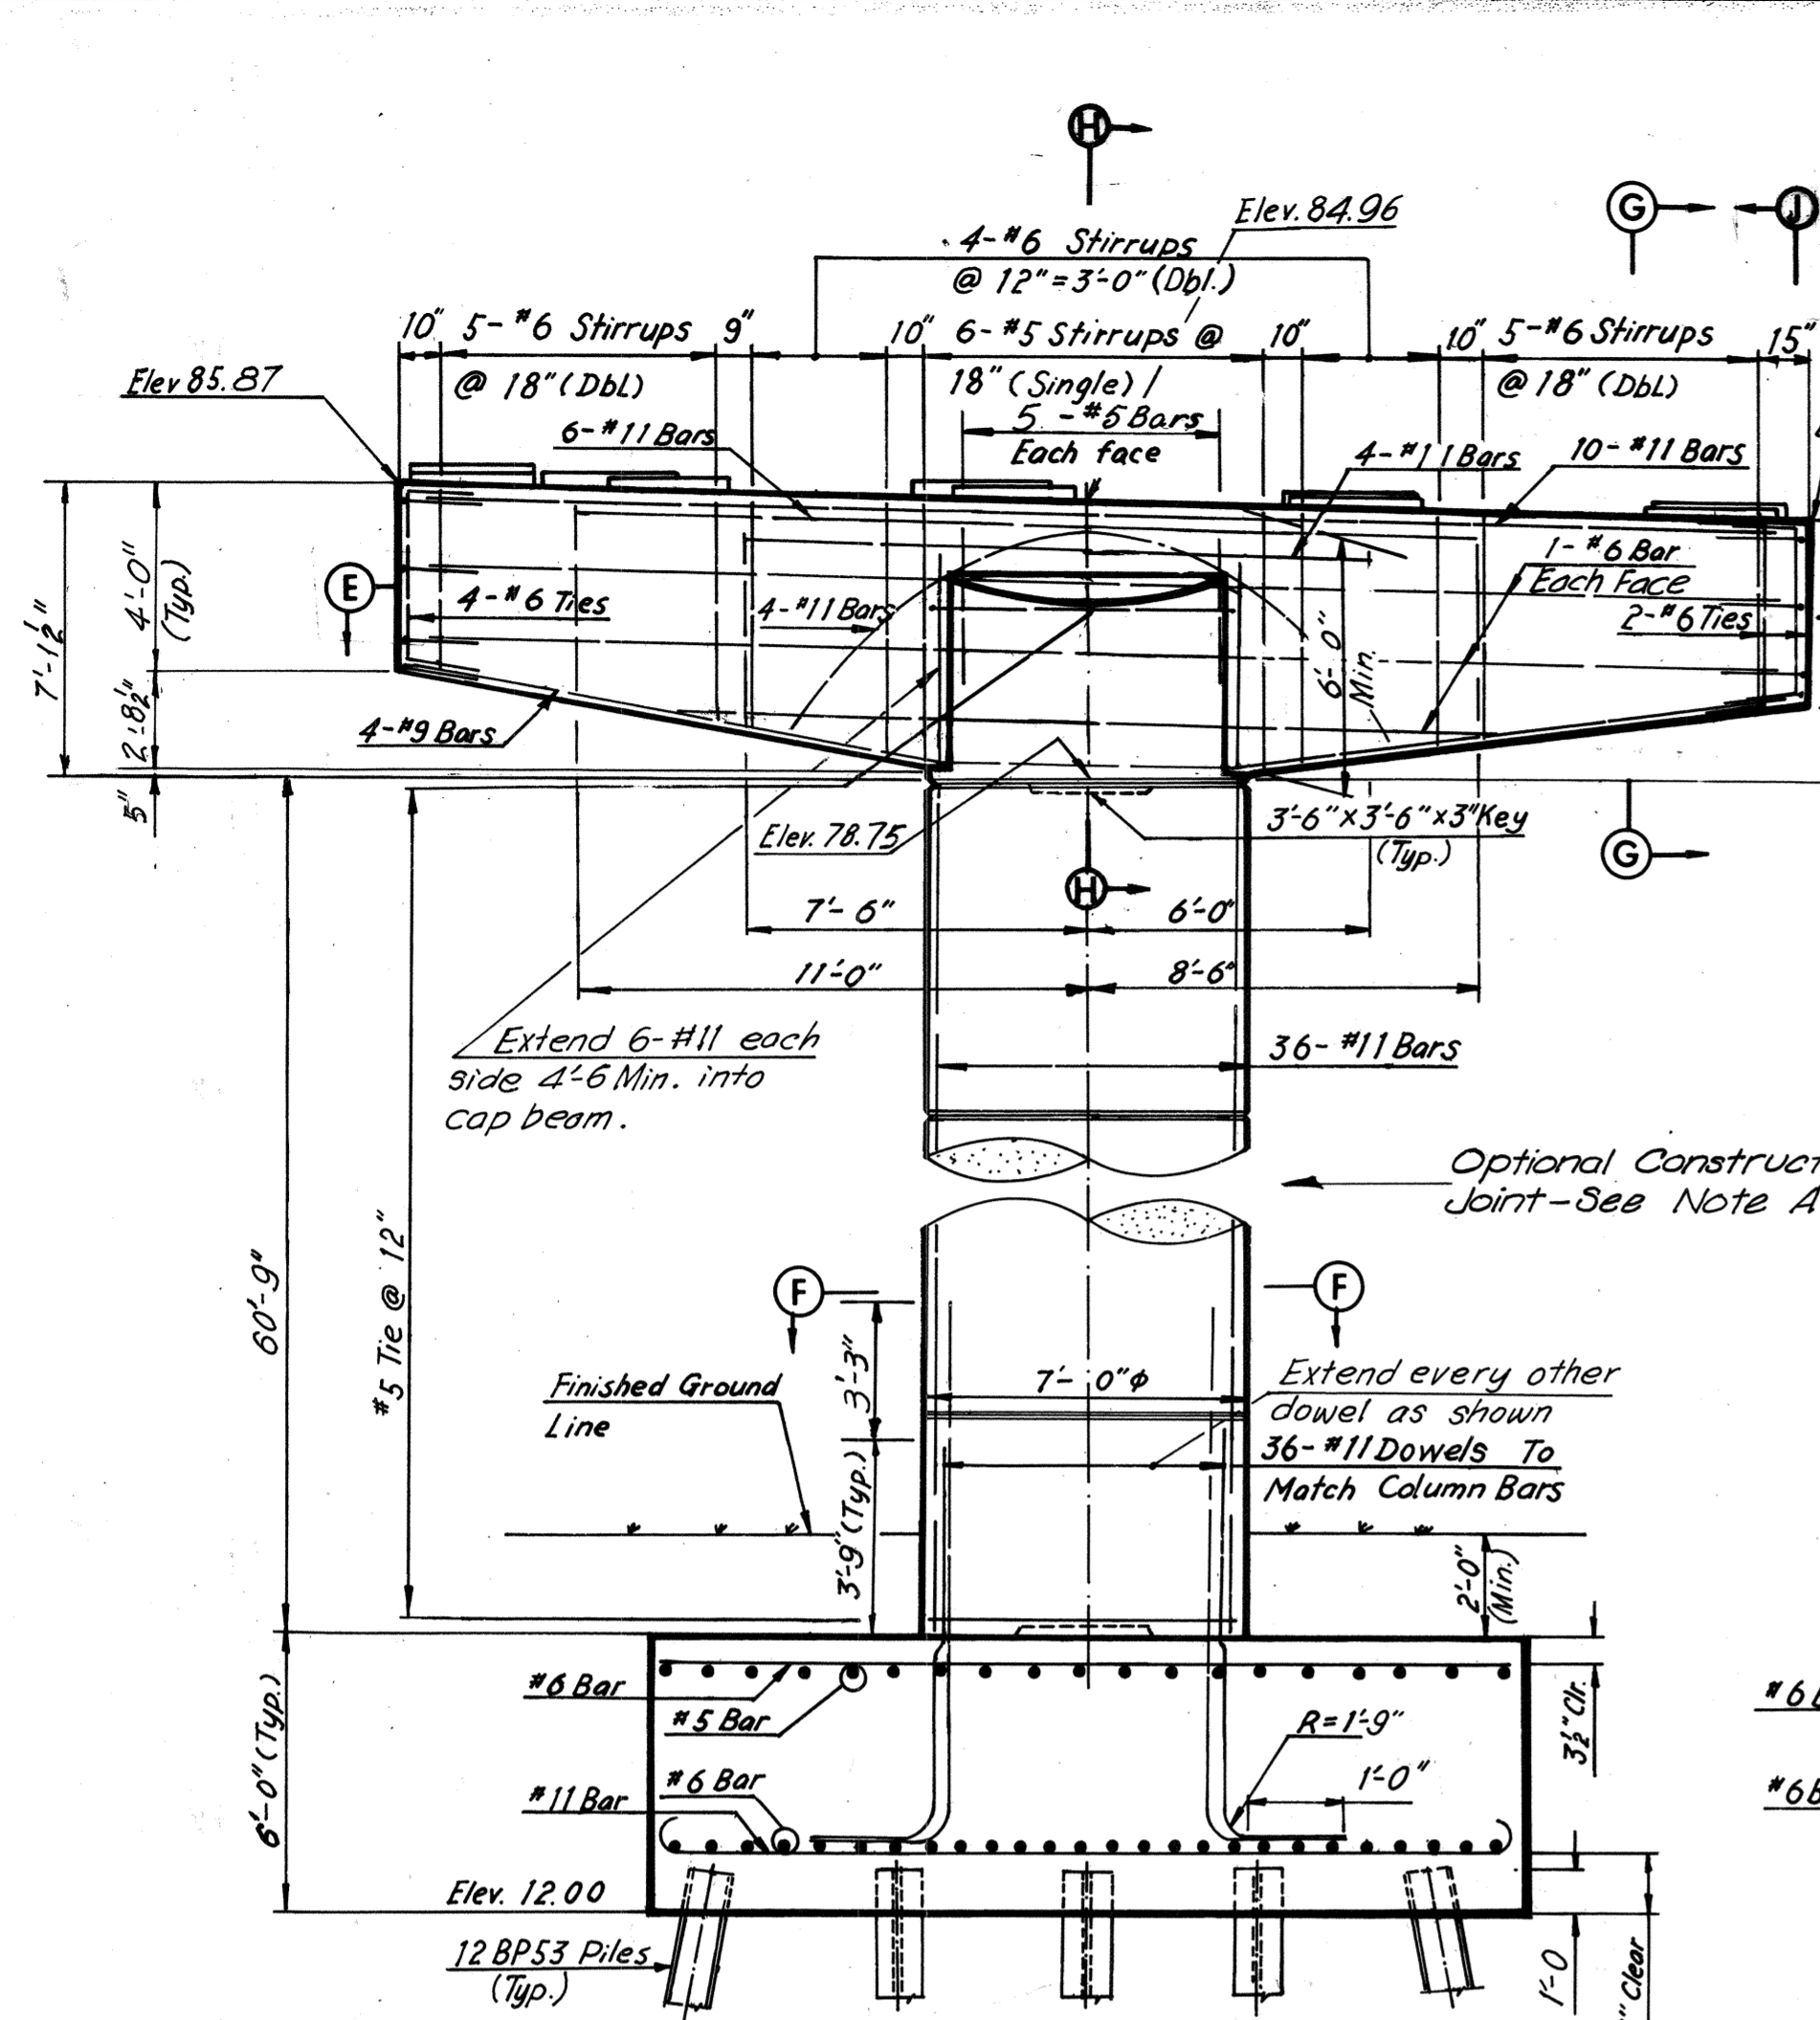

DIMENSIONS OF ANCHOR BOLT SETTING PLAN

Pier	Stringer	α	B	A	B	C	D	E	F	G	H	I	J	K	L
3	S1-3	--	90°00'00"	--	8 1/2"	--	12 1/2"	12 1/2"	6 1/2"	6 1/2"	13"	24 1/2"	8 1/2"	9"	4"
	S2-3	--	90°00'00"	--	8 1/2"	--	12 1/2"	12 1/2"	6 1/2"	6 1/2"	13"	24 1/2"	8 1/2"	9"	4"
	S3-3	--	86°50'50"	1 1/2"	8 1/2"	7 1/2"	12 1/2"	11 1/2"	7 1/2"	5 1/2"	13"	24 1/2"	8 1/2"	9"	4"
	S4-3	--	83°42'49"	1 1/2"	8 1/2"	8 1/2"	12 1/2"	11 1/2"	7 1/2"	5 1/2"	13"	24 1/2"	8 1/2"	9"	4"
	S5-3	--	82°00'00"	1 1/2"	8 1/2"	13"	11 1/2"	8 1/2"	4 1/2"	13"	13"	24 1/2"	8 1/2"	9"	4"
4E	S1-4	77°09'40"	--	6 1/2"	8 1/2"	1 1/2"	14"	11"	9 1/2"	3 3/4"	13 1/2"	25 1/2"	8 3/4"	9"	4"
	S2-4	77°09'40"	--	6 1/2"	8 1/2"	1 1/2"	14"	11"	9 1/2"	3 3/4"	13 1/2"	25 1/2"	8 3/4"	9"	4"
	S3-4	77°09'40"	--	6 1/2"	8 1/2"	1 1/2"	14"	11"	9 1/2"	3 3/4"	13 1/2"	25 1/2"	8 3/4"	9"	4"
	S4-4	77°09'40"	--	6 1/2"	8 1/2"	1 1/2"	14"	11"	9 1/2"	3 3/4"	13 1/2"	25 1/2"	8 3/4"	9"	4"
	S5-4	90°00'00"	--	8 1/2"	--	12 1/2"	12 1/2"	6 1/2"	6 1/2"	13 1/2"	25 1/2"	8 3/4"	9"	4"	4"
4E	S5-4	--	90°00'00"	--	8 1/2"	--	12 1/2"	12 1/2"	6 1/2"	6 1/2"	13 1/2"	25 1/2"	8 3/4"	9"	4"
	S2-5E	87°05'14"	--	7 1/2"	10 1/2"	9 1/2"	14 3/8"	14 3/8"	7"	5 1/2"	12 1/2"	29"	10 1/2"	9"	4"

Notes:
Pier 3 and Pier 4E are made to match existing Pier 86 and 84 respectively, the contractor shall verify the stations. Overexcavation will not be permitted between existing pier and new pier. Estimated pile tip elevations are:
Pier 3: -4.0
Pier 4E: -4.0

Notes:
Piles shall be 2BP53 (Design Capacity = 57 tons), and 10BP42 (Design Capacity = 45 tons) Steel Piles, Location as shown. Batter all piles 3" per foot where shown. For Standard Shoe Detail, see Sheets S1 & S2. For Framing Plan, see Sheets 13 & 14. For Rustication Detail, see Sheet 7. For Steel Pile Details, see Sheet 7. For Quantities of Concrete and Steel, see Sheet 2.

4 As Built TEM G-77

BY	DATE	REVISION	DATE
BY	DATE	REVISION	DATE
MADE	R.C. 3.11.69	Revise Pad Elev. Piers-3&4E	EJM 10-11-74
CHECKED	Y.C.P. 4-25-69	Col. size-Pier 4E	T.E.M. 9-11-74
IN CHARGE	NO.	REVISION	BY DATE

RICHMOND METROPOLITAN AUTHORITY
RICHMOND EXPRESSWAY SYSTEM
DOWNTOWN EXPRESSWAY


BRIDGE NO. 64
RAMP N-W CONNECTION FROM
RICHMOND-PETERSBURG TURNPIKE
PIERS 3 AND 4E

HOWARD, NEEDLES, TAMMEN & BERGENDOFF
consulting engineers
NEW YORK ALEXANDRIA KANSAS CITY

SCALE: As Noted
CONTRACT NO.: 10
SHEET NO. 5 OF 28


AS BUILT

RICHMOND EXPRESSWAY SYSTEM			
SECTION	PROJECT	SHEET NO.	TOTAL SHEETS
10.	DOWNTOWN EXPRESSWAY	104	265

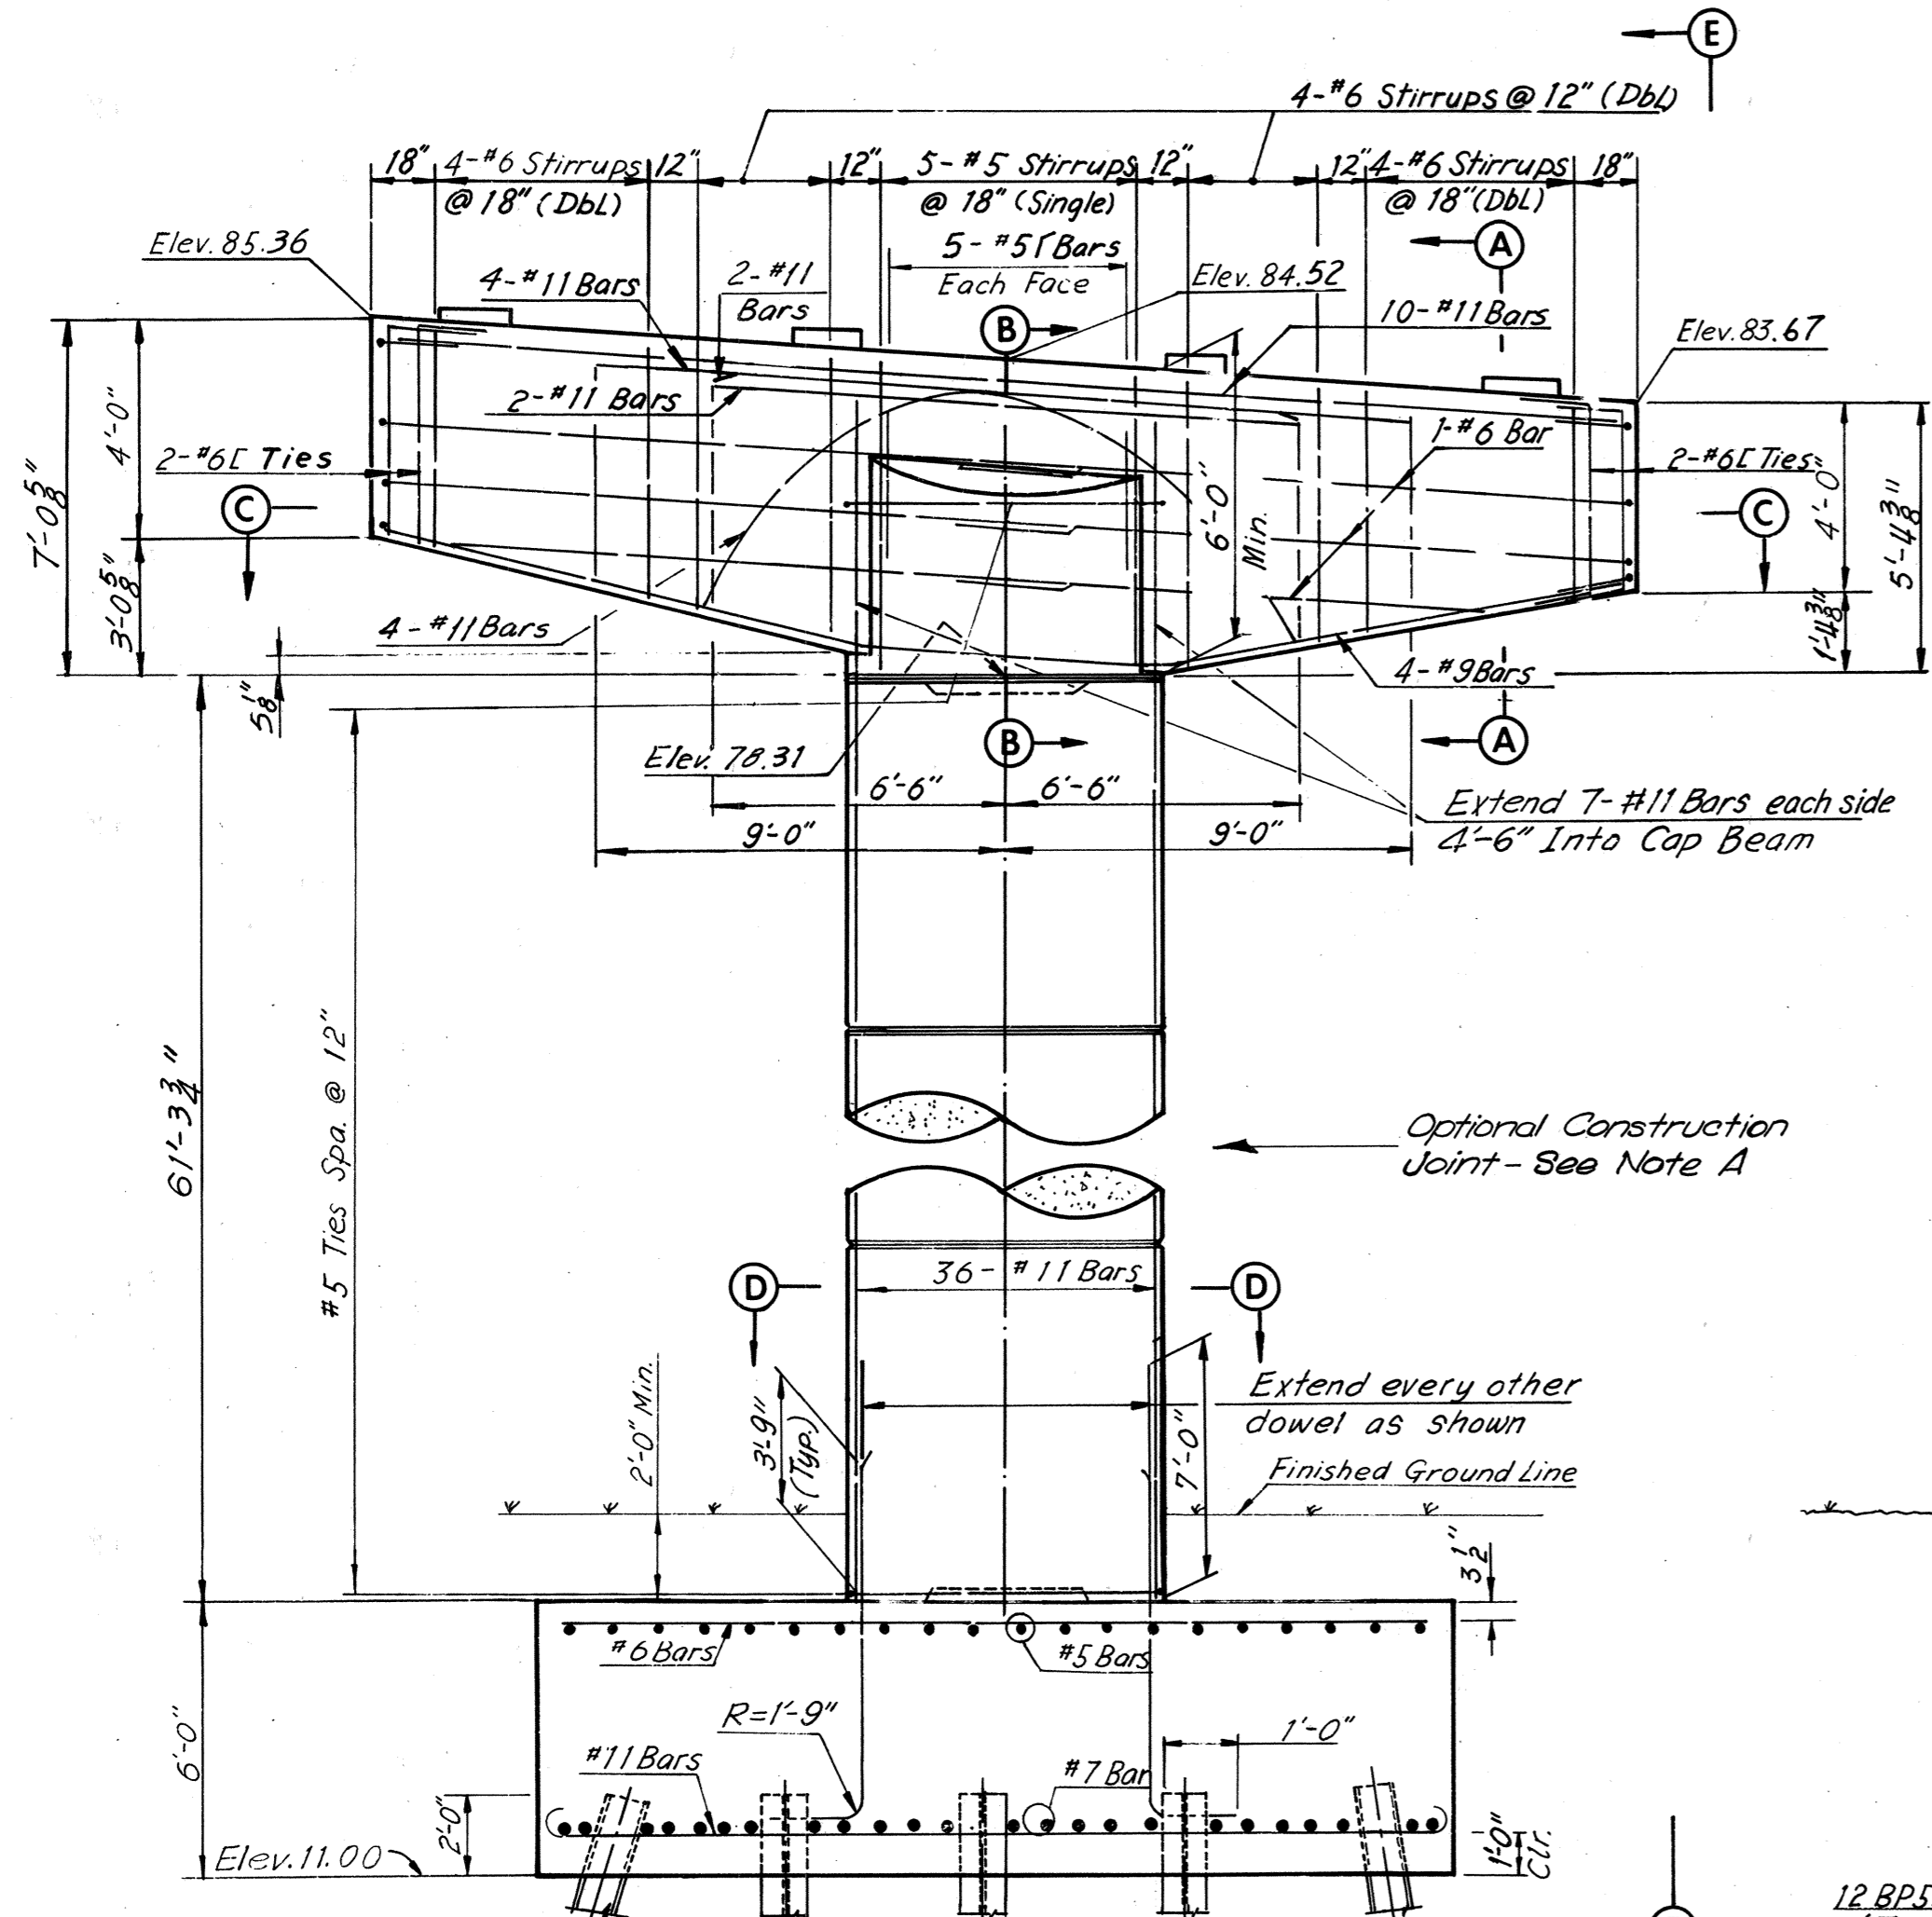


ELEVATION
Scale: 1/4" = 1'-0"


NOTE A
A construction joint will be permitted at a rustication near mid-height of the column. The column reinforcement may be lap spliced near the construction joint. The lap at the splice shall be a minimum of 3'-6". Splices shall be staggered at least 3'-3" between adjacent bars.

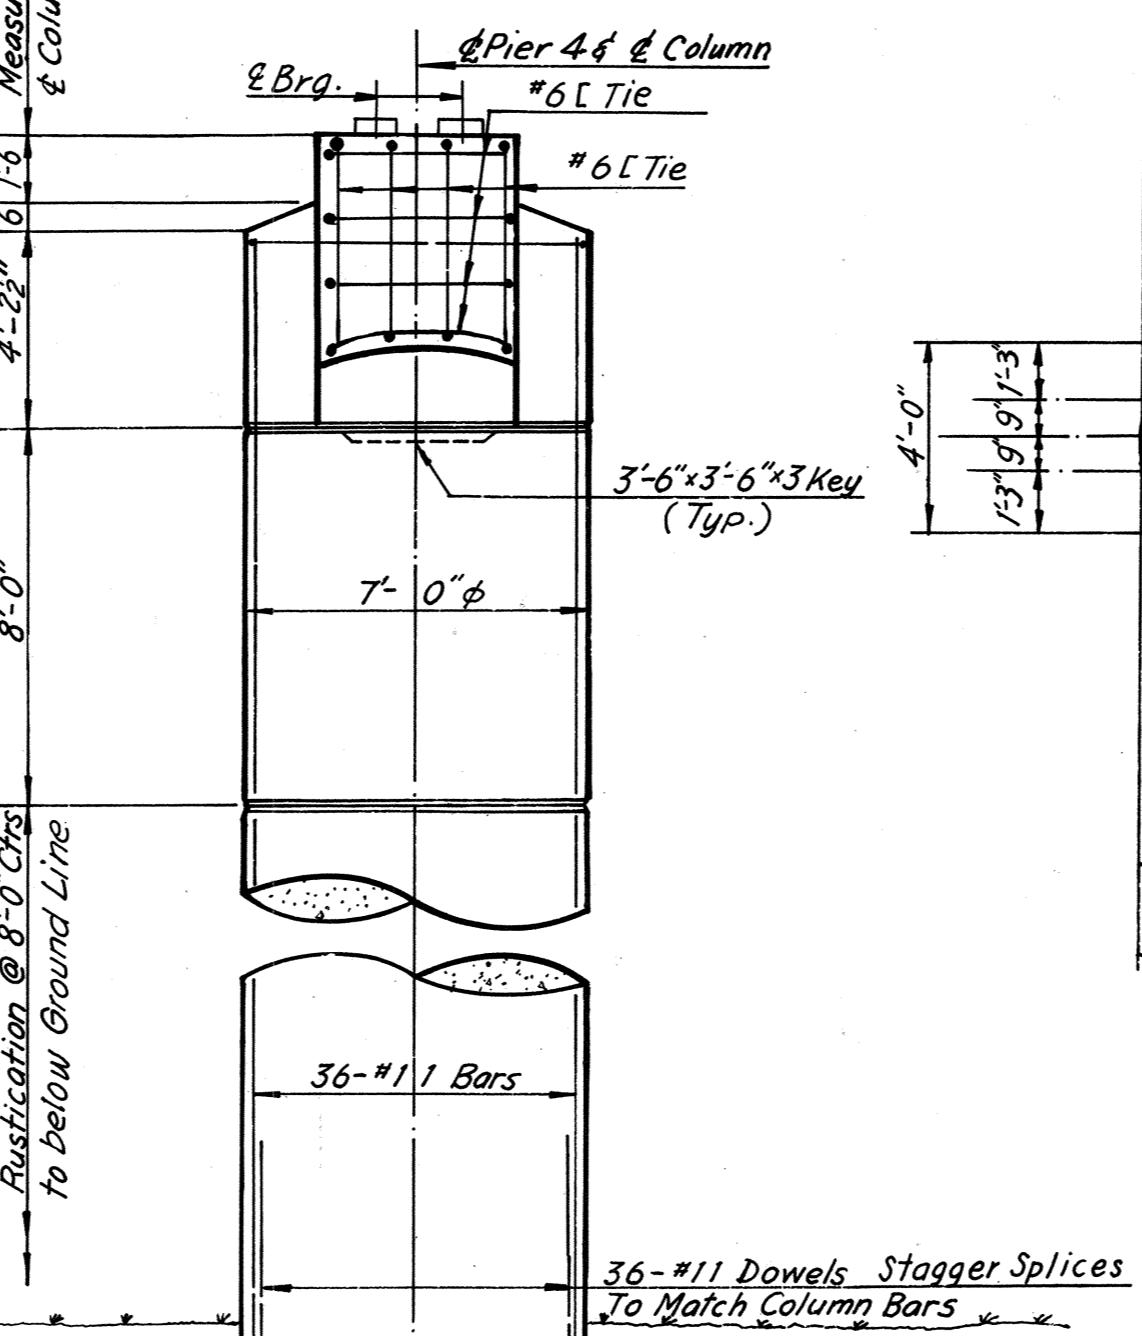


VIEW E-E
Scale: 1/4" = 1'-0"

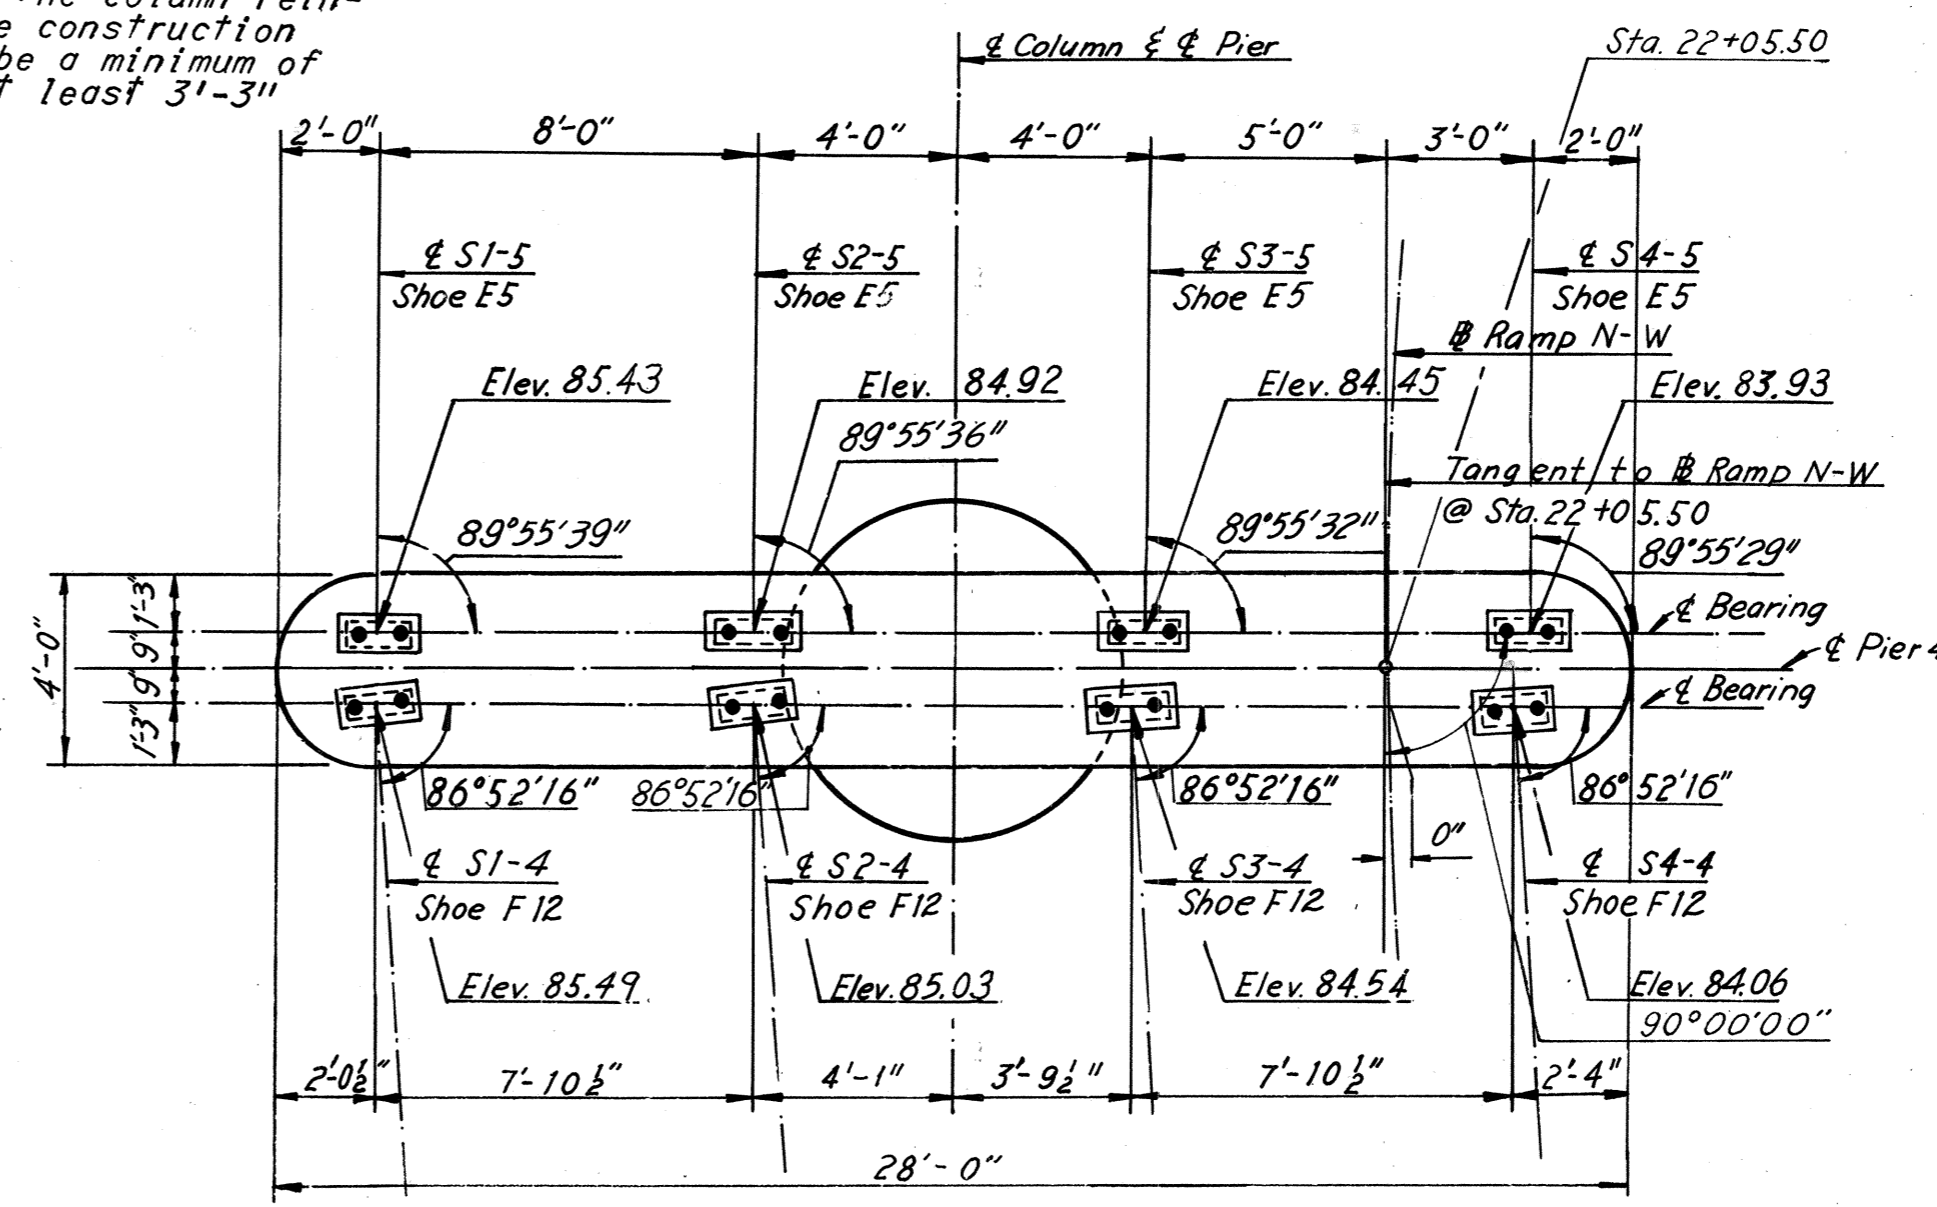


CAP PLAN
Scale: 1/4" = 1'-0"

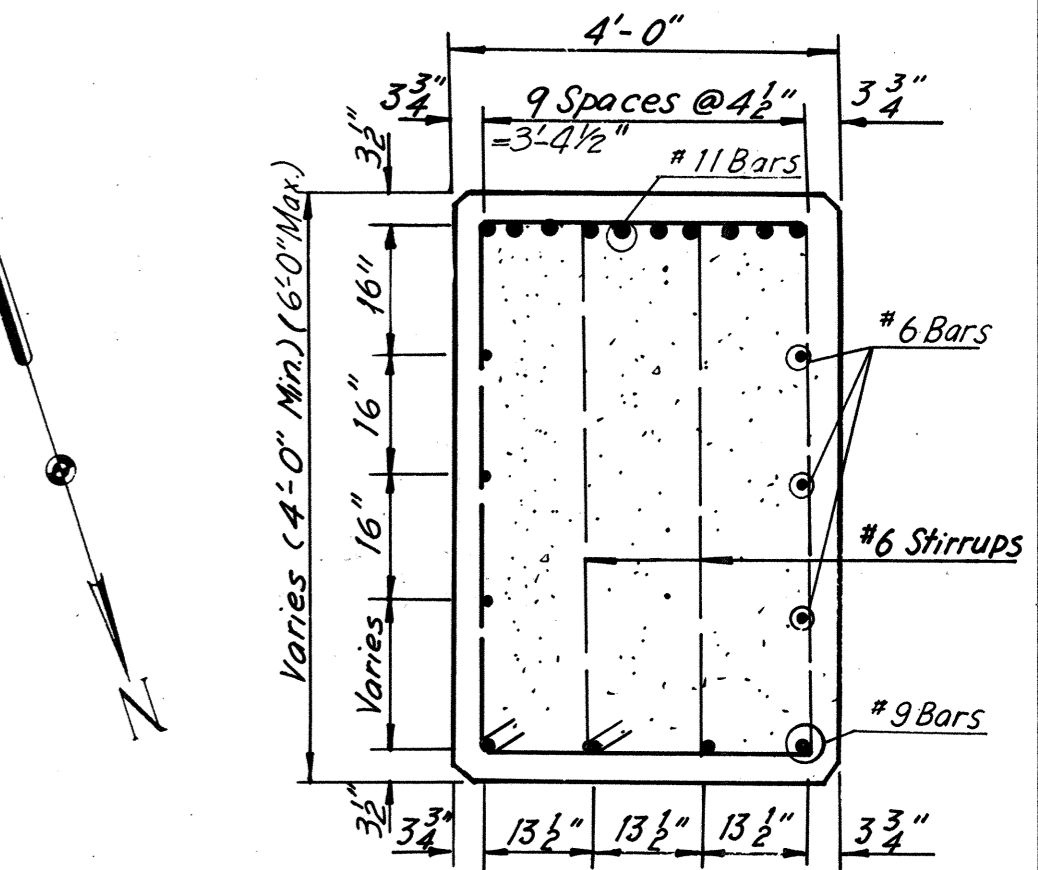


SECTION A-A
Scale: 1/4" = 1'-0"

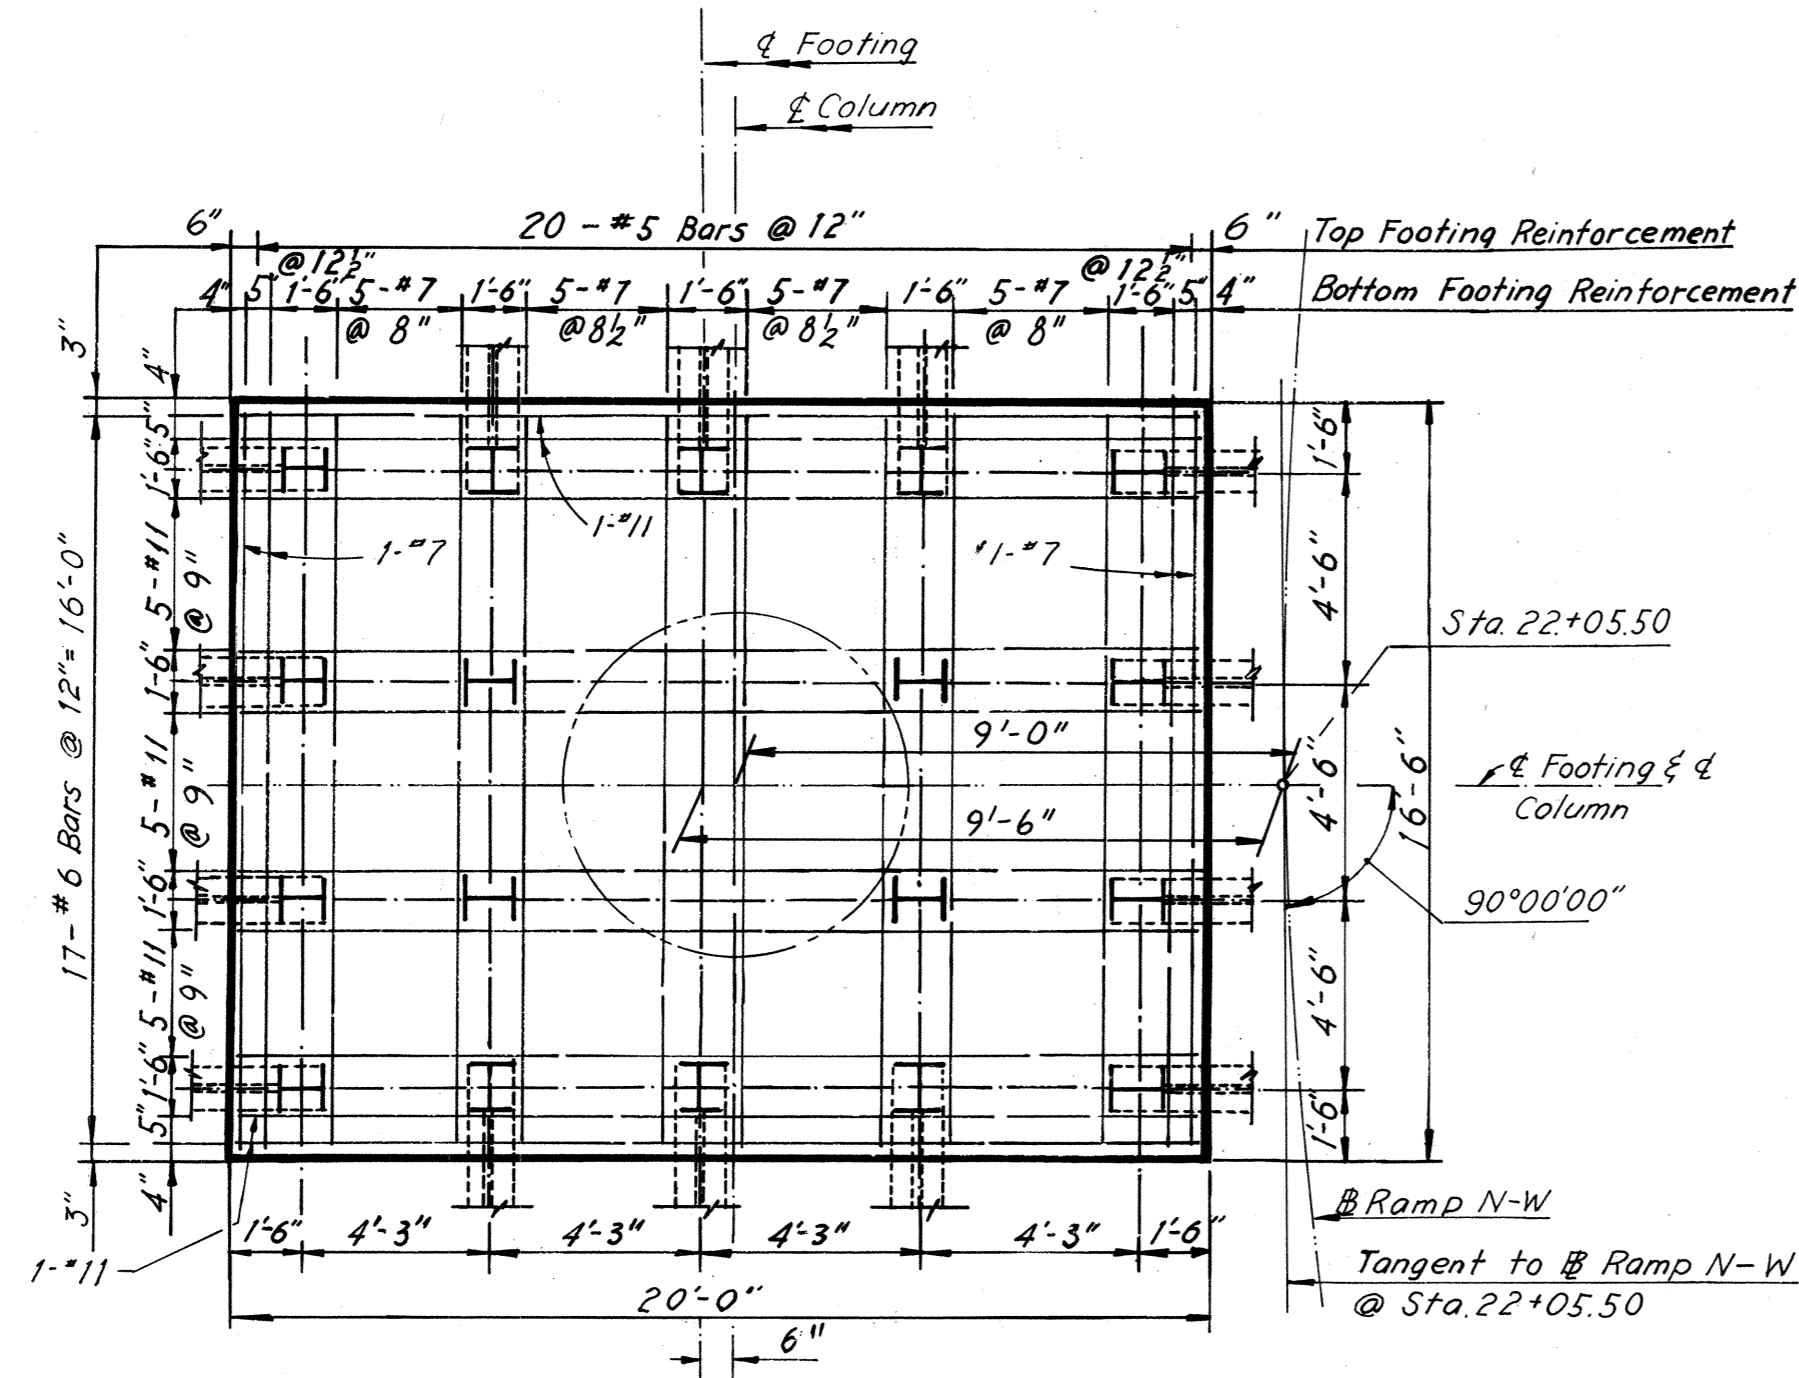


FOOTING PLAN
Scale: 1/4" = 1'-0"

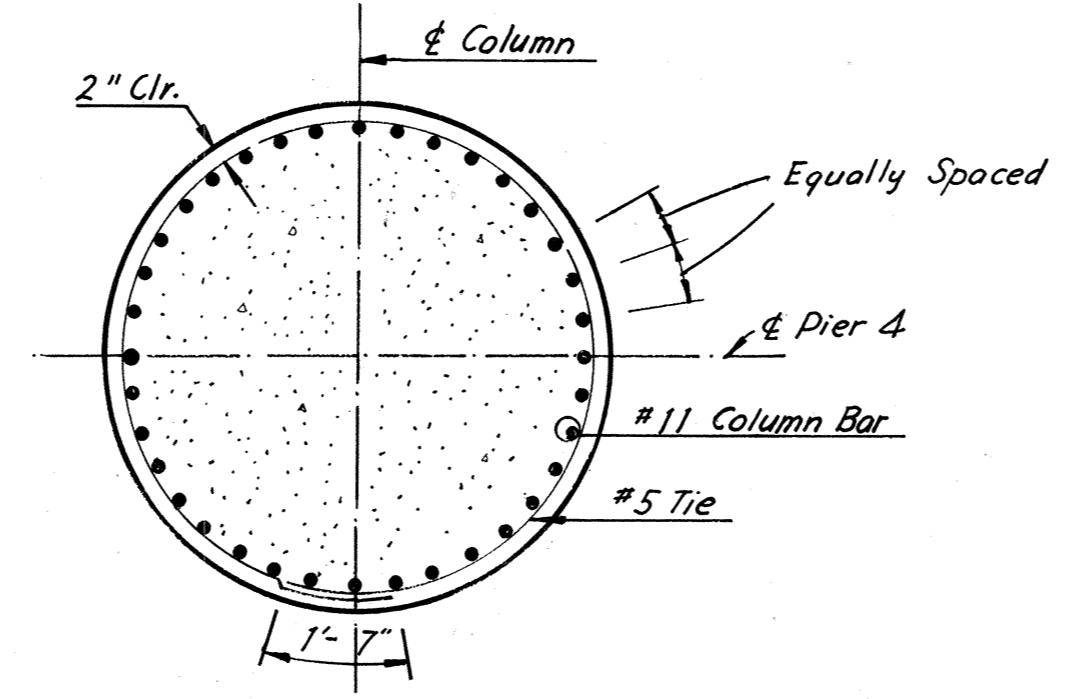


SECTION D-D
Scale: 3/8" = 1'-0"

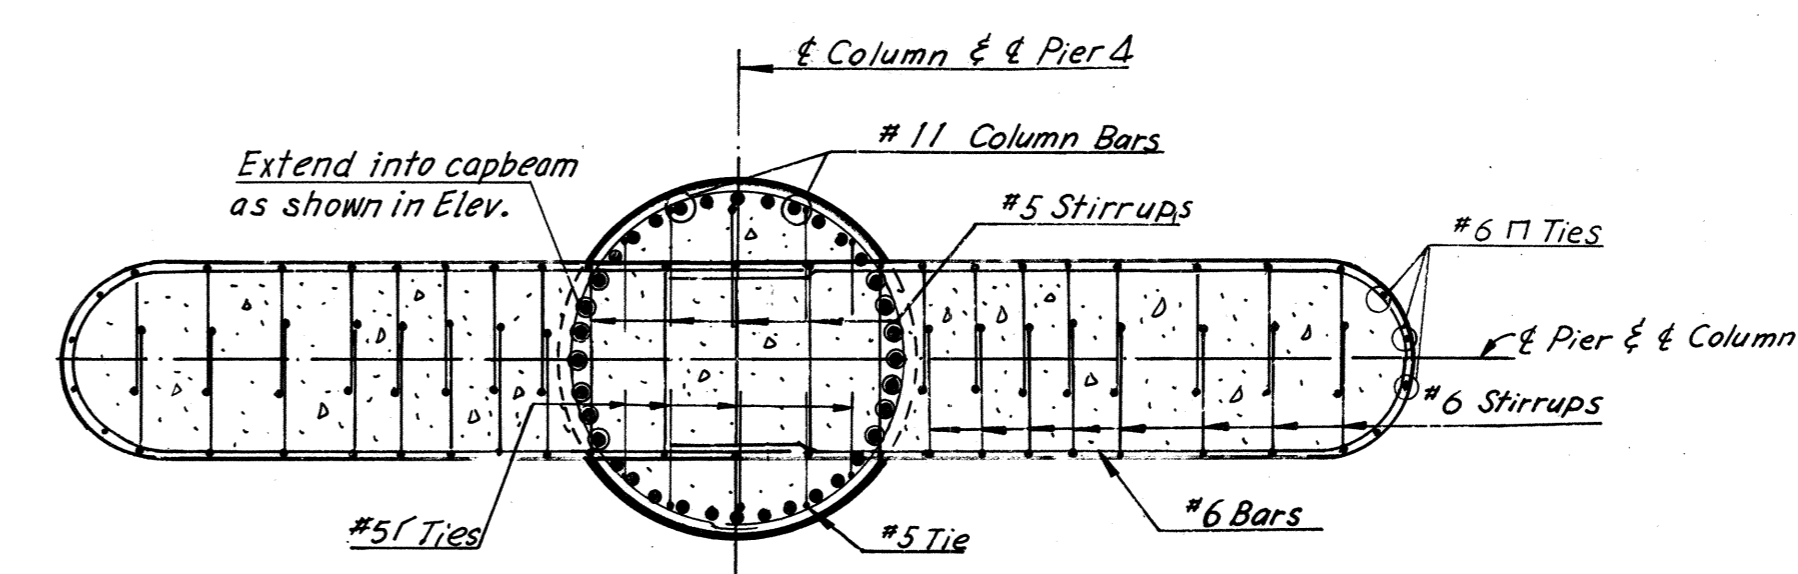

SECTION C-C
Scale: 1/4" = 1'-0"

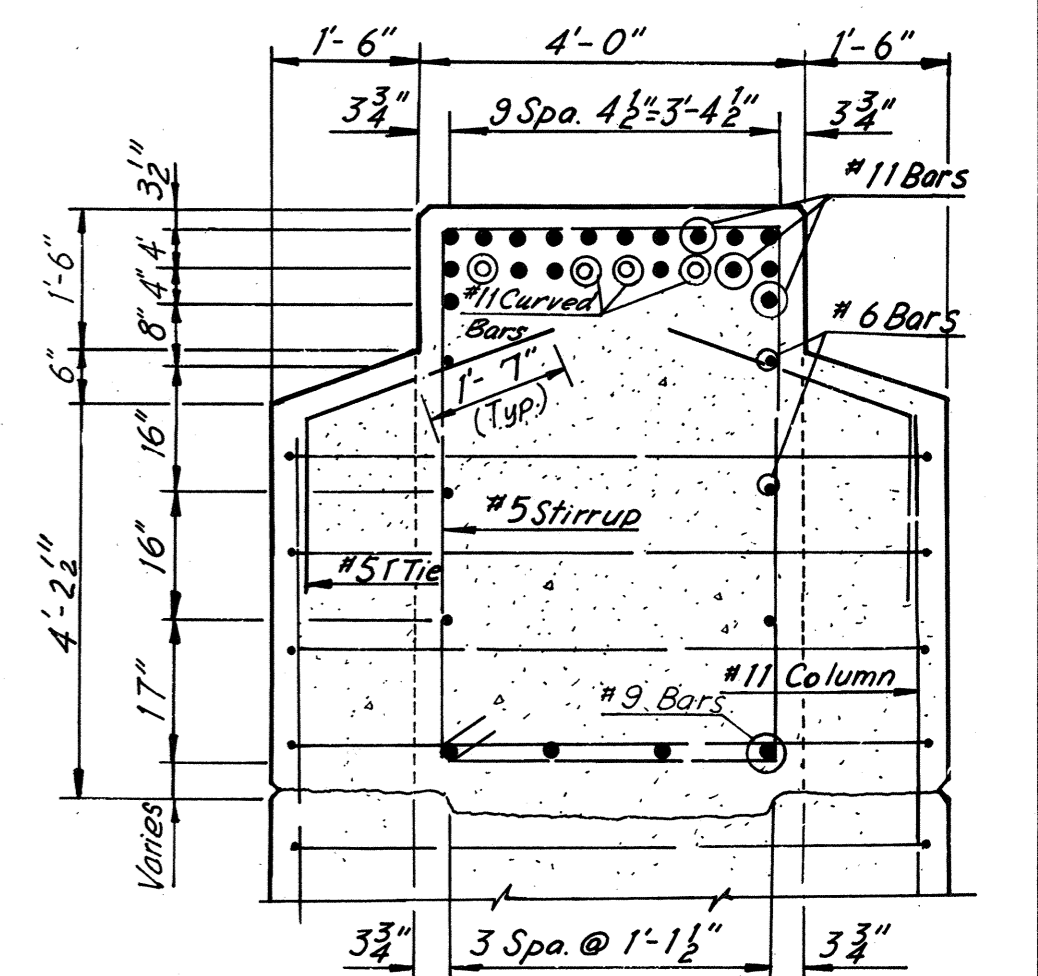

SECTION B-B
Scale: 1/4" = 1'-0"

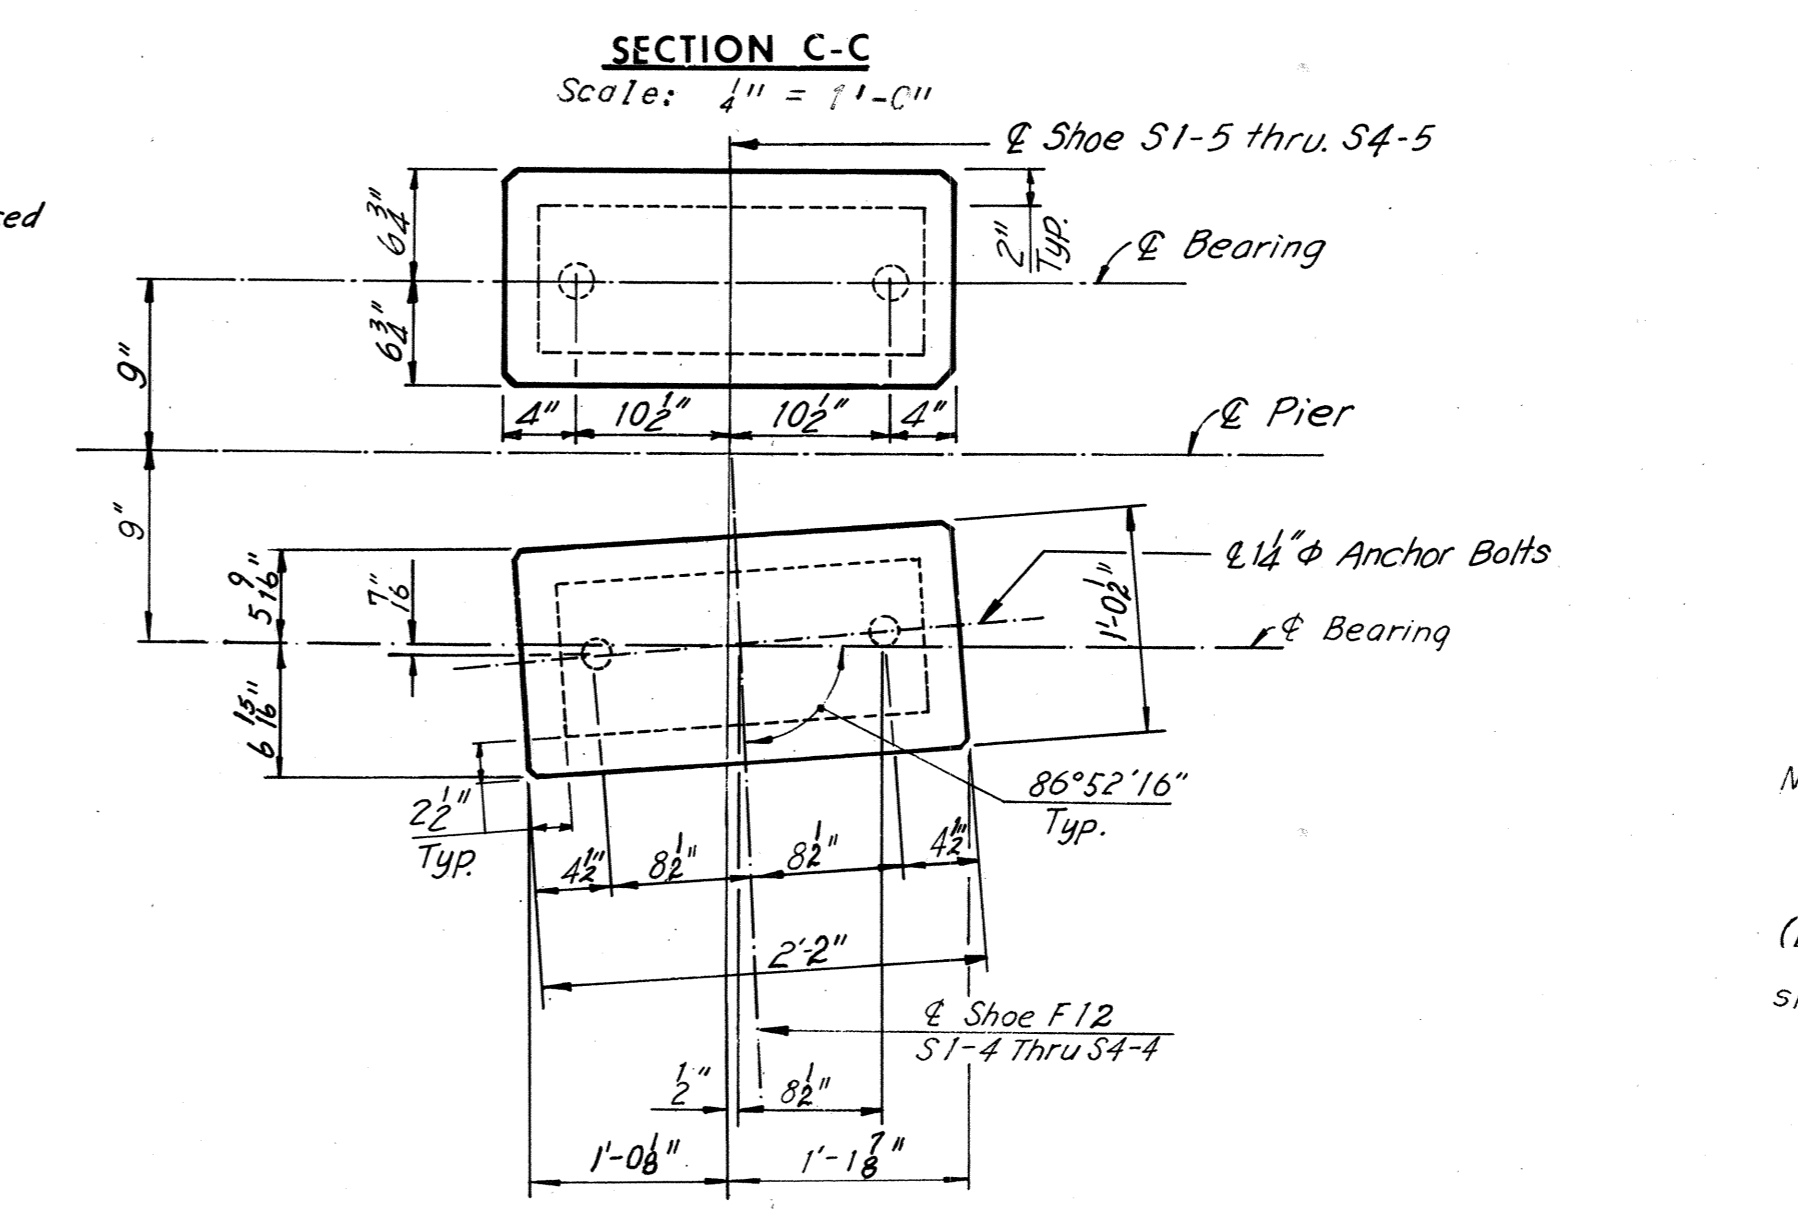

ANCHOR BOLT SETTING PLAN
No Scale

Notes:
For Shoe Details, see Sheets S1 and S2.
For Framing Plans, see Sheets 13 and 15.
For Substructure Quantities, see Sheet 2.
All Piles shall be 120P53 Steel Piles (Design Capacity = 57 tons).
Batter all Piles 3" per foot, where shown.
For Rustication and Pile Details, see Sheet 7.
Estimated Pile Tip Elevation -4.0

Note:
Footing elevations are approximate only and may be varied to suit field conditions as directed by the Engineer. Vertical shaft reinforcing shall not be cut until these elevations are established. Where elevations change more than 2 ft., redesign will be required.

FOOTING FOR PIER 4 IS ECCENTRIC AS SHOWN ON FOOTING PLAN

BY	DATE	DESCRIPTION	BY	DATE
3	As Built	TEM	6-77	
MADE	R.C. 3.13.69	Revised Shoe Size	REG	12-30-74
CHECKED	S.C.C. 4.21.69	Pad Elev. Revised	EJM	10-11-74
IN CHARGE	NO.	REVISION	BY	DATE

RICHMOND METROPOLITAN AUTHORITY
RICHMOND EXPRESSWAY SYSTEM
DOWNTOWN EXPRESSWAY

BRIDGE NO. 64
RAMP N-W CONNECTION FROM
RICHMOND-PETERSBURG TURNPIKE


PIER 4

HOWARD, NEEDLES, TAMMEN & BERGENDOFF
consulting engineers
NEW YORK ALEXANDRIA KANSAS CITY











SCALE: *AS NOTED*
CONTRACT NO.: **10**
SHEET NO. **6** OF **28**

AS BUILT

RICHMOND EXPRESSWAY SYSTEM			
SECTION	PROJECT	SHEET NO.	TOTAL SHEETS
10	DOWNTOWN EXPRESSWAY	105	265

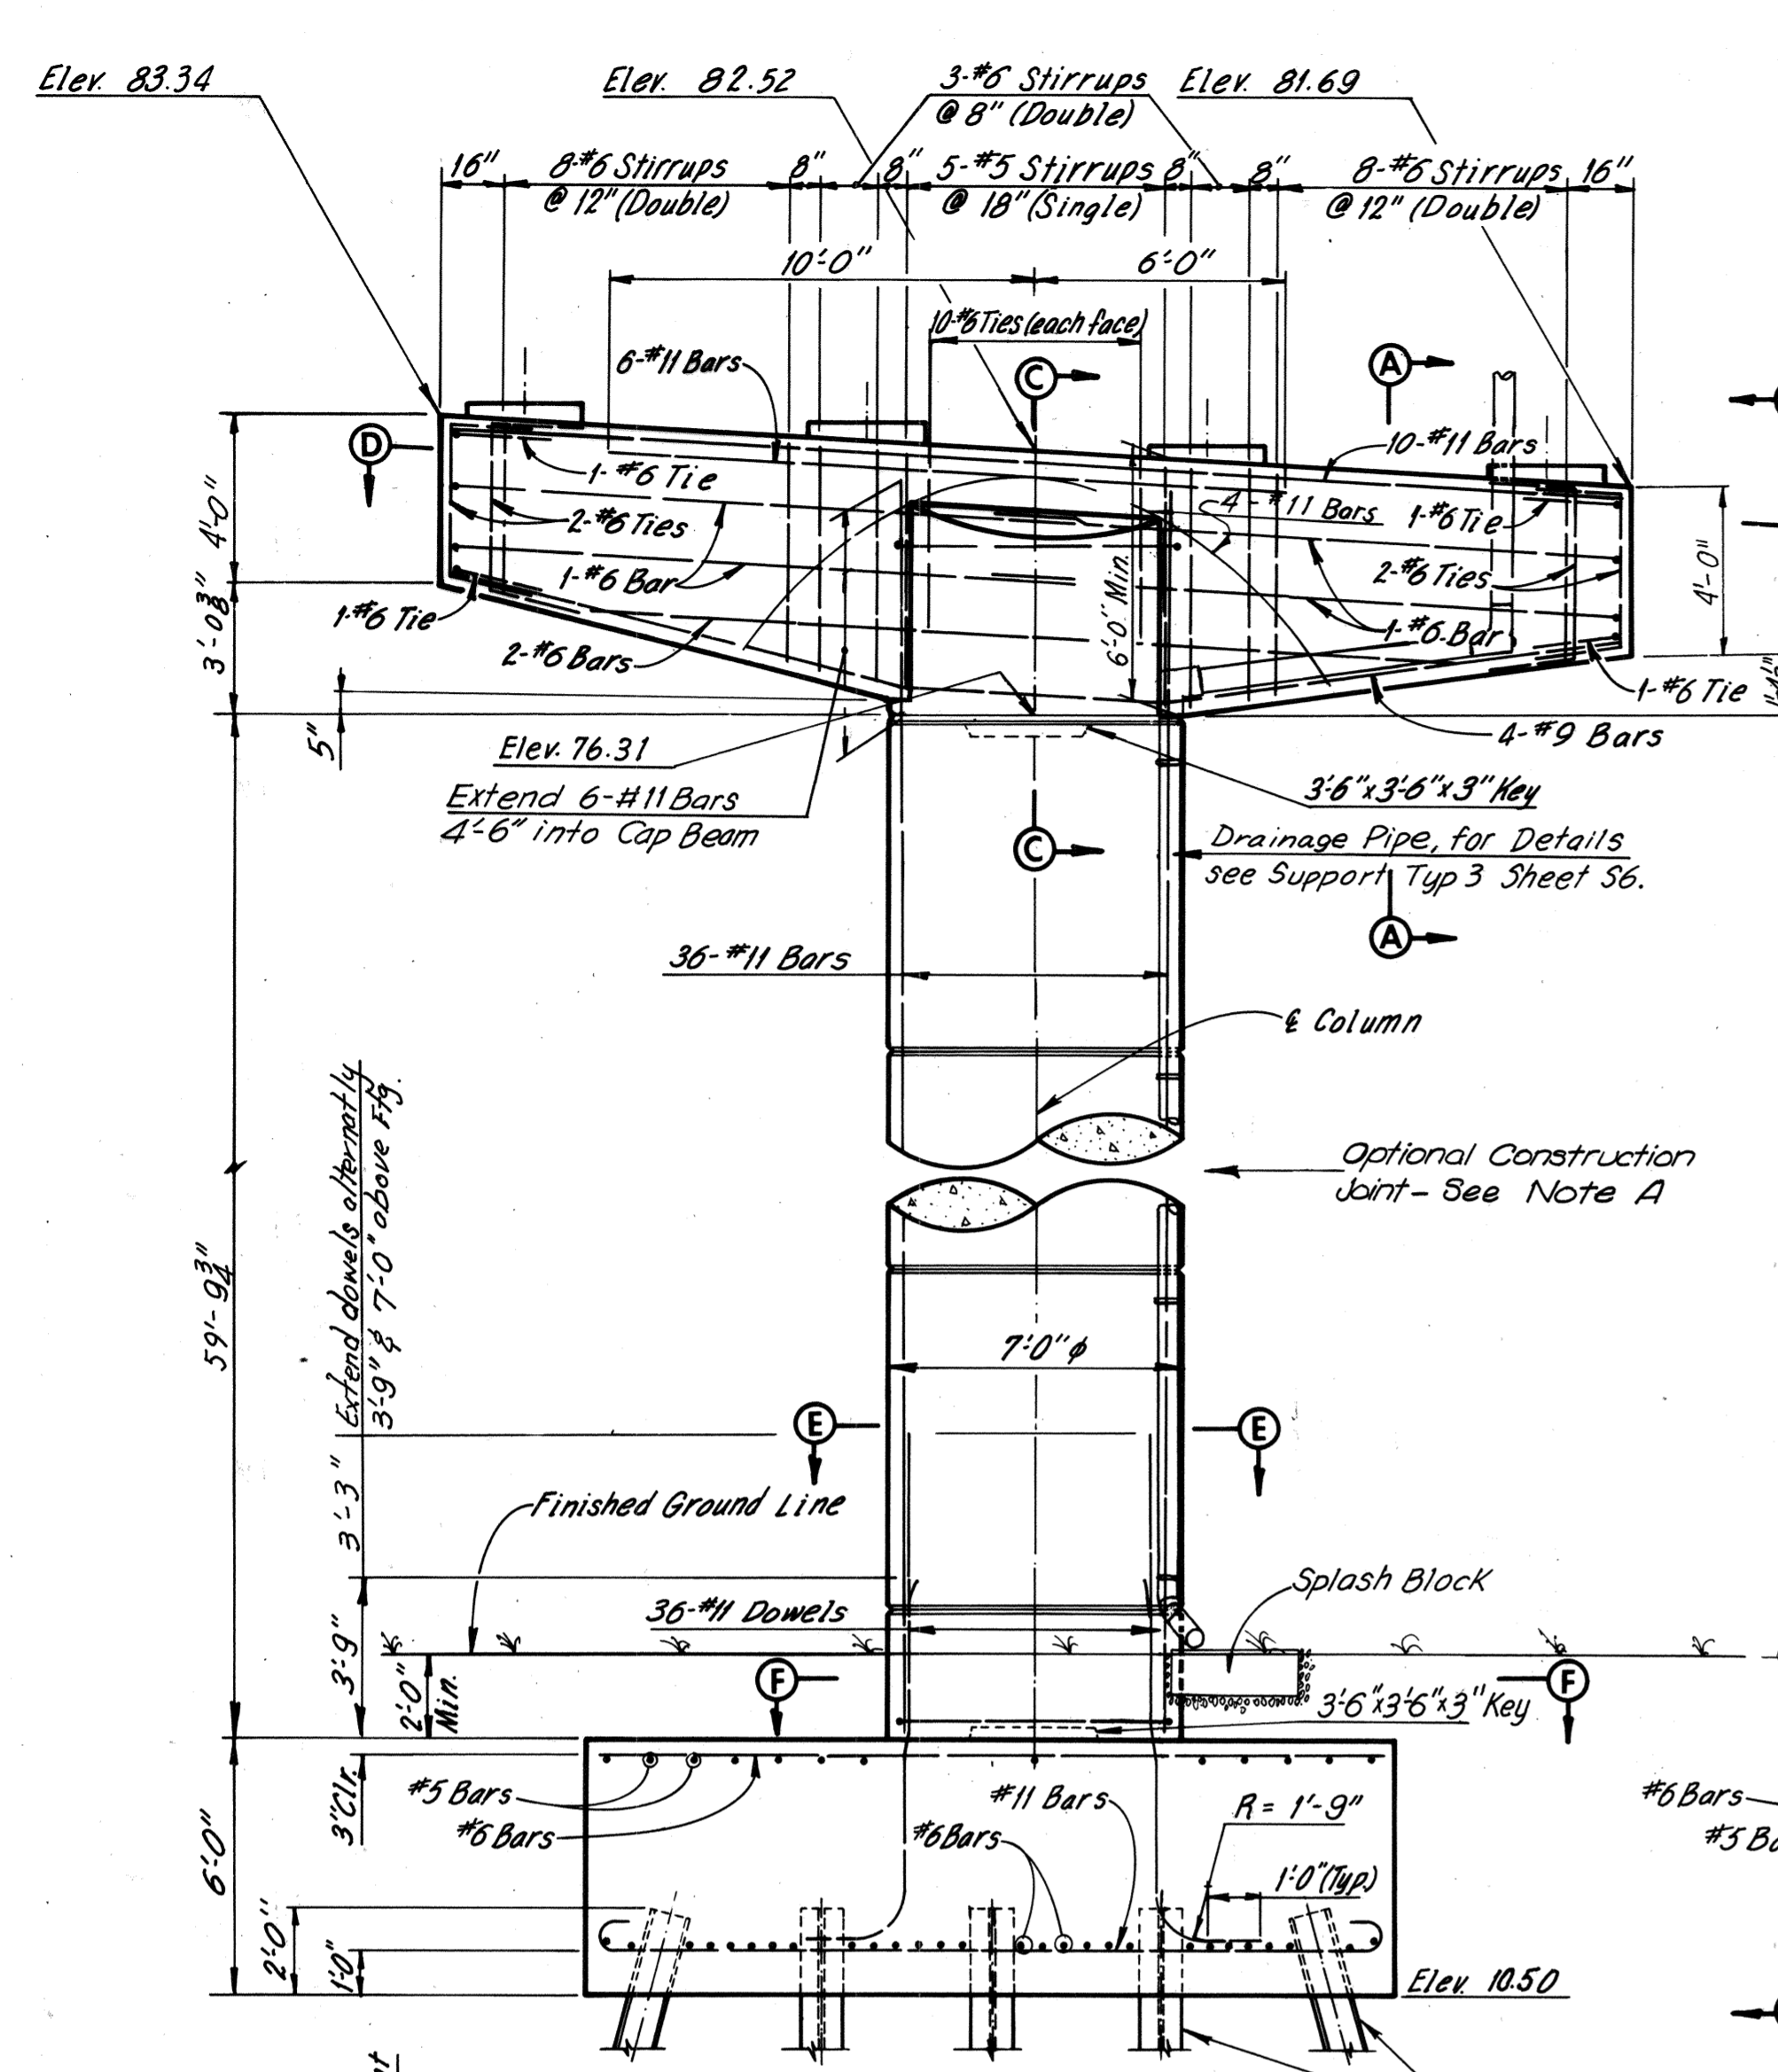

NOTE A
 A construction joint will be permitted at a rustication near mid-height of the column. The column reinforcement may be lap spliced near the construction joint. The lap at the splice shall be a minimum of 3'-6". Splices shall be staggered at least 3'-3" between adjacent bars.

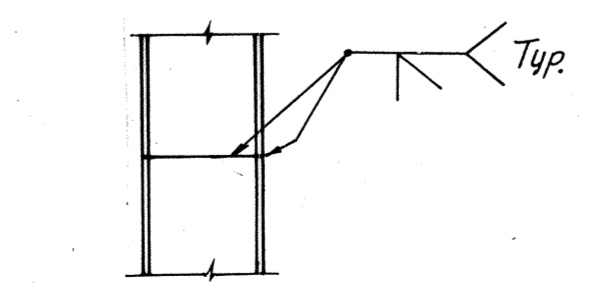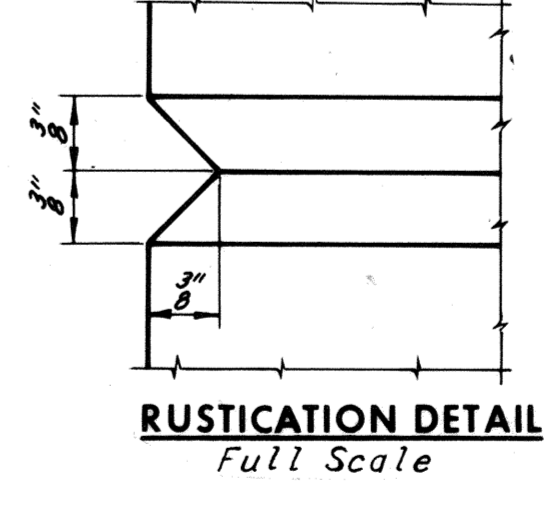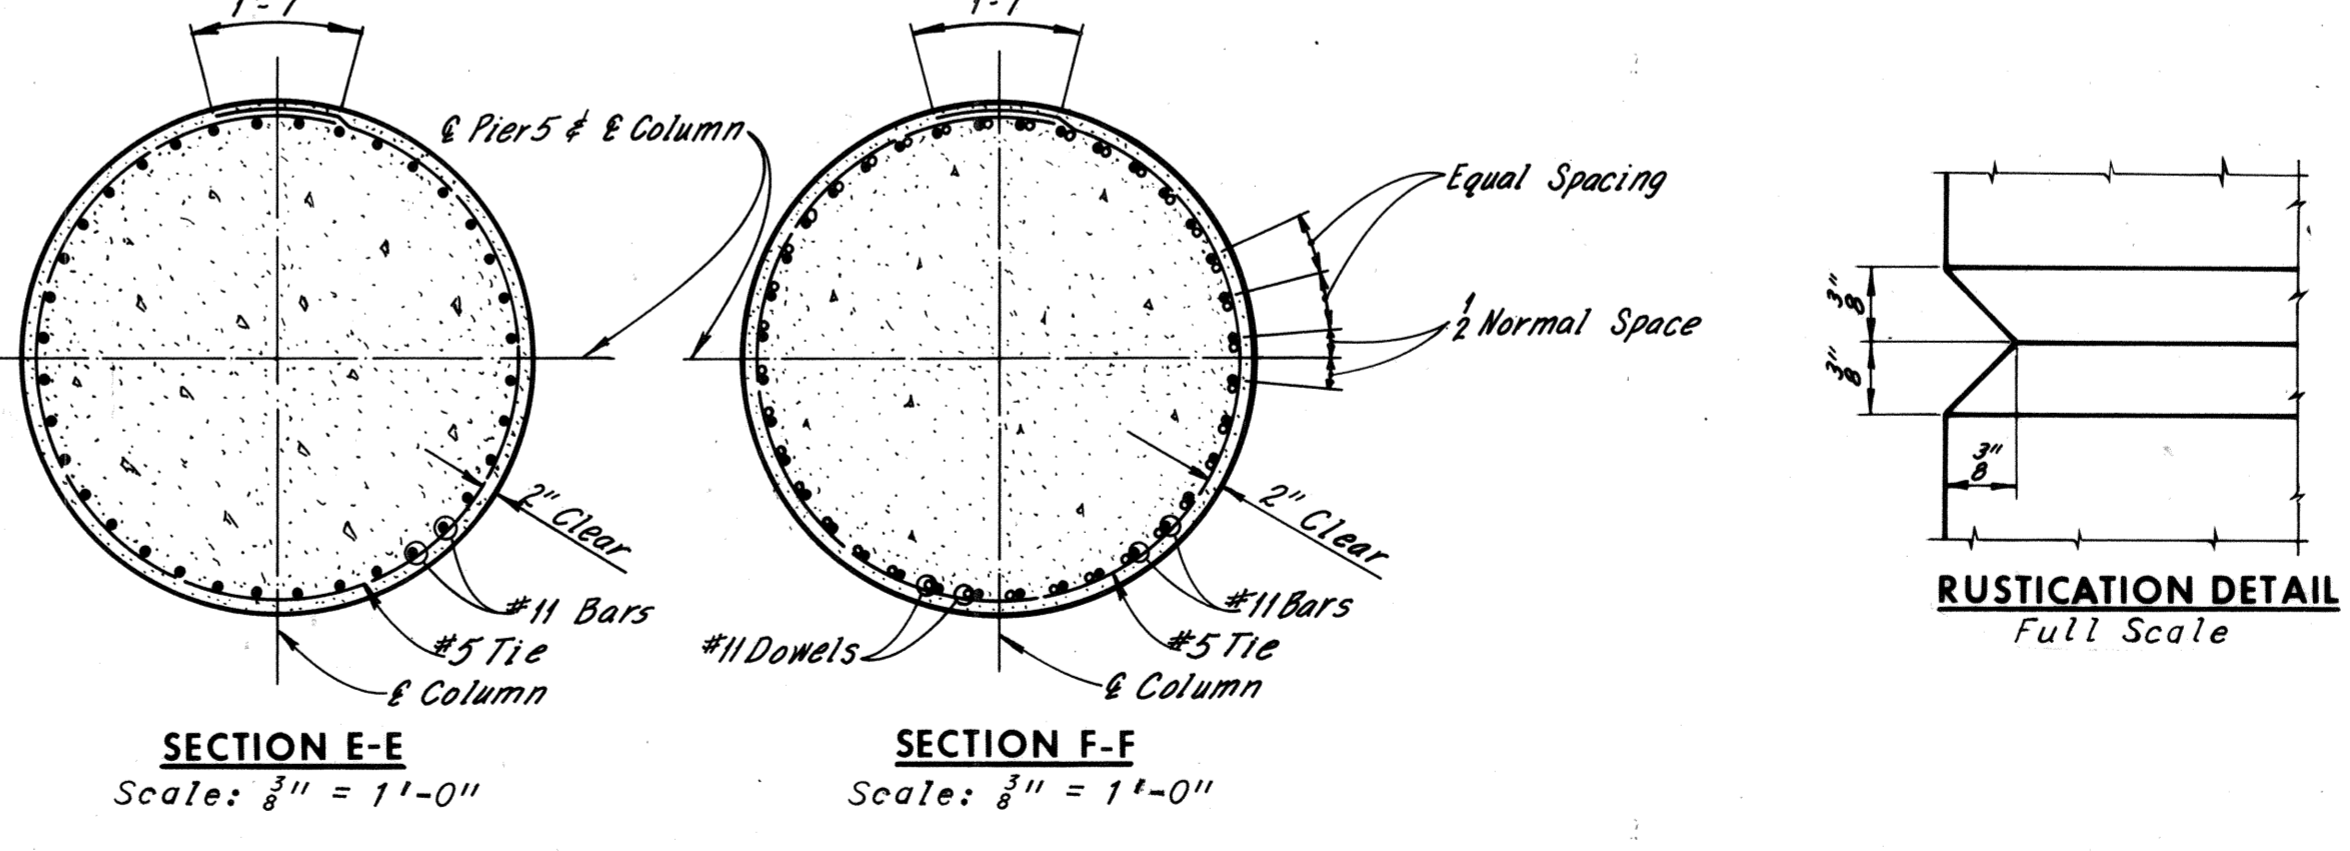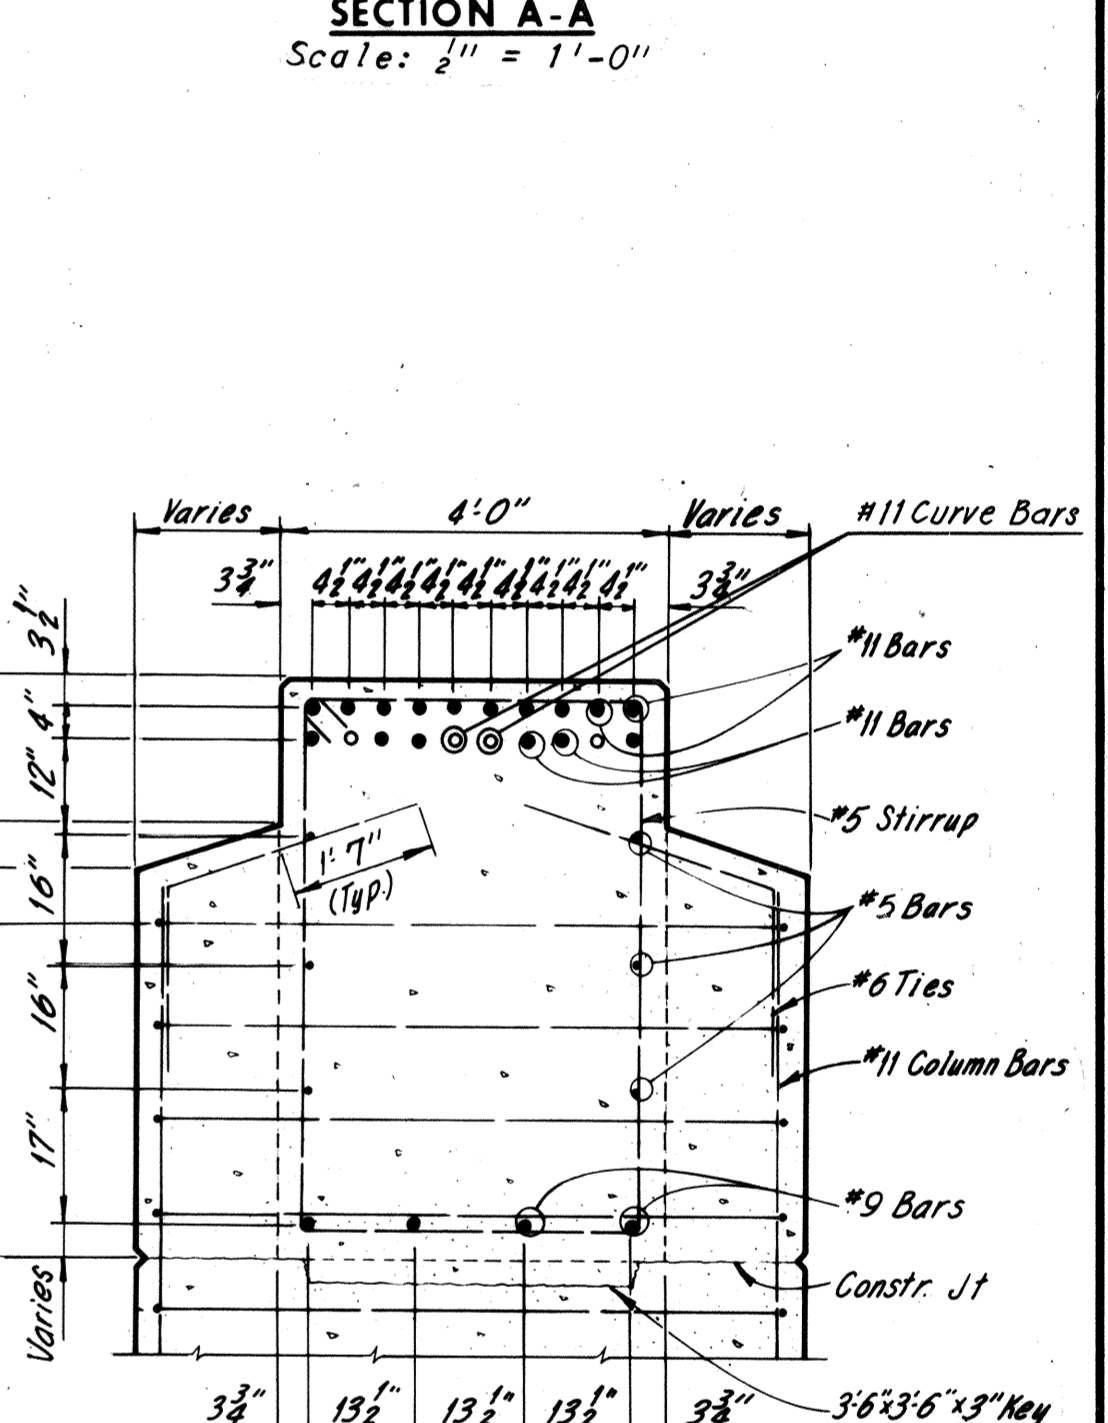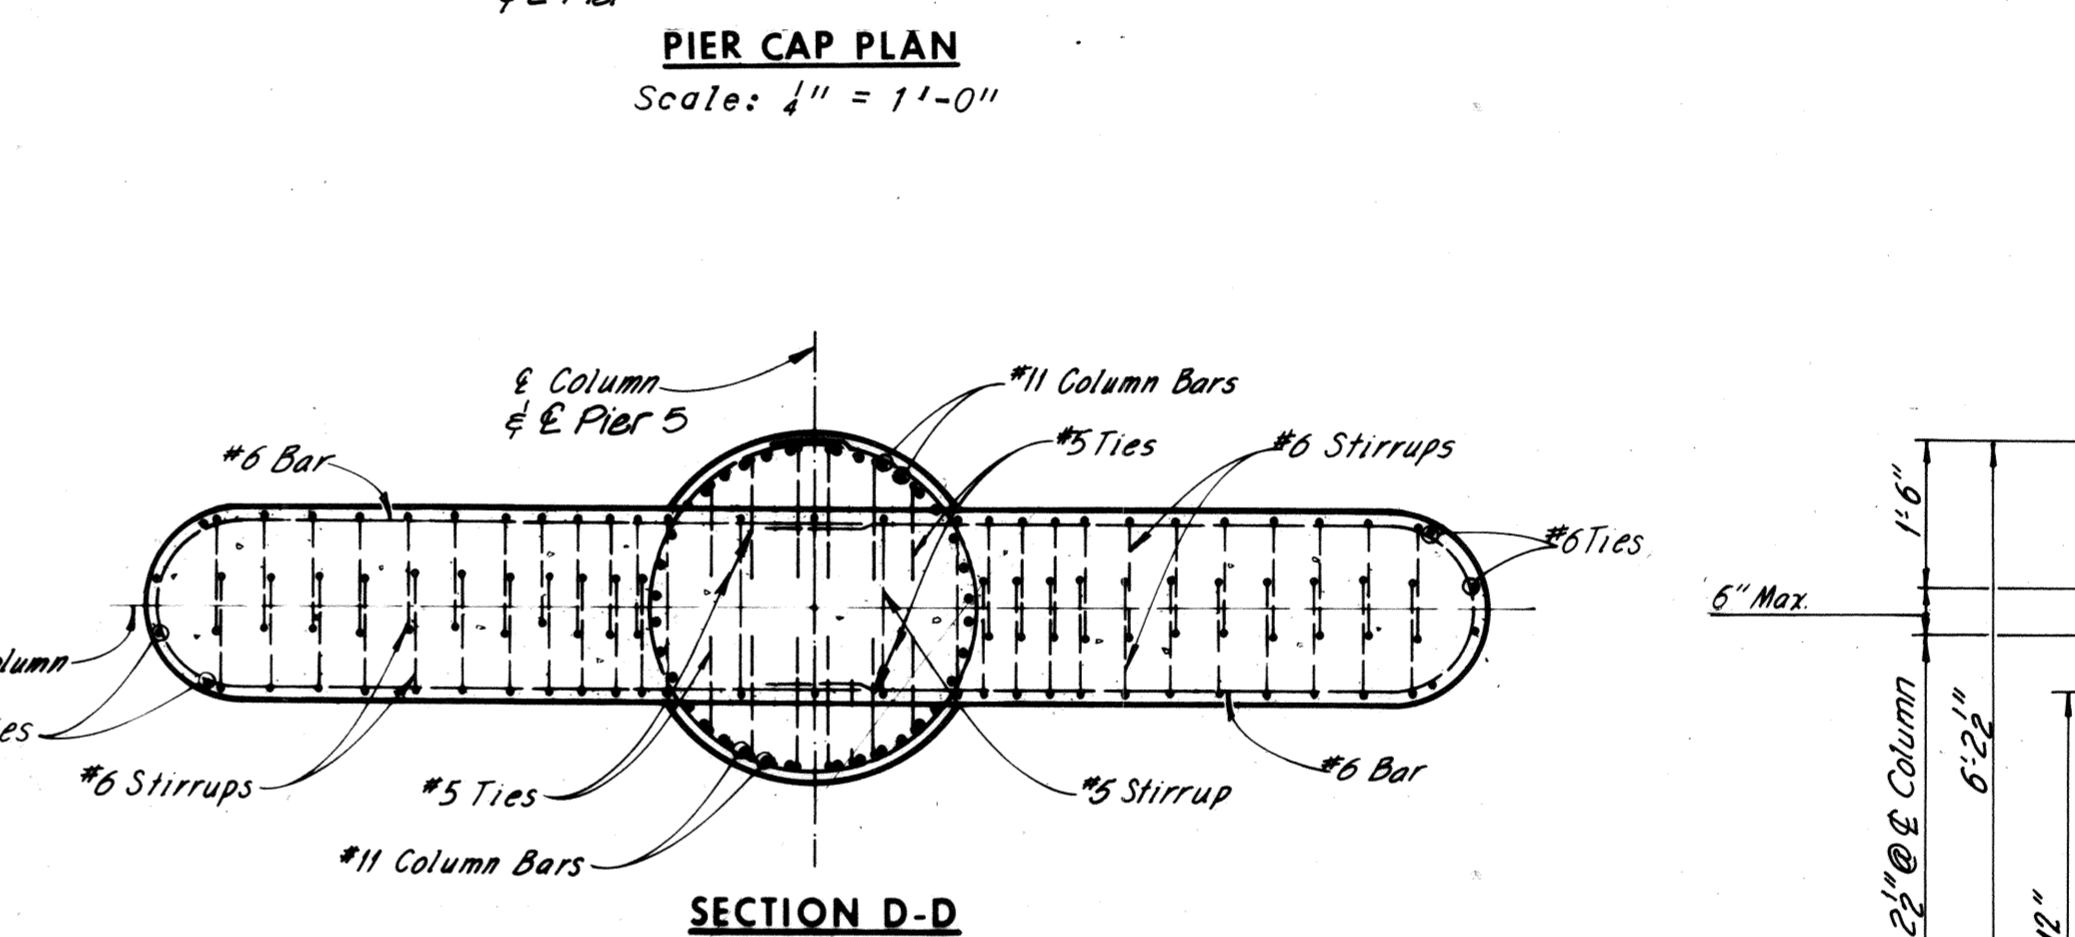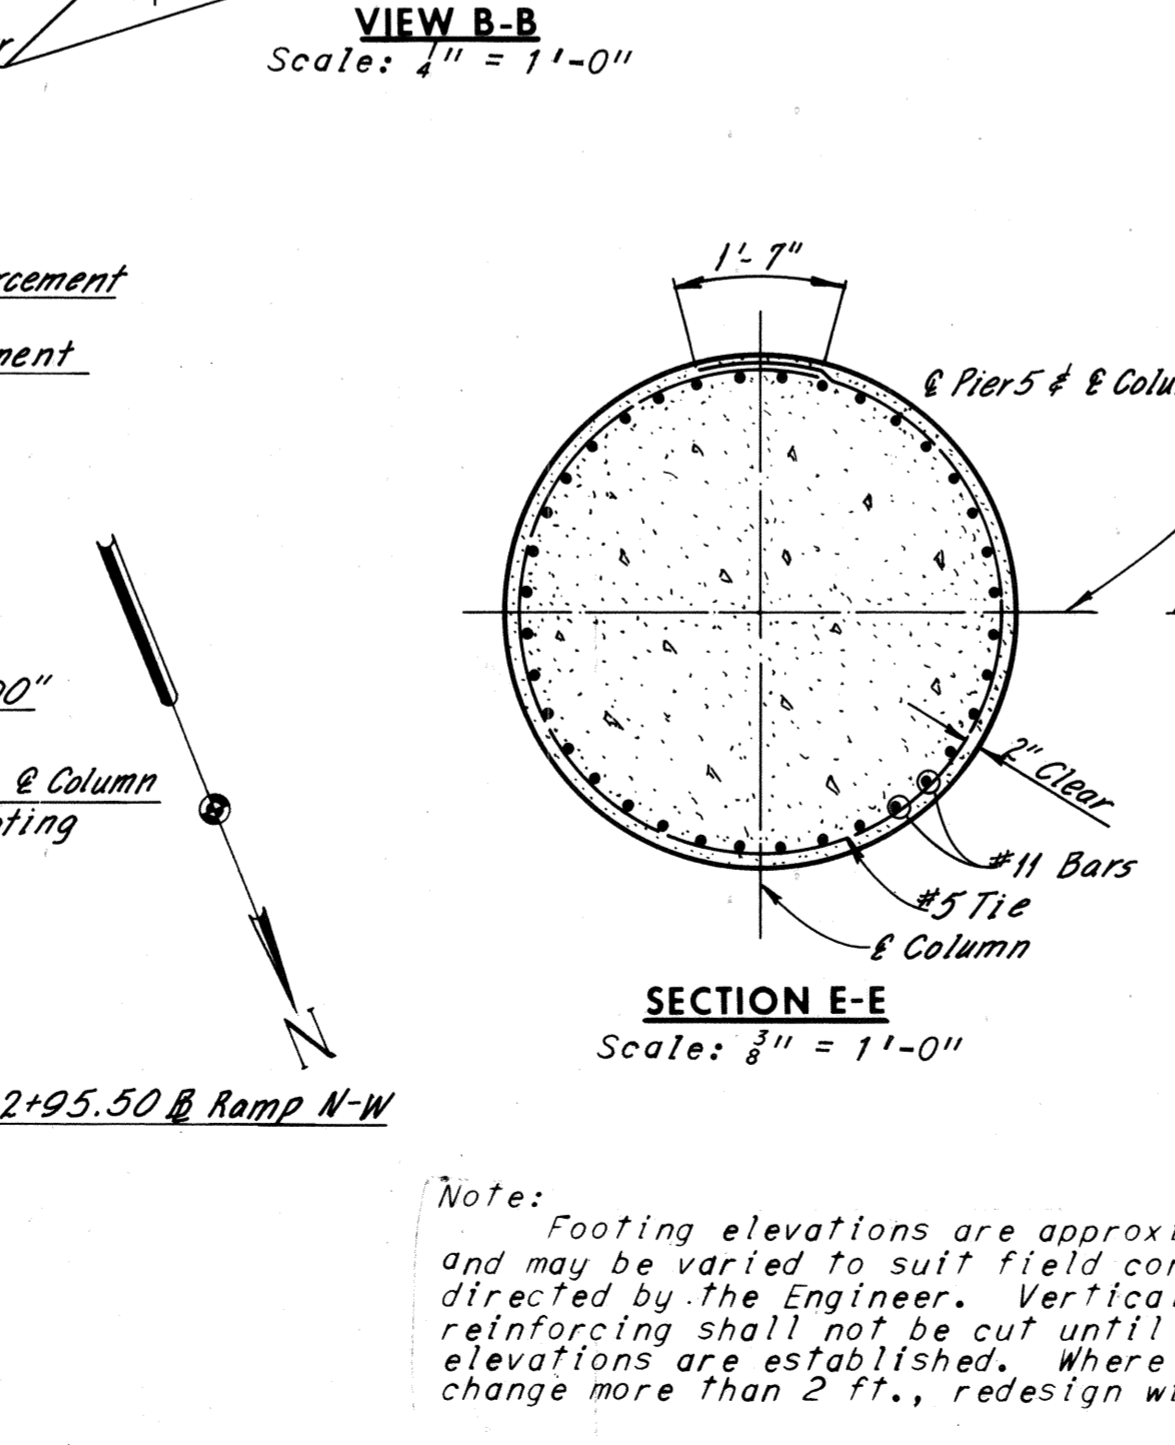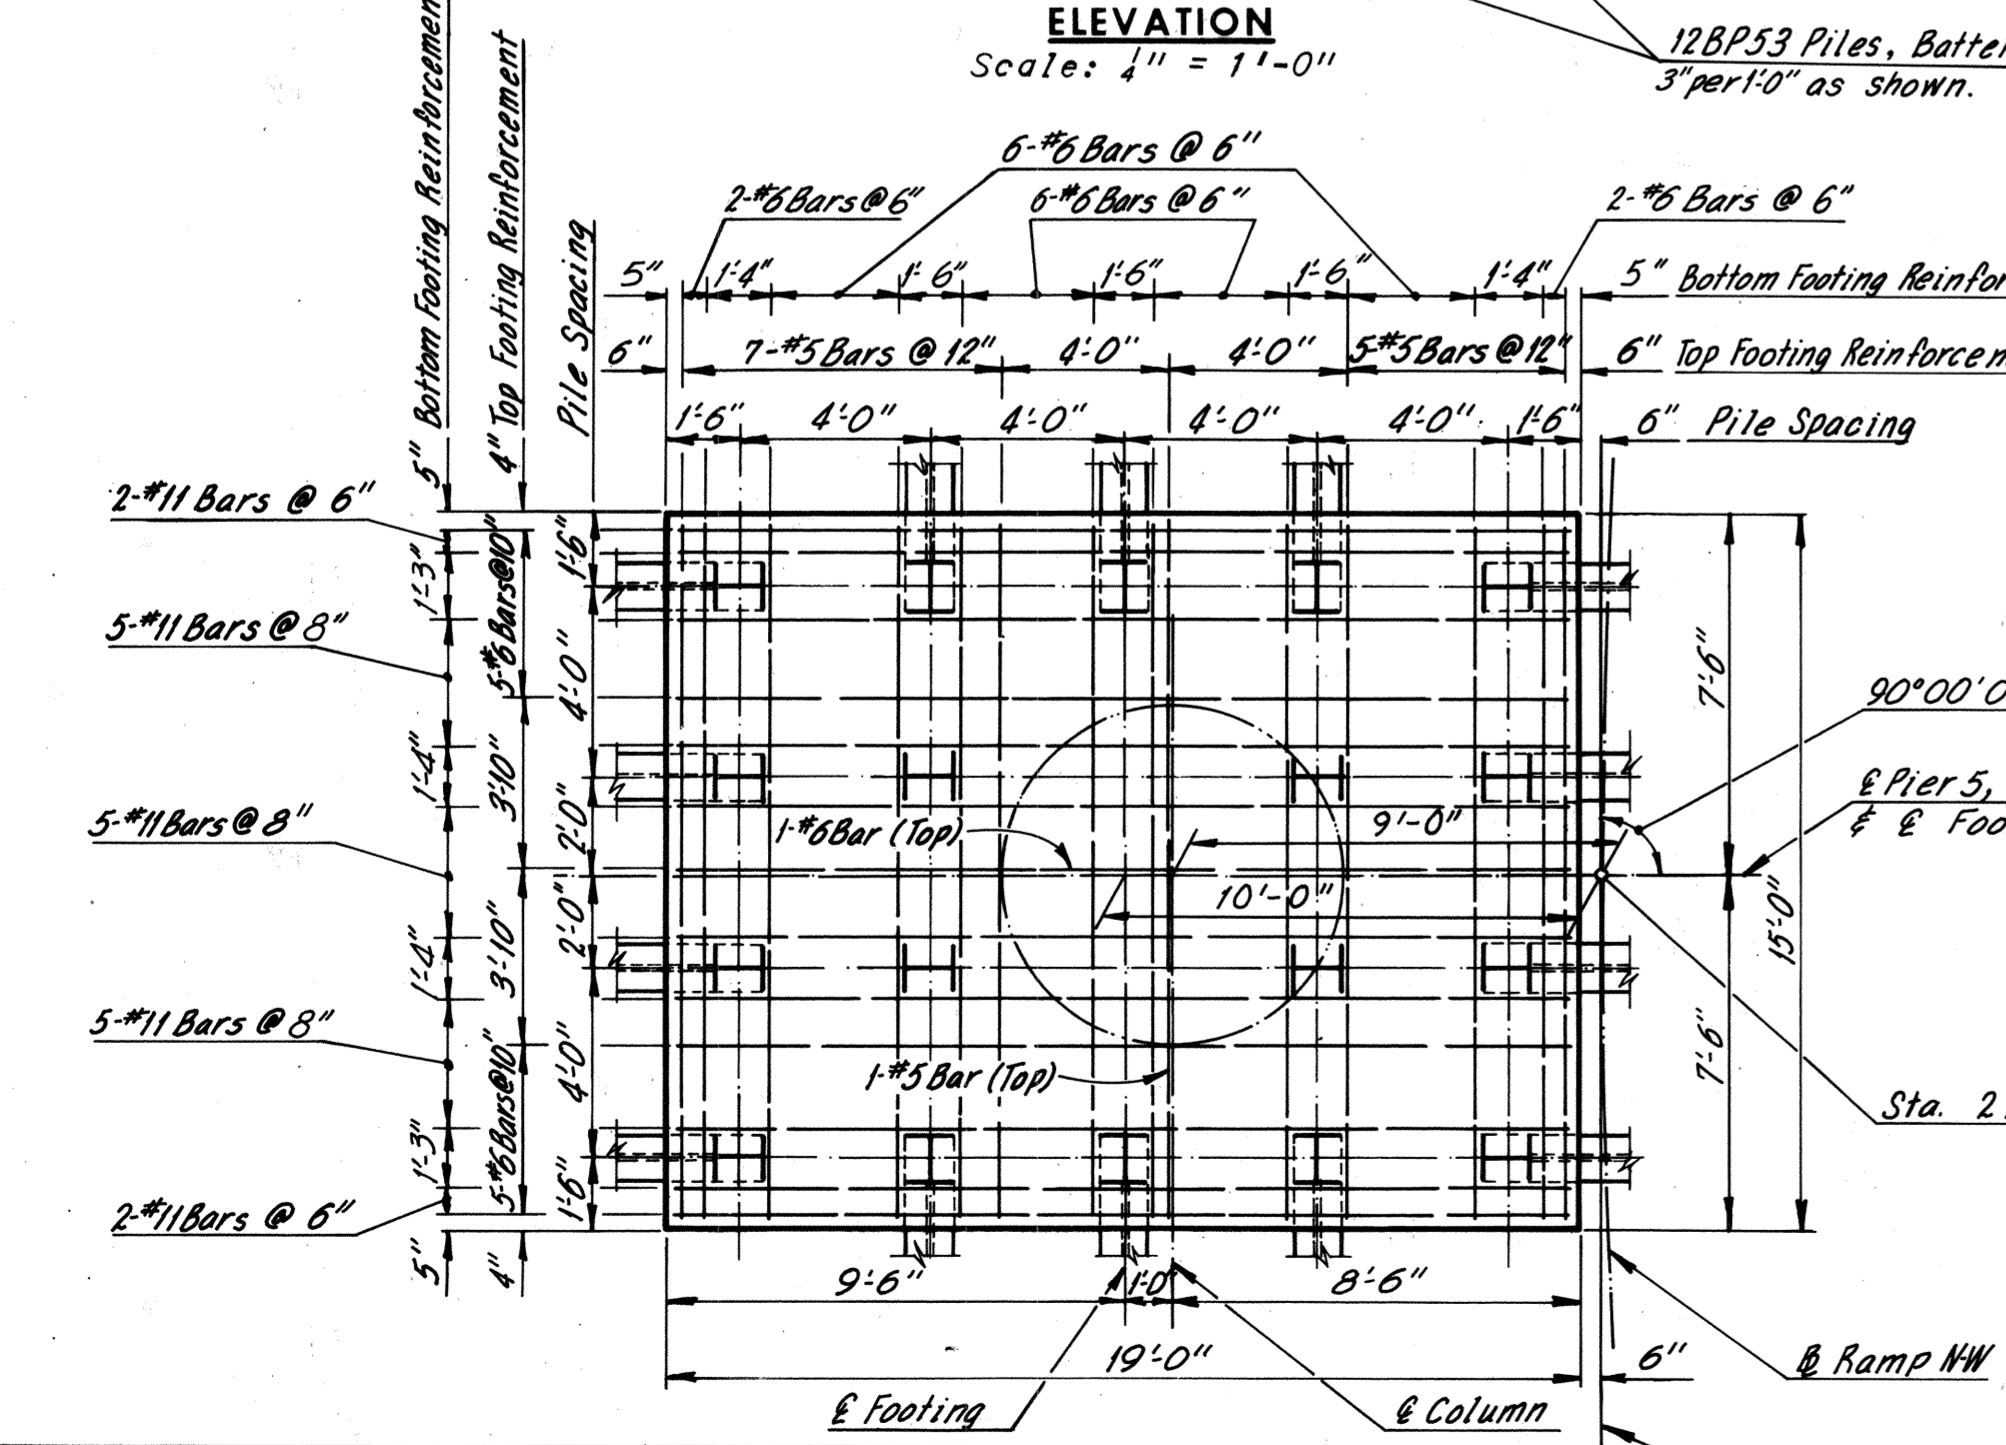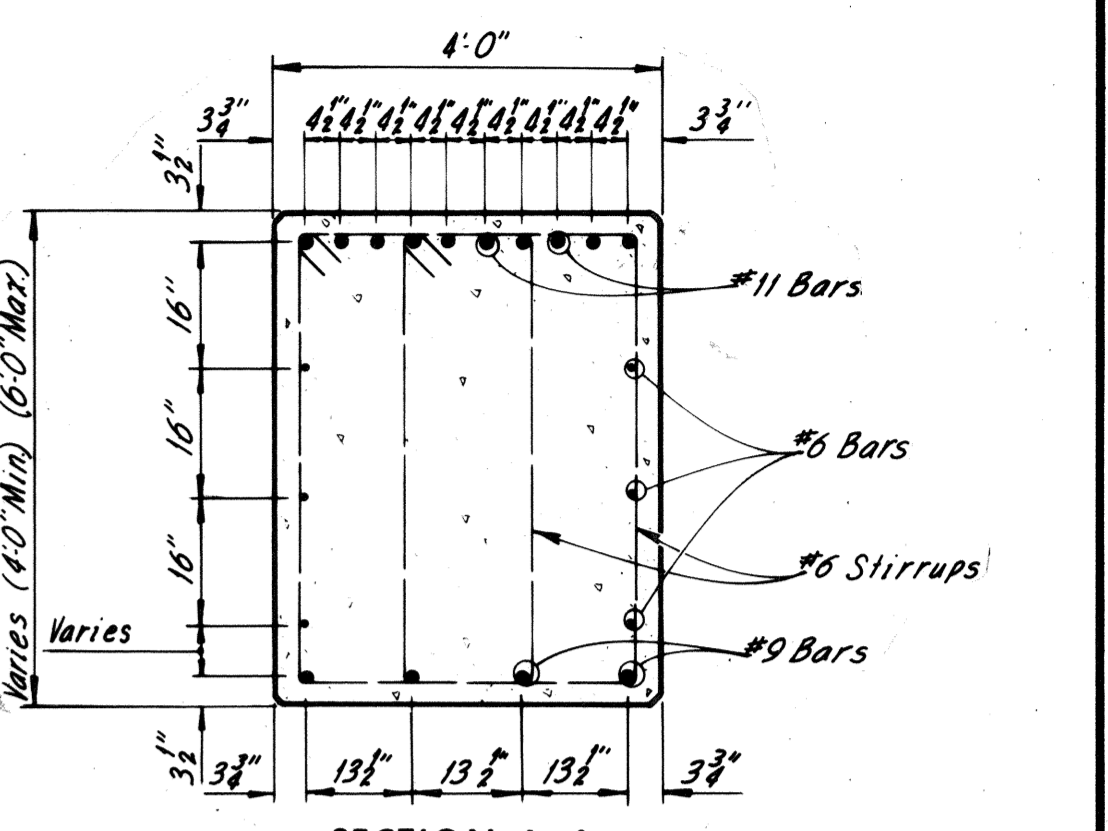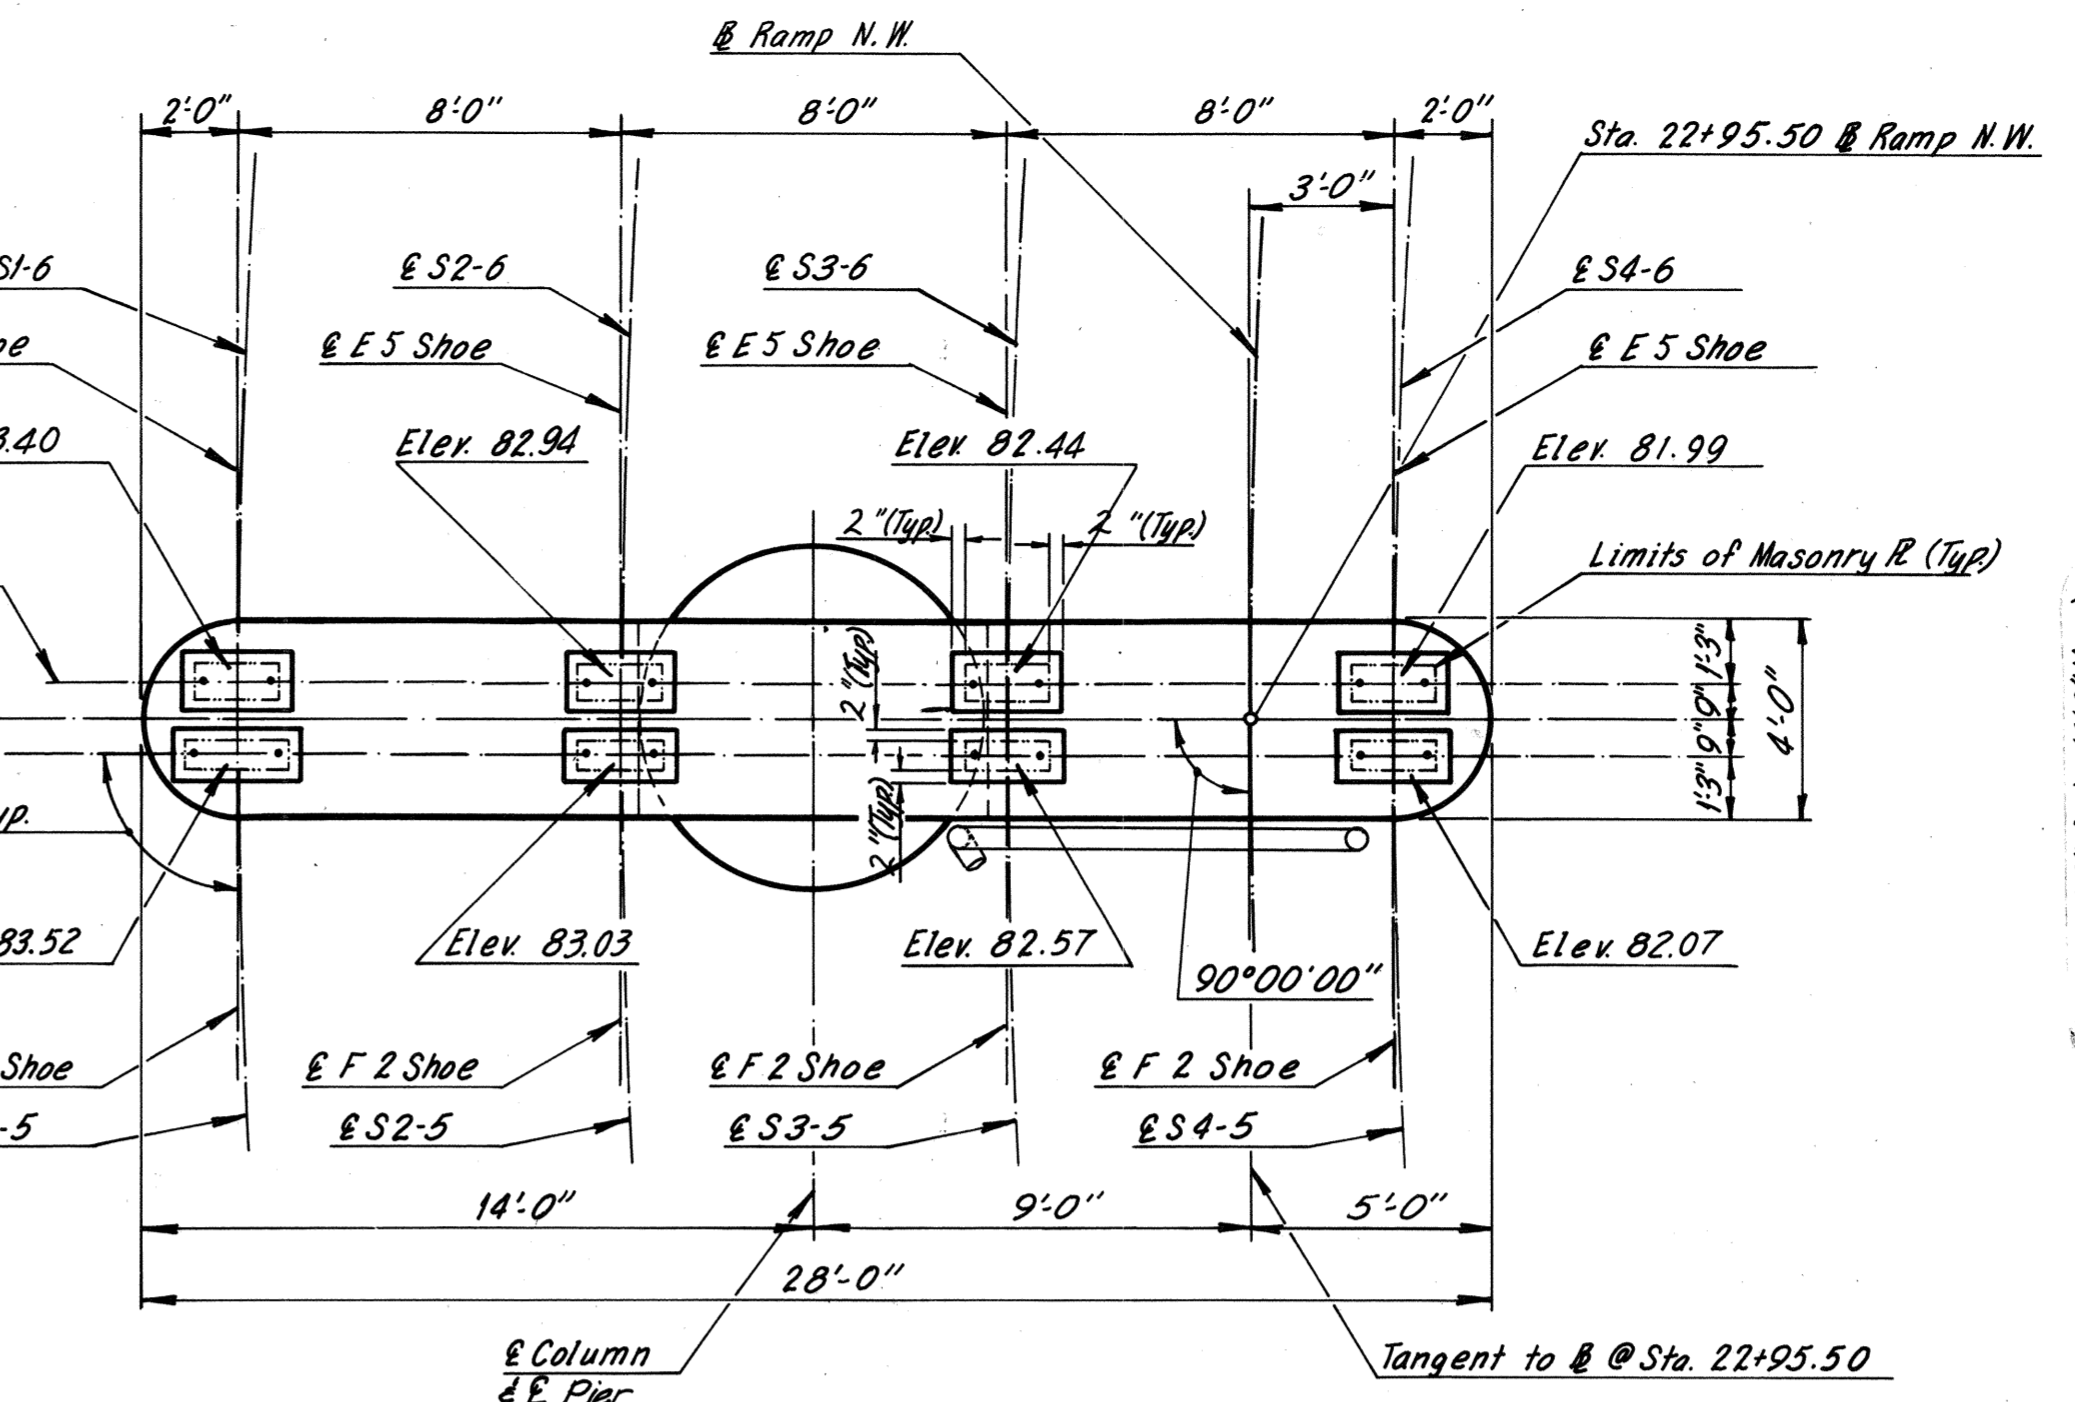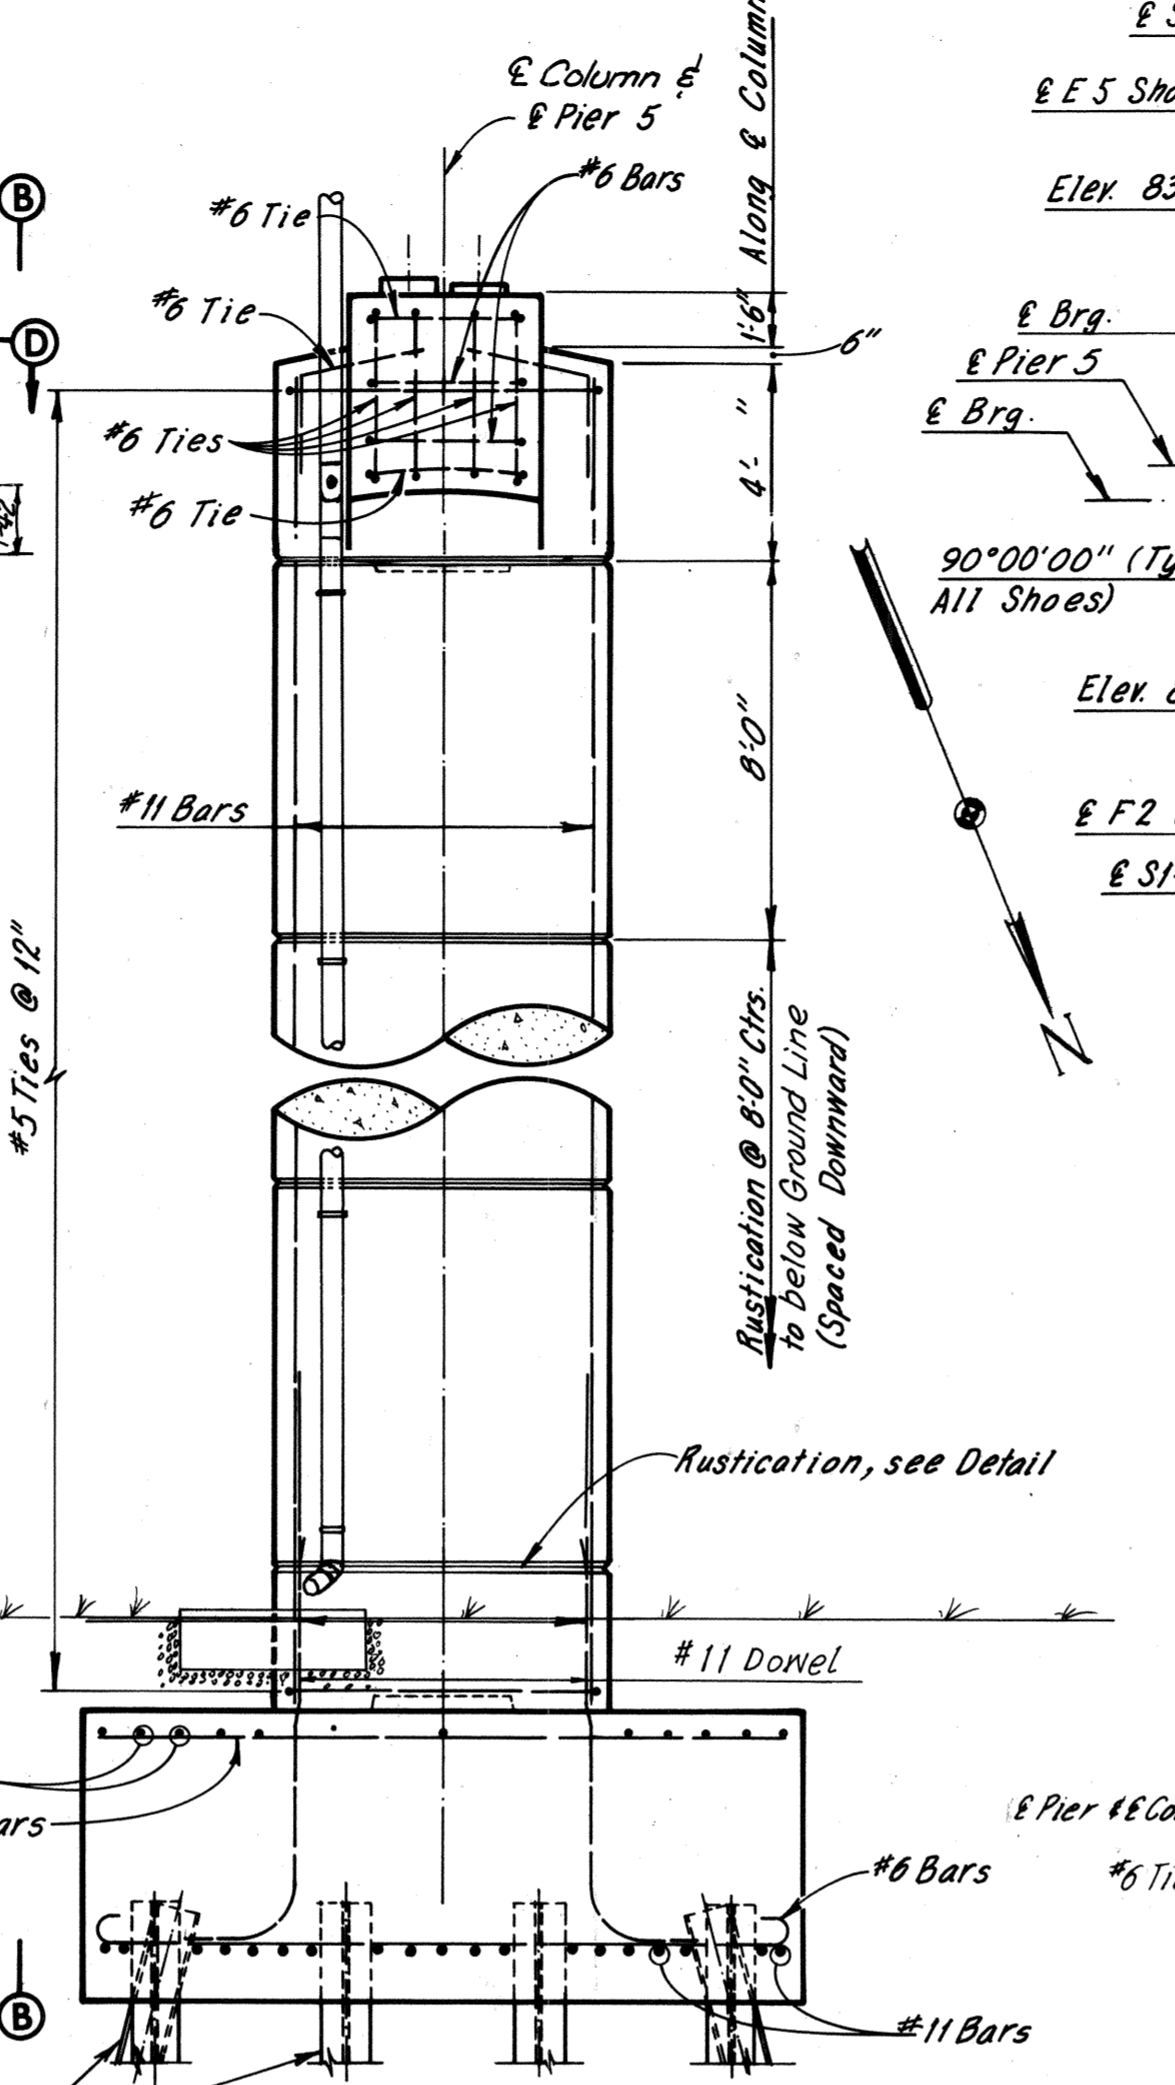

Note: Footing elevations are approximate only and may be varied to suit field conditions as directed by the Engineer. Vertical shaft reinforcing shall not be cut until these elevations are established. Where elevations change more than 2 ft., redesign will be required.

Notes:
 All piles shall be 12BP53 Steel Piles (Design capacity = 57 tons).
 Batter all piles 3" per foot where shown.
 For Standard Shoe Details, see Sheets S7, S2.
 For Framing Plan, see Sheet 15.
 Estimated Pile Tip Elevation -4.0

NO.	REVISION	BY	DATE
1	As Built	TEM	6-77

NO.	REVISION	BY	DATE
2	As Built	TEM	6-77

FOOTING FOR PIER 5 IS ECCENTRIC AS SHOWN ON FOOTING PLAN

RICHMOND METROPOLITAN AUTHORITY
RICHMOND EXPRESSWAY SYSTEM
DOWNTOWN EXPRESSWAY







BRIDGE NO. 64
RAMP N-W CONNECTION FROM
RICHMOND-PETERSBURG TURNPIKE
PIER 5

HOWARD, NEEDLES, TAMMEN & BERGENDOFF
 consulting engineers
 NEW YORK ALEXANDRIA KANSAS CITY

SCALE: As Noted
 CONTRACT NO. 10
 SHEET NO. 7 OF 28

AS BUILT


RICHMOND EXPRESSWAY SYSTEM			
SECTION	PROJECT	SHEET NO.	TOTAL SHEETS
10	DOWNTOWN EXPRESSWAY	106	265

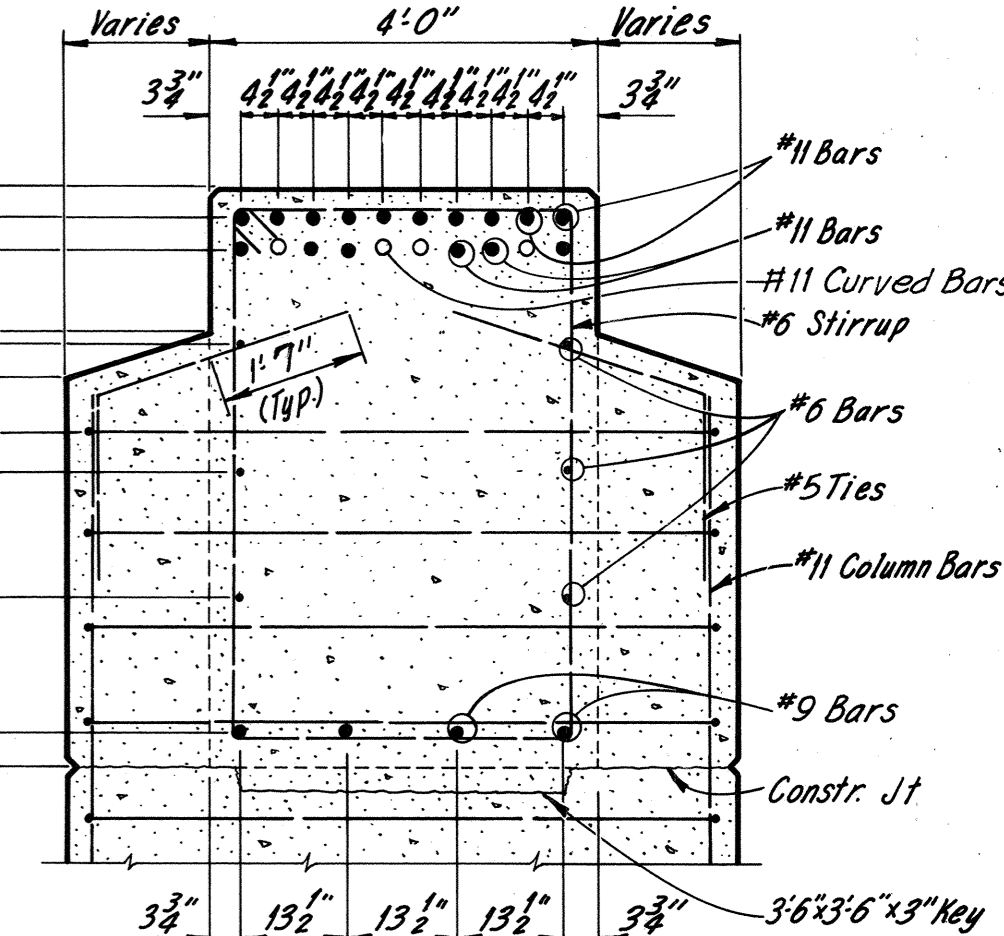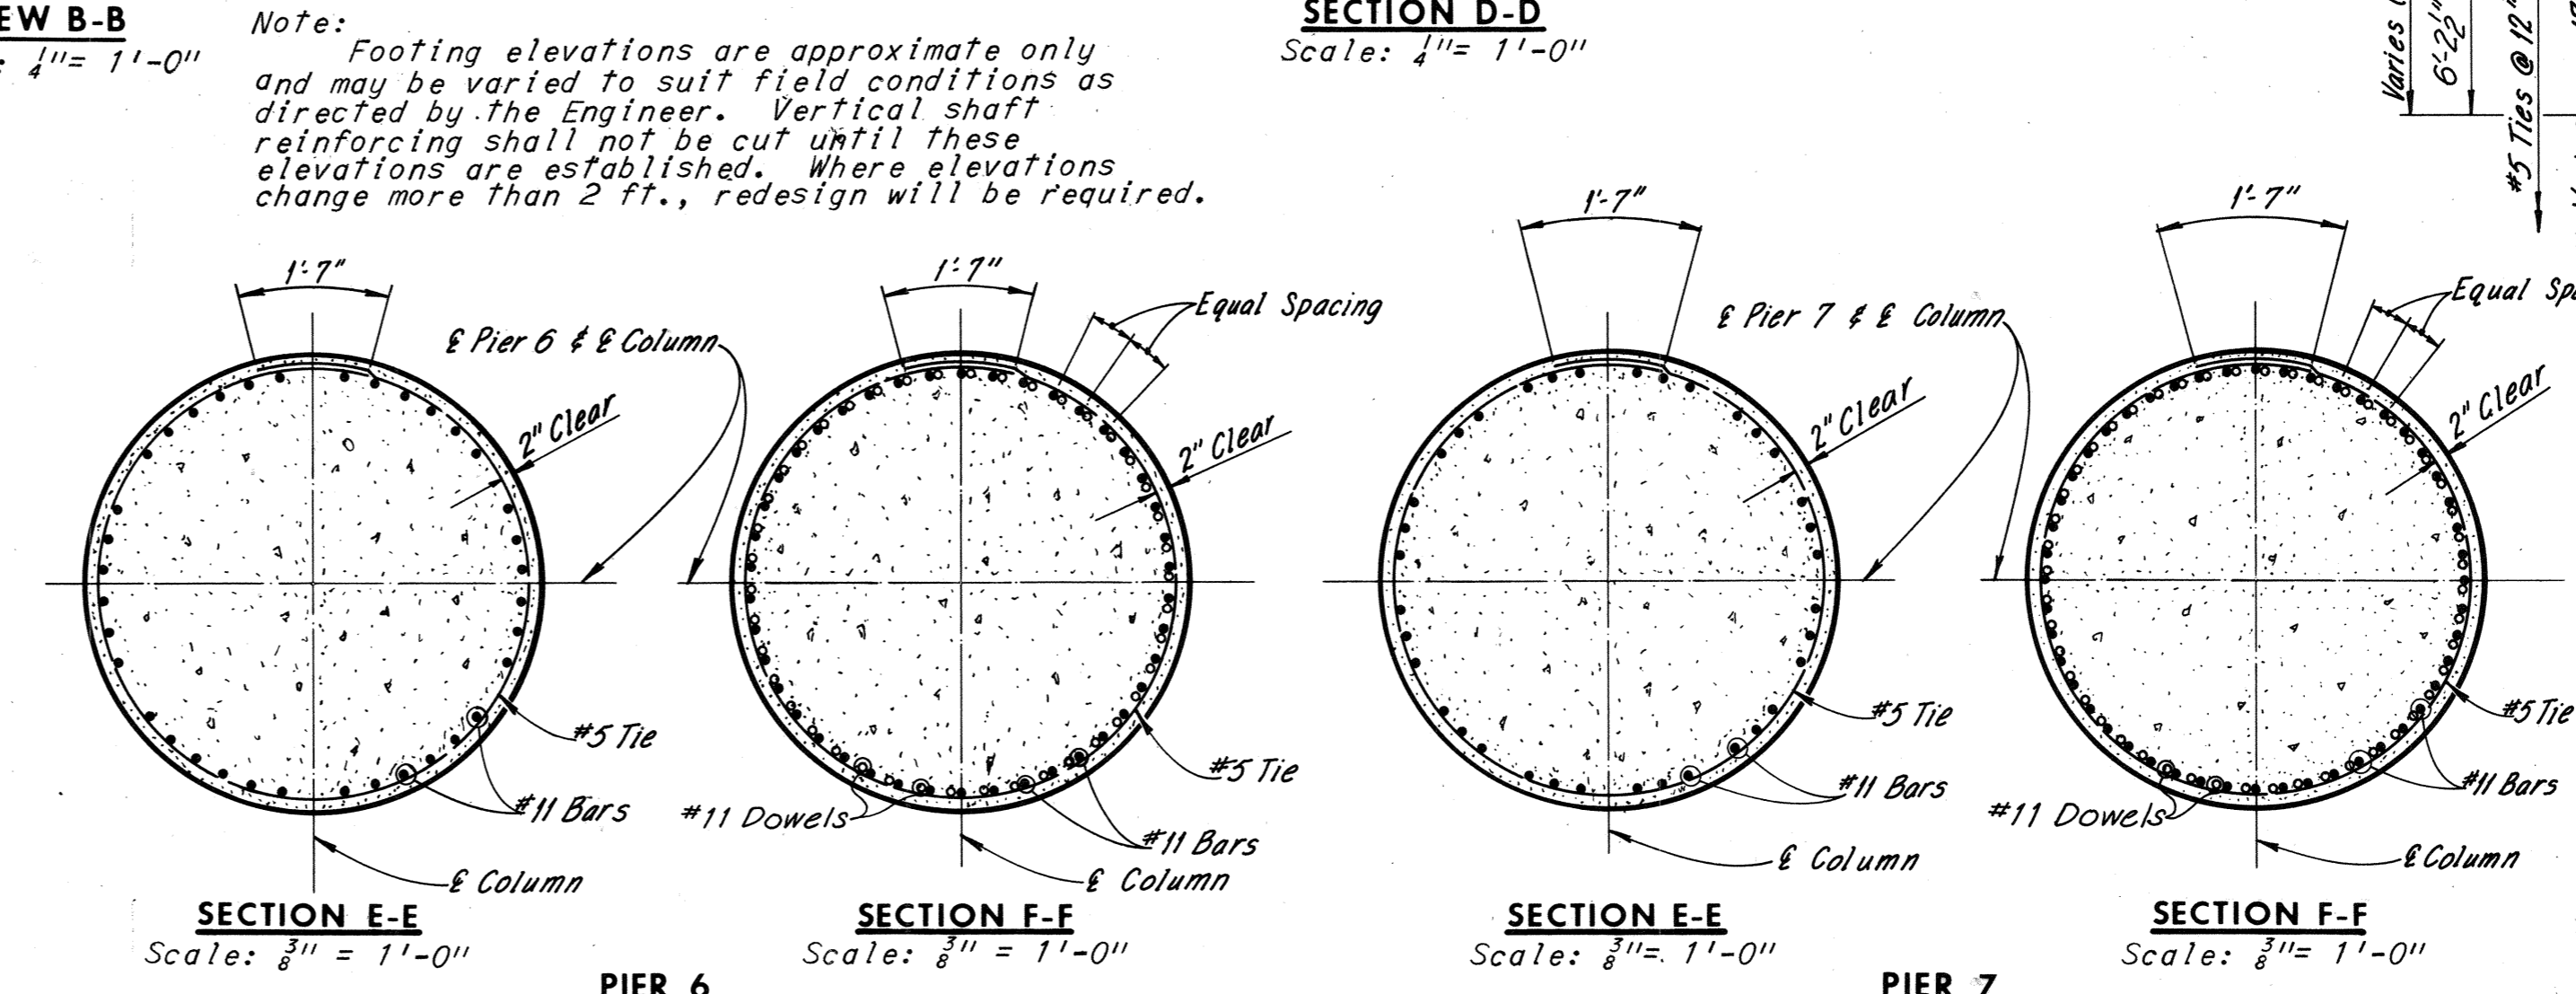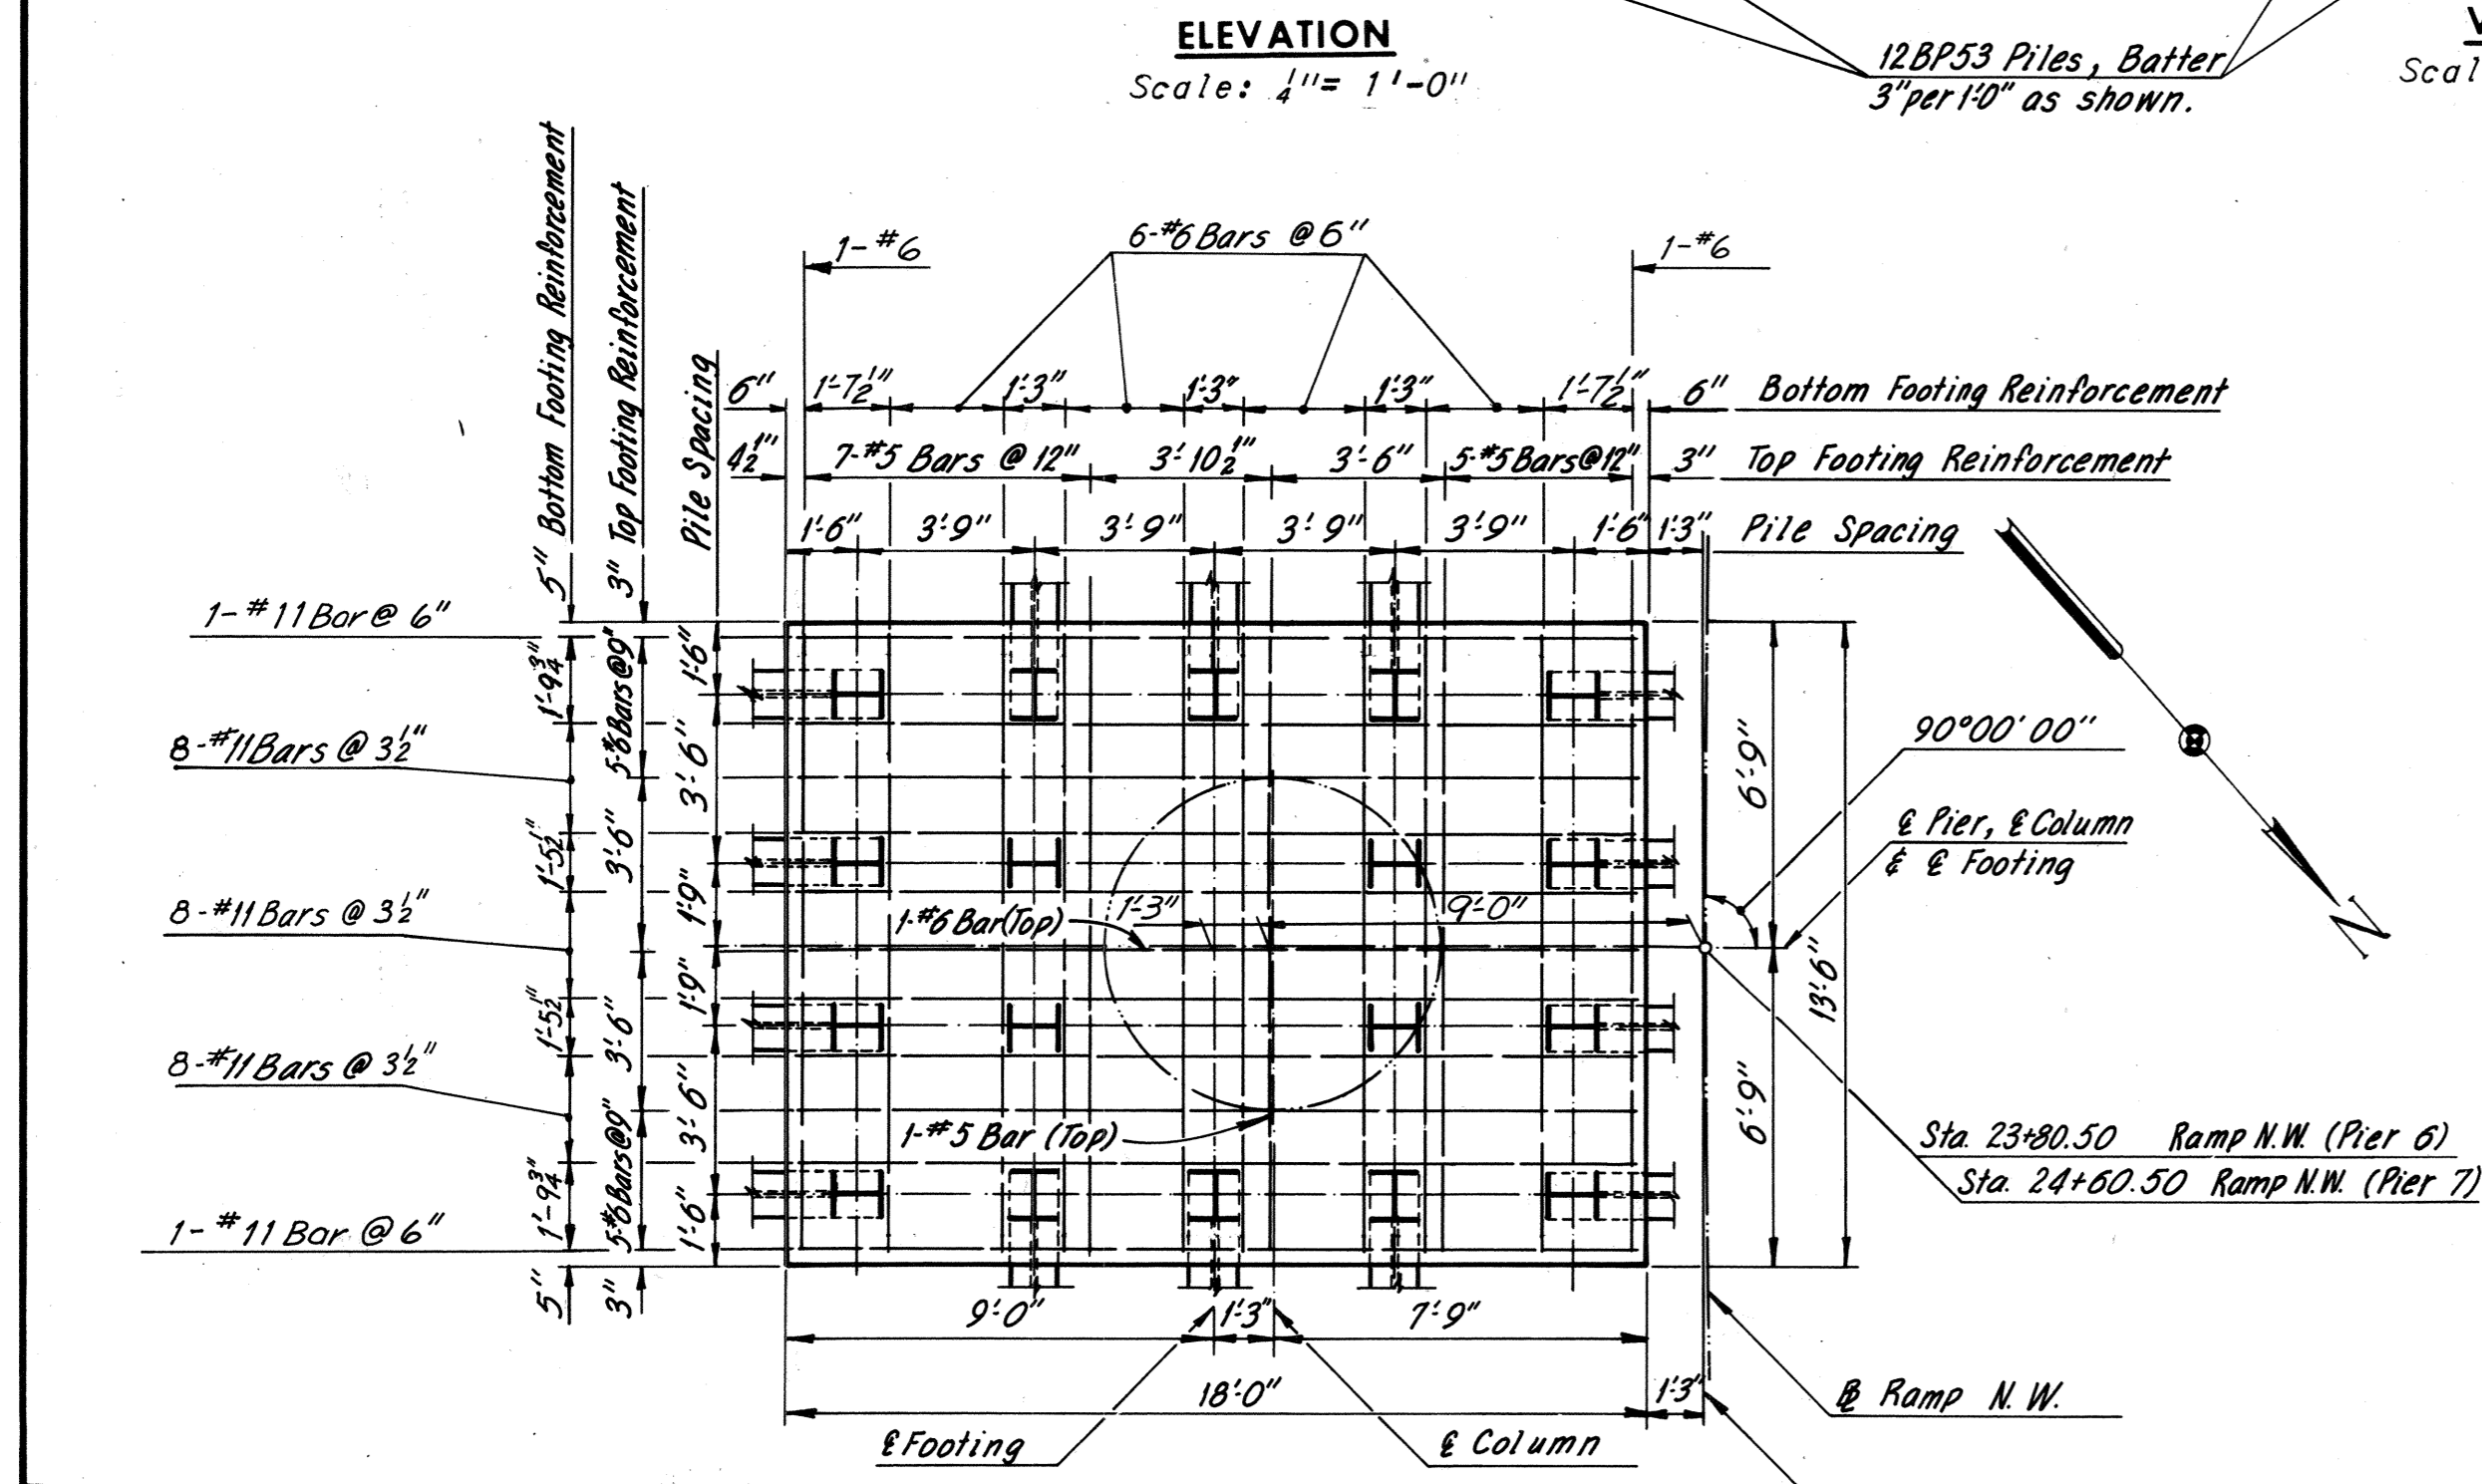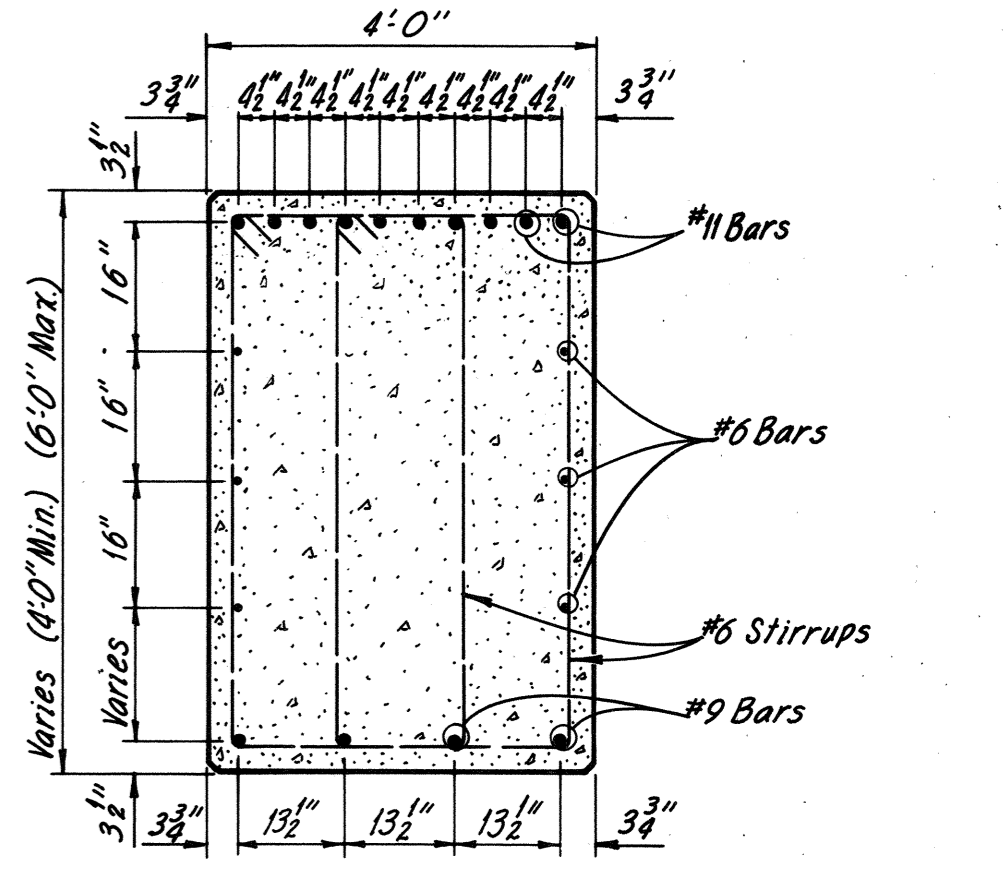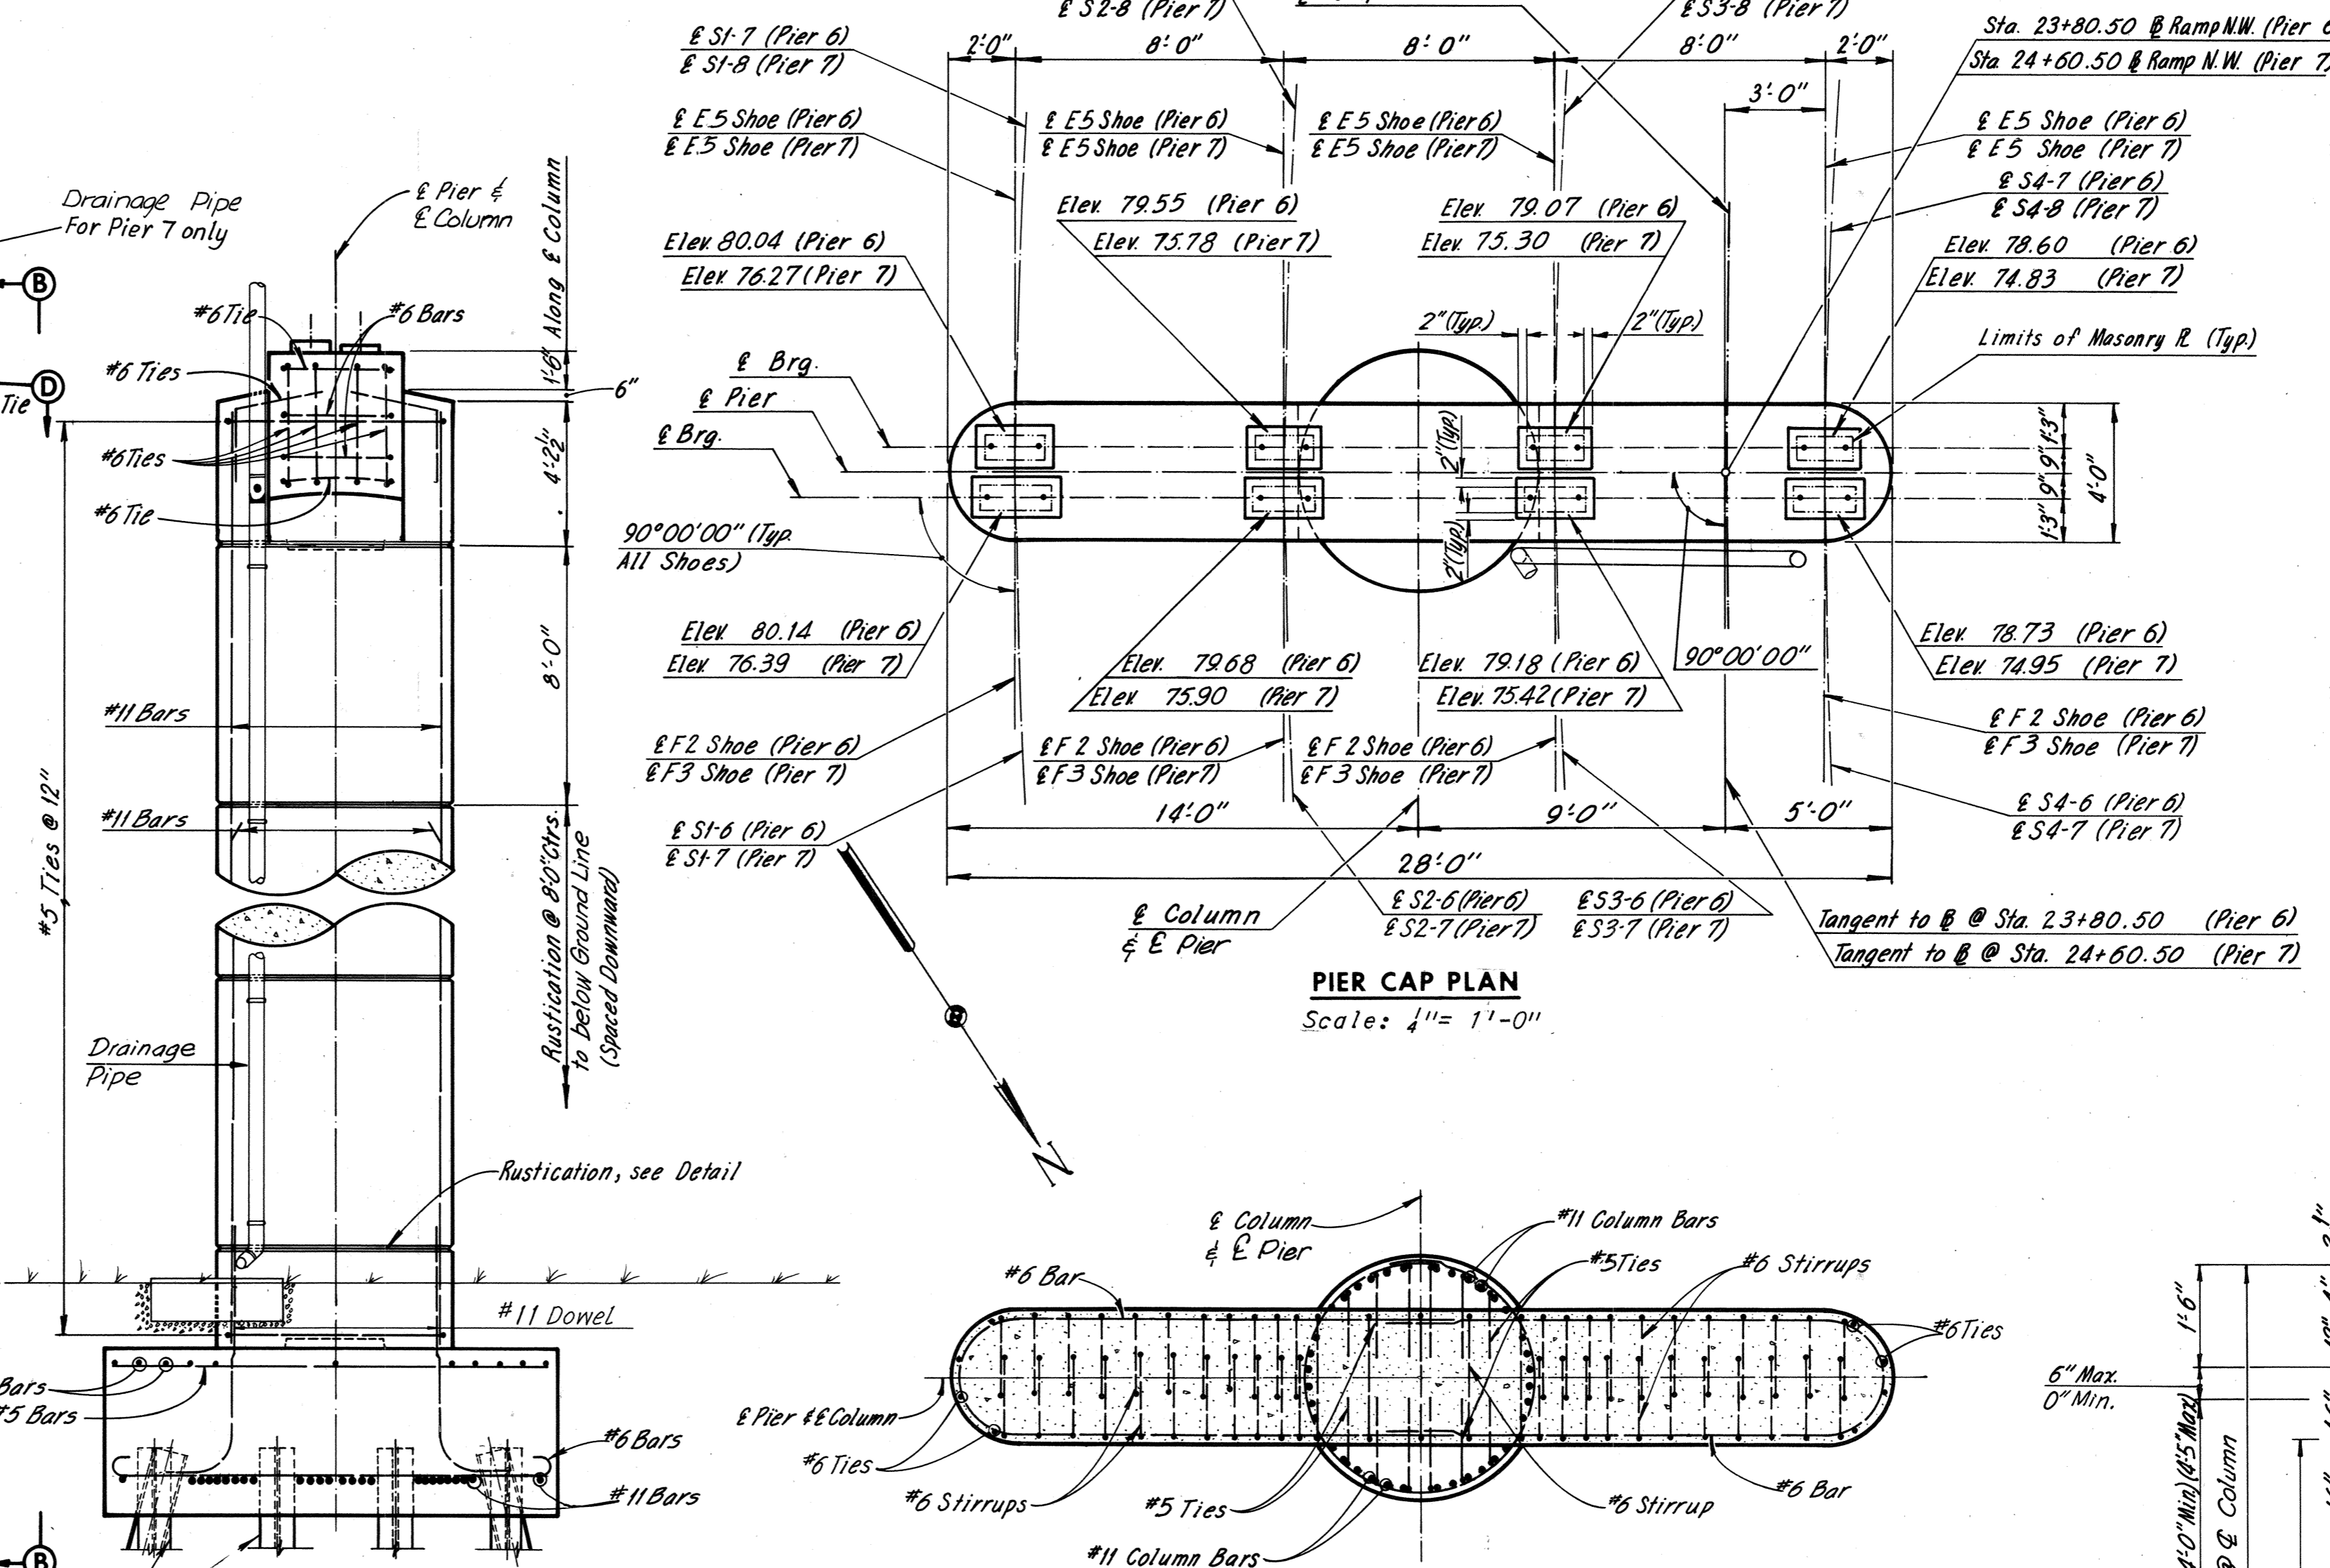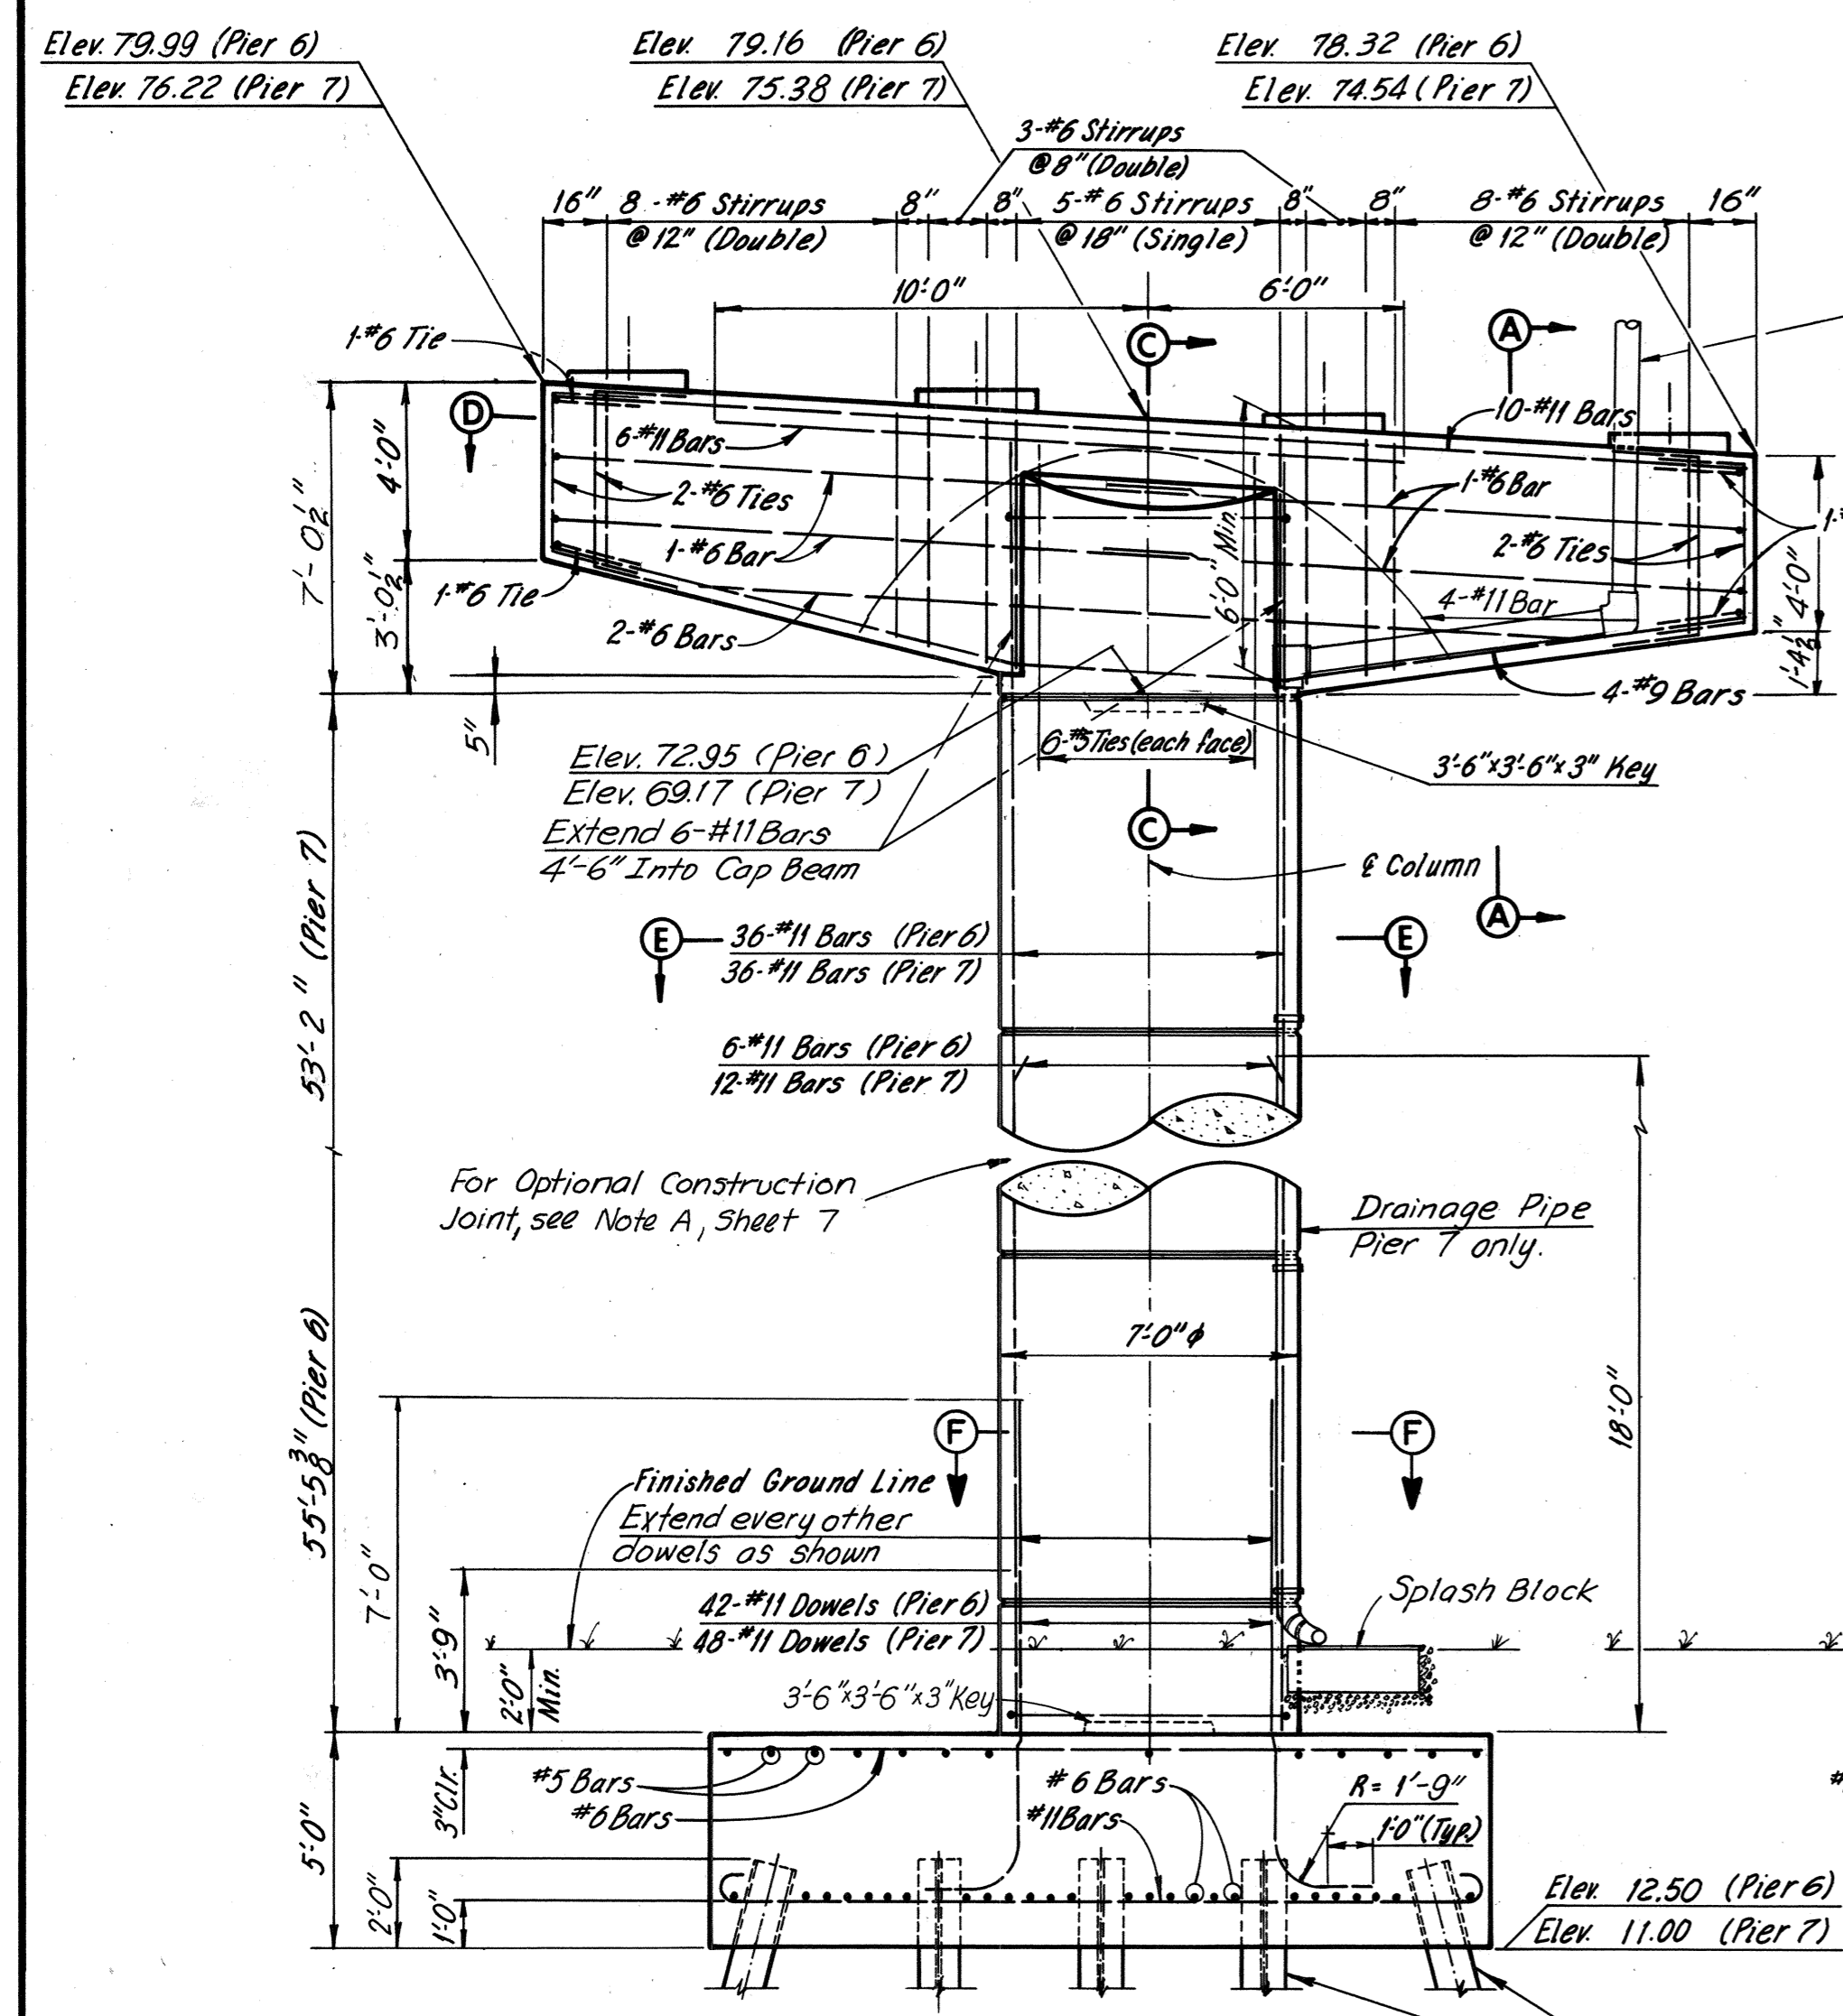

BY	DATE	REVISION	BY	DATE
MADE	D.E.S. 9-12-68	2 As Built	TEM	6-77
CHECKED	K.C.T. 9-17-68			
IN CHARGE				

FOOTING PLAN
Scale: 1/4" = 1'-0"

FOOTINGS FOR PIERS 6 AND 7 ARE ECCENTRIC AS SHOWN ON FOOTING PLAN

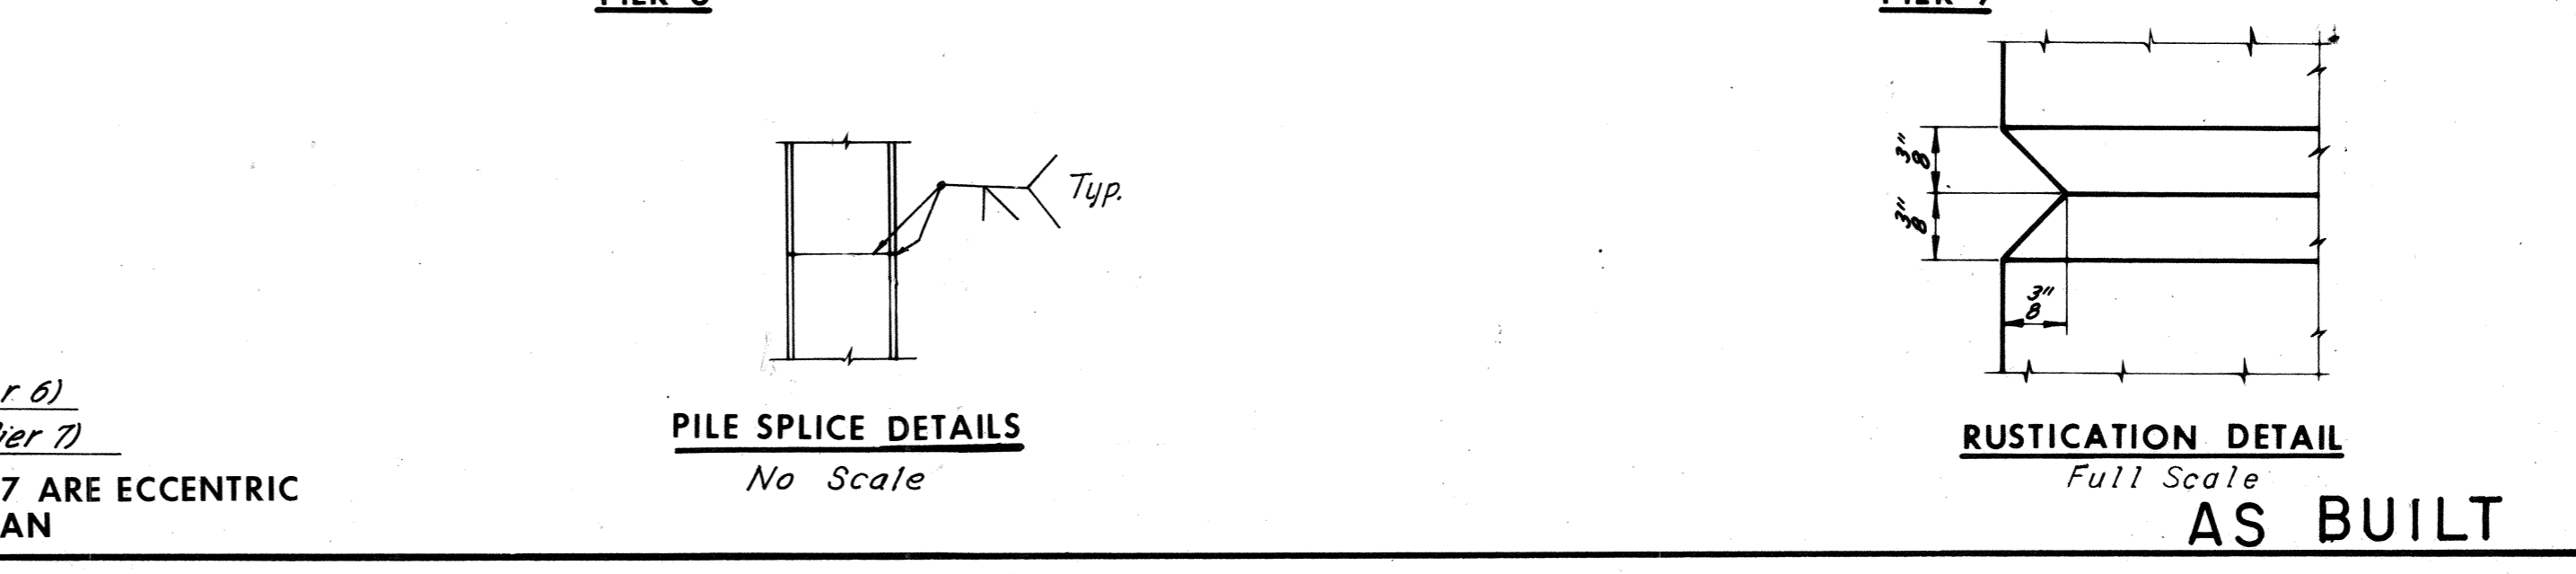

Notes:
 - All piles shall be 12BP53 Steel Piles (Design capacity = 57 tons).
 - Batter all piles 3' per foot where shown.
 - For Standard Shoe Details, see Sheets S1 & S2.
 - For Framing Plan, see Sheets 15 & 16.
 - Estimated Pile Tip Elevation -4.0.
 - For Standard Drainage Details, see Support Type 3, Sheet S6.











RICHMOND METROPOLITAN AUTHORITY
RICHMOND EXPRESSWAY SYSTEM
DOWNTOWN EXPRESSWAY

BRIDGE NO. 64
RAMP N-W CONNECTION FROM
RICHMOND-PETERSBURG TURNPIKE
PIERS 6 AND 7

HOWARD, NEEDLES, TAMMEN & BERGENDOFF
 consulting engineers
 NEW YORK ALEXANDRIA KANSAS CITY

SCALE: As Noted
 CONTRACT NO.: 10
 SHEET NO.: 8 OF 28

RICHMOND EXPRESSWAY SYSTEM			
SECTION	PROJECT	SHEET NO.	TOTAL SHEETS
10	DOWNTOWN EXPRESSWAY	107	265

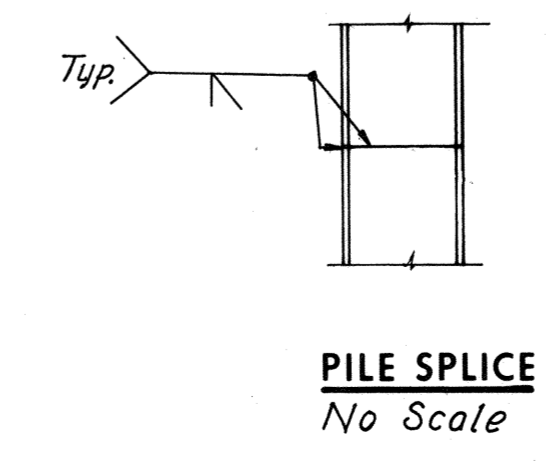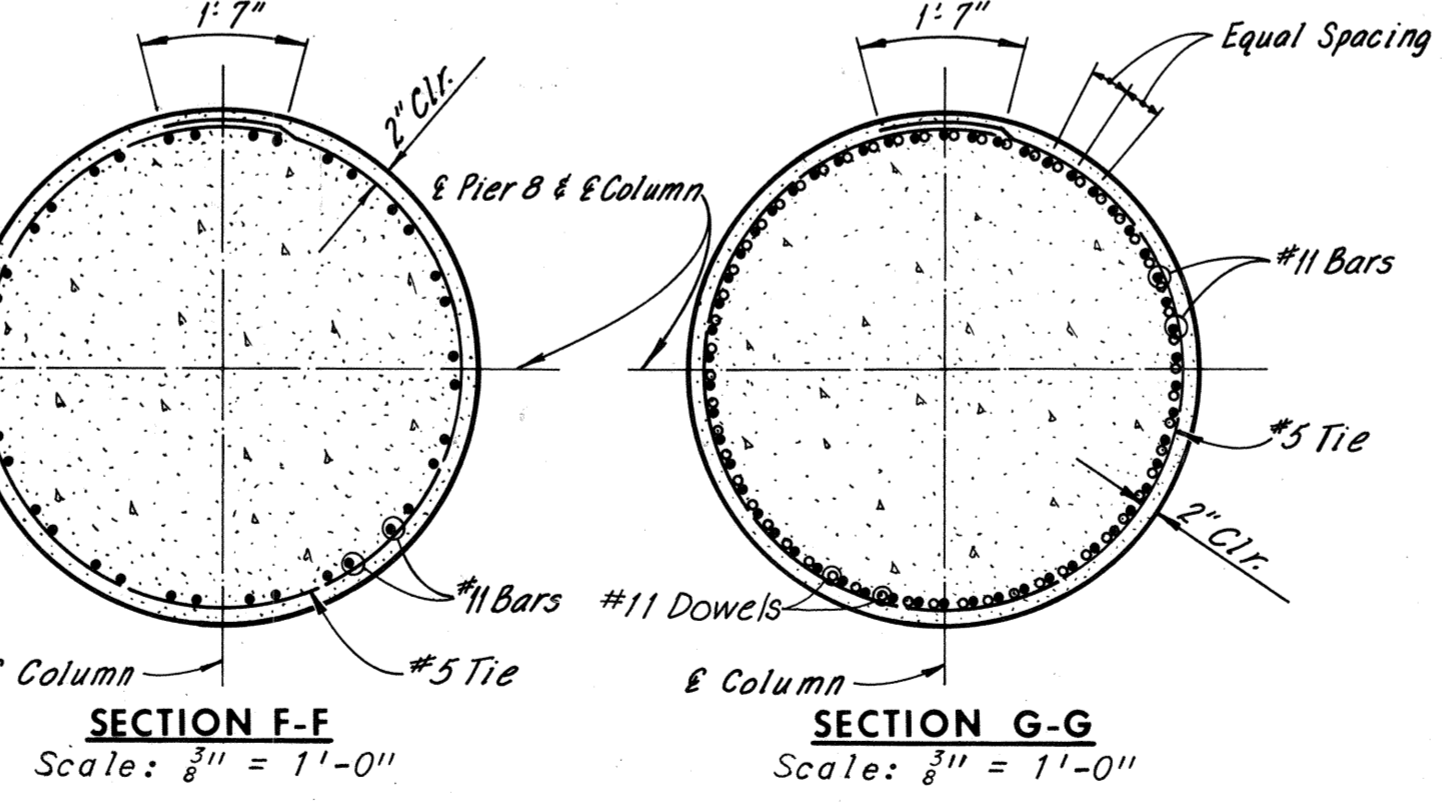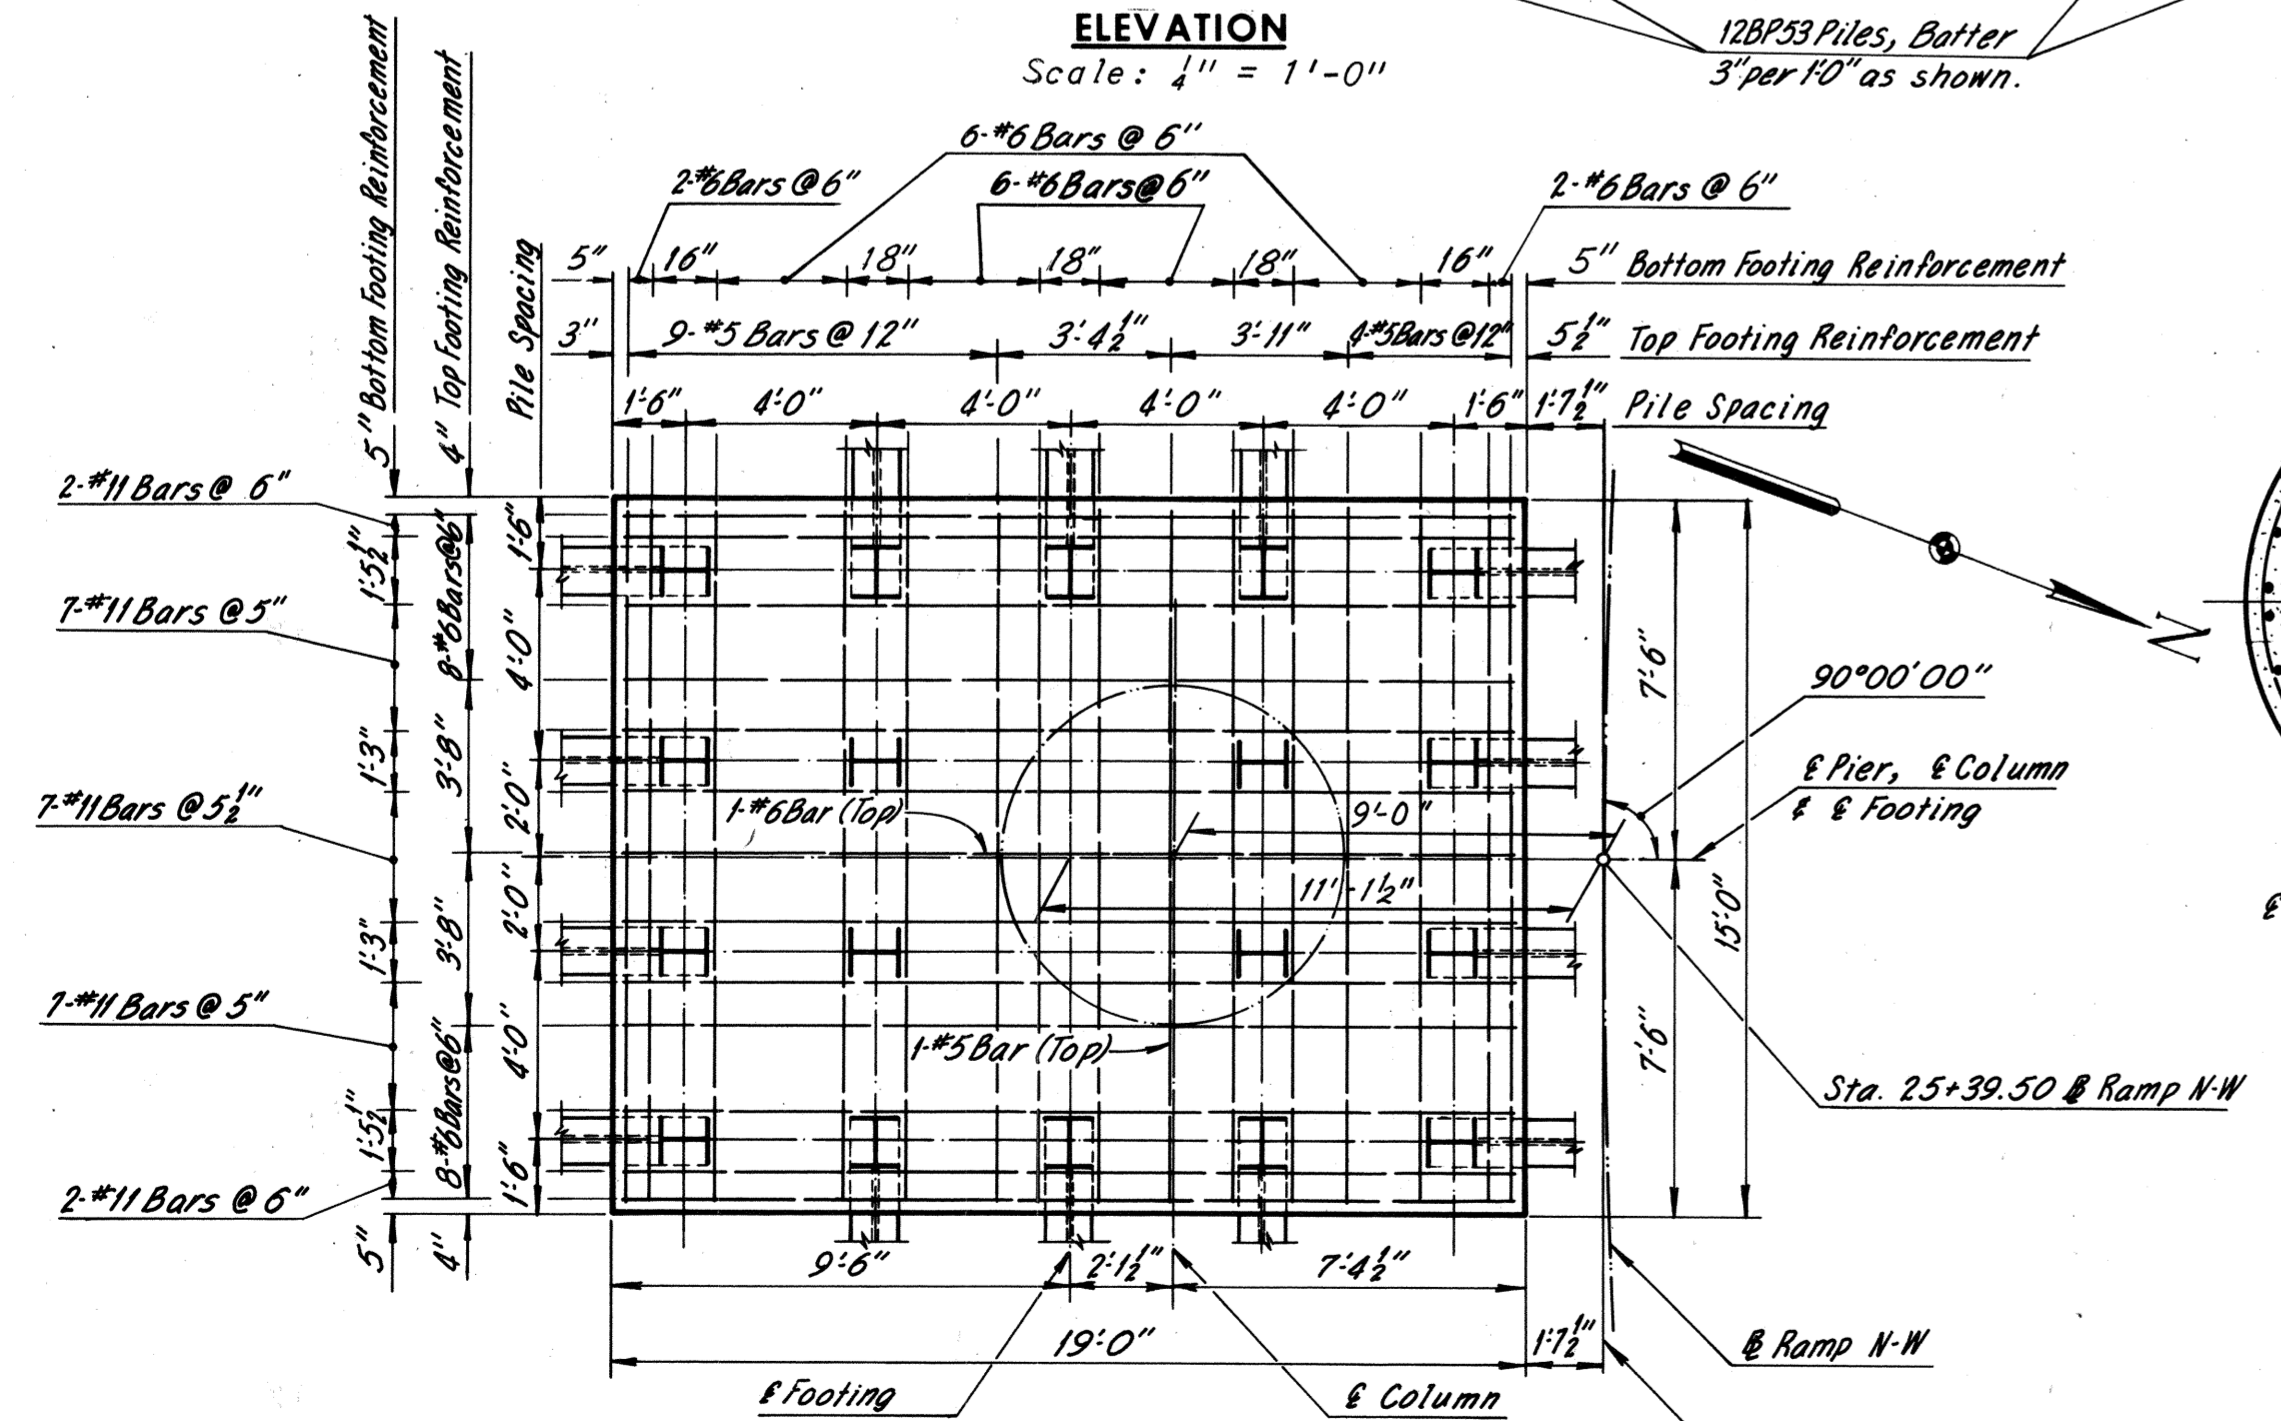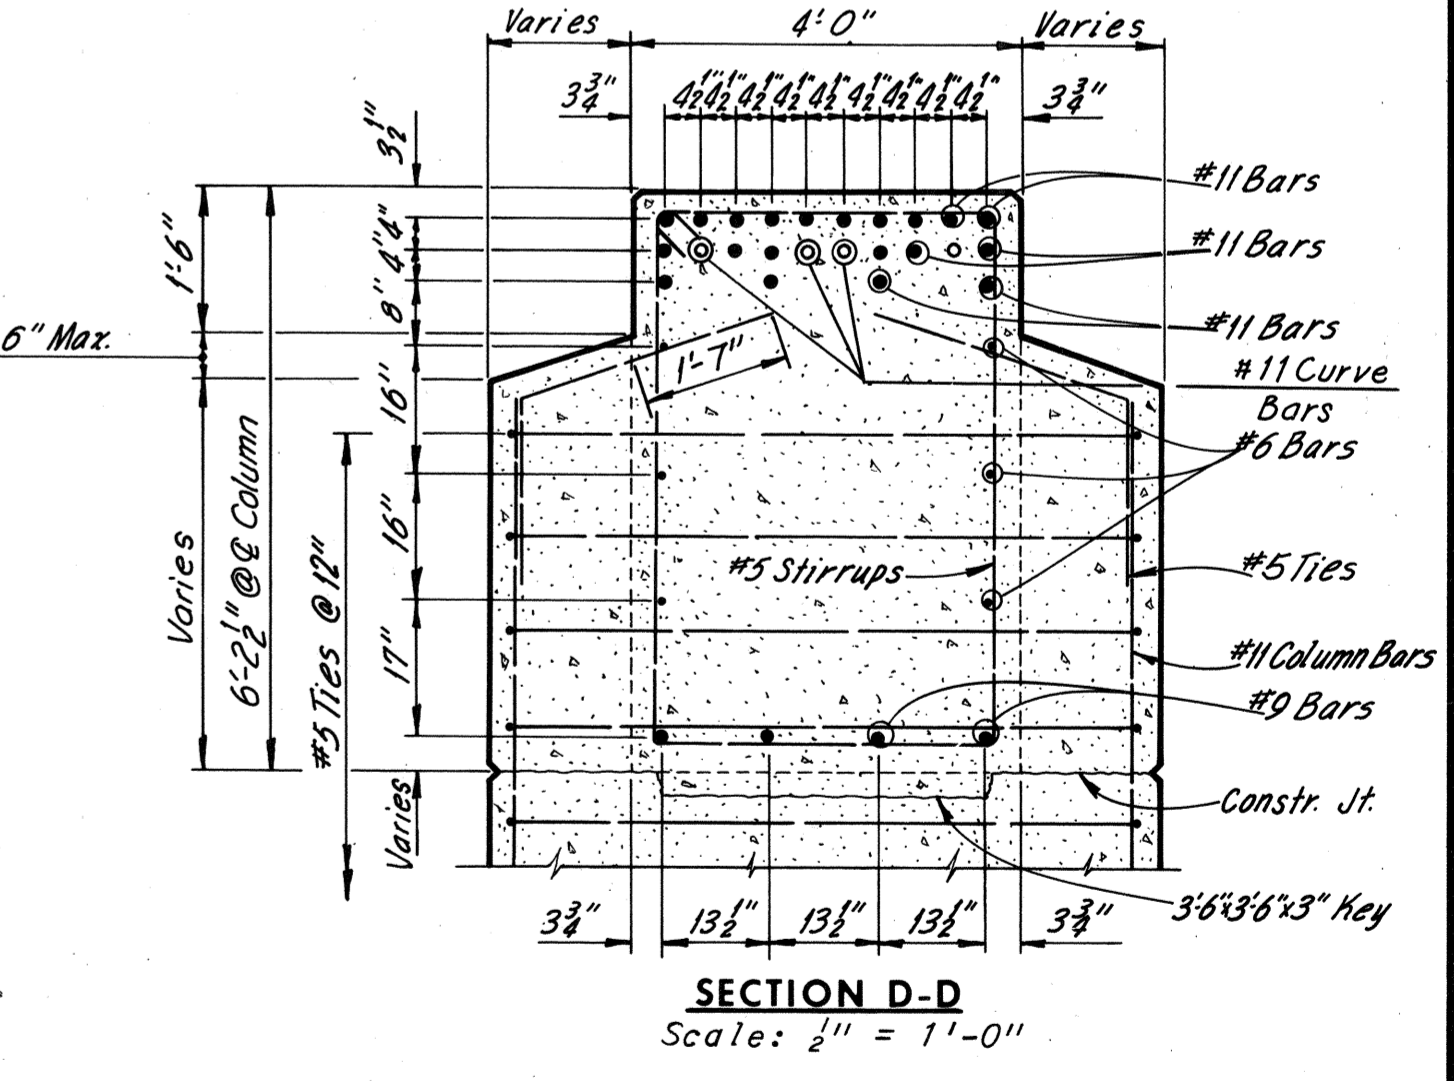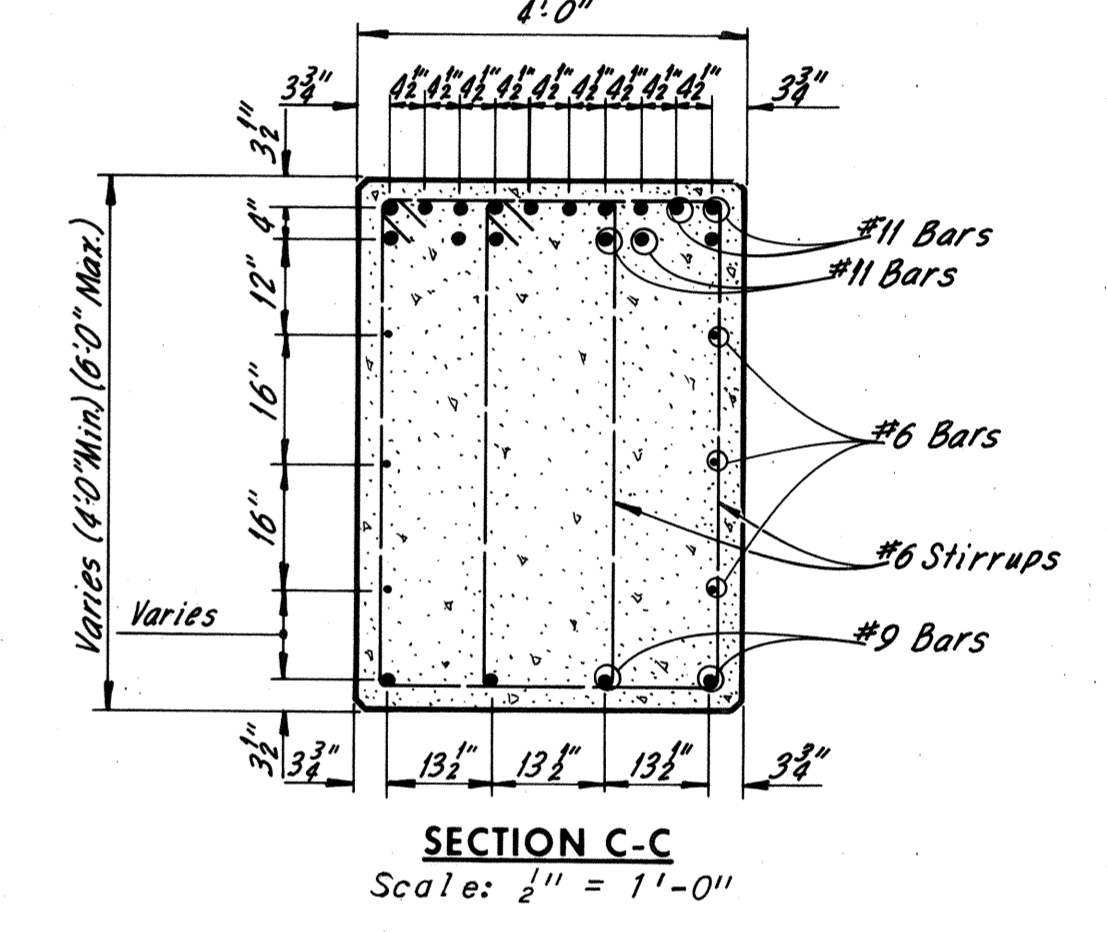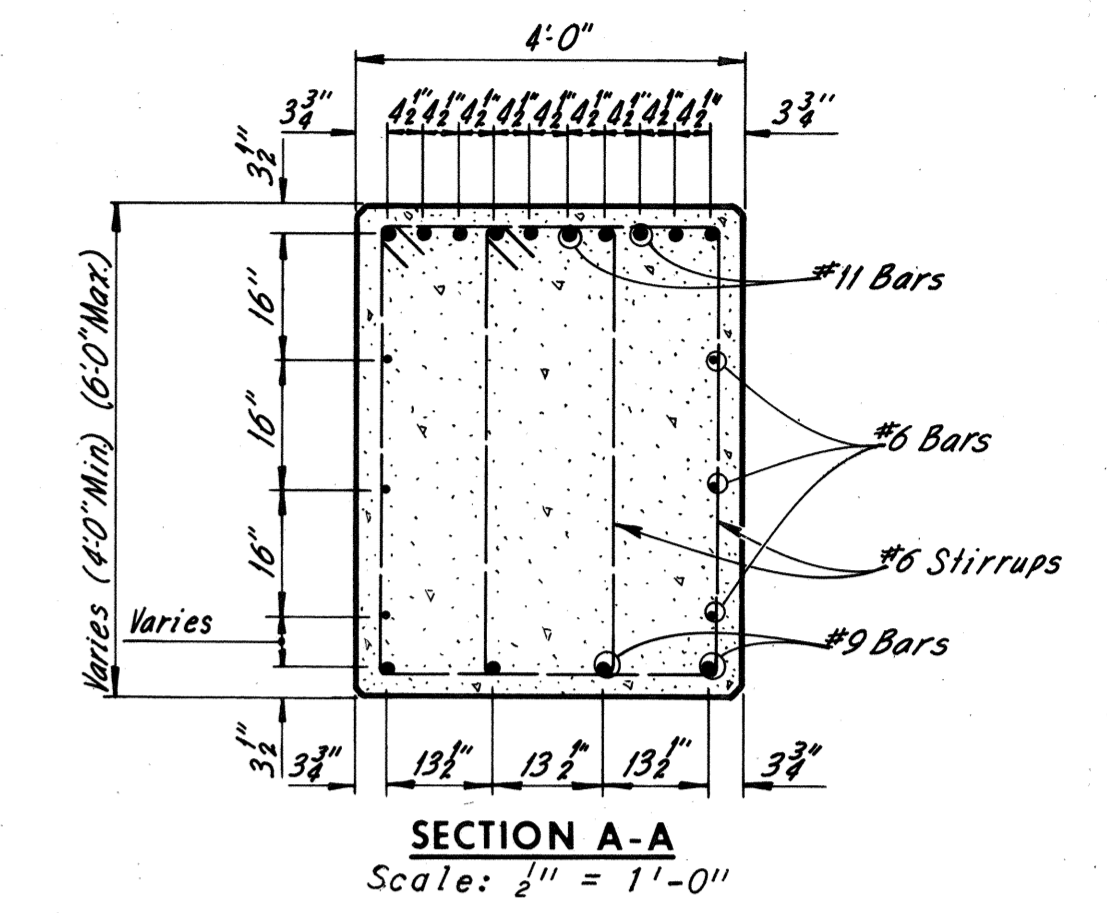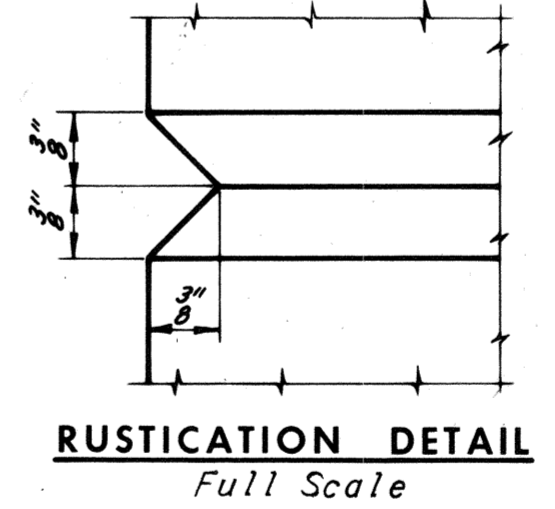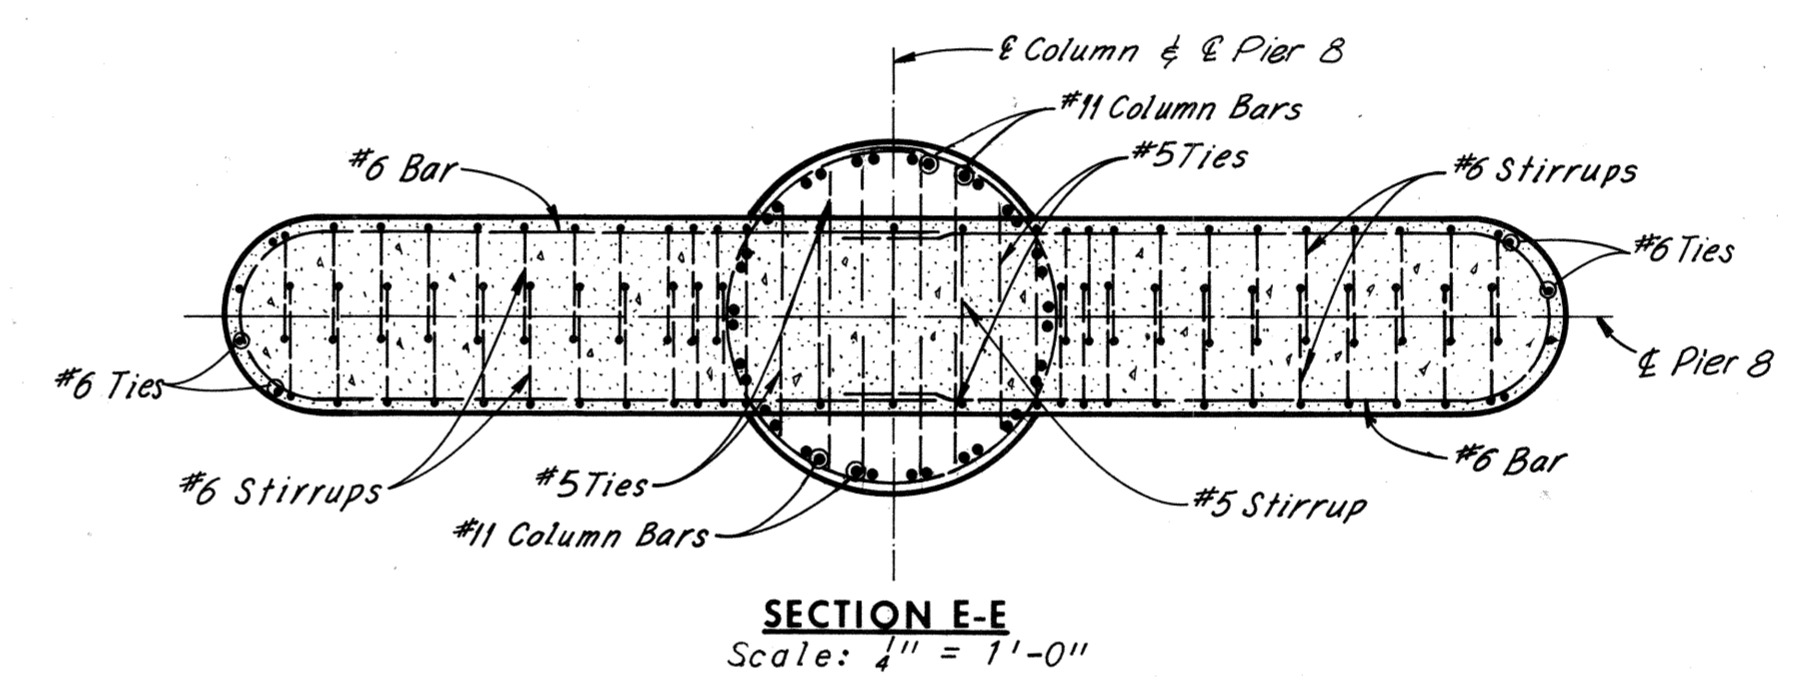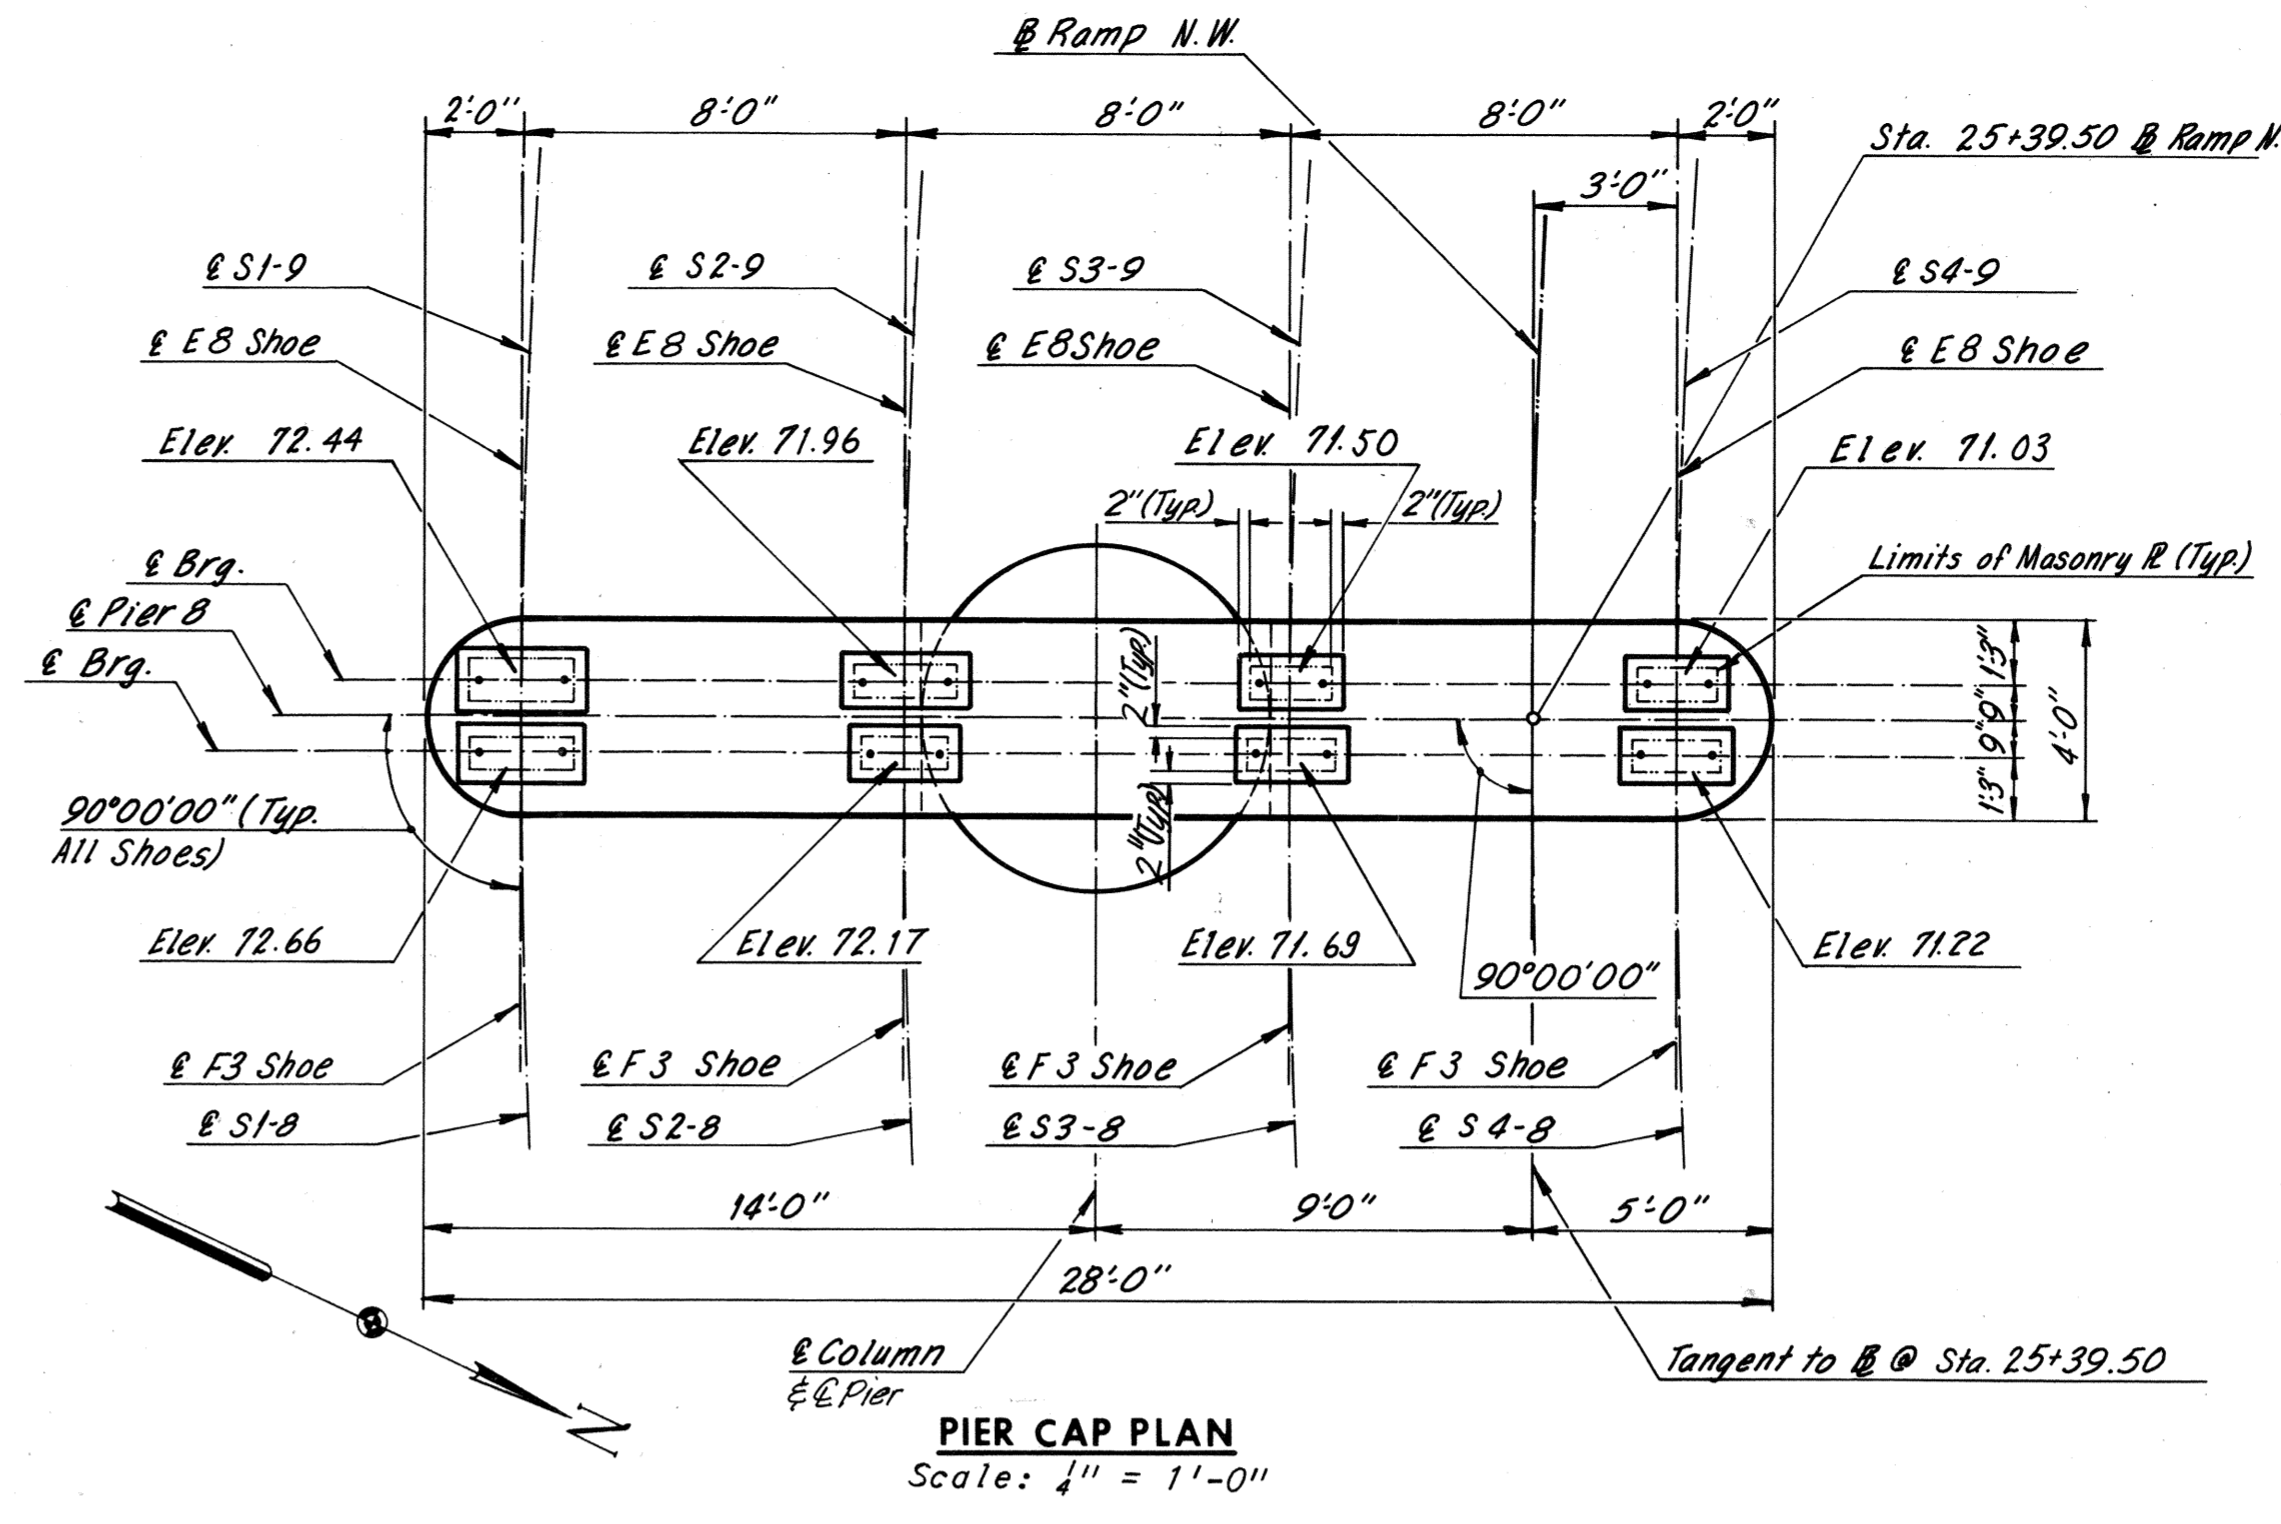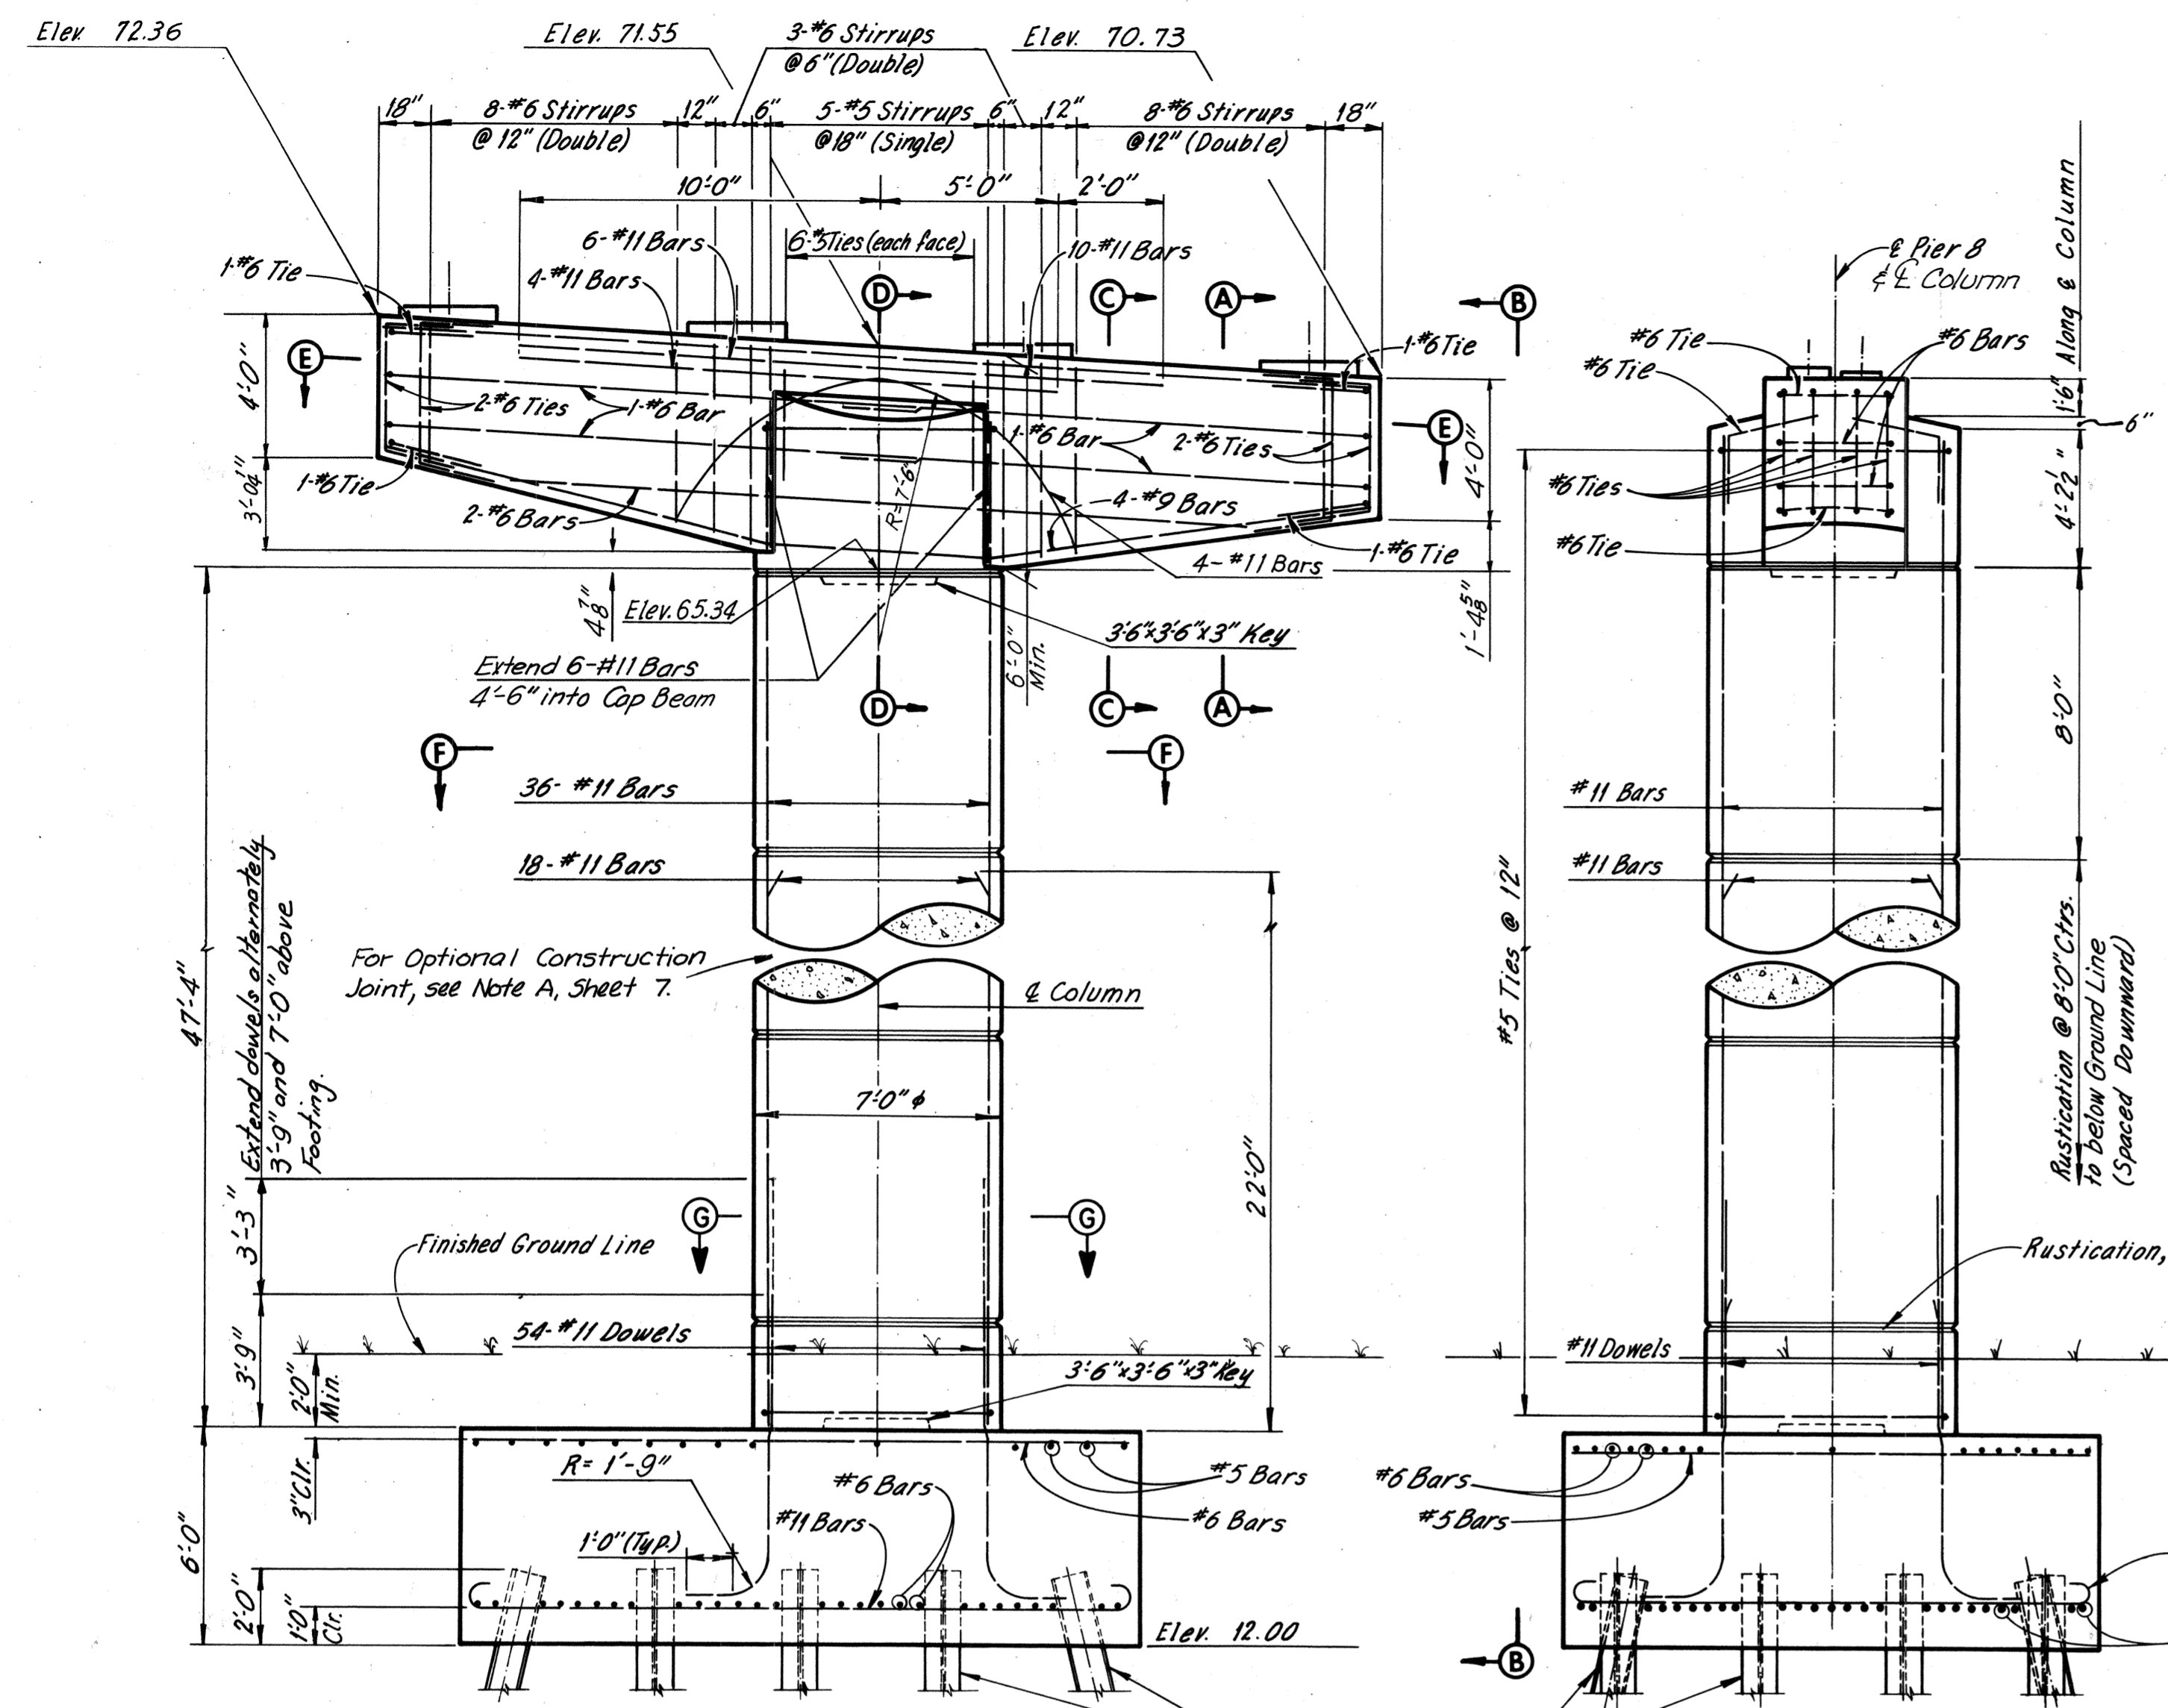

Note: Footing elevations are approximate only and may be varied to suit field conditions as directed by the Engineer. Vertical shaft reinforcing shall not be cut until these elevations are established. Where elevations change more than 2 ft., redesign will be required.

Note: All piles shall be 12BP53 Steel Piles (Design capacity = 57 tons). Batter all piles 3" per foot where shown. For Standard Shoe Details, see Sheet S1 For Framing Plan, see Sheets 16 & 17 Estimated Pile Tip Elevation -4.0

FOOTING FOR PIER 8 IS ECCENTRIC AS SHOWN ON FOOTING PLAN

NO.	REVISION	BY	DATE
2	As Built	TEM	6-77

PRMS 4-19-74
TEM 6-77

RICHMOND METROPOLITAN AUTHORITY
RICHMOND EXPRESSWAY SYSTEM
DOWNTOWN EXPRESSWAY

BRIDGE NO. 64
RAMP N-W CONNECTION FROM
RICHMOND-PETERSBURG TURNPIKE


PIER 8

HOWARD, NEEDLES, TAMMEN & BERGENDOFF
consulting engineers
NEW YORK ALEXANDRIA KANSAS CITY


SCALE: As Shown
CONTRACT NO. 10
SHEET NO. 9 OF 28

AS BUILT


RICHMOND EXPRESSWAY SYSTEM			
SECTION	PROJECT	SHEET NO.	TOTAL SHEETS
10	DOWNTOWN EXPRESSWAY	108	265

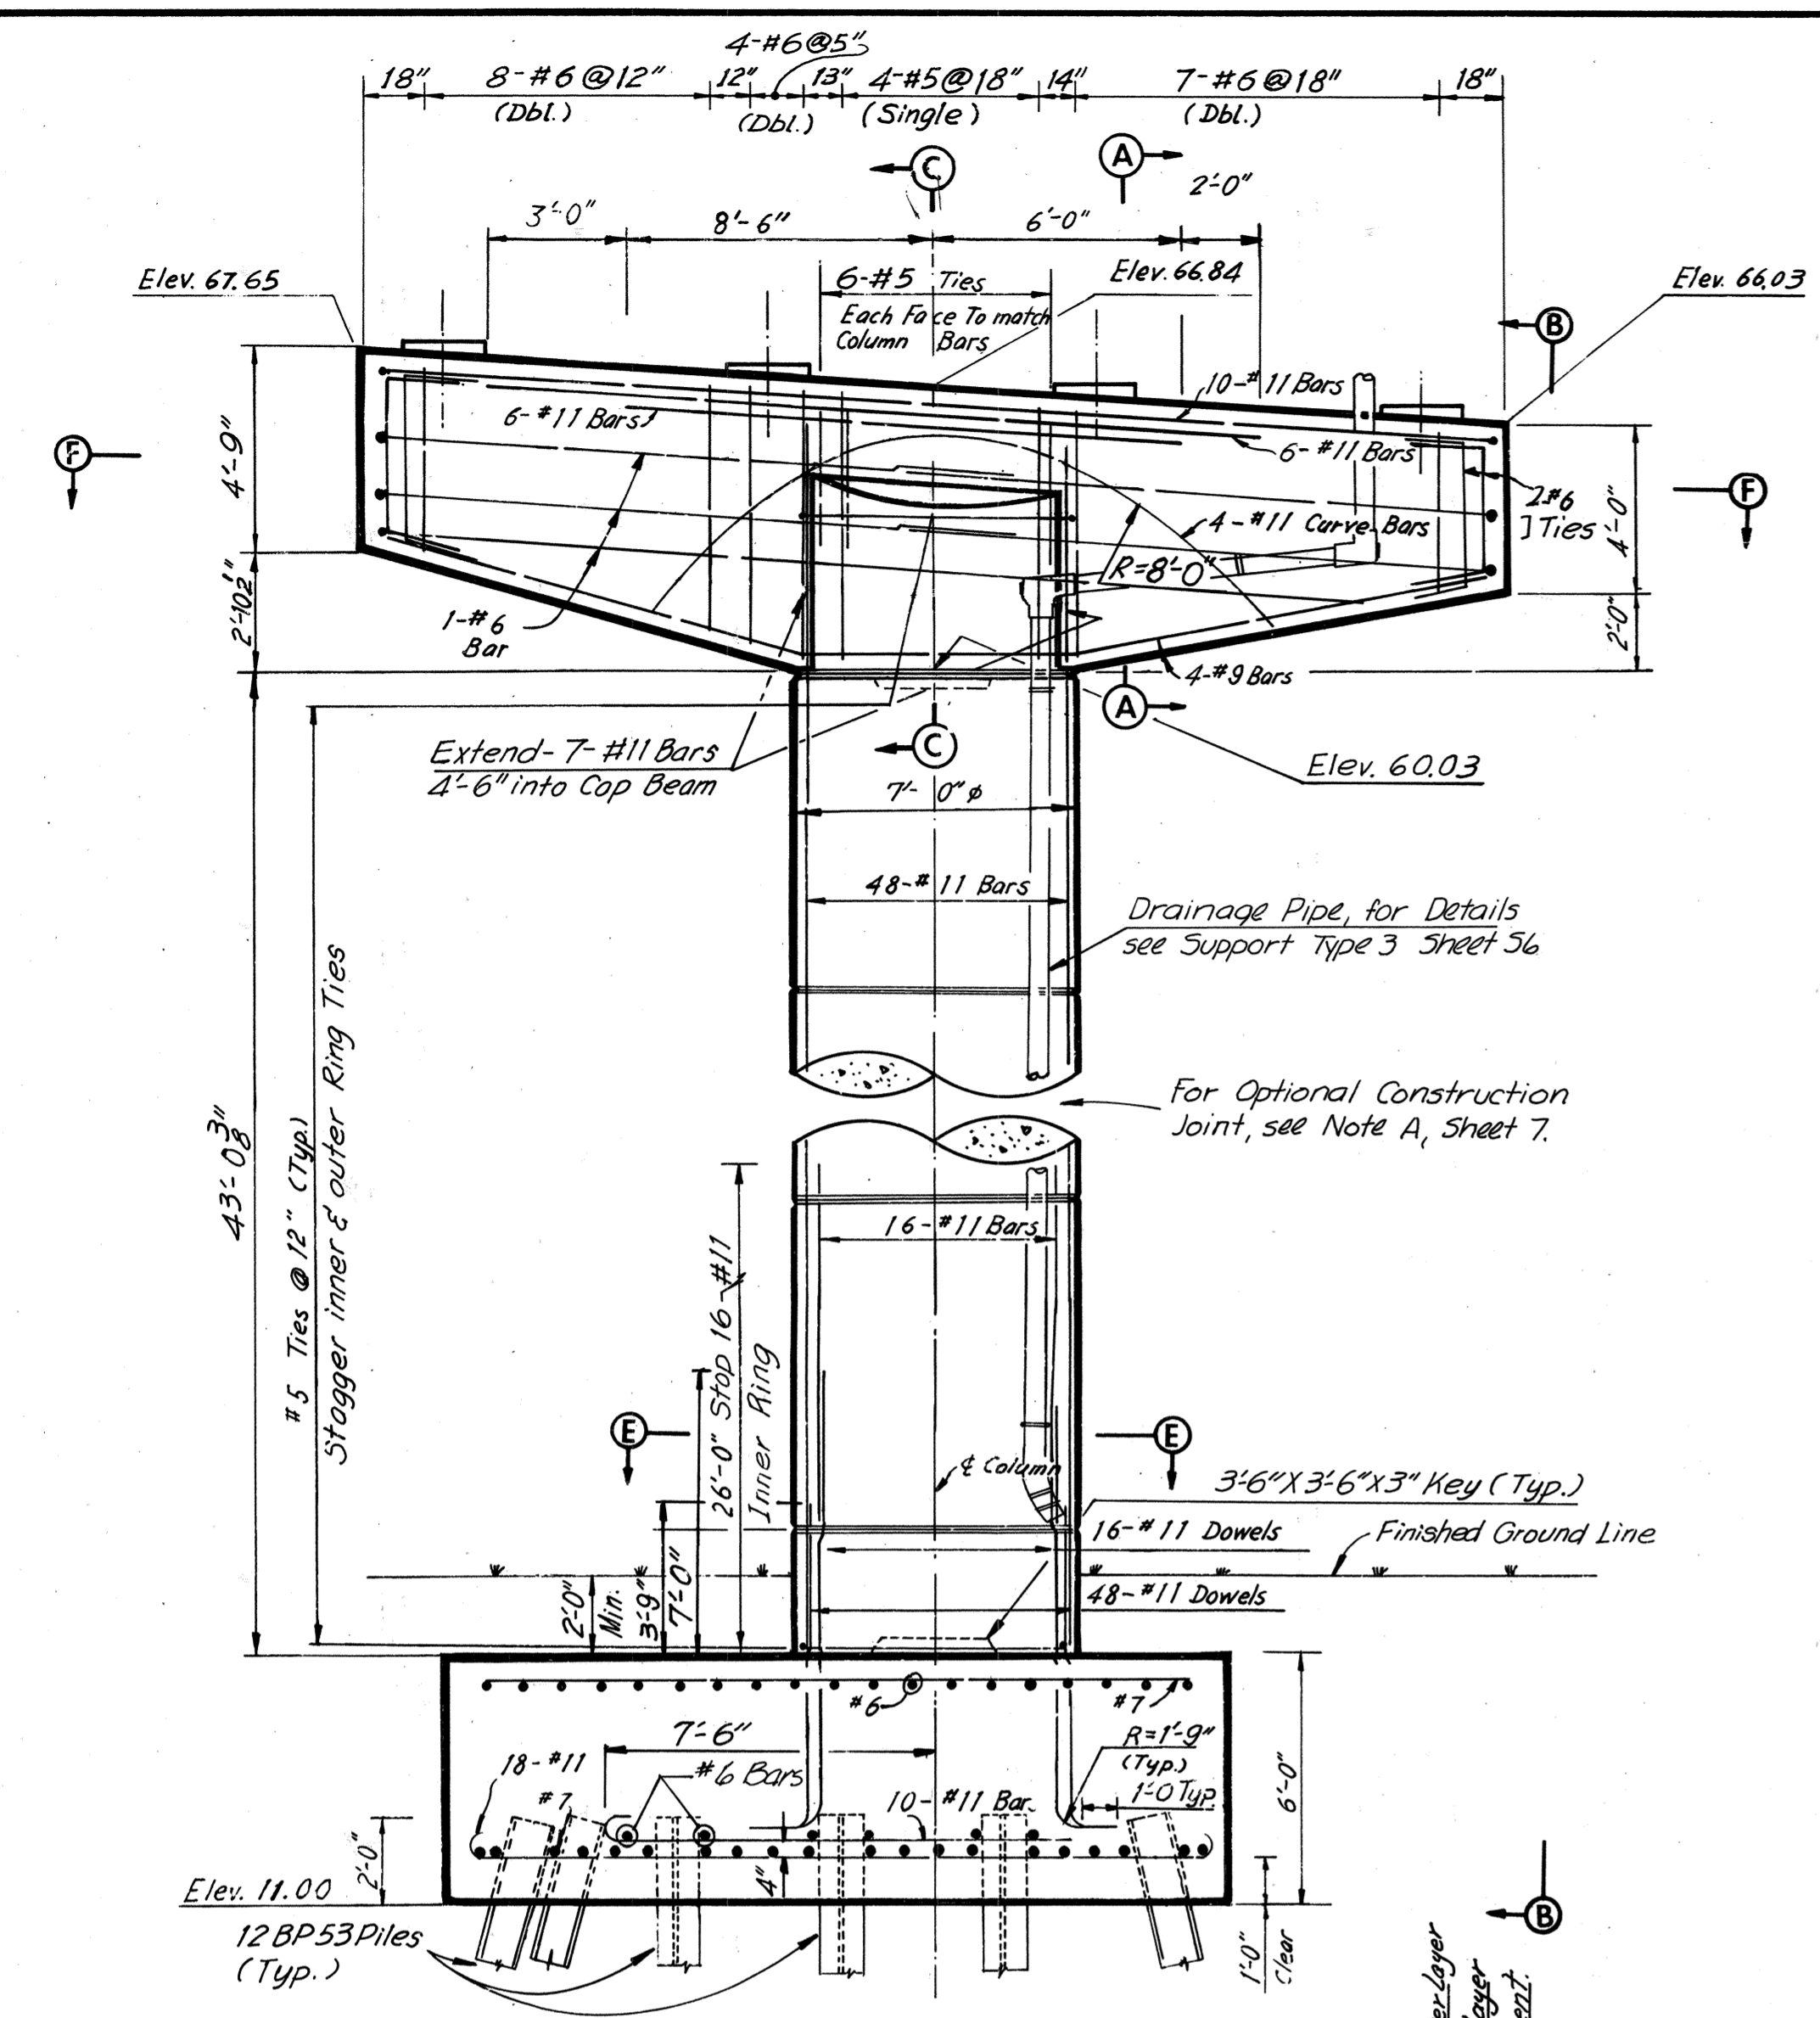


ELEVATION
Scale: 1/4"=1'-0"

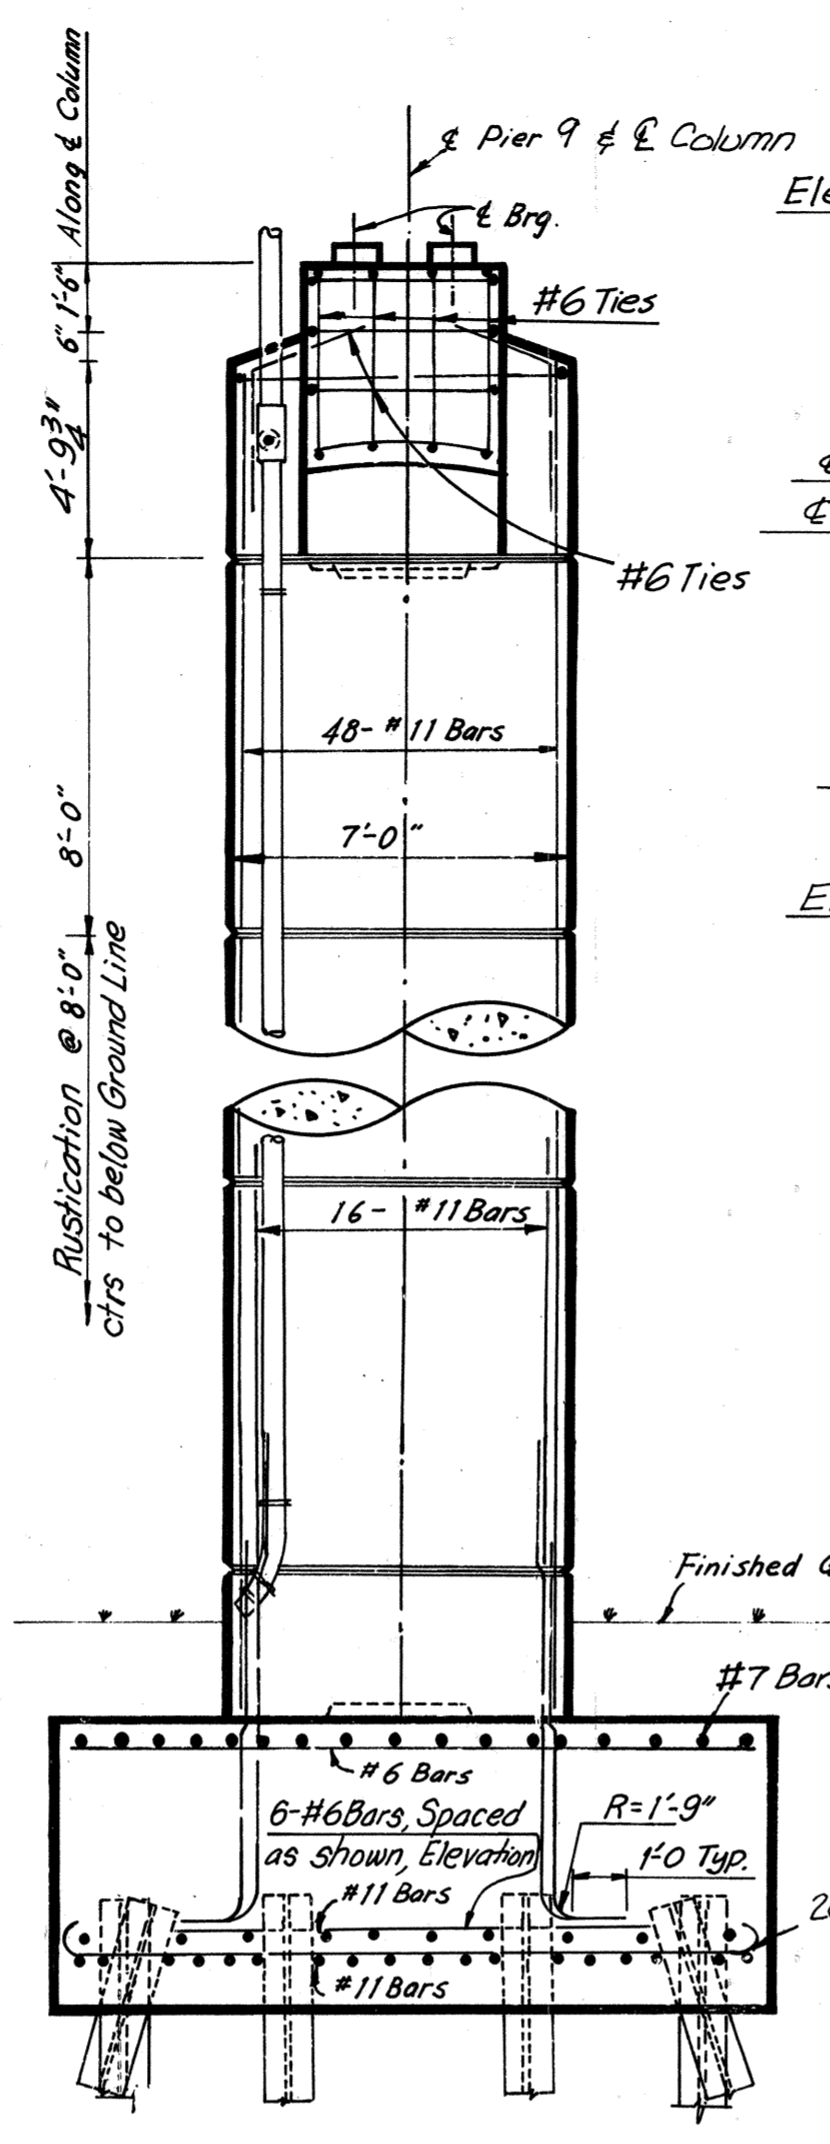


VIEW B-B
Scale: 1/4"=1'-0"

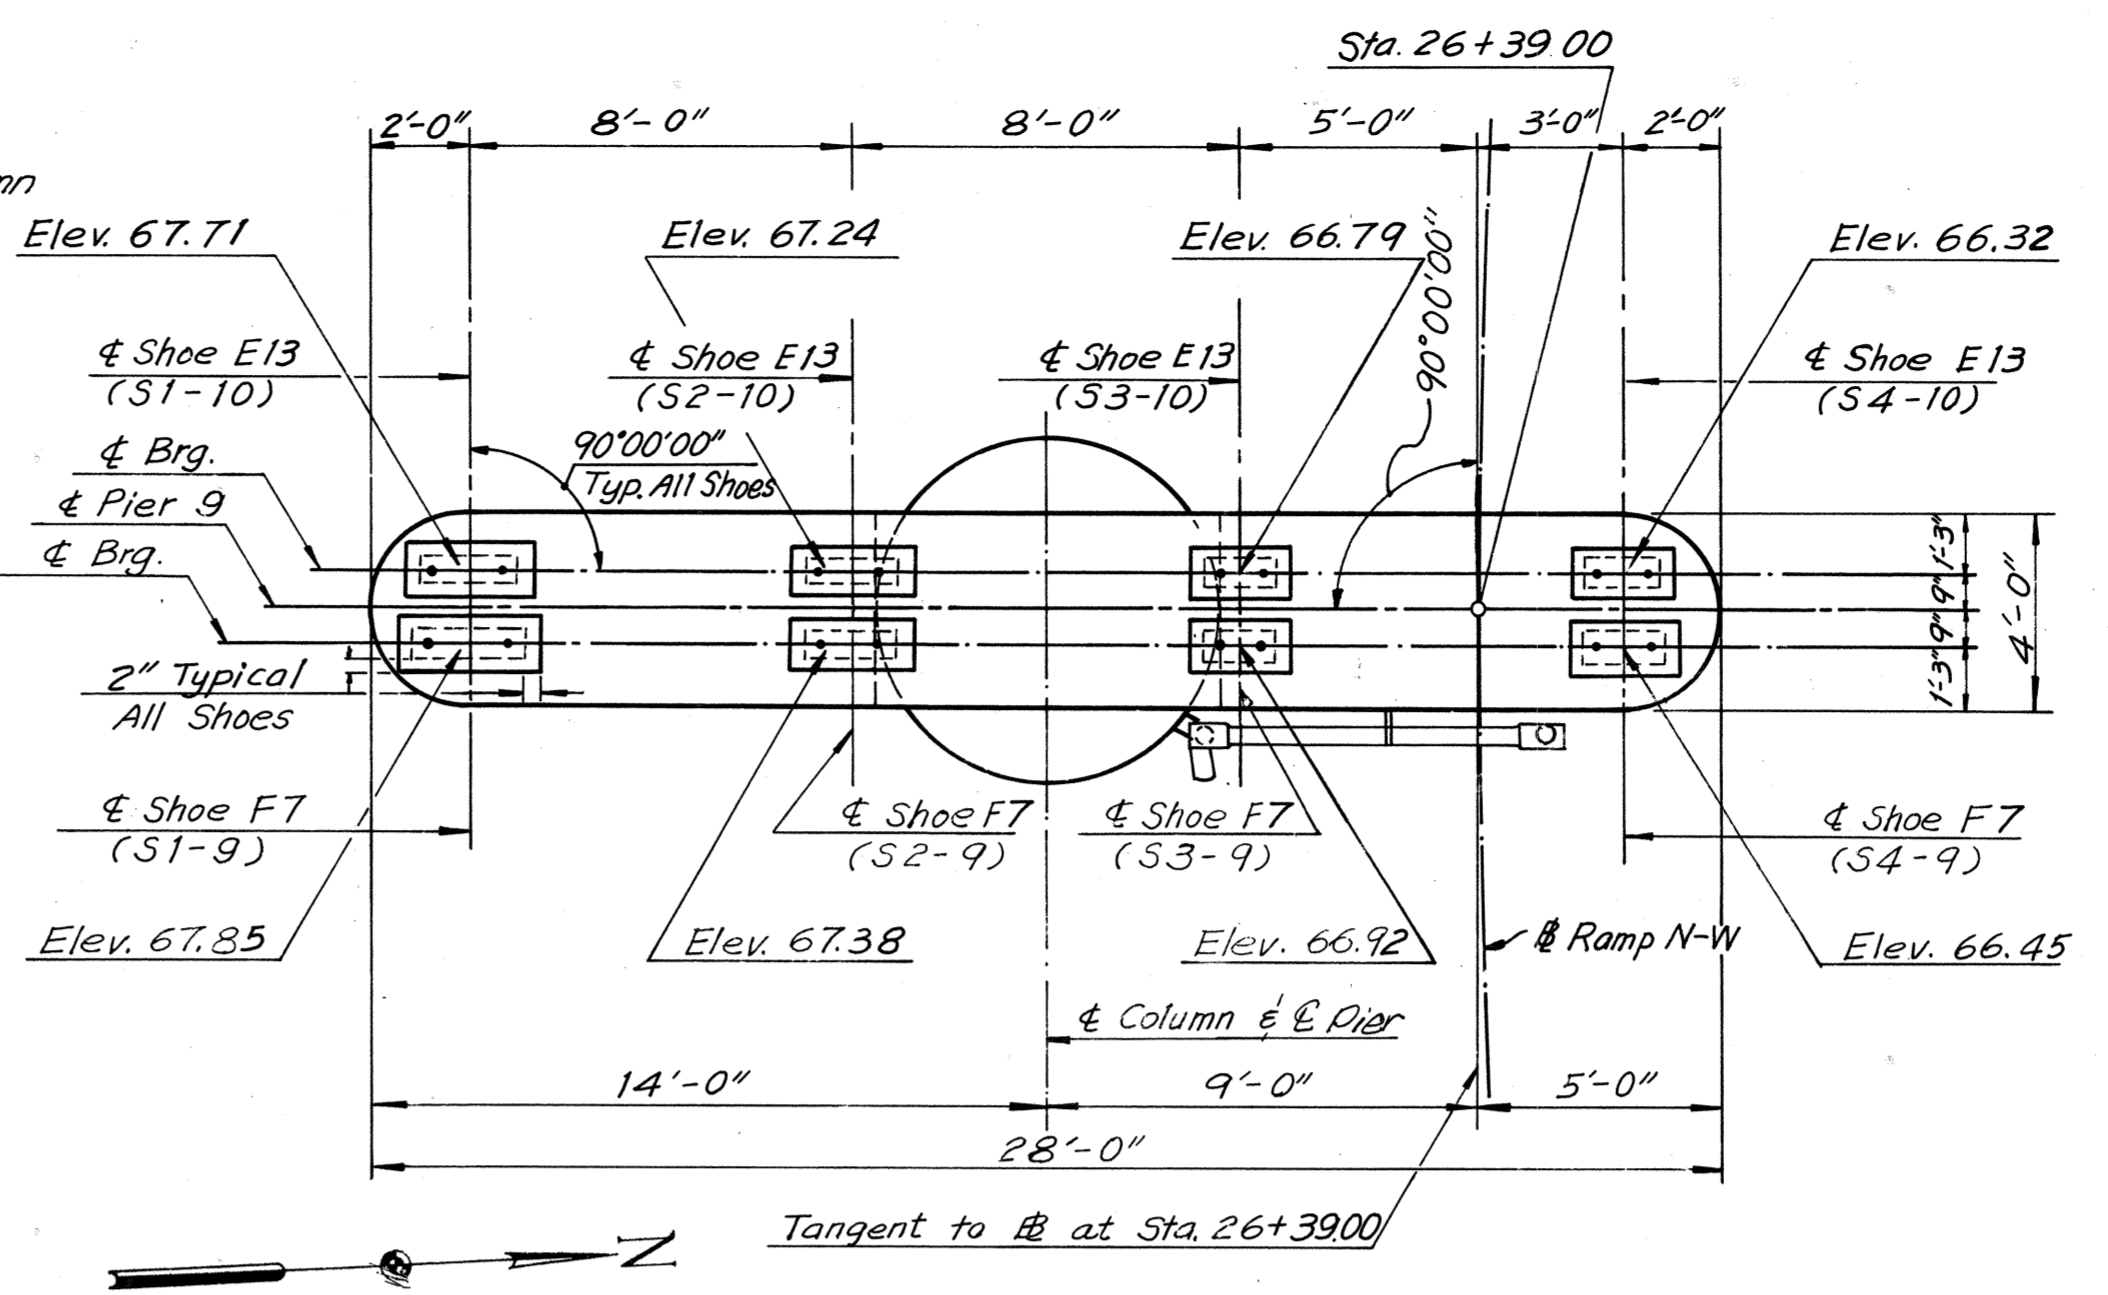


PLAN
Scale: 1/4"=1'-0"

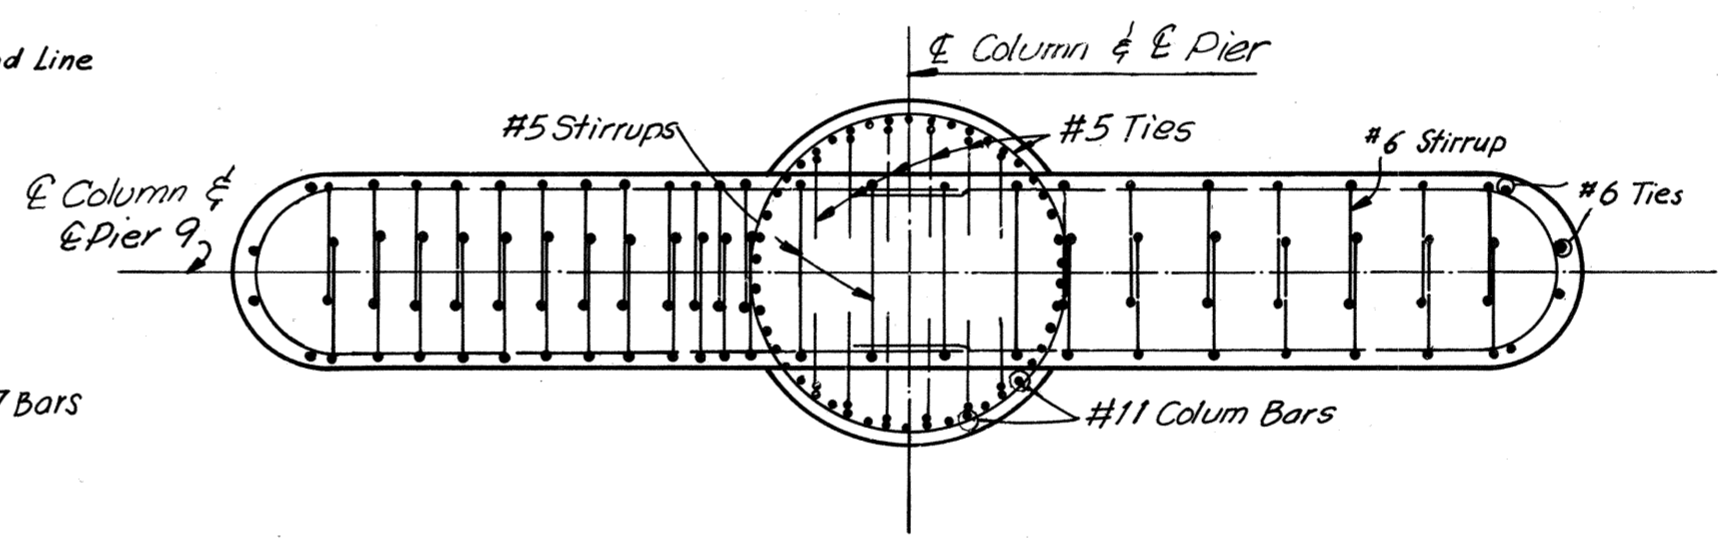


SECTION F-F
Scale: 1/4"=1'-0"

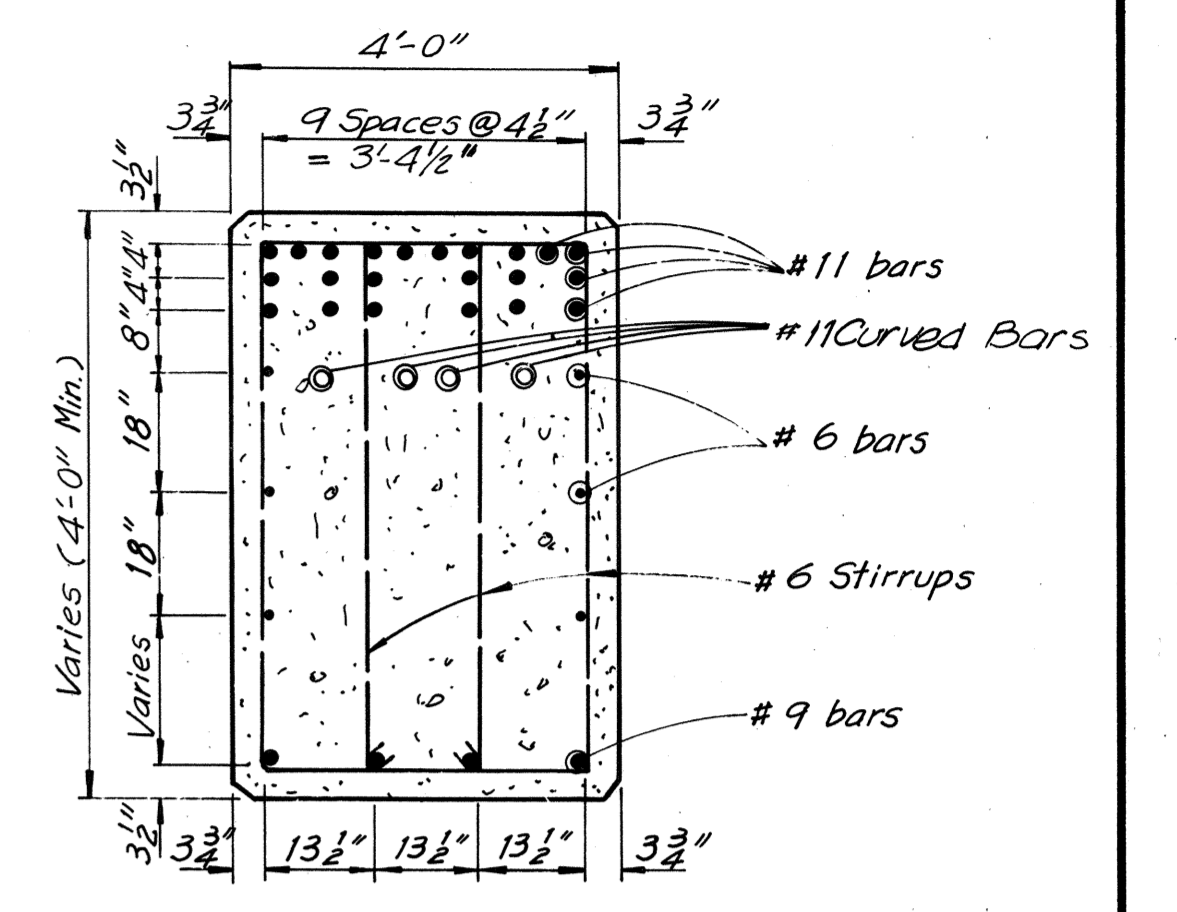


SECTION A-A
Scale: 1/2"=1'-0"

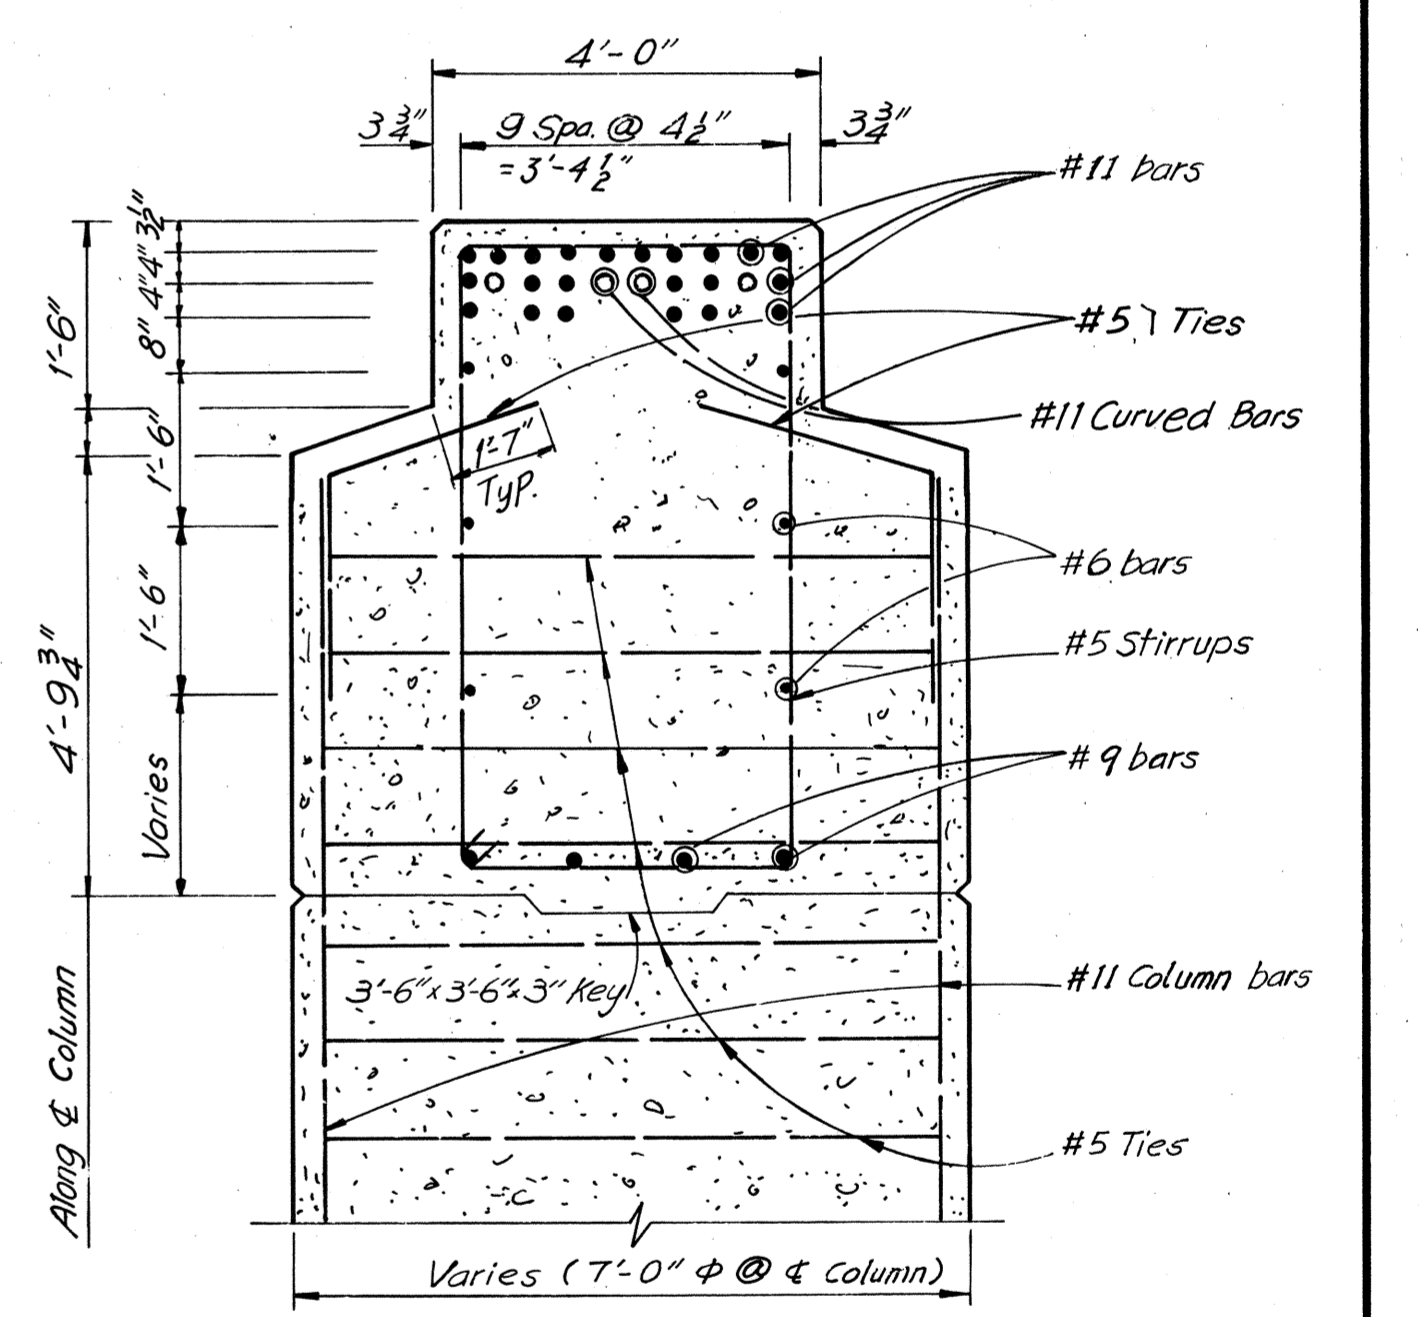

SECTION C-C
Scale: 1/2"=1'-0"

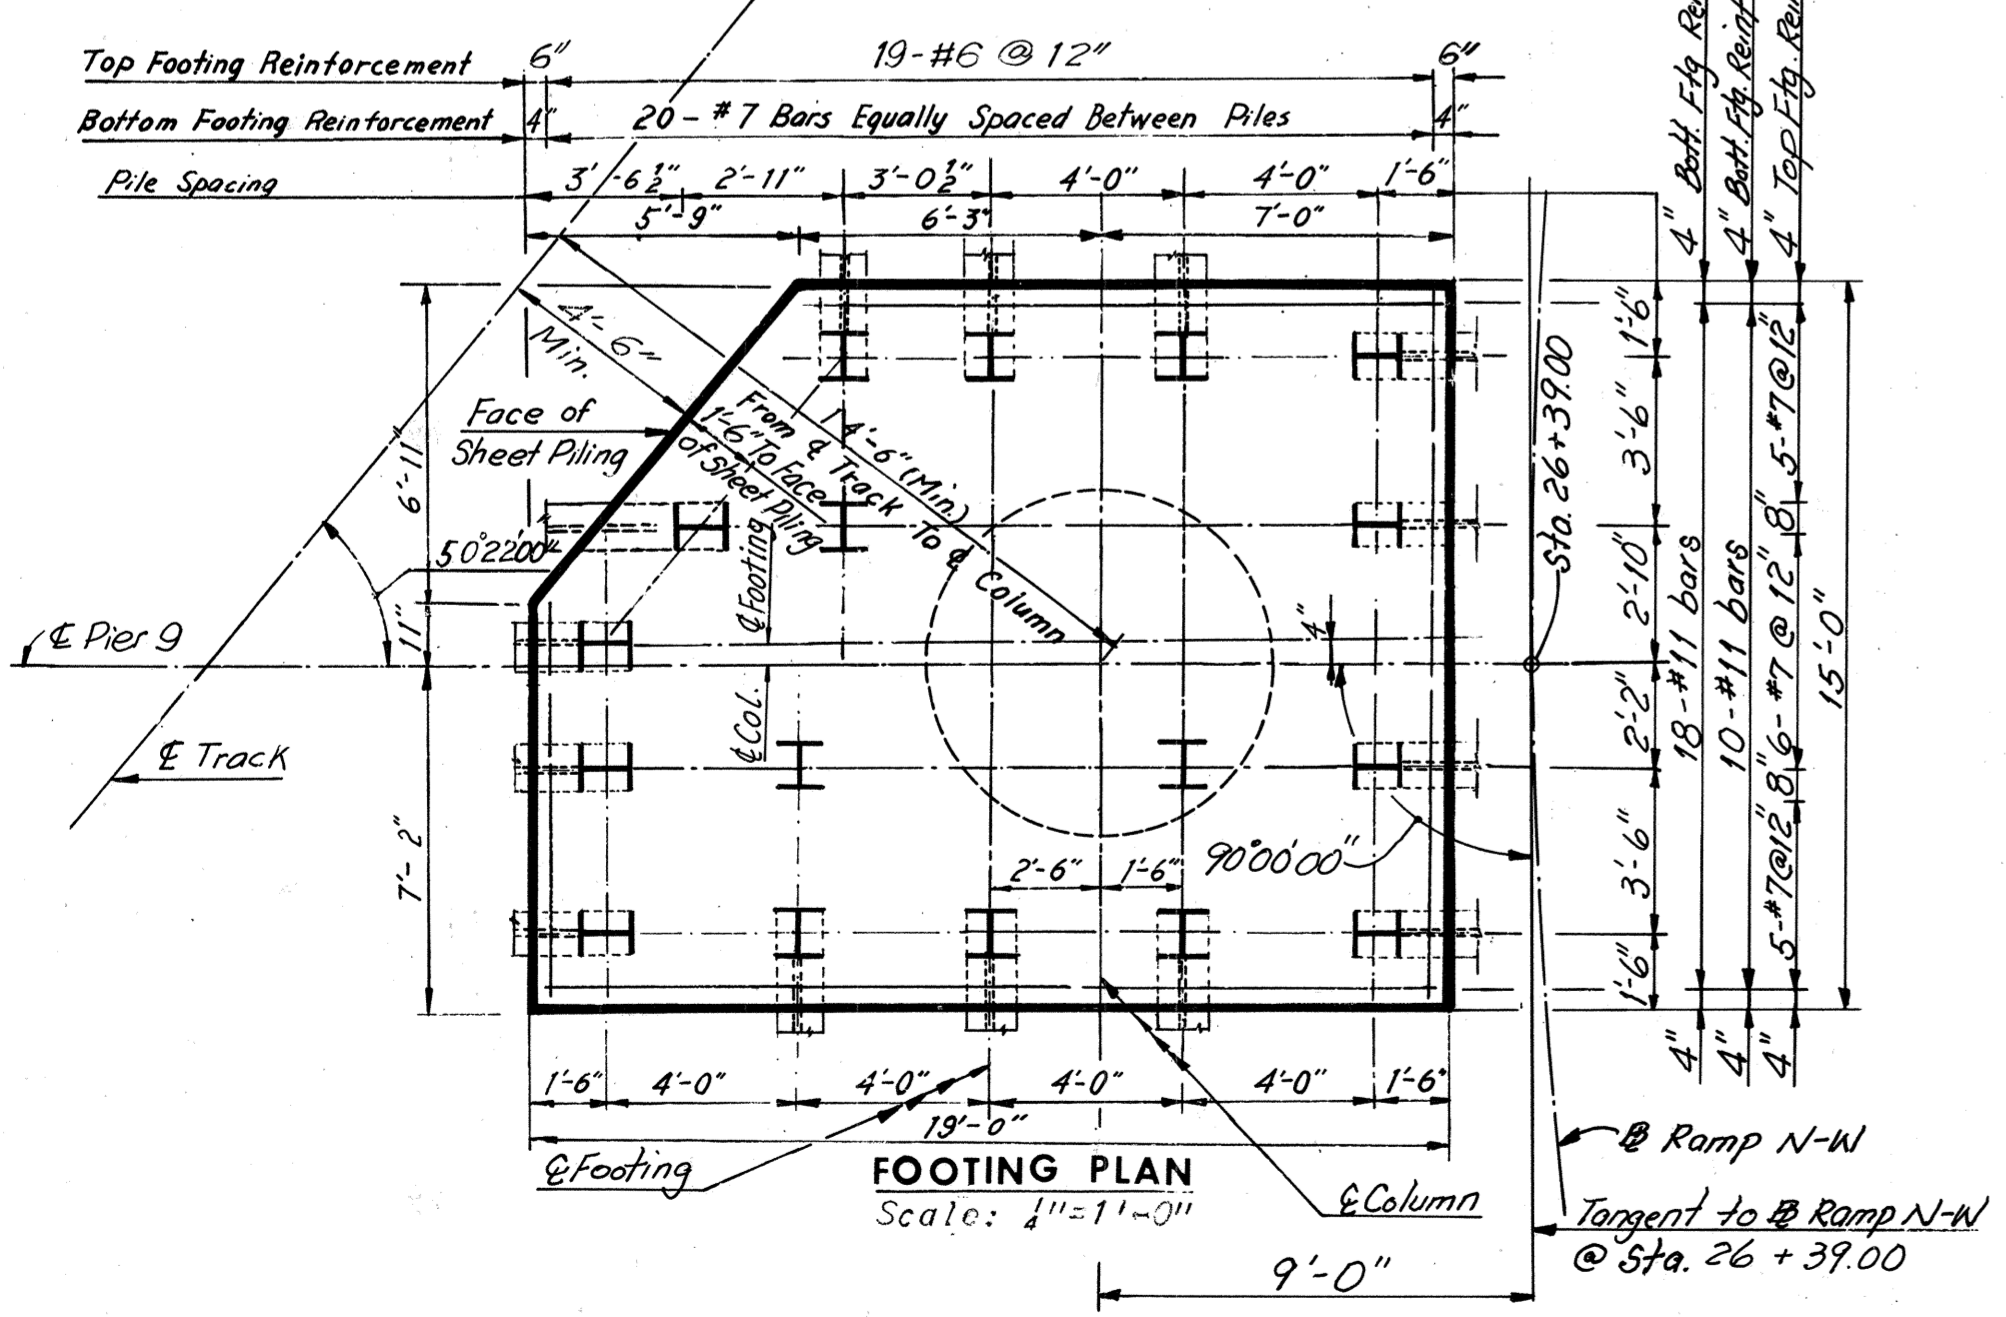

FOOTING PLAN
Scale: 1/4"=1'-0"

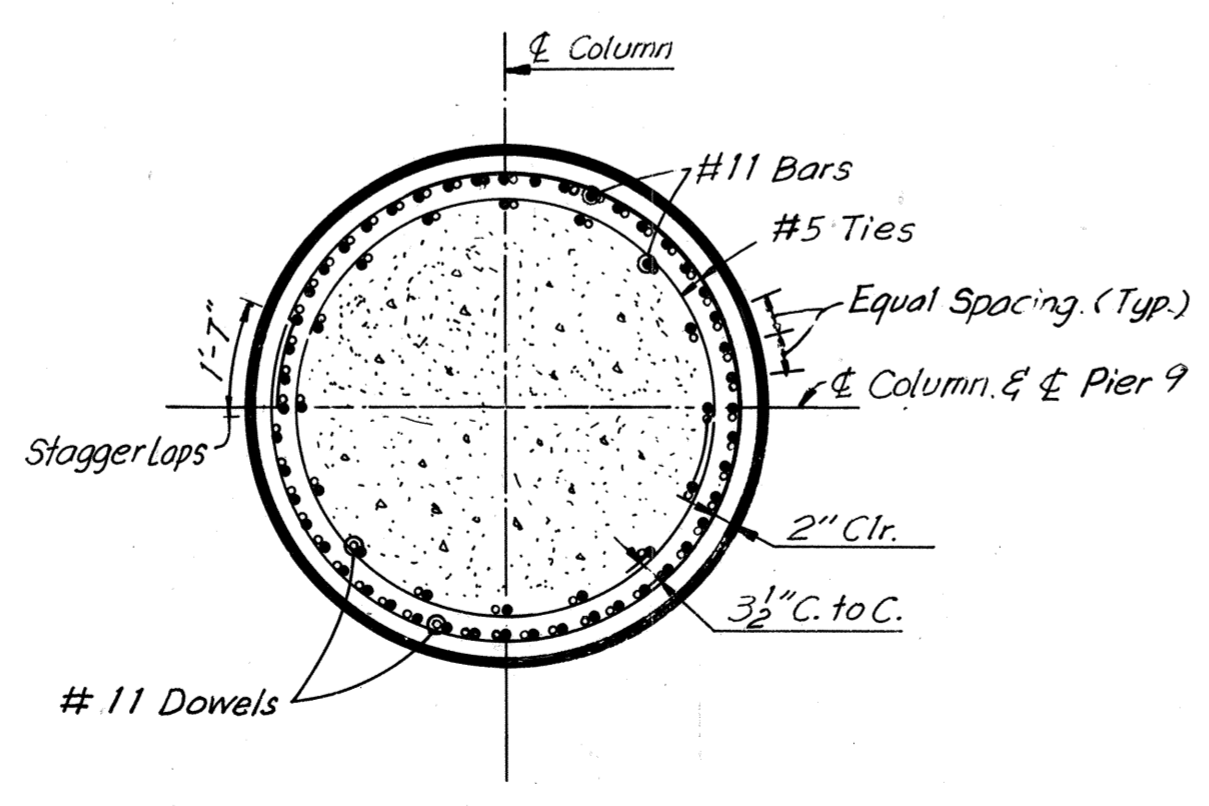

SECTION E-E
Scale: 3/8"=1'-0"

Note: Footing elevations are approximate only and may be varied to suit field conditions as directed by the Engineer. Vertical shaft reinforcing shall not be cut until these elevations are established. Where elevations change more than 2 ft., redesign will be required.

Notes:
All piles shall be 12BP53 steel piles (Design Capacity = 57 ton)
Batter all piles 3" per foot where shown.
For Standard Shoe Detail, see Sheet 51.
For Framing Plan, see Sheet 17.
Estimated Pile Tip Elevation is -5.0
For Rustication Detail, see Sheet 9.
For 12BP53 Steel Pile Details, see Sheet 9.
For Standard Drainage Details, see Support Type 3, Sheet 56.

FOOTING FOR PIER 9 IS ECCENTRIC AS SHOWN ON FOOTING PLAN

BY	DATE	Z	As Built	TEM	6-77
MADE	R.C.	2.5.69	Note Added	PRMS	4-19-74
CHECKED	Y.C.	4-17-69			
IN CHARGE					

**RICHMOND METROPOLITAN AUTHORITY
RICHMOND EXPRESSWAY SYSTEM
DOWNTOWN EXPRESSWAY**


**BRIDGE NO. 64
RAMP N-W CONNECTION FROM
RICHMOND-PETERSBURG TURNPIKE
PIER 9**

HOWARD, NEEDLES, TAMMEN & BERGENDORFF
consulting engineers
NEW YORK ALEXANDRIA KANSAS CITY

SCALE: As Noted
CONTRACT NO. 10
SHEET NO. 10 OF 28


AS BUILT

RICHMOND EXPRESSWAY SYSTEM			
SECTION	PROJECT	SHEET NO.	TOTAL SHEETS
10	DOWNTOWN EXPRESSWAY	109	265

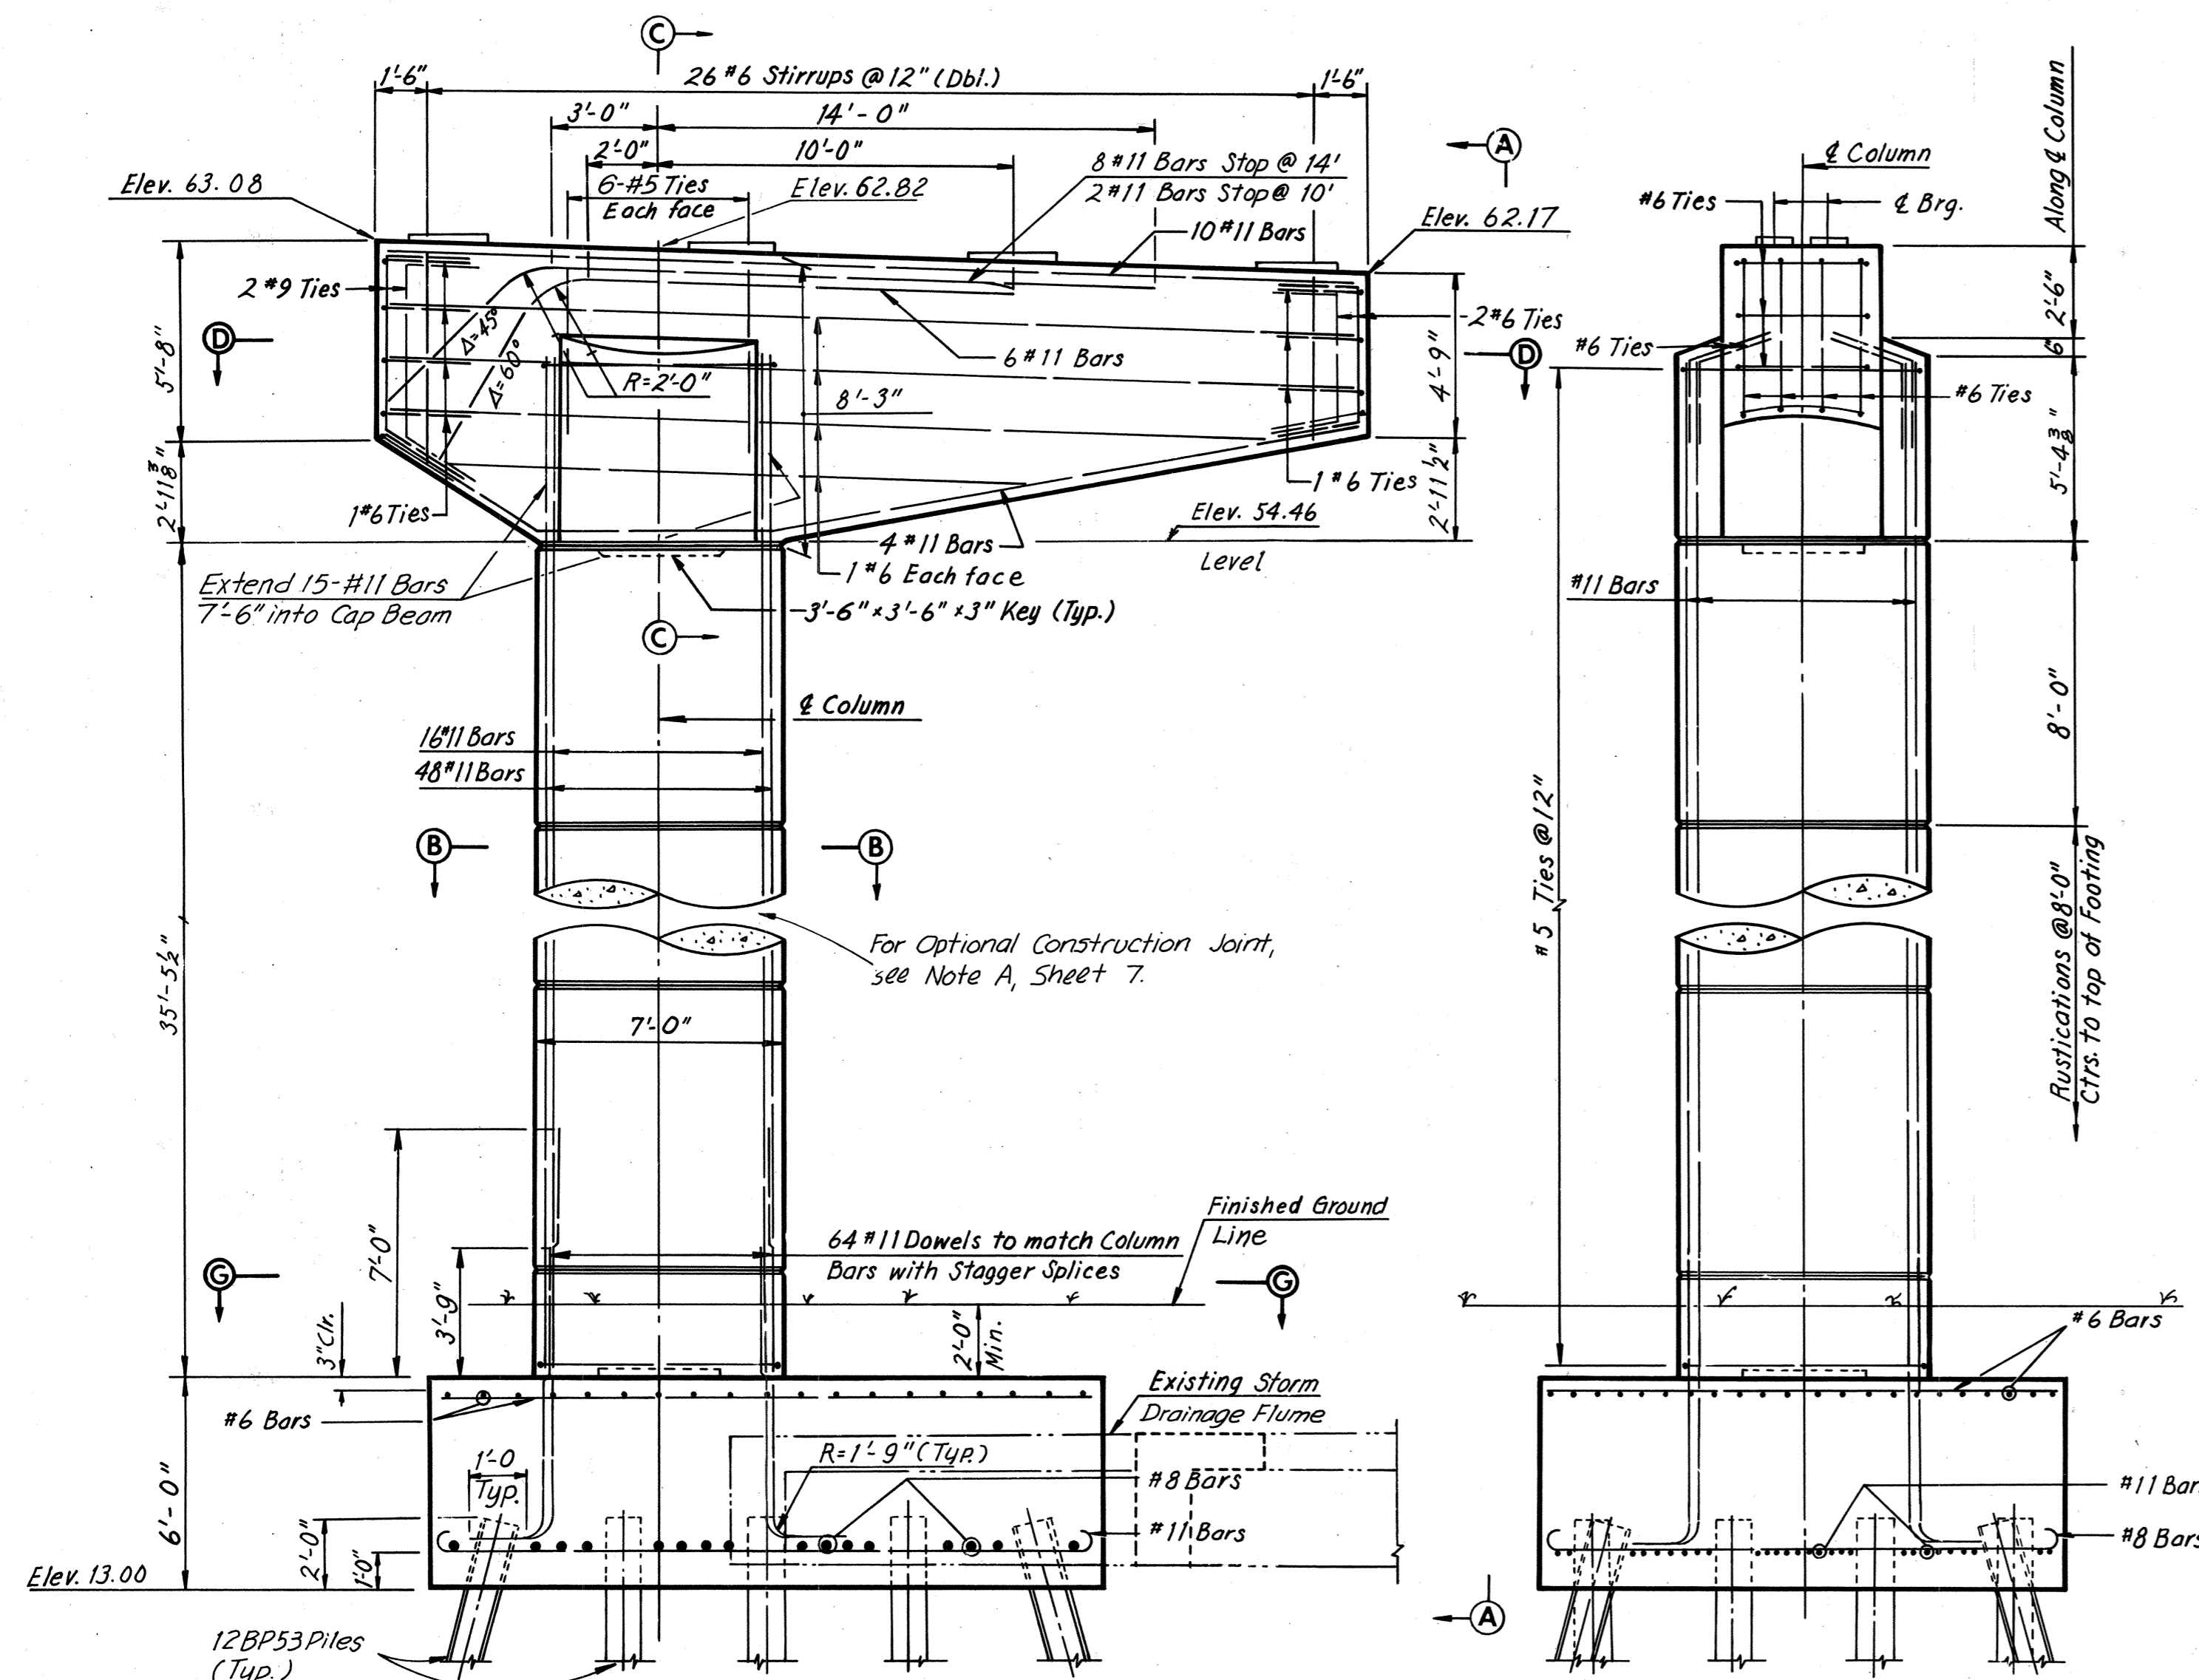


ELEVATION
Scale: 1/4" = 1'-0"


VIEW A-A
Scale: 1/4" = 1'-0"

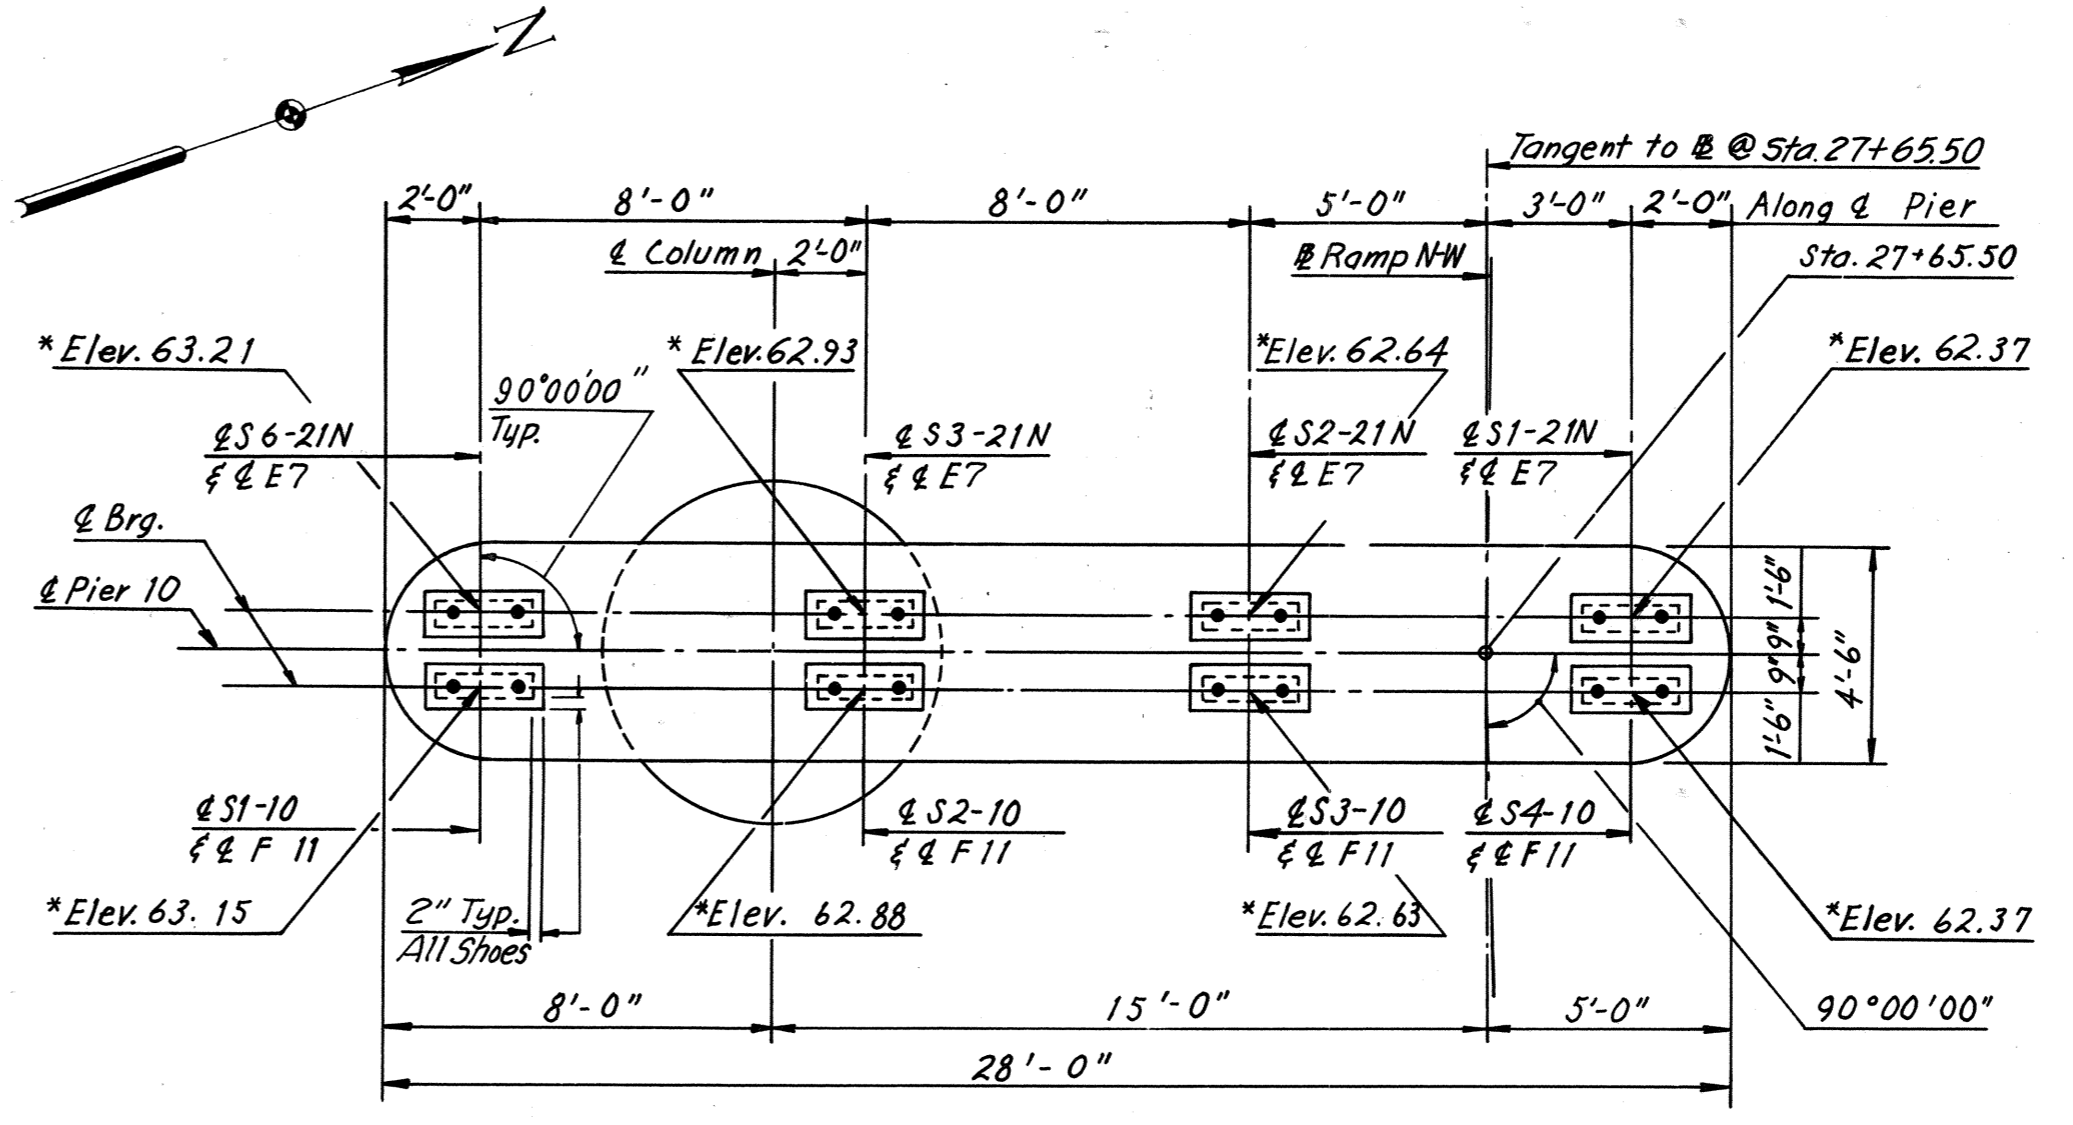

PLAN
Scale: 1/4" = 1'-0"

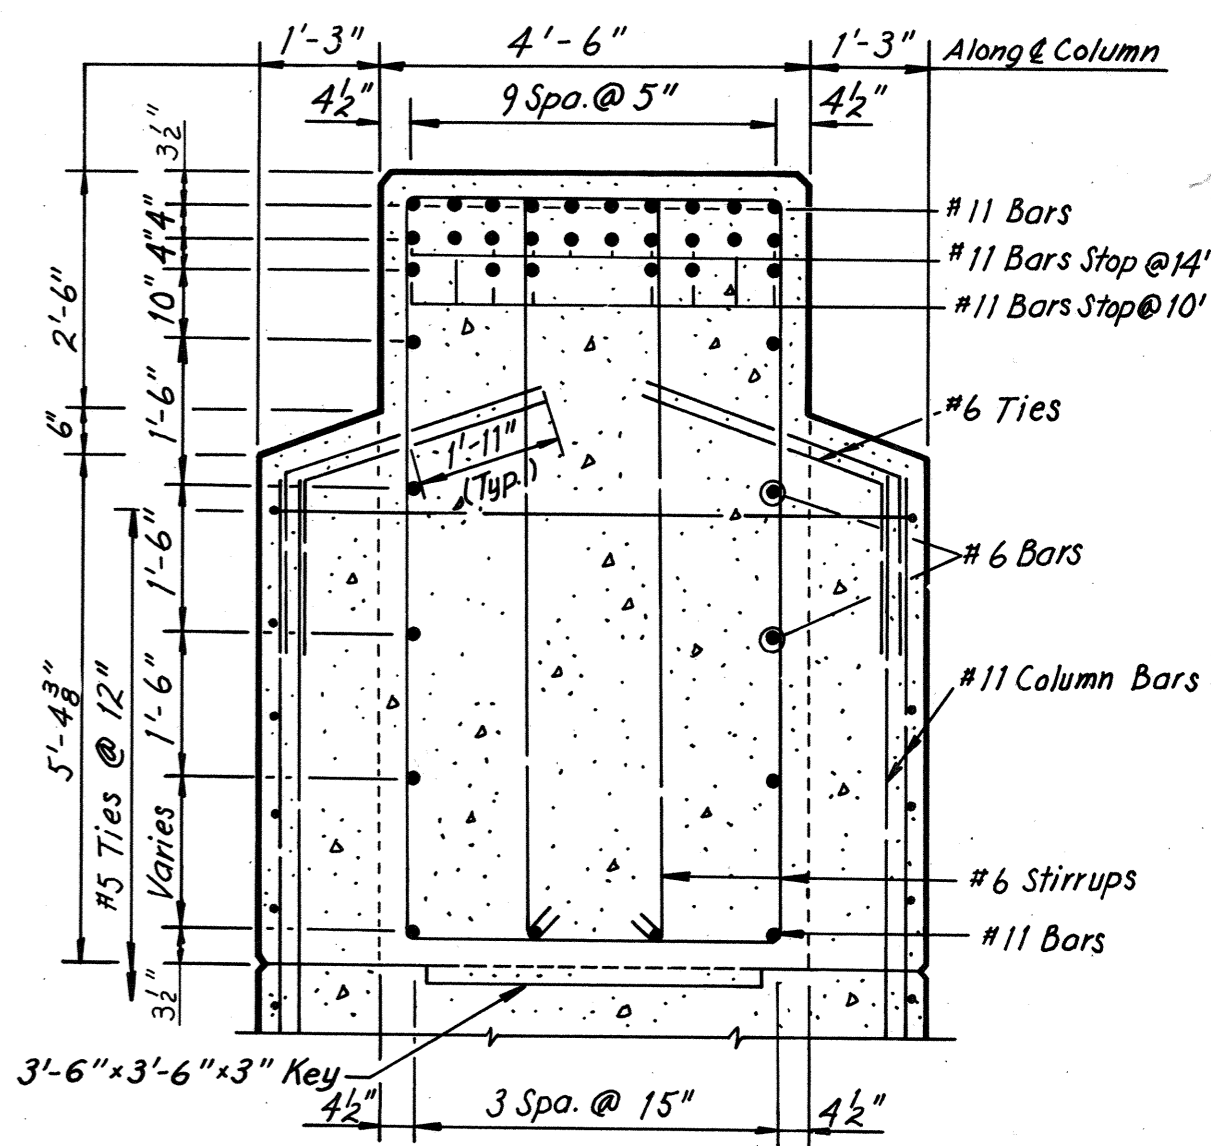

SECTION C-C
Scale: 1/2" = 1'-0"

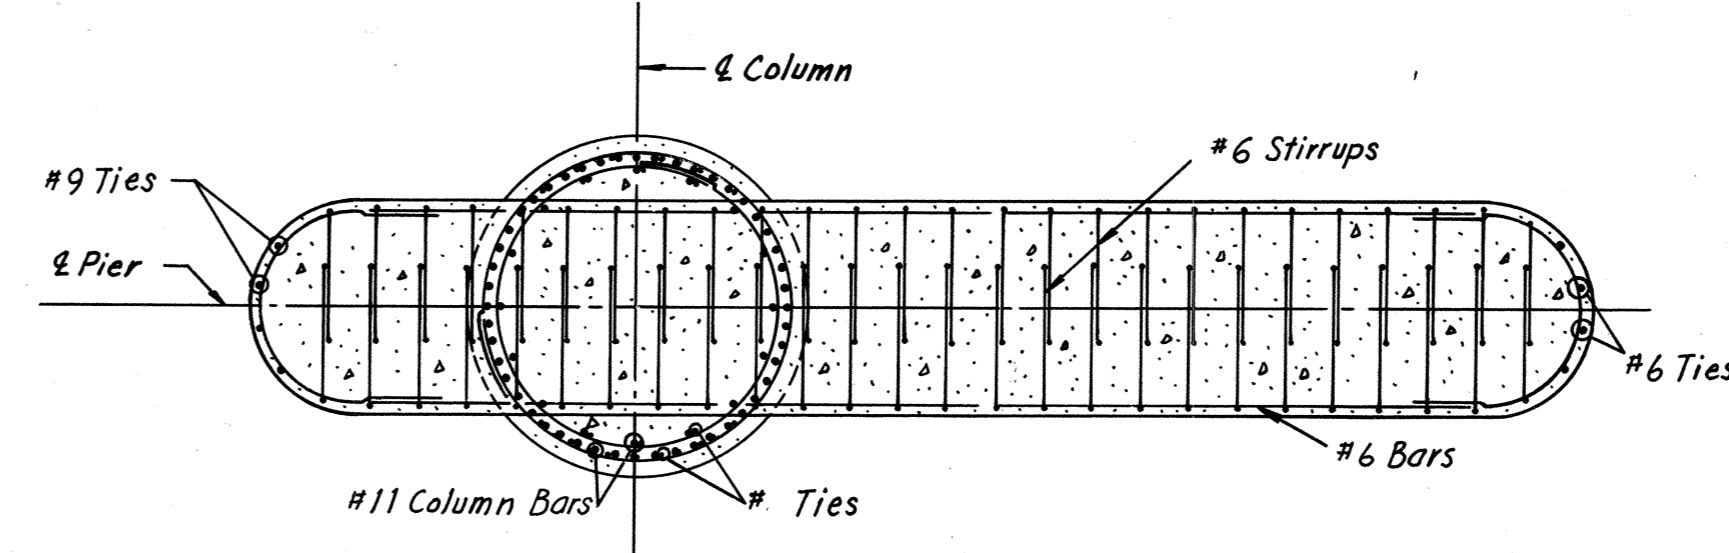


SECTION D-D
Scale: 1/4" = 1'-0"


Note: Footing elevations are approximate only and may be varied to suit field conditions as directed by the Engineer. Vertical shaft reinforcing shall not be cut until these elevations are established. Where elevations change more than 2 ft., redesign will be required. * Denotes the Top Pad Elevation.

Notes: All piles shall be 12BP53 Steel Piles (Design Capacity = 57 tons)
For Standard Shoe Details, see Sheet 31.
For Framing Plan, see Sheet 17.
Estimated Pile Tip Elevation is -9.0 feet.
For Rustication Details, see Sheet 9.
For 12BP53 Steel Pile Details, see Sheet 9.


Note: Piles located within 10 ft. (horizontal distance) of Storm Drainage Flume shall be pre-bored to an Elevation 5 ft. below bottom of sewer.

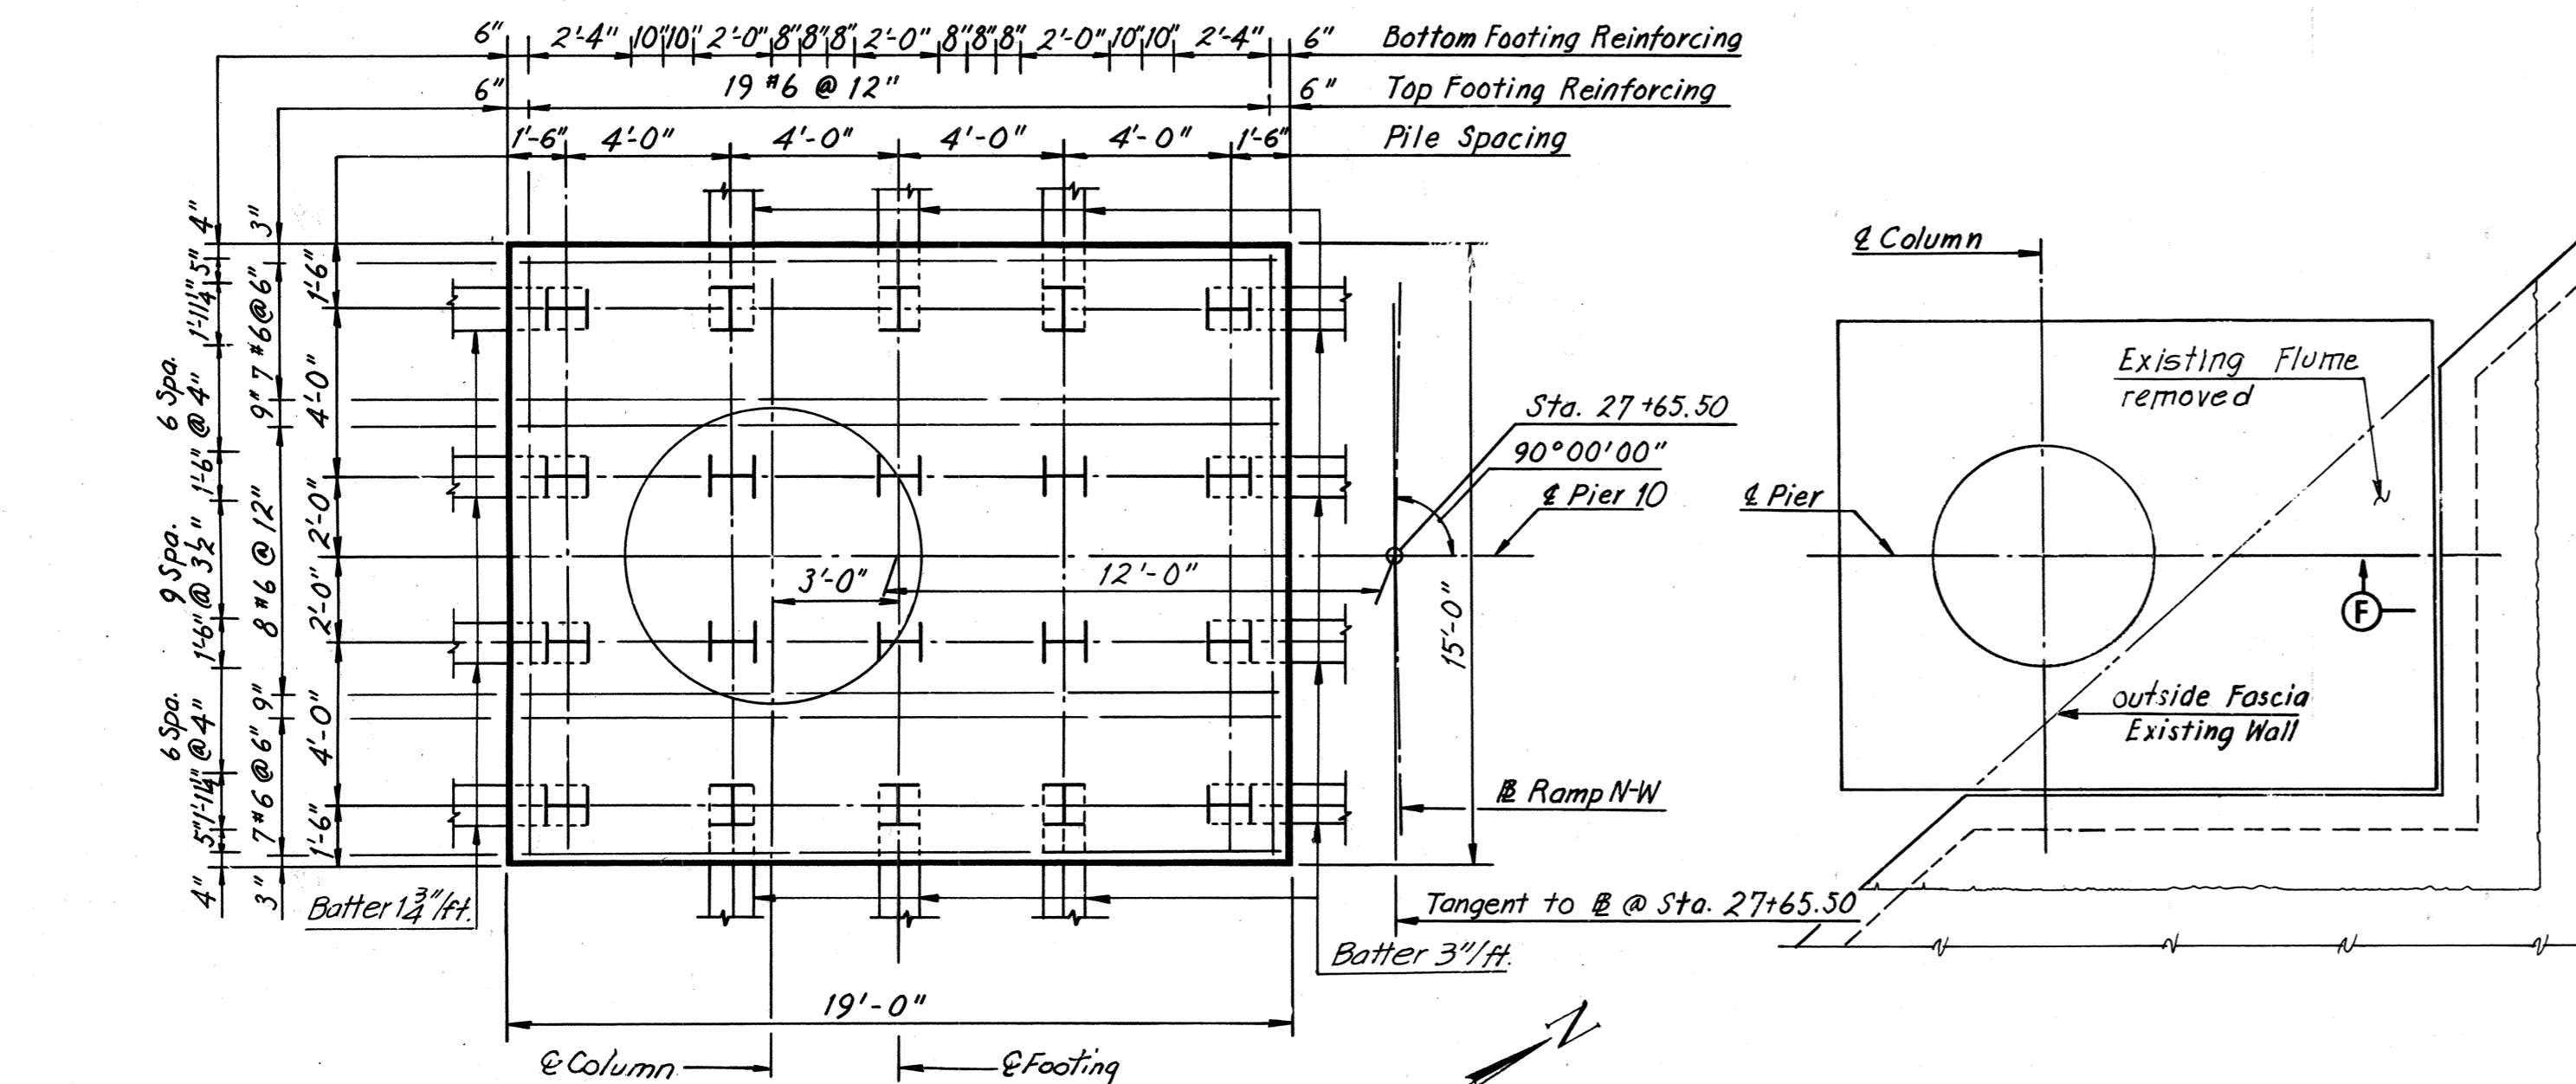


FOOTING PLAN
Scale: 1/4" = 1'-0"

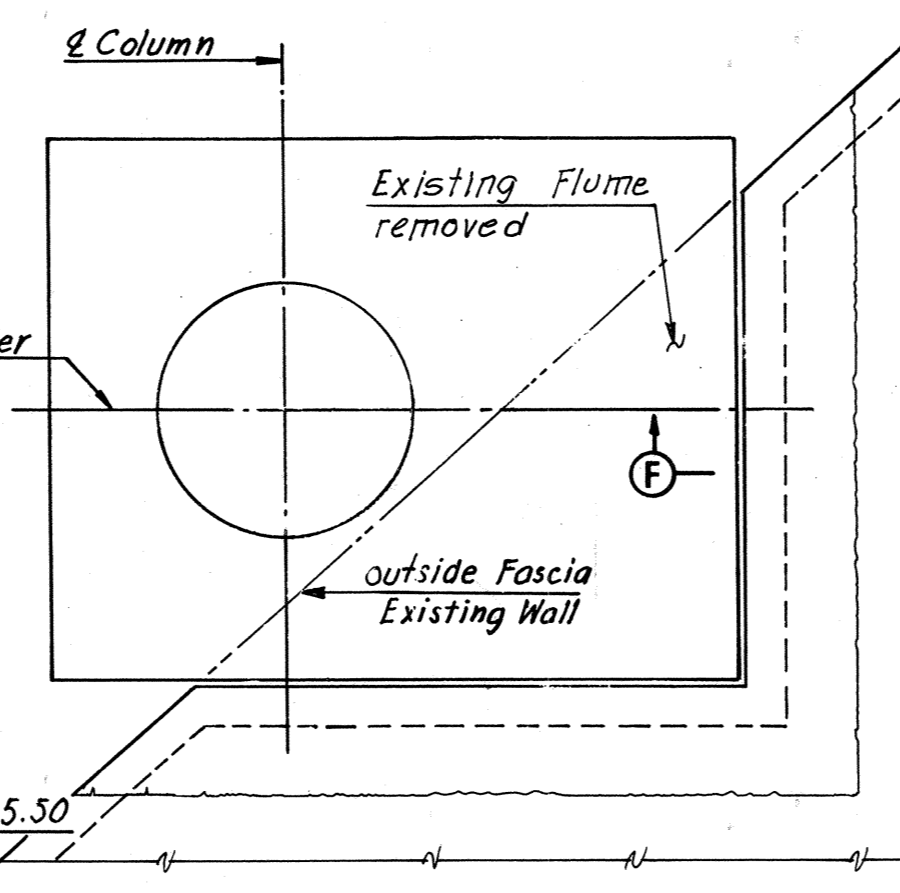

VIEW G-G
Scale: 3/8" = 1'-0"

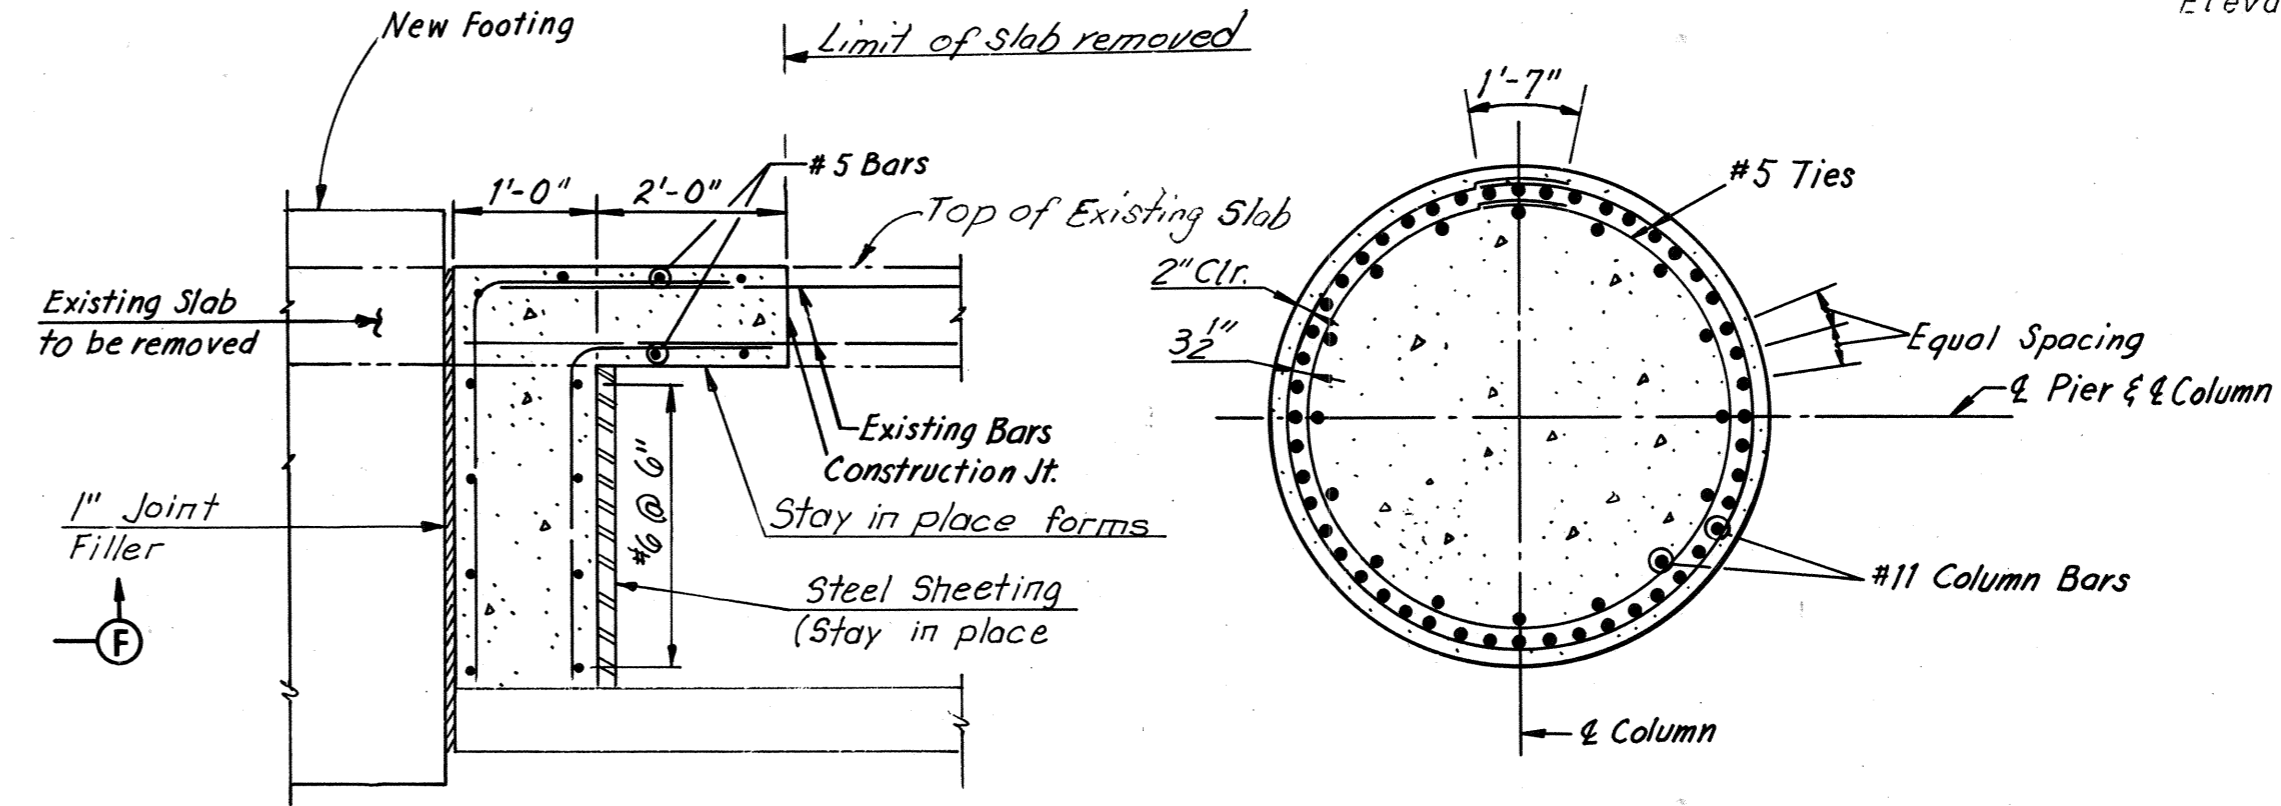

SECTION B-B
Scale: 3/8" = 1'-0"

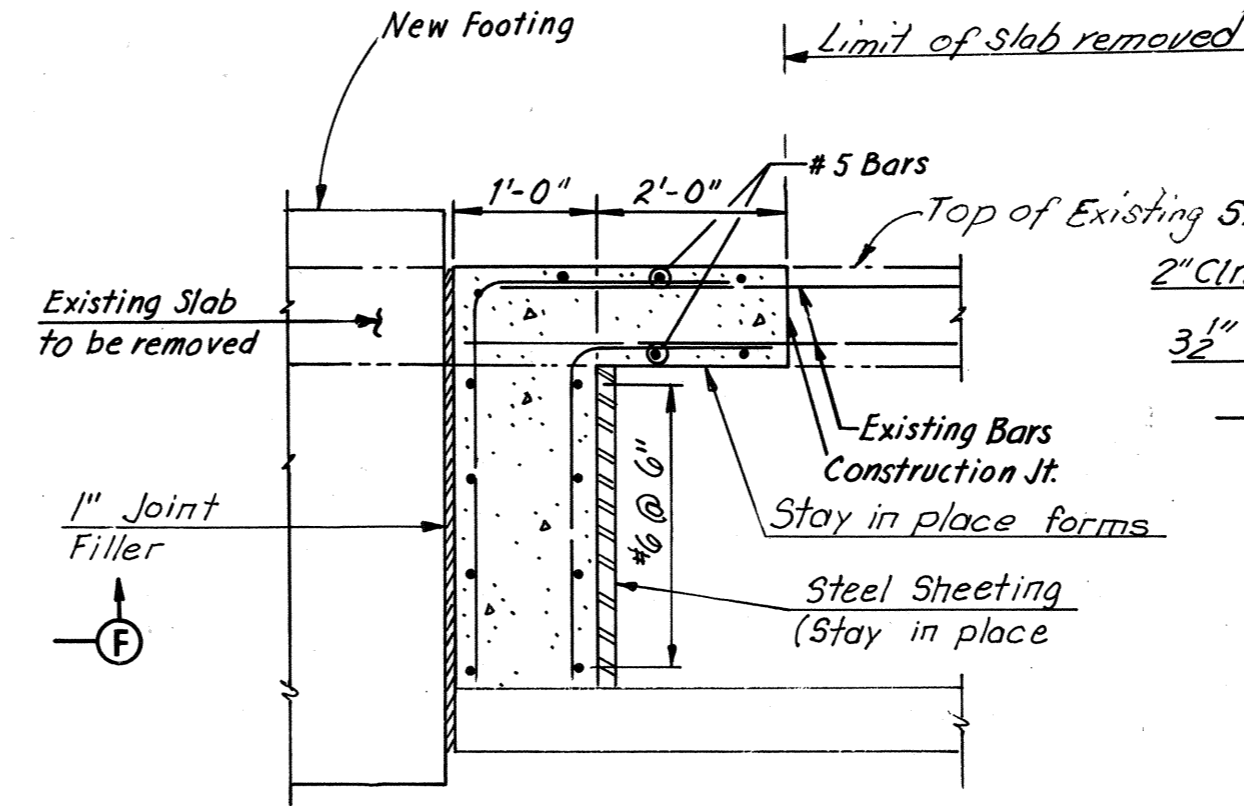

SECTION F-F
Scale: 1/2" = 1'-0"

BY	DATE	Note Added	PRM#
MADE	Y.C.P. 3-10-69	2 As Built	T&M G-77
CHECKED	K.C.I. 4-17-69		
IN CHARGE			

FOOTING FOR PIER 10 IS ECCENTRIC AS SHOWN ON FOOTING PLAN


RICHMOND METROPOLITAN AUTHORITY
RICHMOND EXPRESSWAY SYSTEM
DOWNTOWN EXPRESSWAY

BRIDGE NO. 64
RAMP N-W CONNECTION FROM
RICHMOND-PETERSBURG TURNPIKE
PIER 10


HOWARD, NEEDLES, TAMMEN & BERGENDOFF
consulting engineers
NEW YORK ALEXANDRIA KANSAS CITY

SCALE: As Noted
CONTRACT NO.: 10
SHEET NO. 11 OF 28

AS BUILT

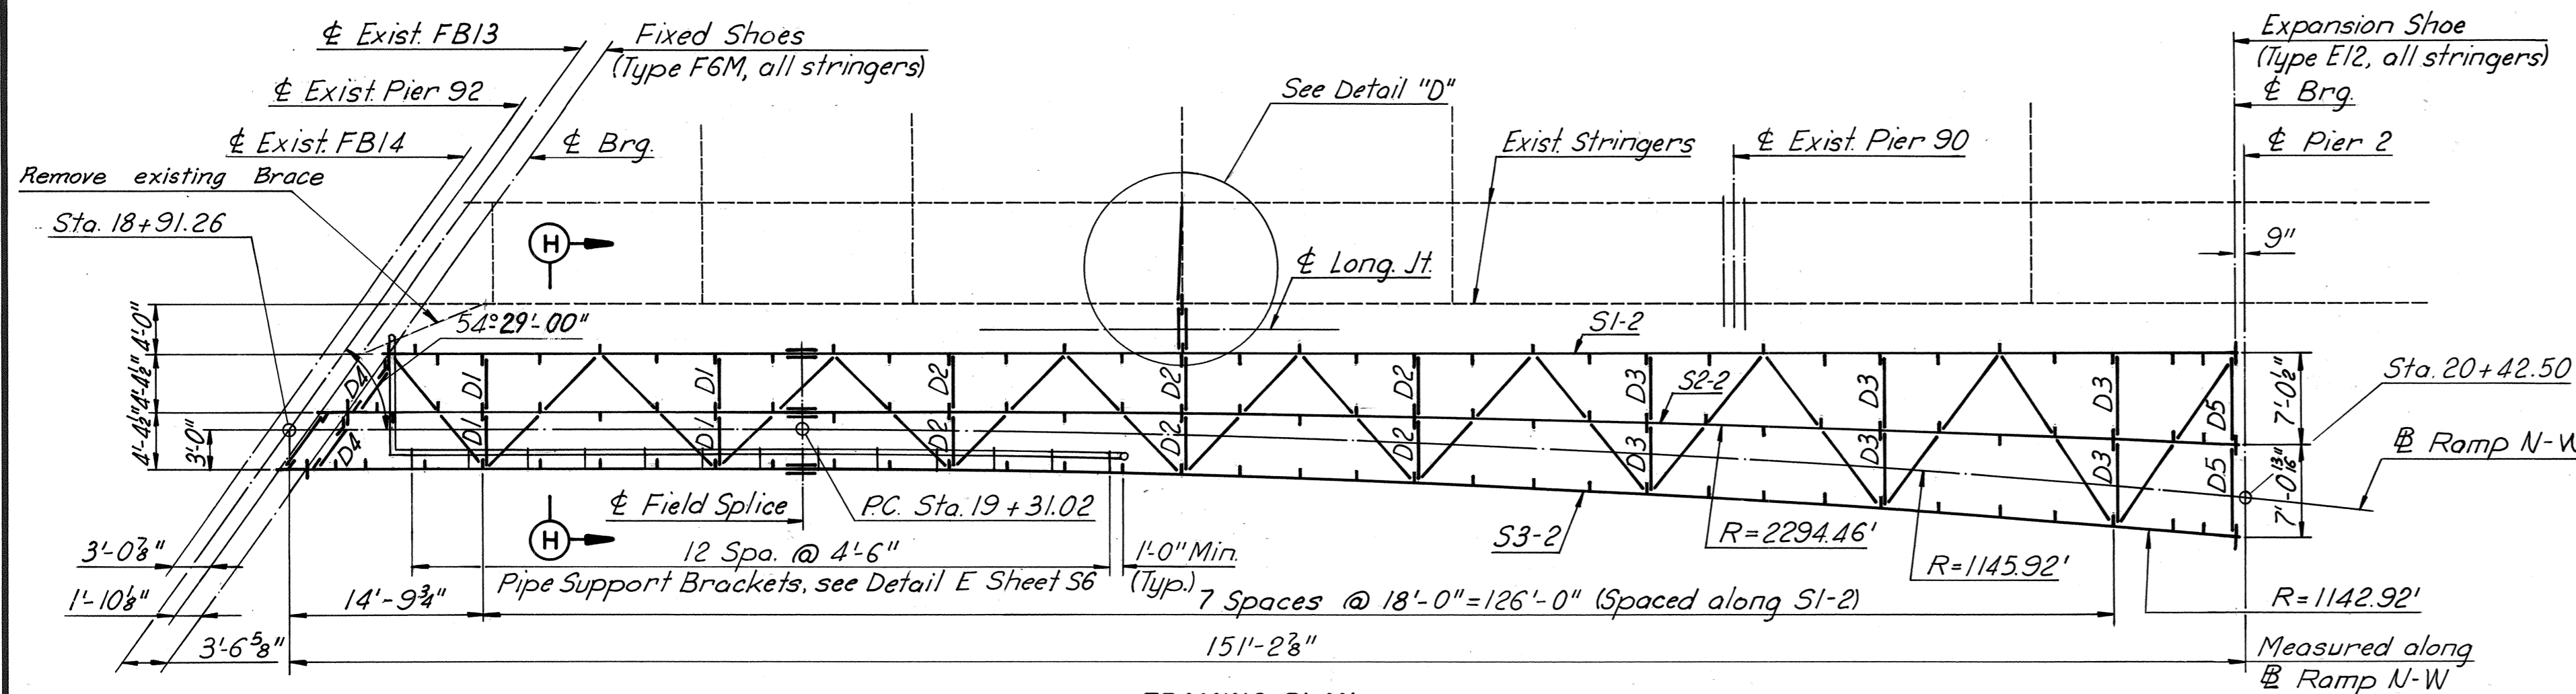


FRAMING PLAN
Scale: 1"=10'-0"

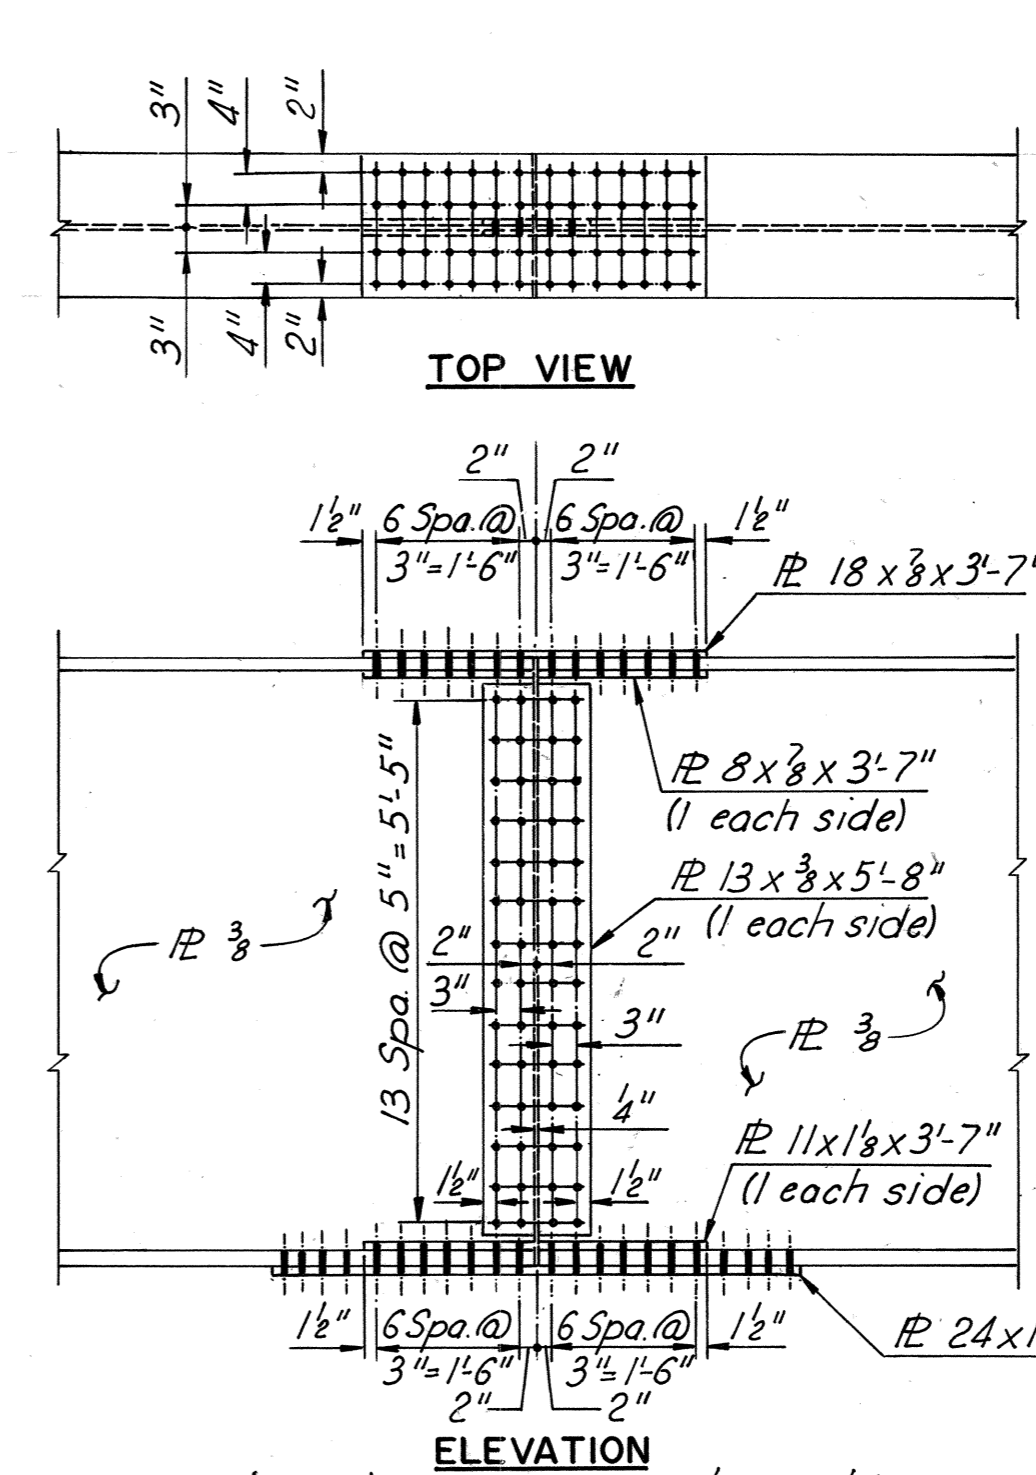


ELEVATION

BOTTOM VIEW

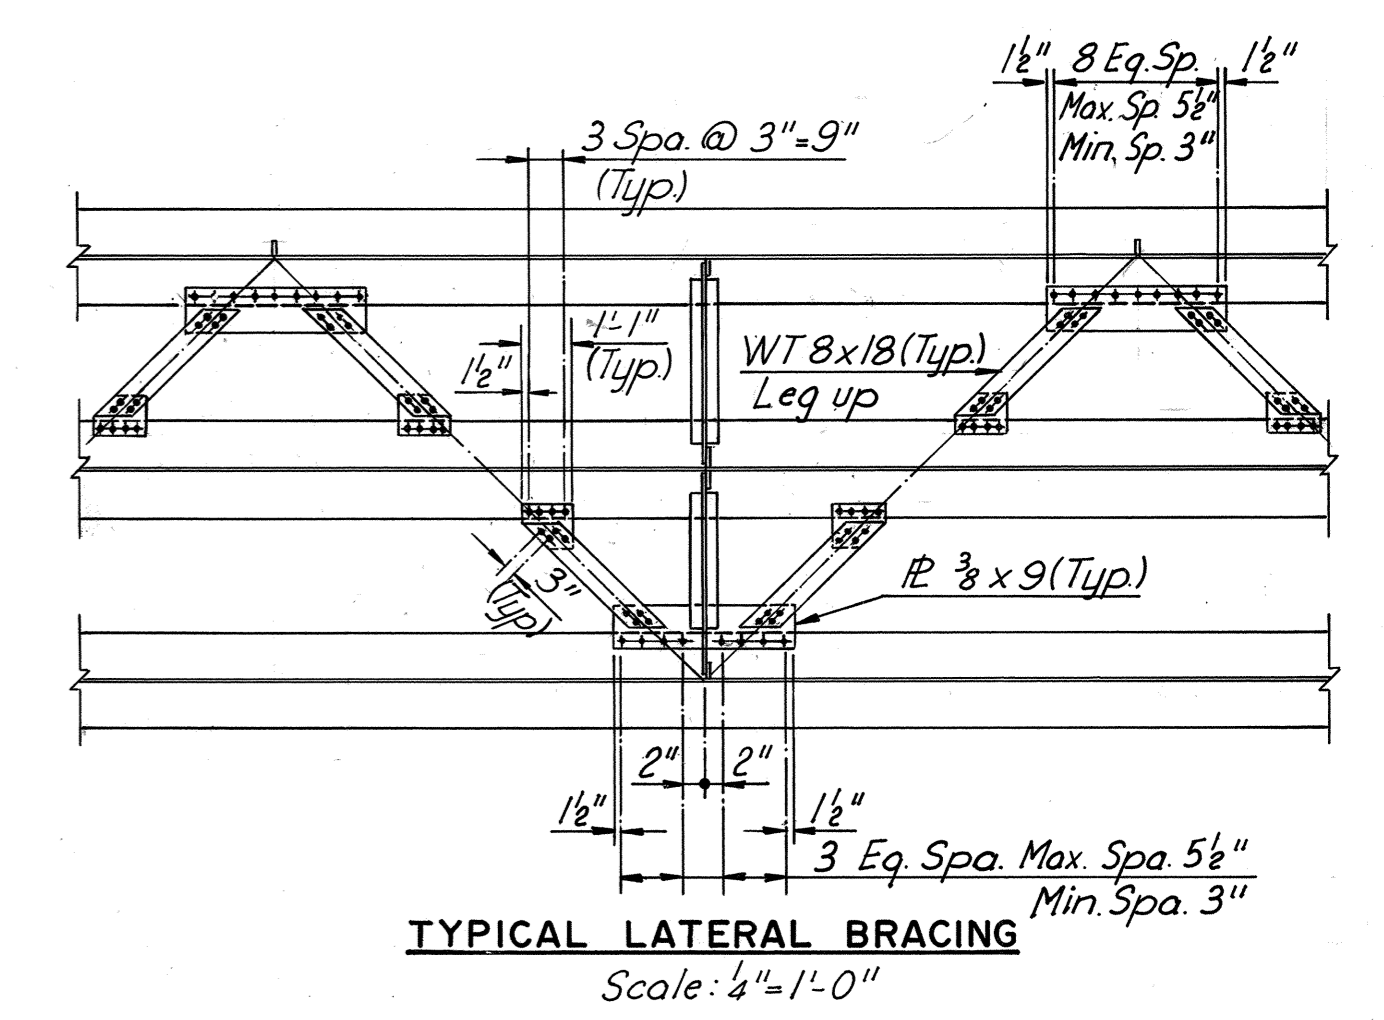


TYPICAL LATERAL BRACING
Scale: 4"=1'-0"

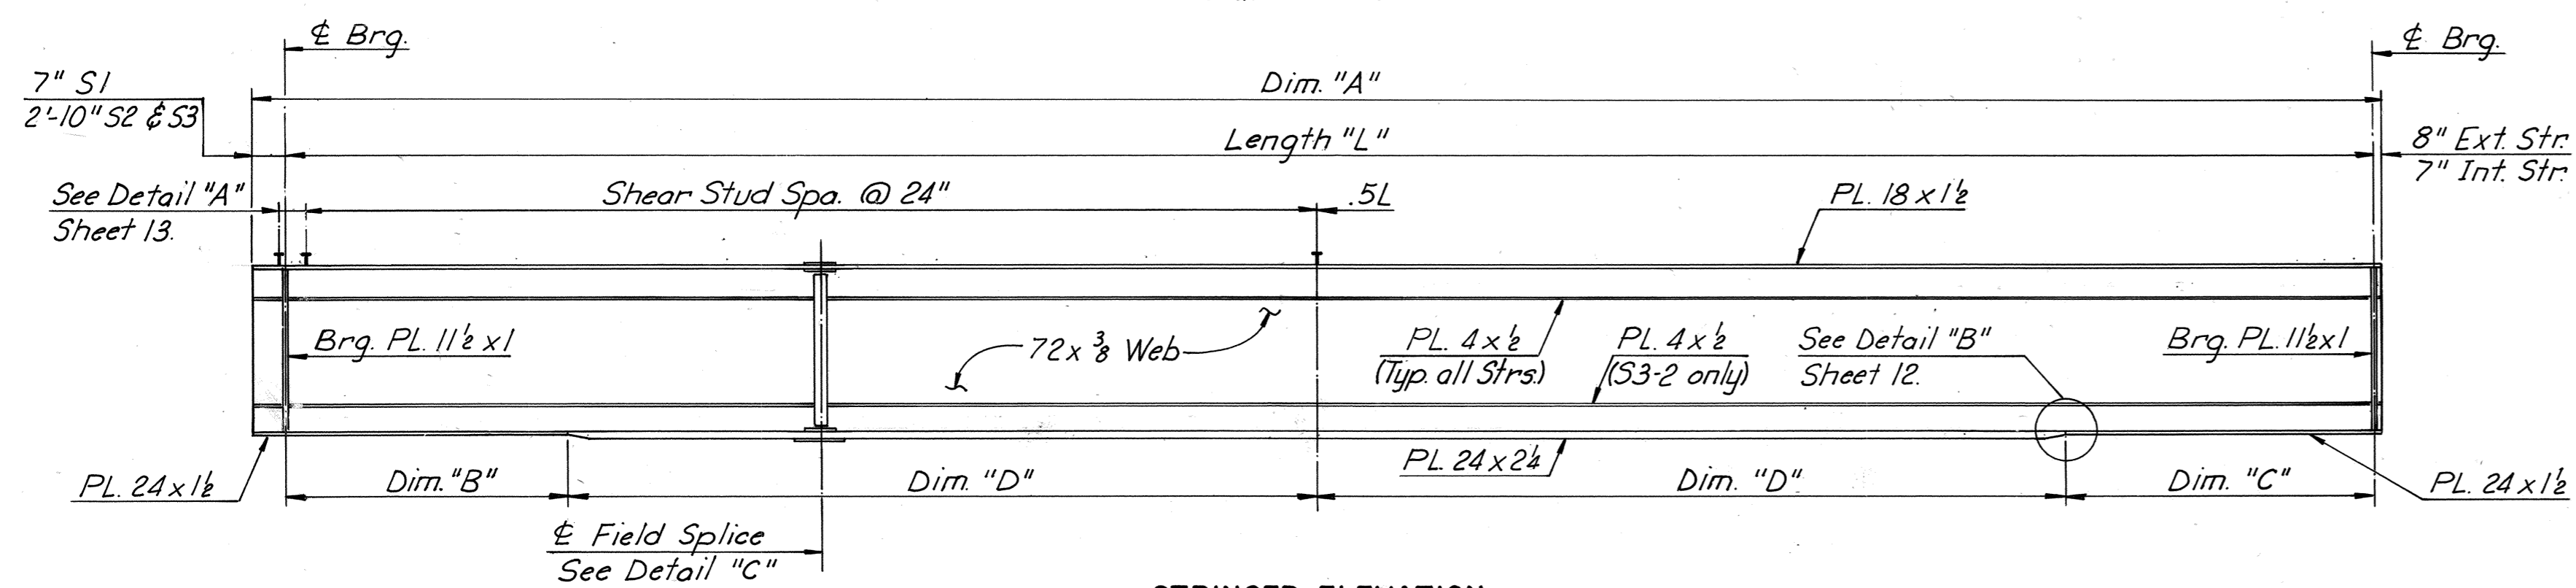


STRINGER ELEVATION
Scale: None

STRINGER SCHEDULE					DEAD LOAD DEFLECTION SCHEDULE						CAMBER SCHEDULE			
STRINGER	LENGTH "L"	DIM. "A"	DIM. "B"	DIM. "C"	DIM. "D"	DUE TO CONCRETE			DUE TO STEEL			CAMBER		
						1/4L	1/2L	3/4L	1/4L	1/2L	3/4L	1/4L	1/2L	3/4L
S1-2	142'-7 1/16"	143'-9 9/16"	19'-0"	19'-7 1/16"	52'-0"	1 3/16"	1 1/16"	1 3/8"	3/4"	1 1/16"	3/4"	3 3/8"	4 1/8"	3 3/8"
S2-2	145'-9 3/8"	149'-2 3/8"	20'-0"	20'-9 3/8"	52'-6"	1 9/16"	2 1/4"	1 3/8"	3/8"	1 7/16"	3/8"	4 3/8"	6 1/4"	4 3/8"
S3-2	149'-1"	152'-6 1/8"	20'-0"	22'-1"	53'-6"	1 3/8"	2 1/2"	1 3/8"	1 5/16"	1 1/4"	1 5/16"	5 1/16"	7 1/8"	5 1/8"


These holes to be shop sub-punched. Ream and connect in field after full dead load deflection has occurred.

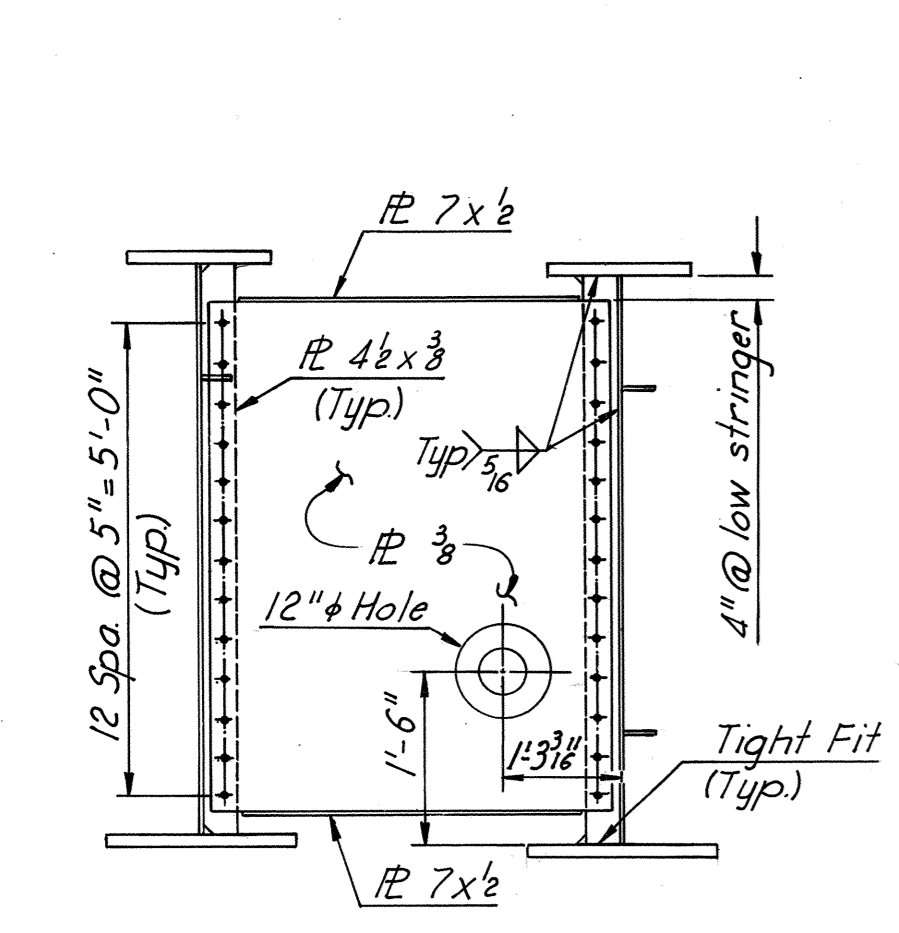


DIAPHRAGM D1
Scale: 1/2"=1'-0"

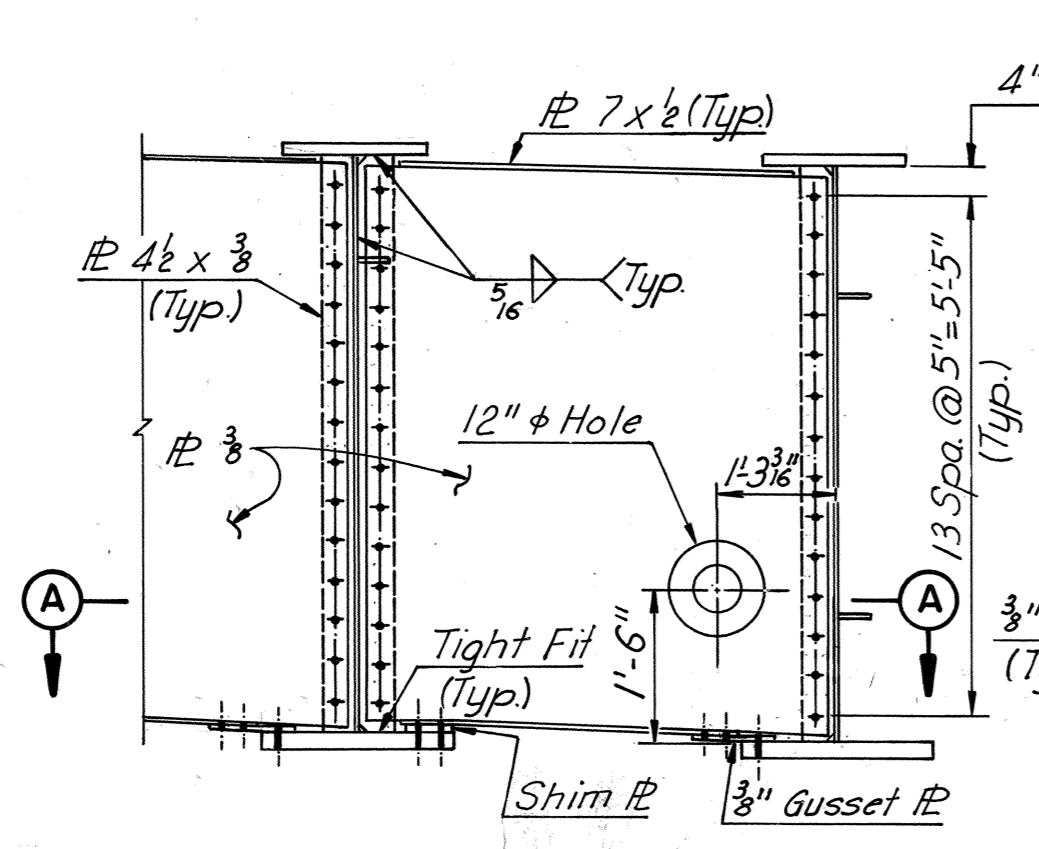


DIAPHRAGM D2
Scale: 1/2"=1'-0"

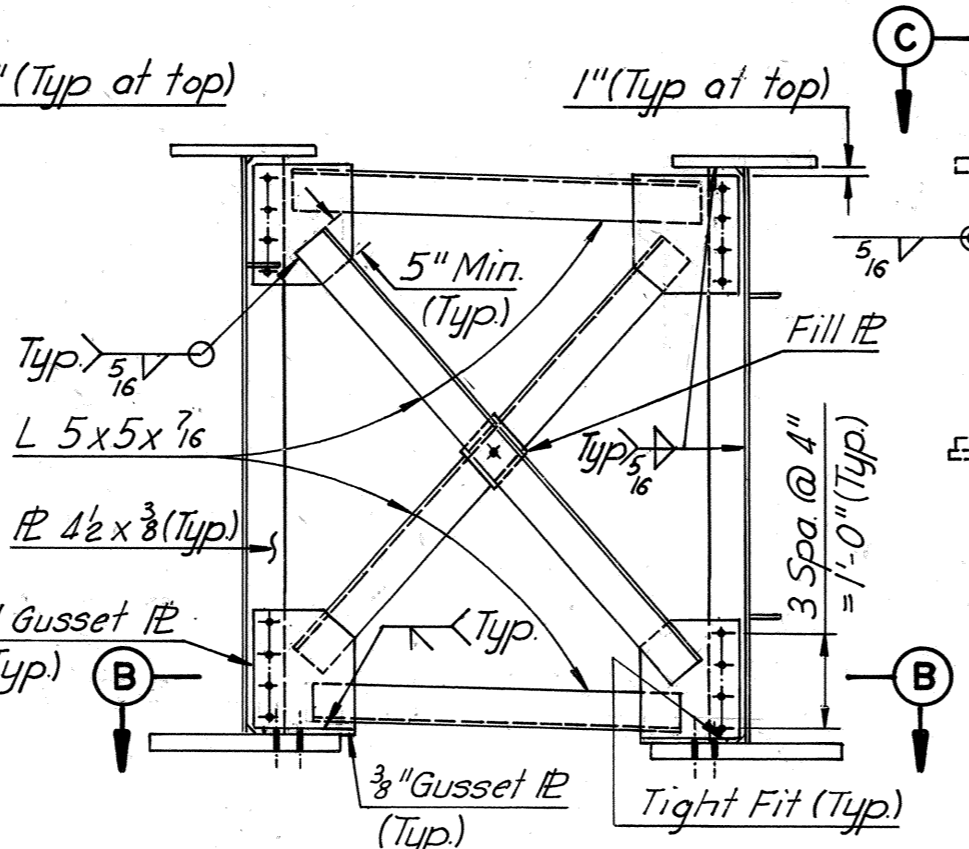


DIAPHRAGM D3
Scale: 1/2"=1'-0"

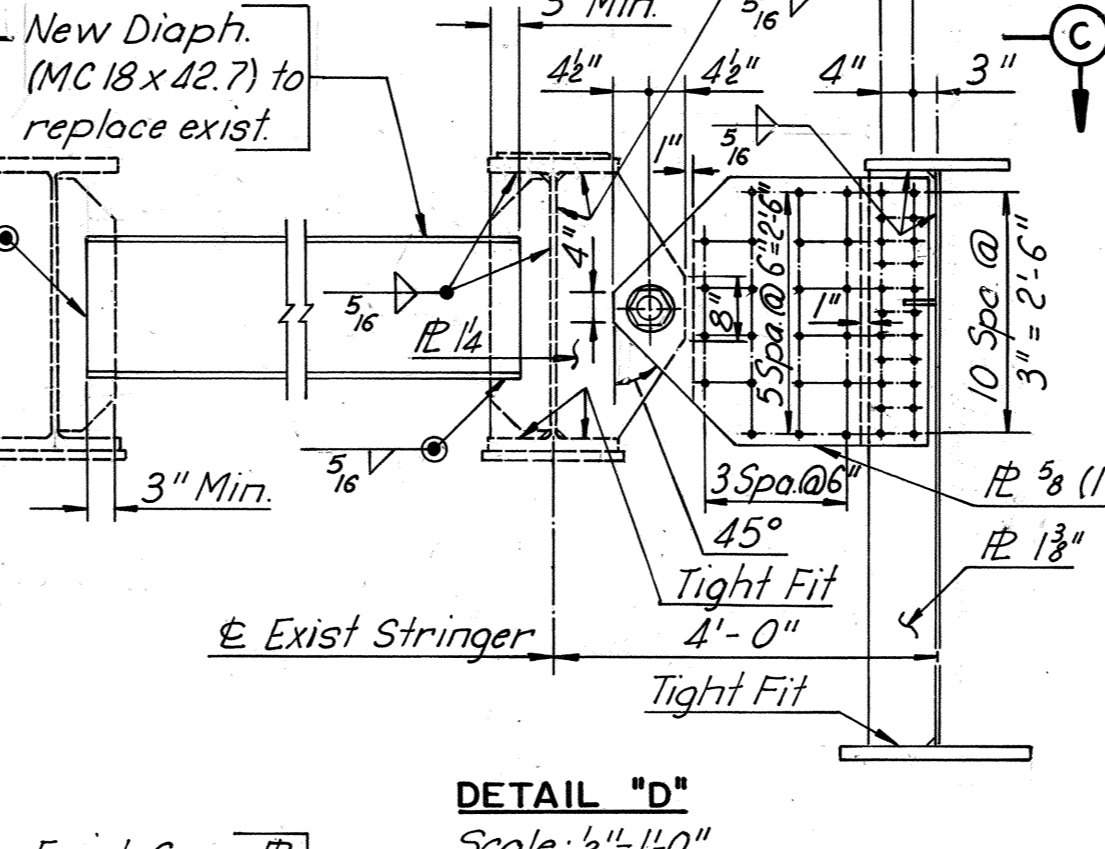


DIAPHRAGM D4
Scale: 1/2"=1'-0"

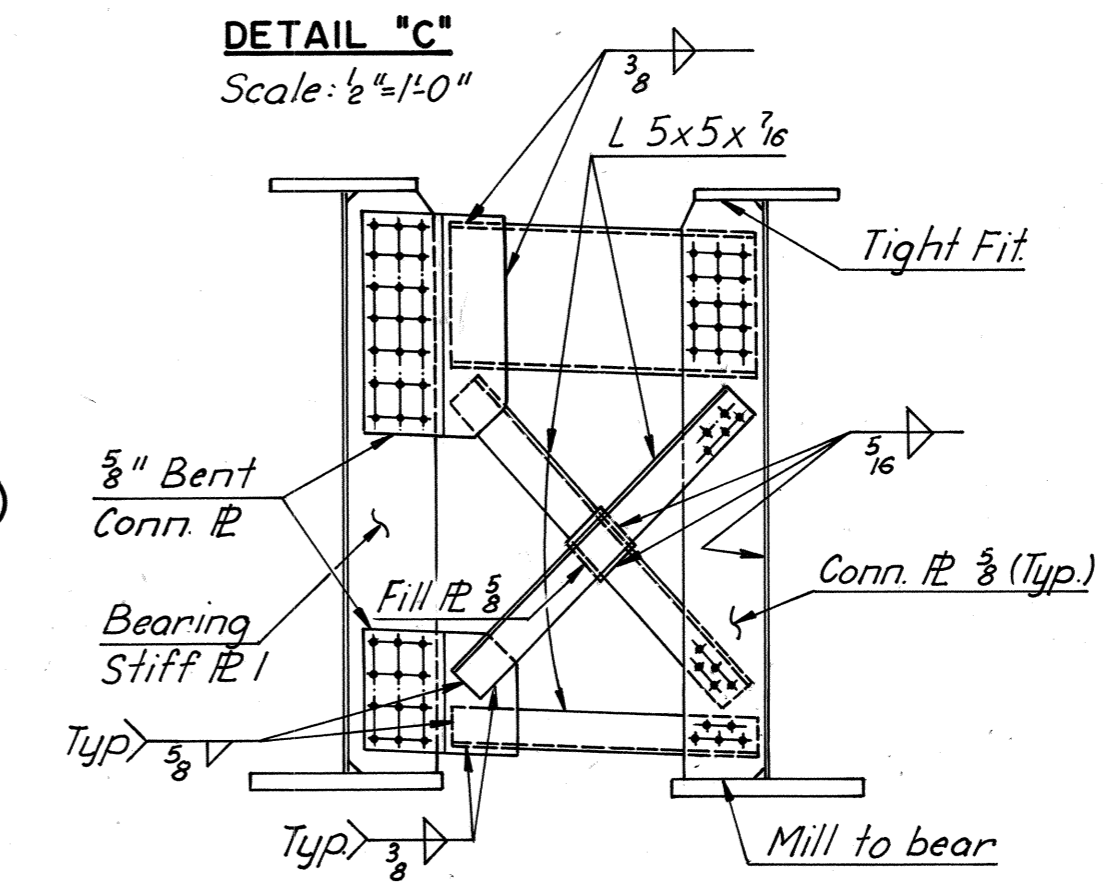

DETAIL "C"
Scale: 1/2"=1'-0"

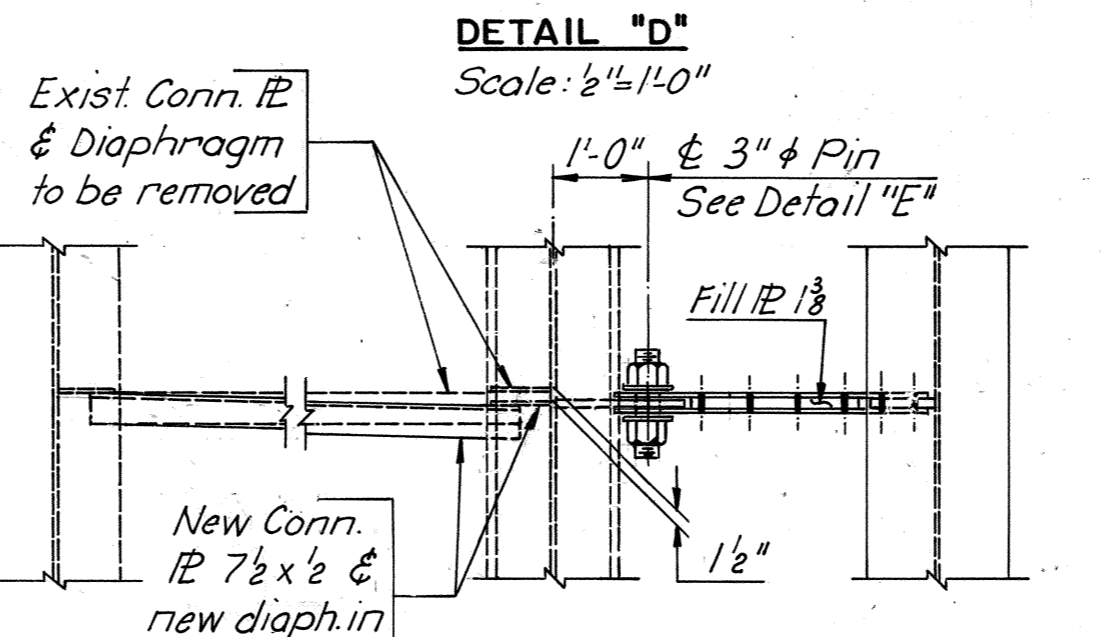

DETAIL "D"
Scale: 1/2"=1'-0"

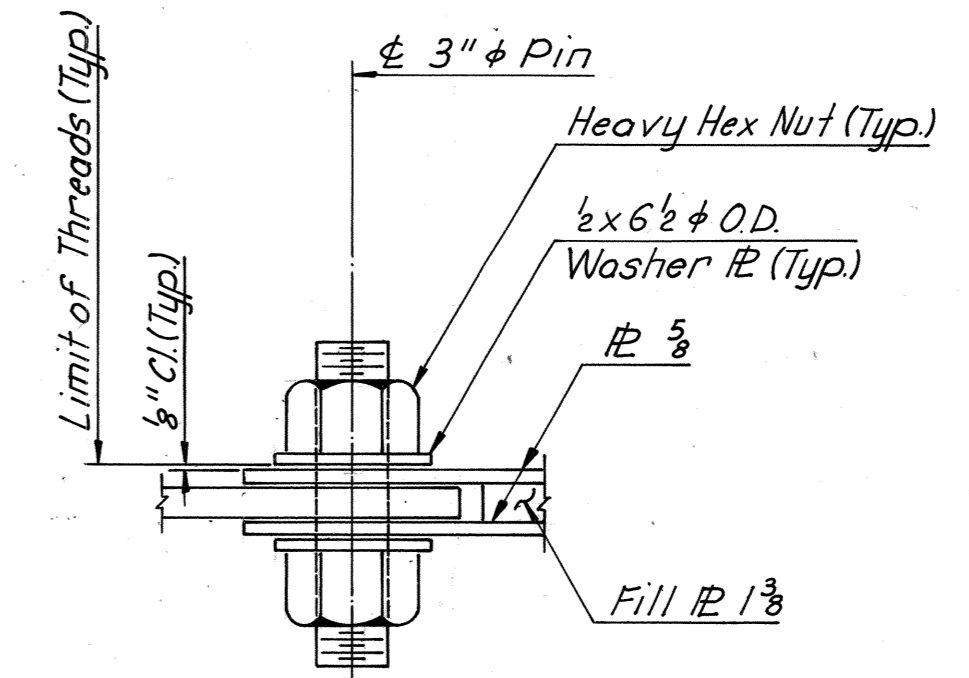

DETAIL "E"
Scale: 1/2"=1'-0"

NOTE: Spot weld nut to pin upon completion of assembly.

- NOTE:**
1. For Diaphragm D5 use type shown as end diaphragm section B-B, Sheet 20.
 2. For notes not shown, see Sheet 12.
 3. For Section H-H see Sheet 19.

DESIGNED		3	As Built	TEM	6-77
DRAWN	N.L.B. 10-7-74	1	Remove Brace & change angle	NLB	12-30-74
CHECKED	R.B.H. 11-4-74	1	New Sheet Added	NLB	10-7-74
IN CHARGE	P.R.Y.	NO.	REVISION	BY	DATE

SECTION A-A
Scale: 1/2"=1'-0"

SECTION B-B
Scale: 1/2"=1'-0"

VIEW C-C
Scale: 1/2"=1'-0"

AS BUILT

RICHMOND METROPOLITAN AUTHORITY
RICHMOND EXPRESSWAY SYSTEM
DOWNTOWN EXPRESSWAY





BRIDGE NO. 64
RAMP N-W CONNECTION FROM
RICHMOND-PETERSBURG TURNPIKE
FRAMING PLAN-UNIT 2

SCALE AS NOTED
DATE _____ SHEET 12b OF 28


HOWARD, NEEDLES, TAMMEN & BERGENDOFF
CONSULTING ENGINEERS
Alexandria, Virginia

HNTB


RICHMOND EXPRESSWAY SYSTEM			
SECTION	PROJECT	SHEET NO.	TOTAL SHEETS
10	DOWNTOWN EXPRESSWAY	110	265

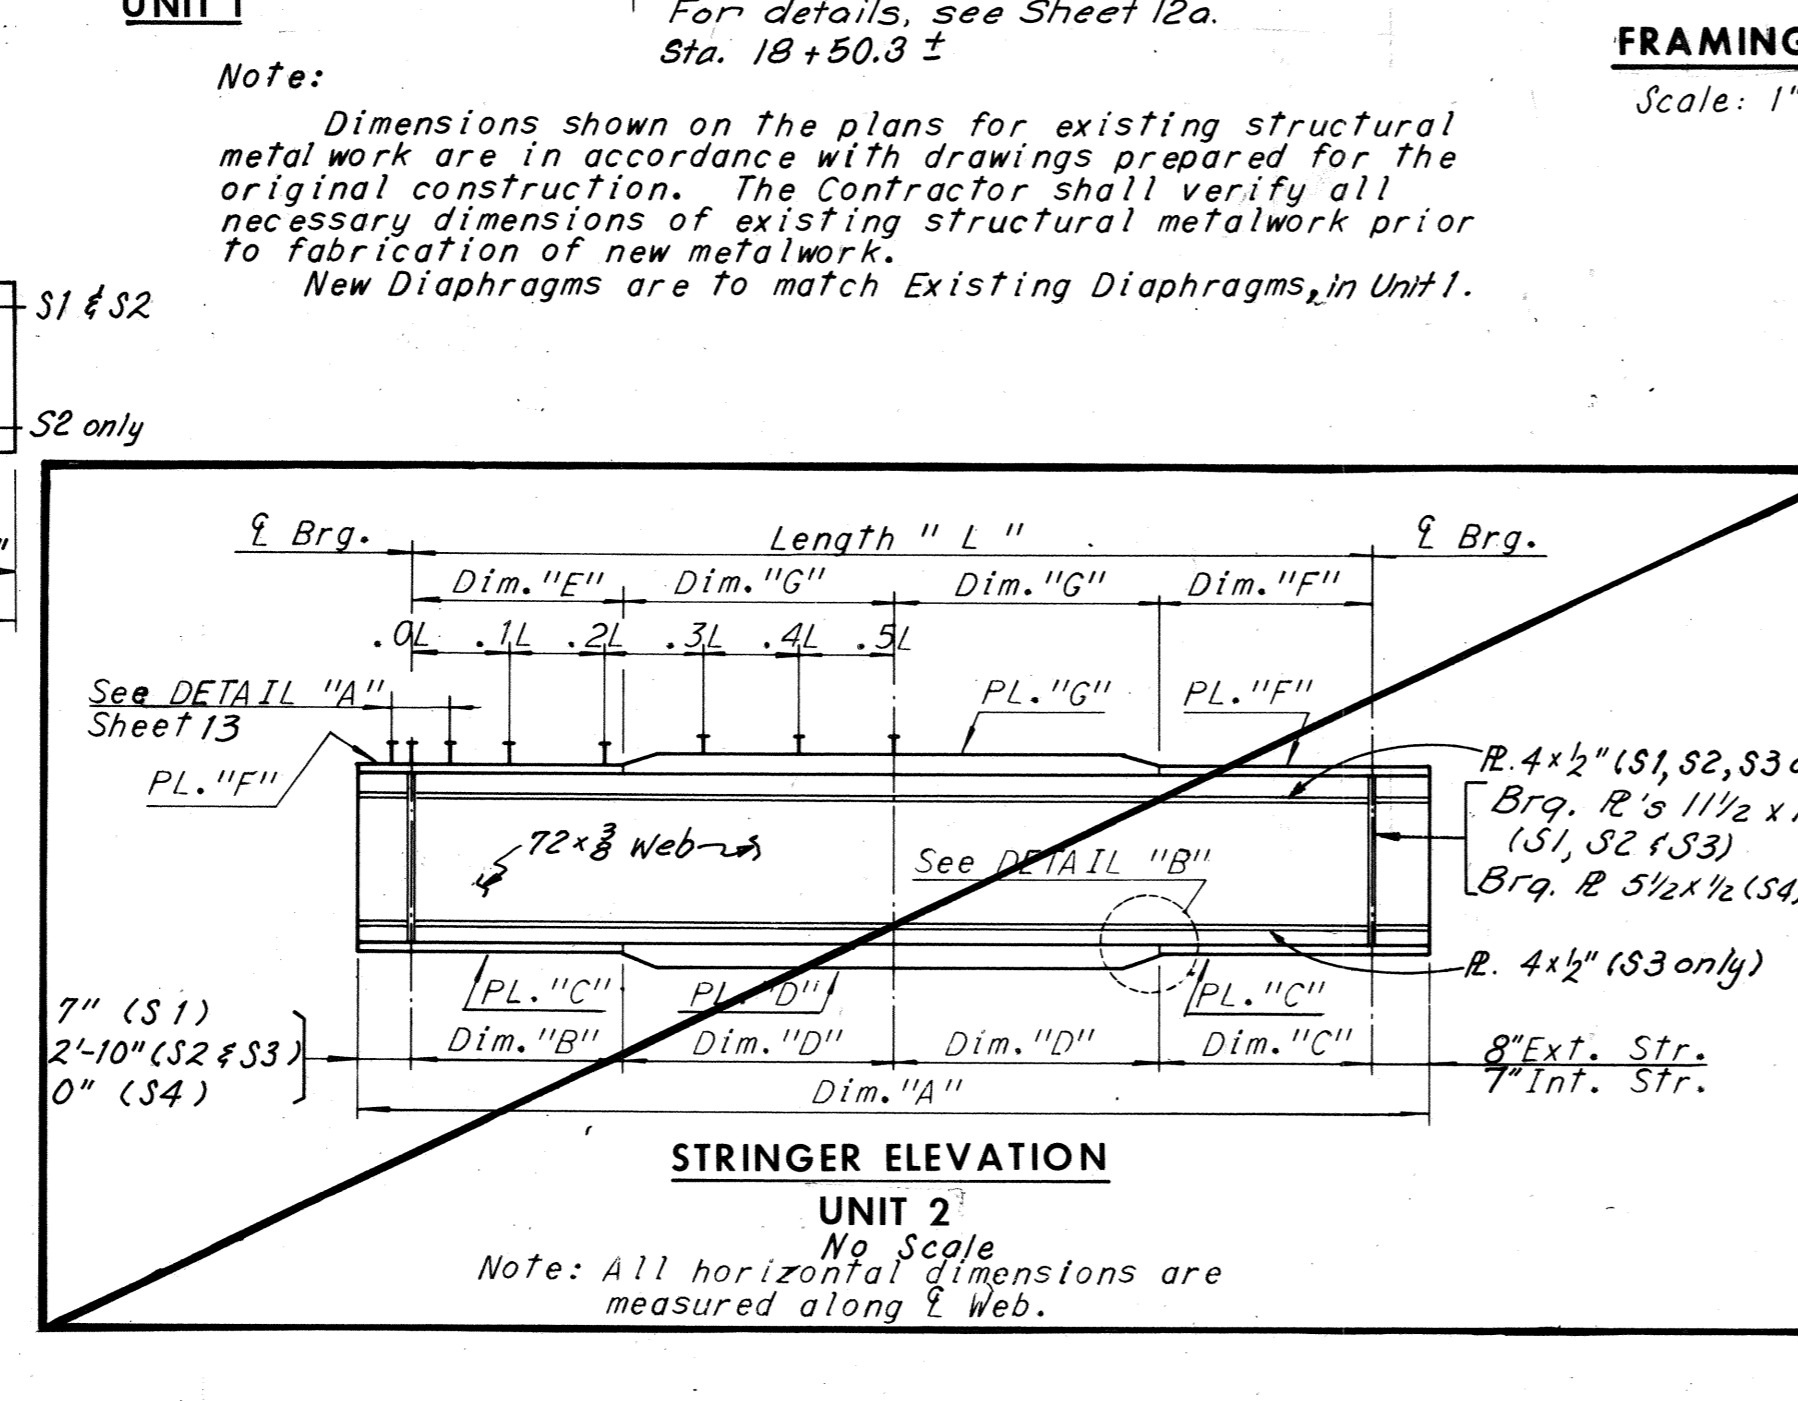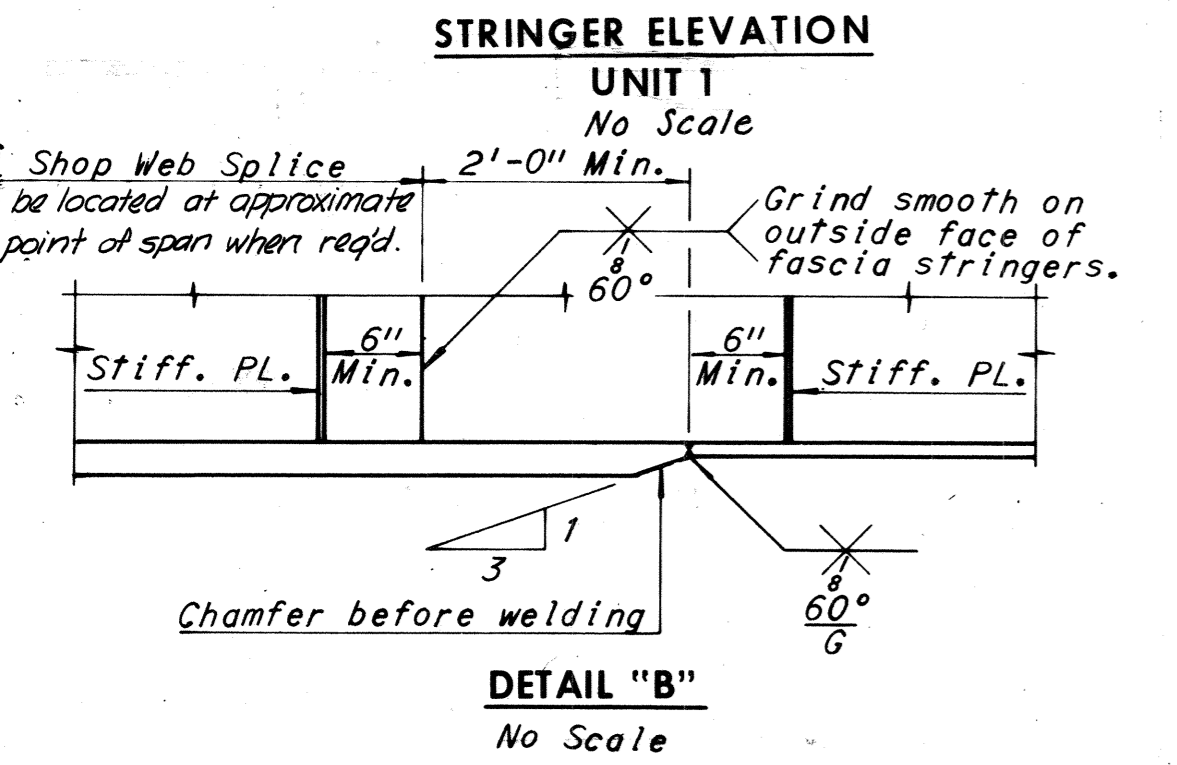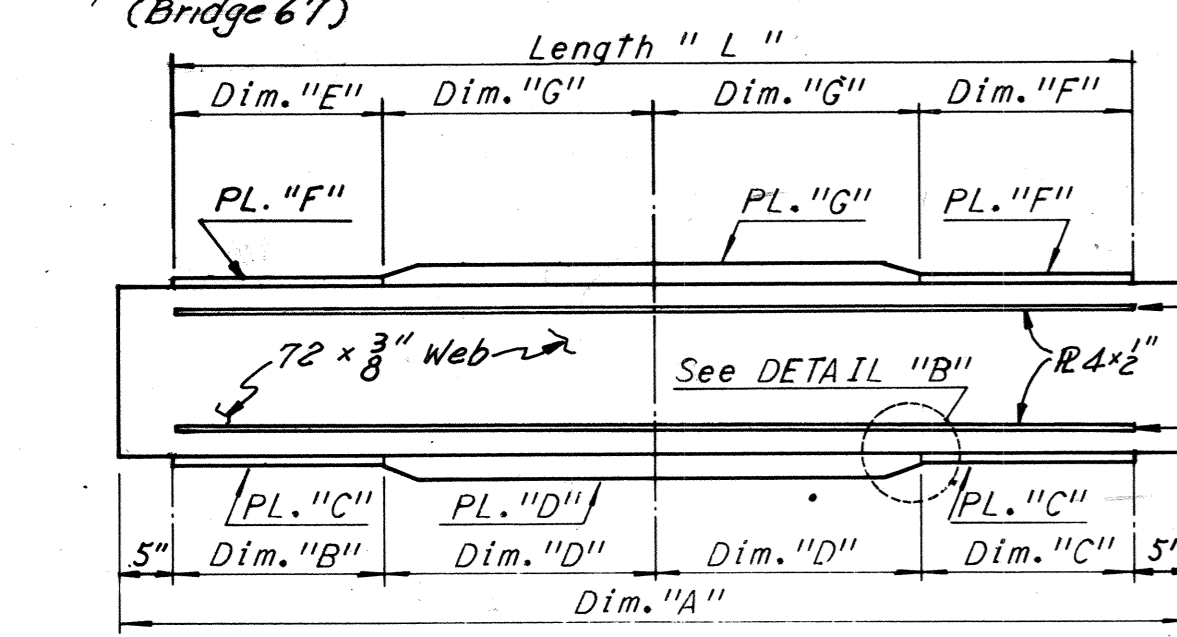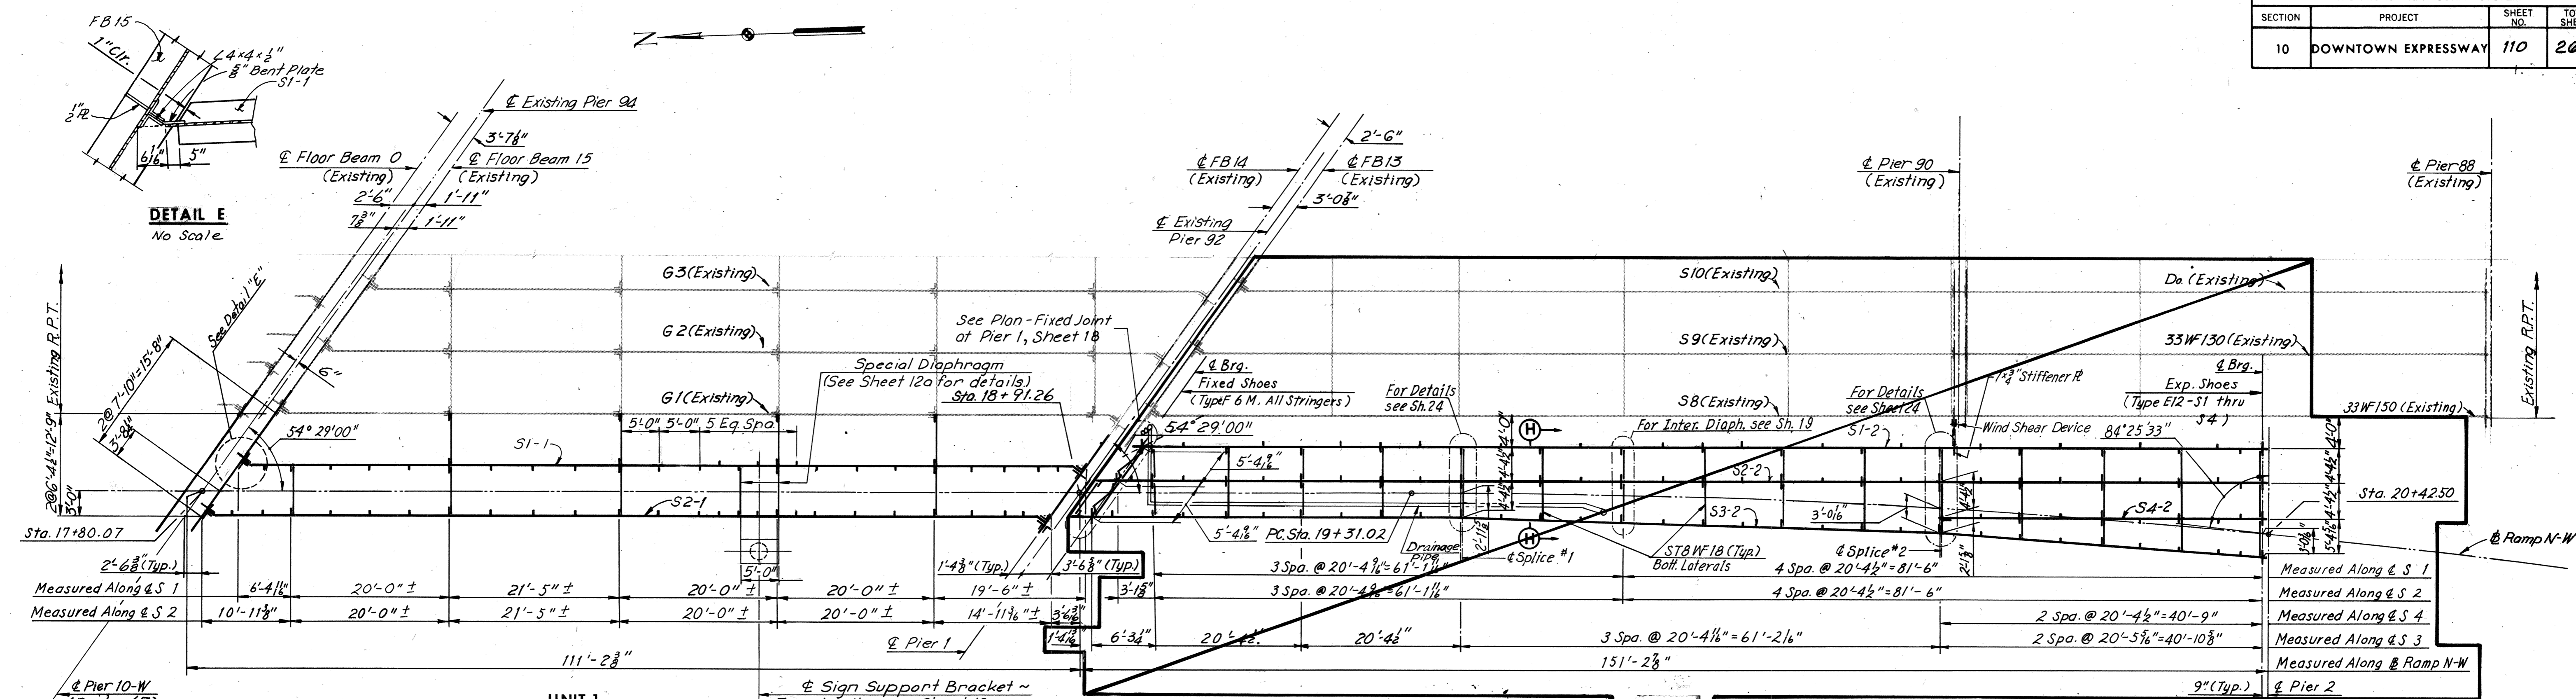

FRAMING PLAN
Scale: 1"=10'-0"

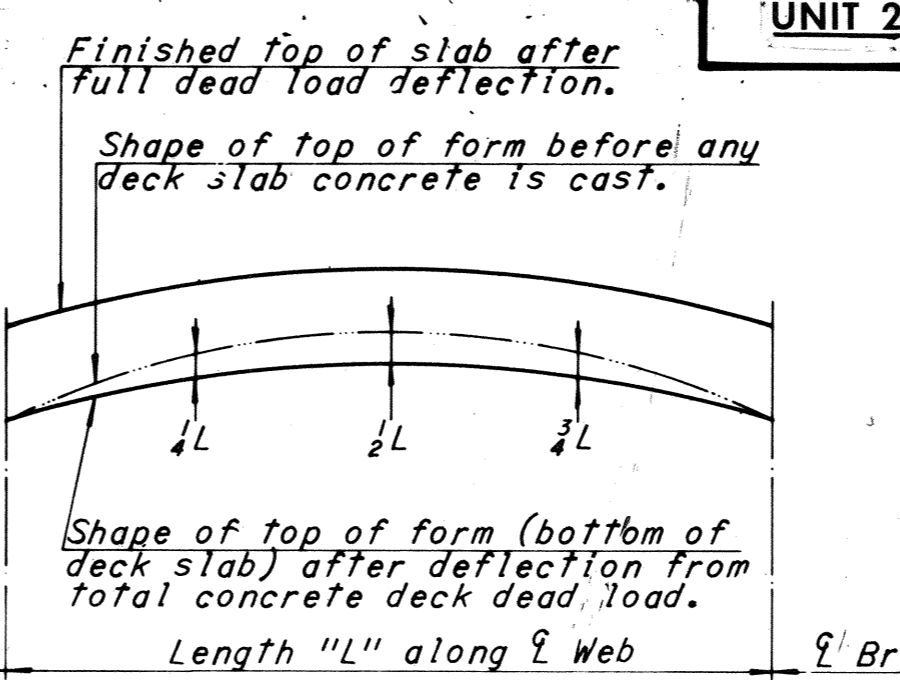

NOTE TO CONTRACTOR
Deflections given are those anticipated to occur in the stringer upon placement of the total concrete deck dead load. In practice, the stringers in place are not likely to have the exact camber to compensate for these deflections during construction. The residual amounts shall be provided by adjusting forms to vary the thickness of the concrete haunch between the bottom of the slab and the top of stringer without altering the slab thickness.

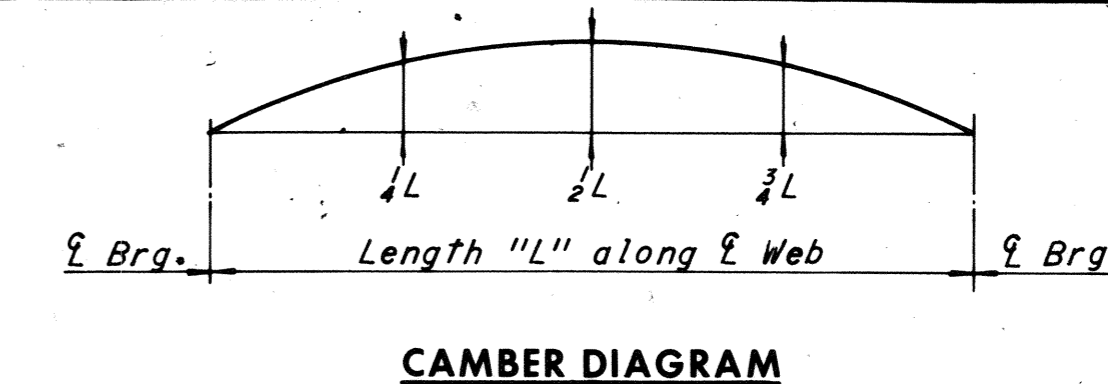

NOTE TO FABRICATOR
The stringers shall be fabricated with an upward camber amounting to the tabulated value. This will provide approximate compensation for deflection under full dead load and for conformity with finished grade.

NOTE: Stringers having a total camber of less than 1" are not required to be shop cambered, but should be turned so that any mill tolerance deviation from straightness will be in the direction shown by the Camber Diagram.

If stringers are not cambered distance top of stringers to top of slab will vary along the stringer in accordance with the offset dimensions shown in the Camber Diagram, and with minimum distance as shown in Cross-Section on Sheet 19.

⊕ Except as shown otherwise

Note: Intermediate stiffener R's 4x2 1/2" shall be equally spaced between diaphragms as shown. The first two stiffeners spaced at the ends of stringers shall be one-half normal spacing within the panel.

It may be necessary to increase Bearing Stiffener size to accommodate erection of end diaphragm.

Note: For Deck Plan, see Sheet 19. For Joint Details, see Sheets 18 & 25. For Standard Shoe Details, see Sheet 51. For Details of FB 14 and FB 15, see Sheet 18. See Sheet 4 for special modifications of masonry plate, F6M @ Pier 1. For Section H-H, see Sheet 19. For Horizontal Stiffener Detail and Flange to Web Welds, see Sheet 15.

EXPANSION SHOE		FIXED SHOE	
TYPE	NO REQD	TYPE	NO REQD
E 12	4	F 6 M	3

UNIT	STRINGER	Dim. "A"	LENGTH	Dim. "B"	Dim. "C"	Dim. "D"	Dim. "E"	Dim. "F"	Dim. "G"	PL. "C"	PL. "D"	PL. "F"	PL. "G"	MAX. SHEAR STUD SPACING					DEAD LOAD DEFLECTION SCHEDULE			CAMBER SCHEDULE		
														0.0L-0.1L*	0.1L-0.2L	0.2L-0.3L	0.3L-0.4L	0.4L-0.5L	1/4L	1/2L	3/4L	1/4L	1/2L	3/4L
1	S1-1	106'-3 3/8"	105'5 3/8"	23'-0 1/8"	23'-0"	29'-8 3/8"	23'-0 1/8"	23'-0"	29'-8 3/8"	18x4"	18x1 1/4"	18x4"	18x1 1/4"	—	—	—	—	—	7/8"	1 1/2"	7/8"	2 3/16"	2 1/8"	2 1/8"
	S2-1	106'-3 3/8"	105'-5 7/8"	23'-0 1/8"	23'-0"	29'-8 3/8"	23'-0 1/8"	23'-0"	29'-8 3/8"	18x4"	18x1 1/4"	18x4"	18x1 1/4"	—	—	—	—	—	7/8"	1 1/2"	7/8"	2 3/16"	2 1/8"	2 3/16"
2	S1-2	143'-6 3/8"	142'-7 1/4"	19'-0"	19'-0"	52'-0"	—	—	71'-3 3/8"	24x1 1/2"	24x2 1/2"	—	18x1"	24"	24"	24"	24"	24"	1 3/8"	2 9/16"	1 3/8"	5 1/16"	5"	3 1/16"
	S2-2	149'-2 5/8"	145'-9 3/8"	20'-0"	20'-0"	52'-6"	—	—	72'-10 1/8"	24x1 1/2"	24x2 1/2"	—	18x1"	24"	24"	24"	24"	1 3/8"	2 9/16"	1 3/8"	4 3/4"	6 3/16"	4 1/4"	
	S3-2	152'-6 3/8"	149'-0 3/8"	20'-0"	22'-0 1/8"	53'-6"	—	—	74'-0 3/8"	24x1 1/2"	24x2 1/2"	—	18x1"	24"	24"	24"	24"	2 1/4"	3 1/8"	2 1/4"	6 1/8"	8 7/16"	6 1/8"	
	S4-2	41'-4"	41'-9"	—	—	20'-4 1/2"	—	—	20'-4 1/2"	—	12x2"	—	12x2"	24"	24"	24"	24"	0	1 1/8"	0	1 1/8"	1 1/8"	1 1/8"	

MADE	BY	DATE	REVISION	BY	DATE
Y.C.P	2-11-69				
S.C.C	4-24-69				

Note: * Spacing begins at termination of 6 spaces @ 4". All steel shall be A36 unless otherwise shown.

Note: For revisions to Unit 2, see Sheet 12a.

RICHMOND METROPOLITAN AUTHORITY
RICHMOND EXPRESSWAY SYSTEM
DOWNTOWN EXPRESSWAY








BRIDGE NO. 64
RAMP N-W CONNECTION FROM
RICHMOND-PETERSBURG TURNPIKE
FRAMING PLAN- UNITS 1

HOWARD, NEEDLES, TAMMEN & BERGENDOFF consulting engineers
NEW YORK ALEXANDRIA KANSAS CITY

SCALE: As Noted
CONTRACT NO. 10
SHEET NO. 12 OF 28

AS BUILT

RICHMOND EXPRESSWAY SYSTEM			
SECTION	PROJECT	SHEET NO.	TOTAL SHEETS
10	DOWNTOWN EXPRESSWAY	112	265

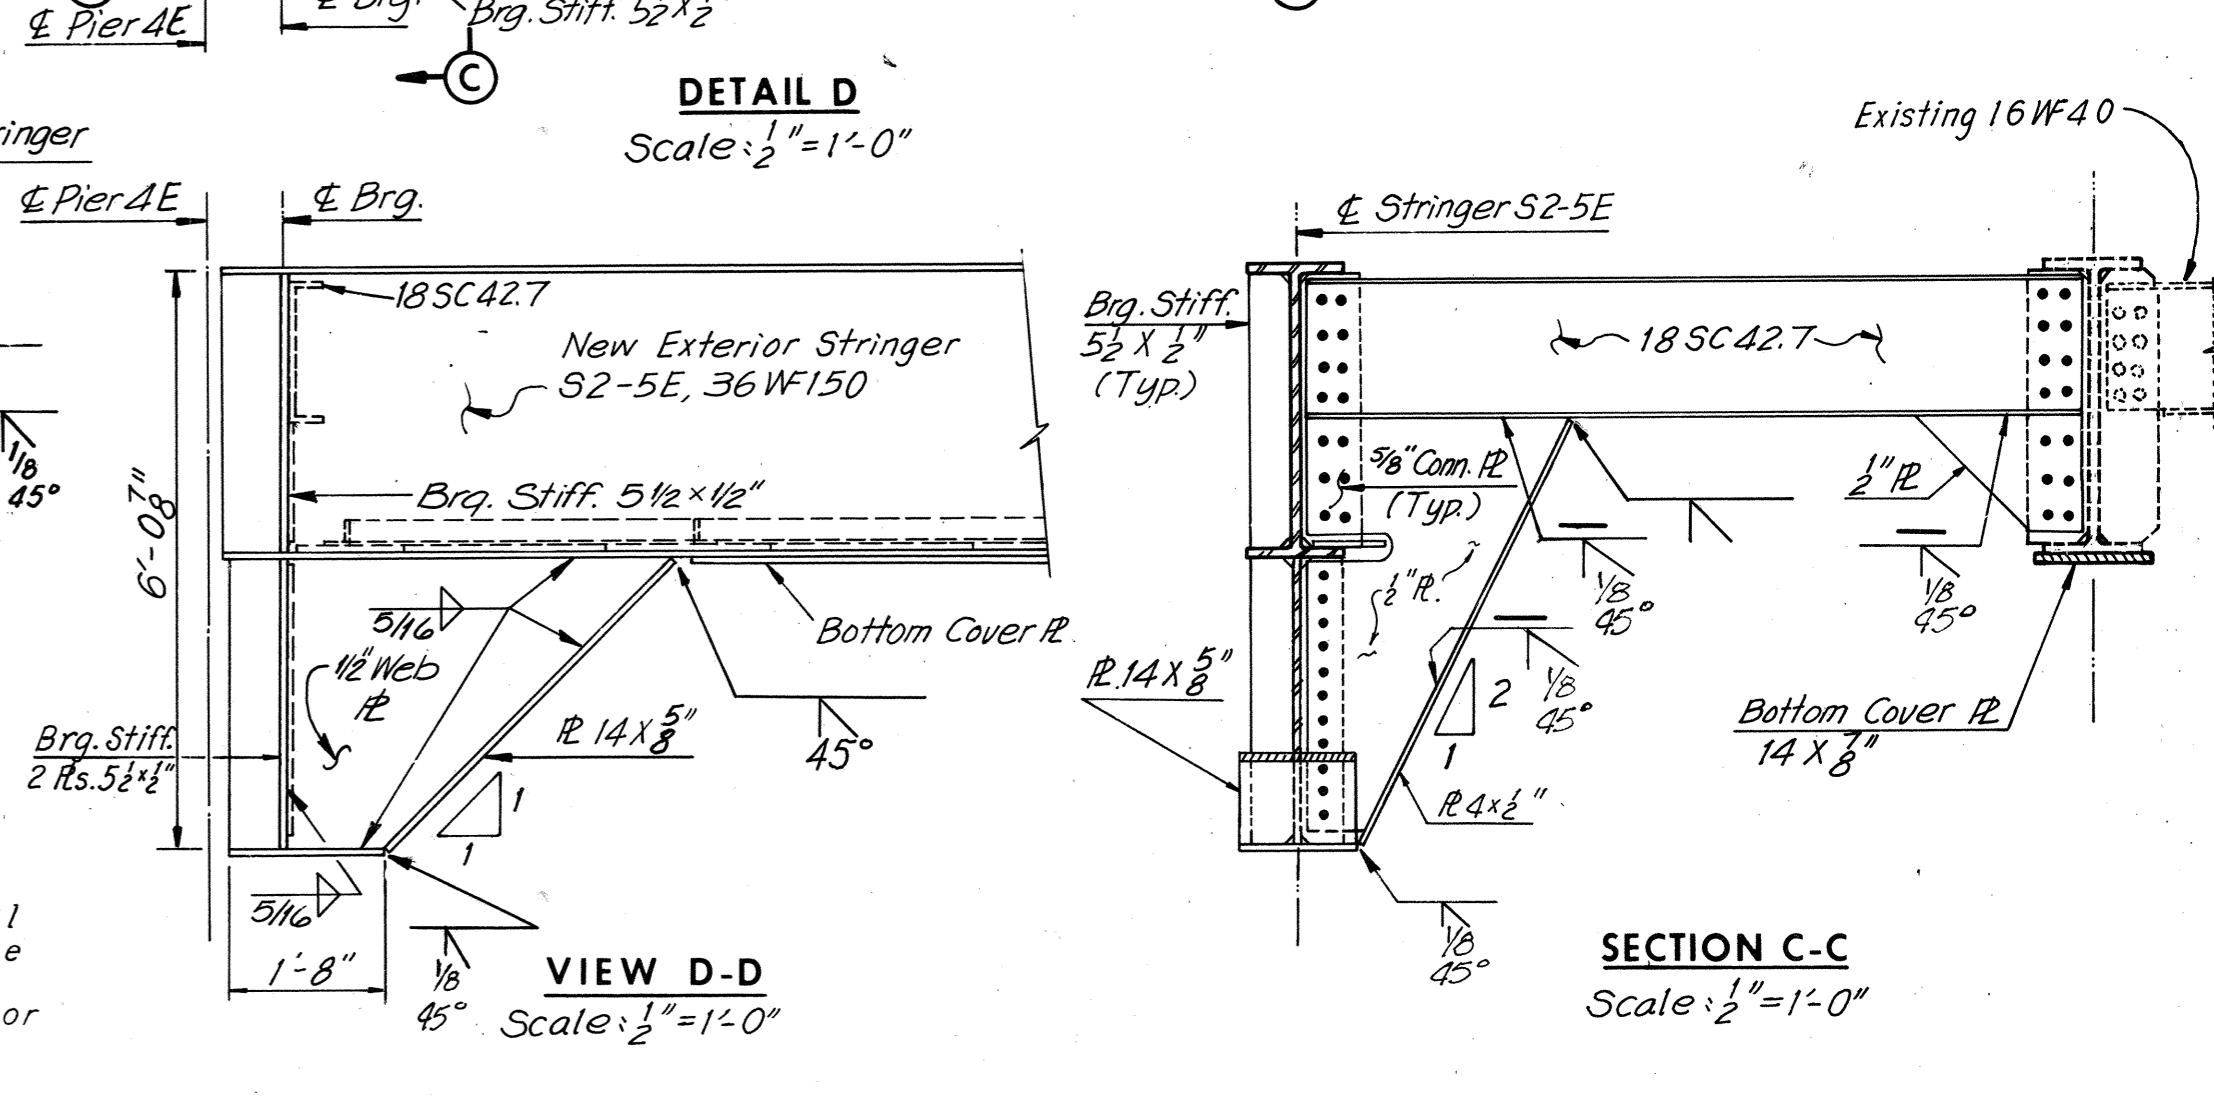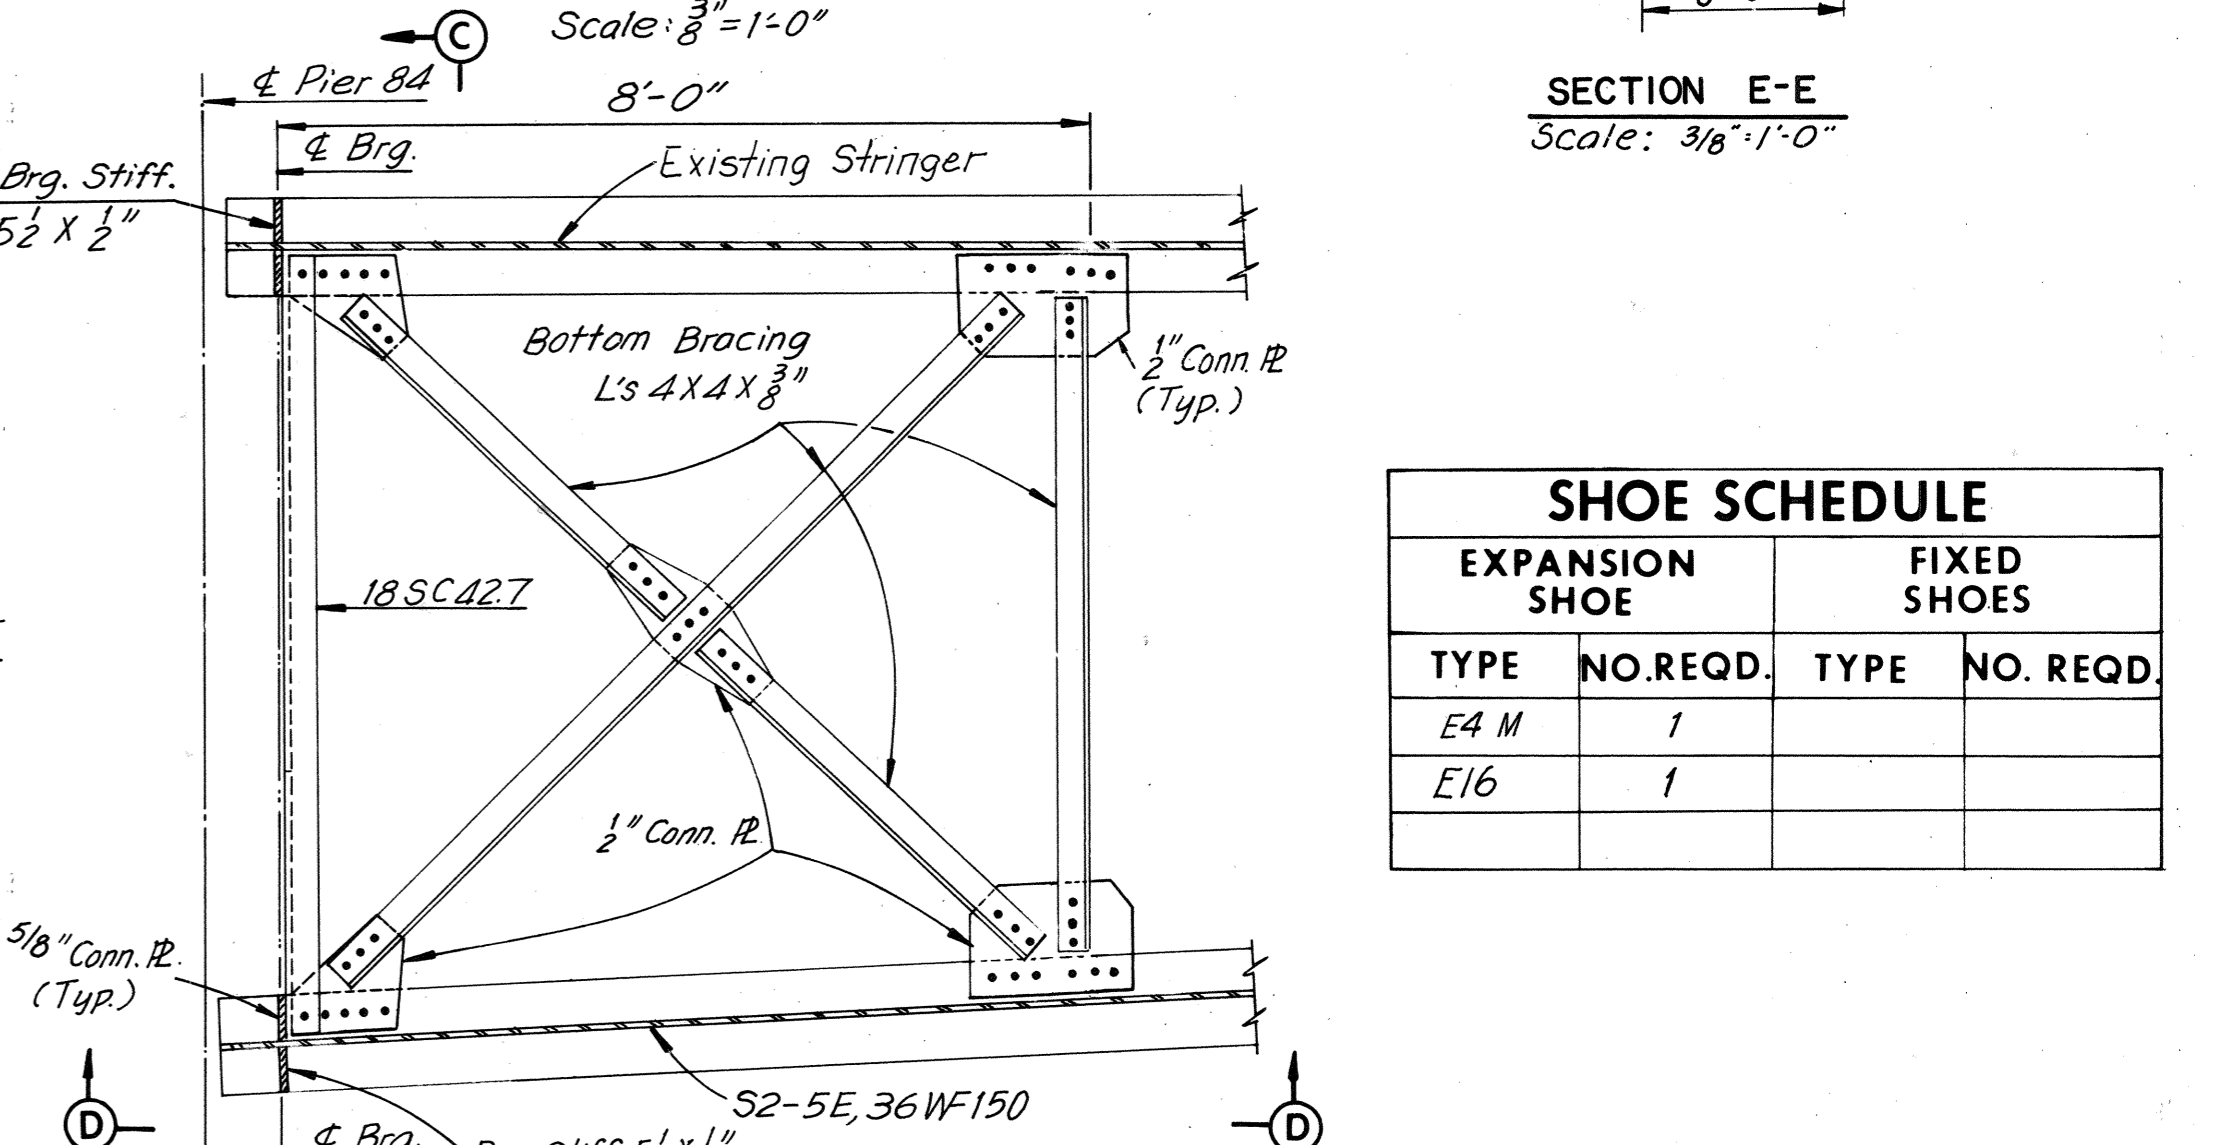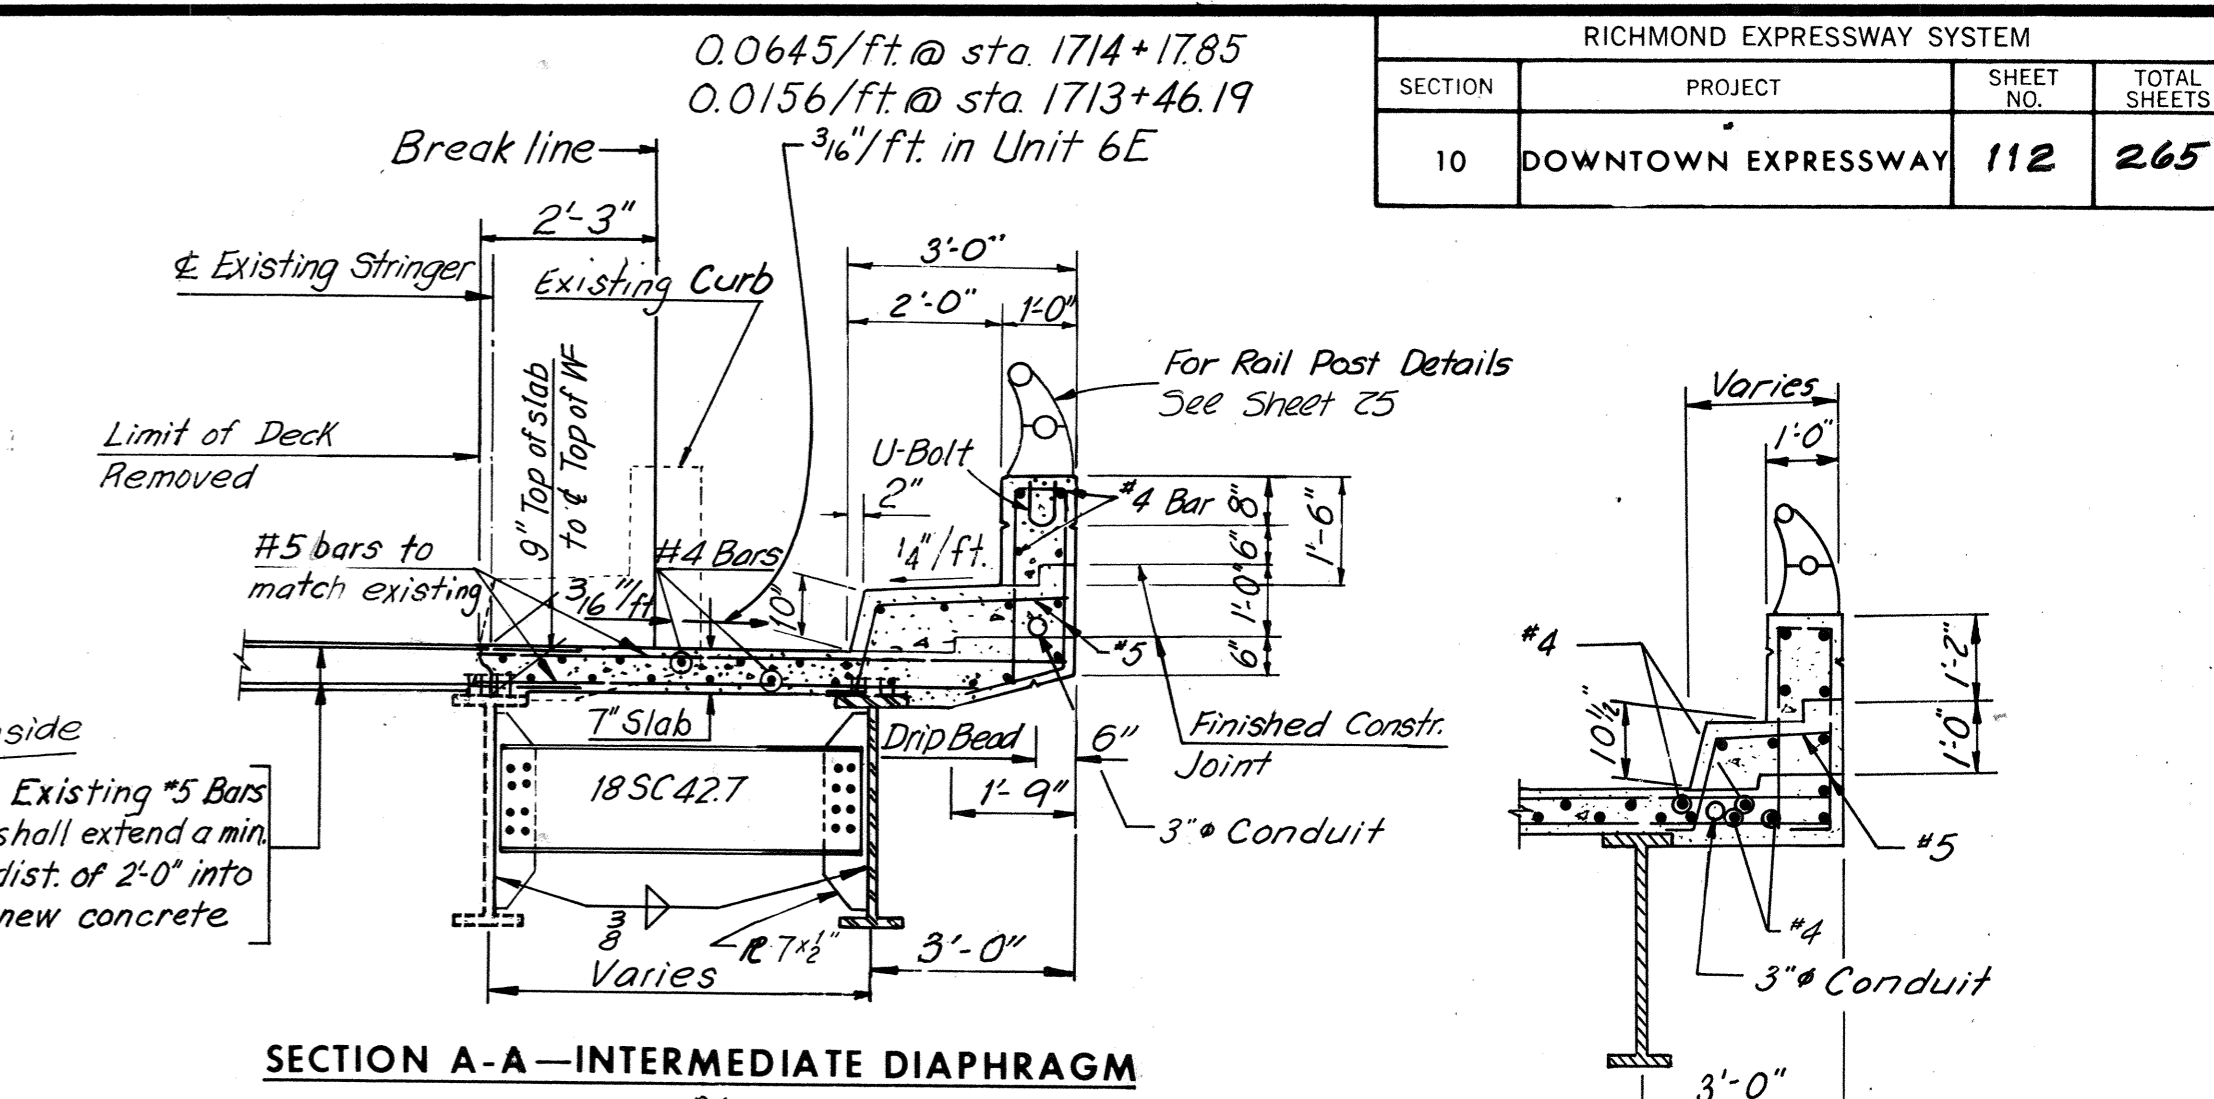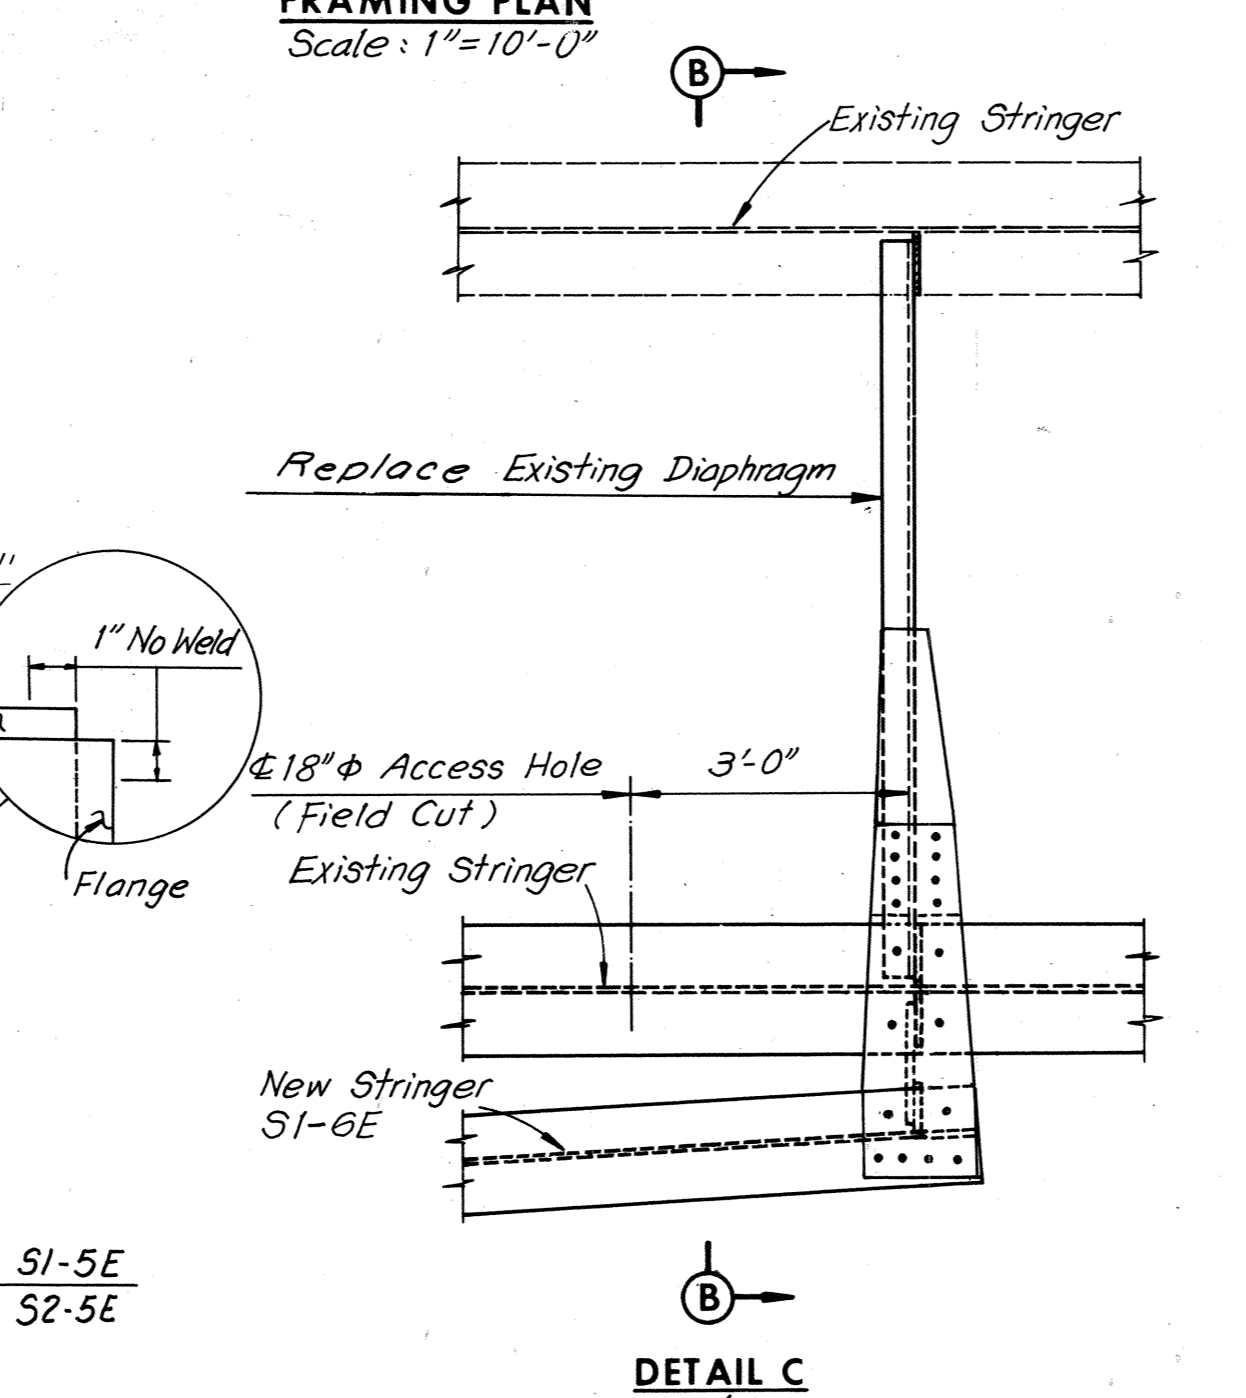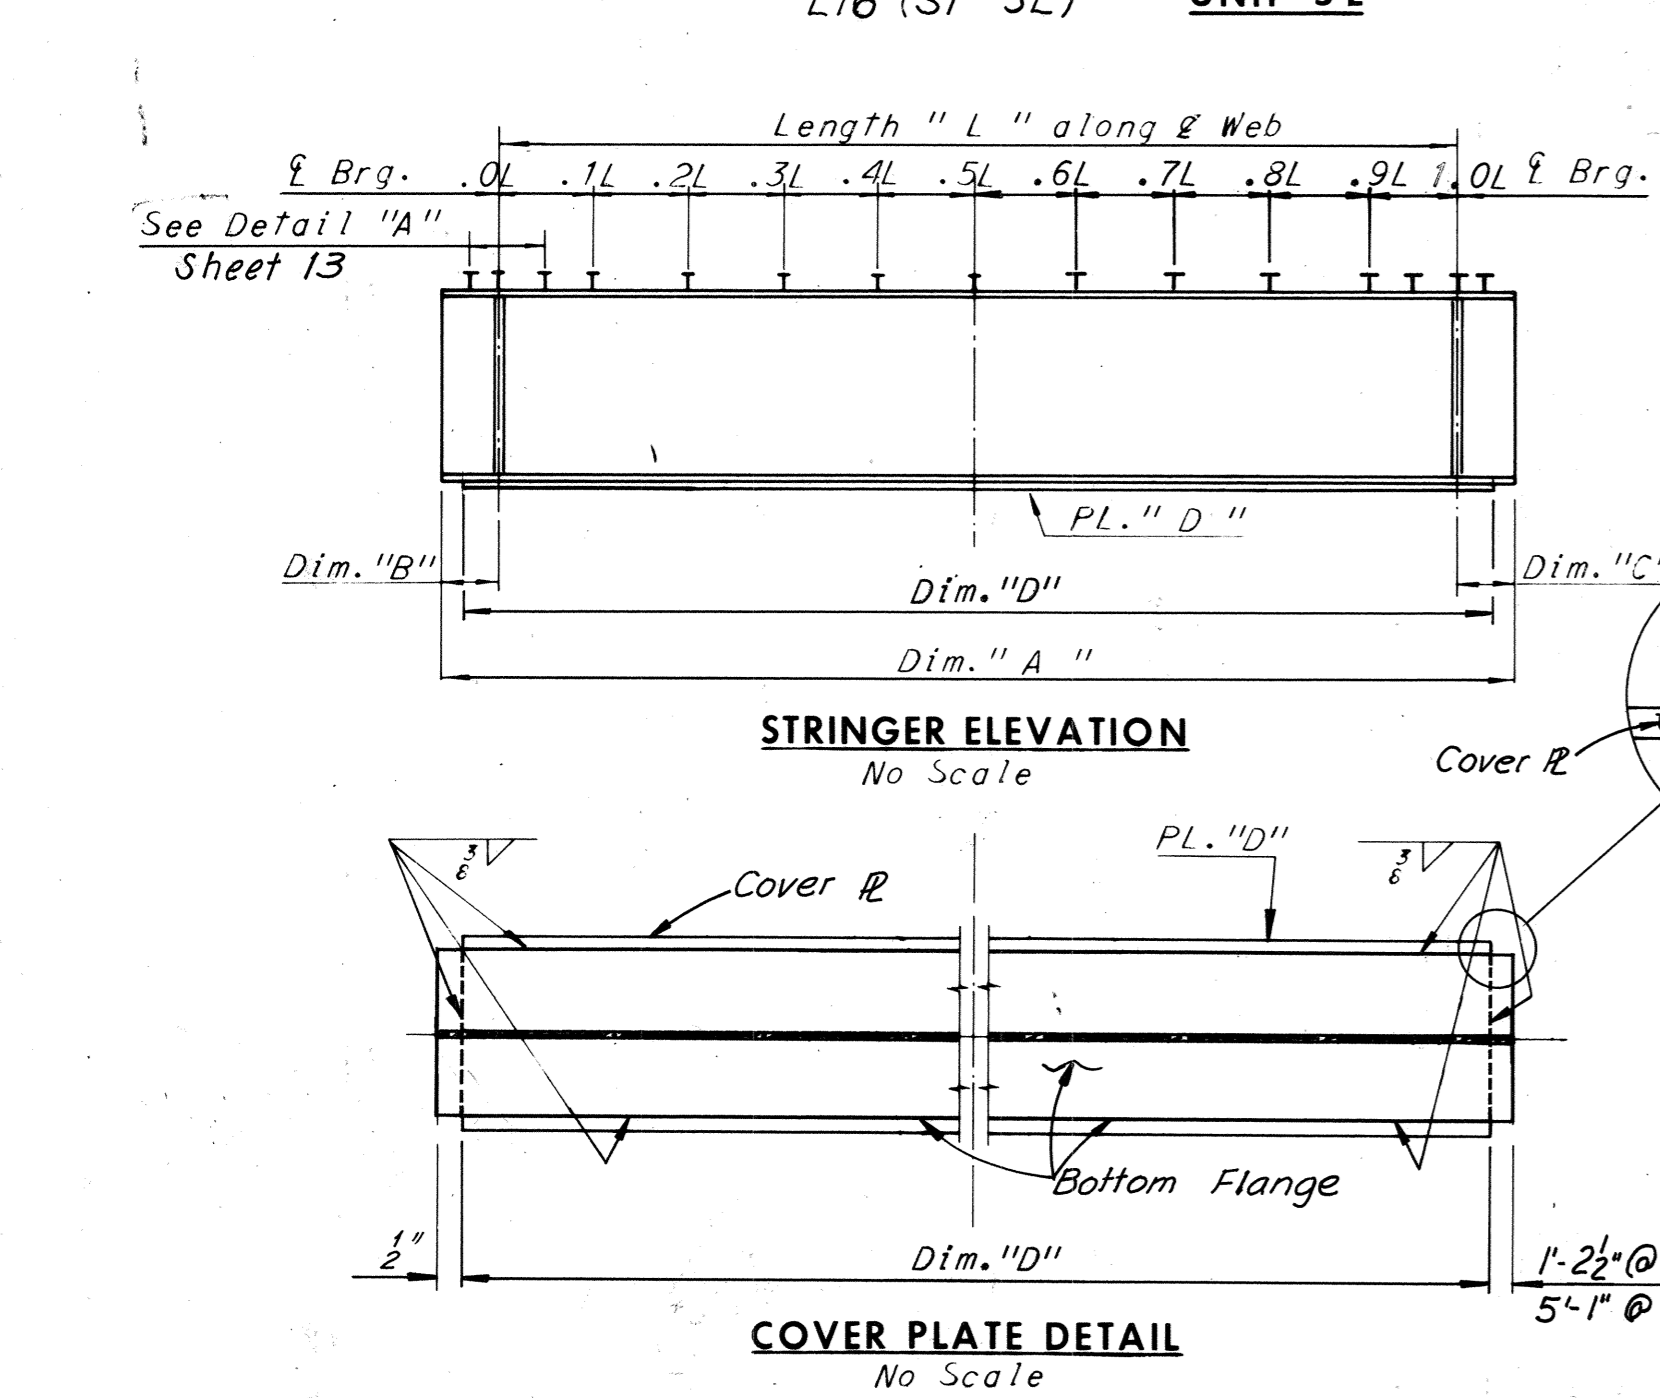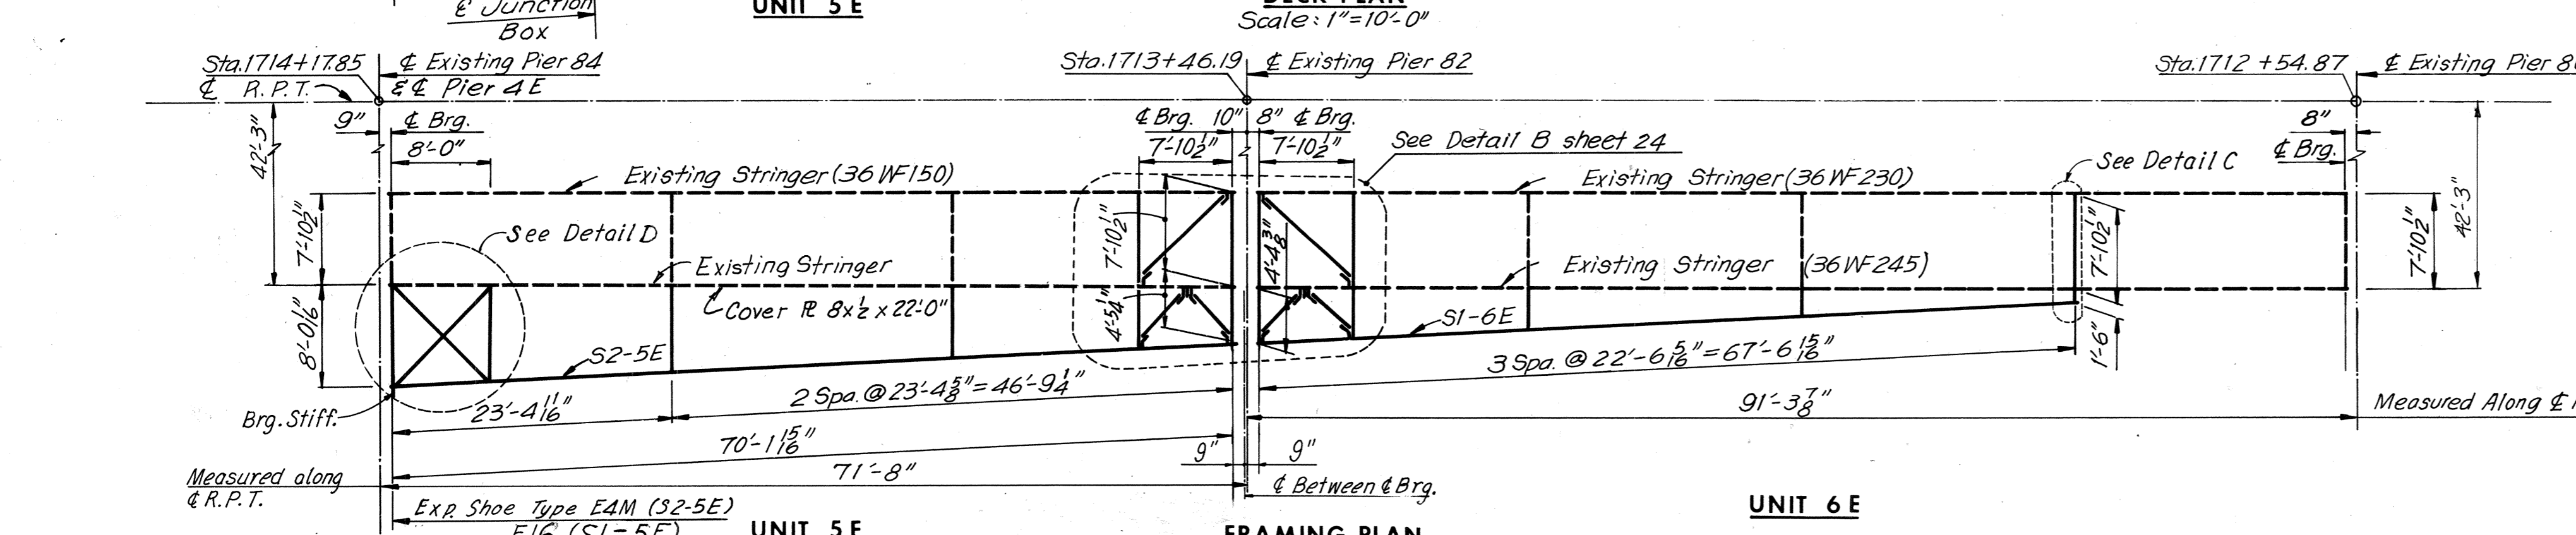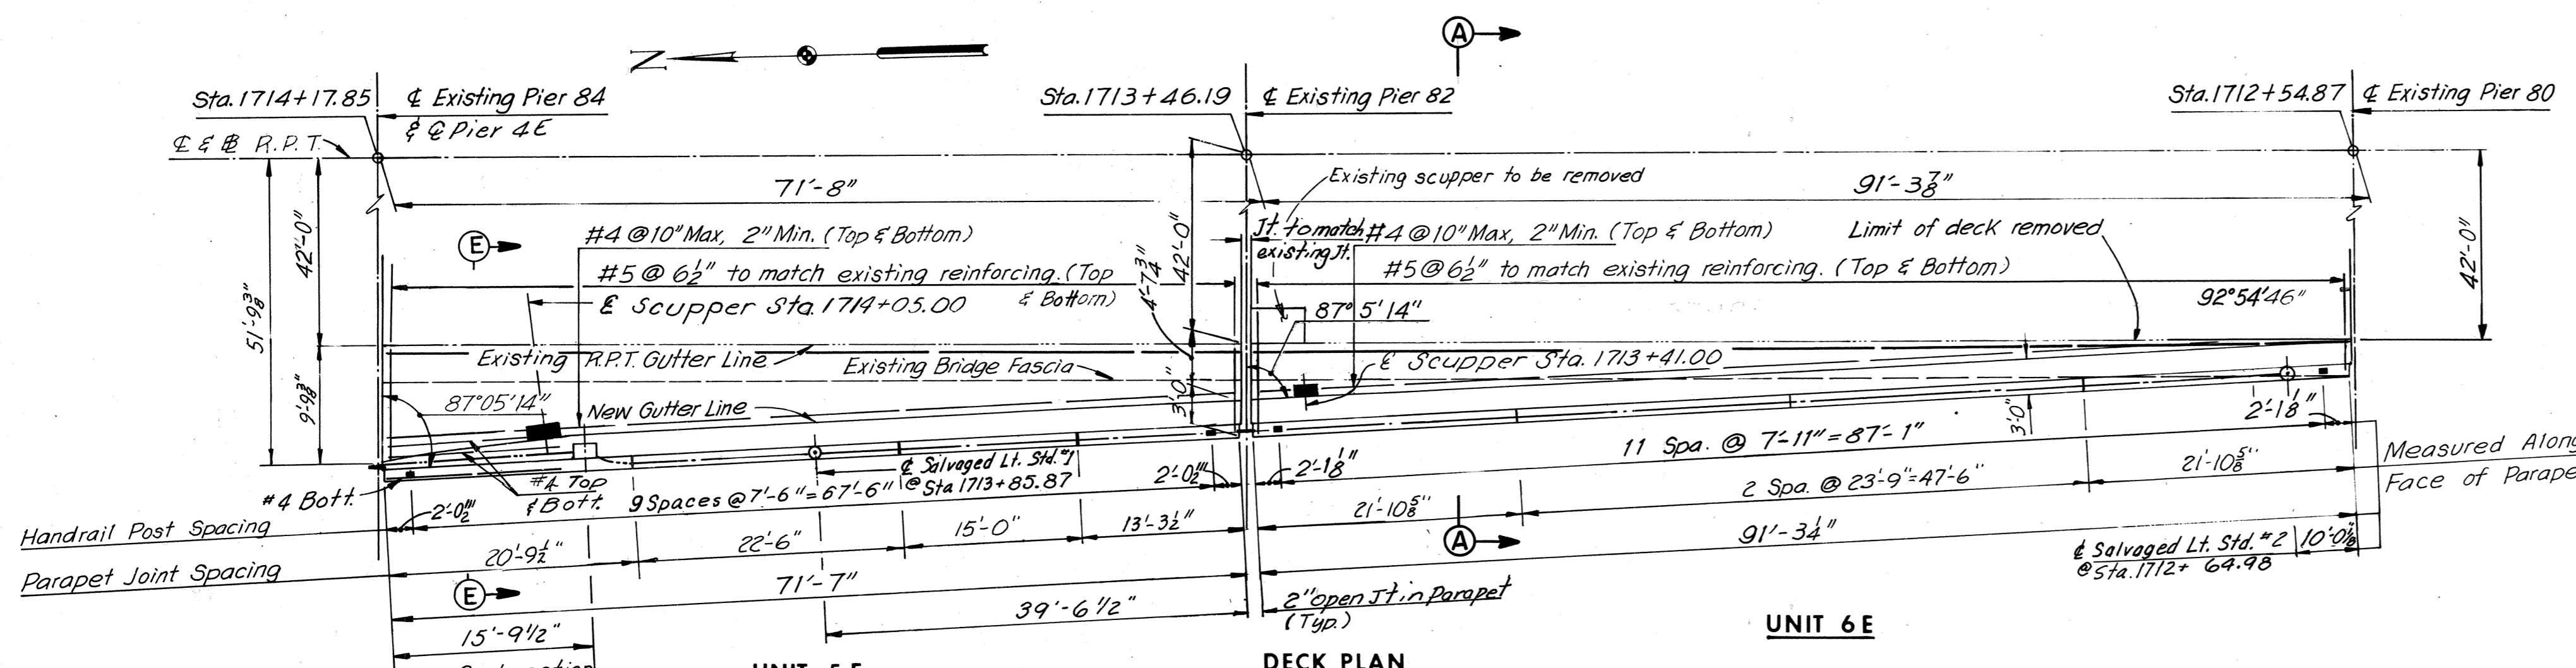

SHOE SCHEDULE			
EXPANSION SHOE		FIXED SHOES	
TYPE	NO. REQD.	TYPE	NO. REQD.
E4 M	1		
E16	1		

NOTE: Contractor shall remove the minimum amount of deck necessary to perform the work shown on this sheet.

Note: Dimensions shown on the plans for existing structural metalwork are in accordance with drawings prepared for the original construction. The Contractor shall verify all necessary dimensions of existing structural metalwork prior to fabrication of new metalwork. New Diaphragms are to match Existing Diaphragms.

UNIT	STRINGER	STRINGER SIZE	Dim. "A"	LENGTH "L"	Dim. "B"	Dim. "C"	Dim. "D"	PL. "D"	MAX. SHEAR STUD SPACING																DEAD LOAD DEFLECTION SCHEDULE						CAMBER SCHEDULE		
																									DUE TO TOTAL CONC.			DUE TO STEEL					
									0.0L-0.1L	0.1L-0.2L	0.2L-0.3L	0.3L-0.4L	0.4L-0.5L	0.5L-0.6L	0.6L-0.7L	0.7L-0.8L	0.8L-0.9L	0.9L-1.0L	1/4L	1/2L	3/4L	1/4L	1/2L	3/4L	1/4L	1/2L	3/4L						
5E	S2-5E	36W 150	71'-5 5/8"	70'-1 1/8"	8"	8"	6'-4"	14x5/8"	9 1/2"	10 1/2"	12"	15"	18 1/2"	19"	17"	14 1/2"	6"	6"	7/8"	1 3/16"	7/8"	1/2"	5/16"	1/4"	1/8"	2 1/16"	1 3/16"						
6E	S1-6E	36W 150	68'-9"	67'-6 1/8"	7"	7 1/8"	--	--	24"	24"	24"	24"	24"	24"	24"	24"	24"	24"	3/4"	1 1/16"	3/4"	3/16"	5/16"	1/4"	1/16"	1 1/16"	1 1/16"	1 1/16"					

* Spacing begins at termination of 6 spaces @ 4".

BY	DATE	REVISION	BY	DATE
MADE	SCC 3/12/69	2 As Built	TEM	6-77
CHECKED	GCC 4/28/69	Deck Plan & Section A-A	TEM	10-74
IN CHARGE				


RICHMOND METROPOLITAN AUTHORITY
RICHMOND EXPRESSWAY SYSTEM
DOWNTOWN EXPRESSWAY

BRIDGE NO. 64
RAMP N-W CONNECTION FROM
RICHMOND-PETERSBURG TURNPIKE
FRAMING PLAN AND DECK PLAN
UNITS 5E AND 6E

HOWARD, NEEDLES, TAMMEN & BERGENDOFF
 consulting engineers
 NEW YORK ALEXANDRIA KANSAS CITY

SCALE: As Noted
 CONTRACT NO. 10
 SHEET NO. 14 OF 28

AS BUILT

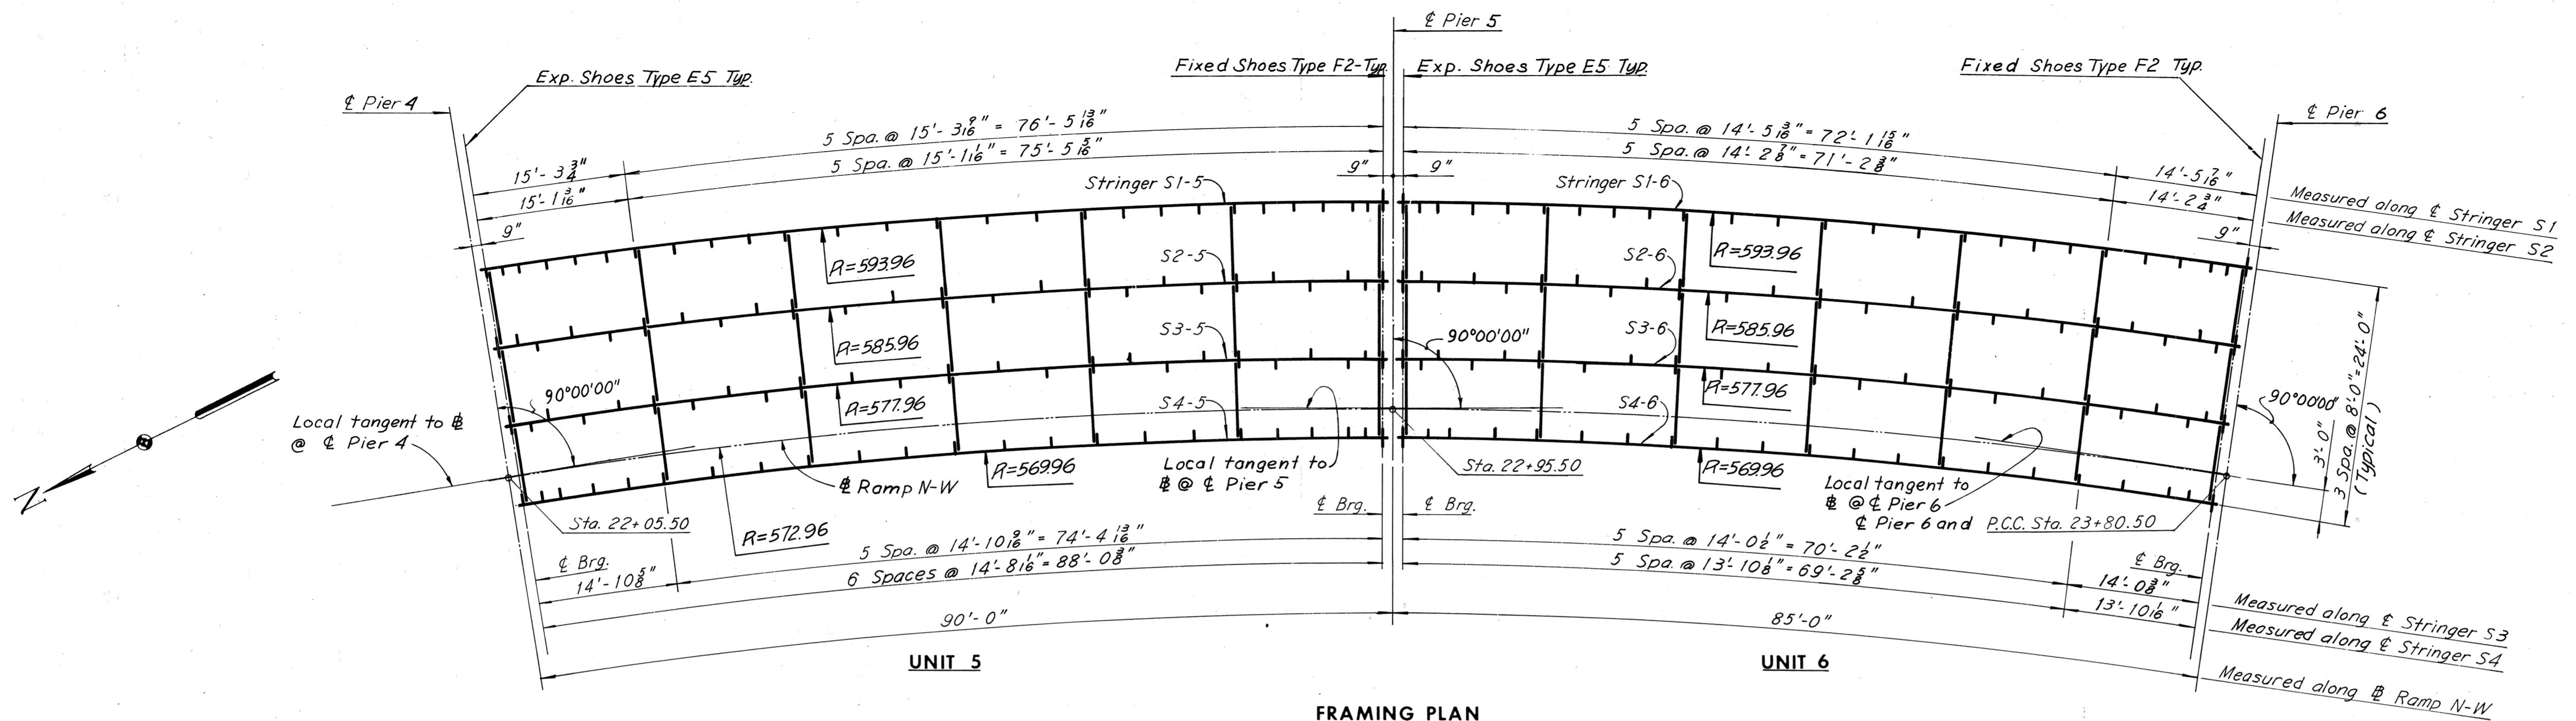


FRAMING PLAN
1" = 10'-0"


CAMBER SCHEDULE				
UNIT	STRINGER	1/4 L	1/2 L	3/4 L
5	S1-5	2 5/8"	3 3/8"	2 3/8"
	S2-5	2 5/8"	3 1/8"	2 3/8"
	S3-5	2 5/8"	3 1/8"	2 1/4"
	S4-5	2 5/8"	3 1/8"	2 1/4"
6	S1-6	2 5/8"	3 1/8"	2 1/4"
	S2-6	2 5/8"	3 1/8"	2 1/4"
	S3-6	2 5/8"	3 1/8"	2 1/4"
	S4-6	2 5/8"	3 1/8"	2 1/4"

SHOE SCHEDULE			
EXPANSION SHOES		FIXED SHOES	
TYPE	NO. REQD.	TYPE	NO. REQD.
E5	8	F2	8


Notes:
 For Joint details see Sheet 26.
 For Superstructure steel quantities see Sheet 2.
 For Diaphragm details see Sheet 21.
 For Shoe details see Sheet 51.
 It may be necessary to increase Bearing Stiffener size to accommodate erection of end diaphragms.

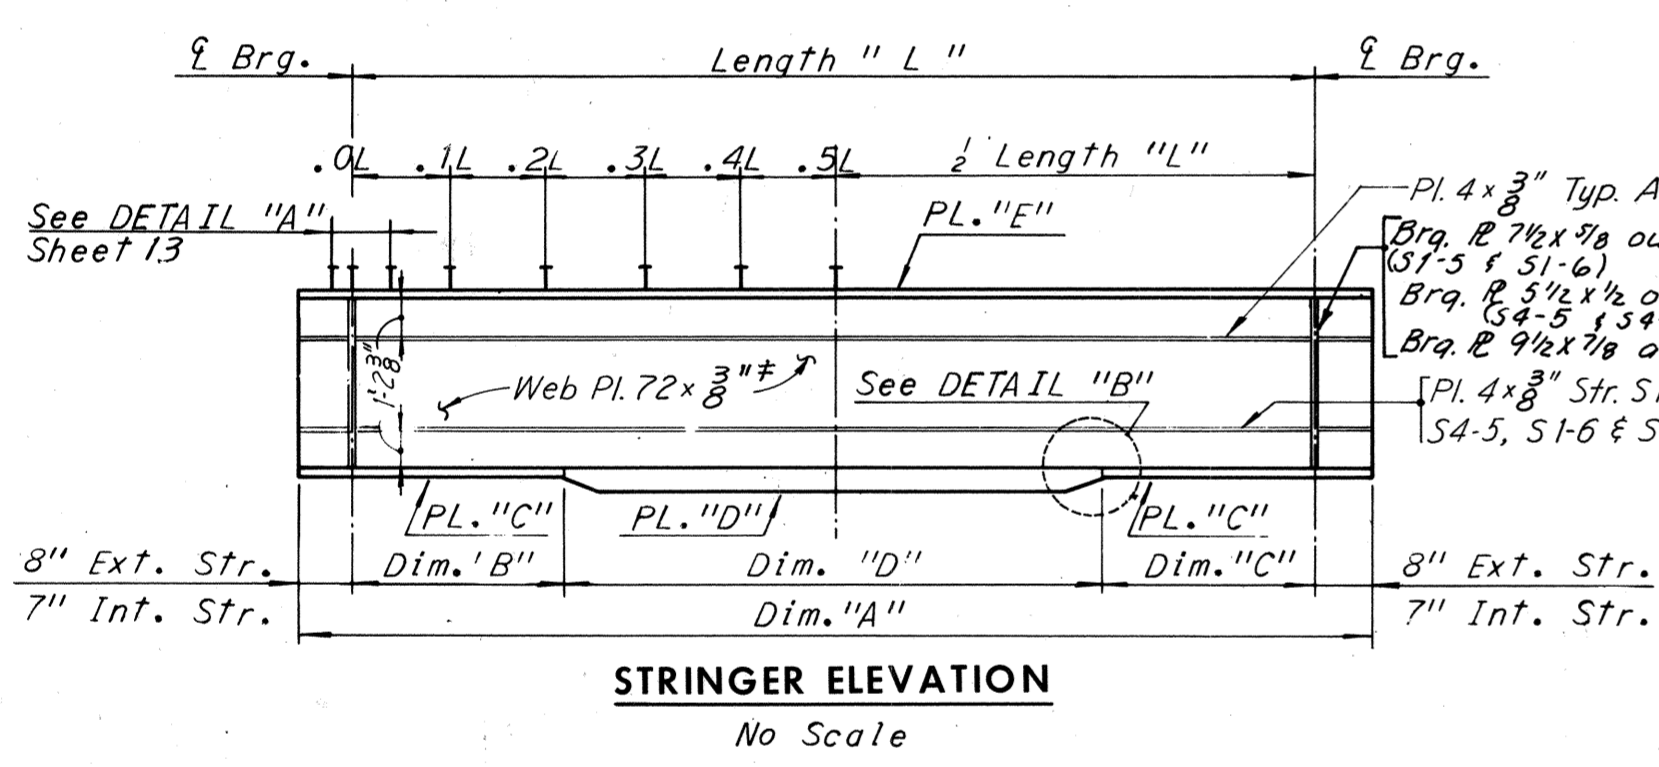


STRINGER ELEVATION
No Scale

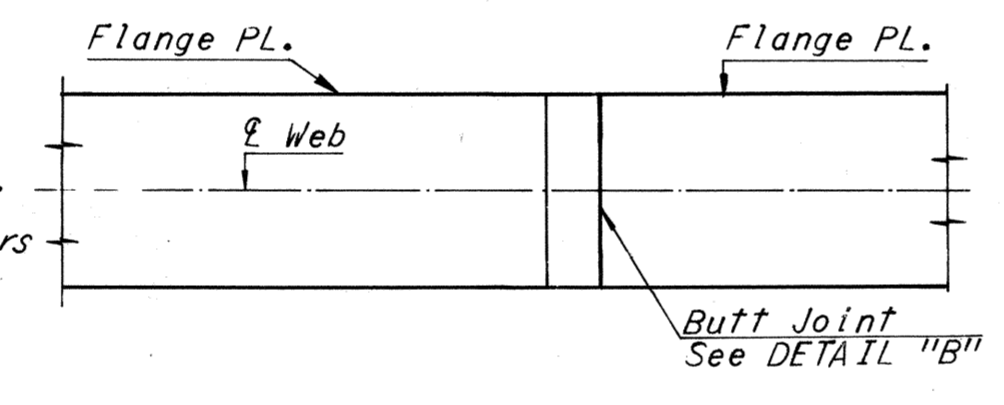

FLANGE PLATE SPICE DETAIL
No Scale

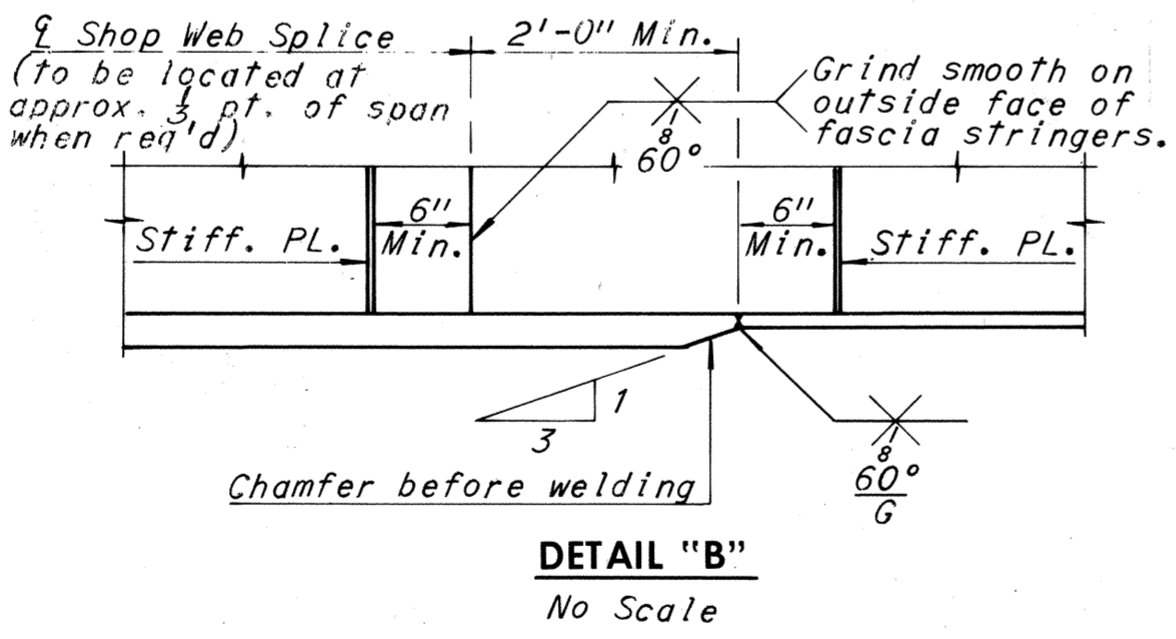


DETAIL "B"
No Scale

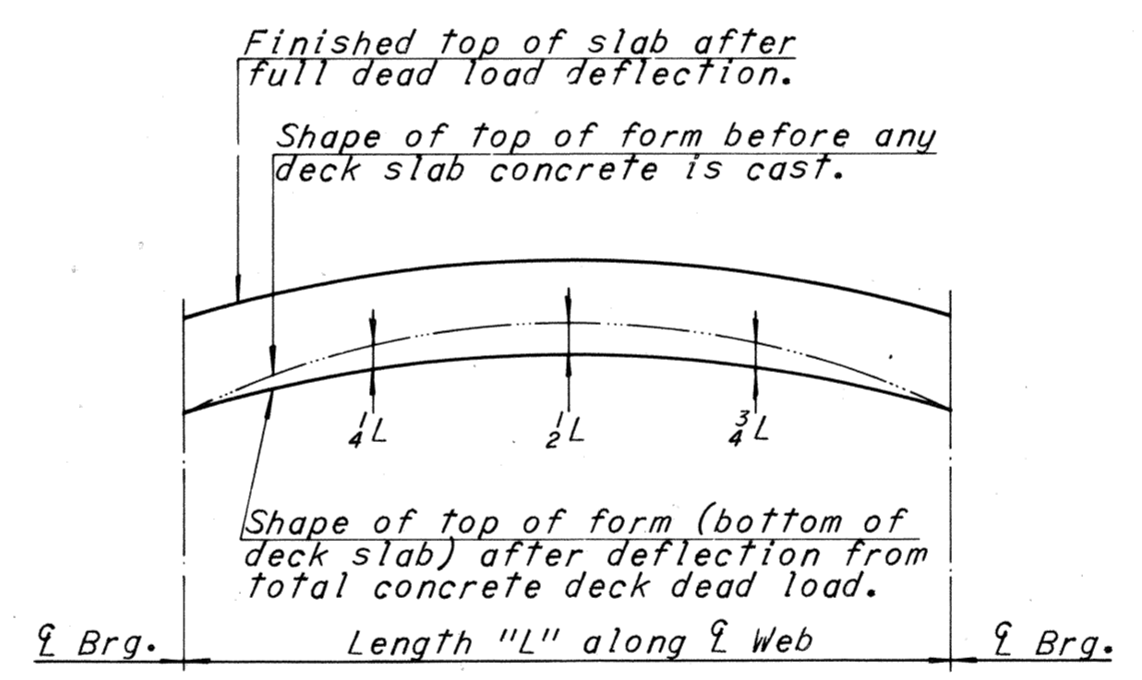

DEAD LOAD DEFLECTION DIAGRAM

NOTE TO CONTRACTOR
 Deflections given are those anticipated to occur in the stringer upon placement of the total concrete deck dead load.
 In practice, the stringers in place are not likely to have the exact camber to compensate for these deflections during construction. The residual amounts shall be provided by adjusting forms to vary the thickness of the concrete haunch between the bottom of the slab and the top of stringer without altering the slab thickness.

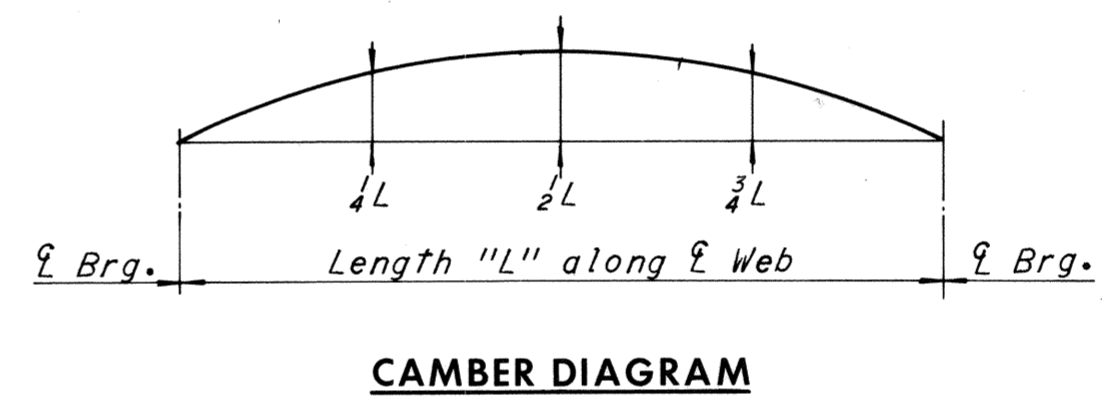


CAMBER DIAGRAM

NOTE TO FABRICATOR
 The stringers shall be fabricated with an upward camber amounting to the tabulated value. This will provide approximate compensation for deflection under full dead load and for conformity with finished grade.

Note:
 Stringers having a total camber of less than 1" are not required to be shop cambered, but should be turned so that any mill tolerance deviation from straightness will be in the direction shown by the Camber Diagram.
 If stringers are not cambered, distance top of stringer to top of slab will vary along the stringer in accordance with the offset dimensions shown in the Camber Diagram, and with minimum distance as shown in Cross-Section on Sheet 21.

UNIT	STRINGER	Dim. "A"	LENGTH "L"	Dim. "B"	Dim. "C"	Dim. "D"	PL. "C" #	PL. "D" #	PL. "E"	DEAD LOAD DEFLECTION SCHEDULE										
										DUE TO TOTAL CONC.					DUE TO STEEL					
										0.0L-0.1L	0.1L-0.2L	0.2L-0.3L	0.3L-0.4L	0.4L-0.5L	1/4 L	1/2 L	3/4 L	1/4 L	1/2 L	3/4 L
5	S1-5	93'-1 9/16"	91'-9 9/16"	17'-11 1/16"	17'-11 7/8"	55'-10"	16x 3/4"	16x 1 1/8"	12x 3/4" #	10 1/2"	12 1/2"	15 1/2"	20"	24"	15 1/16"	1 5/16"	15 1/16"	1 1/2"	5 1/16"	1 1/4"
	S2-5	91'-8 1/2"	90'-6 1/2"	18'-0 1/2"	18'-0 1/2"	54'-6"	12x 1"	12x 1 1/8"	12x 3/4" #	13"	14 1/2"	17"	21 1/2"	24"	13 1/16"	1 1/8"	13 1/16"	1 1/2"	4 1/16"	3 1/16"
	S3-5	90'-5 7/8"	89'-3 7/8"	17'-4 1/8"	17'-4 3/8"	54'-6"	12x 3/4"	12x 1 1/8"	12x 3/4" #	14 1/2"	16 1/2"	19"	23 1/2"	24"	3 1/8"	1"	3 1/8"	3 1/8"	1 1/4"	3 1/16"
	S4-5	89'-4 3/8"	88'-0 3/8"	44'-0 3/8"	44'-0 3/8"	-	12x 1"	-	12x 3/4" #	15 1/2"	18"	21 1/2"	24"	24"	5 1/8"	1 1/8"	5 1/8"	1 1/2"	3 1/16"	1 1/4"
6	S1-6	87'-11 3/8"	86'-7 3/8"	43'-3 3/8"	43'-3 3/8"	-	16x 1 1/8"	-	12x 3/4" #	11"	13"	15 1/2"	20"	24"	3 1/8"	1 1/8"	3 1/8"	3 1/8"	1 1/4"	3 1/16"
	S2-6	86'-7 1/8"	85'-5 1/8"	16'-11 1/8"	16'-11 1/8"	51'-6"	12x 3/4"	12x 1 1/8"	12x 3/4" #	13"	14 1/2"	17"	21 1/2"	24"	11 1/16"	1"	11 1/16"	3 1/16"	1 1/4"	3 1/16"
	S3-6	85'-4 1/8"	84'-2 1/8"	42'-1 1/8"	42'-1 1/8"	-	12x 1 1/8"	-	12x 3/4" #	15"	16 1/2"	19"	23"	24"	5 1/8"	1 1/8"	5 1/8"	1 1/2"	3 1/16"	1 1/4"
	S4-6	84'-4 1/8"	83'-0 1/8"	41'-6 1/8"	41'-6 1/8"	-	12x 3/4"	-	12x 3/4" #	15 1/2"	18"	21 1/2"	24"	24"	9 1/16"	1 1/16"	9 1/16"	1 1/2"	3 1/16"	1 1/4"

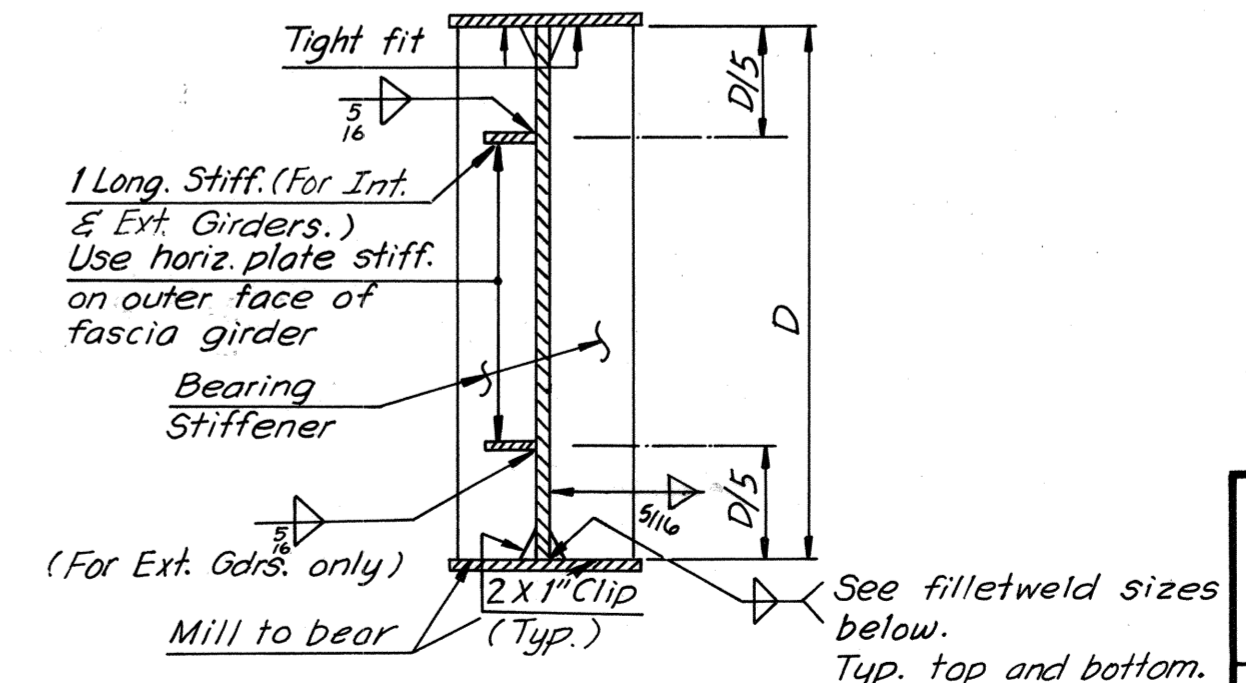

WEB TO FLANGE WELDS AND LONGITUDINAL STIFFENER WELD DETAILS
No Scale

Note:
 Web to flange weld size shall be determined by flange thickness as follows:
 To 12"..... 1/8" weld
 Over 12" to 24"..... 3/8" weld
 Over 24"..... 1/2" weld

RICHMOND METROPOLITAN AUTHORITY
RICHMOND EXPRESSWAY SYSTEM
DOWNTOWN EXPRESSWAY

BRIDGE NO. 64
RAMP N-W CONNECTION FROM
RICHMOND-PETERSBURG TURNPIKE
FRAMING PLAN - UNITS 5 AND 6

HOWARD, NEEDLES, TAMMEN & BERGENOFF
 consulting engineers
 NEW YORK ALEXANDRIA KANSAS CITY





SCALE: Noted
 CONTRACT NO.: 10
 SHEET NO. 15 OF 28

BY	DATE	REVISION	BY	DATE
MHH	8-29-68	3	TEM	6-77

* Spacing begins at termination of 6 spaces @ 4".
 # Denotes A572-Grade 50 steel for thickness of 3/4" and under, and A588 steel for thickness over 3/4".


AS BUILT

RICHMOND EXPRESSWAY SYSTEM			
SECTION	PROJECT	SHEET NO.	TOTAL SHEETS
10	DOWNTOWN EXPRESSWAY	114	265

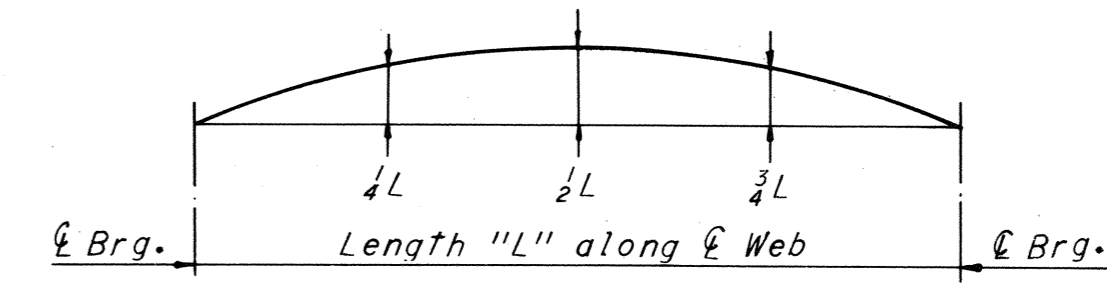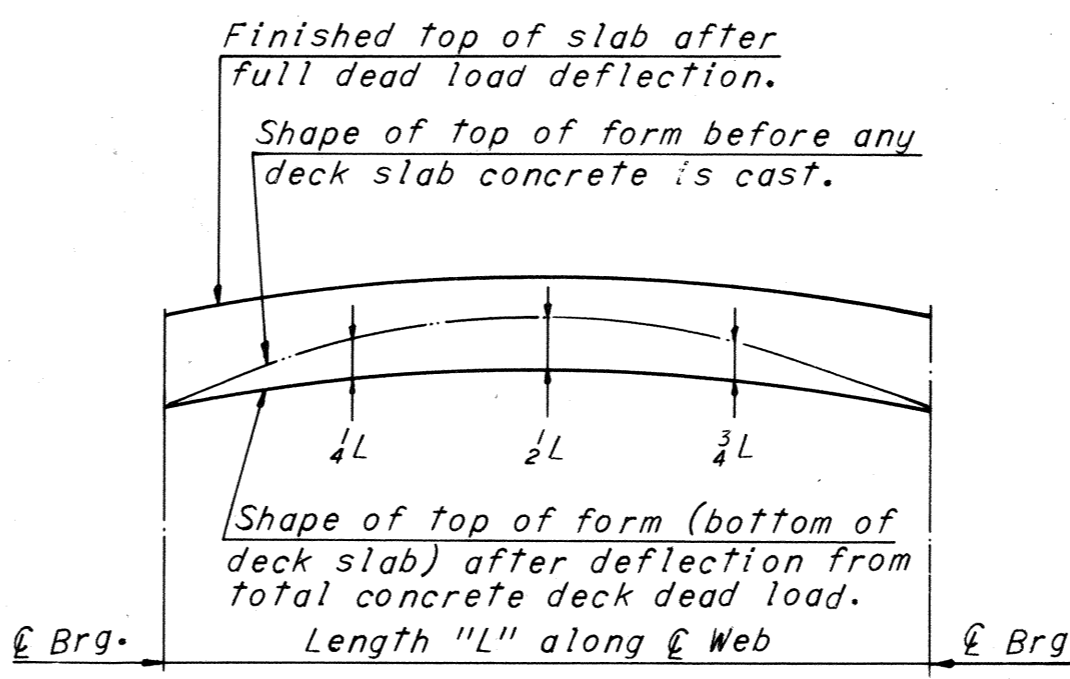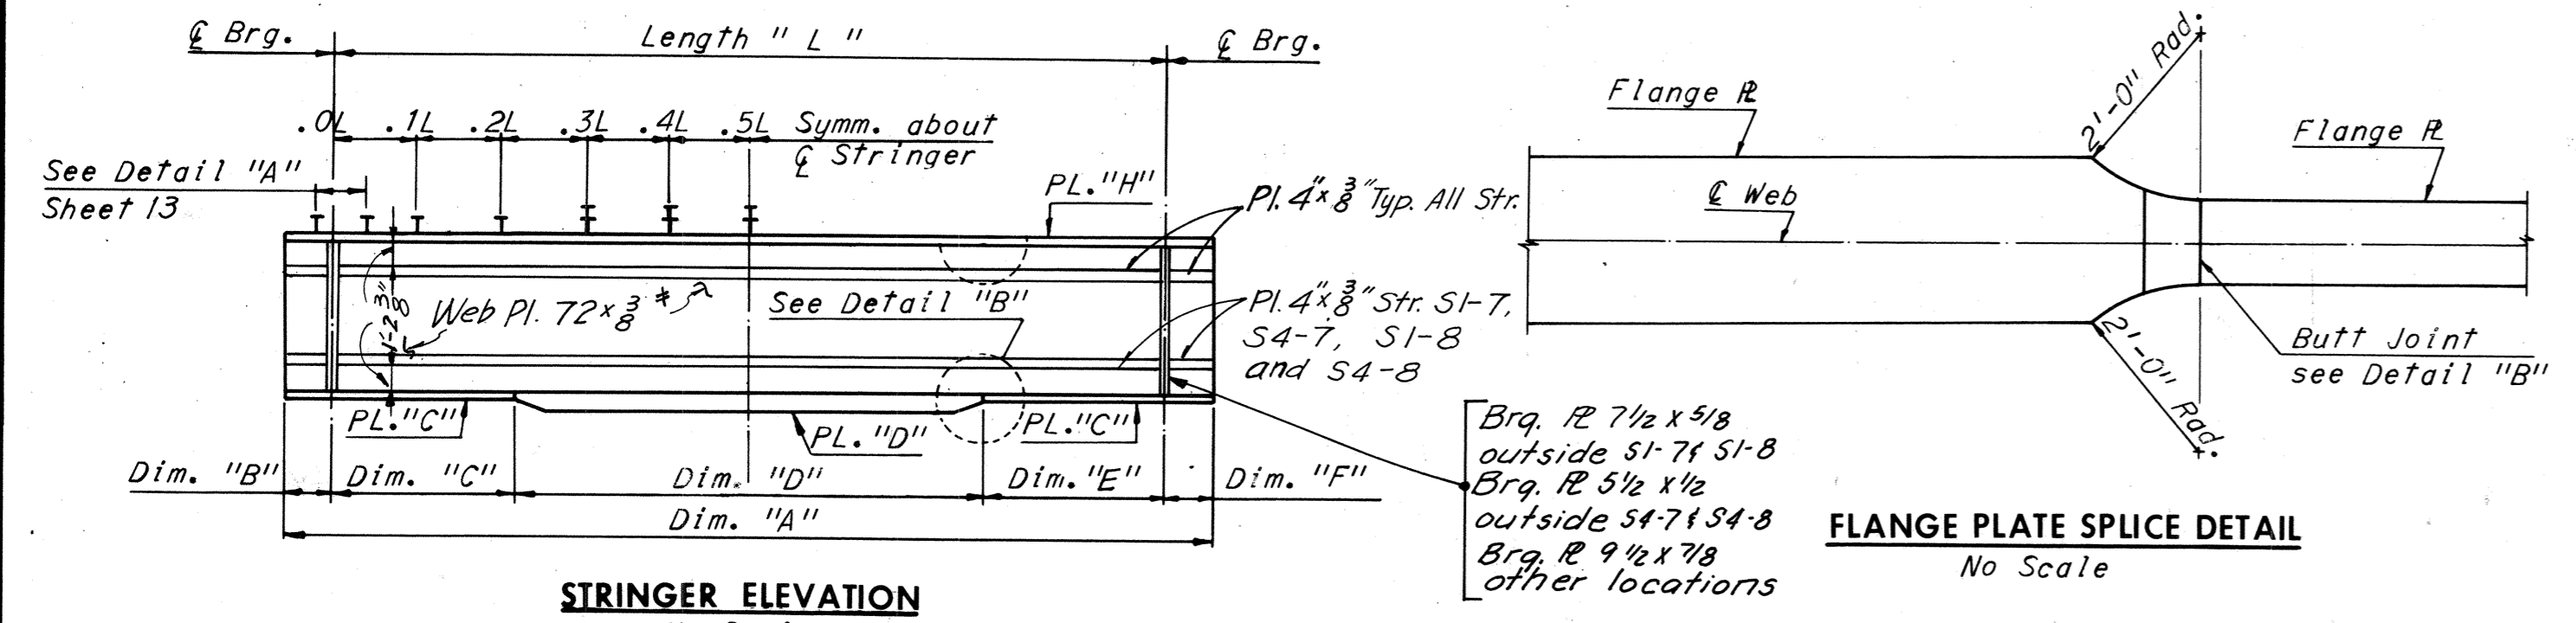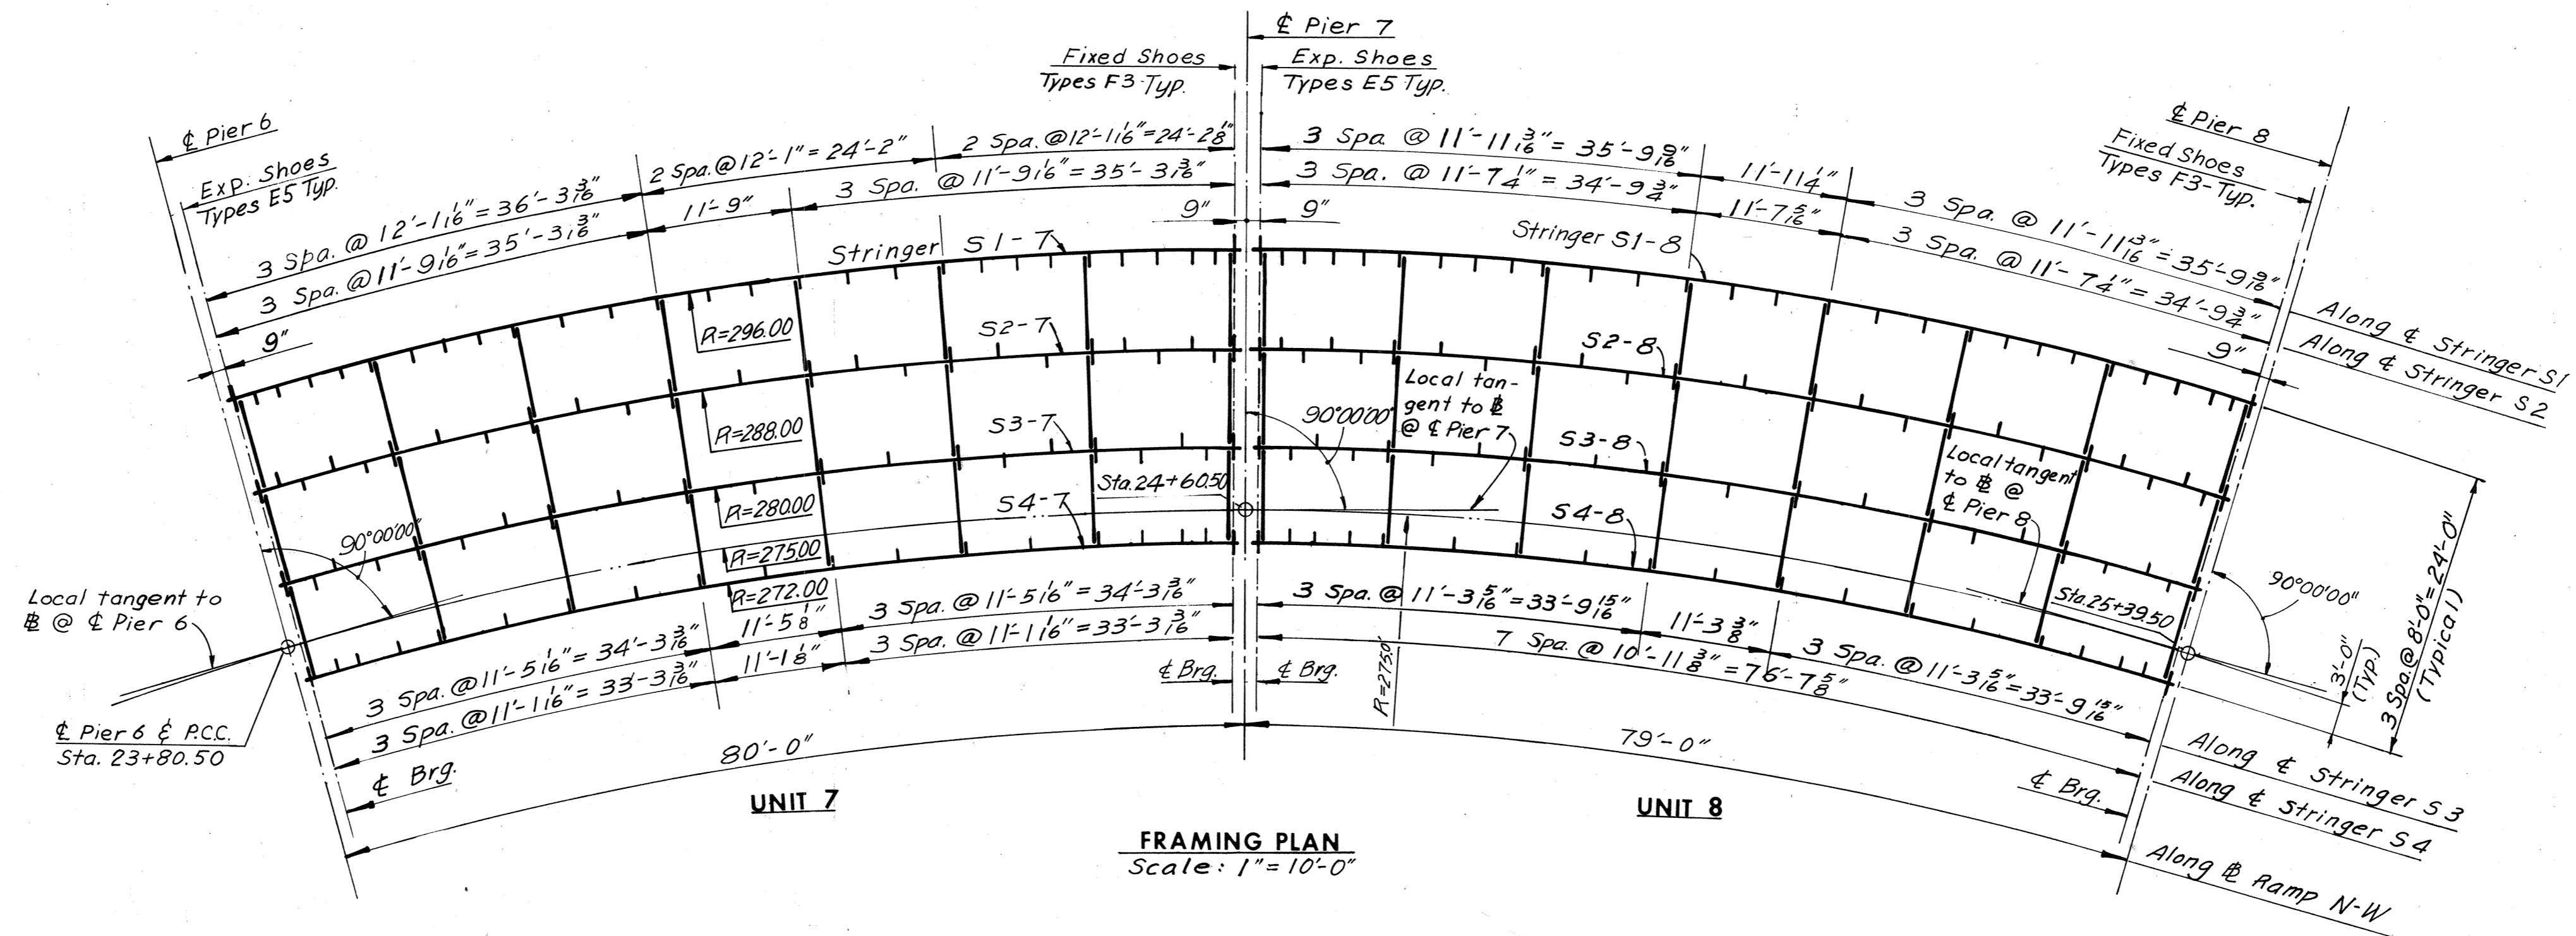

SHOE SCHEDULE			
EXPANSION SHOES		FIXED SHOES	
TYPE	NO. REQD.	TYPE	NO. REQD.
E5	8	F3	8

Notes:
 For Joint details see Sheet 26.
 For Superstructure steel quantities see Sheet 2.
 For Diaphragm details see Sheet 22.
 For Shoe details see Sheet 51.
 It may be necessary to increase Bearing Stiffener size to accommodate erection of end diaphragm.
 For Horizontal Stiffener Detail and Flange to Web Welds, see Sheet 15.

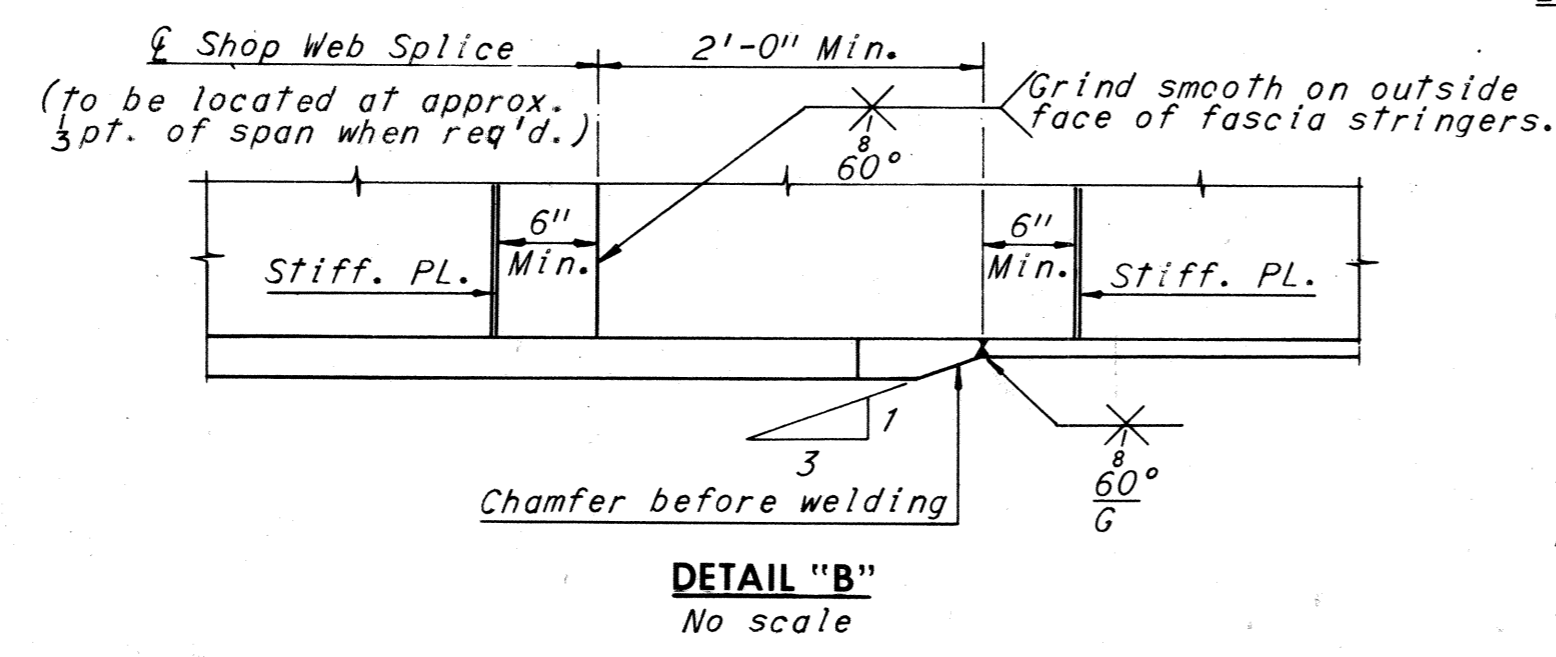

NOTE TO CONTRACTOR
 Deflections given are those anticipated to occur in the stringer upon placement of the total concrete deck dead load.
 In practice, the stringers in place are not likely to have the exact camber to compensate for these deflections during construction. The residual amounts shall be provided by adjusting forms to vary the thickness of the concrete haunch between the bottom of the slab and the top of stringer without altering the slab thickness.

NOTE TO FABRICATOR
 The stringers shall be fabricated with an upward camber amounting to the tabulated value. This will provide approximate compensation for deflection under full dead load and for conformity with finished grade. Dimensions are in inches.

UNIT	STRINGER	STRINGER SCHEDULE										DEAD LOAD DEFLECTION SCHEDULE					CAMBER SCHEDULE										
		Dim. "A"	LENGTH "L"	Dim. "B"	Dim. "C"	Dim. "D"	Dim. "E"	Dim. "F"	PL. "C"	PL. "D"	PL. "H"	MAX. SHEAR STUD SPACING															
												0.0L-0.1L*	0.1L-0.2L	0.2L-0.3L	0.3L-0.4L	0.4L-0.5L	1/4L	1/2L	3/4L								
7	S1-7	85'-11 1/8"	84'-7 1/8"	8"	15'-6 1/8"	53'-6"	15'-6 1/8"	8"	16" x 1 1/2"	12" x 1 1/2"	12" x 1 1/2"	10"	12"	14 1/2"	19"	24"	3/4"	1"	3/4"	3/16"	1/4"	3/16"	1/4"	1/4"	15/16"	3/4"	3/4"
	S2-7	83'-5 3/8"	82'-3 3/8"	7"	15'-10 1/8"	50'-6"	15'-10 1/8"	7"	12" x 1 1/8"	16" x 1 1/8"	12" x 3/4"	12"	13"	16 1/2"	21"	24"	5/8"	7/8"	5/8"	1/8"	3/16"	1/8"	3/4"	1/16"	1/16"	3/4"	
	S3-7	81'-1 1/2"	79'-11 1/2"	7"	39'-11 3/4"	-	39'-11 3/4"	7"	12" x 1 1/8"	-	12" x 3/4"	15 1/2"	17"	20"	24"	24"	1/16"	1/16"	1/16"	1/16"	1/16"	1/16"	1/16"	1/16"	1/16"	1/16"	9/16"
	S4-7	78'-11 1/2"	77'-7 1/2"	8"	38'-9 3/4"	-	38'-9 3/4"	8"	12" x 7/8"	-	12" x 3/4"	17"	19"	23"	24"	24"	5/16"	3/8"	5/16"	1/16"	1/8"	1/16"	1/16"	3/8"	1/2"	3/8"	
8	S1-8	84'-10 3/8"	83'-6 3/8"	8"	15'-0 3/8"	53'-6"	15'-0 3/8"	8"	16" x 1 1/2"	16" x 1 1/2"	12" x 1 1/2"	10"	12"	14 1/2"	19"	24"	11/16"	1"	11/16"	3/16"	1/16"	3/16"	1/16"	3/8"	1/4"	1/8"	
	S2-8	82'-4 1/8"	81'-2 1/8"	7"	15'-4 1/8"	50'-6"	15'-4 1/8"	7"	12" x 1 1/8"	16" x 1 1/8"	12" x 3/4"	12"	13"	16 1/2"	21"	24"	5/8"	7/8"	5/8"	1/8"	3/16"	1/8"	3/16"	1/16"	1/16"	3/4"	
	S3-8	80'-1 1/2"	78'-11 1/2"	7"	39'-5 3/4"	-	39'-5 3/4"	7"	12" x 1 1/8"	-	12" x 3/4"	15 1/2"	17"	20"	24"	24"	7/16"	1/16"	7/16"	1/8"	1/8"	1/8"	1/8"	1/16"	1/16"	3/16"	
	S4-8	77'-11 5/8"	76'-7 5/8"	8"	38'-3 5/8"	-	38'-3 5/8"	8"	12" x 7/8"	-	12" x 3/4"	17"	19"	23"	24"	24"	1/4"	3/8"	1/4"	1/16"	1/8"	1/16"	1/16"	5/16"	1/2"	5/16"	

BY	DATE	REVISION	BY	DATE
BY	DATE	REVISION	BY	DATE
MADE	SCC 8-23-68	3	AS BUILT	6-77
CHECKED				
IN CHARGE				

Notes:
 All steel shall be A36 unless denoted otherwise.
 Exterior stringer longitudinal stiffeners shall be located on the exterior face of the stringer.
 Intermediate stiffener Pls. 4 1/2 x 3/8" shall be equally spaced between diaphragms as shown. The first two stiffener spaces at the ends of stringers shall be one-half the normal spacing within the panel.

* Spacing begins at termination of 6 spaces @ 41.
 * Denotes A572-Grade 50 Steel for thicknesses of 3/4" and under and A588 steel for thicknesses over 3/4"

RICHMOND METROPOLITAN AUTHORITY
 RICHMOND EXPRESSWAY SYSTEM
 DOWNTOWN EXPRESSWAY


BRIDGE NO. 64
 RAMP N-W CONNECTION FROM
 RICHMOND-PETERSBURG TURNPIKE
 FRAMING PLAN - UNITS 7 AND 8

HOWARD, NEEDLES, TAMMEN & BERGENDOFF
 consulting engineers
 NEW YORK ALEXANDRIA KANSAS CITY





SCALE: As Noted
 CONTRACT NO. 10
 SHEET NO. 16 OF 28

AS BUILT

RICHMOND EXPRESSWAY SYSTEM			
SECTION	PROJECT	SHEET NO.	TOTAL SHEETS
10	DOWNTOWN EXPRESSWAY	115	265

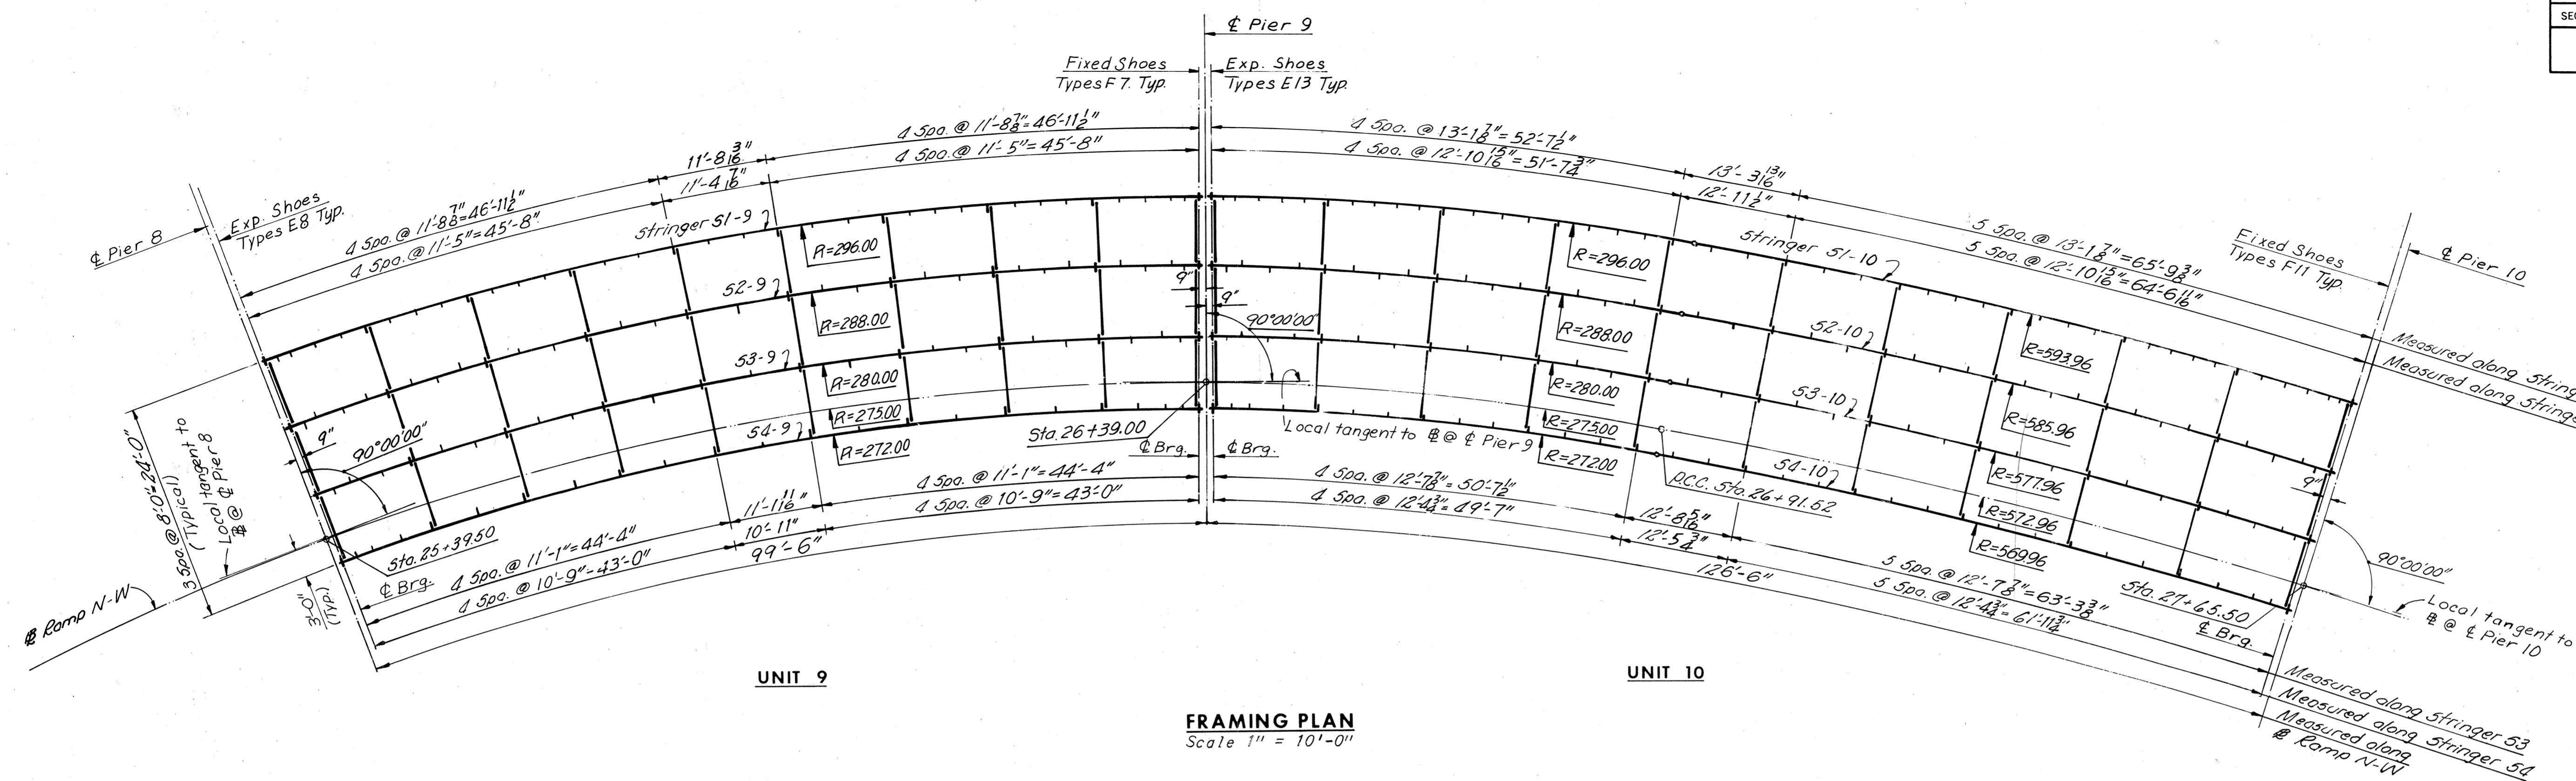


UNIT	STRINGER	1/4L	1/2L	3/4L
9	S1-9	1 1/16"	2 1/8"	1 1/16"
	S2-9	1 3/16"	1 3/8"	1 3/16"
	S3-9	1 1/8"	1 1/4"	1 1/8"
	S4-9	1 1/8"	1 1/4"	1 1/8"
10	S1-10	-1/8"	-3/4"	-1/8"
	S2-10	-1/4"	-1 1/8"	-1/2"
	S3-10	-2 1/16"	-2 1/16"	-2 3/16"
	S4-10	-3 3/8"	-5 1/4"	-3 3/8"

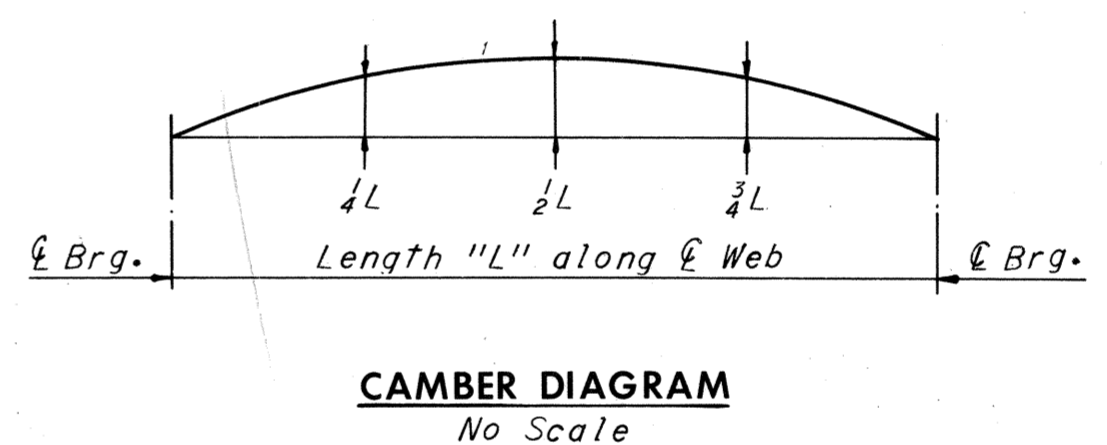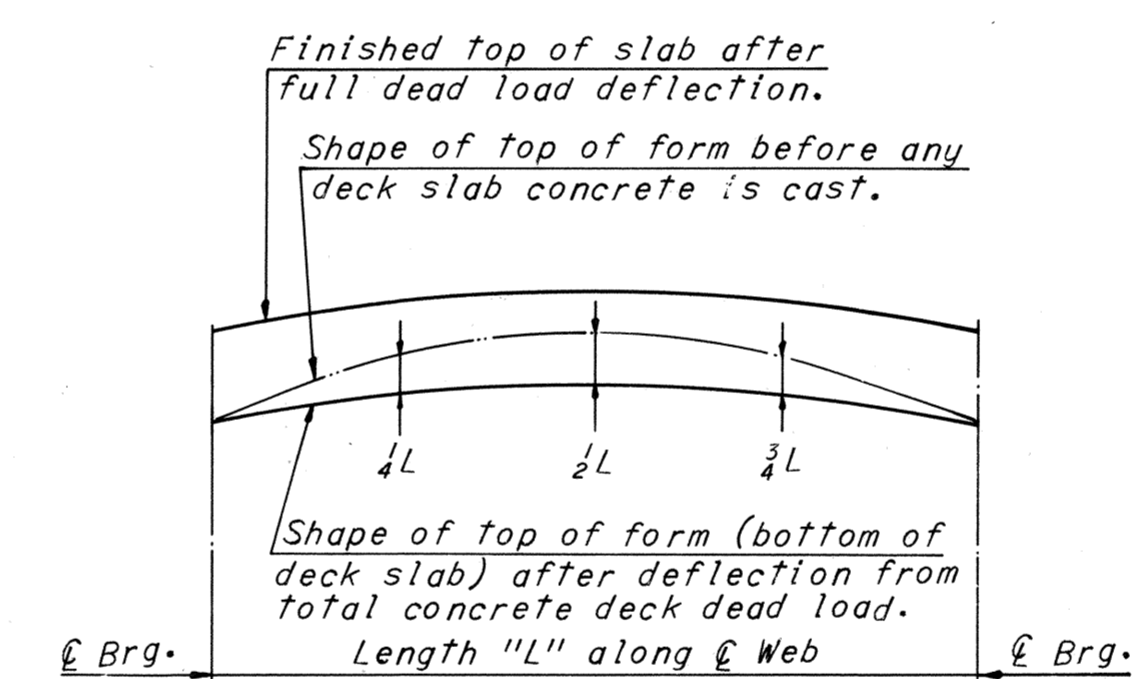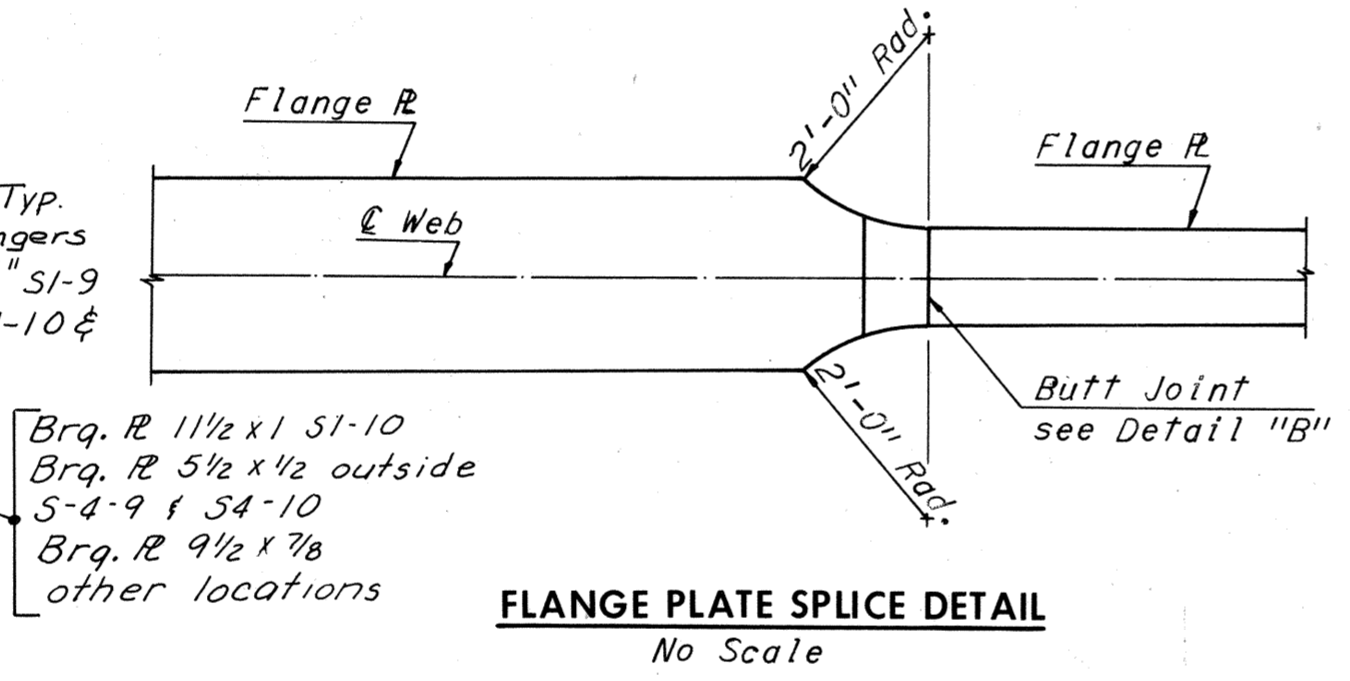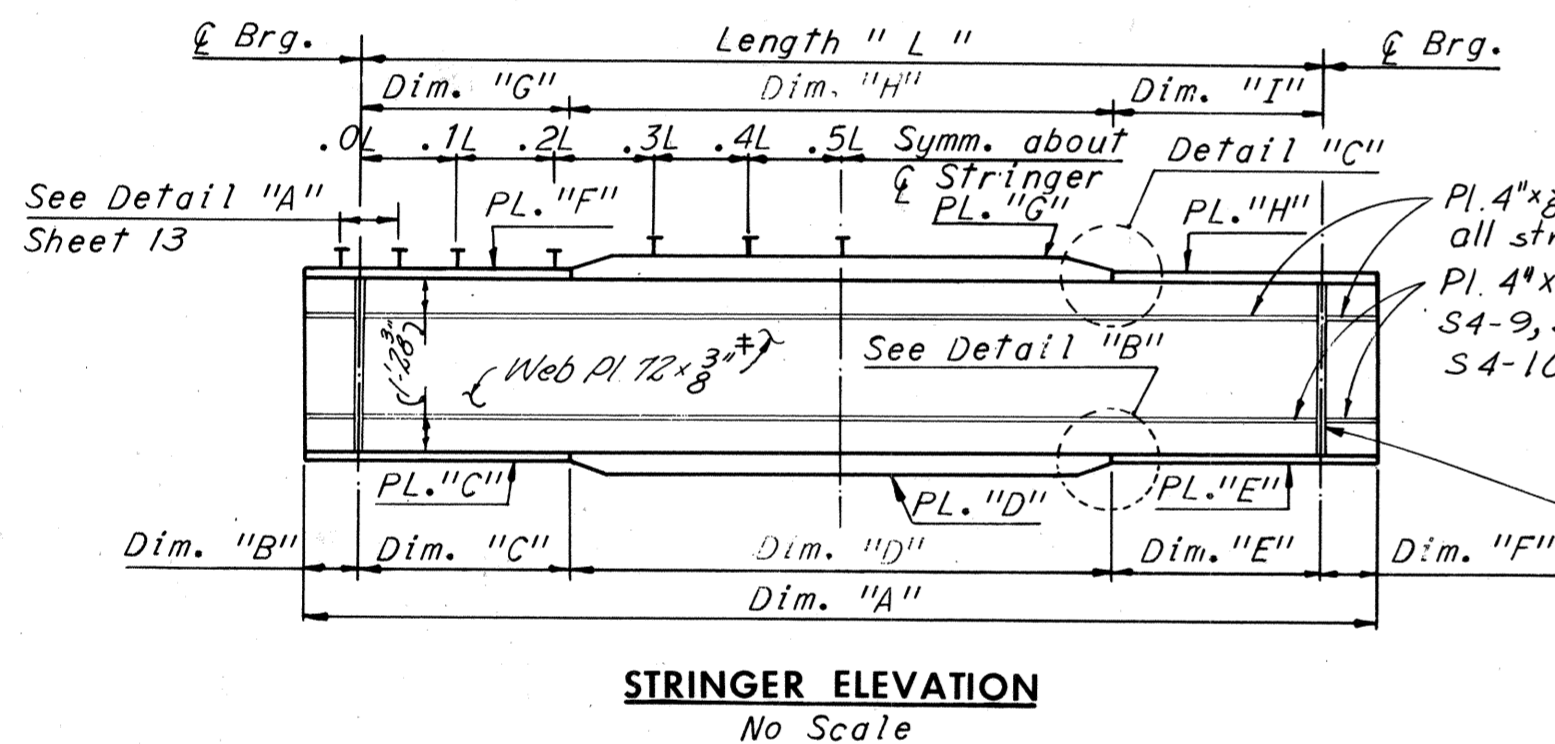

EXPANSION SHOES		FIXED SHOES	
TYPE	NO. REQD.	TYPE	NO. REQD.
E8	4	F7	4
E13	4	F11	4

Note: Web Plate for Stringer S4-9 use A-36.

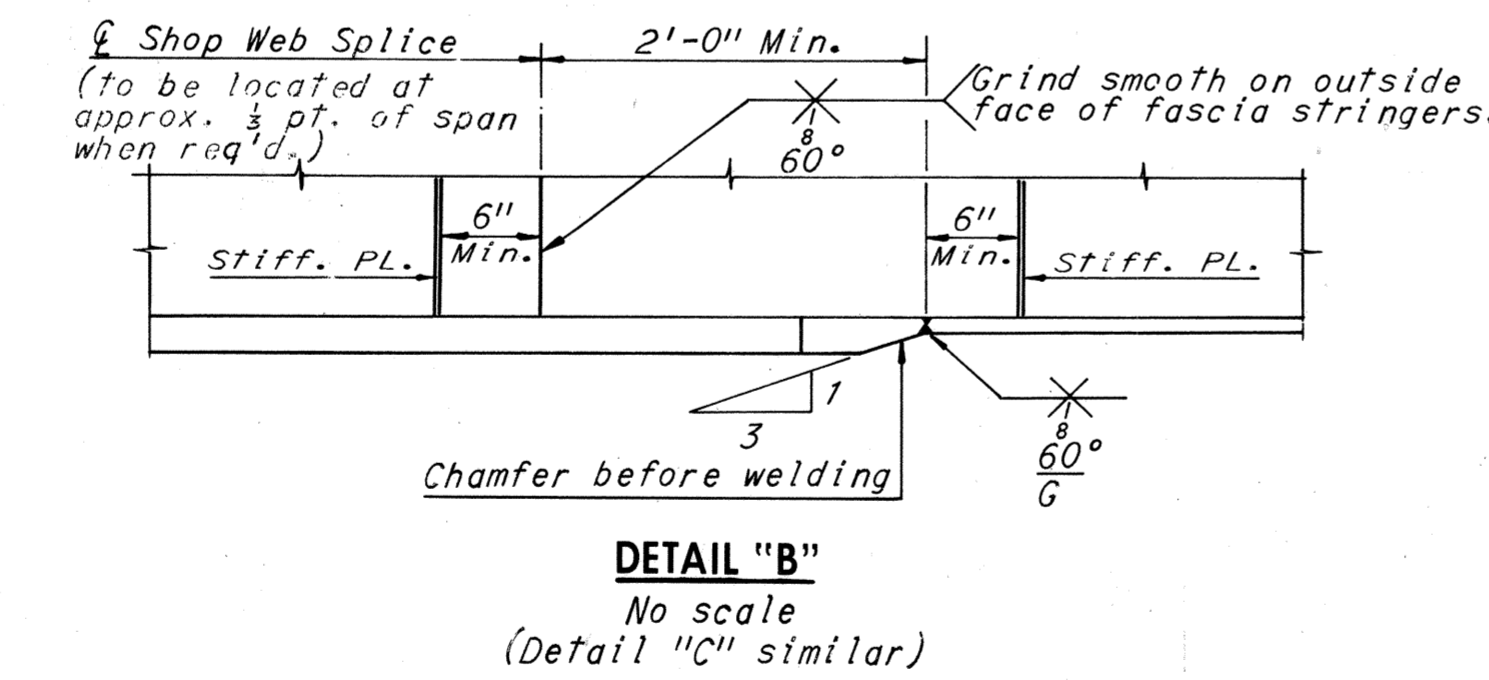

NOTE TO CONTRACTOR
Deflections given are those anticipated to occur in the stringer upon placement of the total concrete deck dead load. In practice, the stringers in place are not likely to have the exact camber to compensate for these deflections during construction. The residual amounts shall be provided by adjusting forms to vary the thickness of the concrete haunch between the bottom of the slab and the top of stringer without altering the slab thickness.

NOTE TO FABRICATOR
The stringers shall be fabricated with an upward camber amounting to the tabulated value. This will provide approximate compensation for deflection under full dead load and for conformity with finished grade. Dimensions are in inches.

Note: Stringers having a total camber of less than 1" are not required to be shop cambered, but should be turned so that any mill tolerance deviation from straightness will be in the direction shown by the Camber Diagram. If stringers are not cambered, distance top of stringers to top of slab will vary along the stringer in accordance with the offset dimensions shown in the Camber Diagram, and with a minimum distance as shown in cross-section on Sheet 23.

Notes: For Diaphragm and Connection Details see Sheet 23. For Joint details see Sheet 21. For Superstructure steel quantities see Sheet 2. It may be necessary to increase Bearing Stiffener size to accommodate erection of end diaphragm. For Horizontal Stiffener Detail and Flange to Web Welds, see Sheet 15.

UNIT	STRINGER	Dim. "A"	LENGTH "L"	Dim. "B"	Dim. "C"	Dim. "D"	Dim. "E"	Dim. "F"	Dim. "G"	Dim. "H"	Dim. "I"	PL. "C"	PL. "D"	PL. "E"	PL. "F"	PL. "G"	PL. "H"	DEAD LOAD DEFLECTION SCHEDULE											
																		MAX. SHEAR STUD SPACING						DUE TO TOTAL CONC.			DUE TO STEEL		
																		0.0L-0.1L*	0.1L-0.2L	0.2L-0.3L	0.3L-0.4L	0.4L-0.5L	1/4L	1/2L	3/4L	1/4L	1/2L	3/4L	
9	S1-9	106'-11 3/8"	105'-7 1/8"	8"	20'-2 3/8"	65'-2 3/8"	20'-2 3/8"	8"	20'-2 3/8"	65'-2 3/8"	20'-2 3/8"	20"x1 3/8"±	20"x2"±	20"x1 3/8"±	16"x 3/8"±	16"x1 3/8"±	16"x 3/8"±	7 1/2"	10 1/2"	14"	18 1/2"	24"	1 3/16"	1 1/8"	1 1/8"	3 1/8"	1 1/8"	3 1/8"	
	S2-9	103'-10 1/8"	102'-8 3/8"	7"	19'-3"	64'-2 1/8"	19'-3"	7"	19'-3"	64'-2 1/8"	19'-3"	16"x1 1/4"±	16"x1 1/4"±	12"x 3/4"±	12"x 3/4"±	12"x 3/4"±	12"x 3/4"±	11 1/2"	17 1/2"	20 1/2"	24"	24"	1 1/8"	1 1/8"	1 1/8"	5 1/8"	1 1/8"	5 1/8"	
	S3-9	100'-11 1/8"	99'-9 1/8"	7"	19'-2 1/8"	61'-4 1/8"	19'-2 1/8"	7"	19'-2 1/8"	61'-4 1/8"	19'-2 1/8"	12"x 3/4"±	12"x 3/4"±	12"x 3/4"±	12"x 3/4"±	12"x 3/4"±	12"x 3/4"±	11 1/2"	17 1/2"	20 1/2"	24"	24"	1 1/8"	1 1/8"	1 1/8"	5 1/8"	1 1/8"	5 1/8"	
	S4-9	98'-3"	96'-11"	8"	18'-5 1/2"	58'-5 1/2"	18'-5 1/2"	8"	18'-5 1/2"	58'-5 1/2"	18'-5 1/2"	12"x 3/4"±	12"x 3/4"±	12"x 3/4"±	12"x 3/4"±	12"x 3/4"±	12"x 3/4"±	18 1/2"	21"	24"	24"	24"	3 1/8"	3 1/8"	3 1/8"	16"	3 1/8"	16"	
10	S1-10	133'-0 1/8"	131'-8 1/8"	8"	25'-0"	82'-8 1/8"	24'-0"	8"	25'-0"	82'-8 1/8"	24'-0"	24"x1 3/8"±	24"x2 1/4"±	24"x1 3/8"±	20"x1 1/2"±	20"x1 1/2"±	20"x1 1/2"±	8 1/2"	10 1/2"	14 1/2"	19 1/2"	24"	1 1/8"	2 1/8"	1 1/8"	5 1/8"	1 1/8"	5 1/8"	
	S2-10	130'-3 1/8"	129'-1 1/8"	7"	24'-6"	80'-1 1/8"	24'-6"	7"	24'-6"	80'-1 1/8"	24'-6"	20"x1 1/4"±	20"x2"±	20"x1 1/4"±	16"x1 1/2"±	16"x1 1/2"±	16"x1 1/4"±	11"	12 1/2"	17"	22"	24"	1 1/8"	2 3/8"	1 1/8"	4 1/8"	1 1/8"	4 1/8"	
	S3-10	127'-9 3/8"	126'-7 3/8"	7"	23'-0"	78'-7 3/8"	25'-0"	7"	24'-0"	70'-7 3/8"	32'-0"	16"x1 1/4"±	16"x1 1/4"±	16"x1 1/4"±	12"x 3/4"±	12"x1 1/4"±	12"x 3/4"±	15"	17"	20 1/2"	24"	24"	1 3/8"	2 1/8"	1 3/8"	4 1/8"	1 3/8"	4 1/8"	
	S4-10	125'-4 1/8"	124'-0 1/8"	8"	22'-0"	78'-0 1/8"	24'-0"	8"	22'-0"	78'-0 1/8"	24'-0"	12"x 1 1/4"±	12"x1 3/8"±	12"x 1 1/4"±	12"x 3/4"±	12"x 3/4"±	12"x 3/4"±	14 1/2"	16 1/2"	21"	24"	24"	1 1/8"	1 1/8"	1 1/8"	3 1/8"	1 1/8"	3 1/8"	

BY	DATE	Note Added	PRMS	4-19-74
MADE	HJC	8-20-68	E.J.M.	10-11-74
CHECKED	RC	10-21-68	TEM	6-77
IN CHARGE				

Note: All steel shall be A36 unless denoted otherwise. Exterior stringer longitudinal stiffeners shall be located on the exterior face of the stringer. Intermediate stiffener Pls. 4 1/2 x 3/8" for top flange width of 12" and 16" and Pls. 5 x 3/8" for top flange width of 20", shall be equally spaced between diaphragms as shown. The first two stiffener spaces at the ends of stringers shall be one-half the normal spacing within the panel.

* Spacing begins at termination of 6 space.
* Denotes A572-Grade 50 steel for thicknesses of 3/4" and under, and A588 for thickness over 3/4".

RICHMOND METROPOLITAN AUTHORITY
RICHMOND EXPRESSWAY SYSTEM
DOWNTOWN EXPRESSWAY

BRIDGE NO. 64
RAMP N-W CONNECTION FROM
RICHMOND-PETERSBURG TURNPIKE


FRAMING PLAN - UNITS 9 AND 10

HOWARD, NEEDLES, TAMMEN & BERGENDOFF
consulting engineers
NEW YORK ALEXANDRIA KANSAS CITY

SCALE: As Noted
CONTRACT NO.: 10
SHEET NO. 17 OF 28


AS BUILT

RICHMOND EXPRESSWAY SYSTEM			
SECTION	PROJECT	SHEET NO.	TOTAL SHEETS
10-	DOWNTOWN EXPRESSWAY	176	265

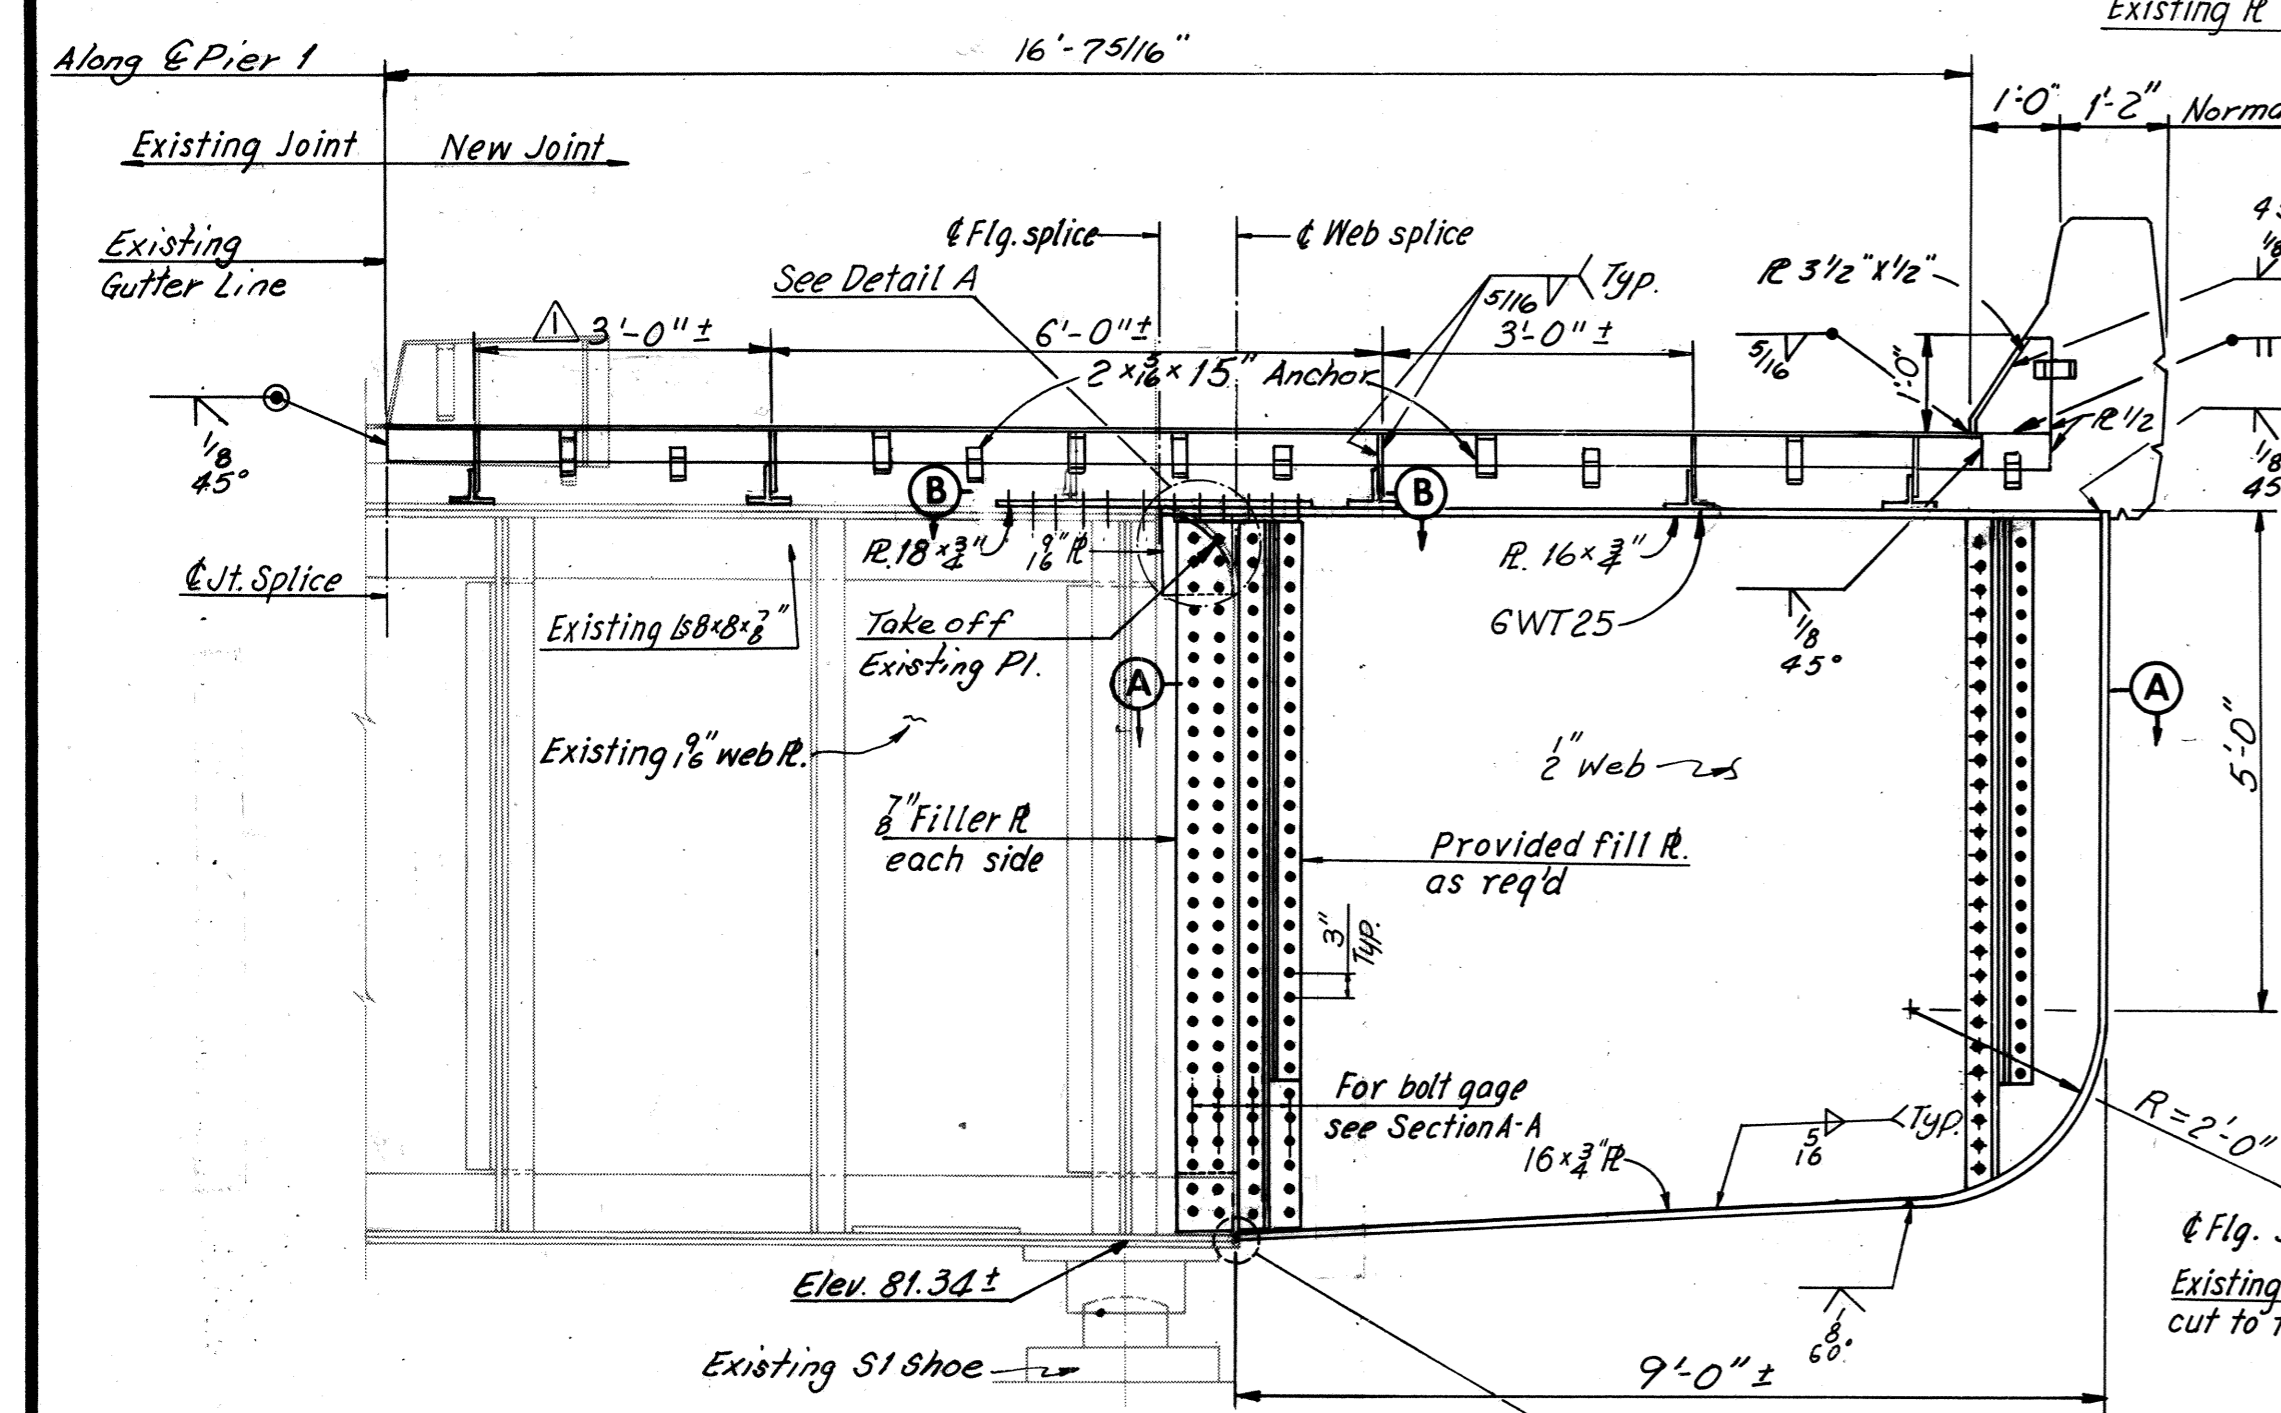


ELEVATION - FLOORBEAM 14
Scale 1/2" = 1'-0"


Bolts - 7/8" ϕ H. S. Bolts, ASTM Spec. A-325 unless otherwise noted.

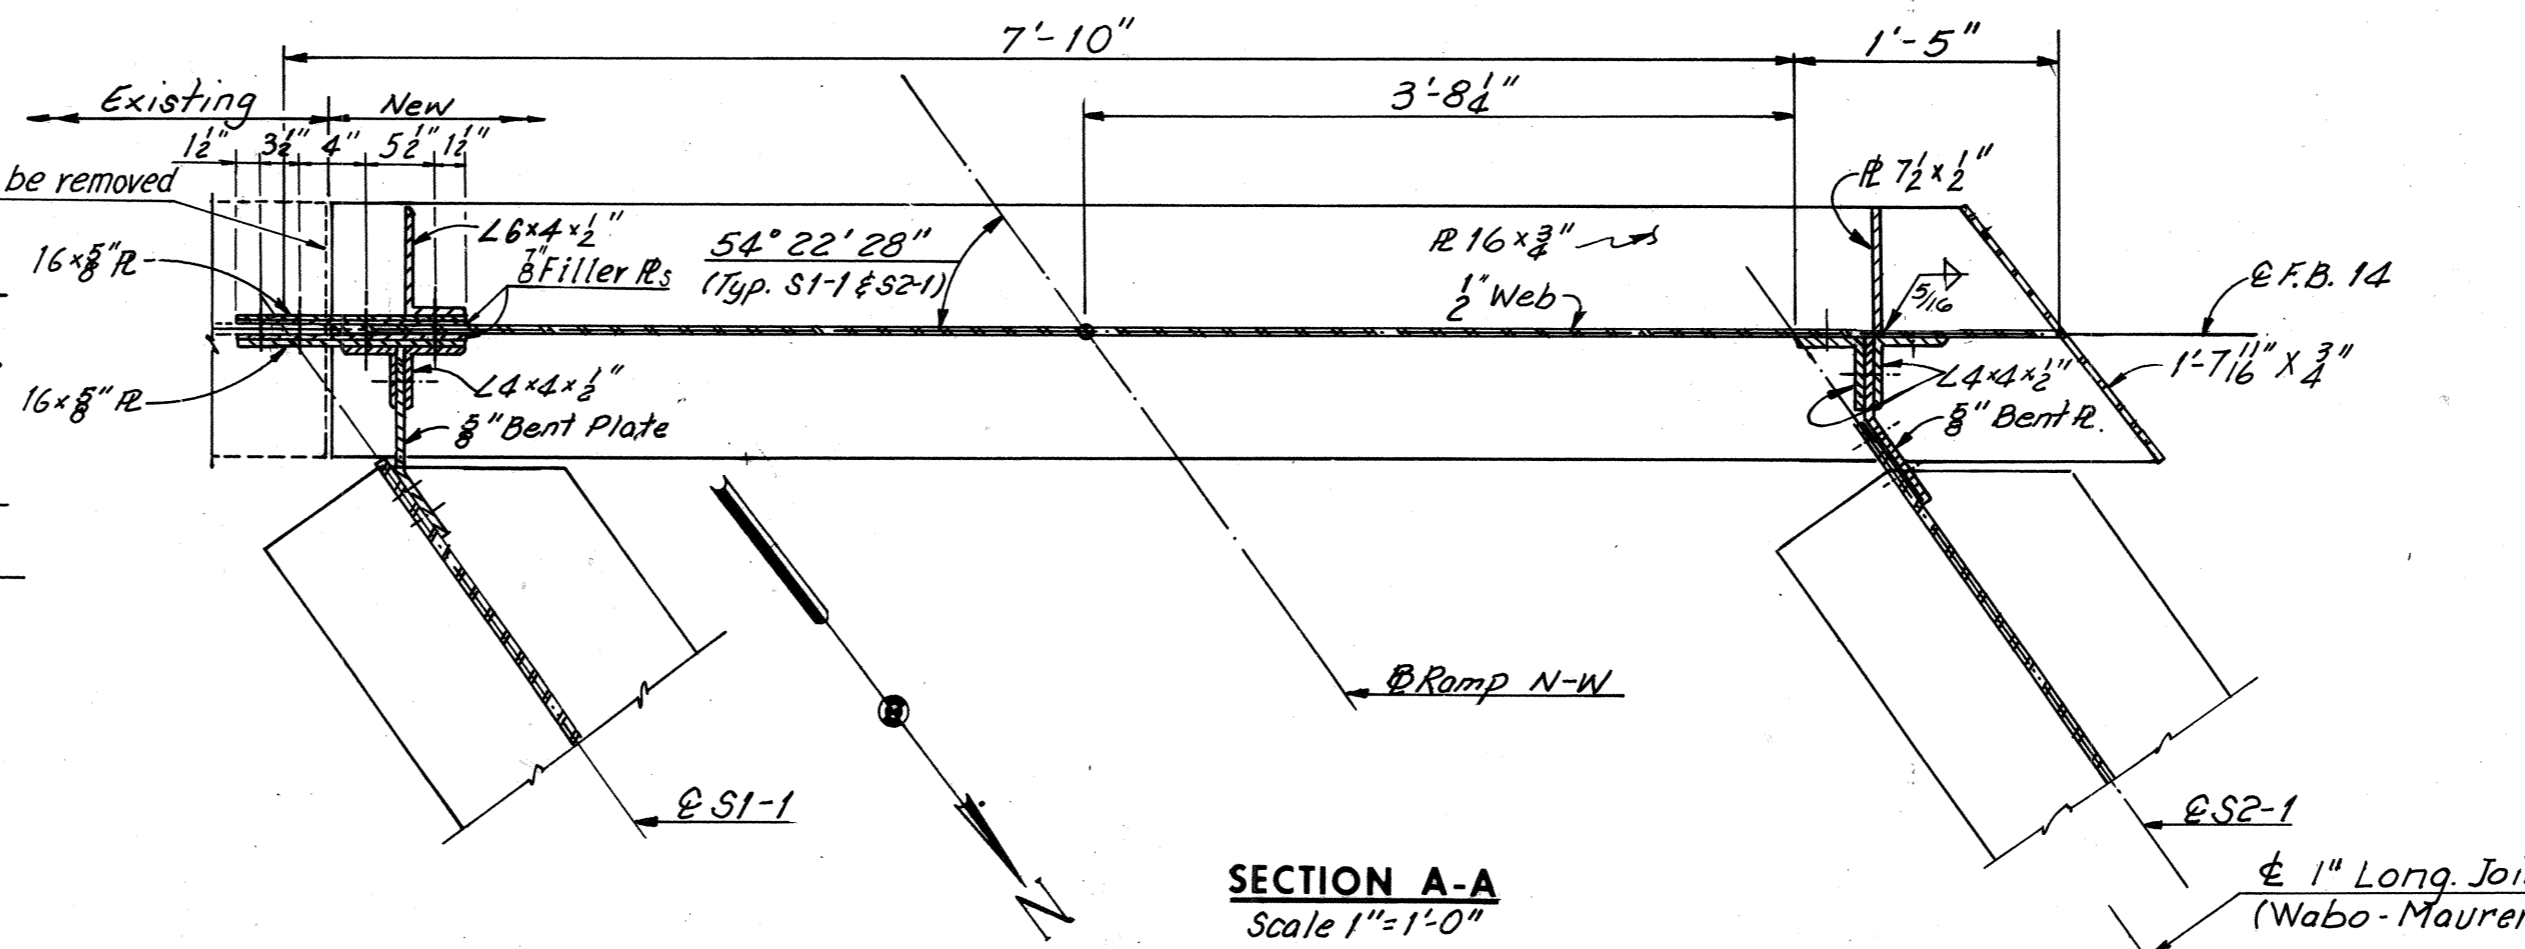


SECTION A-A
Scale 1" = 1'-0"

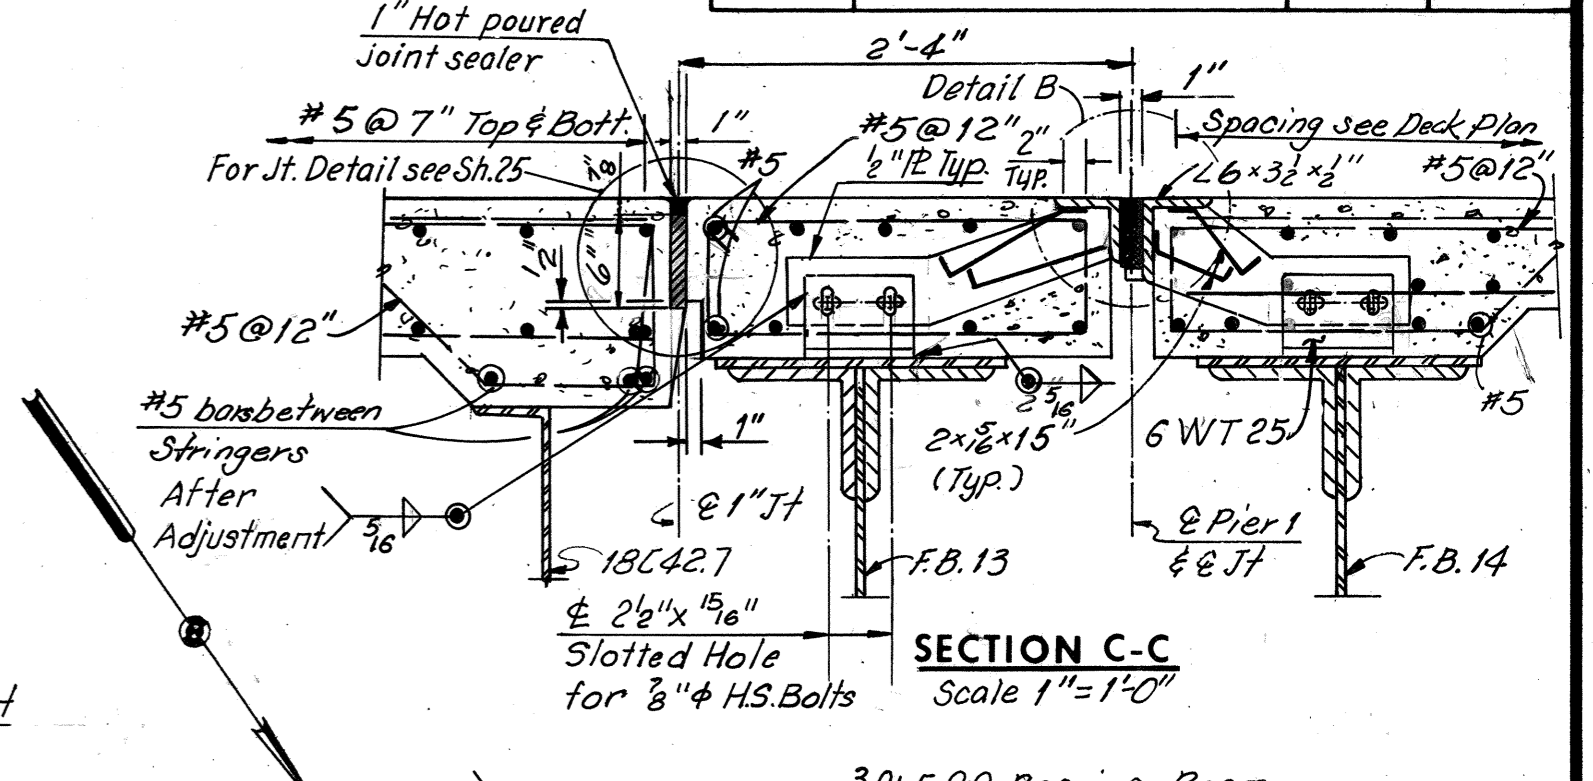


SECTION C-C
Scale 1" = 1'-0"

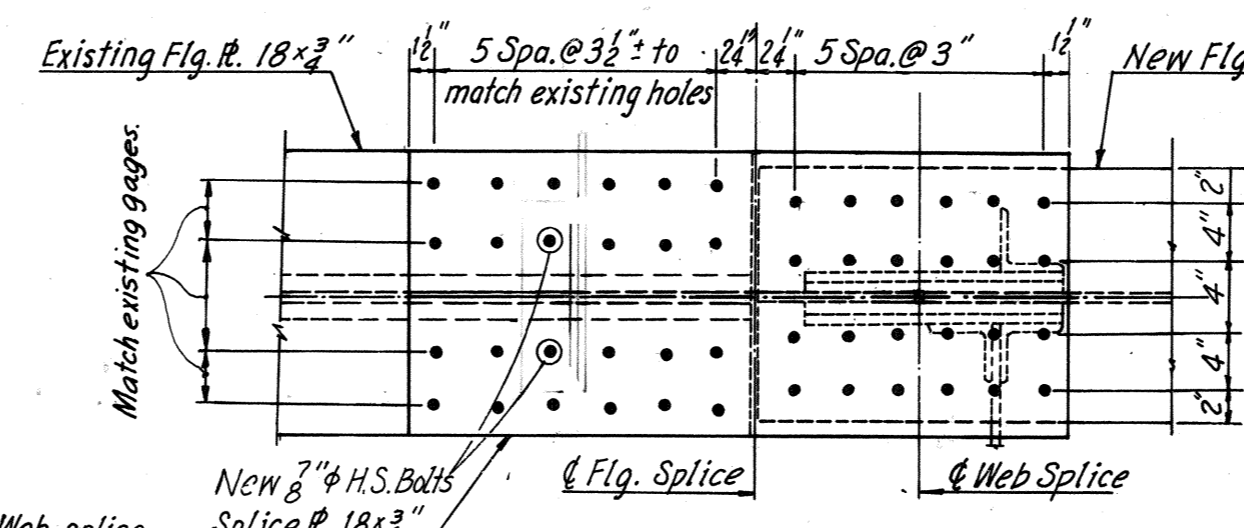


VIEW B-B
Scale 1" = 1'-0"

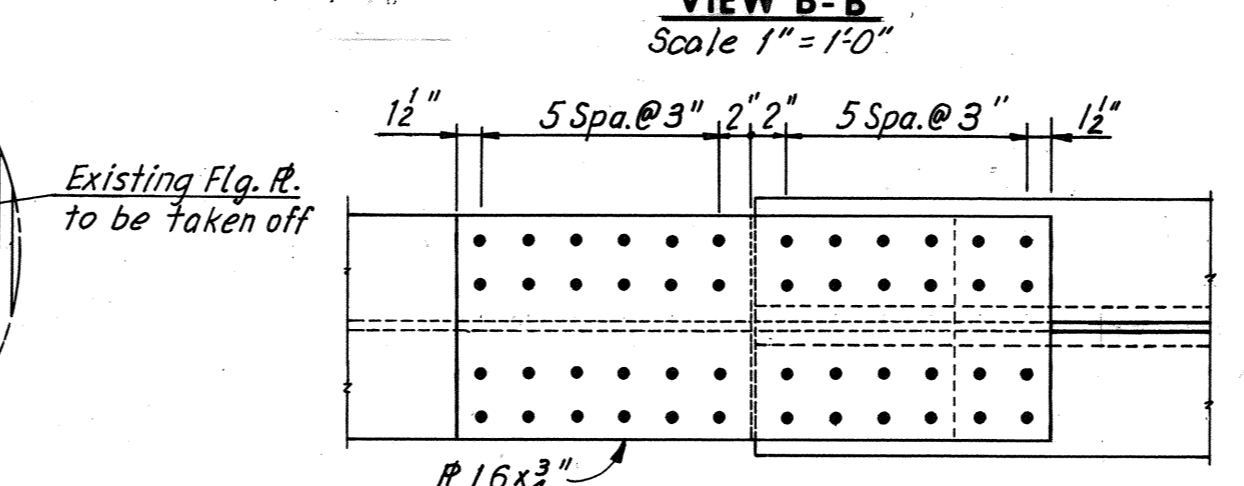

VIEW F-F
Scale 1" = 1'-0"

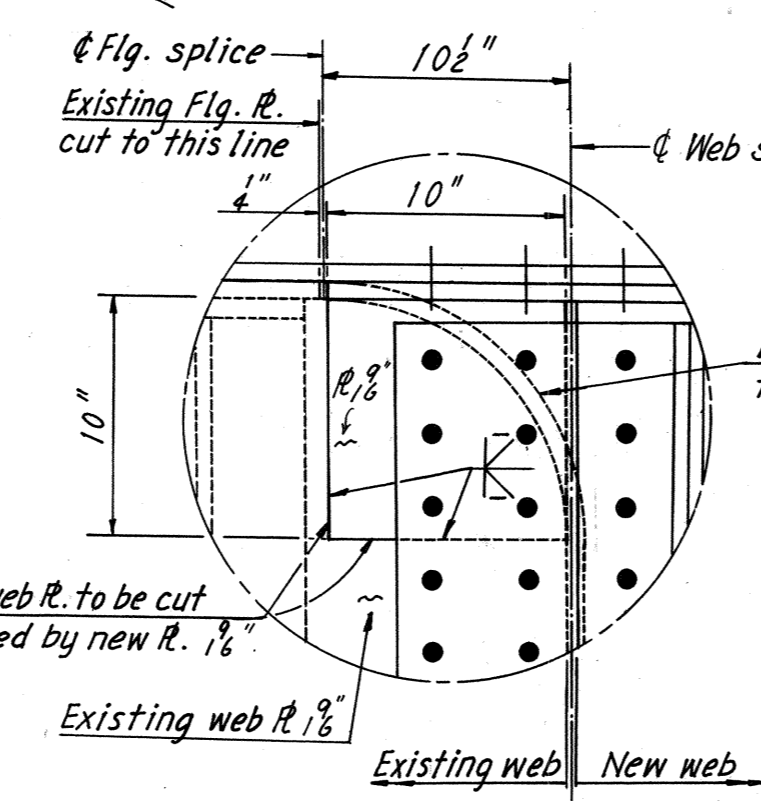


DETAIL A
Scale 3/8" = 1'-0"

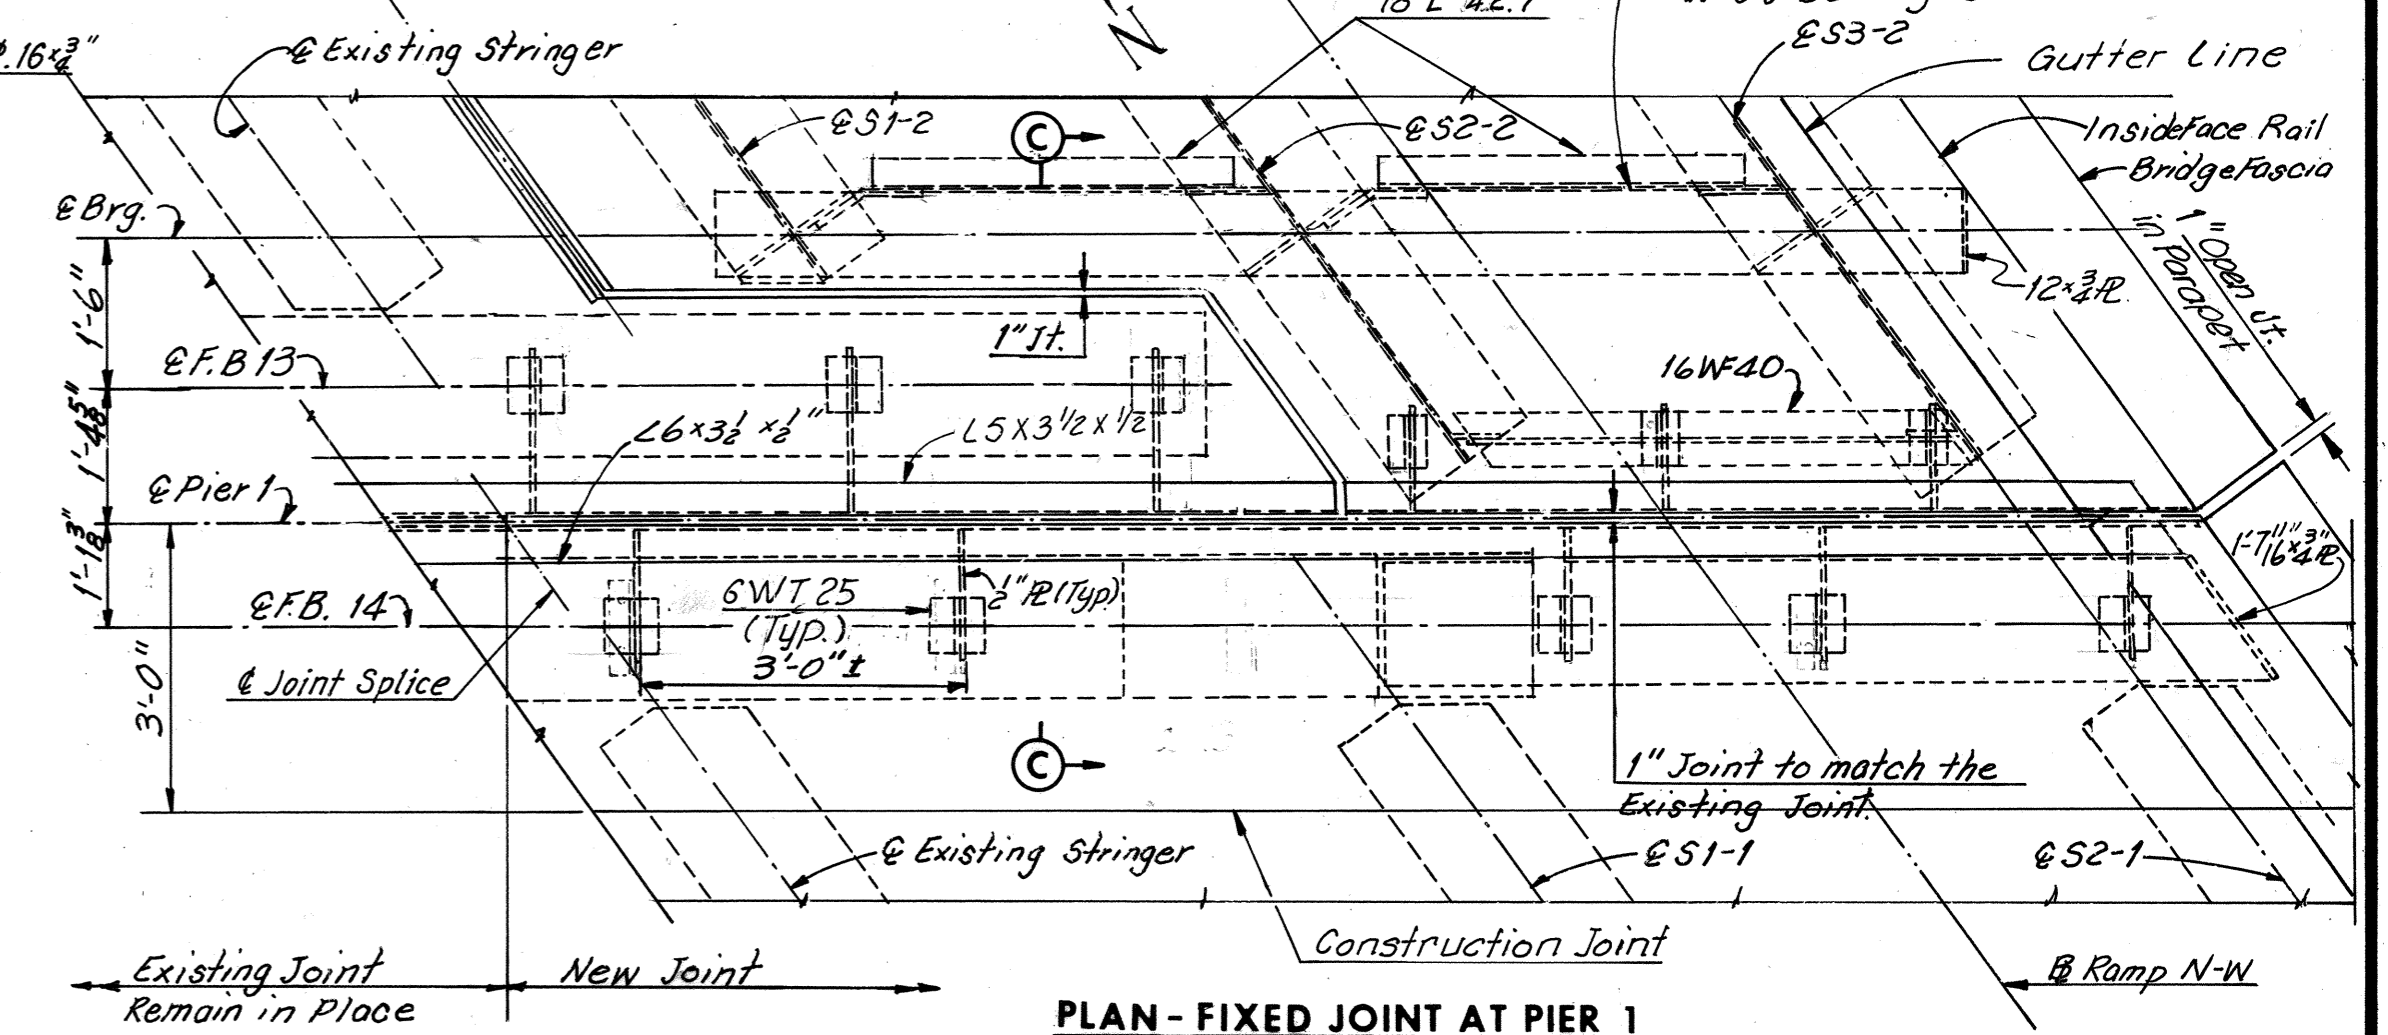


PLAN - FIXED JOINT AT PIER 1
Scale 1/2" = 1'-0"

Note: 1" Joint at pier 1 is to match the existing joint. The Contractor shall verify the location of joint.

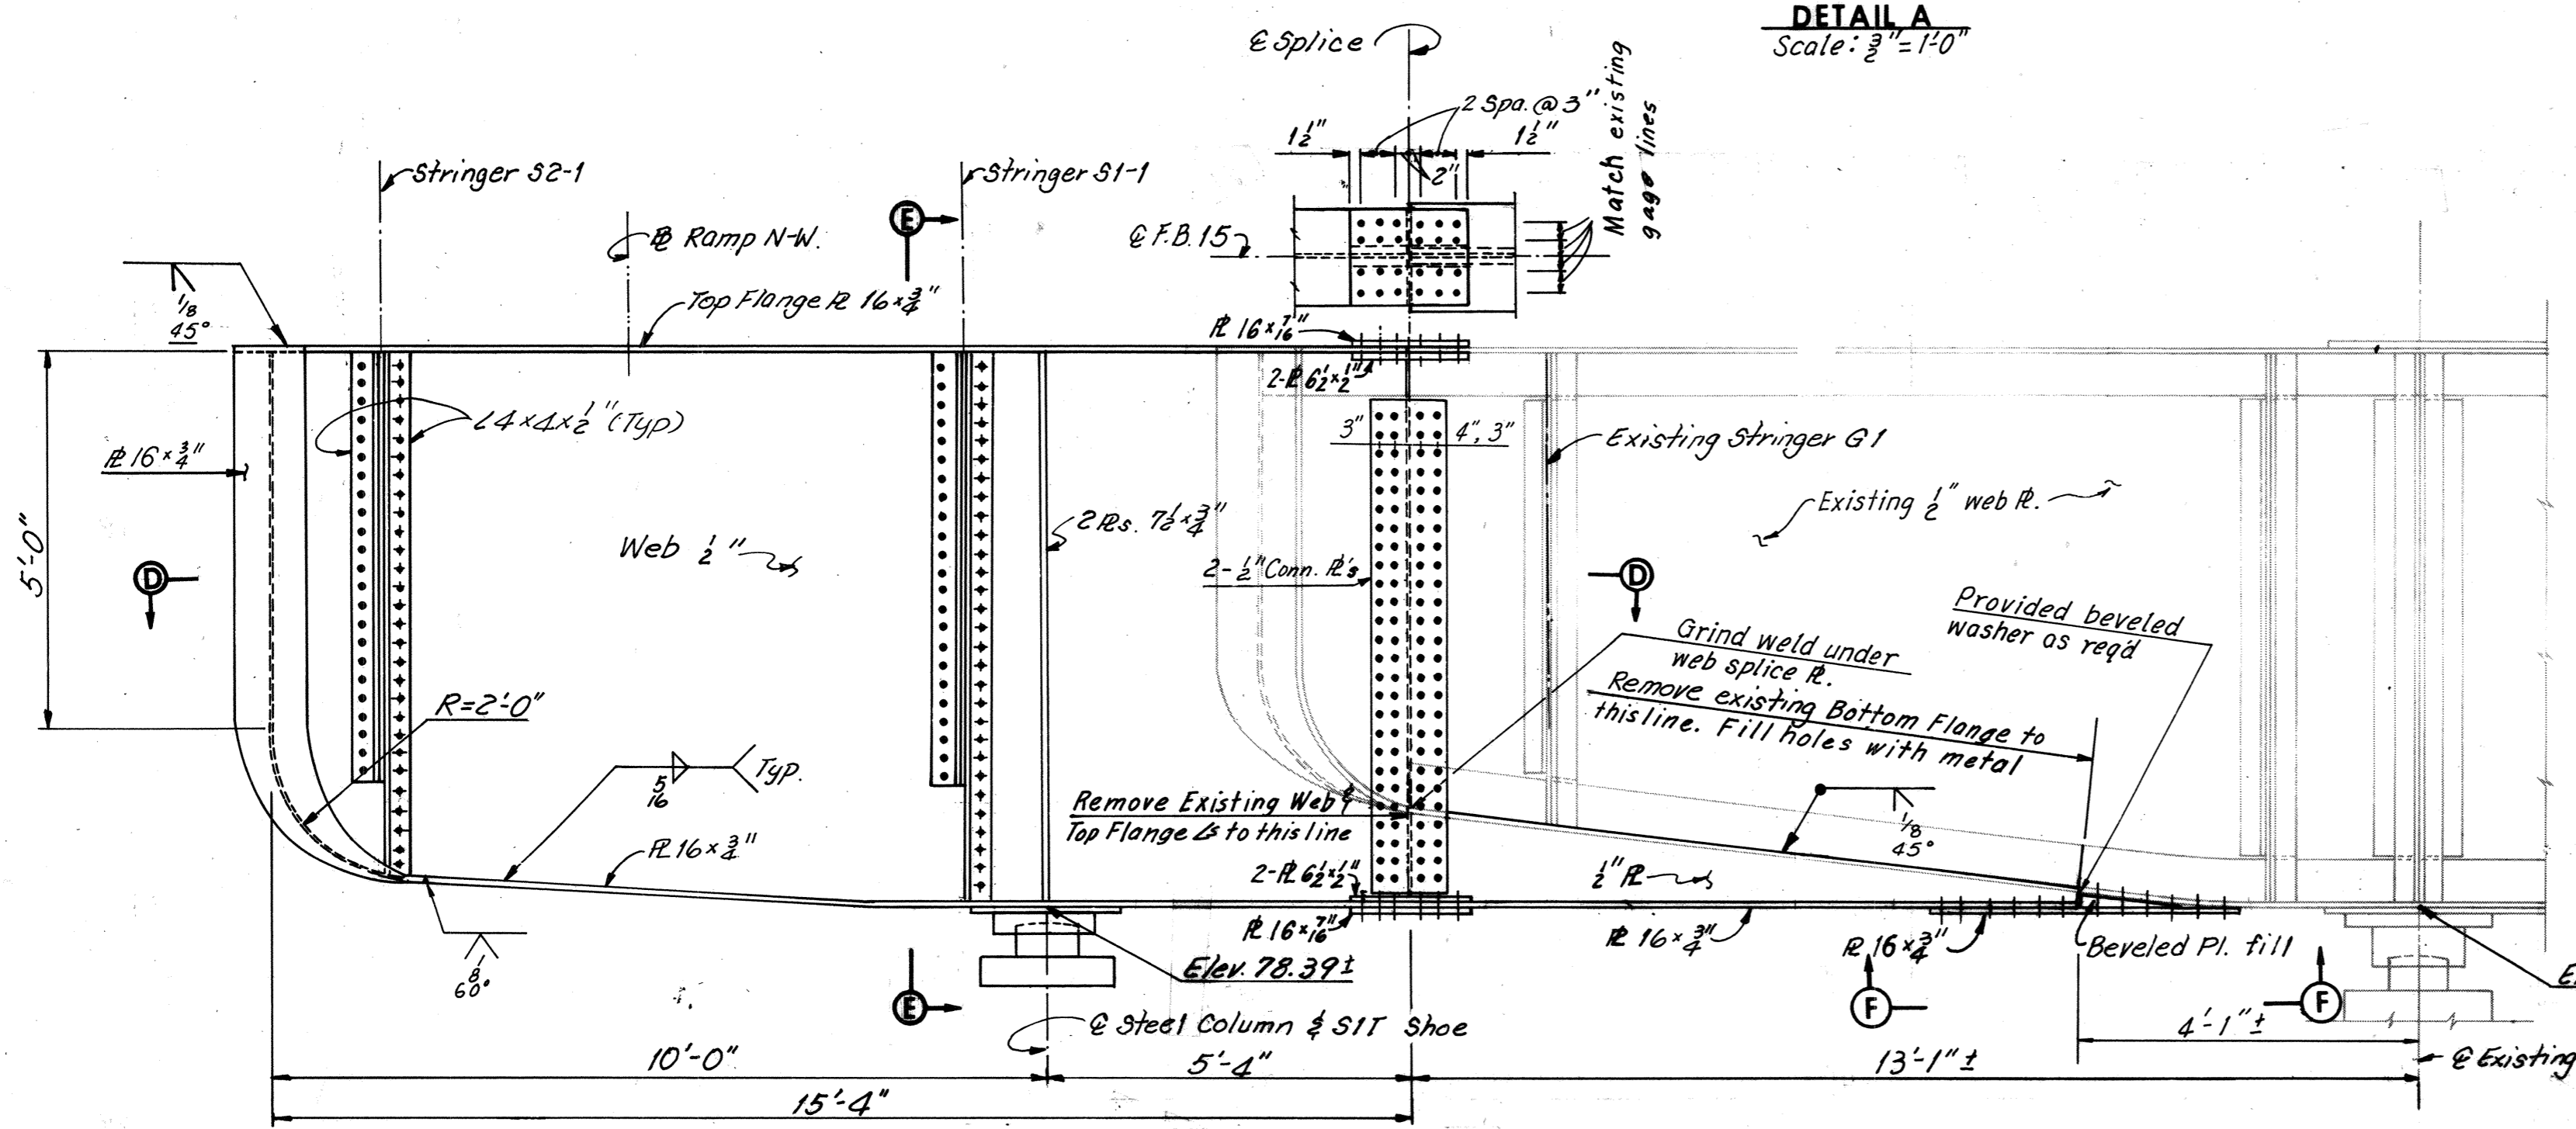

ELEVATION - FLOORBEAM 15
Scale 1/2" = 1'-0"

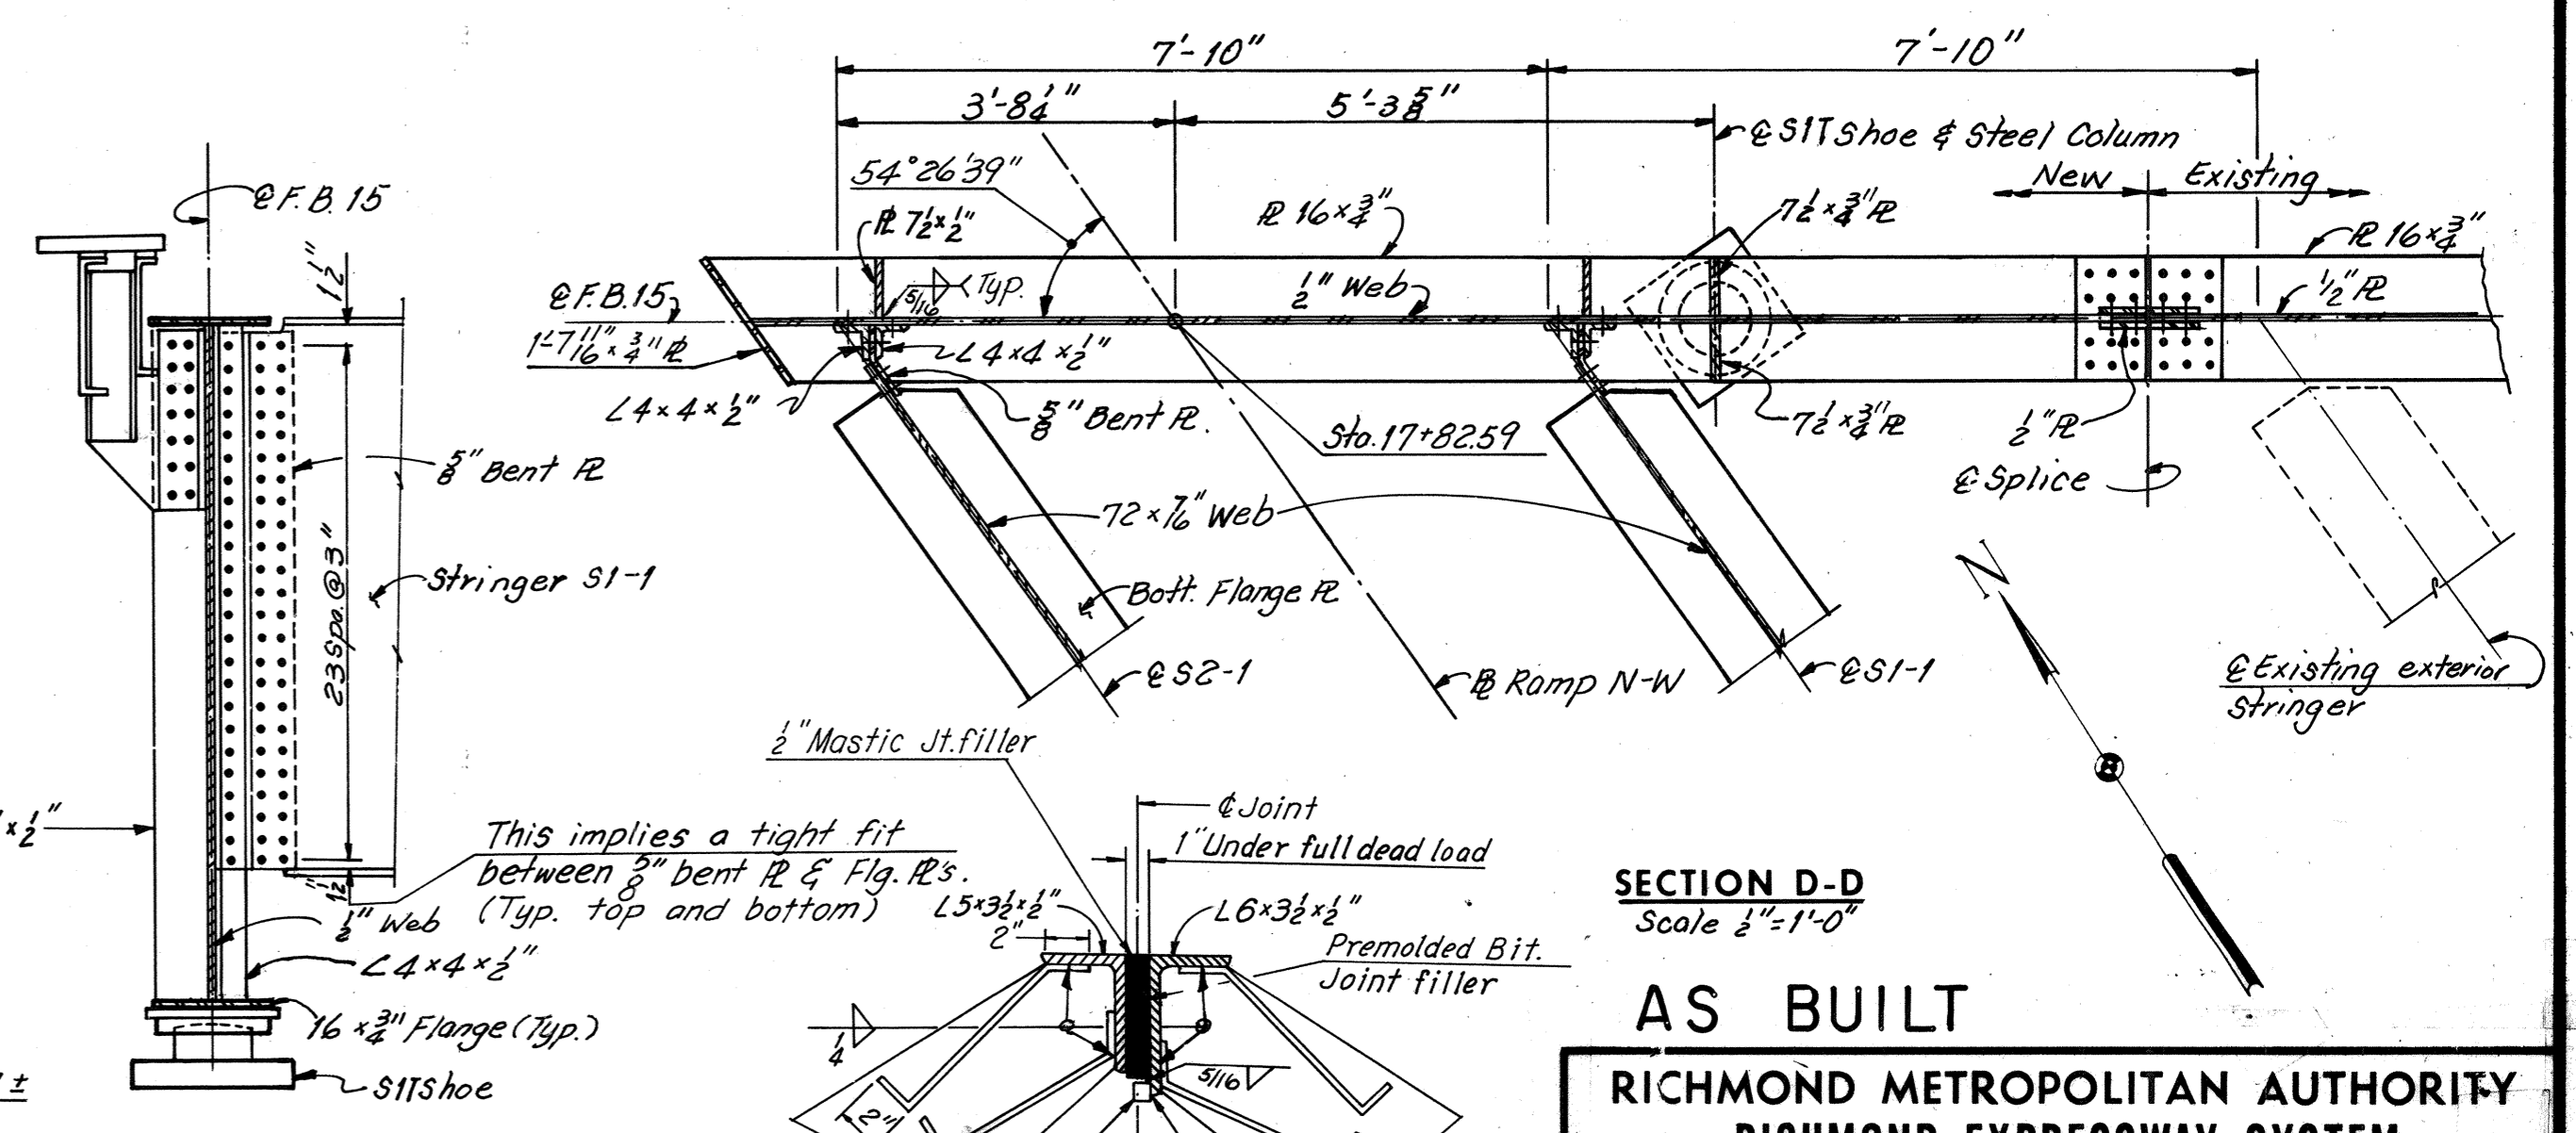

SECTION D-D
Scale 1/2" = 1'-0"

SECTION E-E
Scale 1/2" = 1'-0"

DETAIL B
No Scale

Note: Dimensions shown on the plans for existing structural metalwork are in accordance with drawings prepared for the original construction. The Contractor shall verify all necessary dimensions of existing structural metalwork prior to fabrication of new metalwork.

Note: For Joint Details at F.B. 15, see Sheet 42 Bridge 67. For Framing plan, see Sheet 12. For Steel Column Details, see Sheet 28 Bridge 67. For SIT Shoe Details, see Sheet 47 Bridge 67. All Elevations are to be verified by the Contractor.

BY	DATE	REVISION	BY	DATE
BY	DATE	2	As Built	TEM
MADE	G.C.C. 3-13-69	Unit 2 End Depth		G-77
CHECKED	Y.C.P. 4-25-69	to Pier 1 revised	LBP	10-31-74
IN CHARGE		L3 1/2 x 3 x 1/2 Support		
		Changed to 6W1725		

AS BUILT


RICHMOND METROPOLITAN AUTHORITY
RICHMOND EXPRESSWAY SYSTEM
DOWNTOWN EXPRESSWAY

BRIDGE NO. 64
RAMP N-W CONNECTION FROM
RICHMOND-PETERSBURG TURNPIKE

FRAMING DETAILS








HOWARD, NEEDLES, TAMMEN & BERGENDOFF
consulting engineers
NEW YORK ALEXANDRIA KANSAS CITY

SCALE: As Noted
CONTRACT NO.: 10
SHEET NO. 18 OF 28

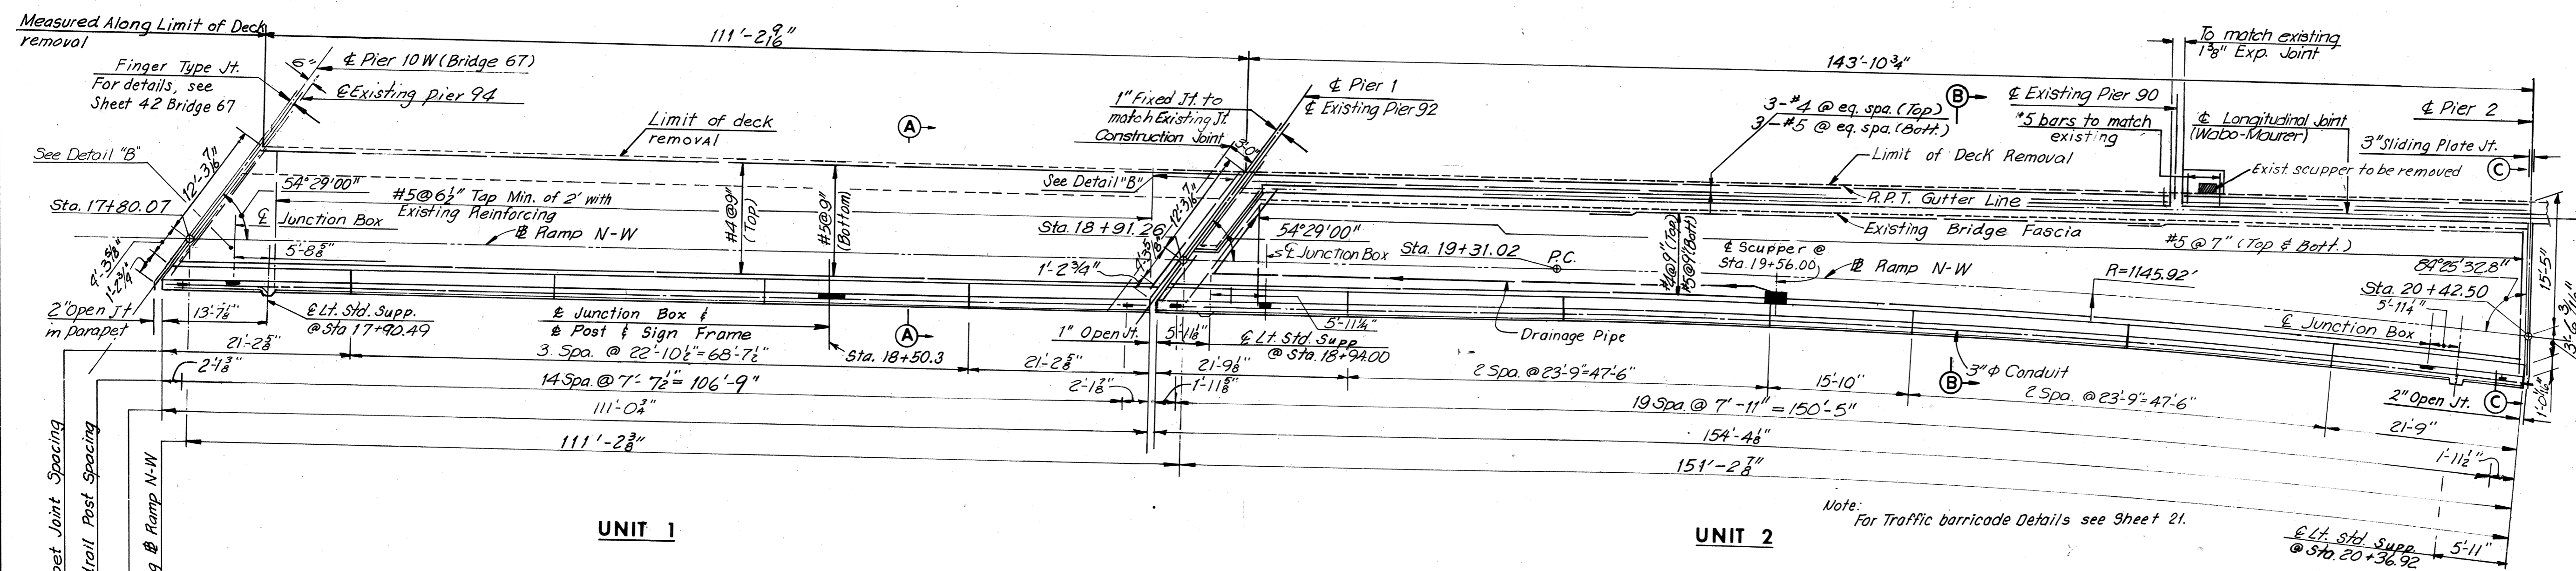

ELEVATION TABLE			
STATION	ELEV. A	ELEV. B	ELEV. C
17+77.57	87.11	-	-
17+80	87.17	87.07	86.78
17+80.07	-	87.07	-
17+87.21	-	-	87.00
17+90	87.44	87.35	87.07
18+00	87.70	87.61	87.35
18+10	87.95	87.87	87.63
18+20	88.19	88.12	87.90
18+30	88.43	88.36	88.15
18+40	88.66	88.59	88.40
18+50	88.88	88.81	88.64
18+60	89.09	89.03	88.87
18+70	89.29	89.24	89.10
18+80	89.49	89.44	89.32
18+88.75	89.65	-	-
18+90	89.67	89.64	89.57
18+91.26	-	89.66	-
18+98.42	-	-	89.72
19+00	89.87	89.84	89.78
19+10	90.06	90.03	89.98
19+20	90.23	90.22	90.18
19+30	90.40	90.39	90.37
19+40	90.56	90.55	90.54
19+50	90.71	90.71	90.71
19+60	90.84	90.85	90.88
19+70	90.95	90.98	91.04
19+80	91.05	91.10	91.20
19+90	91.15	91.21	91.35
20+00	91.24	91.31	91.49
20+10	91.31	91.39	91.64
20+20	91.38	91.47	91.77
20+30	91.43	91.54	91.91
20+40	91.47	91.59	92.04
20+41.28	-	-	92.06
20+42.50	-	91.60	-
20+42.84	91.49	-	-

Elevations given in the Elevation Table may require adjustment in the field.

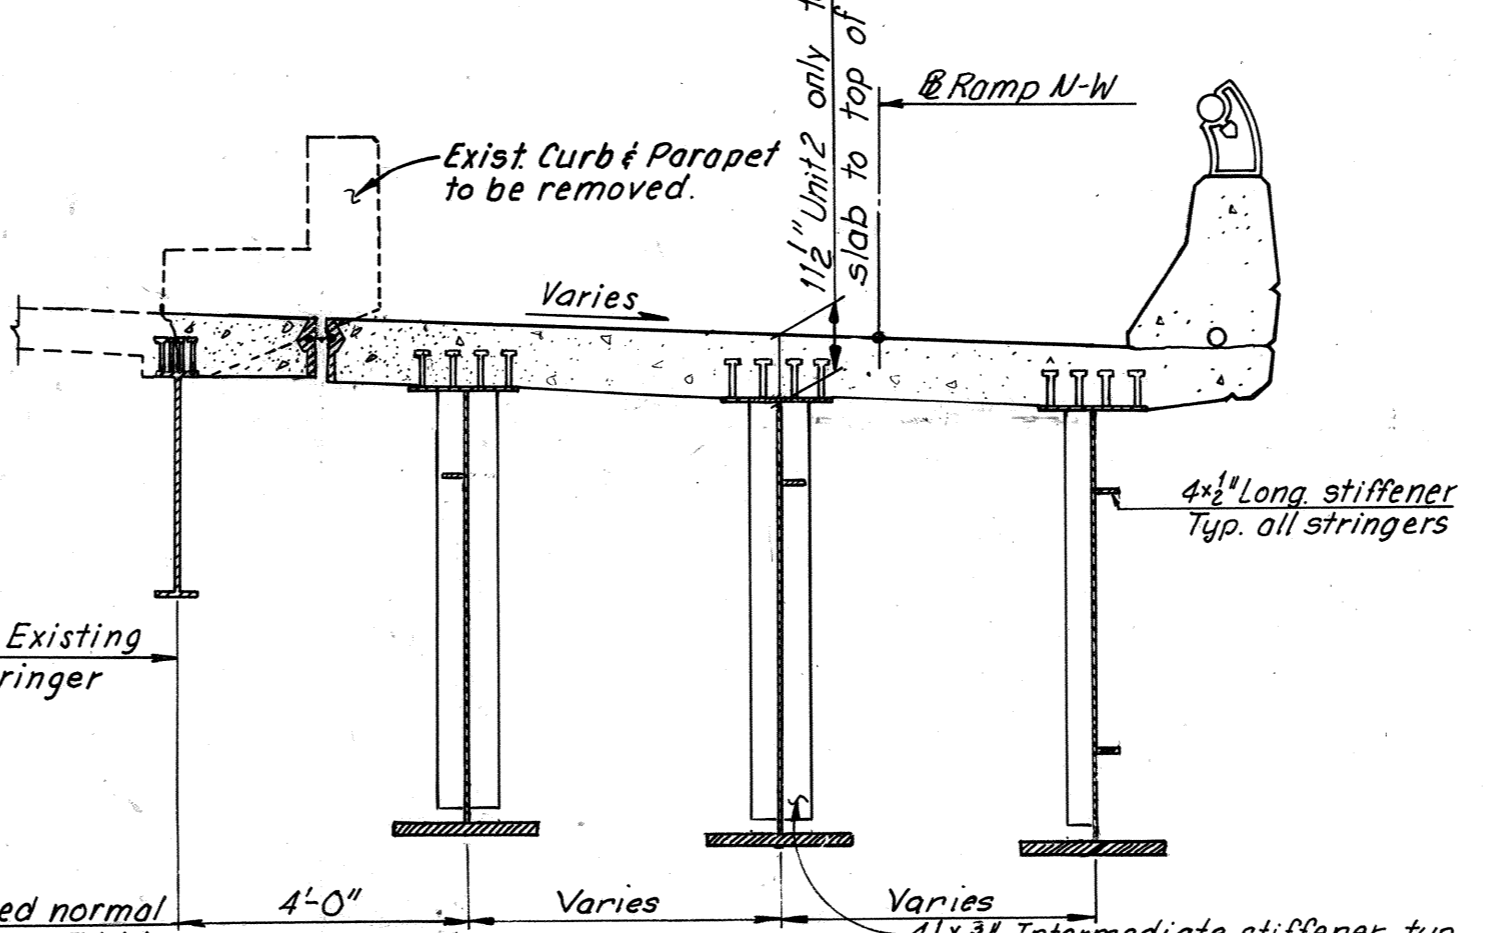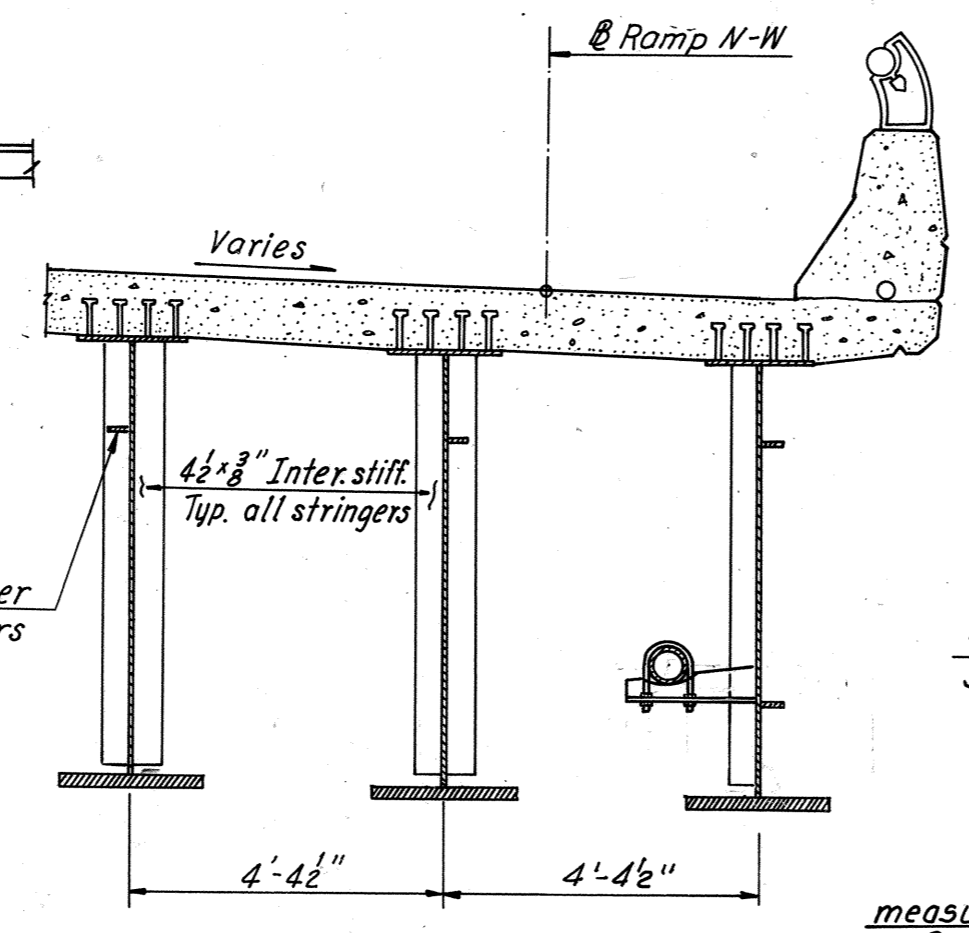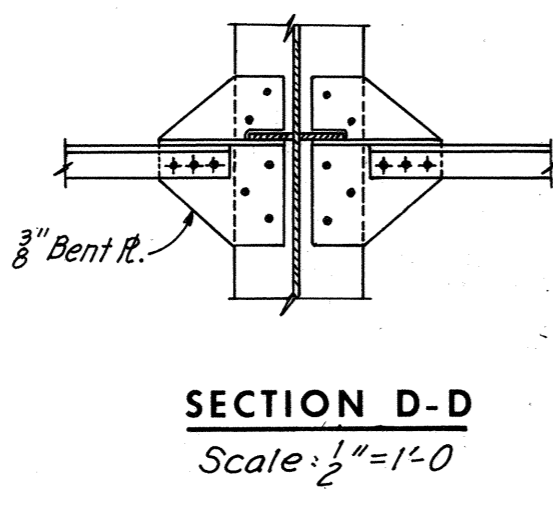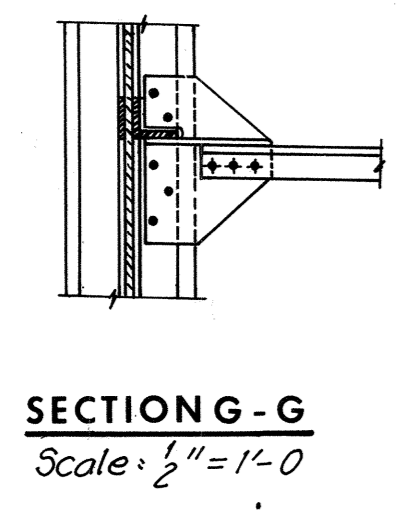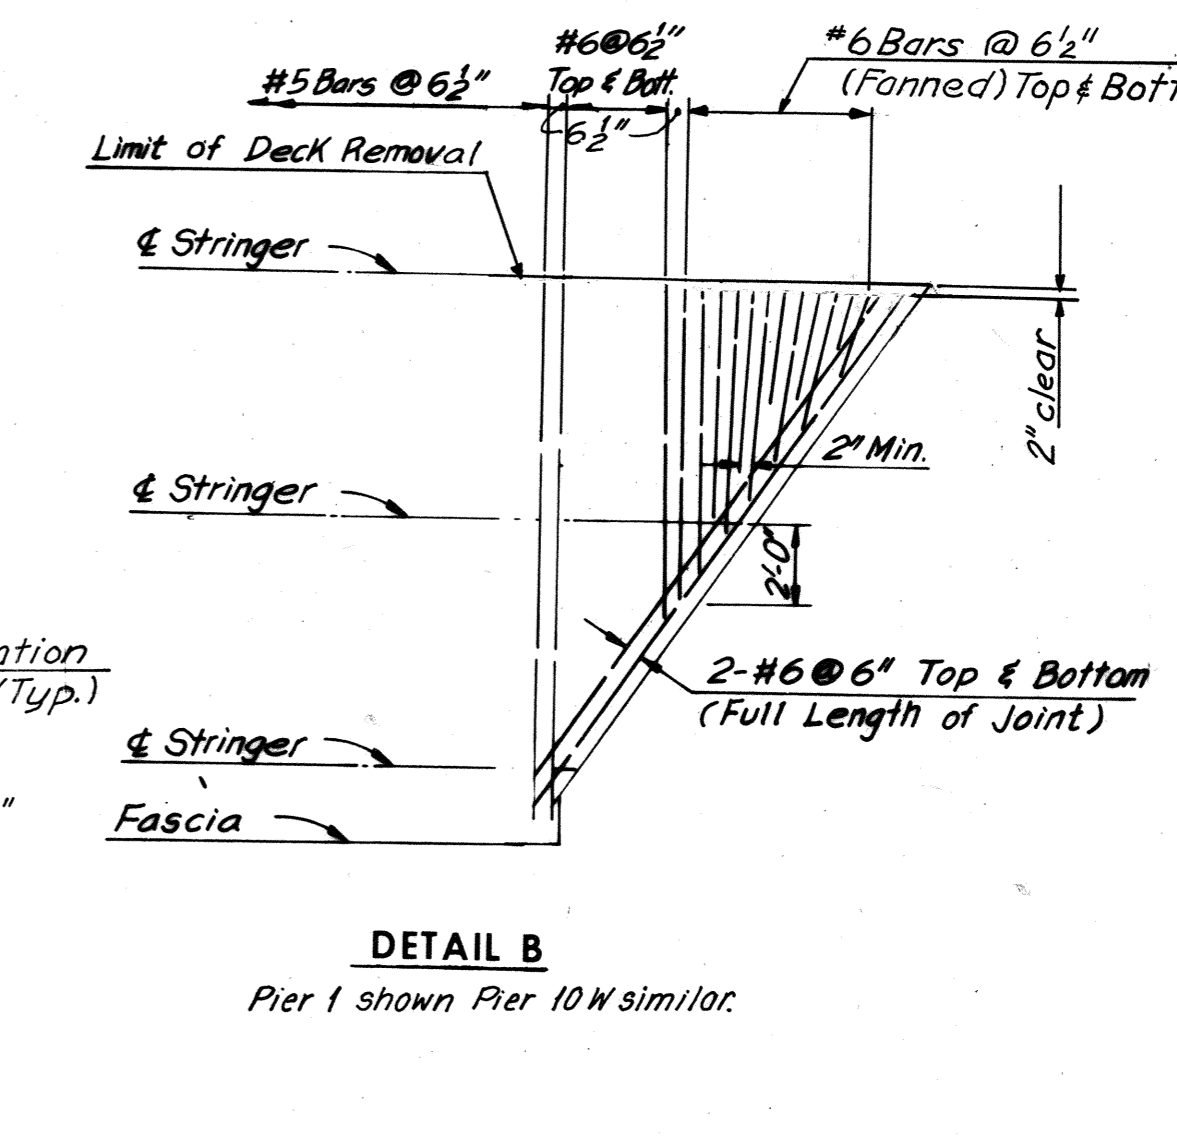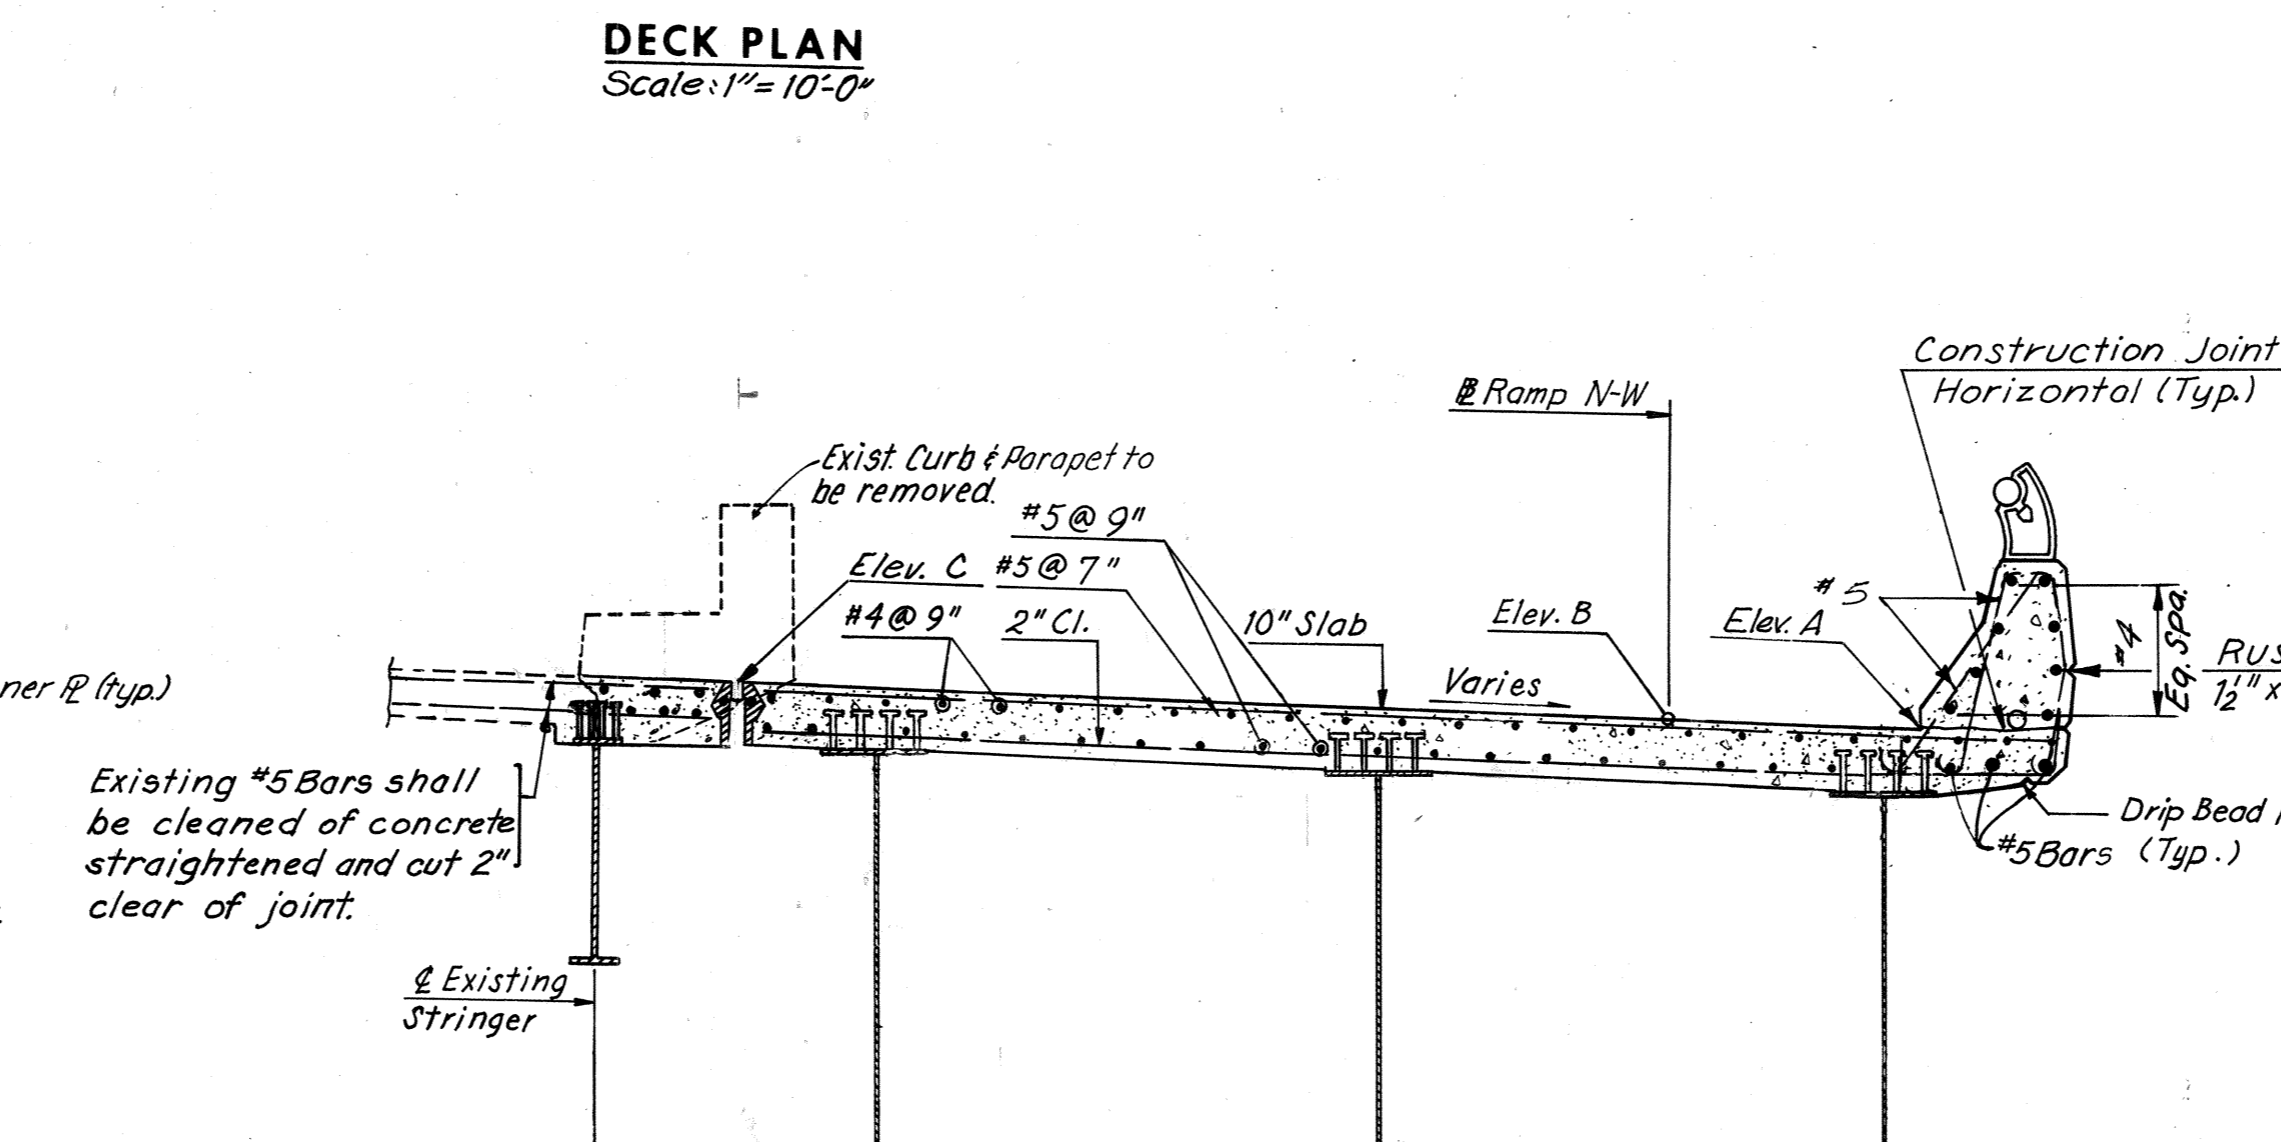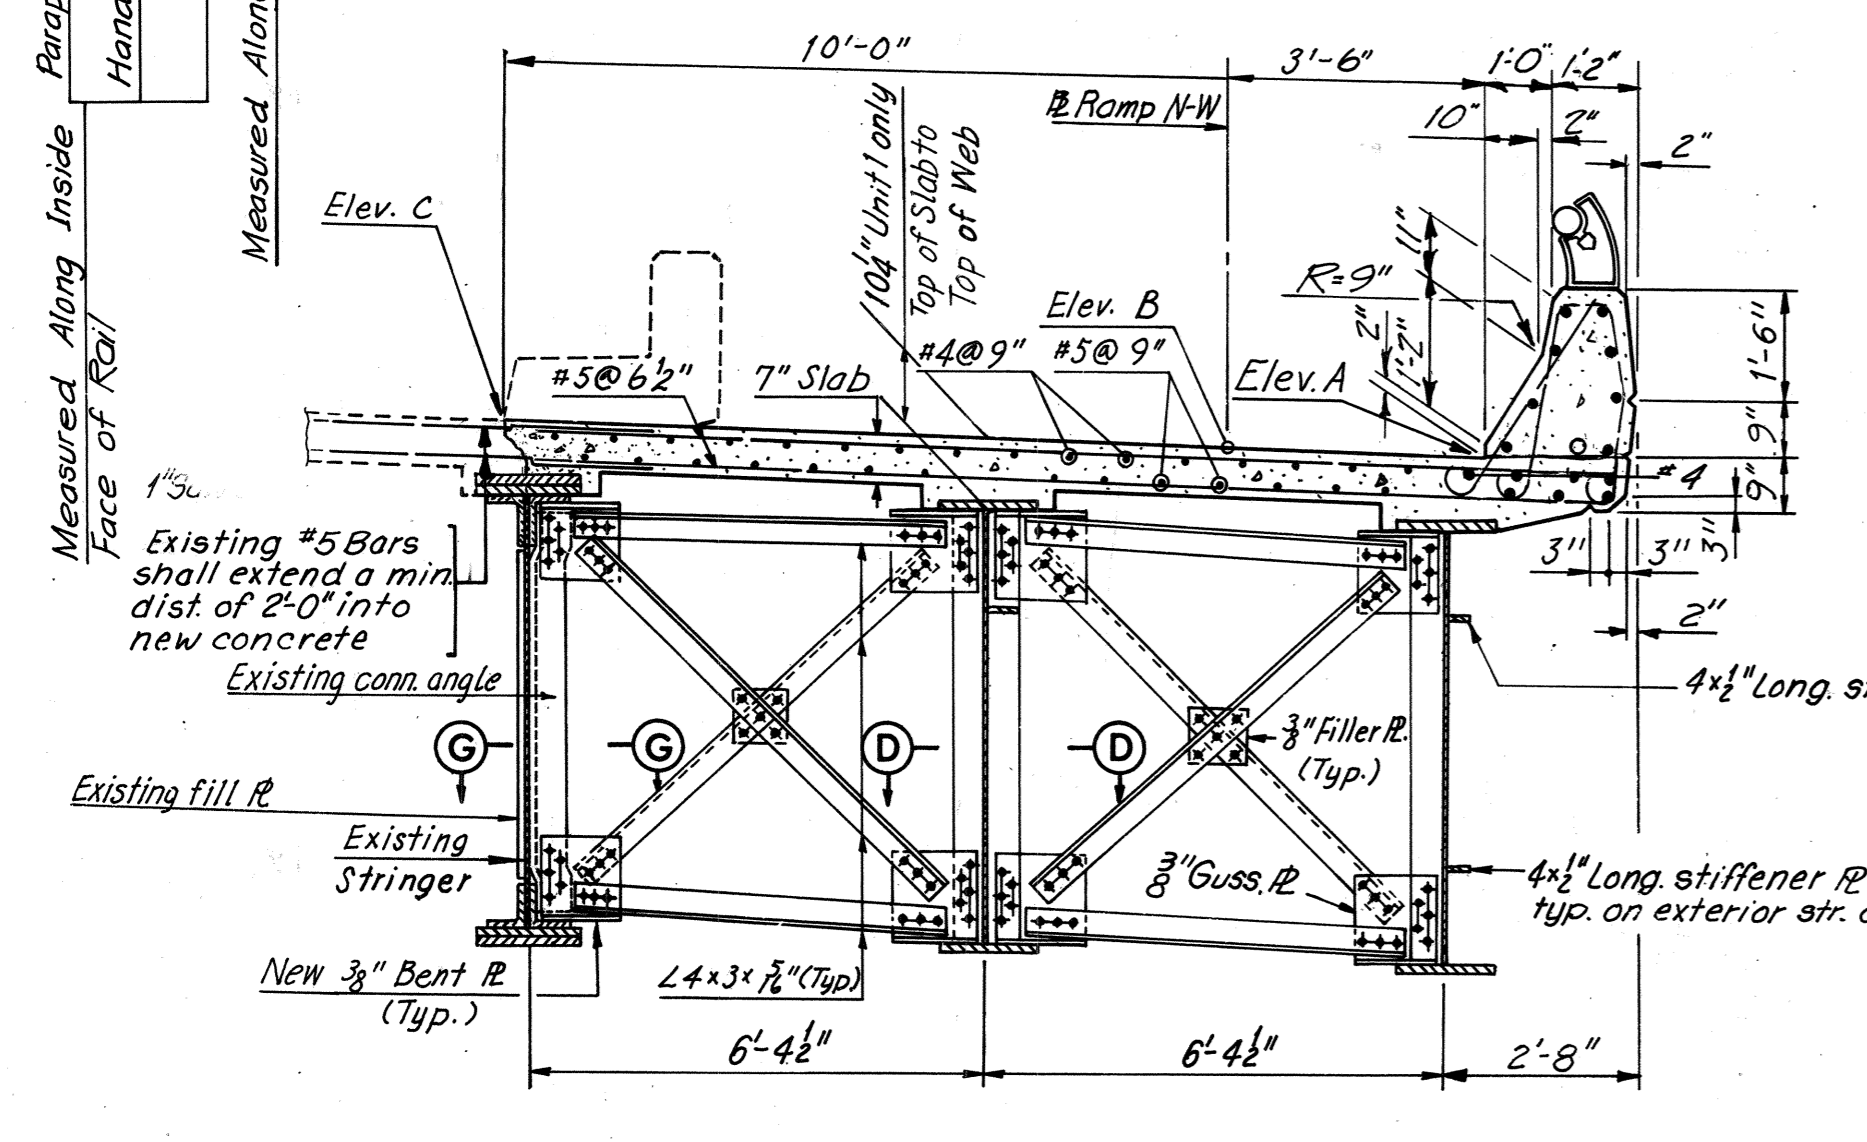

Notes:
For Joint Details, see Sheet 18, 25 and Sheet 42 Bridge 67.
Elevation C is to be confirmed by contractor.
For Framing Plan, see Sheet 12.
For Steel and Concrete Quantities, see Sheet 2.
For Handrail Details, see Sheet S3.
For Lighting Details, see Sheet S4.
For Standard Drainage Details, see Support Type 11 Sheet S6.

RICHMOND METROPOLITAN AUTHORITY
RICHMOND EXPRESSWAY SYSTEM
DOWNTOWN EXPRESSWAY

BRIDGE NO. 64
RAMP N-W CONNECTION FROM
RICHMOND-PETERSBURG TURNPIKE
DECK PLAN UNITS 1 AND 2

HOWARD, NEEDLES, TAMMEN & BERGENDOFF
consulting engineers
ALEXANDRIA KANSAS CITY

SCALE: As Noted
CONTRACT NO.: 10
SHEET NO. 19 OF 28

4 As Built	TEM	G-77
BY	DATE	Note for Table of Elevations
MADE	Y.C.P. 2-12-69	Chg. of Pier Angle Added Jun. Box
CHECKED	SCC. 4-24-69	Deck Plan Sect. A-A, B-B, C-C, H-H, Det. B
IN CHARGE	NO.	REVISION BY DATE
		DWB 1-28-75
		ABJ 1-13-75
		TEM 10-31-74

AS BUILT

RICHMOND EXPRESSWAY SYSTEM			
SECTION	PROJECT	SHEET NO.	TOTAL SHEETS
10	DOWNTOWN EXPRESSWAY	118	265

Elevations given in the Elevation Table may require adjustment in the field.

ELEVATION TABLE			
* STATION	ELEV. A	ELEV. B	ELEV. C
20+41.28	---	---	92.06
+42.50	---	91.61	---
+42.49	91.44	---	---
+50.00	91.49	91.64	92.21
+60.00	91.52	91.68	92.34
+70.00	91.54	91.72	92.52
+80.00	91.58	91.76	92.65
+90.00	91.61	91.80	92.80
21+00.00	91.64	91.84	93.00
+10.00	91.66	91.88	93.22
+20.00	91.70	91.92	93.38
+30.00	91.74	91.96	93.53
21+34.10	---	---	93.59
21+38.68	---	91.98	---
21+39.33	91.76	---	---
+40.00	91.76	91.98	93.67
+50.00	91.76	91.98	93.80
+60.00	91.73	91.95	93.92
+70.00	91.69	91.91	94.01
+80.00	91.63	91.85	94.09
+90.00	91.55	91.77	94.14
21+95.50	---	---	93.18
22+00.00	91.44	91.66	93.05
+05.50	91.39	91.60	92.91

GUTTER LINE ELEVATION		
STATION	ELEV. D	ELEV. E
1714+22.95	94.22	93.73
1714+17.85	94.27	93.85

* Station along @ Ramp N-W.
 ** Station along @ R.P.T..




Notes:
 Elevation C is along W. edge of longitudinal joint before Sta. 21+60.00 and along W. Nose Gutter line after Sta. 21+60.00.
 For elevation D and elevation E, see Section C-C.
 For Joint Details, see Sheet 26.
 For Framing Plan, see Sheet 13.
 For Steel and Concrete Quantities, see Sheet 2.
 For Handrail Details, see Sheet S3.
 For Lighting Details, see Sheet S4.
 For Superstructure details, see Sheet 24.
 For Traffic Barricade Detail, see Sheet 21.

RICHMOND METROPOLITAN AUTHORITY
RICHMOND EXPRESSWAY SYSTEM
DOWNTOWN EXPRESSWAY

BRIDGE NO. 64
RAMP N-W CONNECTION FROM RICHMOND-PETERSBURG TURNPIKE
DECK PLAN - UNITS 3 AND 4

HOWARD, NEEDLES, TAMMEN & BERGENDOFF
 consulting engineers
 NEW YORK ALEXANDRIA KANSAS CITY

SCALE: As Noted
 CONTRACT NO. 10
 SHEET NO. 20 OF 28

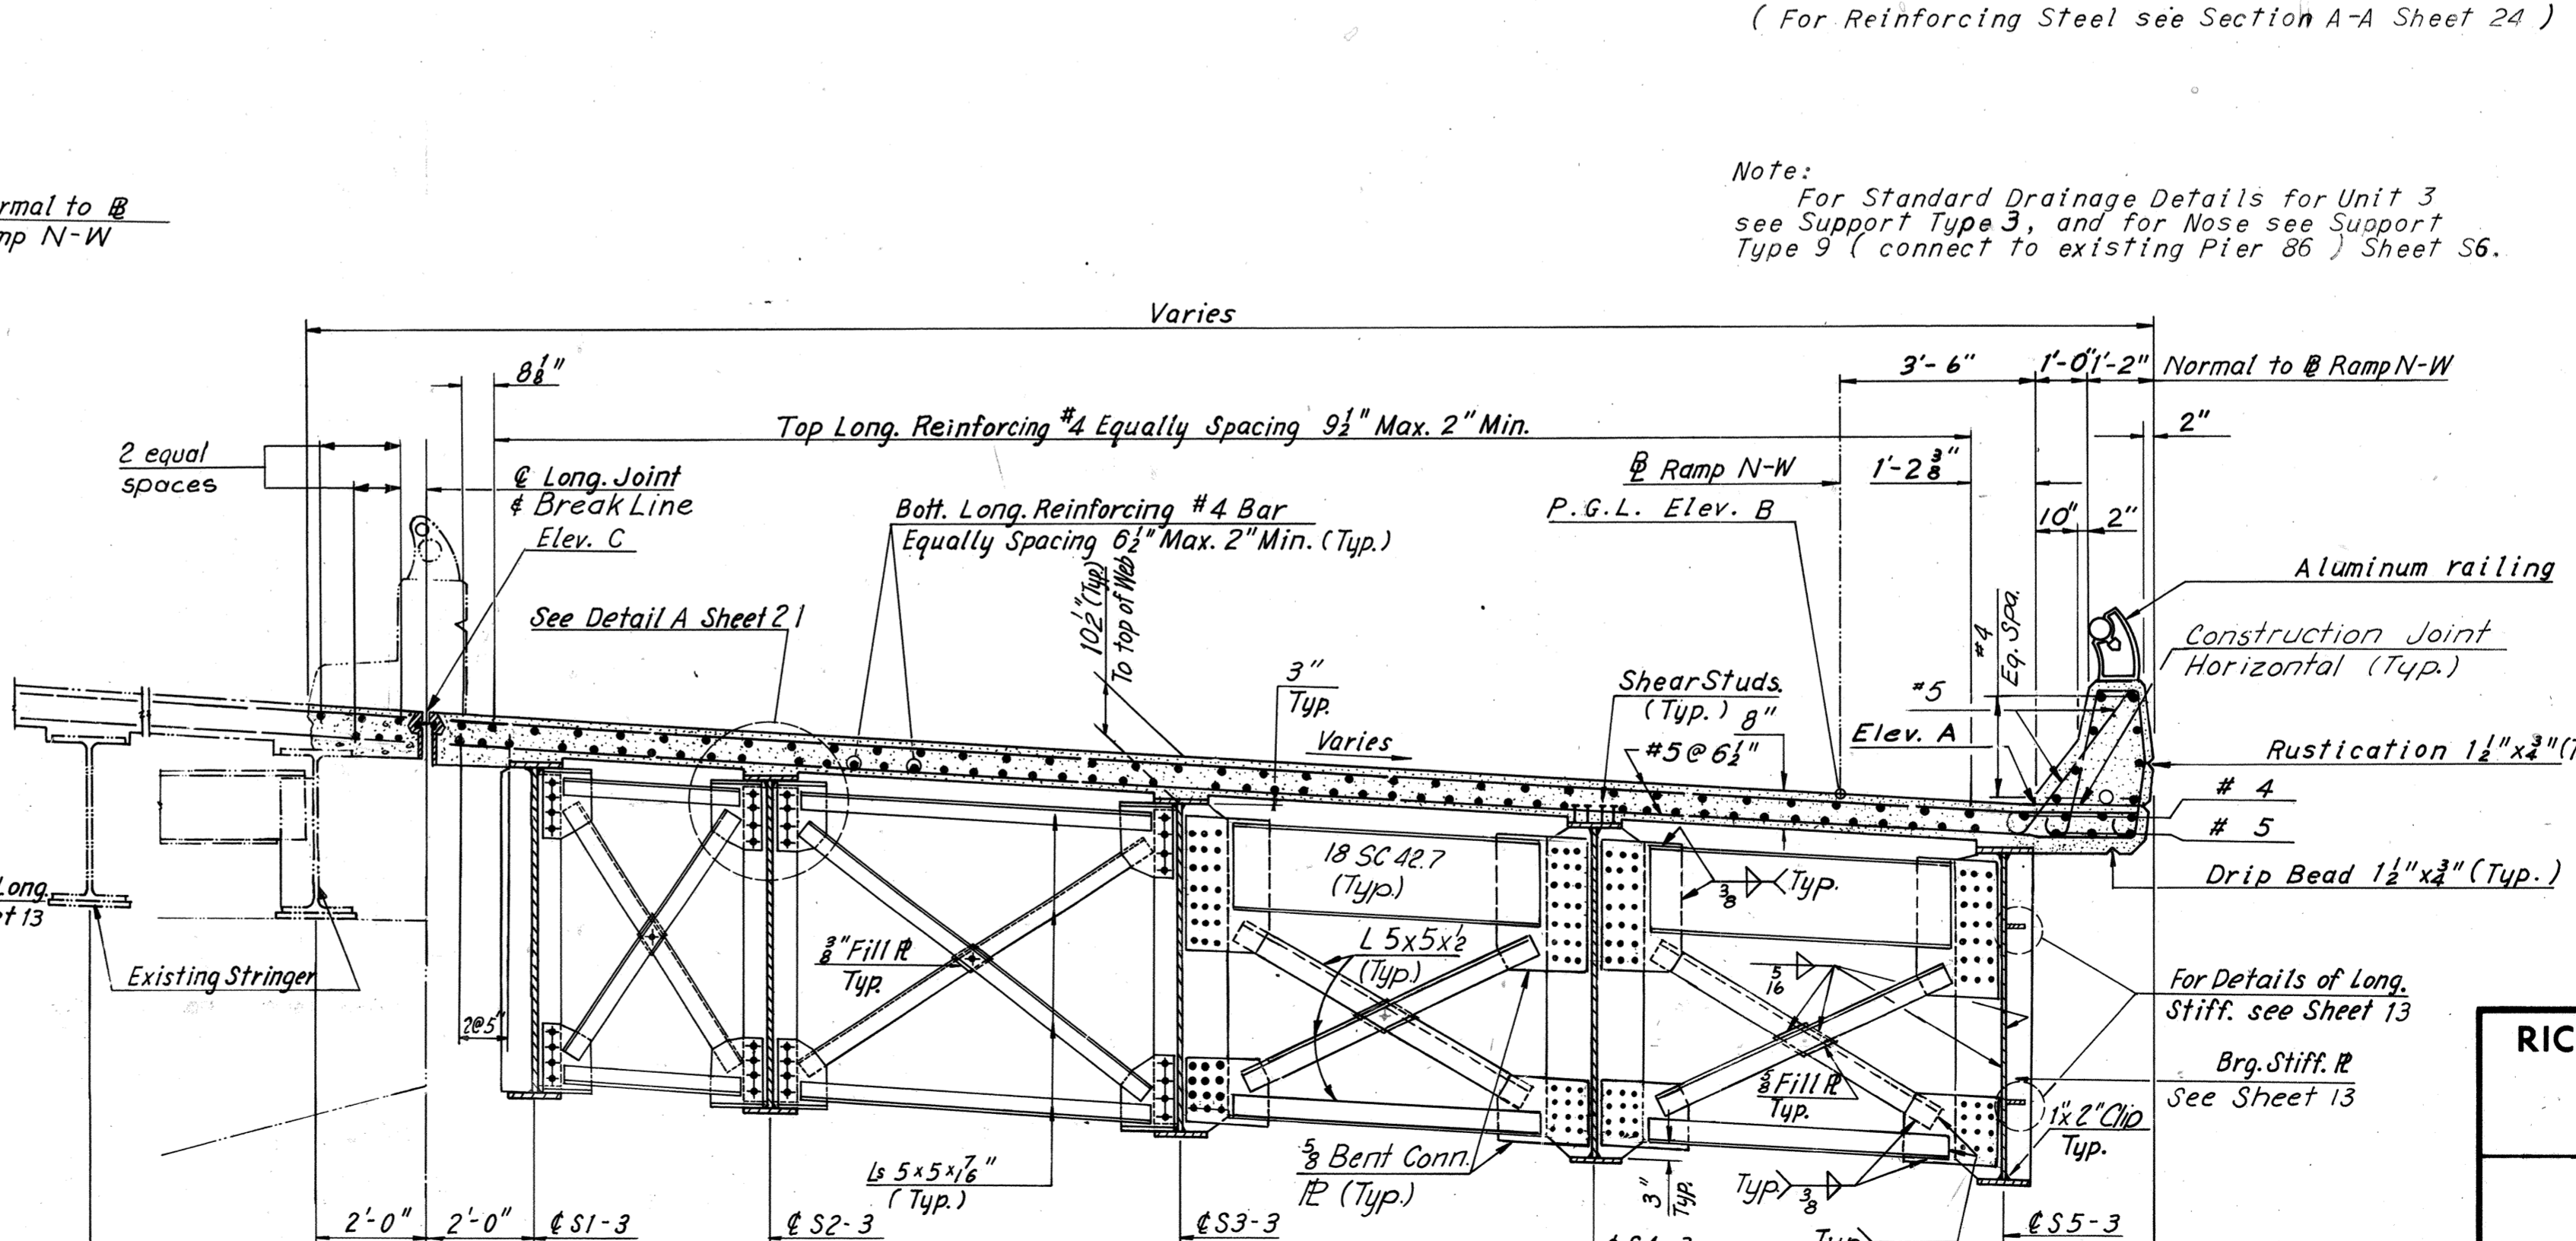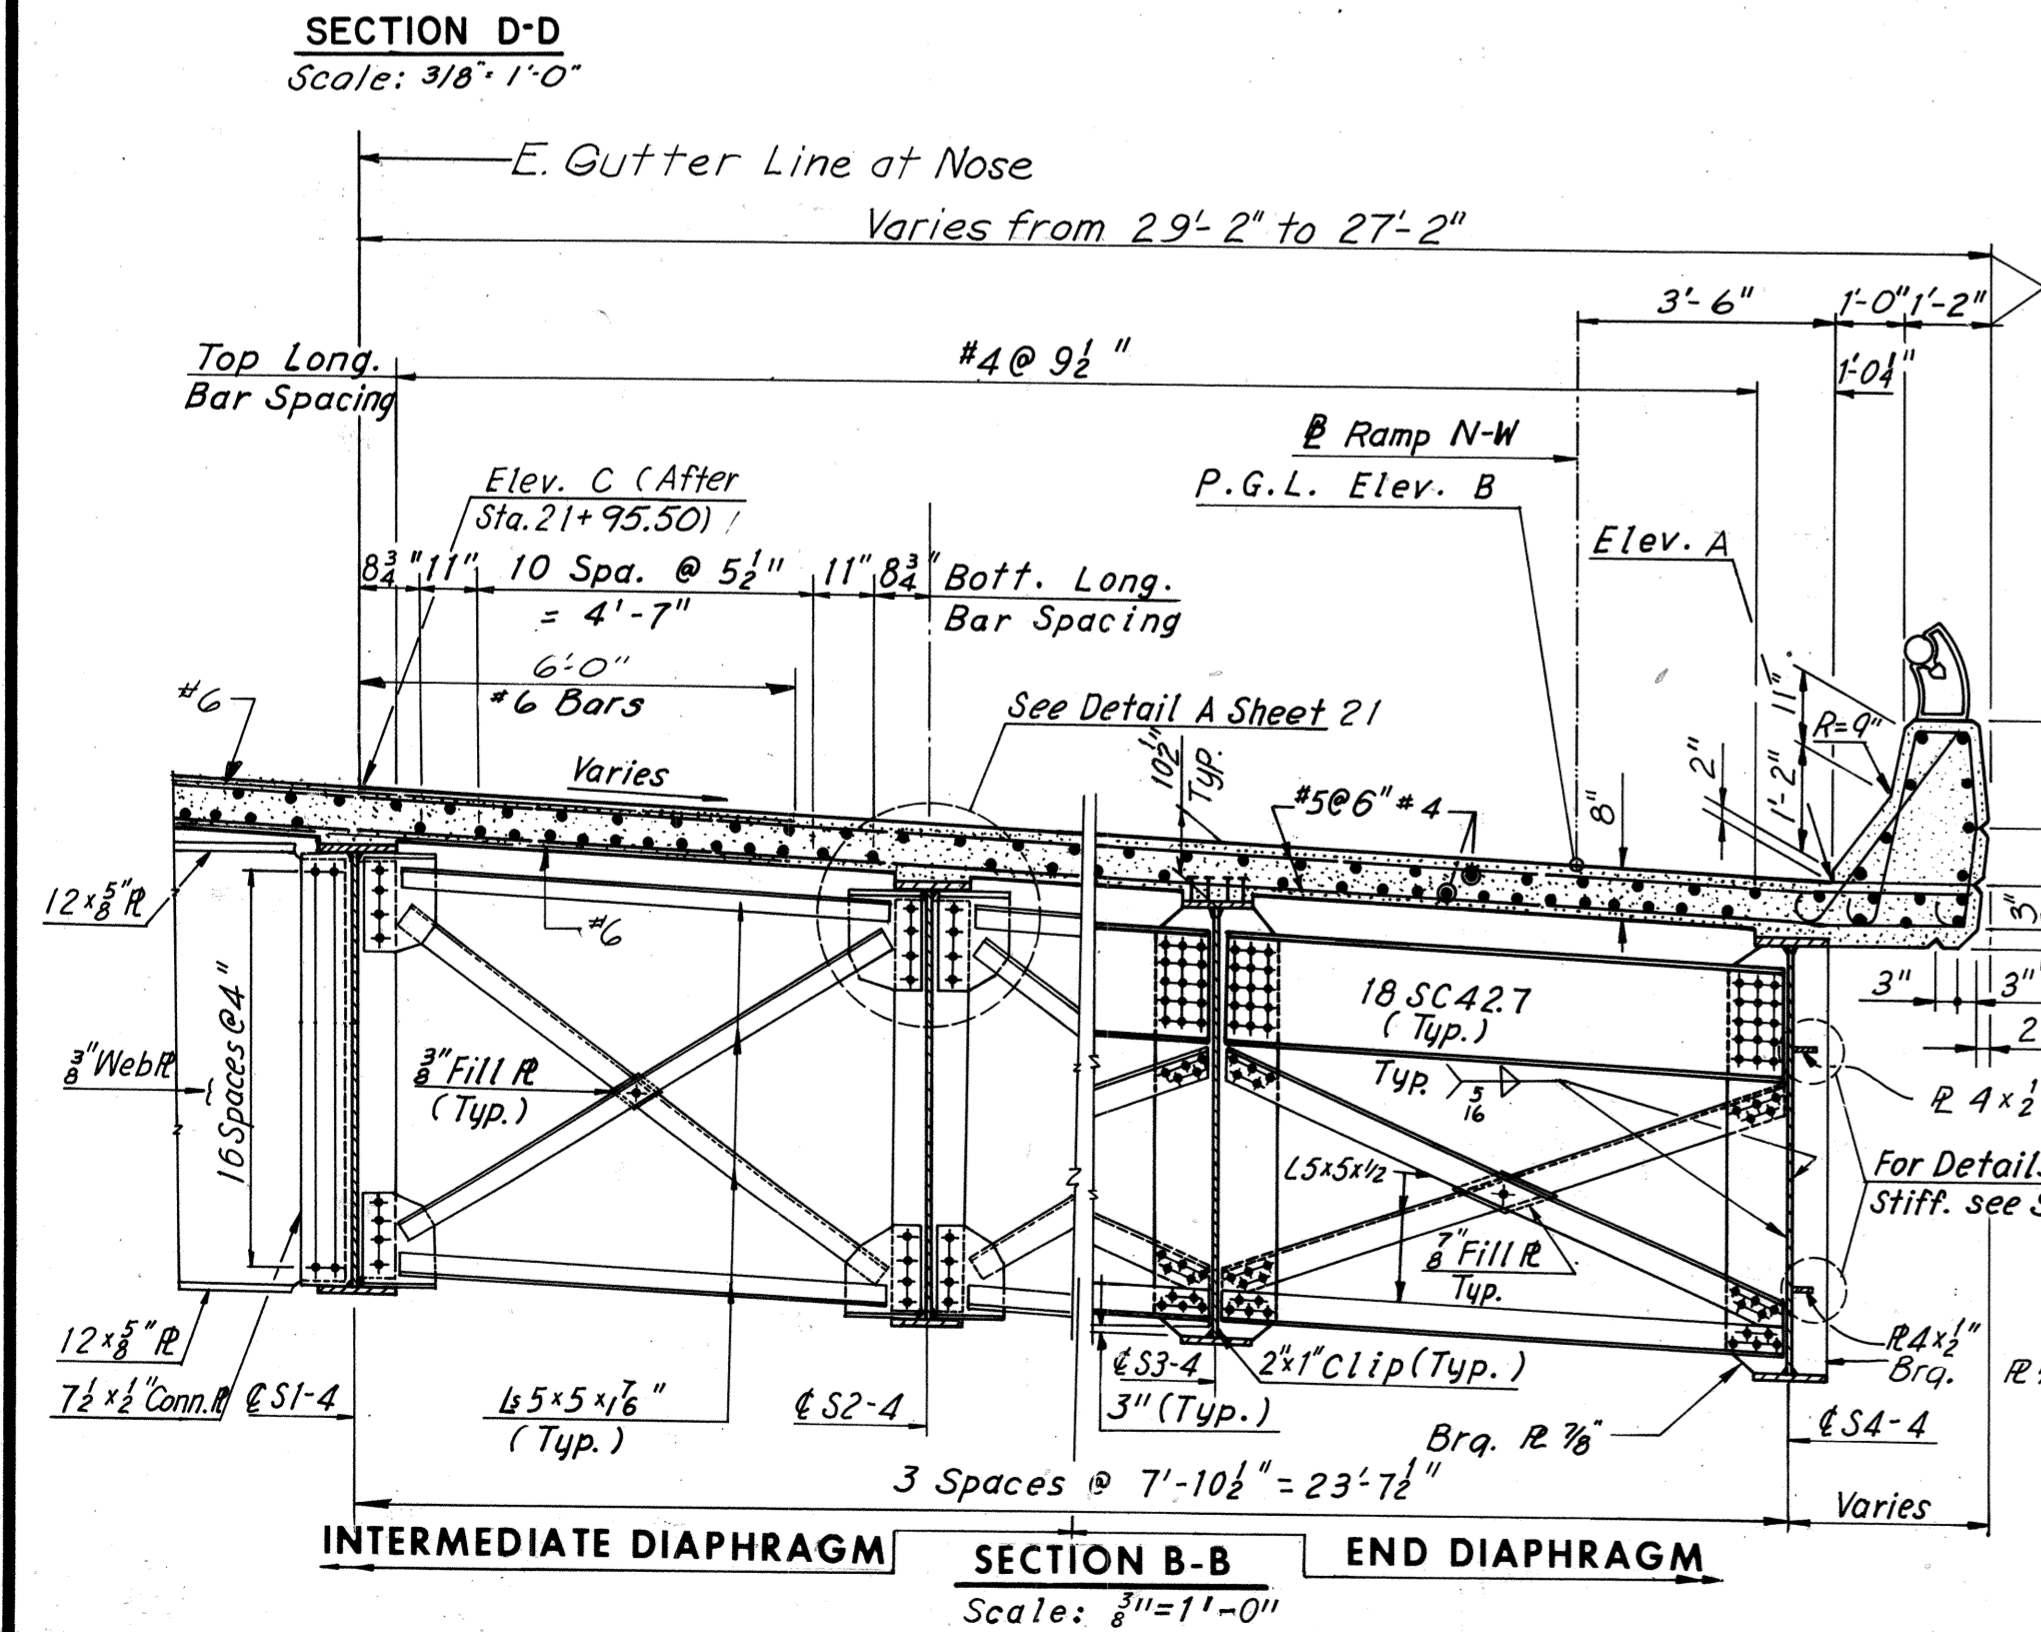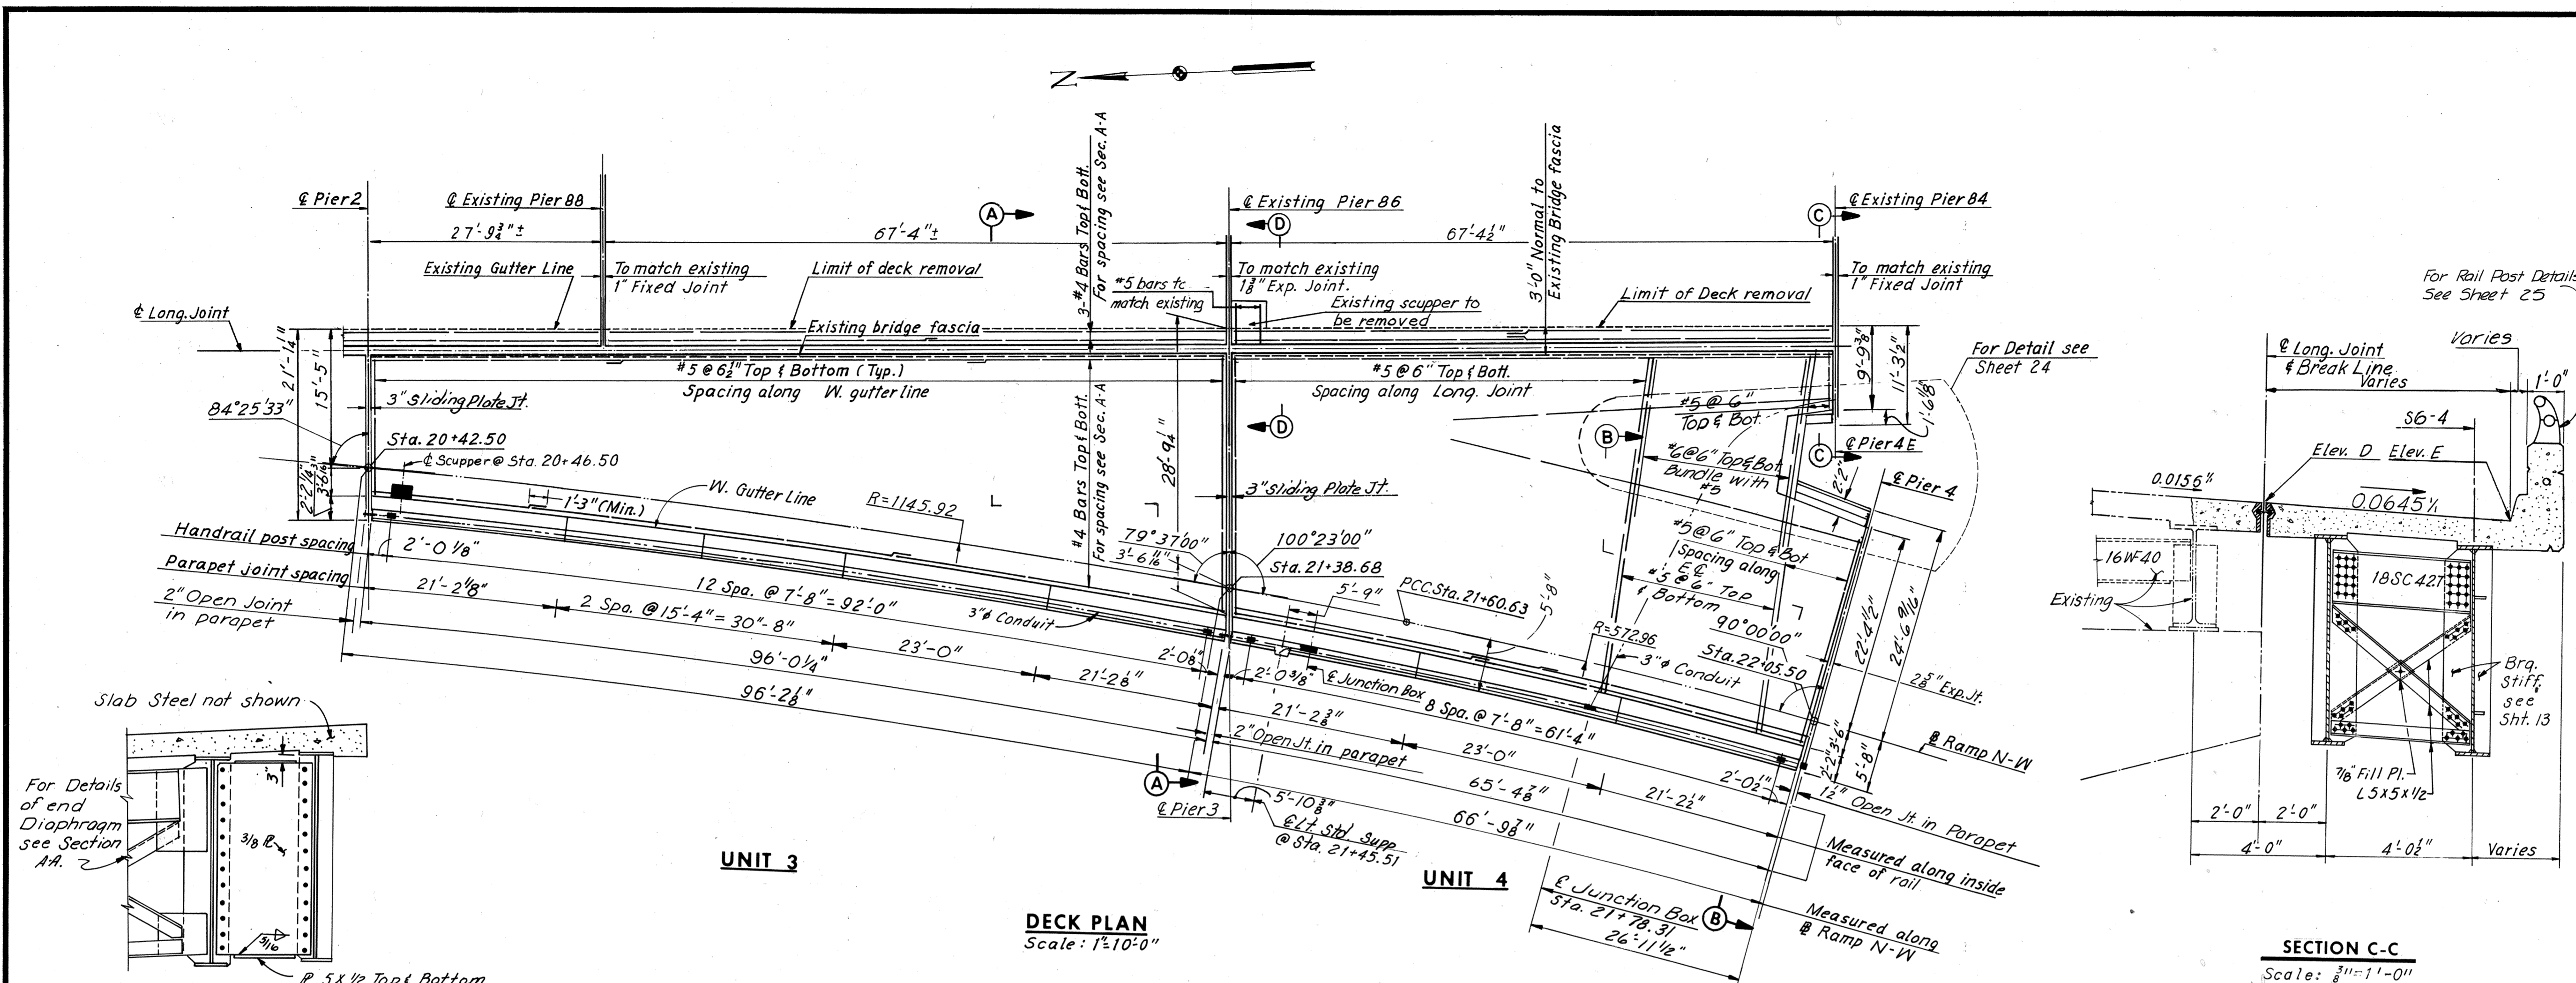


BY	DATE	REVISION	BY	DATE
MADE	K.C.T. 2-19-69			
CHECKED	G.C.C. 4-17-69			
IN CHARGE				


AS BUILT

RICHMOND EXPRESSWAY SYSTEM			
SECTION	PROJECT	SHEET NO.	TOTAL SHEETS
10	DOWNTOWN EXPRESSWAY	119	265


ELEVATION TABLE			
STATION	ELEV. A	ELEV. B	ELEV. C
22+00.00	91.47	91.66	92.97
05.50	91.41	91.60	92.90
10.00	91.36	91.54	92.83
20.00	91.22	91.40	92.67
30.00	91.02	91.23	92.52
40.00	90.84	91.05	92.34
50.00	90.63	90.84	92.13
60.00	90.40	90.61	91.90
70.00	90.16	90.37	91.66
80.00	89.89	90.10	91.39
90.00	89.60	89.81	91.10
95.50	89.43	89.64	90.93
23+00.00	89.29	89.50	90.79
10.00	88.97	89.18	90.47
20.00	88.62	88.83	90.12
30.00	88.25	88.46	89.75
40.00	87.86	88.07	89.36
50.00	87.45	87.66	88.95
60.00	87.01	87.22	88.51
70.00	86.56	86.77	88.06
80.00	86.09	86.30	87.59
80.50	86.07	86.28	87.47
90.00	85.62	85.83	87.12

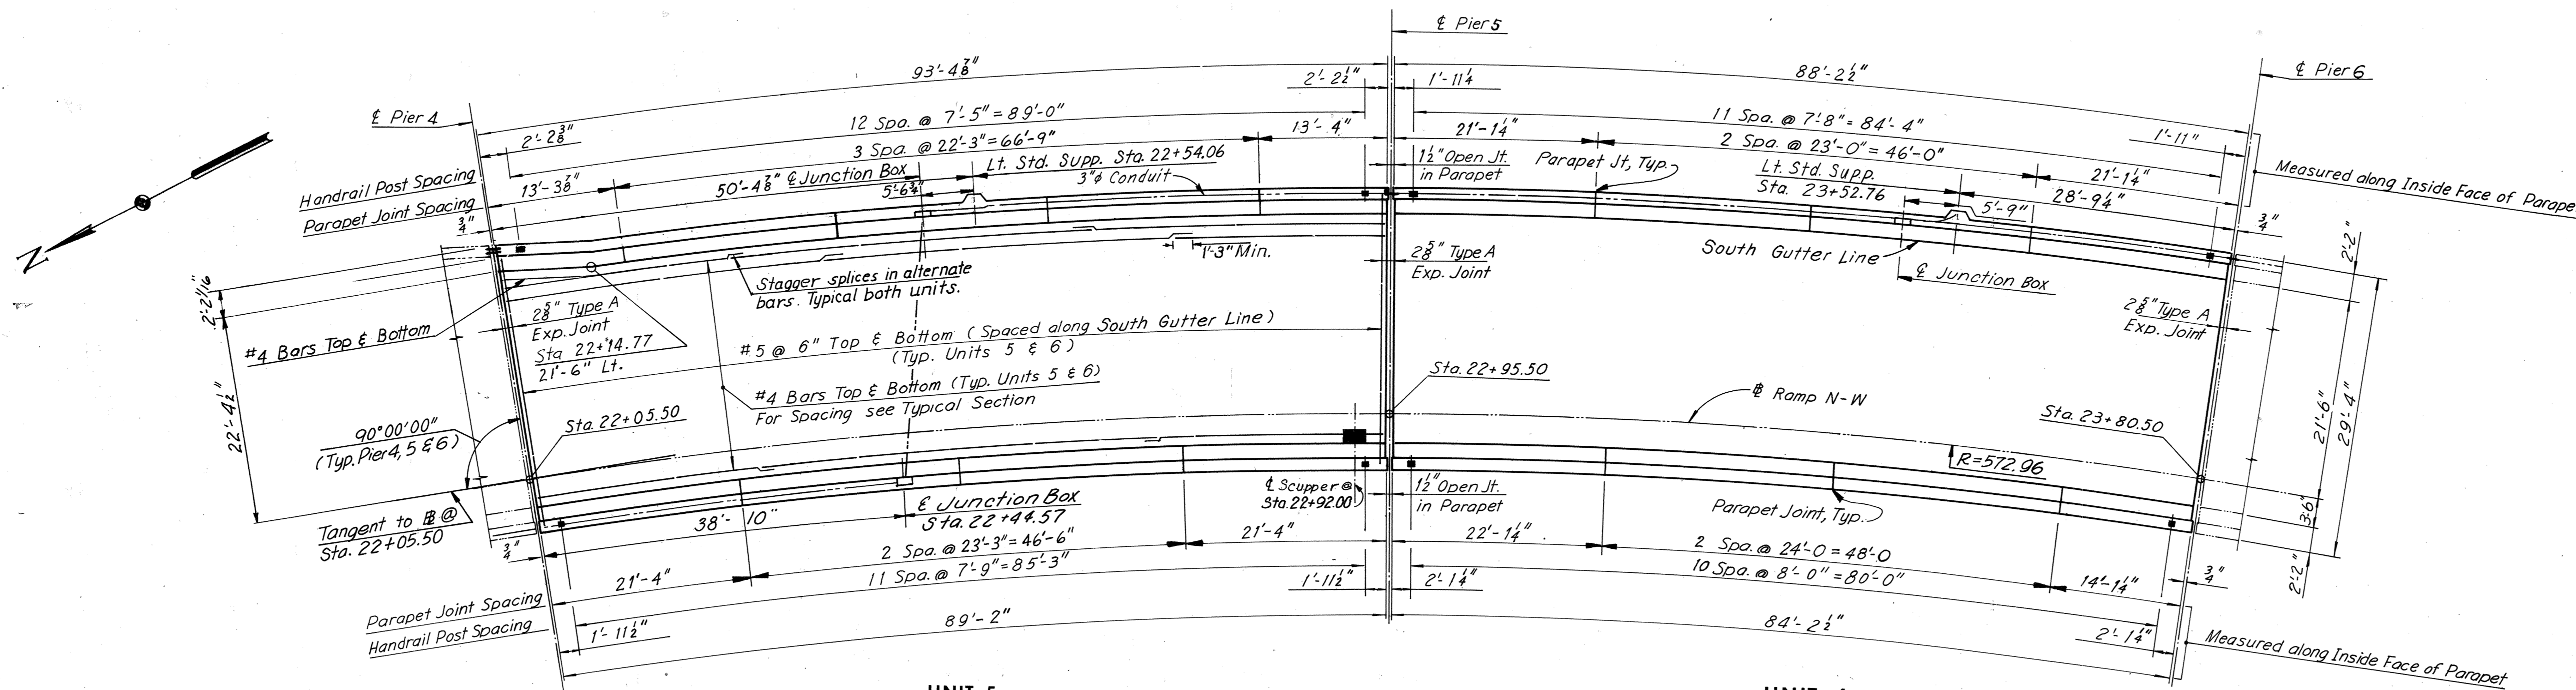


DECK PLAN
Scale: 1" = 10'-0"

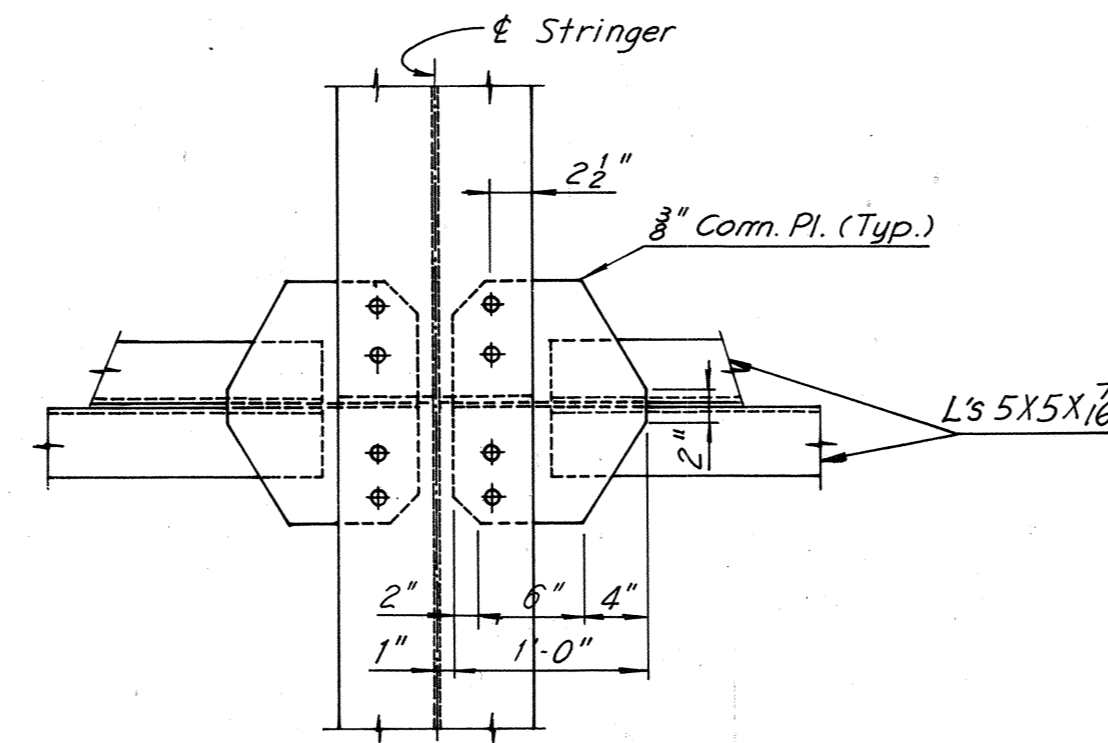


VIEW B-B
Scale: 1" = 1'-0"

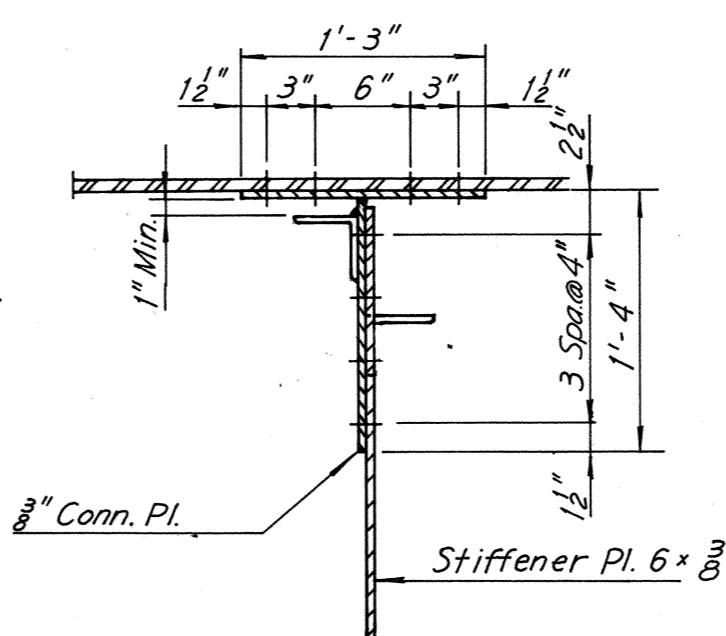


SECTION A-A
Scale: 1" = 1'-0"

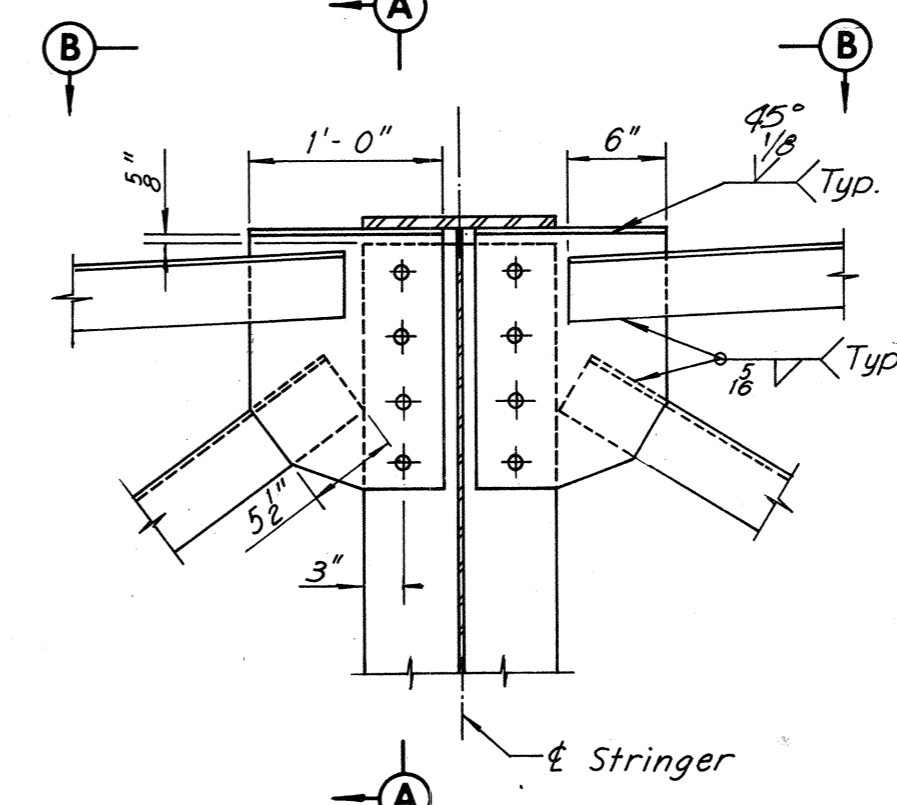

DETAIL A
Scale: 1" = 1'-0"

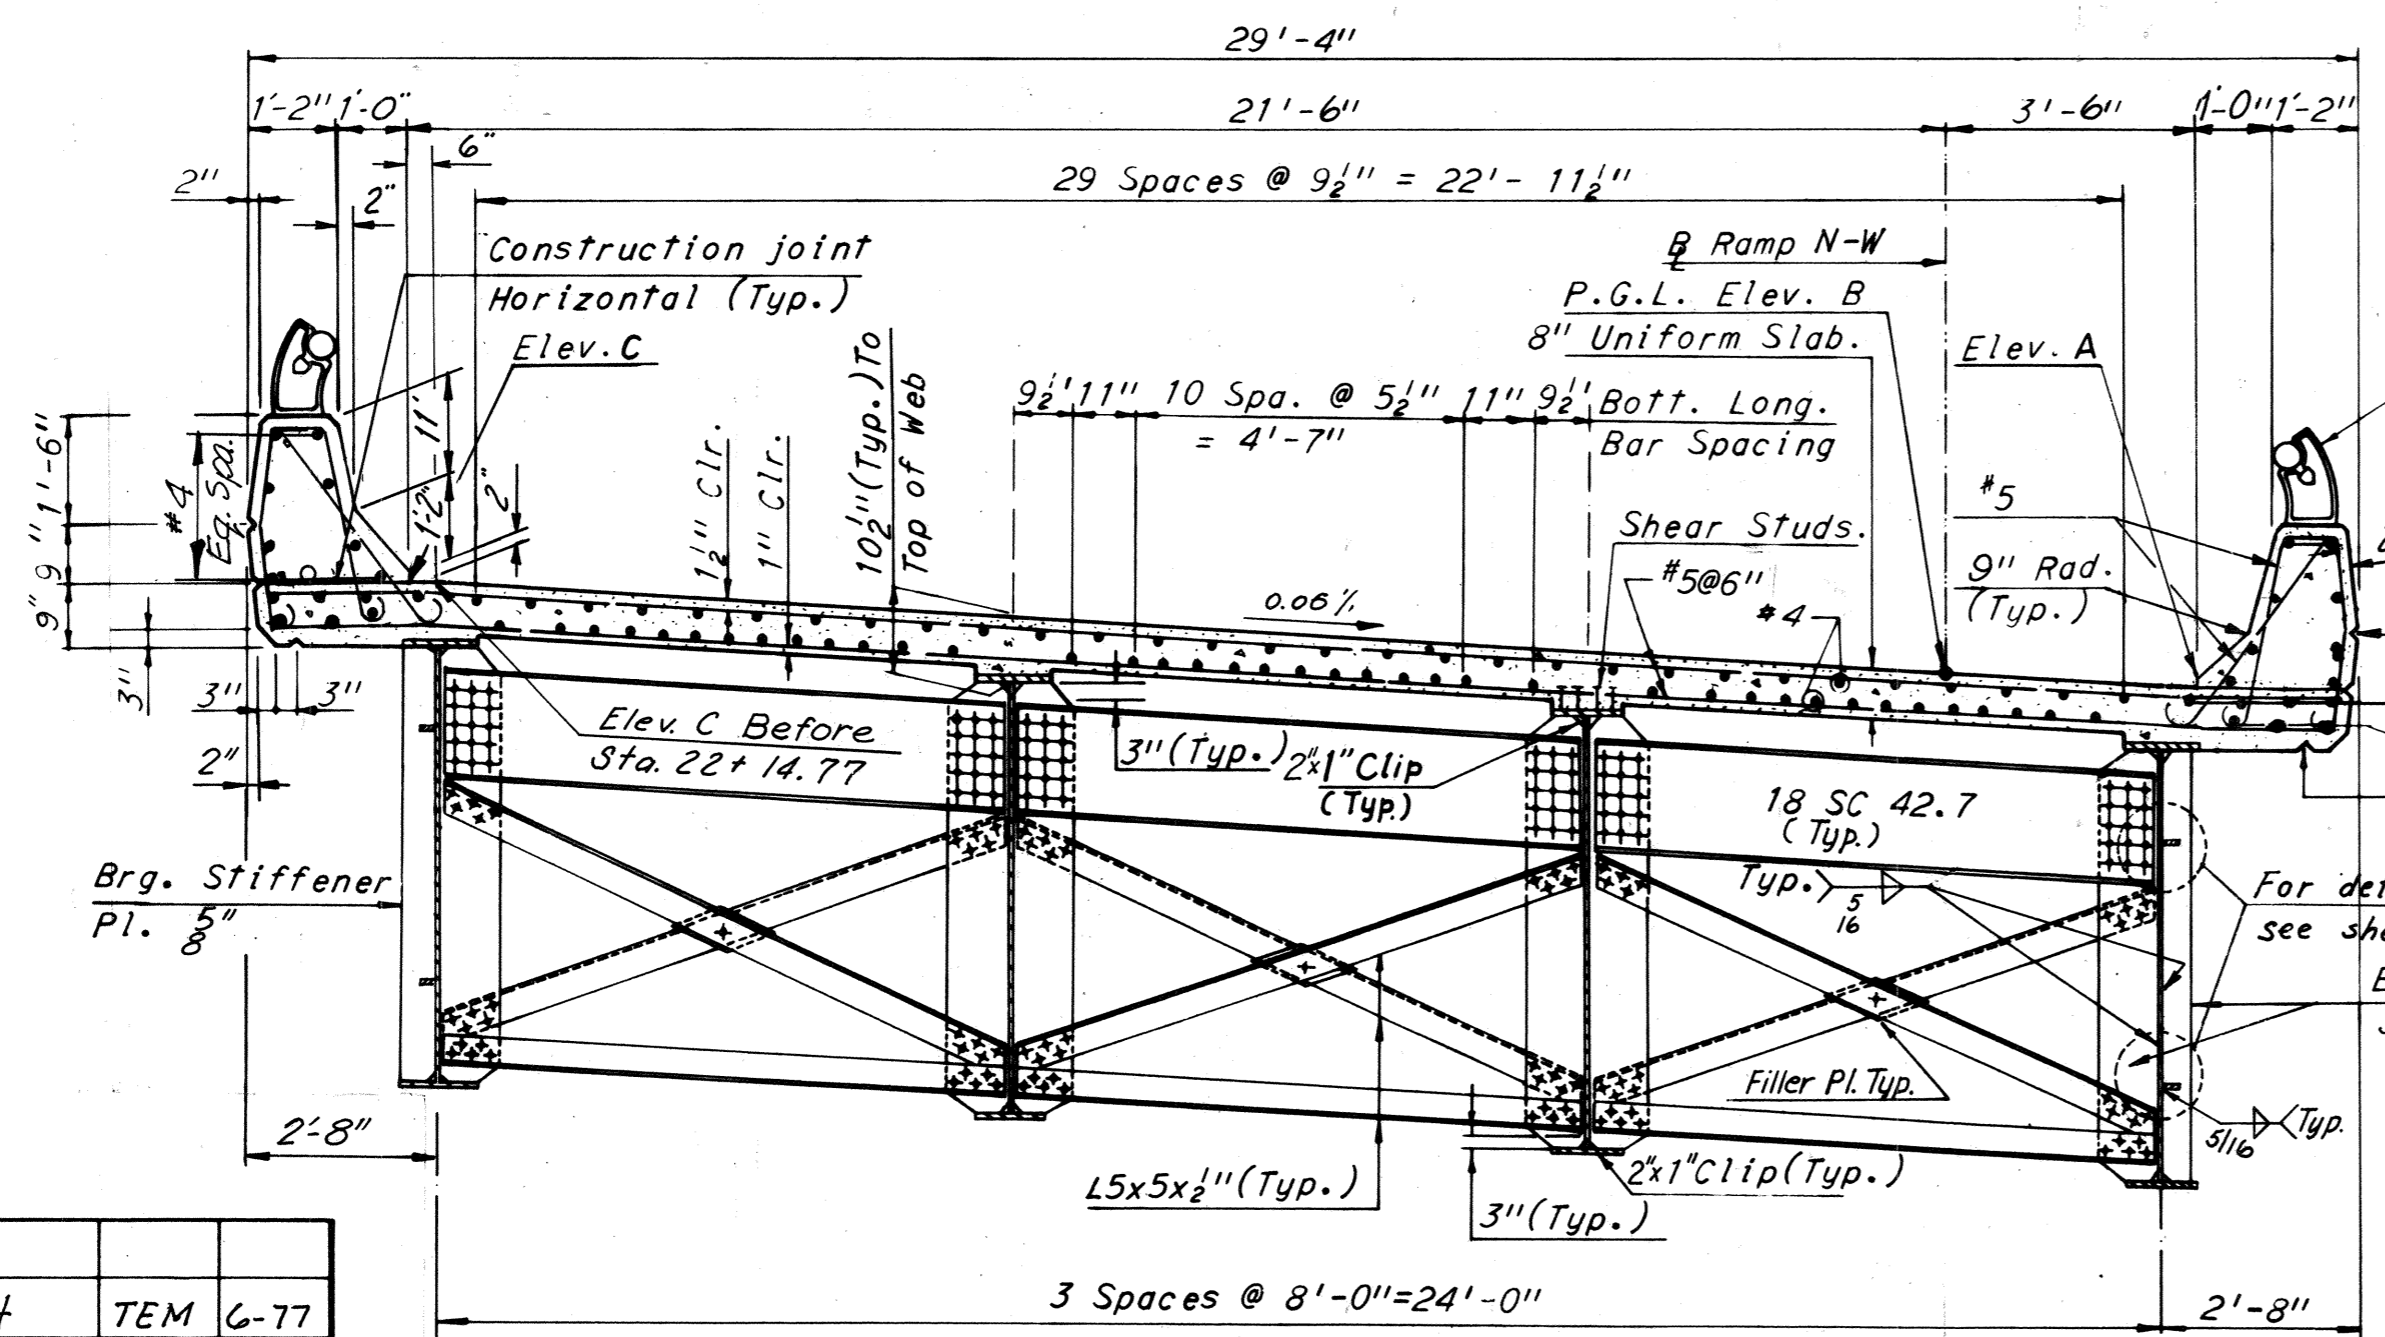

TYPICAL SECTION-END DIAPHRAGM
Scale: 3/8" = 1'-0"

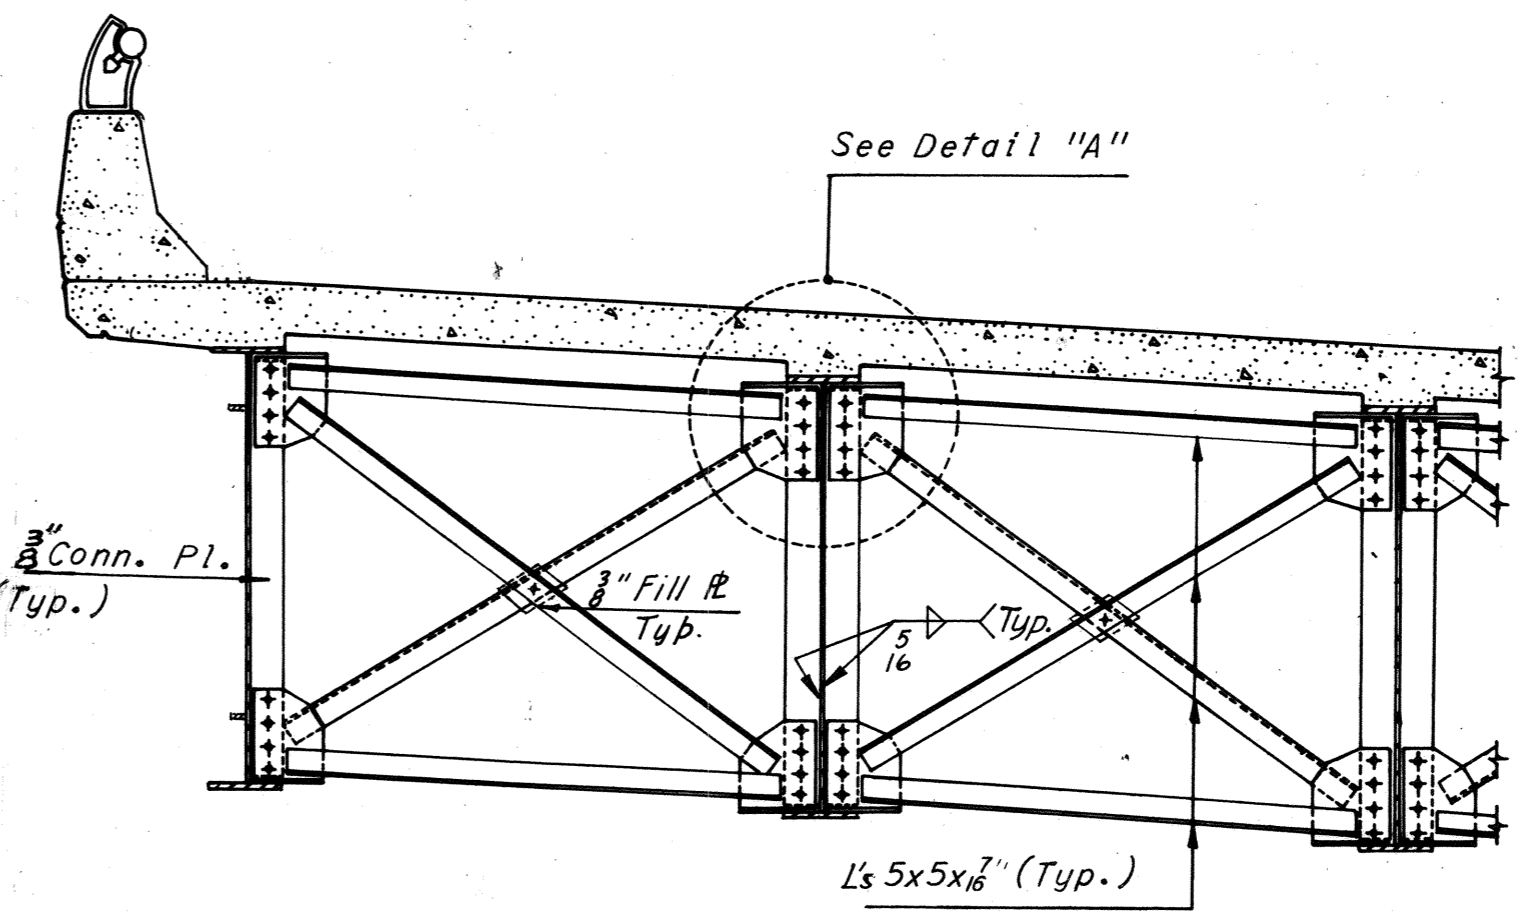

INTERMEDIATE DIAPHRAGM
Scale: 3/8" = 1'-0"

Notes:
For Joint Details, see Sheet 26.
For Framing Plan, see Sheet 15.
For Steel and Concrete Quantities, see Sheet 2.
For Handrail Details, see Sheet S3.
For Lighting Details, see Sheet S4.
For Standard Drainage Details, see Support Type 3 Sheet S6.

BY	DATE	NO.	REVISION	BY	DATE
MADE	MHH 9-4-68	2	As Built	TEM	6-77
CHECKED	R.C. 10-17-68	1	Deck Elev. Rev.	EJM	10-11-74
IN CHARGE					

RICHMOND METROPOLITAN AUTHORITY
RICHMOND EXPRESSWAY SYSTEM
DOWNTOWN EXPRESSWAY

BRIDGE NO. 64
RAMP N-W CONNECTION FROM
RICHMOND-PETERSBURG TURNPIKE
DECK PLAN-UNITS 5 AND 6







HOWARD, NEEDLES, TAMMEN & BERGENDOFF
consulting engineers
NEW YORK ALEXANDRIA KANSAS CITY

SCALE: *As shown*
CONTRACT NO. **10**
SHEET NO. **21** OF **28**

AS BUILT

RICHMOND EXPRESSWAY SYSTEM			
SECTION	PROJECT	SHEET NO.	TOTAL SHEETS
10	DOWNTOWN EXPRESSWAY	120	265

ELEVATION TABLE			
STATION	ELEV. A	ELEV. B	ELEV. C
23+80.00	86.09	86.30	87.59
+80.50	86.07	86.28	87.57
+90.00	85.62	85.83	87.12
24+00.00	85.15	85.36	86.65
+10.00	84.68	84.89	86.18
+20.00	84.21	84.42	85.71
+30.00	83.73	83.94	85.23
+40.00	83.26	83.47	84.76
+50.00	82.79	83.00	84.29
+60.00	82.32	82.53	83.82
+60.50	82.29	82.50	83.79
+70.00	81.85	82.06	83.35
+80.00	81.37	81.58	82.87
+90.00	80.90	81.11	82.40
25+00.00	80.43	80.64	81.93
+10.00	79.96	80.17	81.46
+20.00	79.49	79.70	80.99
+30.00	79.01	79.22	80.51
+39.50	78.57	78.78	80.07
+40.00	78.54	78.75	80.04

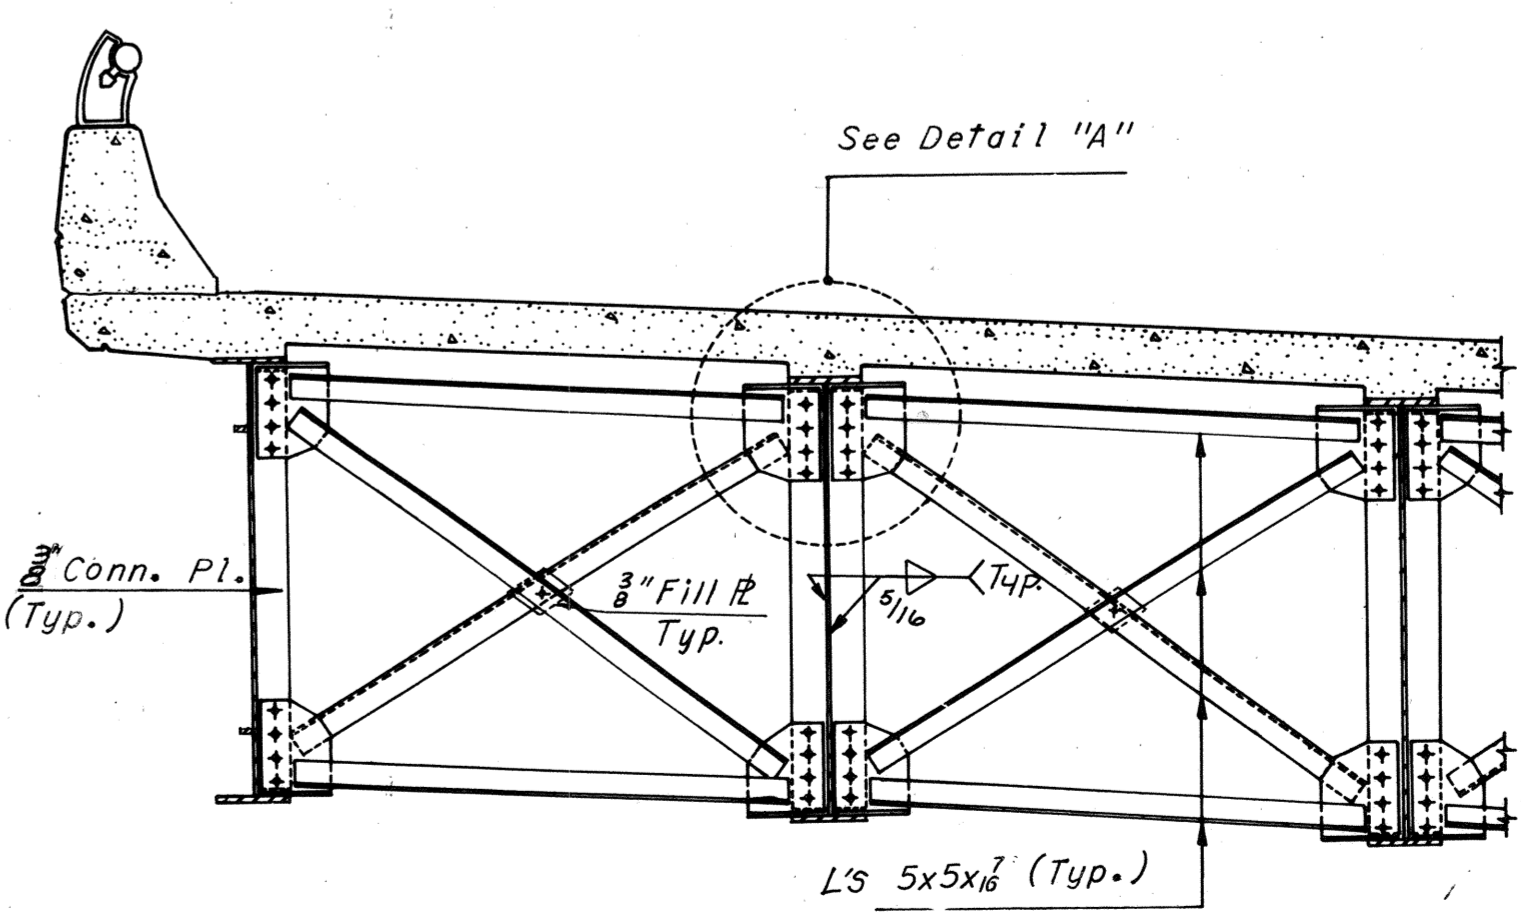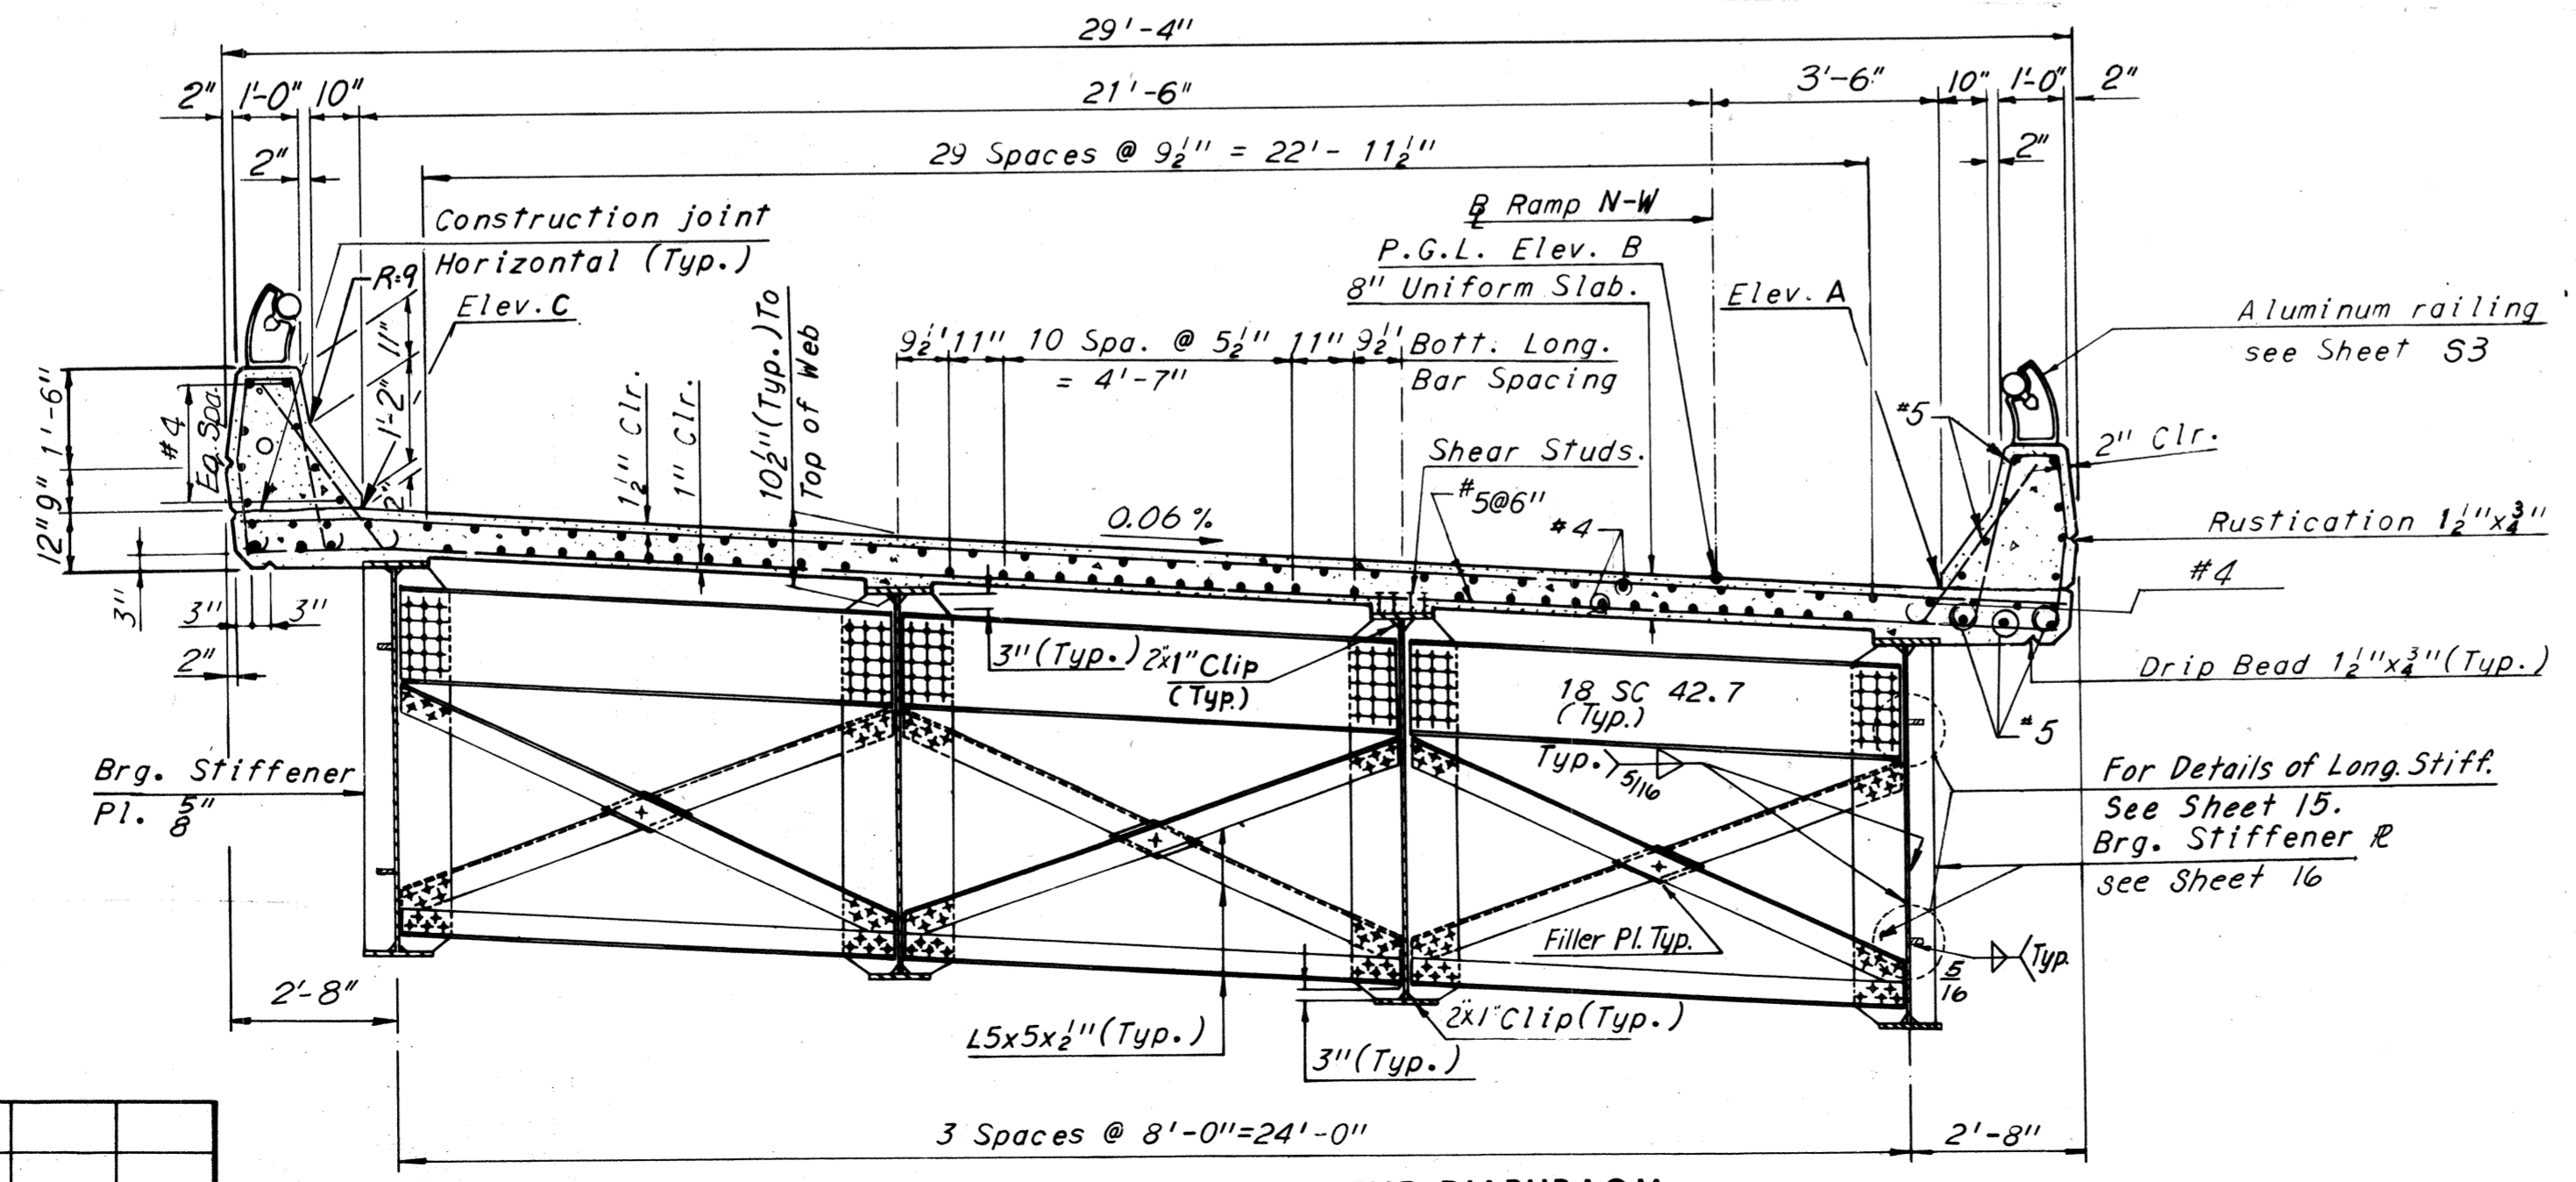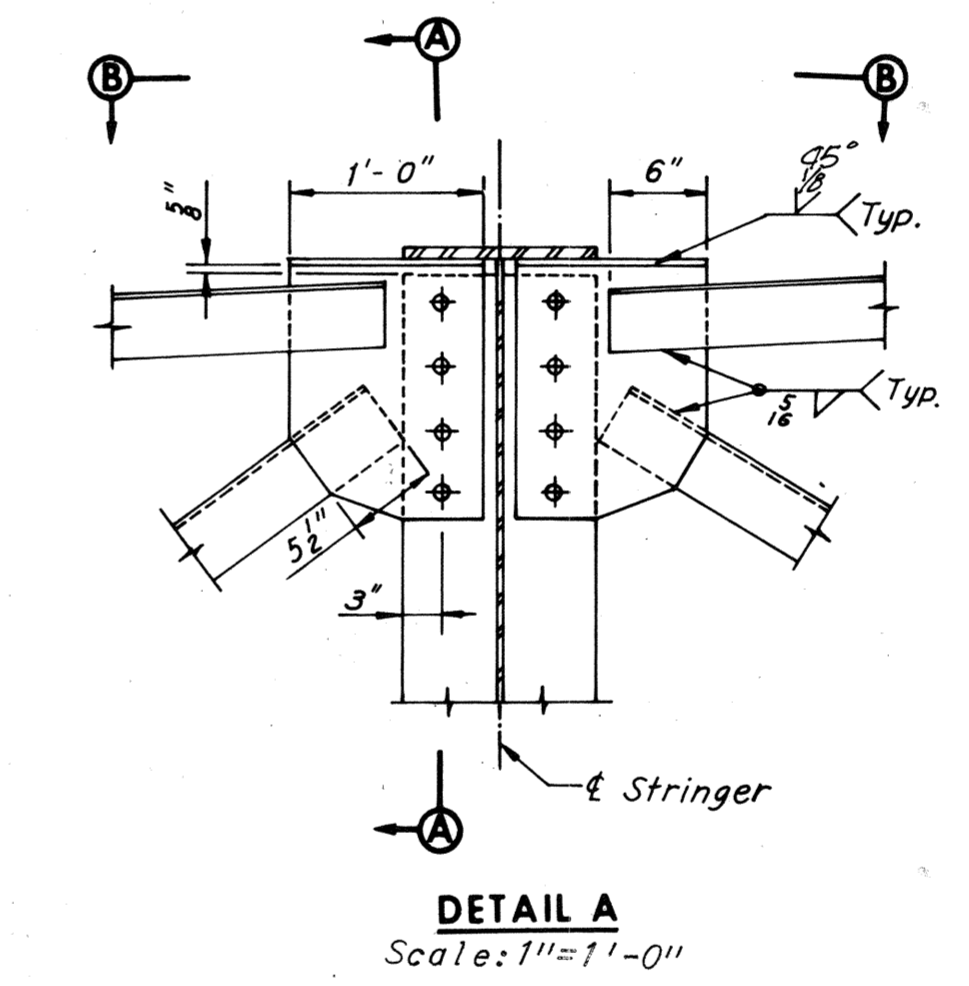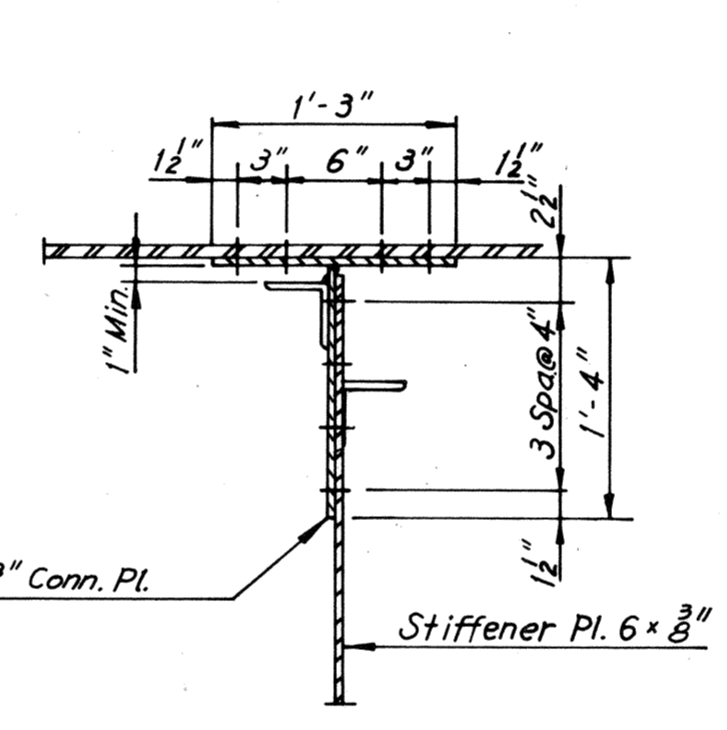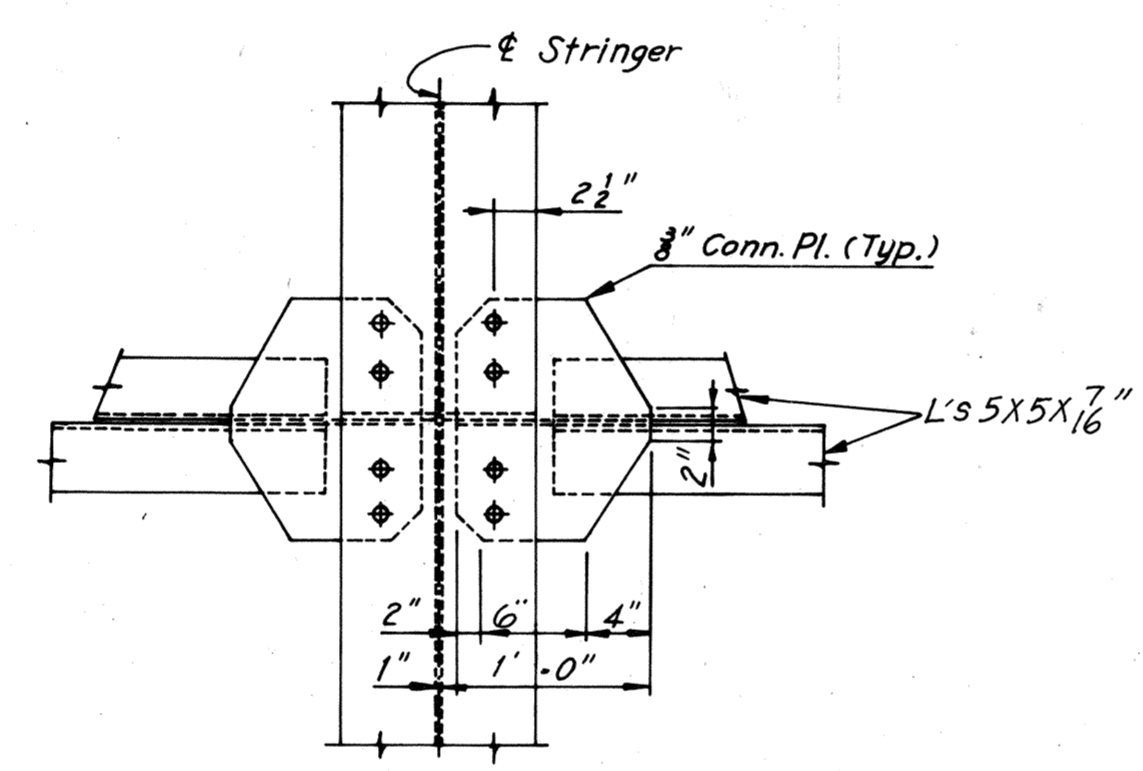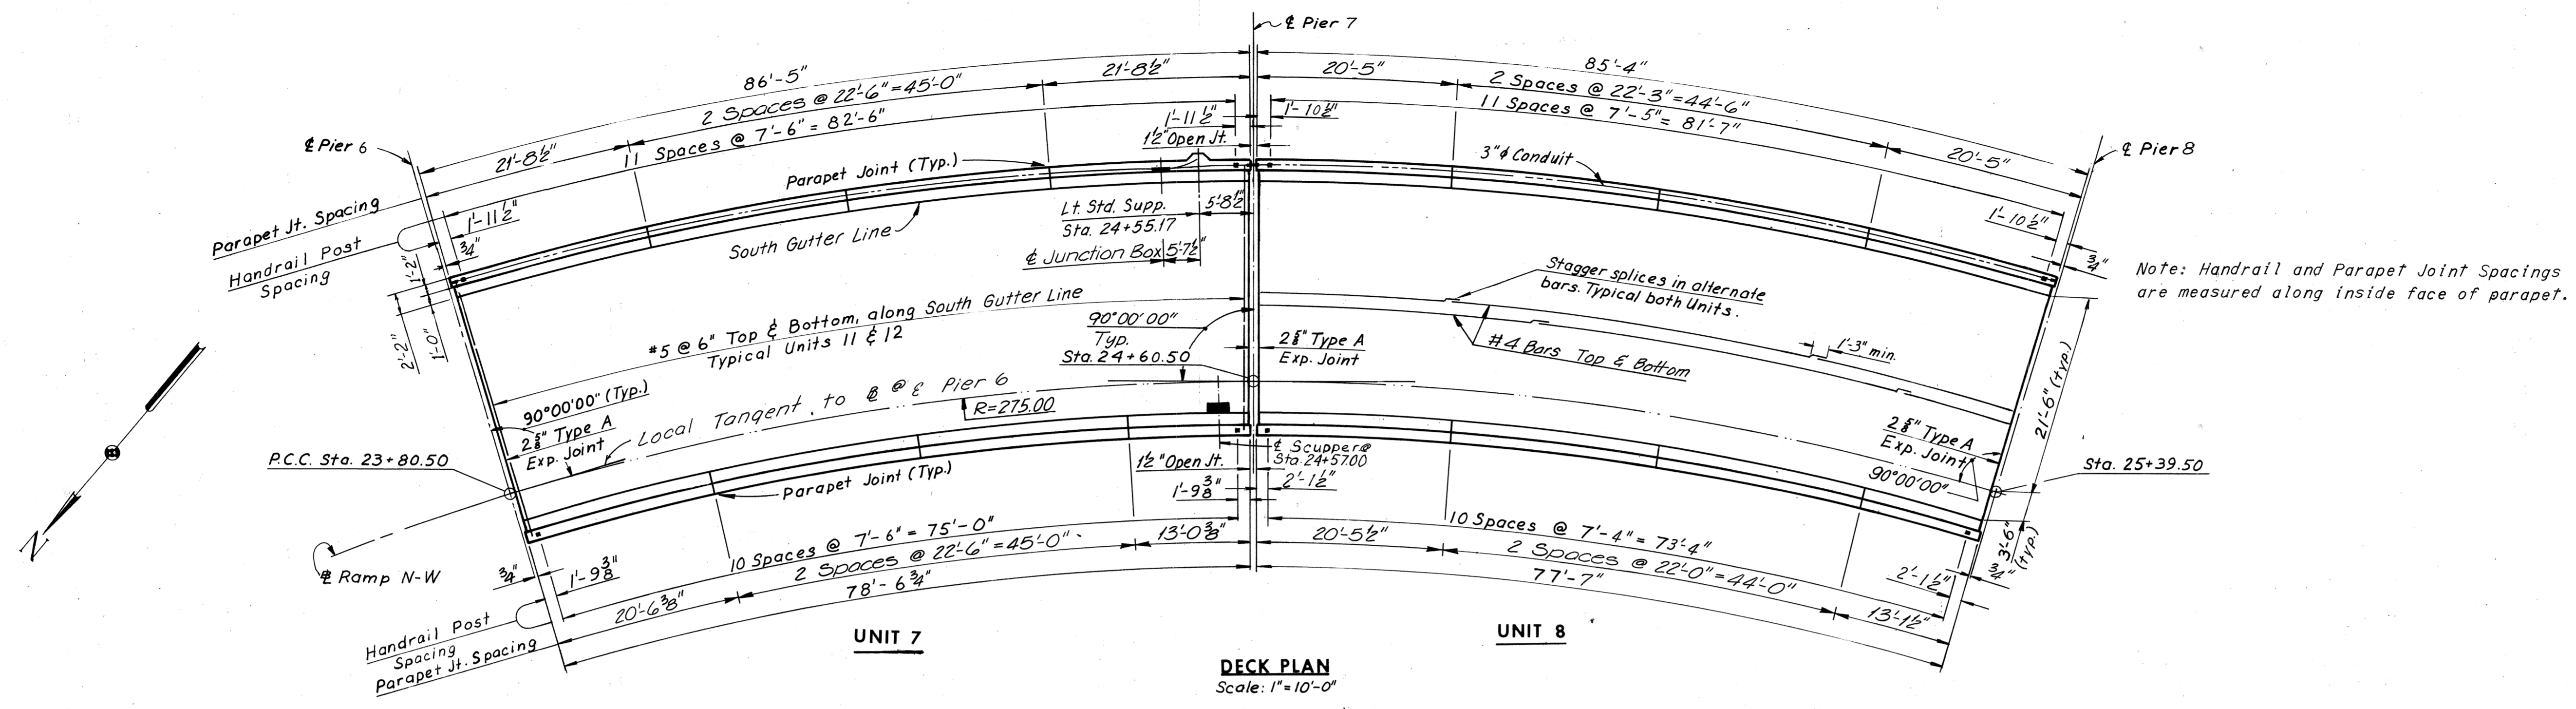

Notes:
 For Joint Details, see Sheet 26.
 For Framing Plan, see Sheet 16.
 For Steel and Concrete Quantities, see Sheet 2.
 For Handrail Details, see Sheet S3.
 For Lighting Details, see Sheet S4.
 For Standard Drainage Details, see Support Type 3 Sheet S6.

RICHMOND METROPOLITAN AUTHORITY
RICHMOND EXPRESSWAY SYSTEM
DOWNTOWN EXPRESSWAY

BRIDGE NO. 64
RAMP N-W CONNECTION FROM
RICHMOND-PETERSBURG TURNPIKE
DECK PLAN UNITS 7 AND 8


SCALE: *As shown*
 HOWARD, NEEDLES, TAMMEN & BERGENDOFF
 consulting engineers
 NEW YORK ALEXANDRIA KANSAS CITY
 CONTRACT NO. 10
 SHEET NO. 22 28

BY	DATE	NO.	REVISION	BY	DATE
MADE	J.D. 8-20-68				
CHECKED	R.C. 10-17-68	1	As Built	TEM	6-77
IN CHARGE					

AS BUILT


RICHMOND EXPRESSWAY SYSTEM			
SECTION	PROJECT	SHEET NO.	TOTAL SHEETS
10	DOWNTOWN EXPRESSWAY	121	265

ELEVATION TABLE			
STATION	ELEV. A	ELEV. B	ELEV. C
25+30.00	79.01	79.22	80.51
25+39.50	78.57	78.78	80.07
25+40.00	78.54	78.75	80.04
25+50.00	78.07	78.28	79.57
25+60.00	77.60	77.81	79.10
25+70.00	77.13	77.34	78.63
25+80.00	76.65	76.86	78.15
25+90.00	76.18	76.39	77.68
26+00.00	75.71	75.92	77.21
26+10.00	75.24	75.45	76.74
26+20.00	74.77	74.98	76.27
26+30.00	74.29	74.50	75.79
26+39.00	73.87	74.08	75.37
26+40.00	73.82	74.03	75.32
26+50.00	73.35	73.56	74.85
26+60.00	72.89	73.10	74.39
26+70.00	72.46	72.67	73.96
26+80.00	72.06	72.27	73.56
26+90.00	71.68	71.89	73.18
27+00.00	71.33	71.54	72.83
27+10.00	71.02	71.22	72.43
27+20.00	70.75	70.93	72.05
27+30.00	70.49	70.66	71.69
27+40.00	70.27	70.42	71.37
27+50.00	70.07	70.21	71.07
27+60.00	69.90	70.03	70.40
27+65.50	69.82	69.94	70.67
27+70.00	69.76	69.87	70.56

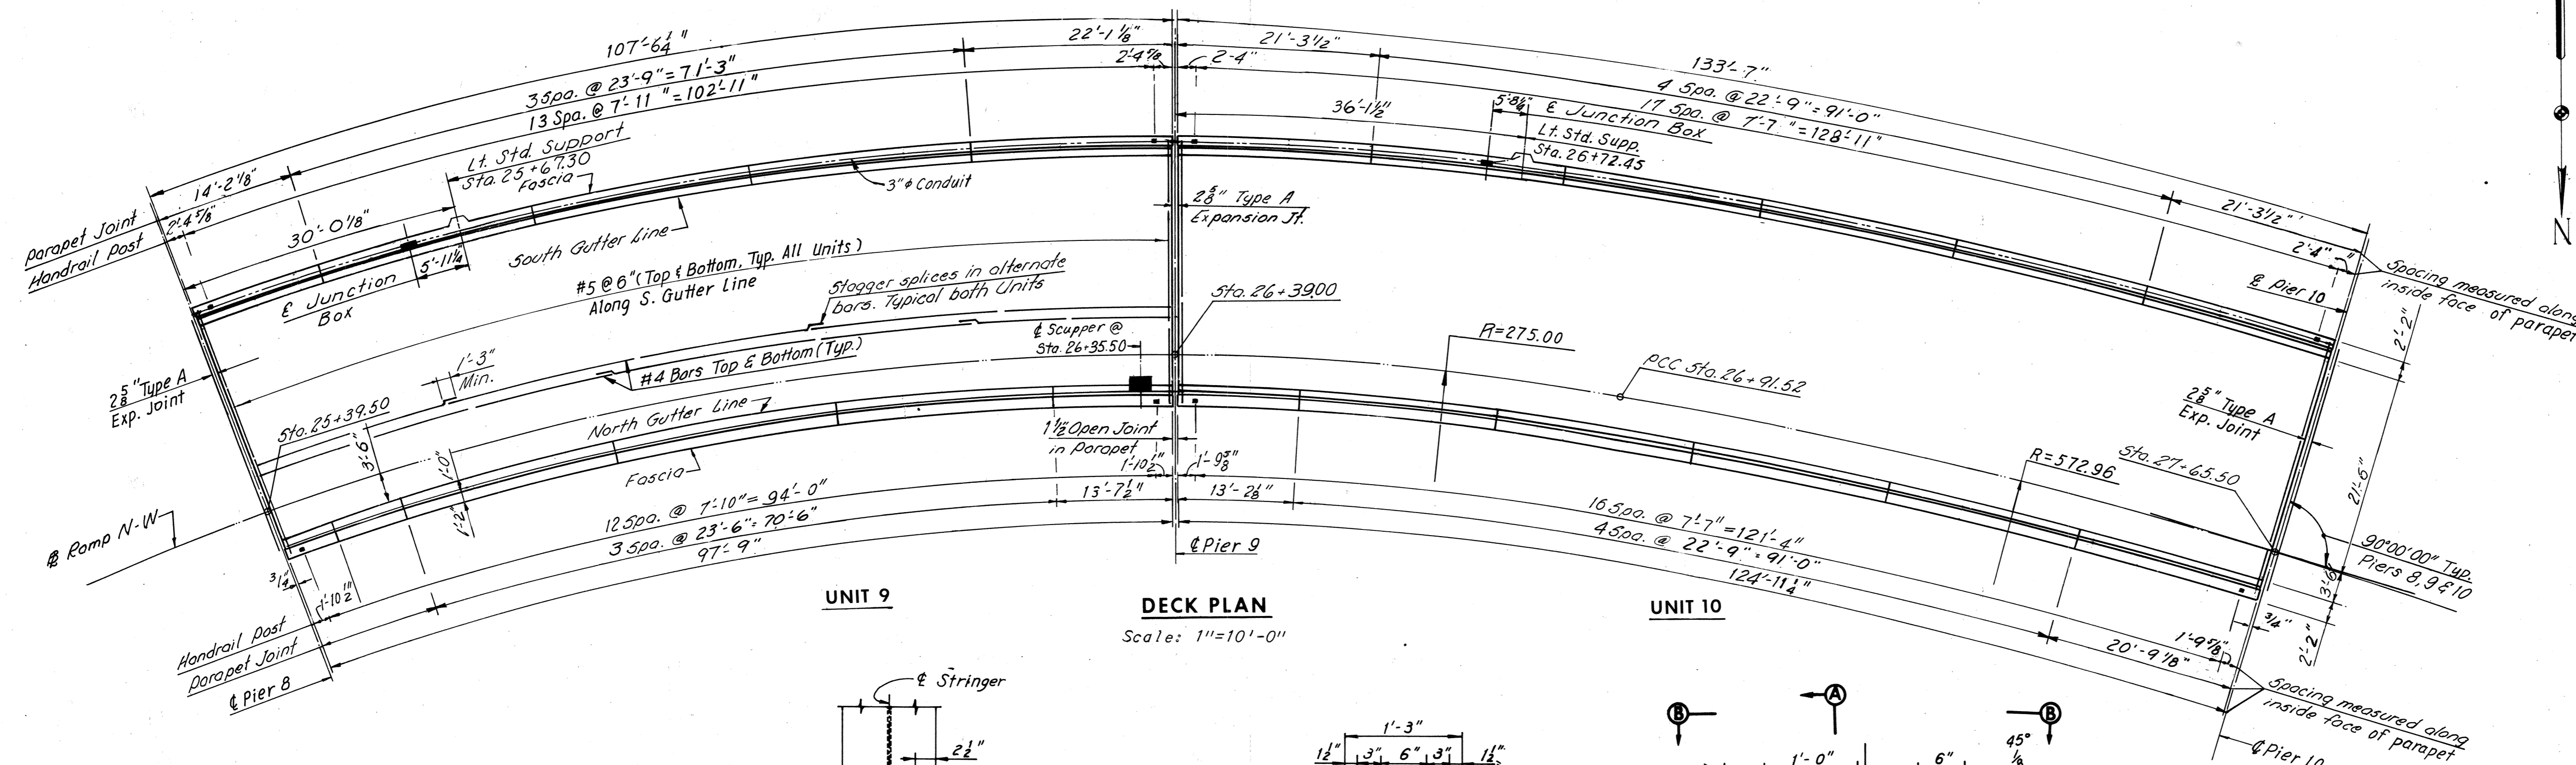


UNIT 9 DECK PLAN
Scale: 1"=10'-0"


UNIT 10 DECK PLAN
Scale: 1"=10'-0"

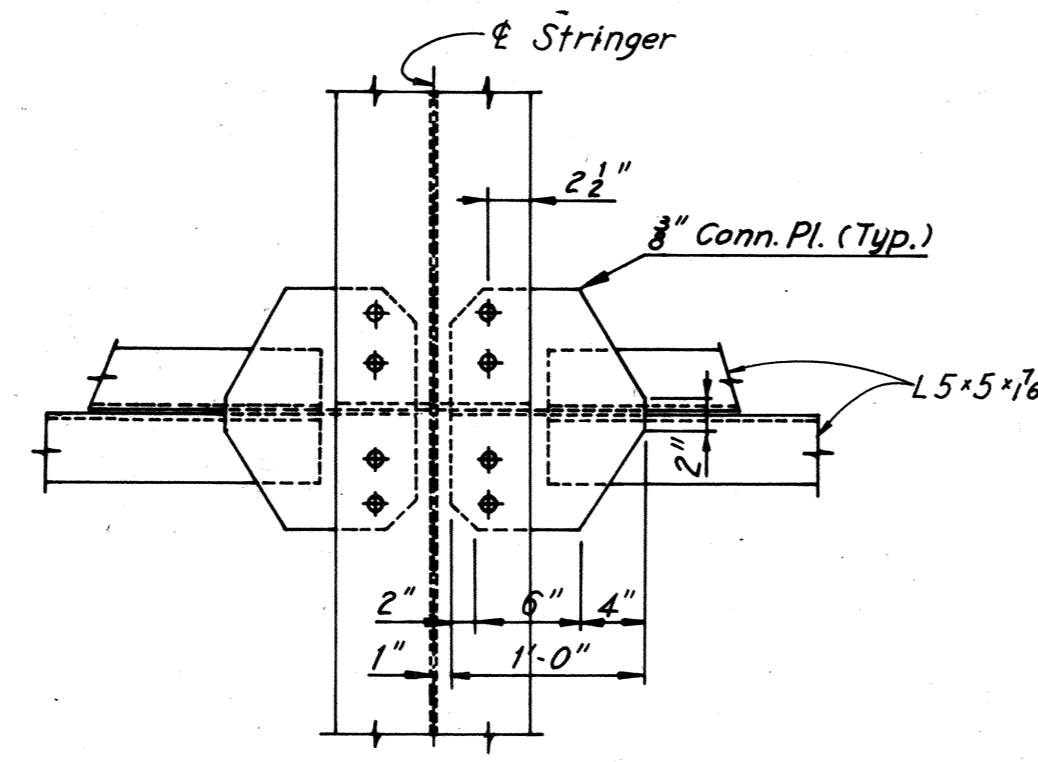


VIEW B-B
Scale: 1"=1'-0"

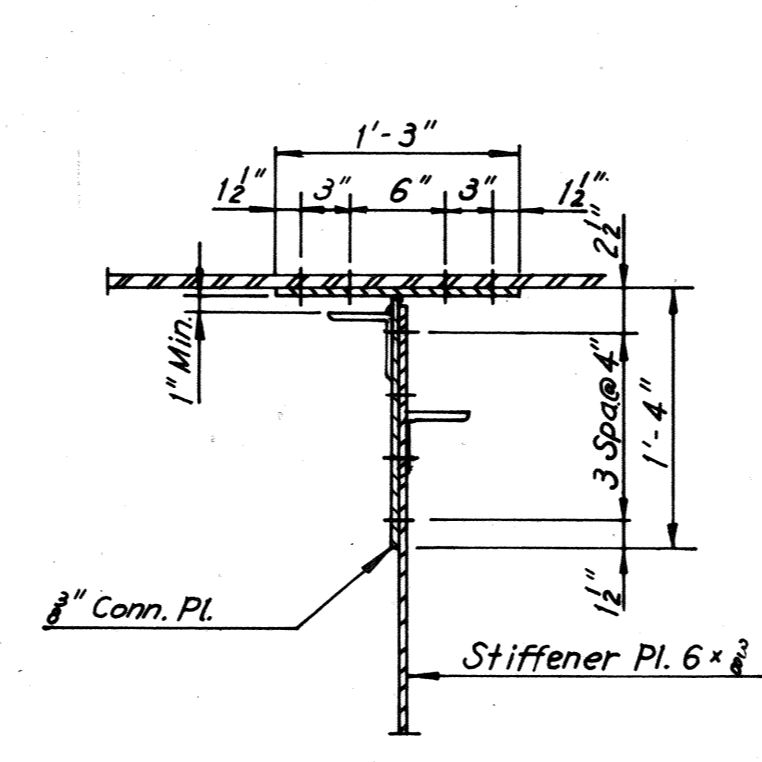

SECTION A-A
Scale: 1"=1'-0"

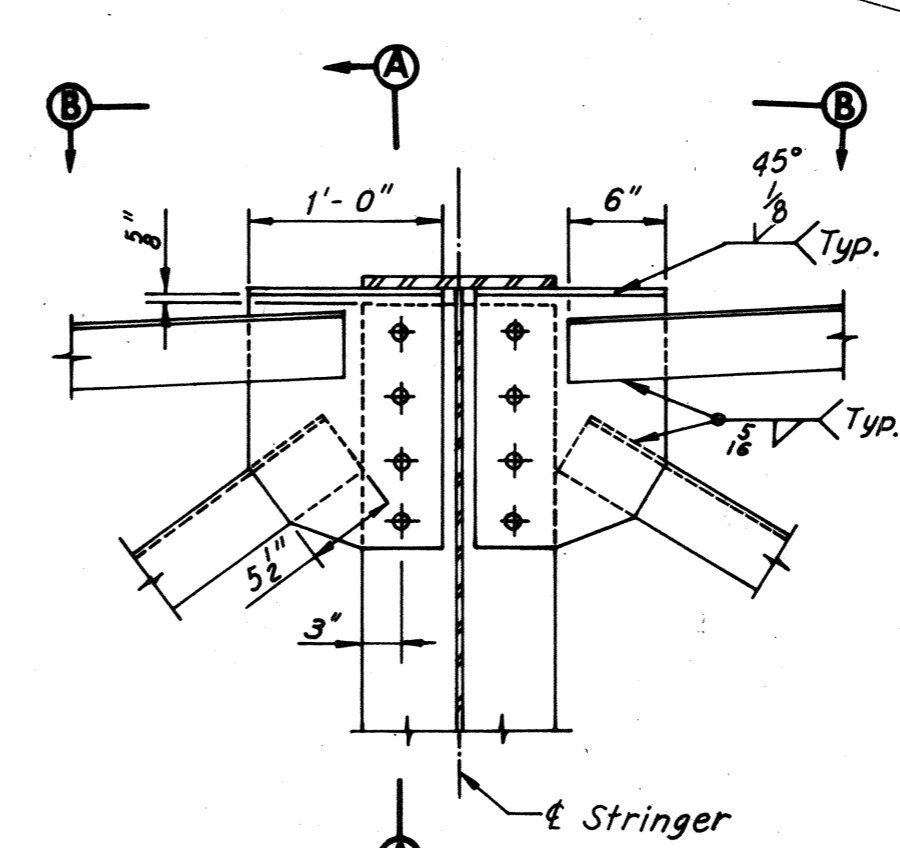

DETAIL A
Scale: 1"=1'-0"

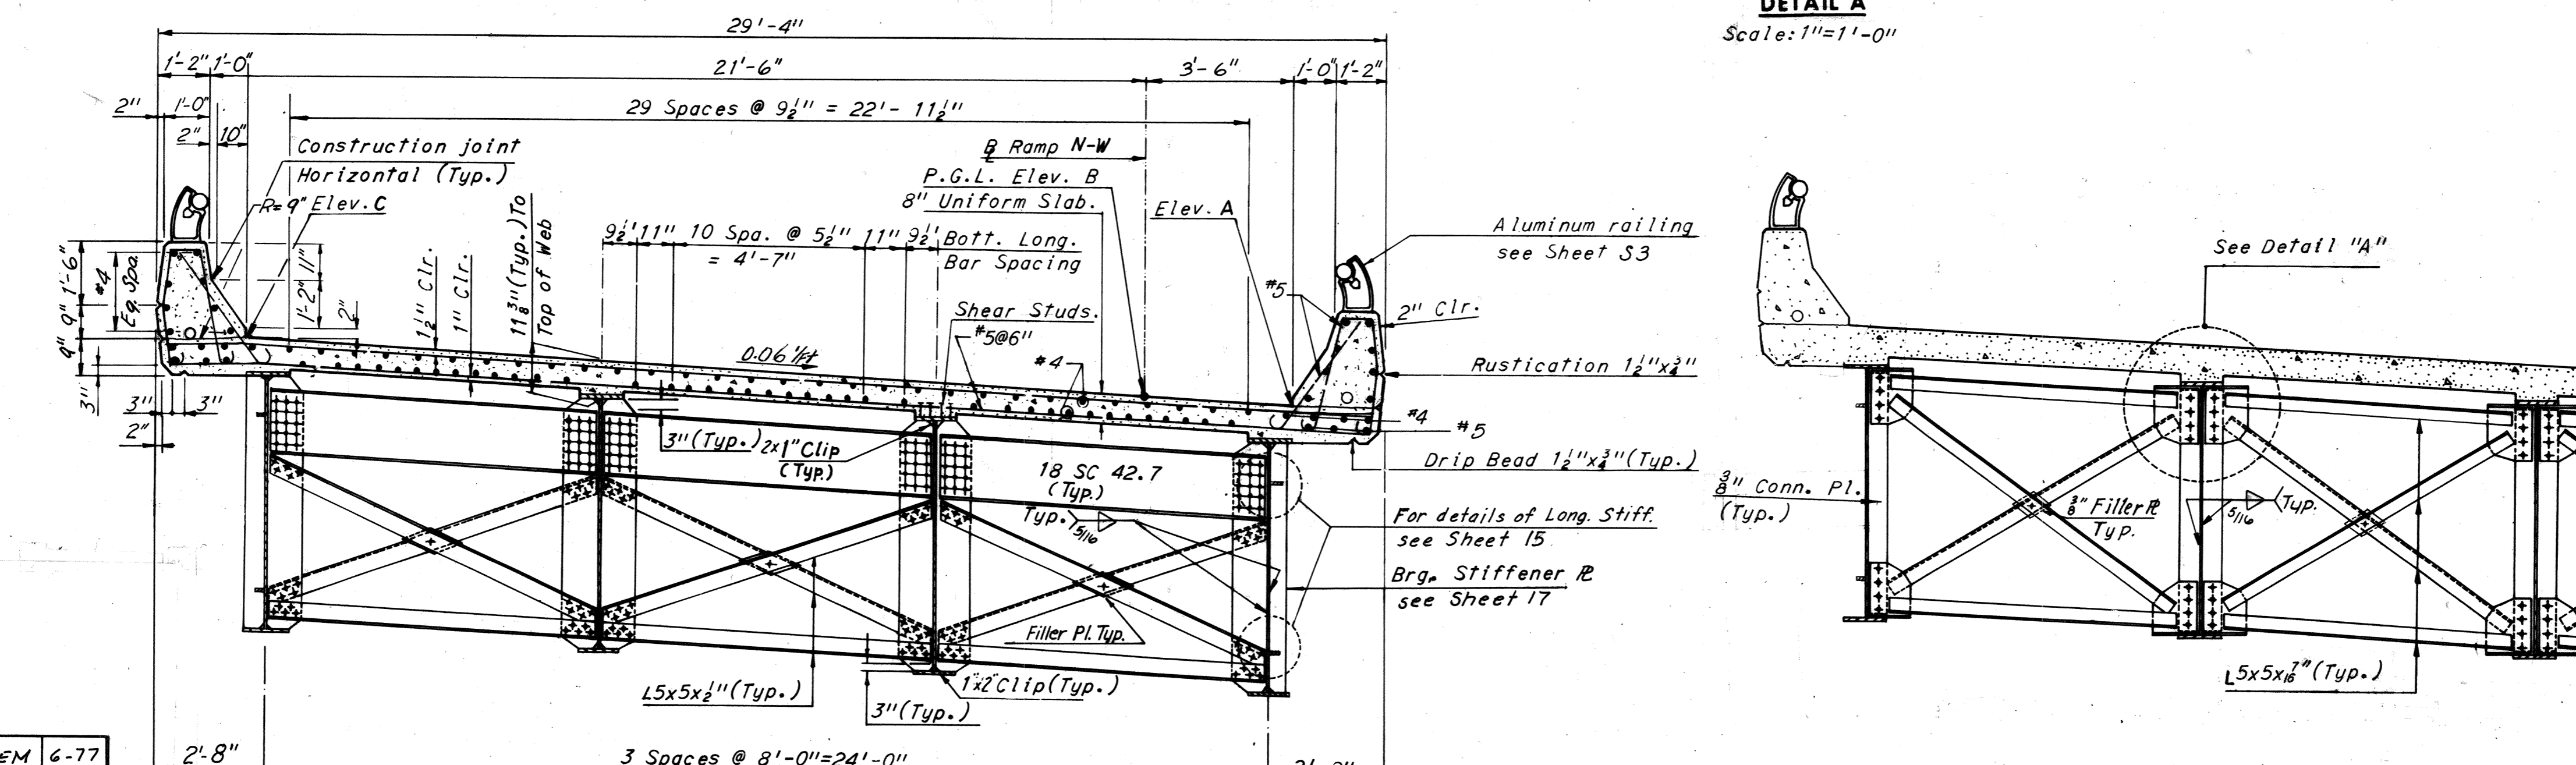

TYPICAL SECTION-END DIAPHRAGM
Scale: 3/8"=1'-0"

INTERMEDIATE DIAPHRAGM
Scale: 3/8"=1'-0"

Notes:
For Joint Details, see Sheet 26.
For Framing Plan, see Sheet 17.
For Steel and Concrete Quantities, see Sheet 2.
For Handrail Details, see Sheet S3.
For Lighting Details, see Sheet S4.
For Standard Drainage Details, see Support Type 3 Sheet S6.

RICHMOND METROPOLITAN AUTHORITY
RICHMOND EXPRESSWAY SYSTEM
DOWNTOWN EXPRESSWAY

BRIDGE NO. 64
RAMP N-W CONNECTION FROM
RICHMOND-PETERSBURG TURNPIKE
DECK PLAN - UNITS 9 AND 10


HOWARD, NEEDLES, TAMMEN & BERGENDOFF
consulting engineers
NEW YORK ALEXANDRIA KANSAS CITY

SCALE: As shown
CONTRACT NO. 10
SHEET NO. 23 OF 28


NO.	REVISION	BY	DATE
2	As Built	TEM	6-77
1	Changed Deck Elev.	EJM	10-11-74
1	Revised Fascia to Stringer Dimension	TEM	10-11-74

AS BUILT


RICHMOND EXPRESSWAY SYSTEM			
SECTION	PROJECT	SHEET NO.	TOTAL SHEETS
10	DOWNTOWN EXPRESSWAY	122	265

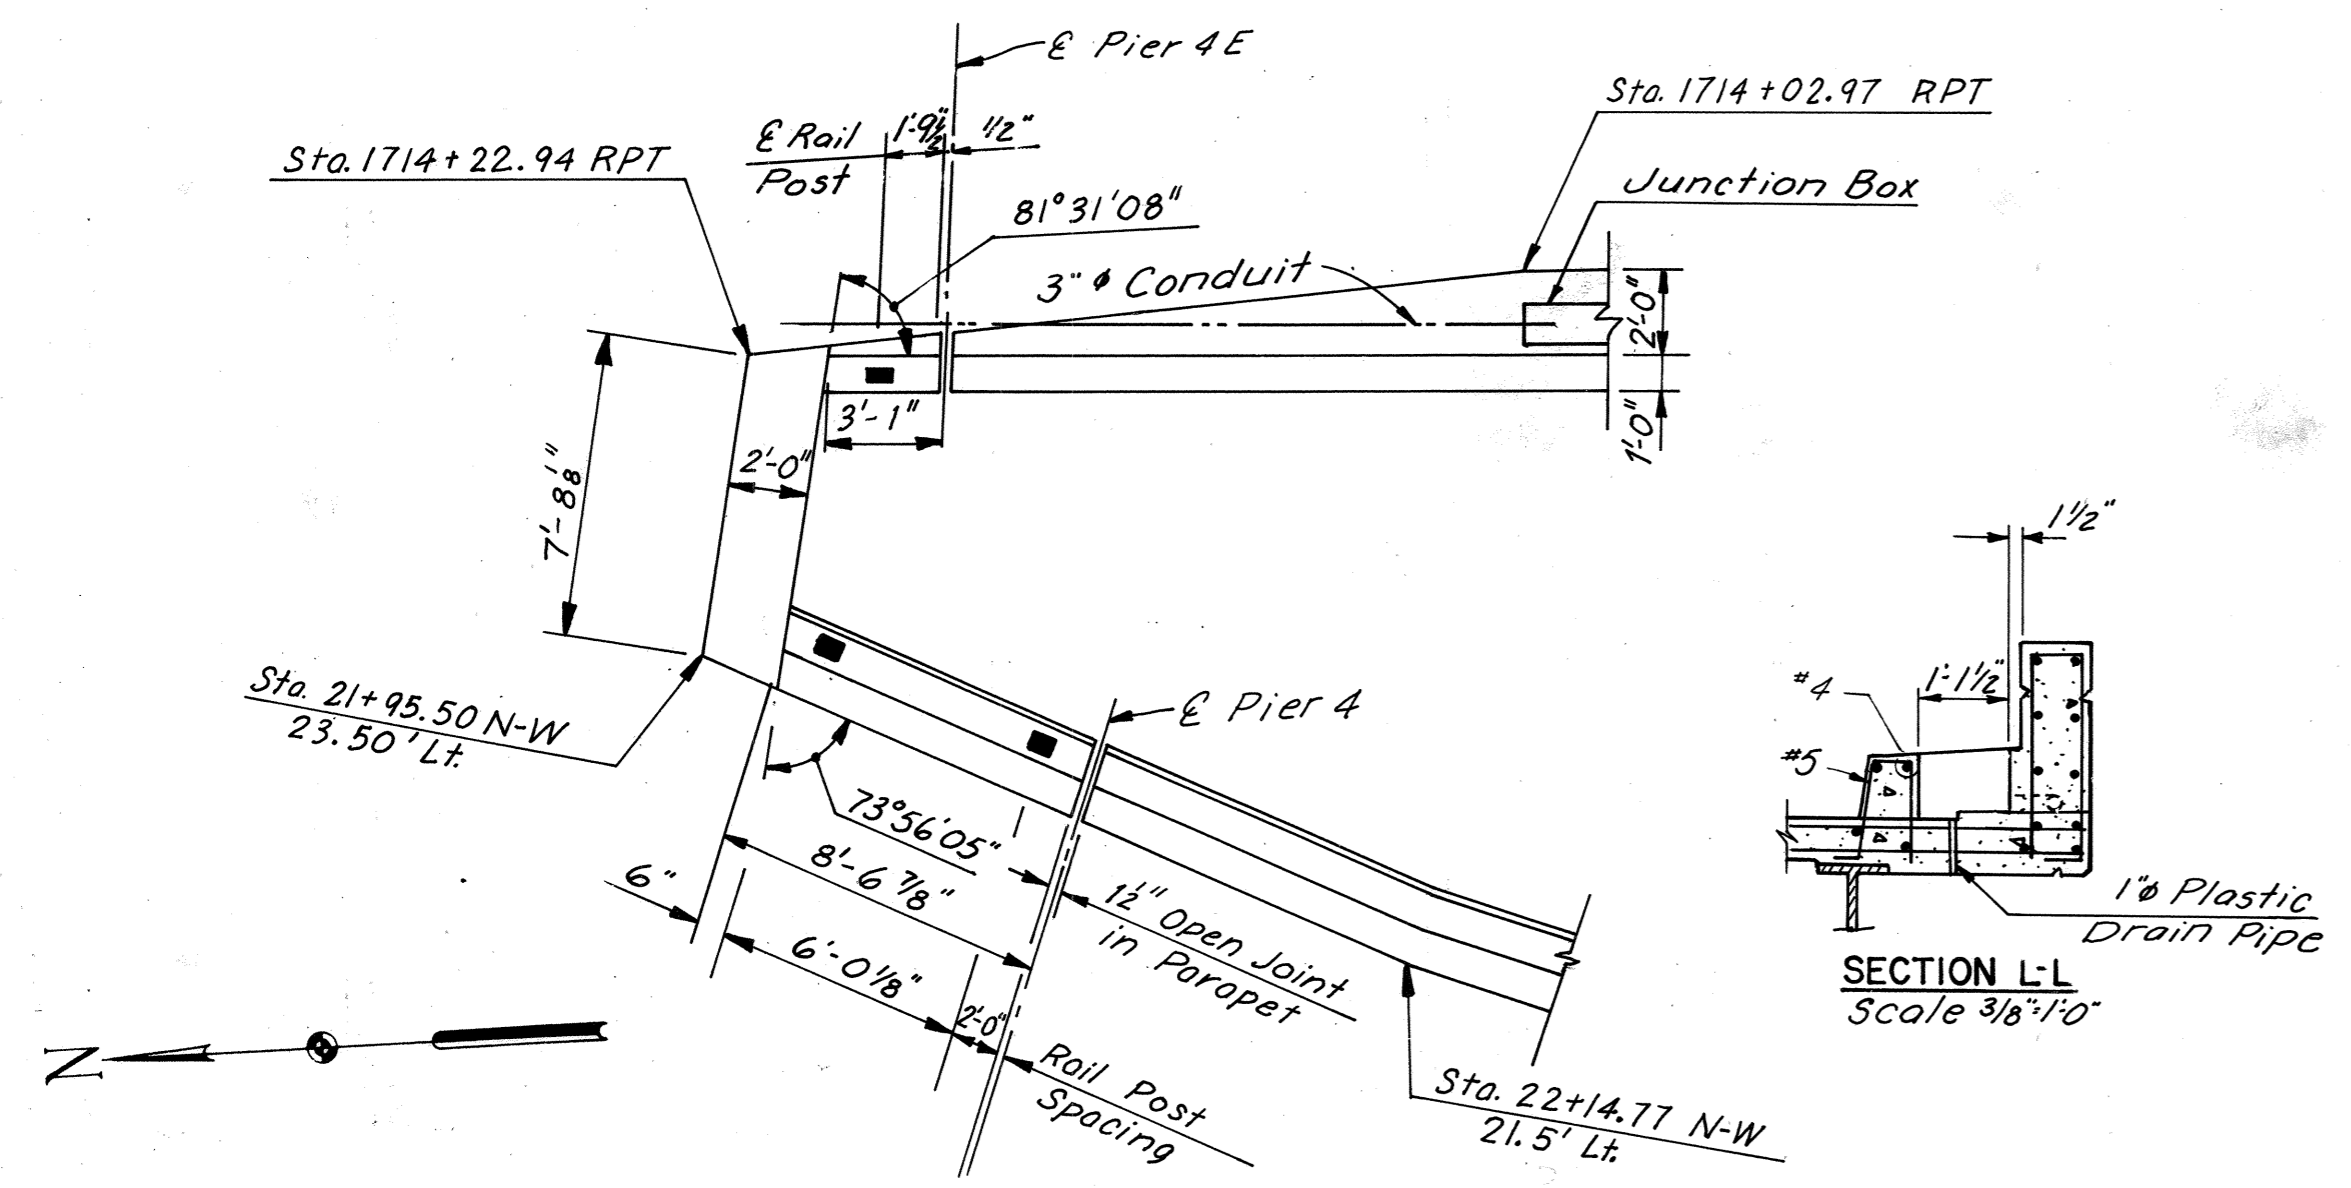


CURB & PARAPET DETAIL
Scale: 1"=5'-0"

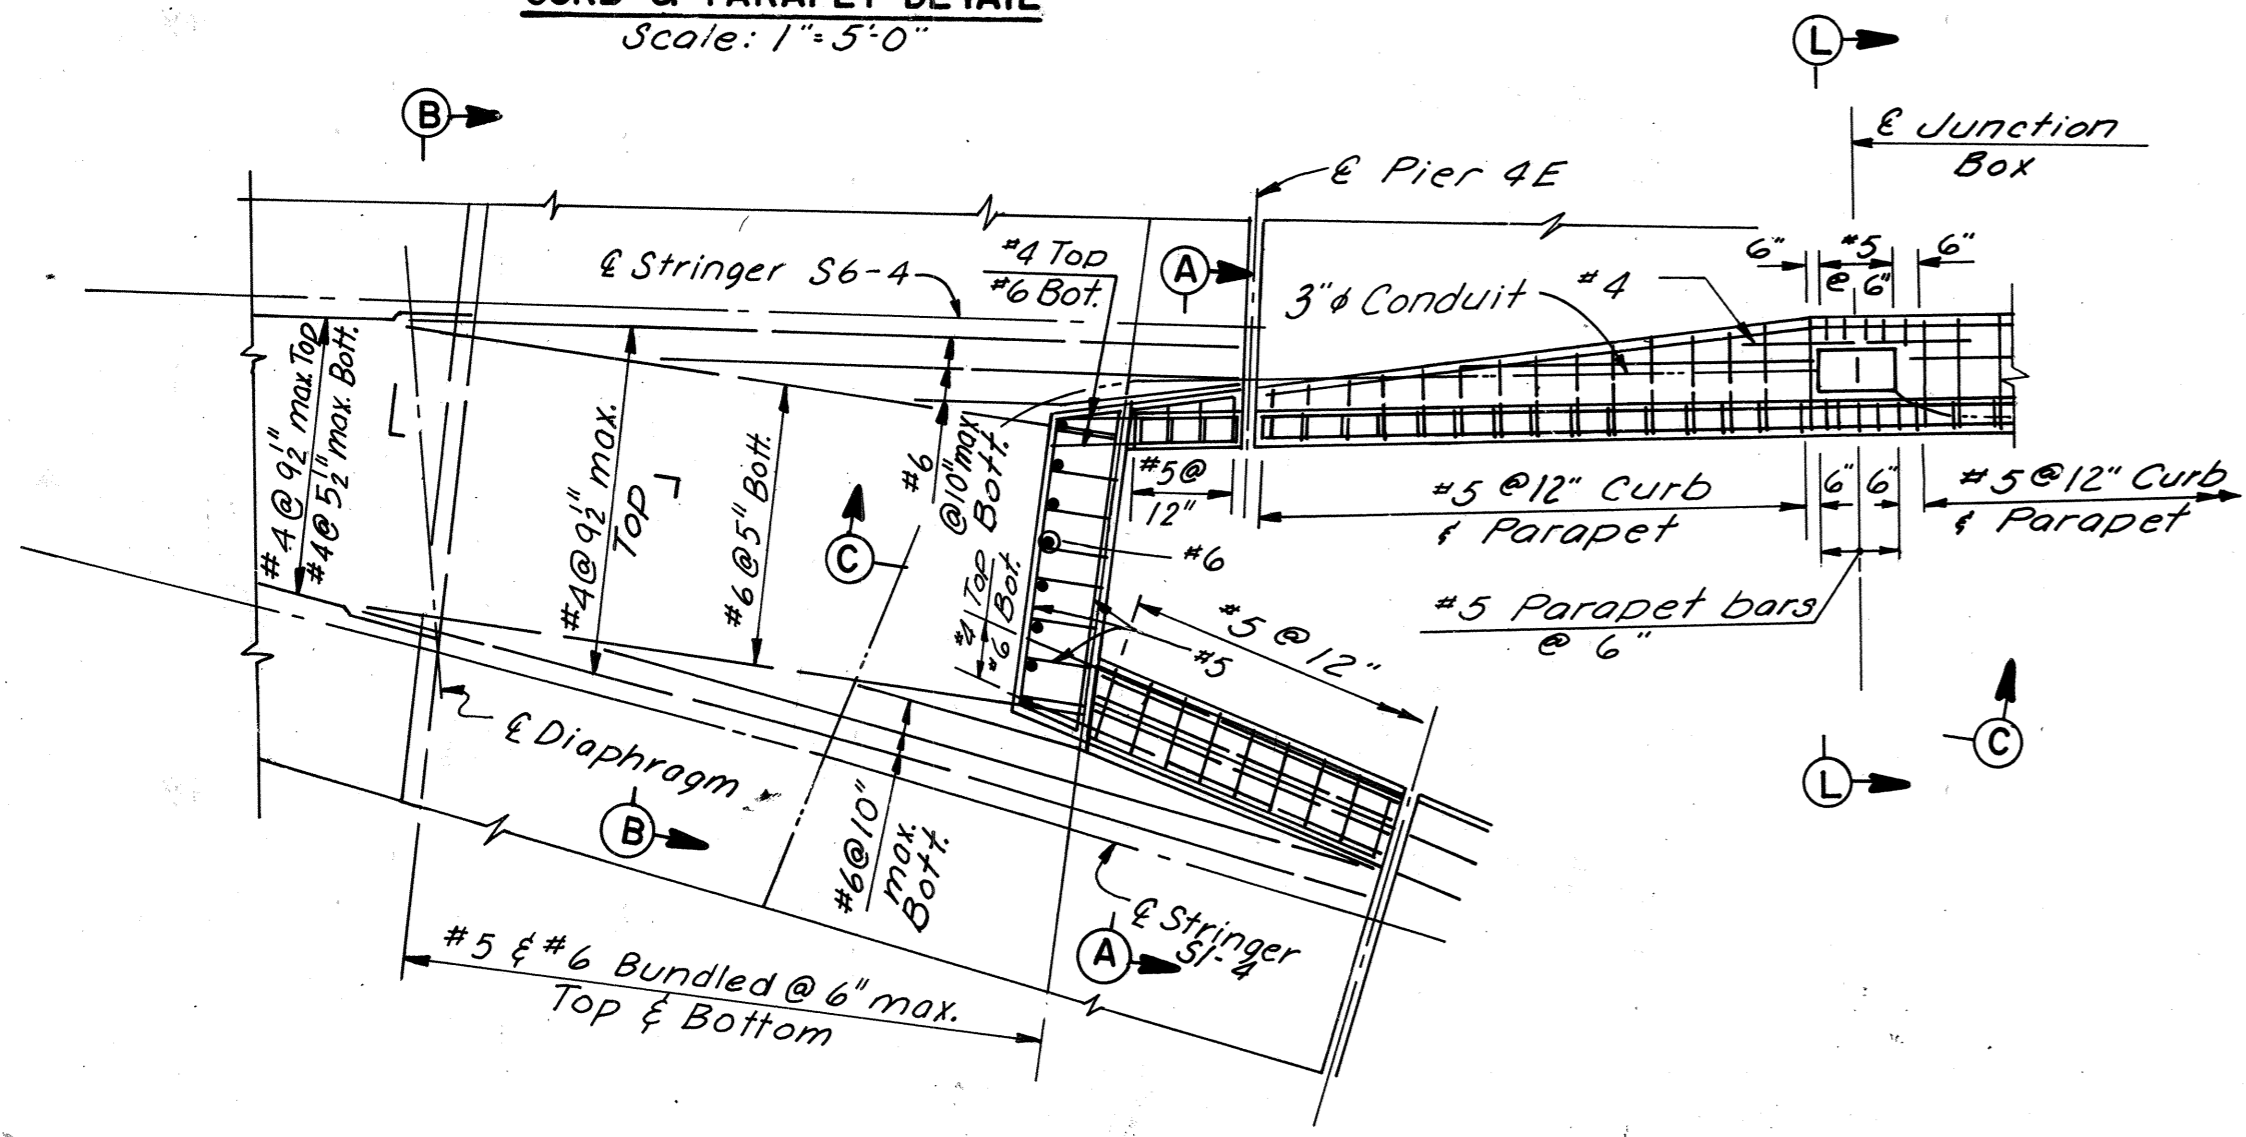


NOSE AND SLAB DETAIL
Scale: 1"=5'-0"

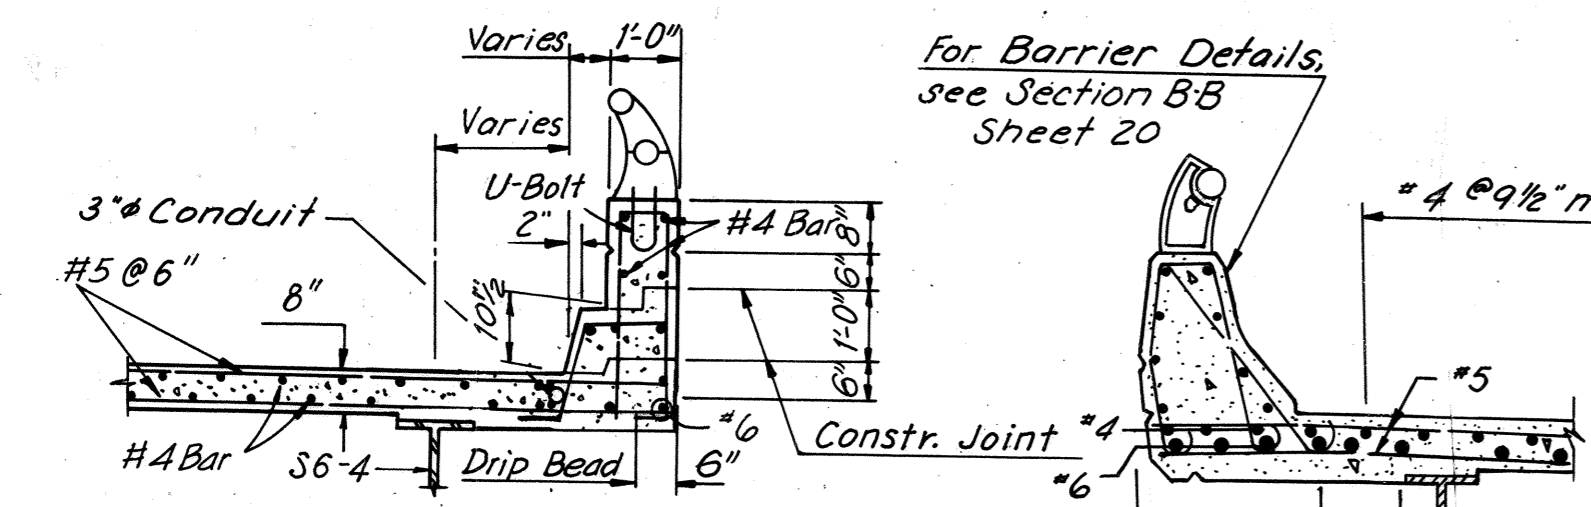


SECTION A-A
Scale: 3/8"=1'-0"

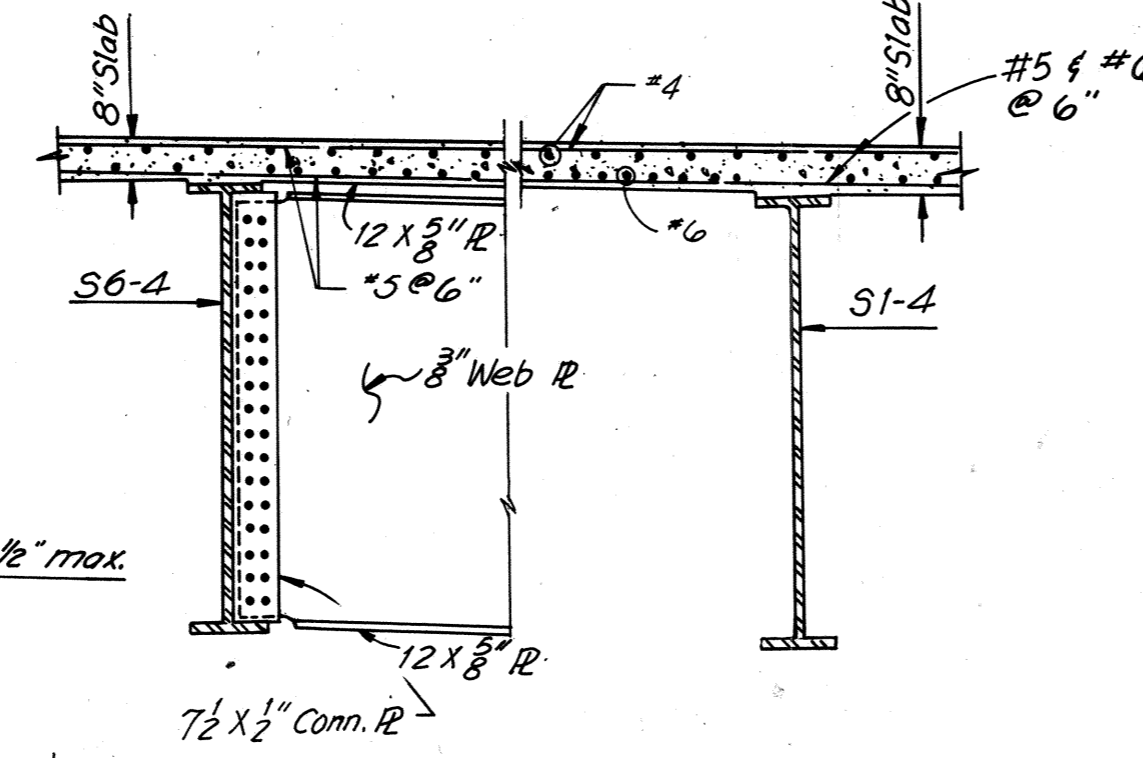


SECTION B-B
Scale: 3/8"=1'-0"

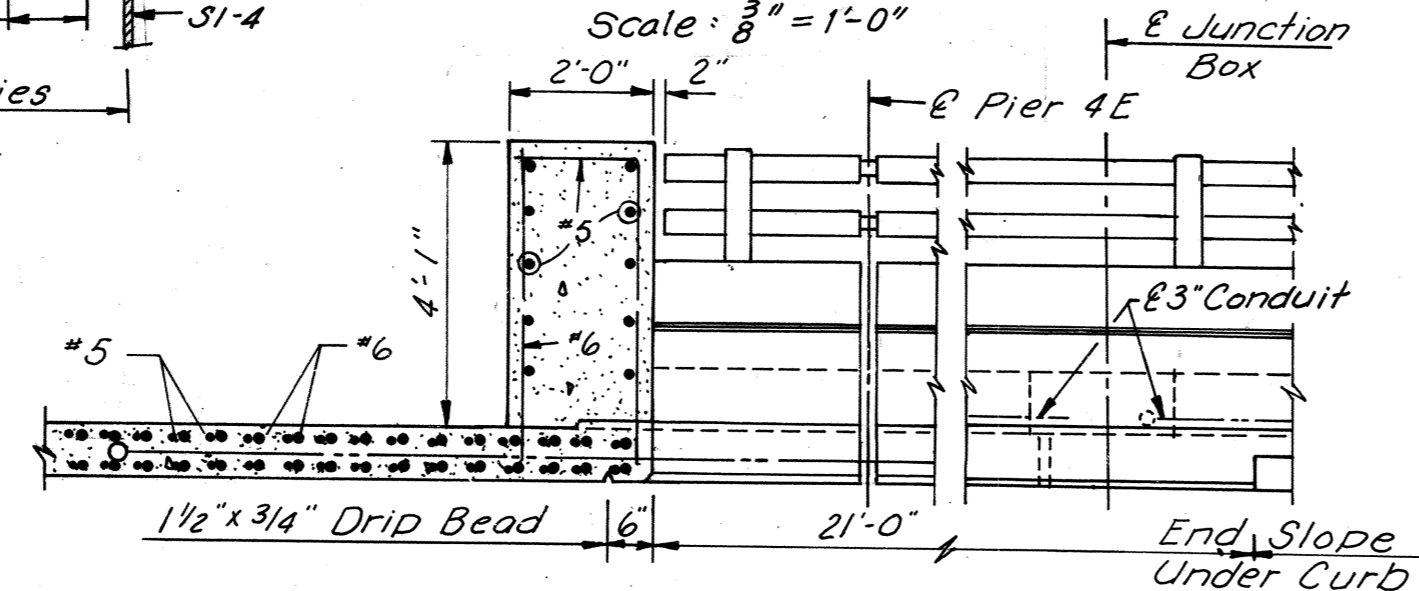


SECTION C-C
Scale: 3/8"=1'-0"

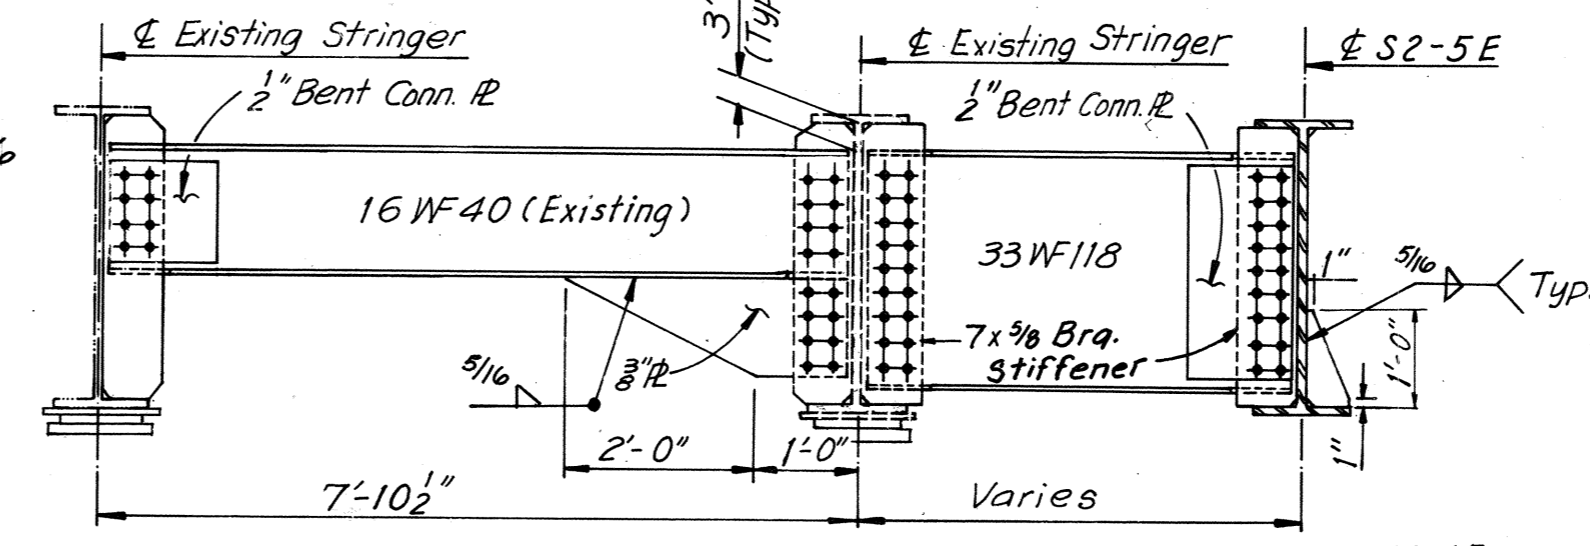


SECTION D-D
Scale: 1/2"=1'-0"

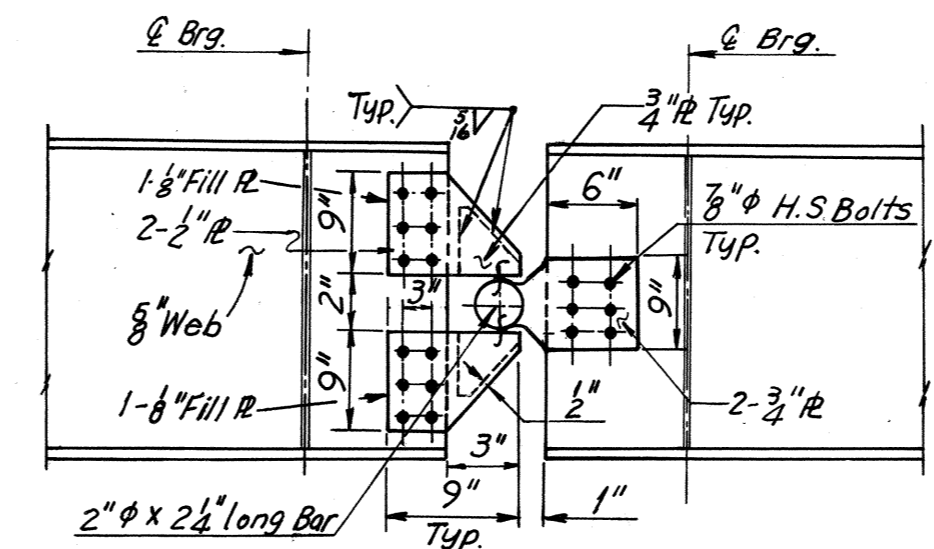


VIEW J-J
No Scale

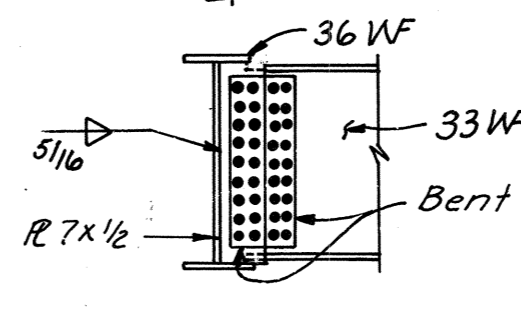

SECTION M-M
Scale: 3/8"=1'-0"

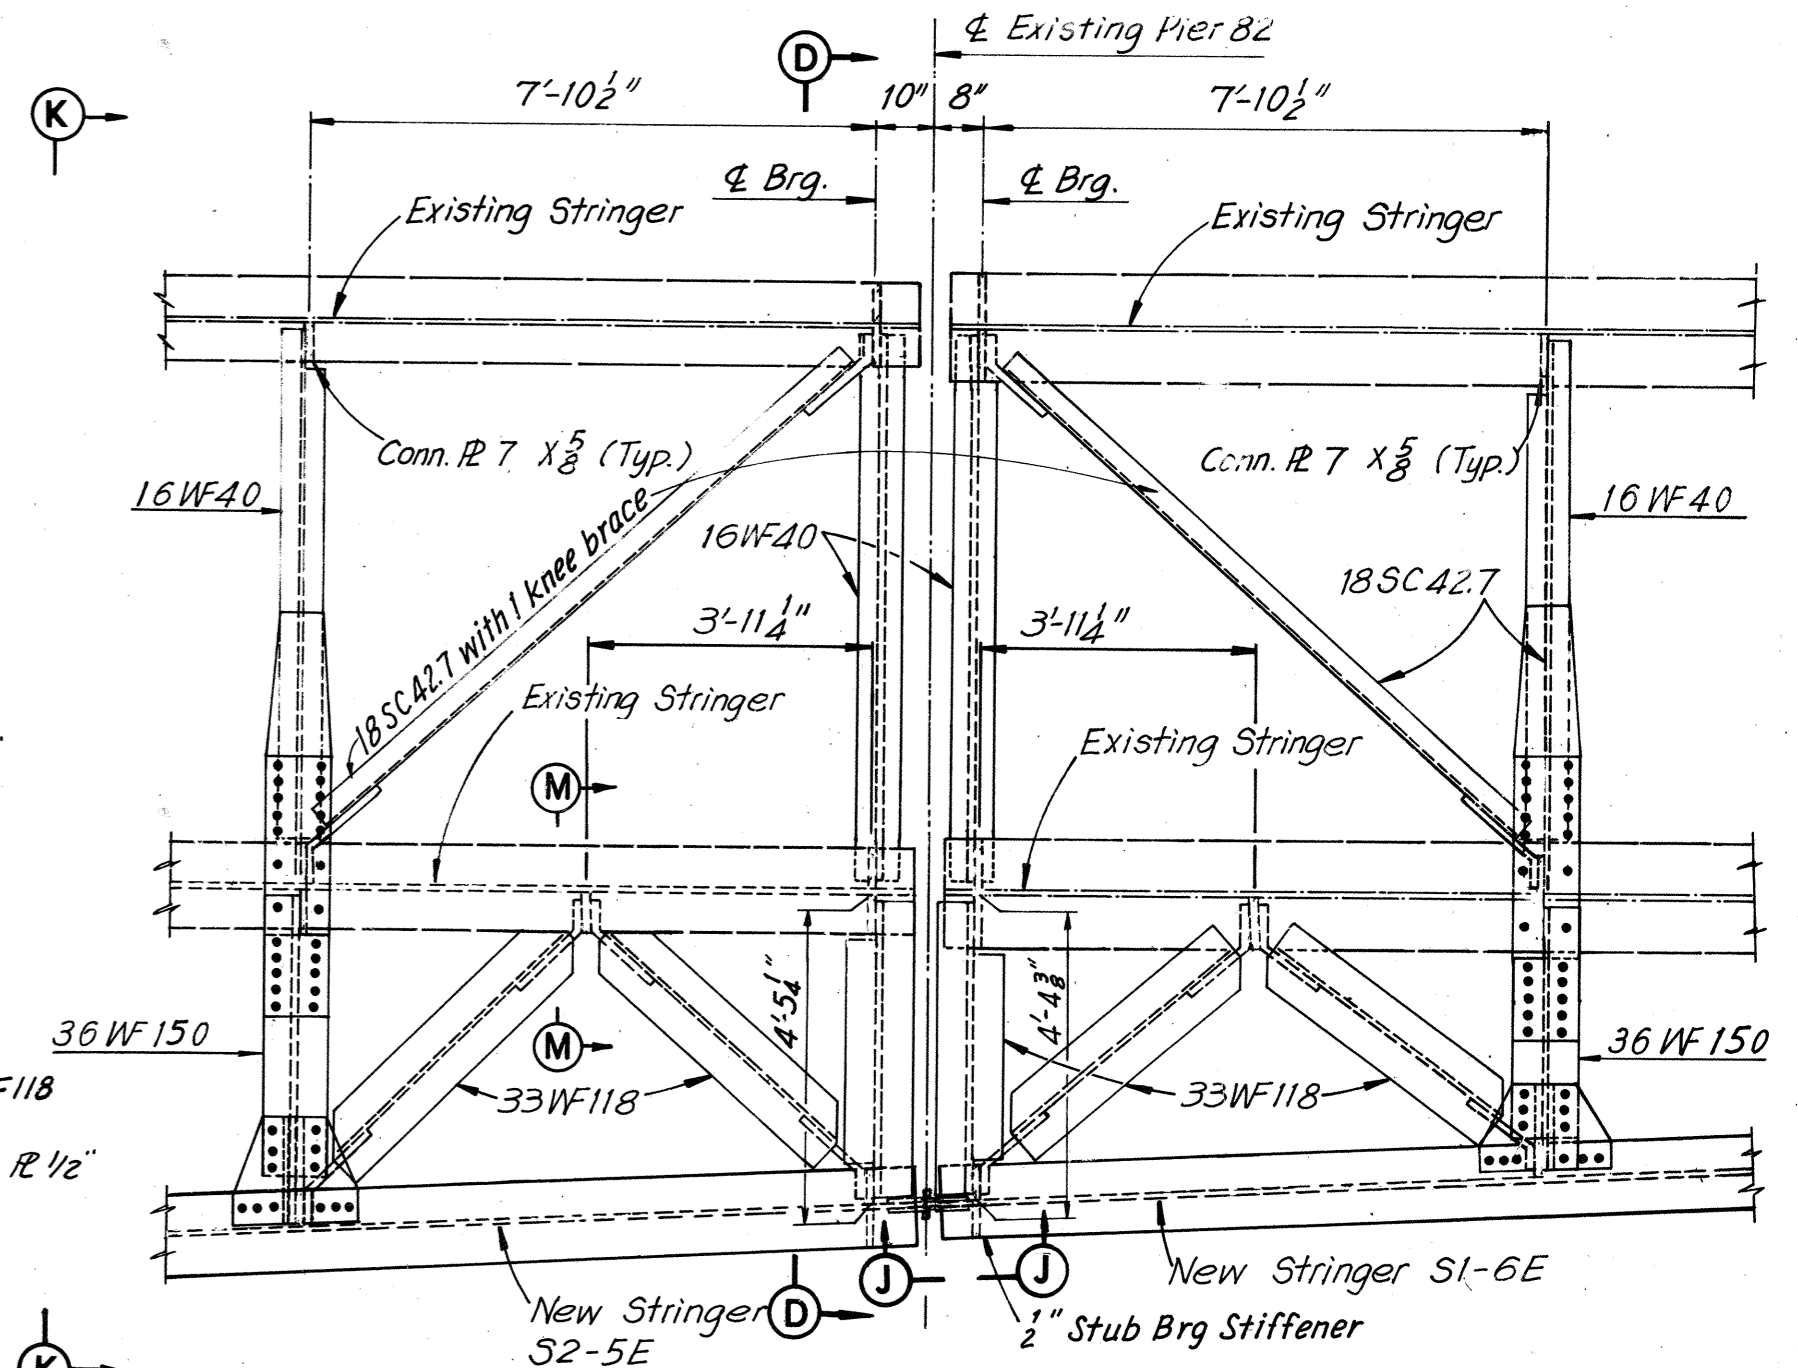

DETAIL B
Scale: 3/8"=1'-0"

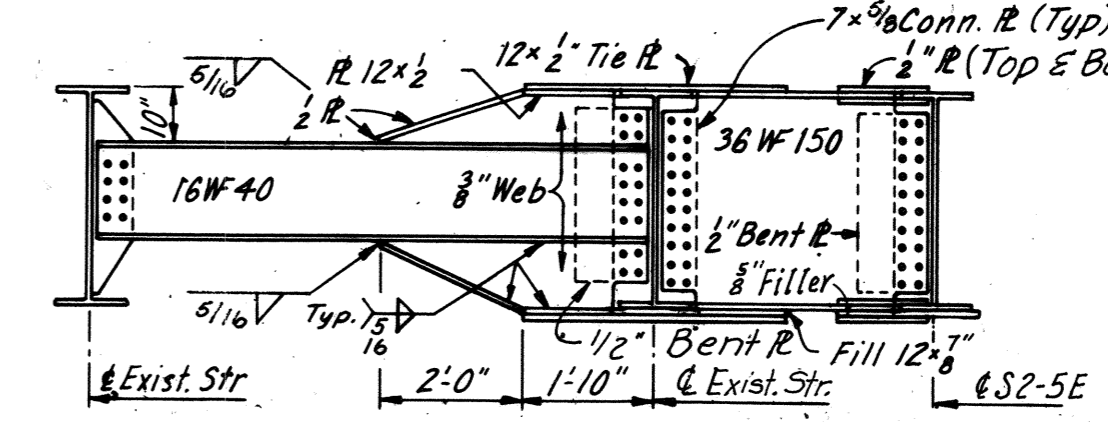

SECTION K-K
Scale: 3/8"=1'-0"

BY	DATE	REVISION	BY	DATE
MADE	SCC 2-28-69 K.C.T. 3-24-69	2	As Built	TEM 6-77
CHECKED	G.C.C. 4-21-69	1	Unit 2 Details Deleted	TEM 10-74
IN CHARGE				

RICHMOND METROPOLITAN AUTHORITY
RICHMOND EXPRESSWAY SYSTEM
DOWNTOWN EXPRESSWAY





BRIDGE NO. 64
RAMP N-W CONNECTION FROM
RICHMOND-PETERSBURG TURNPIKE
SUPERSTRUCTURE DETAILS

HOWARD, NEEDLES, TAMMEN & BERGENDOFF
consulting engineers
NEW YORK ALEXANDRIA KANSAS CITY

SCALE: As Noted
CONTRACT NO.: 10
SHEET NO. 24 OF 28

AS BUILT









RICHMOND EXPRESSWAY SYSTEM			
SECTION	PROJECT	SHEET NO.	TOTAL SHEETS
10	DOWNTOWN EXPRESSWAY	123	265

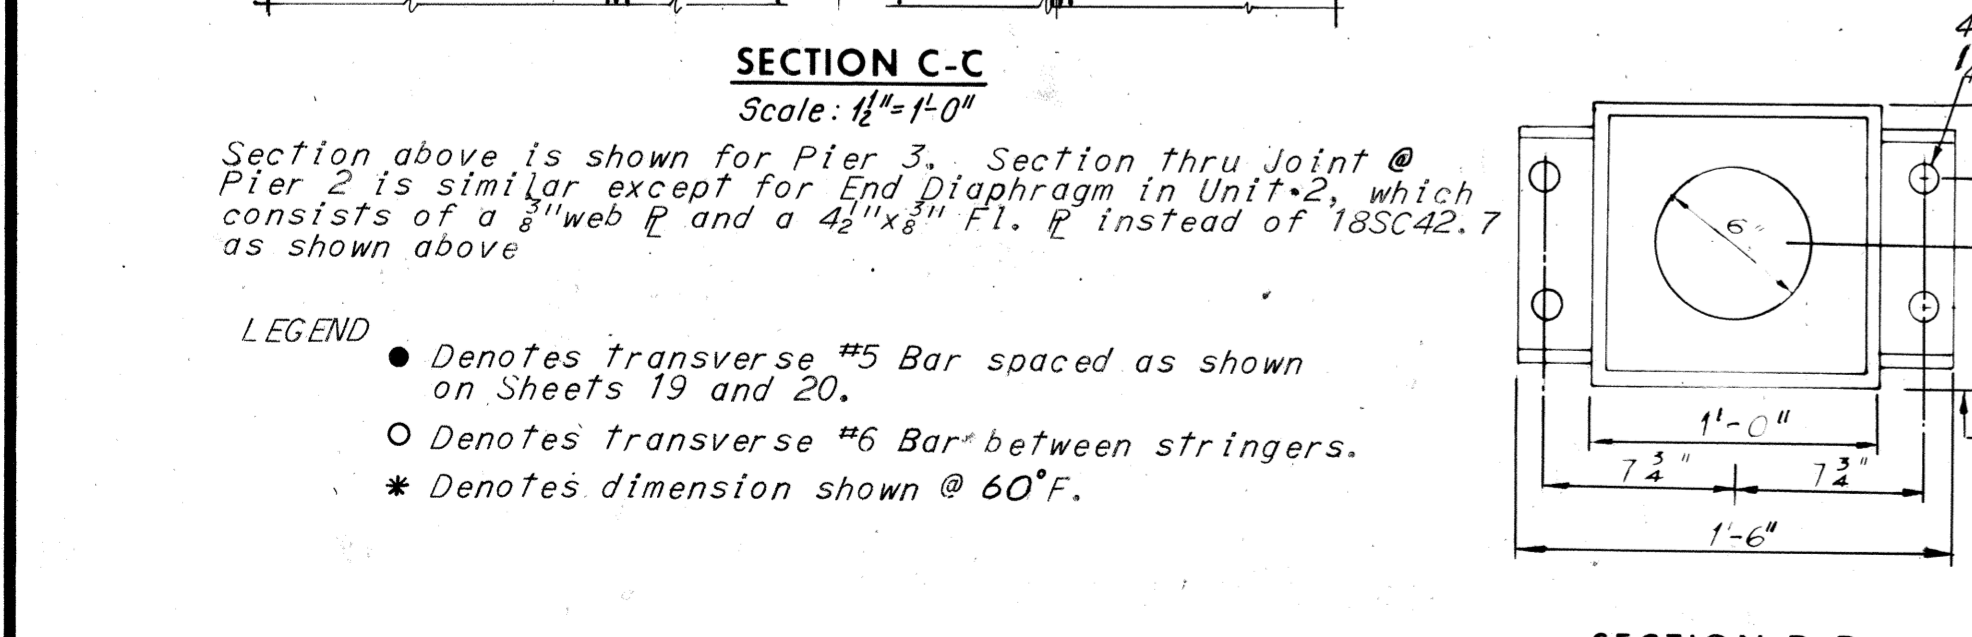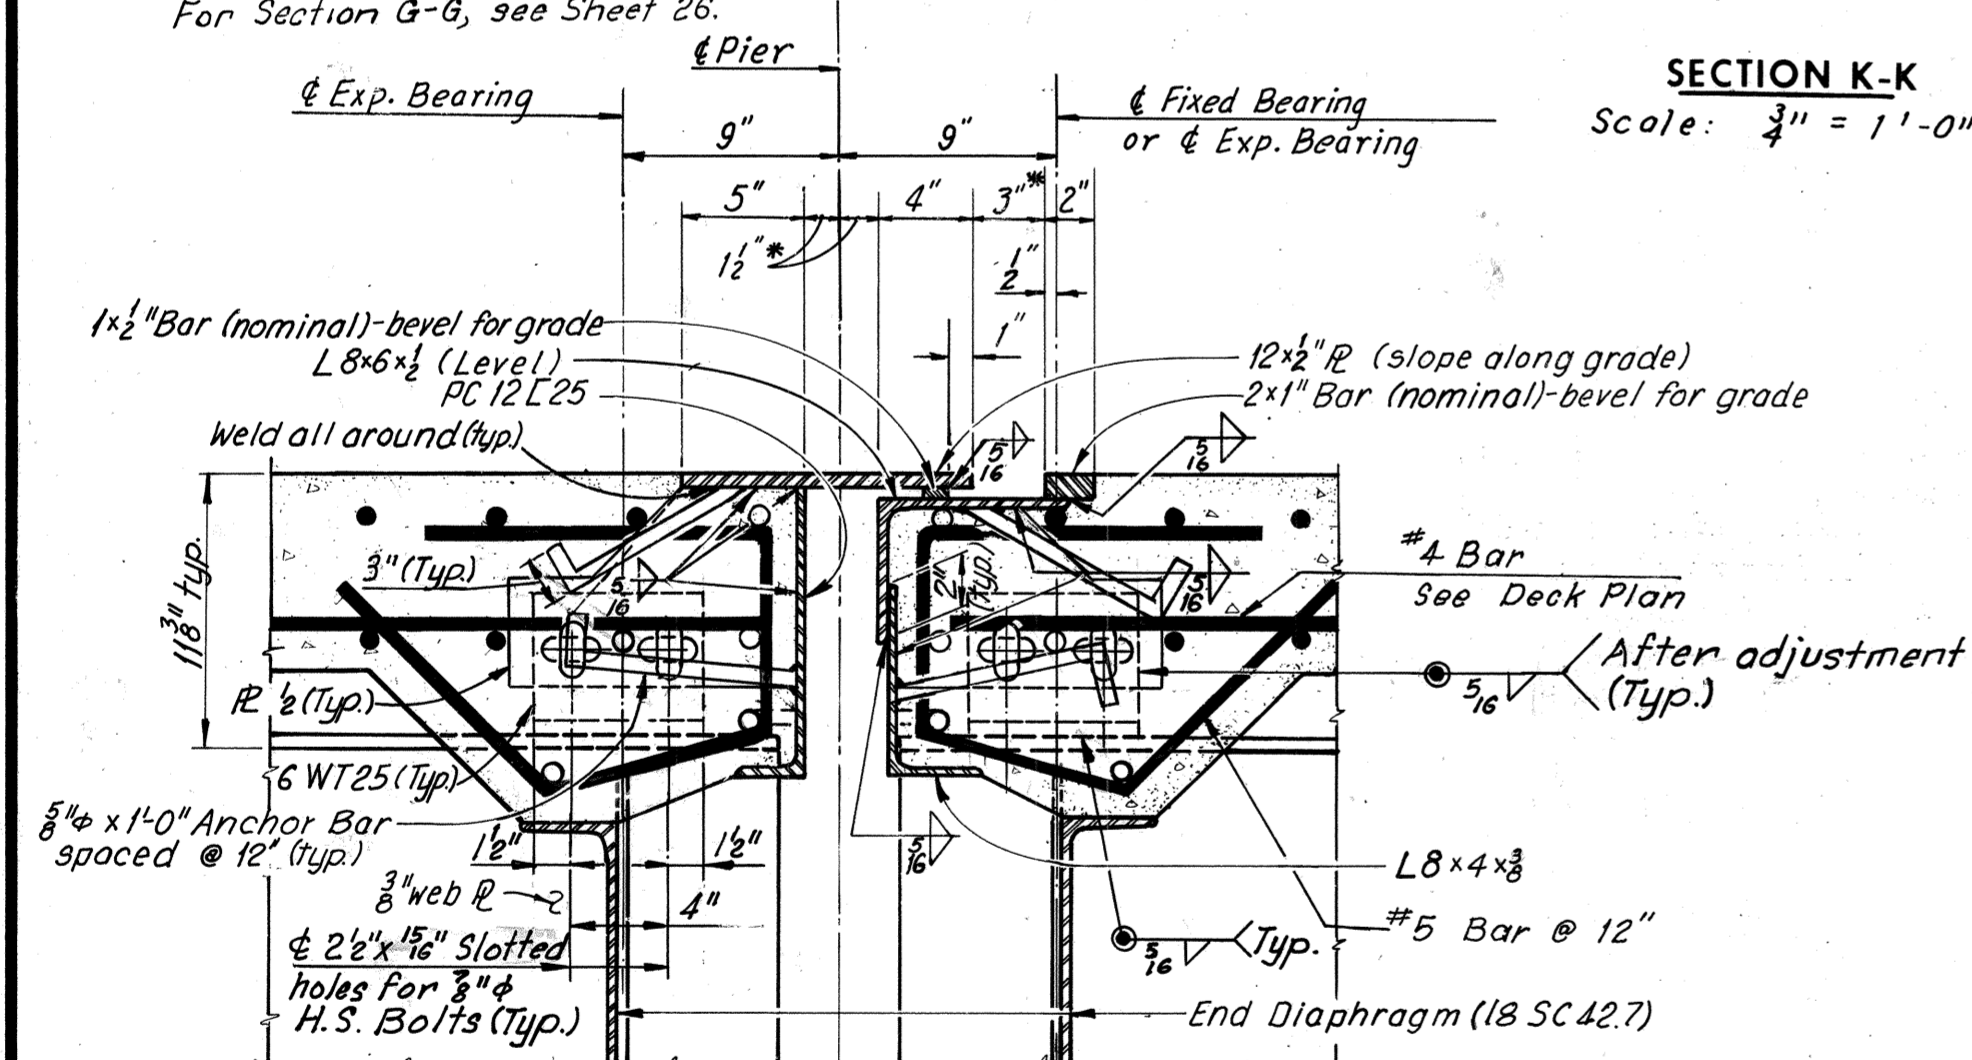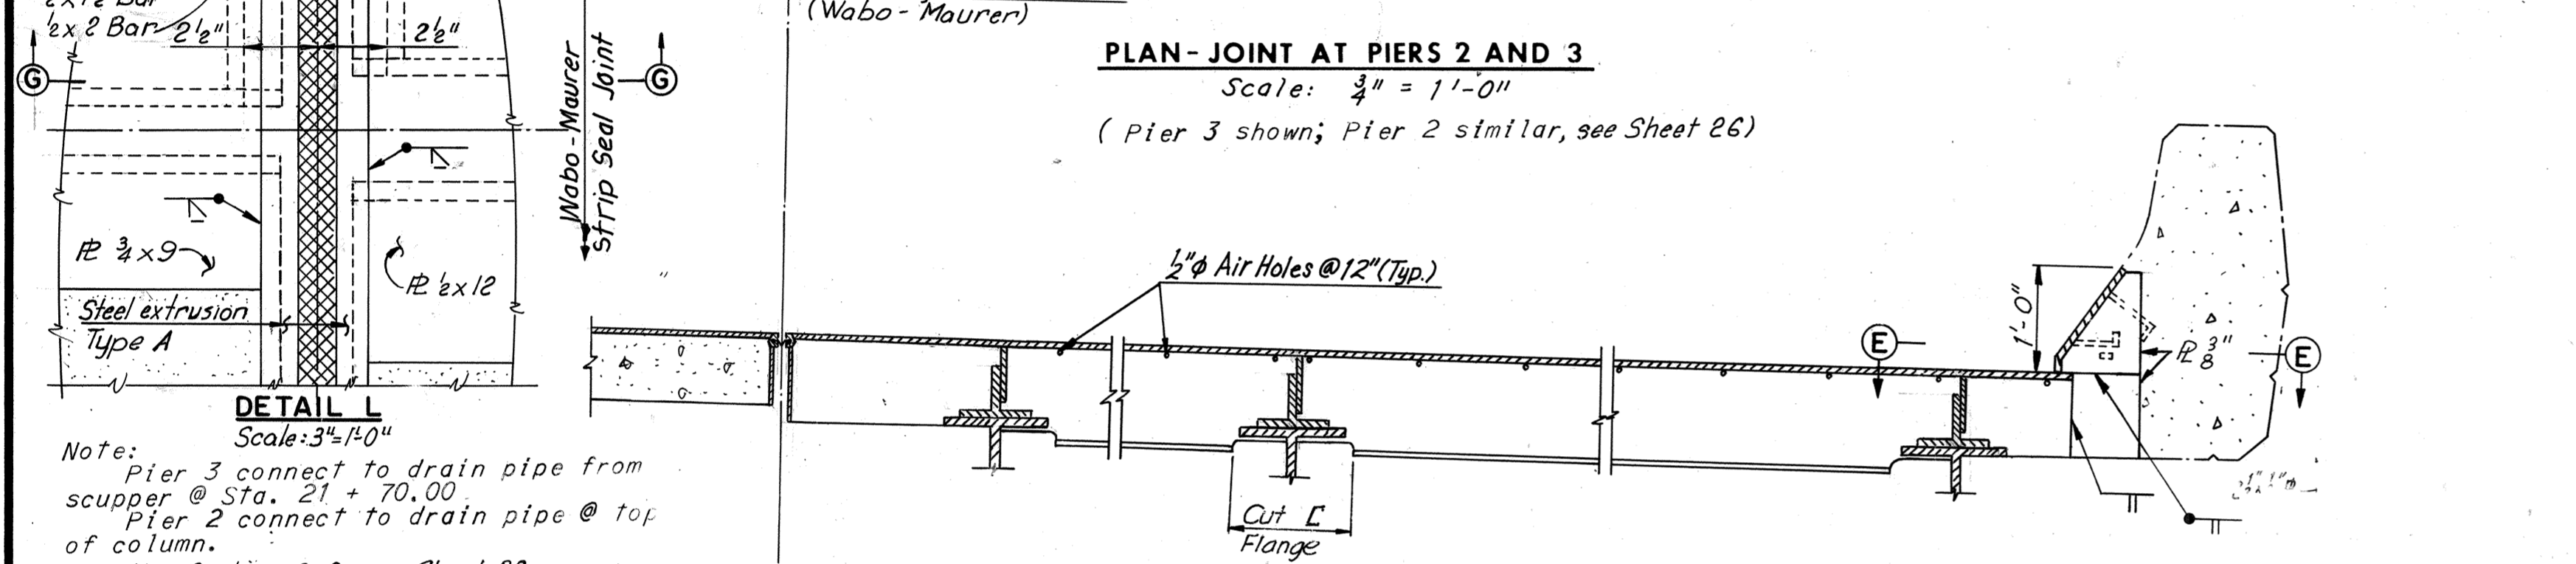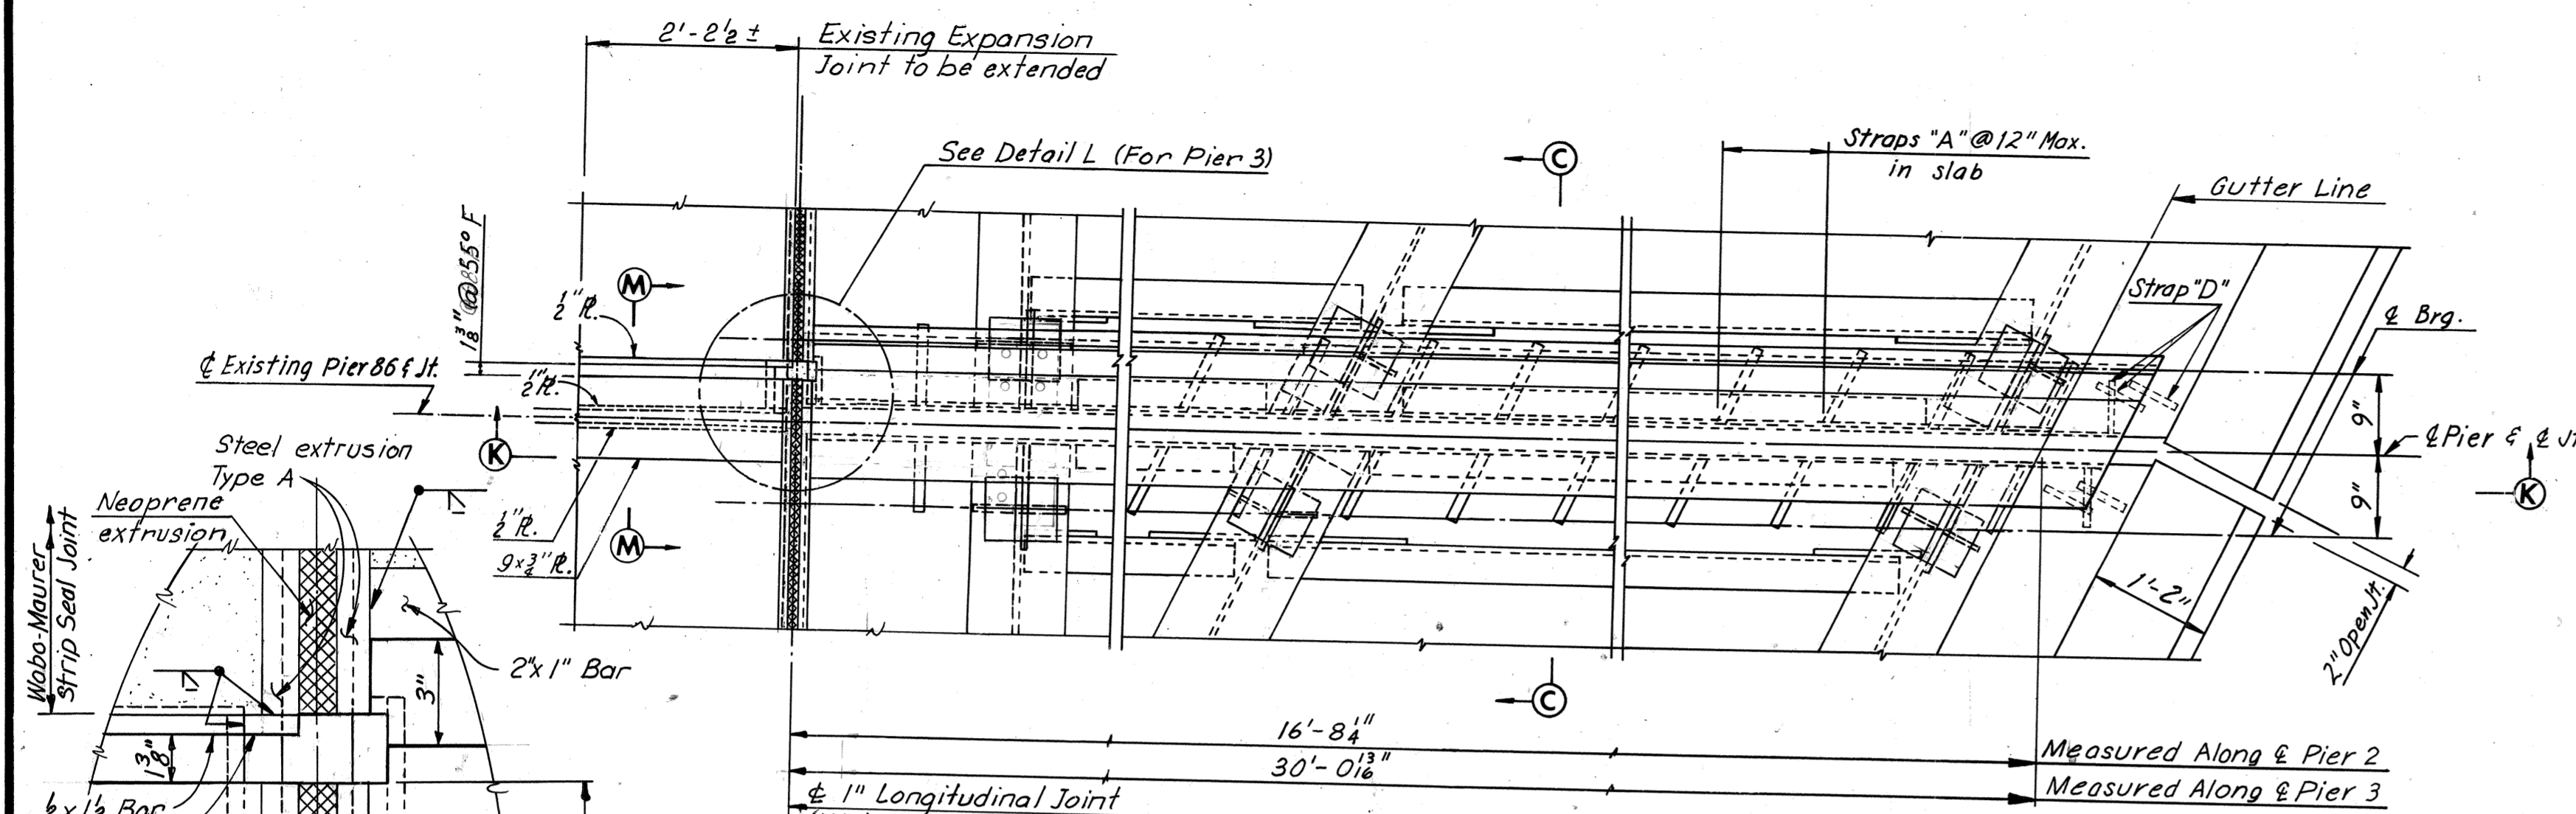

LEGEND

- Denotes transverse #5 Bar spaced as shown on Sheets 19 and 20.
- Denotes transverse #6 Bar between stringers.
- * Denotes dimension shown @ 60°F.

2	As Built	TEM	G-77
MADE	Y.C.P. 3-20-69	NLB	10-31-74
CHECKED	G.C.C. 4-21-69		
IN CHARGE			

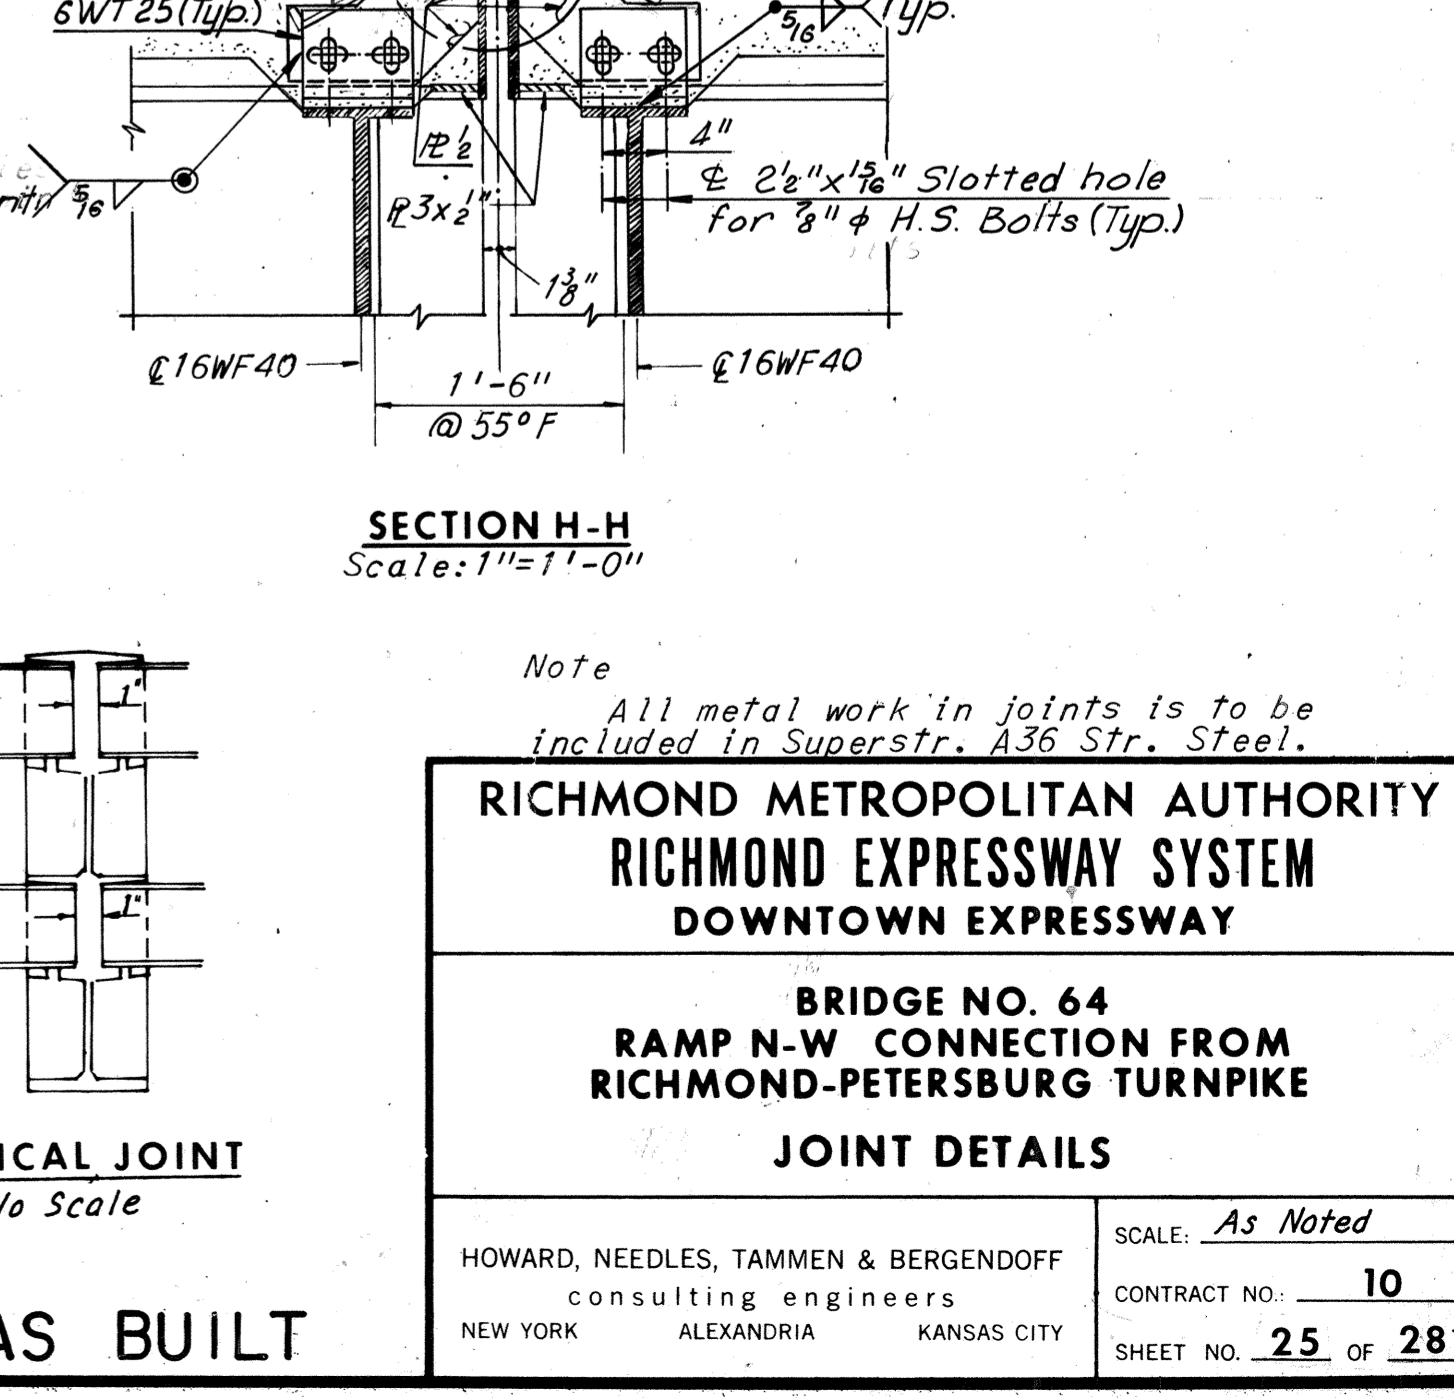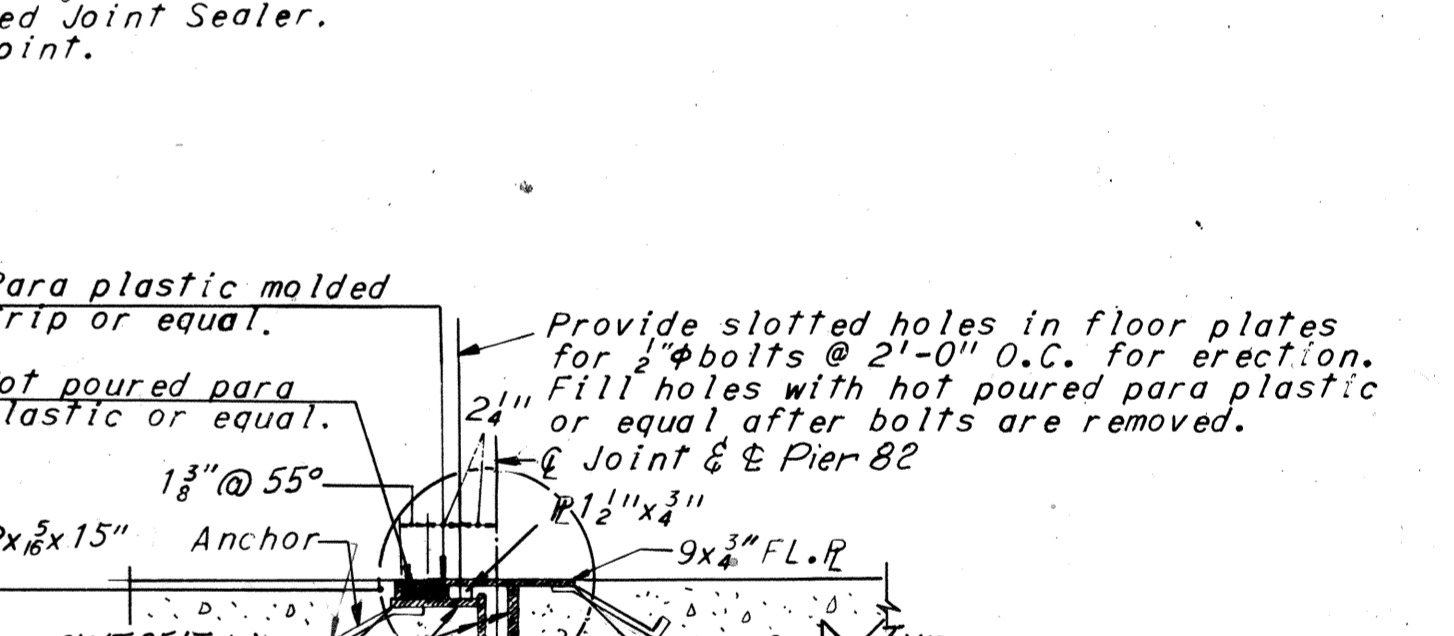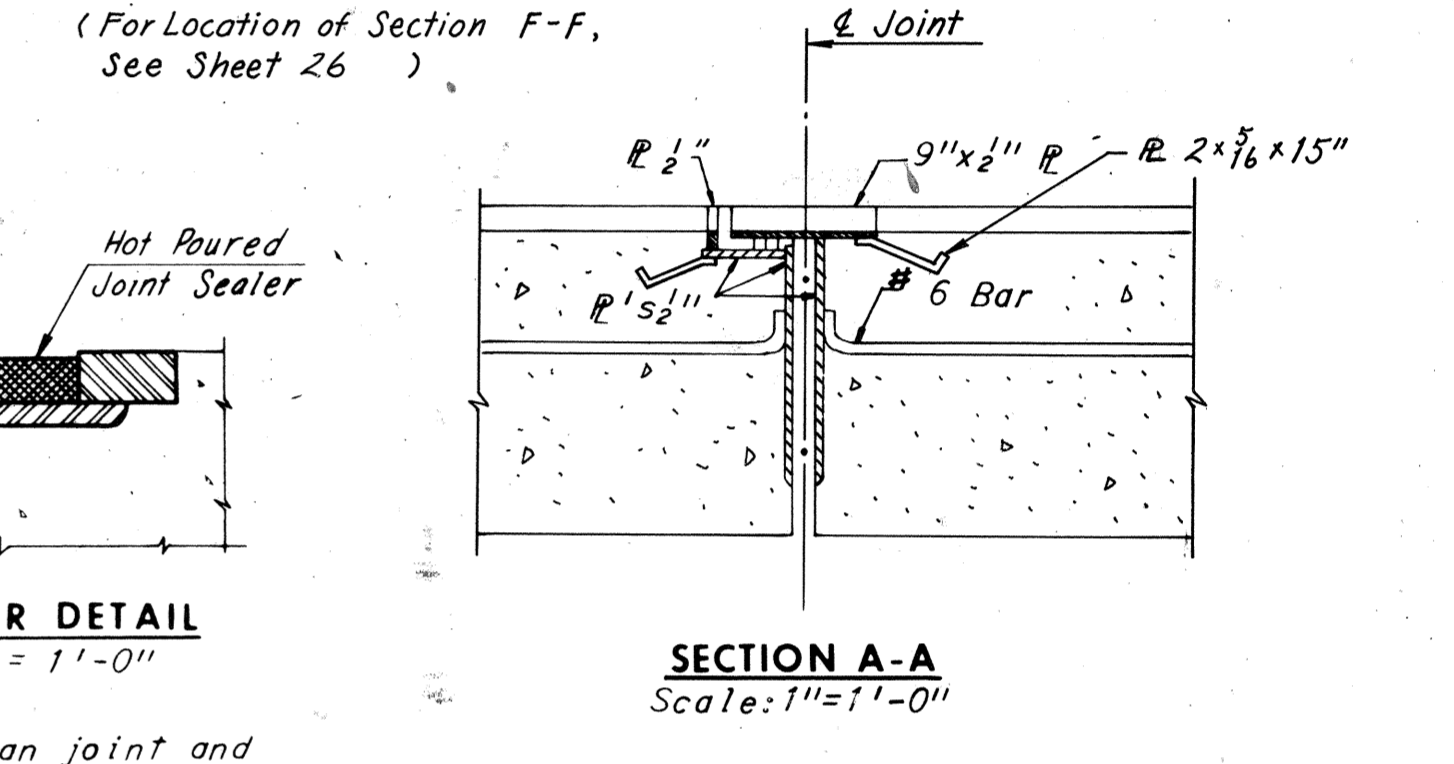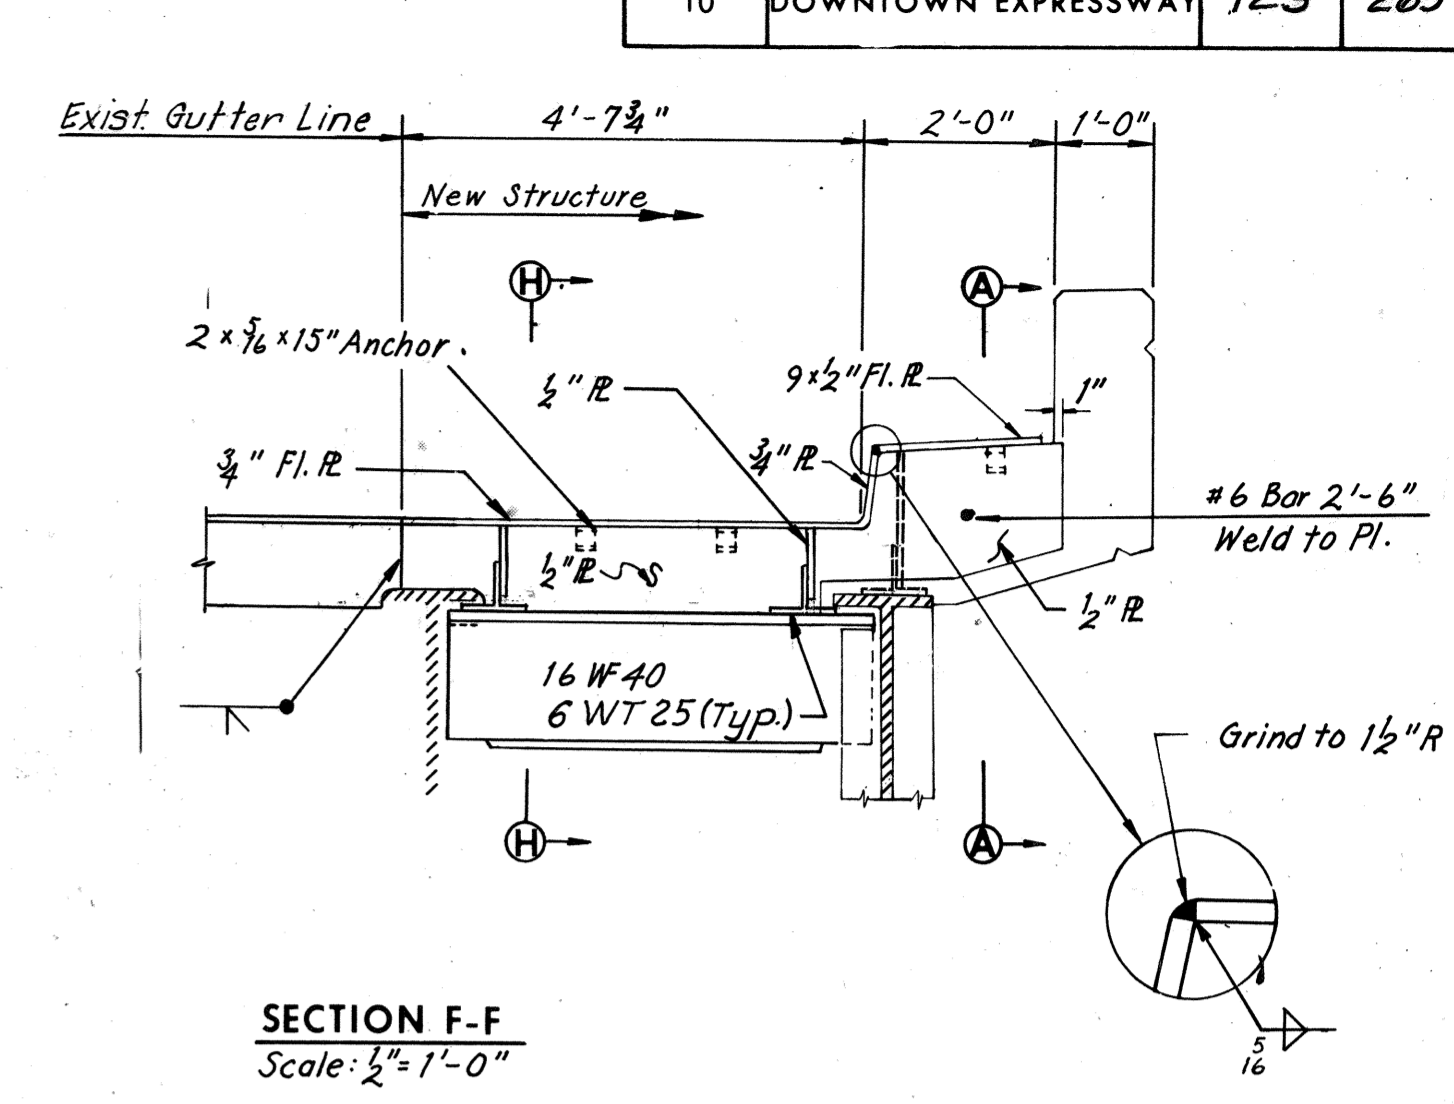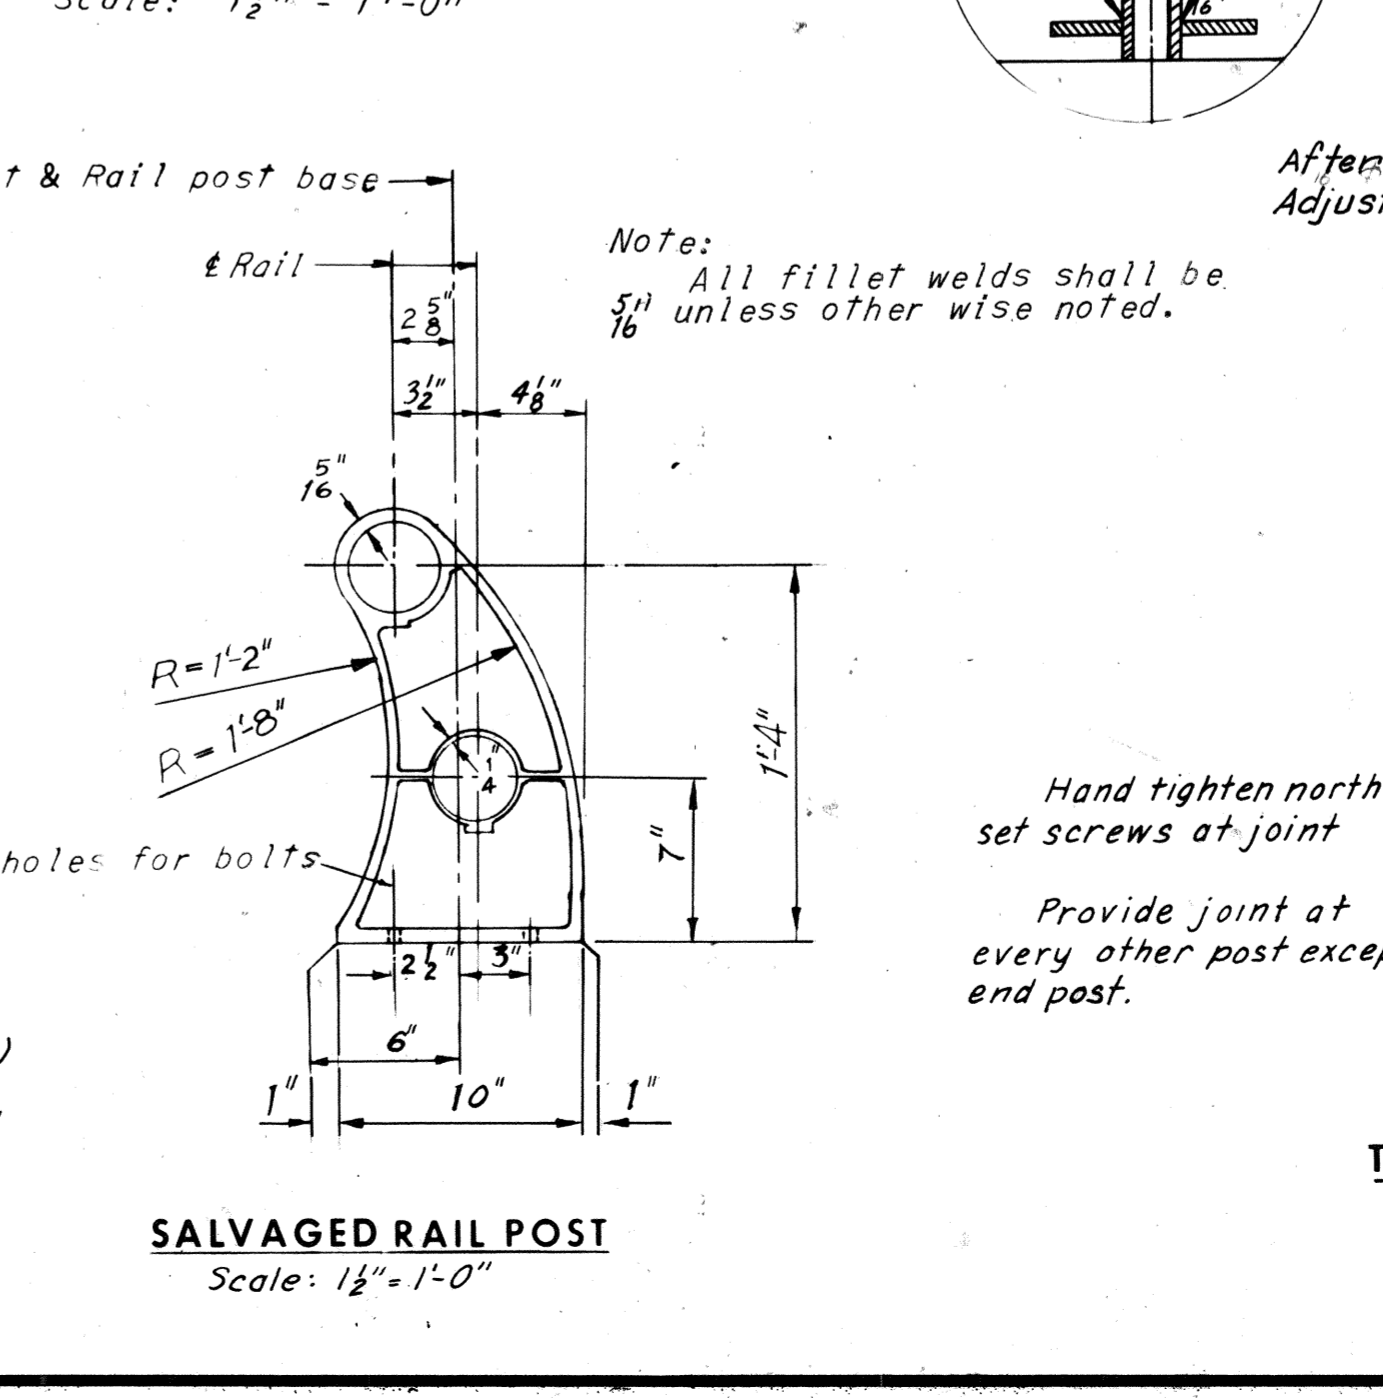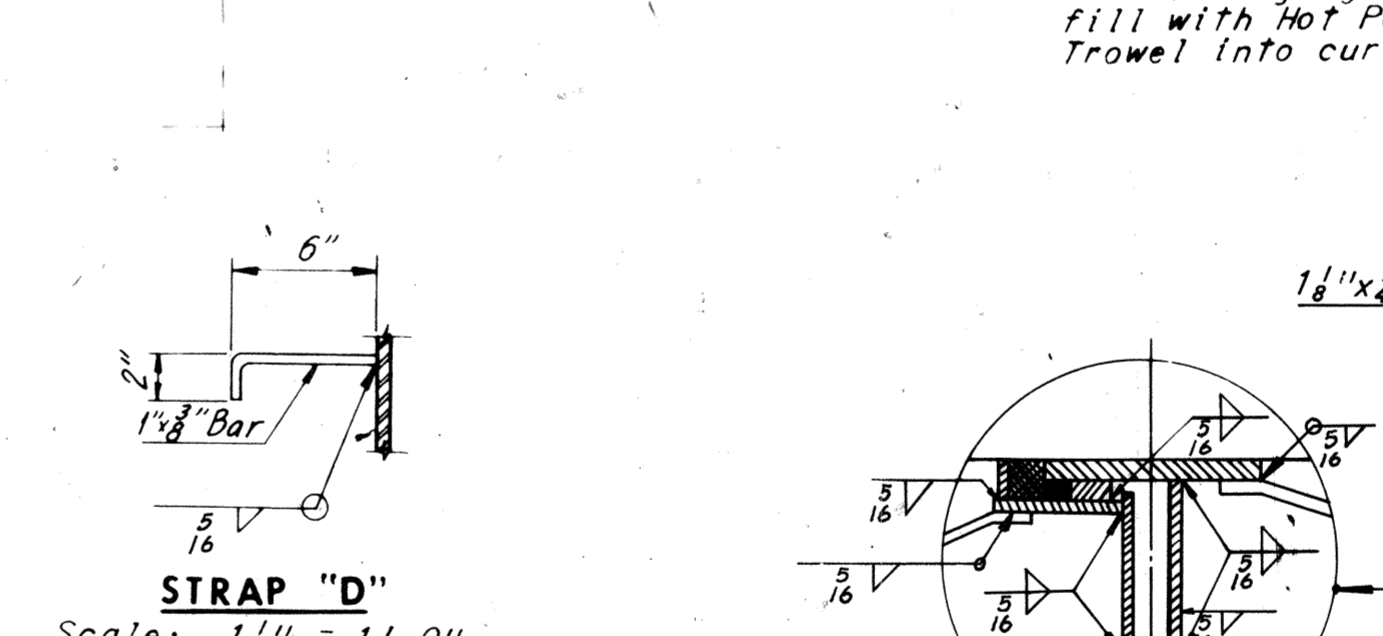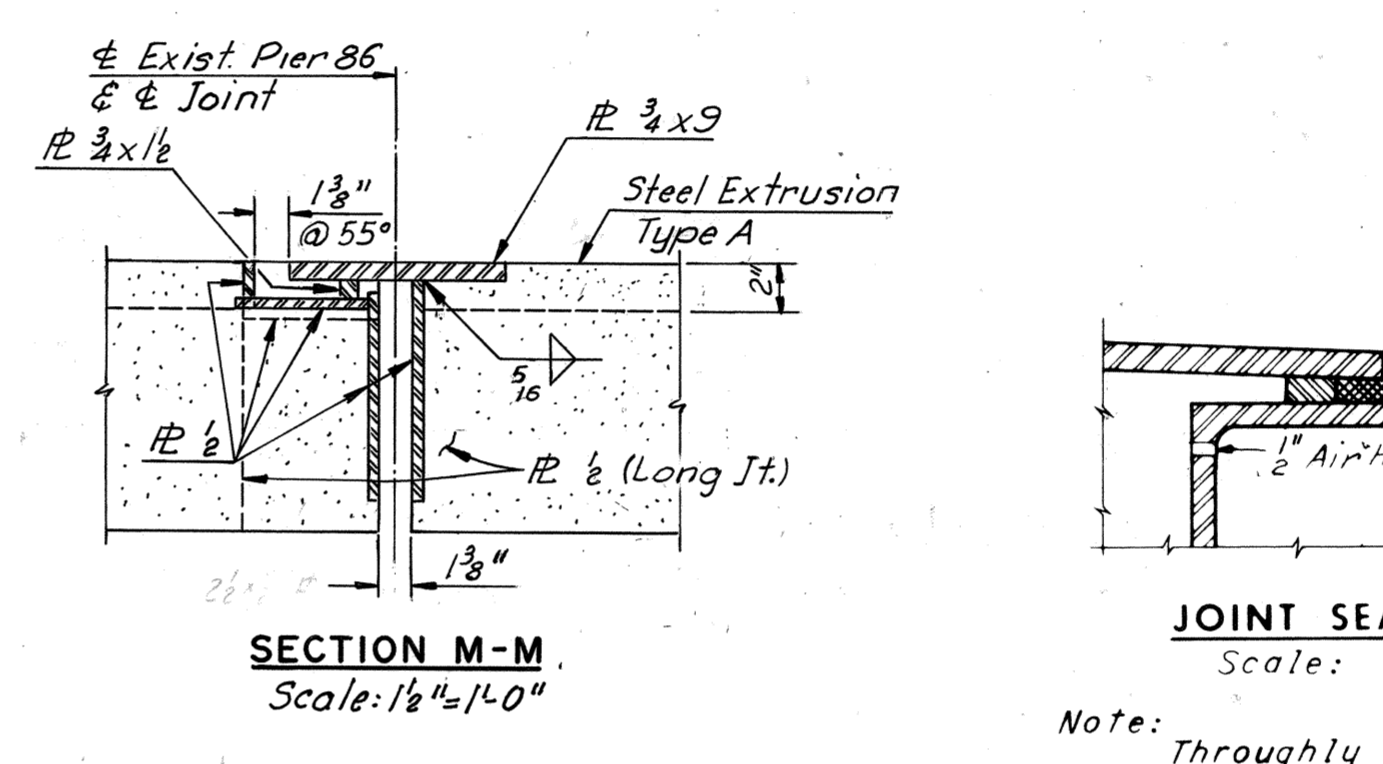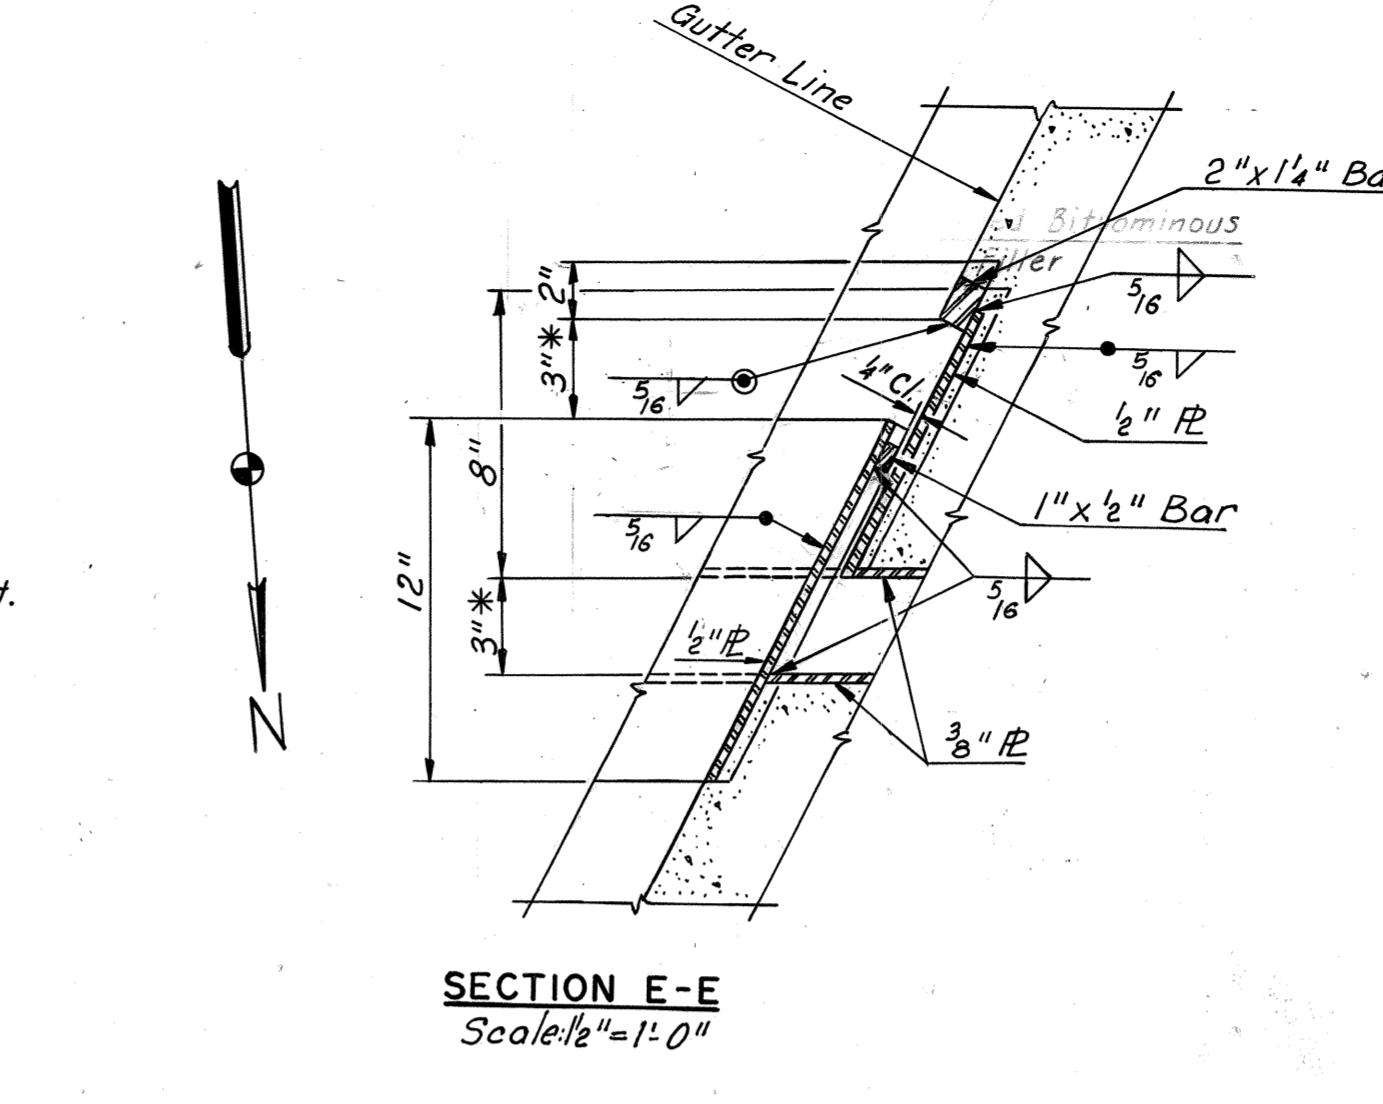

AS BUILT

Hand tighten north set screws at joint. Provide joint at every other post except end post.

Richmond Metropolitan Authority
RICHMOND EXPRESSWAY SYSTEM
DOWNTOWN EXPRESSWAY

BRIDGE NO. 64
RAMP N-W CONNECTION FROM RICHMOND-PETERSBURG TURNPIKE


HOWARD, NEEDLES, TAMMEN & BERGENDOFF
 consulting engineers
 NEW YORK ALEXANDRIA KANSAS CITY

SCALE: As Noted
 CONTRACT NO. 10
 SHEET NO. 25 OF 28


RICHMOND EXPRESSWAY SYSTEM			
SECTION	PROJECT	SHEET NO.	TOTAL SHEETS
10	DOWNTOWN EXPRESSWAY	124	265

NOTES FOR FILLED JOINTS:

Joints shall be free of cracked and spalled areas and their faces shall be free of all foreign matter, curing compound, oils, greases and dirt. All faces must be sandblasted or brushed with a mechanical rotary wire brush. Just prior to sealing, the joint shall be blown out with oil-free and water-free compressed air.

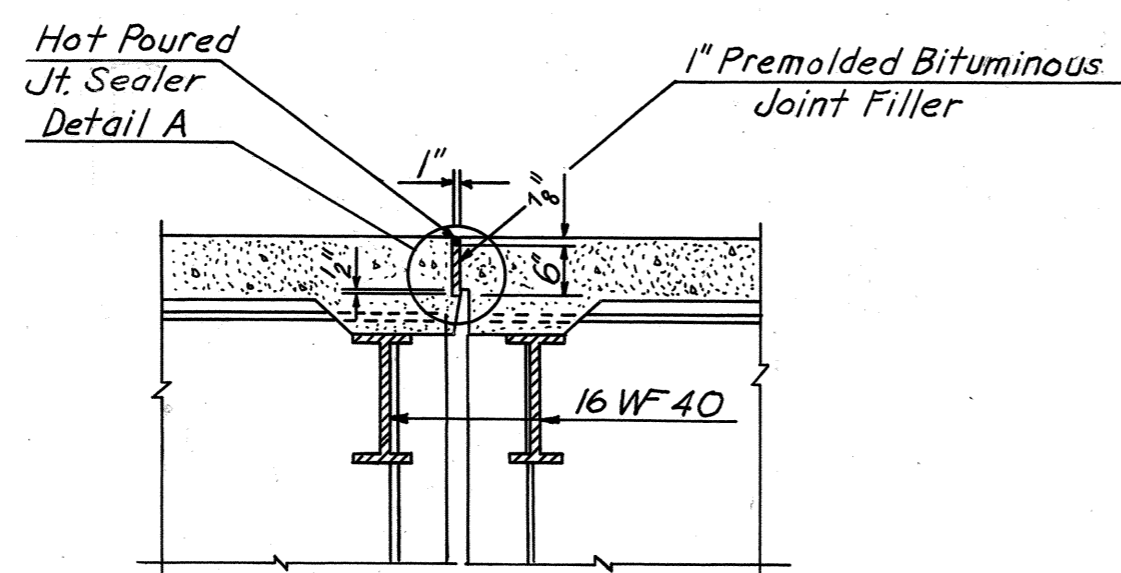


TYPICAL SECTION THRU 1" FIXED JOINT
Scale: 1/2"=1'-0"

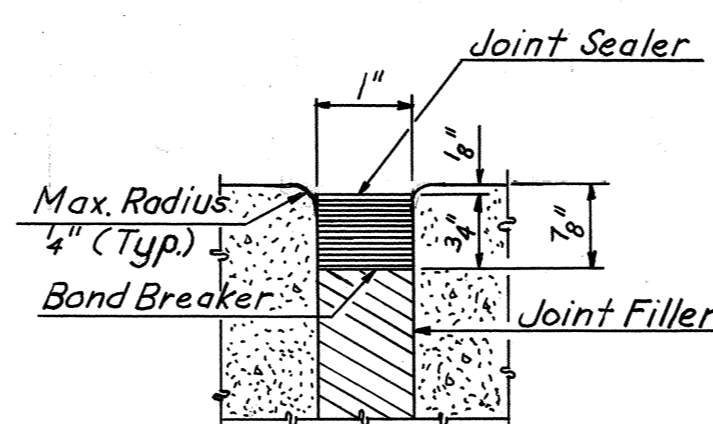

DETAIL A
No Scale

Note: Joint filler material and copper flashing to be included in price bid for Superstr. Concrete

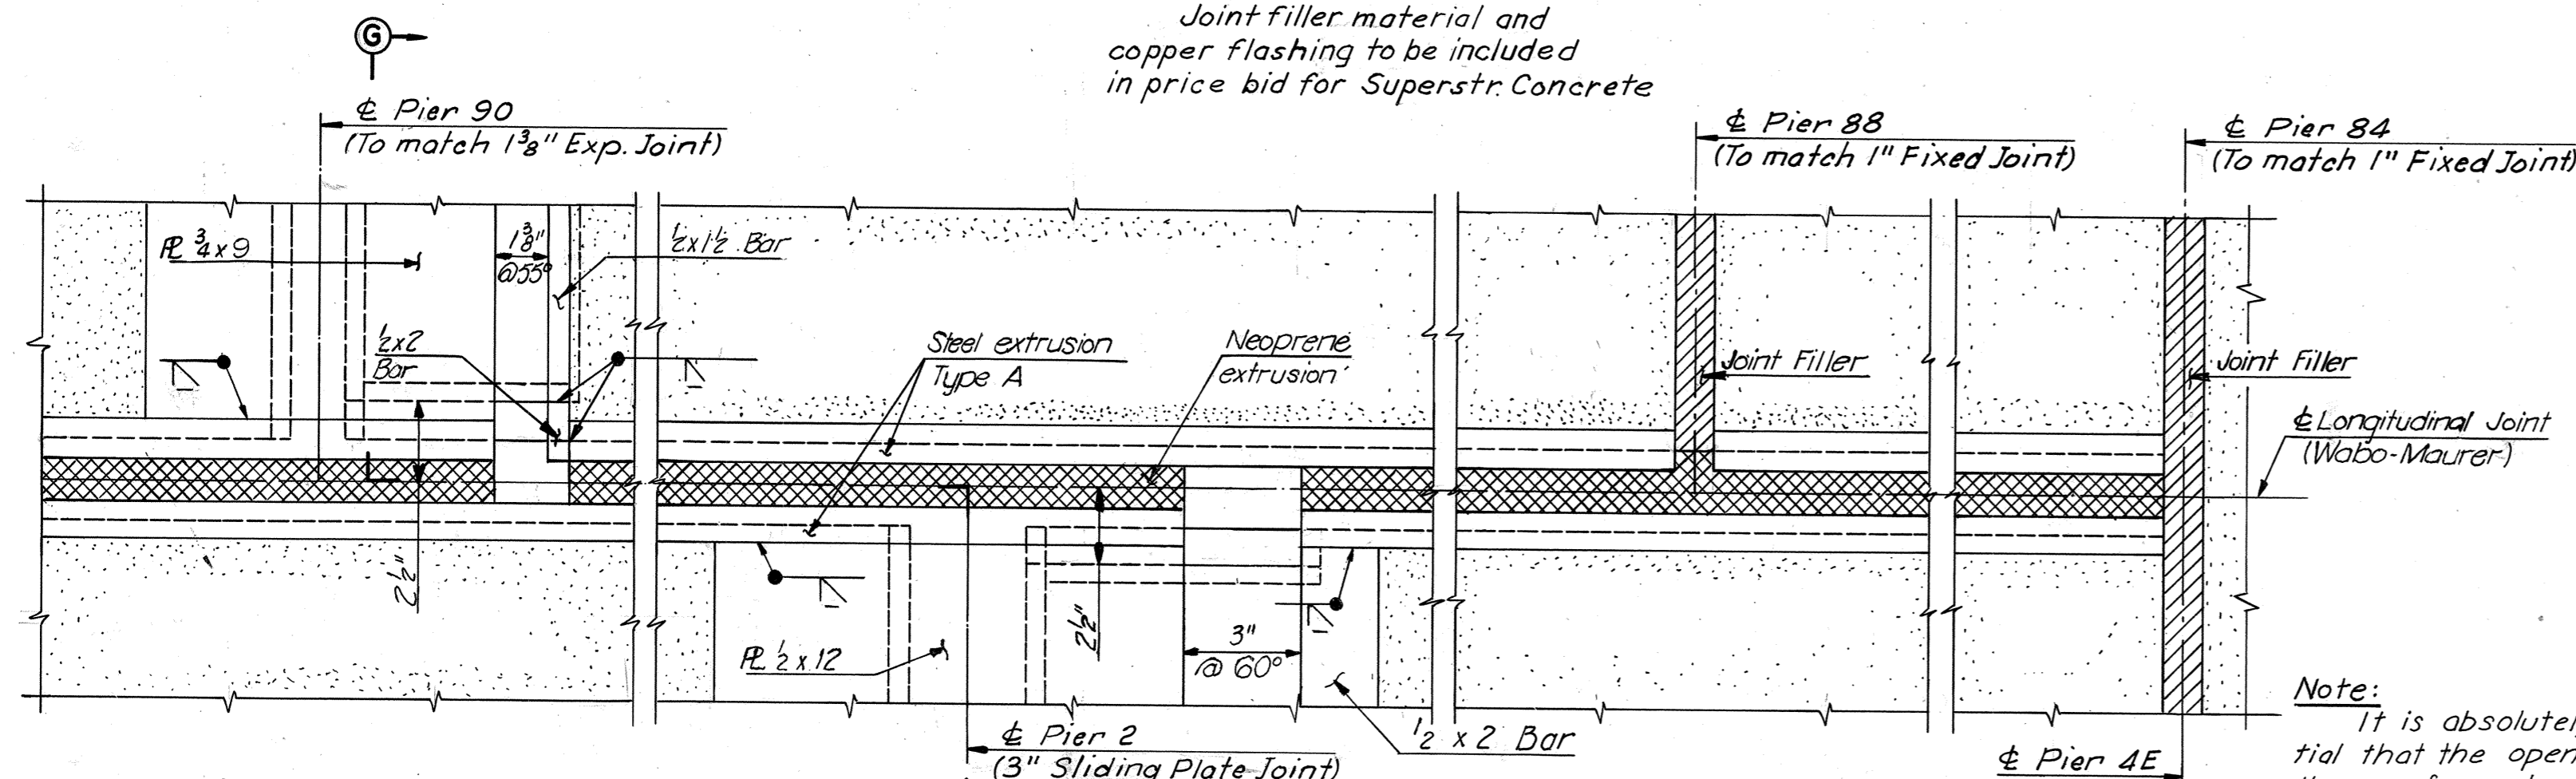

PLAN-LONGITUDINAL JOINT
Scale: 3/4"=1'-0"


NOTE: For Plan of Pier 3 & existing Pier 86, see Sheet 25.

Note: It is absolutely essential that the openings for the preformed neoprene joint sealers be accurately formed and constructed to smooth, straight lines. The size of opening shall be adjusted to allow for anticipated dead load rotation of the ends of the slab and for the temperature of the time of construction.


NOTES FOR WABO-MAURER JOINT:

Do not use steel extrusions as screed support. Steel extrusion shall conform to ASTM A36. Structural steel shall conform to ASTM A588. Steel assembly shall be shop welded to convenient lengths and butt welded in the field to desired length. Joint shall conform to grade of deck slab. Steel assembly shall be sandblasted in the shop prior to painting. Steel assembly shall receive one shop coat of epoxy zinc paint.

Neoprene extrusion shall be roughened with a wire brush before bonding to steel extrusion with Bon Lastic Adhesive. Groove in steel extrusion to be blown out with oil-free and water-free compressed air prior to installation of Neoprene extrusion. The Wabo-Maurer joint assembly shall be installed in accordance with manufacturer's recommended construction methods.

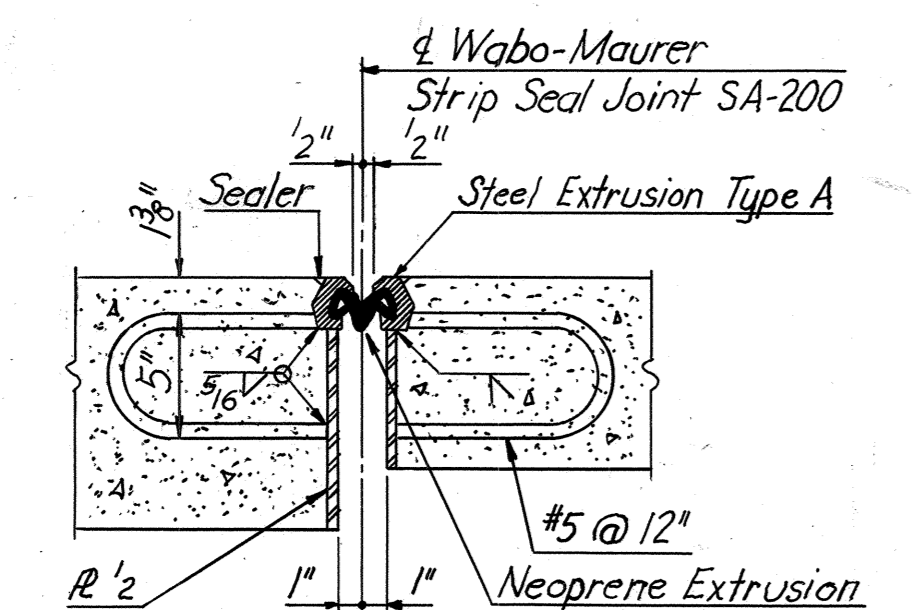


TYPICAL SECTION THRU WABO-MAURER JOINT
Scale: 1/2"=1'-0"

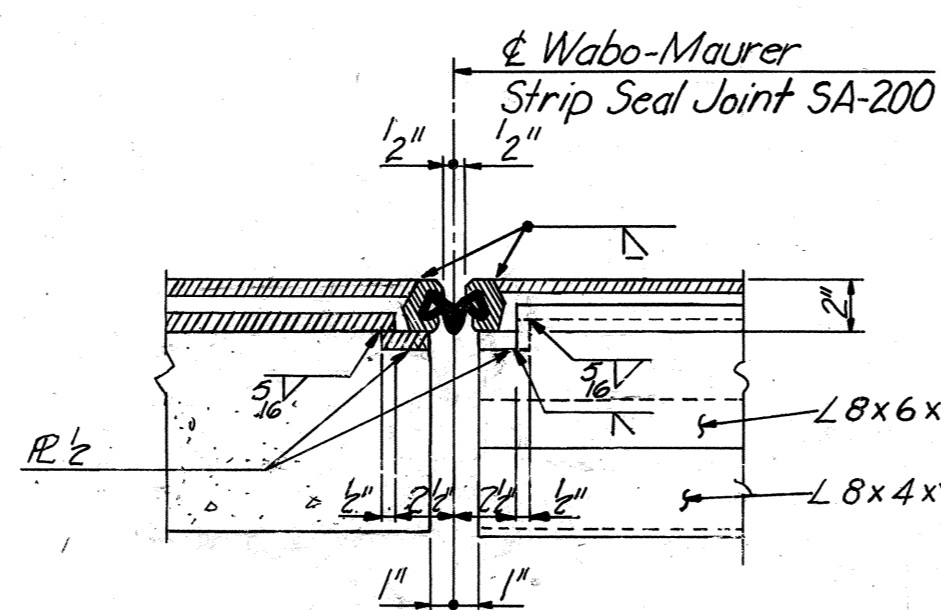


SECTION G-G
Scale: 1/2"=1'-0"


NOTE: Steel extrusion of Wabo-Maurer Joint to rest & slide on P.L. For location of Sect. G-G, see Plan-Long. Joint above & Detail L. Sheet 25.

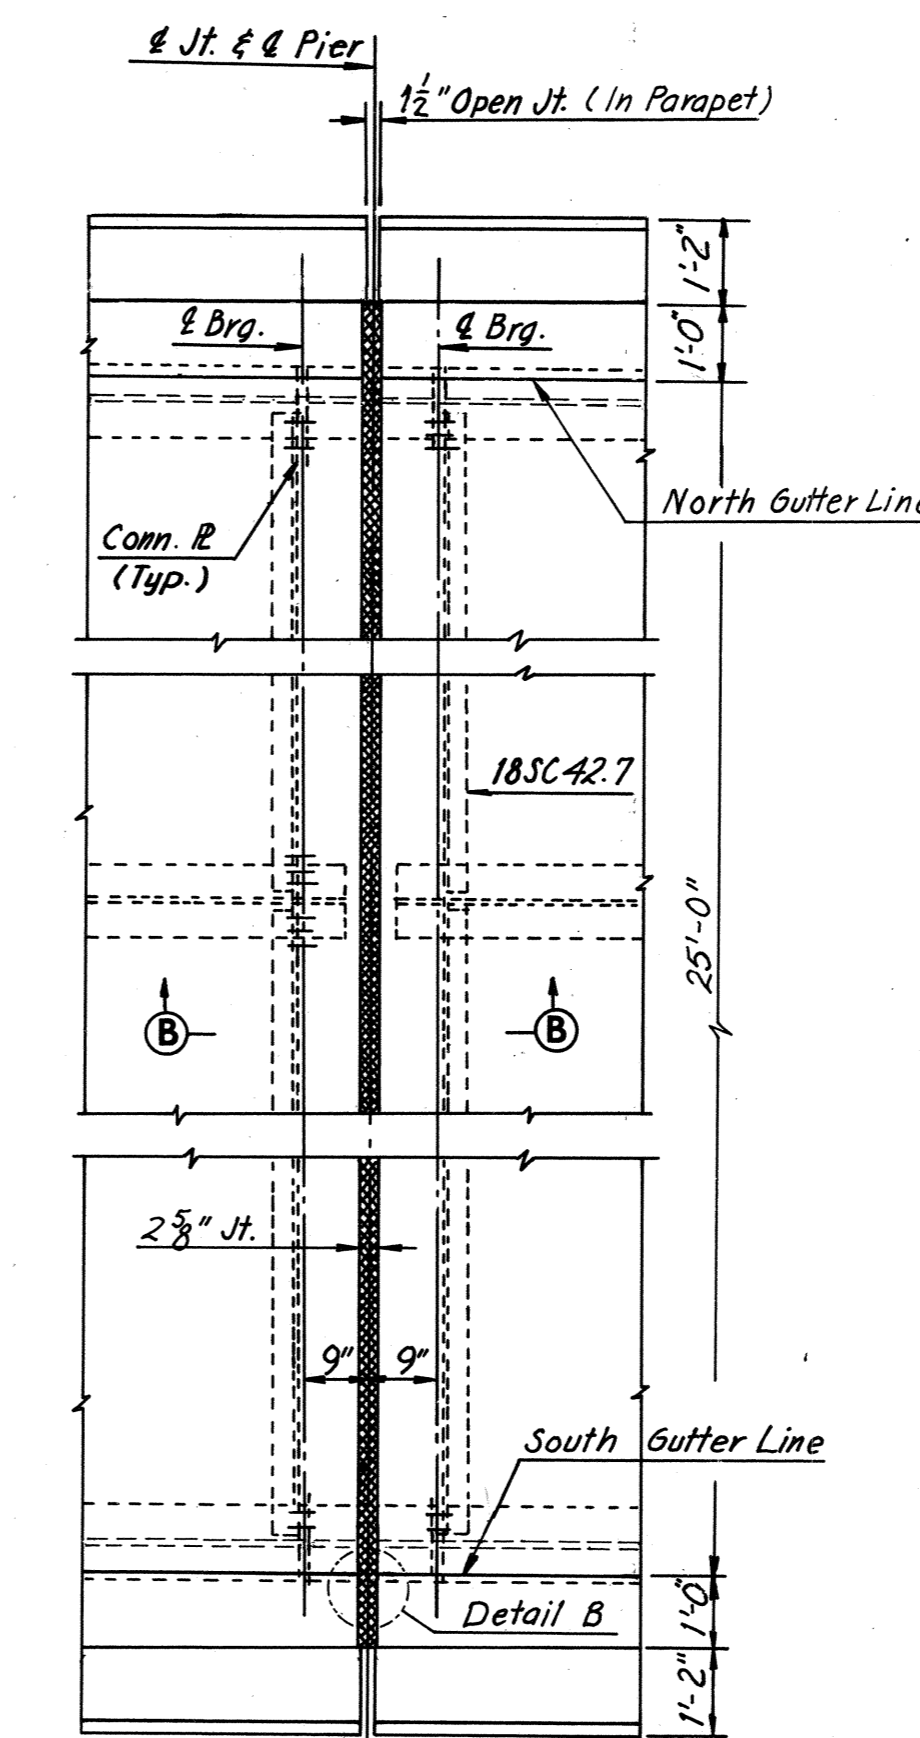

PLAN-JOINT AT PIERS 4, 5, 6, 7, 8 AND 9
Scale: 3/8"=1'-0"

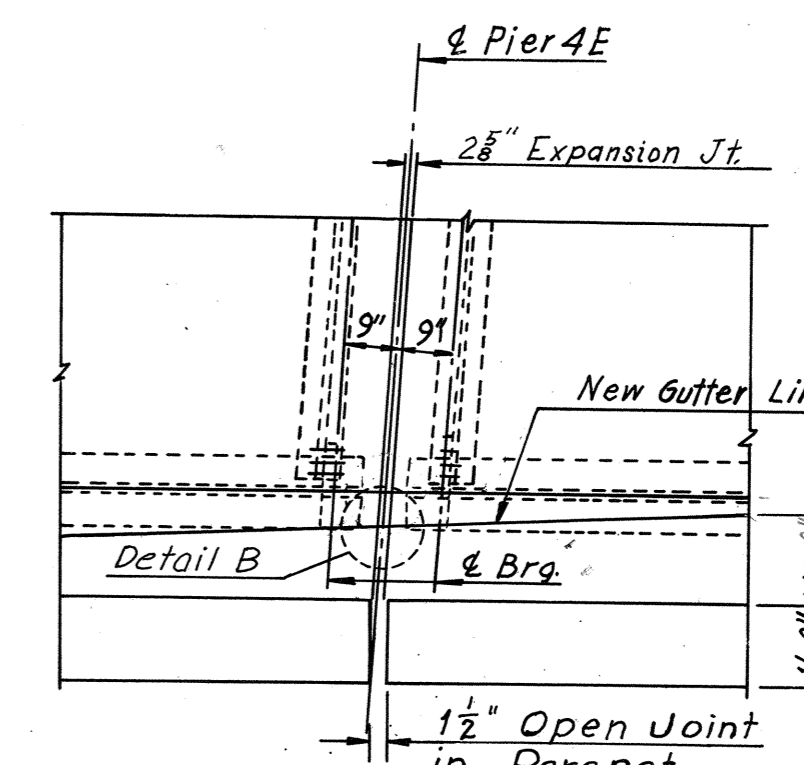


PLAN-JOINT AT PIER 4E
Scale: 3/8"=1'-0"

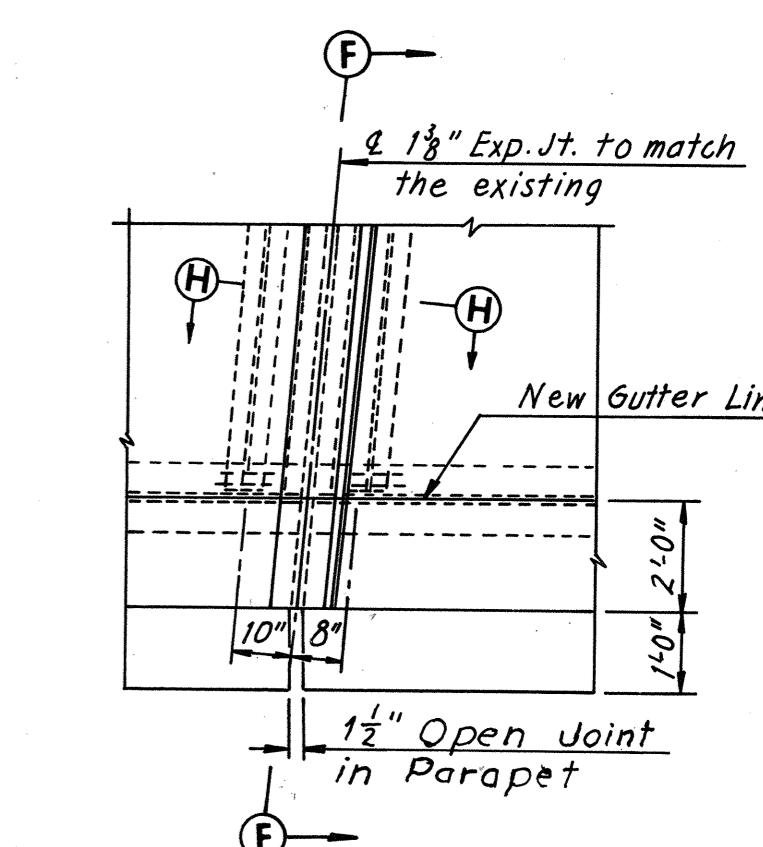


PLAN-JOINT AT EXISTING PIER 82
Scale: 3/8"=1'-0"


(For Section F-F & Section H-H, See Sheet 25)

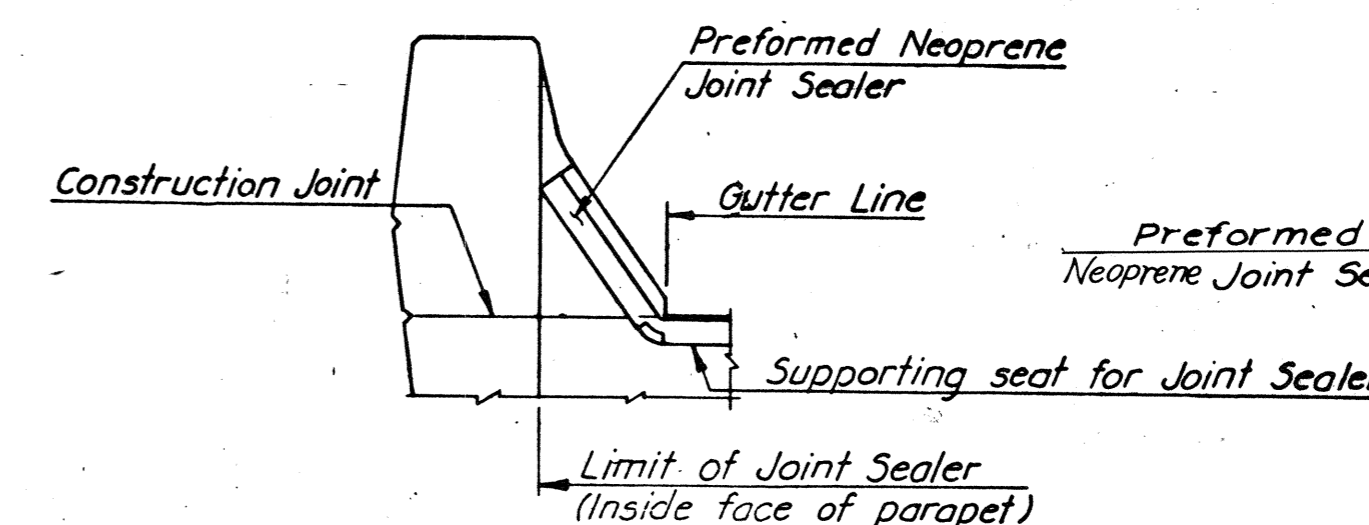


TREATMENT OF TYPE "A" JOINT AT GUTTER
PIERS 4, 5, 6, 7, 8 AND 9
No Scale

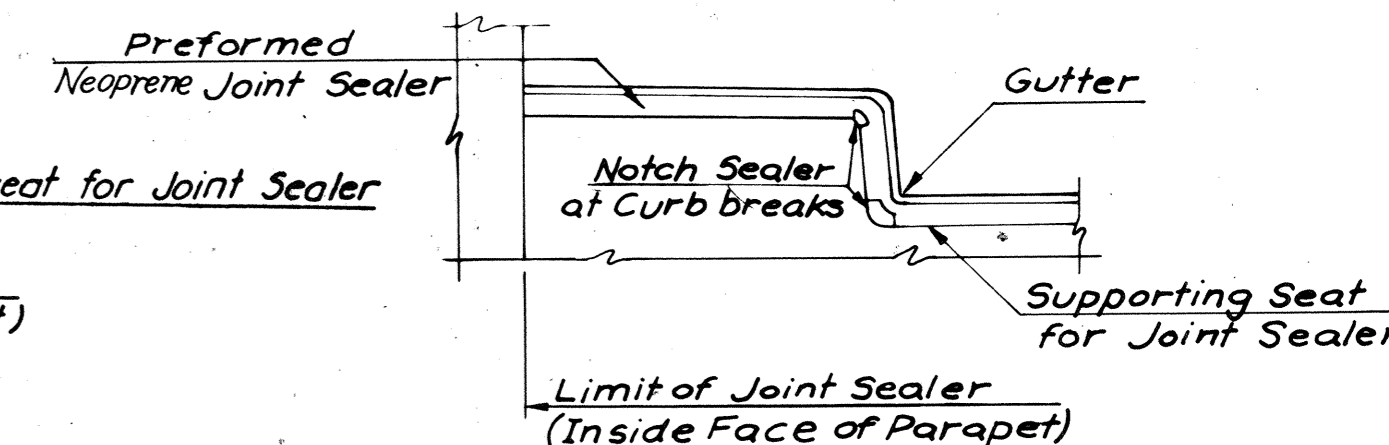

TREATMENT OF TYPE "A" JOINT AT CURB
PIER 4E
No Scale

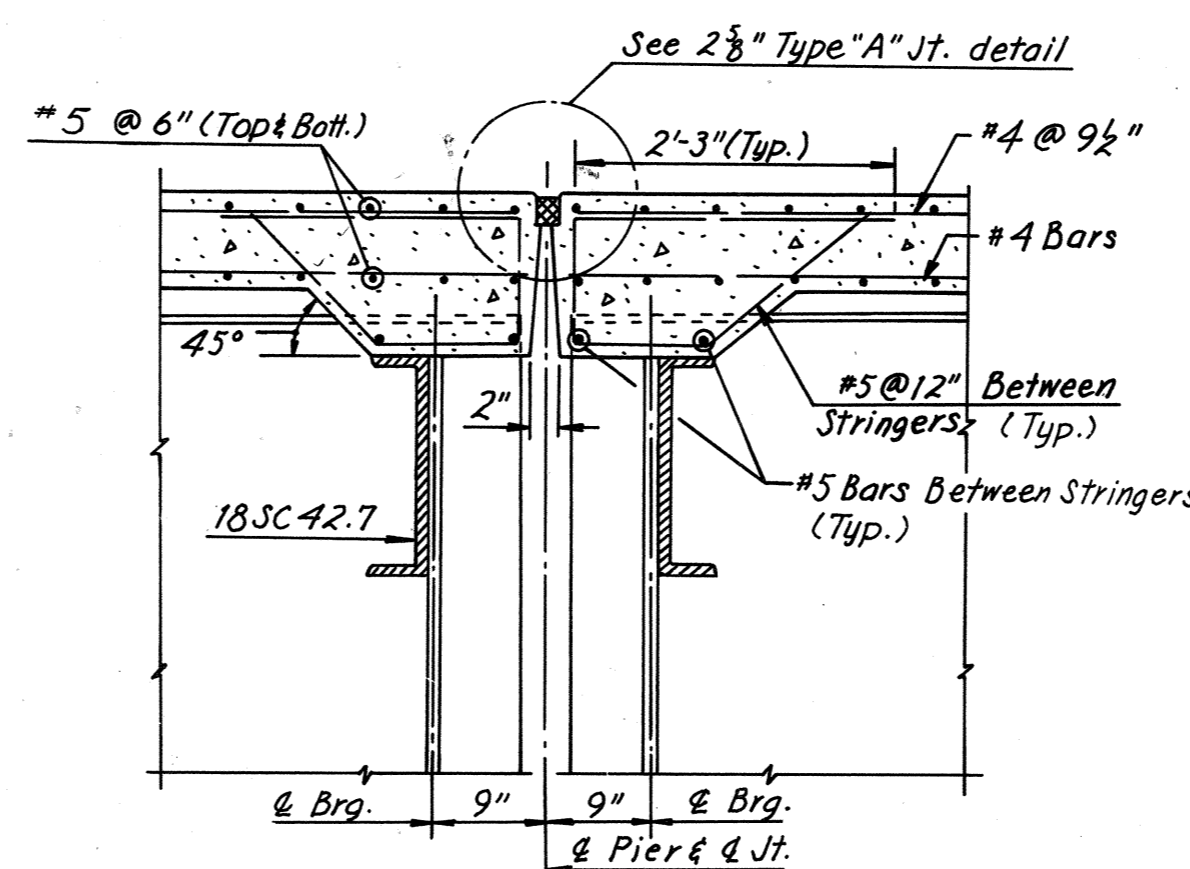

SECTION B-B
Scale: 3/4"=1'-0"

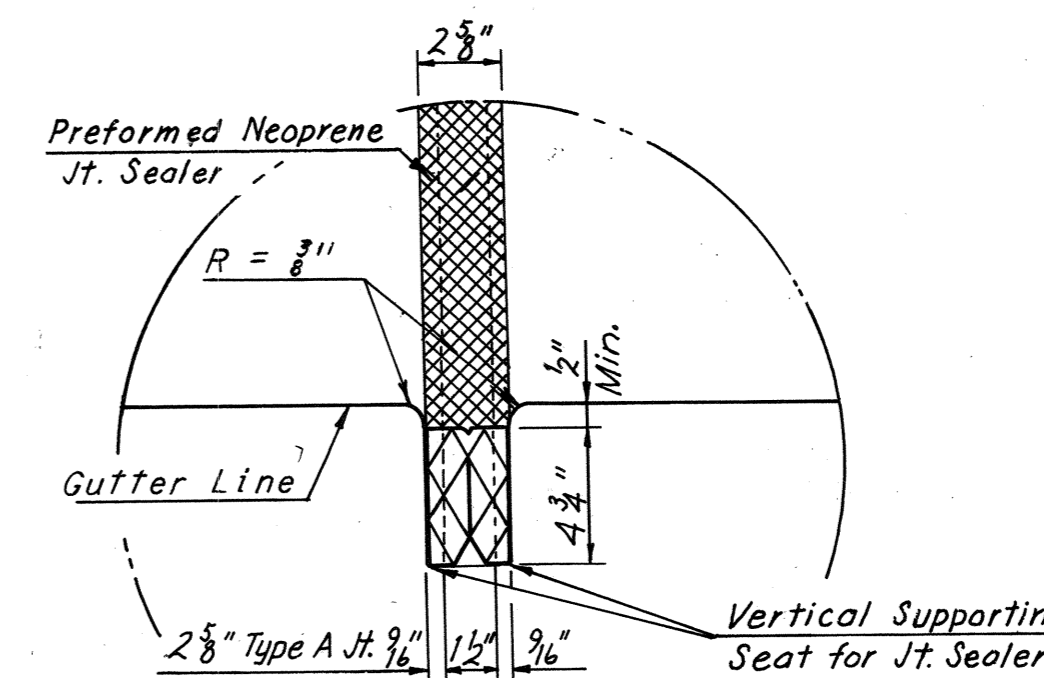

DETAIL B
No Scale

BY	DATE	Z	As Built	TEM	G-77
MADE	Y.C.P. 3-18-69				
CHECKED	G.C.C. 4-21-69				
IN CHARGE		NO.	REVISION	BY	DATE

RICHMOND METROPOLITAN AUTHORITY
RICHMOND EXPRESSWAY SYSTEM
DOWNTOWN EXPRESSWAY

BRIDGE NO. 64
RAMP N-W CONNECTION FROM
RICHMOND-PETERSBURG TURNPIKE
JOINT DETAILS

HOWARD, NEEDLES, TAMMEN & BERGENDOFF
consulting engineers
NEW YORK ALEXANDRIA KANSAS CITY

SCALE: *As Noted*
CONTRACT NO. **10**
SHEET NO. **26** OF **28**

AS BUILT



RICHMOND METROPOLITAN TRANSPORTATION
AUTHORITY

RICHMOND EXPRESSWAY SYSTEM
CONTRACT NO. PC – 2018
PROTECTIVE COATING OF STRUCTURES


Bridge 65

Downtown Expressway

Ramp S-W Connection from
Richmond - Petersburg Turnpike



RECORD SET PLANS (Next 38)

RICHMOND EXPRESSWAY SYSTEM			
SECTION	PROJECT	SHEET NO.	TOTAL SHEETS
11	DOWNTOWN EXPRESSWAY	26	97

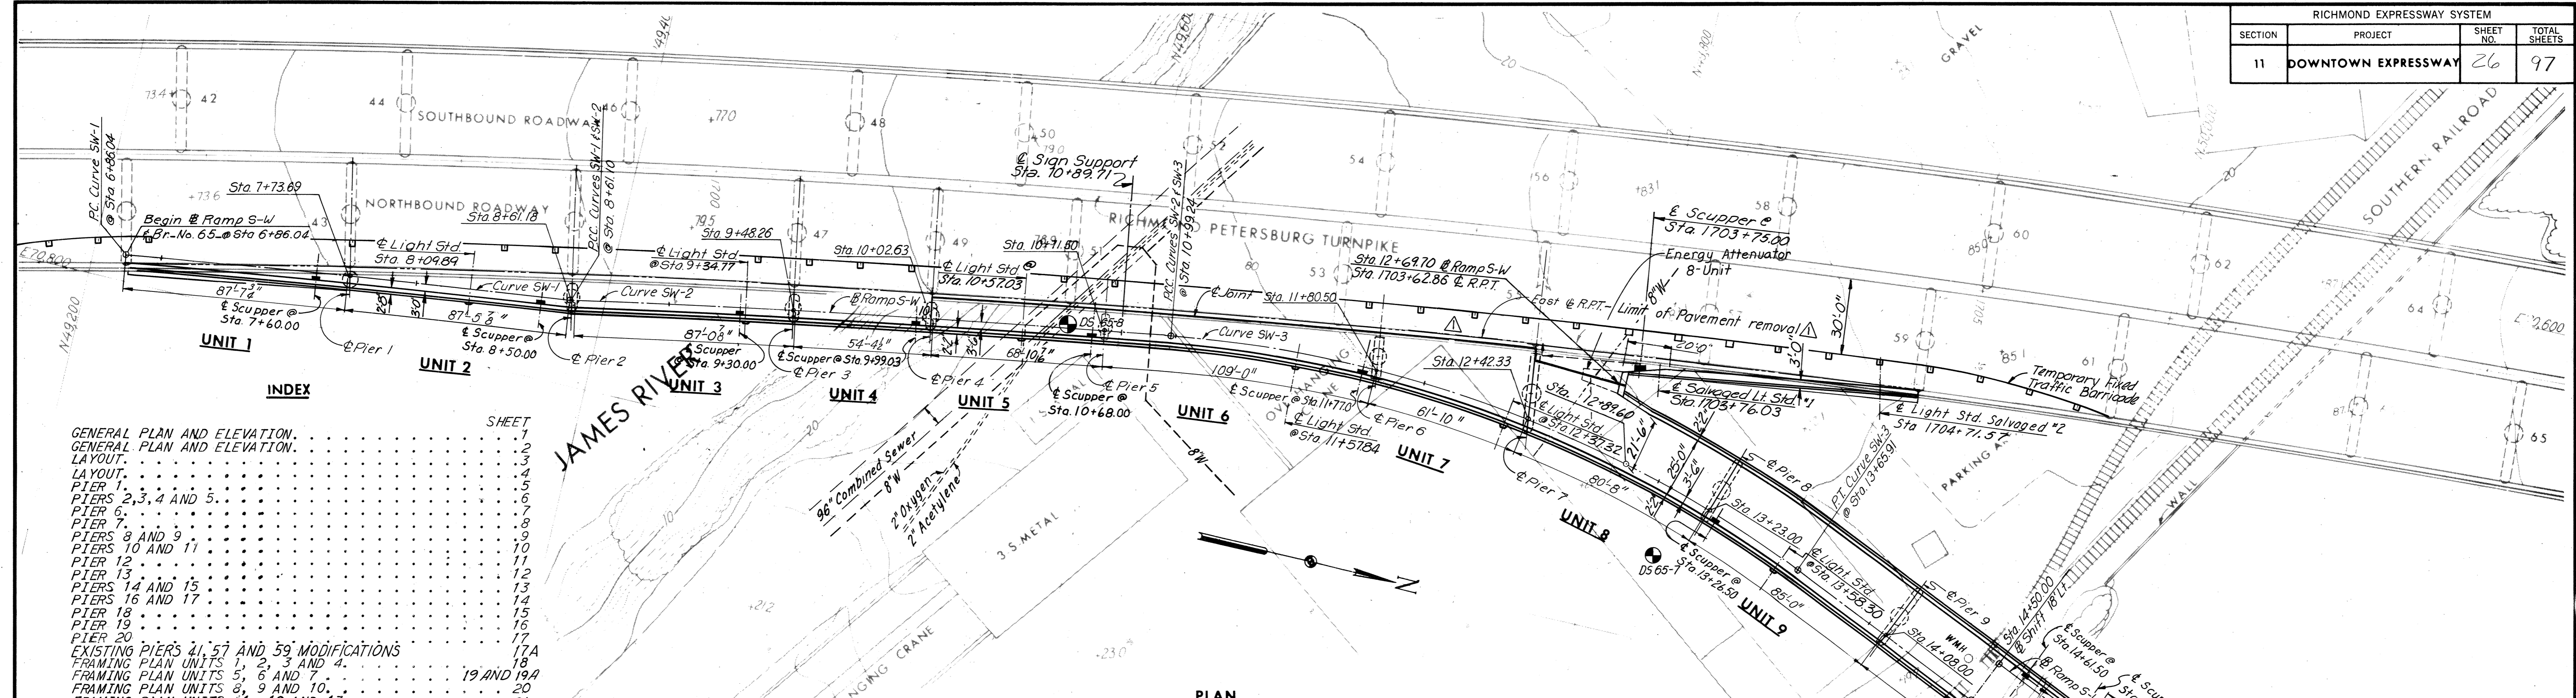

INDEX

GENERAL PLAN AND ELEVATION.	SHEET 1
GENERAL PLAN AND ELEVATION.	2
LAYOUT.	3
LAYOUT.	4
PIER 1.	5
PIERS 2, 3, 4 AND 5.	6
PIER 6.	7
PIERS 8 AND 9.	8
PIERS 10 AND 11.	9
PIER 12.	10
PIER 13.	11
PIERS 14 AND 15.	12
PIERS 16 AND 17.	13
PIER 18.	14
PIER 19.	15
PIER 20.	16
EXISTING PIERS 21, 57 AND 59 MODIFICATIONS.	17A
FRAMING PLAN UNITS 1, 2, 3 AND 4.	18
FRAMING PLAN UNITS 5, 6 AND 7.	19 AND 19A
FRAMING PLAN UNITS 8, 9 AND 10.	20
FRAMING PLAN UNITS 11, 12 AND 13.	21
FRAMING PLAN UNITS 14, 15 AND 16.	22
FRAMING PLAN UNITS 17 AND 18.	23
FRAMING PLAN UNITS 19 AND 20.	24
DECK PLAN UNITS 1, 2, 3 AND 4.	25
DECK PLAN UNITS 5, 6 AND 7.	26
DECK PLAN UNITS 8, 9 AND 10.	27
DECK PLAN UNITS 11, 12 AND 13.	28
DECK PLAN UNITS 14, 15 AND 16.	29
DECK PLAN UNITS 17 AND 18.	30
DECK PLAN UNITS 19 AND 20.	31
SUPERSTRUCTURE DETAILS.	32
FIRE PROTECTION. (DELETED)	33
JOINT DETAILS.	34 AND 35
BORING LOGS.	36 THRU 38
FRAMING PLAN UNITS 8 AND 8W.	20A

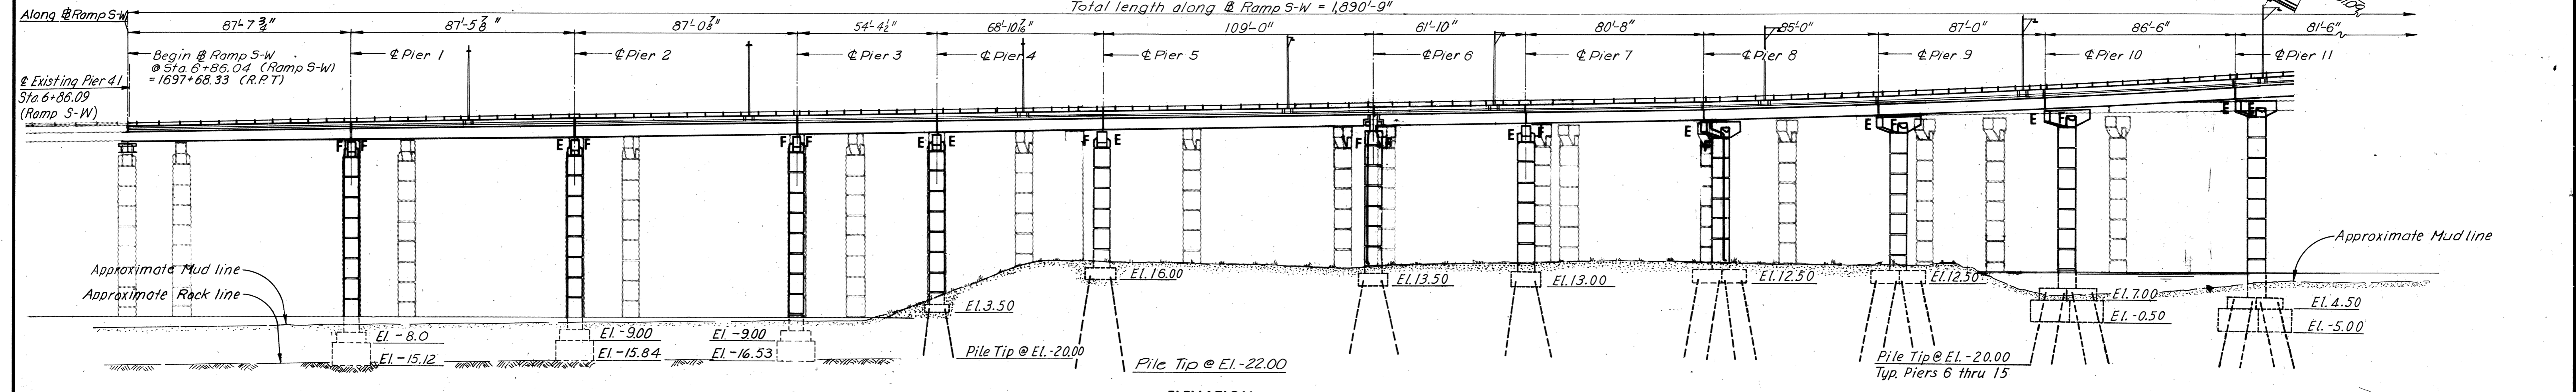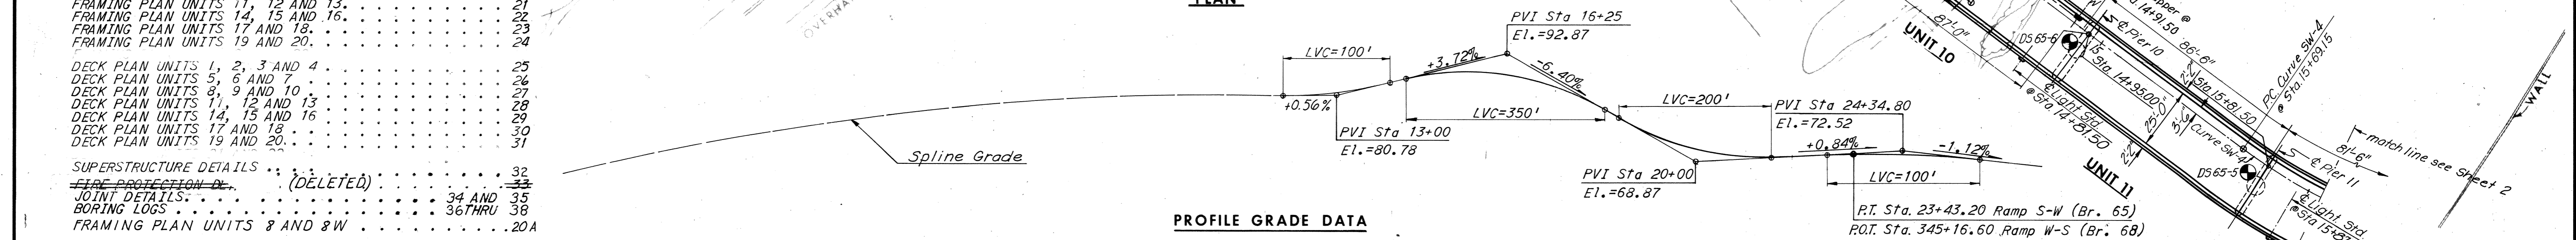


Notes:

- For General Plan and Elevation Units 12 thru 20 see Sheet 2.
- For Layout of Ramp S-W, see Sheets 3 and 4.
- For Estimated Quantities, see Sheet 4.
- For Boring Logs, see Sheets 36 thru 38.
- For General Notes, see Sheet 4.

NO.	REVISION	BY	DATE
1	Sheet 20a Added	TEM	9-9-75
2	Profile Ramp W-S	TEM	9-8-75
3	Limit of pavement removal & Sheet 17A added	ABP	8-25-75

Substructure Note: Footings for Piers 1, 2 and 3 shall be founded on concrete seals socketed 1'-0" into solid rock.

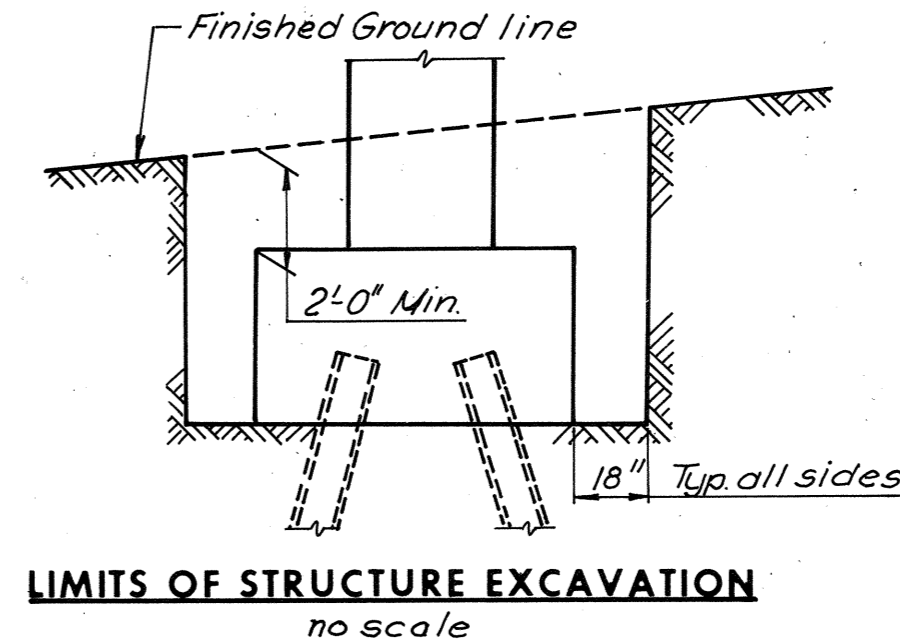

AS BUILT



RICHMOND METROPOLITAN AUTHORITY
RICHMOND EXPRESSWAY SYSTEM
DOWNTOWN EXPRESSWAY

BRIDGE NO. 65
RAMP S-W CONNECTION FROM
RICHMOND-PETERSBURG TURNPIKE
GENERAL PLAN AND ELEVATION

HOWARD, NEEDLES, TAMMEN & BERGENDOFF
consulting engineers
NEW YORK ALEXANDRIA KANSAS CITY

SCALE: 1"=30'-0"
CONTRACT NO. 11
SHEET NO. 1 OF 38

RICHMOND EXPRESSWAY SYSTEM			
SECTION	PROJECT	SHEET NO.	TOTAL SHEETS
11	DOWNTOWN EXPRESSWAY	27	97

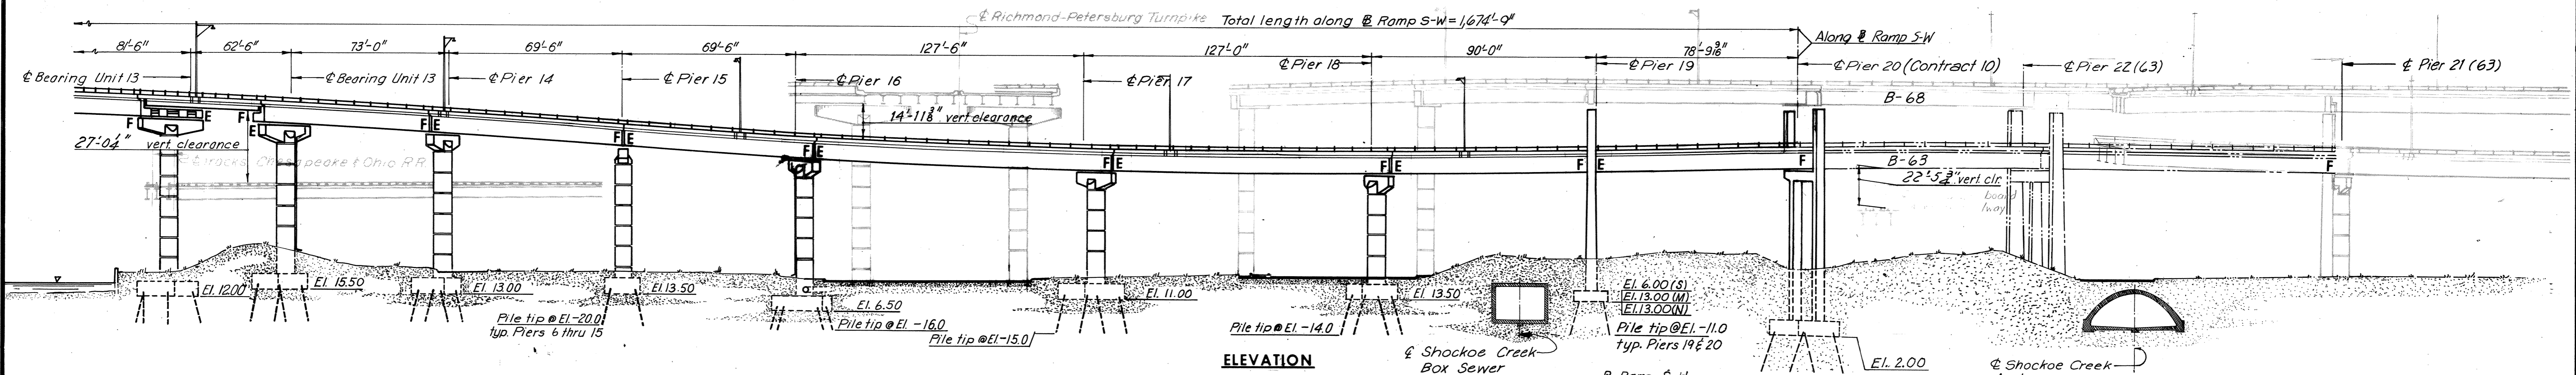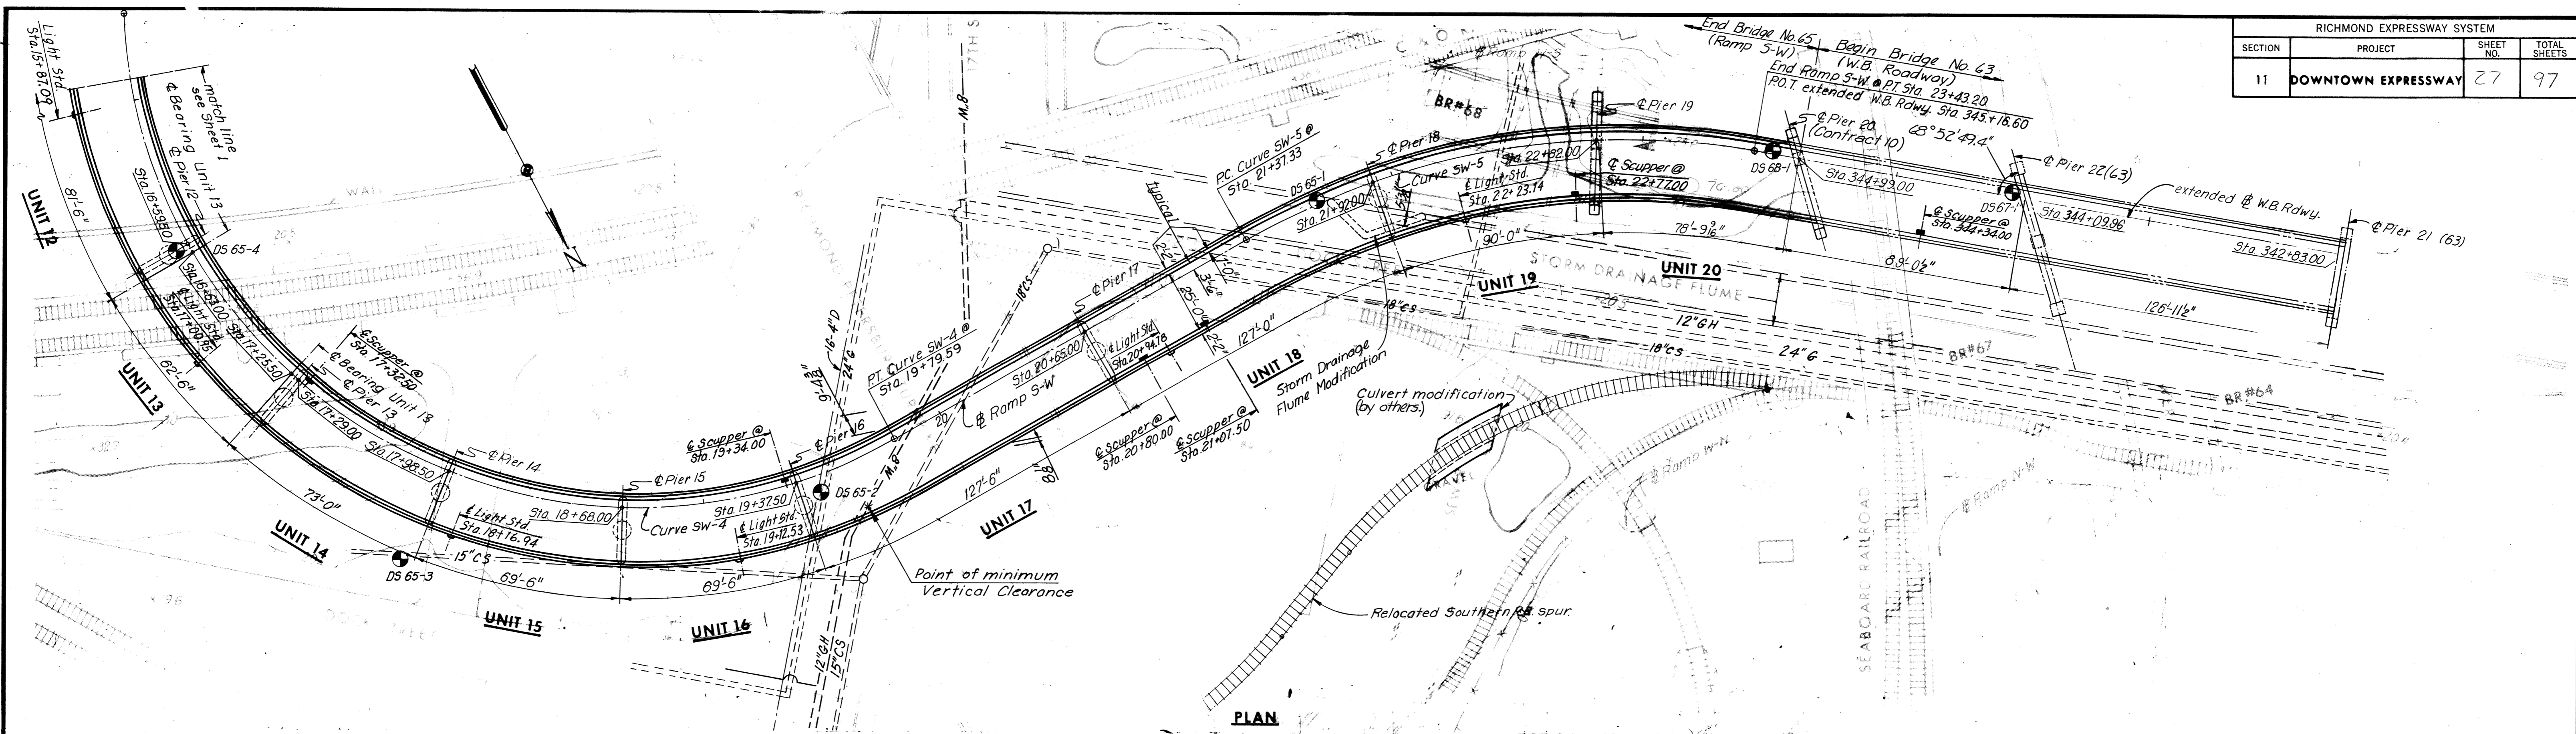

ELEVATION

<p>Curve: SW-1</p> <p>P.I. = Sta. 7+73.58 Δ = 1°45'02" D = 1°00' T = 87.53' L = 175.05' R = 5,729.58'</p>	<p>Curve: SW-2</p> <p>P.I. = Sta. 9+80.19 Δ = 2°24'12" D = 1°00'33" T = 119.09' L = 238.14' R = 5,677.58'</p>	<p>Curve: SW-3</p> <p>P.I. = Sta. 12+36.15 Δ = 3°00'00" D = 1°00' T = 136.91' L = 266.67' R = 477.47'</p>
---	---	---

<p>Curve: SW-4</p> <p>P.I. = Sta. 18+95.05 Δ = 11°25'03" D = 28°21'51" T = 325.90' L = 410.44' R = 202.00'</p>	<p>Curve: SW-5</p> <p>P.I. = Sta. 22+44.51 Δ = 3°19'04" D = 19°05'55" T = 107.17' L = 205.87' R = 300.00'</p>
--	---

<p>Richmond-Petersburg Turnpike</p> <p>Curve: R.P.T.-1</p> <p>P.I. = Sta. 1704+68.83 Δ = 15°03'56" D = 1°00' T = 757.65' L = 1,506.56' R = 5,729.58'</p>	<p>Curve: R.P.T.-2</p> <p>P.I. = Sta. 1723+07.01 Δ = 33°27'07" D = 4°00' T = 430.45' L = 836.30' R = 1,432.39'</p>
---	--

Notes:
For General Plan and Elevation Units 1 thru 11, see Sheet 1.
For Layout of Ramp S-W, see Sheets 3 and 4.
For Estimated Quantities, see Sheet 4.
For Boring Logs, see Sheets 36 thru 38.
For General Notes, see Sheet 4.


HORIZONTAL CURVE DATA

AS BUILT
RICHMOND METROPOLITAN AUTHORITY
RICHMOND EXPRESSWAY SYSTEM
DOWNTOWN EXPRESSWAY
BRIDGE NO. 65
RAMP S-W CONNECTION FROM
RICHMOND-PETERSBURG TURNPIKE
GENERAL PLAN AND ELEVATION

HOWARD, NEEDLES, TAMMEN & BERGENDOFF
consulting engineers
NEW YORK ALEXANDRIA KANSAS CITY
SCALE: 1"=30'-0"
CONTRACT NO. 11
SHEET NO. 2 OF 38

BY	DATE				
MADE	J.V.	4-2-69			
CHECKED	K.C.P.	5-28-69			
IN CHARGE			NO.	REVISION	BY DATE

RICHMOND EXPRESSWAY SYSTEM			
SECTION	PROJECT	SHEET NO.	TOTAL SHEETS
11	DOWNTOWN EXPRESSWAY	28	97

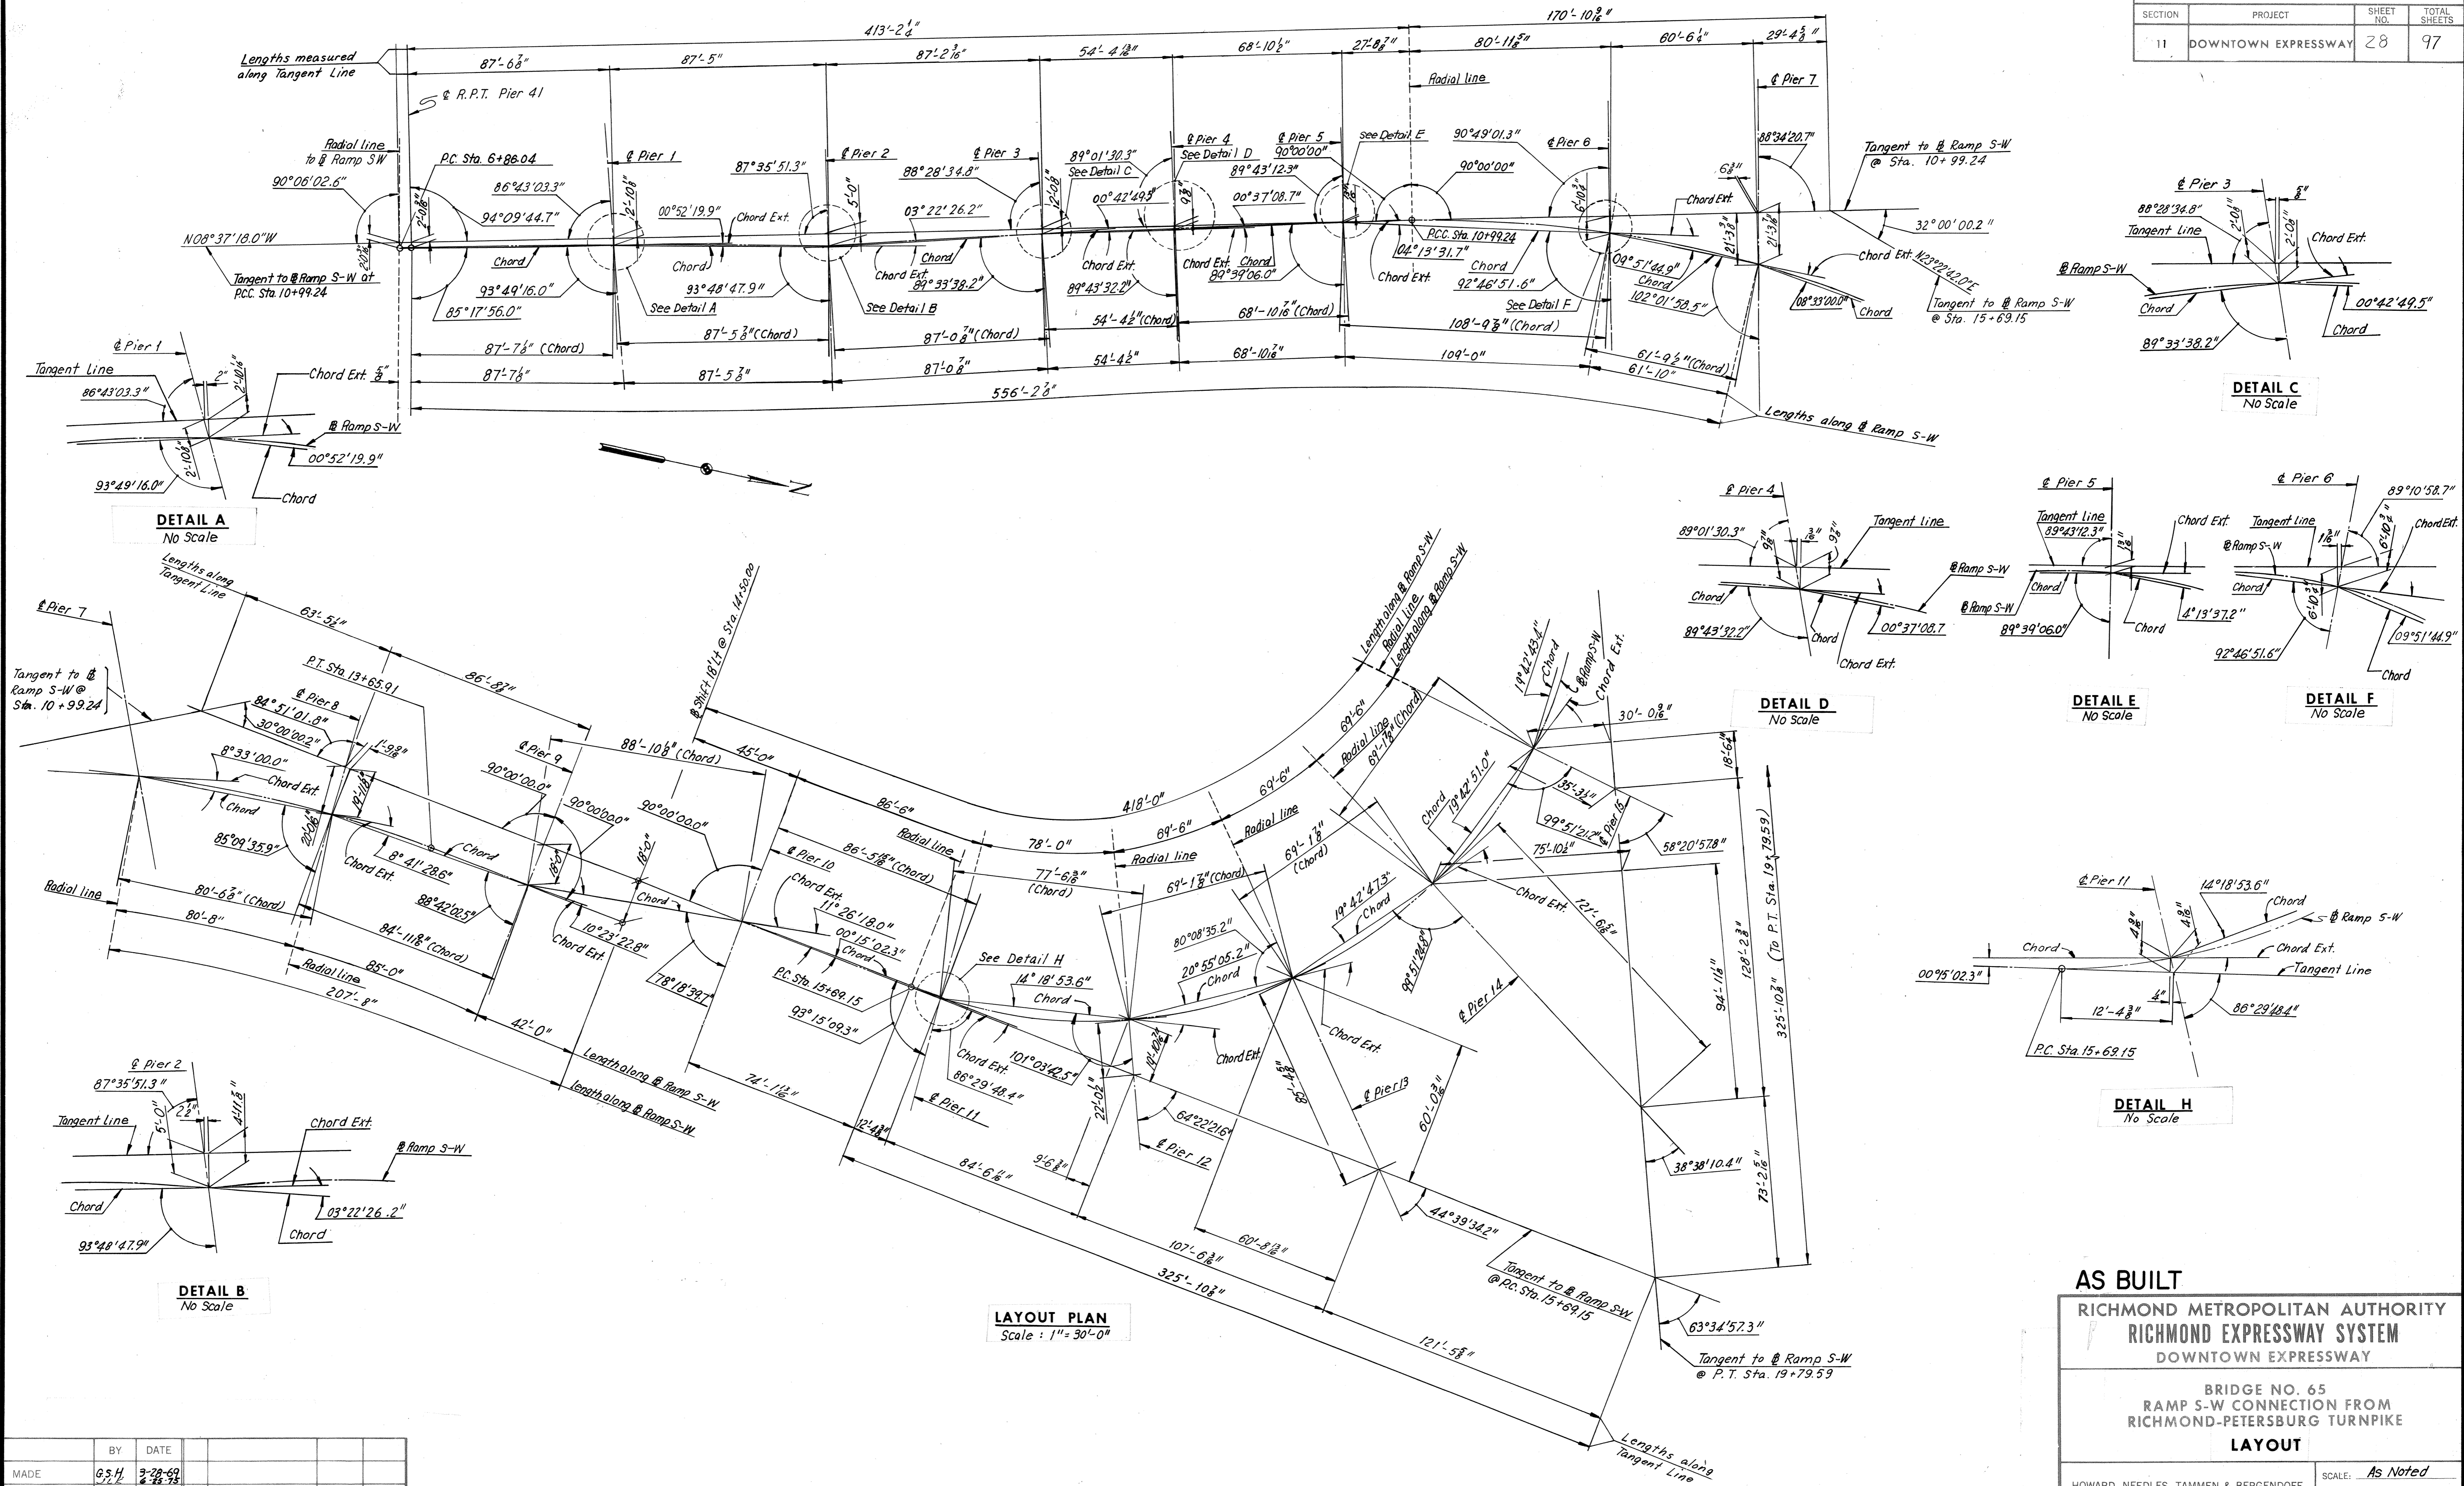

BY	DATE				
MADE	G.S.H.	3-28-69			
CHECKED	K.C.T.	5-7-69			
IN CHARGE	C.W.S.	7-7-68			
	NO.	REVISION	BY	DATE	

AS BUILT

RICHMOND METROPOLITAN AUTHORITY
RICHMOND EXPRESSWAY SYSTEM
DOWNTOWN EXPRESSWAY





BRIDGE NO. 65
RAMP S-W CONNECTION FROM
RICHMOND-PETERSBURG TURNPIKE

LAYOUT

HOWARD, NEEDLES, TAMMEN & BERGENDOFF
consulting engineers
NEW YORK ALEXANDRIA KANSAS CITY

SCALE: As Noted
CONTRACT NO.: 11
SHEET NO. 3 OF 38

RICHMOND EXPRESSWAY SYSTEM			
SECTION	PROJECT	SHEET NO.	TOTAL SHEETS
11	DOWNTOWN EXPRESSWAY	29	97

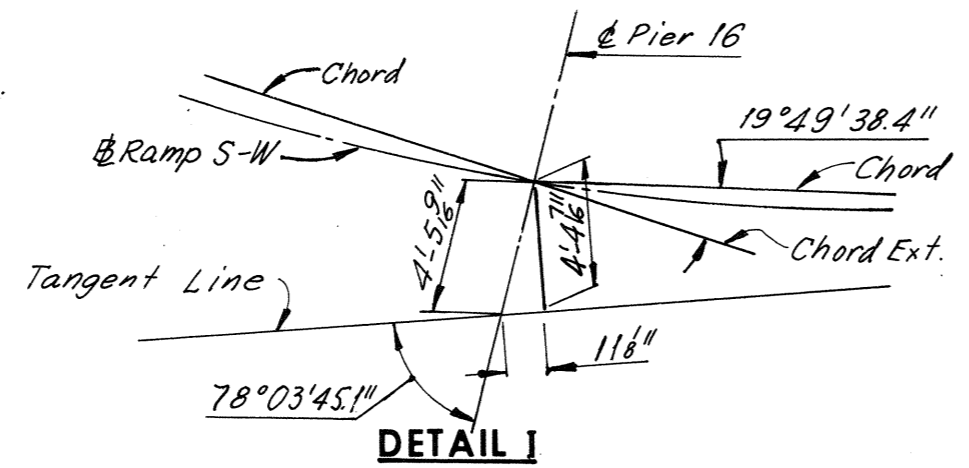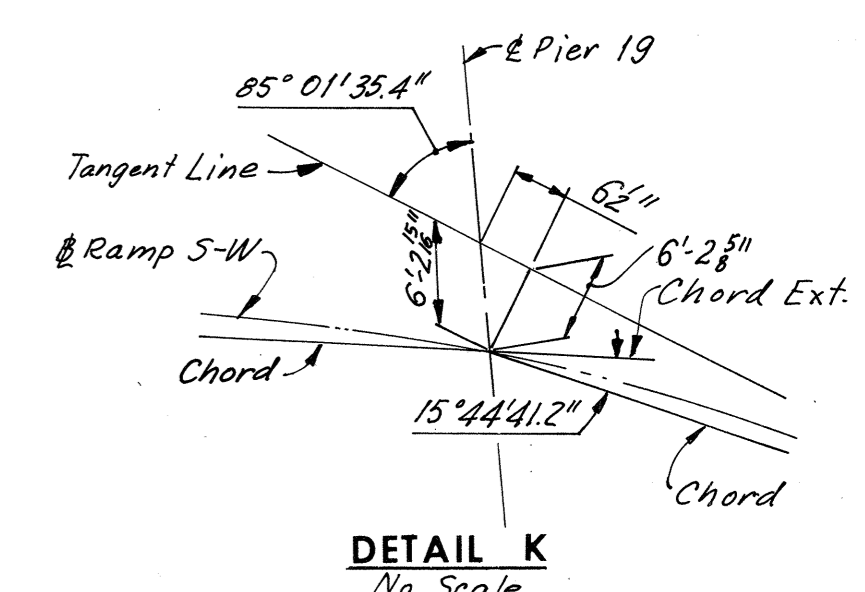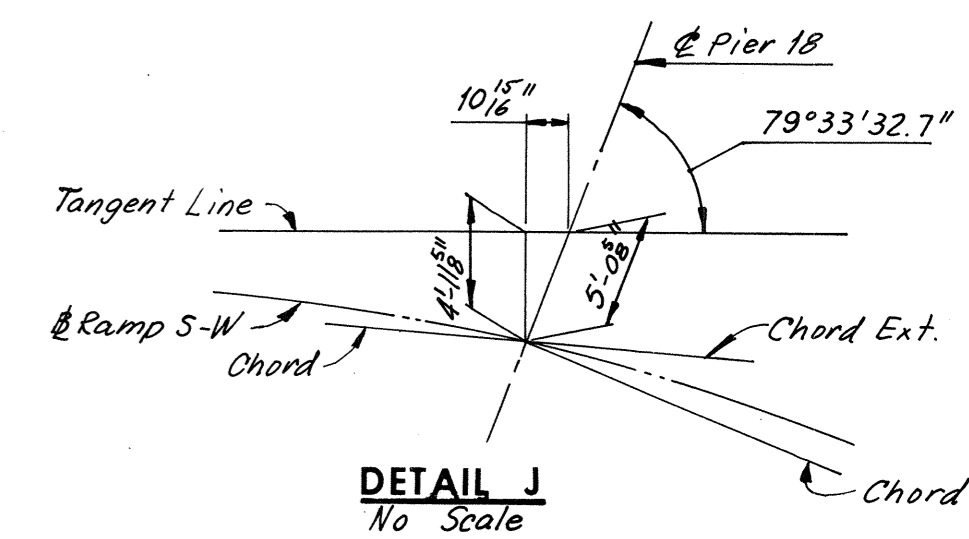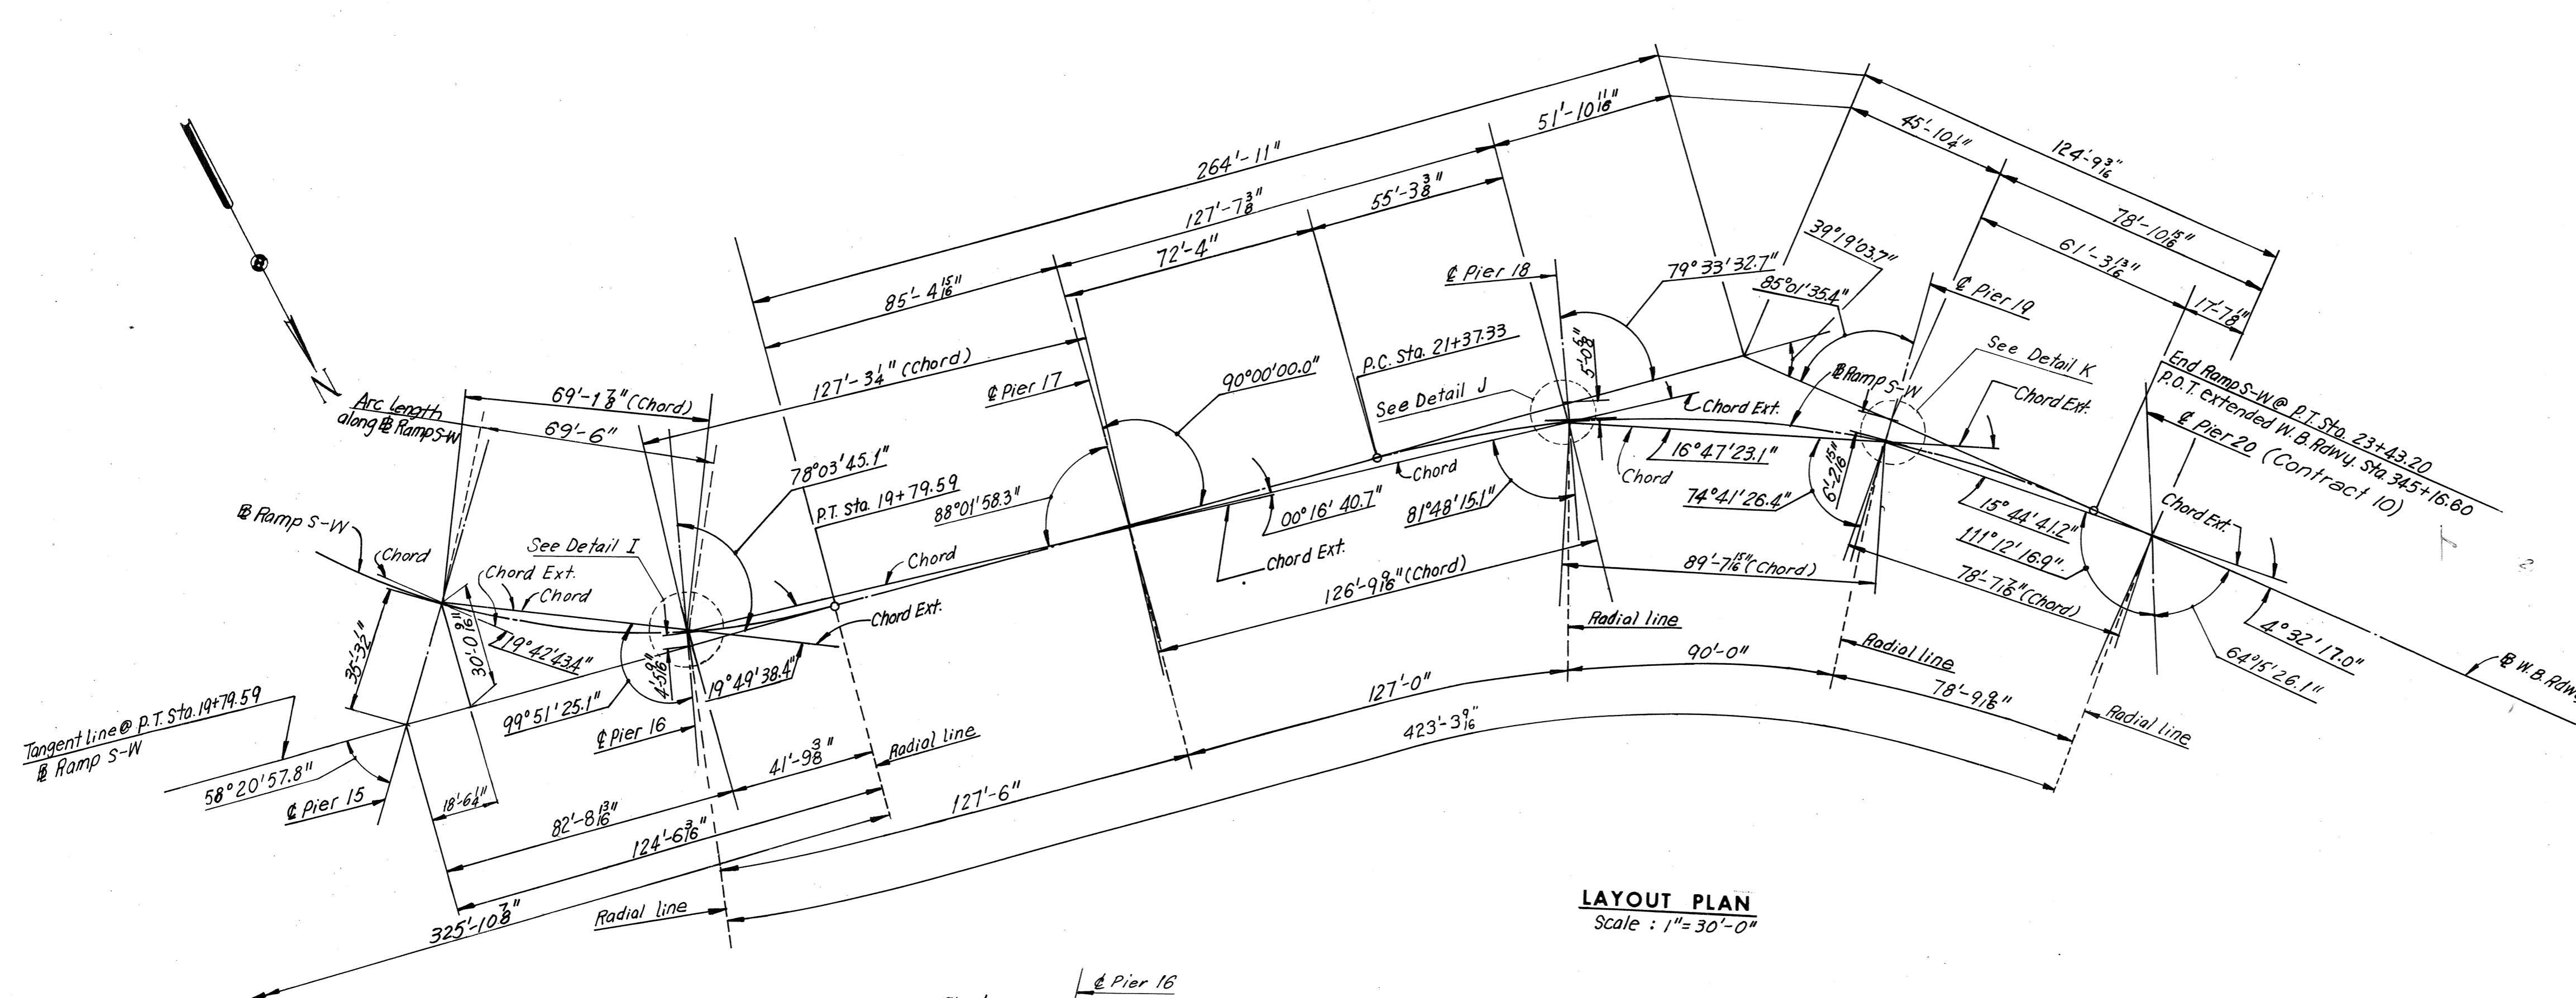

ESTIMATED QUANTITIES

	Structure Excavation Cu. Yds.	Concrete (±) Cu. Yds.	Reinforcing Steel Lbs.	Str. Steel Mild Carbon Lbs.	Str. Steel High Strength Lbs.	Aluminum Rolling (1-Rail) Lin. Ft.	Steel Piles 10BP42 Lin. Ft.	Steel Piles 12BP53 Lin. Ft.
Superstructure	---	1454.8	340,730	1,074,600	476,400	2,820	---	---
Substructure	2,741 *	2,702.8	386,910	15,100	12,000	---	1,152	7,497
Total	2,741 *	4157.6 †	727,640	1,089,700	488,400	2,820	1,152	7,497

	Temporary Barricade Lin. Ft.	Tremie Concrete Class T3 Cu. Yds.	Metal Conduit Lin. Ft.	Energy Attenuator 8-Unit Each	Modifications to R.P. Turnpike Bridge Lump Sum	Bridge Drainage Metal Work Lbs.	Modifications to Storm Drain. Flume Cu. Yds.	Pipe Support @ Pier 16 Lump Sum
Superstructure	---	---	1800	1	1	19,960	48	---
Substructure	---	472.6	---	---	---	---	---	1
Total	840	472.6	1800	1	1	19,960	48	1

GENERAL NOTES:

- ROADWAY:** One 25'-0" clear roadway transitioning into a 13'-6" widening of existing Richmond-Petersburg Turnpike.
- CAPACITY:** Dead load includes 15 lbs. per sq. ft. for future wearing surface. Live load HS 20-44 loading and alternate military loading.
- SPECIFICATIONS:**
 - GENERAL: Virginia Department of Highway Road and Bridge Specifications 1970.
 - DESIGN: A.A.S.H.O. Standard Specifications for Highway Bridges 1973, modified by Special Design provisions.
 - WELDING: 1972 Structural Welding Code of the American Welding Society.
- CONTRACT SPECIAL PROVISIONS:** Specifications and Contract Special Provisions referred to above are necessary to make these plans complete.
- DATUM:** City of Richmond
- TEMPERATURE:** The normal temperature referred to in the plans is 60°F. The temperature range for movement is 0°F to 120°F.
- DIMENSIONS:** All dimensions are measured horizontally and vertically unless otherwise noted.
- EXCAVATION:** Excavation below subgrade and cut slope template shall be classified as Structure Excavation. All excavation above these limits shall be classified as Regular Excavation and is not included in the Structural Quantities.

Foundations:

Foundations shall rest on firm material. Foundation material shall be dry and special attention is called to Section 401.05 of General Specifications and to the Contract Special Provisions concerning preparation of foundations for footings. Concrete in superstructure shall be Class A4. All other concrete shall be Class A3 except that footing seals shall be Tremie Concrete Class T3 as indicated on the detailed drawings. All exposed edges and corners shall have a 1/4" chamfer or fillet unless otherwise noted. Care in the method of vibration, the use of low-slump concrete, and or other means shall be employed to prevent downgrade movement of newly placed slab concrete. Finishing Concrete Surfaces: See Standard Architectural Detail Sheets and the Contract Special Provisions for types and details. All reinforcing steel shall be deformed bars conforming to ASTM A615 Grade 40. All reinforcing bar dimensions on the detailed drawings are to centers of bars unless otherwise noted. Clear distance between reinforcing steel and face of concrete shall be as noted on the plans. All bar laps shall be 30 diameters of the smaller diameter bar unless otherwise noted.

Steel Notes:

Structural steel shall conform to A.S.T.M. Designations A36, A572-Grade 50 and A588 as noted. See Special Provisions. All field connections shall be made with high strength bolts. High strength bolts shall be 1/2" diameter unless otherwise noted and shall conform to A.S.T.M. Specification A-325.

* Including 757 Cu. Yds. of "Underwater" Excavation for Piers 1, 2, 3, 10 and 11.

† All Concrete for Superstructure shall be Class A4 and for Substructure Class A3. Concrete for footing seals shall be Tremie Concrete Class T3 and is listed separately.

BY	DATE	Conc. & Reinf. Quant.	TEM	DATE
MADE	G.S.H. 3-28-69	Layout Dim. and * at Pier 16	TEM	7-76
CHECKED	K.C.T. 5-7-69	Concrete & Struc. Steel Quant.	TEM	8-75
IN CHARGE	NO.	REVISION	BY	DATE

AS BUILT








RICHMOND METROPOLITAN AUTHORITY
RICHMOND EXPRESSWAY SYSTEM
DOWNTOWN EXPRESSWAY

BRIDGE NO. 65
RAMP S-W CONNECTION FROM
RICHMOND-PETERSBURG TURNPIKE
LAYOUT


HOWARD, NEEDLES, TAMMEN & BERGENDOFF
consulting engineers
NEW YORK ALEXANDRIA KANSAS CITY

SCALE: As Noted
CONTRACT NO. 11
SHEET NO. 4 OF 38

RICHMOND EXPRESSWAY SYSTEM			
SECTION	PROJECT	SHEET NO.	TOTAL SHEETS
11	DOWNTOWN EXPRESSWAY	30	97

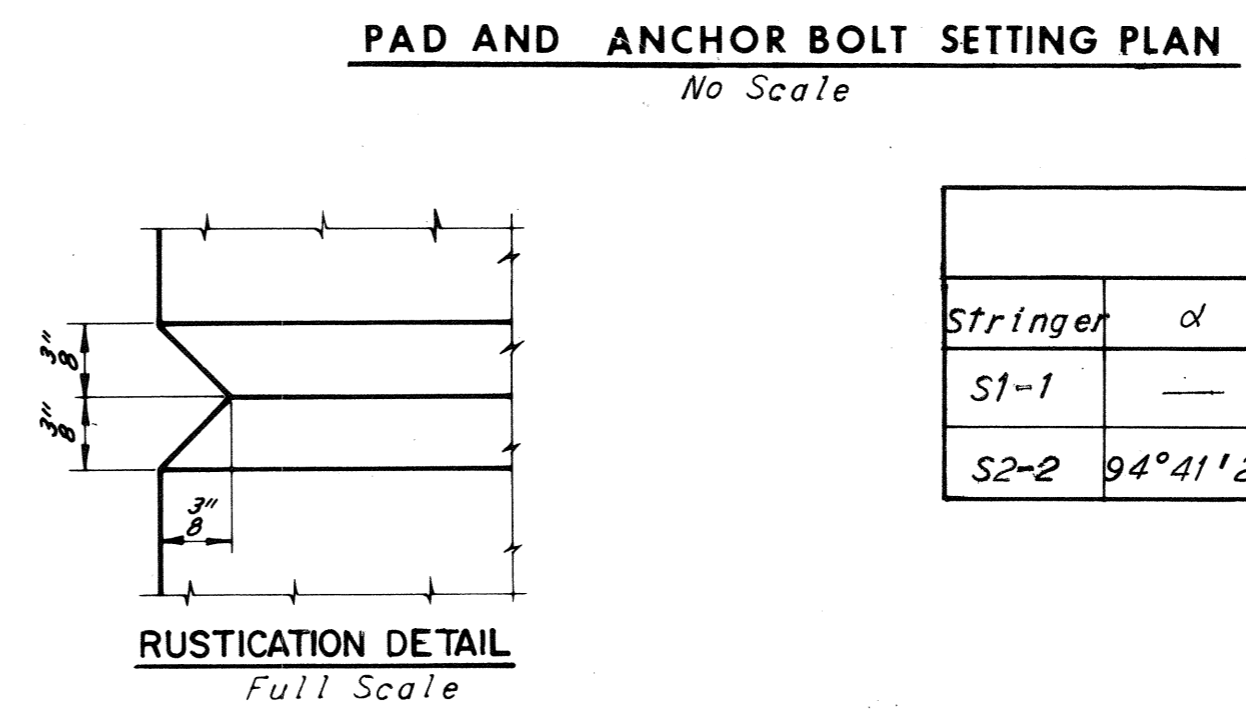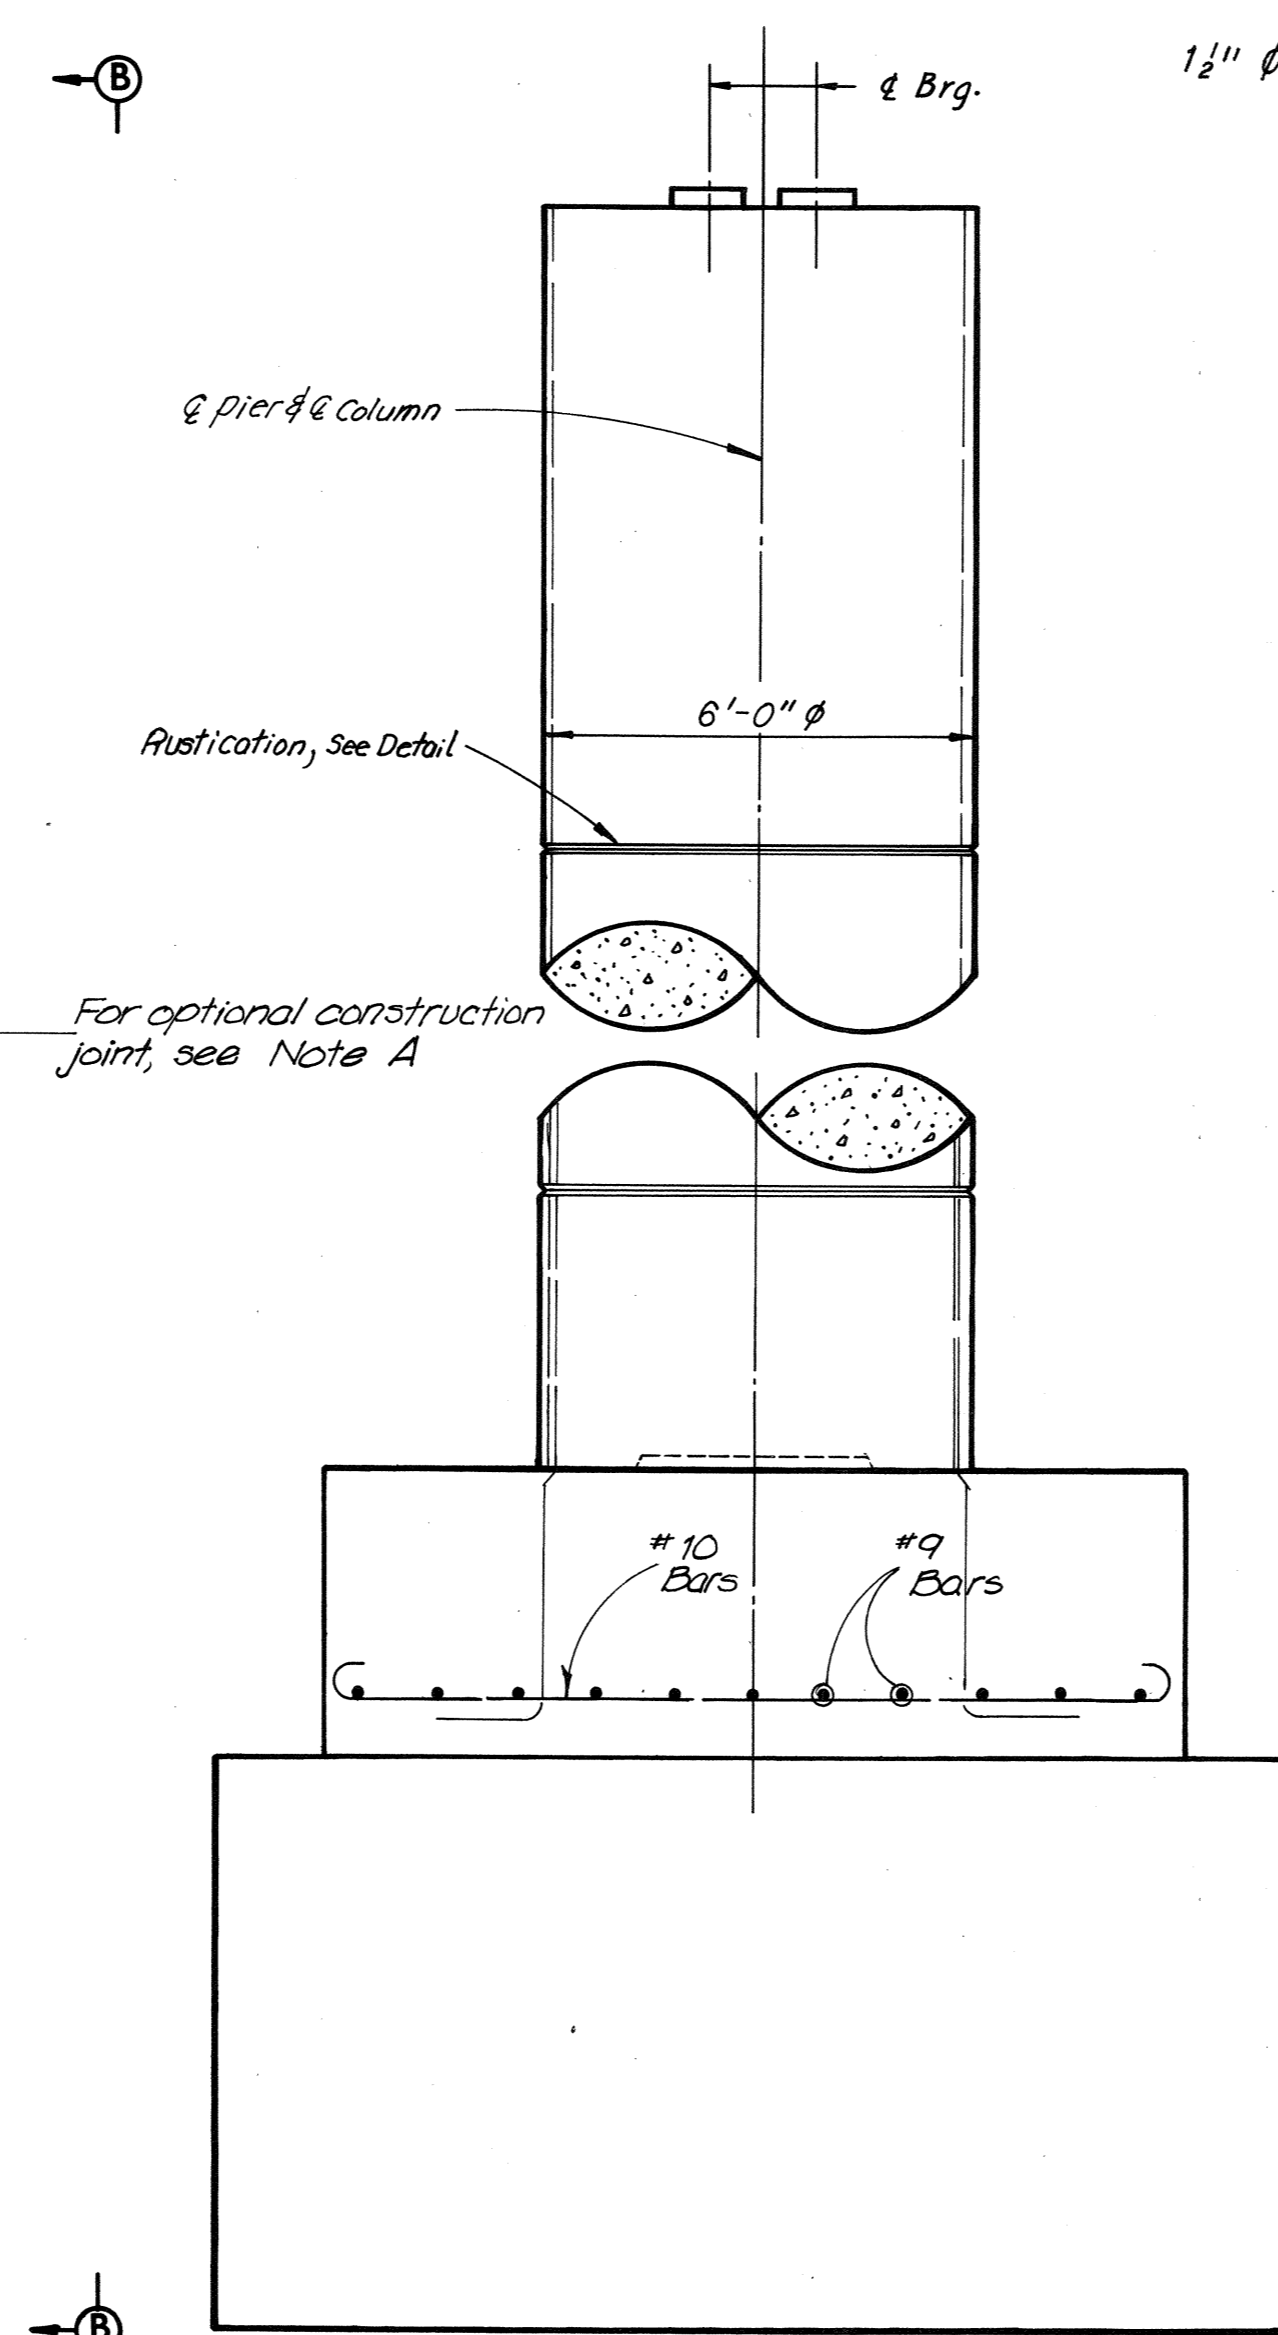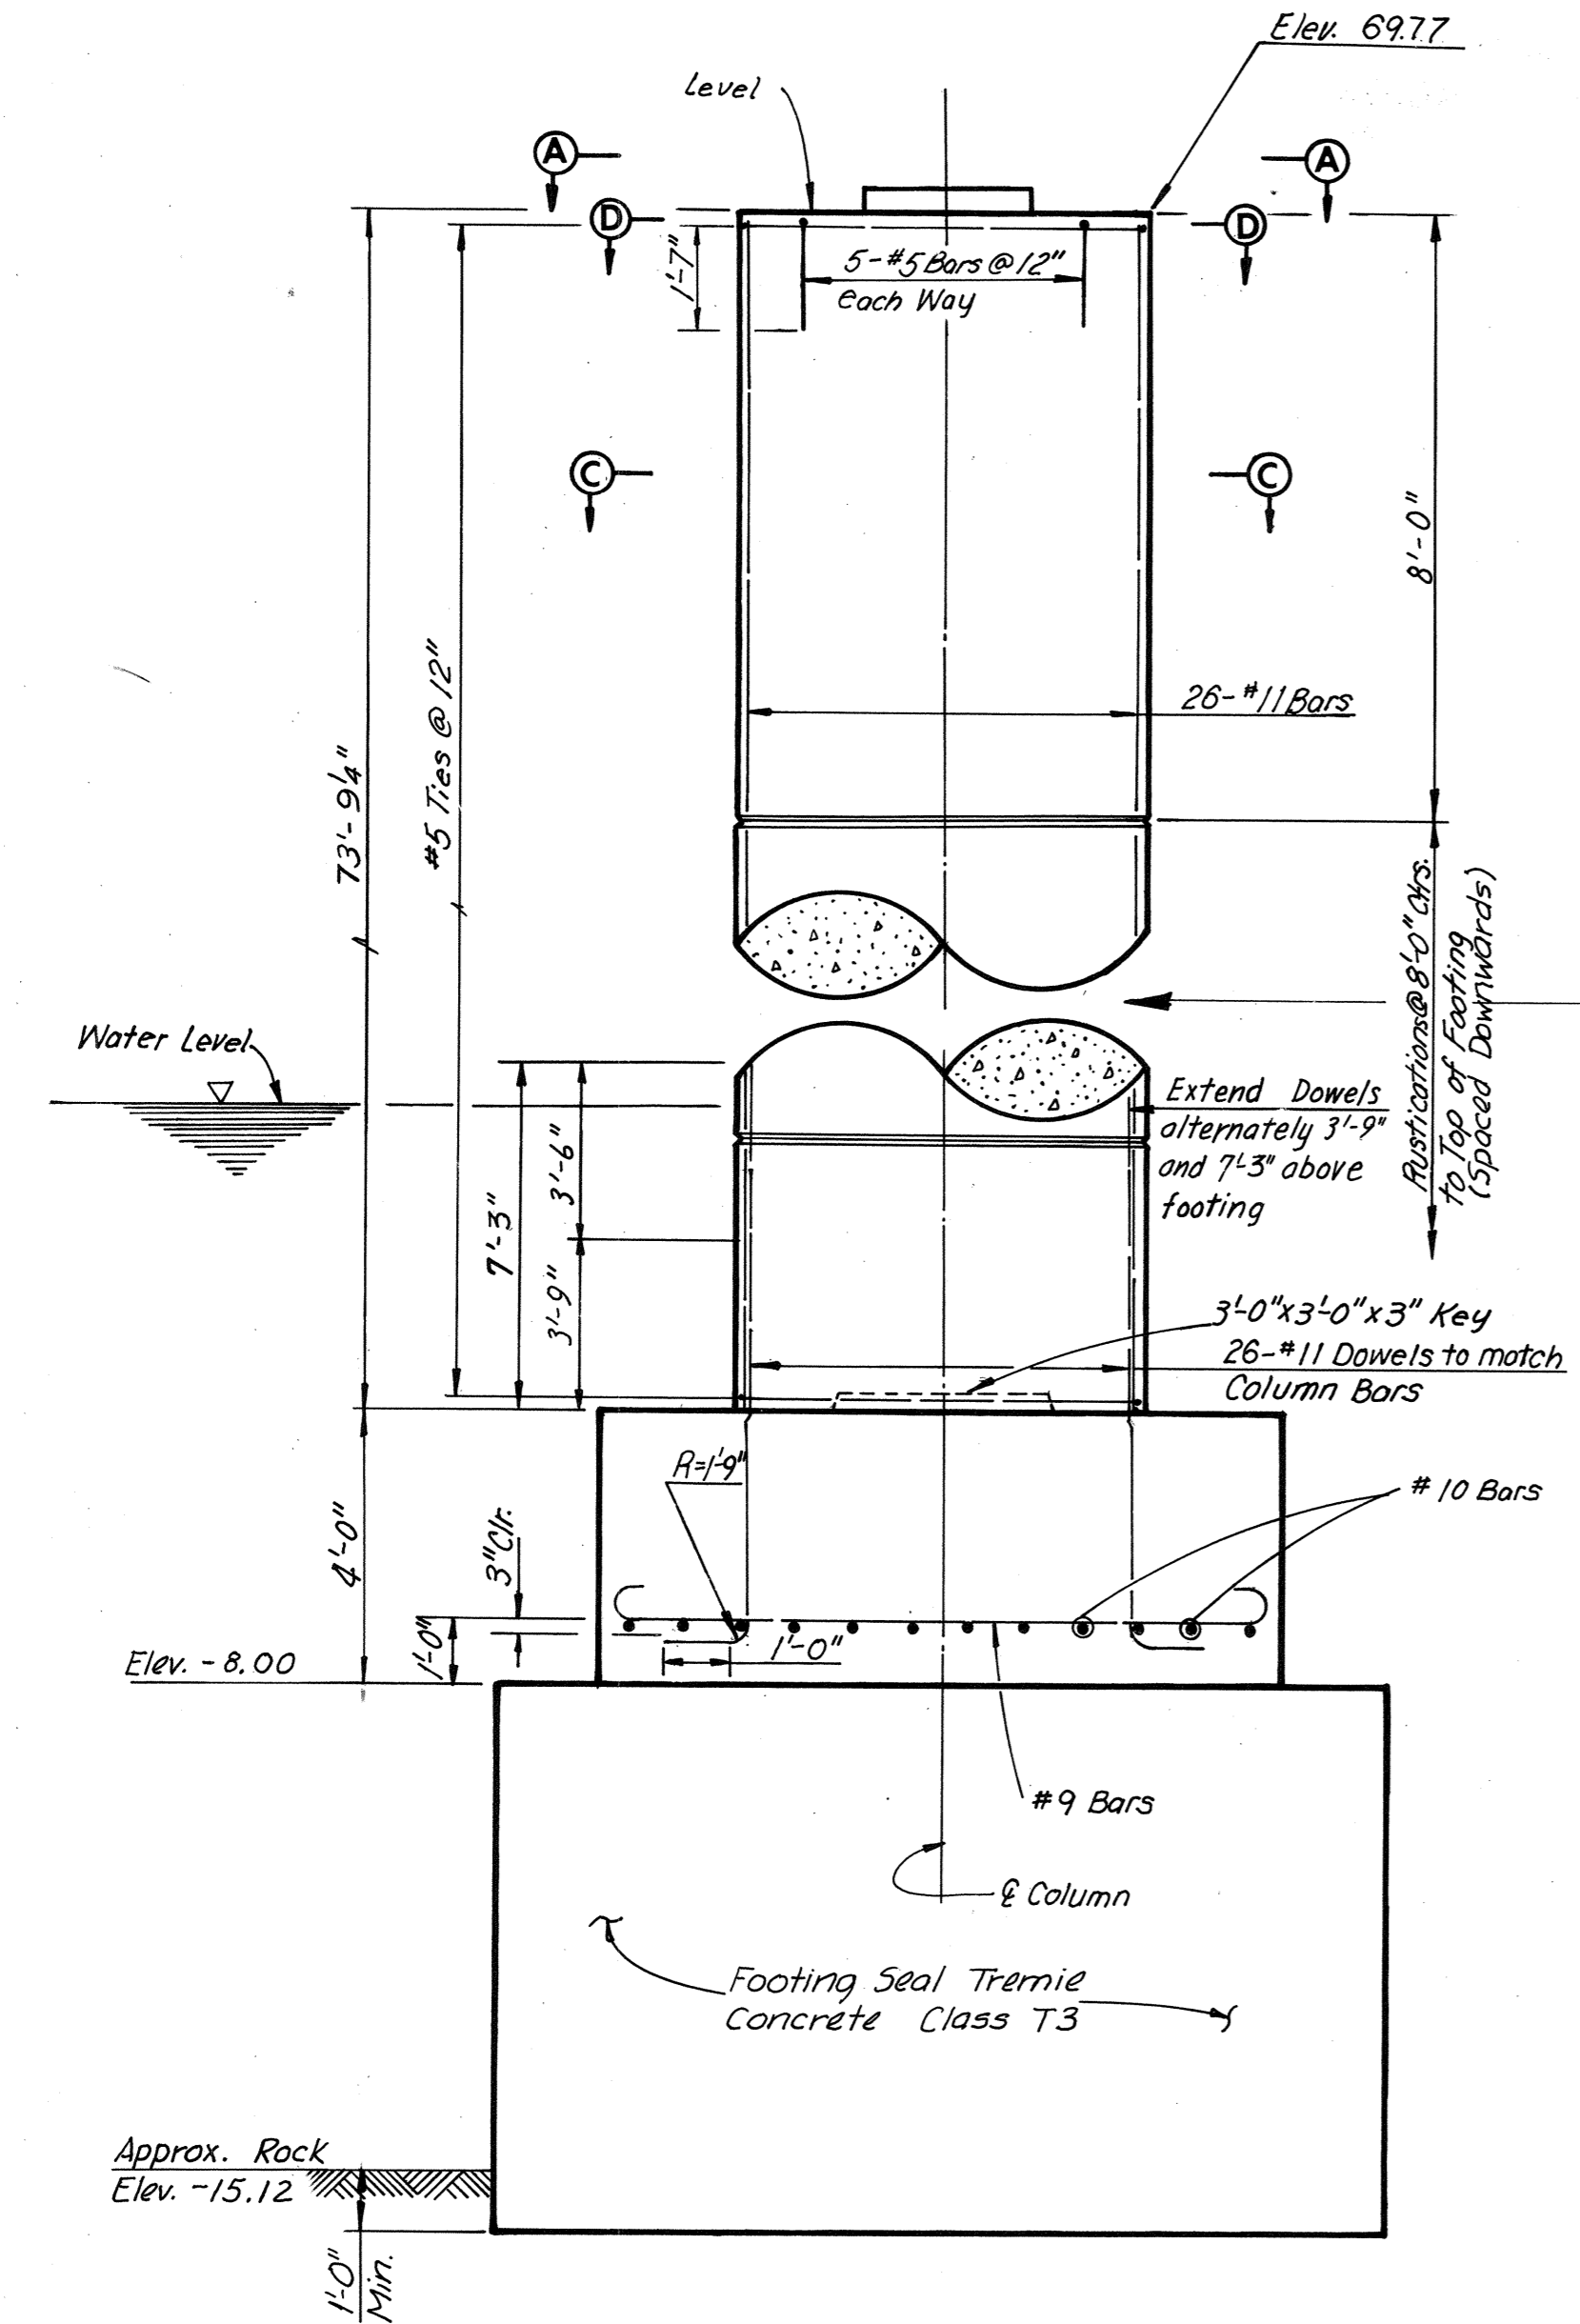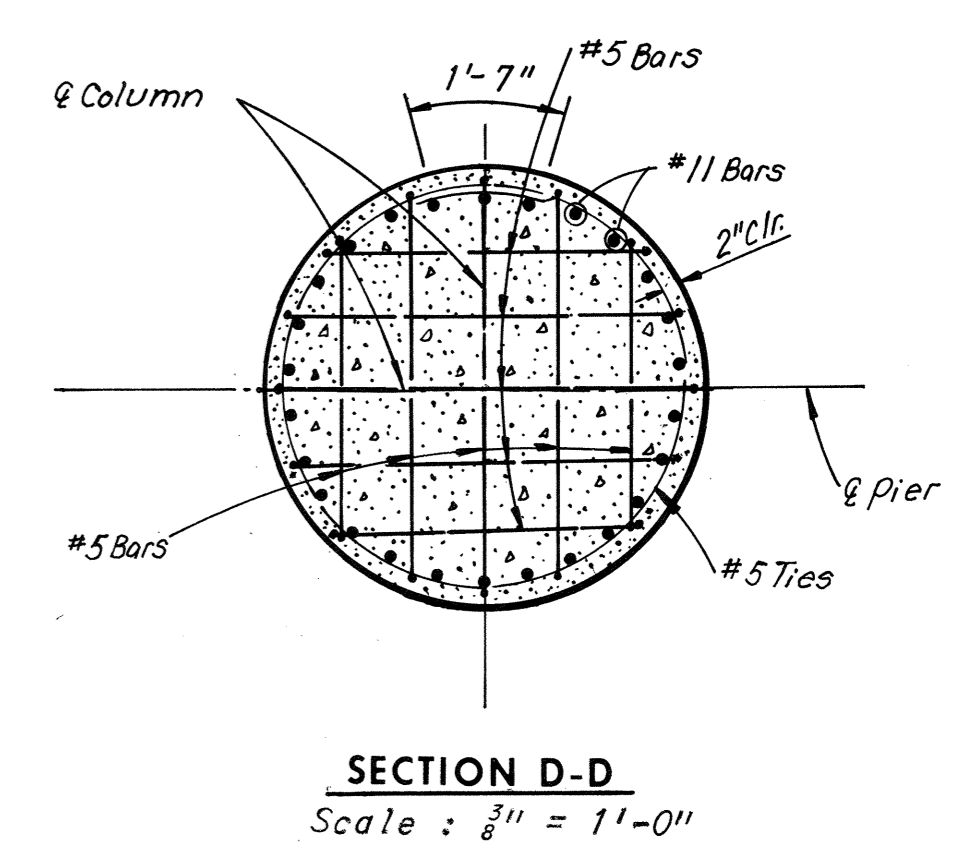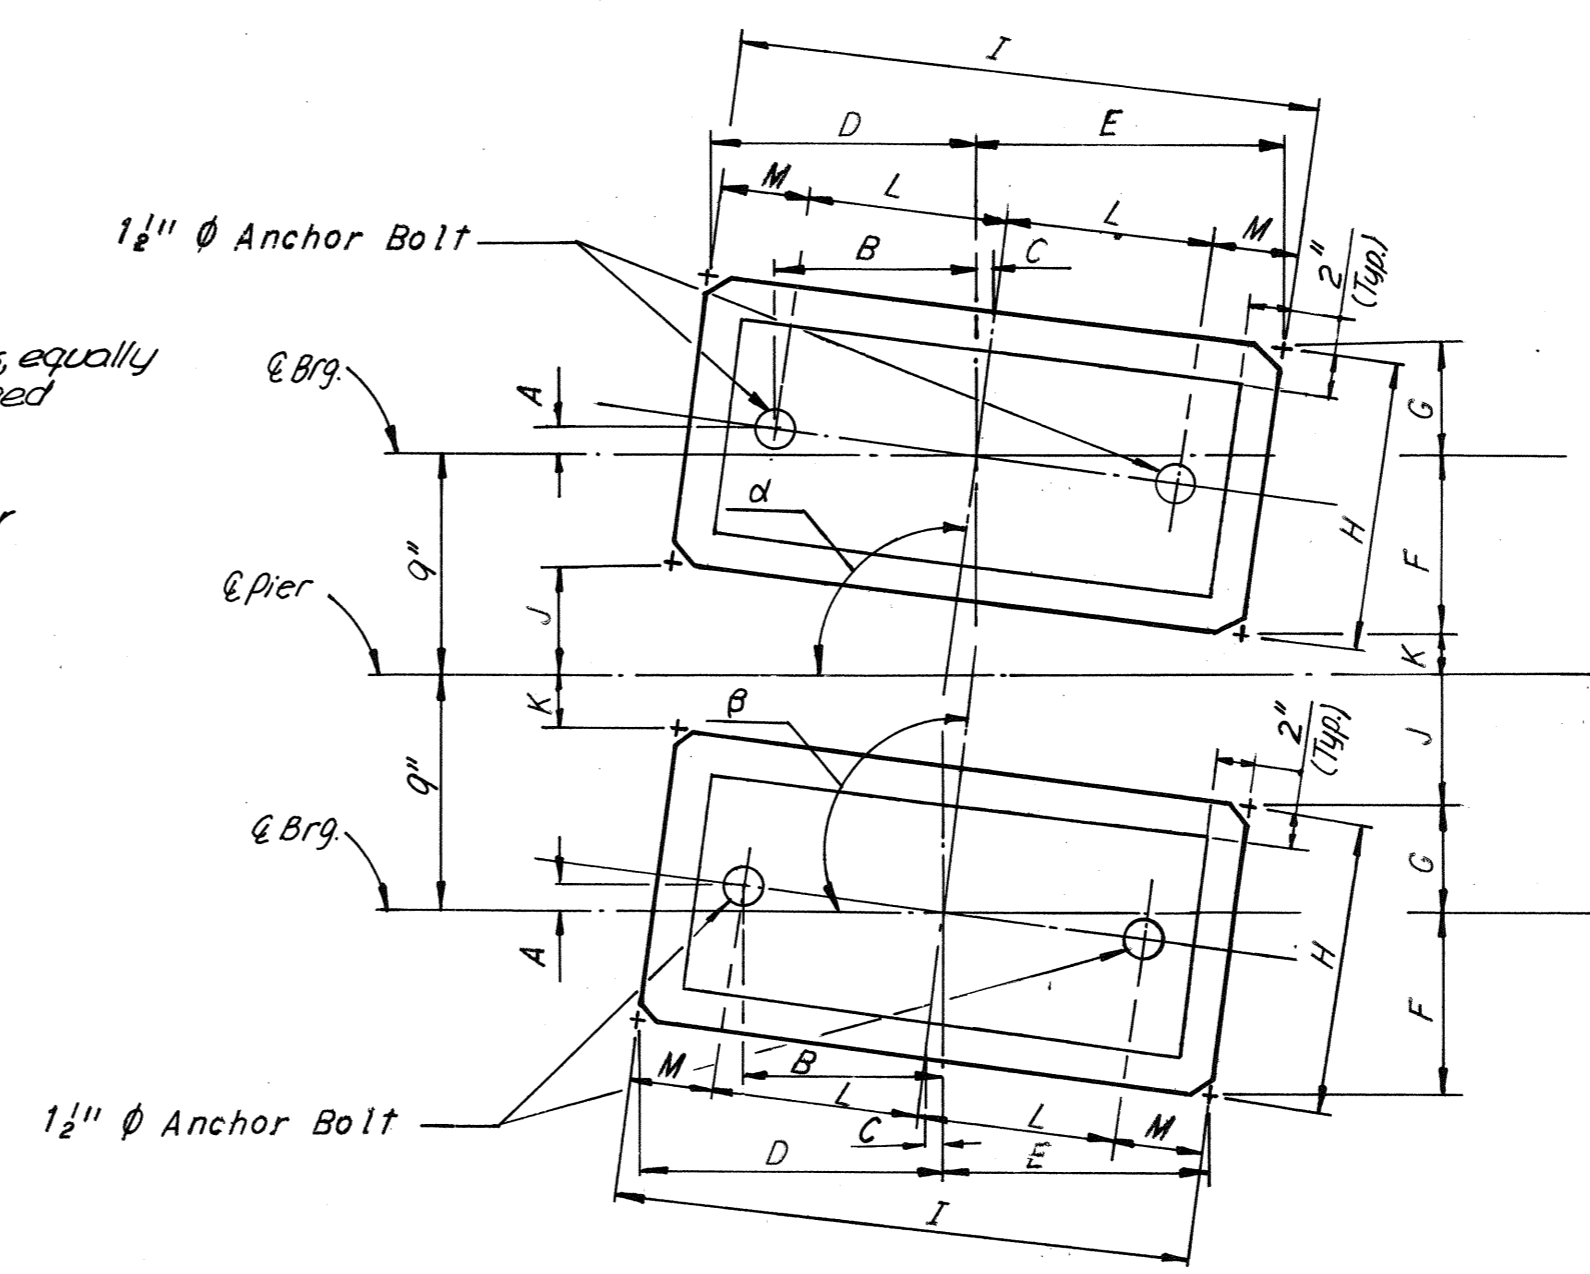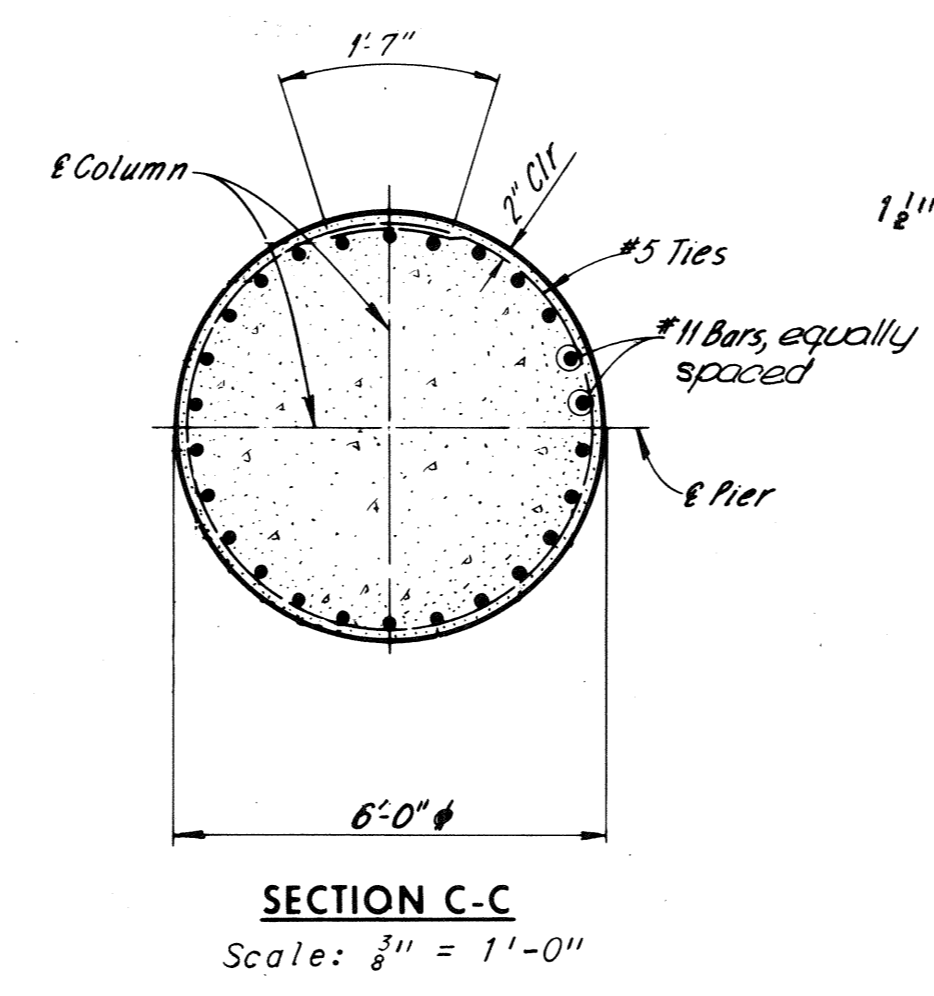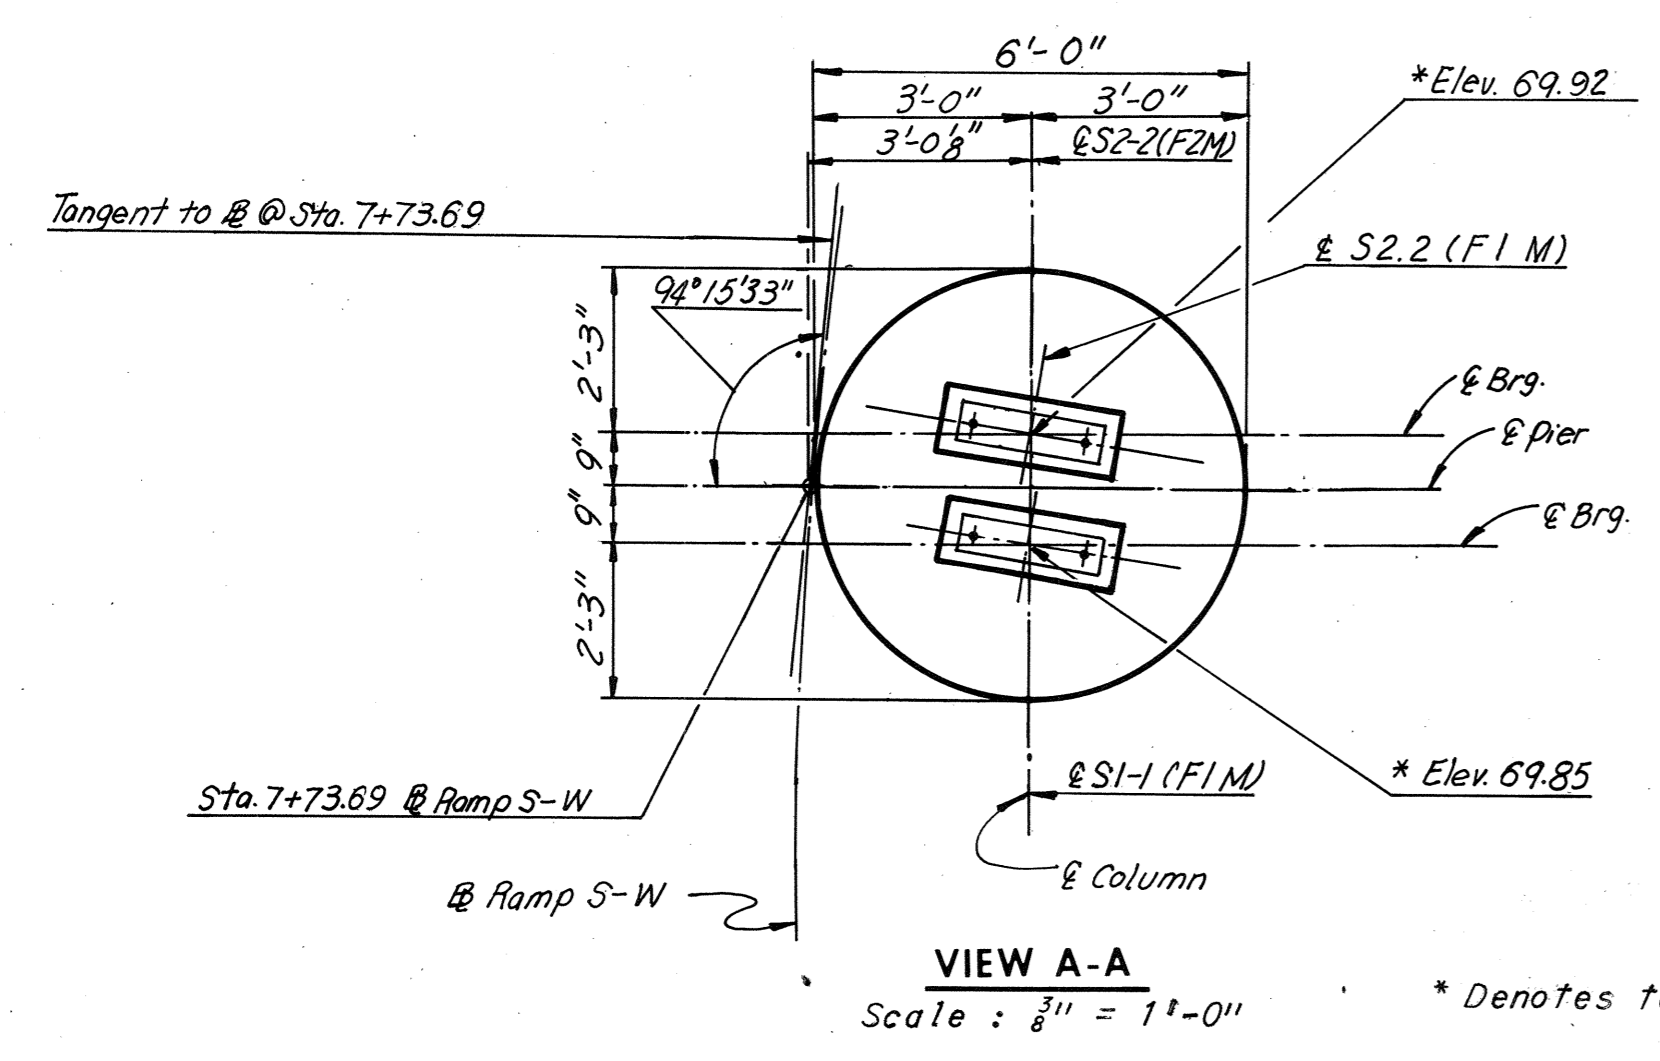

DIMENSIONS FOR PAD ANCHOR BOLT SETTING PLAN															
Stringer	α	β	A	B	C	D	E	F	G	H	I	J	K	L	M
S1-1	—	92°00'58"	5/16"	8"	1/2"	12 1/16"	12 3/16"	6 3/16"	5 5/8"	1 1/2"	2'-1"	3 1/16"	2 13/16"	8"	4 1/2"
S2-2	94°41'20"	—	5/8"	8"	1/2"	12"	12 1/8"	6 3/4"	4 1/16"	1 1/2"	2'-1"	4 5/16"	2 1/4"	8"	4 1/2"

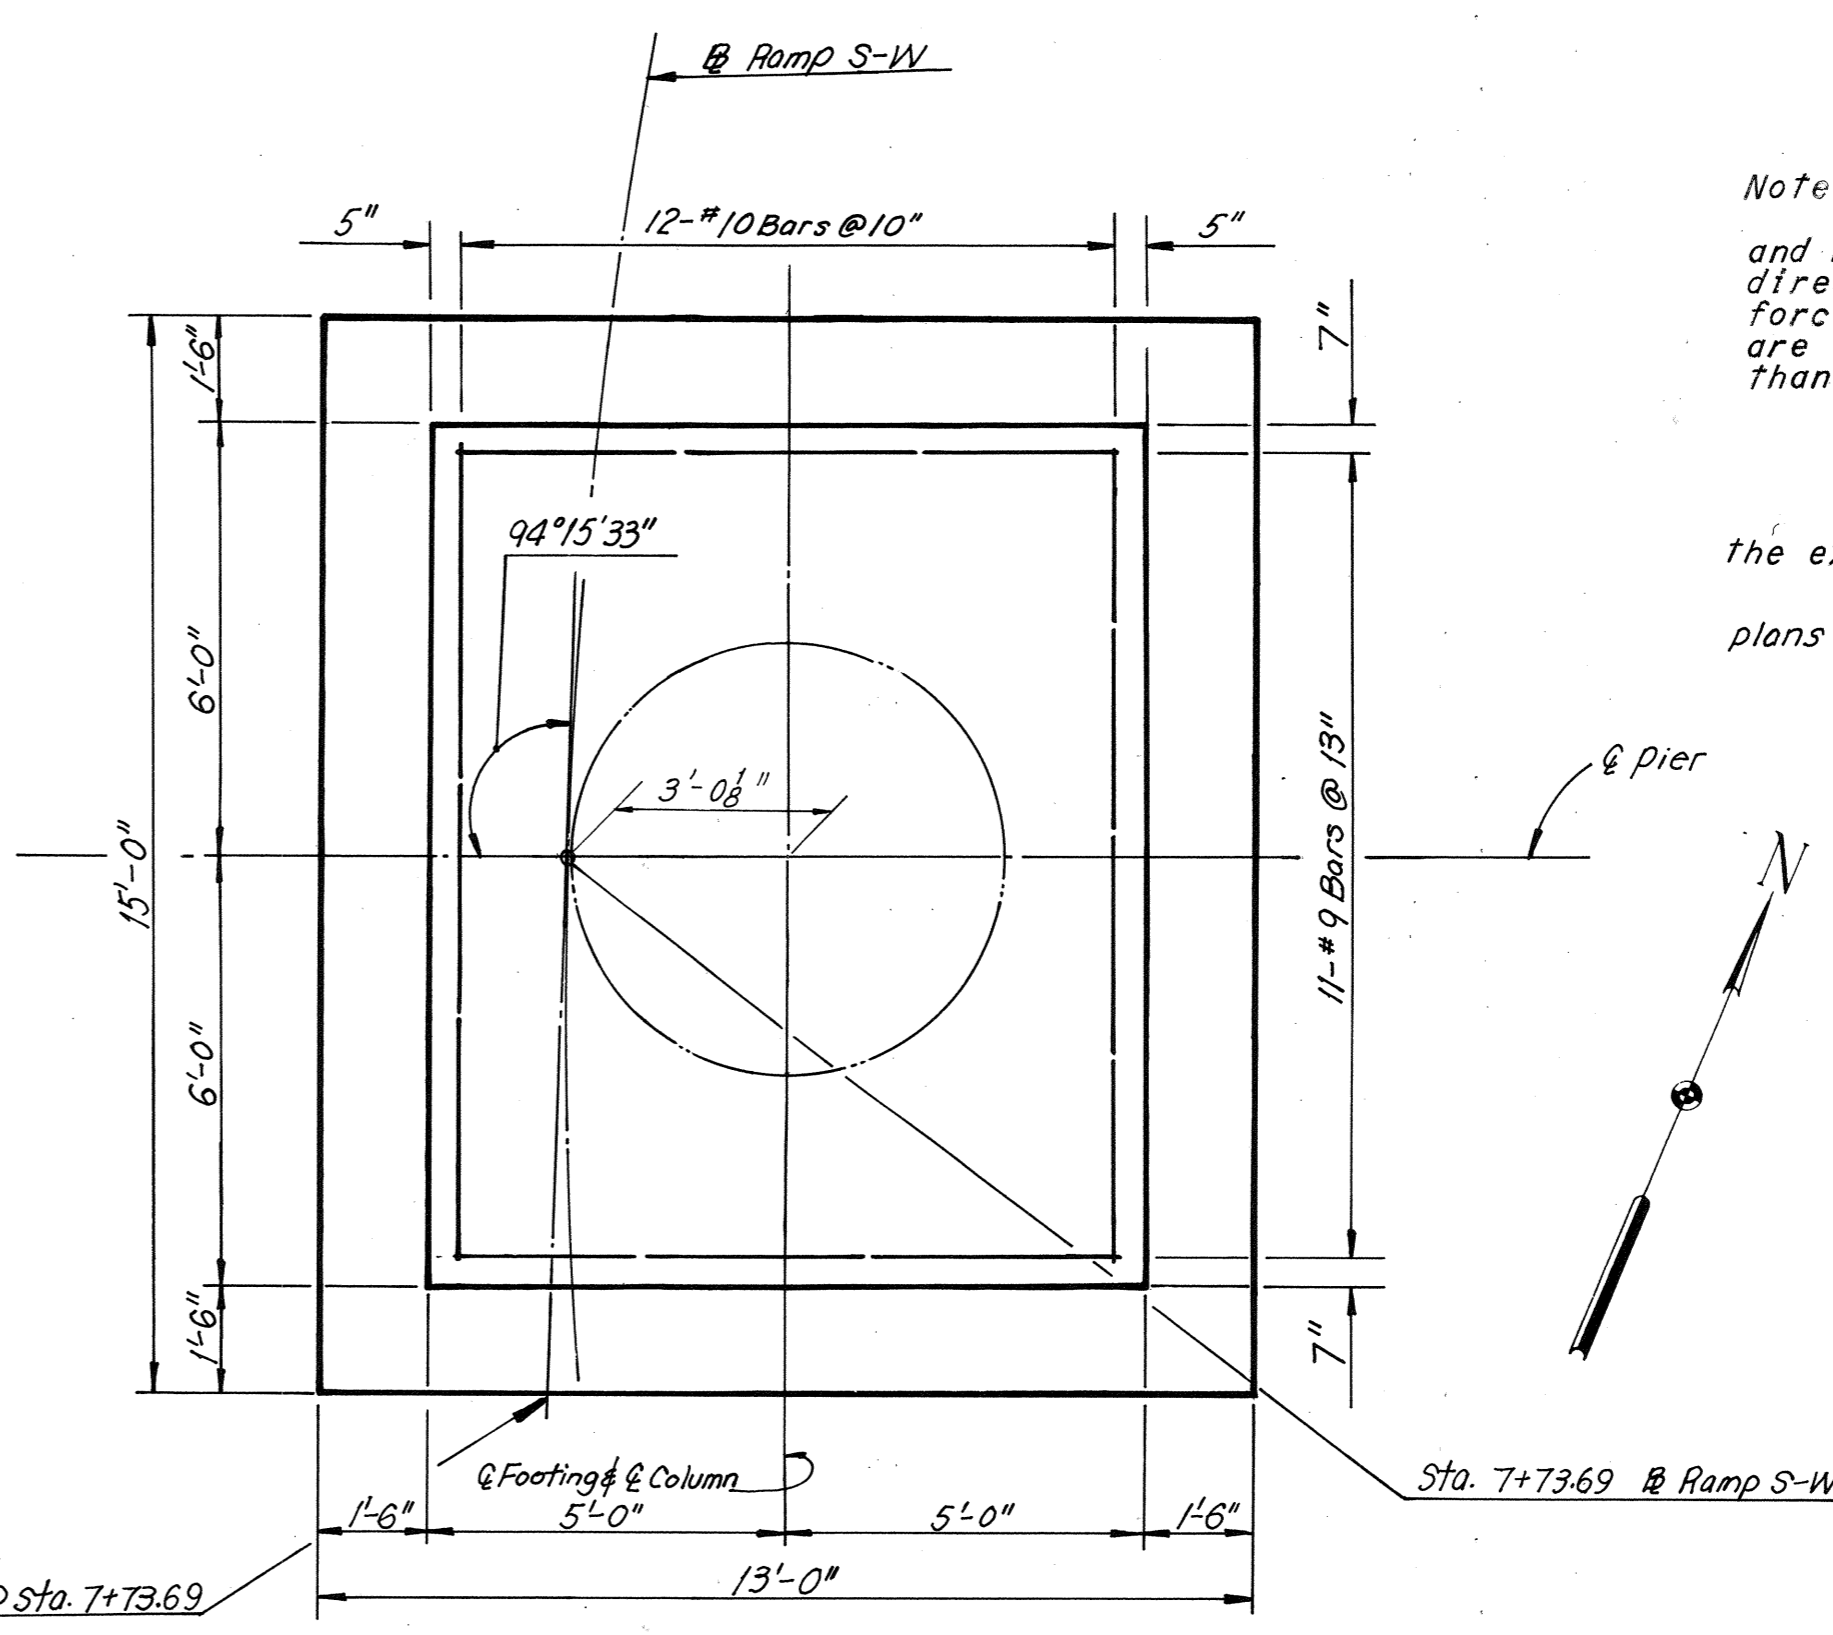

Notes:
 Footing elevations are approximate only and may be varied to suit field conditions as directed by the Engineer. Vertical shaft reinforcing shall not be cut until these elevations are established. Where elevations change more than 2 ft., redesign will be required.
 For Standard Shoe Details, see Sheet S1 & S2.
 For Framing Plan, see Framing Plan Sheets 19.
 For Quantities of Steel and Concrete, see Sheet 4.
 Overexcavation will not be permitted between the existing pier and new pier.
 Pier 1 is to match existing Pier 43. Station shown on plans shall be verified by the Contractor in the field.

ELEVATION PLAN
 Scale : 3/8" = 1'-0"

VIEW B-B
 Scale : 3/8" = 1'-0"

FOOTING PLAN
 Scale : 3/8" = 1'-0"





NOTE A
 A construction joint will be permitted at a rustication near mid-height of the column. The column reinforcement may be lap spliced near the construction joint. The lap at the splice shall be a minimum of 3'-6". Splices shall be staggered at least 3'-3" between adjacent bars.

BY	DATE	REVISION	BY	DATE
G.S.H.	2-10-89	Pad Elev Shoe Type & Anchor Bolt set. Dim.	T.E.M.	4-76
J.L.K.	6-25-75	Pad Elev, Str. no. & column height	T.E.M.	9-5-75
K.C.T.	2-18-89			






AS BUILT
 RICHMOND METROPOLITAN AUTHORITY
 RICHMOND EXPRESSWAY SYSTEM
 DOWNTOWN EXPRESSWAY
 BRIDGE NO. 65
 RAMP S-W CONNECTION FROM
 RICHMOND-PETERSBURG TURNPIKE
 PIER 1

HOWARD, NEEDLES, TAMMEN & BERGENDOFF
 consulting engineers
 NEW YORK ALEXANDRIA KANSAS CITY

SCALE: As Noted
 CONTRACT NO. 11
 SHEET NO. 5 OF 38

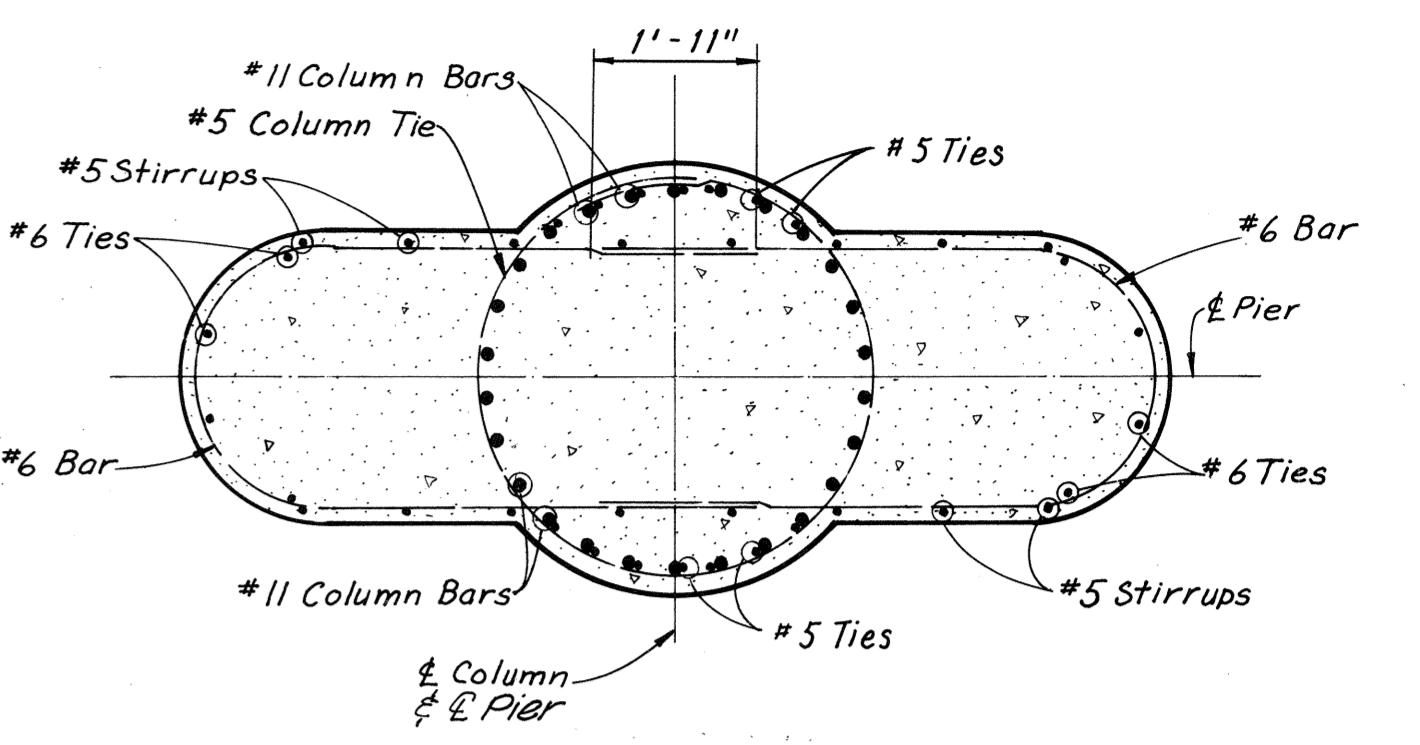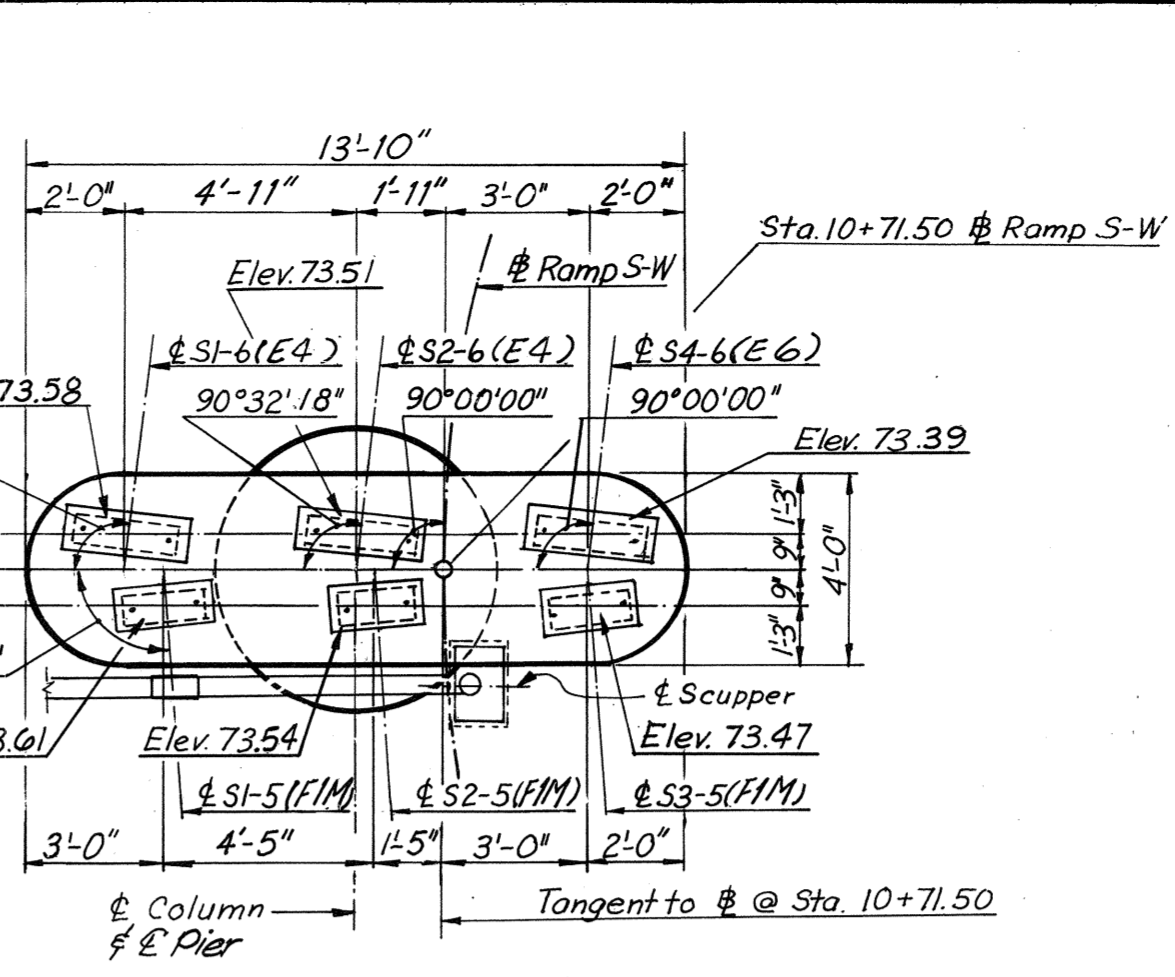
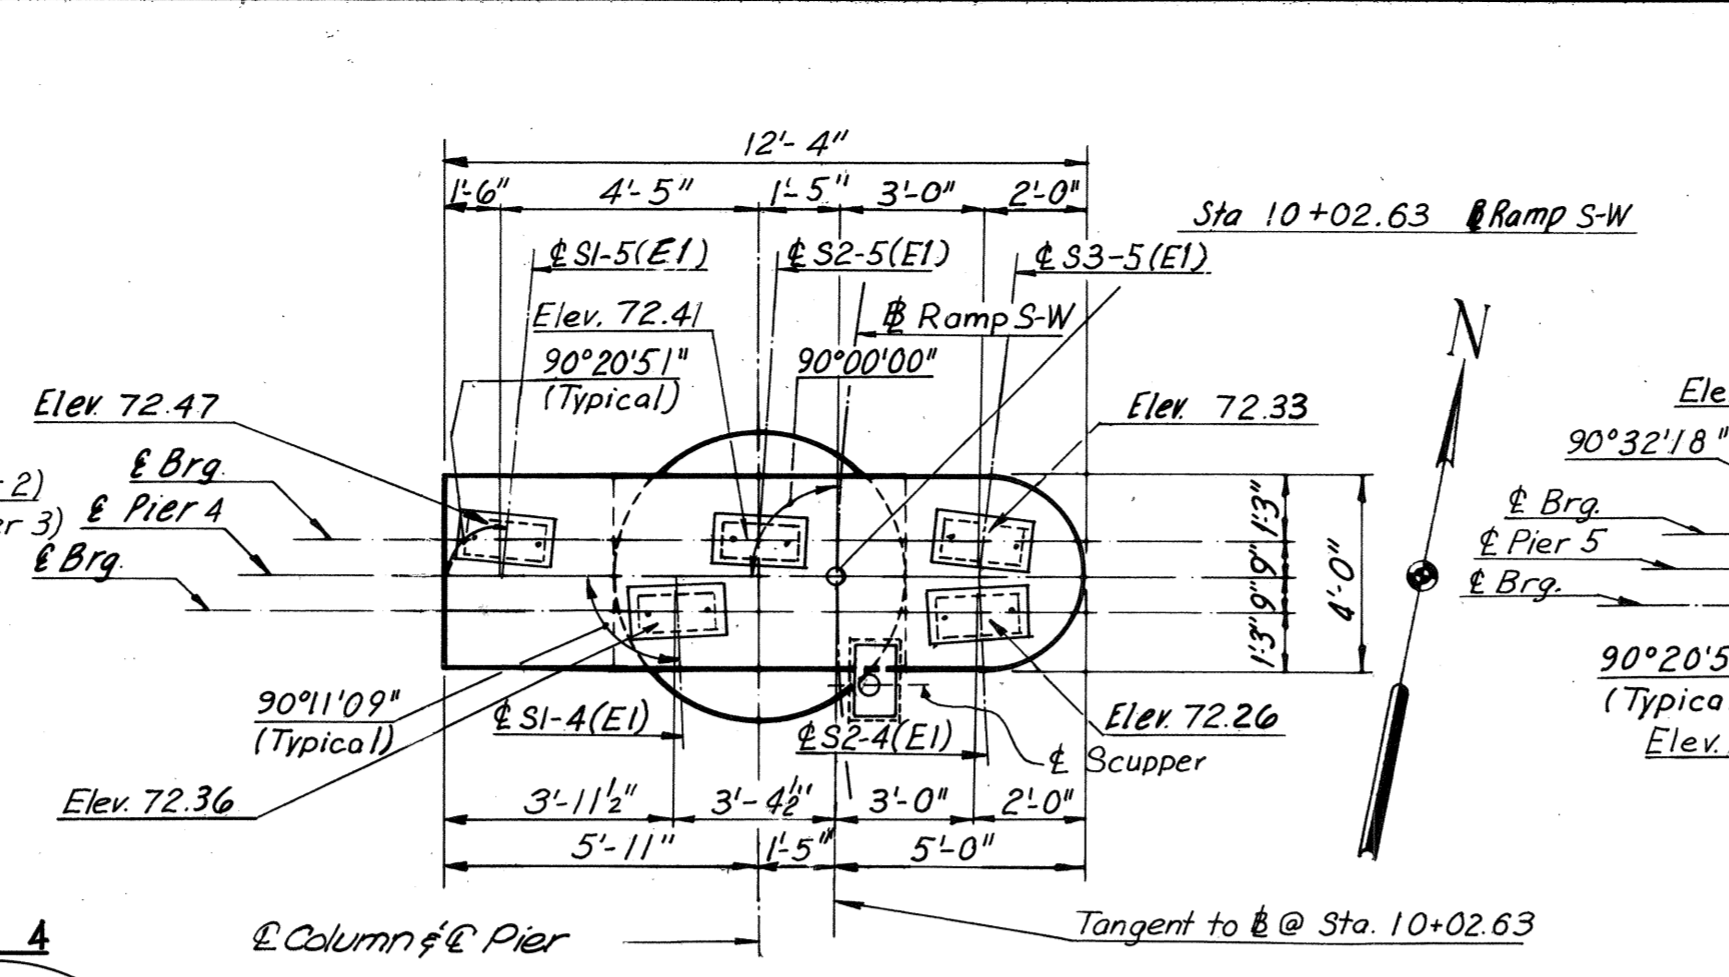
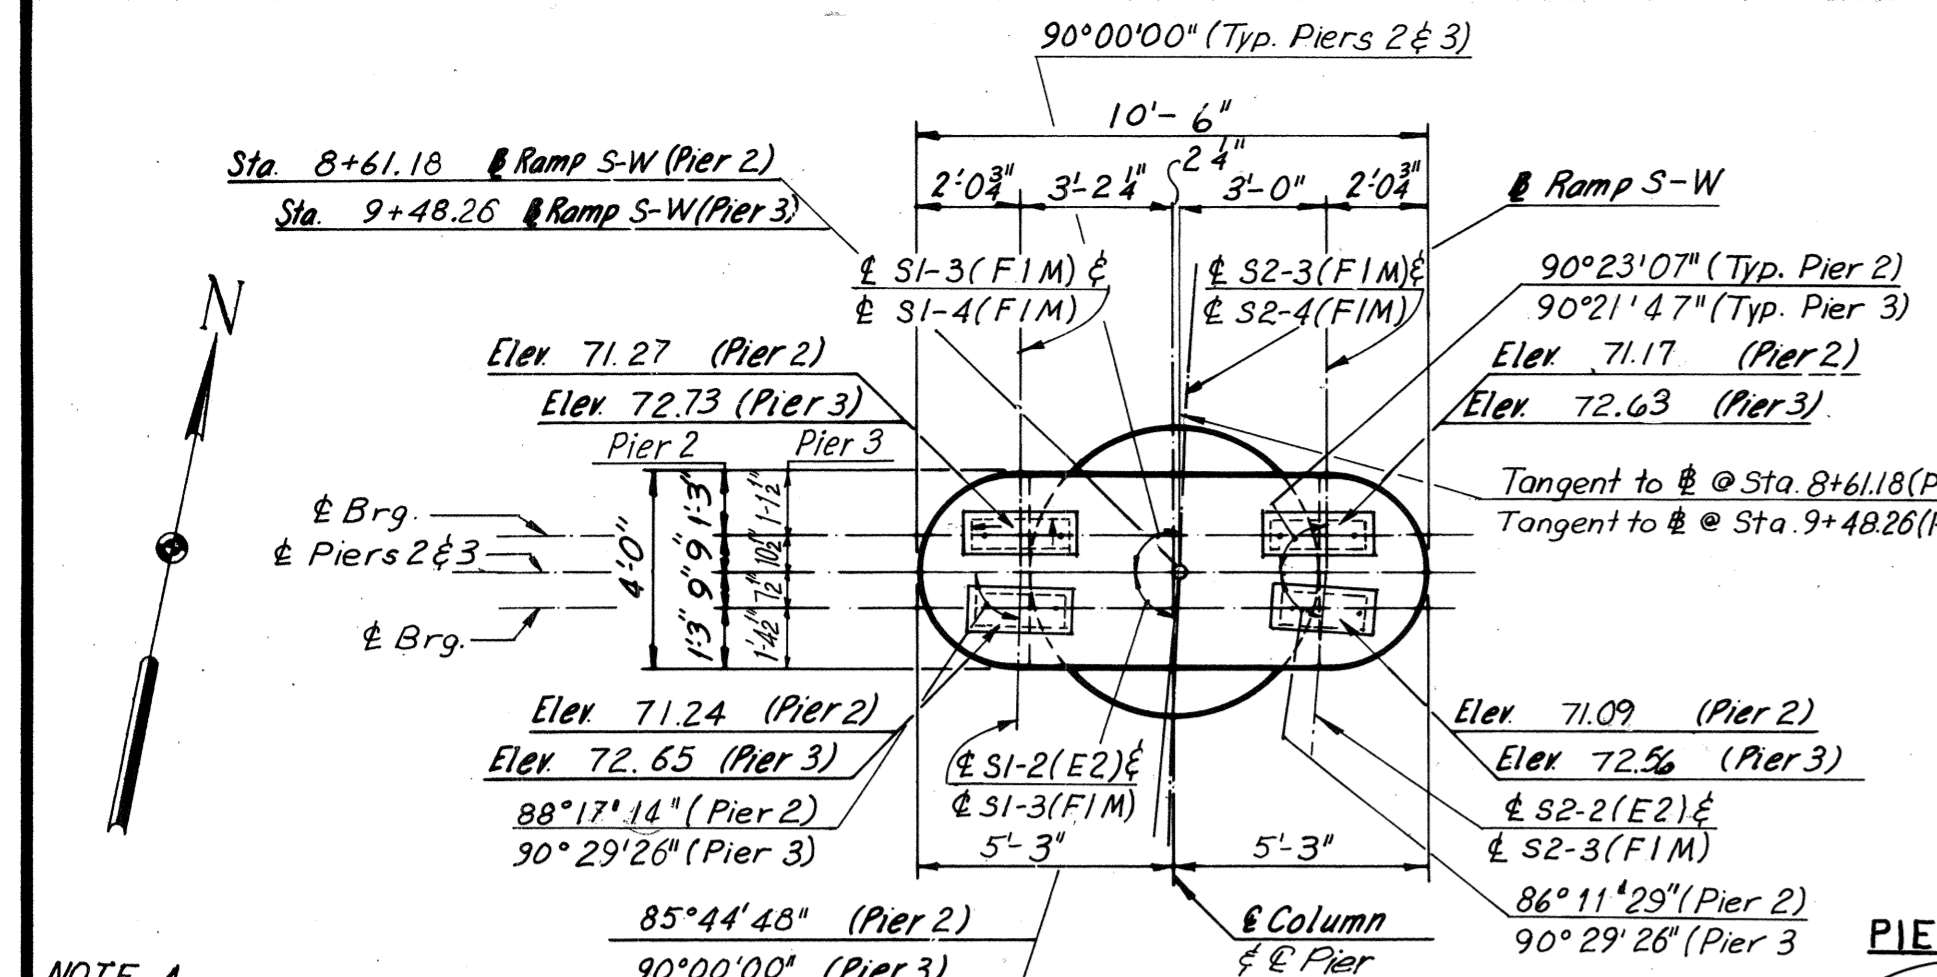


NOTE A
A construction joint will be permitted if a rustication near mid-height of the column. The column reinforcement may be lap spliced near the construction joint. The lap at the splice shall be a minimum of 3'-6". Splices shall be staggered at least 3'-3" between adjacent bars.

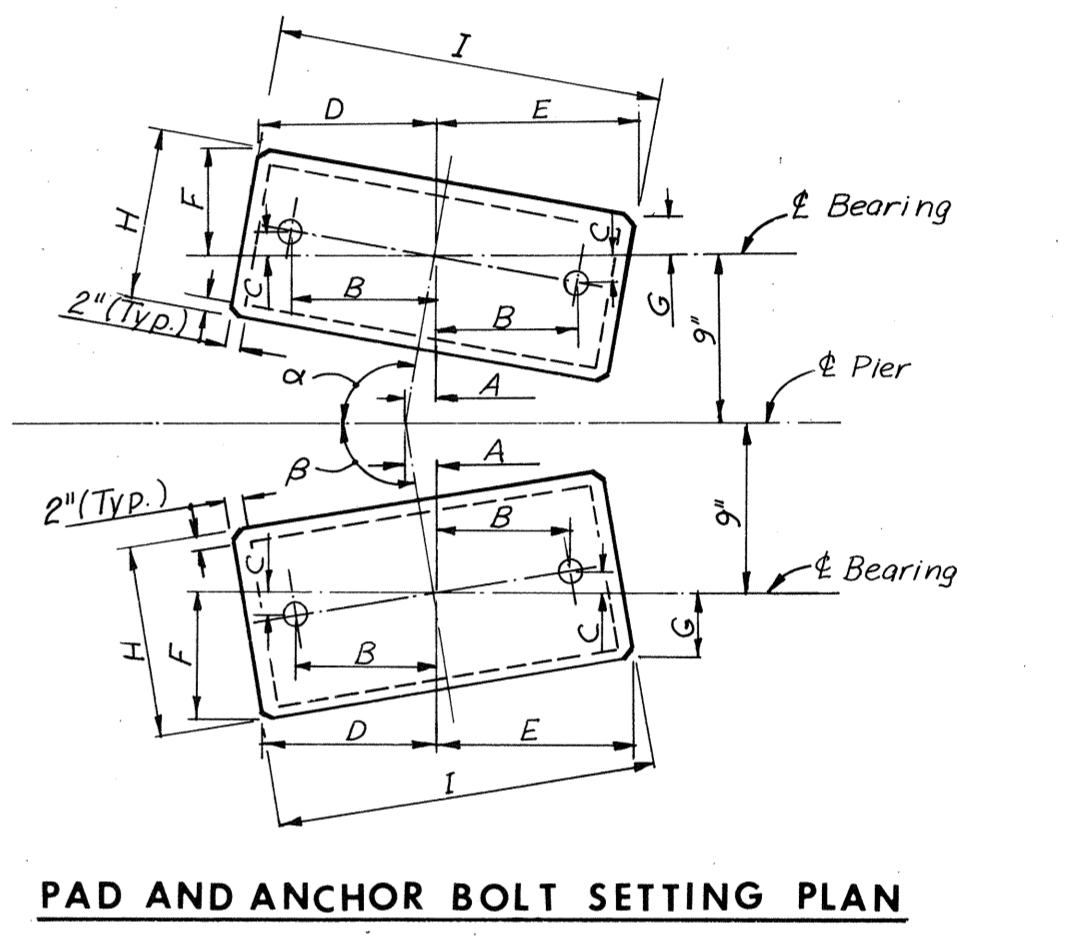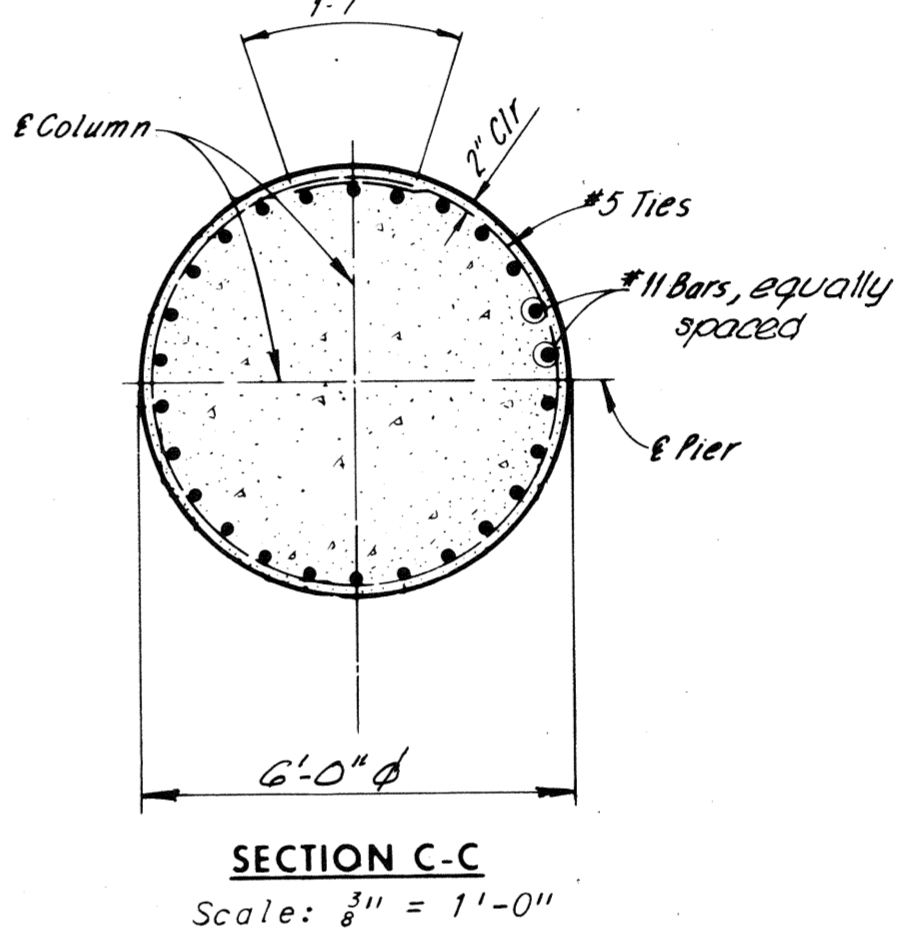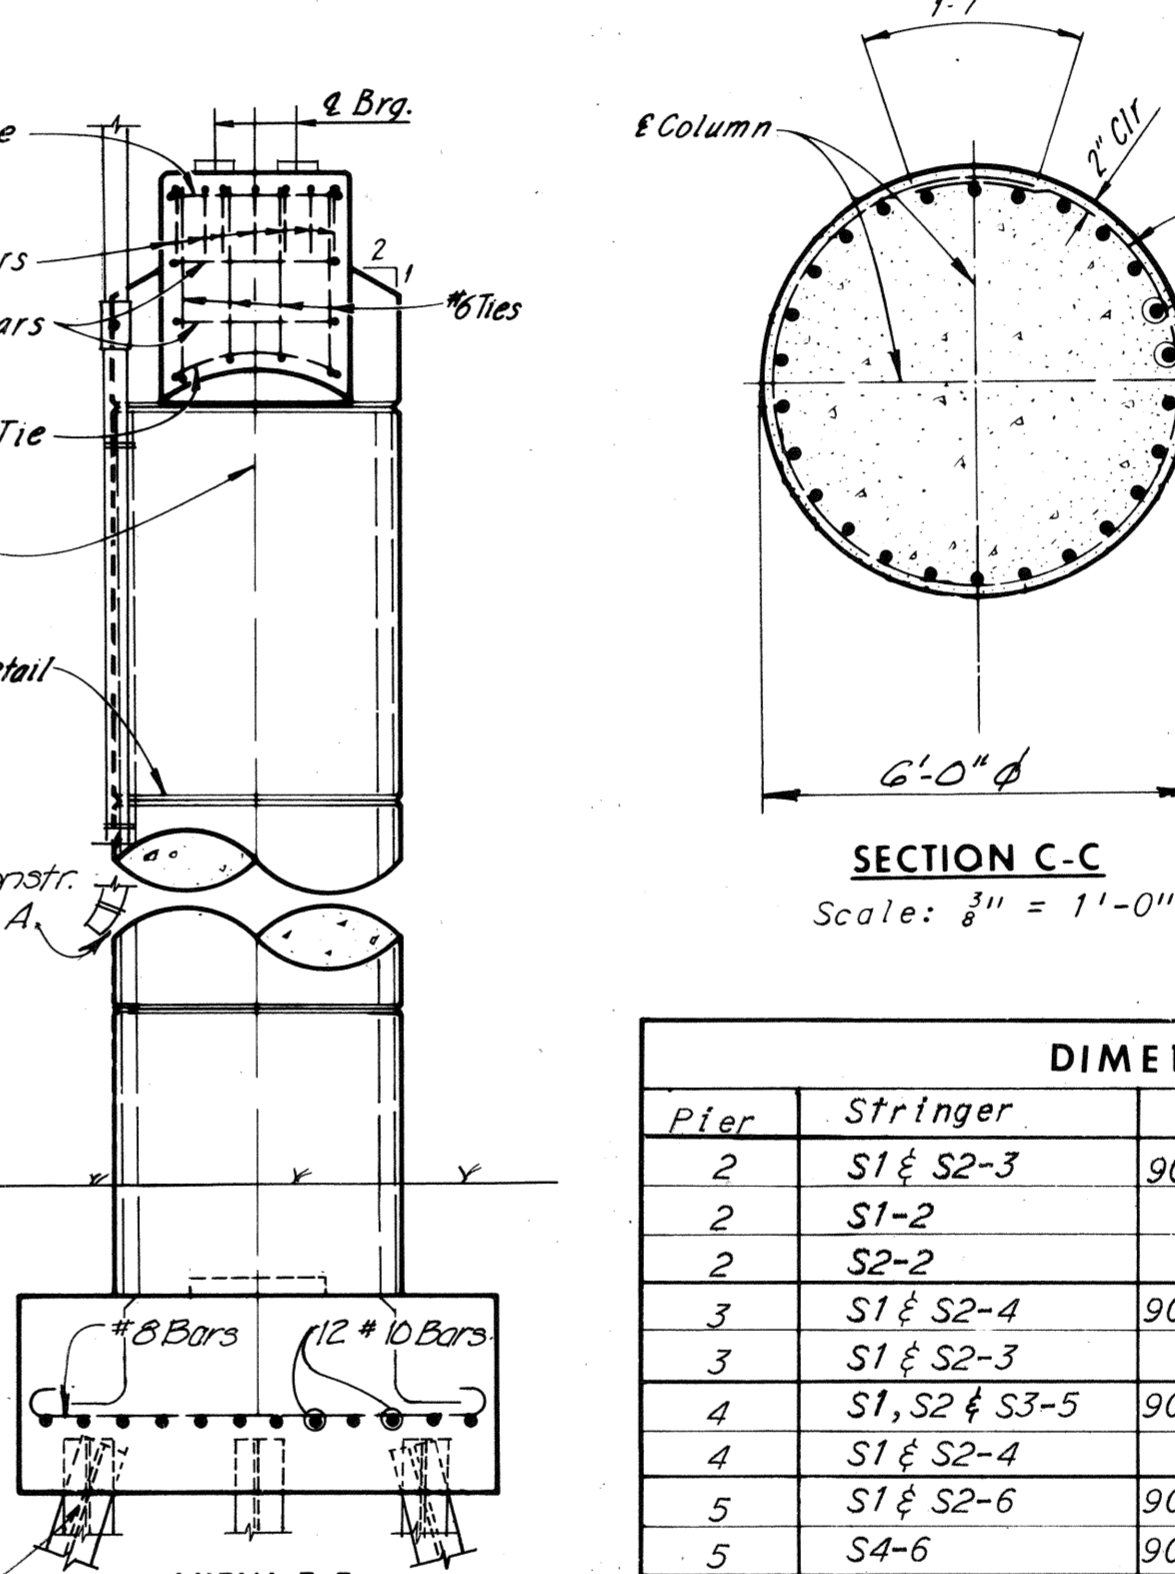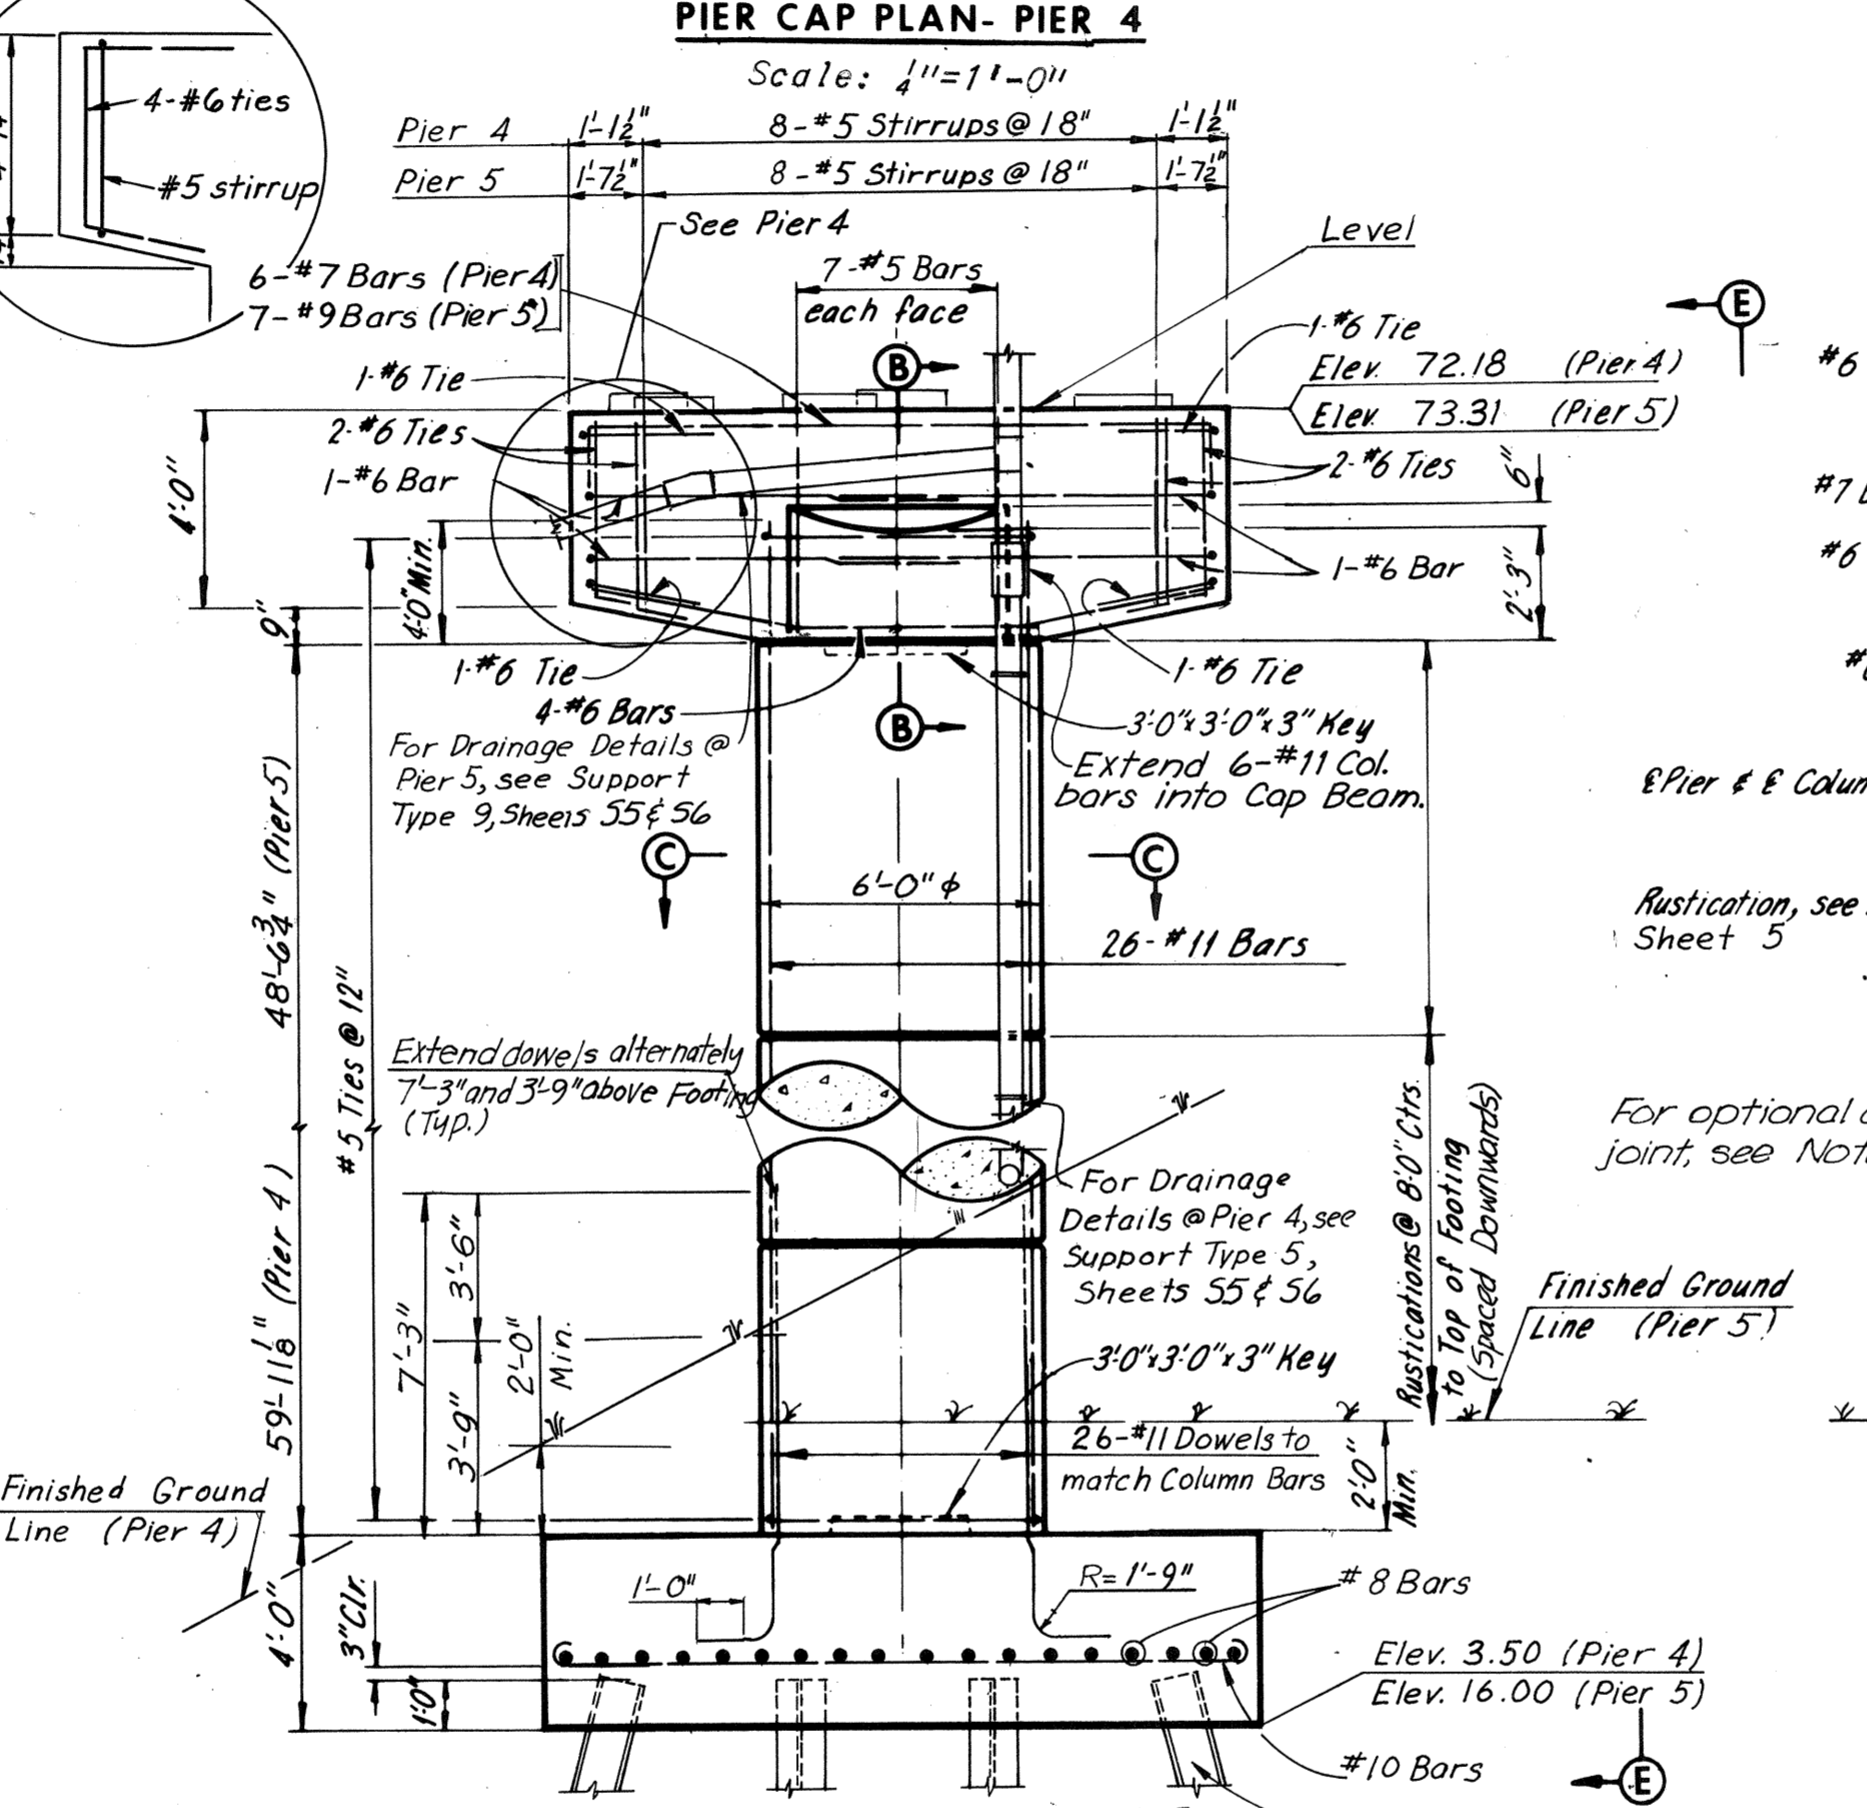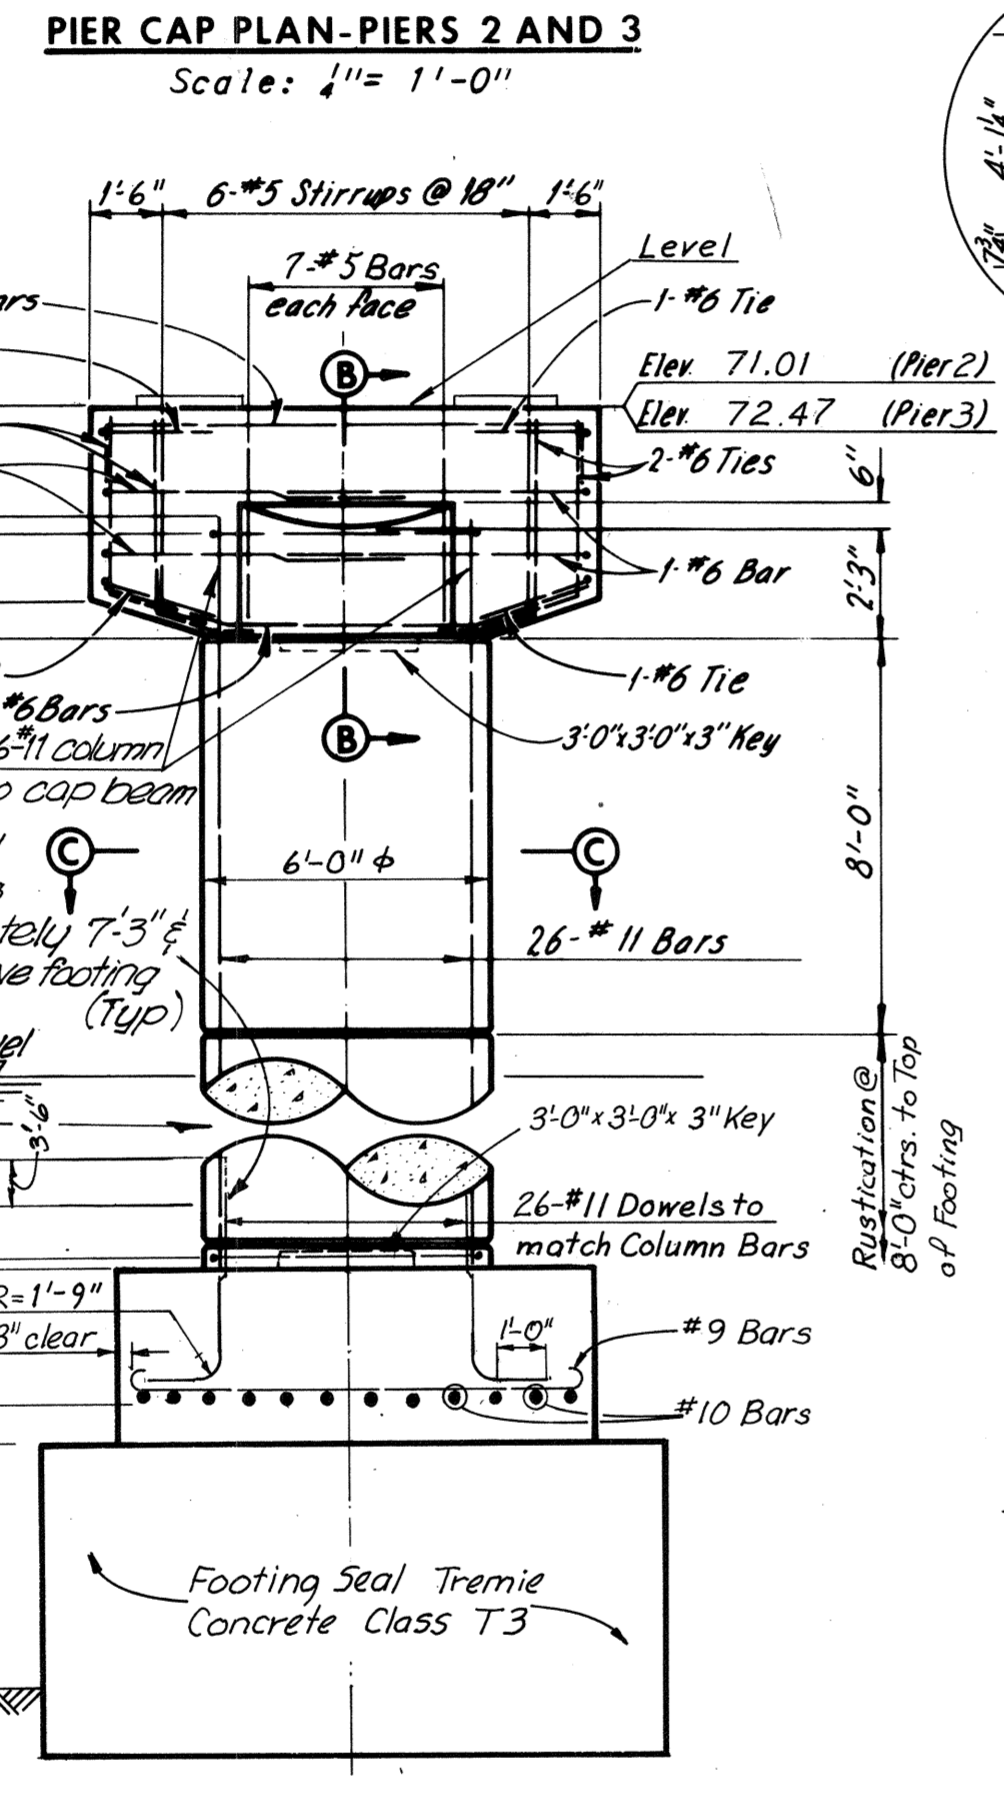

Pier	Stringer	α	β	A	B	C	D	E	F	G	H	I
2	S1 & S2-3	90°29'20"	-	4"	8"	16"	12 3/8"	12 3/8"	5 1/2"	5 1/2"	11 1/2"	2'-1 1/2"
2	S1-2	-	88°17'14"	4"	8 1/2"	12 1/8"	12 1/8"	6 1/8"	6 1/8"	11 1/2"	1'-1 1/2"	2'-0 1/2"
2	S2-2	-	86°11'29"	8"	8 1/2"	11 1/8"	11 1/8"	5 1/8"	7 1/8"	11 1/2"	1'-1 1/2"	2'-0 1/2"
3	S1 & S2-4	90°21'47"	-	16"	8"	16"	12 3/8"	12 3/8"	5 1/2"	5 1/2"	11 1/2"	2'-1 1/2"
3	S1 & S2-3	-	90°29'26"	16"	8"	16"	12 3/8"	12 3/8"	5 1/2"	5 1/2"	11 1/2"	2'-1 1/2"
4	S1, S2 & S3-5	90°20'51"	-	16"	8 1/2"	16"	12 1/8"	12 1/8"	6 1/8"	5 1/8"	1'-0"	2'-0 1/2"
4	S1 & S2-4	-	90°11'09"	16"	8 1/2"	16"	12 1/8"	12 1/8"	6 1/8"	5 1/8"	1'-0"	2'-0 1/2"
5	S1 & S2-6	90°32'18"	-	16"	10 1/2"	16"	14 1/8"	14 1/8"	6 1/8"	6 1/8"	1'-0 1/2"	2'-5"
5	S4-6	90°00'00"	-	0"	11 1/4"	0"	15 1/4"	15 1/4"	6 1/4"	6 1/4"	1'-0 1/2"	2'-6 1/2"
5	S1, S2 & S3-5	-	90°20'51"	16"	8"	16"	12 1/8"	12 1/8"	5 1/8"	5 1/8"	11 1/2"	2'-1"

Notes:
Overexcavation will not be permitted between existing piers and new piers.
Piers 2, 3 and 4 are to match existing Piers 45, 47 and 49 respectively. Stations shown on the plans shall be verified by the contractor in the field.
All piles shall be 10BP42 Steel Piles (Design Capacity = 45 tons).
For Framing Plans, see Sheets 18 & 19.
Estimated pile tip elevation - 20.0
Pier 4 and - 22.0 Pier 5.
Batter piles 3" per foot where shown.
For Rustication Detail, see Sheet 10.
For Pile Detail, see Sheet 9.
For Quantities of Steel and Concrete, see Sheet 4.

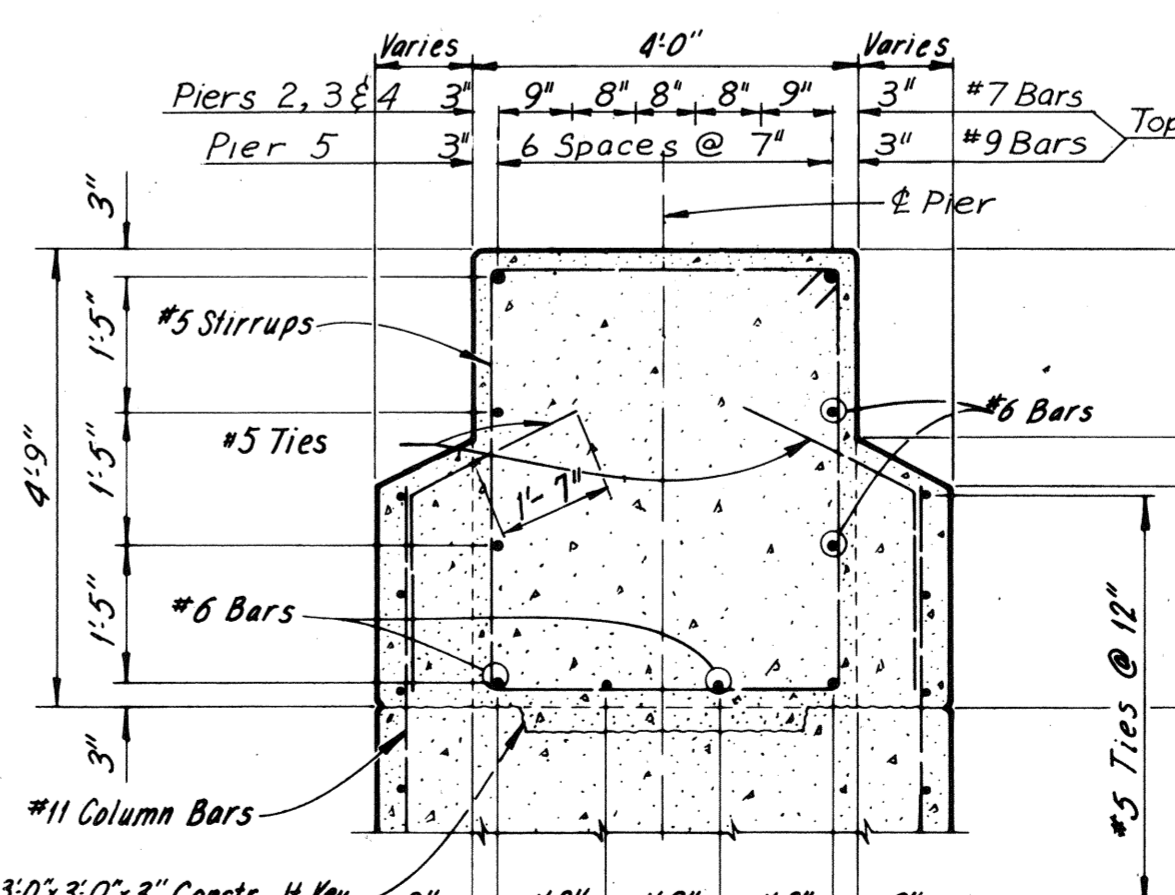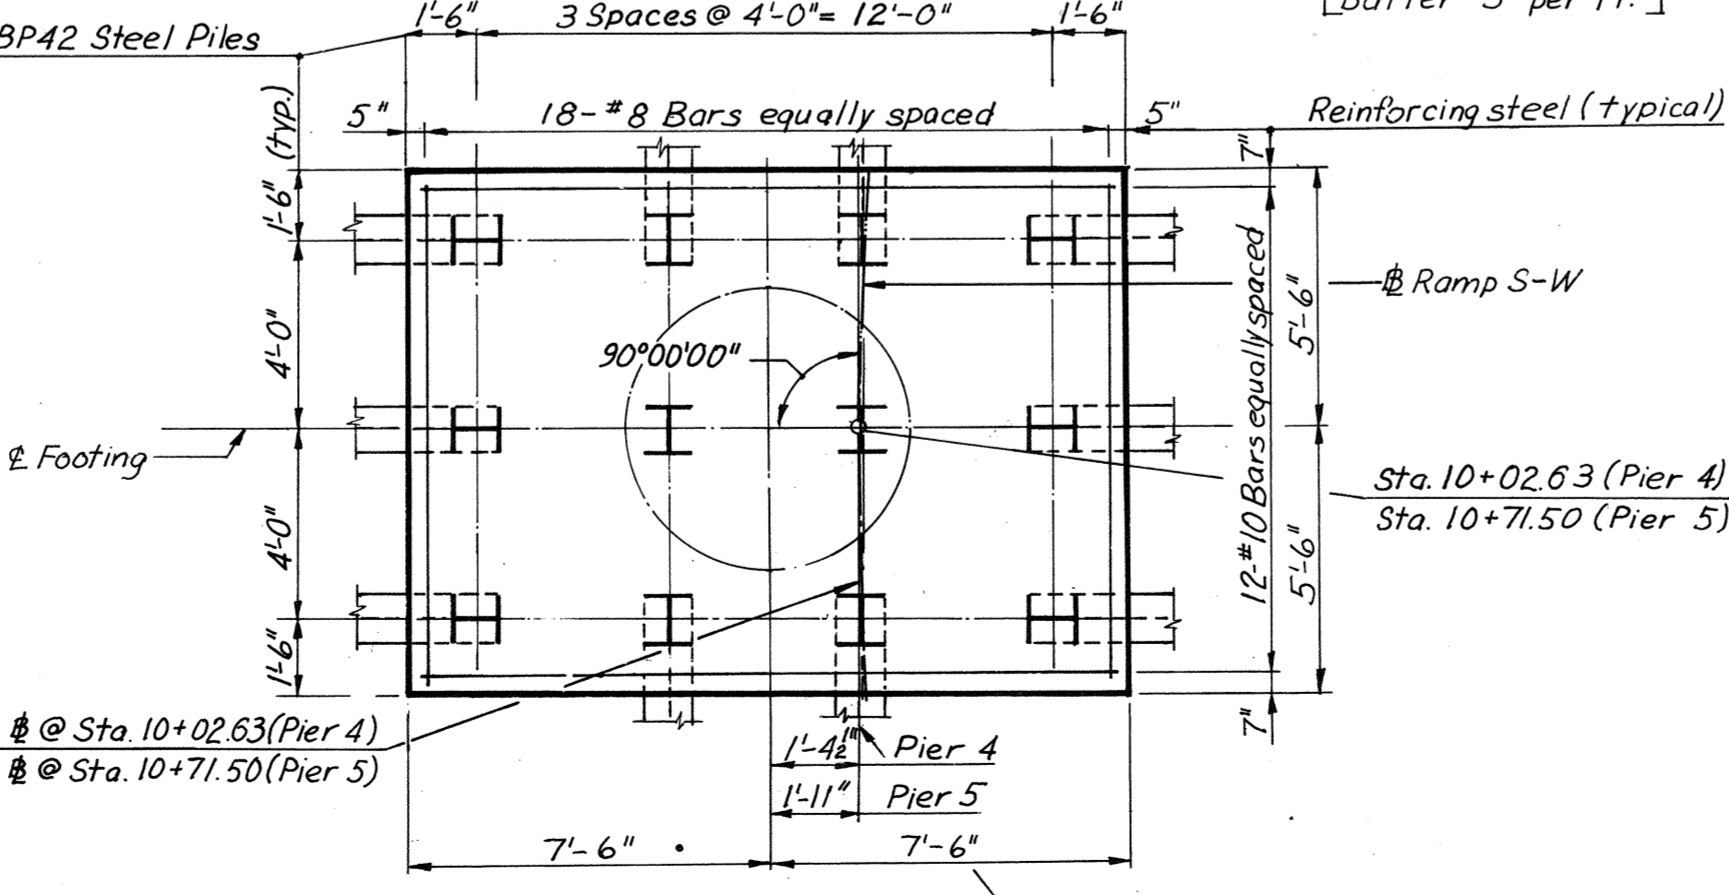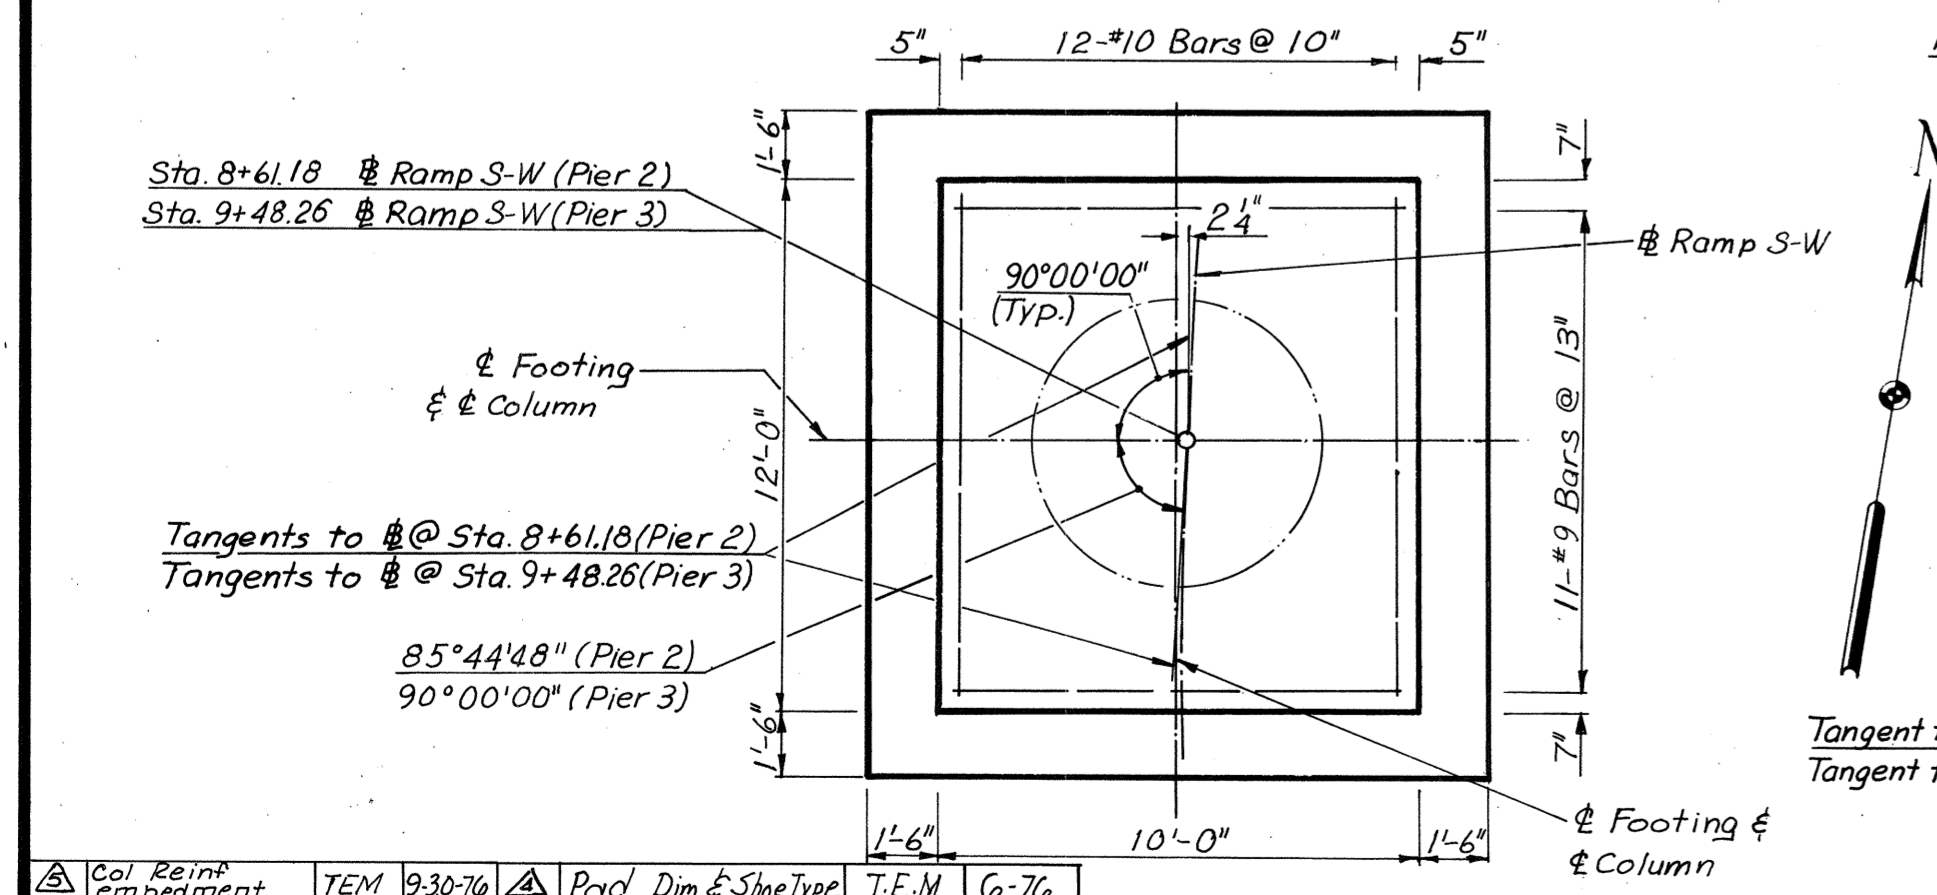

NO.	REVISION	BY	DATE
1	Col Reinf. Amendment	TEM	9-30-76
2	Pad Elev. & Shoe Type	TEM	5-76
3	Pad Elev. Shoe Type & Anchor Bolt Set. Plan	TEM	4-76
4	Pad Elev. & Col. Dim.	TEM	9-8-75

FOOTING PLAN - PIERS 2 AND 3
Scale: 1/4" = 1'-0"
Note: Footing elevations are approximate only and may be varied to suit field conditions as directed by the Engineer. Vertical shaft reinforcing shall not be cut until these elevations are established. Where elevations change more than 2 ft., redesign will be required.

FOOTING PLAN - PIERS 4 AND 5
Scale: 1/4" = 1'-0"
Tangent to @ Sta. 10+02.63 (Pier 4)
Tangent to @ Sta. 10+71.50 (Pier 5)


AS BUILT

RICHMOND METROPOLITAN AUTHORITY
RICHMOND EXPRESSWAY SYSTEM
DOWNTOWN EXPRESSWAY


BRIDGE NO. 65
RAMP S-W CONNECTION FROM
RICHMOND-PETERSBURG TURNPIKE
PIERS 2, 3, 4 AND 5

HOWARD, NEEDLES, TAMMEN & BERGENDOFF
consulting engineers
NEW YORK ALEXANDRIA KANSAS CITY


SCALE: As Noted
CONTRACT NO. 11
SHEET NO. 6 OF 38

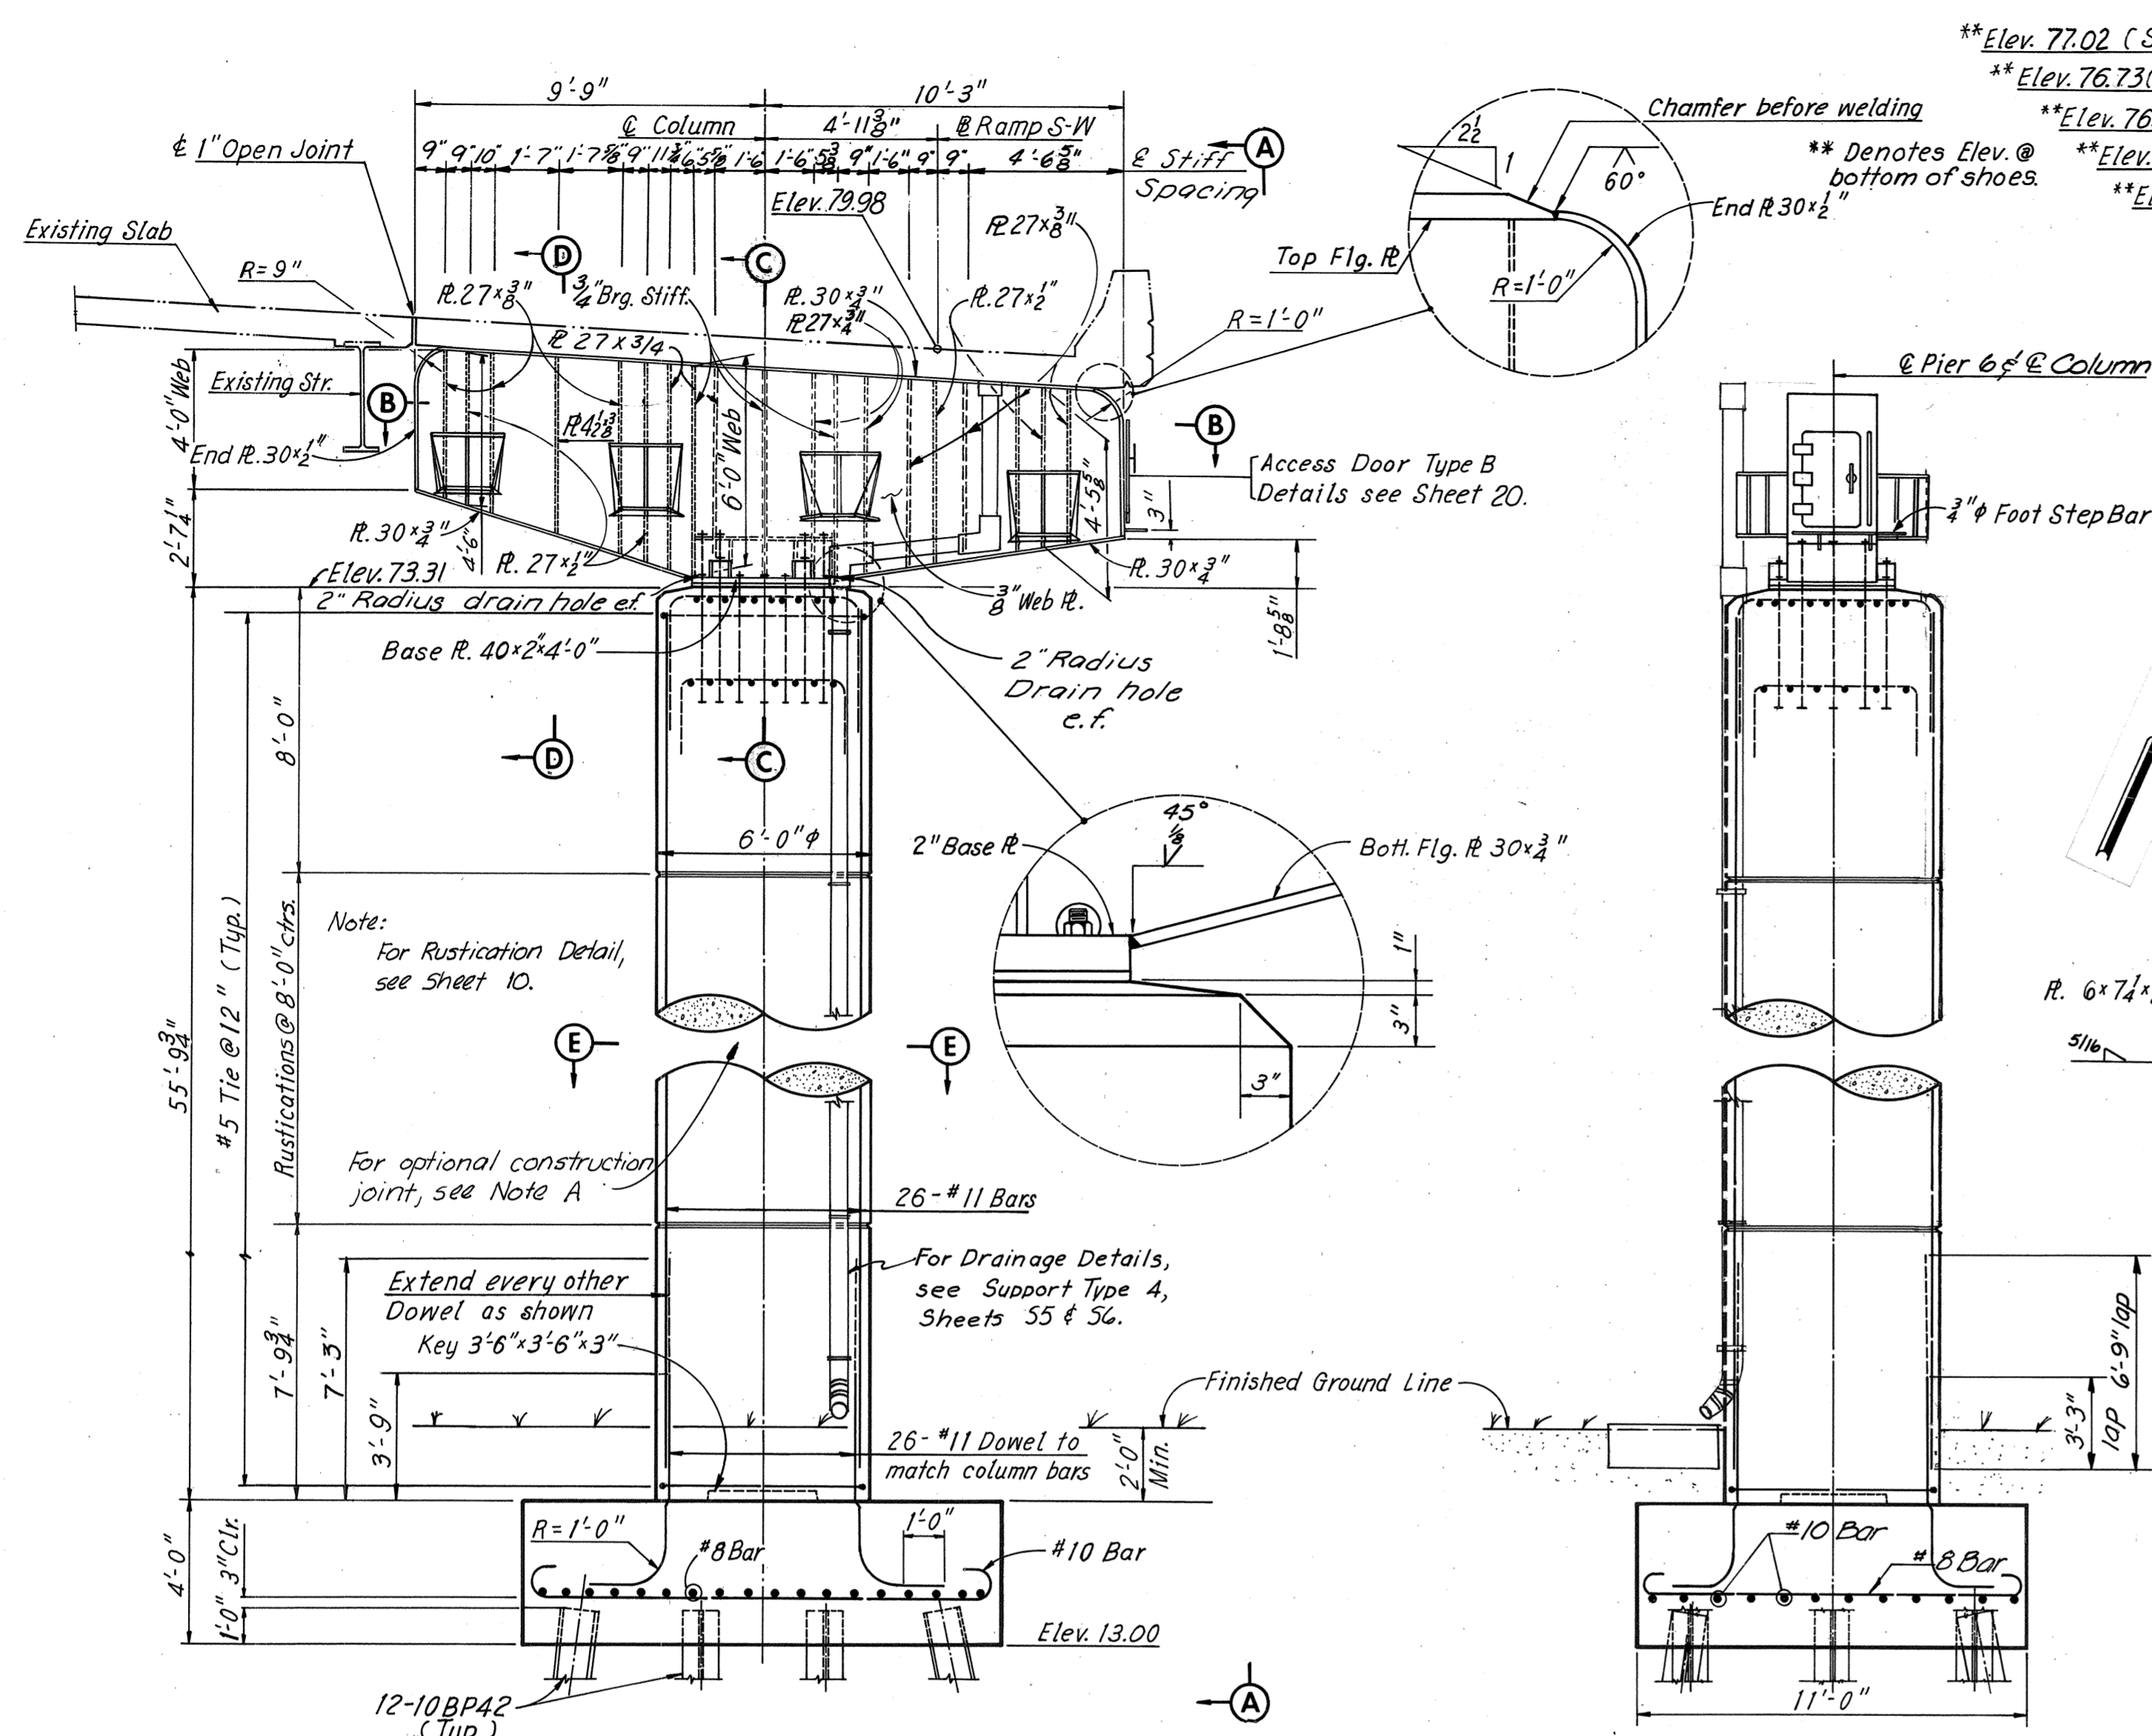

ELEVATION
 Scale: 1/4"=1'-0"

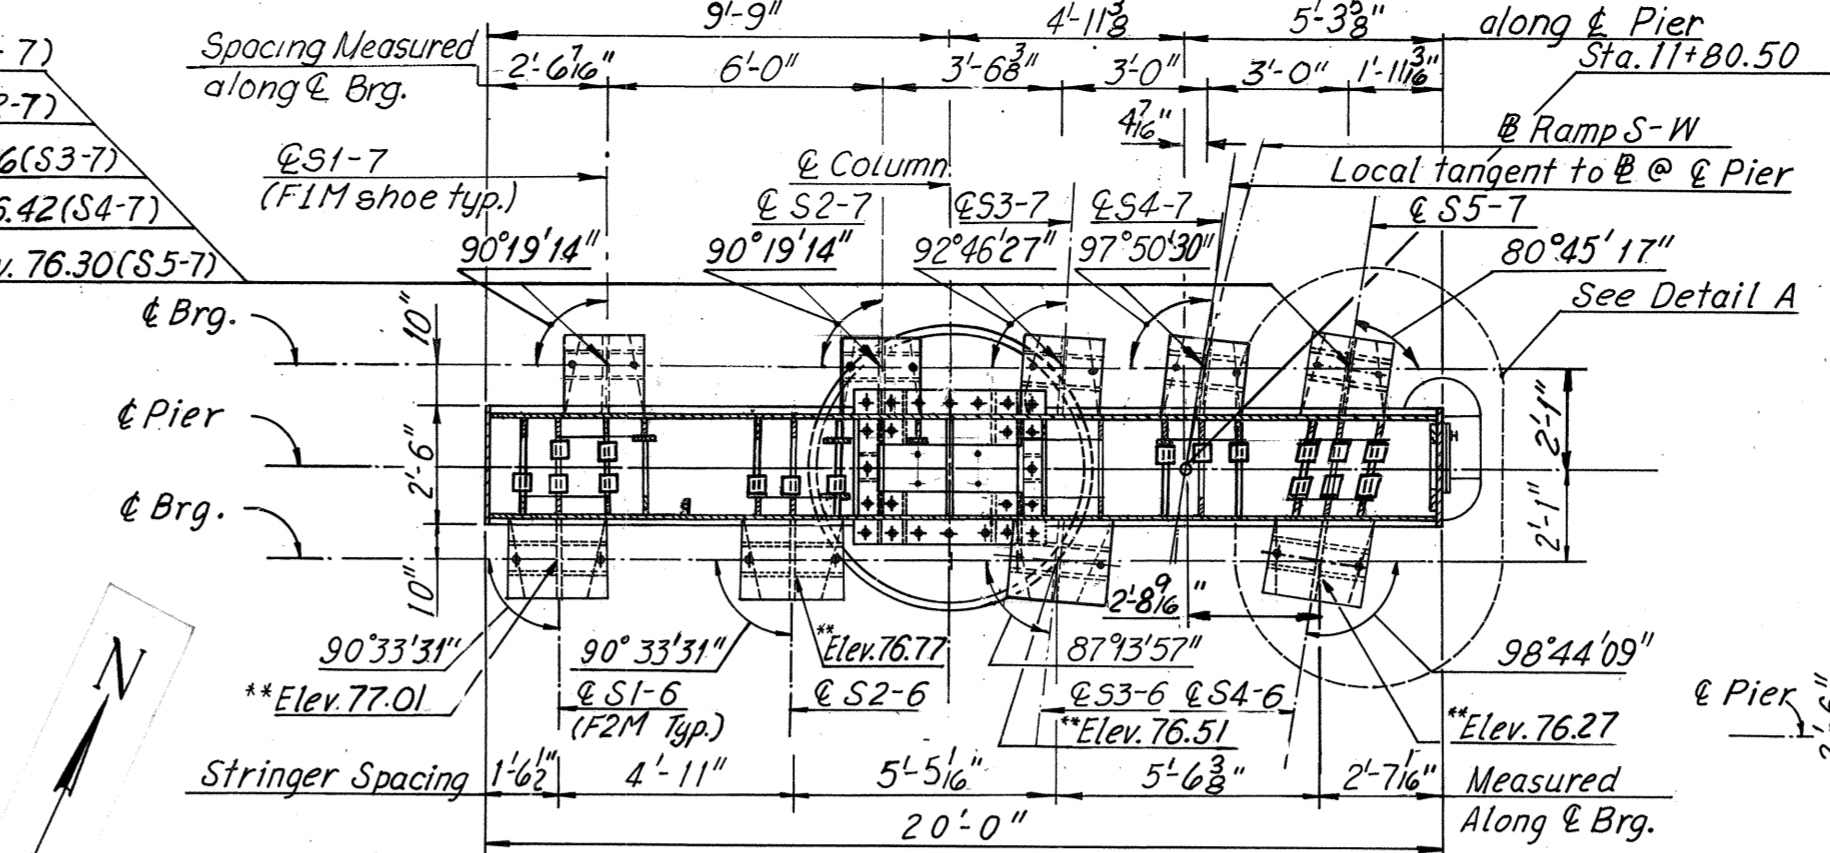


SECTION B-B
 Scale: 1/4"=1'-0"

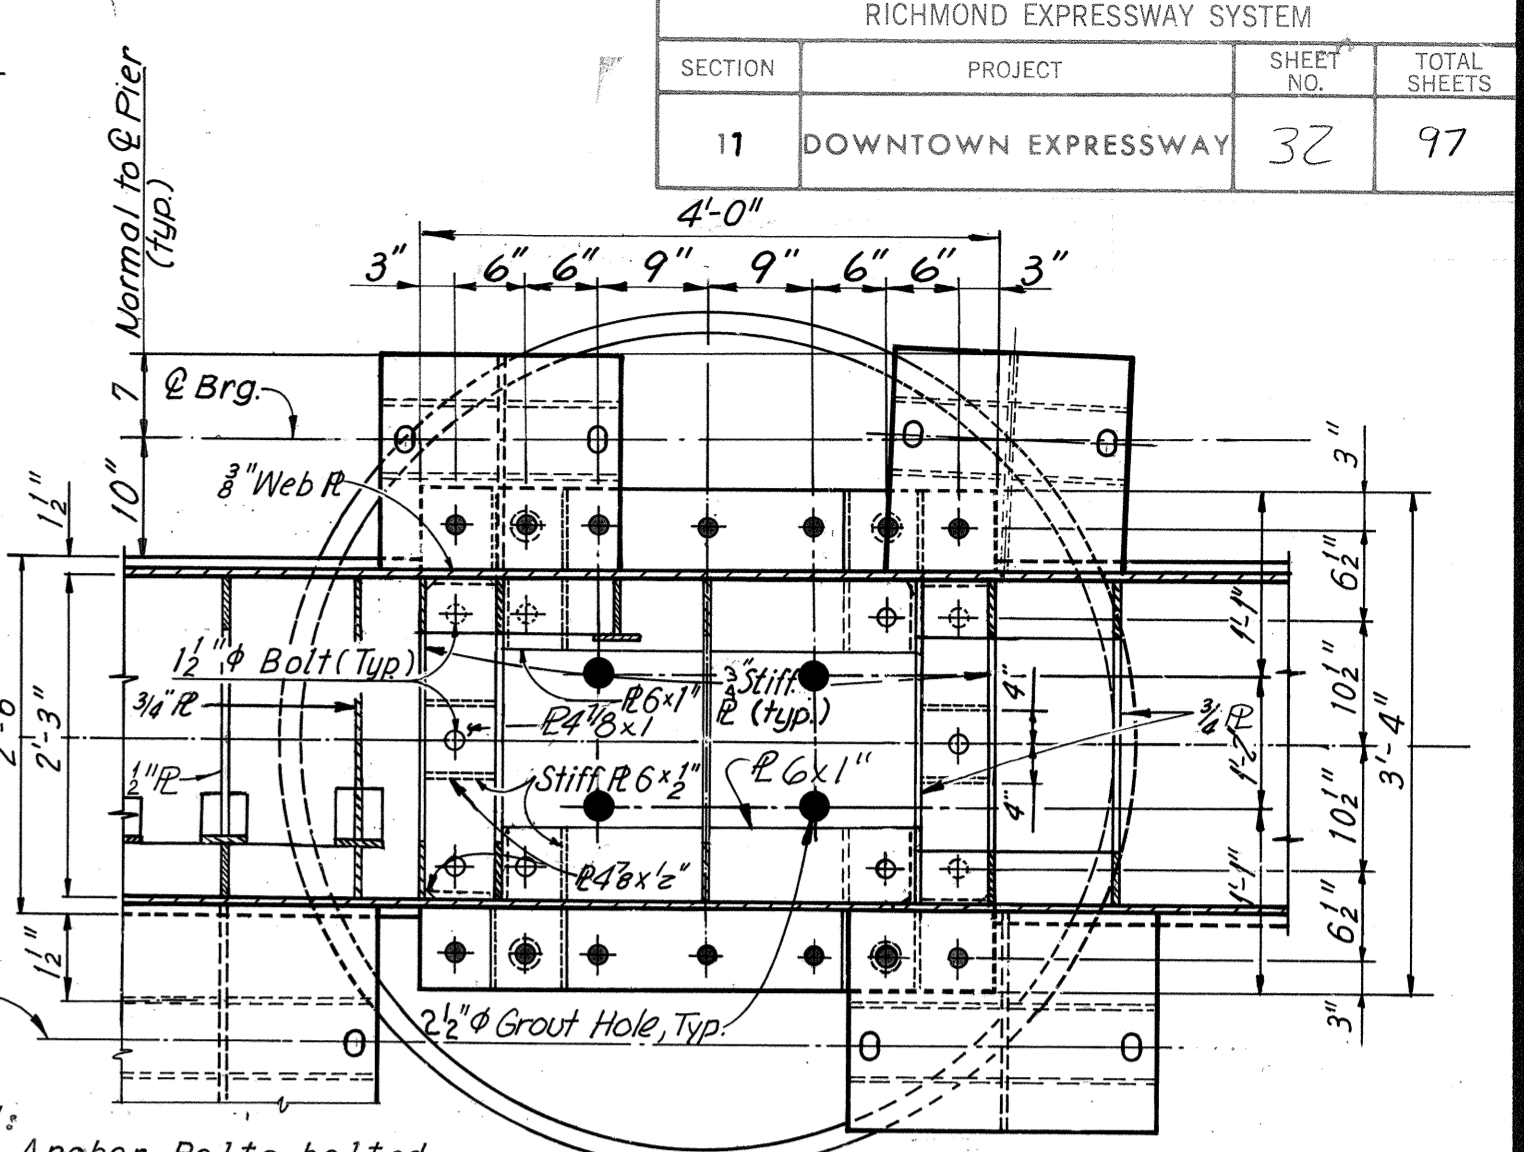


BASE PLATE PLAN
 Scale: 3/8"=1'-0"

- Legend:**
- Anchor Bolts bolted to Baseplate.
 - Adjustment Bolts bolted to 3/8" bracket.
 - Anchor Bolts bolted to 1" bracket inside Cap Beam.

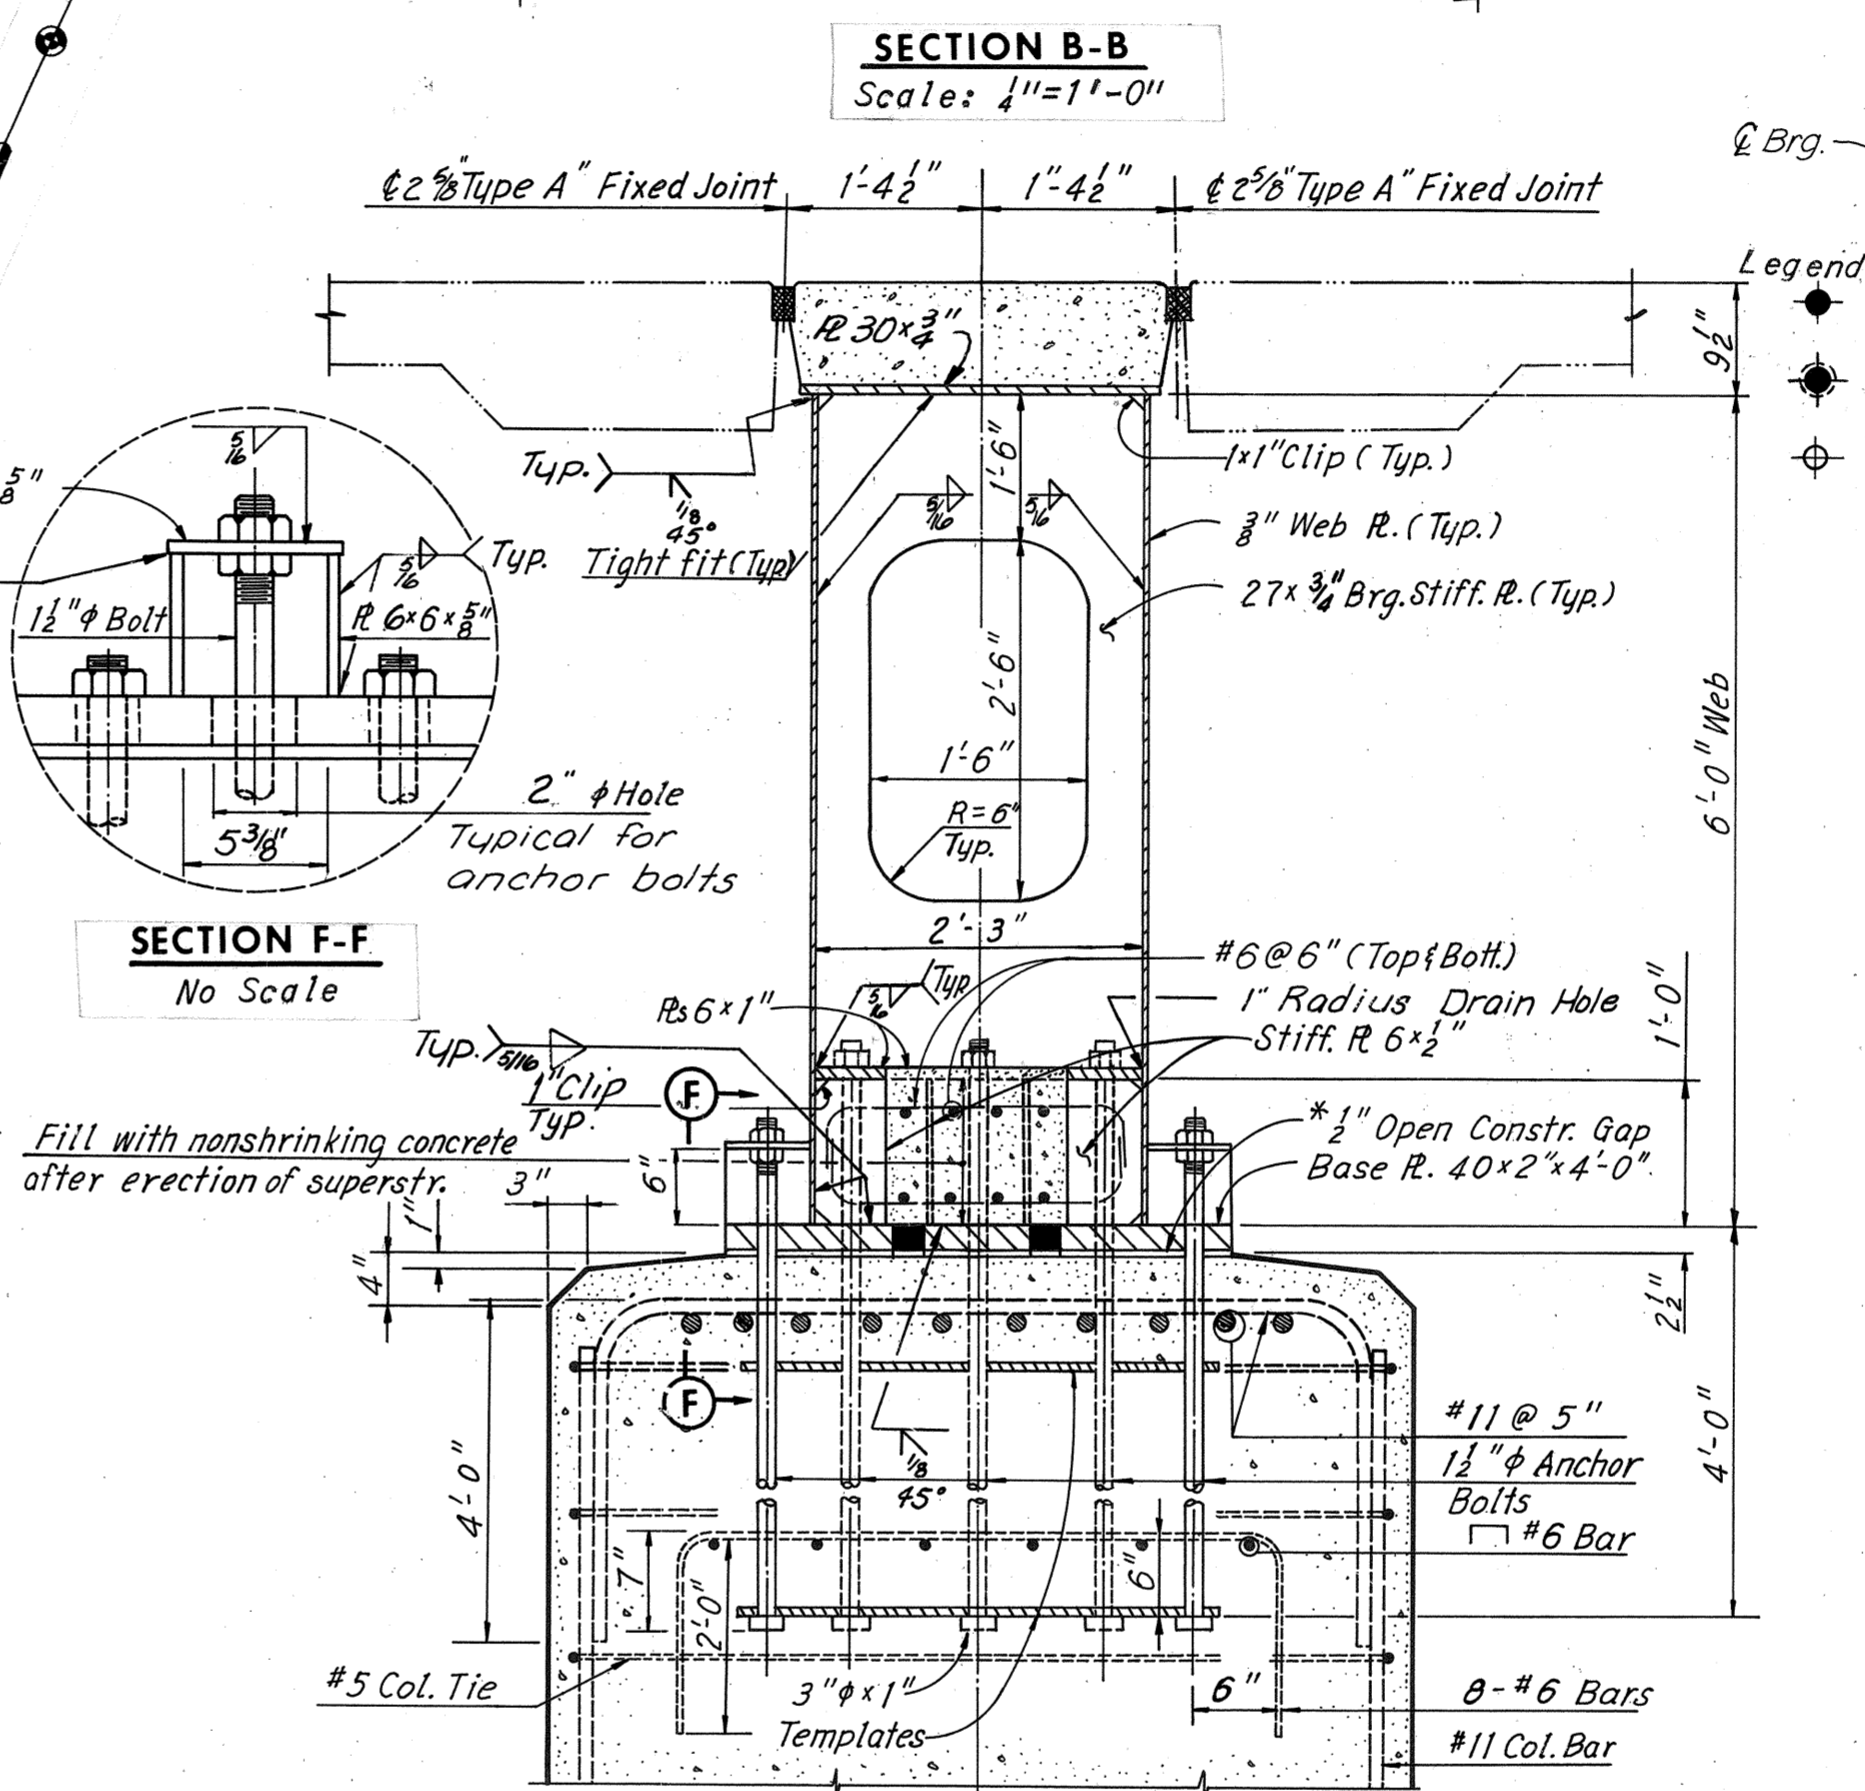

SECTION C-C
 Scale: 3/8"=1'-0"

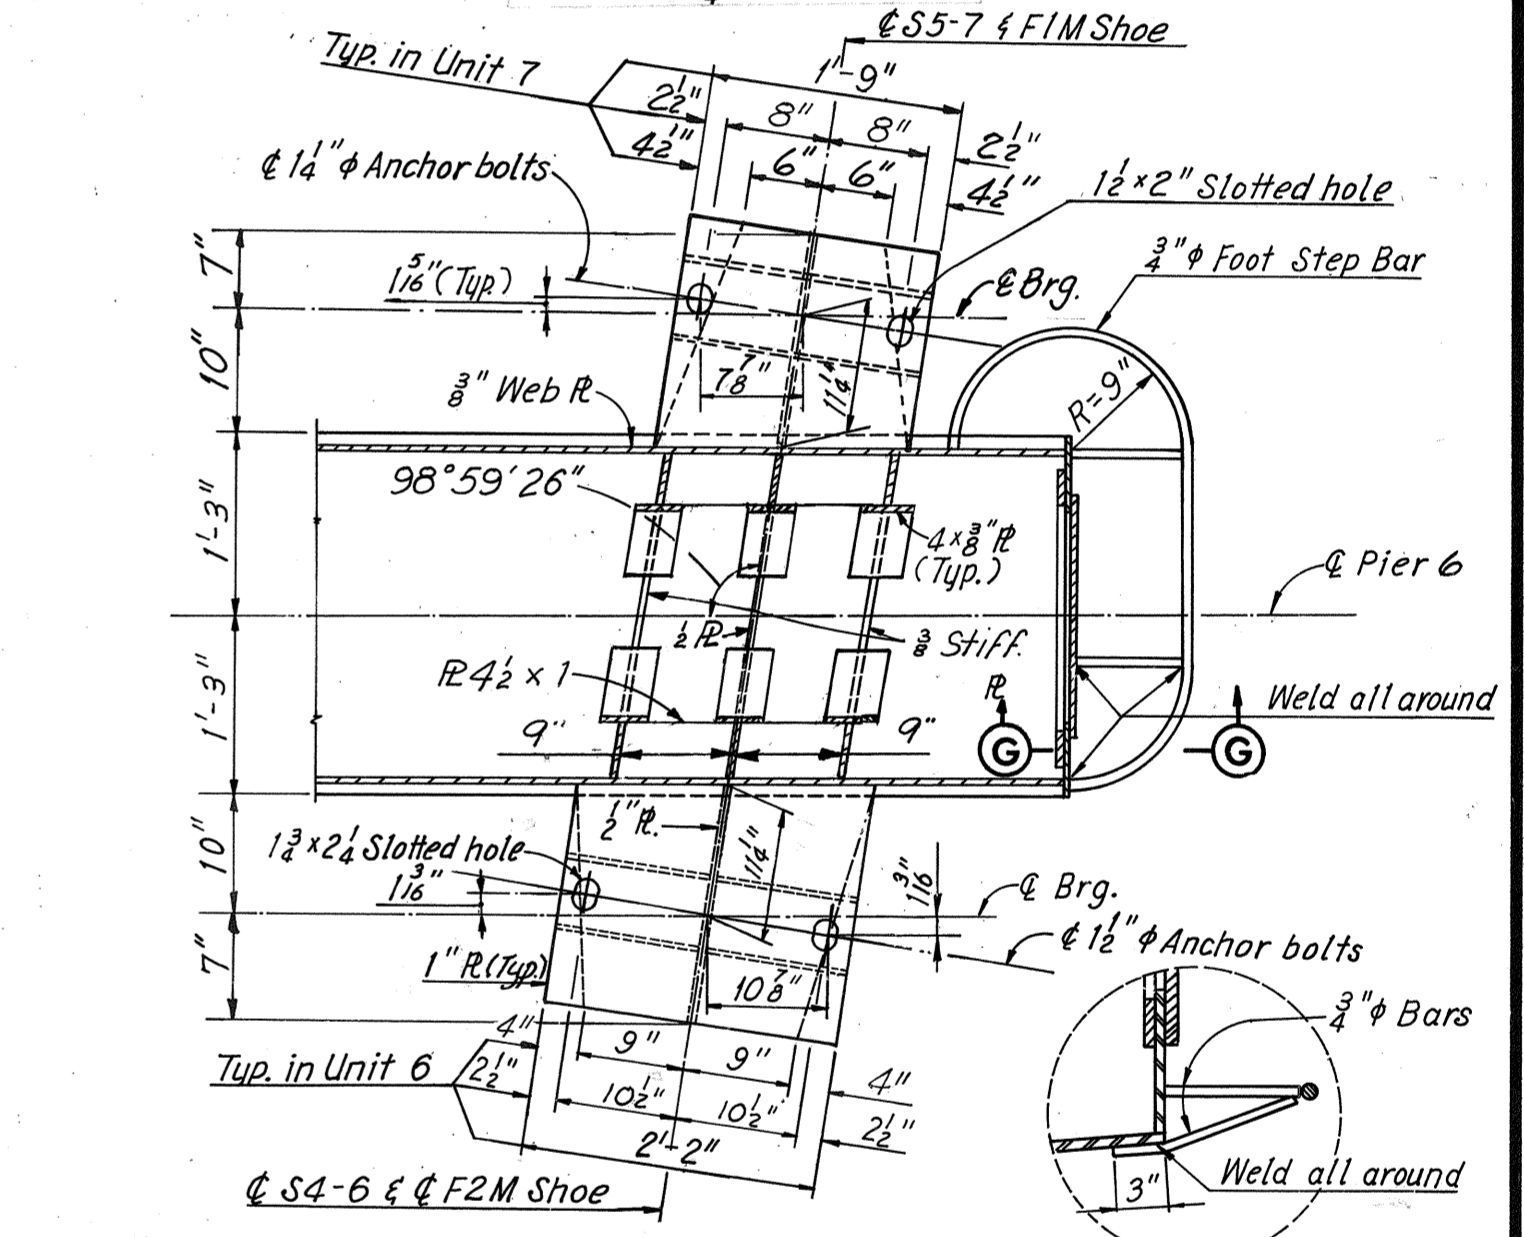

DETAIL A
 Scale: 3/8"=1'-0"

SECTION G-G
 No Scale


Notes:
 For Joint Details see Sheet 34 and 35.
 For Shear Stud Details see Sheet 20.
 For Shear Details see Sheet S1 and S2.
 For Bearing Pile Details see Sheet 9.
 Estimated Pile tip Elevation = -20.0
 All piles shall be 10BP42 (Design capacity = 45 tons).

Note:
 All anchor bolts connecting cap beam to column shall be 1/2" in Dia. and each nut shall have washer (not shown on details)


AS BUILT
 RICHMOND METROPOLITAN AUTHORITY
 RICHMOND EXPRESSWAY SYSTEM
 DOWNTOWN EXPRESSWAY
 BRIDGE NO. 65
 RAMP S-W CONNECTION FROM
 RICHMOND-PETERSBURG TURNPIKE
PIER 6

HOWARD, NEEDLES, TAMMEN & BERGENDOFF
 consulting engineers
 NEW YORK ALEXANDRIA KANSAS CITY
 SCALE: As Noted
 CONTRACT NO. 11
 SHEET NO. 7 OF 38

NOTE A
 A construction joint will be permitted at a rustication near mid-height of the column. The column reinforcement may be lap spliced near the construction joint. The lap at the splice shall be a minimum of 3'-6". Splices shall be staggered at least 3'-3" between adjacent bars.

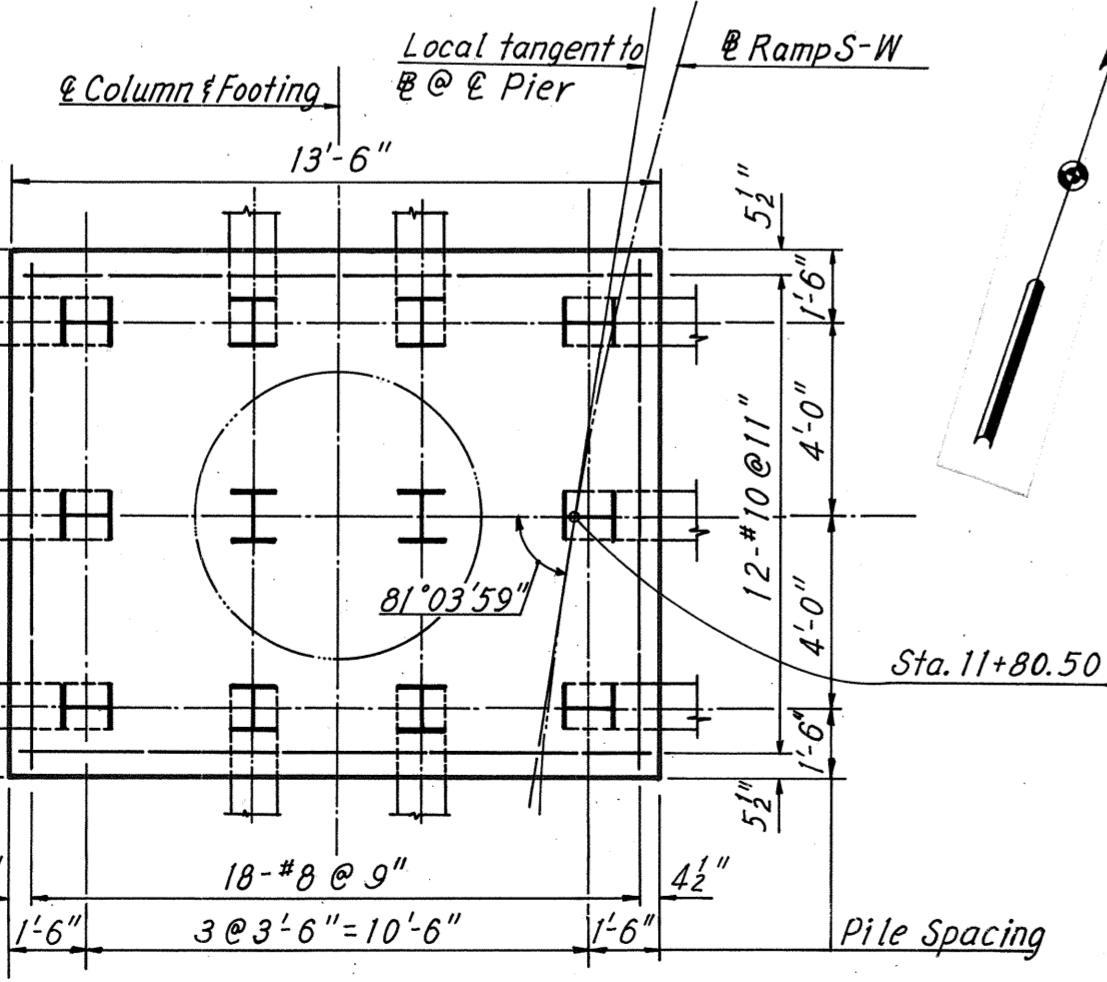

FOOTING PLAN
 Scale: 1/4"=1'-0"








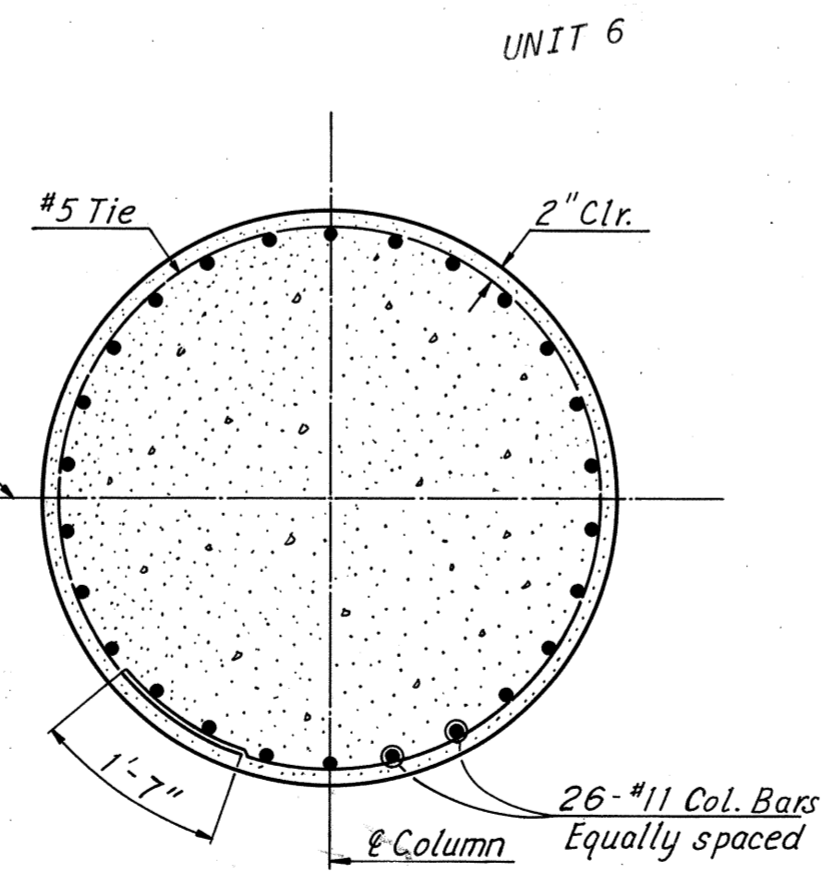


SECTION E-E
 Scale: 1/2"=1'-0"



Note:
 Footing elevations are approximate only and may be varied to suit field conditions as directed by the Engineer. Vertical shaft reinforcement shall not be cut until these elevations are established. Where elevations change more than 2 ft., redesign will be required.

Note:
 All Structural Steel for Pier 6 shall be A36.
 Top of cap beam, Pier 6, need not be cambered.

BY	DATE	Shoe Plate Dim. in Detail A	T.E.M.	8-76
MADE	K.C.T. 8-13-69	Pier Cap Dim.	T.E.M.	3-76
CHECKED	J.L.K. 6-25-75	Pad Elev. & Col. Dim.	T.E.M.	9-8-75
IN CHARGE	S.C.C. 5-27-69			
	NO.	REVISION	BY	DATE

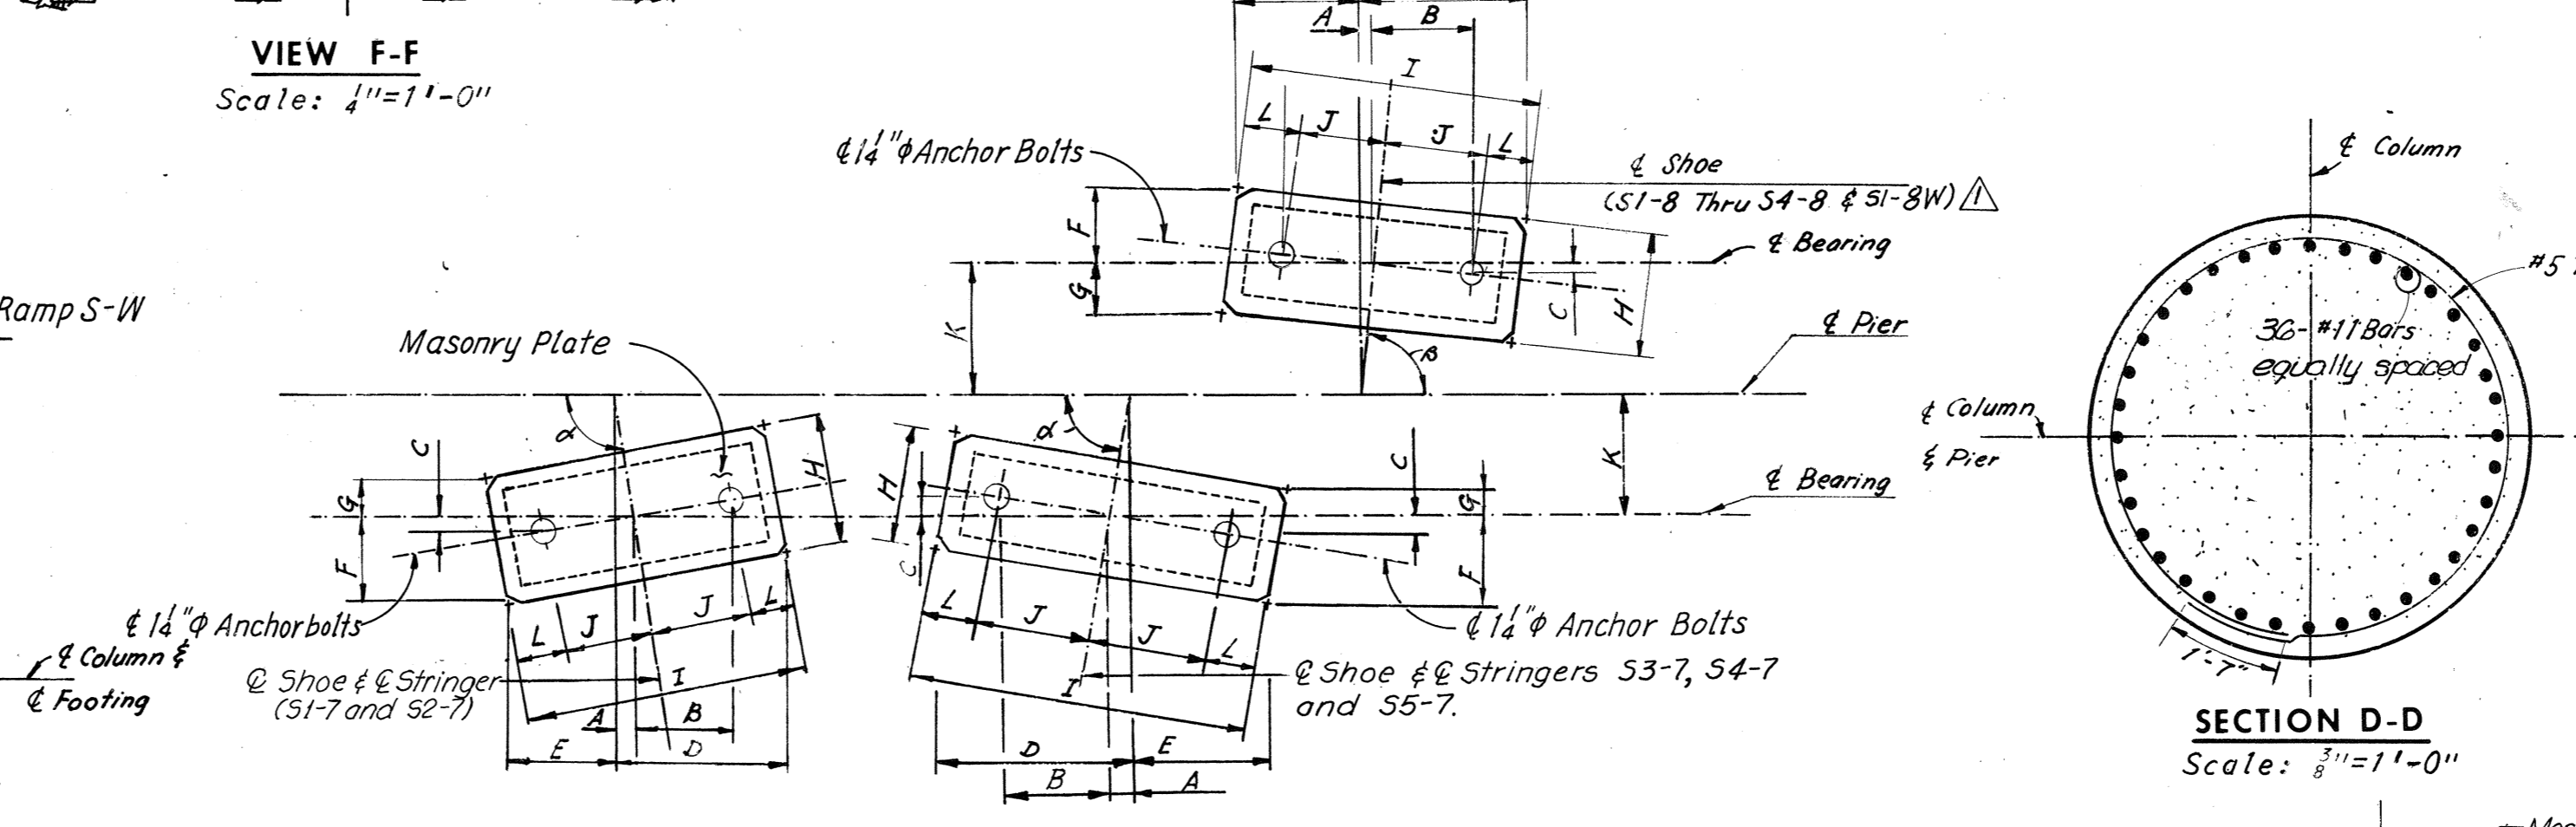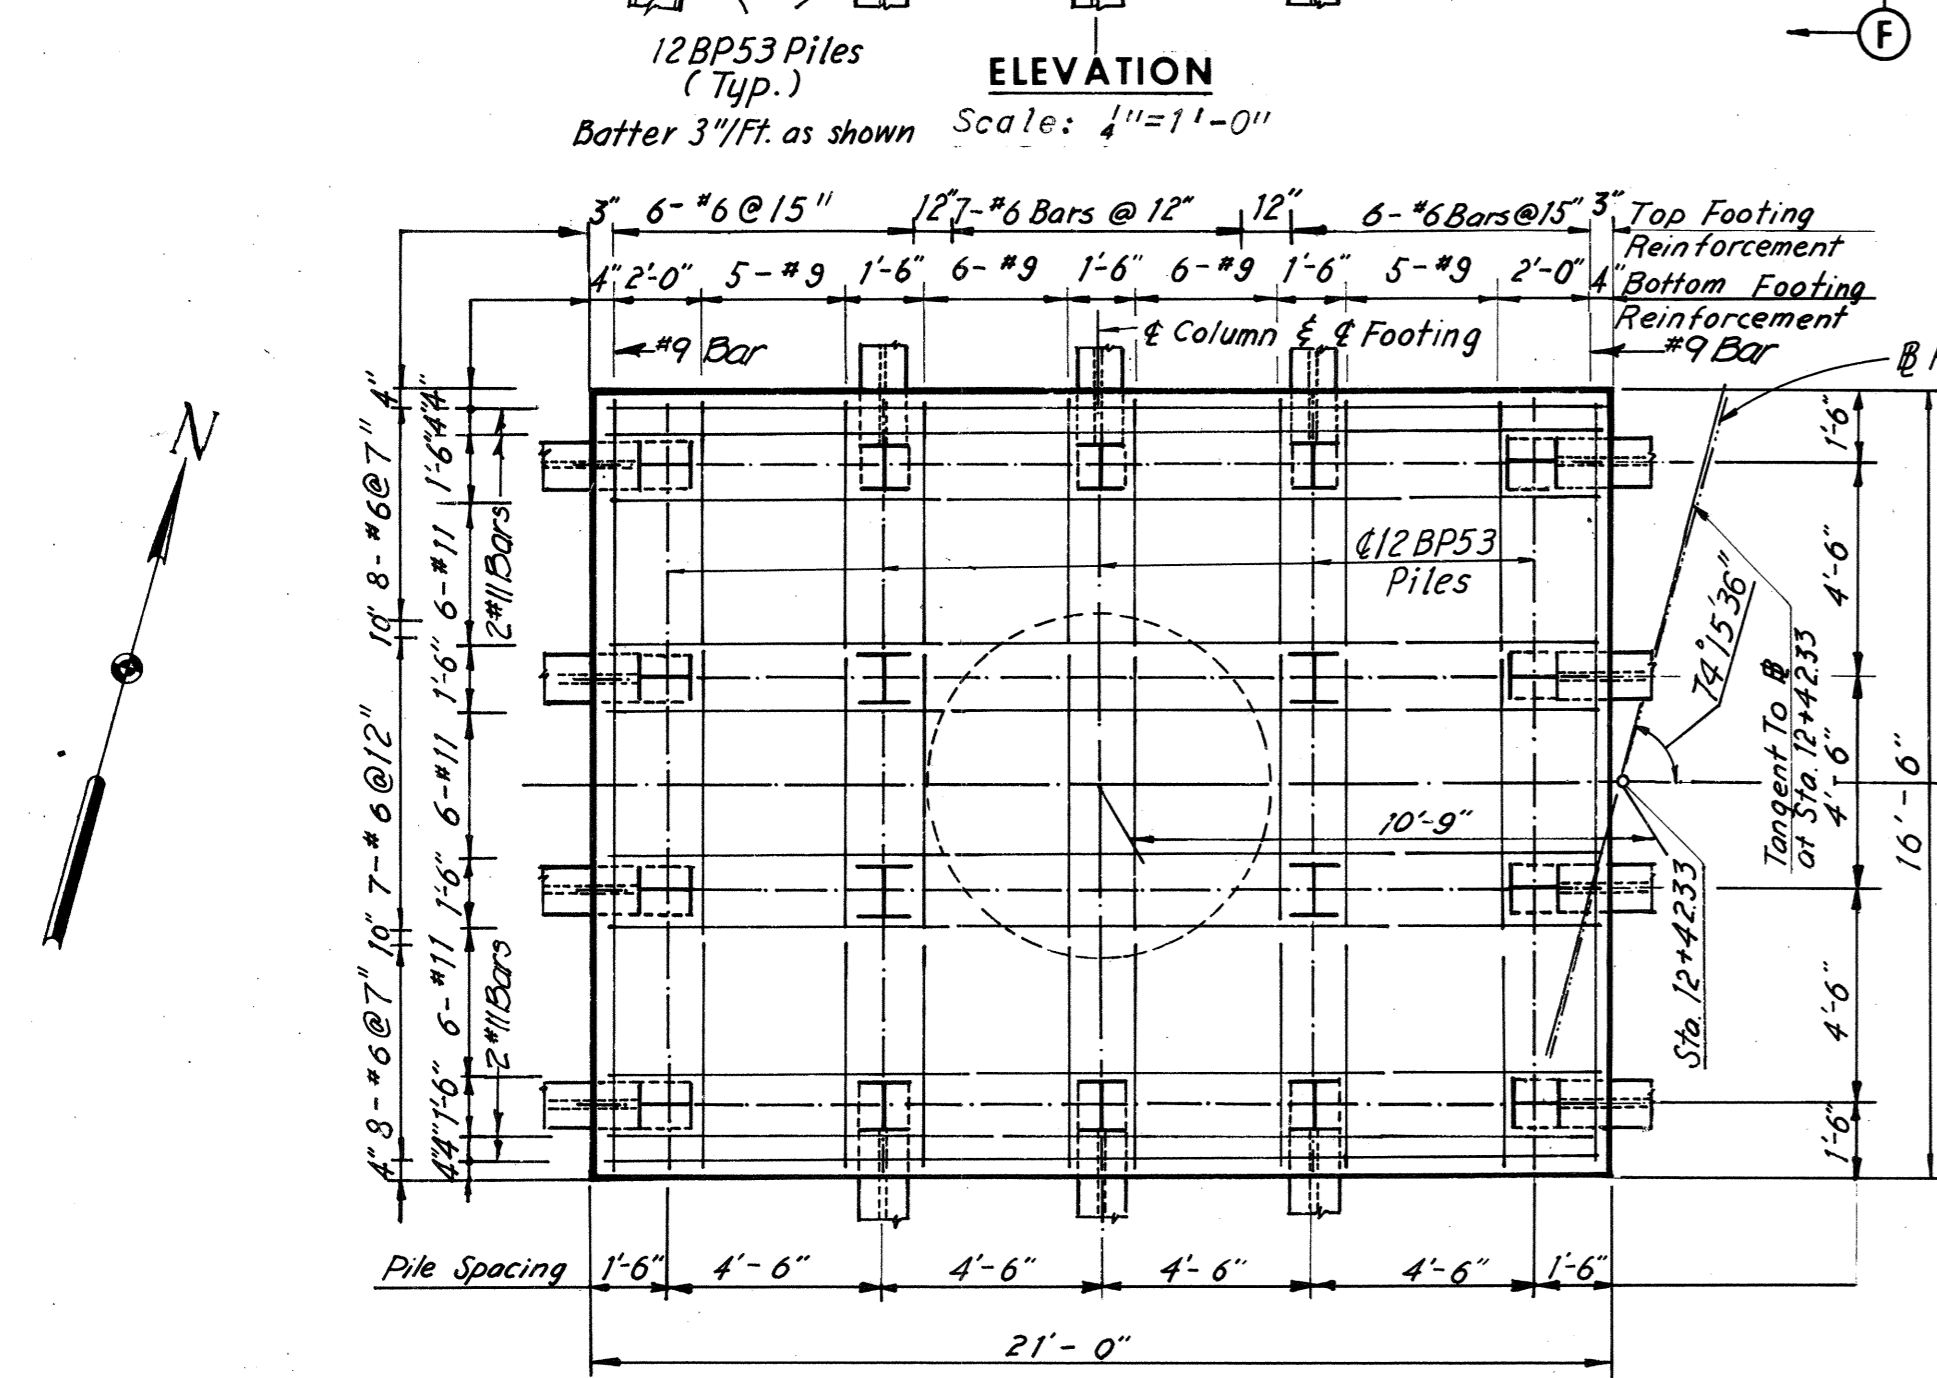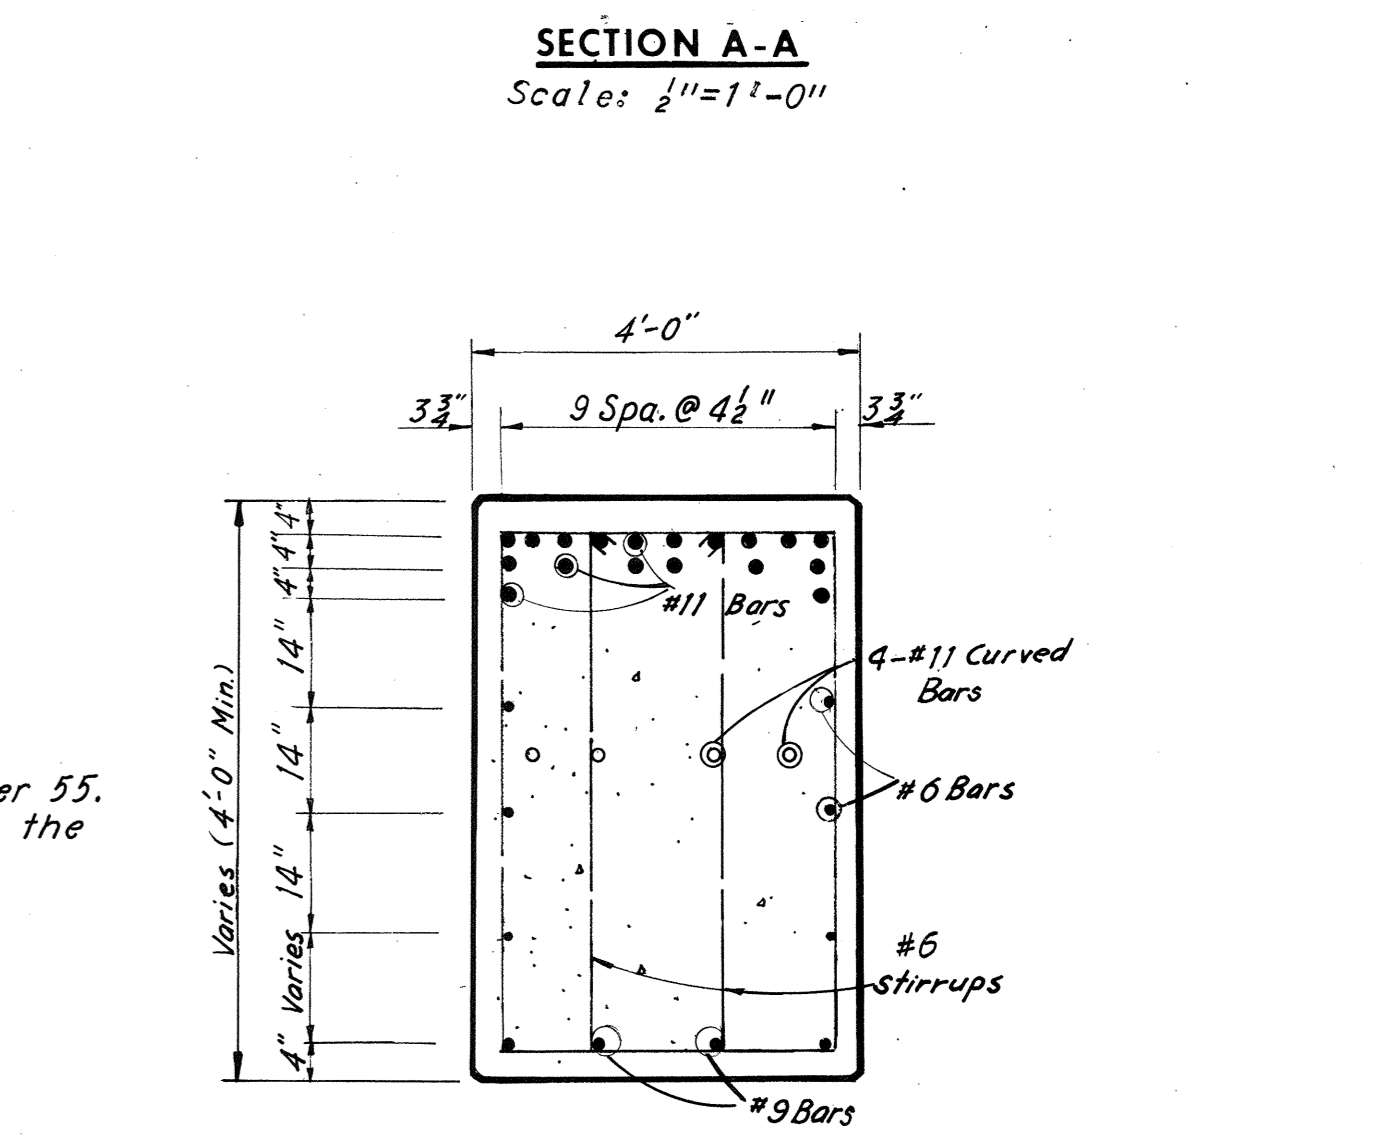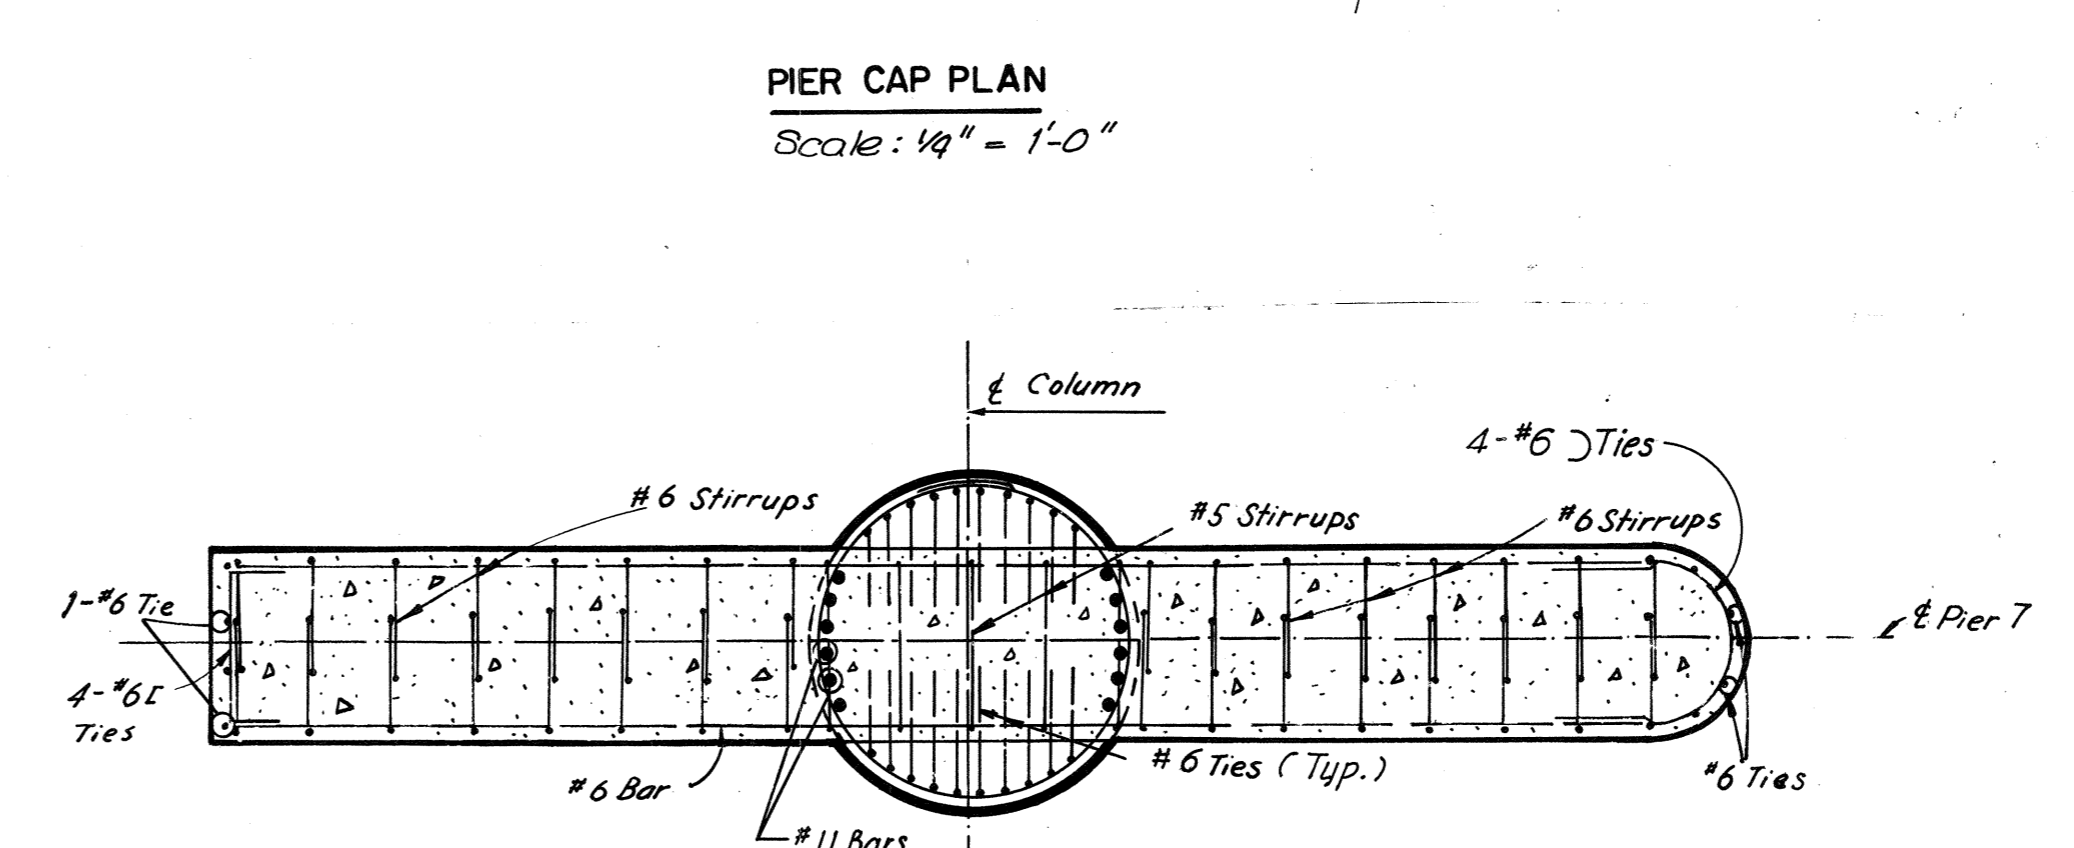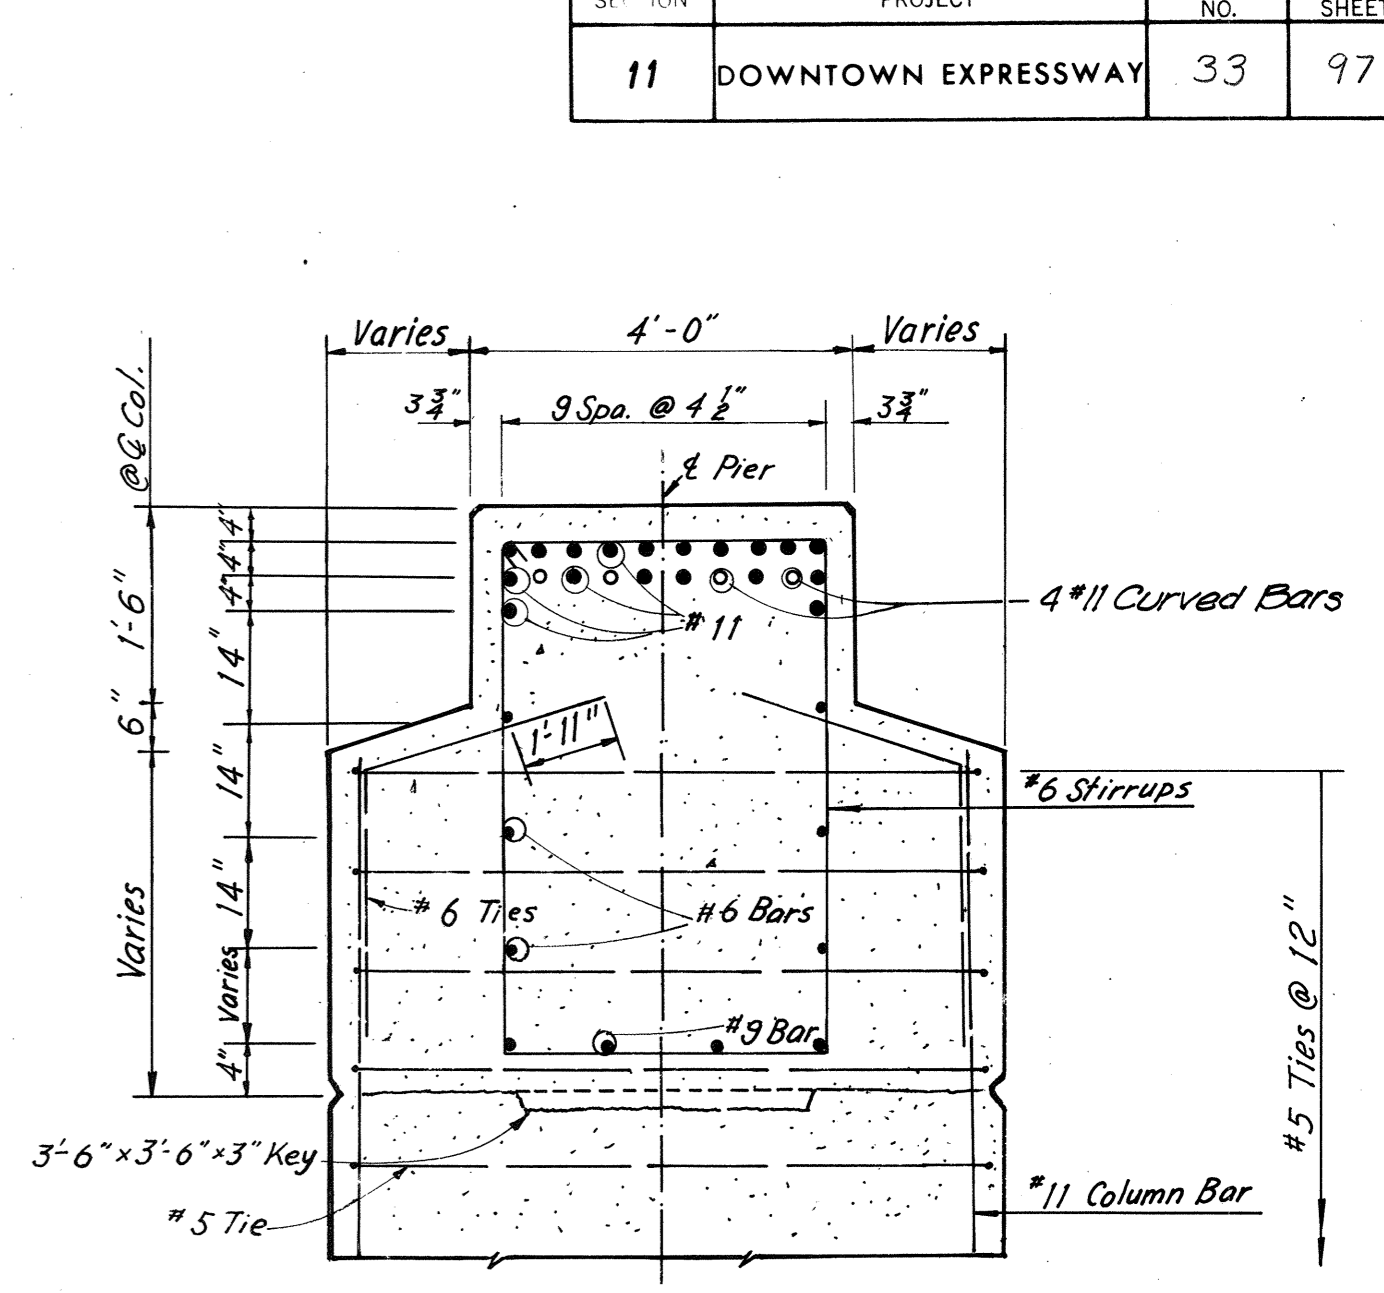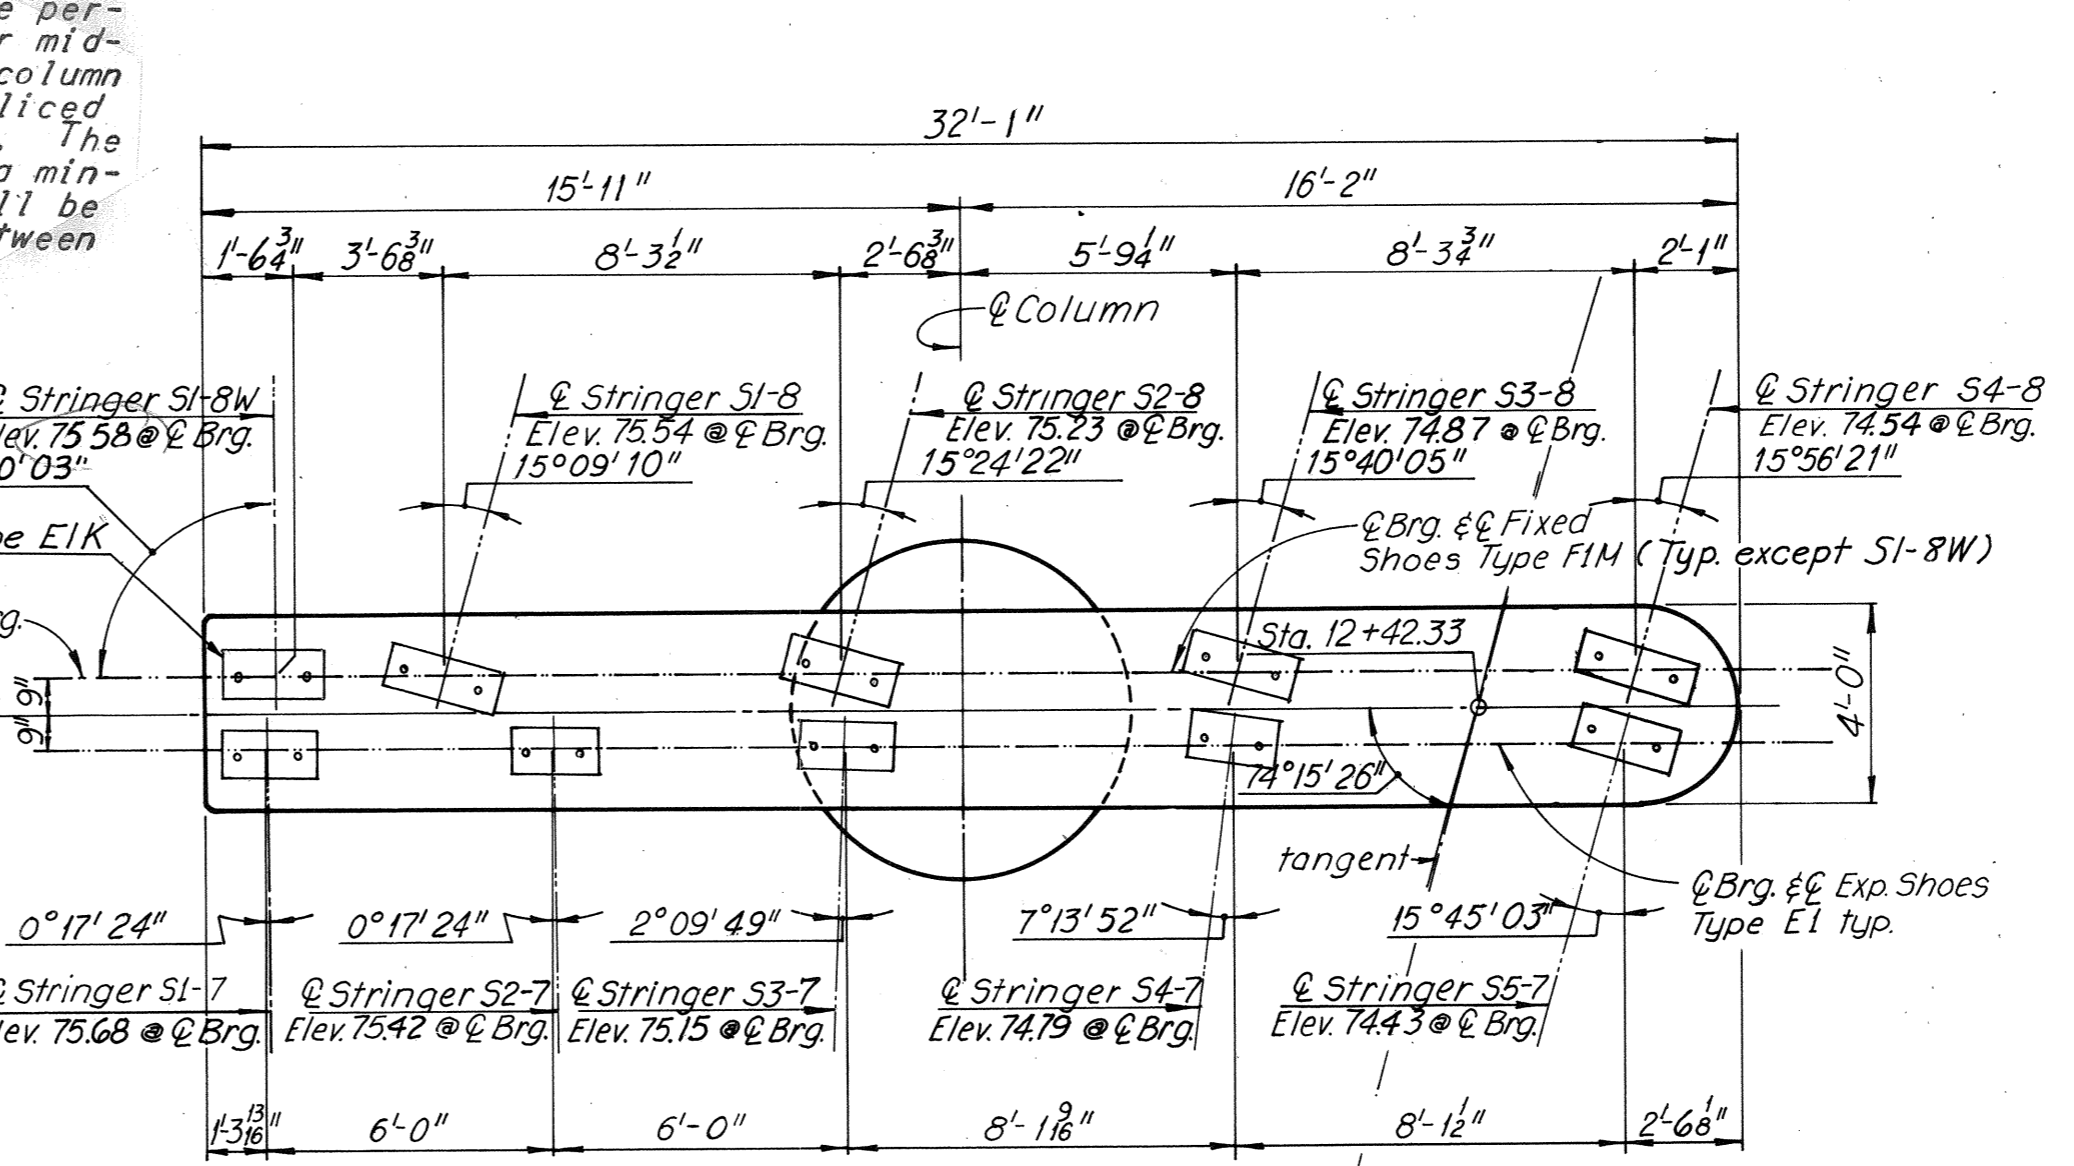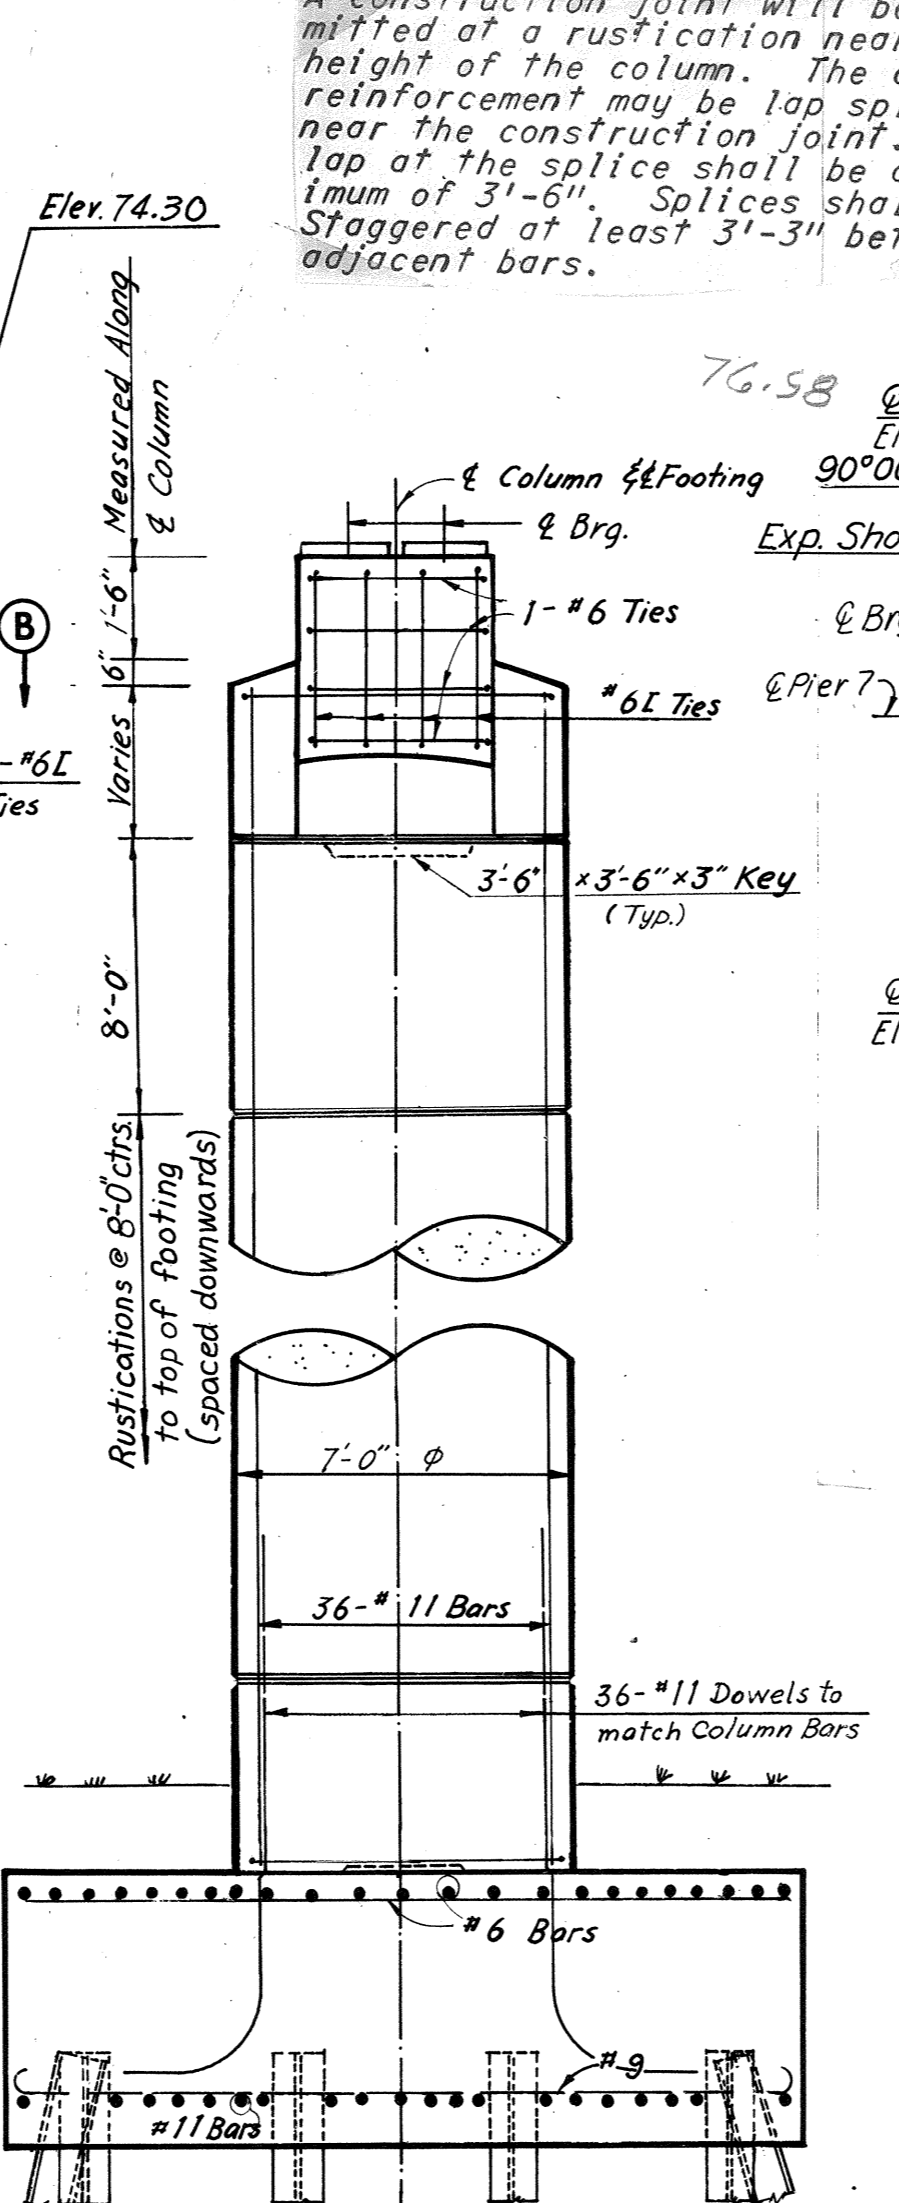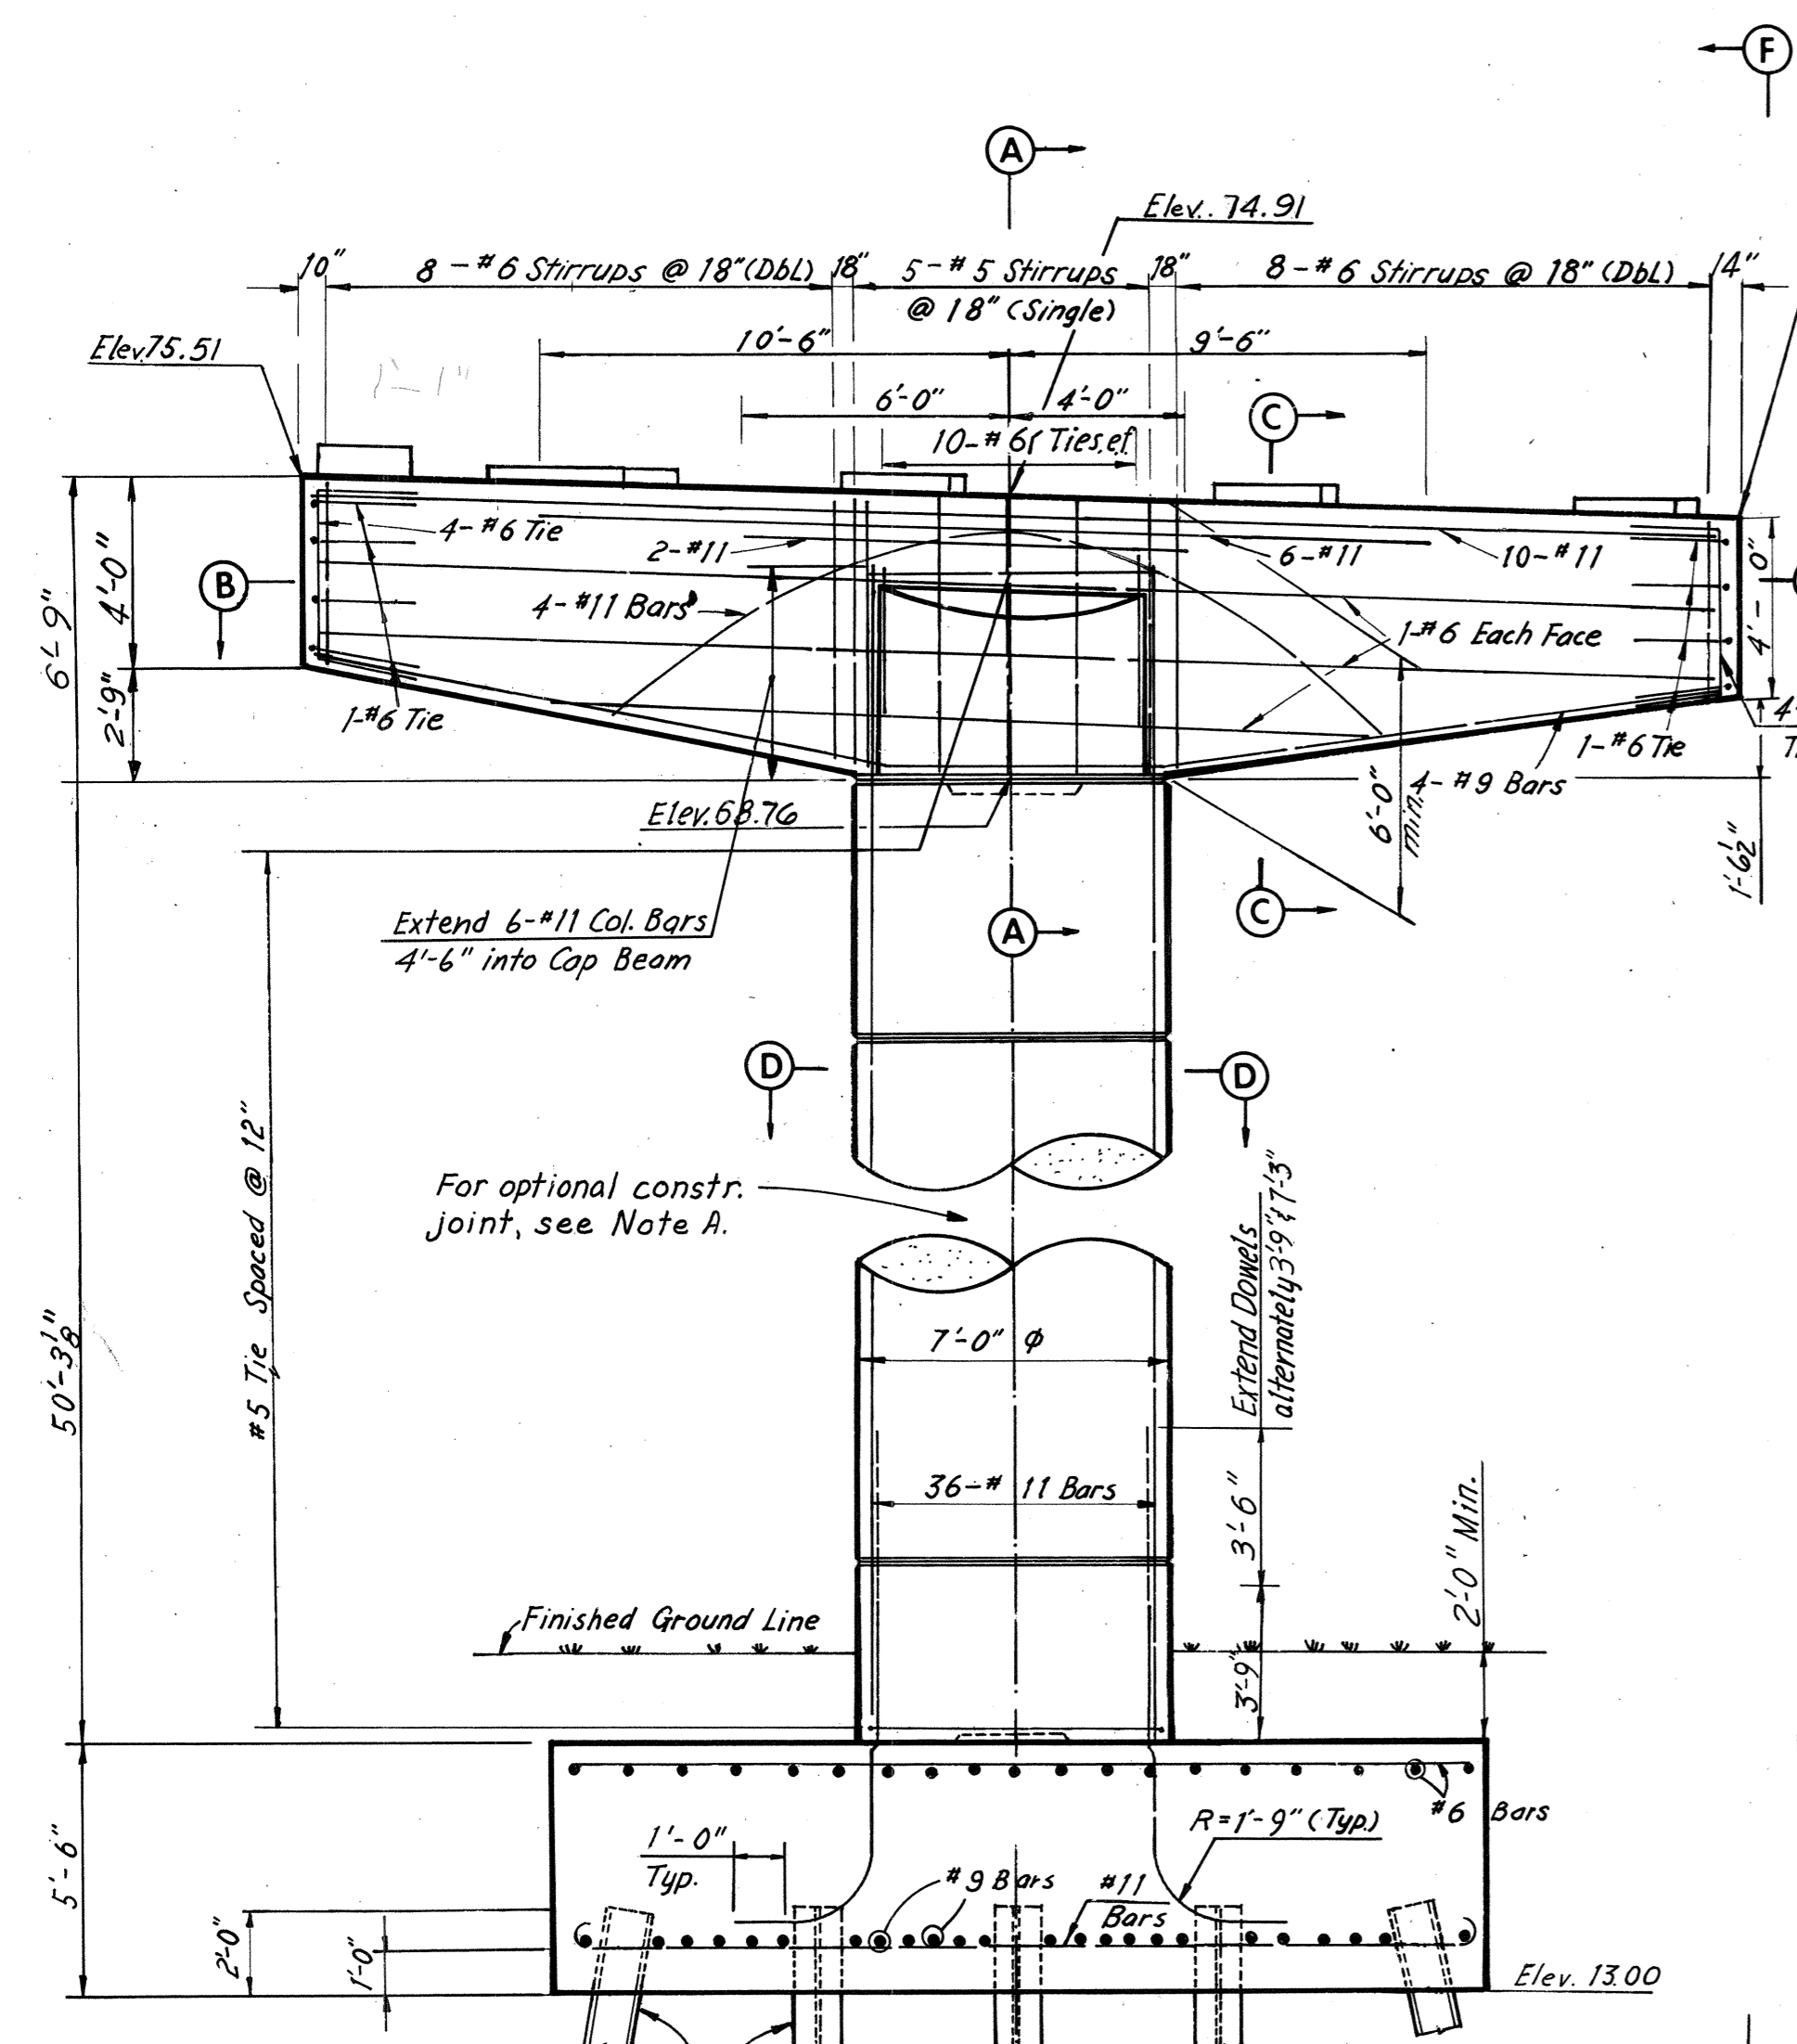

Stringer	α	B	A	R	C	D	E	F	G	H	I	J	K	L
S1-7	90°17'24"	--	16"	8 1/2"	16"	1'-0 3/8"	1'-0 3/8"	6 1/2"	5 3/8"	1'-0"	2'-0 1/2"	8 1/2"	9"	4"
S2-7	90°17'24"	--	16"	8 1/2"	16"	1'-0 3/8"	1'-0 3/8"	6 1/2"	5 3/8"	1'-0"	2'-0 1/2"	8 1/2"	9"	4"
S3-7	87°50'11"	--	16"	8 1/2"	16"	1'-0 3/8"	1'-0 3/8"	6 1/2"	5 3/8"	1'-0"	2'-0 1/2"	8 1/2"	9"	4"
S4-7	82°46'08"	--	16"	8 3/8"	16"	1'-2 1/8"	1'-2 1/8"	7 1/2"	4 1/2"	1'-0"	2'-0 1/2"	8 1/2"	9"	4"
S5-7	74°14'57"	--	2 3/8"	7 7/8"	2 3/8"	1'-3 1/8"	7 7/8"	9 3/8"	2 3/8"	1'-0"	2'-0 1/2"	8 1/2"	9"	4"
S1-8	--	74°50'50"	2 3/8"	10 1/2"	2 3/8"	1'-6 3/8"	10 3/8"	9 1/2"	1 3/8"	11"	2'-6"	10 1/2"	9"	4 1/2"
S2-8	--	74°35'38"	2 3/8"	10 1/2"	2 3/8"	1'-6 3/8"	10 3/8"	9 3/8"	1 3/8"	11"	2'-6"	10 1/2"	9"	4 1/2"
S3-8	--	74°19'55"	2 3/8"	10 1/2"	2 3/8"	1'-6 3/8"	10 3/8"	9 3/8"	1 3/8"	11"	2'-6"	10 1/2"	9"	4 1/2"
S4-8	--	74°03'39"	2 3/8"	10 1/2"	2 3/8"	1'-6 3/8"	10 3/8"	9 3/8"	1 3/8"	11"	2'-6"	10 1/2"	9"	4 1/2"
S1-8W	--	89°59'57"	--	8 1/2"	--	1'-0 1/4"	1'-0 1/4"	6"	6"	1'-0"	2'-0 1/2"	8 1/2"	9"	4"

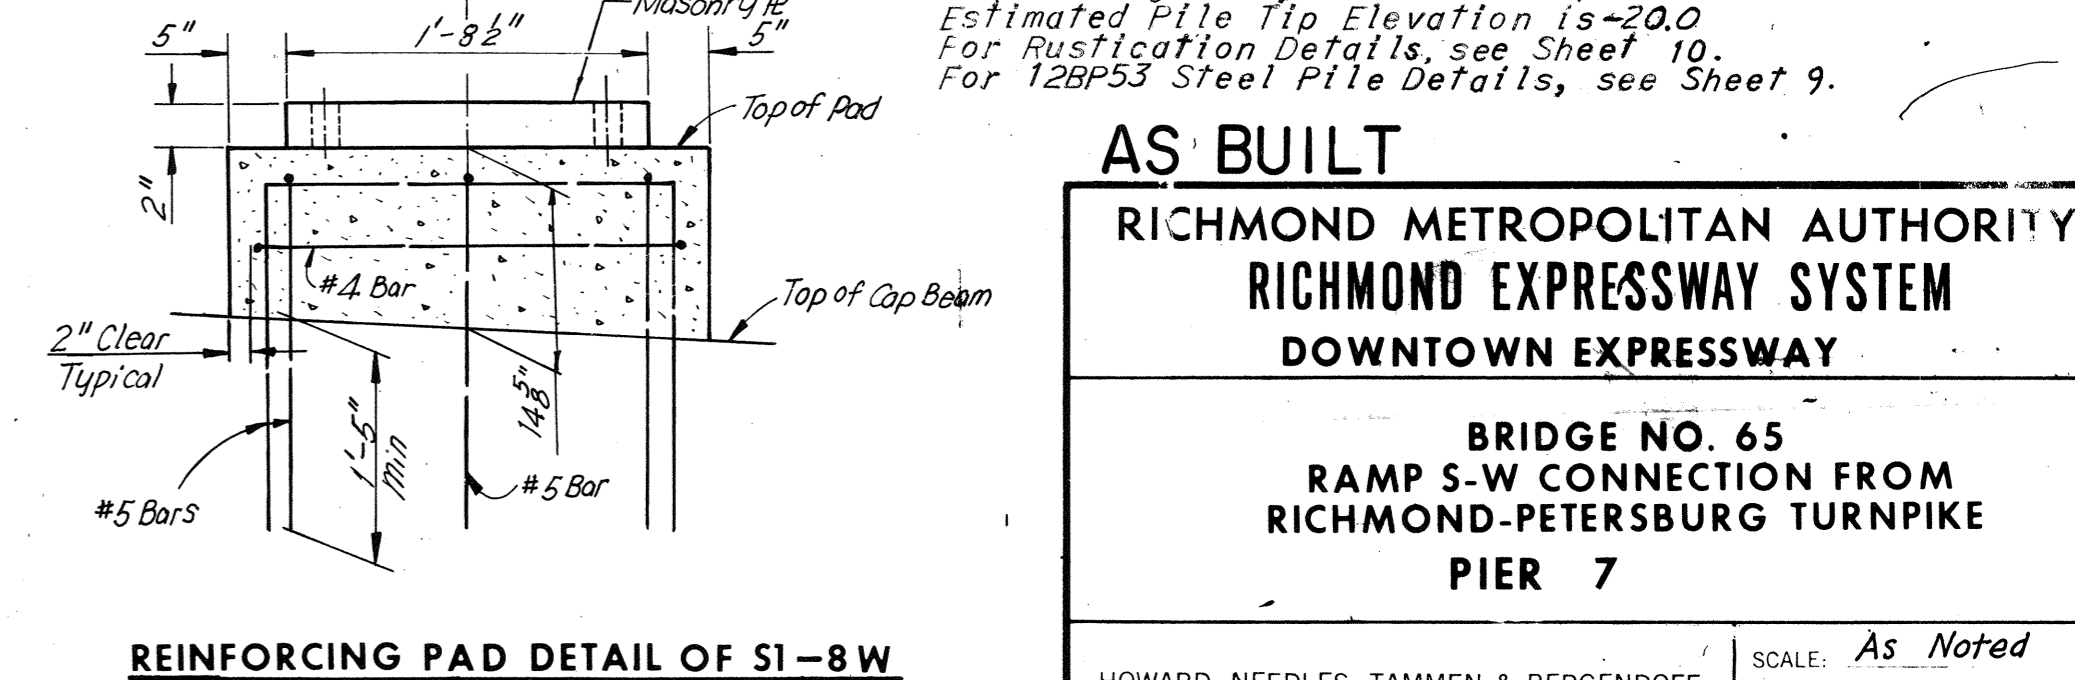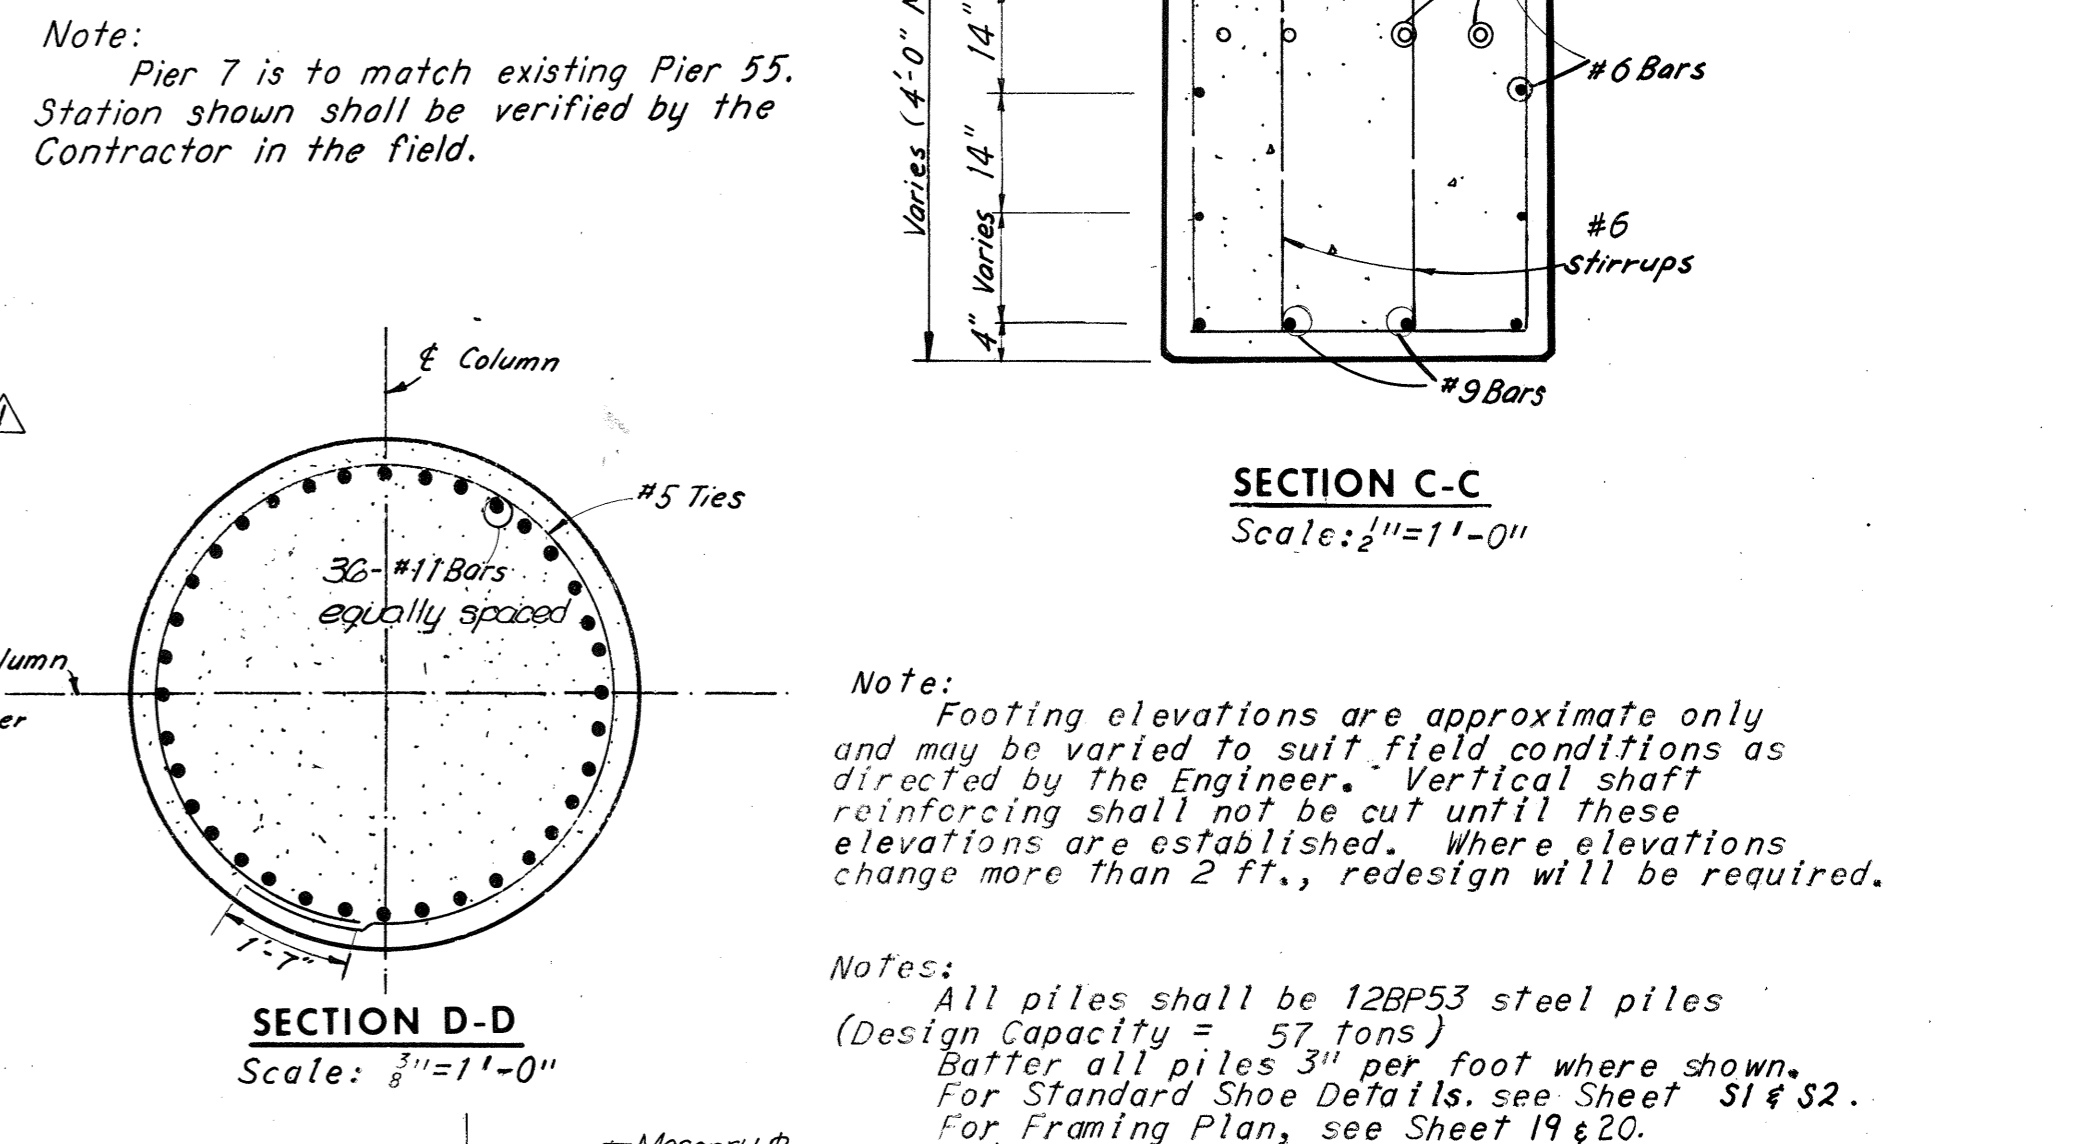

NOTE A
A construction joint will be permitted at a rustication near mid-height of the column. The column reinforcement may be lap spliced near the construction joint. The lap at the splice shall be a minimum of 3'-6". Splices shall be staggered at least 3'-3" between adjacent bars.

Note:
Pier 7 is to match existing Pier 55. Station shown shall be verified by the Contractor in the field.

Note:
Footing elevations are approximate only and may be varied to suit field conditions as directed by the Engineer. Vertical shaft reinforcing shall not be cut until these elevations are established. Where elevations change more than 2 ft., redesign will be required.

Notes:
All piles shall be 12BP53 steel piles (Design Capacity = 57 tons)
Batter all piles 3" per foot where shown.
For Standard Shoe Details, see Sheet S1 & S2.
For Framing Plan, see Sheet 19 & 20.
Estimated Pile Tip Elevation is -20.0
For Rustication Details, see Sheet 10.
For 12BP53 Steel Pile Details, see Sheet 9.

AS BUILT

RICHMOND METROPOLITAN AUTHORITY
RICHMOND EXPRESSWAY SYSTEM
DOWNTOWN EXPRESSWAY


BRIDGE NO. 65
RAMP S-W CONNECTION FROM
RICHMOND-PETERSBURG TURNPIKE
PIER 7

HOWARD, NEEDLES, TAMMEN & BERGENDOFF
consulting engineers
NEW YORK ALEXANDRIA KANSAS CITY

SCALE: As Noted
CONTRACT NO: 11
SHEET NO. 8 OF 38


BY	DATE	Cap Dimensions	PRY	10-76
MADE	R.C.	2-17-89	TEM	9-8-75
CHECKED	JLK	6-26-75	TEM	9-2-75
IN CHARGE	YCP	3-3-89	NO.	REVISION

RICHMOND EXPRESSWAY SYSTEM			
SECTION	PROJECT	SHEET NO.	TOTAL SHEETS
11	DOWNTOWN EXPRESSWAY	35	97

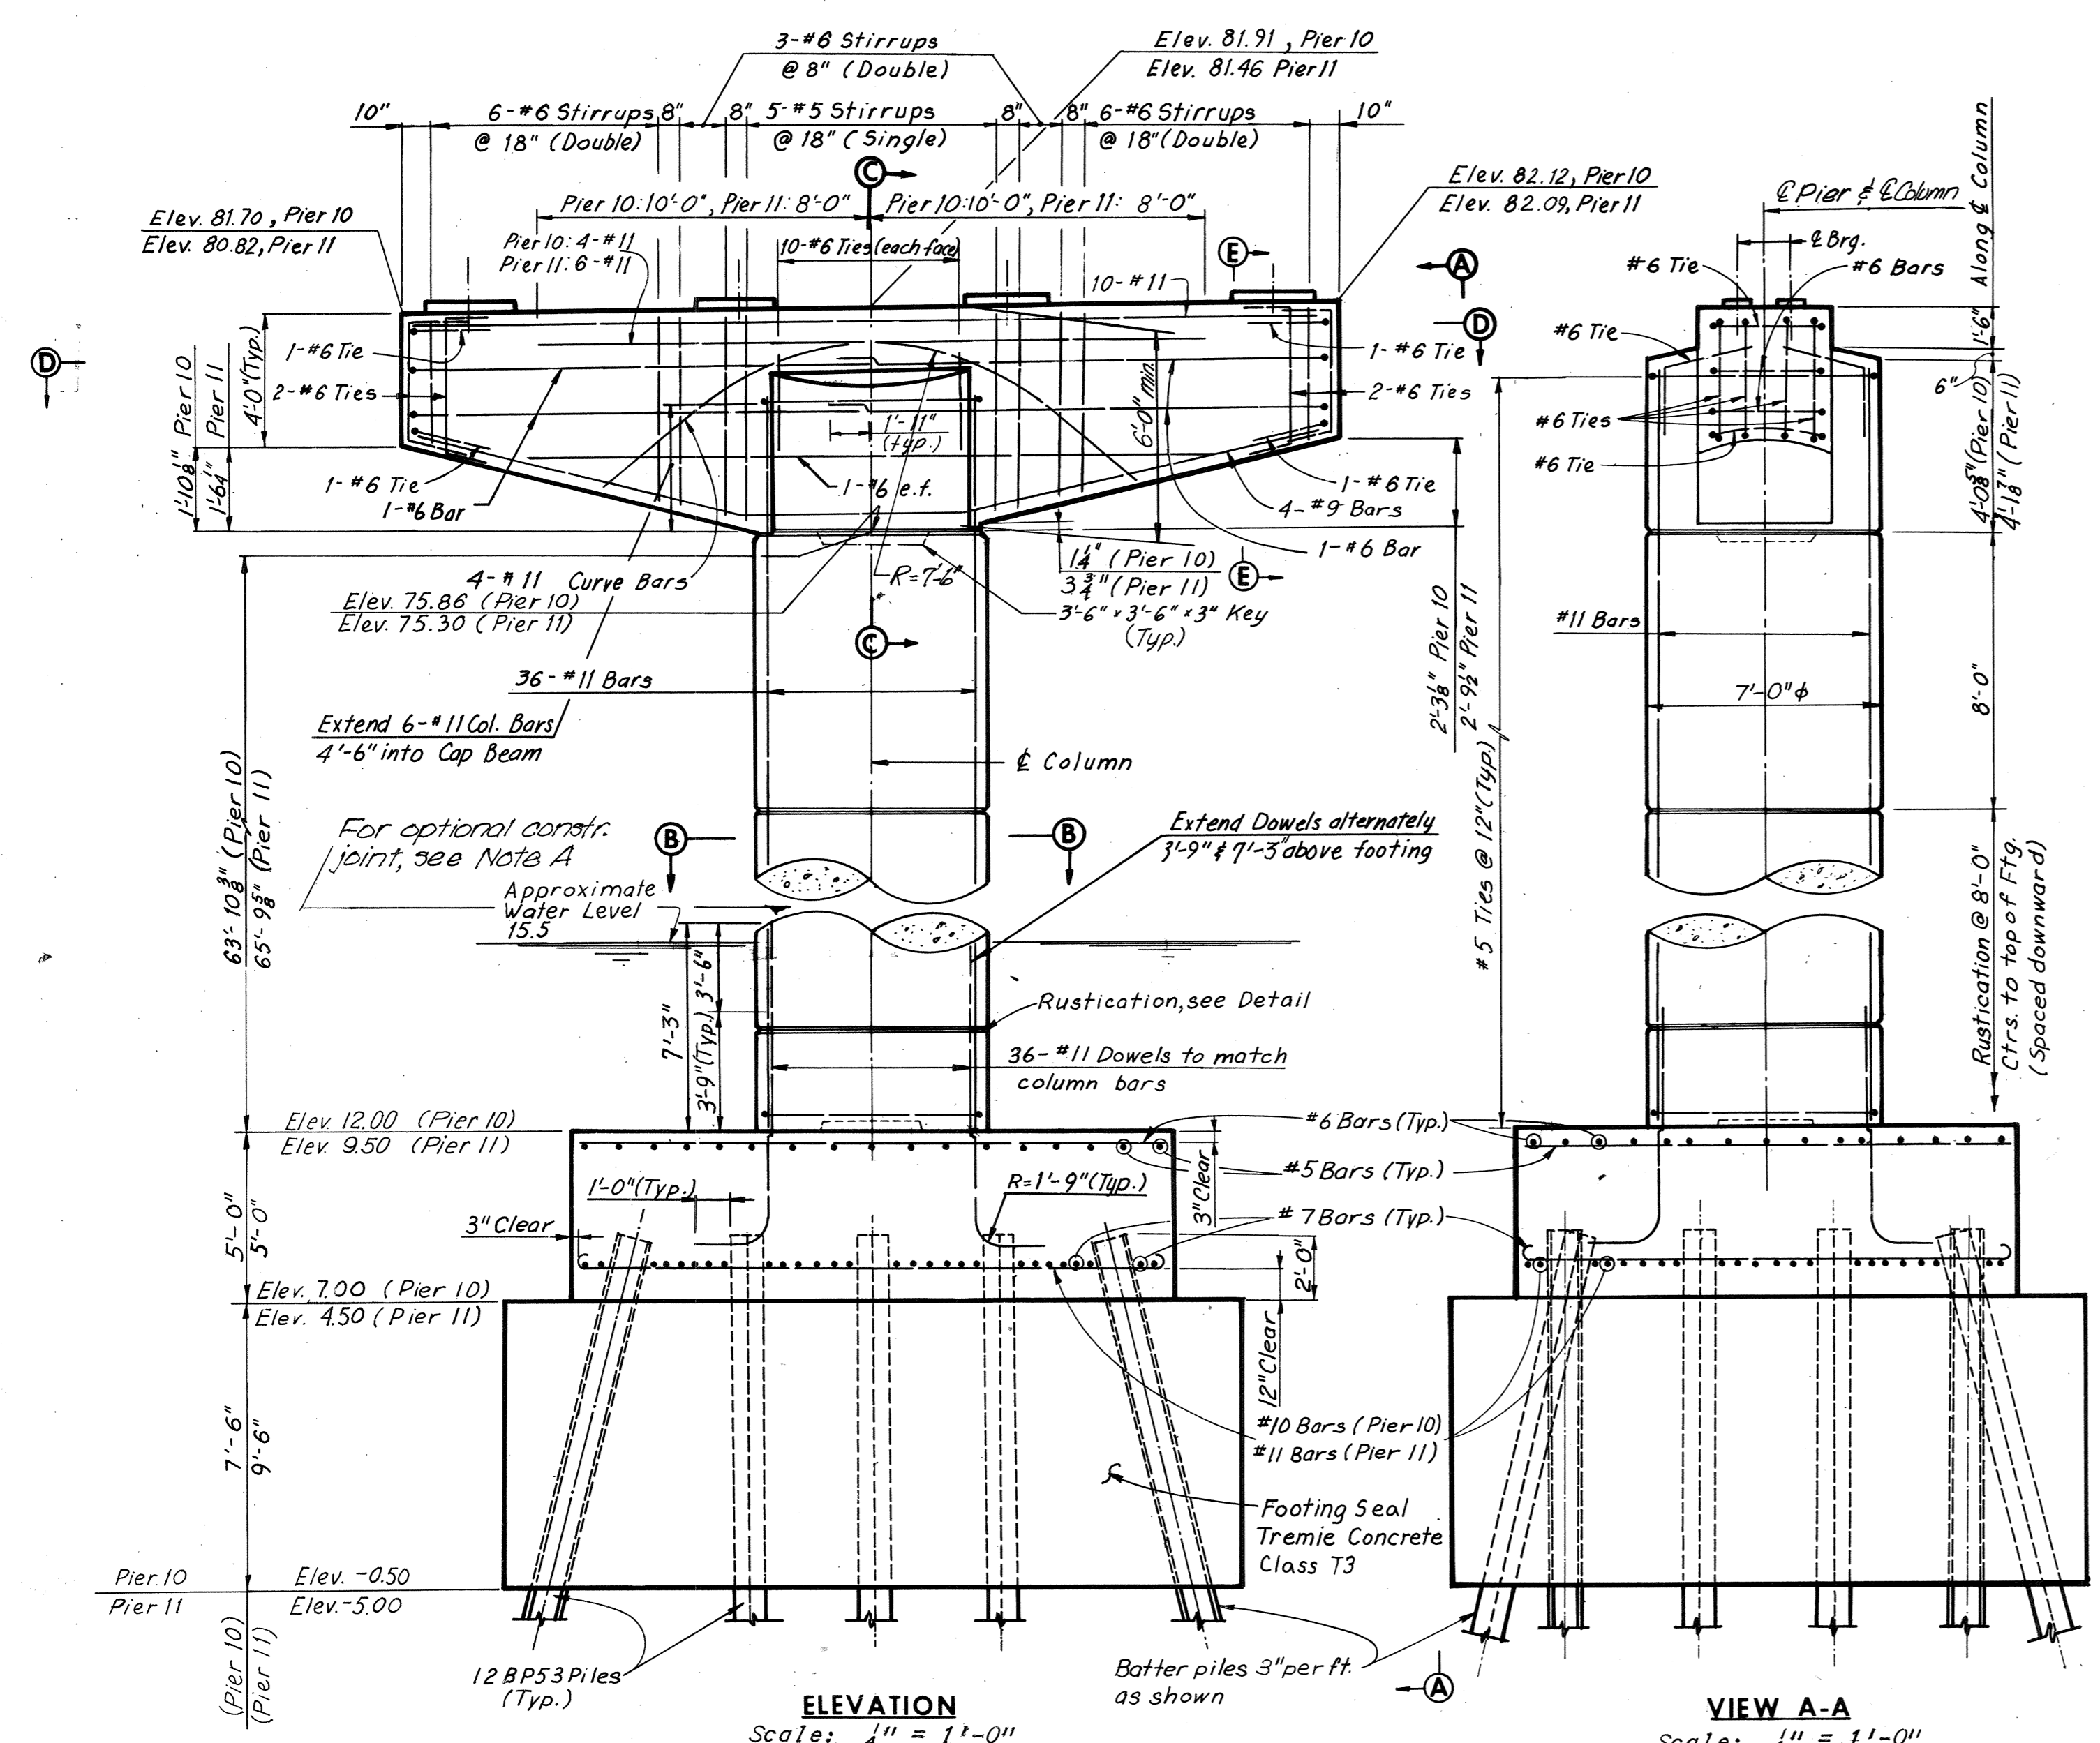


ELEVATION
Scale: 1/4" = 1'-0"


VIEW A-A
Scale: 1/4" = 1'-0"

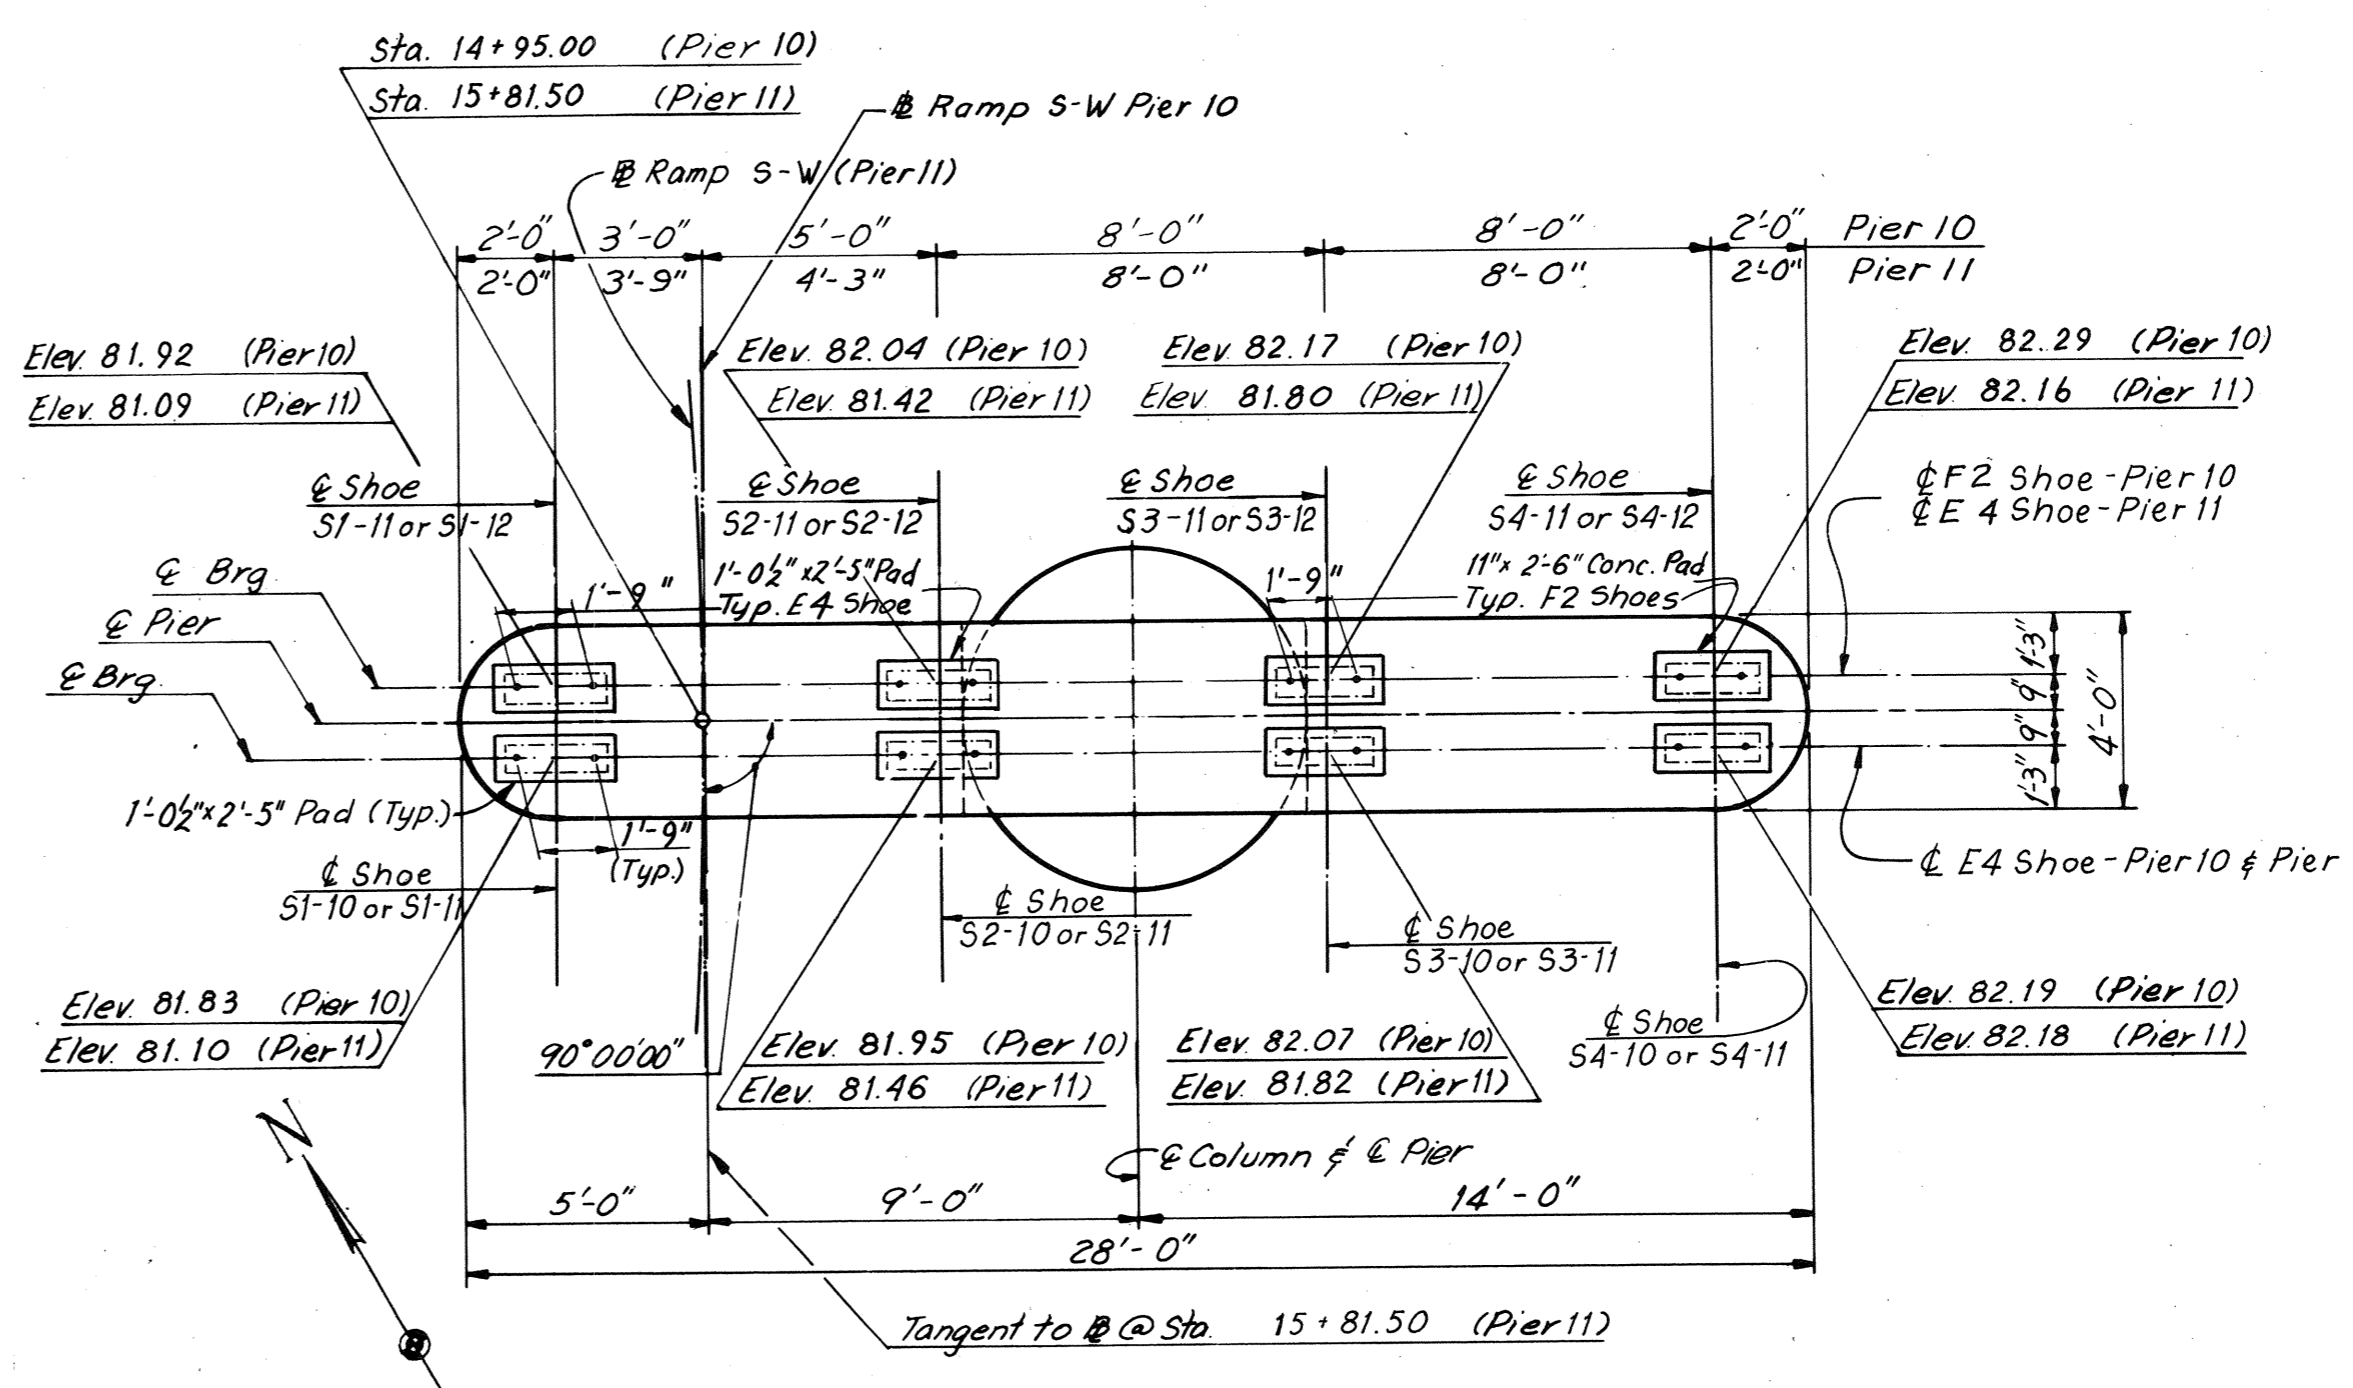


PLAN
Scale: 1/4" = 1'-0"

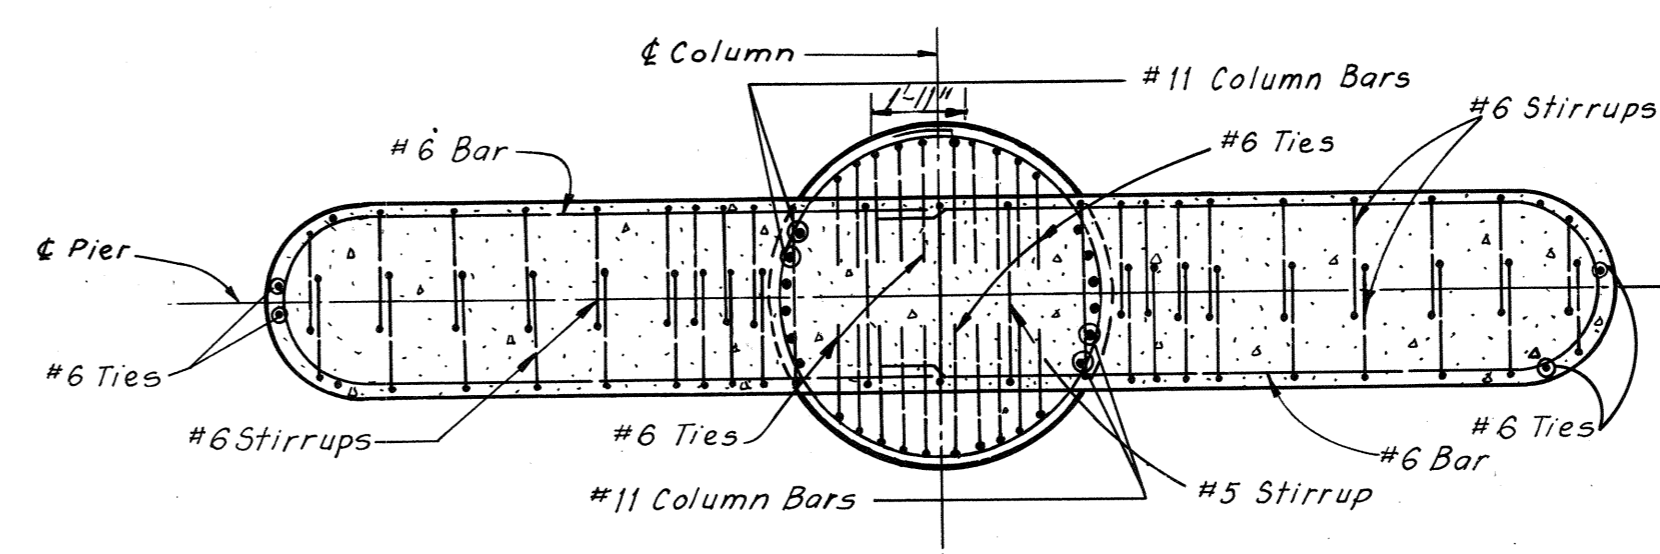


SECTION D-D
Scale: 1/4" = 1'-0"

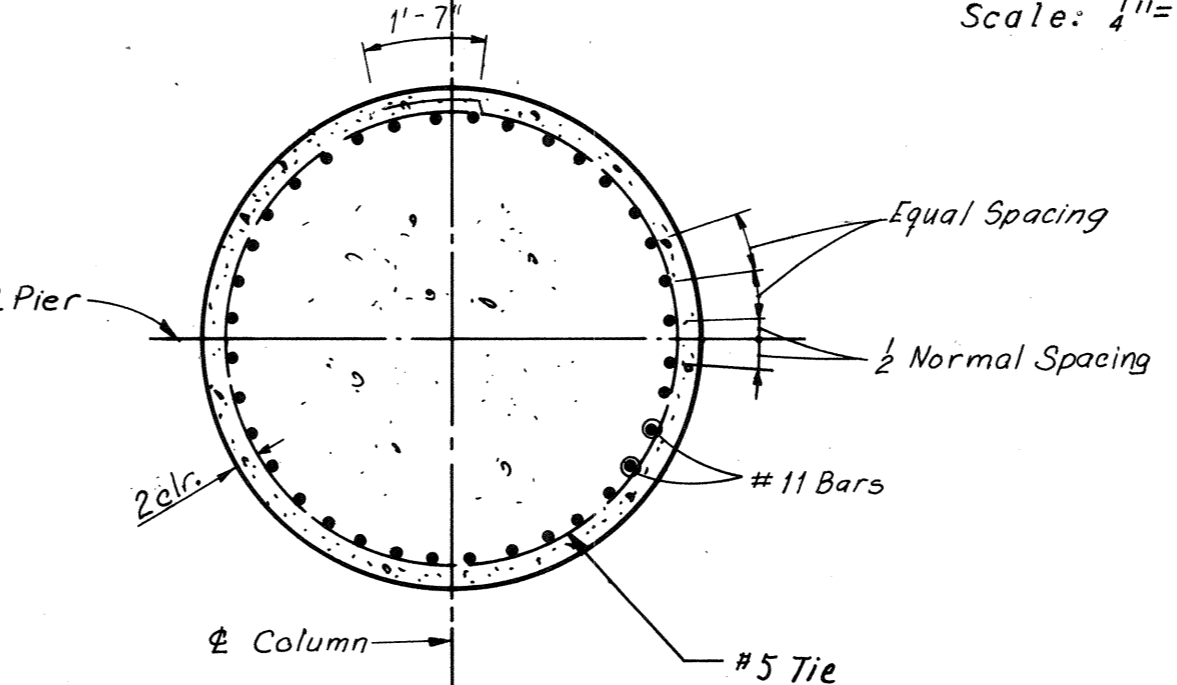


SECTION B-B
Scale: 3/8" = 1'-0"

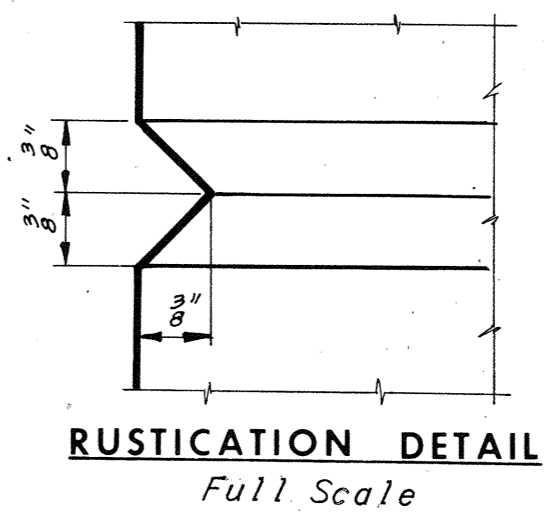

RUSTICATION DETAIL
Full Scale

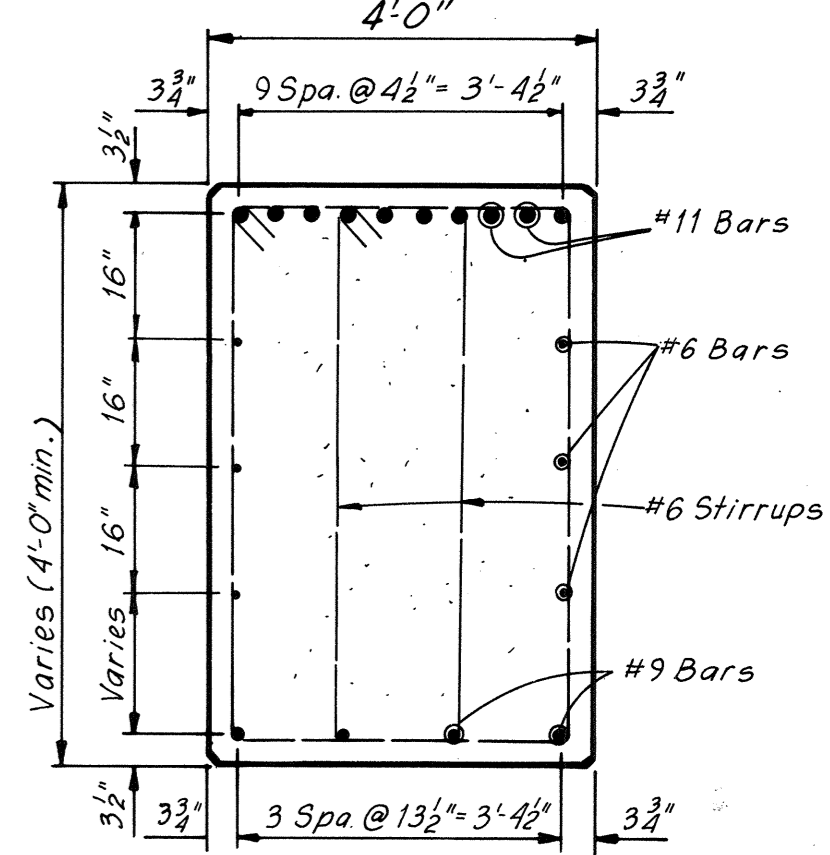


SECTION E-E
Scale: 1/2" = 1'-0"

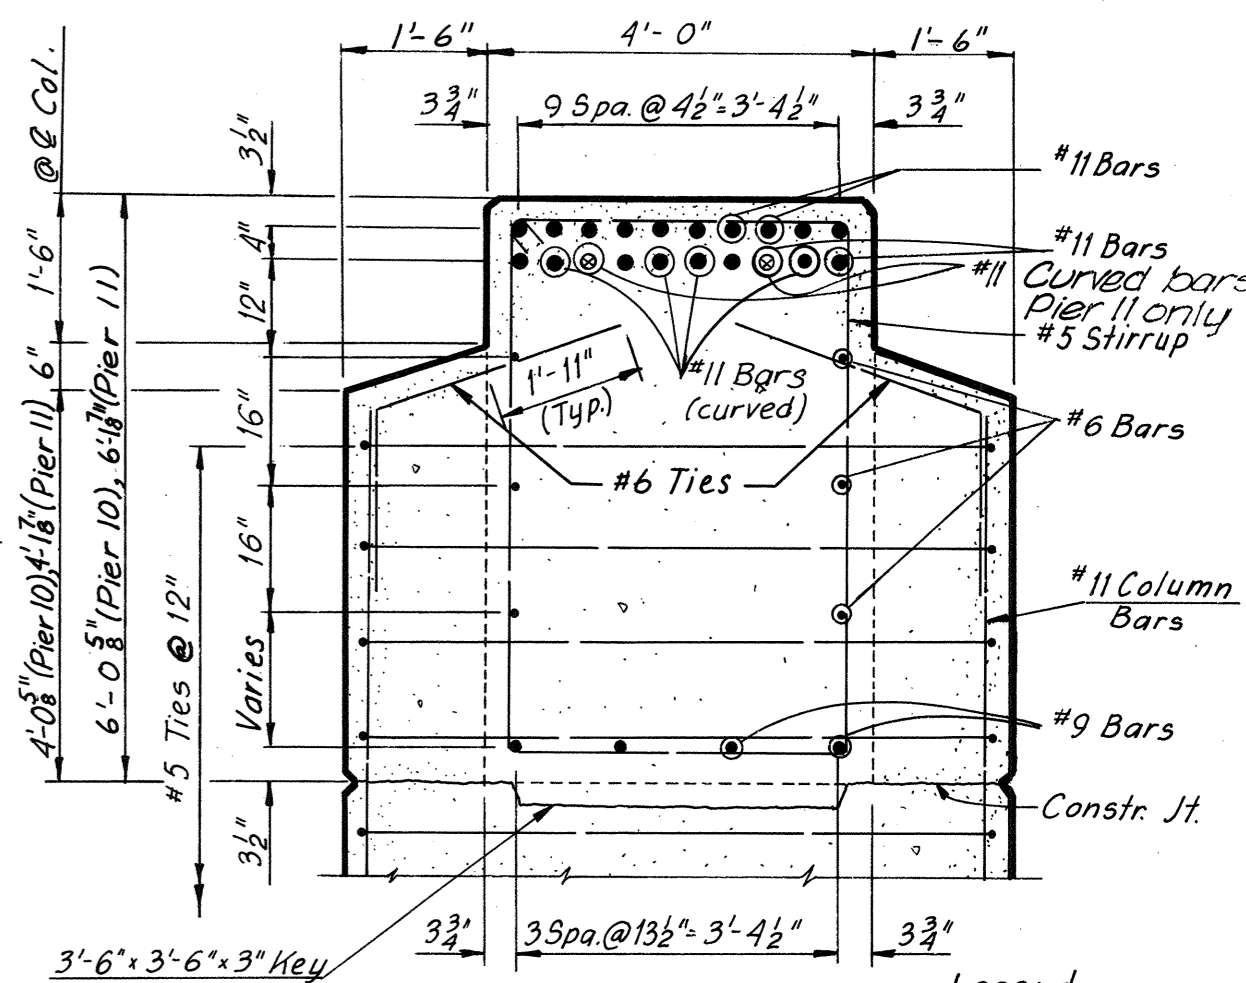

SECTION C-C
Scale: 1/2" = 1'-0"

Legend:
● Piers 10 & 11
○ Pier 11 only

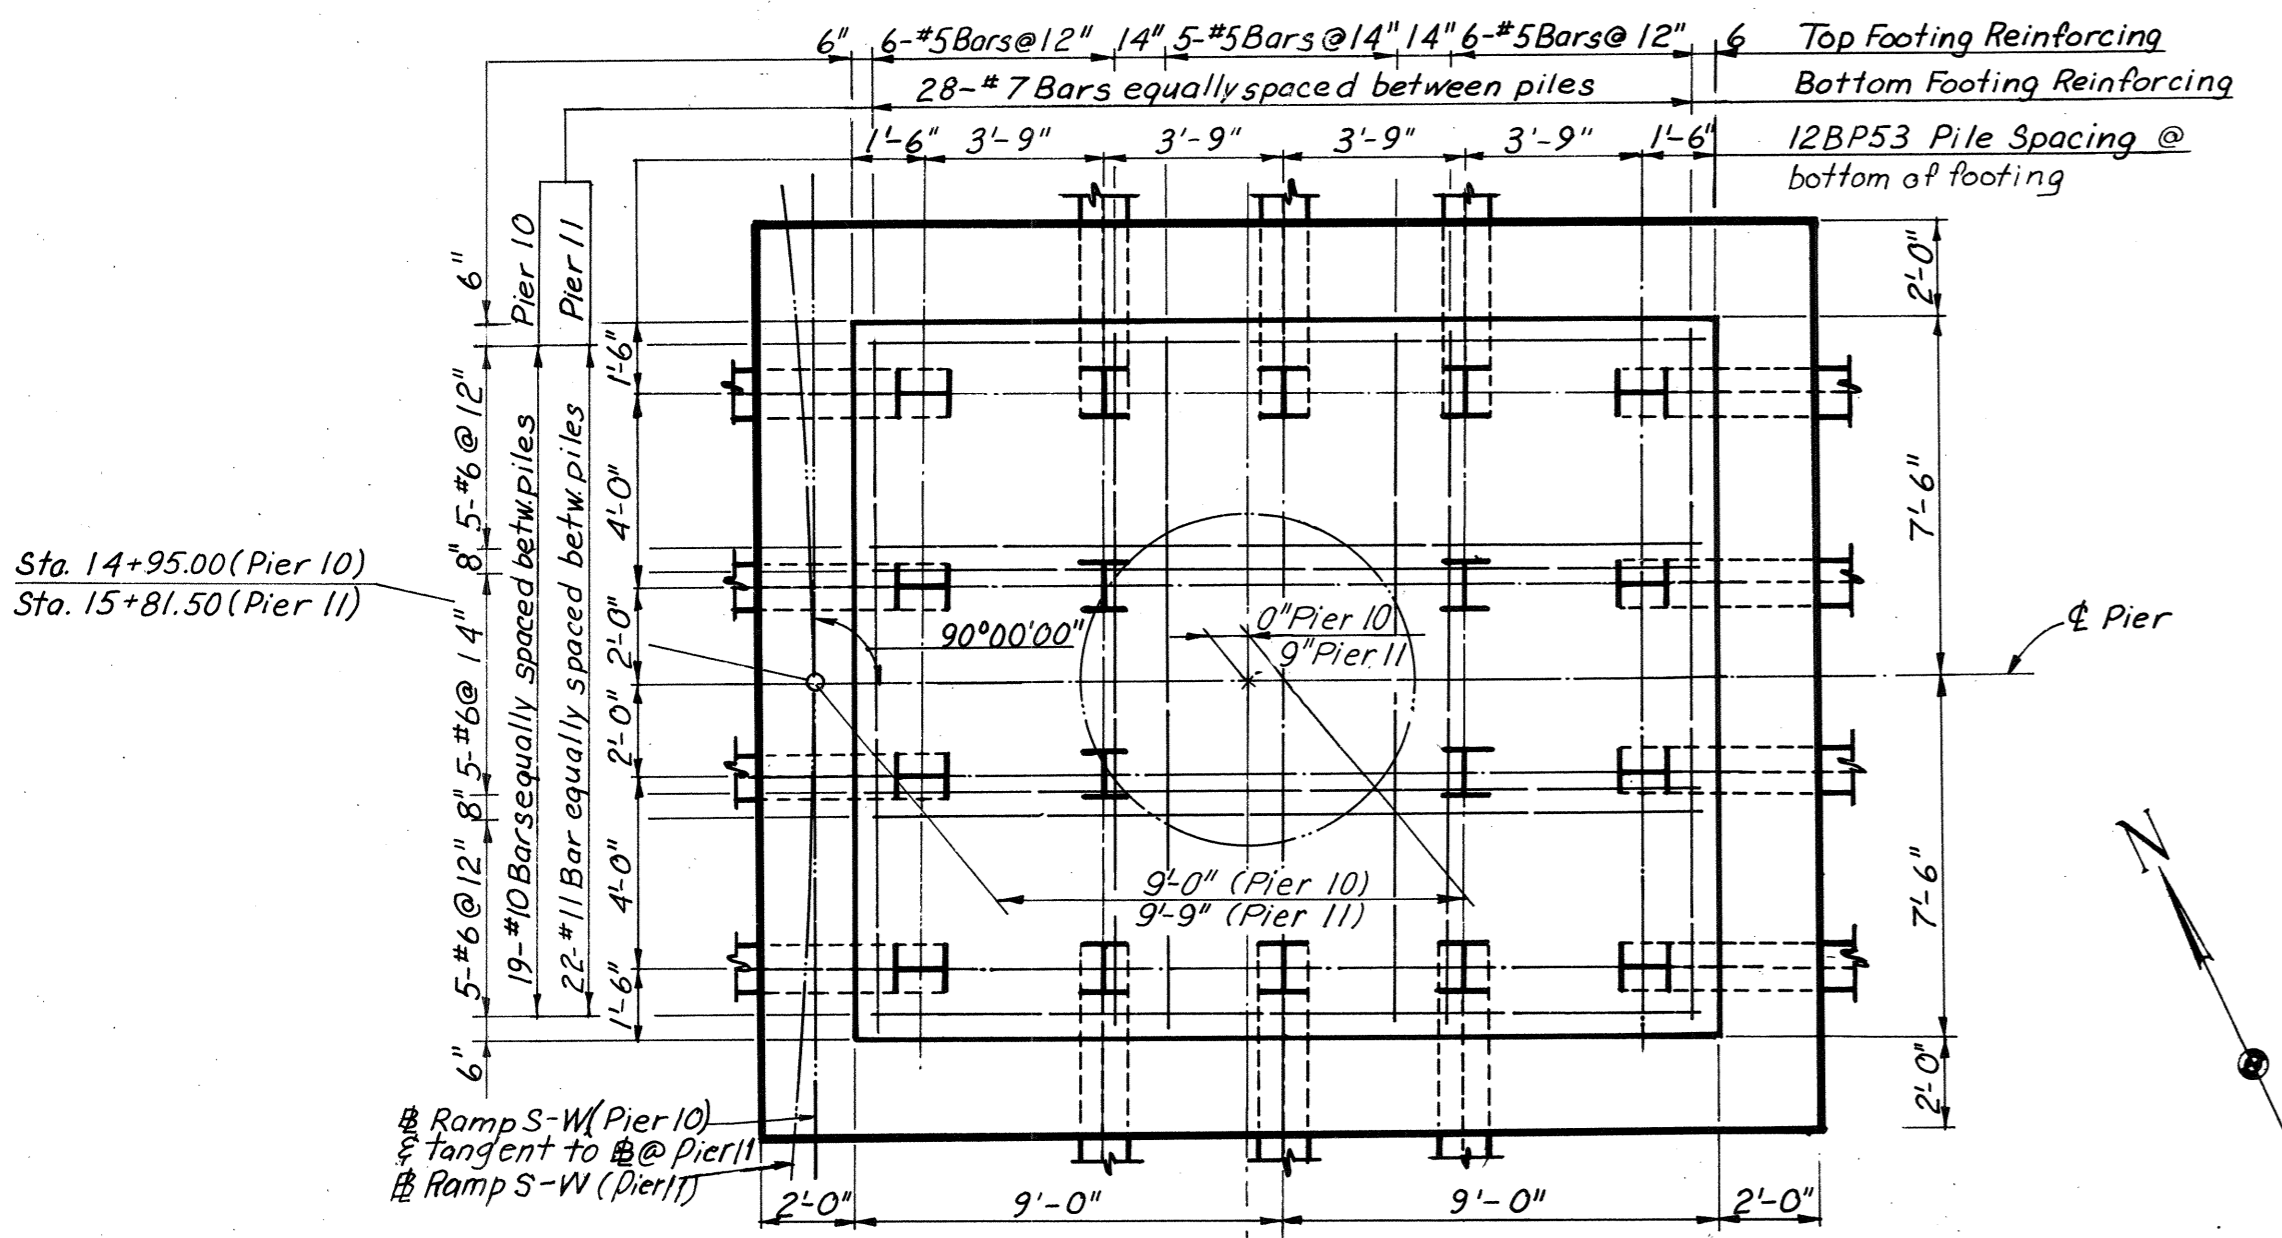

FOOTING PLAN
Scale: 1/4" = 1'-0"

FOOTING FOR PIER 11 IS ECCENTRIC AS SHOWN ON FOOTING PLAN

Note:
Bottom reinforcement shown in View A-A is for Pier 11 only. Bottom reinforcement for Pier 10 is similar except in size & number.

Note:
For layout of Piers 10 and 11 See Sheet 3.
Pile dimensions given on Footing Plan are measured at bottom of Footing (Elev. 7.00 Pier 10 and Elev. 4.50 Pier 11).

NOTE A
A construction joint will be permitted at a rustication near mid-height of the column. The column reinforcement may be lap spliced near the construction joint. The lap at the splice shall be a minimum of 3'-6". Splices shall be staggered at least 3'-3" between adjacent bars.

Note:
Footing elevations are approximate only and may be varied to suit field conditions as directed by the Engineer. Vertical shaft reinforcement shall not be cut until these elevations are established. Where elevations change more than 2 ft., redesign will be required.


Notes:
All piles shall be 12BP53 Steel Piles (Design capacity = 57 tons).
Batter piles 3" per ft. as shown.
For Standard Shoe Details see Sheet S1 & S2.
For Framing Plans see Sheet 20 & 21.
Estimated Pile Tip elevation -20.0

AS BUILT
RICHMOND METROPOLITAN AUTHORITY
RICHMOND EXPRESSWAY SYSTEM
DOWNTOWN EXPRESSWAY
BRIDGE NO. 65
RAMP S-W CONNECTION FROM
RICHMOND-PETERSBURG TURNPIKE
PIERS 10 AND 11

MADE	BY	DATE	NO.	REVISION	BY	DATE
CEB/JD	CEB	12-18-68				
GSH	GSH	1-24-69				


HOWARD, NEEDLES, TAMMEN & BERGENDOFF consulting engineers NEW YORK ALEXANDRIA KANSAS CITY	SCALE: As Noted CONTRACT NO.: 11 SHEET NO. 10 OF 38
---	---

RICHMOND EXPRESSWAY SYSTEM			
SECTION	PROJECT	SHEET NO.	TOTAL SHEETS
11	DOWNTOWN EXPRESSWAY	37	97

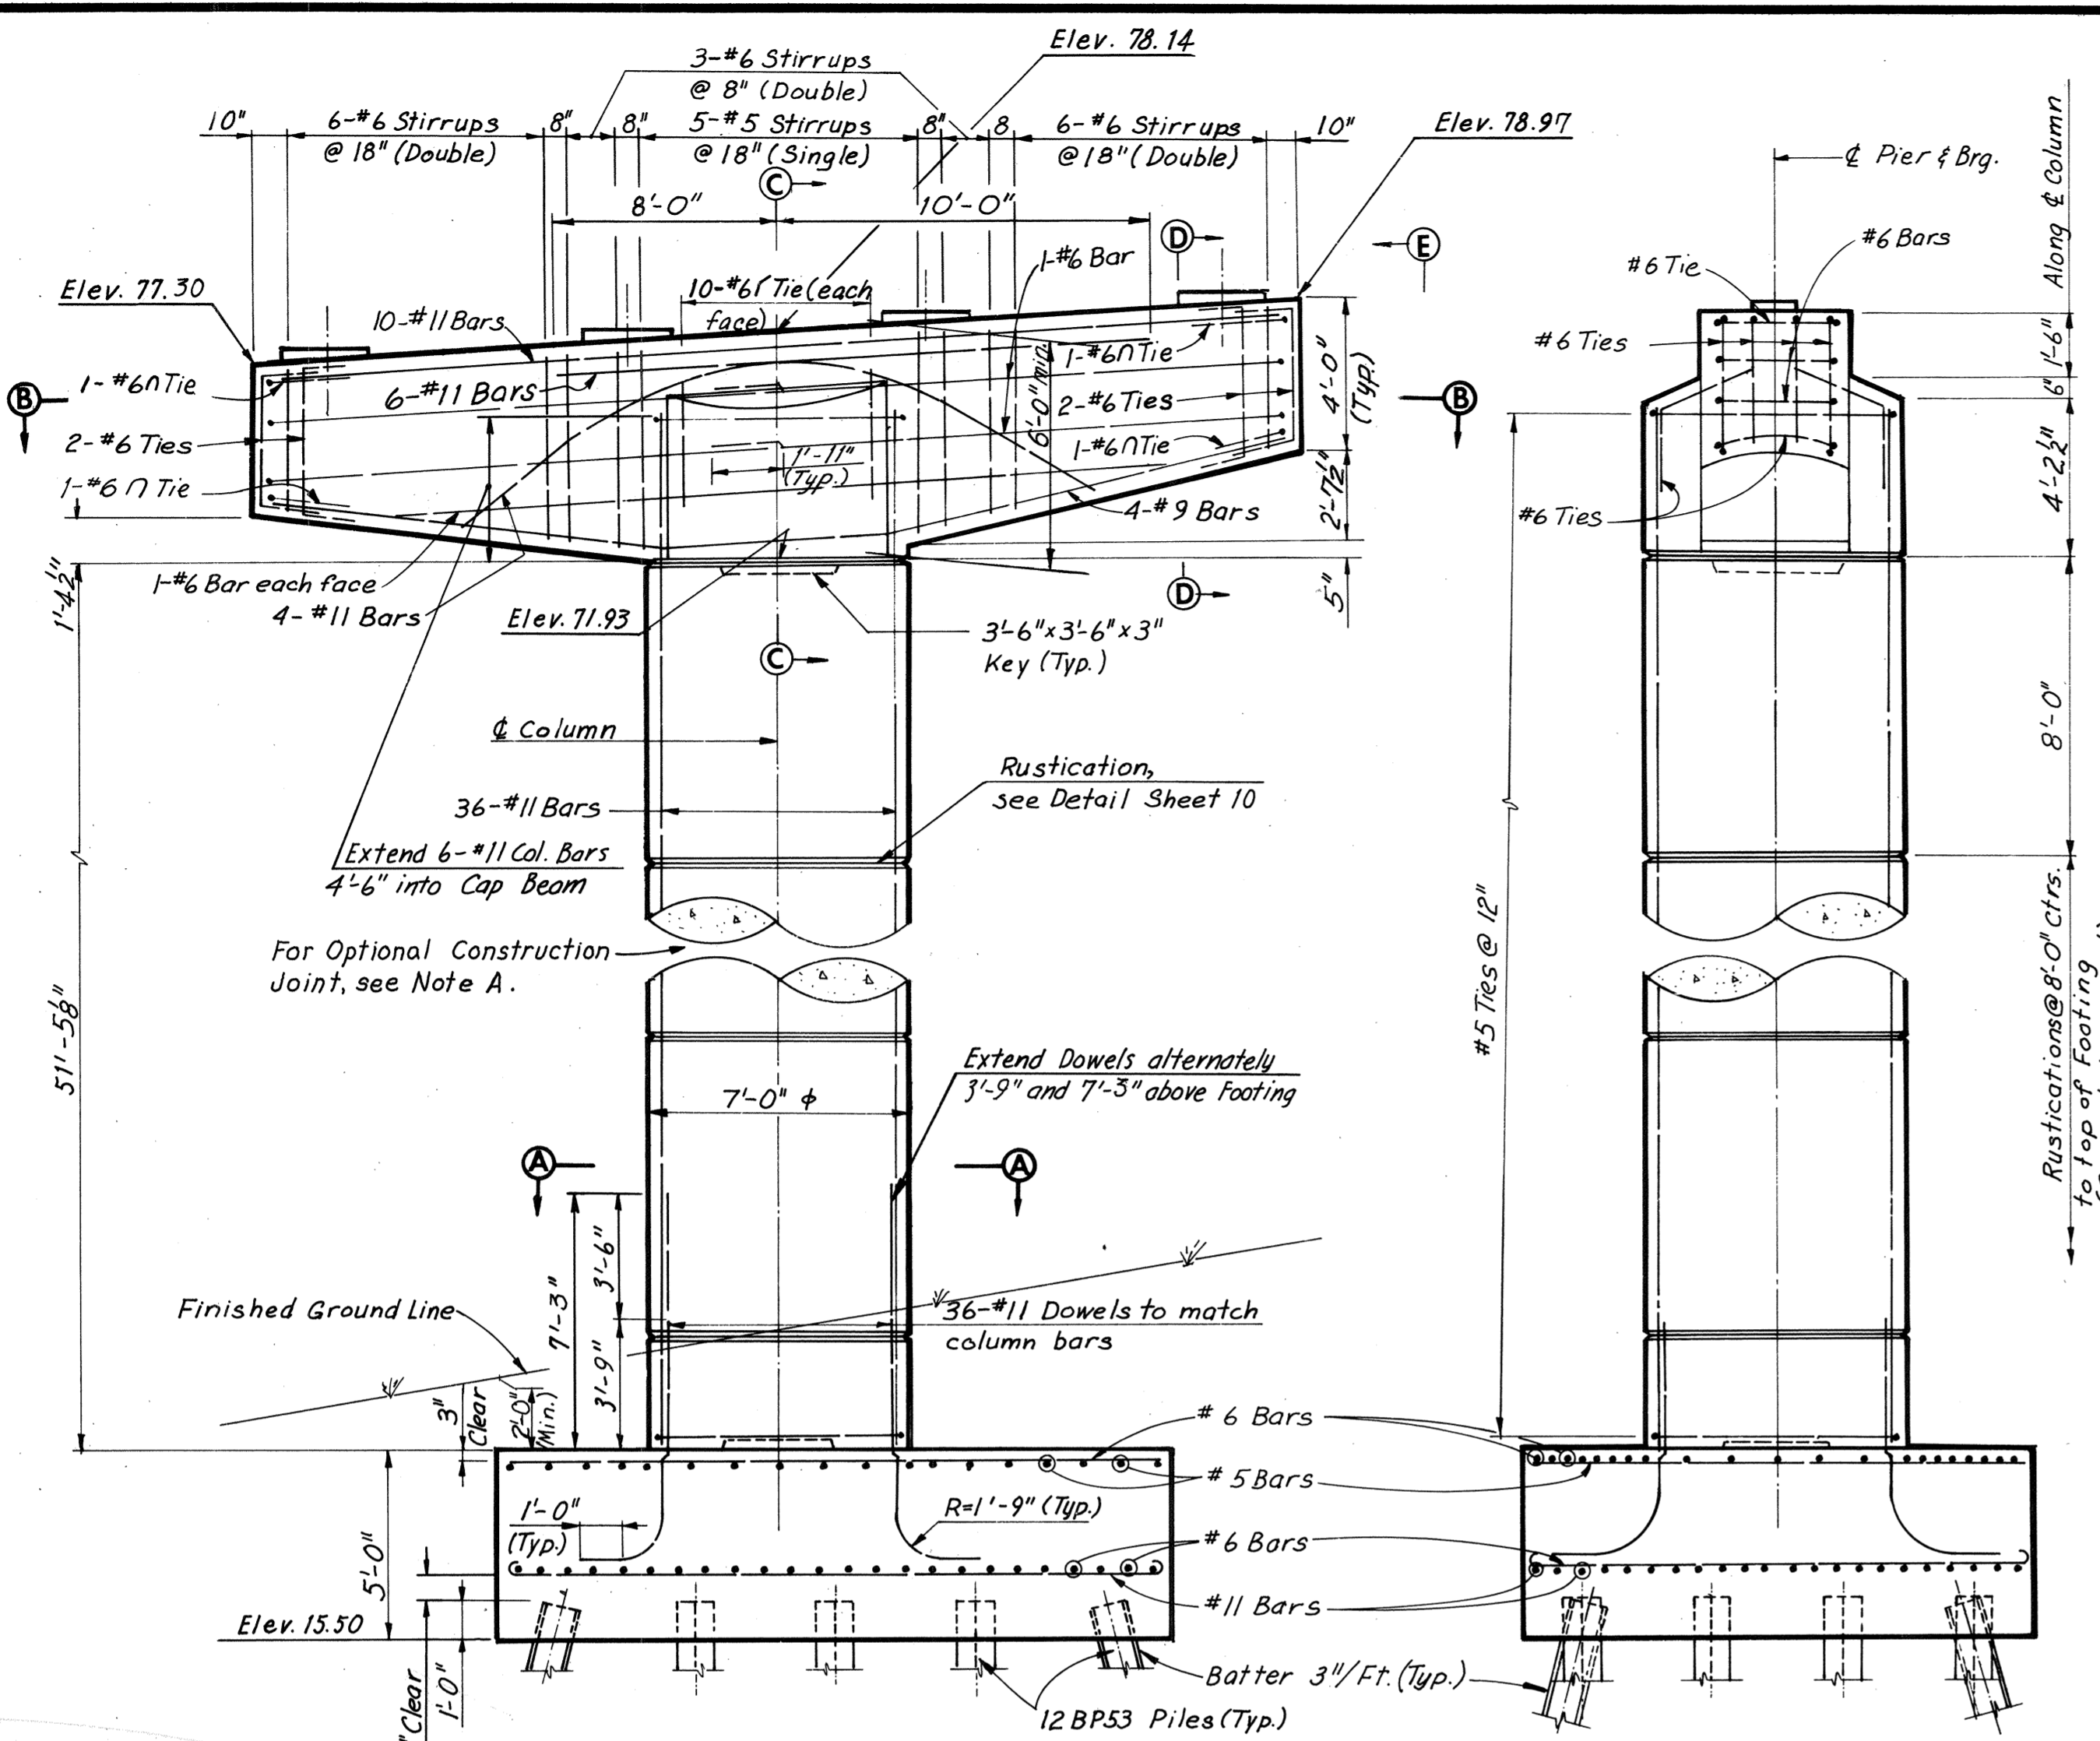


ELEVATION
Scale: 1/4" = 1'-0"


VIEW E-E
Scale: 1/4" = 1'-0"

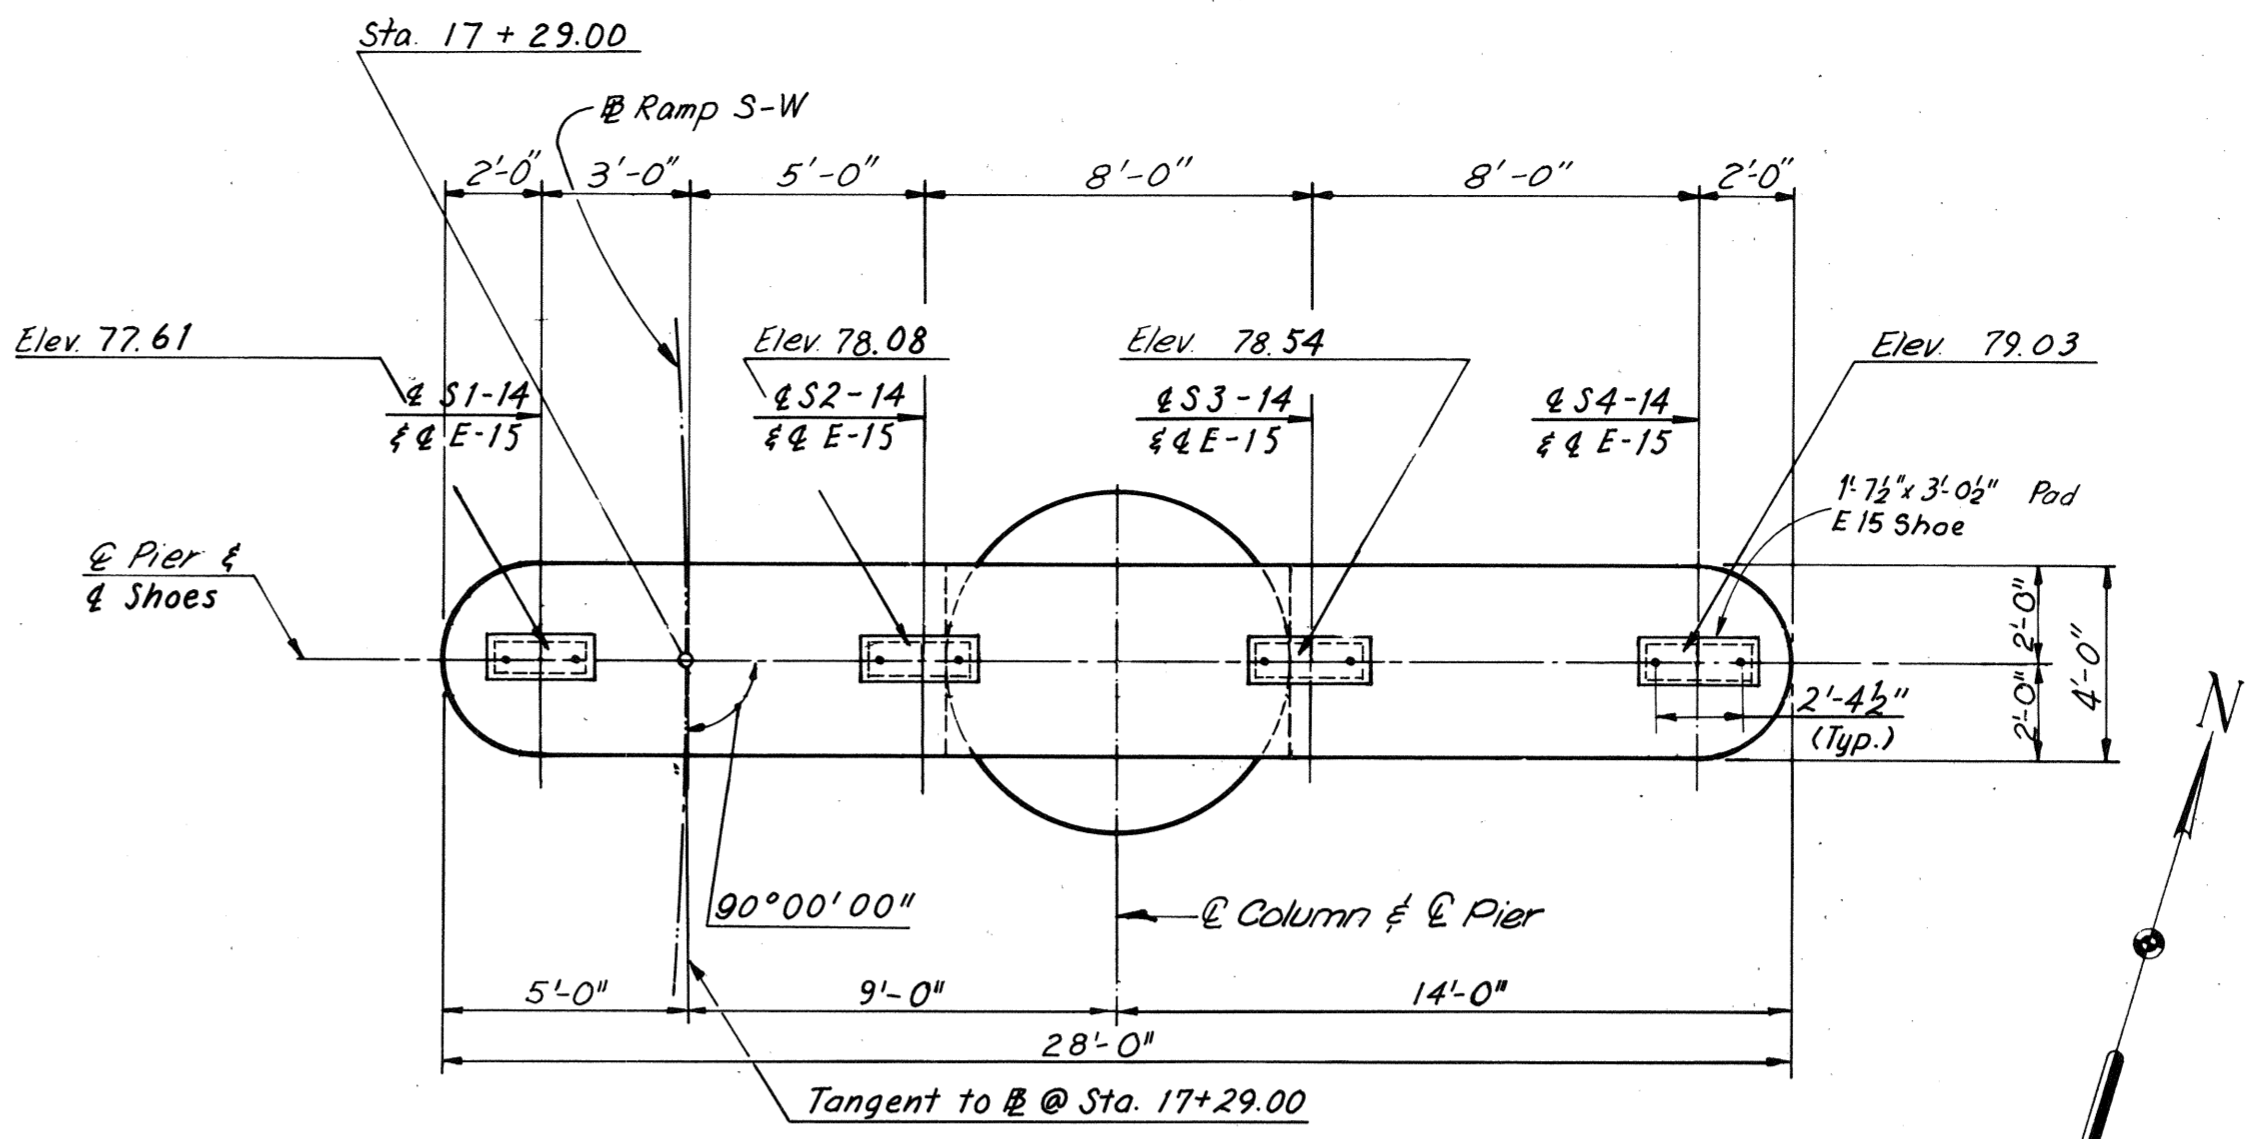


PLAN
Scale: 1/4" = 1'-0"

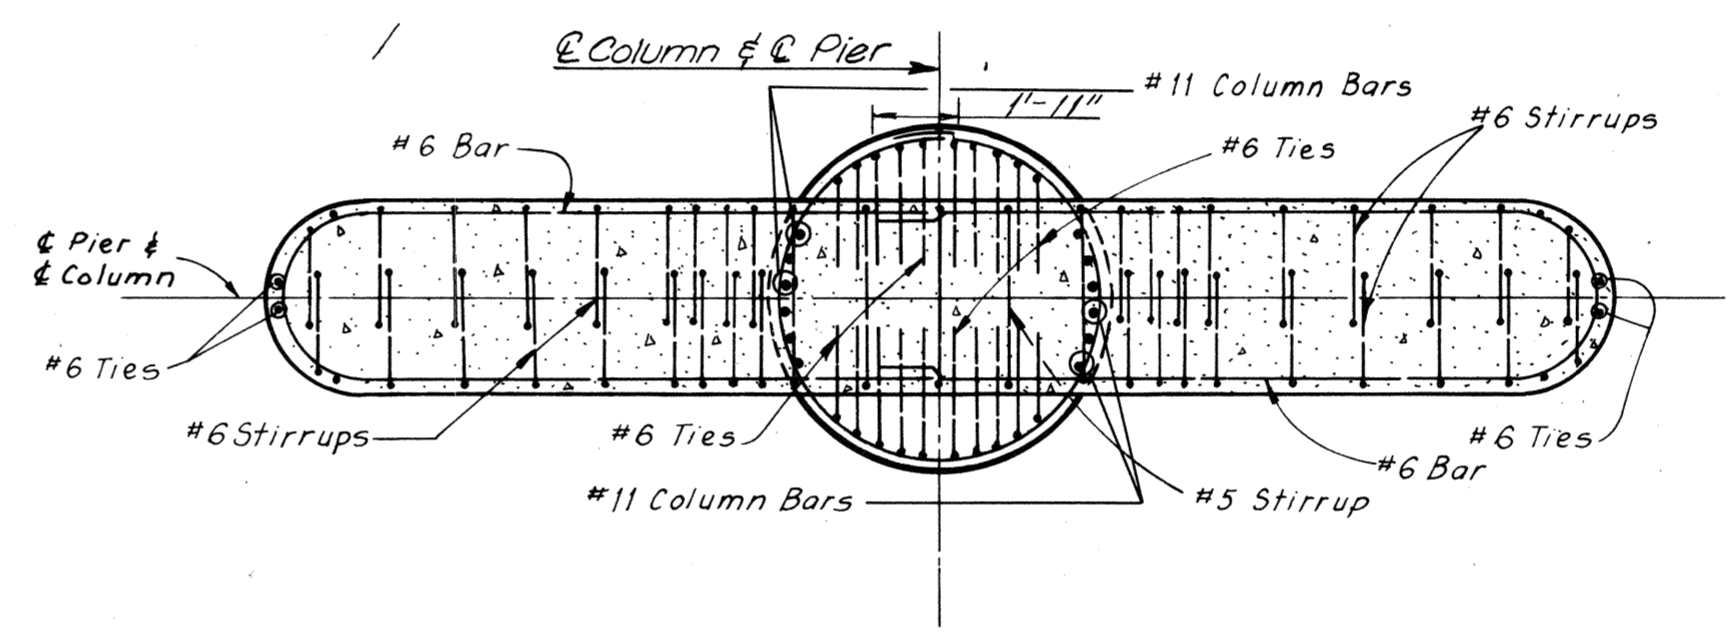


SECTION B-B
Scale: 1/4" = 1'-0"

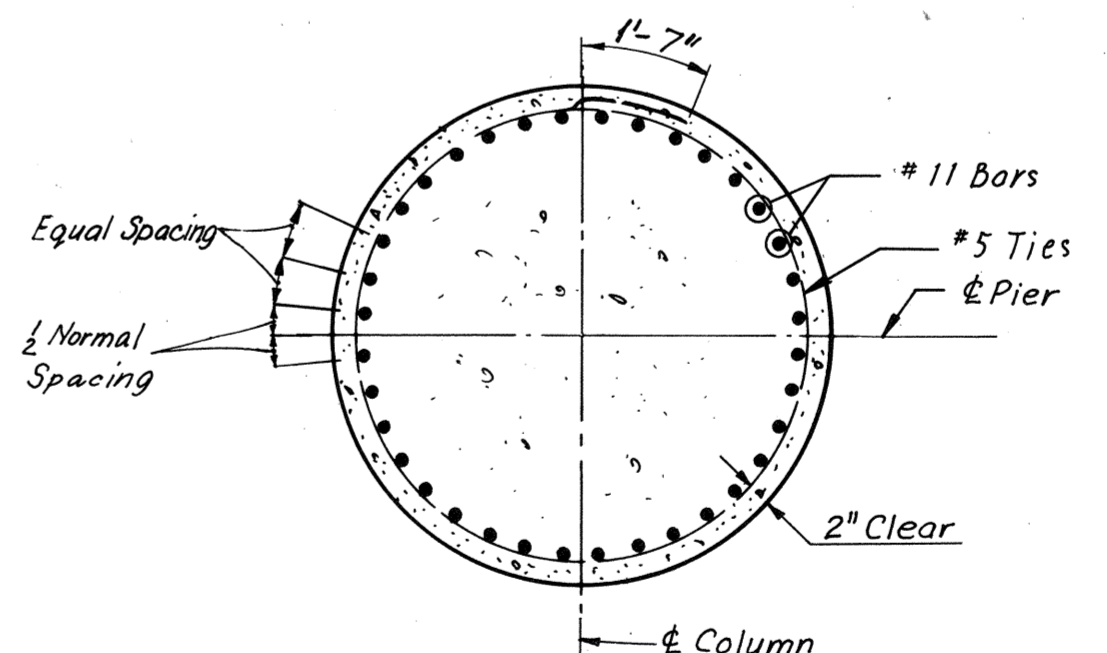

SECTION A-A
Scale: 3/8" = 1'-0"

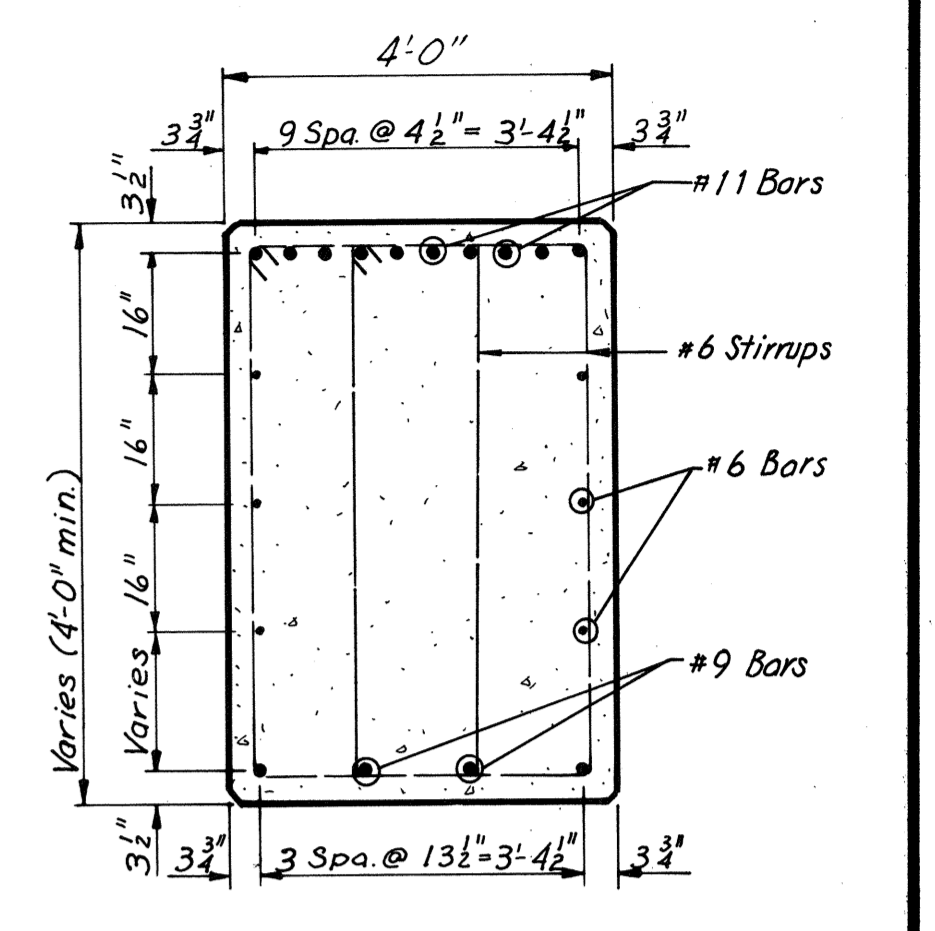

SECTION D-D
Scale: 1/2" = 1'-0"

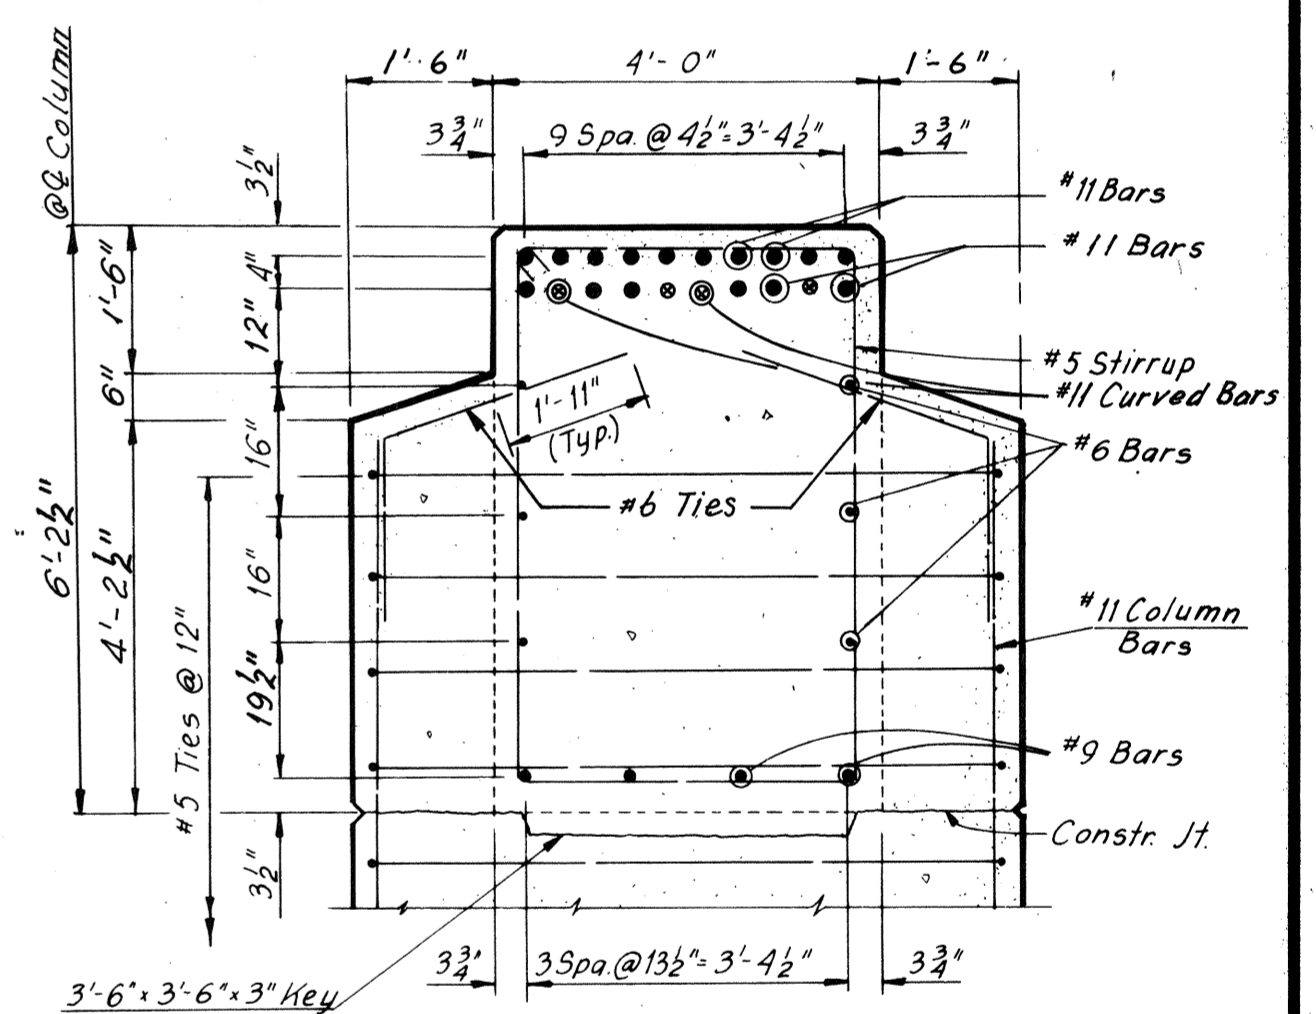


SECTION C-C
Scale: 1/2" = 1'-0"

NOTE A:
A construction joint will be permitted at a rustication near mid-height of the column. The column reinforcement may be lap spliced near the construction joint. The lap of the splice shall be a minimum of 3'-6". Splices shall be staggered at least 3'-3" between adjacent bars.

Note:
Footing elevations are approximate only and may be varied to suit field conditions as directed by the Engineer. Vertical shaft reinforcing shall not be cut until these elevations are established. Where elevations change more than 2 ft., redesign will be required.

Notes:
All piles shall be 12BP53 steel piles (Design Capacity = 57 Ton).
Batter all piles 3" per foot where shown.
For Standard Shoe Details, see Sheets S14 S2.
For Framing Plan, see Sheet 22.
Estimated Pile Tip Elevation is - 20.0.
For Rustication Details, see Sheet 10.
For 12BP53 Steel Pile Details, see Sheet 9.

Note:
Existing Flood-protection dike is to be restored to original contour upon completion of Pier construction.

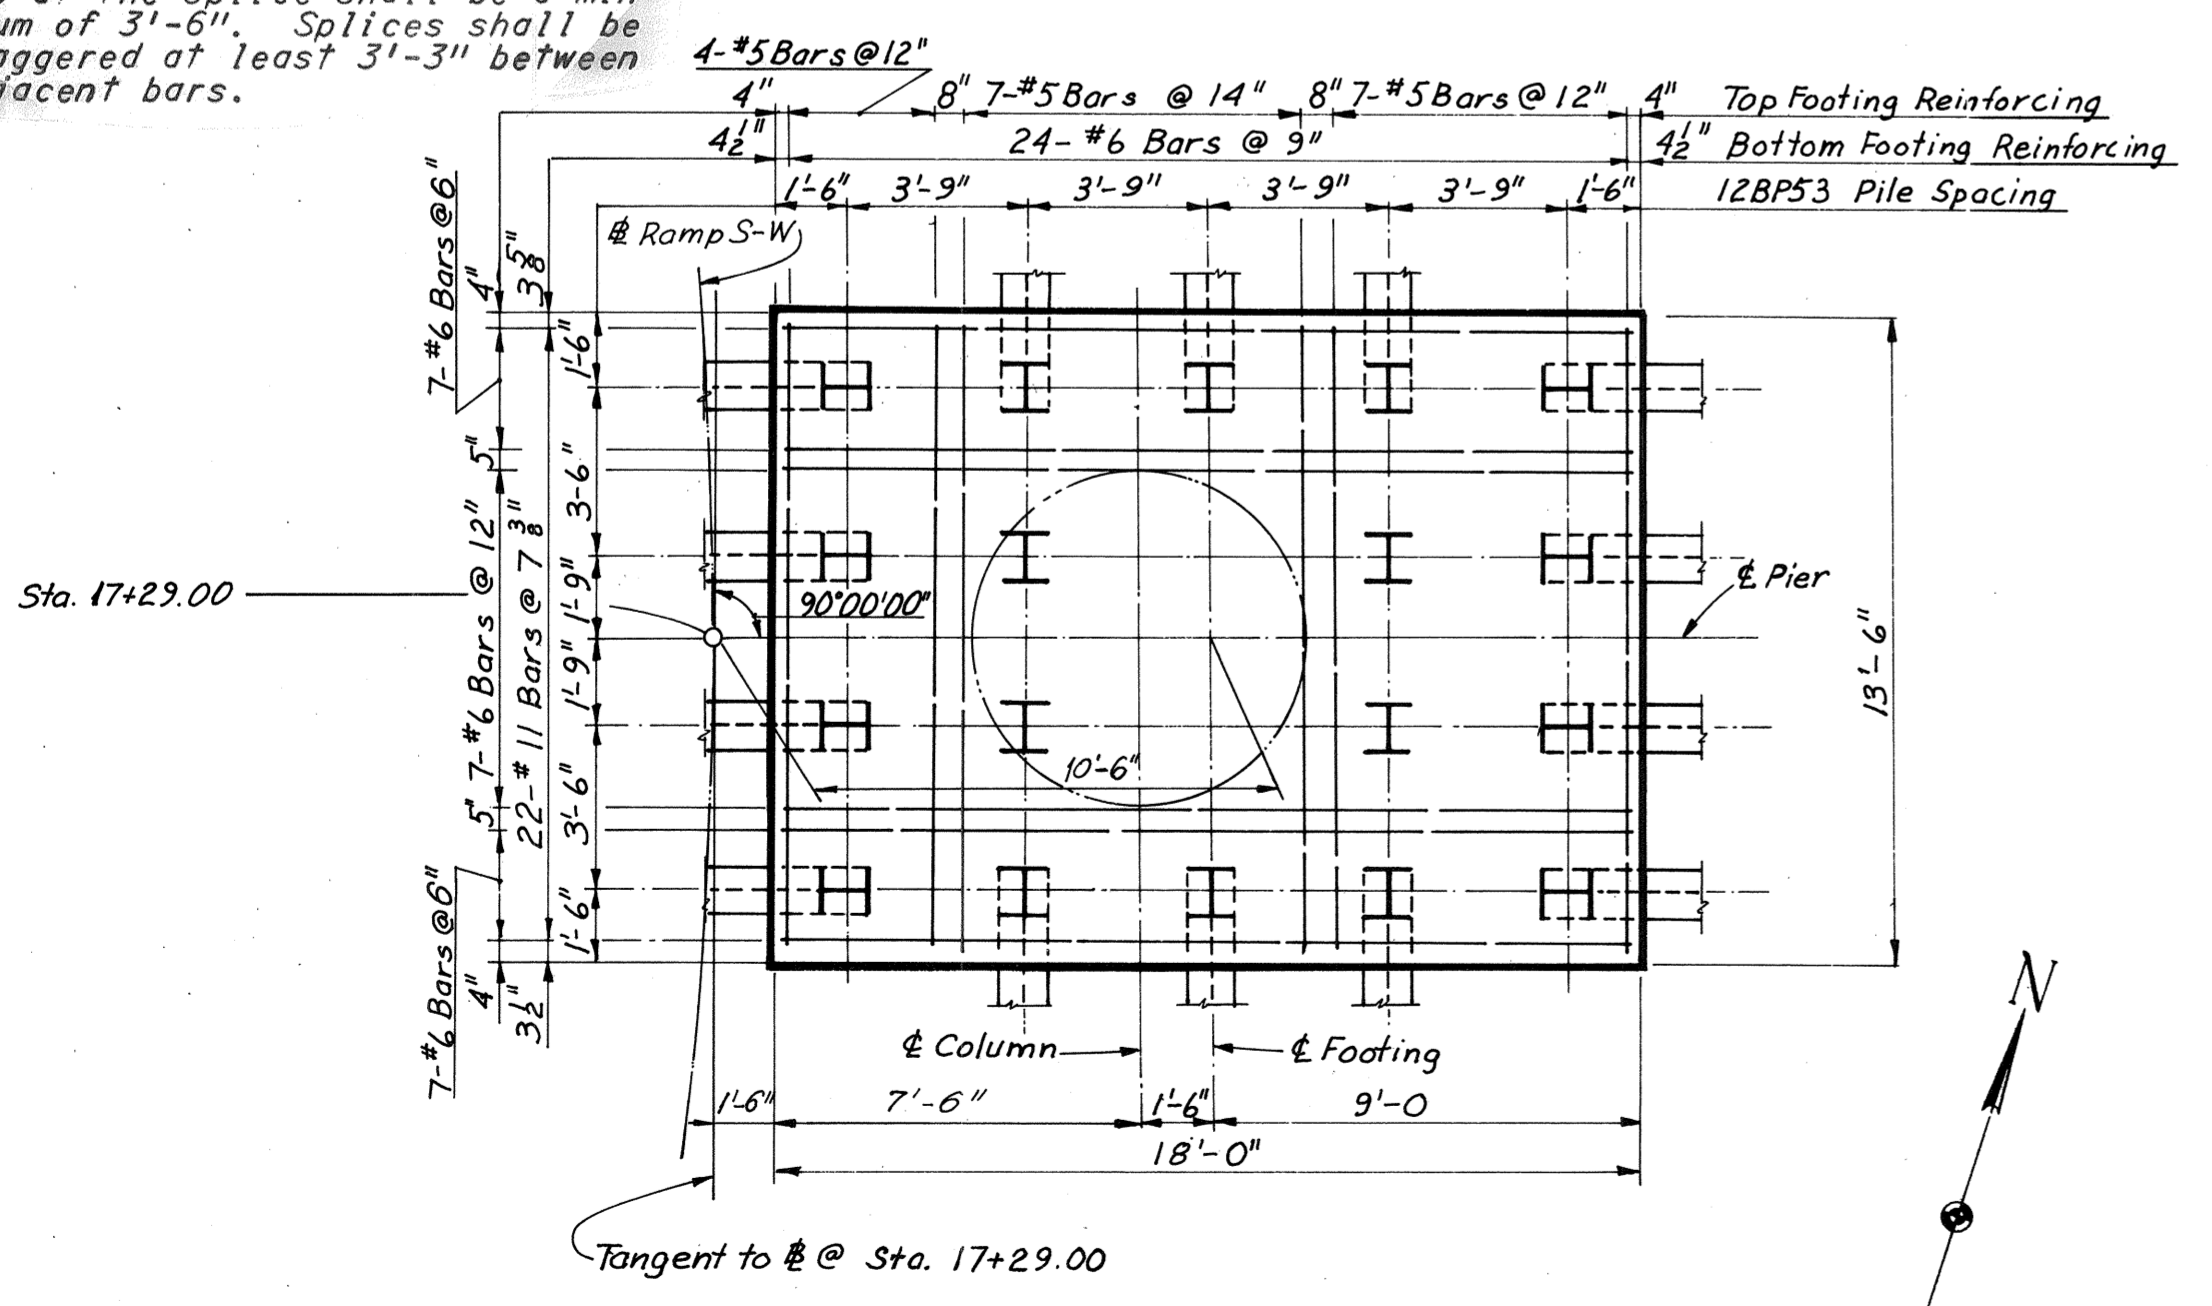

FOOTING PLAN
Scale: 1/4" = 1'-0"

FOOTING FOR PIER 13 IS ECCENTRIC AS SHOWN ON FOOTING PLAN

MADE	BY	DATE	NO.	REVISION	BY	DATE
	DP/STA	1-6-69				
	GSH	1-20-69				

AS BUILT



RICHMOND METROPOLITAN AUTHORITY
RICHMOND EXPRESSWAY SYSTEM
DOWNTOWN EXPRESSWAY

BRIDGE NO. 65
RAMP S-W CONNECTION FROM
RICHMOND-PETERSBURG TURNPIKE
PIER 13


HOWARD, NEEDLES, TAMMEN & BERGENDOFF
consulting engineers
NEW YORK ALEXANDRIA KANSAS CITY

SCALE: As Noted.
CONTRACT NO. 11
SHEET NO. 12 OF 38

RICHMOND EXPRESSWAY SYSTEM			
SECTION	PROJECT	SHEET NO.	TOTAL SHEETS
11	DOWNTOWN EXPRESSWAY	38	97

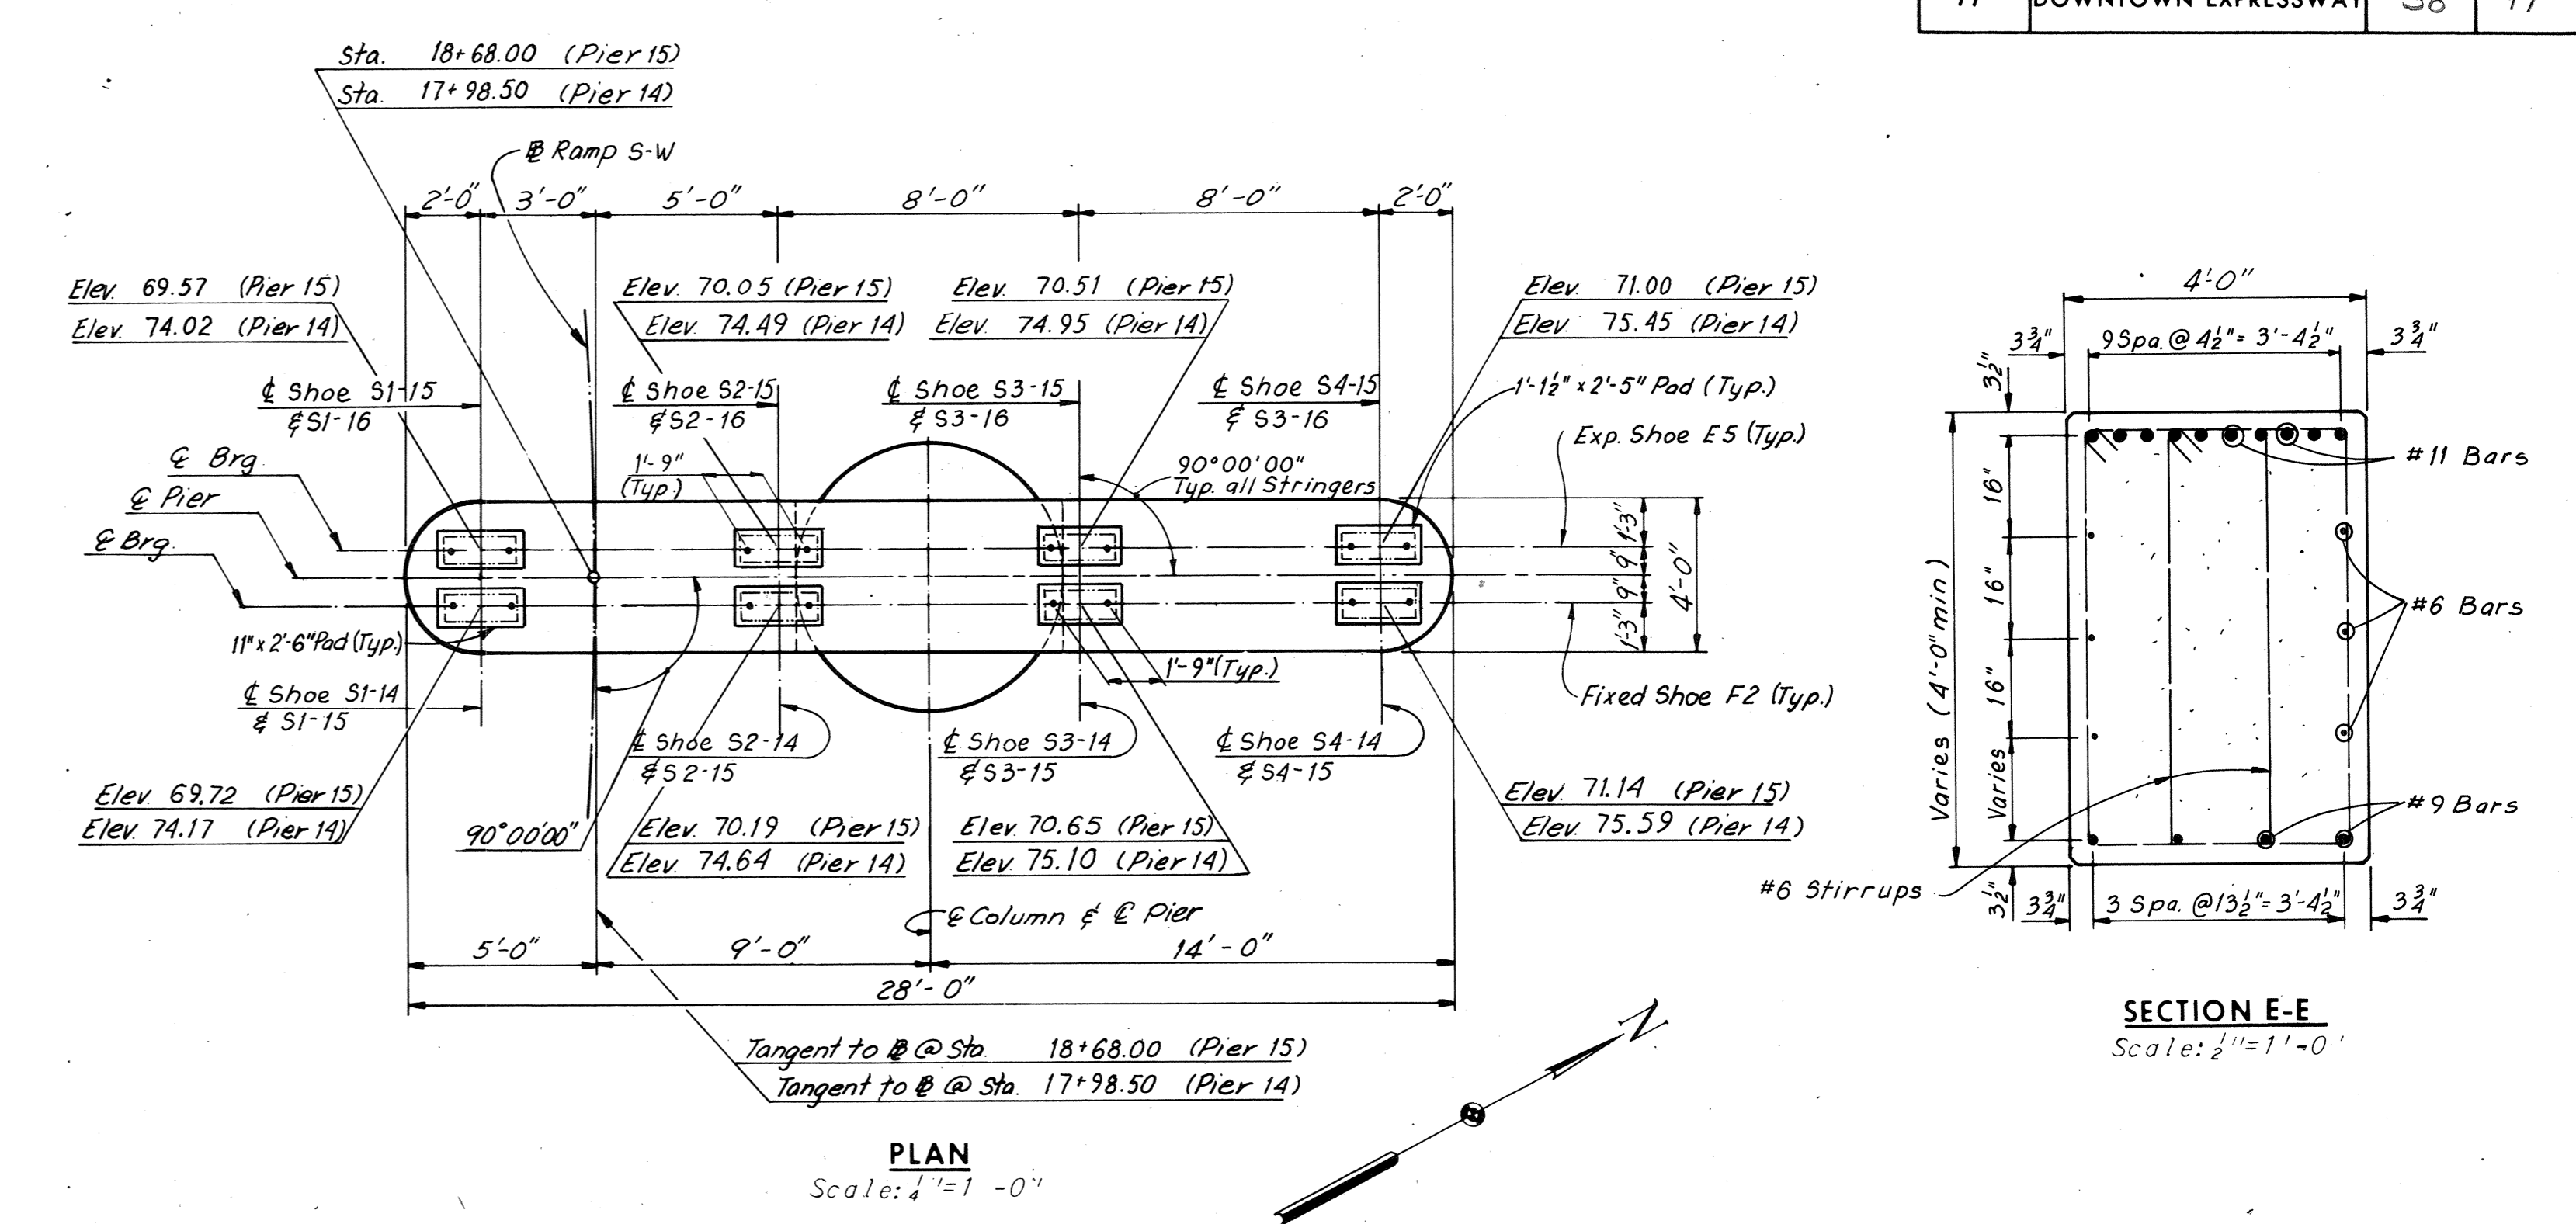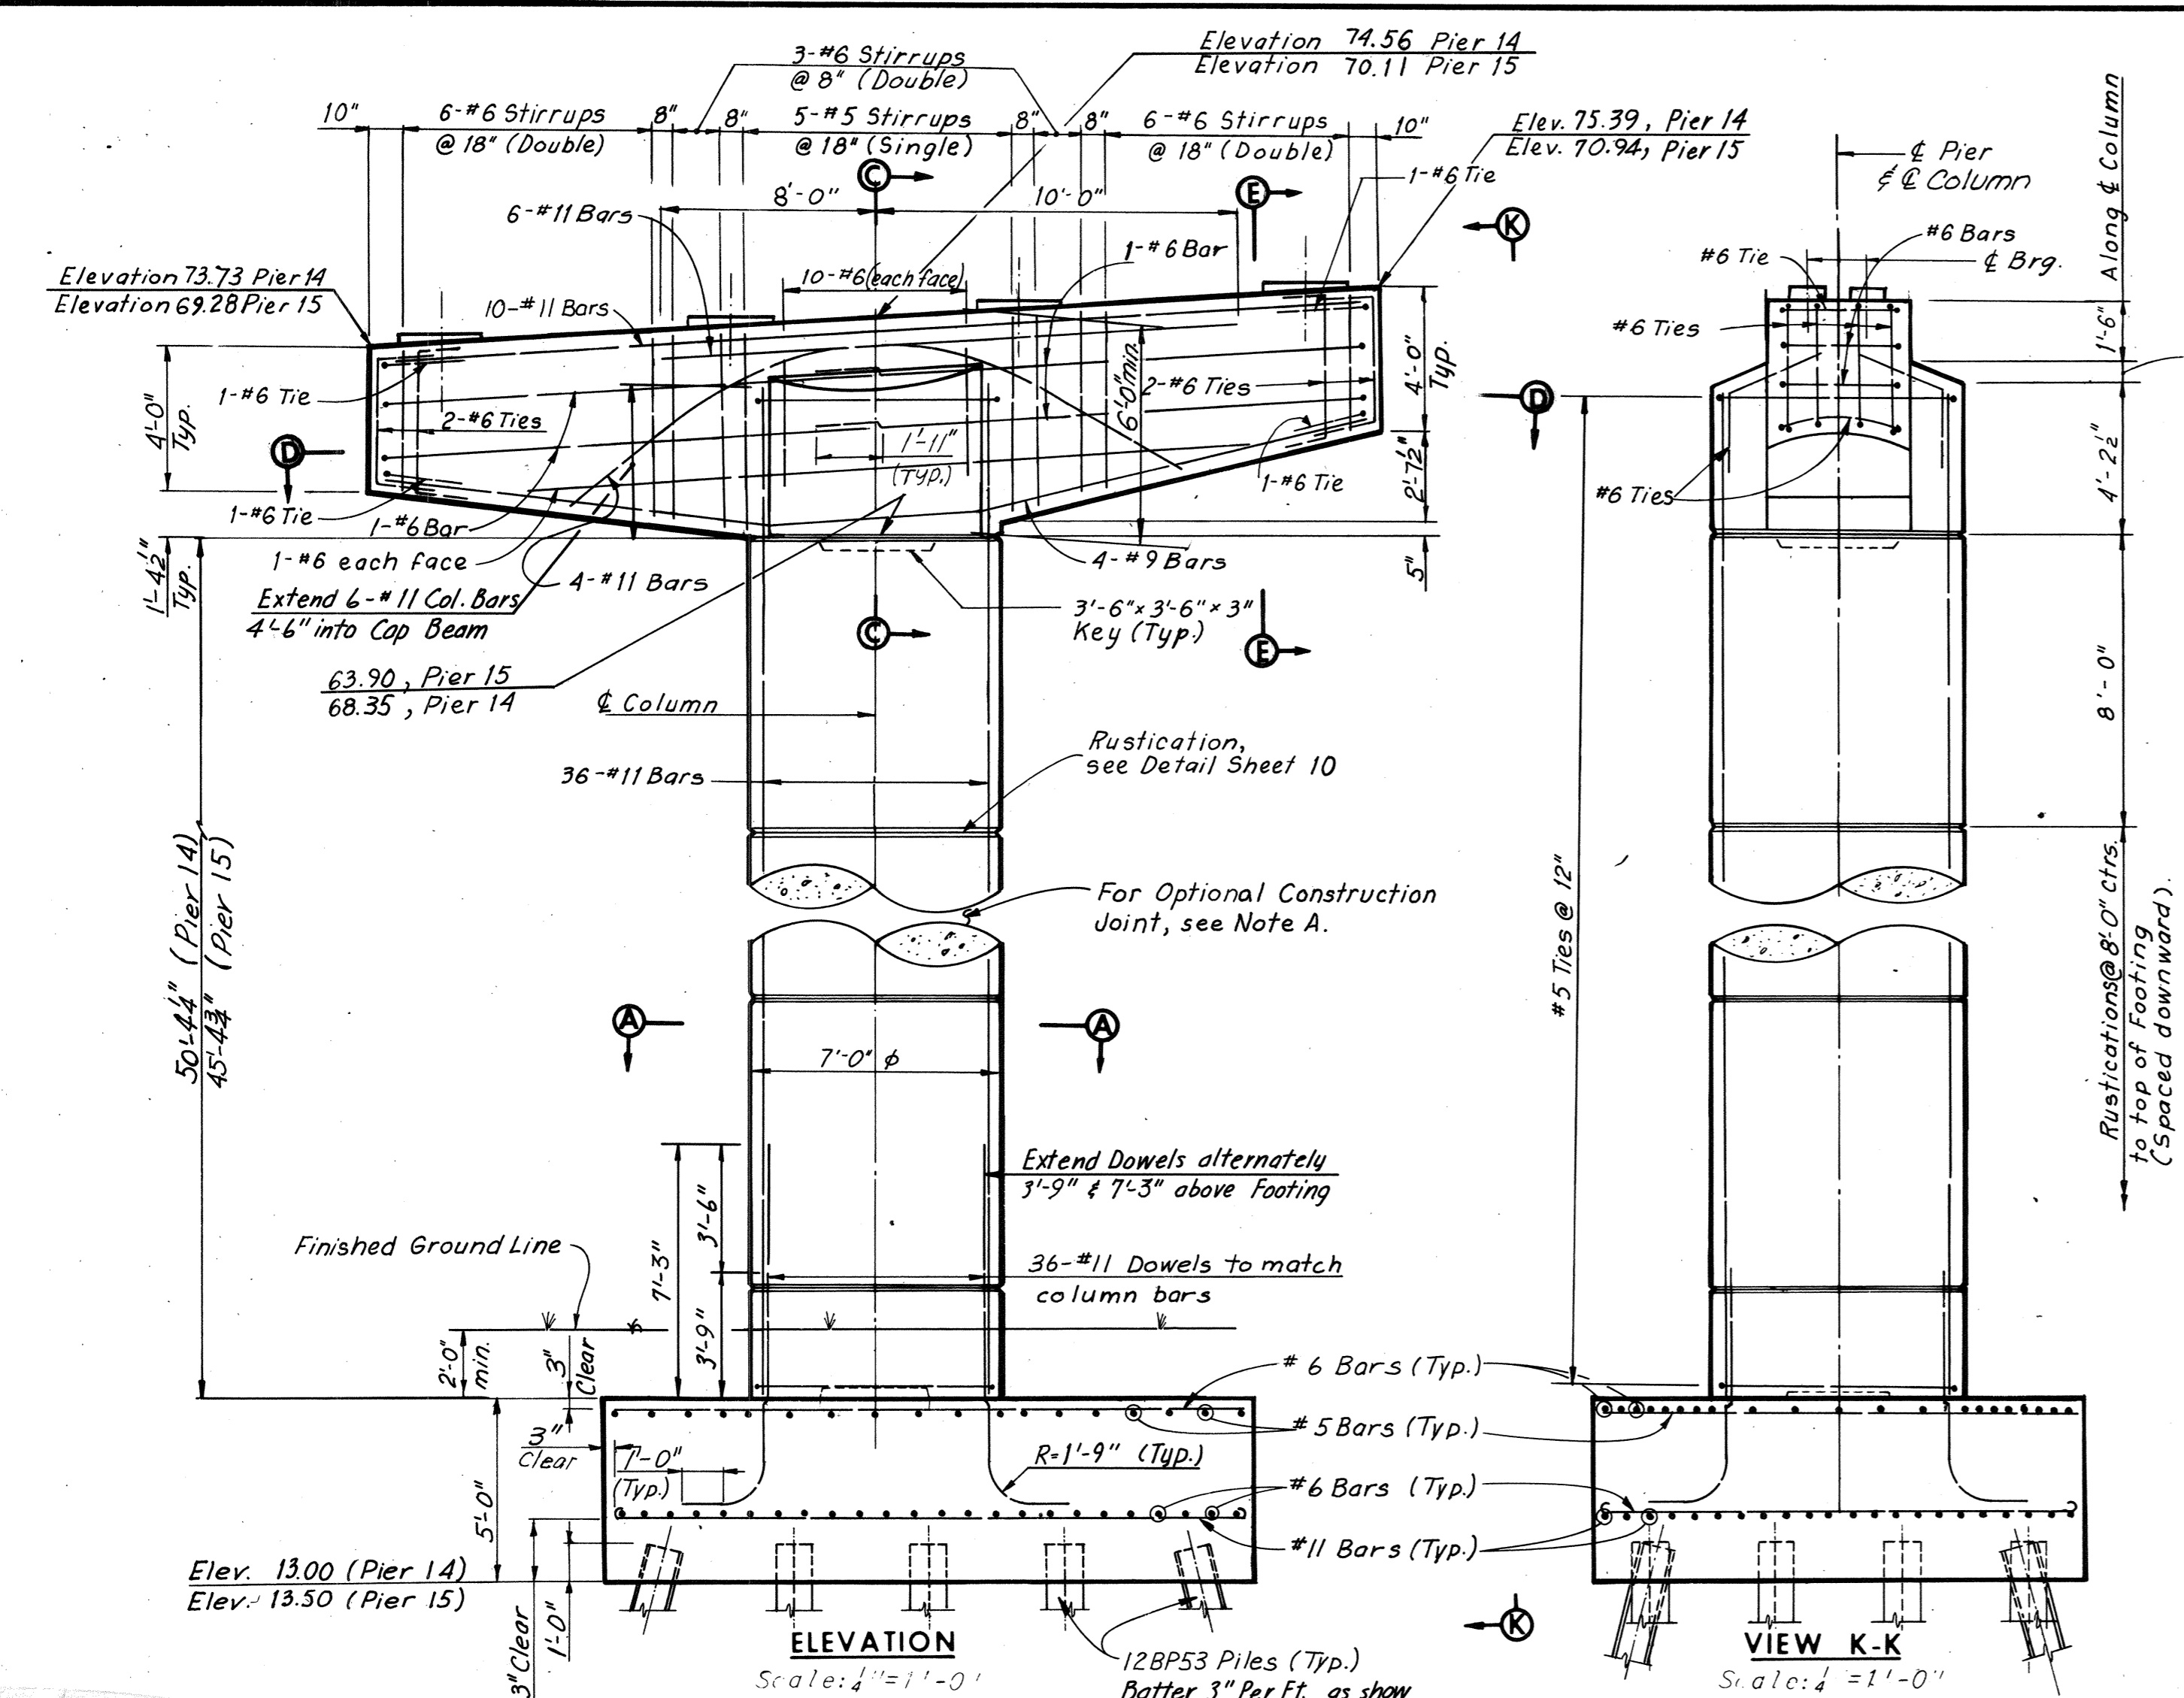

NOTE A
A construction joint will be permitted at a rustication near mid-height of the column. The column reinforcement may be lap spliced near the construction joint. The lap at the splice shall be a minimum of 3'-6". Splices shall be staggered at least 3'-3" between adjacent bars.

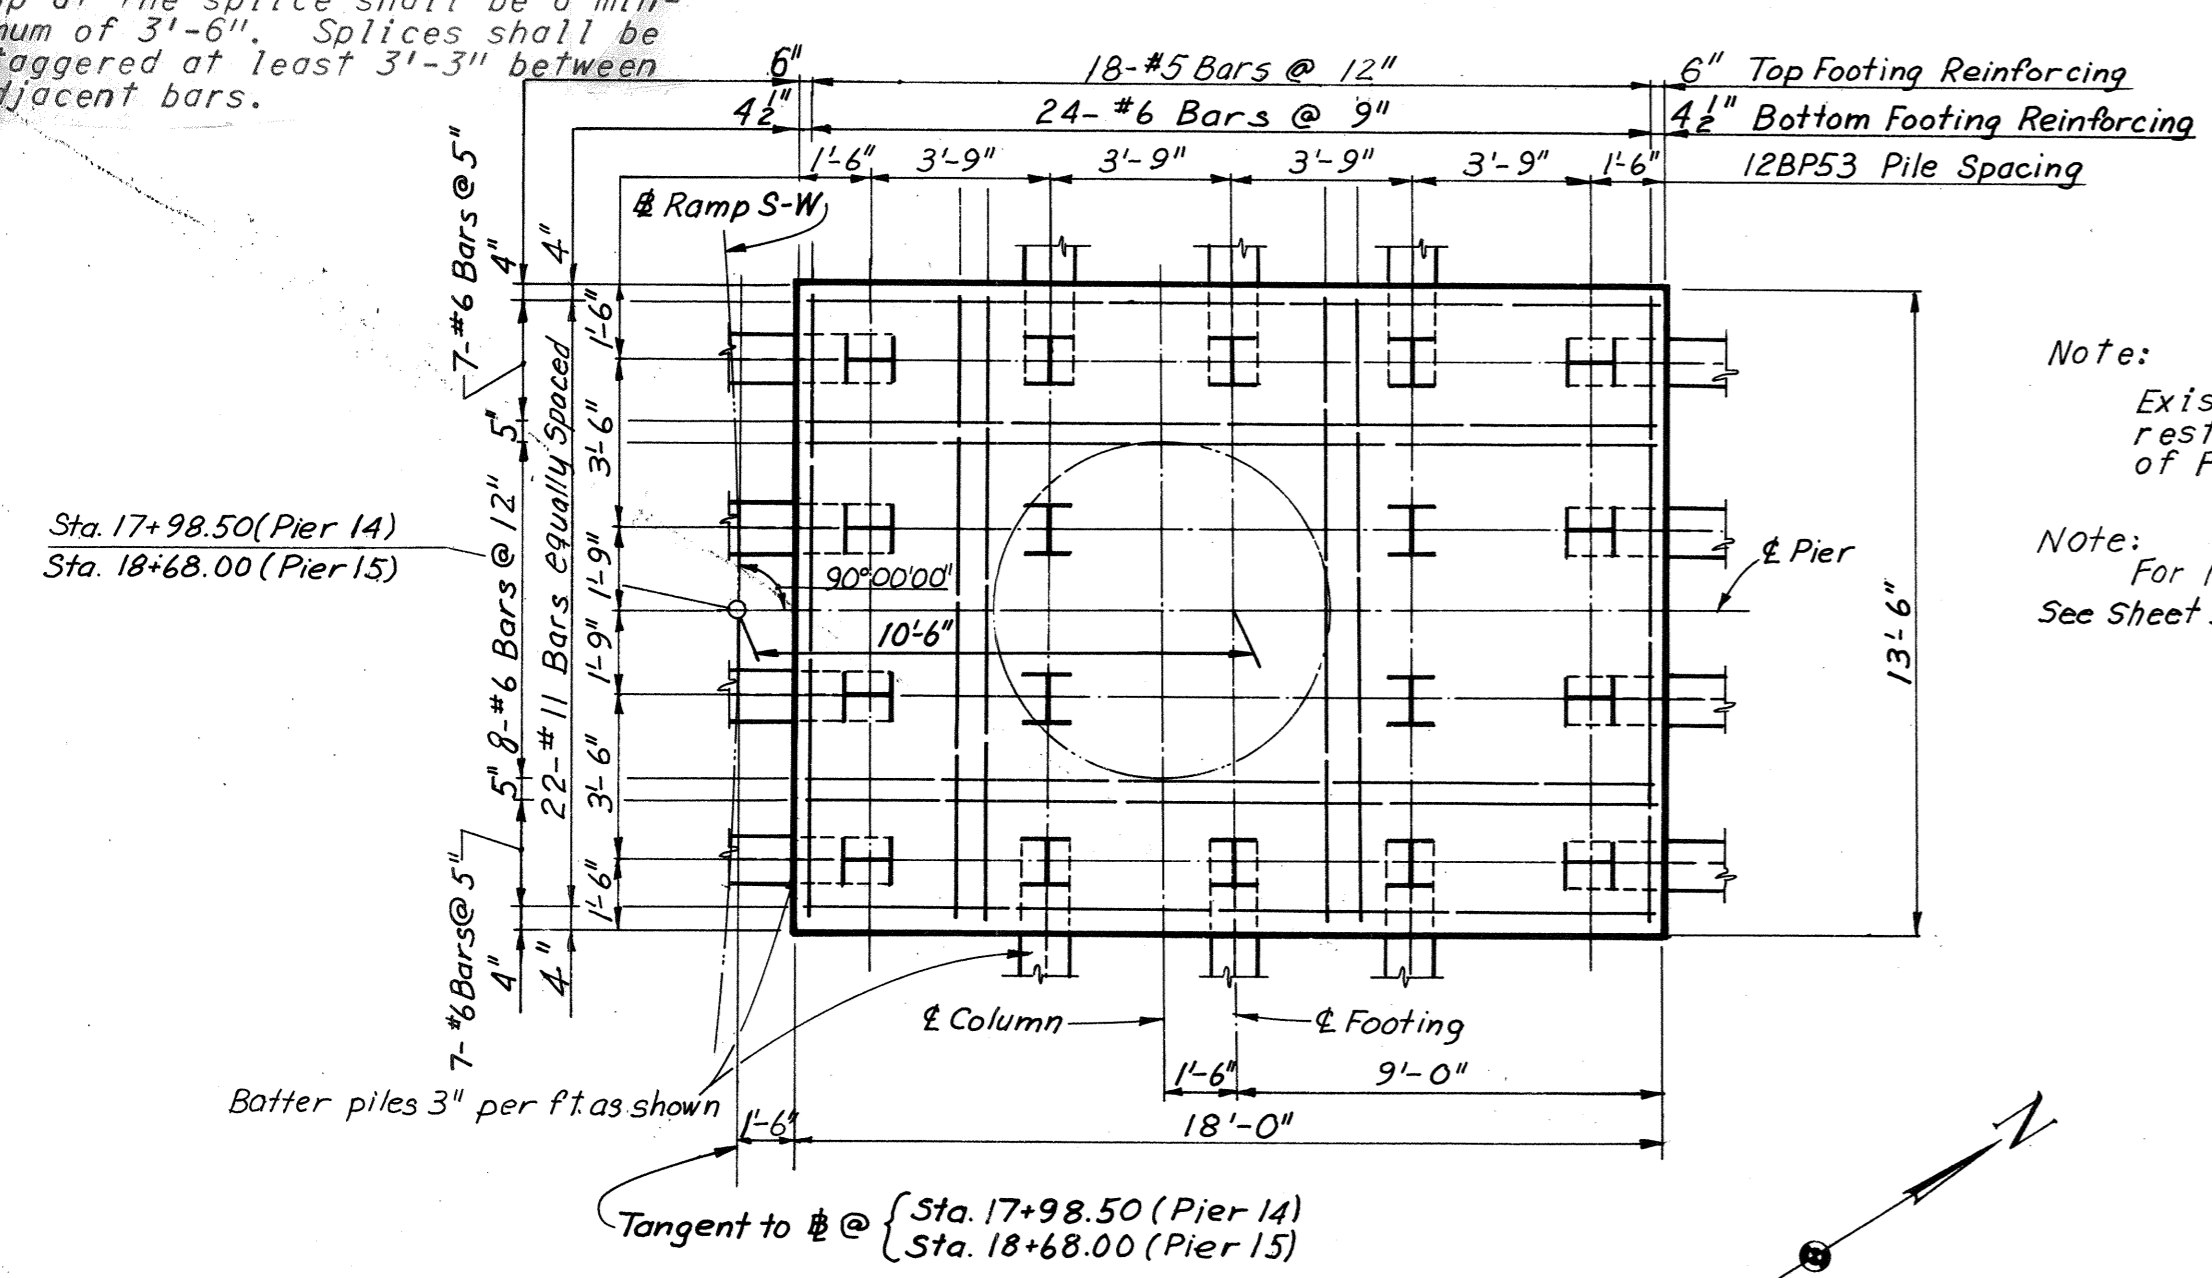




Note:
Existing Flood-protection dike is to be restored to original contour upon completion of Pier construction.

Note:
For layout of Piers 14 and 15 See Sheet 3.

FOOTINGS FOR PIERS 14 AND 15 ARE ECCENTRIC AS SHOWN ON FOOTING PLAN

Note:
Dimensions given in Footing Plan are measured at bottom of Footing.

Note:
Footing elevations are approximate only and may be varied to suit field conditions as directed by the Engineer. Vertical shaft reinforcement shall not be cut until these elevations are established. Where elevations change more than 2 ft., redesign will be required.

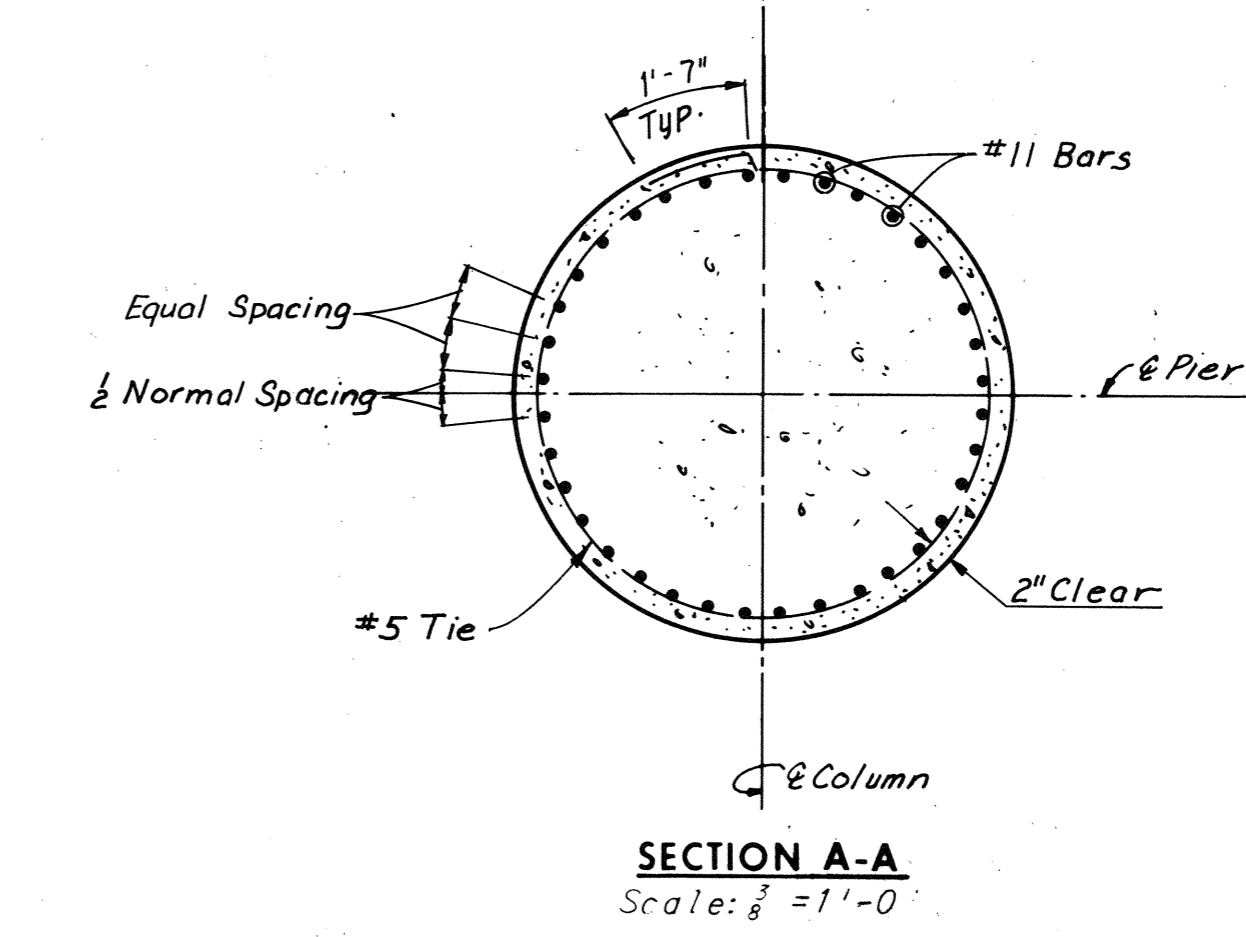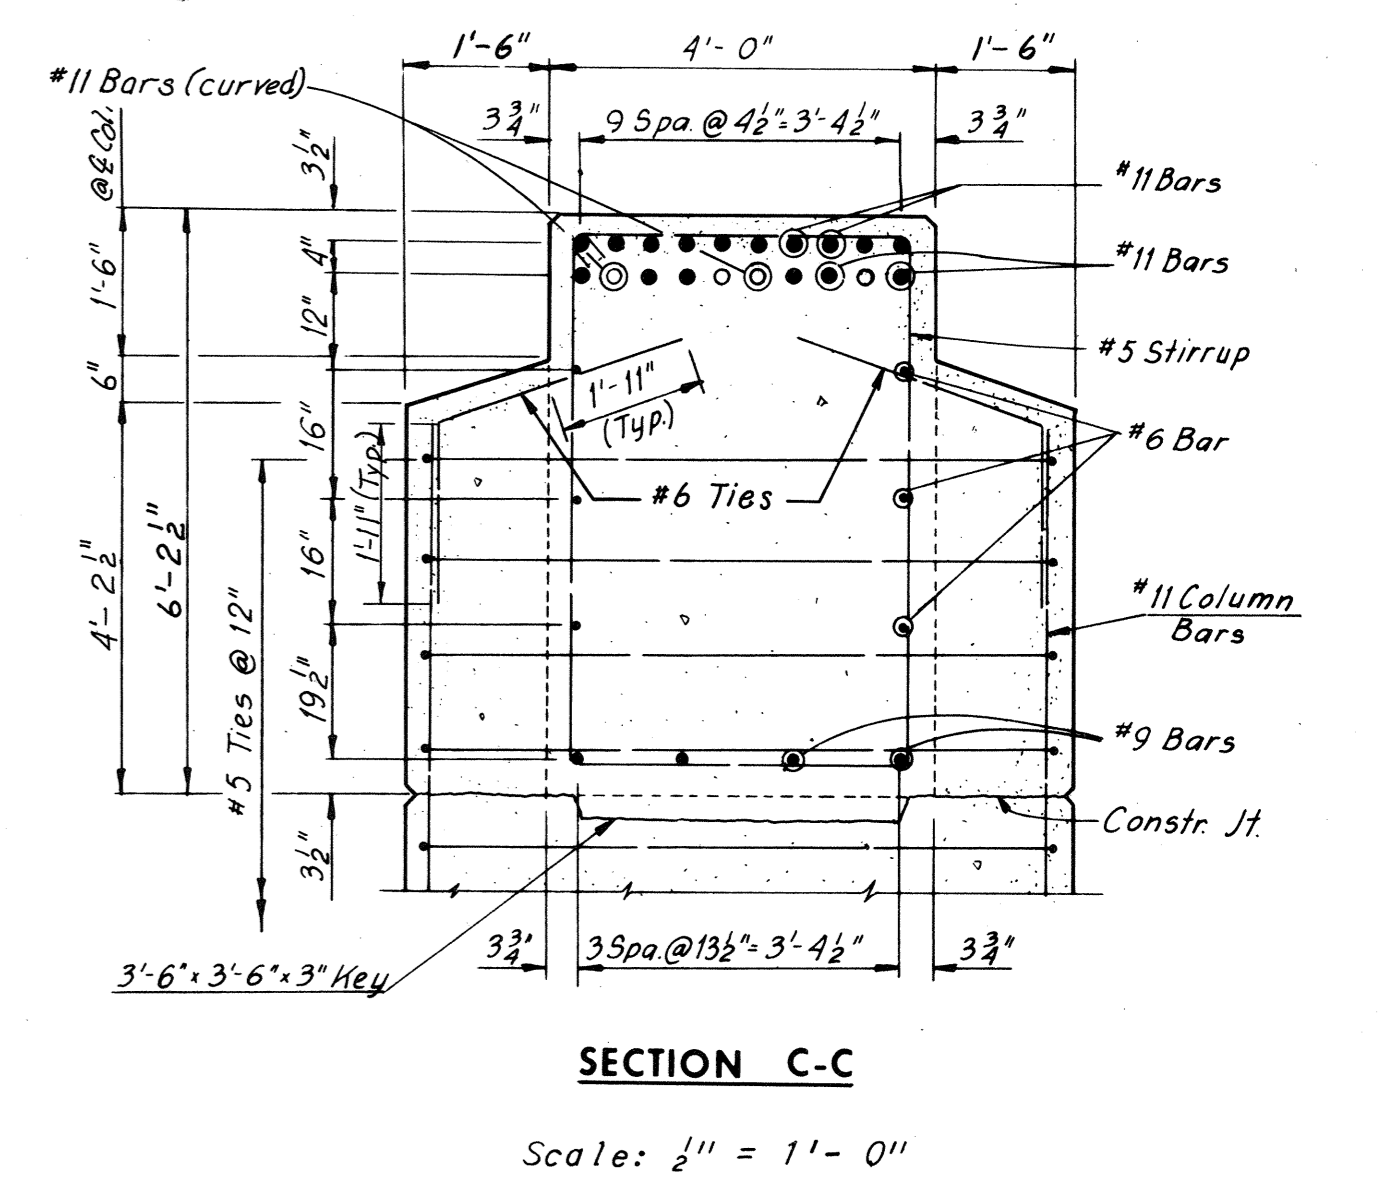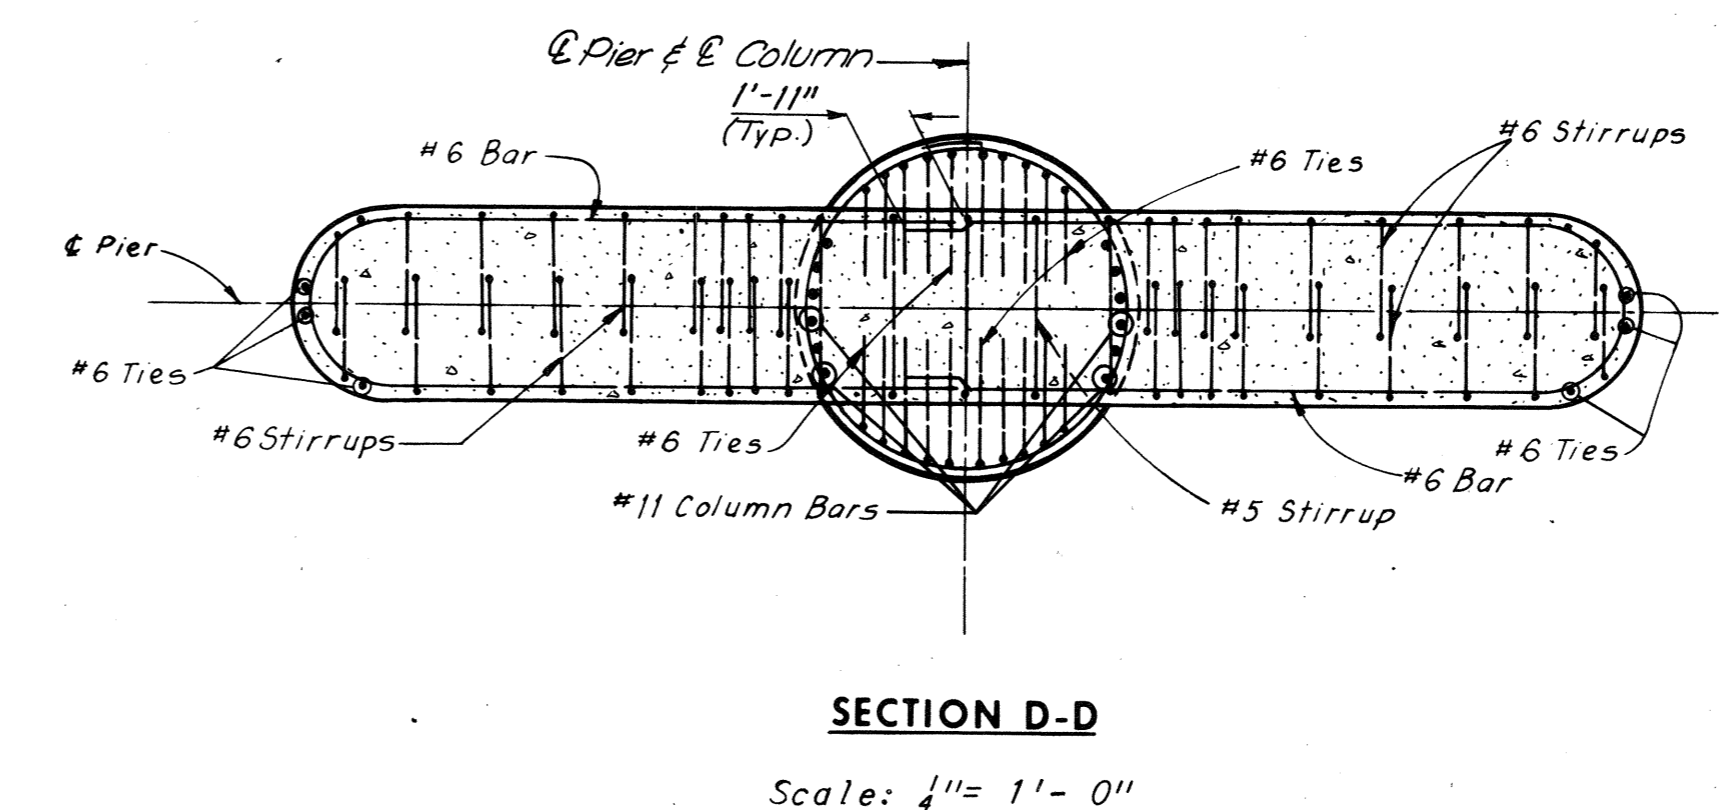

BY	DATE				
MADE	CEB/JD	12-19-68			
CHECKED	RC	1.20.69			
IN CHARGE			NO.	REVISION	BY DATE

Notes:
All piles shall be 12BP53 Steel Piles (Design capacity = 57 tons).
Batter piles 3" per ft., as shown.
For Shoe Details see Sheet S1&S2.
For Steel Pile Details see Sheet 9.
For Framing Plans see Sheet 22.
Estimated Pile Tip elevations -20.0.

AS BUILT

RICHMOND METROPOLITAN AUTHORITY
RICHMOND EXPRESSWAY SYSTEM
DOWNTOWN EXPRESSWAY









BRIDGE NO. 65
RAMP S-W CONNECTION FROM
RICHMOND-PETERSBURG TURNPIKE
PIERS 14 AND 15

HOWARD, NEEDLES, TAMMEN & BERGENDOFF
consulting engineers
NEW YORK ALEXANDRIA KANSAS CITY

SCALE: *As Noted*
CONTRACT NO. 11
SHEET NO. 13 OF 38

RICHMOND EXPRESSWAY SYSTEM			
SECTION	PROJECT	SHEET NO.	TOTAL SHEETS
11	DOWNTOWN EXPRESSWAY	39	97

NOTE A
A construction joint will be permitted at a rustication near mid-height of the column. The column reinforcement may be lap spliced near the construction joint. The lap at the splice shall be a minimum of 3'-6". Splices shall be staggered at least 3'-3" between adjacent bars.

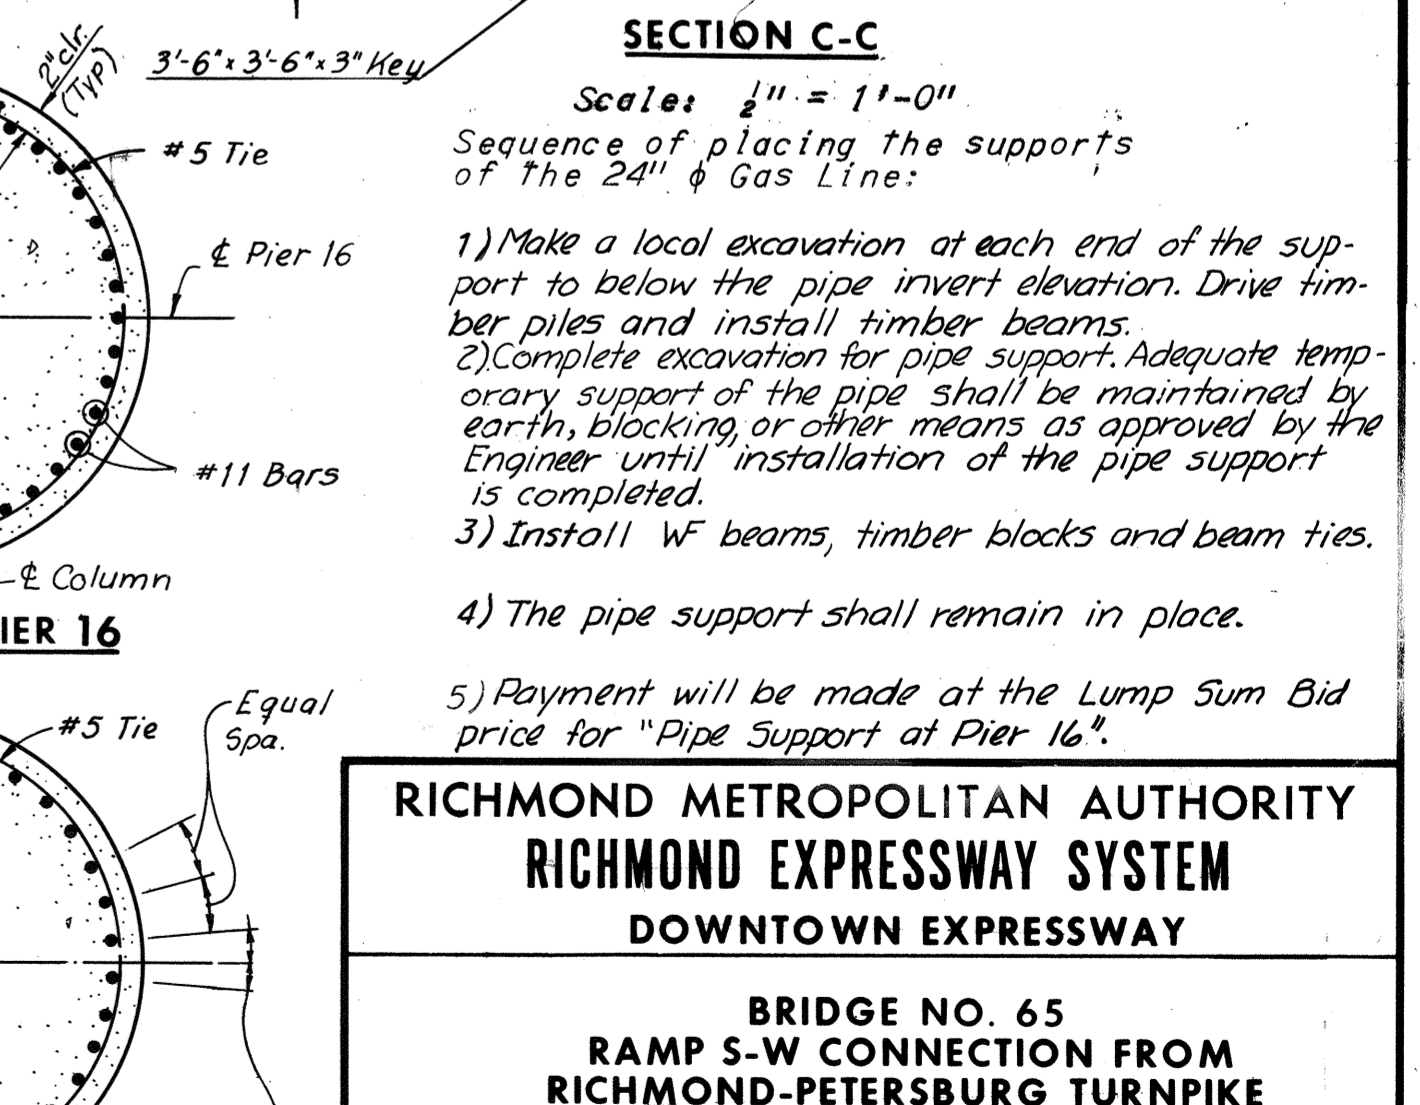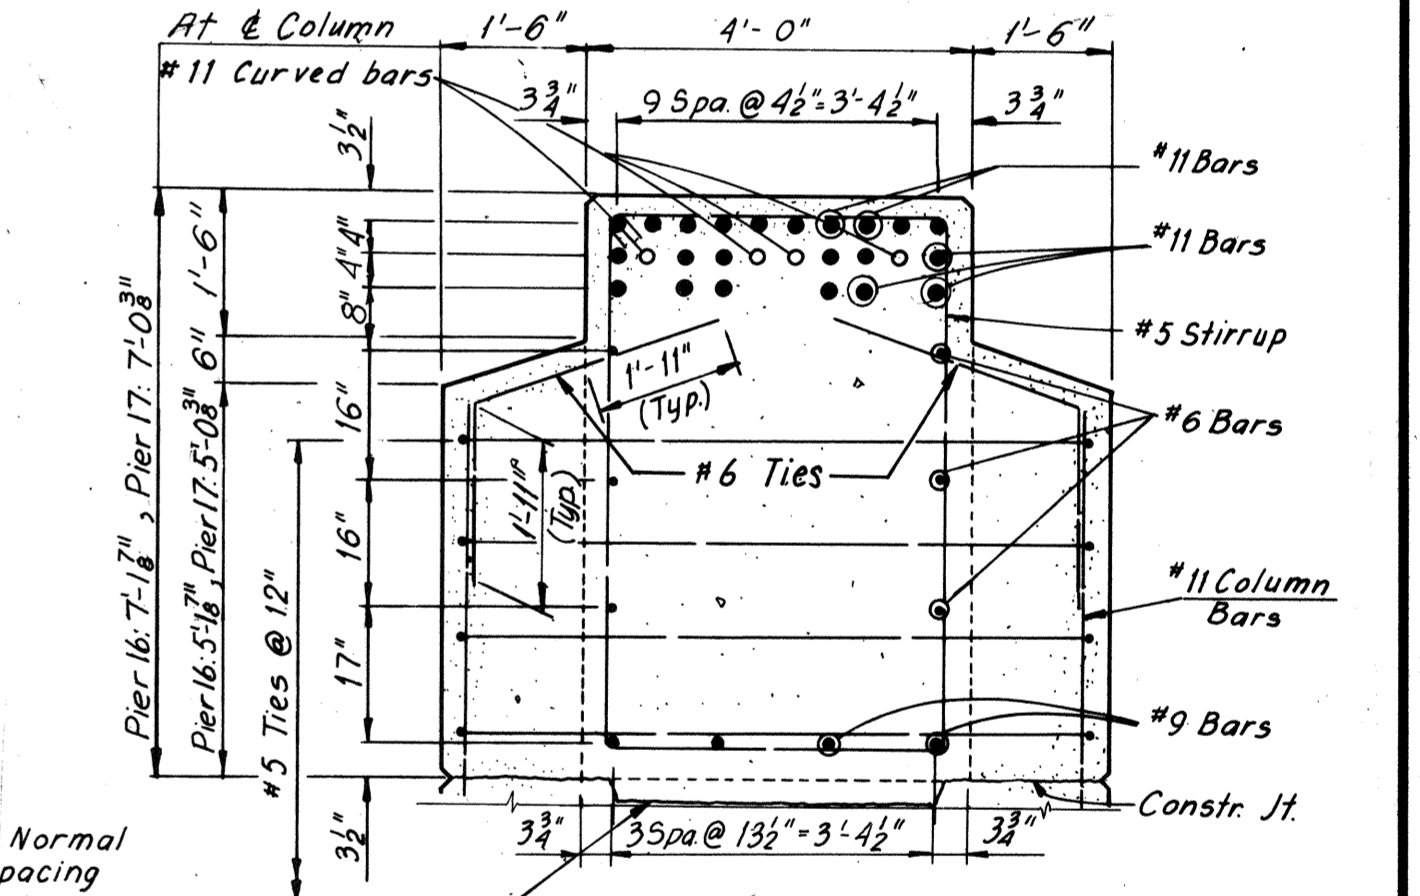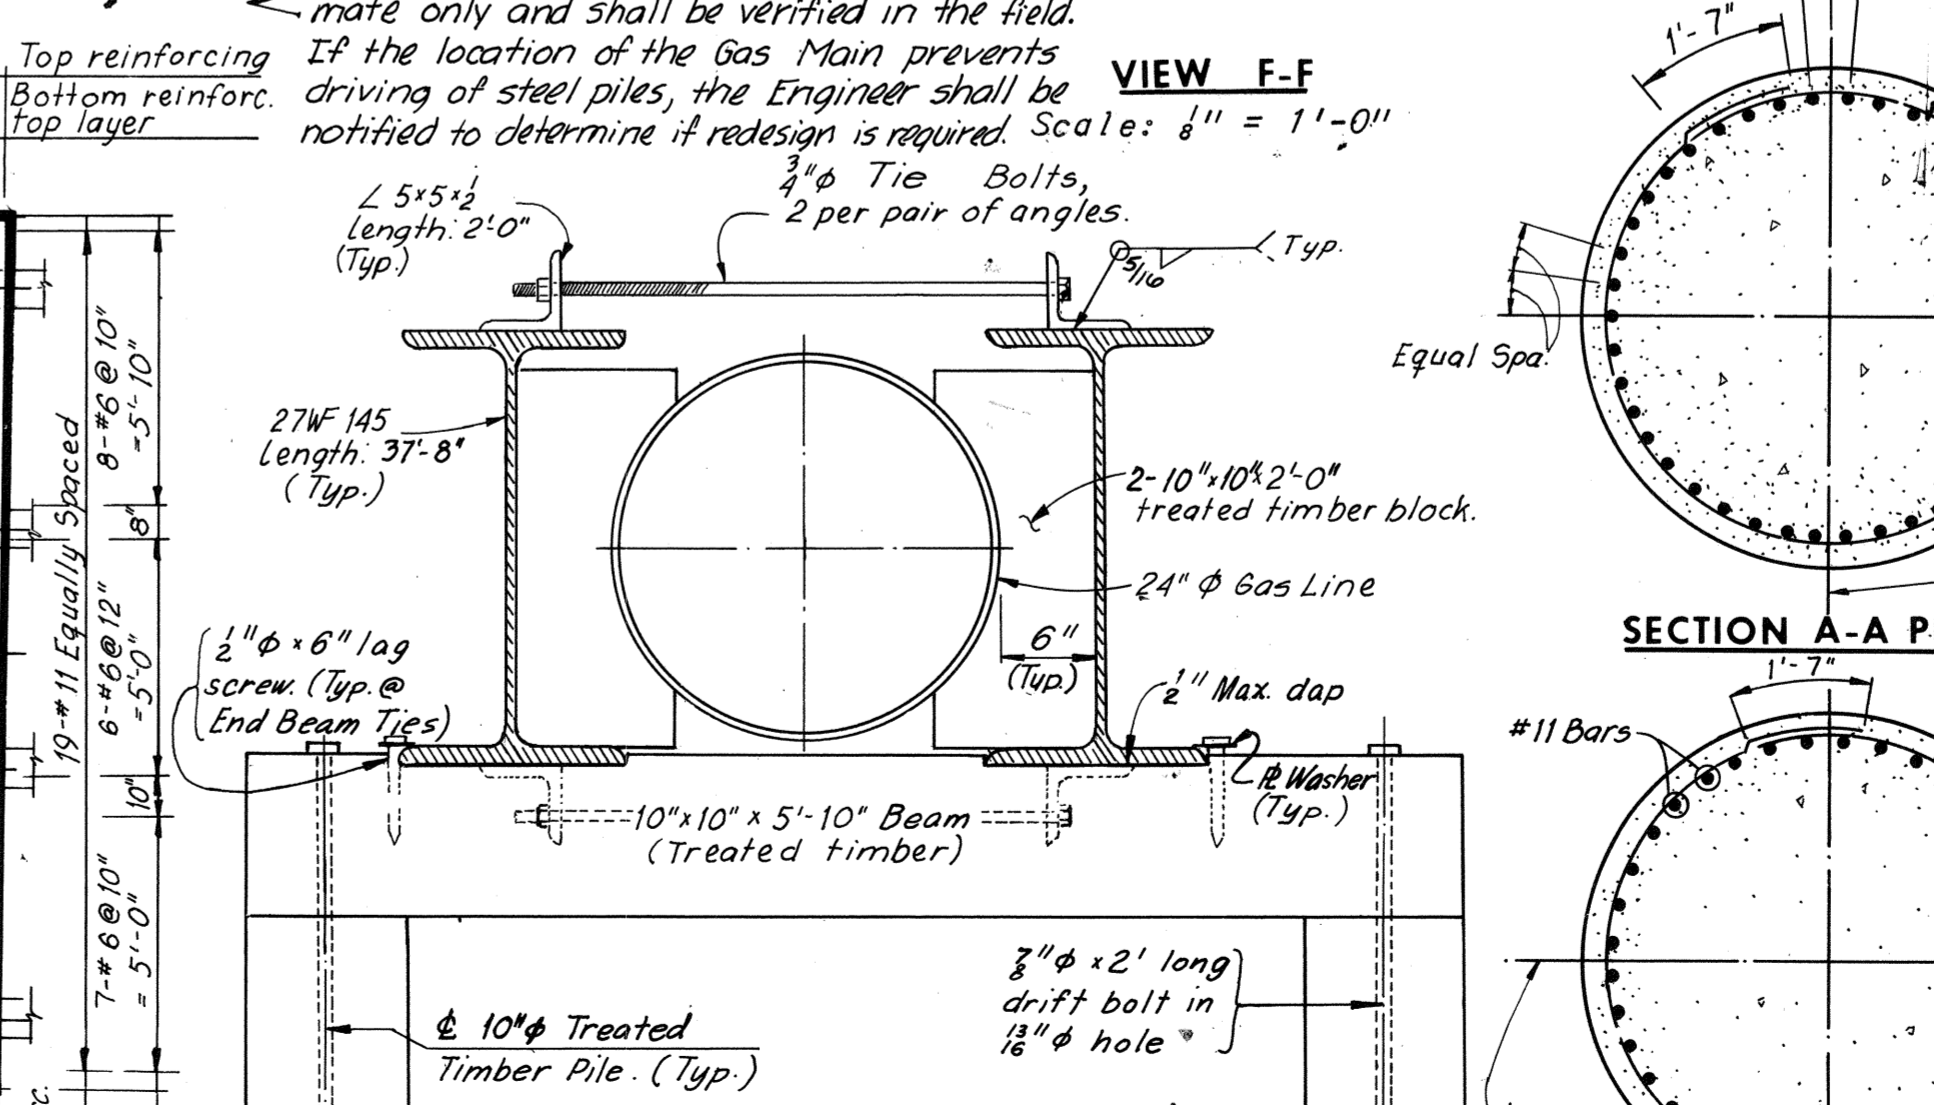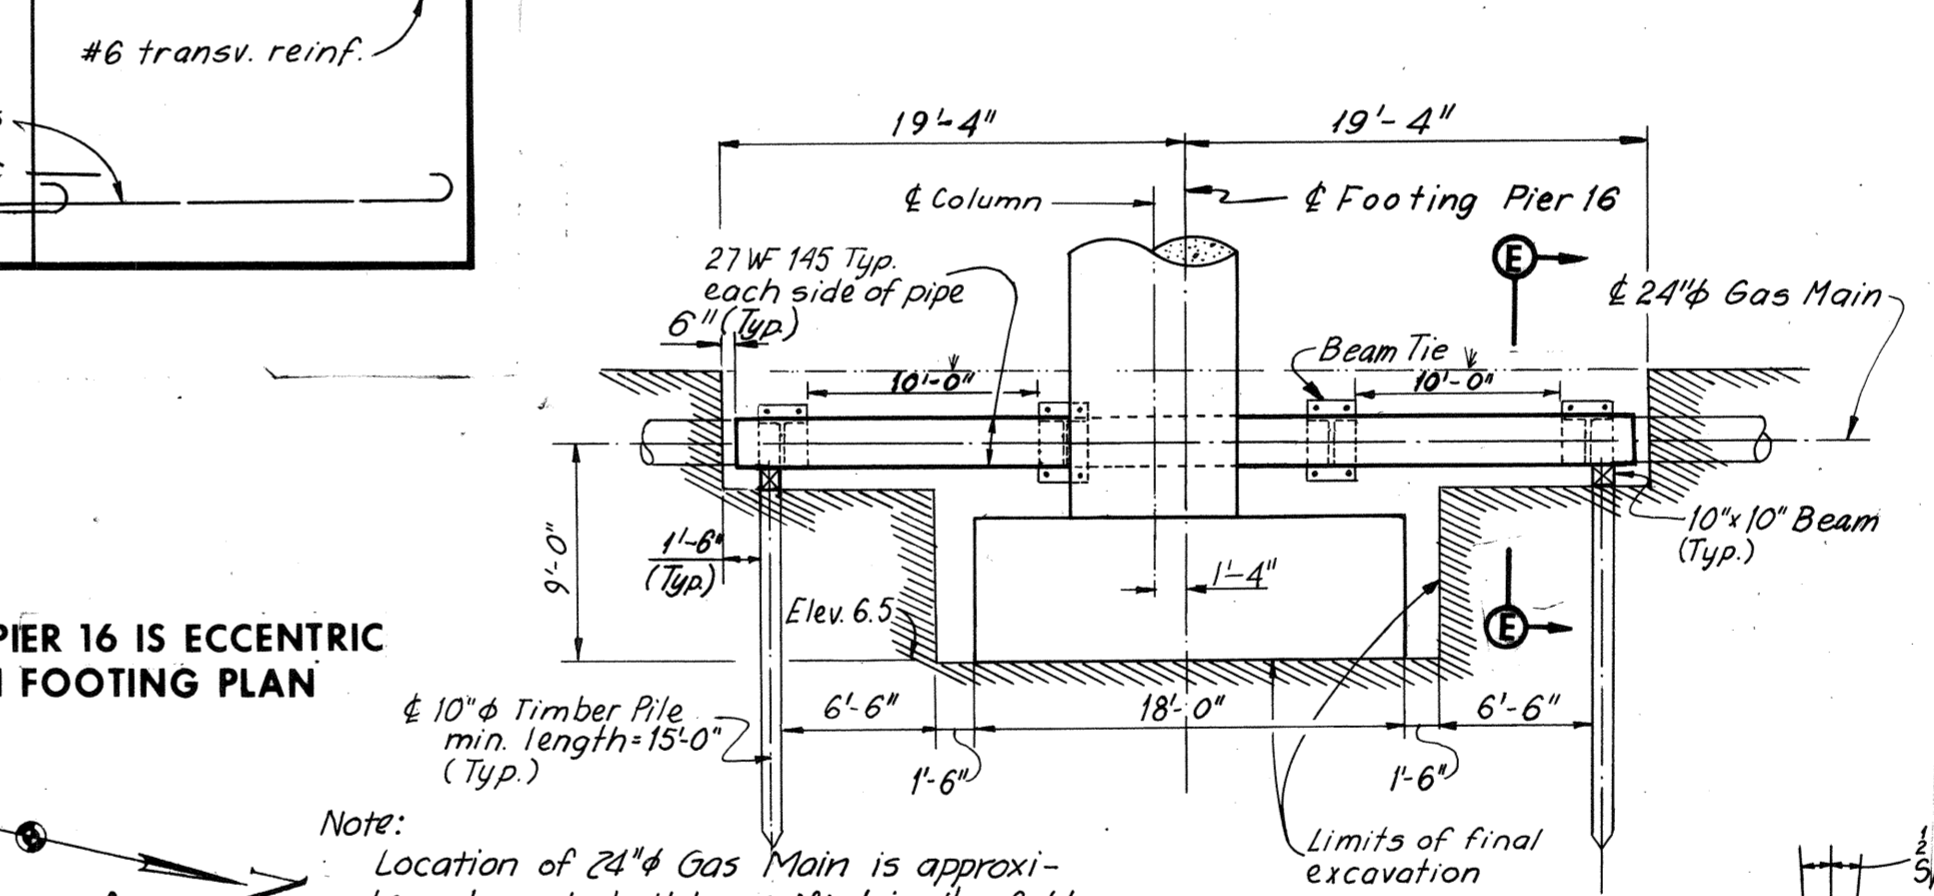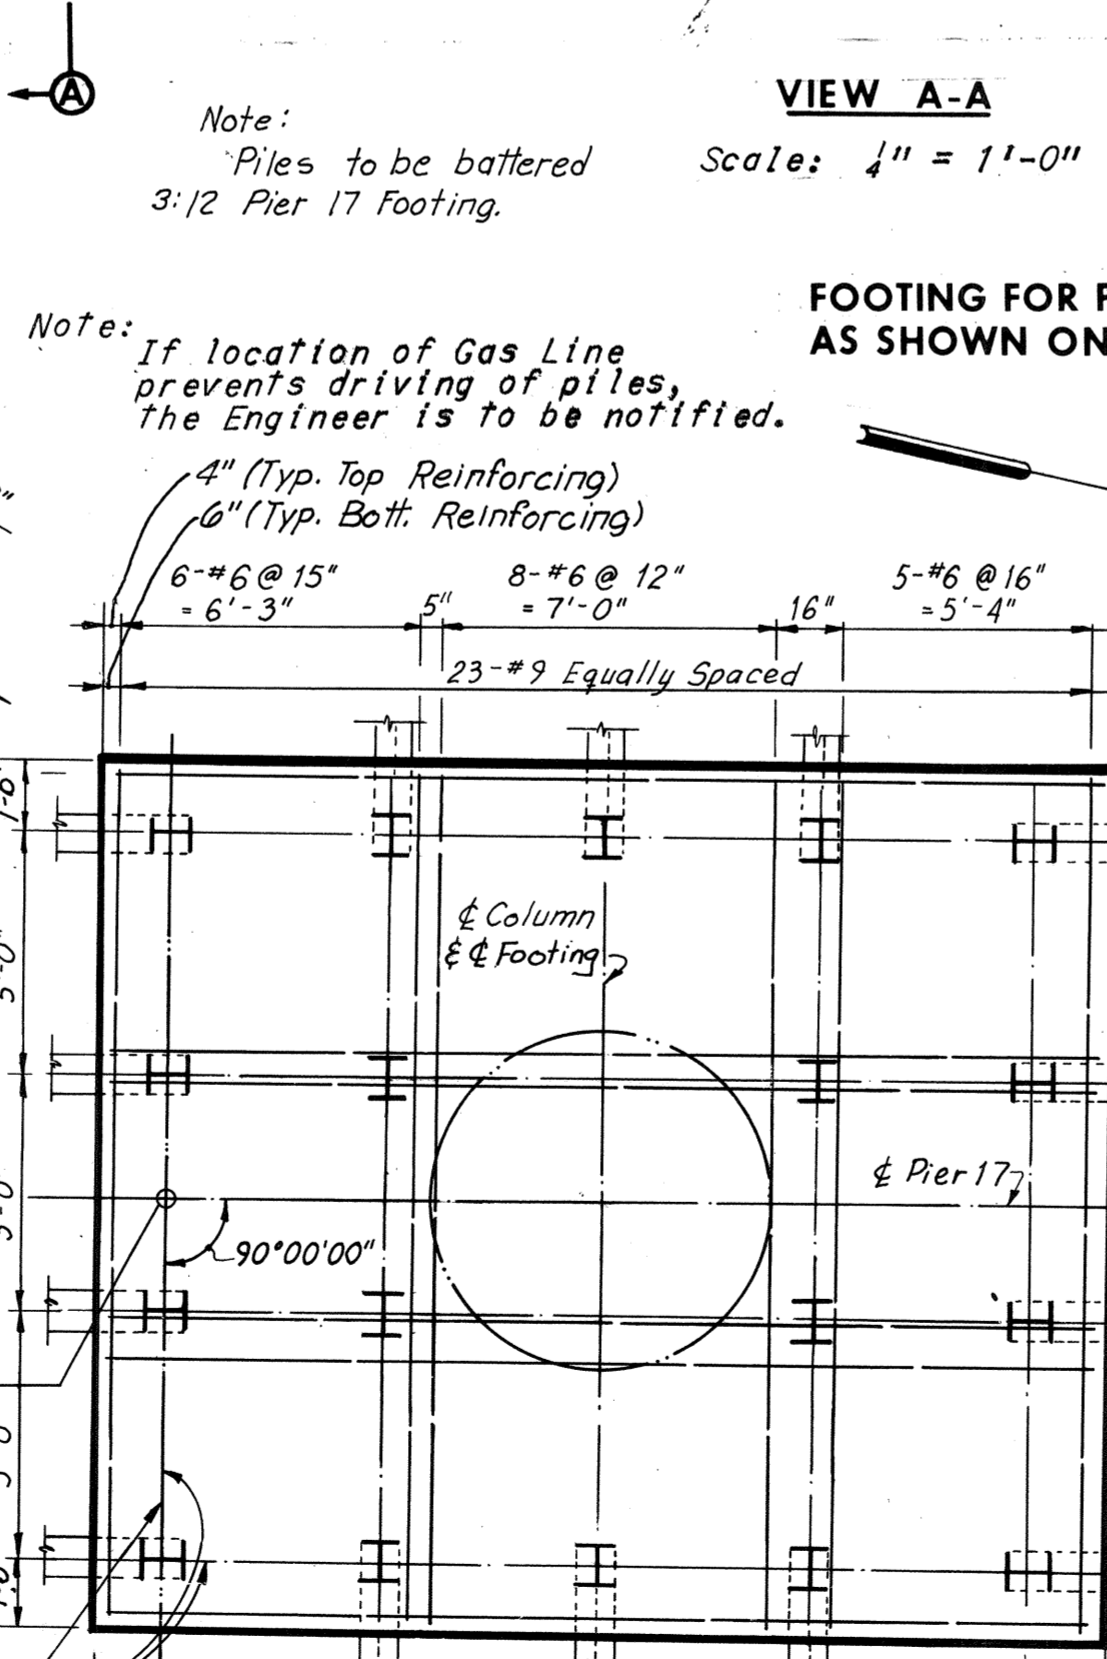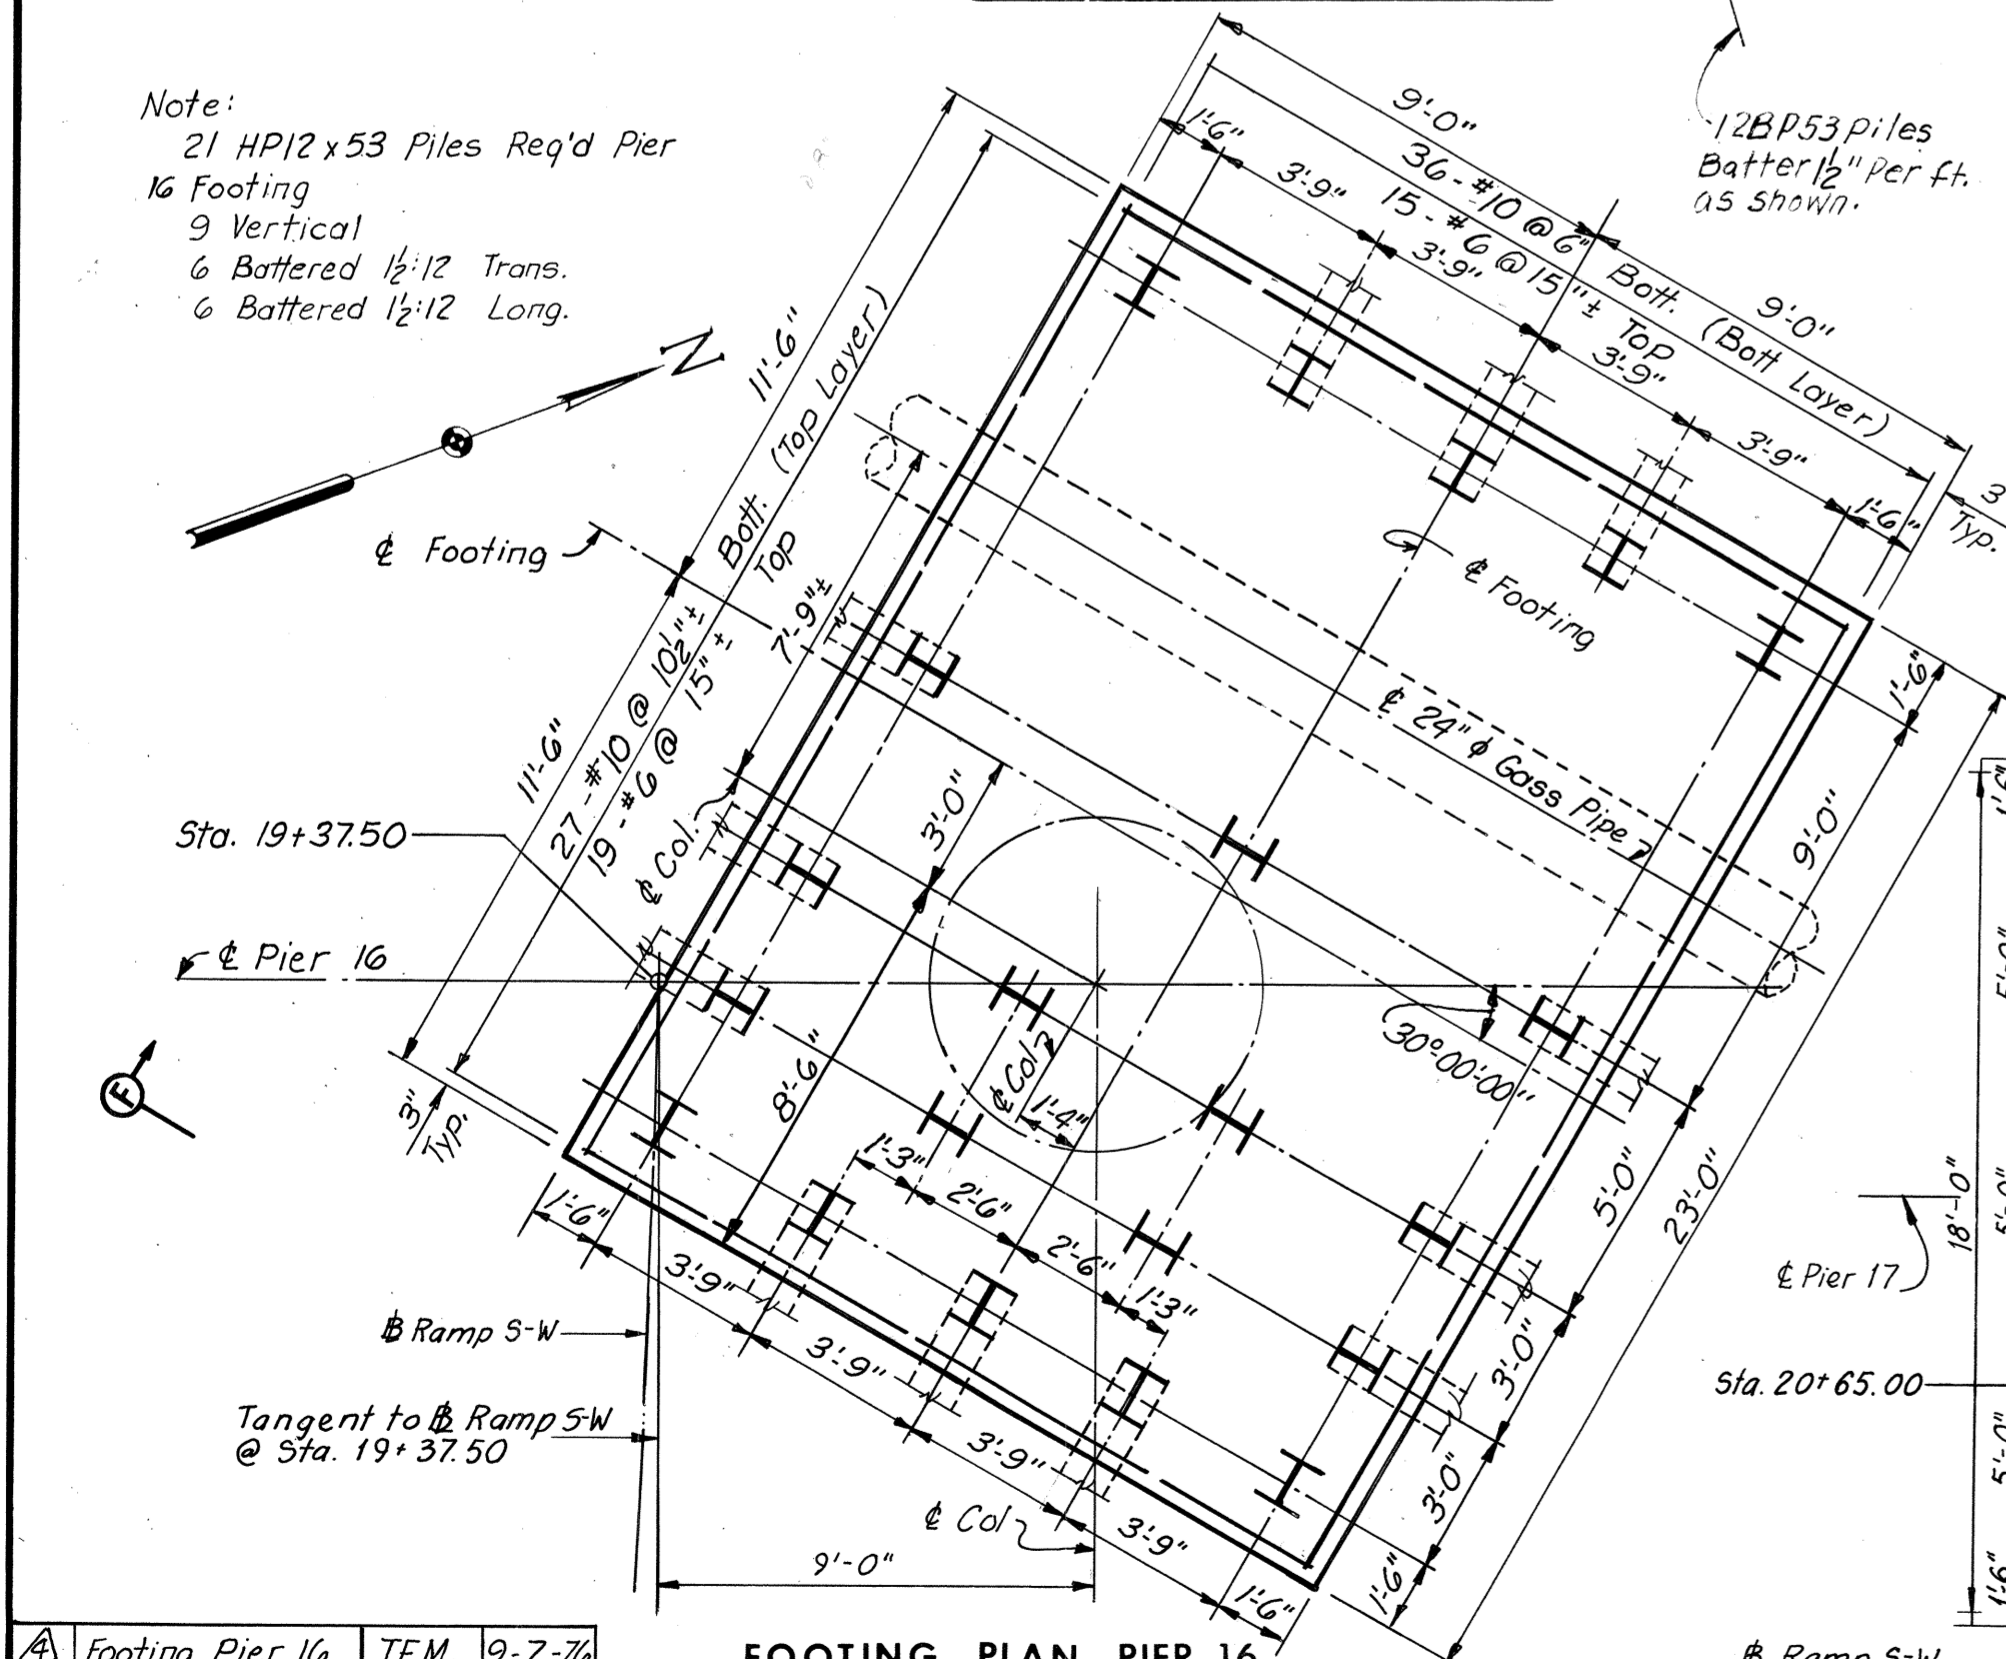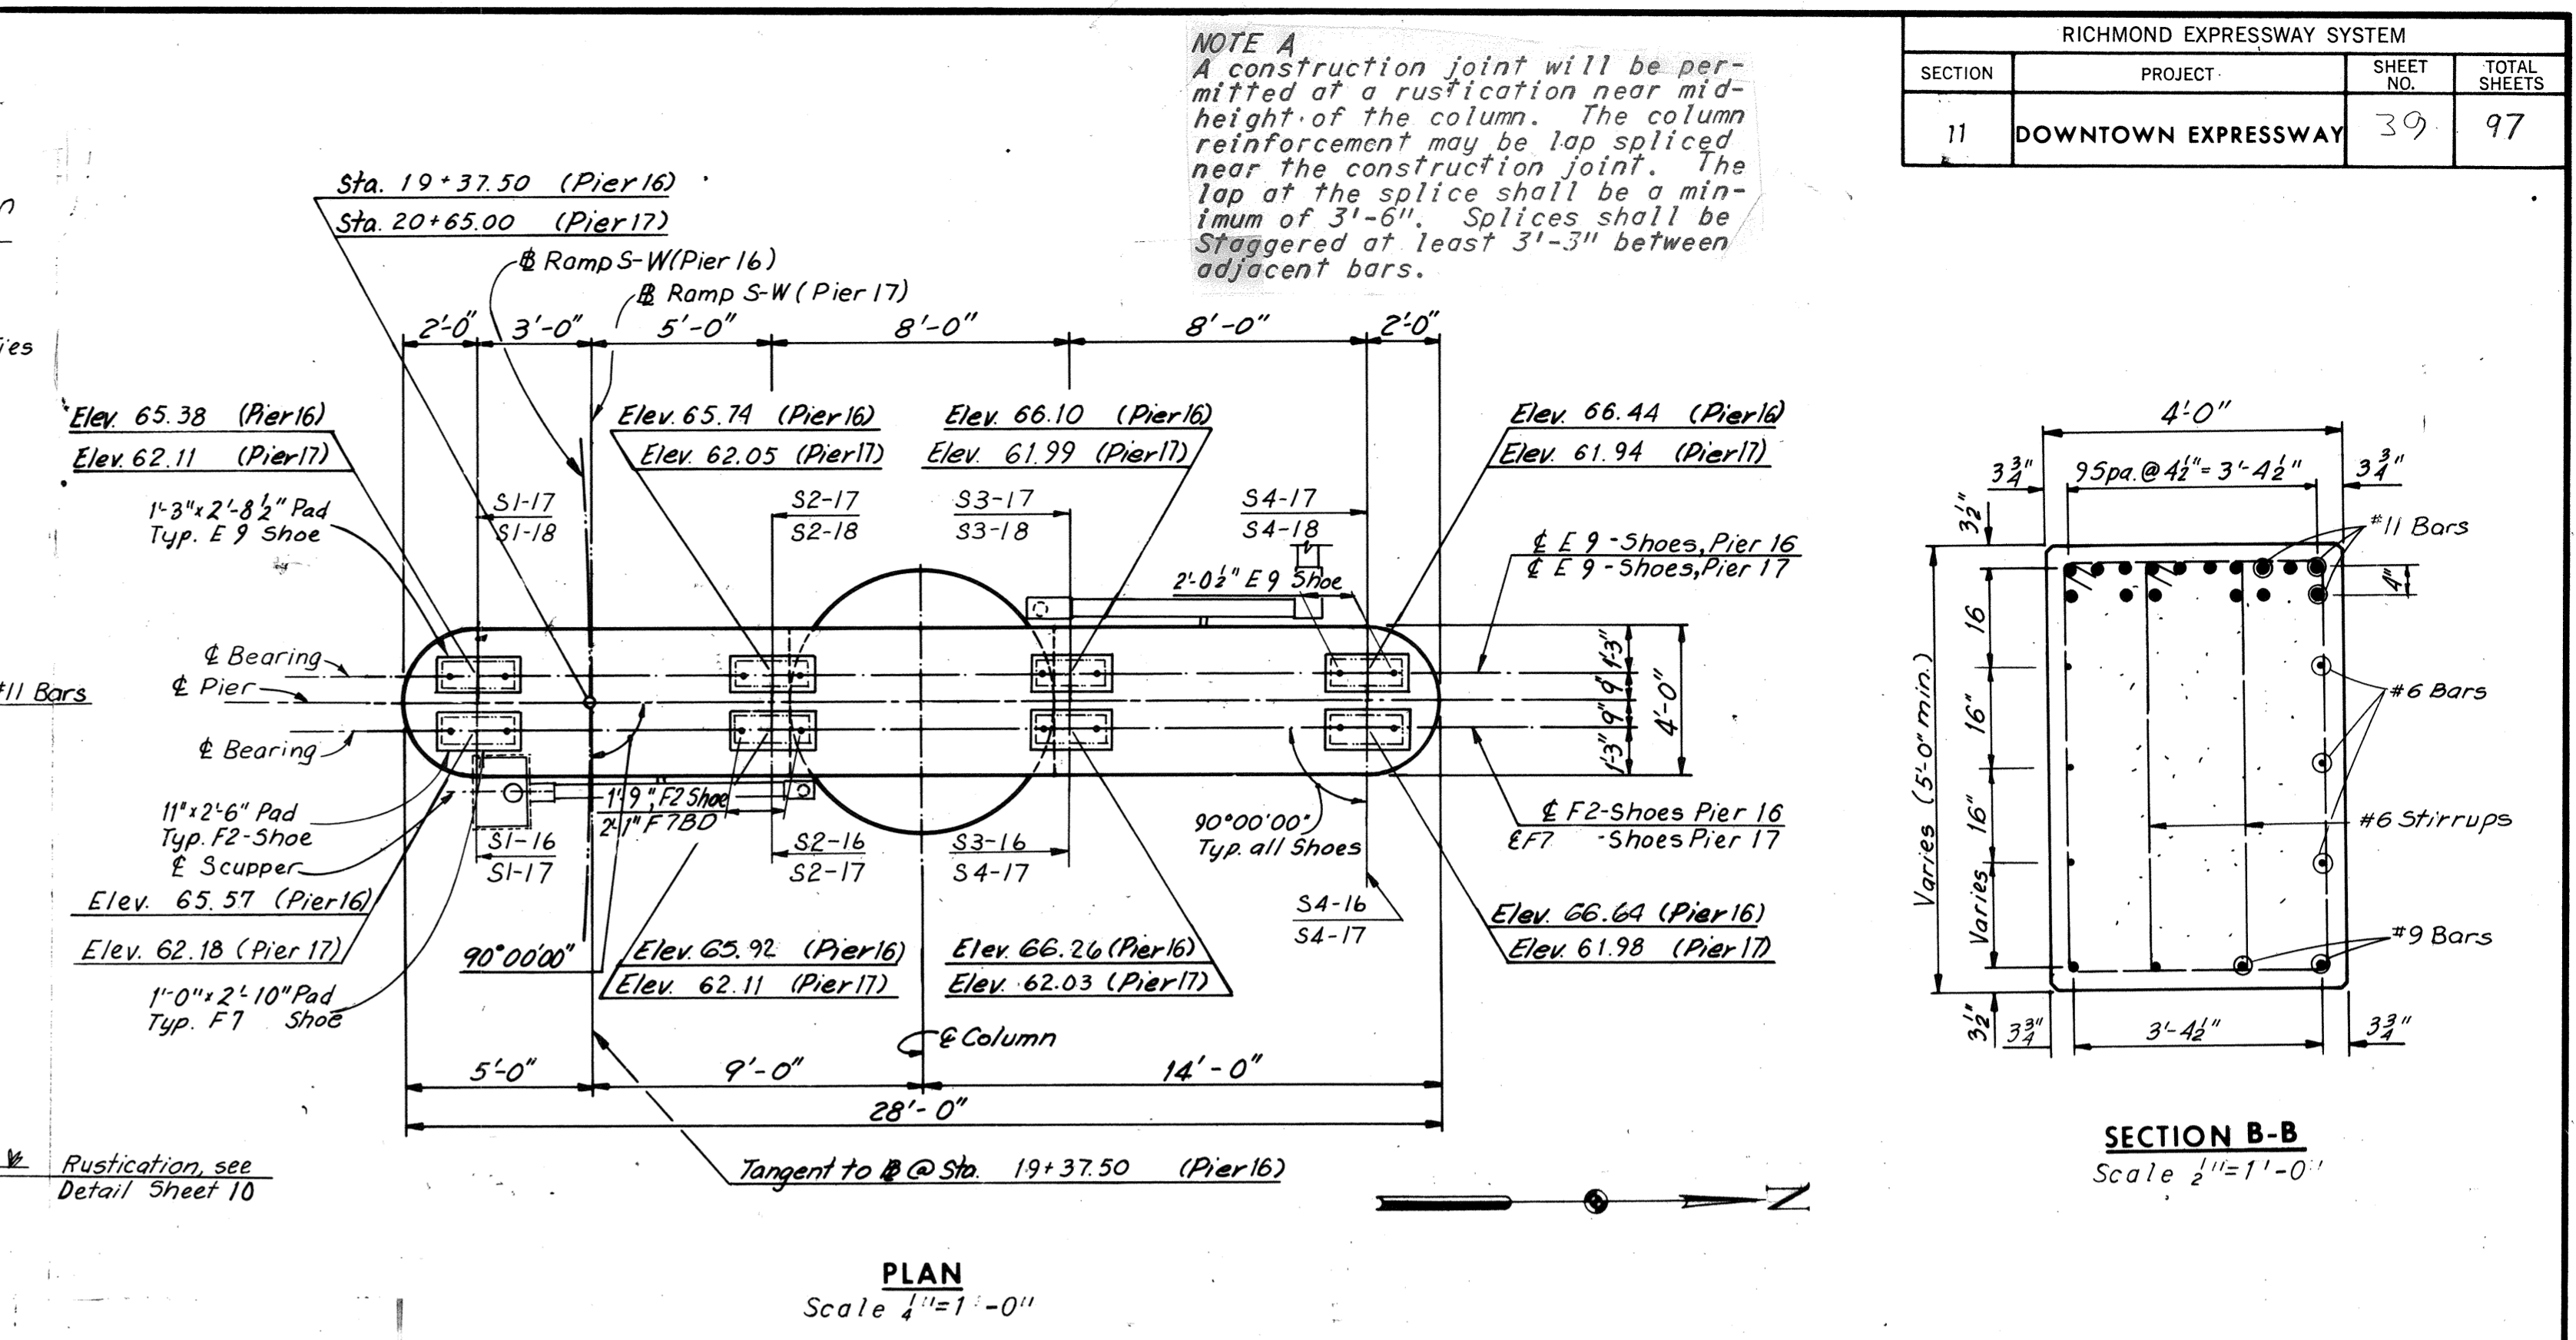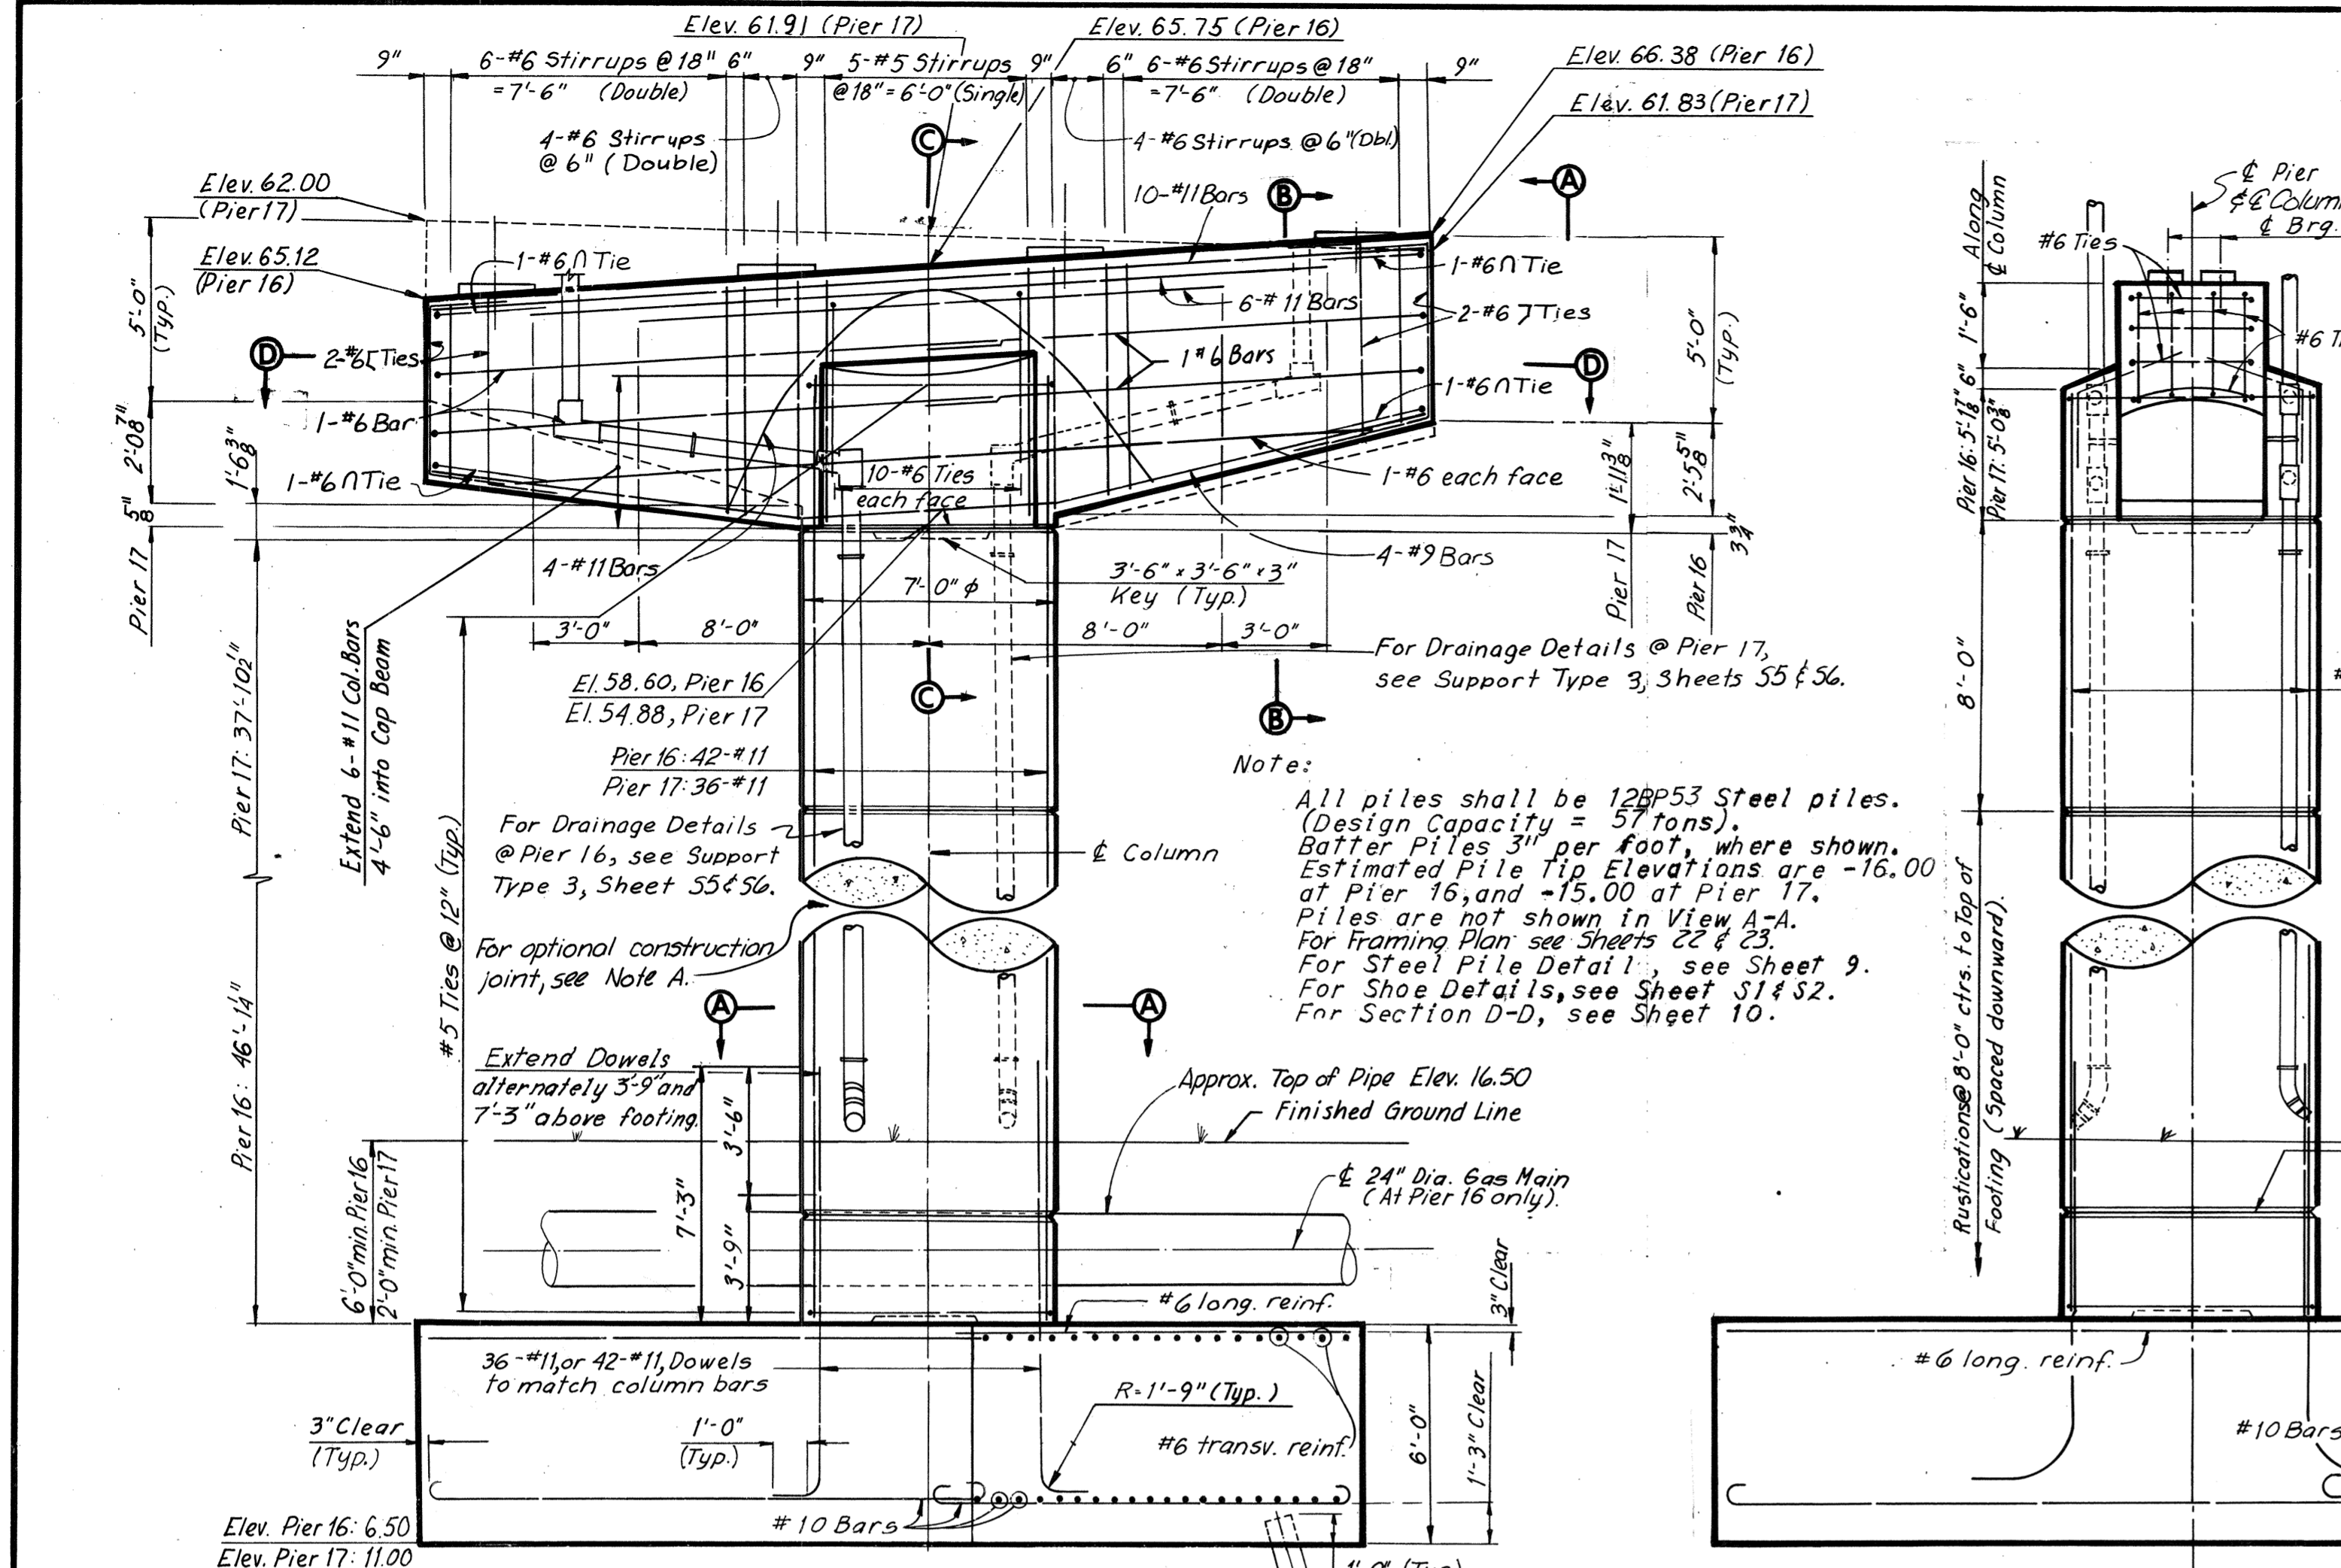

NO.	REVISION	BY	DATE
1	Pier Dim Pier 17	J.E.M.	8-26-76
2	Pad Elev. Pier 16	T.E.M.	5-76
3	Shoe Type revised	C.B.P.	8-25-75

Note:
Dimensions given in Footing Plan are measured at bottom of footing.

RICHMOND METROPOLITAN AUTHORITY
RICHMOND EXPRESSWAY SYSTEM
DOWNTOWN EXPRESSWAY










BRIDGE NO. 65
RAMP S-W CONNECTION FROM
RICHMOND-PETERSBURG TURNPIKE
PIERS 16 AND 17

HOWARD, NEEDLES, TAMMEN & BERGENDOFF
consulting engineers
NEW YORK ALEXANDRIA KANSAS CITY

SCALE: As Noted
CONTRACT NO. 11
SHEET NO. 14 of 38

AS BUILT

RICHMOND EXPRESSWAY SYSTEM			
SECTION	PROJECT	SHEET NO.	TOTAL SHEETS
11	DOWNTOWN EXPRESSWAY	40	97

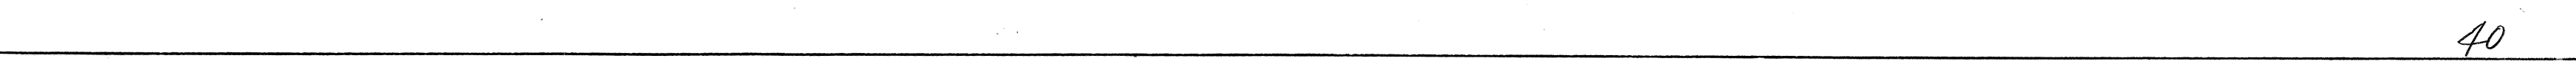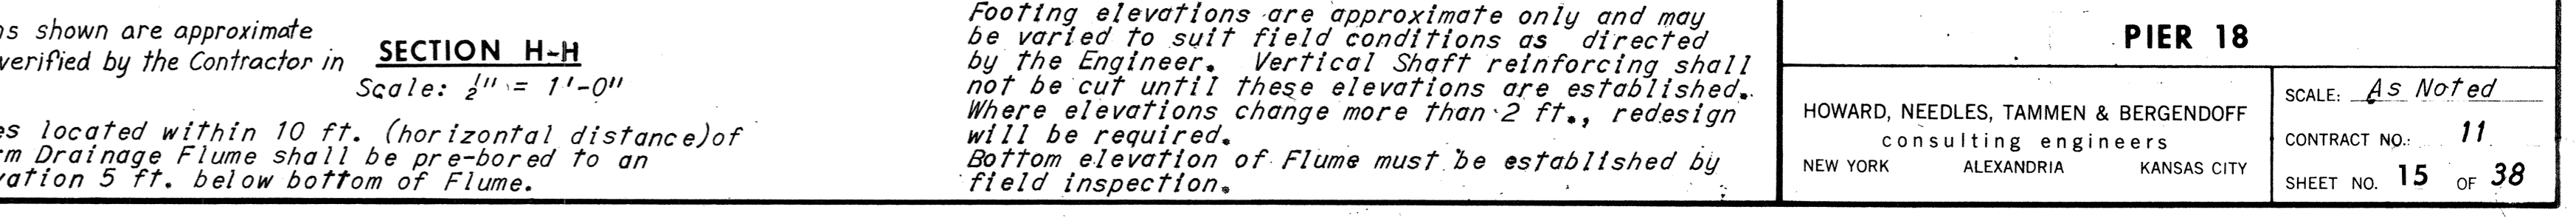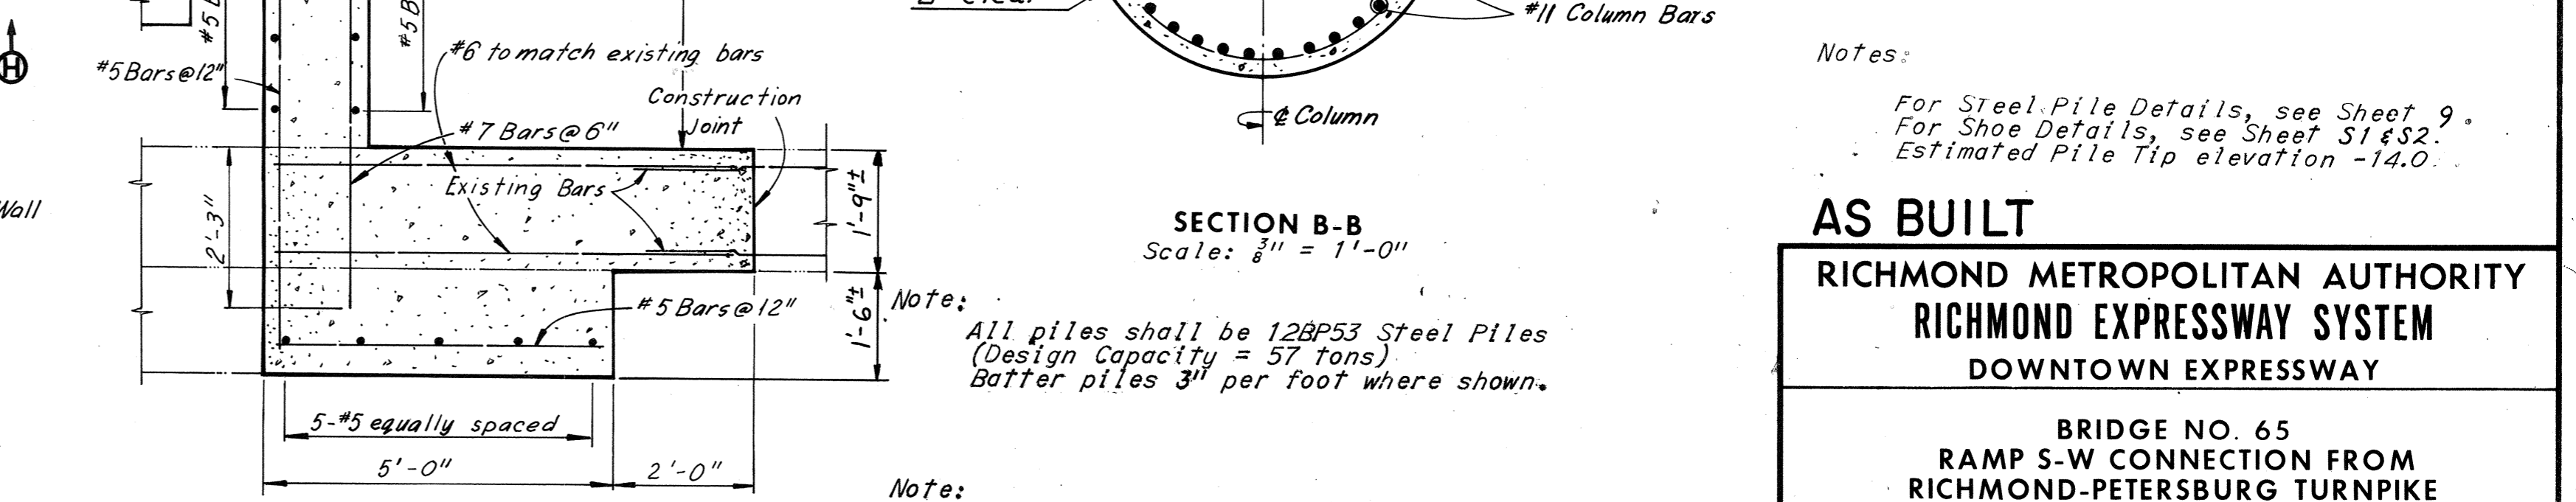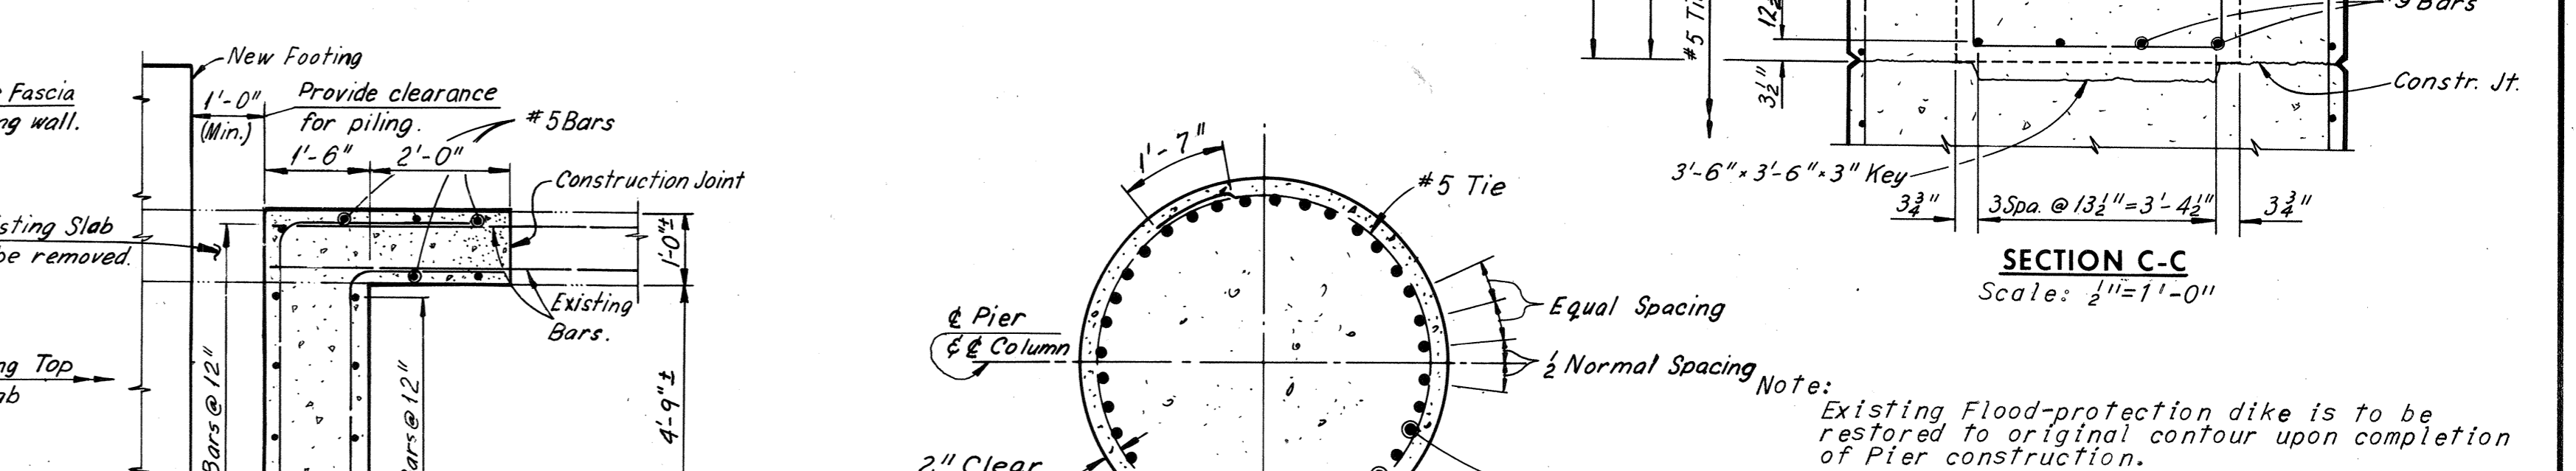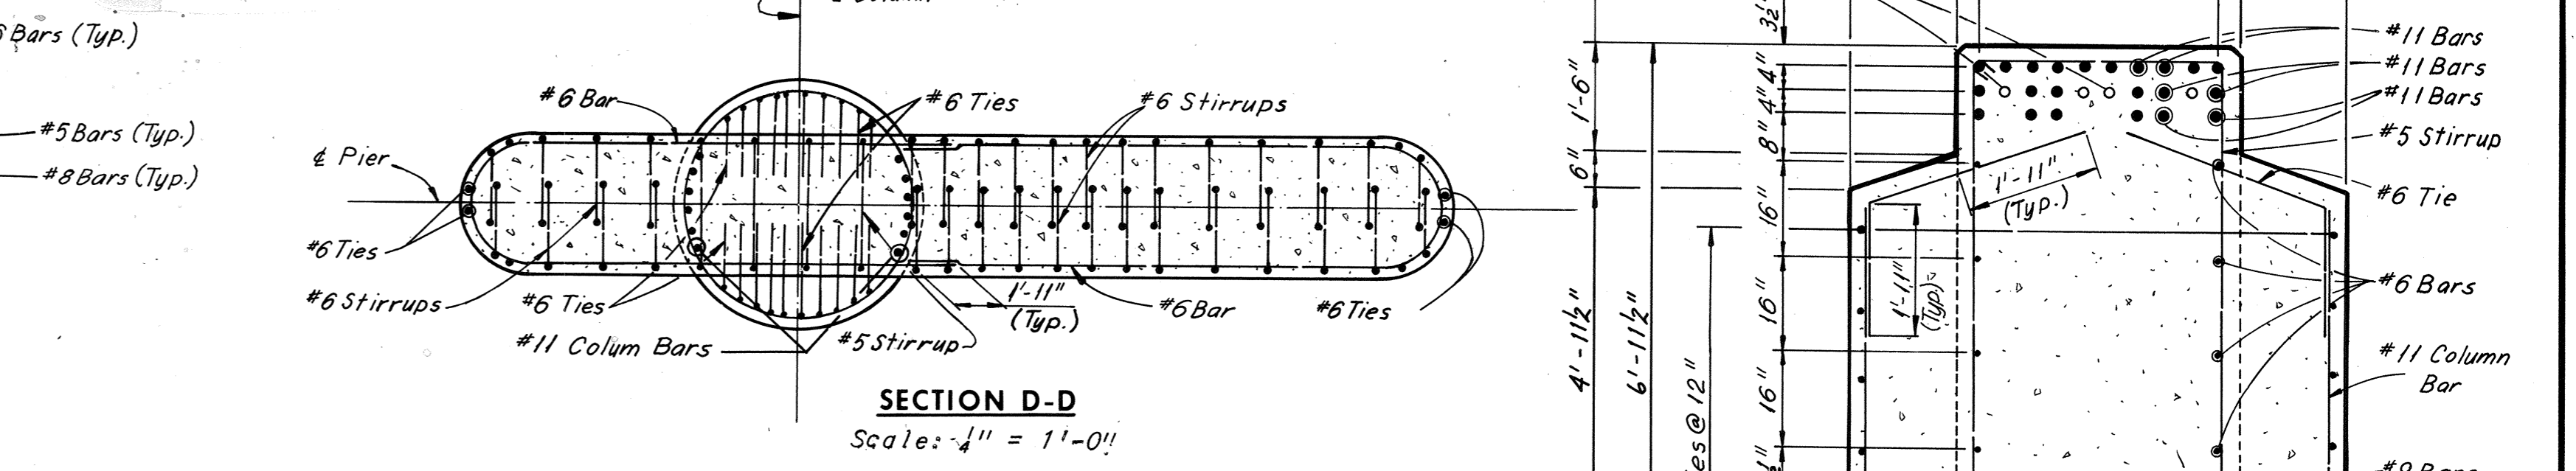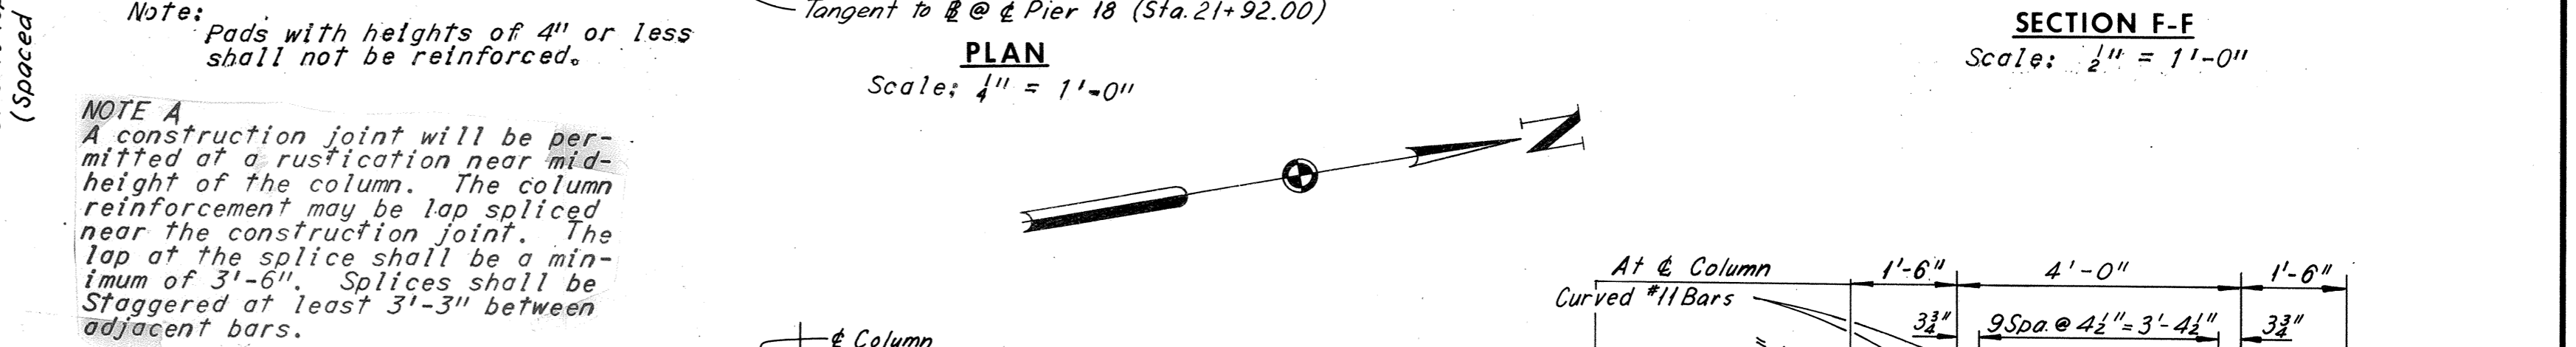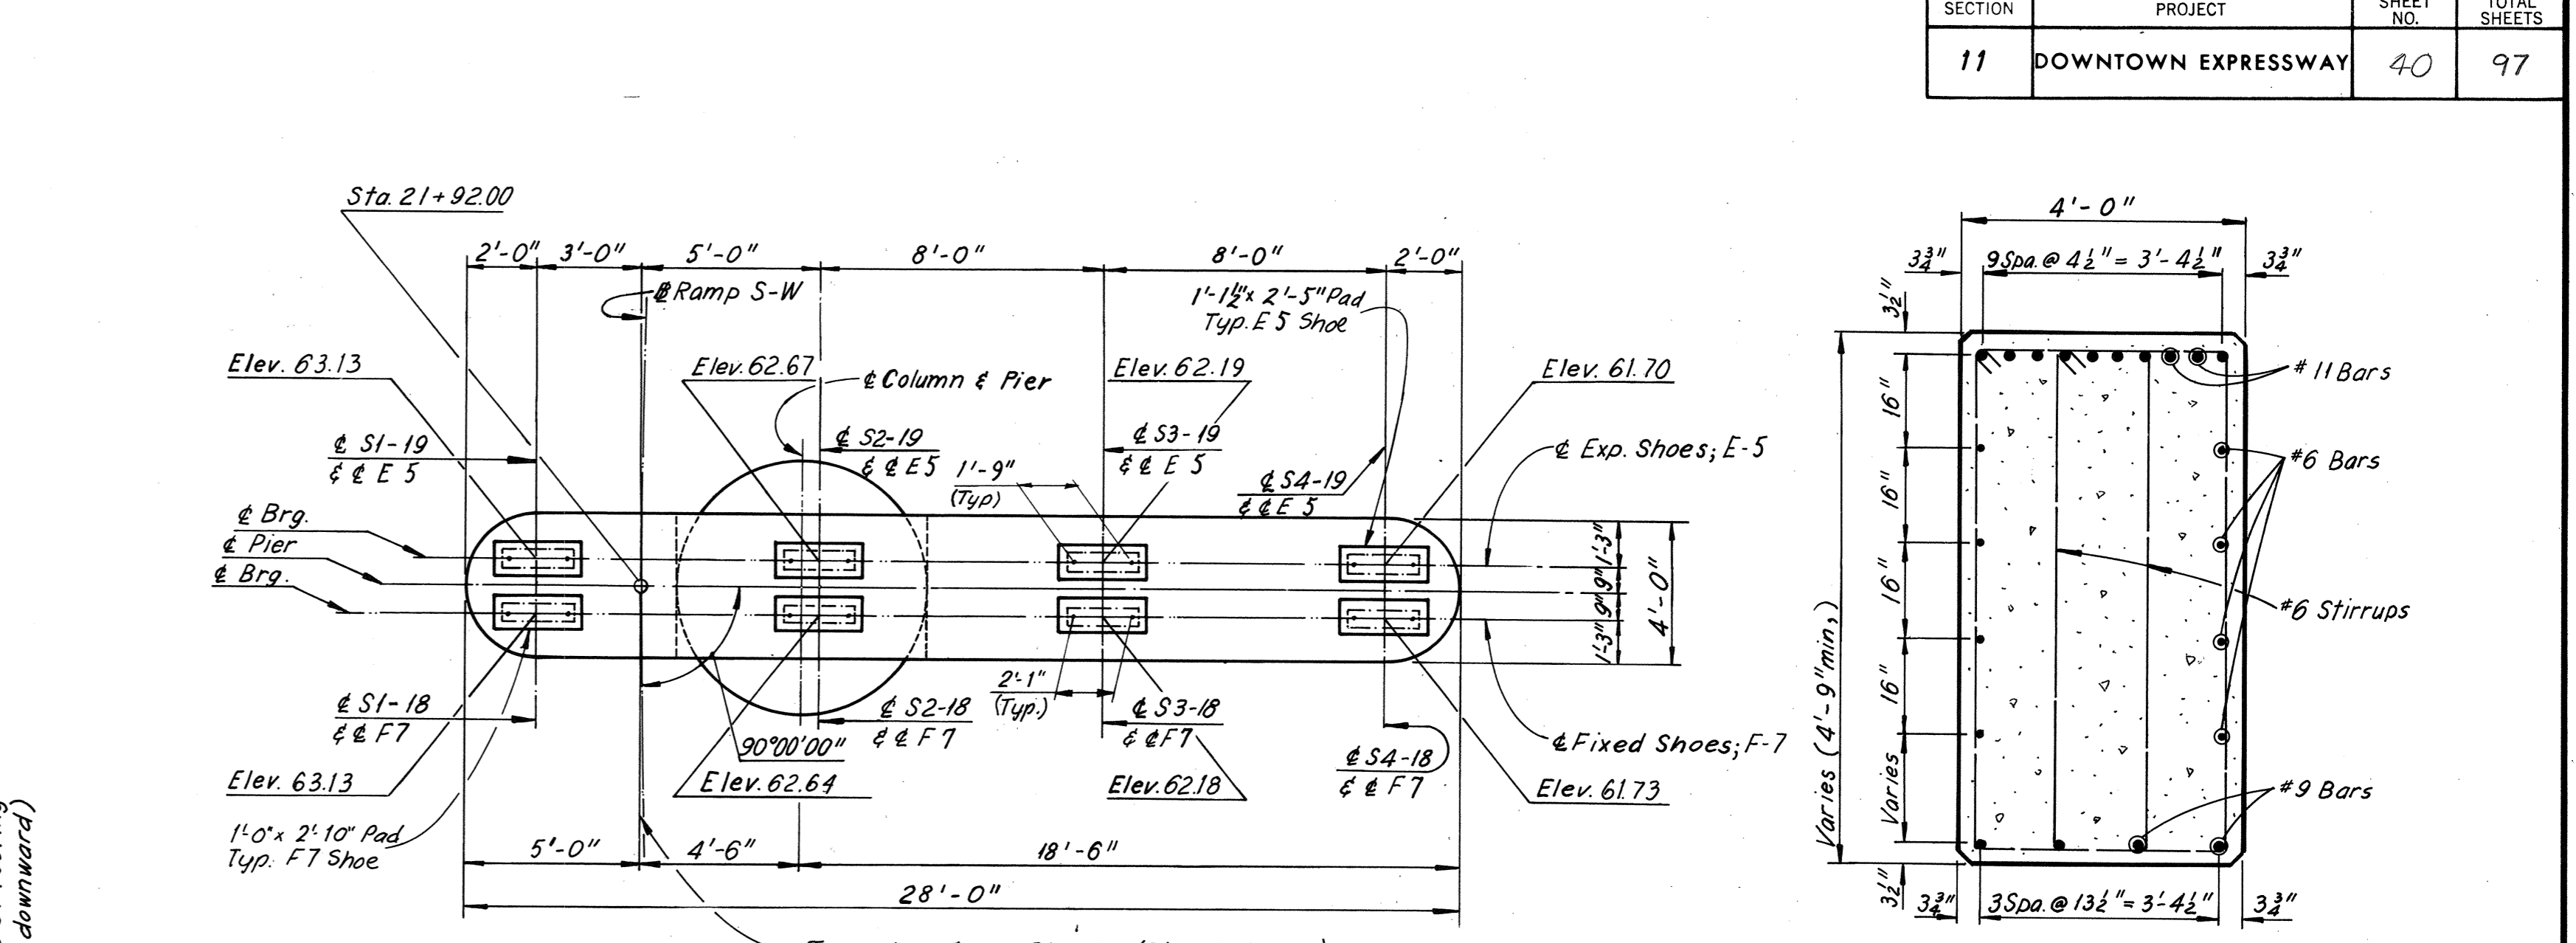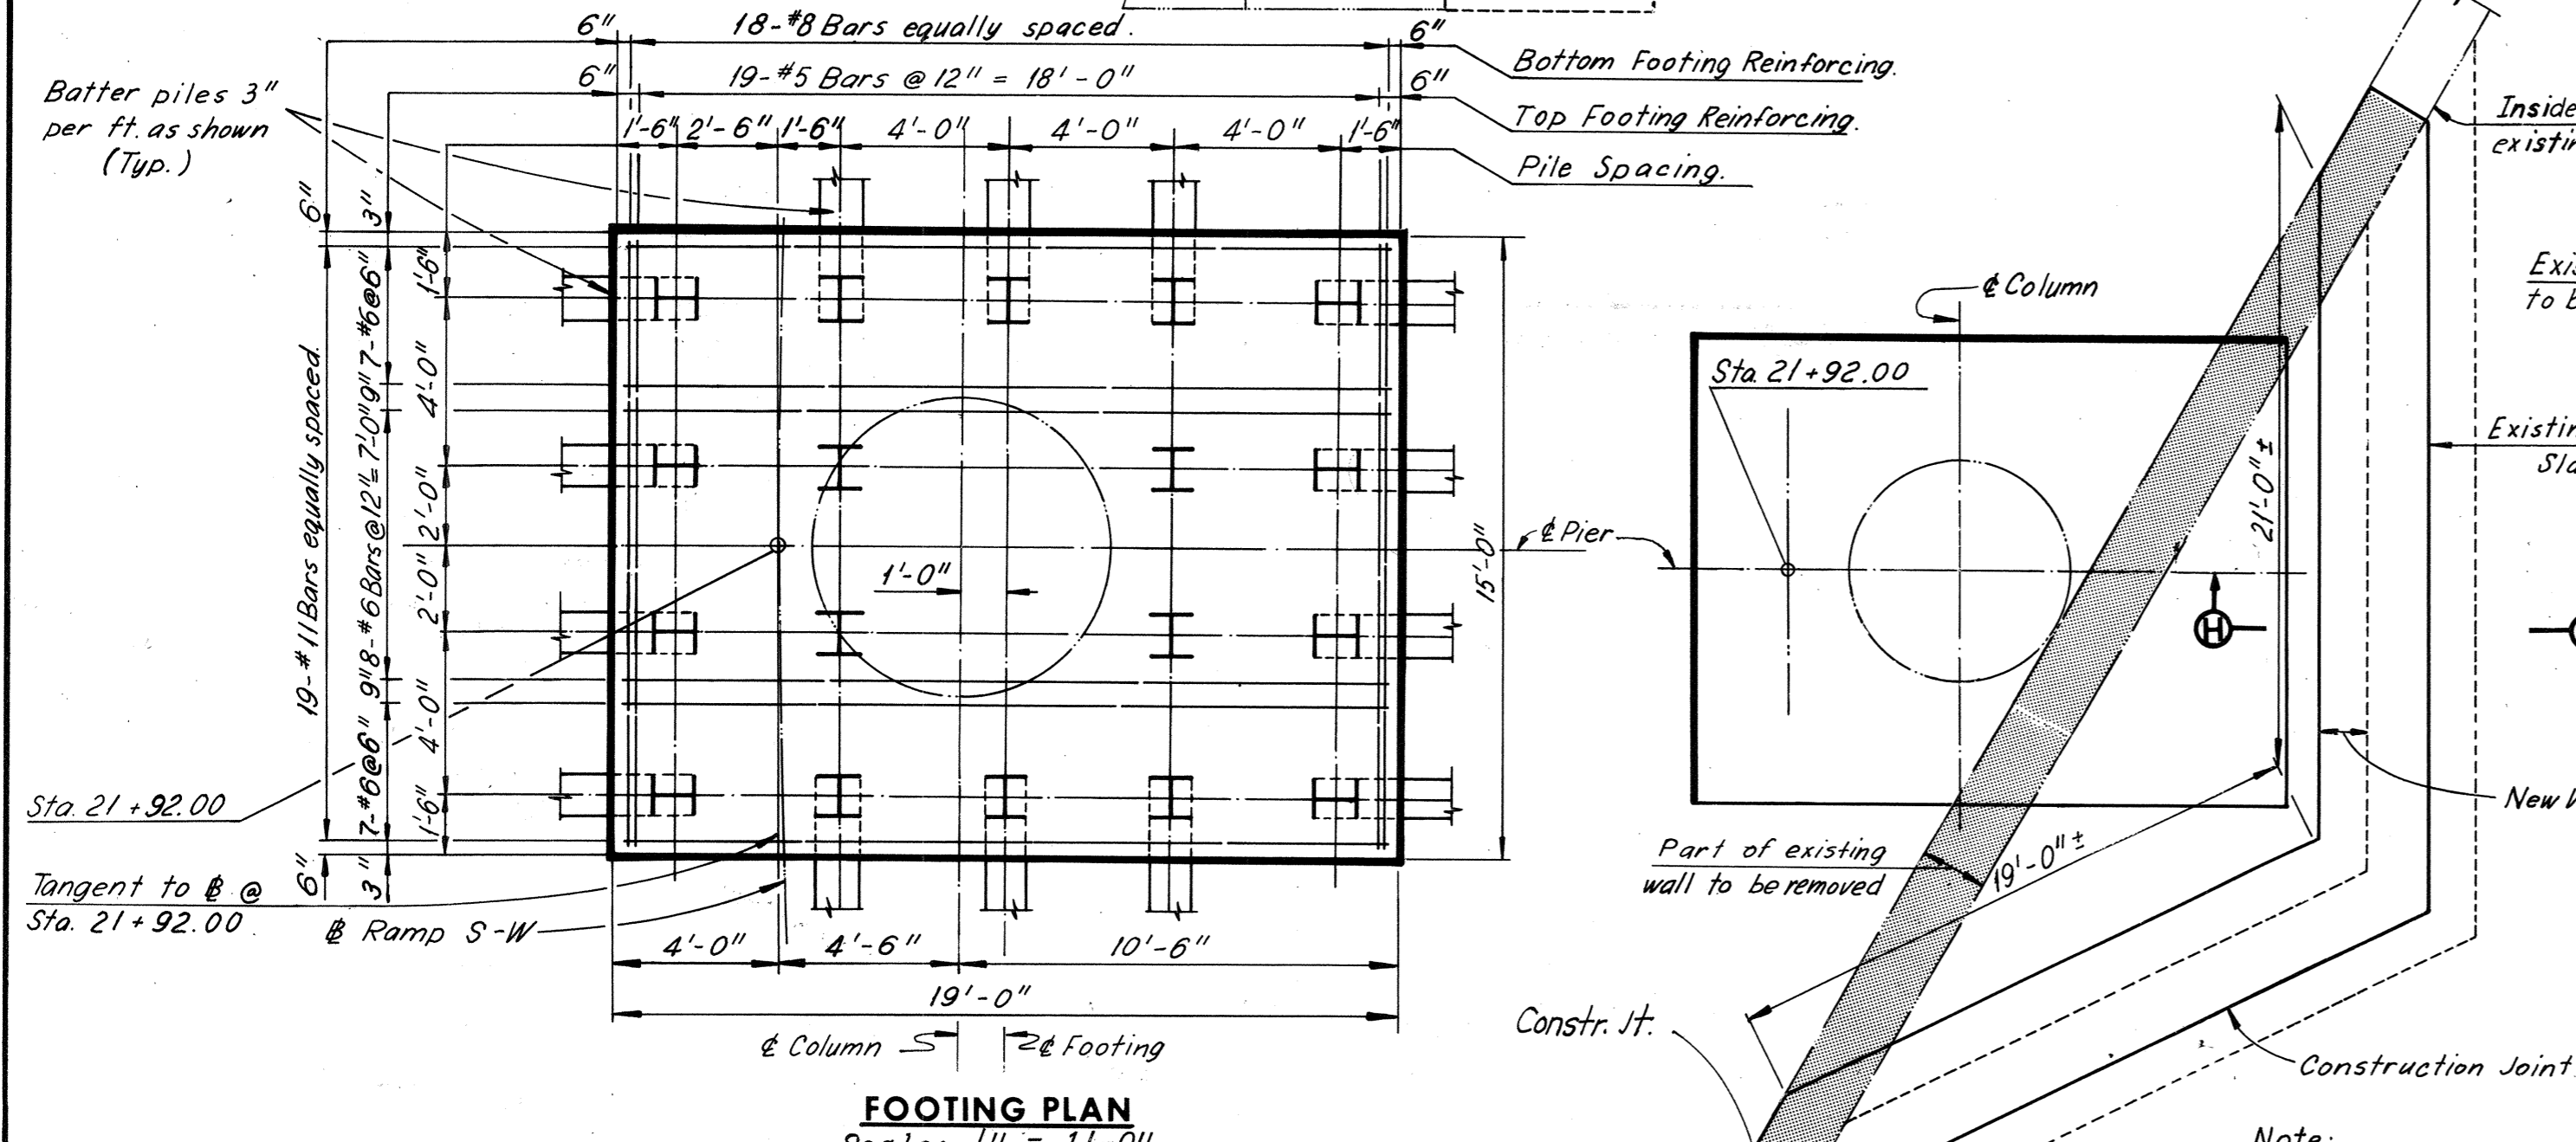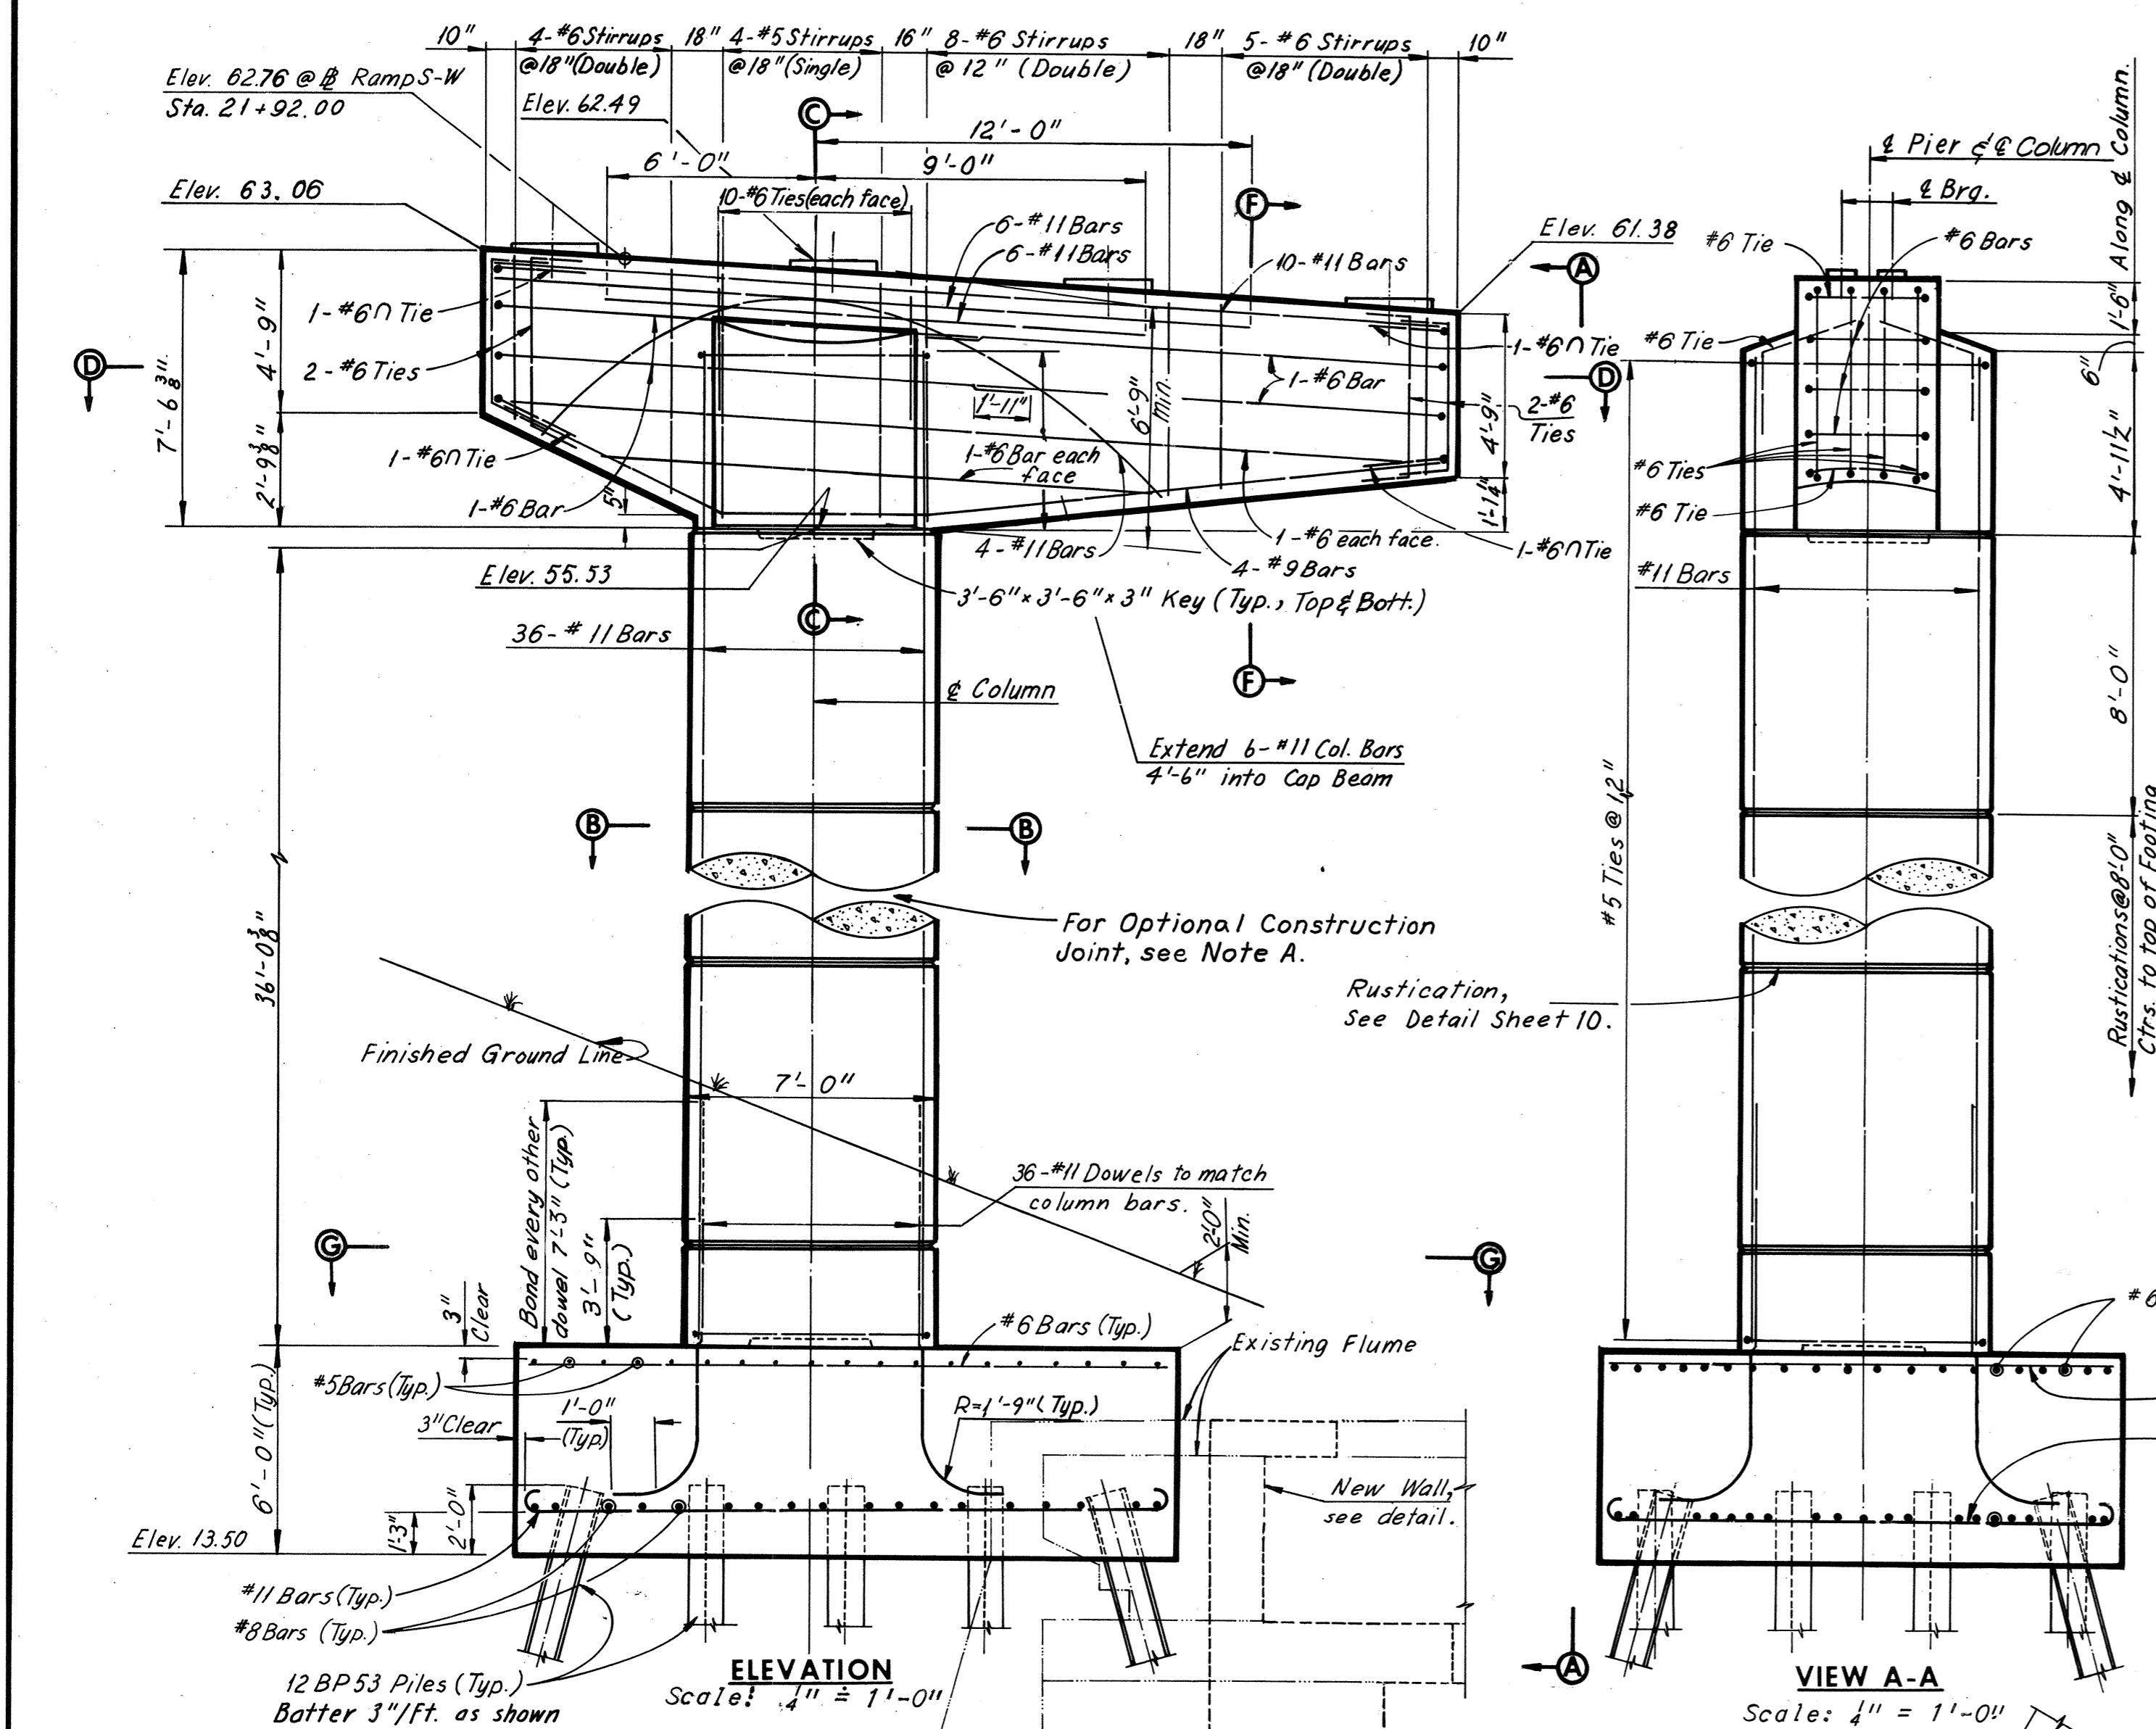

NOTE A
A construction joint will be permitted at a rustication near mid-height of the column. The column reinforcement may be lap spliced near the construction joint. The lap at the splice shall be a minimum of 3'-6". Splices shall be staggered at least 3'-3" between adjacent bars.

Notes:
Existing Flood-protection dike is to be restored to original contour upon completion of Pier construction.
For Steel Pile Details, see Sheet 9.
For Shoe Details, see Sheet 31 & 32.
Estimated Pile Tip elevation -14.0.

Note:
Footing elevations are approximate only and may be varied to suit field conditions as directed by the Engineer. Vertical shaft reinforcing shall not be cut until these elevations are established. Where elevations change more than 2 ft., redesign will be required.
Bottom elevation of Flume must be established by field inspection.

BY	DATE	NO.	REVISION	BY	DATE
PTA	12-20-68				
J.D.	1-15-69		Rev. Footing Reinf.	TEM	9-8-75




FOOTING FOR PIER 18 IS ECCENTRIC AS SHOWN ON FOOTING PLAN

AS BUILT
RICHMOND METROPOLITAN AUTHORITY
RICHMOND EXPRESSWAY SYSTEM
DOWNTOWN EXPRESSWAY
BRIDGE NO. 65
RAMP S-W CONNECTION FROM
RICHMOND-PETERSBURG TURNPIKE
PIER 18

HOWARD, NEEDLES, TAMMEN & BERGENDOFF
consulting engineers
NEW YORK ALEXANDRIA KANSAS CITY


SCALE: As Noted
CONTRACT NO. 11
SHEET NO. 15 OF 38

RICHMOND EXPRESSWAY SYSTEM			
SECTION	PROJECT	SHEET NO.	TOTAL SHEETS
11	DOWNTOWN EXPRESSWAY	41	97

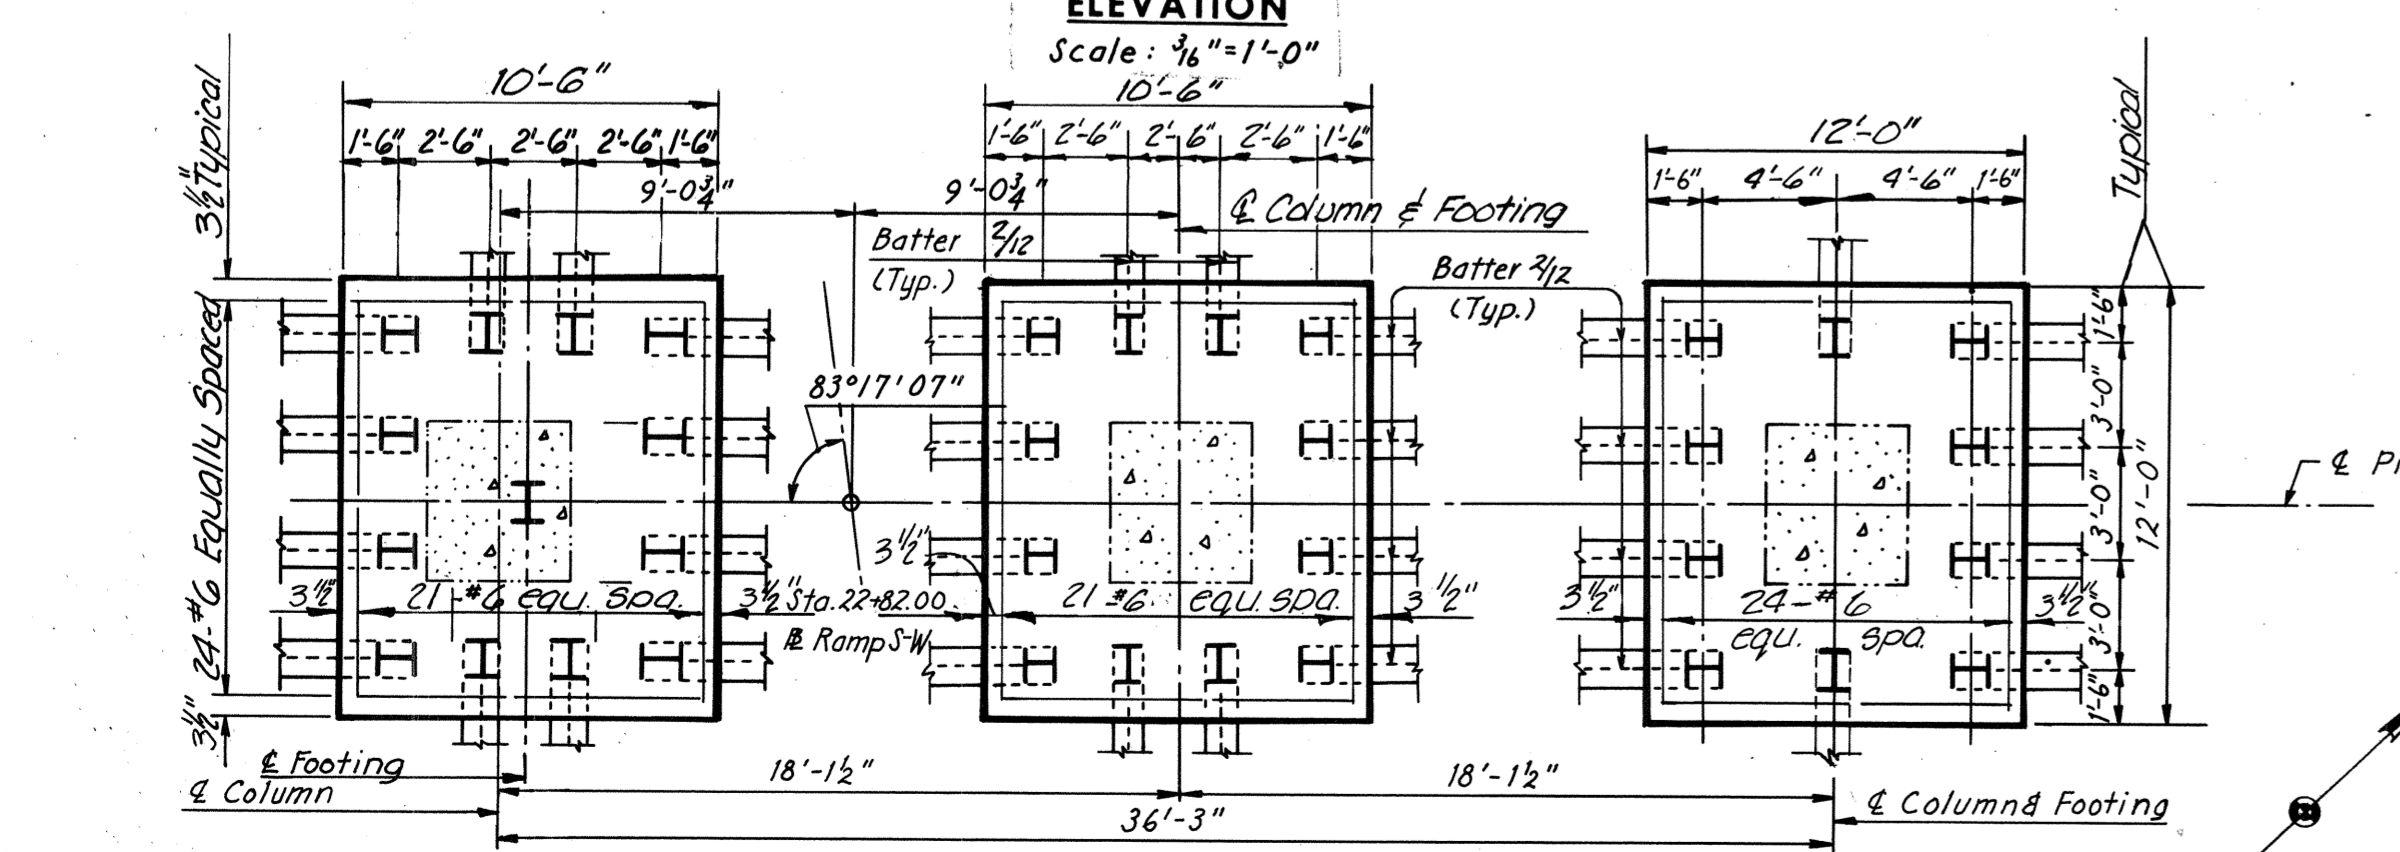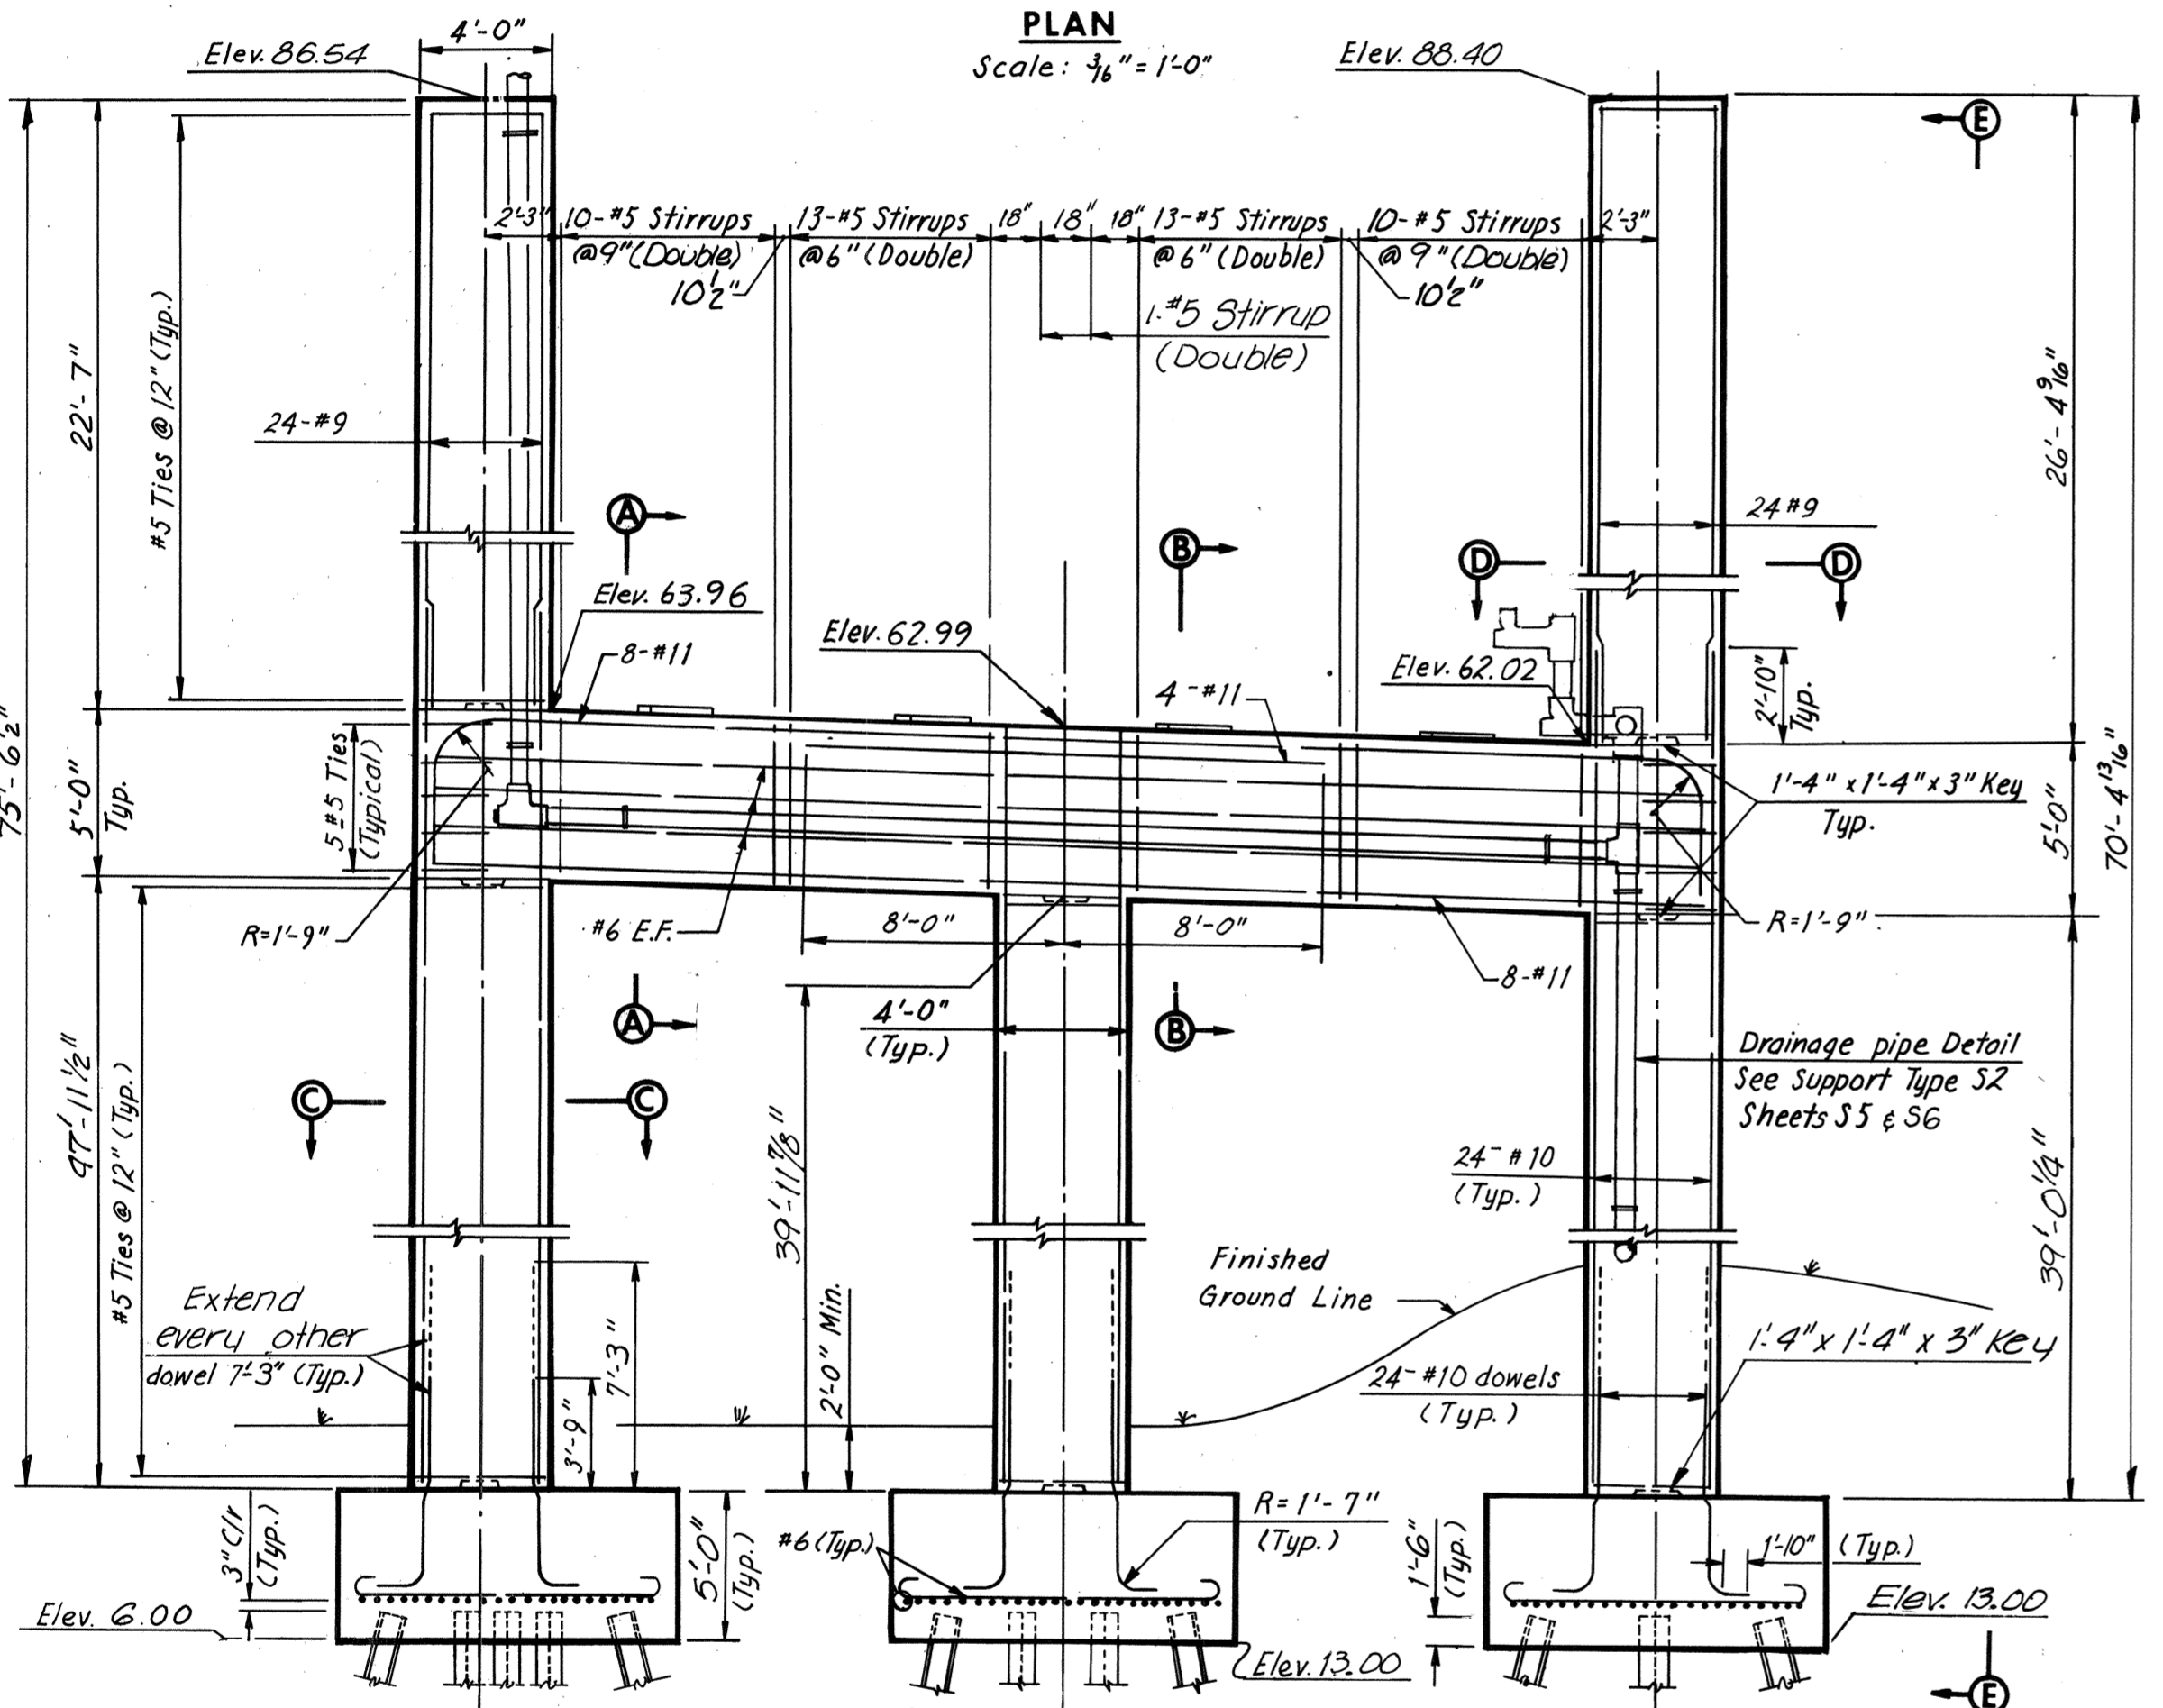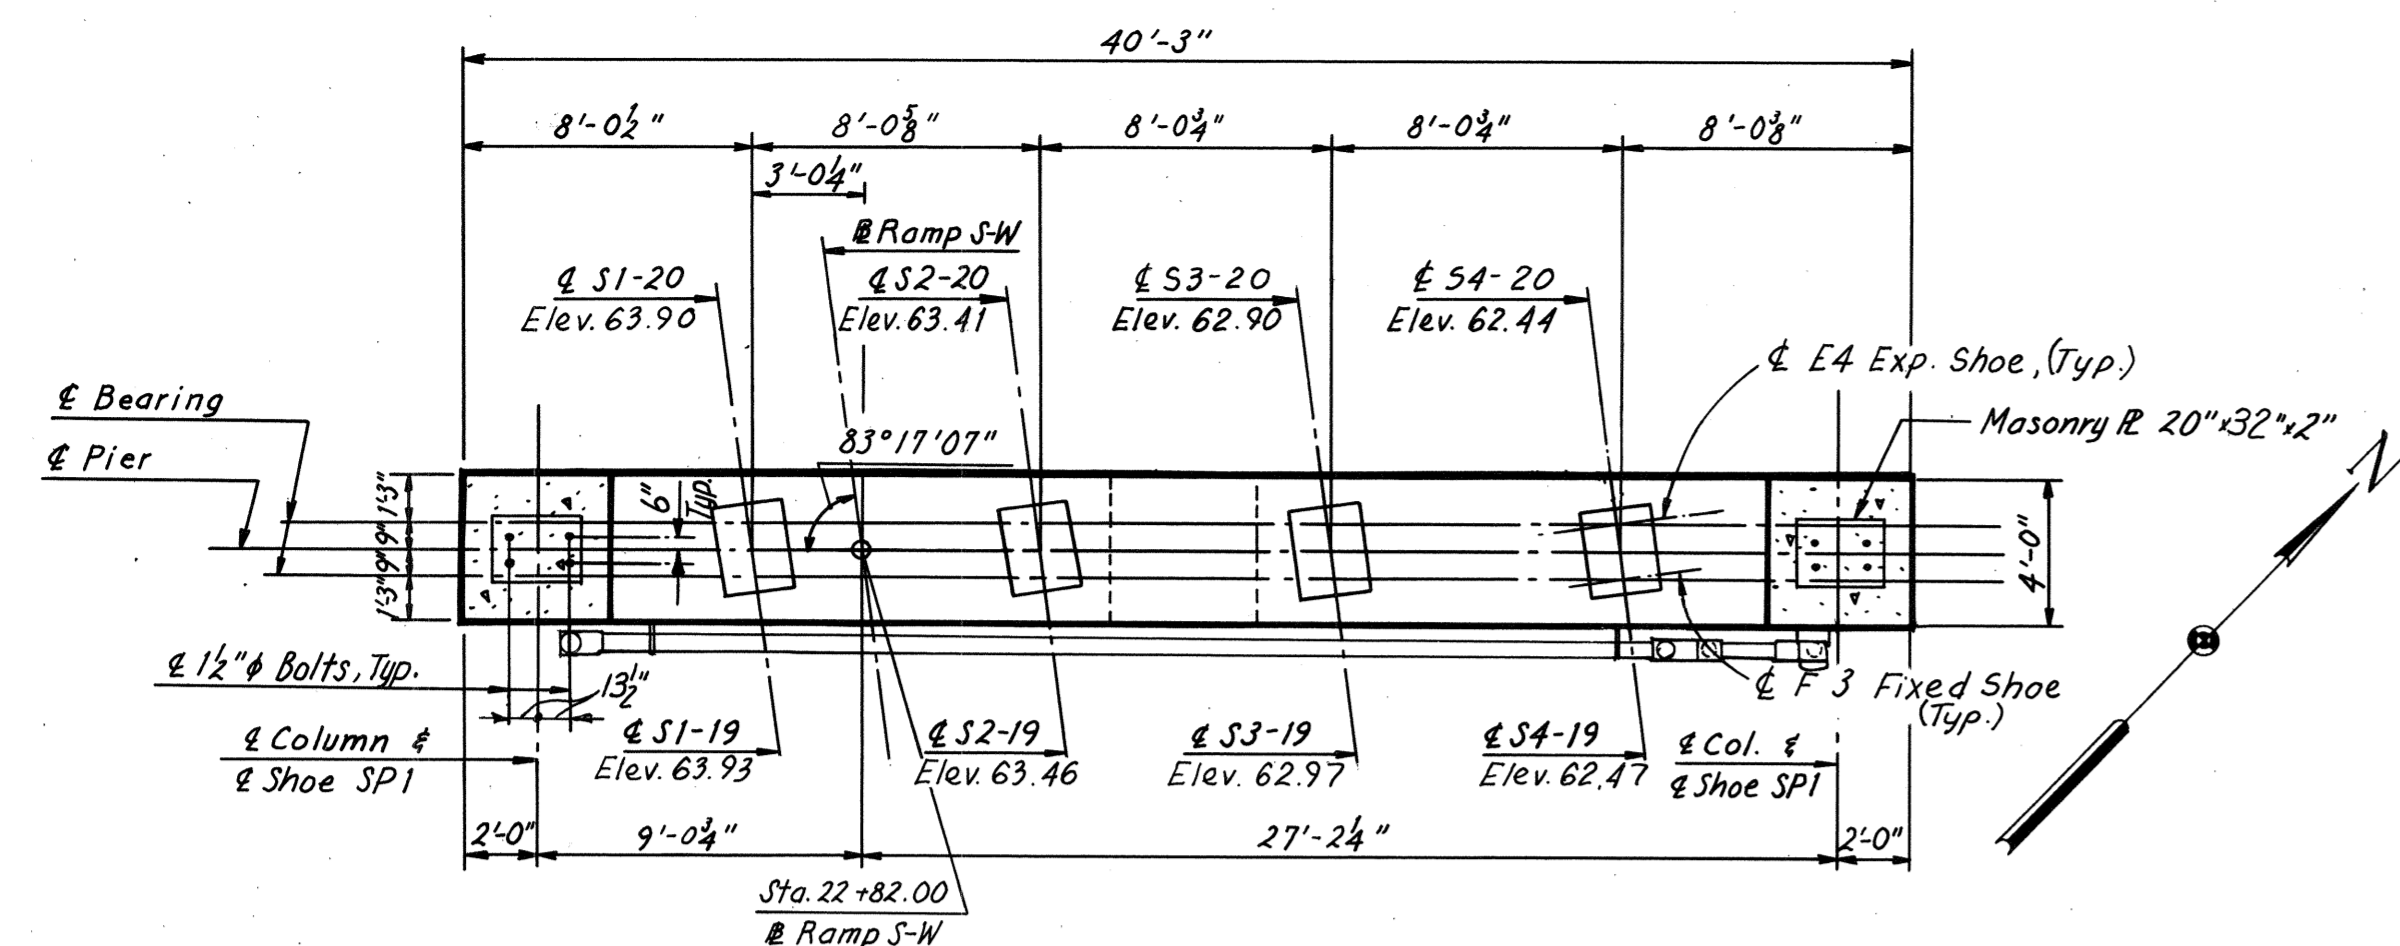


MADE	BY	DATE	NO.	REVISION	BY	DATE
	Y.C.P.	12-26-68		Shoe SPI	TEM	3-76
	JD	1-22-69		Rev. Elevations	SSS	12-75


FOOTING PLAN
Scale: 3/16" = 1'-0"

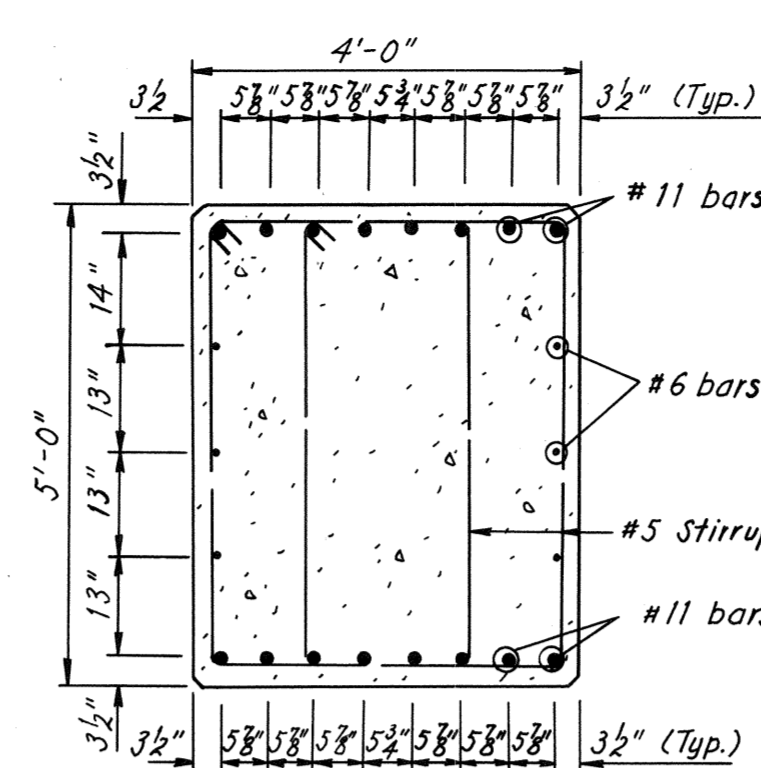


SECTION A-A
Scale: 1/2" = 1'-0"

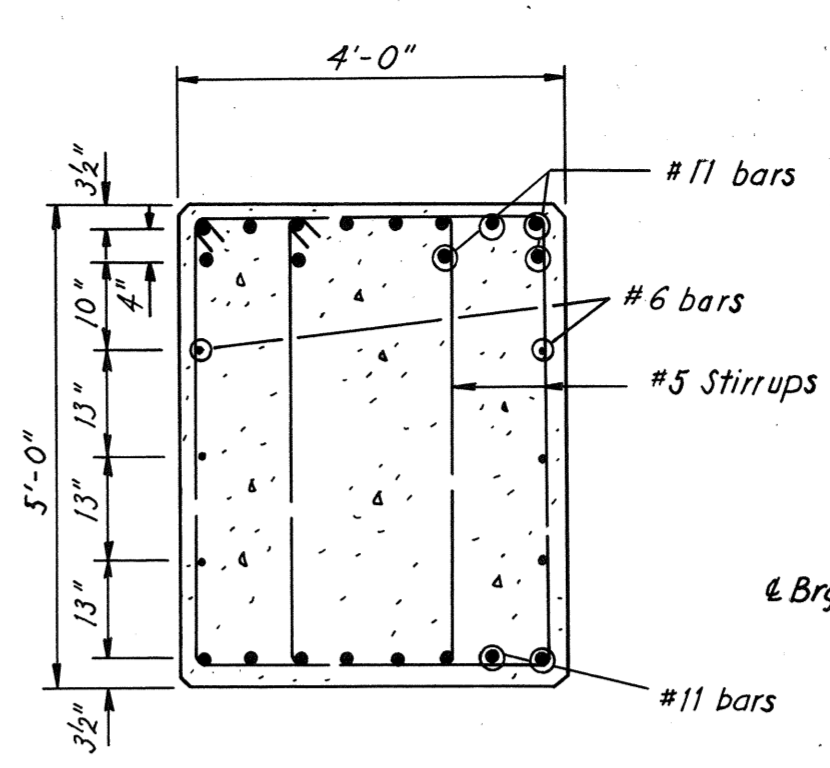


SECTION B-B
Scale: 1/2" = 1'-0"

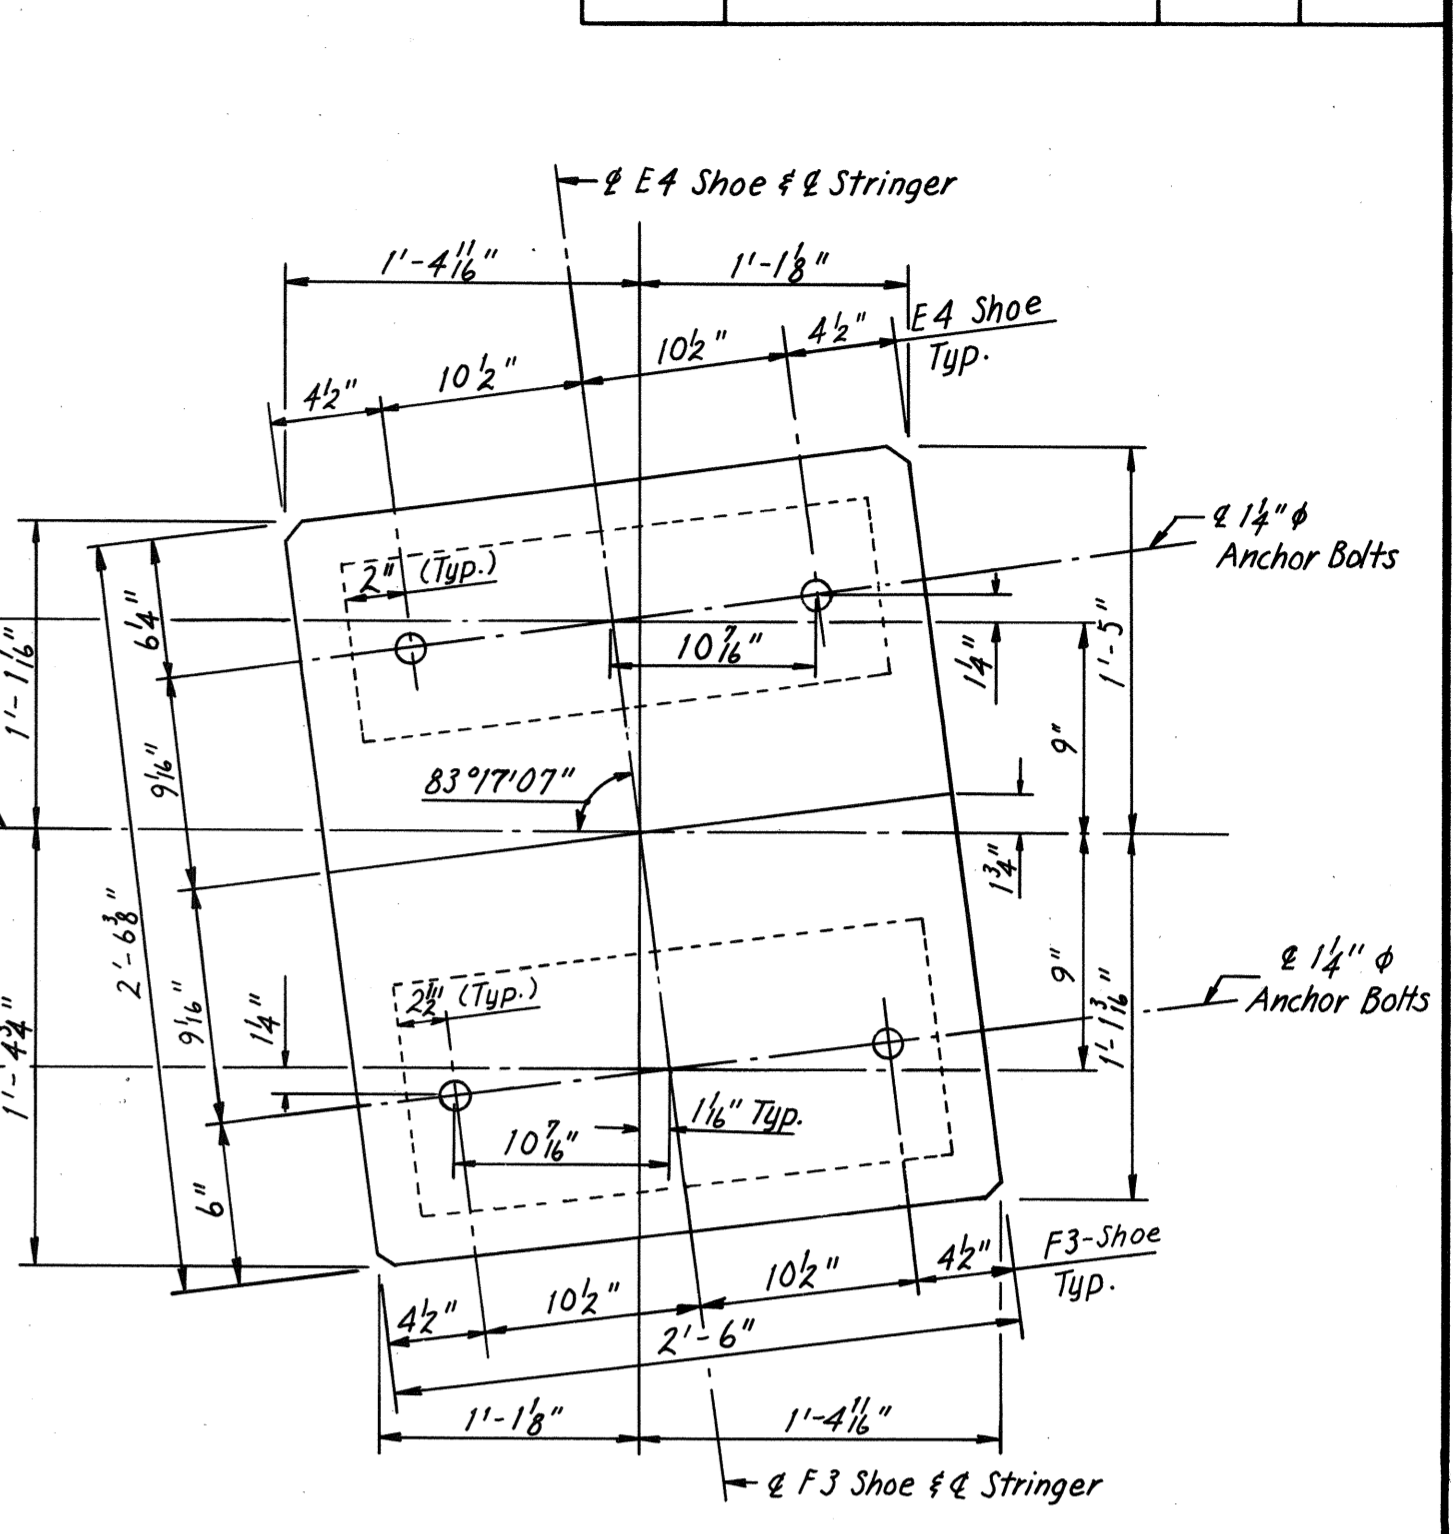


PAD AND ANCHOR BOLT SETTING PLAN
No Scale

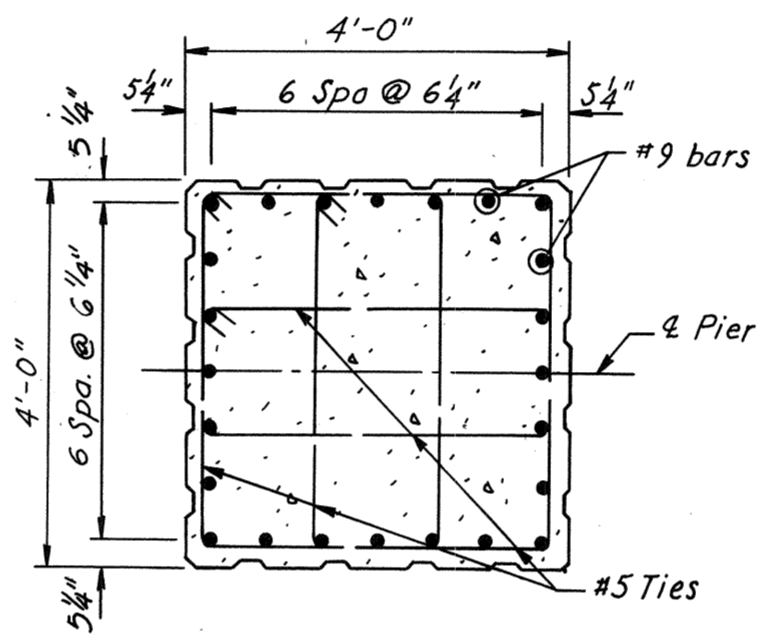


SECTION D-D
Scale: 1/2" = 1'-0"

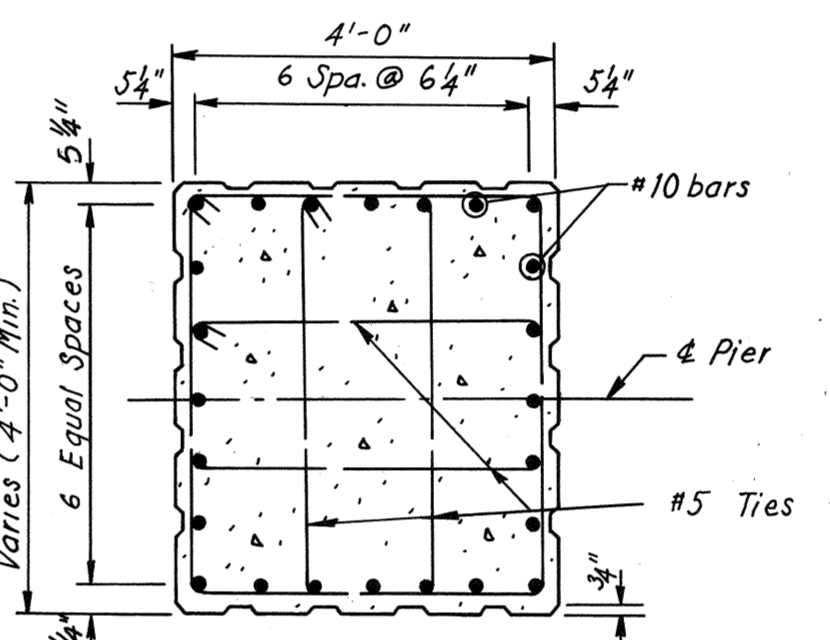

SECTION C-C
No Scale

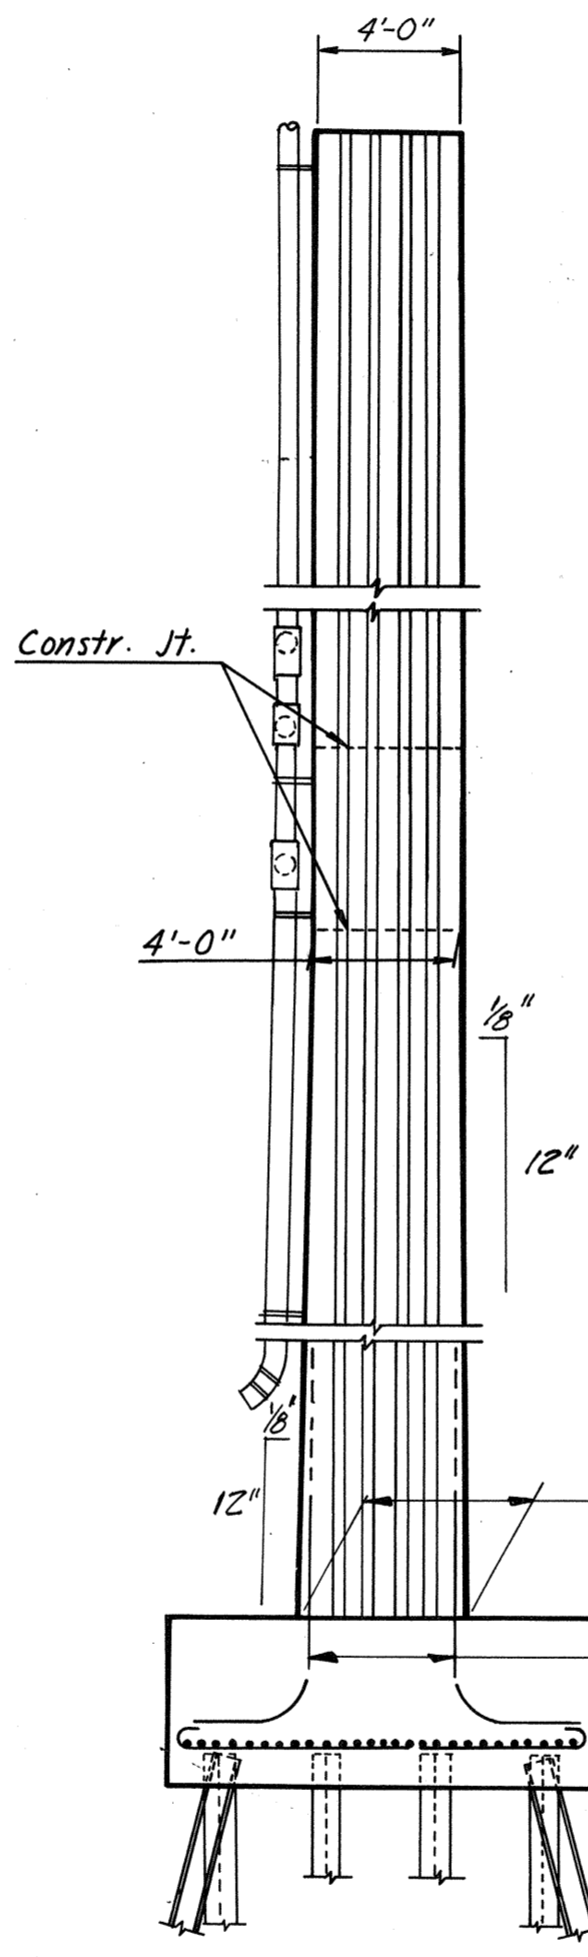


VIEW E-E
Scale: 3/16" = 1'-0"

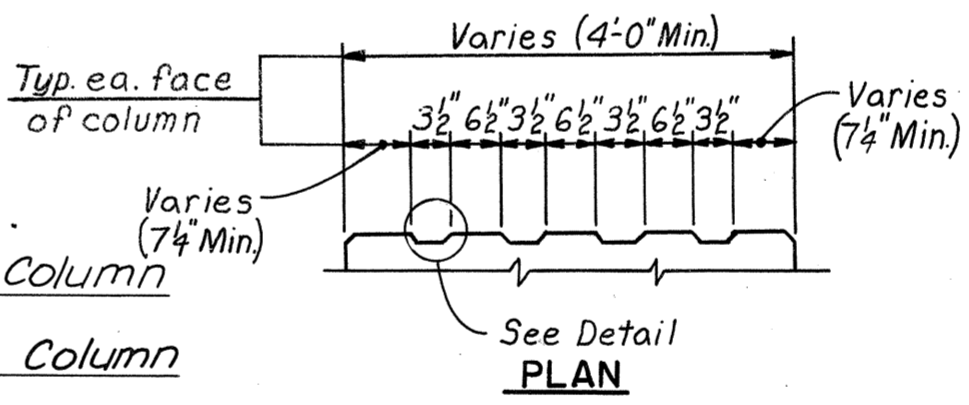

RUSTICATION DETAIL

DETAIL

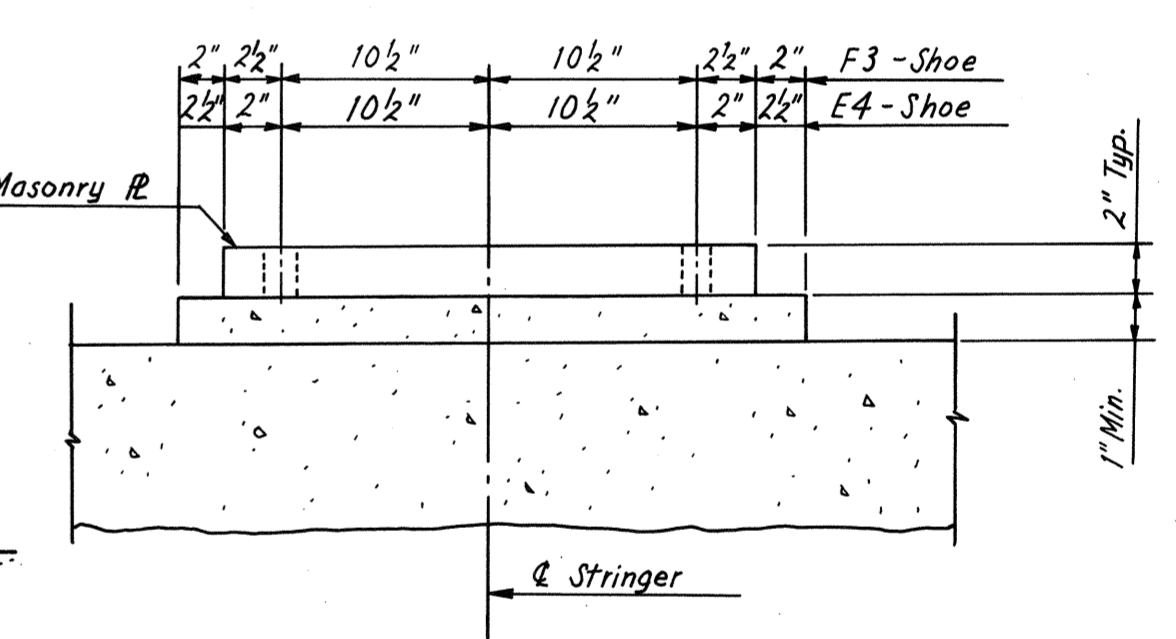

PAD ELEVATION VIEW
No Scale

Note: Existing Flood-protection dike is to be restored to original contour upon completion of Pier construction.

Note: Footing elevations are approximate only and may be varied to suit field conditions as directed by the Engineer. Vertical shaft reinforcement shall not be cut until these elevations are established. Where elevations change more than 2 ft., redesign will be required.











AS BUILT

RICHMOND METROPOLITAN AUTHORITY
RICHMOND EXPRESSWAY SYSTEM
DOWNTOWN EXPRESSWAY

BRIDGE NO. 65
RAMP S-W CONNECTION FROM
RICHMOND-PETERSBURG TURNPIKE
PIER 19

HOWARD, NEEDLES, TAMMEN & BERGENDOFF
consulting engineers
NEW YORK ALEXANDRIA KANSAS CITY

SCALE: As Noted
CONTRACT NO. 11
SHEET NO. 16 OF 38

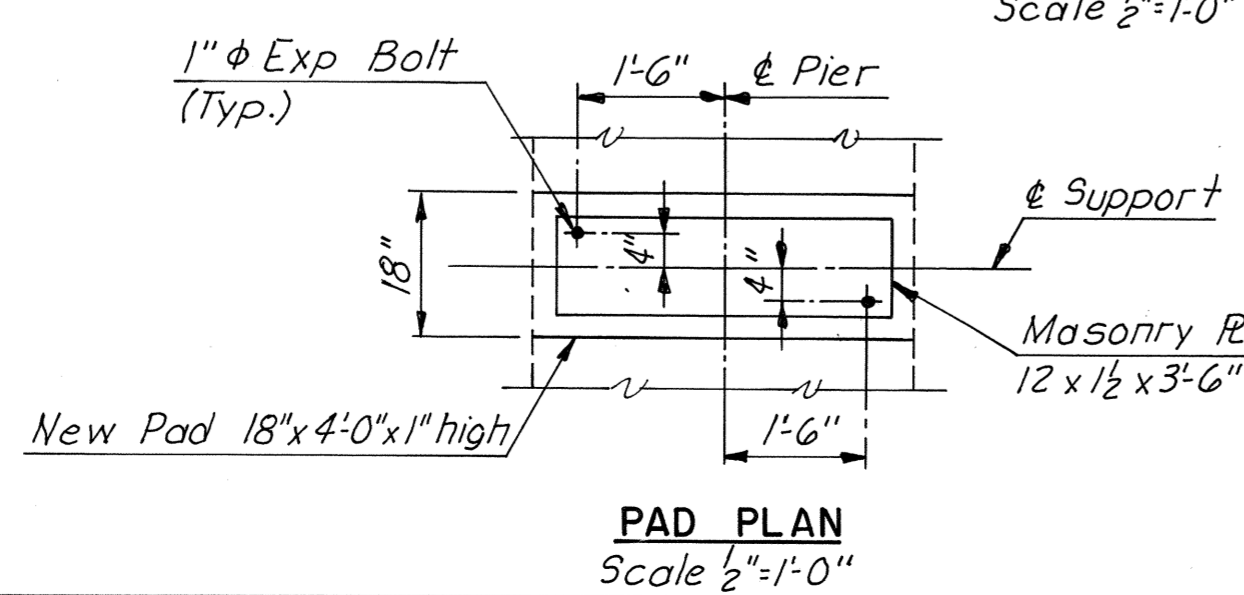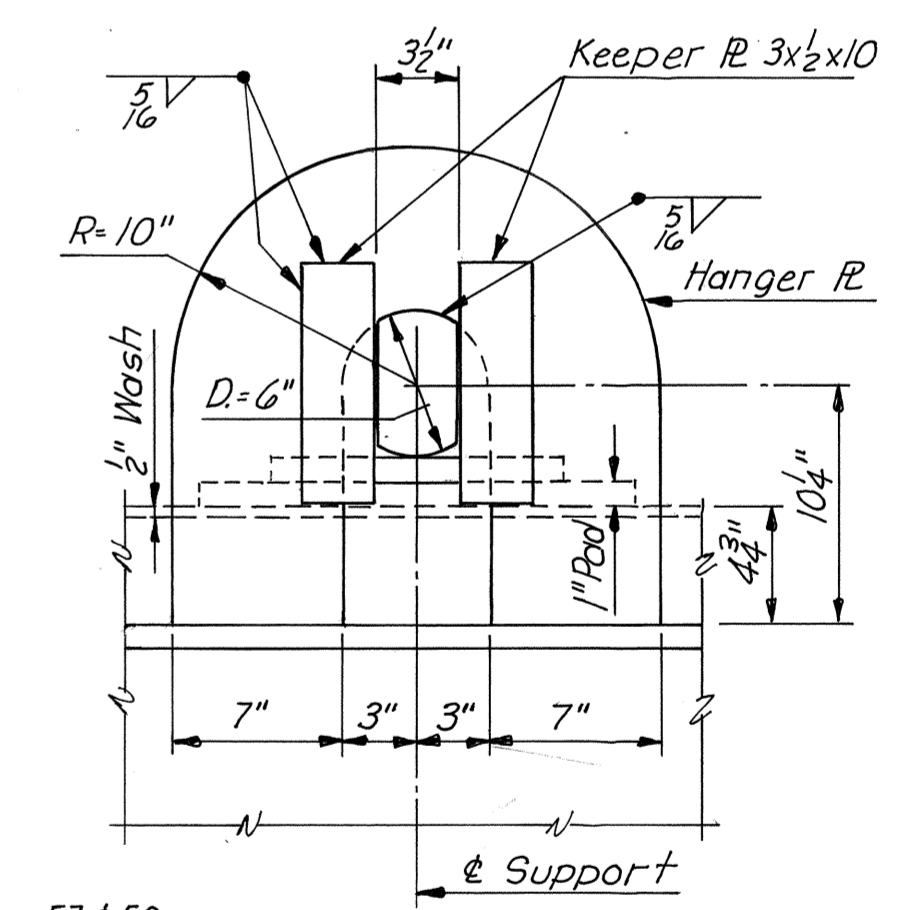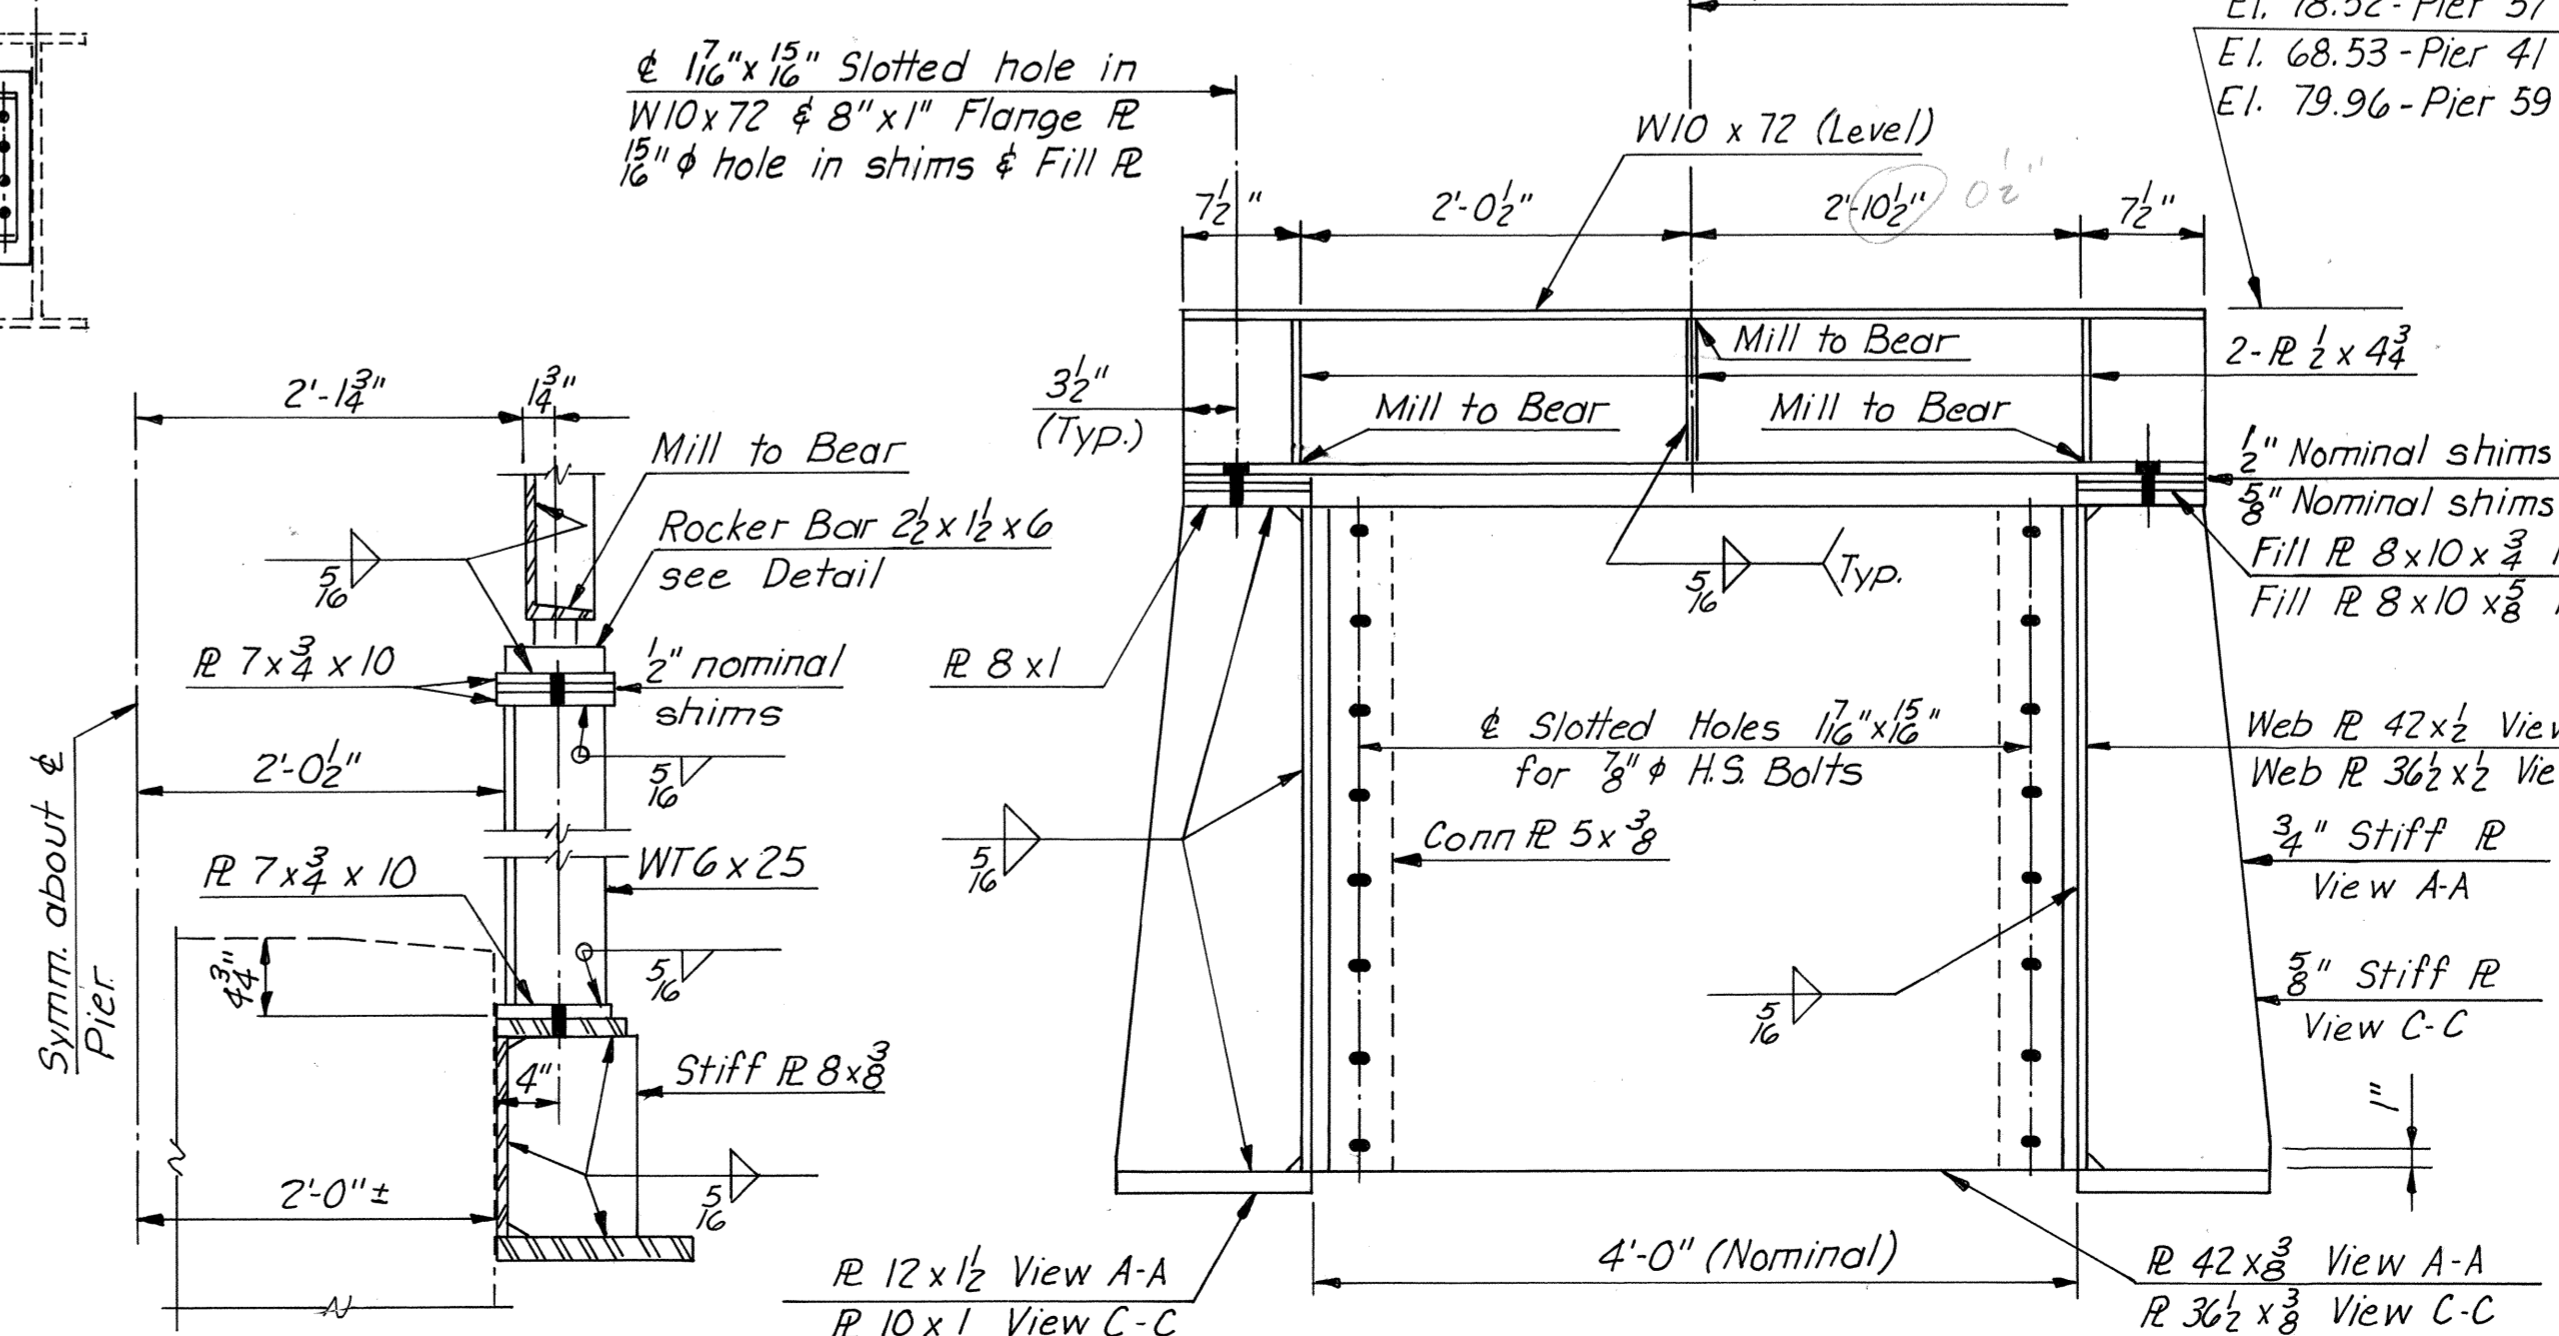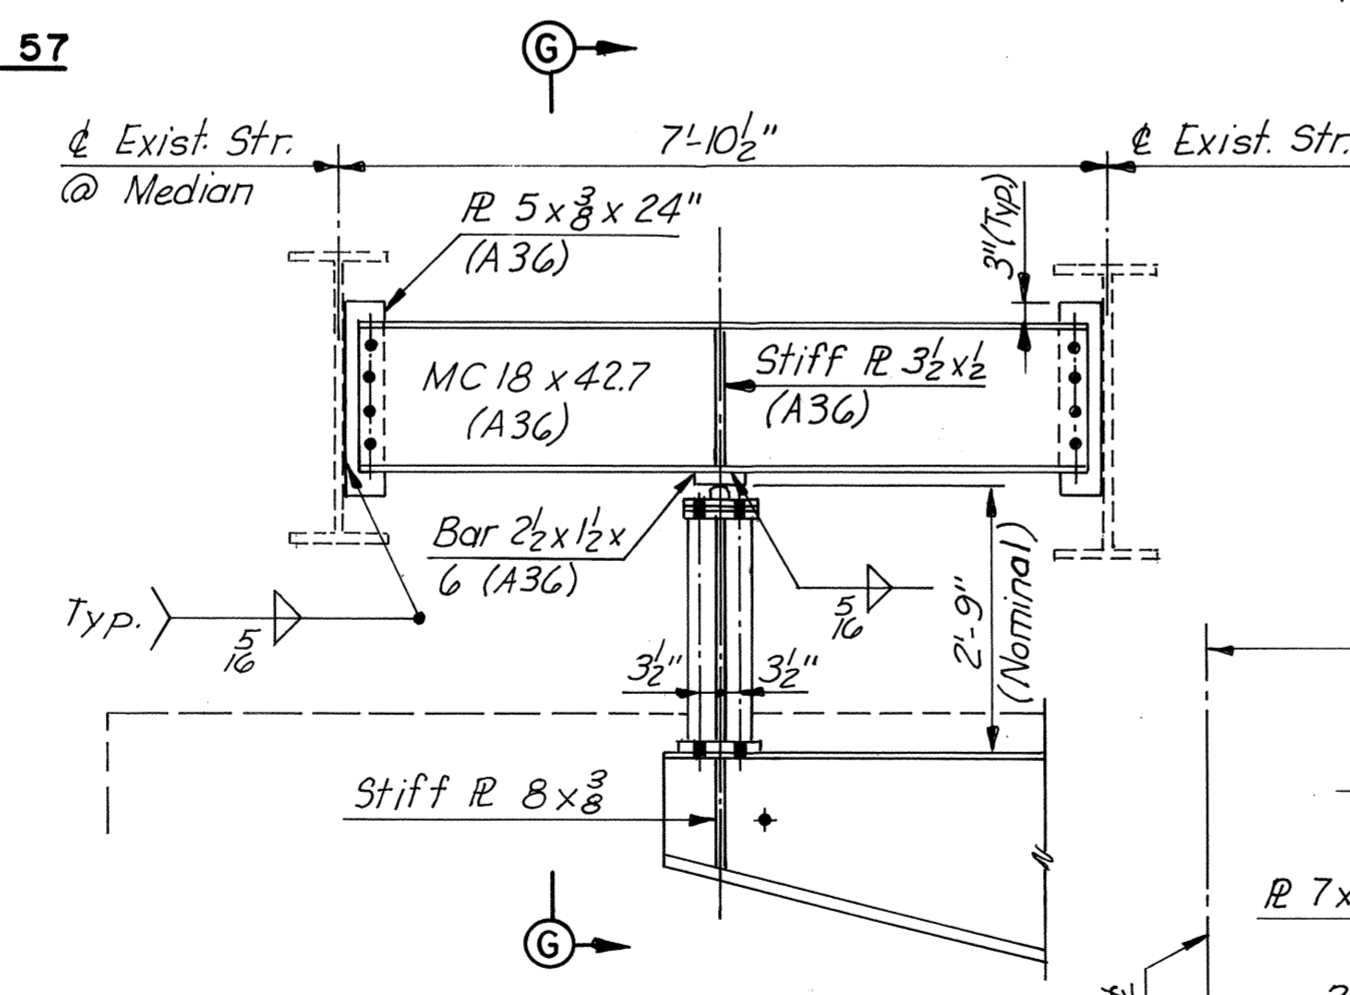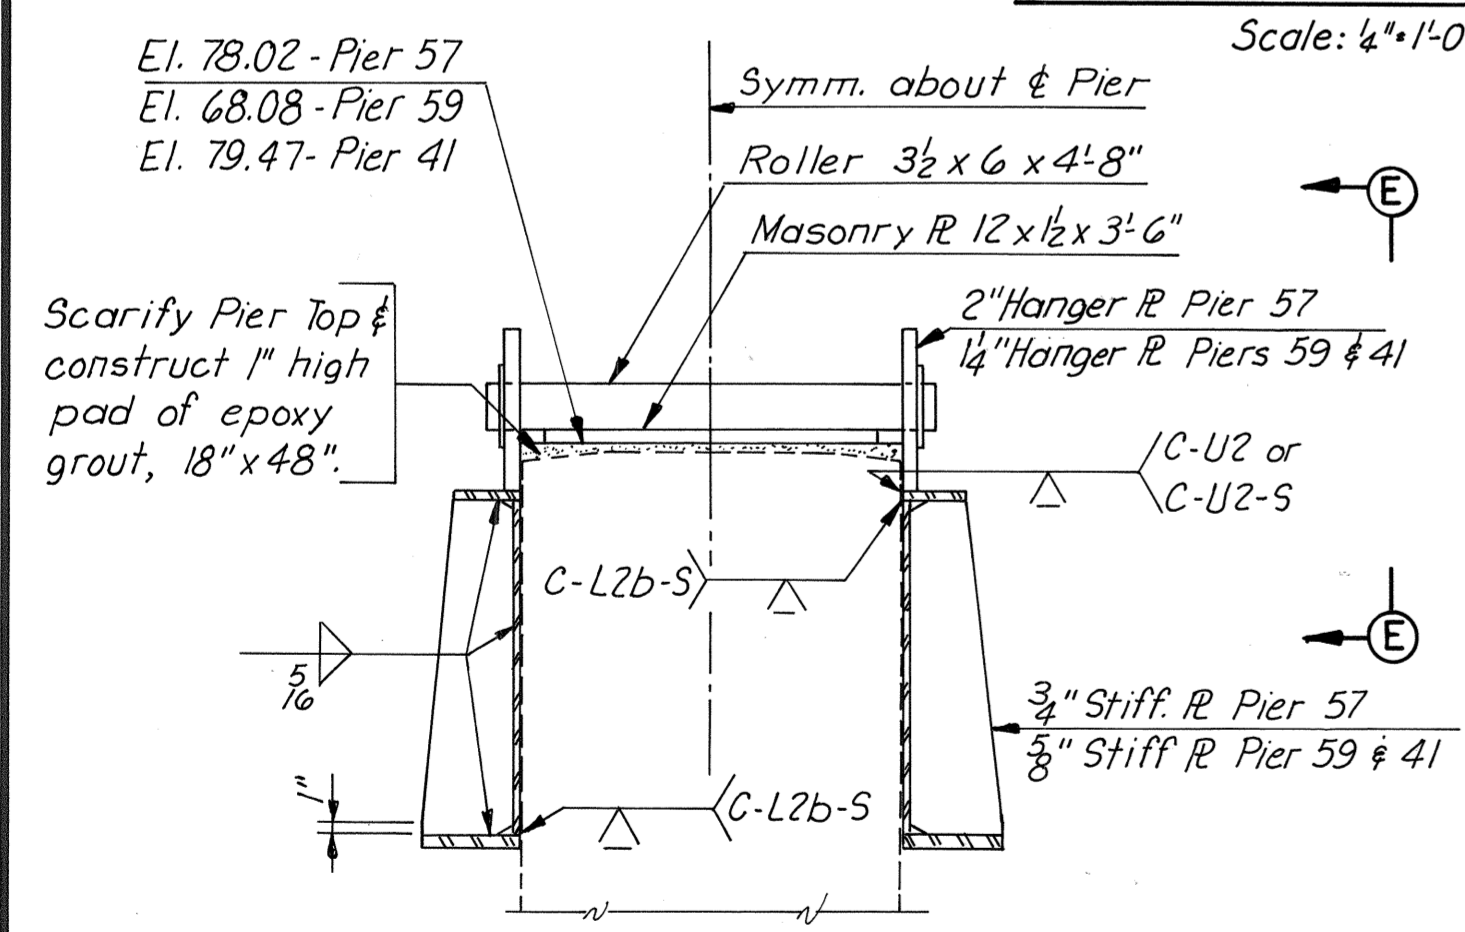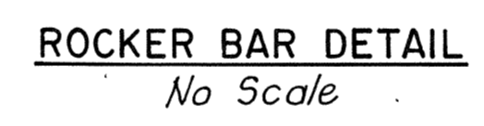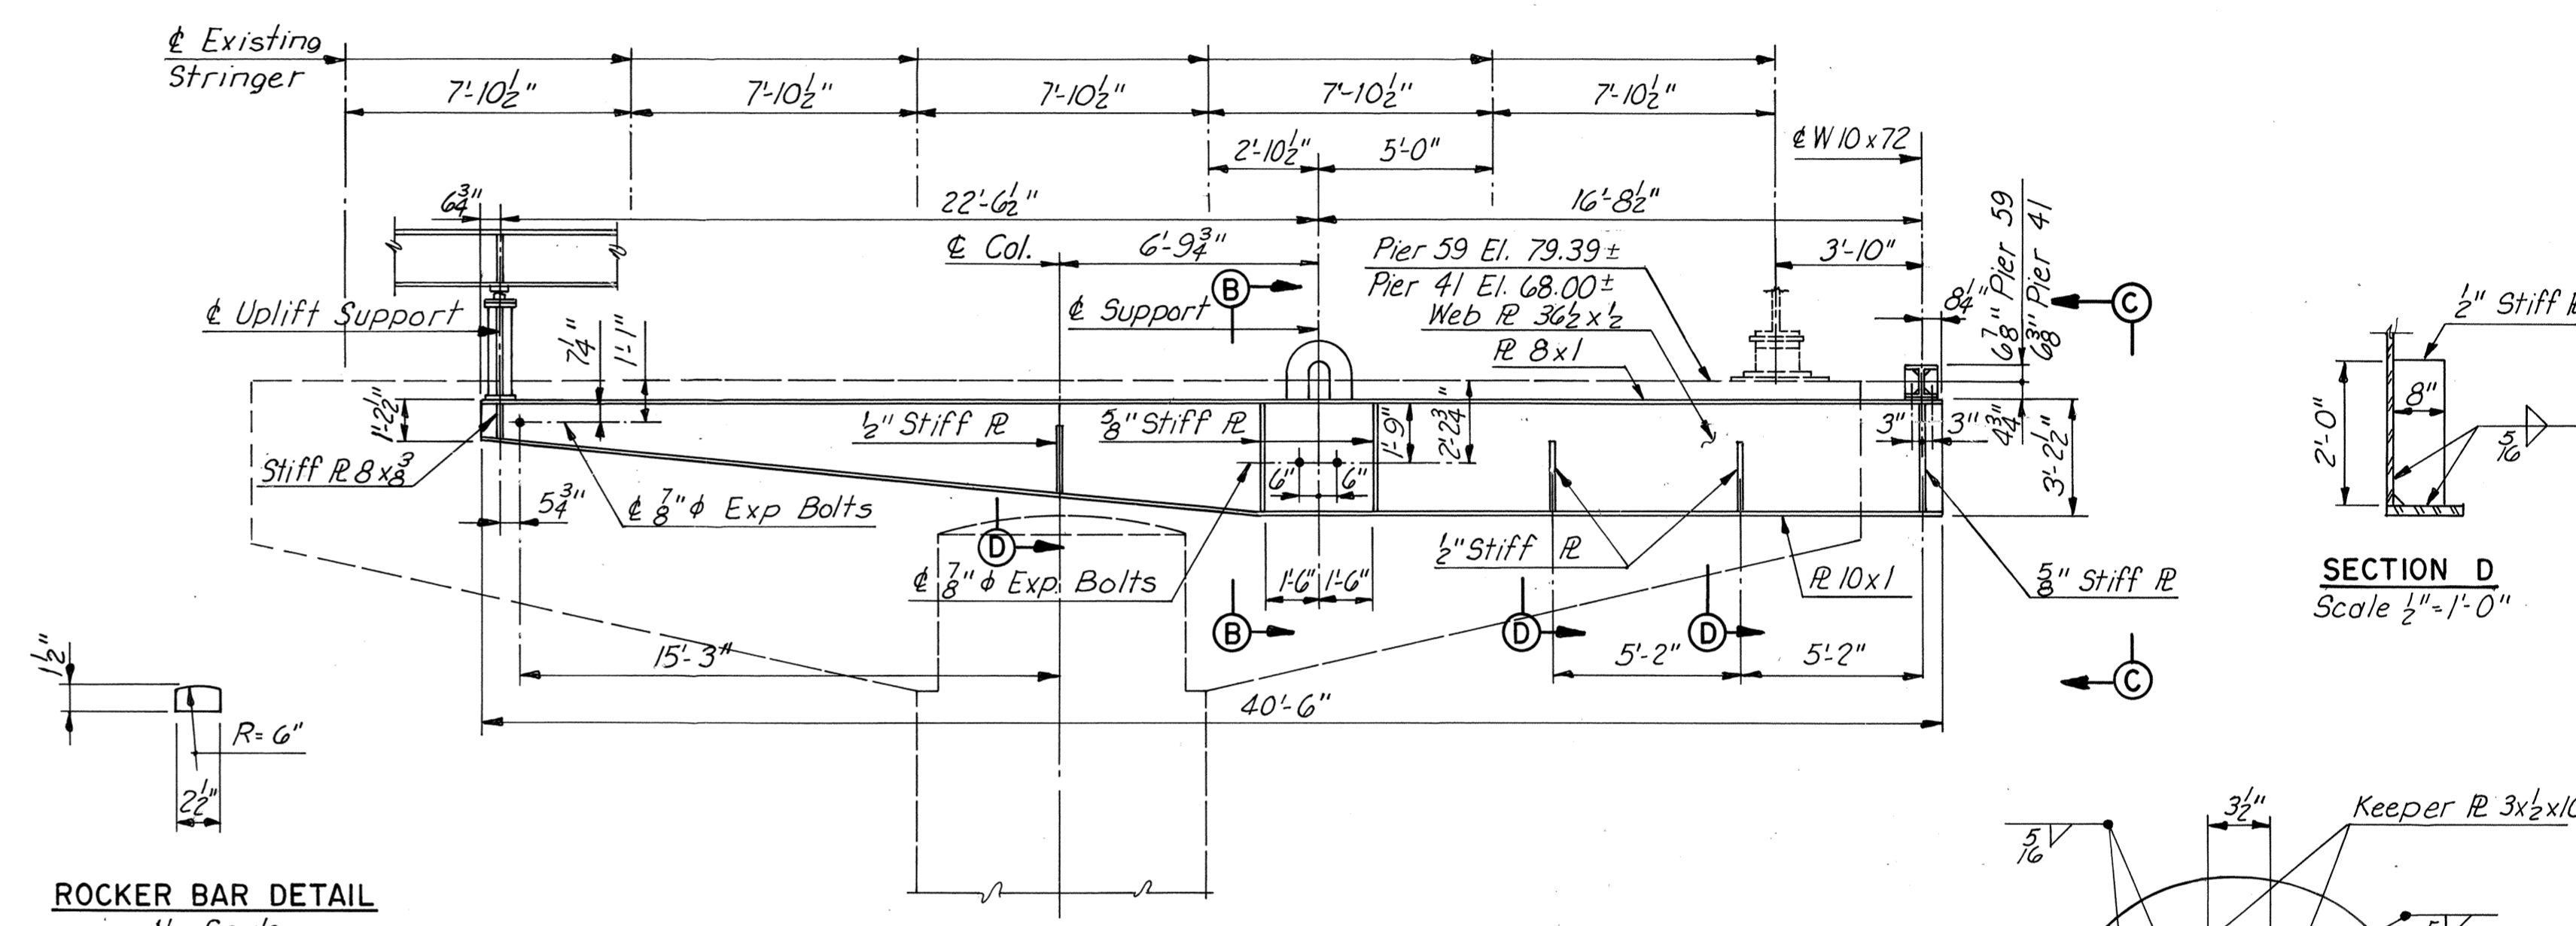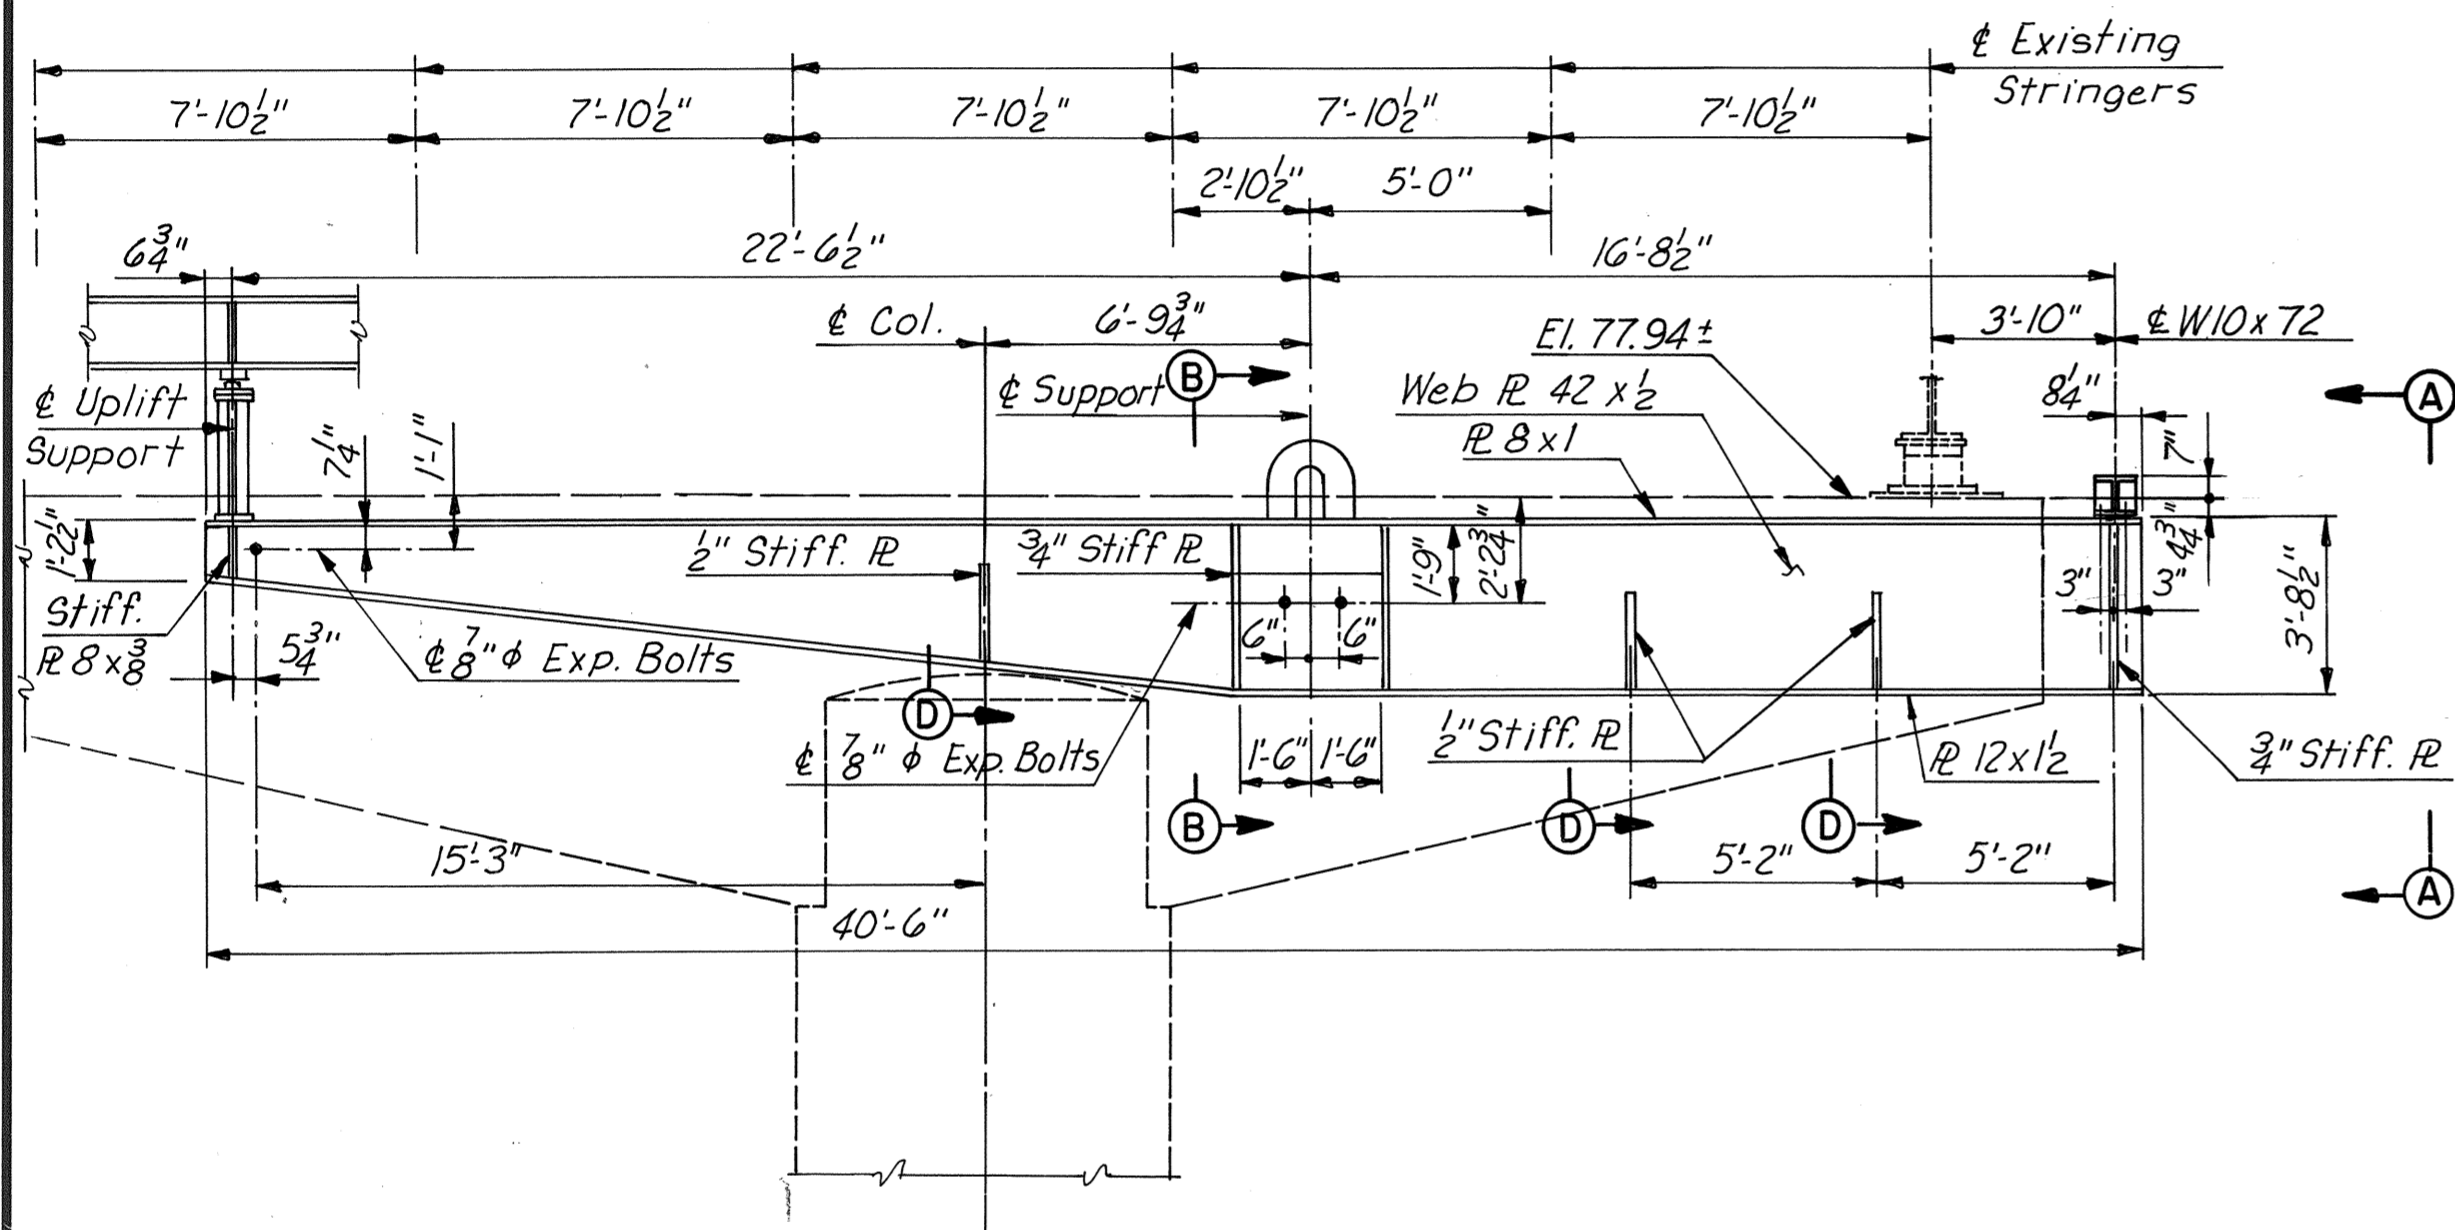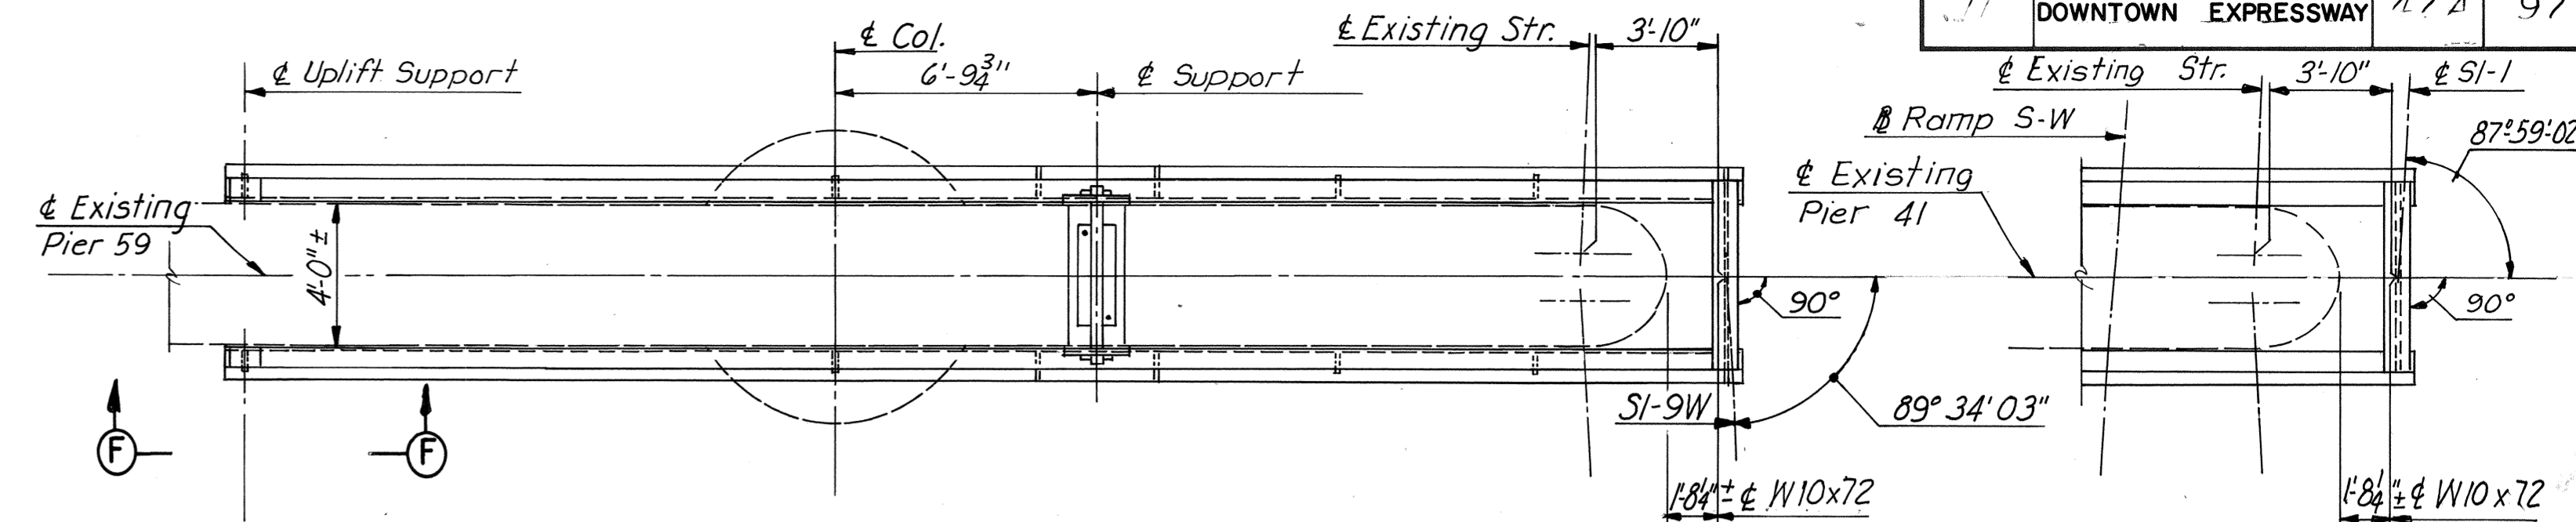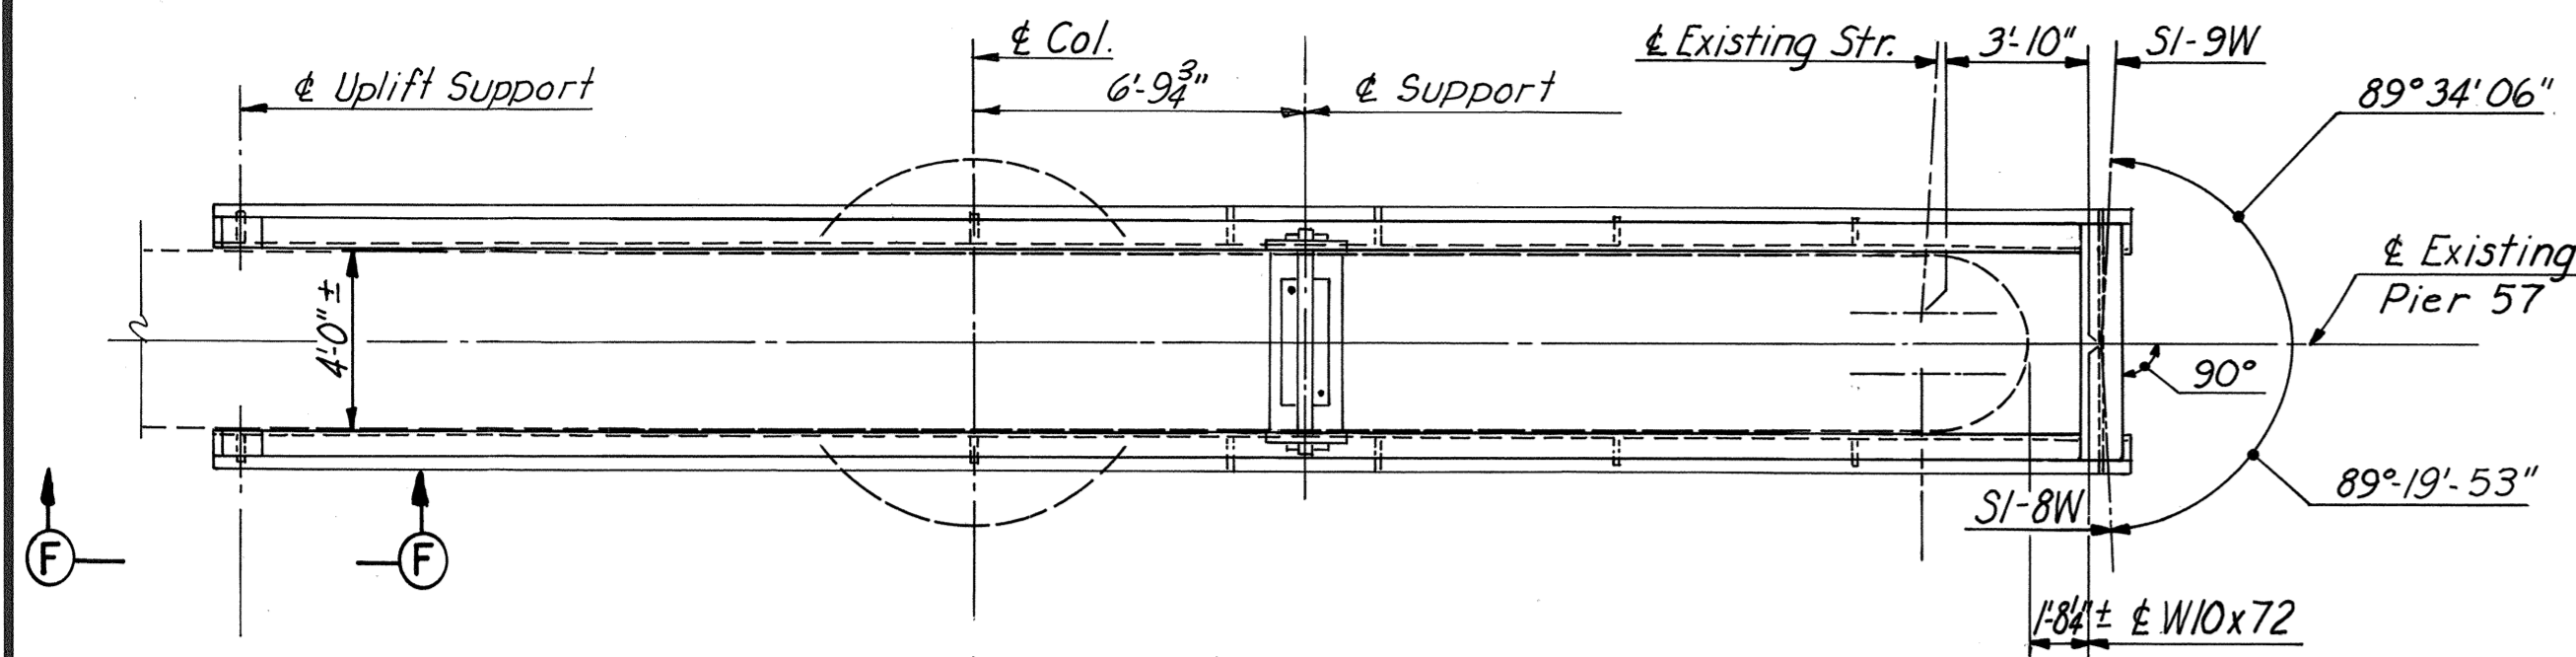

AS BUILT
NOTE: Structural steel shall be A588 except as noted.

RICHMOND METROPOLITAN AUTHORITY
RICHMOND EXPRESSWAY SYSTEM
DOWNTOWN EXPRESSWAY

BRIDGE NO. 65
RAMP S-W CONNECTION TO
RICHMOND - PETERSBURG TURNPIKE


EXISTING PIERS 41, 57 & 59 MODIFICATIONS

SCALE As Noted
DATE

HOWARD, NEEDLES, TAMMEN & BERGENDOFF
CONSULTING ENGINEERS
Alexandria, Virginia

SHEET 17A OF 38
HNTB

DESIGNED	NO.	REVISION	BY	DATE
	1	Entire Sheet	TEM	10-76
	2	Elev. and Dim.	TEM	9-8-75
	3	New Sheet added	d.B.P.	8-25-75
	4			

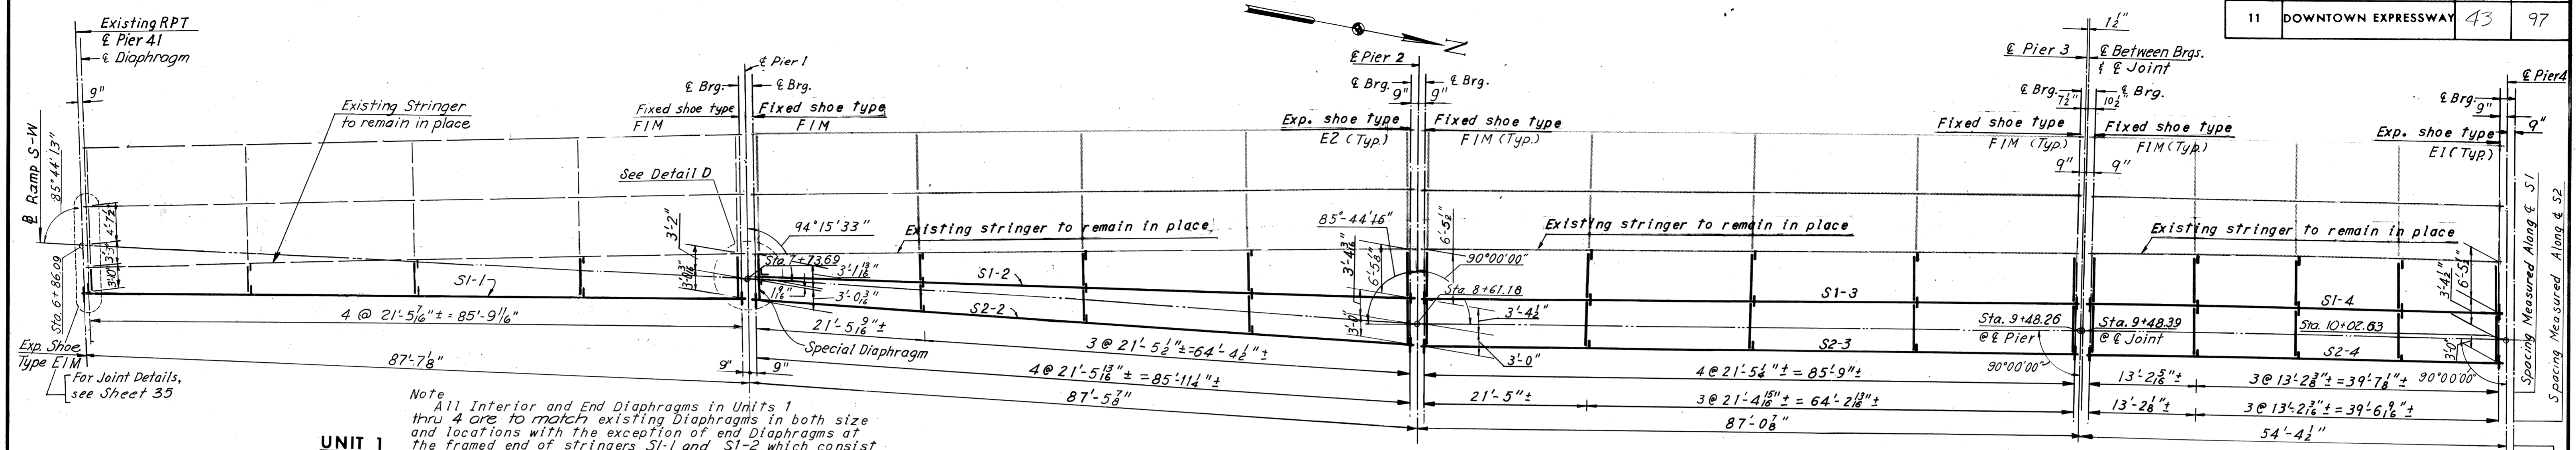













UNIT 1
 Note: All Interior and End Diaphragms in Units 1 thru 4 are to match existing Diaphragms in both size and locations with the exception of end Diaphragms at the framed end of stringers S1-1 and S1-2 which consist of Full depth Diaphragms as shown in Sections C-C, D-D and Detail D, and Section G-G.

UNIT 2

UNIT 3

UNIT 4

EXPANSION SHOE		FIXED SHOES	
TYPE	NO. REQ'D.	TYPE	NO. REQ'D.
E1	2	FIM	8
E2	2		
E1M	1		

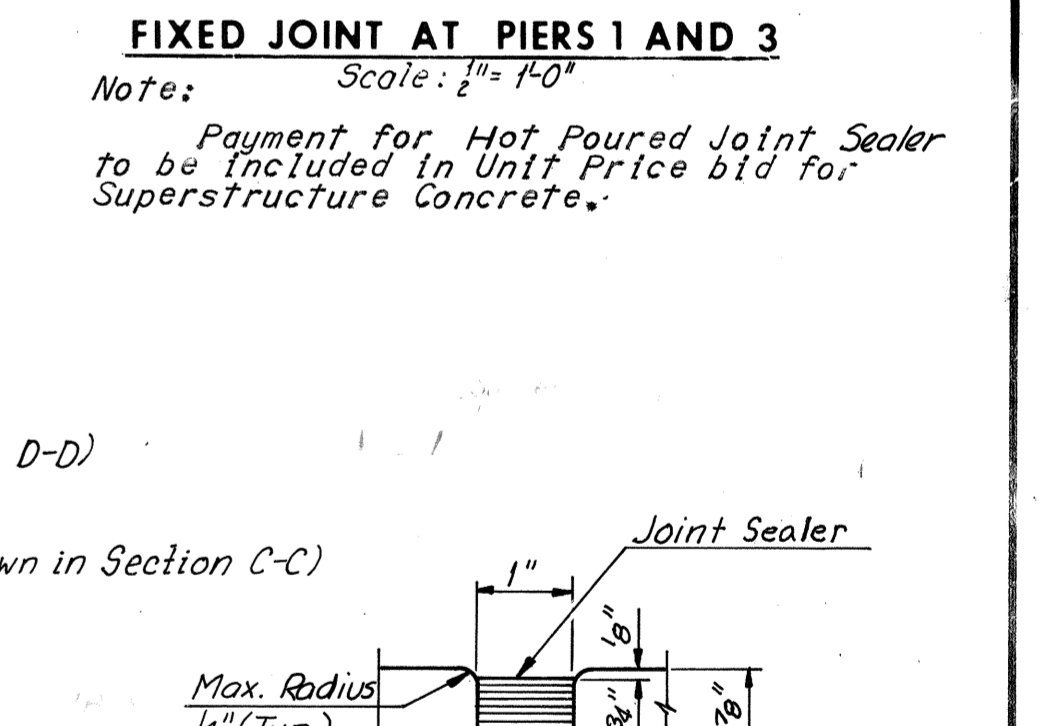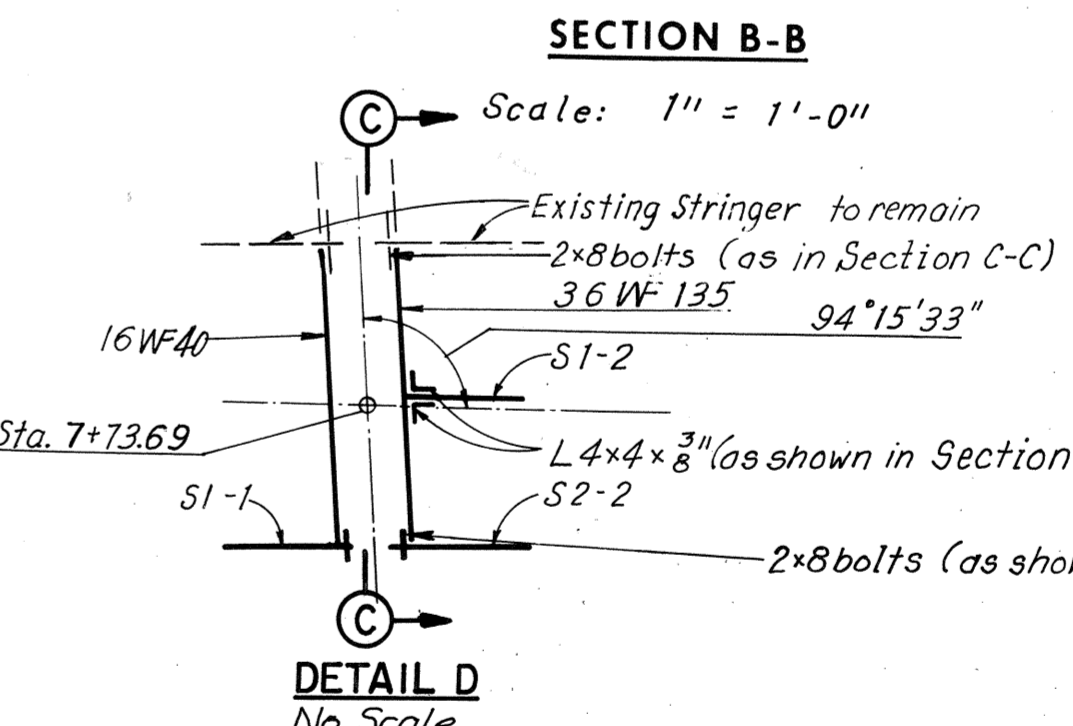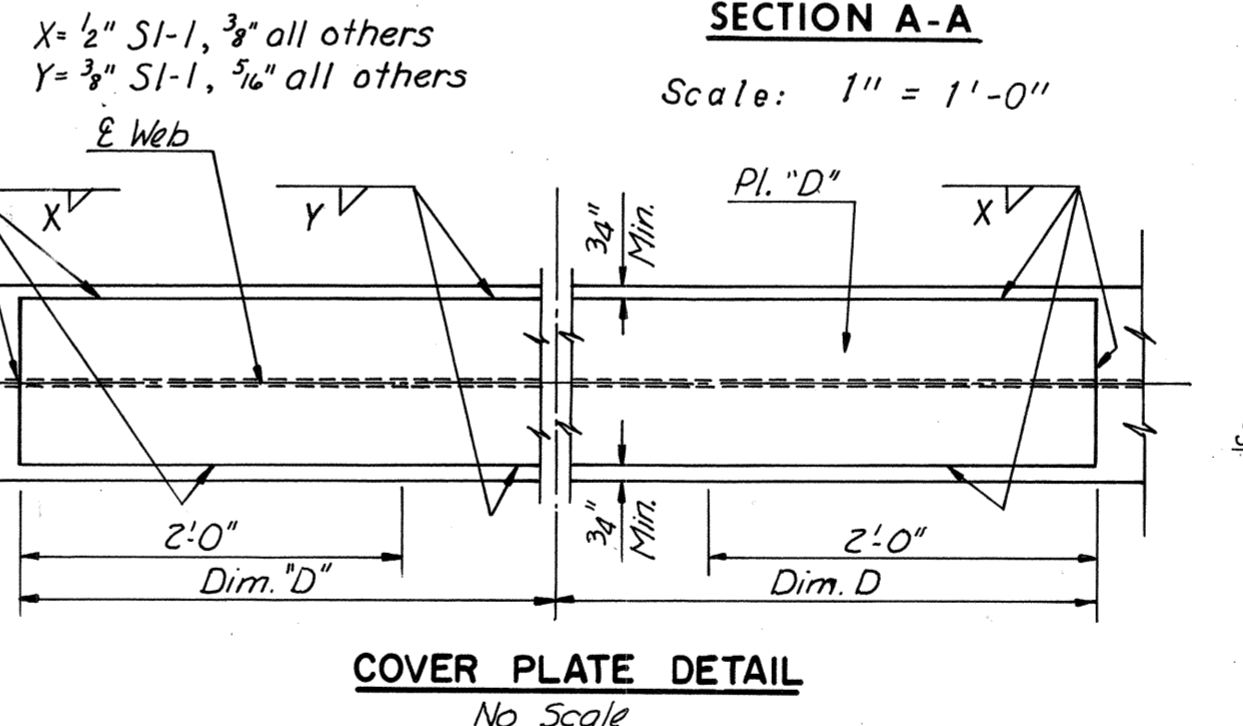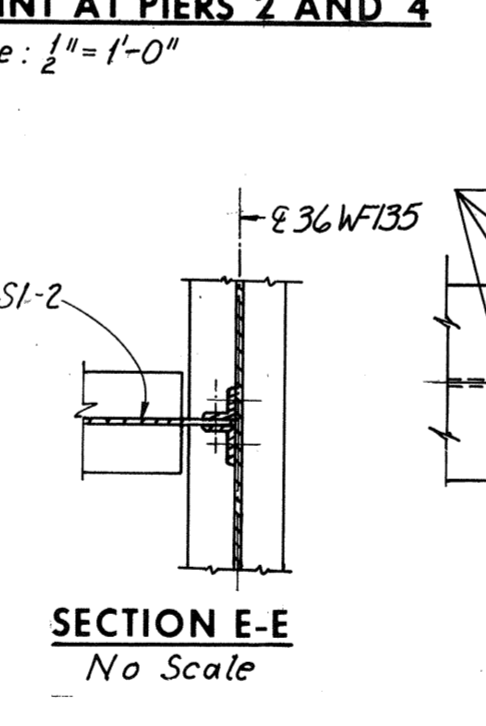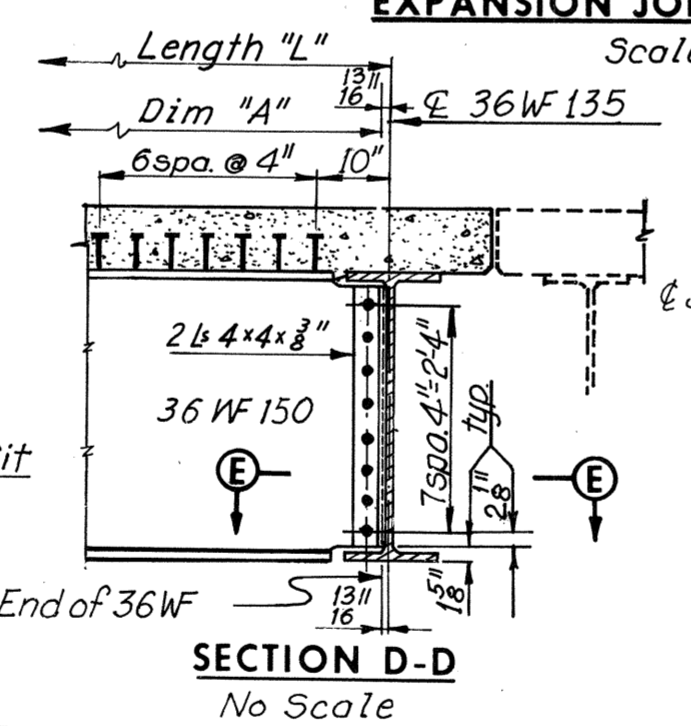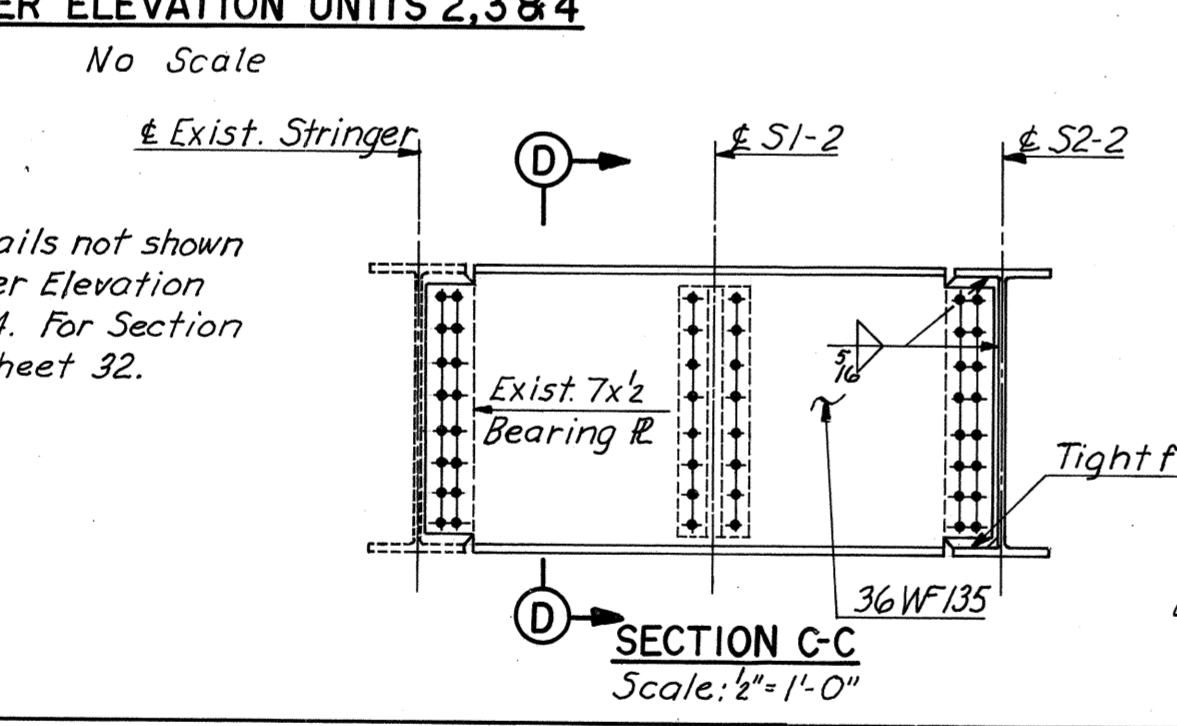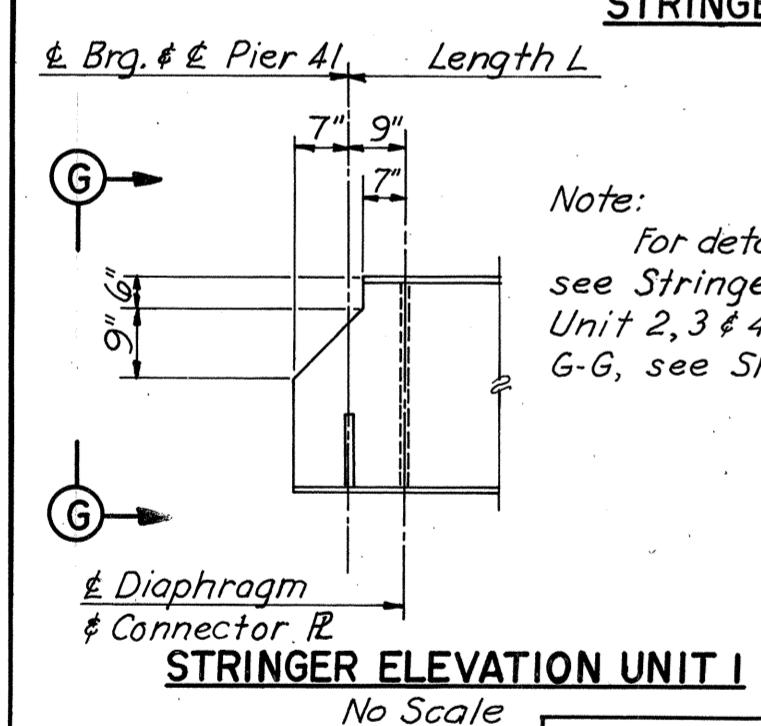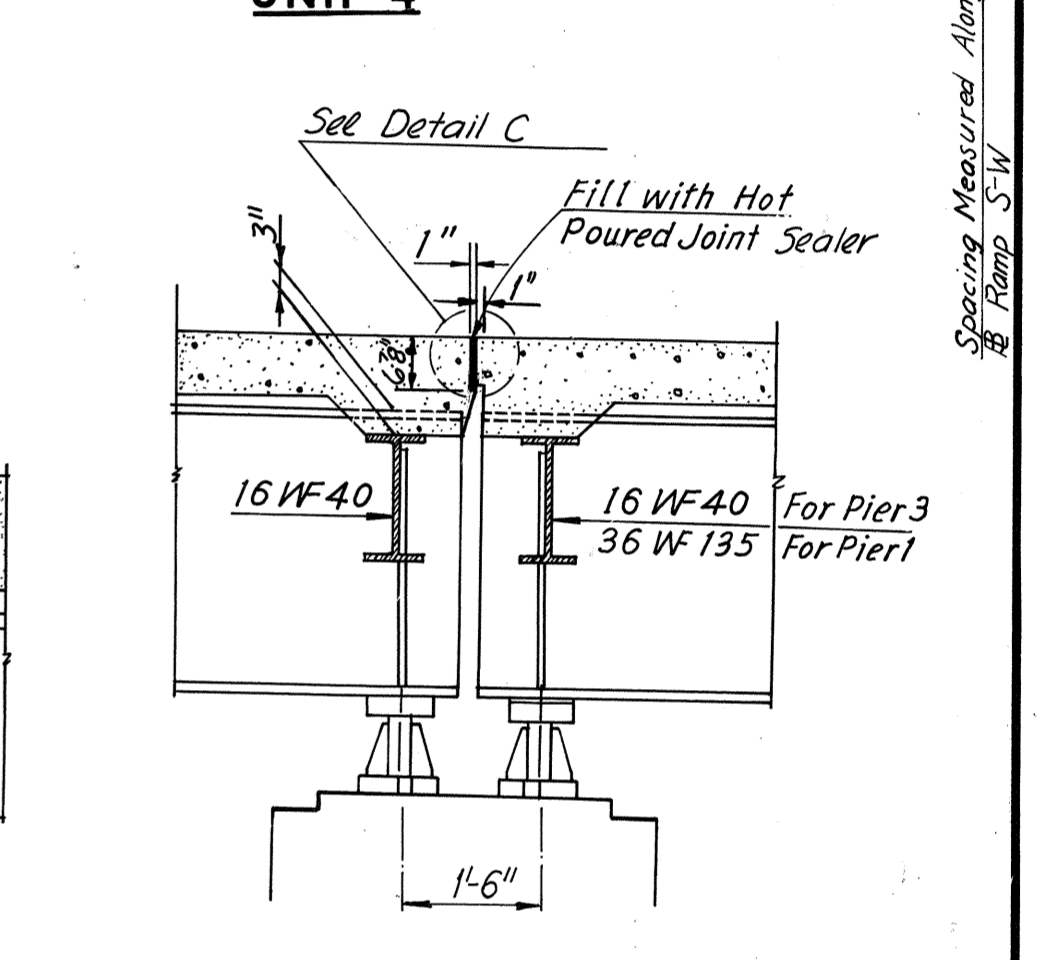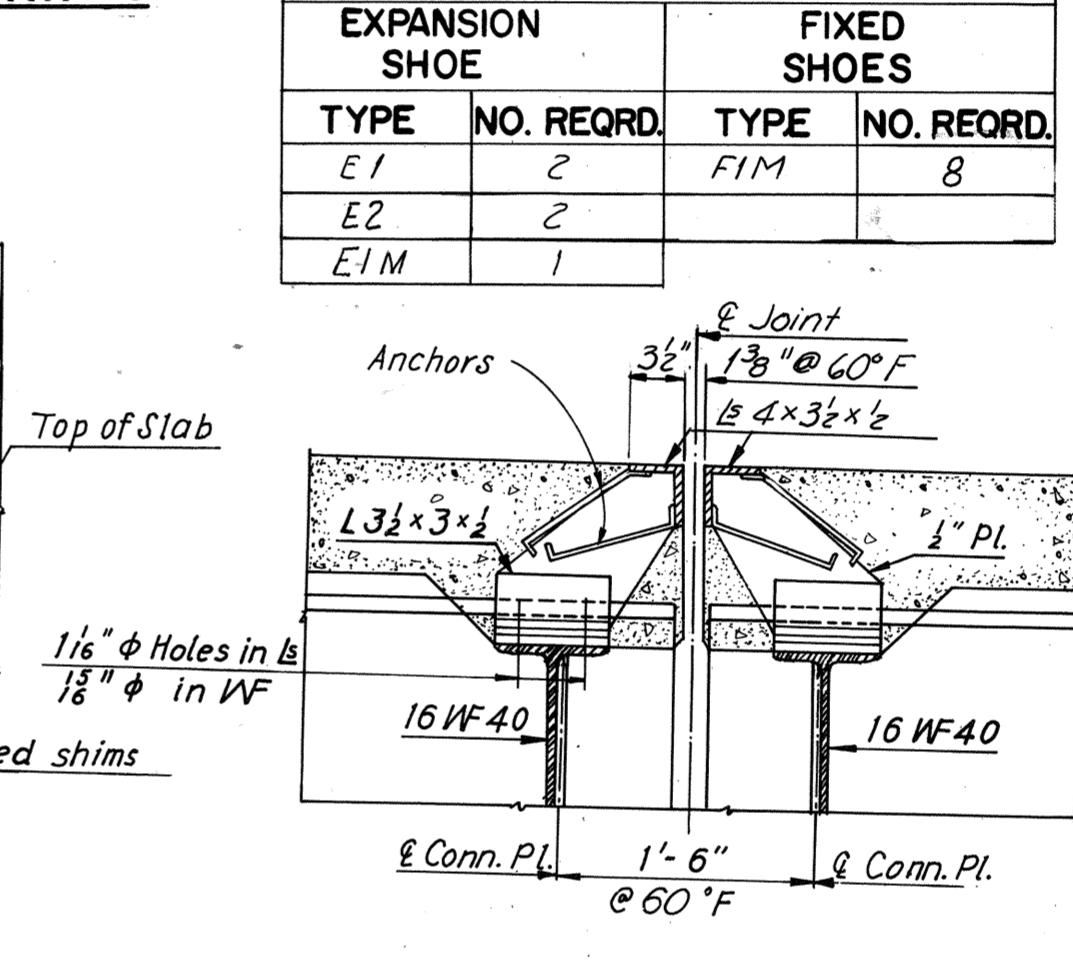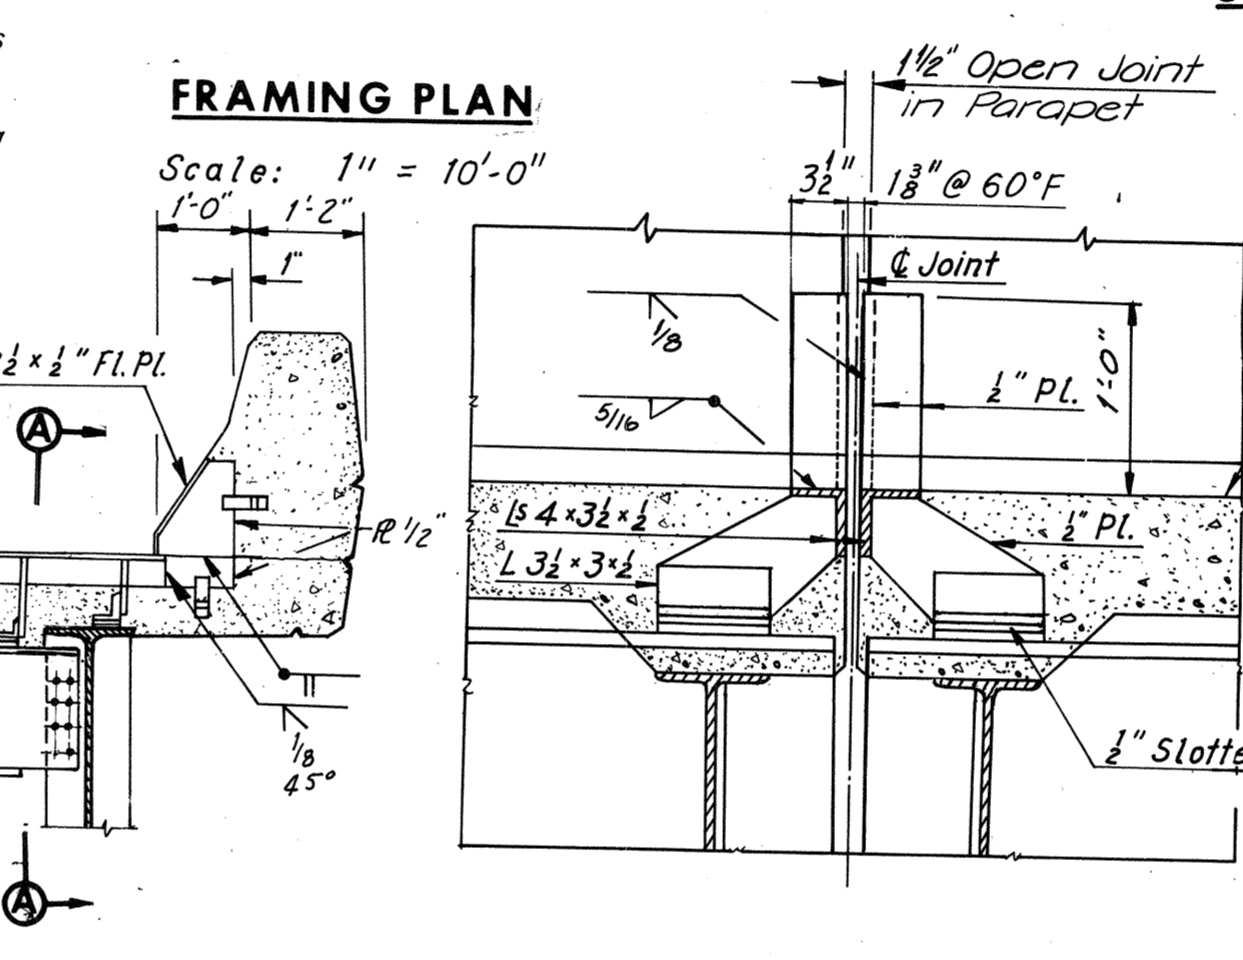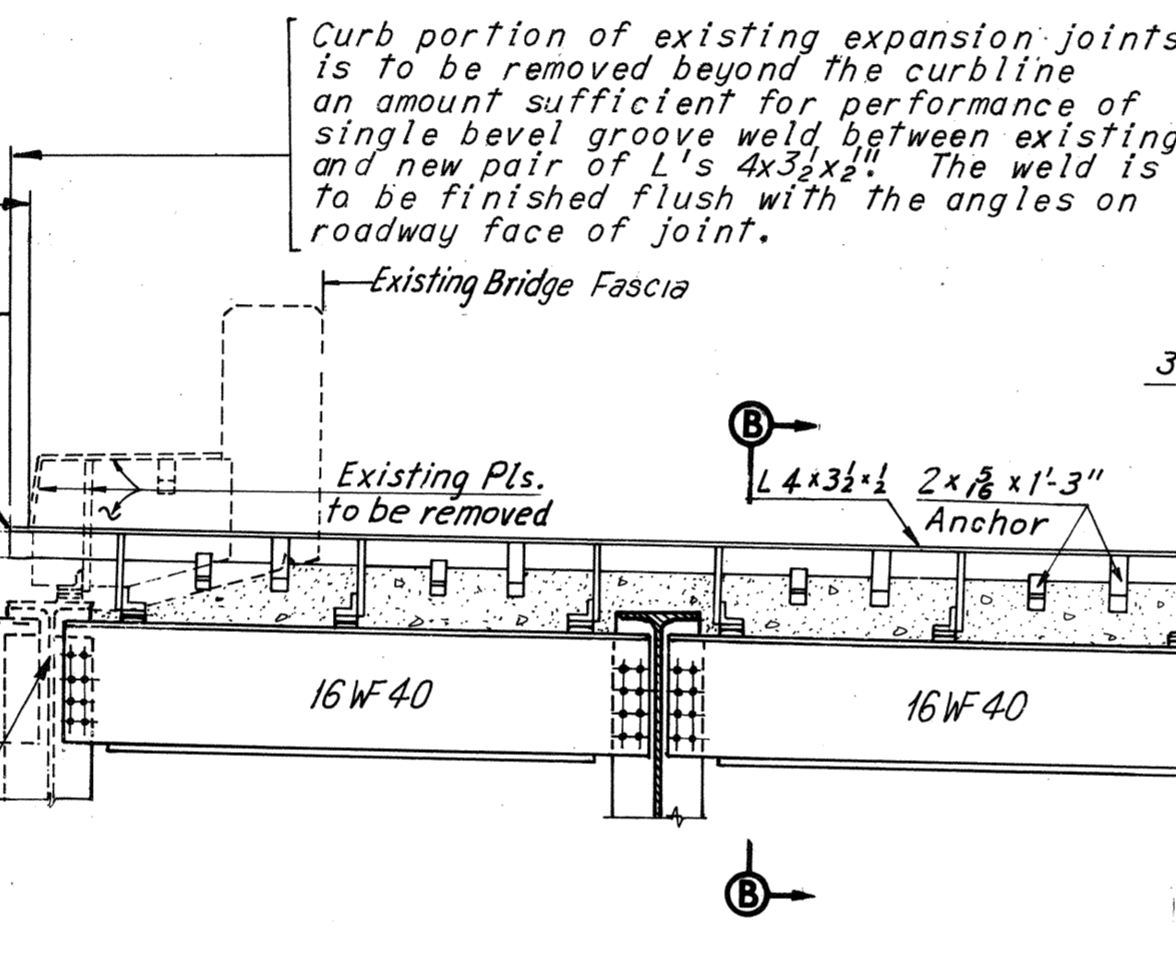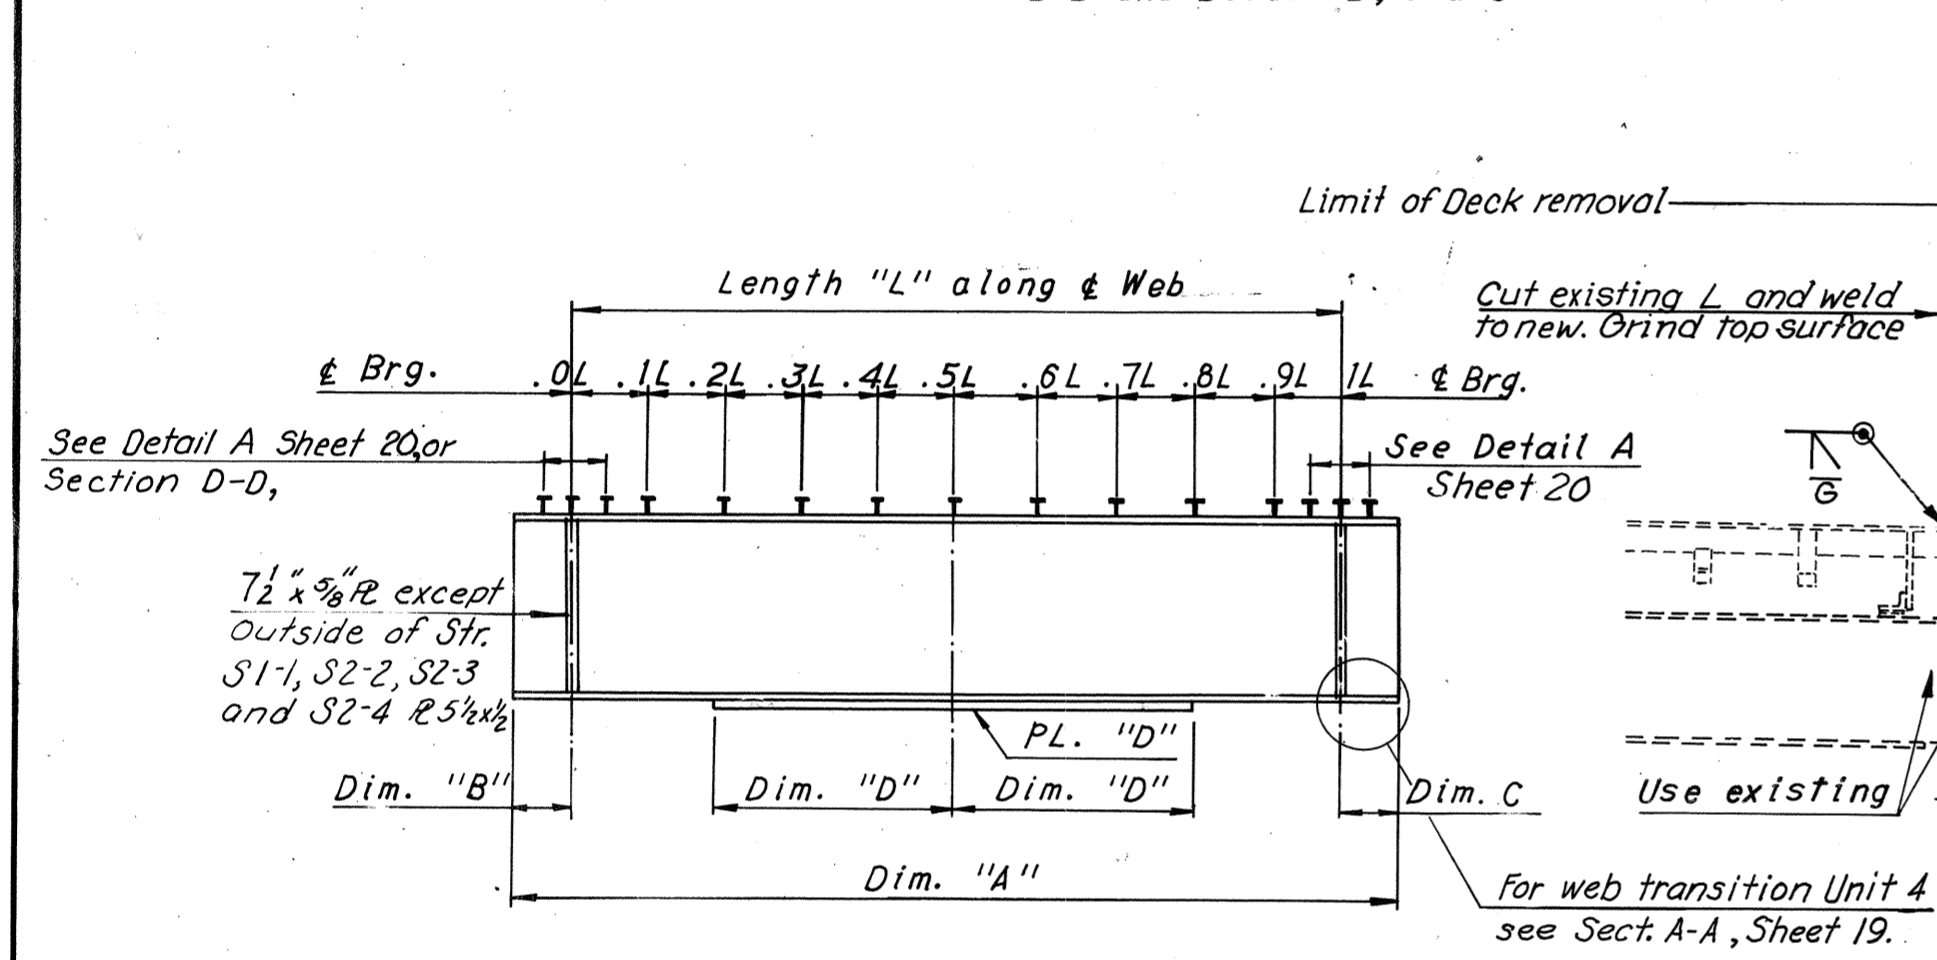

UNIT	STRINGER	STRINGER SIZE	DIM "A"	LENGTH "L"	DIM "B"	DIM "C"	DIM "D"	PL. "D"	MAX SHEAR STUD SPACING **																DEAD LOAD DEFLECTION SCHEDULE			CAMBER SCHEDULE		
									0.0L-0.1L	0.1L-0.2L	0.2L-0.3L	0.3L-0.4L	0.4L-0.5L	0.5L-0.6L	0.6L-0.7L	0.7L-0.8L	0.8L-0.9L	0.9L-1.0L	1.0L-1.1L	1.1L-1.2L	1.2L-1.3L	1.3L-1.4L	1.4L-1.5L	1.5L-1.6L	1.6L-1.7L	1.7L-1.8L	1.8L-1.9L	1.9L-2.0L	1/4L	1/2L
1	S1-1	36WF182	87'-8 1/2"	86'-6 1/2"	7"	7"	29'-9"	10 1/2" x 1 3/8"	18"	19"	24"	24"	24"	24"	24"	24"	24"	24"	19"	18"	1 3/8	1 5/8	1 7/8	1 3/4	2 1/8	2 3/8	2 1/2			
2	S1-2	36WF150	86'-3 1/2"	85'-9 1/2"	7"	7"	32'-6"	10 1/2" x 3/8"	18"	18"	20 1/2"	24"	24"	24"	24"	24"	24"	24"	19"	18"	1 5/8	2 1/8	1 3/4	2 1/8	2 3/8	2 1/2	2 1/4			
2	S2-2	36WF194	87'-2 1/2"	85'-11 1/2"	7 1/2"	8"	42'-0"	10 1/2" x 1 1/8"	15 1/2"	15 1/2"	18"	22"	22"	22"	22"	22"	22"	22"	19"	18"	1 3/8	2 1/8	1 3/4	2 1/8	2 3/8	2 1/2	2 1/4			
3	S1-3	36WF194	86'-11"	85'-9"	7"	7"	32'-0"	10 1/2" x 1 1/8"	12"	12"	13 1/2"	17 1/2"	20 1/2"	22"	22"	22"	22"	24"	19"	18"	1 3/8	2 1/8	1 3/4	2 1/8	2 3/8	2 1/2	2 1/4			
3	S2-3	36WF194	86'-11 1/2"	85'-7 1/2"	8"	7 1/2"	42'-0"	10 1/2" x 1 3/8"	10 1/2"	10 1/2"	12"	14 1/2"	17 1/2"	20"	20"	20"	20"	20"	19"	18"	1 3/8	2 1/8	1 3/4	2 1/8	2 3/8	2 1/2	2 1/4			
4	S1-4	36WF150	53'-11 1/2"	52'-9 1/2"	7"	7"	—	—	12 1/2"	14"	16"	18 1/2"	22 1/2"	22 1/2"	22 1/2"	22 1/2"	22 1/2"	22 1/2"	19"	18"	1 3/8	2 1/8	1 3/4	2 1/8	2 3/8	2 1/2	2 1/4			
4	S2-4	36WF150	54'-0 1/2"	52'-0 1/2"	7 1/2"	8"	—	—	11"	12 1/2"	14 1/2"	17"	21 1/2"	21 1/2"	21 1/2"	21 1/2"	21 1/2"	21 1/2"	19"	18"	1 3/8	2 1/8	1 3/4	2 1/8	2 3/8	2 1/2	2 1/4			

BY	DATE	REVISION	DATE
ACT	11-6-68		
JLA	6-26-75		
PTA	01-20-89		

Note: Dimensions shown on the plans for existing structural metal work are in accordance with drawings prepared for the original construction. The Contractor shall verify all necessary dimensions of existing structural metal work prior to preparing shop drawings for new metalwork.

*.....Length "L" is measured from & Diaphragm to & Brg and dimension "A" is out to out of stringer.

**Use 2-1/8" Shear Stud all Stringers this sheet.

* Spacing begins at termination of 7 spaces @ 4" as shown in Detail A Sheet 20. This Detail is typical for all stringer ends except framed ends of stringers S1-1 and S1-2 which are shown in Section D-D.

Note: For Dead Load Deflection Diagram and Detail A, see Sheet 20.

Notes: All structural steel shall be A36 unless denoted otherwise. For Superstructure Steel Quantities see Sheet 4. For Shoe Details see Sheets S1 and S2. For additional Diaphragm Details see Sheet 25. For Shear Stud Details see Sheet 20. All transverse dimensions shown on Joint Details are normal to & Joint. All structural steel for expansion Joints shall be of A588 steel.

AS BUILT








RICHMOND METROPOLITAN AUTHORITY
RICHMOND EXPRESSWAY SYSTEM
DOWNTOWN EXPRESSWAY

BRIDGE NO. 65
RAMP S-W CONNECTION FROM
RICHMOND-PETERSBURG TURNPIKE
FRAMING PLAN - UNITS 1, 2, 3 AND 4

HOWARD, NEEDLES, TAMMEN & BERGENDOFF
 consulting engineers
 NEW YORK ALEXANDRIA KANSAS CITY

SCALE: As Noted
 CONTRACT NO.: 11
 SHEET NO. 18 of 38

RICHMOND EXPRESSWAY SYSTEM			
SECTION	PROJECT	SHEET NO.	TOTAL SHEETS
11	DOWNTOWN EXPRESSWAY	42	97

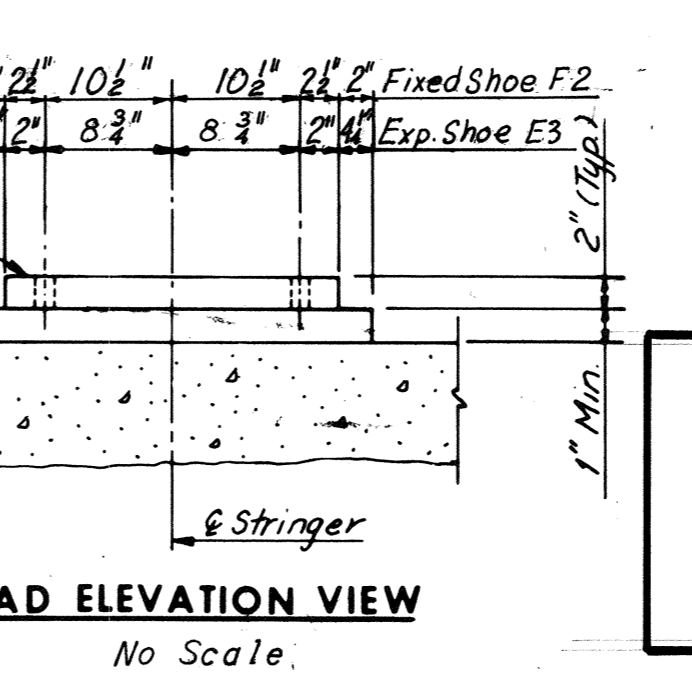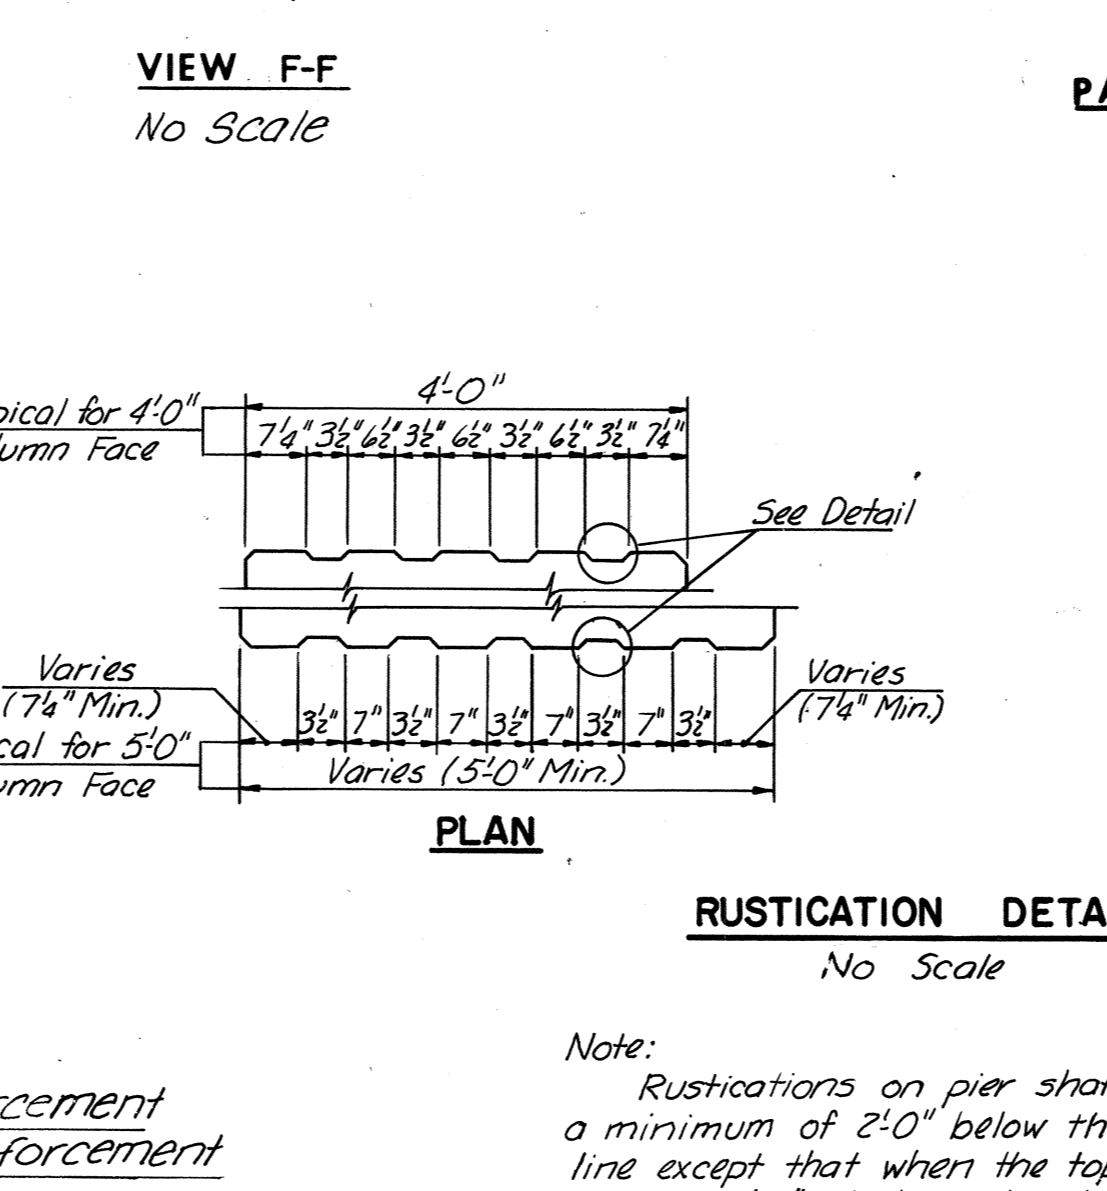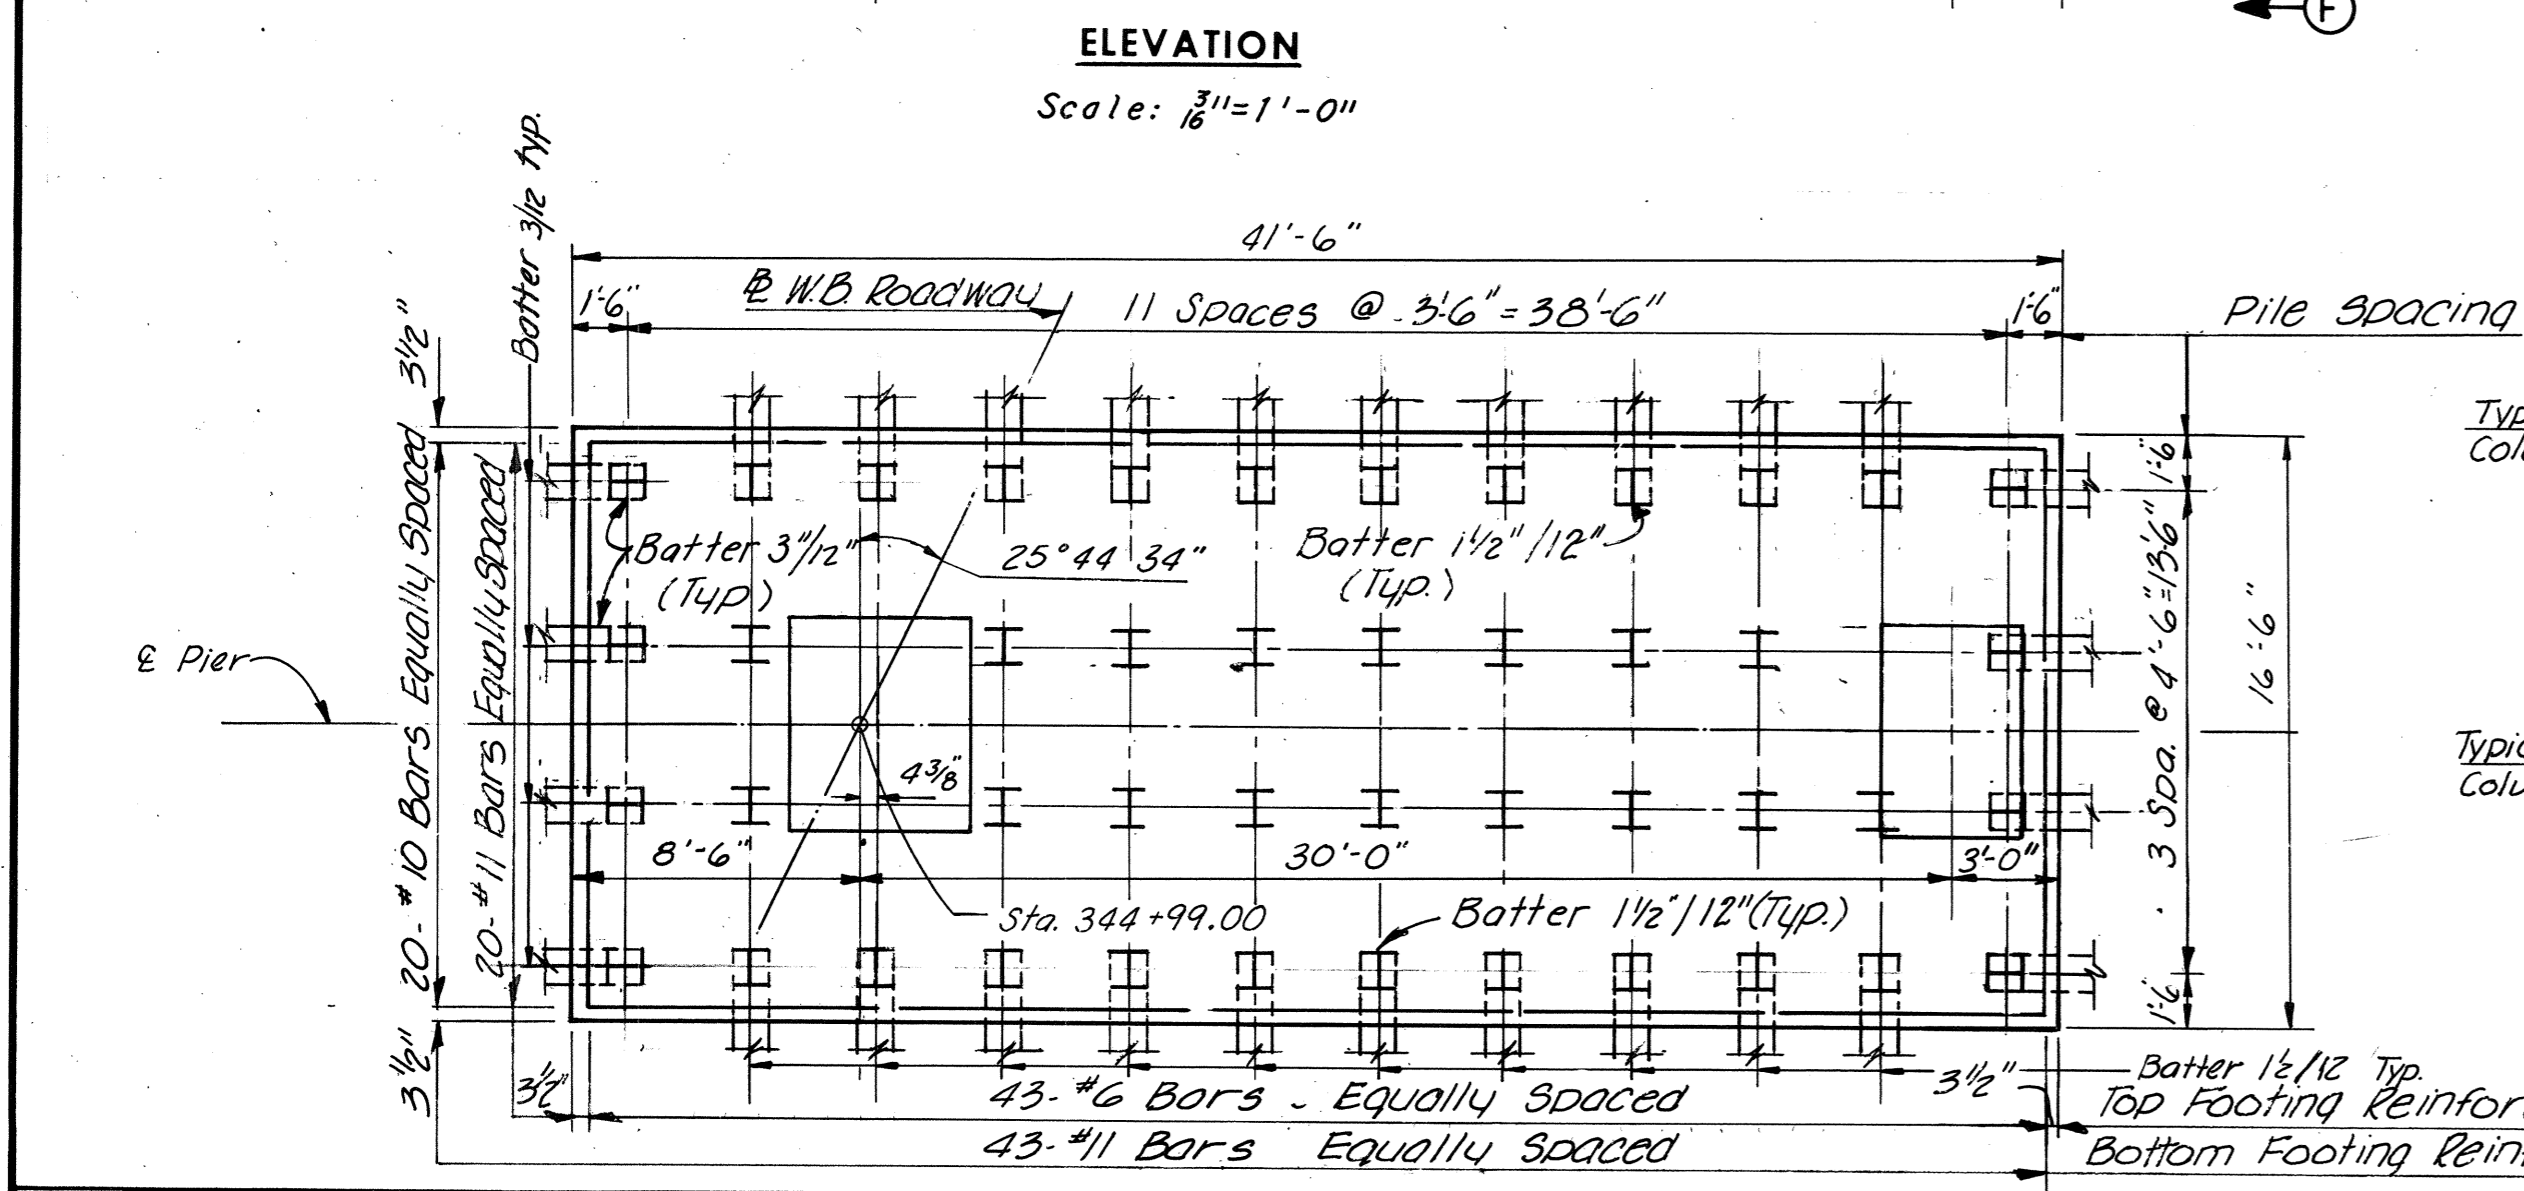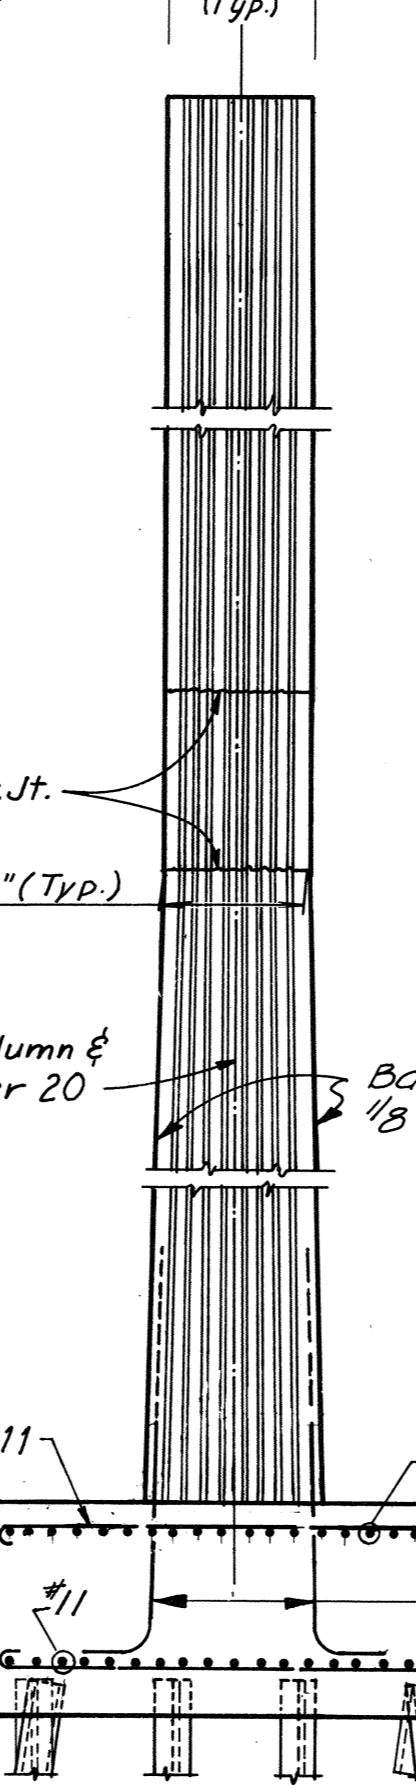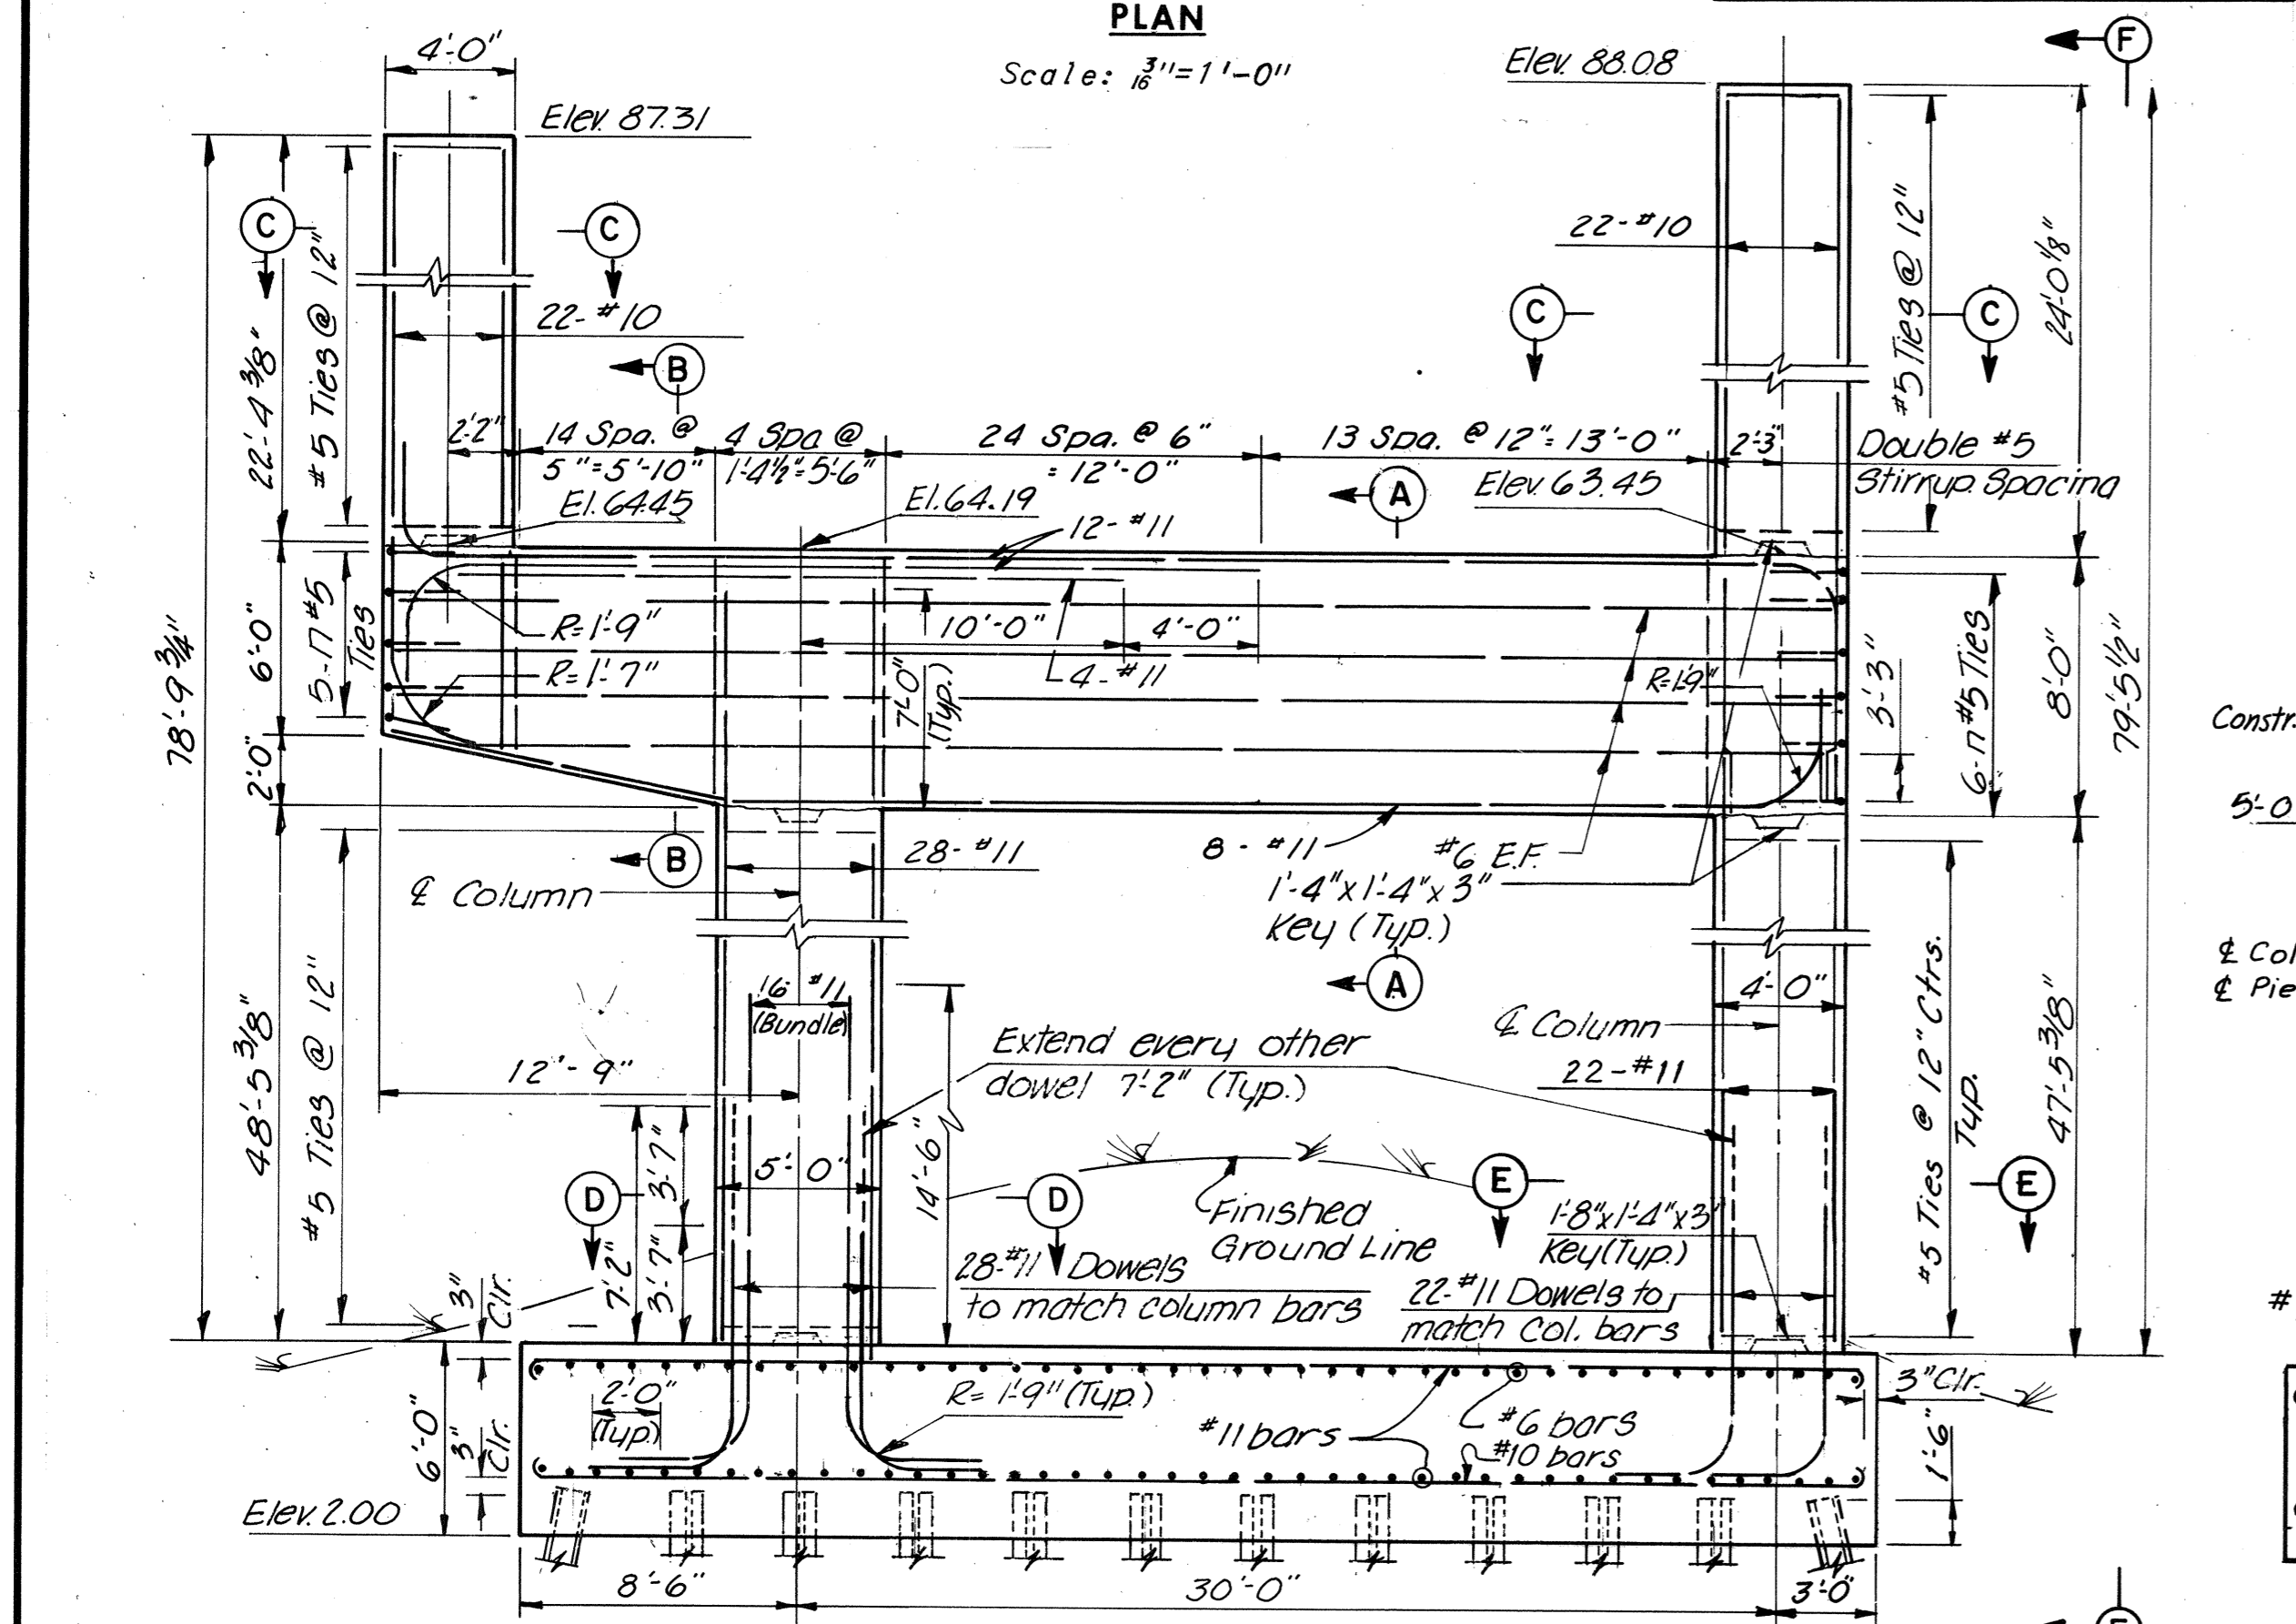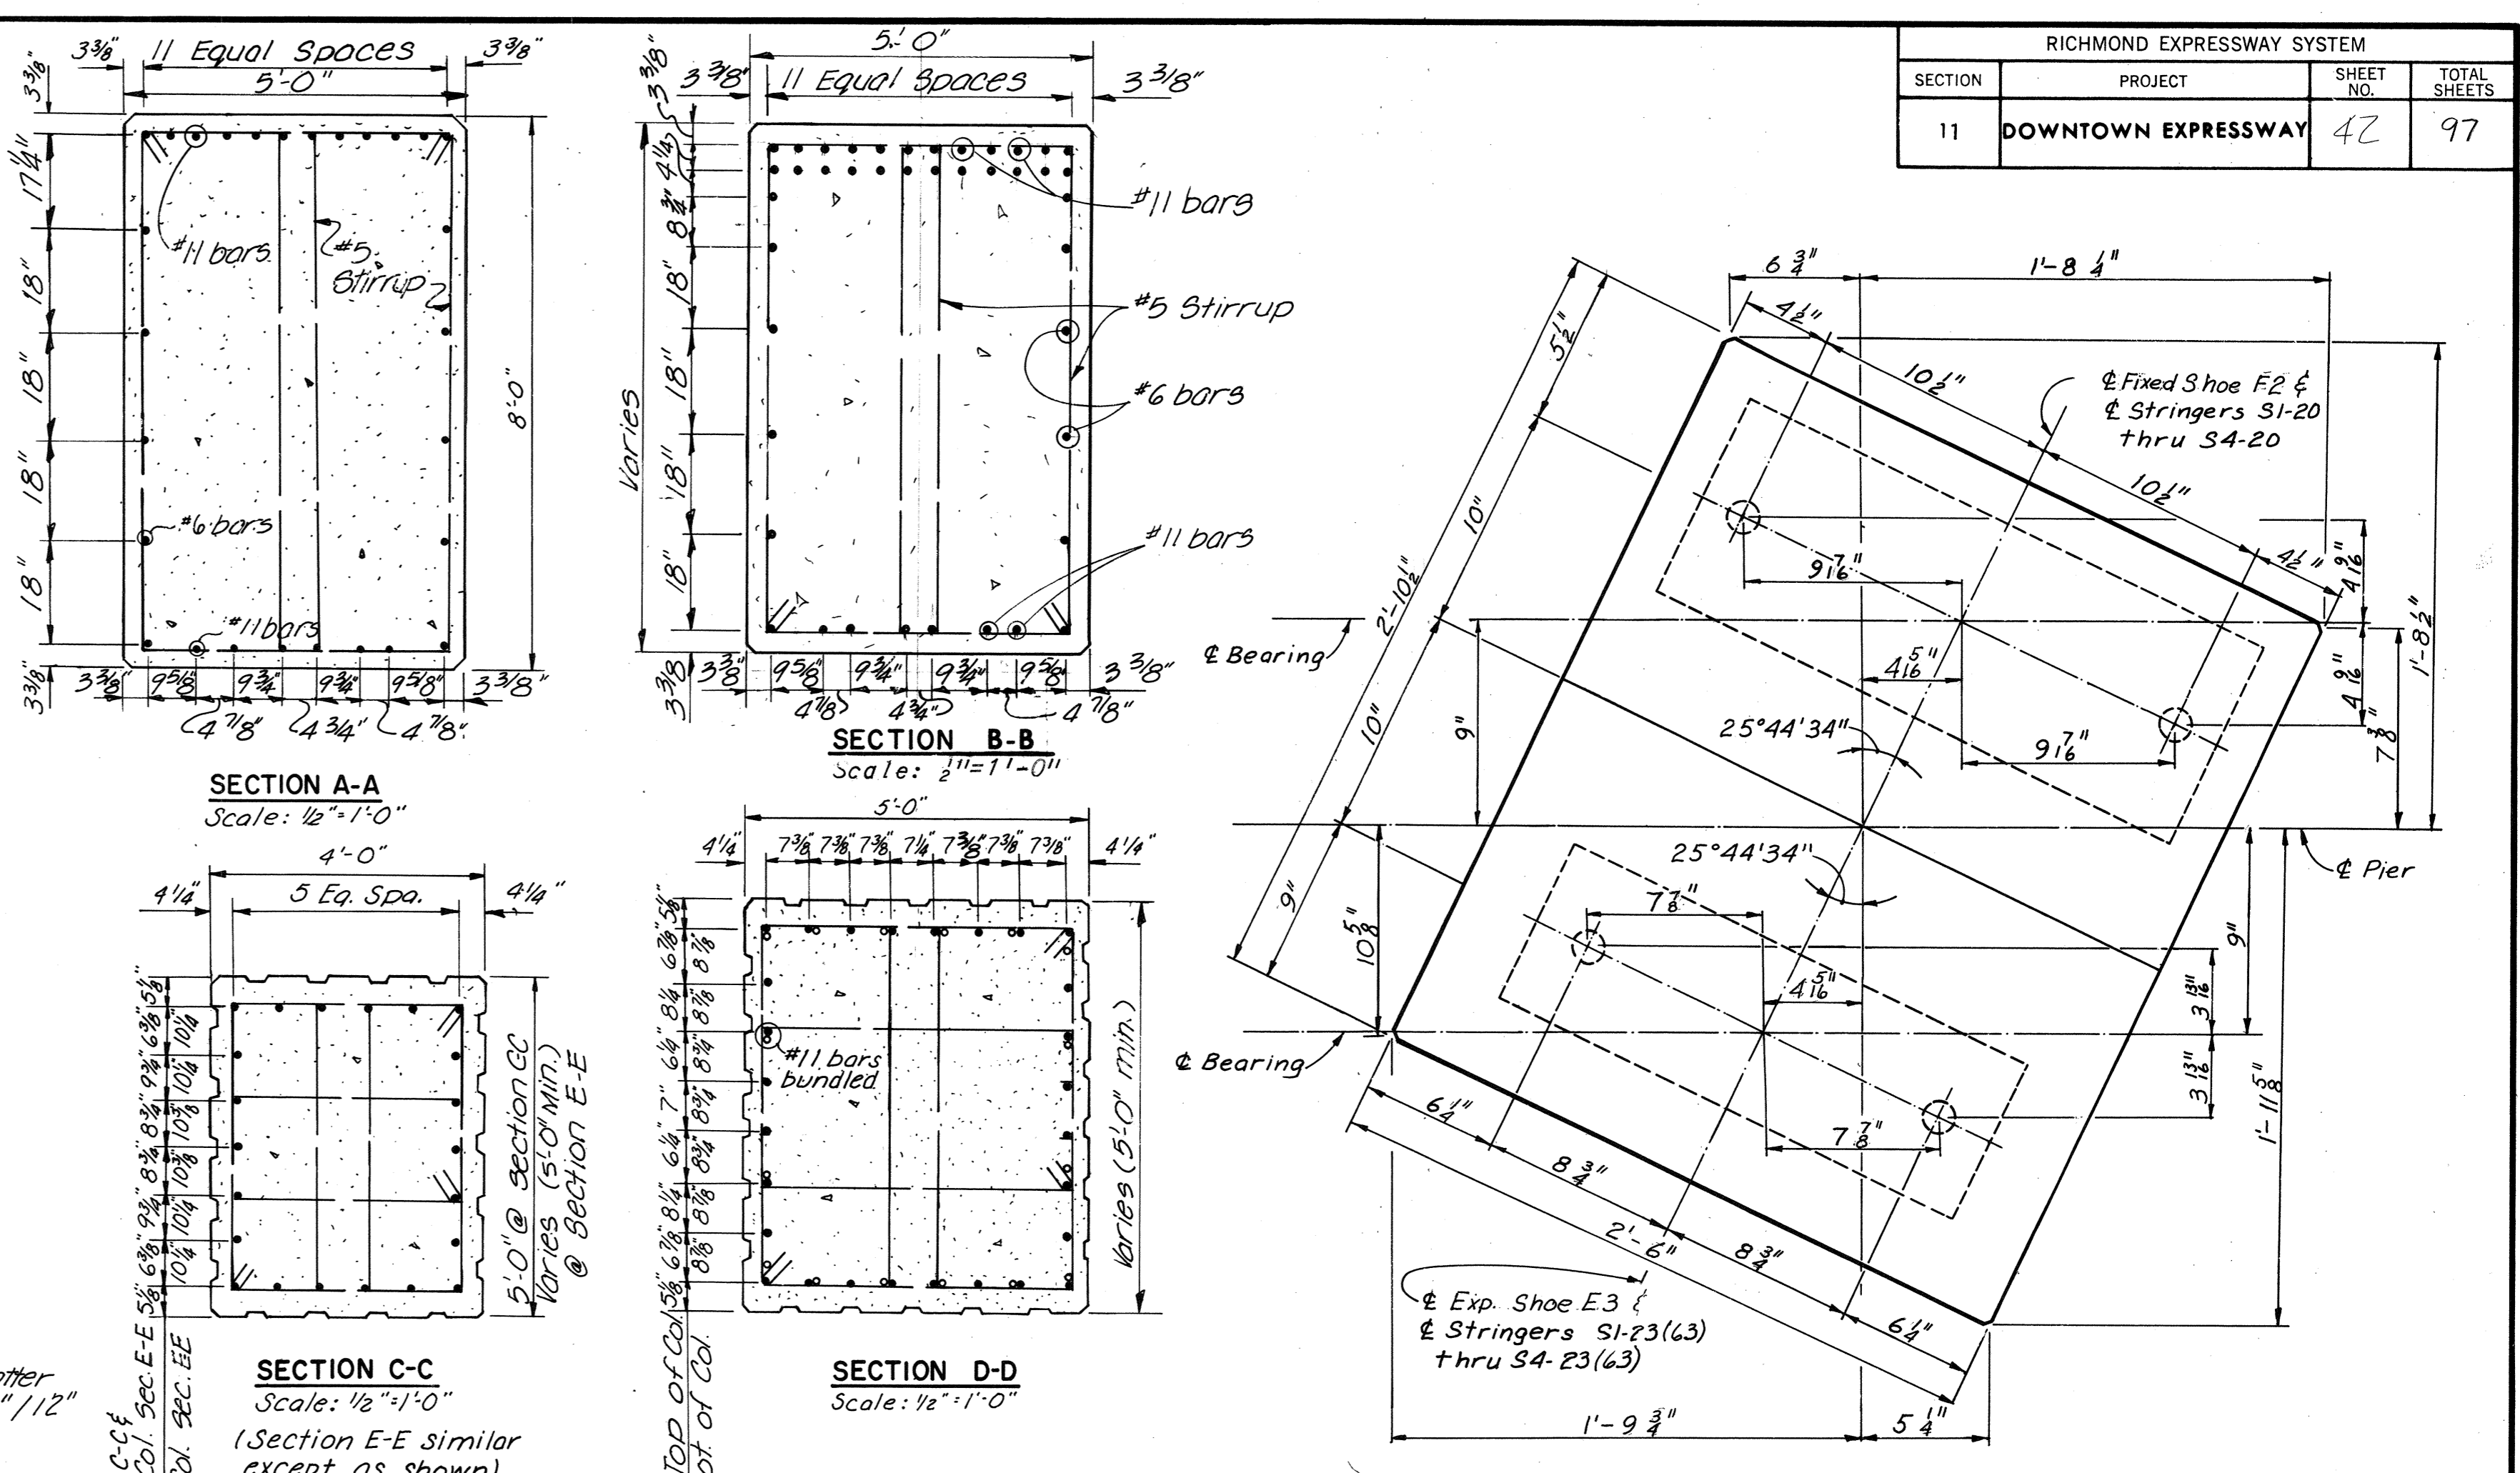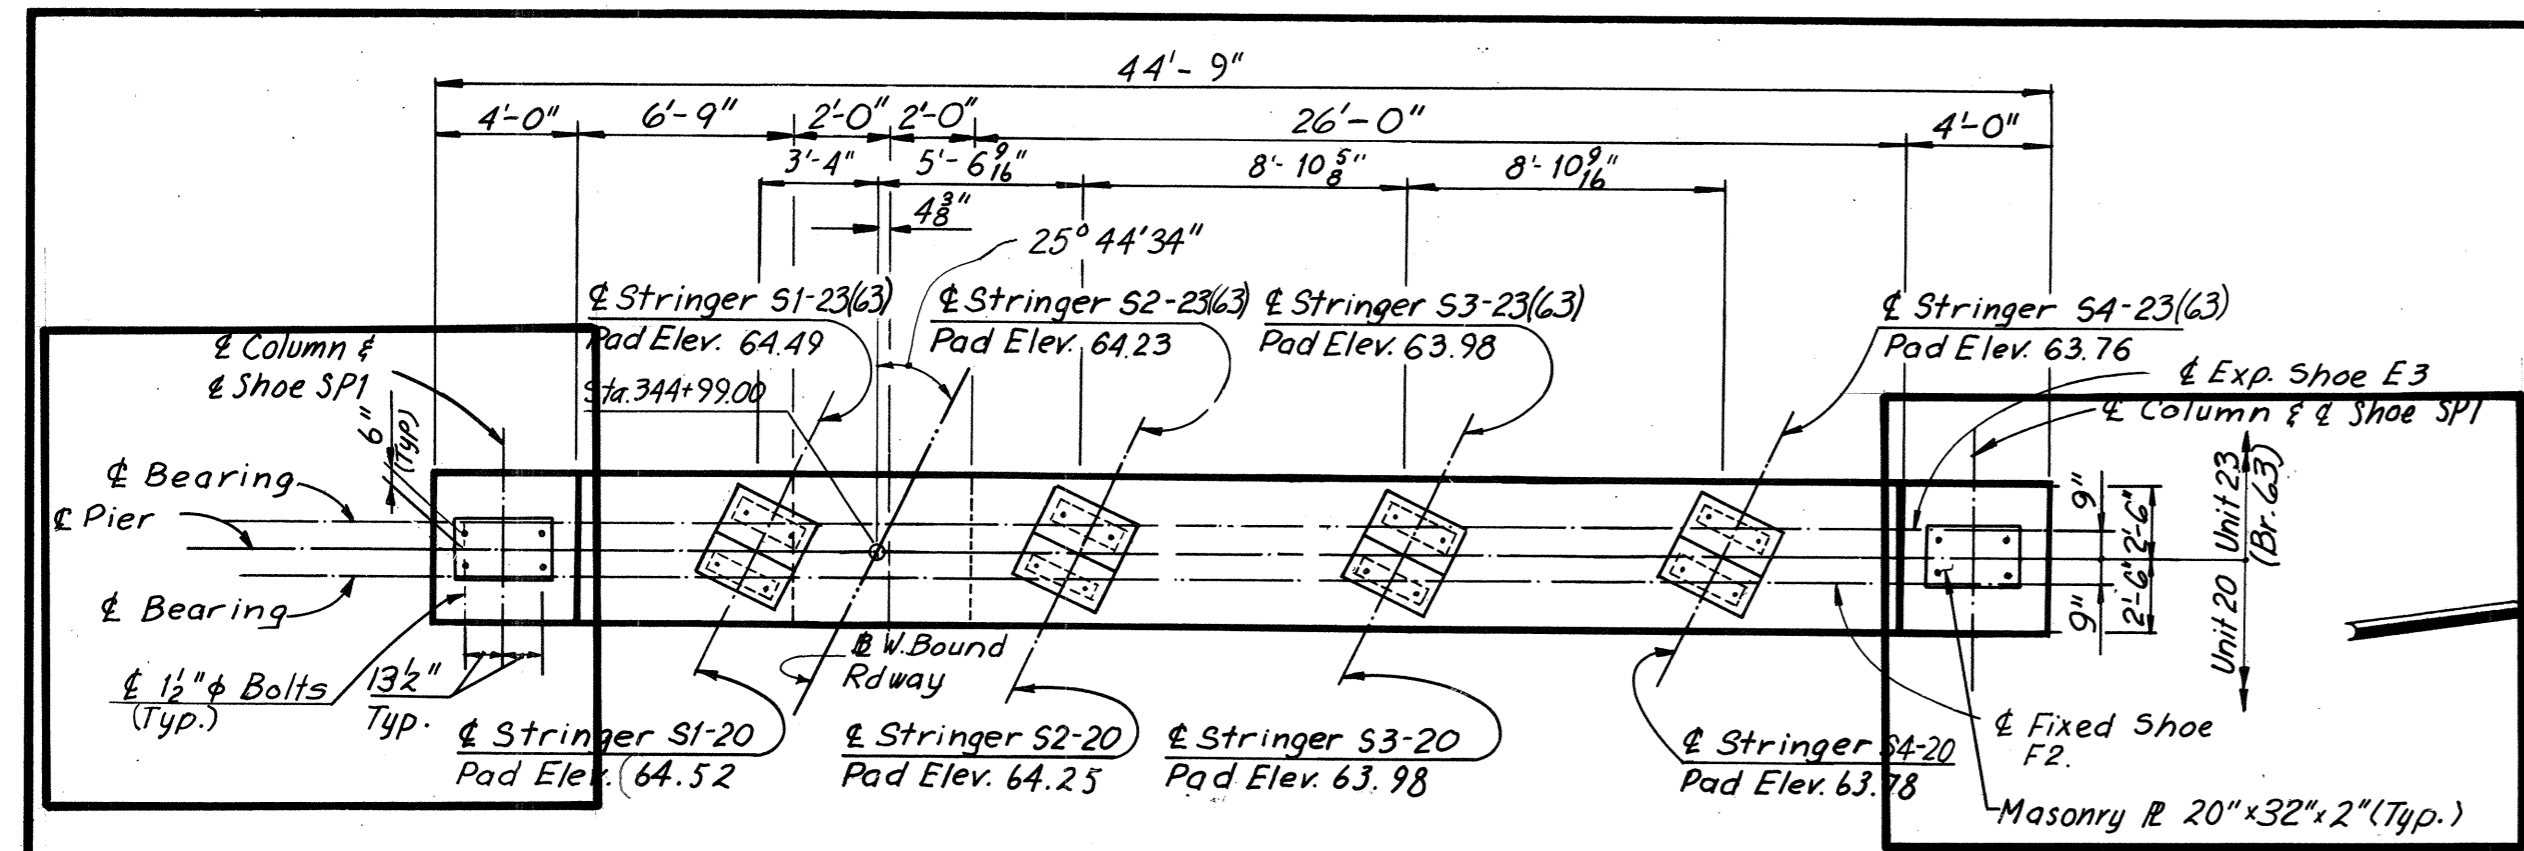


NOTE:
Pier 20 was constructed as part of Contract 10 with the exception of the anchor bolts for the upper steel capbeam (SPI Shoes). These shall be supplied and drilled in place as part of Contract 11.

Note:
Anchor Bolts and Setting Template for the shoes at Unit 23(63) shall be furnished by others for setting in the pier cap by the Contractor.

Note:
All piles shall be 12BP53 Steel Piles (Design Capacity = 57 tons).
Batter all transverse piles 3" per foot where shown.
Batter all longitudinal piles 1/2" per foot where shown.
For Standard Shoe details, see Sheet S1 & S2.
For Framing Plan, see Sheet 24.
Estimated Pile Tip Elevation = 11.0.

Note:
Footing elevations are approximate only and may be varied to suit field conditions as directed by the Engineer. Vertical shaft reinforcing shall not be cut until these elevations are established. Where elevations change more than 2ft. redesign will be required.

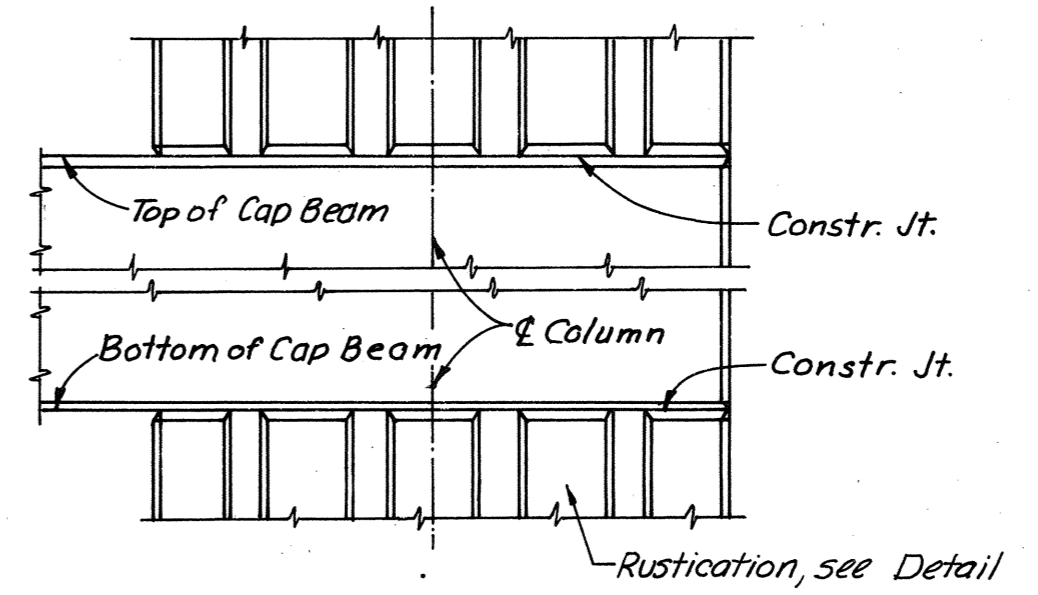

BY	DATE	REVISION	BY	DATE
J.D.	12-13-68	Shoe SPI	T.E.M.	3-76
C.E.B.	1-17-69	Right Col. Elev.	T.E.M.	3-76
		Rev. Elevations	SSS	12-75

NO.	REVISION	BY	DATE


AS BUILT
RICHMOND METROPOLITAN AUTHORITY
RICHMOND EXPRESSWAY SYSTEM
DOWNTOWN EXPRESSWAY

BRIDGE NO. 65
RAMP S-W CONNECTION FROM
RICHMOND-PETERSBURG TURNPIKE
PIER 20


HOWARD, NEEDLES, TAMMEN & BERGENDOFF
consulting engineers
NEW YORK ALEXANDRIA KANSAS CITY

SCALE: As Noted
CONTRACT NO. 11
SHEET NO. 17 OF 38


RICHMOND EXPRESSWAY SYSTEM			
SECTION	PROJECT	SHEET NO.	TOTAL SHEETS
II	DOWNTOWN EXPRESSWAY	44A	97

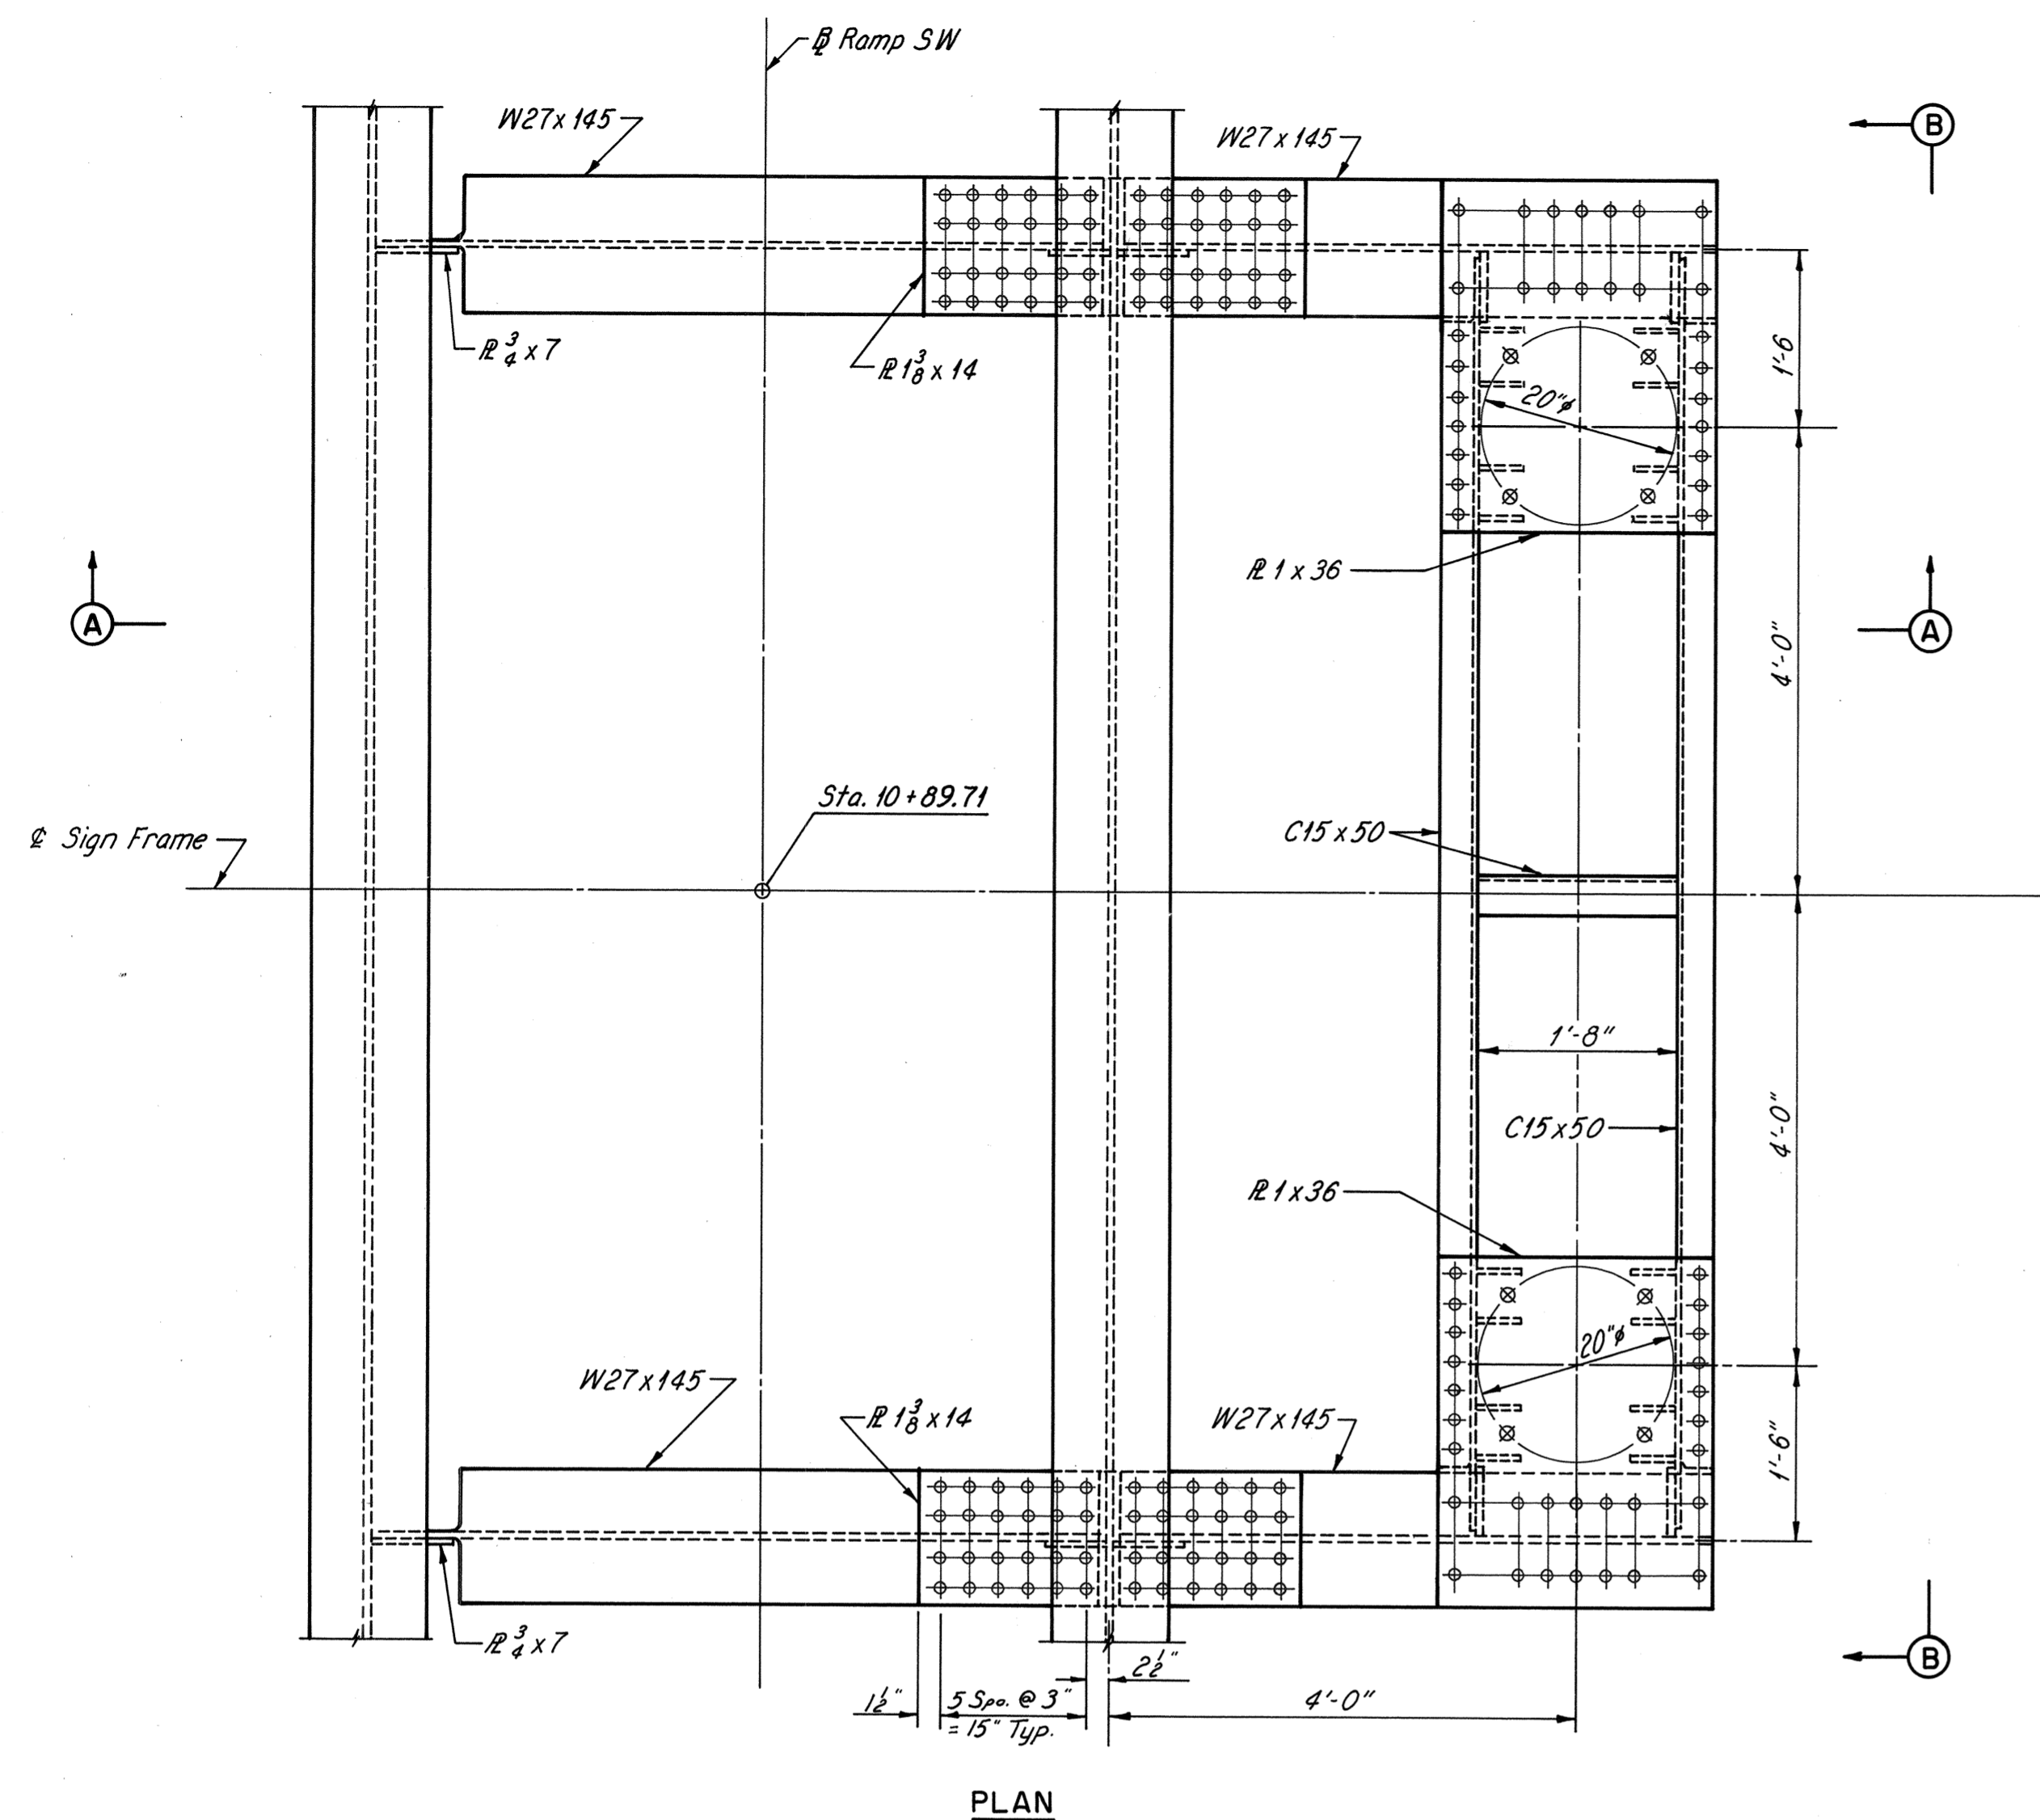

PLAN

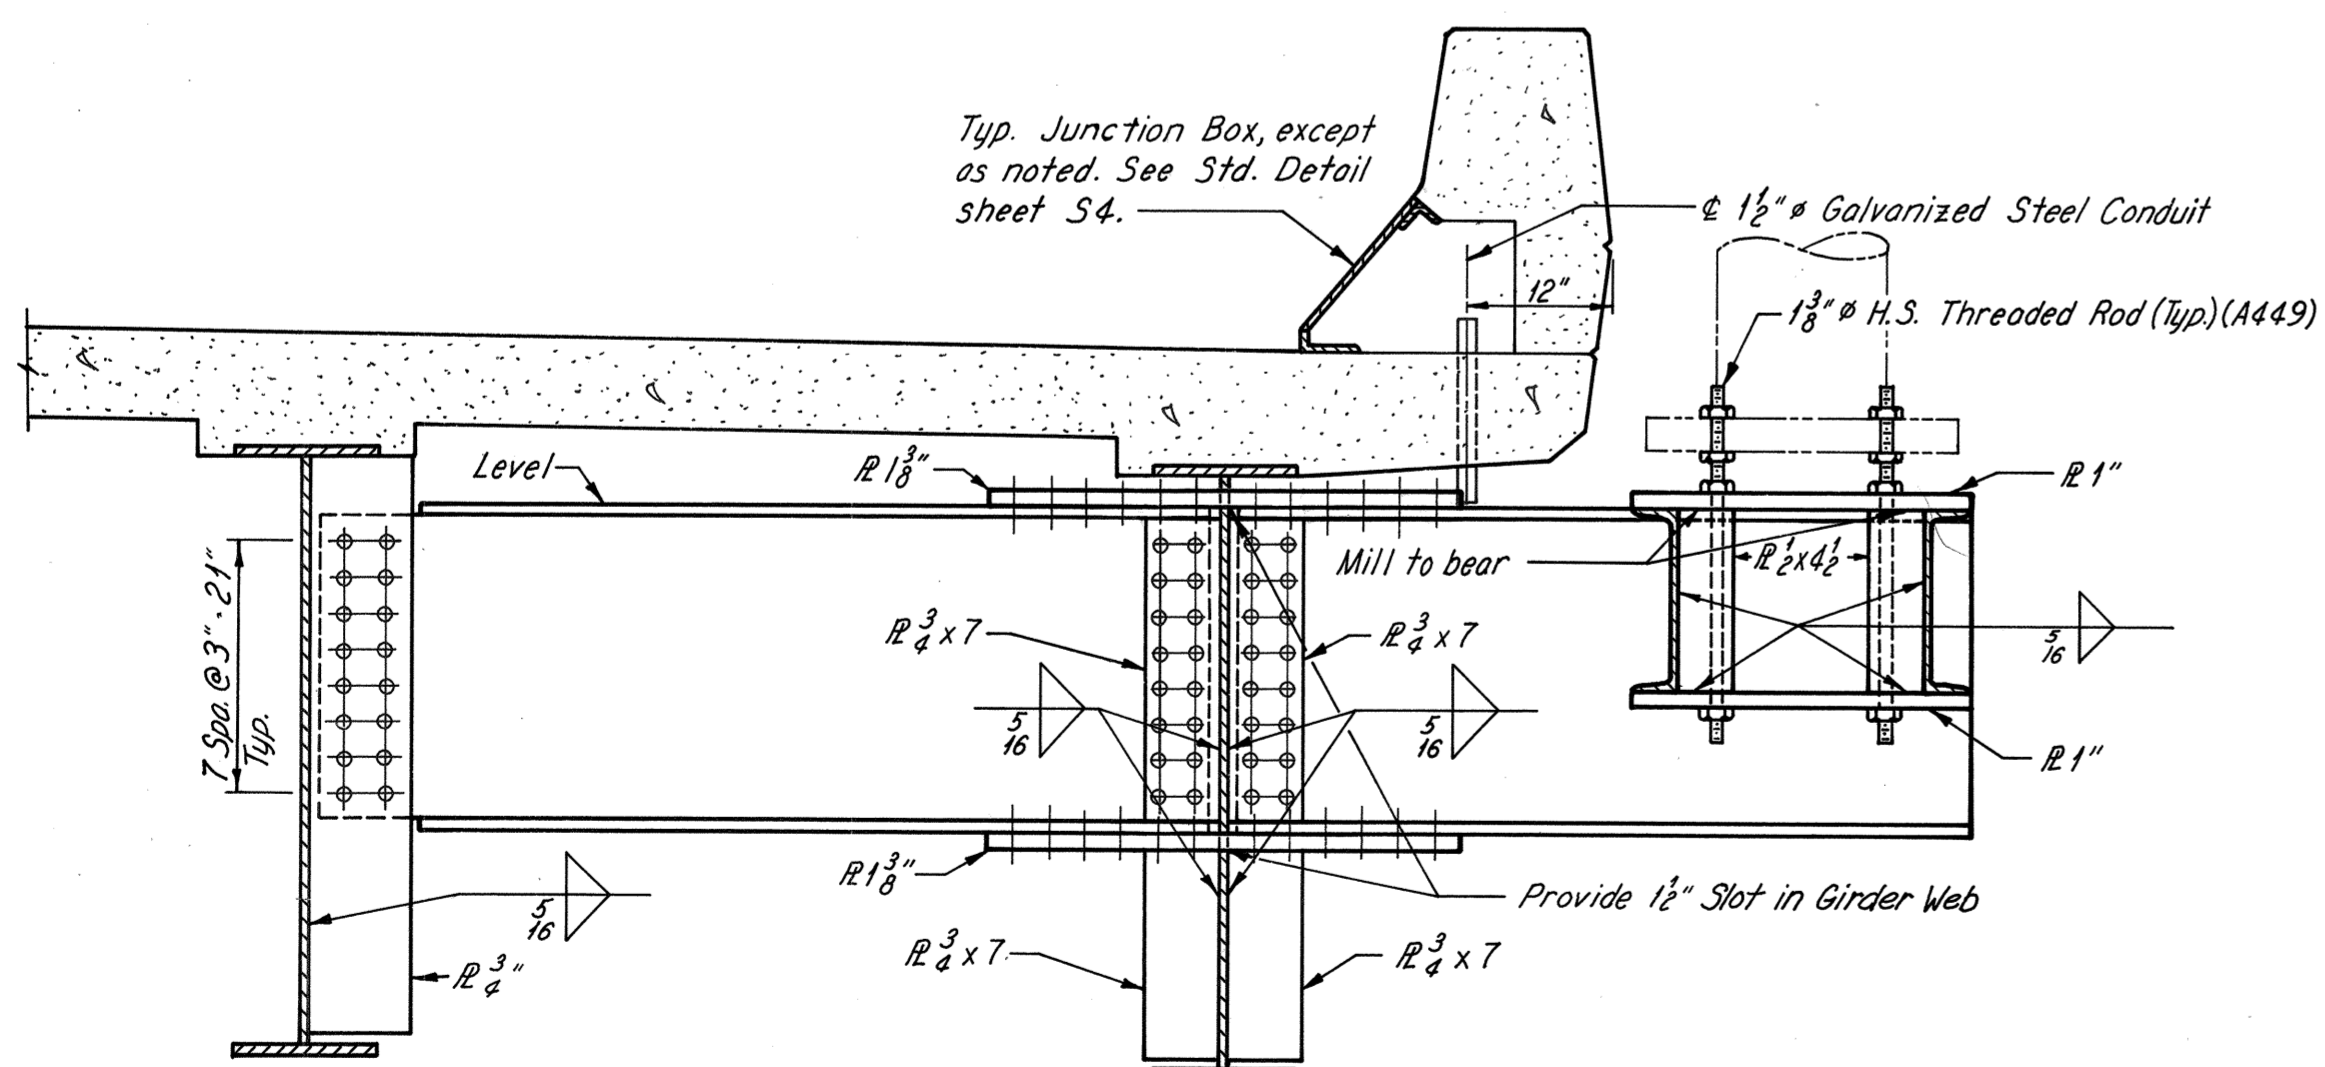

SECTION A-A

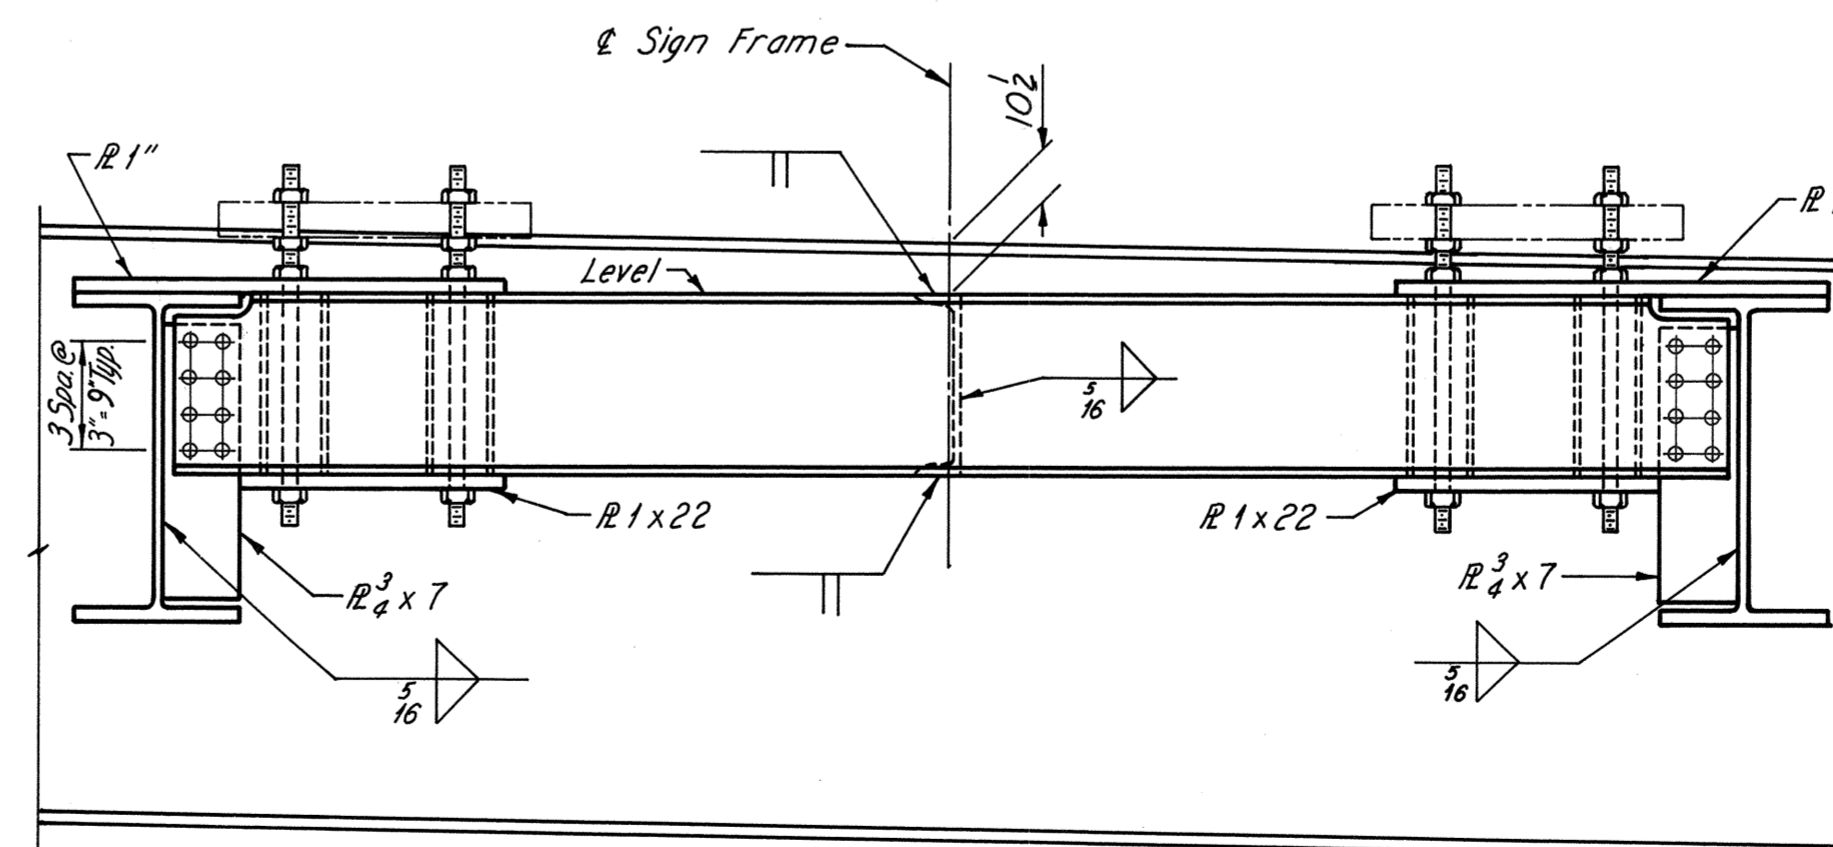

VIEW B-B

- Notes:
1. See Framing Plan Sheet 16 for location of sign support diaphragms.
 2. All material shall be ASTM A36 steel, except anchor bolt assemblies.
 3. Care shall be taken to ensure vertical alignment of the end frame. Any vertical misalignment shall be taken up in the leveling nuts.
 4. For signing and sign pole details, see Roadway Plans.
 5. All bolts to be 7/8" H.S. unless noted otherwise.

MADE	BY	DATE	NO.	REVISION	BY	DATE
JLK	JLK	7-23-75				
DWB	DWB	7-23-75	1	Dim & Sign Frame to & Level Channel	TEM	4-76

AS BUILT


RICHMOND METROPOLITAN AUTHORITY
RICHMOND EXPRESSWAY SYSTEM
 DOWNTOWN EXPRESSWAY

BRIDGE NO. 65
 RAMP W-S CONNECTION FROM
 RICHMOND-PETERSBURG TURNPIKE
 SIGN SUPPORT BRACKET DETAILS UNIT 6

HOWARD, NEEDLES, TAMMEN & BERGENDOFF
 consulting engineers
 NEW YORK ALEXANDRIA KANSAS CITY

SCALE: *As Shown*
 CONTRACT NO.: 11
 SHEET NO. 19A OF 38

RICHMOND EXPRESSWAY SYSTEM			
SECTION	PROJECT	SHEET NO.	TOTAL SHEETS
11	DOWNTOWN EXPRESSWAY	44	97

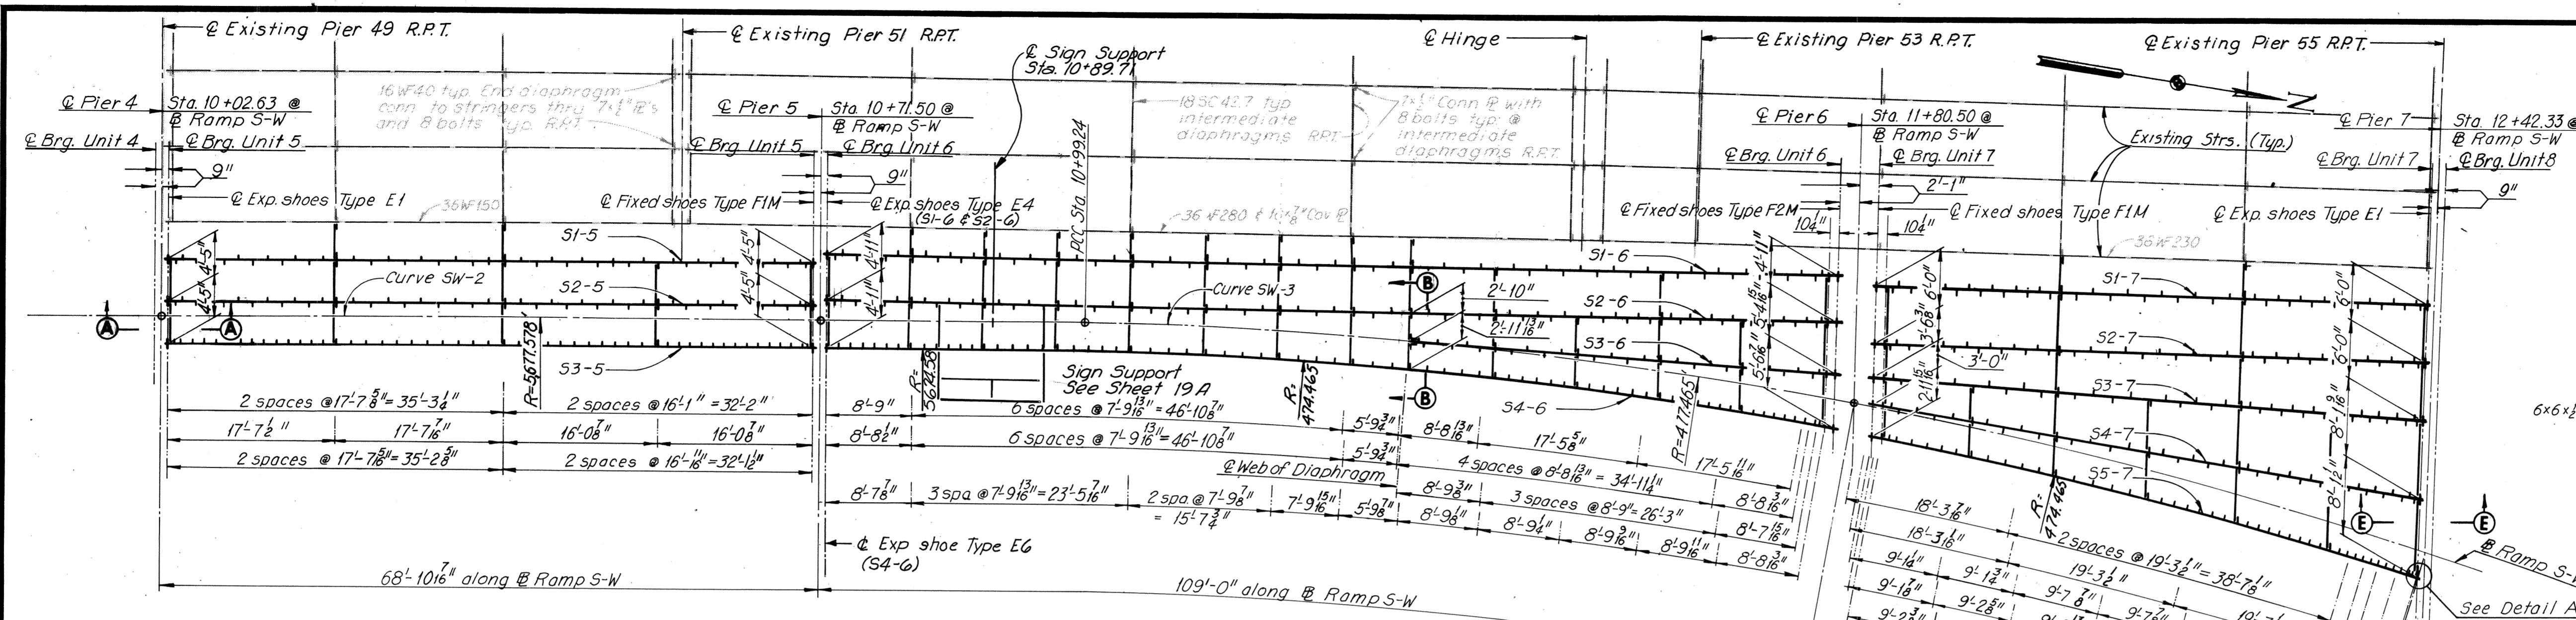


NOTES:

UNIT 5
Dimensions shown on the plans for existing structural metalwork are in accordance with drawings prepared for the original construction.
The Contractor shall verify all necessary dimensions of existing structural metalwork prior to preparing shop drawings for new metalwork.
New Diaphragms are to match existing Diaphragms as shown in "Framing Plan".
Connection bolts in Diaphragms between existing exterior stringer and new stringer S1, shall not be fully tightened until new concrete deck slab has been poured.
Intermediate stiffener Rs 4 1/2"x8" shall be equally spaced between Diaphragms as shown.
The first two stiffener spaces at the ends of stringers shall be one-half the normal spacing within the panel.
All horizontal dimensions in "Stringer Elevations" are measured along @ Web.
It may be necessary to increase Bearing Stiffener size to accommodate erection of end diaphragms.


FRAMING PLAN
Scale 1/4"=1'-0"

SHOE SCHEDULE


FIXED SHOES		EXPANSION SHOES	
TYPE	NO. REQD	TYPE	NO. REQD
F1M	8	E1	8
F2M	4	E4	2
		E6	1

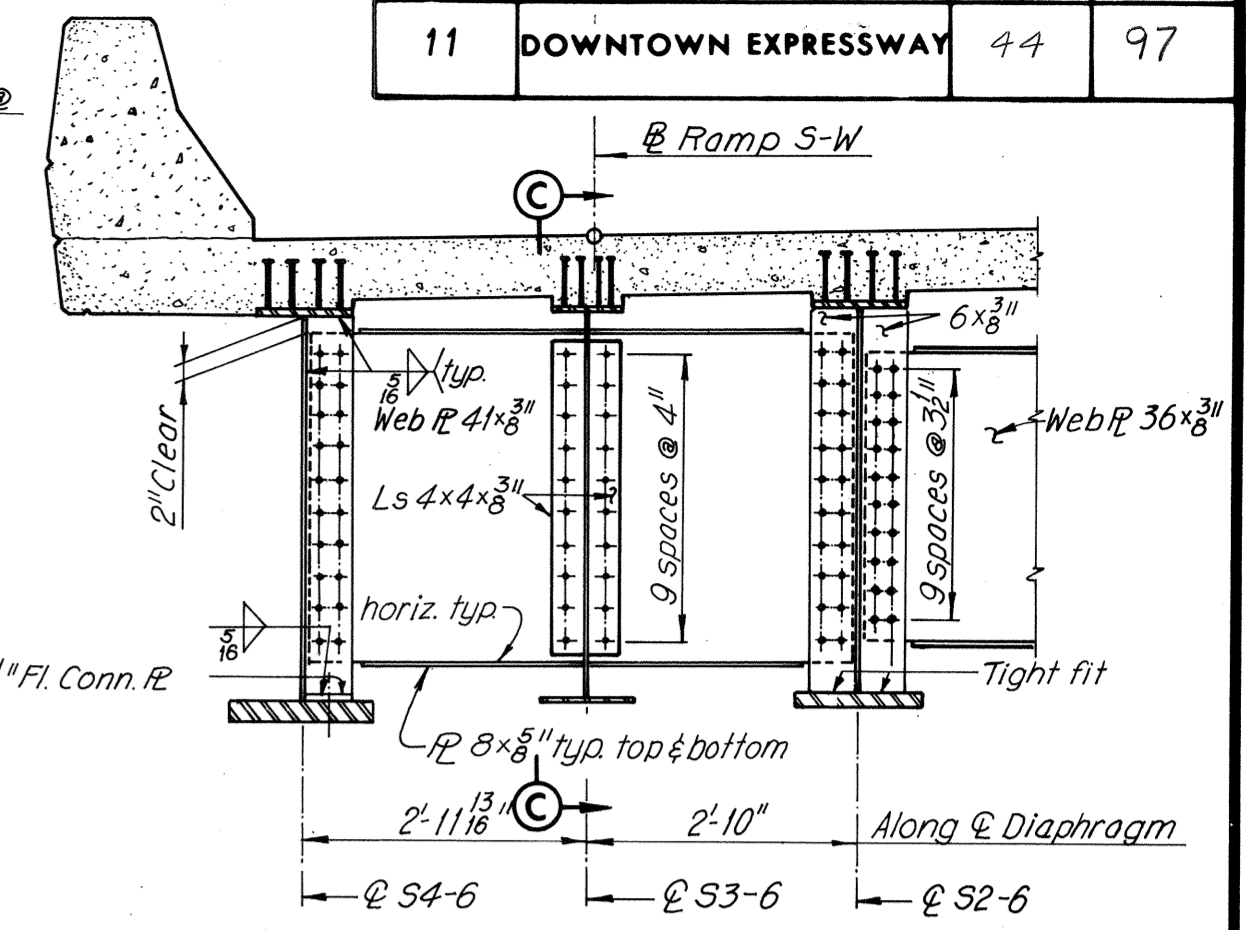


SECTION B-B
Scale 1/2"=1'-0"

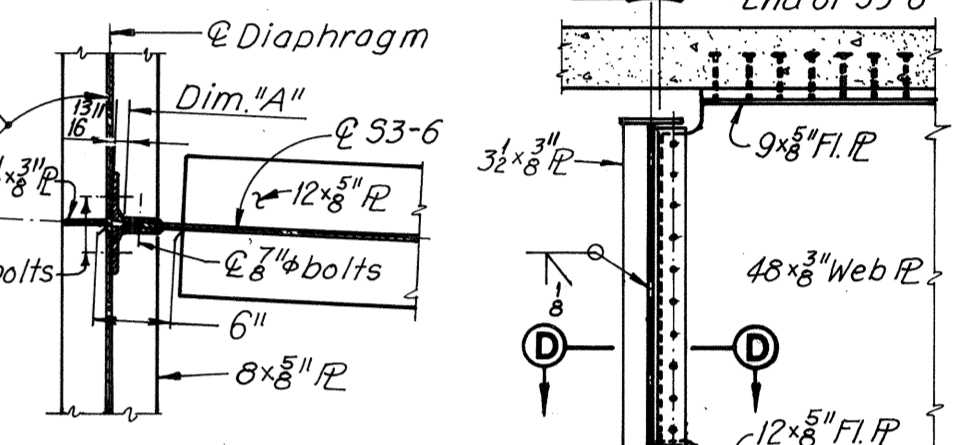

SECTION D-D
SECTION C-C
DETAILS OF FRAMED END STRINGER S3-6
Scale 1/2"=1'-0"

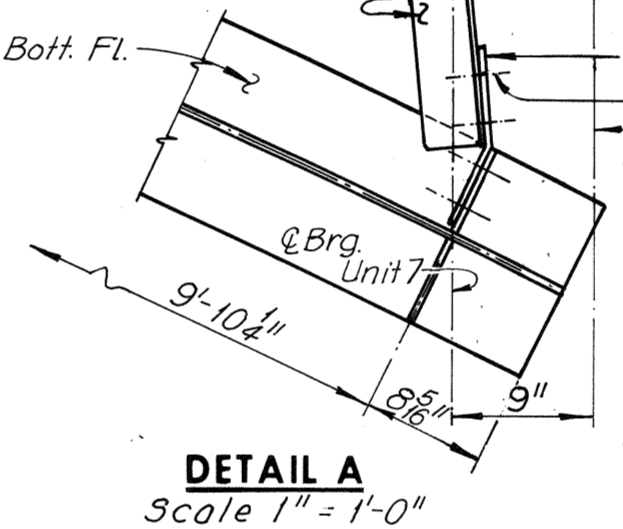


DETAIL A
Scale 1"=1'-0"

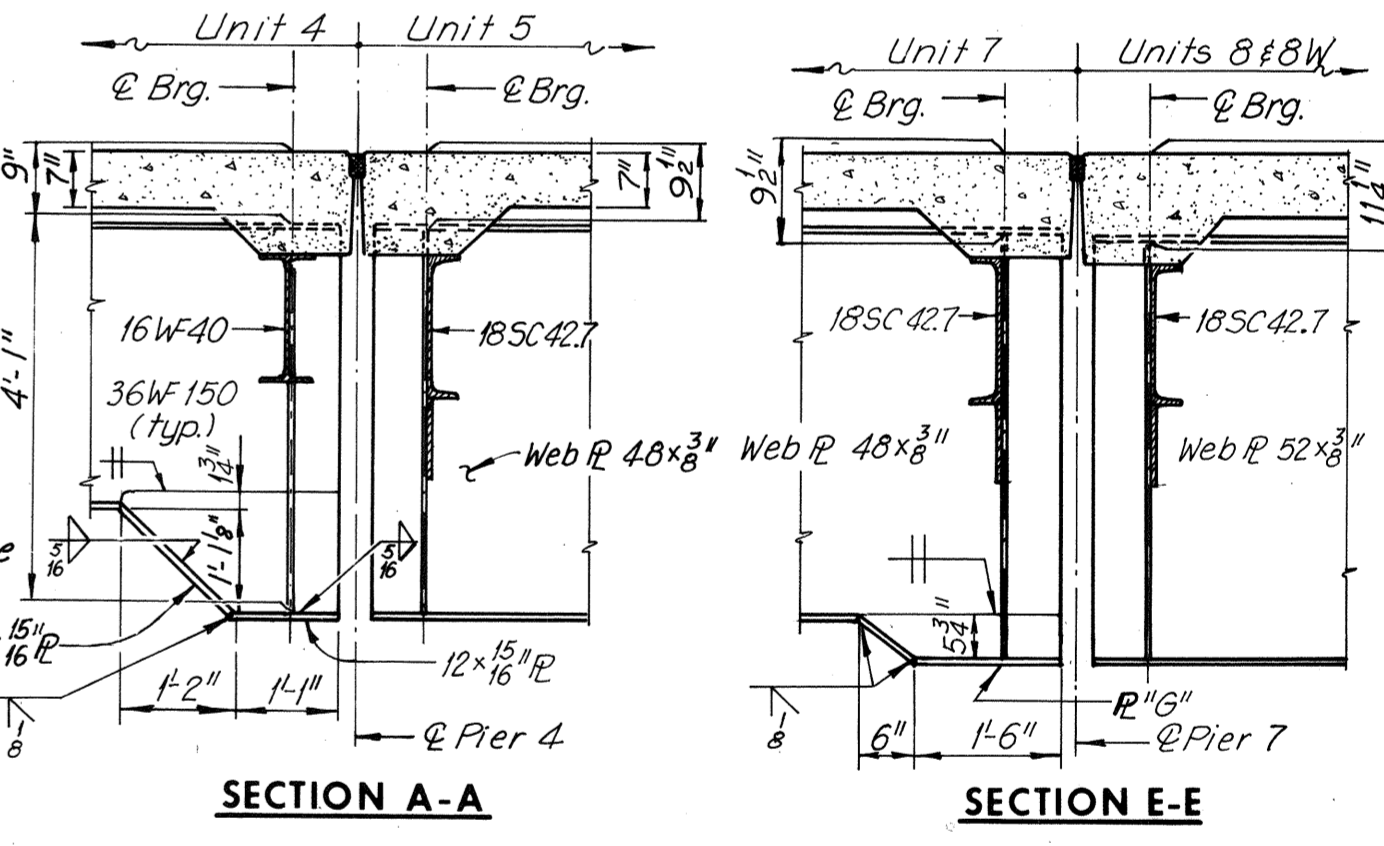


SECTION A-A
SECTION E-E


Note: Web transition @ Pier 7 is shown for stringers S1-7 through S5-7.

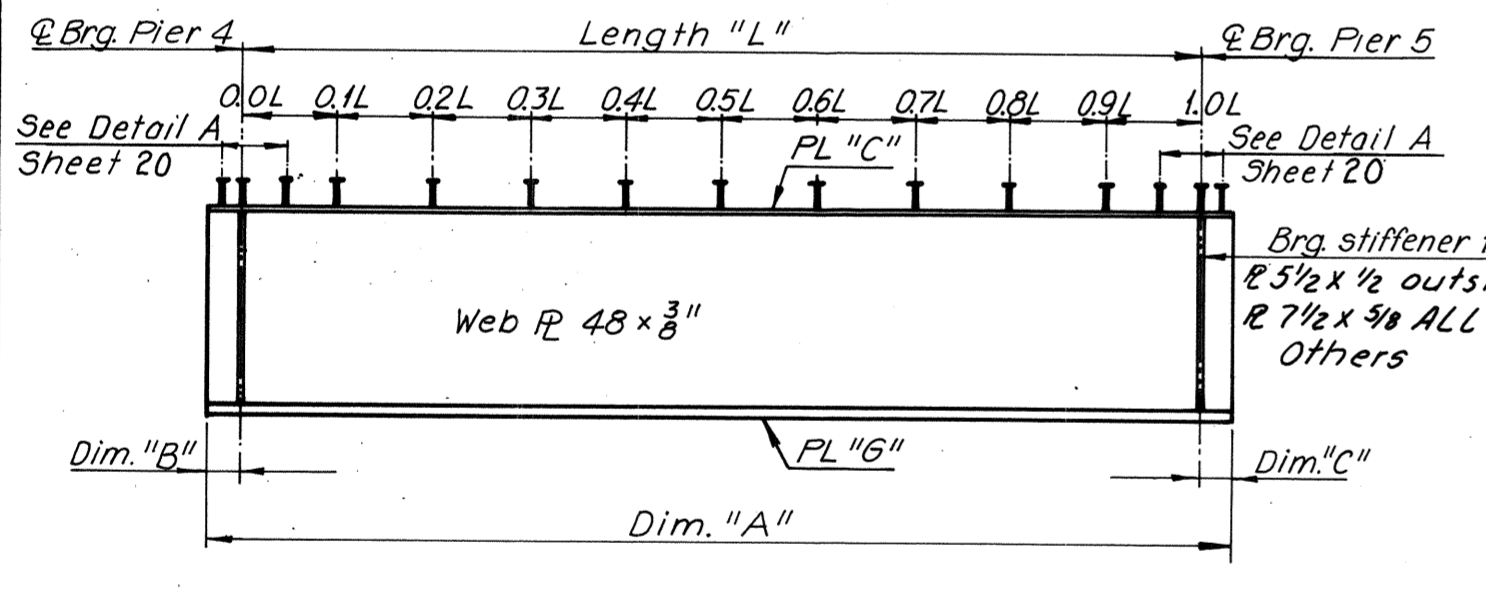

STRINGER ELEVATION UNIT 5

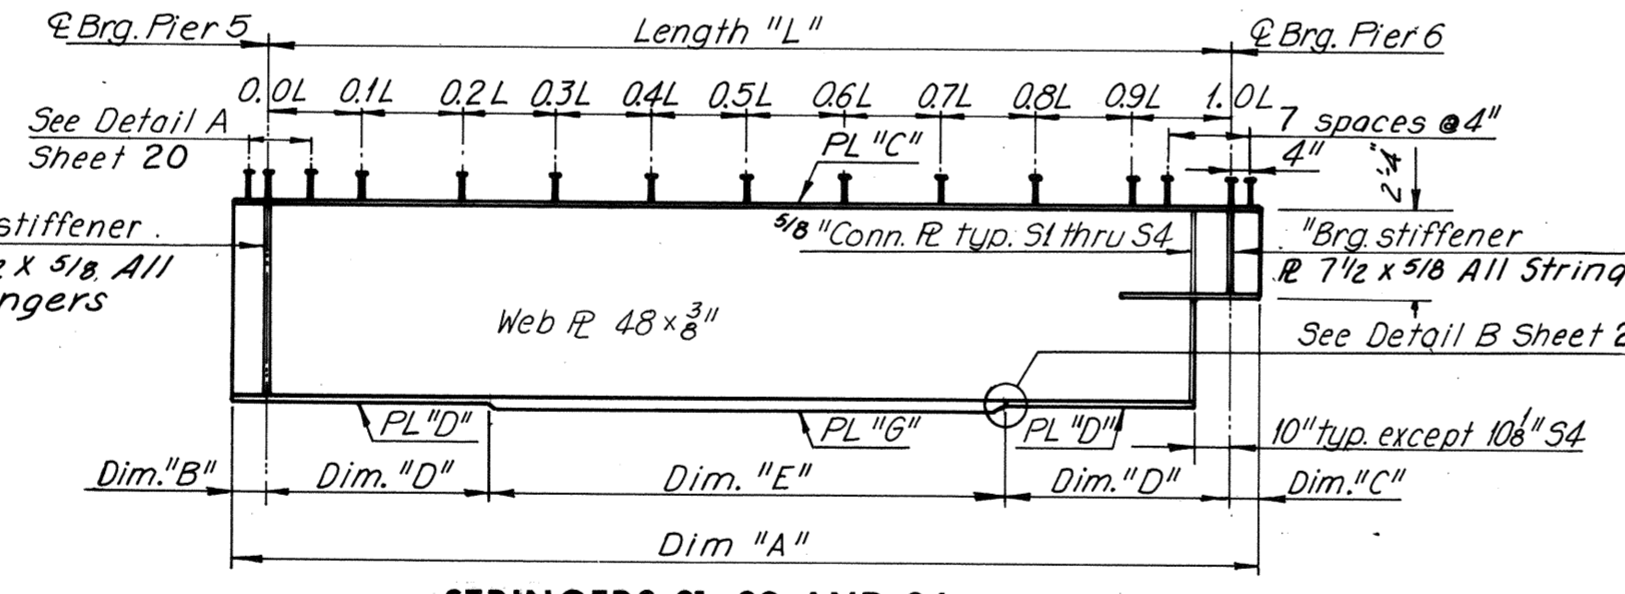

STRINGERS S1, S2 AND S4
STRINGER ELEVATIONS UNIT 6

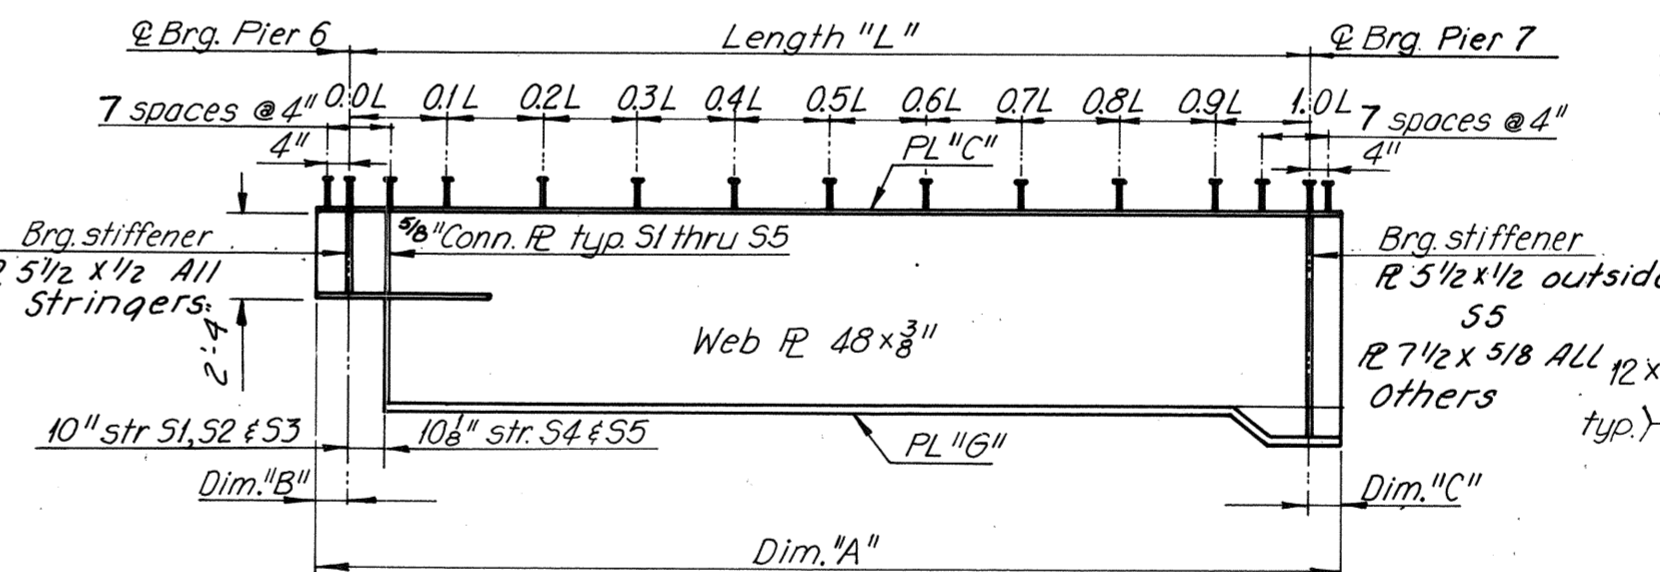

STRINGER ELEVATION UNIT 7

DETAILS OF WEB TRANSITION AT PIERS 4 AND 7
Scale 1/2"=1'-0"

UNIT	STRINGER	DIM. "A"	LENGTH "L"	DIM. "B"	DIM. "C"	DIM. "D"	DIM. "E"	PL. "C"	PL. "D"	PL. "G"	MAX. SHEAR STUD SPACING **												DEAD LOAD DEFLECTION SCHEDULE			CAMBER SCHEDULE		
											0.0L-0.1L	0.1L-0.2L	0.2L-0.3L	0.3L-0.4L	0.4L-0.5L	0.5L-0.6L	0.6L-0.7L	0.7L-0.8L	0.8L-0.9L	0.9L-1.0L	1/4L	1/2L	3/4L	1/4L	1/2L	3/4L		
											18"	20"	23"	24"	24"	24"	24"	23"	20"	18"	1/2"	1/16"	1/2"	13/16"	1/8"	7/8"		
5	S1-5	68'-7 1/2"	67'-5 1/2"	7"	7"	--	--	9 x 3/8"	--	12"x1 1/2"	18"	20"	23"	24"	24"	24"	24"	23"	20"	18"	3/8"	9/16"	3/8"	11/16"	1"	3/4"		
	S2-5	68'-6 1/2"	67'-4 1/2"	7"	7"	--	--	9 1/2 x 3/8"	--	12"x1 1/2"	18"	20"	23"	24"	24"	24"	24"	23"	20"	18"	1/2"	11/16"	1/2"	13/16"	1 1/8"	7/8"		
	S3-5	68'-8 1/2"	67'-4 1/2"	8"	8"	--	--	9 1/2 x 3/8"	--	12"x1 1/2"	15"	17"	20"	24"	24"	24"	24"	20"	17"	15"	5/8"	7/8"	5/8"	15/16"	1 1/2"	1"		
6	S1-6	107'-1 1/2"	106'-1-0"	7"	6 1/2"	16'-0"	74'-0"	16"x1 1/2"	16"x1 1/2"	16"x1 1/2"	18"	20"	24"	24"	24"	24"	24"	24"	20"	18"	1 1/4"	1 1/8"	1 1/2"	1 1/8"	2 3/8"	2"		
	S2-6	107'-0 3/4"	105'-10 3/8"	7"	6 1/2"	12'-11 3/8"	80'-0"	16"x1 1/2"	16"x1 1/2"	16"x1 1/2"	17"	20"	24"	24"	24"	24"	24"	21"	18"	14"	1 3/8"	2 1/8"	1 1/2"	1 1/8"	2 3/8"	2"		
	S3-6	45'-0 1/4"	44'-6 3/8"	--	6 1/2"	--	--	9 1/2 x 3/8"	--	12"x1 1/2"	17"	17"	17"	17"	17"	17"	17"	17"	17"	17"	1 1/8"	1/8"	1 1/8"	1/8"	1 1/8"	1 1/8"		
	S4-6	107'-3 3/8"	106'-1-1 1/2"	8"	6 3/8"	16'-0"	74'-1-1 1/2"	18"x1 1/2"	18"x1 1/2"	18"x1 1/2"	15"	17"	21"	24"	24"	24"	24"	24"	19"	15"	2"	2 1/8"	2"	2 1/8"	3 1/2"	2 1/2"		
7	S1-7	58'-10 1/2"	57'-8 3/4"	6 1/2"	7"	--	--	9 1/2 x 3/8"	--	12"x1 1/2"	15"	17"	19"	22"	24"	24"	24"	22"	19"	17"	1 1/4"	3/8"	1/4"	5/16"	7/16"	5/16"		
	S2-7	58'-9 1/2"	57'-8"	6 1/2"	7"	--	--	9 1/2 x 3/8"	--	12"x1 1/2"	15"	17"	19"	22"	24"	24"	24"	22"	19"	17"	1 1/4"	3/8"	1/4"	5/16"	7/16"	5/16"		
	S3-7	58'-9 1/2"	57'-8"	6 1/2"	7"	--	--	9 1/2 x 3/8"	--	12"x1 1/2"	18"	18"	24"	24"	24"	24"	22"	17"	15"	14"	1 1/4"	3/8"	1/4"	5/16"	7/16"	5/16"		
	S4-7	59'-2 1/4"	58'-0 3/4"	6 3/8"	7 1/2"	--	--	9 1/2 x 3/8"	--	12"x1 1/2"	18"	18"	24"	24"	24"	24"	22"	17"	16"	14"	1 1/4"	3/8"	1/4"	5/16"	7/16"	5/16"		
S5-7	60'-2"	58'-11 1/4"	6 3/8"	8 3/8"	--	--	9 1/2 x 3/8"	--	12"x1 1/2"	16"	16"	22"	22"	22"	22"	22"	18"	15"	13"	1 1/4"	3/8"	1/2"	3/8"	1 1/16"	15/16"	5/8"		

Notes:
For Superstructure Steel Quantities see Sheet 4.
For additional Diaphragm Details see Sheet 26.
For Deck Plan see Sheet 26.
For Dead Load Deflection and Camber Diagram see Sheet 20.
For Joint Details see Sheets 34 and 35.
For Detail "A" see Sheet 20.
For Standard Shoe Details see Sheets S1 and S2.
For Flange to Web welds see Sheet 24.

BY	DATE	REVISION	BY	DATE
J.M.A.	1-16-69	Dimension Changes	J.M.A.	9-8-75
A.M.H.	6-21-75	Diaphragms removed & Note revised	J.M.A.	8-25-75

** Use 2-3/8" Shear Studs on stringers S3-6 and S1-7 through S5-7
#.....Spacing begins at termination of 7 spaces @ 4"
#.....See Stringer Elevation of stringer S3-6
** Use 2-3/8" Shear Studs on stringers S1-5, S2-5 and S3-5
NOTE: see Stringer Elevation above.

ALL STRUCTURAL STEEL SHALL BE A-36


RICHMOND METROPOLITAN AUTHORITY
RICHMOND EXPRESSWAY SYSTEM
DOWNTOWN EXPRESSWAY

BRIDGE NO. 65
RAMP S-W CONNECTION FROM
RICHMOND-PETERSBURG TURNPIKE
FRAMING PLAN-UNITS 5, 6 AND 7


HOWARD, NEEDLES, TAMMEN & BERGENDOFF
consulting engineers
NEW YORK ALEXANDRIA KANSAS CITY

SCALE: As shown
CONTRACT NO. 11
SHEET NO. 19 OF 38


AS BUILT

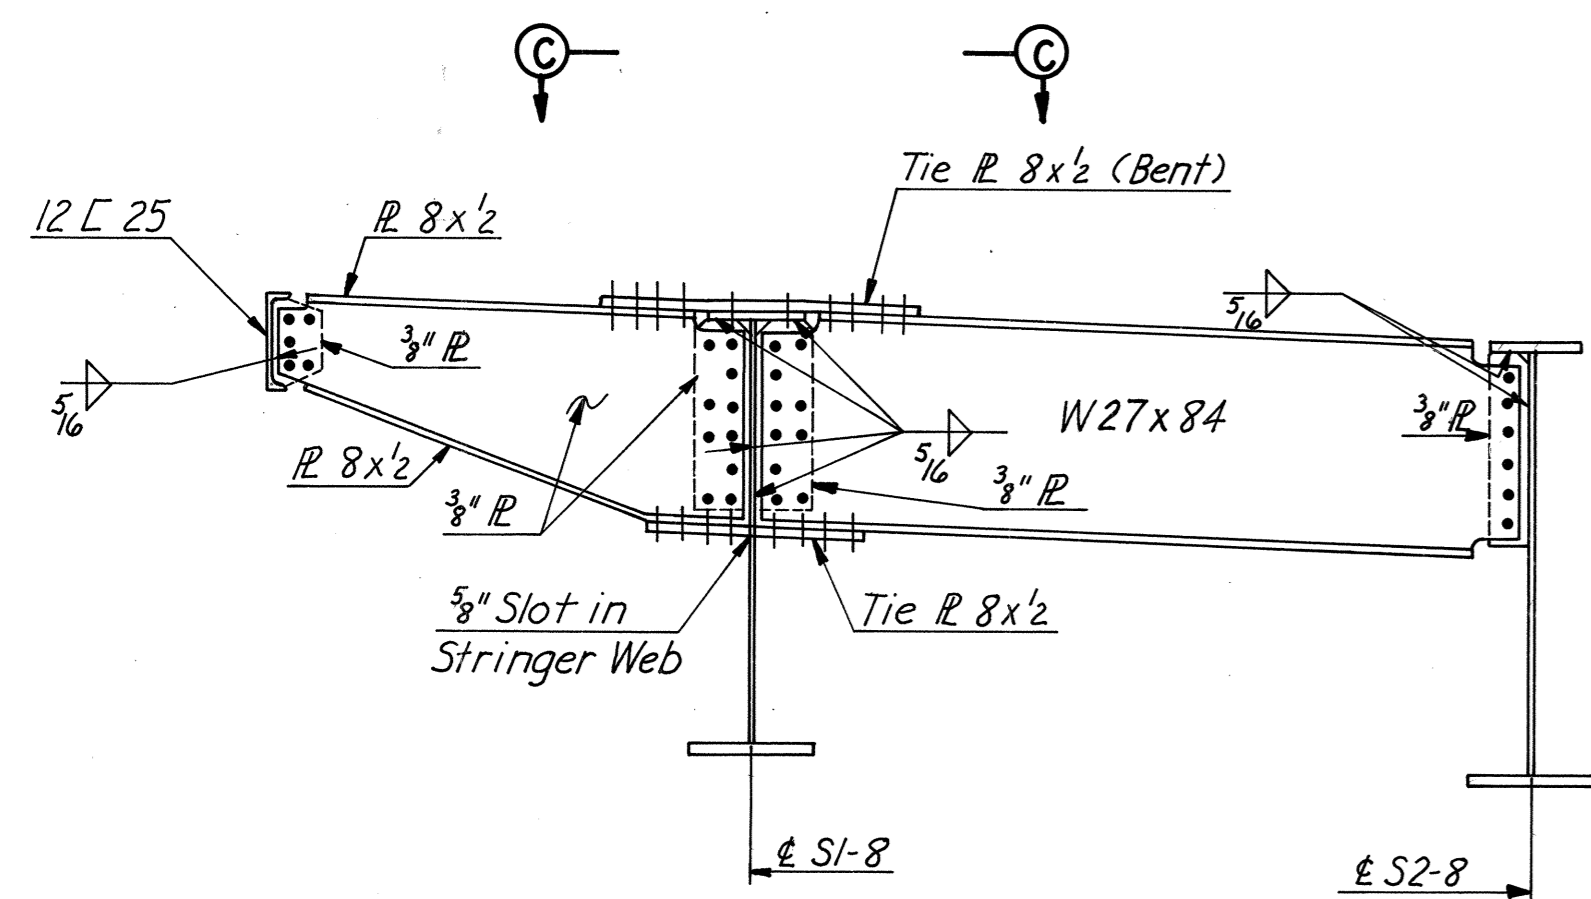


SECTION A-A

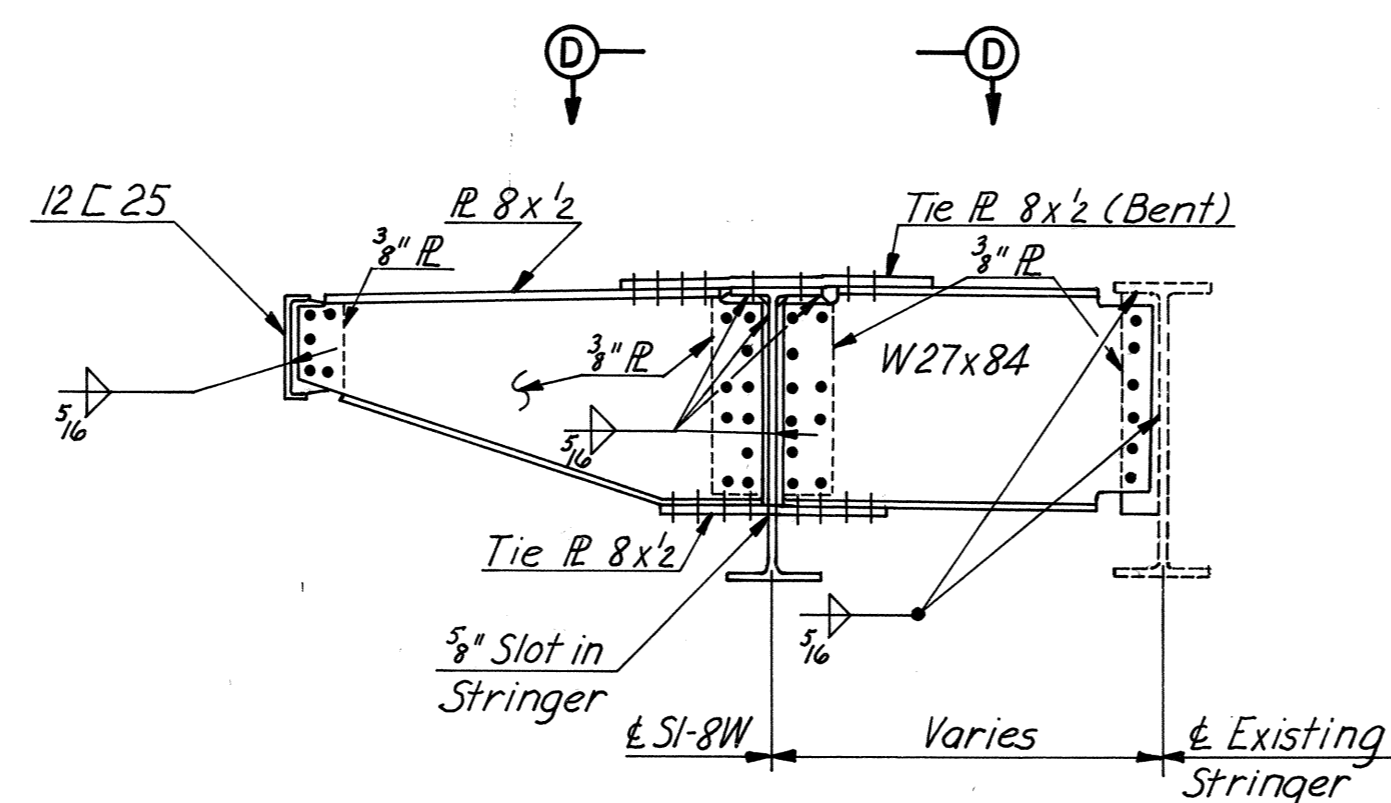


SECTION M-M

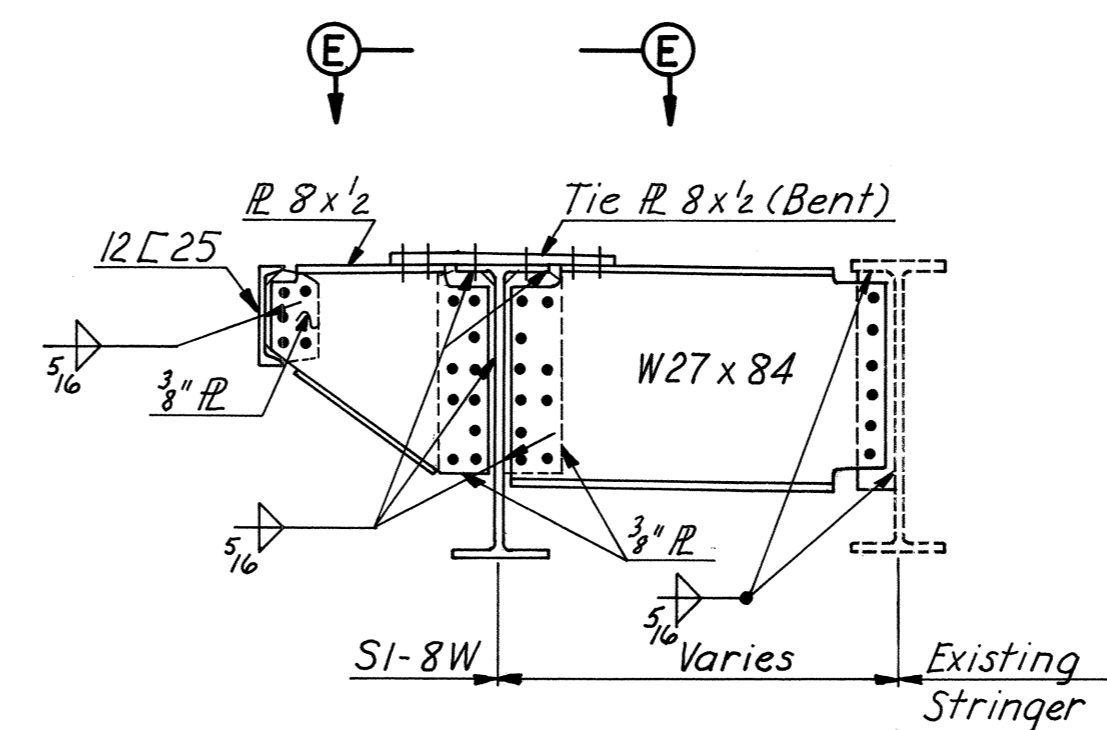


SECTION N-N

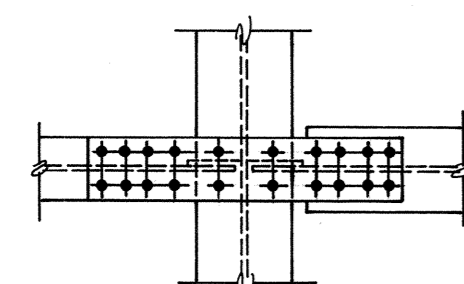


SECTION C-C

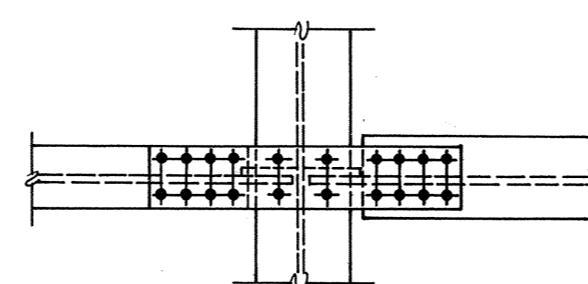

SECTION D-D

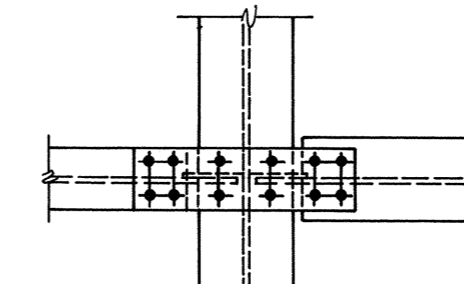

SECTION E-E

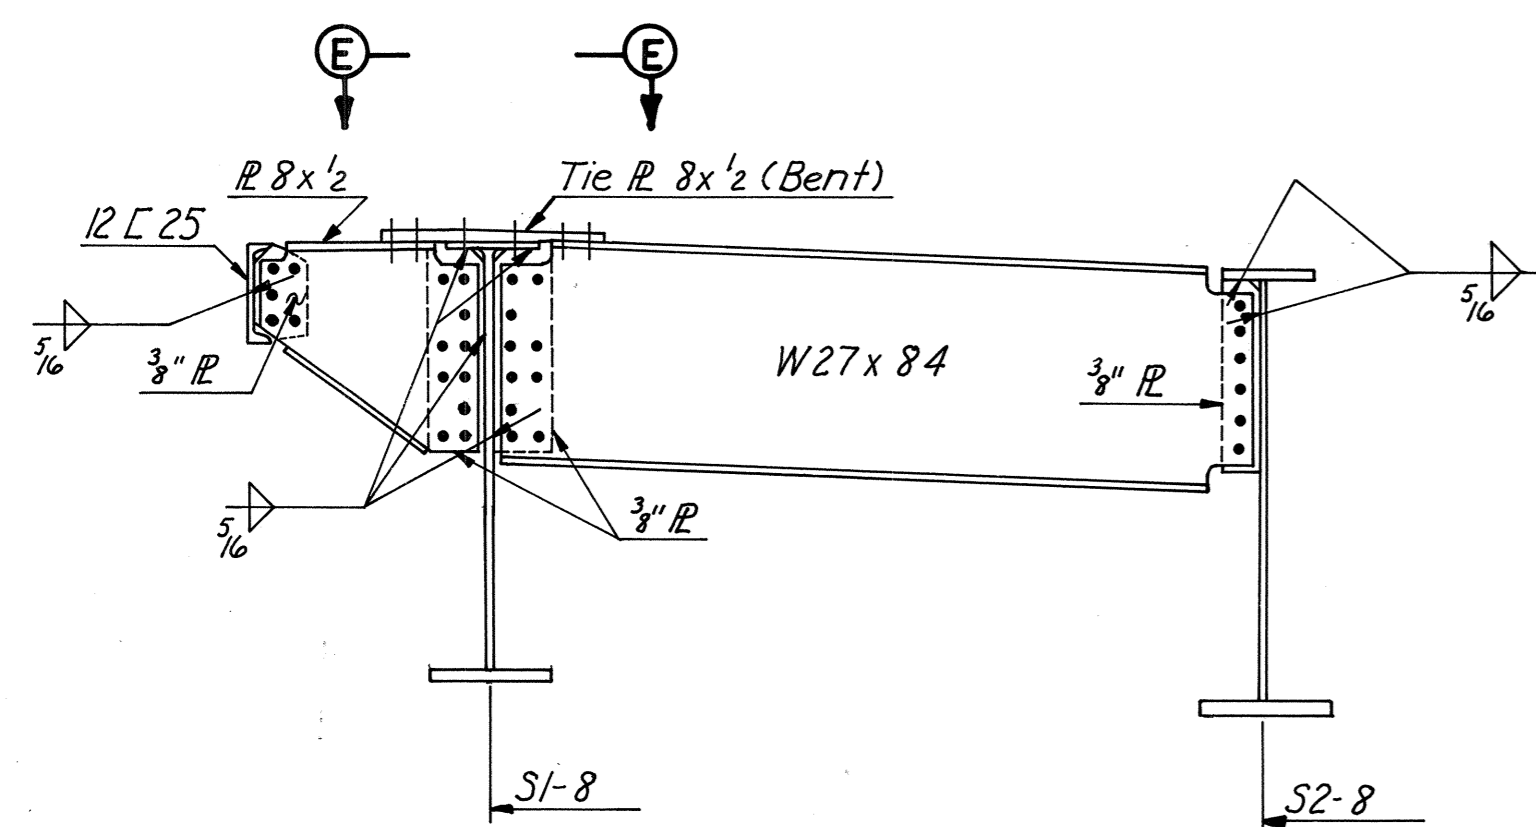

SECTION B-B

NOTE:
 For location of Sections A-A & B-B, see Sheet 20.
 For location of Sections M-M & N-N, see Sheet 32.

DESIGNED					
DRAWN	E.J.M.	9-75			
CHECKED			△ New Sheet	TEM.	9-9-75
IN CHARGE	P.R.Y.	NO.	REVISION	BY	DATE

AS BUILT

RICHMOND METROPOLITAN AUTHORITY
RICHMOND EXPRESSWAY SYSTEM

BRIDGE NO. 65
 RAMP S W CONNECTION FROM
 RICHMOND PETERSBURG TURNPIKE
 FRAMING DETAILS UNIT 8 & 8W



SCALE As Noted
 DATE _____

SHEET 20a OF 38

HOWARD, NEEDLES, TAMMEN & BERGENDOFF
 CONSULTING ENGINEERS
 Alexandria, Virginia

HNTB


RICHMOND EXPRESSWAY SYSTEM			
SECTION	PROJECT	SHEET NO.	TOTAL SHEETS
11	DOWNTOWN EXPRESSWAY	45	97

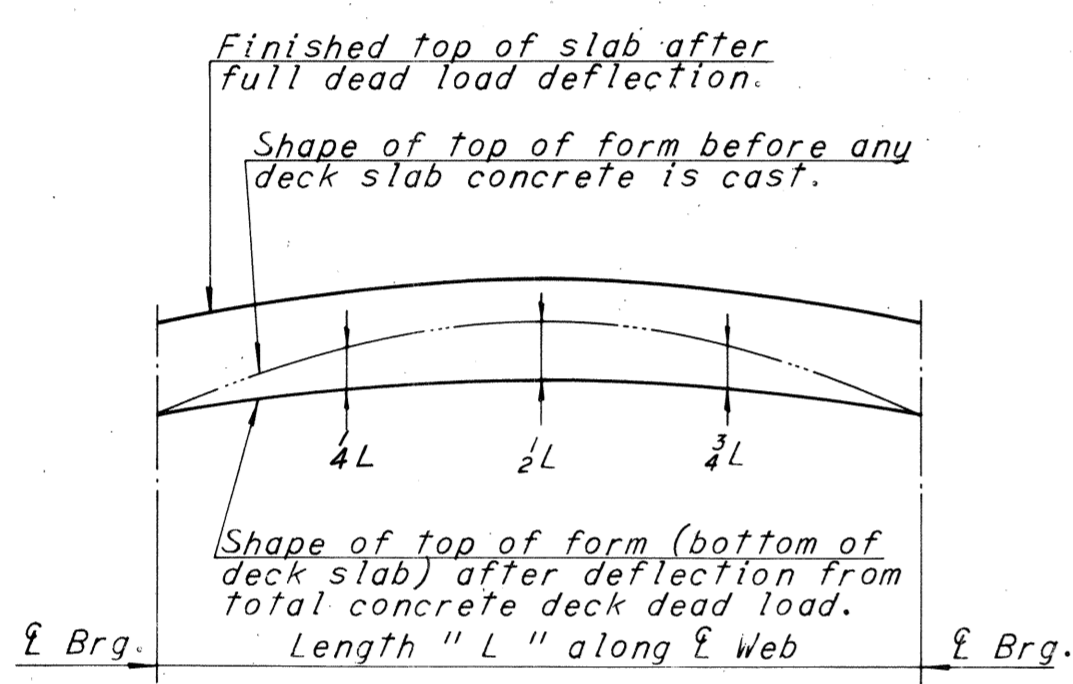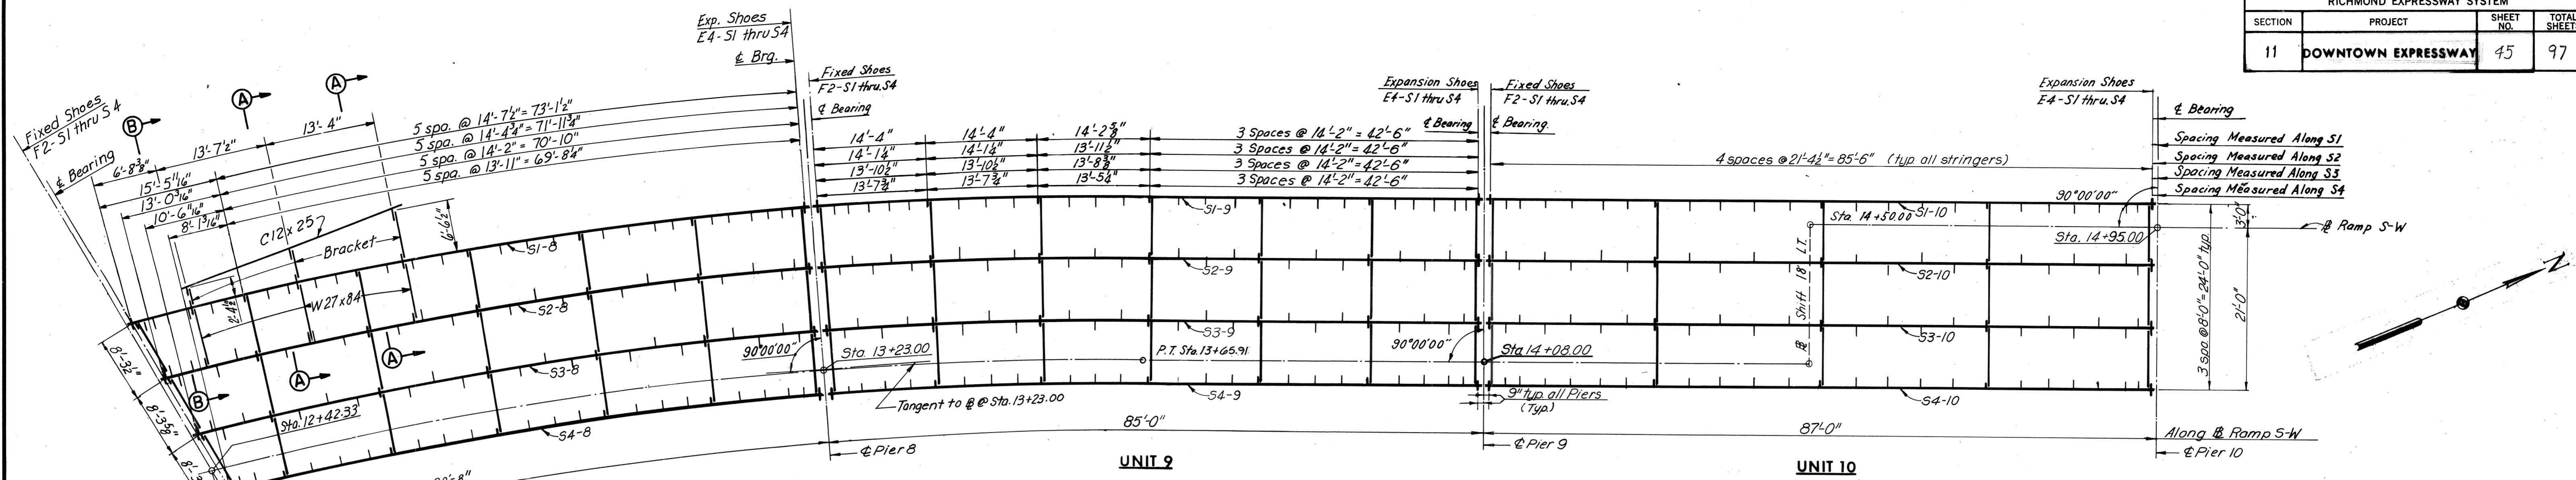

DEAD LOAD DEFLECTION DIAGRAM

NOTE TO CONTRACTOR

Deflections given are those anticipated to occur in the stringer upon placement of the total concrete deck dead load. In practice, the stringers in place are not likely to have the exact camber to compensate for these deflections during construction. The residual amounts shall be provided by adjusting forms to vary the thickness of the concrete haunch between the bottom of the slab and the top of stringer without altering the slab thickness.

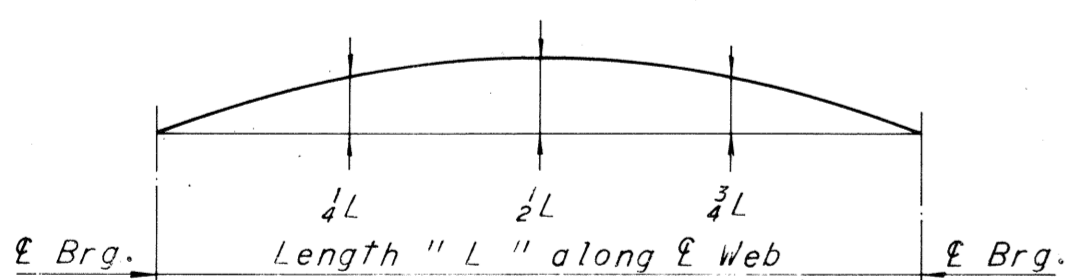

CAMBER DIAGRAM

NOTE TO FABRICATOR


The stringers shall be fabricated with a total camber amounting to the tabulated value. A positive number indicates an upward camber and negative number indicates a downward camber. This will provide approximate compensation for deflection under full dead load and for conformity with finished grade. Dimensions are in inches.

Notes:


Stringers having a total camber of less than 1" are not required to be shop cambered, but should be turned so that any mill tolerance deviation from straightness will be in the direction shown by the Camber Diagram.

If stringers are not cambered, distance from top of stringers to top of slab will vary along the stringer in accordance with the offset dimensions shown in the Camber Diagram, and with minimum distance as shown in cross section on sheet 27.

BY	DATE	REVISION	BY	DATE
AMH	1-24-69	Re-design S1-8+S2-8	AMH	1-24-69
AMH	1-24-69	Bracket Unit B	AMH	1-24-69

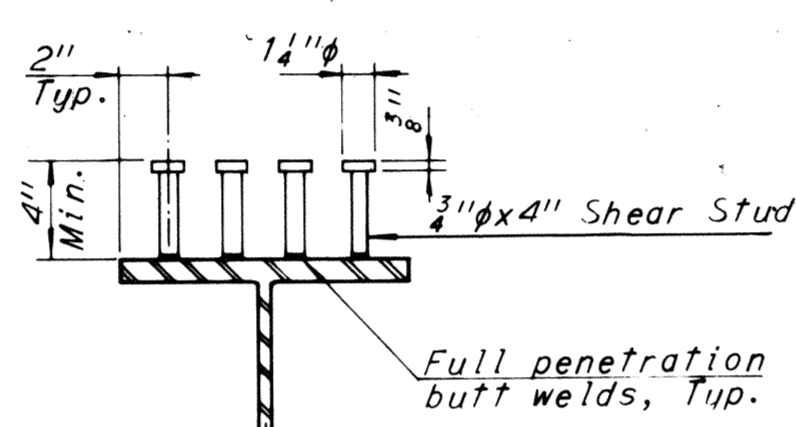


SHEAR STUD DETAIL

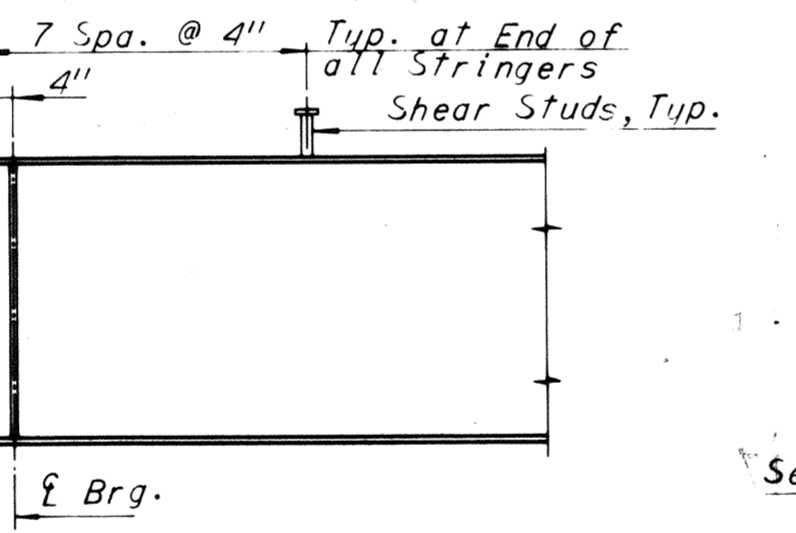

SHEAR STUD NOTE


Contractor may, if he elects, use three 7/8" diameter studs at the same longitudinal spacing in lieu of the four 3/4" diameter studs shown.

Stud rows shall be placed parallel to the main deck reinforcement.

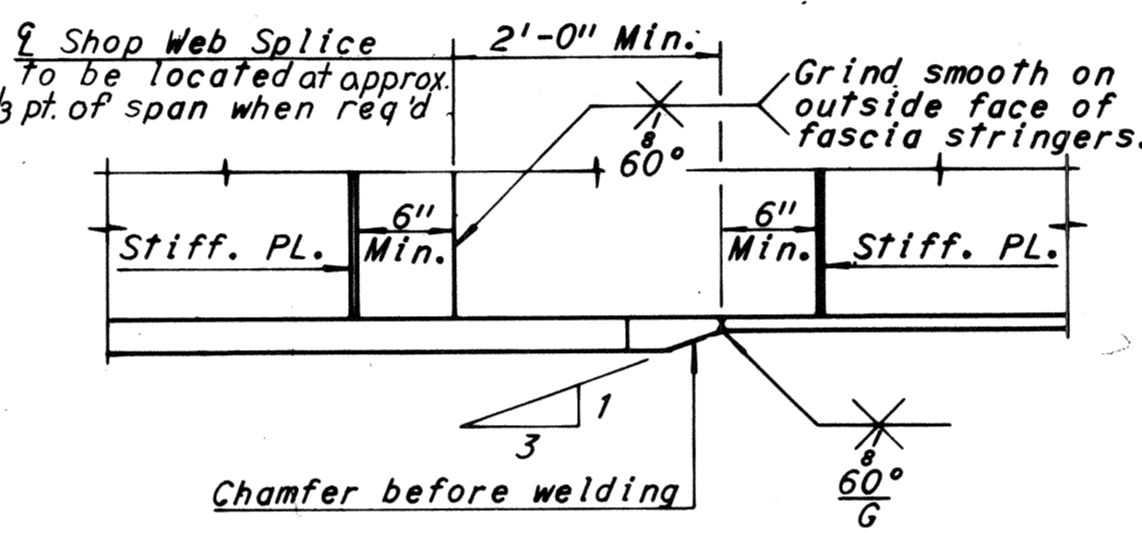


DETAIL "B"

Denotes A572-Grade 50 Steel for thickness of 3/4" and under and A588 Steel for thickness over 3/4".

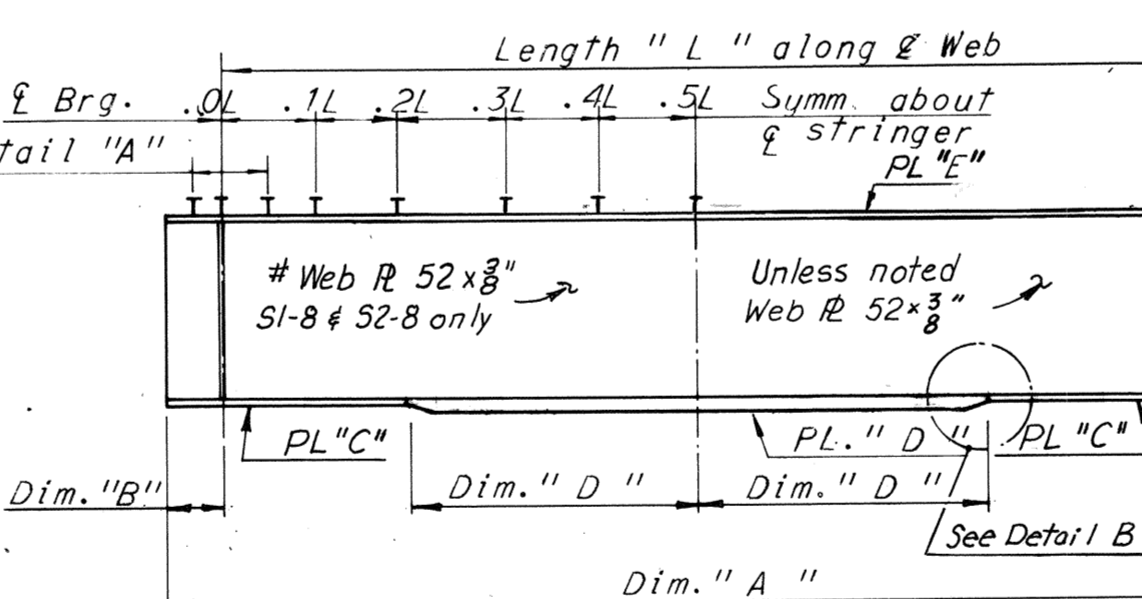


STRINGER ELEVATION

UNIT	STRINGER	Dim. "A"	LENGTH "L"	Dim. "B"	Dim. "D"	PL "C"	PL "D"	PL "E"	MAX. SHEAR STUD SPACING					DEAD LOAD DEFLECTION SCHEDULE			CAMBER SCHEDULE		
									0.0L-0.1L	0.1L-0.2L	0.2L-0.3L	0.3L-0.4L	0.4L-0.5L	1/4L	1/2L	3/4L	1/4L	1/2L	3/4L
8	S1-8	89'-11 3/8"	88'-7 3/8"	8"	26'-6"	#16x1 1/2"	#16x2"	#12x1"	9"	10"	12"	16 1/2"	20"	1 1/4"	1 3/4"	1 1/4"	-3/4"	-1"	-1 1/4"
	S2-8	86'-1 1/8"	84'-11 3/8"	7"	30'-0"	#16x1"	#16x1 1/2"	#12x3/4"	11 1/2"	12 1/2"	15"	18"	21 1/2"	1 3/16"	1 1/16"	1 3/16"	-1 3/4"	-1 1/4"	-1 3/4"
	S3-8	82'-1 1/8"	81'-4 1/8"	7"	24'-0"	16x1 1/2"	16x1 3/4"	12x1"	12"	13"	15"	19"	23"	7/8"	1 1/4"	1 1/4"	-1 1/8"	-1 1/2"	-1 1/8"
	S4-8	79'-1 1/8"	77'-9 1/8"	8"	26'-0"	16x 3/4"	16x1 1/8"	12x3/4"	12"	13 1/2"	16"	19"	24"	3/4"	1 1/16"	3/4"	-1 1/4"	-1 5/8"	-1 1/4"
9	S1-9	86'-8 3/8"	85'-4 3/8"	8"	27'-6"	16x1 1/2"	16x2 1/2"	12x3/4"	10"	11"	14"	16 1/2"	21"	1 1/4"	1 3/4"	1 1/4"	1 1/2"	2 1/8"	1 1/2"
	S2-9	85'-10"	84'-8"	7"	28'-0"	16x1 1/2"	16x2"	12x3/4"	11"	12 1/2"	15 1/2"	18"	22"	1"	1 3/8"	1"	1 1/4"	1 1/16"	1 1/4"
	S3-9	85'-1 1/8"	83'-11 3/8"	7"	30'-0"	16x 3/4"	16x1 1/2"	12x3/4"	11 1/2"	13"	16"	19"	23"	1"	1 3/8"	1"	1 3/16"	1 5/8"	1 3/16"
	S4-9	84'-6 3/8"	83'-2 3/8"	8"	28'-0"	16x 3/4"	16x1 1/2"	12x3/4"	11 1/2"	13 1/2"	17"	20 1/2"	24"	1 1/8"	1 5/16"	1 1/8"	1 5/16"	1 9/16"	1 1/8"
10	S1-10	86'-10"	85'-6"	8"	29'-0"	16x 3/4"	16x1 1/2"	12x3/4"	10 1/2"	11 1/2"	15"	18"	23"	1 1/8"	1 9/16"	1 1/8"	1 3/16"	1 5/8"	1 3/16"
	S2-10	86'-8"	85'-6"	7"	29'-0"	16x 3/4"	16x1 1/2"	12x3/4"	11 1/2"	12 1/2"	15 1/2"	18 1/2"	22"	1 1/16"	1 1/2"	1 1/16"	1 9/16"	3 1/2"	2 1/16"
	S3-10	86'-8"	85'-6"	7"	29'-0"	16x 3/4"	16x1 1/2"	12x3/4"	11 1/2"	12 1/2"	15 1/2"	18 1/2"	22"	1 1/16"	1 1/2"	1 1/16"	1 13/16"	3 1/2"	2 13/16"
	S4-10	86'-10"	85'-6"	8"	29'-0"	16x 3/4"	16x1 1/2"	12x3/4"	10 1/2"	11 1/2"	15"	18"	23"	1 1/8"	1 9/16"	1 1/8"	2 3/16"	3 1/2"	2 1/16"

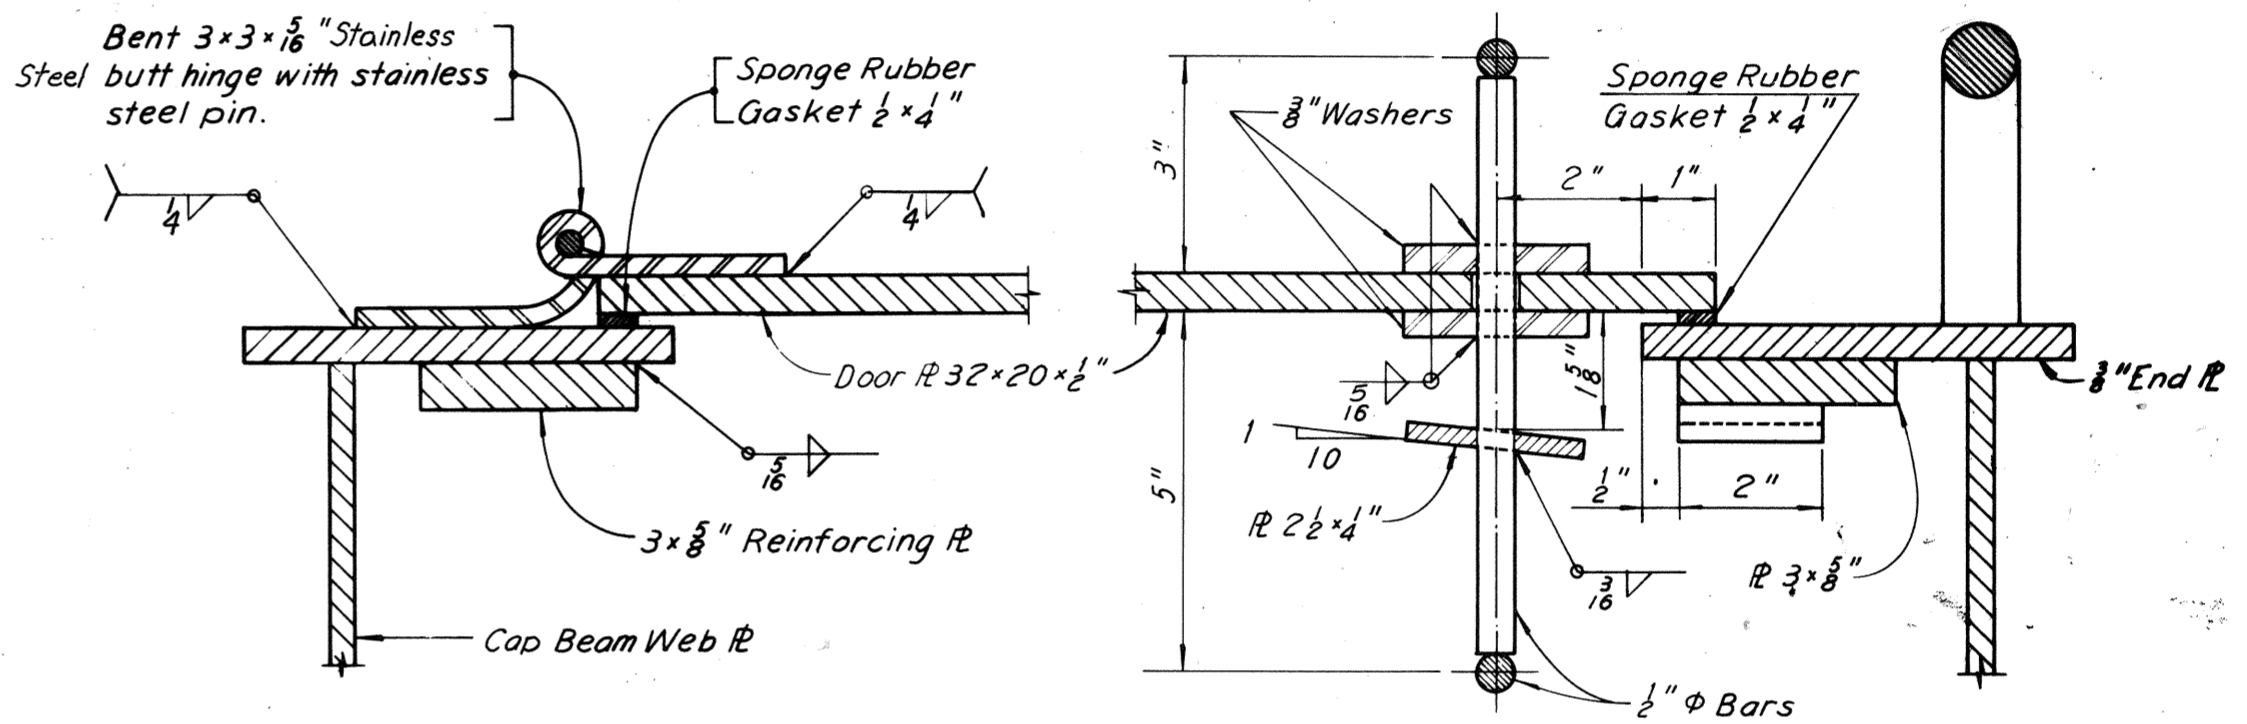

SECTION C-C

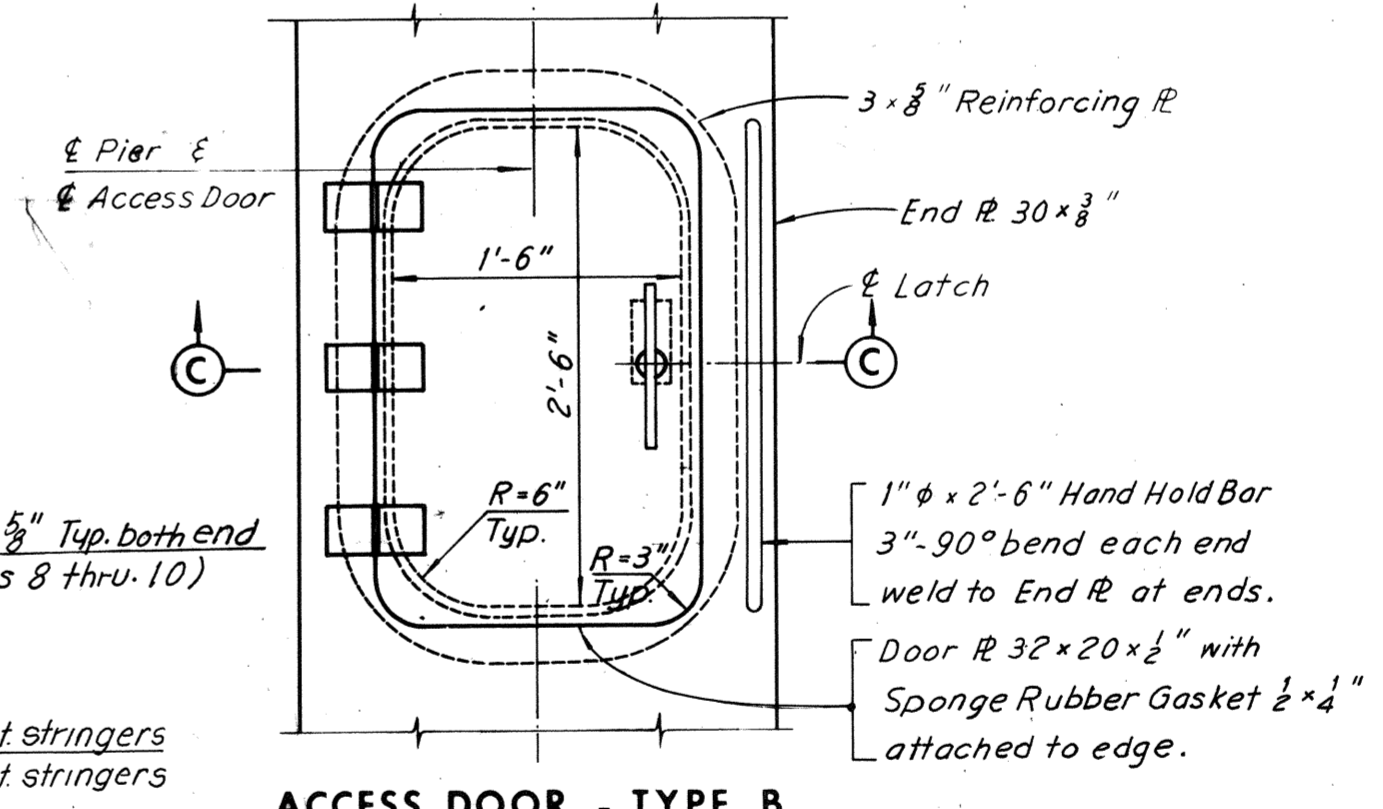

ACCESS DOOR - TYPE B

For the location of Access Door Type-B, see sheet 7.

* Spacing begins at termination of 7 spaces @ 4".

SHOE SCHEDULE			
EXPANSION SHOES		FIXED SHOES	
TYPE	NO. REQD.	TYPE	NO. REQD.
E	12	F	12

Notes:

All steel shall be A36 steel unless denoted otherwise.

Intermediate stiffener plates shall be equally spaced between diaphragms as shown.

The first two plates of the ends of stringers shall be one half the normal spacing within the panel.

All intermediate stiffeners shall be Pl. 4 x 3/8".

For framing and connecting detail, see sheet 27.

For shoe detail, see sheet S1 & S2.

All Horizontal Dimensions are measured along & Web.

For Web to Flange Welds and Longitudinal Stiffener Details, see Sheet 24.

For Diaphragm Details, see Sheet 27.

For Structural Steel Quantities, see Sheet 4.

For Joint Details, see Sheets 34 and 35.

It may be necessary to increase Bearing Stiffener size to accommodate erection of end diaphragms.

For Sections A-A and B-B see Sheet 20a.

AS BUILT

RICHMOND METROPOLITAN AUTHORITY
RICHMOND EXPRESSWAY SYSTEM
DOWNTOWN EXPRESSWAY

BRIDGE NO. 65
RAMP S-W CONNECTION FROM
RICHMOND-PETERSBURG TURNPIKE
FRAMING PLAN UNITS 8,9 AND 10

HOWARD, NEEDLES, TAMMEN & BERGENDOFF
consulting engineers
NEW YORK ALEXANDRIA KANSAS CITY






SCALE: As Noted

CONTRACT NO.: 11

SHEET NO. 20 OF 38

RICHMOND EXPRESSWAY SYSTEM			
SECTION	PROJECT	SHEET NO.	TOTAL SHEETS
11	DOWNTOWN EXPRESSWAY	46	97


SHOE SCHEDULE			
EXPANSION SHOES		FIXED SHOES	
TYPE	NO. REQD.	TYPE	NO. REQD.
E4	8	F2	4
E4B4	6	F3	4
		F2B4	6

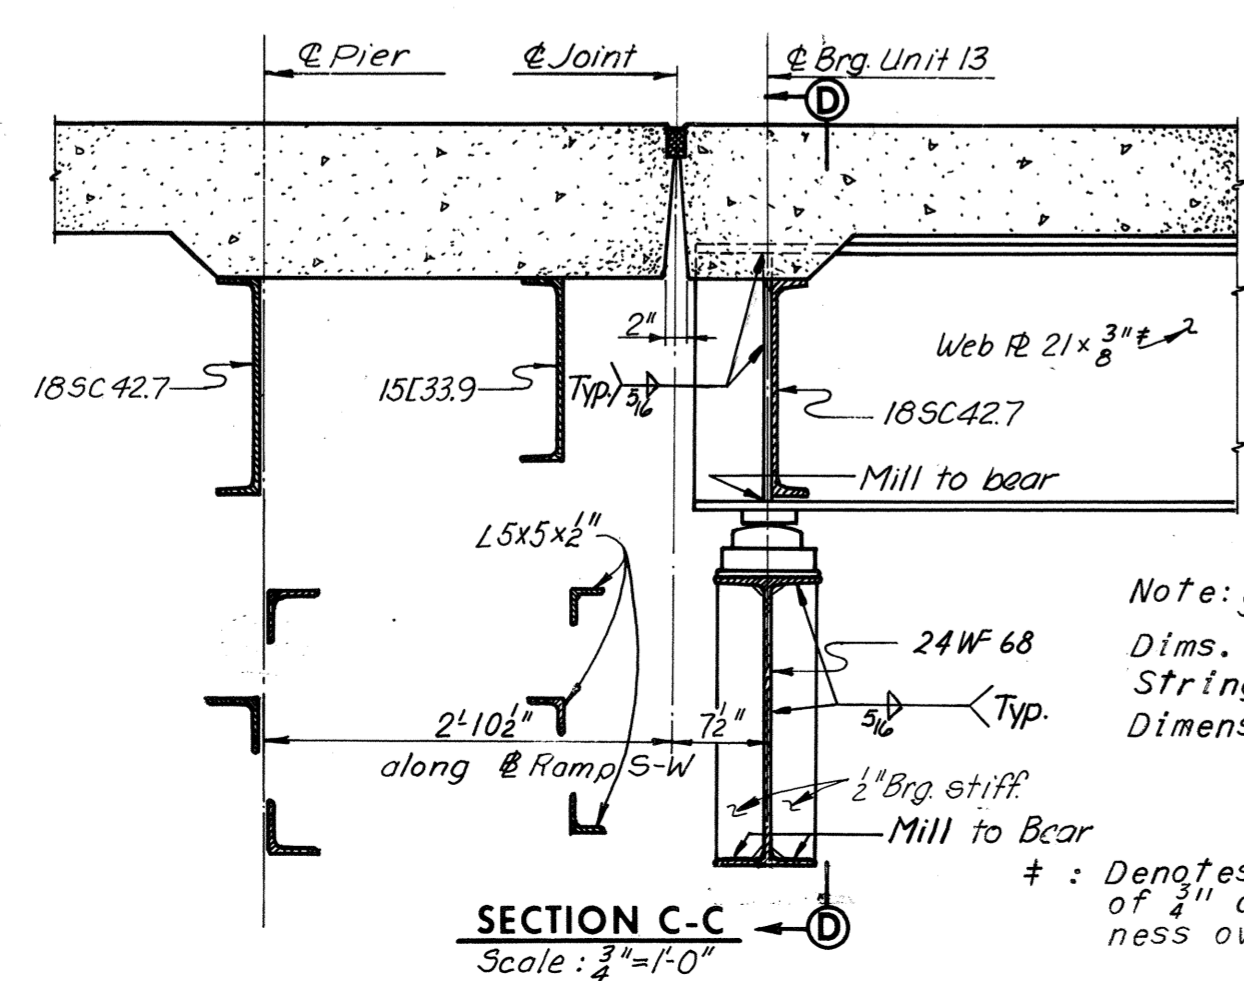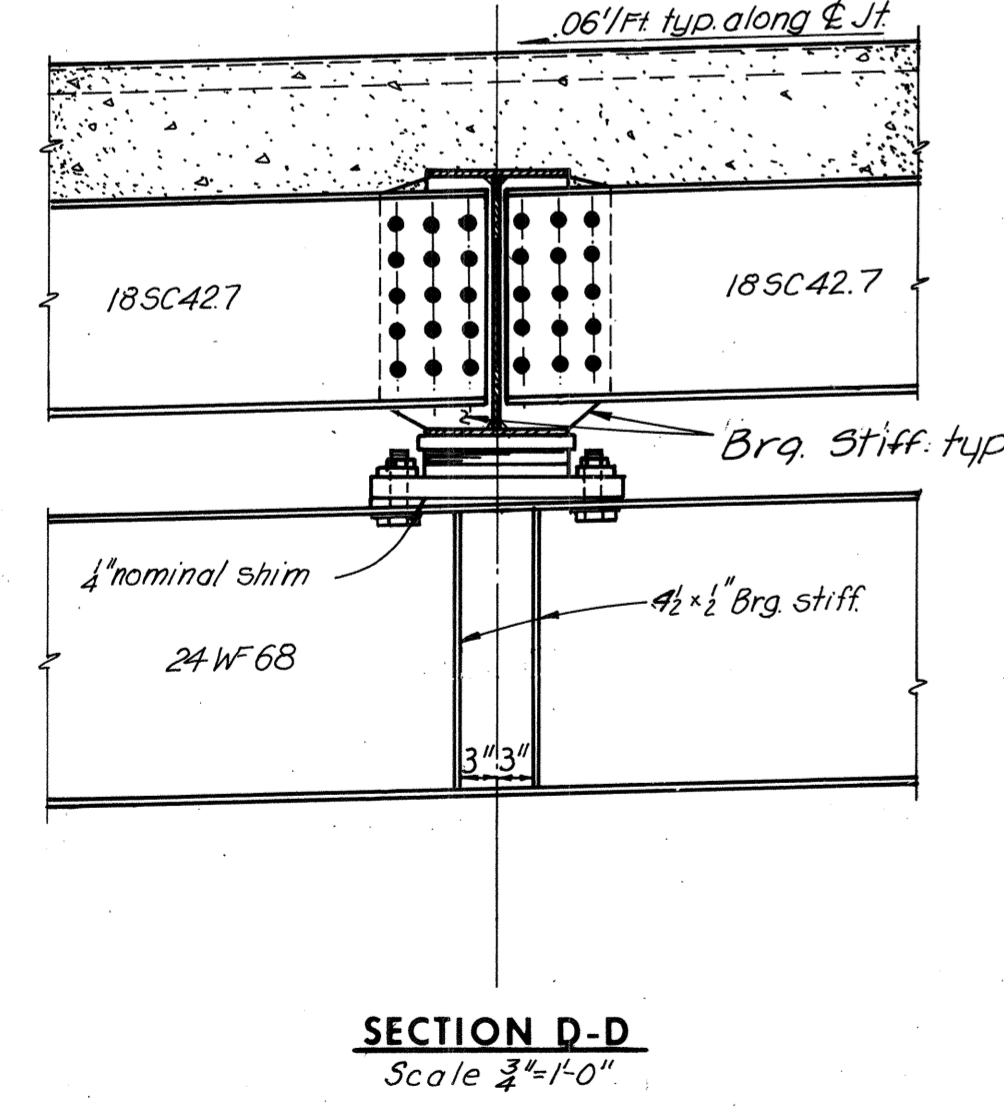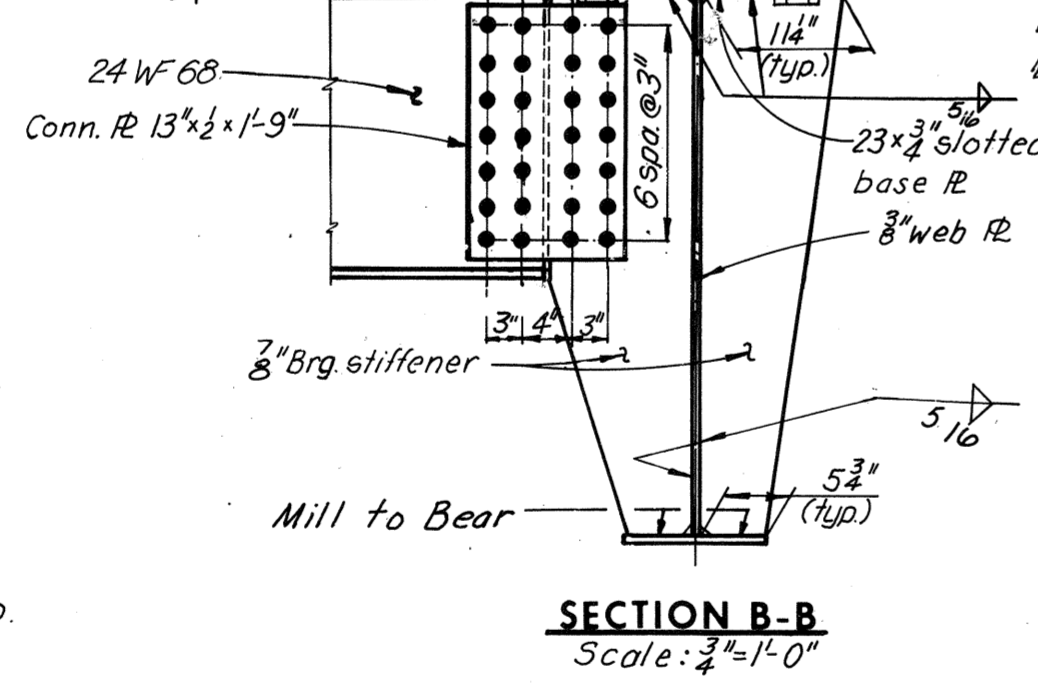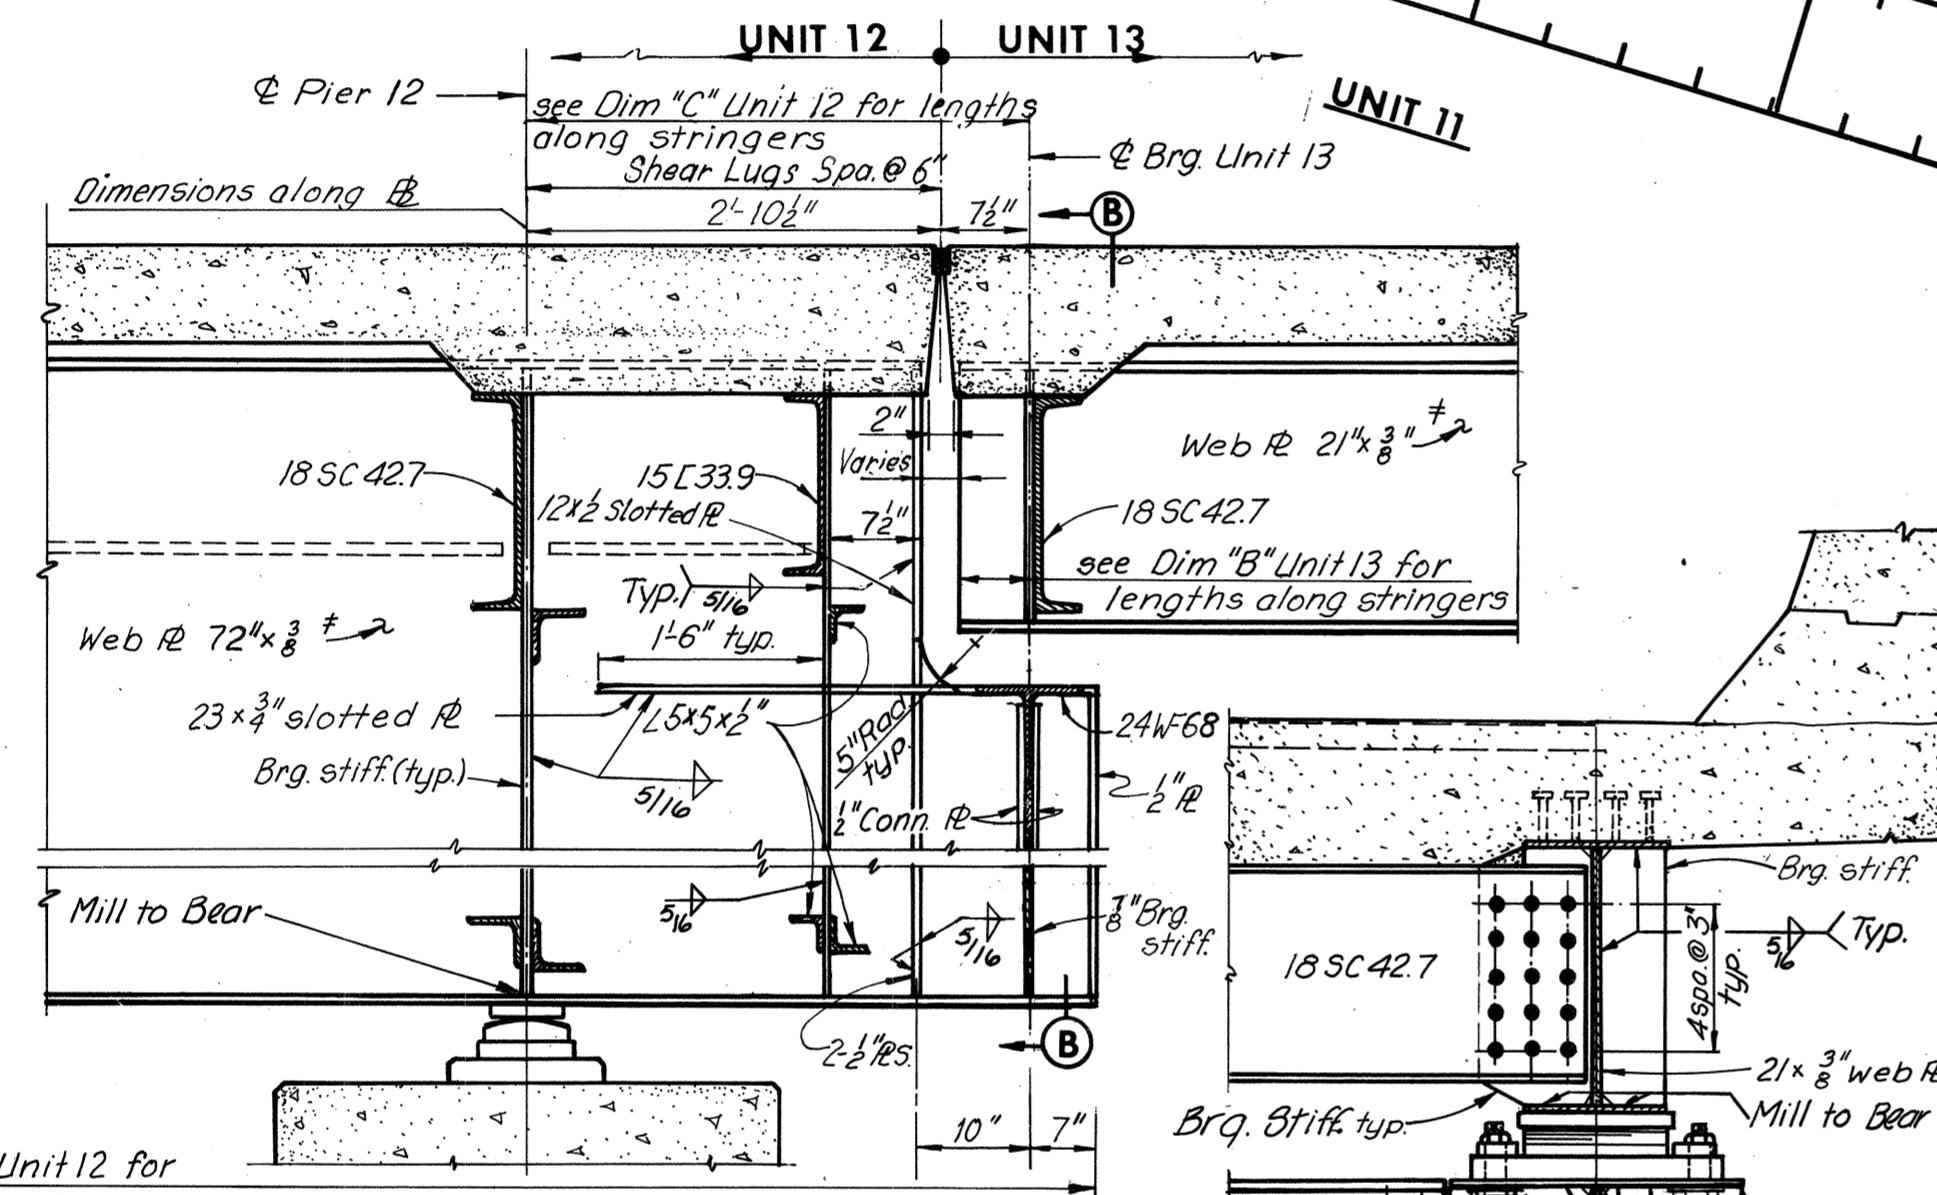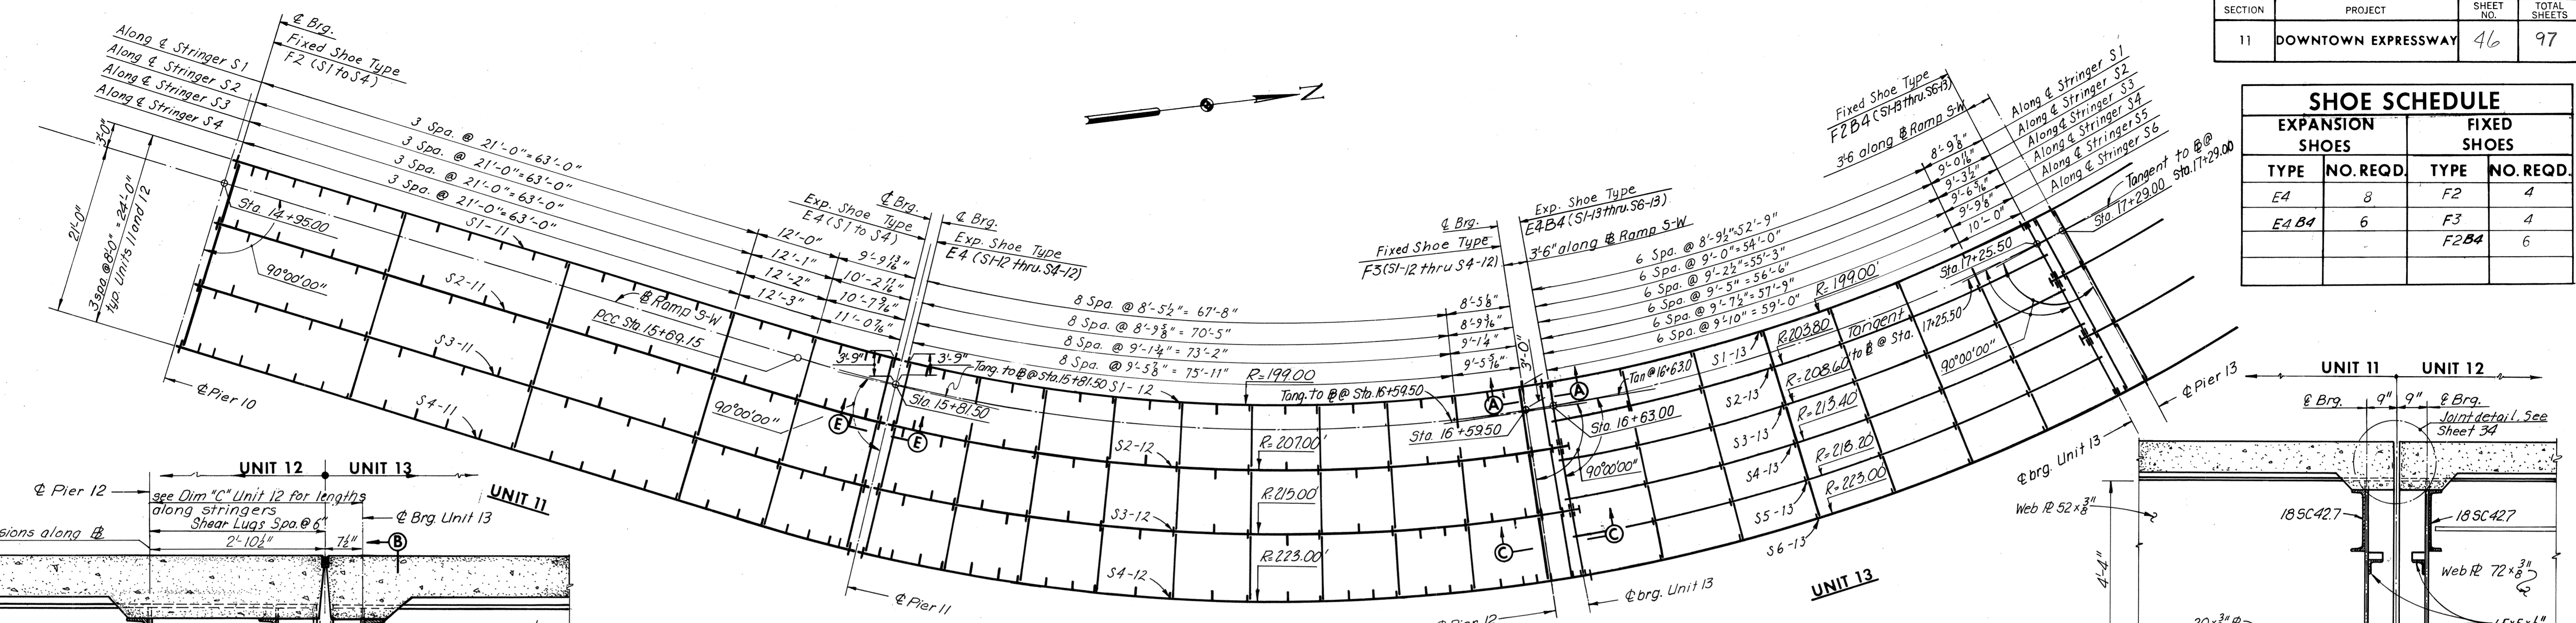


Note: It may be necessary to increase bearing stiffener size to accommodate erection of end diaphragms.

UNIT 12

FRAMING PLAN
Scale: 1"=10'-0"

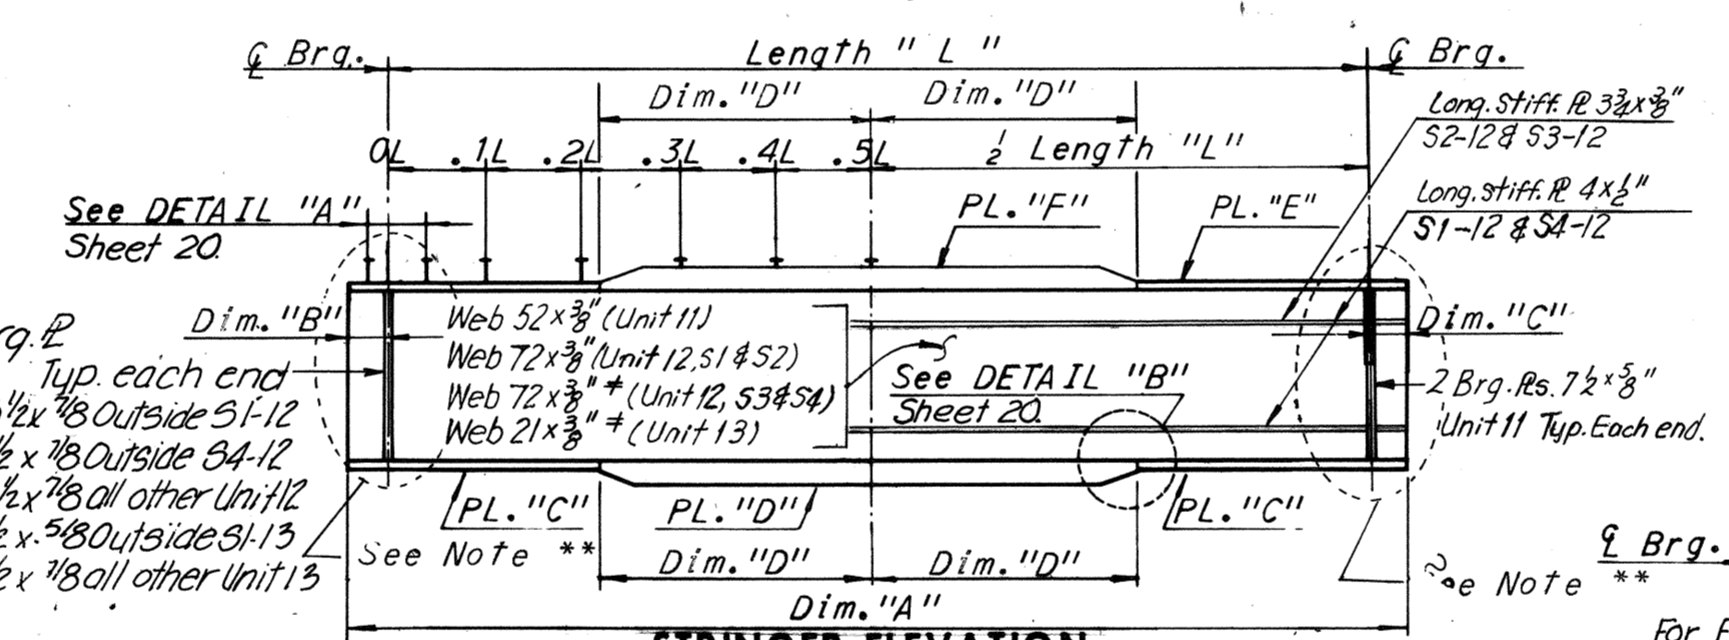

Note: Shear lug spacing shown above are typical for both halves of the stringer.

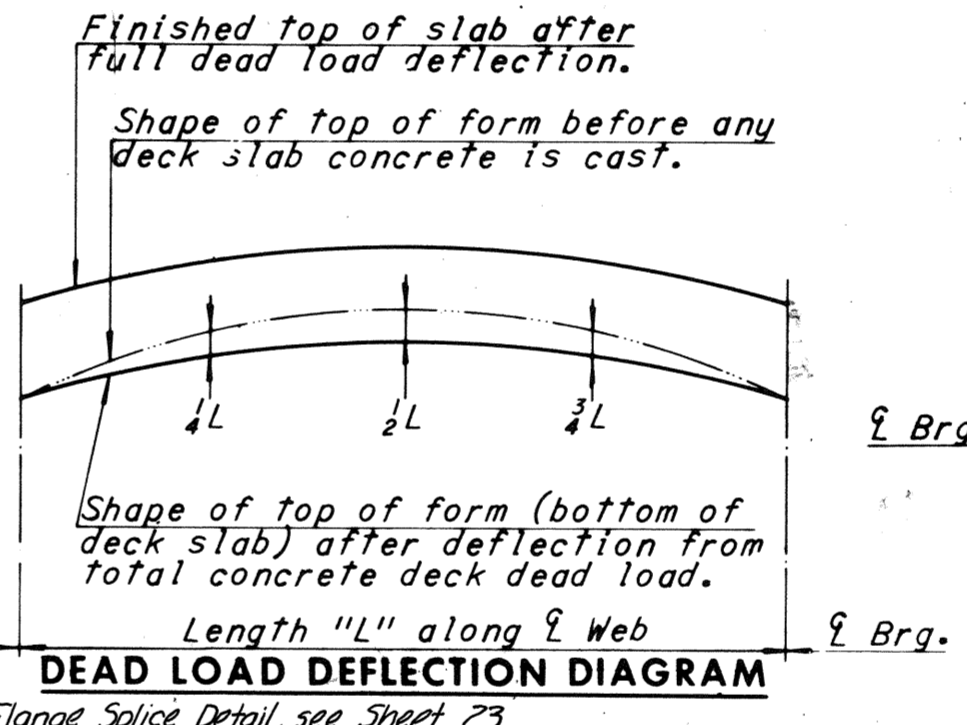

CAMBER DIAGRAM

Notes:
For Diaphragm Details, see Sheet 28.
For Shear Stud Details, see Sheet 20.
For Structural Steel Quantities, see Sheet 4.
For Joint Details, see Sheets 34 and 35.
For Shoe Details, see Sheet S1 & S2.

UNIT	STRINGER	Dim. "A"	LENGTH "L"	Dim. "C"	Dim. "D"	Dim. "B"	PL. "C"	PL. "D"	PL. "E"	PL. "F"	MAX. SHEAR STUD SPACING					DEAD LOAD DEFLECTION SCHEDULE			CAMBER SCHEDULE									
											0.0L-0.1L					0.1L-0.2L			0.2L-0.3L		0.3L-0.4L	0.4L-0.5L	1/4L	1/2L	3/4L	1/4L	1/2L	3/4L
											0.0L-0.1L	0.1L-0.2L	0.2L-0.3L	0.3L-0.4L	0.4L-0.5L	1/4L	1/2L	3/4L	1/4L	1/2L	3/4L							
11	S1-11	86'-1 1/8"	84'-9 1/8"	8"	29'-0"	8"	16x3/4"	16x1 1/2"	12x3/4"	—	10 1/2"	12"	15"	18"	23"	1 1/8"	1 1/16"	1 1/8"	3 5/8"	5"	3 5/8"							
	S2-11	86'-5 1/8"	85'-3 1/8"	7"	29'-2"	7"	16x3/4"	16x1 1/2"	12x3/4"	—	11 1/2"	12 1/2"	15 1/2"	18 1/2"	22"	1 1/16"	1 1/2"	1 1/16"	3 5/8"	5"	3 7/8"							
	S3-11	86'-11 1/8"	85'-9 1/8"	7"	29'-6"	7"	16x3/4"	16x1 1/2"	12x3/4"	—	11 1/2"	12 1/2"	15 1/2"	18 1/2"	22"	1 1/8"	1 1/16"	1 1/8"	3 3/4"	5 1/16"	3 3/4"							
	S4-11	87'-7 1/8"	86'-3 1/8"	8"	29'-8"	8"	16x3/4"	16x1 1/2"	12x3/4"	—	10 1/2"	12"	15"	18"	23"	1 3/16"	1 5/8"	1 3/16"	3 7/8"	5 1/4"	3 7/8"							
12	S1-12	80'-9 1/2"	76'-1 1/2"	3'-5 1/2"	—	8"	12x3/4"	—	12x3/4"	—	16 1/2"	19 1/2"	22 1/2"	24"	24"	1 1/4"	3/8"	1 1/4"	2 3/16"	2 7/8"	2 3/16"							
	S2-12	83'-11 1/2"	79'-2 1/2"	3'-7"	—	7"	16x3/4"	—	12x3/4"	—	14"	16 1/2"	19 1/2"	24"	24"	3/8"	1/2"	3/8"	2 9/16"	3 1/2"	2 5/8"							
	S3-12	87'-1 1/2"	82'-3 1/2"	3'-8 1/2"	25'-0"	7"	12x1 1/4"	16x1 1/2"	12x3/4"	—	13 1/2"	14 1/2"	17"	21"	24"	5/8"	13/16"	5/8"	3 1/8"	4 1/4"	3 3/16"							
	S4-12	90'-5 1/2"	85'-4 1/2"	3'-10 1/2"	24'-6"	8"	16x1 1/4"	16x1 1/2"	12x1 1/4"	—	12 1/2"	13"	16"	21"	24"	7/8"	1 1/4"	7/8"	3 1/16"	5 1/8"	3 3/16"							
13	S1-13	62'-6 1/2"	61'-6 1/2"	6"	—	6"	16x3/4"	—	12x3/4"	—	8 1/2"	9 1/2"	12"	15 1/2"	20 1/2"	7/8"	1 1/4"	7/8"	2 7/16"	3 3/8"	2 7/16"							
	S2-13	64'-0 1/2"	63'-0 1/2"	6"	—	6"	16x3/4"	—	12x3/4"	—	8 1/2"	10"	13"	16 1/2"	21"	7/8"	1 1/4"	7/8"	2 1/2"	3 7/16"	2 1/2"							
	S3-13	65'-6 1/2"	64'-6 1/2"	6"	18'-6"	6"	16x3/4"	20x1 1/4"	12x1 1/4"	—	8"	9"	12"	16"	20"	1 3/16"	1 5/8"	1 3/16"	2 3/16"	3 13/16"	2 3/16"							
	S4-13	67'-0 1/2"	66'-0 1/2"	6"	18'-6"	6"	16x3/4"	20x1 1/4"	16x3/4"	—	8"	9"	11 1/2"	14 1/2"	18 1/2"	1 3/8"	1 5/16"	1 3/8"	3"	4 1/8"	3"							
	S5-13	68'-6 1/2"	67'-6 1/2"	6"	19'-6"	6"	16x3/4"	20x1 1/4"	16x3/4"	—	7 1/2"	8 1/2"	11 1/2"	14 1/2"	19 1/2"	1 1/2"	2 1/16"	1 1/2"	3 1/8"	4 1/4"	3 1/8"							
	S6-13	70'-0"	69'-0"	6"	19'-6"	6"	20x1 1/4"	24x1 1/4"	16x1 1/4"	20x1 1/4"	6 1/2"	7 1/2"	10"	13 1/2"	19"	2 3/16"	3"	2 3/16"	3 13/16"	5 1/4"	3 13/16"							

NOTE TO FABRICATOR

The stringers shall be fabricated with an upward camber amounting to the tabulated value. This will provide approximate compensation for deflection under full dead load and for conformity with finished grade.

Note: Stringers having a total camber of less than 1" are not required to be shop cambered, but should be turned so that any mill tolerance deviation from straightness will be in the direction shown by the Camber Diagram.

If stringers are not cambered, distance top of stringers to top of slab will vary along the stringer in accordance with the offset dimensions shown in the Camber Diagram, and with minimum distance as shown in Cross-Section on Sheet 29.

NOTE TO CONTRACTOR

Deflections given are those anticipated to occur in the stringer upon placement of the total concrete deck dead load.

In practice, the stringers in place are not likely to have the exact camber to compensate for these deflections during construction. The residual amounts shall be provided by adjusting forms to vary the thickness of the concrete haunch between the bottom of the slab and the top of stringer without altering the slab thickness.

RICHMOND METROPOLITAN AUTHORITY
RICHMOND EXPRESSWAY SYSTEM
DOWNTOWN EXPRESSWAY


BRIDGE NO. 65
RAMP S-W CONNECTION FROM
RICHMOND-PETERSBURG TURNPIKE
FRAMING PLAN UNITS 11, 12 AND 13

HOWARD, NEEDLES, TAMMEN & BERGENDOFF
consulting engineers
NEW YORK ALEXANDRIA KANSAS CITY

SCALE: As Noted
CONTRACT NO. 11
SHEET NO. 21 38


MADE	JV	1-21-69			
CHECKED	AMH	1-27-69			
IN CHARGE			NO.	REVISION	BY DATE

RICHMOND EXPRESSWAY SYSTEM			
SECTION	PROJECT	SHEET NO.	TOTAL SHEETS
11	DOWNTOWN EXPRESSWAY	47	97

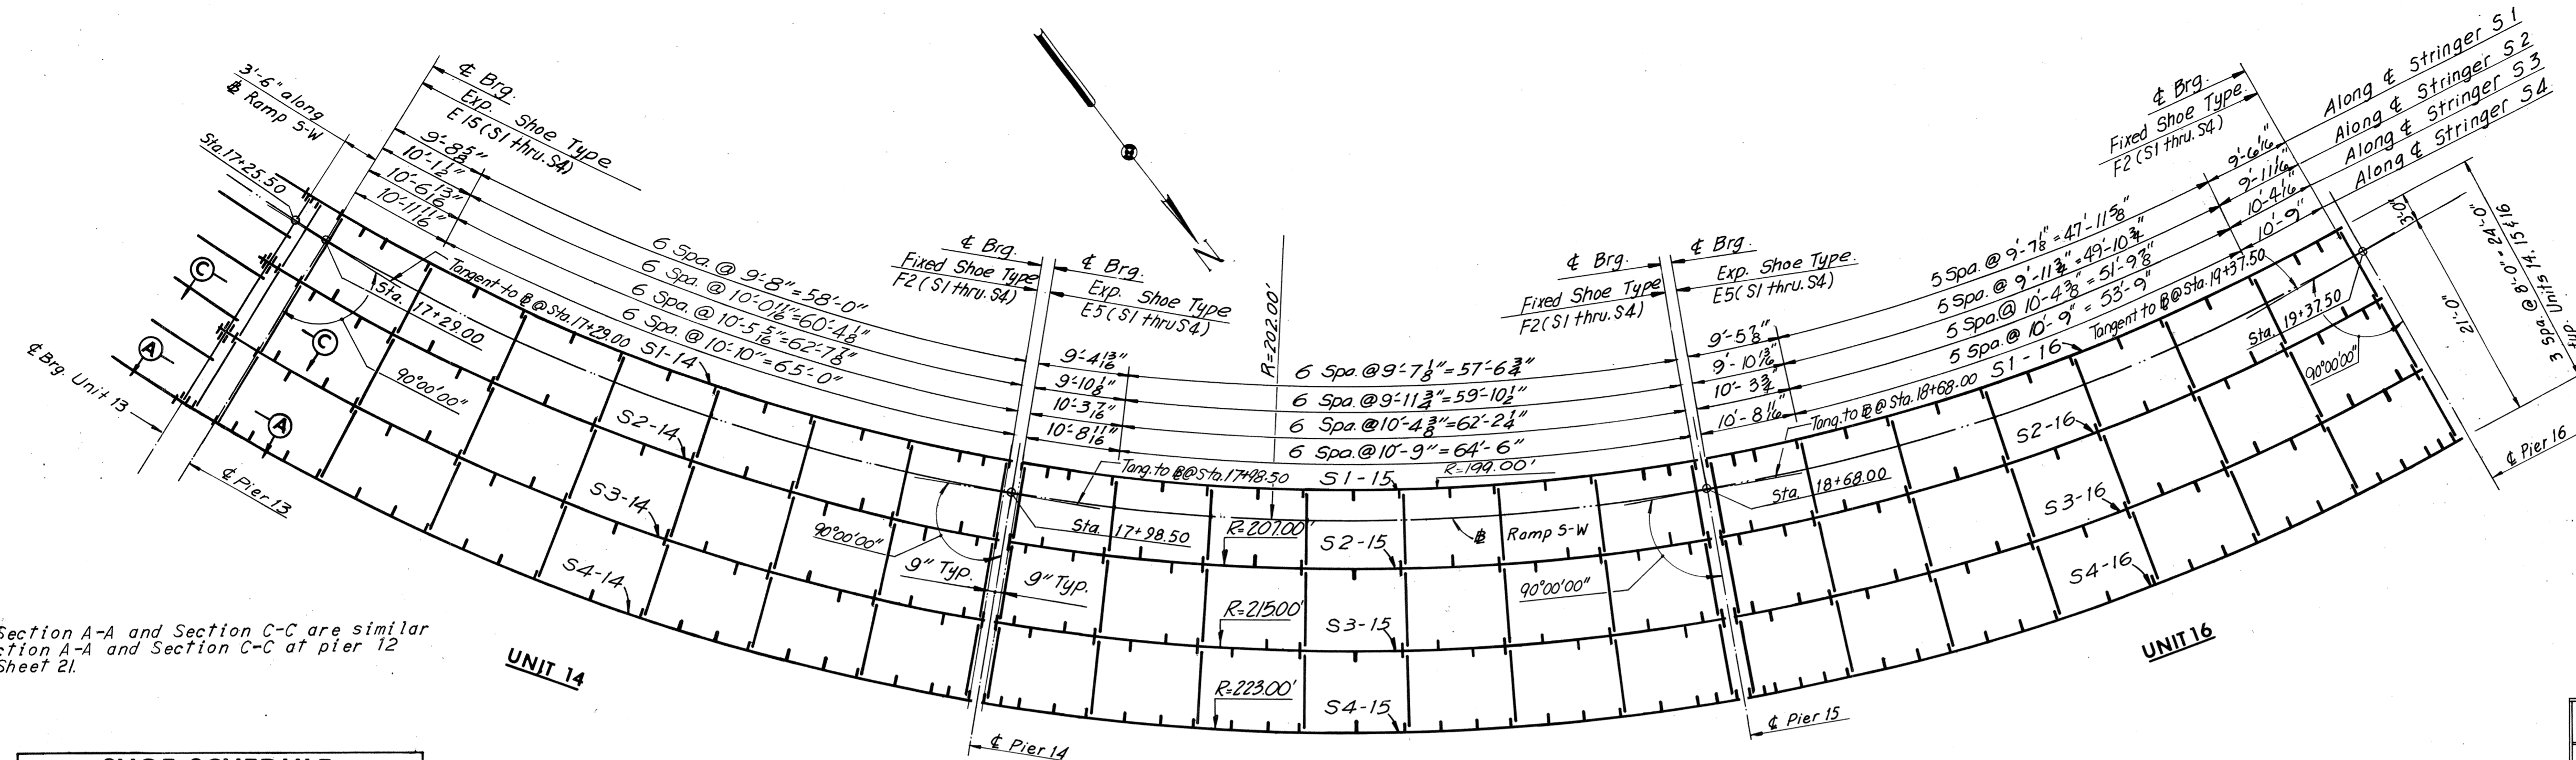


Note: Section A-A and Section C-C are similar to Section A-A and Section C-C at pier 12 see, Sheet 21.

EXPANSION SHOE		FIXED SHOES	
TYPE	NO. REQD.	TYPE	NO. REQD.
E5	8	F2	12
E15	4		

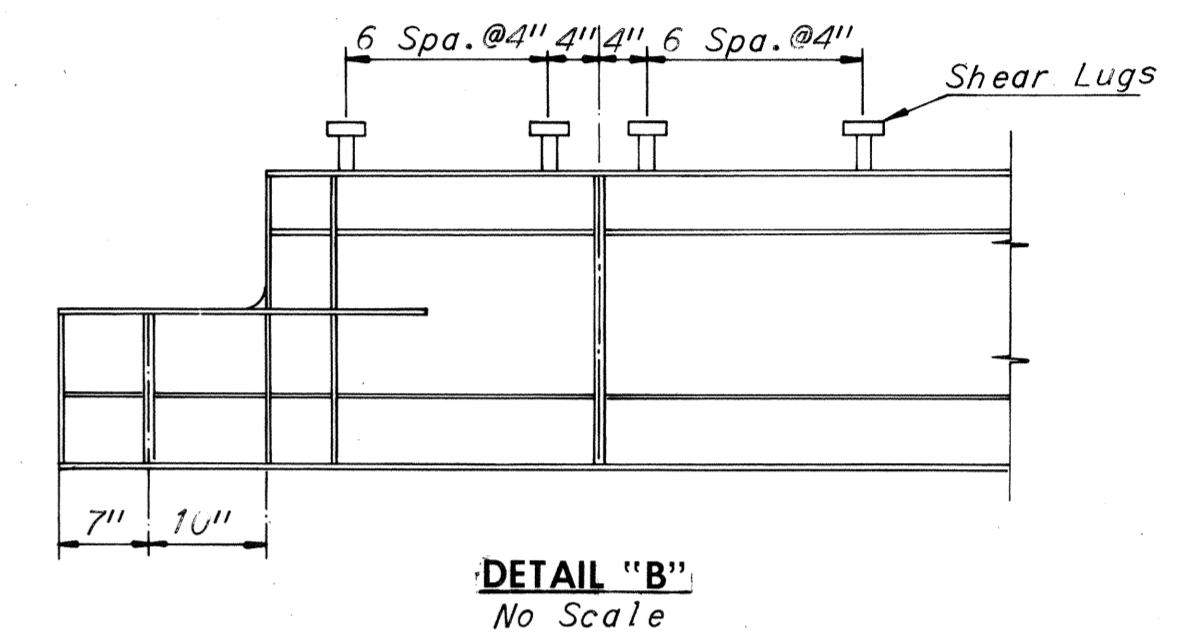


FRAMING PLAN
Scale 1" = 10'-0"

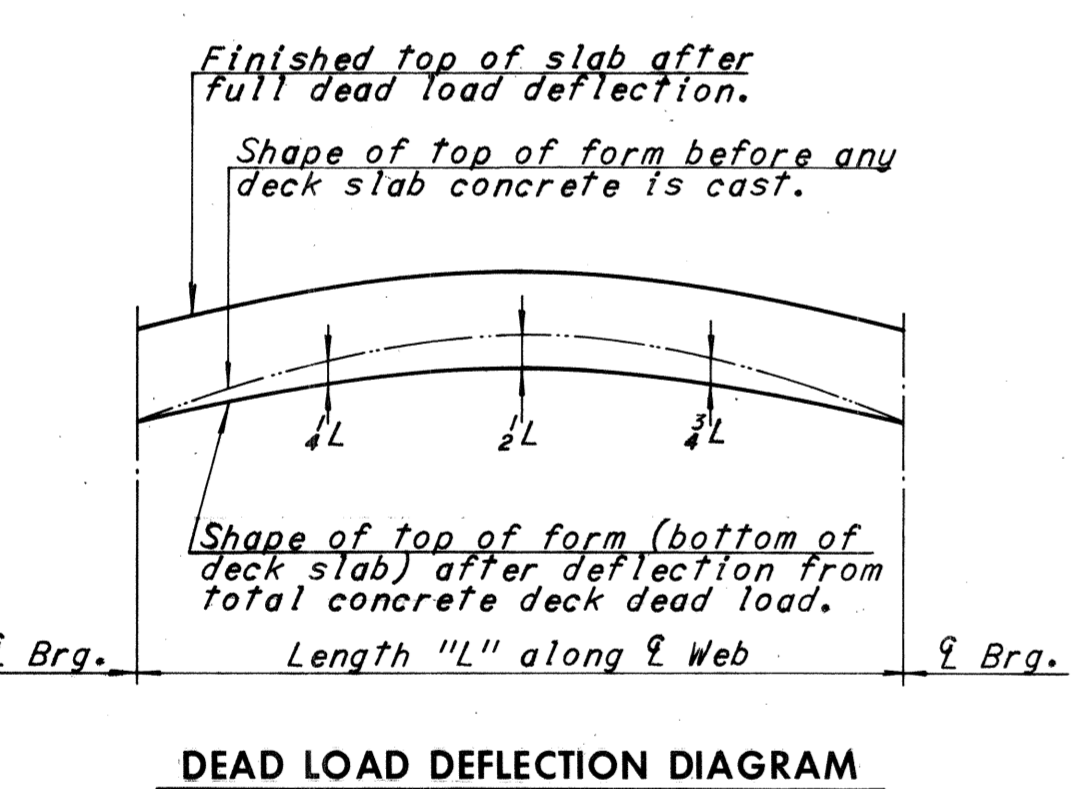

DEAD LOAD DEFLECTION DIAGRAM

NOTE TO CONTRACTOR


Deflections given are those anticipated to occur in the stringer upon placement of the total concrete deck dead load. In practice, the stringers in place are not likely to have the exact camber to compensate for these deflections during construction. The residual amounts shall be provided by adjusting forms to vary the thickness of the concrete haunch between the bottom of the slab and the top of stringer without altering the slab thickness.

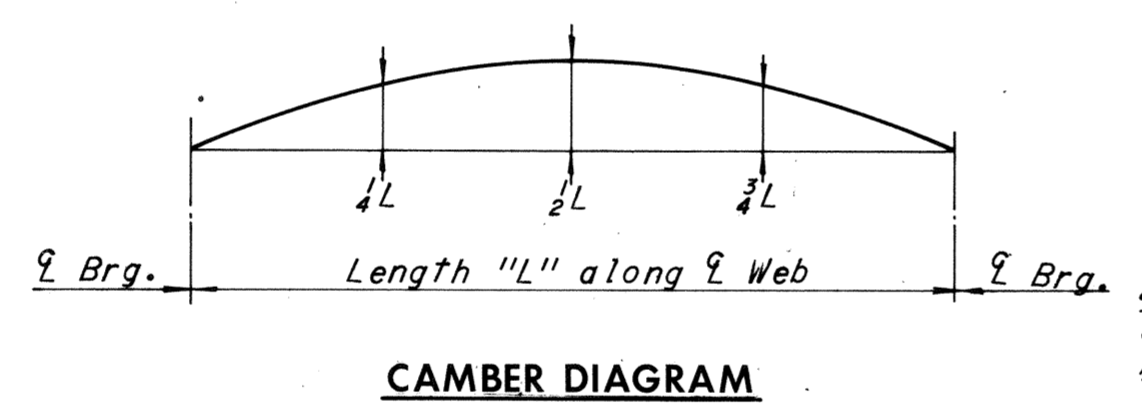


CAMBER DIAGRAM

NOTE TO FABRICATOR

The stringers shall be fabricated with an upward camber amounting to the tabulated value. This will provide approximate compensation for deflection under full dead load and for conformity with finished grade. Stringers having a total camber of less than 1" are not required to be shop cambered, but should be turned so that any mill tolerance deviation from straightness will be in the direction shown by the Camber Diagram. If stringers are not cambered, distance top of stringers to top of slab will vary along the stringer in accordance with the offset dimensions shown in the Camber Diagram, and with minimum distance as shown in Cross-Section on Sheet 29.

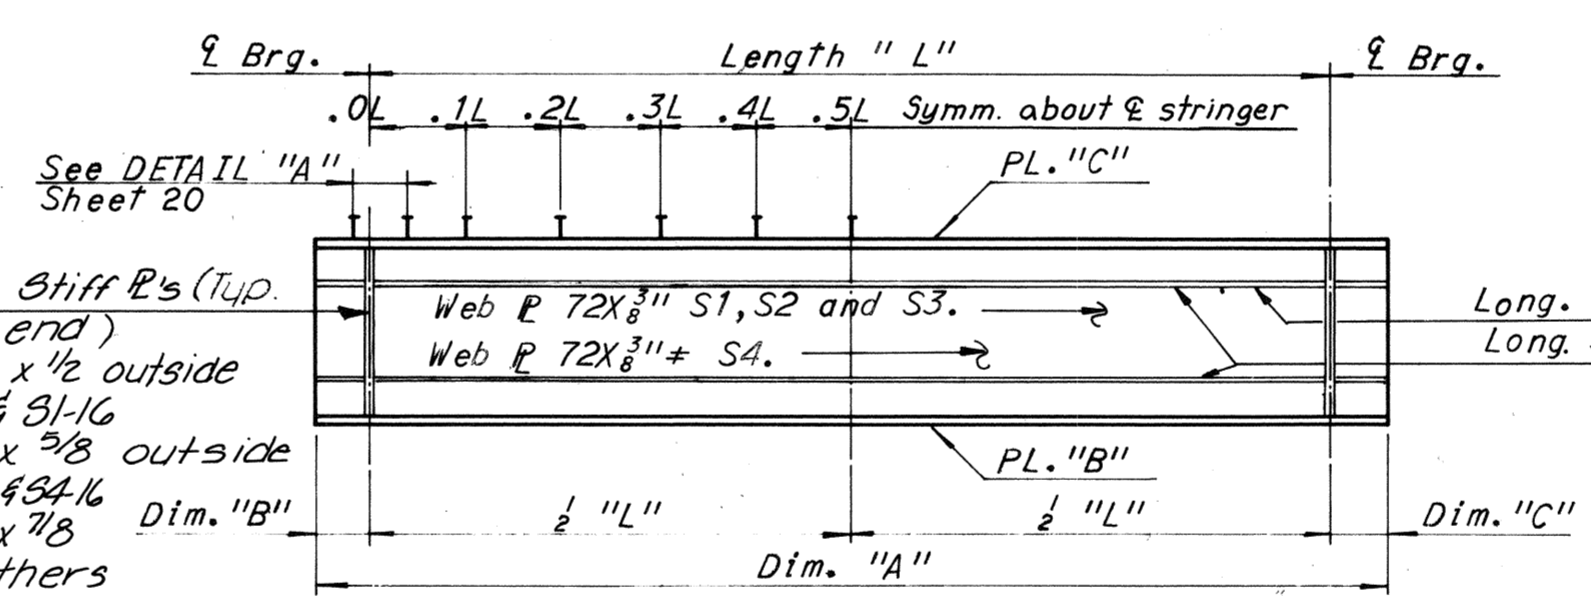

STRINGER ELEVATION
UNITS 15 AND 16
No Scale

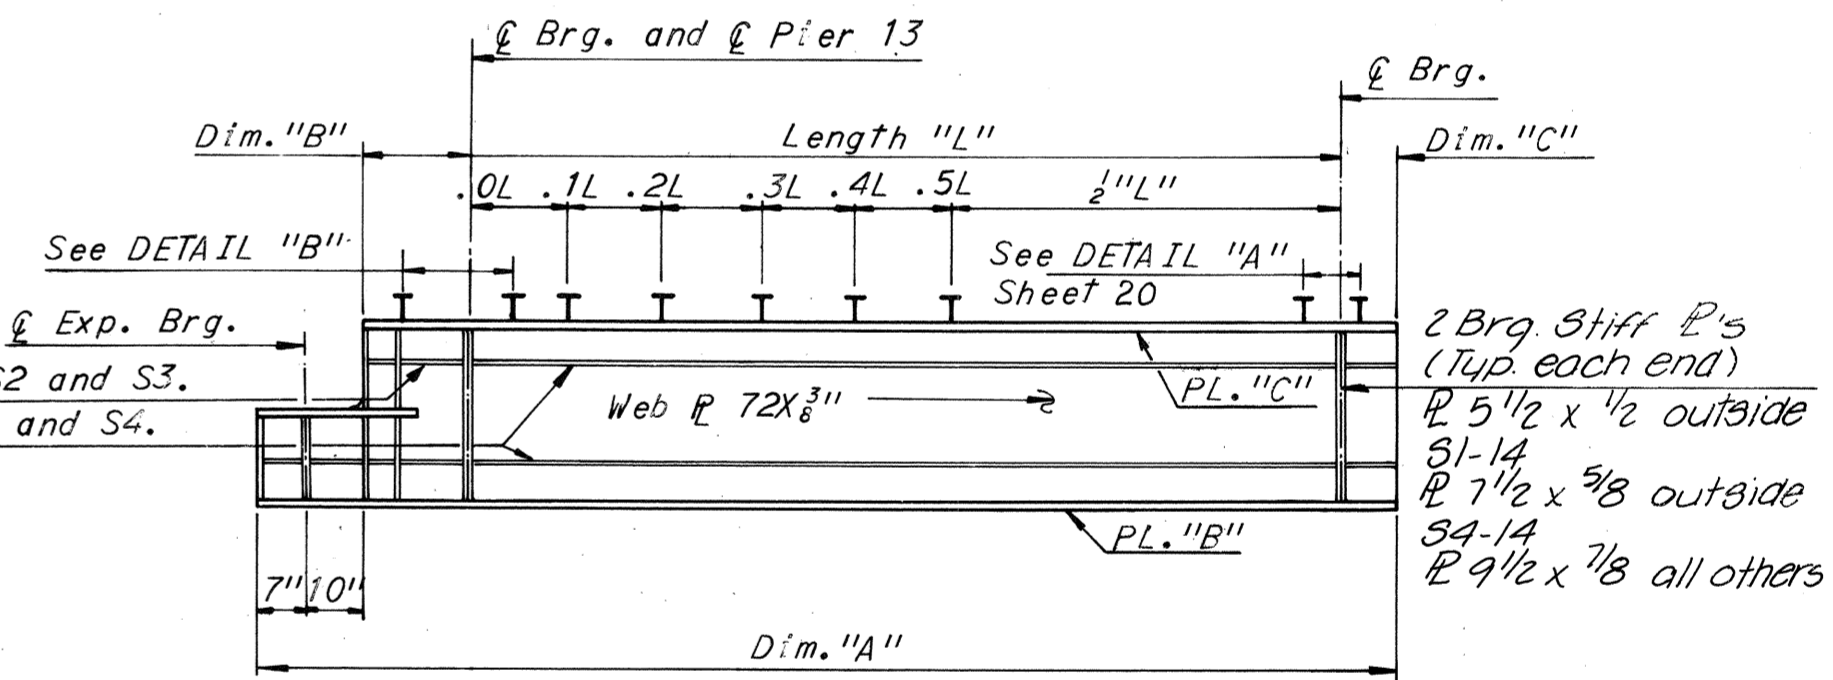

STRINGER ELEVATION
UNIT 14
No Scale

Notes:
All Horizontal Dimensions are measured along & Web.
For Web to Flange Welds and Longitudinal Stiffener Details, see Sheet 24.
For Diaphragm Details, see Sheet 29.
For Shear Stud Details, see Sheet 20.
For Structural Steel Quantities, see Sheet 4.
For Joint Details, see Sheets 34 and 35.
For Shoe Details, see Sheet S1 & S2.
It may be necessary to increase bearing stiffener size to accommodate erection of end diaphragms.

UNIT	STRINGER	Dim "A"	LENGTH "L"	Dim. "B"	Dim. "C"	PL. "B"	PL. "C"	MAX. SHEAR STUD SPACING					DEAD LOAD DEFLECTION SCHEDULE			CAMBER SCHEDULE		
								0.0L-0.1L	0.1L-0.2L	0.2L-0.3L	0.3L-0.4L	0.4L-0.5L	1/4L	1/2L	3/4L	1/4L	1/2L	3/4L
								14	S1 - 14	72'-5"	67'-8 1/2"	2'-7 1/2"	8"	12 x 3/4"	12 x 3/4"	20"	23"	24"
14	S2 - 14	75'-2 1/2"	70'-5 3/8"	2'-9 1/2"	7"	16 x 3/4"	12 x 3/4"	17"	19"	22"	24"	24"	1/4"	5/16"	1/4"	1 7/8"	2 1/2"	1 7/8"
14	S3 - 14	78'-1 3/4"	73'-2 1/8"	2'-10 1/2"	7"	16 x 1 1/8"	12 x 3/4"	14 1/2"	16"	18 1/2"	21 1/2"	24"	3/8"	1/2"	3/8"	2"	2 1/16"	2"
14	S4 - 14	81'-1 1/8"	75'-11 1/8"	3'-0 3/8"	8"	16 x 1 1/8"	12 x 3/4"	11 1/2"	13 1/2"	15 1/2"	19"	23 1/2"	9/16"	13/16"	9/16"	2 3/16"	3"	2 3/16"
15	S1 - 15	68'-3 3/8"	66'-11 3/8"	8"	8"	12 x 3/4"	12 x 3/4"	20"	23"	24"	24"	24"	1/8"	3/16"	1/8"	3/16"	1/4"	3/16"
15	S2 - 15	70'-10 3/8"	69'-8 3/8"	7"	7"	16 x 3/4"	12 x 3/4"	17"	19"	22"	24"	24"	1/4"	5/16"	1/4"	5/16"	7/16"	5/16"
15	S3 - 15	73'-7 1/8"	72'-5 1/8"	7"	7"	16 x 1 1/8"	12 x 3/4"	14 1/2"	16"	18 1/2"	21 1/2"	24"	3/8"	1/2"	3/8"	7/16"	5/8"	7/16"
15	S4 - 15	76'-6 1/8"	75'-2 1/8"	8"	8"	16 x 1 1/8"	12 x 3/4"	11 1/2"	13 1/2"	15 1/2"	19"	23 1/2"	9/16"	13/16"	9/16"	1 1/16"	1 5/16"	1 1/16"
16	S1 - 16	68'-3 3/8"	66'-11 3/8"	8"	8"	12 x 3/4"	12 x 3/4"	20"	23"	24"	24"	24"	1/8"	3/16"	1/8"	3/16"	1 1/4"	1 3/16"
16	S2 - 16	70'-10 3/8"	69'-8 3/8"	7"	7"	16 x 3/4"	12 x 3/4"	17"	19"	22"	24"	24"	1/4"	5/16"	1/4"	7/16"	1 1/16"	1 1/16"
16	S3 - 16	73'-7 1/8"	72'-5 1/8"	7"	7"	16 x 1 1/8"	12 x 3/4"	14 1/2"	16"	18 1/2"	21 1/2"	24"	3/8"	1/2"	3/8"	5/16"	7/8"	1 5/16"
16	S4 - 16	76'-6 1/8"	75'-2 1/8"	8"	8"	16 x 1 1/8"	12 x 3/4"	11 1/2"	13 1/2"	15 1/2"	19"	23 1/2"	9/16"	13/16"	9/16"	1 1/16"	1 1/2"	1 1/16"

* . . . Denotes A572 Grade 50 steel for thicknesses of 3/4" and under and A588 for thicknesses over 3/4".
* . . . Spacing begins @ termination of 7 spaces @ 4"

MADE	BY	DATE			
CHECKED	AMH	1-27-69	Diaph. Spacing Unit 16	TEM	5-76
IN CHARGE			NO.	REVISION	BY
					DATE


AS BUILT

RICHMOND METROPOLITAN AUTHORITY
RICHMOND EXPRESSWAY SYSTEM
DOWNTOWN EXPRESSWAY

BRIDGE NO. 65
RAMP S-W CONNECTION FROM
RICHMOND-PETERSBURG TURNPIKE
FRAMING PLAN UNITS 14, 15 AND 16

HOWARD, NEEDLES, TAMMEN & BERGENDOFF
consulting engineers
NEW YORK ALEXANDRIA KANSAS CITY

SCALE: As Noted
CONTRACT NO. 11
SHEET NO. 22 OF 38

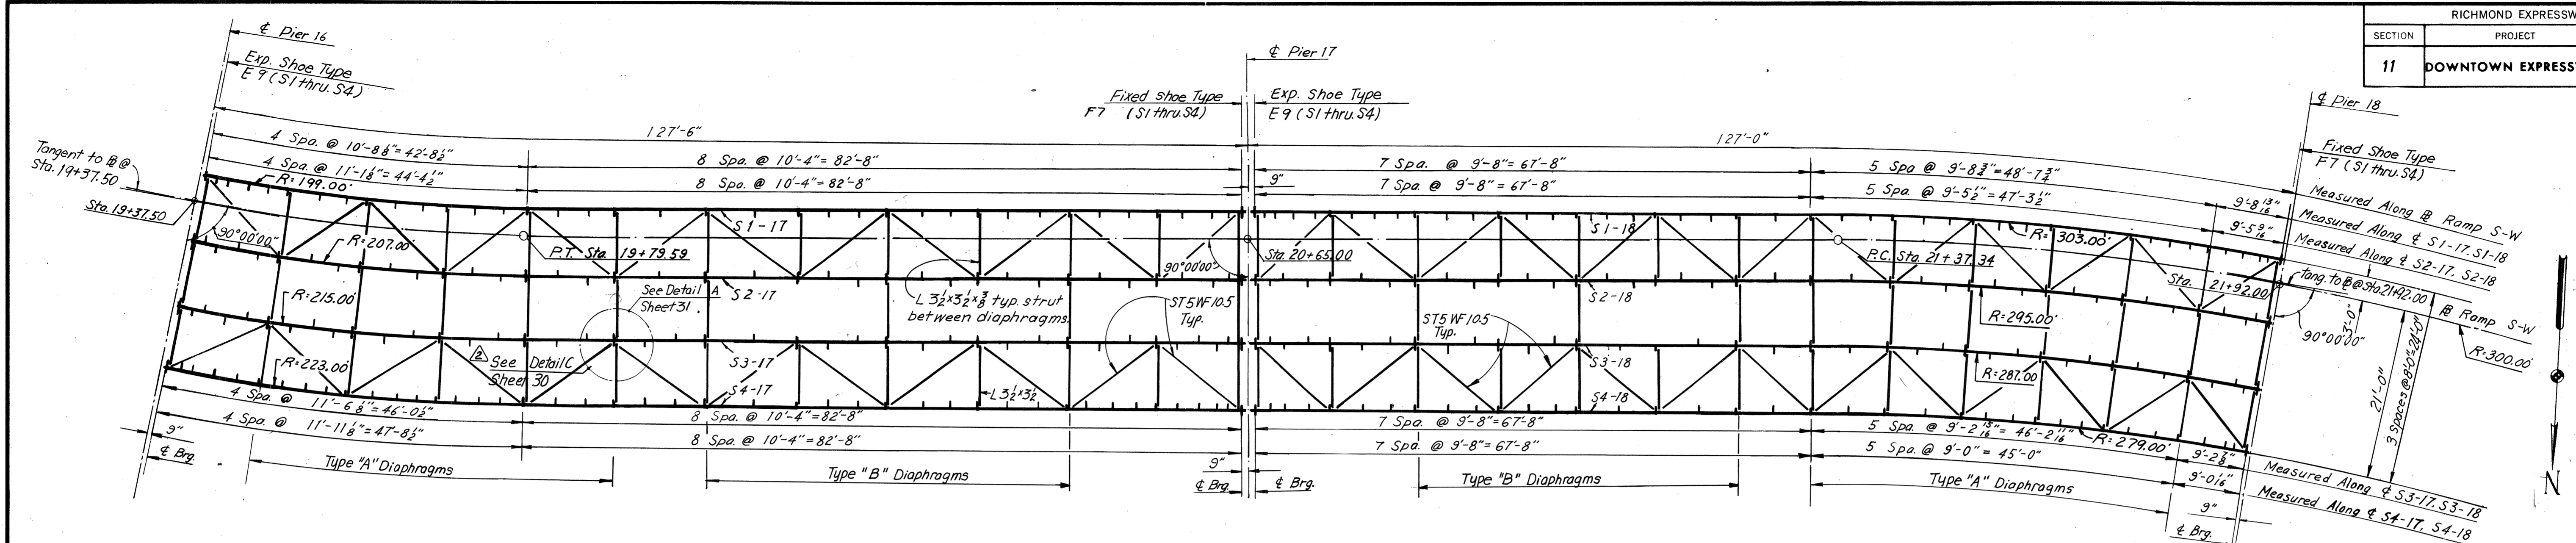

Note:
 Detail A Sheet 31 to be used at top flange of all Type "A" Diaphragms.
 Detail A Sheet 31 to be used at bottom flange of all Type "A" Diaphragms without Lateral Bracing.
 Detail C Sheet 30 to be used at bottom flange of all Type "A" and "B" Diaphragms with Lateral Bracing.
 Section C-C Sheet 30 portion marked "Without Lateral Bracing" to be used at all other Type "B" Diaphragm connections.


UNIT 17

FRAMING PLAN
 Scale: 1"=10'-0"


UNIT 18

Note: For Details of Intermediate diaphragms Types "A" and "B" see, Sheet 30.


SHOE SCHEDULE			
EXPANSION SHOES		FIXED SHOES	
TYPE	NO. REQD.	TYPE	NO. REQD.
E9	8	F7	8

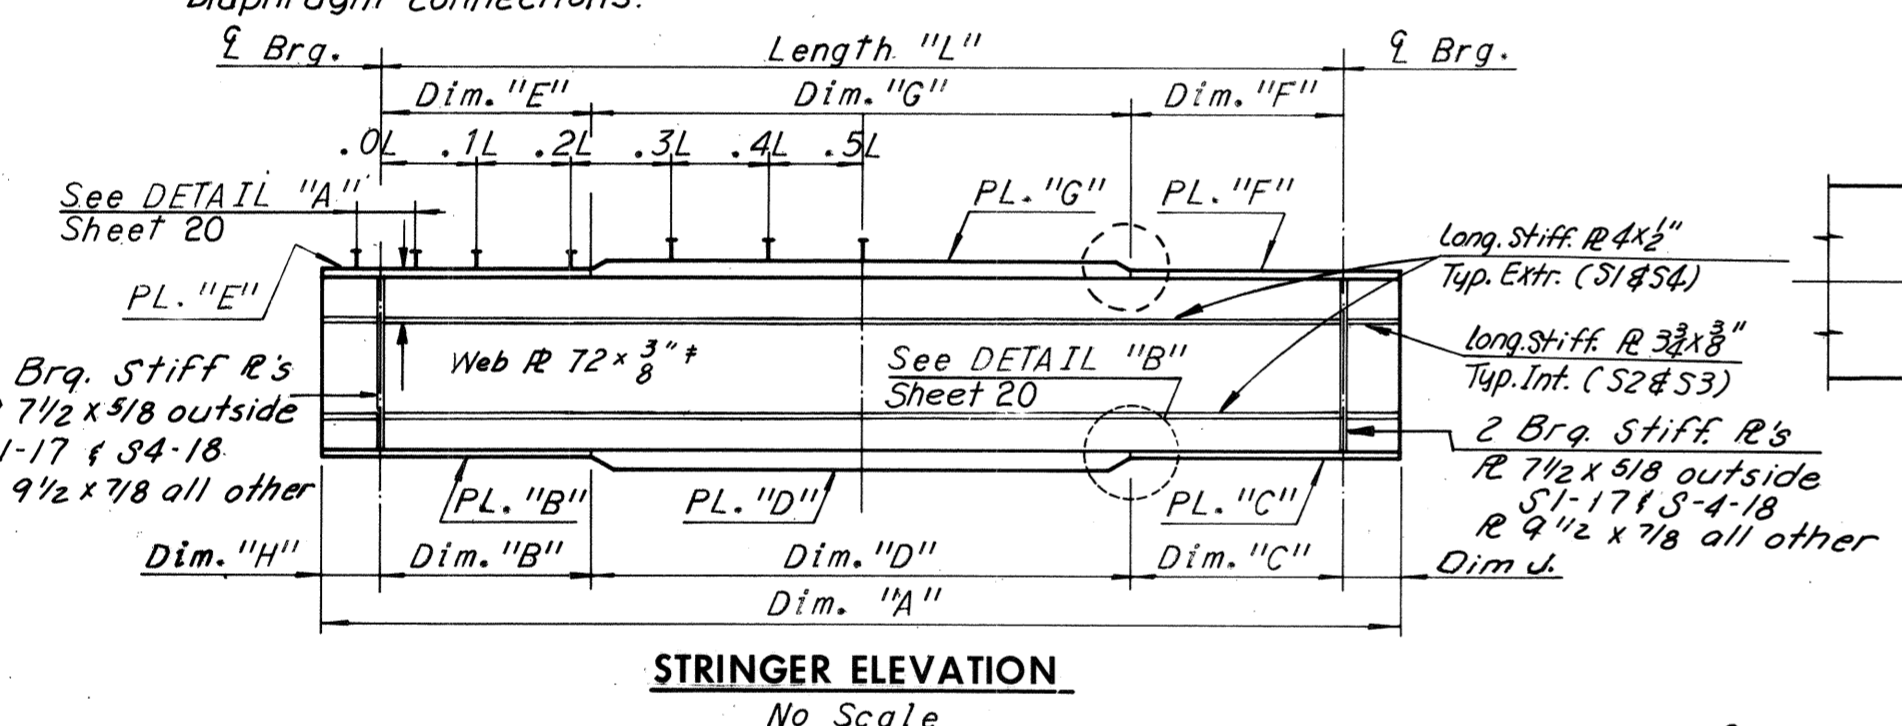


STRINGER ELEVATION
 No Scale

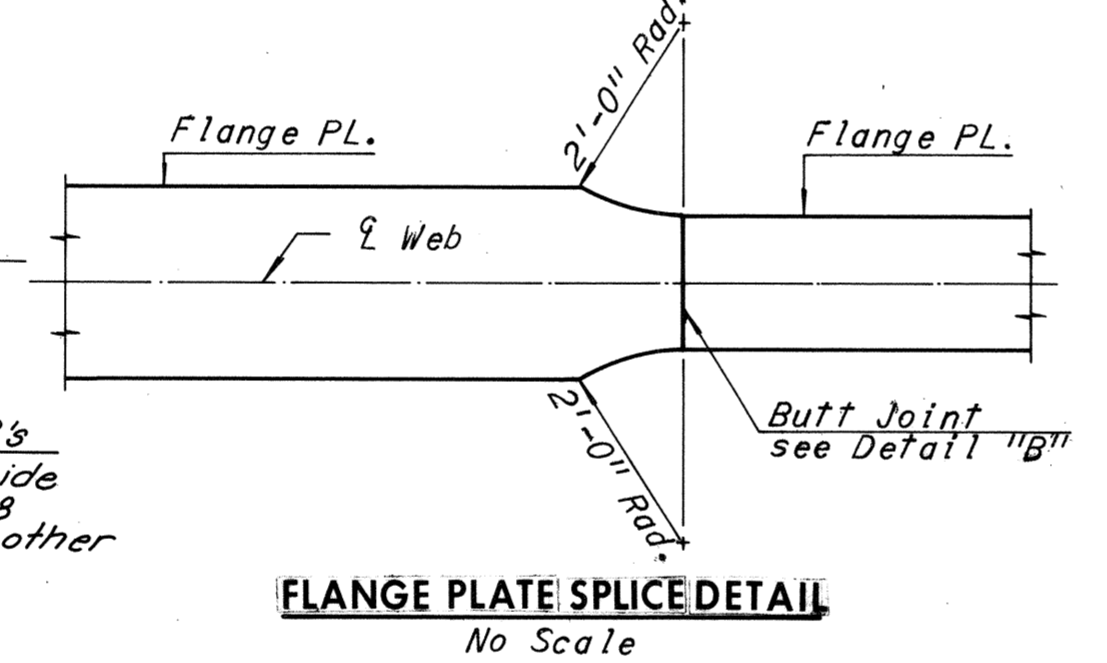

FLANGE PLATE SPICE DETAIL
 No Scale

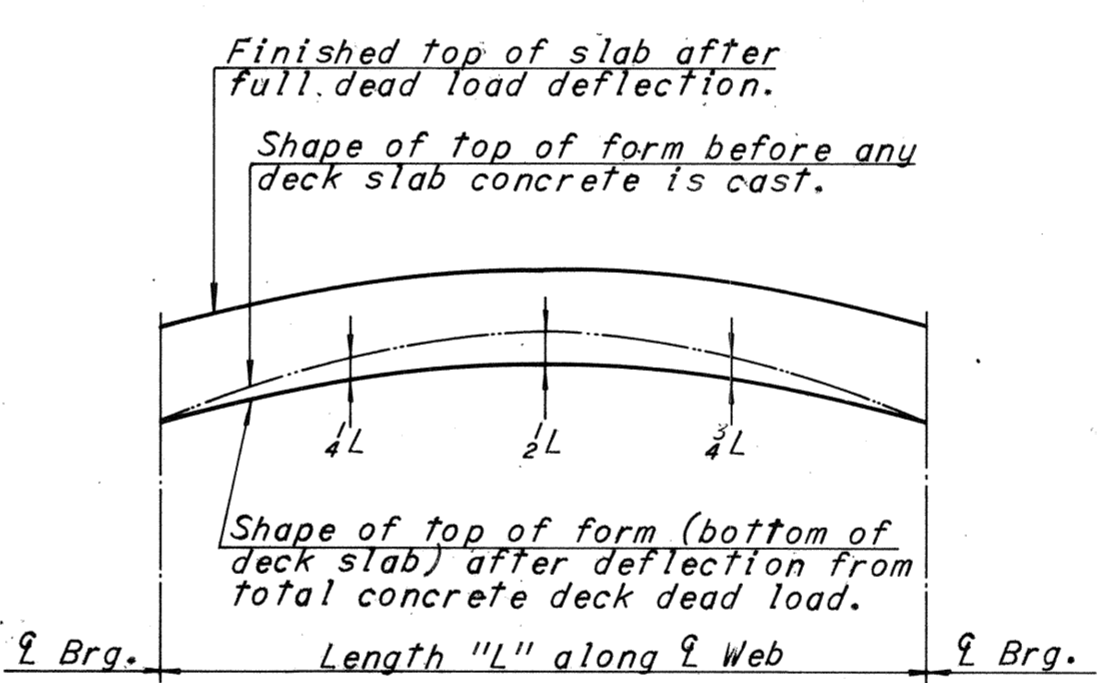

DEAD LOAD DEFLECTION DIAGRAM

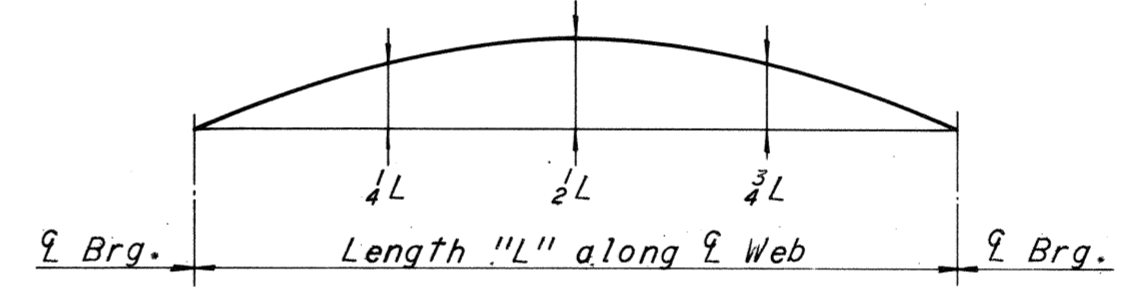

CAMBER DIAGRAM

NOTE TO FABRICATOR


The stringers shall be fabricated with a total camber amounting to the tabulated value. A positive number indicates an upward camber and a negative number indicates a downward camber. This will provide approximate compensation for deflection under full load and for conformity with finished grade.

Note: Stringers having a total camber of less than 1" are not required to be shop cambered, but should be turned so that any mill tolerance deviation from straightness will be in the direction shown by the Camber Diagram.

If stringers are not cambered, distance top of stringers to top of slab will vary along the stringer in accordance with the offset dimensions shown in the Camber Diagram, and with minimum distance as shown in Cross-Section on Sheet 30.

NOTE TO CONTRACTOR

Deflections given are those anticipated to occur in the stringer upon placement of the total concrete deck dead load. In practice, the stringers in place are not likely to have the exact camber to compensate for these deflections during construction. The residual amounts shall be provided by adjusting forms to vary the thickness of the concrete haunch between the bottom of the slab and the top of stringer without altering the slab thickness.

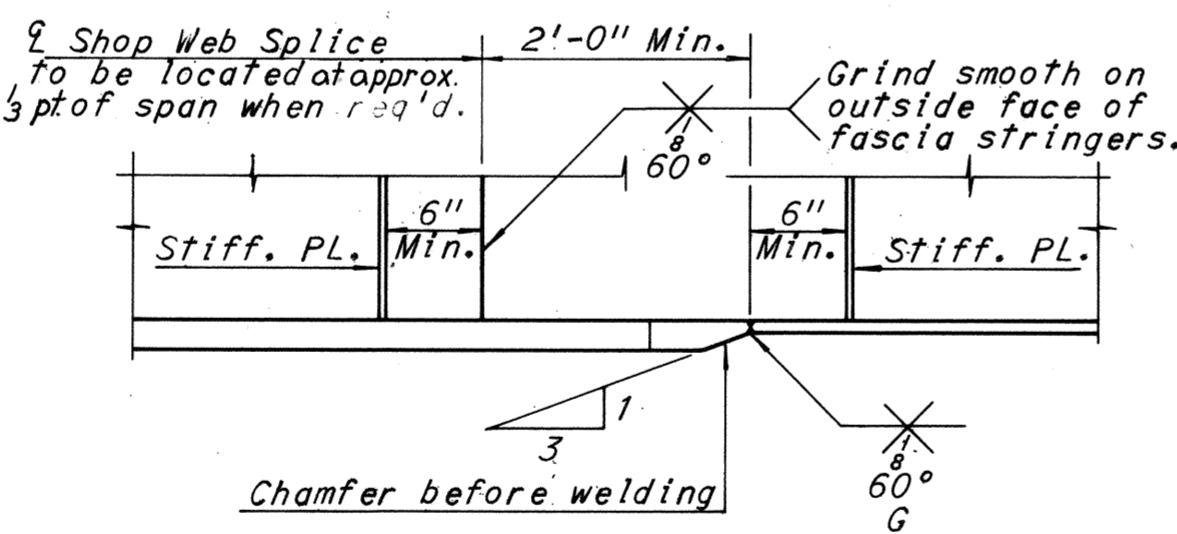

DETAIL "B"
 No Scale

Notes:
 All steel shall be A36 unless otherwise shown. Exterior stringer longitudinal stiffeners shall be located on the exterior face of the stringer. Intermediate stiffeners shall be equally spaced between diaphragms as shown. The first two stiffener spaces at the ends of stringers shall be one-half the normal spacing within the panel. All intermediate stiffeners shall be 4 1/2" x 3/8" except where the width of top flange plate is 20" or over, Pl. 5x3/8" shall be used.

Note: All horizontal dimensions are measured along Web.

Notes: All Horizontal Dimensions are measured along Web. For Web to Flange Welds and Longitudinal Stiffener Details, see Sheet 24. For Diaphragm Details, see Sheet 30. For Shear Stud Details, see Sheet 20. For Structural Steel Quantities, see Sheet 4. For Joint Details, see Sheets 34 and 35. For Shoe Details, see Sheet 31 & 32. It may be necessary to increase Bearing Stiffener size to accommodate erection of end diaphragms.

UNIT	STRINGER	Dim. "A"	LENGTH	Dim. "B"	Dim. "C"	Dim. "D"	Dim. "E"	Dim. "F"	Dim. "G"	Dim. "H"	Dim. "J"	PL. "B"	PL. "C"	PL. "D"	PL. "E"	PL. "F"	PL. "G"	DEAD LOAD DEFLECTION SCHEDULE					CAMBER SCHEDULE					
																		0.0L-0.1L	0.1L-0.2L	0.2L-0.3L	0.3L-0.4L	0.4L-0.5L	1/4"	1/2"	3/4"			
17	S1-17	126'-8 1/2"	125'-4 1/2"	23'-8 1/2"	23'-8 1/2"	78'-0"	23'-8 1/2"	23'-8 1/2"	78'-0"	8"	8"	16 x 1 3/8"	16 x 1 1/2"	20 x 1 3/8"	12 x 1 1/2"	12 x 3/4"	16 x 1 1/2"	12"	14 1/2"	18 1/2"	23 1/2"	24"	1 1/4"	1 1/2"	1 1/2"	-4 1/8"	-6 1/8"	-4 1/8"
	S2-17	128'-2 1/2"	127'-0 1/2"	25'-0"	25'-0"	77'-0 1/2"	—	26'-6 1/2"	100'-6"	7"	7"	16 x 1 3/8"	16 x 1 1/2"	16 x 1 3/8"	—	12 x 3/4"	12 x 1 1/2"	12 1/2"	15"	19"	24"	24"	1 1/4"	2 1/8"	1 1/4"	-4 1/8"	-5 3/8"	-4 1/8"
	S3-17	129'-10 1/2"	128'-8 1/2"	25'-0"	25'-0"	78'-8 1/2"	25'-10 1/2"	25'-10 1/2"	77'-0"	7"	7"	20 x 1 3/8"	16 x 1 1/2"	20 x 1 3/8"	16 x 1 1/2"	12 x 1 1/2"	16 x 1 1/2"	11"	13"	17 1/2"	23"	24"	1 3/8"	2 1/4"	1 3/8"	-3 5/16"	-4 1/16"	-3 3/4"
	S4-17	131'-8 1/2"	130'-4 1/2"	25'-6"	25'-6"	79'-4 1/2"	25'-6"	25'-6"	79'-4 1/2"	8"	8"	20 x 1 3/8"	20 x 1 3/8"	20 x 2 1/4"	16 x 1 3/8"	16 x 1 1/2"	16 x 1 1/2"	10 1/2"	13"	15 1/2"	20 1/2"	24"	2"	2 3/4"	1 5/16"	-2 3/4"	-4 1/8"	-3 1/2"
18	S1-18	127'-4 1/2"	126'-0 1/2"	25'-3 1/2"	27'-3 1/2"	73'-6"	25'-3 1/2"	27'-3 1/2"	73'-6"	8"	8"	20 x 1 3/8"	20 x 1 1/2"	24 x 1 3/8"	16 x 1 1/2"	16 x 1 1/2"	20 x 1 1/2"	10"	12"	17"	23 1/2"	24"	2 1/8"	3"	2 3/16"	3/4"	2 1/2"	2 3/16"
	S2-18	125'-9 1/2"	124'-7 1/2"	24'-6"	24'-6"	75'-7 1/2"	24'-6"	24'-6"	75'-7 1/2"	7"	7"	16 x 1 3/8"	16 x 1 3/8"	20 x 1 3/8"	12 x 1 1/2"	12 x 1 1/2"	16 x 1 1/2"	11 1/2"	14"	18"	23 1/2"	24"	1 1/4"	2 5/16"	1 1/4"	1/8"	1 7/16"	1 1/8"
	S3-18	124'-3 1/2"	123'-1 1/2"	24'-0"	24'-0"	75'-1 1/2"	24'-0"	24'-0"	75'-1 1/2"	7"	7"	16 x 1 3/8"	16 x 1 3/8"	16 x 2"	12 x 3/4"	12 x 1 1/2"	12 x 1 1/2"	12 1/2"	15"	19"	24"	24"	1 7/16"	1 5/16"	1 3/8"	-3/8"	5/8"	3/16"
	S4-18	123'-0 1/2"	121'-8 1/2"	30'-0"	24'-0"	67'-8 1/2"	—	—	—	121'-8 1/2"	8"	8"	16 x 1 1/2"	16 x 1 1/2"	20 x 1 1/2"	—	—	12 x 3/4"	10"	12"	15"	20"	24"	1 3/8"	1 3/4"	1 1/8"	-1/2"	1 1/4"

Note: Shear stud spacing as shown is typical for both halves of the stringers. Spacing begins at termination of 7 spaces @ 4". # Denotes A572 Grade 50 Steel for thickness of 3/8" and under and A588 Steel for thickness over 3/8".

BY	DATE	REVISION	BY	DATE
MADE	R.C. 11.21.68	Note added	TEM	3-76
CHECKED	S.C.C. 12.1.68	Delete F18D Shoes & Sheet No. rev.	A.B.P.	8-25-75
IN CHARGE				


AS BUILT

RICHMOND METROPOLITAN AUTHORITY
RICHMOND EXPRESSWAY SYSTEM
DOWNTOWN EXPRESSWAY





BRIDGE NO. 65
RAMP S-W CONNECTION FROM
RICHMOND-PETERSBURG TURNPIKE
FRAMING PLAN - UNITS 17 AND 18

SCALE: As Noted
 HOWARD, NEEDLES, TAMMEN & BERGENDOFF
 consulting engineers
 NEW YORK ALEXANDRIA KANSAS CITY
 CONTRACT NO. 11
 SHEET NO. 23 of 38


RICHMOND EXPRESSWAY SYSTEM			
SECTION	PROJECT	SHEET NO.	TOTAL SHEETS
17	DOWNTOWN EXPRESSWAY	49	97

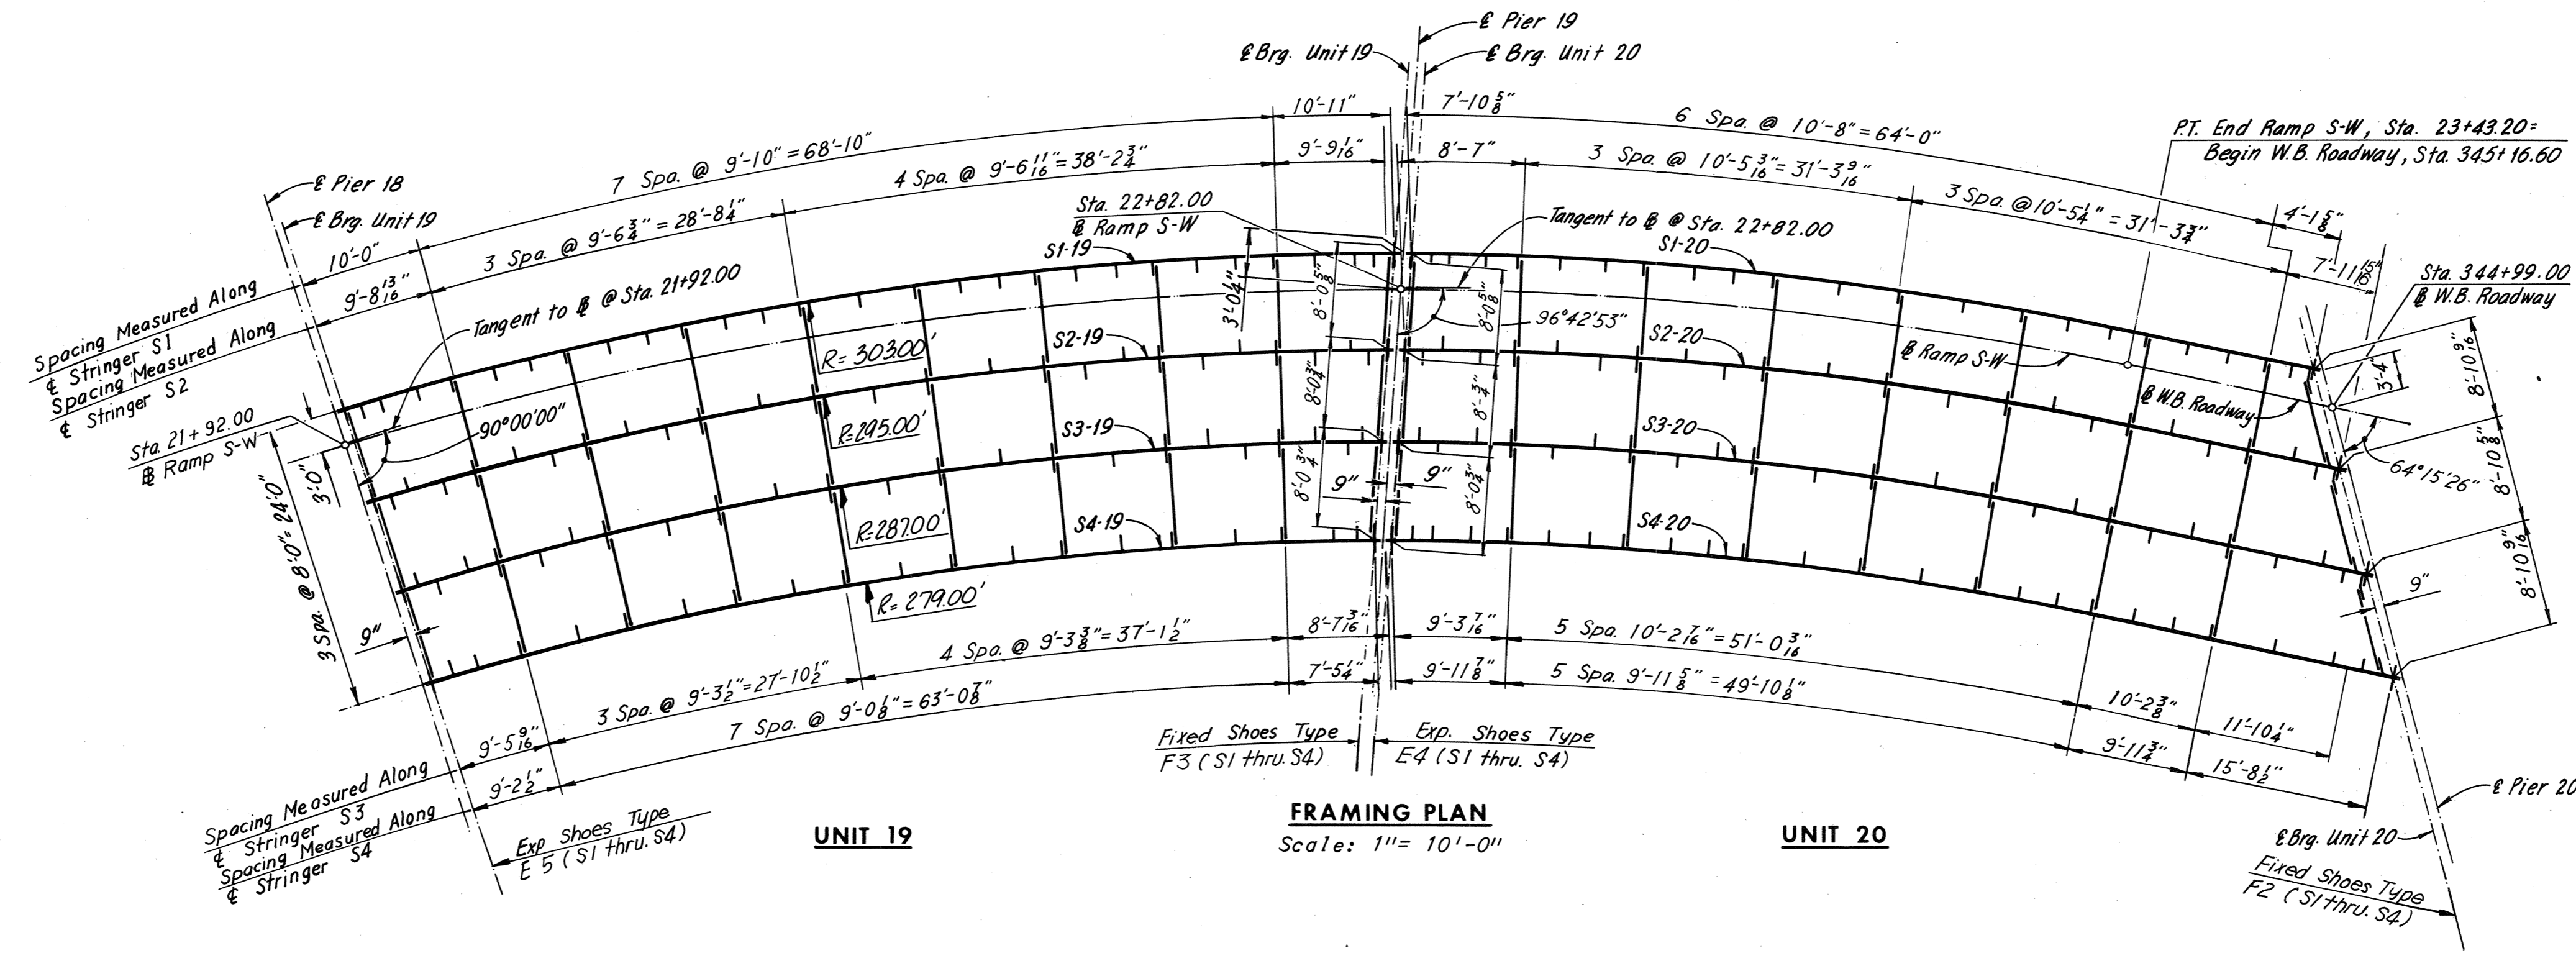

SHOE SCHEDULE			
EXPANSION SHOES		FIXED SHOES	
TYPE	NO. REQD.	TYPE	NO. REQD.
E4	4	F2	4
E5	4	F3	4

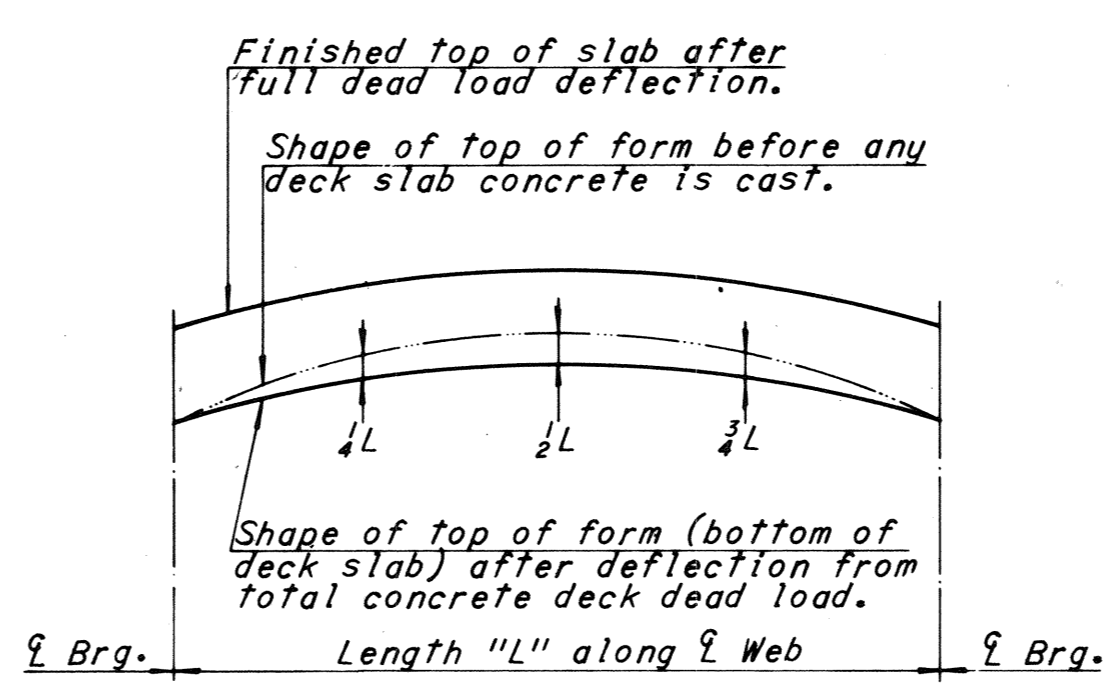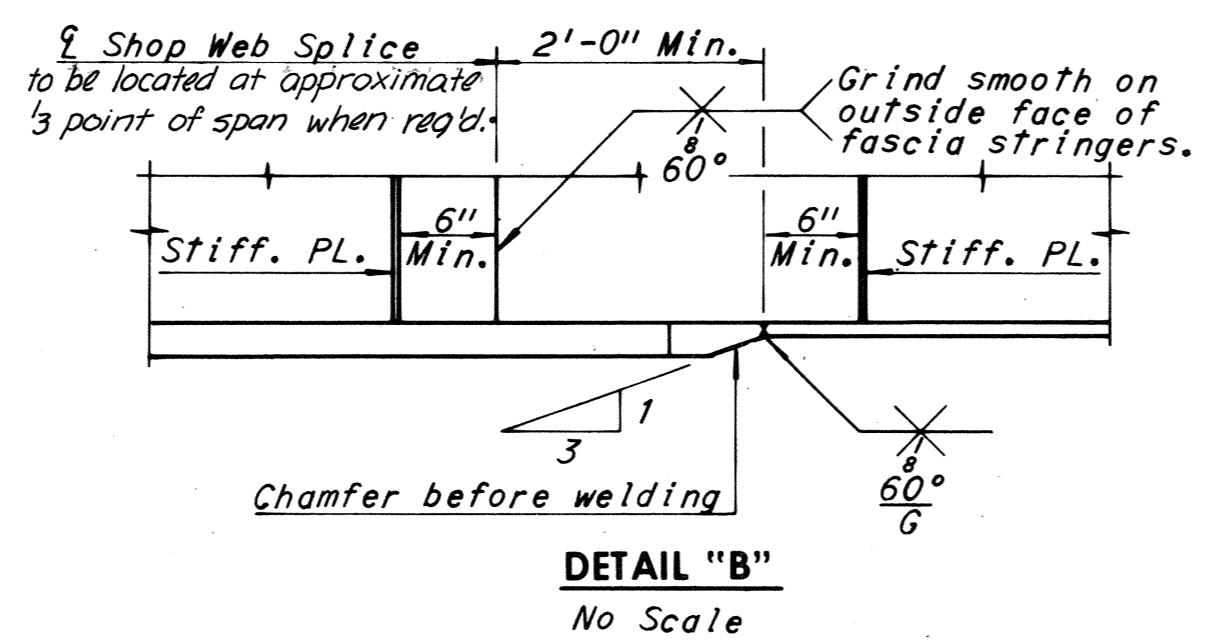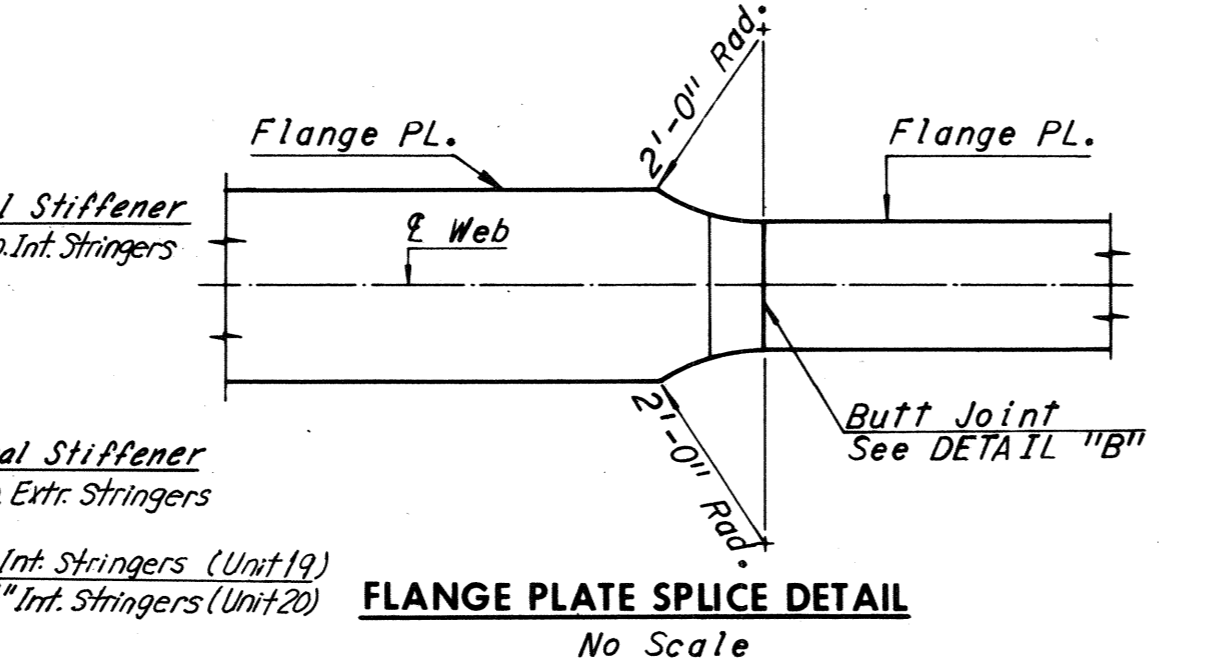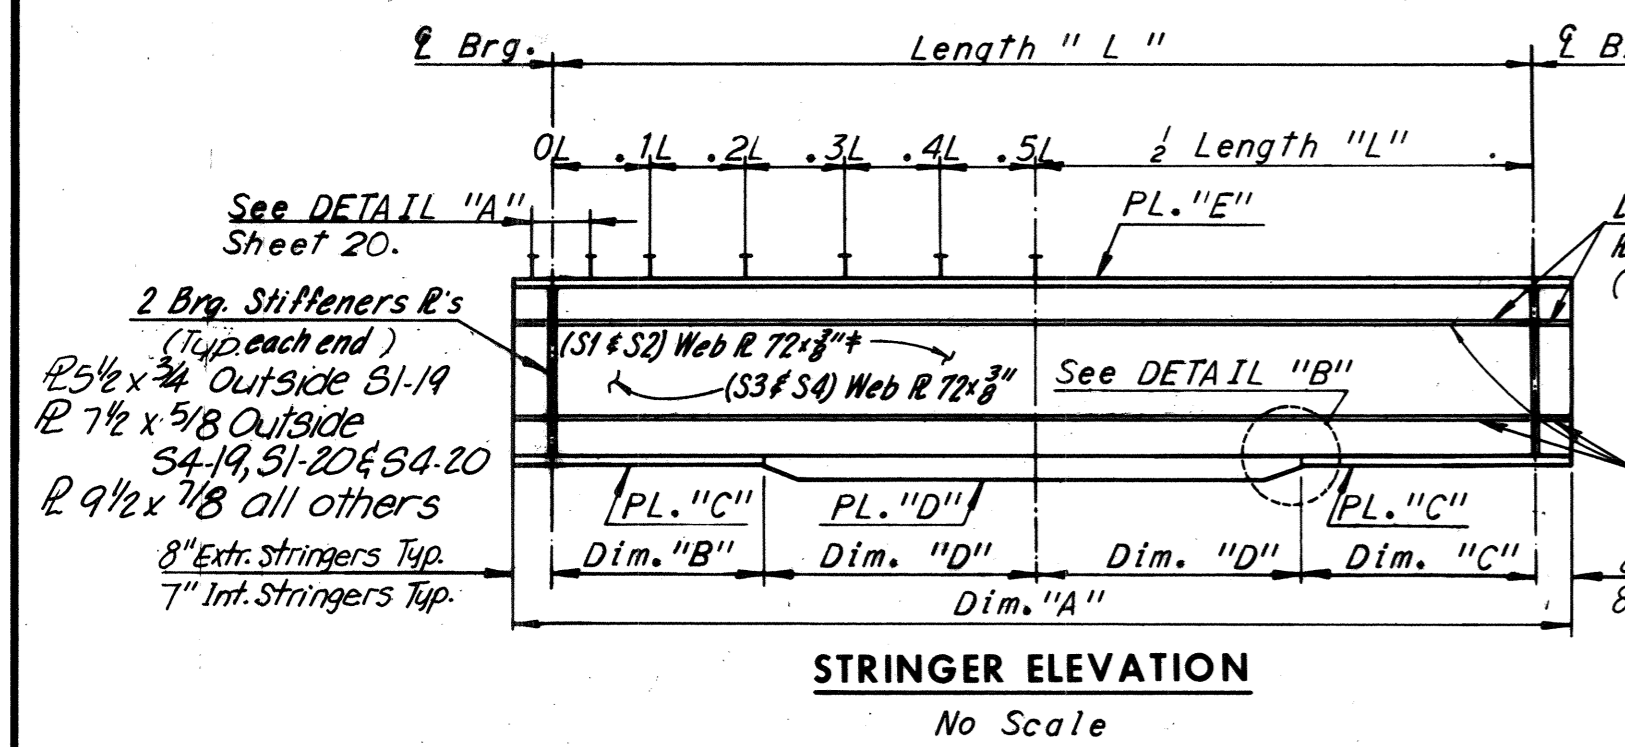


NOTE TO CONTRACTOR
Deflections given are those anticipated to occur in the stringer upon placement of the total concrete deck dead load. In practice, the stringers in place are not likely to have the exact camber to compensate for these deflections during construction. The residual amounts shall be provided by adjusting forms to vary the thickness of the concrete haunch between the bottom of the slab and the top of stringer without altering the slab thickness.

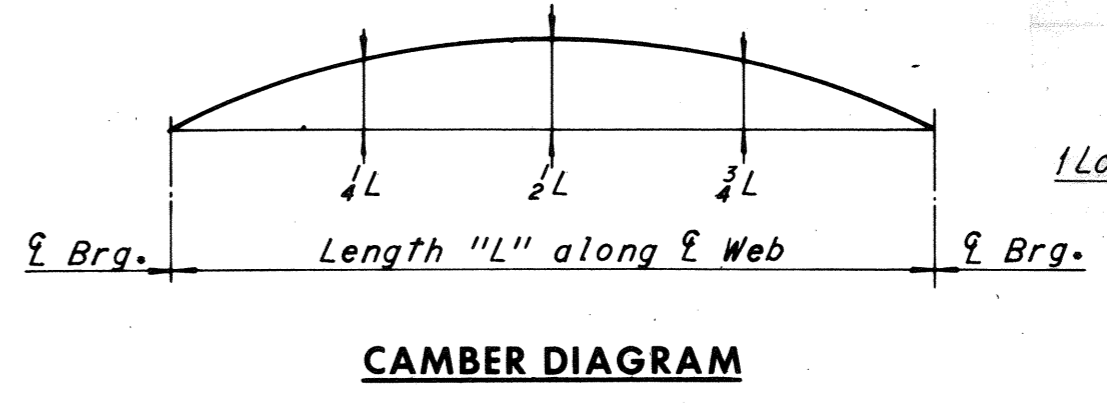

NOTE TO FABRICATOR
The stringers shall be fabricated with an upward camber amounting to the tabulated value. This will provide approximate compensation for deflection under full dead load and for conformity with finished grade. Dimensions are in inches.

NOTE:
If stringers are not cambered, top of stringers to top of slab will vary along the stringer in accordance with the offset dimensions shown in the Camber Diagram, and with minimum distance as shown in Cross-Section on Sheet 33.

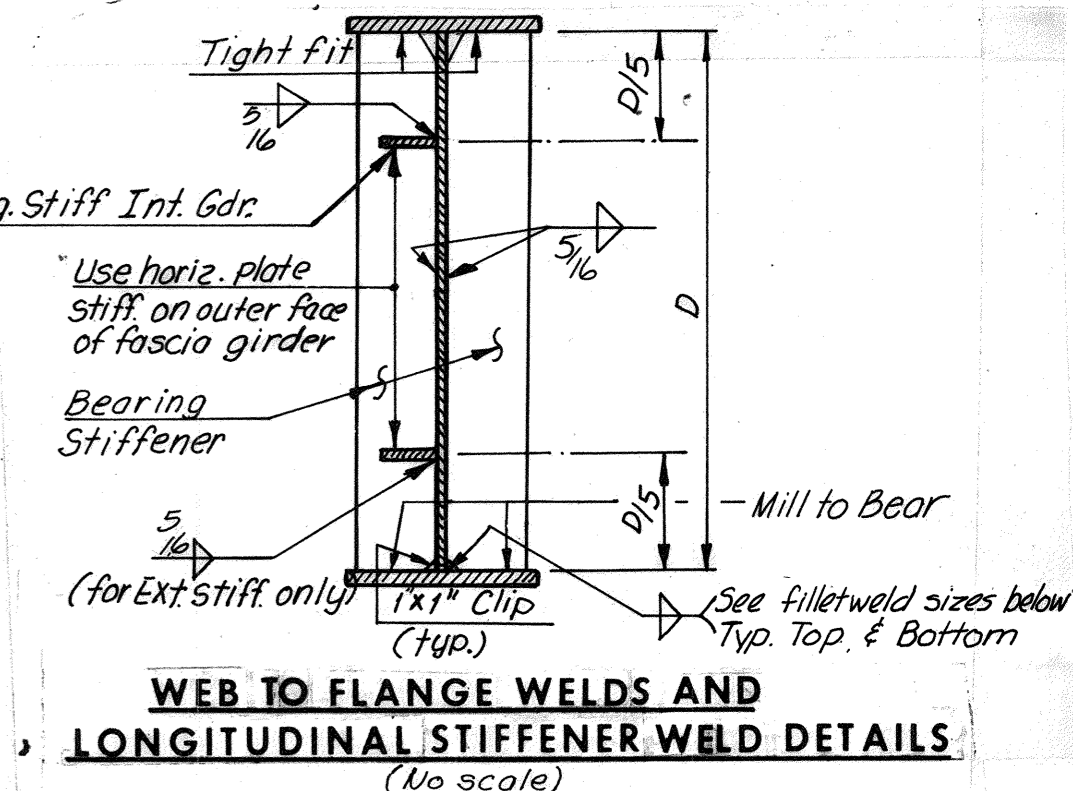

NOTE:
Web to flange weld size shall be determined by flange thickness as follows:
To 1/2".....3/8" weld
over 1/2" to 2 1/2".....5/8" weld
over 2 1/2".....1" weld

Notes:
All Horizontal Dimensions are measured along \bar{L} Web.

UNIT	STRINGER	STRINGER SCHEDULE					MAX. SHEAR STUD SPACING					DEAD LOAD DEFLECTION SCHEDULE			CAMBER SCHEDULE					
		Dim. "A"	LENGTH "L"	Dim. "B"	Dim. "C"	Dim. "D"	PL. "C"	PL. "D"	PL. "E"	0.0L-0.1L	0.1L-0.2L	0.2L-0.3L	0.3L-0.4L	0.4L-0.5L	1/4L	1/2L	3/4L	1/4L	1/2L	3/4L
19	S1-19	91'-1"	89'-9"	13'-10 1/2"	13'-10 1/2"	31'-0"	12 x 1 1/4"	16 x 1 1/2"	12 x 1 1/4"	11"	12 1/2"	16"	19"	24"	1"	1 3/8"	1"	1 1/8"	1 9/16"	1 1/8"
	S2-19	87'-6 1/2"	86'-4 1/2"	12'-2 3/8"	12'-2 3/8"	31'-0"	12 x 3/4"	16 x 1 1/4"	12 x 3/4"	11 1/2"	13"	17 1/2"	20 1/2"	24"	3/4"	1"	3/4"	7/8"	1 1/8"	7/8"
	S3-19	84'-2 1/2"	83'-0 3/8"	12'-0 3/8"	12'-0 3/8"	29'-6"	12 x 3/4"	16 x 1 1/4"	12 x 3/4"	14"	16"	21 1/2"	24"	24"	7/16"	5/8"	7/16"	9/16"	3/4"	9/16"
	S4-19	81'-0 3/8"	79'-8 3/8"	39'-10 3/8"	39'-10 3/8"		16 x 7/8"		12 x 3/4"	20 1/2"	23 1/2"	24"	24"	24"	1/2"	5/16"	1/2"	5/16"	1/2"	5/16"
20	S1-20	77'-5 1/2"	76'-0 1/2"	38'-0 1/2"	38'-0 1/2"		16 x 3/4"		12 x 3/4"	13"	14 1/2"	17 1/2"	21"	24"	5/8"	7/8"	5/8"	7/8"	1 1/8"	3/4"
	S2-20	80'-5"	79'-2 1/2"	39'-7 1/2"	39'-7 1/2"		16 x 7/8"		12 x 3/4"	14"	16"	18 1/2"	22"	24"	9/16"	1 1/16"	9/16"	5/8"	1 1/16"	5/8"
	S3-20	83'-7"	82'-4 1/2"	41'-2 1/2"	41'-2 1/2"		16 x 1 1/8"		12 x 3/4"	16 1/2"	19"	21 1/2"	24"	24"	7/16"	9/16"	7/16"	1/2"	3/4"	1/2"
	S4-20	86'-11 1/4"	85'-6 1/4"	42'-9 1/4"	42'-9 1/4"		16 x 3/4"		12 x 3/4"	17 1/2"	20"	23 1/2"	24"	24"	5/16"	7/16"	5/16"	7/16"	5/8"	7/16"

NOTE:
All steel shall be A36 unless otherwise shown. Exterior Stringer Longitudinal Stiffeners shall be located on the exterior face of the stringer. Intermediate stiffener Pls. 4 1/2" x 8" shall be equally spaced between diaphragms as shown. The first two stiffener spaces at the ends of stringers shall be one-half the normal spacing within the panel.

Legend:
* Denotes A572-Grade 50 steel for thicknesses of 3/4" and under, and A588 steel for thicknesses over 3/4".
* Spacing begins at termination of 7 spaces @ 4".

AS BUILT

**RICHMOND METROPOLITAN AUTHORITY
RICHMOND EXPRESSWAY SYSTEM
DOWNTOWN EXPRESSWAY**



**BRIDGE NO. 65
RAMP S-W CONNECTION FROM
RICHMOND-PETERSBURG TURNPIKE
FRAMING PLAN - UNITS 19 AND 20**

HOWARD, NEEDLES, TAMMEN & BERGENDOFF
consulting engineers
NEW YORK ALEXANDRIA KANSAS CITY




SCALE: As Noted
CONTRACT NO.: 11
SHEET NO. 24 OF 38

BY	DATE			
MADE	D.E.S.	12-3-68		
CHECKED	AMH	1-27-69	Diaph. layout of Pier 19	T.E.M. 8-76
IN CHARGE				

RICHMOND EXPRESSWAY SYSTEM			
SECTION	PROJECT	SHEET NO.	TOTAL SHEETS
11	DOWNTOWN EXPRESSWAY	50	97

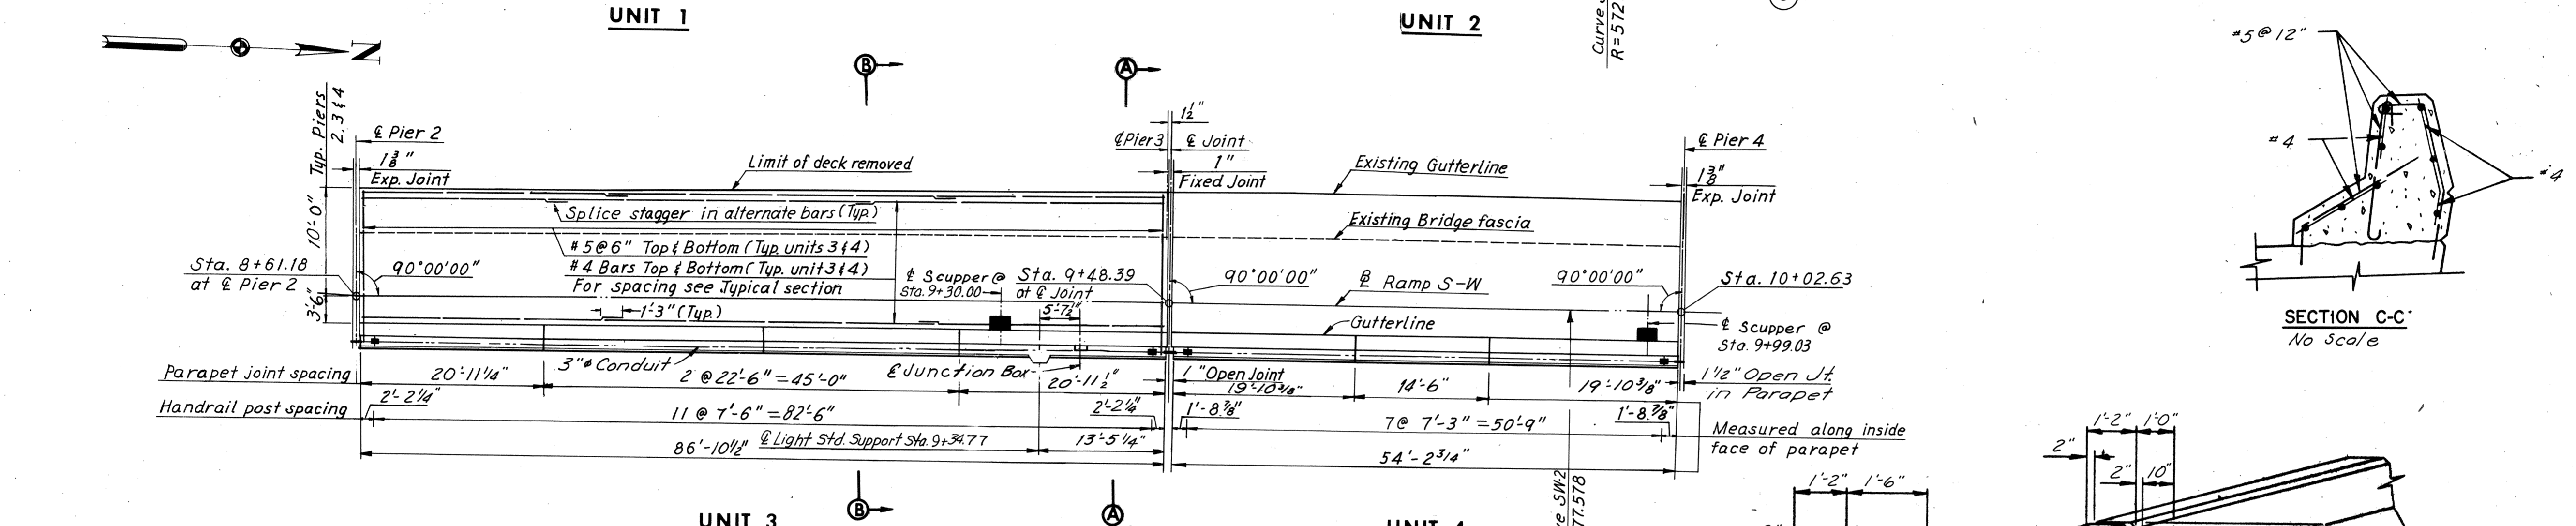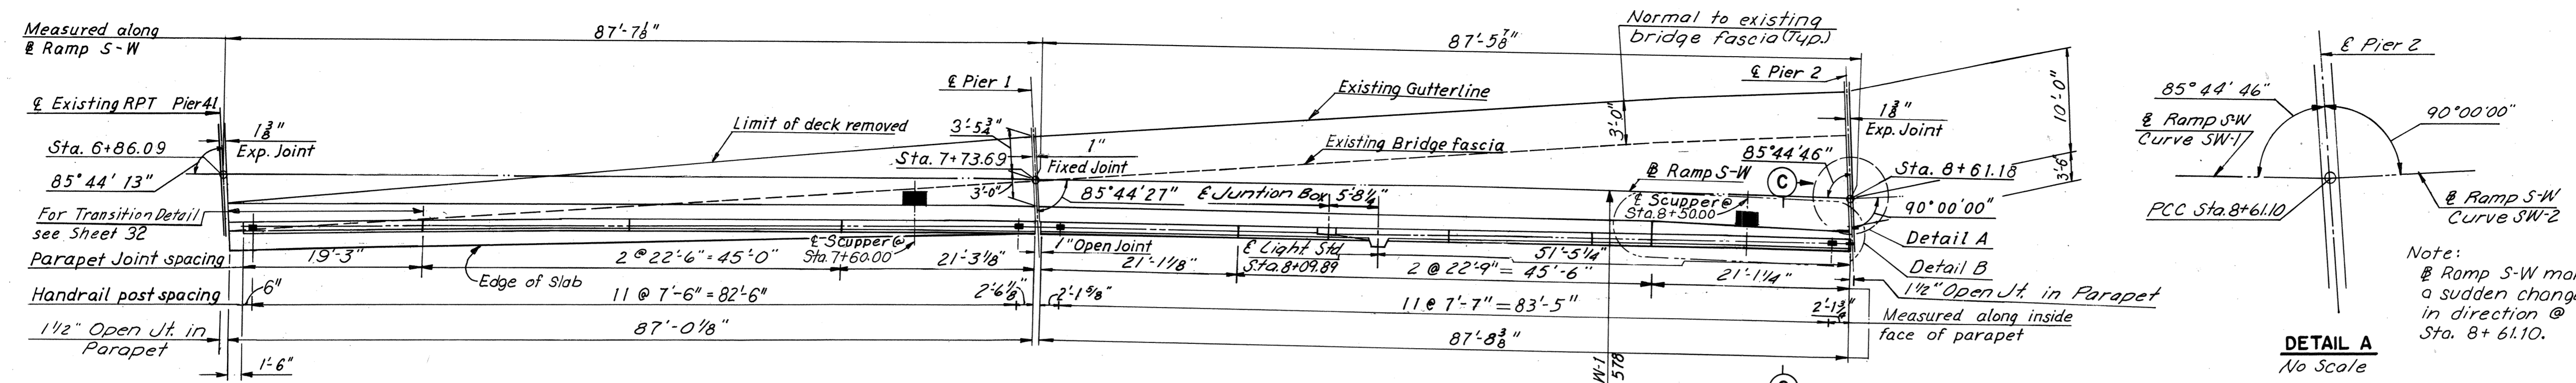


DECK PLAN
Scale: 1"=10'-0"

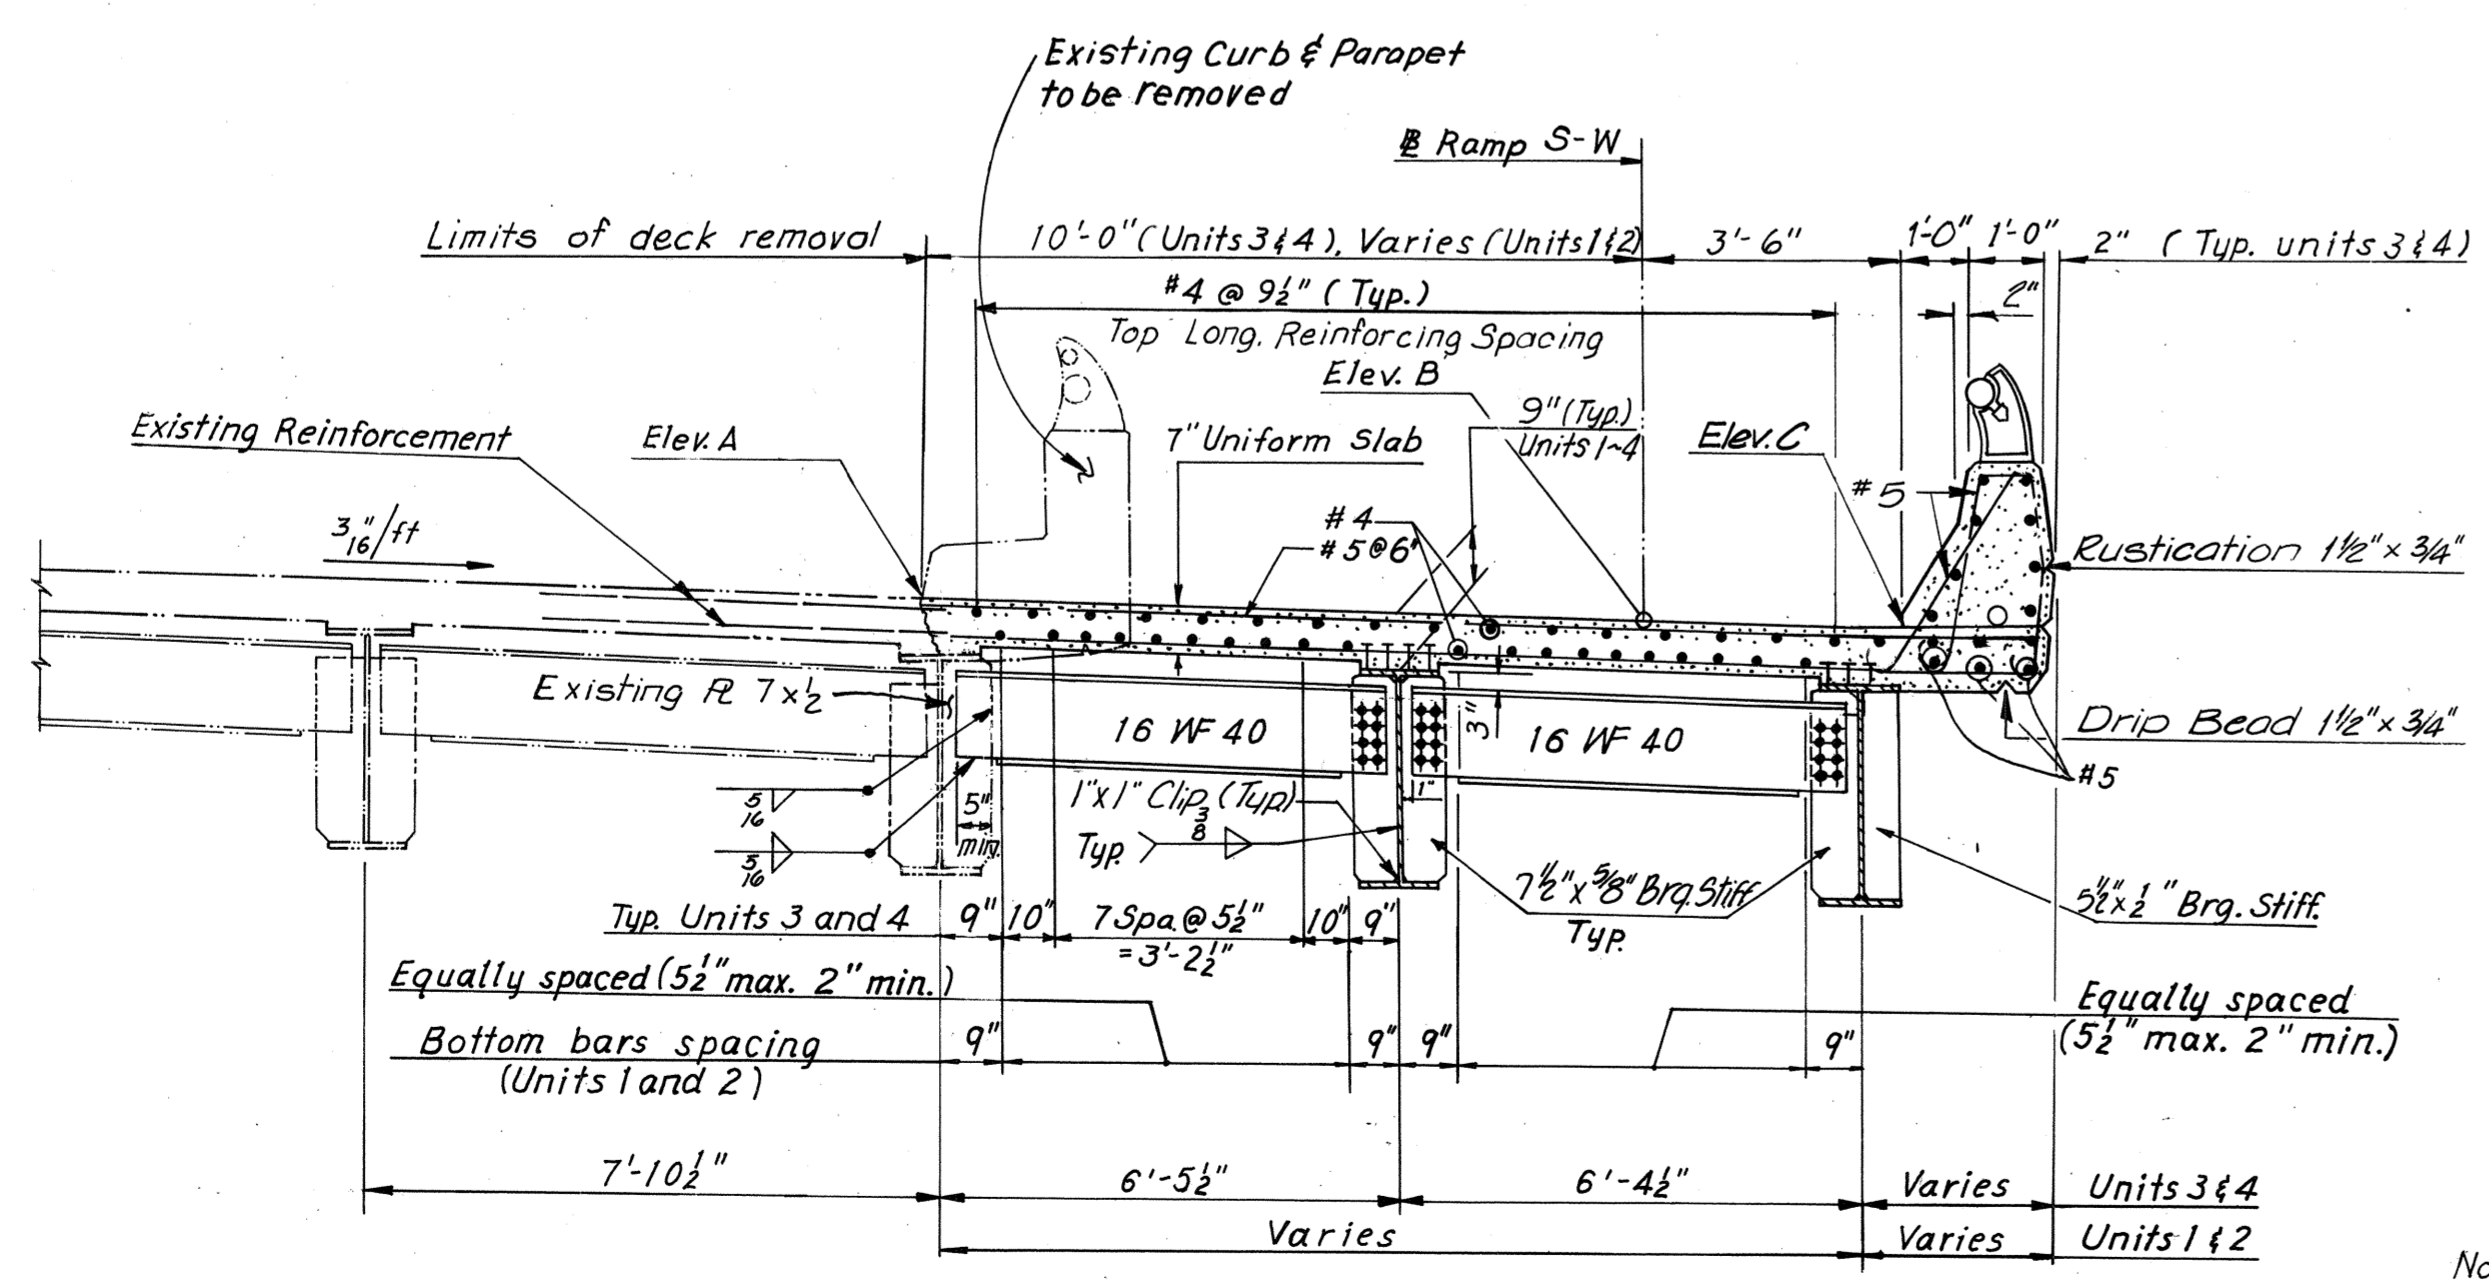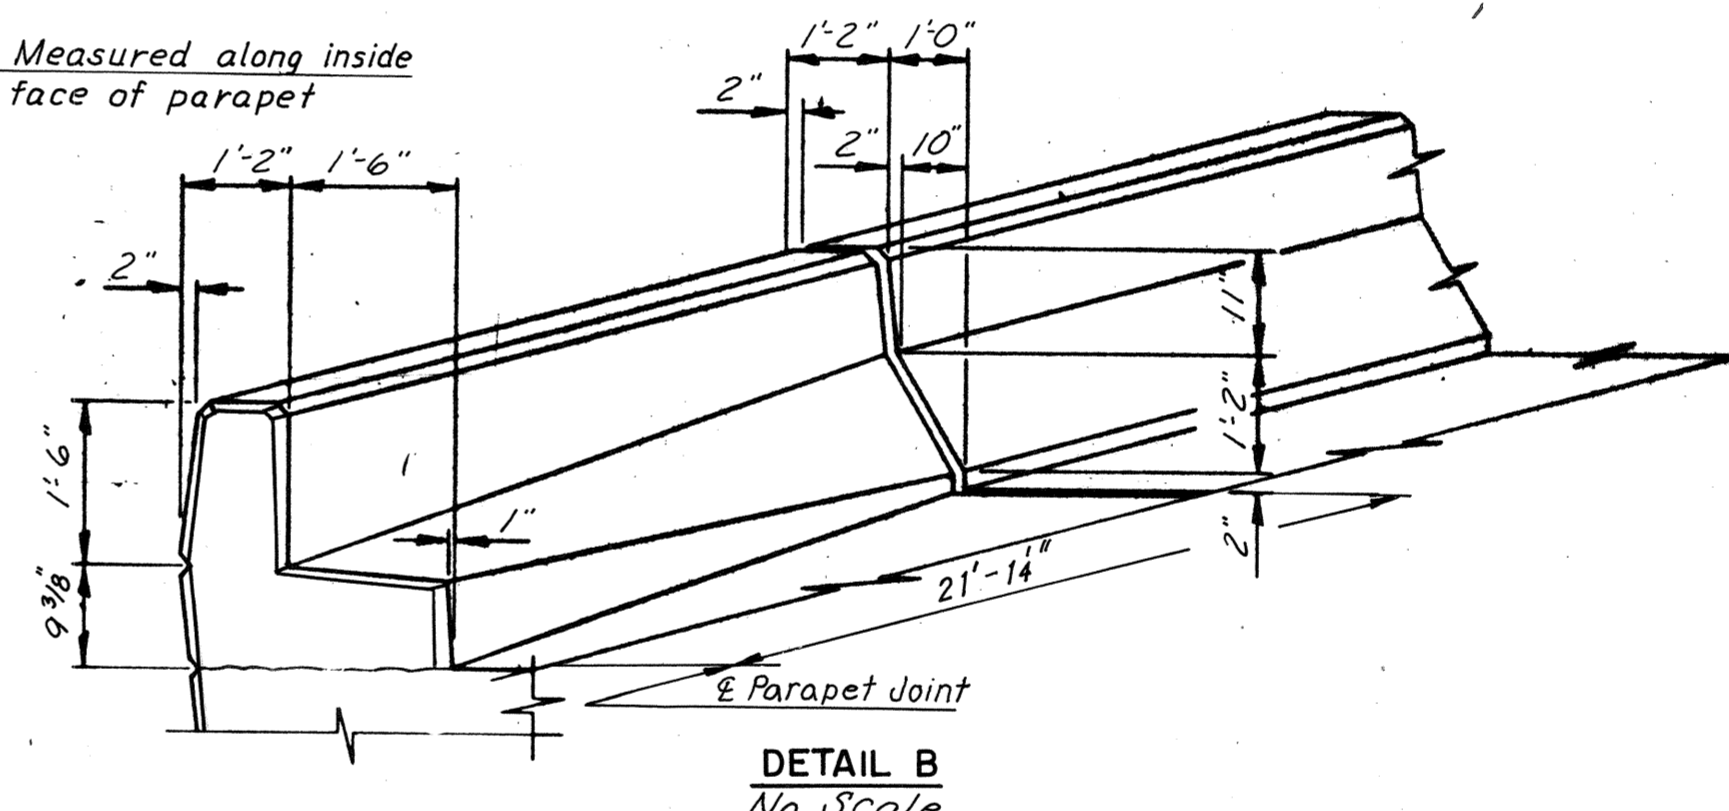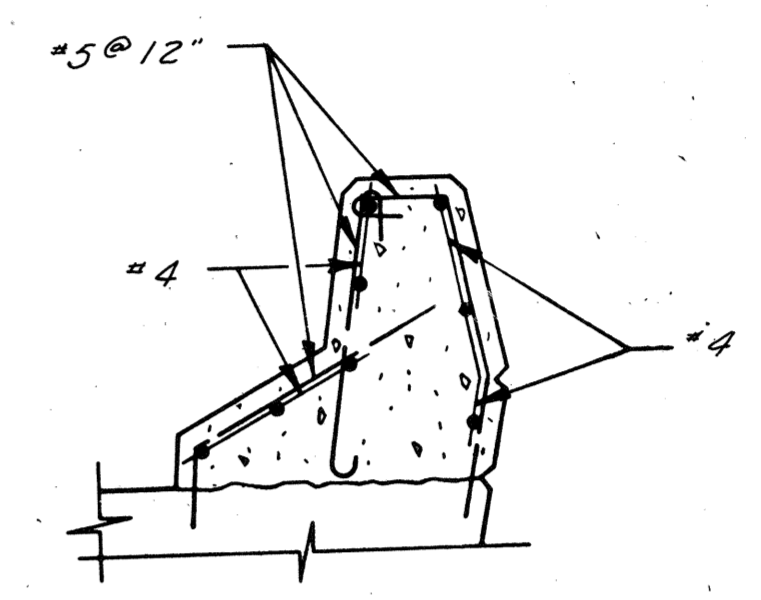

END DIAPHRAGM

SECTION A-A

Scale: 3/8" = 1'-0"

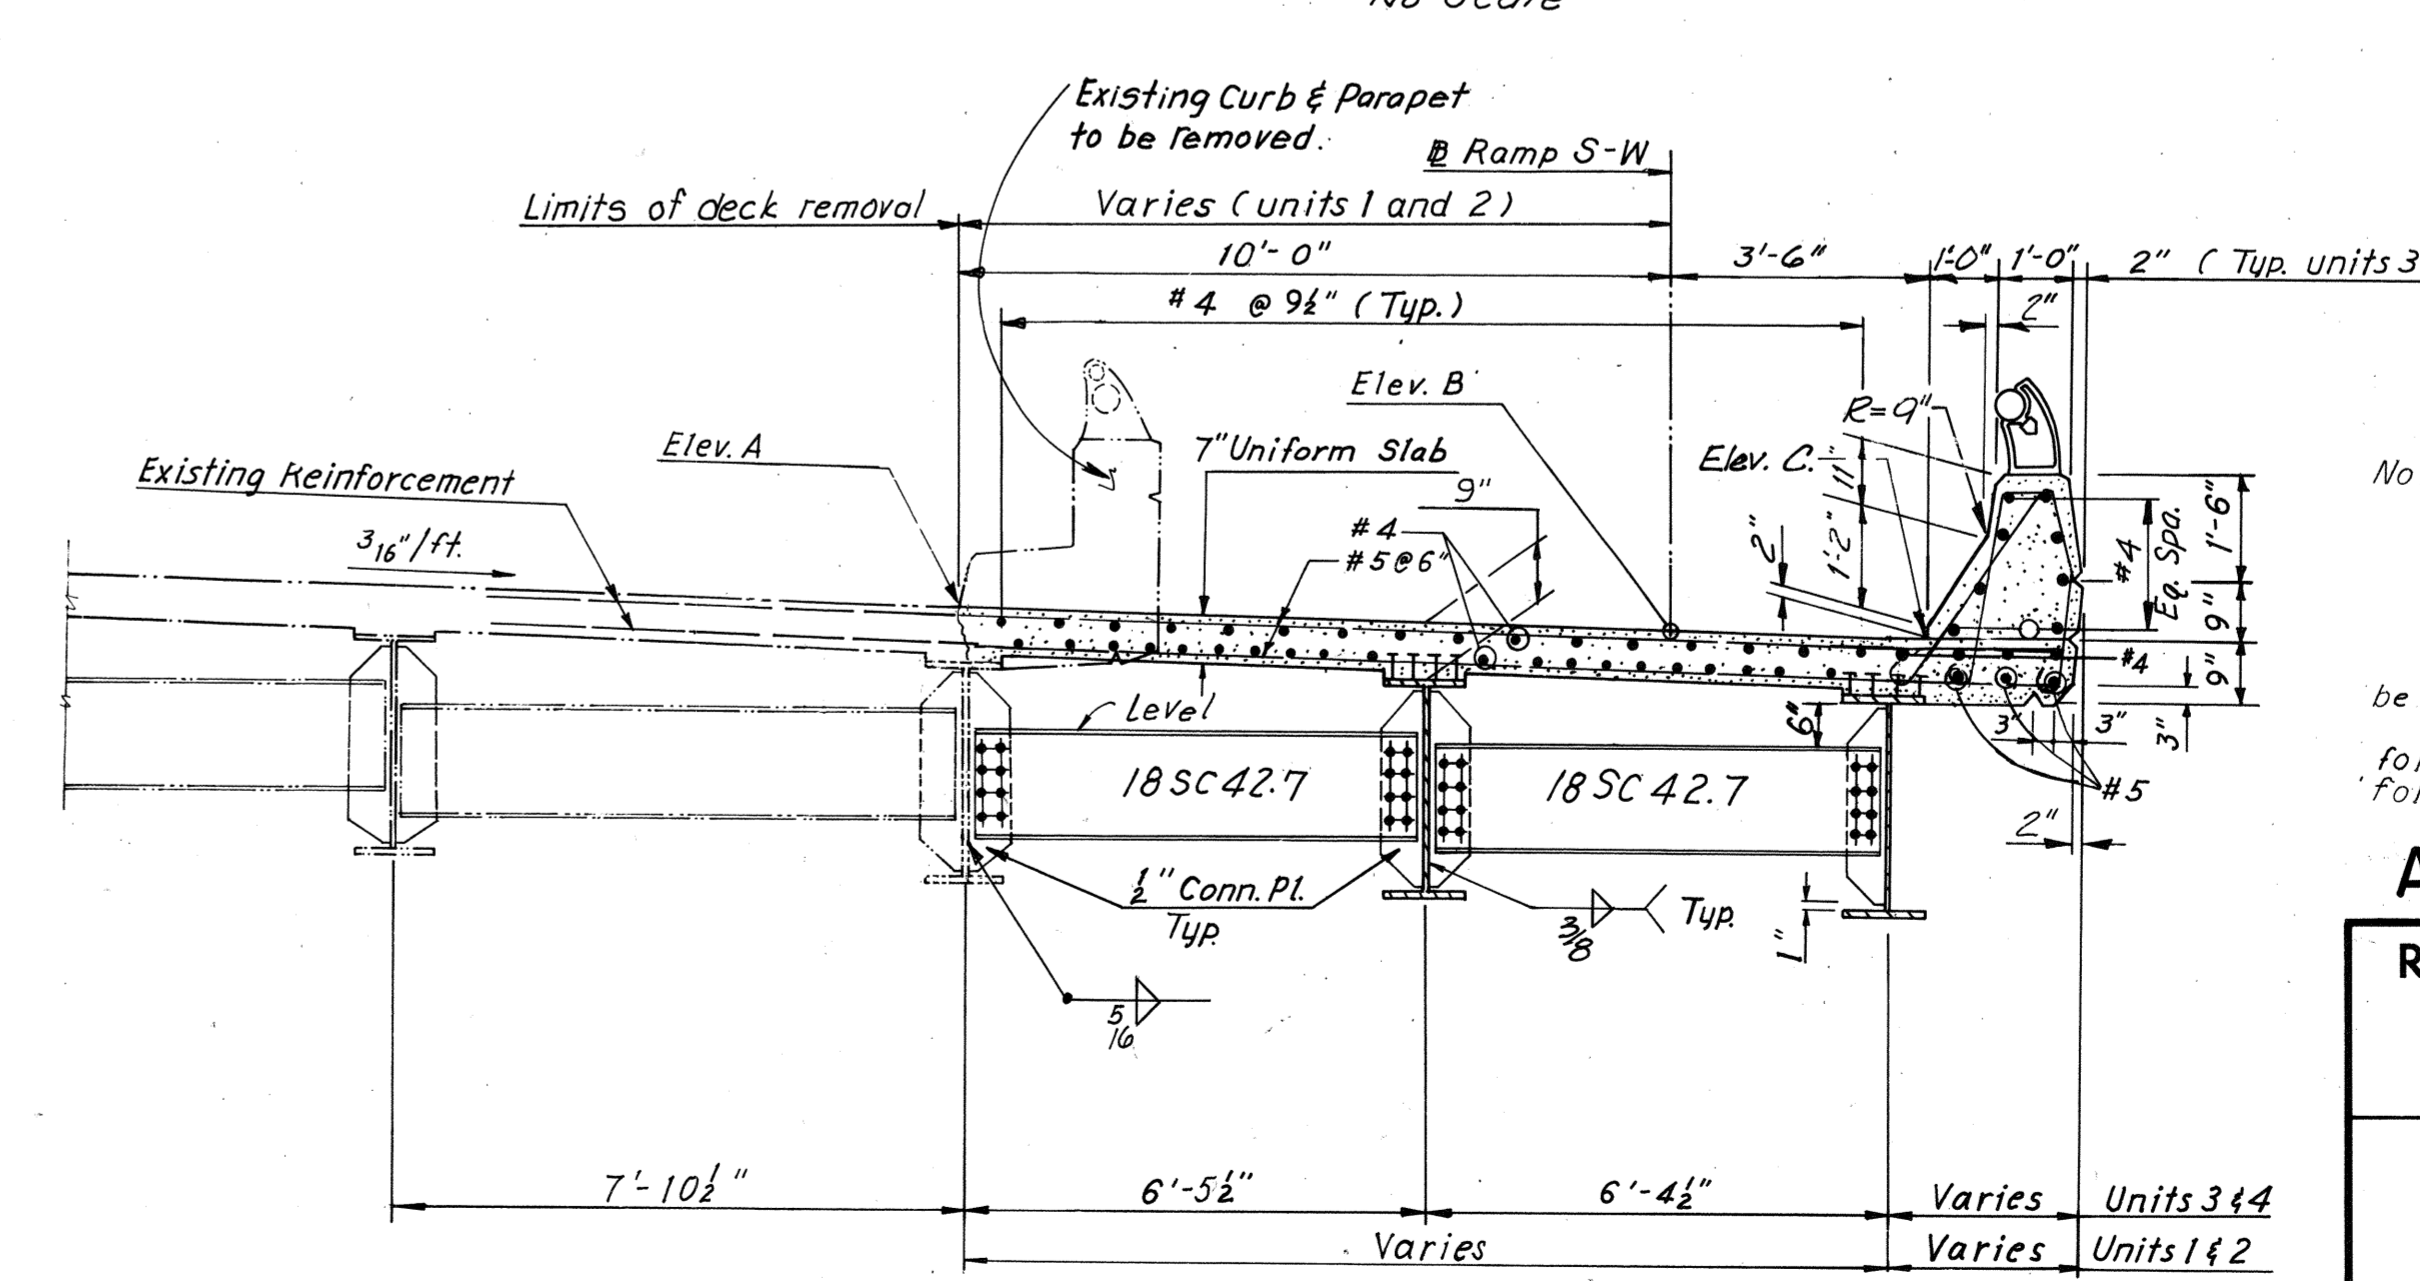

INTERMEDIATE DIAPHRAGM

SECTION B-B

Scale: 3/8" = 1'-0"

ELEVATION TABLE			
STATION	ELEV. A	ELEV. B	ELEV. C
6+86.09	—	72.84	—
+90.00	—	72.90	72.85
+70.00	—	73.05	73.00
+10.00	—	73.19	73.15
+20.00	—	73.35	73.30
+30.00	73.50	73.49	73.45
+40.00	73.66	73.64	73.60
+50.00	73.82	73.79	73.75
+60.00	73.98	73.94	73.89
+70.00	74.14	74.09	74.04
+73.69	74.20	74.15	74.10
+80.00	74.30	74.24	74.19
+90.00	74.46	74.39	74.34
8+00.00	74.62	74.54	74.49
+10.00	74.79	74.69	74.64
+20.00	74.95	74.84	74.79
+30.00	75.11	74.99	74.94
+40.00	75.27	75.15	75.09
+50.00	75.43	75.29	75.23
+60.00	75.59	75.44	75.39
+61.18	75.61	75.45	75.40
+70.00	75.75	75.60	75.54
+80.00	75.91	75.76	75.70
+90.00	76.08	75.92	75.86
9+00.00	76.24	76.08	76.02
+10.00	76.40	76.24	76.19
+20.00	76.56	76.40	76.35
+30.00	76.72	76.56	76.51
+40.00	76.88	76.72	76.67
+48.39	77.02	76.86	76.81
+50.00	77.04	76.89	76.83
+60.00	77.20	77.05	76.99
+70.00	77.37	77.21	77.15
+80.00	77.53	77.37	77.32
+90.00	77.69	77.53	77.48
10+00.00	77.85	77.69	77.64
+02.63	77.89	77.74	77.68

Note A:
Elev. A from Sta. 6+86.09 to 10+02.63 is given along the existing Gutter Line R.P.T. and is radial to the existing Base Line R.P.T. at the respective stations as given along the Base Line Ramp S-W. Cross Slope is radial to the Base Line R.P.T. Elev. A is to be field verified. Minor adjustments may be required.

Note:
For Framing plan, see Sheet 18.
For Joint Details, see Sheet 18.
For Quantities, see Sheet 4.
For Handrail Detail, see Sheet S3.
Elev. A is to be confirmed by contractor.
Cross Slope in Units 1 and 2 should be normal to R.P.T.
For Drainage Details see Support Type 6 for Units 1, 2 and 3, and Support Type 5 for Unit 4, see Sheets 55 & 56.

AS BUILT

RICHMOND METROPOLITAN AUTHORITY
RICHMOND EXPRESSWAY SYSTEM
DOWNTOWN EXPRESSWAY


BRIDGE NO. 65
RAMP S-W CONNECTION FROM
RICHMOND-PETERSBURG TURNPIKE
DECK PLAN UNITS 1, 2, 3 AND 4

HOWARD, NEEDLES, TAMMEN & BERGENDOFF
consulting engineers
NEW YORK ALEXANDRIA KANSAS CITY




SCALE: As Noted
CONTRACT NO. 11
SHEET NO. 25 OF 38

BY	DATE	REVISION	BY	DATE
HCT	11-2-68	Deck Elev.	T.E.M.	9-8-75
JLK	6-27-75	Limits of deck removal Sect A & B	T.E.M.	8-25-75
YCP	1-17-69			
IN CHARGE				




RICHMOND EXPRESSWAY SYSTEM			
SECTION	PROJECT	SHEET NO.	TOTAL SHEETS
11	DOWNTOWN EXPRESSWAY	51	97

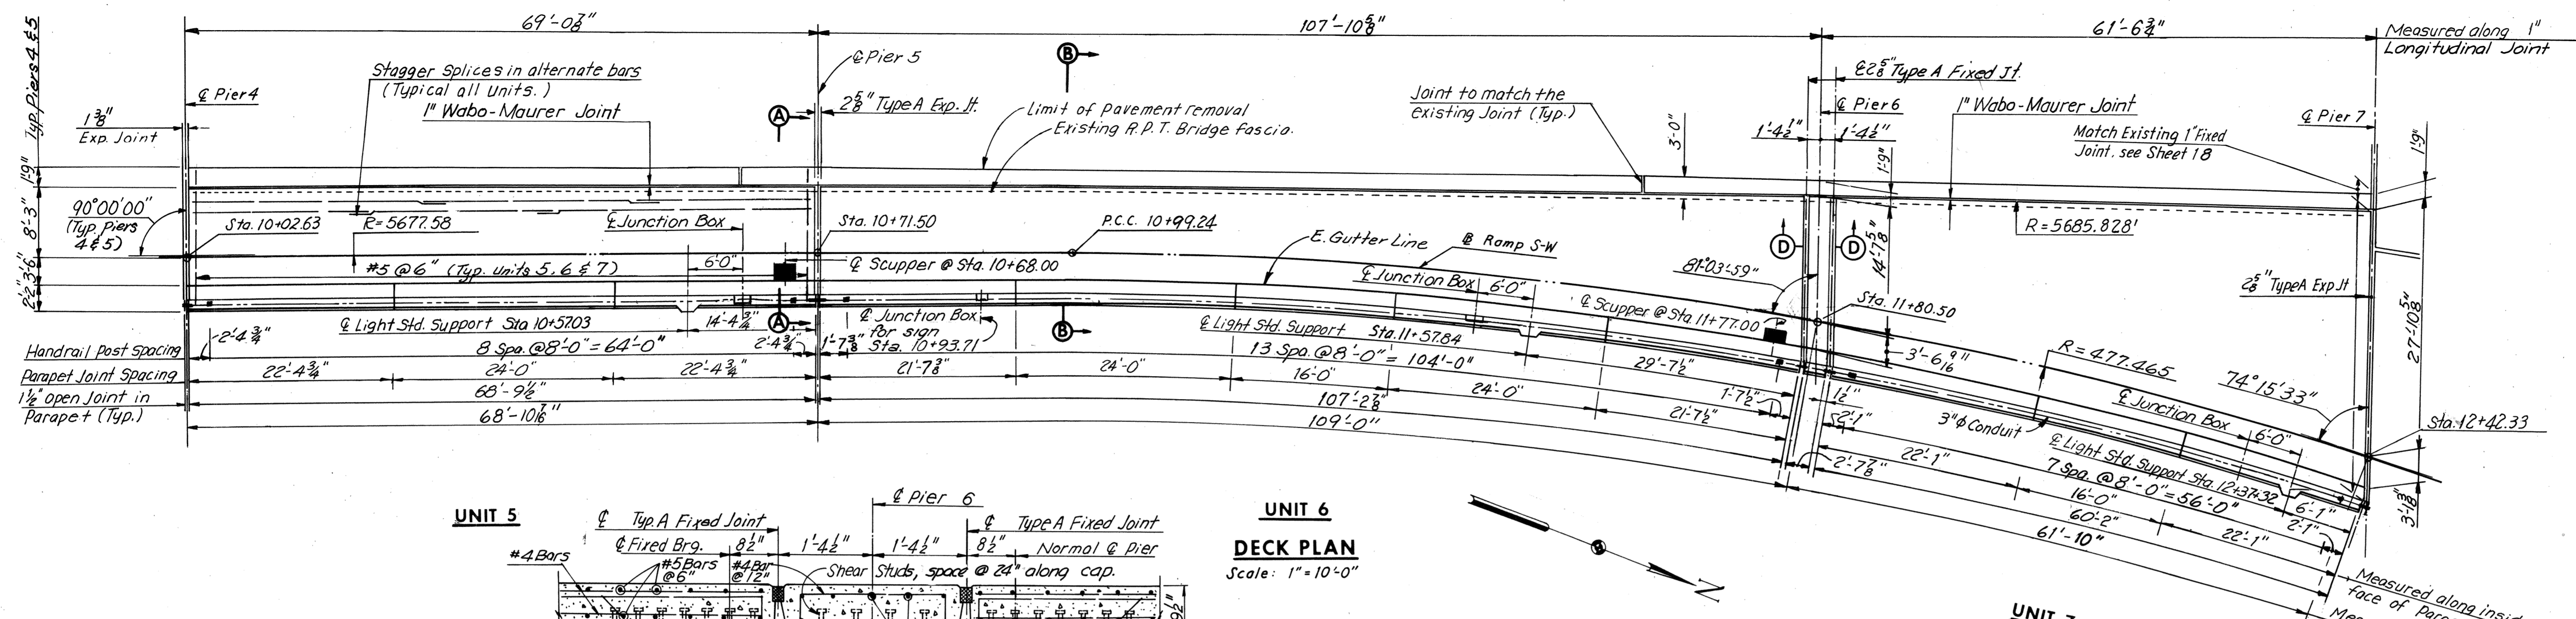


ELEVATION TABLE			
STATION	ELEV. A	ELEV. B	ELEV. C
10+02.63	77.83	77.74	77.68
+10	77.95	77.86	77.80
+20	78.12	77.02	77.96
+30	78.27	78.18	78.12
+40	78.44	78.34	78.29
+50	78.60	78.50	78.45
+60	78.76	78.66	78.61
+70	78.92	78.82	78.77
+71.50	78.94	78.85	78.80
+80	79.08	78.97	78.91
+90	79.24	79.11	79.04
11+00	79.40	79.24	79.16
+10	79.57	79.36	79.27
+20	79.73	79.47	79.36
+30	79.89	79.57	79.45
+40	80.05	79.66	79.53
+50	80.21	79.74	79.60
+60	80.37	79.82	79.68
+70	80.53	79.90	79.76
+79.11	80.67	79.97	79.83
+80	80.69	79.98	79.84
+80.50	80.70	79.98	79.84
+81.89	80.72	80.00	79.86
+90	80.86	80.06	79.92
12+00	81.01	80.14	80.00
+10	81.17	80.22	80.08
+20	81.33	80.29	80.15
+30	81.48	80.36	80.22
+40	81.64	80.43	80.29
+42.33	81.68	80.45	80.31

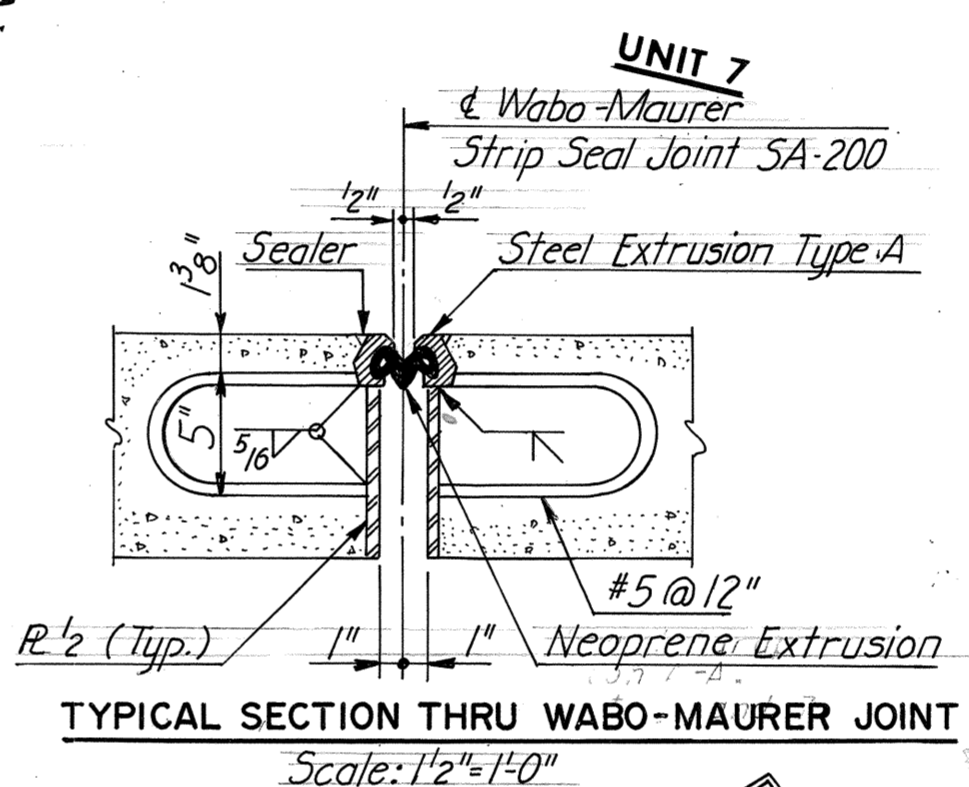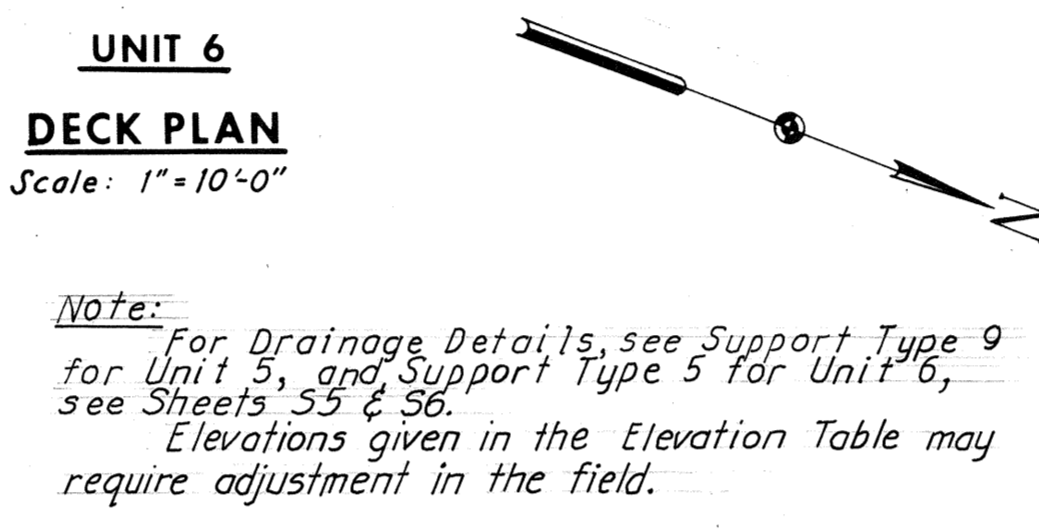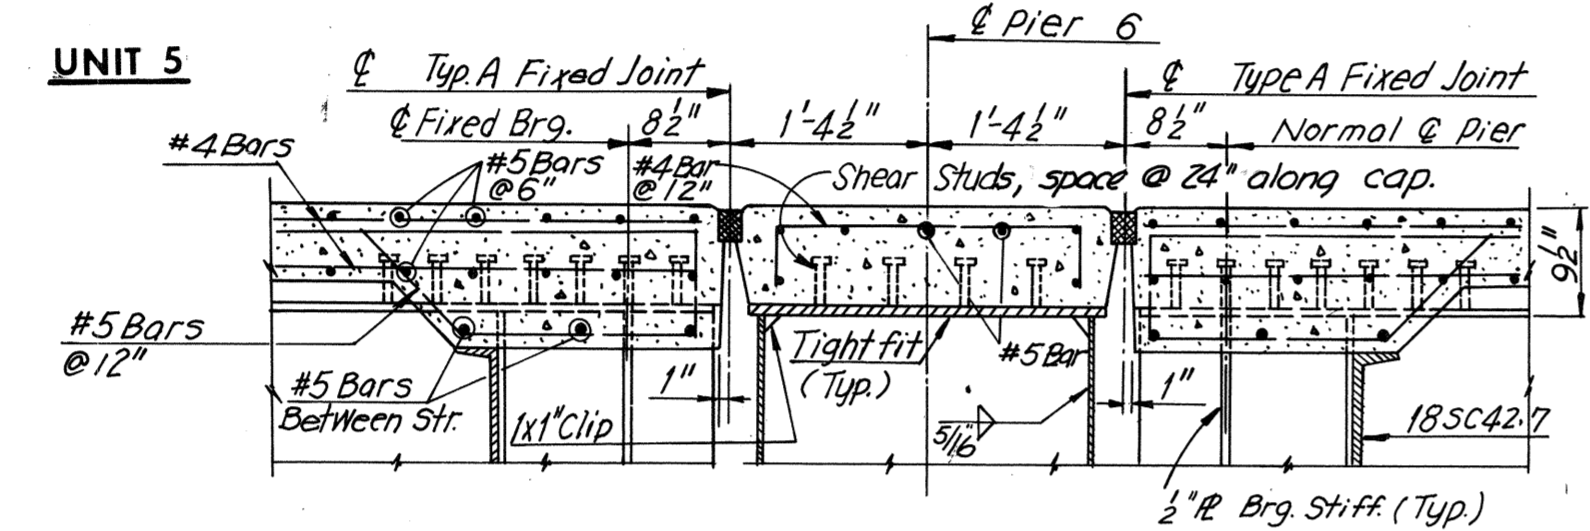

Note A:
Elev. A from Sta. 10+02.63 to 12+42.33 is given along the longitudinal joint and is radial to the existing Base Line R.P.T. at the respective stations as given along the Base Line Ramp S-W. Cross Slope is radial to the Base Line R.P.T.
Elev. A is to be field verified. Minor adjustments may be required.

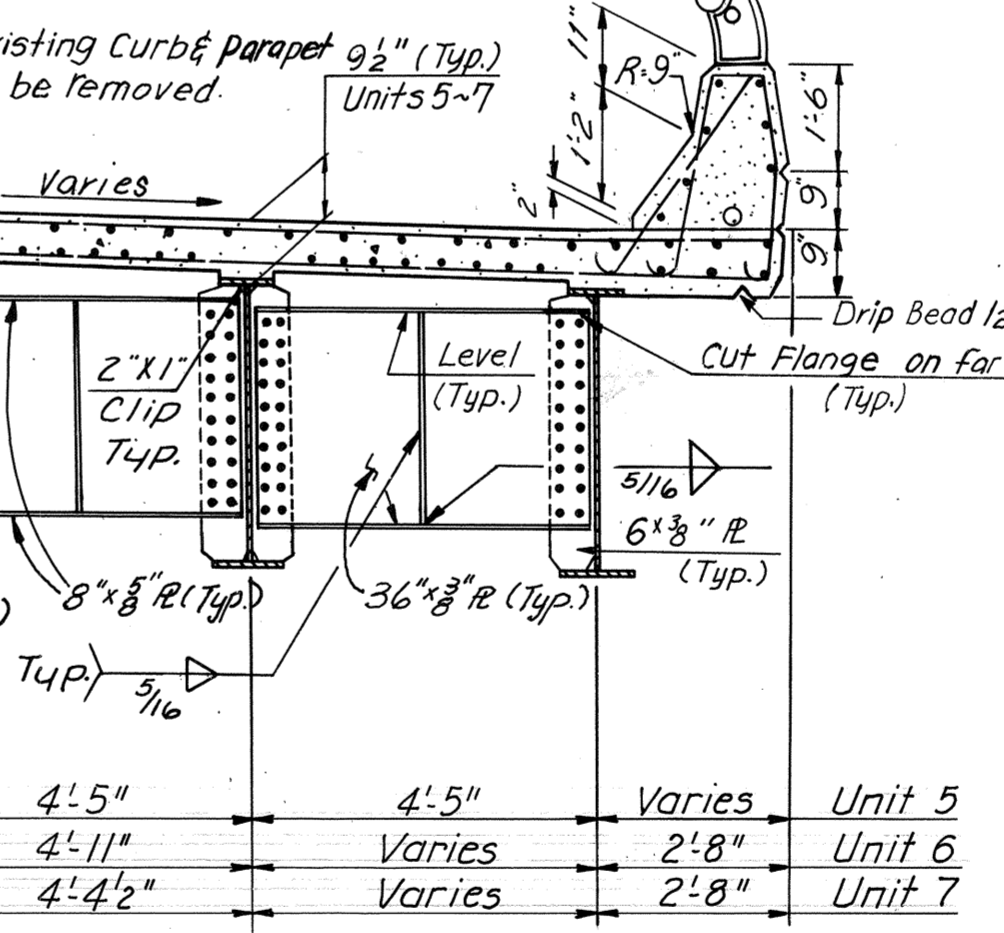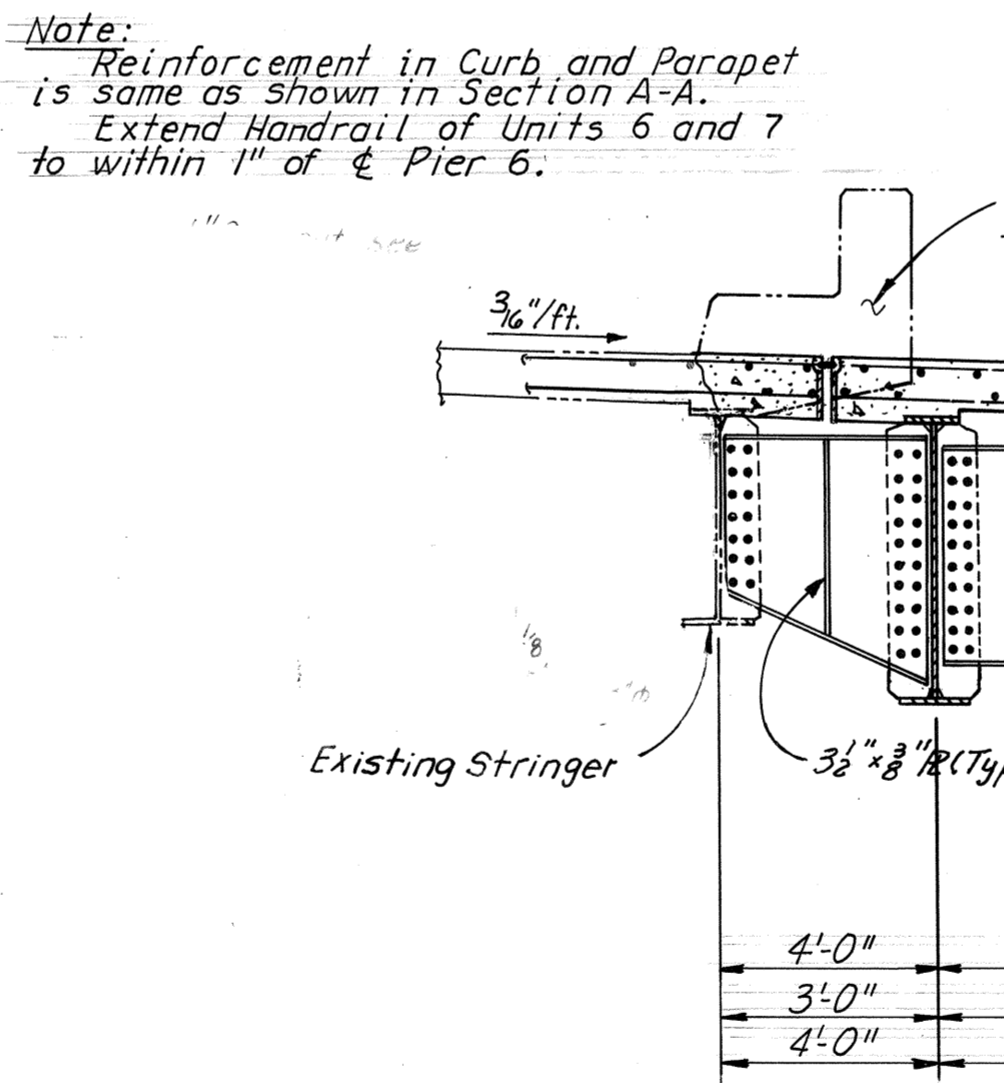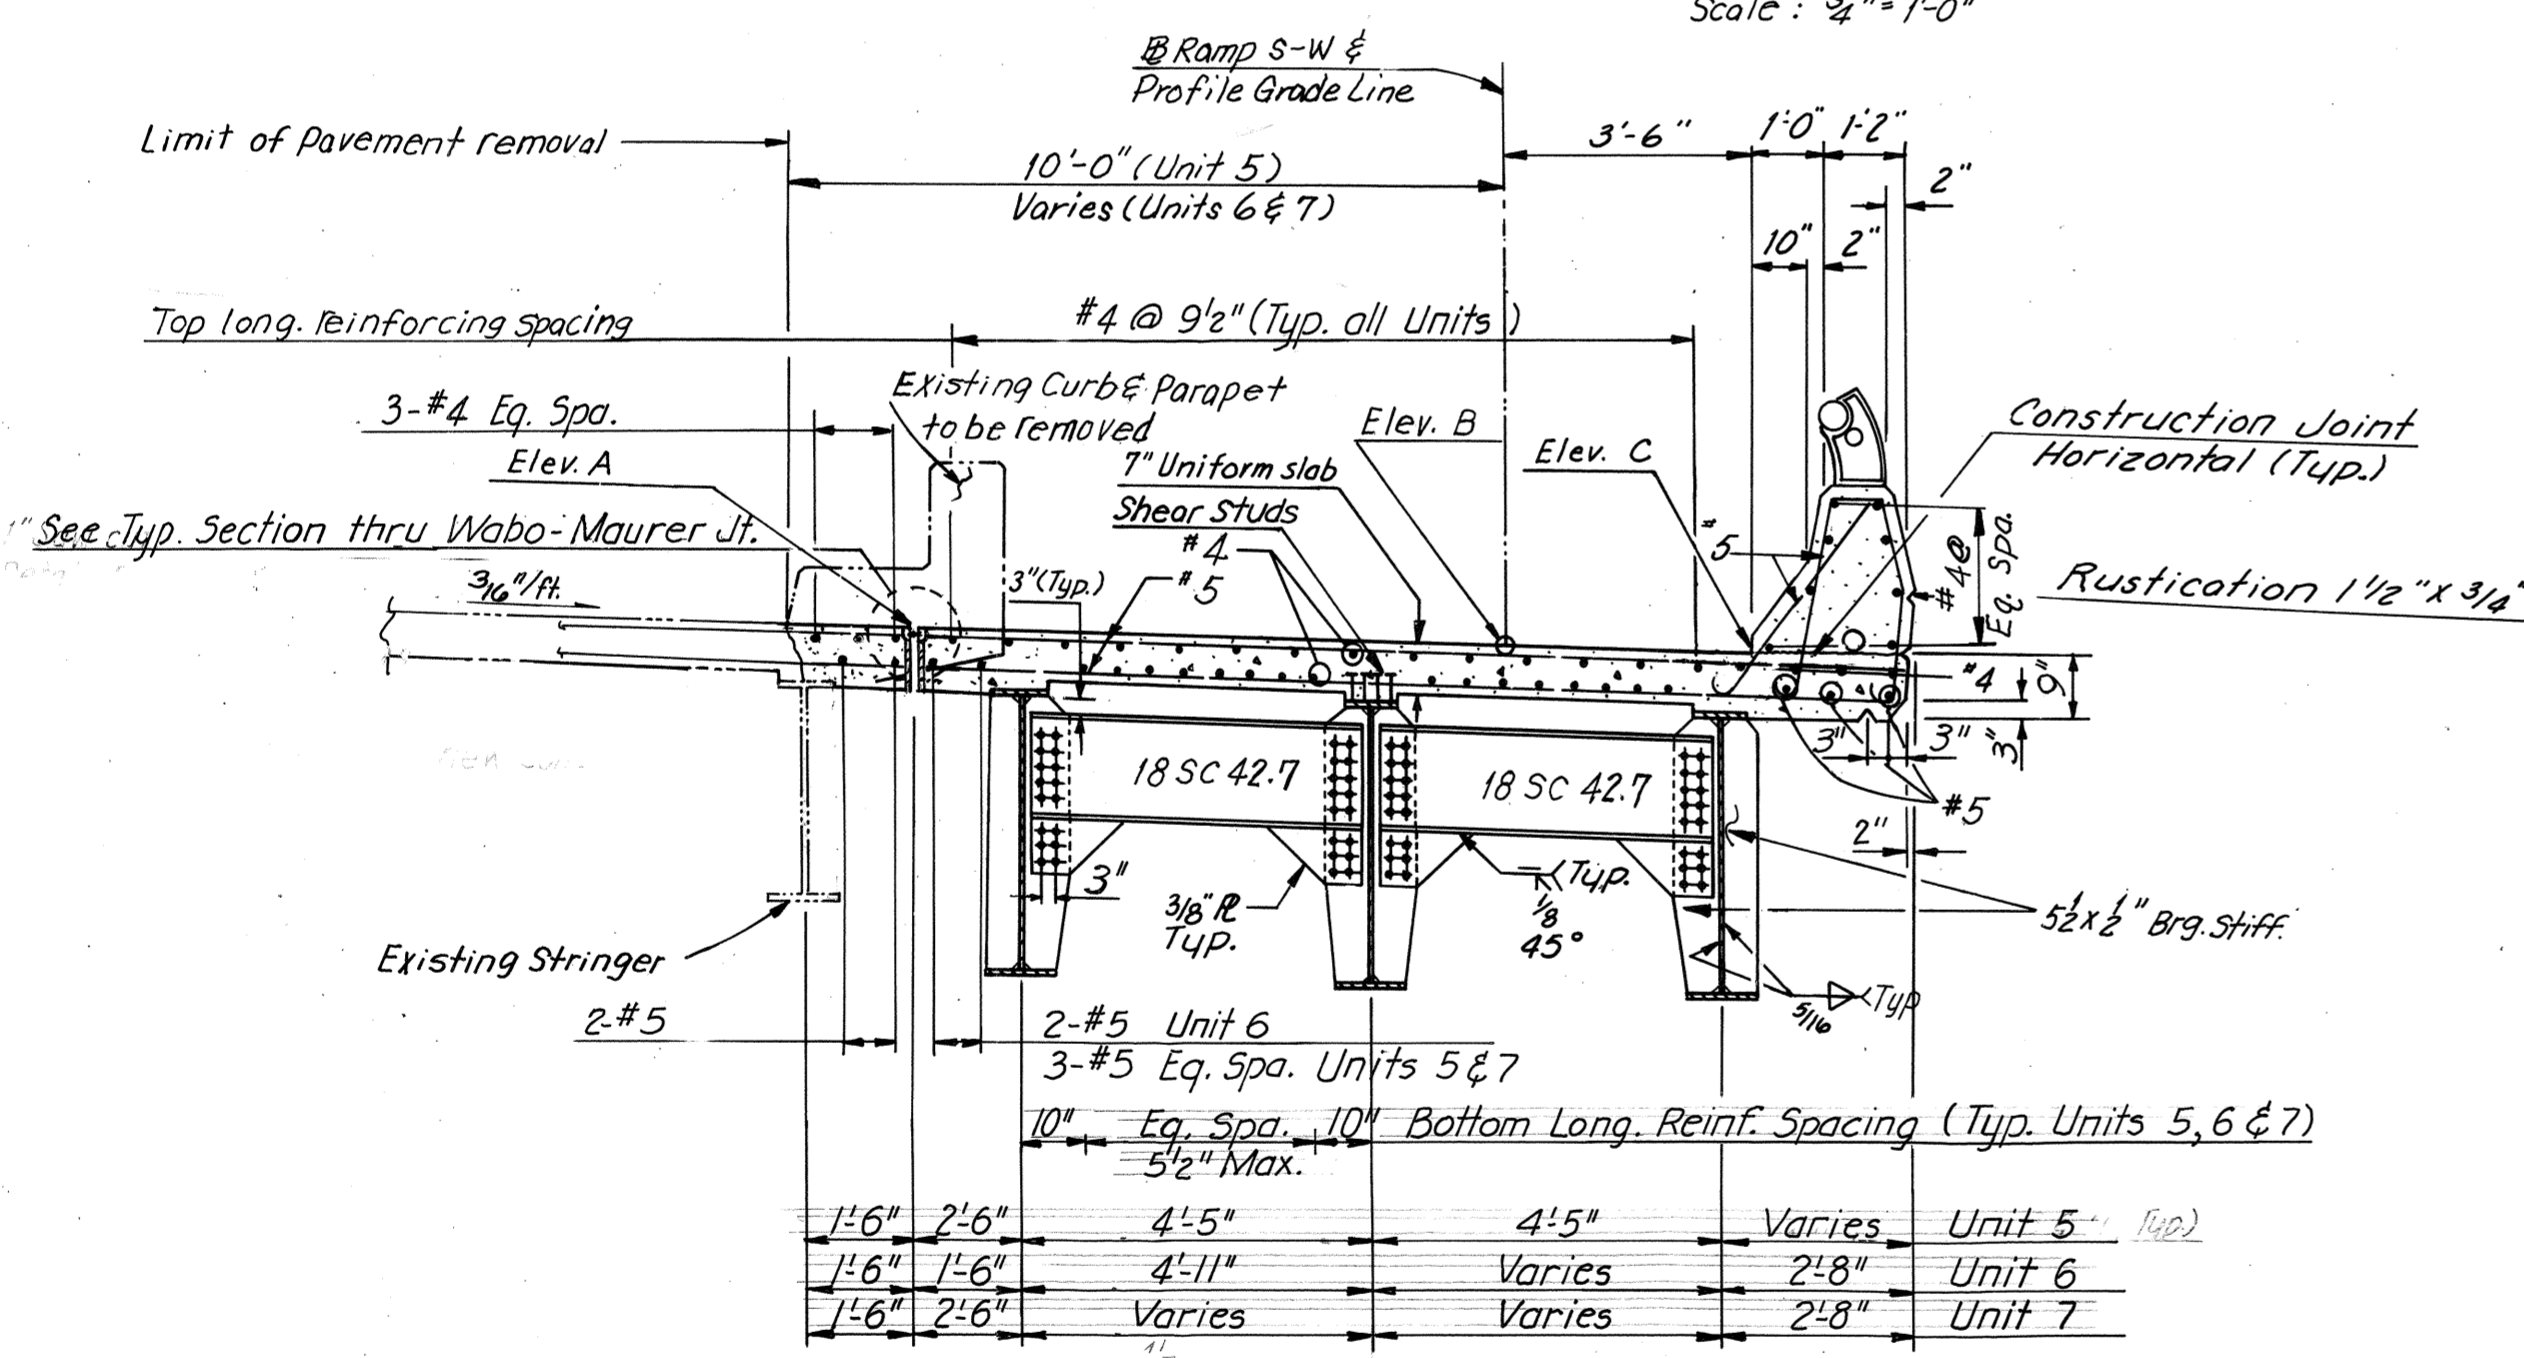

Notes for Wabo-Maurer Joint:
Do not use steel extrusions as screed support.
Steel extrusion shall conform to ASTM A36.
Structural steel shall conform to ASTM A588.
Steel assembly shall be shop welded to convenient lengths and butt welded in the field to desired length. Joint shall conform to grade of deck slab.
Steel assembly shall be sandblasted in the shop prior to painting.
Steel assembly shall receive one shop coat of epoxy zinc paint.
Neoprene extrusion shall be roughened with a wire brush before bonding to steel extrusion with Bon Lastic.
Adhesive. Groove in steel extrusion to be blown out with oil-free and water-free compressed air prior to installation of Neoprene extrusion.
The Wabo-Maurer joint assembly shall be installed in accordance with manufacturer's recommended construction methods.

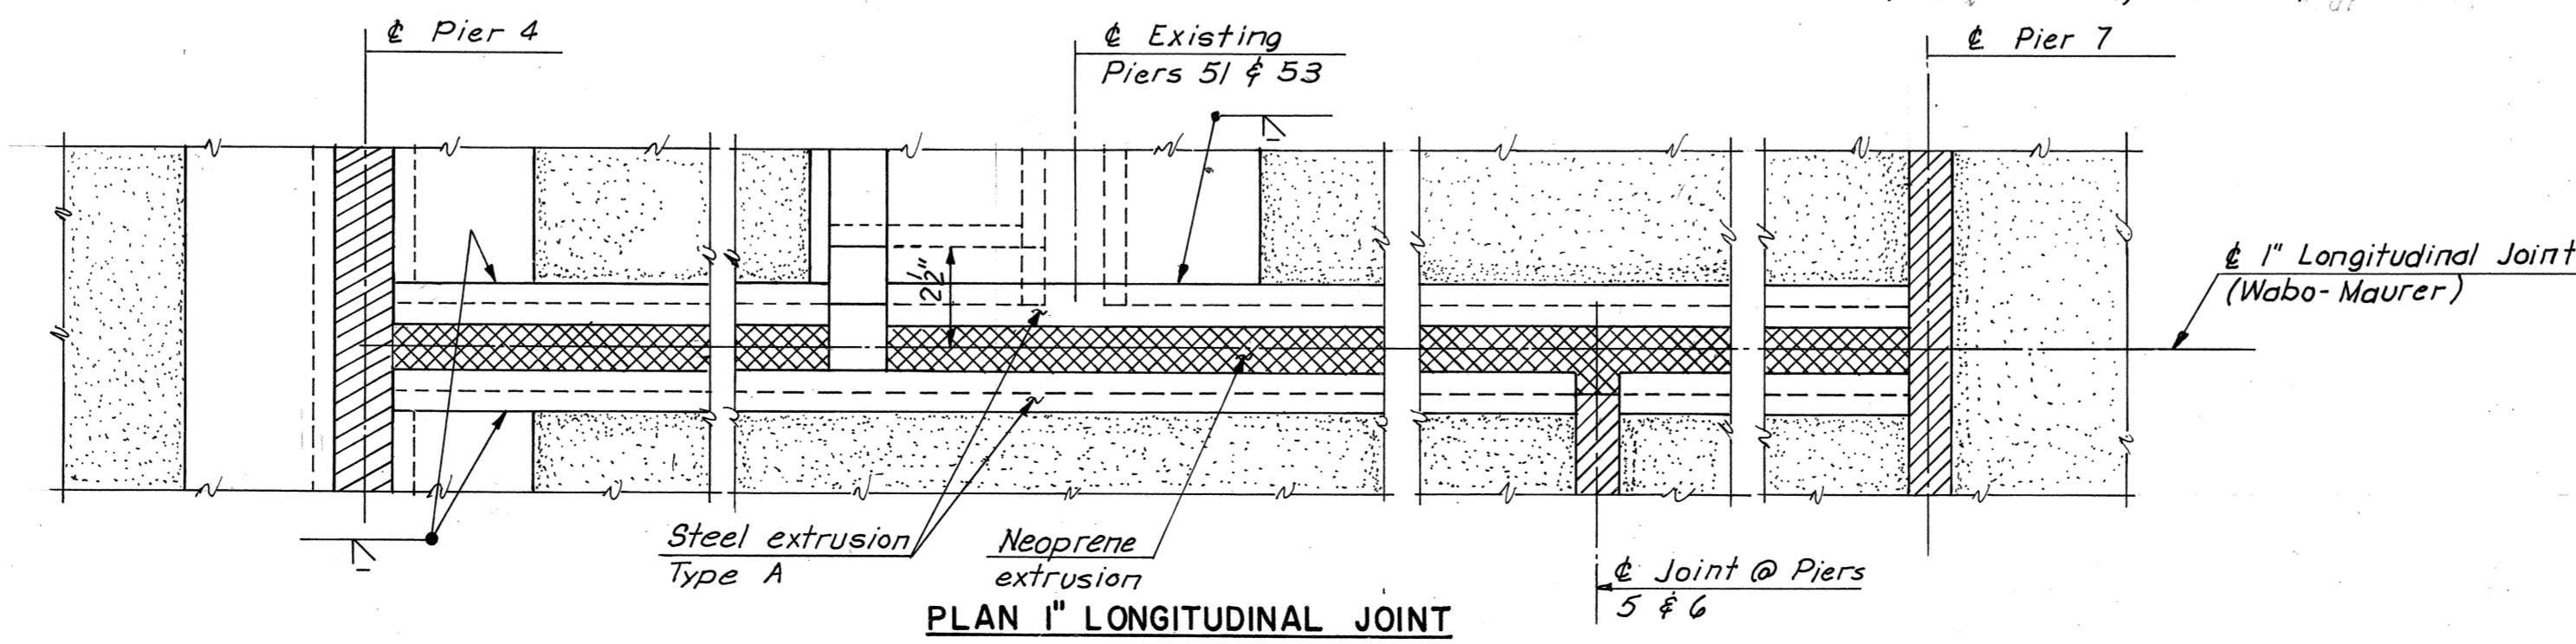

BY	DATE	REVISION	BY	DATE
G.C.C.	11-5-68	Deck Elev	TEM	5-76
J.L.K.	6-27-75	Deck Elev & Dim.	TEM	9-8-75
V.C.R.	1-20-69	Limit of pavement removal & 1" Longit. joint revised, Det. A removed & Wabo-Maurer joint added	G.B.P.	8-25-75

AS BUILT

RICHMOND METROPOLITAN AUTHORITY
RICHMOND EXPRESSWAY SYSTEM
DOWNTOWN EXPRESSWAY

BRIDGE NO. 65
RAMP S-W CONNECTION FROM
RICHMOND-PETERSBURG TURNPIKE
DECK PLAN UNITS 5, 6 AND 7








HOWARD, NEEDLES, TAMMEN & BERGENDOFF
 consulting engineers
 W. YORK ALEXANDRIA KANSAS CITY

SCALE: As Noted
 CONTRACT NO. 11
 SHEET NO. 26 OF 38




RICHMOND EXPRESSWAY SYSTEM			
SECTION	PROJECT	SHEET NO.	TOTAL SHEETS
11	DOWNTOWN EXPRESSWAY	52	97

* Elev. given along E of joint along lines radial to Ramp S-W

ELEVATION TABLE			
STATION	ELEV. A	ELEV. B	ELEV. C
12+42.33	81.38	80.45	80.31
12+40	*81.53		
12+50	*81.62	80.50	80.36
12+60	*81.72	80.57	80.43
12+70	*81.82	80.68	80.54
12+80	81.72	80.81	80.66
12+90	81.83	80.98	80.83
13+00	82.03	81.17	81.03
13+10	82.26	81.40	81.26
13+20	82.53	81.67	81.52
13+23	82.62	81.75	81.61
13+30	82.80	81.96	81.82
13+40	83.07	82.28	82.15
13+50	83.37	82.64	82.52
13+60	83.67	83.01	82.90
13+70	83.96	83.38	83.29
13+80	84.26	83.76	83.68
13+90	84.56	84.13	84.06
14+00	84.86	84.50	84.44
14+08	85.10	84.80	84.75
14+10	85.16	84.87	84.82
14+20	85.47	85.24	85.20
14+30	85.76	85.62	85.60
14+40	86.06	85.99	85.98
14+50	86.36	86.36	86.36
14+60	86.71	86.72	86.79
14+70	87.03	87.05	87.19
14+80	87.32	87.35	87.57
14+90	87.57	87.62	87.91
14+95	87.69	87.74	88.08

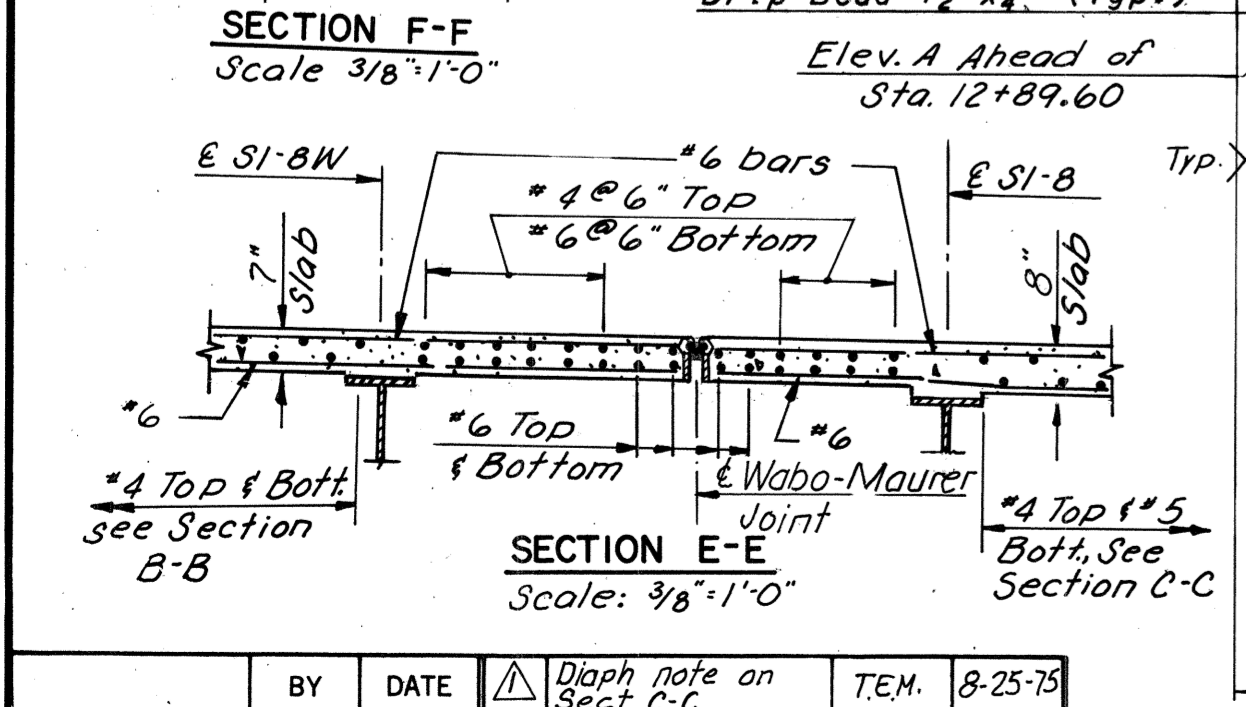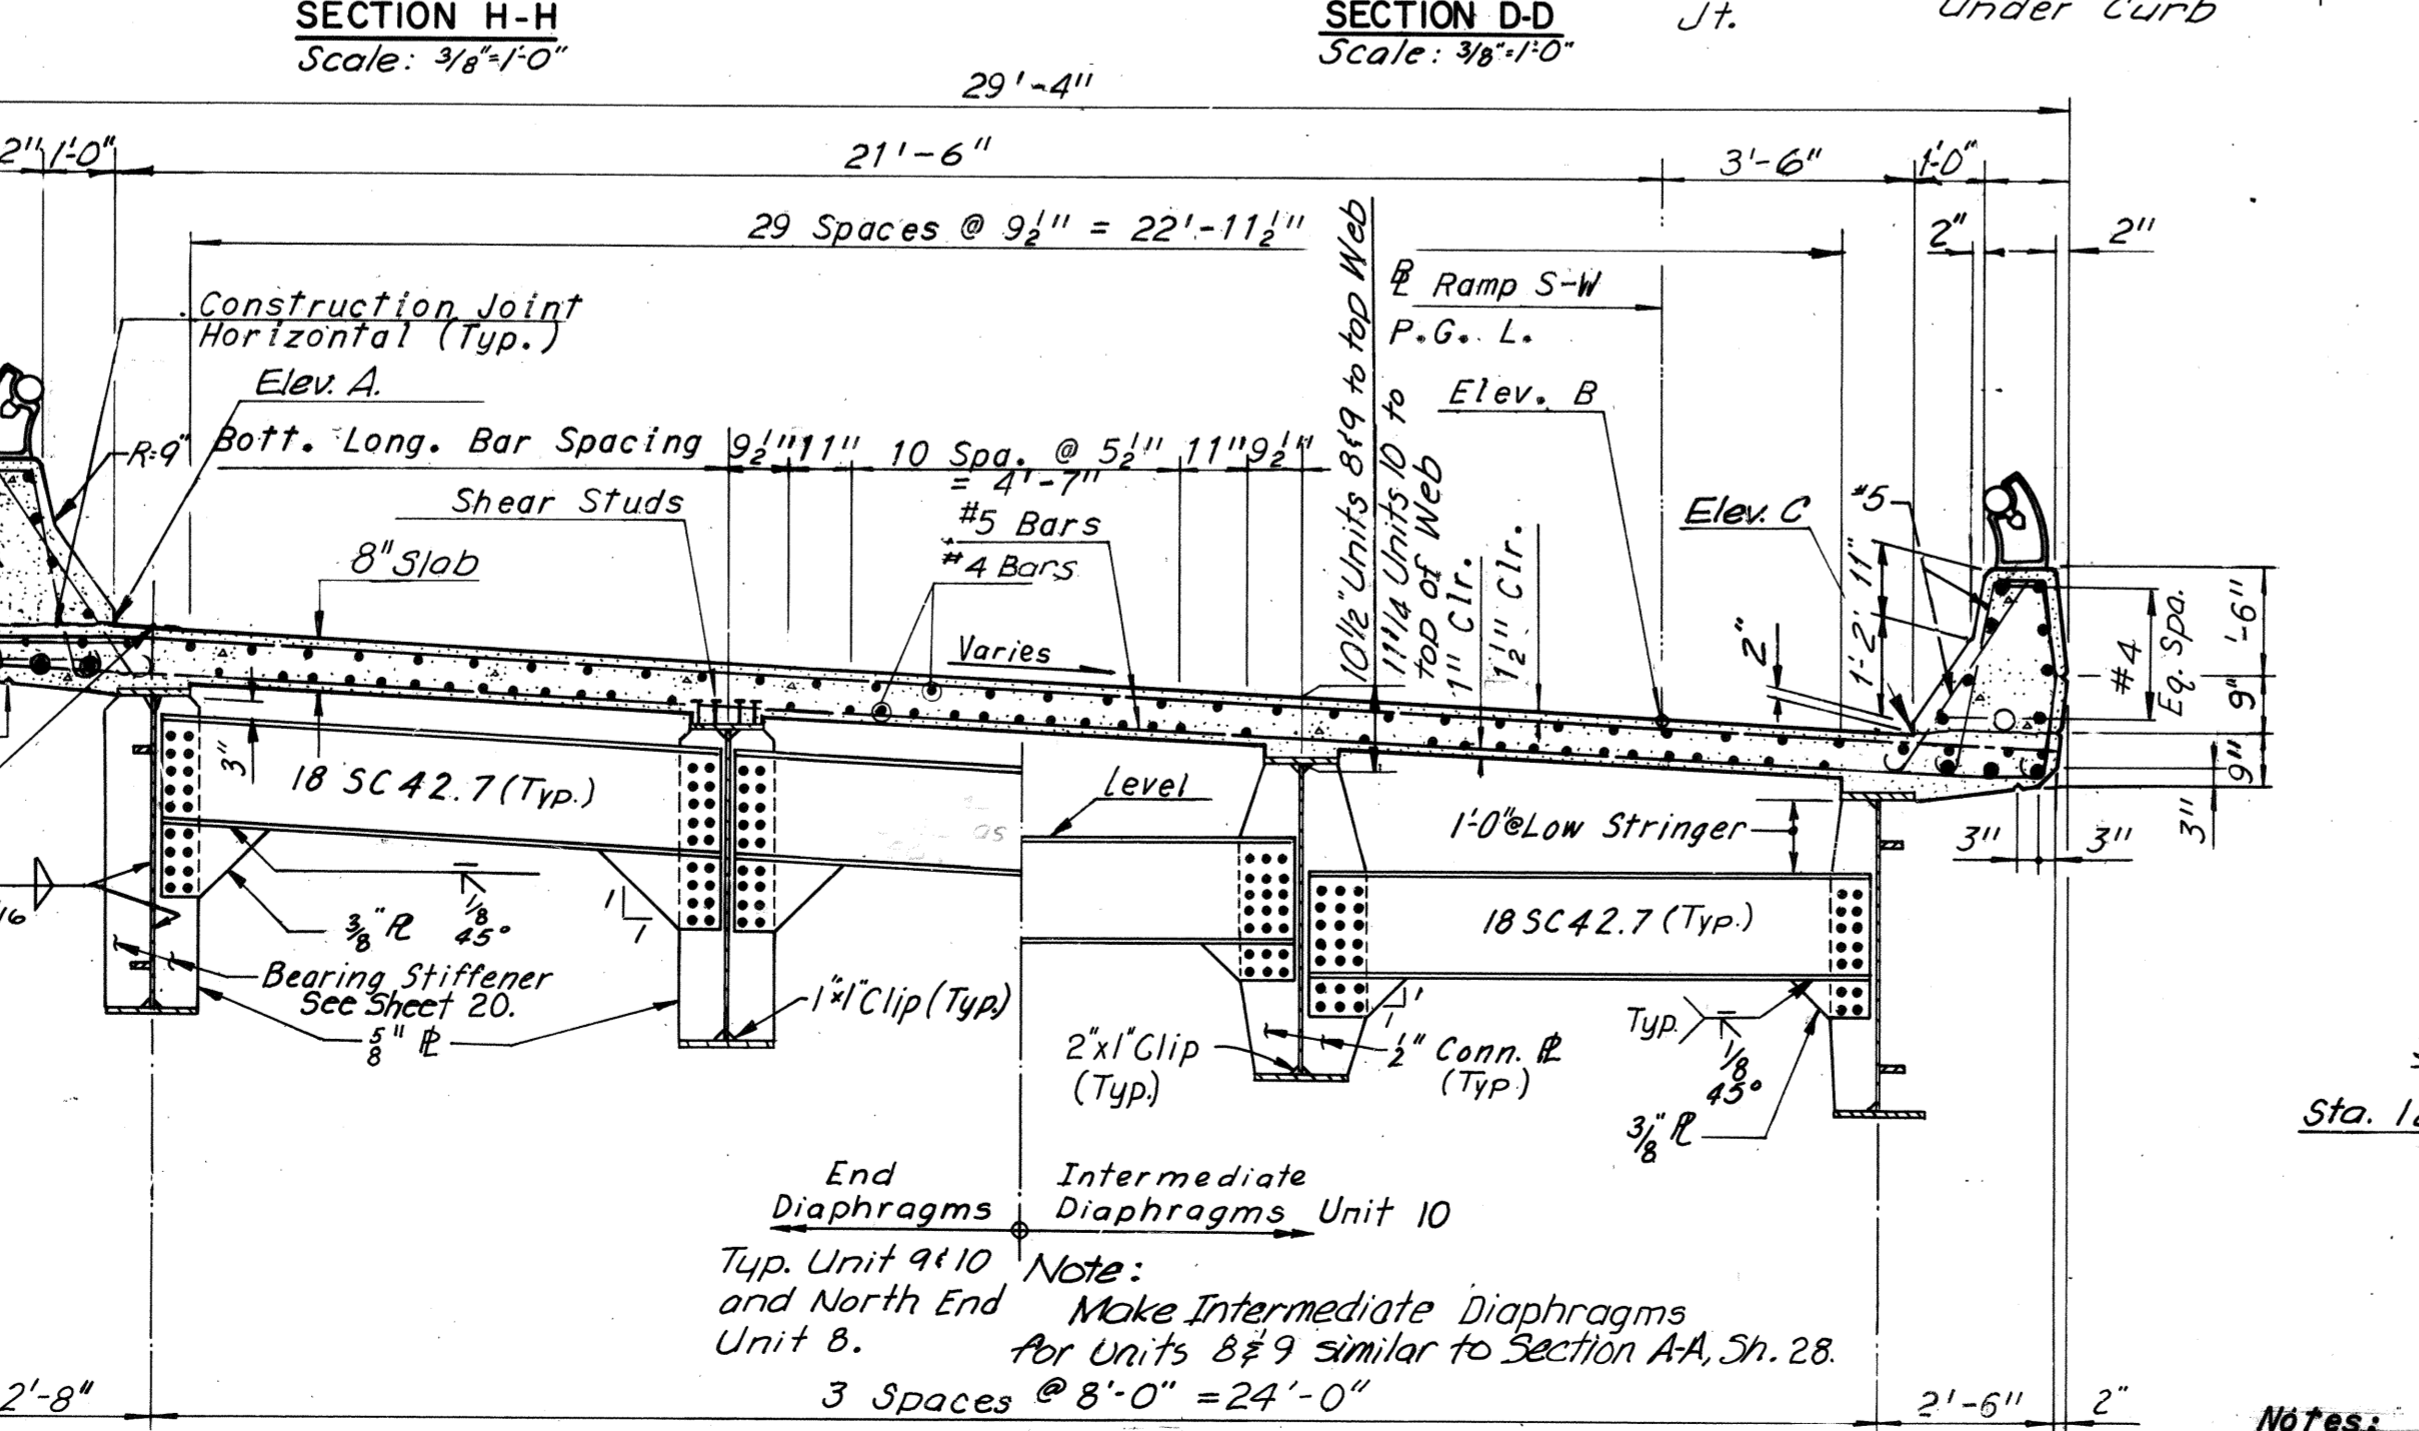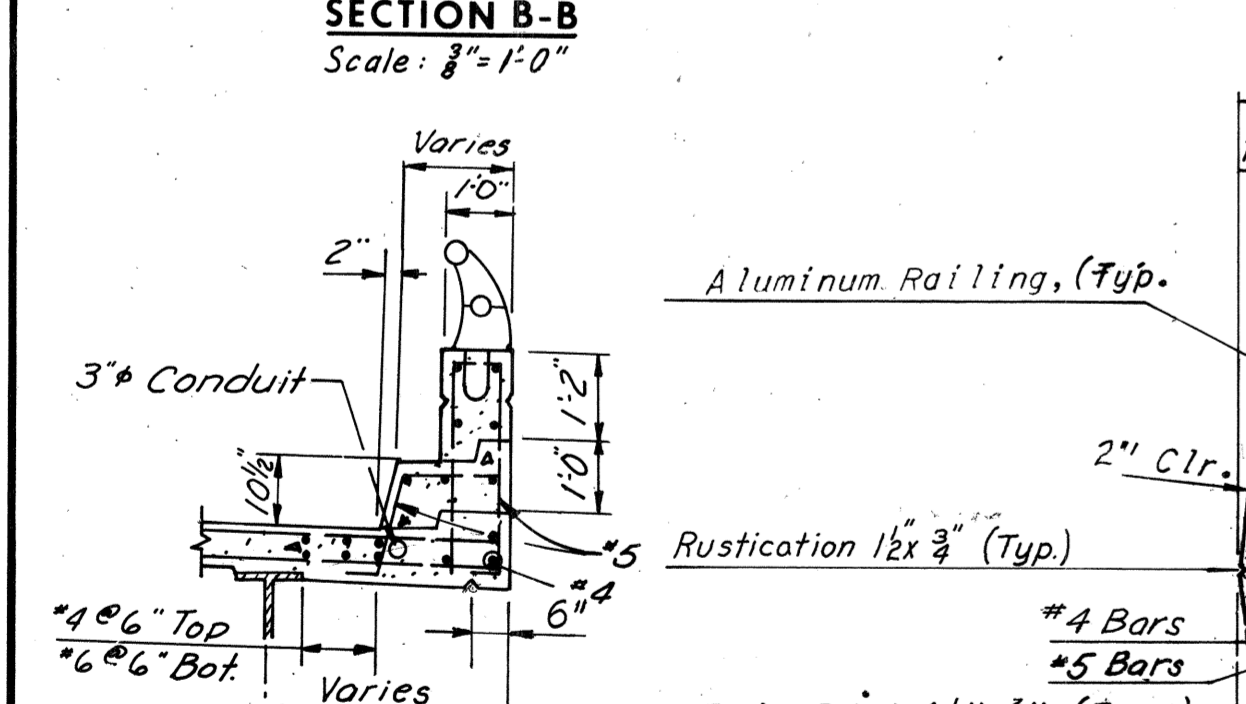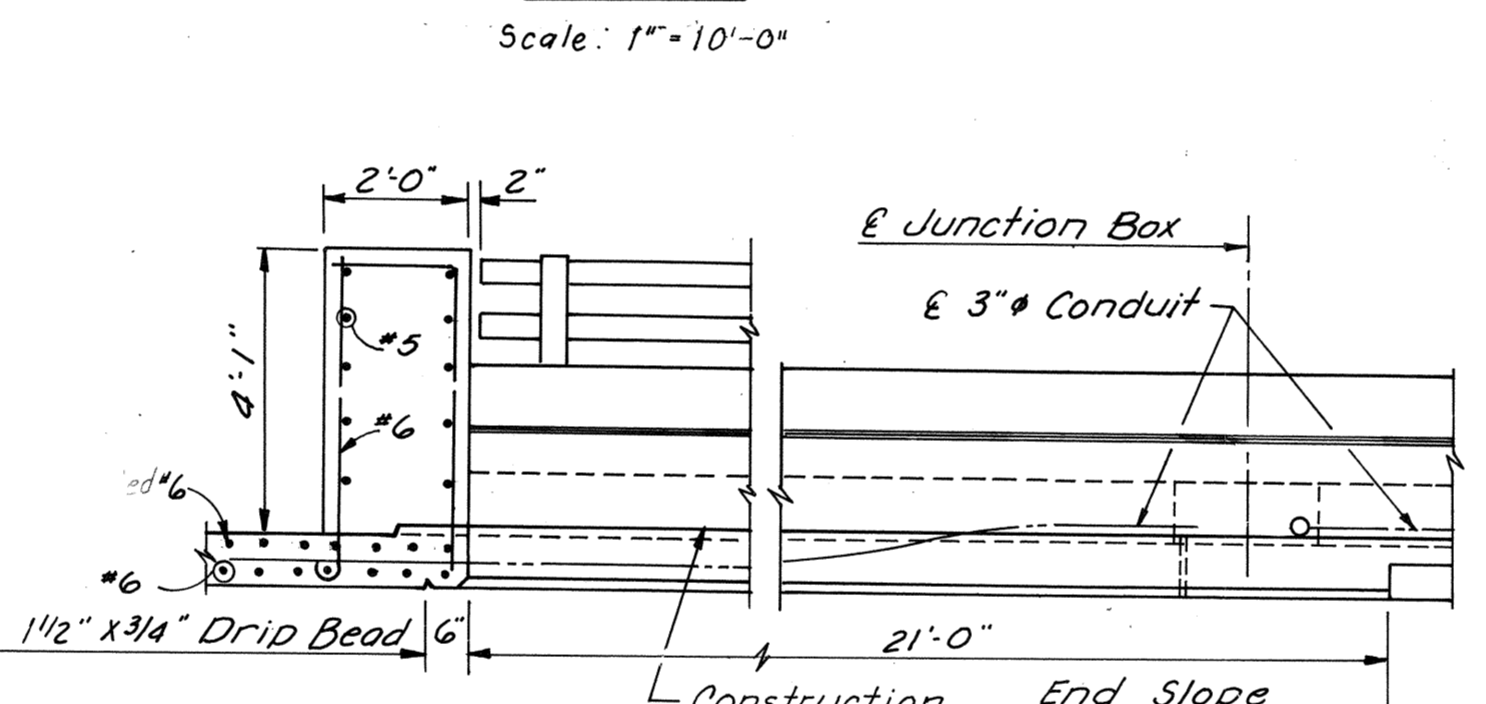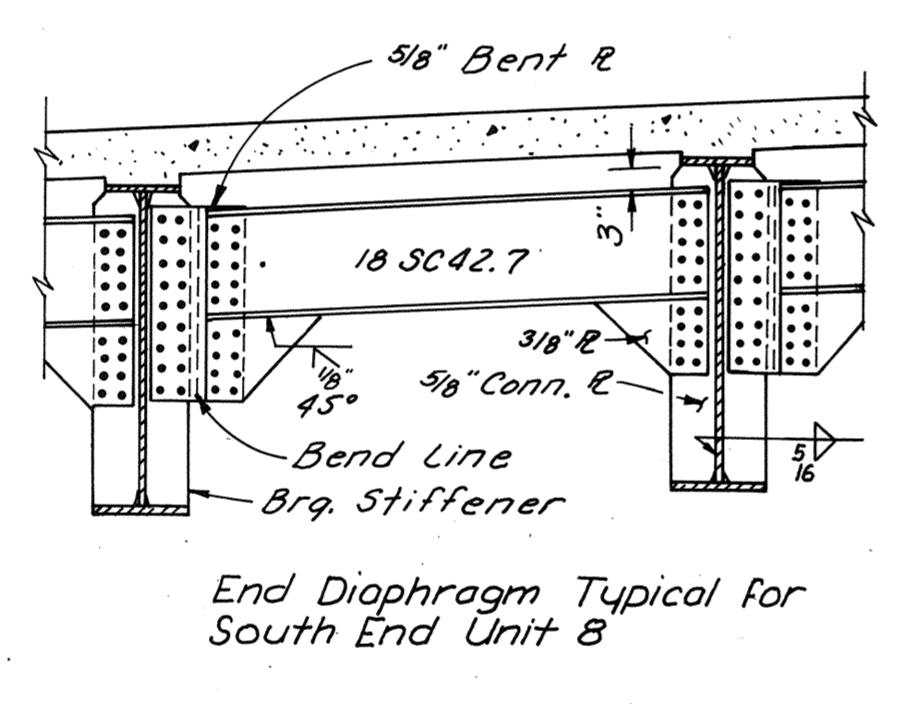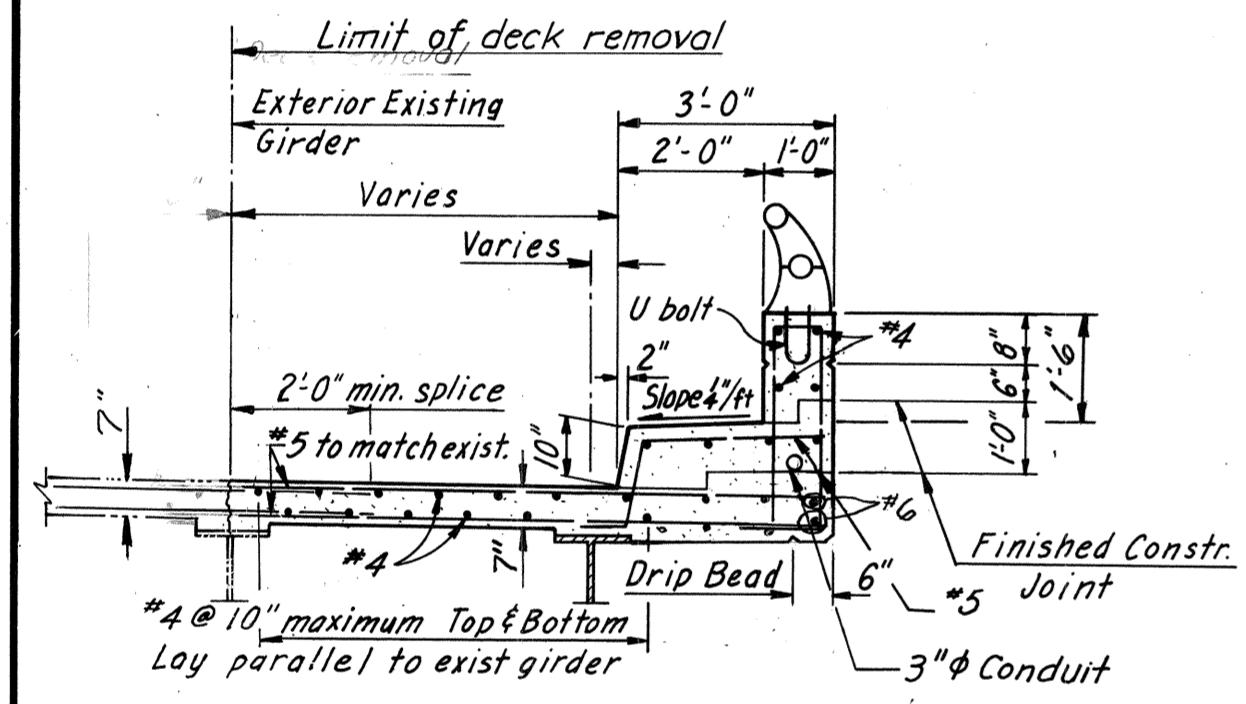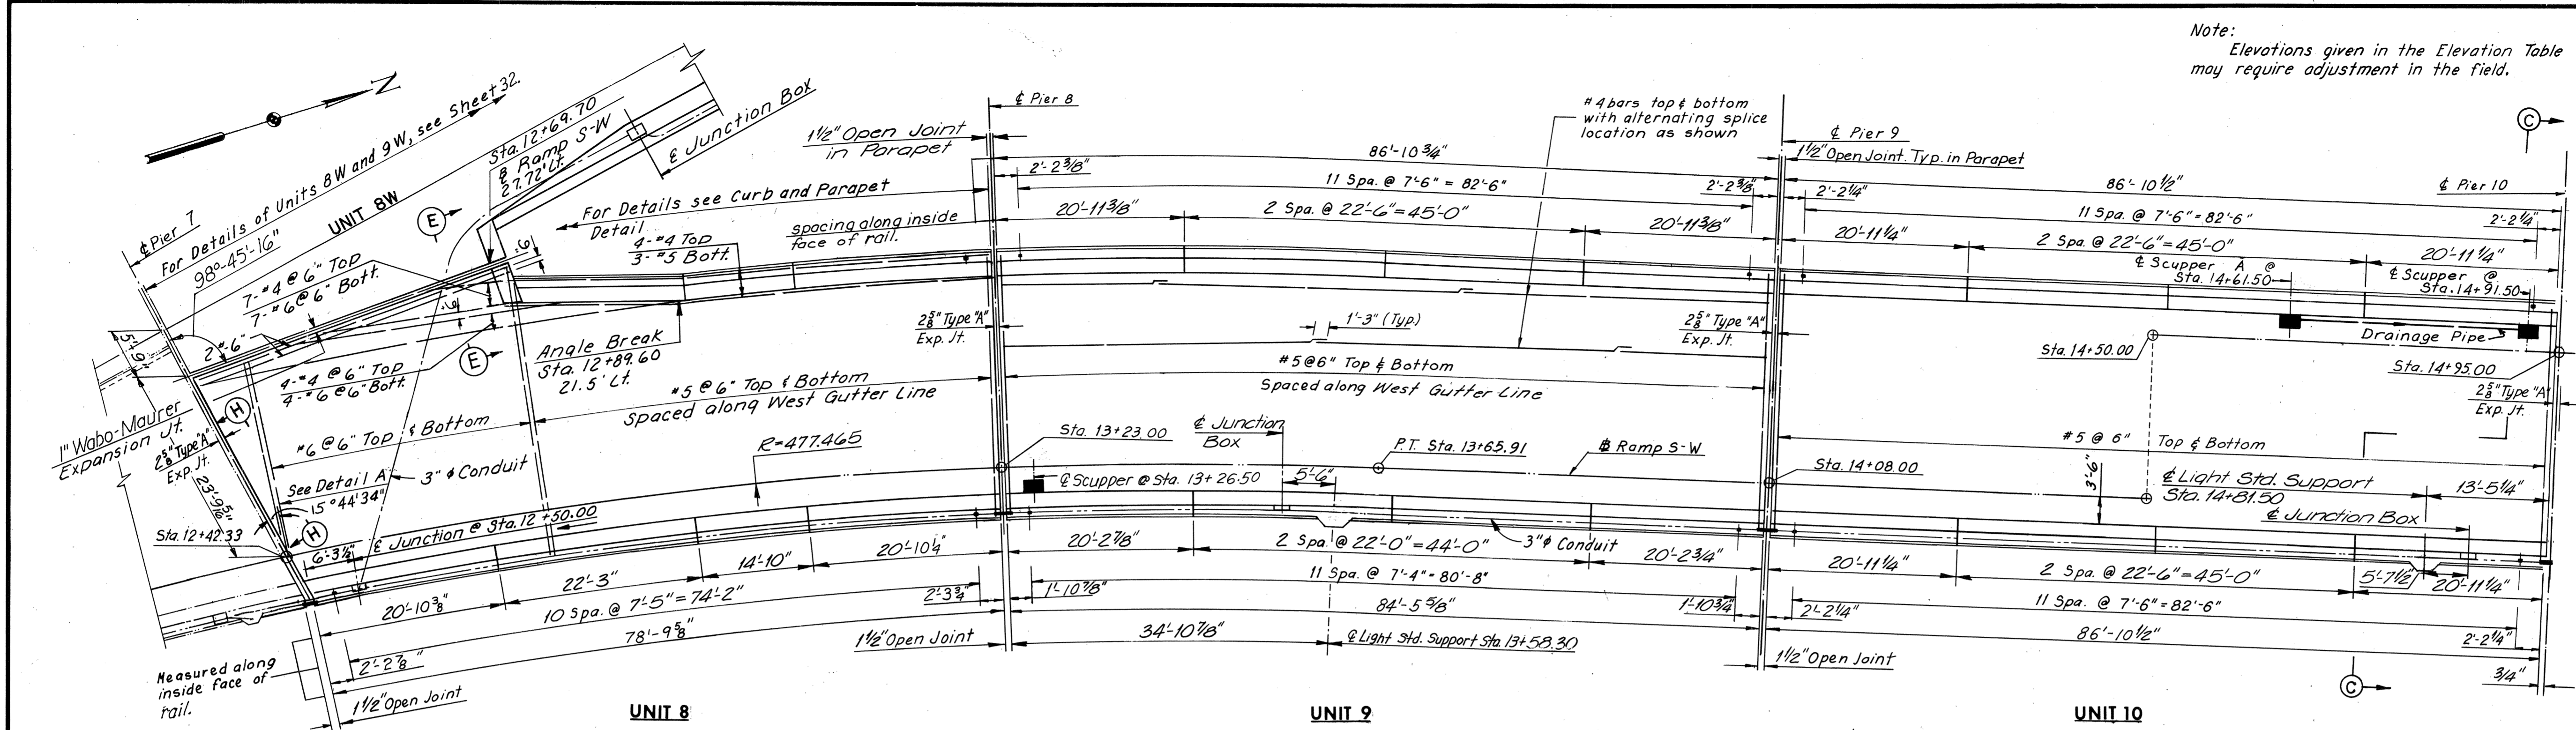

NO.	REVISION	BY	DATE
1	Diaph note on Sect C-C	TEM	8-25-75
2	Limit of slab removal, joint, slab thickness & #6 bundled bars rev.	A.B.P.	8-25-75

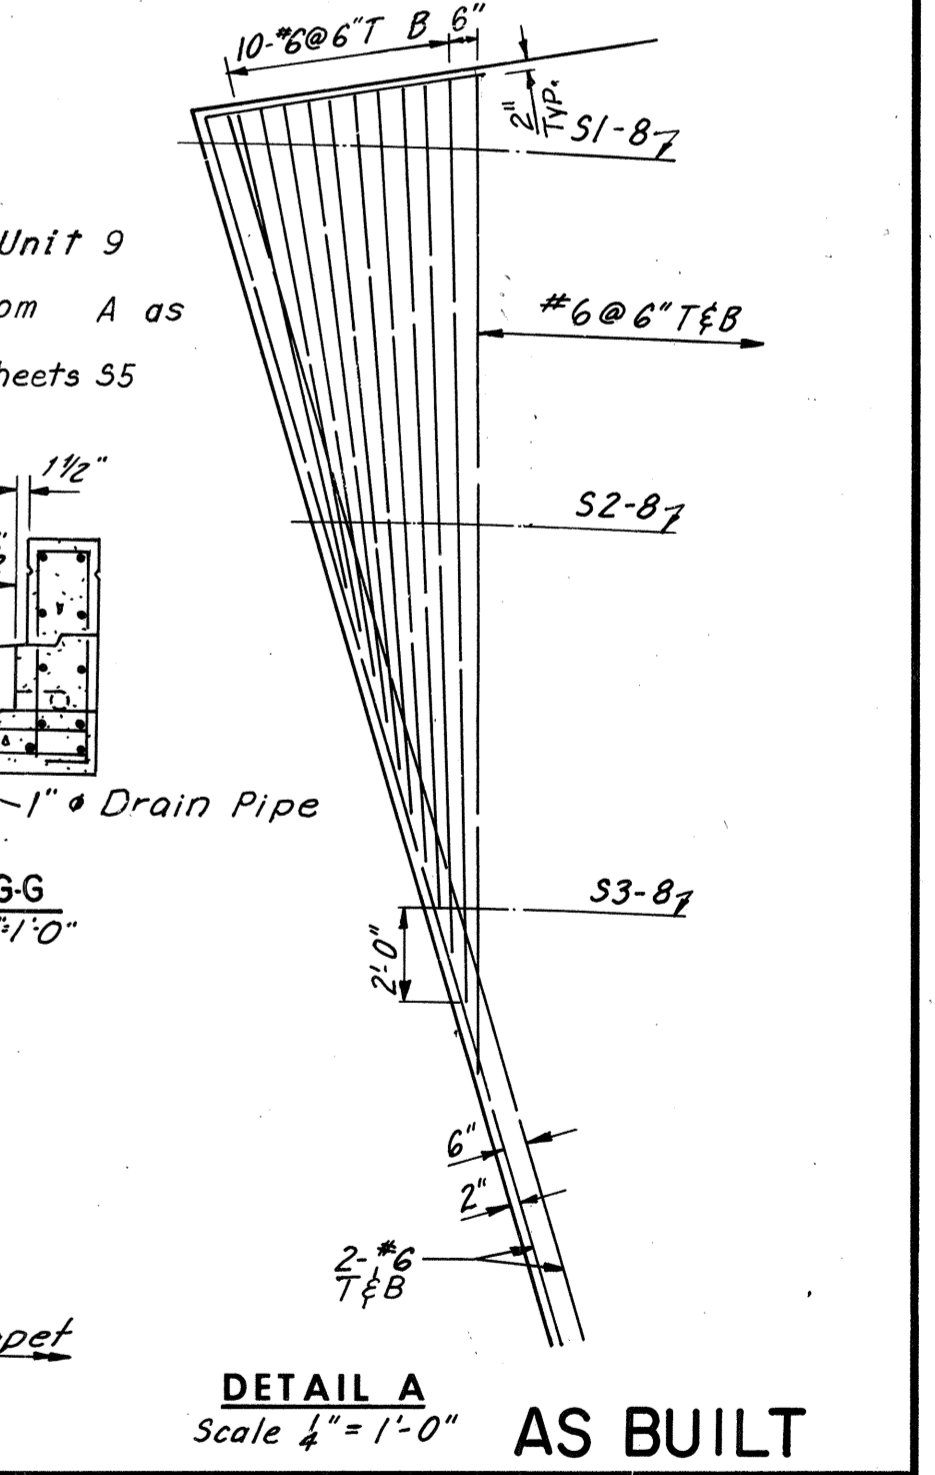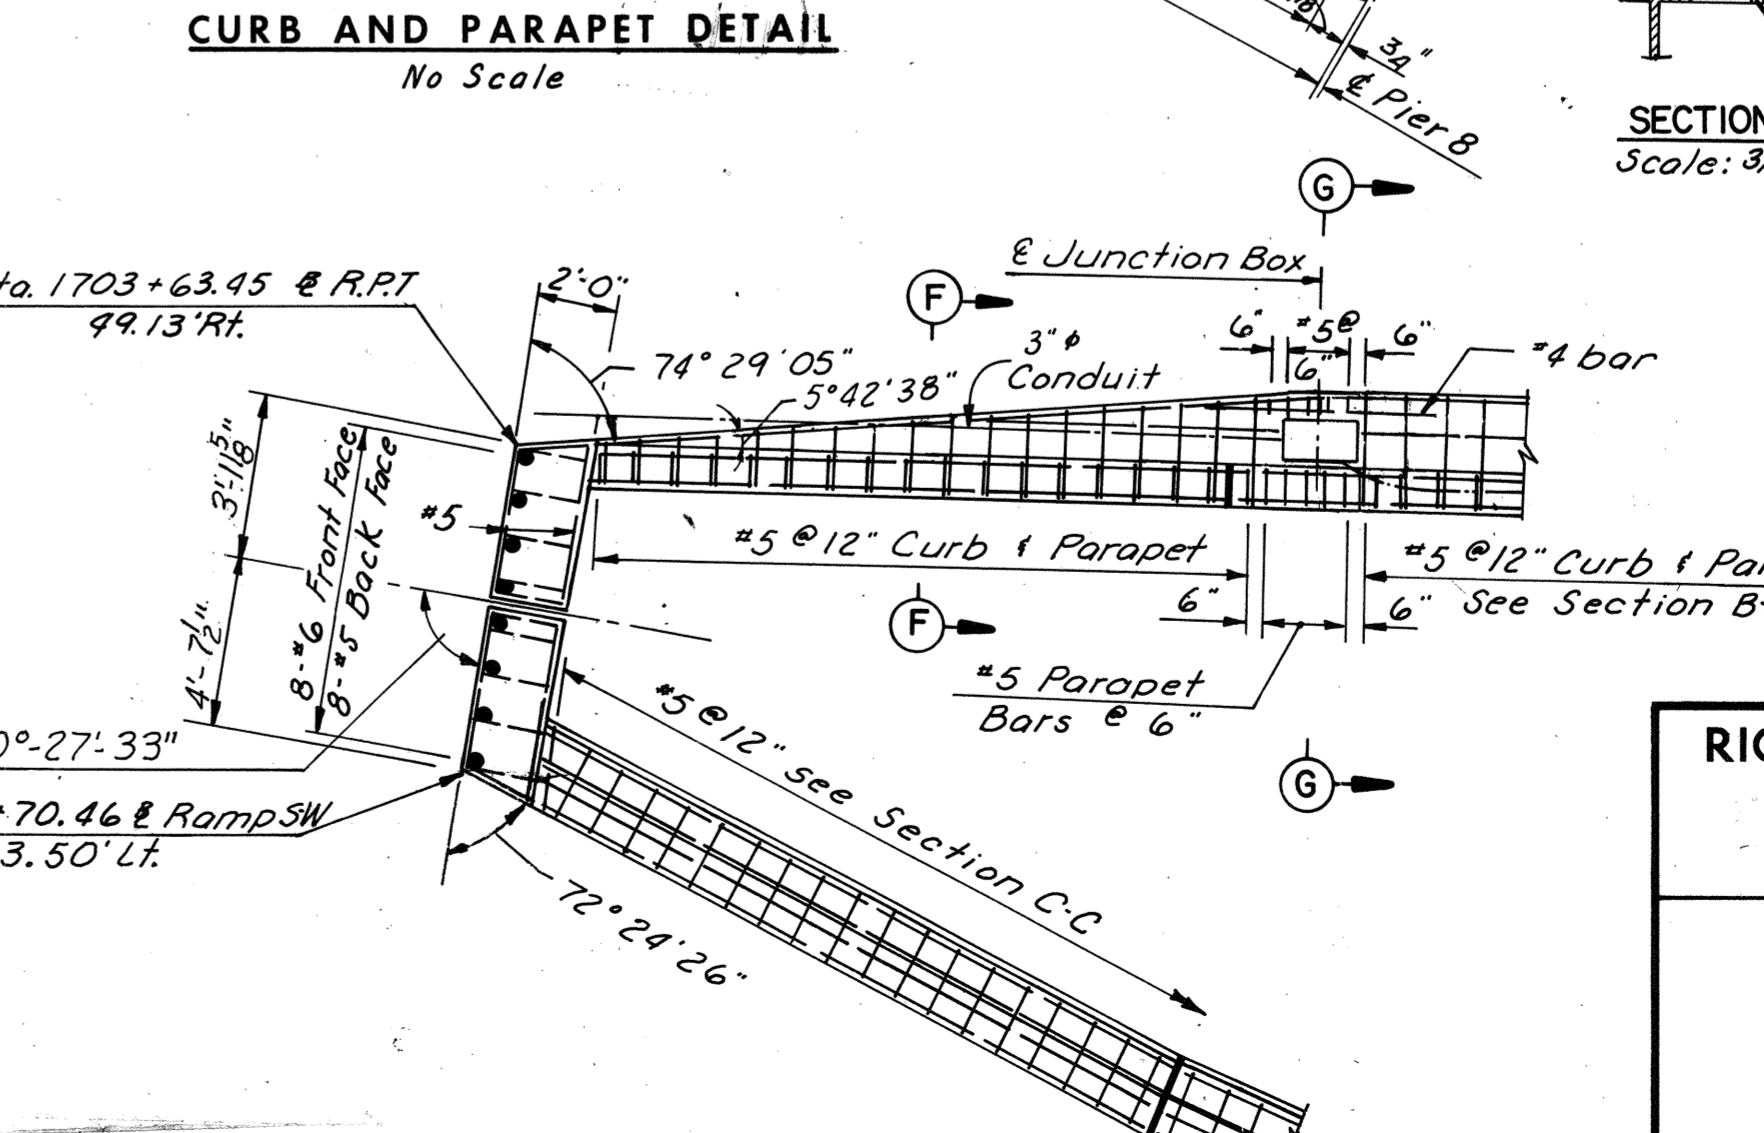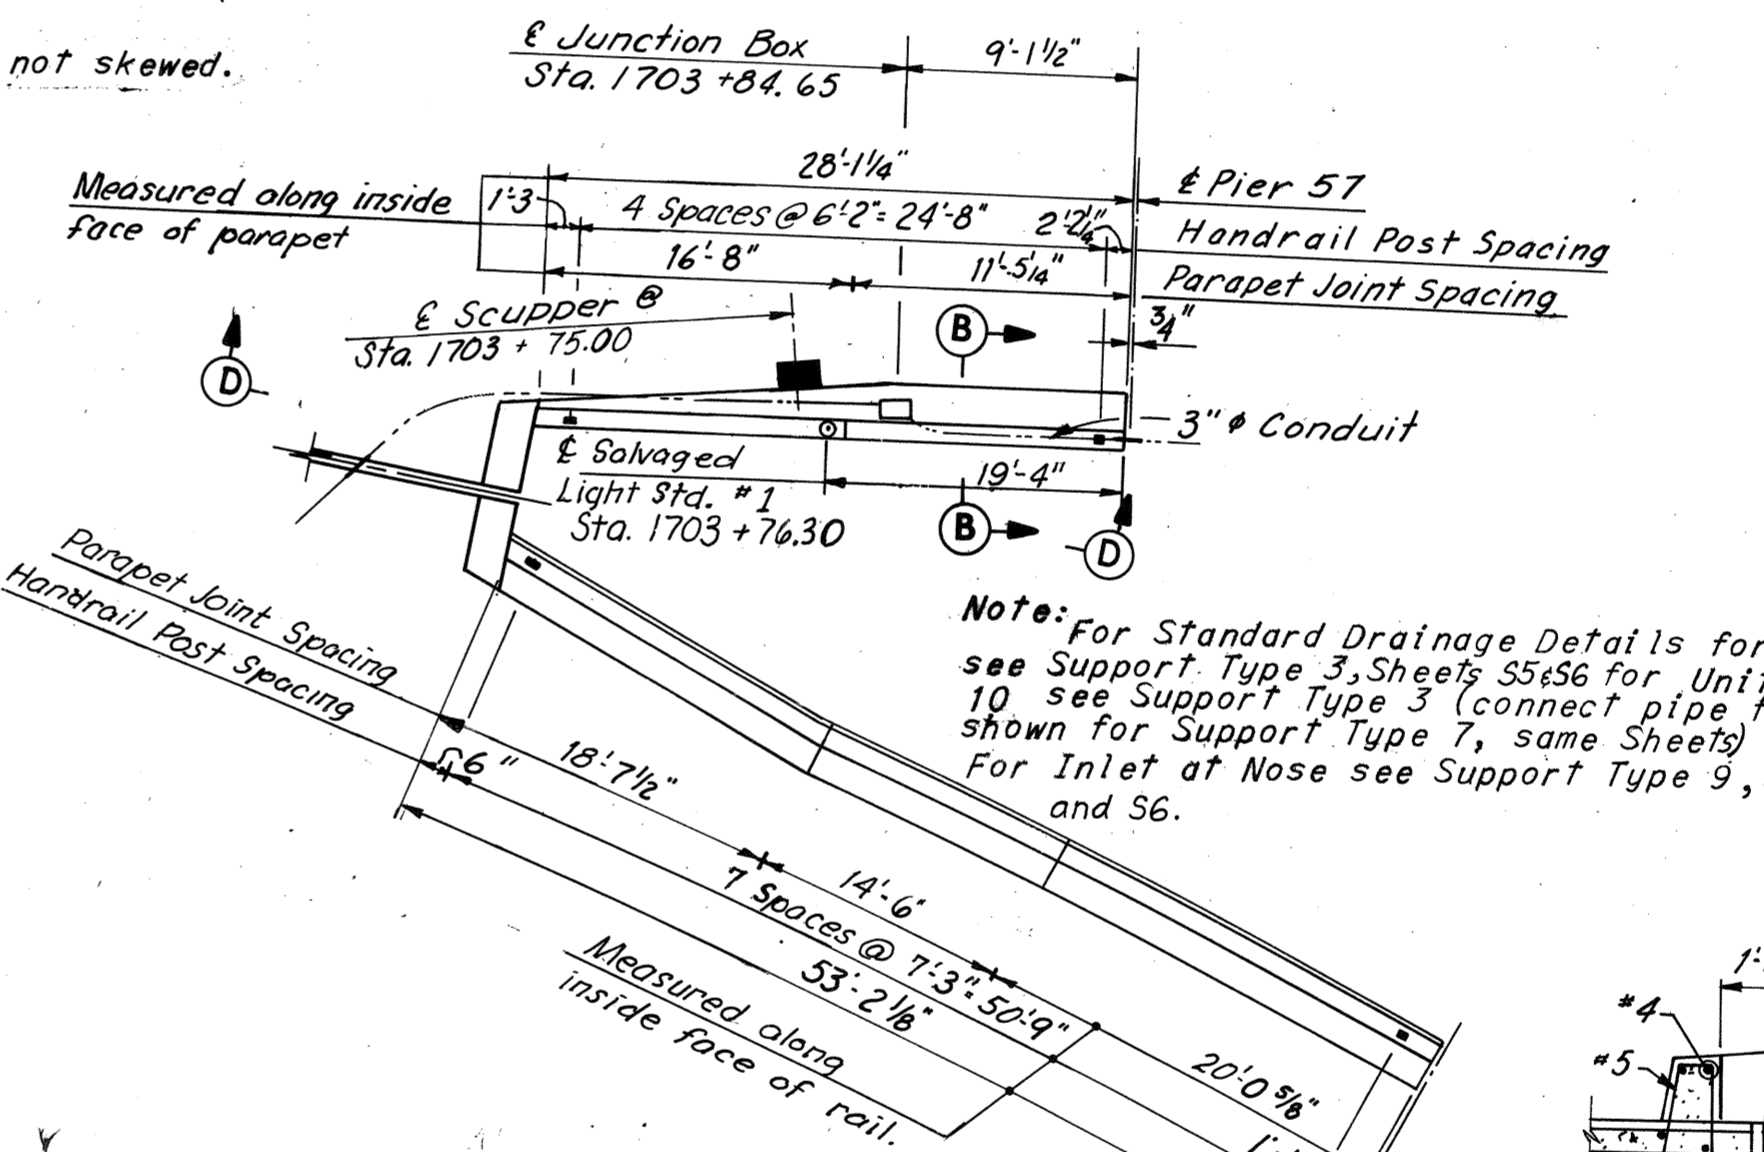

BY	DATE	REVISION	BY	DATE
MADE	C.E.B.	1-30-69		
CHECKED	R.C.	4-22-69		
IN CHARGE				

NO.	REVISION	BY	DATE
1	Section B-B	TEM	11-76
2	Joint Location	PRY	10-76
3	Deck Elev.	TEM	9-8-75

Notes:
 For Framing Plan see Sheet 20.
 For Joint Details, see Sheet 34 & 35.
 For Quantities see Sheet 4.
 For Handrail Details, see Sheet 33.


RICHMOND METROPOLITAN AUTHORITY
RICHMOND EXPRESSWAY SYSTEM
DOWNTOWN EXPRESSWAY

BRIDGE NO. 65
RAMP S-W CONNECTION FROM
RICHMOND-PETERSBURG TURNPIKE
DECK PLAN UNITS 8.9 AND 10


HOWARD, NEEDLES, TAMMEN & BERGENDOFF
 Consulting Engineers
 NEW YORK ALEXANDRIA KANSAS CITY

SCALE: As Noted
 CONTRACT NO. 11
 SHEET NO. 27 of 38

RICHMOND EXPRESSWAY SYSTEM			
SECTION	PROJECT	SHEET NO.	TOTAL SHEETS
11	DOWNTOWN EXPRESSWAY	53	97

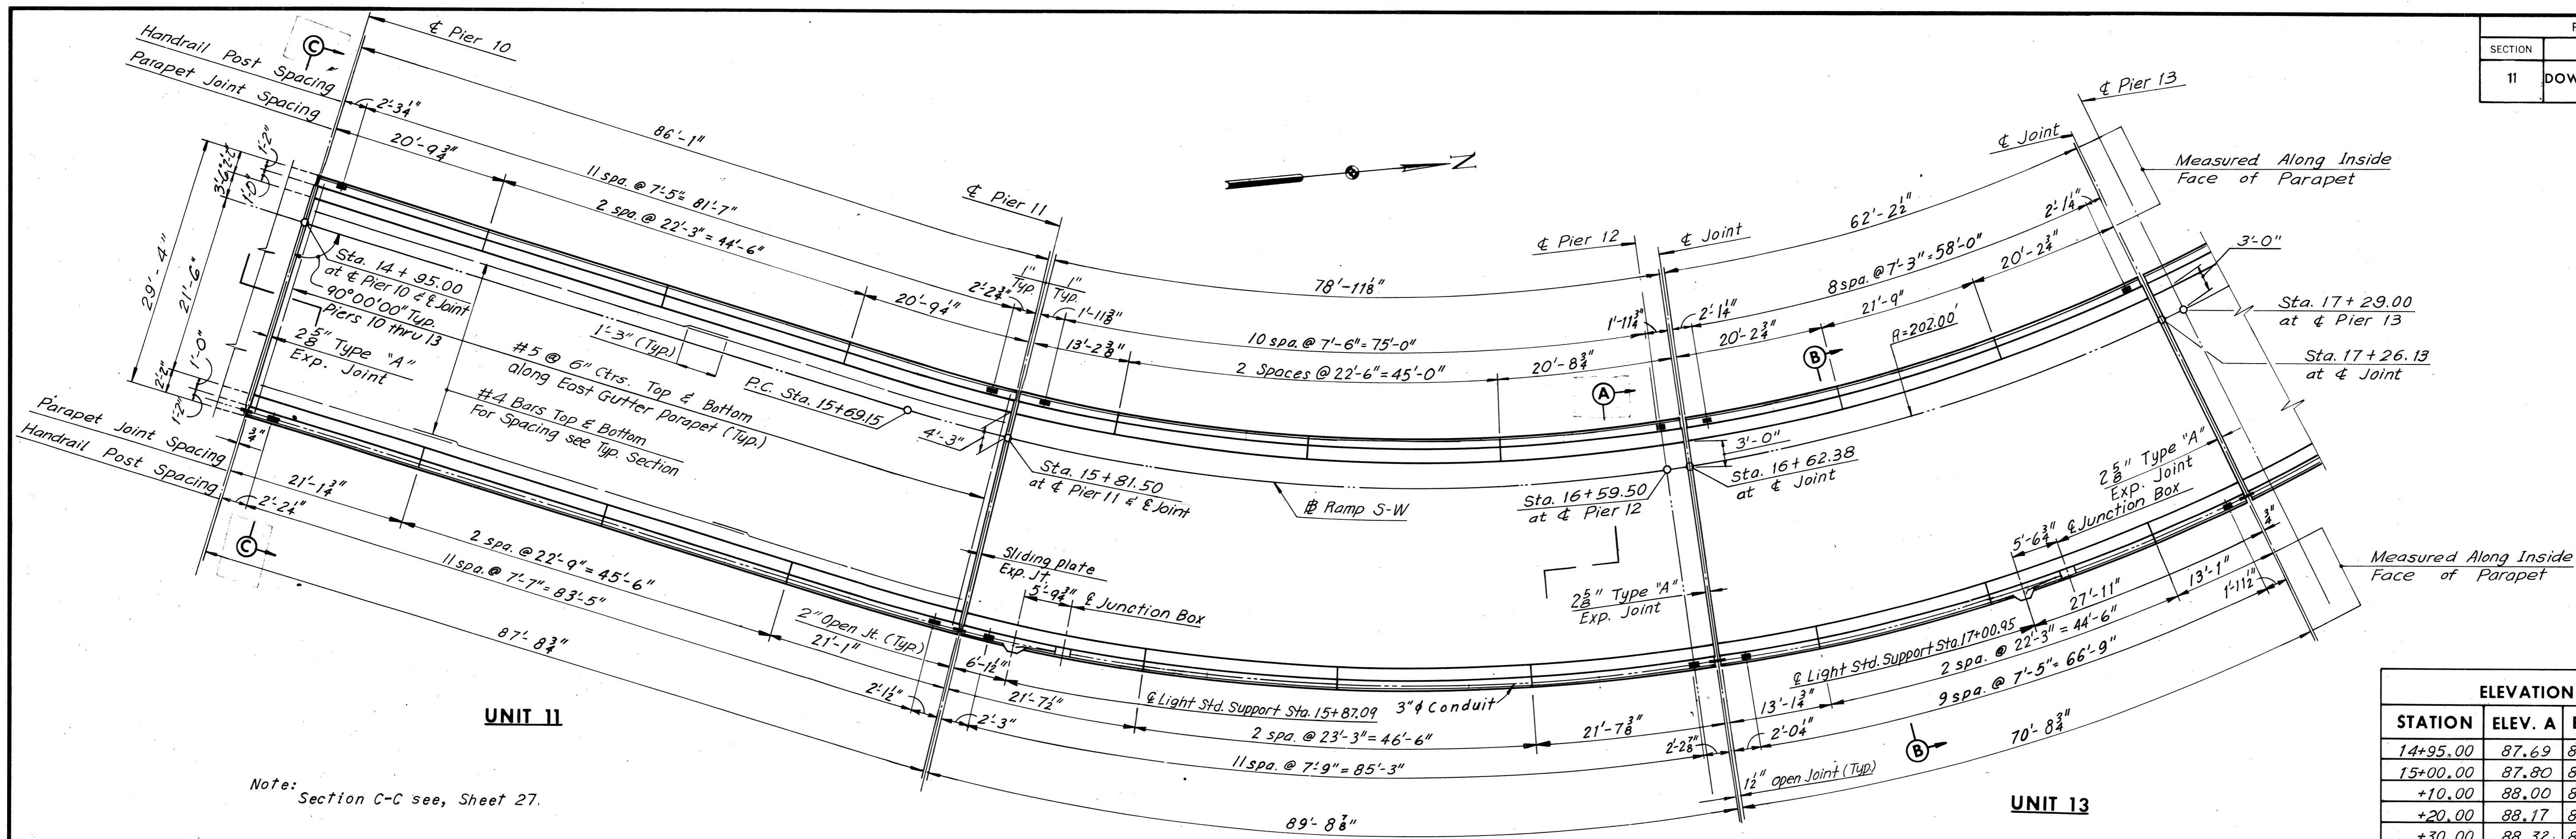

ELEVATION TABLE			
STATION	ELEV. A	ELEV. B	ELEV. C
14+95.00	87.69	87.74	88.07
15+00.00	87.80	87.86	88.23
+10.00	88.00	88.07	88.51
+20.00	88.17	88.26	88.77
+30.00	88.32	88.41	89.00
+40.00	88.42	88.54	89.20
+50.00	88.51	88.63	89.37
+60.00	88.57	88.70	89.51
+70.00	88.60	88.74	89.63
+80.00	88.60	88.75	89.71
+81.50	88.60	88.75	89.72
+90.00	88.57	88.73	89.76
16+00.00	88.50	88.69	89.80
+10.00	88.42	88.61	89.79
+20.00	88.31	88.51	89.73
+30.00	88.17	88.37	89.63
+40.00	88.00	88.21	89.49
+50.00	87.81	88.02	89.31
+59.50		87.81	
+60.00	87.59	87.80	89.09
+62.38	87.53	87.74	89.03
+70.00	87.34	87.55	88.84
+80.00	87.06	87.27	88.56
+90.00	86.75	86.96	88.26
17+00.00	86.41	86.62	87.91
+10.00	86.05	86.26	87.55
+20.00	85.65	85.86	87.15
+26.12	85.40	85.61	86.90
+29.00		85.49	

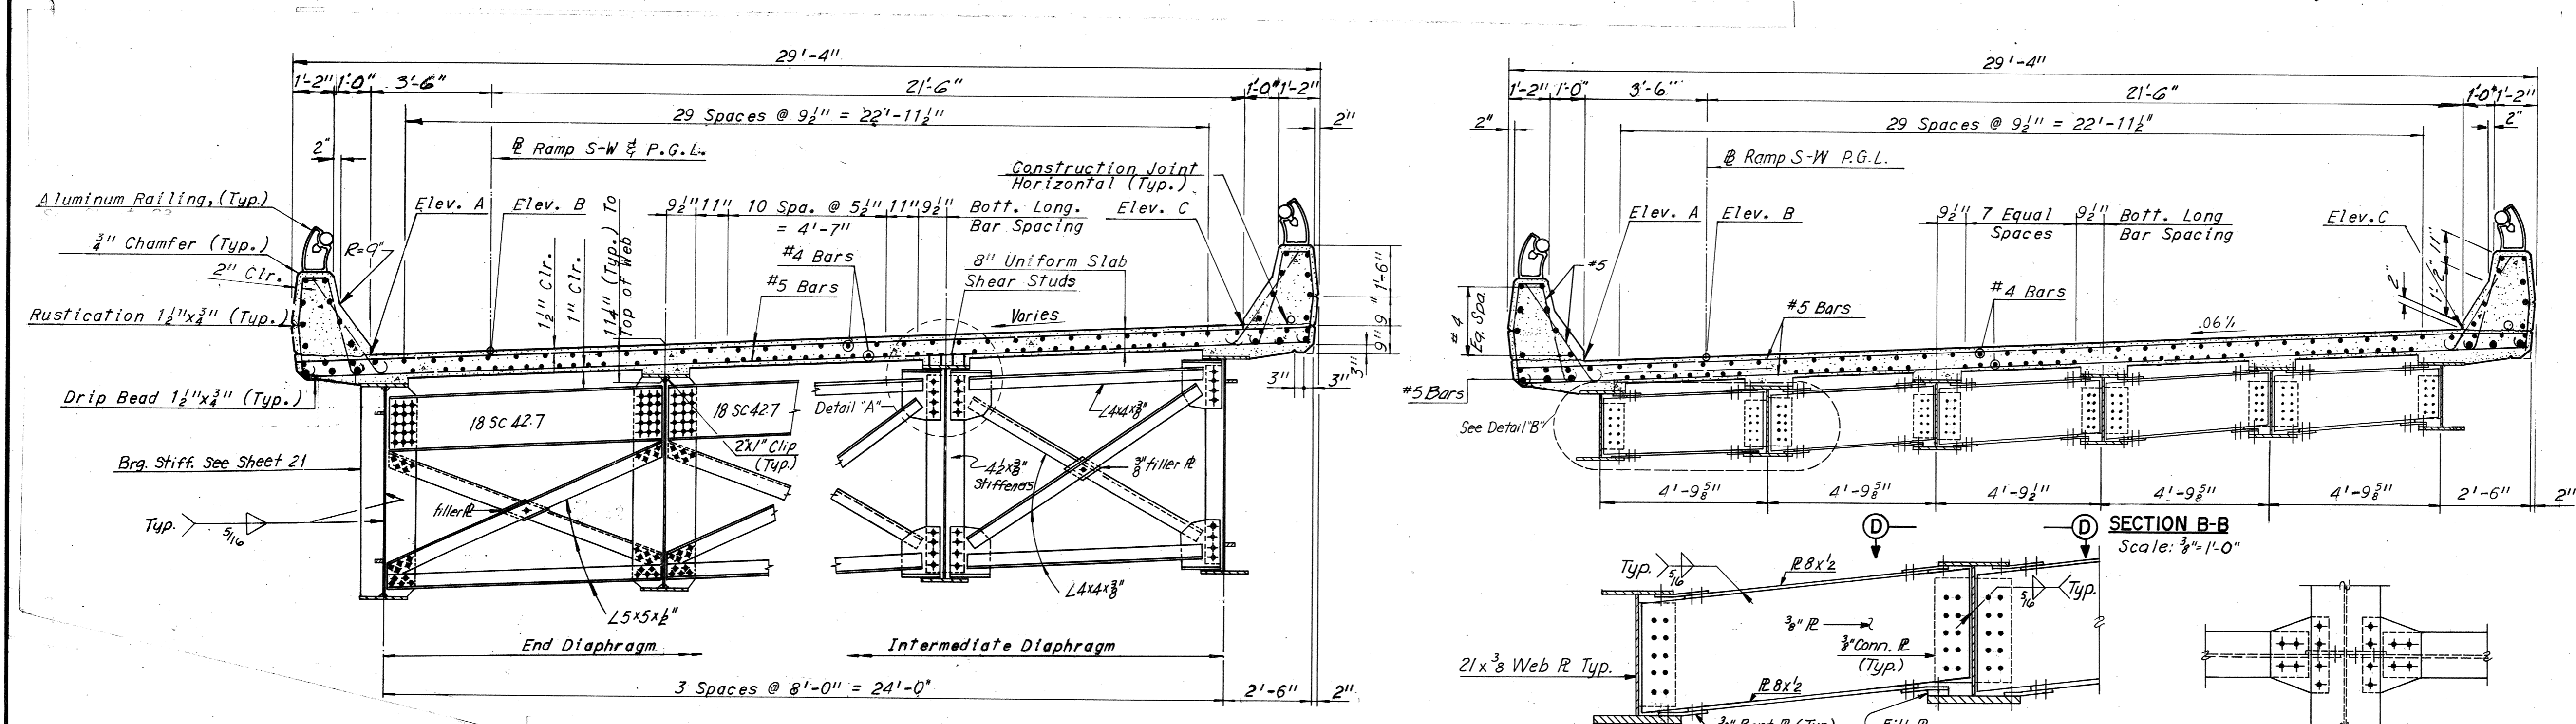

BY	DATE			
MADE	SCC	10-31-68		
CHECKED	G.S.H.	1-14-69	Detail B & View D-D revised	A.B.P. 8-25-76
IN CHARGE				

RICHMOND METROPOLITAN AUTHORITY
RICHMOND EXPRESSWAY SYSTEM
DOWNTOWN EXPRESSWAY

BRIDGE NO. 65
RAMP S-W CONNECTION FROM
RICHMOND-PETERSBURG TURNPIKE
DECK PLAN UNITS 11 12 AND 13



HOWARD, NEEDLES, TAMMEN & BERGENDOFF
 consulting engineers
 NEW YORK ALEXANDRIA KANSAS CITY

SCALE: _____
 CONTRACT NO. 11
 SHEET NO. 28 OF 38

AS BUILT


RICHMOND EXPRESSWAY SYSTEM			
SECTION	PROJECT	SHEET NO.	TOTAL SHEETS
11	DOWNTOWN EXPRESSWAY	54	97

ELEVATION TABLE			
STATION	ELEV. A	ELEV. B	ELEV. C
17+29.00	85.28	85.49	86.78
+30.00	85.23	85.44	86.73
+40.00	84.78	84.99	86.28
+50.00	84.30	84.51	85.80
+60.00	83.74	84.00	85.29
+70.00	83.25	83.46	84.75
+80.00	82.68	82.89	84.18
+90.00	82.09	82.30	83.59
+98.50	81.56	81.77	83.06
18+00.00	81.46	81.67	82.96
+10.00	80.82	81.03	82.82
+20.00	80.18	80.39	81.68
+30.00	79.54	79.75	81.04
+40.00	78.90	79.11	80.40
+50.00	78.26	78.47	79.74
+60.00	77.62	77.83	79.12
+68.00	77.11	77.32	78.61
+70.00	76.98	77.19	78.48
+80.00	76.36	76.57	77.86
+90.00	75.75	75.96	77.25
19+00.00	75.12	75.33	76.62
19+10.00	74.52	74.72	75.93
19+20.00	73.93	74.12	75.24
19+30.00	73.37	73.54	74.57
19+37.50	72.98	73.13	74.09

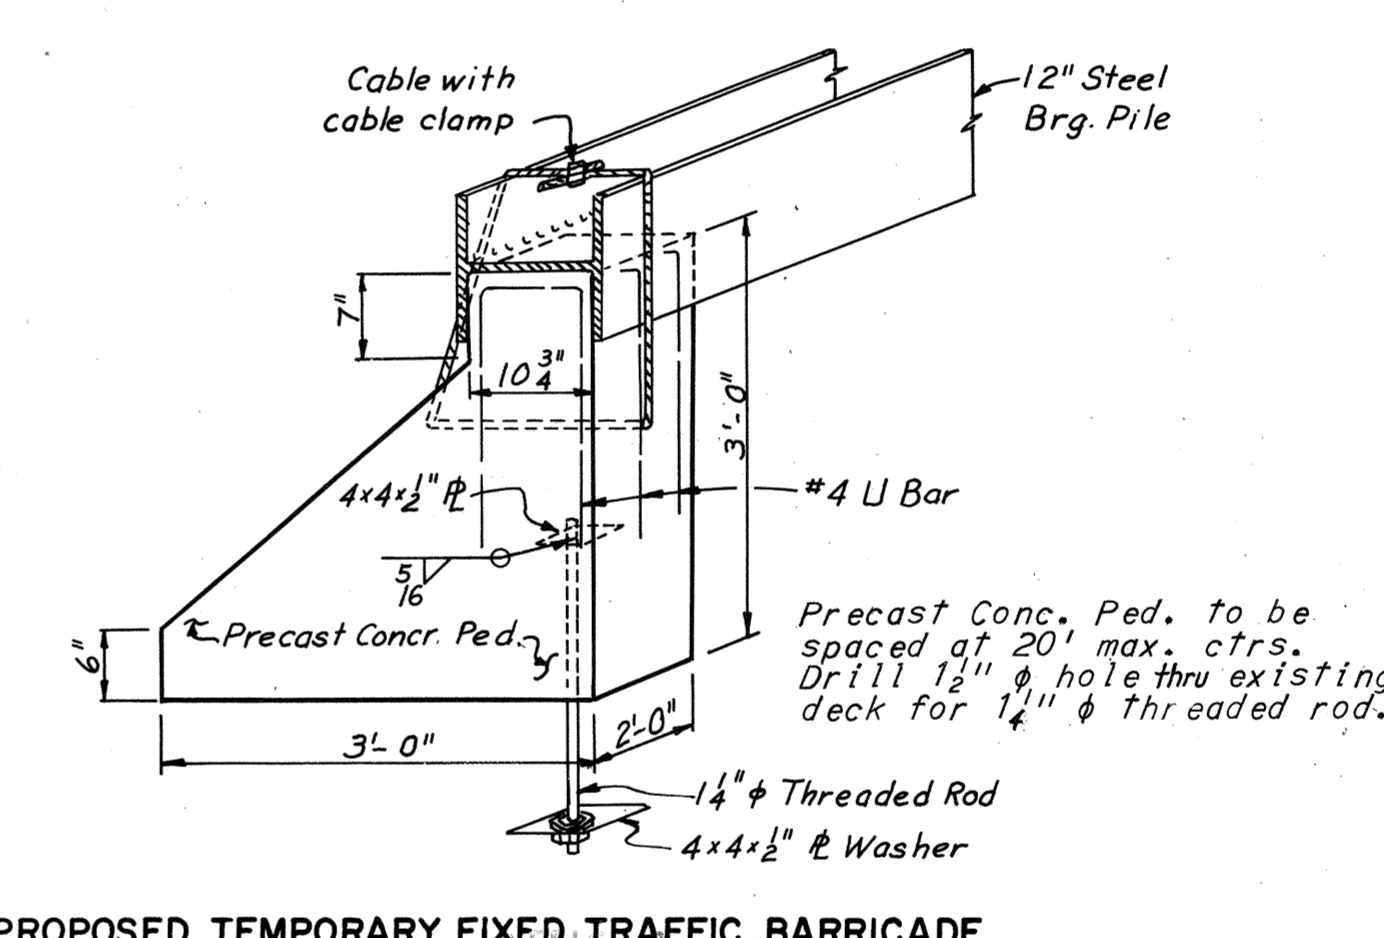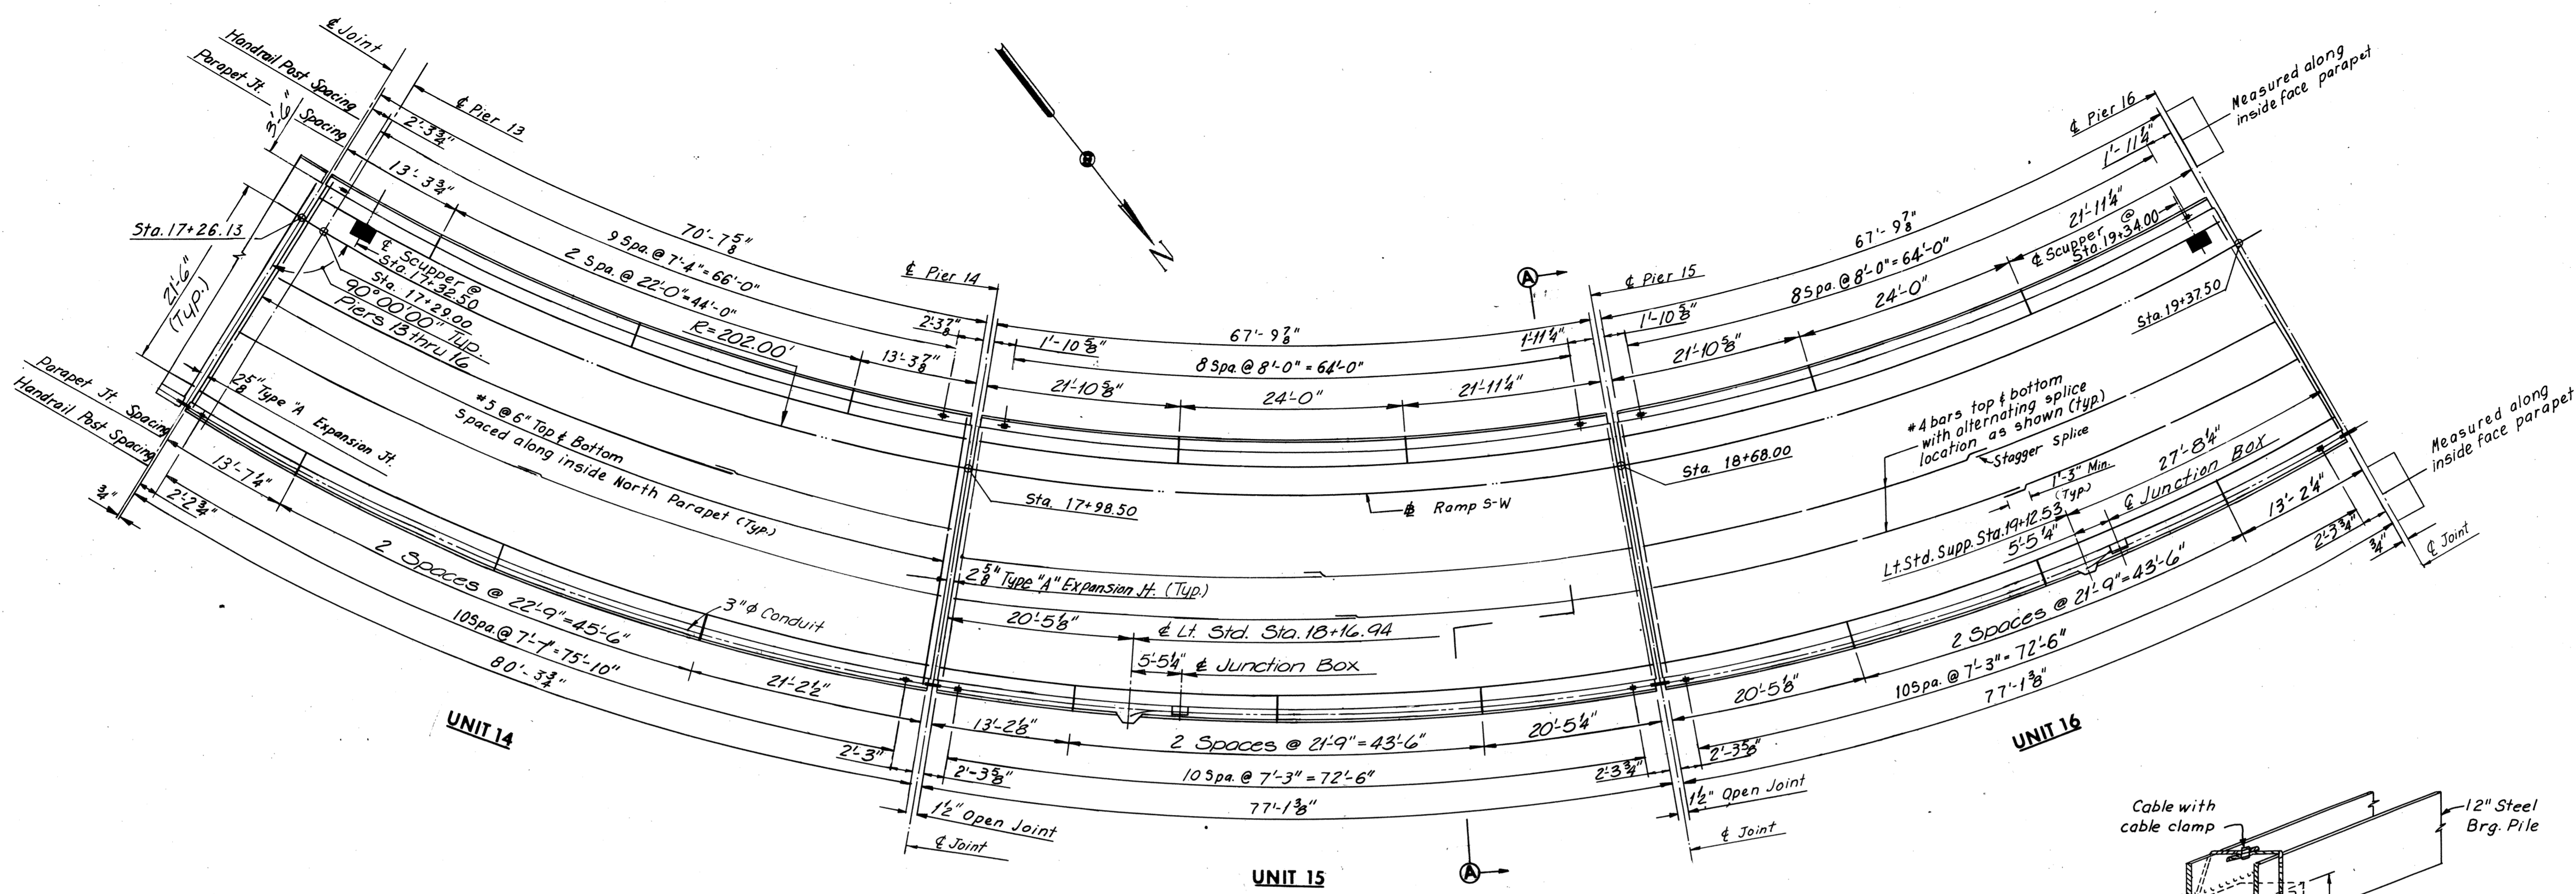

Notes:
 For Framing Plan see Sheet 22
 For Joint Details, see Sheet 34 & 35
 For Quantities see Sheet 4
 For Handrail Details, see Sheet S3.

Note: For Standard Drainage Details for Units 14 and 16, see Support Type 3 Sheets S5 & S6.

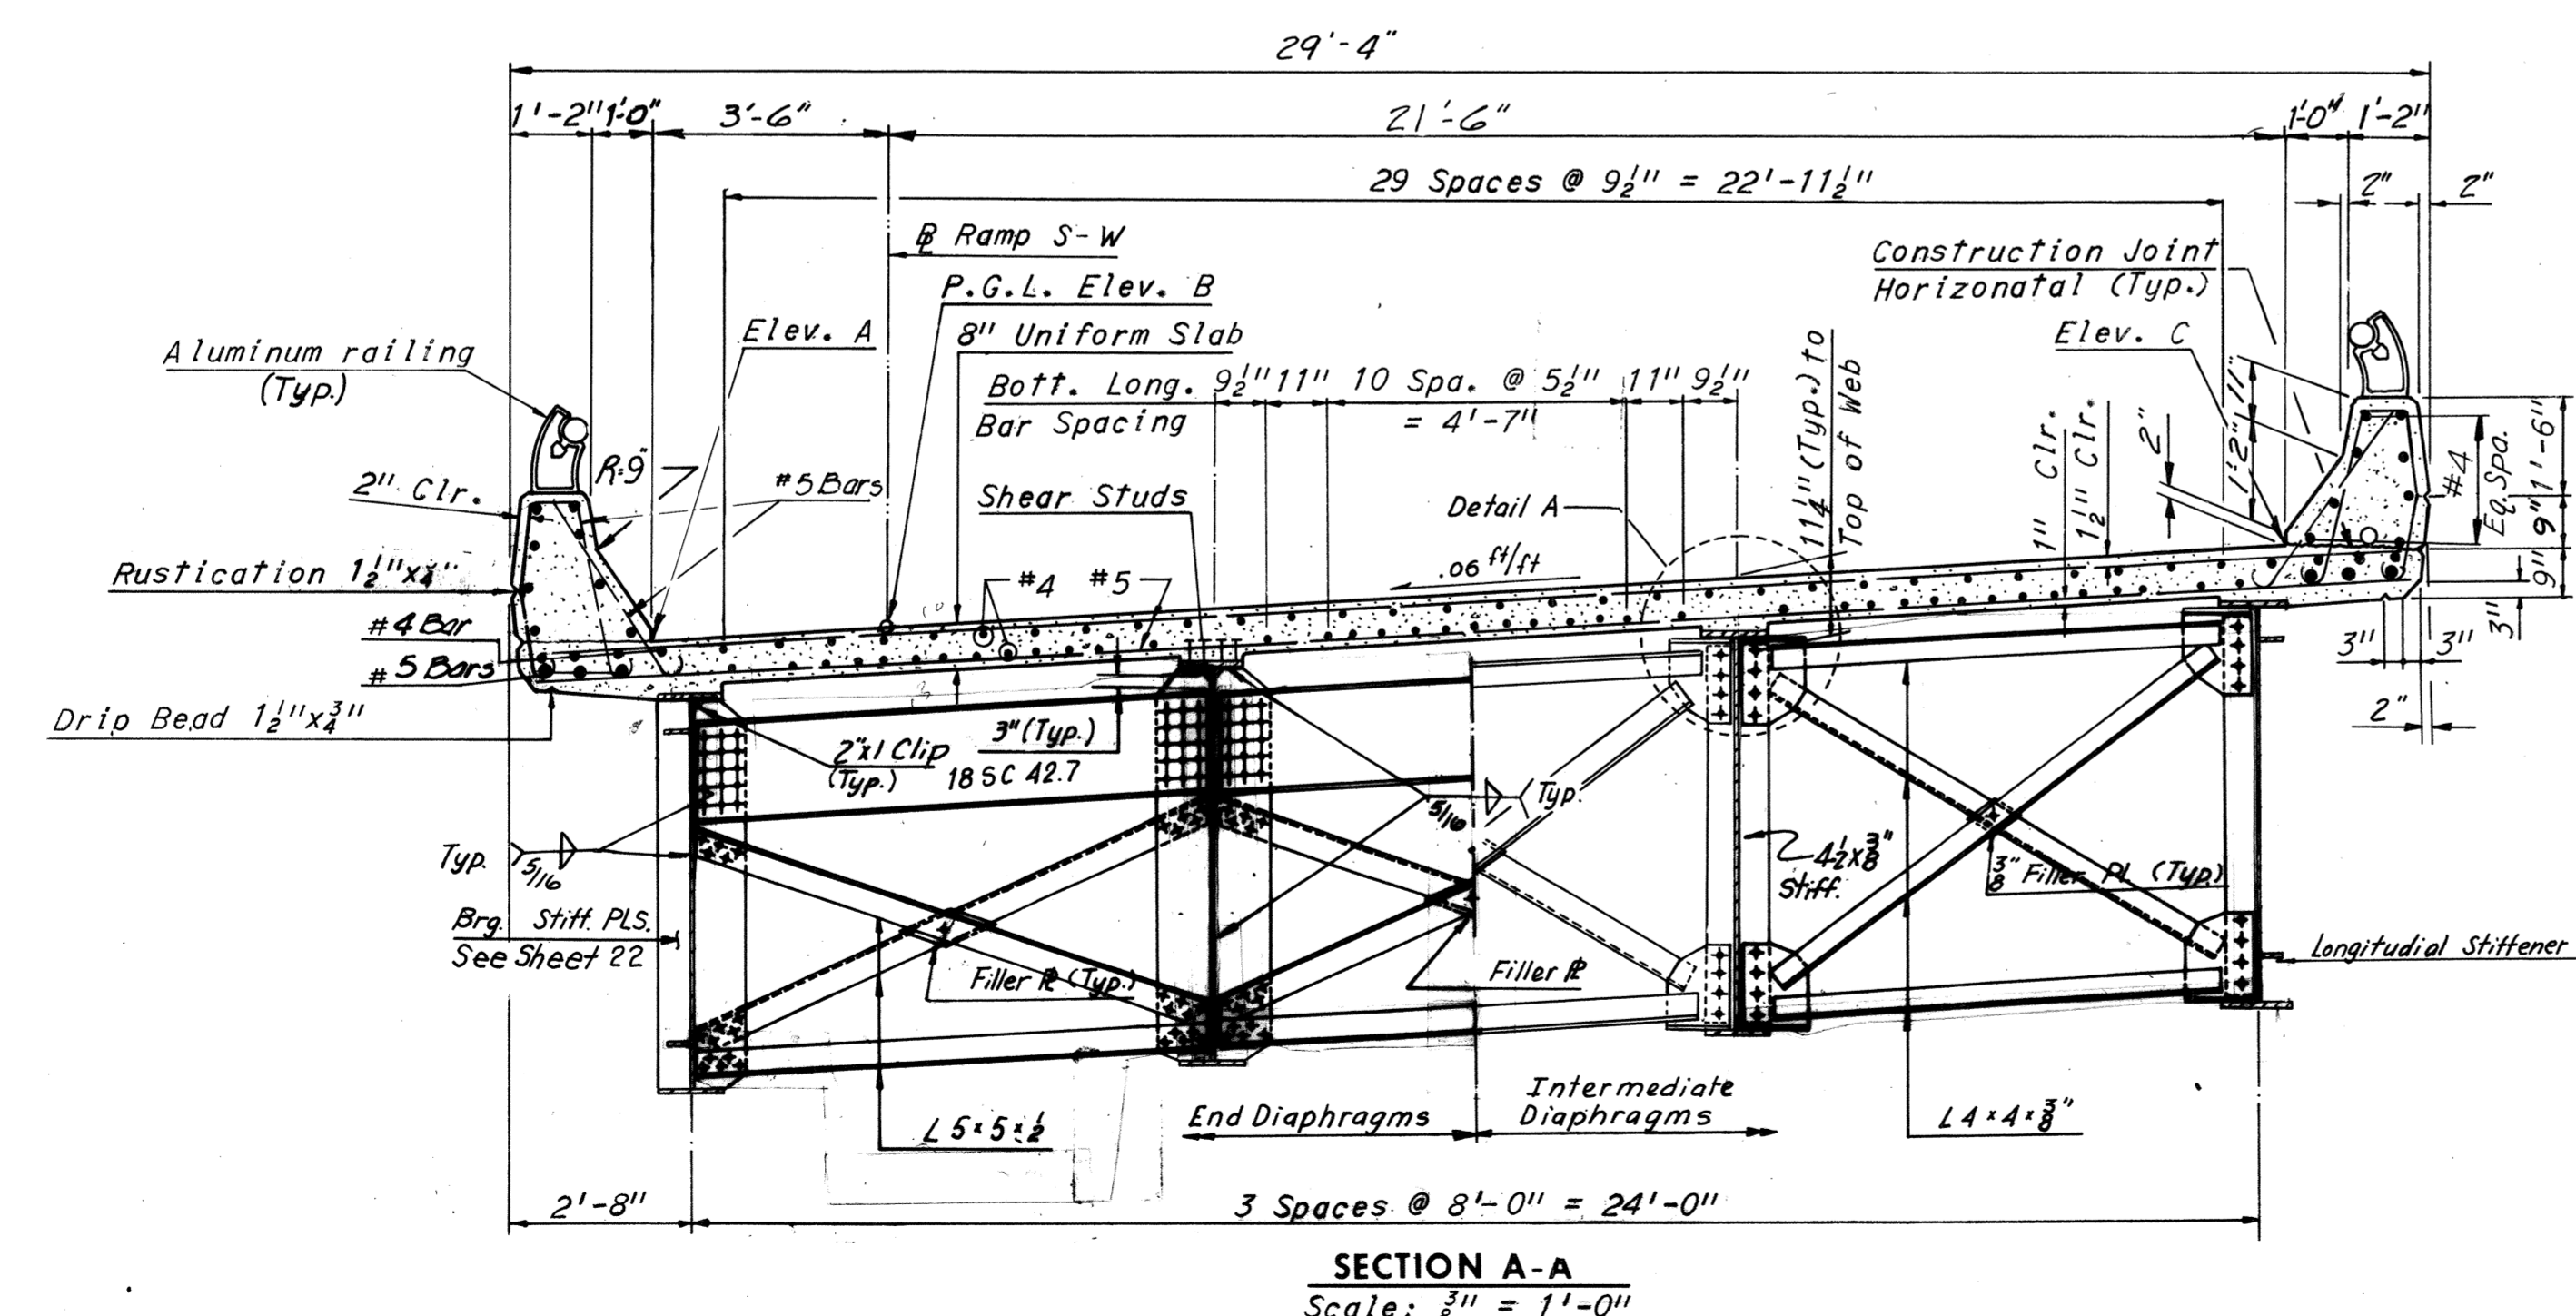

Note:
For Detail A, See Sheet 31.

BY	DATE	NO.	REVISION	BY	DATE
MADE	C.E.B.	12-10-68			
CHECKED	Y.C.P.	1-15-69			
IN CHARGE					

AS BUILT


RICHMOND METROPOLITAN AUTHORITY
RICHMOND EXPRESSWAY SYSTEM
DOWNTOWN EXPRESSWAY

BRIDGE NO. 65
RAMP S-W CONNECTION FROM
RICHMOND-PETERSBURG TURNPIKE
DECK PLAN UNITS 14, 15 AND 16



HOWARD, NEEDLES, TAMMEN & BERGENDOFF
 consulting engineers
 NEW YORK ALEXANDRIA KANSAS CITY

SCALE: As Noted
 CONTRACT NO. 11
 SHEET NO. 29 OF 38



RICHMOND EXPRESSWAY SYSTEM			
SECTION	PROJECT	SHEET NO.	TOTAL SHEETS
11	DOWNTOWN EXPRESSWAY	55	97

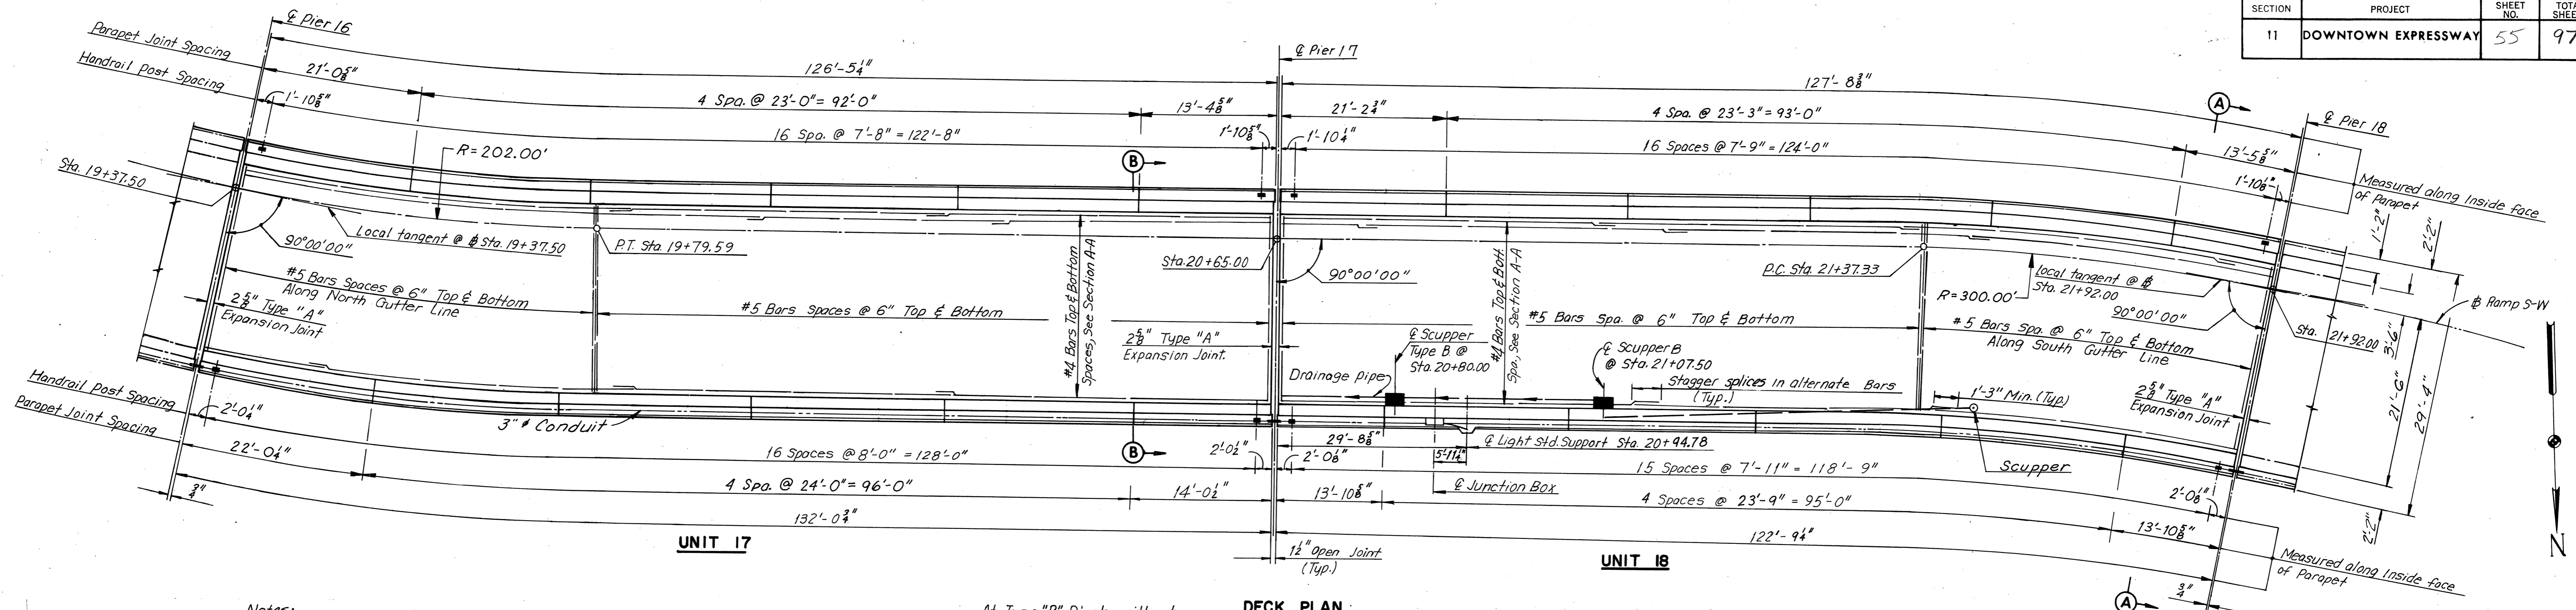

Notes:
 For Framing Plan see Sheet 23.
 For Joint Details, see Sheet 35.
 For Quantities, see Sheet 4.
 For Handrail Details see Sheet 53.
 For Standard Drainage Details for Unit 18, see Support Type 3, Sheets 55 & 56 (connect pipe from A to pipe from B as shown for Support Type 7).

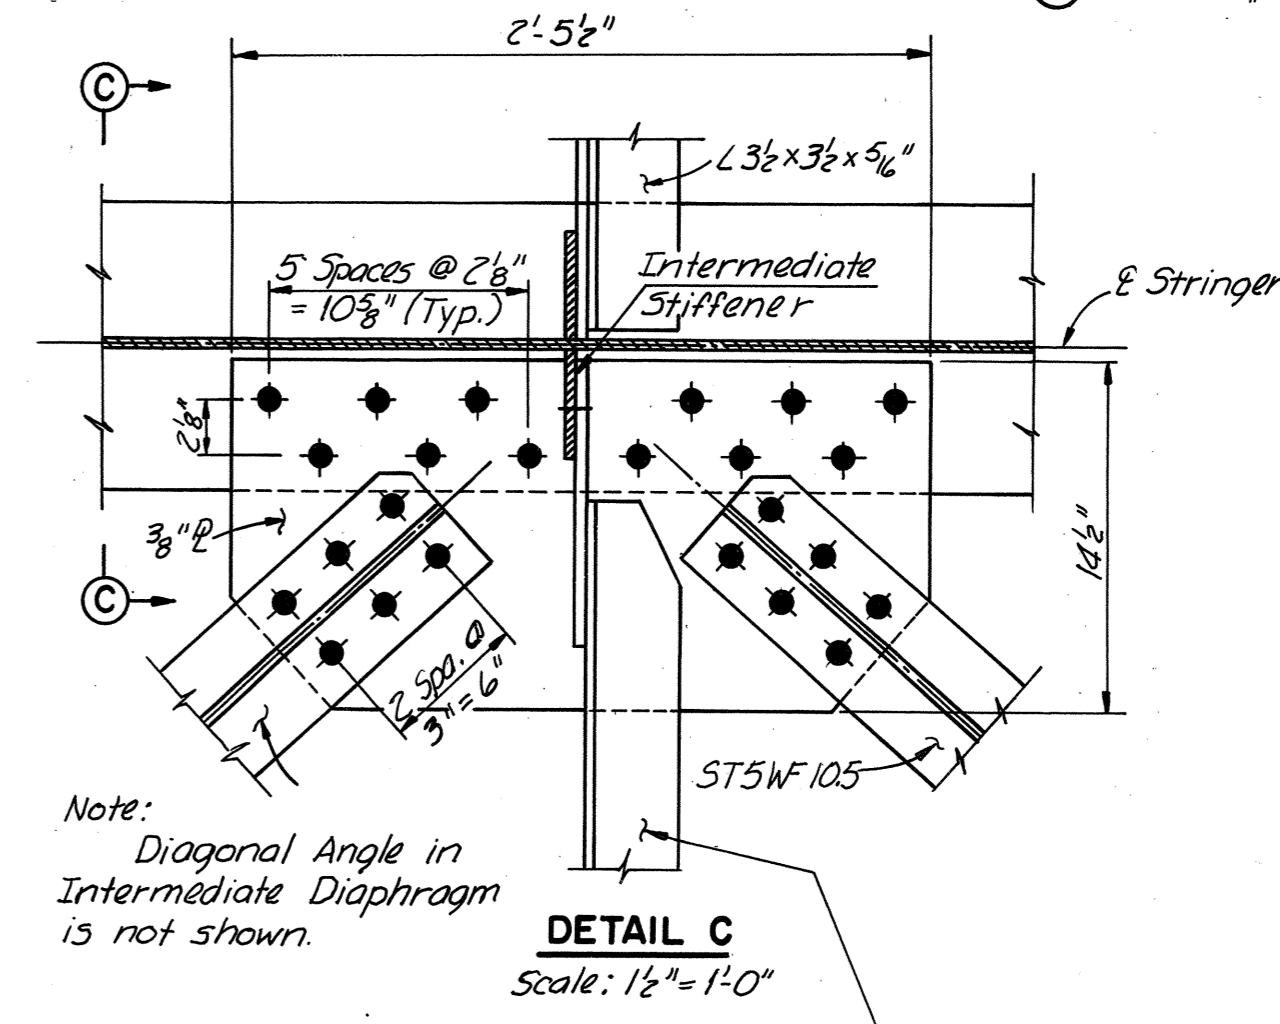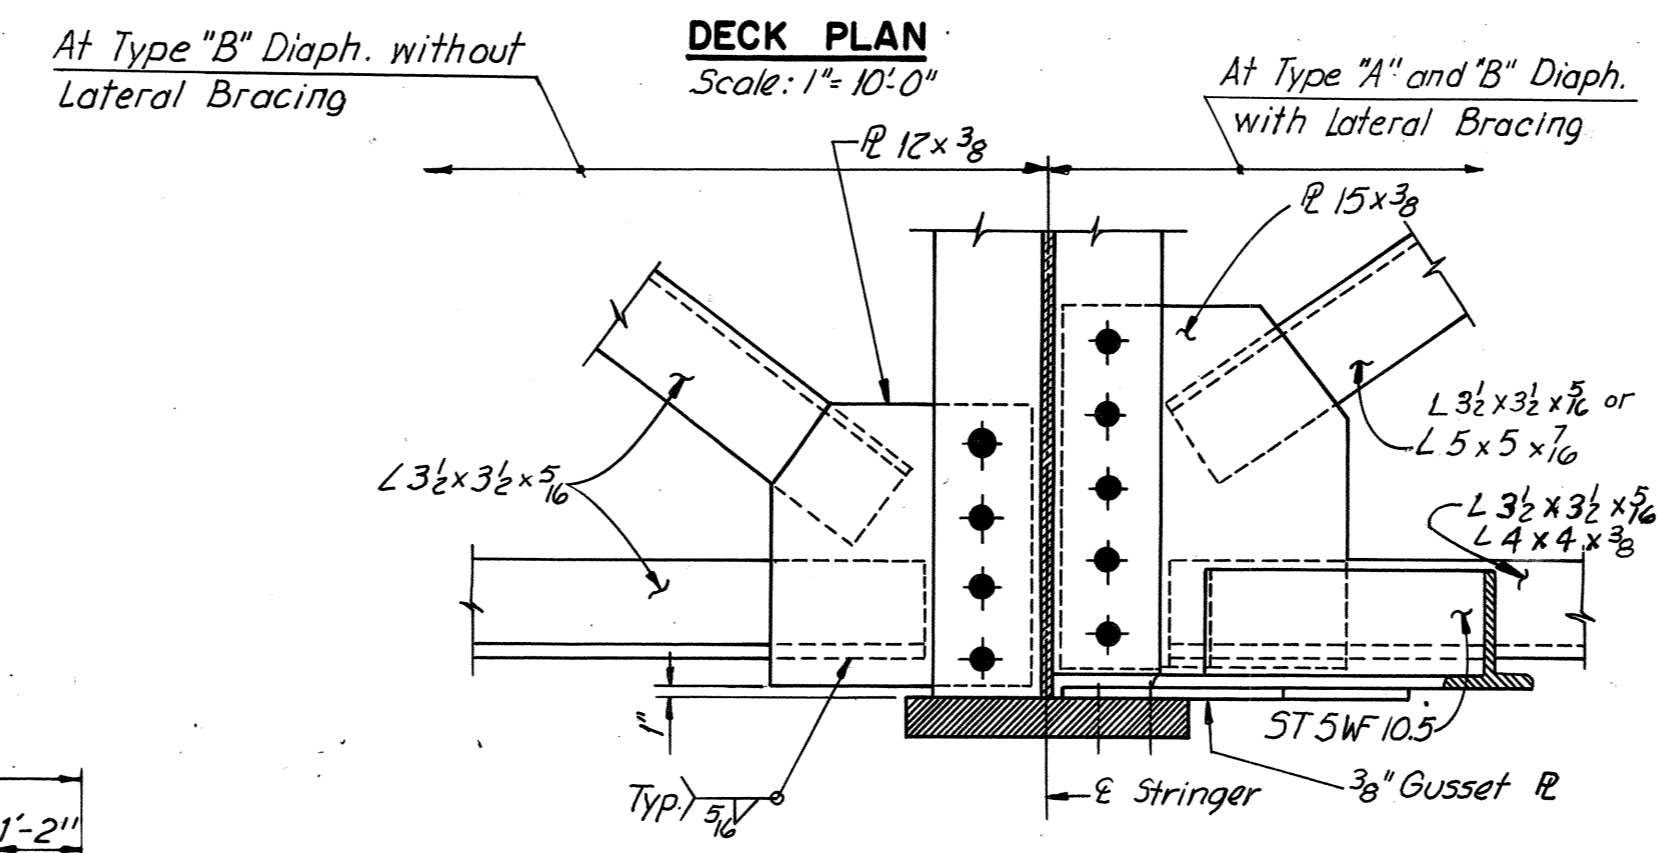

STATION	ELEVATION TABLE		
	ELEV. A	ELEV. B	ELEV. C
19+37.50	72.98	73.13	74.09
+40.00	72.85	73.00	73.94
+50.00	72.38	72.52	73.38
+60.00	71.95	72.08	72.86
+70.00	71.56	71.68	72.37
+80.00	71.21	71.31	71.97
+90.00	70.89	70.98	71.49
20+00.00	70.61	70.68	71.11
+10.00	70.36	70.42	70.77
+20.00	70.15	70.20	70.46
+30.00	69.98	70.01	70.18
+40.00	69.85	69.86	69.94
+50.00	69.74	69.74	69.74
+60.00	69.68	69.66	69.56
+65.00	69.66	69.64	69.48
+70.00	69.65	69.62	69.42
+80.00	69.67	69.61	69.30
+90.00	69.71	69.64	69.23
21+00.00	69.79	69.71	69.20
+10.00	69.89	69.79	69.18
+20.00	70.00	69.88	69.15
+30.00	70.10	69.96	69.13
+40.00	70.19	70.05	69.12
+50.00	70.29	70.13	69.10
+60.00	70.40	70.21	69.07
+70.00	70.50	70.30	69.06
+80.00	70.59	70.38	69.09
+90.00	70.68	70.47	69.18
+92.00	70.70	70.49	69.20

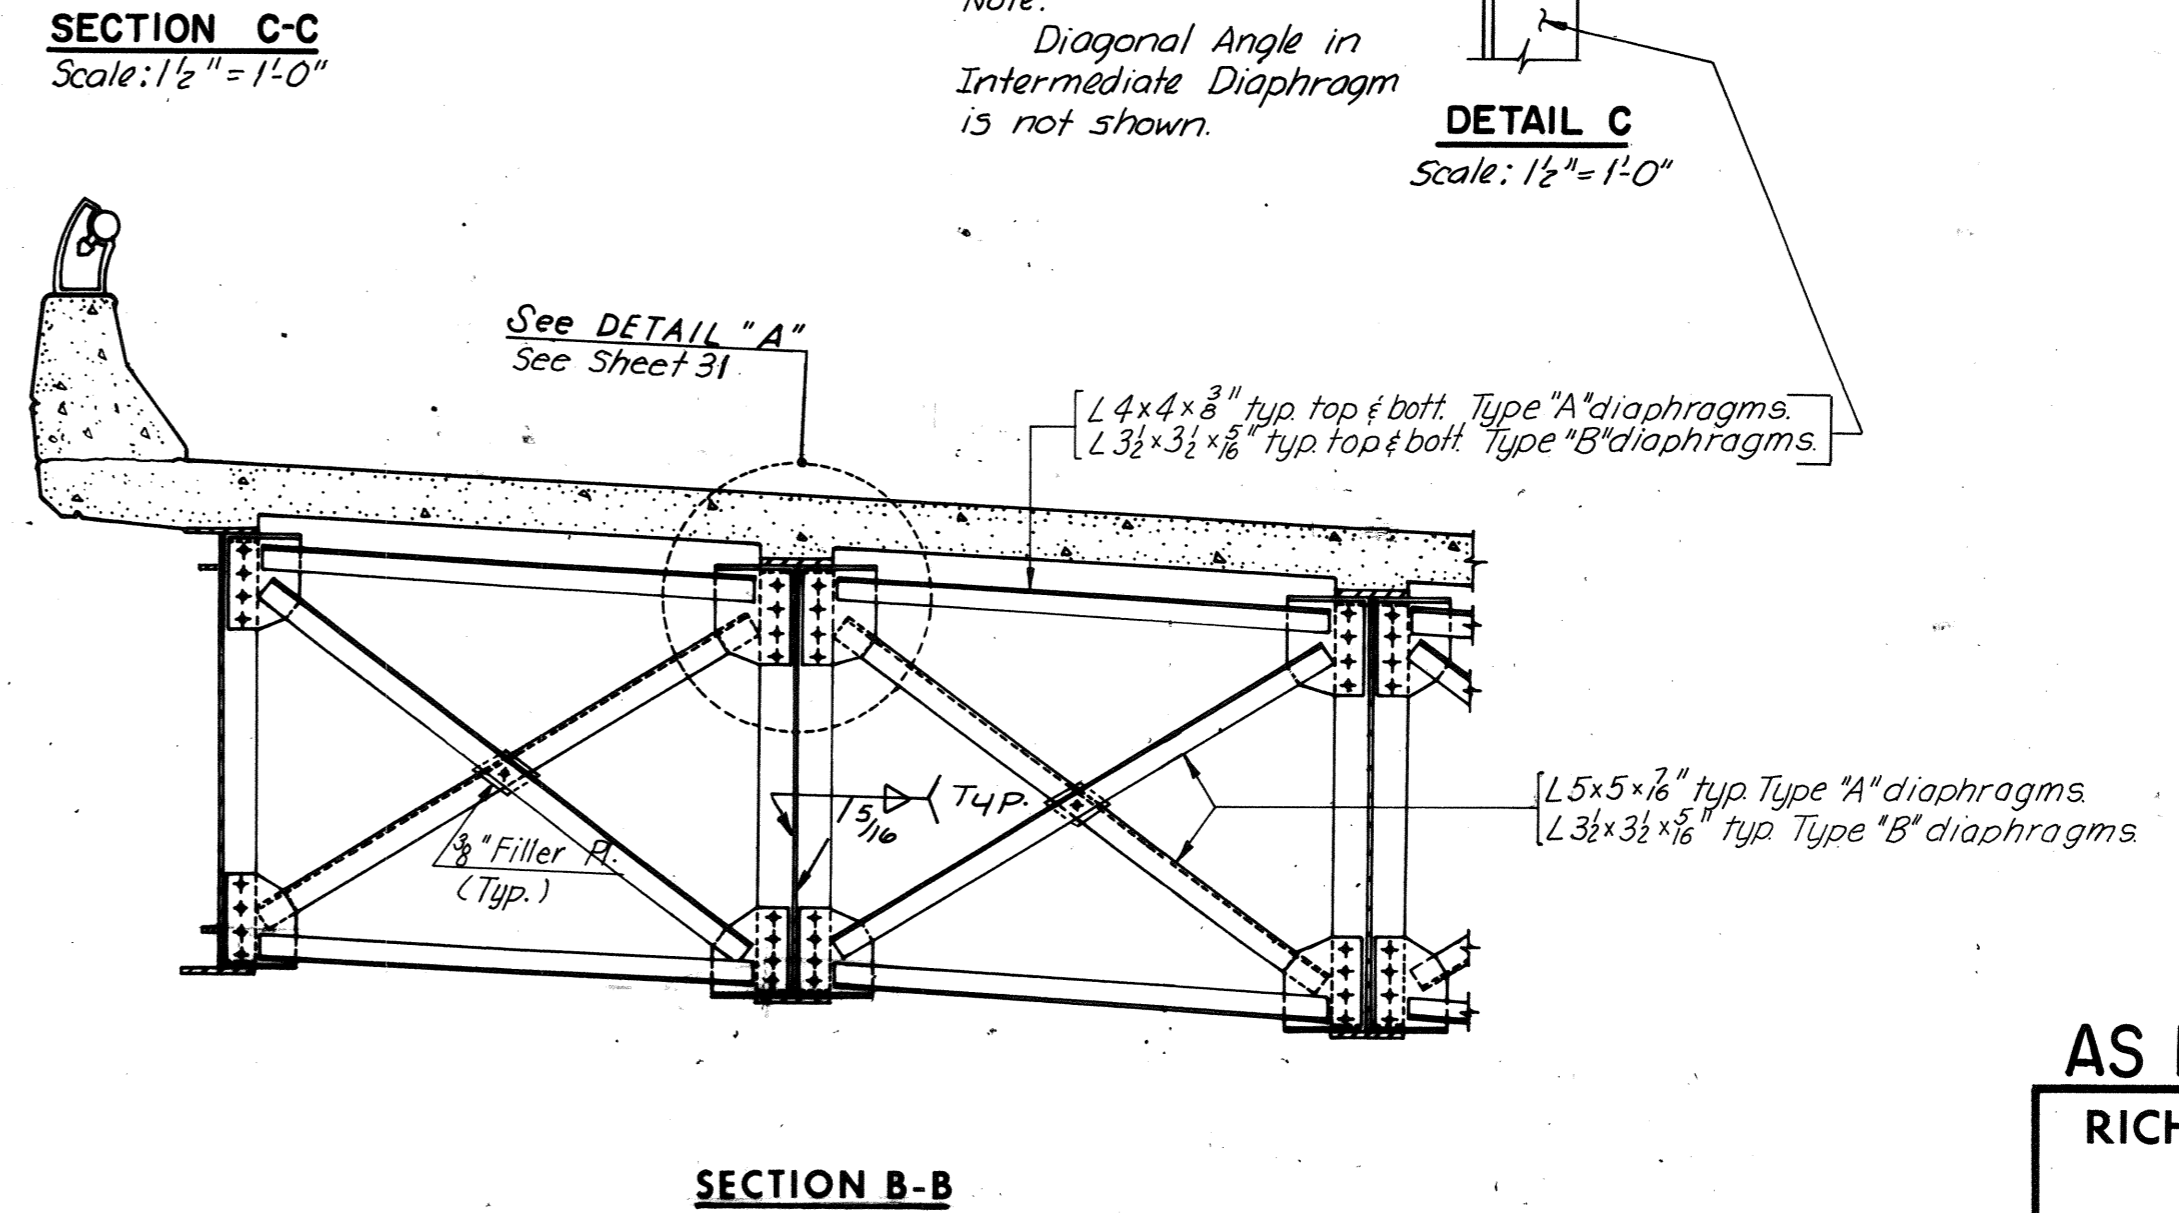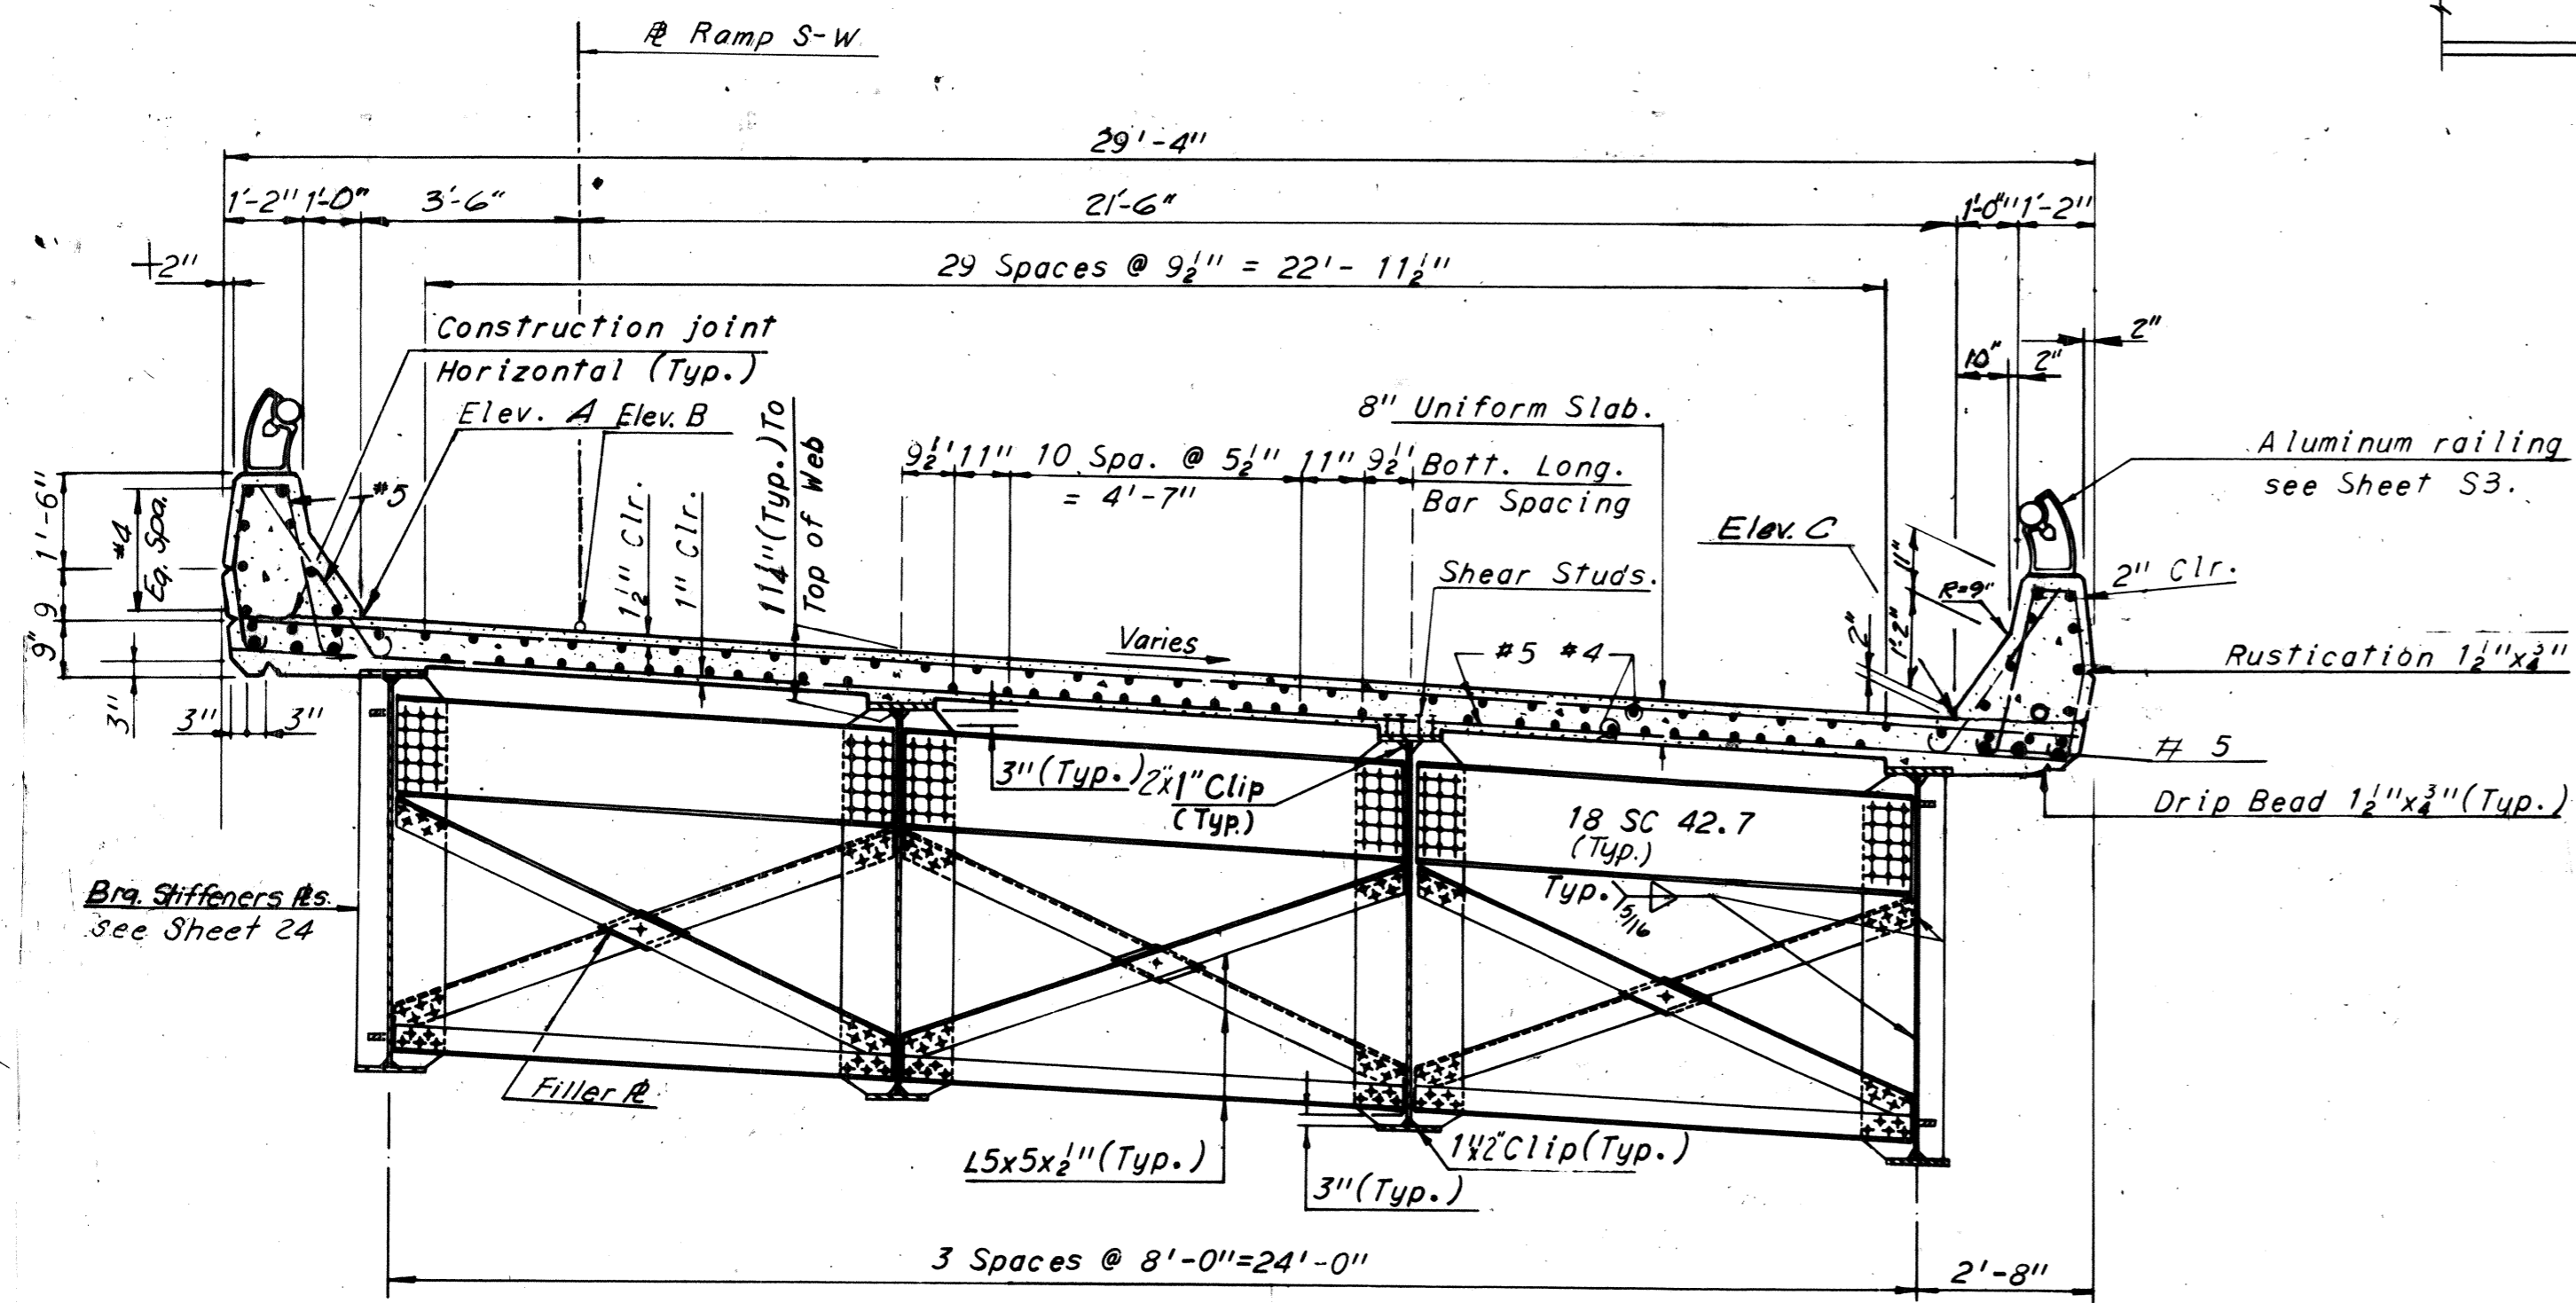

Note:
 For location of End diaphragms See Sheet 23.

Note:
 For location of Intermediate diaphragms Types "A" and "B" see Sheet 23.

BY	DATE				
MADE	R.C.	11.18.68			
CHECKED	Y.C.P.	1-14-69	Diaph.	TEM	3-76
IN CHARGE			NO.	REVISION	BY DATE


AS BUILT
RICHMOND METROPOLITAN AUTHORITY
RICHMOND EXPRESSWAY SYSTEM

BRIDGE NO. 65
RAMP S-W CONNECTION FROM
RICHMOND-PETERSBURG TURNPIKE
DECK PLAN UNITS 17 AND 18




HOWARD, NEEDLES, TAMMEN & BERGENDOFF
 consulting engineers
 NEW YORK ALEXANDRIA KANSAS CITY

SCALE: As Noted
 CONTRACT NO. 11
 SHEET NO. 30 OF 38



RICHMOND EXPRESSWAY SYSTEM			
SECTION	PROJECT	SHEET NO.	TOTAL SHEETS
II	DOWNTOWN EXPRESSWAY	56	97

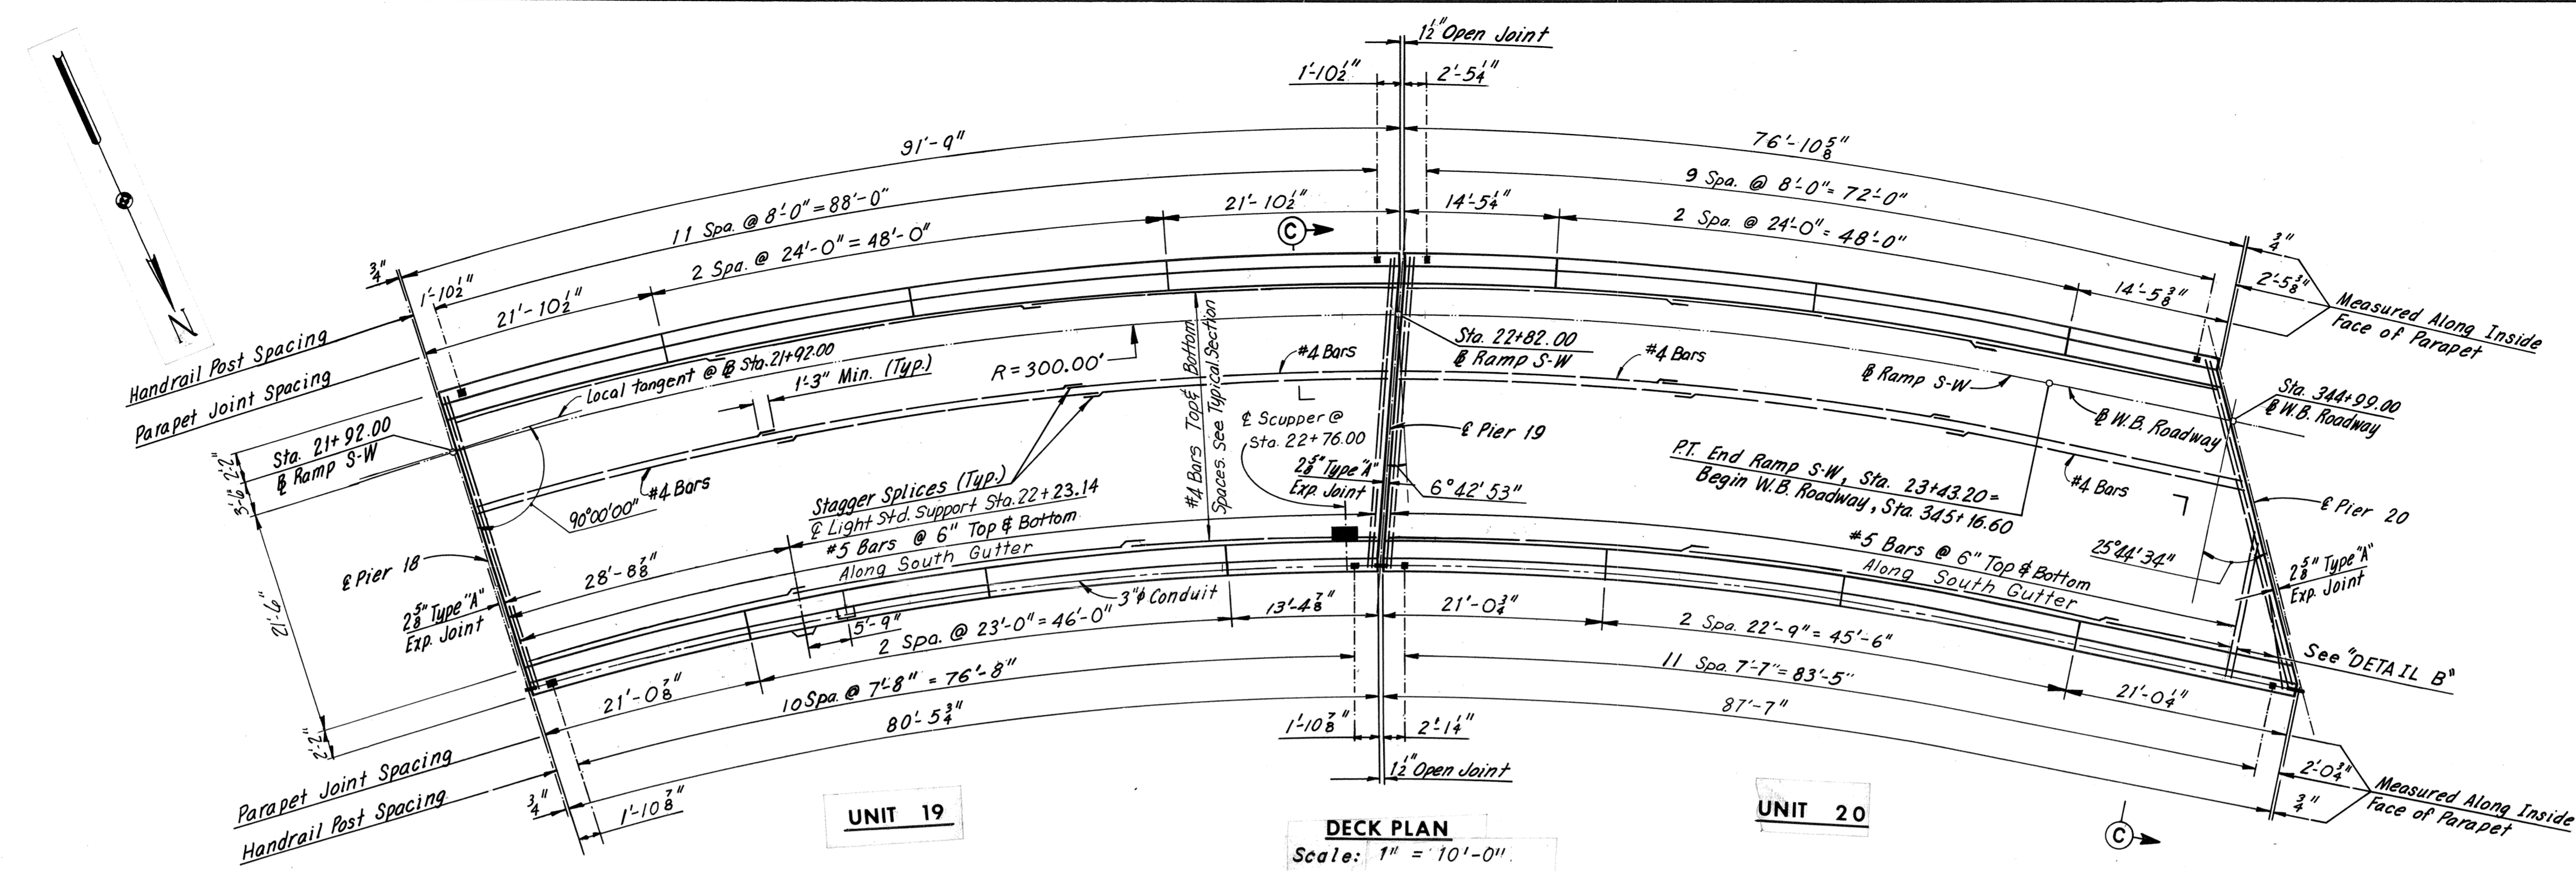

ELEVATION TABLE			
STATION	ELEV. A	ELEV. B	ELEV. C
21+92.00	70.70	70.49	69.26
22+00.00	70.76	70.55	69.32
+10.00	70.84	70.63	69.40
+20.00	70.93	70.72	69.49
+30.00	71.01	70.80	69.57
+40.00	71.09	70.88	69.65
+50.00	71.18	70.97	69.74
+60.00	71.26	71.05	69.82
+70.00	71.35	71.14	69.91
22+79.34	—	—	69.99
+80.00	71.43	71.22	69.99
+82.00	—	71.24	—
22+82.35	71.45	—	—
+90.00	71.51	71.30	70.07
23+00.00	71.60	71.39	70.14
+10.00	71.67	71.47	70.32
+20.00	71.74	71.56	70.48
+30.00	71.81	71.64	70.59
+40.00	71.88	71.72	70.75
23+43.20	71.90	71.75	70.80
345+16.60	71.90	71.75	70.80
345+10.00	71.95	71.81	70.91
345+00.45	72.02	—	—
345+00.00	72.03	71.89	71.07
344+99.00	—	71.90	—
344+88.87	—	—	71.25

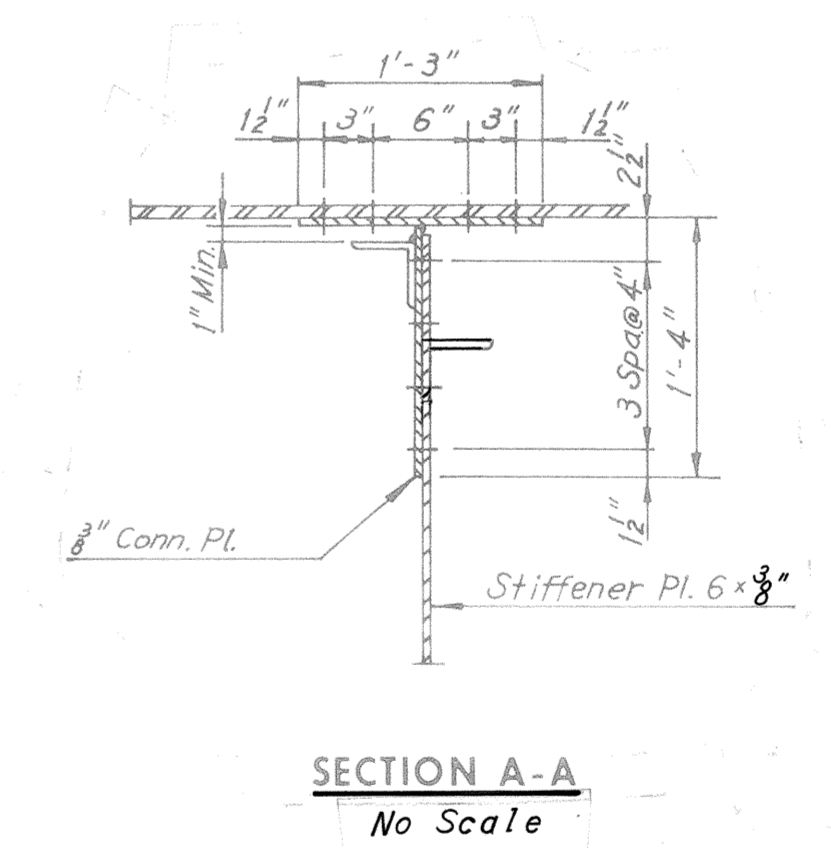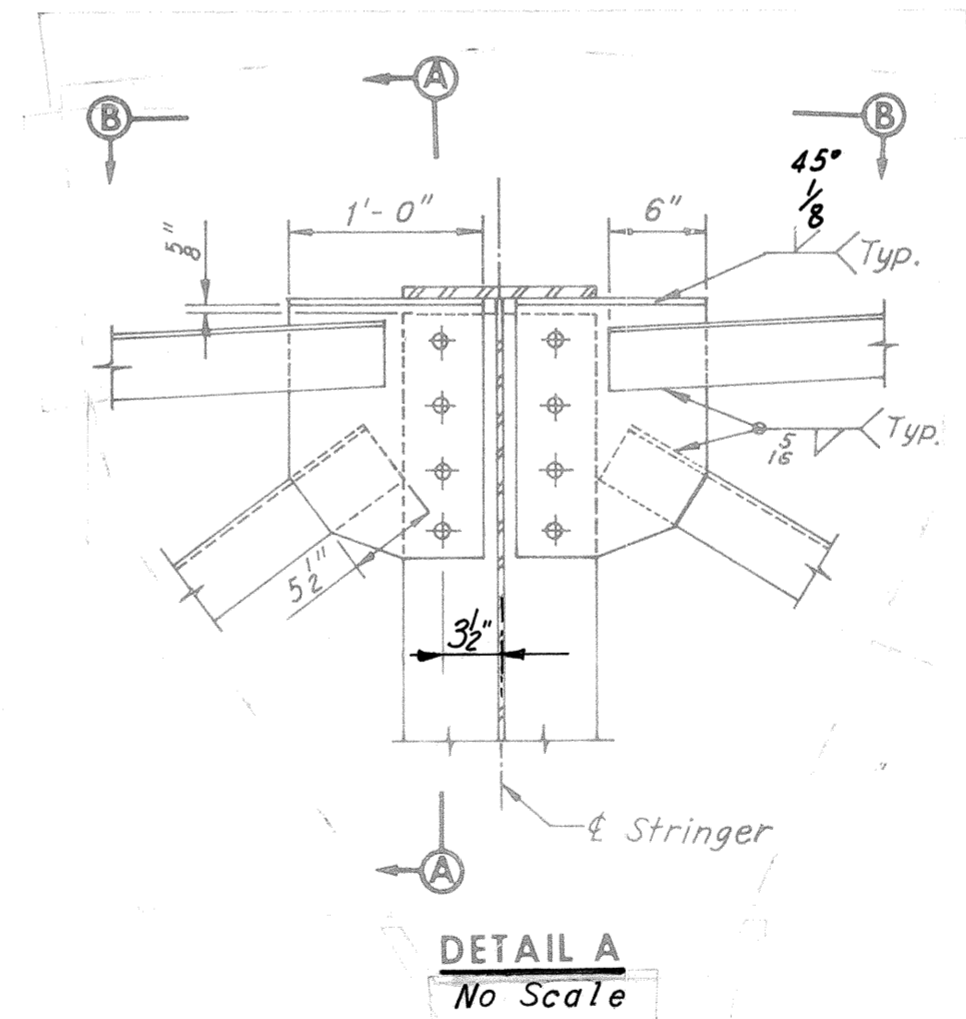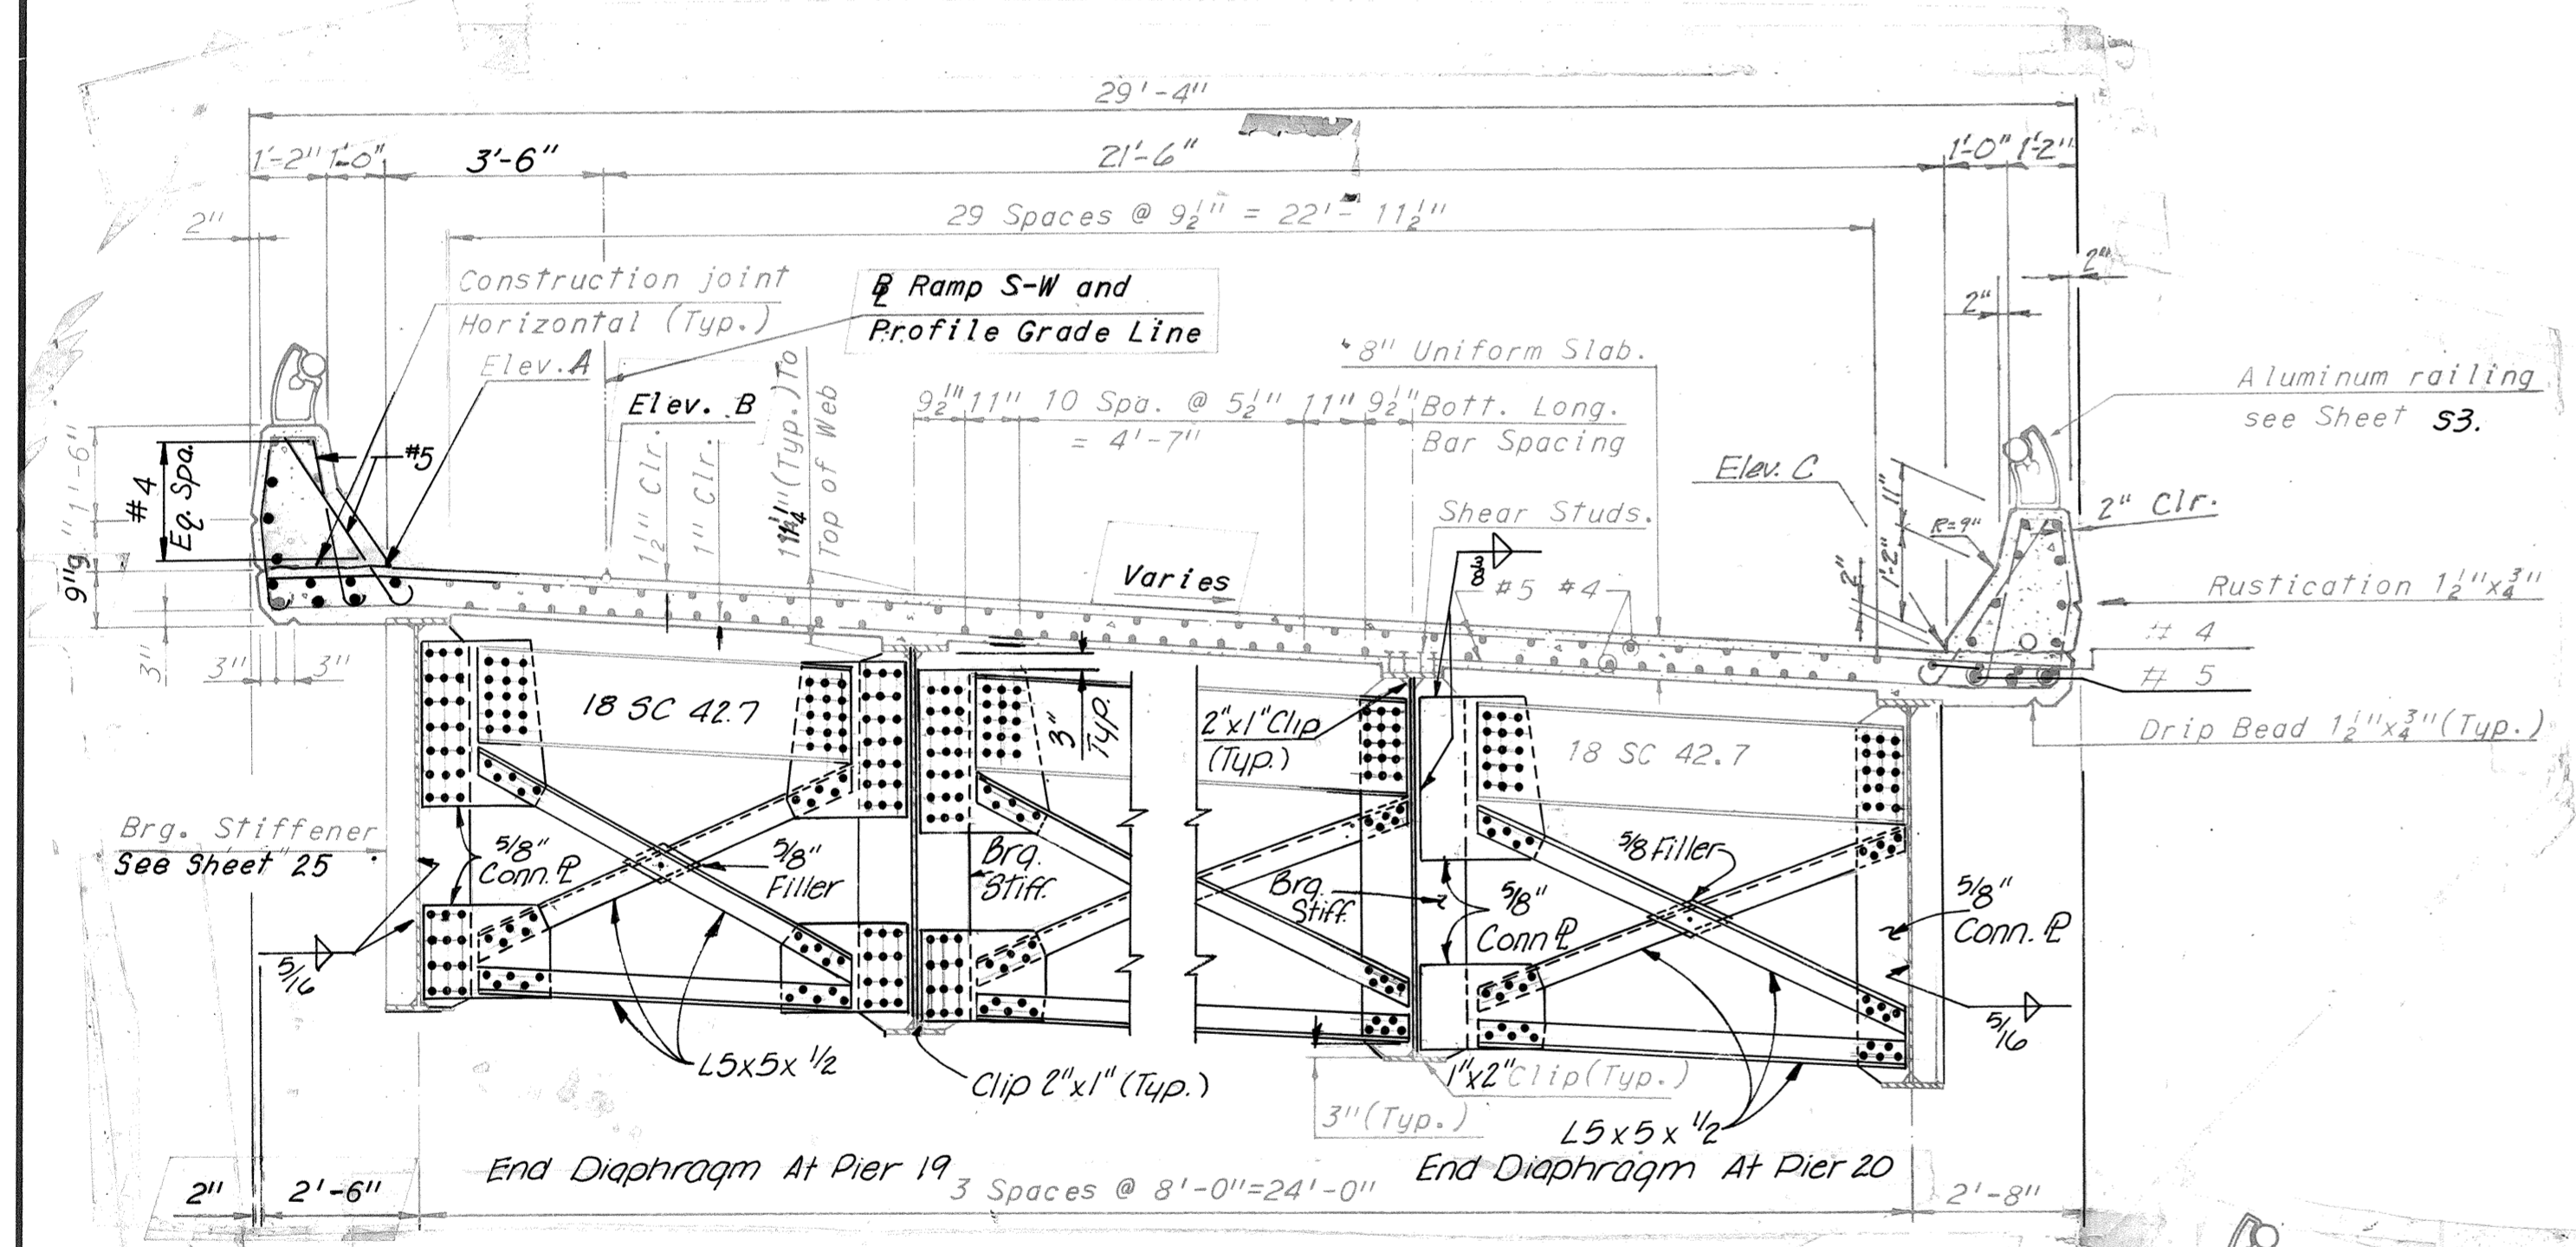

Notes:
 For Framing Plan see Sheet 24
 For Joint Details, see Sheet 37 & 38
 For Quantities see Sheet 4
 For Handrail Details, see Sheet 53.
 Note: For Standard Drainage Details for Unit 20 see Support Type 2 Sheet 55.

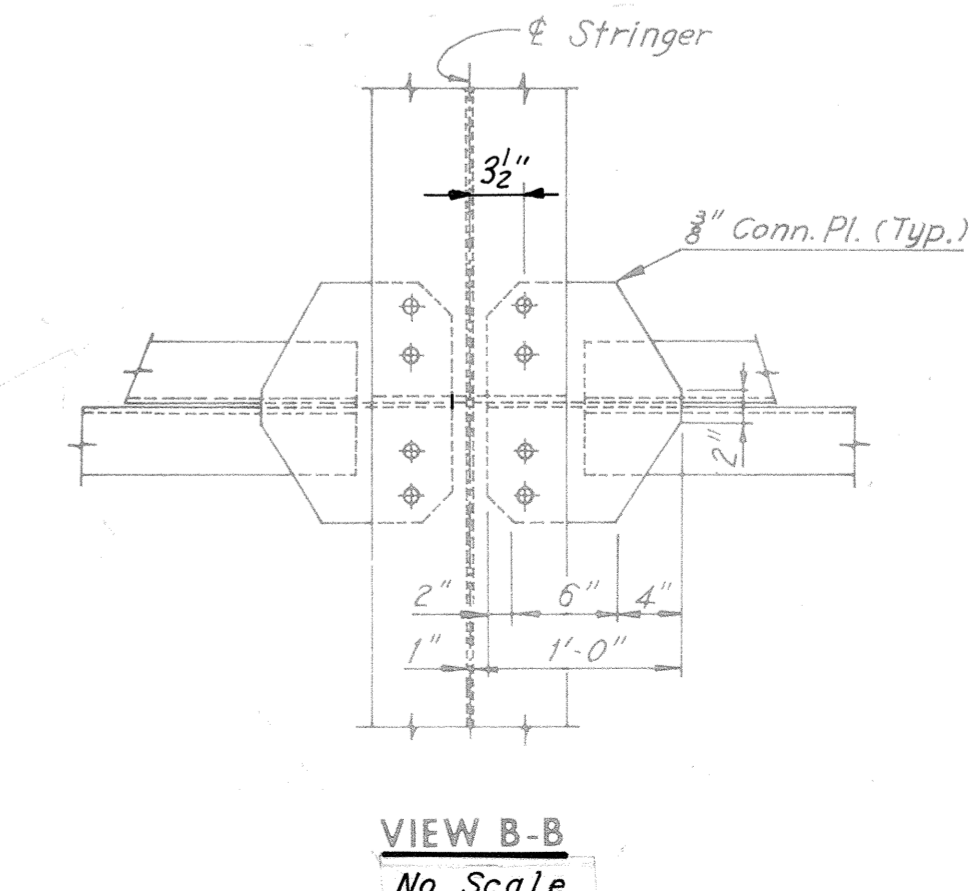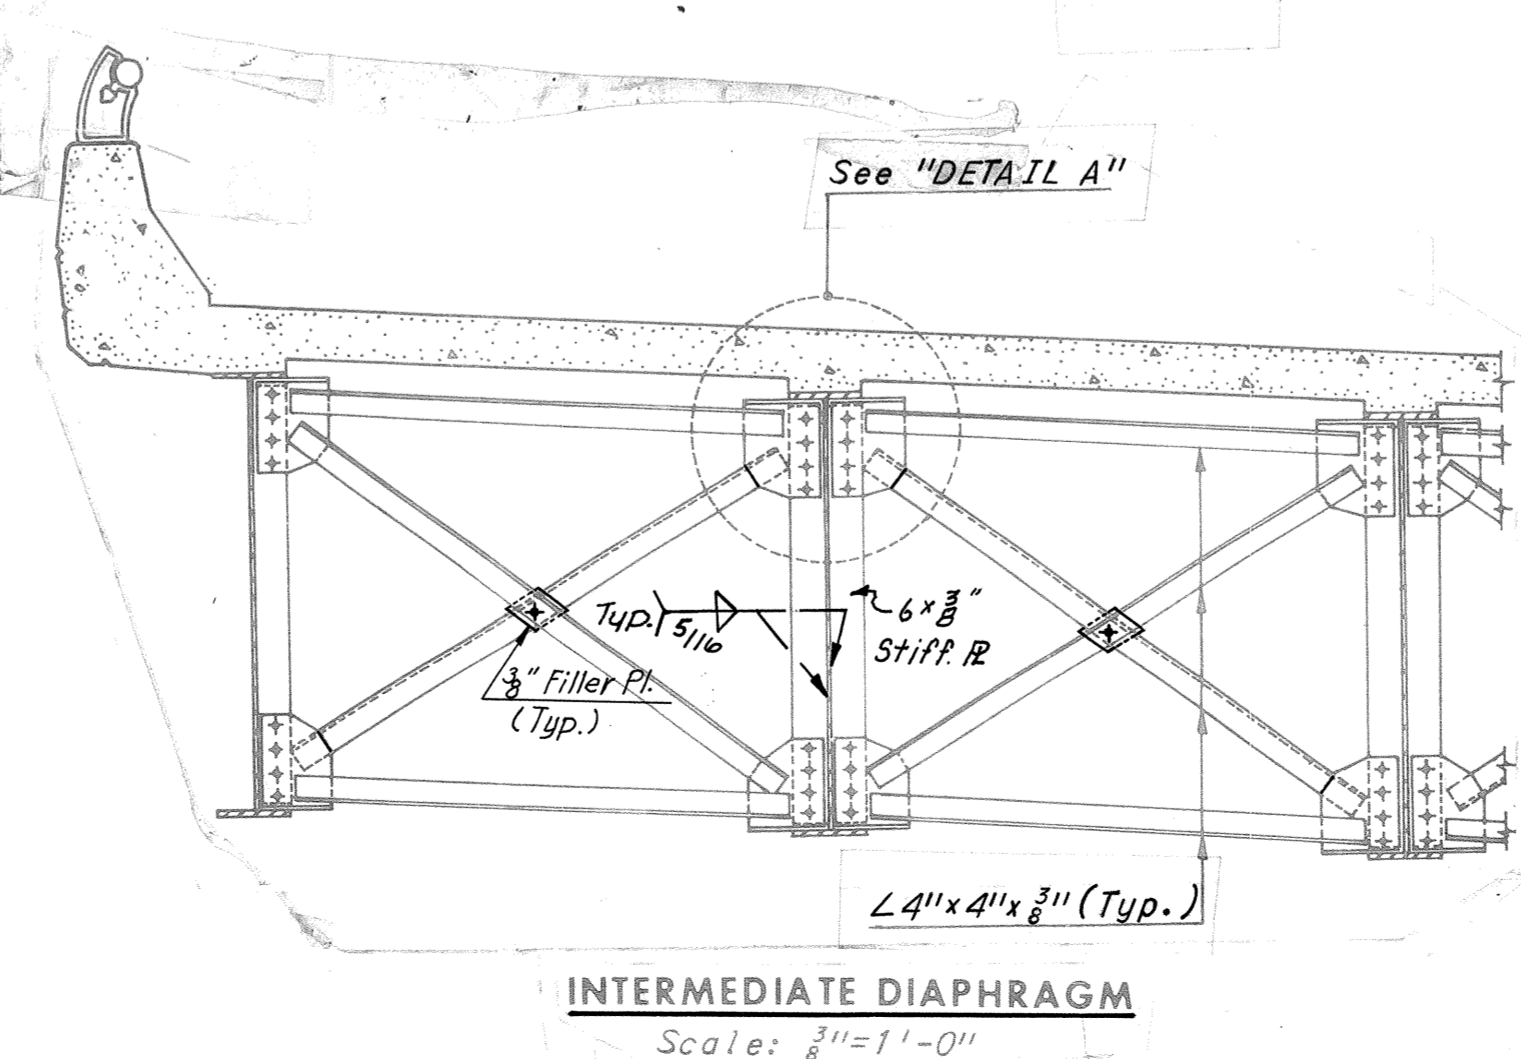

Note: For details of end diaphragm at Pier 18 see Section A-A, Sheet 32.

MADE	BY	DATE	NO.	REVISION	BY	DATE
	D.E.S.					
CHECKED	Y.C.P	1-14-69			TEM	8-76
IN CHARGE						

AS BUILT
RICHMOND METROPOLITAN AUTHORITY
RICHMOND EXPRESSWAY SYSTEM
 DOWNTOWN EXPRESSWAY



BRIDGE NO. 65
 RAMP S-W CONNECTION FROM
 RICHMOND-PETERSBURG TURNPIKE

DECK PLAN - UNITS 19 AND 20


HOWARD, NEEDLES, TAMMEN & BERGENDOFF
 consulting engineers
 NEW YORK ALEXANDRIA KANSAS CITY

SCALE: As Noted
 CONTRACT NO. 11
 SHEET NO. 31 OF 38



RICHMOND EXPRESSWAY SYSTEM			
SECTION	PROJECT	SHEET NO.	TOTAL SHEETS
11	DOWNTOWN EXPRESSWAY	57	97

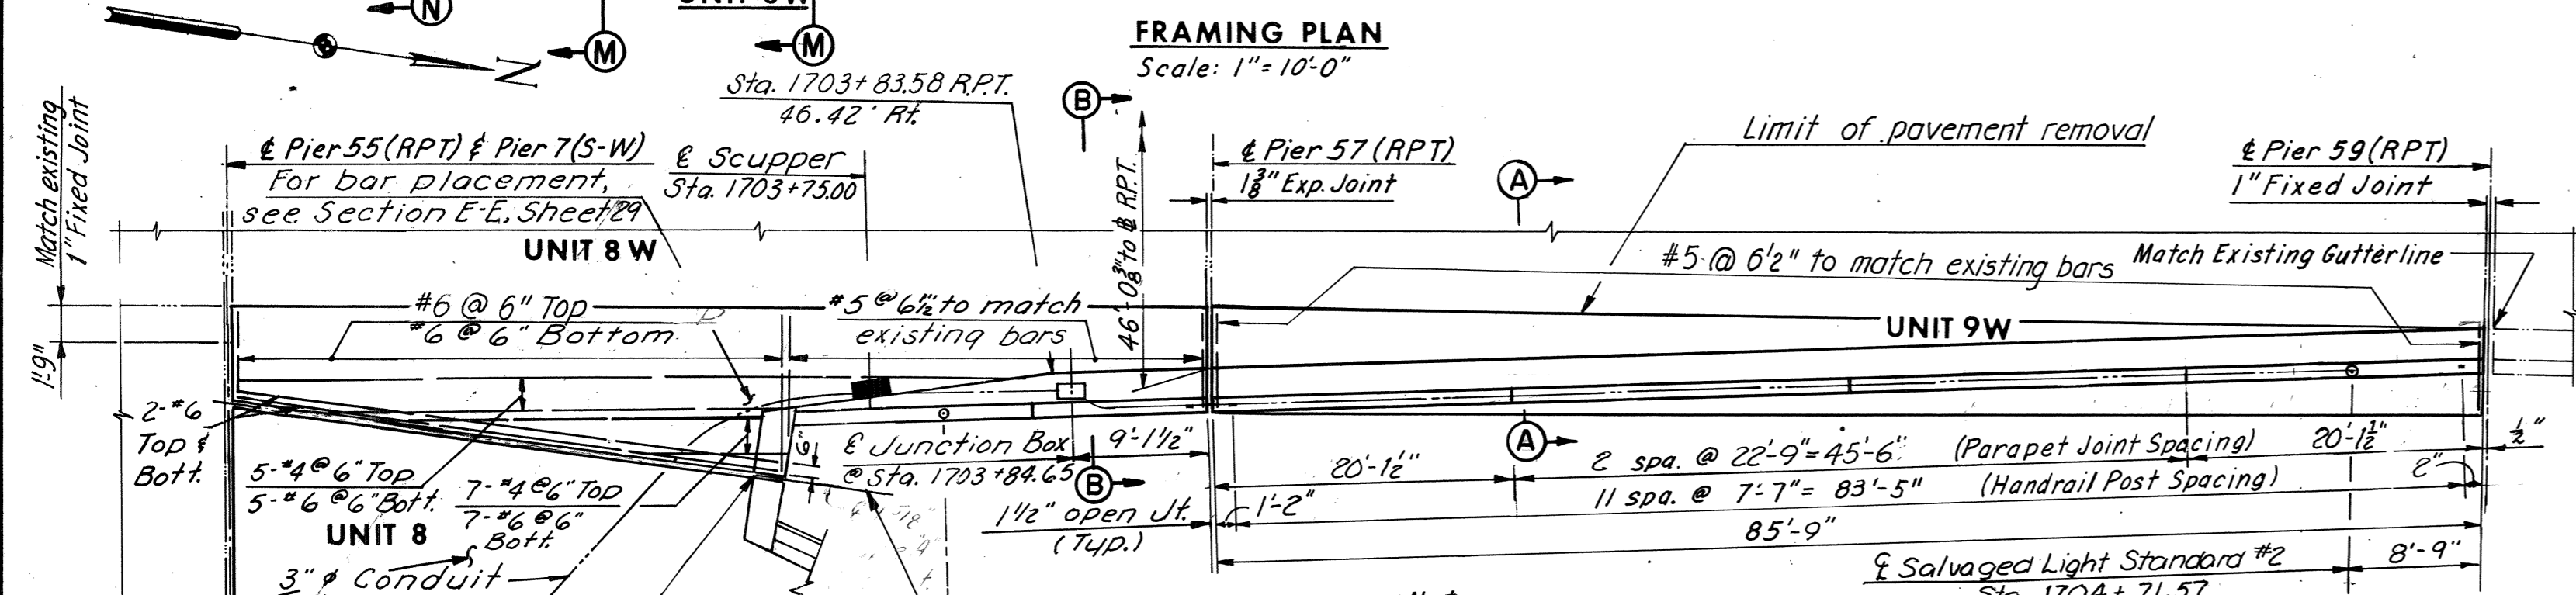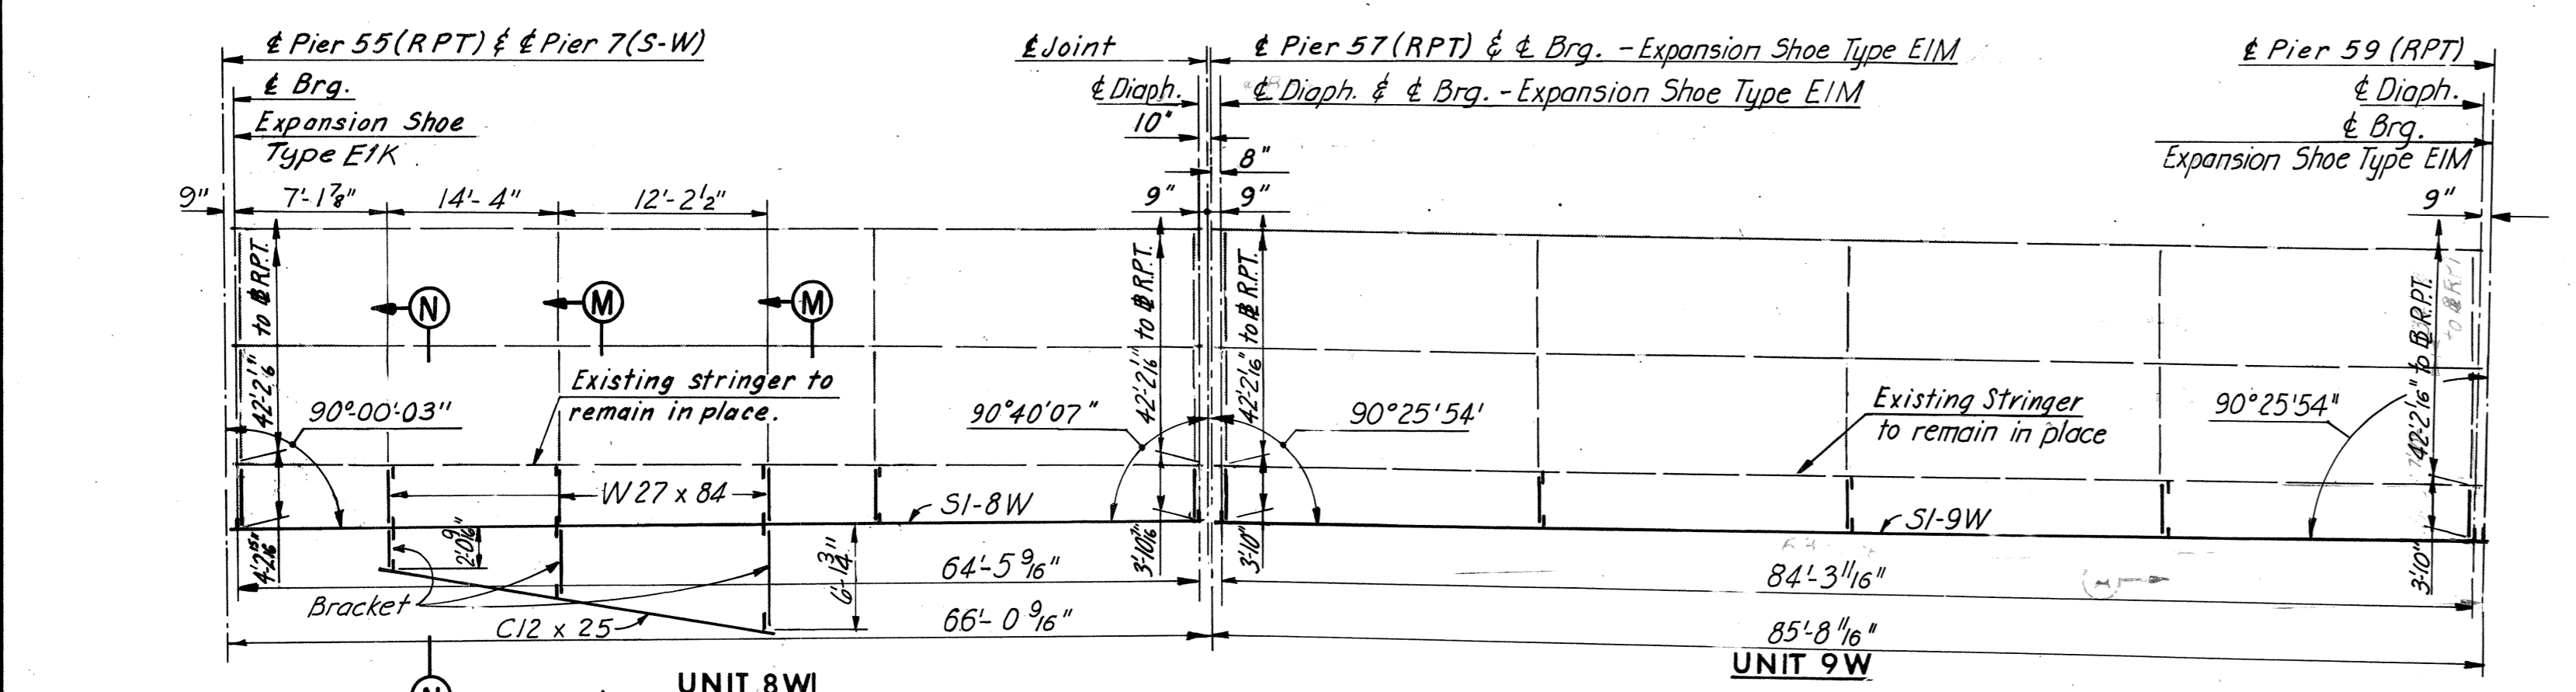



Note:
 For Fixed Joint Details at Pier 55, see Sheet 18.
 For Section B-B, see Sheet 27.
 For further details of nose and parapet, see Sheet 27.
 For location of Transition Detail see Unit 1, Sheet 25.
 For diagrams and notes of Dead Load Deflection and Camber, see Sheet 20.
 For Sections M-M & N-N see Sheet 20a.

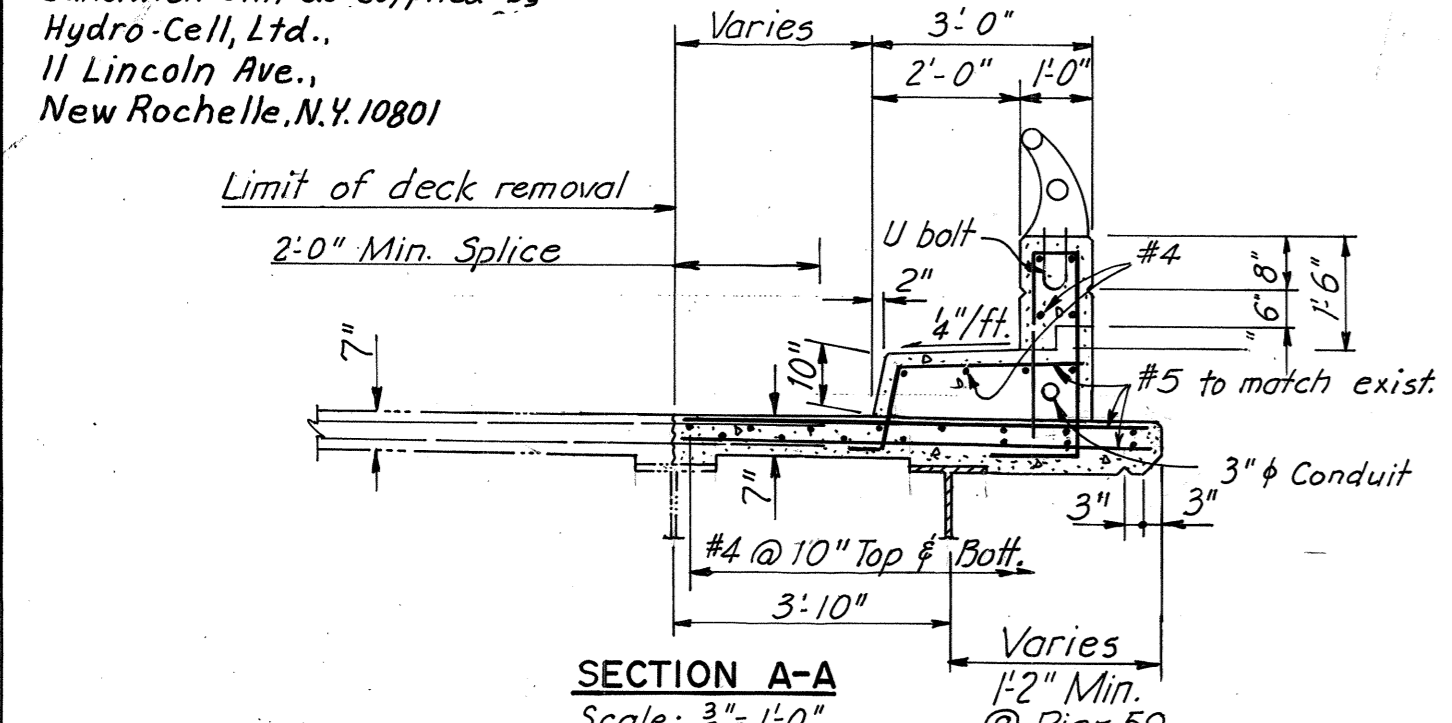

STRINGER	DEAD LOAD DEFLECTION SCHEDULE			CAMBER SCHEDULE		
	1/4L	1/2L	3/4L	1/4L	1/2L	3/4L
SI-8W	1 1/8"	1 3/8"	1 3/8"	1 1/8"	1 1/8"	1"
SI-9W	1 1/2"	1 7/8"	1 1/2"	2"	2 1/4"	2"

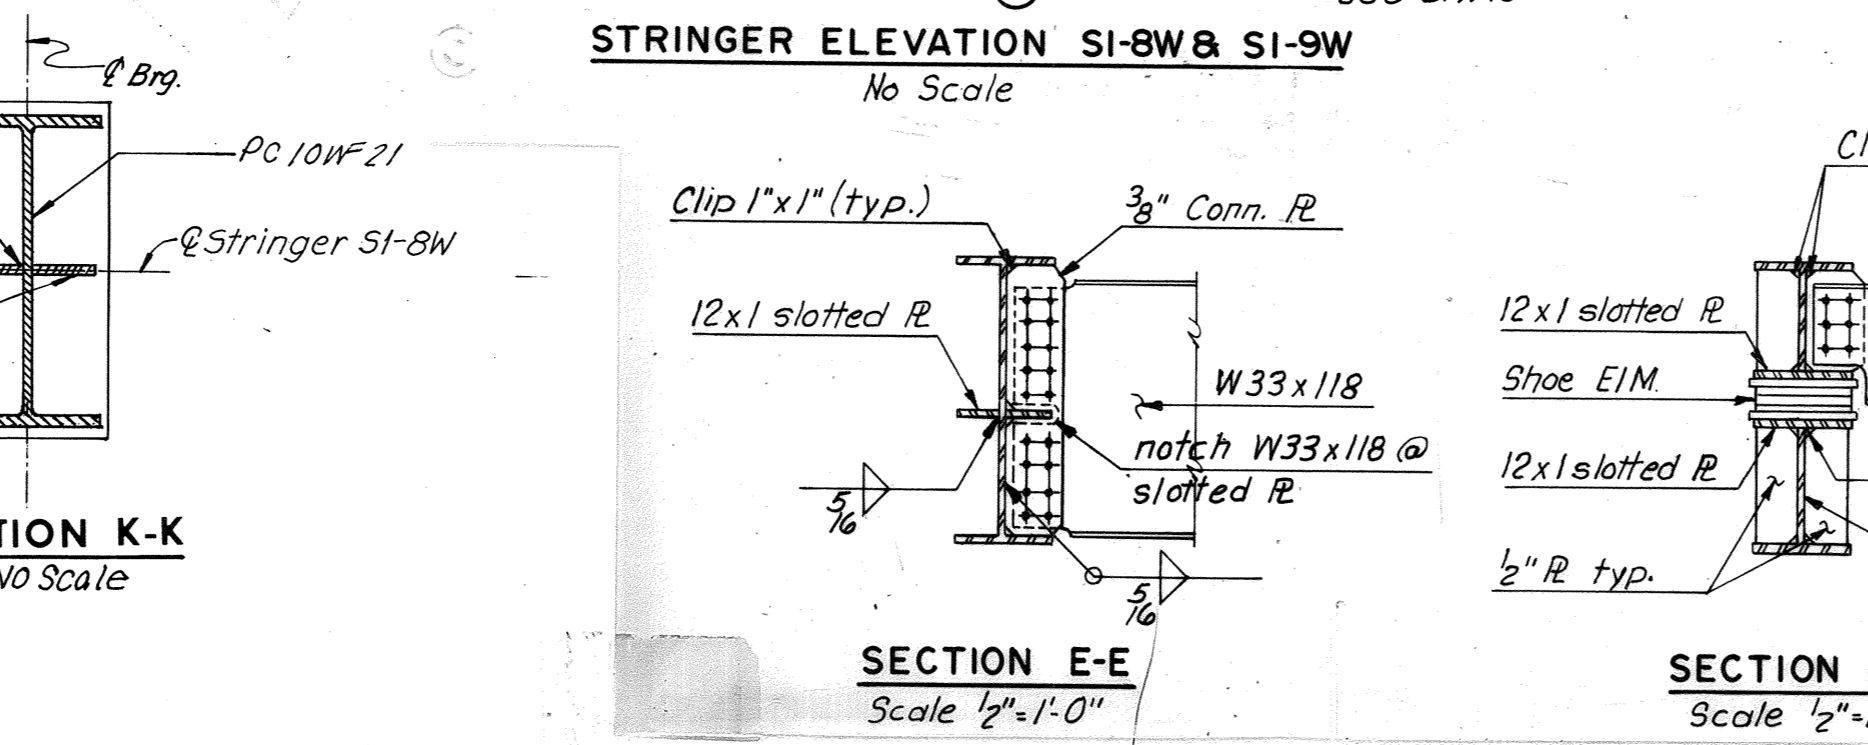
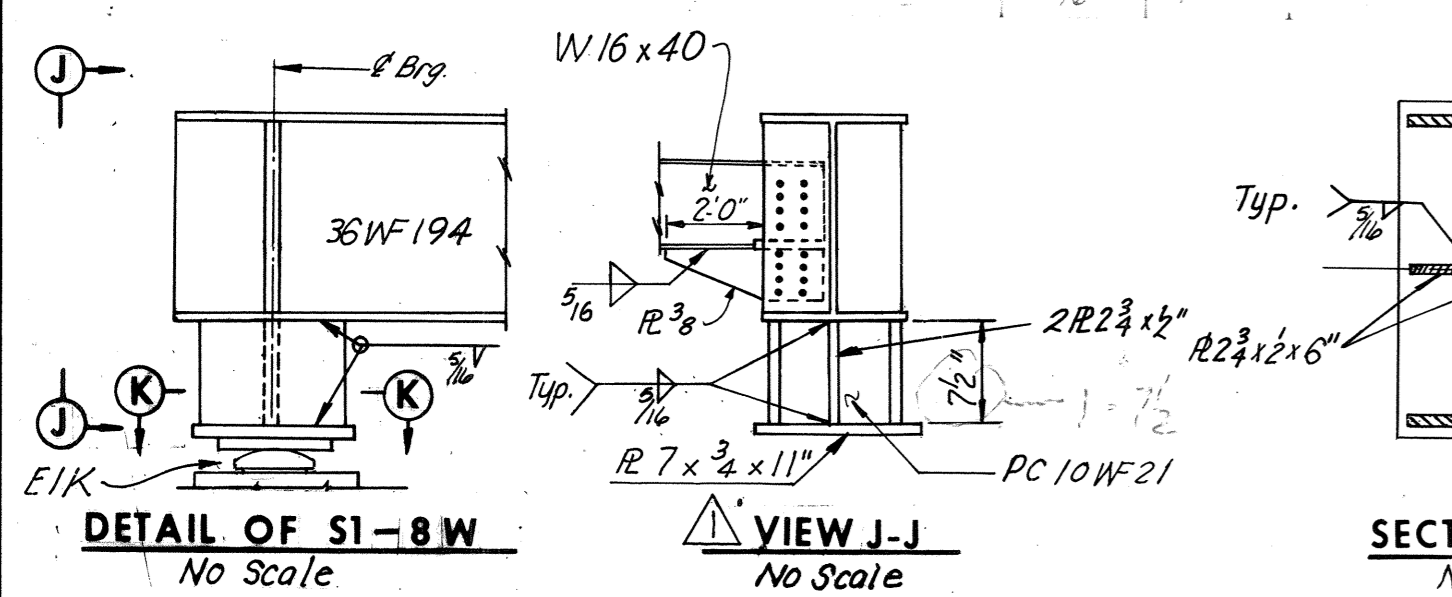


BY	DATE	DESCRIPTION	PRY.	DATE
AMH	2-19-69	Dimensions Added	TEM	9-9-75
KCT	5-8-69	Angle @ Pier 7	T.E.M.	9-5-75
		Major revisions	A.B.P.	8-25-78

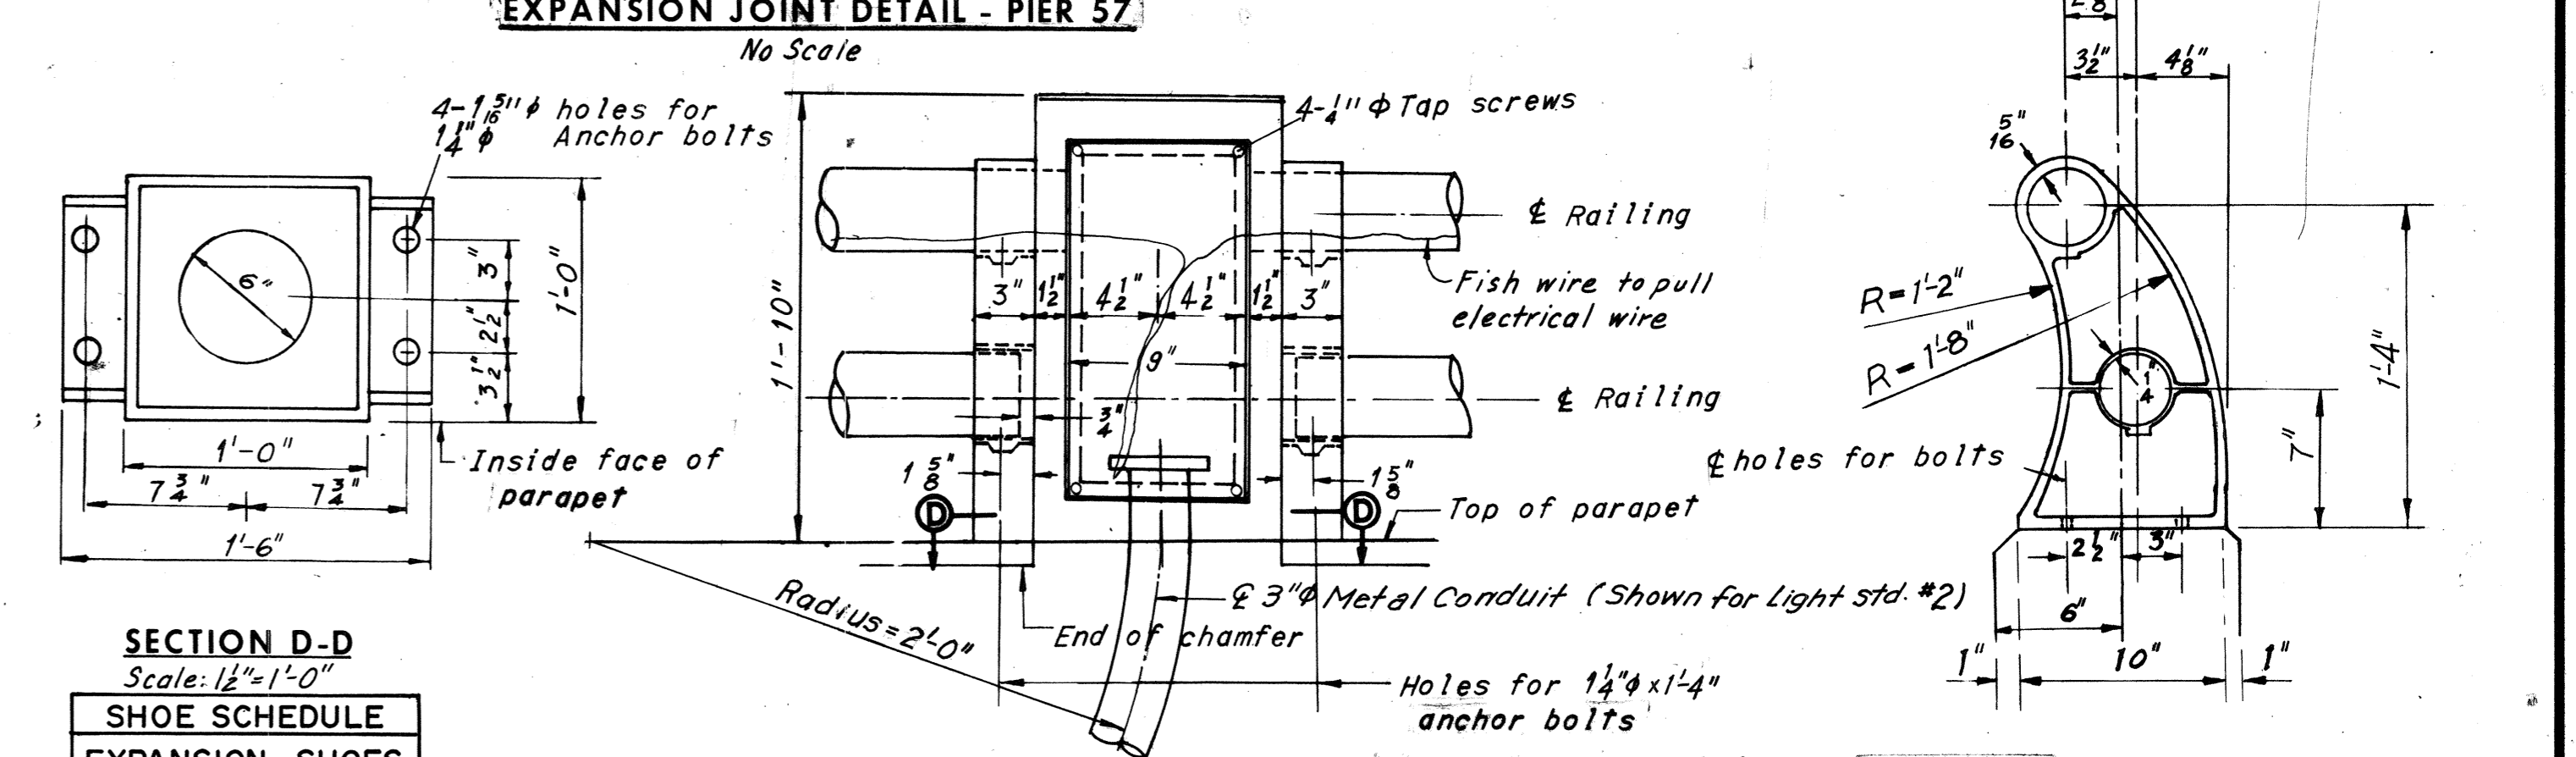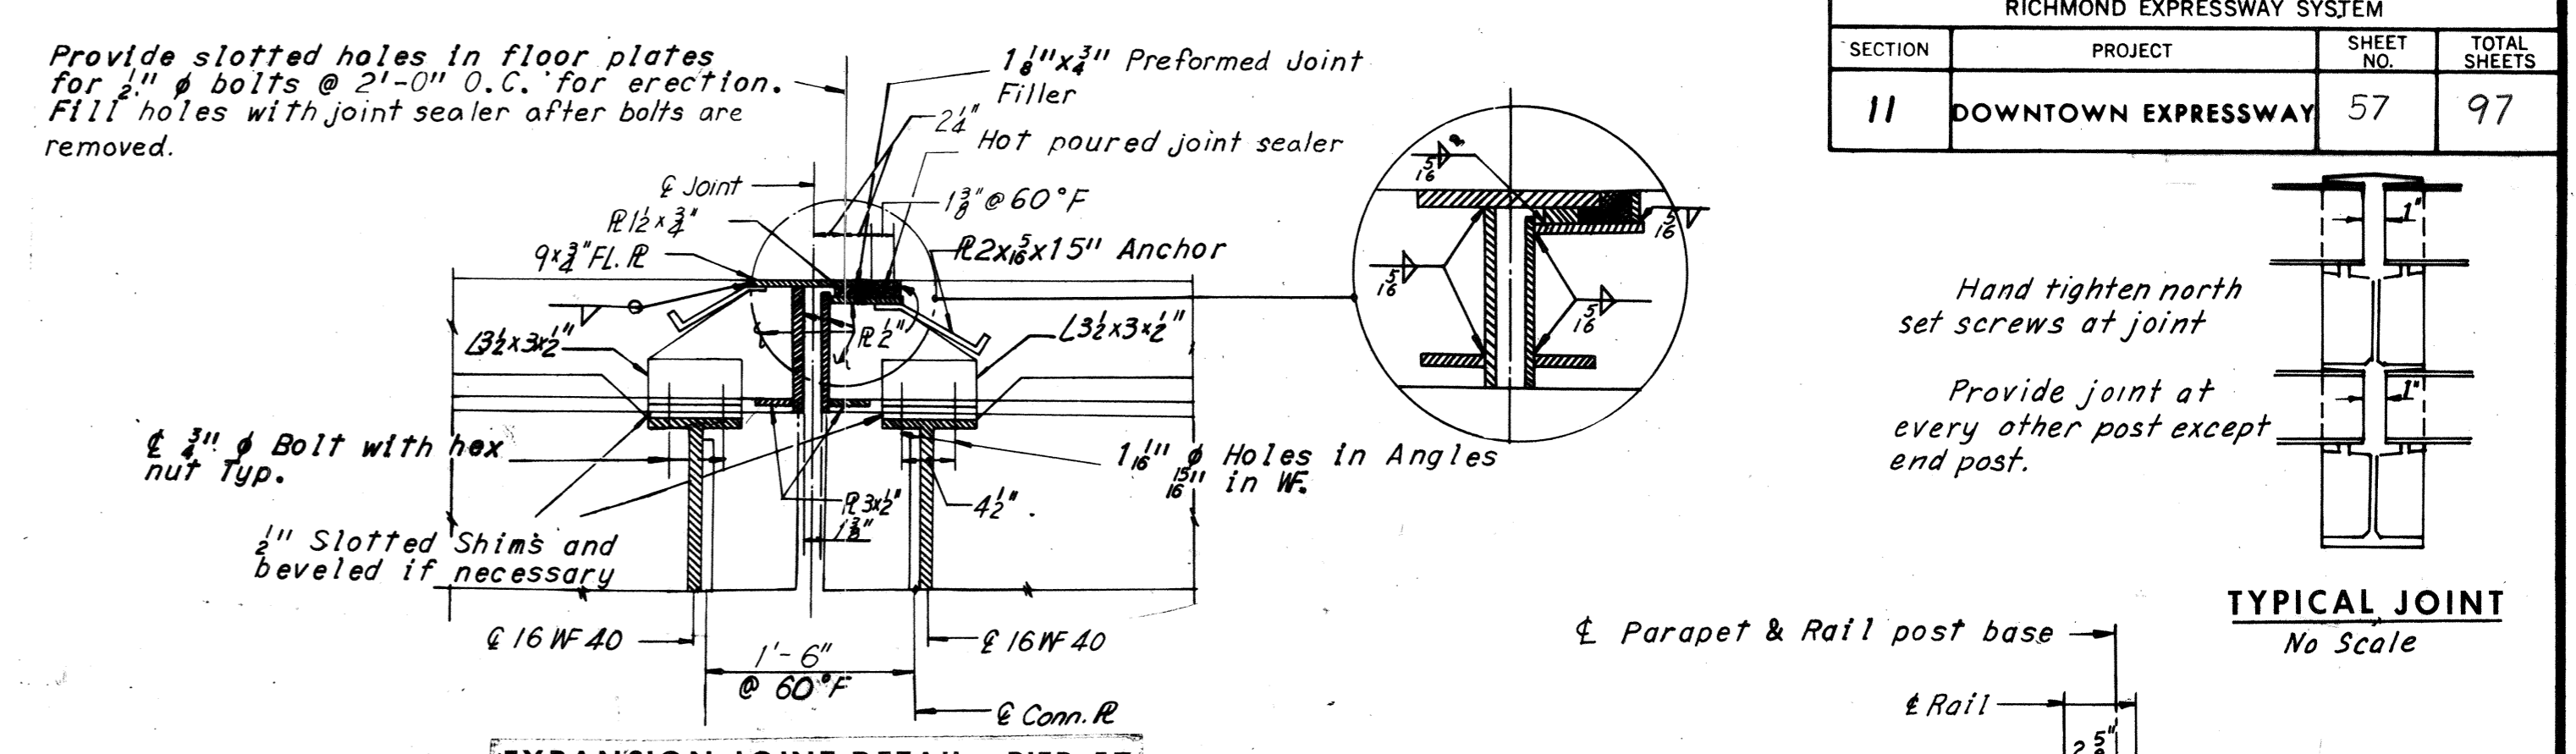

SECTION D-D
Scale: 1/2" = 1'-0"

SHOE SCHEDULE	
TYPE	NO. REQD.
EIM	3
EIK	1

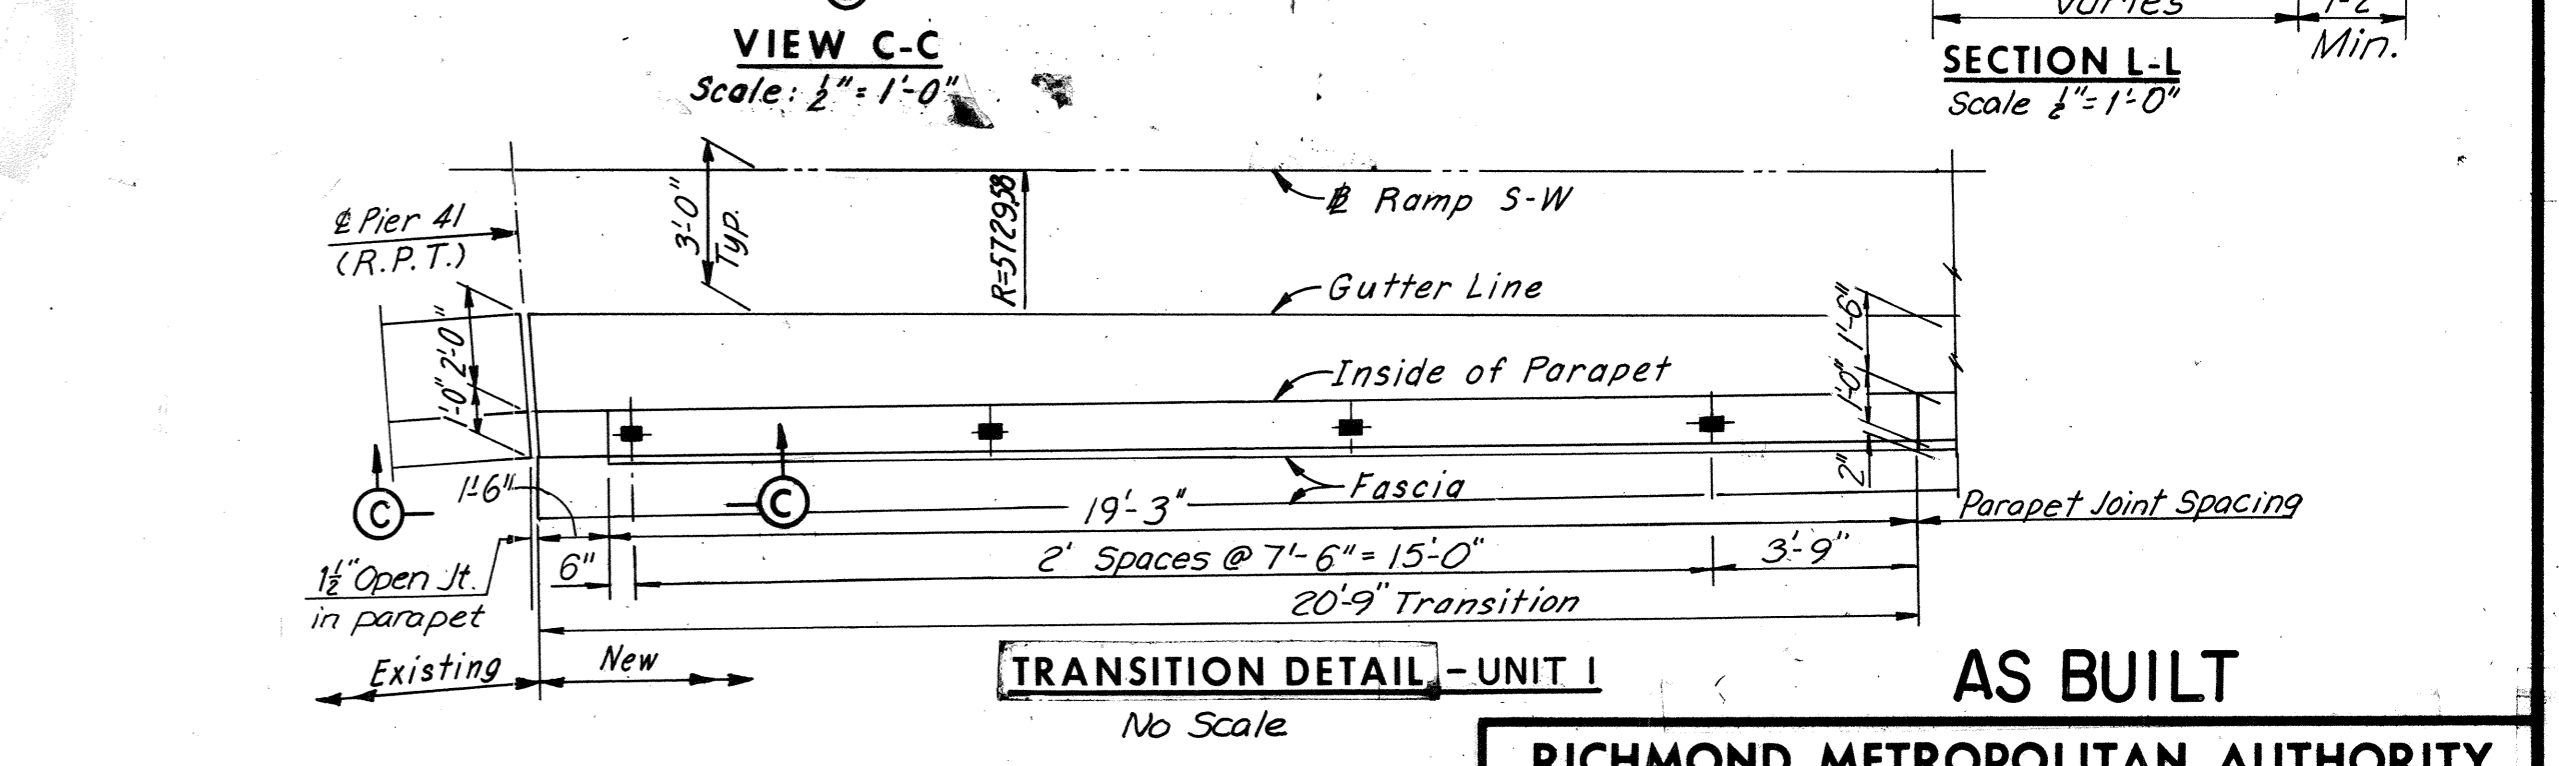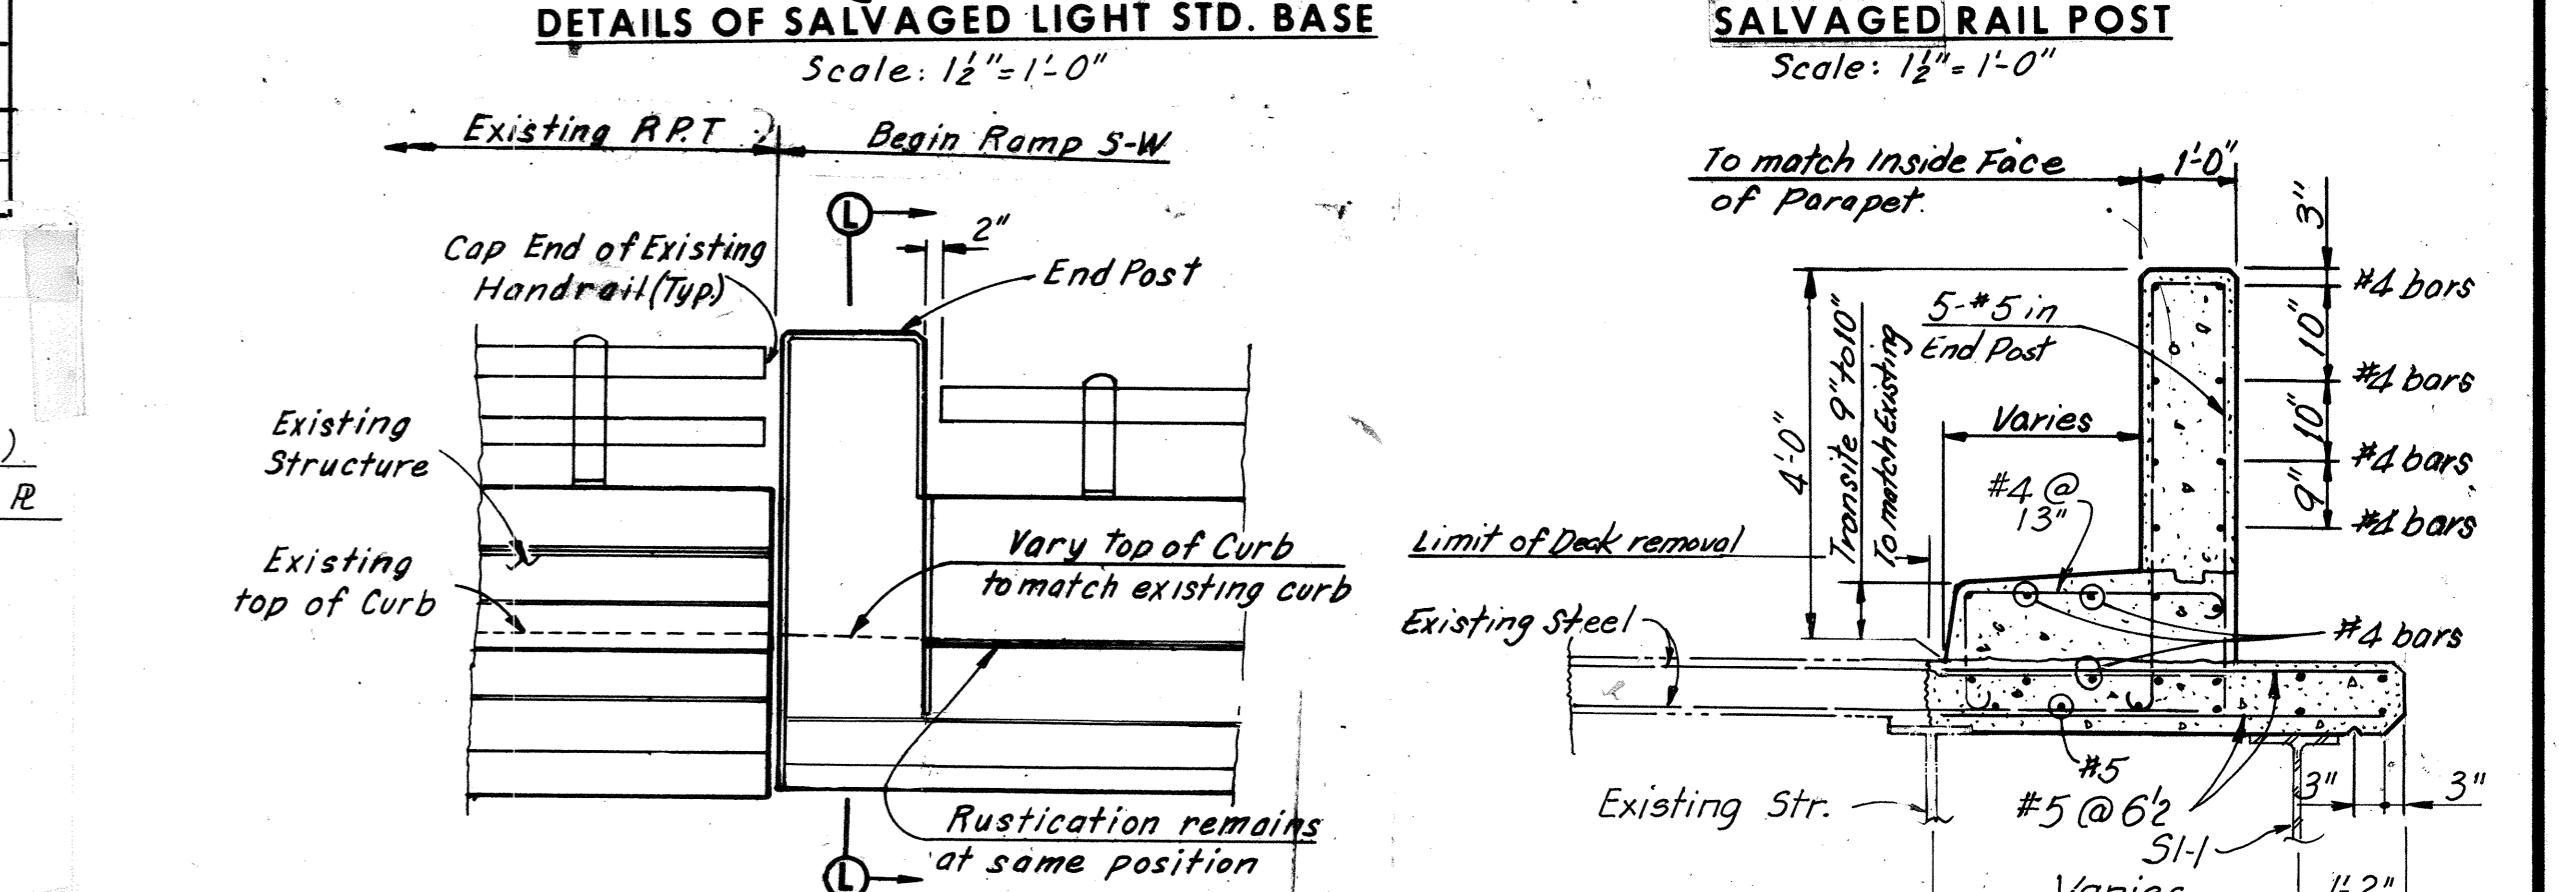

AS BUILT

RICHMOND METROPOLITAN AUTHORITY
RICHMOND EXPRESSWAY SYSTEM
DOWNTOWN EXPRESSWAY

BRIDGE NO. 65
RAMP S-W CONNECTION FROM
RICHMOND-PETERSBURG TURNPIKE
SUPERSTRUCTURE DETAILS

HOWARD, NEEDLES, TAMMEN & BERGENDOFF
consulting engineers
NEW YORK ALEXANDRIA KANSAS CITY

SCALE: As Noted
CONTRACT NO. 11
SHEET NO. 32 OF 38

ELASTOMERIC EXP. DAM ADJUSTMENT SCHEDULE									
TEMPERATURE AT TIME OF DECK LAYOUT									
120°									
100°									
80°									
60°									
40°									
20°									
0°									
BOLT SPACING DIM "X"	7 ⁵ / ₈ "	7 ⁷ / ₈ "	8 ¹ / ₈ "	8 ³ / ₈ "	8 ⁵ / ₈ "	8 ⁷ / ₈ "	9 ¹ / ₈ "	9 ³ / ₈ "	9 ⁵ / ₈ "
RECESS WIDTH DIM. "Y" (-0, +1/4")	9 ⁵ / ₈ "	9 ⁷ / ₈ "	10 ¹ / ₈ "	10 ³ / ₈ "	10 ⁵ / ₈ "	10 ⁷ / ₈ "	11 ¹ / ₈ "	11 ³ / ₈ "	11 ⁵ / ₈ "
SLAB OPENING DIM "W"	1"	1 ¹ / ₄ "	1 ¹ / ₂ "	1 ³ / ₄ "	2"	2 ¹ / ₄ "	2 ¹ / ₂ "	2 ³ / ₄ "	3"

NOTES
 *Dimension shown is at 60° F. For Dim. "W", "X" and "Y" adjustment due to temperature change, see Adjustment Schedule.

Reinforced Elastomeric Expansion Dam, Transflex type 200A or Onflex type 25, to be installed in accordance with the manufacturer's specifications. The manufacturer's representative shall be present during installation.

Shop drawings, showing complete details and dimensions of the dam and other pertinent information for installation of a practical leakproof joint, shall be prepared in accordance with these specifications. Review of shop drawings by the Engineer shall be required prior to installation of the expansion dam.

TRANSFLEX 200A


Curb and gutter sections shall be a one piece molded section or shall be pre-assembled by the manufacturer and all joints therein vulcanized.

Units of the dam shall have tongue and groove joints at the ends of all units to provide for a positive leakproof connection between adjacent units.


ONFLEX 25

Elastomeric membrane shall be one piece premolded unit extending full length of the aluminum extrusion.


Aluminum extrusions to be continuous with mitered and welded joints at the gutter lines.

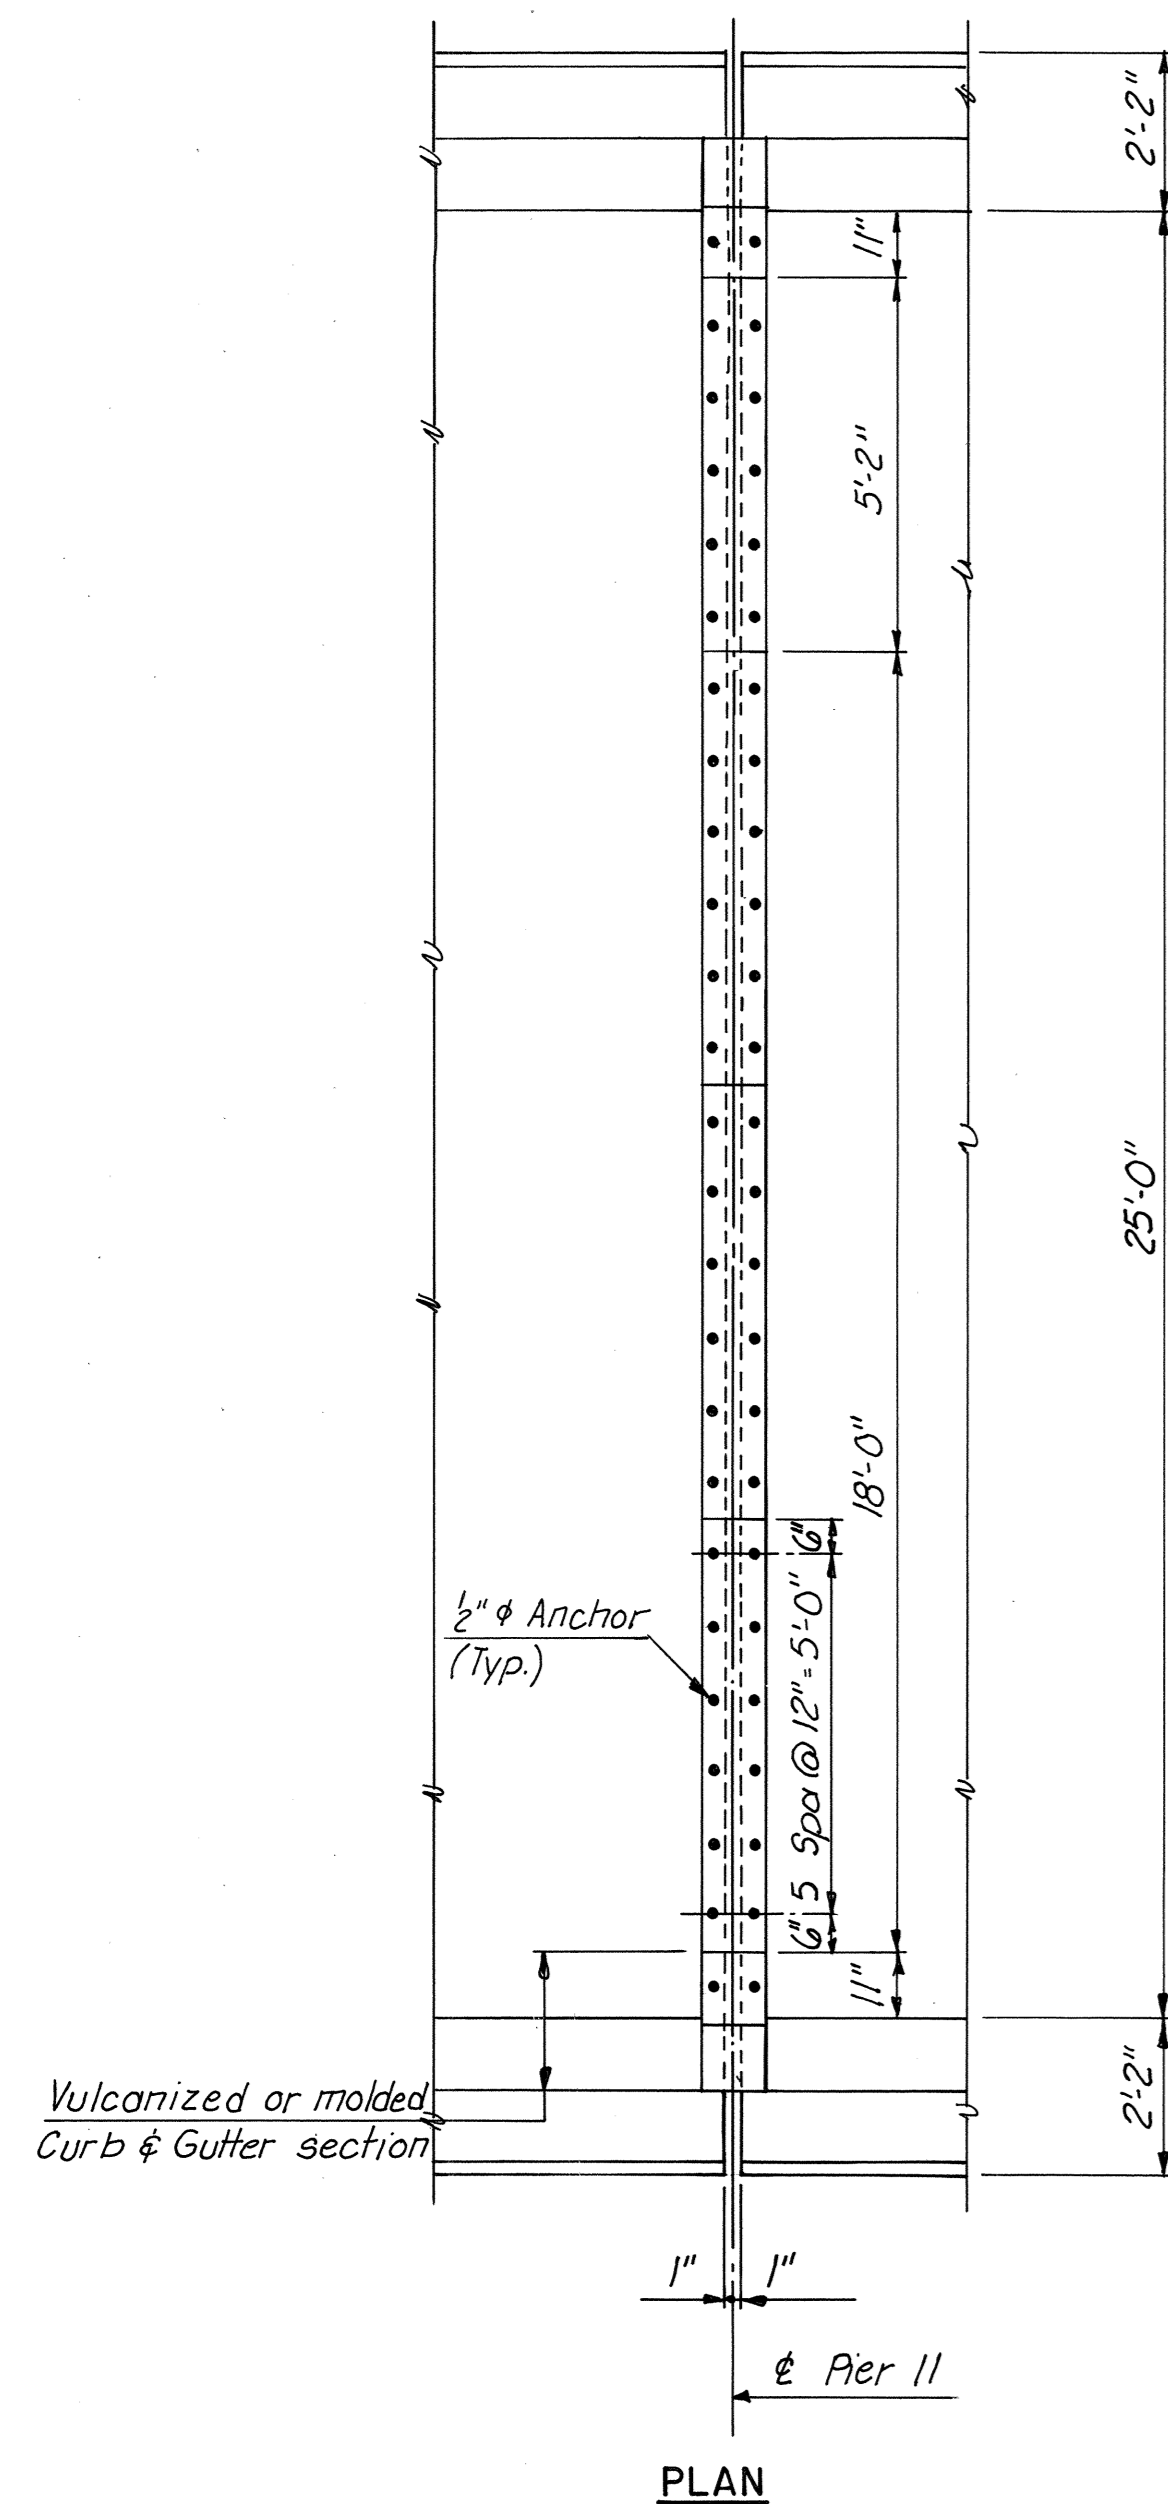


NOTE
 Plan is shown for Transflex 200A. Onflex 25 is similar except as noted under Notes Onflex 25.

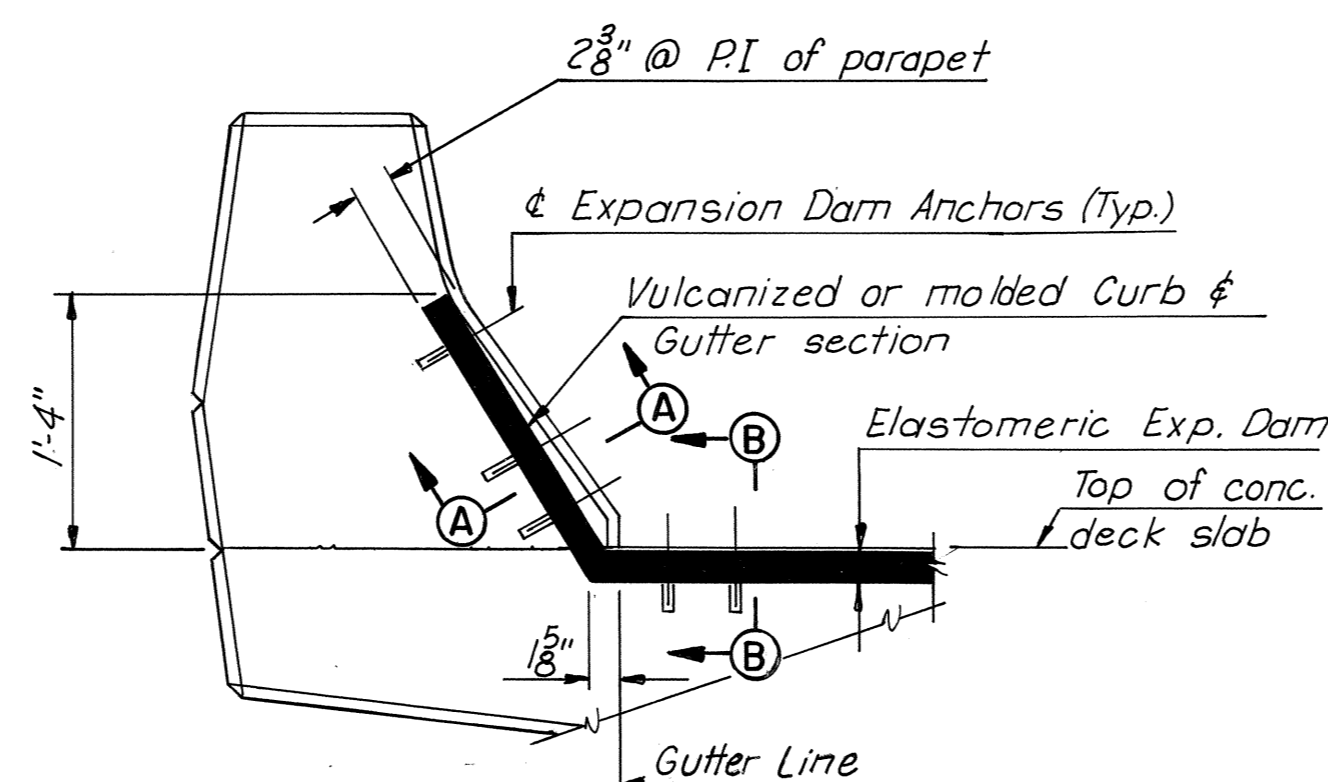

TYPICAL SECTION A-A

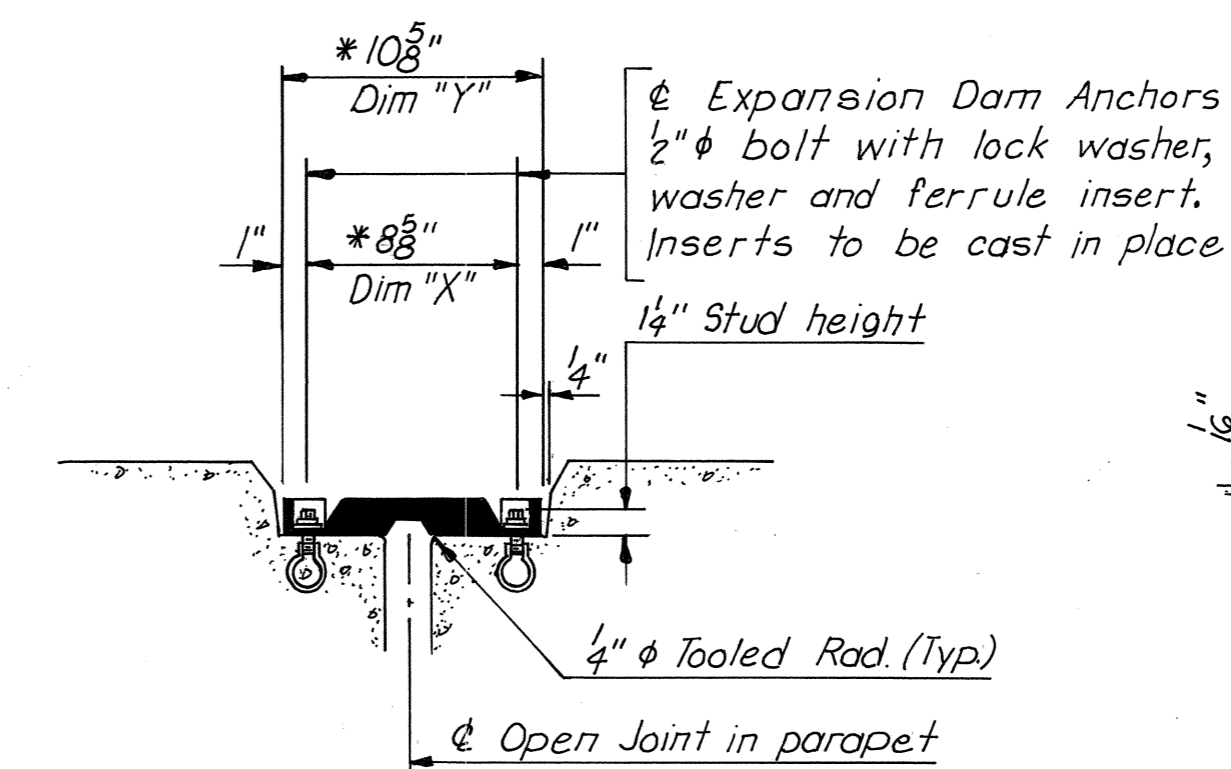


SECTION A-A

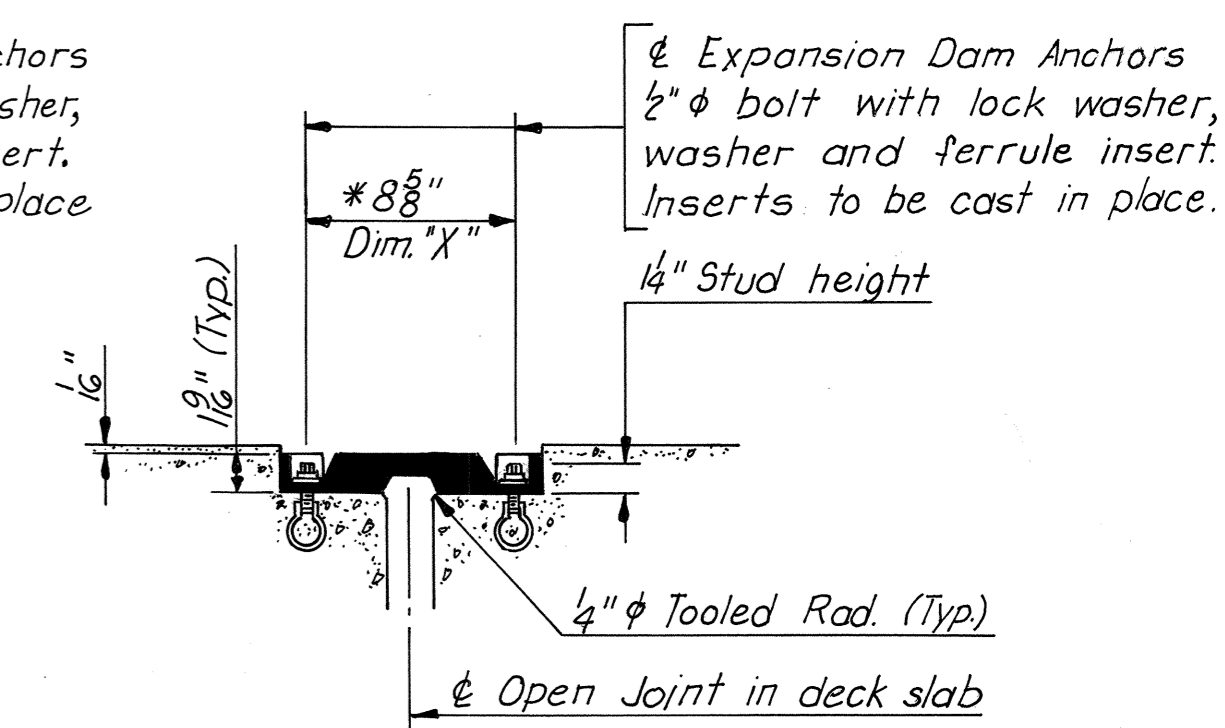


SECTION B-B

TRANSFLEX 200A JOINT DETAILS

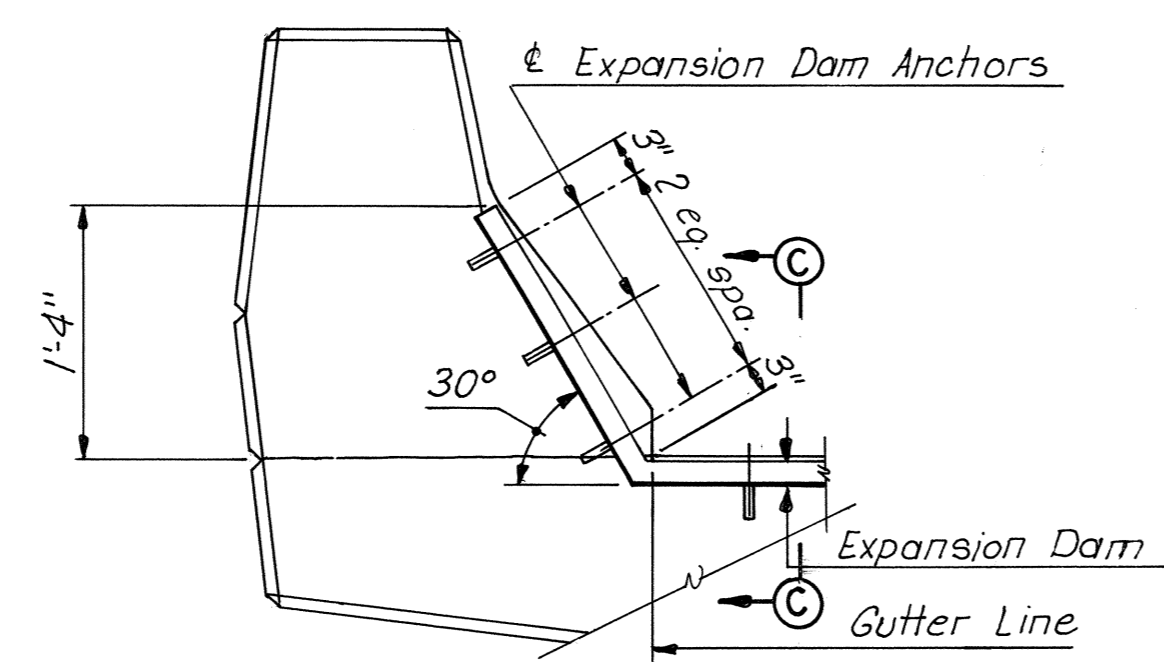

TYPICAL SECTION C-C

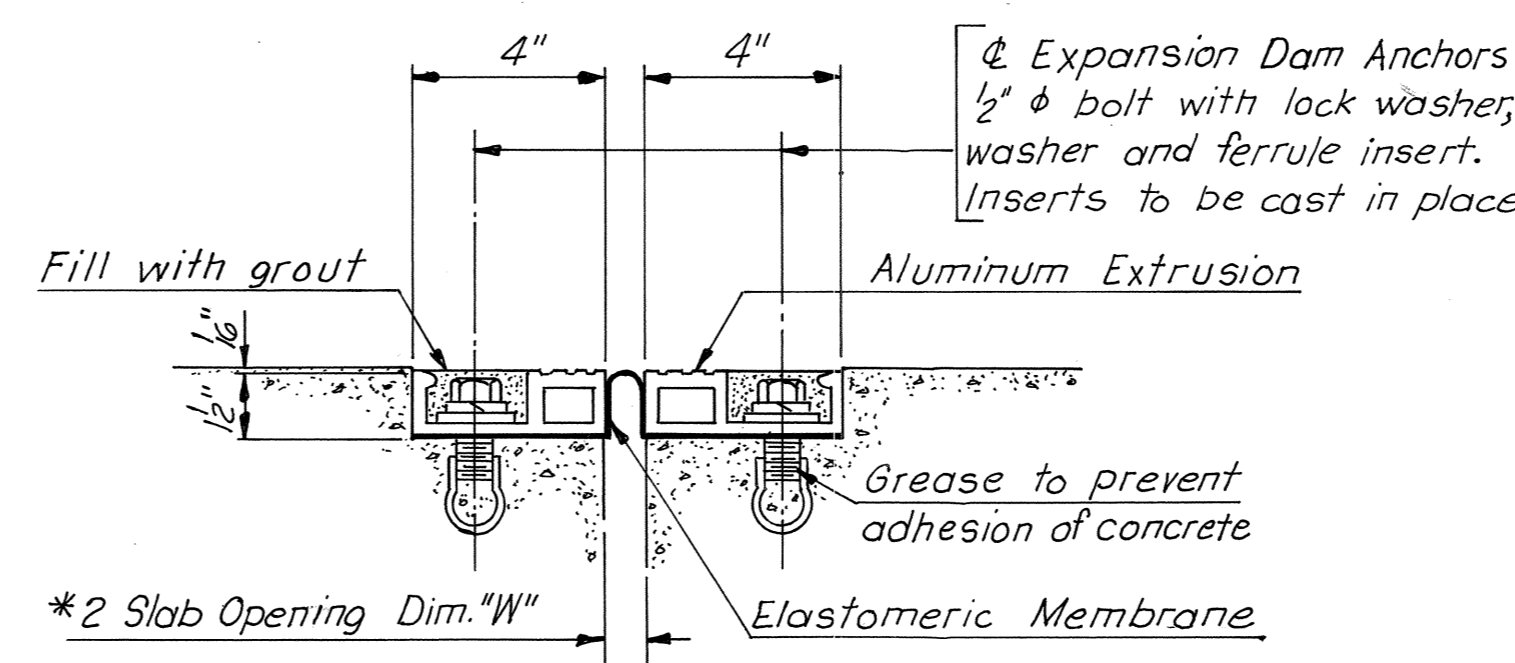

SECTION C-C

ONFLEX 25 JOINT DETAILS

DESIGNED					
DRAWN	TEM	9-30-76			
CHECKED			1 New Sheet	TEM	9-30-76
IN CHARGE			NO. REVISION	BY	DATE


AS BUILT
RICHMOND METROPOLITAN AUTHORITY
RICHMOND EXPRESSWAY SYSTEM
 DOWNTOWN EXPRESSWAY

BRIDGE NO. 65
 RAMP S-W CONNECTION FROM
 RICHMOND-PETERSBURG TURNPIKE
 JOINT DETAILS - PIER II

SCALE _____
 DATE _____ SHEET 34A OF _____


HOWARD, NEEDLES, TAMMEN & BERGENDOFF
 CONSULTING ENGINEERS
 Alexandria, Virginia **HNTB**

RICHMOND EXPRESSWAY SYSTEM			
SECTION	PROJECT	SHEET NO.	TOTAL SHEETS
11	DOWNTOWN EXPRESSWAY	59	97

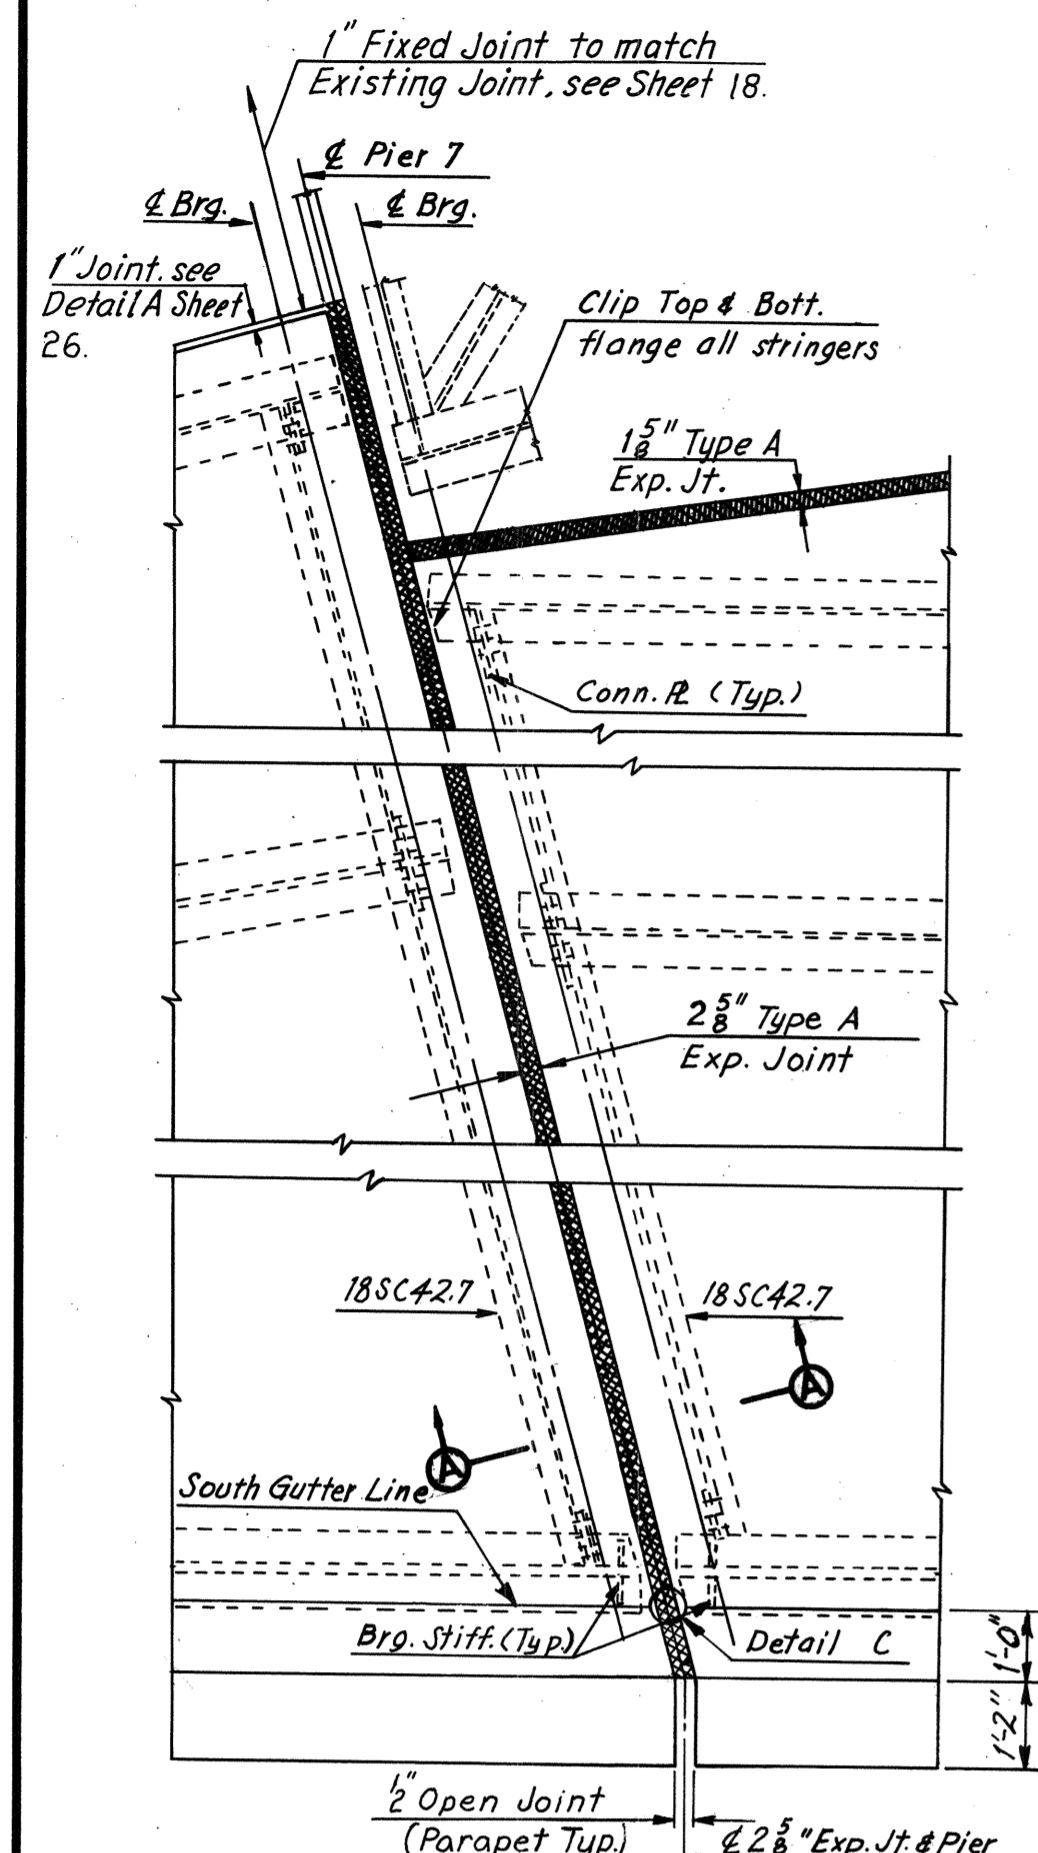


PLAN — JOINT AT PIER 7
Scale: 3/8" = 1'-0"


Note: For Detail C, See Sheet 35.

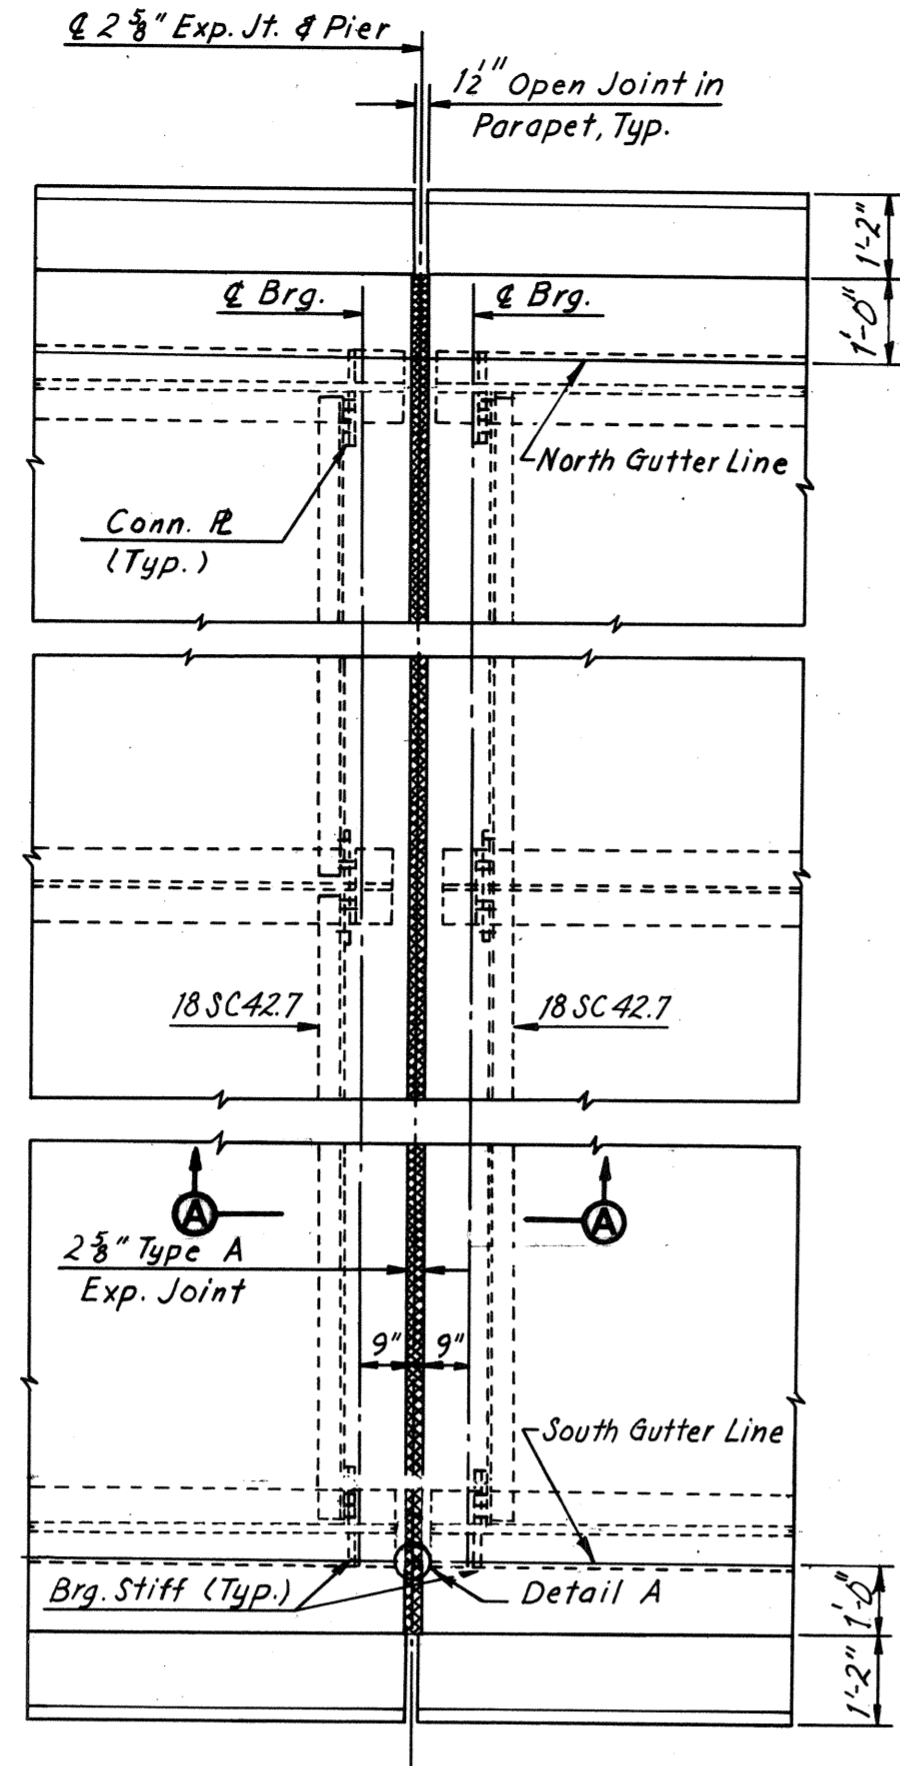


PLAN — JOINT AT PIERS 8, 9, 10, 17 AND 18
Scale: 3/8" = 1'-0"
(Piers 4 and 5 similar)

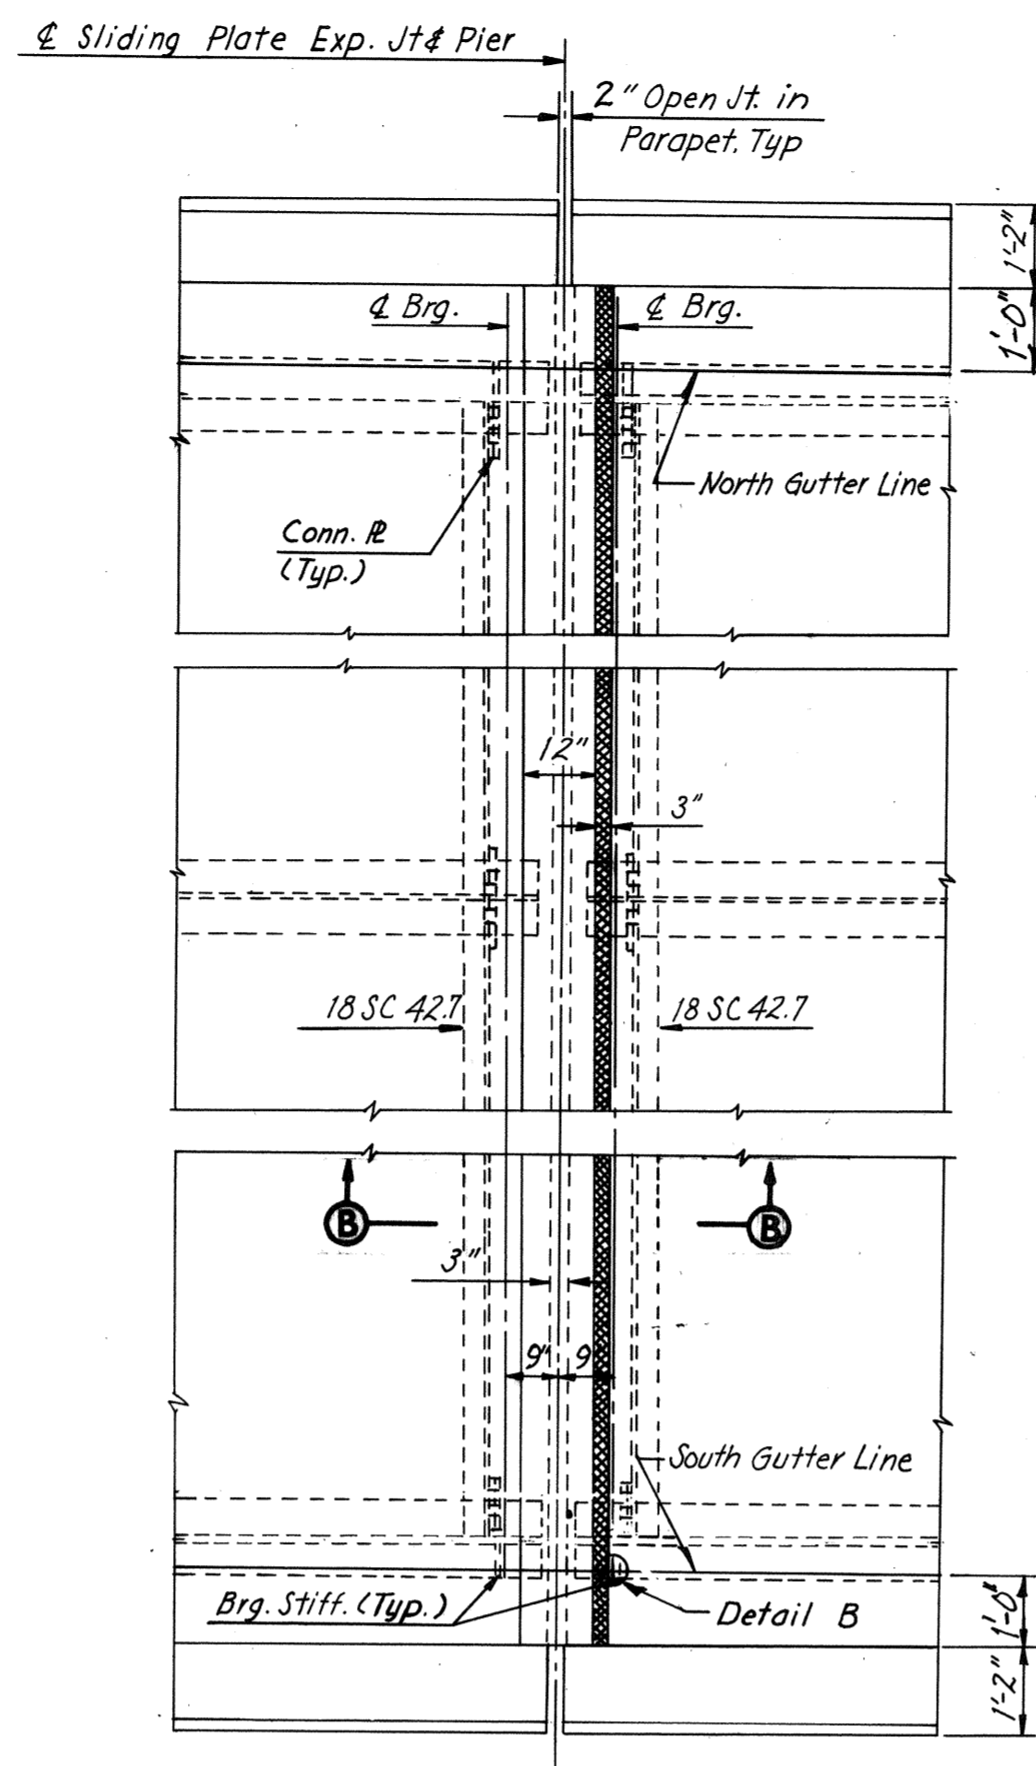


PLAN — JOINT AT PIER 11
Scale: 3/8" = 1'-0"

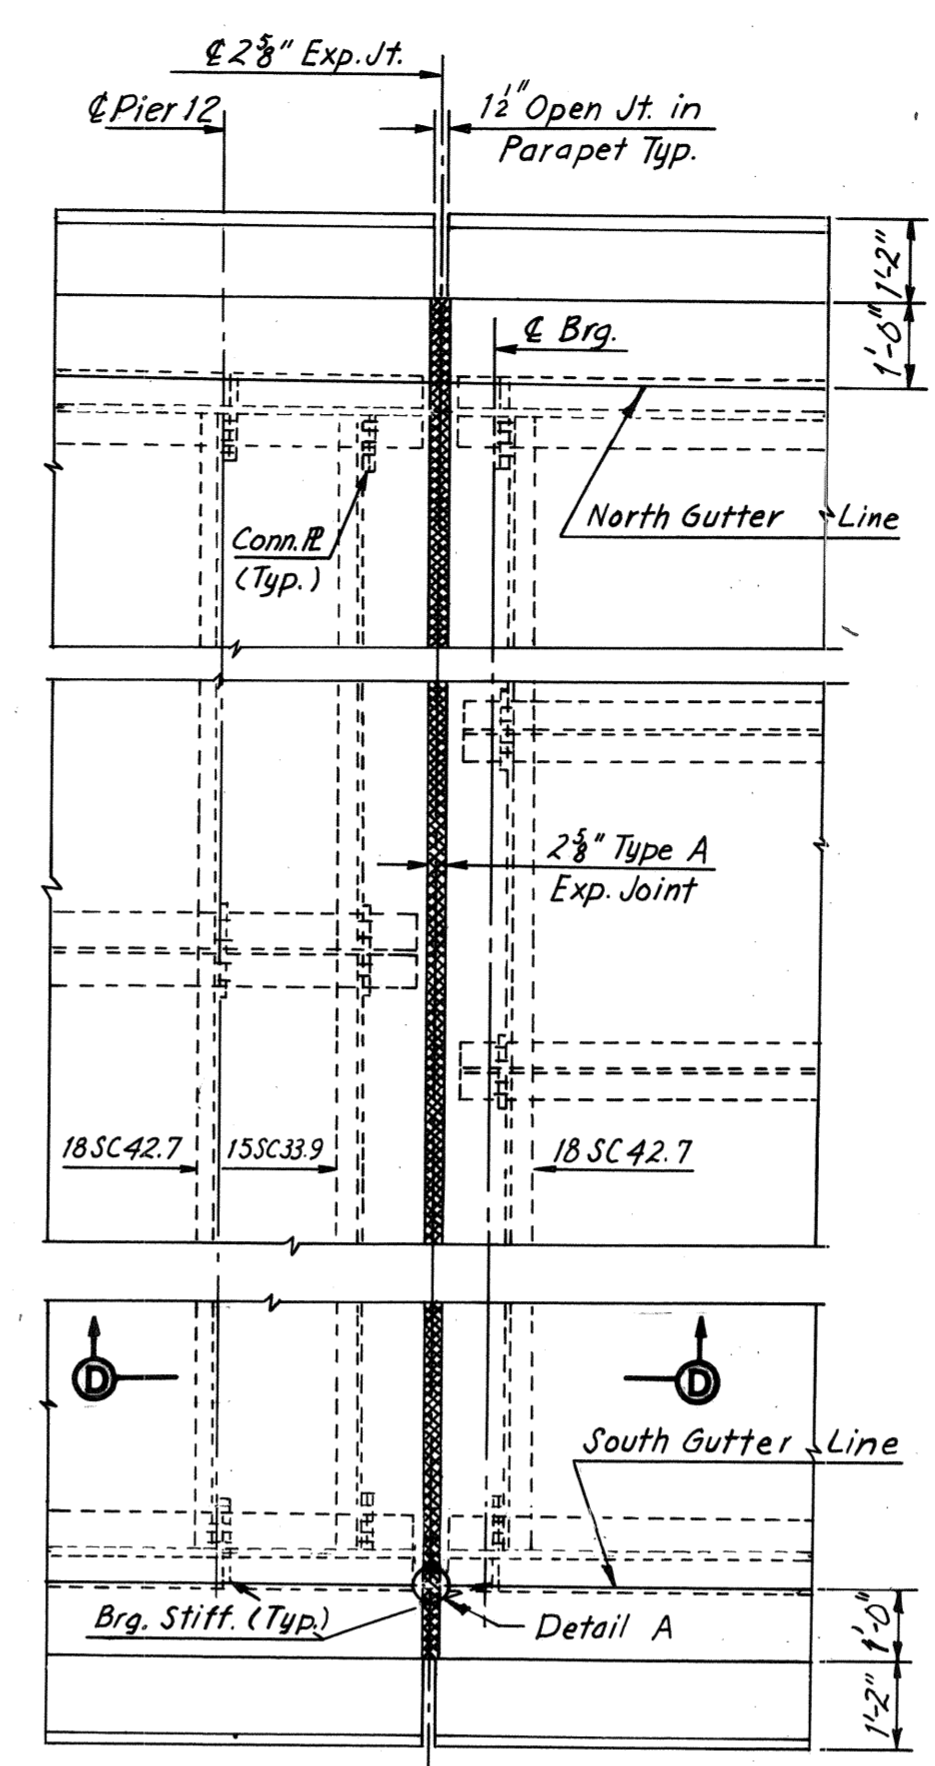


PLAN — JOINT AT PIER 12
Scale: 3/8" = 1'-0"

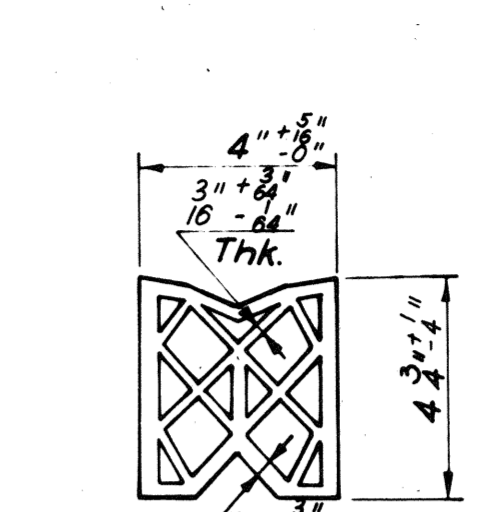


PREFORMED NEOPRENE JOINT SEALER FOR 2 3/8" TYPE "A" JOINT

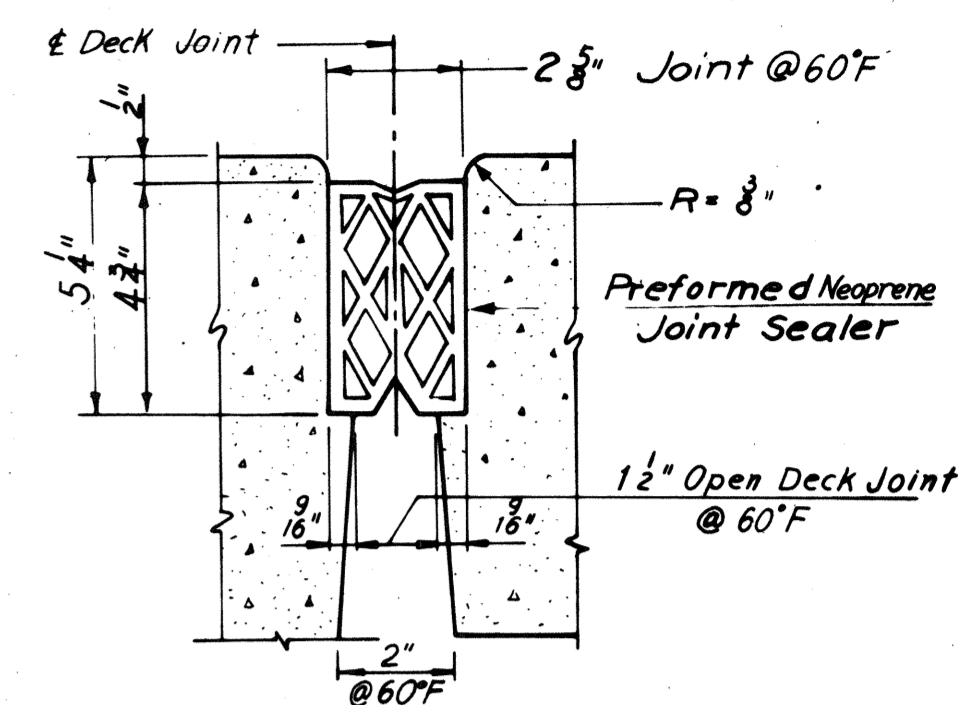


2 3/8" TYPE "A" JOINT

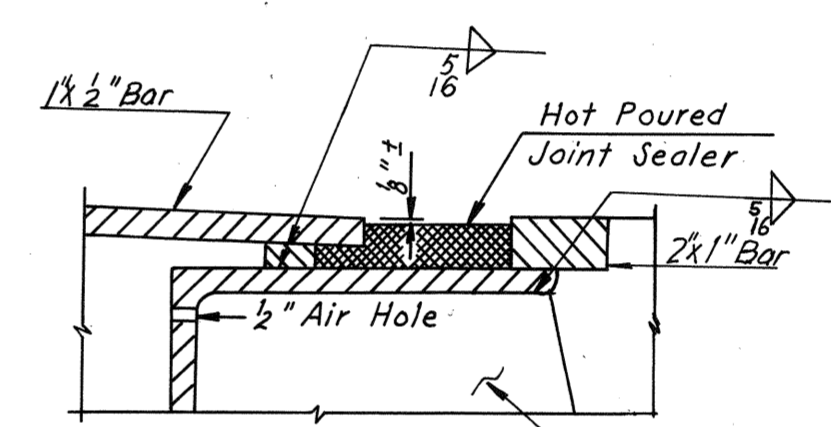

DETAIL B
Scale: 3/4" = 1'-0"

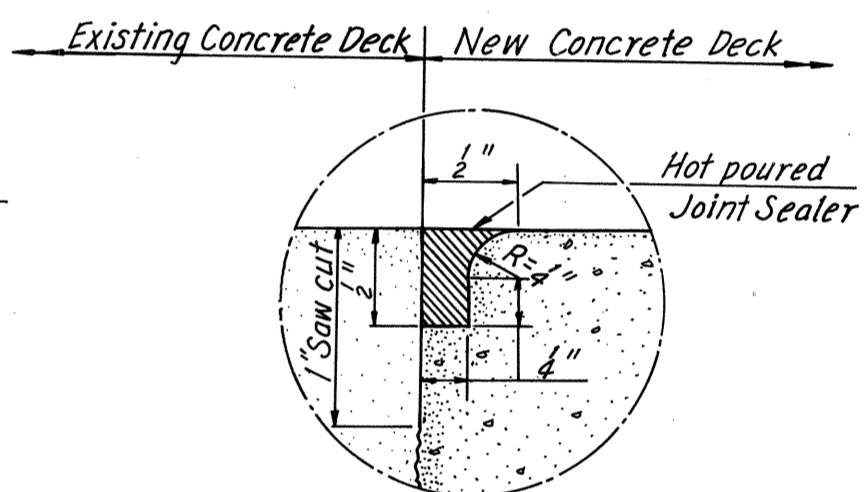


DETAIL D
Full Scale

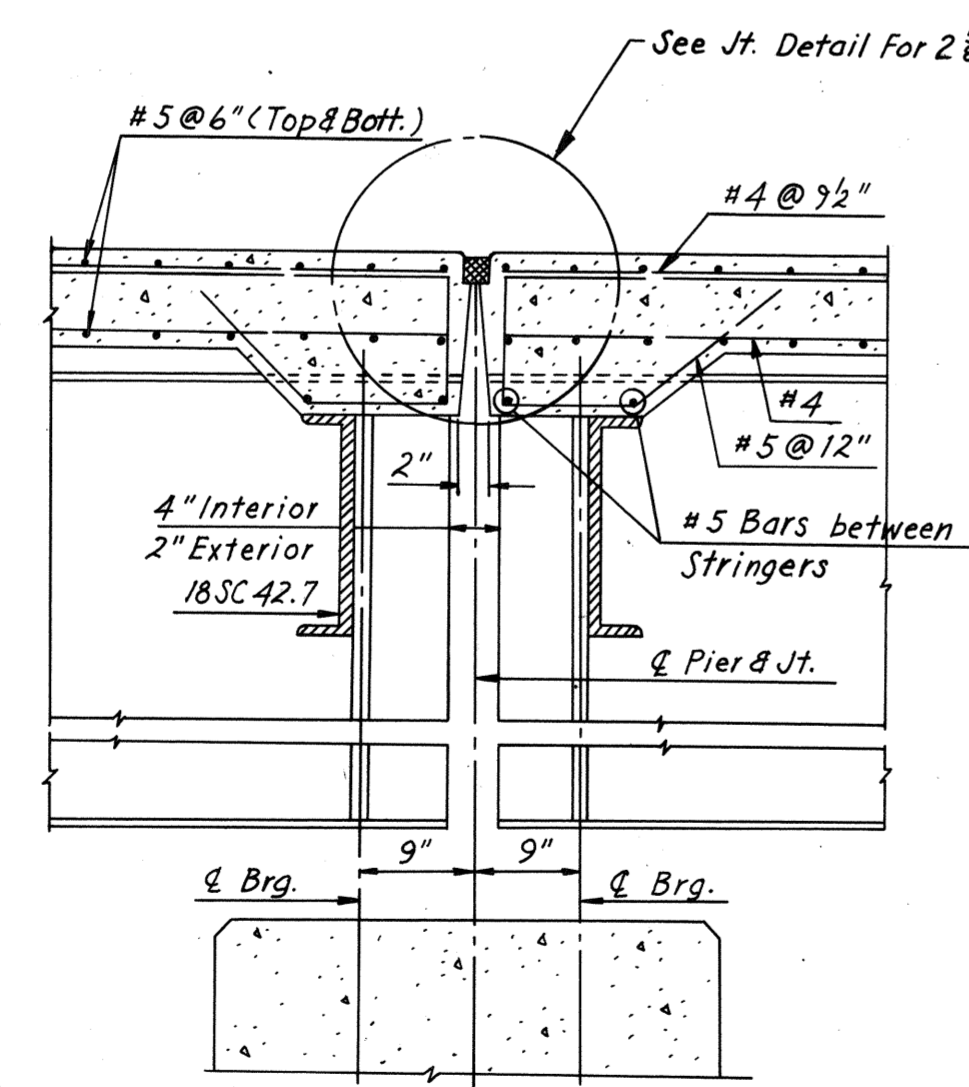


SECTION A-A
Scale: 3/4" = 1'-0"


For Piers 17 and 18 see Section C-C, Sheet 35.

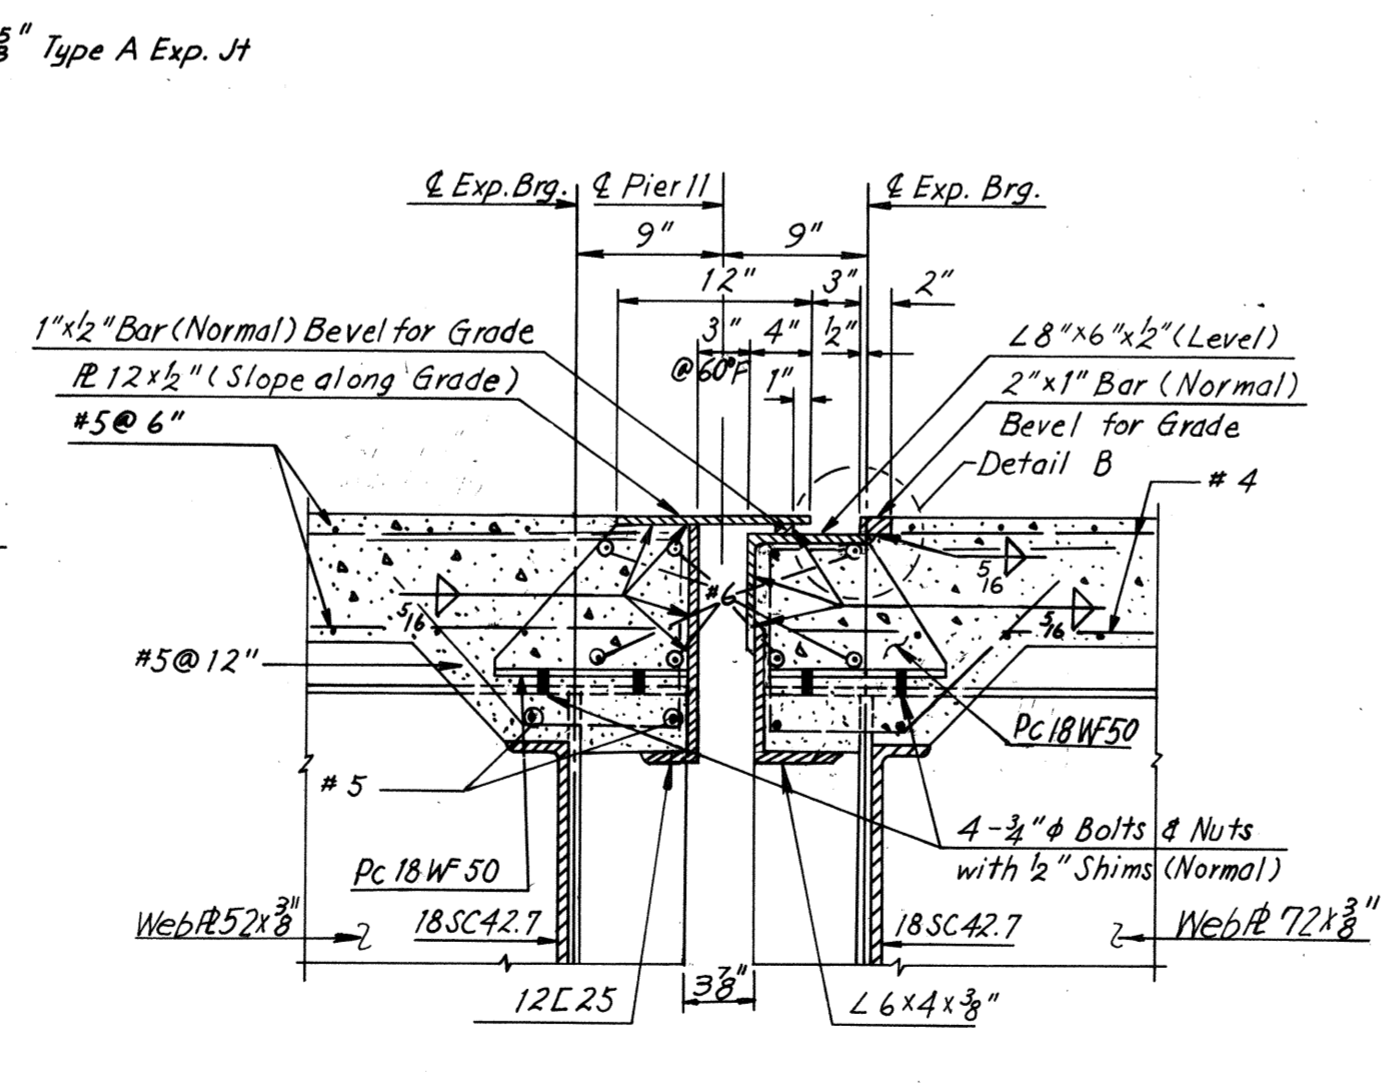

SECTION B-B
Scale: 1" = 1'-0"

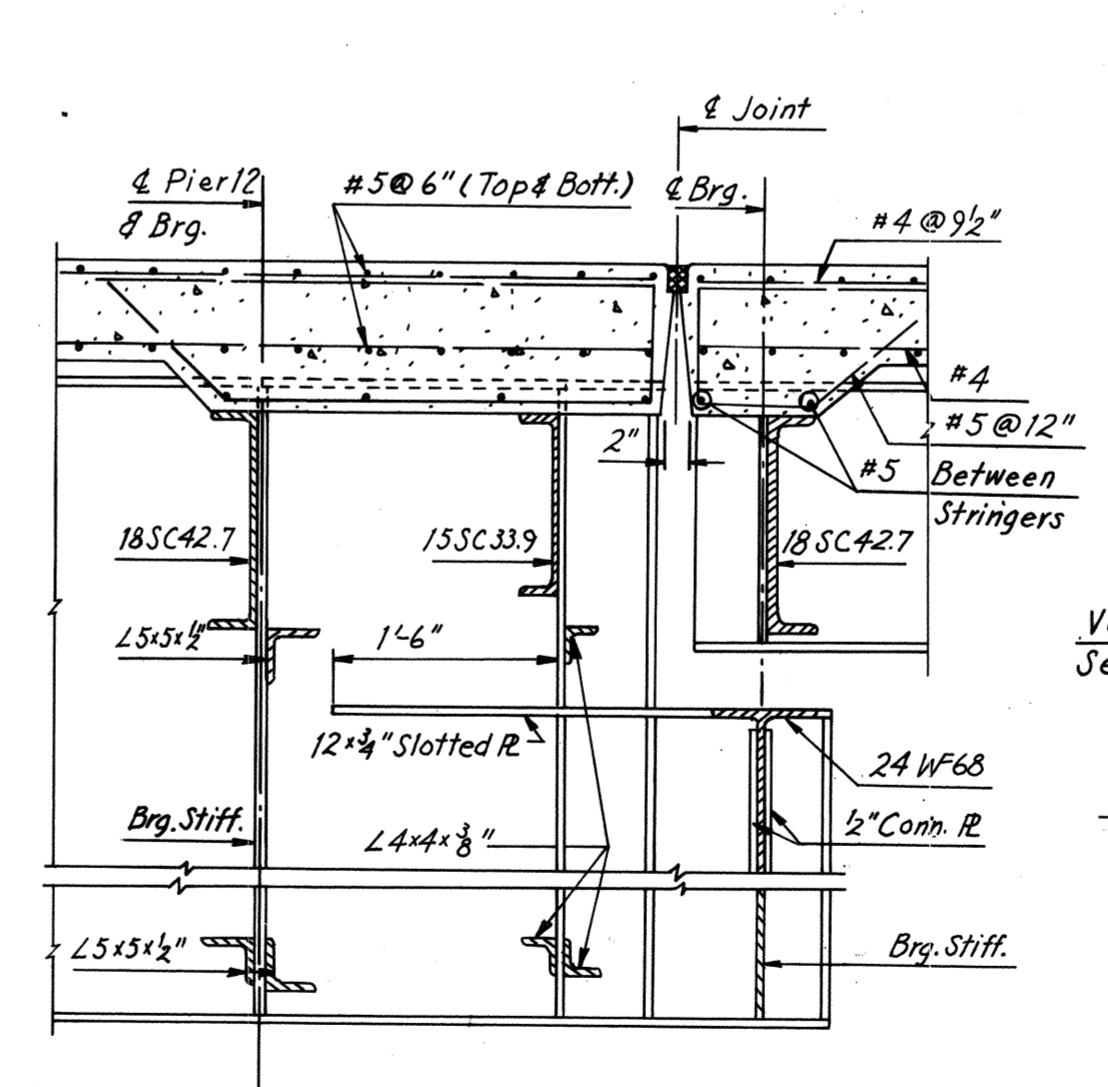

SECTION D-D
Scale: 3/4" = 1'-0"

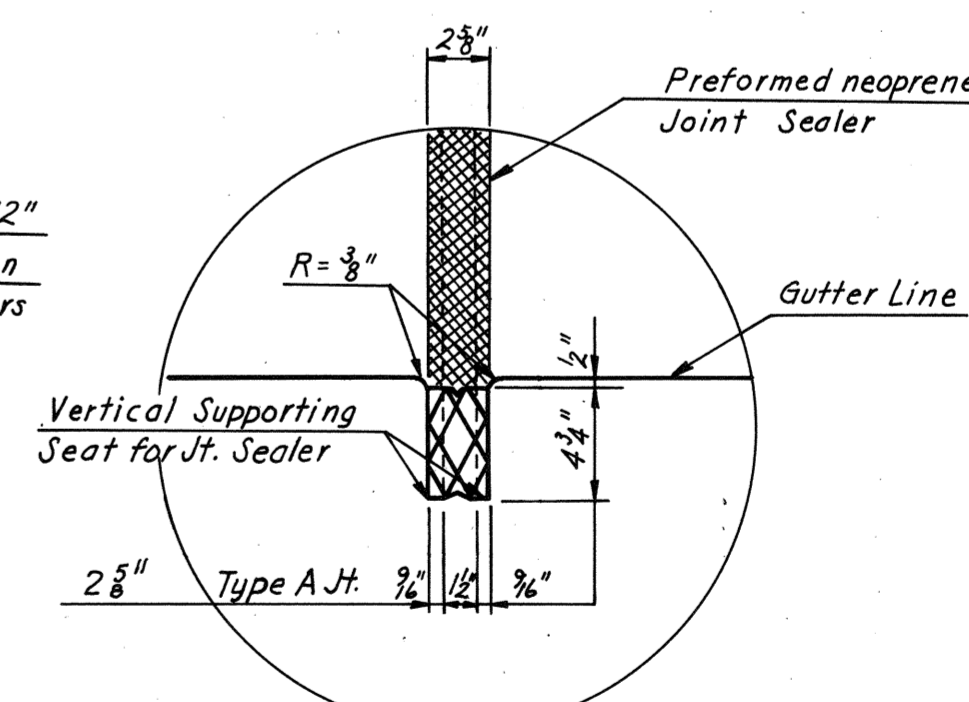

DETAIL A
No Scale

Note: It is absolutely essential that the openings for the preformed neoprene joint sealers be accurately formed and constructed to smooth, straight lines. The size of opening shall be adjusted to allow for anticipated dead load rotation of the ends of the slab and for the temperature at the time of construction.

Note: All horizontal dimensions shown above are normal to & Joint.

BY	DATE	NO.	REVISION	BY	DATE
MADE	Y.C.P.	12-18-68			
CHECKED	G.S.H.	1-29-69			
IN CHARGE					


AS BUILT

RICHMOND METROPOLITAN AUTHORITY
RICHMOND EXPRESSWAY SYSTEM
DOWNTOWN EXPRESSWAY


BRIDGE NO. 65
RAMP S-W CONNECTION FROM
RICHMOND-PETERSBURG TURNPIKE
JOINT DETAILS

HOWARD, NEEDLES, TAMMEN & BERGENDOFF
consulting engineers
NEW YORK ALEXANDRIA KANSAS CITY


SCALE: As Noted
CONTRACT NO. 11
SHEET NO. 34 OF 38

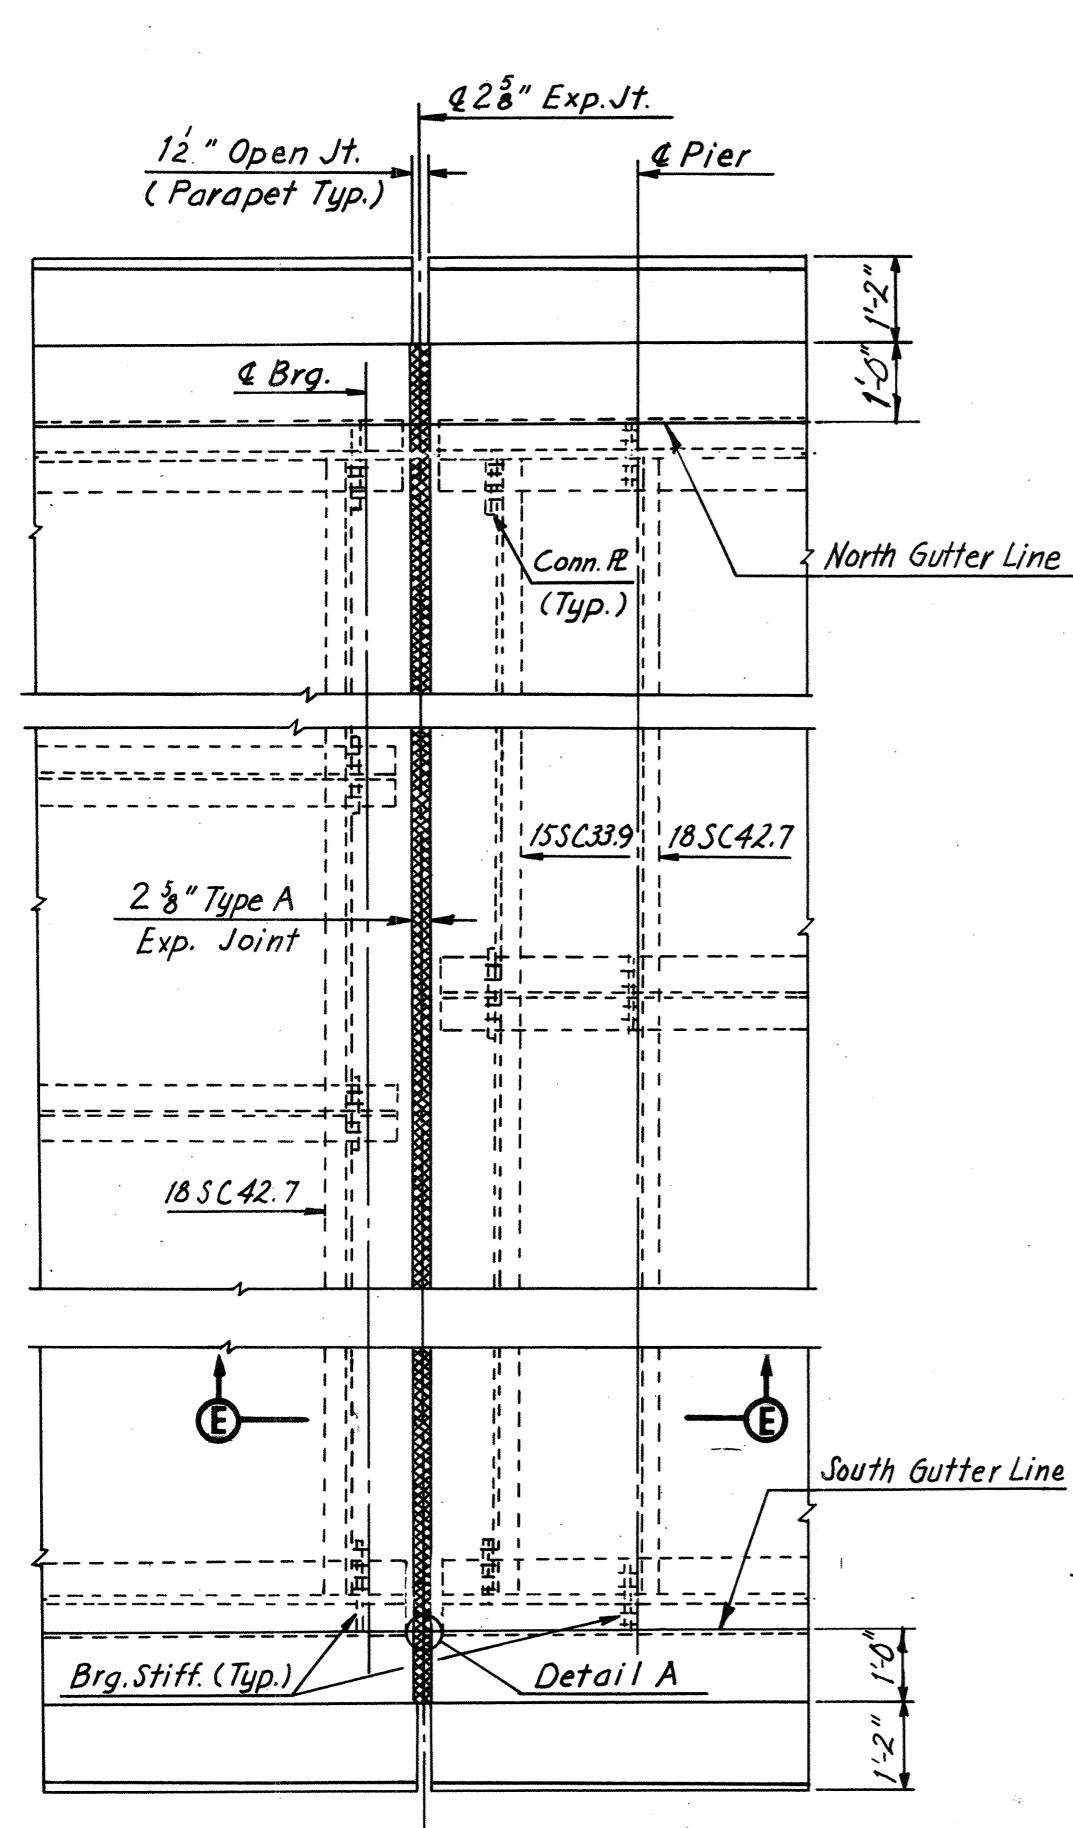


PLAN — JOINT AT PIER 13
Scale: 3/8" = 1'-0"

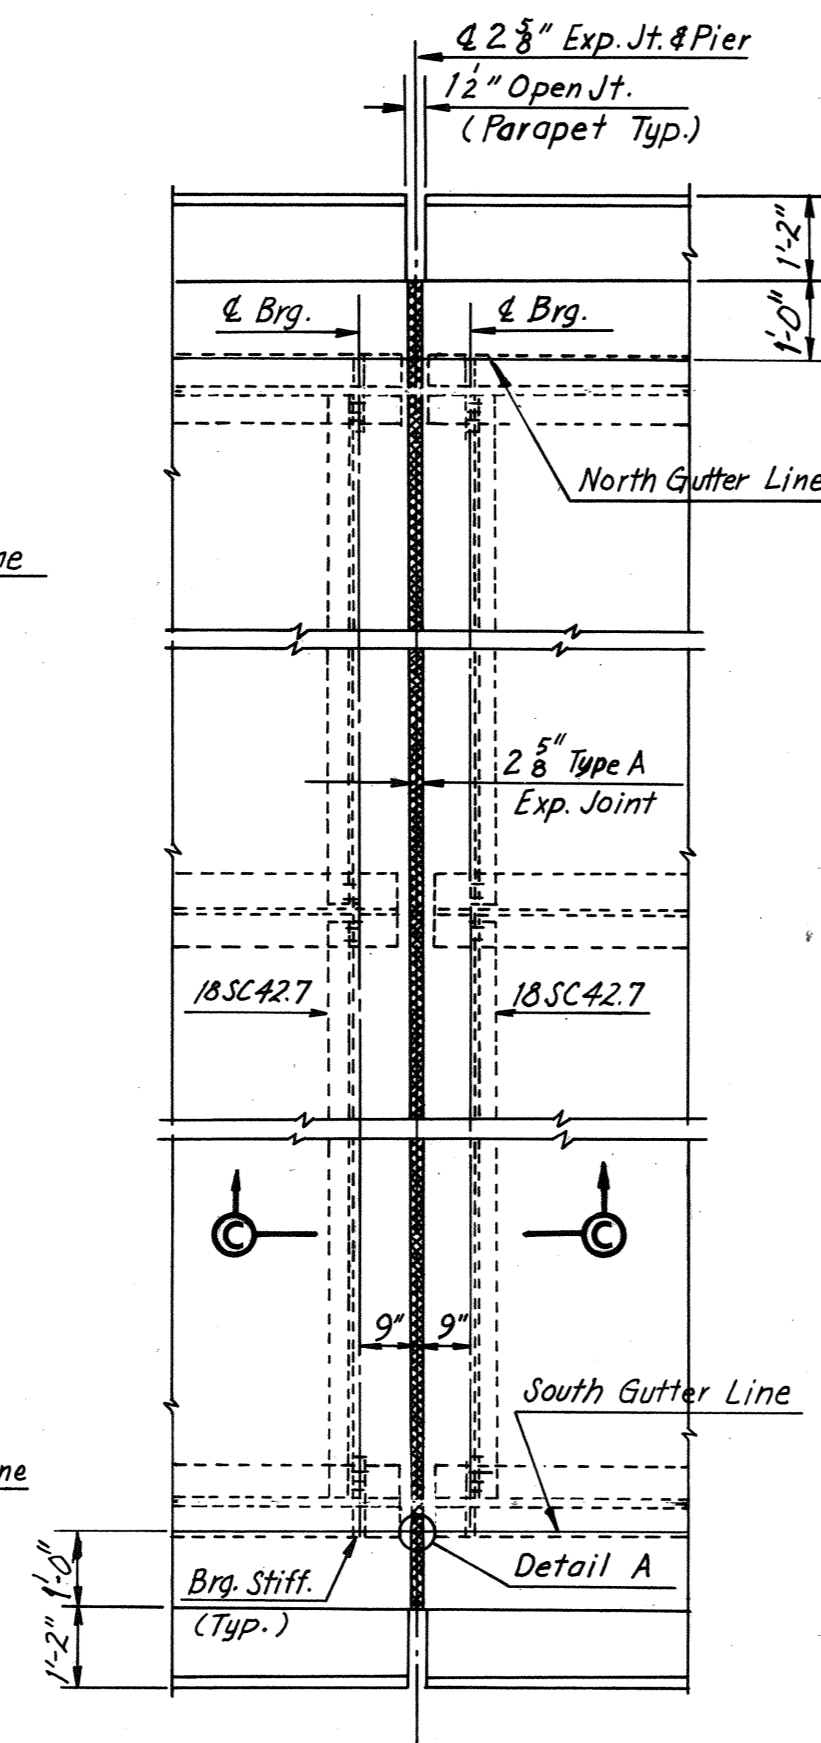

PLAN — JOINT AT PIERS 14, 15 AND 16
Scale: 3/8" = 1'-0"

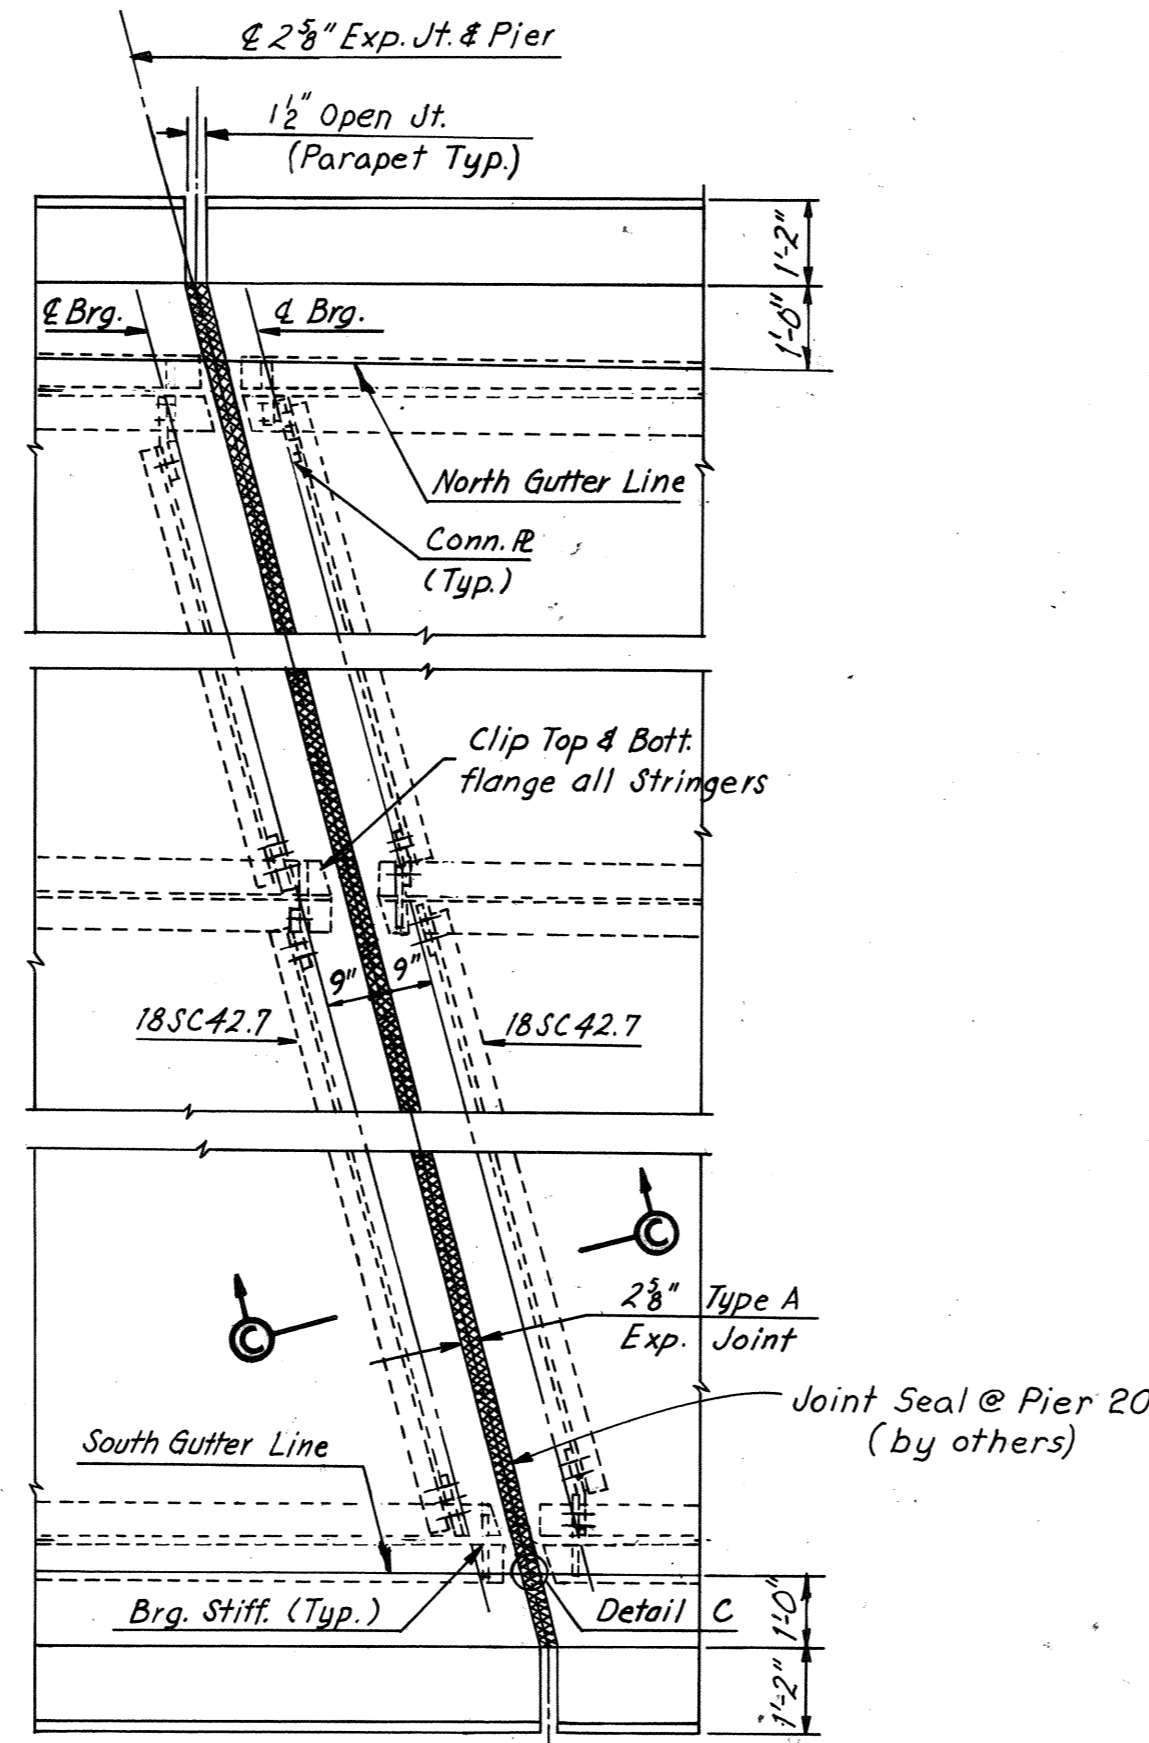


PLAN — JOINT AT PIERS 19 AND 20
Scale: 3/8" = 1'-0"

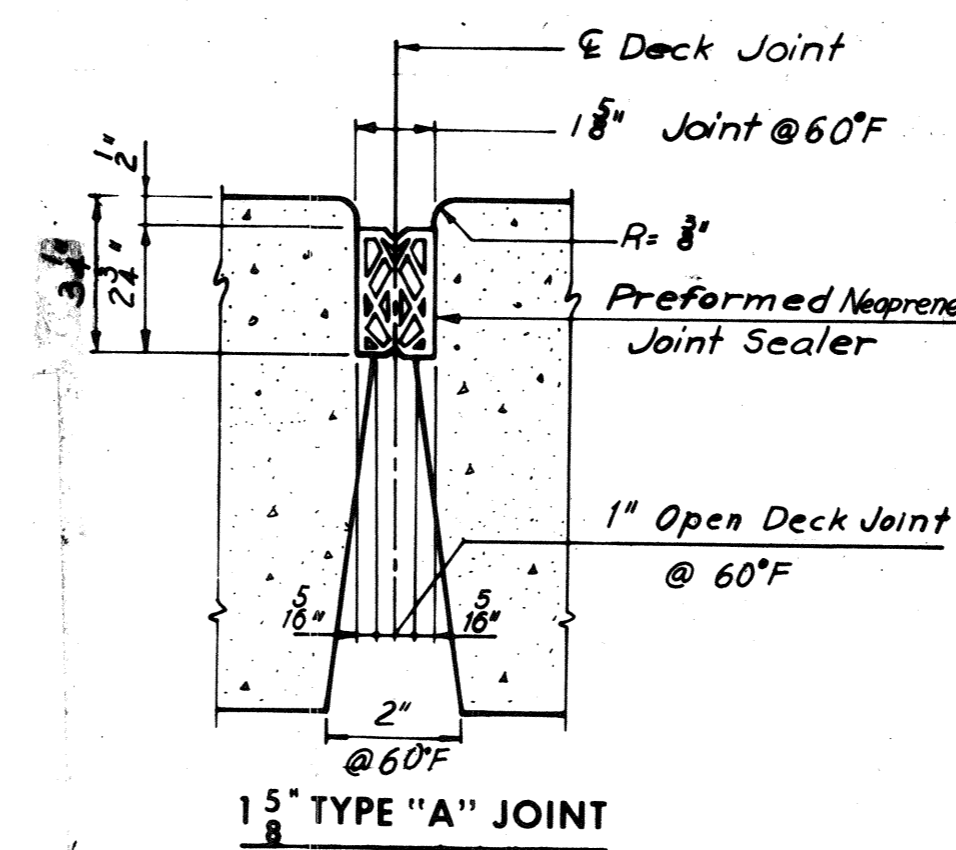


1 1/2" TYPE "A" JOINT
PREFORMED NEOPRENE JOINT SEALER
FOR 1 1/2" TYPE "A" JOINT

Curb portion of existing expansion joints is to be removed beyond the curbline an amount sufficient for performance of single bevel groove weld between existing and new pair of L's 4x3 1/2". The weld is to be finished flush with the angles on roadway face of joint.

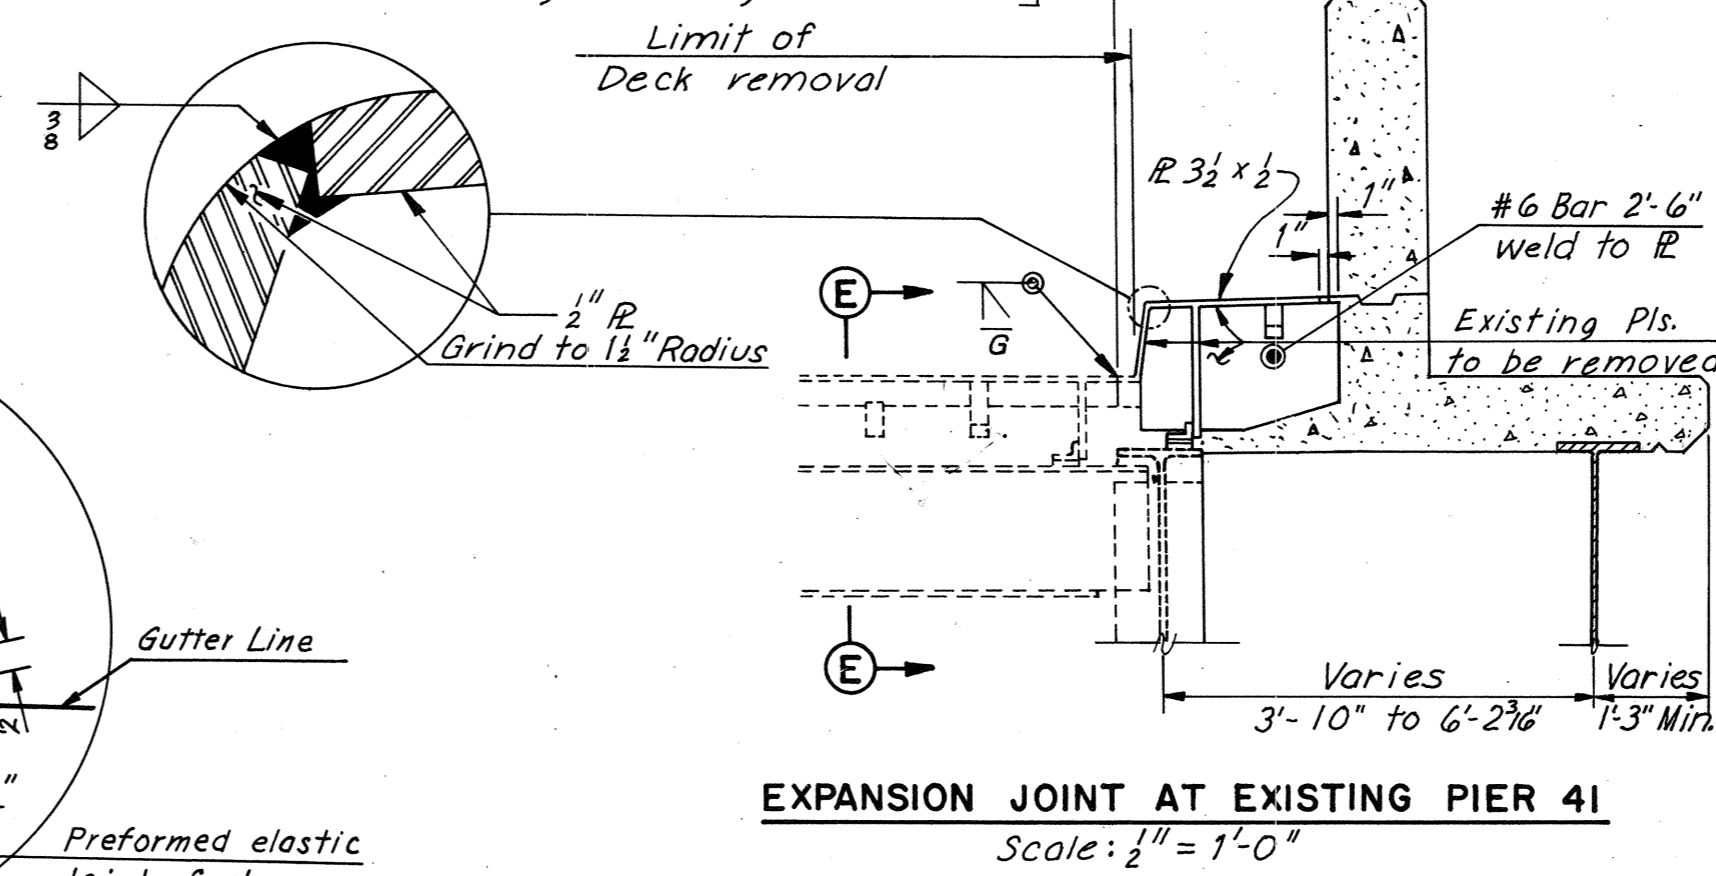


EXPANSION JOINT AT EXISTING PIER 41
Scale: 1/2" = 1'-0"

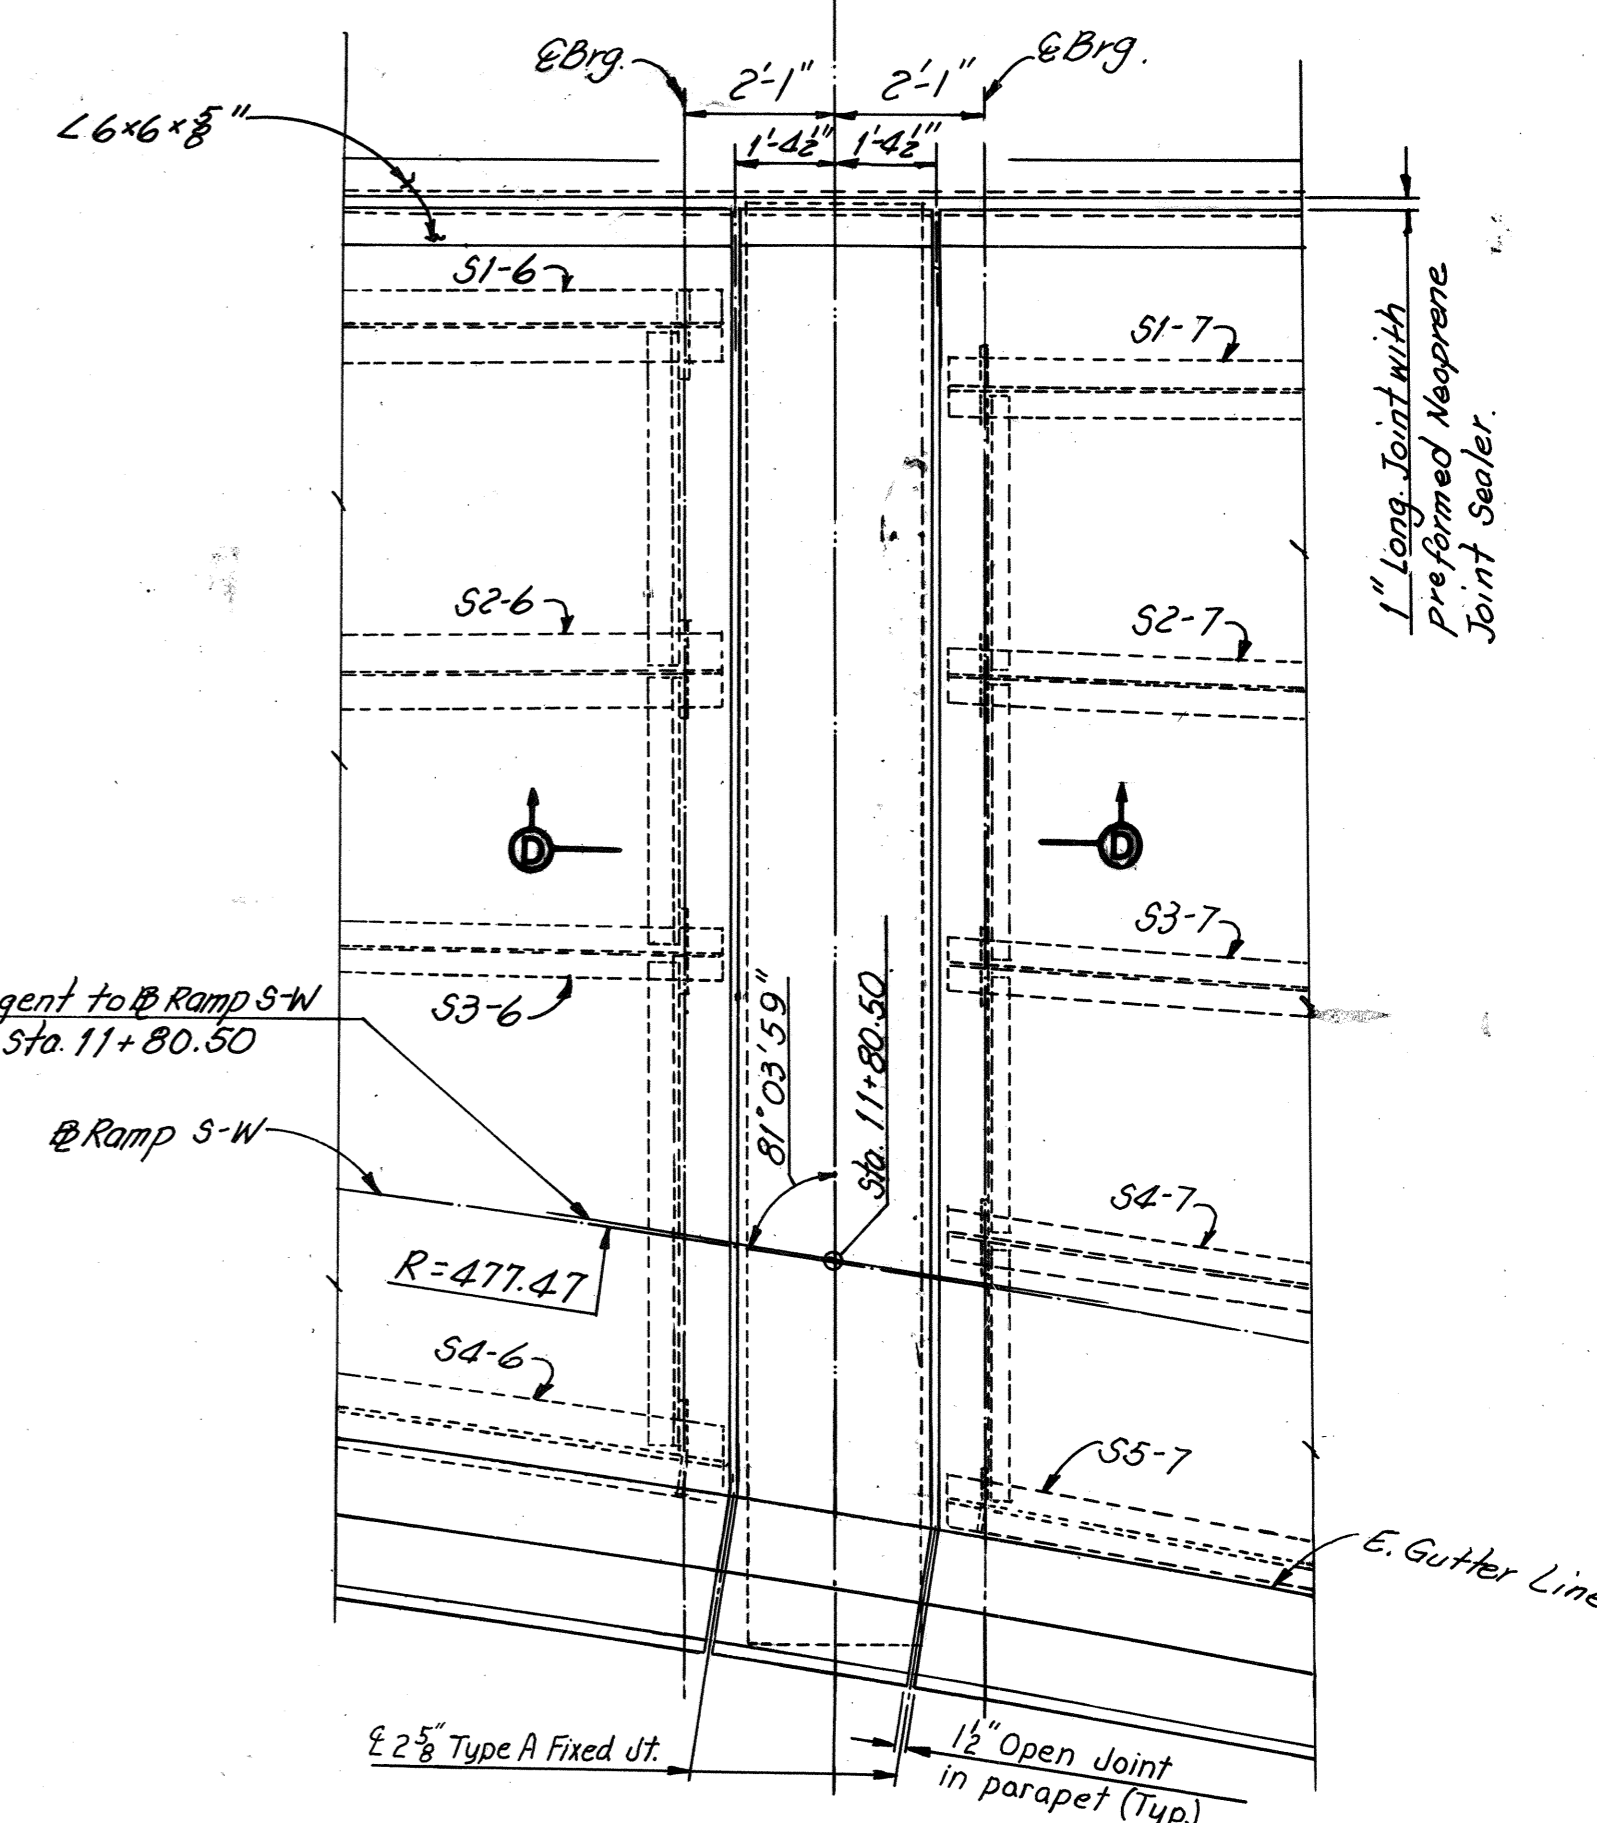


PLAN — JOINT AT PIER 6
Scale: 3/8" = 1'-0"

Note: For Section D-D, see Sheet 7 & 26.

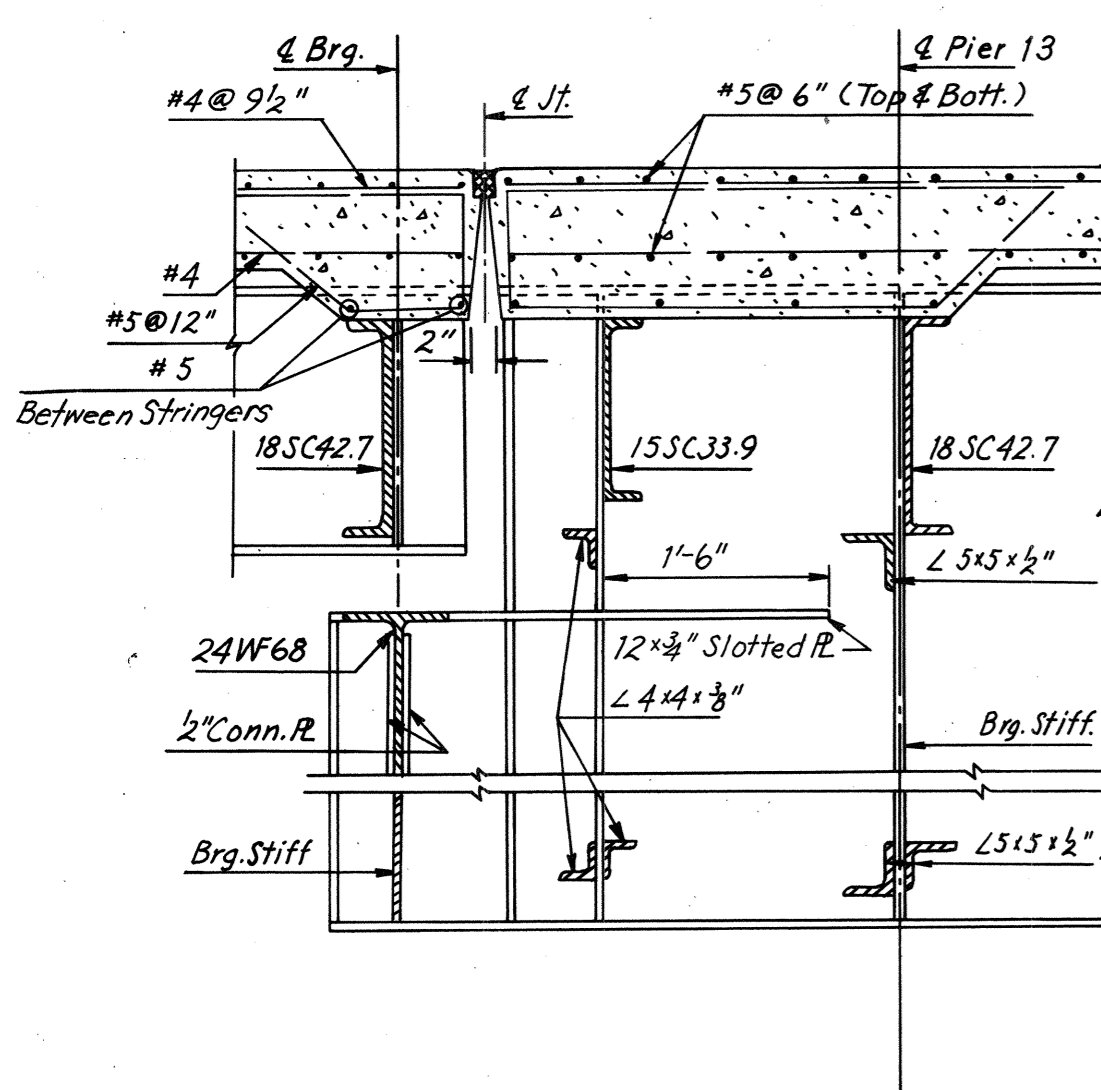


SECTION E-E
Scale: 3/4" = 1'-0"

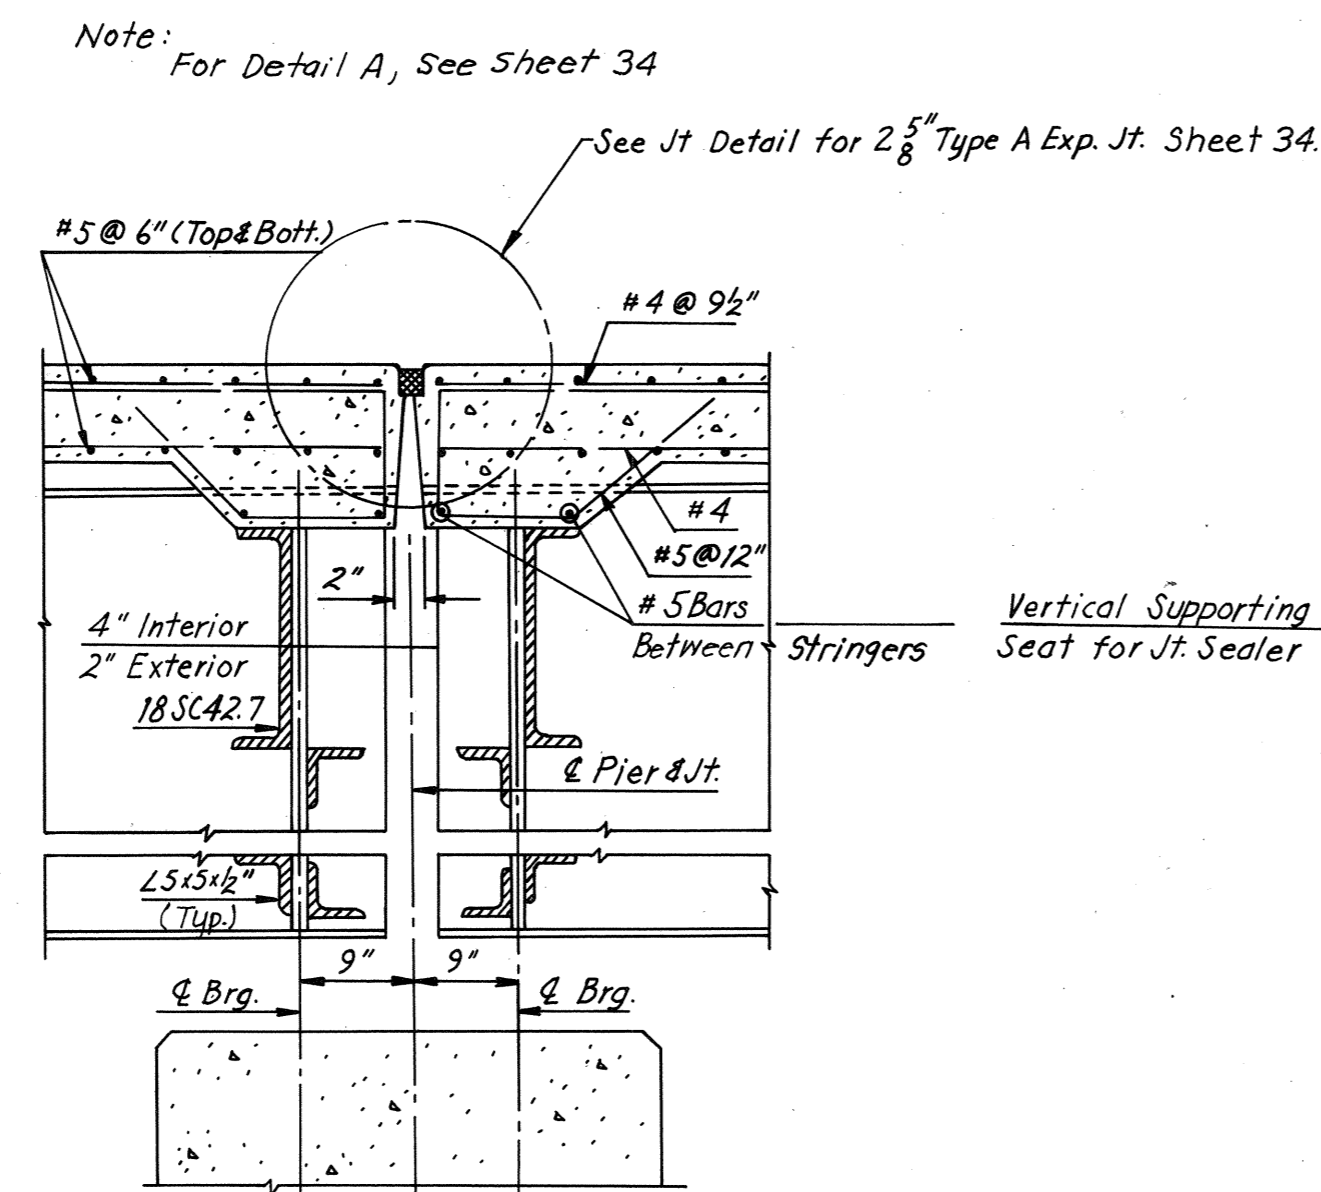


SECTION C-C
Scale: 3/4" = 1'-0"

Note: All horizontal dimension of sections shown above are normal to Q joint and pier.

Notes: For Details of bearing stiffeners and connection plates, see Framing Plan Sheets.
For End Diaphragms, See Cross Sections-Deck Plan Sheets.

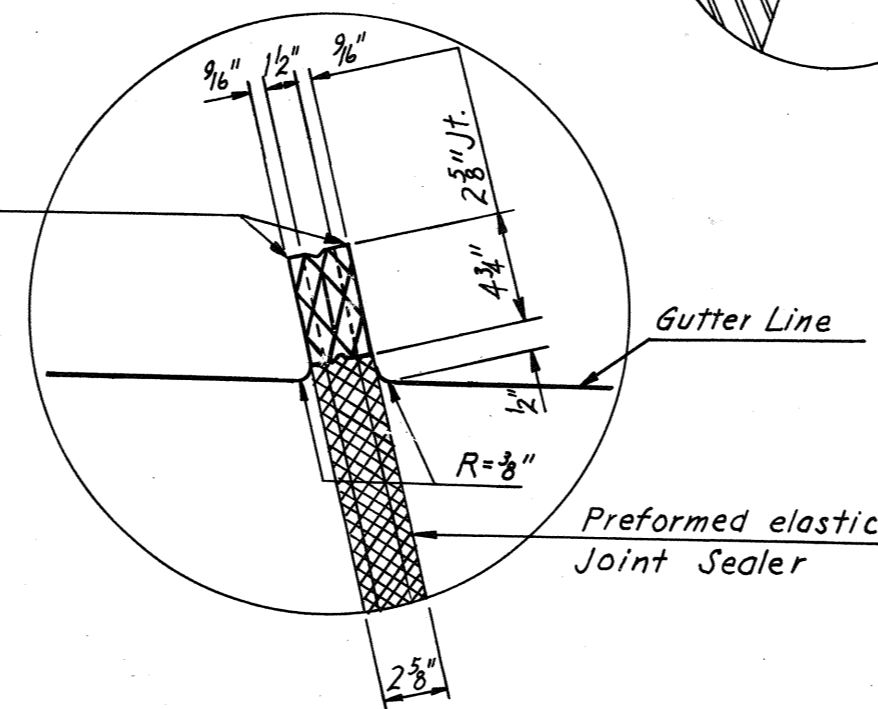


DETAIL C
No Scale

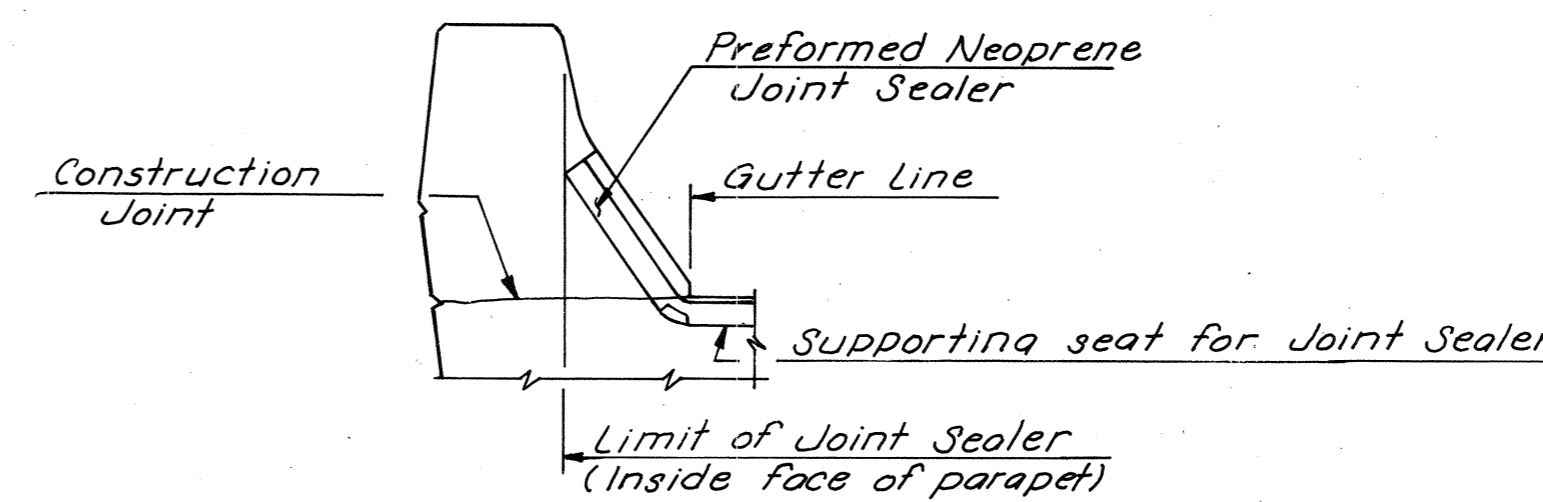

TREATMENT OF TYPE "A" JOINT AT GUTTER
No Scale

Note: All horizontal dimensions shown above are normal to Q joint.

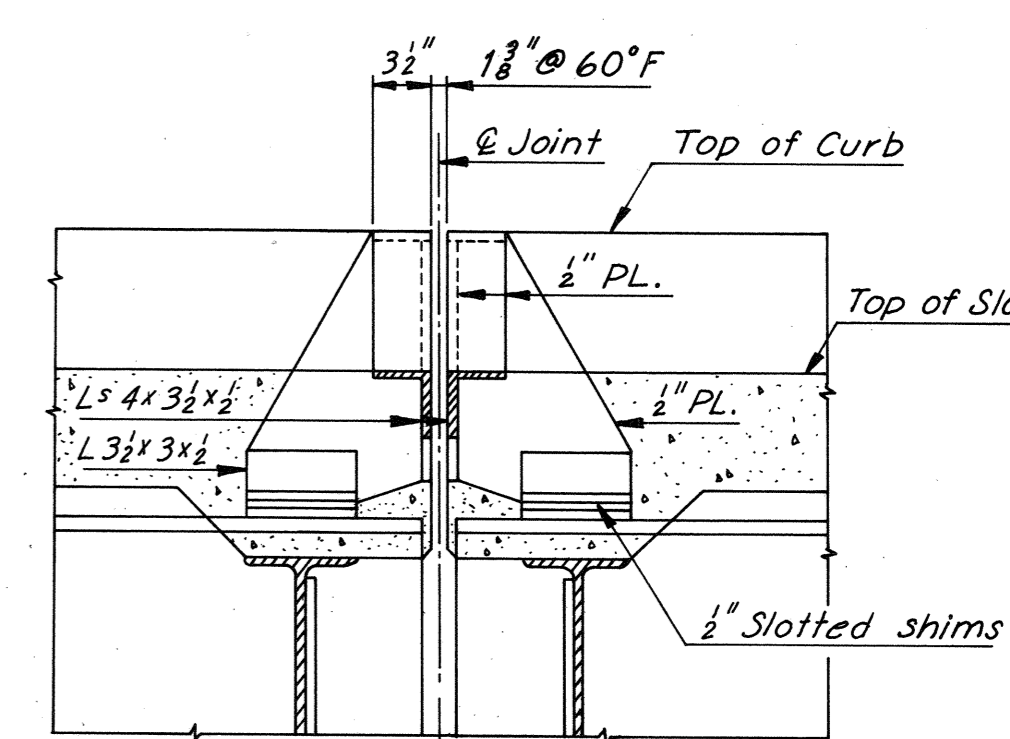

SECTION E-E
Scale: 1" = 1'-0"

AS BUILT

RICHMOND METROPOLITAN AUTHORITY
RICHMOND EXPRESSWAY SYSTEM
DOWNTOWN EXPRESSWAY

BRIDGE NO. 65
RAMP S-W CONNECTION FROM
RICHMOND-PETERSBURG TURNPIKE
JOINT DETAILS

SCALE: As Noted
HOWARD, NEEDLES, TAMMEN & BERGENDOFF
consulting engineers
NEW YORK ALEXANDRIA KANSAS CITY
CONTRACT NO. 11
SHEET NO. 35 OF 38

BY	DATE			
MADE	Y.C.P.	12-18-68		
CHECKED	G.S.H.	1-28-69	Revised Exp. Jt. at Pier 41	TEM 9-9-75
IN CHARGE				
NO.	REVISION	BY	DATE	



RICHMOND METROPOLITAN TRANSPORTATION
AUTHORITY

RICHMOND EXPRESSWAY SYSTEM
CONTRACT NO. PC – 2018
PROTECTIVE COATING OF STRUCTURES


Bridge 66

Downtown Expressway



**Eastbound Roadway Over
12th St. - R.R. Tracks and 16th St.**

RECORD SET PLANS (Next 43)

RICHMOND EXPRESSWAY SYSTEM			
SECTION	PROJECT	SHEET NO.	TOTAL SHEETS
10	DOWNTOWN EXPRESSWAY	127	265

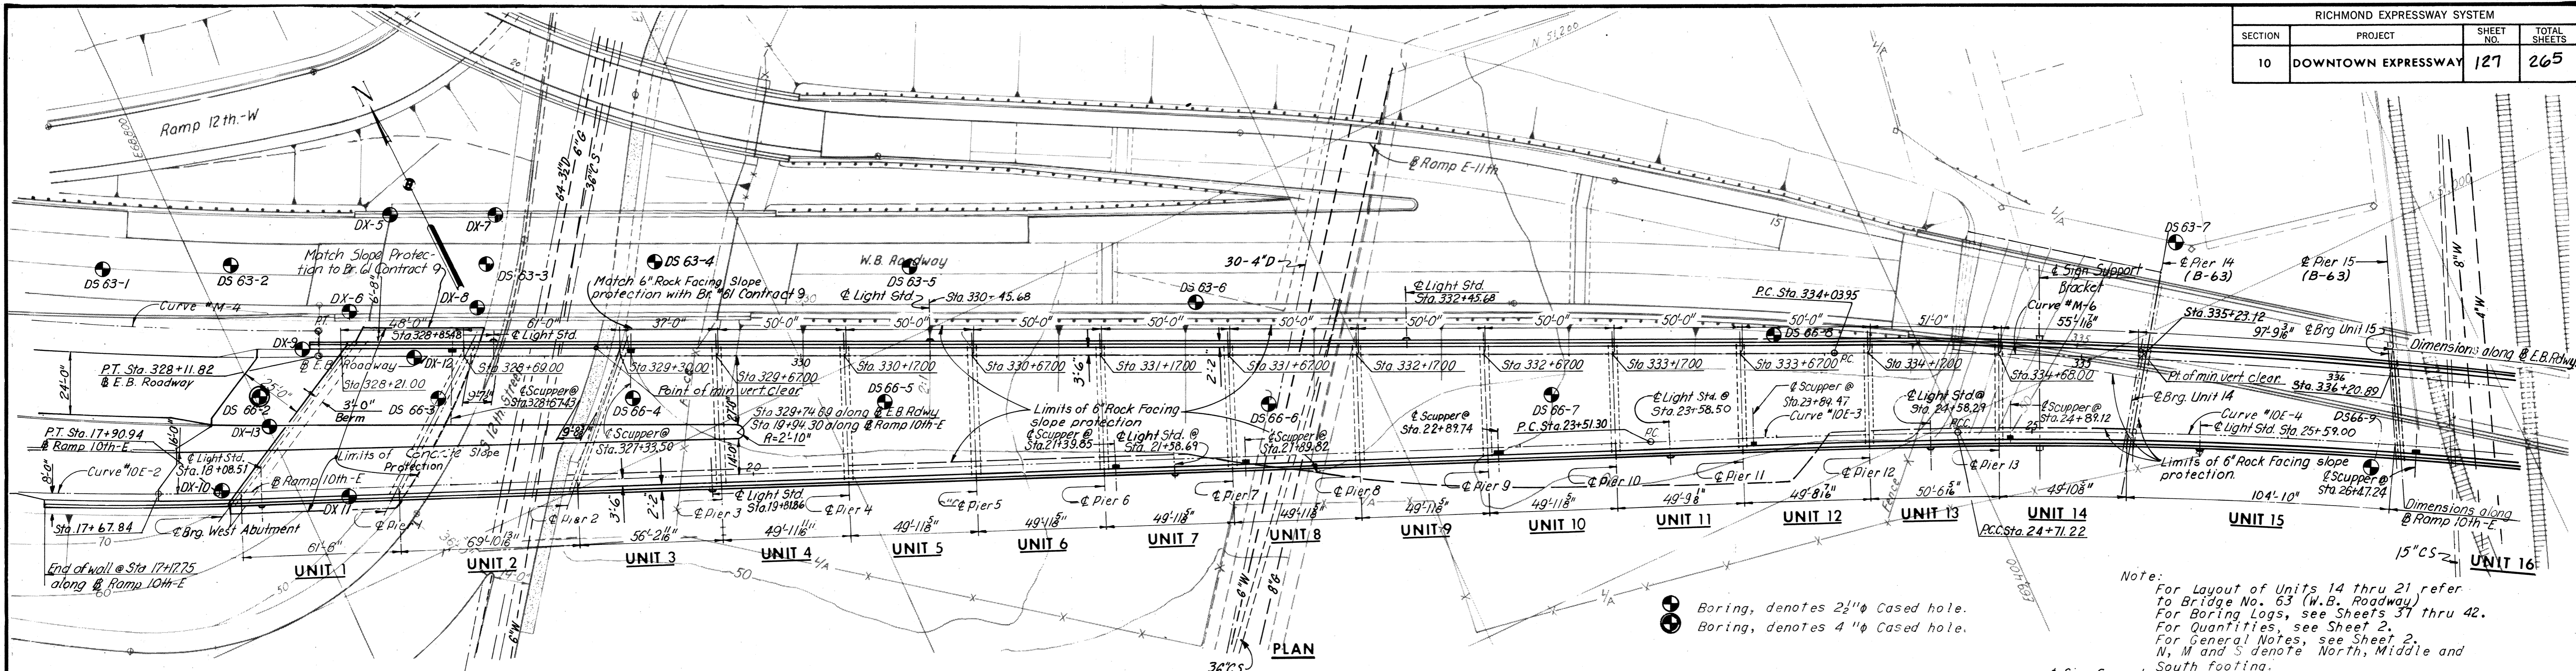

Note:
 For Layout of Units 14 thru 21 refer to Bridge No. 63 (W.B. Roadway)
 For Boring Logs, see Sheets 31 thru 42.
 For Quantities, see Sheet 2.
 For General Notes, see Sheet 2.
 N, M and S denote North, Middle and South footing.

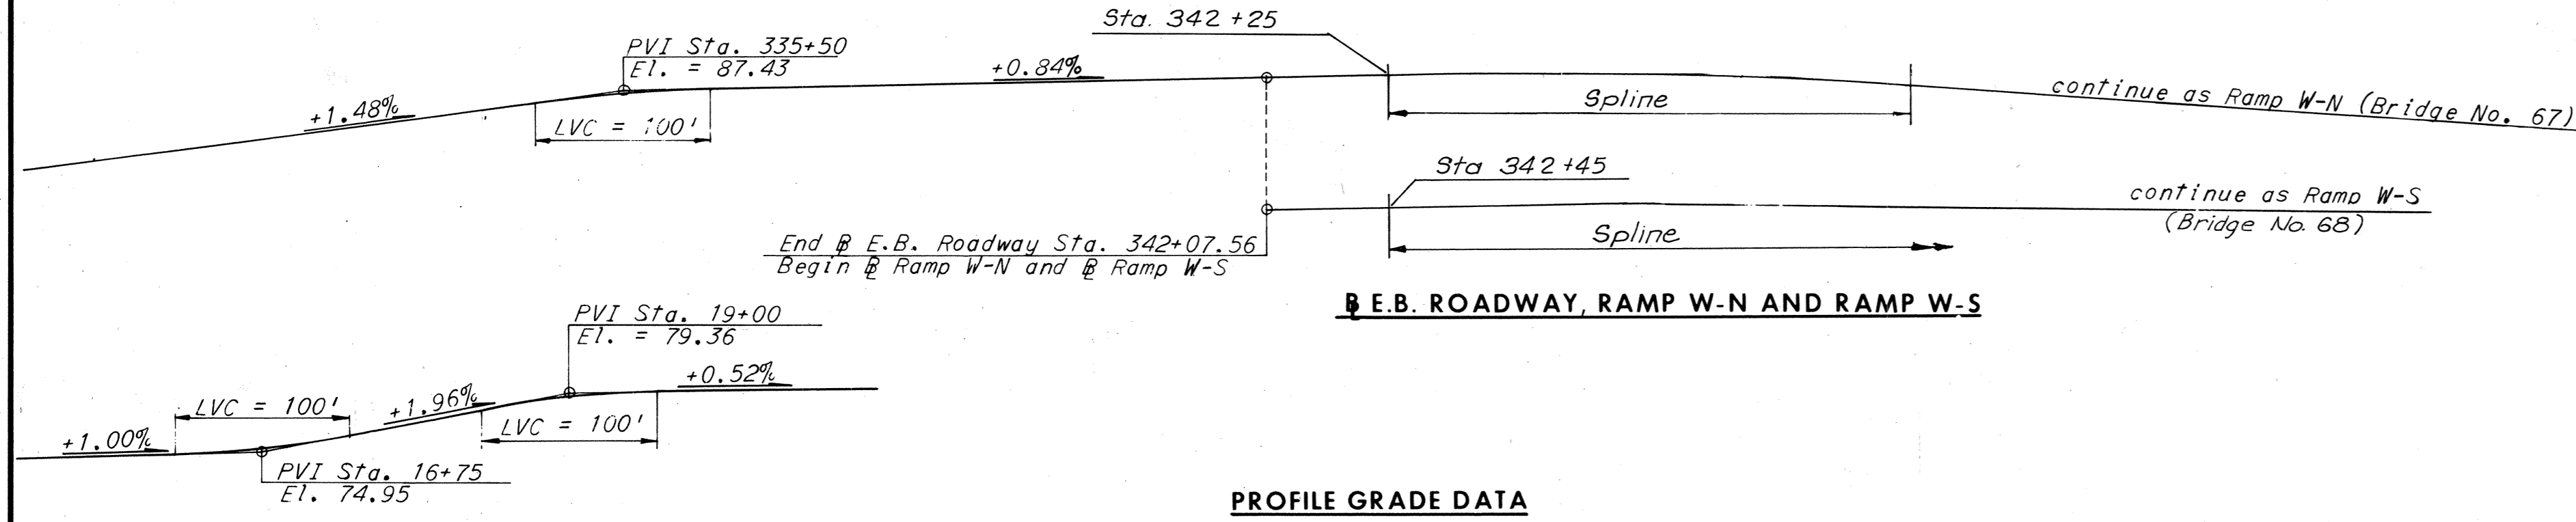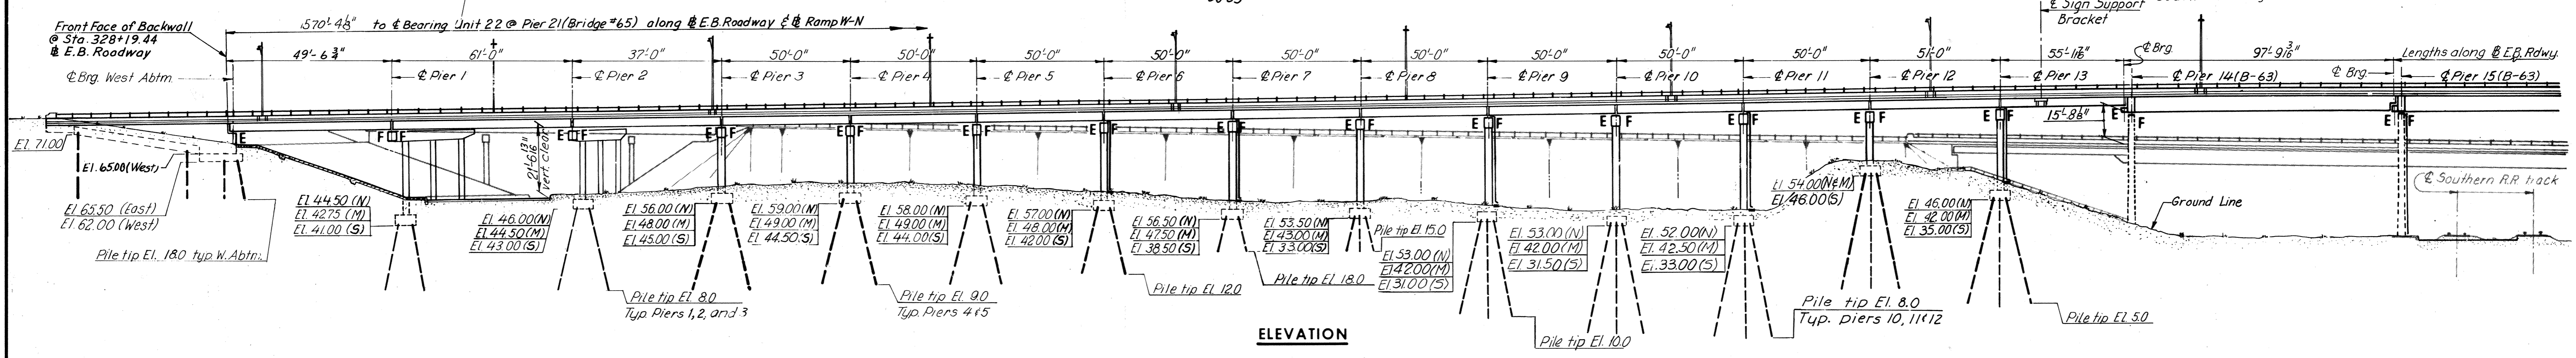


NO.	REVISION	BY	DATE
3	As Built	TEM	8-76
	Sign Support Bracket & Sh. 16A & 20A added	R.B.H.	9-74
	Footing elev. & piles, Piers 8, 9, 10, 11, 12 & 13	R.B.H.	8-74

MADE	BY	DATE
J.V.	G.C.C.	9-12-68
CHECKED	G.C.C.	5-26-69
IN CHARGE		

Downtown Expressway Curve: M-2		E.B. Roadway Curve: M-6		Ramp W-N Curve: W-N-1	
P.I.	= 326+57.21	P.I.	= 336+40.09	P.I.	= 345+25.47
Δ	= 12°25'03"	Δ	= 11°45'56"	Δ	= 64°53'49"
D	= 4°00'	D	= 2°30'	D	= 11°27'33"
T	= 155.83'	T	= 236.14'	T	= 317.90'
L	= 310.44'	L	= 470.62'	L	= 566.33'
R	= 1,432.40'	R	= 2,291.83'	R	= 500.00'

Ramp 10th-E Curve: 10E-2		Ramp 10th-E Curve: 10E-3		Ramp 10th-E Curve: 10E-4	
P.I.	= 17+36.87	P.I.	= 24+11.27	P.I.	= 26+80.64
Δ	= 6°29'42"	Δ	= 1°11'57"	Δ	= 12°30'55"
D	= 6°00'	D	= 1°00'	D	= 3°00'
T	= 54.18'	T	= 59.97'	T	= 209.42'
L	= 108.25'	L	= 119.93'	L	= 417.18'
R	= 954.93'	R	= 5,729.58'	R	= 1,909.86'

INDEX	SHEET
GENERAL PLAN AND ELEVATION	1
GENERAL PLAN AND ELEVATION	2
WEST ABUTMENT	3
WEST ABUTMENT DETAILS	4
WEST ABUTMENT RETAINING WALL	5
PIER 1	6
PIER 2	7
PIERS 3 AND 4	8
PIERS 5 AND 6	9
PIERS 7 AND 8	10
PIERS 9 AND 10	11
PIERS 11 AND 12	12
PIER 13	13
FRAMING PLAN UNITS 1, 2, 3 AND 4	14
FRAMING PLAN UNITS 5, 6, 7, 8 AND 9	15
FRAMING PLAN UNITS 10, 11, 12, 13 AND 14	16
FRAMING PLAN UNITS 15 AND 16	17
FRAMING PLAN UNITS 17 AND 18	18
FRAMING PLAN UNITS 19 AND 20	19
FRAMING PLAN UNITS 21 AND 22	20
FRAMING PLAN UNIT 23	21
FRAMING DETAILS PIERS 14, 15 AND 16	22
FRAMING DETAILS PIERS 17, 18, 19 AND 20	23
FRAMING DETAILS PIER 21	24
FRAMING DETAILS PIER 22 (BR 63)	25
FRAMING DETAILS UNITS 21 AND 22	26
FRAMING DETAILS UNITS 18, 21 AND 22	27
DECK PLAN UNITS 1, 2, 3 AND 4	28
DECK PLAN UNITS 5, 6, 7, 8 AND 9	29
DECK PLAN UNITS 10, 11, 12, 13 AND 14	30
DECK PLAN UNITS 15 AND 16	31
DECK PLAN UNITS 17 AND 18	32
DECK PLAN UNITS 19 AND 20	33
DECK PLAN UNITS 21 AND 22	34
DECK PLAN UNIT 23	35
JOINT DETAILS	36
SUPERSTRUCTURE DETAILS	37 AND 38
APPROACH SLABS AND ROCK FACING SLOPE PROTECTION	39
CONCRETE SLAB SLOPE PROTECTION DETAILS	40
BORING LOGS	41 THRU 46
STANDARD DETAILS	51 THRU 57

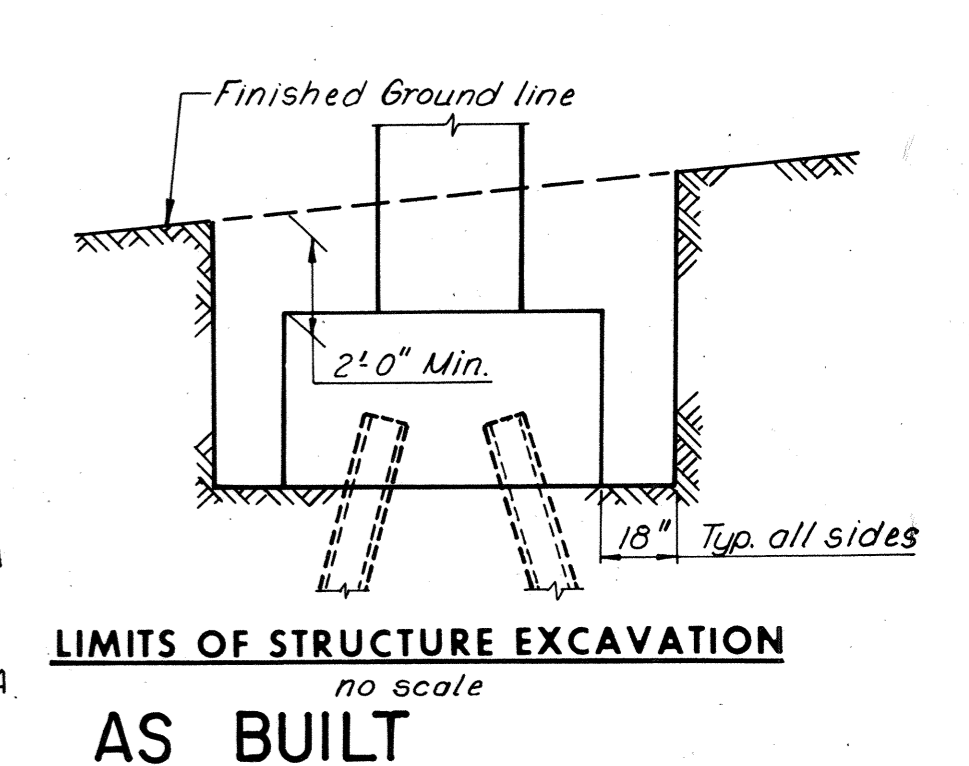


RICHMOND METROPOLITAN AUTHORITY
RICHMOND EXPRESSWAY SYSTEM
DOWNTOWN EXPRESSWAY

BRIDGE NO. 66
EASTBOUND ROADWAY OVER
12TH ST. - R.R. TRACKS AND 16TH ST.
GENERAL PLAN AND ELEVATION

HOWARD, NEEDLES, TAMMEN & BERGENDOFF
 consulting engineers
 NEW YORK ALEXANDRIA KANSAS CITY

SCALE: 1"=30'
 CONTRACT NO. 10
 SHEET NO. 1 OF 46

RICHMOND EXPRESSWAY SYSTEM			
SECTION	PROJECT	SHEET NO.	TOTAL SHEETS
10	DOWNTOWN EXPRESSWAY	128	265

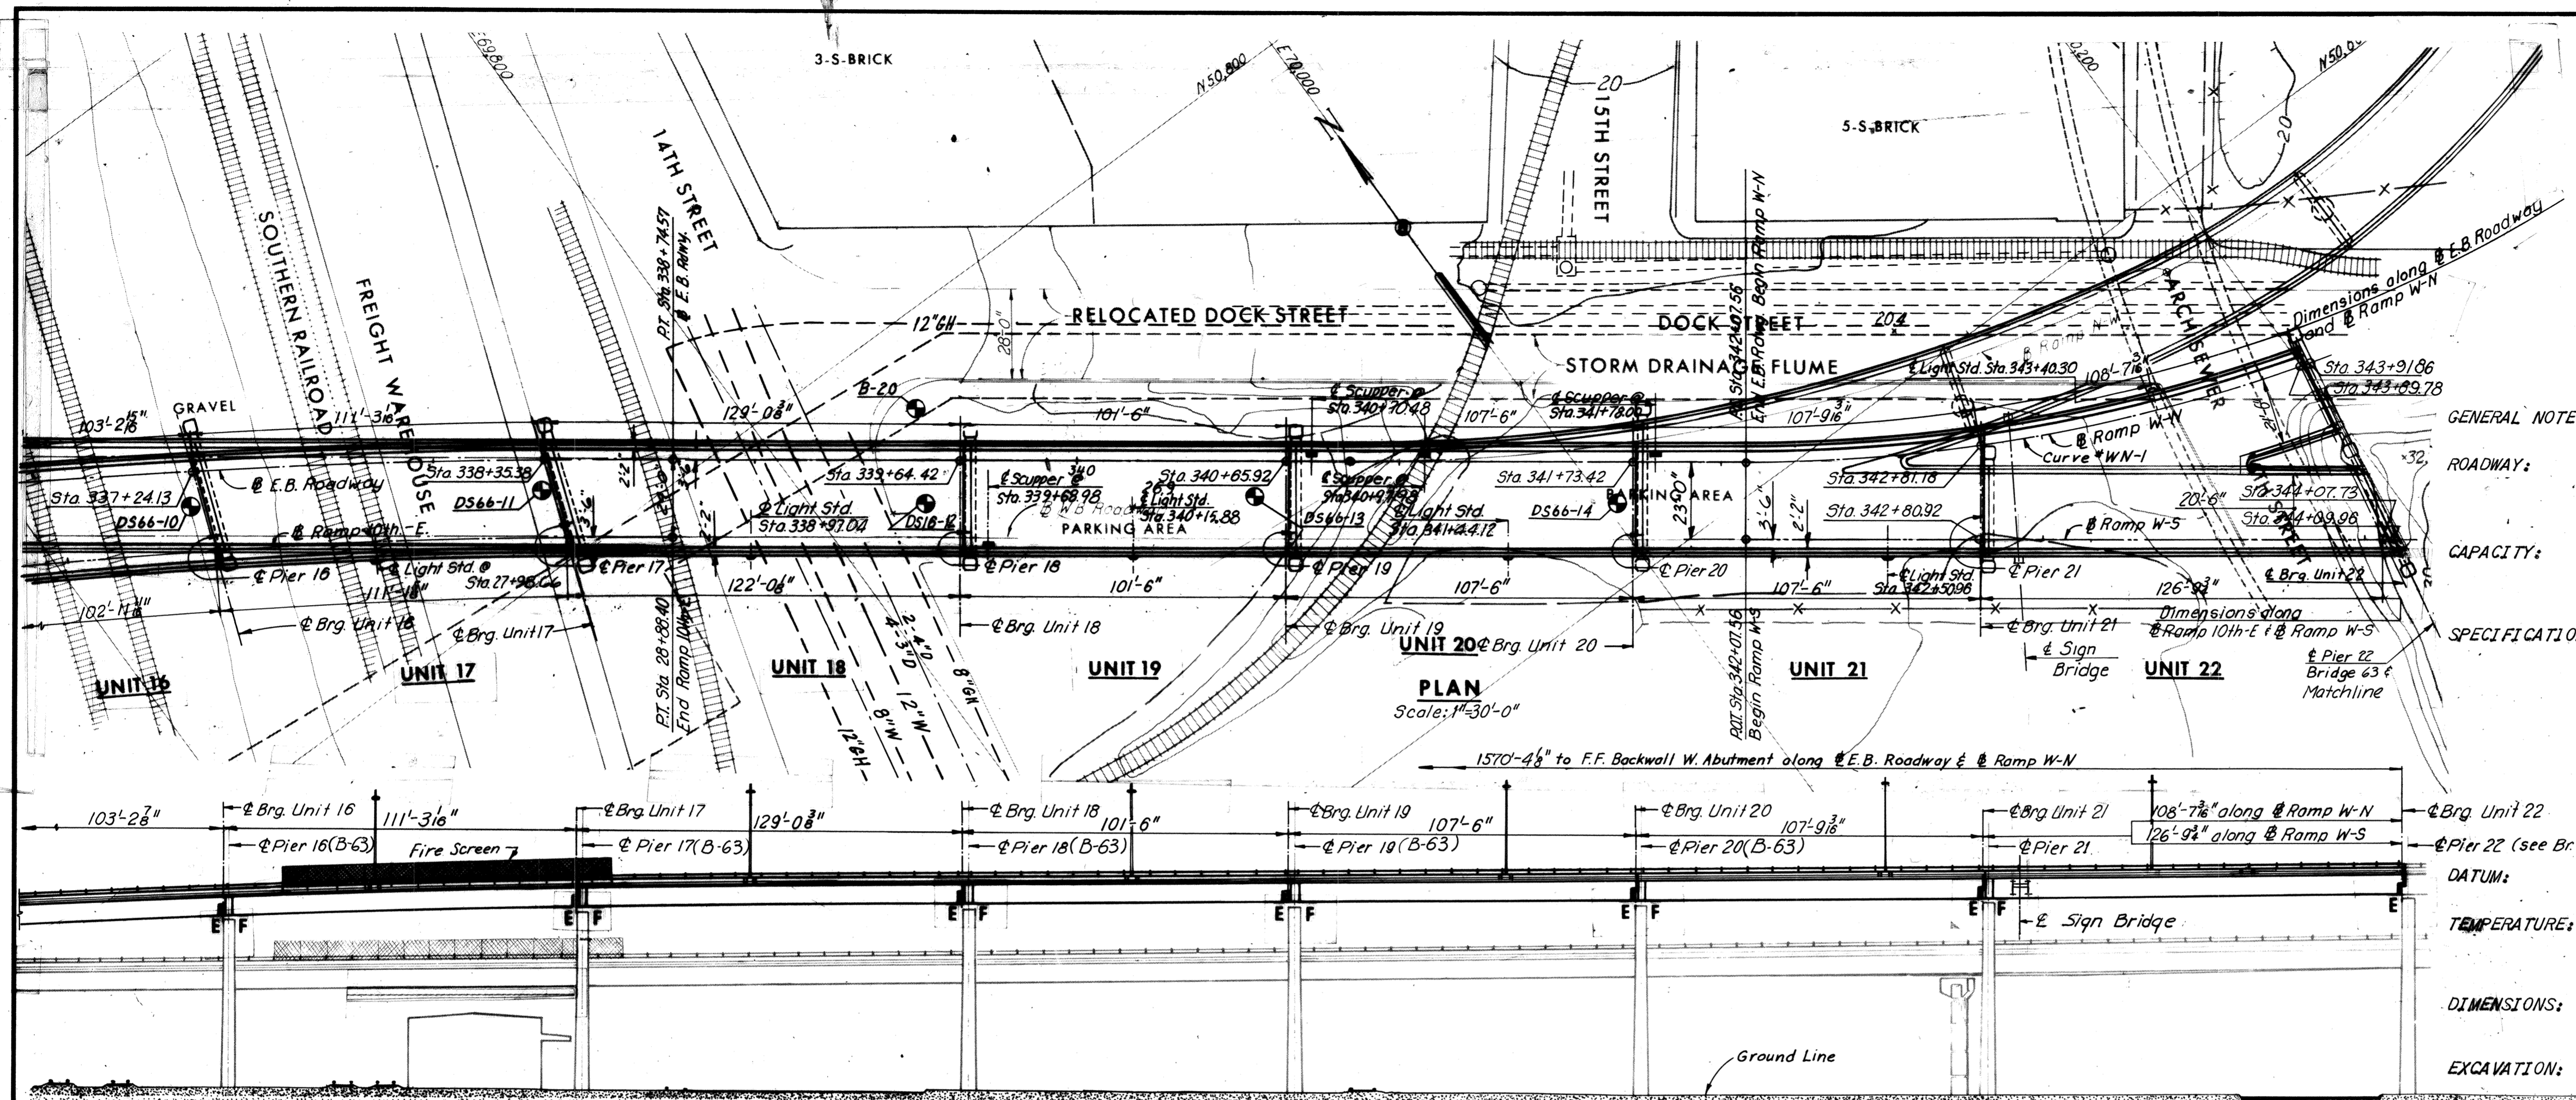

GENERAL NOTES:

ROADWAY: One variable width roadway transitioning from E.B. Roadway Downtown Expressway and Ramp 10th-E into Ramps W-N and W-S (Bridges No. 67 and 68)

CAPACITY: Dead load includes 15 Lbs. per sq. ft. for future wearing surface. Live load, HS 20-44 loading and alternate military loading.

SPECIFICATIONS:

GENERAL: Virginia Department of Highway Road and Bridge Specifications 1970

DESIGN: A.A.S.H.O. Standard Specifications for Highway Bridges 1973 modified by Special Design provisions.

WELDING: 1972 Structural Welding Code of the American Welding Society.

CONTRACT SPECIAL PROVISIONS: Specifications and Contract Special Provisions referred to above are necessary to make these plans complete

DATUM: City of Richmond

TEMPERATURE: The normal temperature referred to in the plans is 60°F. The temperature range for movement is 0°F to 120°F.

DIMENSIONS: All dimensions are measured horizontally and vertically unless otherwise noted.

EXCAVATION: Excavation below subgrade and cut slope template shall be classified as Structure Excavation. All excavation above these limits shall be classified as Regular Excavation and is not included in the Structural Quantities.


Notes:
 For Vertical and Horizontal Curve Data see Sheet 1.
 For Layout of Units 14 thru 22 refer to Bridge No. 63 (Westbound Roadway).

ESTIMATED QUANTITIES

	Structure Excavation Cu. Yds.	Concrete (#) Cu. Yds.	Reinforcing Steel Lbs.	Str. Steel Mild Carbon Lbs.	Str. Steel High Strength Lbs.	Aluminum Railing (1-Rail) Lin. Ft.	Porous Backfill Cu. Yds.	Underdrain 6" Dia. Pipe Lin. Ft.	Steel Piles 10BP42 Lin. Ft.
Superstructure	--	2,237.6	530,060	1,564,700	567,800	3,241	--	--	---
Substructure	1,835	1,256.6	155,030	---	---	84	34	150	9,410
Total	1,835	3,494.2 #	685,890	1,564,700	567,800	3,325	34	150	9,410

	Asphalt Damp-proofing Sq. Yds.	Approach Slab Concrete (#) Cu. Yds.	Fire Screen Lin. Ft.	Approach Slab Reinforcing Steel (Lbs.)	Metal Conduit Lin. Ft.	Concrete Slope Protection Sq. Yds.	Bridge Drainage Metal Work Lbs.	Rock Facing Slope Prot. Sq. Yds.	Energy Attenuator Each
Superstructure	--	--	210	---	2,214	--	11,870	--	1
Substructure	105	91.5	---	23,870	92	559	--	3,320	---
Total	105	91.5 #	210	23,870	2,306	559	11,870	3,320	1


All Concrete for Superstructure shall be Class A4 and for Substructure Class A3.

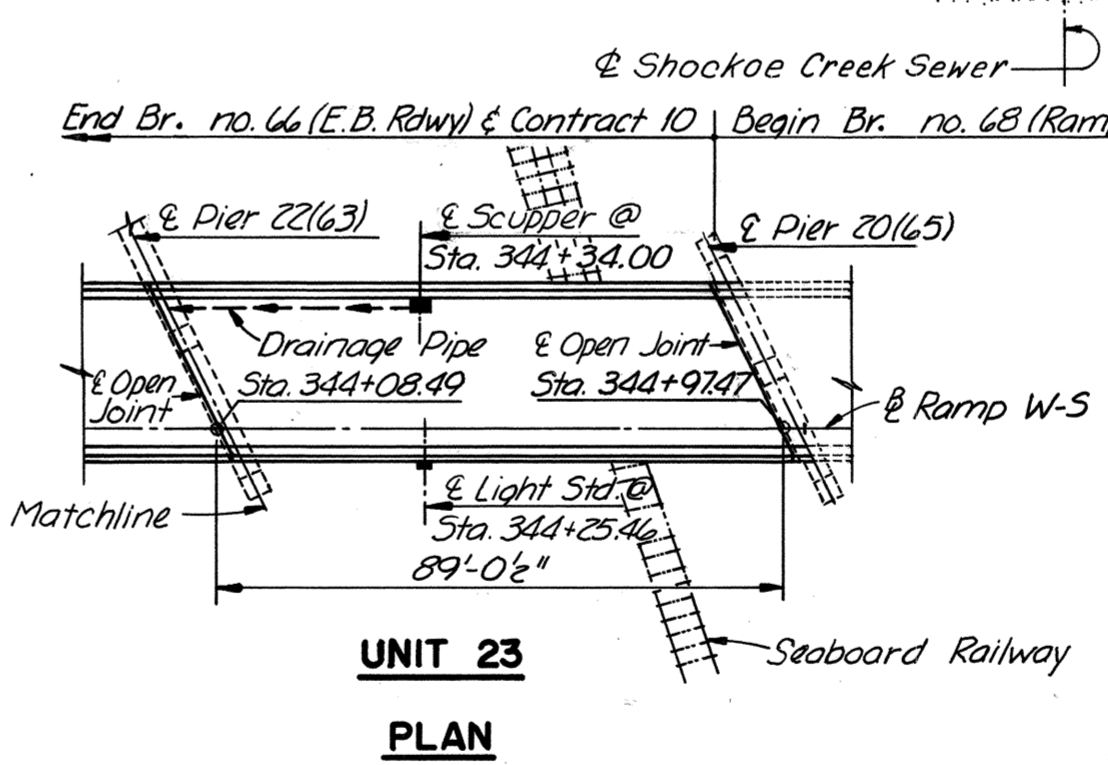

FOUNDATIONS: Footings shall rest on firm material. Foundation material shall be dry and special attention is called to Section 401.05 of General Specifications and to the Contract Special Provisions, concerning preparation of foundations for footings.

CONCRETE NOTES: Concrete in superstructure shall be Class A-4. All other concrete shall be Class A-3. All exposed edges and corners shall have a 3/4" chamfer or fillet unless otherwise noted. Care in the method of vibration, the use of low-slump concrete, and or other means shall be employed to prevent downgrade movement of newly placed slab concrete. Finishing Concrete Surfaces: See Standard Architectural Detail Sheets and the Contract Special Provisions for types and details. All reinforcing steel shall be deformed bars conforming to ASTM A615 Grade 40. All reinforcing bar dimensions on the detailed drawings are to centers of bars unless otherwise noted. Clear distance between reinforcing steel and face of concrete shall be as noted on the plans. All bar laps shall be 30 diameters of the smaller diameter bar unless otherwise noted.

STEEL NOTES: Structural steel shall conform to A.S.T.M. Designations A36, A572 - Grade 50 and A588 as noted. See Special Provisions. All field connections shall be made with high strength bolts. High strength bolts shall be 7/8" diameter unless otherwise noted and shall conform to A.S.T.M. Specification A-325.

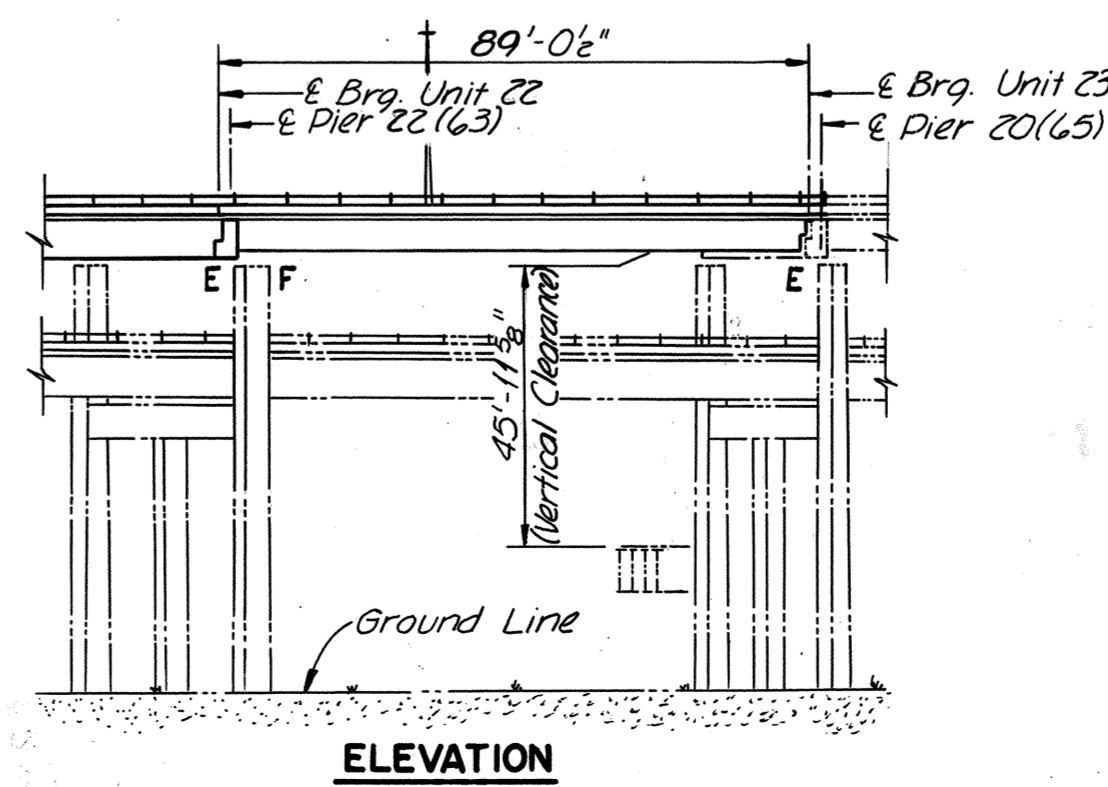

BY	DATE	Span Fixities & R.R. name added	PRMS	4-19-74	
MADE	J.V.	1-9-69	Sign Bridge added	R.B.H.	9-74
CHECKED	G.C.C.	5-26-69	Struct. 311 City	TEM	8-76
IN CHARGE			As Built		
	NO.	REVISION	BY	DATE	

AS BUILT


RICHMOND METROPOLITAN AUTHORITY
RICHMOND EXPRESSWAY SYSTEM
DOWNTOWN EXPRESSWAY

BRIDGE NO. 66
EASTBOUND ROADWAY OVER
12TH ST. - R.R. TRACKS AND 16TH ST.
GENERAL PLAN AND ELEVATION

HOWARD, NEEDLES, TAMMEN & BERGENDOFF
 consulting engineers
 NEW YORK ALEXANDRIA KANSAS CITY


SCALE: As Noted
 CONTRACT NO. 10
 SHEET NO. 2 of 46

RICHMOND EXPRESSWAY SYSTEM			
SECTION	PROJECT	SHEET NO.	TOTAL SHEETS
10	DOWNTOWN EXPRESSWAY	129	265

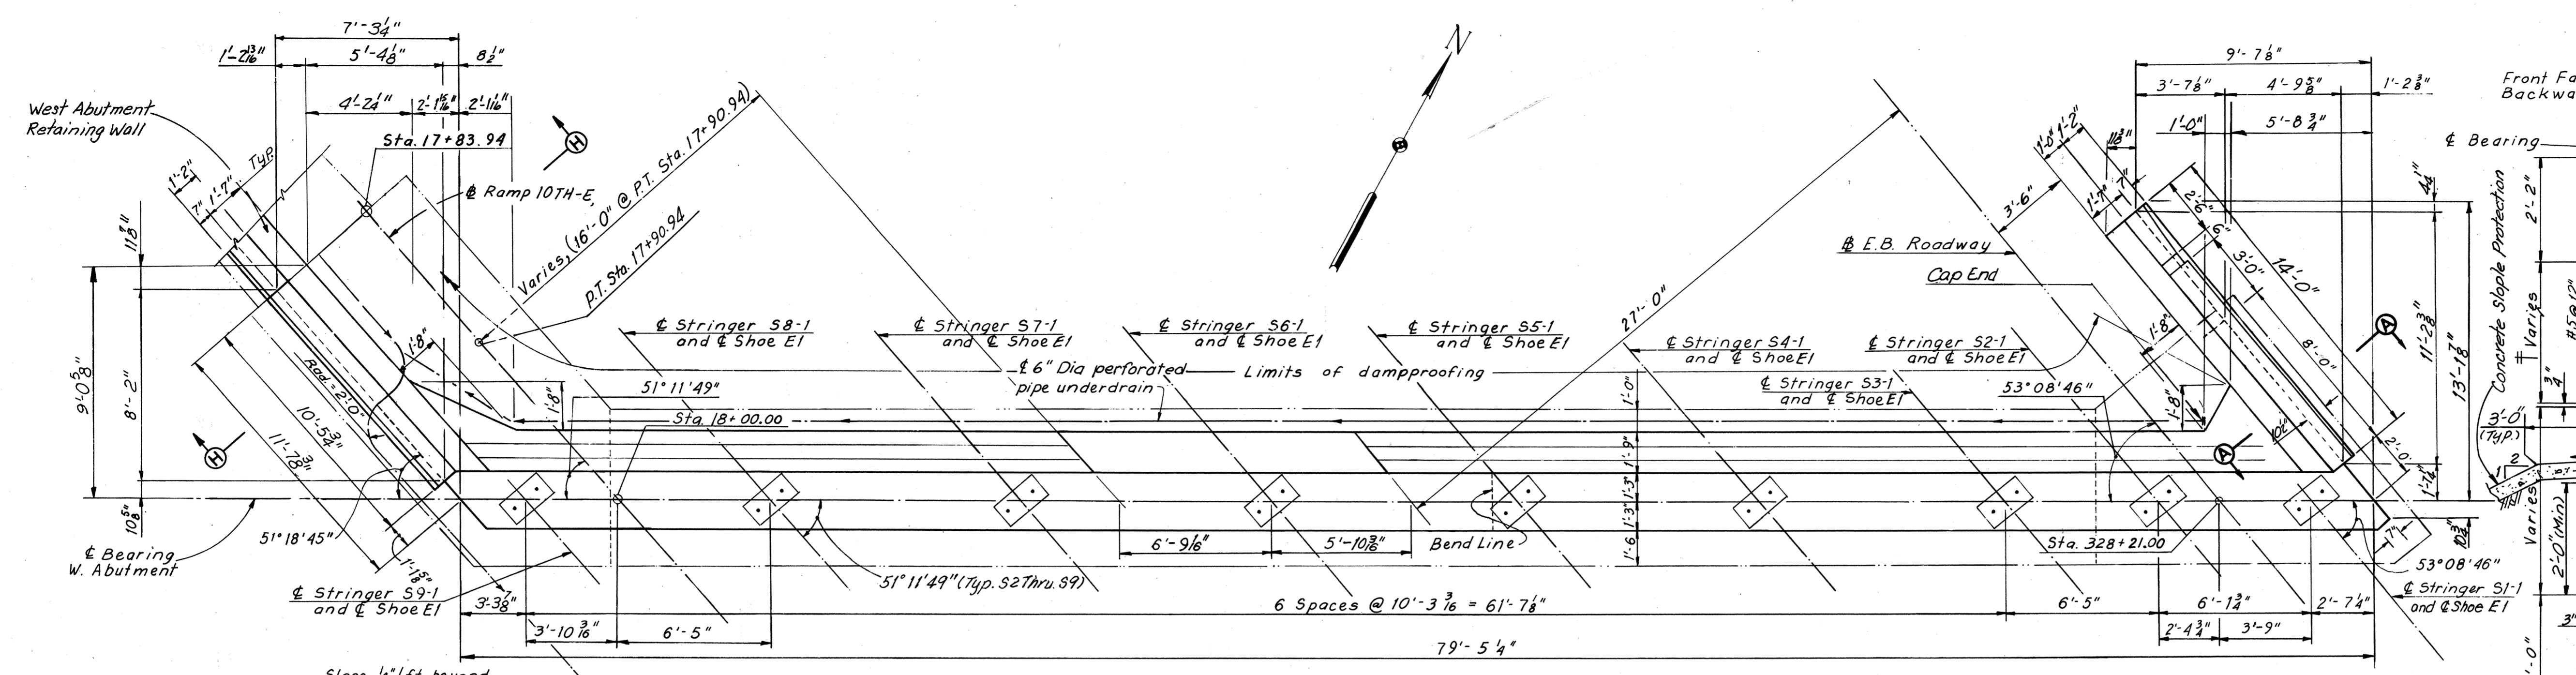

PLAN
No Scale


Note: Elevations denoted with an asterisk (*) are at Front Face of Backwall.

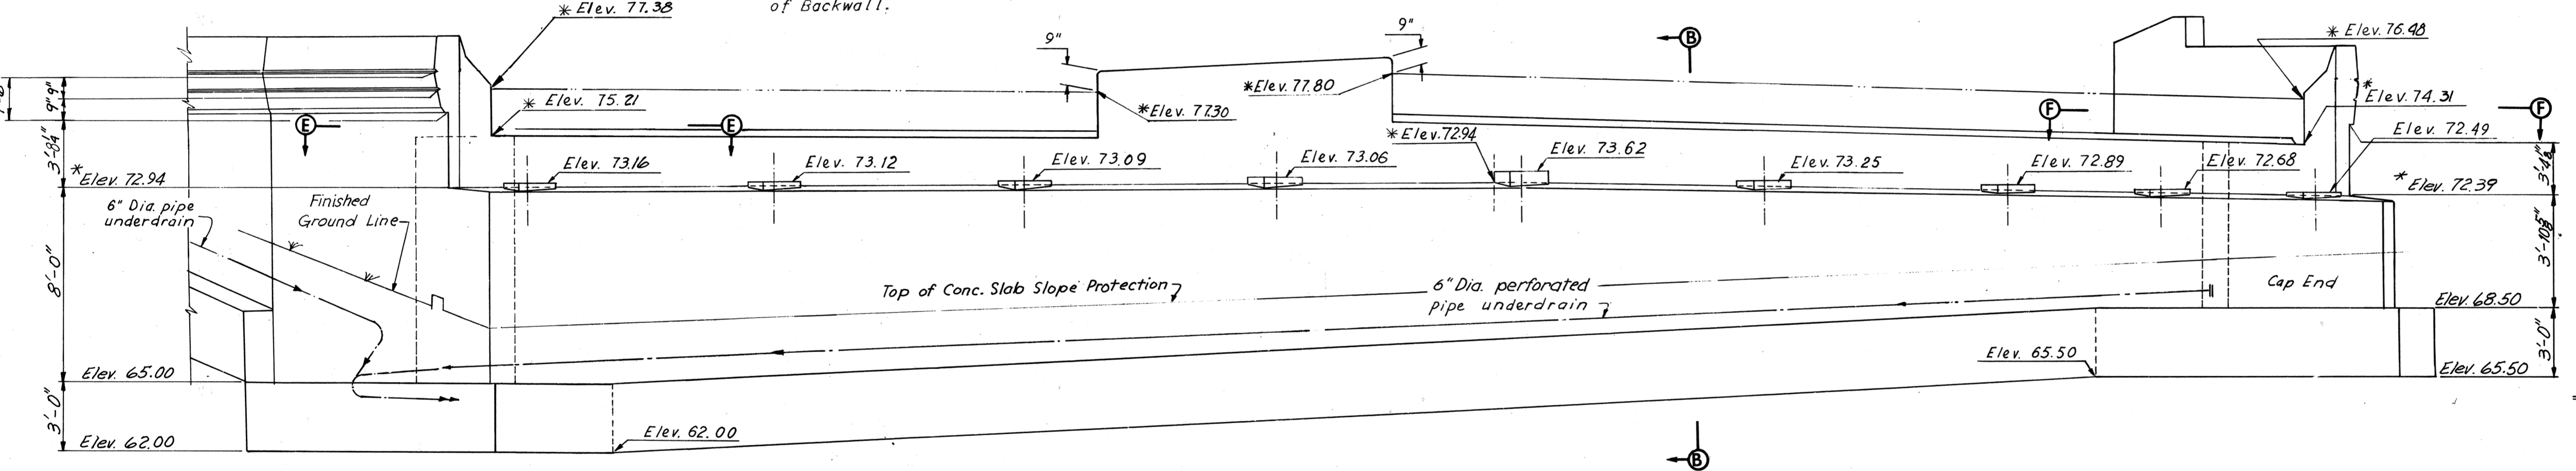


ELEVATION
No Scale

Note: Piles in Elevation are not shown. See Footing Plan for position of piles. Estimated pile tip Elevation 18.0'. Pile spacing measured at bottom of Footing.

Note: For Sections A-A, E-E and F-F, see Sheet 4.

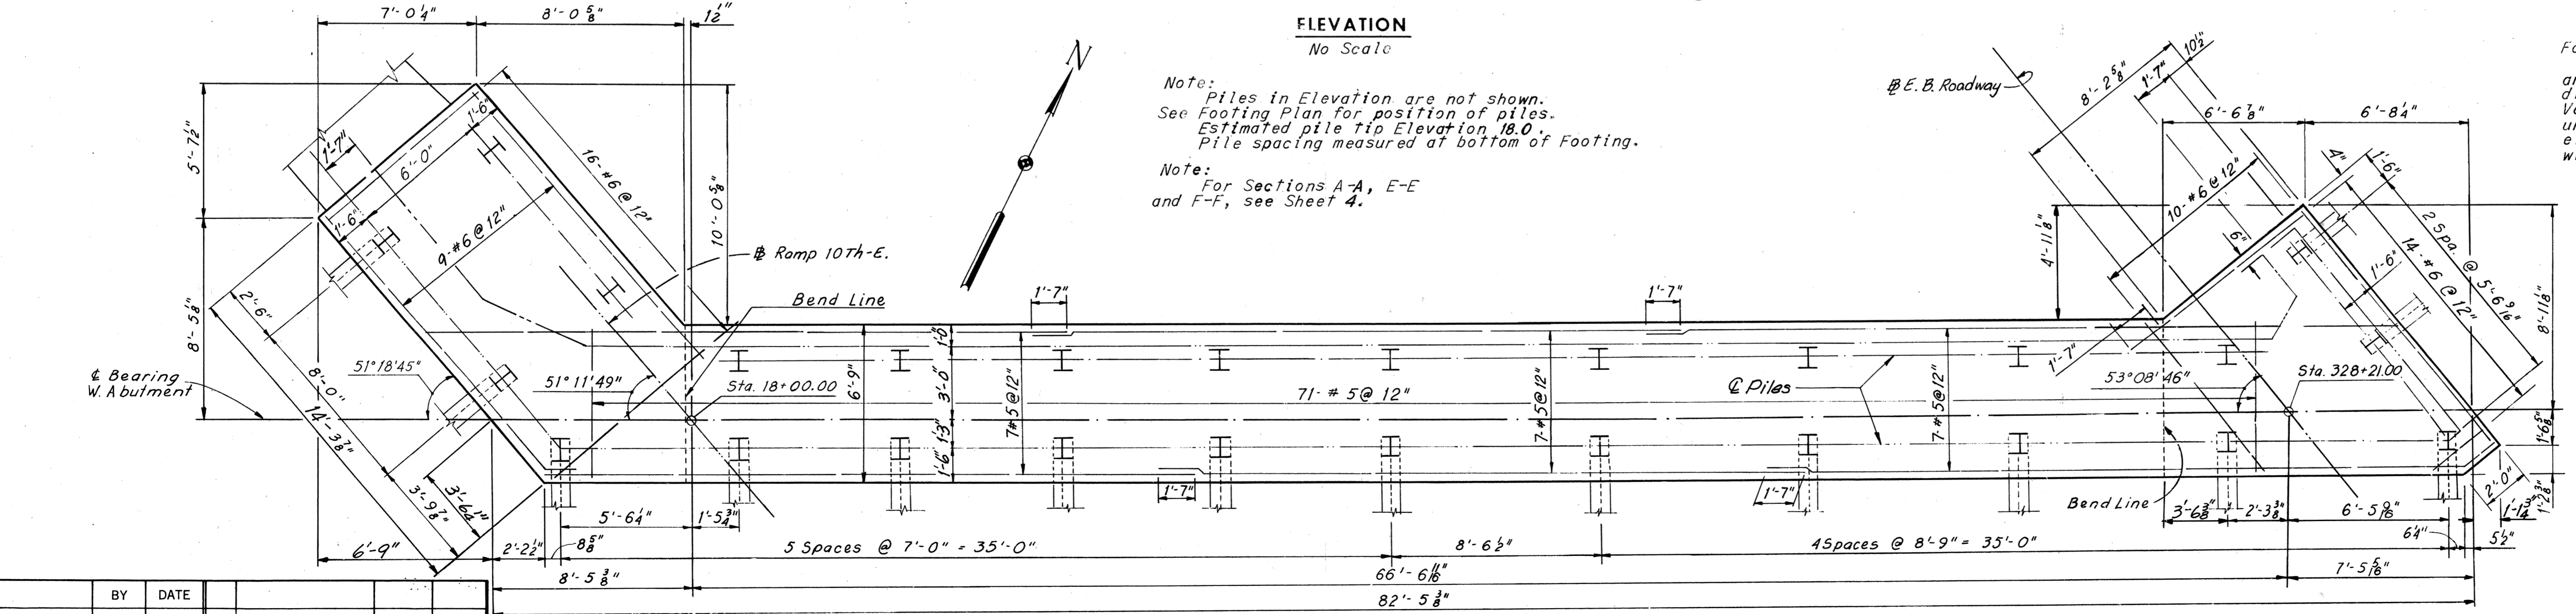

FOOTING PLAN
No Scale

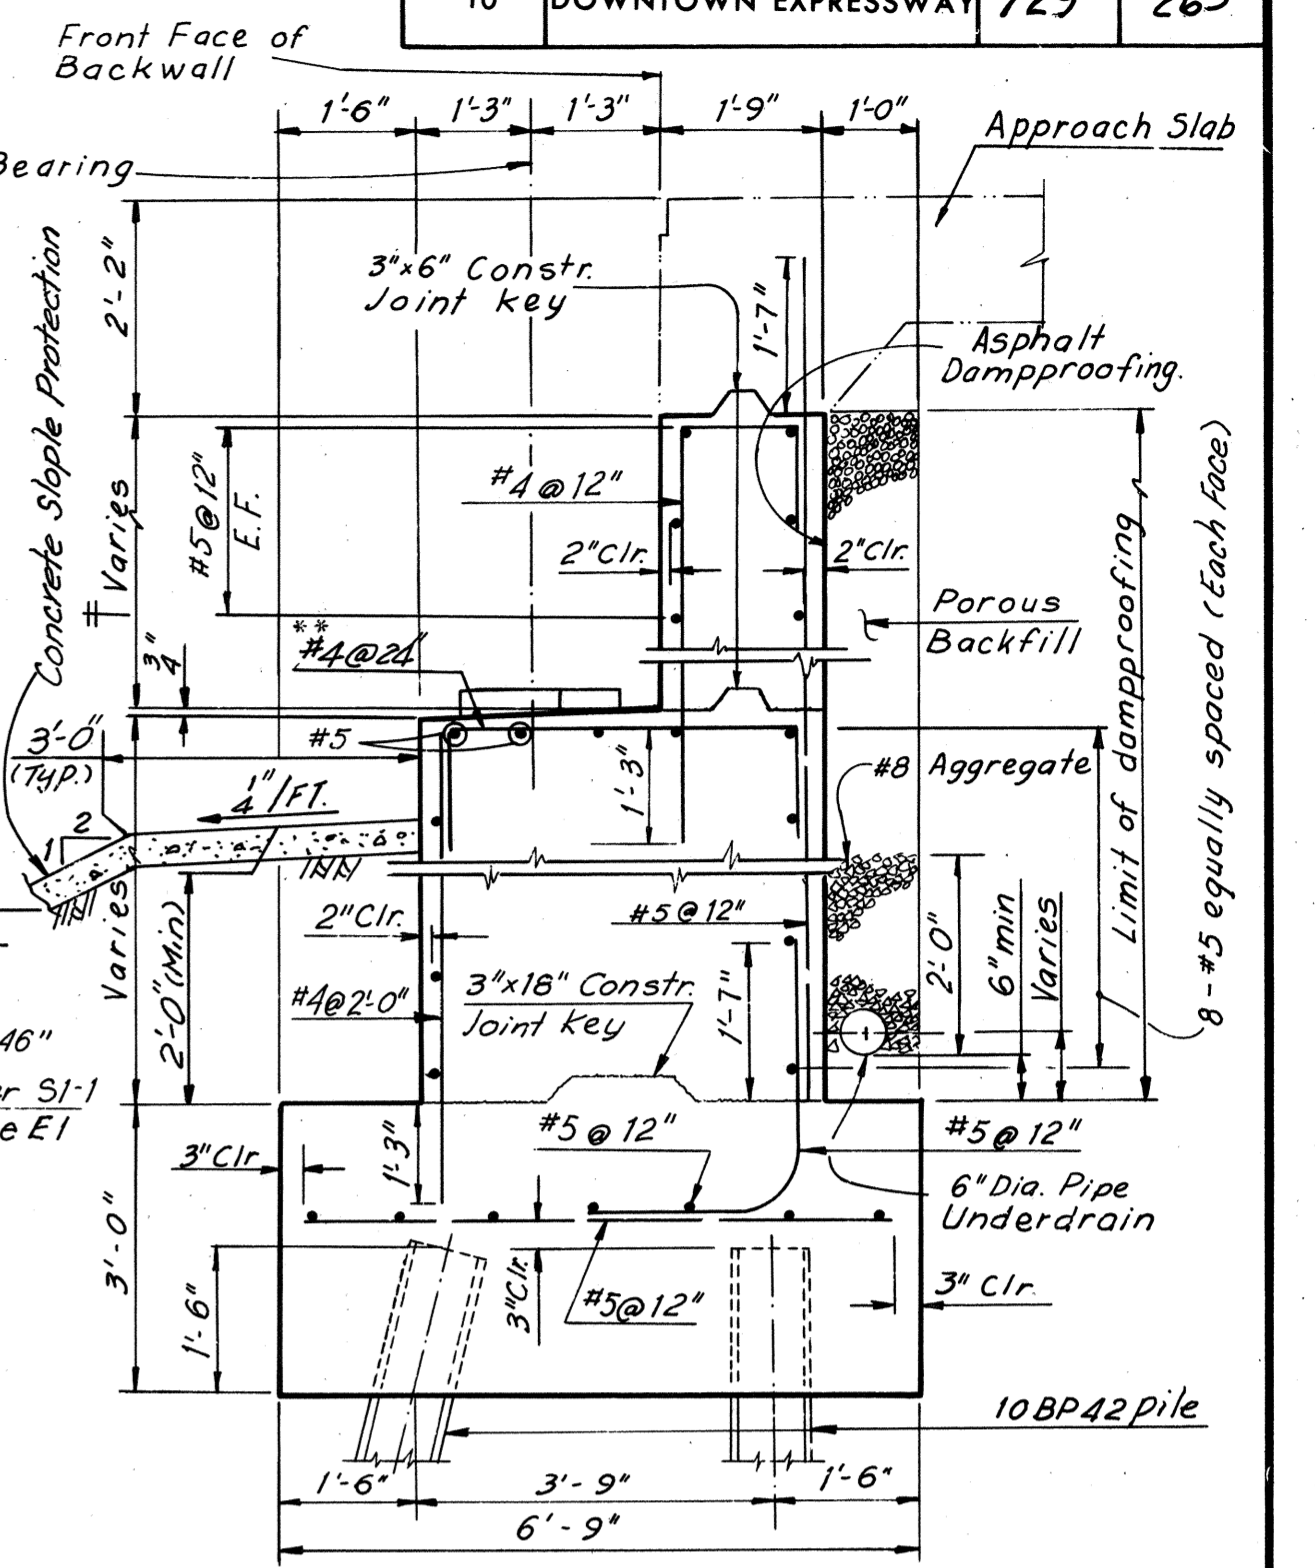

SECTION B-B
Scale: 2" = 1'-0"

** Provide two additional #4 bars @ 24" at each unreinforced bearing pad.

Note: All piles shall be 10BP42 Steel Piles (Design Capacity = 45 tons).
 Batter piles 3" per foot where shown.
 For Steel pile details, see Sheet 4.
 For North Wingwall elevation and details, see Sheet 4.
 For South Wingwall and Retaining wall elevation and details, see Sheet 5.
 For Rail Post Spacing, see Sheet 5.
 For Anchor Bolt setting plan and reinforcing pad details, see Sheet 4.
 For Framing Plan, see Sheet 14.

† Top of backwall to conform to Roadway.

Foundation Note: Footing elevations are approximate only and may be varied to suit field conditions as directed by the Engineer. Vertical wall reinforcing shall not be cut until these elevations are established. Where elevations change more than 2 ft. redesign will be required.

Note: For Architectural treatment of Abutments and Wingwalls, see Sheet S7.

BY	DATE	NO.	REVISION	BY	DATE
MADE	C.E.B. 7-26-68				
CHECKED	G.C.C. 8-15-68	1	As Built	TEM	8-76
IN CHARGE					

RICHMOND METROPOLITAN AUTHORITY
RICHMOND EXPRESSWAY SYSTEM
DOWNTOWN EXPRESSWAY


BRIDGE NO. 66
EASTBOUND ROADWAY OVER
12TH ST. - R.R. TRACKS AND 16TH ST.
WEST ABUTMENT

HOWARD, NEEDLES, TAMMEN & BERGENDOFF
 consulting engineers
 NEW YORK AL. INDRIA KANSAS CITY


SCALE: As Noted
 CONTRACT NO.: 10
 NO. 3 OF 46

AS BUILT

RICHMOND EXPRESSWAY SYSTEM			
SECTION	PROJECT	SHEET NO.	TOTAL SHEETS
10	DOWNTOWN EXPRESSWAY	130	265

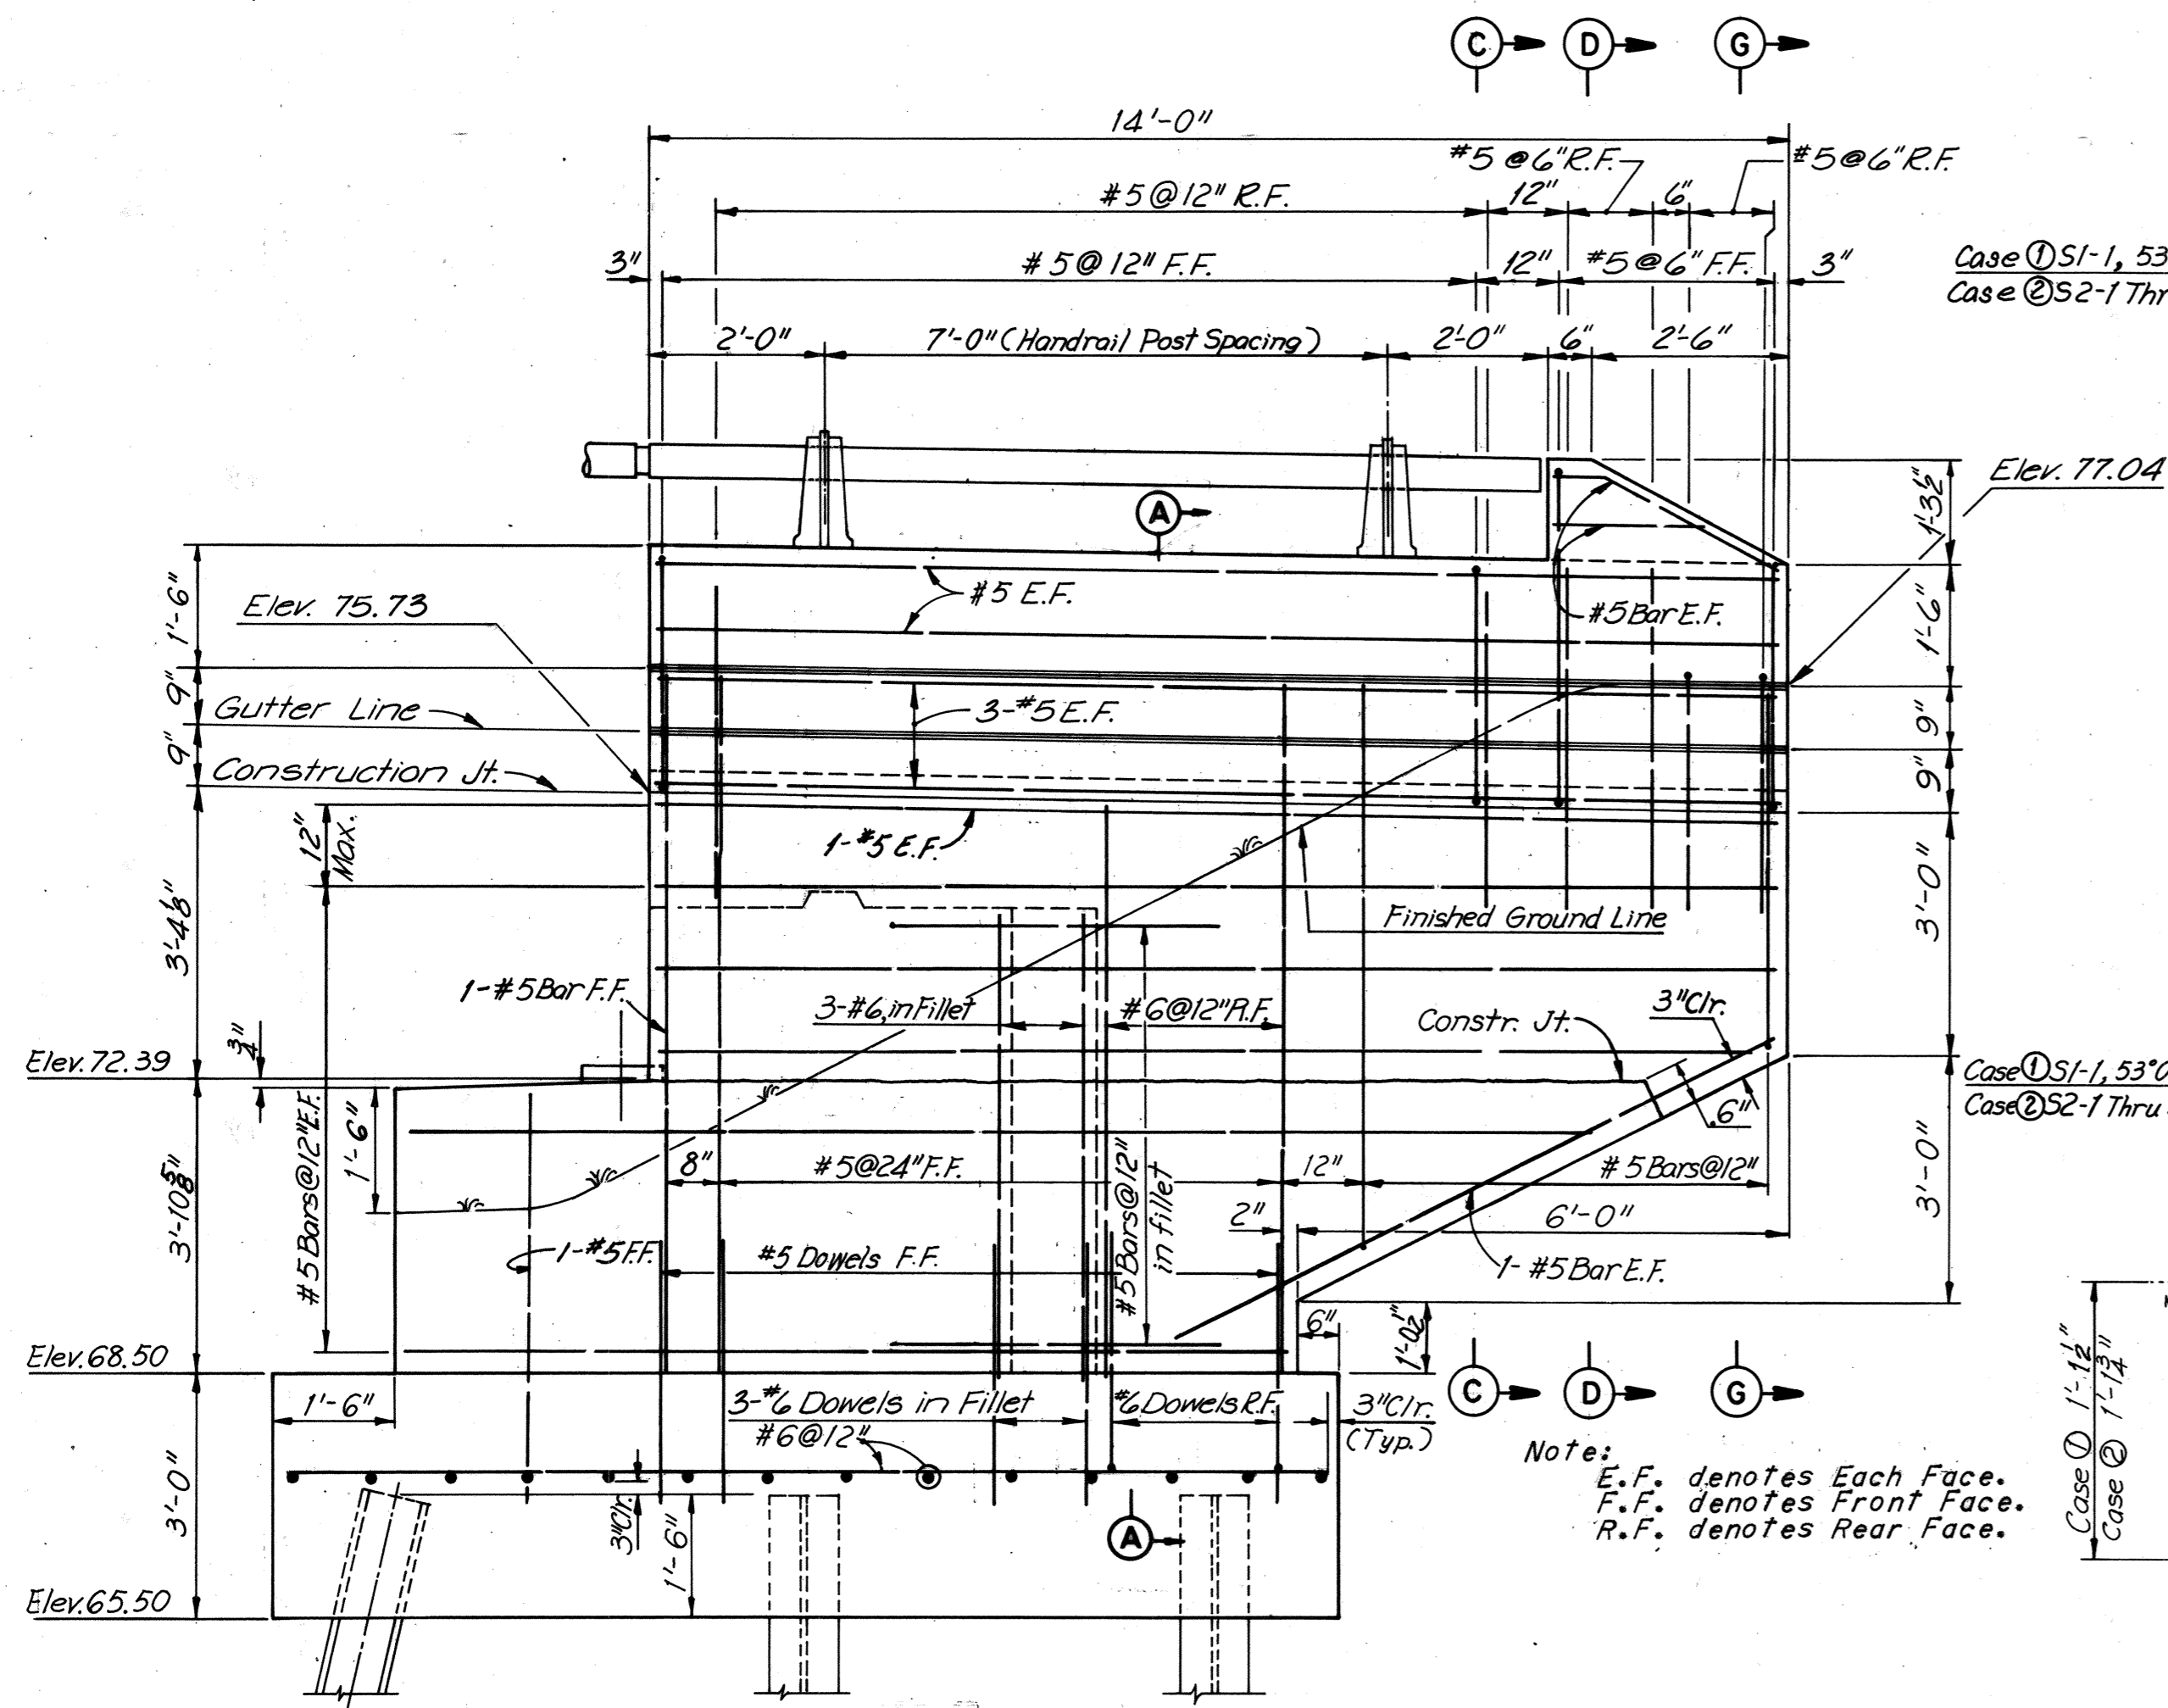


NORTH WINGWALL ELEVATION
Scale: 1/4" = 1'-0"

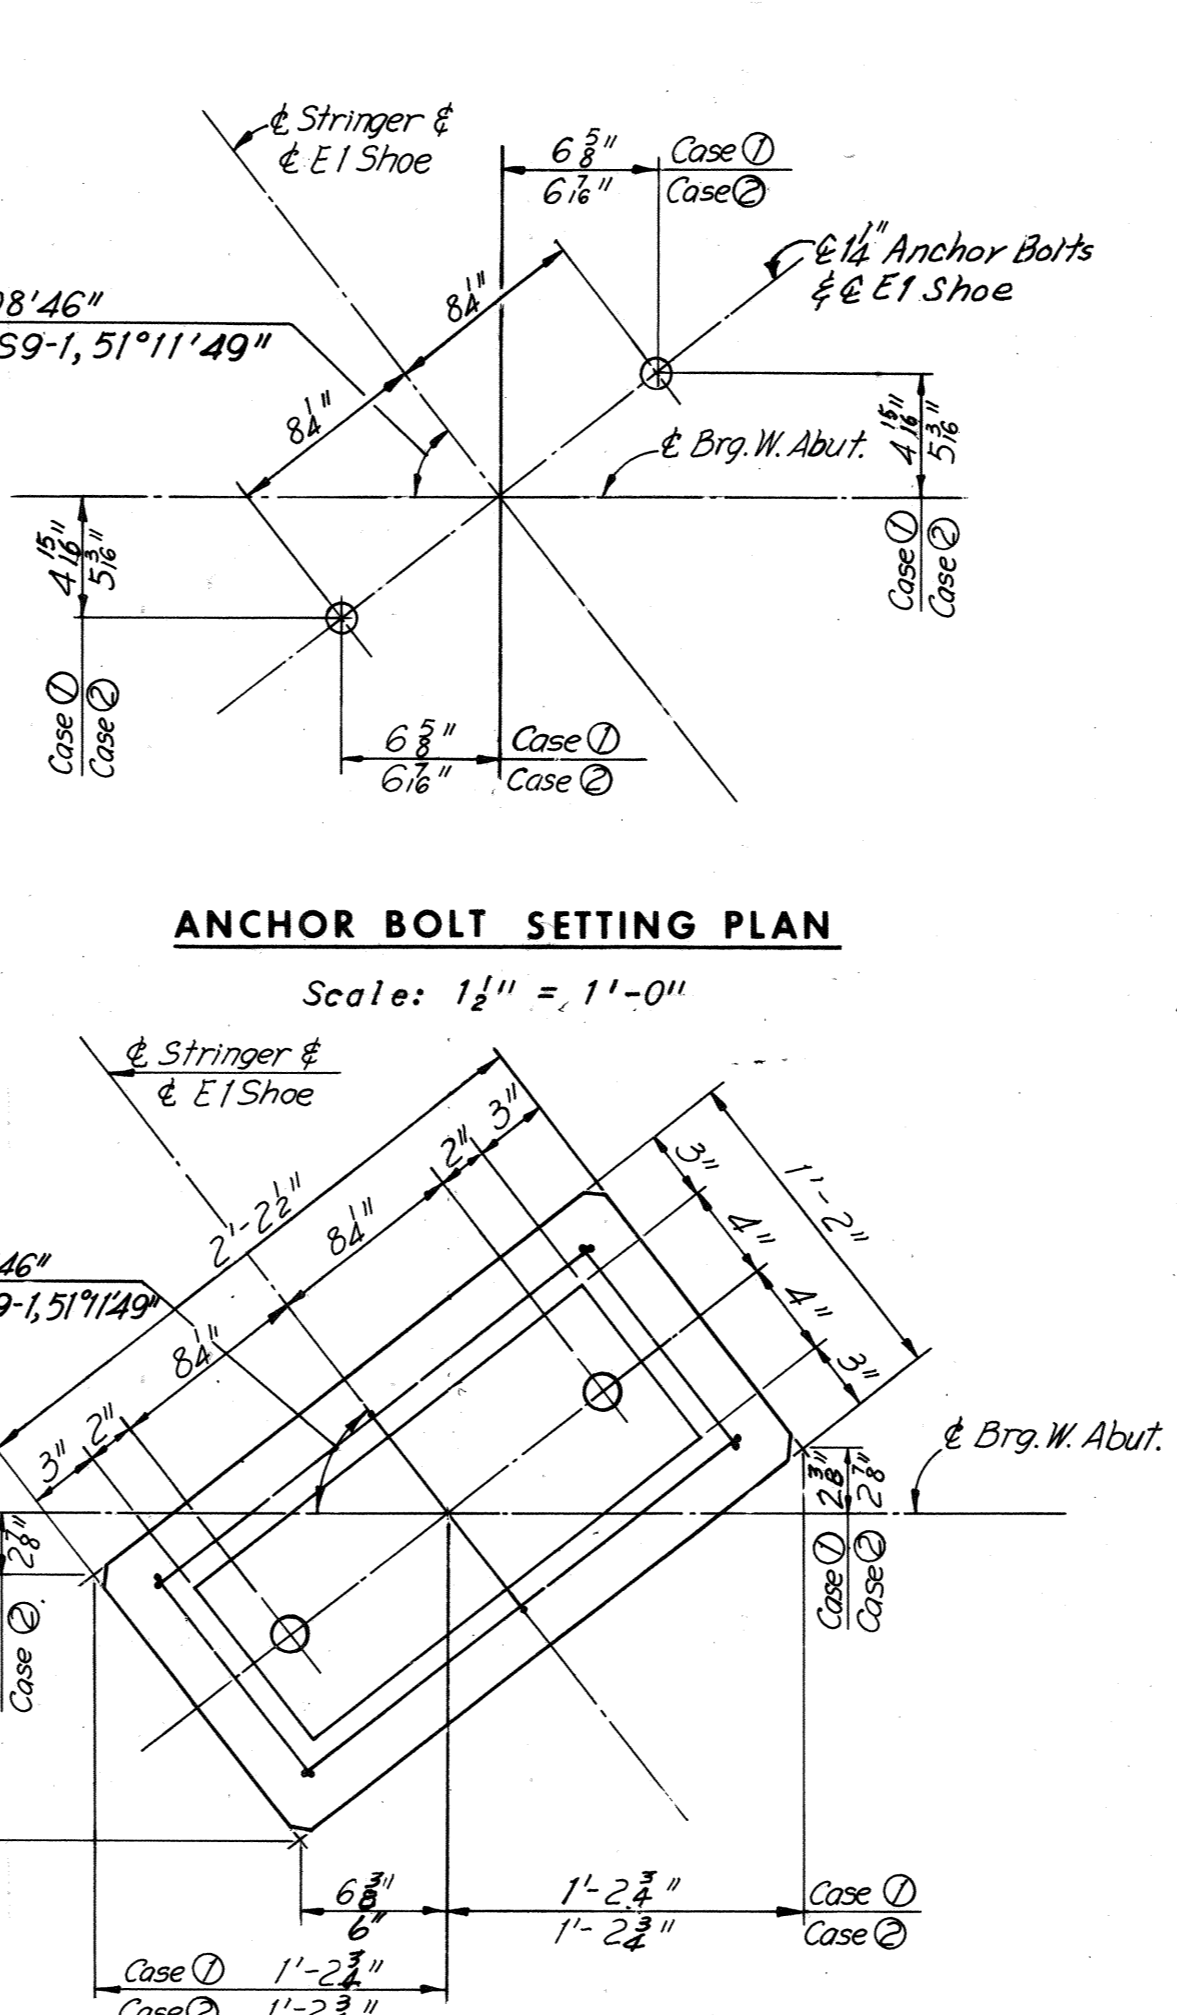


ANCHOR BOLT SETTING PLAN
Scale: 1/2" = 1'-0"

Note: No reinforcing steel required for pad height less than 4".


Note: All piles shall be 10BP42 steel piles (Design Capacity = 45 Tons).
Batter piles 3" per foot where shown.
Estimated pile tip Elev. 18.0.
For Abutment, see Sheet 3.
For Standard Handrail details, see Sheet S3.
For Standard Shoe details, see Sheets S1 & S2.
For Framing Plan, see Sheet 14.
For architectural treatment of Abutments and Wingwalls, see Sheet 5

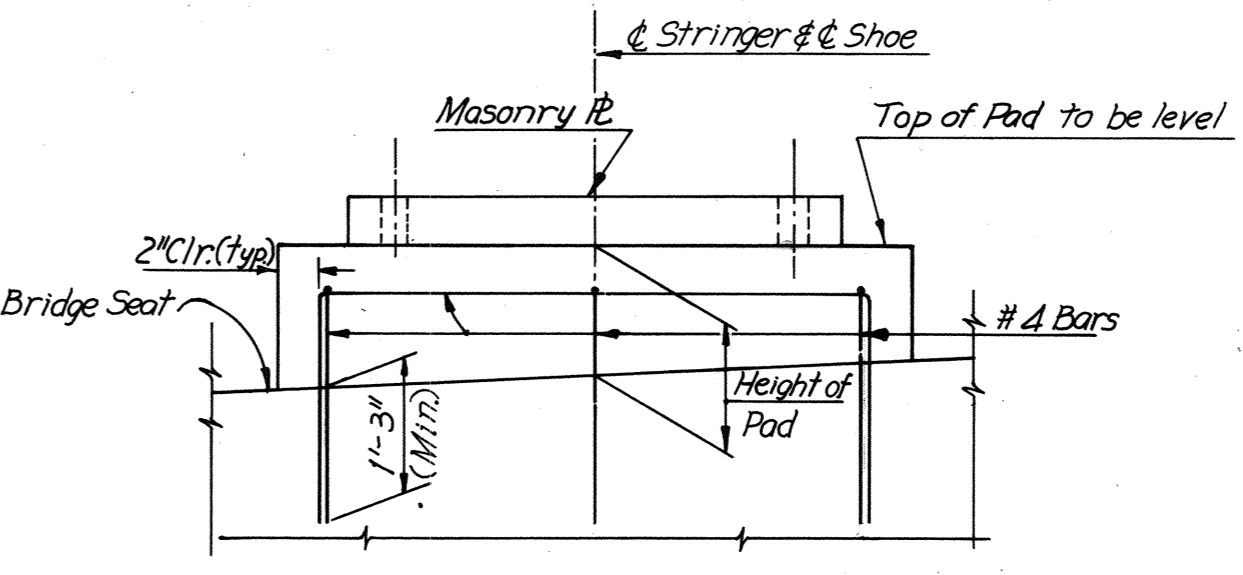


PAD ELEVATION
Scale: 1/2" = 1'-0"

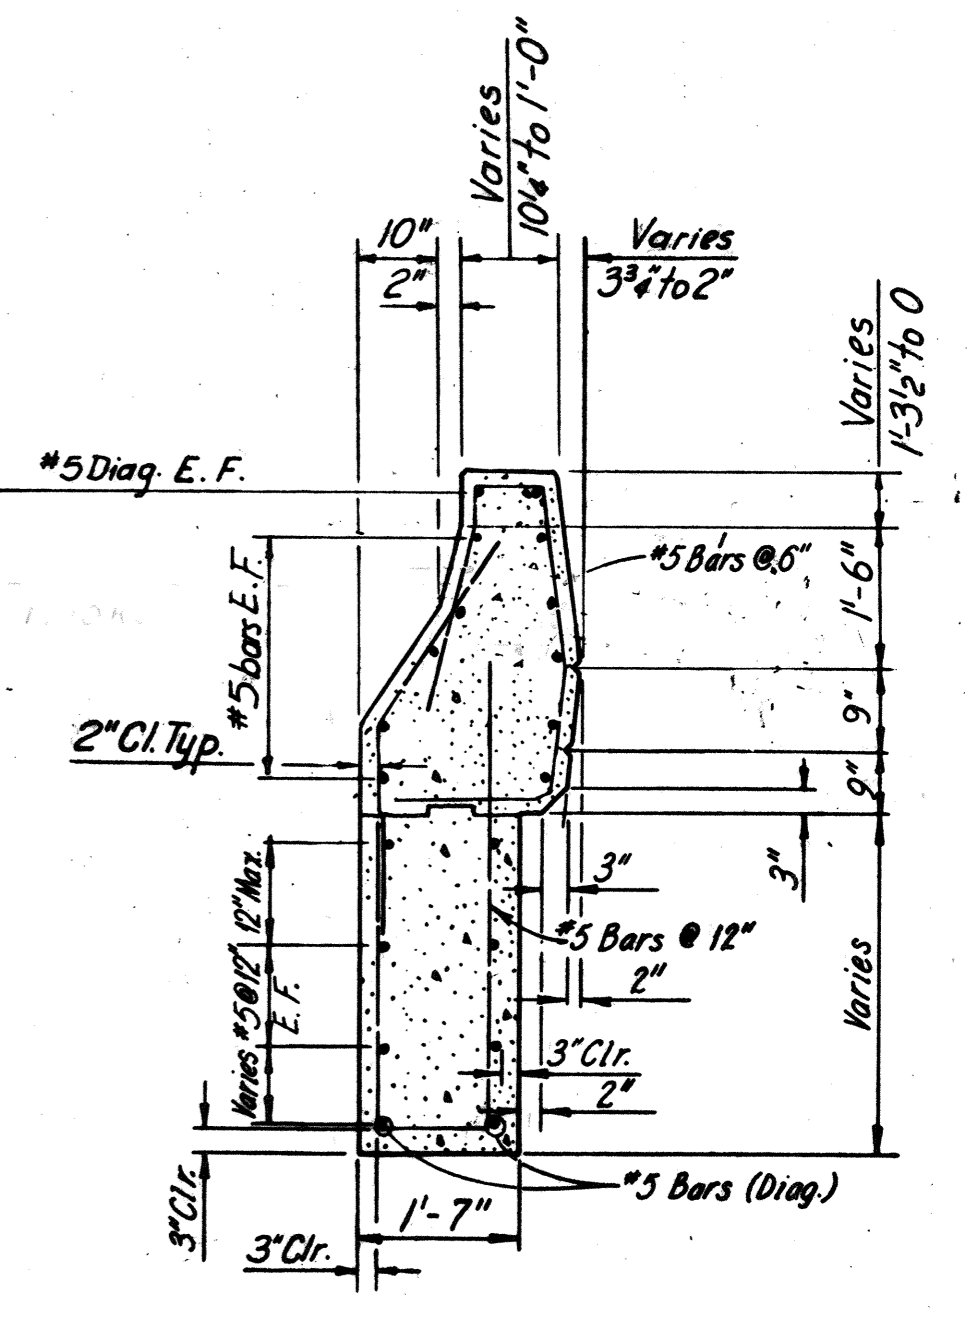


SECTION G-G
Scale: 1/2" = 1'-0"

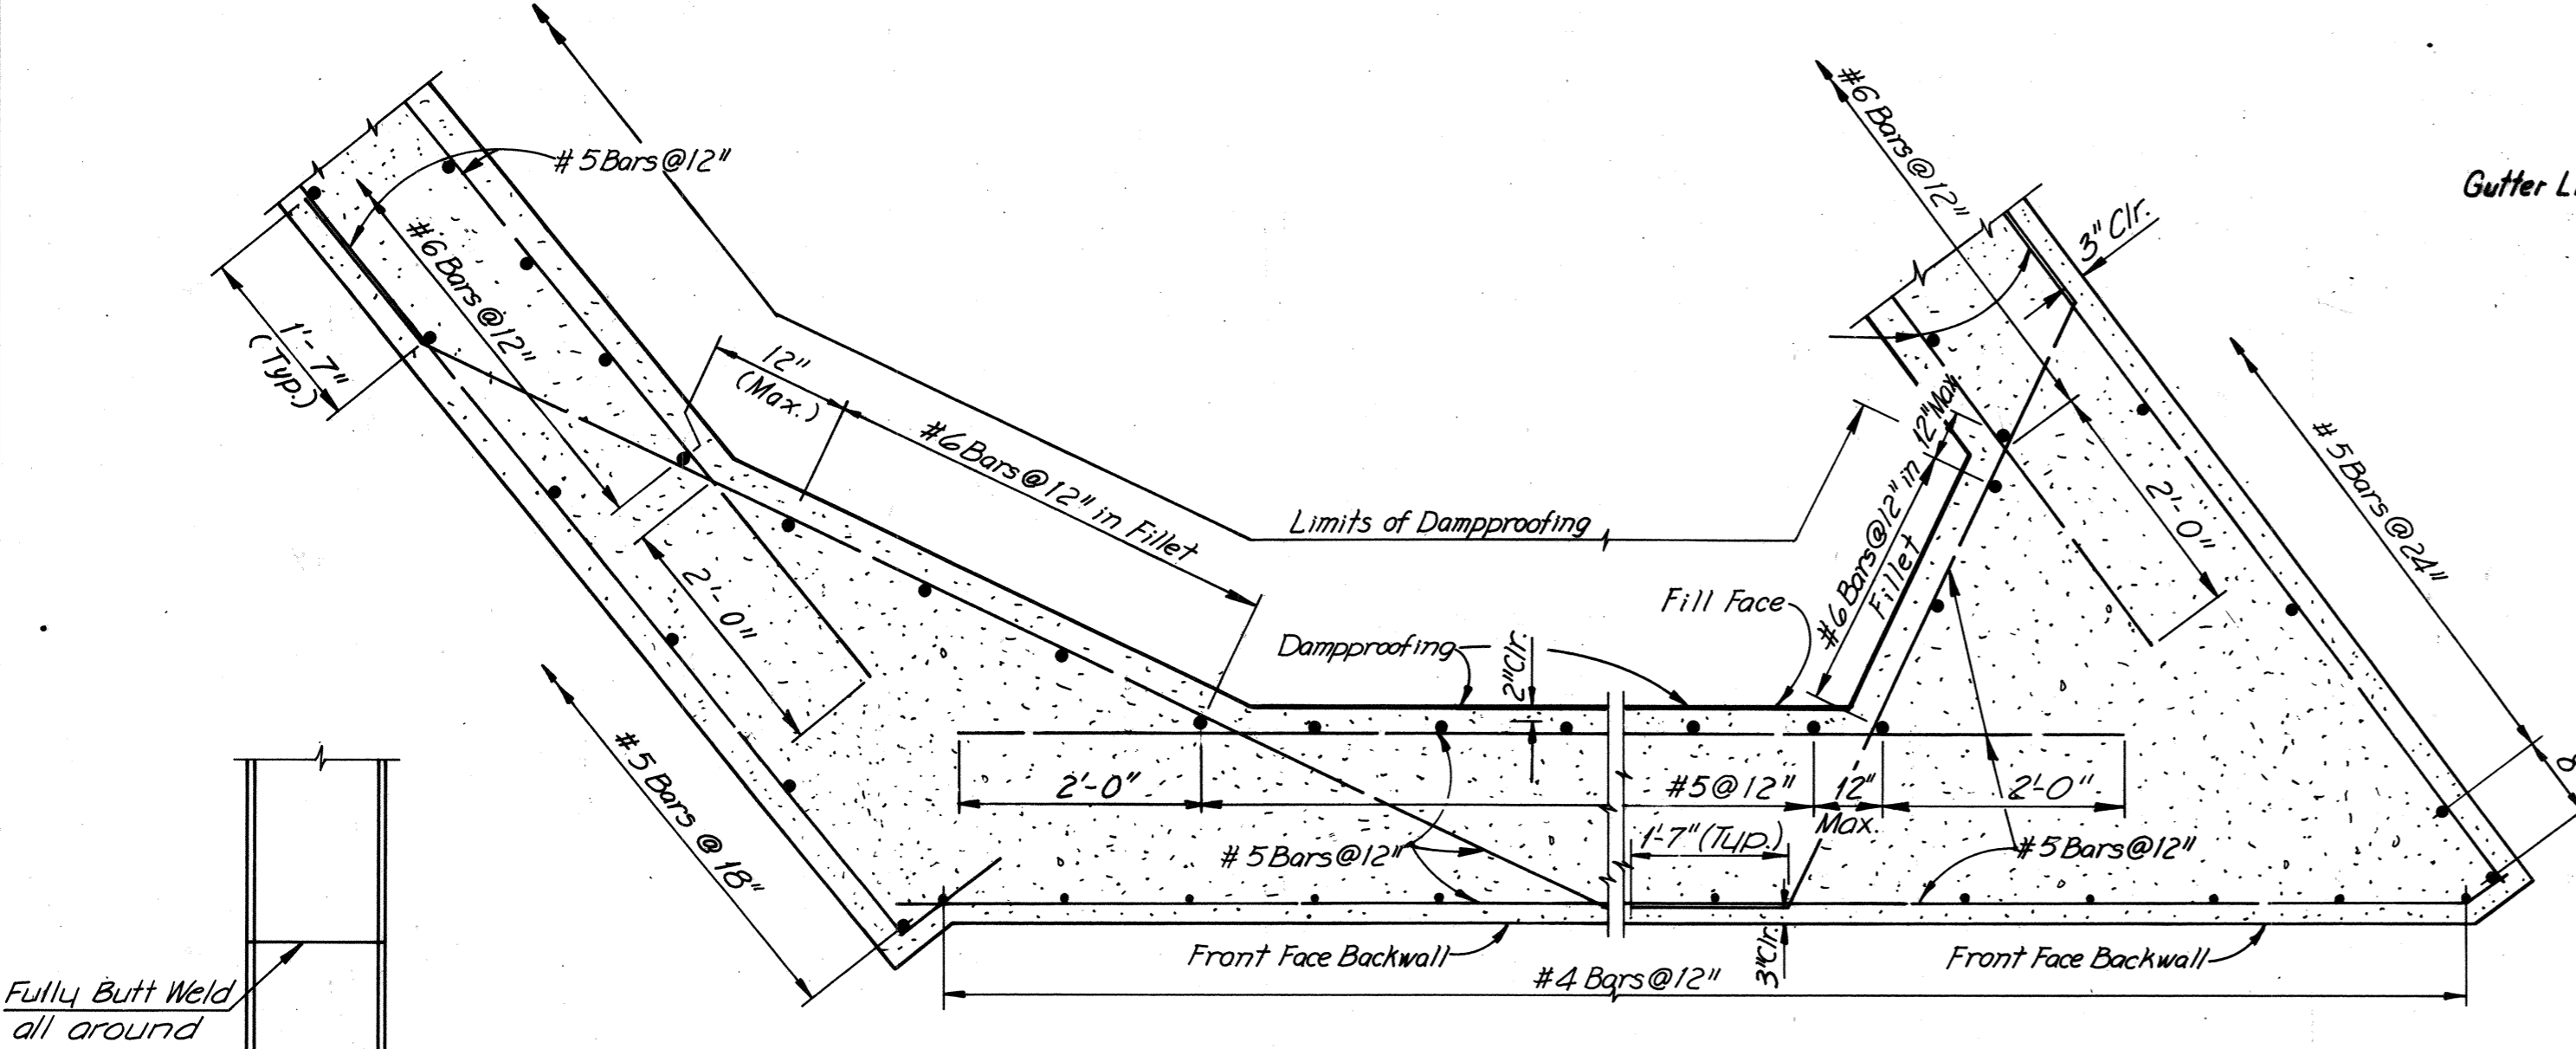


FILLET DETAILS
Scale: 3/4" = 1'-0"

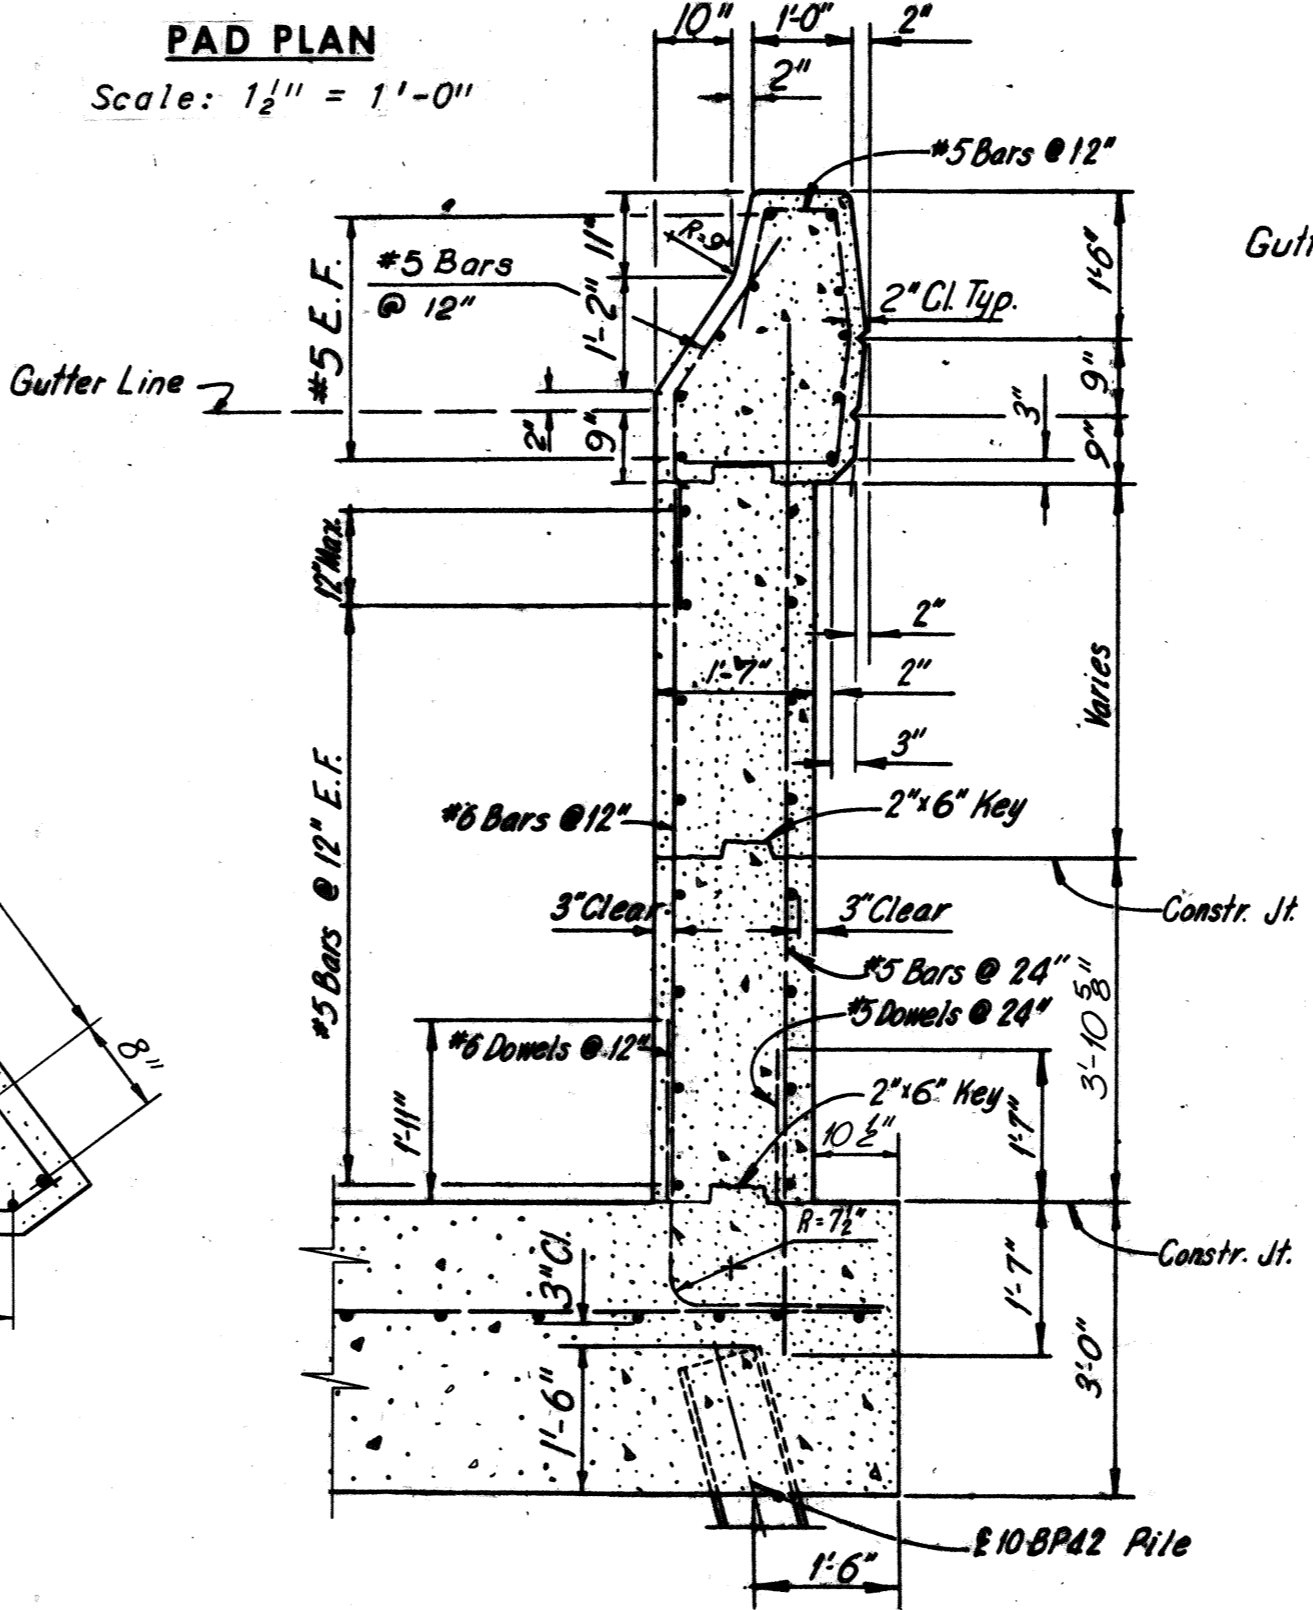

SECTION A-A
Scale: 1/2" = 1'-0"

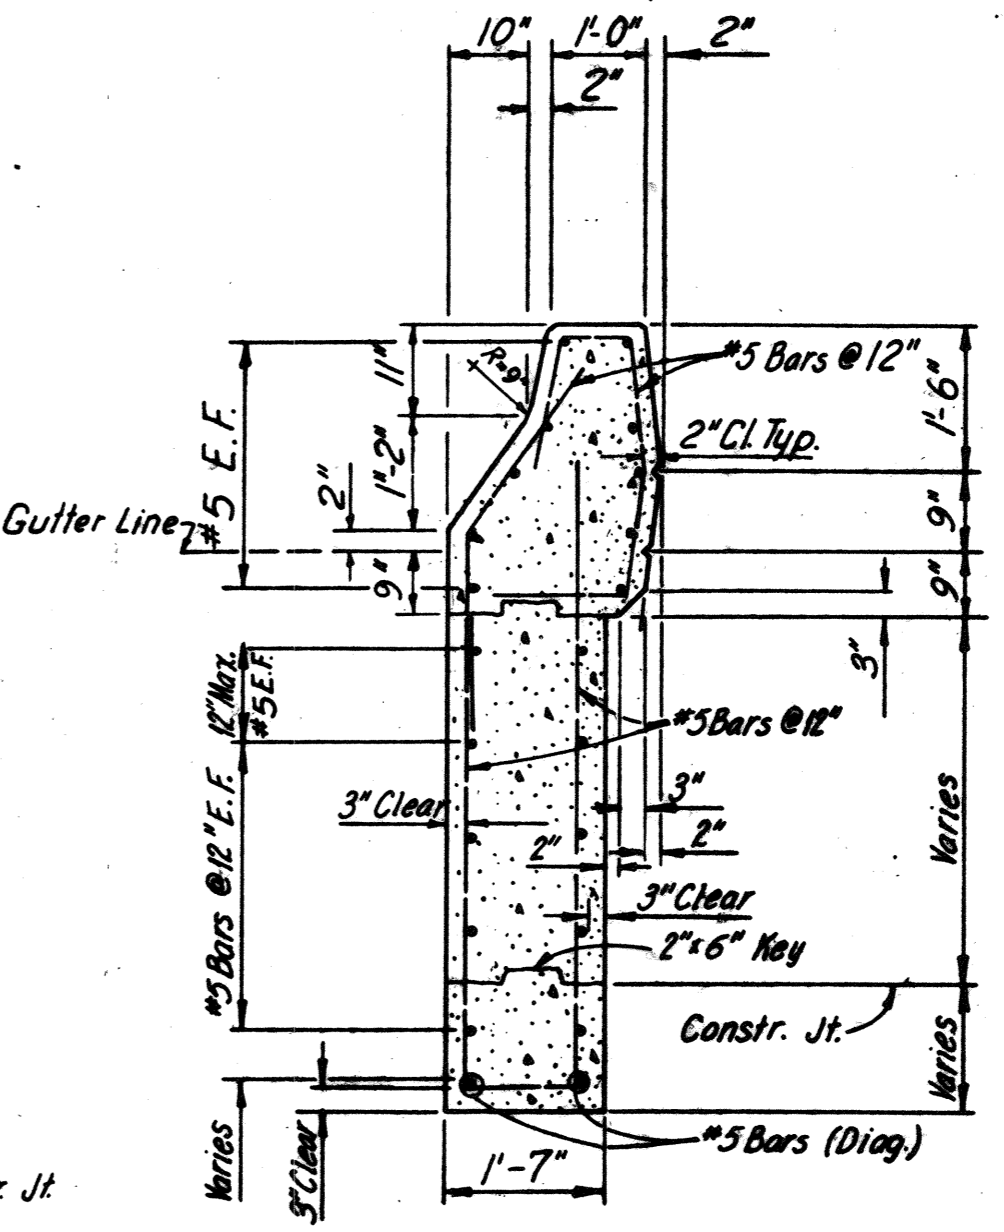

SECTION C-C
Scale: 1/2" = 1'-0"

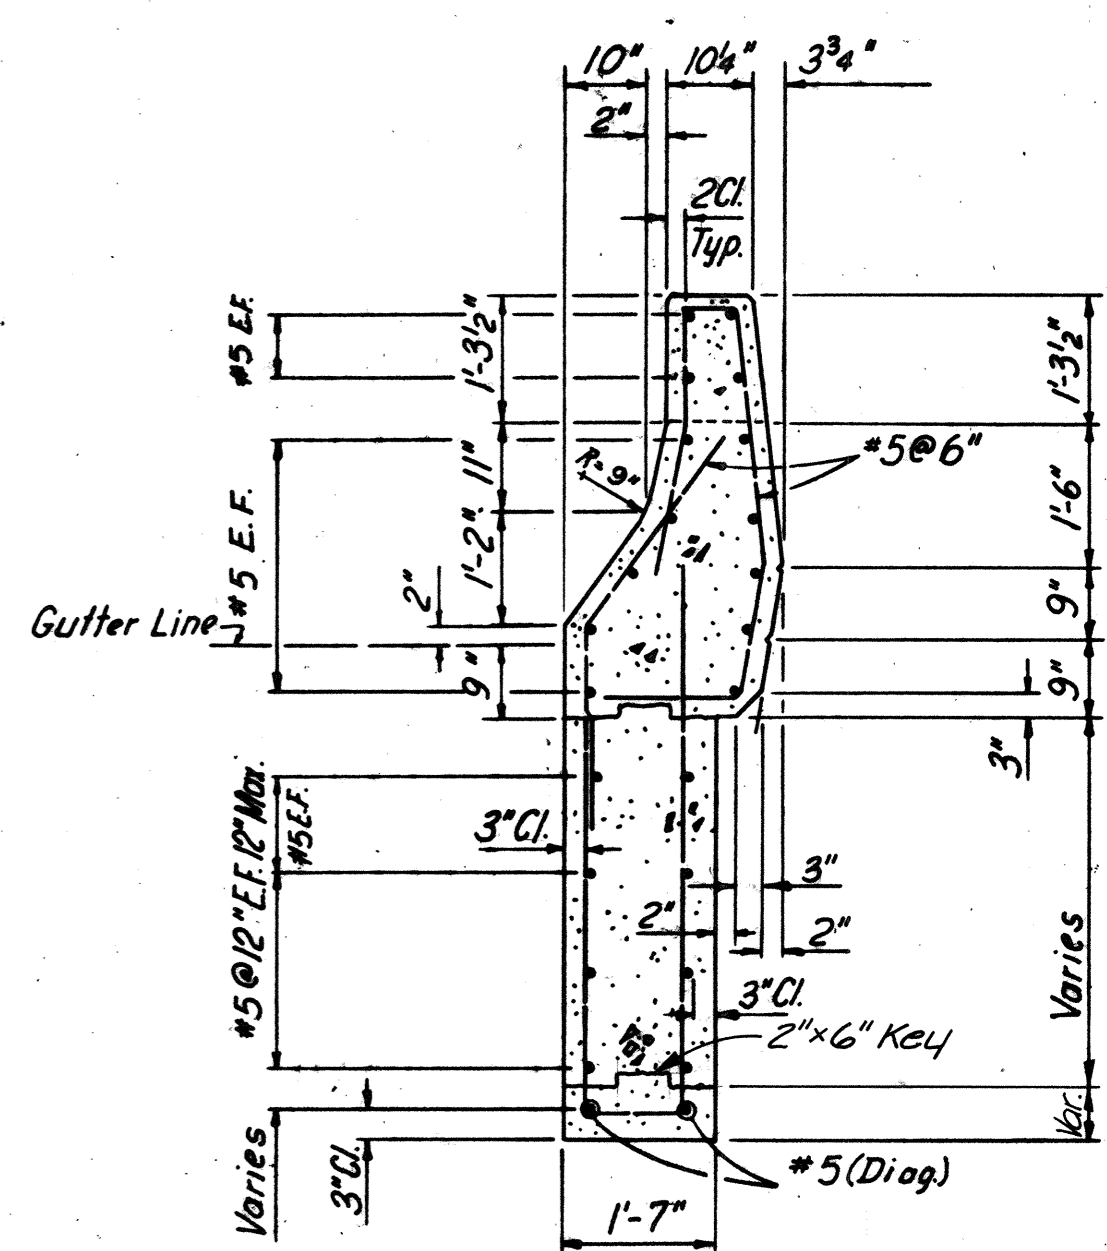

SECTION D-D
Scale: 1/2" = 1'-0"

DETAIL OF STEEL PILE SPLICE

MADE	BY	DATE			
	AHH	7-23-68			
CHECKED	G.C.C.	8-21-68	1	As Built	TEM 8-76
IN CHARGE			NO.	REVISION	BY DATE

RICHMOND METROPOLITAN AUTHORITY
RICHMOND EXPRESSWAY SYSTEM

BRIDGE NO. 66
EASTBOUND ROADWAY OVER
12TH ST. - R.R. TRACKS AND 16TH ST.




WEST ABUTMENT DETAILS

HOWARD, NEEDLES, TAMMEN & BERGENDOFF
consulting engineers
NEW YORK ALEXANDRIA KANSAS CITY

SCALE: As Noted
CONTRACT NO. 10
SHEET NO. 4 OF 46

AS BUILT


RICHMOND EXPRESSWAY SYSTEM			
SECTION	PROJECT	SHEET NO.	TOTAL SHEETS
10	DOWNTOWN EXPRESSWAY	131	265

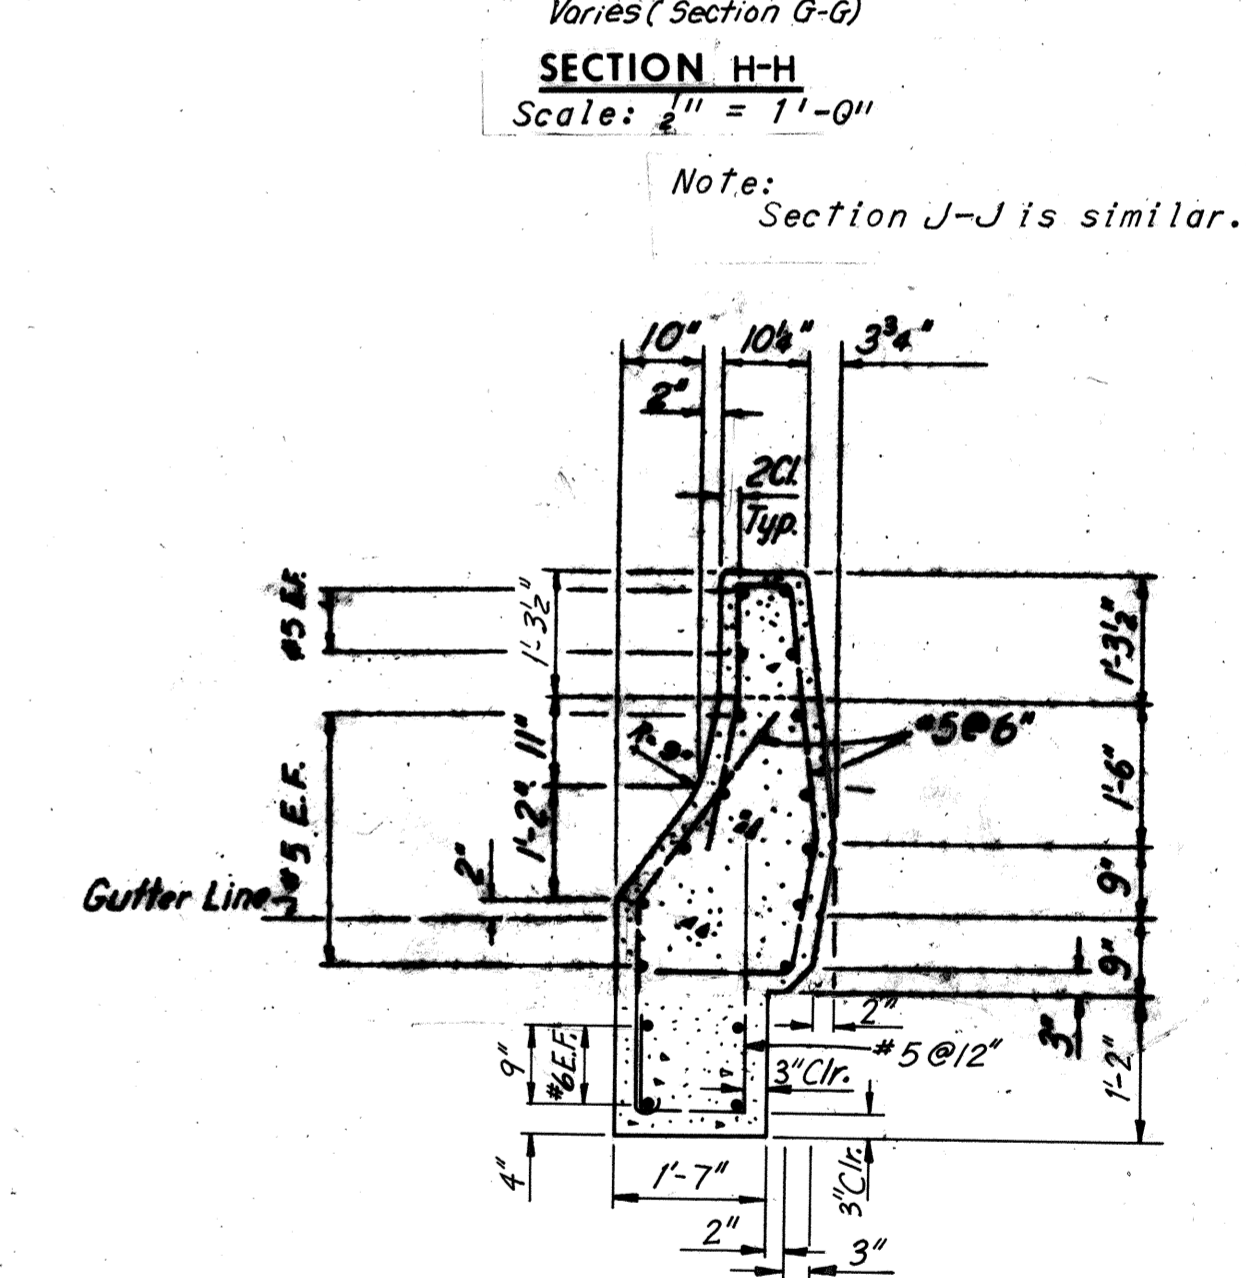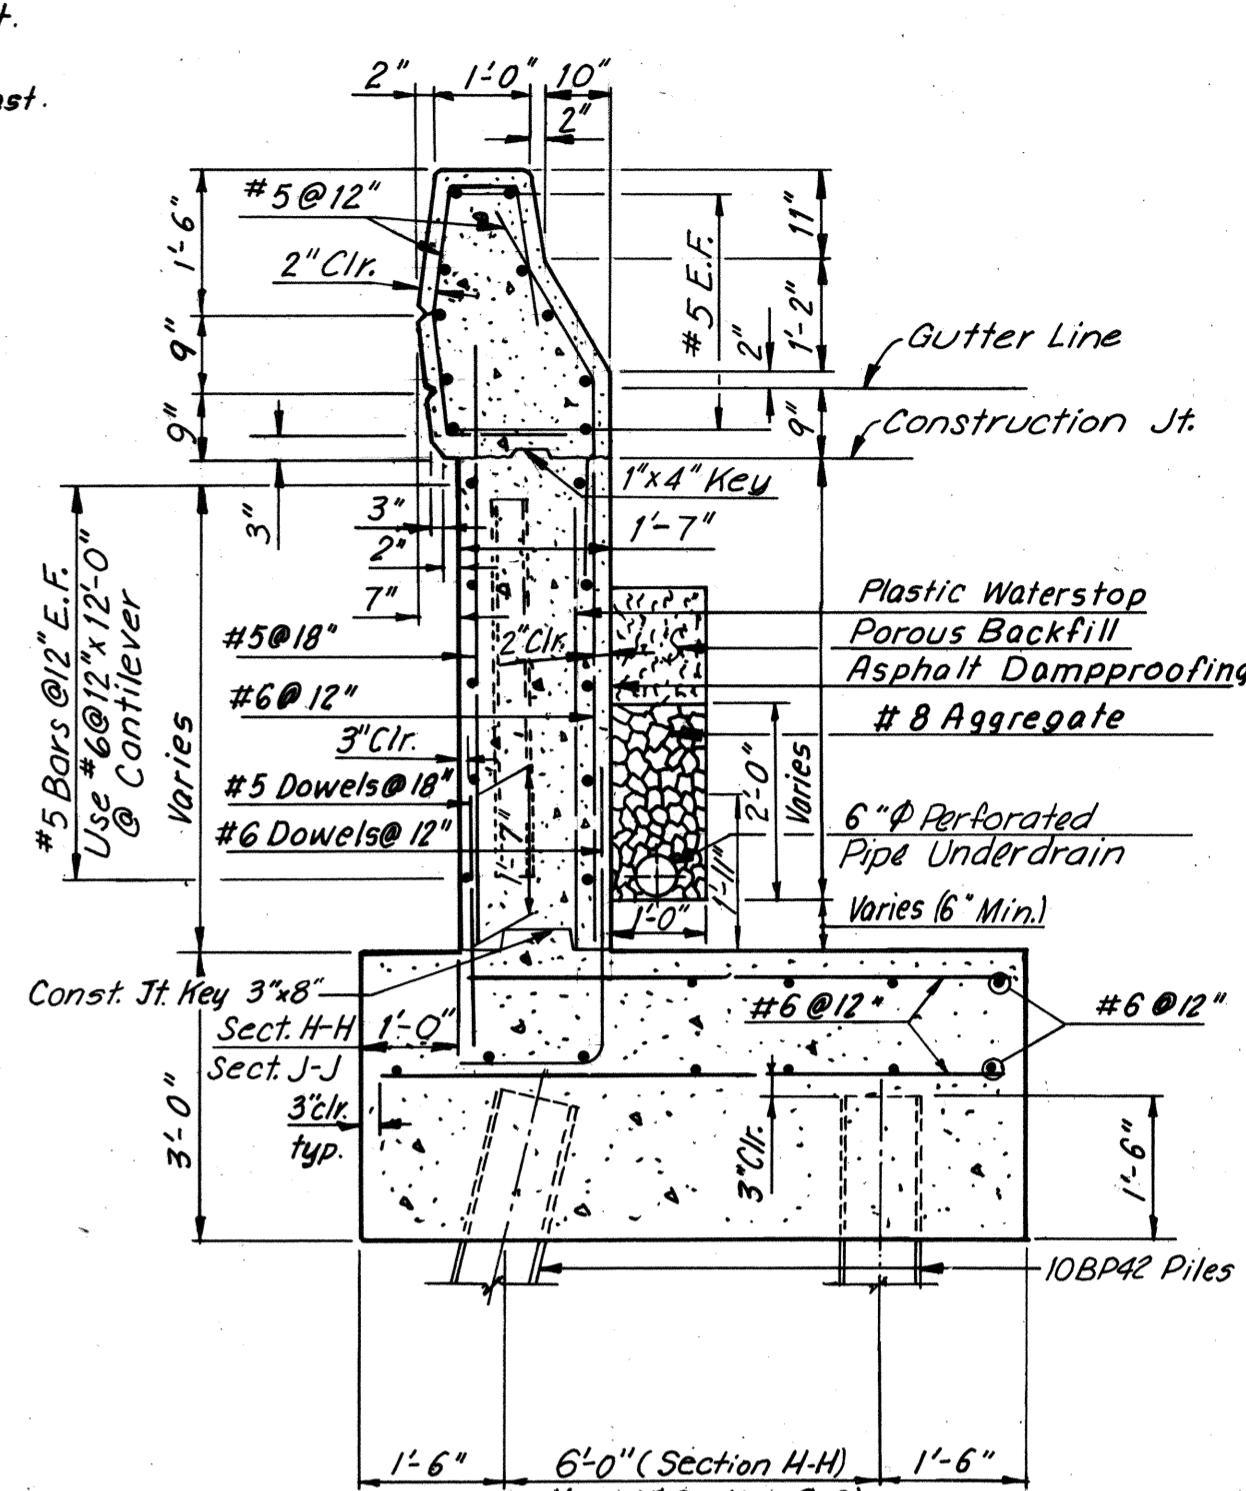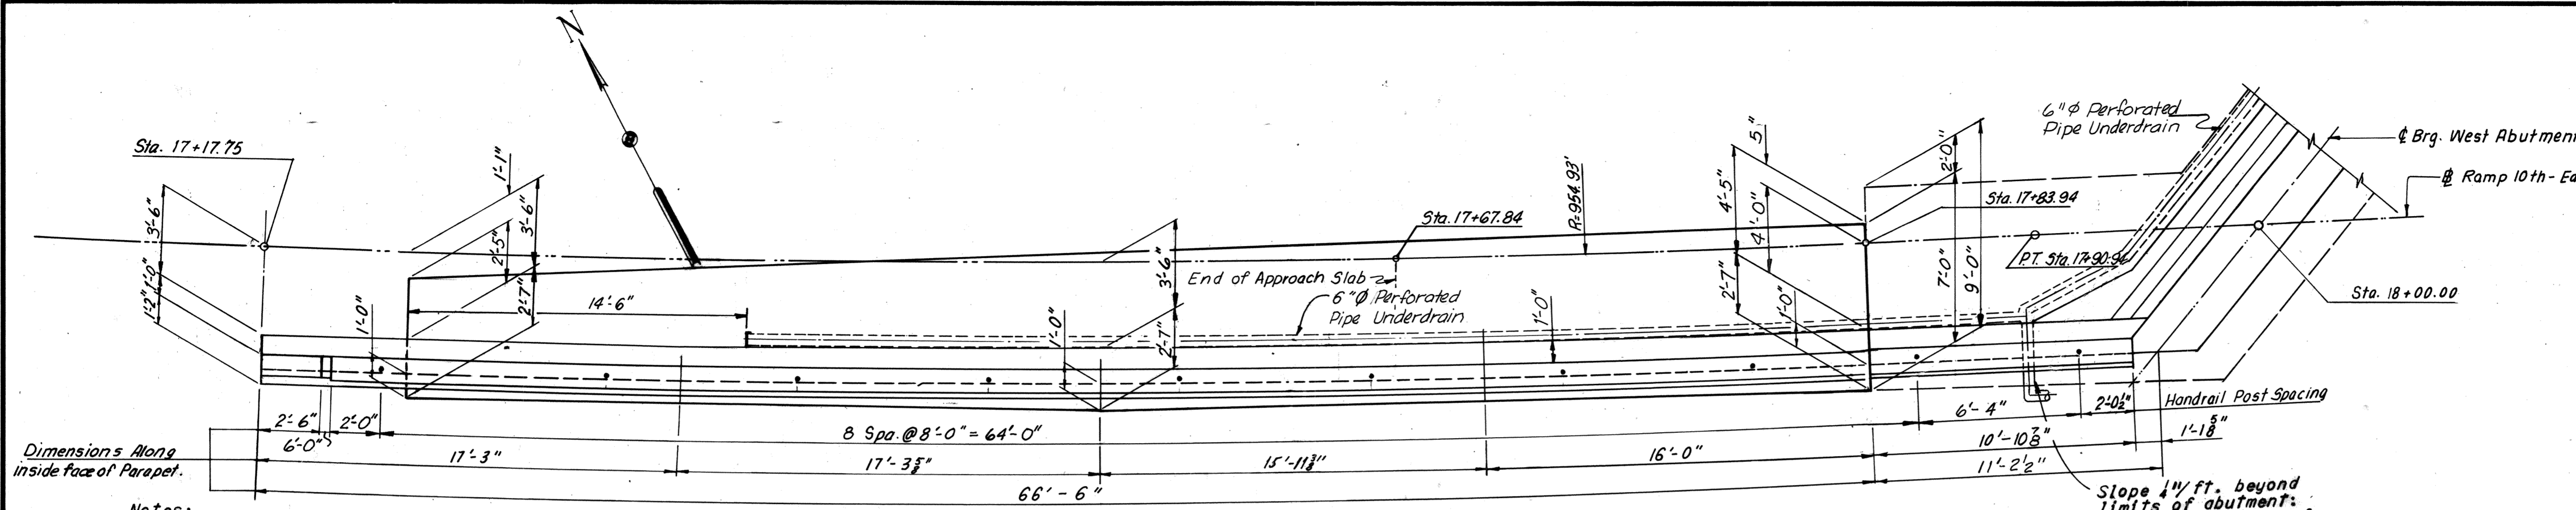

Notes:
 Ends of footing are on Radial Lines.
 Longitudinal dimensions in Footing Plan are along inside face of parapet.
 For Handrail Details, see Standard Architectural Details, Sheet S3.
 All piles are 10BP42 Piles & Design Capacity = 45 Tons.
 Battered Piles are battered 3" per foot.
 For West Abutment Details, see Sheets 3 & 4.


PLAN
 Scale: 1/4" = 1'-0"

Note:
 Piles not shown in Plan or Elevation Views. For location, see Footing Plan Sheet 3.

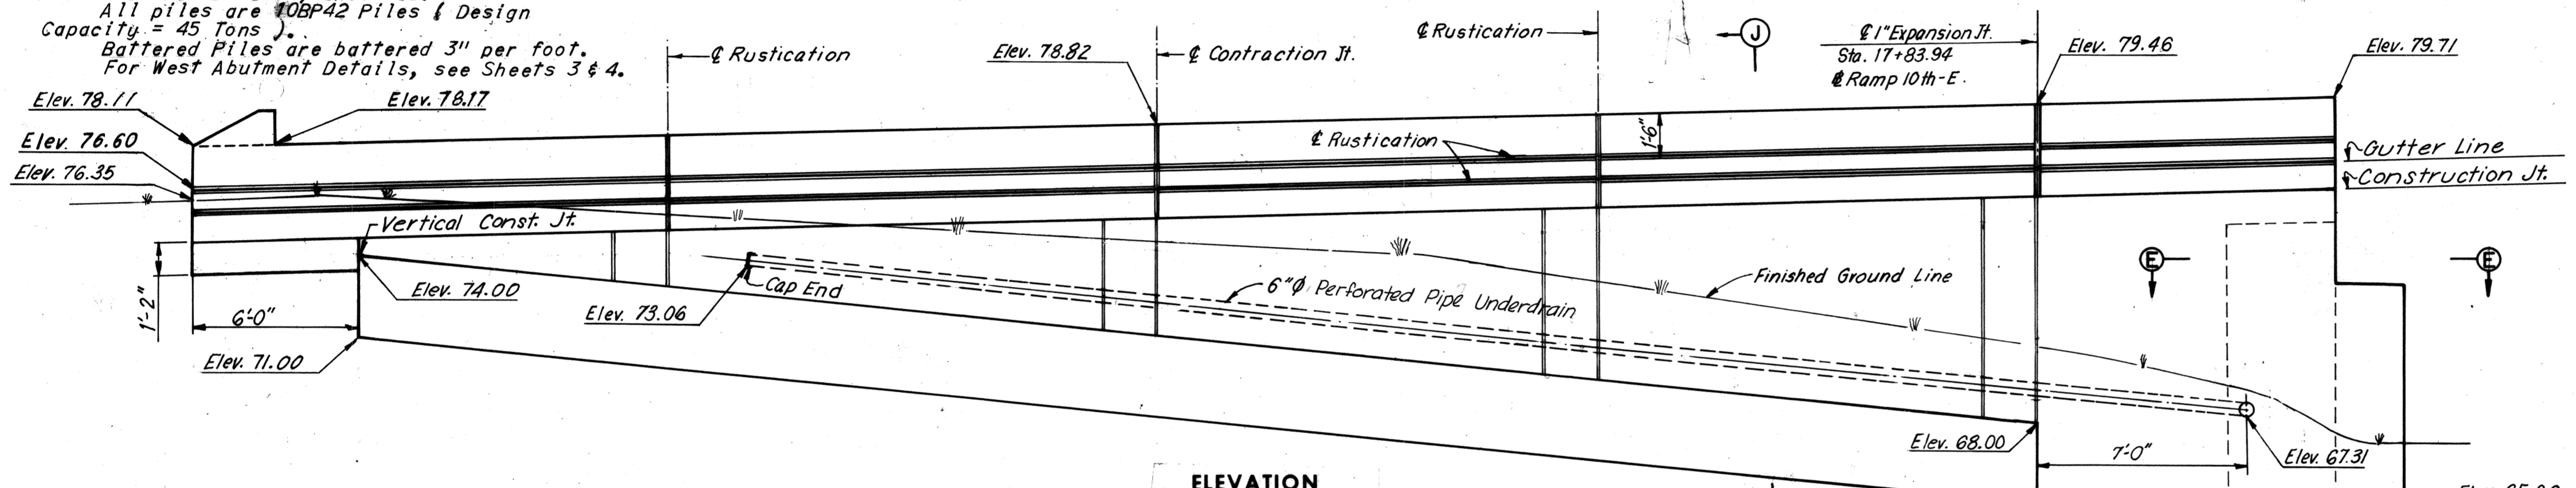


ELEVATION
 Scale: 1/4" = 1'-0"


Note:
 Pile spacing is measured at bottom of Footing.

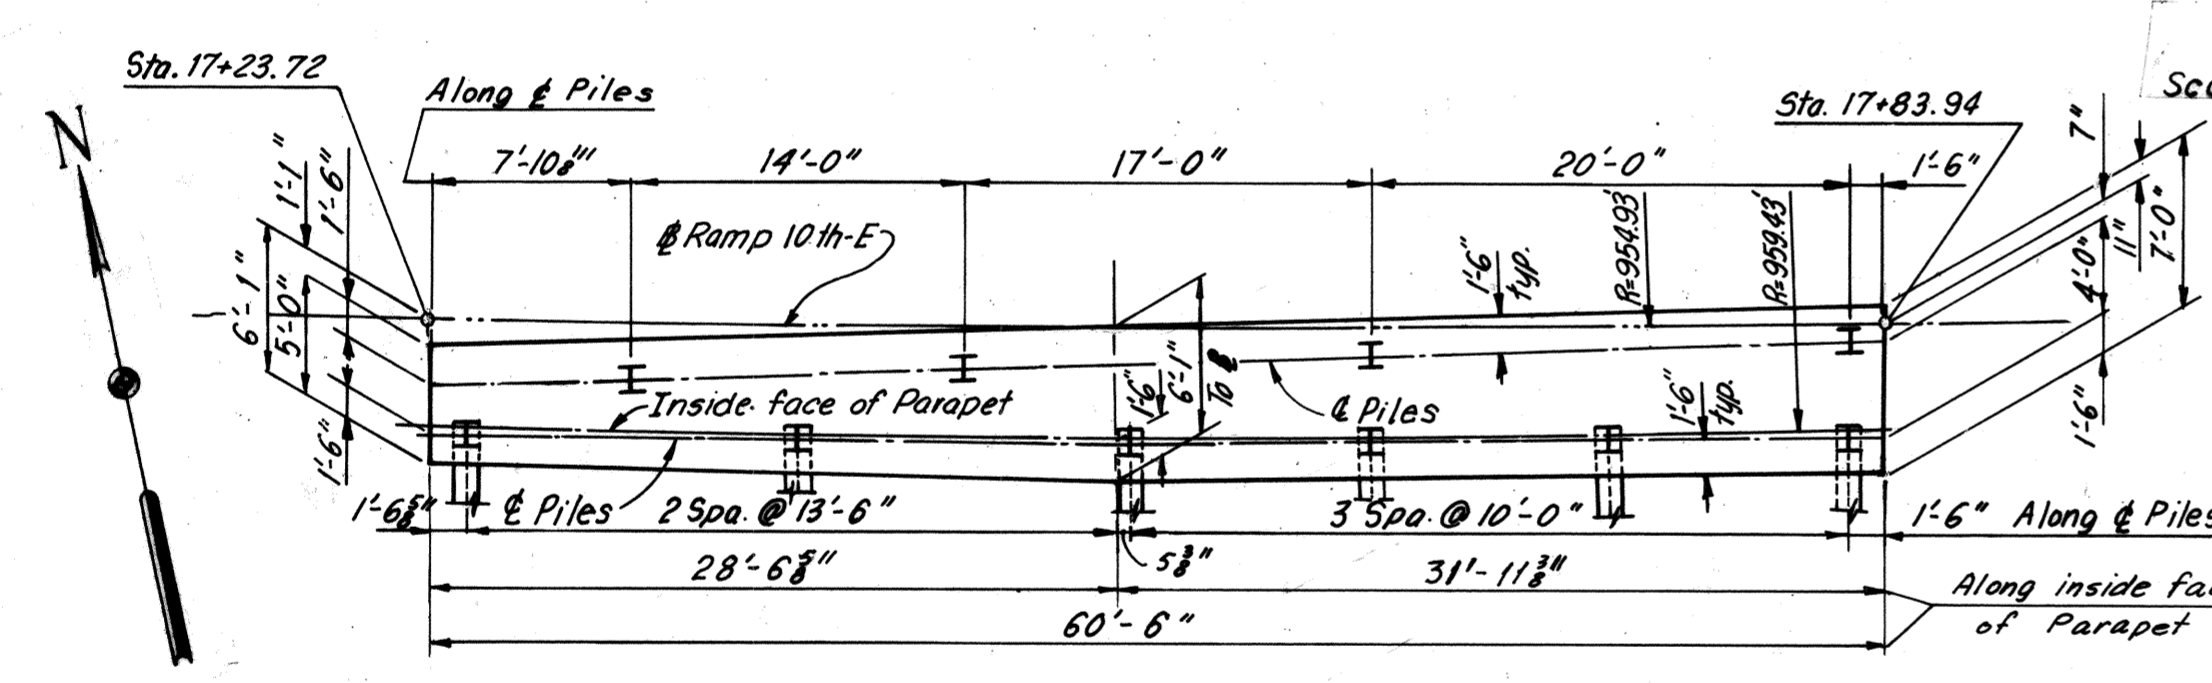


FOOTING PLAN
 Scale: 1/4" = 1'-0"

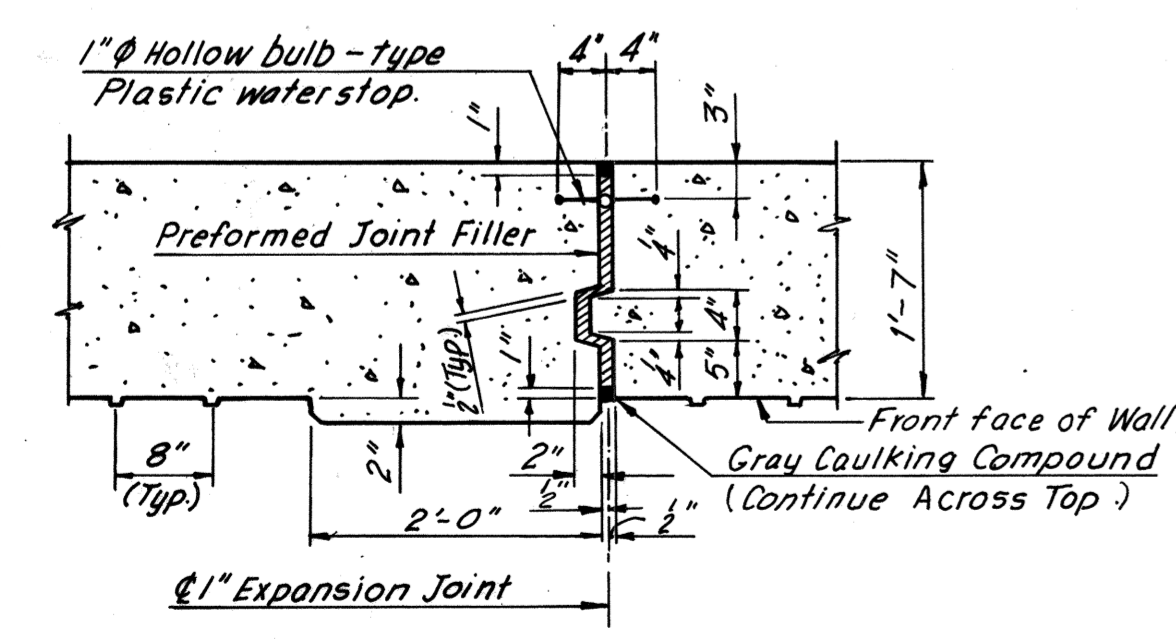


EXPANSION JOINT DETAIL
 Scale: 3/8" = 1'-0"

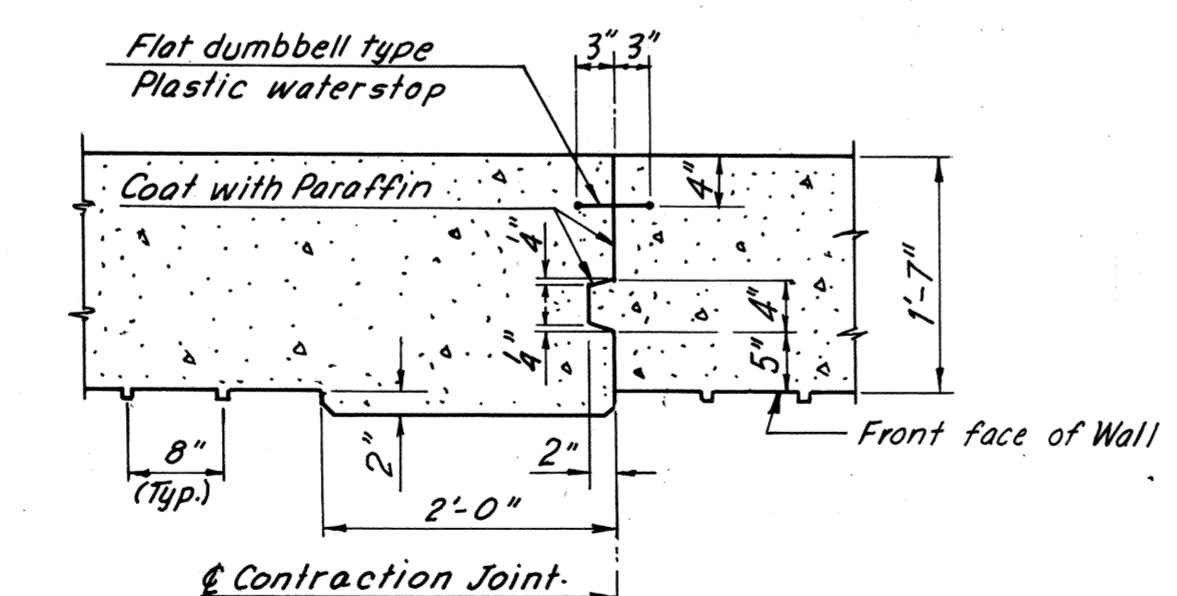

CONTRACTION JOINT DETAIL
 Scale: 1/2" = 1'-0"

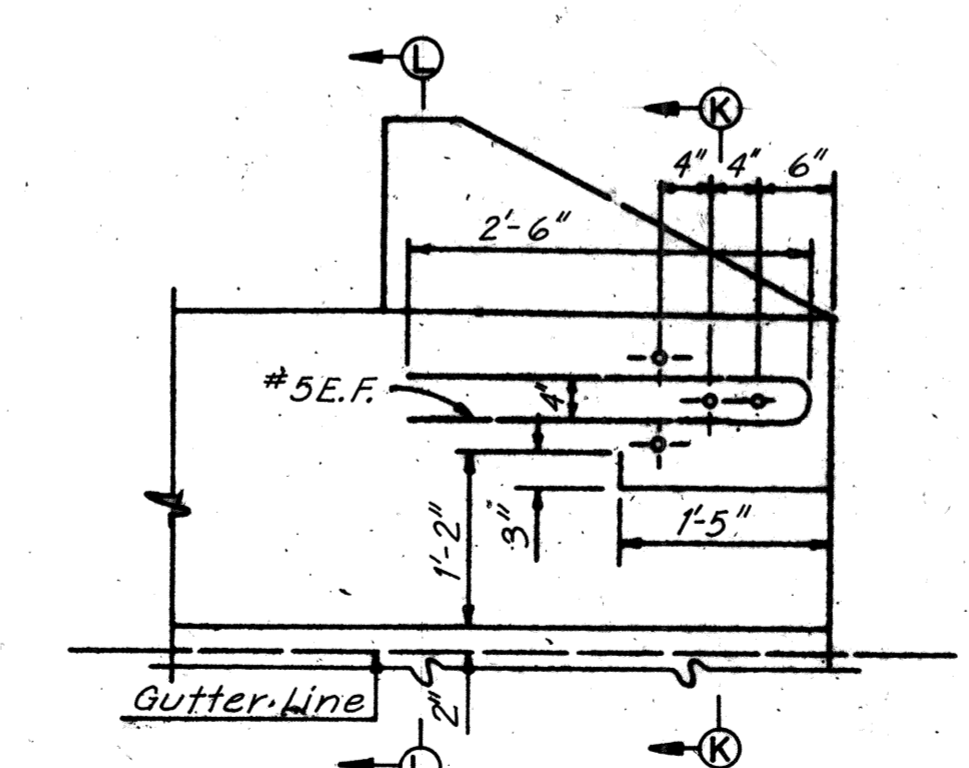

GUARDRAIL ATTACHMENT
 Scale: 3/8" = 1'-0"

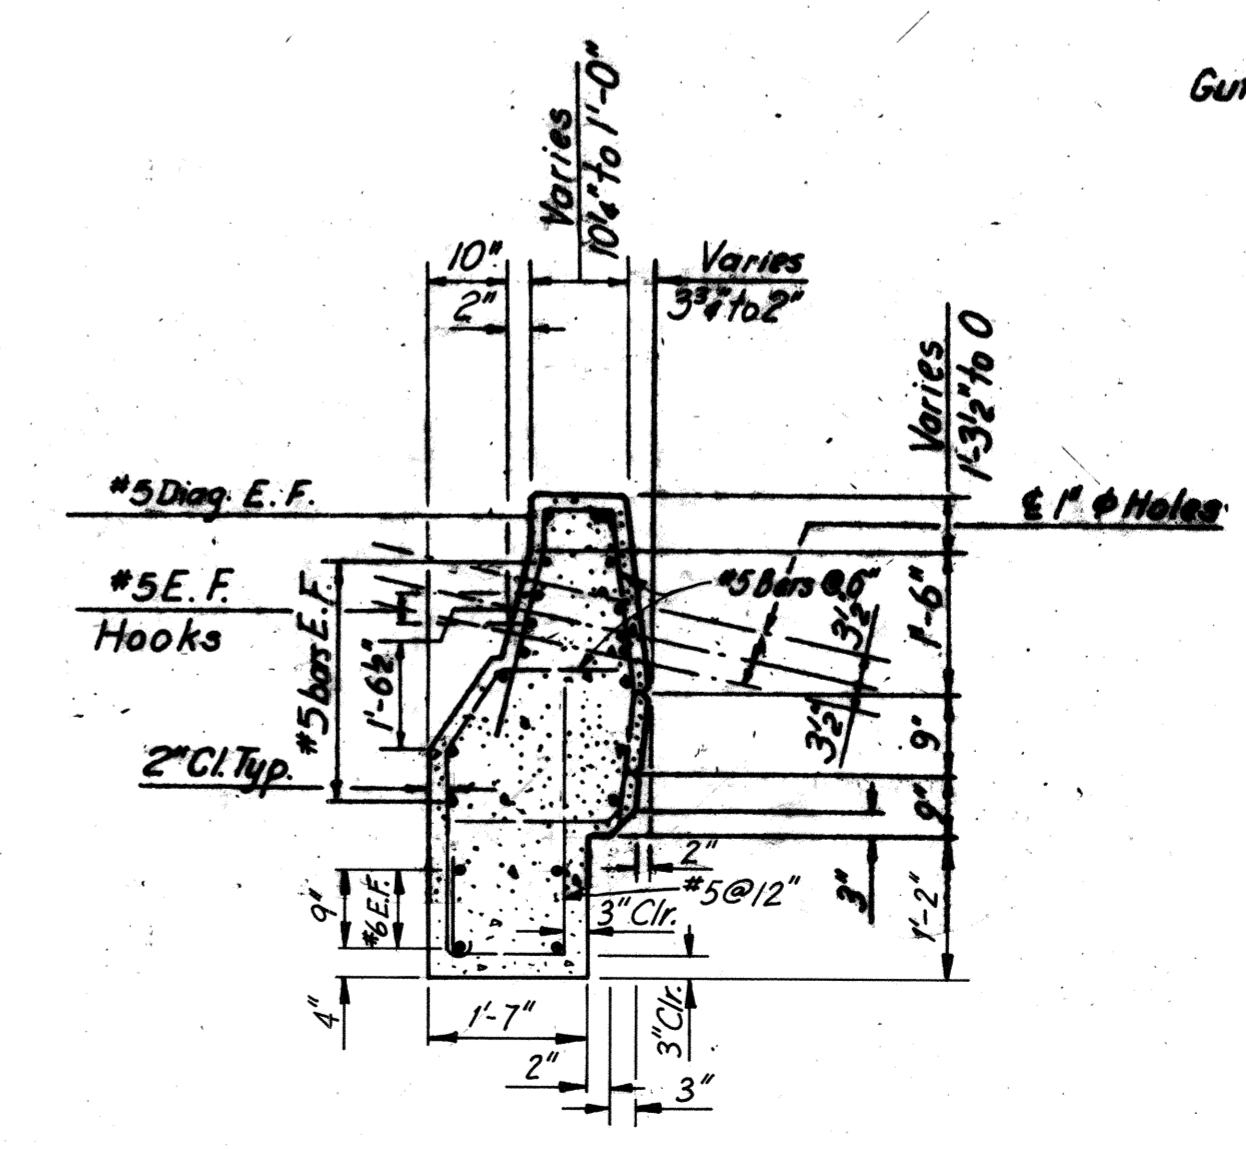

SECTION K-K
 Scale: 1/2" = 1'-0"

BY	DATE	Underdrain changed Add Guard Rail Attach.	PRMS	4-19-74
MADE	M.A.R.	7-23-68	2 As Built	TEM 8-76
CHECKED	RLM	8-14-68		
IN CHARGE				

RUSTICATION DETAIL
 No Scale

RICHMOND METROPOLITAN AUTHORITY
RICHMOND EXPRESSWAY SYSTEM

BRIDGE NO. 66
EASTBOUND ROADWAY OVER
12TH ST. - R.R. TRACKS AND 16TH ST.
WEST ABUTMENT RETAINING WALL










HOWARD, NEEDLES, TAMMEN & BERGENDOFF
 consulting engineers
 NEW YORK ALEXANDRIA KANSAS CITY

SCALE: As Noted
 CONTRACT NO. 10
 SHEET NO. 5 OF 46

AS BUILT

1828-22-10-066

RICHMOND EXPRESSWAY SYSTEM			
SECTION	PROJECT	SHEET NO.	TOTAL SHEETS
10	DOWNTOWN EXPRESSWAY	132	265

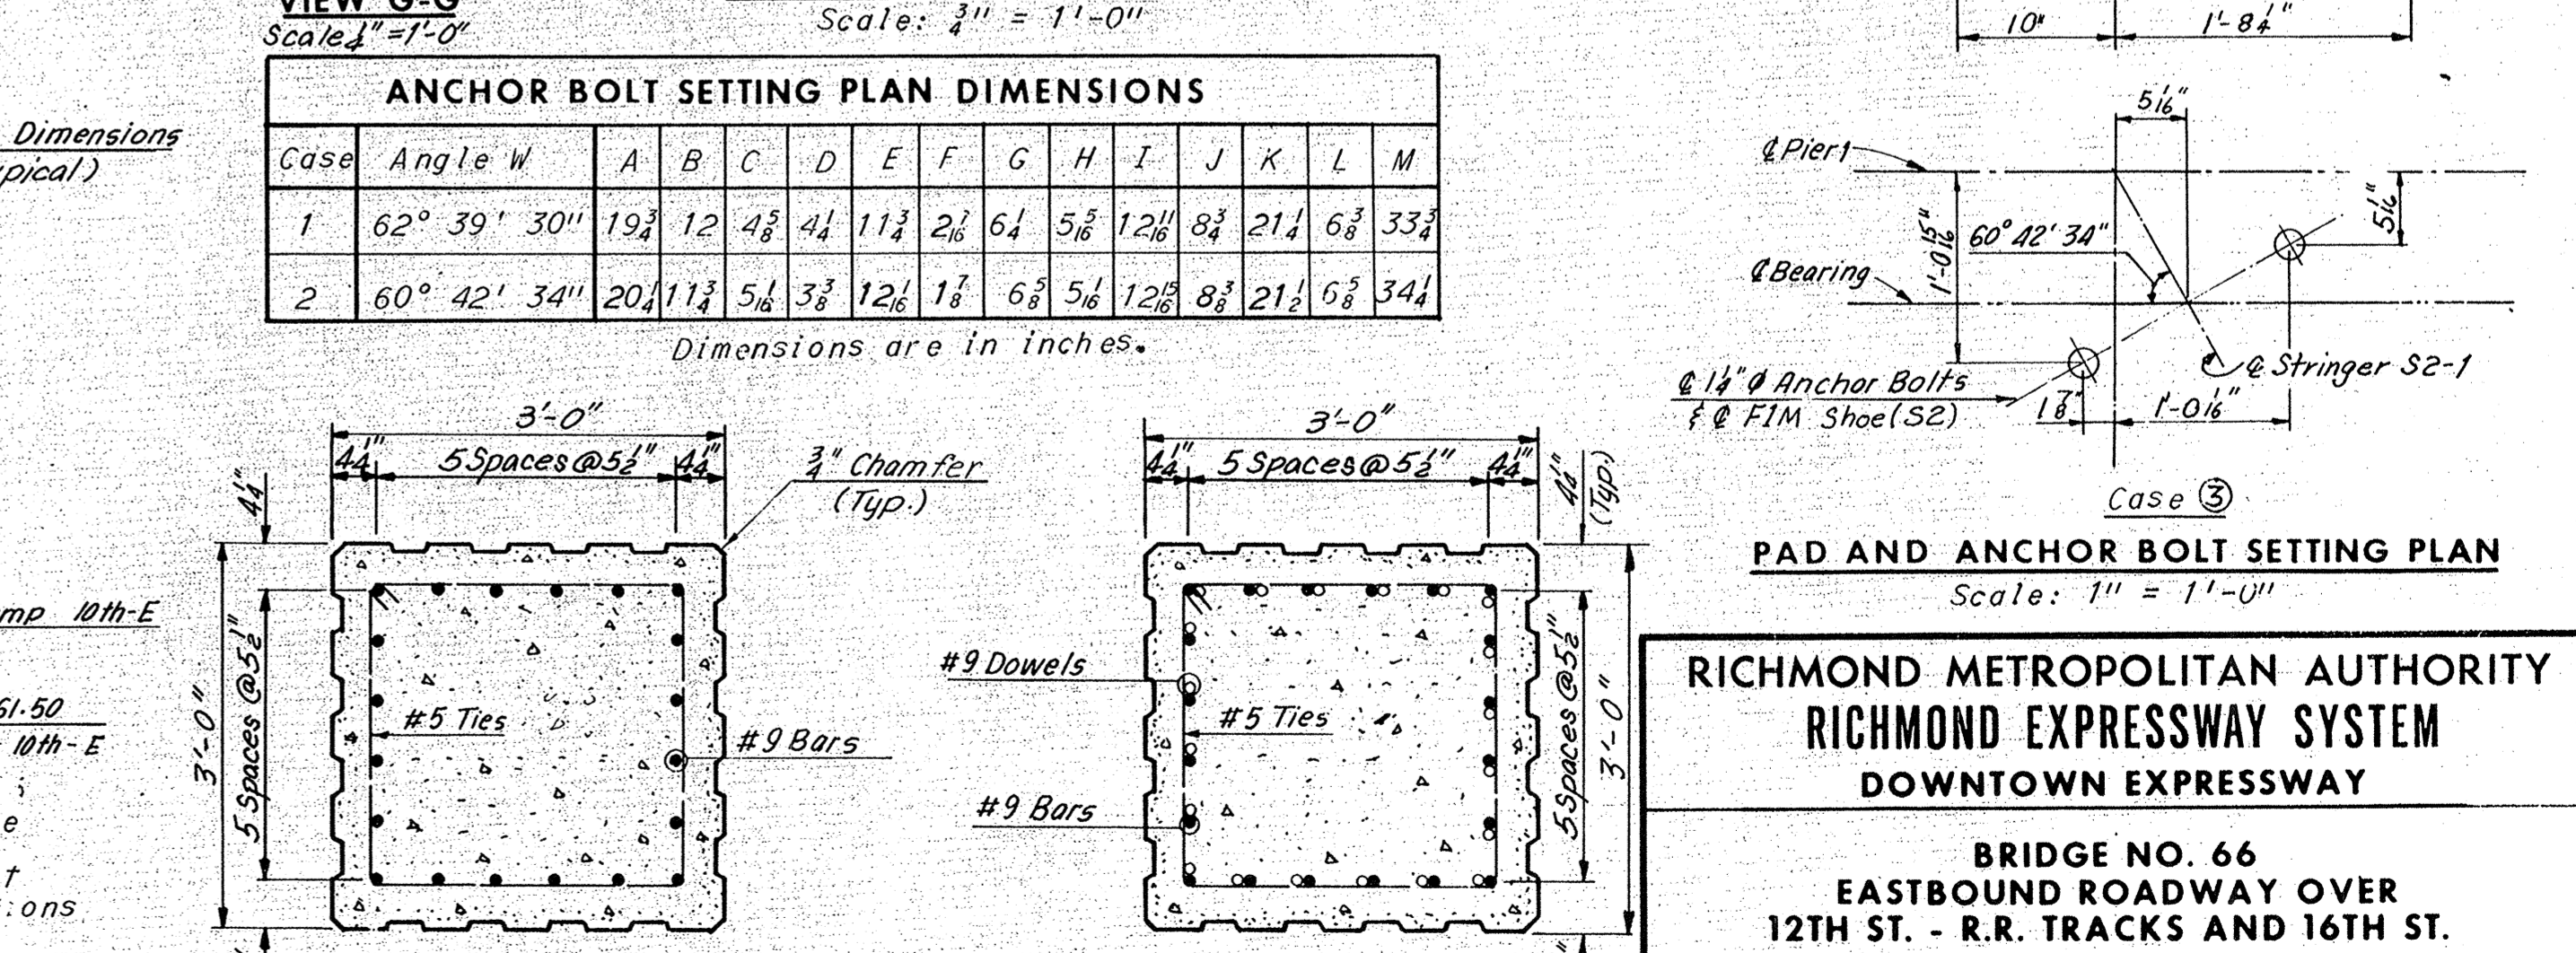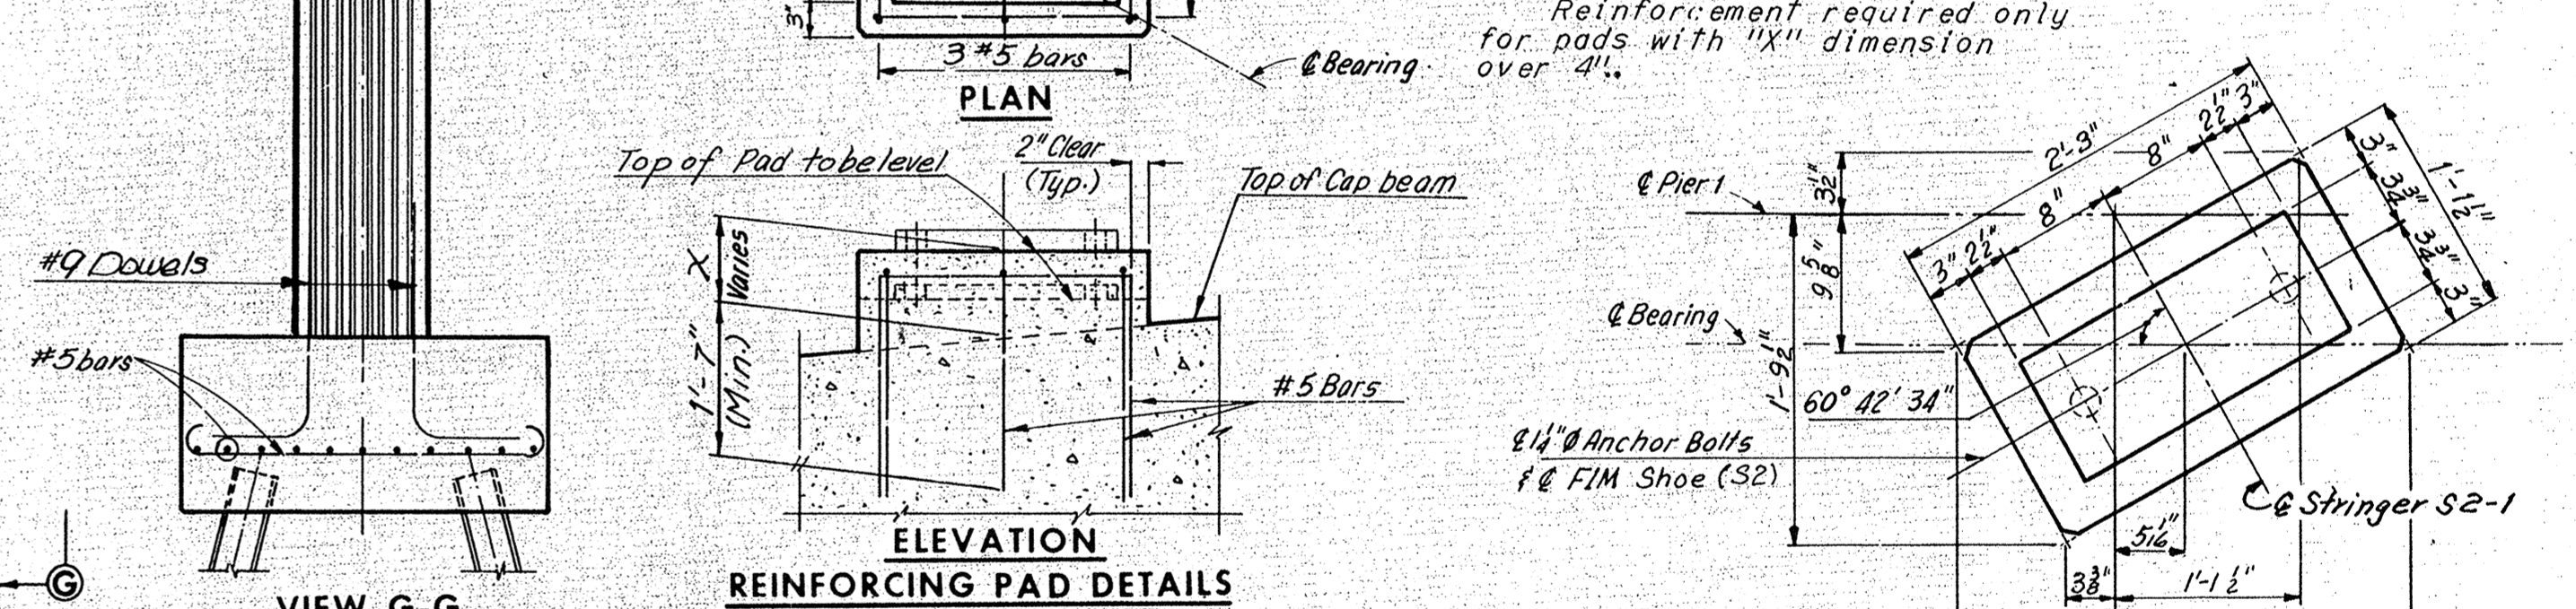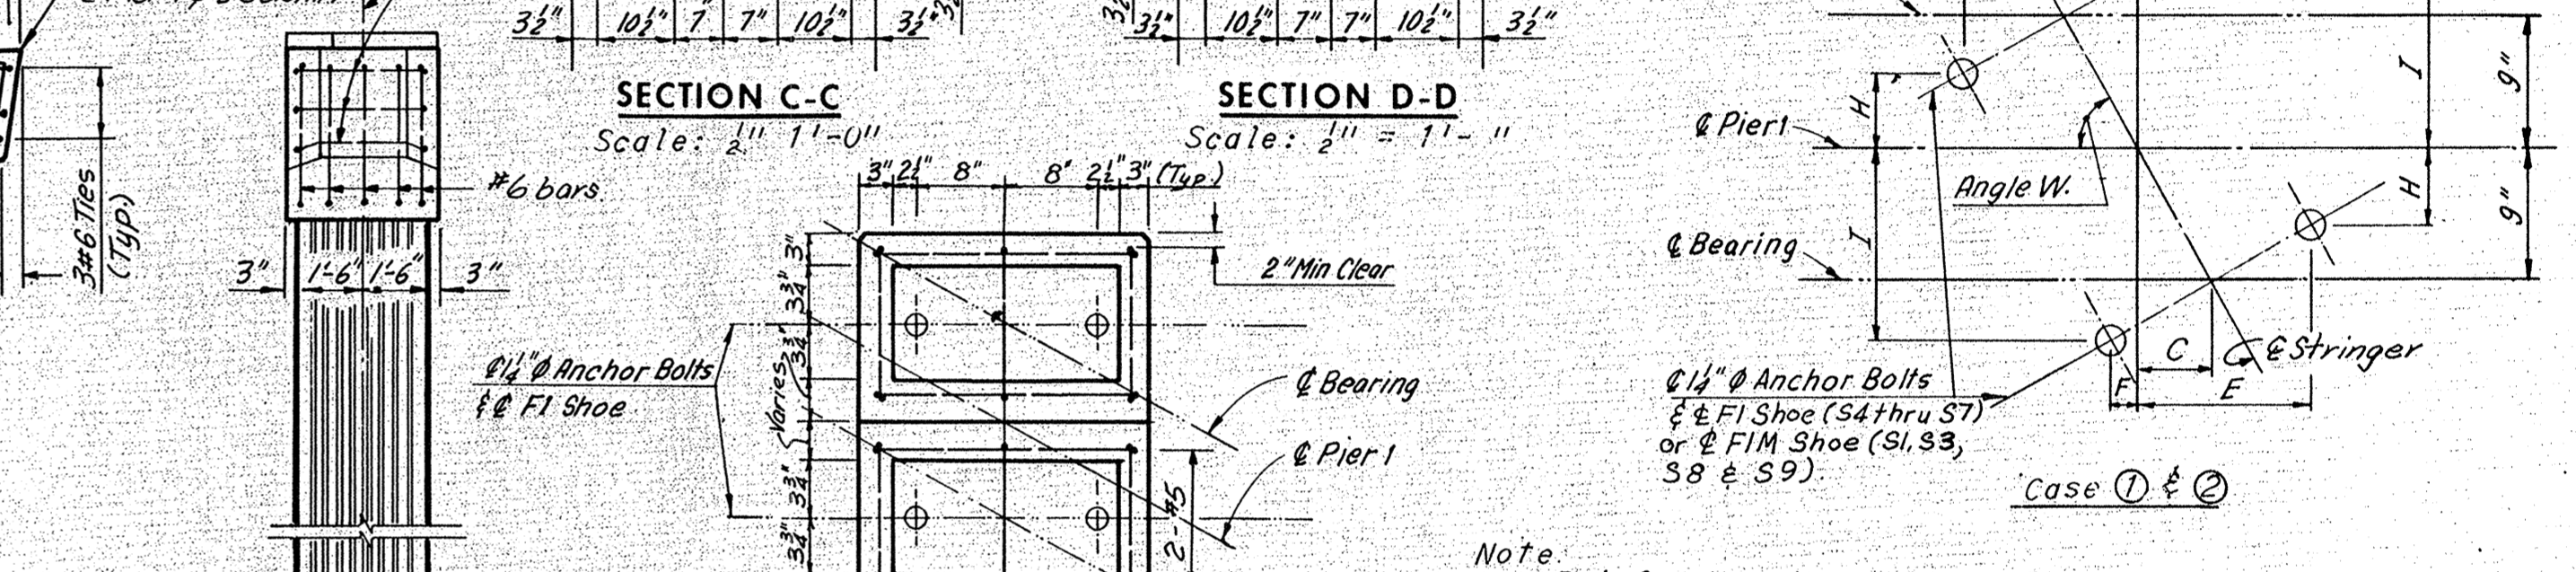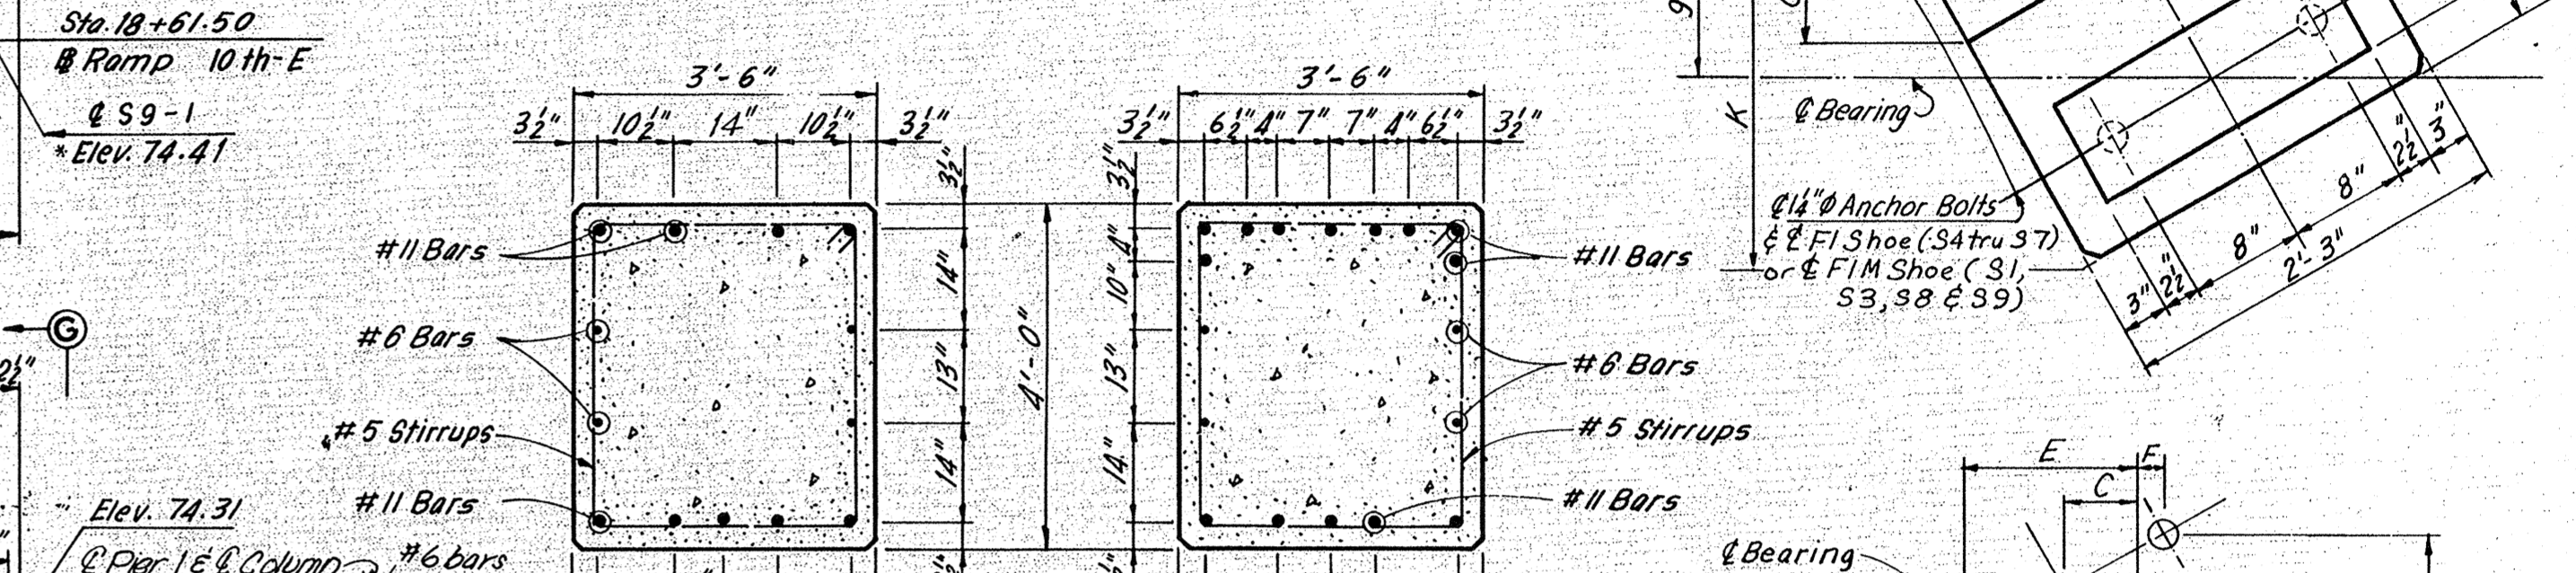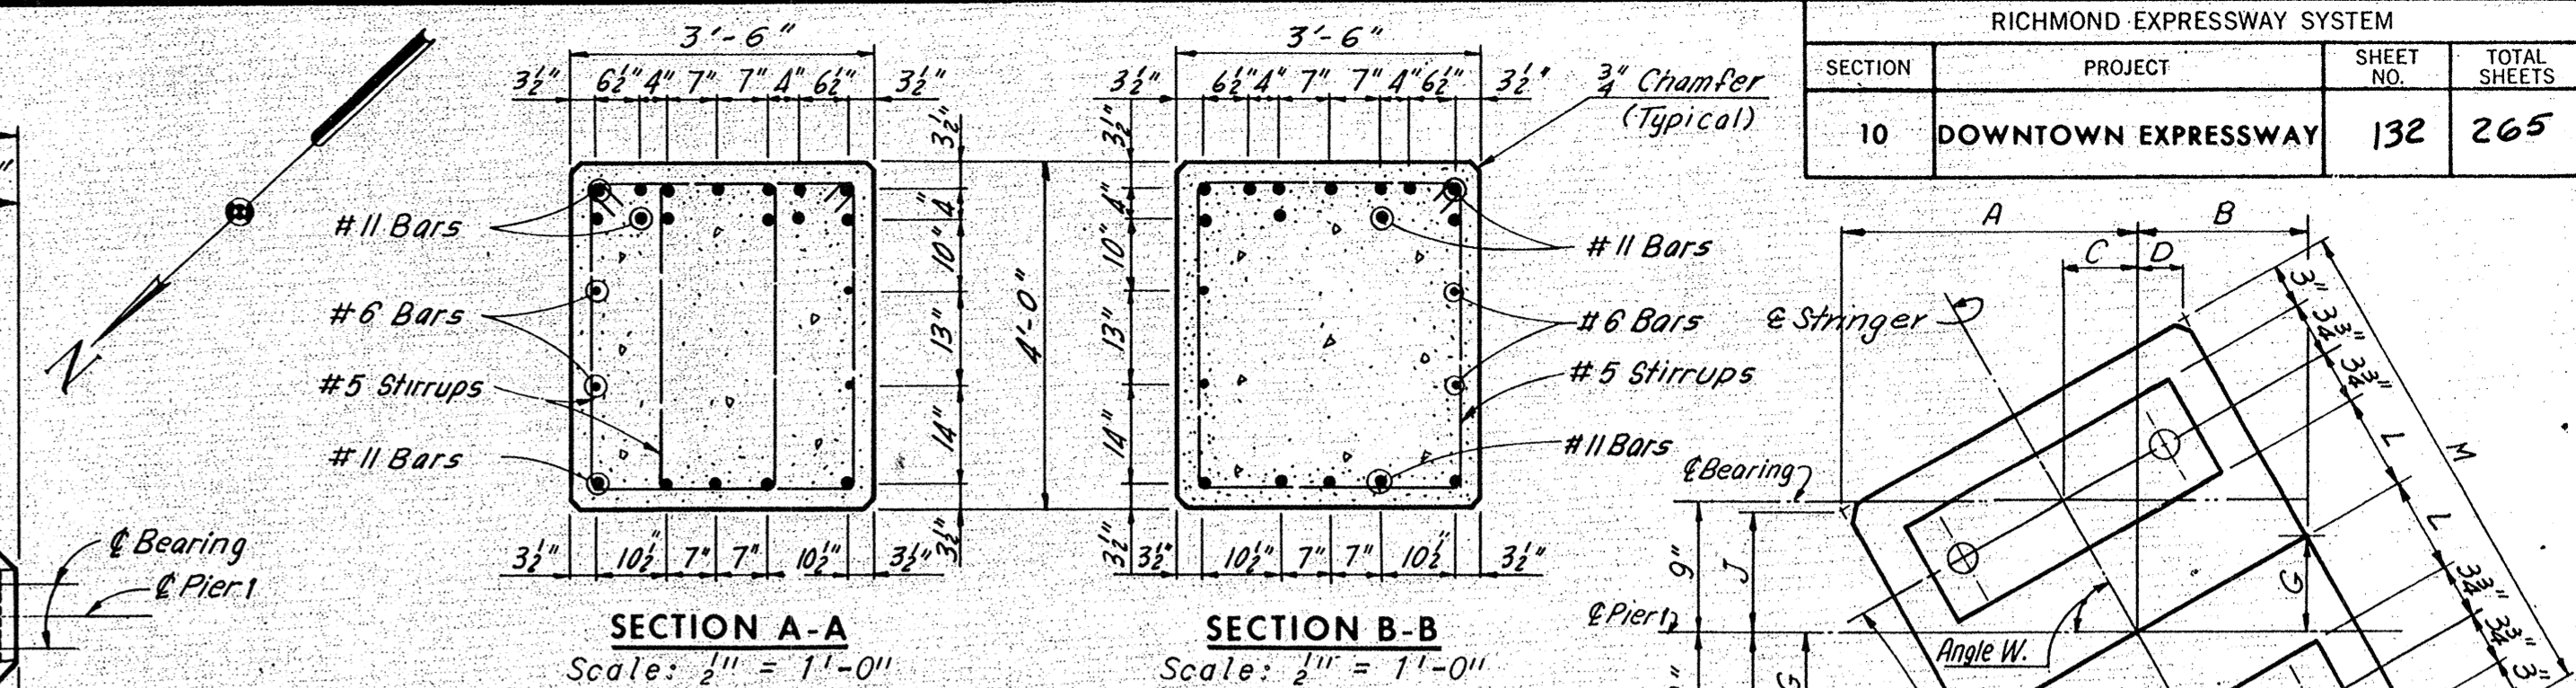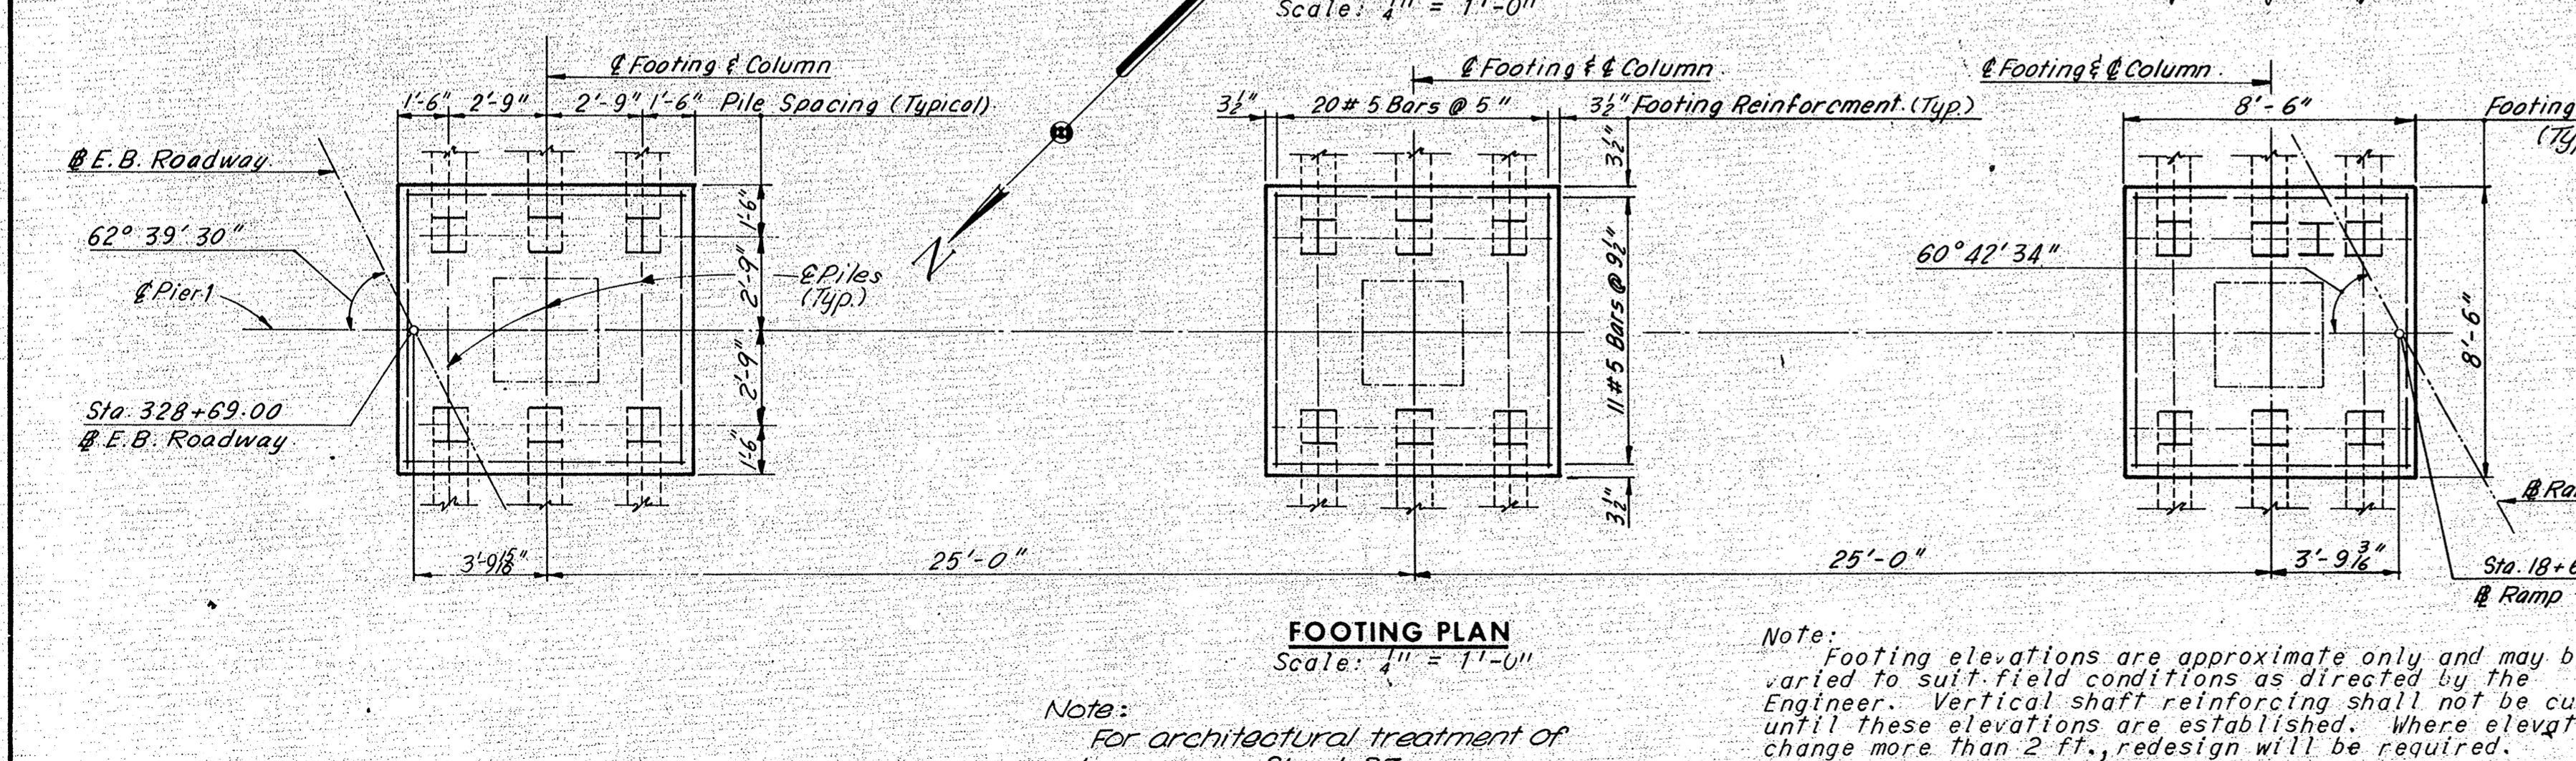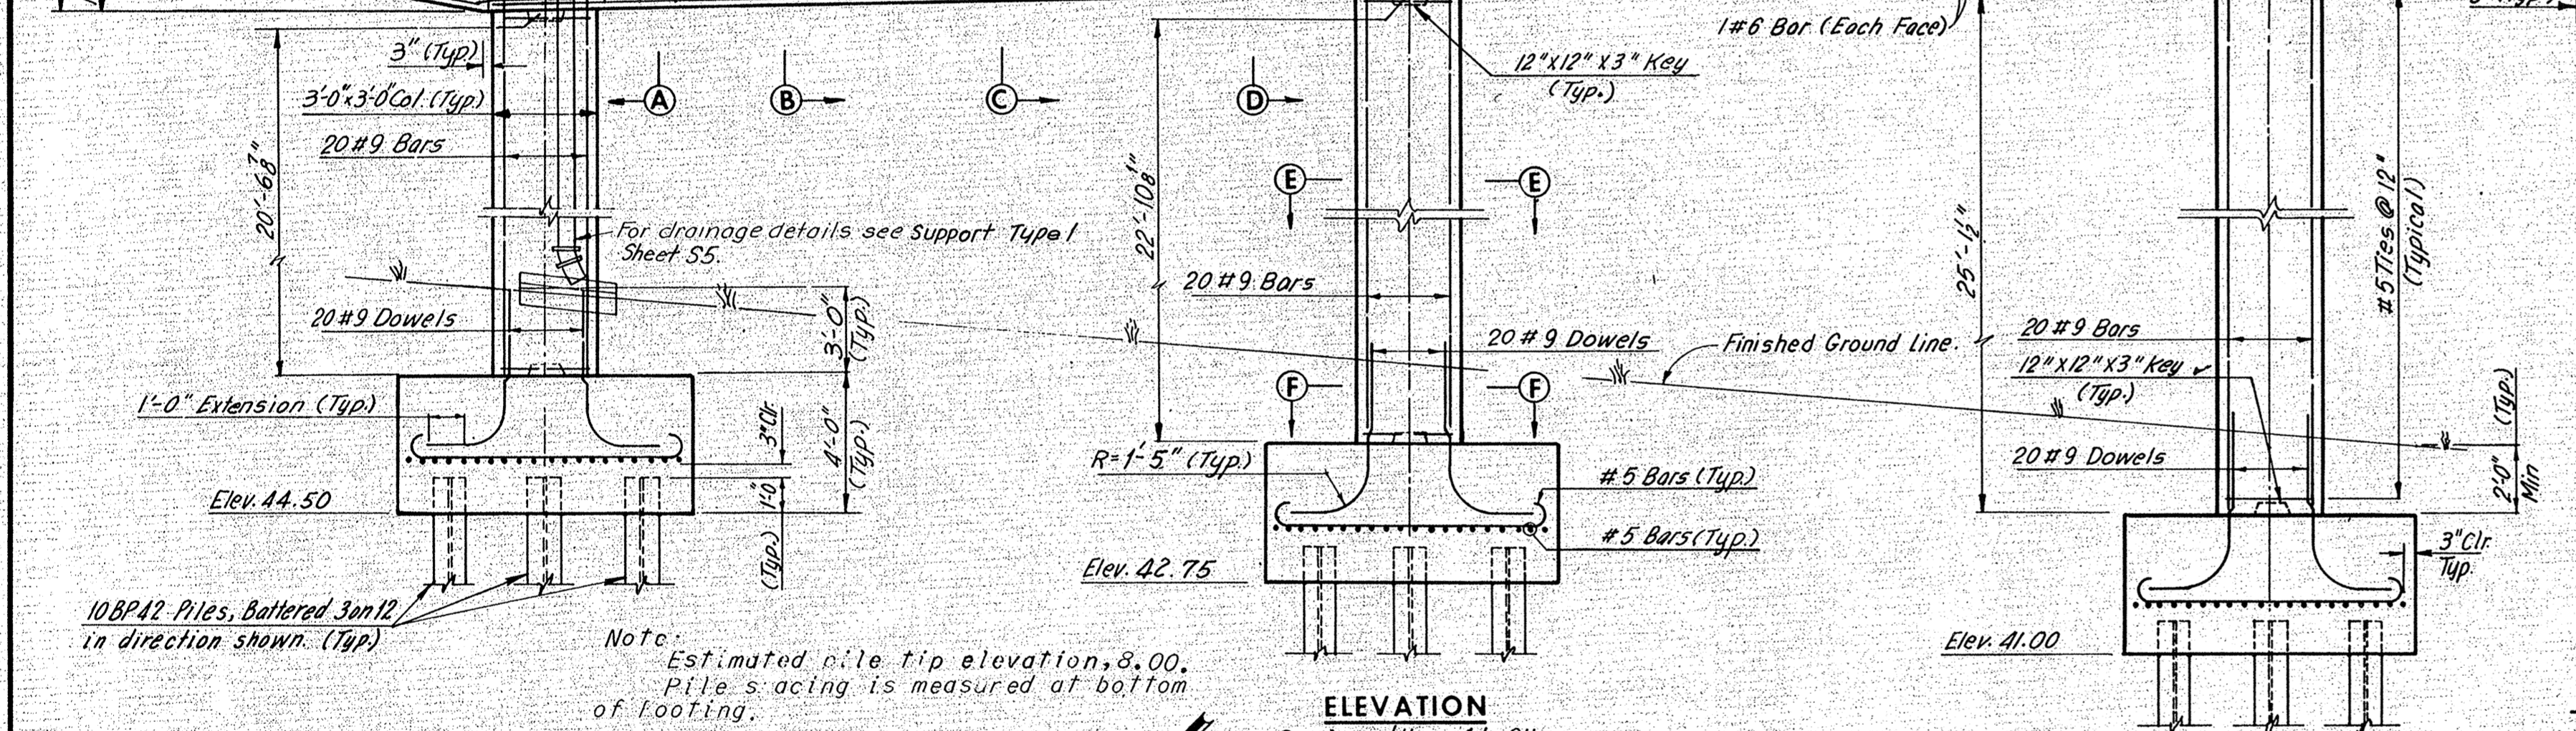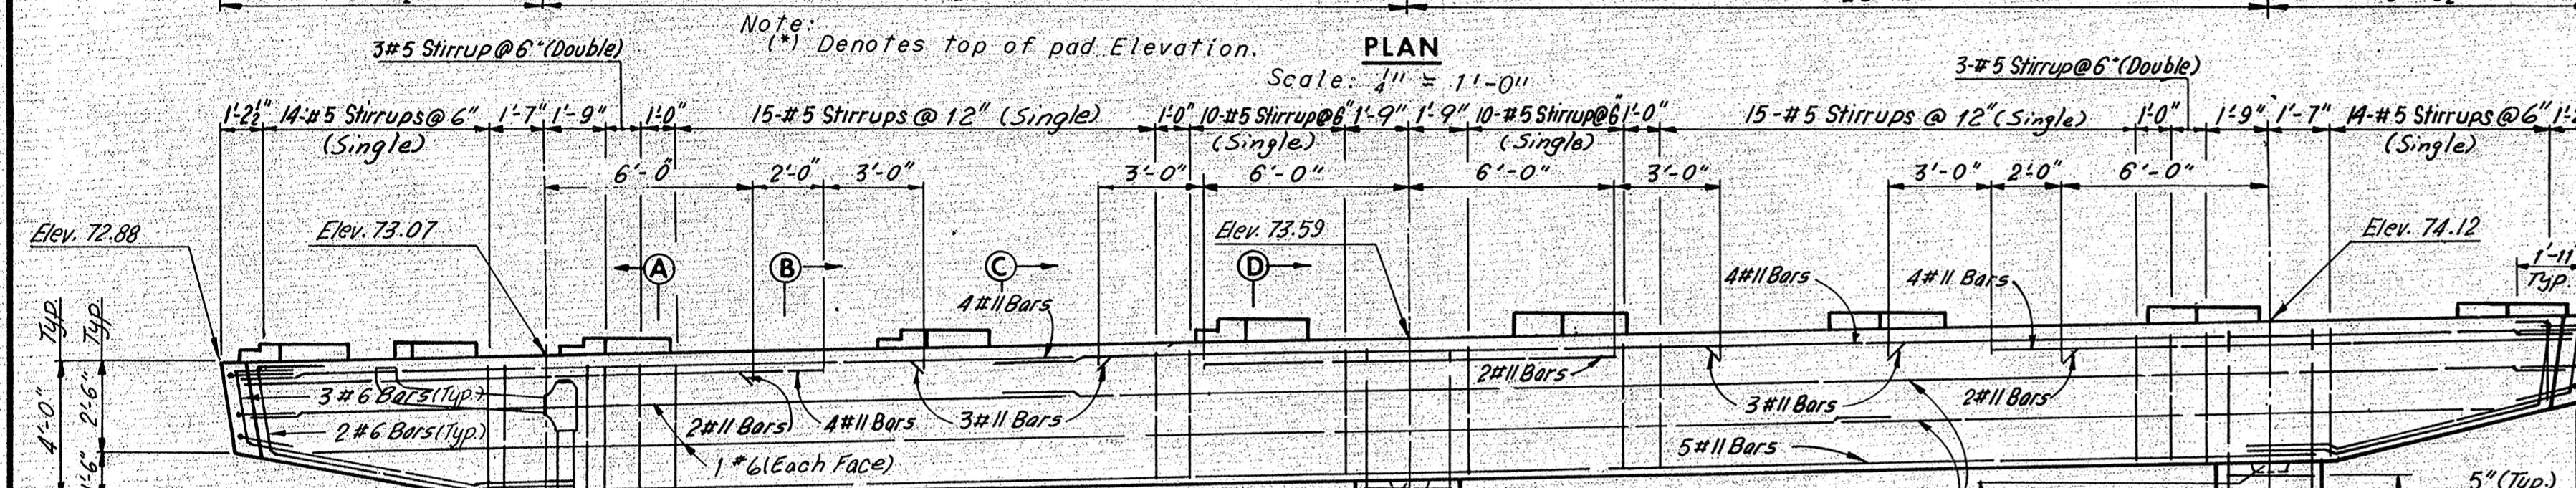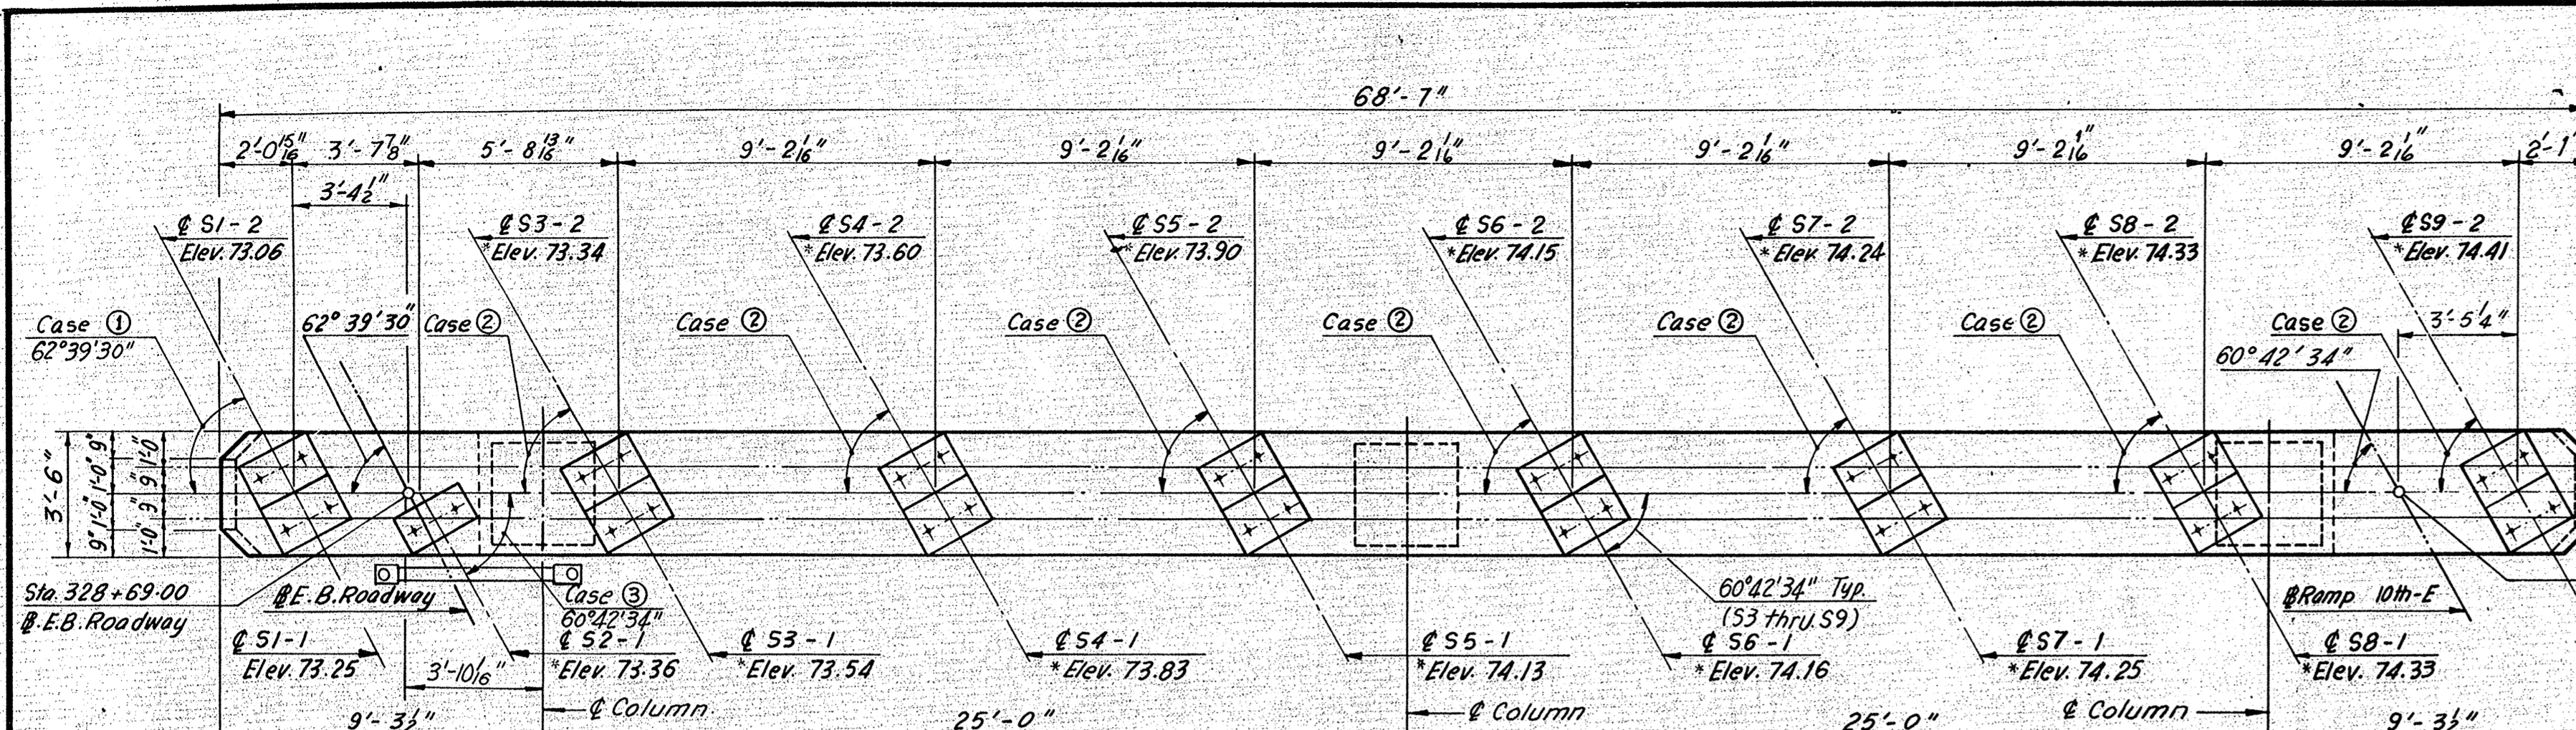

BY	DATE	NO.	REVISION	BY	DATE
MAR	7-31-68	2	As Built	TEM	8-76
CHECKED	RLM	8-15-68	Dimensions	RWZ	10-74
IN CHARGE					

Note: Footing elevations are approximate only and may be varied to suit field conditions as directed by the Engineer. Vertical shaft reinforcing shall not be cut until these elevations are established. Where elevations change more than 2 ft., redesign will be required.

Note: All piles shall be 10BP42 Steel Piles (Design capacity = 45 tons).
Batter all piles 3" per foot where shown.
For Standard Shoe details, see Sheets Stand S2 for Framing Plan, see Sheet 14.
For Steel Pile Details, See Sheet 11

RICHMOND METROPOLITAN AUTHORITY
RICHMOND EXPRESSWAY SYSTEM
DOWNTOWN EXPRESSWAY

BRIDGE NO. 66
EASTBOUND ROADWAY OVER
12TH ST. - R.R. TRACKS AND 16TH ST.











PIER 1

HOWARD, NEEDLES, TAMMEN & BERGENDOFF
 consulting engineers
 NEW YORK ALEXANDRIA KANSAS CITY

SCALE: As Noted
 CONTRACT NO. 10
 SHEET NO. 6 OF 46

AS BUILT

RICHMOND EXPRESSWAY SYSTEM			
SECTION	PROJECT	SHEET NO.	TOTAL SHEETS
10	DOWNTOWN EXPRESSWAY	133	265

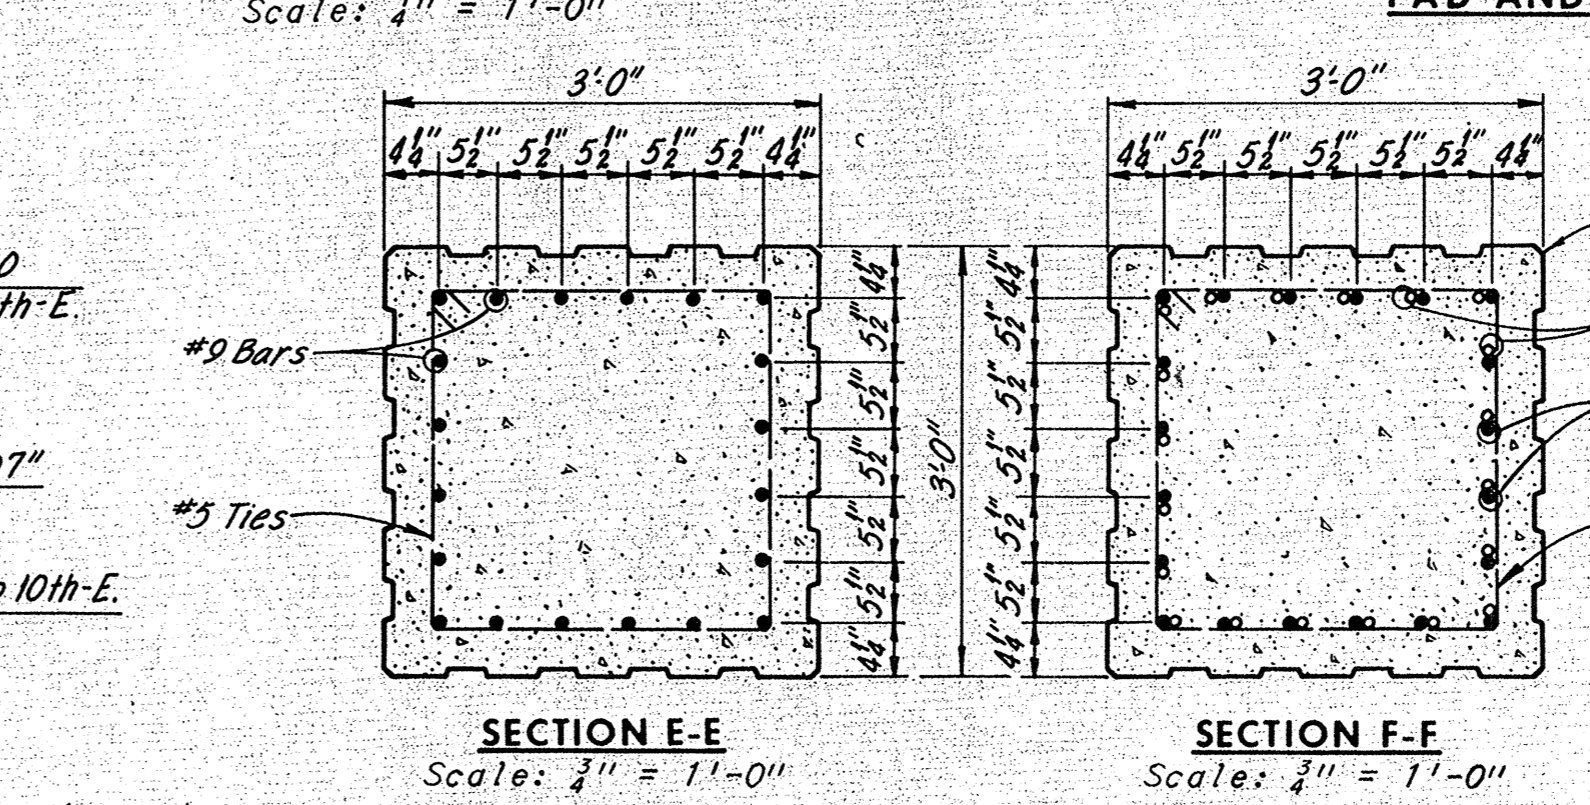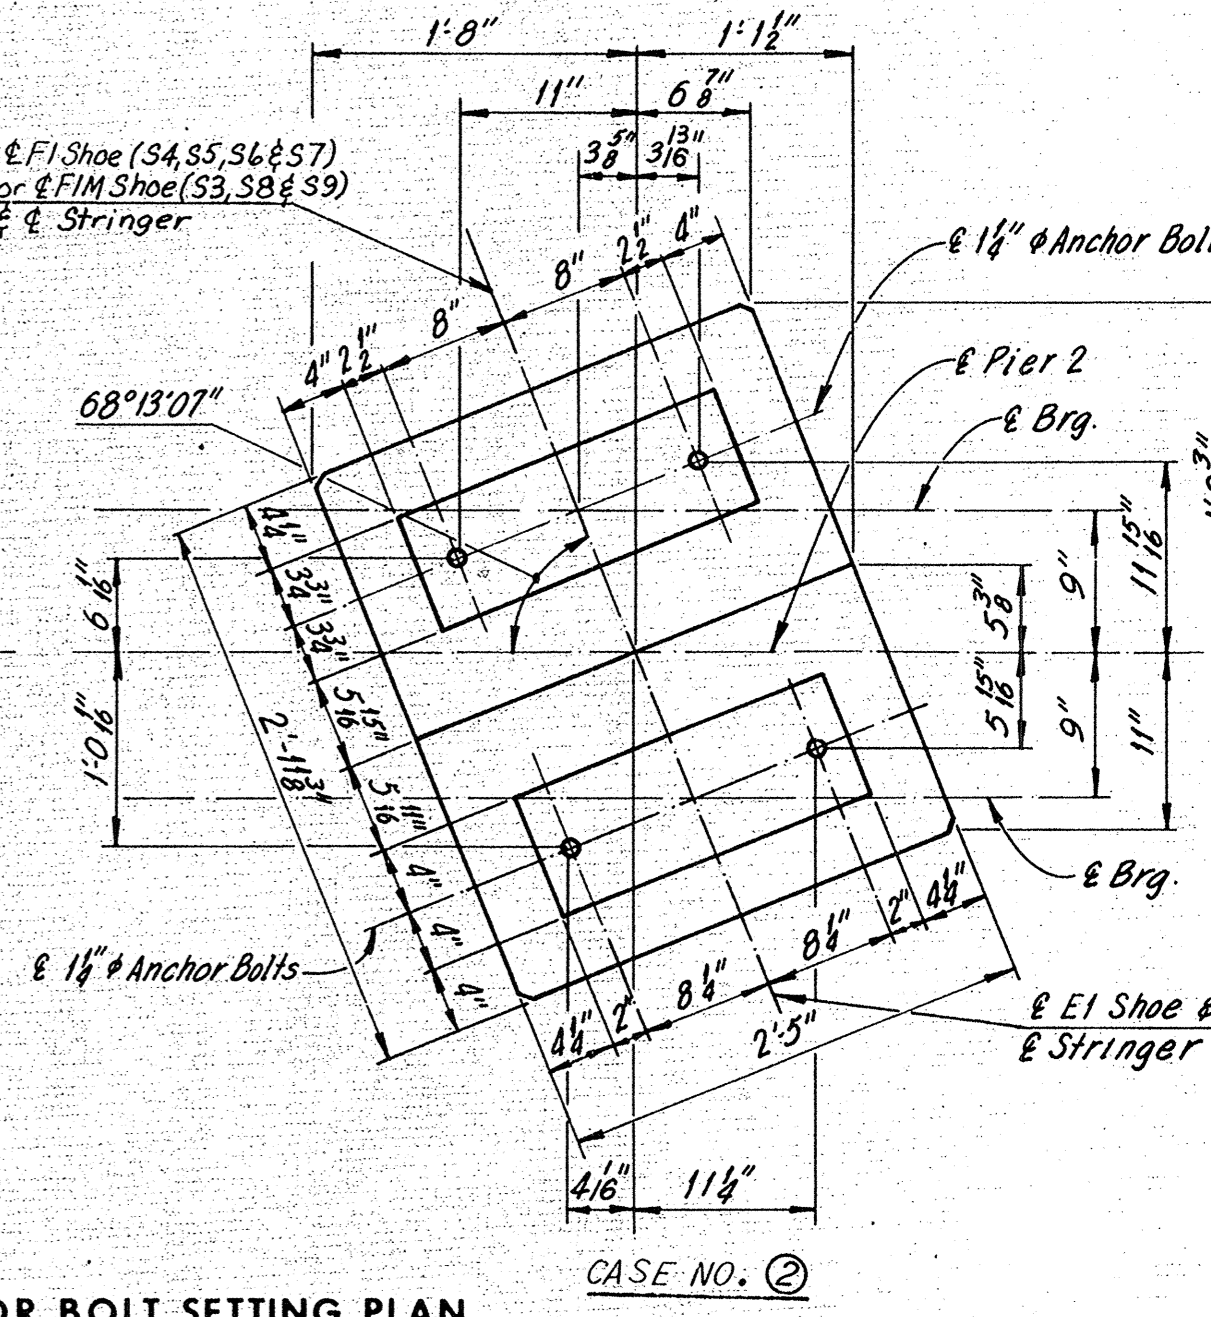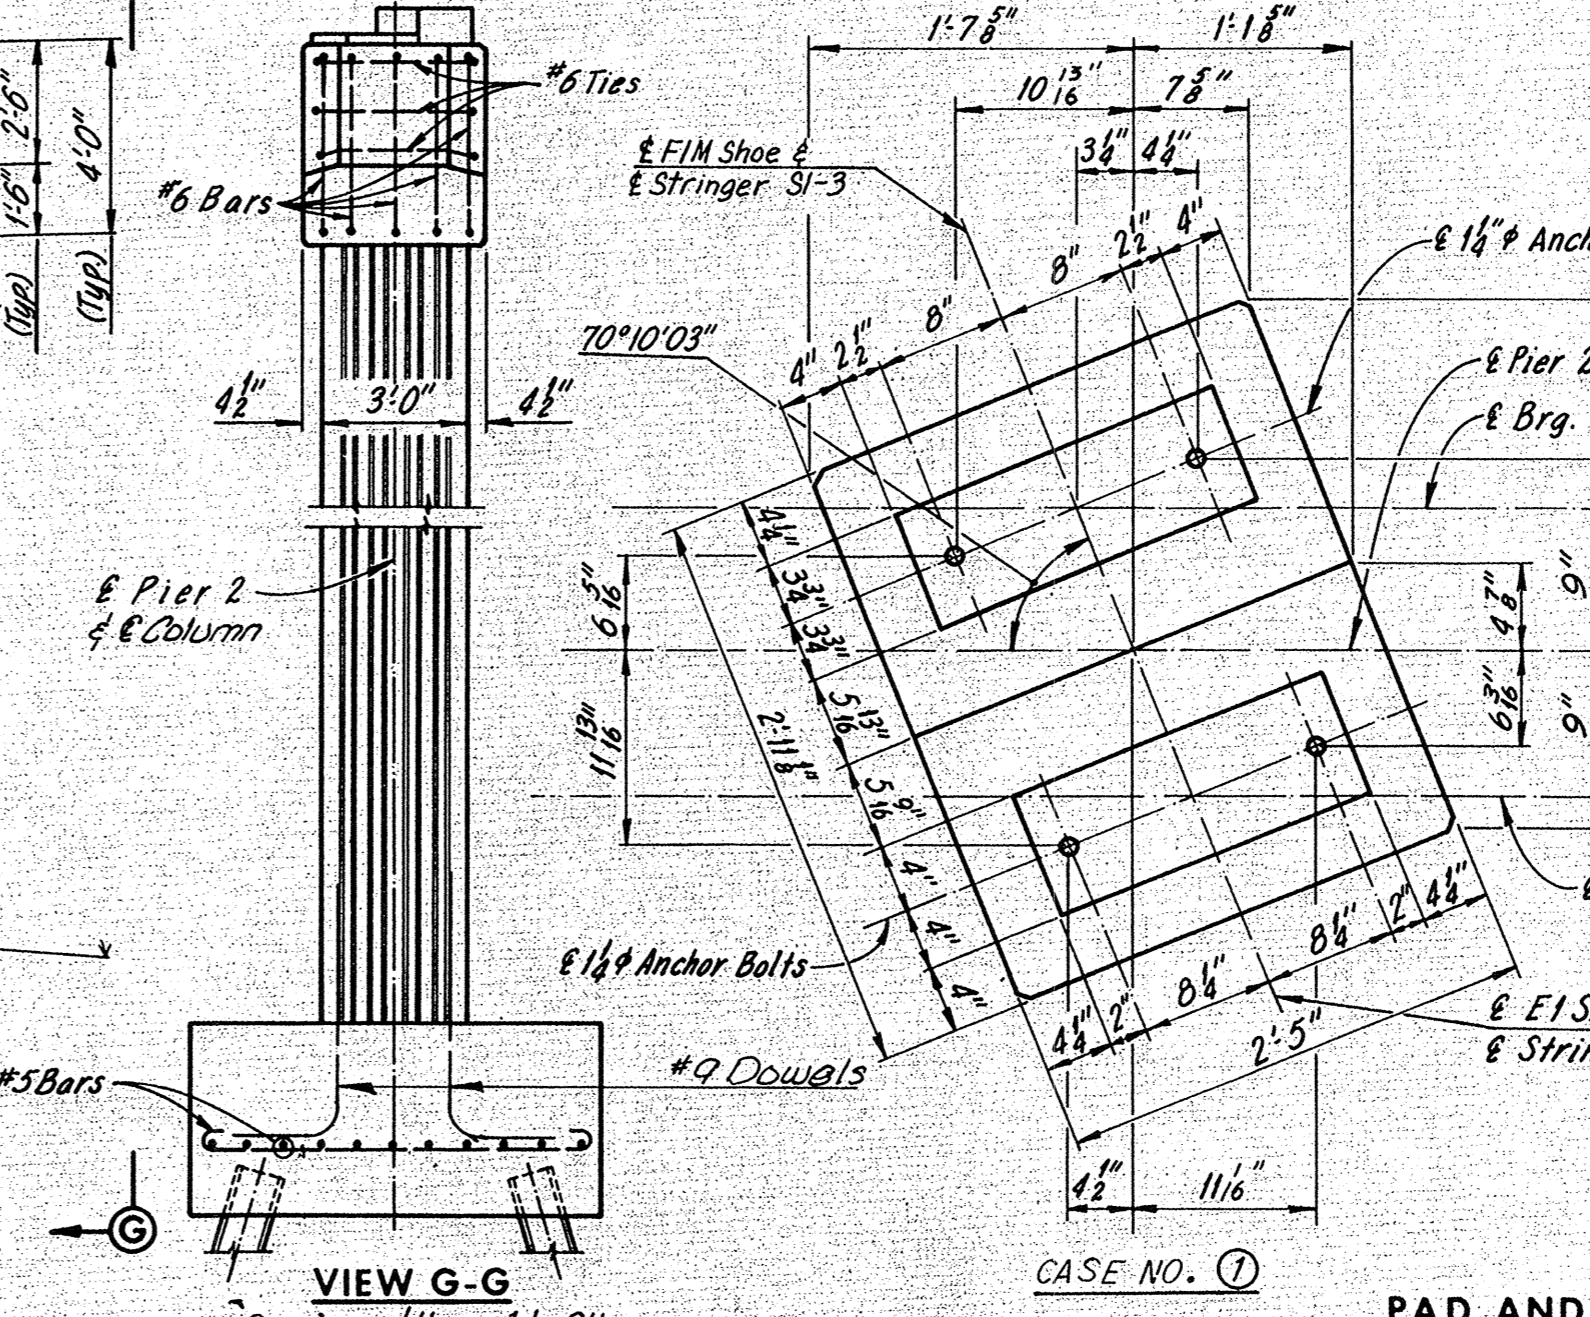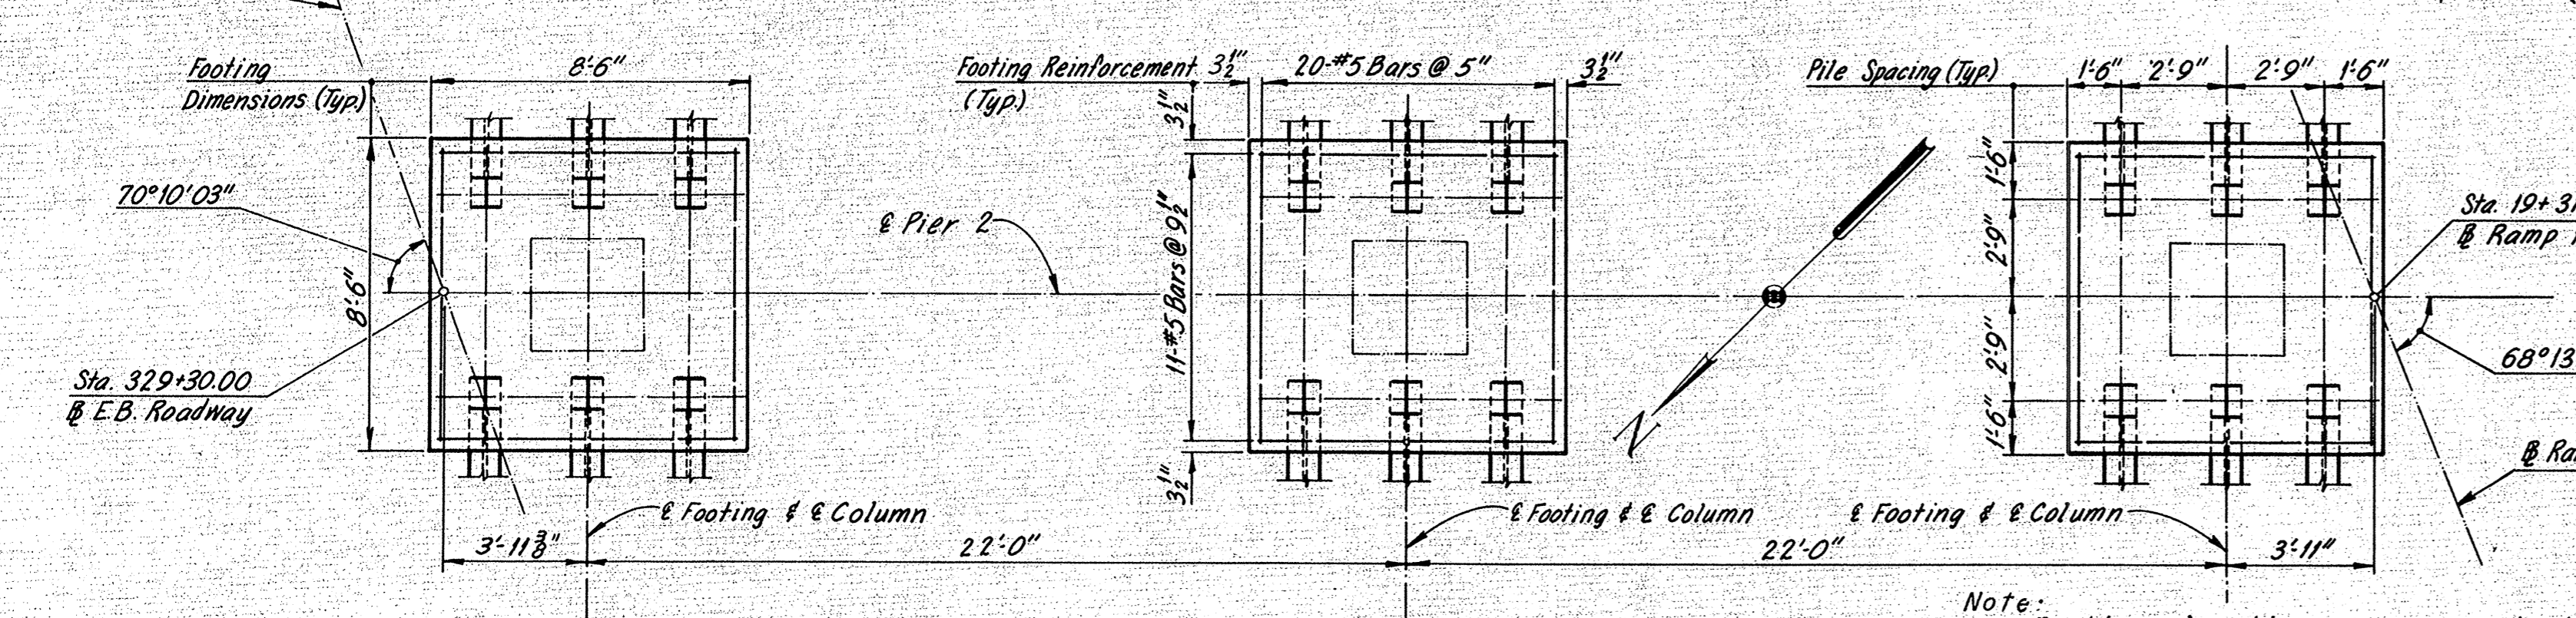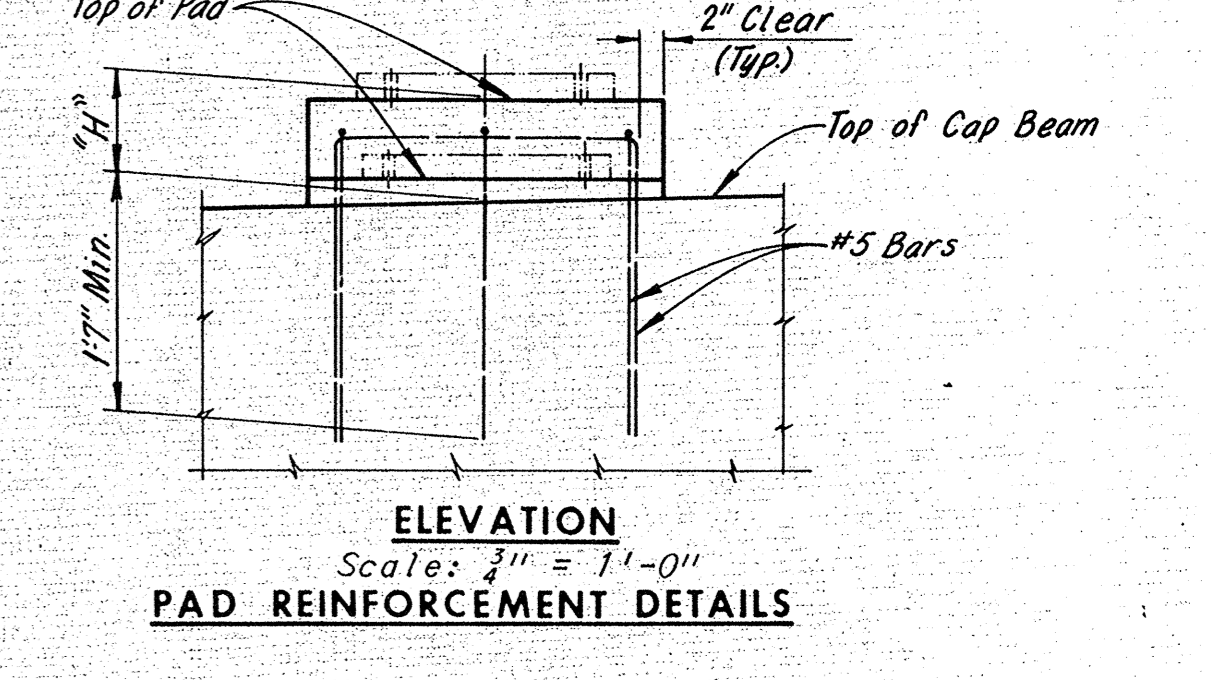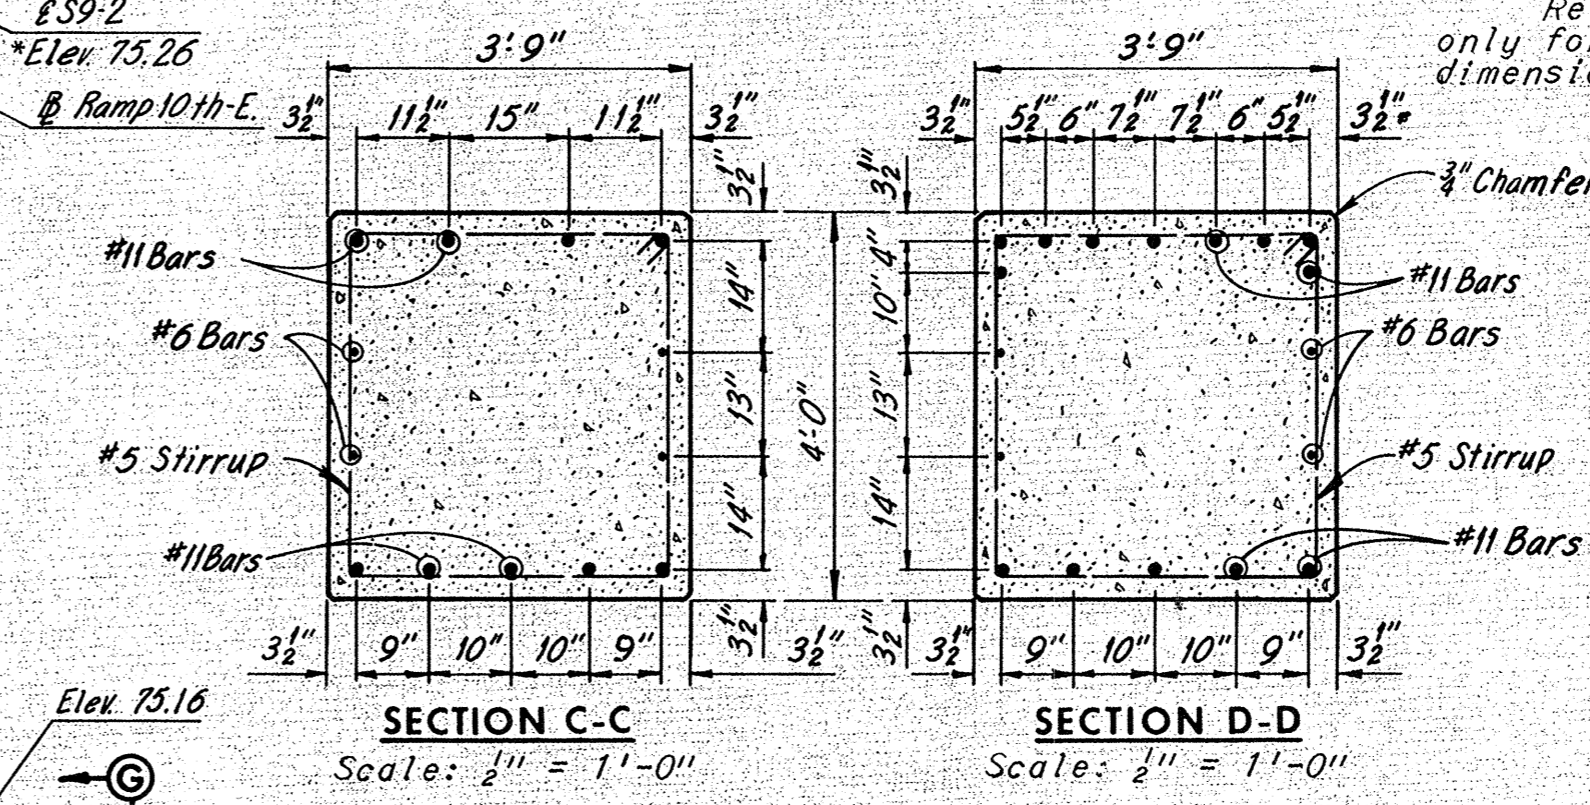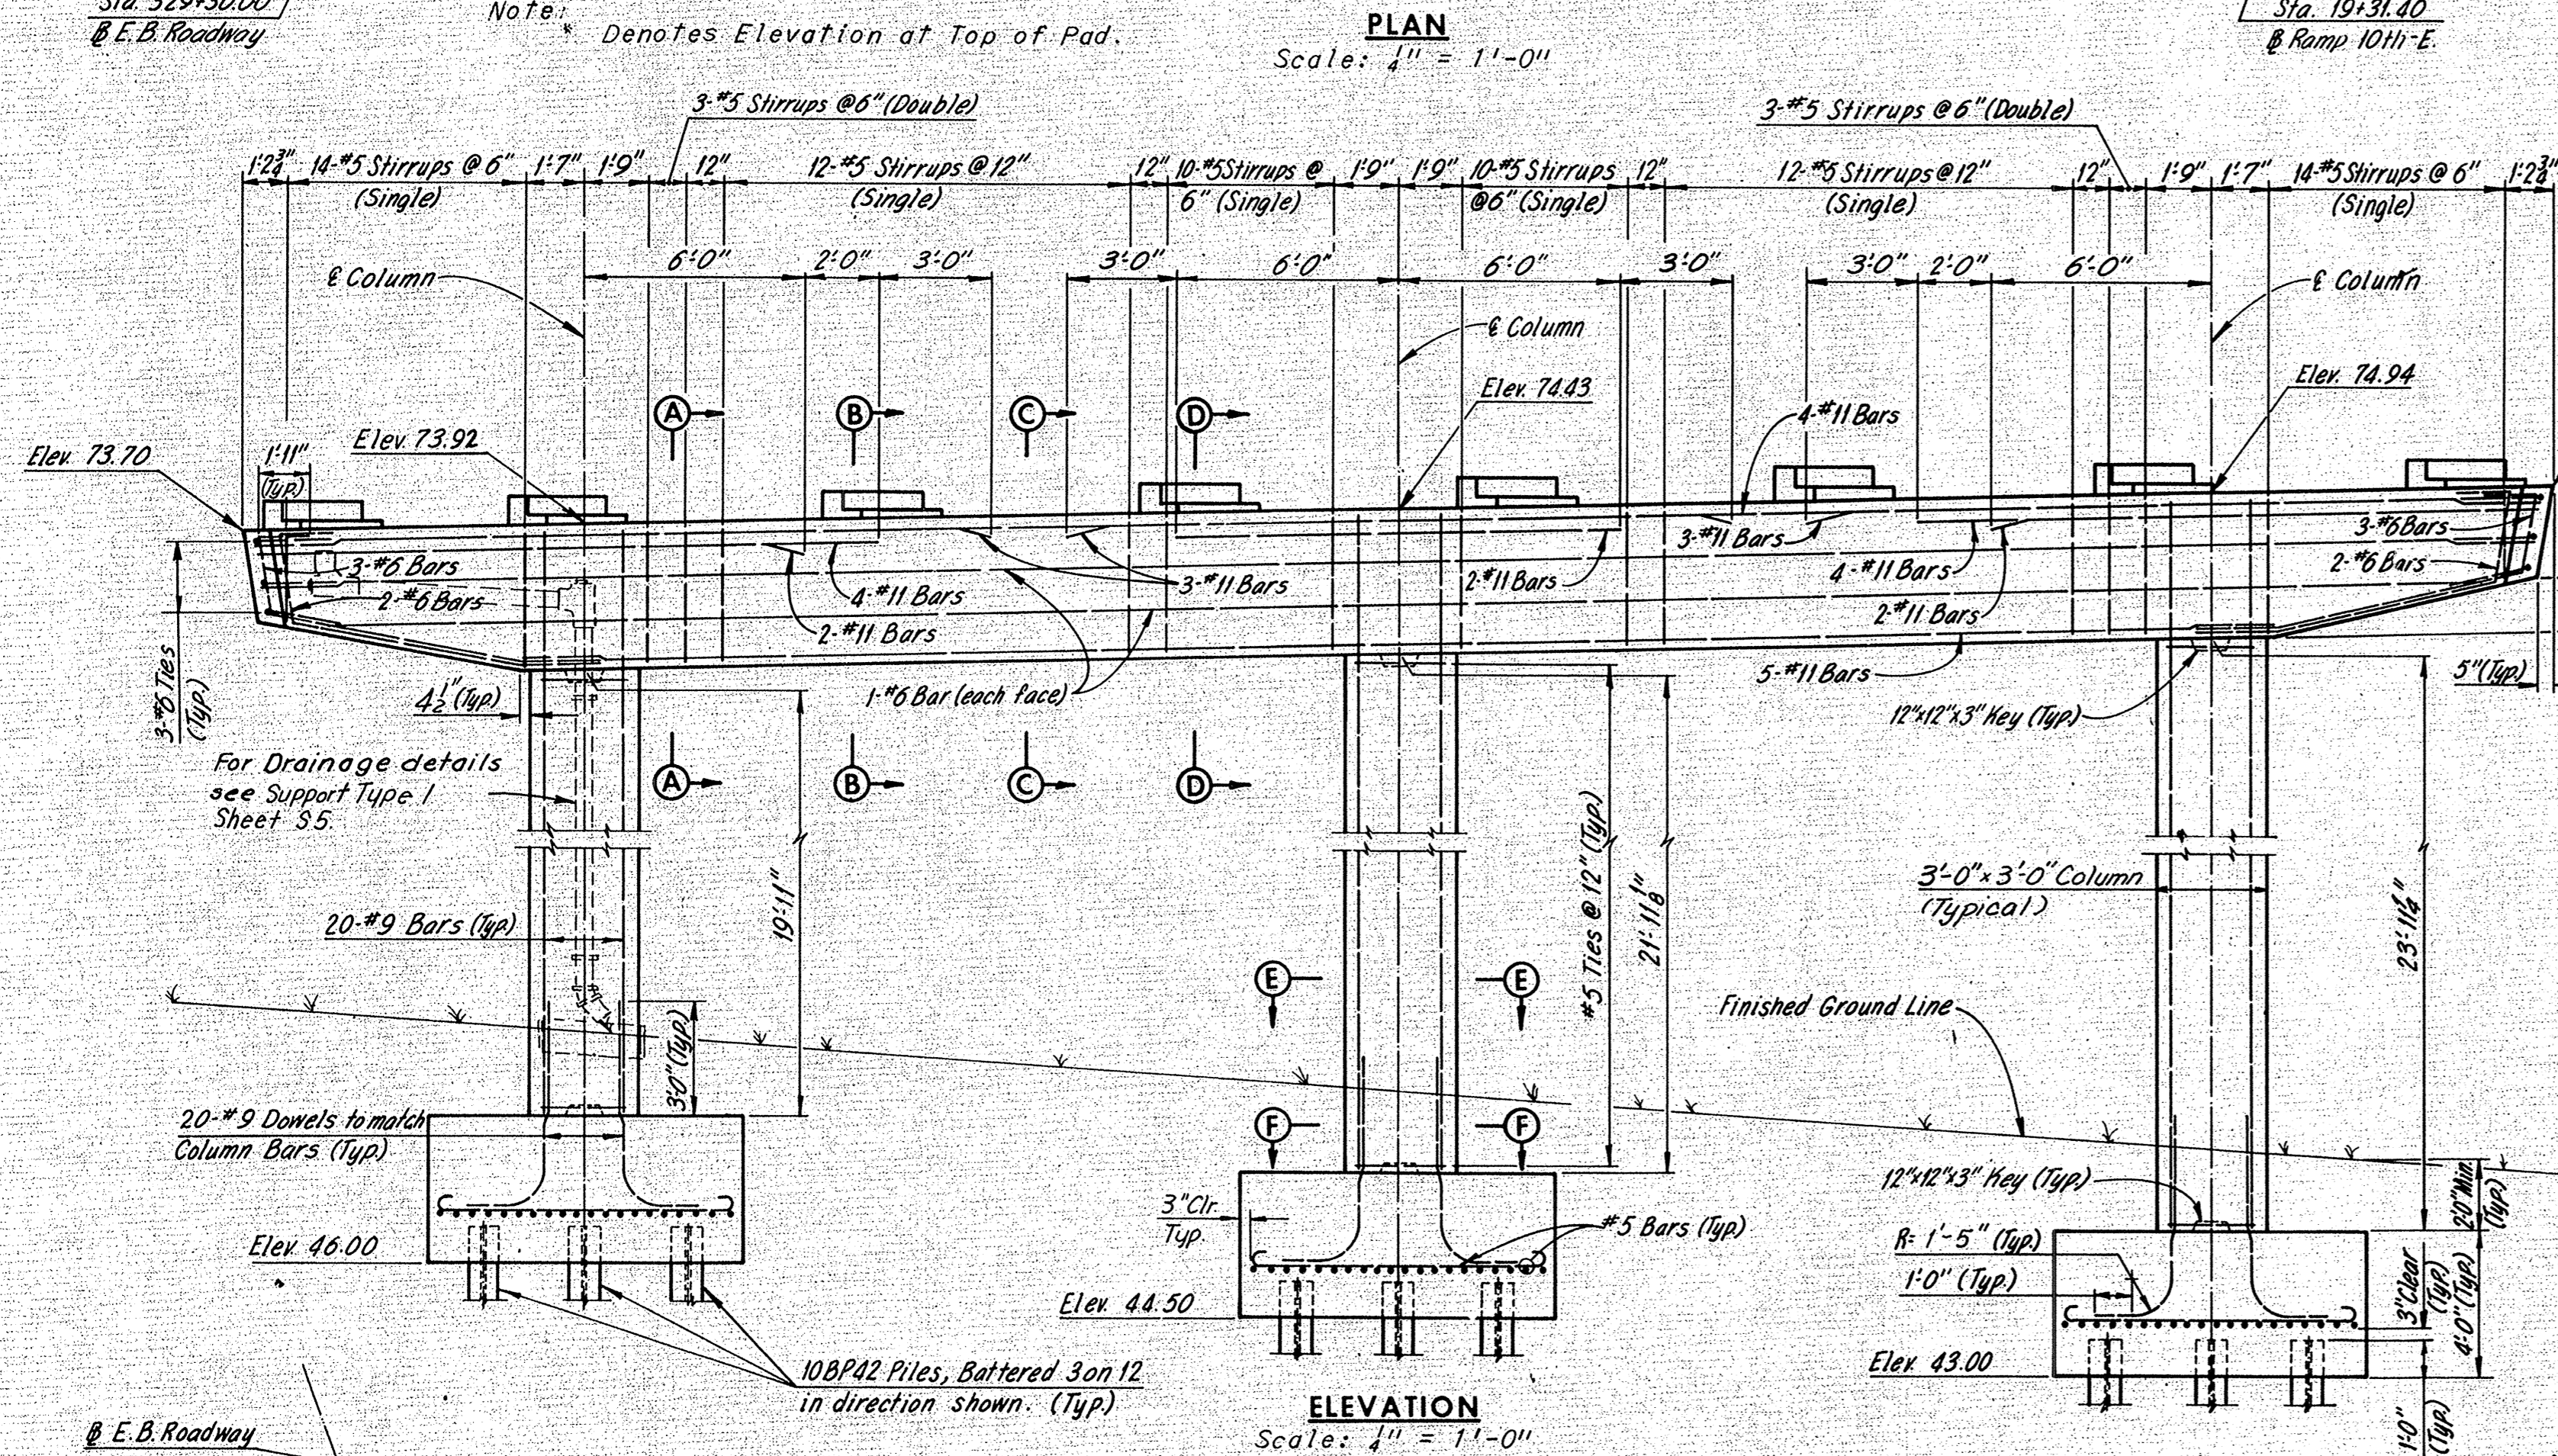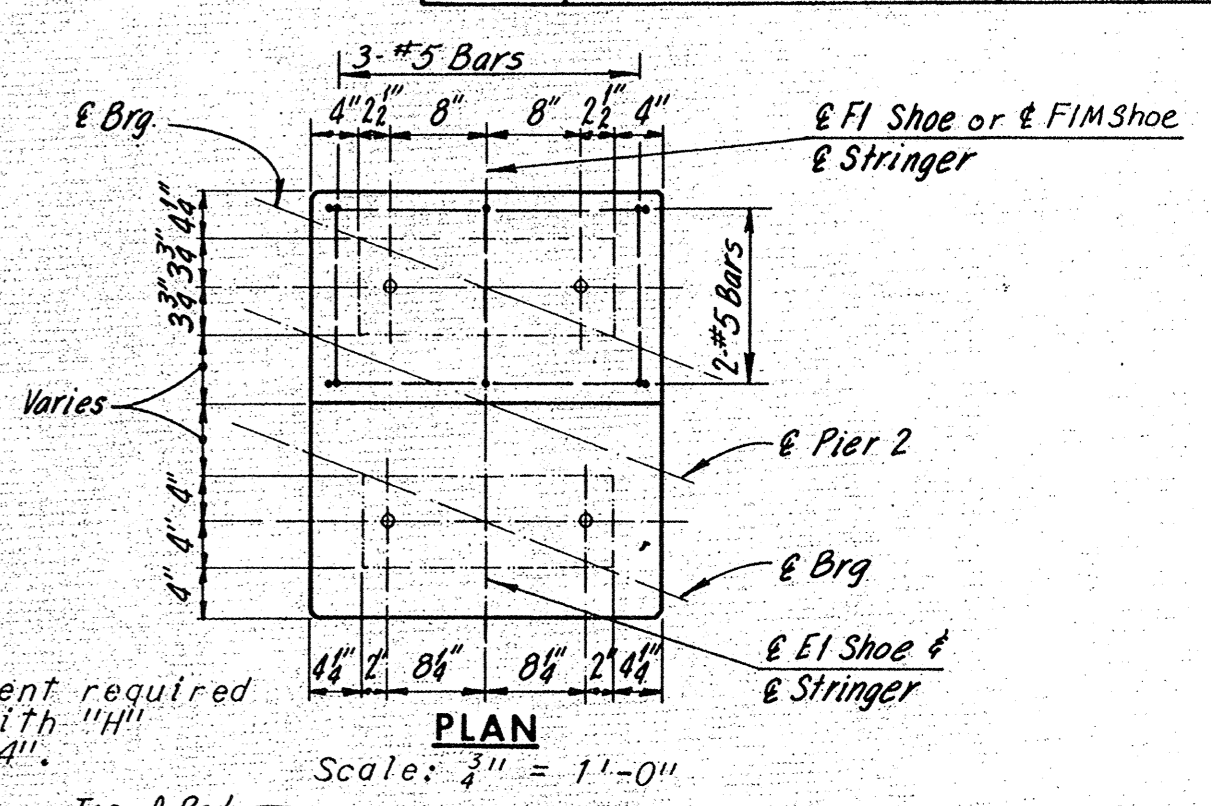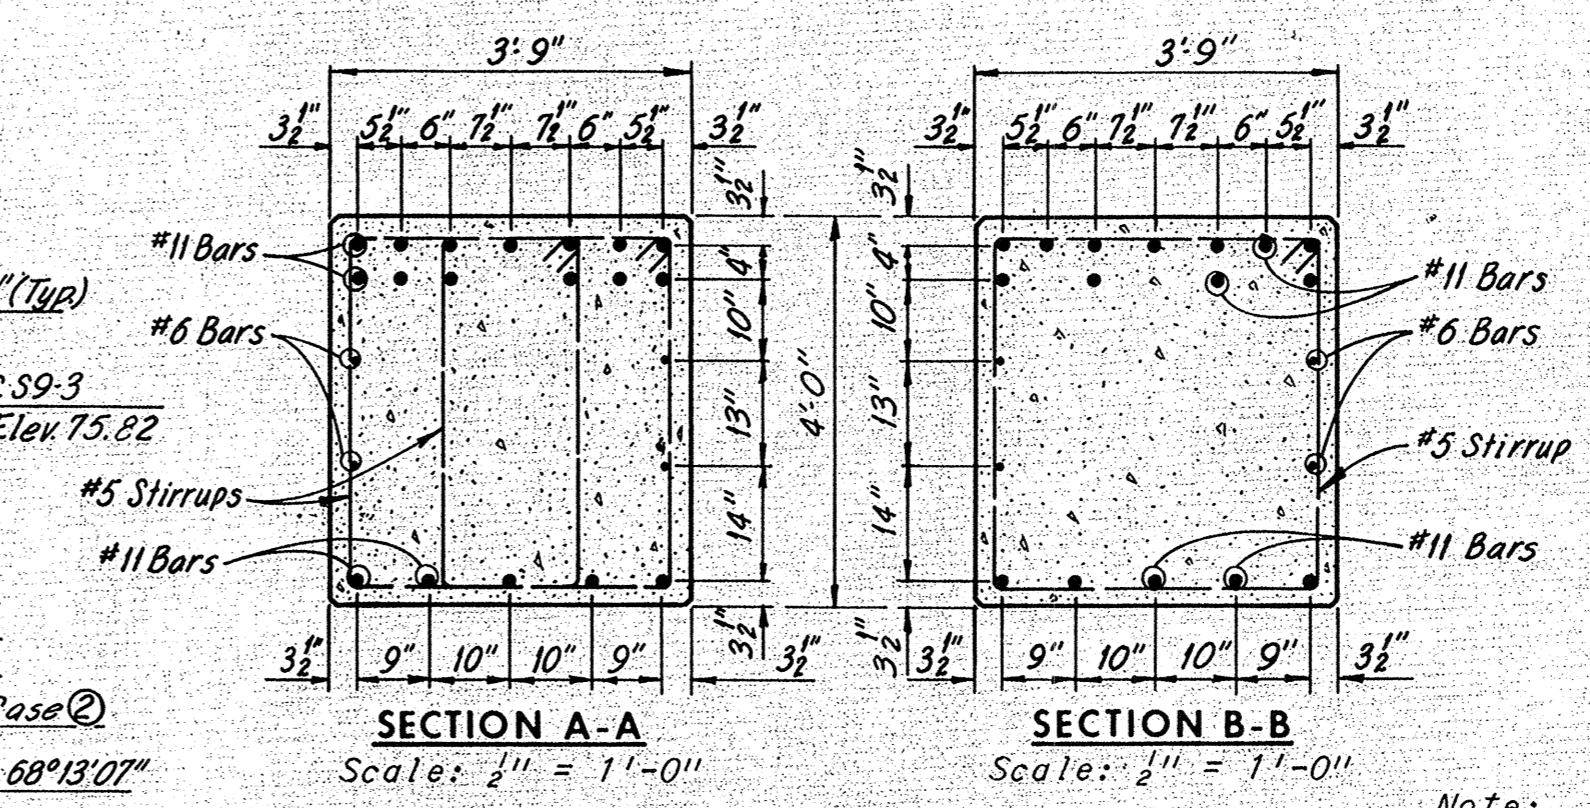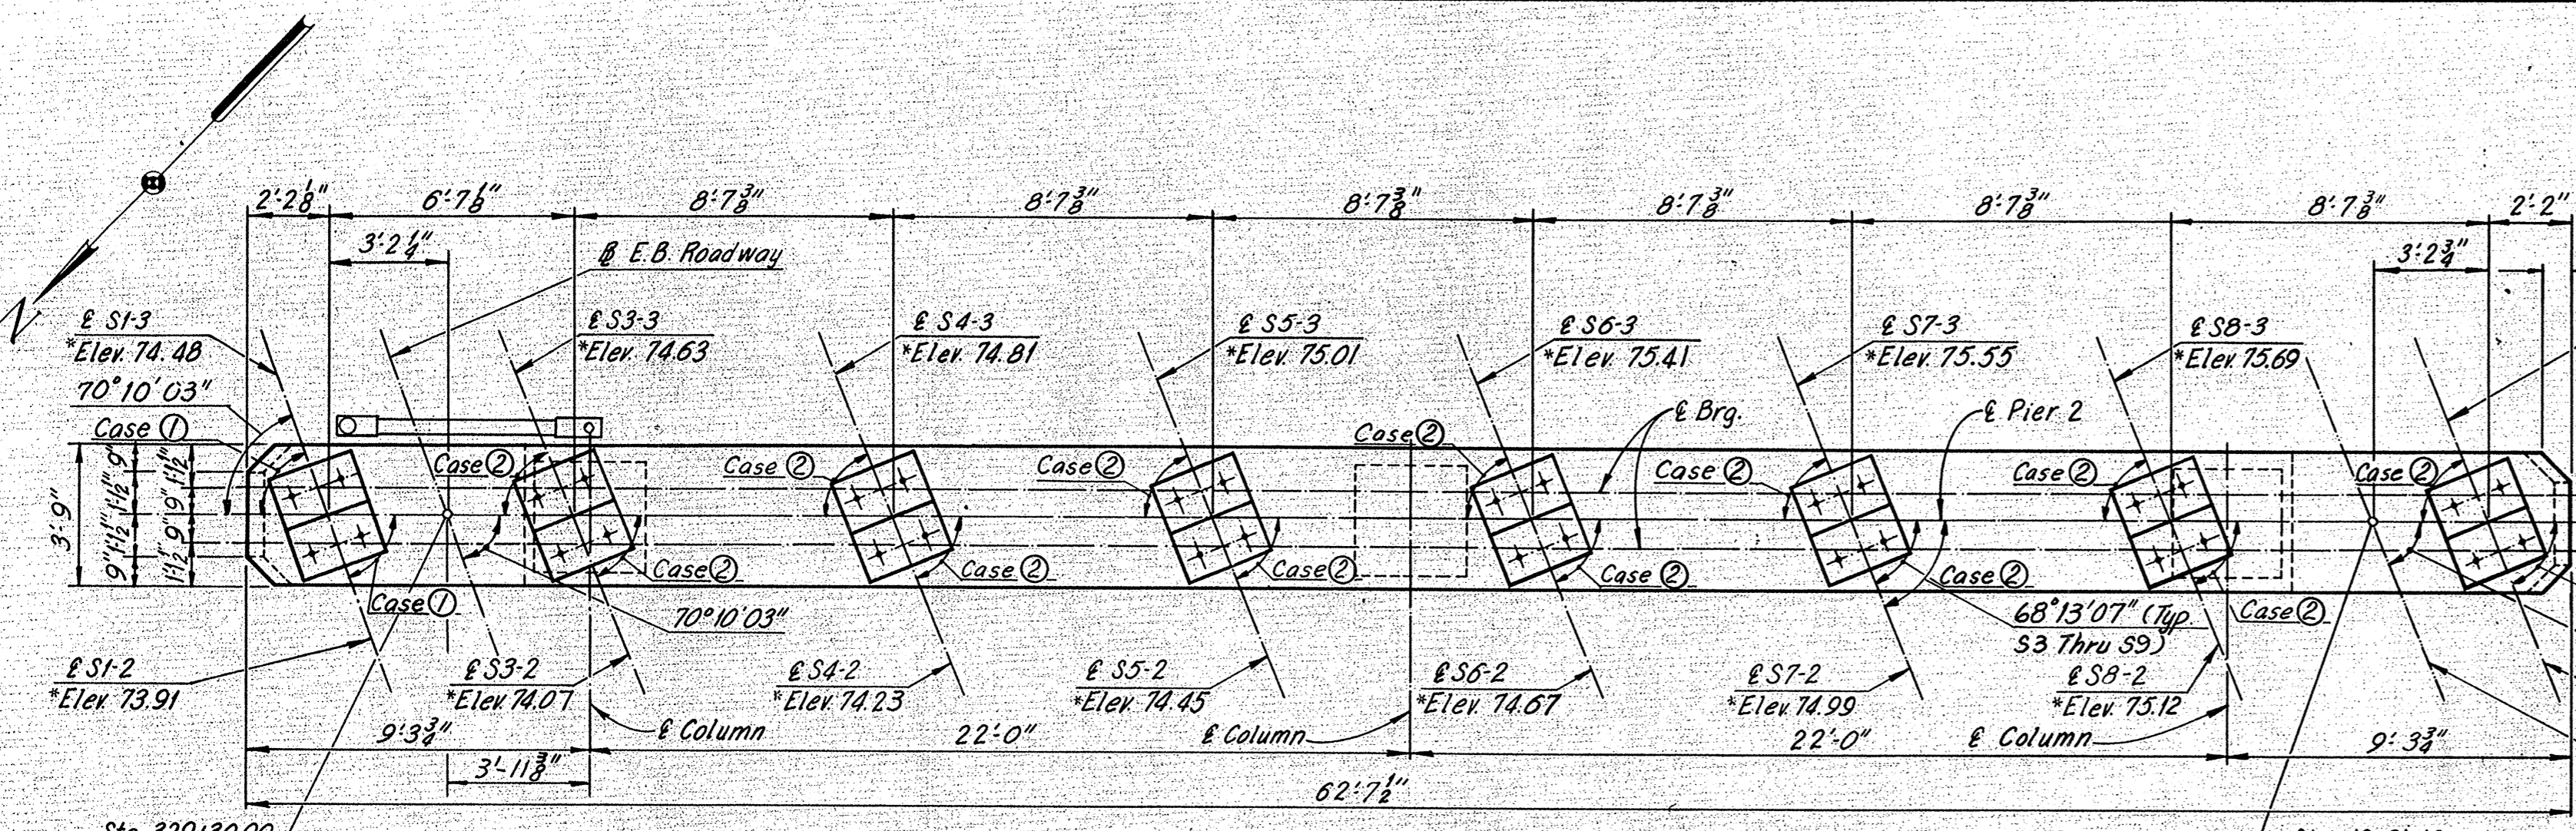

Note: All piles shall be 10BP42 steel piles (Design capacity = 45 tons).
Batter all pile 3" per foot in direction shown.
For Steel Pile Details, see Sheet 11.
For Standard Shoe Details, see Sheets S1 & S2.
For Framing Plan, see Sheet 14.
Estimated Pile Tip Elev., 8.00.

MADE	BY	DATE			
CHECKED	RLM	8-15-68	1	As Built	TEM 8-76
IN-CHARGE			NO.	REVISION	BY
					DATE

Note: Footing elevations are approximate and may be varied to suit field conditions as directed by the Engineer. Vertical shaft reinforcement shall not be cut until these elevations are established. Where elevations change more than 2 ft., redesign will be required.

Note: Pile spacing is measured at bottom of footing.

Note: For architectural treatment of columns, see Sheet 37.

RICHMOND METROPOLITAN AUTHORITY
RICHMOND EXPRESSWAY SYSTEM
DOWNTOWN EXPRESSWAY


BRIDGE NO. 66
EASTBOUND ROADWAY OVER
12TH ST. - R.R. TRACKS AND 16TH ST.
PIER 2

HOWARD, NEEDLES, TAMMEN & BERGENDOFF
consulting engineers
NEW YORK ALEXANDRIA KANSAS CITY


SCALE: As Noted
CONTRACT NO.: 10
SHEET NO. 7 OF 46

AS BUILT

RICHMOND EXPRESSWAY SYSTEM			
SECTION	PROJECT	SHEET NO.	TOTAL SHEETS
10	DOWNTOWN EXPRESSWAY	134	265

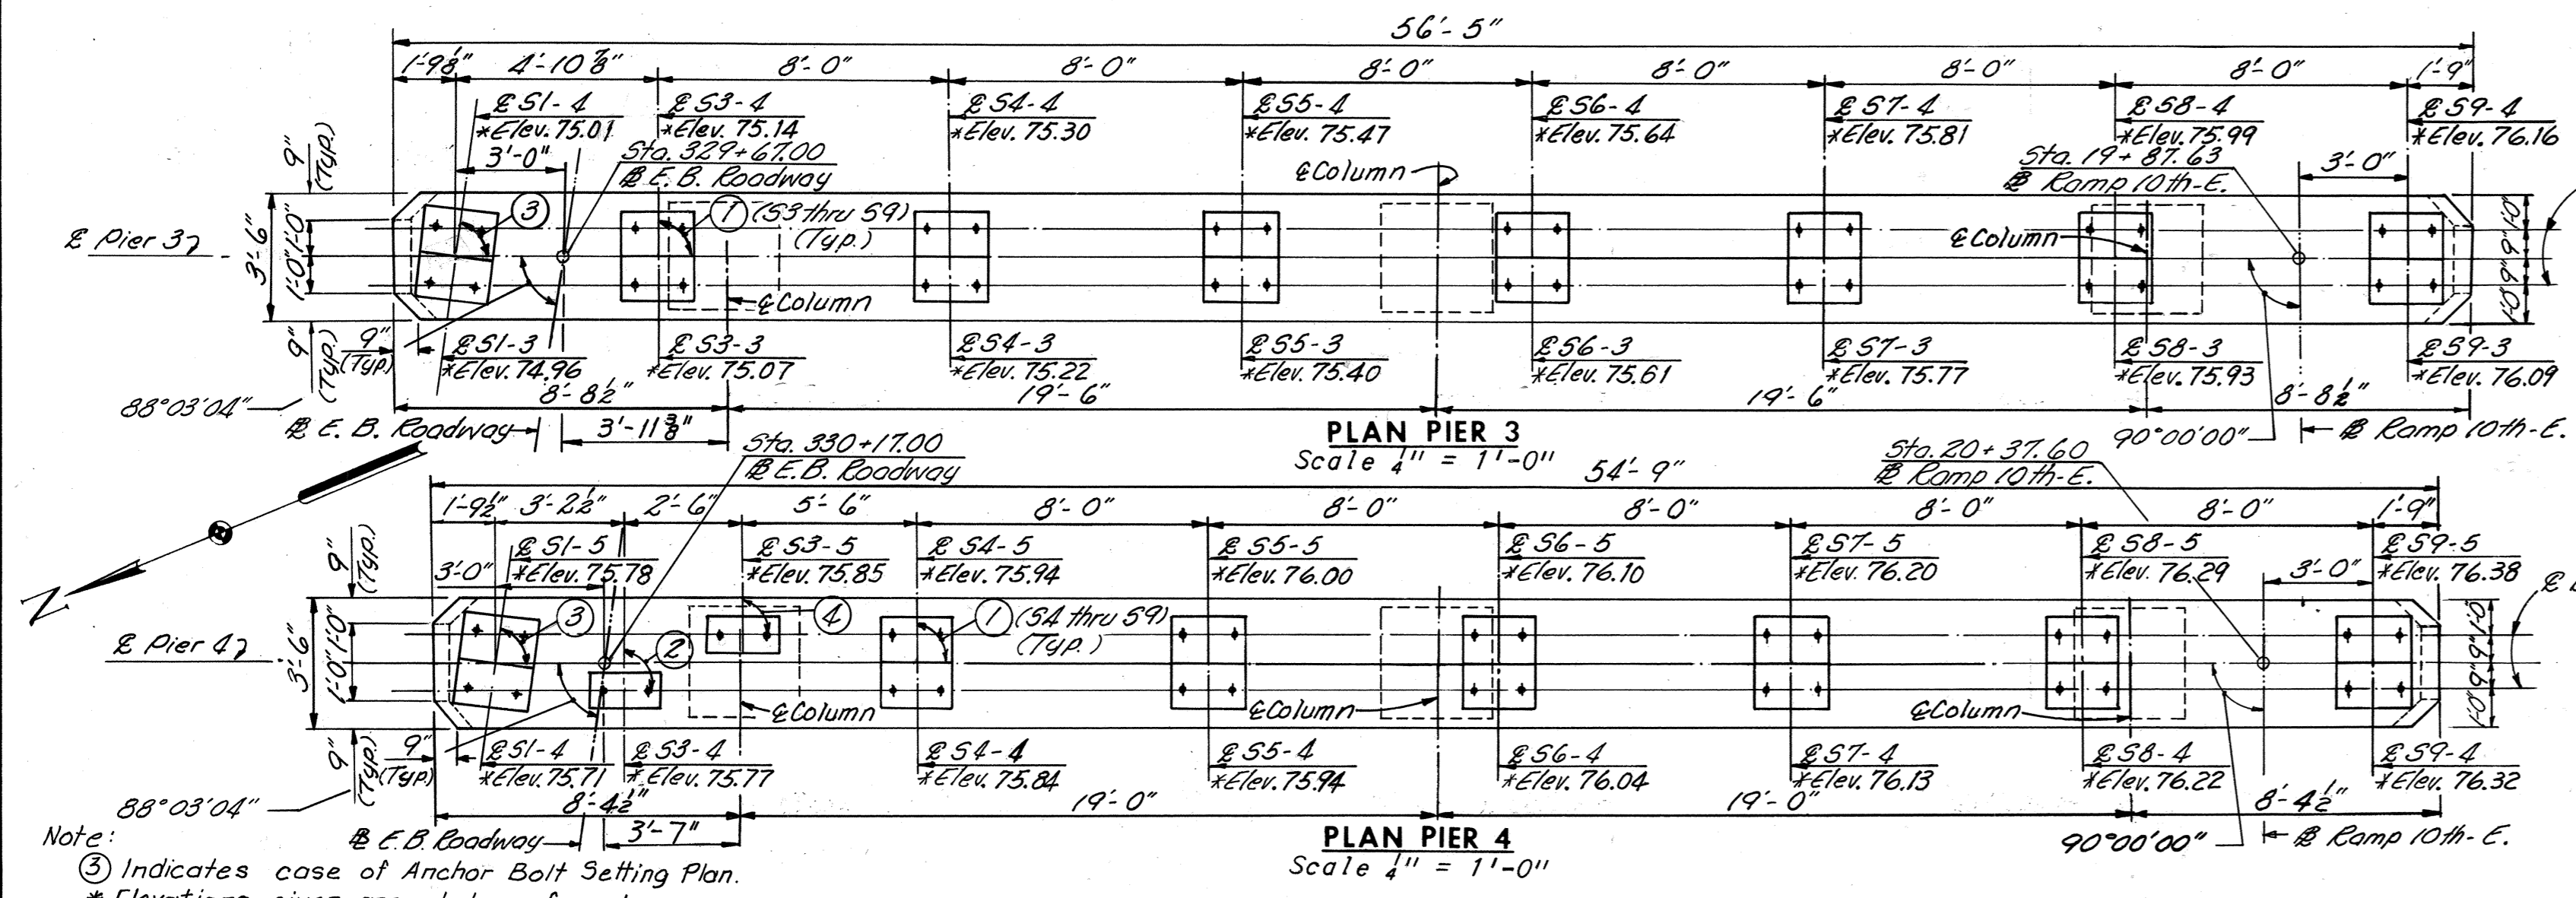


Note:
 (3) Indicates case of Anchor Bolt Setting Plan.
 * Elevations given are at top of pad.


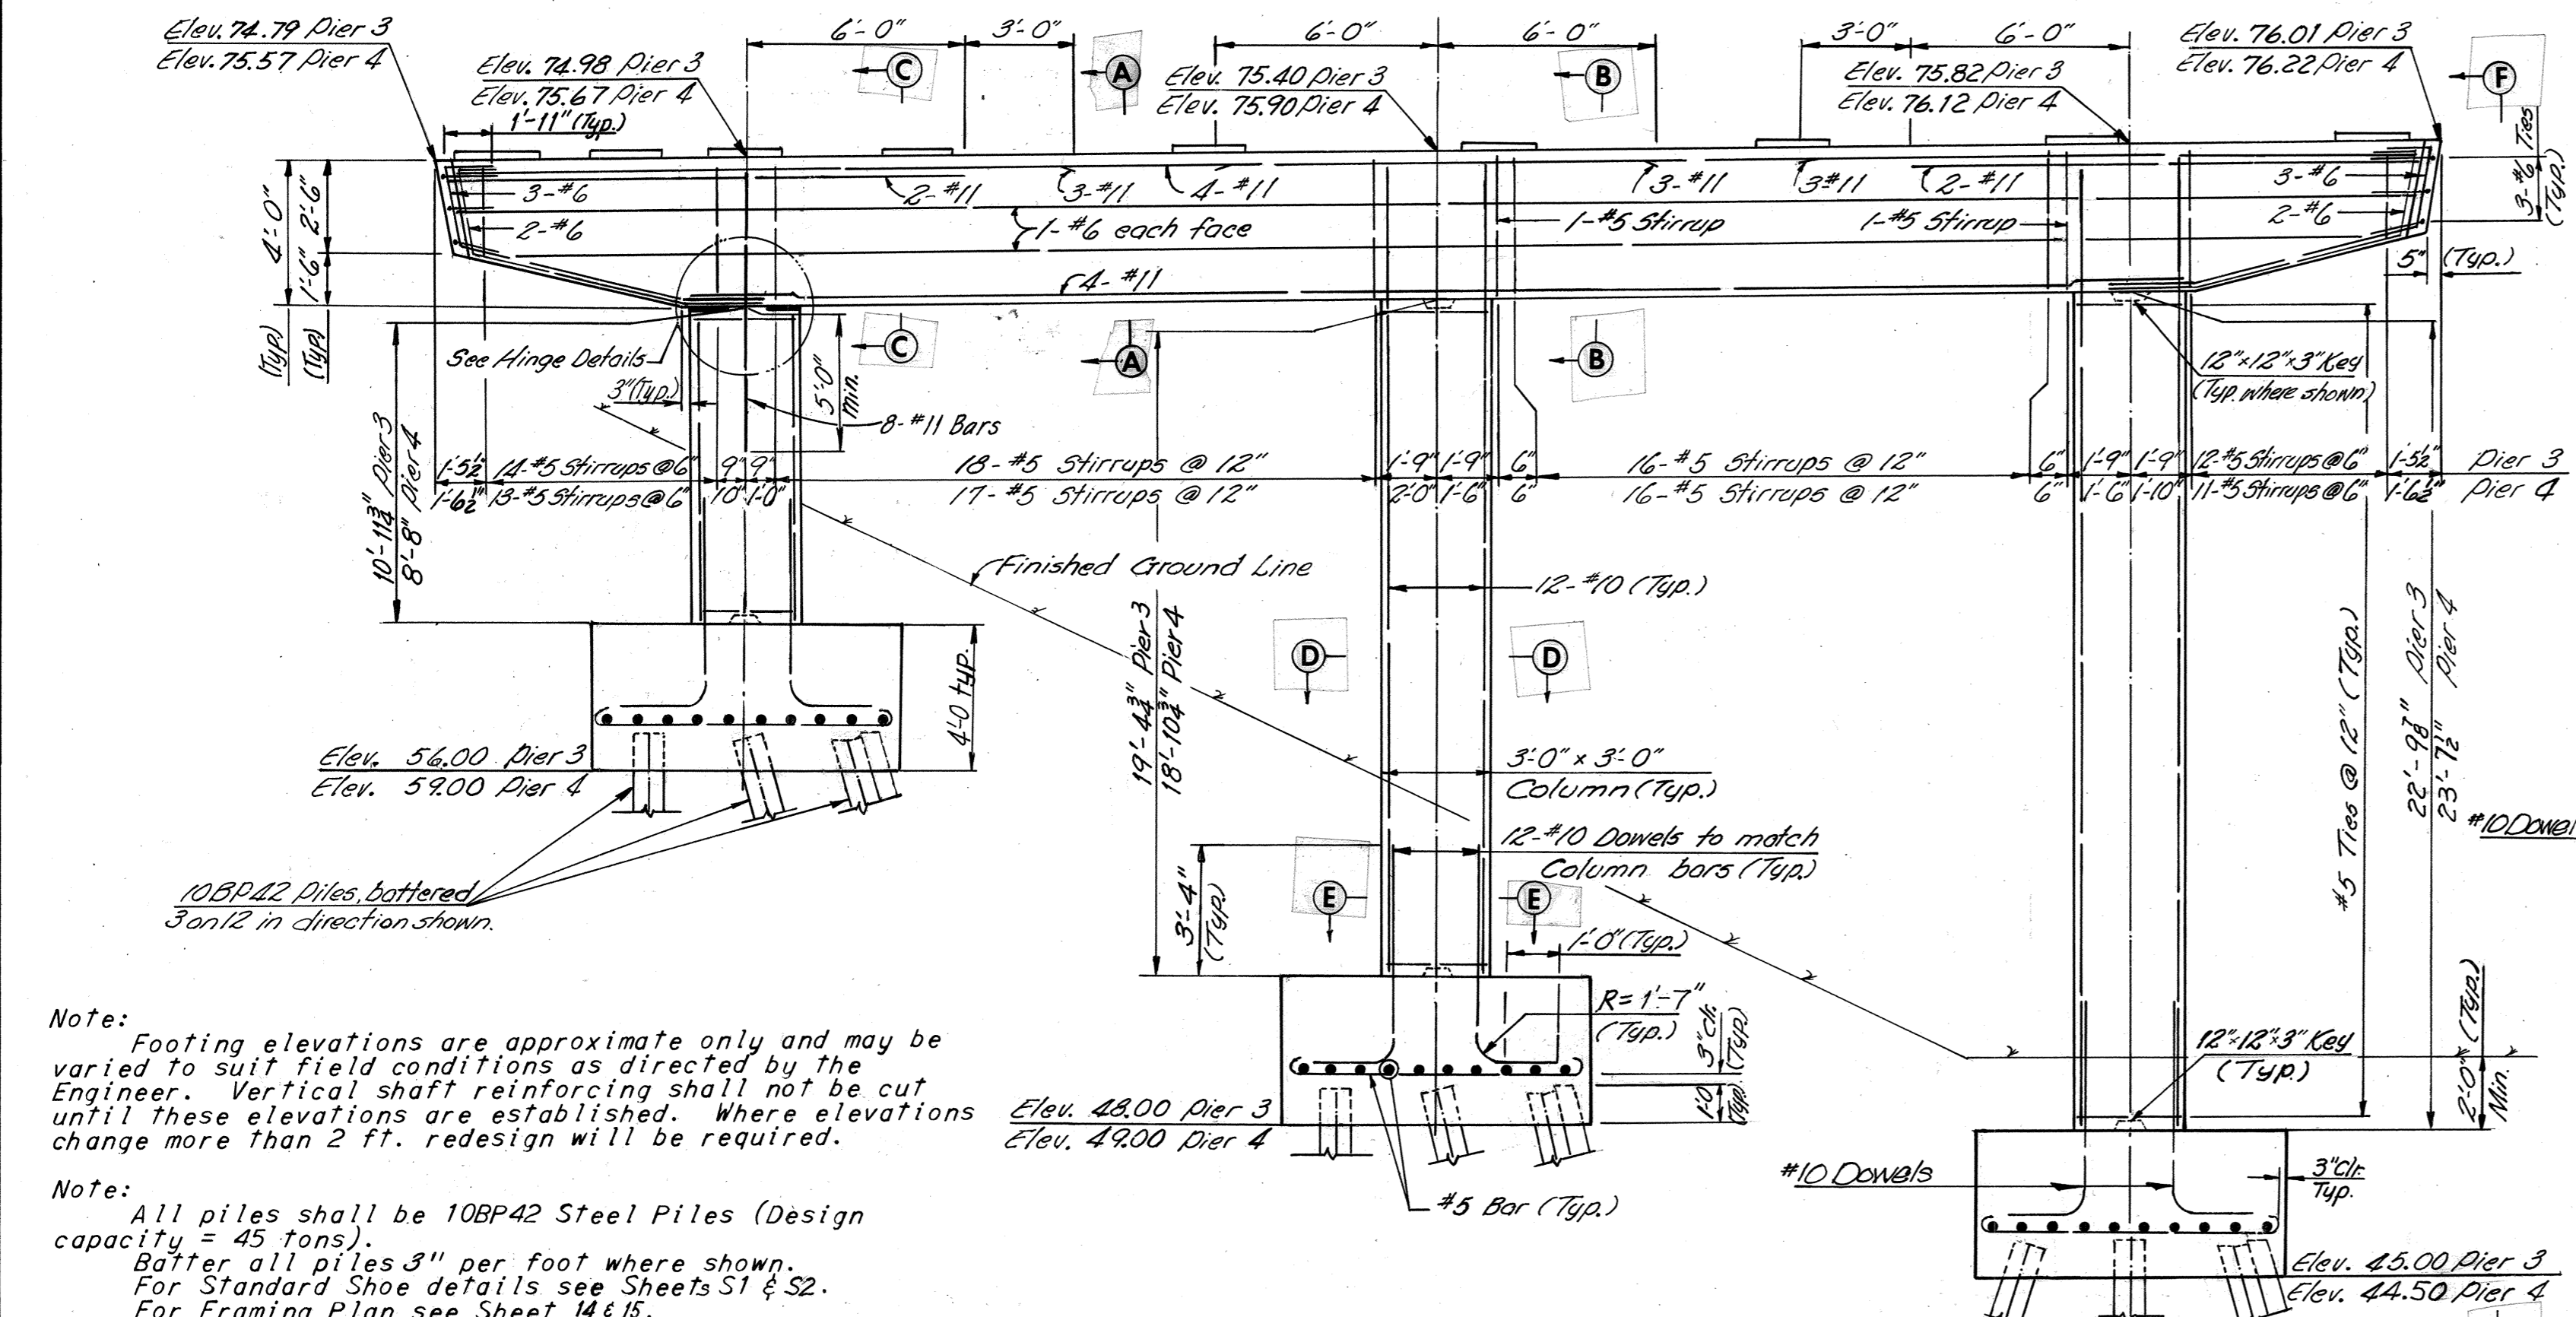


Note:
 Footing elevations are approximate only and may be varied to suit field conditions as directed by the Engineer. Vertical shaft reinforcing shall not be cut until these elevations are established. Where elevations change more than 2 ft. redesign will be required.


Note:
 All piles shall be 10BP42 Steel Piles (Design capacity = 45 tons).
 Batter all piles 3" per foot where shown.
 For Standard Shoe details see Sheets S1 & S2.
 For Framing Plan see Sheet 14.15.
 For Steel Pile Details see Sheet 11.
 Estimated Pile Tip elevation 8.00 (Pier 3), 9.00 (Pier 4)
 & Column & Footing

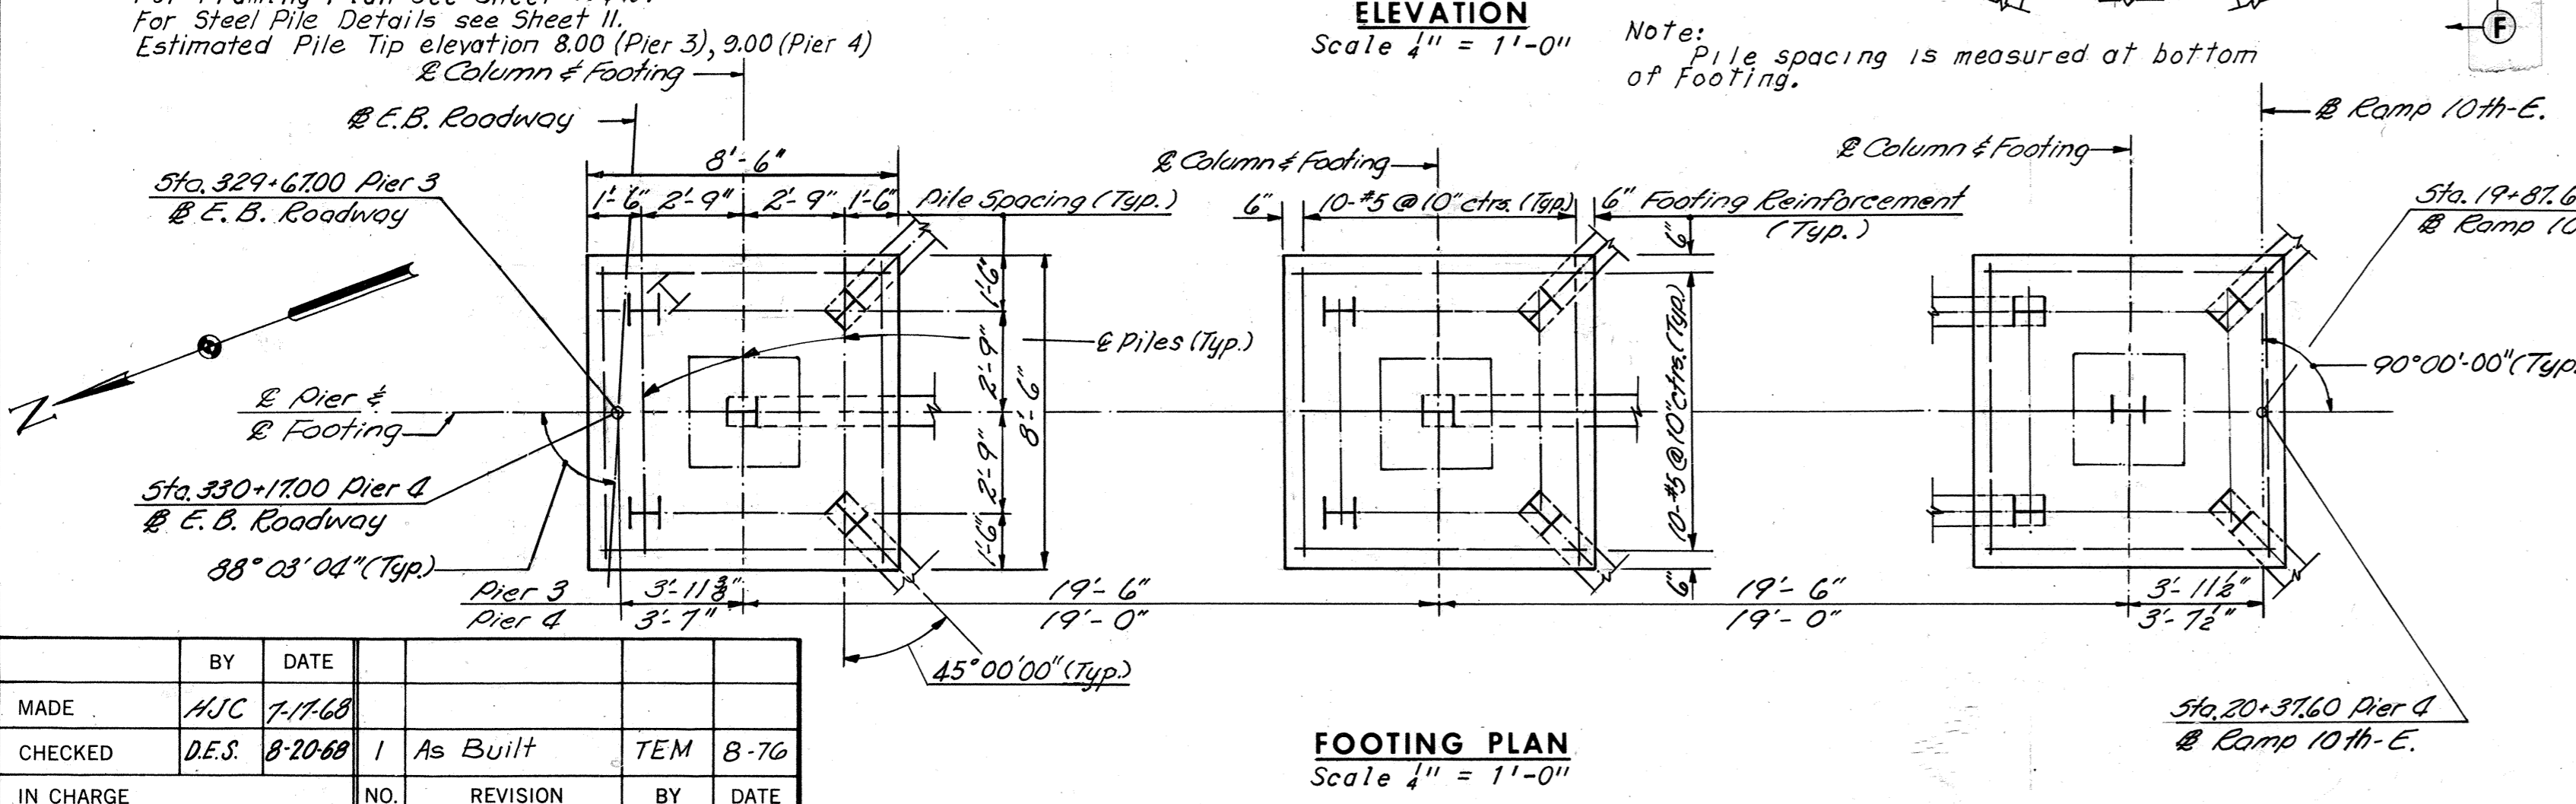

BY	DATE	NO.	REVISION	BY	DATE
MADE	HJC	7-17-68			
CHECKED	D.E.S.	8-20-68	1 As Built	TEM	8-76
IN CHARGE					

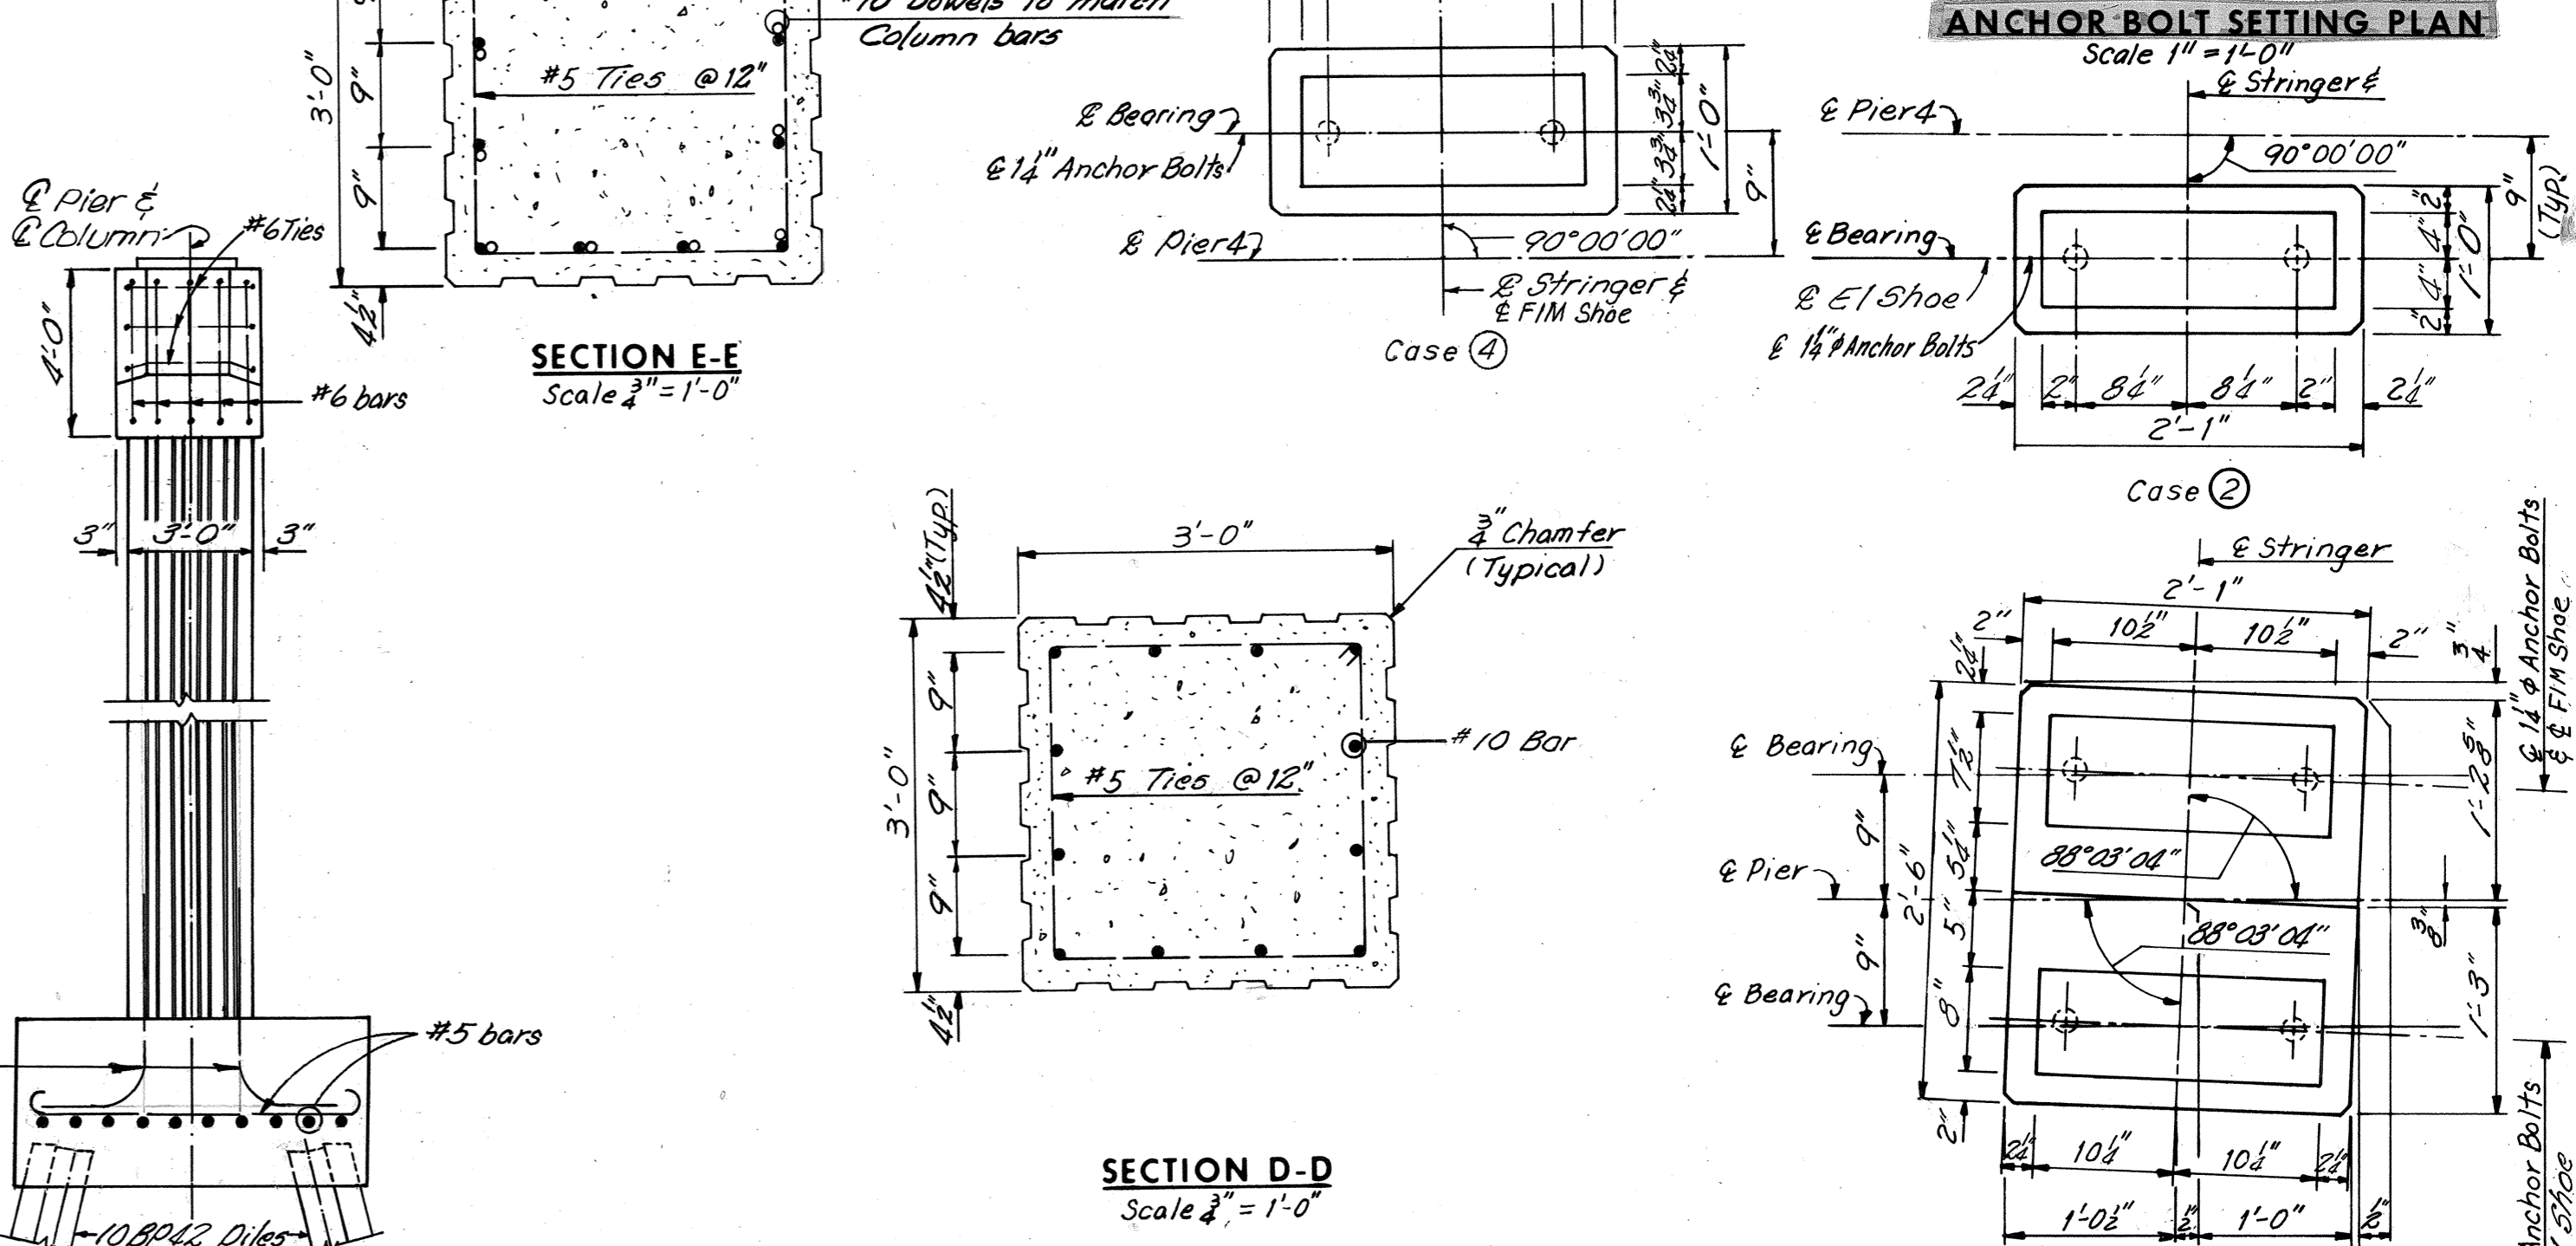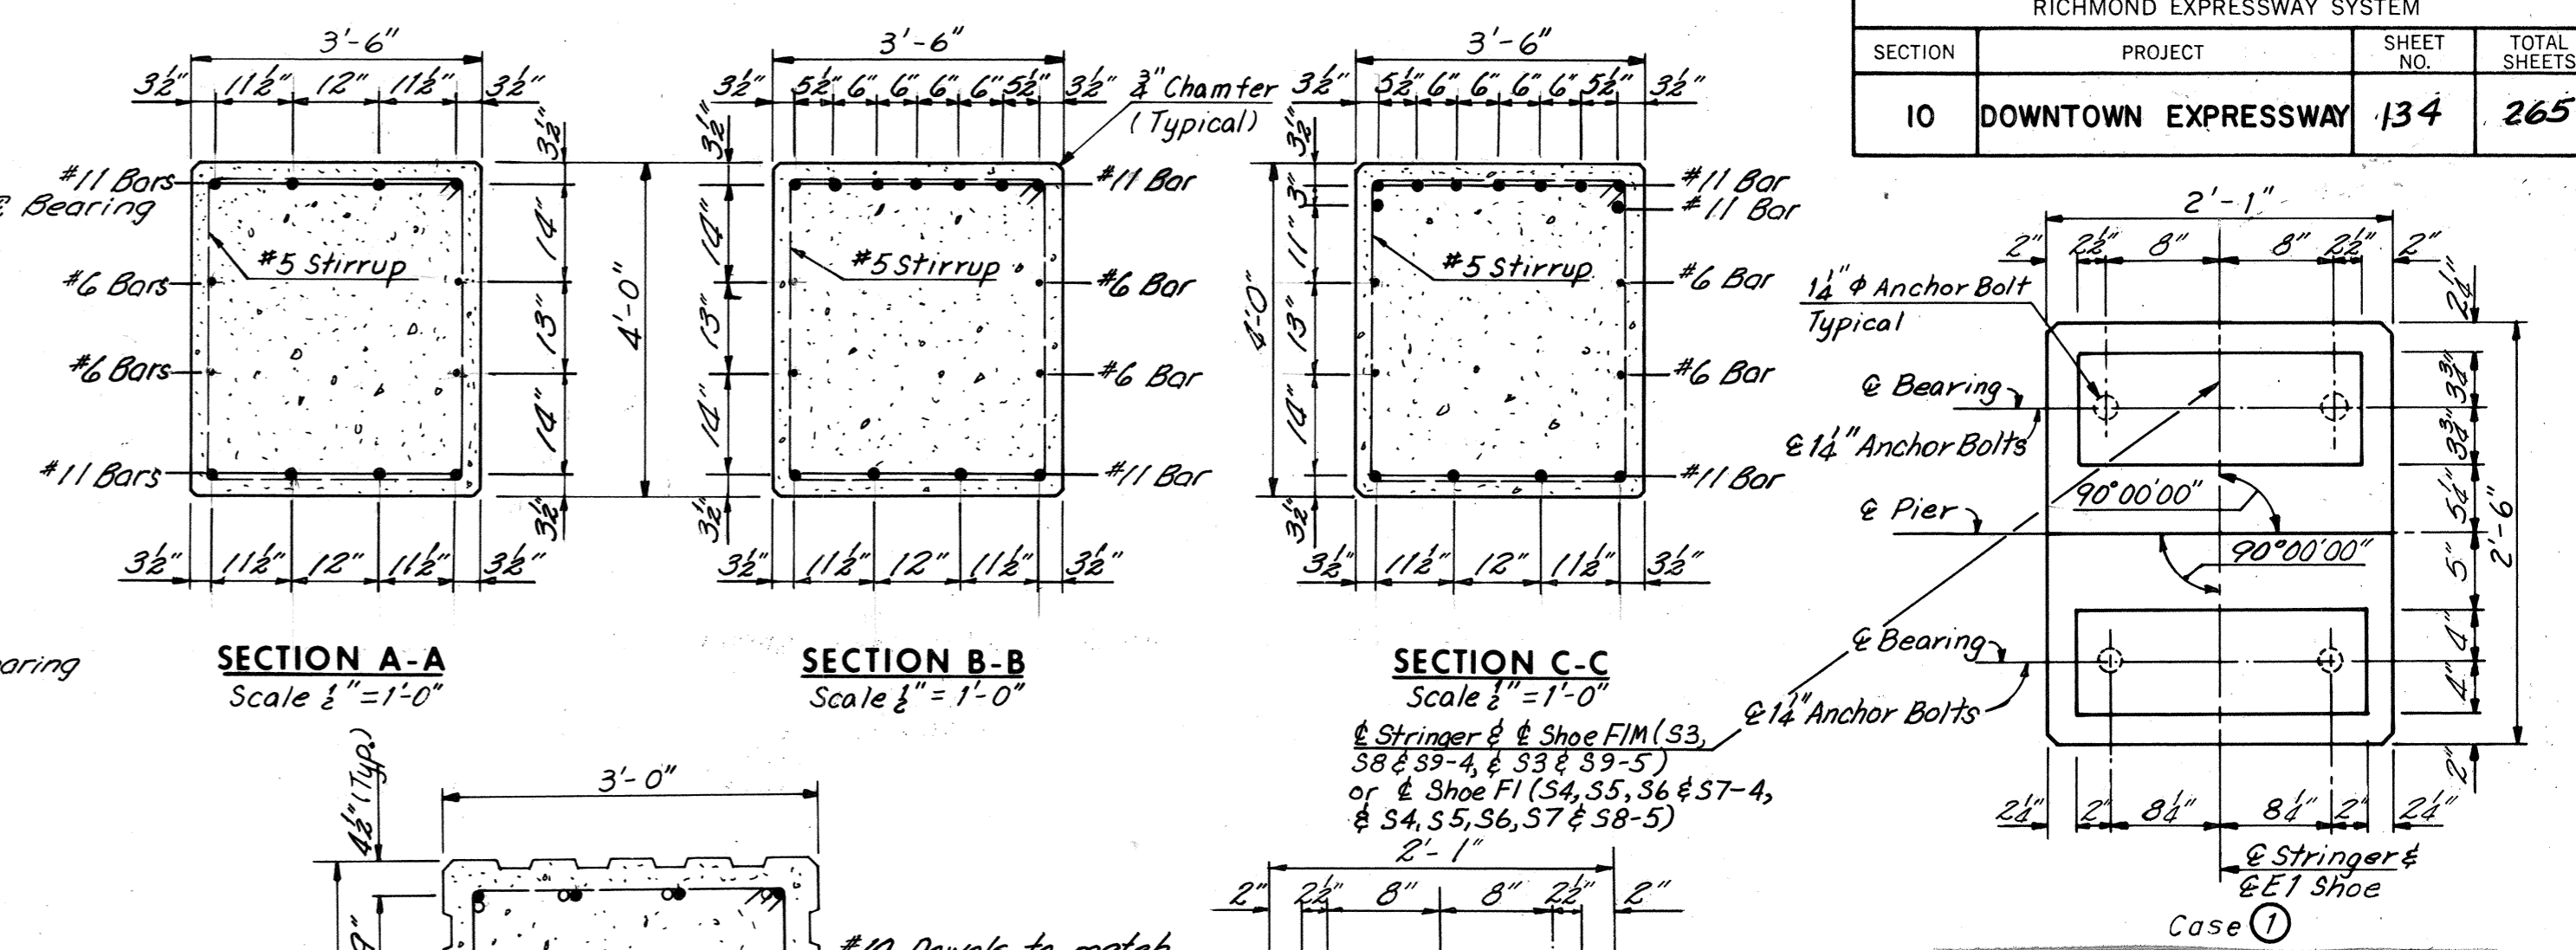

Note:
 For architectural treatment of columns, see Sheet 37.

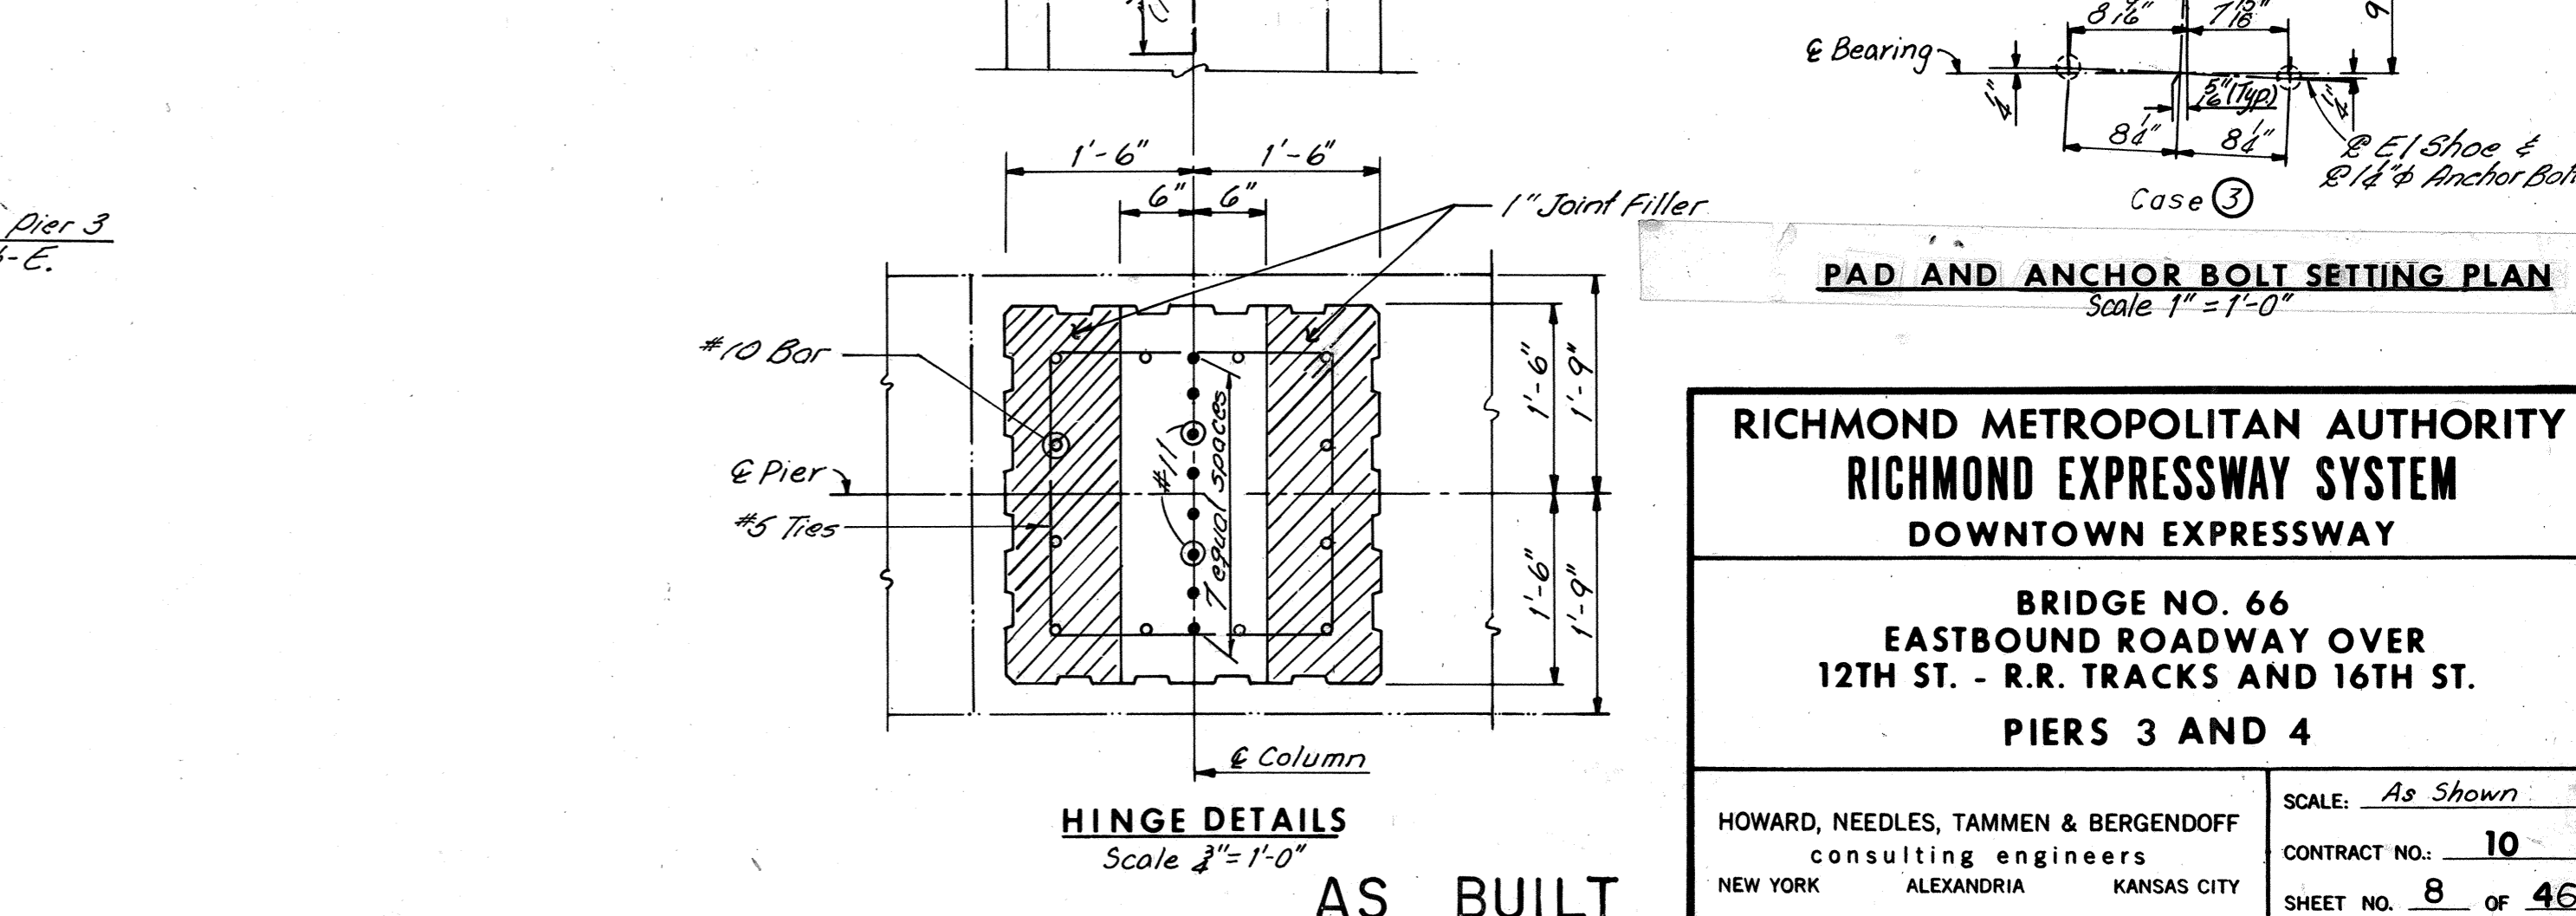

RICHMOND METROPOLITAN AUTHORITY
RICHMOND EXPRESSWAY SYSTEM
DOWNTOWN EXPRESSWAY

BRIDGE NO. 66
EASTBOUND ROADWAY OVER
12TH ST. - R.R. TRACKS AND 16TH ST.
PIERS 3 AND 4















HOWARD, NEEDLES, TAMMEN & BERGENDOFF
 consulting engineers
 NEW YORK ALEXANDRIA KANSAS CITY

SCALE: As Shown
 CONTRACT NO.: 10
 SHEET NO. 8 OF 46

AS BUILT

RICHMOND EXPRESSWAY SYSTEM			
SECTION	PROJECT	SHEET NO.	TOTAL SHEETS
10	DOWNTOWN EXPRESSWAY	135	265

See F1 Shoe (S4, S5, S6, S7 & S8-6, S4, S5, S6, S7 & S8-7) or F1M Shoe (S3 & S9-6, S9-7)

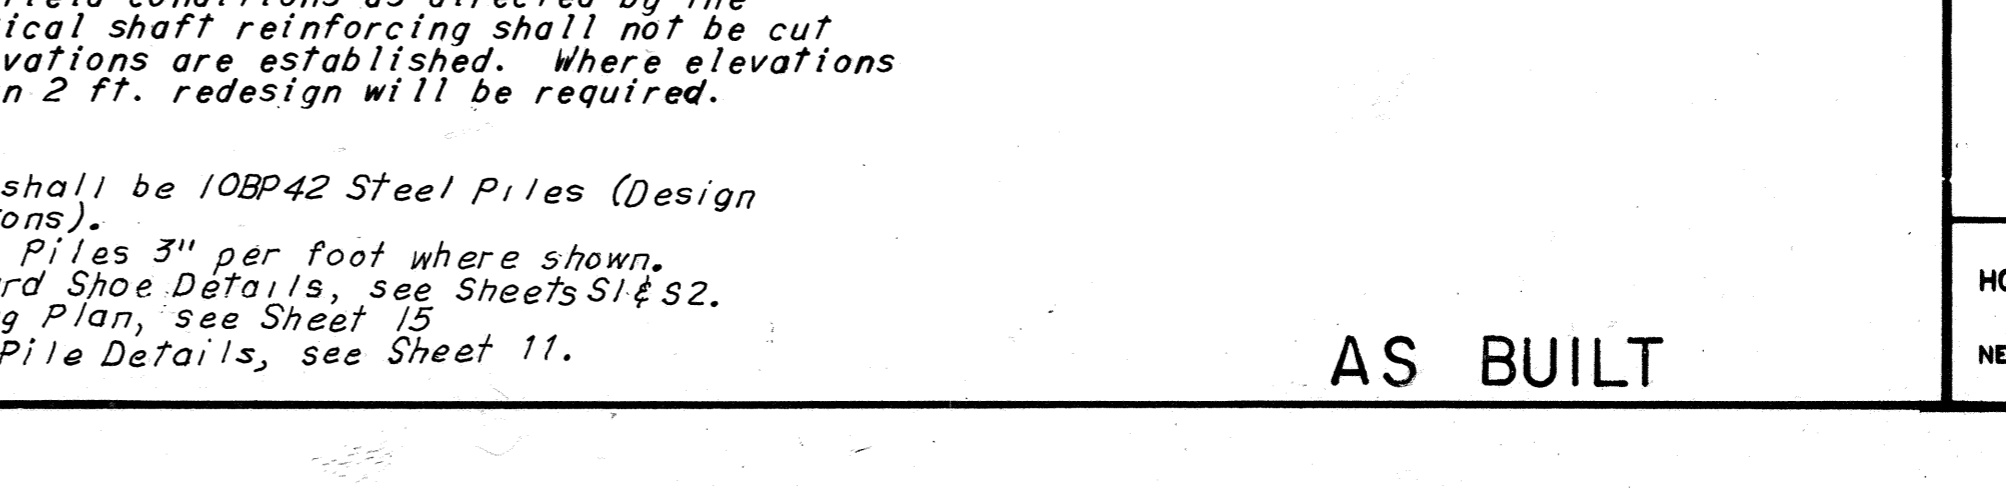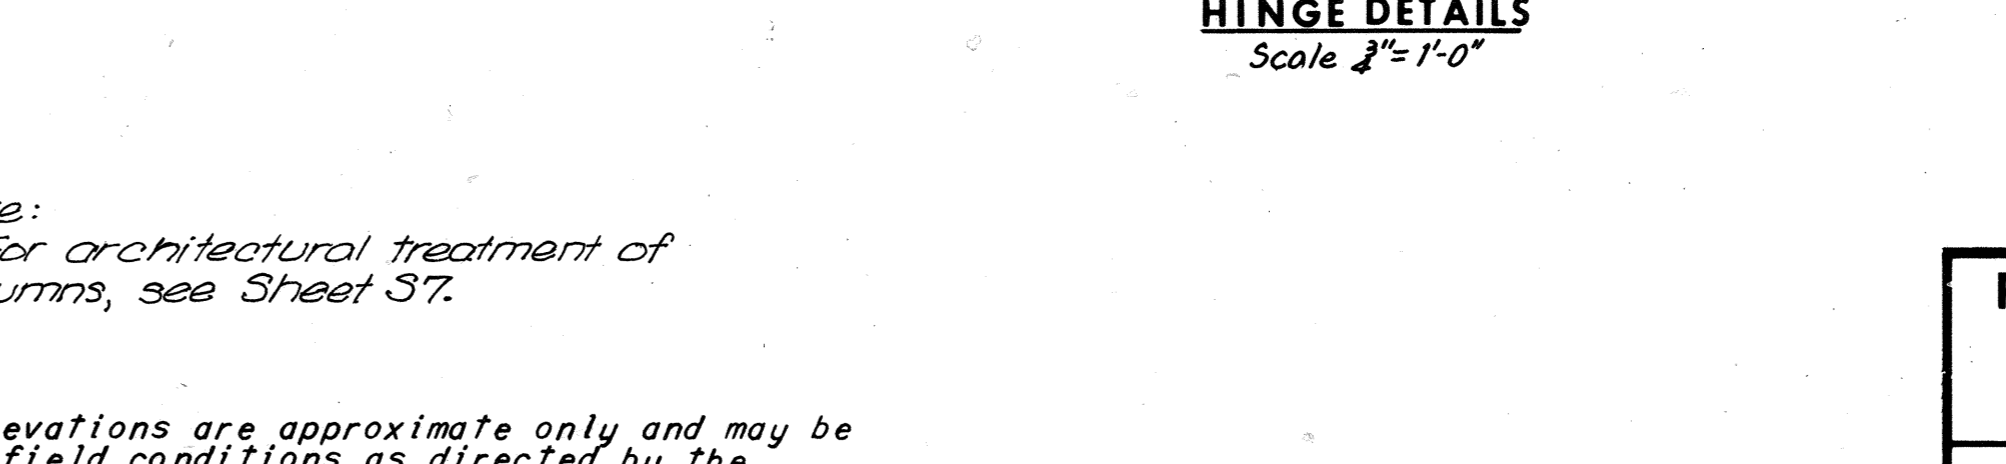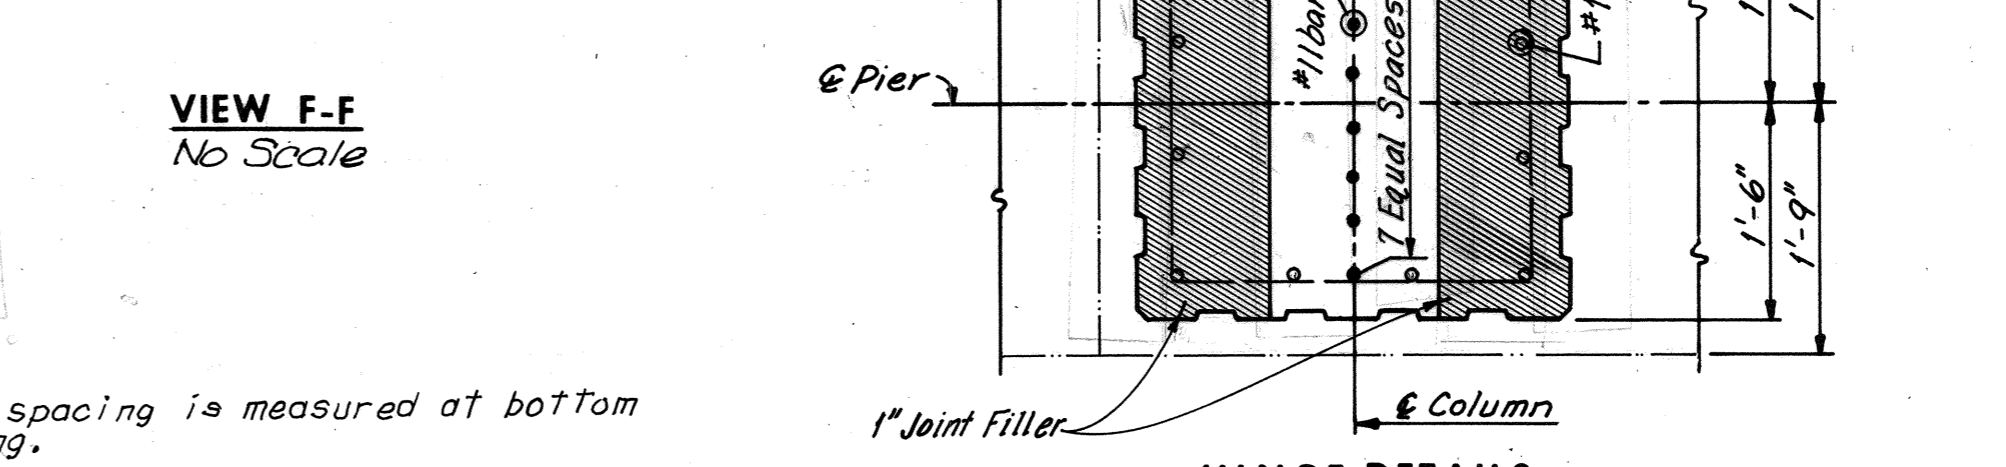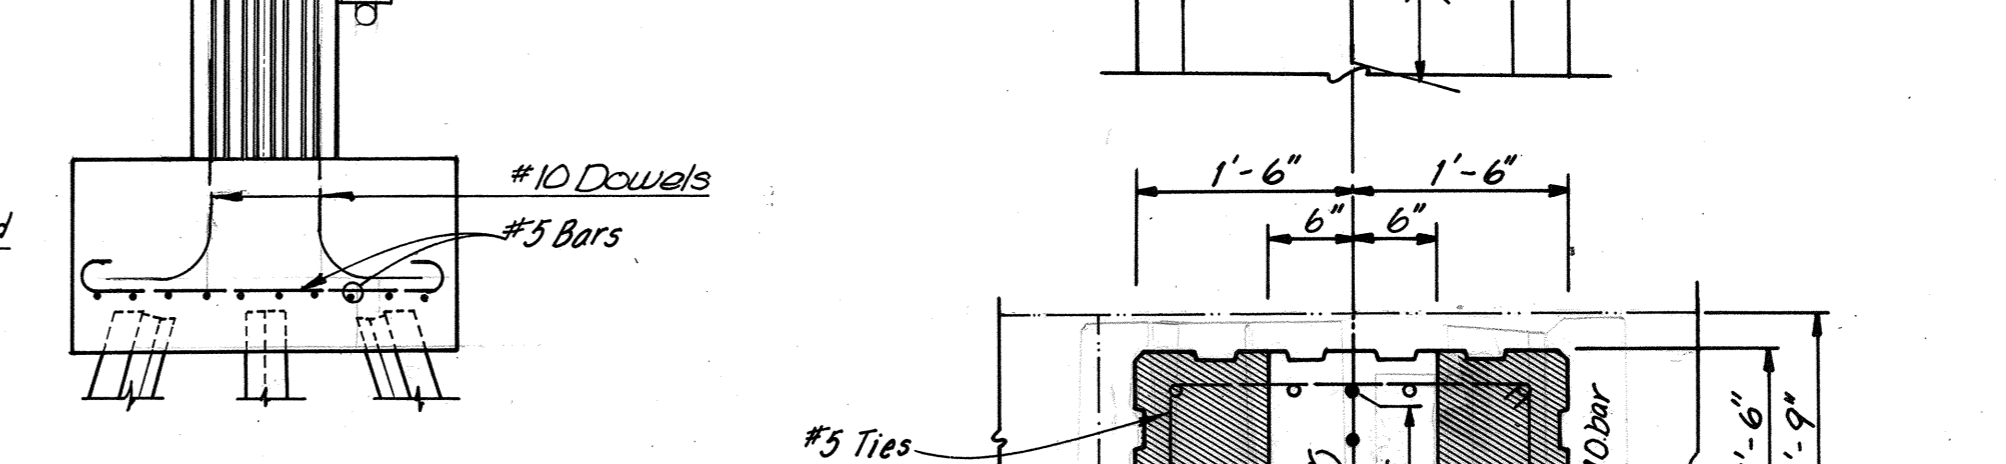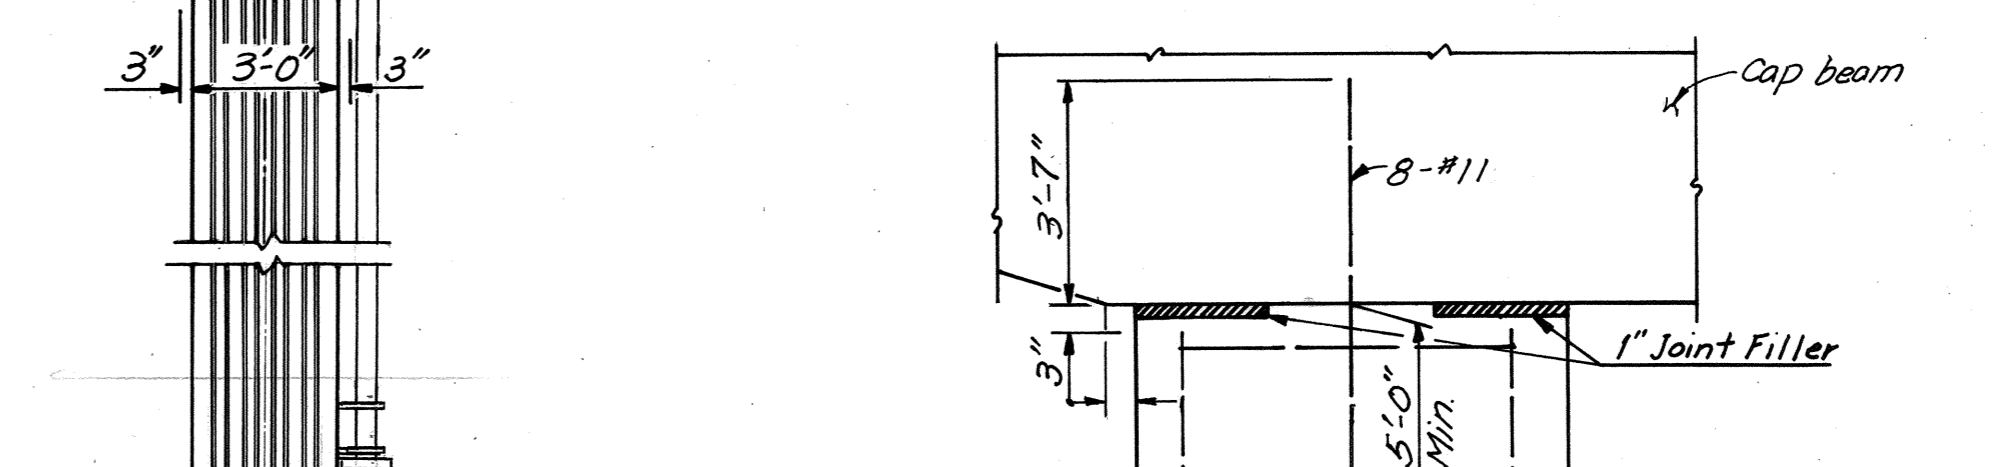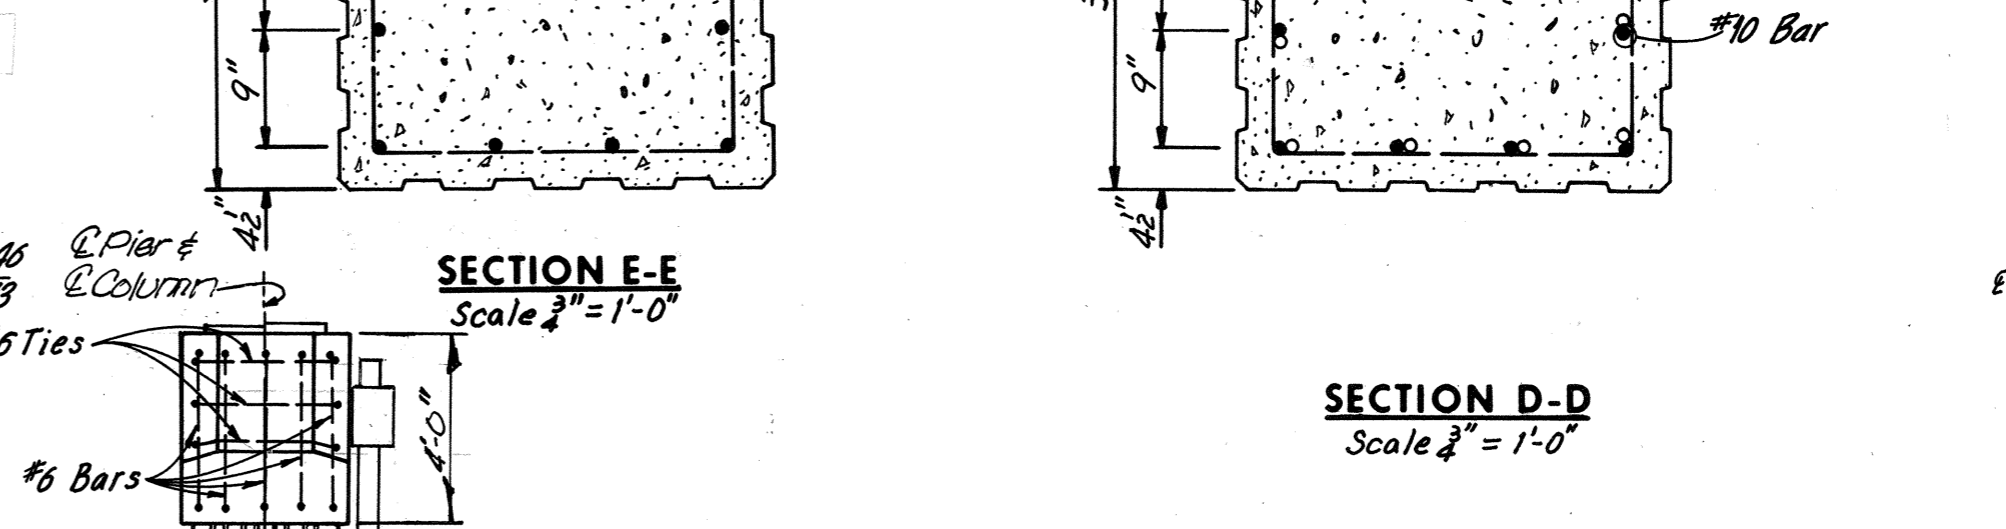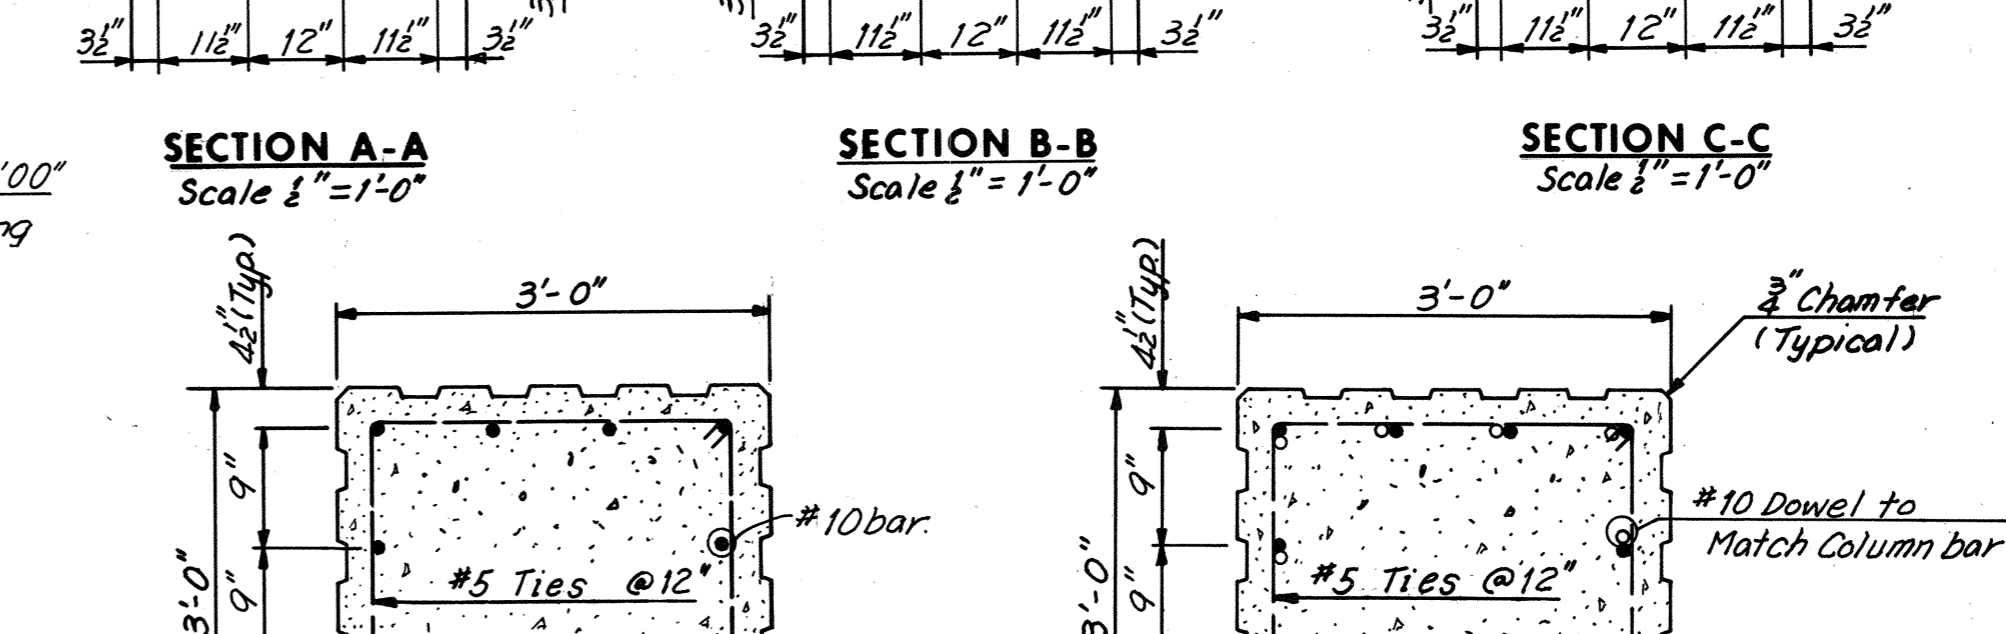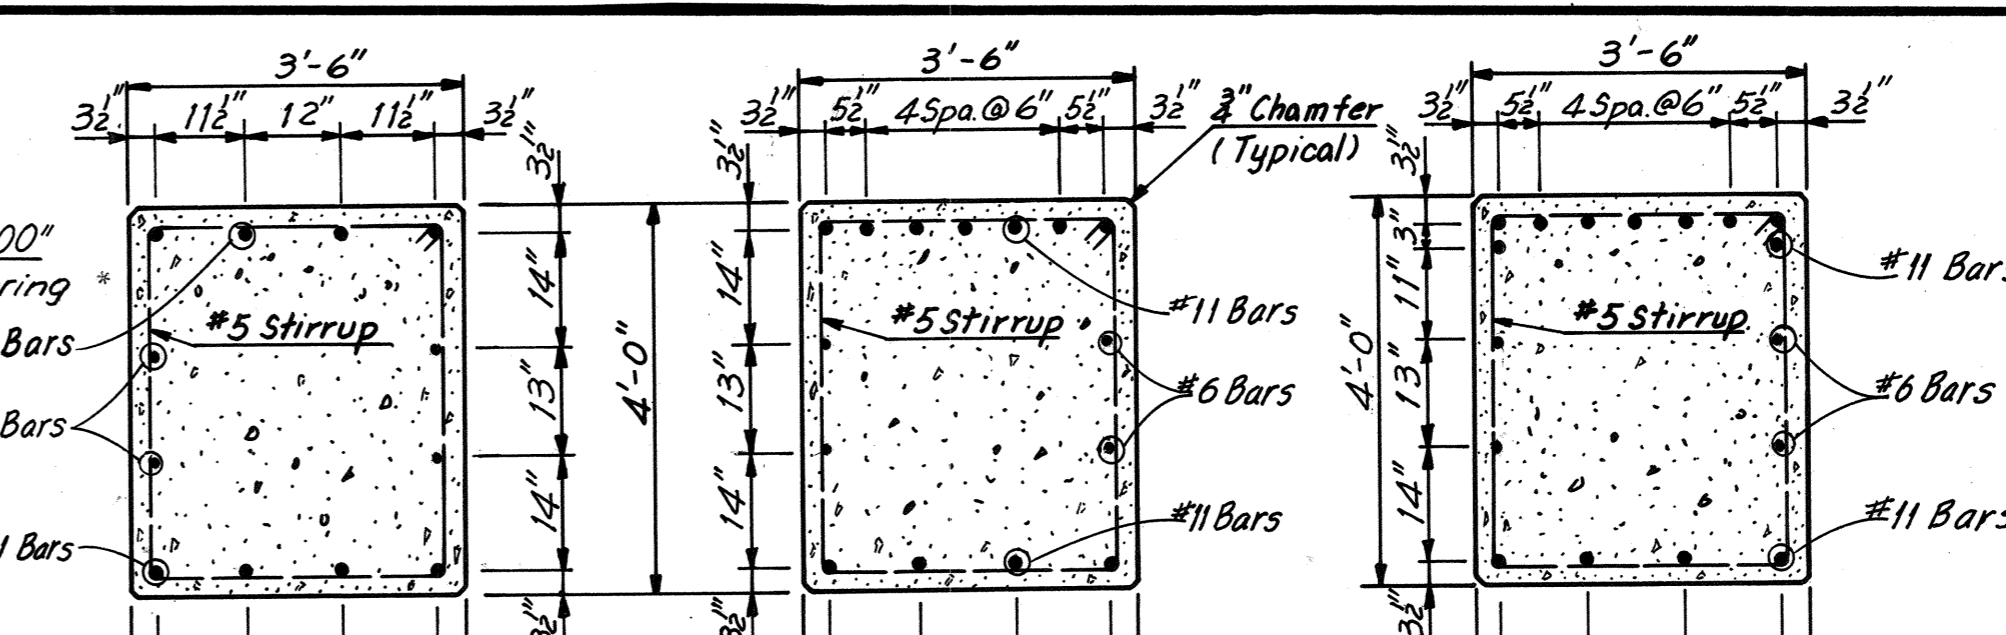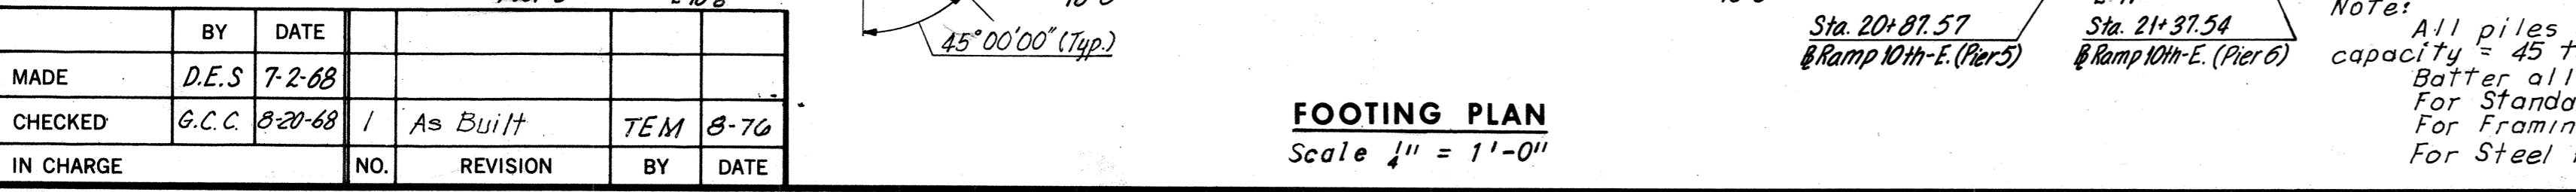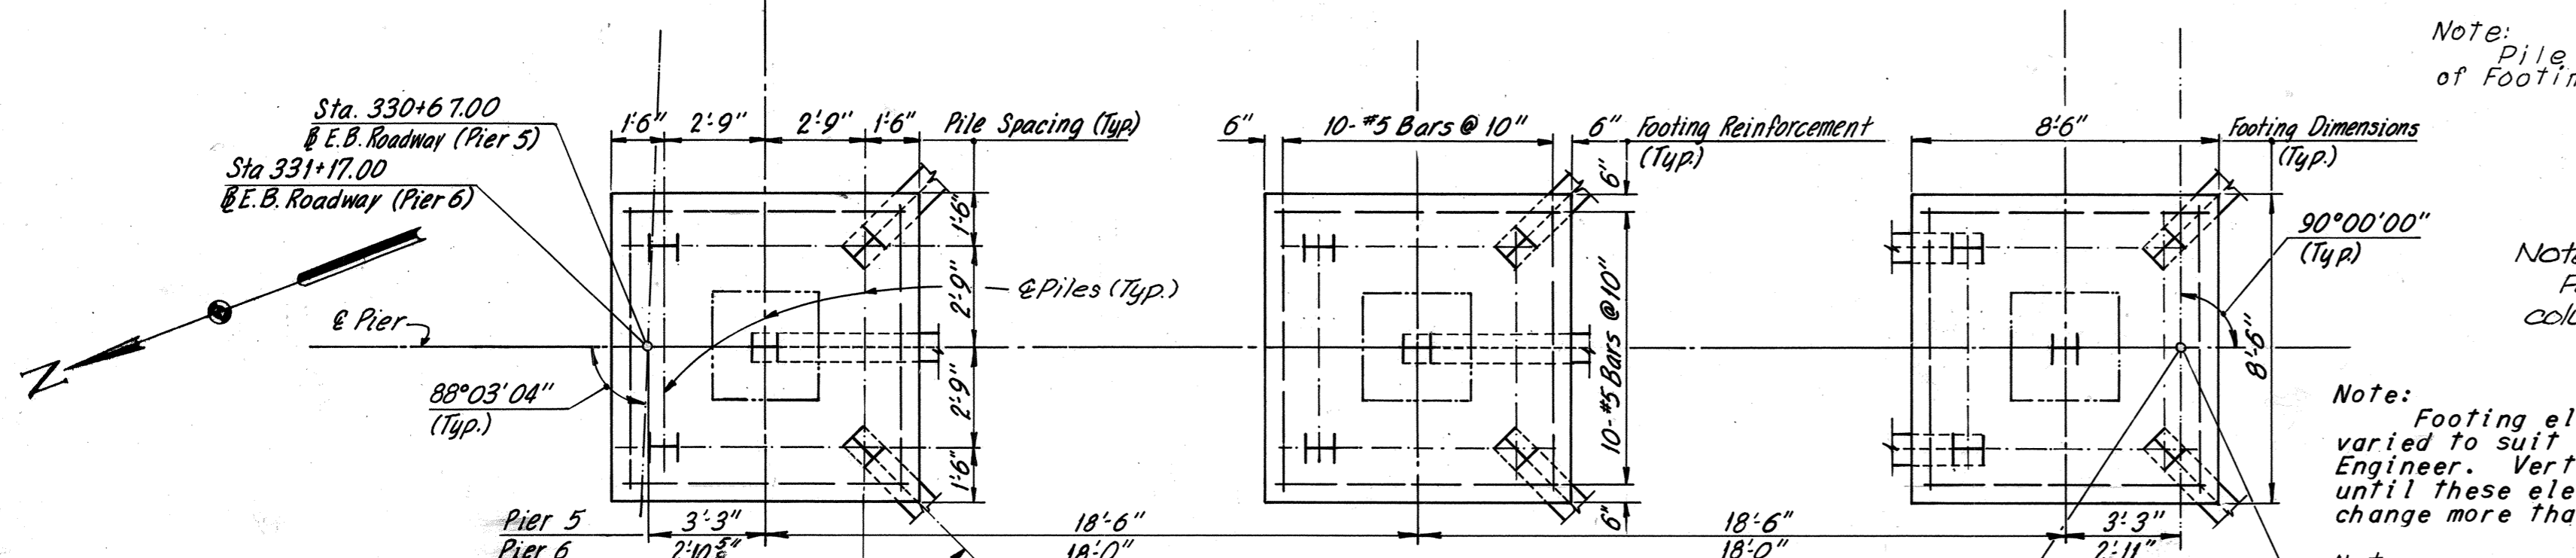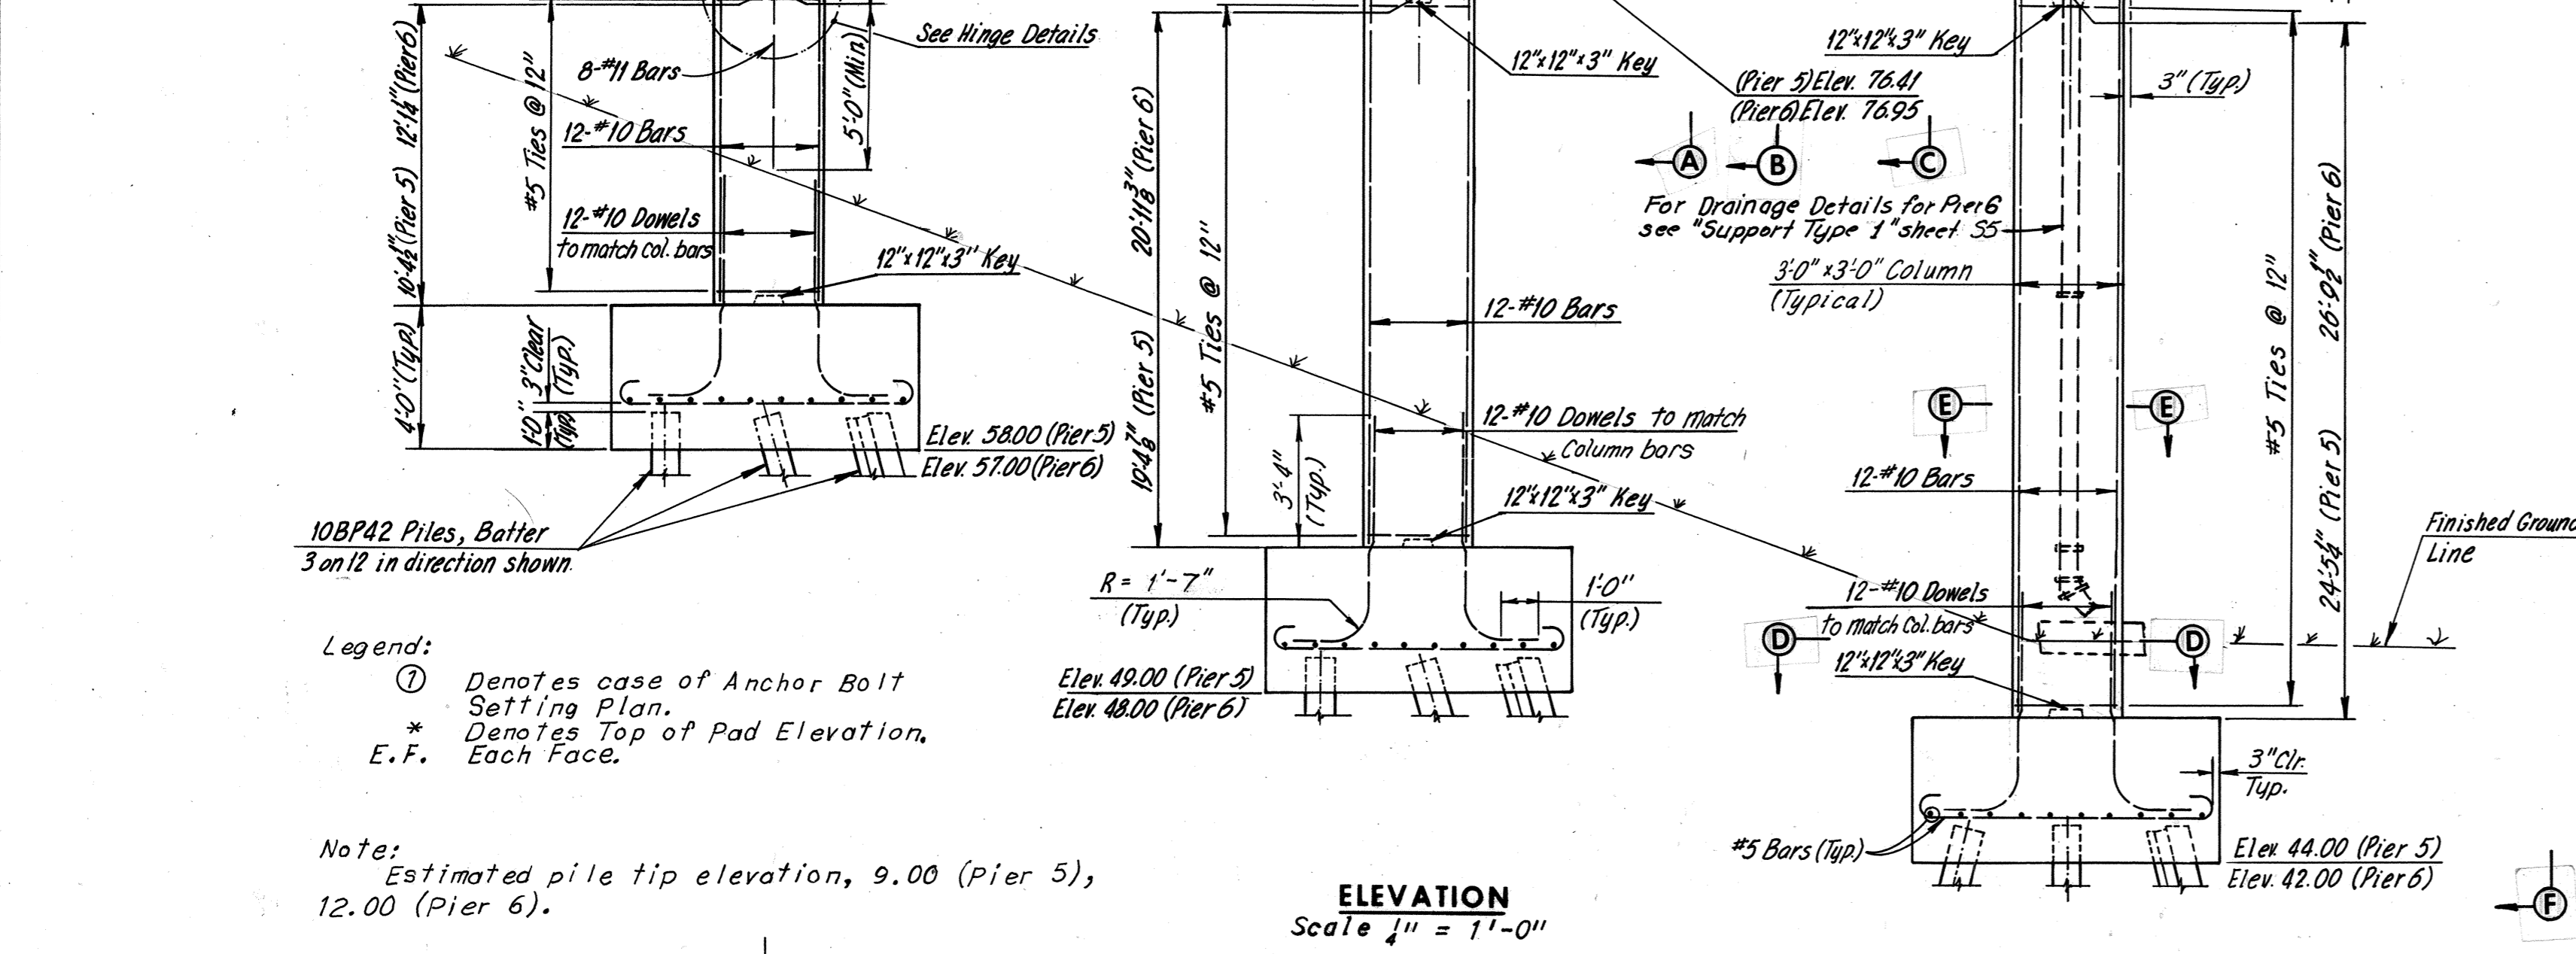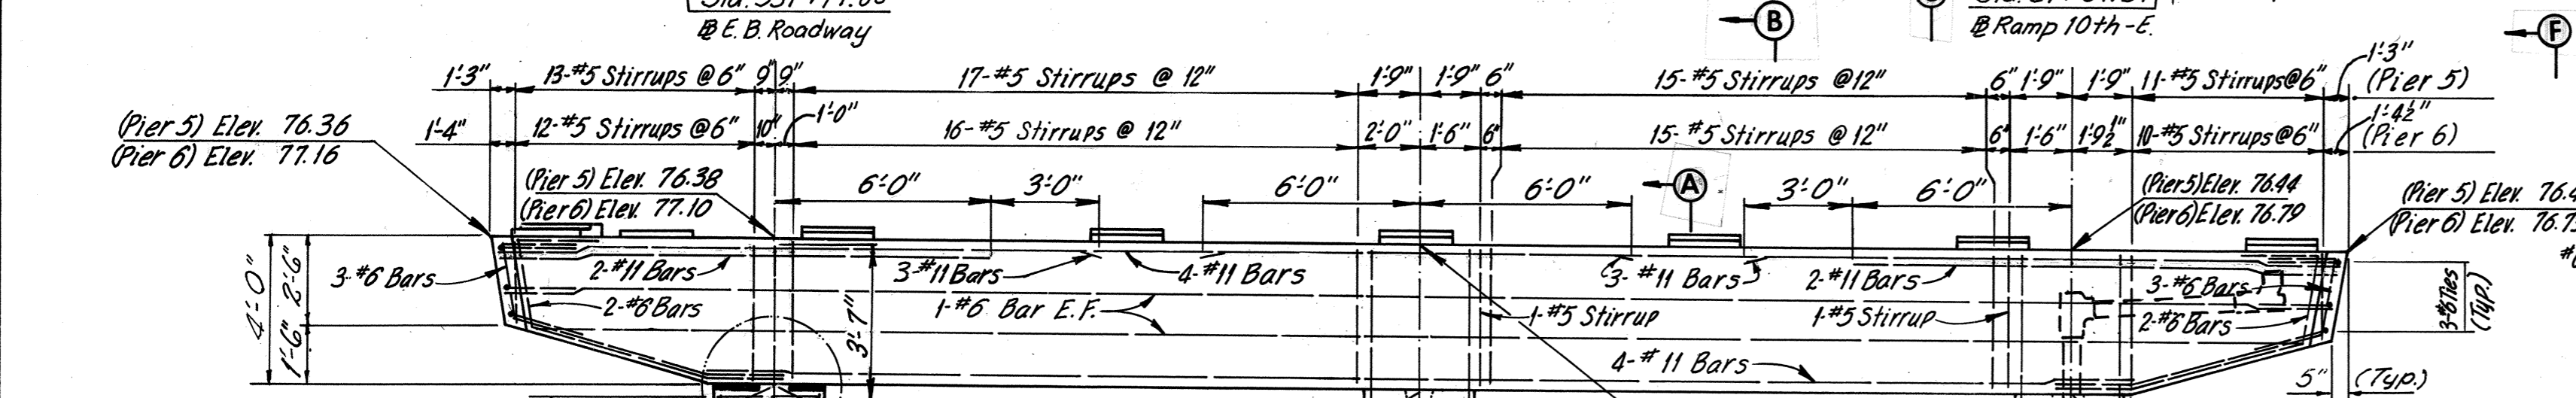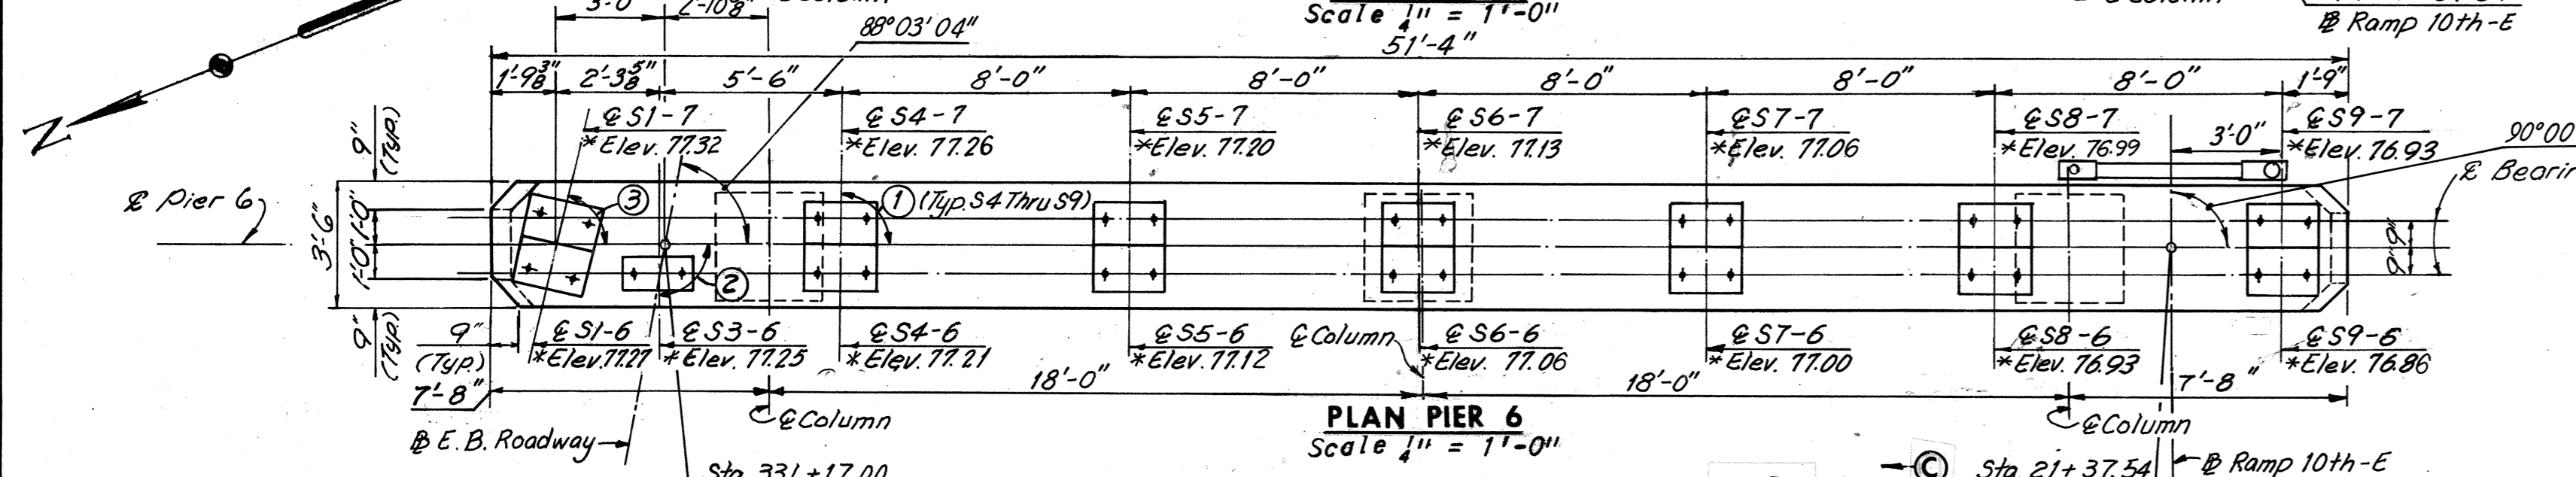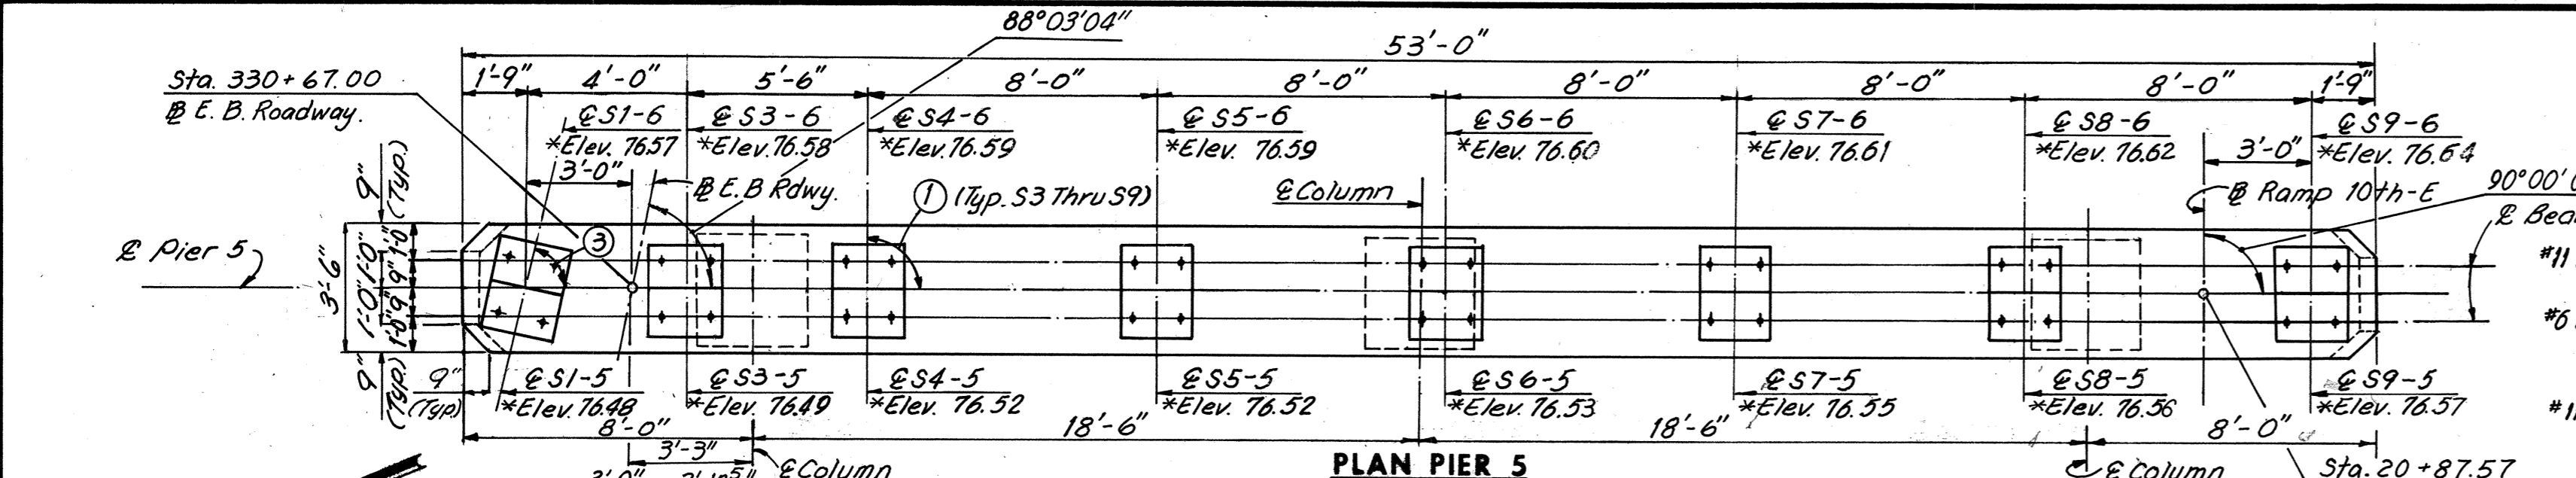

Legend:
 ① Denotes case of Anchor Bolt Setting Plan.
 * Denotes Top of Pad Elevation.
 E.F. Each Face.

Note:
 Estimated pile tip elevation, 9.00 (Pier 5),
 12.00 (Pier 6).

Note:
 For Drainage Details for Pier 6
 see "Support Type 1" sheet 35

Note:
 Pile spacing is measured at bottom
 of footing.

Note:
 For architectural treatment of
 columns, see Sheet 57.

Note:
 Footing elevations are approximate only and may be
 varied to suit field conditions as directed by the
 Engineer. Vertical shaft reinforcing shall not be cut
 until these elevations are established. Where elevations
 change more than 2 ft. redesign will be required.

Note:
 All piles shall be 10BP42 Steel Piles (Design
 capacity = 45 tons).
 Batter all Piles 3" per foot where shown.
 For Standard Shoe Details, see Sheets S1 & S2.
 For Framing Plan, see Sheet 15
 For Steel Pile Details, see Sheet 11.

BY	DATE	NO.	REVISION	BY	DATE
MADE	D.E.S 7-2-68				
CHECKED	G.C.C 8-20-68	1	As Built	TEM 8-76	
IN CHARGE					

RICHMOND METROPOLITAN AUTHORITY
RICHMOND EXPRESSWAY SYSTEM
DOWNTOWN EXPRESSWAY

BRIDGE NO. 66
EASTBOUND ROADWAY OVER
12TH ST. - R.R. TRACKS AND 16TH ST.
PIERS 5 AND 6









HOWARD, NEEDLES, TAMMEN & BERGENDOFF
 consulting engineers
 NEW YORK ALEXANDRIA KANSAS CITY

SCALE: As Shown
 CONTRACT NO. 10
 SHEET NO. 9 of 46

AS BUILT

RICHMOND EXPRESSWAY SYSTEM			
SECTION	PROJECT	SHEET NO.	TOTAL SHEETS
10	DOWNTOWN EXPRESSWAY	136A	265

± FIM Shoes (S9-9) or ± FI Shoe (S4, S5, S6, S7, S8-9)

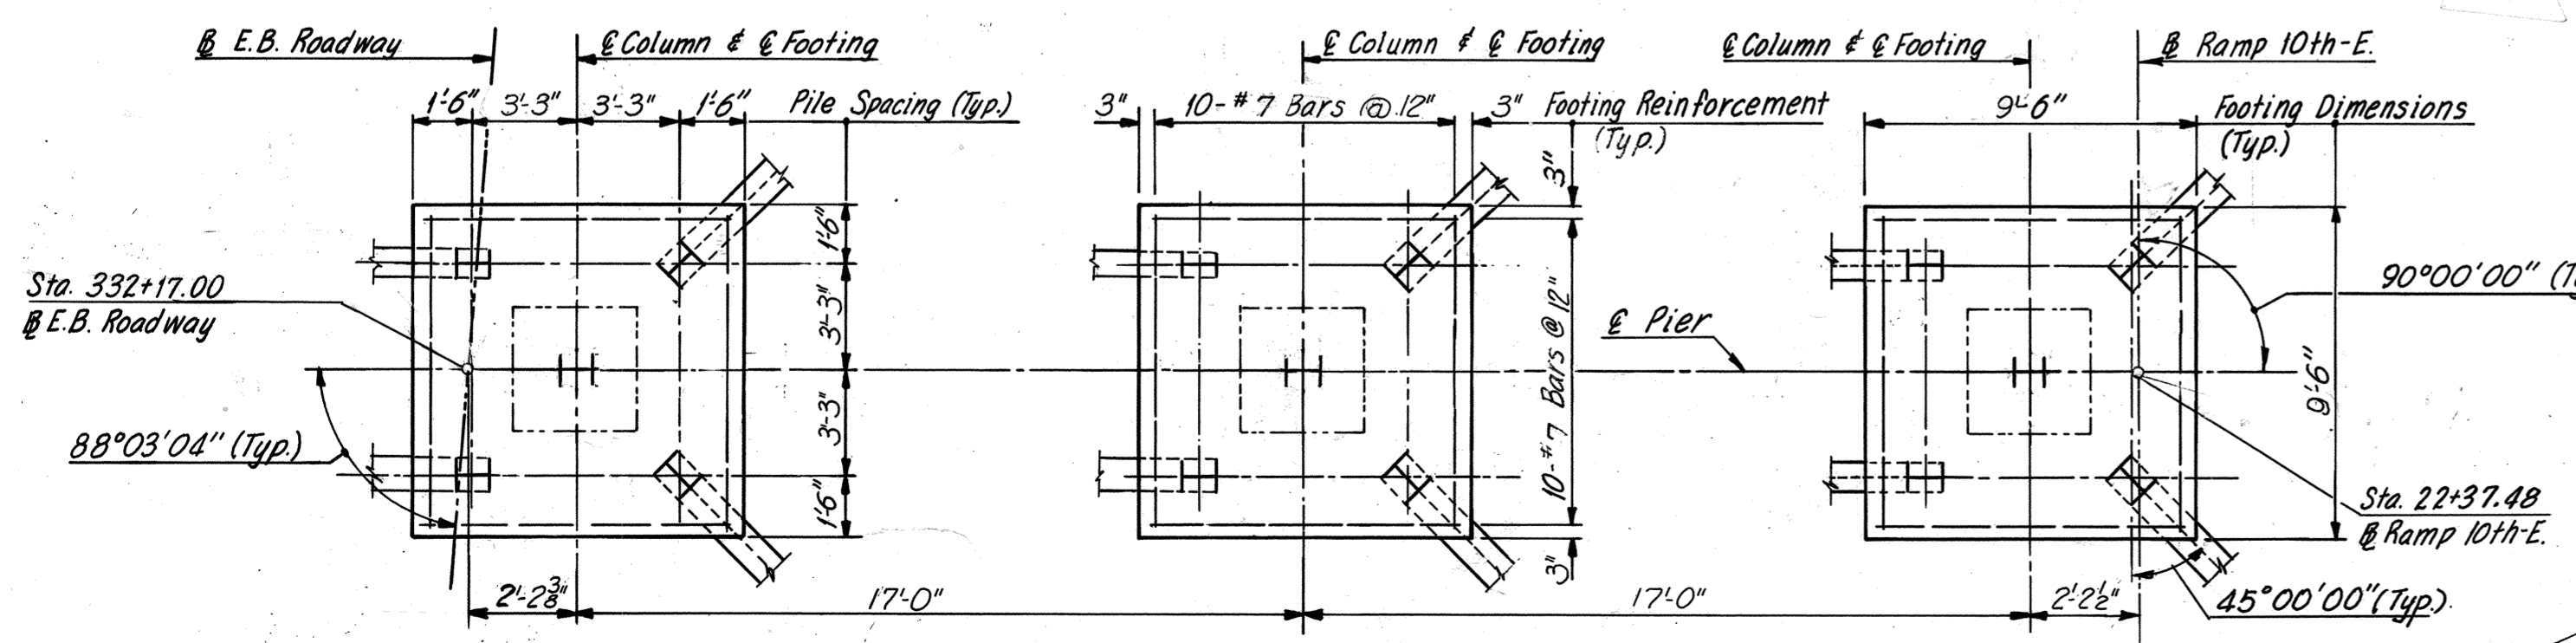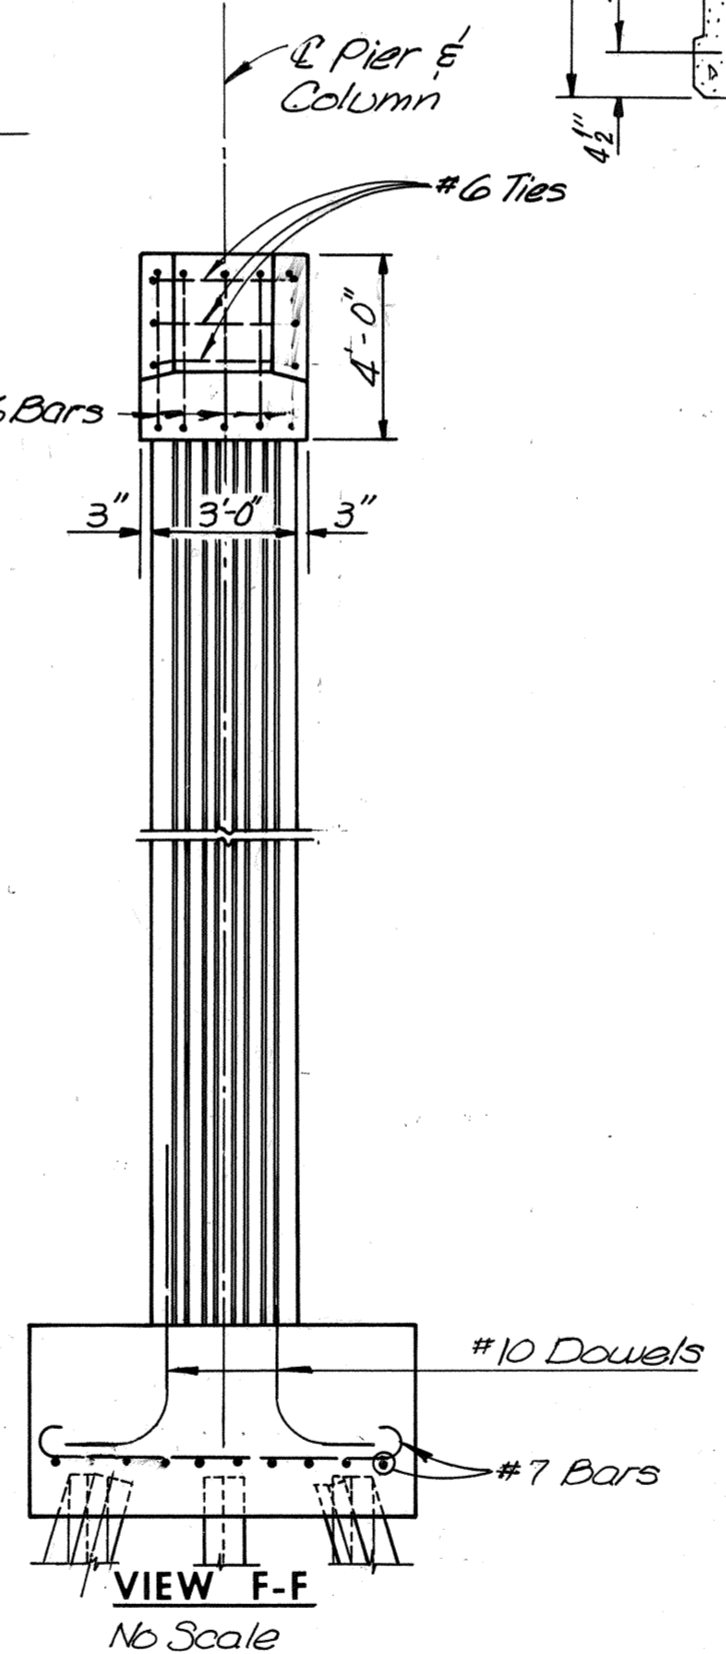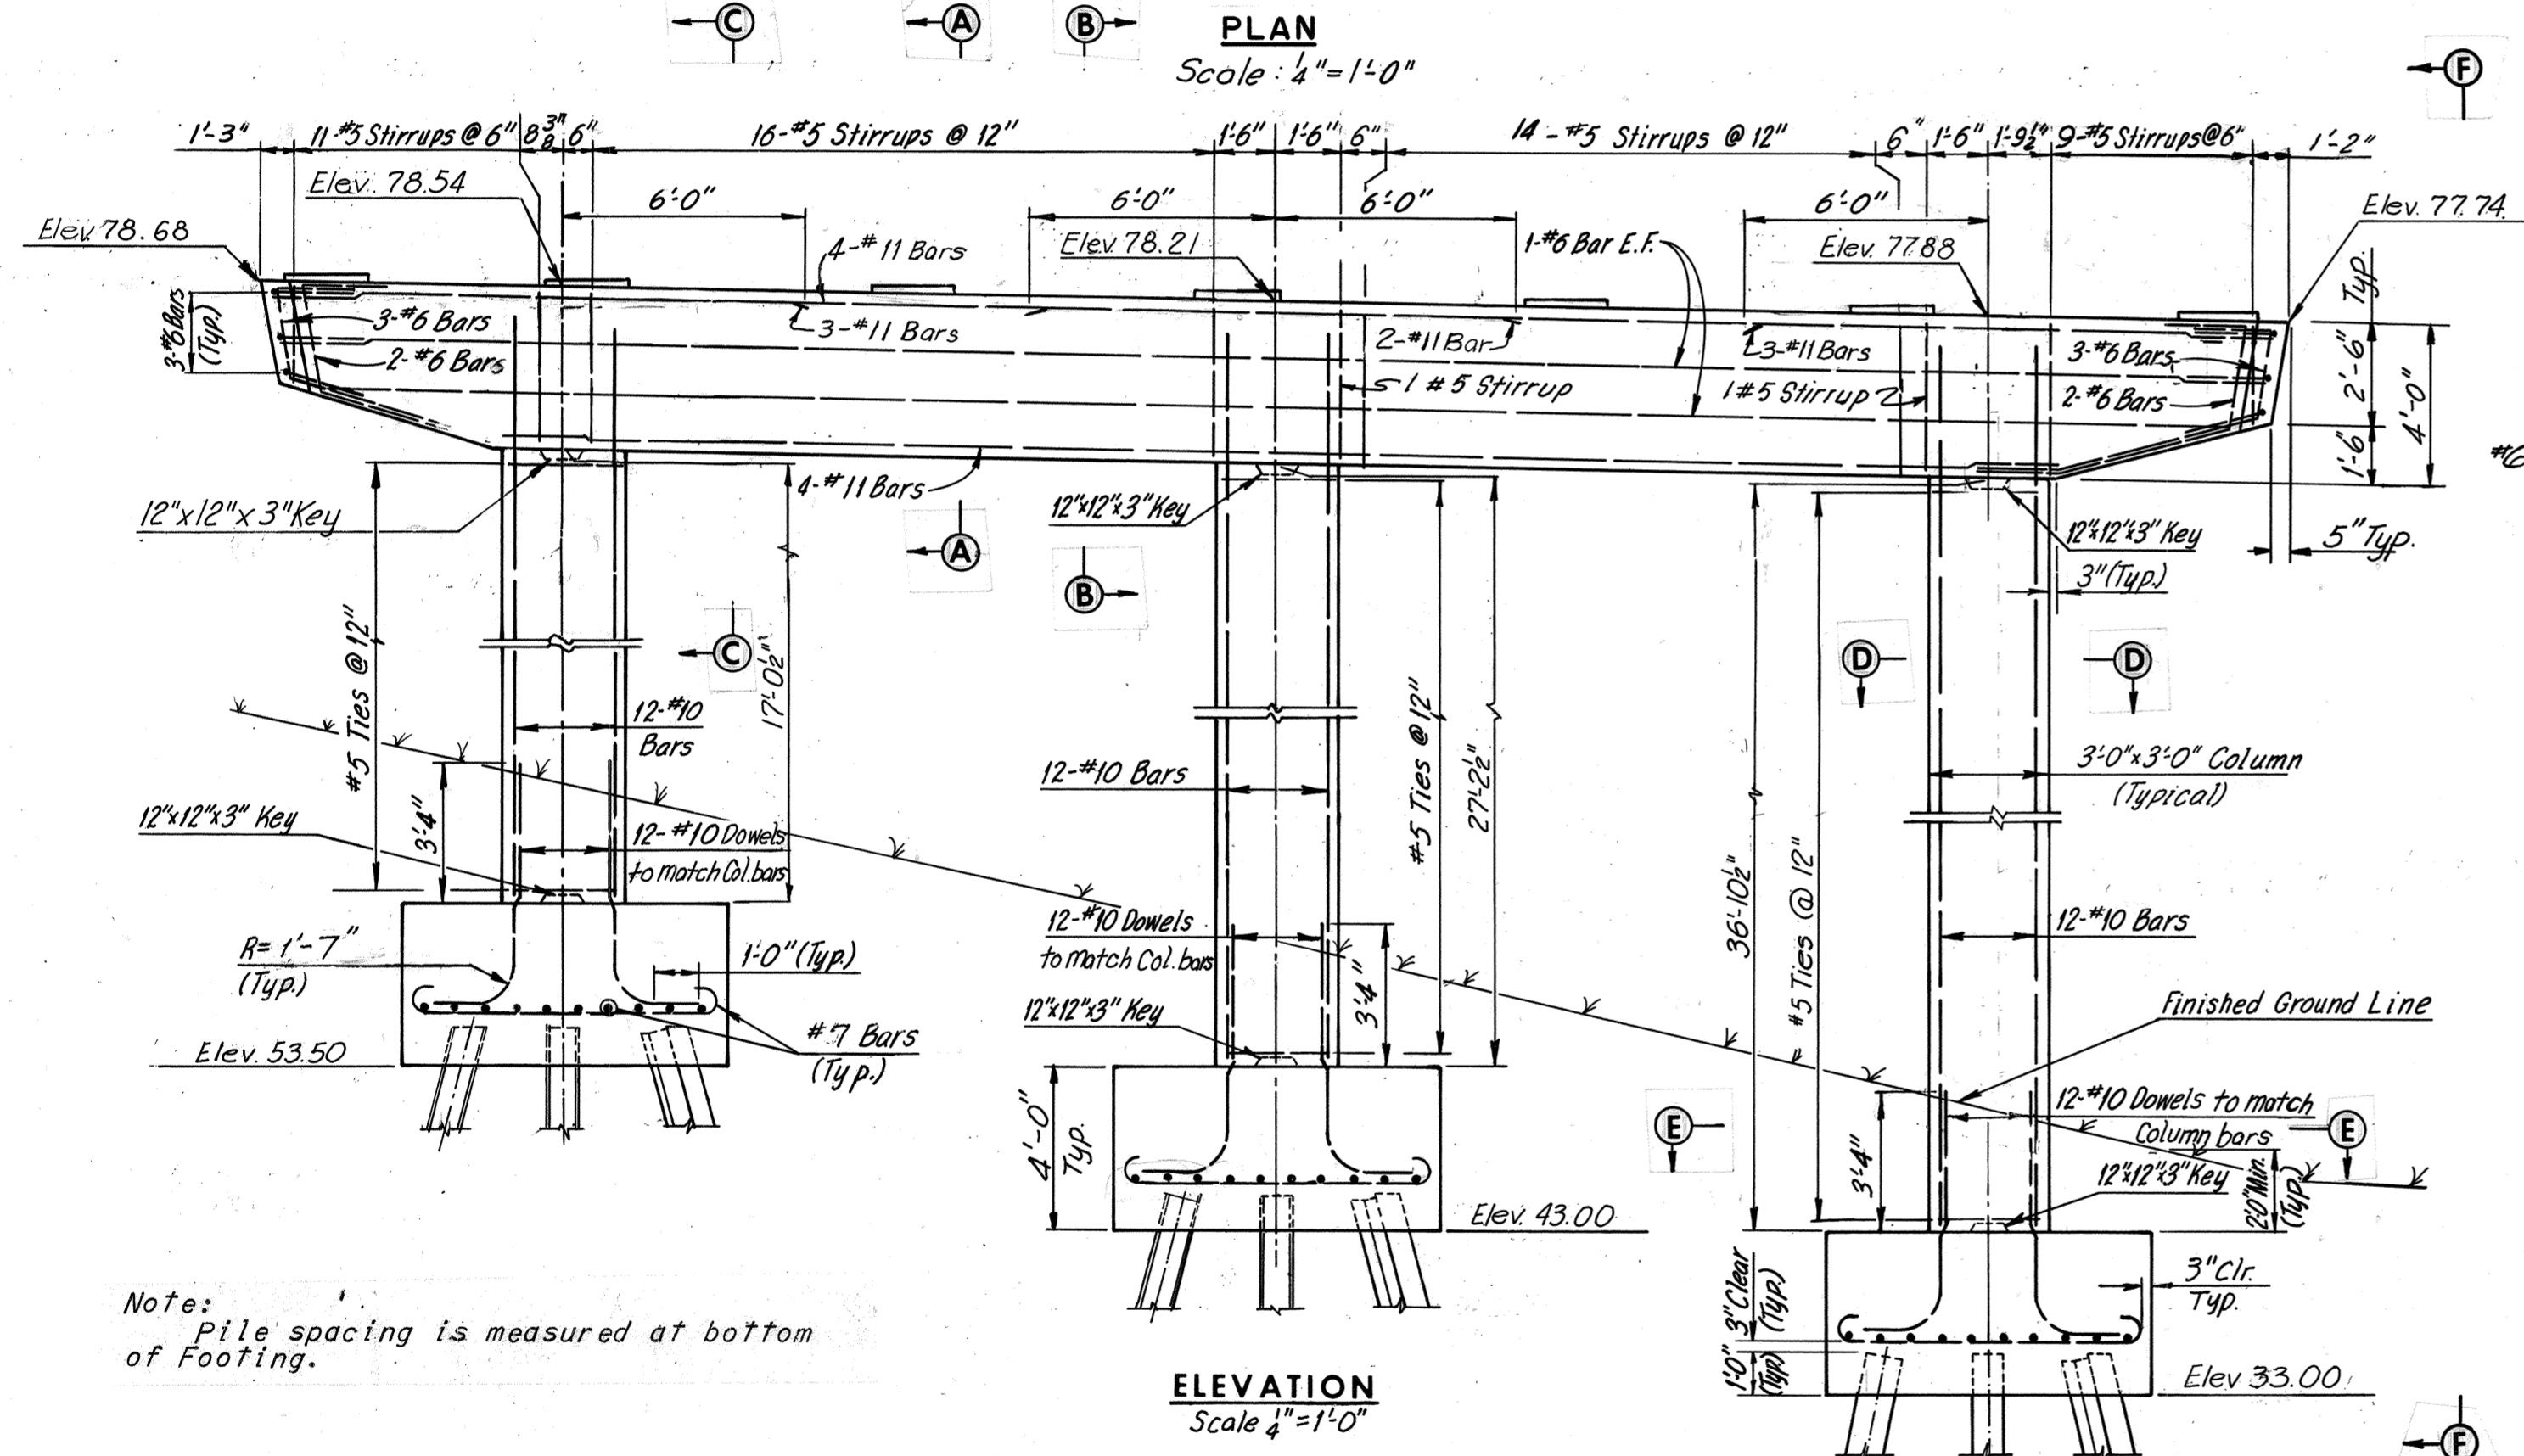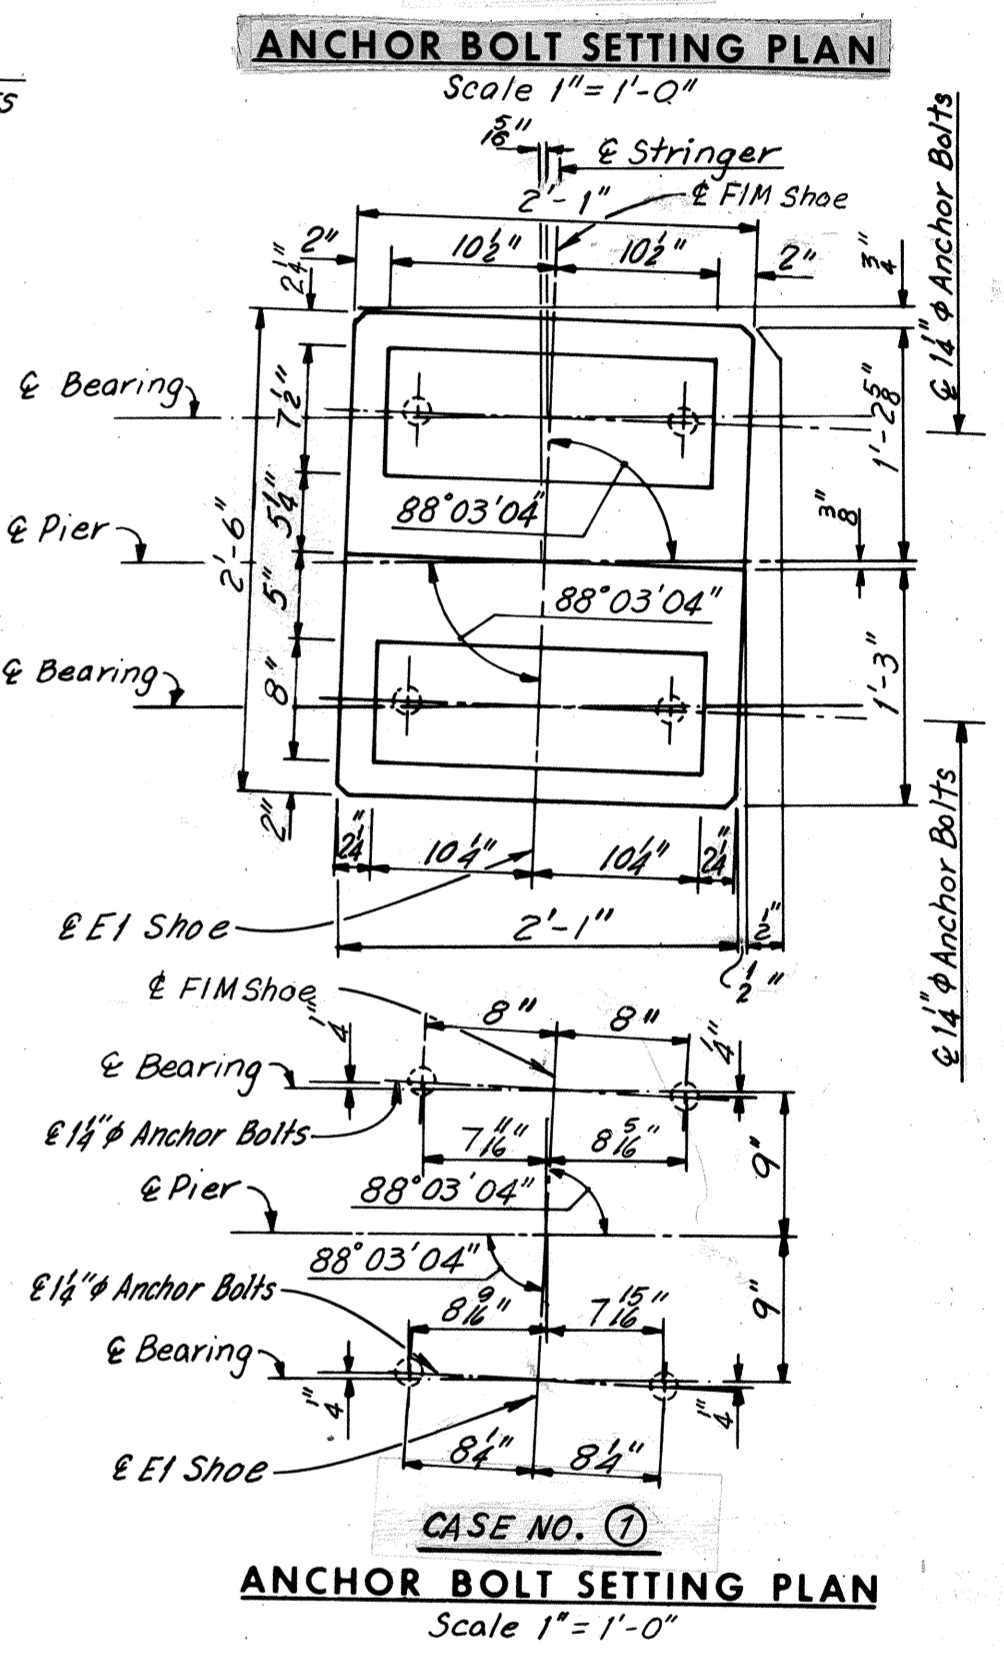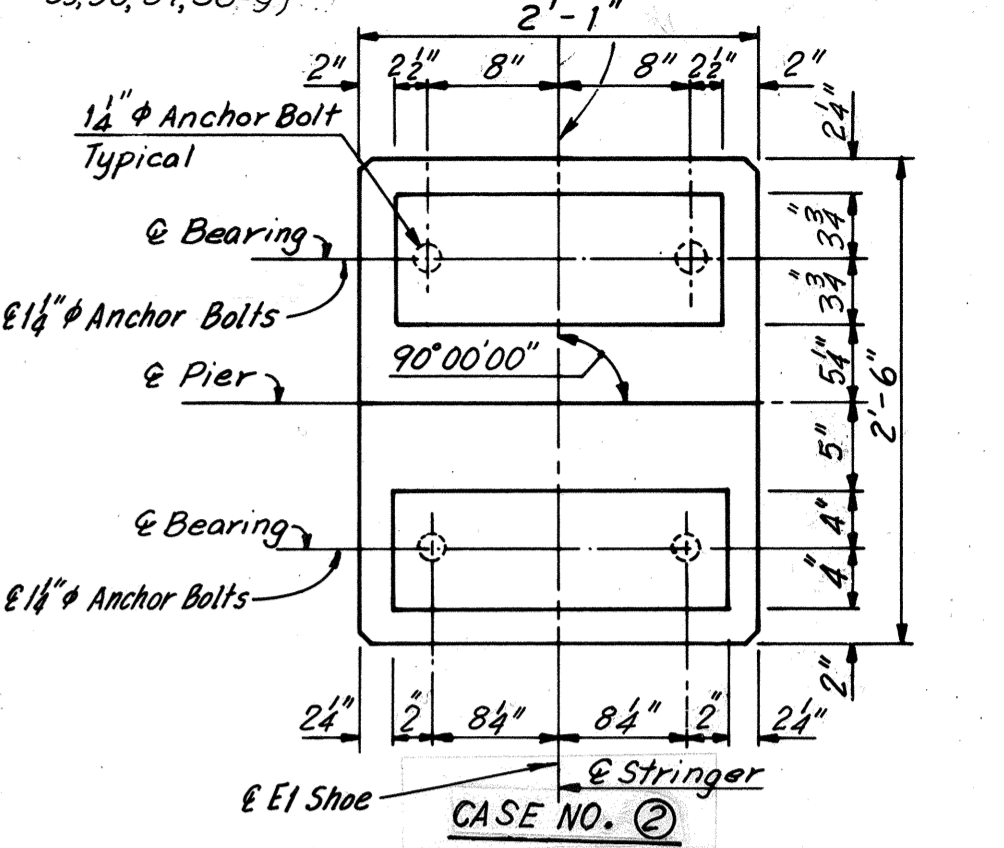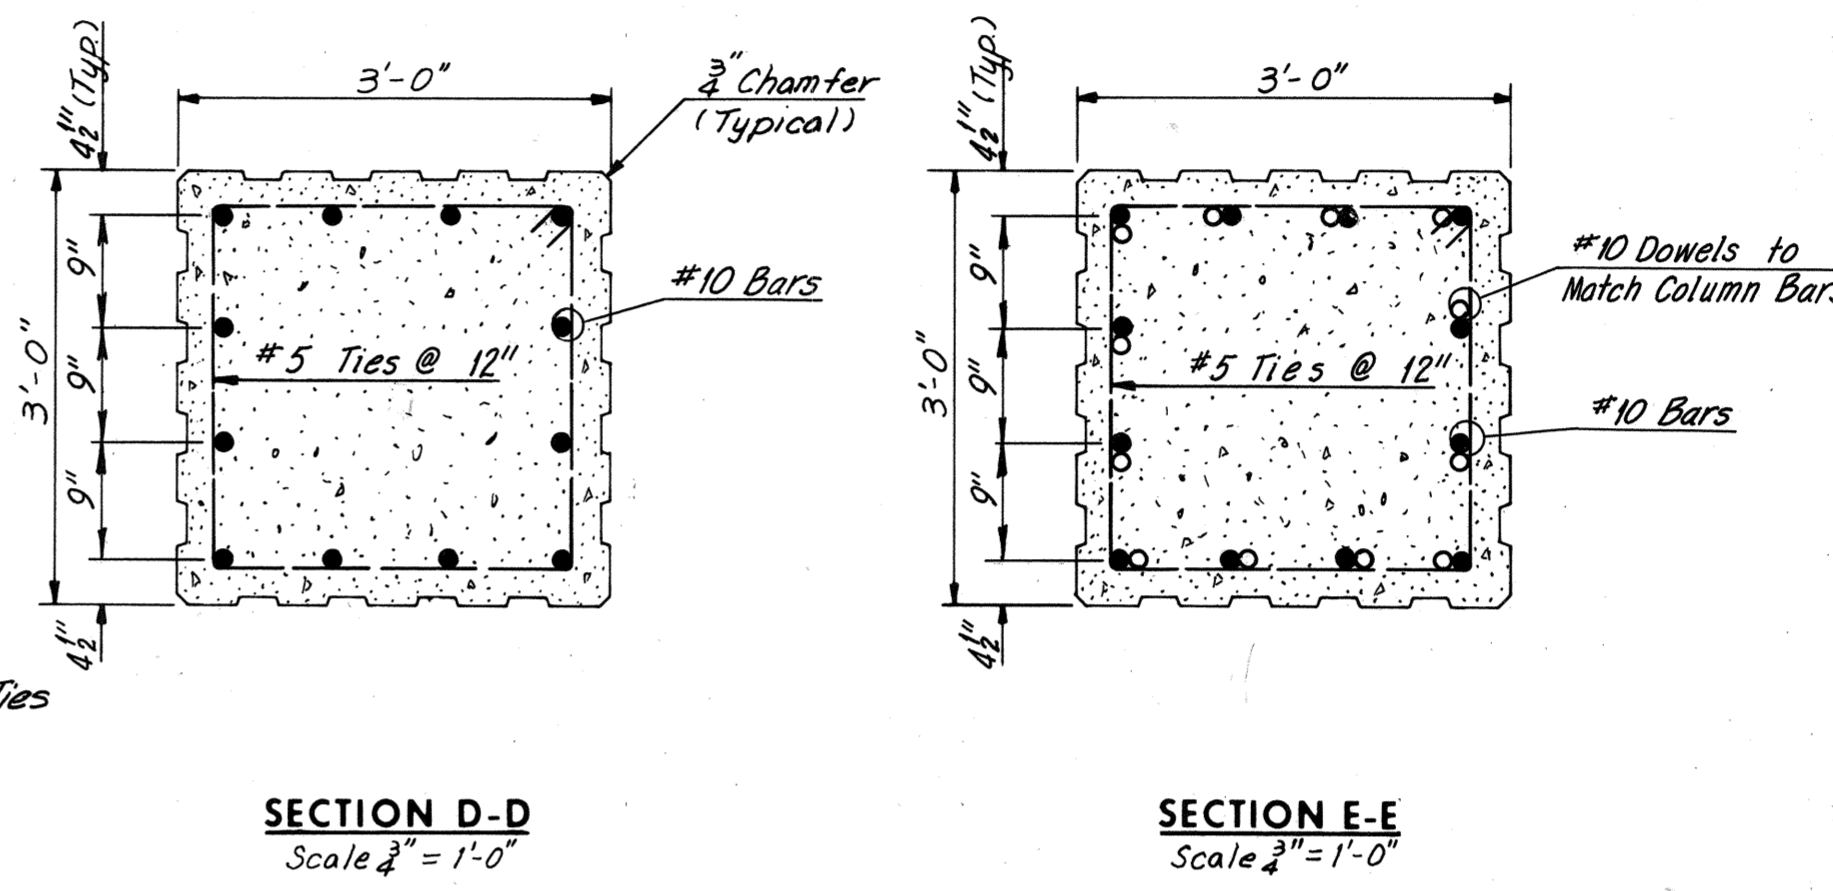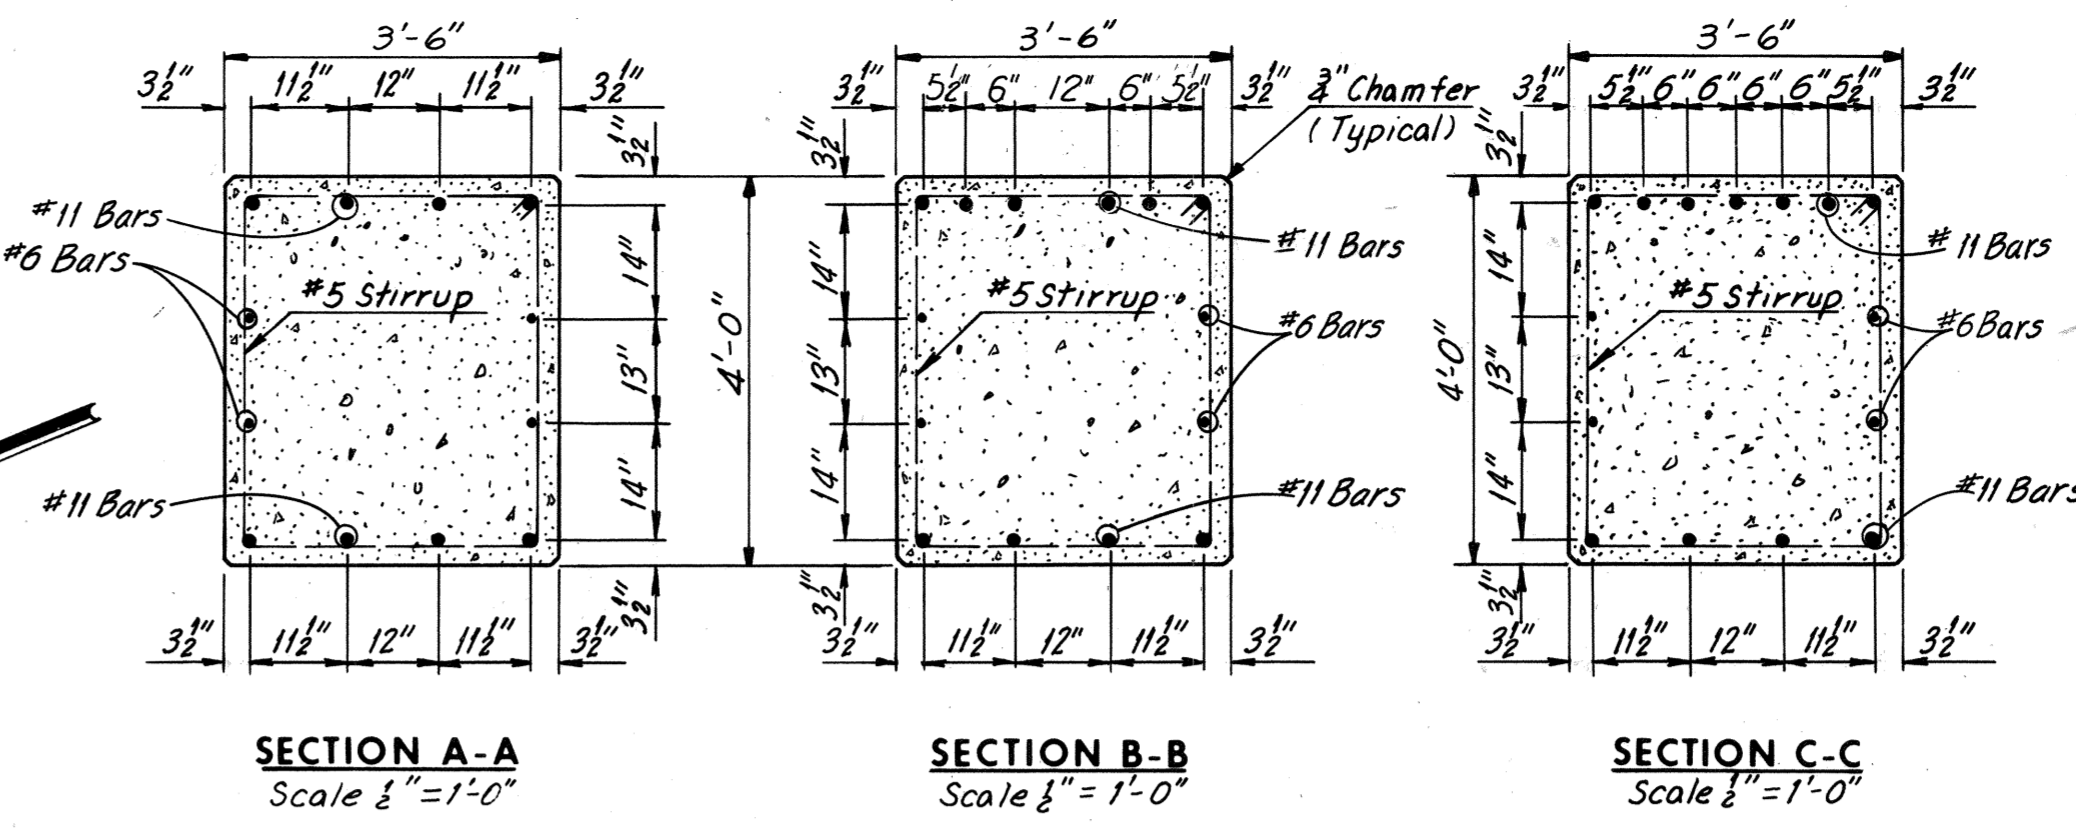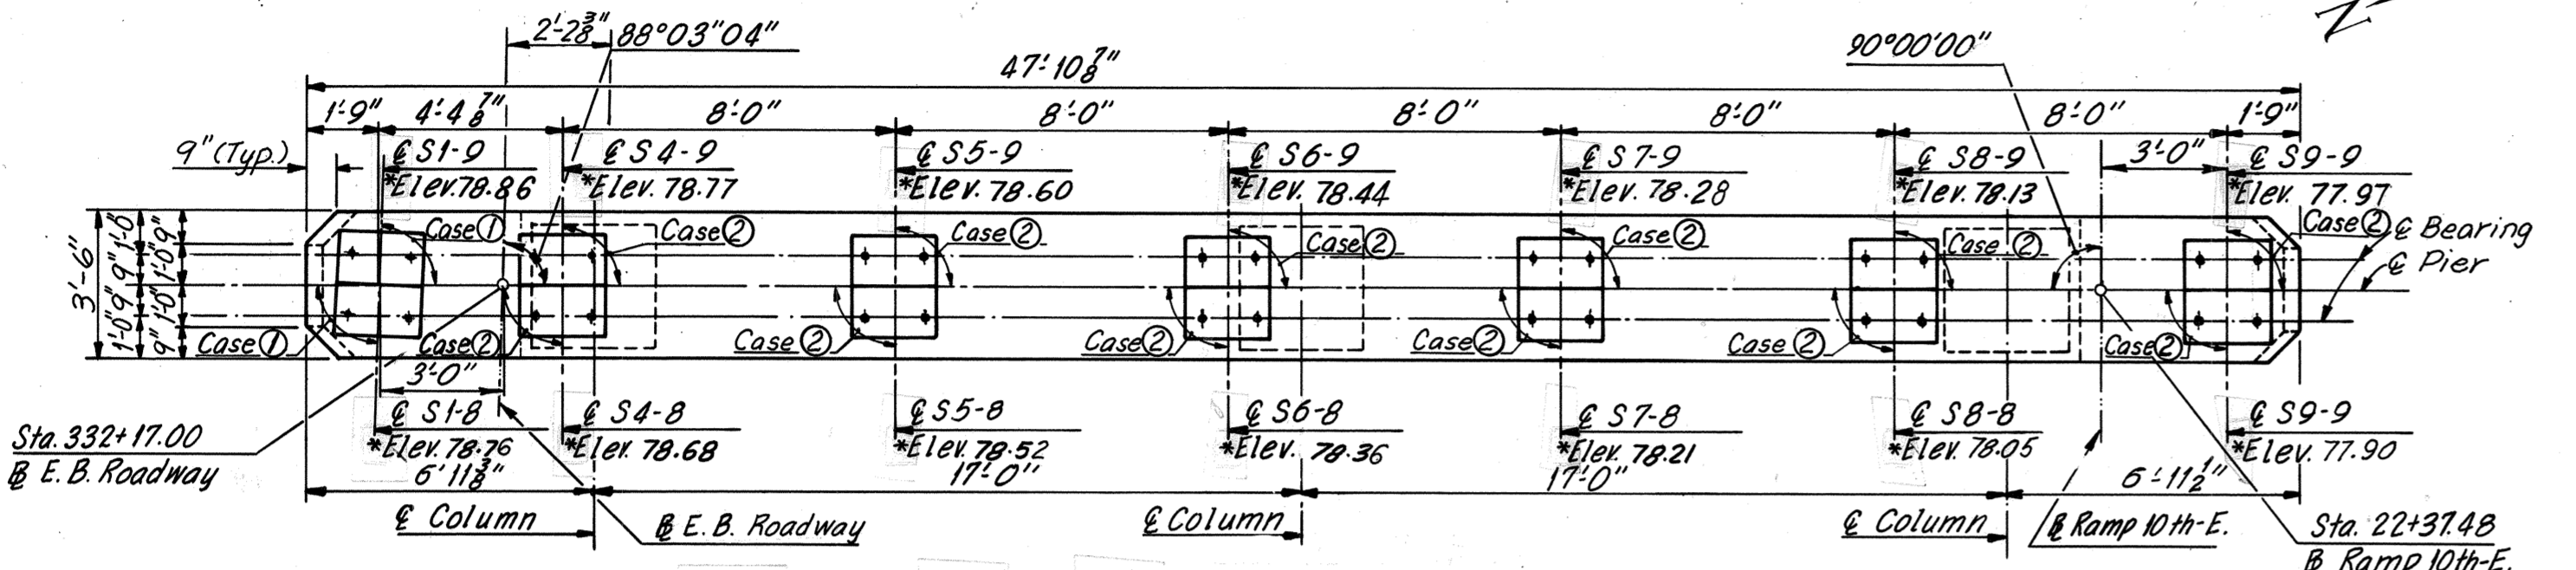

Note: For architectural treatment of columns, see Sheet 57.

Note: Footing elevations are approximate only and may be varied to suit field conditions as directed by the Engineer. Vertical shaft reinforcing shall not be cut until these elevations are established. Where elevations change more than 2 ft., redesign will be required.

Note: All piles shall be 10BP42 Steel Piles (Design capacity = 45 tons).
 Batter all piles 3" per foot where shown.
 For Standard Shoe details see Sheets Sland S2
 For Framing Plan see Sheet 15.
 For Steel Pile Details, see Sheet 11.
 E.F. = Each Face.
 *Denotes top of pad elevation.
 Estimated Pile Tip elevation, 15.00

BY	DATE	2	As Built	TEM	8-76
MADE	DES.	7-10-68	Pier 7 limited this sheet. Pile elev. shown. Rein. Pile cal. pgs. Hinge omitted.	R.B.H.	8-74
CHECKED	M.A.A.	7-31-68			
IN CHARGE					
NO.	REVISION	BY	DATE		

RICHMOND METROPOLITAN AUTHORITY
RICHMOND EXPRESSWAY SYSTEM
DOWNTOWN EXPRESSWAY

BRIDGE NO. 66
EASTBOUND ROADWAY OVER
12TH ST. - R.R. TRACKS AND 16TH ST.









PIER 8

HOWARD, NEEDLES, TAMMEN & BERGENDOFF
 consulting engineers
 NEW YORK ALEXANDRIA KANSAS CITY

SCALE: As Noted
 CONTRACT NO: 10
 SHEET NO. 10A OF 46

AS BUILT

RICHMOND EXPRESSWAY SYSTEM			
SECTION	PROJECT	SHEET NO.	TOTAL SHEETS
10	DOWNTOWN EXPRESSWAY	136	265

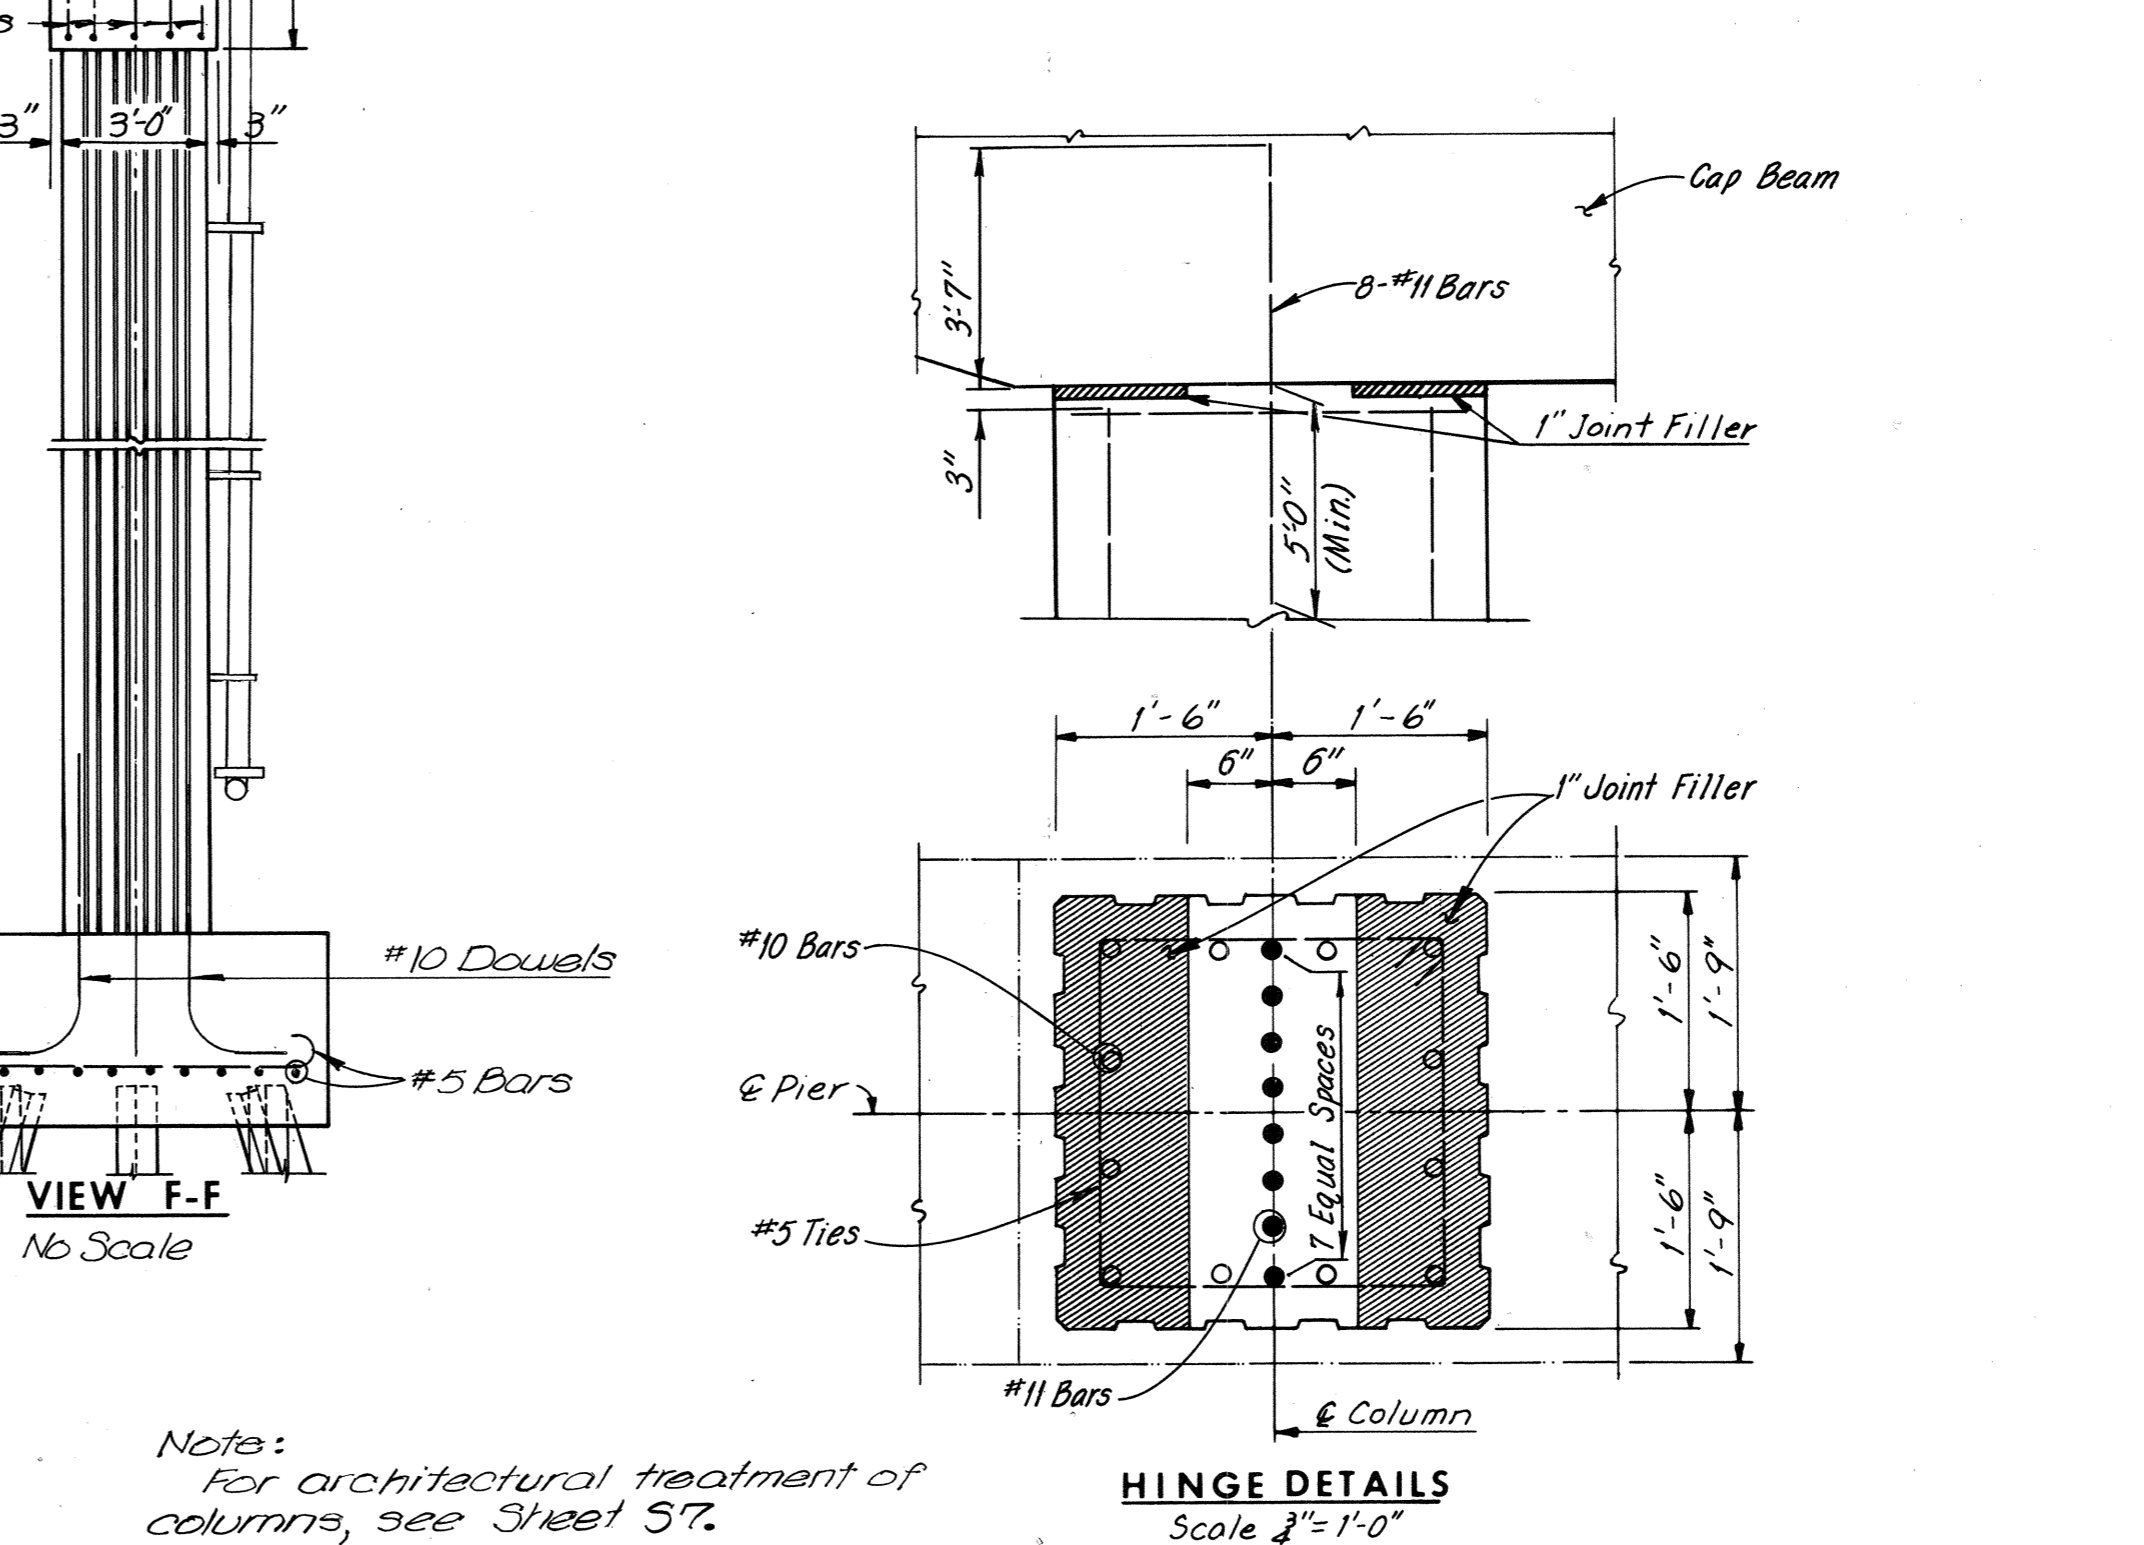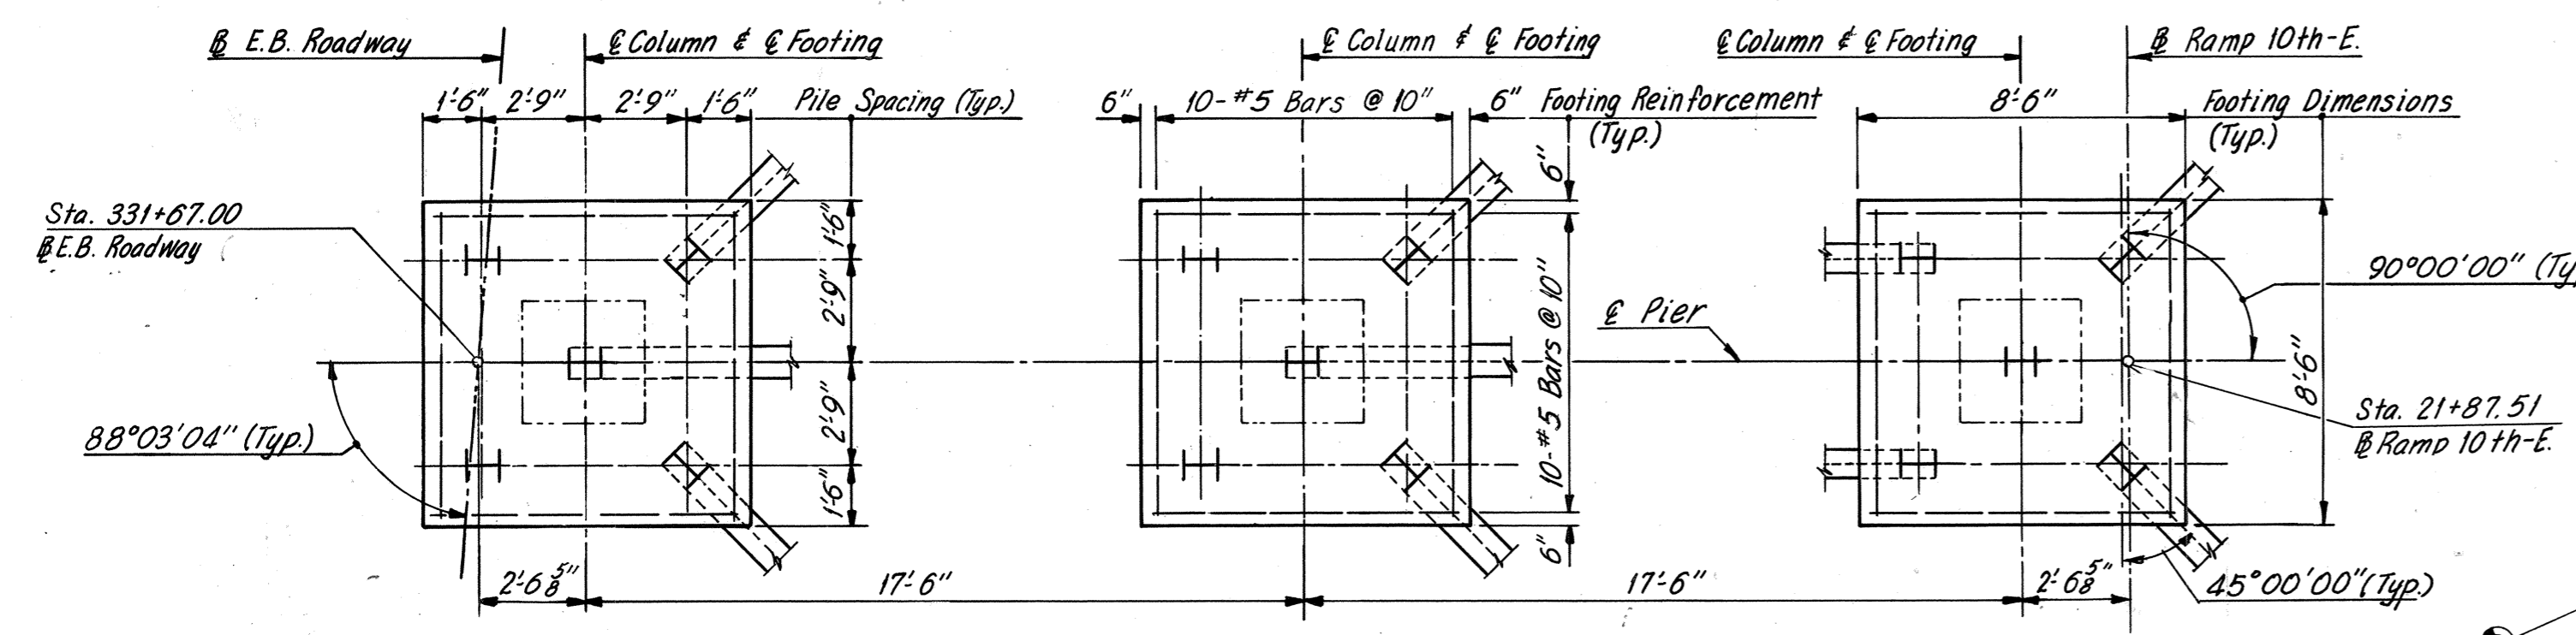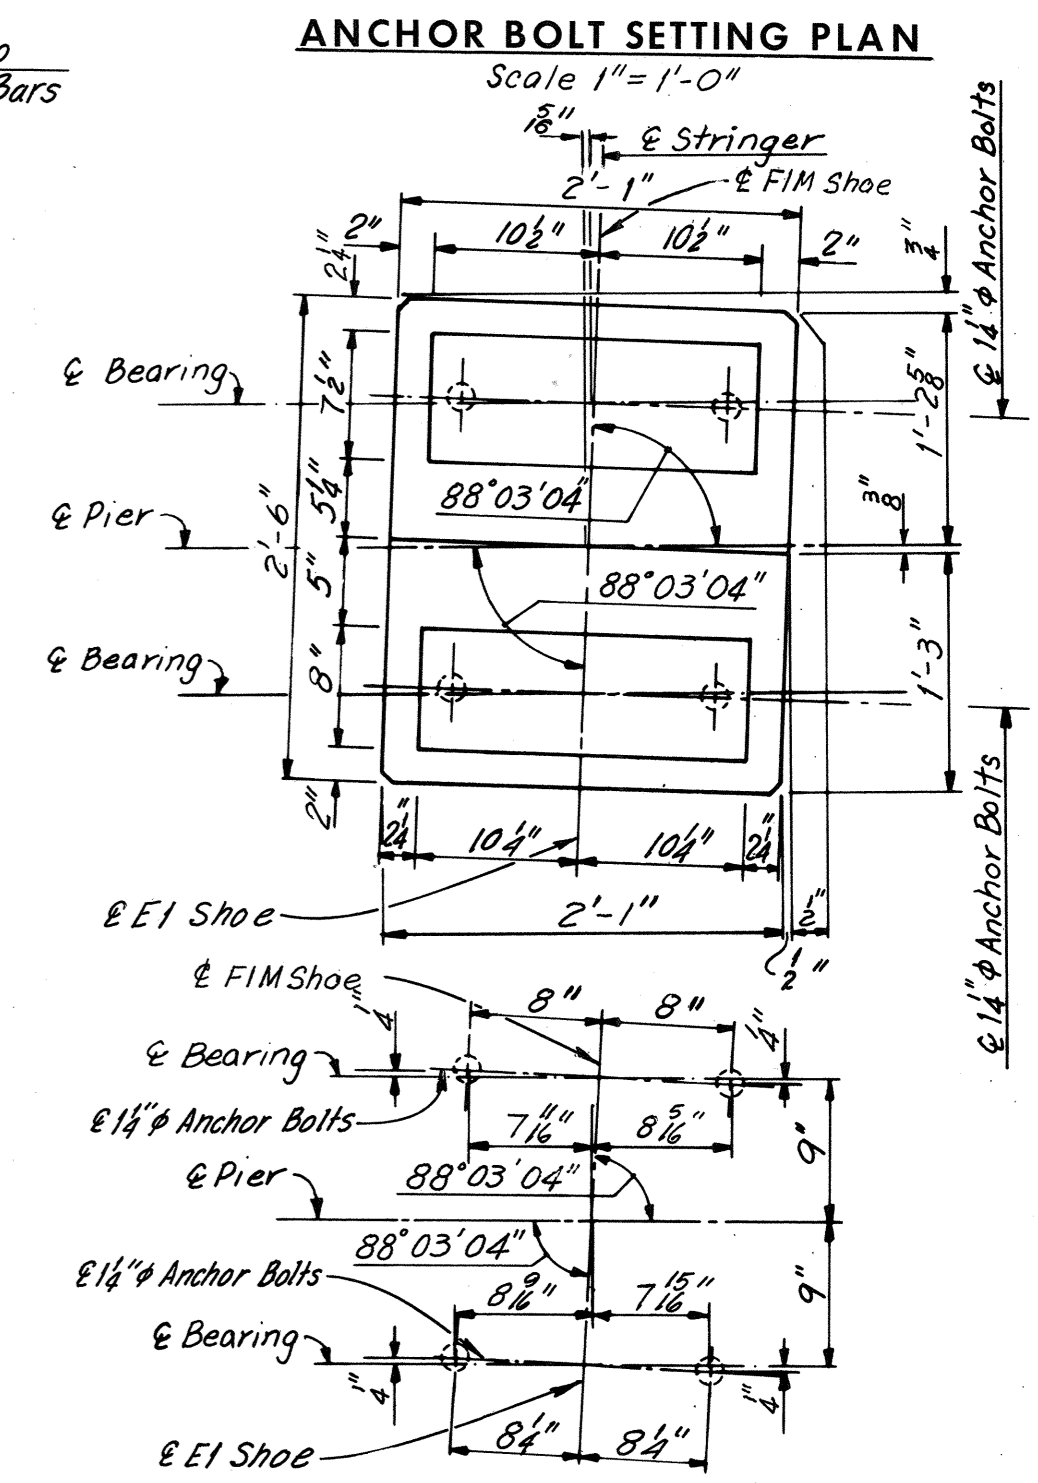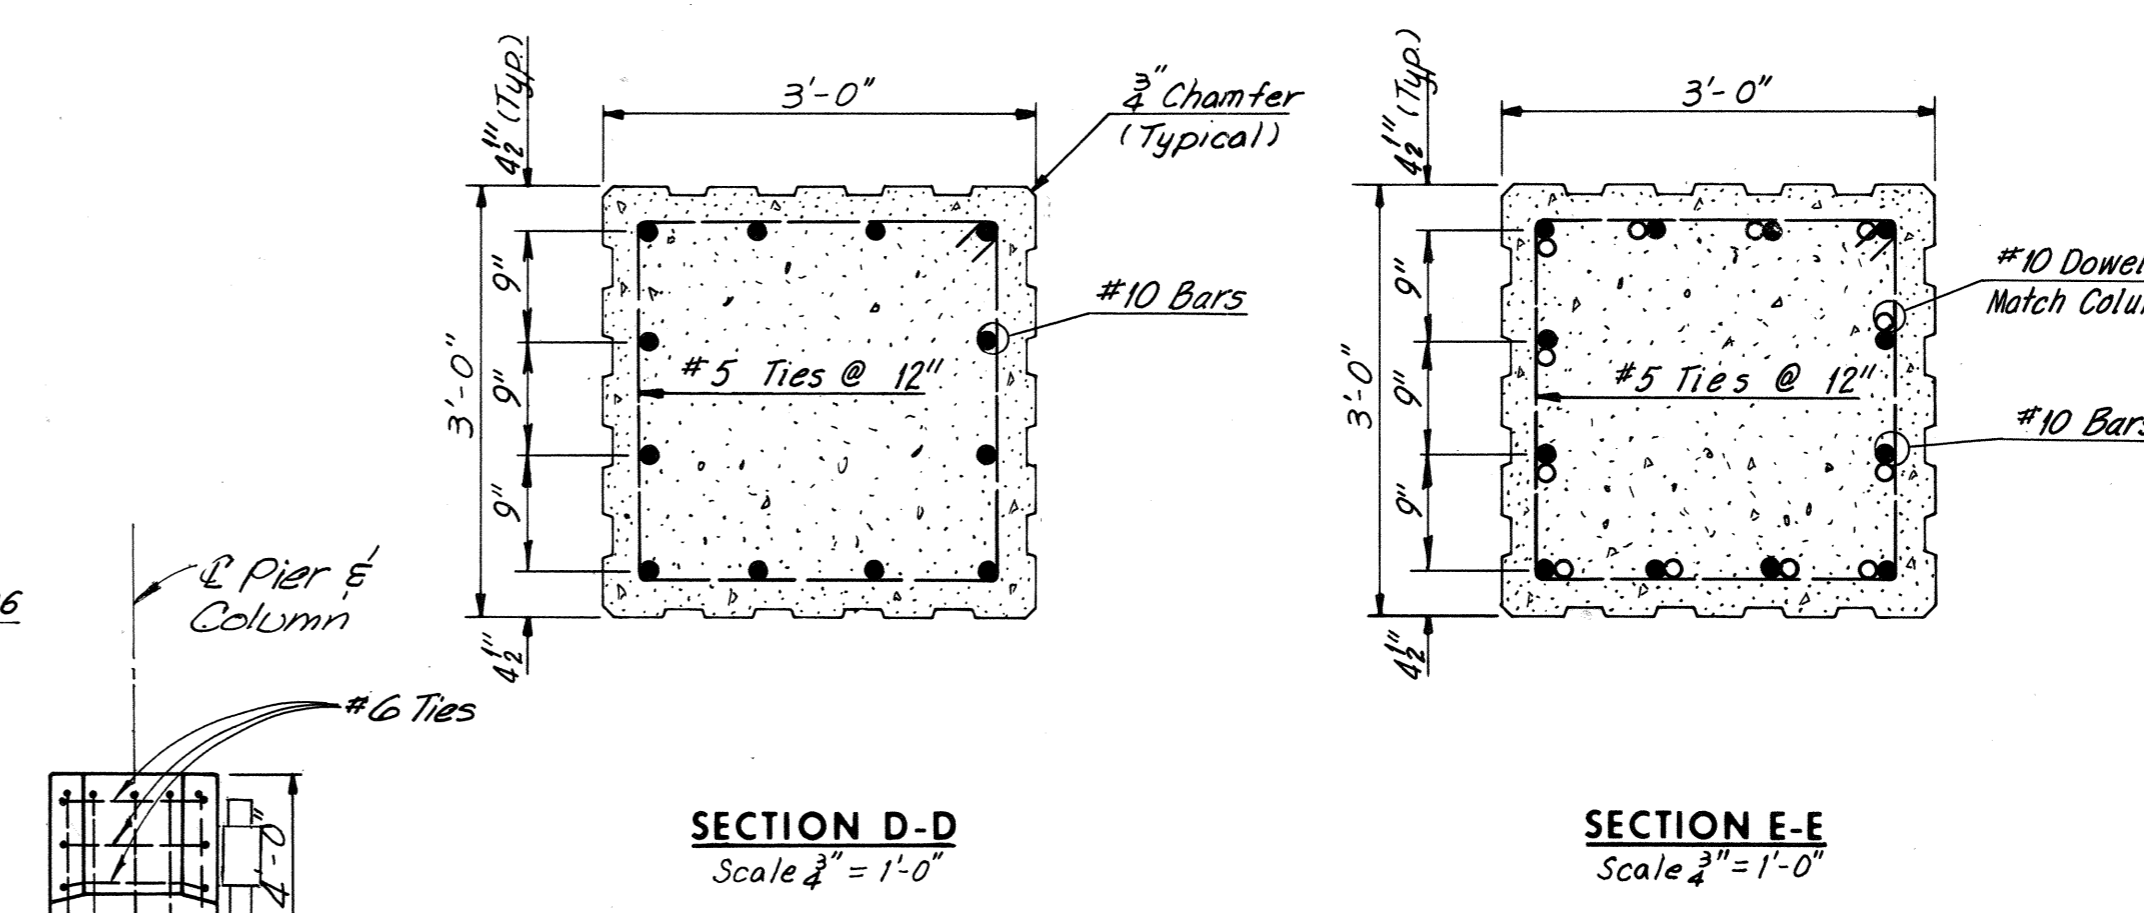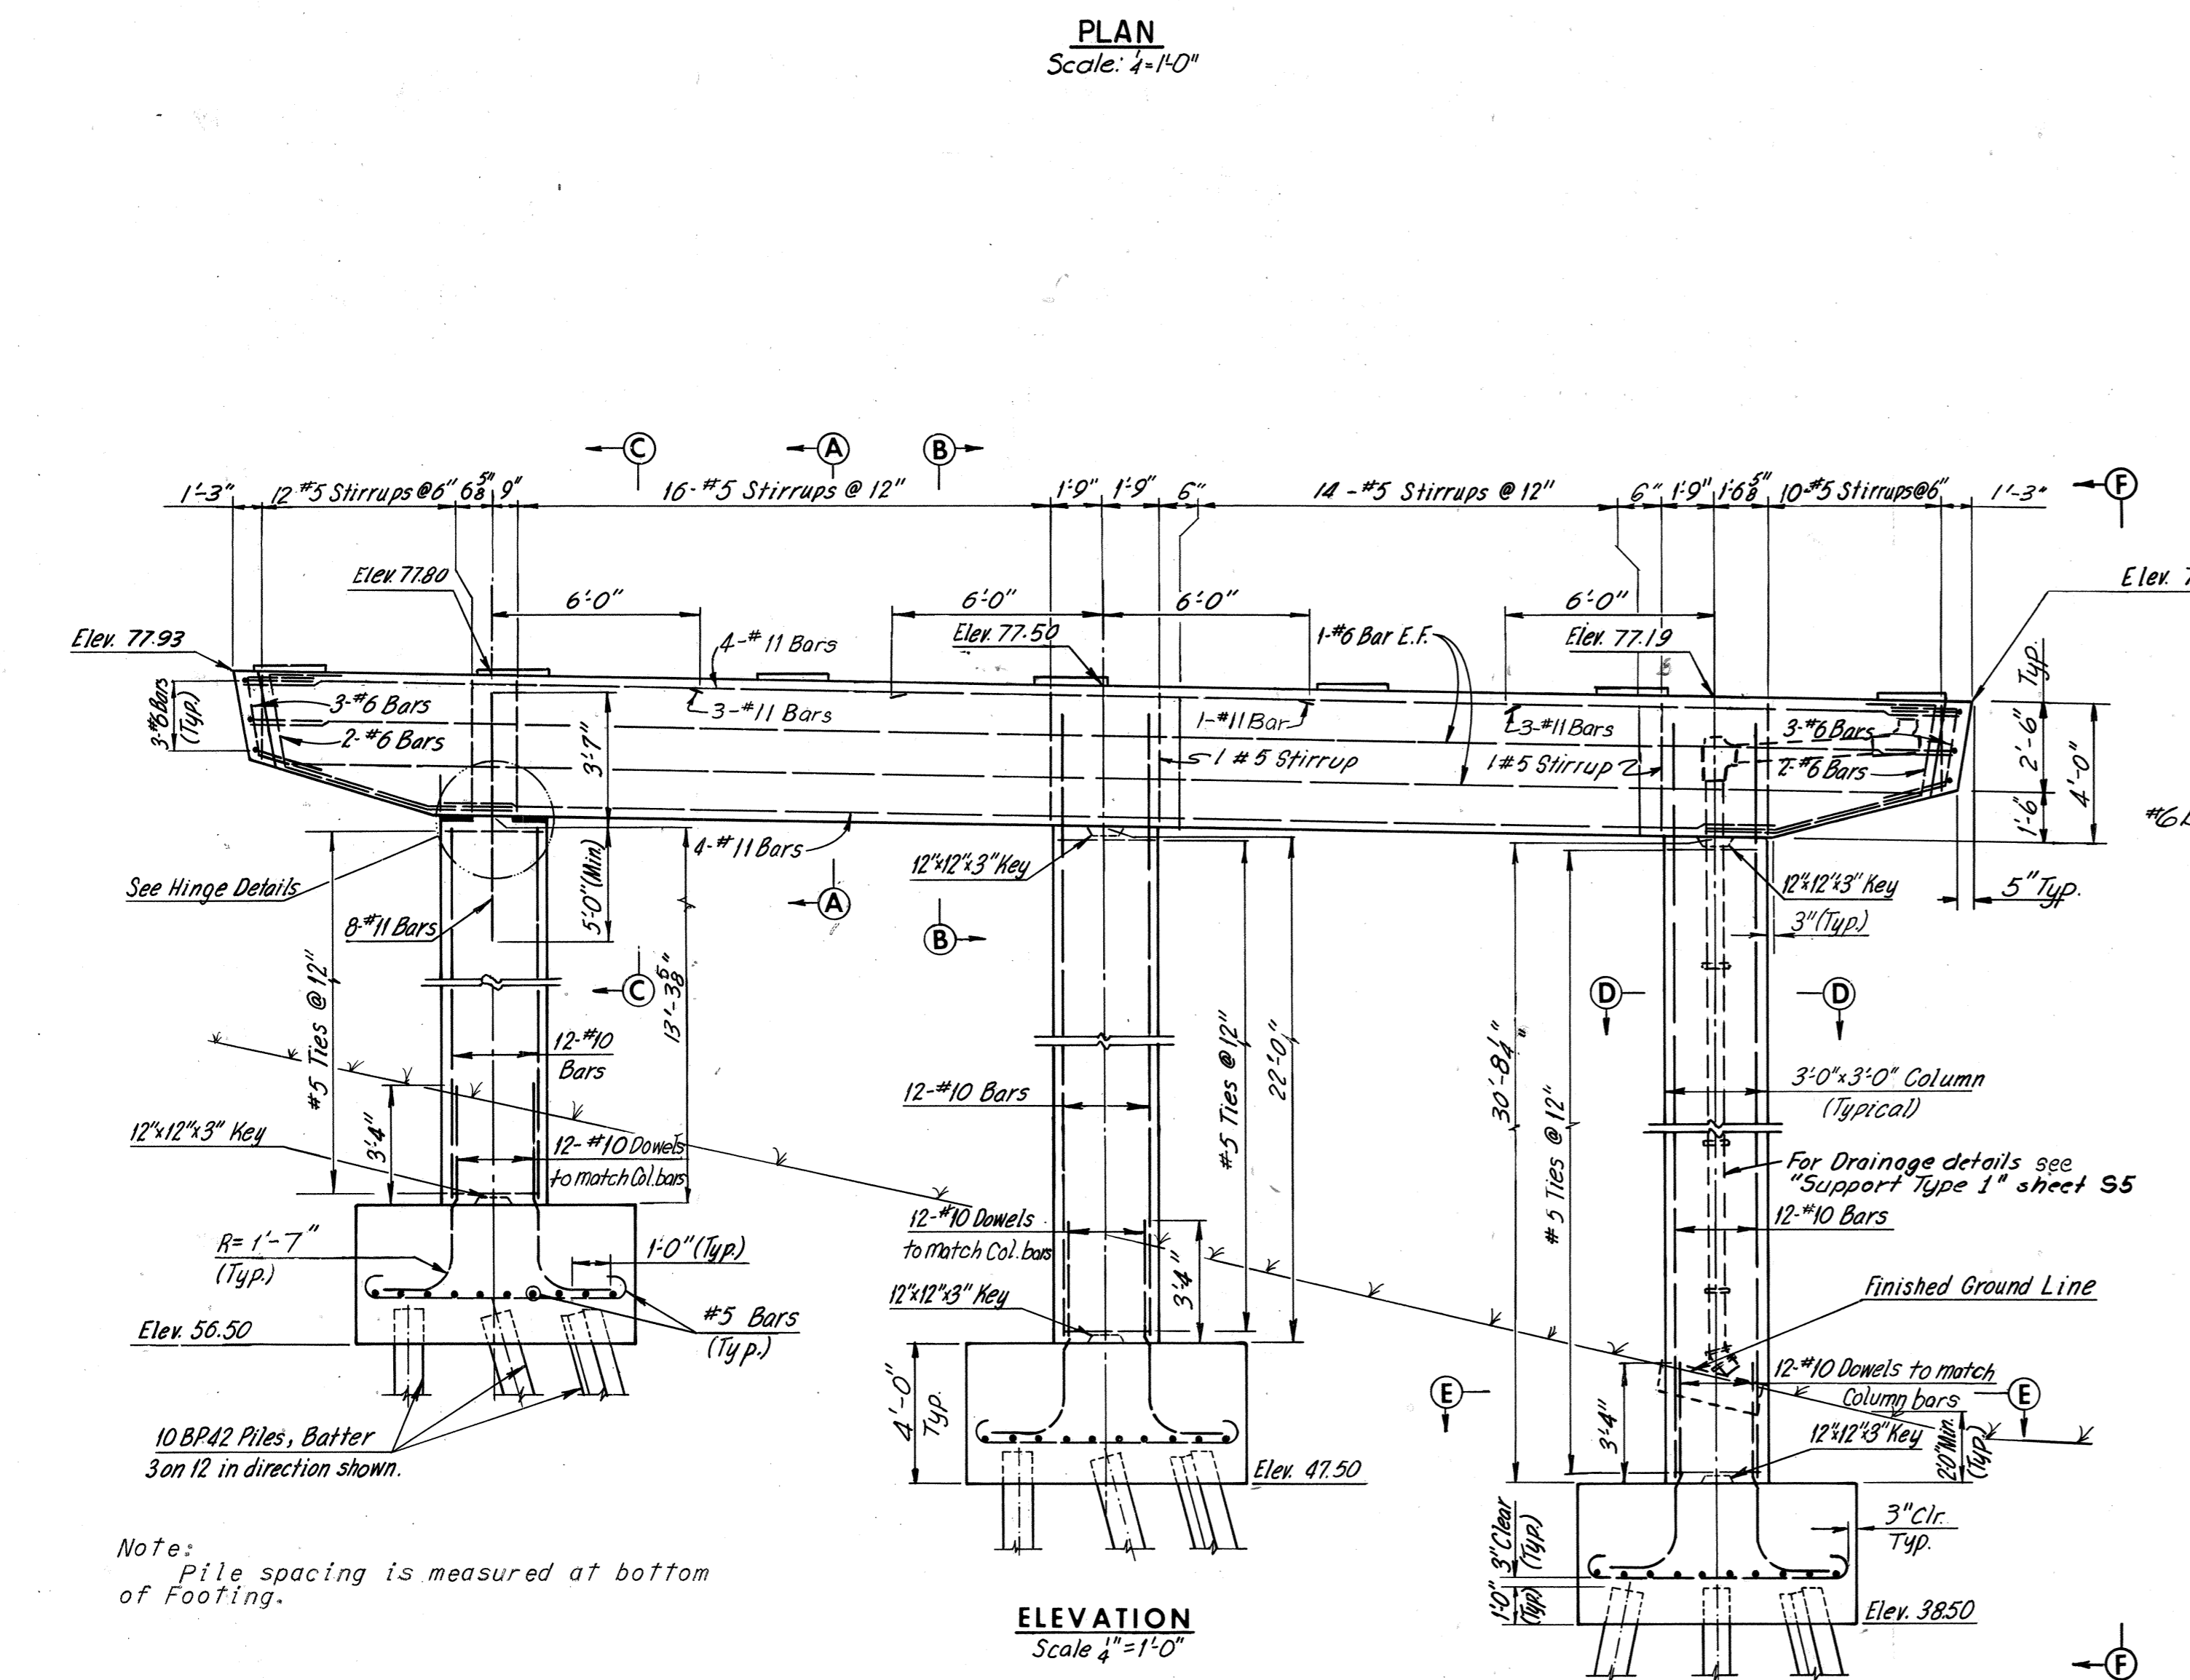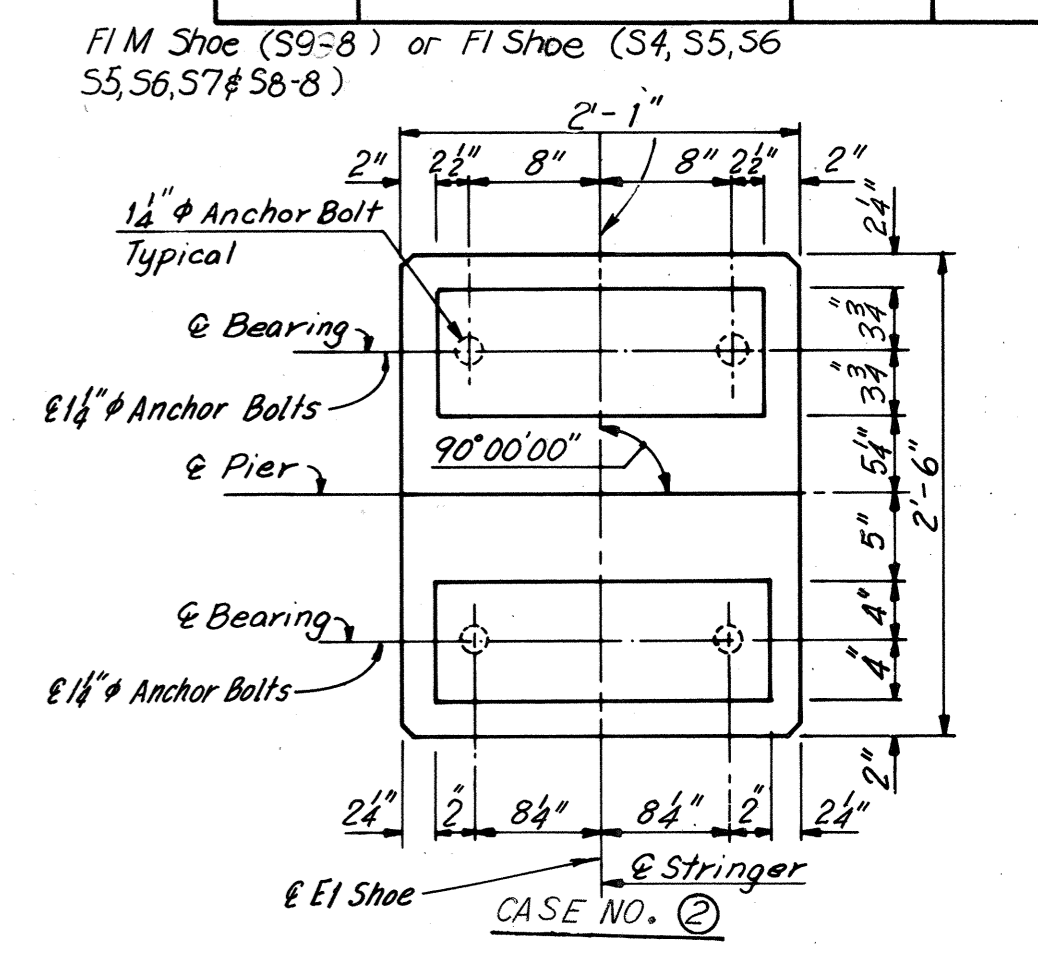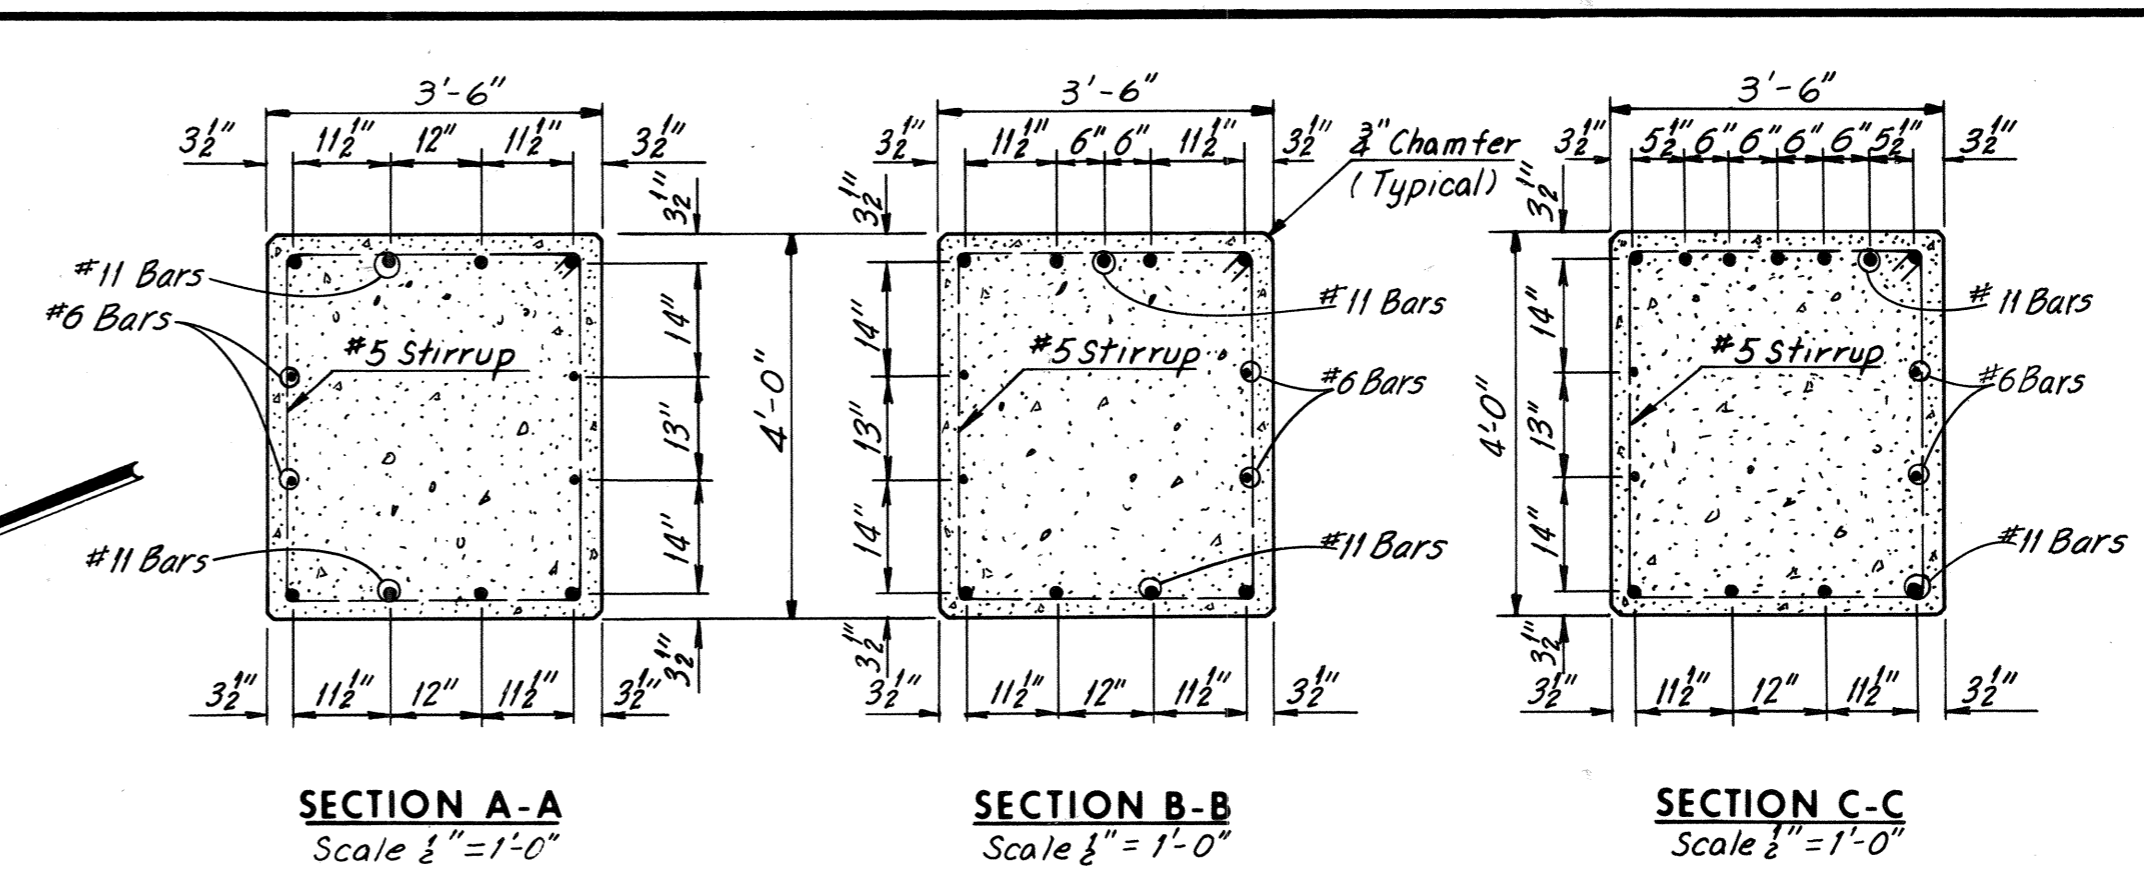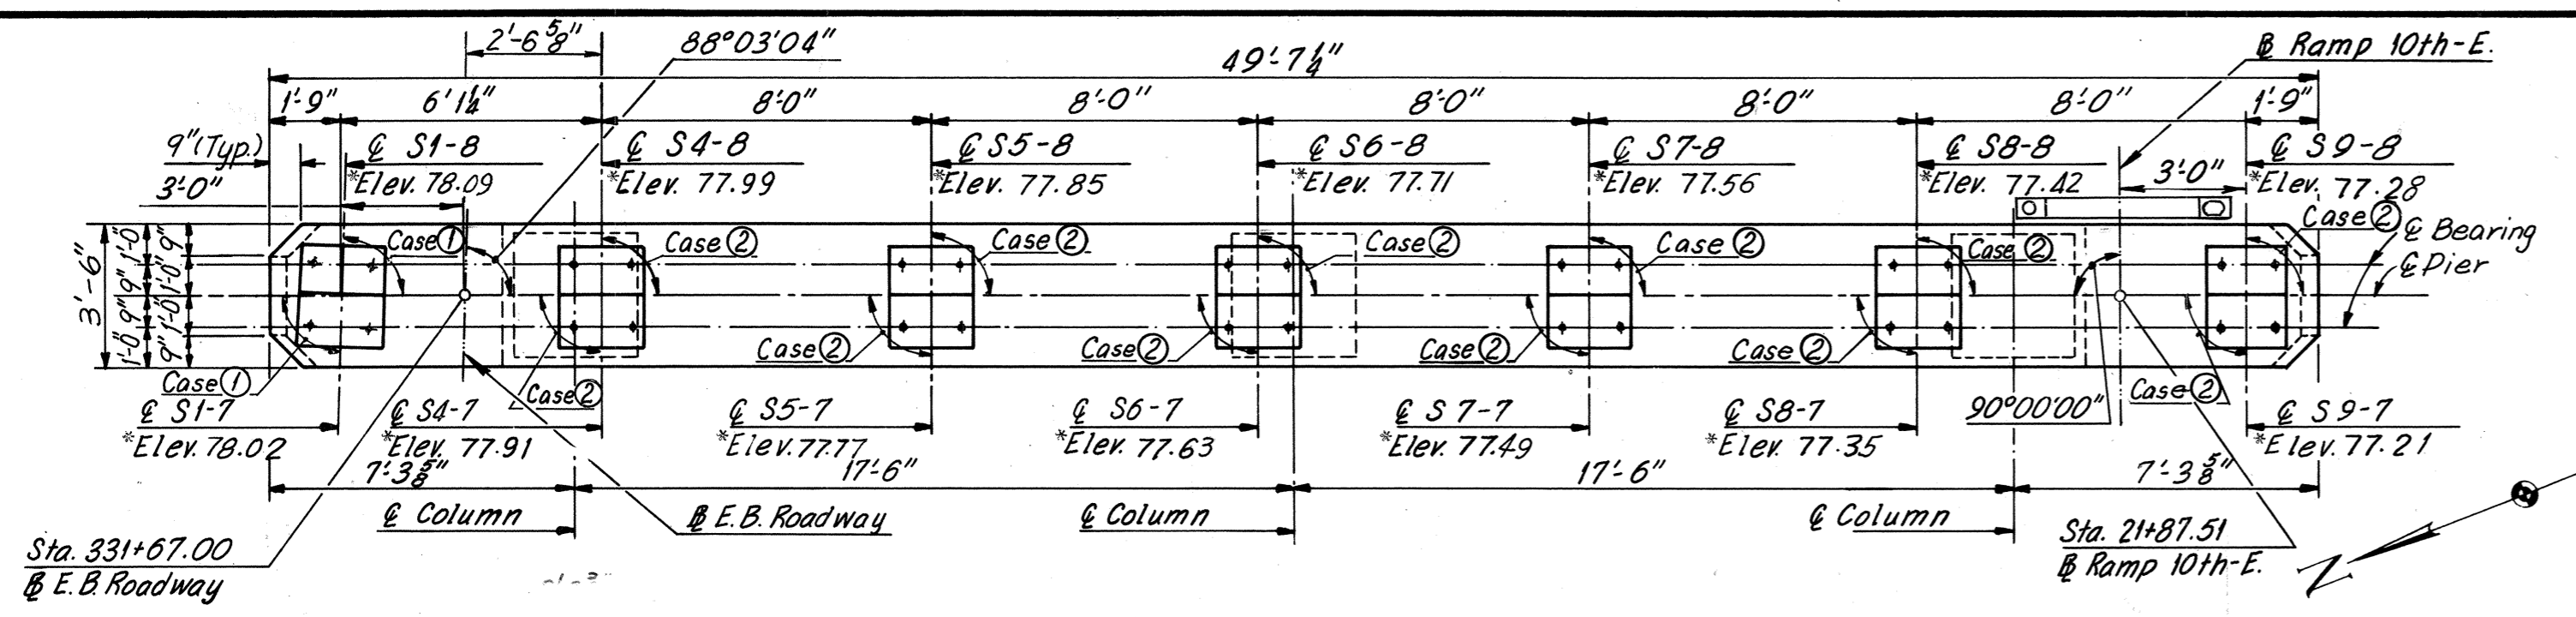

Note: For architectural treatment of columns, see Sheet 57.

Note: Footing elevations are approximate only and may be varied to suit field conditions as directed by the Engineer. Vertical shaft reinforcing shall not be cut until these elevations are established. Where elevations change more than 2 ft., redesign will be required.

Note: All piles shall be 10BP42 Steel Piles (Design capacity = 45 tons).
 Batter all piles 3" per foot where shown.
 For Standard Shoe details see Sheets Sland S2
 For Framing Plan see Sheet 15.
 For Steel Pile Details, see Sheet 11.
 E.F. = Each Face.
 *Denotes top of pad elevation.
 Estimated Pile Tip elevation, 18.00

RICHMOND METROPOLITAN AUTHORITY
RICHMOND EXPRESSWAY SYSTEM
DOWNTOWN EXPRESSWAY

BRIDGE NO. 66
EASTBOUND ROADWAY OVER
12TH ST. - R.R. TRACKS AND 16TH ST.
PIER 7





HOWARD, NEEDLES, TAMMEN & BERGENDOFF
 consulting engineers
 NEW YORK ALEXANDRIA KANSAS CITY

SCALE: As Noted
 CONTRACT NO.: 10
 SHEET NO. 10 of 46








BY	DATE	REVISION	BY	DATE
DES.	7-10-68	1	As Built	TEM 8-76
CHECKED	M.A.R. 7-31-68	Δ	Pier & Limited this sheet	R.B.H. 8-74
IN CHARGE				

AS BUILT

RICHMOND EXPRESSWAY SYSTEM			
SECTION	PROJECT	SHEET NO.	TOTAL SHEETS
10	DOWNTOWN EXPRESSWAY	137	265

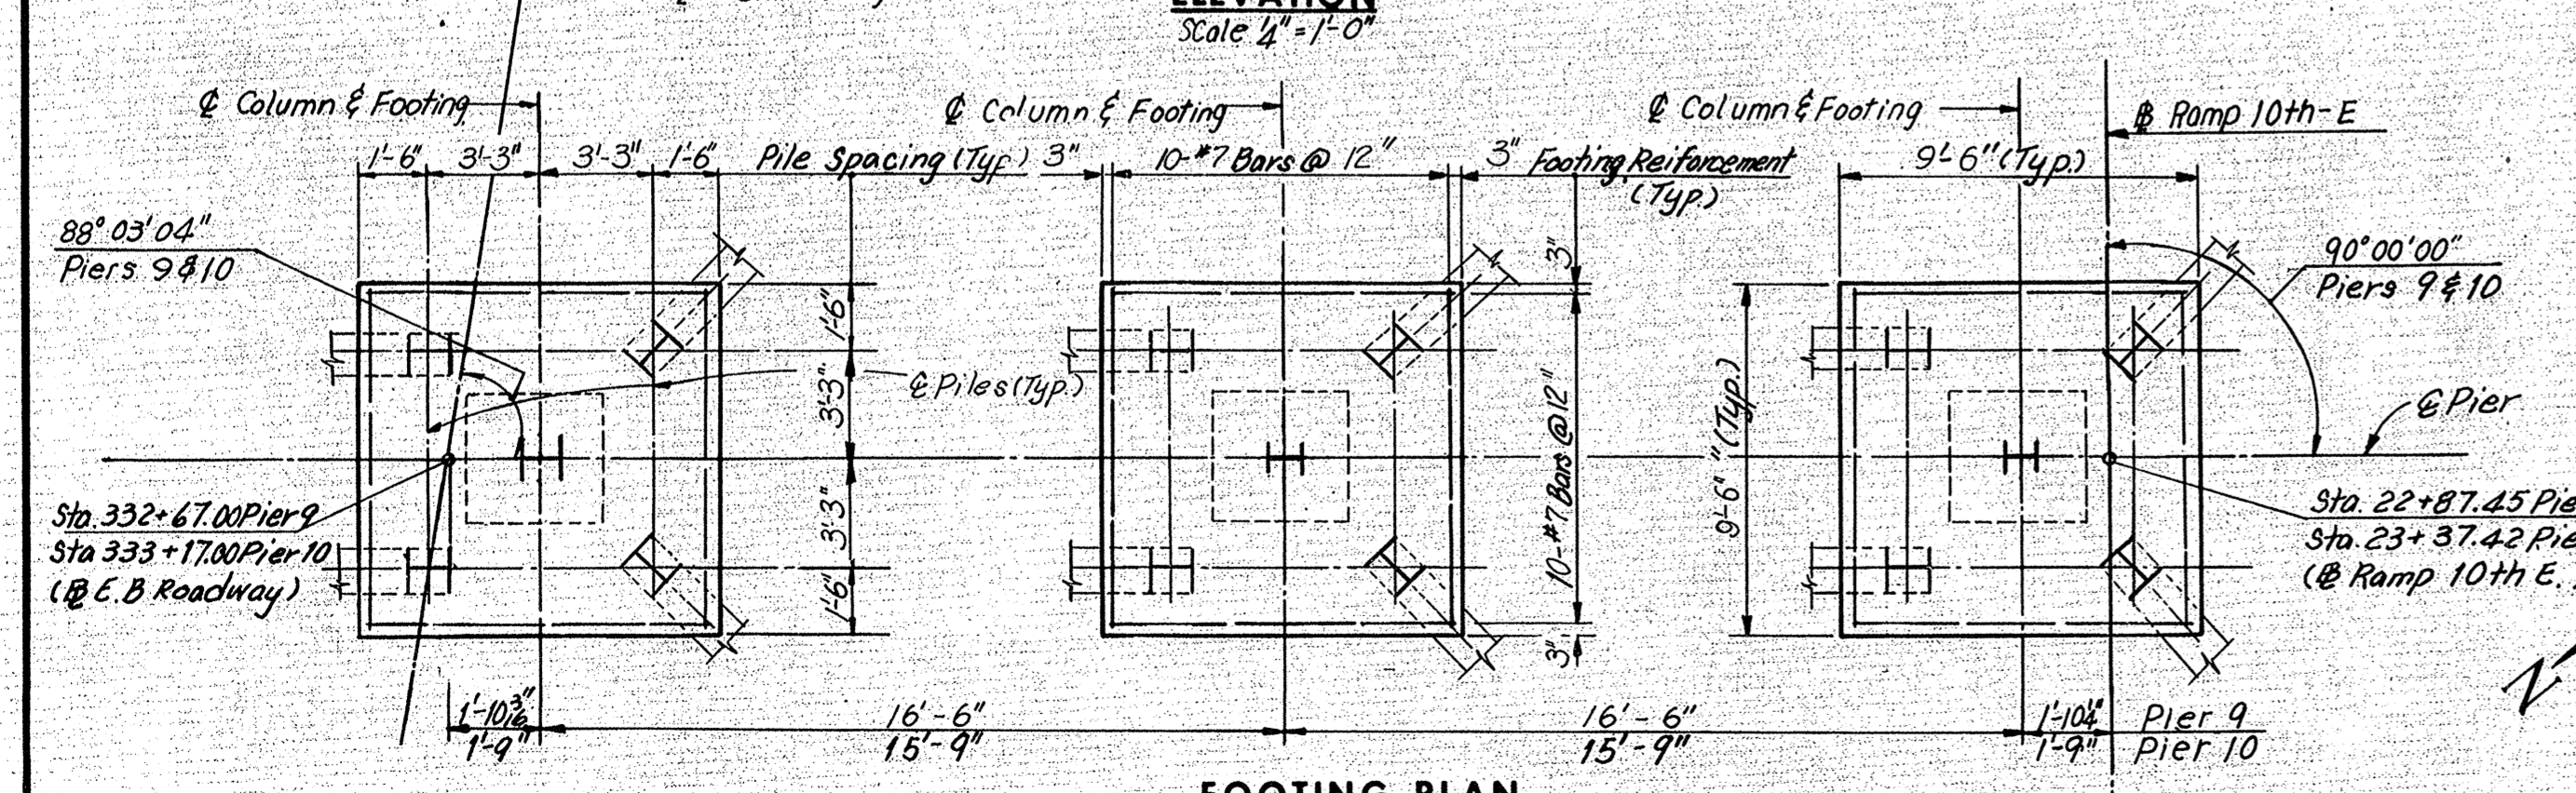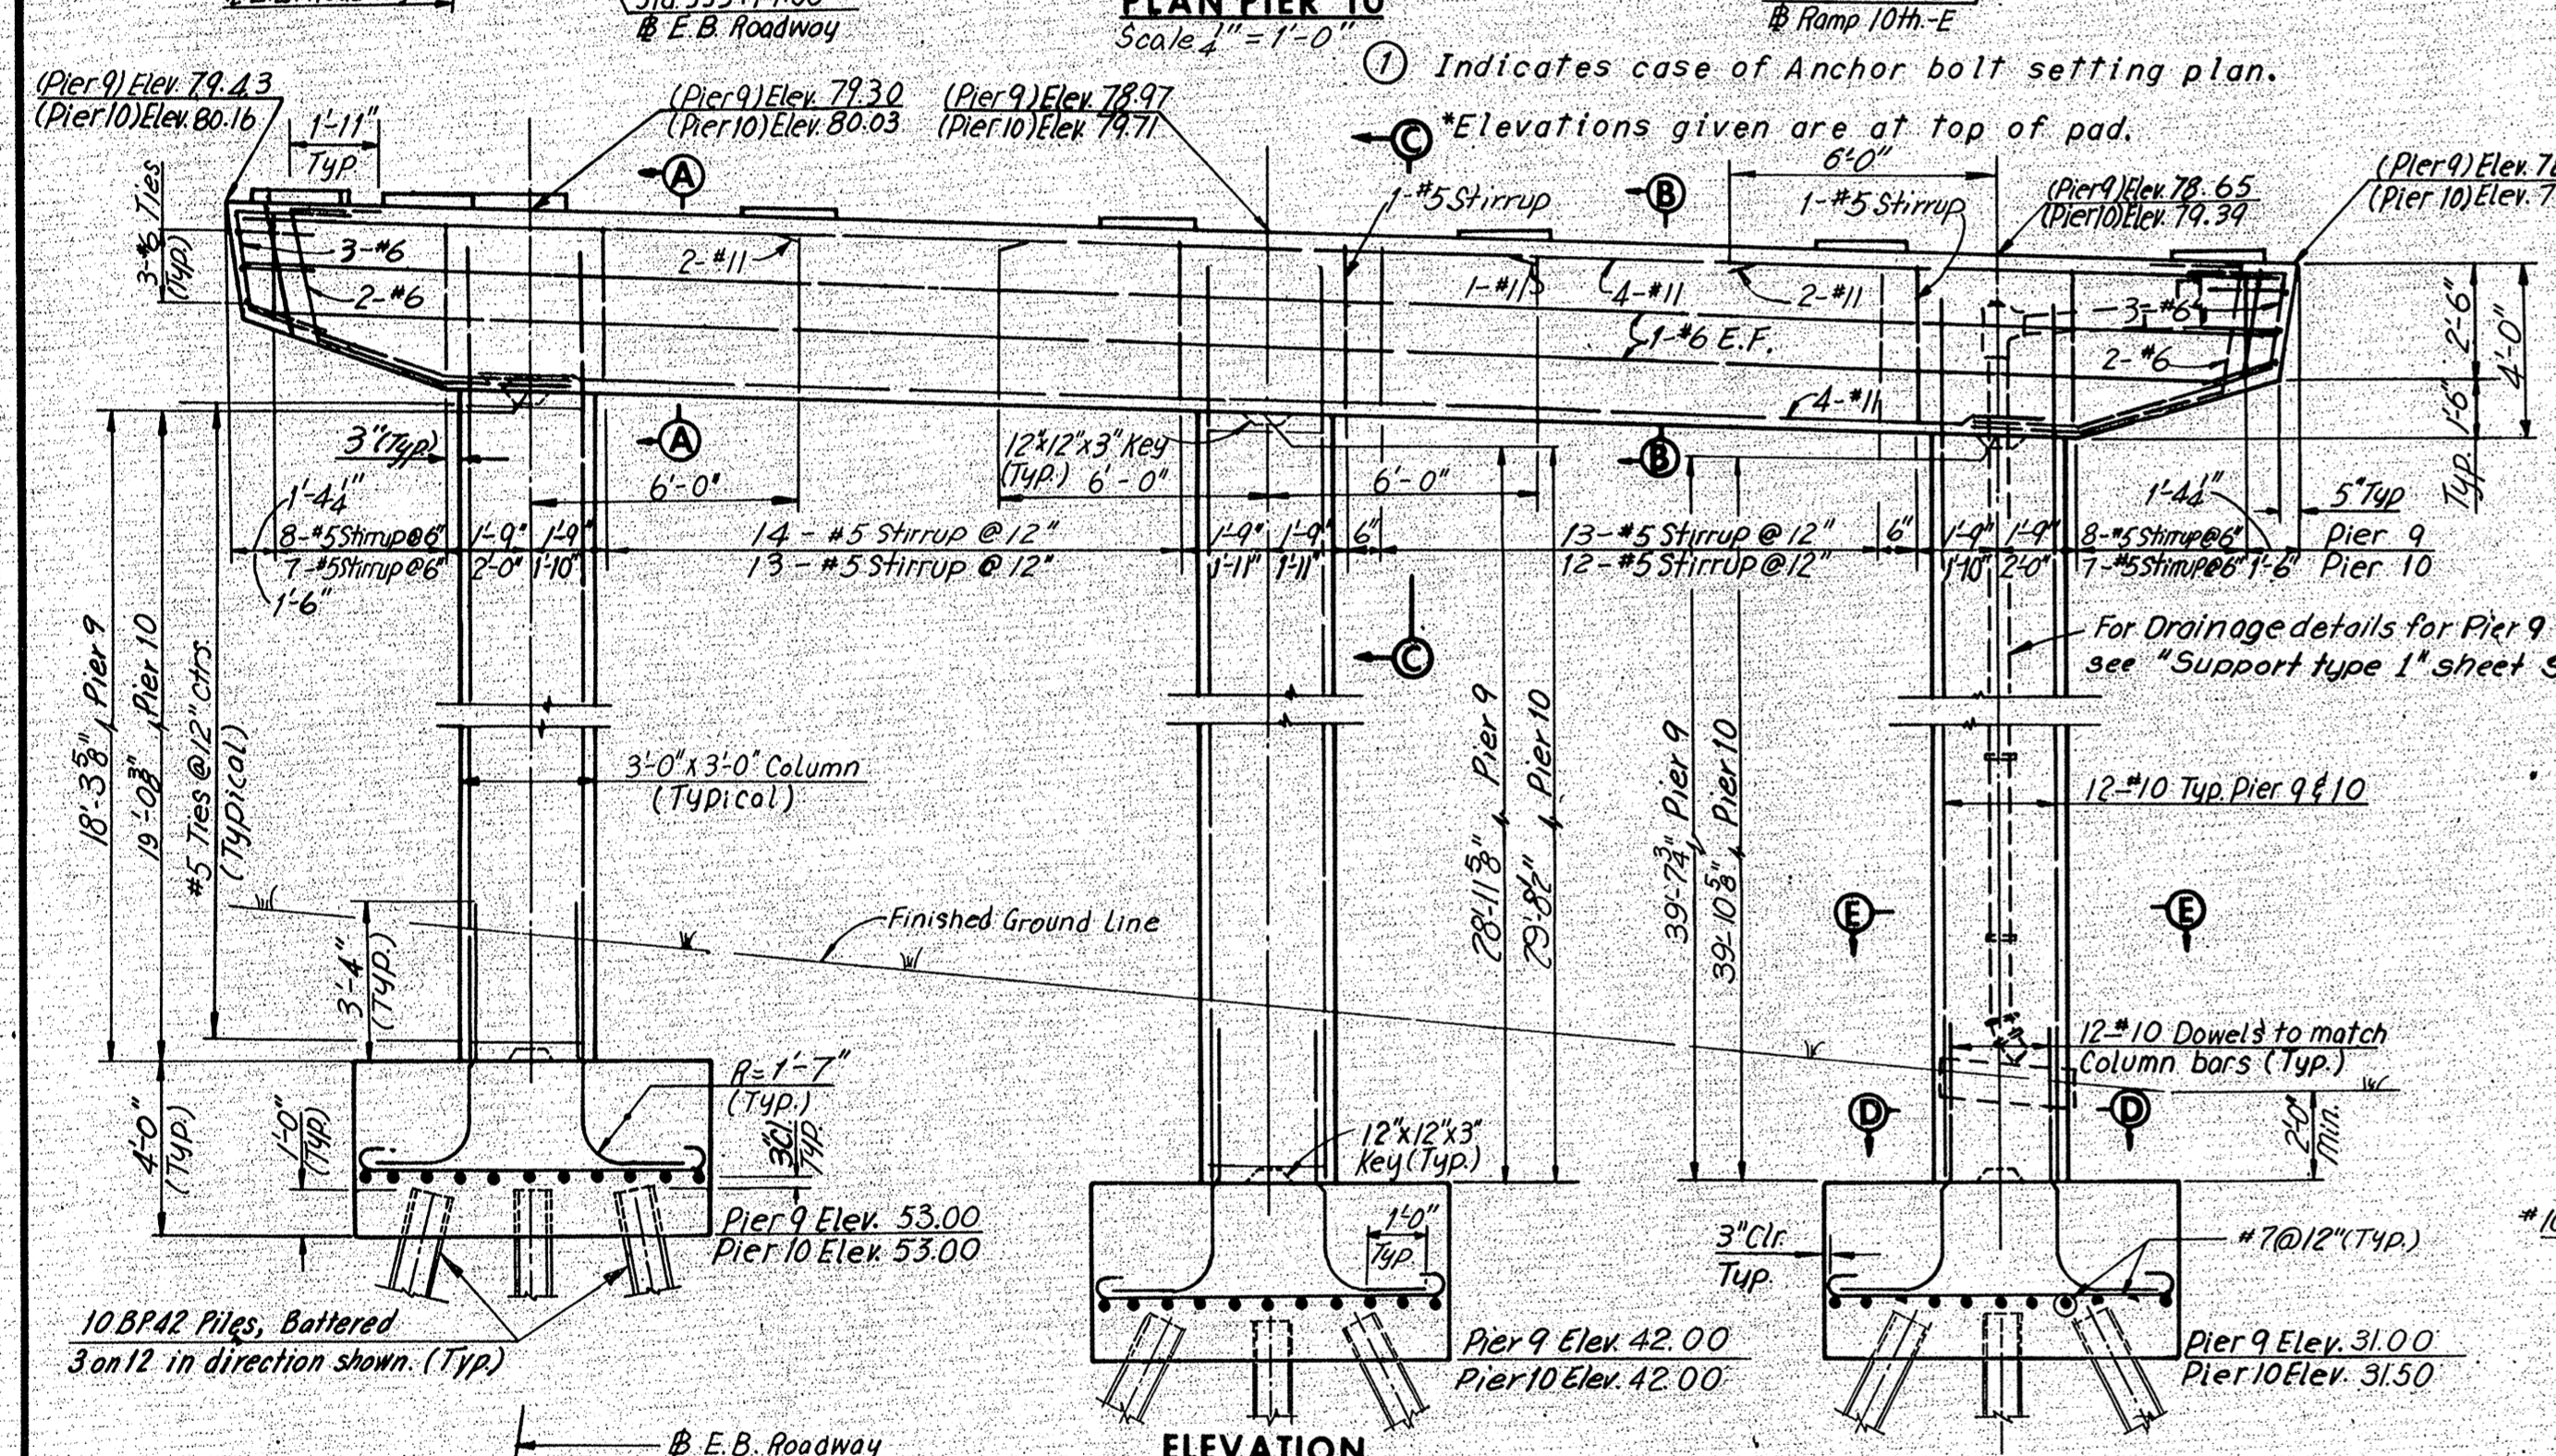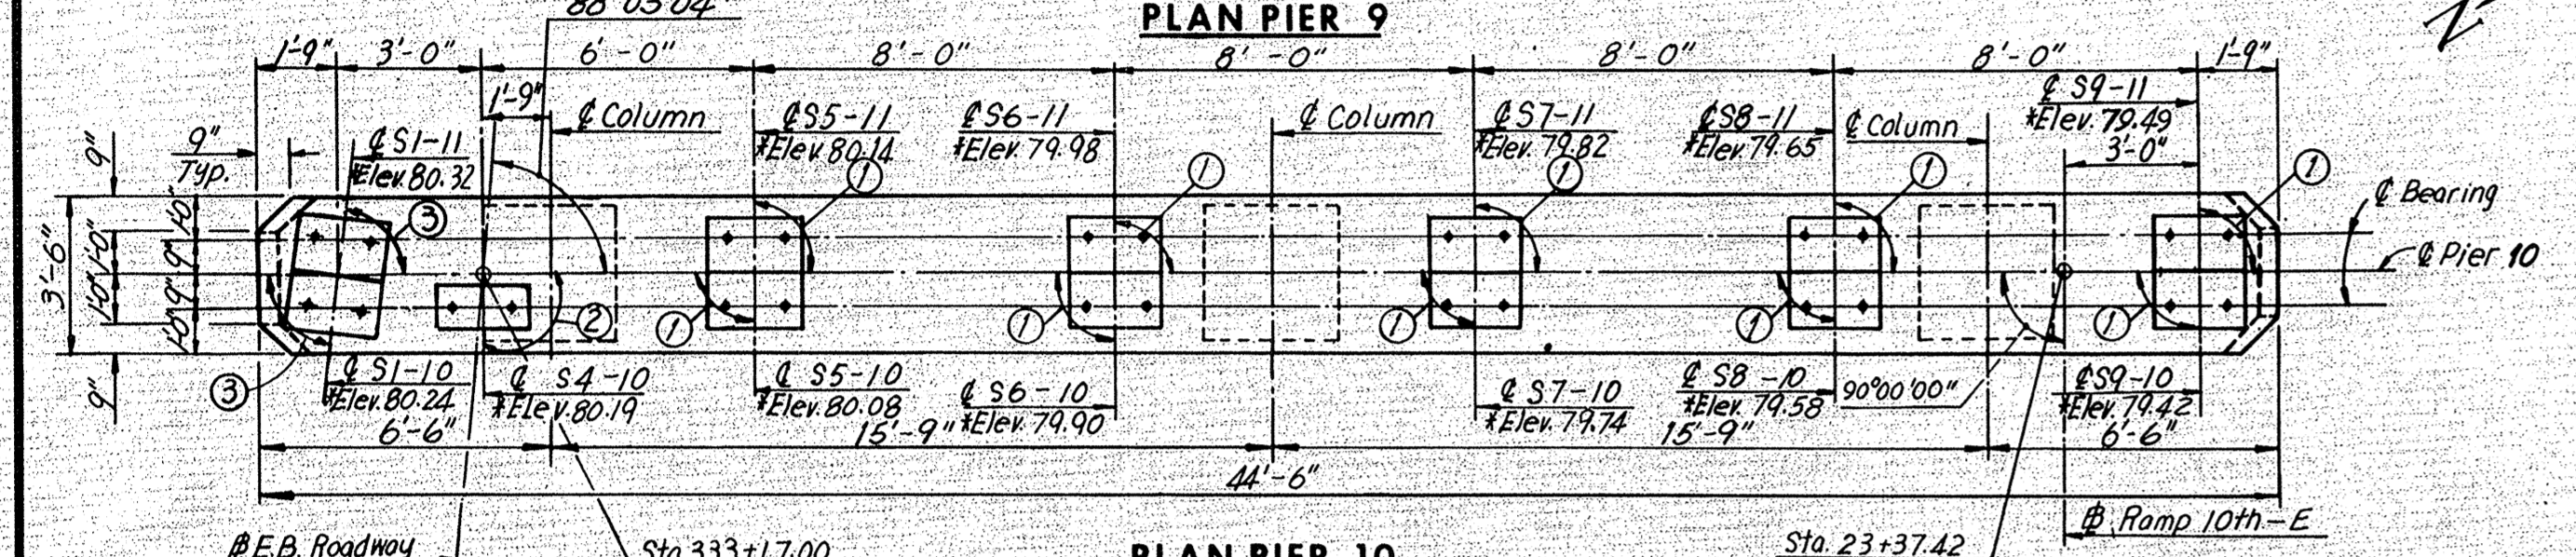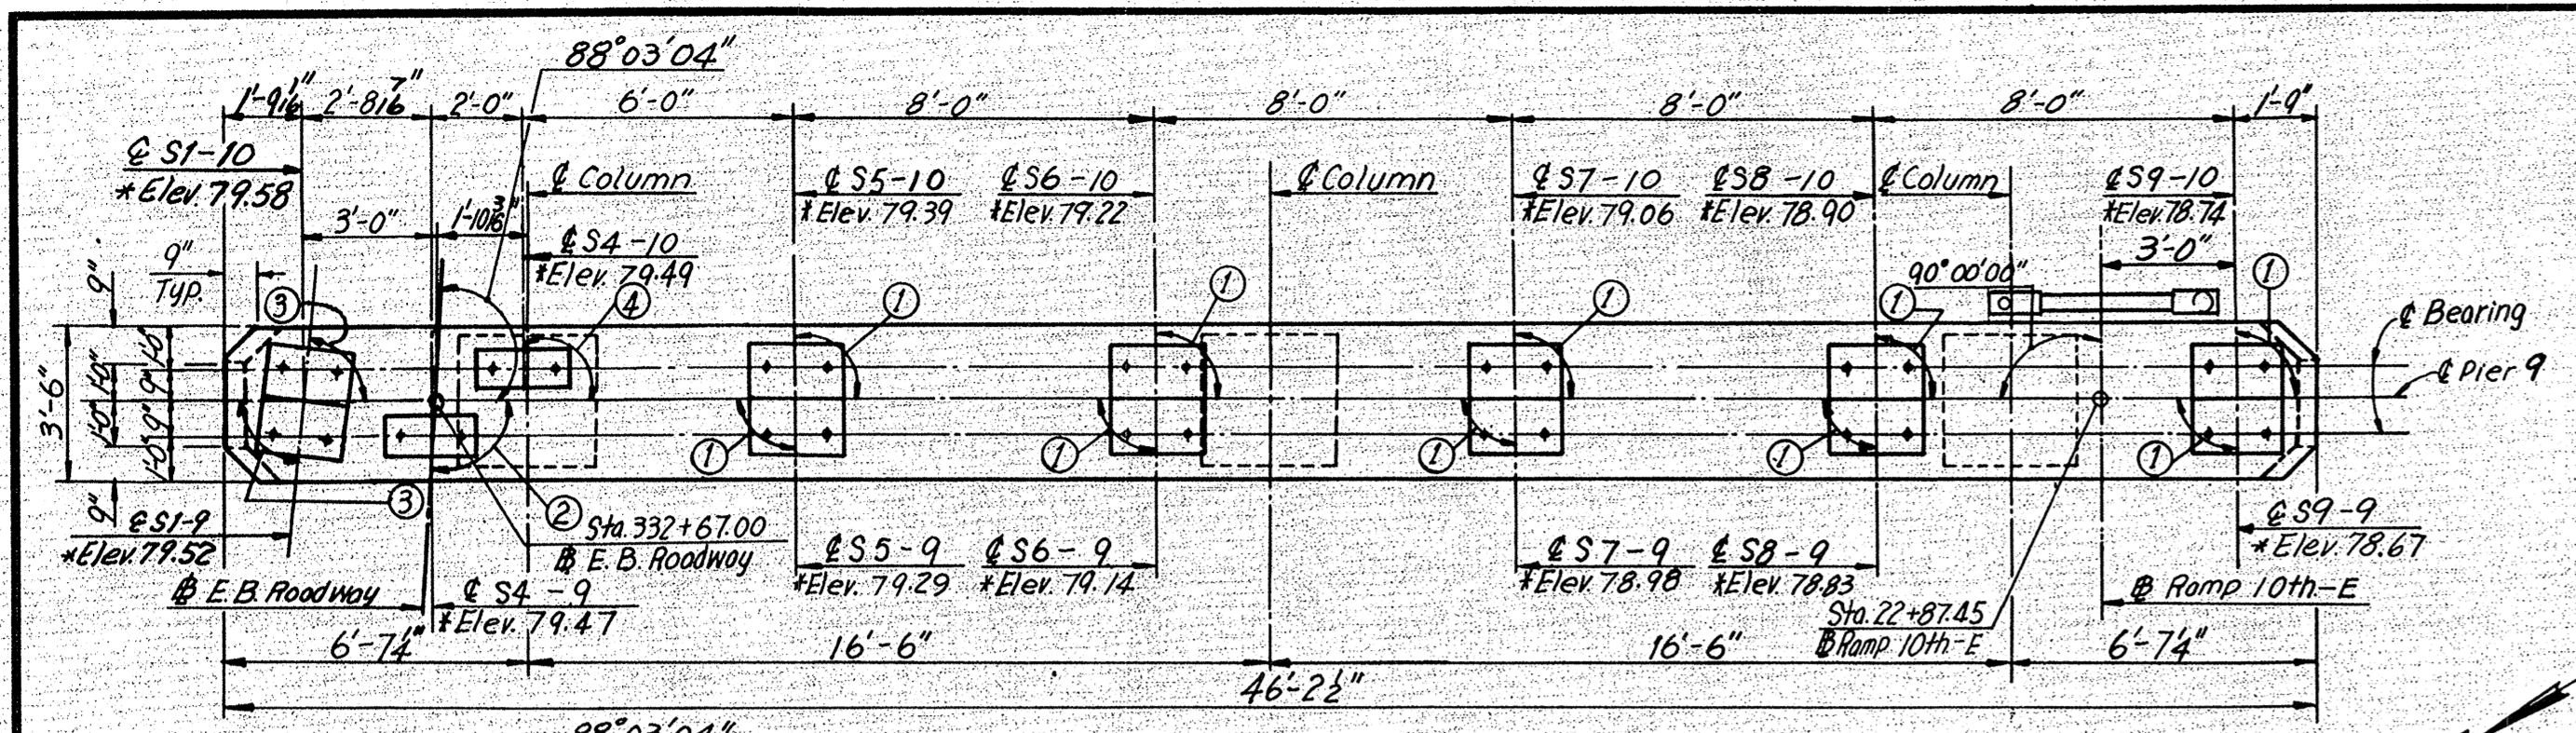

BY	DATE	Z	As Built	TEM	8-76
MADE	G.S.H.	7-24-68	Footing Elev, Dims, Reinf, & pile pattern	R.B.H.	8-74
CHECKED	G.C.C.	8-21-68	Col. heights		
IN CHARGE					

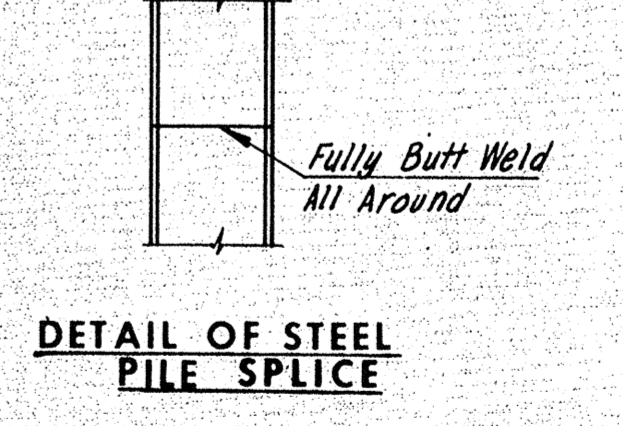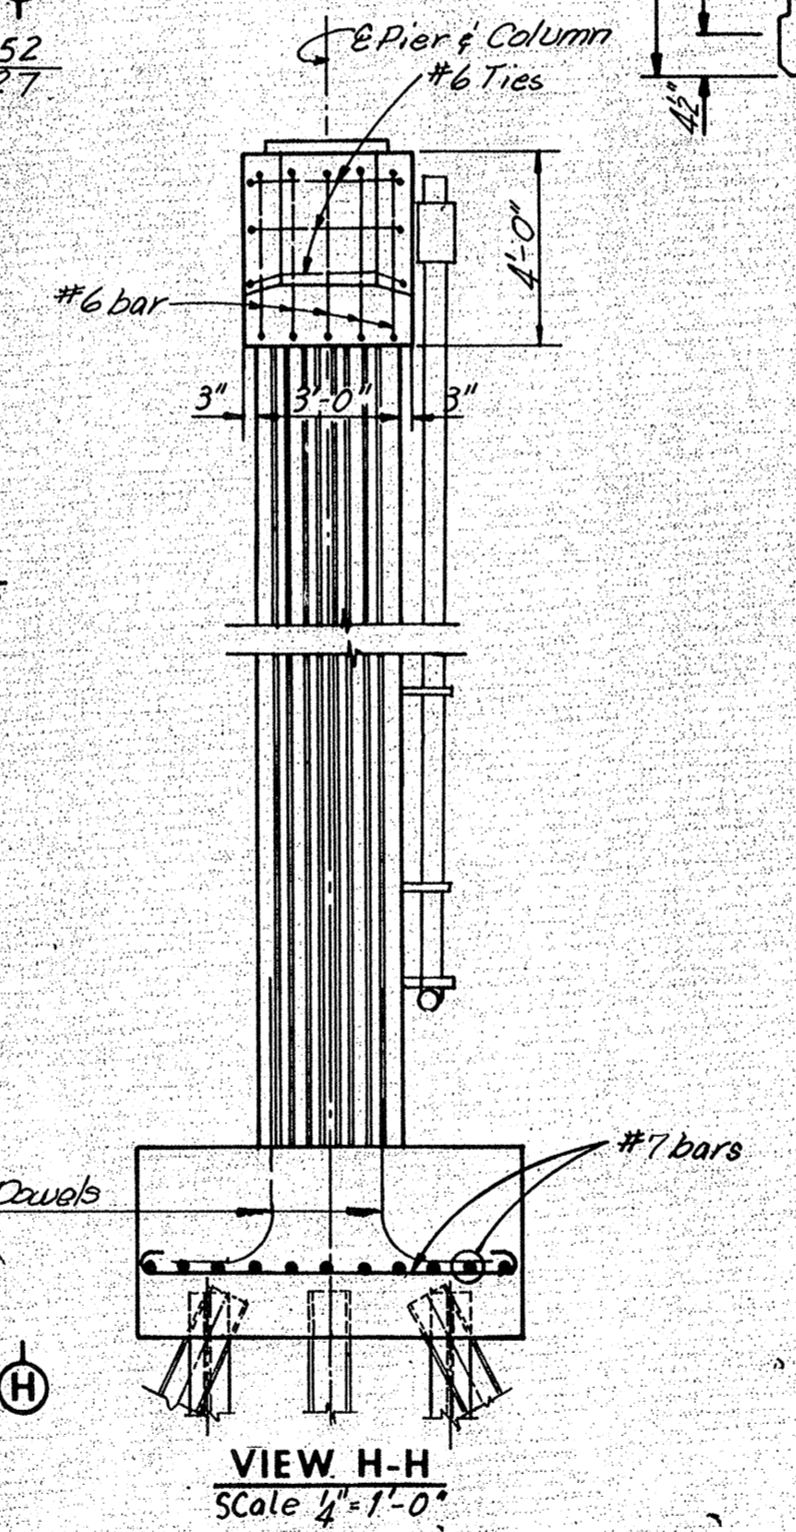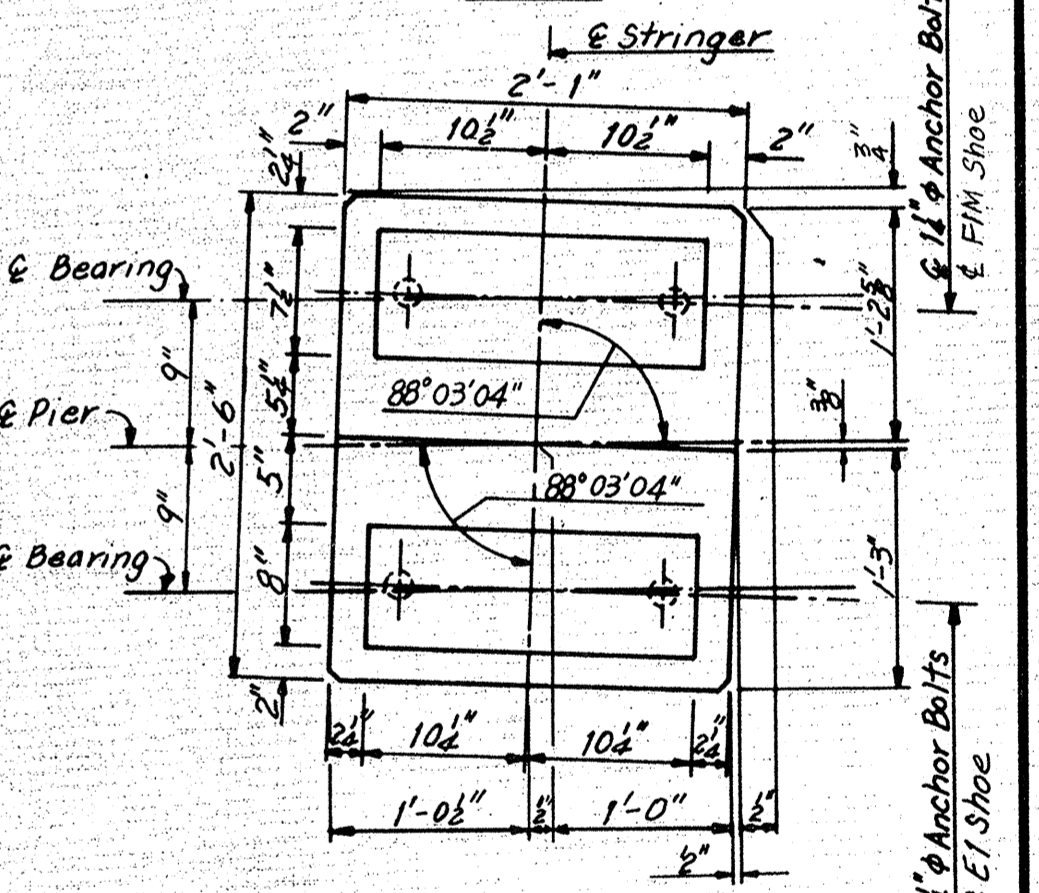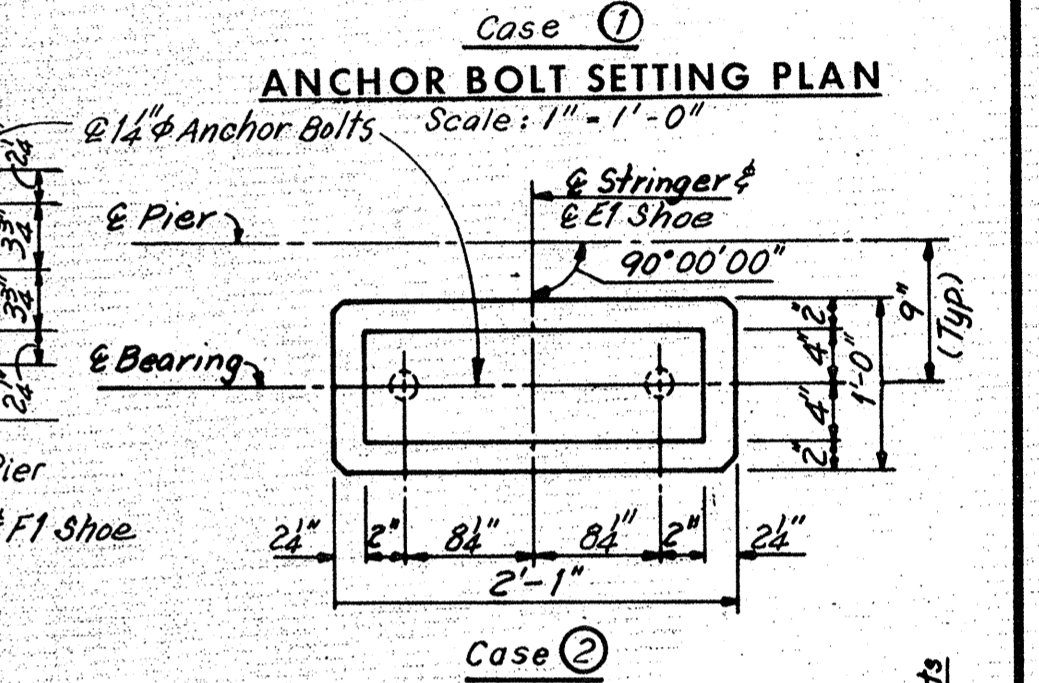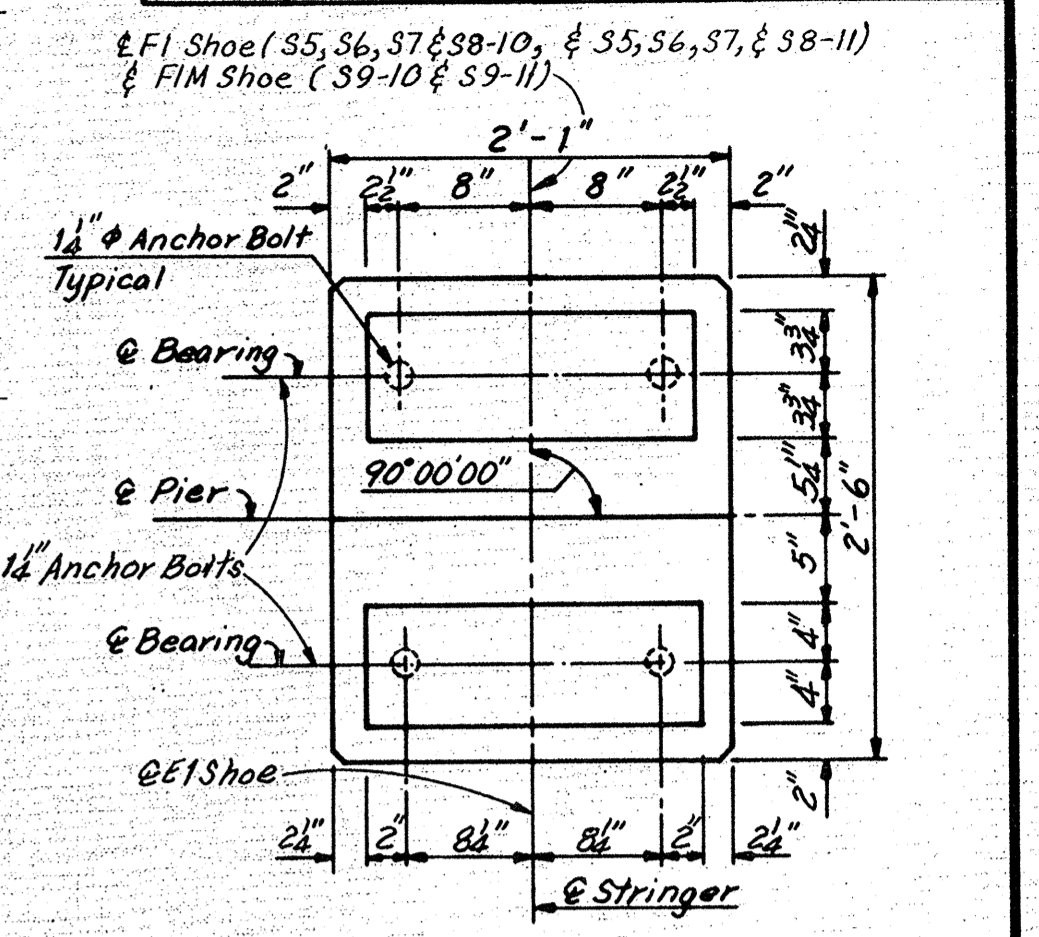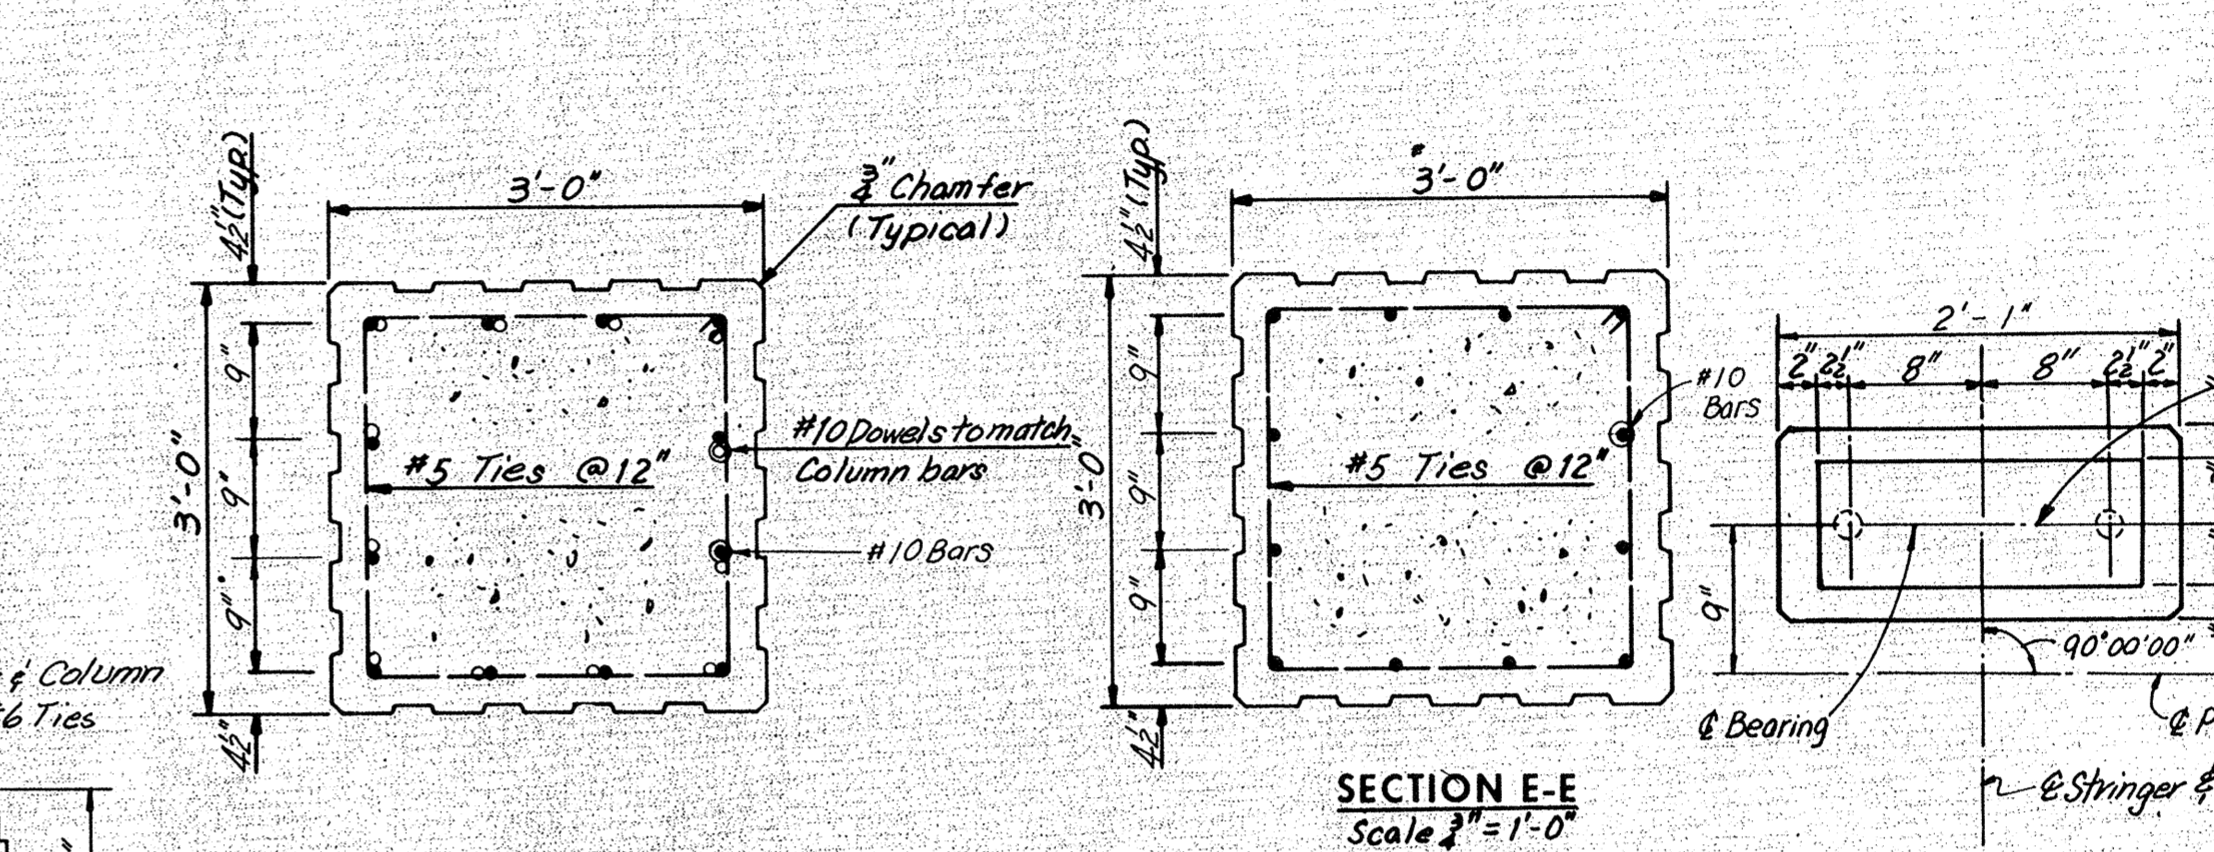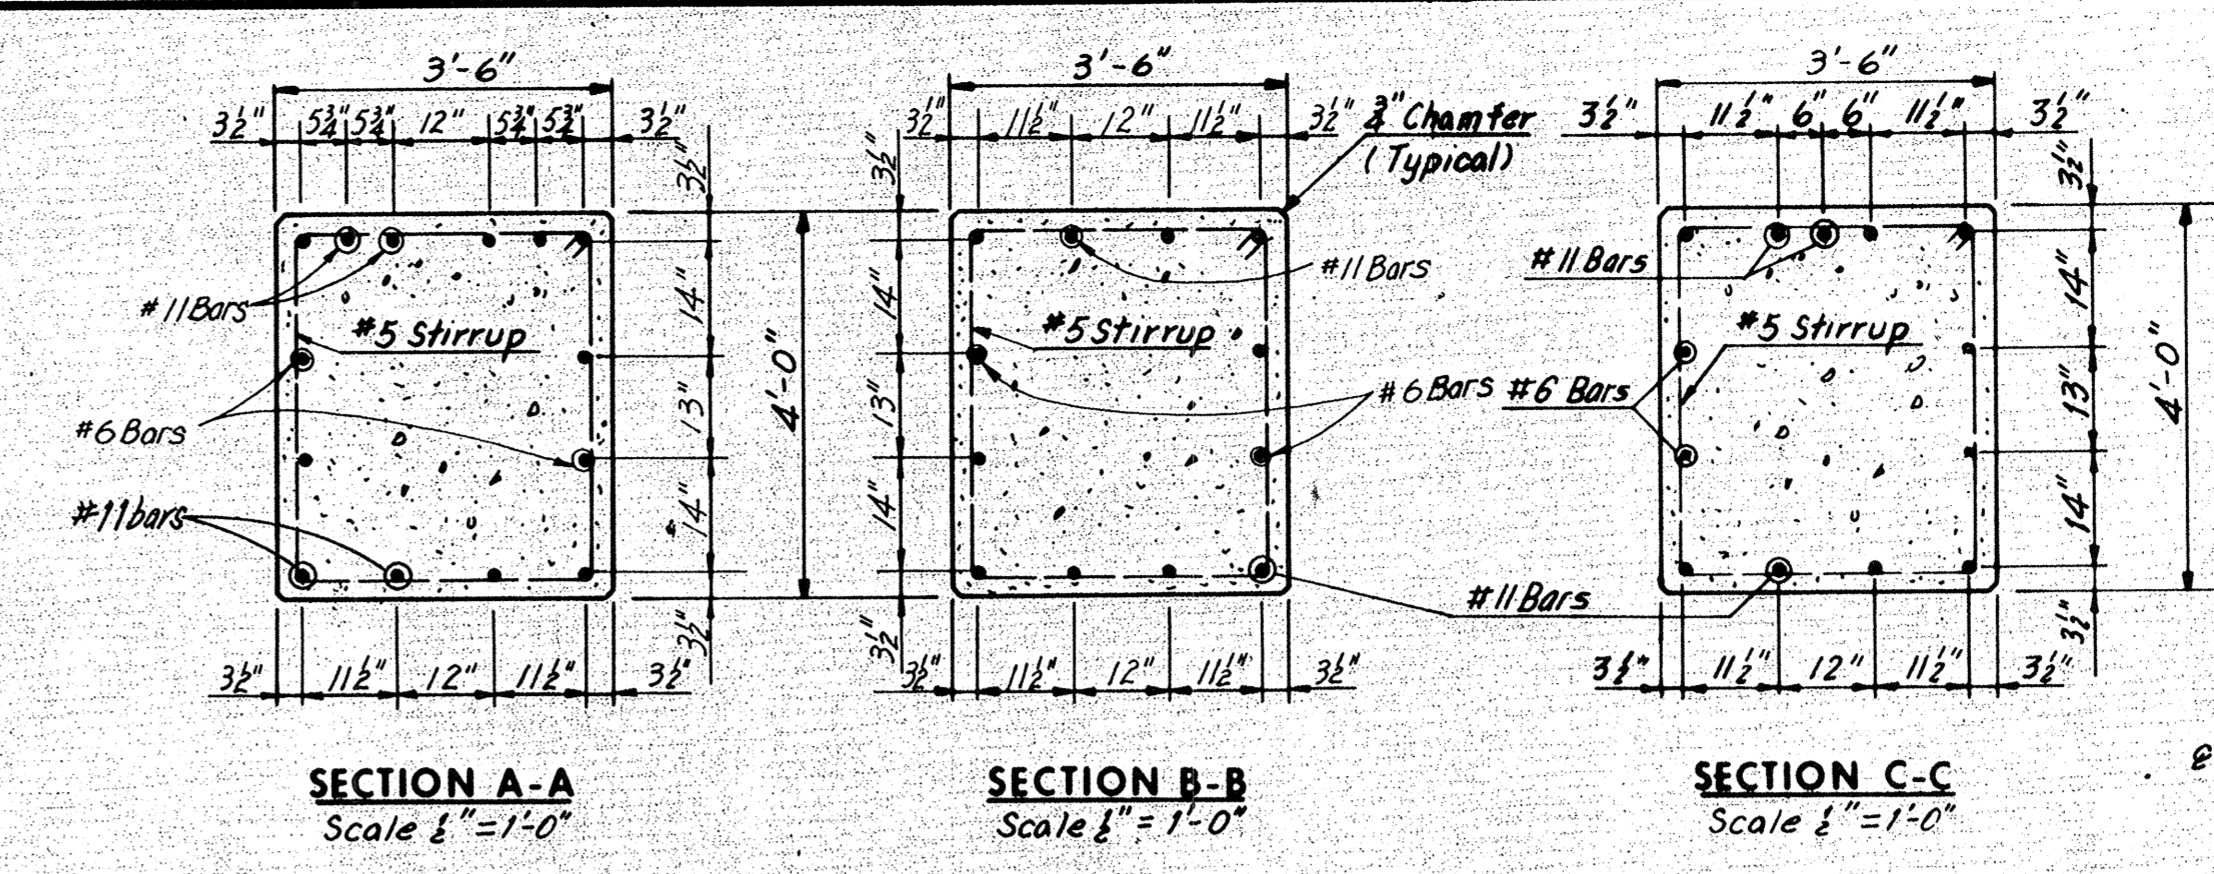

Note: Footing elevations are approximate only and may be varied to suit field conditions as directed by the Engineer. Vertical shaft reinforcing shall not be cut until these elevations are established. Where elevations change more than 2 ft., redesign will be required.

Note: All piles shall be 10BR42 Steel Piles (Design capacity = 45 tons).
Batter all piles 3" per foot where shown.
For Standard Shoe Details, see Sheets S1 and S2.
For Framing Plan, see Sheets 15 & 16.
Estimated Pile Tip Elevation 10.00 (Pier 9), 8.00 (Pier 10).

For architectural treatment of column, see Sheet 57.

RICHMOND METROPOLITAN AUTHORITY
RICHMOND EXPRESSWAY SYSTEM
DOWNTOWN EXPRESSWAY





BRIDGE NO. 66
EASTBOUND ROADWAY OVER
12TH ST. - R.R. TRACKS AND 16TH ST.
PIERS 9 AND 10

HOWARD, NEEDLES, TAMMEN & BERGENDOFF
 consulting engineers
 NEW YORK ALEXANDRIA KANSAS CITY

SCALE: As Shown
 CONTRACT NO.: 10
 SHEET NO. 11 OF 46


AS BUILT

RICHMOND EXPRESSWAY SYSTEM			
SECTION	PROJECT	SHEET NO.	TOTAL SHEETS
10	DOWNTOWN EXPRESSWAY	138	265

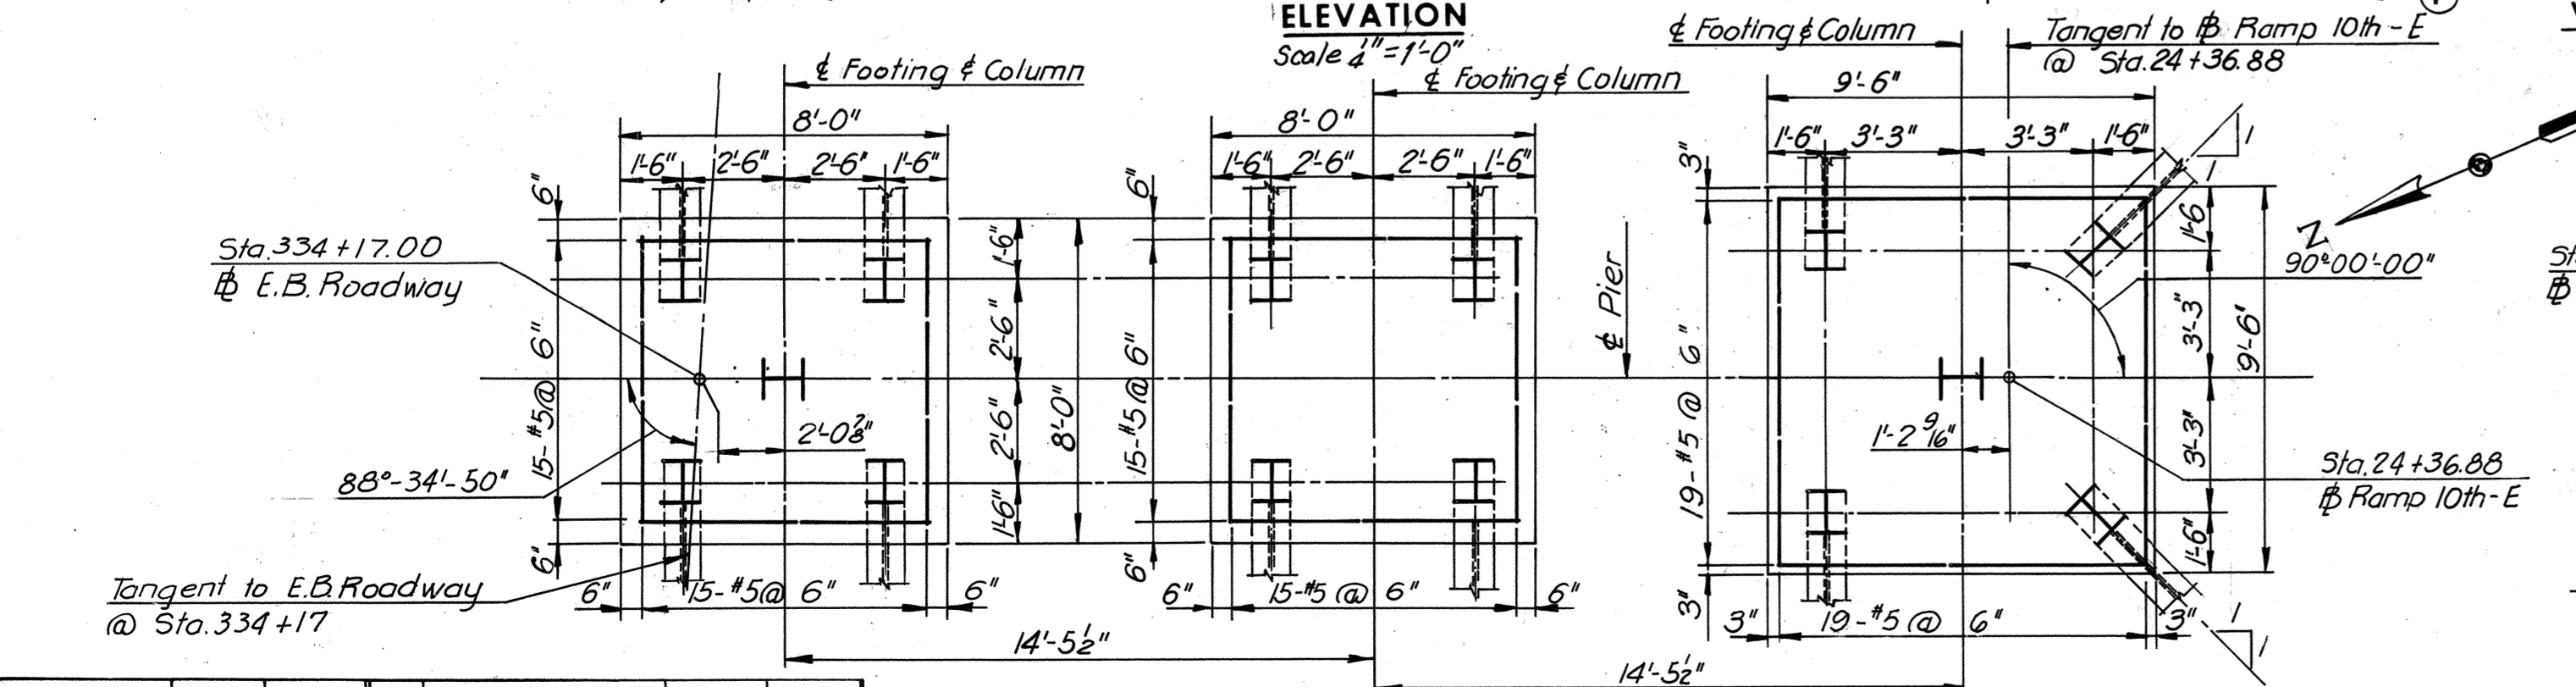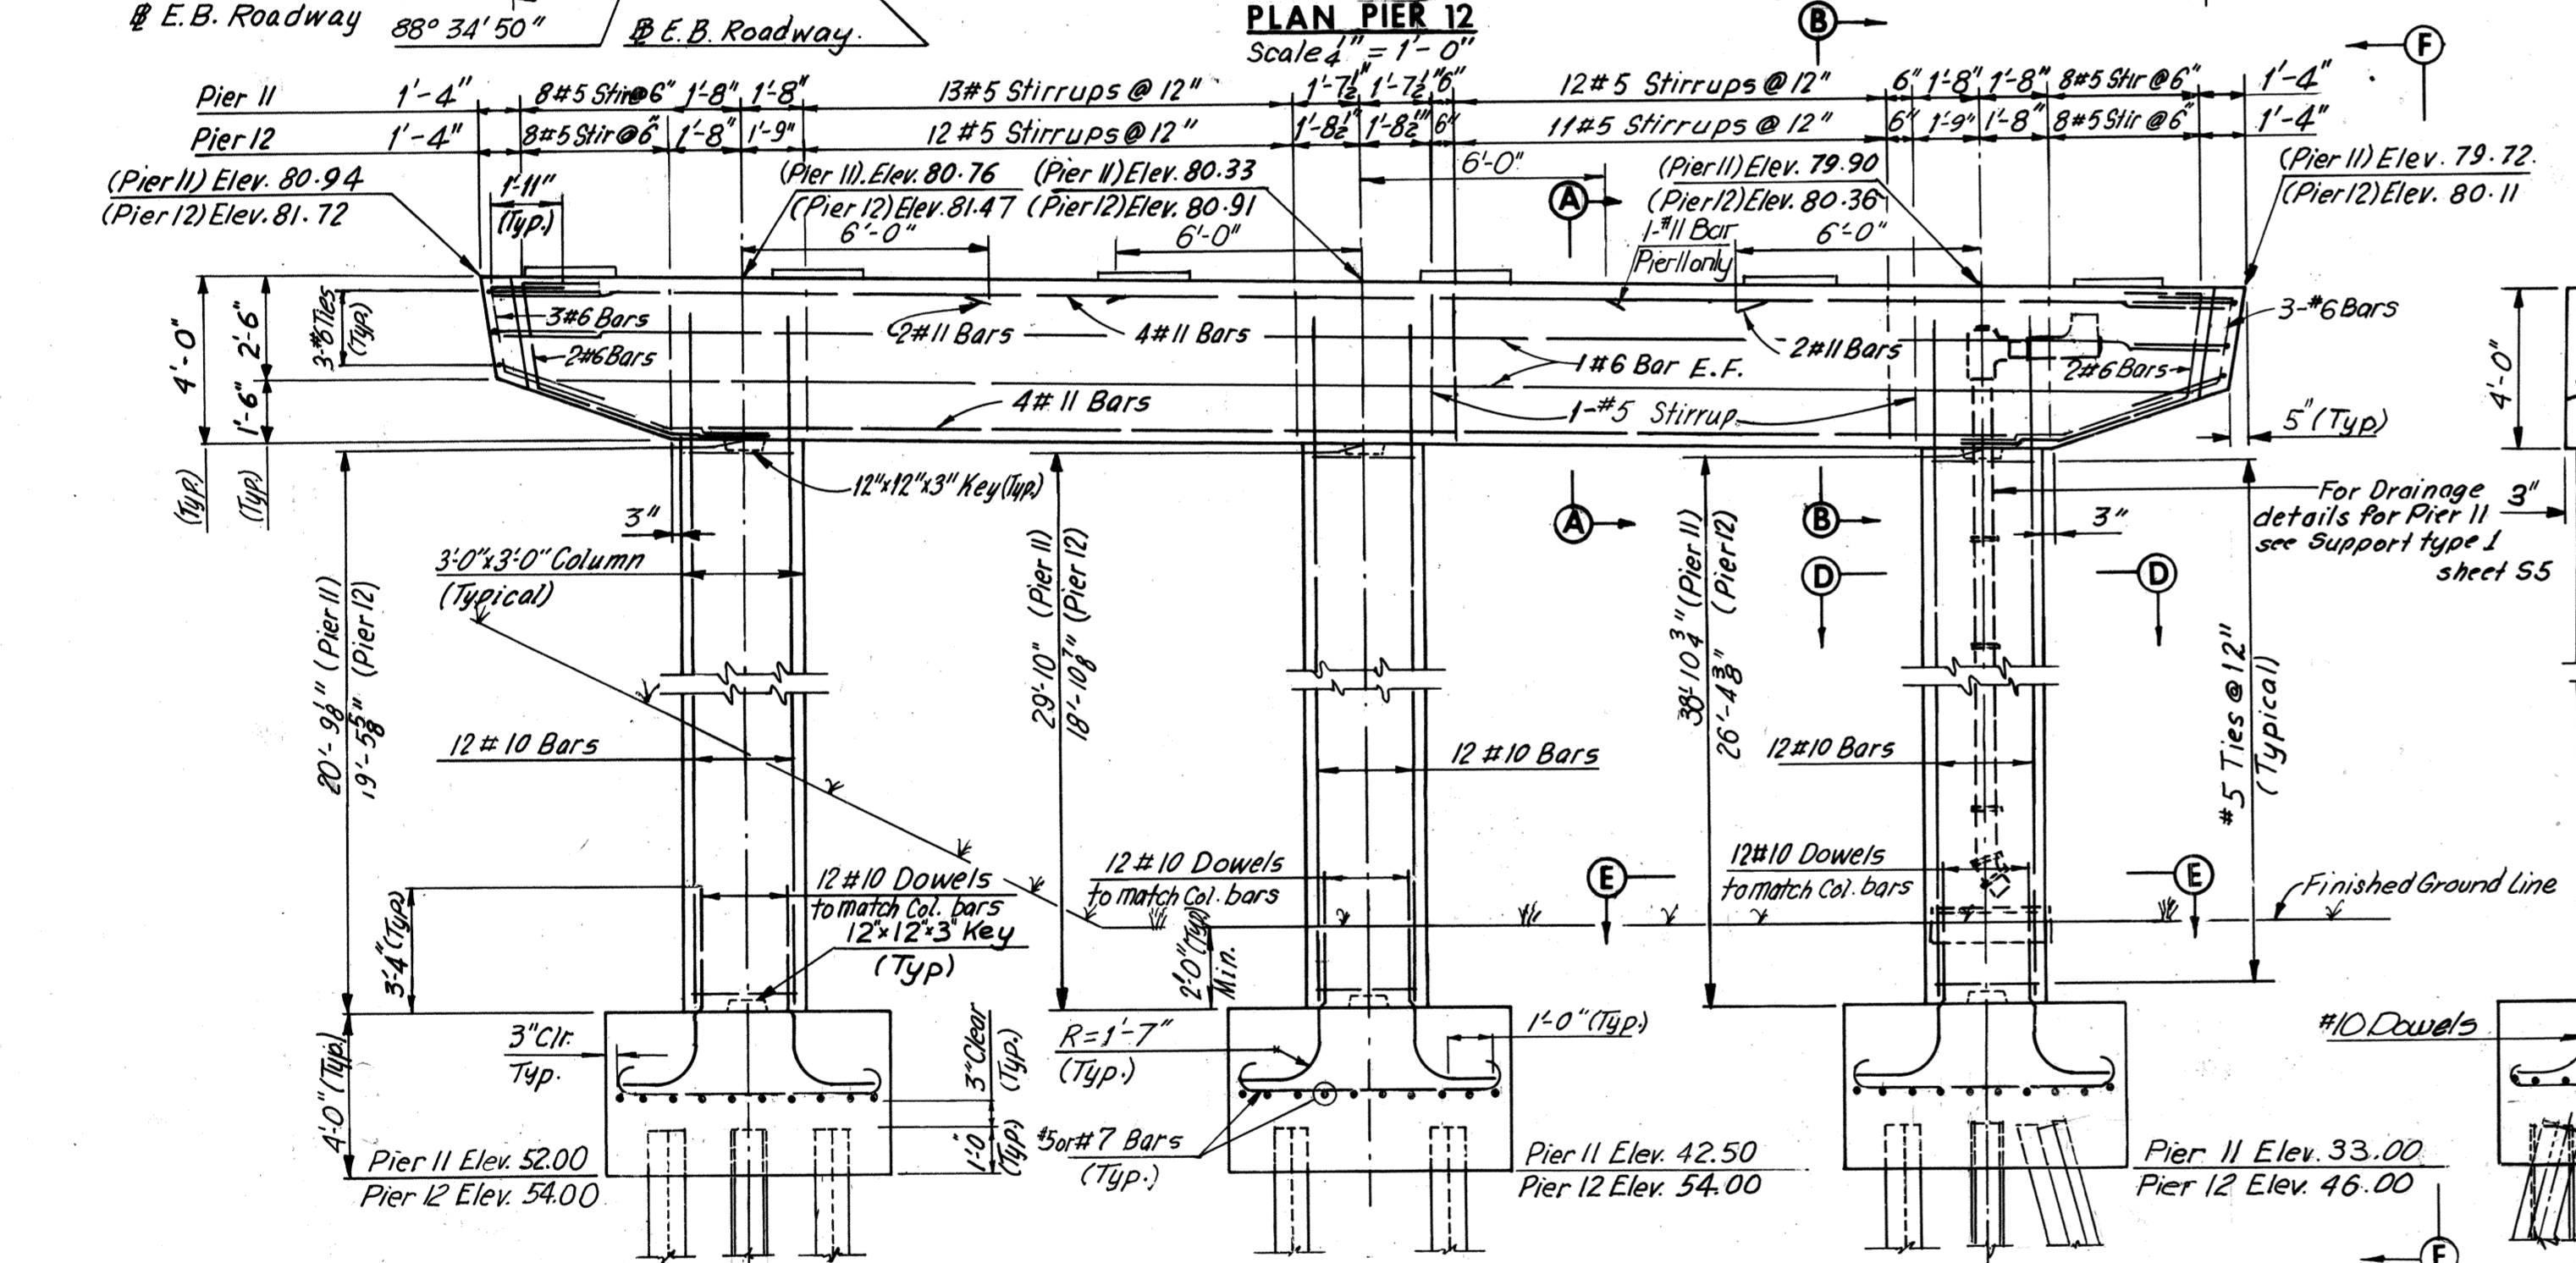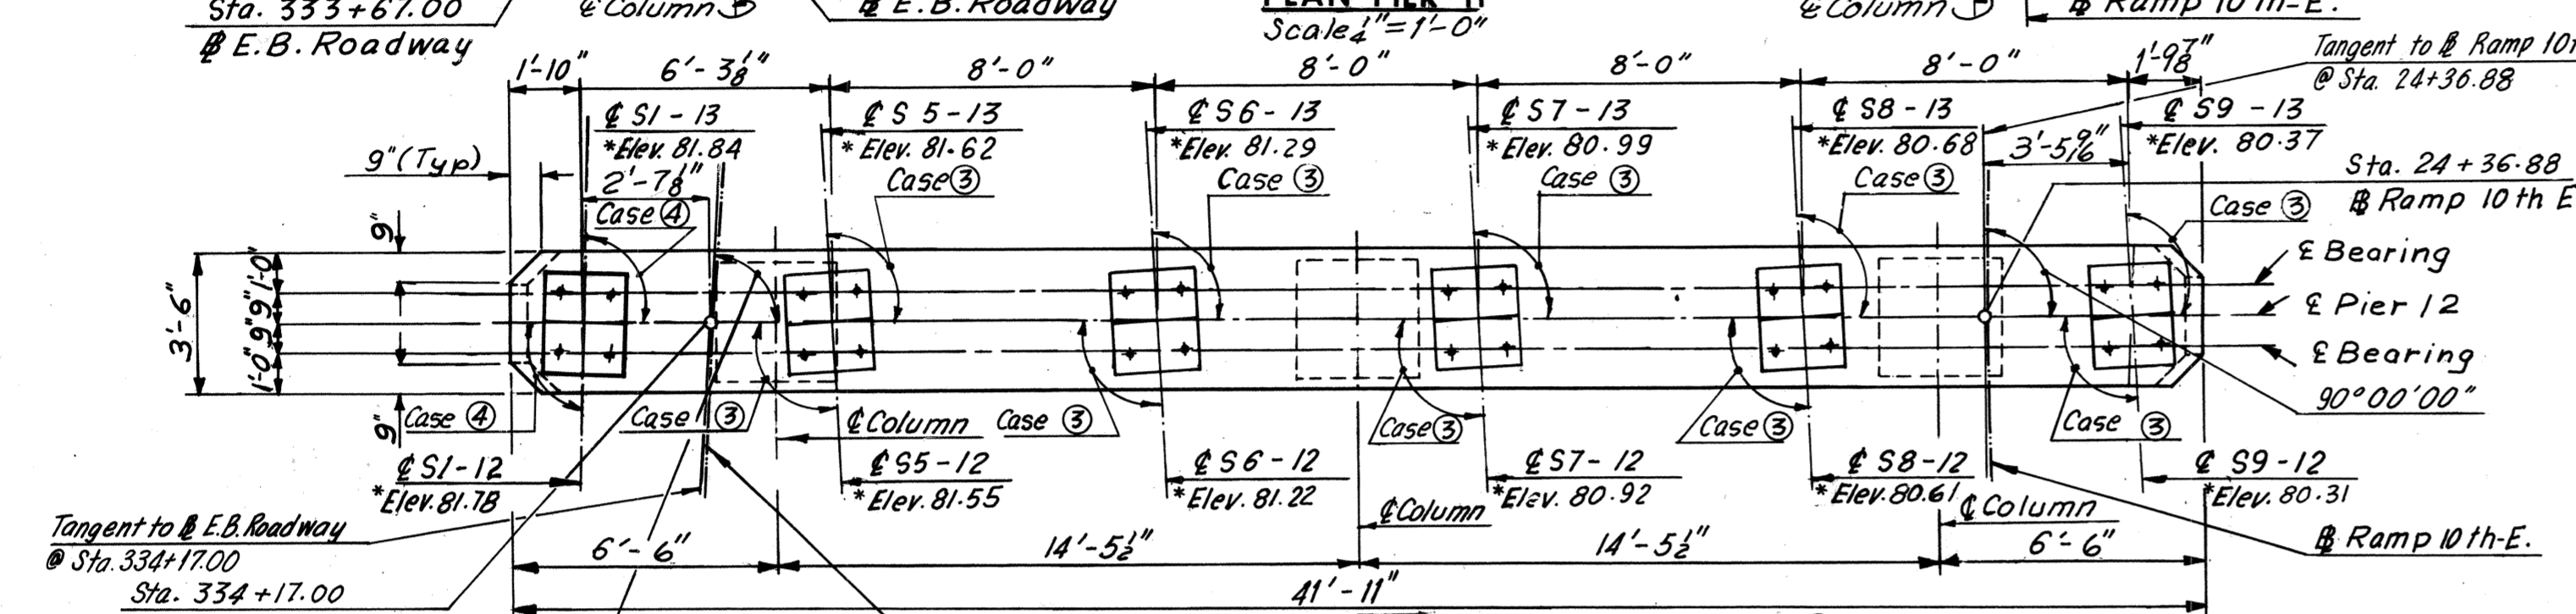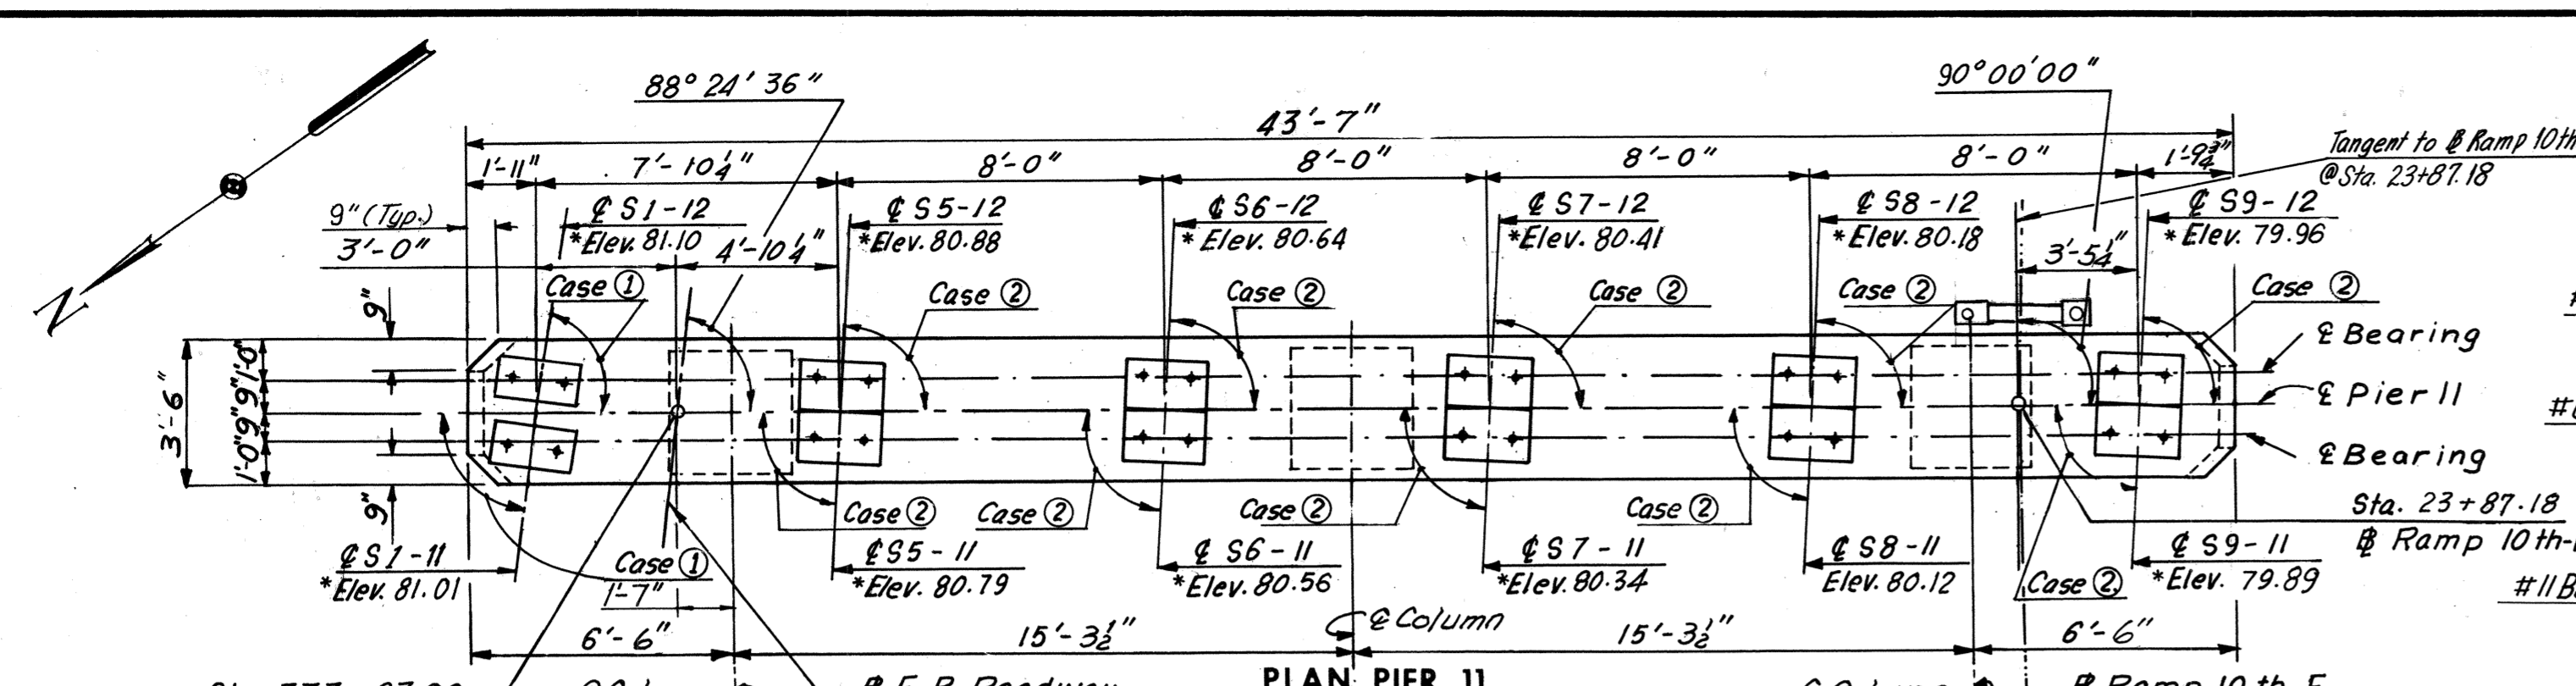



MADE	CHECKED	IN CHARGE	BY	DATE	NO.	REVISION	BY	DATE
M.A.R.	G.C.C.			7-17-68	2	As Built	TEM	8-76
				8-20-68		Flg. sizes, Reinf. & Piling	P.R.Y.	8-74

FOOTING PLAN-PIER 12 Scale: 1/4" = 1'-0"

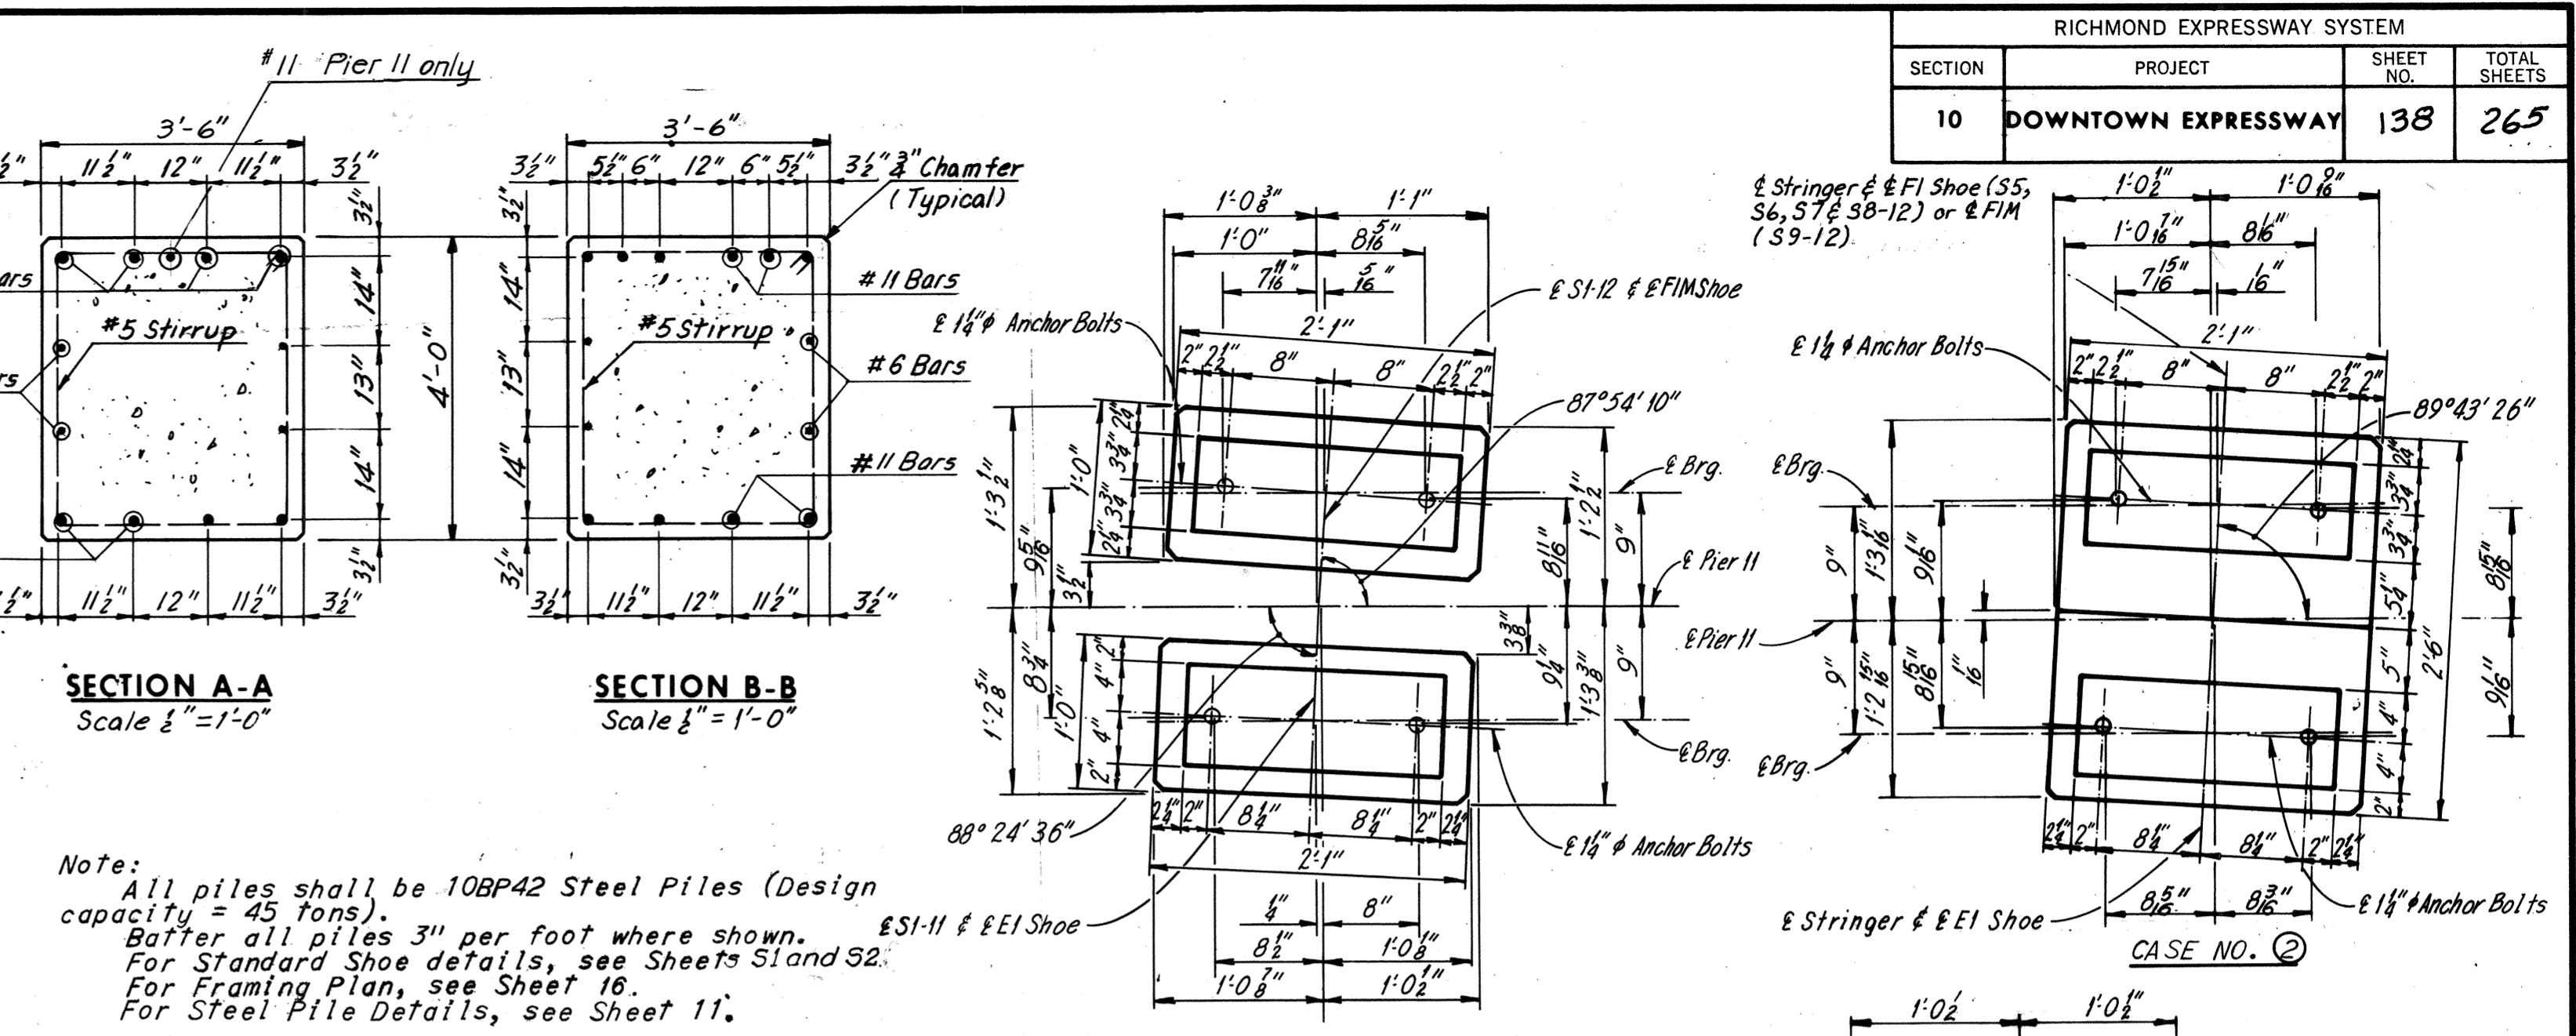

Note: All piles shall be 10BP42 Steel Piles (Design capacity = 45 tons).
 Batter all piles 3" per foot where shown.
 For Standard Shoe details, see Sheets S1 and S2.
 For Framing Plan, see Sheet 16.
 For Steel Pile Details, see Sheet 11.

Note: * Denotes top of pad elevation.
 Estimated pile tip elevation, 8.00 (Piers 11 and 12).
 E.F. Denotes Each Face.

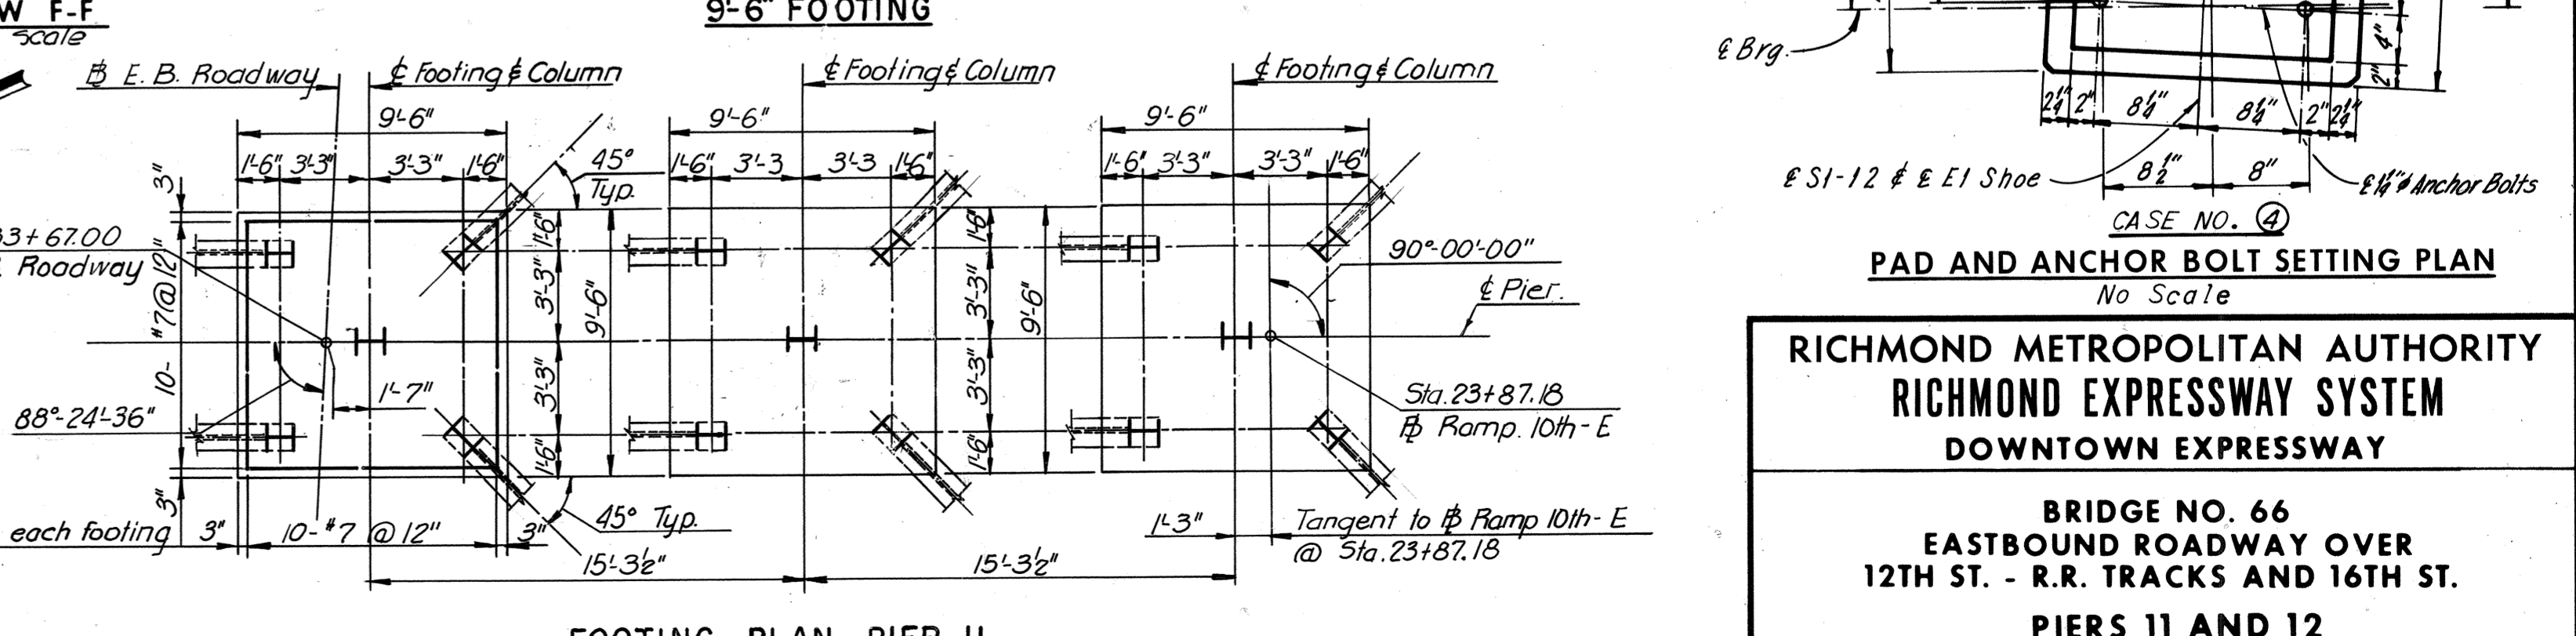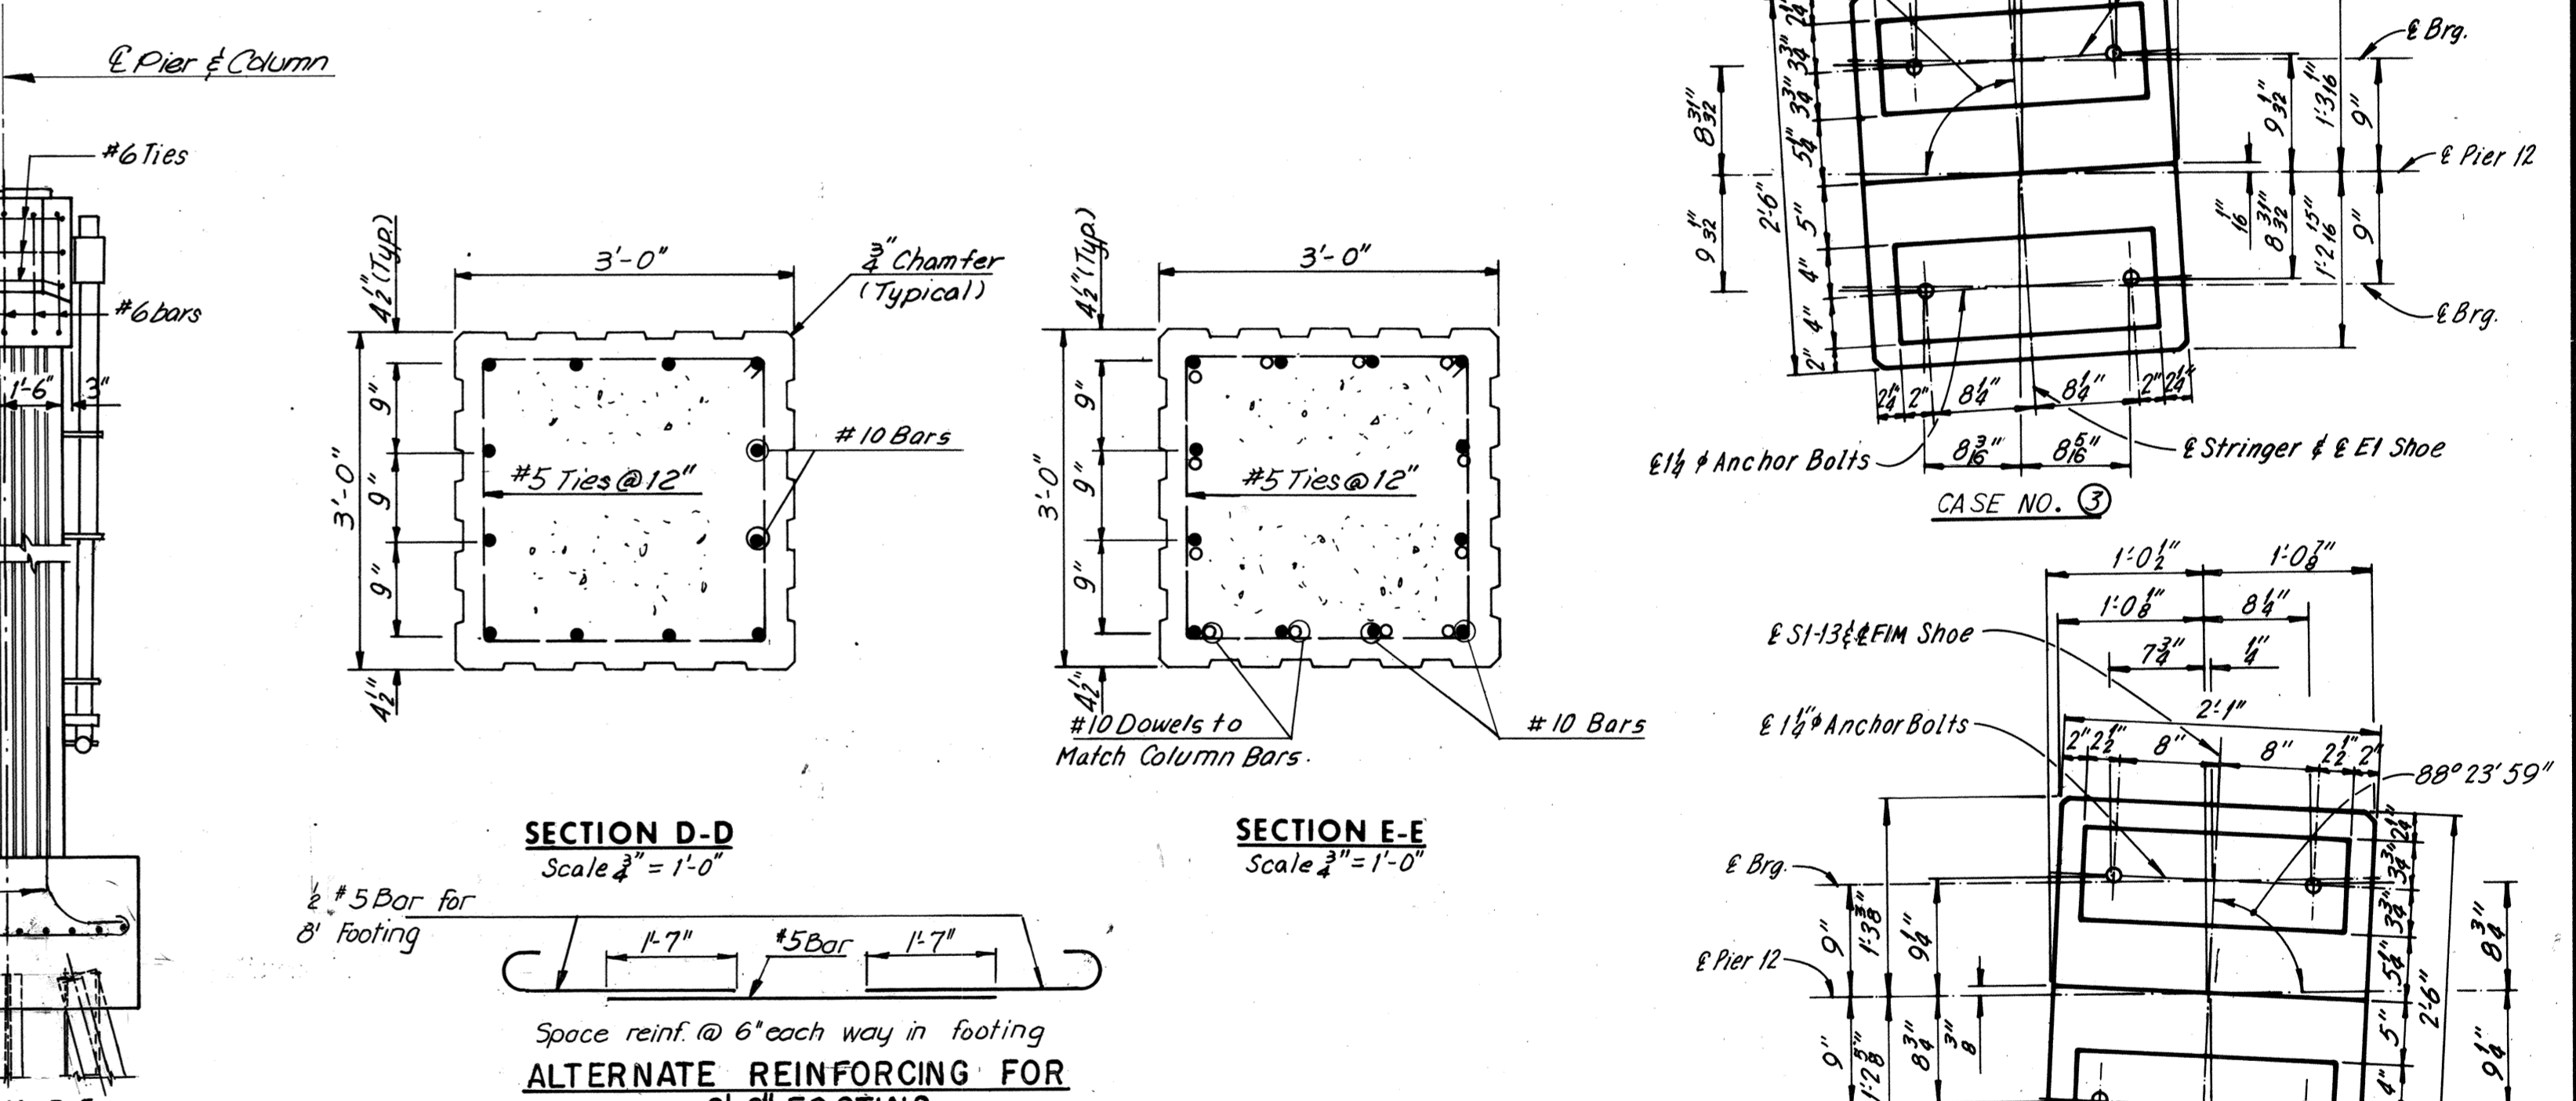

RICHMOND METROPOLITAN AUTHORITY
RICHMOND EXPRESSWAY SYSTEM
DOWNTOWN EXPRESSWAY







BRIDGE NO. 66
EASTBOUND ROADWAY OVER
12TH ST. - R.R. TRACKS AND 16TH ST.
PIERS 11 AND 12

HOWARD, NEEDLES, TAMMEN & BERGENDOFF
 consulting engineers
 NEW YORK ALEXANDRIA KANSAS CITY

SCALE: As Noted
 CONTRACT NO. 10
 SHEET NO. 12 OF 46




AS BUILT

RICHMOND EXPRESSWAY SYSTEM			
SECTION	PROJECT	SHEET NO.	TOTAL SHEETS
10	DOWNTOWN EXPRESSWAY	139	265

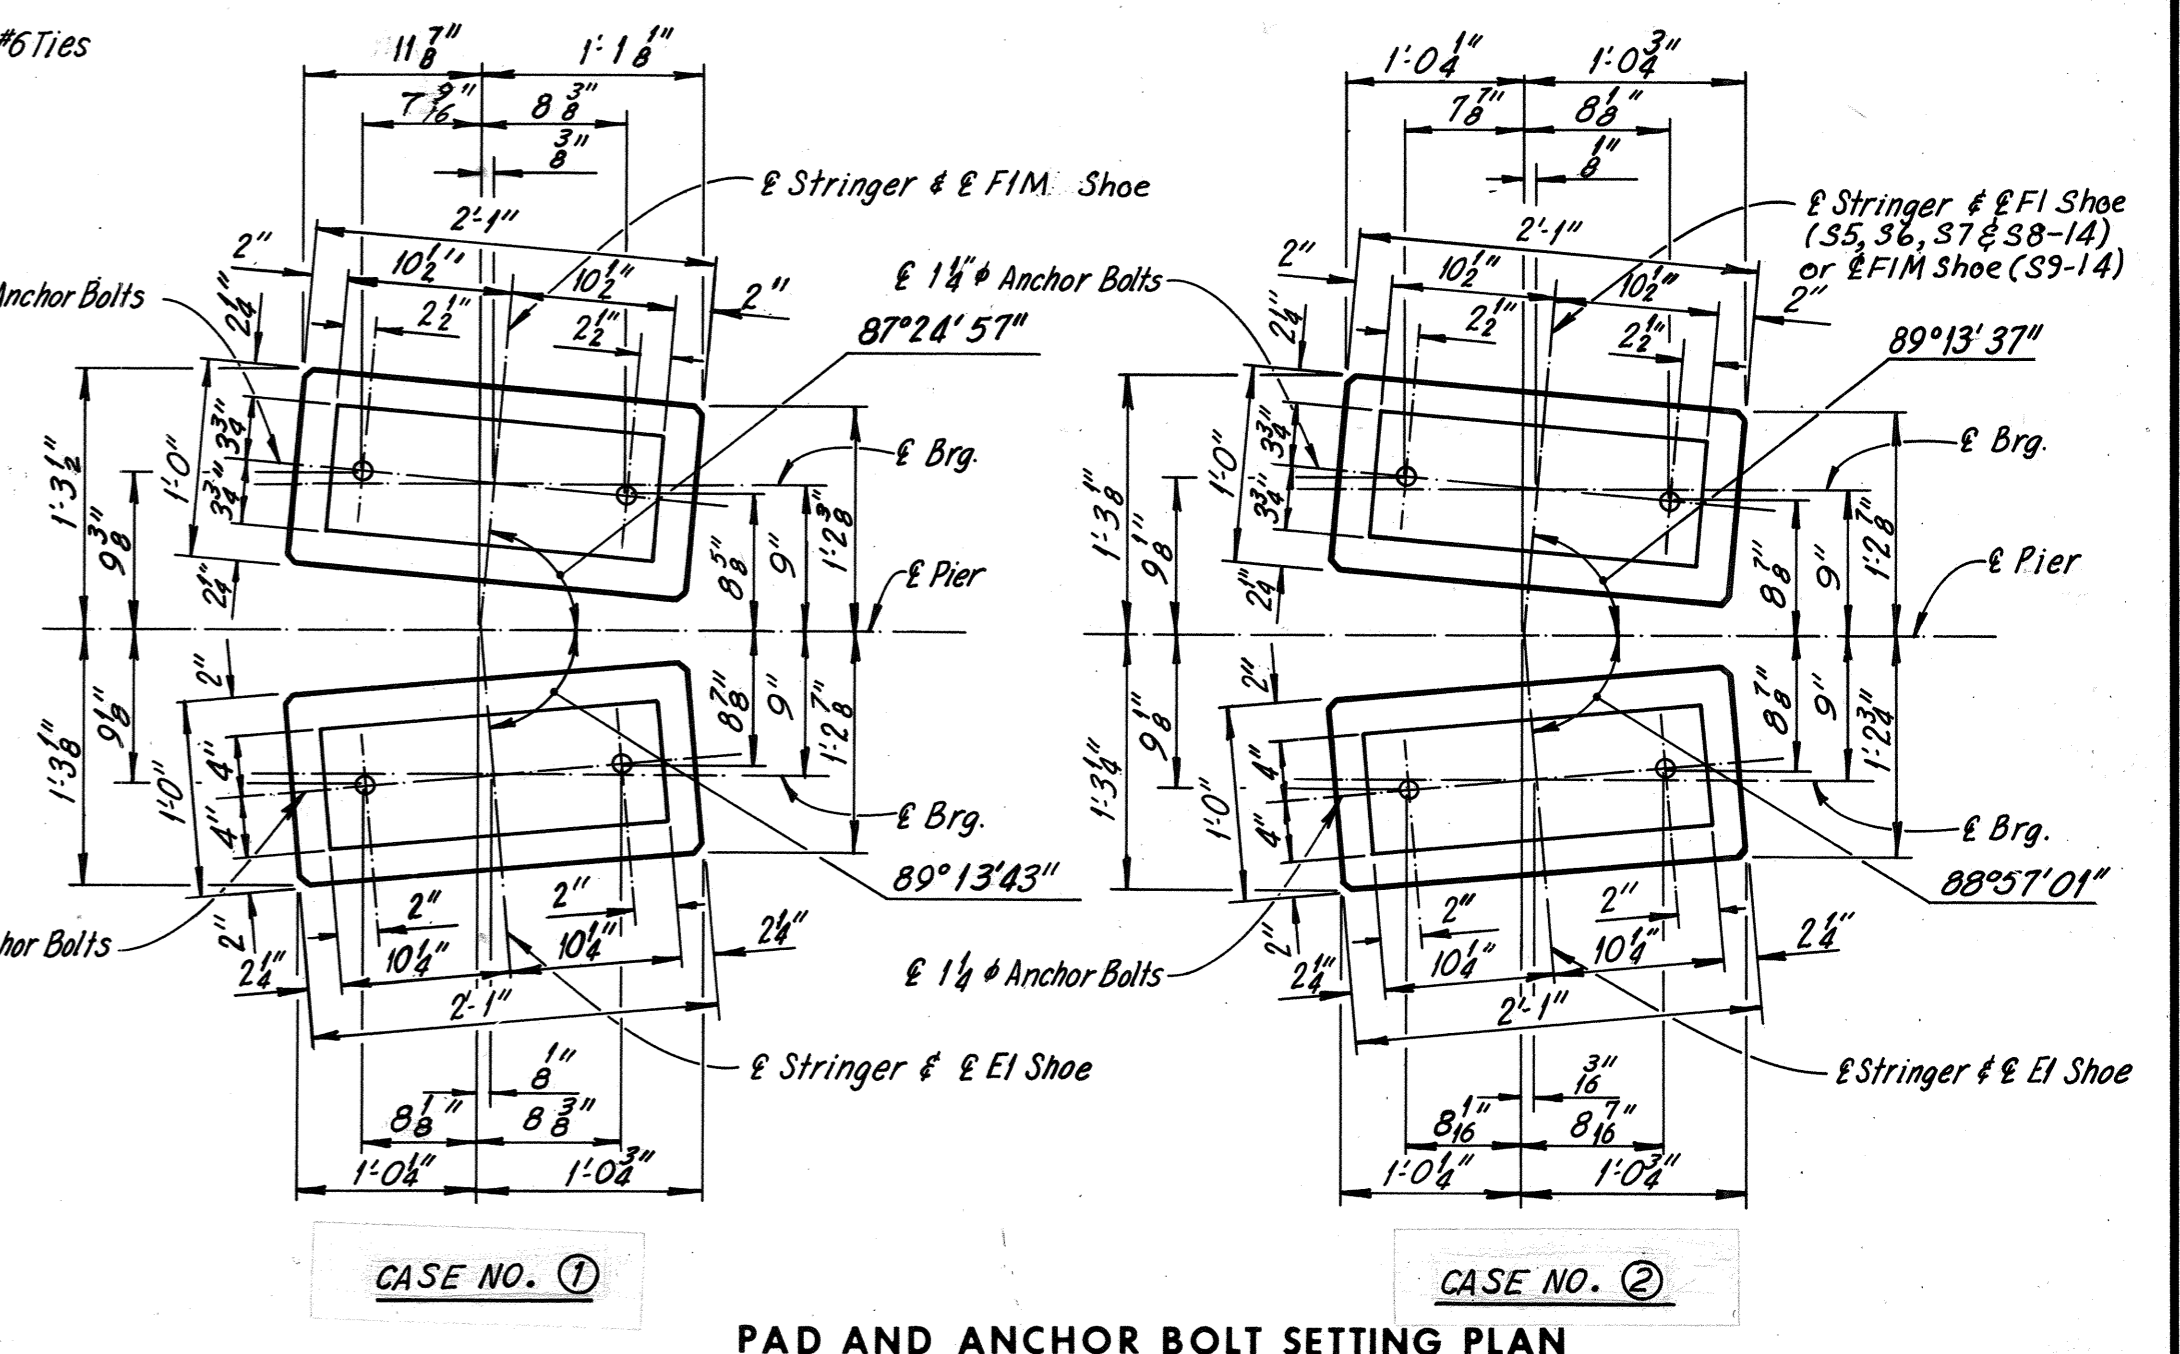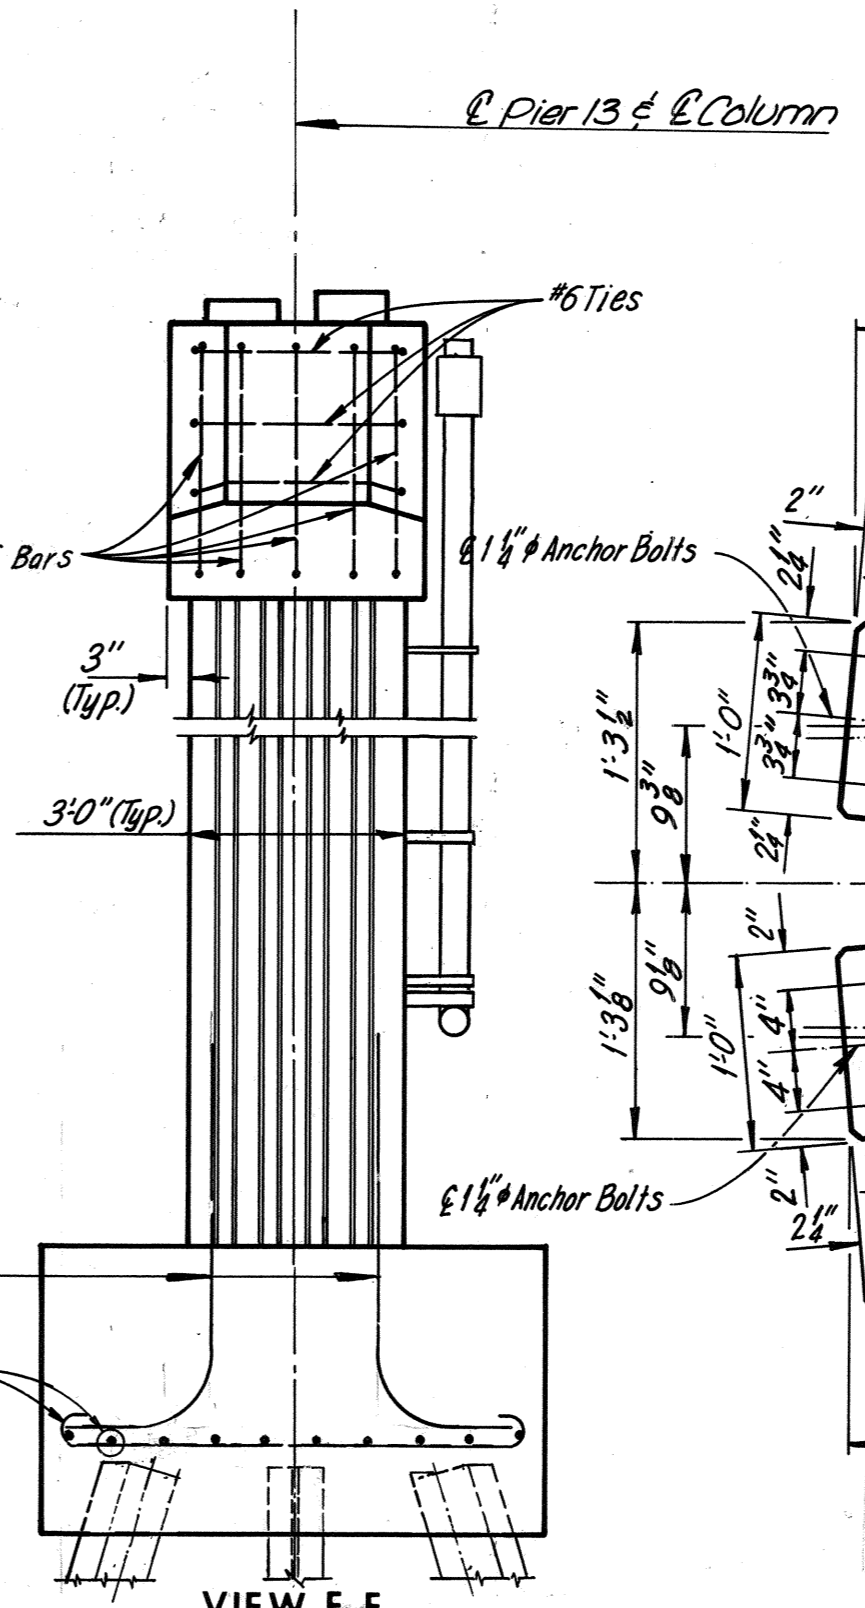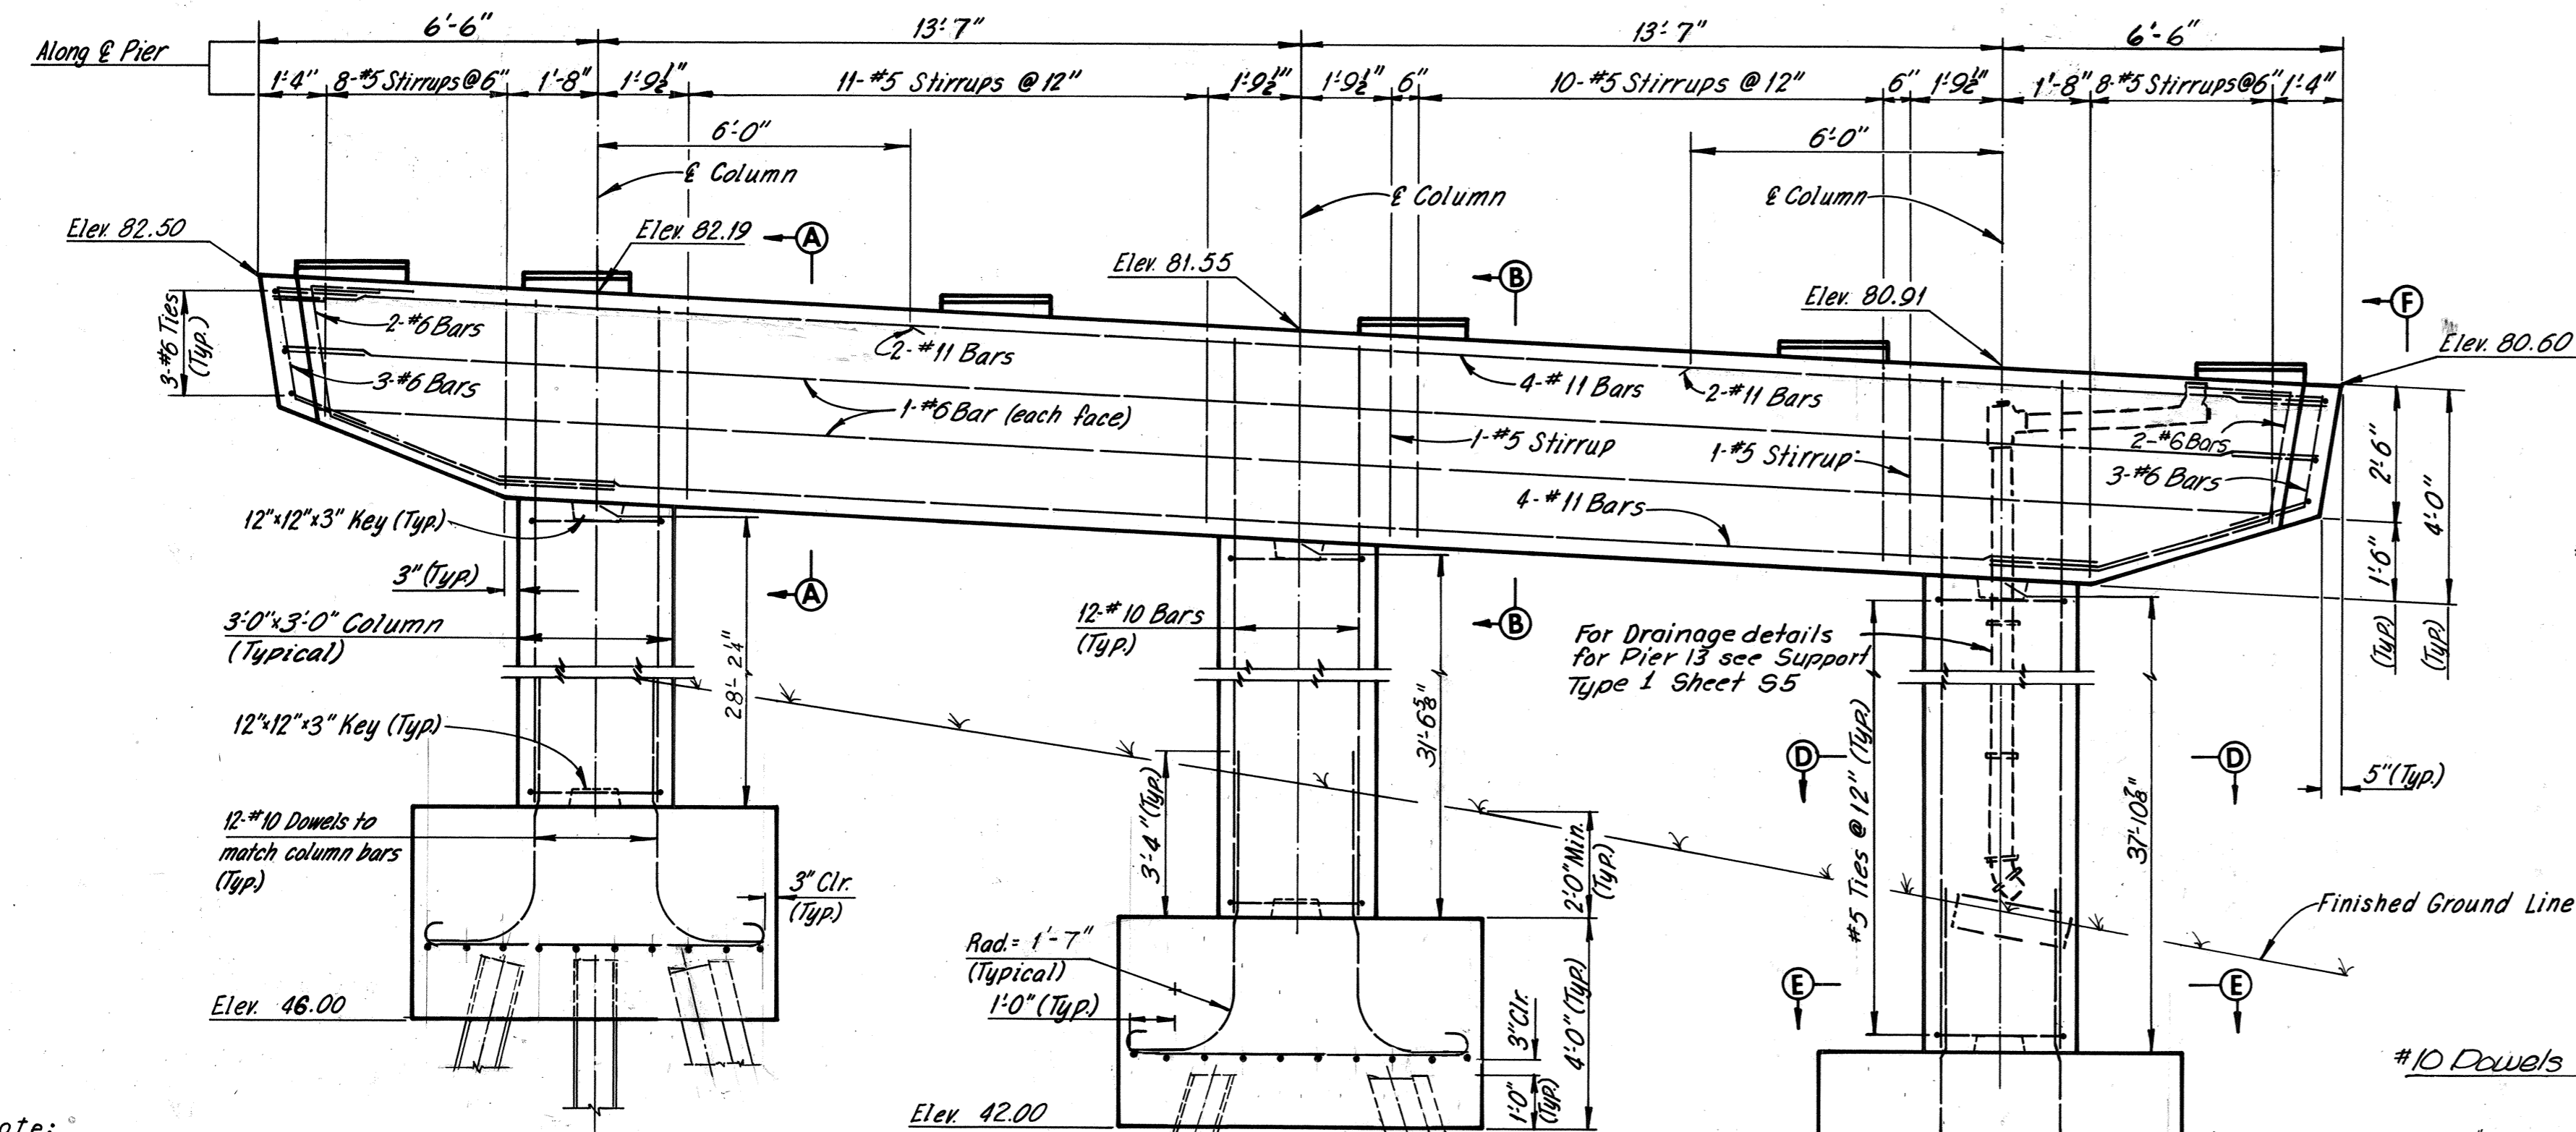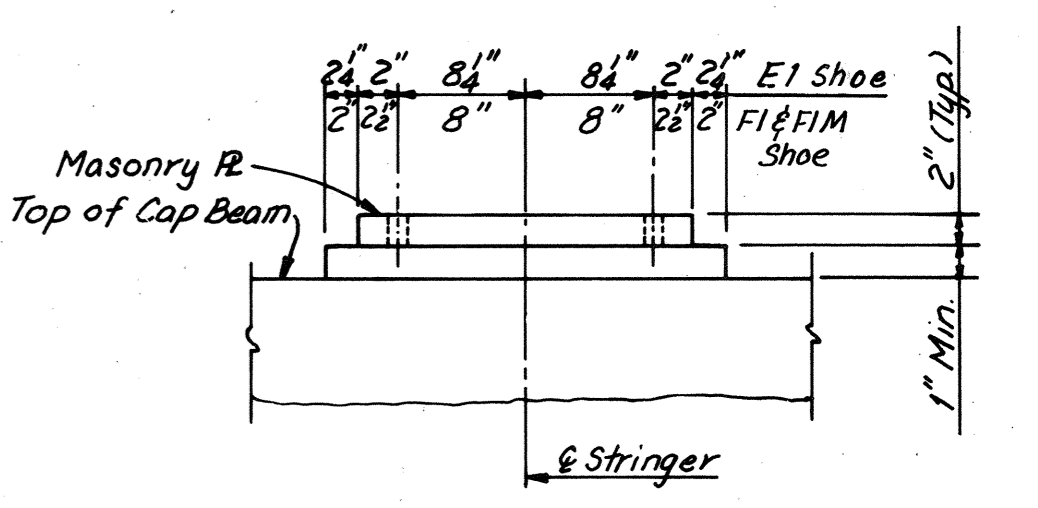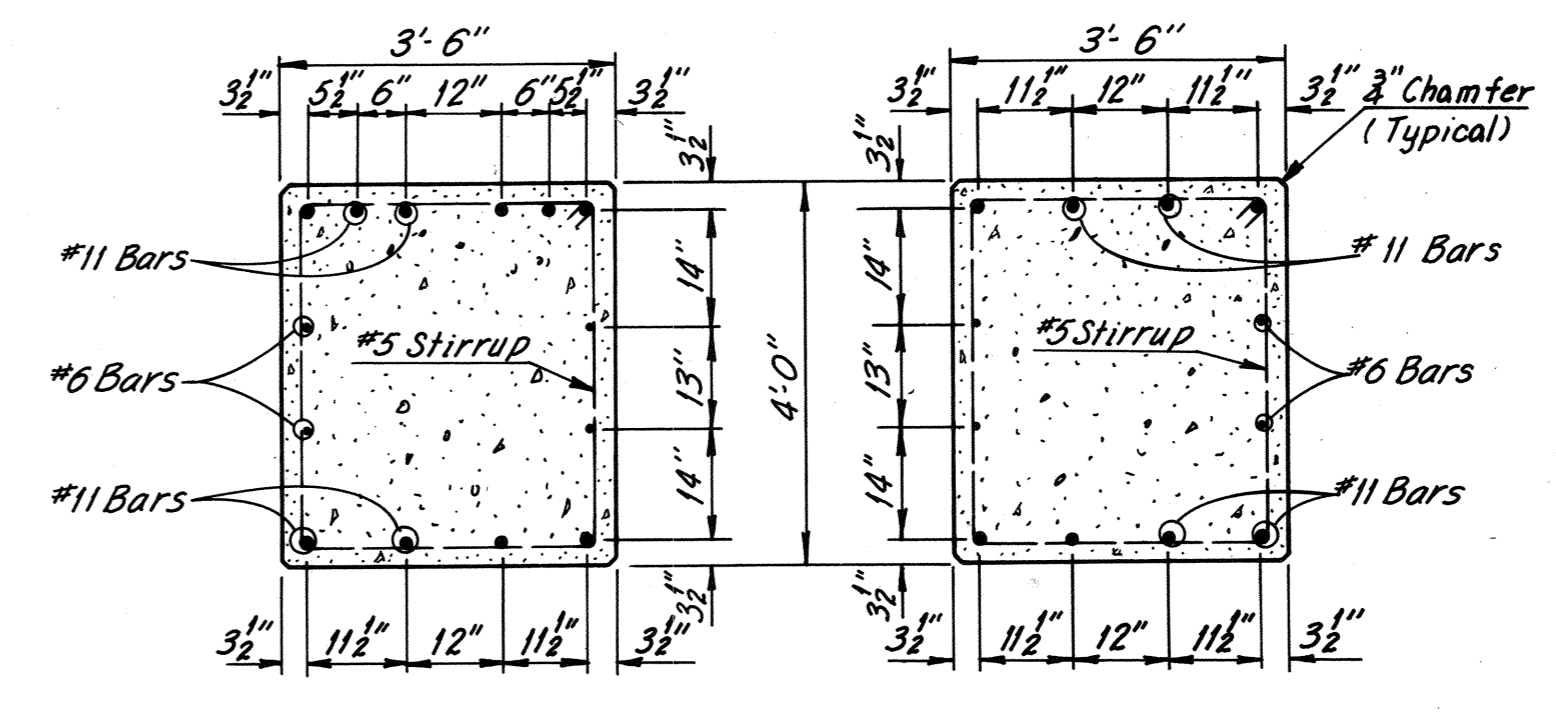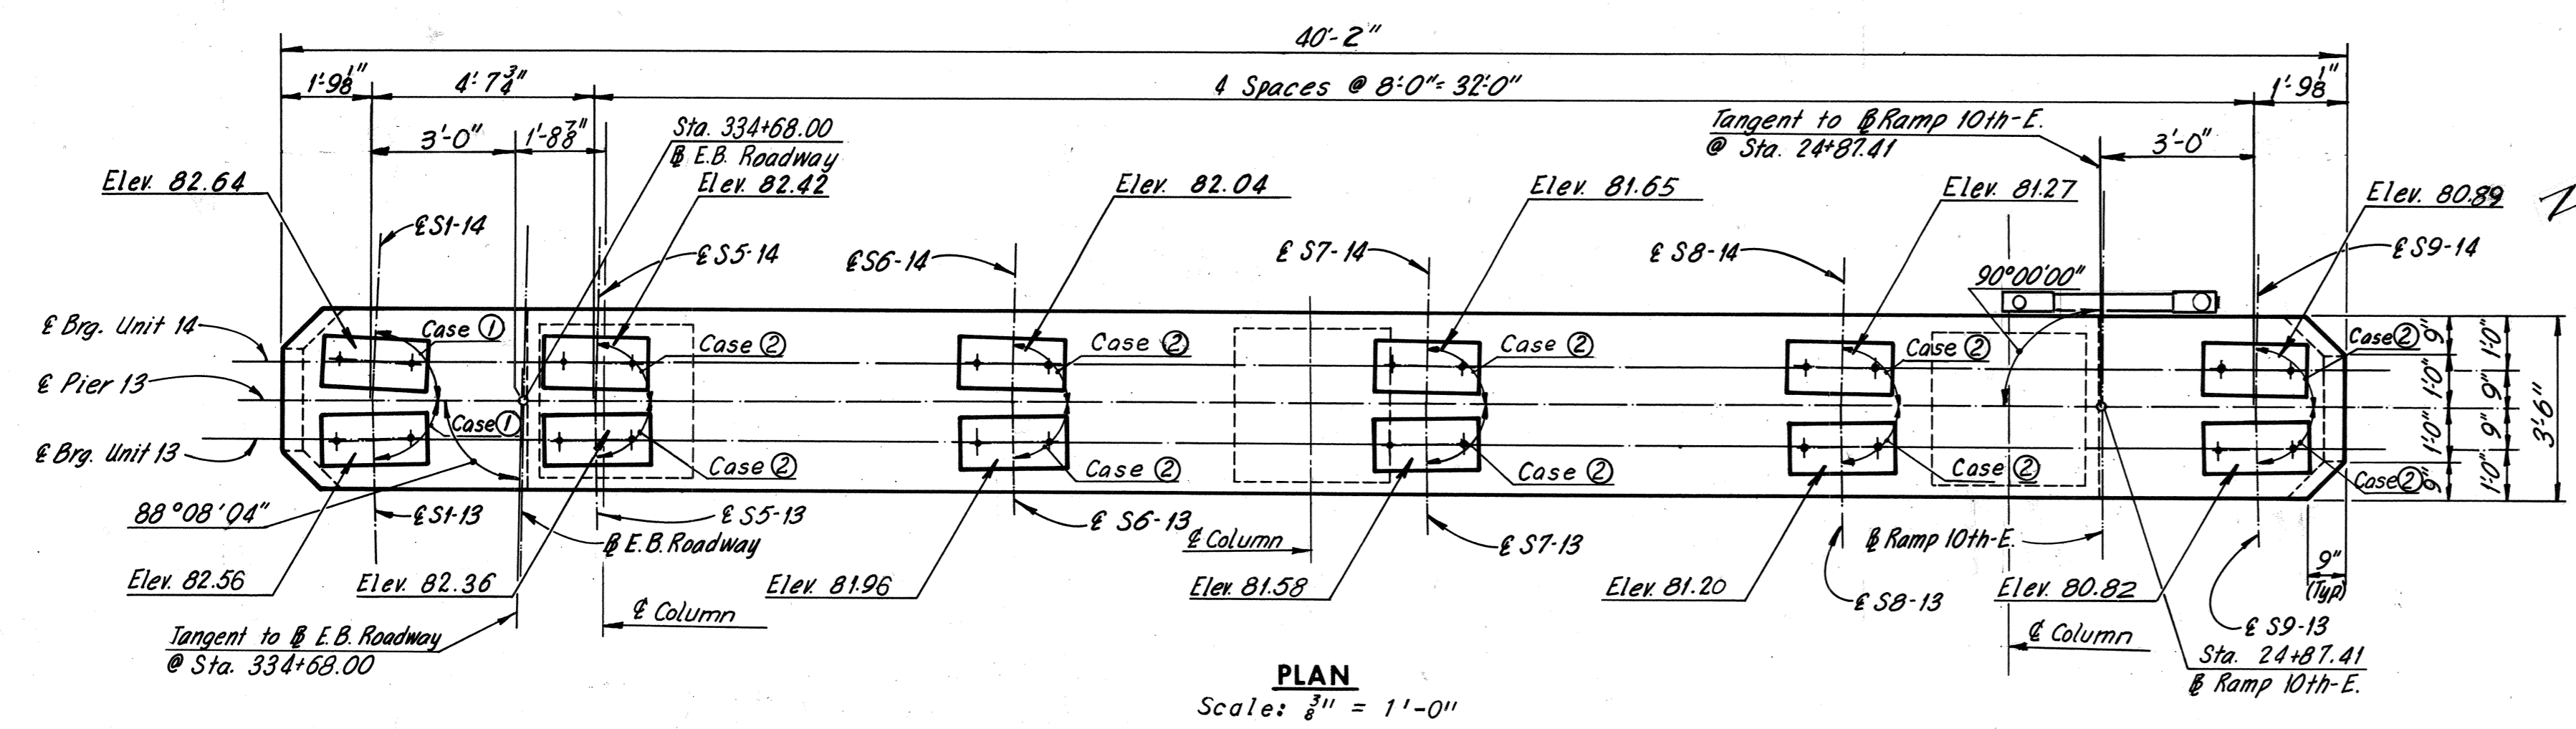

Note: Footing elevations are approximate only and may be varied to suit field conditions as directed by the Engineer. Vertical shaft reinforcing shall not be cut until these elevations are established. Where elevations change more than 2 ft. redesign will be required.

Note: All piles shall be 10BP42 Steel Piles (Design capacity = 45 tons).
Batter all piles 3" per foot where shown.
For Standard Shoe details see Sheets S1 and S2.
For Framing Plan see Sheet 16.
For Steel Pile Details, see Sheet 11.
Estimated Pile Tip Elev., 5.00.
For architectural treatment of columns, see Sheet S7.

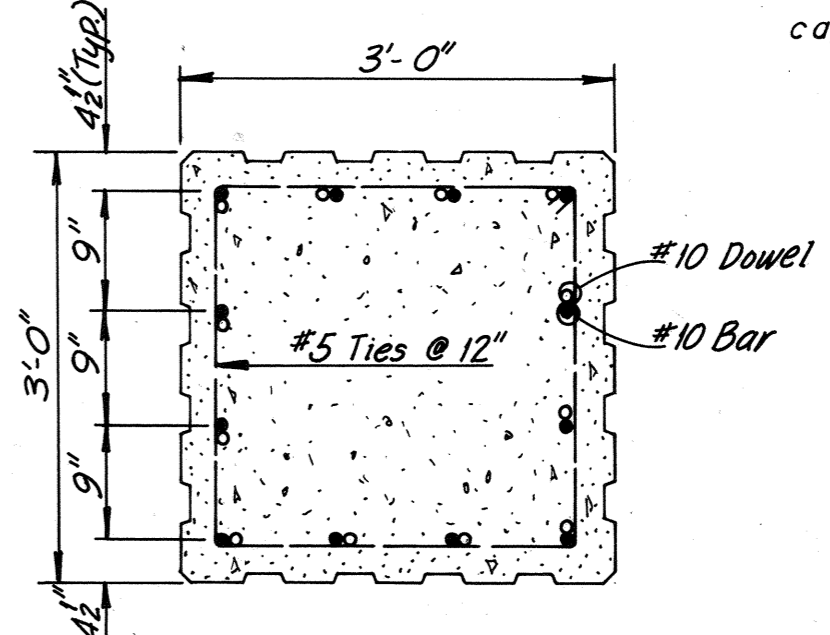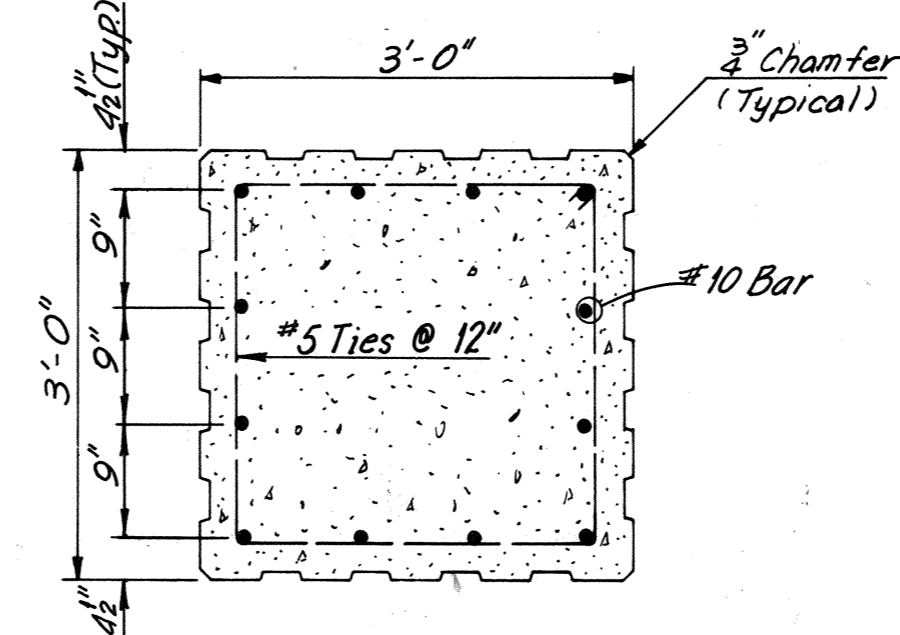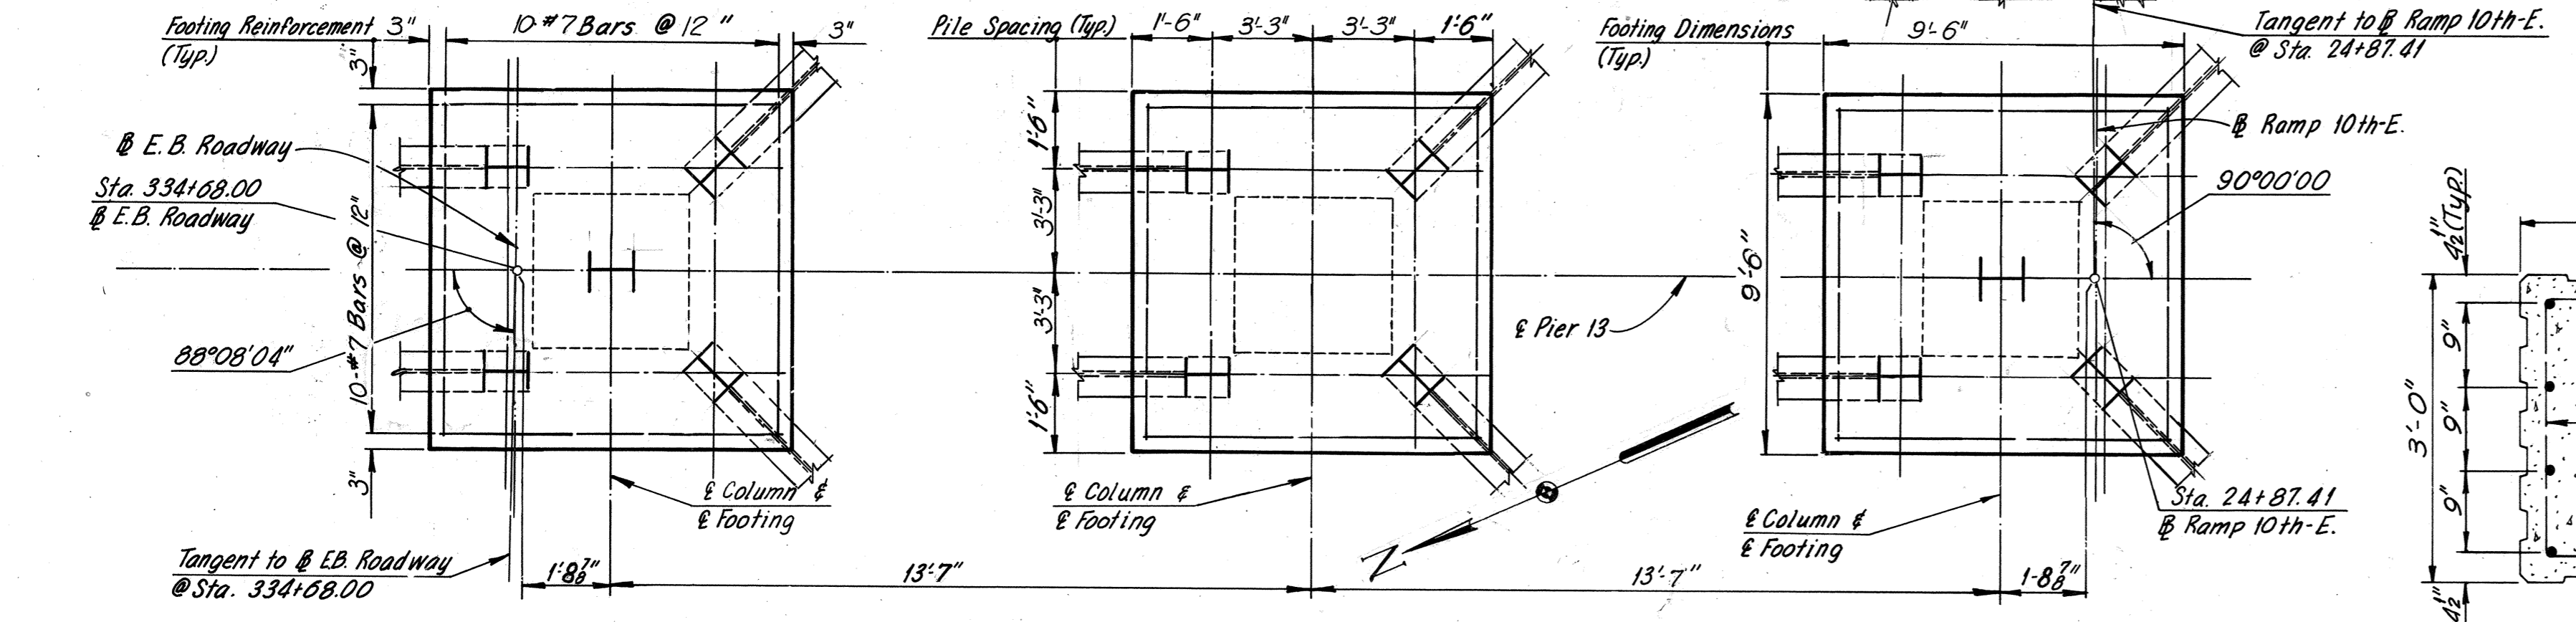

NO.	REVISION	BY	DATE
2	As Built	TEM	8-76
	Footing elev. Revis.	R.B.H.	8-74
	Pile pattern, Dim.		
	Col. heights		


RICHMOND METROPOLITAN AUTHORITY
RICHMOND EXPRESSWAY SYSTEM
DOWNTOWN EXPRESSWAY

BRIDGE NO. 66
EASTBOUND ROADWAY OVER
12TH ST. - R.R. TRACKS AND 16TH ST.
PIER 13



HOWARD, NEEDLES, TAMMEN & BERGENDOFF
consulting engineers
NEW YORK ALEXANDRIA KANSAS CITY

SCALE: As Noted
CONTRACT NO. 10
SHEET NO. 13 OF 46

AS BUILT

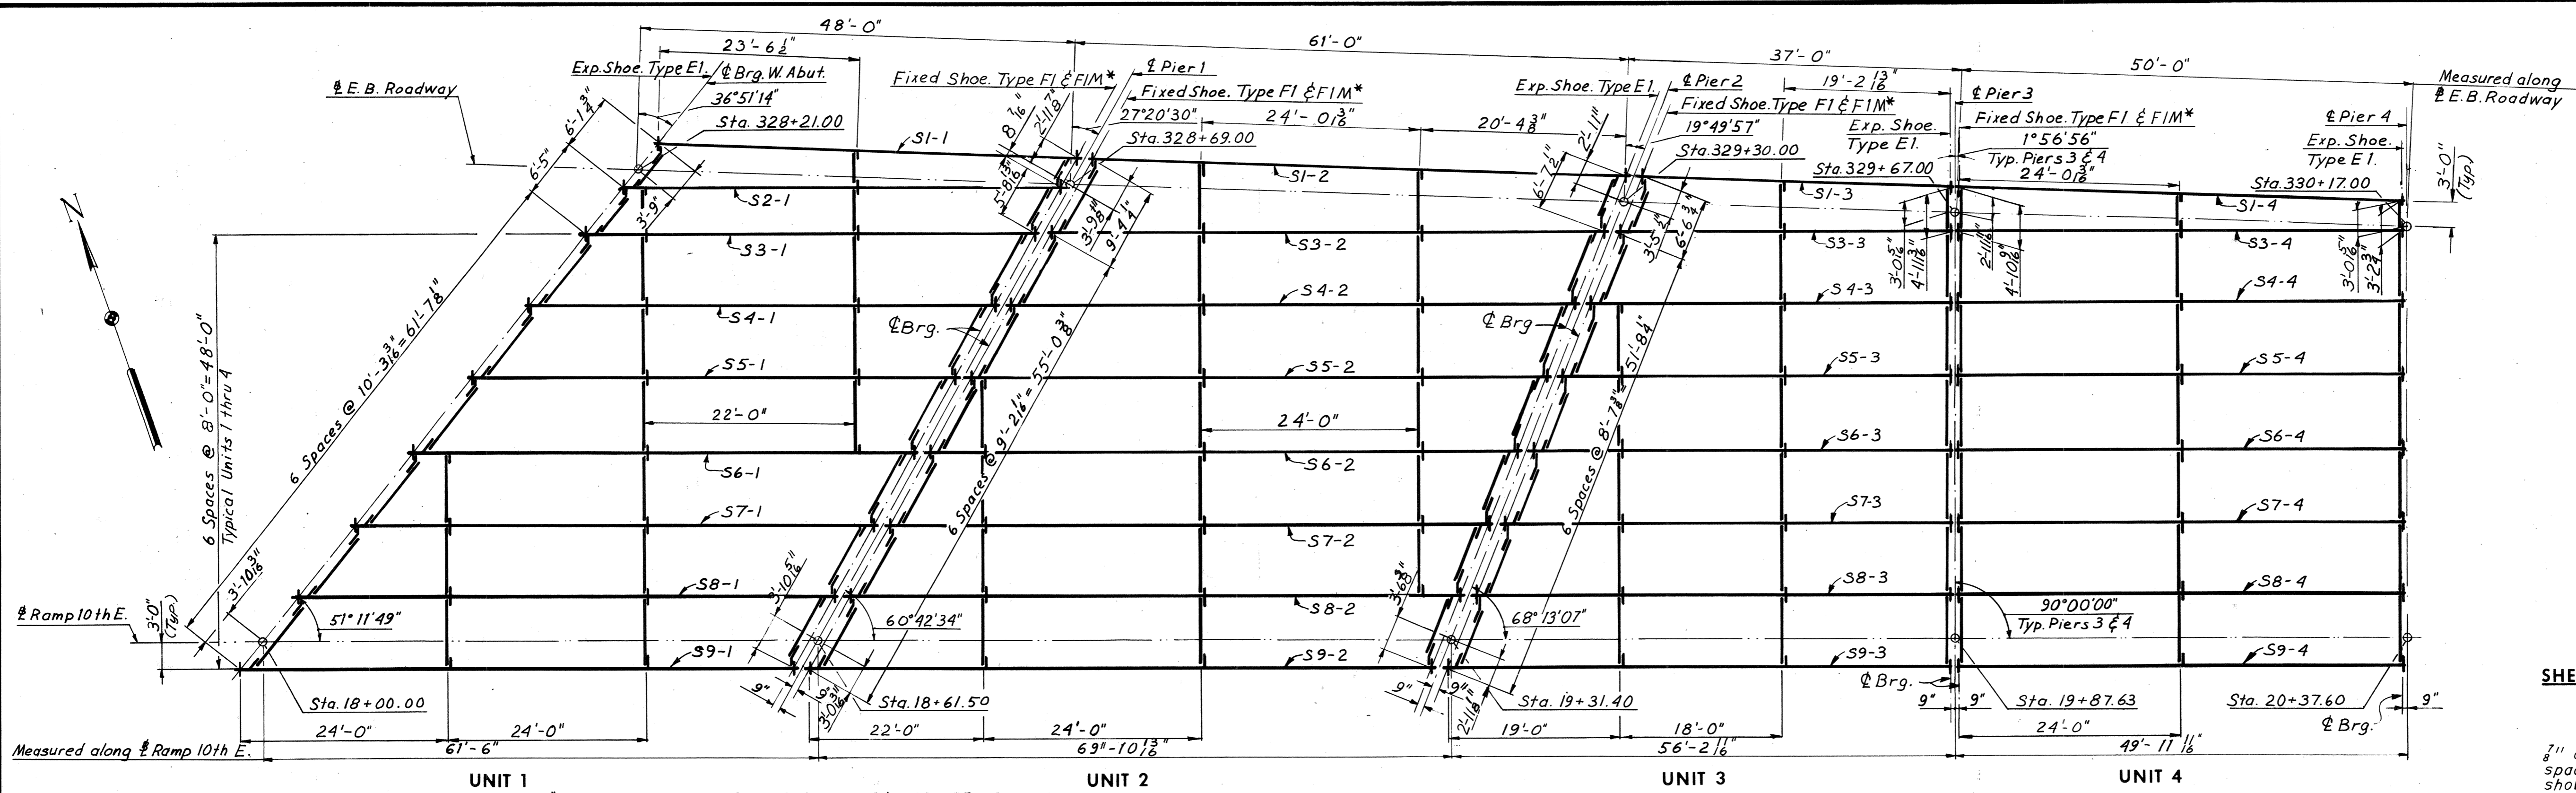

FRAMING PLAN
Scale: 1"=10'-0"

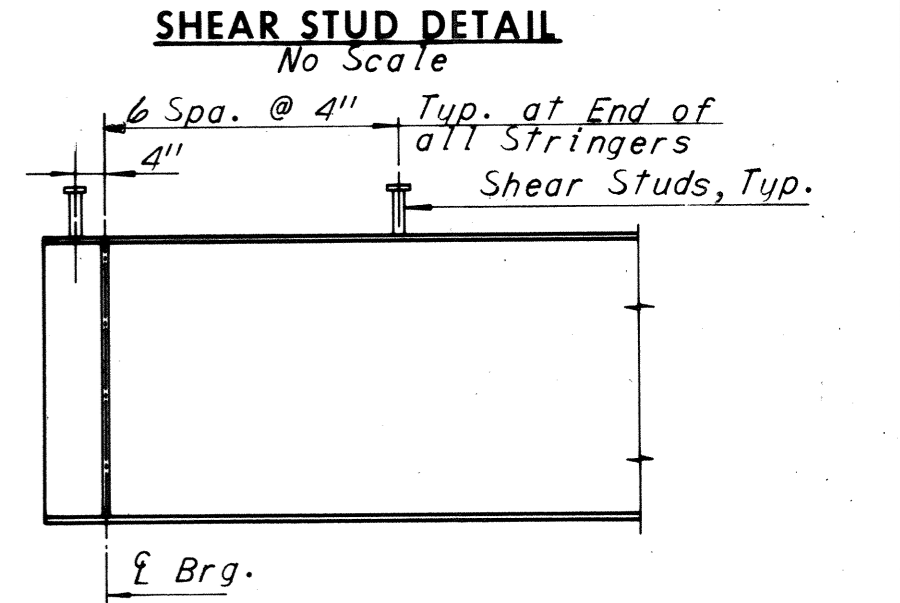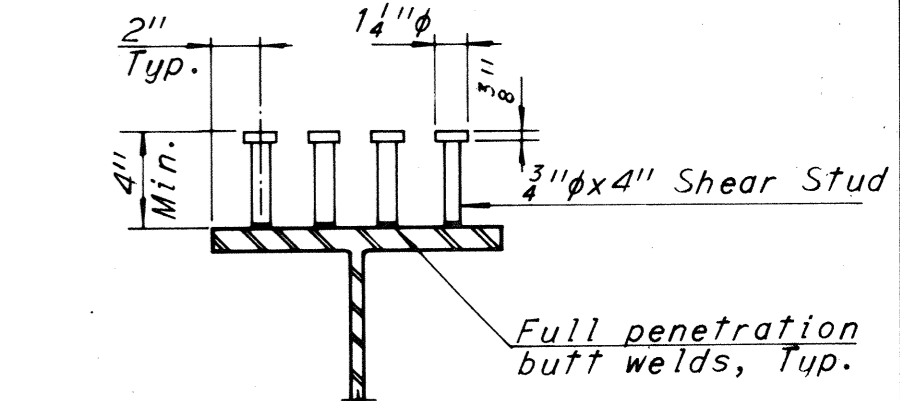


SHEAR STUD NOTE
Capacity = 3,400 lbs. per stud.
Contractor may, if he elects, use three 3/4" diameter studs of the same longitudinal spacing in lieu of the four 3/4" diameter studs shown.
Stud rows shall be placed parallel to the main deck reinforcement.

UNIT	STRINGER	STRINGER SIZE	Dim. "A"	LENGTH "L"	Dim. "B"	Dim. "C"	Dim. "D"	PL. "D"	MAX. SHEAR STUD SPACING					DEAD LOAD DEFLECTION SCHEDULE			CAMBER SCHEDULE					
									0.0L-0.1L	0.1L-0.2L	0.2L-0.3L	0.3L-0.4L	0.4L-0.5L	1/4L	1/2L	3/4L	1/4L	1/2L	3/4L			
									1	S1-1	33 WF 118	48'-6 1/2"	46'-5 1/2"	1'-4 1/2"	9"	0	0	13"	14 1/2"	17"	20 1/2"	24"
4	S9-4	30 WF 108	49'-9 3/4"	48'-5 3/4"	8"	8"	19'-0"	9x3 1/2"	7"	8"	9 1/2"	11 1/2"	14"	5"	10"	5"	8"	5"	5"	5"	5"	5"


Notes:
For Diaphragm and Connection Details, see Sheet 26.
For Joint Details, see Sheet 37.
For Shoe Details, see Sheets S1 and S2.
For angles between Piers and Stringers, see Sheets 3, 6, 7 & 8.
For Superstructure steel quantities, see Sheet 2.

* Spacing begins at termination of 6 spaces @ 4".
Note: All steel shall be A36 unless otherwise denoted.

BY	DATE	REVISION	BY	DATE
MADE	J.D. 8-6-68	2 As Built	TEM	8-7-68
CHECKED	J.V. 10-22-68	1 Pier 1, 2 Dim. Change	LBP	10-16-74
IN CHARGE				


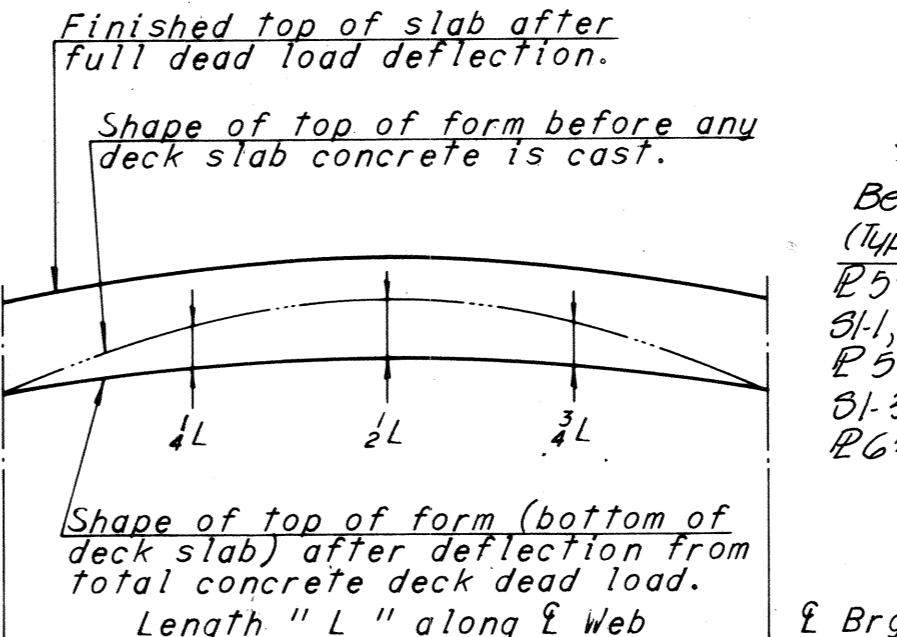


NOTE TO CONTRACTOR
Deflections given are those anticipated to occur in the stringer upon placement of the total concrete deck load.
In practice, the stringers in place are not likely to have the exact camber to compensate for these deflections during construction. The residual amounts shall be provided by adjusting forms to vary the thickness of the concrete haunch between the bottom of the slab and the top of stringer without altering the slab thickness.

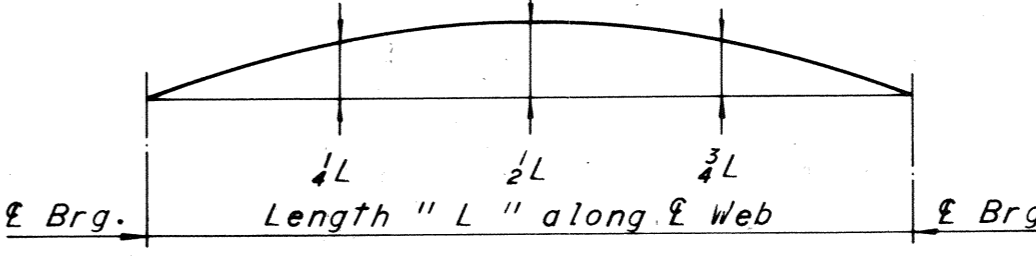

NOTE TO FABRICATOR
The stringers shall be fabricated with an upward camber amounting to the tabulated value.
This will provide approximate compensation for deflection under full dead load and for conformity with finished grade.
Dimensions are in inches.

SHOE SCHEDULE			
EXPANSION SHOES		FIXED SHOES	
TYPE	NO. REQD.	TYPE	NO. REQD.
EL	33	F1	16
		F1M	17

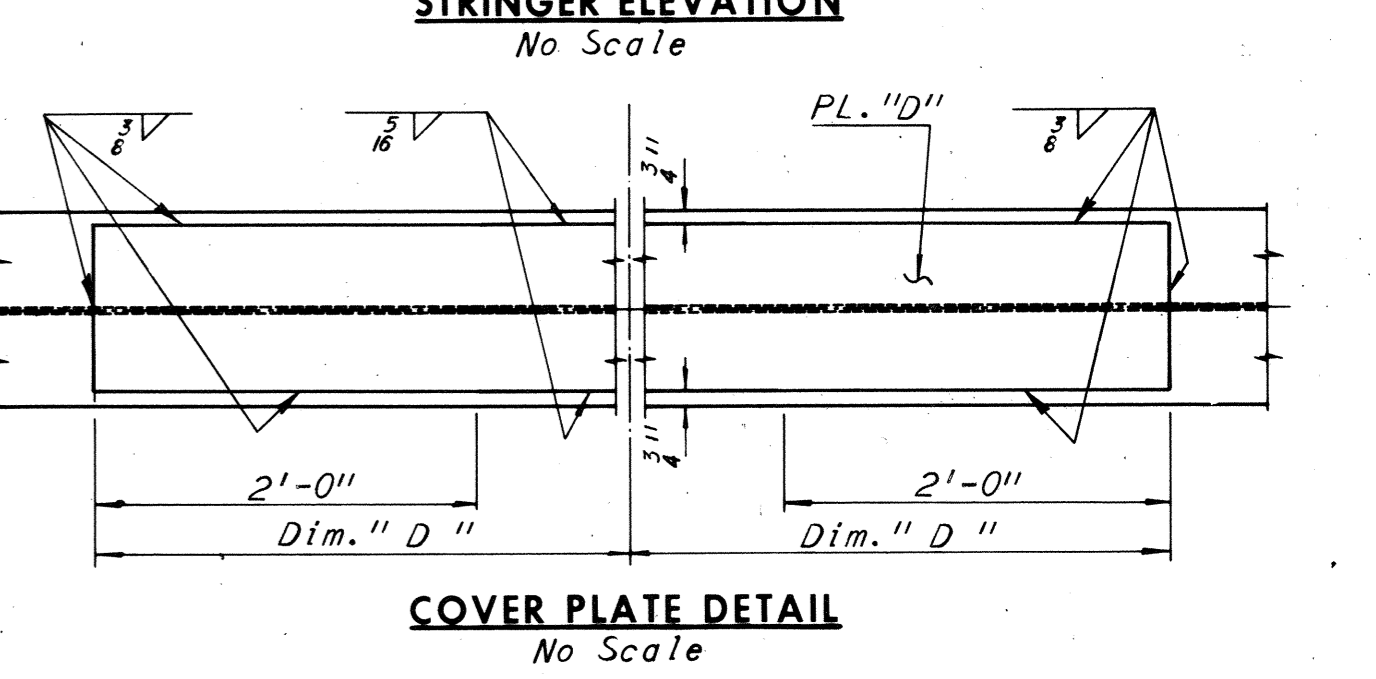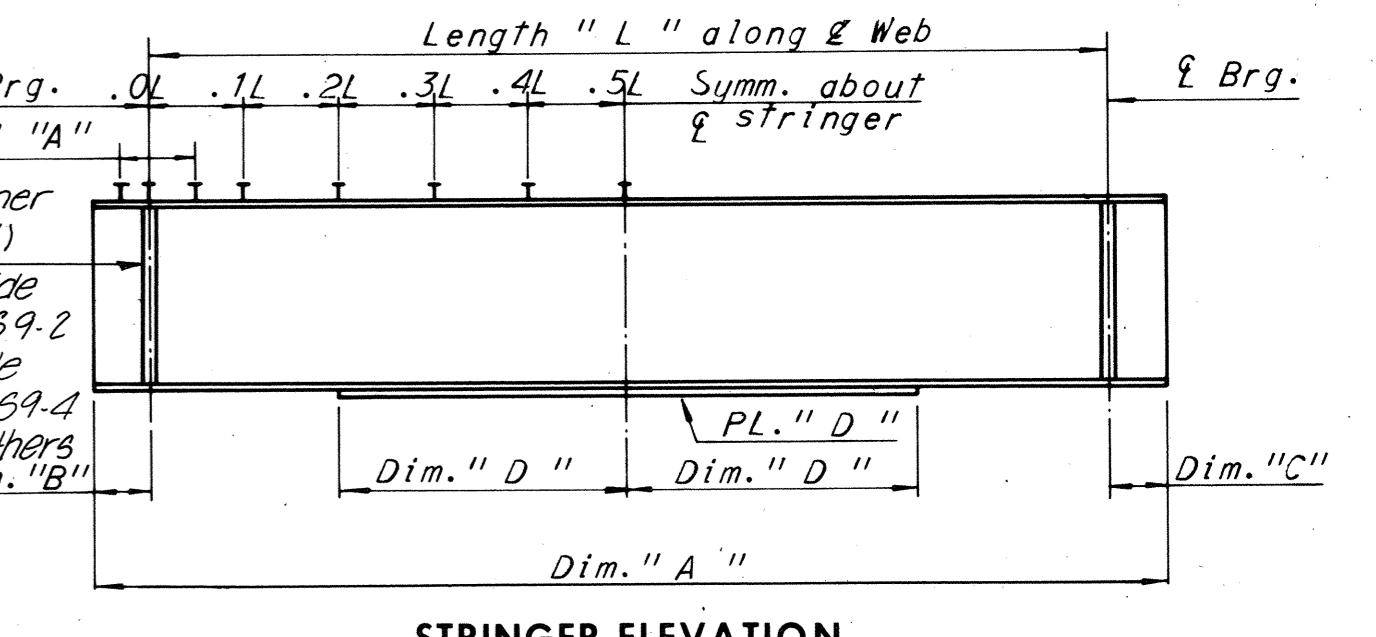

Note: Stringers having a total camber of less than 1" are not required to be shop cambered, but should be turned so that any mill tolerance deviation from straightness will be in the direction shown by the Camber Diagram.
If stringers are not cambered, distance top of stringers to top of slab will vary along the stringer in accordance with the offset dimensions shown in the Camber Diagram, and with minimum distance as shown in cross-section on Sheet 28.


RICHMOND METROPOLITAN AUTHORITY
RICHMOND EXPRESSWAY SYSTEM
DOWNTOWN EXPRESSWAY

BRIDGE NO. 66
EASTBOUND ROADWAY OVER
12TH ST. - R.R. TRACKS AND 16TH ST.
FRAMING PLAN - UNITS 1,2,3 AND 4

HOWARD, NEEDLES, TAMMEN & BERGENDOFF
consulting engineers
NEW YORK ALEXANDRIA KANSAS CITY

SCALE: 1"=10' Unless as shown
CONTRACT NO. 10
SHEET NO. 14 OF 46

AS BUILT

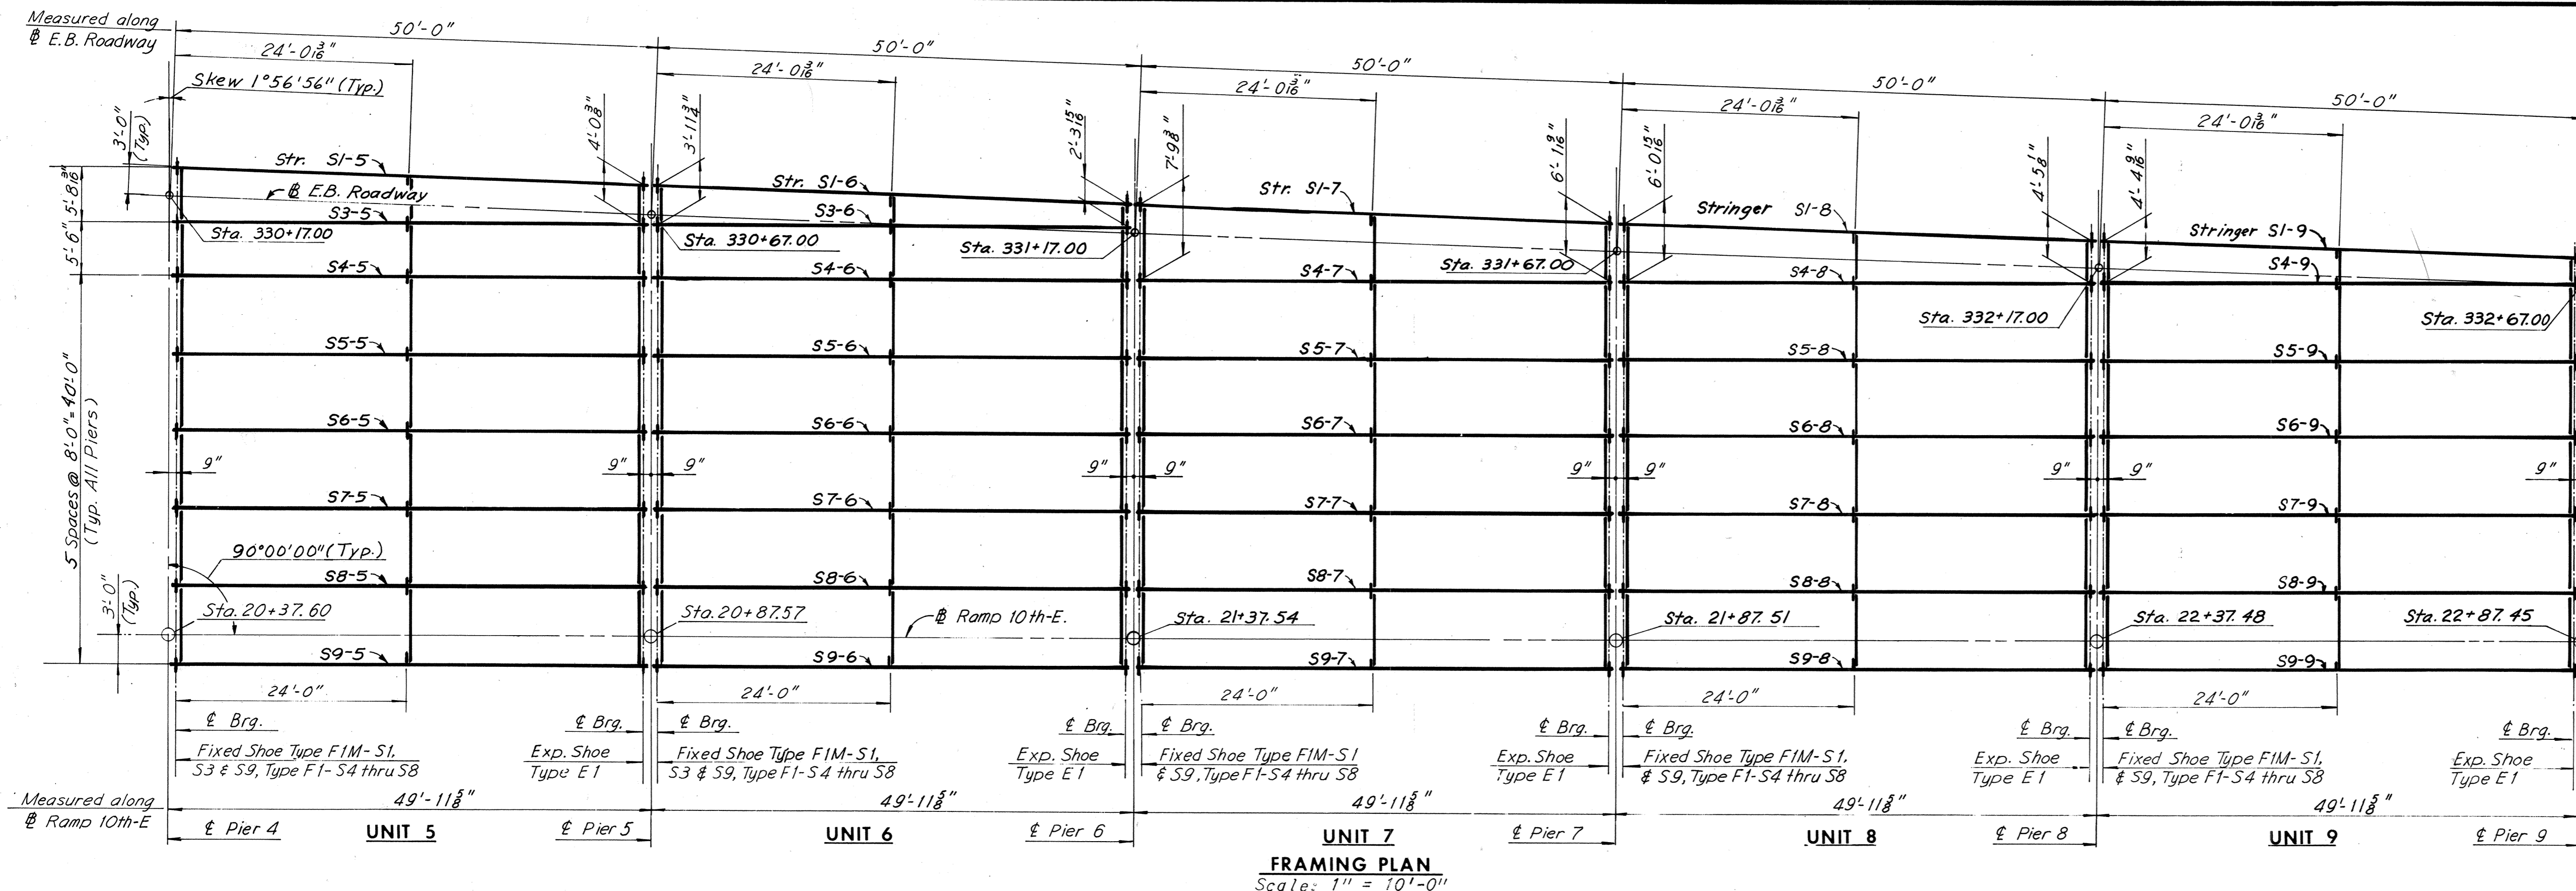

SHOE SCHEDULE			
EXPANSION SHOES		FIXED SHOES	
TYPE	NO. REQD.	TYPE	NO. REQD.
E1	37	F1	25
		F1M	12

FRAMING PLAN
Scale: 1" = 10'-0"


UNIT	STRINGER	STRINGER SIZE	Dim. "A"	LENGTH "L"	Dim. "B"	Dim. "C"	Dim. "D"	PL. "D"	MAX. SHEAR STUD SPACING					DEAD LOAD DEFLECTION SCHEDULE			CAMBER SCHEDULE			
									0.0L-0.1L	0.1L-0.2L	0.2L-0.3L	0.3L-0.4L	0.4L-0.5L	1/4L	1/2L	3/4L	1/4L	1/2L	3/4L	
									0.0L-0.1L	0.1L-0.2L	0.2L-0.3L	0.3L-0.4L	0.4L-0.5L	1/4L	1/2L	3/4L	1/4L	1/2L	3/4L	
5	S1-5	30 W 108	49'-10"	48'-6"	8"	8"	0	0	11"	11 1/2"	13 1/2"	16 1/2"	20 1/2"	2"	1 1/2"	1"	1/2"	1/4"	1/4"	1/4"
	S3-5	30 W 108	49'-7 3/8"	48'-5 3/8"	7"	7"	0	0	10"	11 1/2"	13"	15 1/2"	19"	2"	1 1/2"	1"	1/2"	1/4"	1/4"	1/4"
	S4-5	30 W 99	49'-7 3/8"	48'-5 3/8"	7"	7"	18'-0"	9x3 3/4"	8"	9"	11"	12 1/2"	15"	2"	1 1/2"	1"	1/2"	1/4"	1/4"	1/4"
	S5-5	30 W 108	49'-7 3/8"	48'-5 3/8"	7"	7"	18'-6"	9x3 3/4"	7"	7 1/2"	9 1/2"	11"	13"	2"	1 1/2"	1"	1/2"	1/4"	1/4"	1/4"
	S6-5	30 W 108	49'-7 3/8"	48'-5 3/8"	7"	7"	18'-6"	9x3 3/4"	7"	7 1/2"	9 1/2"	11"	13"	2"	1 1/2"	1"	1/2"	1/4"	1/4"	1/4"
6	S7-5	30 W 108	49'-7 3/8"	48'-5 3/8"	7"	7"	18'-6"	9x3 3/4"	7"	7 1/2"	9 1/2"	11"	13"	2"	1 1/2"	1"	1/2"	1/4"	1/4"	1/4"
	S8-5	30 W 108	49'-7 3/8"	48'-5 3/8"	7"	7"	18'-6"	9x3 3/4"	7"	7 1/2"	9 1/2"	11"	13"	2"	1 1/2"	1"	1/2"	1/4"	1/4"	1/4"
	S9-5	30 W 108	49'-9 3/8"	48'-5 3/8"	8"	8"	19'-0"	9x3 3/4"	7 1/2"	8"	9 1/2"	11 1/2"	14"	2"	1 1/2"	1"	1/2"	1/4"	1/4"	1/4"
9	S1-9	30 W 99	49'-10"	48'-6"	8"	8"	0	0	14"	15"	18"	22"	24"	2"	1 1/2"	1"	1/2"	1/4"	1/4"	1/4"
	S4-9	30 W 99	49'-7 3/8"	48'-5 3/8"	7"	7"	17'-0"	9x3 3/4"	9"	10"	12"	14"	17"	2"	1 1/2"	1"	1/2"	1/4"	1/4"	1/4"
	S5-9	30 W 108	49'-7 3/8"	48'-5 3/8"	7"	7"	18'-6"	9x3 3/4"	7"	7 1/2"	9 1/2"	11"	13"	2"	1 1/2"	1"	1/2"	1/4"	1/4"	1/4"
	S6-9	30 W 108	49'-7 3/8"	48'-5 3/8"	7"	7"	18'-6"	9x3 3/4"	7"	7 1/2"	9 1/2"	11"	13"	2"	1 1/2"	1"	1/2"	1/4"	1/4"	1/4"
9	S7-9	30 W 108	49'-7 3/8"	48'-5 3/8"	7"	7"	18'-6"	9x3 3/4"	7"	7 1/2"	9 1/2"	11"	13"	2"	1 1/2"	1"	1/2"	1/4"	1/4"	1/4"
	S8-9	30 W 108	49'-7 3/8"	48'-5 3/8"	7"	7"	18'-6"	9x3 3/4"	7"	7 1/2"	9 1/2"	11"	13"	2"	1 1/2"	1"	1/2"	1/4"	1/4"	1/4"
	S9-9	30 W 108	49'-9 3/8"	48'-5 3/8"	8"	8"	19'-0"	9x3 3/4"	7 1/2"	8"	9 1/2"	11 1/2"	14"	2"	1 1/2"	1"	1/2"	1/4"	1/4"	1/4"

* Spacing begins at termination of 6 spaces @ 4".

Notes: For Diaphragm and Connection Details, see Sheet 29.


Note: All steel shall be A36 unless denoted otherwise.

For Joint Details, see Sheet 37.
For Shoe Details, see Sheet 51 and 52.
For Shear Stud Details, see Sheet 14.
For angles between Piers and Stringers, see Sheets 8, 9, 10 & 11.
For Superstructure steel quantities, see Sheet 2.

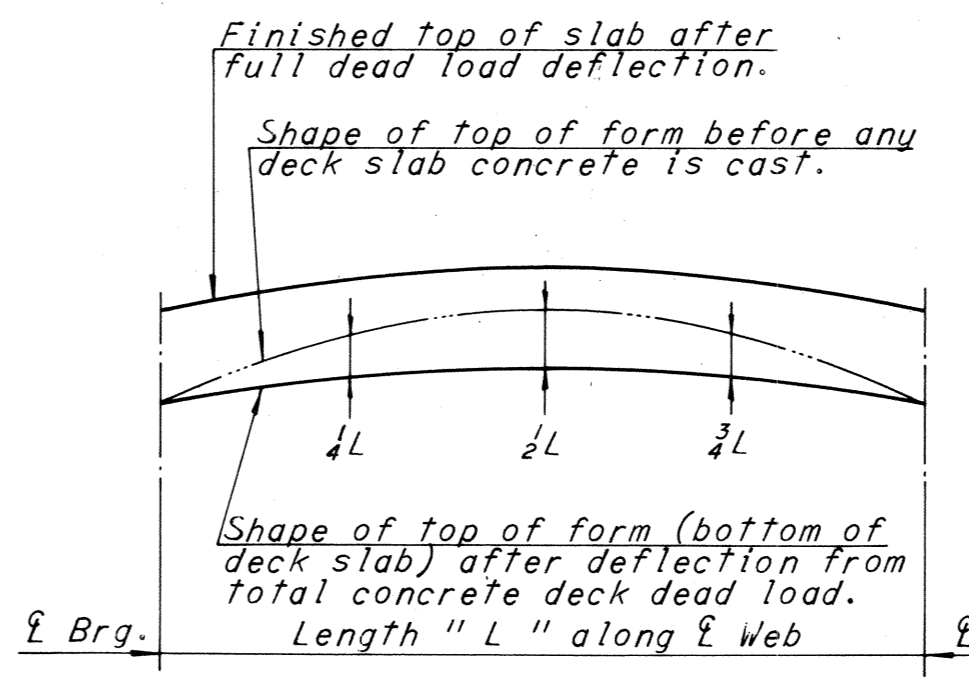


DEAD LOAD DEFLECTION DIAGRAM

NOTE TO CONTRACTOR
Deflections given are those anticipated to occur in the stringer upon placement of the total concrete deck dead load. In practice, the stringers in place are not likely to have the exact camber to compensate for these deflections during construction. The residual amounts shall be provided by adjusting forms to vary the thickness of the concrete haunch between the bottom of the slab and the top of stringer without altering the slab thickness.

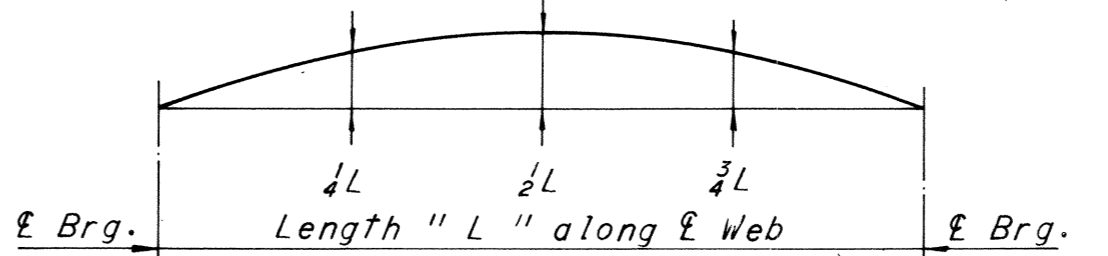


CAMBER DIAGRAM

NOTE TO FABRICATOR
The stringers shall be fabricated with an upward camber amounting to the tabulated value. This will provide approximate compensation for deflection under full dead load and for conformity with finished grade. Dimensions are in inches.

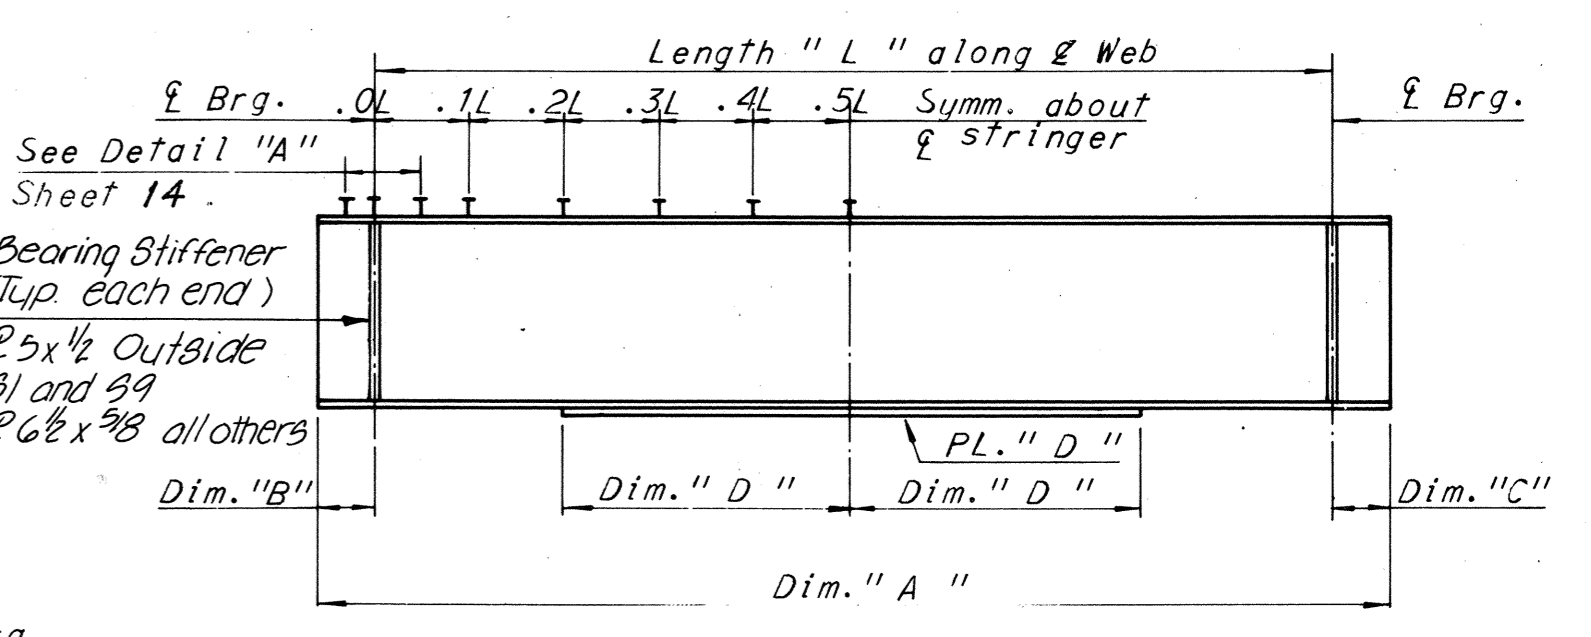

STRINGER ELEVATION
No Scale

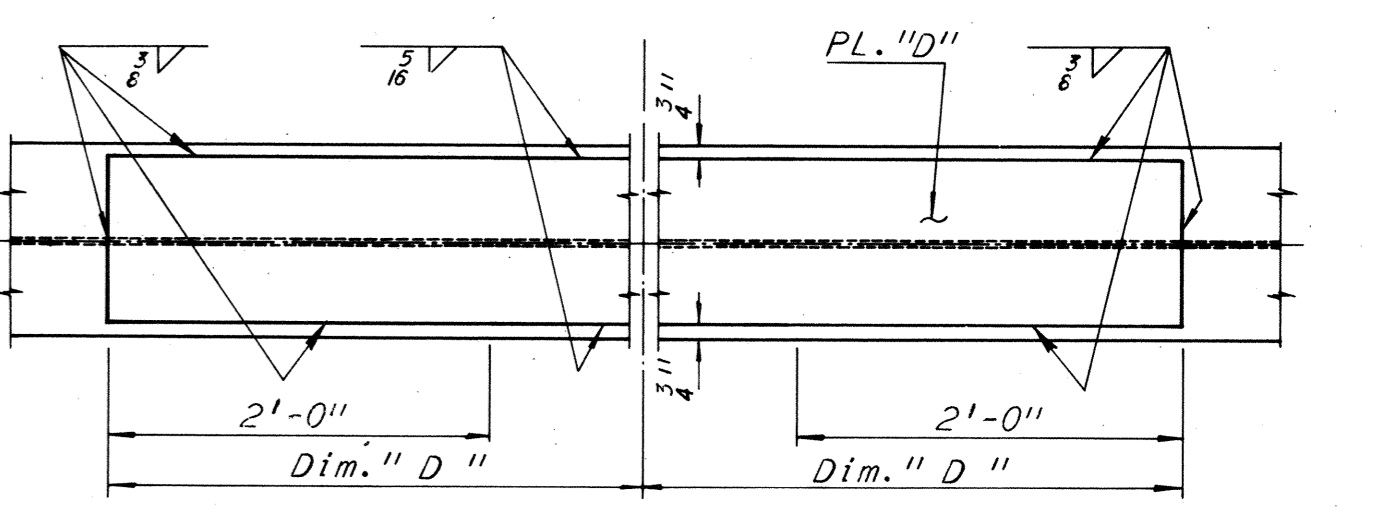

COVER PLATE DETAIL
No Scale

Note: Stringers having a total camber of less than 1" are not required to be shop cambered, but should be turned so that any mill tolerance deviation from straightness will be in the direction shown by the Camber Diagram. If stringers are not cambered, distance top of stringers to top of slab will vary along the stringer in accordance with the offset dimensions shown in the Camber Diagram, and with minimum distance as shown in cross-section on Sheet 29.

BY	DATE	REVISION	BY	DATE
SAH	8-2-68			
JD	10-21-68	1 As Built	TEM	8-76

RICHMOND METROPOLITAN AUTHORITY
RICHMOND EXPRESSWAY SYSTEM
DOWNTOWN EXPRESSWAY


BRIDGE NO. 66
EASTBOUND ROADWAY OVER
12TH ST. - R.R. TRACKS AND 16TH ST.
FRAMING PLAN - UNITS 5, 6, 7, 8, AND 9

HOWARD, NEEDLES, TAMMEN & BERGENOFF
consulting engineers
NEW YORK ALEXANDRIA KANSAS CITY


SCALE: 1"=10' Unless as shown
CONTRACT NO.: 10
SHEET NO. 15 OF 46

AS BUILT


RICHMOND EXPRESSWAY SYSTEM			
SECTION	PROJECT	SHEET NO.	TOTAL SHEETS
10	DOWNTOWN EXPRESSWAY	142A	265

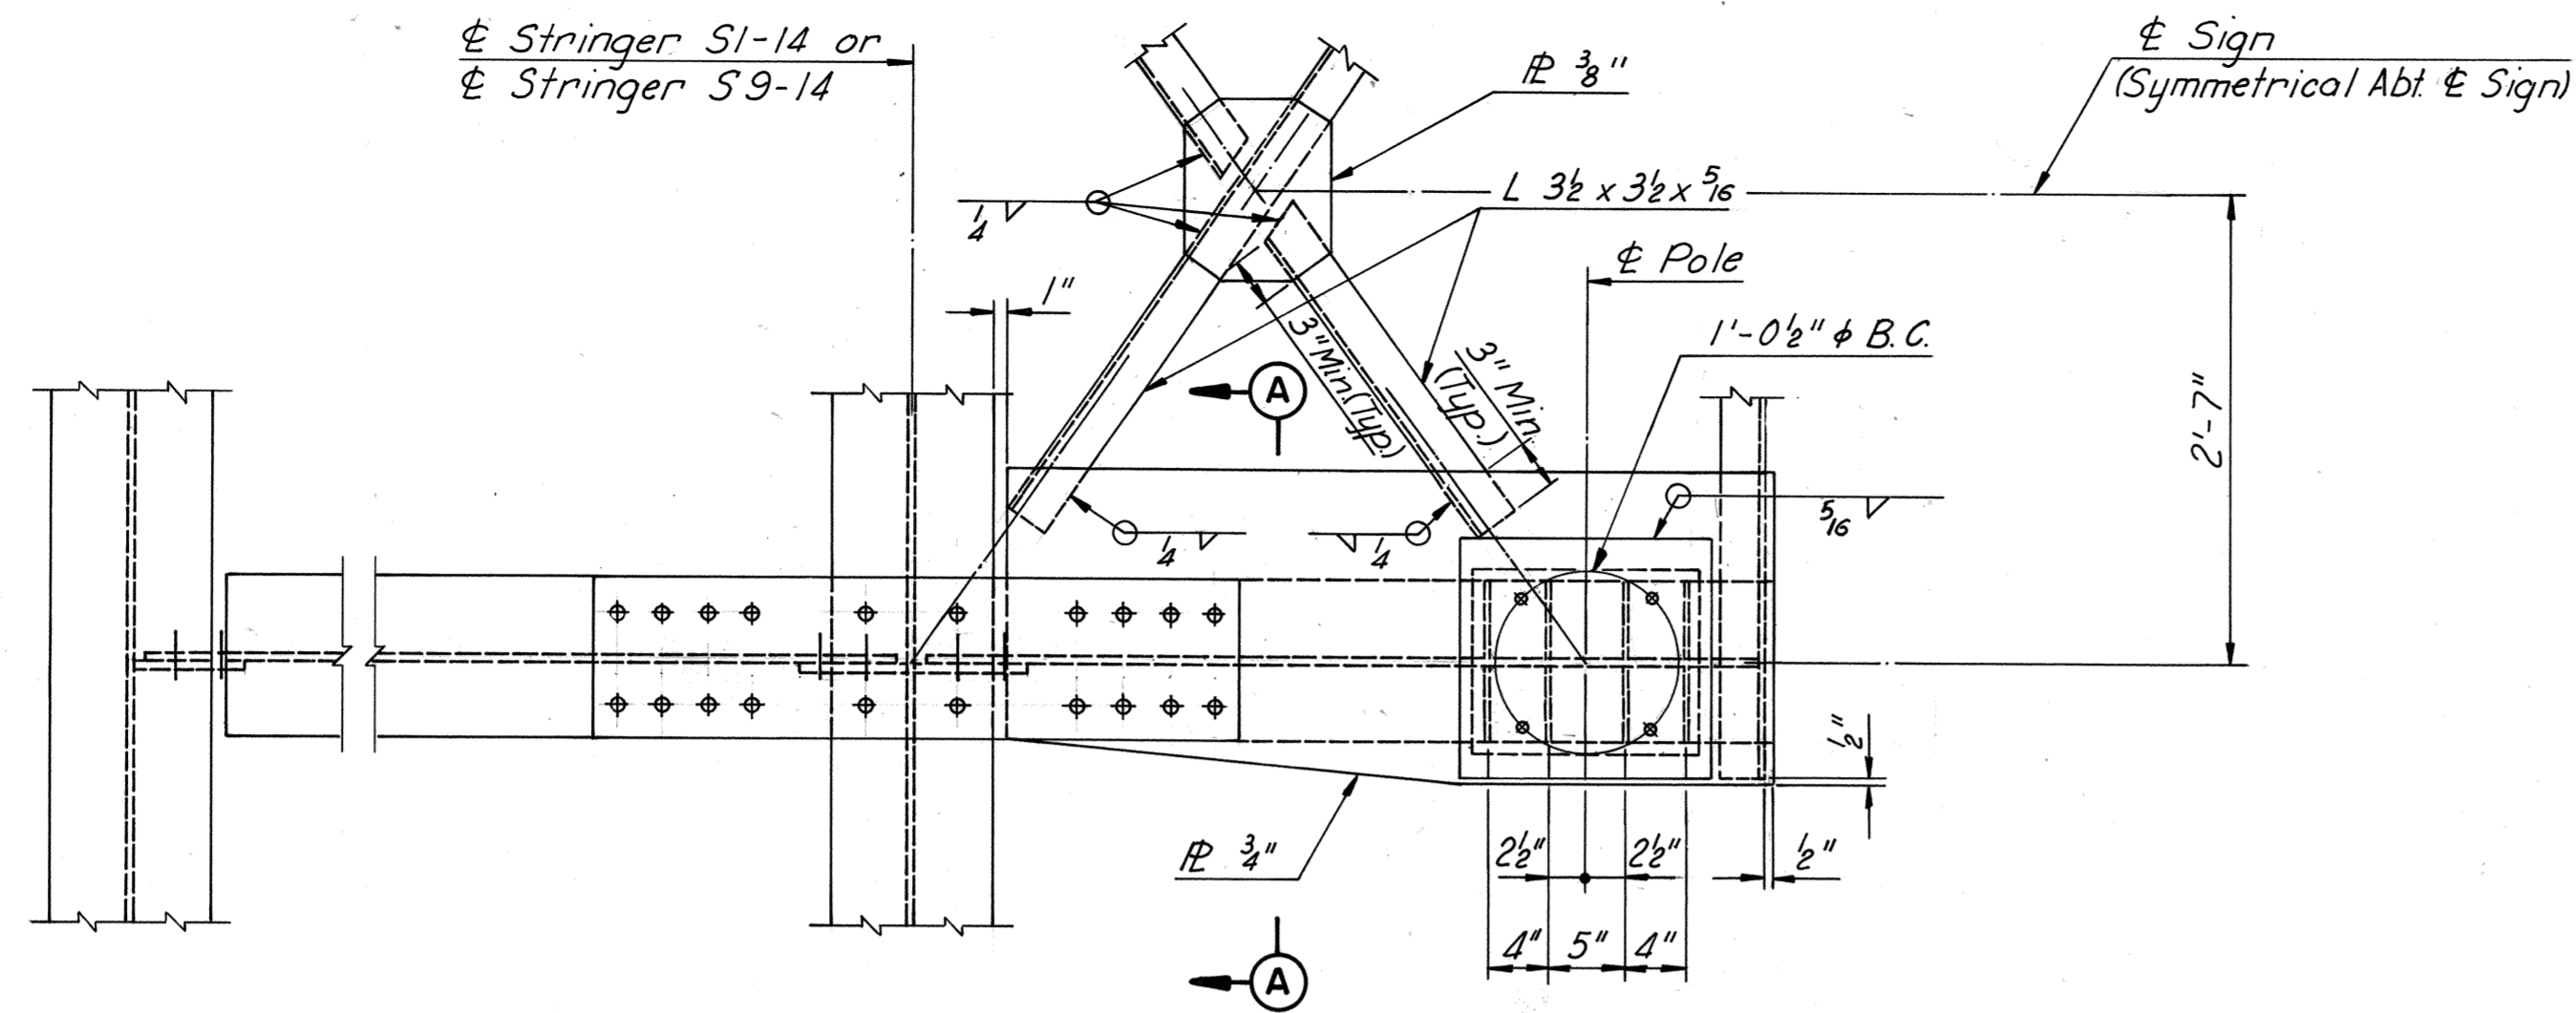


HALF PLAN
Scale: 1"=1'-0"

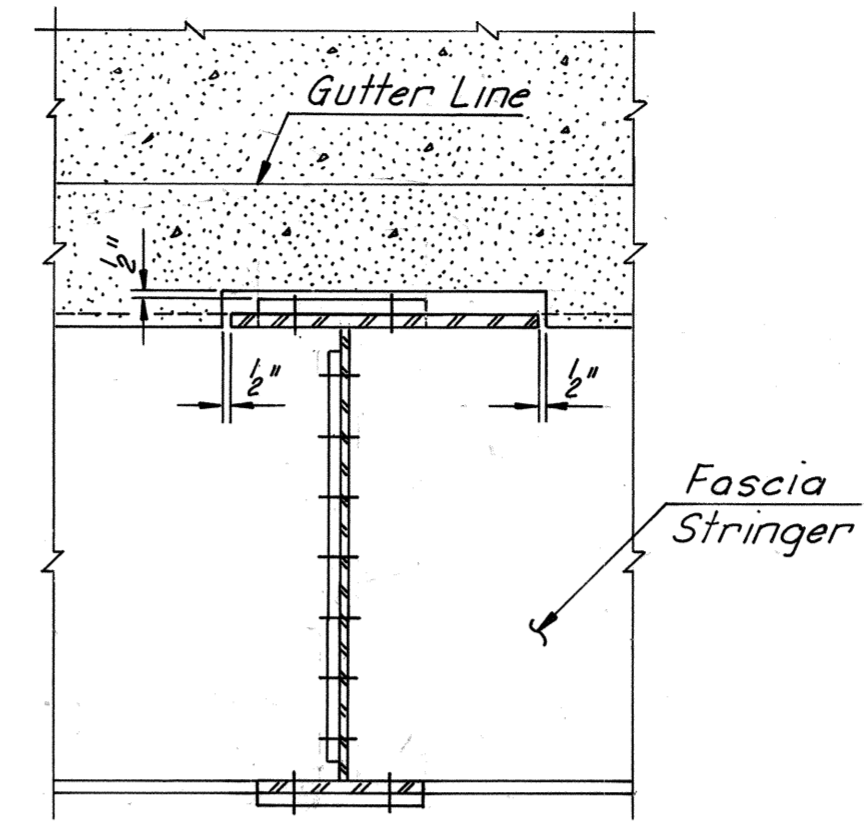


SECTION A-A
Scale: 1"=1'-0"

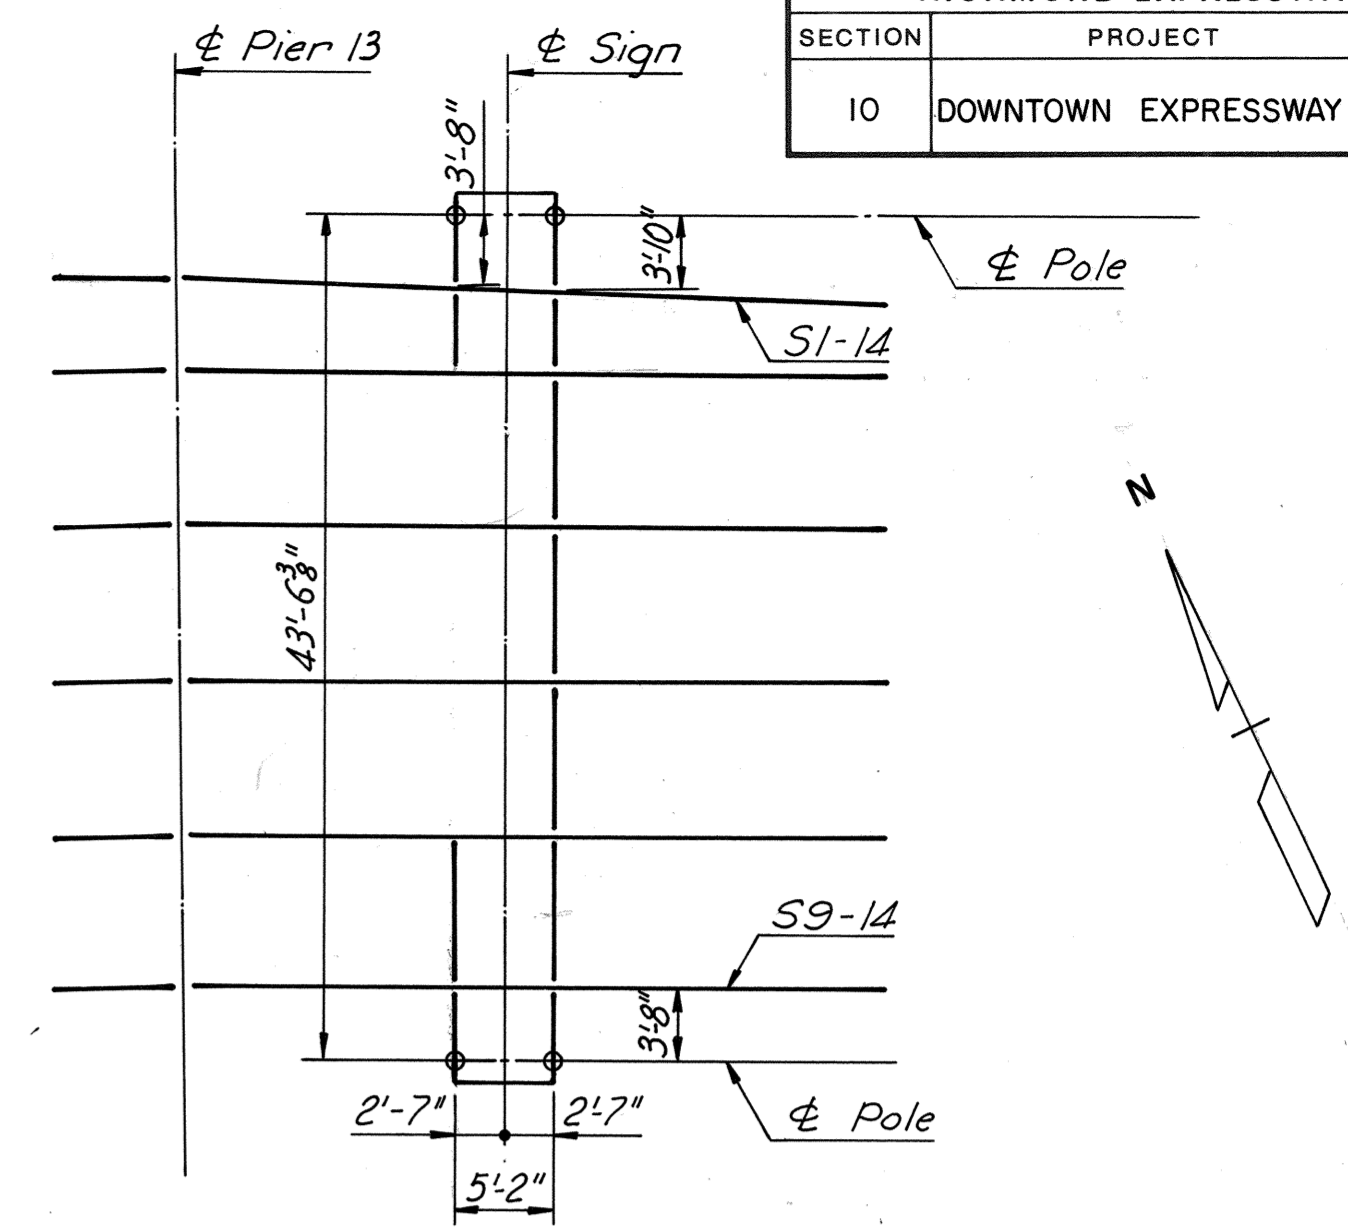

LAYOUT PLAN
Scale: 1"=10'-0"

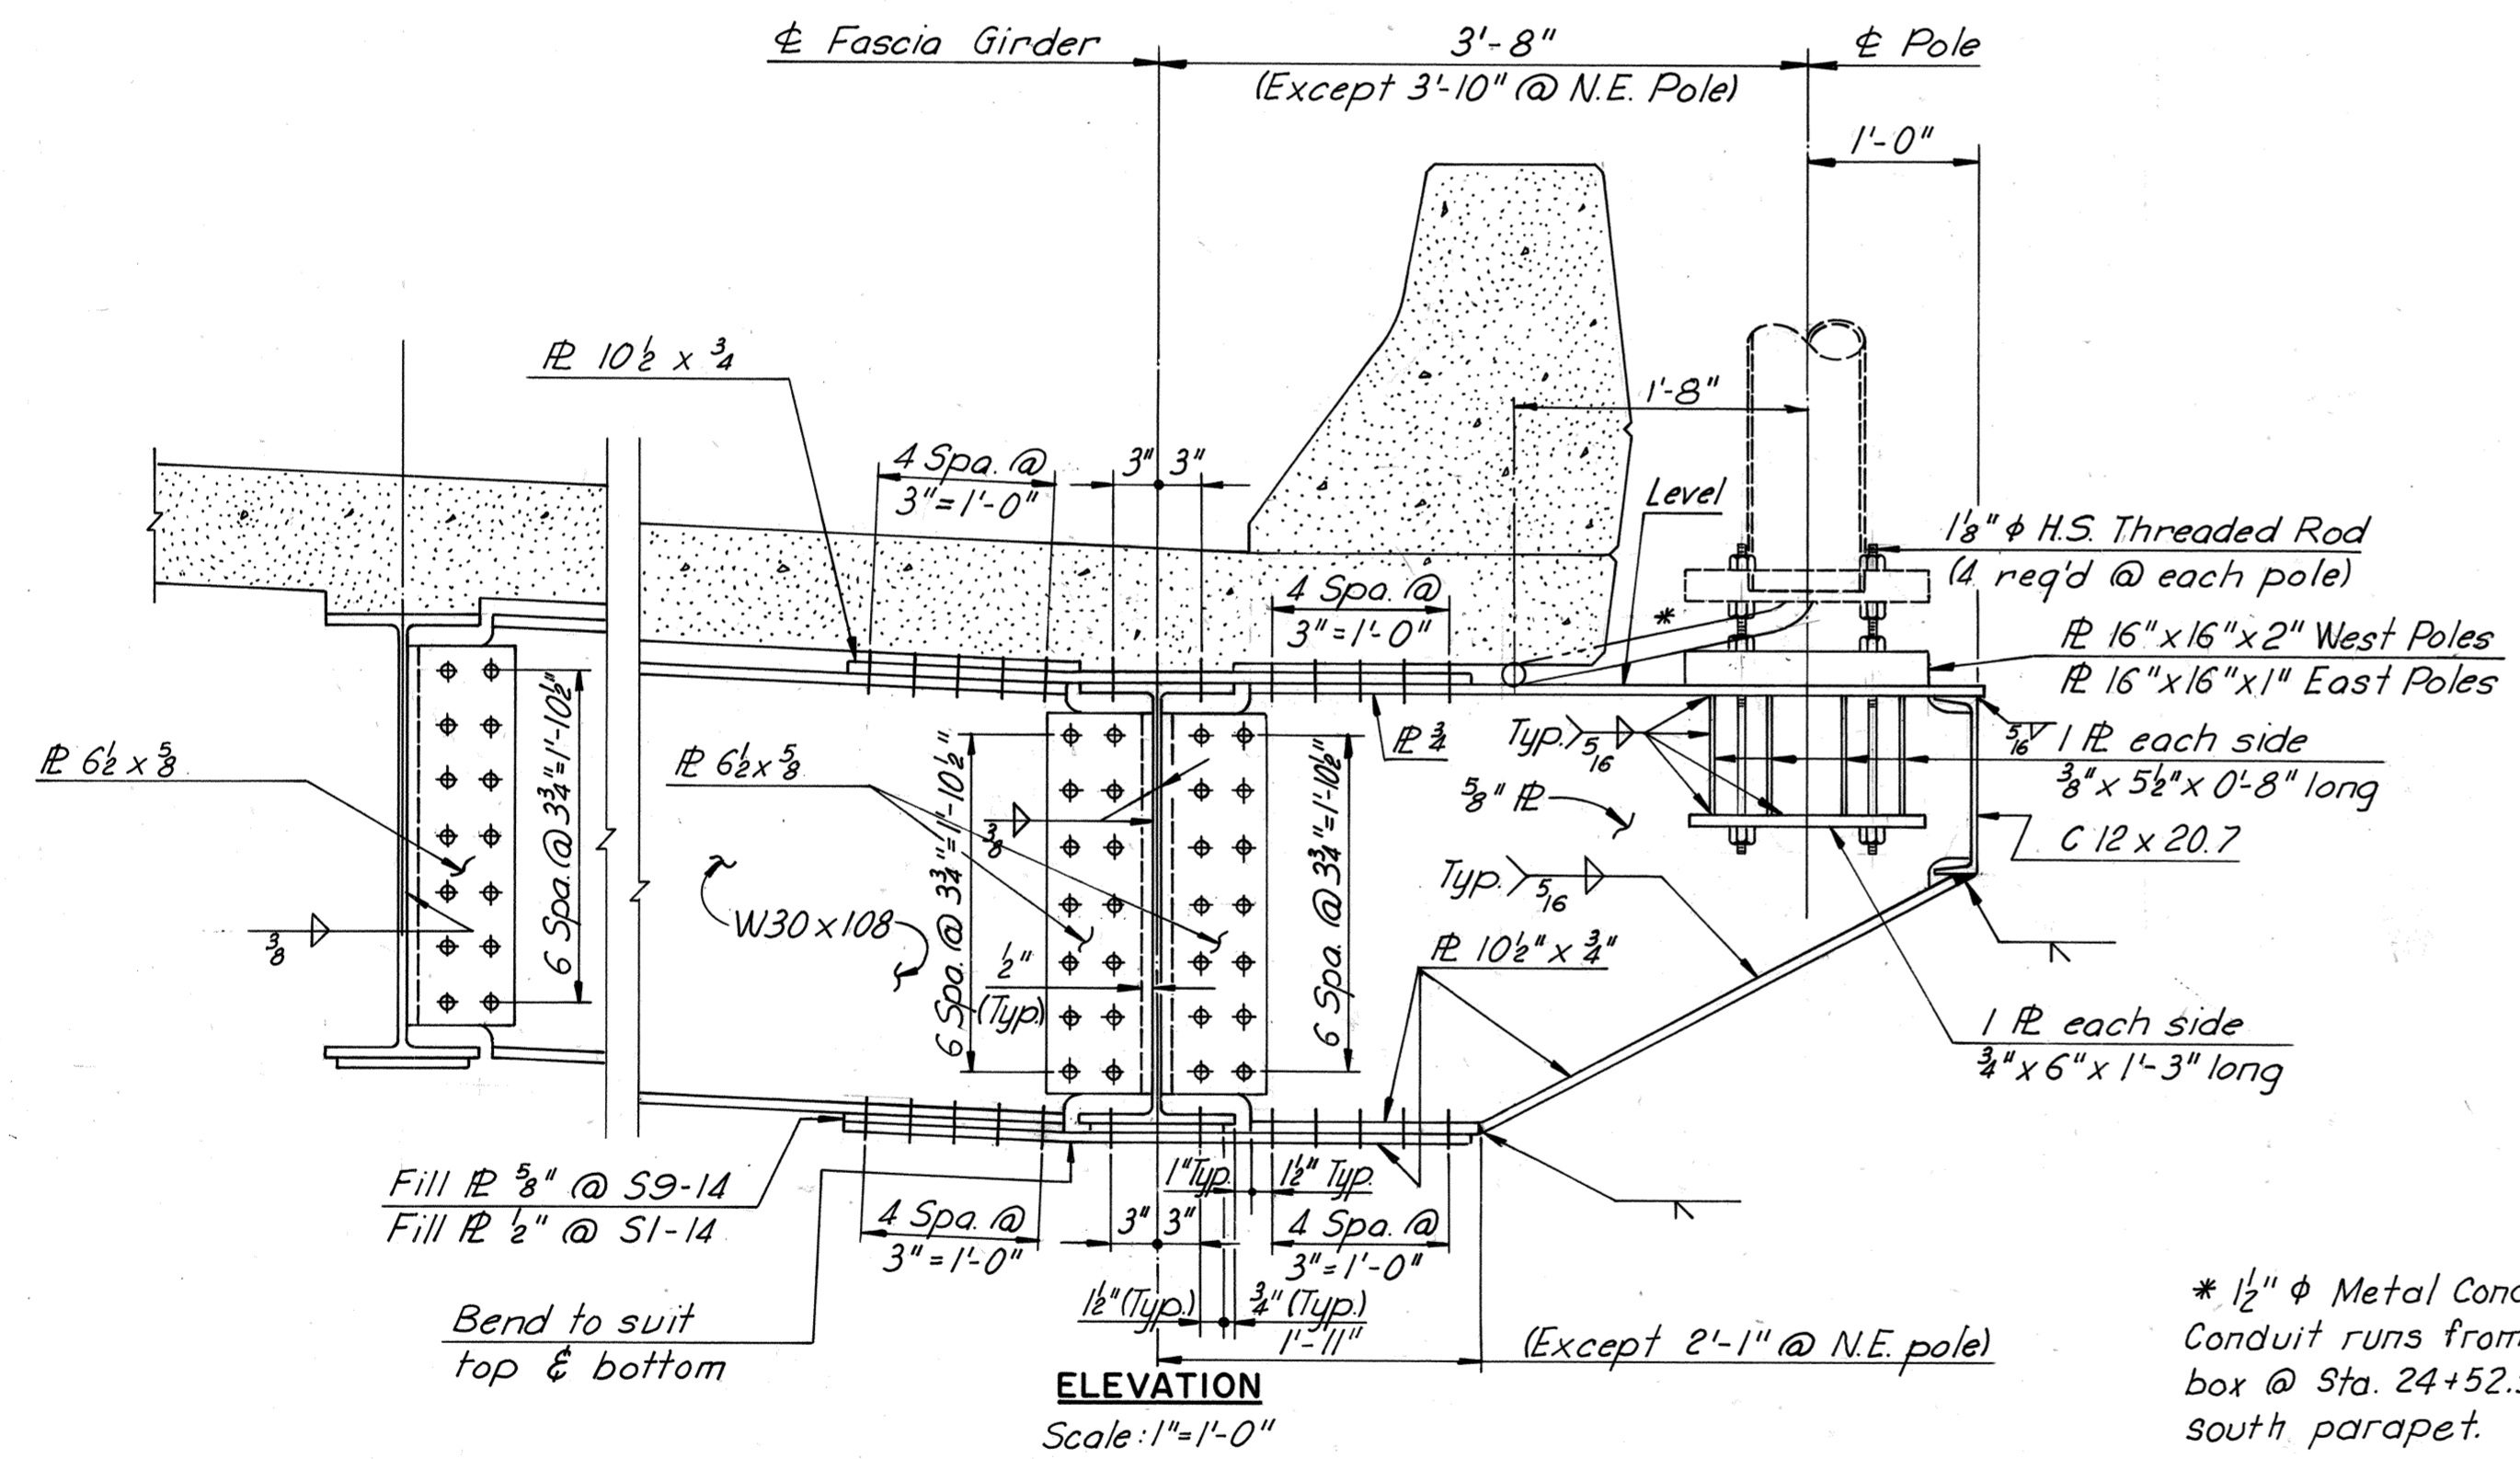

ELEVATION
Scale: 1"=1'-0"

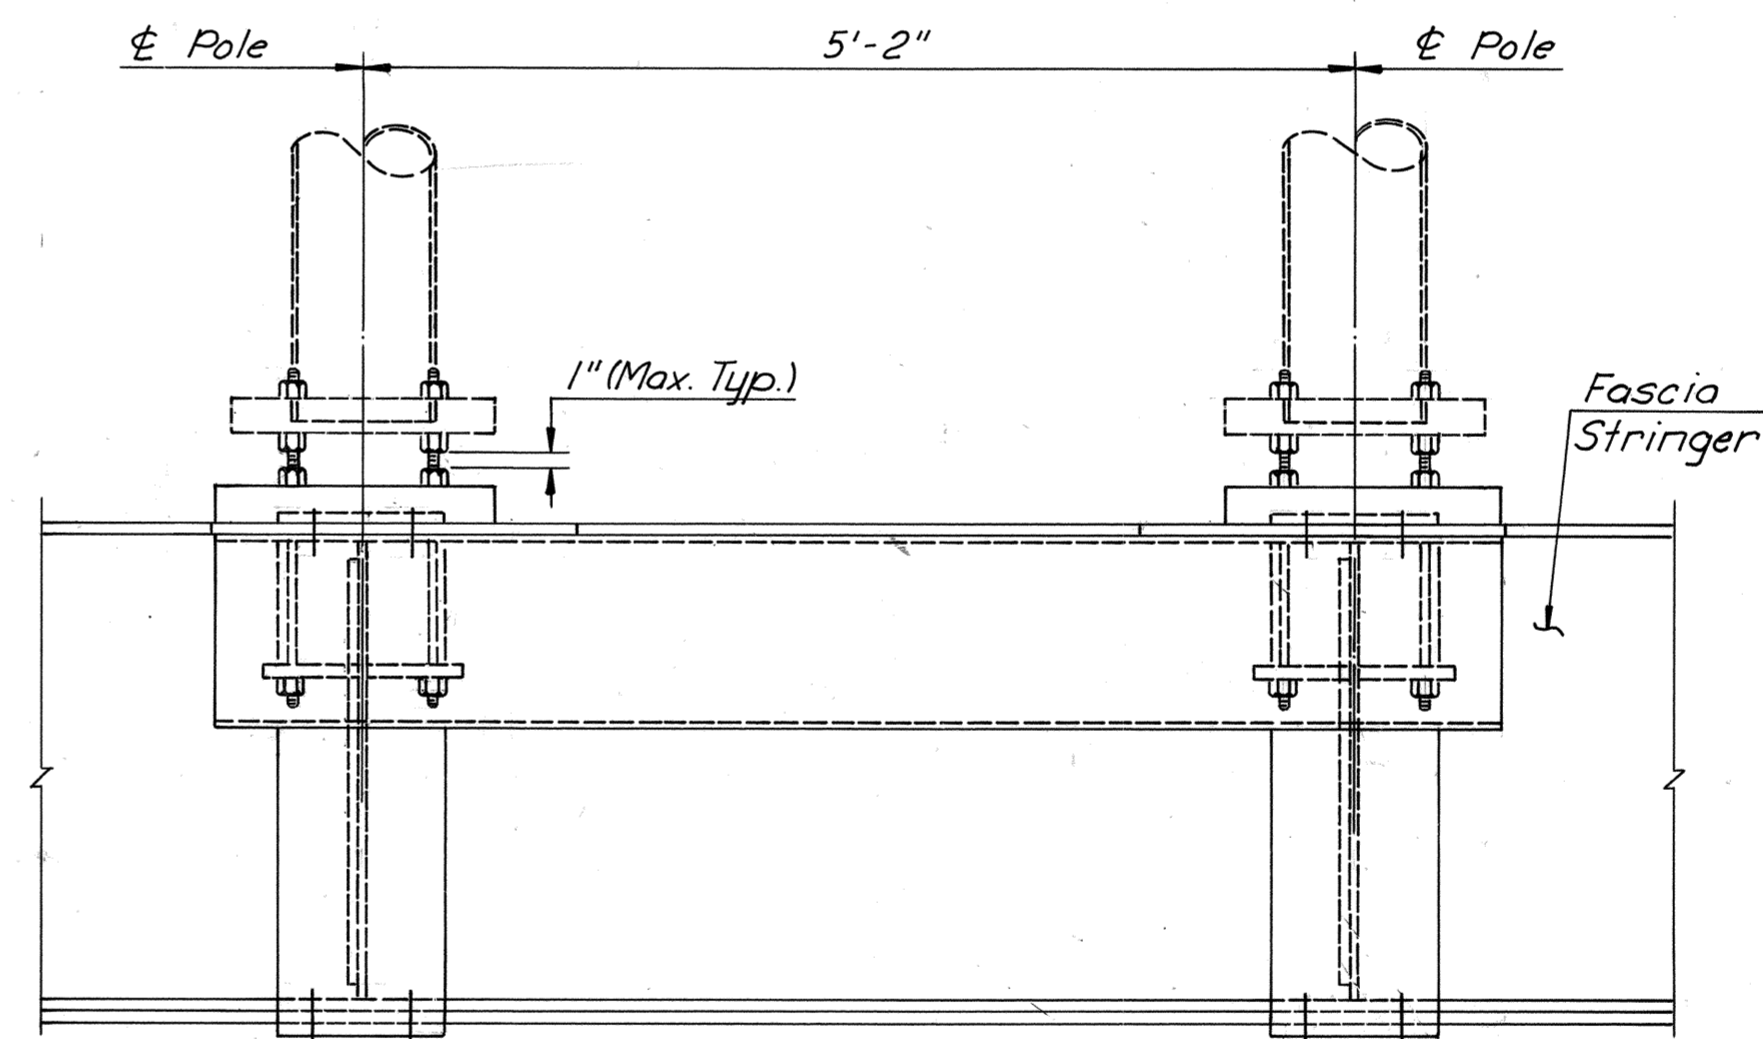

END ELEVATION
Scale: 1"=1'-0"

- NOTES:**
1. See Framing Plan Sheet 16 for location of sign support diaphragms.
 2. All material shall be ASTM A36 steel, except anchor bolt assemblies.
 3. Care shall be taken to ensure vertical alignment of the end frame. Any vertical misalignment shall be taken up in the leveling nuts.
 4. For signing and sign pole details, see Roadway Plans.
 5. All bolts to be 3/8" ϕ H.S. unless noted otherwise.

* 1/2" ϕ Metal Conduit
Conduit runs from junction box @ Sta. 24+52.54 under south parapet.

DESIGNED	DRAWN	CHECKED	IN CHARGE	NO.	REVISION	BY	DATE
	MLB	R.B.H.	P.R.Y.	2	As Built	TEM	8-76
				1	New Sheet Added	R.B.H.	9-74


AS BUILT

RICHMOND METROPOLITAN AUTHORITY
RICHMOND EXPRESSWAY SYSTEM
DOWNTOWN EXPRESSWAY

BRIDGE NO. 66
EASTBOUND ROADWAY OVER
12TH ST. - R.R. TRACKS AND 16TH ST.
SIGN SUPPORT BRACKET DETAILS-UNIT 14

SCALE AS SHOWN
DATE _____ SHEET 16A OF 46


HOWARD, NEEDLES, TAMMEN & BERGENDOFF
CONSULTING ENGINEERS
Alexandria, Virginia **HNTB**

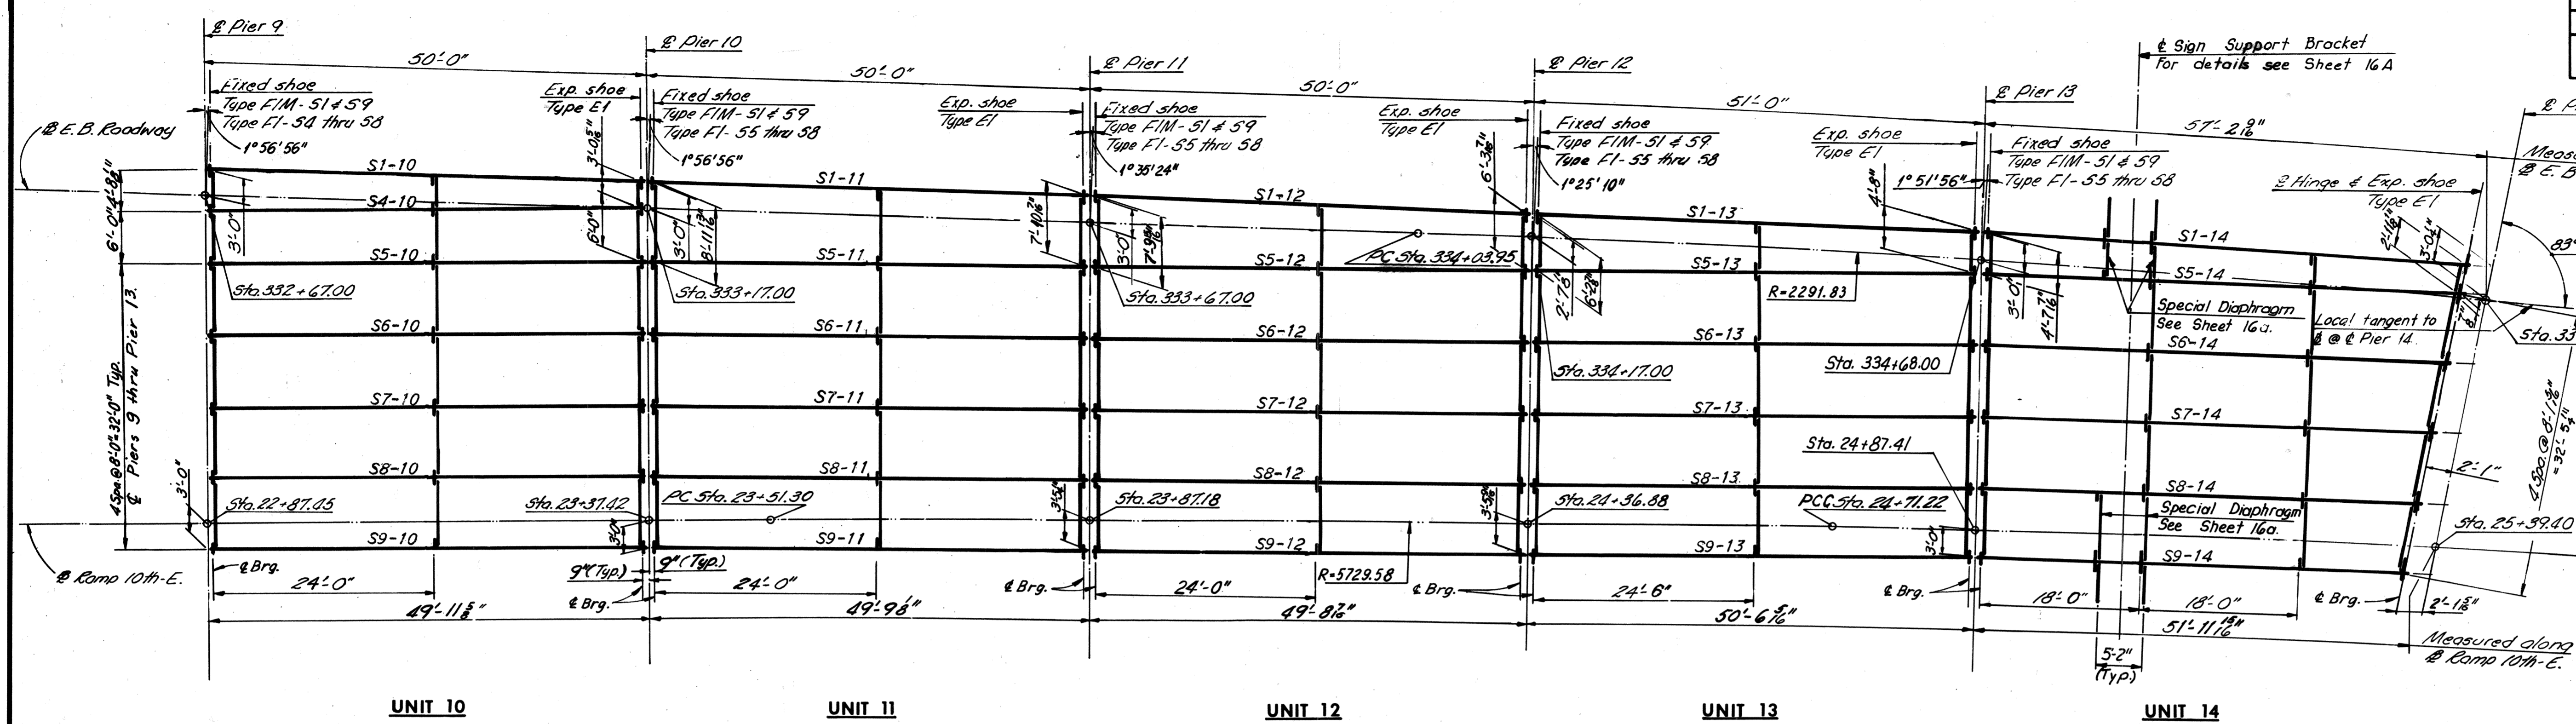

EXPANSION SHOES		FIXED SHOES	
TYPE	NO. REQD.	TYPE	NO. REQD.
E1	31	F1	21
		FIM	10


FRAMING PLAN
Scale 1" = 10'-0"

UNIT	STRINGER	STRINGER SIZE	Dim. "A"	LENGTH "L"	Dim. "B"	Dim. "C"	Dim. "D"	PL. "D"	MAX. SHEAR STUD SPACING					DEAD LOAD DEFLECTION SCHEDULE			CAMBER SCHEDULE		
									0.0L-0.1L	0.1L-0.2L	0.2L-0.3L	0.3L-0.4L	0.4L-0.5L	1/4L	1/2L	3/4L	1/4L	1/2L	3/4L
									11"	11 1/2"	11"	16 1/2"	20 1/2"	1/8"	3/8"	1/2"	1/8"	3/8"	1/2"
10	S1-10	30 WF 108	49'-10"	48'-6"	8"	8"			11"	11 1/2"	11"	16 1/2"	20 1/2"	1/8"	3/8"	1/2"	1/8"	3/8"	1/2"
	S4-10	30 WF 108	49'-7 1/2"	48'-5 1/2"	7"	7"			10 1/2"	11 1/2"	11"	15 1/2"	19"	1/8"	3/8"	1/2"	1/8"	3/8"	1/2"
	S5-10	30 WF 99	49'-7 1/2"	48'-5 1/2"	7"	7"	18'-0"	9 1/2"x 3/4"	8"	9"	11"	12 1/2"	15"	1/8"	3/8"	1/2"	1/8"	3/8"	1/2"
	S6-10	30 WF 108	49'-7 1/2"	48'-5 1/2"	7"	7"	18'-6"	9 1/2"x 3/4"	7"	7 1/2"	9 1/2"	11"	13"	1/8"	3/8"	1/2"	1/8"	3/8"	1/2"
	S7-10	30 WF 108	49'-7 1/2"	48'-5 1/2"	7"	7"	18'-6"	9 1/2"x 3/4"	7"	7 1/2"	9 1/2"	11"	13"	1/8"	3/8"	1/2"	1/8"	3/8"	1/2"
	S8-10	30 WF 108	49'-7 1/2"	48'-5 1/2"	7"	7"	18'-6"	9 1/2"x 3/4"	7"	7 1/2"	9 1/2"	11"	13"	1/8"	3/8"	1/2"	1/8"	3/8"	1/2"
11	S9-10	30 WF 108	49'-9 3/8"	48'-5 1/2"	8"	8"	19'-0"	9 1/2"x 3/4"	7"	8"	9 1/2"	11 1/2"	14"	1/8"	3/8"	1/2"	1/8"	3/8"	1/2"
	S1-11	30 WF 108	49'-10 3/8"	48'-6 1/2"	8"	8"	18'-0"	9 1/2"x 3/4"	7"	8"	9 1/2"	11 1/2"	14"	1/8"	3/8"	1/2"	1/8"	3/8"	1/2"
	S6-12	30 WF 108	49'-6 3/4"	48'-4 3/4"	7"	7"	18'-6"	9 1/2"x 3/4"	7"	7 1/2"	9 1/2"	11"	13"	1/8"	3/8"	1/2"	1/8"	3/8"	1/2"
	S7-12	30 WF 108	49'-5 1/2"	48'-3 1/2"	7"	7"	18'-6"	9 1/2"x 3/4"	7"	7 1/2"	9 1/2"	11"	13"	1/8"	3/8"	1/2"	1/8"	3/8"	1/2"
	S8-12	30 WF 108	49'-4 1/2"	48'-2 1/2"	7"	7"	18'-6"	9 1/2"x 3/4"	7"	7 1/2"	9 1/2"	11"	13"	1/8"	3/8"	1/2"	1/8"	3/8"	1/2"
13	S9-12	30 WF 108	49'-6 1/4"	48'-2 1/4"	8"	8"	19'-0"	9 1/2"x 3/4"	7"	8"	9 1/2"	11 1/2"	14"	1/8"	3/8"	1/2"	1/8"	3/8"	1/2"
	S1-13	30 WF 99	50'-10 3/8"	49'-6 3/8"	8"	8"	18'-0"	9 1/2"x 3/4"	9 1/2"	10 1/2"	13"	15 1/2"	19 1/2"	1/8"	3/8"	1/2"	1/8"	3/8"	1/2"
	S5-13	30 WF 99	50'-7 1/2"	49'-5 1/2"	7"	7"	18'-0"	9 1/2"x 3/4"	8 1/2"	9 1/2"	11 1/2"	13 1/2"	16"	1/8"	3/8"	1/2"	1/8"	3/8"	1/2"
	S6-13	30 WF 108	50'-5 3/8"	49'-3 3/8"	7"	7"	18'-6"	9 1/2"x 3/4"	7"	7 1/2"	9 1/2"	11"	13"	1/8"	3/8"	1/2"	1/8"	3/8"	1/2"
	S7-13	30 WF 108	50'-4 3/8"	49'-2 3/8"	7"	7"	18'-6"	9 1/2"x 3/4"	7"	7 1/2"	9 1/2"	11"	13"	1/8"	3/8"	1/2"	1/8"	3/8"	1/2"
	S8-13	30 WF 108	50'-3 1/4"	49'-1 1/4"	7"	7"	18'-6"	9 1/2"x 3/4"	7"	7 1/2"	9 1/2"	11"	13"	1/8"	3/8"	1/2"	1/8"	3/8"	1/2"
14	S9-13	30 WF 108	50'-3 3/8"	48'-11 3/8"	8"	8"	19'-0"	9 1/2"x 3/4"	7"	8"	9 1/2"	11 1/2"	14"	1/8"	3/8"	1/2"	1/8"	3/8"	1/2"
	S1-14	30 WF 108	56'-1 1/8"	54'-10 3/8"	8"	7 1/2"	20'-0"	9 1/2"x 1"	9"	10 1/2"	13"	15 1/2"	19 1/2"	1/8"	3/8"	1/2"	1/8"	3/8"	1/2"
	S5-14	30 WF 108	55'-6 1/8"	54'-3 5/8"	7"	7 1/2"	20'-9"	9 1/2"x 3/4"	7 1/2"	8 1/2"	11"	13"	15 1/2"	1/8"	3/8"	1/2"	1/8"	3/8"	1/2"
	S6-14	30 WF 108	54'-0 1/2"	52'-10 3/8"	7"	7 1/2"	21'-6"	9 1/2"x 1 1/4"	6 1/2"	7 1/2"	9 1/2"	11"	13"	1/8"	3/8"	1/2"	1/8"	3/8"	1/2"
	S7-14	30 WF 108	52'-7 1/8"	51'-5 3/8"	7"	7 1/2"	20'-6"	9 1/2"x 1"	7"	7 1/2"	9 1/2"	11"	13"	1/8"	3/8"	1/2"	1/8"	3/8"	1/2"
	S8-14	30 WF 108	51'-2 1/8"	50'-0 3/8"	7"	7 1/2"	19'-0"	9 1/2"x 3/4"	7"	7 1/2"	9 1/2"	11"	13"	1/8"	3/8"	1/2"	1/8"	3/8"	1/2"

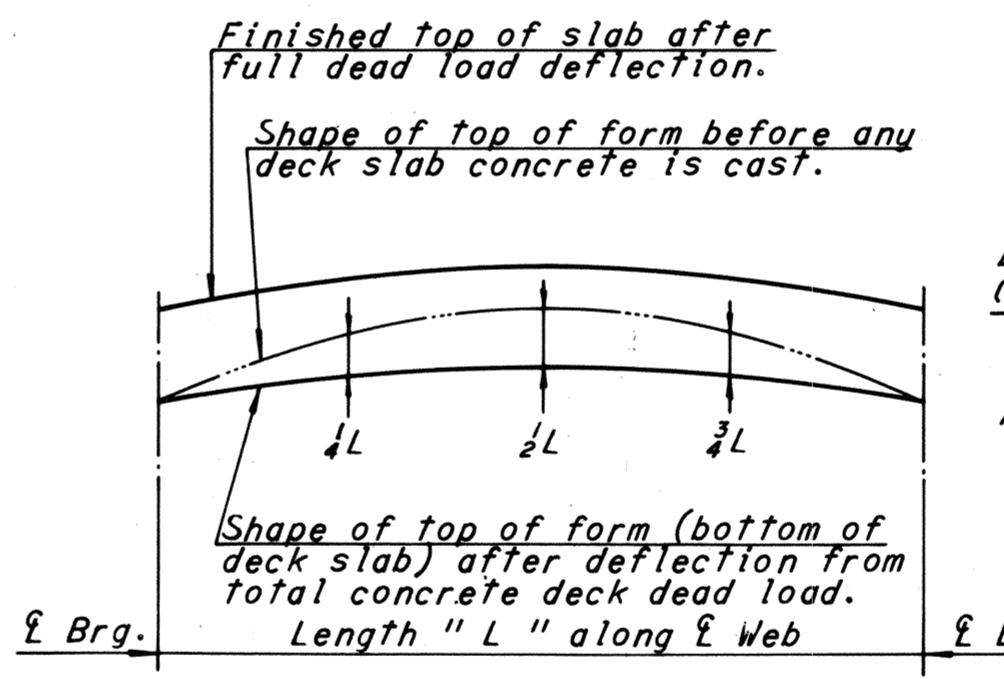


DEAD LOAD DEFLECTION DIAGRAM


NOTE TO CONTRACTOR
Deflections given are those anticipated to occur in the stringer upon placement of the total concrete deck dead load. In practice, the stringers in place are not likely to have the exact camber to compensate for these deflections during construction. The residual amounts shall be provided by adjusting forms to vary the thickness of the concrete haunch between the bottom of the slab and the top of stringer without altering the slab thickness.

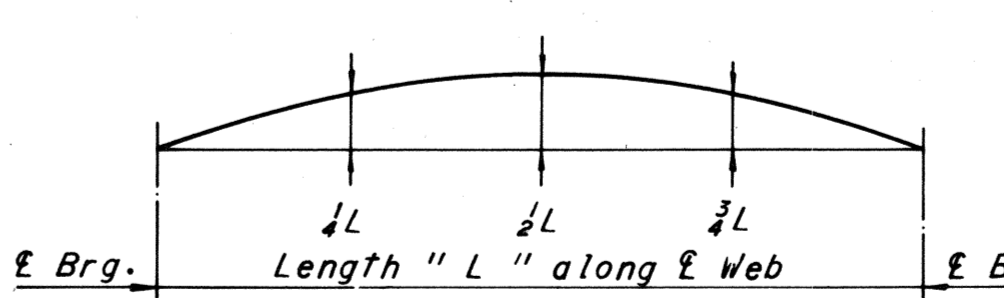

CAMBER DIAGRAM

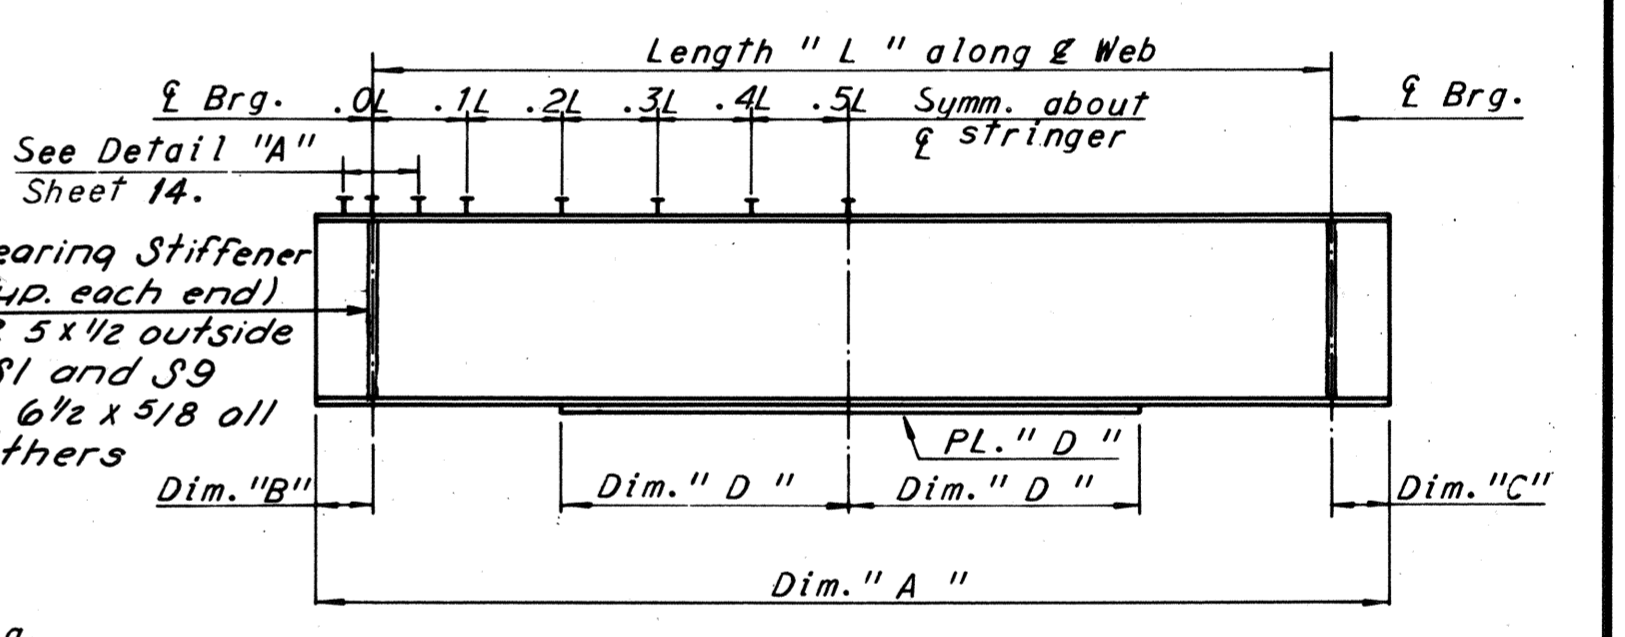

STRINGER ELEVATION
No Scale

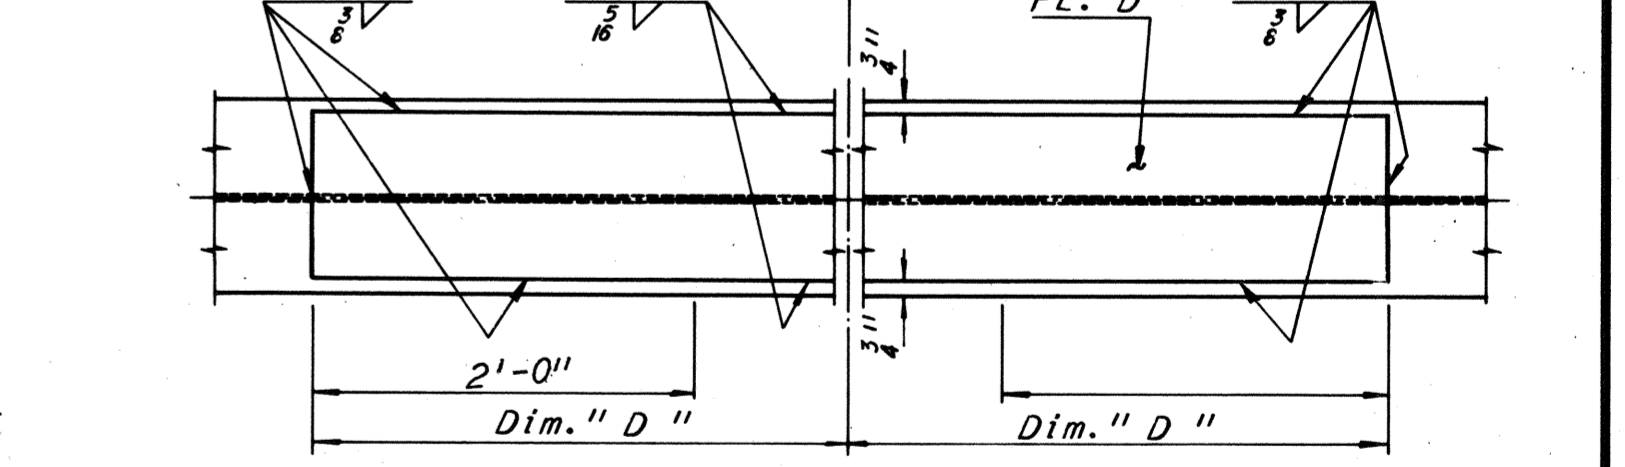

COVER PLATE DETAIL
No Scale

Note: Stringers having a total camber of less than 1" are not required to be shop cambered, but should be turned so that any mill tolerance deviation from straightness will be in the direction shown by the Camber Diagram. If stringers are not cambered, distance top of stringers to top of slab will vary along the stringer in accordance with the offset dimensions shown in the Camber Diagram, and with minimum distance as shown in cross-section on Sheet 30.

Note: All steel shall be A36 unless otherwise shown.

Notes:
For Joint Details, see Sheet 37.
For Superstructure steel quantities, see Sheet 2.
For Framing Details, see Sheet 22.
For Diaphragm Details, see Sheet 30.
For Shear Stud Details, see Sheet 14.
For angles between Piers and Stringers, see Sheets 11, 12, 13 & 22.
For Shoe Details, see Sheet S1 & S2.

* Spacing begins at termination of 6 spaces @ 4".

BY	DATE	ADD SIGN SUPPORT BRACKET	TEM.	7-74
MADE	11/10	2	As Built	8-76
CHECKED	P7A	11-5-68		
IN CHARGE				

RICHMOND METROPOLITAN AUTHORITY
RICHMOND EXPRESSWAY SYSTEM
DOWNTOWN EXPRESSWAY

BRIDGE NO. 66
EASTBOUND ROADWAY OVER
12TH ST. - R.R. TRACKS AND 16TH ST.


FRAMING PLAN - UNITS 10, 11, 12, 13 AND 14

HOWARD, NEEDLES, TAMMEN & BERGENDOFF
consulting engineers
NEW YORK ALEXANDRIA KANSAS CITY

SCALE: 1"=10' Unless as shown
CONTRACT NO.: 10
SHEET NO. 16 OF 46

AS BUILT

Note: Dimensions shown at piers are between extended centerlines of stringers.

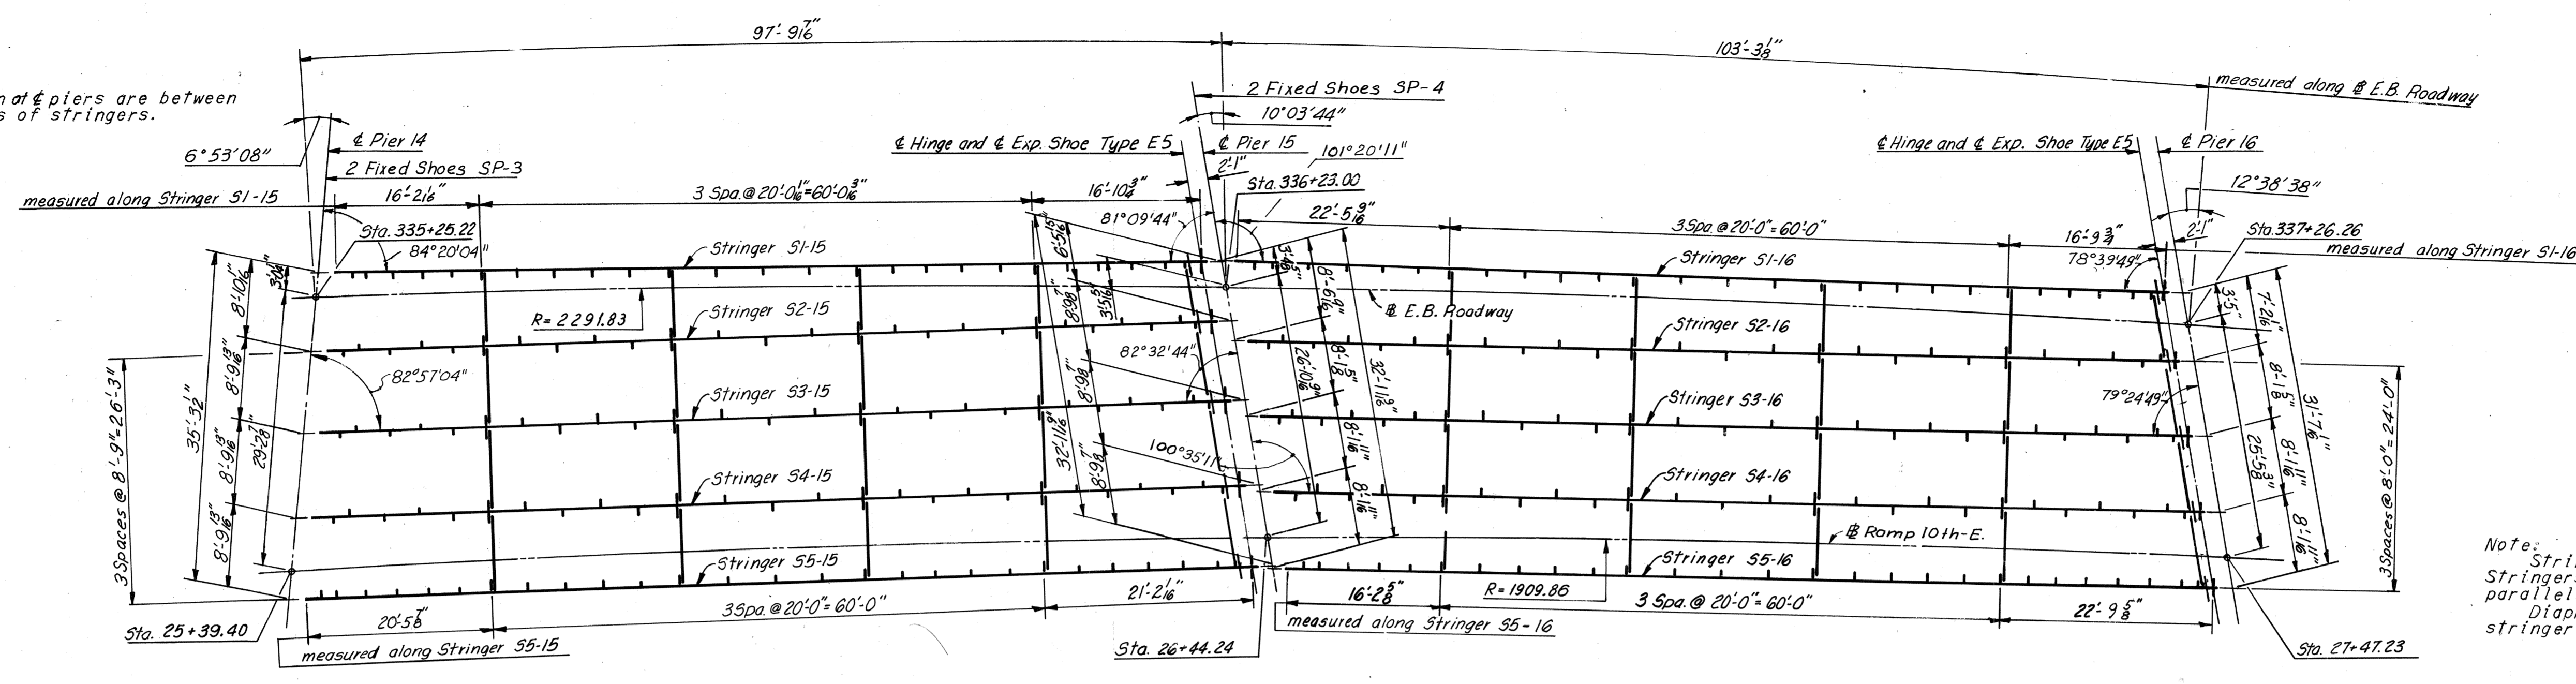


Note: Stringers S2-15 thru S5-15 and Stringers S2-16 thru S5-16 are parallel. Diaphragm spacing is shown along stringer length "L".


UNIT 15

UNIT 16


FRAMING PLAN
Scale: 1/8" = 1'-0"

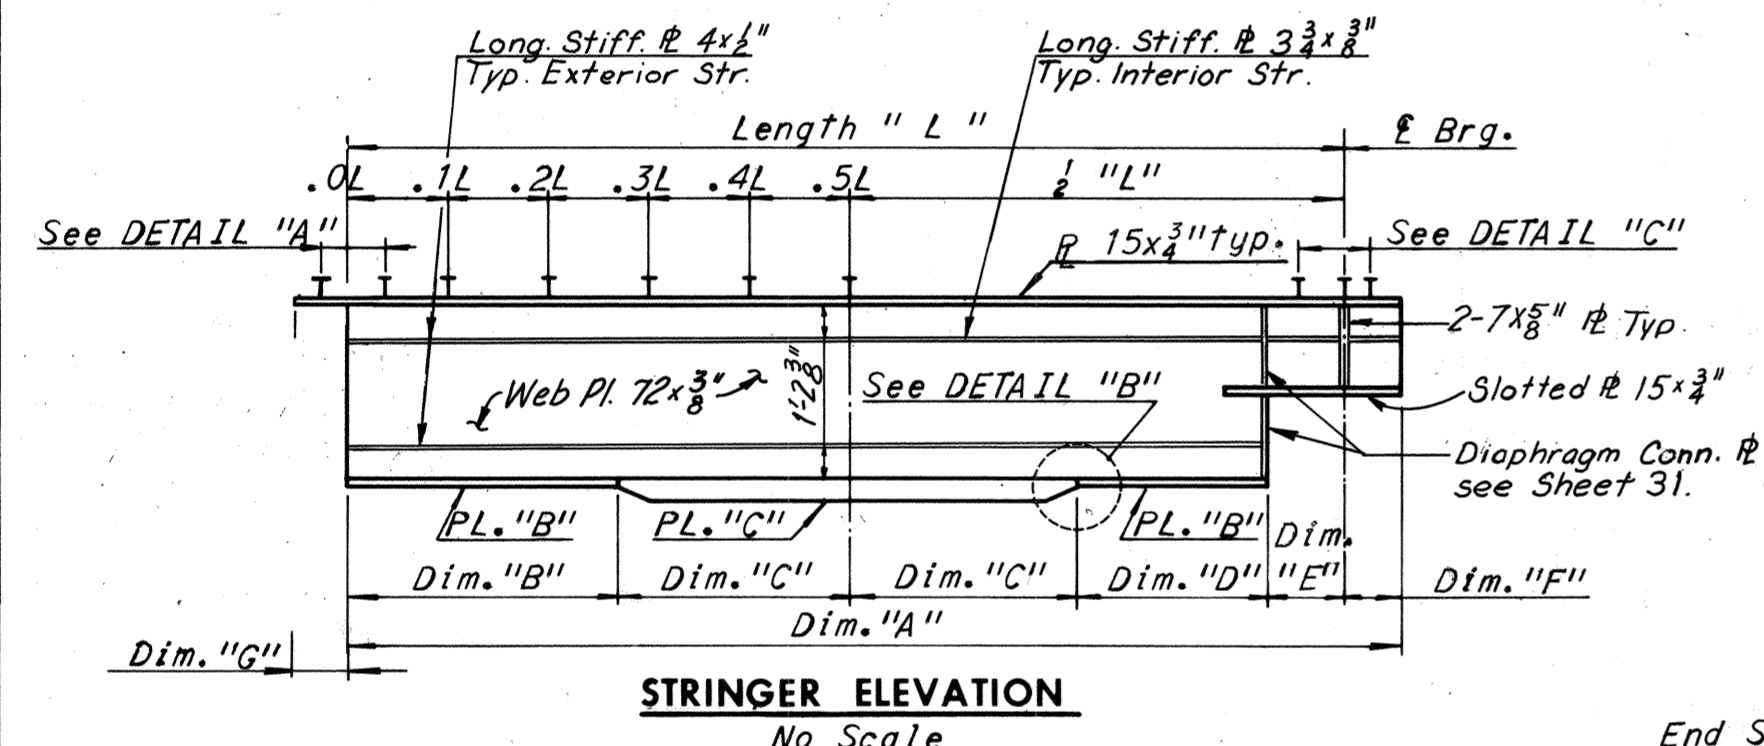

STRINGER ELEVATION
No Scale

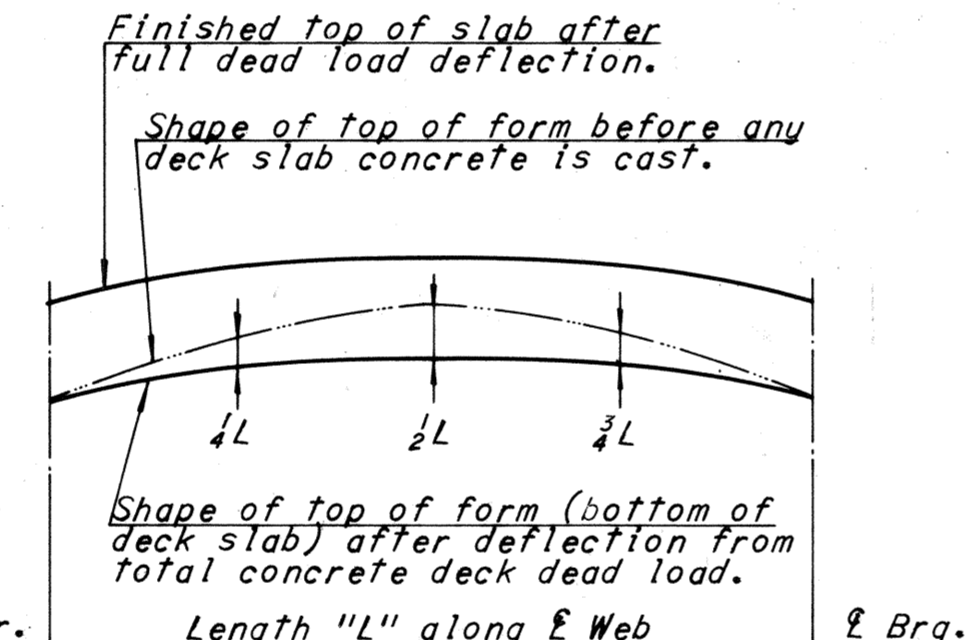


DEAD LOAD DEFLECTION DIAGRAM

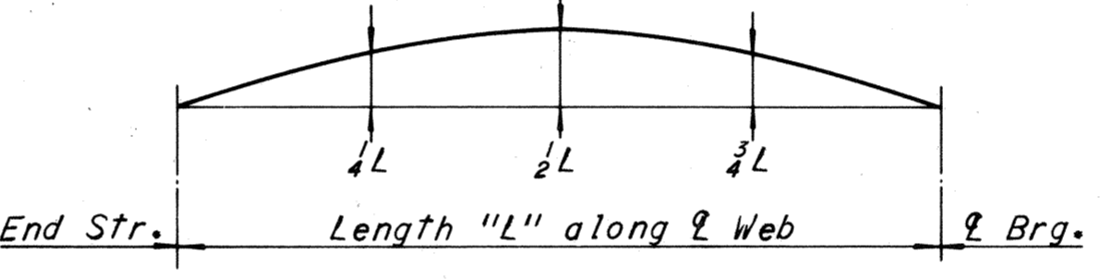

CAMBER DIAGRAM


NOTE TO FABRICATOR
The stringers shall be fabricated with an upward camber amounting to the tabulated value. This will provide approximate compensation for deflection under full dead load and for conformity with finished grade. Dimensions are in inches. Stringers having a total camber of less than 1" are not required to be shop cambered, but should be turned so that any mill tolerance deviation from straightness will be in the direction shown by the Camber Diagram. If stringers are not cambered, distance top of stringers to top of slab will vary along the stringer in accordance with the offset dimensions shown in the Camber Diagram, and with minimum distance as shown in cross-section on Sheet 31.

NOTE TO CONTRACTOR
Deflections given are those anticipated to occur in the stringer upon placement of the total concrete deck dead load. In practice, the stringers in place are not likely to have the exact camber to compensate for these deflections during construction. The residual amounts shall be provided by adjusting forms to vary the thickness of the concrete haunch between the bottom of the slab and the top of stringer without altering the slab thickness.

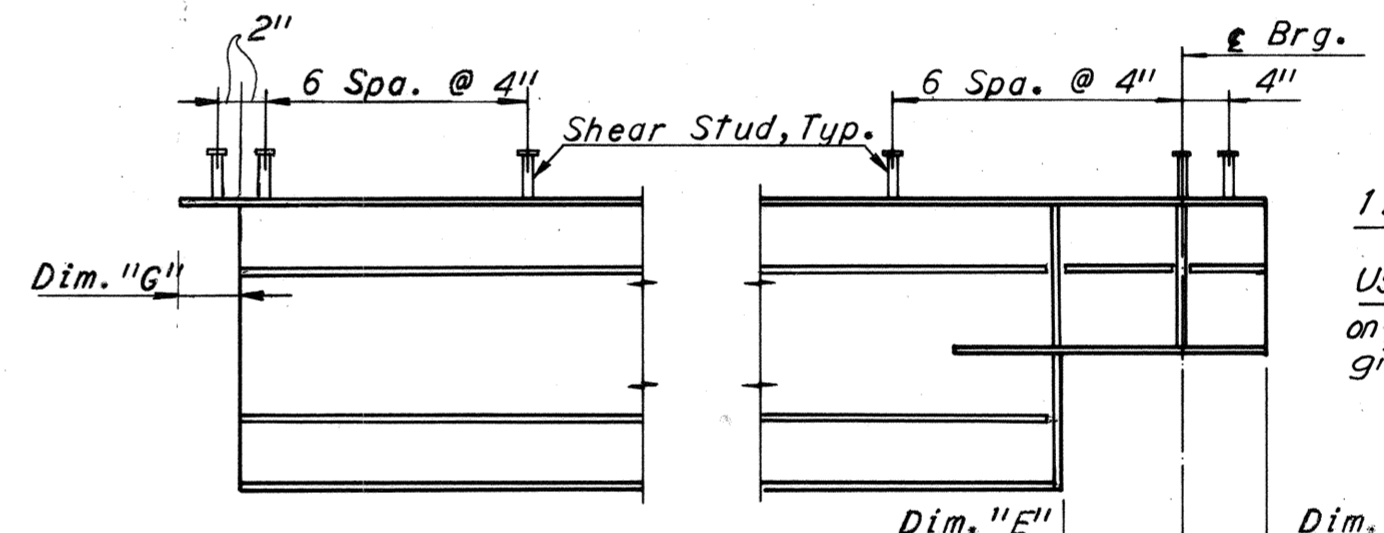

DETAIL "A"
No Scale

DETAIL "C"
No Scale

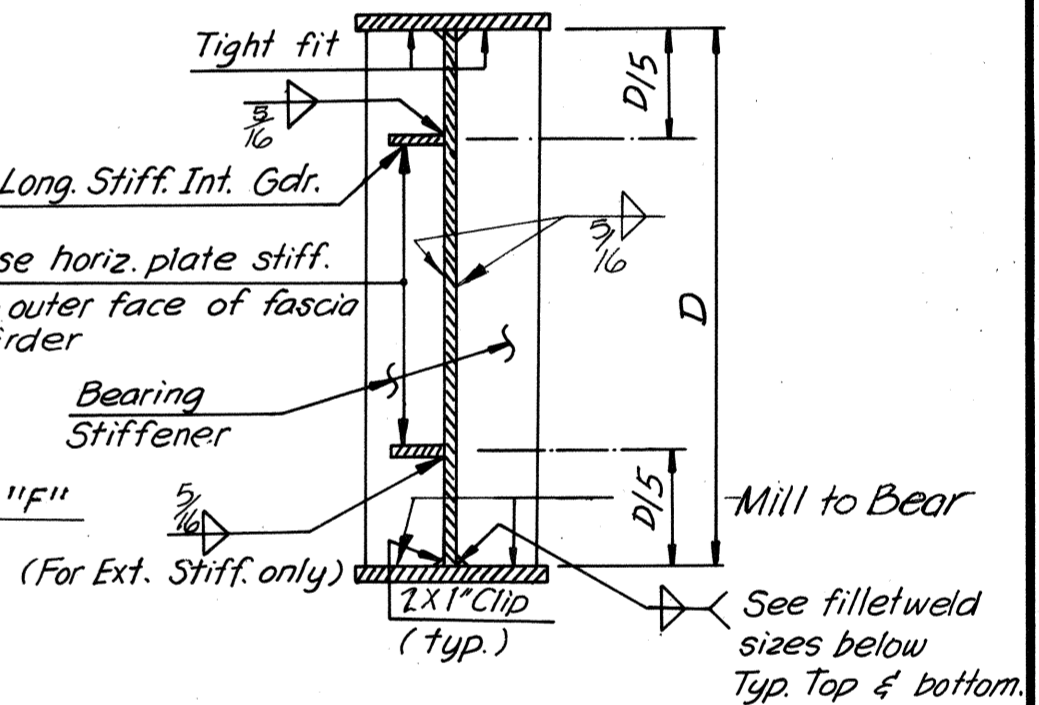

WEB TO FLANGE WELDS AND LONGITUDINAL STIFFENER WELD DETAILS
No Scale

Note: Web to flange weld size shall be determined by flange thickness as follows:
To 1 1/2" 5/8" weld
over 1 1/2" To 2 1/4" 3/4" weld

SHOE SCHEDULE			
FIXED SHOES		EXPANSION SHOES	
TYPE	NO. REQD.	TYPE	NO. REQD.
SP-3	2	E5	10
SP-4	2		

Notes:
For Superstructure steel quantities, see Sheet 2.
For Joint Details, see Sheet 38.
For Shoe Details, see Sheets 51 and 52.
For Diaphragm Details, see Sheet 31.
For Framing Details, see Sheet 22.
For Shear Stud Details, see Sheet 14.
For Angles between Piers and Stringers see Sheet 22.

UNIT	STRINGER	STRINGER SCHEDULE									MAX. SHEAR STUD SPACING					DEAD LOAD DEFLECTION SCHEDULE			CAMBER SCHEDULE				
		Dim. "A"	LENGTH "L"	Dim. "B"	Dim. "C"	Dim. "D"	Dim. "E"	Dim. "F"	Dim. "G"	PL. "B"	PL. "C"	0.0L-0.1L*	0.1L-0.2L	0.2L-0.3L	0.3L-0.4L	0.4L-0.5L	1/4L	1/2L	3/4L	1/4L	1/2L	3/4L	
15	S1-15	93'-8 1/2"	93'-1"	23'-3 1/2"	23'-3"	22'-5 3/8"	10 1/2"	7 1/2"	6 3/8"	15x2 1/2"	15x1 1/2"	13 1/2"	15 1/2"	19"	24"	1 1/8"	1 1/8"	1 1/8"	1 3/8"	1 1/8"	1 1/8"	1 1/8"	1 1/8"
	S2-15	95'-6 1/2"	94'-11 1/8"	24'-5 3/8"	23'-0"	23'-7 1/2"	10 1/2"	7 1/2"	6 3/8"	15x2 1/2"	15x1 1/2"	14"	16"	18 1/2"	21 1/2"	1 1/8"	1 1/8"	1 1/8"	1 1/2"	1 1/8"	1 1/8"	1 1/8"	
	S3-15	97'-9 1/2"	97'-2 1/2"	22'-1 1/4"	26'-6"	21'-3 3/8"	10 1/2"	7 1/2"	6 3/8"	15x2 1/2"	15x1 1/2"	14"	16"	18"	21"	1 1/8"	1 1/8"	1 1/8"	1 5/8"	1 1/8"	1 1/8"	1 1/8"	
	S4-15	100'-0 3/8"	99'-5 1/2"	24'-2 3/8"	25'-6"	23'-4 3/8"	10 1/2"	7 1/2"	6 3/8"	15x2 1/2"	15x1 1/2"	14"	16"	18 1/2"	21"	1 1/8"	1 1/8"	1 1/8"	1 5/8"	1 1/8"	1 1/8"	1 1/8"	
	S5-15	102'-3"	101'-7 3/8"	24'-4"	26'-6"	23'-5 3/8"	10 1/2"	7 1/2"	6 3/8"	15x2 1/2"	15x1 1/2"	13 1/2"	15 1/2"	18 1/2"	23"	1 1/8"	1 1/8"	1 1/8"	1 3/8"	1 1/8"	1 1/8"	1 1/8"	
16	S1-16	99'-10 7/8"	99'-3 3/8"	23'-7 3/8"	26'-0"	22'-9 1/2"	10 3/8"	7 1/2"	6 3/8"	15x2 1/2"	15x1 1/2"	14"	16"	19"	24"	1 1/8"	1 1/8"	1 1/8"	1 3/8"	1 1/8"	1 1/8"	1 1/8"	
	S2-16	99'-7 3/8"	99'-0 1/2"	24'-6 3/8"	25'-0"	23'-7 3/8"	10 3/8"	7 1/2"	6 3/8"	15x2 1/2"	15x1 1/2"	15"	17"	19 1/2"	22 1/2"	1 1/8"	1 1/8"	1 1/8"	1 3/8"	1 1/8"	1 1/8"	1 1/8"	
	S3-16	99'-7 3/8"	99'-0 1/2"	24'-0 3/8"	25'-6"	23'-1 1/8"	10 3/8"	7 1/2"	6 3/8"	15x2 1/2"	15x1 1/2"	15"	17"	19 1/2"	22 1/2"	1 1/8"	1 1/8"	1 1/8"	1 3/8"	1 1/8"	1 1/8"	1 1/8"	
	S4-16	99'-7 3/8"	99'-0 1/2"	24'-0 3/8"	25'-6"	23'-1 1/8"	10 3/8"	7 1/2"	6 3/8"	15x2 1/2"	15x1 1/2"	15"	17"	19 1/2"	22 1/2"	1 1/8"	1 1/8"	1 1/8"	1 3/8"	1 1/8"	1 1/8"	1 1/8"	
	S5-16	99'-7 3/8"	99'-0 1/2"	24'-0 3/8"	25'-6"	23'-1 1/8"	10 3/8"	7 1/2"	6 3/8"	15x2 1/2"	15x1 1/2"	14"	16 1/2"	19 1/2"	24"	1 1/8"	1 1/8"	1 1/8"	1 3/8"	1 1/8"	1 1/8"	1 1/8"	

Note All structural steel in Units 15 and 16 is A36.

* Spacing begins at termination of 6 spaces @ 4"

Longitudinal stiffeners shall be located on the exterior face of the exterior Stringers.

Intermediate stiffener Pls. 4 1/2 x 3/8" shall be equally spaced between diaphragms as shown. The first two stiffener spaces at the ends of stringers shall be one-half the normal spacing within the panel.

BY	DATE			
MADE	RLM	7-31-68		
CHECKED	PTA	11-4-68	As Built	TEM 8-76
IN CHARGE				

AS BUILT

RICHMOND METROPOLITAN AUTHORITY
RICHMOND EXPRESSWAY SYSTEM
DOWNTOWN EXPRESSWAY

BRIDGE NO. 66
EASTBOUND ROADWAY OVER
12TH ST. - R.R. TRACKS AND 16TH ST.


FRAMING PLAN - UNITS 15 AND 16

HOWARD, NEEDLES, TAMMEN & BERGENDOFF
consulting engineers
NEW YORK ALEXANDRIA KANSAS CITY

SCALE: As Noted
CONTRACT NO.: 10
SHEET NO. 17 OF 46

Note: Stringers S2-17 thru S5-17 and Stringers S1-18 thru S5-18 are parallel. Diaphragm spacing is shown along stringer length "L".

Dimensions shown at Piers are between extended center lines of stringers.

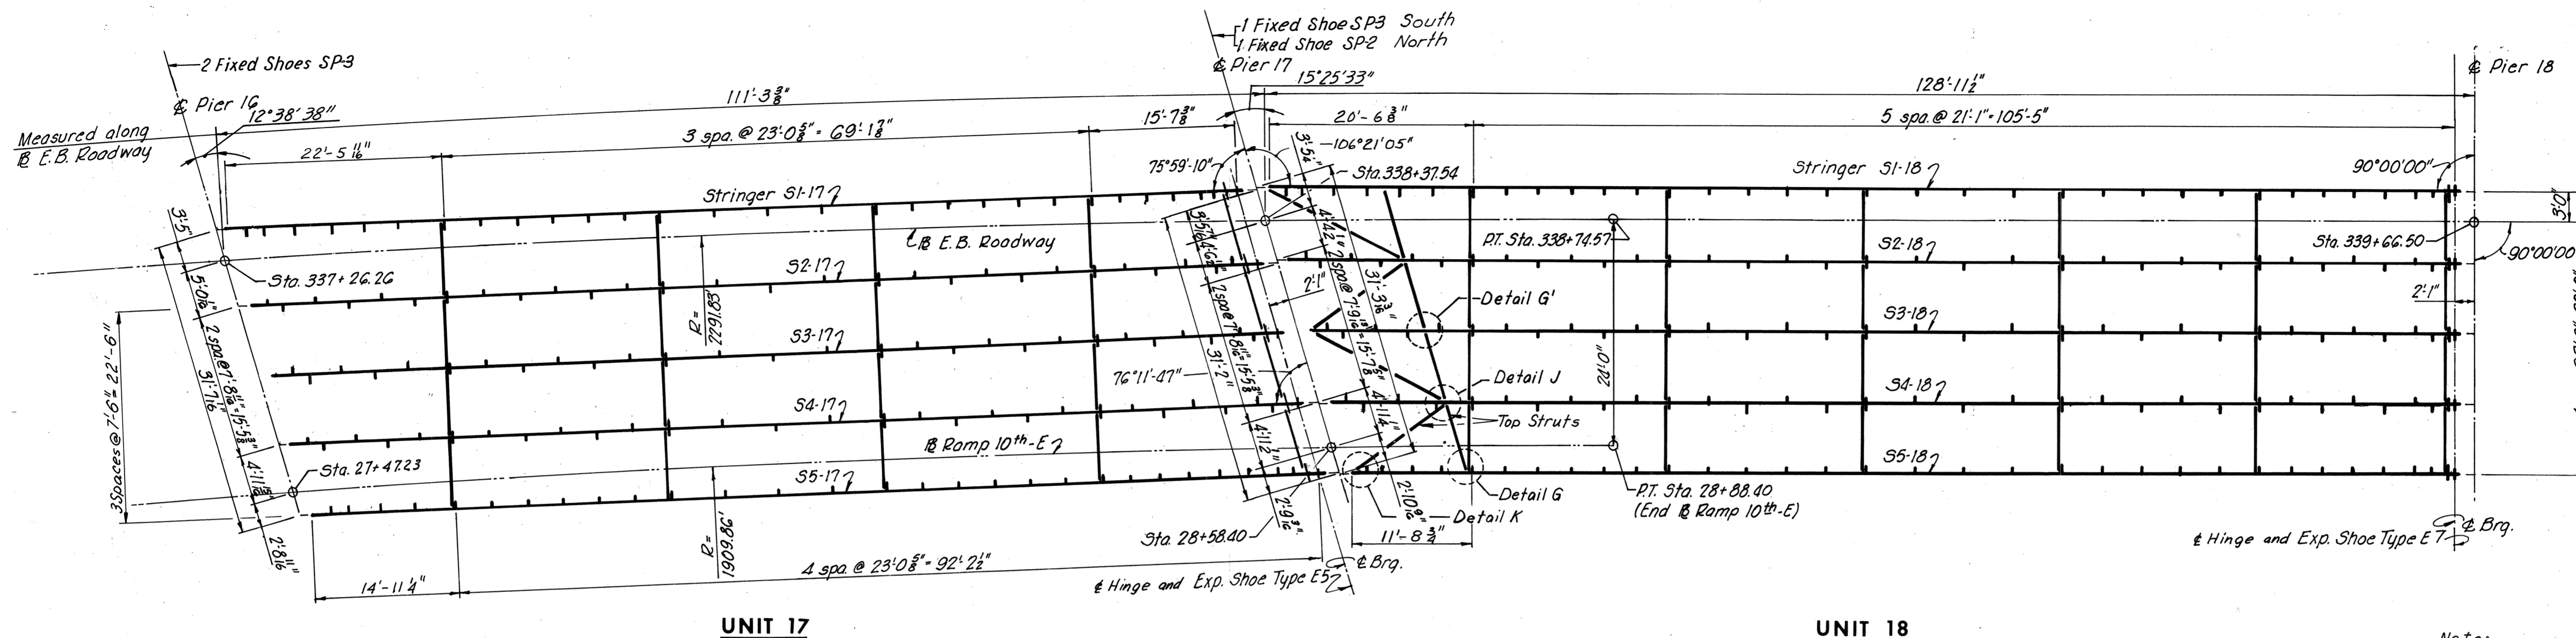


UNIT 17


UNIT 18

FRAMING PLAN
Scale: 1"=10'-0"


Note: For web to flange weld sizes and longitudinal stiffener plate details see Sheet 17.

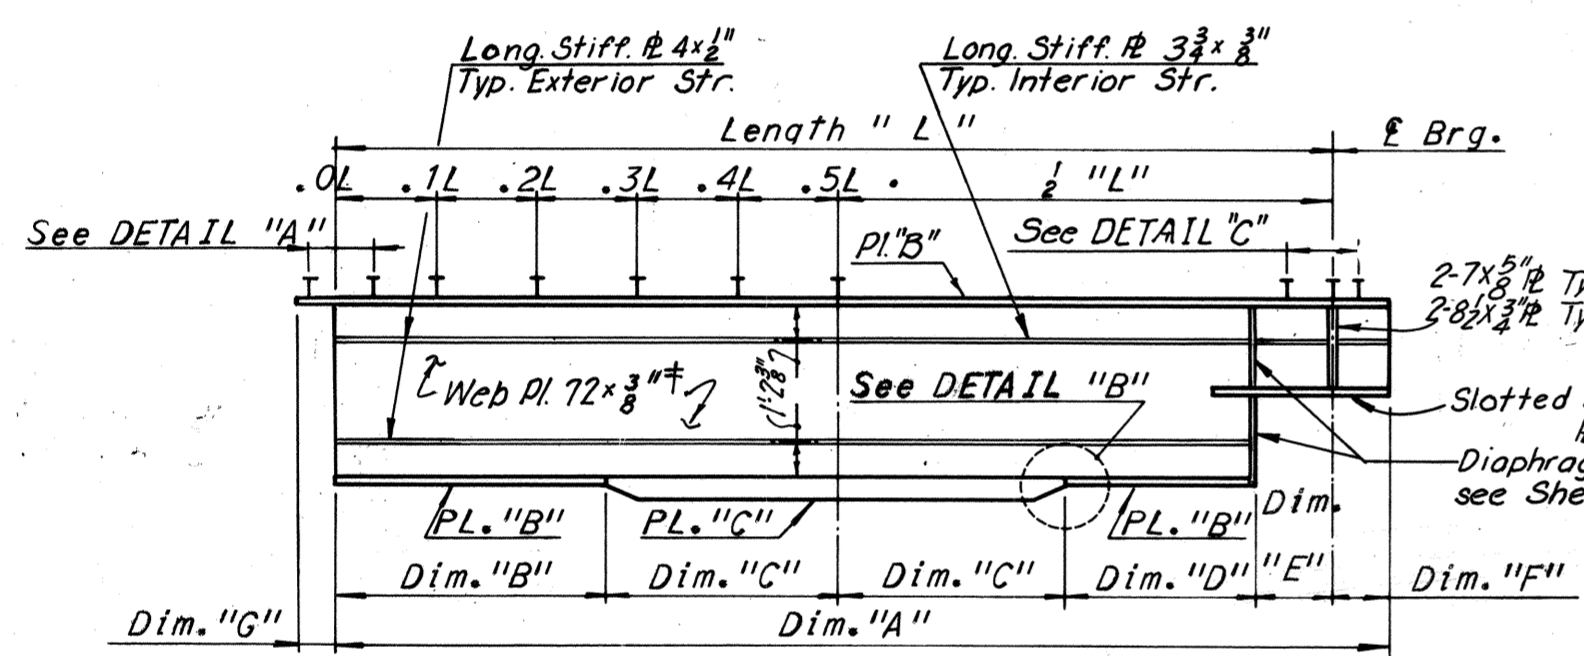

STRINGER ELEVATION
No Scale

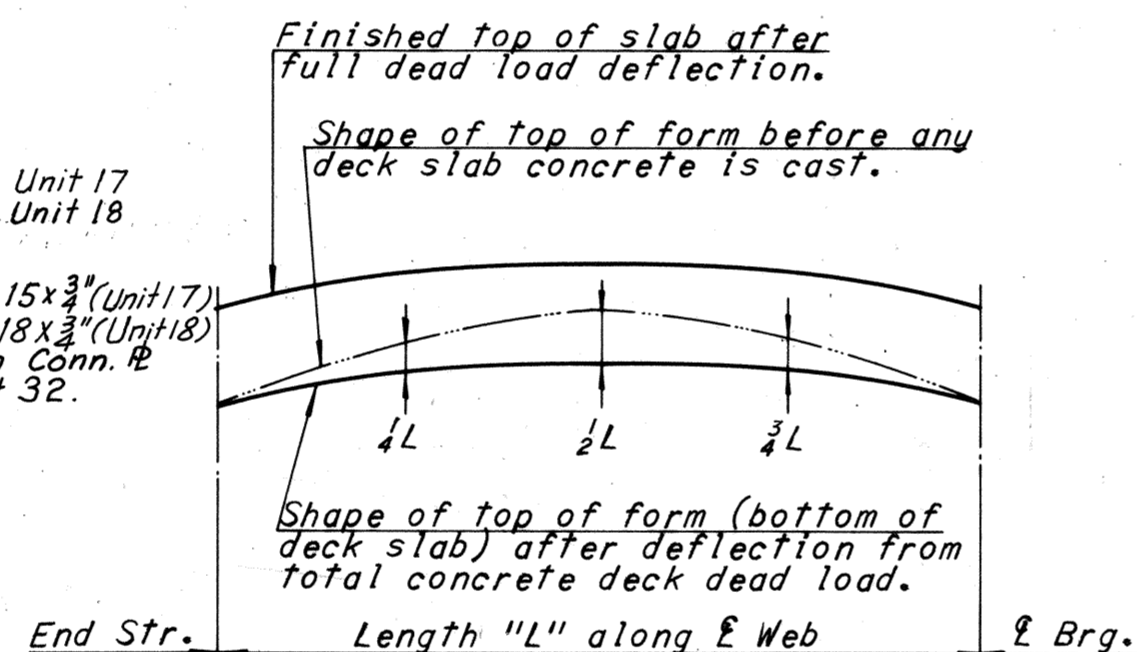

DEAD LOAD DEFLECTION DIAGRAM

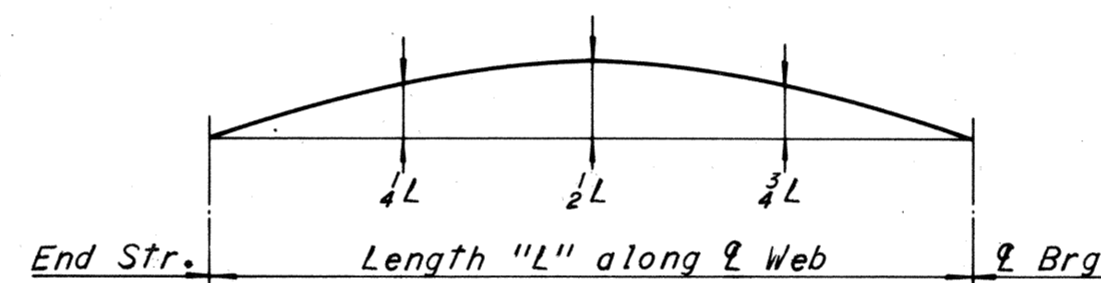


CAMBER DIAGRAM

NOTE TO FABRICATOR

The stringers shall be fabricated with an upward camber amounting to the tabulated value. This will provide approximate compensation for deflection under full dead load and for conformity with finished grade. Dimensions are in inches. Stringers having a total camber of less than 1" are not required to be shop cambered, but should be turned so that any mill tolerance deviation from straightness will be in the direction shown by the Camber Diagram. If stringers are not cambered, distance top of stringers to top of slab will vary along the stringer in accordance with the offset dimensions shown in the Camber Diagram, and with minimum distance as shown in cross-section on Sheet 32.

NOTE TO CONTRACTOR

Deflections given are those anticipated to occur in the stringer upon placement of the total concrete deck dead load. In practice, the stringers in place are not likely to have the exact camber to compensate for these deflections during construction. The residual amounts shall be provided by adjusting forms to vary the thickness of the concrete haunch between the bottom of the slab and the top of stringer without altering the slab thickness.

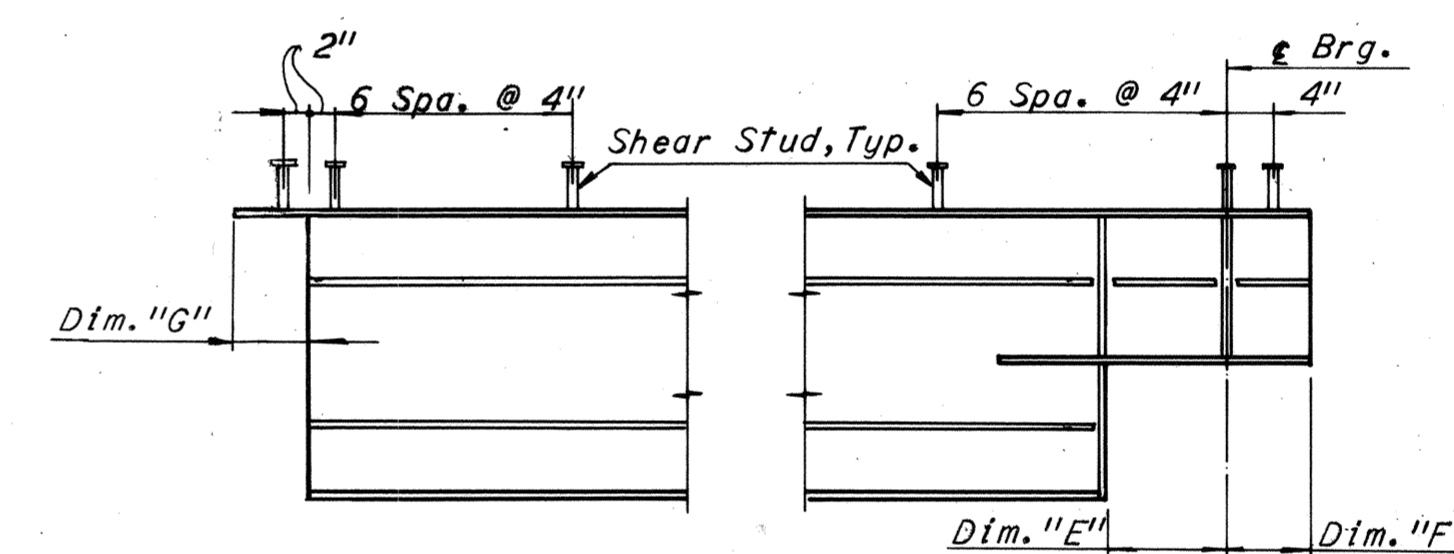

DETAIL "A"
No Scale

DETAIL "C"
No Scale

SHOE SCHEDULE

EXPANSION SHOES		FIXED SHOES	
TYPE	NO. REQD.	TYPE	NO. REQD.
E5	5	SP-2	1
E7	5	SP-3	3

Note: Longitudinal stiffeners shall be located on the exterior face of the exterior Stringers. Intermediate stiffener Pls. 4x 3/4" shall be equally spaced between diaphragms as shown. The first two stiffener spaces at the ends of stringers shall be one-half the normal spacing within the panel. All steel shall be A36 unless otherwise noted.

Notes: For Framing Details, see Sheet 22 and 23. For Joint Details, see Sheet 38. For Shoe Details, see Sheets 51 & 52. For Diaphragm Details, see Sheet 32. For Superstructure steel quantities, see Sheet 2. For Details G, G', J and K, see Sheet 27. For Shear Stud Details, see Sheet 14. For Anales between Piers and Stringers, see Sheets 22 & 23.

UNIT	STRINGER	Dim. "A"	LENGTH "L"	Dim. "B"	Dim. "C"	Dim. "D"	STRINGER SCHEDULE					DEAD LOAD DEFLECTION SCHEDULE					CAMBER SCHEDULE					
							Dim. "E"	Dim. "F"	Dim. "G"	PL. "B"	PL. "C"	0.0L-0.1L*	0.1L-0.2L	0.2L-0.3L	0.3L-0.4L	0.4L-0.5L	1/4L	1/2L	3/4L			
							Dim. "E"	Dim. "F"	Dim. "G"	PL. "B"	PL. "C"	0.0L-0.1L*	0.1L-0.2L	0.2L-0.3L	0.3L-0.4L	0.4L-0.5L	1/4L	1/2L	3/4L			
17	S1-17	107'-10 3/4"	107'-2 5/8"	26'-7 1/2"	27'-0"	25'-9 1/8"	10 3/8"	7 1/4"	6 1/4"	# 15x 3/4"	# 15x 1 1/4"	13 1/4"	15 1/2"	18 1/2"	23"	24"	1 5/8"	2 1/4"	1 3/8"	2"	2 3/4"	2 1/2"
	S2-17	107'-9"	107'-1 3/4"	28'-6 1/2"	25'-0"	27'-8 3/8"	10 3/8"	7 1/4"	6 1/4"	# 15x 3/4"	# 15x 1 1/4"	14 1/2"	17"	19 1/2"	22"	24"	1 5/8"	2 1/4"	1 3/8"	1 1/2"	2 3/8"	1 3/4"
	S3-17	107'-9"	107'-1 3/4"	28'-6 1/2"	25'-0"	27'-8 3/8"	10 3/8"	7 1/4"	6 1/4"	# 15x 3/4"	# 15x 1 1/4"	14 1/2"	17"	19 1/2"	22"	24"	1 5/8"	2 1/4"	1 3/8"	1 1/2"	2 3/8"	1 3/4"
	S4-17	107'-9"	107'-1 3/4"	28'-6 1/2"	25'-0"	27'-8 3/8"	10 3/8"	7 1/4"	6 1/4"	# 15x 3/4"	# 15x 1 1/4"	14 1/2"	17"	19 1/2"	22"	24"	1 5/8"	2 1/4"	1 3/8"	1 1/2"	2 3/8"	1 3/4"
	S5-17	107'-9"	107'-1 3/4"	28'-0 1/2"	25'-6"	27'-2 3/8"	10 3/8"	7 1/4"	6 1/4"	# 15x 3/4"	# 15x 1 1/4"	14"	16"	19"	24"	24"	1 3/8"	2 3/8"	1 3/8"	1"	1 1/2"	3"
18	S1-18	126'-6 3/4"	125'-11 3/8"	30'-11 1/8"	32'-0"	30'-1 1/8"	10"	7"	6 3/4"	# 18x 7/8"	# 18x 1 1/4"	14"	16 1/2"	19 1/2"	24"	24"	2 1/4"	3 3/8"	2 1/4"	2 5/8"	4 1/8"	2 5/8"
	S2-18	124'-4"	123'-9"	34'-10 1/2"	27'-0"	34'-0 1/2"	10"	7"	6 3/4"	# 18x 7/8"	# 18x 1 1/4"	16"	18 1/2"	21 1/2"	24"	24"	2 1/4"	2 5/8"	2 1/4"	2 5/8"	3 1/8"	2 5/8"
	S3-18	122'-1 1/8"	121'-6 3/8"	36'-3 3/8"	24'-6"	35'-5 1/4"	10"	7"	6 3/4"	# 18x 7/8"	# 18x 1 1/4"	16"	18 1/2"	21 1/2"	23 1/2"	24"	2"	2 1/4"	2"	2 5/8"	3 3/8"	2 5/8"
	S4-18	119'-11 3/8"	119'-4 3/8"	37'-0 1/2"	21'-6"	36'-2 1/8"	10"	7"	6 3/4"	# 18x 7/8"	# 18x 1 1/4"	16"	18 1/2"	21 1/2"	23 1/2"	24"	1 3/8"	2 5/8"	1 3/8"	2 5/8"	3 7/8"	2 5/8"
	S5-18	117'-8 1/4"	117'-1 1/4"	37'-0 1/2"	21'-6"	36'-2 1/8"	10"	7"	6 3/4"	# 18x 7/8"	# 18x 1 1/4"	14 1/2"	17"	20"	24"	24"	1 3/8"	2 1/2"	1 3/8"	2 1/2"	3 3/8"	2 5/8"

*Spacing begins at termination of 6 spaces @ 4".

† Denotes A572-Grade 50 steel for thickness of 3/4" and under and A388 steel for thickness over 3/4".

MADE	BY	DATE	NO.	REVISION	BY	DATE
FLD	8-20-68	2	As Built	TEM	8-76	
PTA	4-25-69	1	Pier 17 Shoes	DWB	11/14/74	
NO.	REVISION	BY	DATE			

RICHMOND METROPOLITAN AUTHORITY
RICHMOND EXPRESSWAY SYSTEM
DOWNTOWN EXPRESSWAY


BRIDGE NO. 66
EASTBOUND ROADWAY OVER
12TH ST. - R.R. TRACKS AND 16TH ST.
FRAMING PLAN - UNITS 17 AND 18

HOWARD, NEEDLES, TAMMEN & BERGENDOFF
consulting engineers
NEW YORK ALEXANDRIA KANSAS CITY

SCALE: As Noted
CONTRACT NO.: 10
SHEET NO. 18 OF 46

AS BUILT


RICHMOND EXPRESSWAY SYSTEM			
SECTION	PROJECT	SHEET NO.	TOTAL SHEETS
10	DOWNTOWN EXPRESSWAY	145	265

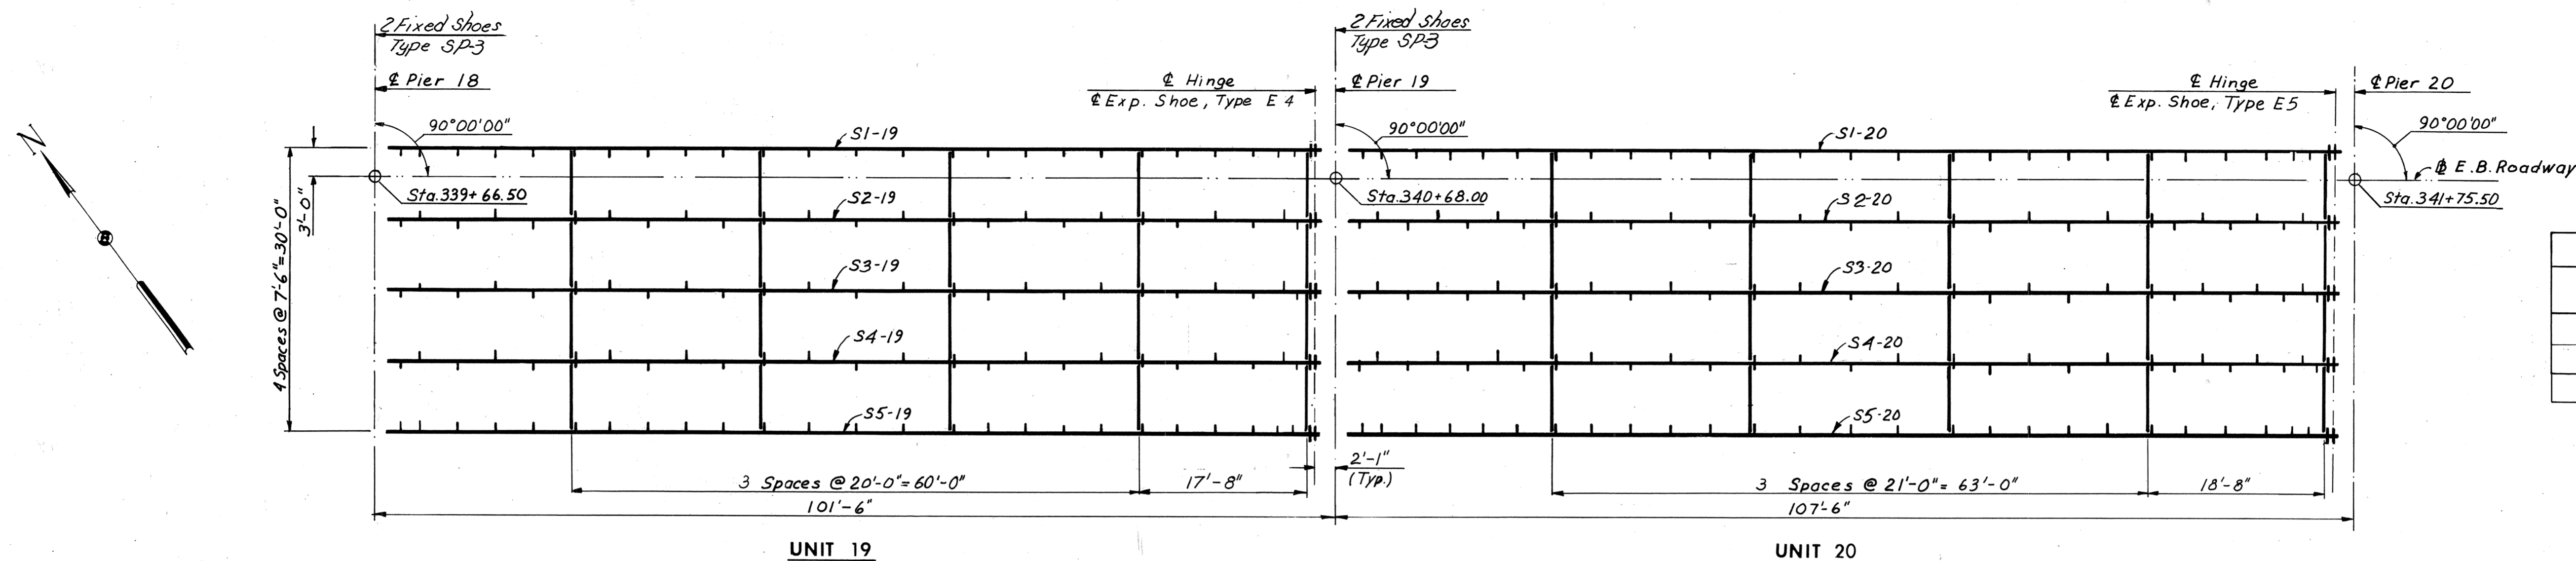


SHOE SCHEDULE			
EXPANSION SHOES		FIXED SHOES	
TYPE	NO. REQD.	TYPE	NO. REQD.
E4	5	SP-3	4
E5	5		

FRAMING PLAN
Scale: 1" = 10'-0"


Note: For web to flange weld sizes and Longitudinal Stiffener Plate details see Sheet 17.

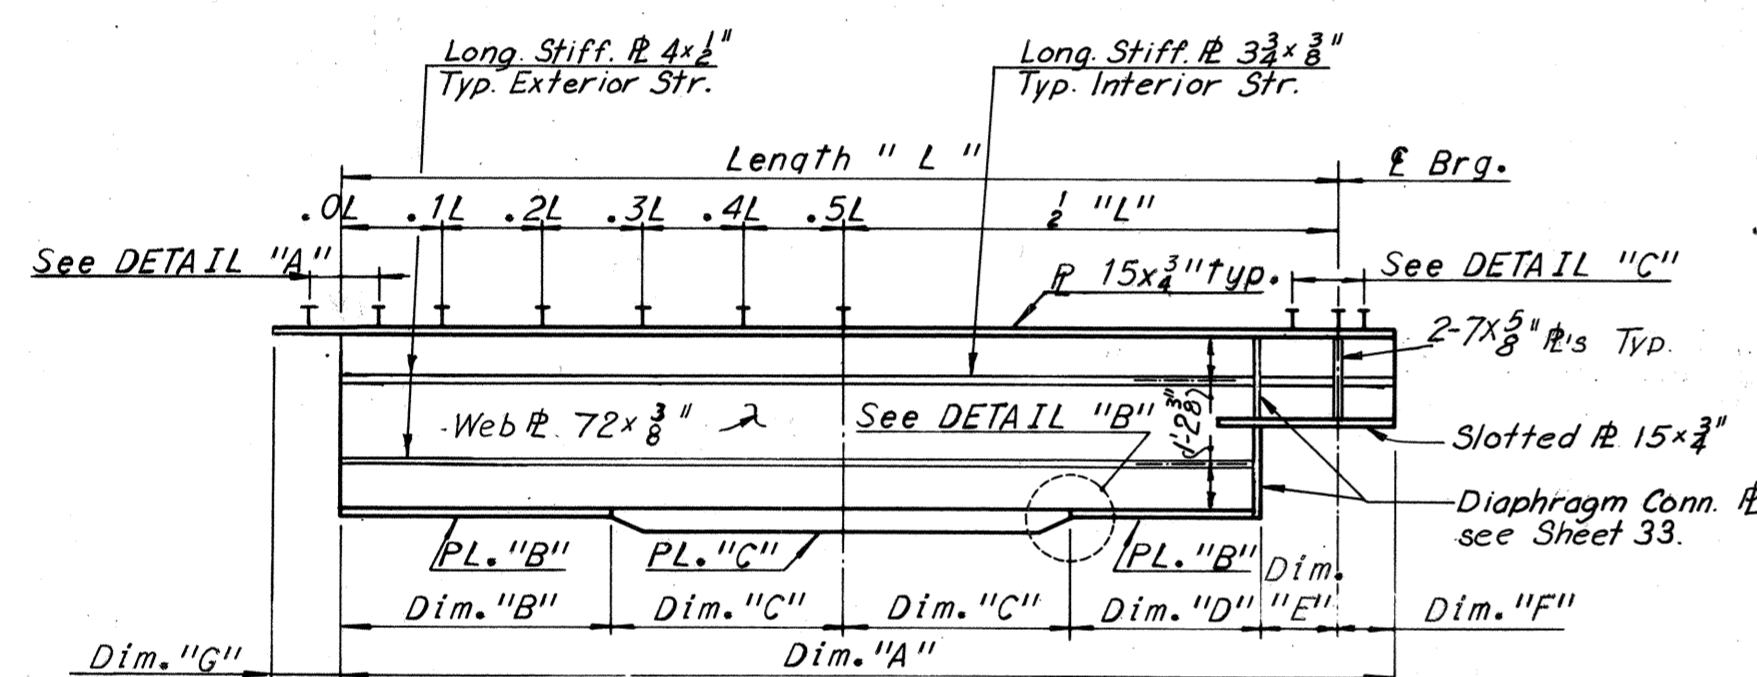

STRINGER ELEVATION
No Scale

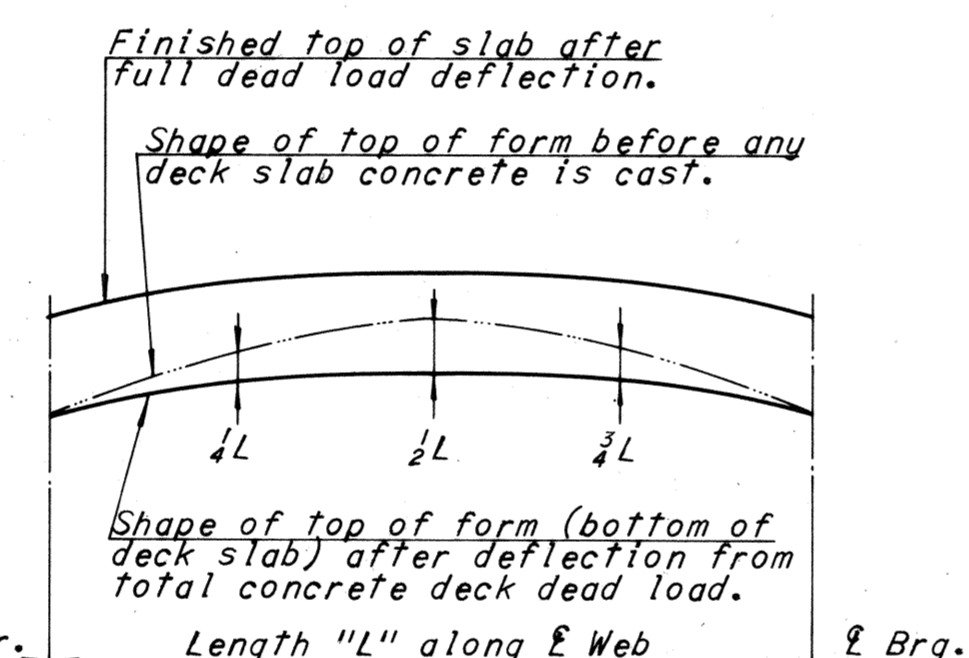

DEAD LOAD DEFLECTION DIAGRAM

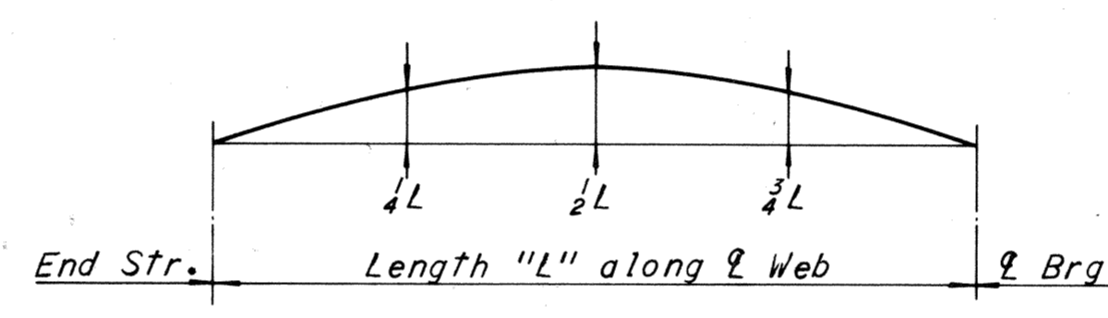


CAMBER DIAGRAM

NOTE TO FABRICATOR

The stringers shall be fabricated with an upward camber amounting to the tabulated value. This will provide approximate compensation for deflection under full dead load and for conformity with finished grade. Dimensions are in inches. Stringers having a total camber of less than 1" are not required to be shop cambered, but should be turned so that any mill tolerance deviation from straightness will be in the direction shown by the Camber Diagram. If stringers are not cambered, distance top of stringers to top of slab will vary along the stringer in accordance with the offset dimensions shown in the Camber Diagram, and with minimum distance as shown in cross-section on Sheet 33.

NOTE TO CONTRACTOR


Deflections given are those anticipated to occur in the stringer upon placement of the total concrete deck dead load. In practice, the stringers in place are not likely to have the exact camber to compensate for these deflections during construction. The residual amounts shall be provided by adjusting forms to vary the thickness of the concrete haunch between the bottom of the slab and the top of stringer without altering the slab thickness.

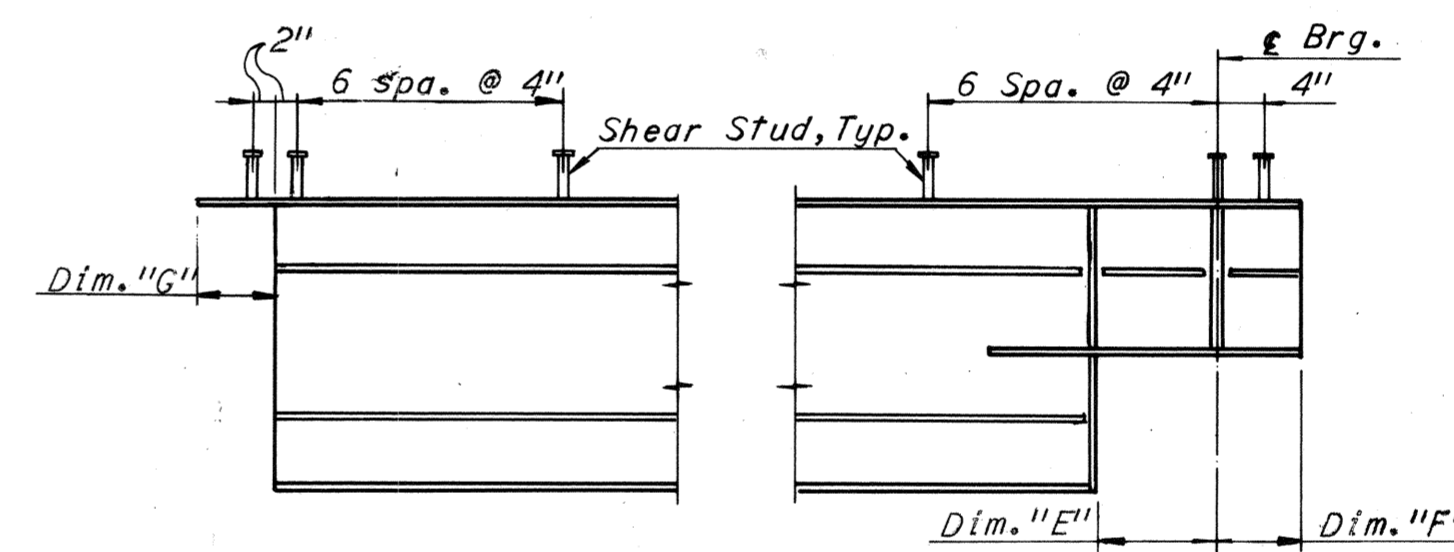

DETAIL "A"
No Scale

DETAIL "C"
No Scale

Note: Longitudinal stiffeners shall be located on the exterior face of the exterior stringers. Intermediate stiffener Pls. 4 1/2 x 3/8 shall be equally spaced between diaphragms as shown. The first two stiffener spaces at the end of stringers shall be one-half the normal spacing within the panel.

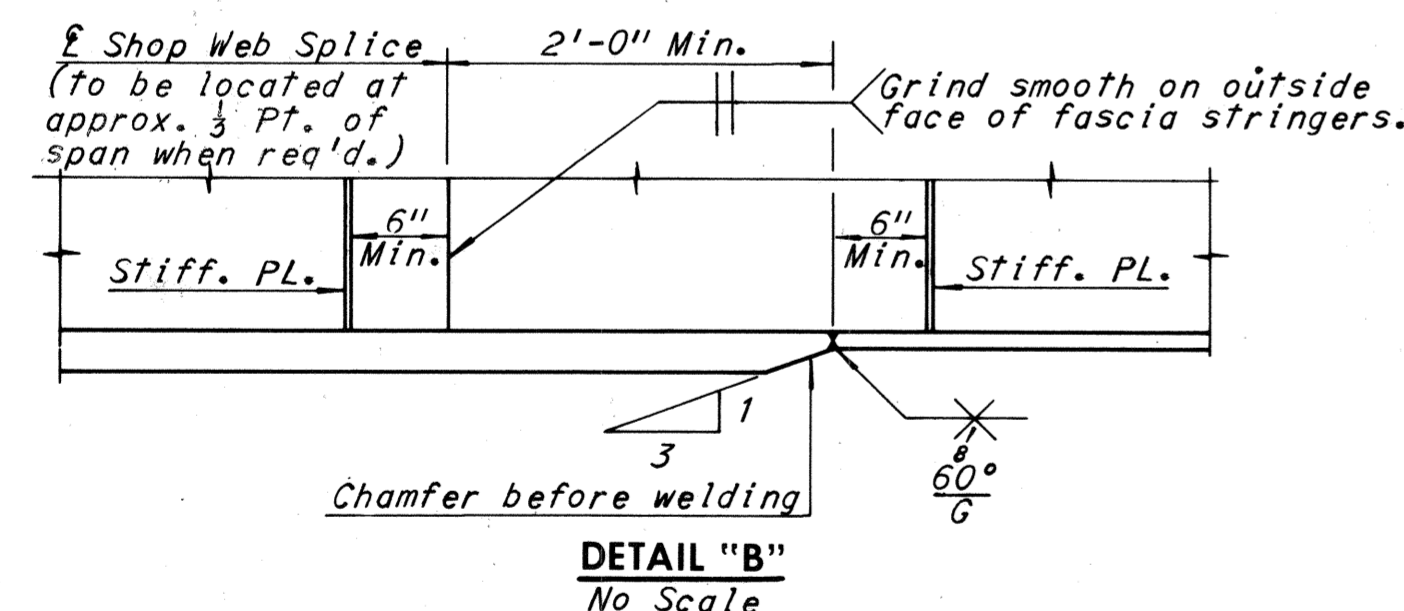

DETAIL "B"
No Scale

Notes: For Superstructure steel quantities, see Sheet 2. For Diaphragm Details, see Sheet 33. For Shoe Details, see Sheets S1-S2. For Joint Details, see Sheet 38. For Framing Details, see Sheet 23. For Shear Stud Details, see Sheet 14. For Angles between Piers and Stringers, see Sheet 23.

UNIT	STRINGER	Dim. "A"	LENGTH "L"	Dim. "B"	Dim. "C"	Dim. "D"	Dim. "E"	Dim. "F"	Dim. "G"	PL. "B"	PL. "C"	MAX. SHEAR STUD SPACING					DEAD LOAD DEFLECTION SCHEDULE			CAMBER SCHEDULE			
												0.0L-0.1L	0.1L-0.2L	0.2L-0.3L	0.3L-0.4L	0.4L-0.5L	1/4L	1/2L	3/4L	1/4L	1/2L	3/4L	
												17"	20"	24"	24"	1"	1 1/8"	1"	1 1/4"	1 1/8"	1 1/4"		
19	S1-19	98'-2 1/2"	97'-7 1/4"	23'-9 3/8"	25'-0"	22'-11 3/8"	10"	7"	6 1/2"	15x1 1/4"	15x1 1/4"	14 1/2"	17"	20"	24"	24"	1"	1 1/8"	1"	1 1/4"	1 1/8"	1 1/4"	1 1/4"
	S2-19	98'-2 1/2"	97'-7 1/4"	24'-9 3/8"	24'-0"	23'-11 3/8"	10"	7"	6 1/2"	15x1 1/4"	15x1 1/4"	16"	18"	21"	24"	24"	1"	1 1/8"	1"	1 1/4"	1 1/8"	1 1/4"	1 1/4"
	S3-19	98'-2 1/2"	97'-7 1/4"	24'-9 3/8"	24'-0"	23'-11 3/8"	10"	7"	6 1/2"	15x1 1/4"	15x1 1/4"	16"	18"	21"	24"	24"	1"	1 1/8"	1"	1 1/4"	1 1/8"	1 1/4"	1 1/4"
	S4-19	98'-2 1/2"	97'-7 1/4"	24'-9 3/8"	24'-0"	23'-11 3/8"	10"	7"	6 1/2"	15x1 1/4"	15x1 1/4"	16"	18"	21"	24"	24"	1"	1 1/8"	1"	1 1/4"	1 1/8"	1 1/4"	1 1/4"
	S5-19	98'-2 1/2"	97'-7 1/4"	23'-9 3/8"	25'-0"	22'-11 3/8"	10"	7"	6 1/2"	15x1 1/4"	15x1 1/4"	14 1/2"	17"	20"	24"	24"	1"	1 1/8"	1"	1 1/4"	1 1/8"	1 1/4"	1 1/4"
* Spacing begins at termination of 6 spaces @ 4"

Note: All structural steel in Units 19 and 20 is A36.

MADE	J.D.	8-6-68			
CHECKED	PTA	11-4-68	As Built	TEM	8-76
IN CHARGE					

RICHMOND METROPOLITAN AUTHORITY
RICHMOND EXPRESSWAY SYSTEM
DOWNTOWN EXPRESSWAY






BRIDGE NO. 66
EASTBOUND ROADWAY OVER
12TH ST. - R.R. TRACKS AND 16TH ST.
FRAMING PLAN - UNITS 19 AND 20

HOWARD, NEEDLES, TAMMEN & BERGENDOFF
consulting engineers
NEW YORK ALEXANDRIA KANSAS CITY

SCALE: As Noted
CONTRACT NO.: 10
SHEET NO. 19 OF 46

AS BUILT

RICHMOND EXPRESSWAY SYSTEM			
SECTION	PROJECT	SHEET NO.	TOTAL SHEETS
10	DOWNTOWN EXPRESSWAY	146A	265

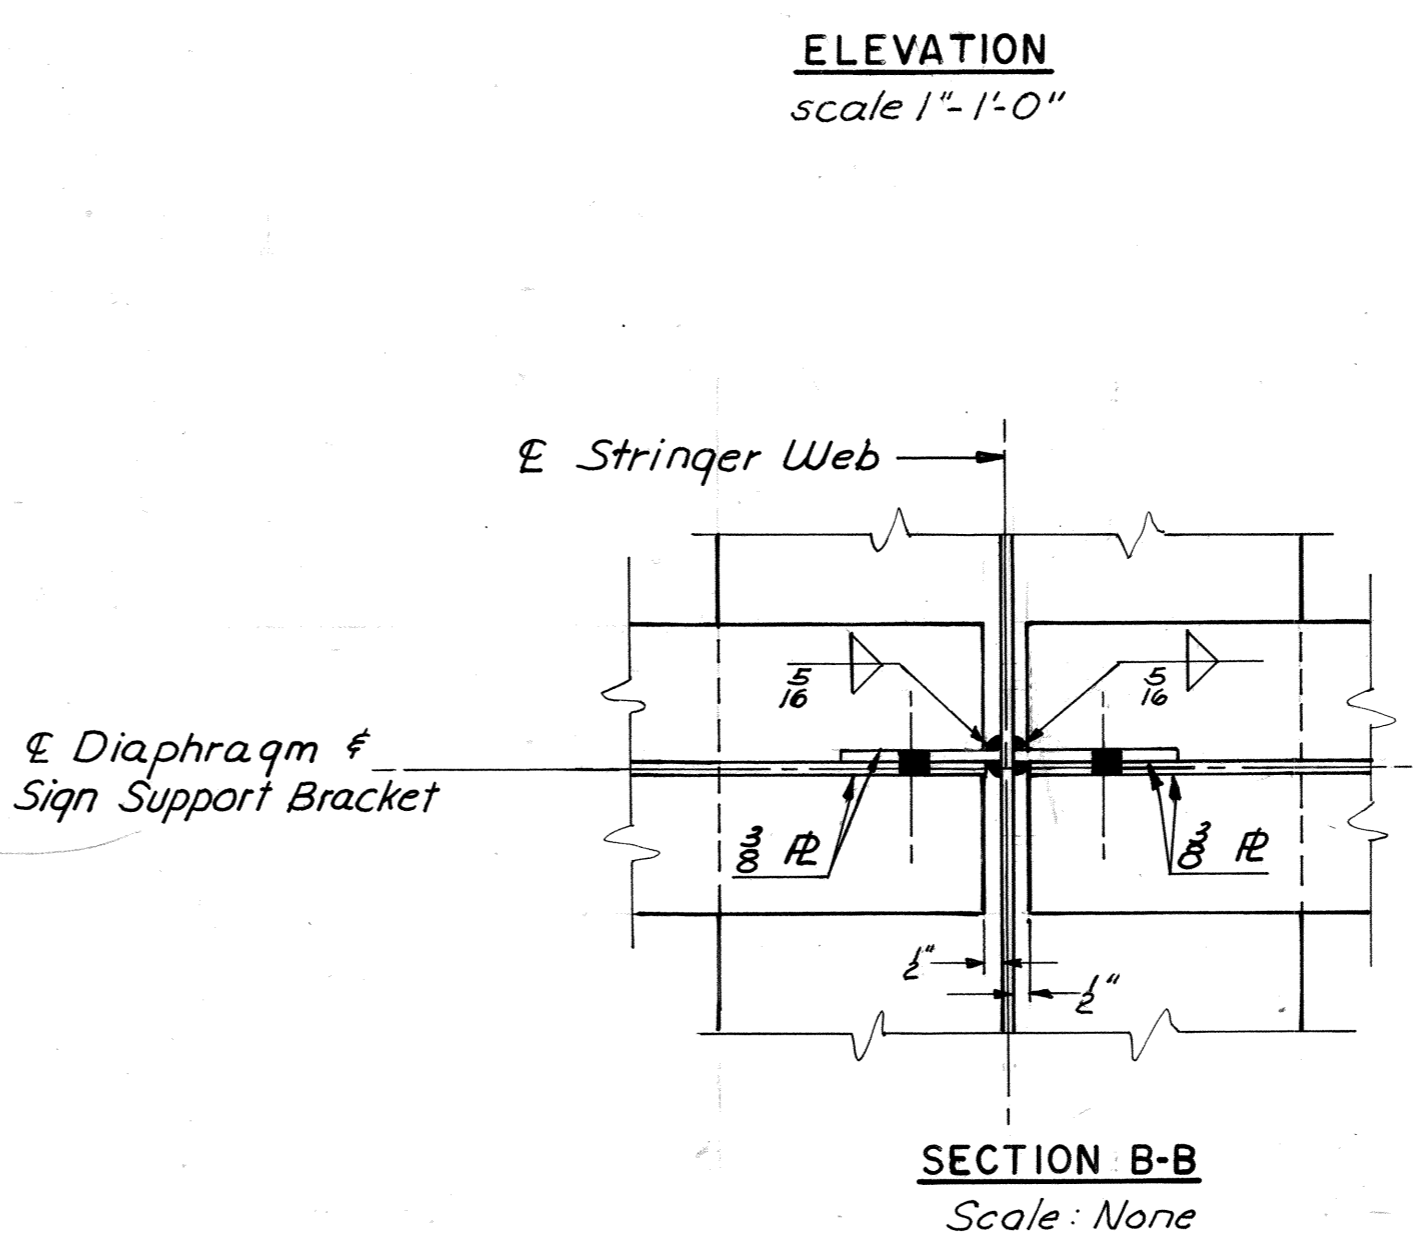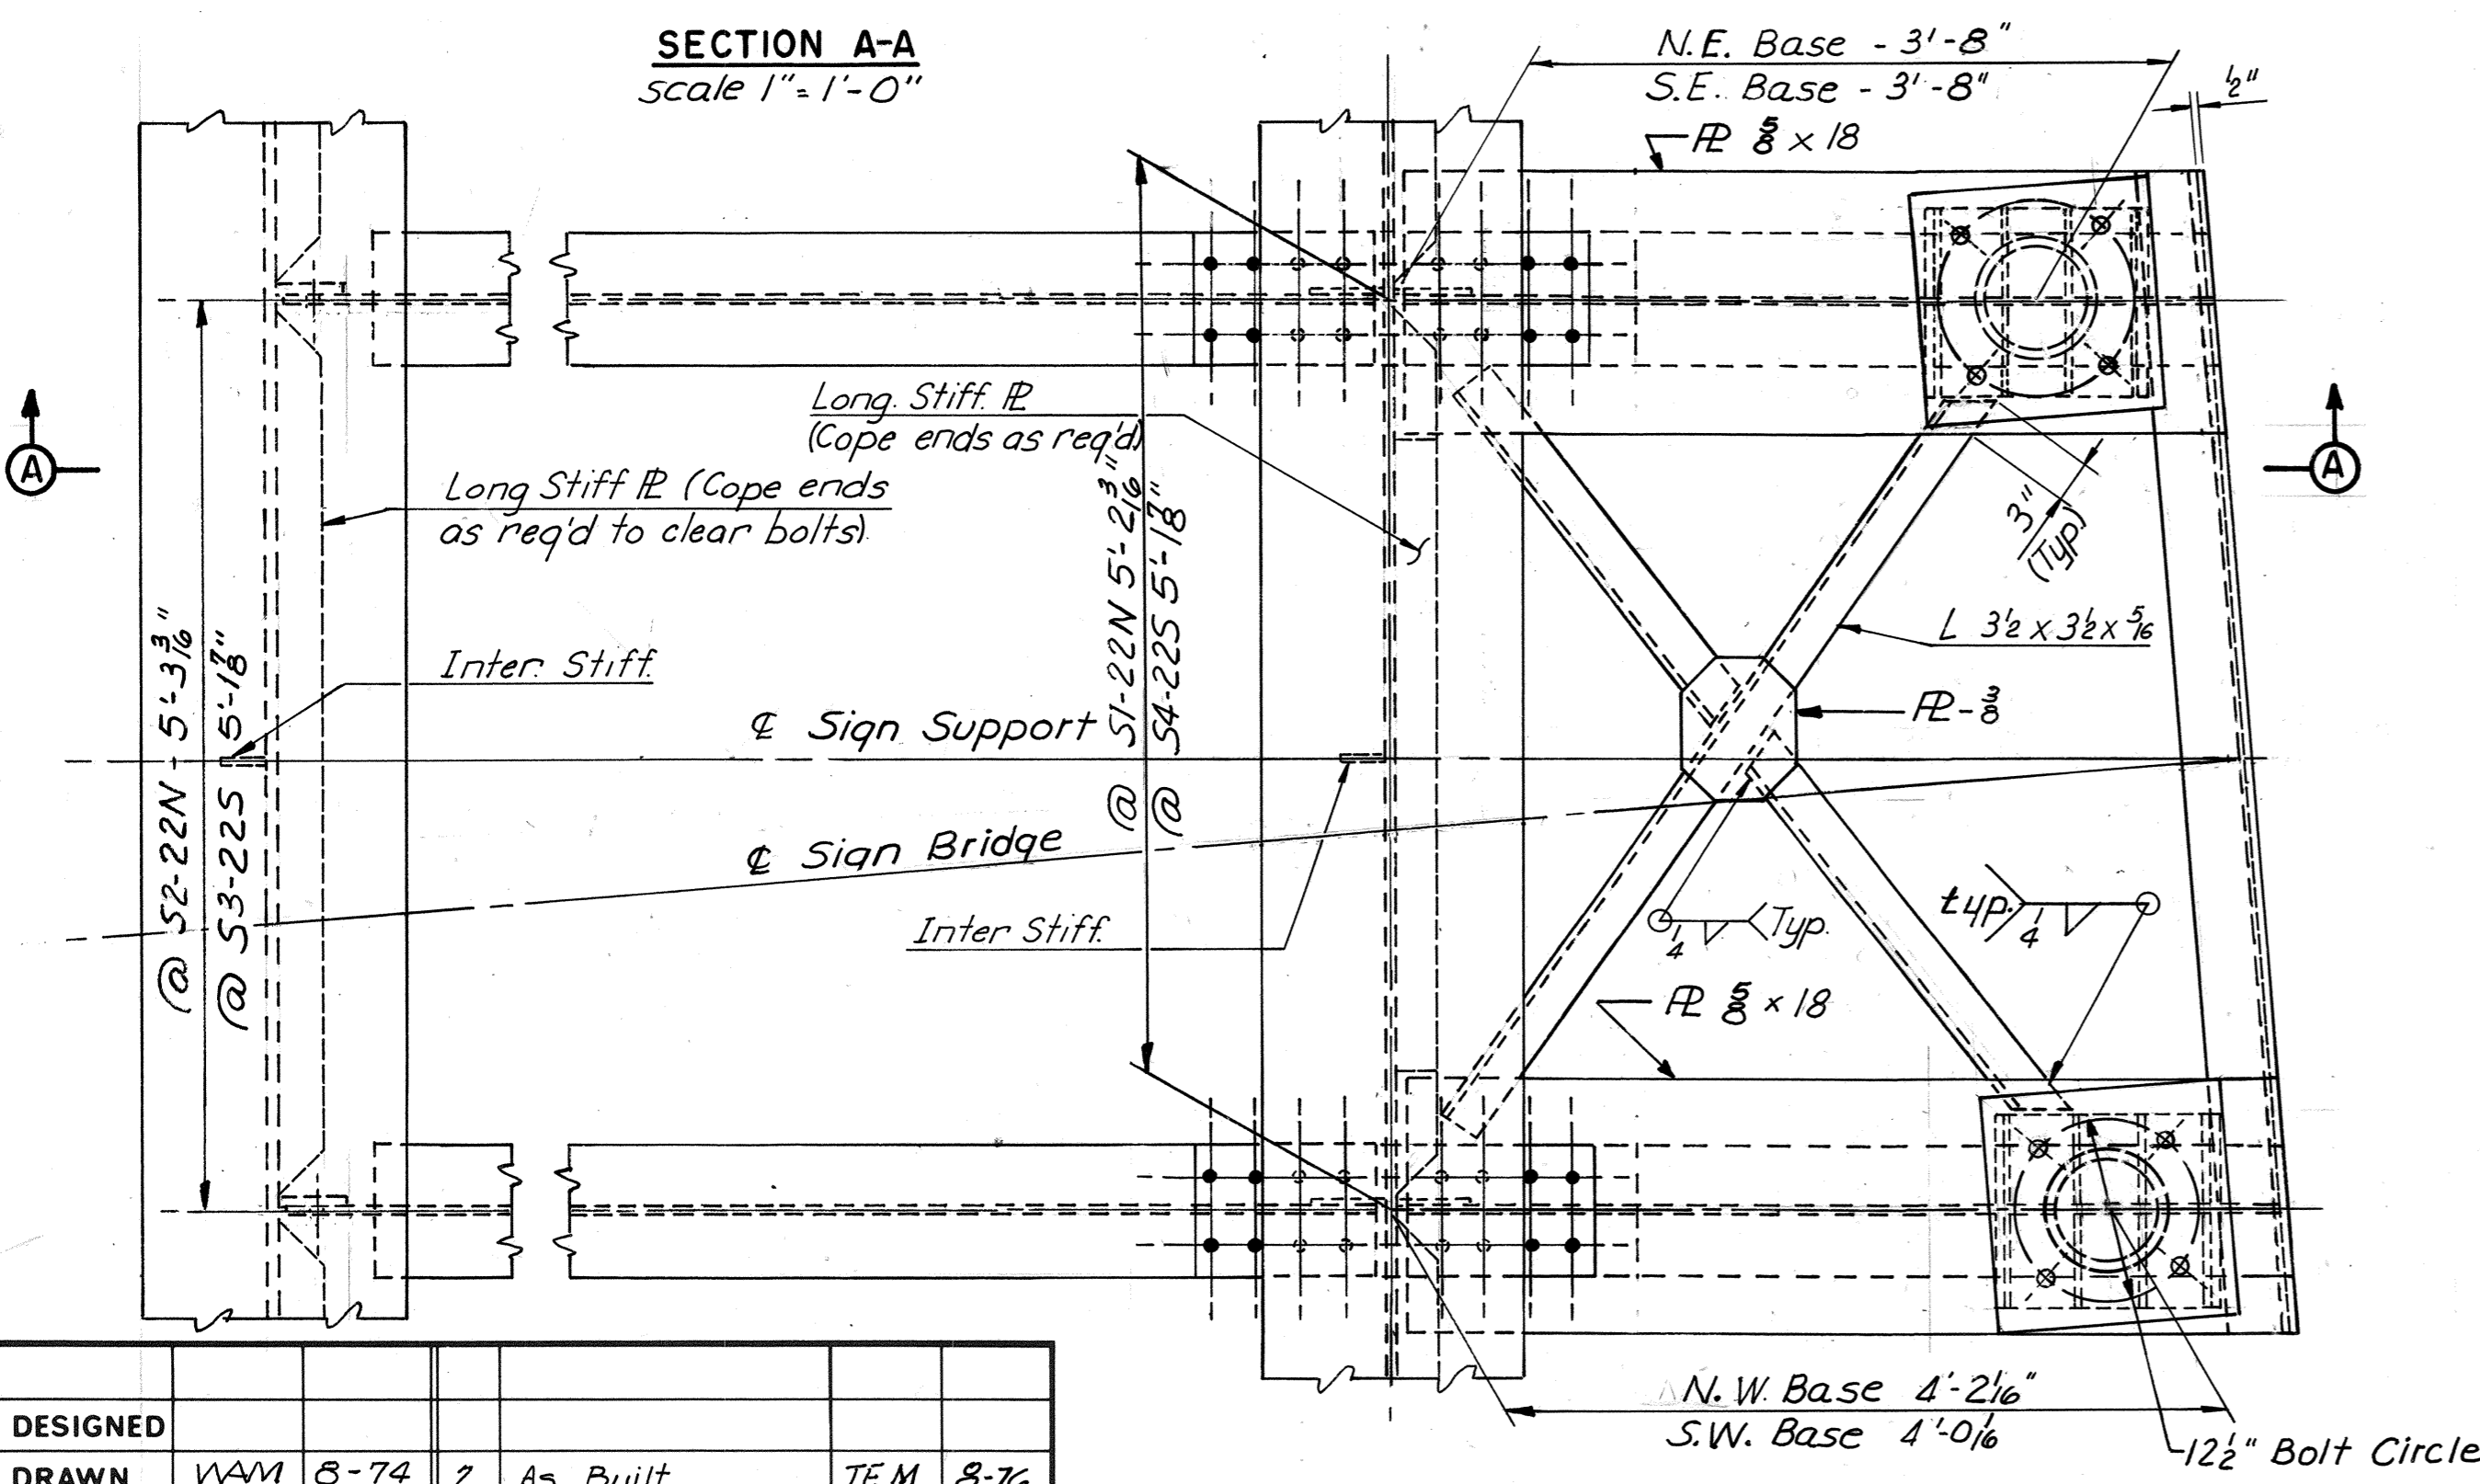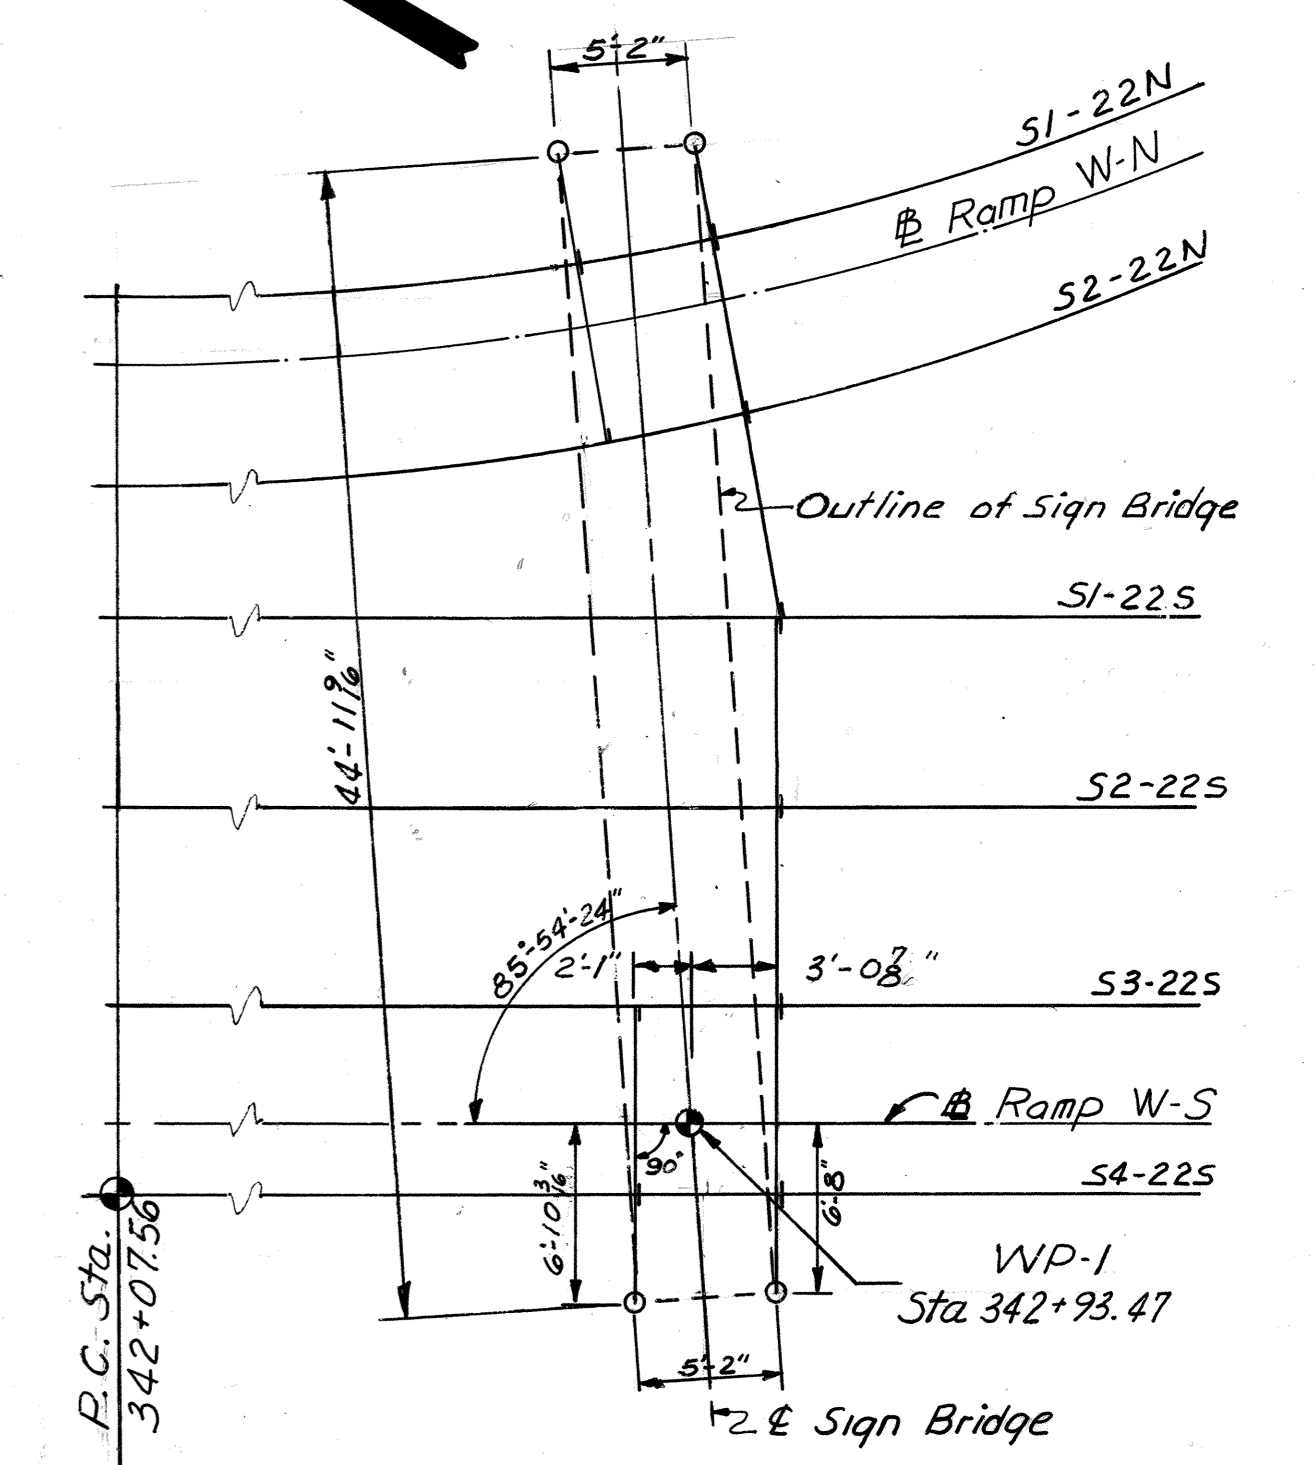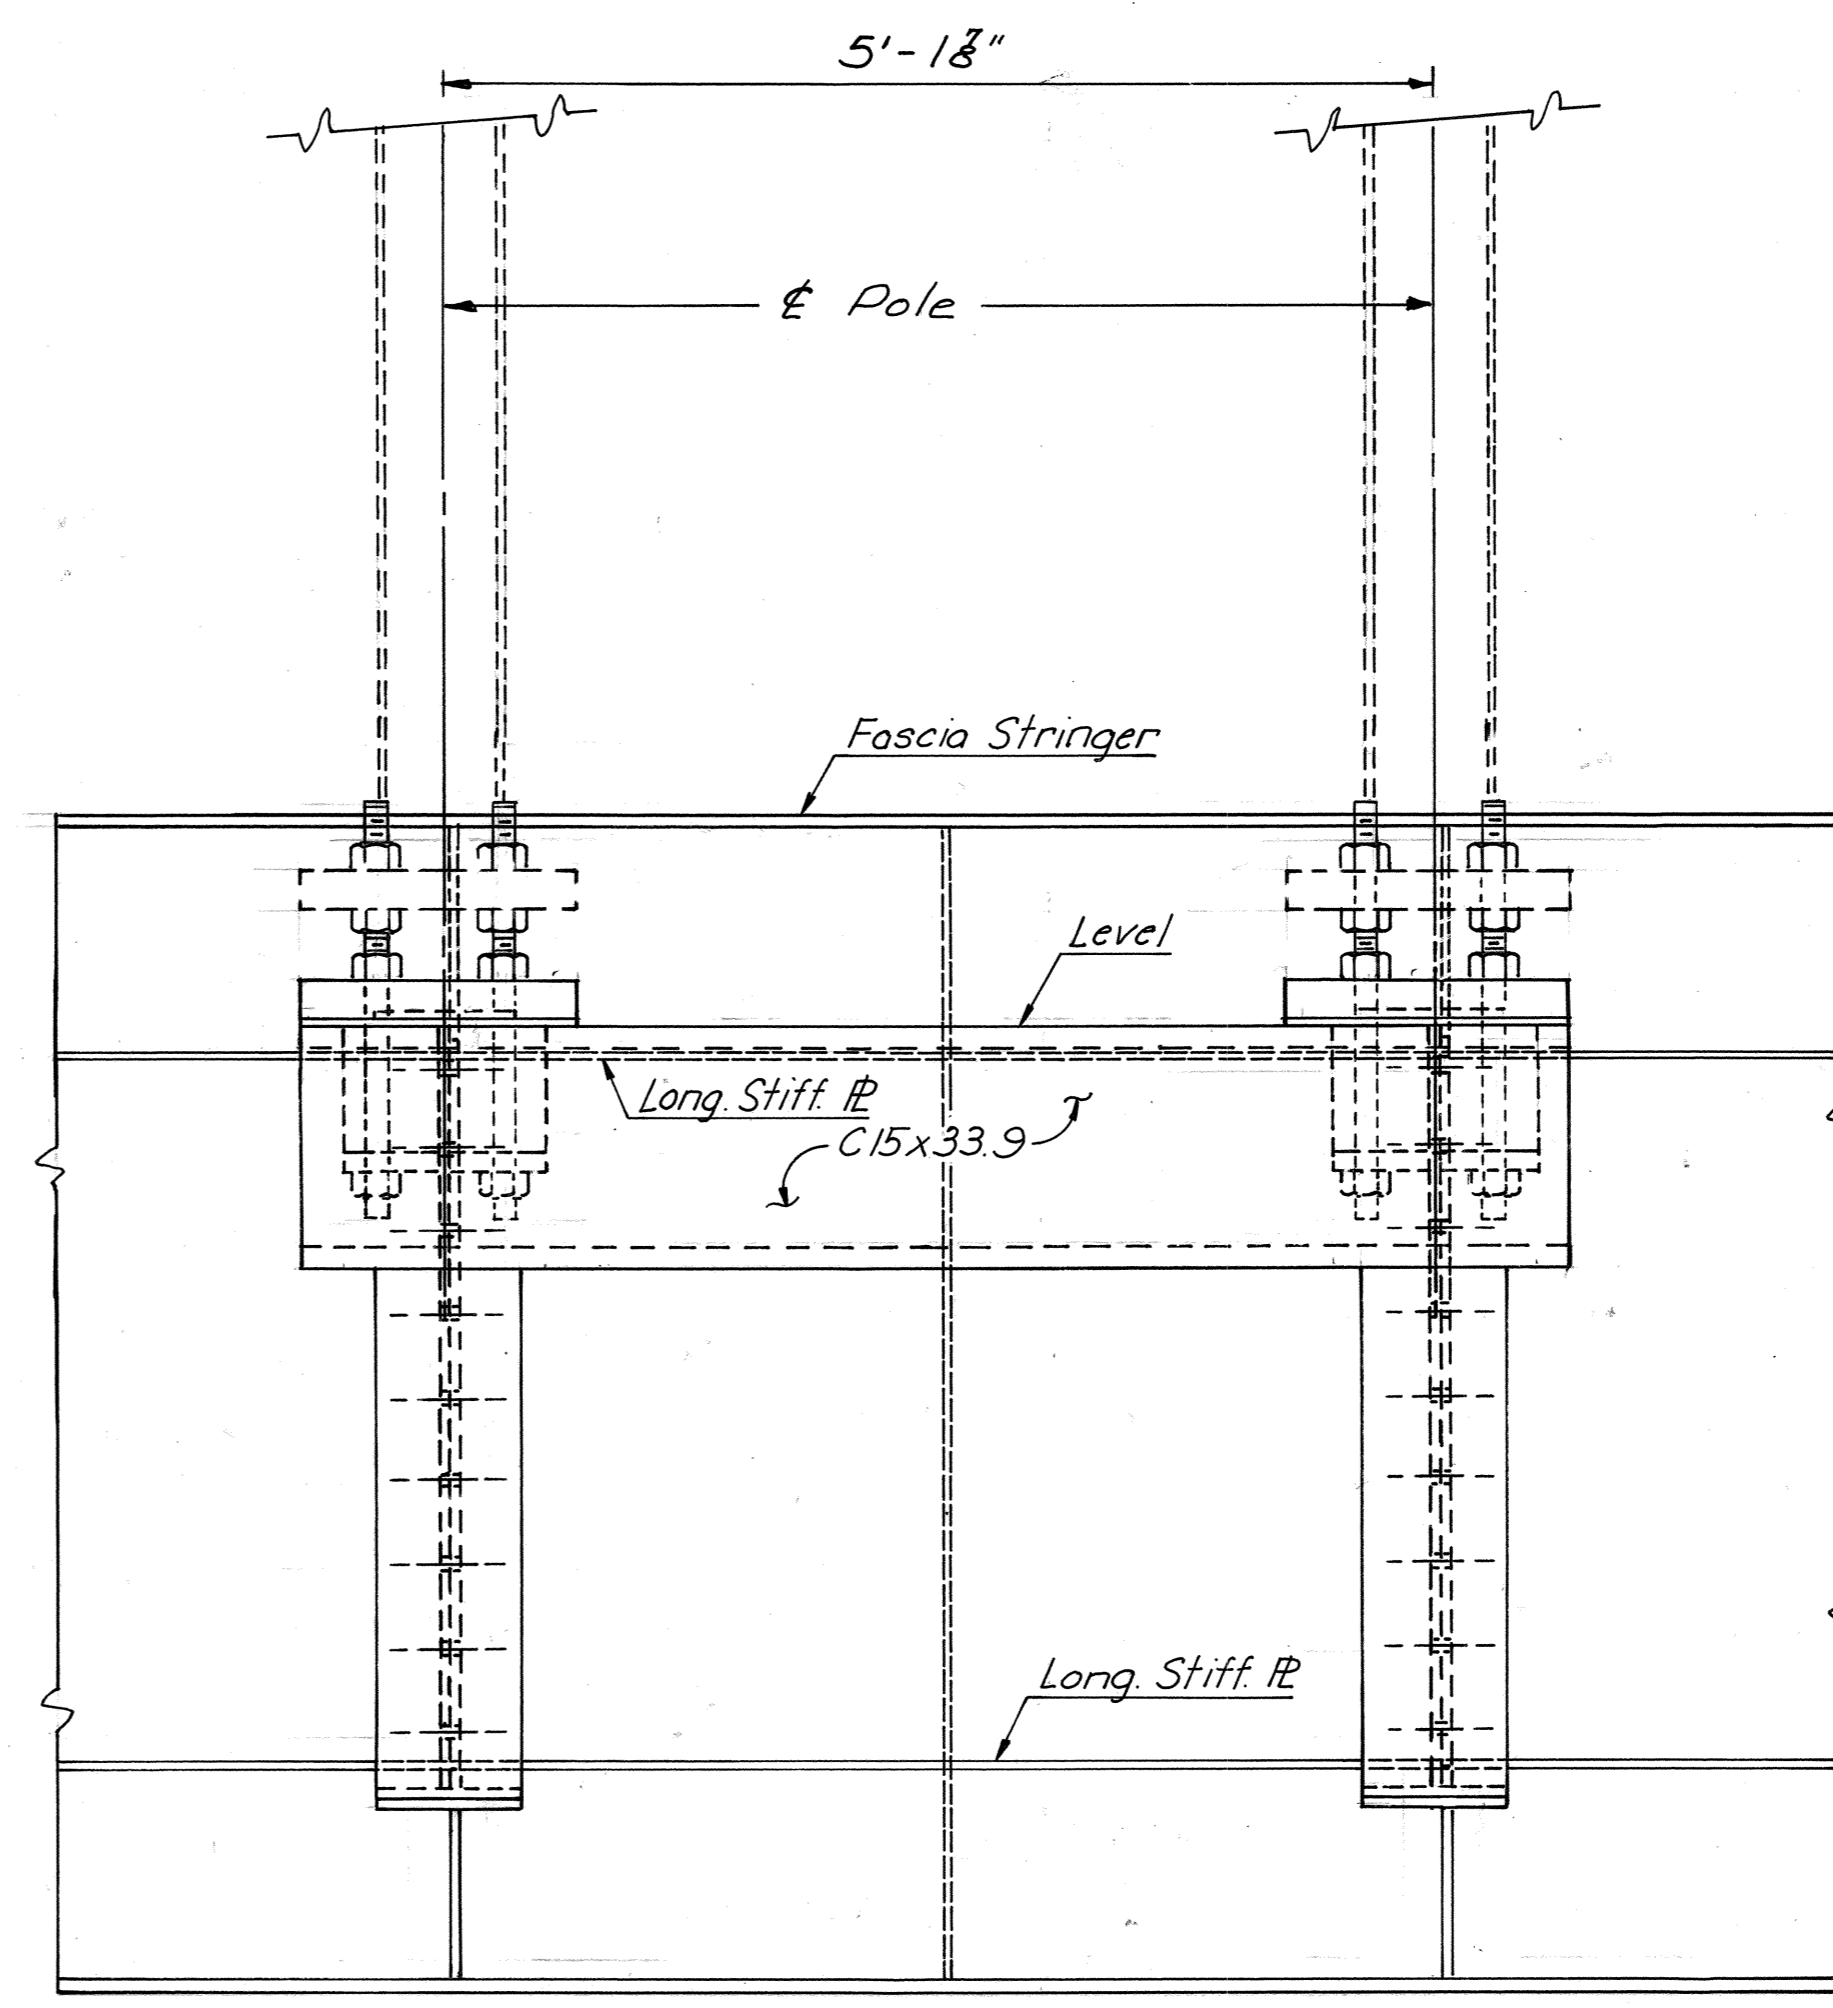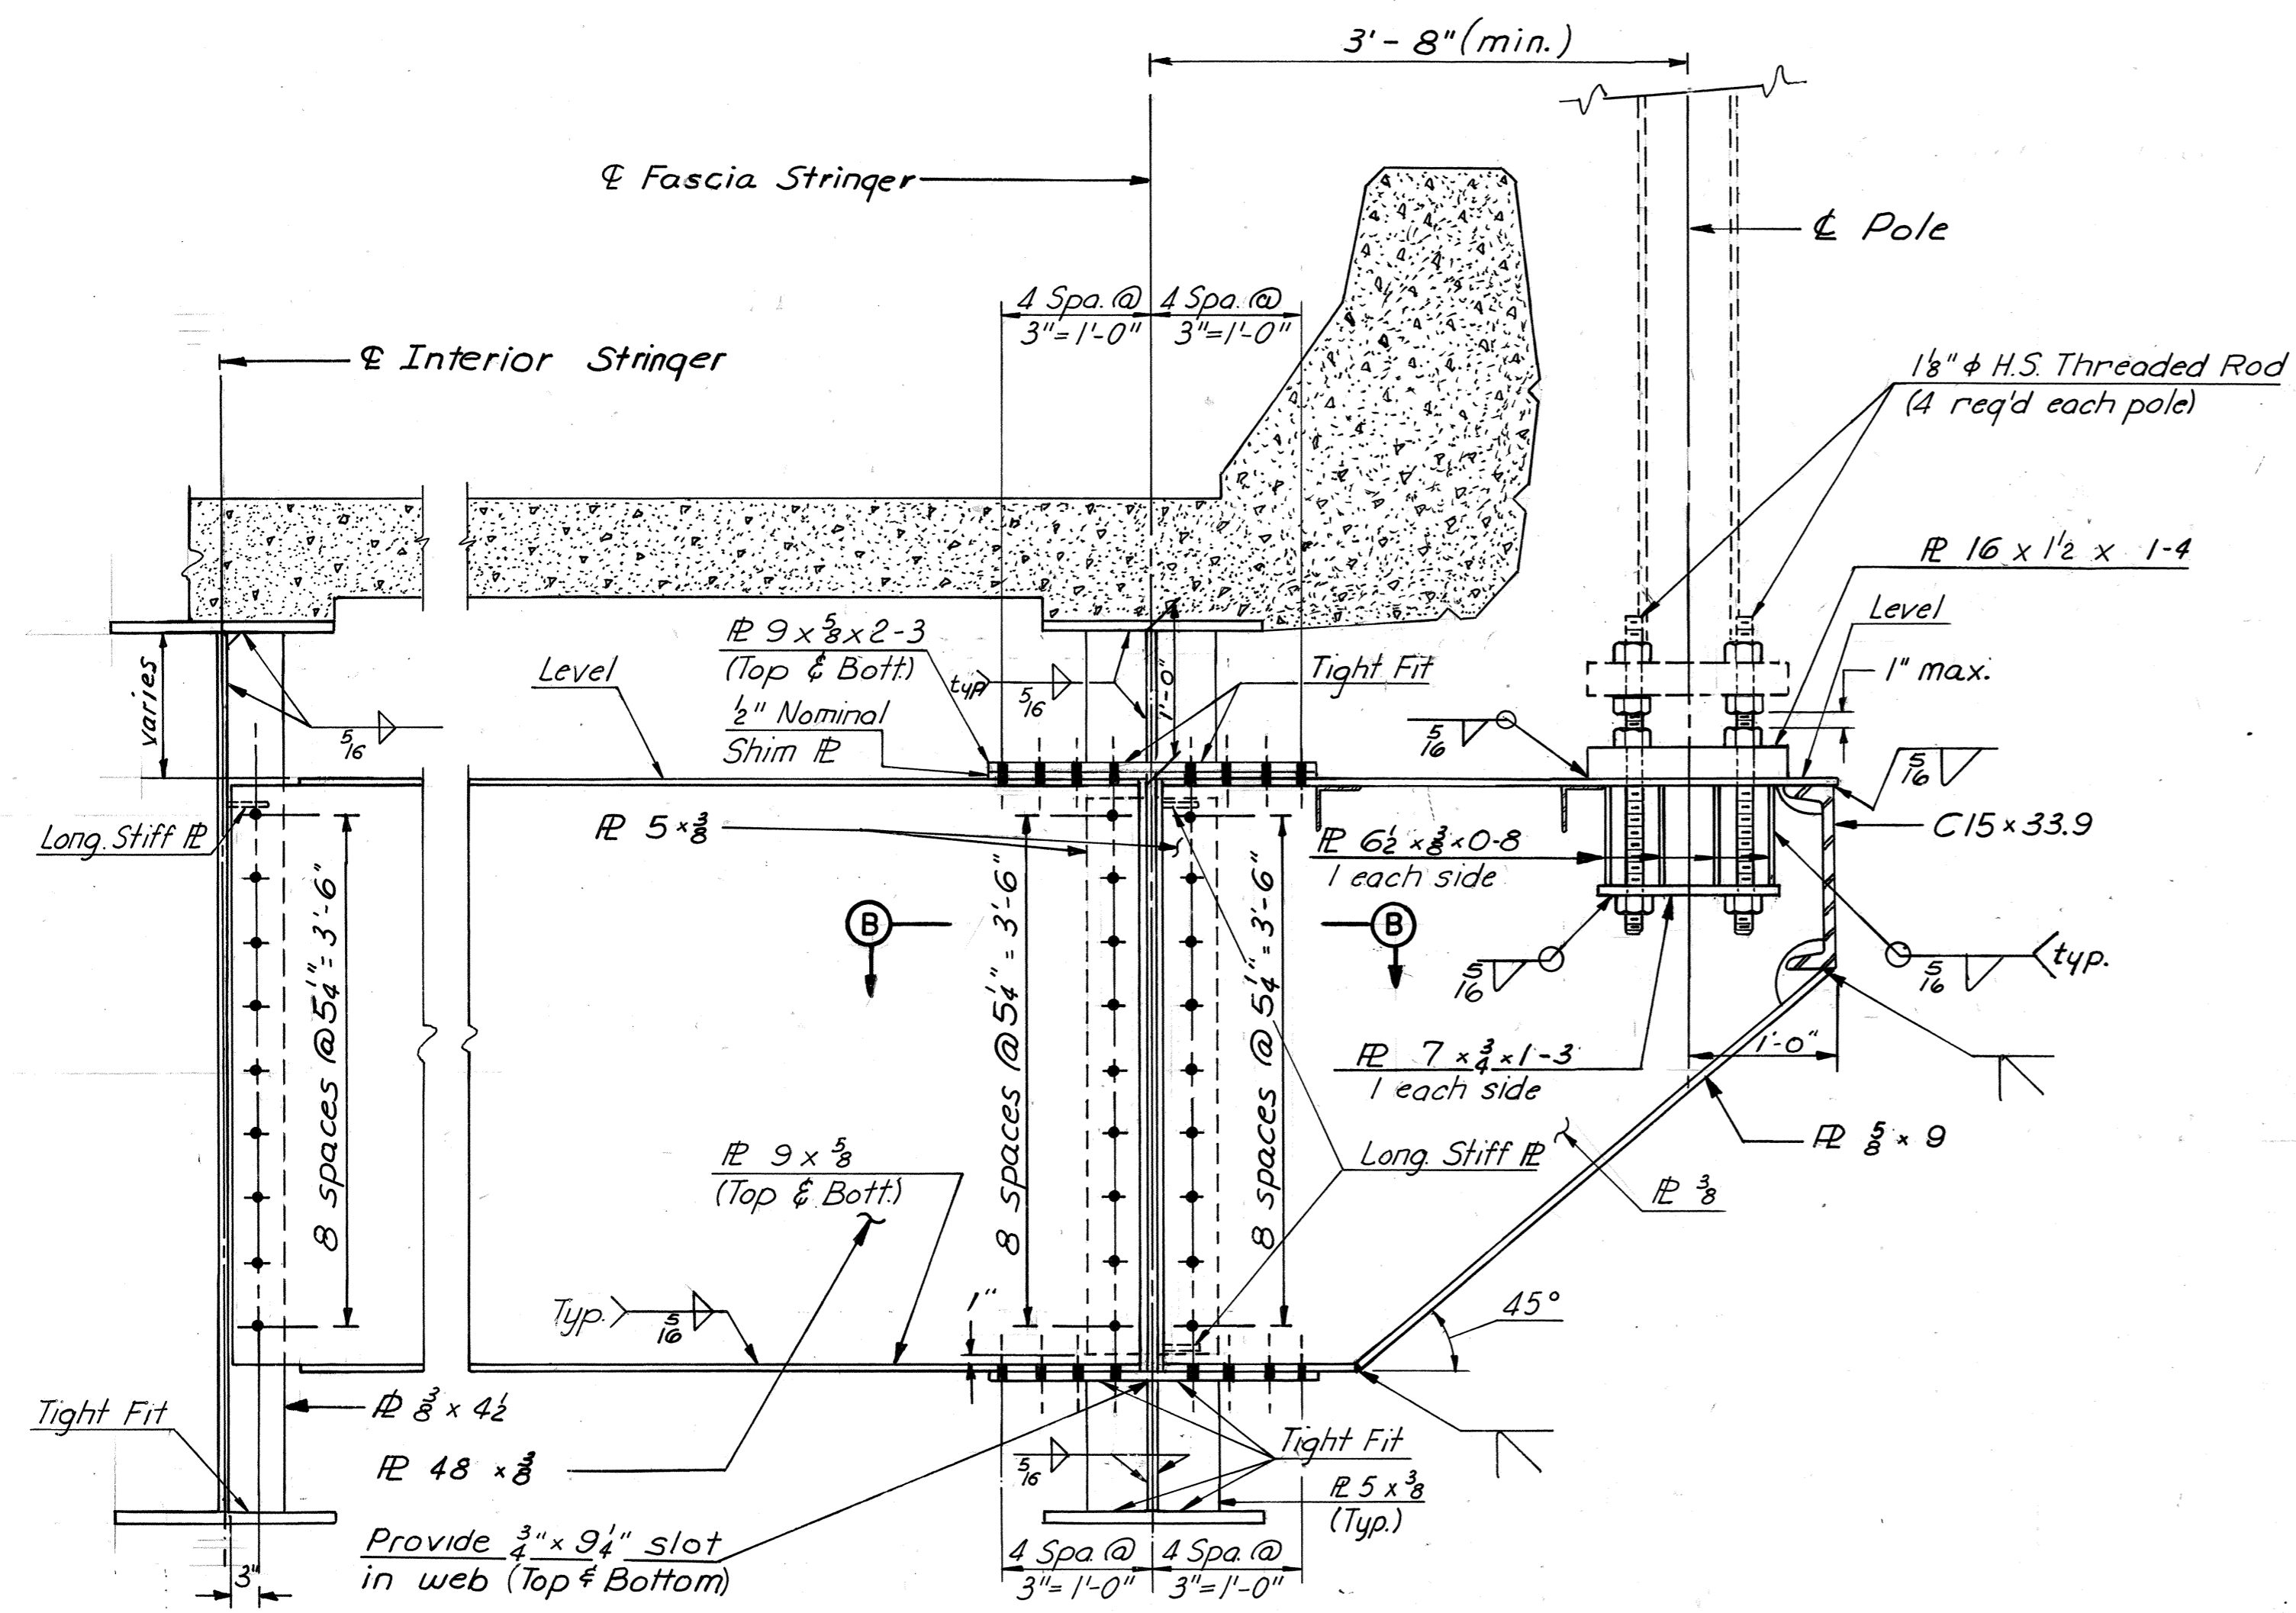

- NOTES:**
1. All bolts to be $\frac{3}{8}$ " # H.S. (except as noted)
 2. See Framing Plan, Sheet 20, for location of sign support diaphragms.
 3. All material shall be ASTM-A36 steel except anchor bolt assemblies.
 4. Care shall be taken to insure vertical alignment of the end frame. Any misalignment shall be taken up in the leveling nut.
 5. For signing and sign pole details see roadway plans.

DESIGNED	DRAWN	CHECKED	IN CHARGE	PRY.	NO.	REVISION	BY	DATE
	WAM 8-74	RBH 9-74						
	2 As Built	New Sheet Added						
	TEM 8-76	RBH 9-74						

PLAN scale 1"=1'-0"

AS BUILT

RICHMOND METROPOLITAN AUTHORITY
RICHMOND EXPRESSWAY SYSTEM

BRIDGE NO. 66
 EASTBOUND ROADWAY OVER 12th STREET
 R.R. TRACKS and 16th STREET


SIGN SUPPORT DETAILS — UNIT 22

SCALE As Noted
 DATE _____ SHEET 20A OF 46

HOWARD, NEEDLES, TAMMEN & BERGENDOFF
 CONSULTING ENGINEERS
 Alexandria, Virginia


HNTB

RICHMOND EXPRESSWAY SYSTEM			
SECTION	PROJECT	SHEET NO.	TOTAL SHEETS
10	DOWNTOWN EXPRESSWAY	146	265

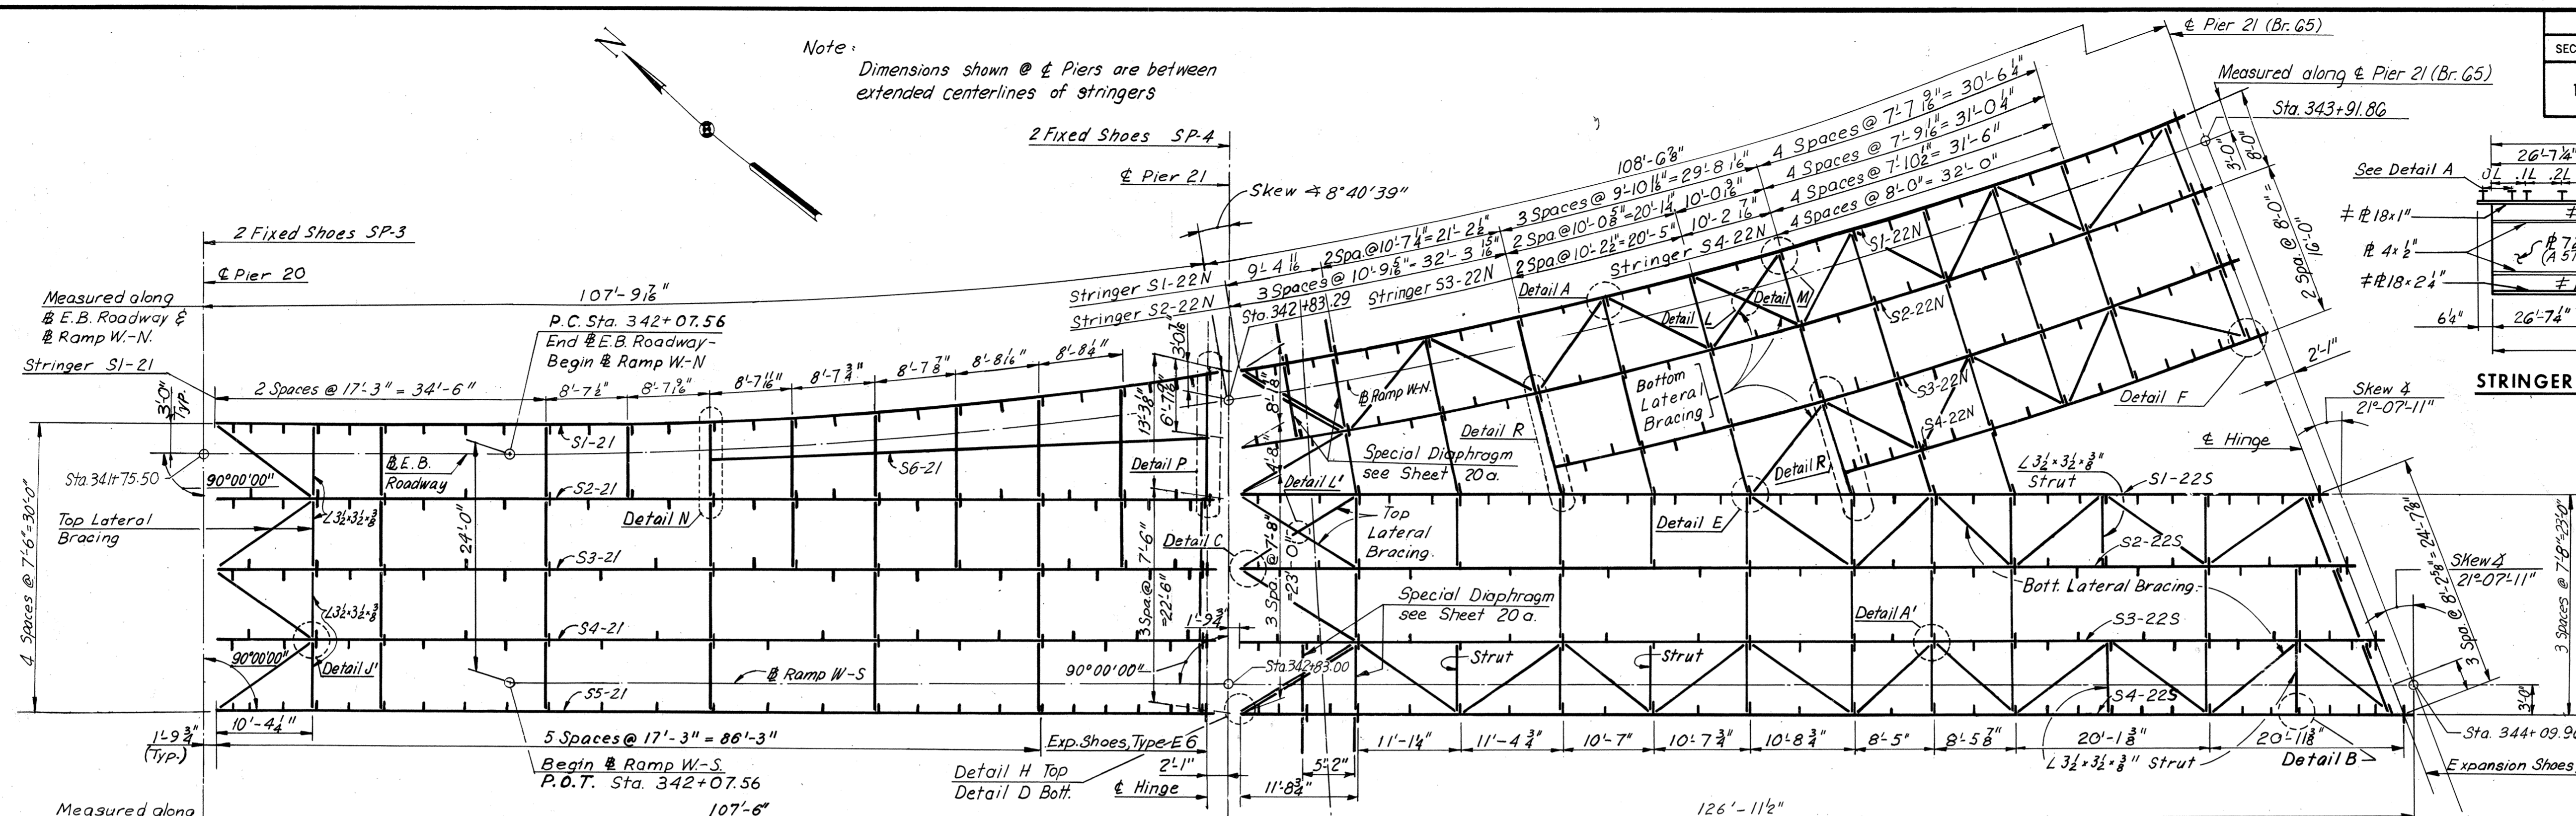


STRINGER ELEVATION FOR S1-22S
No Scale

DETAIL D
No Scale

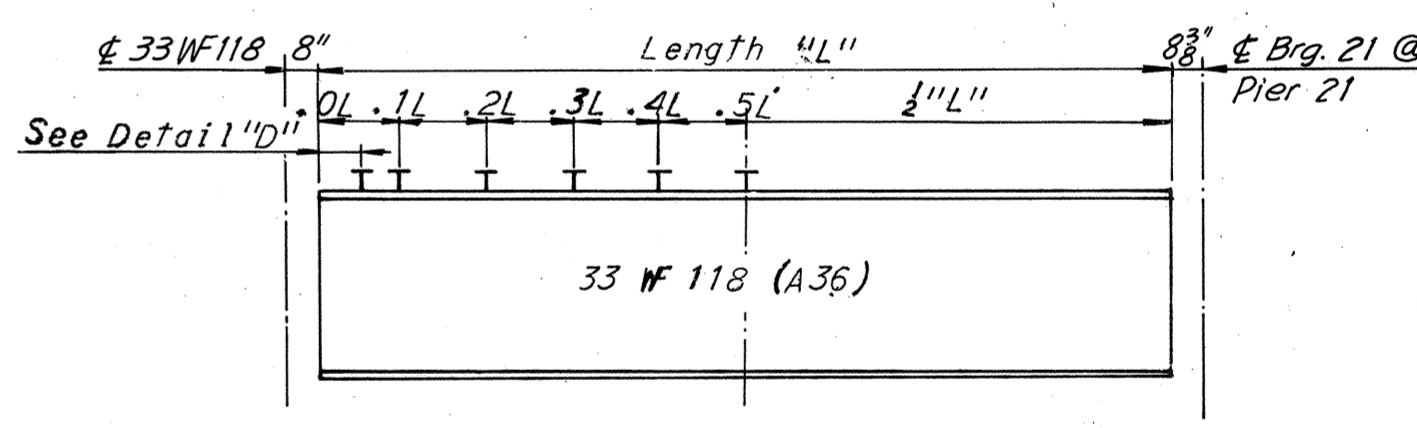

STRINGER ELEVATION FOR S6-21
No Scale

FRAMING PLAN
Scale: 1" = 10'-0"

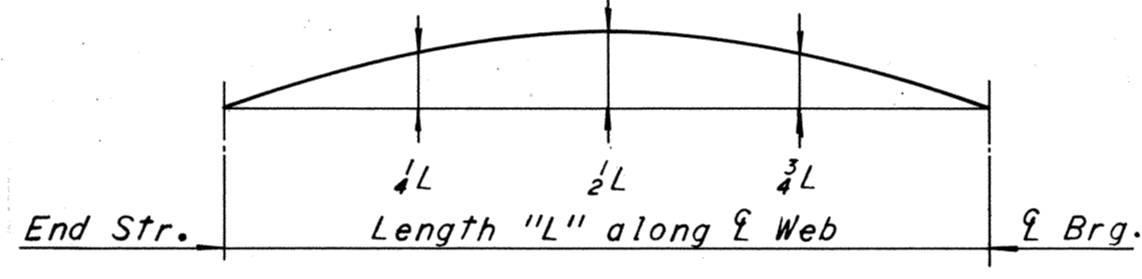

CAMBER DIAGRAM


NOTE TO FABRICATOR
The stringers shall be fabricated with an upward camber amounting to the tabulated value. This will provide approximate compensation for deflection under full dead load and for conformity with finished grade. Dimensions are in inches.

SHOE SCHEDULE			
EXPANSION SHOES		FIXED SHOES	
TYPE	NO. REQD.	TYPE	NO. REQD.
E6	5	SP-3	2
E7	8	SP-4	2

NOTE TO CONTRACTOR
Deflections given are those anticipated to occur in the stringer upon placement of the total concrete deck dead load. In practice, the stringers in place are not likely to have the exact camber to compensate for these deflections during construction. The residual amounts shall be provided by adjusting forms to vary the thickness of the concrete haunch between the bottom of the slab and the top of stringer without altering the slab thickness.

Note:
All steel shall be A36 unless otherwise noted. Longitudinal stiffeners shall be located on the exterior face of the exterior stringers. Intermediate stiffener pls. 4 1/2" x 3/8" shall be equally spaced between diaphragms as shown. The first two stiffener spaces at the ends of stringers shall be one-half the normal spacing within the panel.

UNIT	STRINGER	Dim. "A"	LENGTH	Dim. "B"	Dim. "C"	Dim. "D"	Dim. "E"	Dim. "F"	Dim. "G"	PL. "B"	PL. "C"	DEAD LOAD DEFLECTION SCHEDULE					CAMBER SCHEDULE					
												MAX. SHEAR STUD SPACING					1/4L	1/2L	3/4L	1/4L	1/2L	3/4L
												0.0L-0.1L*	0.1L-0.2L	0.2L-0.3L	0.3L-0.4L	0.4L-0.5L						
21	S1-21	104'-5 3/8"	103'-10 1/2"	19'-5 1/4"	32'-6"	18'-7 1/8"	10 1/2"	7 1/8"	6 1/2"	18x 3/8	18x 1 1/8	14"	16"	20"	24"	13 1/16"	1 1/8"	3/8"	2 1/8"	3 1/16"	2 3/8"	
	S2-21	104'-2 1/4"	103'-7 1/4"	15'-9 3/8"	36'-0"	14'-11 3/8"	10"	7"	6 1/2"	12x 3/8	12x 1 1/8	11"	12 1/2"	16"	18 1/2"	17 1/16"	2 1/16"	1 1/2"	1 13/16"	2 1/8"	1 13/16"	
	S3-21	104'-2 1/4"	103'-7 1/4"	22'-3 3/8"	29'-6"	21'-5 3/8"	10"	7"	6 1/2"	15x 3/8	15x 1 1/8	15 1/2"	18"	21"	24"	1 3/8"	1 3/8"	1 3/8"	1 1/2"	2 1/8"	1 1/2"	
	S4-21	104'-2 1/4"	103'-7 1/4"	22'-3 3/8"	29'-6"	21'-5 3/8"	10"	7"	6 1/2"	15x 3/8	15x 1 1/8	15 1/2"	18"	21"	24"	1 3/8"	1 3/8"	1 3/8"	1 1/2"	2 1/8"	1 1/2"	
	S5-21	104'-2 1/4"	103'-7 1/4"	22'-3 3/8"	29'-6"	21'-5 3/8"	10"	7"	6 1/2"	15x 1	15x 1 1/2	14 1/2"	17"	20"	24"	1 1/8"	1 3/8"	1 3/8"	1 1/2"	2 1/8"	1 1/2"	
	S6-21		50'-4 3/8"										12"	13 1/2"	15"	17 1/2"	20 1/2"	3 3/8"	1 1/2"	1 5/8"	1 5/8"	
22	S1-22N	104'-1 3/8"	103'-6 3/8"	21'-9 3/8"	30'-0"	20'-11 3/8"	10"	7"	6 3/8"	18x 3/8	18x 1 1/8	15"	17 1/2"	22"	24"	7 3/8"	1 3/8"	3 3/8"	4 1/2"	3 1/16"	3 1/16"	
	S2-22N	107'-0 3/8"	106'-5 3/8"	17'-2 3/8"	36'-0"	16'-4 1/8"	10"	7"	6 3/8"	18x 3/8	18x 1 1/8	13"	14 1/2"	17 1/2"	20 1/2"	17 1/16"	1 3/8"	1 3/8"	4 1/16"	6 7/16"	4 3/8"	
	S3-22N	75'-4 3/8"	74'-9 3/8"	16'-4 1/8"	21'-0"	15'-6 3/8"	10"	7"		12x 3/8	12x 1 1/4"	12 1/2"	13 3/4"	15 1/2"	19"	22 1/2"	3 3/8"	1 1/2"	2 3/16"	3 1/8"	2 3/8"	
	S4-22N	45'-5 3/8"	44'-10 3/8"	22'-5 3/8"	27'-6"	21'-7 1/8"	10"	7"		10x 3/8		17 1/2"	19"	22"	24"	1 1/8"	1 3/8"	1 1/8"	1 1/2"	2 1/8"	1 1/2"	
	S1-22S	115'-9 3/8"	115'-2 1/4"										10"	10 1/2"	11 1/2"	14 1/2"	24"	1 1/8"	1 3/8"	3 3/8"	4 1/16"	3 3/8"
	S2-22S	118'-9 3/8"	118'-1 3/8"	38'-6 3/8"	20'-6"	32'-8 3/8"	10 3/4"	7 1/2"	6 1/4"	18x 3/8	18x 1	15 1/2"	17 1/2"	20 1/2"	22"	1 13/16"	2 1/2"	4"	5 3/8"	4 1/16"	4 1/16"	
S3-22S	121'-8 1/8"	121'-1 3/8"	35'-0 5/8"	25'-6"	34'-1 1/8"	10 3/4"	7 1/2"	6 1/4"	18x 3/8	18x 1 1/4	15 1/2"	17 1/2"	20 1/2"	23"	1 13/16"	2 1/2"	4 1/8"	6"	4 3/8"	4 3/8"		
S4-22S	124'-8 3/8"	124'-0 3/8"	31'-0 1/8"	31'-0"	30'-11 1/8"	10 3/4"	7 1/2"	6 1/4"	18x 3/8	18x 1 1/4	14"	16"	19"	24"	2 1/8"	3"	4 1/16"	6 1/2"	4 1/16"	4 1/16"		

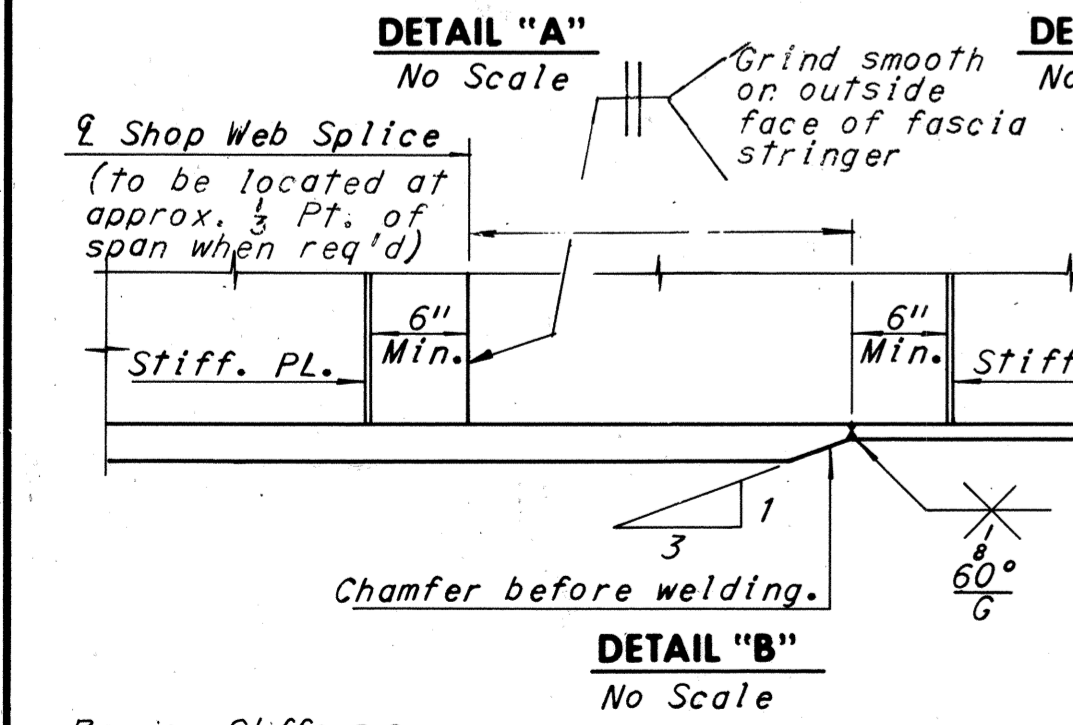

DETAIL "A" No Scale
DETAIL "B" No Scale
DETAIL "C" No Scale

BY	DATE	Notes, Deletions & Changes Completed	PRMS	4-19-74
MADE	GSH	08-06-68	Dim. & Mat. Change	K.D.P. 6-74
CHECKED	JD	10-21-68	Add Sign Support Bracket	TEM 7-74
IN CHARGE	NO.	REVISION	BY	DATE
	4	As Built	TEM	8-76

Notes:
For Superstructure steel quantities, see Sheet 2.
For Joint details, see Sheet 38.
For framing details, see Sheets 23 thru 27.
For Shoe details, see Sheets S14S2.
For Shear Stud detail, see Sheet 14.
For Diaphragm details, see Sheets 33 & 34.
For Details A, A', B, C, D, E, F, H, J', L, L', M, see Sheet 27.
For Details N, P and R, see Sheet 26.
For Angles between Piers and Stringers, see Sheets 23 & 24.



RICHMOND METROPOLITAN AUTHORITY
RICHMOND EXPRESSWAY SYSTEM
DOWNTOWN EXPRESSWAY

BRIDGE NO. 66
EASTBOUND ROADWAY OVER
12TH ST. - R.R. TRACKS AND 16TH ST.
FRAMING PLAN - UNITS 21 AND 22

HOWARD, NEEDLES, TAMMEN & BERGENDOFF
consulting engineers
NEW YORK ALEXANDRIA KANSAS CITY

SCALE: As Noted
CONTRACT NO.: 10
SHEET NO.: 20 OF 46

AS BUILT

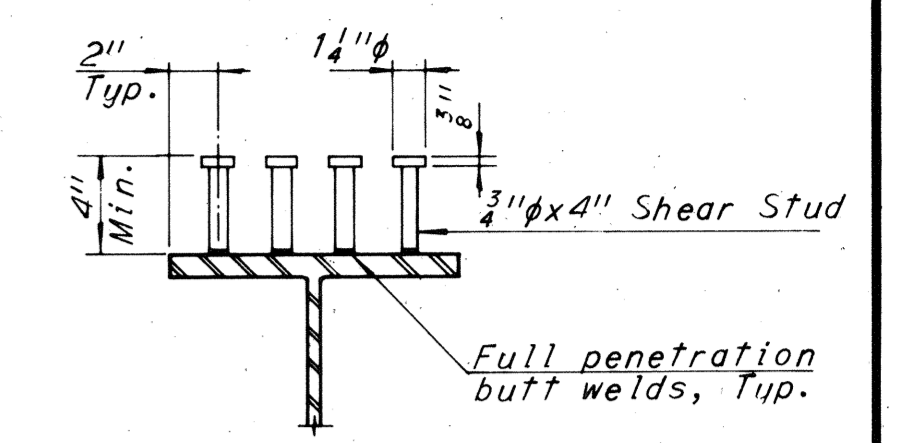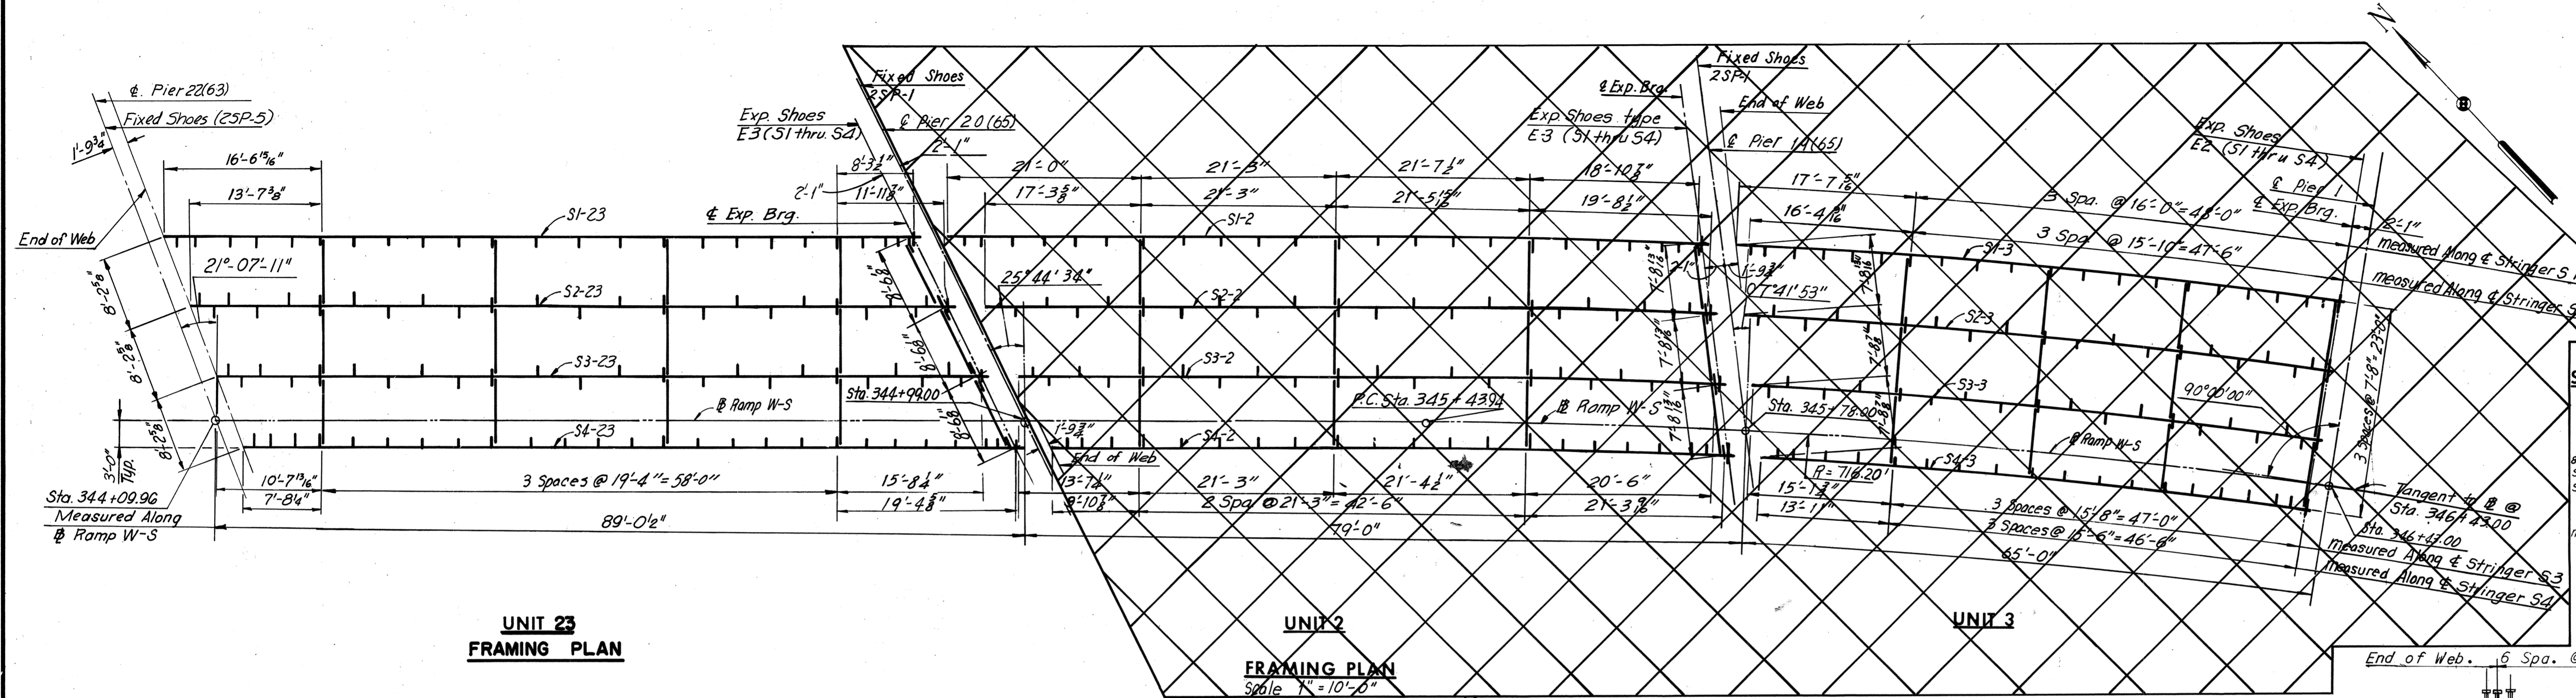


SHEAR STUD DETAIL
No Scale

SHEAR STUD NOTE
Capacity = 3,400 lbs. per stud.
Contractor may, if he elects, use three 7/8" diameter studs at the same longitudinal spacing in lieu of the four 1/2" diameter studs shown.
Stud rows shall be placed parallel to the main deck reinforcement.


UNIT 23 FRAMING PLAN

UNIT 2 FRAMING PLAN


UNIT 3 FRAMING PLAN

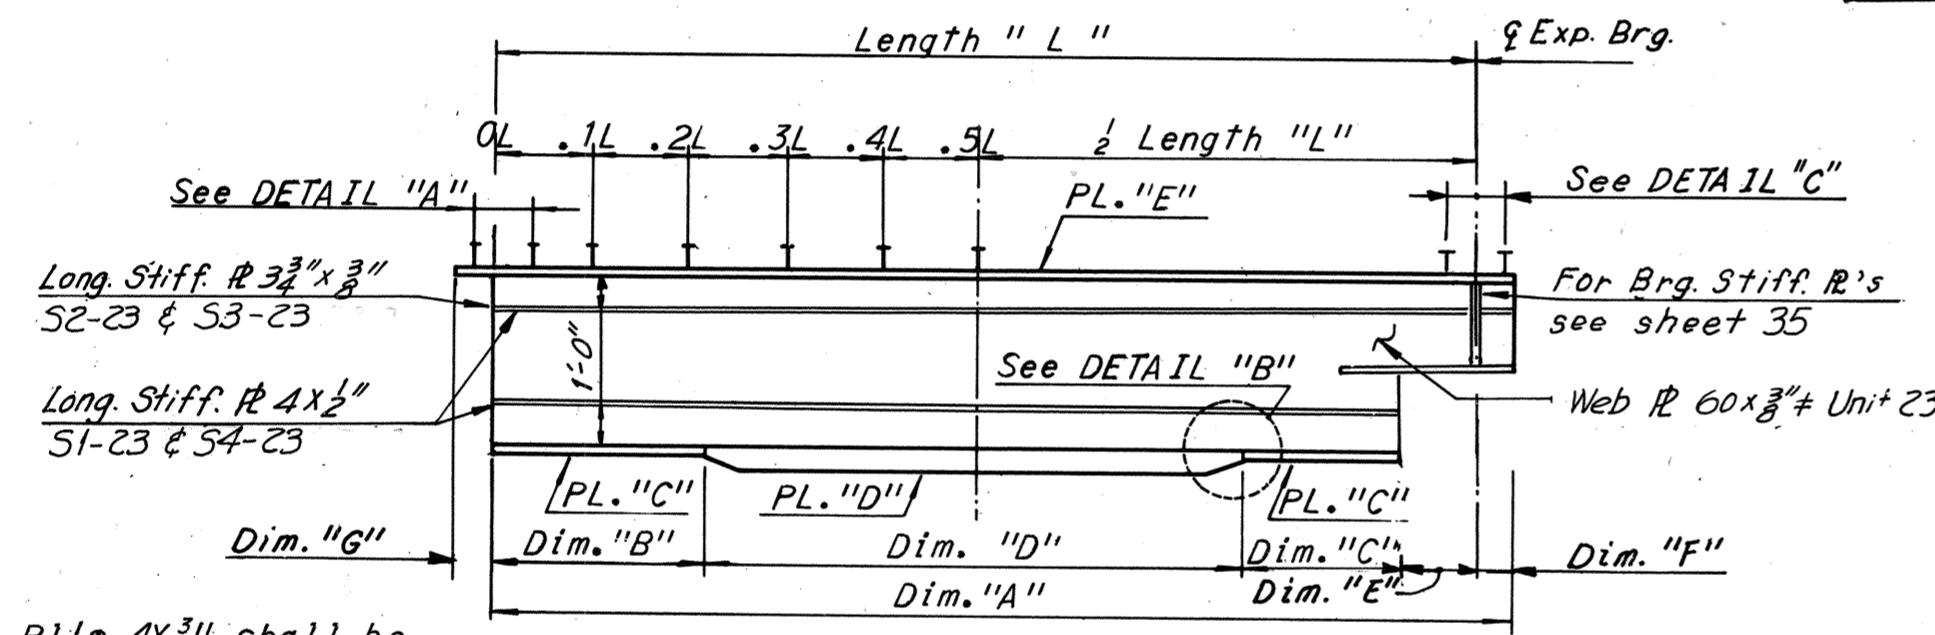

STRINGER ELEVATION
No Scale

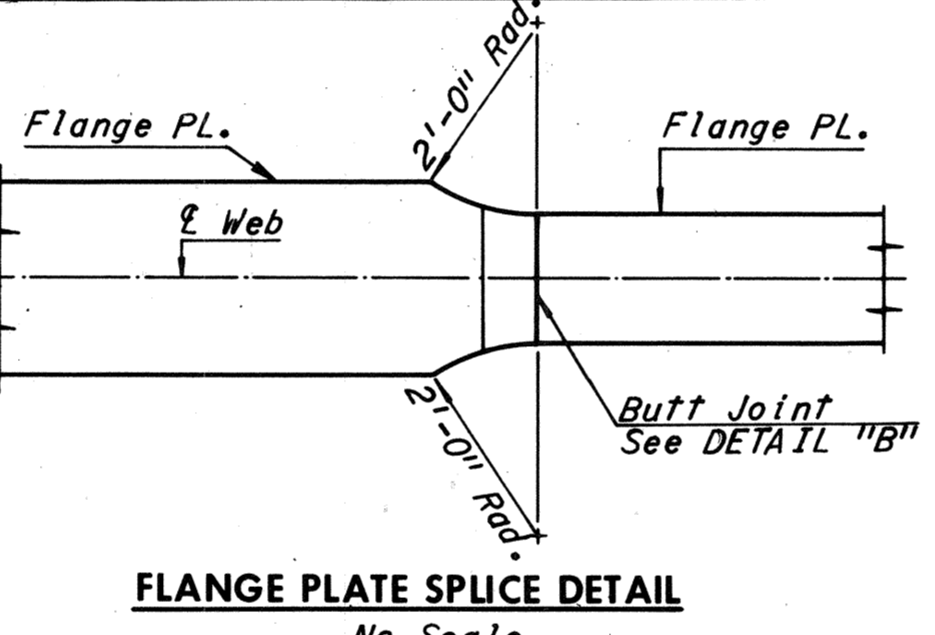


FLANGE PLATE SPICE DETAIL
No Scale

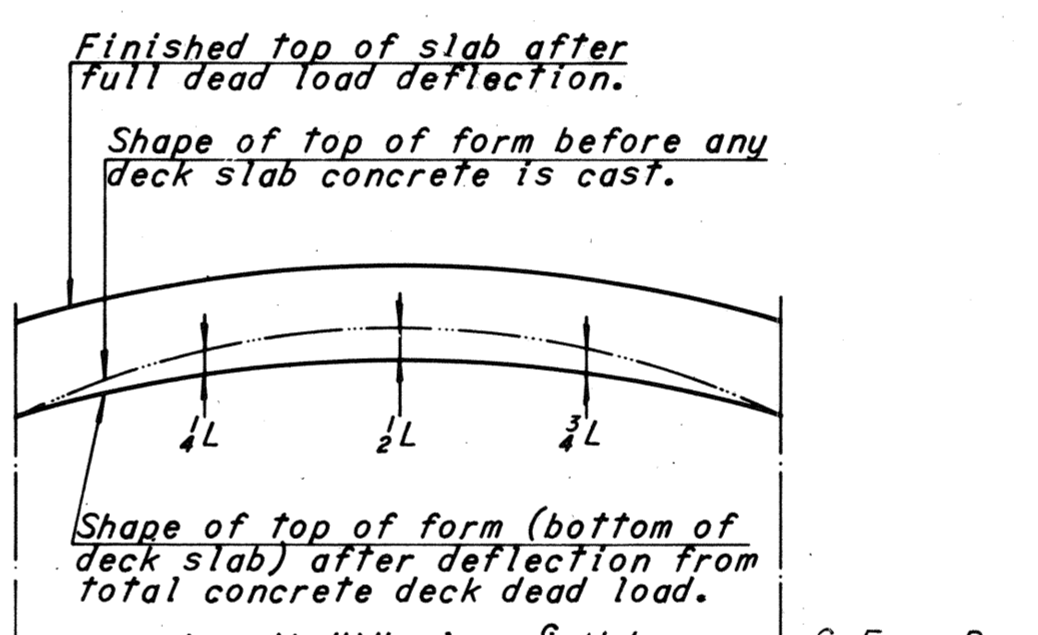


DEAD LOAD DEFLECTION DIAGRAM

NOTE TO CONTRACTOR
Deflections given are those anticipated to occur in the stringer upon placement of the total concrete deck dead load.
In practice, the stringers in place are not likely to have the exact camber to compensate for these deflections during construction. The residual amounts shall be provided by adjusting forms to vary the thickness of the concrete haunch between the bottom of the slab and the top of stringer without altering the slab thickness.

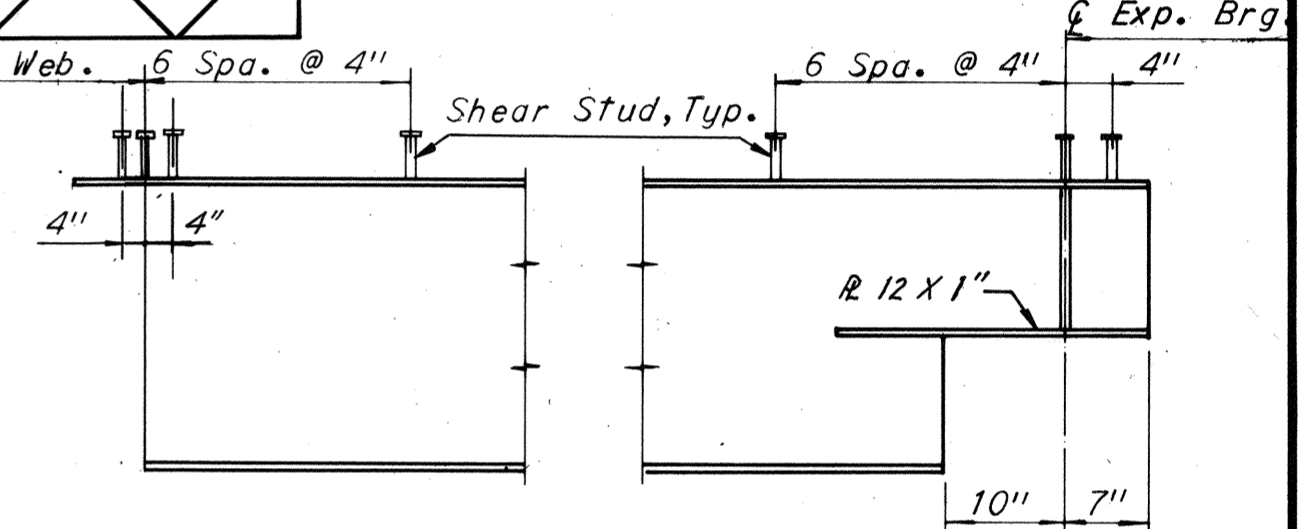

DETAIL "A" No Scale
DETAIL "C" (Normal to Exp. Brg.) No Scale

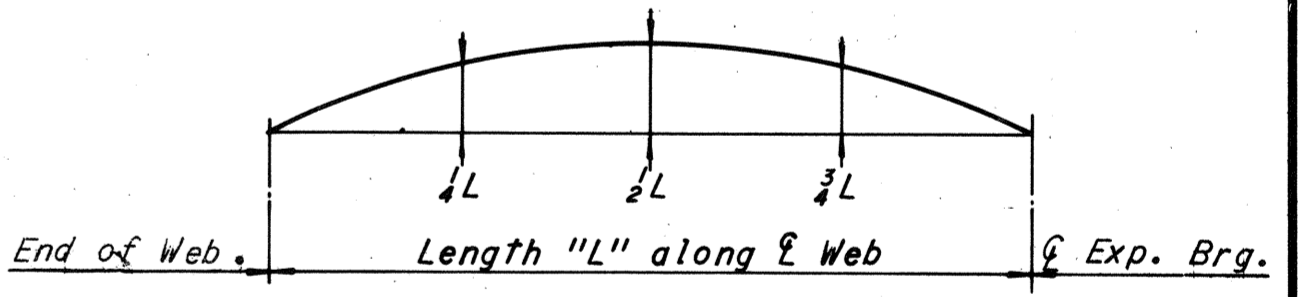


CAMBER DIAGRAM

NOTE TO FABRICATOR
The stringers shall be fabricated with an upward camber amounting to the tabulated value. This will provide approximate compensation for deflection under full dead load and for conformity with finished grade.
Dimensions are in inches.

Note:
Intermediate stiffener PL's 4X1/2" shall be equally spaced between diaphragms as shown. The first two stiffeners at the ends of stringers shall be one-half the normal spacing within the panel.

SHOE SCHEDULE			
EXPANSION SHOES		FIXED SHOES	
TYPE	NO. REQD.	TYPE	NO. REQD.
E3	4	Sp-5	2

Notes:
For Framing Details @ piers 22(63), and 20(65), see Sheet 25.
For Diaphragm connections see Sheet 35.
For Shoe Details, see Sheet S1 and S2.
For Superstructure steel quantities, see sheet 2.
For joint details, see Sheet 35.
Exterior stringer longitudinal stiffeners shall be located on the exterior face of the stringer.

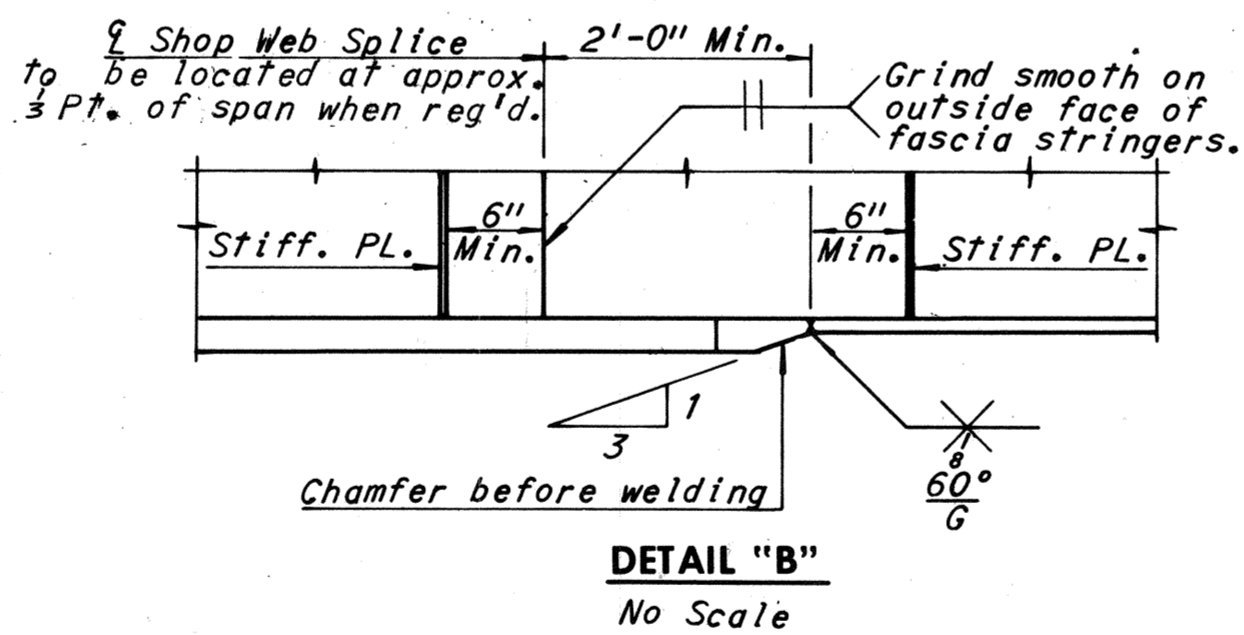

DETAIL "B"
No Scale

UNIT	STRINGER	Dim. "A"	LENGTH "L"	Dim. "B"	Dim. "C"	Dim. "D"	Dim. "E"	Dim. "F"	Dim. "G"	PL "C"	PL "D"	PL "E"	MAX. SHEAR STUD SPACING					DEAD LOAD DEFLECTION SCHEDULE			CAMBER SCHEDULE				
													0.0L-0.1L	0.1L-0.2L	0.2L-0.3L	0.3L-0.4L	0.4L-0.5L	1/4L	1/2L	3/4L	1/4L	1/2L	3/4L		
													23	S1-23	83'-6 3/8"	82'-10 7/8"	9'-5 1/4"	8'-6 1/8"	64'-0"	11 1/2"	7 3/4"	6 1/8"	12 x 3/4"	12 x 1 1/4"	12 x 3/4"
23	S2-23	84'-3"	83'-7 1/4"	11'-3 3/8"	10'-4 1/2"	61'-0"	11 1/2"	7 3/4"	6 1/8"	12 x 3/4"	12 x 1 1/4"	12 x 3/4"	11 1/2"	14 1/2"	17 1/2"	20 1/2"	24"	1 1/8"	1 3/8"	1 1/8"	1 3/8"	1 3/8"	1 3/8"	1 3/8"	1 3/8"
23	S3-23	84'-11 1/8"	84'-4 1/8"	11'-8 1/8"	10'-8 3/8"	61'-0"	11 1/2"	7 3/4"	6 1/8"	12 x 3/4"	12 x 1 1/4"	12 x 3/4"	11 1/2"	14 1/2"	17 1/2"	20 1/2"	24"	1 1/8"	1 3/8"	1 1/8"	1 3/8"	1 3/8"	1 3/8"	1 3/8"	1 3/8"
23	S4-23	85'-8 3/8"	85'-0 3/8"	10'-6 3/8"	9'-7 3/8"	64'-0"	11 1/2"	7 3/4"	6 1/8"	12 x 3/4"	12 x 1 1/4"	12 x 3/4"	11 1/2"	13 1/2"	17"	20 1/2"	24"	1 1/8"	1 3/8"	1 1/8"	1 3/8"	1 3/8"	1 3/8"	1 3/8"	1 3/8"
2	S1-2	83'-4 3/8"	82'-9 3/8"	12'-10 3/8"	12'-0 3/8"	57'-0"	10 1/2"	7 1/2"	6 1/8"	12 x 3/4"	12 x 1 1/4"	12 x 3/4"	12 1/2"	14 1/2"	17 1/2"	21 1/2"	24"	3/4"	1 1/8"	3/4"	1 3/8"	2 1/8"	1 3/8"	1 3/8"	1 3/8"
2	S2-2	80'-4 1/8"	79'-9 1/8"	14'-4 1/8"	13'-6 1/8"	51'-0"	10 1/2"	7 1/2"	6 1/8"	12 x 3/4"	12 x 1 1/4"	12 x 3/4"	13"	14 1/2"	18"	21 1/2"	24"	1 1/8"	1 3/8"	1 1/8"	1 3/8"	1 3/8"	1 3/8"	1 3/8"	1 3/8"
2	S3-2	77'-3 3/8"	76'-8 3/8"	—	—	75'-10 3/8"	10 1/2"	7 1/2"	6 1/8"	—	12 x 1 1/4"	12 x 3/4"	13 1/2"	15 1/2"	17 1/2"	20 1/2"	24"	5/8"	1 1/8"	5/8"	1 3/8"	1 3/8"	1 3/8"	1 3/8"	1 3/8"
2	S4-2	74'-3 3/8"	73'-8 3/8"	—	—	72'-10 3/8"	10 1/2"	7 1/2"	6 1/8"	—	12 x 1 1/4"	12 x 3/4"	13"	15"	17 1/2"	21"	24"	1/2"	1 1/8"	1/2"	1 3/8"	1 3/8"	1 3/8"	1 3/8"	1 3/8"
3	S1-3	66'-2 3/8"	65'-7 3/8"	10'-3 3/8"	9'-5 3/8"	45'-0"	10"	7"	6 1/8"	12 x 1"	16 x 1 1/4"	12 x 3/4"	10"	11 1/2"	14"	17"	22"	1/2"	1 1/8"	1/2"	1 3/8"	2 3/8"	1 3/8"	1 3/8"	1 3/8"
3	S2-3	64'-5 3/8"	63'-10 3/8"	9'-11 3/8"	9'-1 3/8"	44'-0"	10"	7"	6 1/8"	12 x 1"	16 x 1 1/4"	12 x 3/4"	10 1/2"	12"	14"	18"	19 1/2"	3/4"	1 1/8"	3/4"	1 3/8"	2 1/8"	1 3/8"	1 3/8"	1 3/8"
3	S3-3	62'-8 3/8"	62'-1 3/8"	11'-8 3/8"	10'-2 3/8"	40'-0"	10"	7"	6 1/8"	12 x 1"	16 x 1 1/4"	12 x 3/4"	12"	13 1/2"	16"	18 1/2"	22"	3/8"	1 1/8"	3/8"	1 3/8"	1 3/8"	1 3/8"	1 3/8"	1 3/8"
3	S4-3	61'-0"	60'-5"	—	—	59'-7"	10"	7"	6 1/8"	—	12 x 1 1/4"	12 x 3/4"	12"	14"	16"	19 1/2"	24"	5/16"	1 1/8"	5/16"	3/4"	1"	1 3/8"	1 3/8"	1 3/8"

Note: All steel shall be A36 unless shown otherwise.
* Spacing begins at termination of 6 spaces @ 4"
† Denotes A572-Grade 50 Steel for thickness of 3/4" and under and A588 Steel for thickness over 3/4".

BY	DATE	Shoe Callout Added	PRM's	4-19-74
MADE	GSH	12-10-68	As Built	TE M
CHECKED	JD	4-28-69		8-76
IN CHARGE				

RICHMOND METROPOLITAN AUTHORITY
RICHMOND EXPRESSWAY SYSTEM
DOWNTOWN EXPRESSWAY


BRIDGE NO. 66
EASTBOUND ROADWAY OVER
12TH ST.-R.R. TRACKS AND 16TH ST.
FRAMING PLAN UNIT 23

HOWARD, NEEDLES, TAMMEN & BERGENDOFF
consulting engineers
NEW YORK ALEXANDRIA KANSAS CITY


SCALE: As Noted
CONTRACT NO.: 10
SHEET NO. 21 OF 46

AS BUILT


RICHMOND EXPRESSWAY SYSTEM			
SECTION	PROJECT	SHEET NO.	TOTAL SHEETS
10	DOWNTOWN EXPRESSWAY	148	265

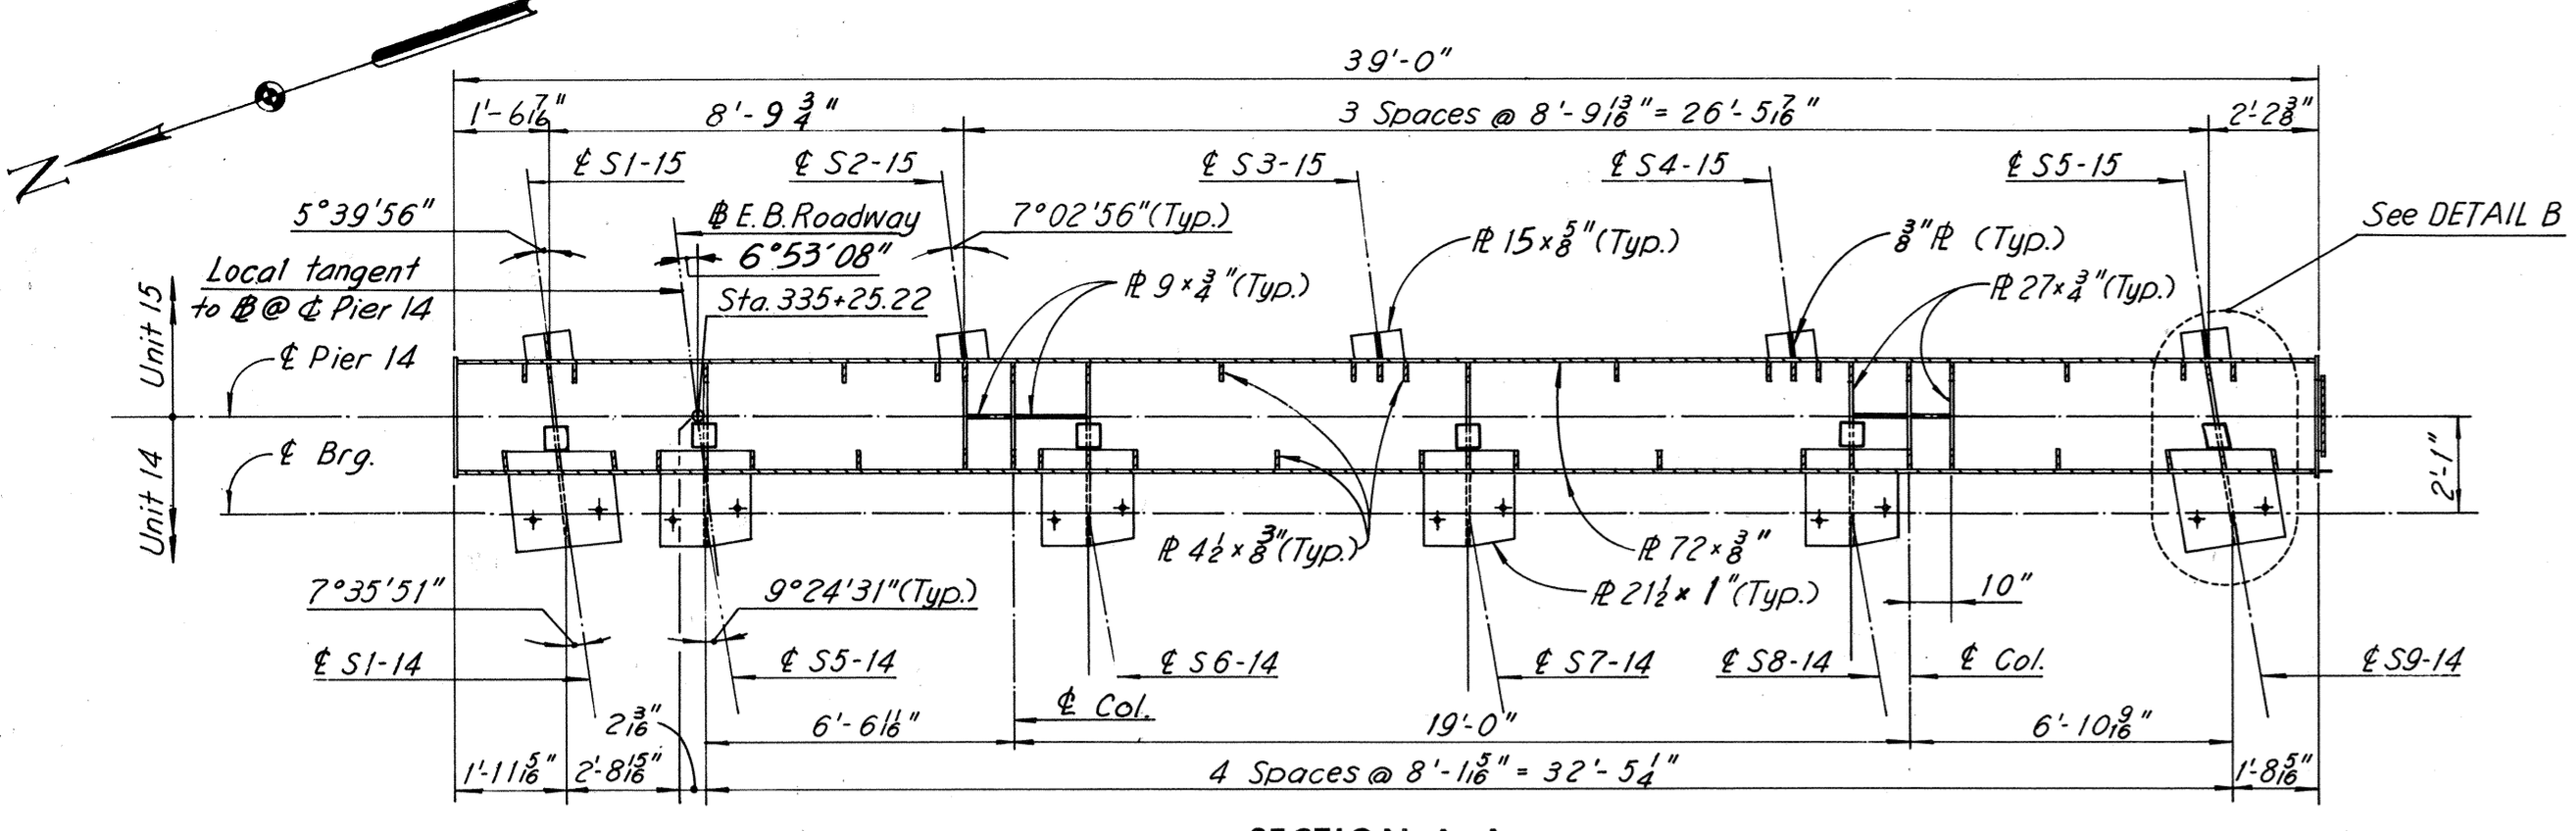


SECTION A-A
Scale: 1/4" = 1'-0"

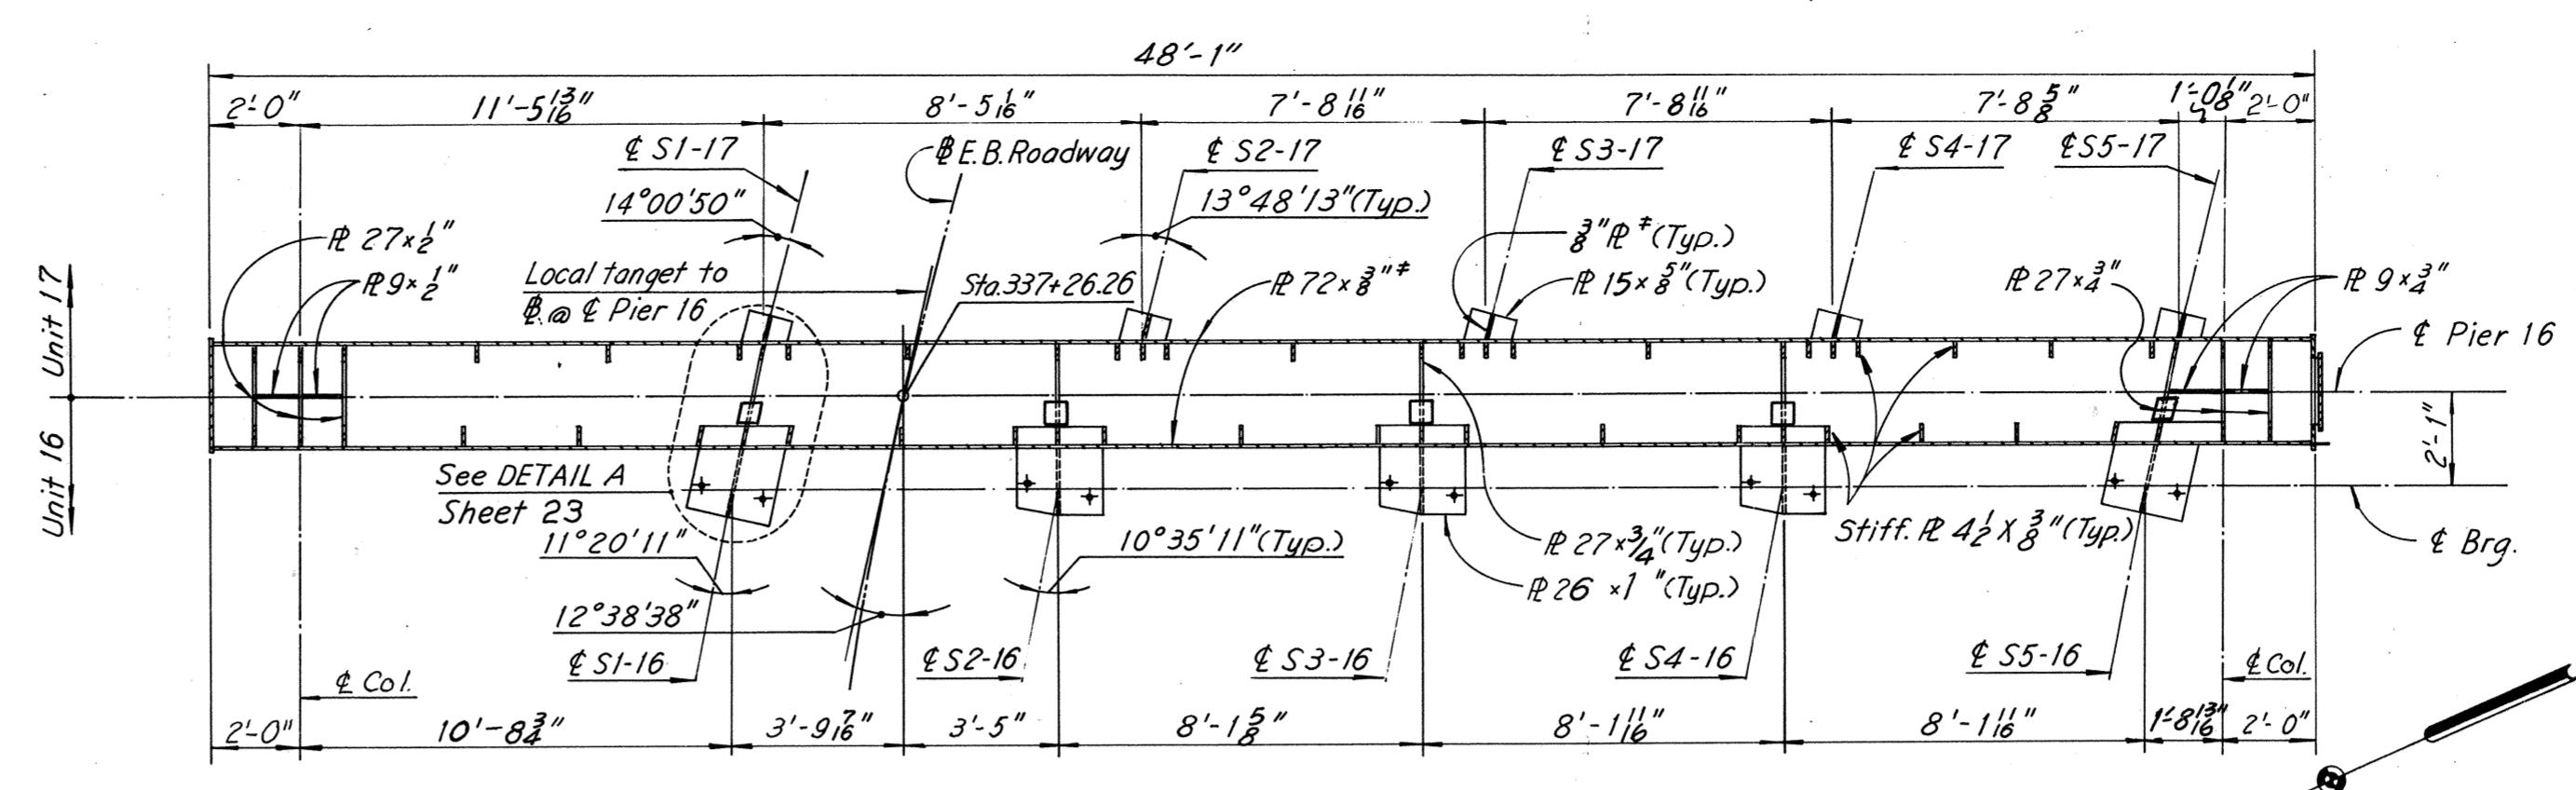


SECTION C-C
Scale: 1/4" = 1'-0"

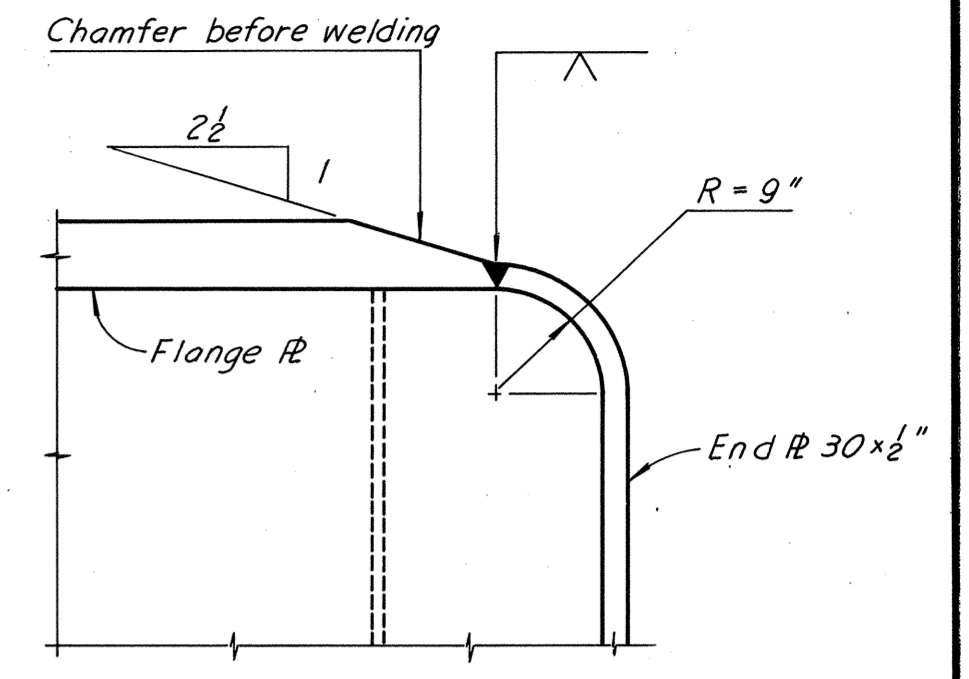

DETAIL A
No Scale

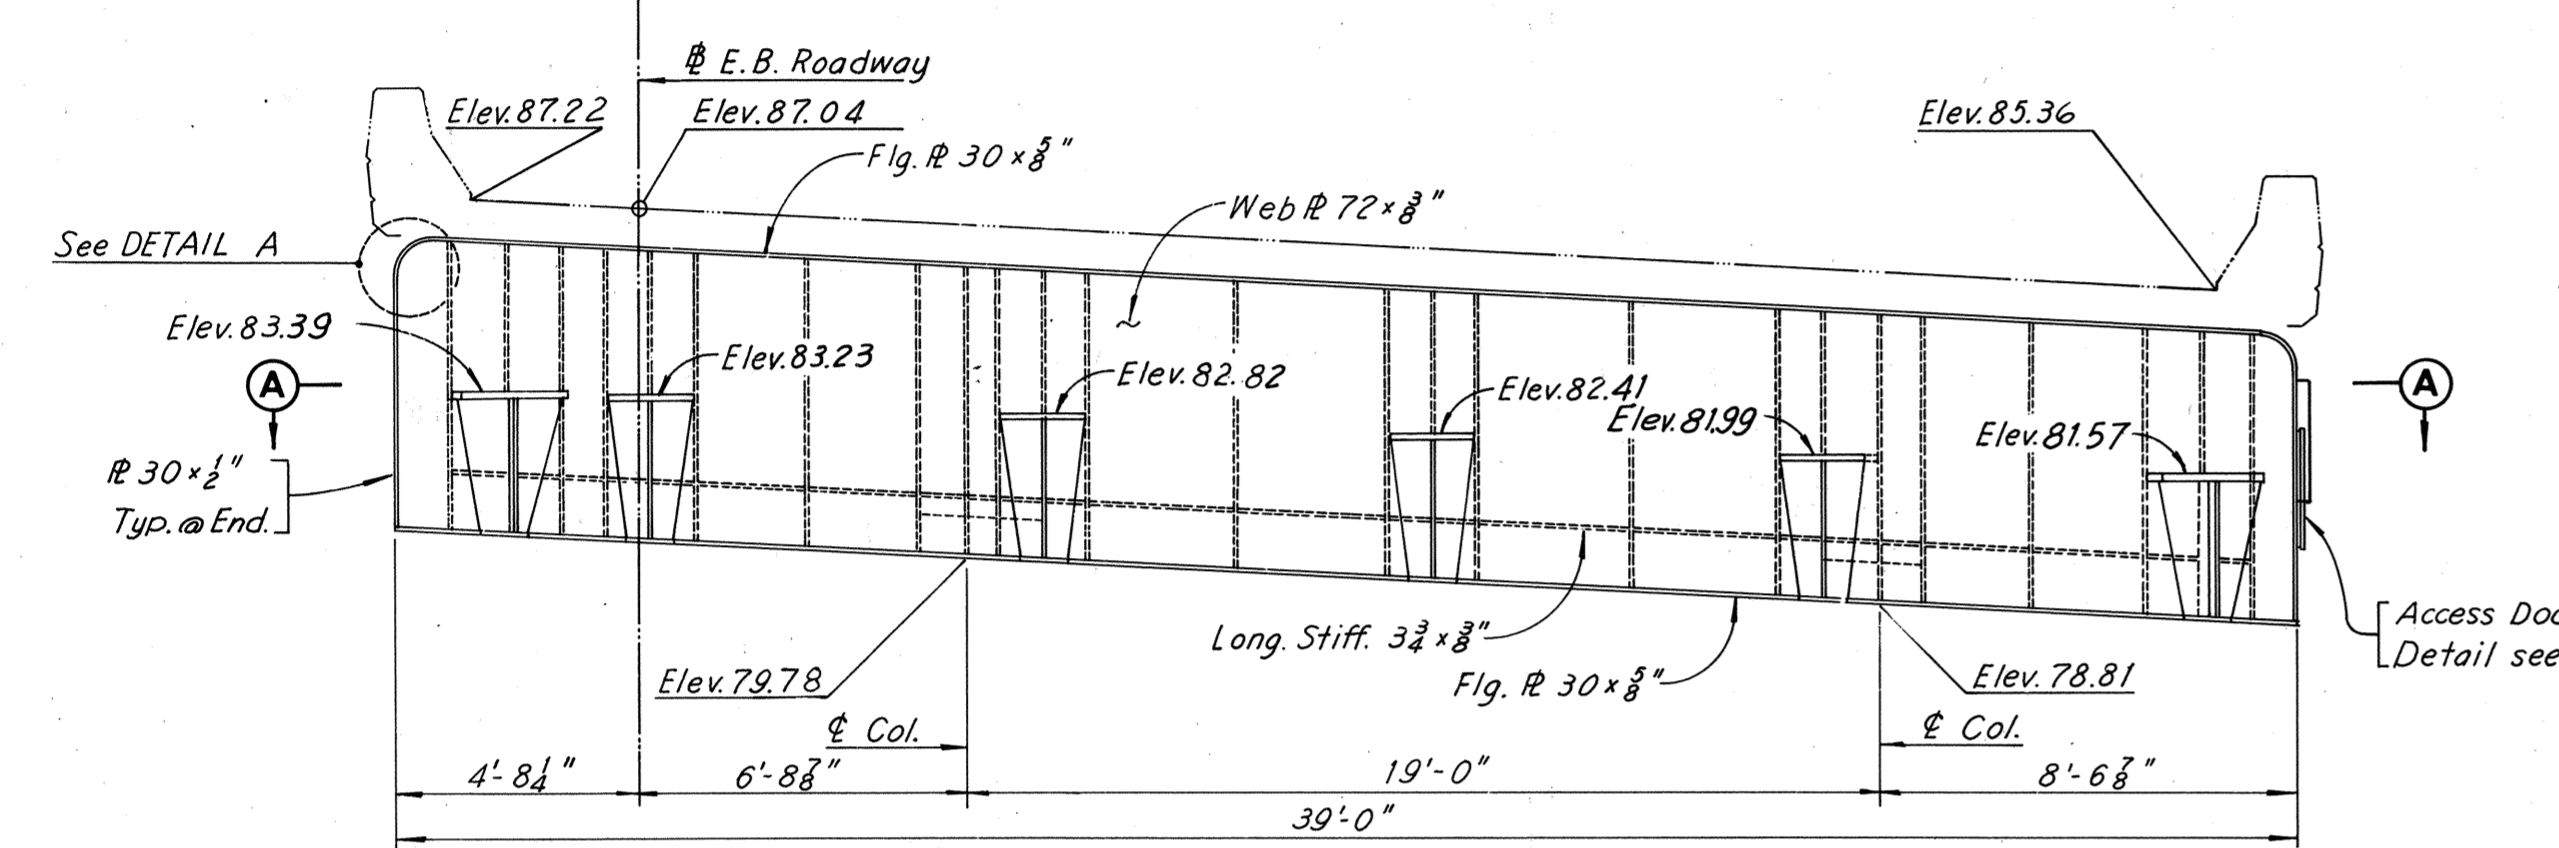


CAP BEAM ELEVATION - PIER 14
Scale: 1/4" = 1'-0"

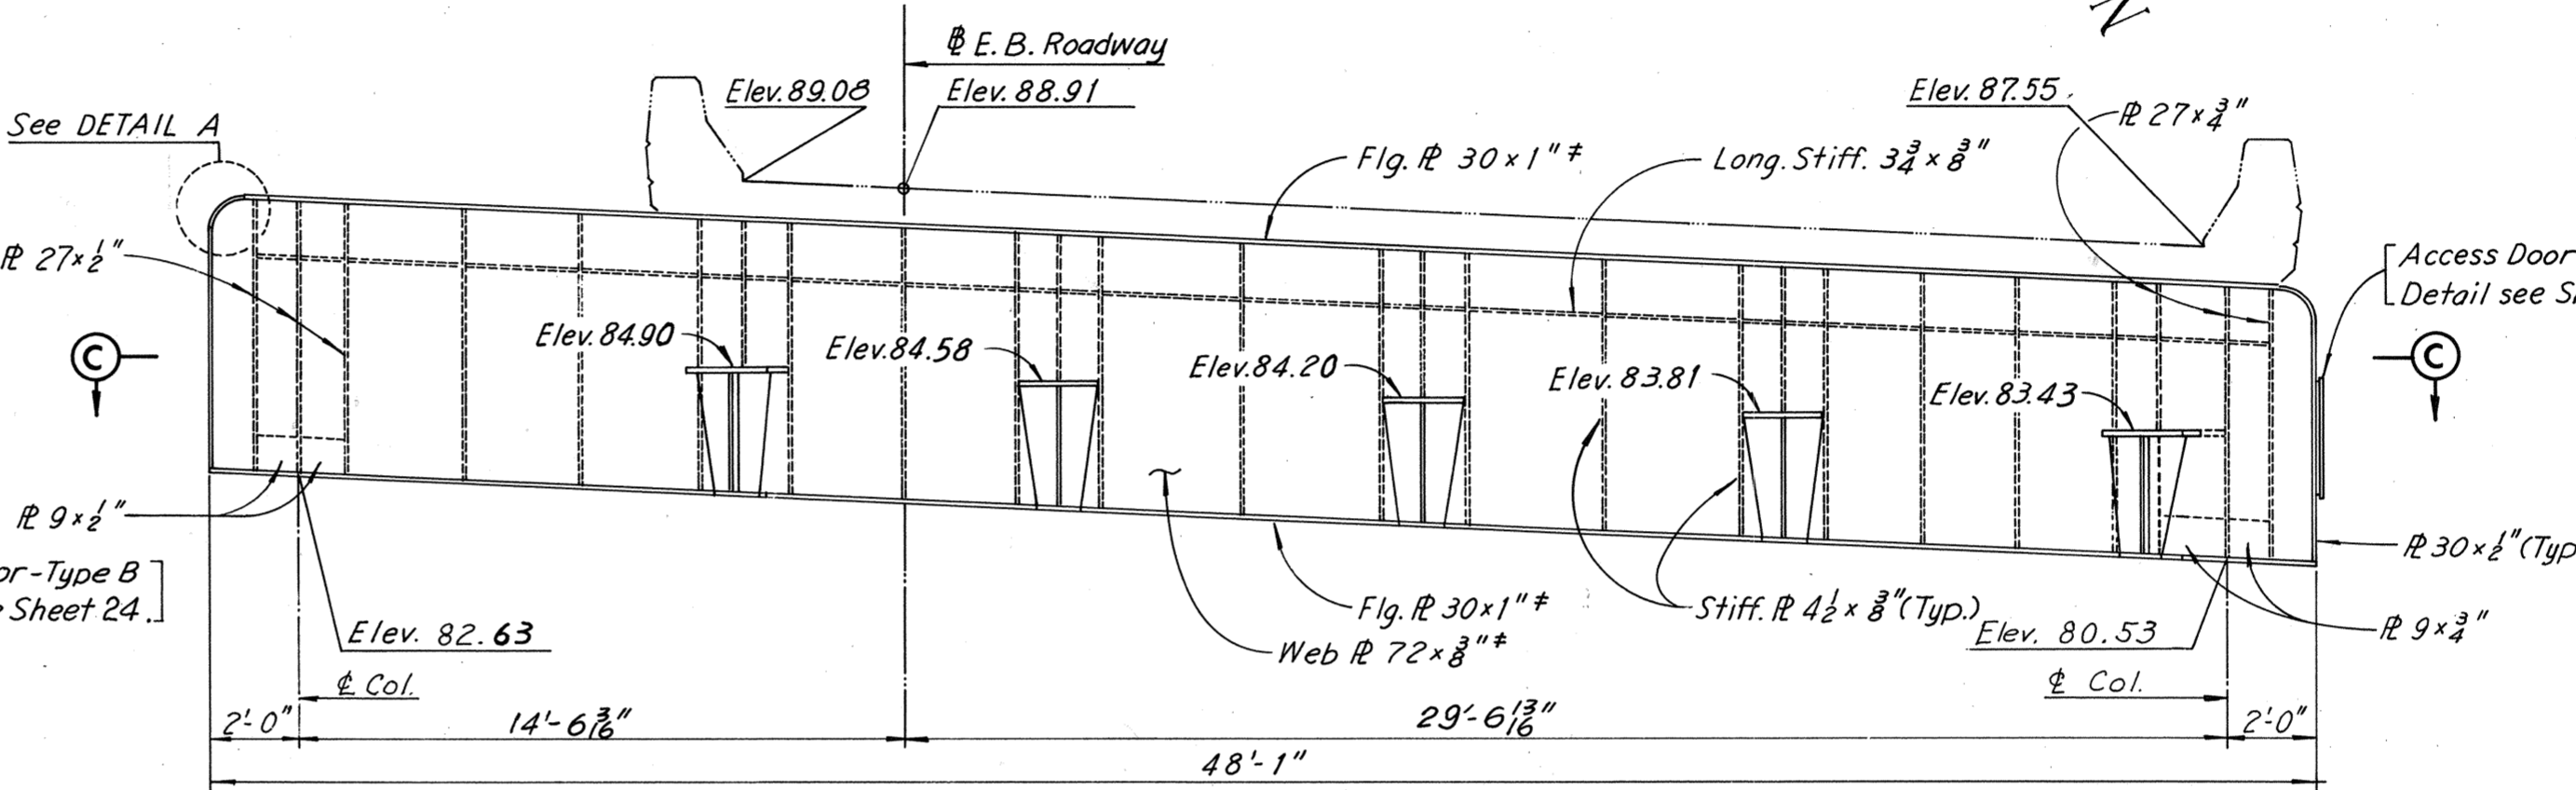


CAP BEAM ELEVATION - PIER 16
Scale: 1/4" = 1'-0"


Notes:
For Framing Plans see: Sheet 16 for Unit 14, Sheet 17 for Units 15 & 16, Sheet 18 for Unit 17.
For Deck Plans see: Sheet 30 for Unit 14, Sheet 31 for Units 15 & 16, Sheet 32 for Unit 17.

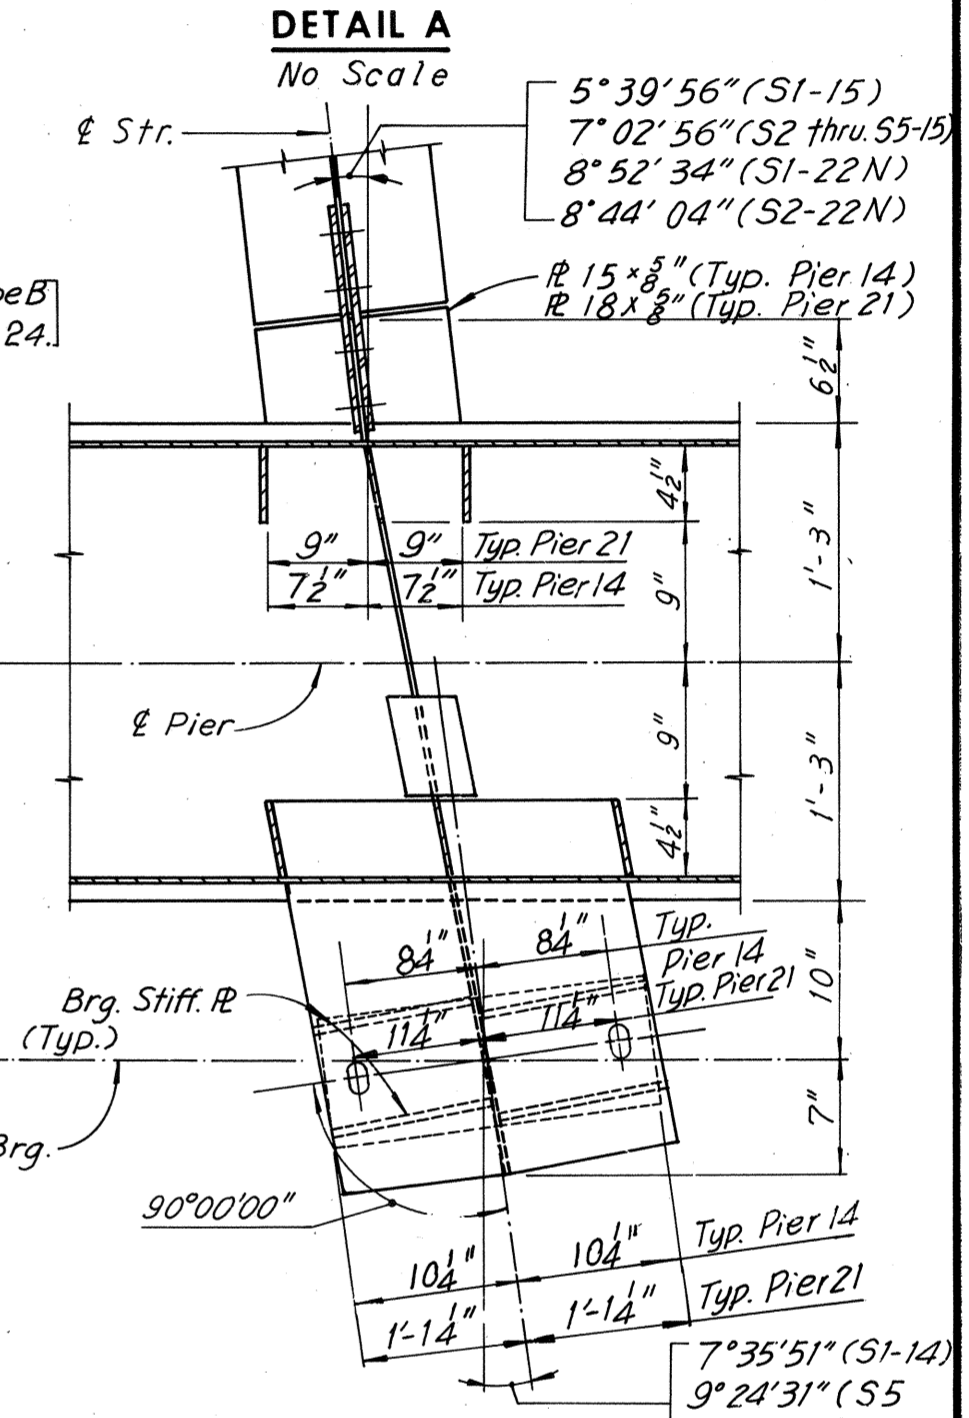

DETAIL B
No Scale

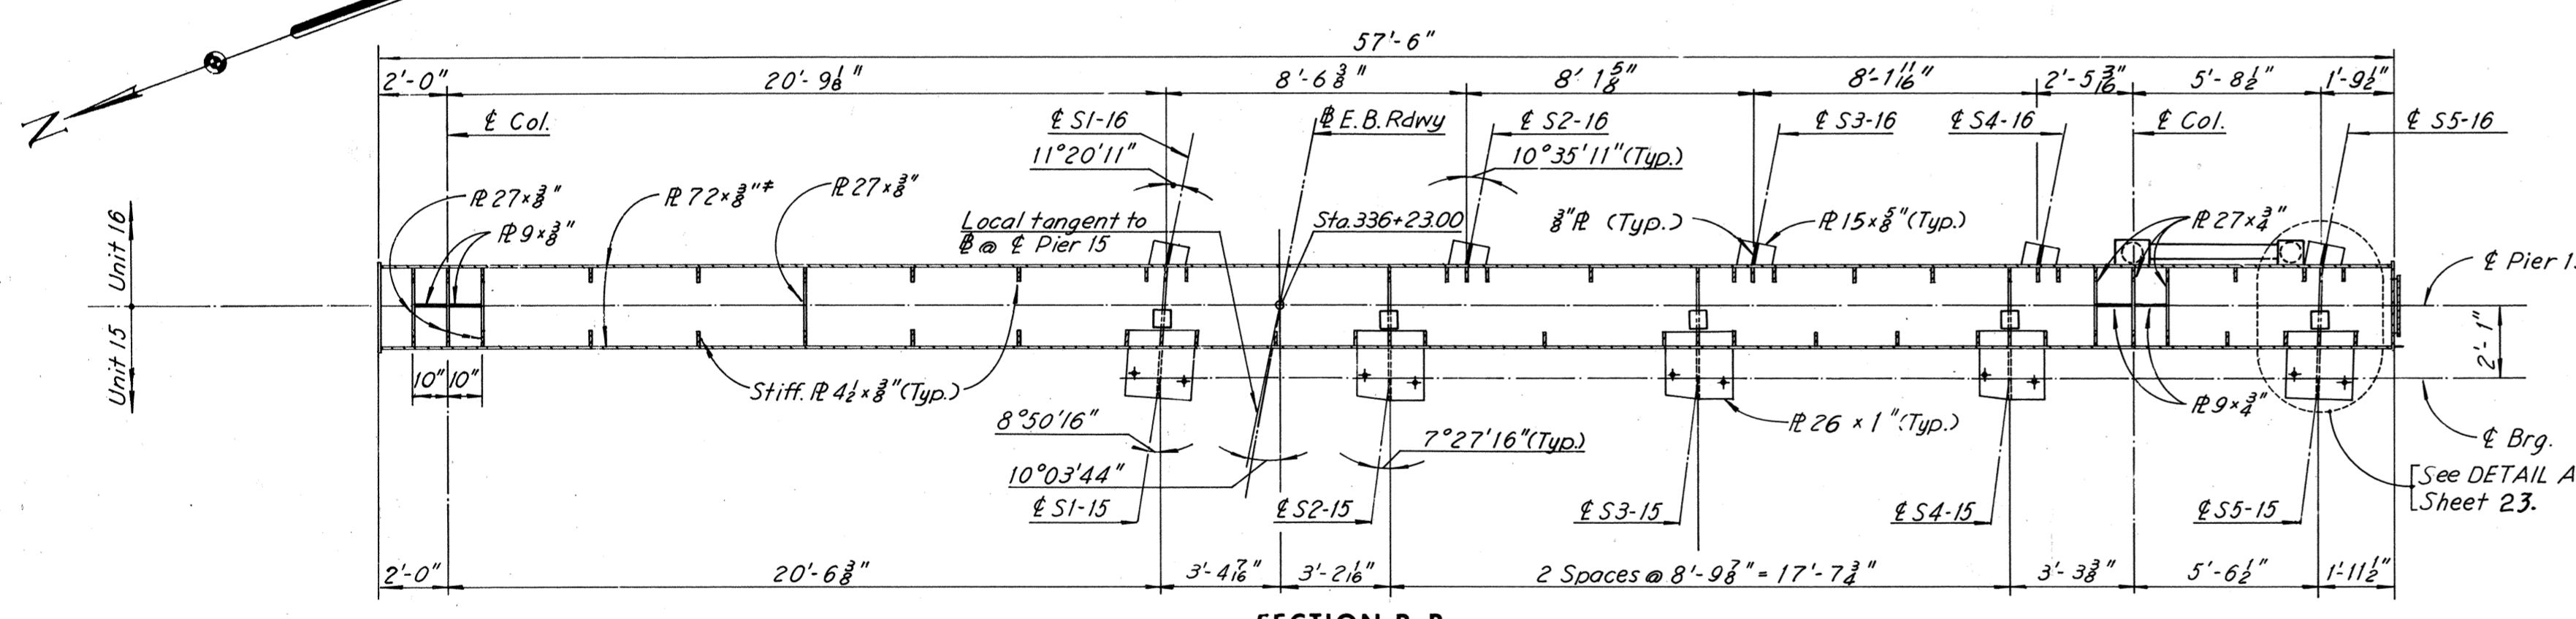


SECTION B-B
Scale: 1/4" = 1'-0"

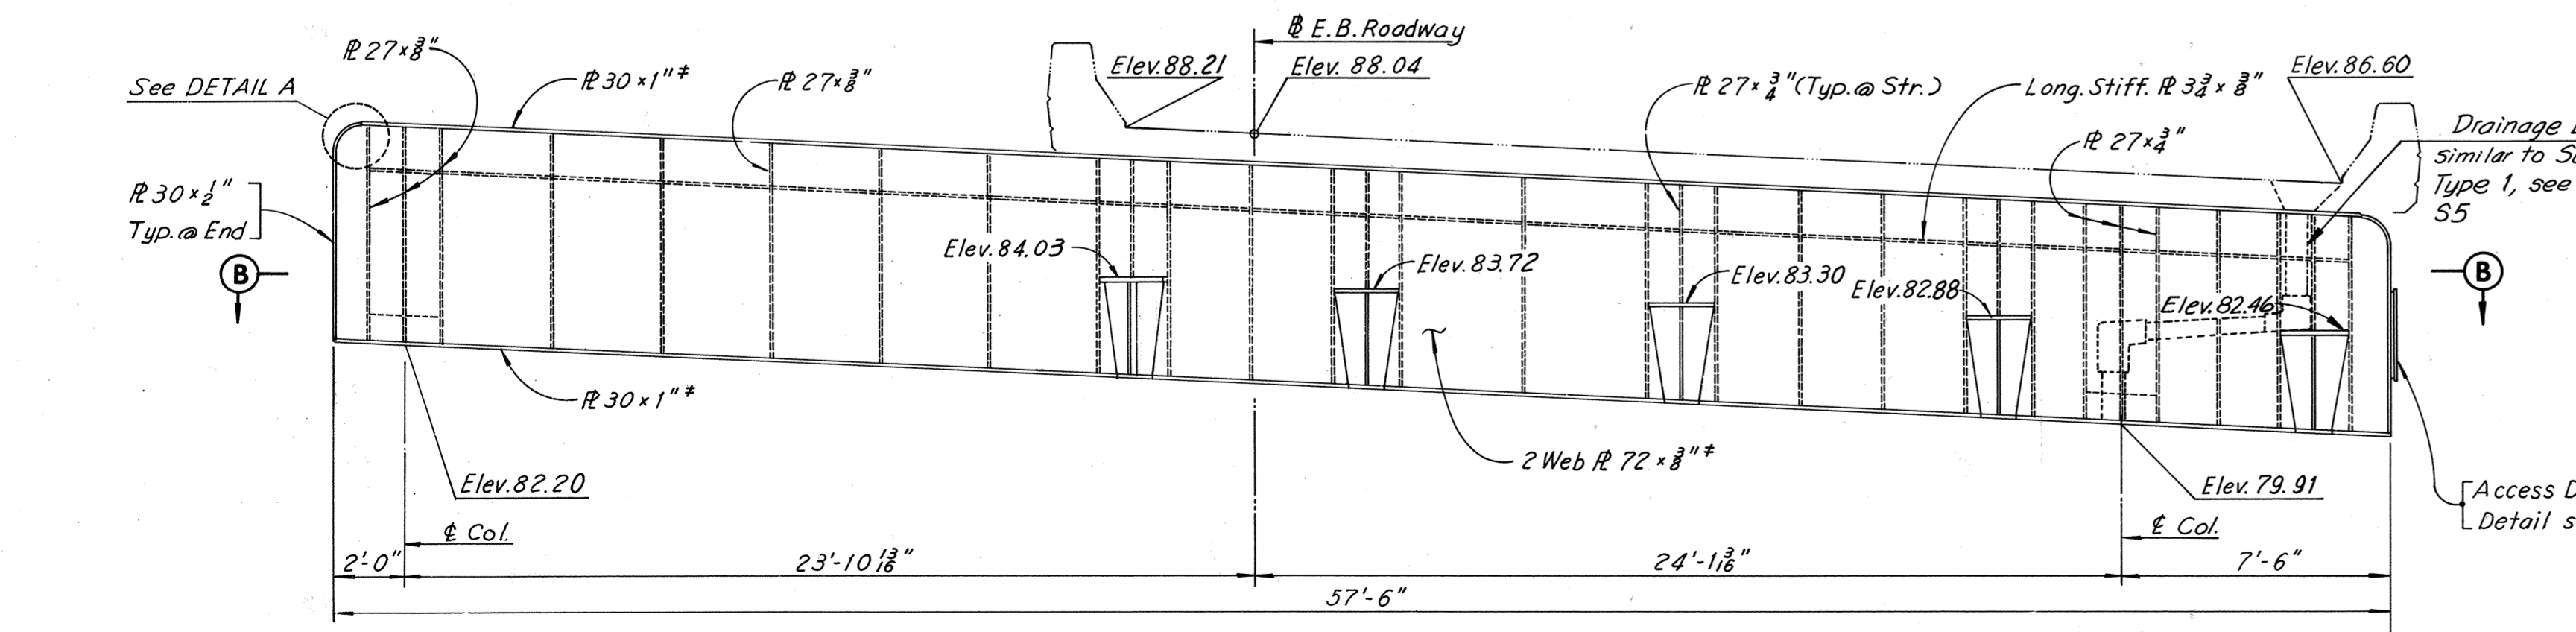

CAP BEAM ELEVATION - PIER 15
Scale: 1/4" = 1'-0"


Note: All steel shall be A36 unless denoted otherwise. * Denotes A572-Grade 50 steel for thickness of 3/4" and under and A588 steel for thickness over 3/4". Provide Drain Holes at lower end of cap beam. All elevations shown are final elevations.

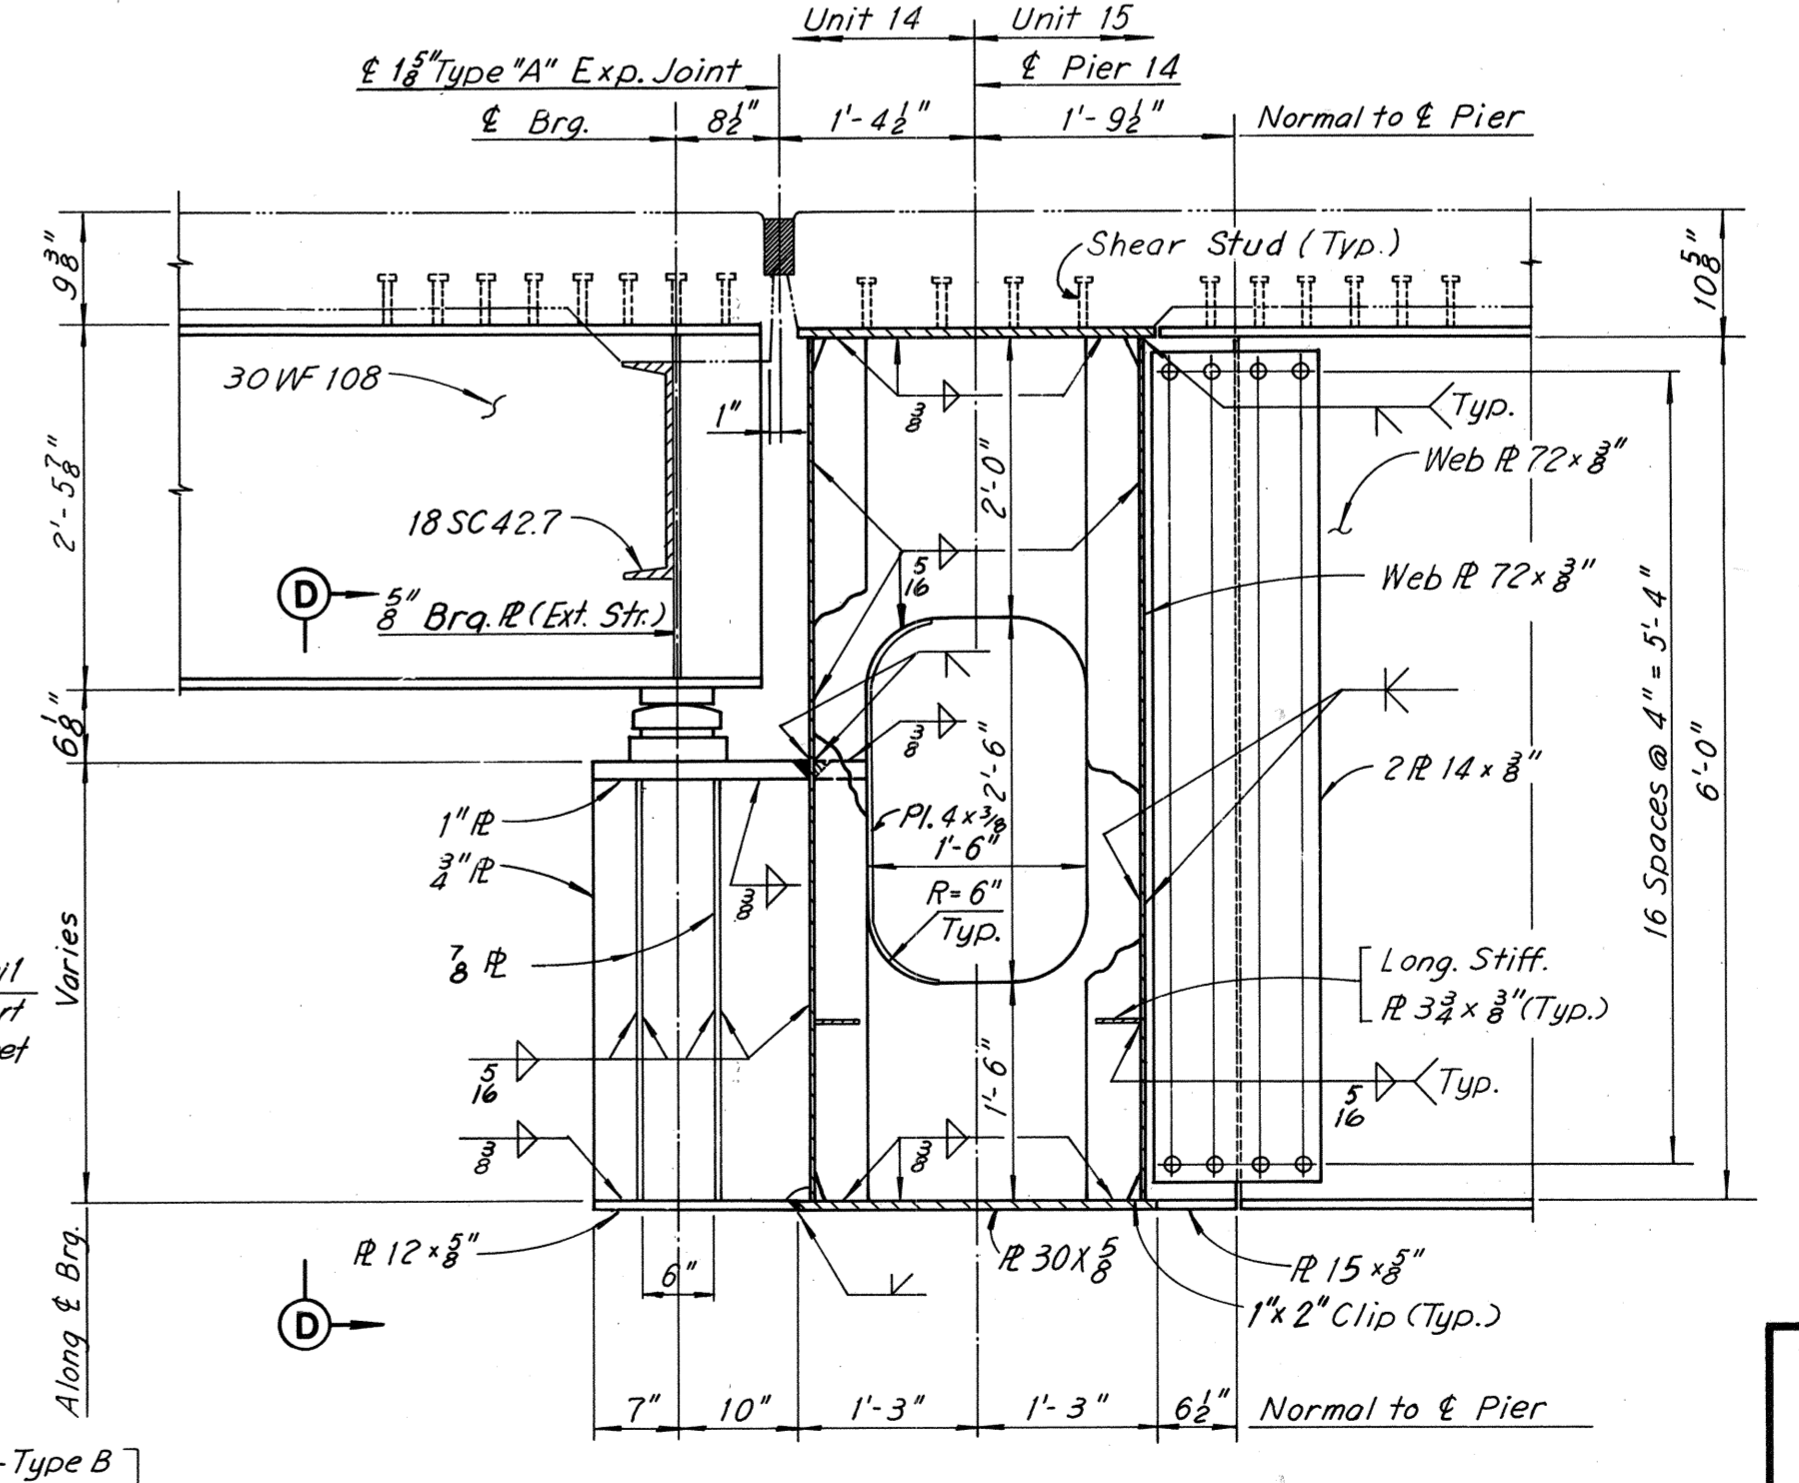

TYPICAL SECTION - PIER 14
Scale: 3/8" = 1'-0"

Note: TYPICAL SECTION for Piers 15 and 16, see TYPICAL SECTION, Sheet 23.

Note: Shear studs are placed in rows with four shear studs in each row. Rows are spaced at 24" centers within limits of concrete deck.

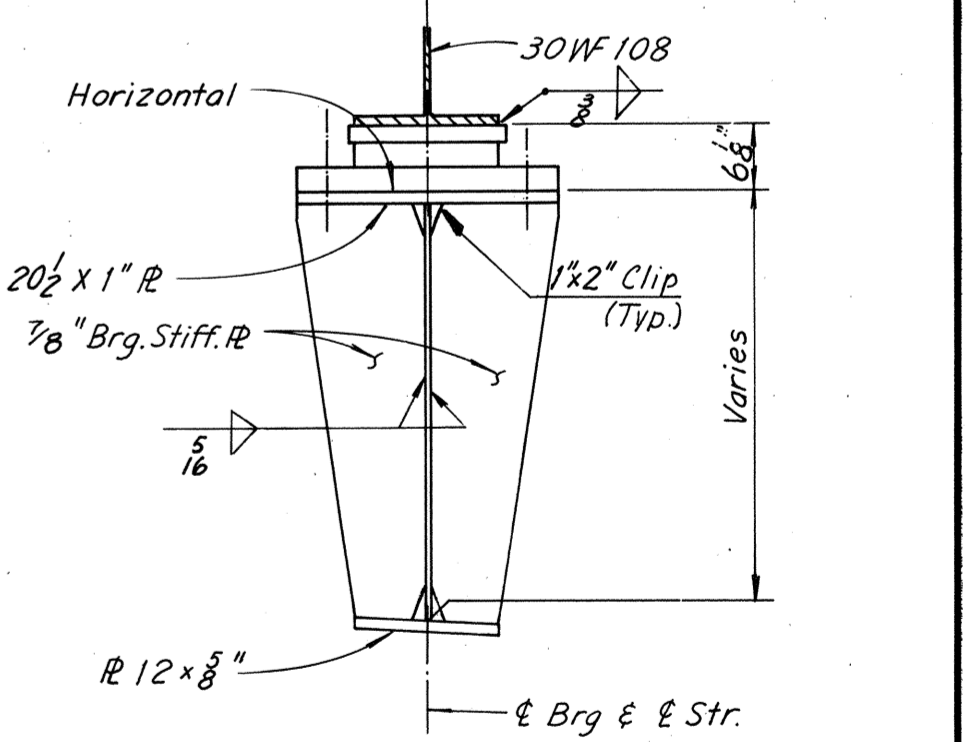

SECTION D-D
No Scale

BY	DATE	Note changed	PRMS	4-19-74
MADE	M.H.H. 12-7-68	Z. As Built	TEM	8-76
CHECKED	J.D. 1-29-69			
IN CHARGE				

RICHMOND METROPOLITAN AUTHORITY
RICHMOND EXPRESSWAY SYSTEM
DOWNTOWN EXPRESSWAY


BRIDGE NO. 66
EASTBOUND ROADWAY OVER
12TH ST. - R.R. TRACKS AND 16TH ST.
FRAMING DETAILS
PIERS 14, 15 AND 16

HOWARD, NEEDLES, TAMMEN & BERGENDOFF
consulting engineers
NEW YORK ALEXANDRIA KANSAS CITY


SCALE: As Noted
CONTRACT NO.: 10
SHEET NO. 22 OF 46

AS BUILT


RICHMOND EXPRESSWAY SYSTEM			
SECTION	PROJECT	SHEET NO.	TOTAL SHEETS
10	DOWNTOWN EXPRESSWAY	149	265

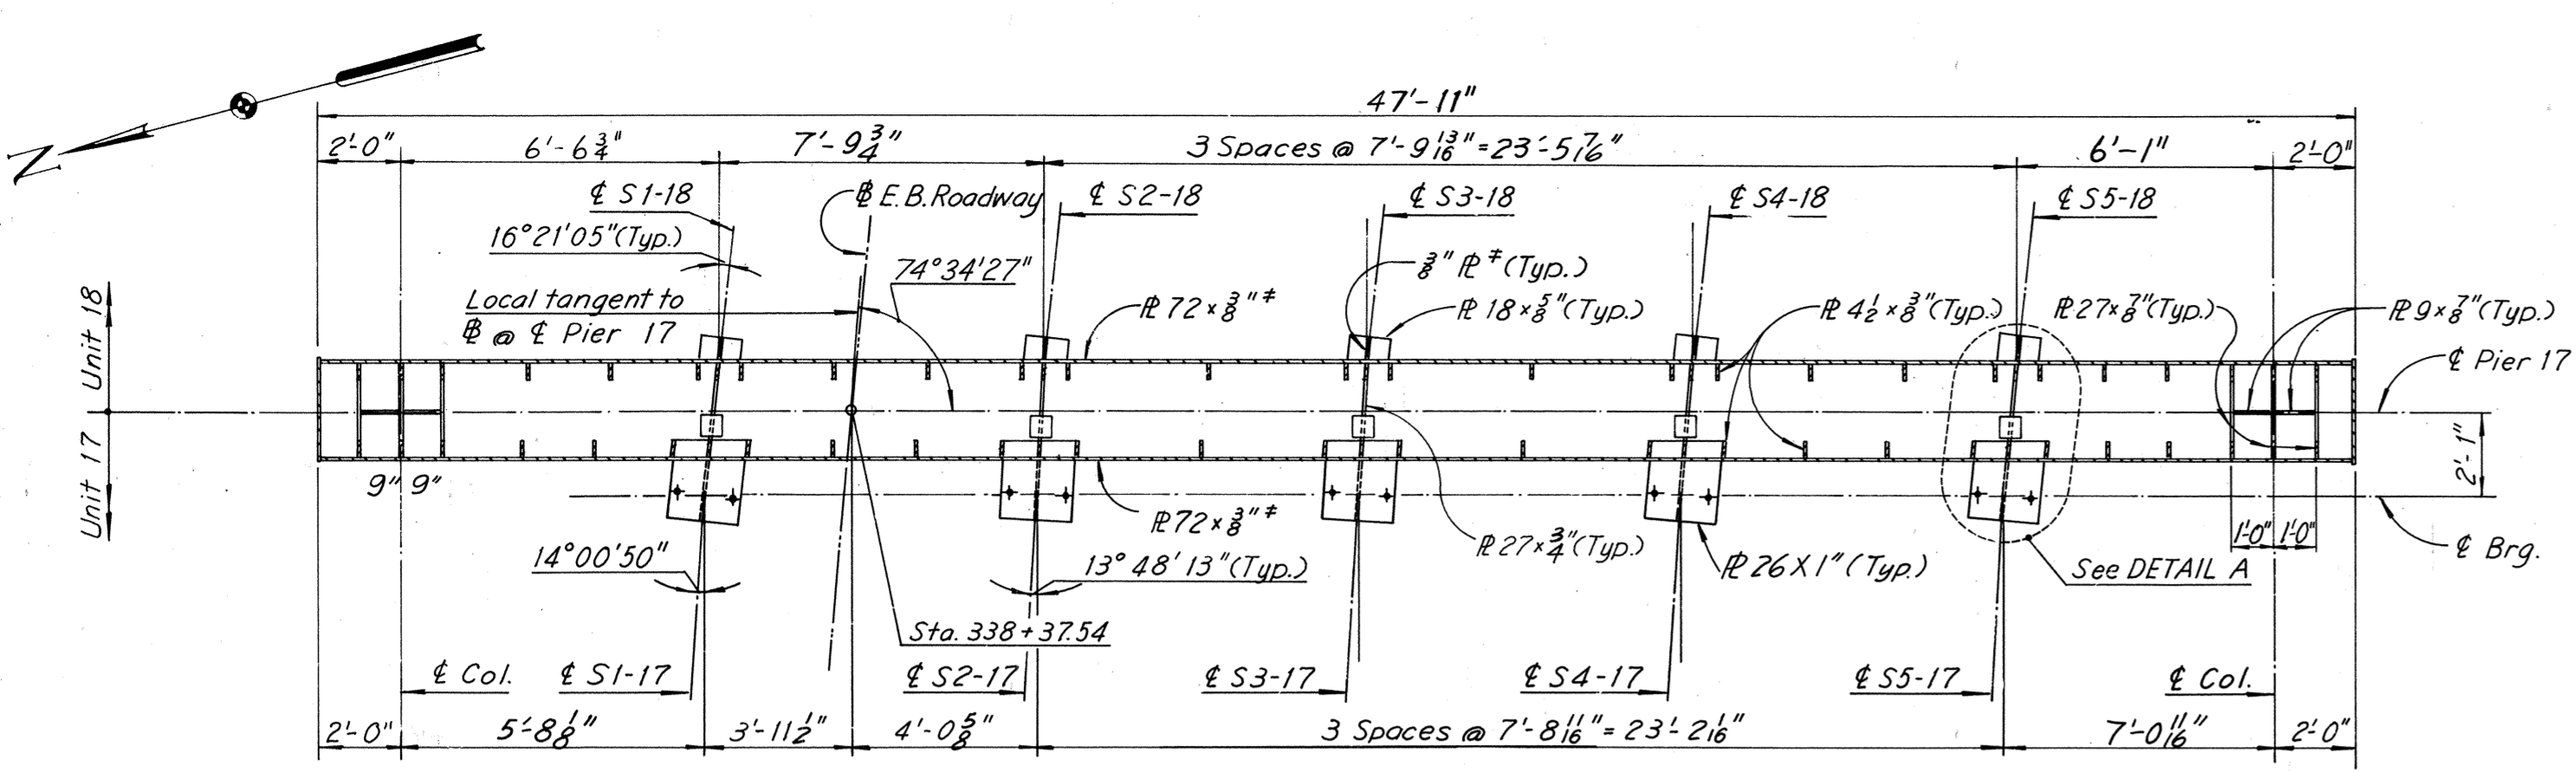


SECTION A-A
Scale: 1/4" = 1'-0"

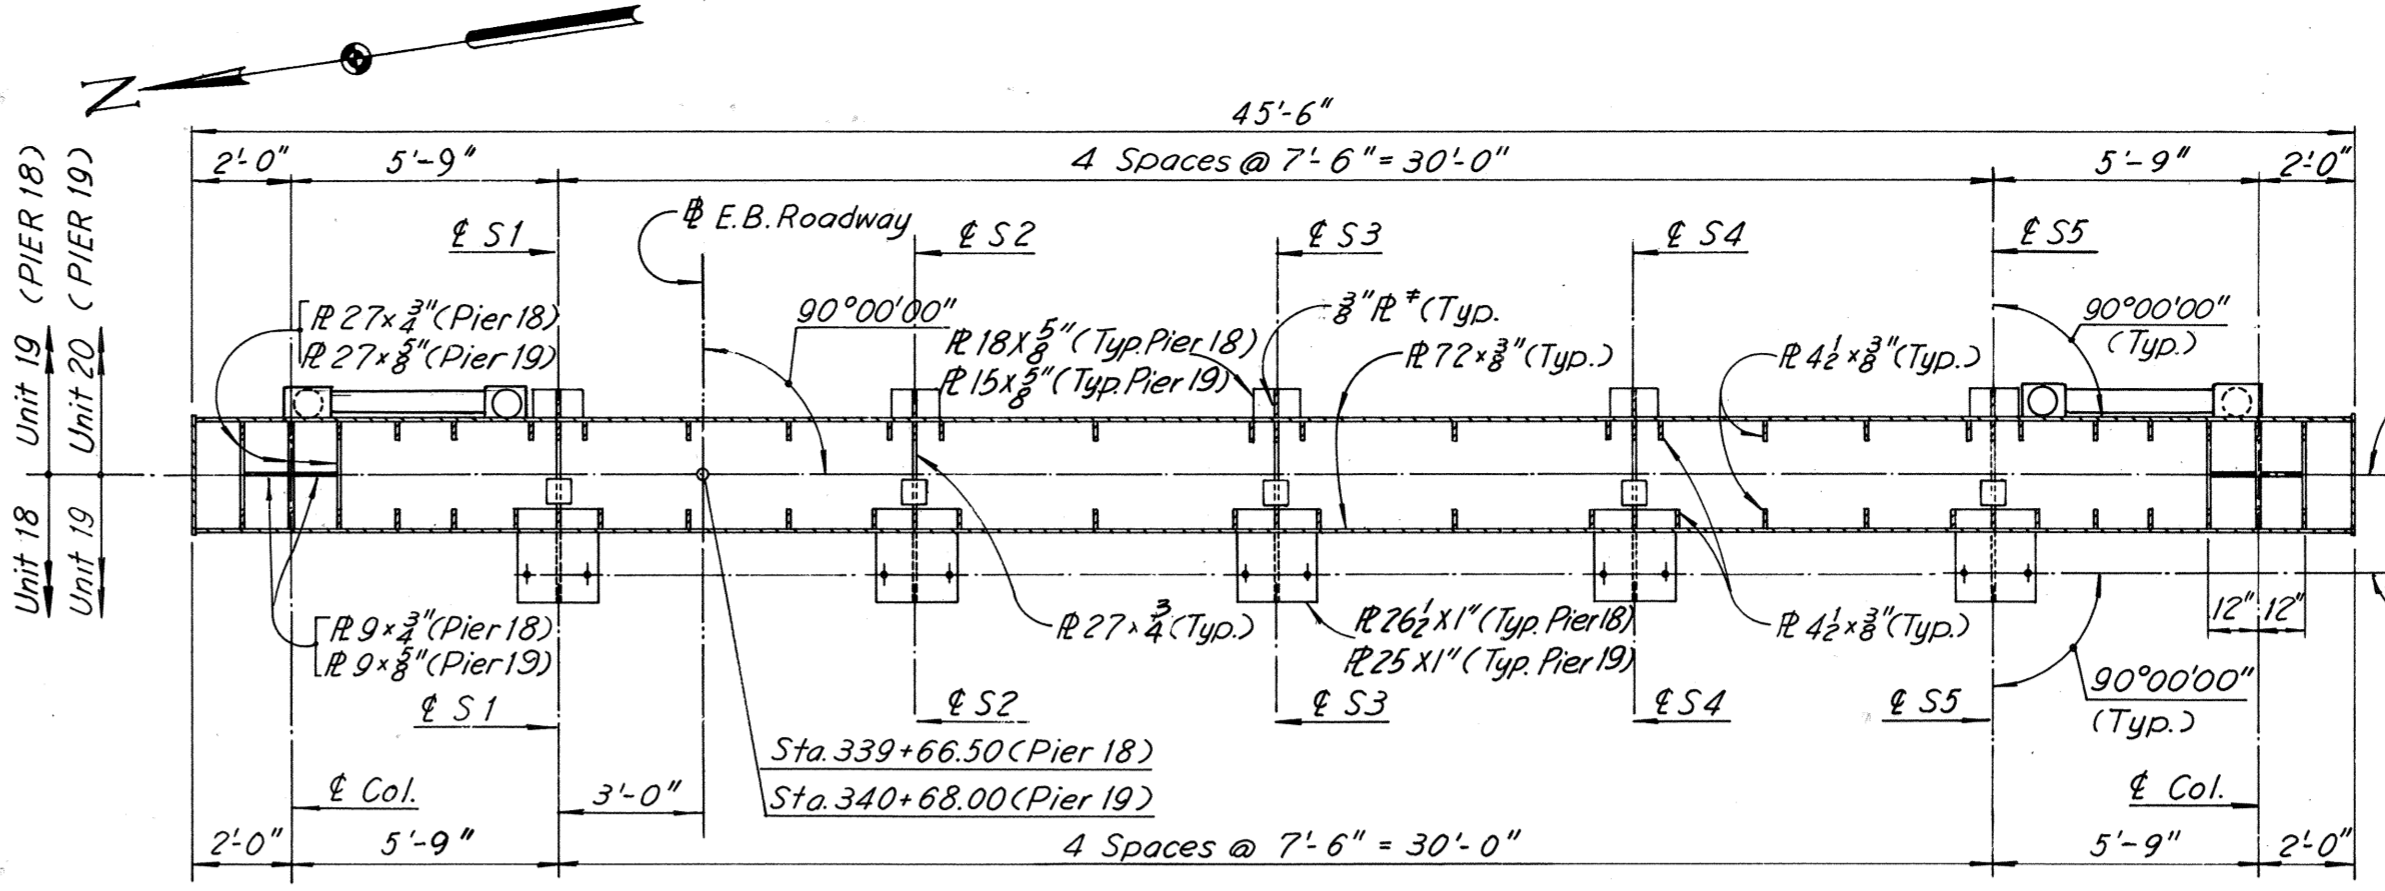


SECTION B-B
Scale: 1/4" = 1'-0"

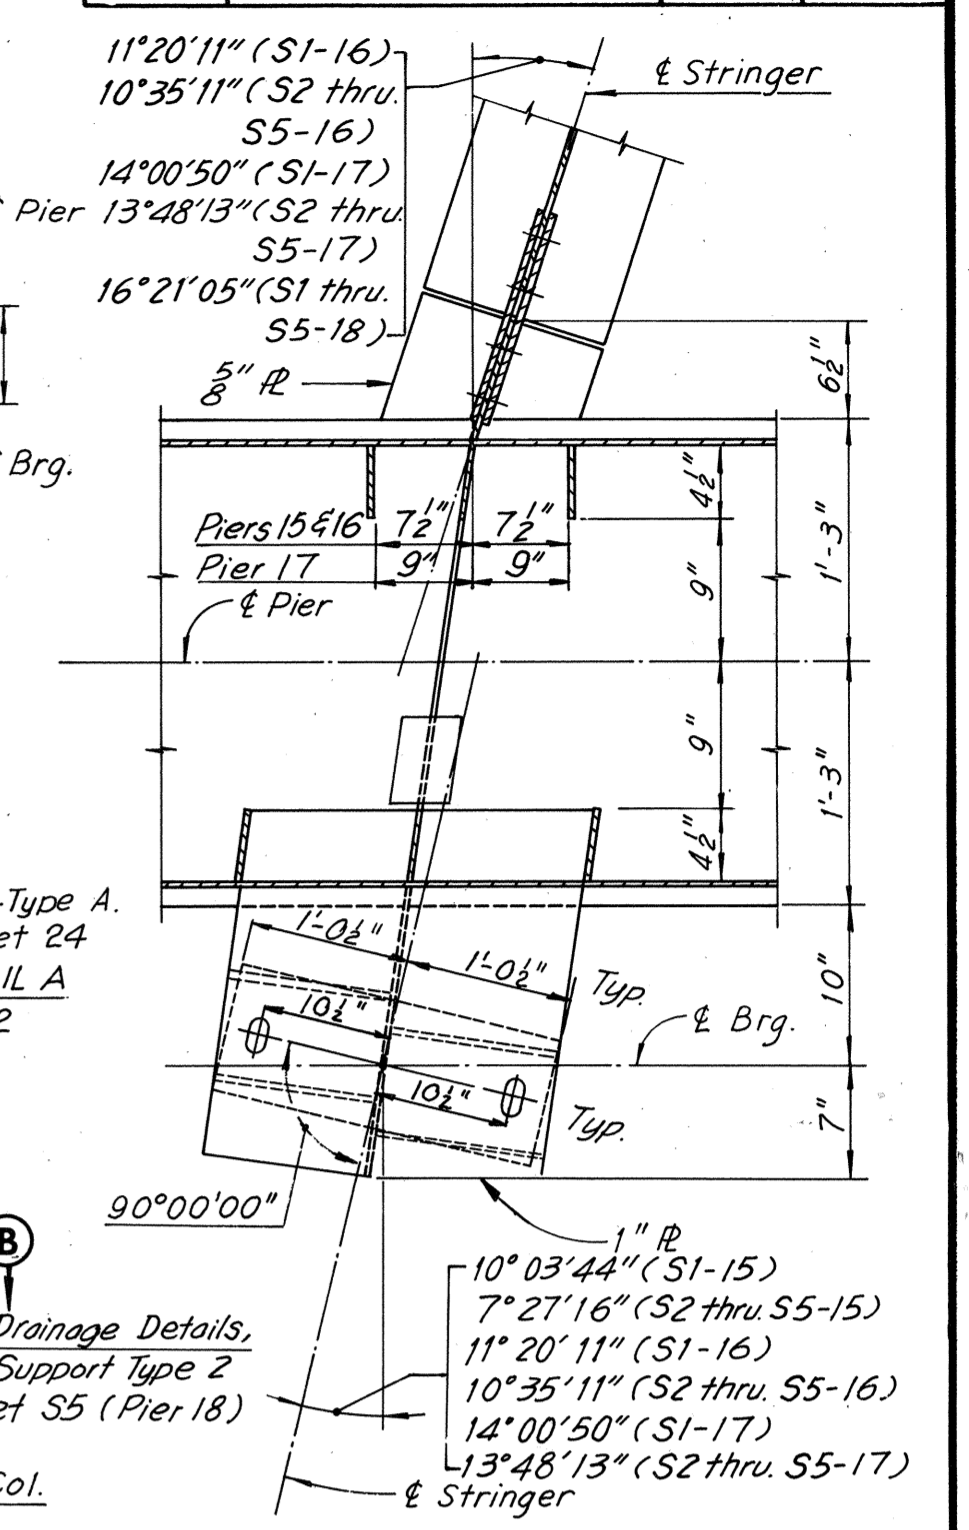


DETAIL A
No Scale

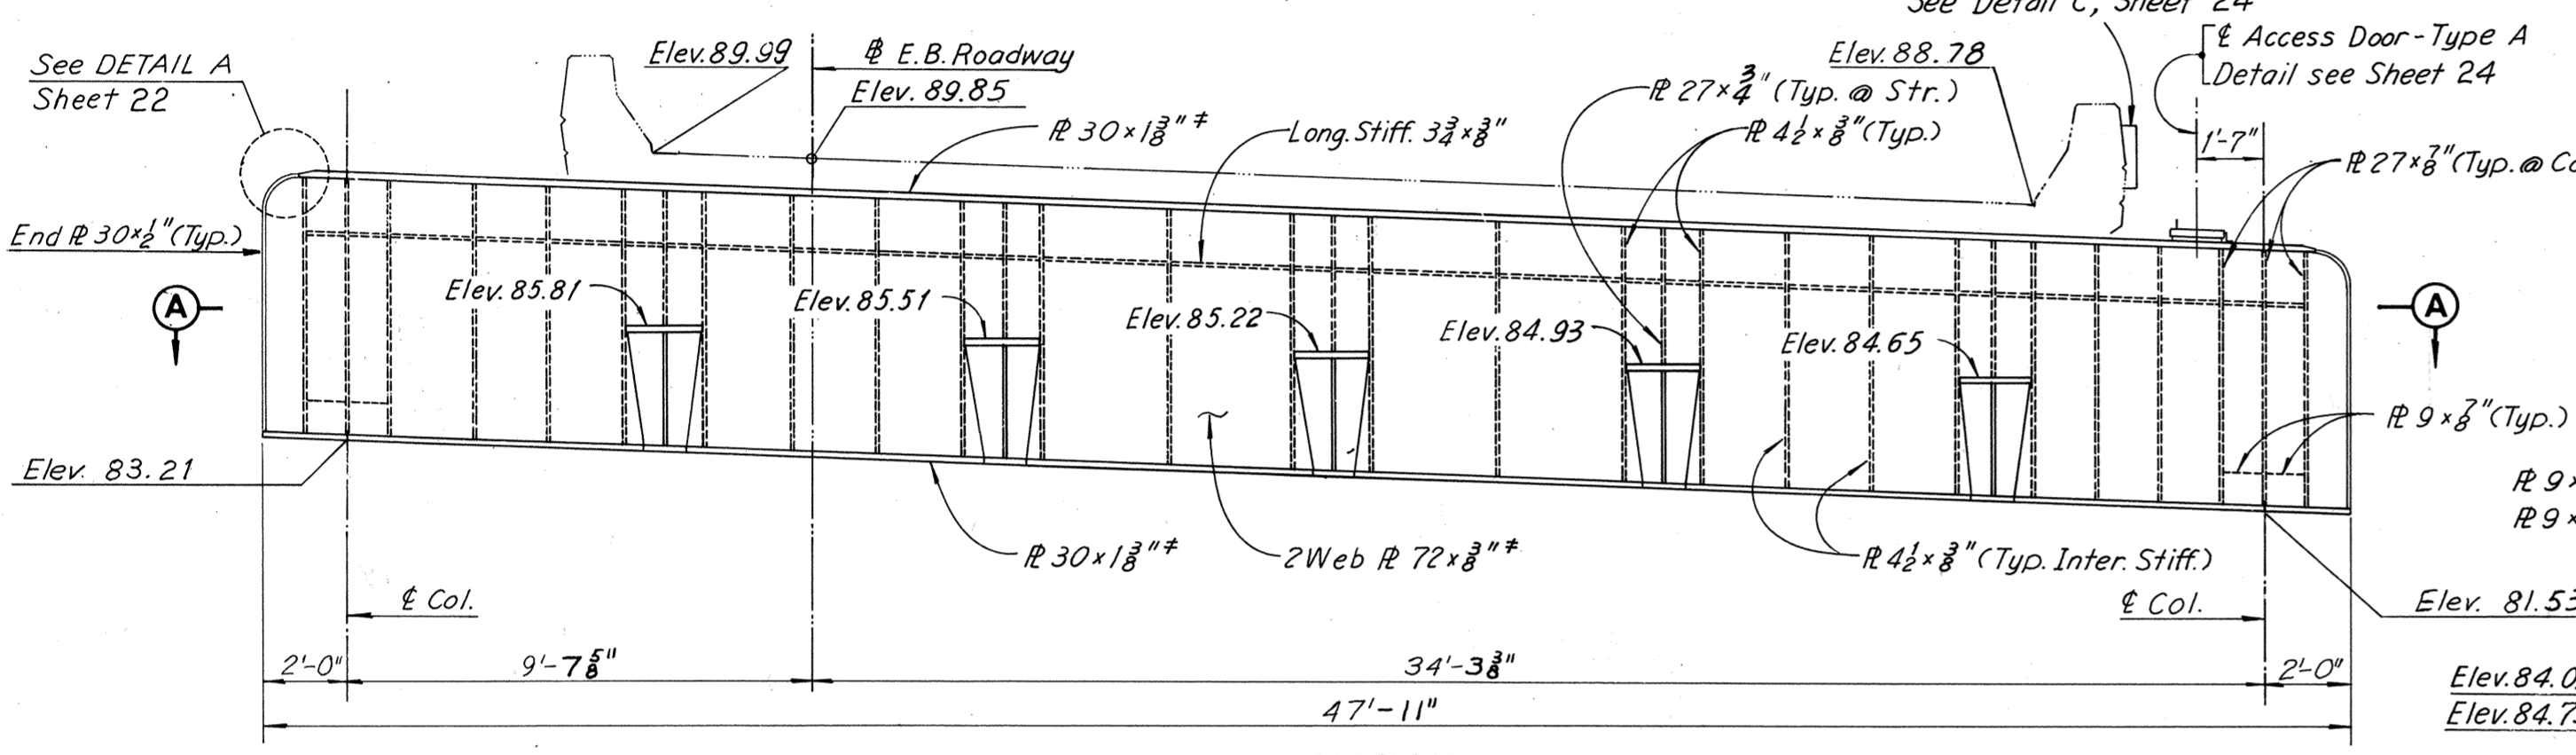


CAP BEAM ELEVATION - PIER 17
Scale: 1/4" = 1'-0"

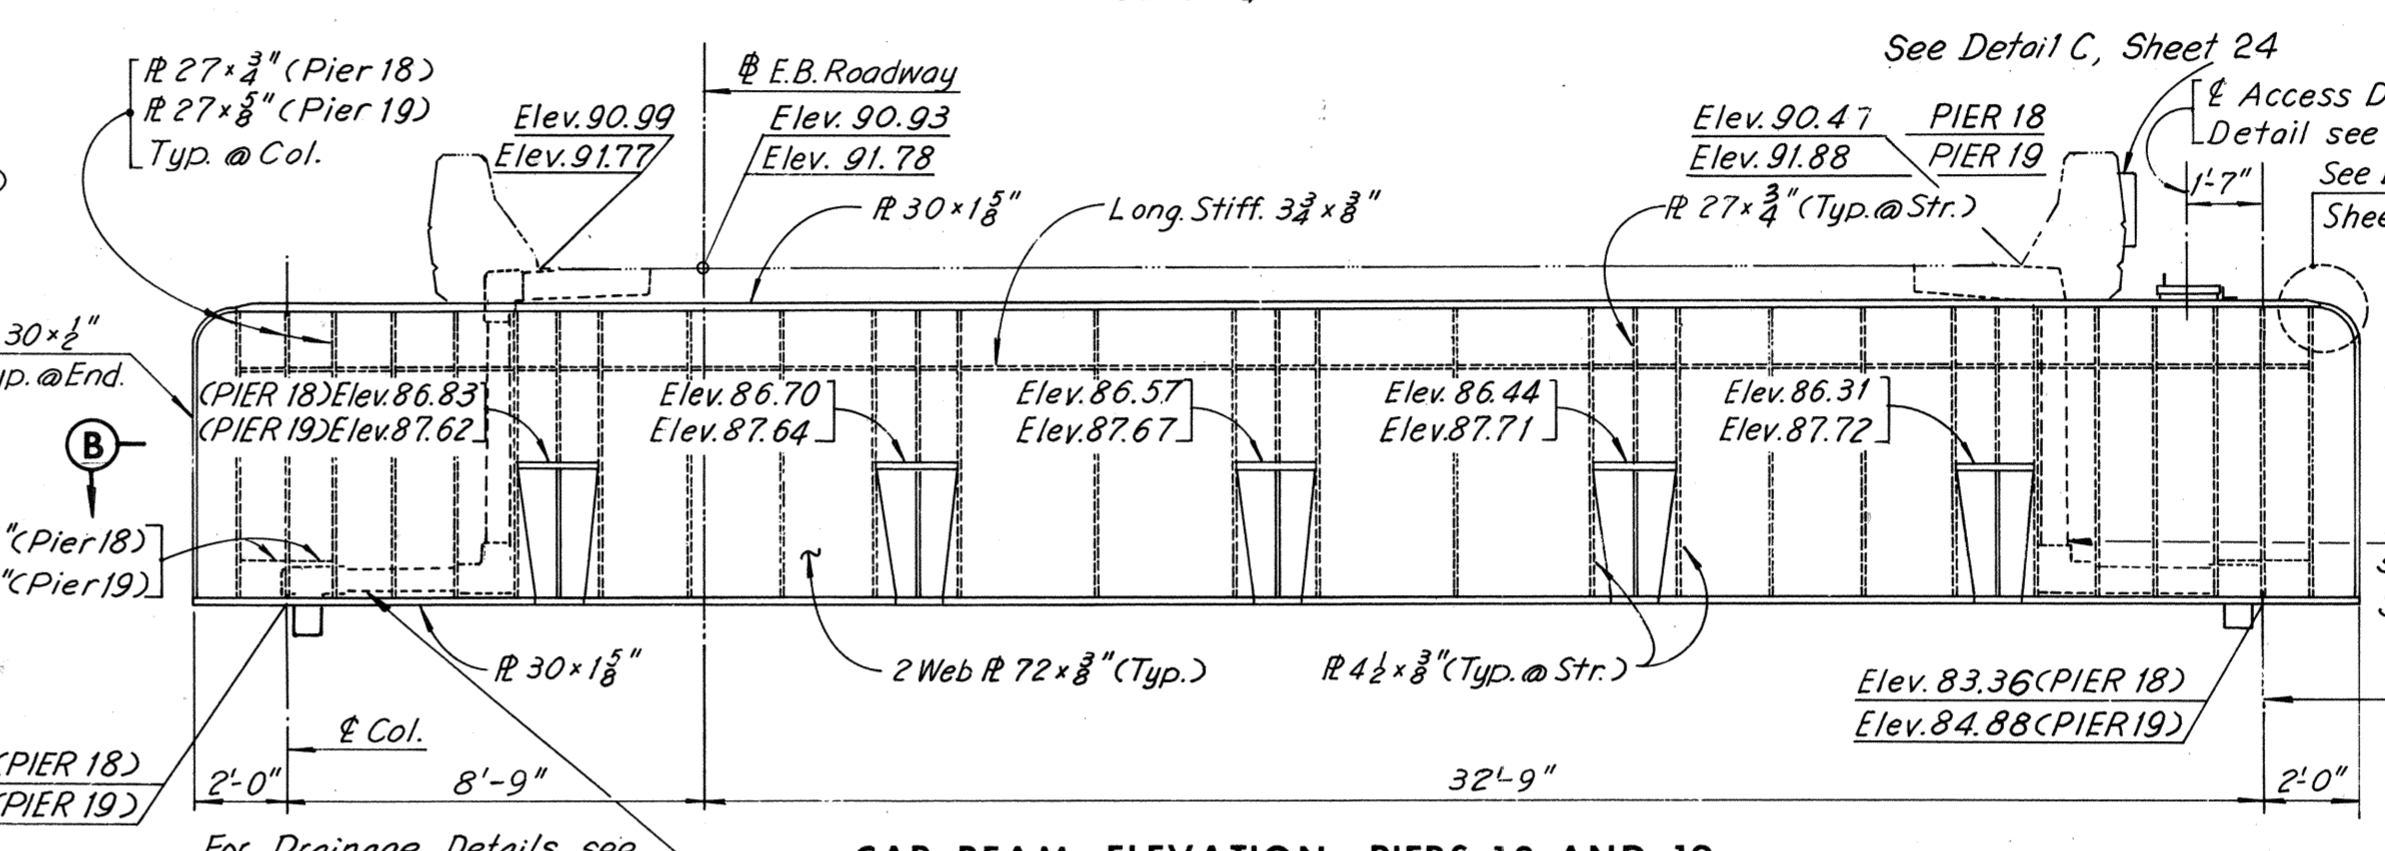


CAP BEAM ELEVATION - PIERS 18 AND 19
Scale: 1/4" = 1'-0"

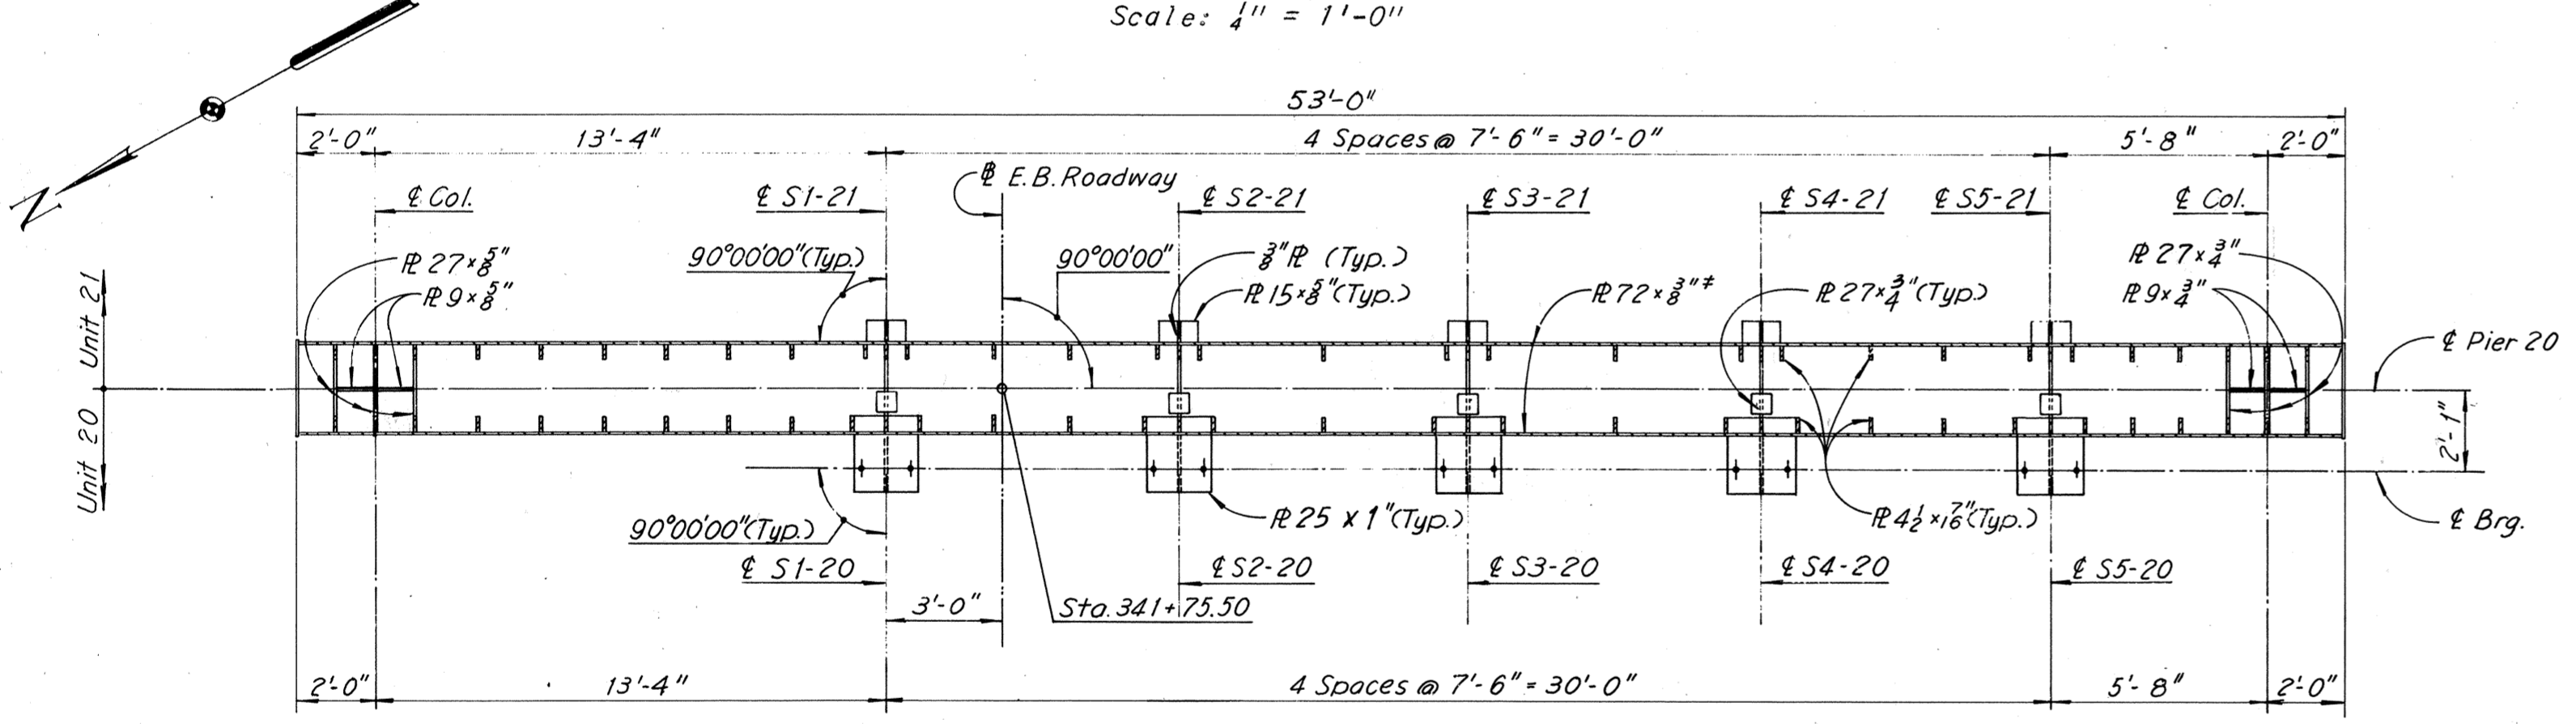


SECTION C-C
Scale: 1/4" = 1'-0"

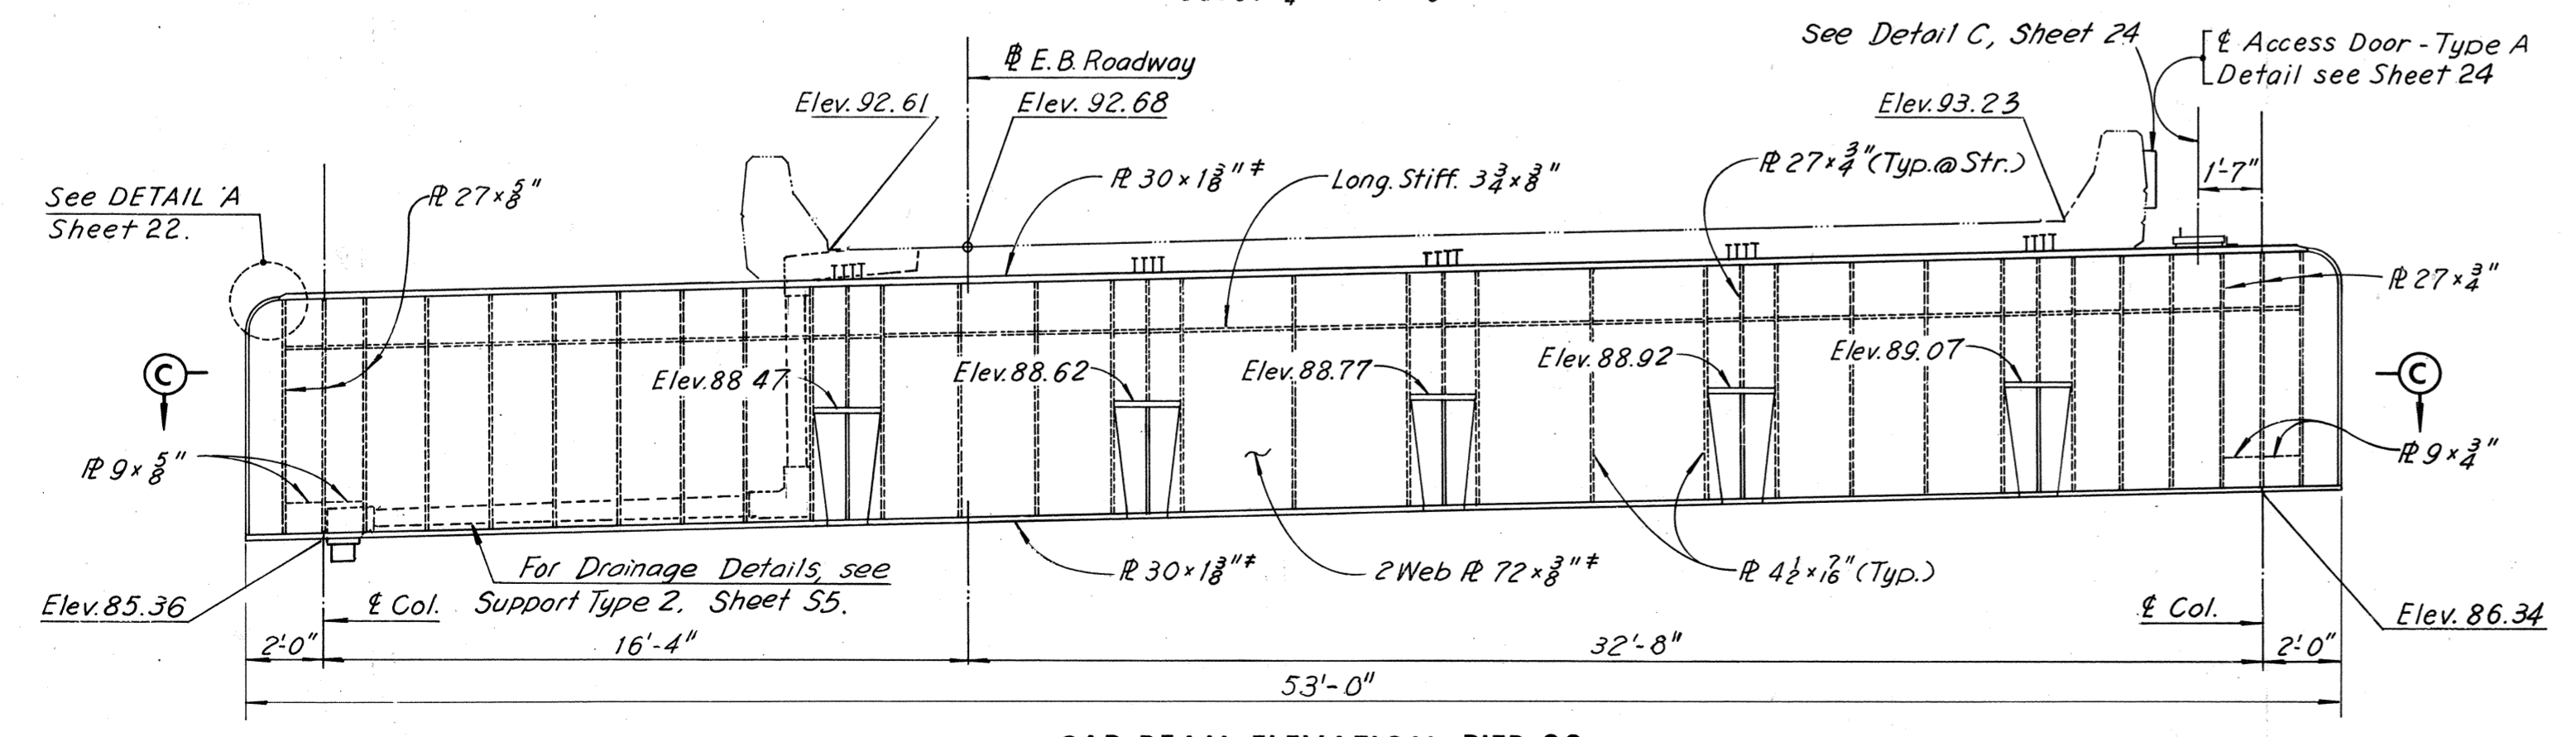

CAP BEAM ELEVATION - PIER 20
Scale: 1/4" = 1'-0"

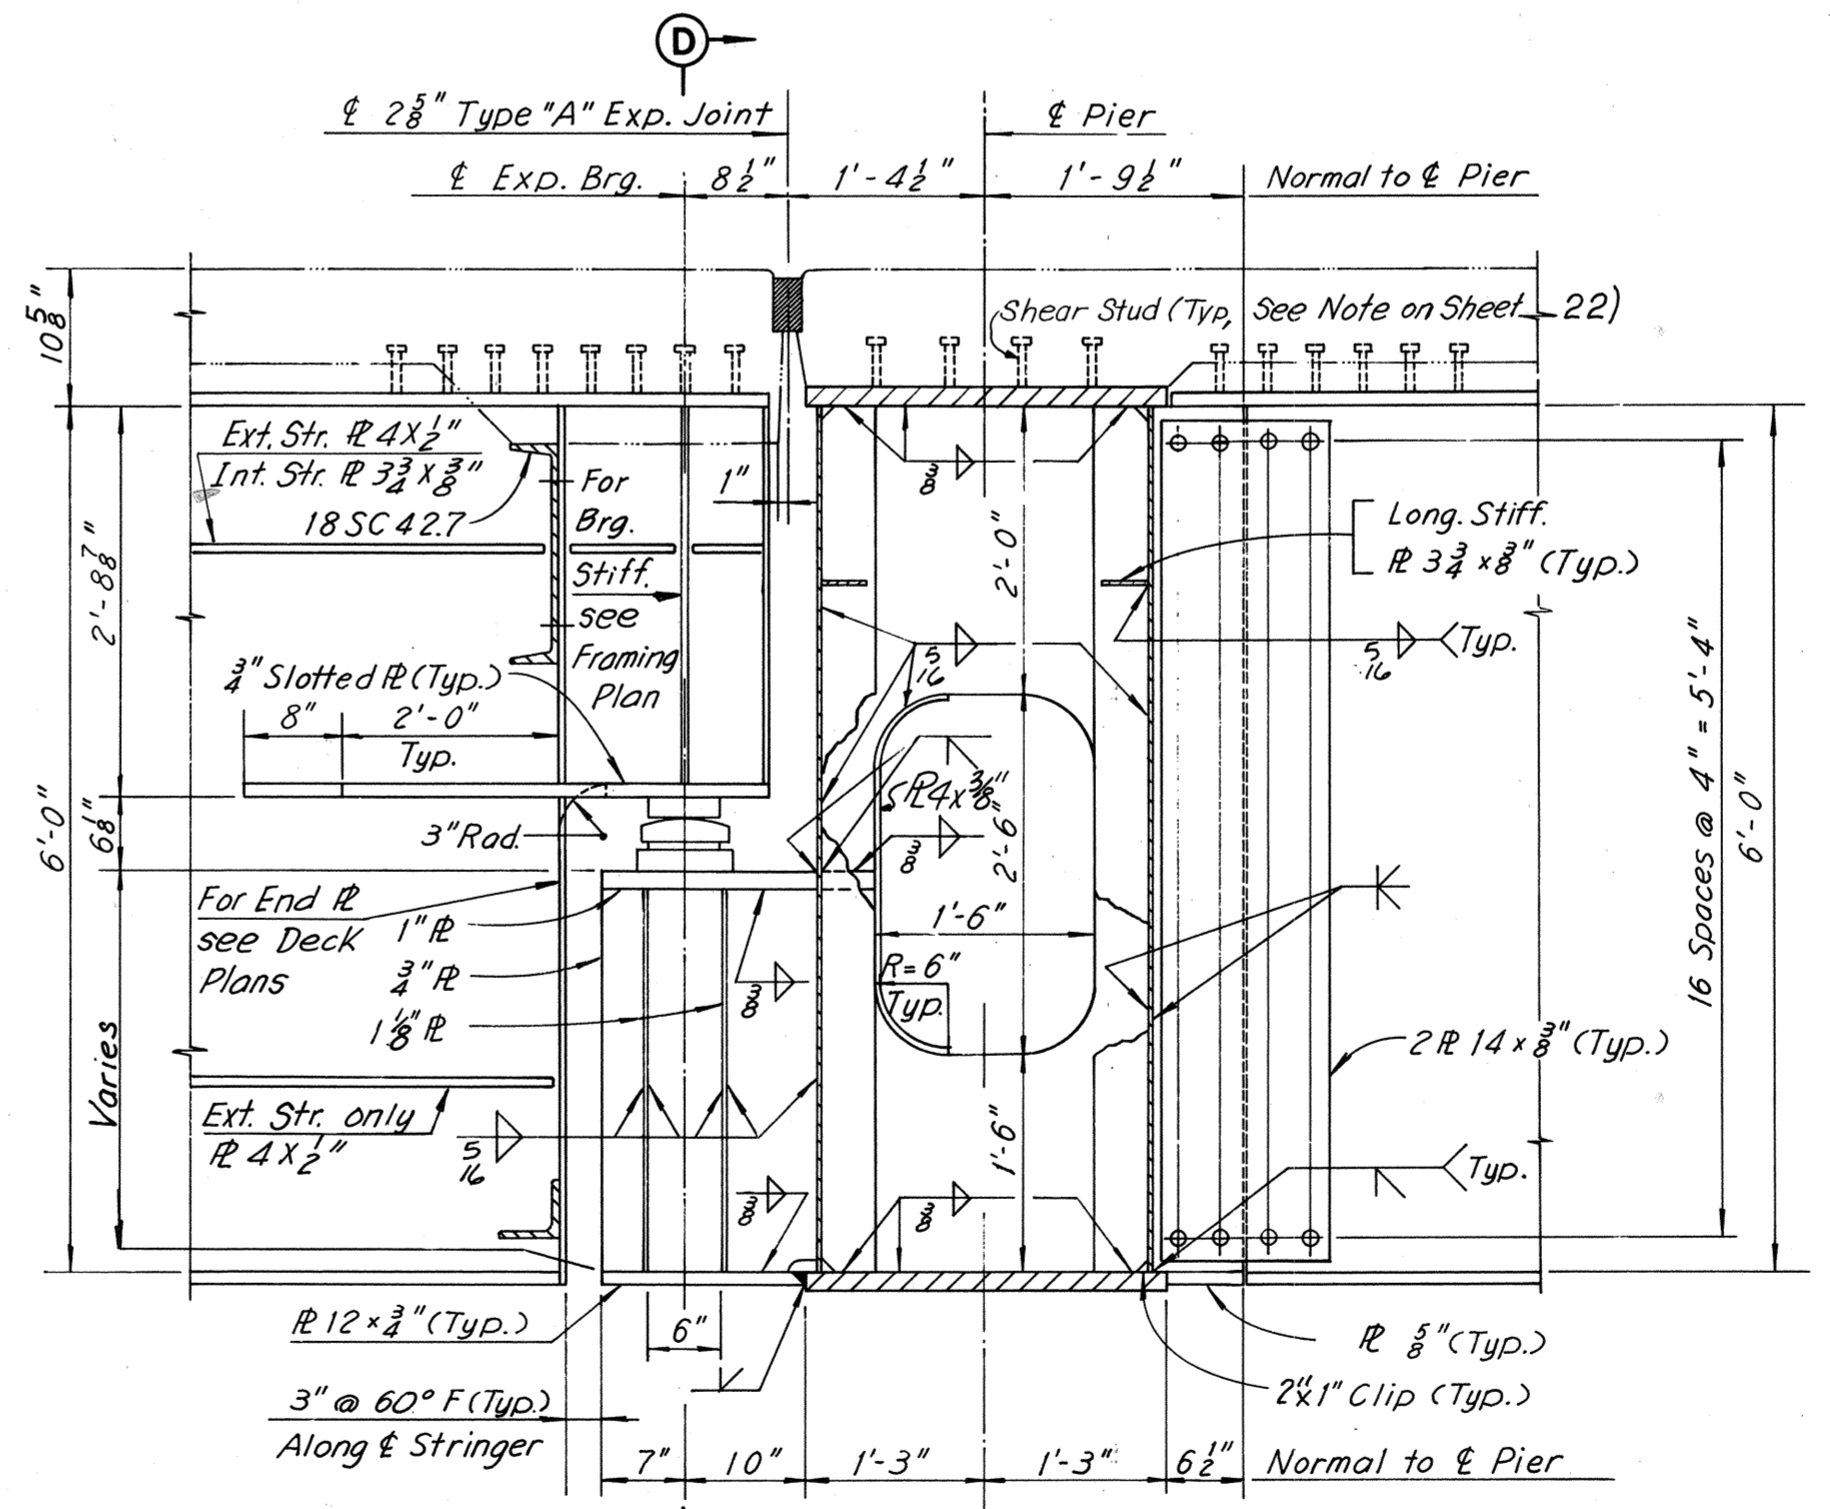

TYPICAL SECTION
Scale: 3/4" = 1'-0"

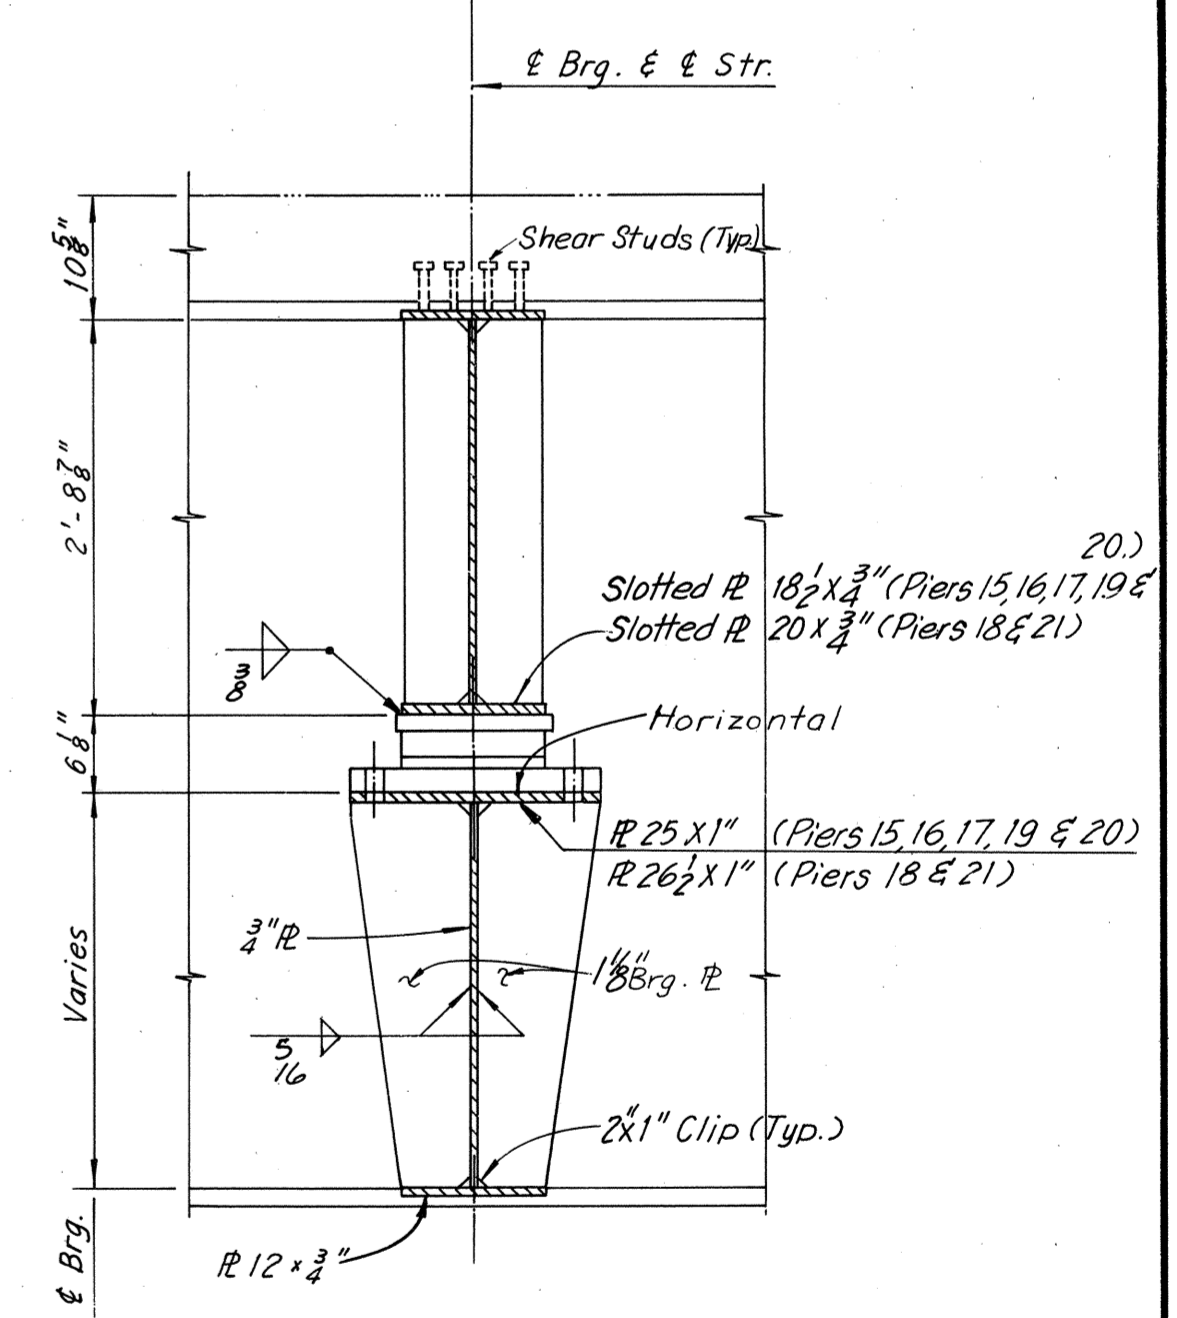

SECTION D-D
Scale: 1/4" = 1'-0"

Notes:
For Framing Plans see:
Sheet 18 for Units 17 & 18.
Sheet 19 for Units 19 & 20.
Sheet 20 for Units 21 & 22.
For Deck Plans see:
Sheet 32 for Units 17 & 18.
Sheet 33 for Units 19 & 20.
Sheet 34 for Units 21 & 22.

Note:
All steel shall be A36 unless denoted otherwise.
* Denotes A572-Grade 50 steel for thickness of 3/4" and under and A588 steel for thickness over 3/4".
Provide Drain Holes at lower end of cap beam.
All elevations shown are final elevations.

BY	DATE	REVISION	BY	DATE
MADE	M.H.H. 12-17-68			
CHECKED	J.D. 1-29-69	1	As Built	TEM 8-76
IN CHARGE				




RICHMOND METROPOLITAN AUTHORITY
RICHMOND EXPRESSWAY SYSTEM
DOWNTOWN EXPRESSWAY

BRIDGE NO. 66
EASTBOUND ROADWAY OVER
12TH ST. - R.R. TRACKS AND 16TH ST.
FRAMING DETAILS
PIERS 17, 18, 19 AND 20

SCALE: As Noted
CONTRACT NO.: 10
SHEET NO. 23 OF 46

HOWARD, NEEDLES, TAMMEN & BERGENDOFF
consulting engineers
NEW YORK ALEXANDRIA KANSAS CITY

AS BUILT

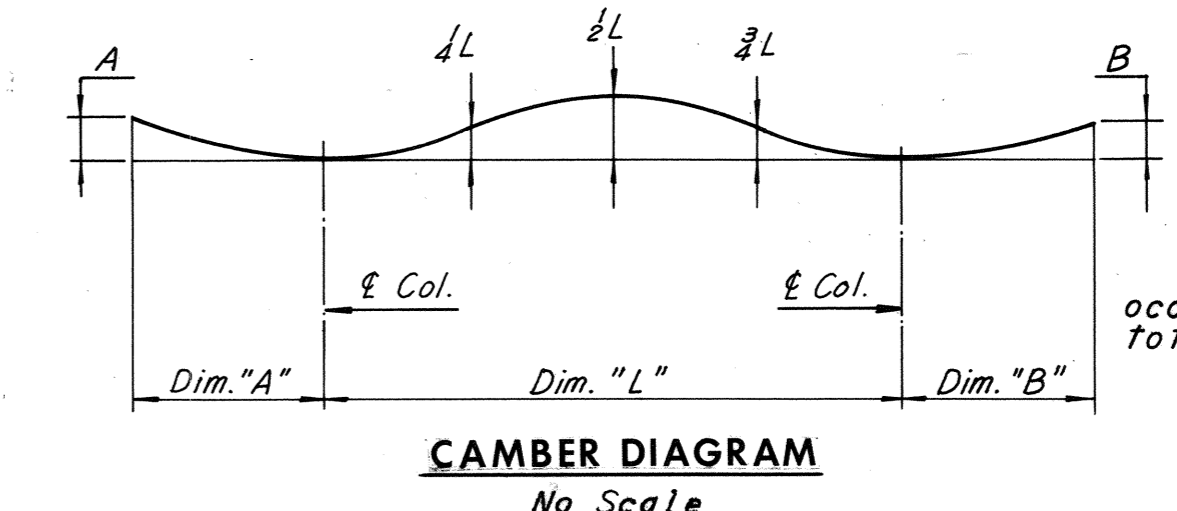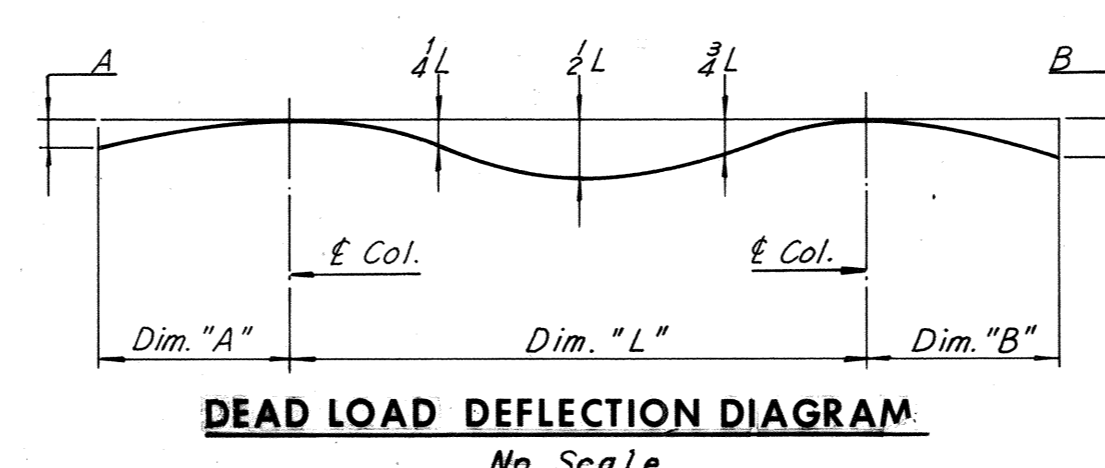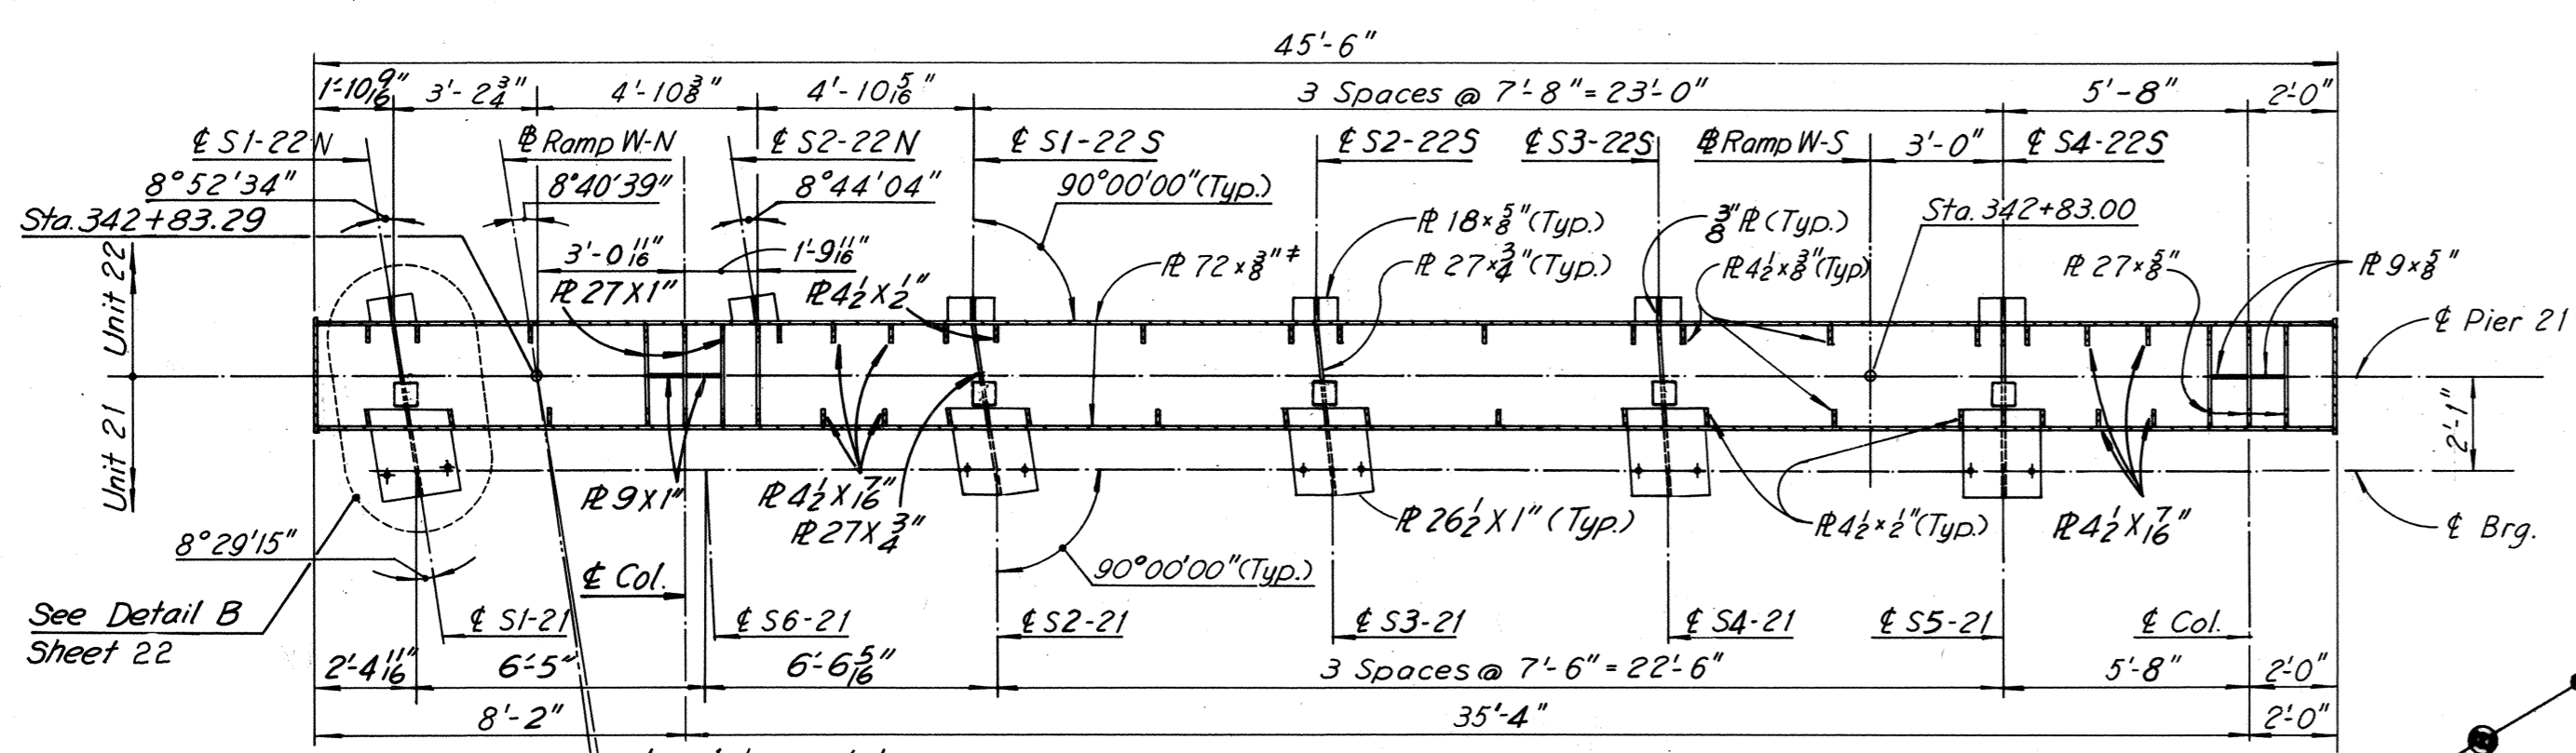


NOTE TO CONTRACTOR
Deflections given are those anticipated to occur in the stringer upon placement of the total concrete deck dead load.

NOTE TO FABRICATOR
The cap beams shall be fabricated with an upward camber amounting to the tabulated value. This will provide approximate compensation for deflection under full dead load and for conformity with finished grade. Dimensions are in inches.








PIER	CAP BEAM SCHEDULE			DEAD LOAD DEFLECTION SCHEDULE				CAMBER SCHEDULE				
	Dim "A"	Dim. "L"	Dim. "B"	Δ	1/4L	1/2L	3/4L	A	1/4L	1/2L	3/4L	B
14	11'-5 1/2"	19'-0"	8'-6 1/2"	0	0	0	0	0	0	0	0	0
15	2'-0"	48'-0"	7'-5"	0	1/8	1/8	4	0	4	8	16	-1/8
16	2'-0"	44'-11"	2'-0"	0	4	8	4	0	5	16	16	0
17	2'-0"	43'-11"	2'-0"	0	4	12	4	0	16	8	16	0
18	2'-0"	41'-6"	2'-0"	0	8	16	8	0	16	4	16	0
19	2'-0"	41'-6"	2'-0"	0	8	16	8	0	16	4	16	0
20	2'-0"	49'-0"	2'-0"	0	16	16	16	0	8	8	8	0
21	8'-2"	35'-4"	2'-0"	-1/16	1/16	8	1/16	0	-1/16	8	8	0

Note: A negative deflection indicates an upward deflection, and a negative camber indicates a downward camber.

Note: Cap beams having a total camber of less than 1" are not required to be shop cambered, but should be turned so that any mill tolerance deviation from straightness will be in the direction shown by the Camber Diagram.
If cap beams are not cambered, distance top of cap beams to top of slab will vary along the cap beams in accordance with the offset dimensions shown in the Camber Diagram and Contractor shall adjust the bearing pads.

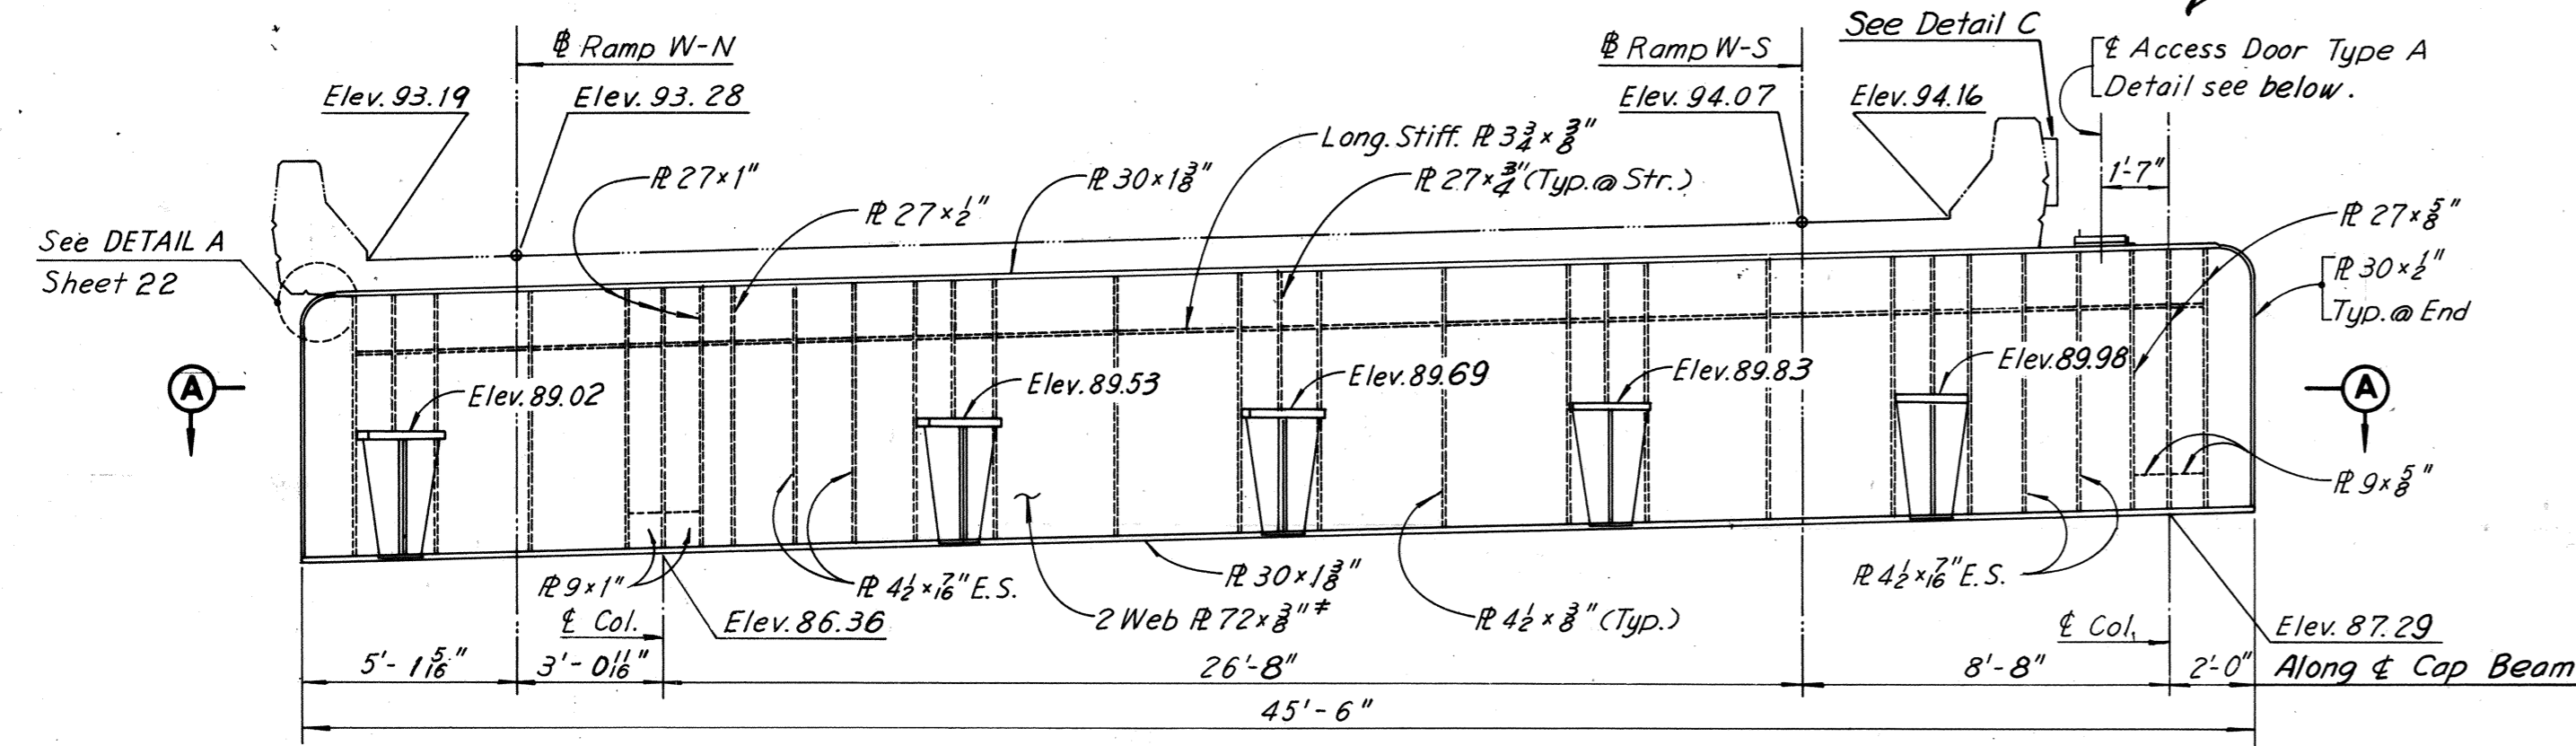

Notes:
For Framing Plan Units 21 and 22, see Sheet 20.
For Typical Section through Cap Beam see Sheet 23.
For Deck Plan Units 21 & 22, see Sheet 34.

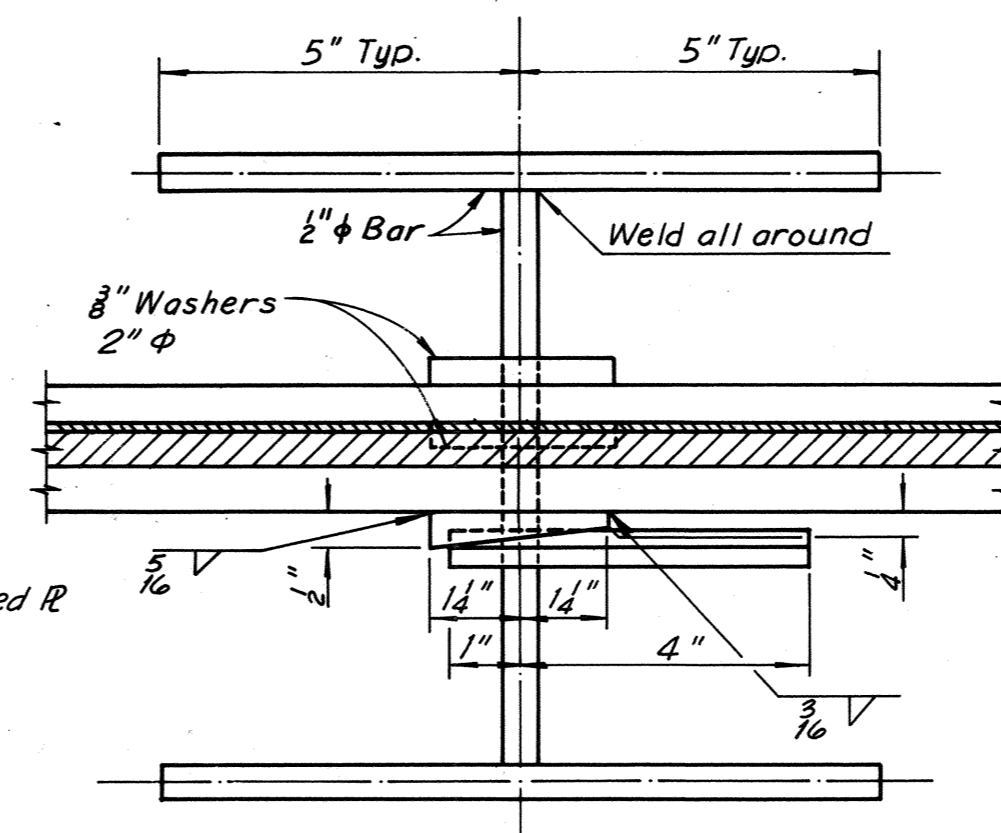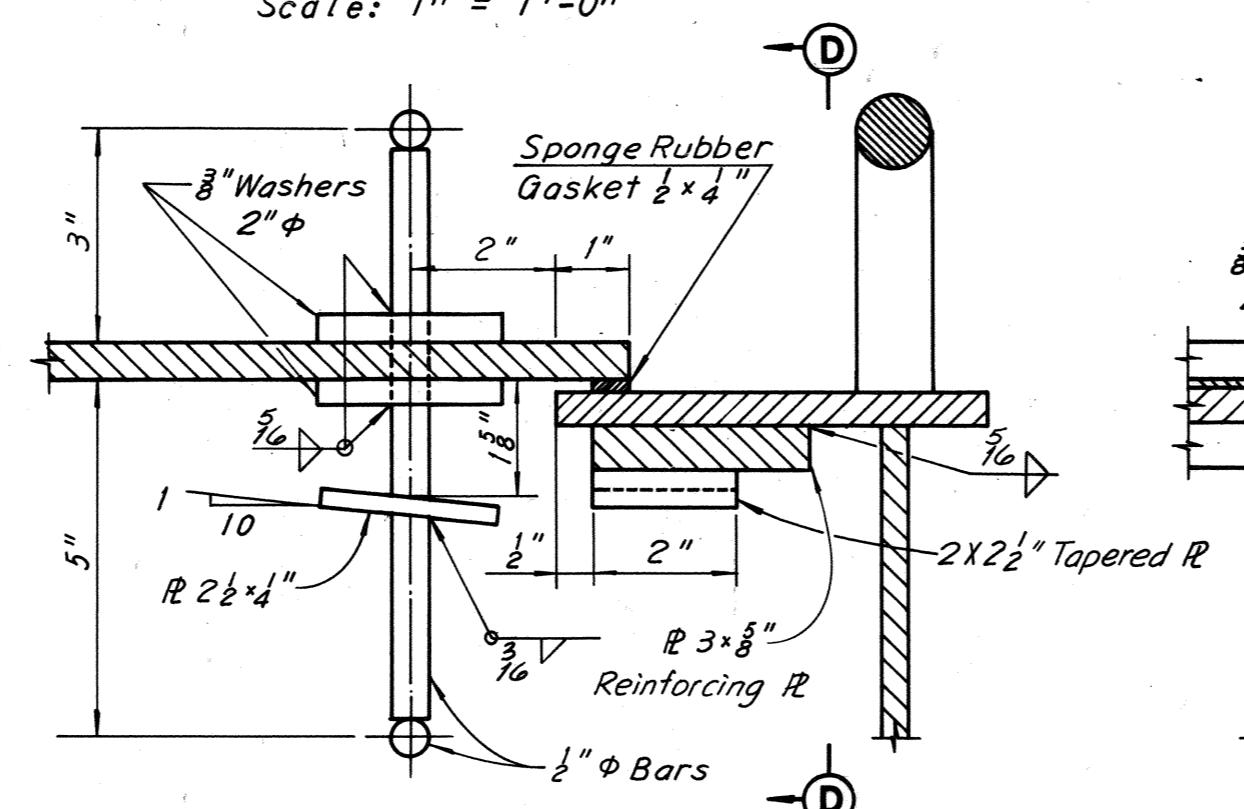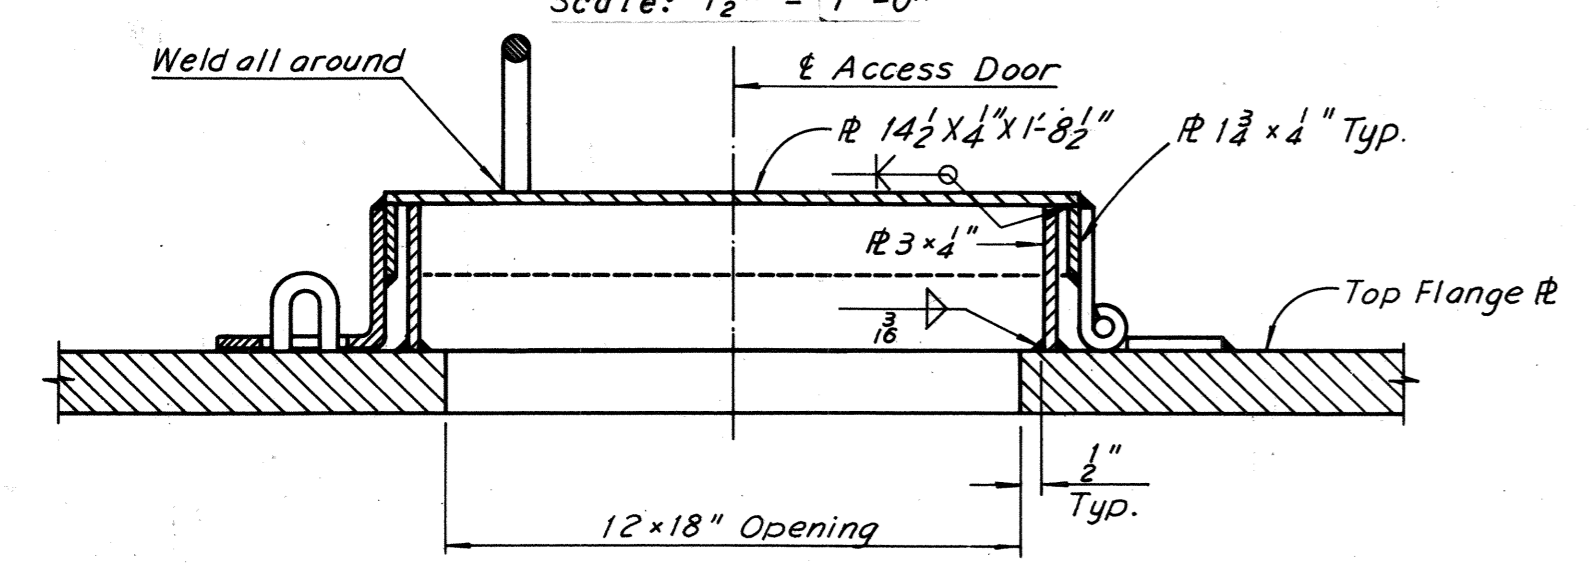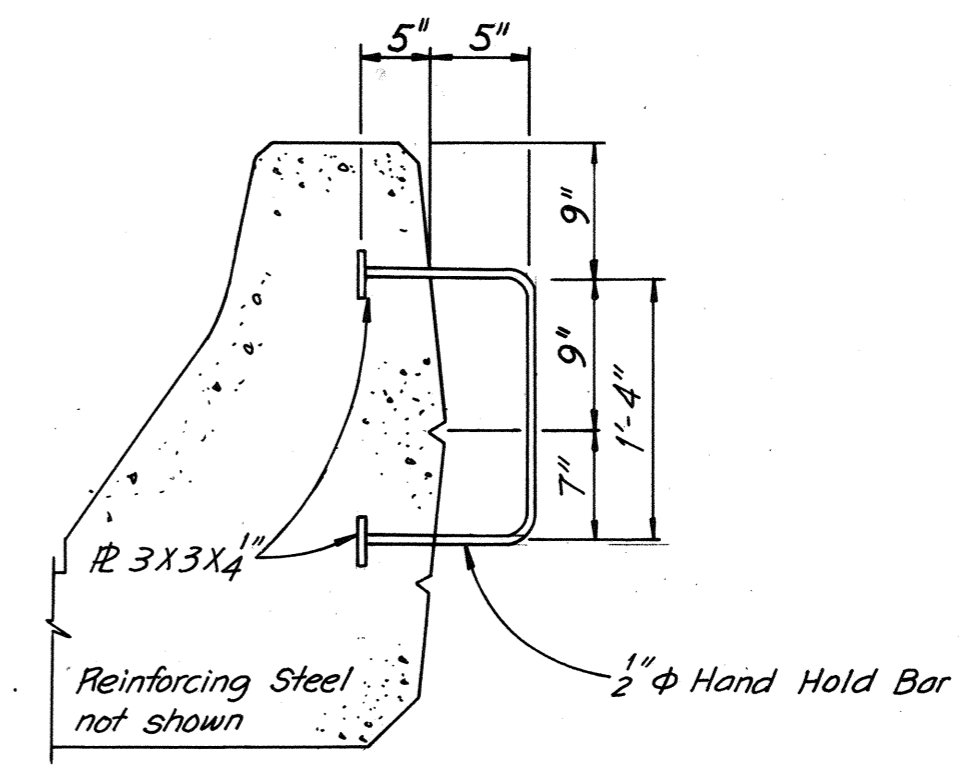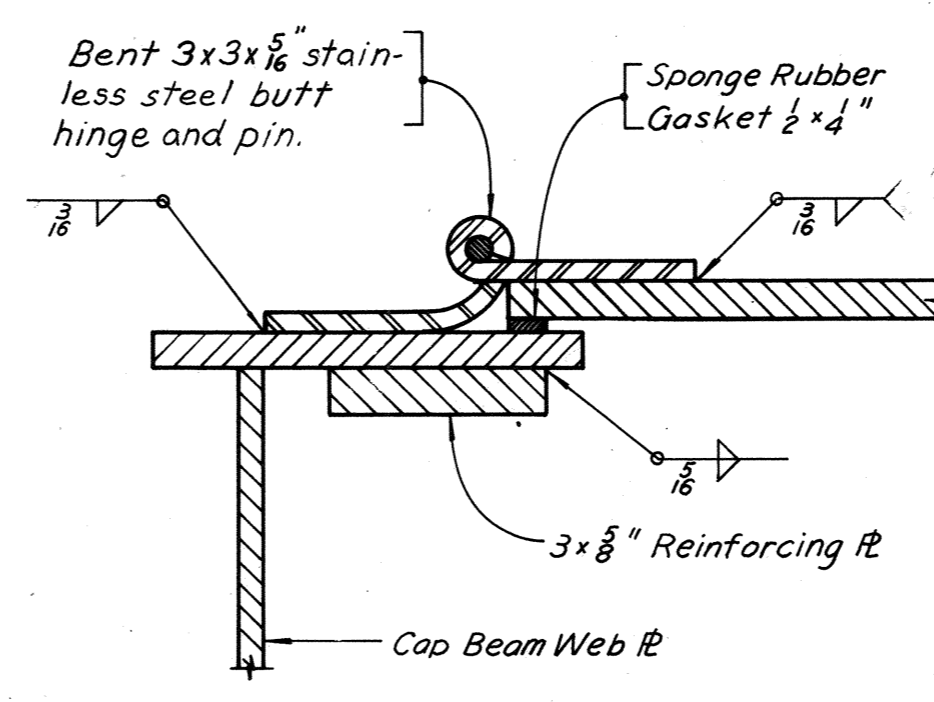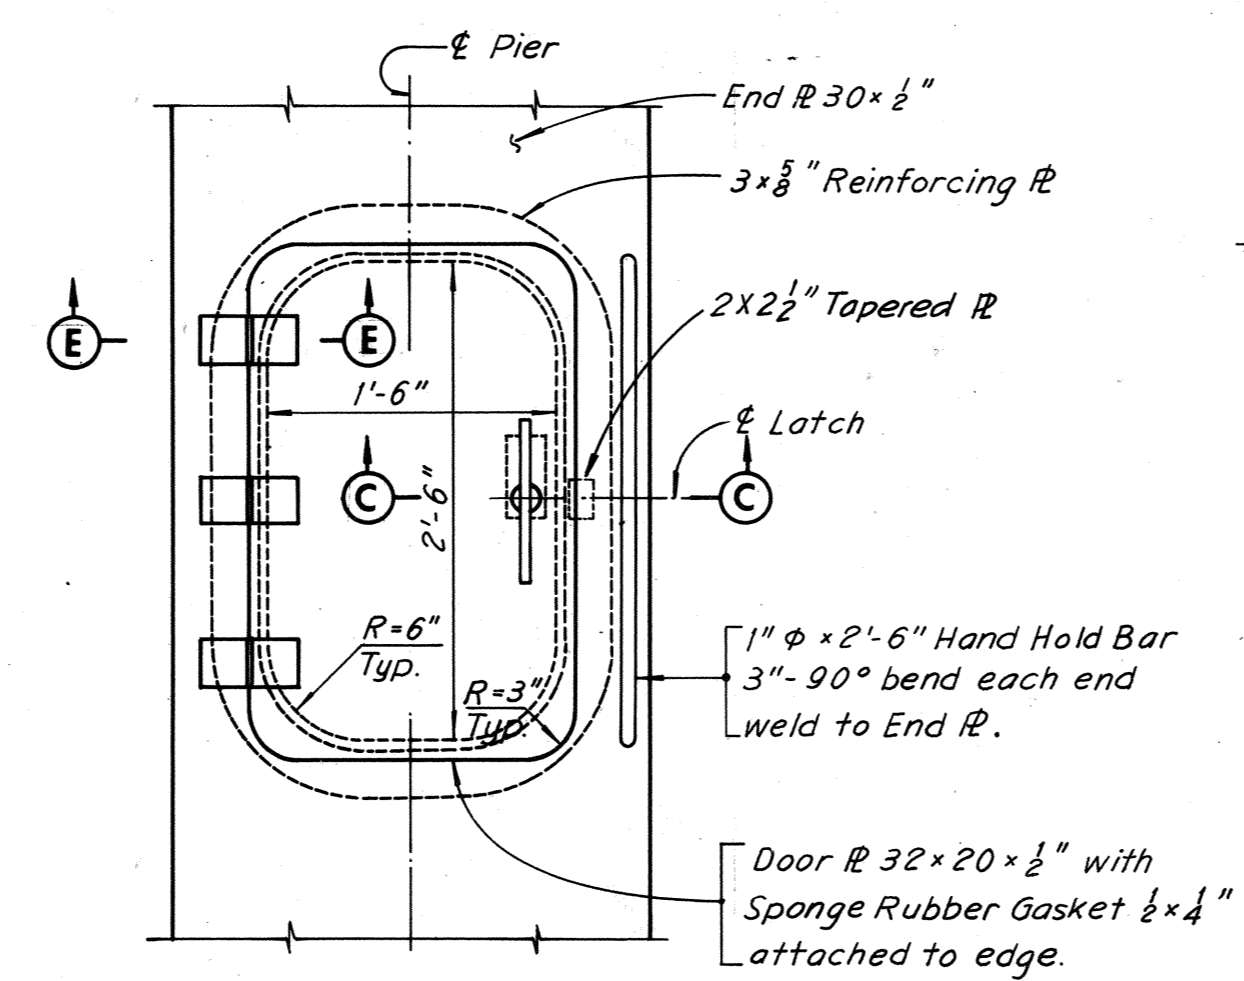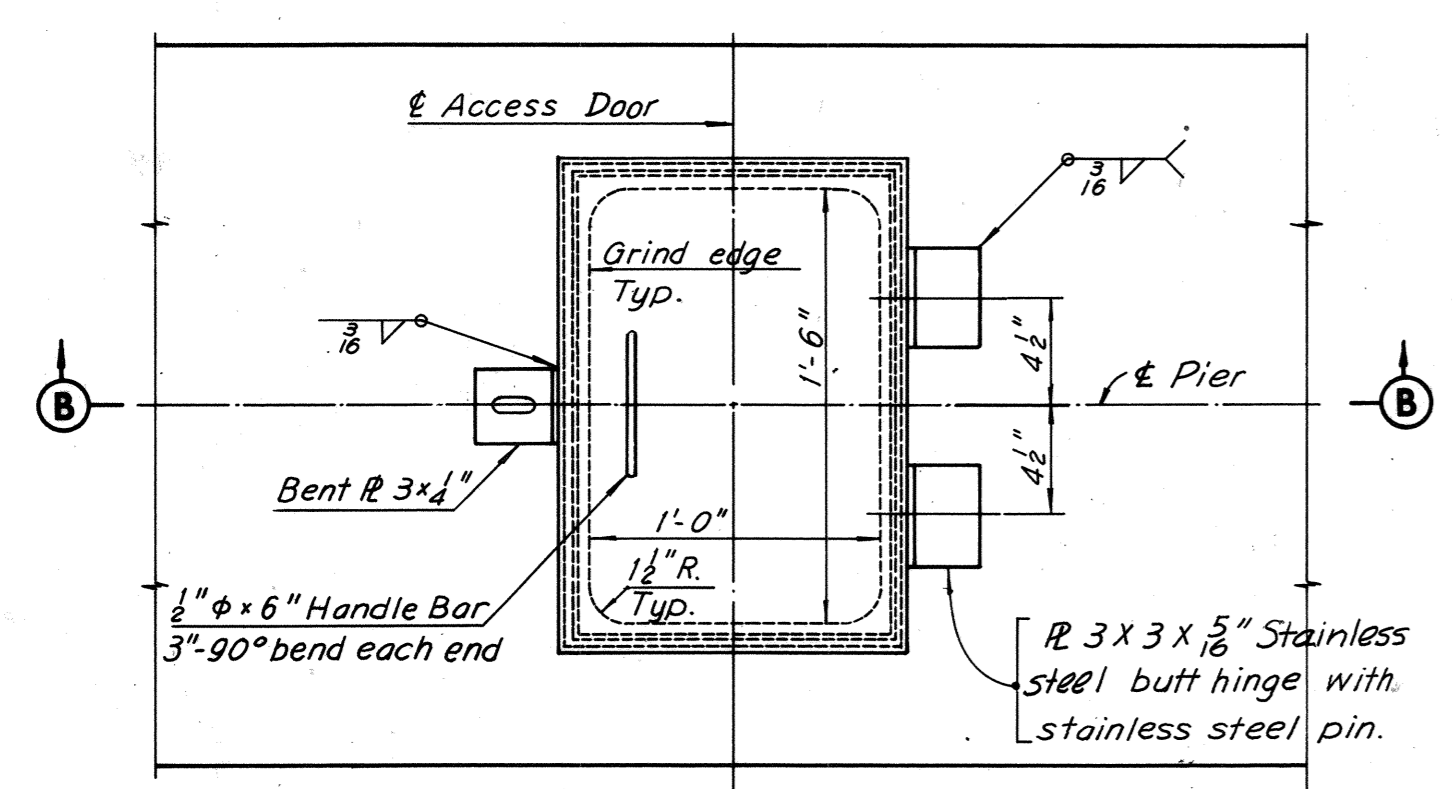

Notes:
All Steel is A36 unless otherwise shown.
Use A572 Grade 50 for thickness of 3/4" and less, and A588 for thickness over 3/4".

RICHMOND METROPOLITAN AUTHORITY
RICHMOND EXPRESSWAY SYSTEM
DOWNTOWN EXPRESSWAY

BRIDGE NO. 66
EASTBOUND ROADWAY OVER
12TH ST. - R.R. TRACKS AND 16TH ST.
FRAMING DETAILS PIER 21








HOWARD, NEEDLES, TAMMEN & BERGENDOFF
consulting engineers
NEW YORK ALEXANDRIA KANSAS CITY

SCALE: As Noted
CONTRACT NO.: 10
SHEET NO. 24 OF 46

BY	DATE	1	Note & Welds Changed	PRMS	4-19-74
MADE	M.H.H.	12-27-68	2	As Built	TEM 8-76
CHECKED	J.D.	5-7-69			
IN CHARGE			NO.	REVISION	BY DATE

AS BUILT

RICHMOND EXPRESSWAY SYSTEM			
SECTION	PROJECT	SHEET NO.	TOTAL SHEETS
10	DOWNTOWN EXPRESSWAY	151	265

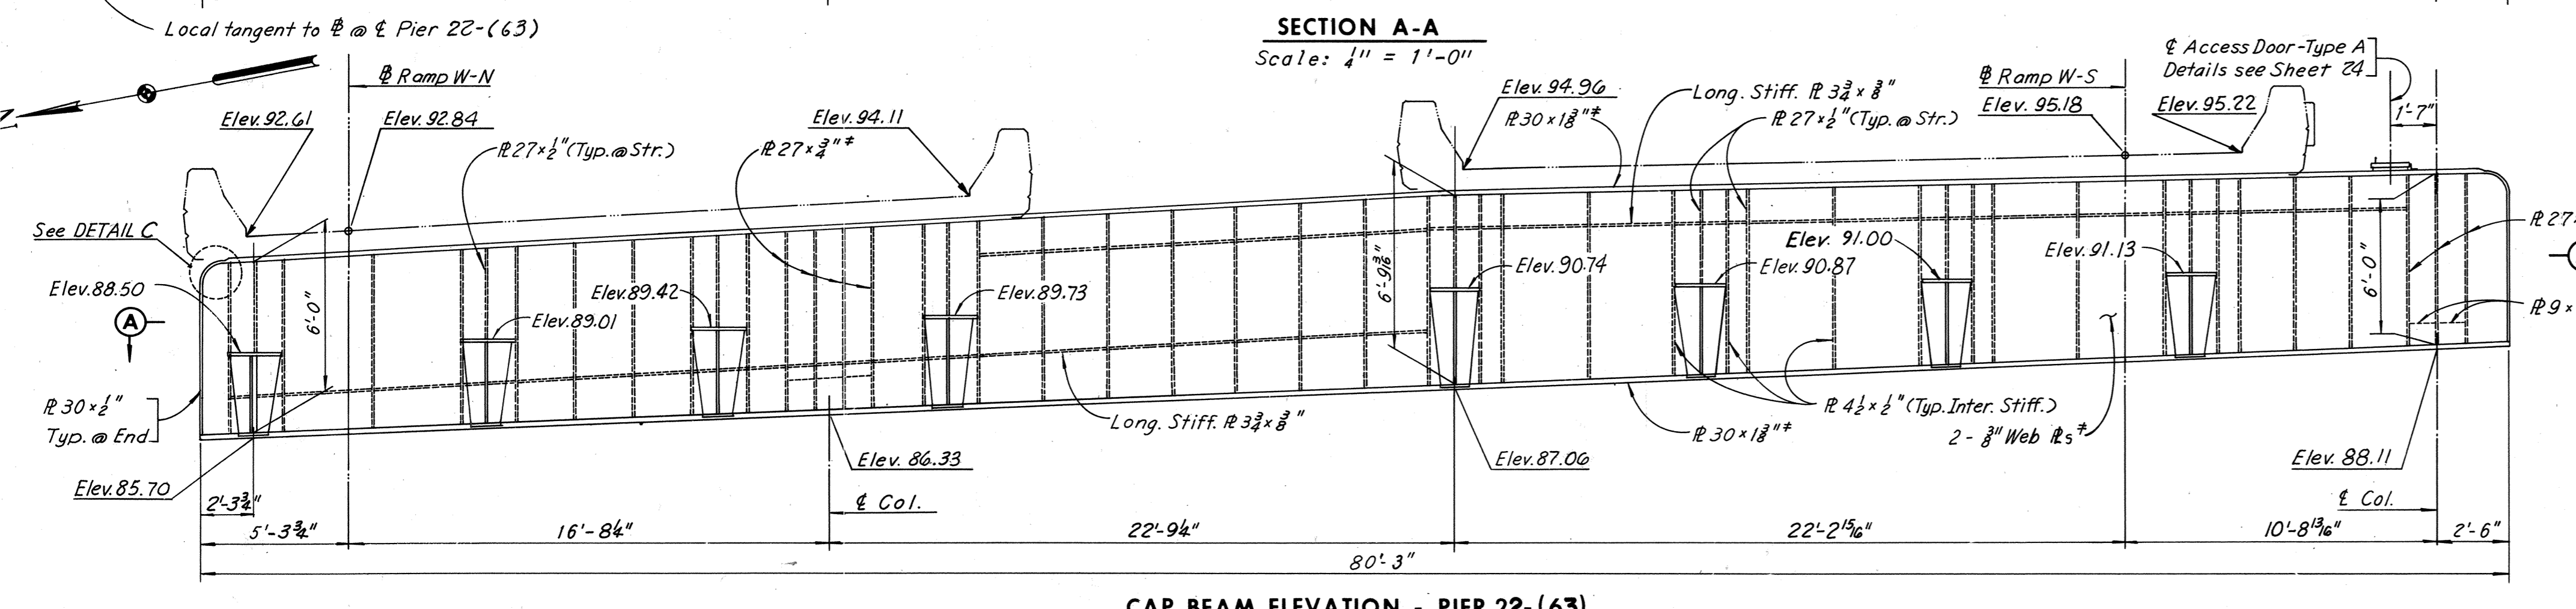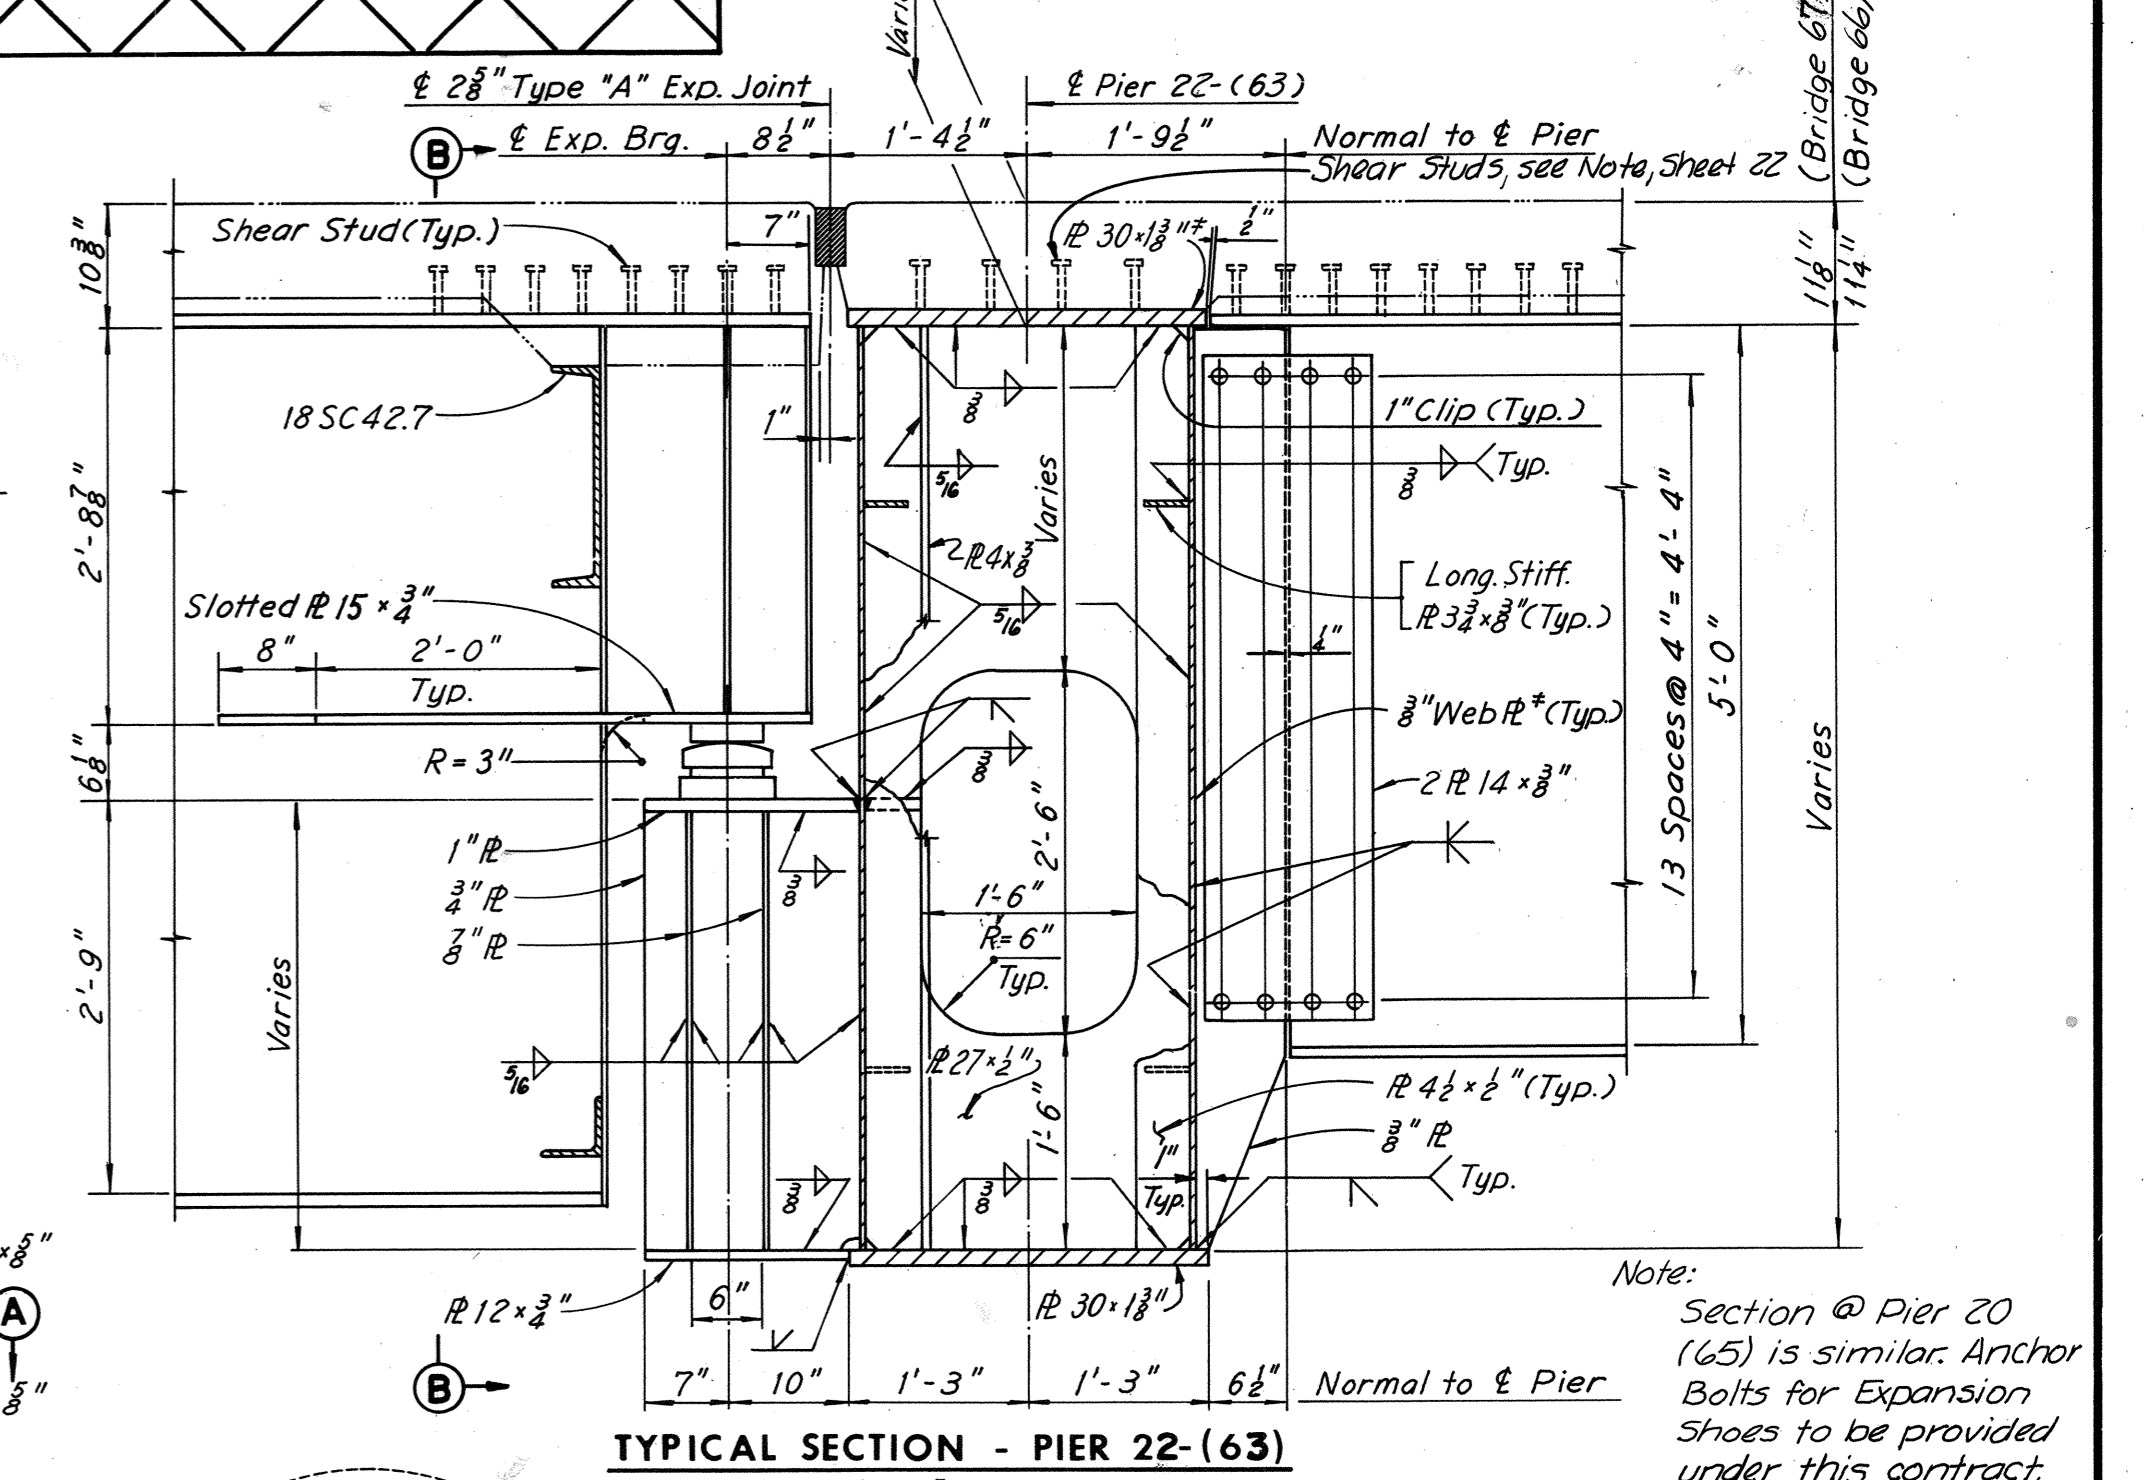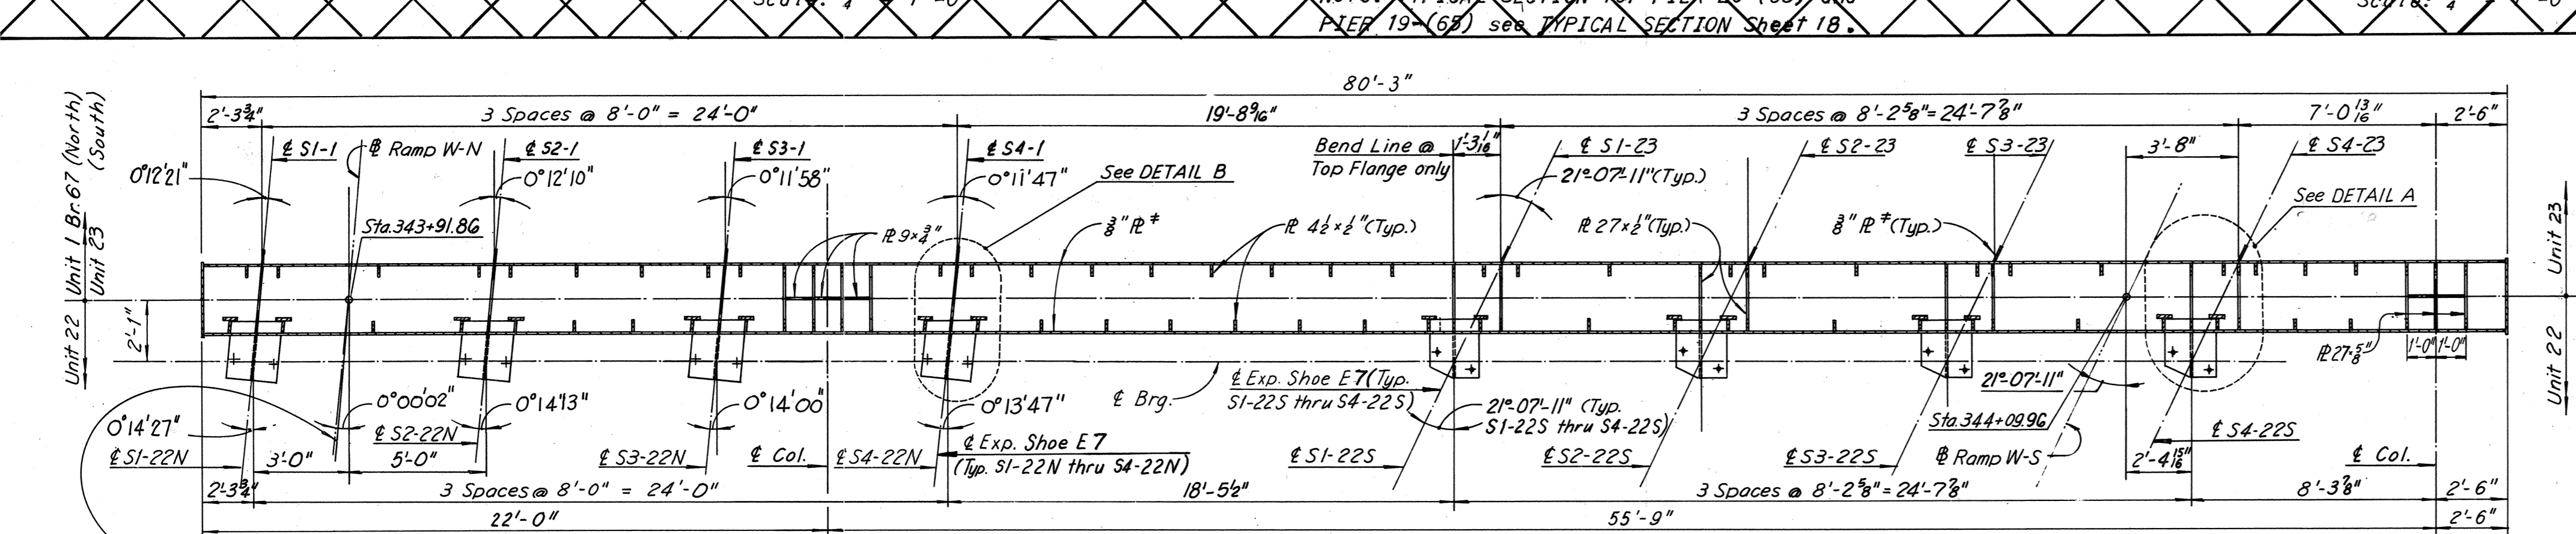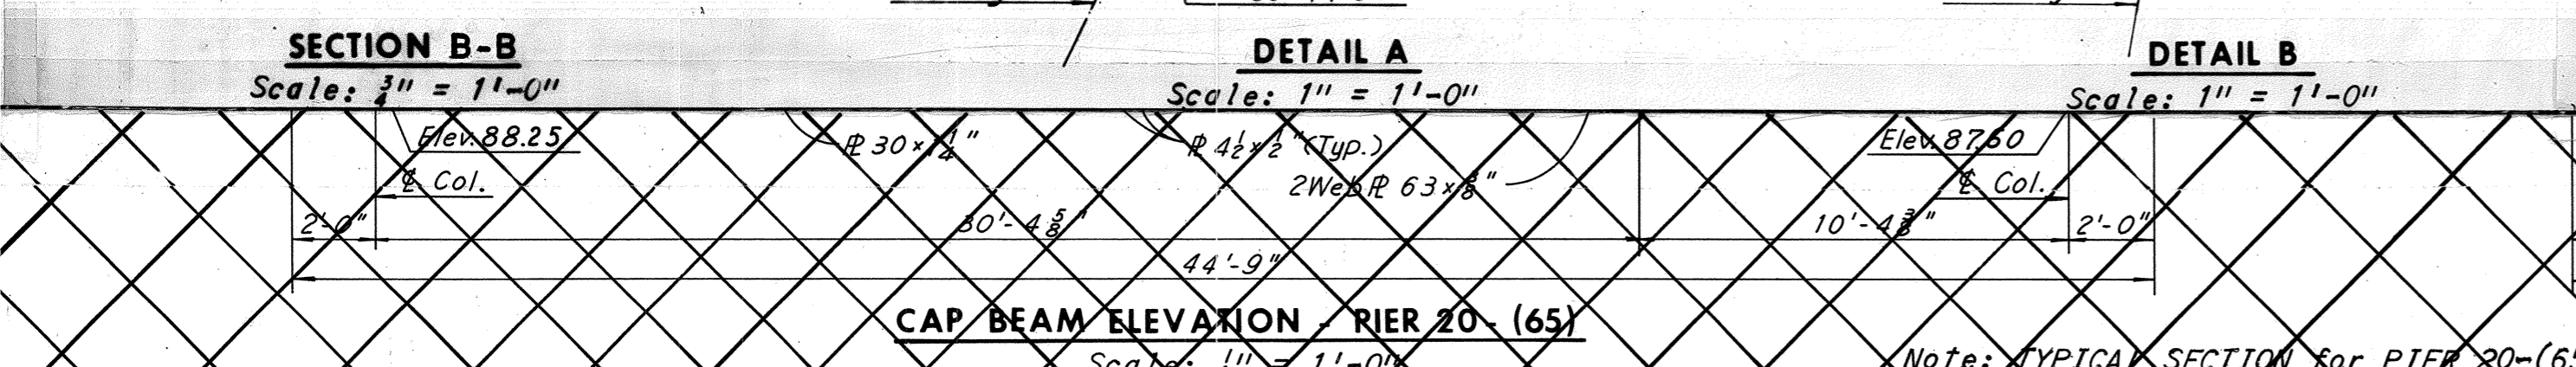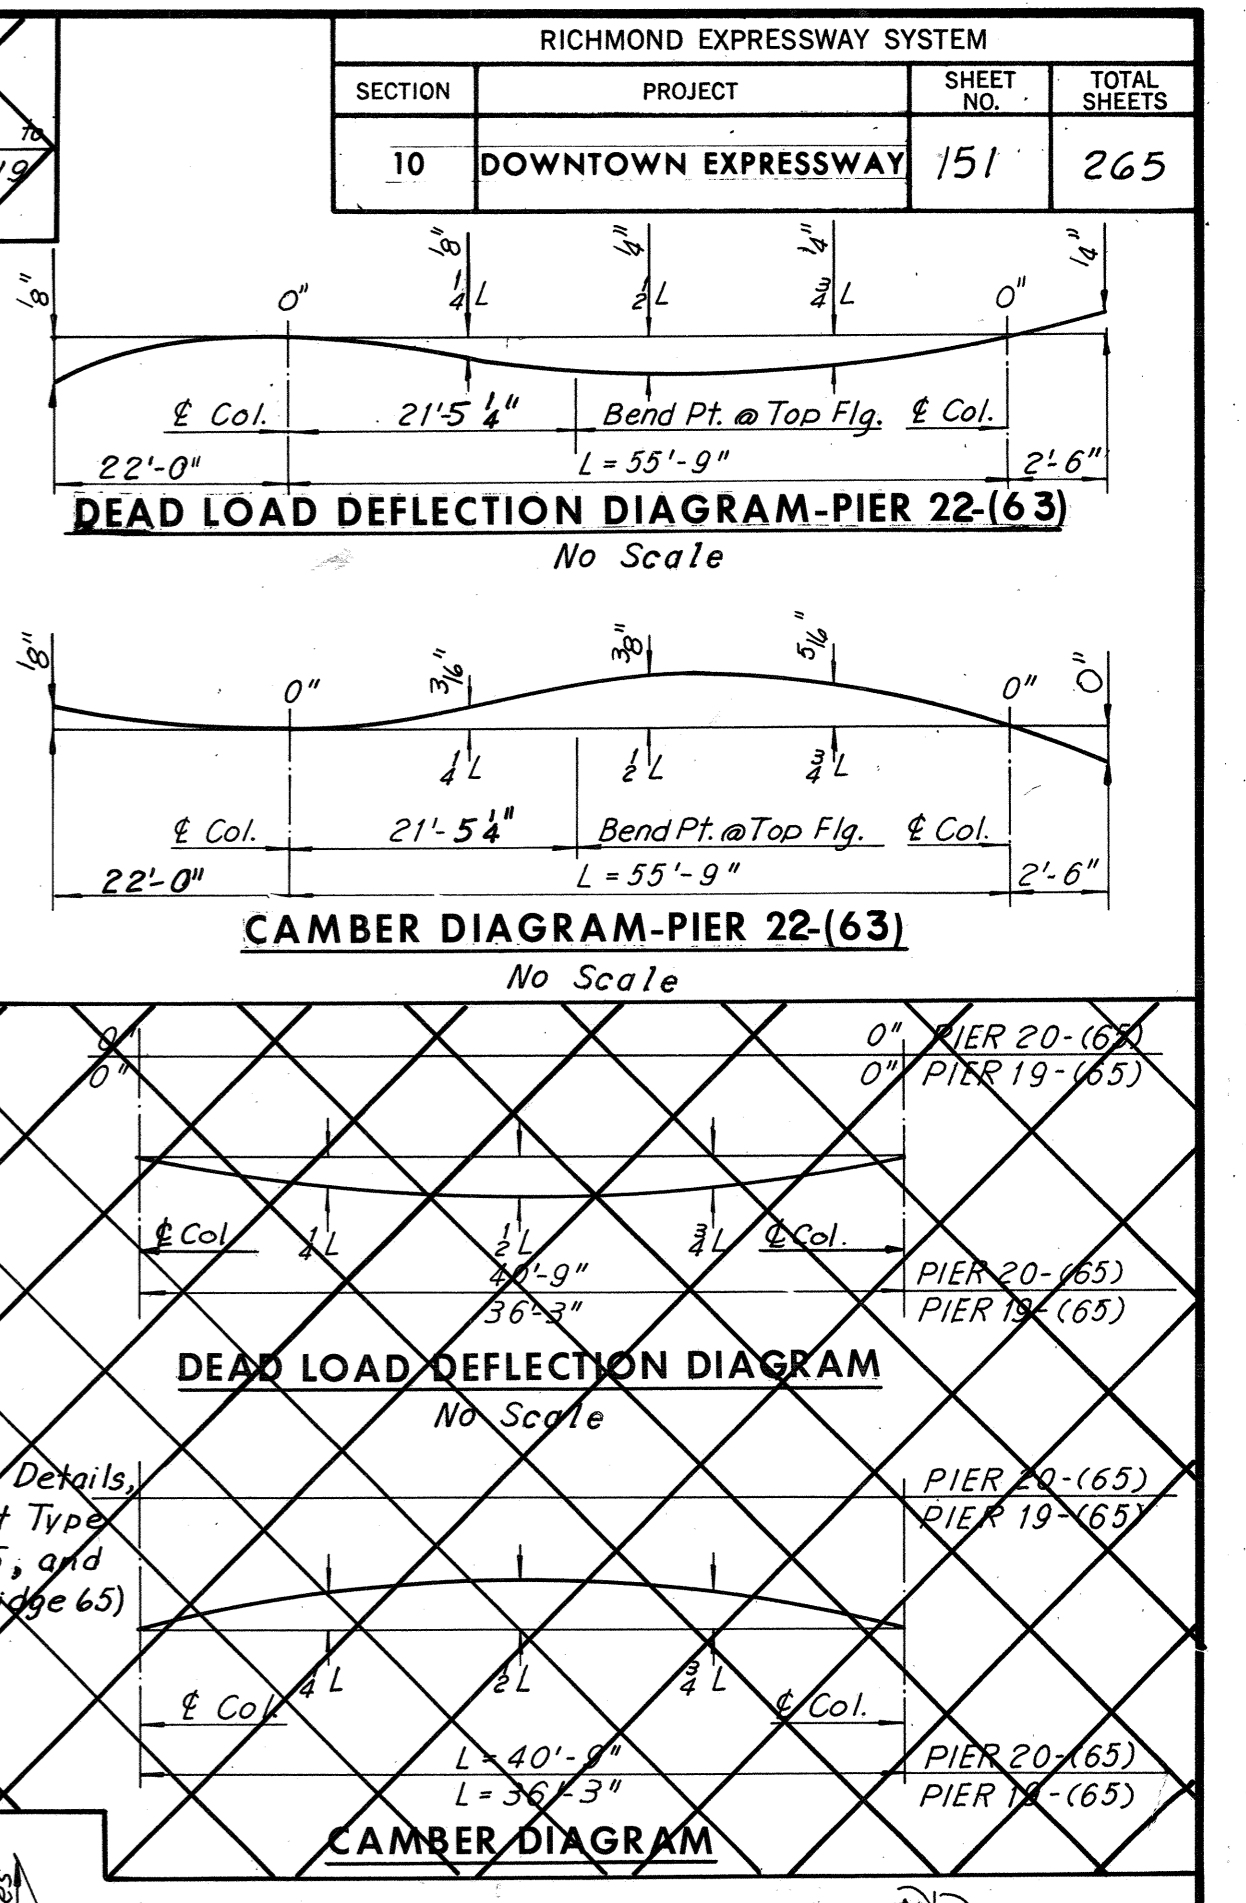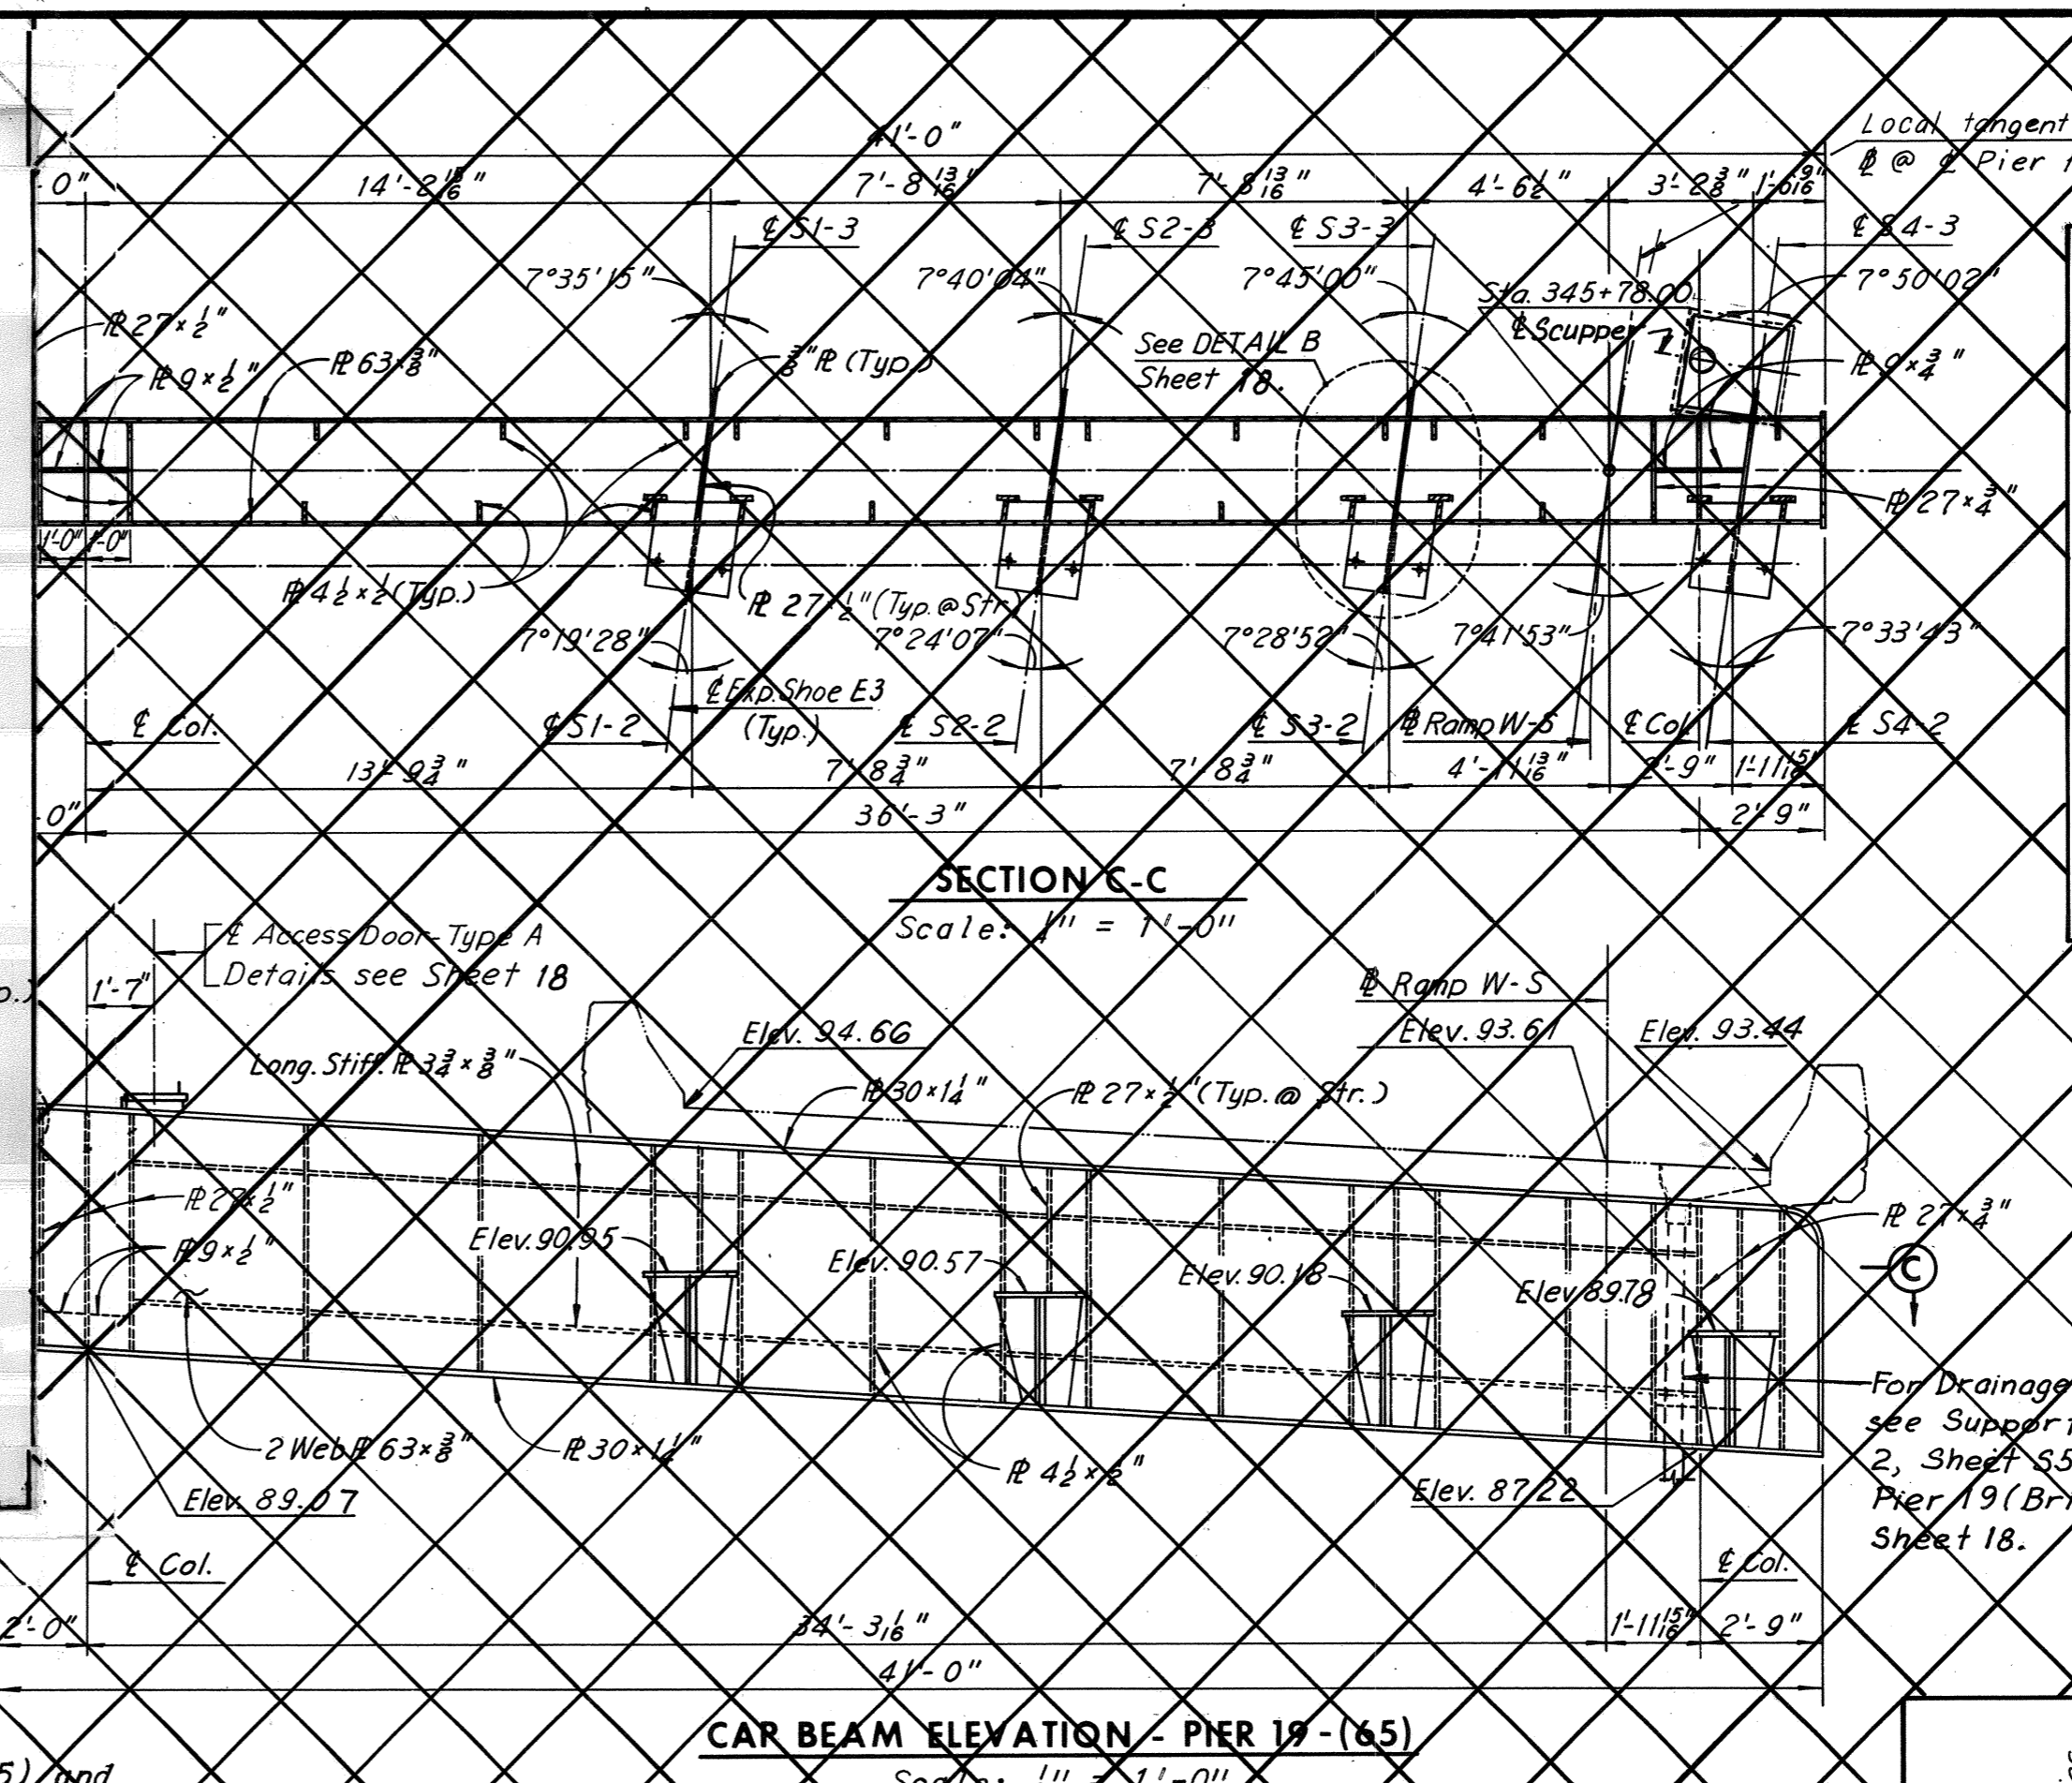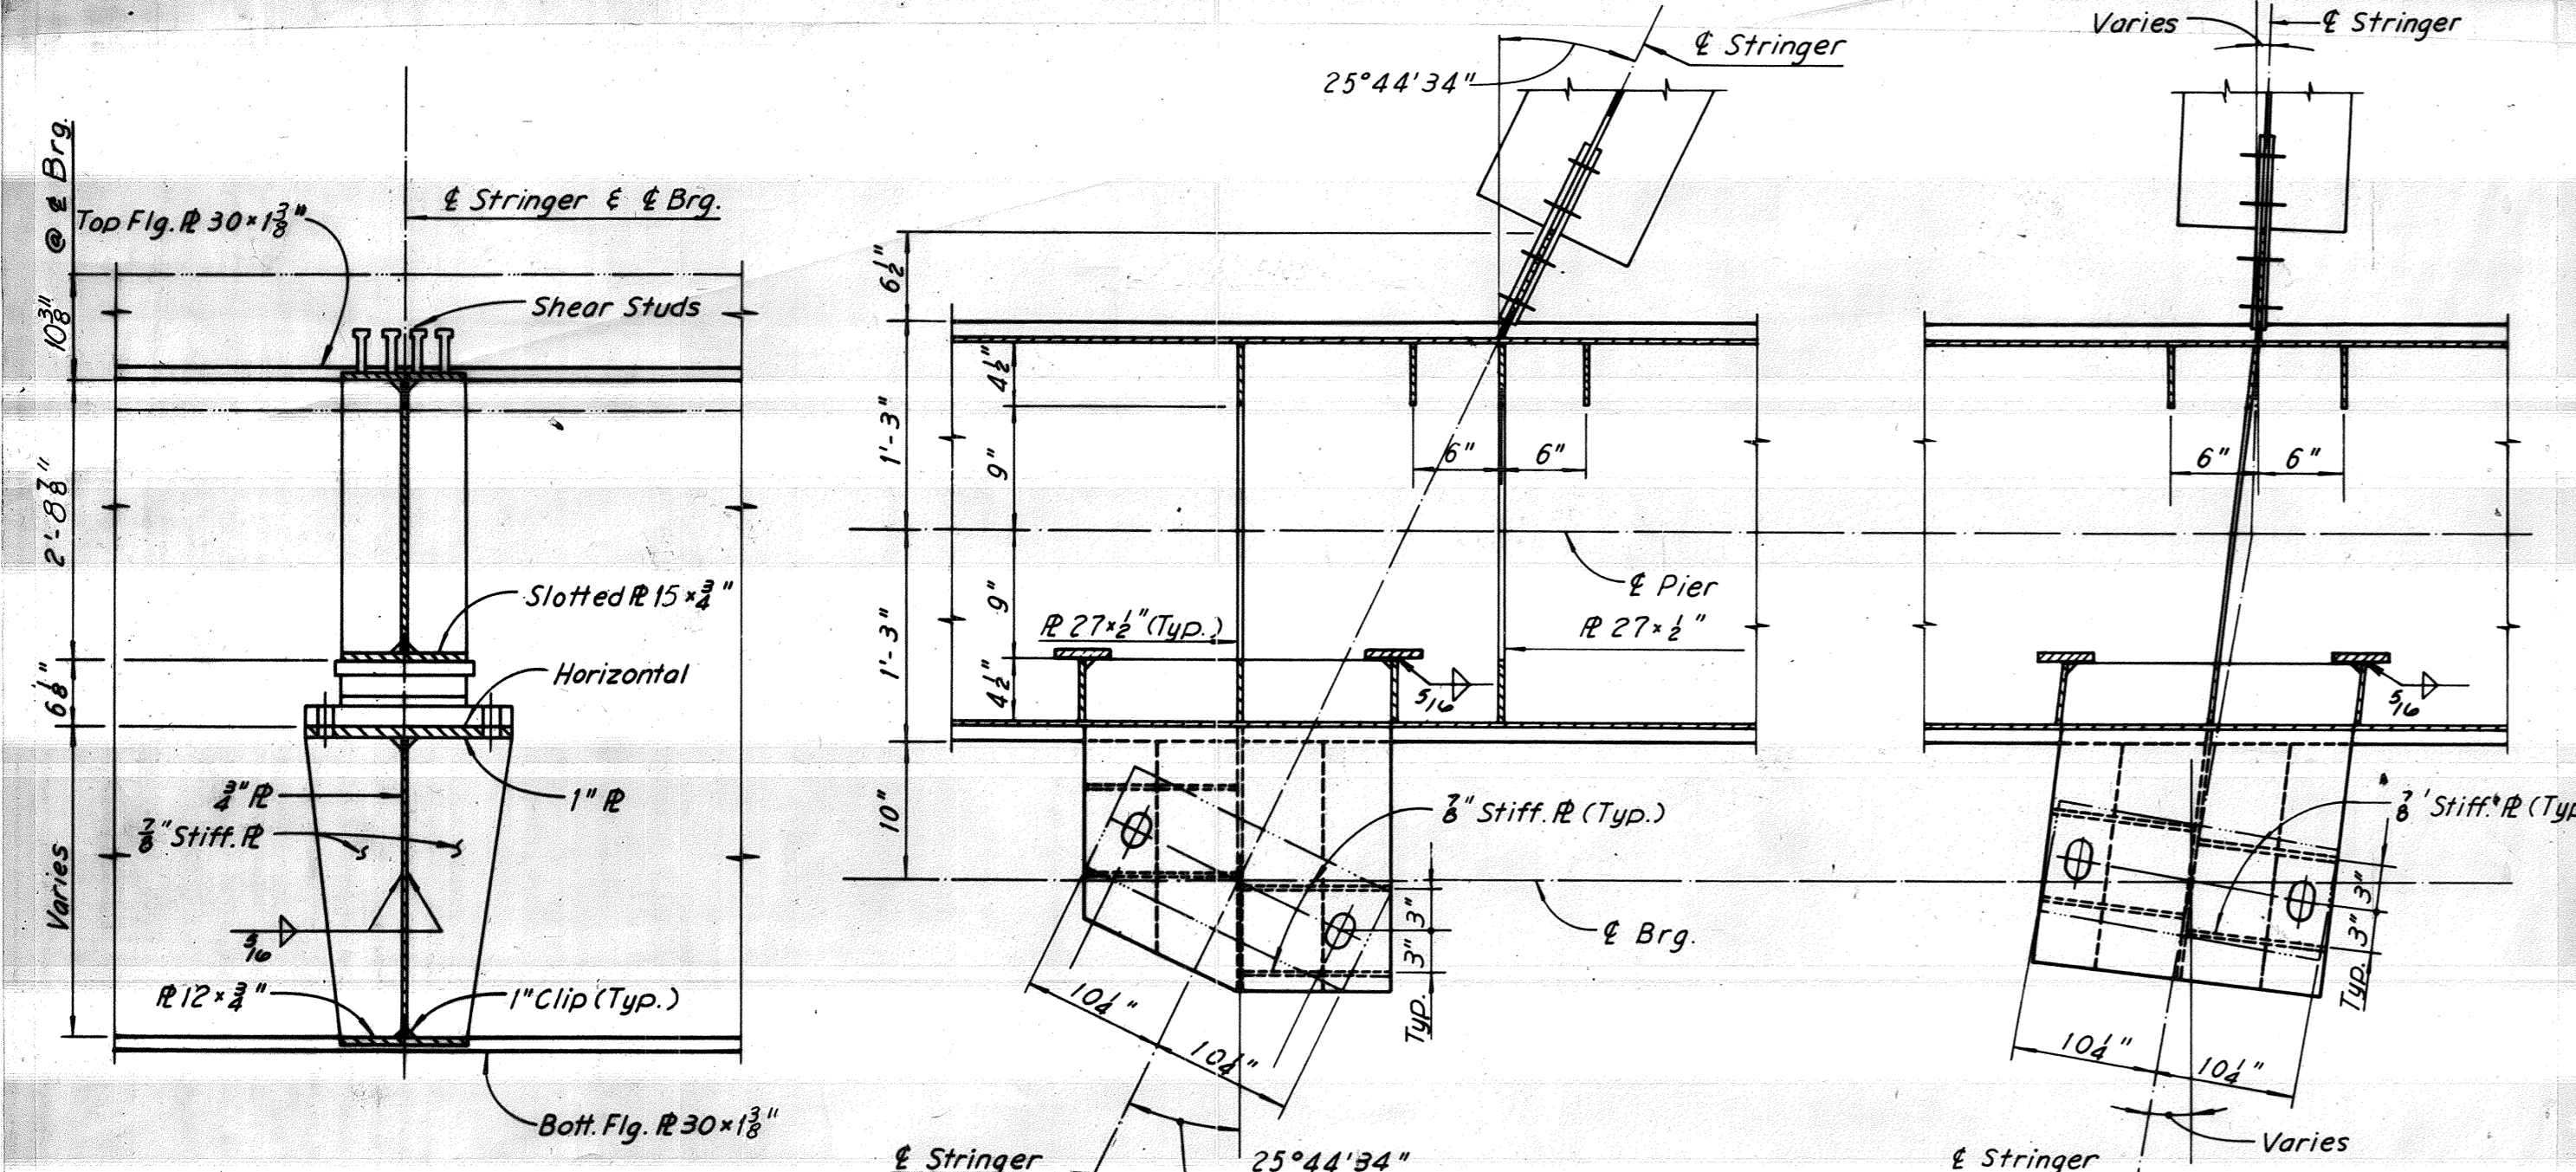

RICHMOND METROPOLITAN AUTHORITY
RICHMOND EXPRESSWAY SYSTEM
DOWNTOWN EXPRESSWAY

BRIDGE NO. 66
EASTBOUND ROADWAY OVER
12TH ST. - R.R. TRACKS AND 16TH ST.
FRAMING DETAILS
PIER 22 (BR. 63)

SCALE: As Noted
CONTRACT NO.: 10
SHEET NO. 25 OF 46

HOWARD, NEEDLES, TAMMEN & BERGENDOFF
consulting engineers
NEW YORK ALEXANDRIA


BY	DATE	Notes, Deflections & Cambers Added	PRMS	4-19-74
MADE	MHH	2-1-69	2	As Built
CHECKED	JD	6-6-69		
IN CHARGE				

Notes:
All steel shall be A36 unless denoted otherwise.
* Denotes A572-Grade 50 steel for thickness of 3/4" and under and A588 steel for thickness over 3/4".
Provide Drain Holes at lower end.
All elevations shown are final elevations.


Notes:
For Framing Plan, see Sheet 21.
For Joint Details, see Sheet 38.

AS BUILT


RICHMOND EXPRESSWAY SYSTEM			
SECTION	PROJECT	SHEET NO.	TOTAL SHEETS
10	DOWNTOWN EXPRESSWAY	152	265

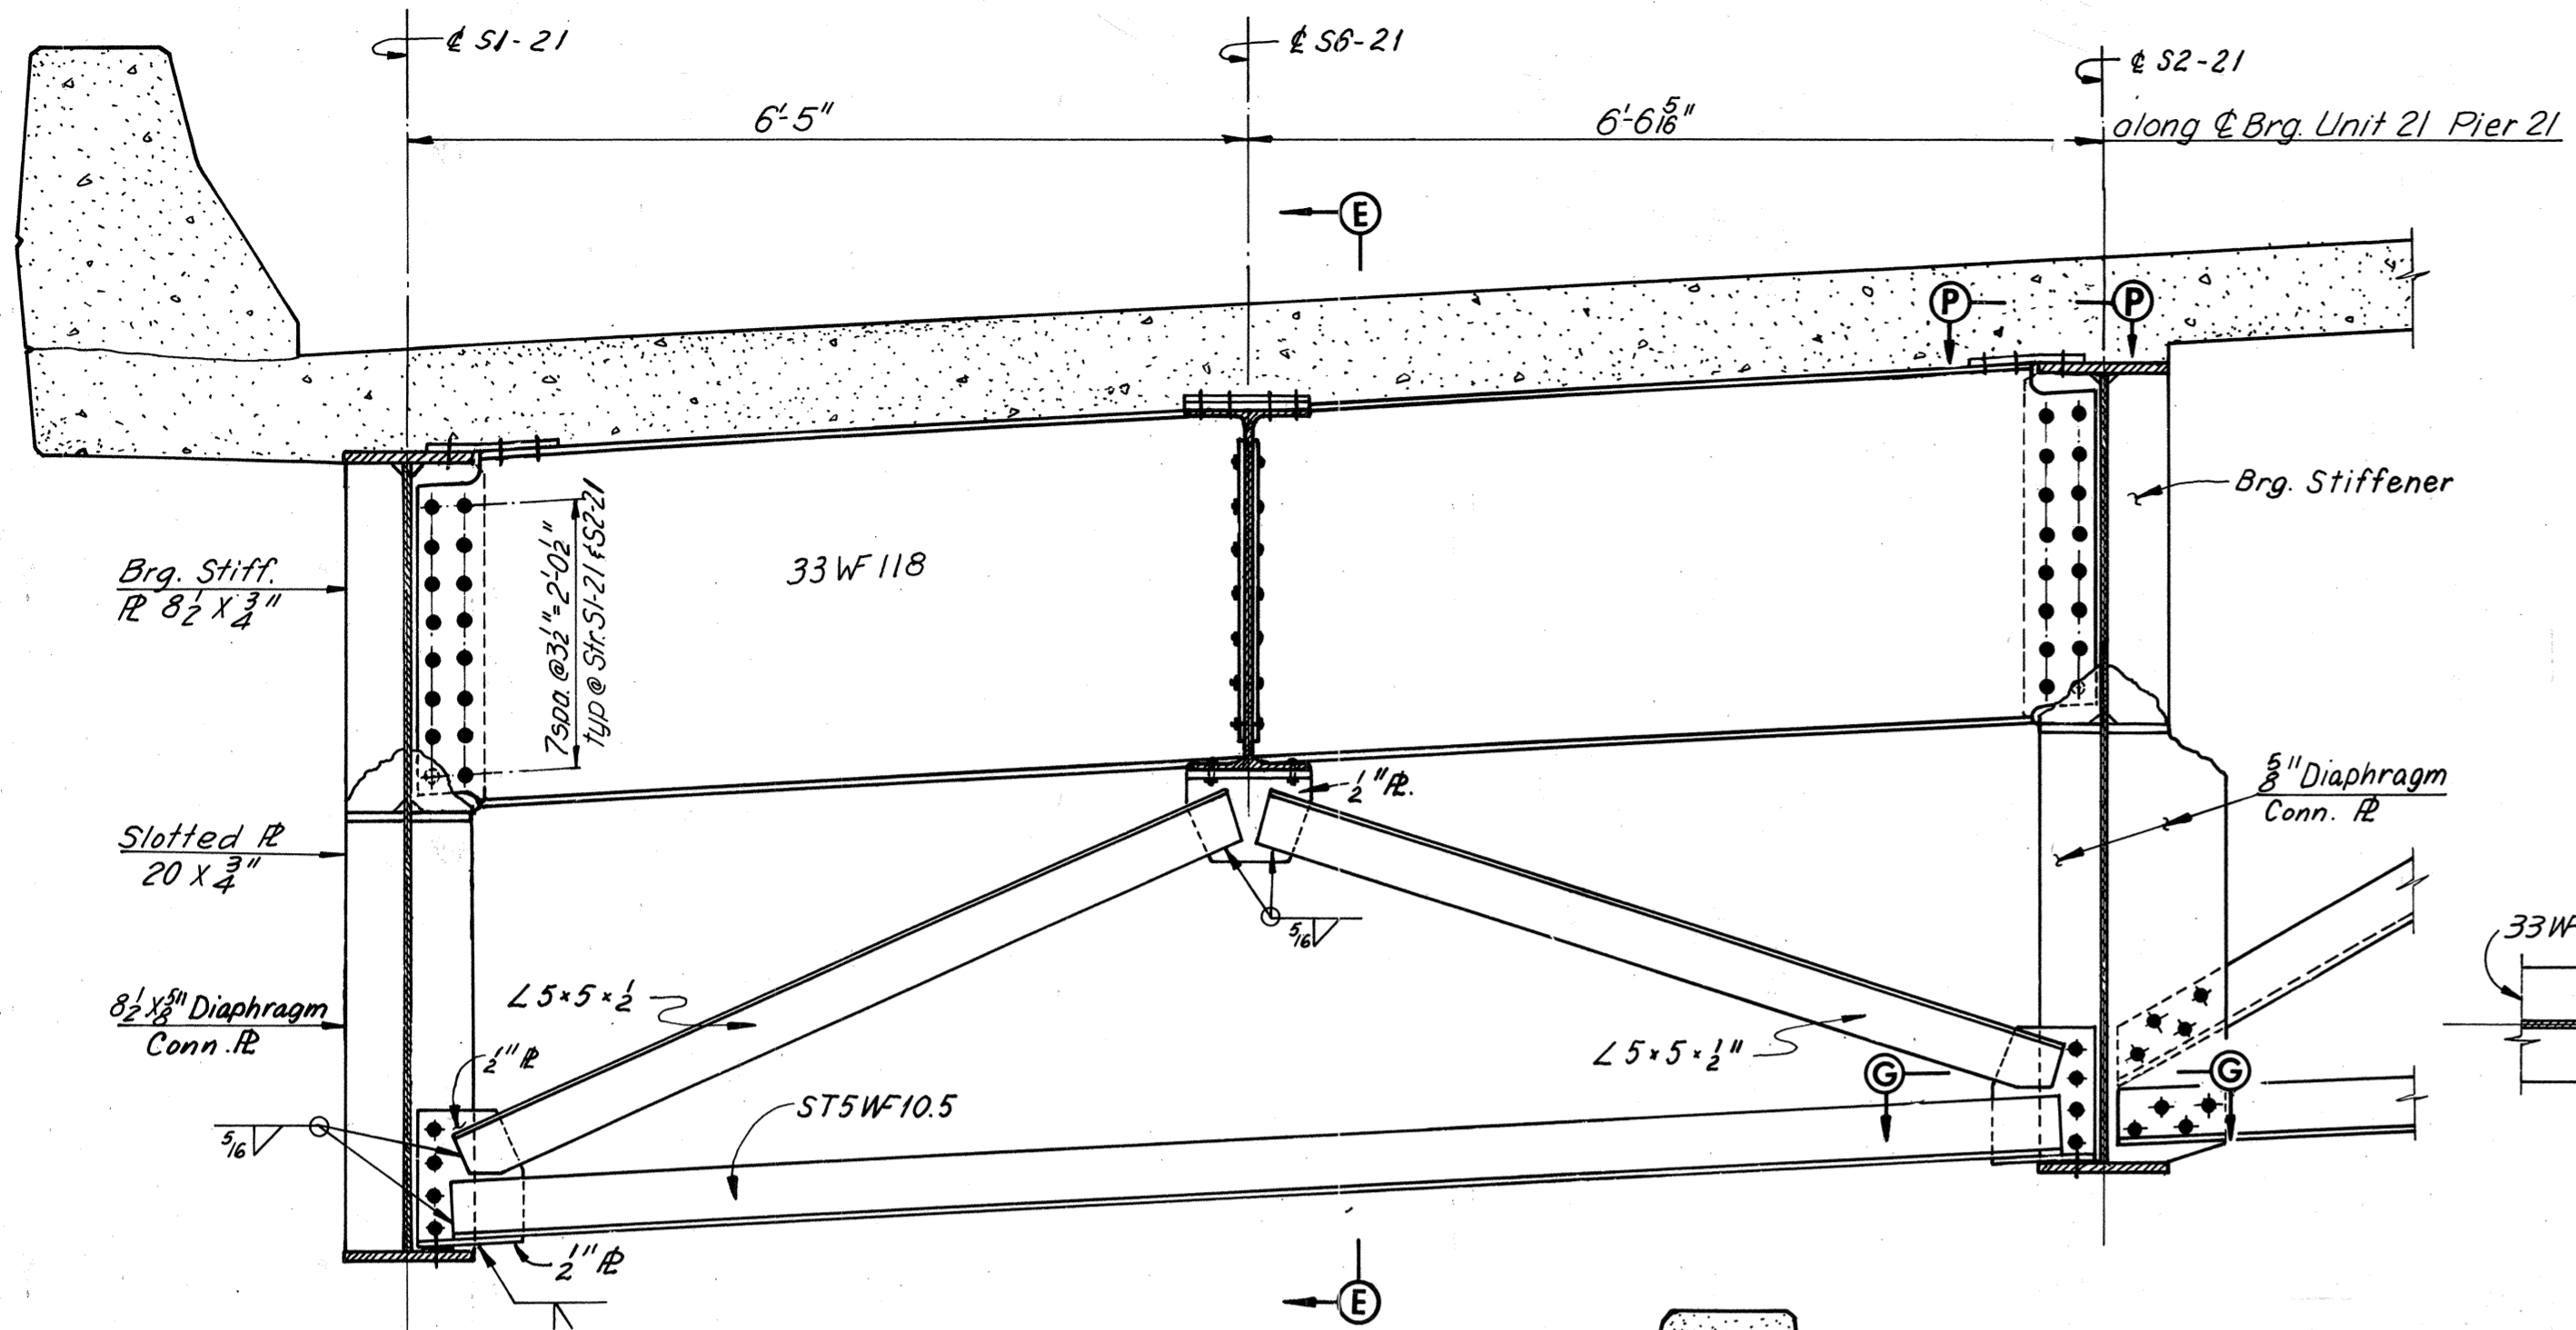


DETAIL P
Scale: 3/4" = 1'-0"
Looking East.

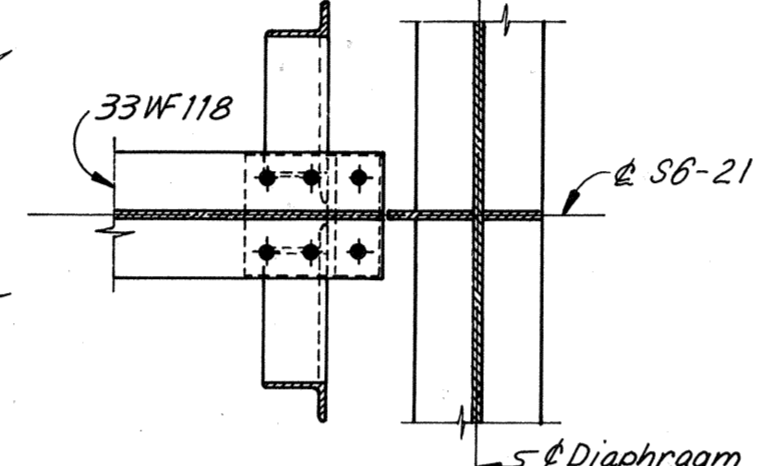


SECTION F-F
Scale: 3/4" = 1'-0"

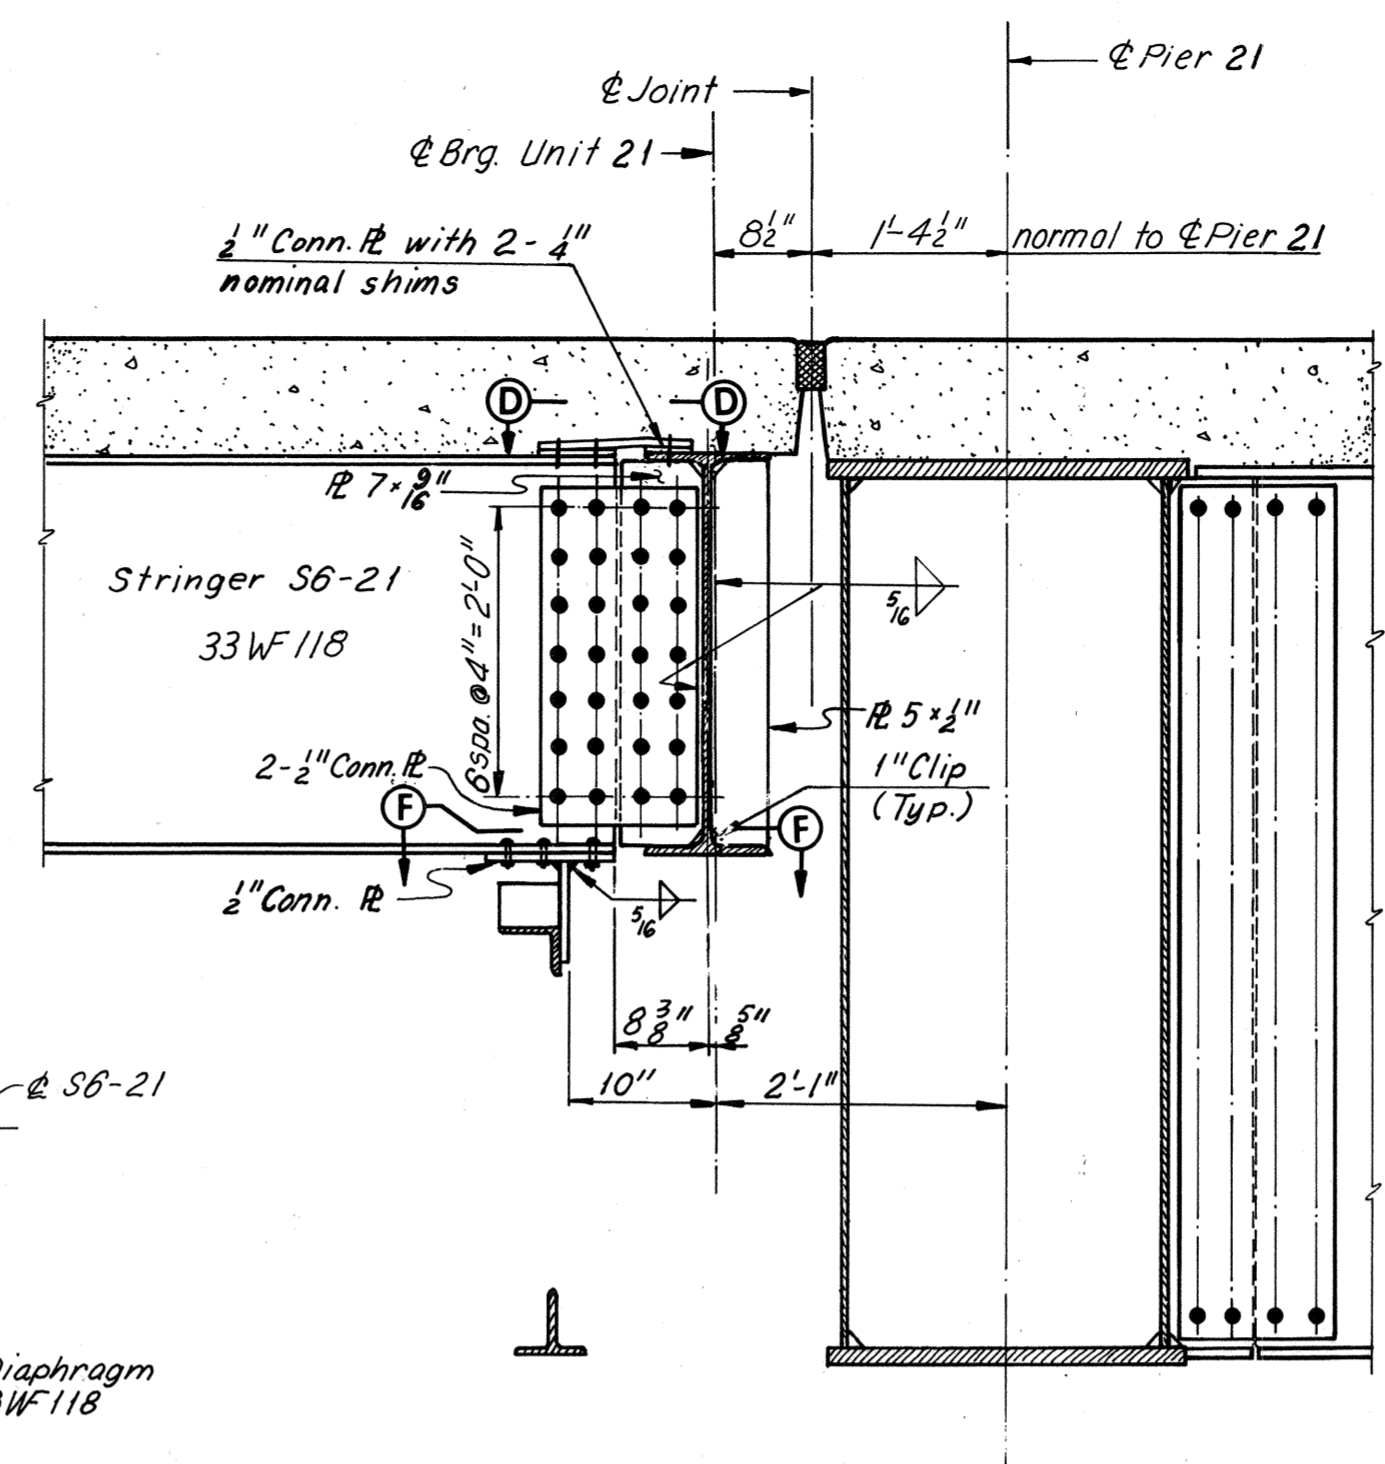


SECTION E-E
Scale: 3/4" = 1'-0"

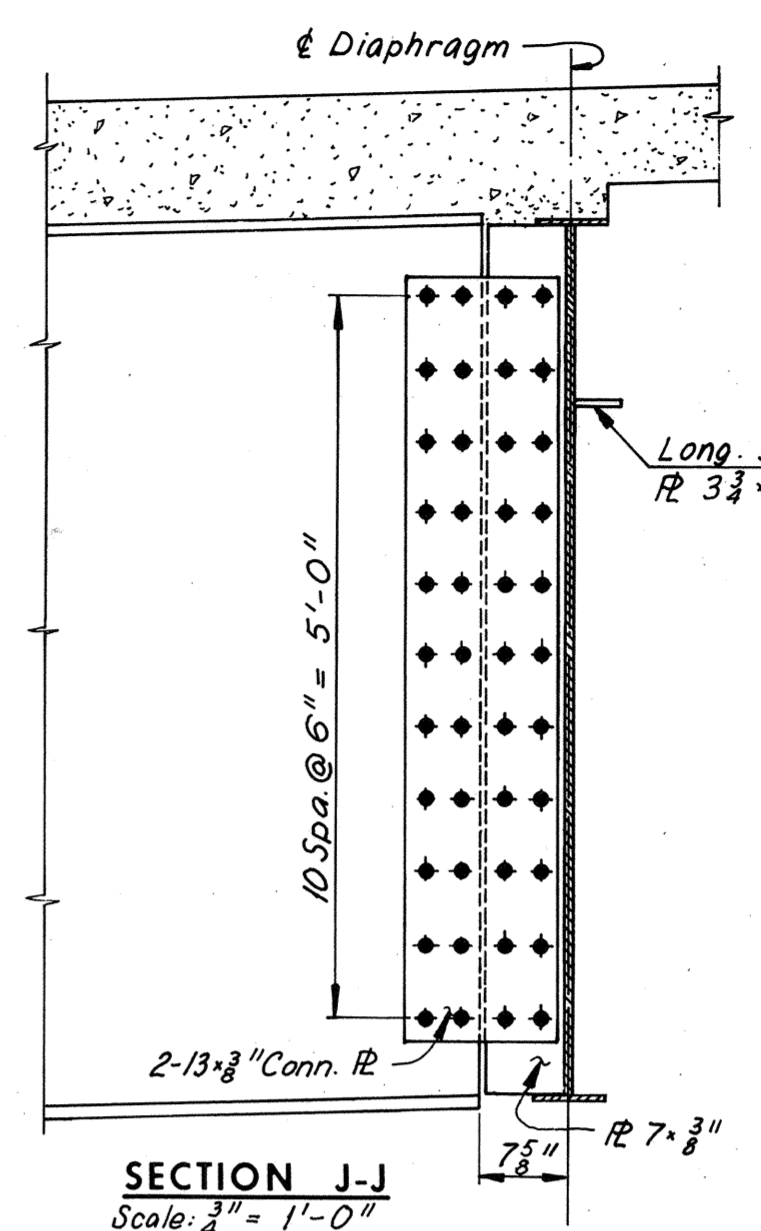


SECTION J-J
Scale: 3/4" = 1'-0"

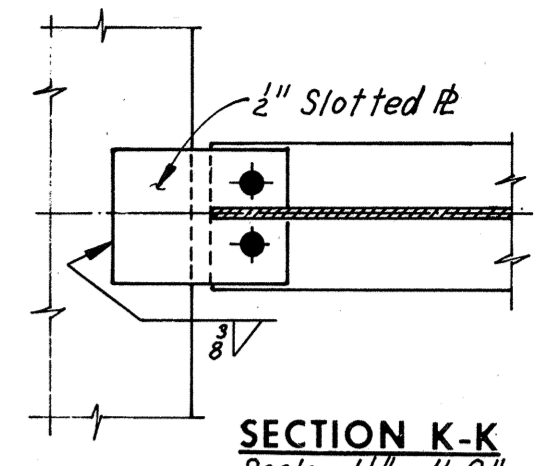


SECTION K-K
Scale: 1/2" = 1'-0"

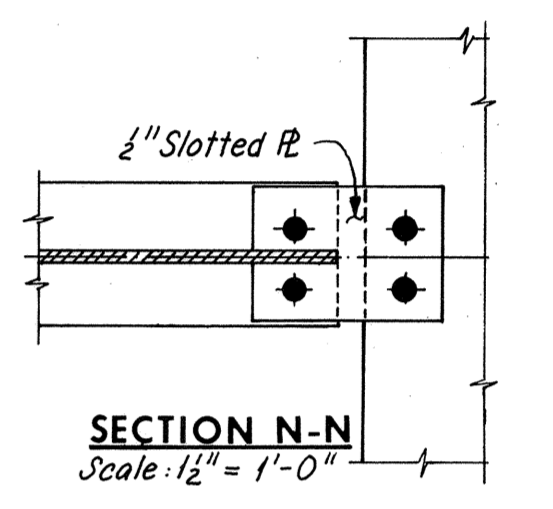


SECTION N-N
Scale: 1/2" = 1'-0"

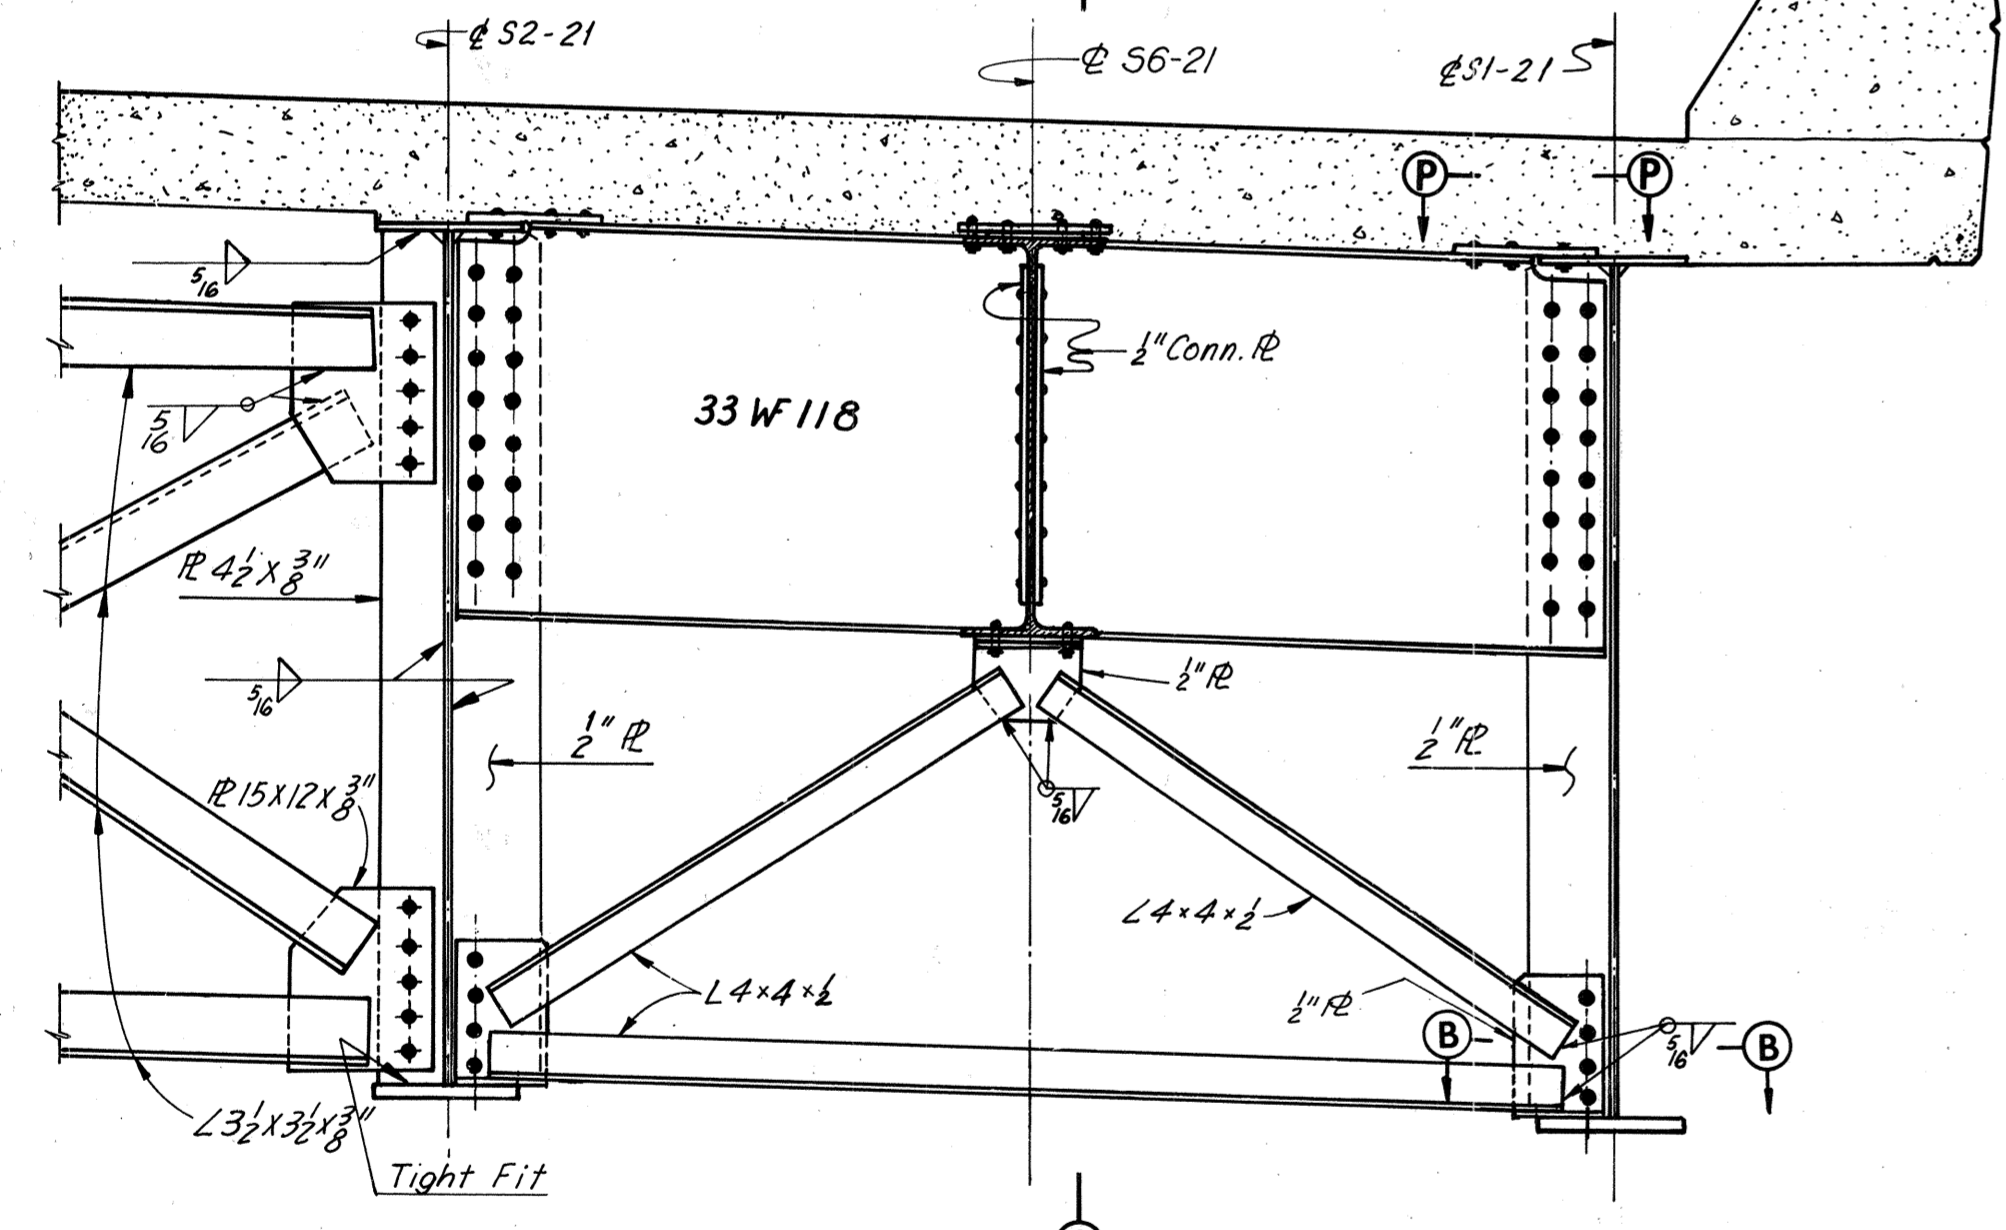


DETAIL N
Scale: 3/4" = 1'-0"
Looking West

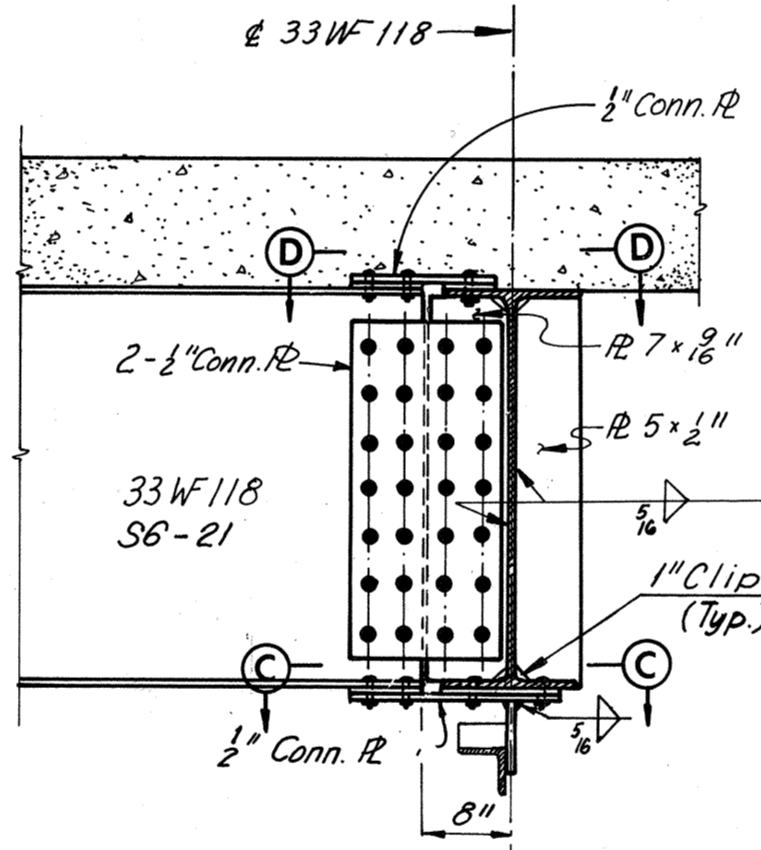


SECTION A-A
Scale: 3/4" = 1'-0"

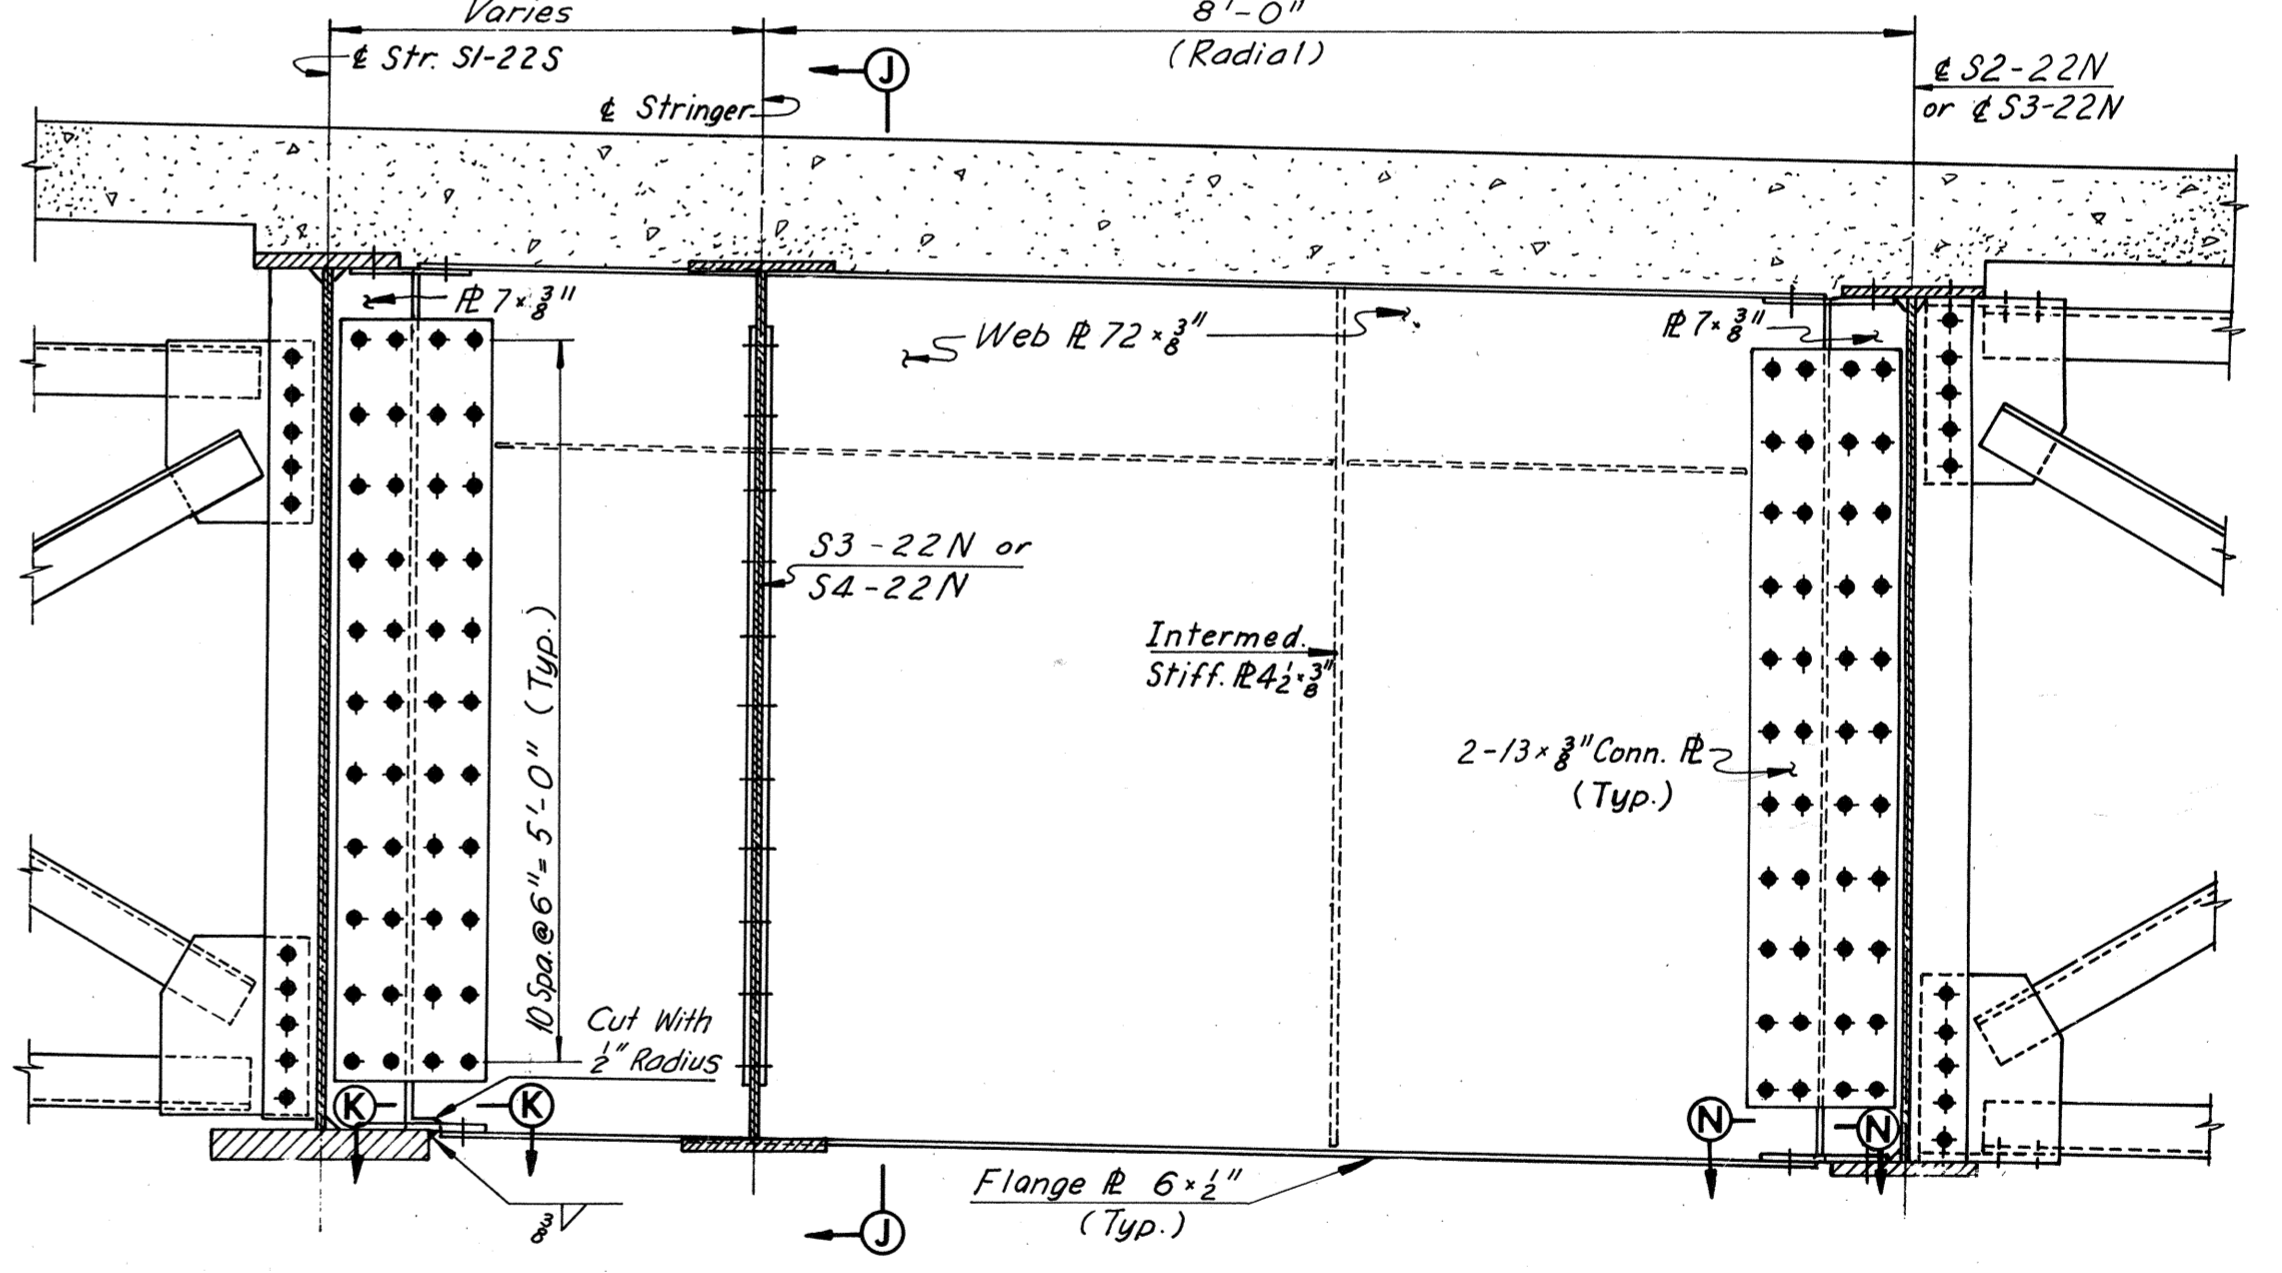


DETAIL R
Scale: 3/4" = 1'-0"
Looking West

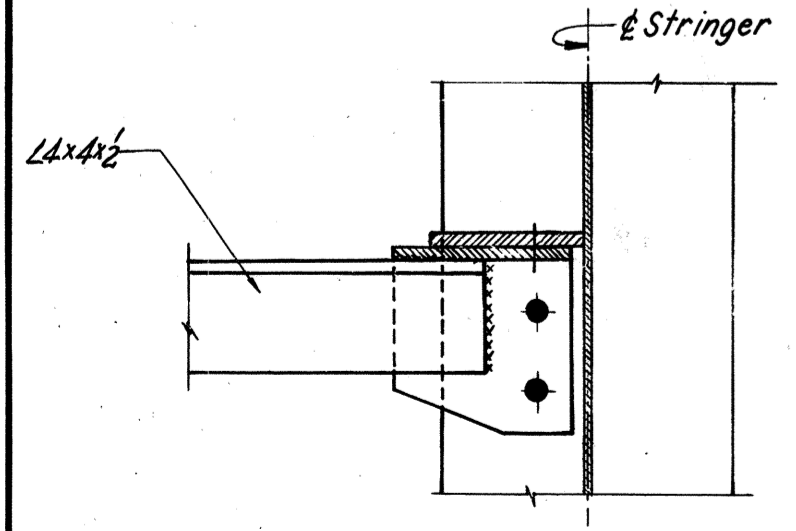


SECTION B-B
Scale: 1/2" = 1'-0"

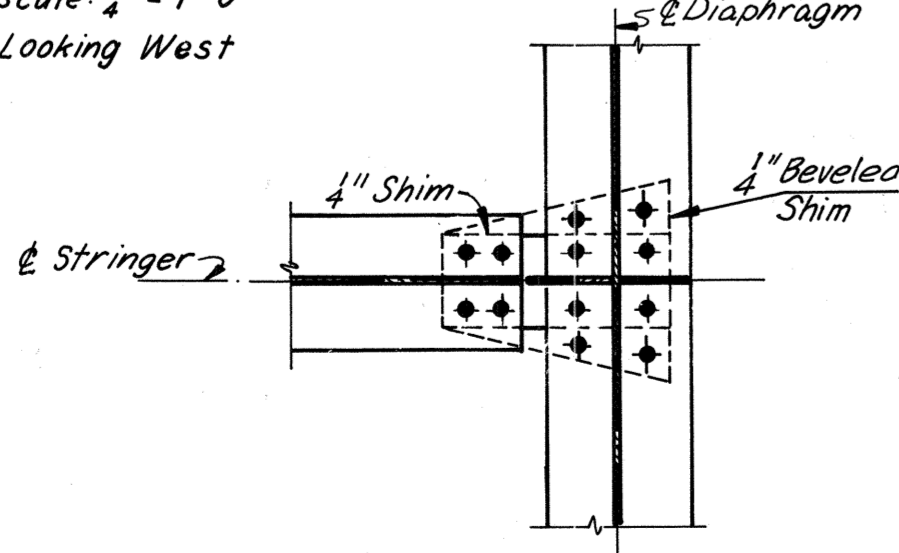

SECTION C-C
Scale: 3/4" = 1'-0"

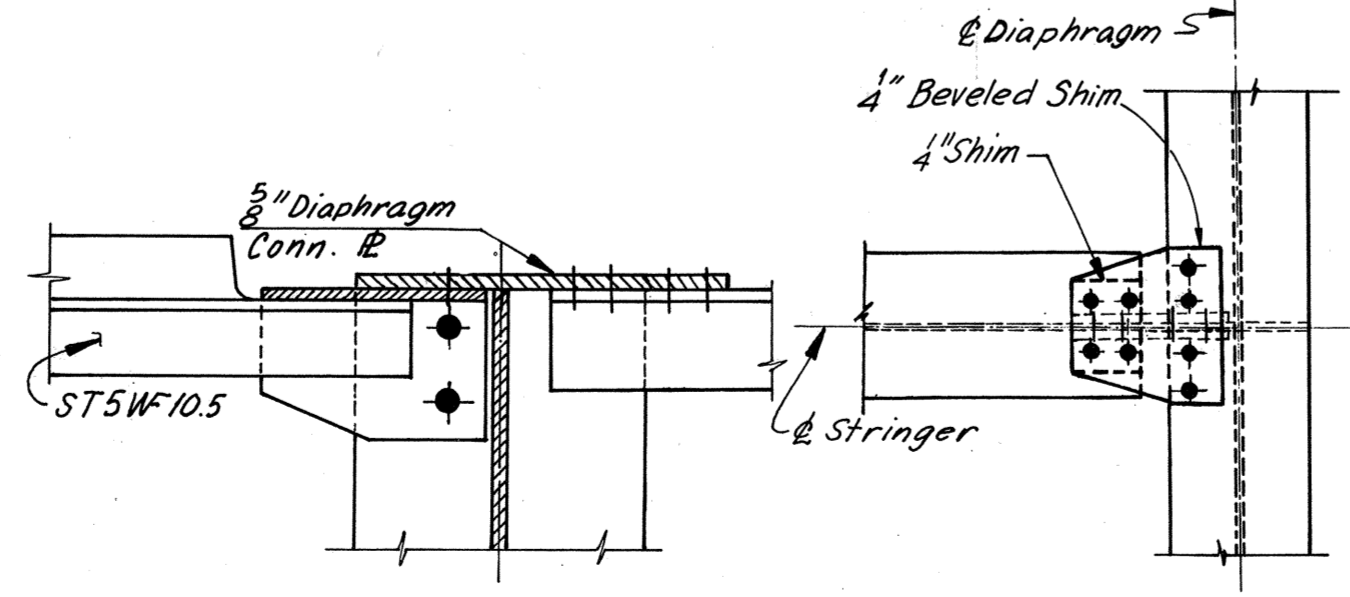

SECTION G-G
Scale: 1/2" = 1'-0"

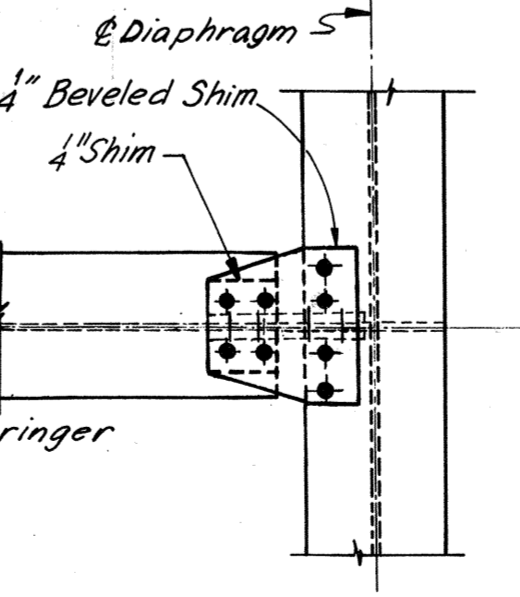

SECTION D-D
Scale: 3/4" = 1'-0"
Section P-P similar

Note:
For location of Details N, P and R, see Sheet 20.
All steel for diaphragms and connections shall be A36 unless otherwise noted.

MADE	BY	DATE	NO.	REVISION	BY	DATE
	PTA	12-12-68				
	AMH	2-7-69	1	As Built	TEM	8-76





















RICHMOND METROPOLITAN AUTHORITY
RICHMOND EXPRESSWAY SYSTEM
DOWNTOWN EXPRESSWAY

BRIDGE NO. 66
EASTBOUND ROADWAY OVER
12TH ST. - R.R. TRACKS AND 16TH ST.
FRAMING DETAILS
UNITS 21 AND 22

HOWARD, NEEDLES, TAMMEN & BERGENDOFF
consulting engineers
NEW YORK ALEXANDRIA KANSAS CITY

SCALE: *As Noted*
CONTRACT NO.: 10
SHEET NO. 26 OF 46

AS BUILT

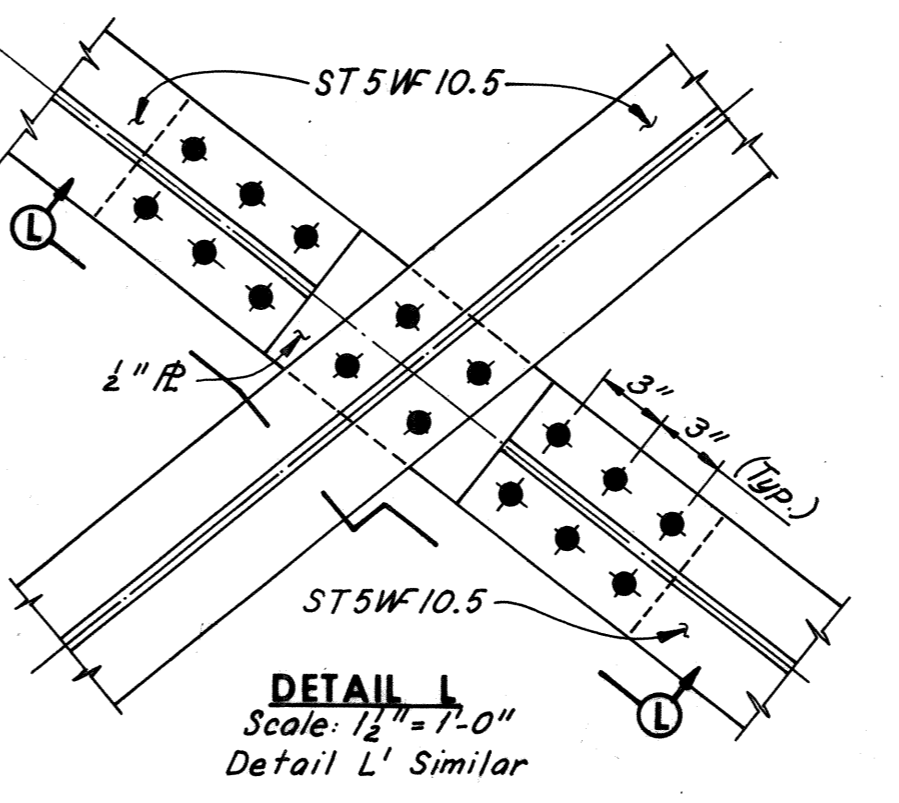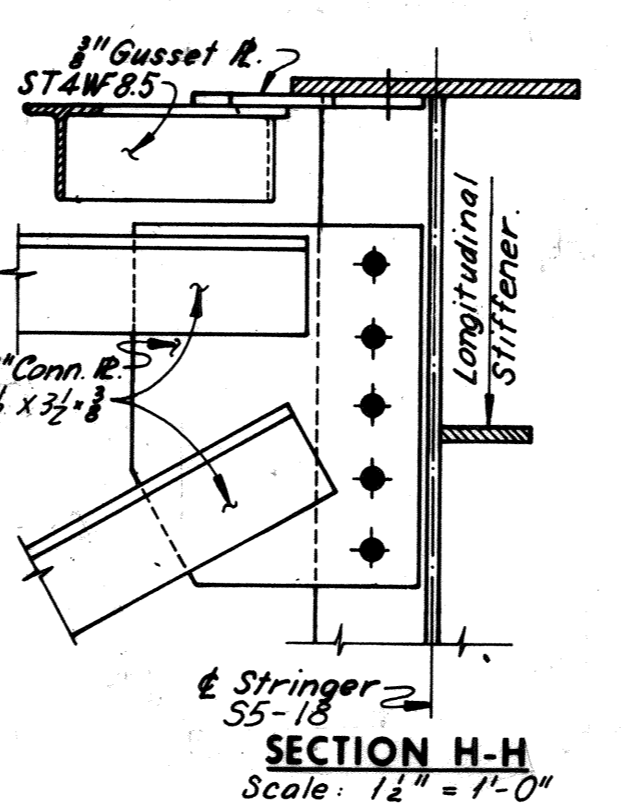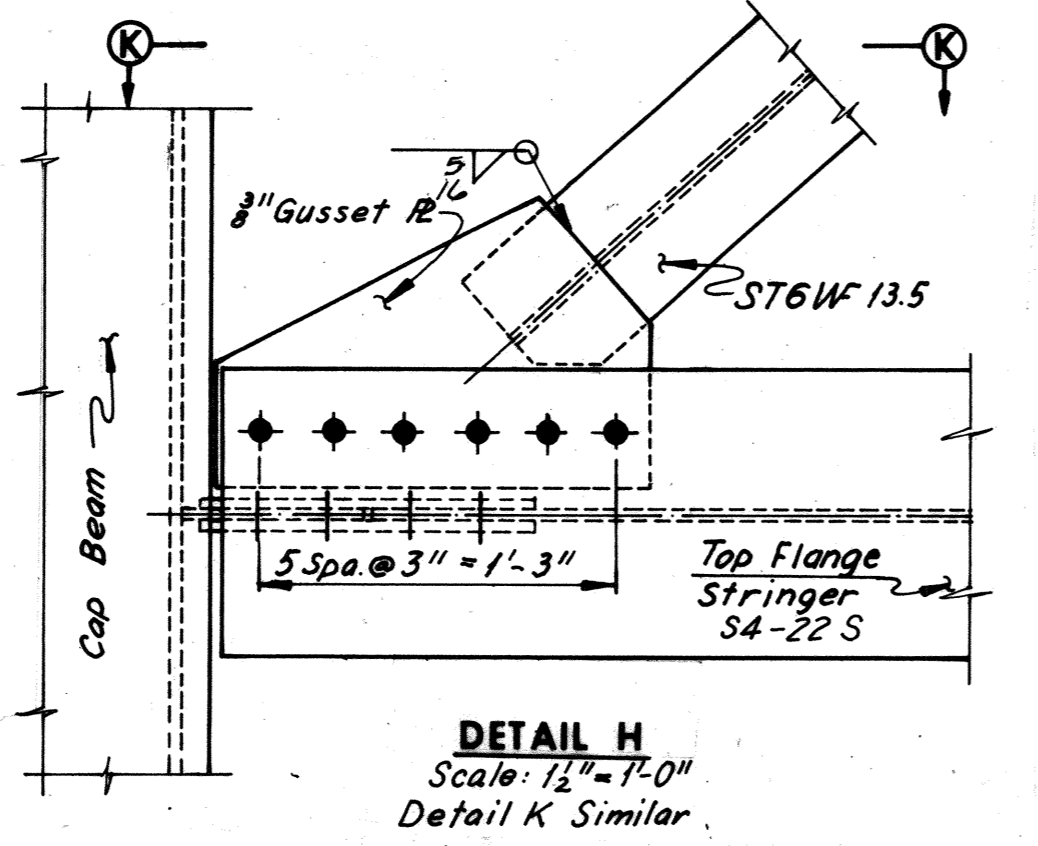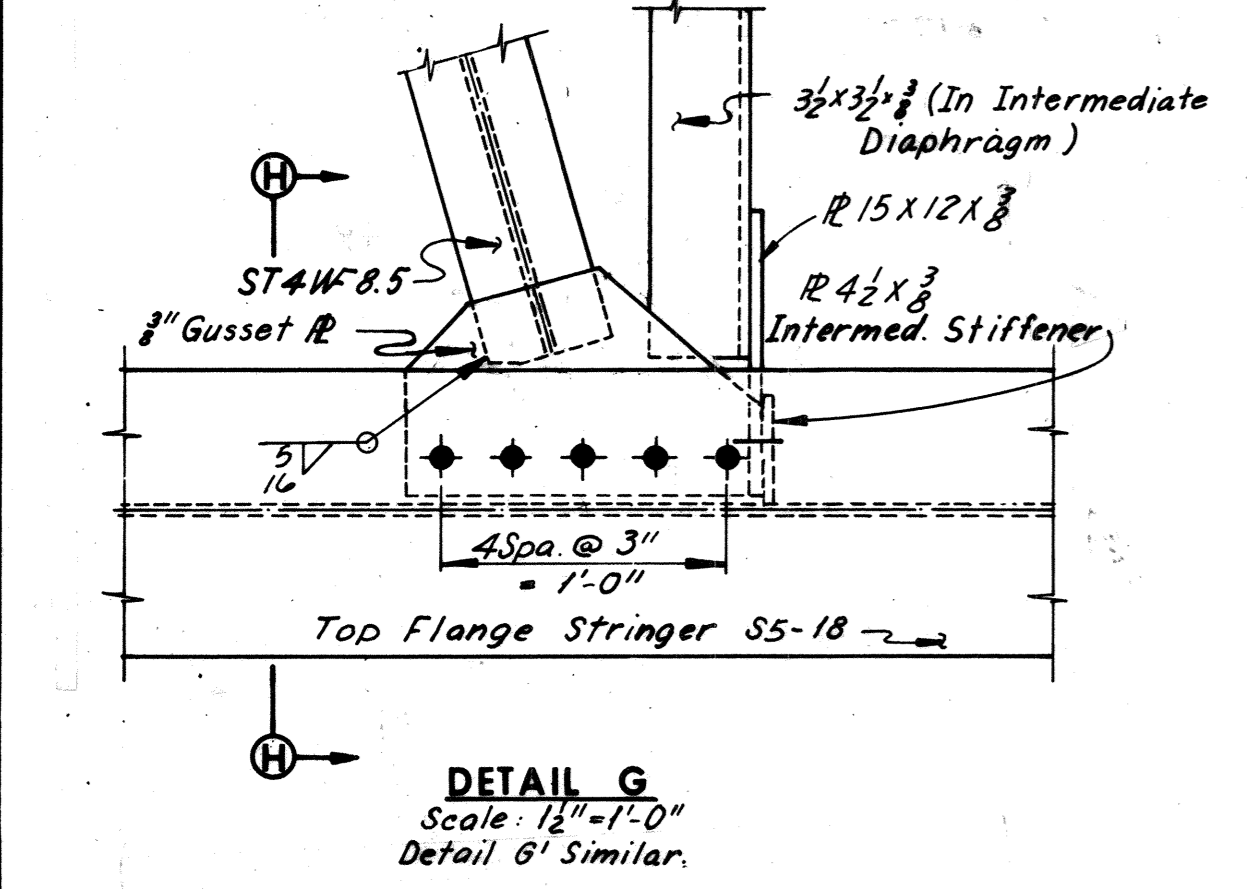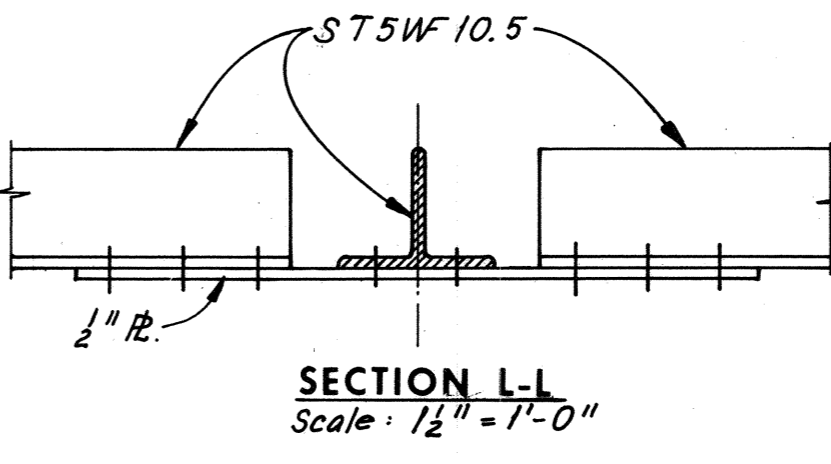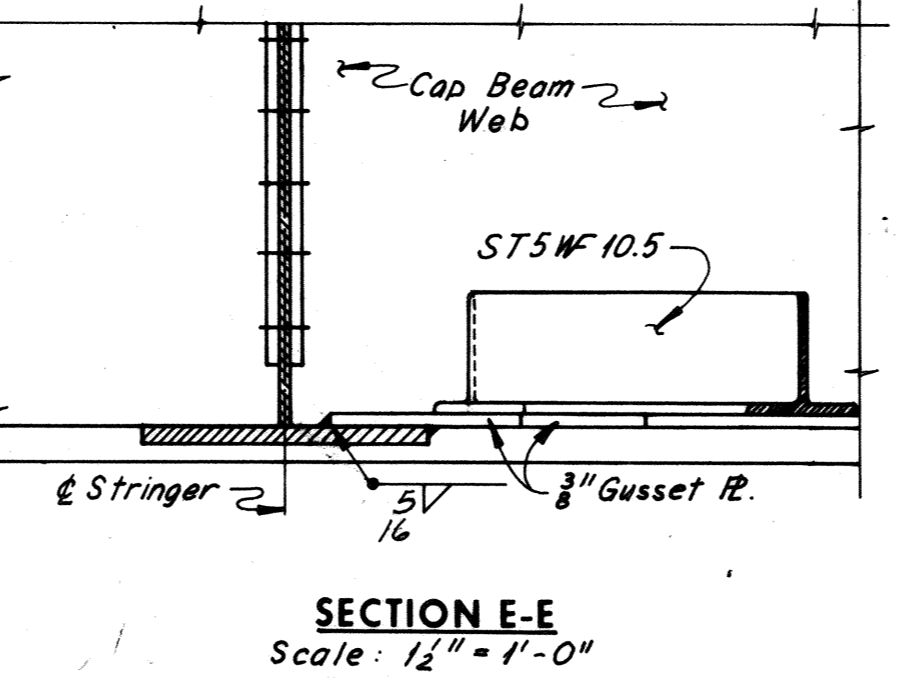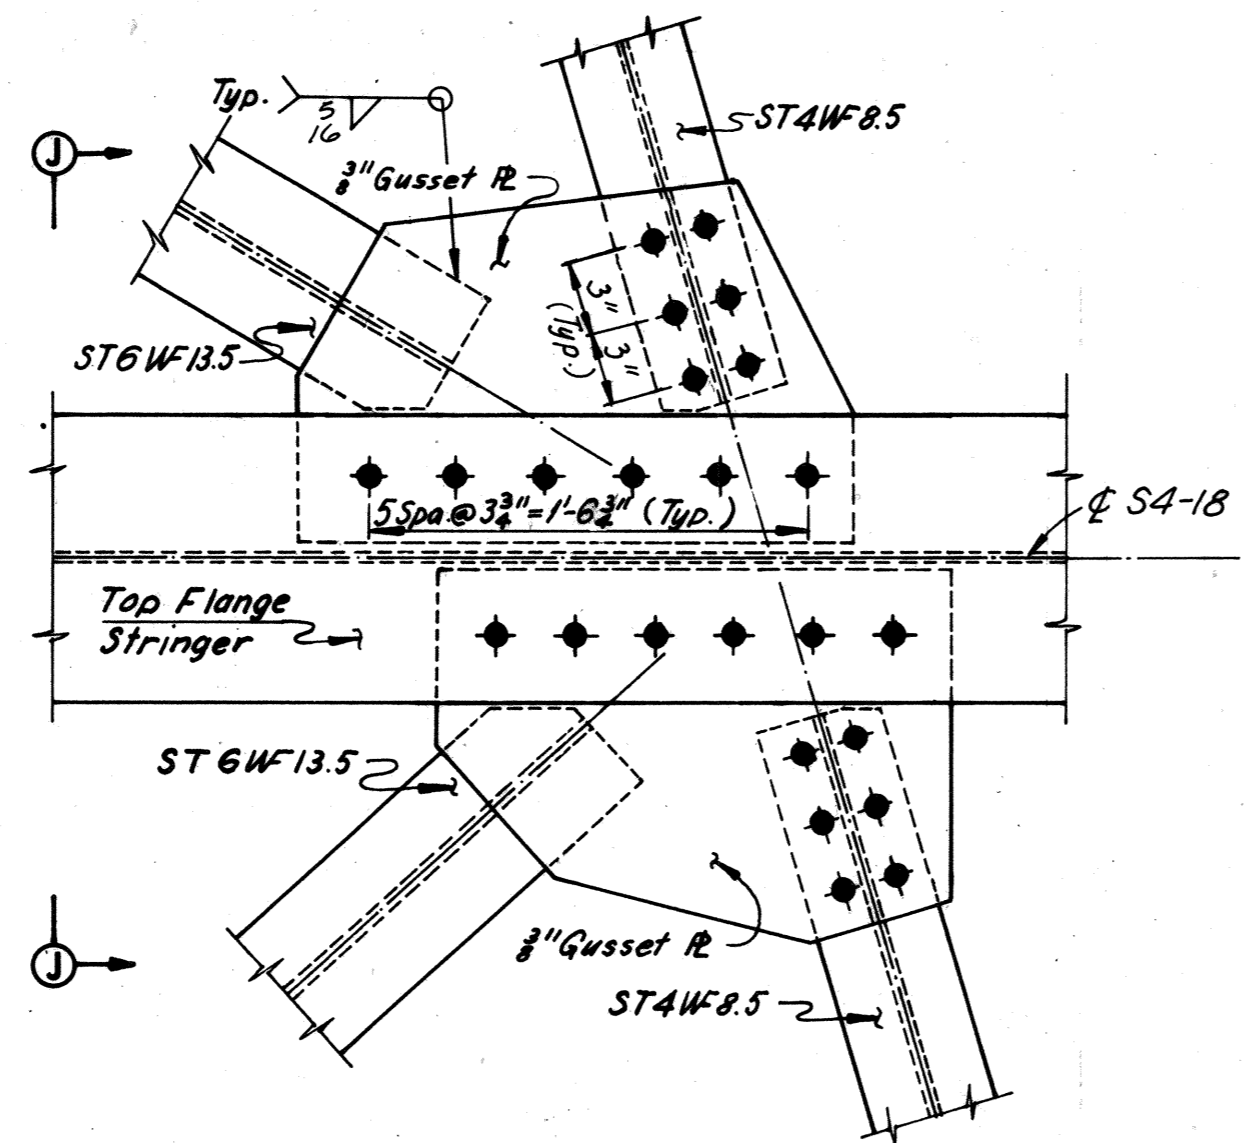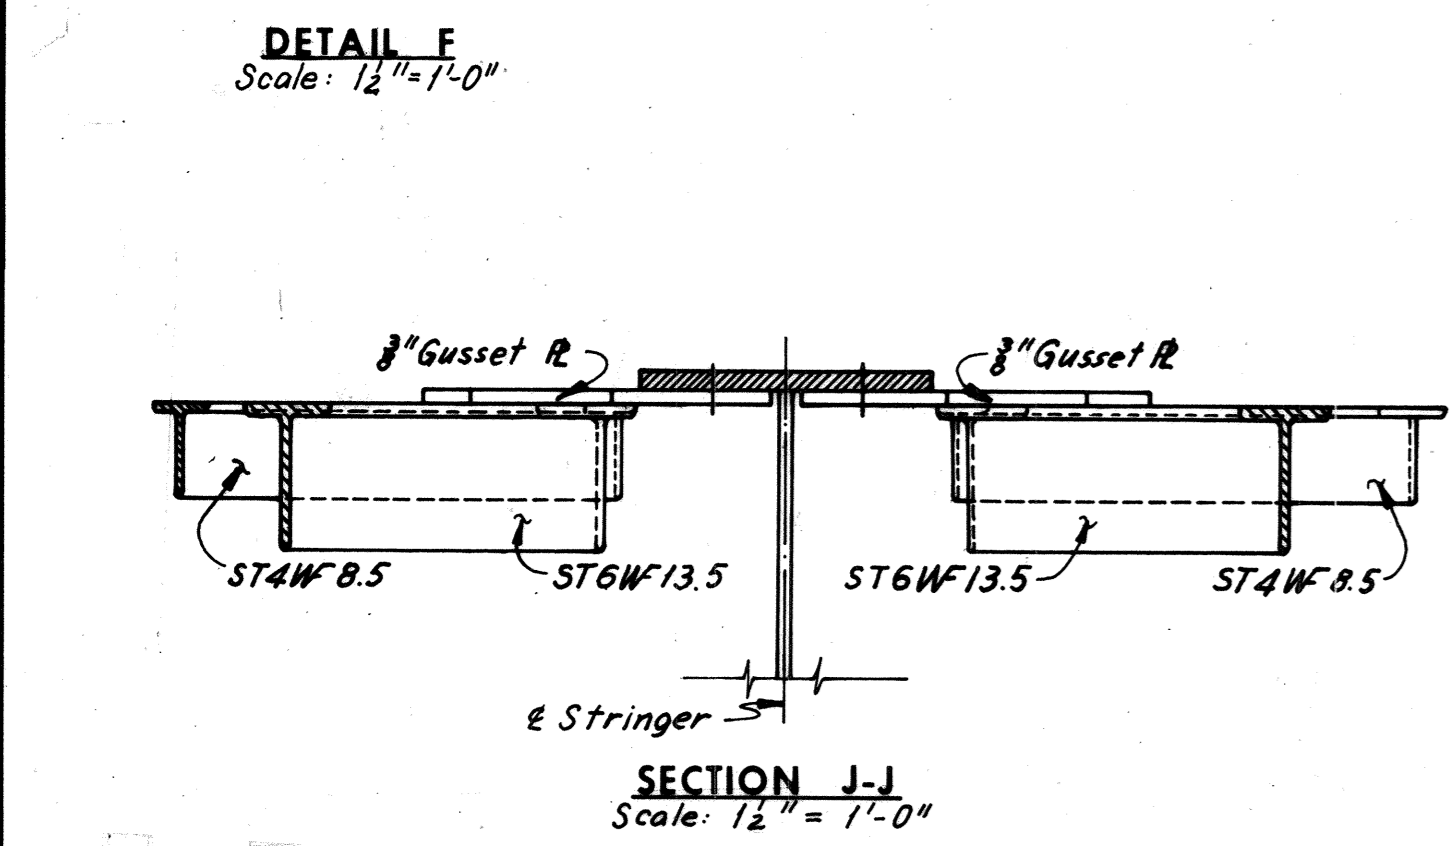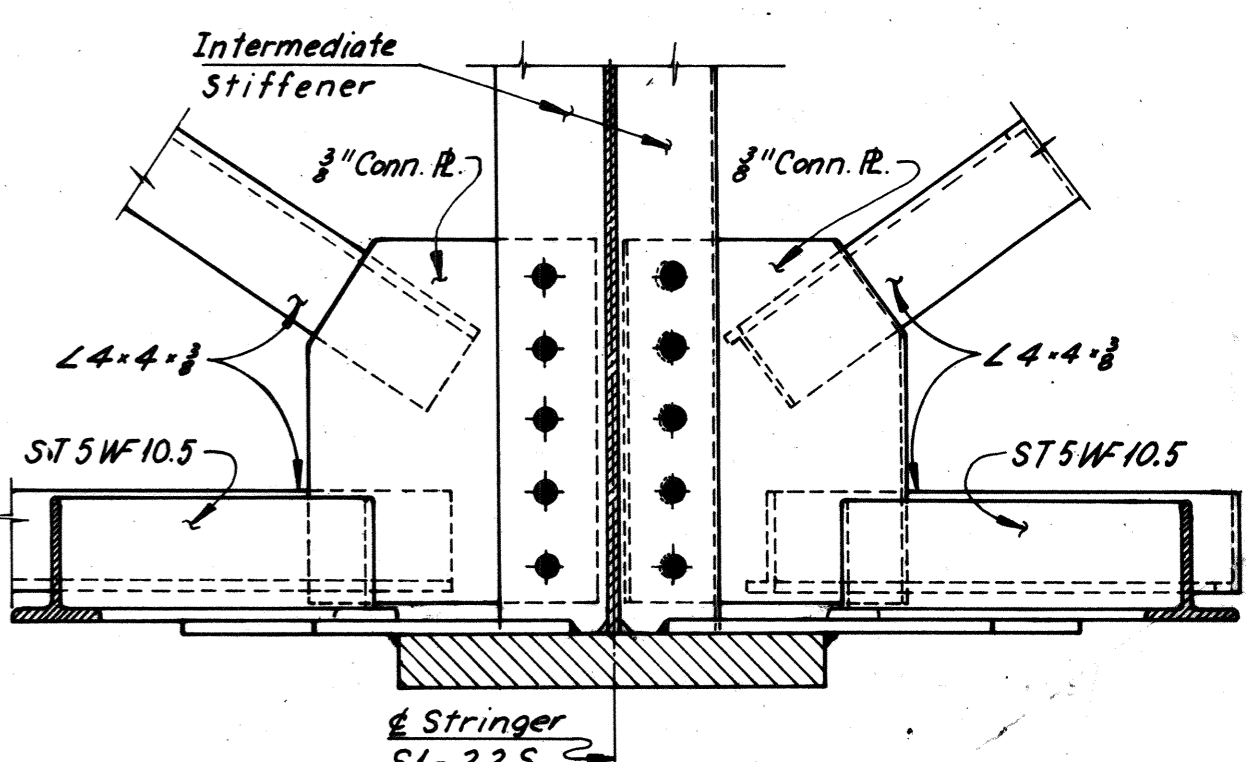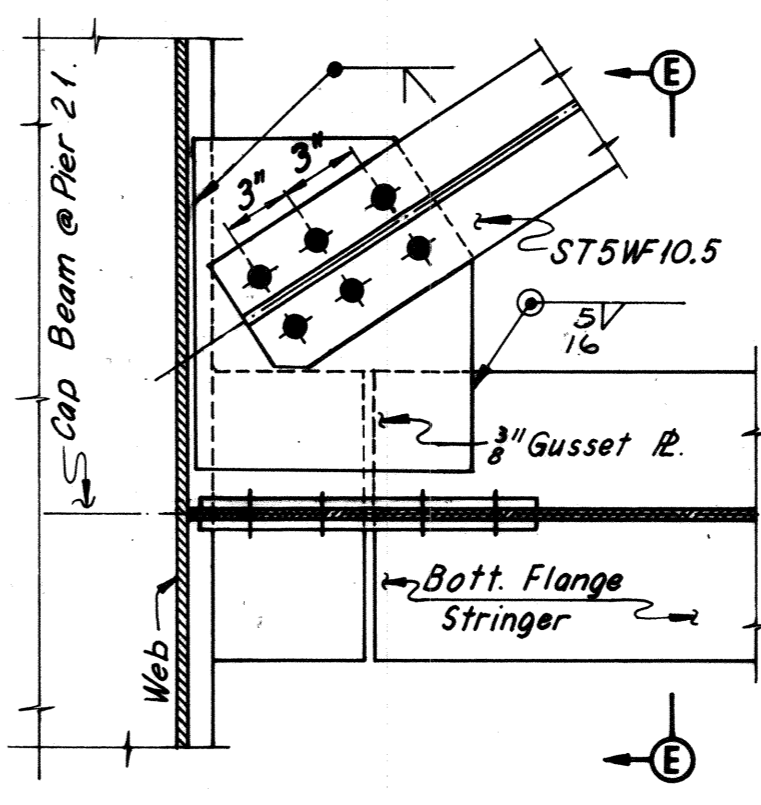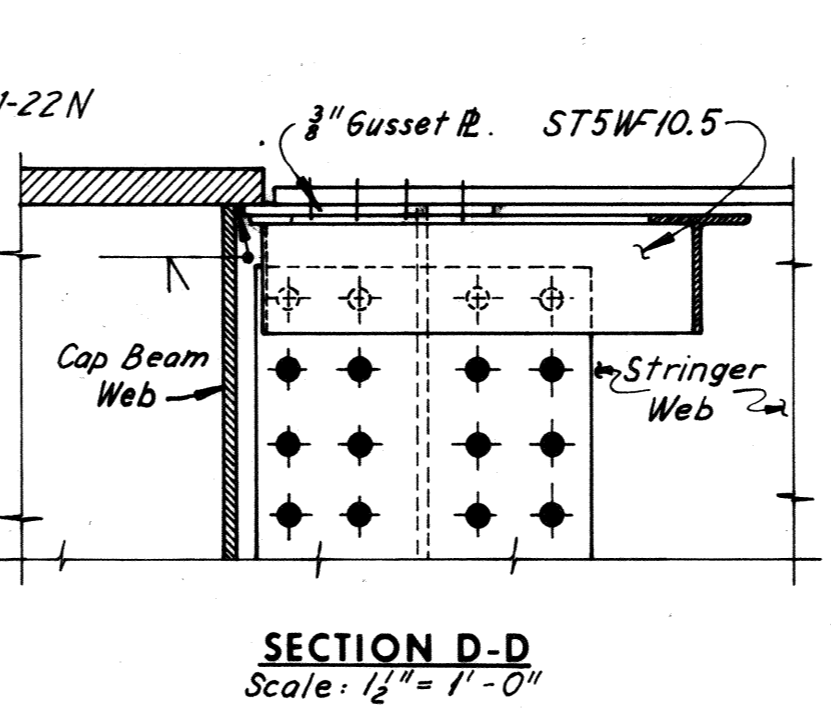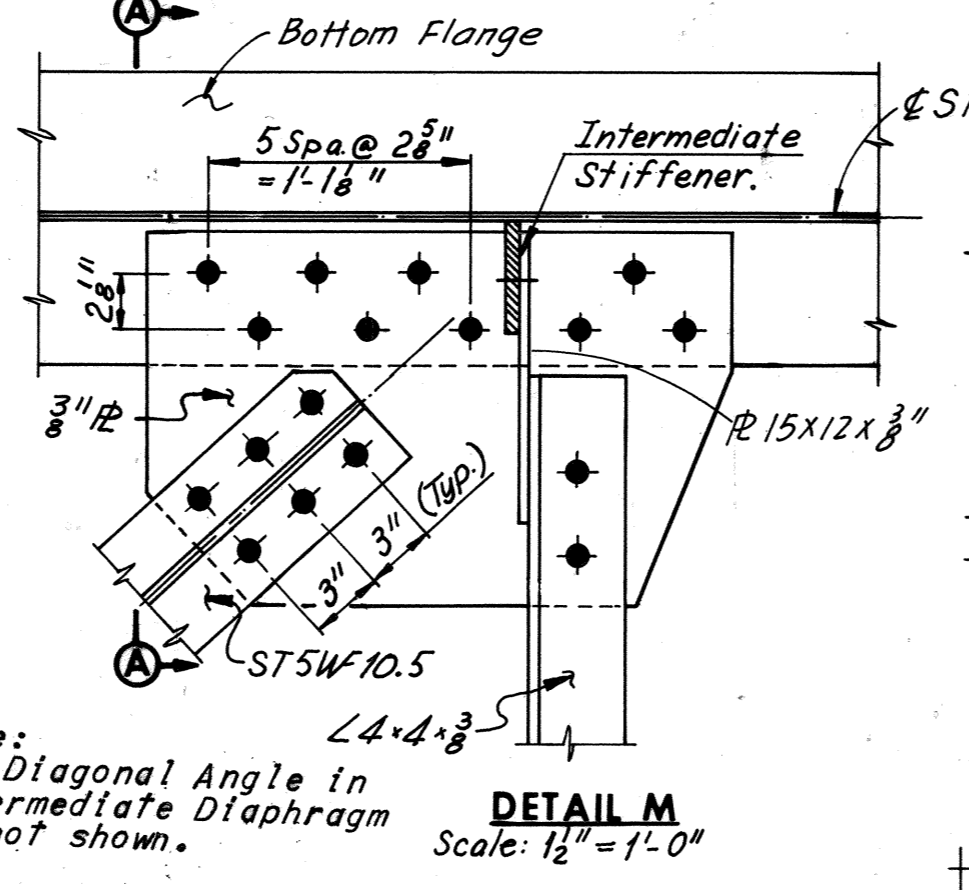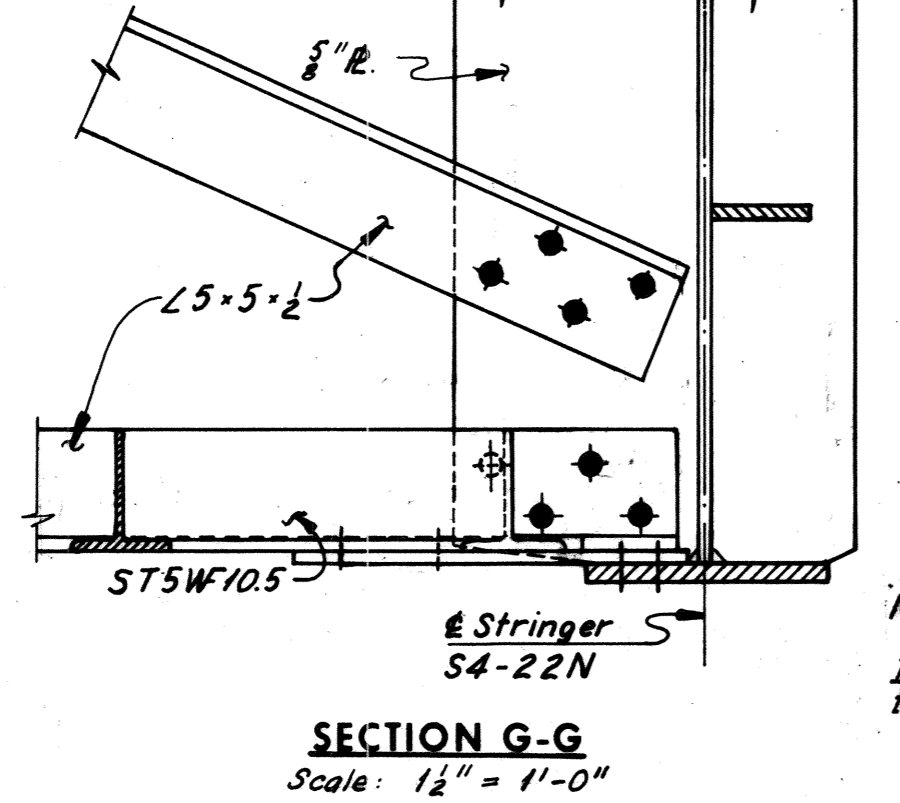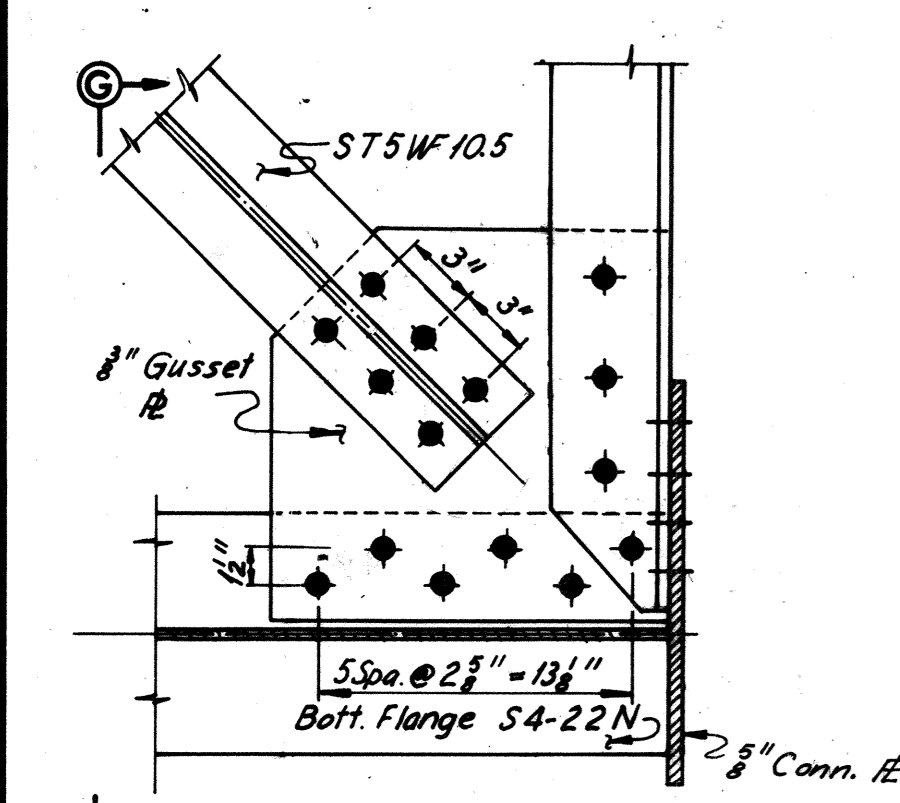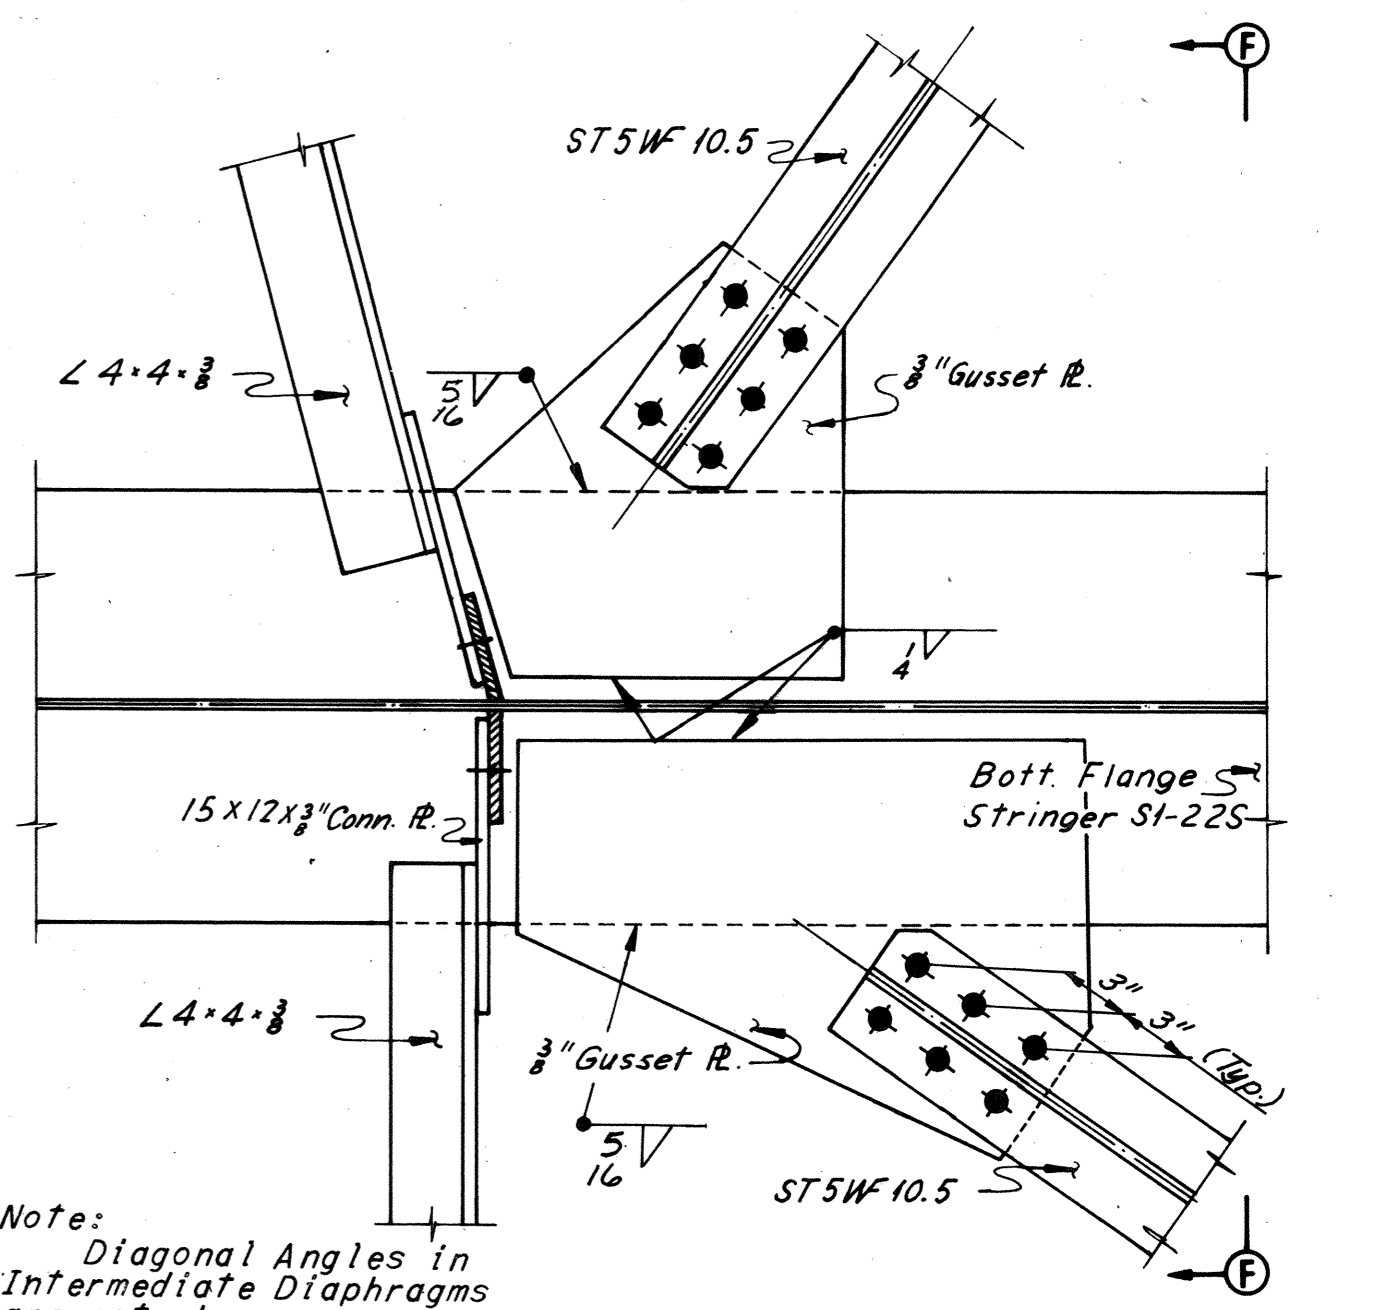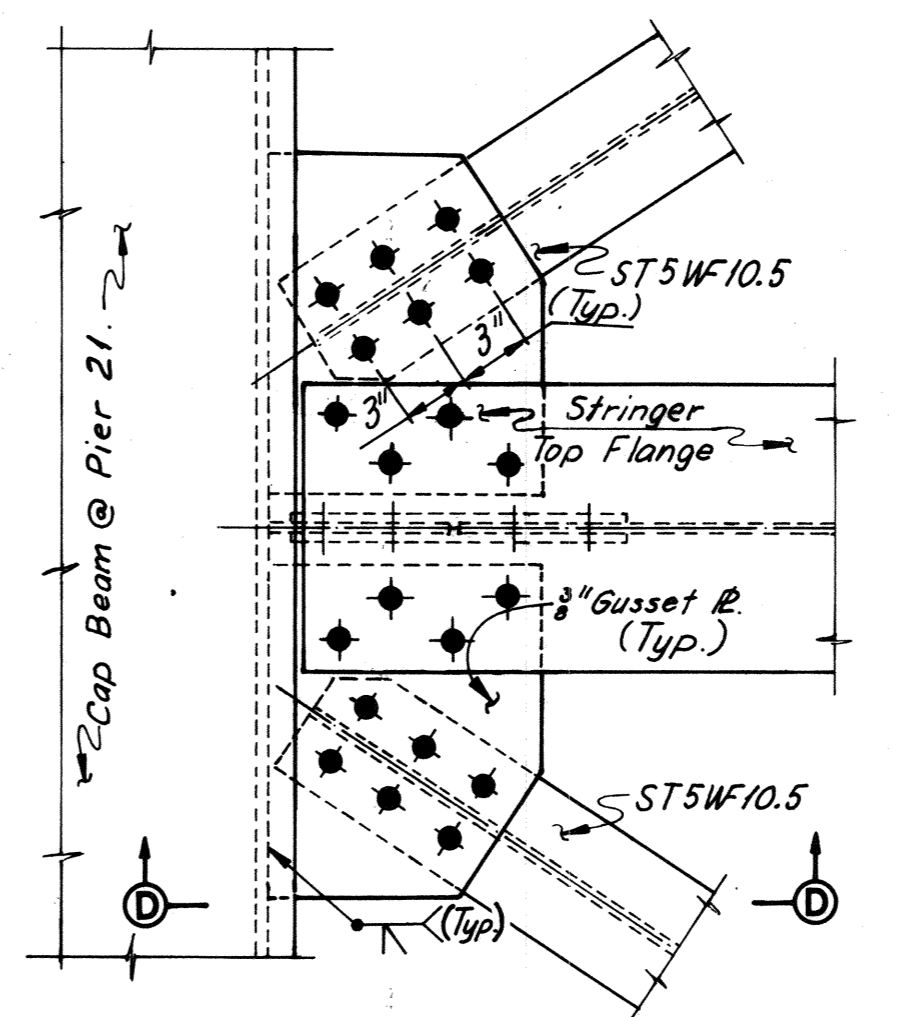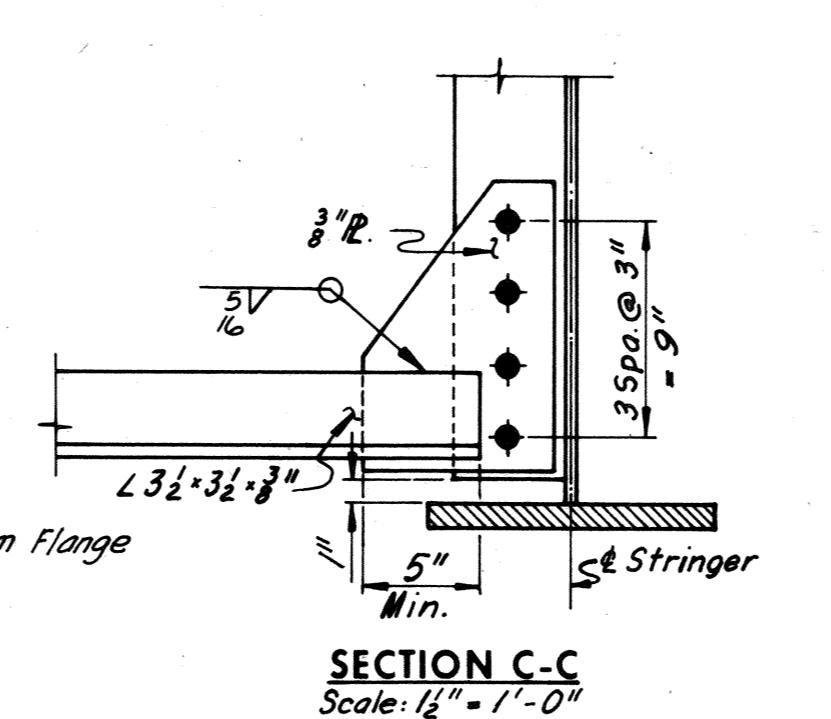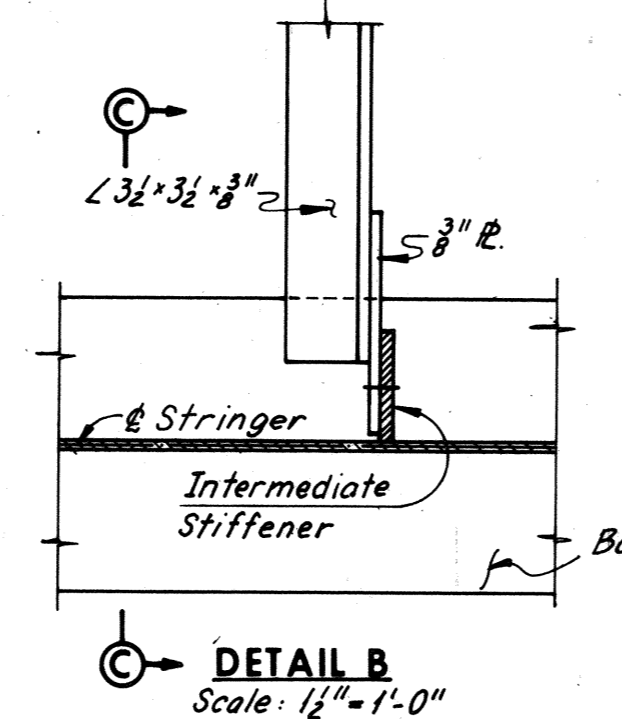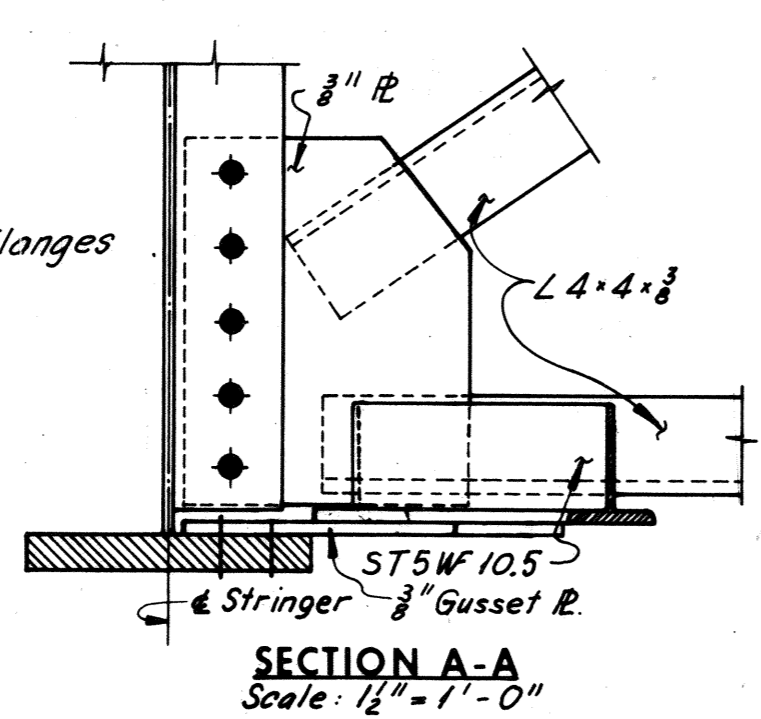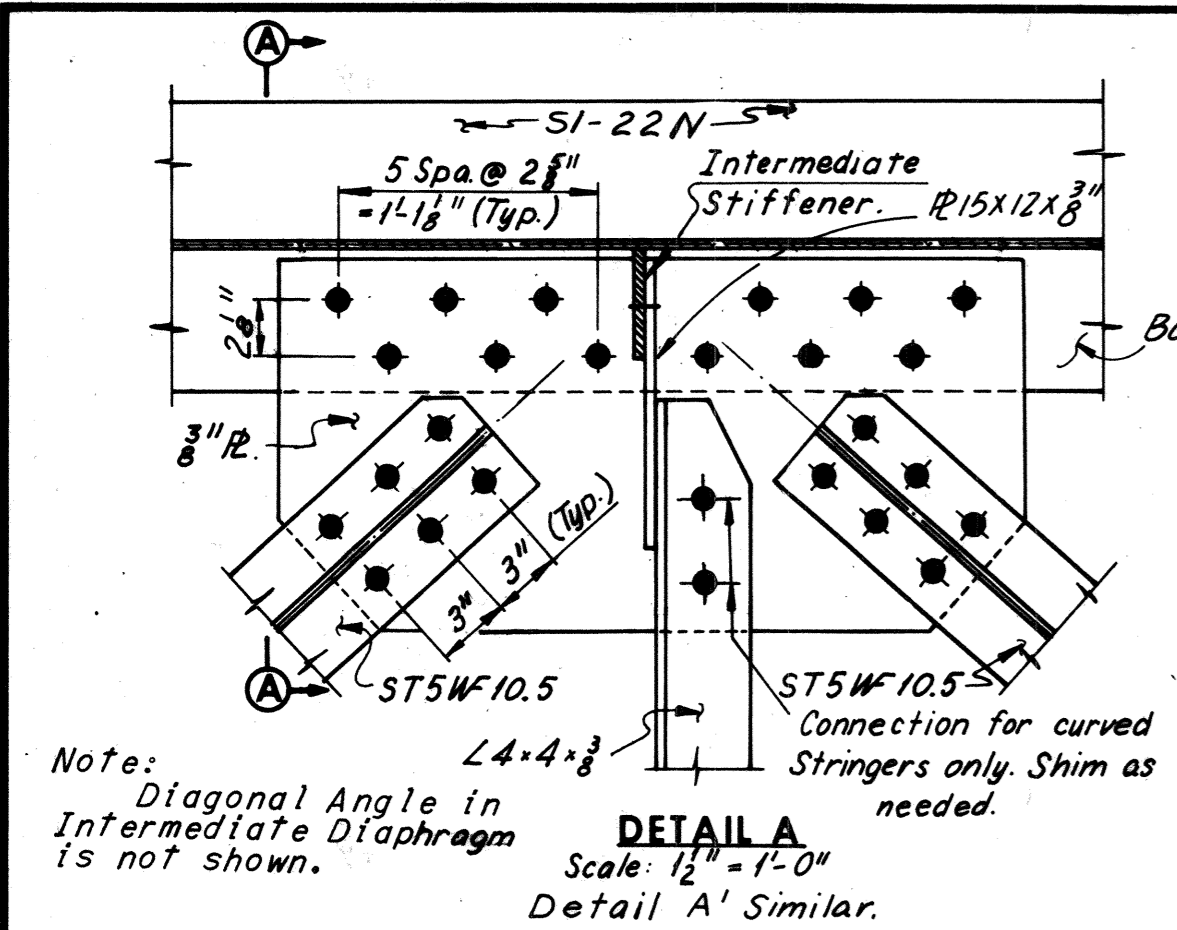

Note:
For location of Details A, A', B, C, D, E, F, H, J, L, L' and M, see Sheet 20.
For location of Details G, G', J and K, see Sheet 18.

BY	DATE				
MADE	PTA	12-14-68			
CHECKED	AMH	2-10-69	As Built	TEM	8-76
IN CHARGE					
	NO.	REVISION	BY	DATE	

RICHMOND METROPOLITAN AUTHORITY
RICHMOND EXPRESSWAY SYSTEM
DOWNTOWN EXPRESSWAY


BRIDGE NO. 66
EASTBOUND ROADWAY OVER
12TH ST. R.R. TRACKS AND 16TH ST.
FRAMING DETAILS
UNITS 18, 21 AND 22

HOWARD, NEEDLES, TAMMEN & BERGENDOFF
consulting engineers
NEW YORK ALEXANDRIA KANSAS CITY

SCALE: As Noted
CONTRACT NO. 10
SHEET NO. 27 OF 46




AS BUILT

RICHMOND EXPRESSWAY SYSTEM			
SECTION	PROJECT	SHEET NO.	TOTAL SHEETS
10	DOWNTOWN EXPRESSWAY	154	265

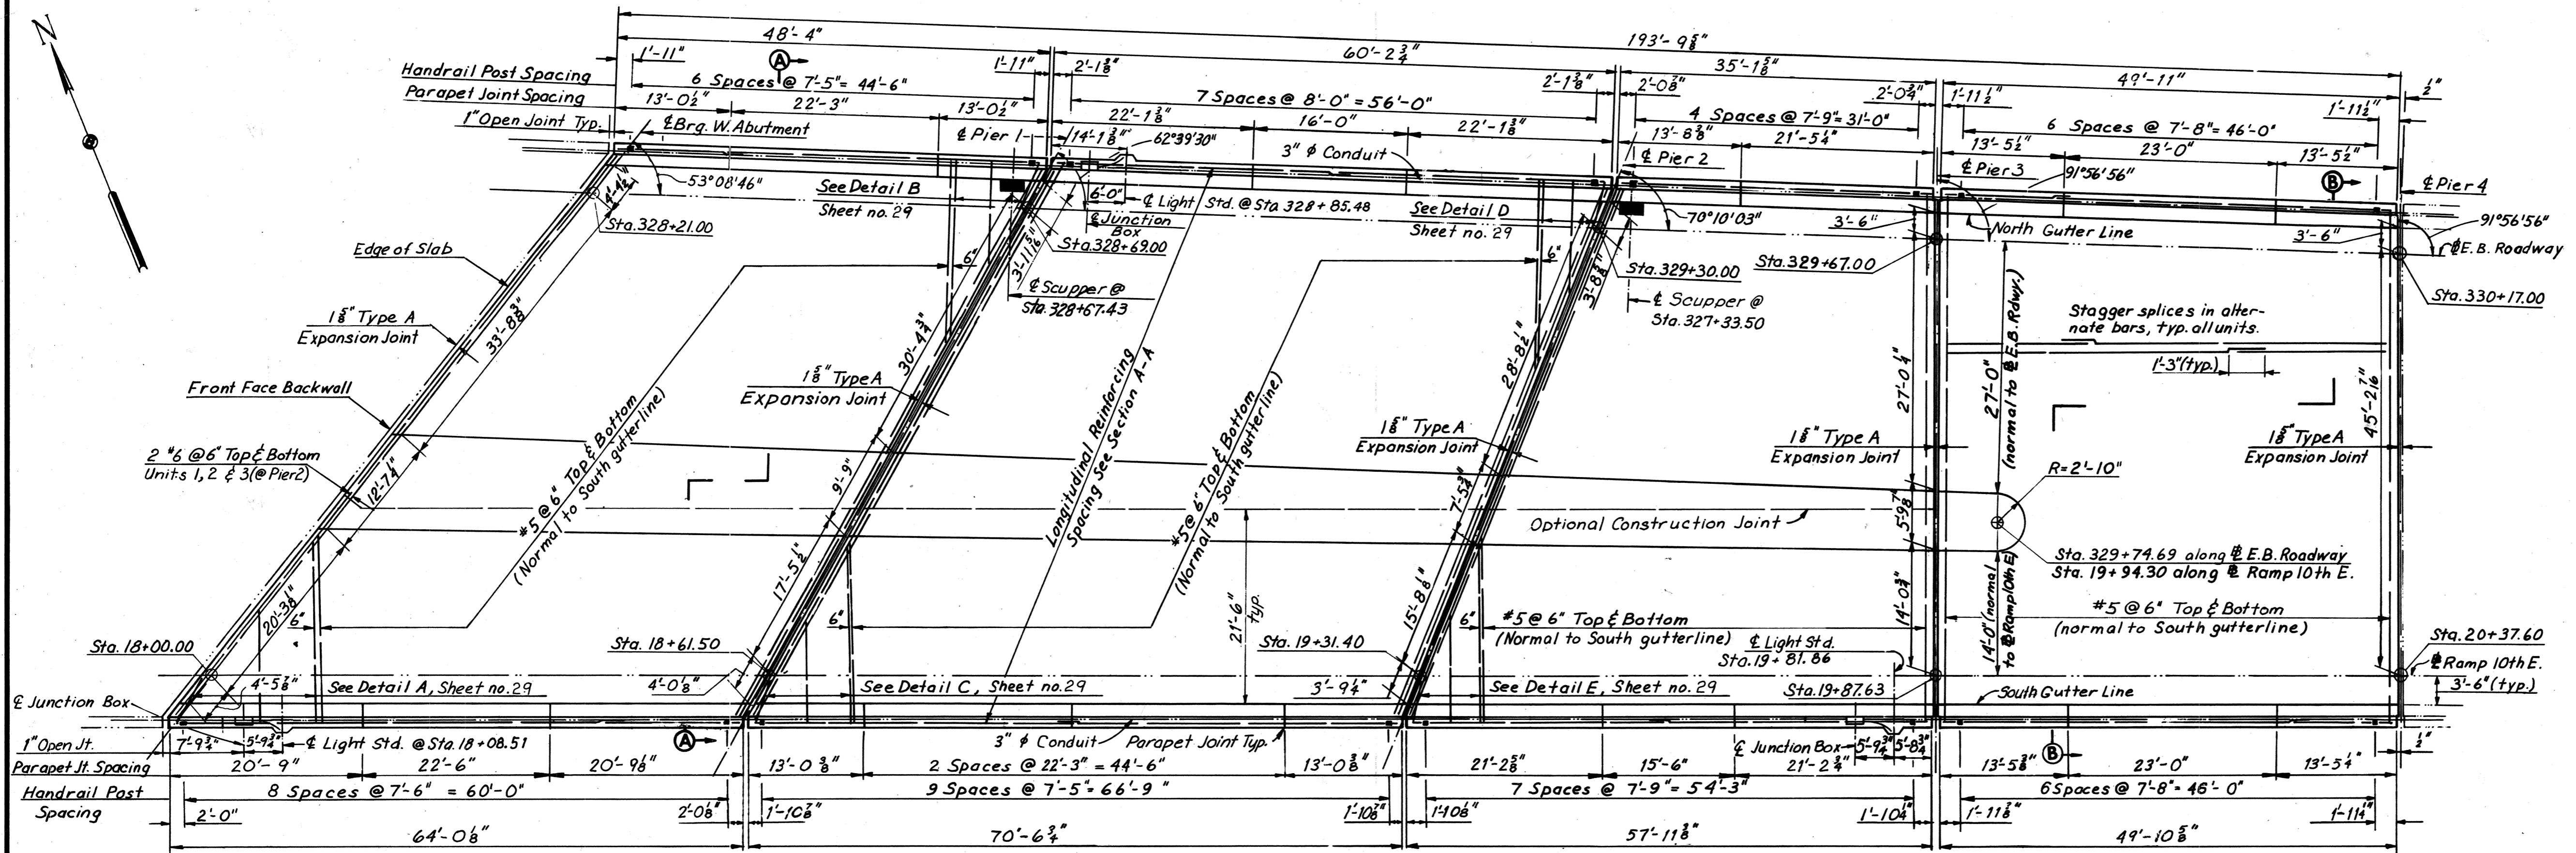

ELEVATION TABLE					
STATION	ELEV. A	ELEV. B	ELEV. C	ELEV. E	ELEV.
328+00.00	76.13	76.33	77.81		
+00.00			77.81		
+10.00	76.29	76.48	77.91		
+20.00	76.44	76.63	78.00		
+21.00		76.64			
+23.62	76.50				
+30.00	76.61	76.77	78.10		
+40.00	76.76	76.92	78.19		
+50.00	76.91	77.07	78.28		
+55.04			78.33		
+60.00	77.07	77.22	78.38		
+69.00		77.35			
+70.00	77.22	77.37	78.47		
+70.81	77.25				
+80.00	77.38	77.51	78.57		
+90.00	77.53	77.66	78.66		
329+00.00	77.68	77.81	78.75		
+10.00	77.84	77.96	78.85		
+20.00	77.99	78.11	78.94		
+20.26			78.95		
+30.00	78.16	78.25	79.04		
+31.26	78.17				
+40.00	78.31	78.40	79.13		
+50.00	78.46	78.55	79.22		
+60.00	78.62	78.70	79.32		
+66.88	78.73				
+67.00		78.80			
+67.92			79.39		
+70.00	78.77	78.85	79.41		
+80.00	78.93	78.99	79.88	79.94	
+90.00	79.08	79.14	79.93	79.99	
330+00.00	79.23	79.29	79.98	80.03	80.03
+10.00	79.39	79.44	80.03	80.08	
+16.88	79.51				
+17.00		79.54			
+18.54			80.08		
+18.64				80.12	
+20.00	79.54	79.59	80.08	80.13	

Note: For Elevations along Ramp 10th East, see Sheet 33.

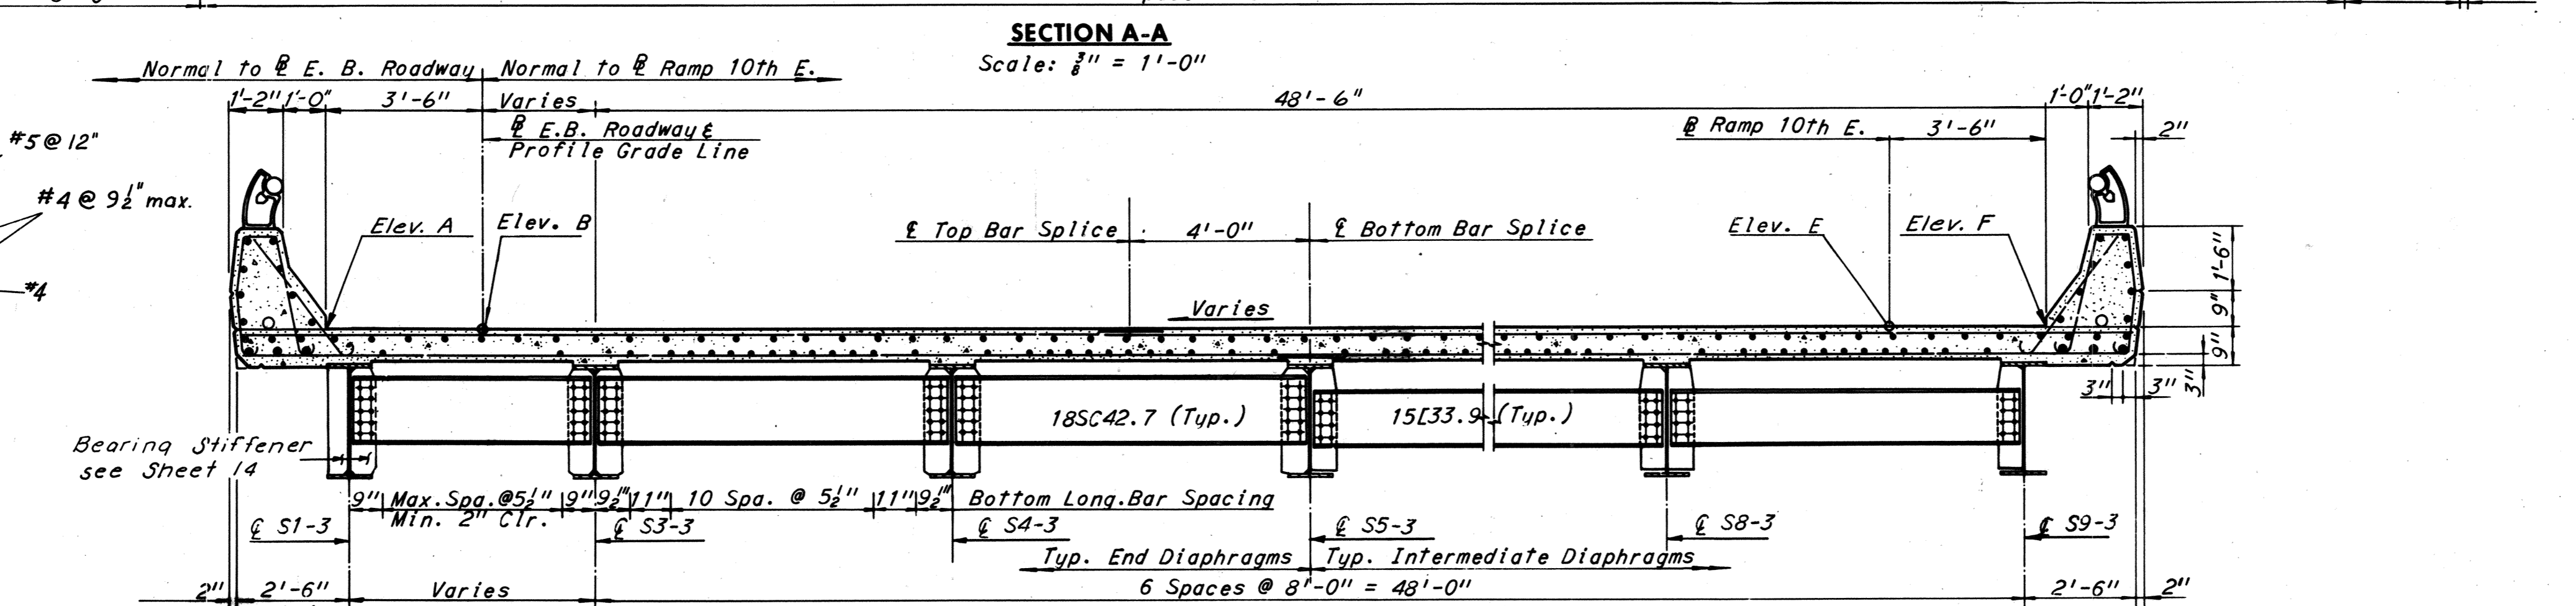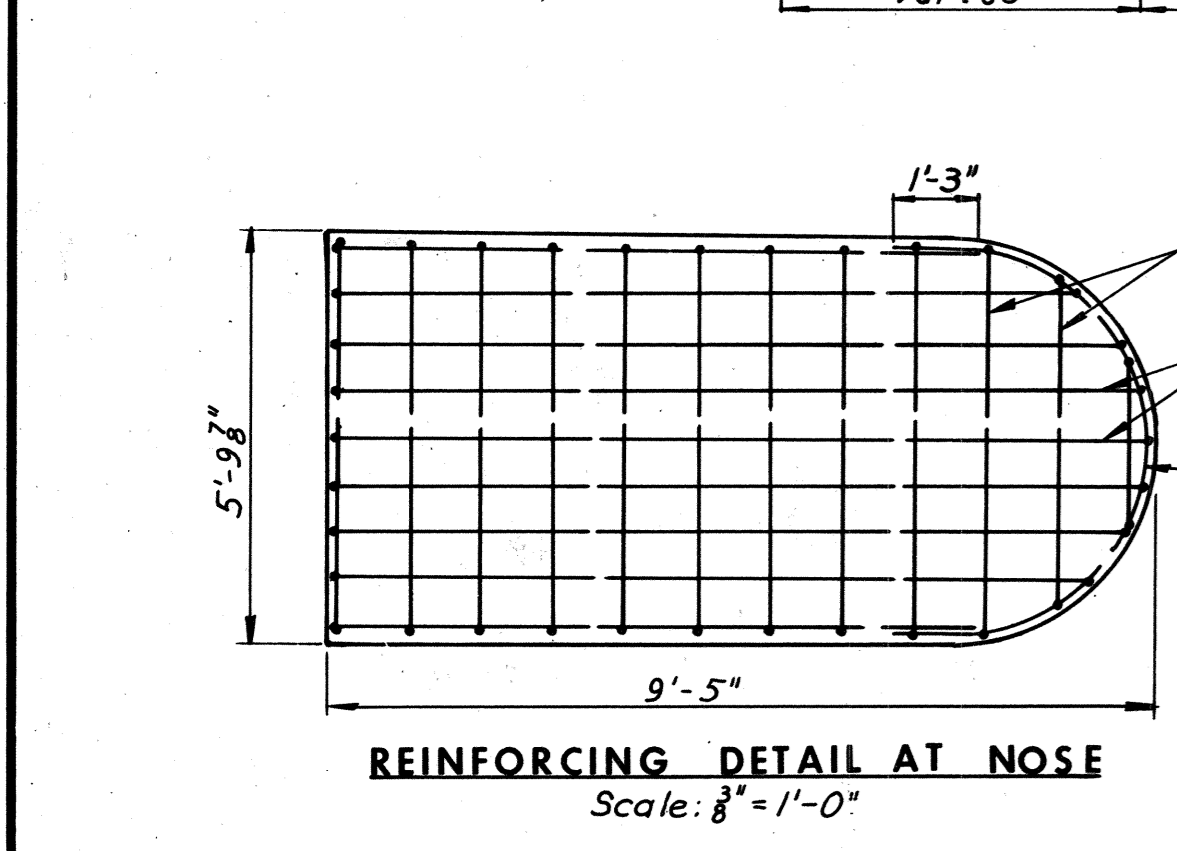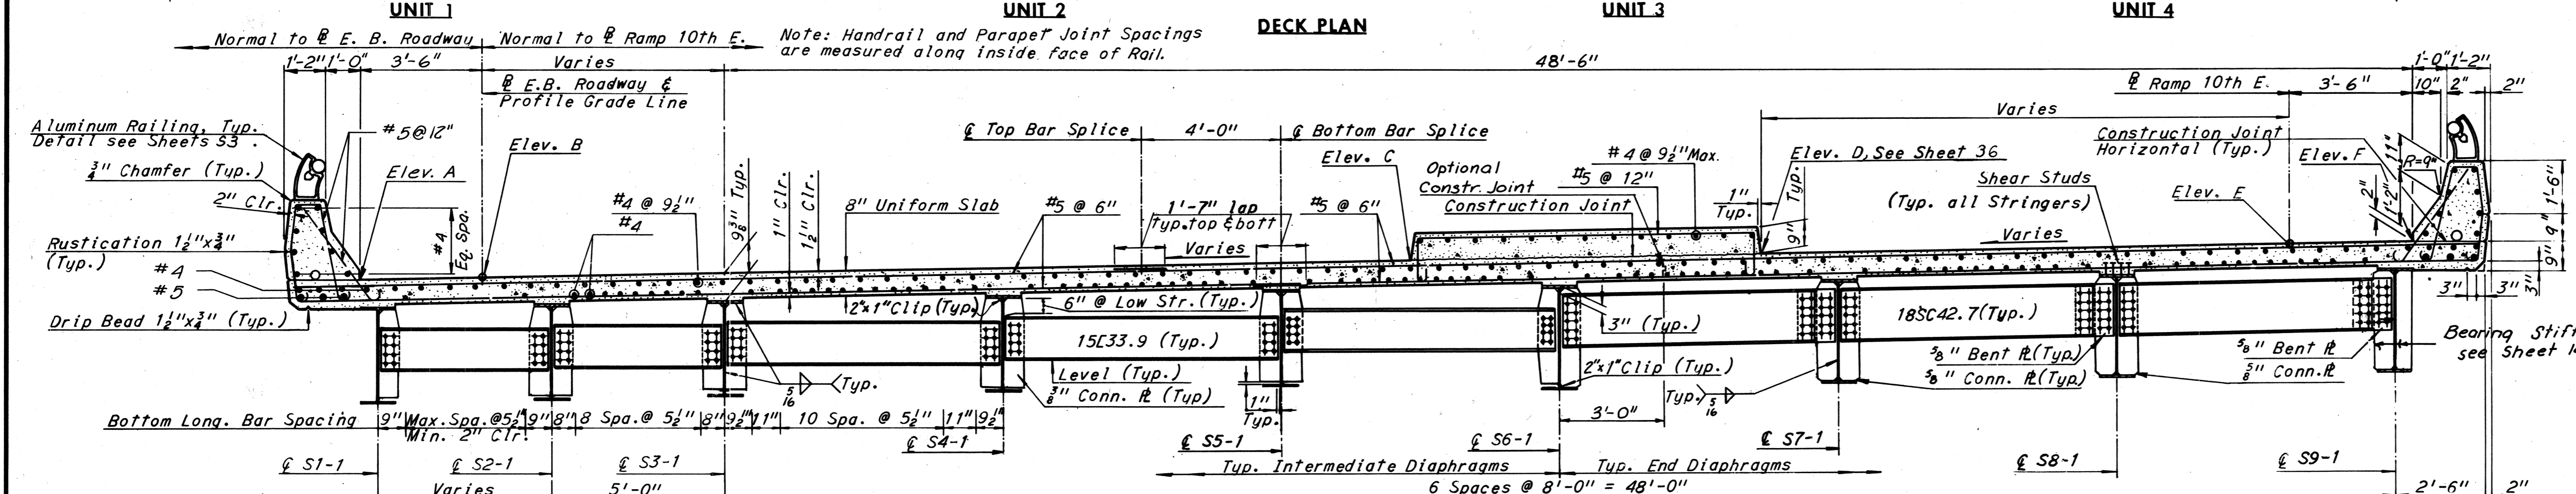

Notes:
 For Joint Details, see Sheet 37.
 For Framing Plan, see Sheet 14.
 For Handrail Details, see Sheet S3.
 For Superstructure quantities, see Sheet 2.
 For Details A, B, C, D and E, see Sheet 29.
 For Standard Drainage Details, see Support Type 1, Sheet S5 & S6.

BY	DATE	Bar Space Added	PRMS	4-19-74
MADE	J.D.	8-6-68	Z As Built	T.E.M. 8-76
CHECKED	J.V.	10-23-68		
IN CHARGE				

Note: Transverse dimensions given in Sections A-A and B-B are normal to Ramp 10th-E.

AS BUILT


RICHMOND METROPOLITAN AUTHORITY
RICHMOND EXPRESSWAY SYSTEM
DOWNTOWN EXPRESSWAY

BRIDGE NO. 66
EASTBOUND ROADWAY OVER
12TH ST. - R.R. TRACKS AND 16TH ST.
DECK PLAN - UNITS 1,2,3 AND 4


HOWARD, NEEDLES, TAMMEN & BERGENDOFF
 consulting engineers
 NEW YORK ALEXANDRIA KANSAS CITY

SCALE: 1"=10' Unless shown
 CONTRACT NO.: 10
 SHEET NO. 28 OF 46

RICHMOND EXPRESSWAY SYSTEM			
SECTION	PROJECT	SHEET NO.	TOTAL SHEETS
10	DOWNTOWN EXPRESSWAY	155	265

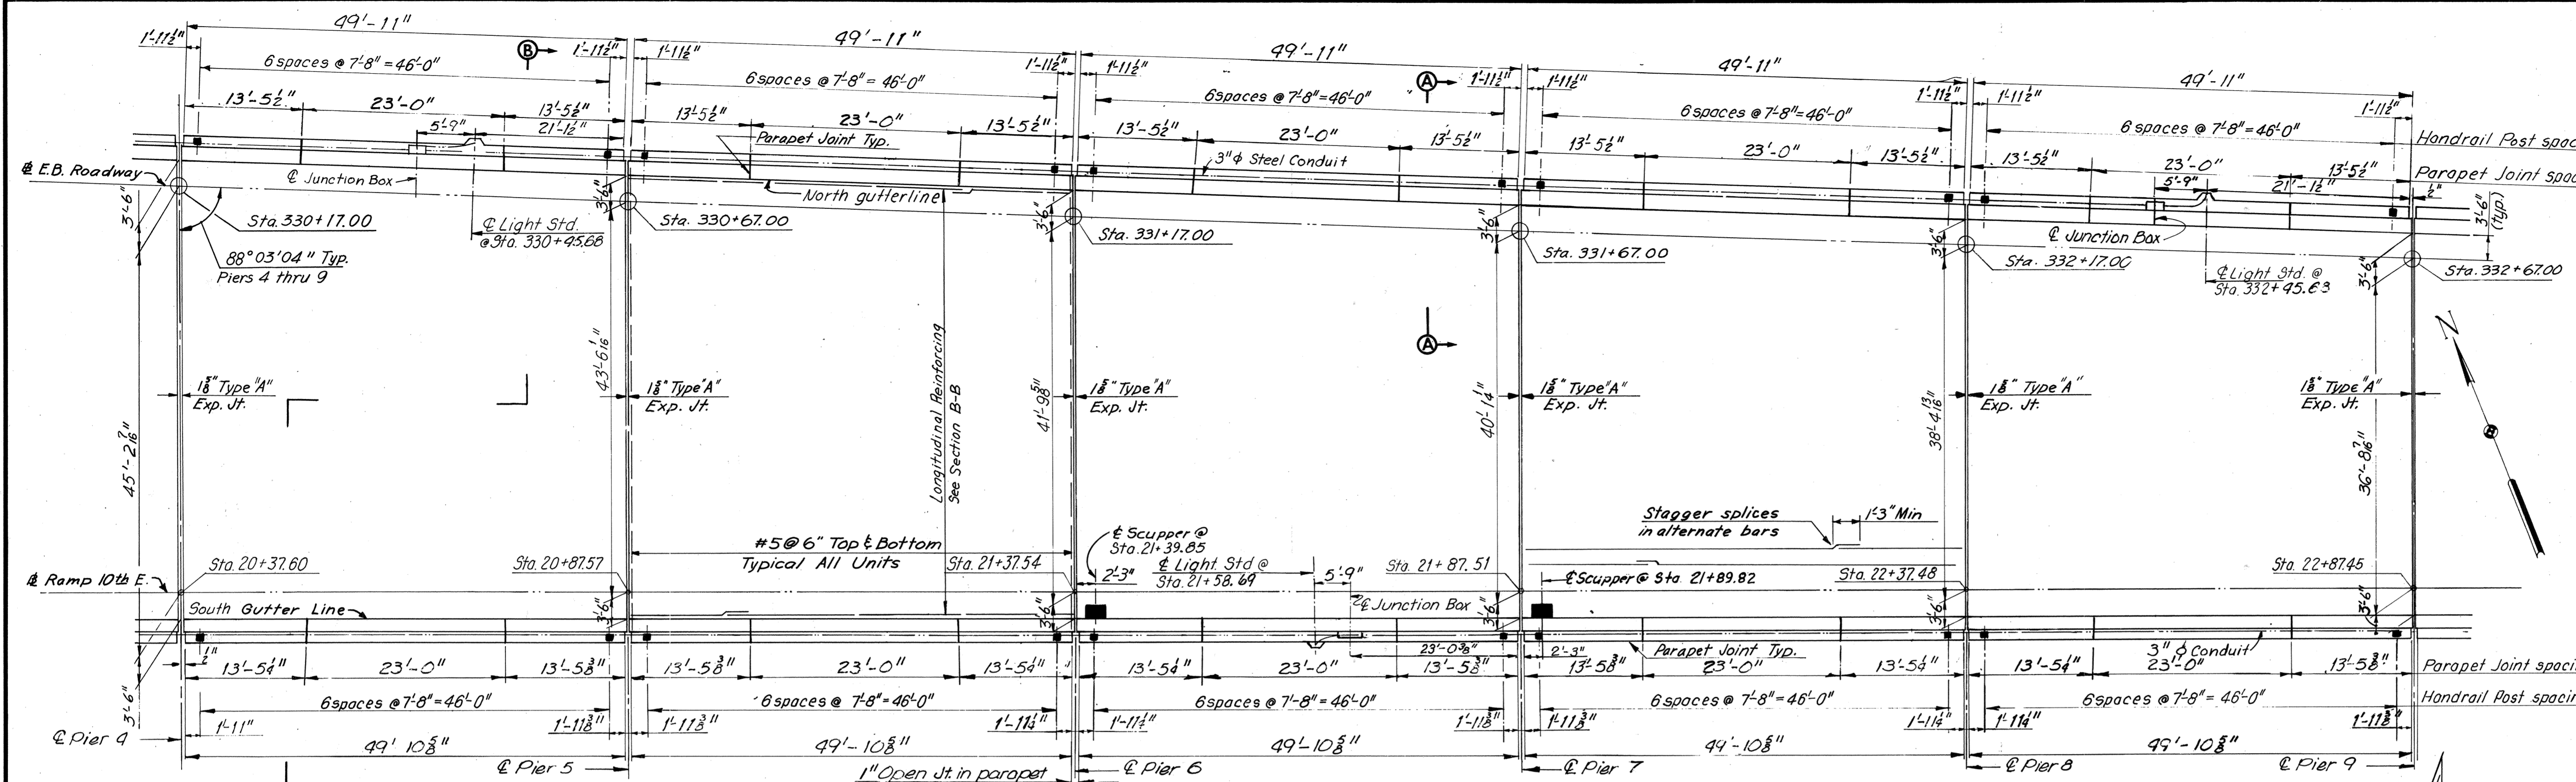

ELEVATION TABLE			
STATION	ELEV. A	ELEV. B	ELEV. C
330+10.00	79.39	79.44	80.08
+16.88	79.50	--	--
+17.00	--	79.54	--
+18.66	--	--	80.12
+20.00	79.54	79.59	80.13
+30.00	79.71	79.73	80.16
+40.00	79.86	79.88	80.21
+50.00	80.02	80.03	80.27
+60.00	80.17	80.18	80.32
+66.88	80.28	--	--
+67.00	--	80.28	--
+68.60	--	--	80.36
+70.00	80.32	80.33	80.37
+80.00	80.48	80.47	80.43
+90.00	80.63	80.62	80.49
331+00.00	80.79	80.77	80.54
+10.00	80.94	80.92	80.60
+16.88	81.05	--	--
+17.00	--	81.02	--
+18.54	--	--	80.65
+20.00	81.09	81.07	80.66
+30.00	81.26	81.21	80.72
+40.00	81.41	81.36	80.78
+50.00	81.57	81.51	80.84
+60.00	81.72	81.66	80.92
+66.88	81.82	--	--
+67.00	--	81.76	--
+68.48	--	--	81.00
+70.00	81.87	81.81	81.01
+80.00	82.02	81.95	81.12
+90.00	82.17	82.10	81.25
332+00.00	82.32	82.25	81.40
+10.00	82.47	82.40	81.56
+16.88	82.57	--	--
+17.00	--	82.50	--
+18.42	--	--	81.69
+20.00	82.62	82.55	81.71
+30.00	82.76	82.69	81.86
+40.00	82.91	82.84	82.02
+50.00	83.06	82.99	82.17
+60.00	83.21	83.14	82.33
+66.88	83.31	--	--
+67.00	--	83.24	--
+68.37	--	--	82.46
+70.00	83.36	83.29	82.48

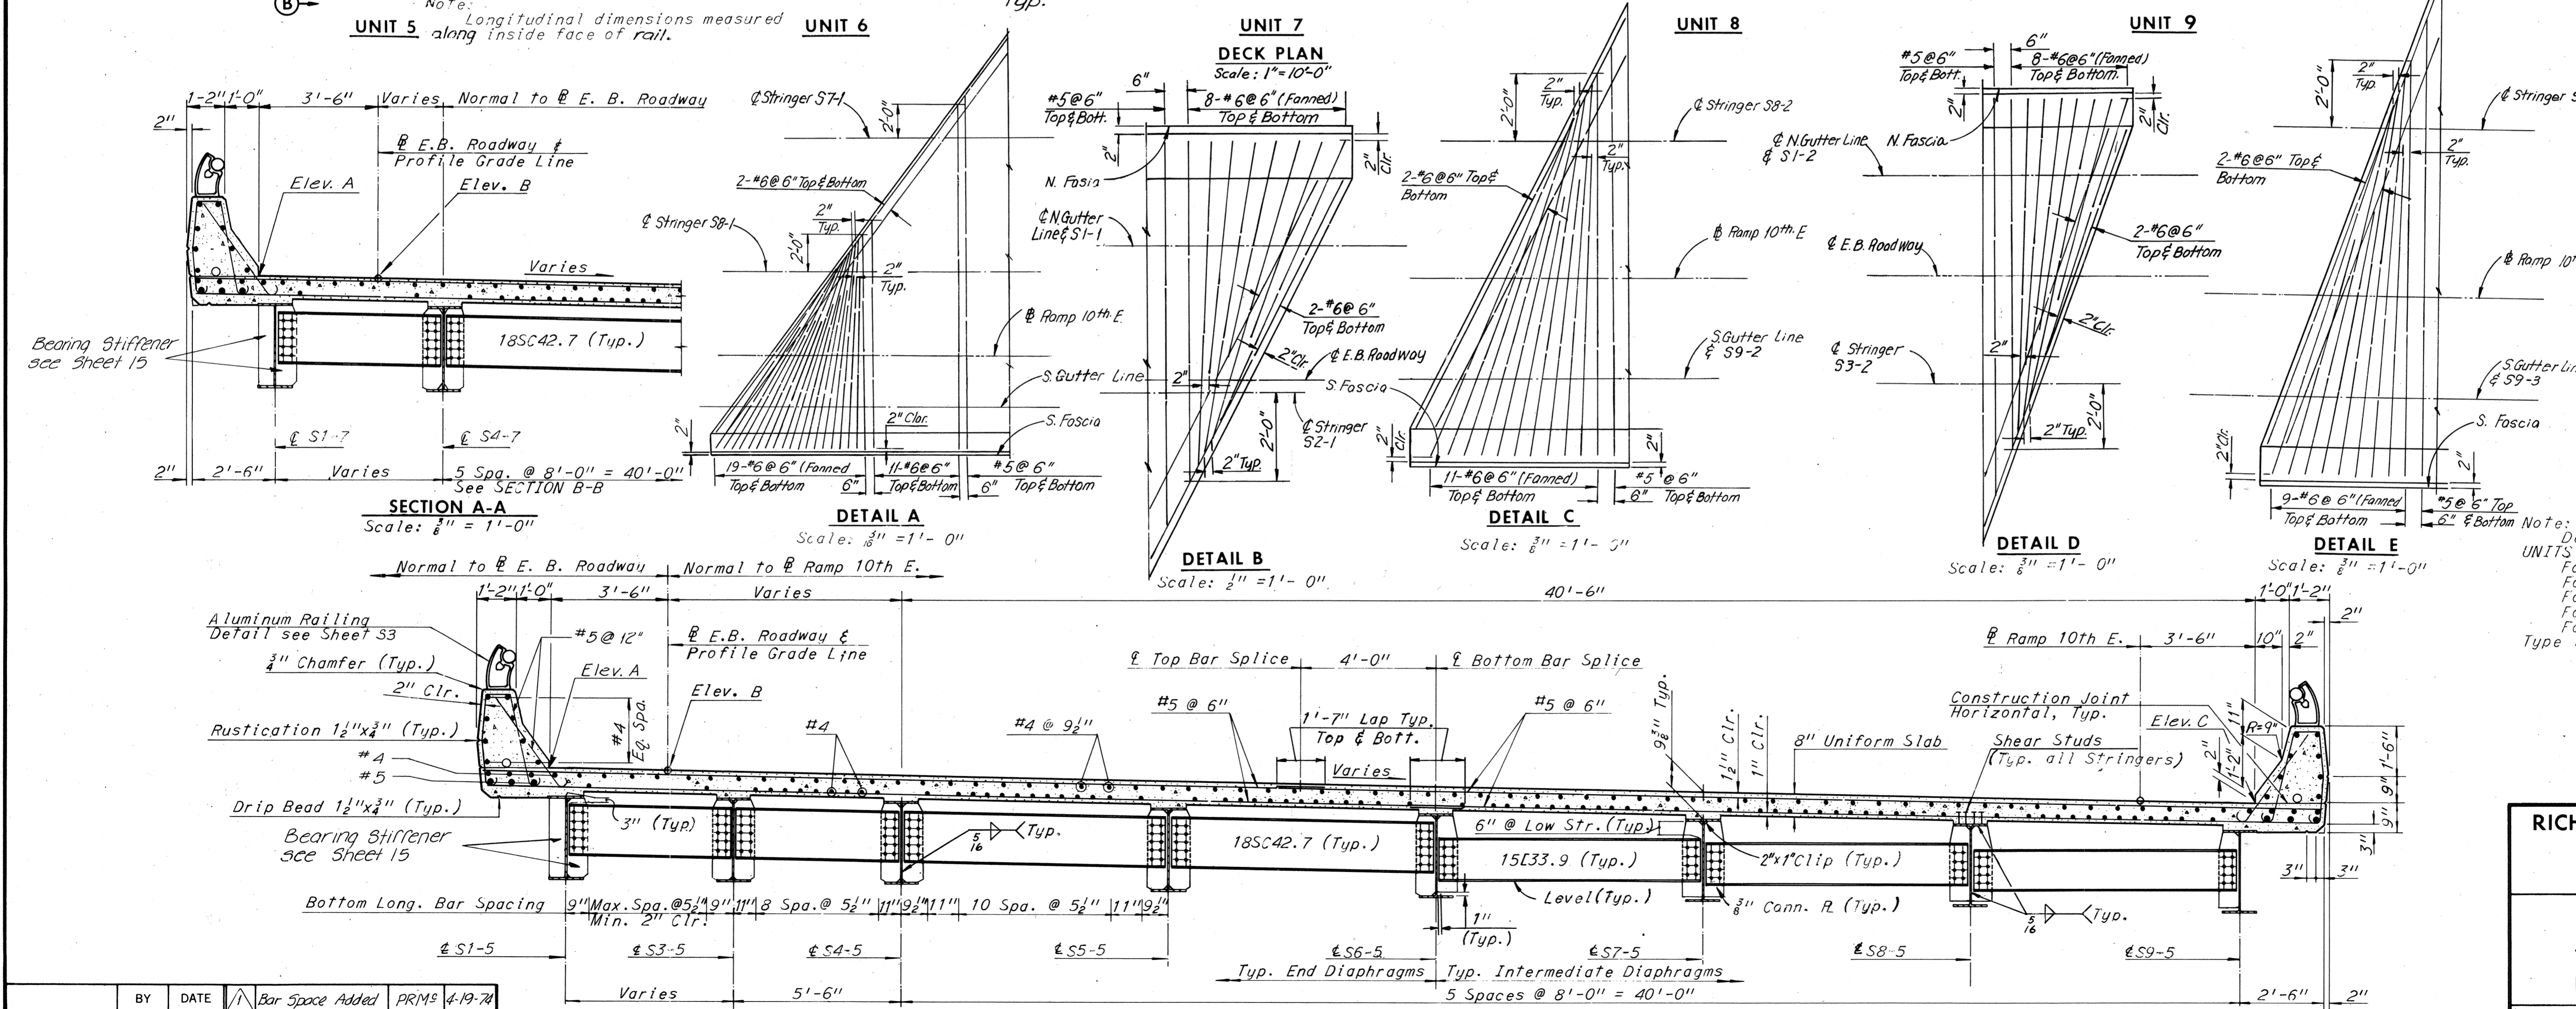

Details A through E belong to DECK-PLAN-UNITS 1, 2, 3 and 4, see Sheet 28
 For Joint Details, see Sheet 37
 For Framing Plan, see Sheet 15.
 For Handrail Details, see Sheet S3.
 For Superstructure Quantities, see Sheet 2.
 For Standard Drainage Details, see Support Type 1, Sheet S5496.

BY	DATE	Bar Space Added	PRMS	4-19-74
MADE	SHS 8-2-68	2 As Built	TEM	8-76
CHECKED	AHH 11-1-68			
IN CHARGE				

RICHMOND METROPOLITAN AUTHORITY
RICHMOND EXPRESSWAY SYSTEM
DOWNTOWN EXPRESSWAY


BRIDGE NO. 66
EASTBOUND ROADWAY OVER
12TH ST. - R.R. TRACKS AND 16TH ST.
DECK PLAN-UNITS 5, 6, 7, 8, AND 9

HOWARD, NEEDLES, TAMMEN & BERGENDOFF
 Consulting Engineers
 NEW YORK ALEXANDRIA KANSAS CITY

SCALE: As Noted
 CONTRACT NO. 10
 SHEET NO. 29 OF 46


AS BUILT

RICHMOND EXPRESSWAY SYSTEM			
SECTION	PROJECT	SHEET NO.	TOTAL SHEETS
10	DOWNTOWN EXPRESSWAY	156	265

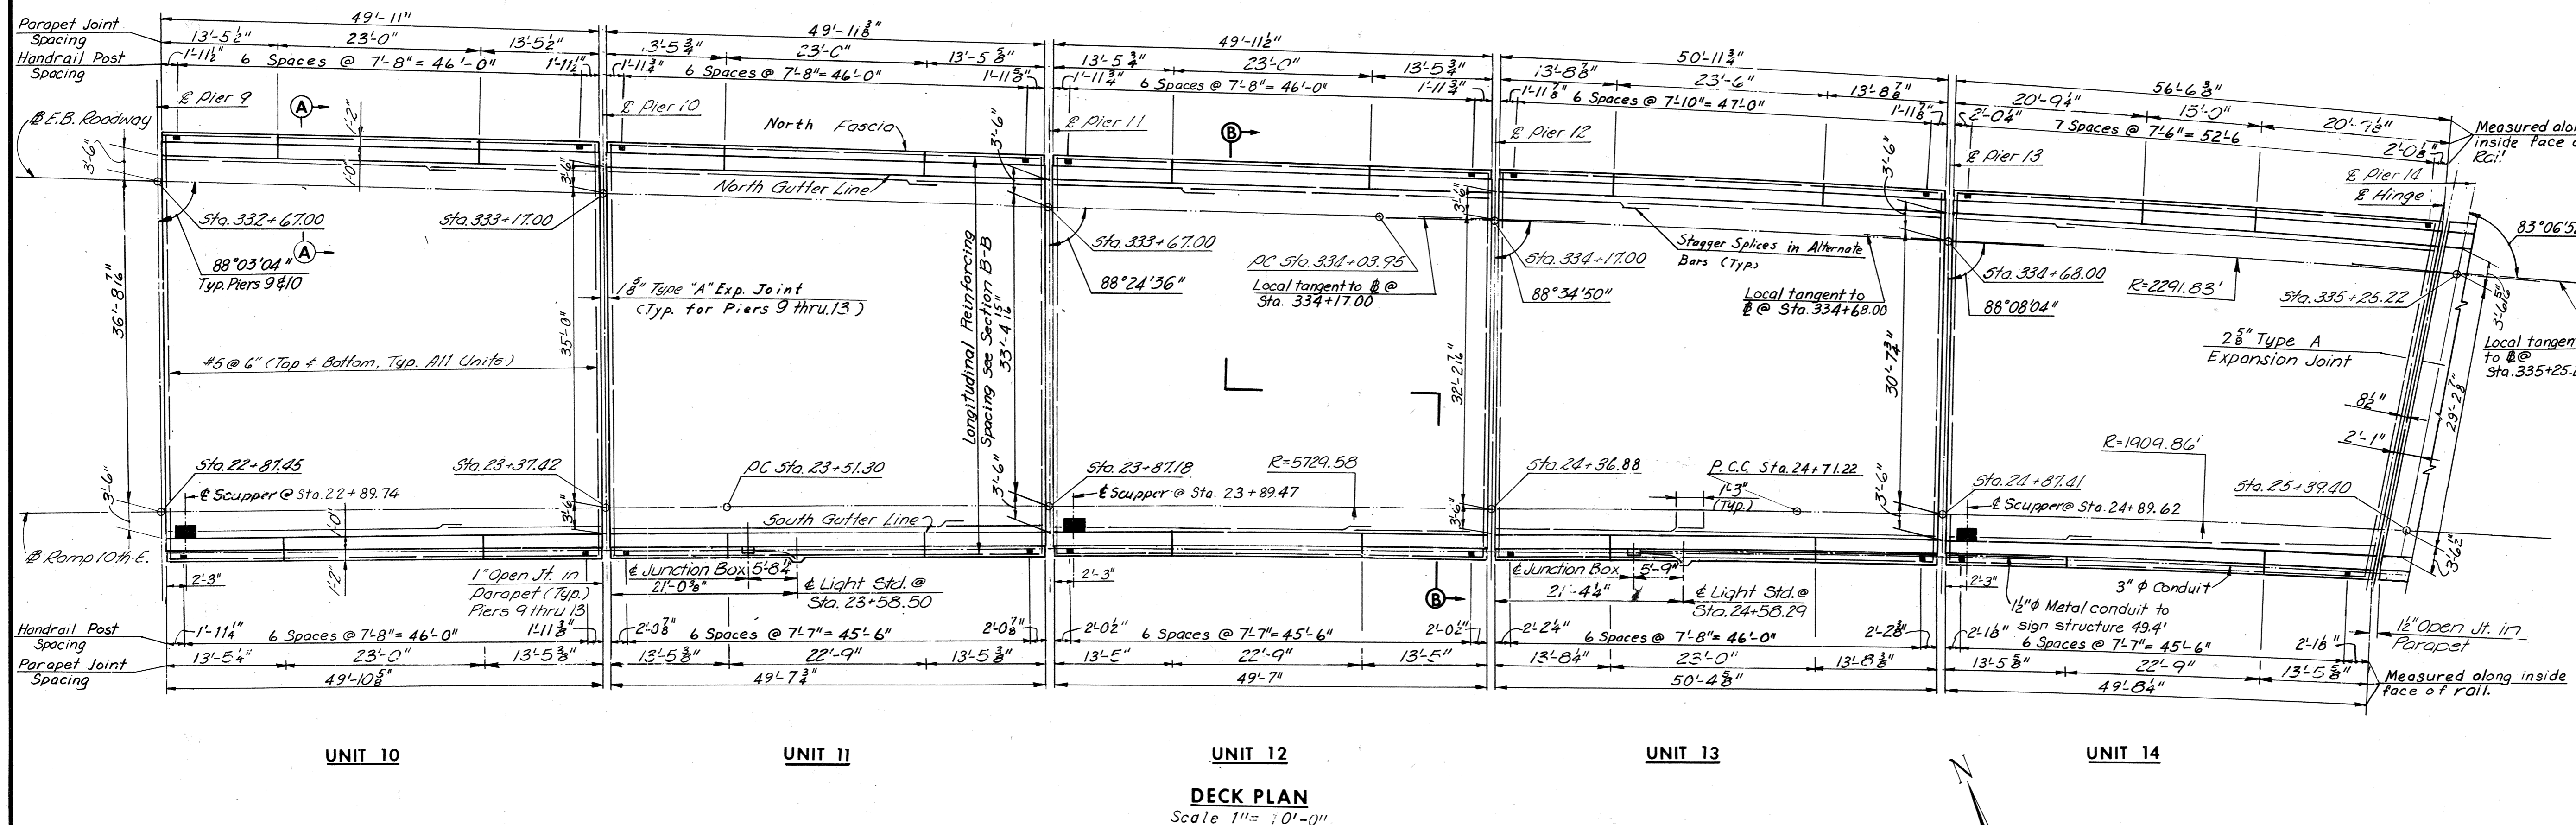


ELEVATION TABLE

STATION	ELEV. A	ELEV. B	ELEV. C
332+60.00	83.21	83.14	82.33
332+66.88	83.31	---	---
332+67.00	---	83.24	---
332+68.37	---	---	82.46
332+70.00	83.36	83.29	82.48
332+80.00	83.50	83.43	82.64
332+90.00	83.65	83.58	82.79
333+00.00	83.80	83.73	82.95
333+10.00	83.95	83.88	83.10
333+16.88	84.05	---	---
333+17.00	---	83.98	---
333+18.31	---	---	83.21
333+20.00	84.10	84.03	83.23
333+30.00	84.25	84.17	83.35
333+40.00	84.40	84.32	83.45
333+50.00	84.56	84.47	83.54
333+60.00	84.71	84.62	83.62
333+66.90	84.82	---	---
333+67.00	---	84.72	---
333+68.02	---	---	83.69
333+70.00	84.86	84.77	83.70
333+80.00	85.03	84.91	83.78
333+90.00	85.18	85.06	83.86
334+00.00	85.34	85.21	83.94
334+10.00	85.49	85.36	84.03
334+16.91	85.60	---	---
334+17.00	---	85.46	---
334+17.88	---	---	84.10
334+20.00	85.64	85.51	84.12
334+30.00	85.80	85.65	84.20
334+40.00	85.95	85.80	84.30
334+50.00	86.11	85.95	84.39
334+60.00	86.26	86.10	84.49
334+67.89	86.38	---	---
334+68.00	---	86.22	---
334+69.11	---	---	84.63
334+70.00	86.41	86.25	84.61
334+80.00	86.56	86.39	84.74
334+90.00	86.71	86.54	84.88
335+00.00	86.86	86.69	85.04
335+10.00	87.01	86.84	85.20
335+20.00	87.15	86.97	85.35
335+25.64	87.23	---	---
335+25.22	---	87.04	---
335+21.29	---	---	85.36
335+30.00	87.29	87.11	85.49

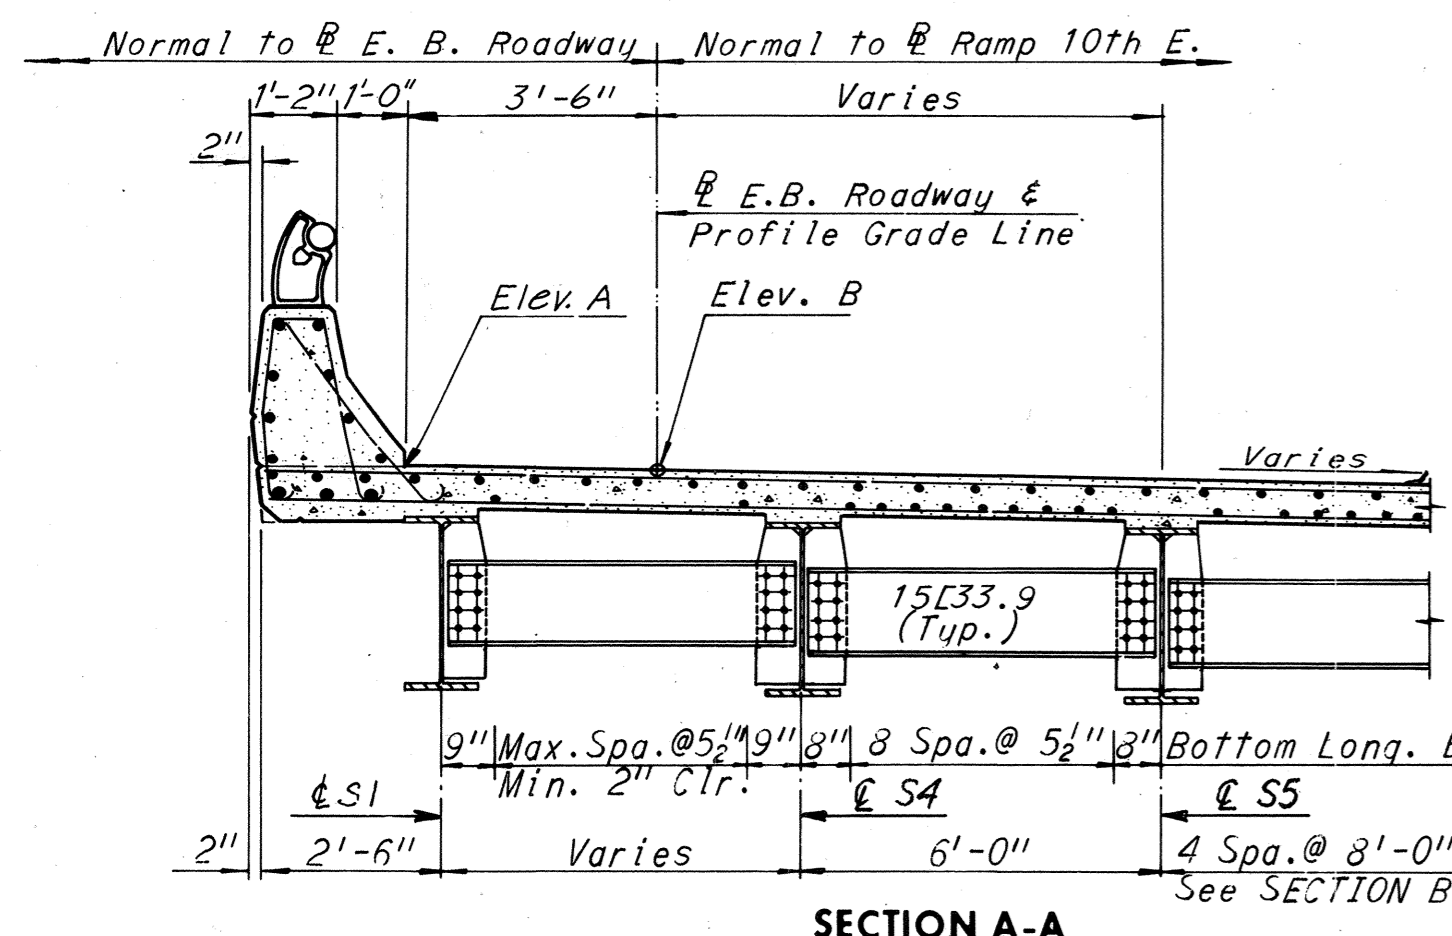

SECTION A-A
Scale: 3/8" = 1'-0"

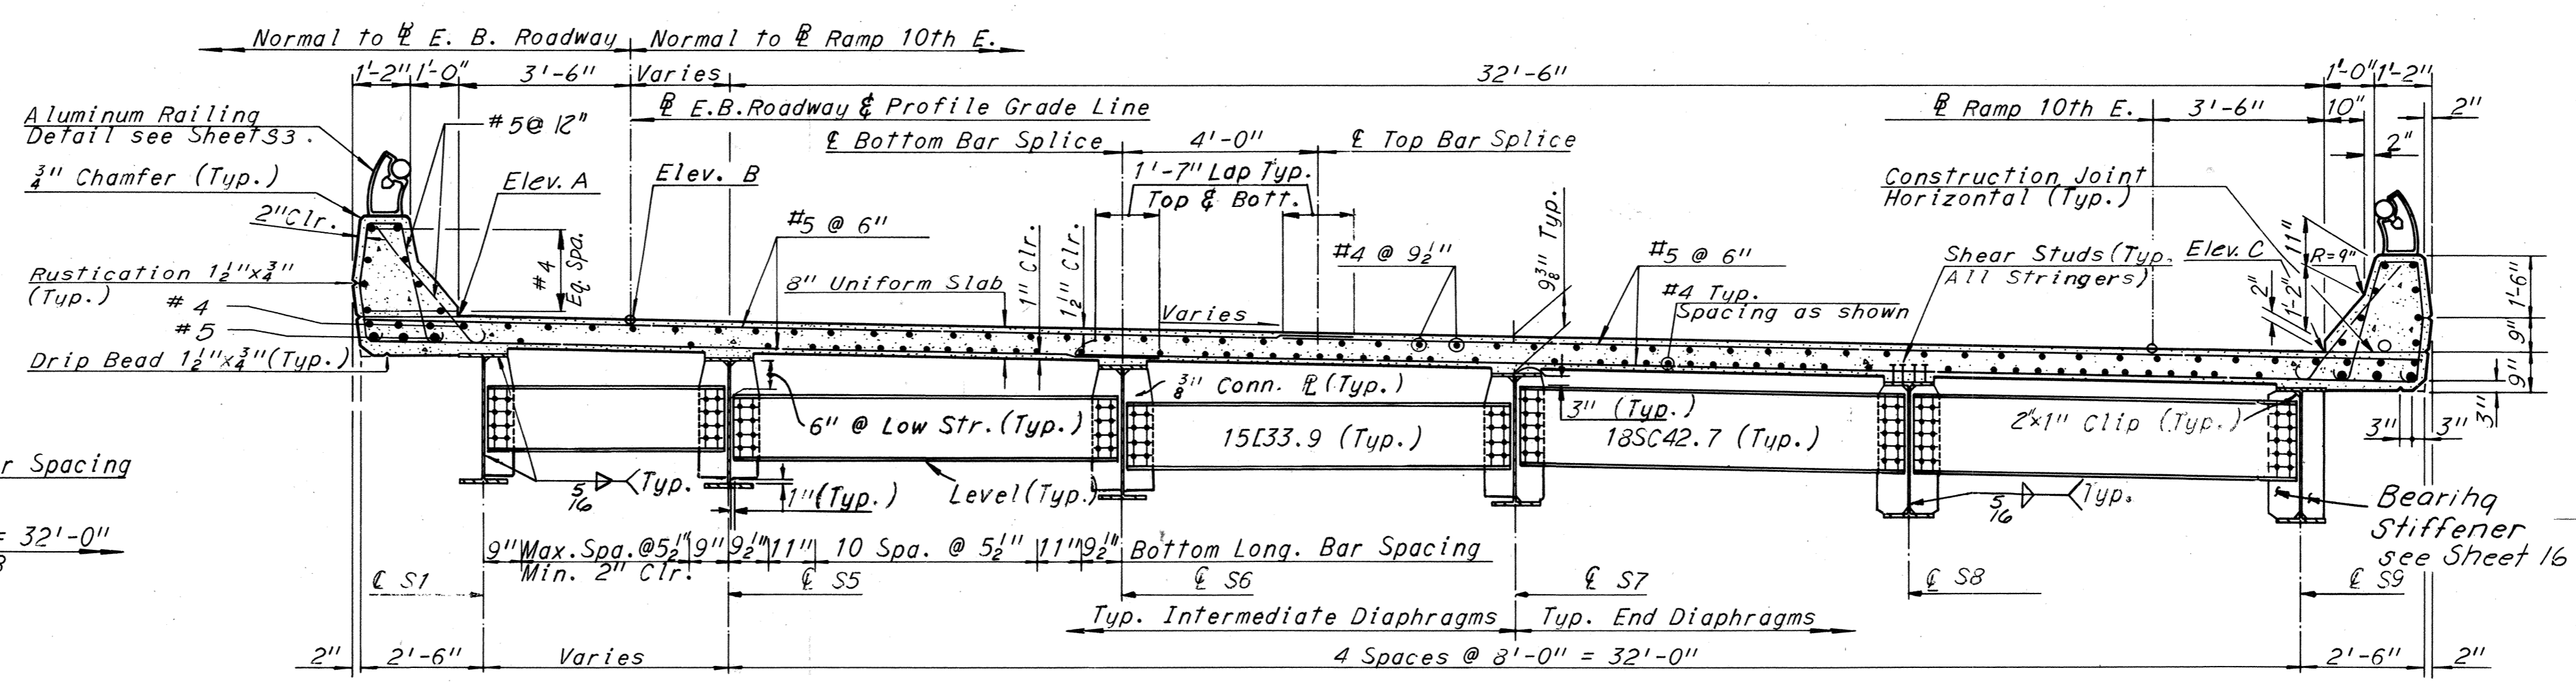

SECTION B-B
Scale: 3/8" = 1'-0"

Notes:
 For Joint Details, see Sheet 37
 For Framing Plan, see Sheet 16
 For Handrail Details, see Sheet 53
 For Superstructure Quantities, see Sheet 2.
 For Standard Drainage Details, see Support Type 1, Sheet S5E56.

RICHMOND METROPOLITAN AUTHORITY
RICHMOND EXPRESSWAY SYSTEM
DOWNTOWN EXPRESSWAY

BRIDGE NO. 66
EASTBOUND ROADWAY OVER
12TH ST - R.R. TRACKS AND 16TH ST.
DECK PLAN - UNITS 10, 11, 12, 13 AND 14

HOWARD, NEEDLES, TAMMEN & BERGENDOFF
 consulting engineers
 NEW YORK ALEXANDRIA KANSAS CITY




SCALE: As Noted
 CONTRACT NO.: 10
 SHEET NO. 30 OF 46

BY	DATE	Bar Space Added	PRMS	4-19-74		
MADE	HJC	8-5-68	2	As Built	TEM	8-76
CHECKED	JD	10-21-68				
IN CHARGE						

AS BUILT

RICHMOND EXPRESSWAY SYSTEM			
SECTION	PROJECT	SHEET NO.	TOTAL SHEETS
10	DOWNTOWN EXPRESSWAY	157	265

ELEVATION TABLE			
STATION	ELEV. A	ELEV. B	ELEV. C
335+10.00	87.01	86.84	85.20
+20.00	87.15	86.97	85.35
+21.29	—	—	85.36
+25.22	87.22	—	—
+30.00	87.18	87.11	85.50
+40.00	87.40	87.23	85.64
+50.00	87.53	87.35	85.76
+60.00	87.63	87.46	85.89
+70.00	87.74	87.57	86.01
+80.00	87.85	87.67	86.11
+90.00	87.93	87.76	86.23
336+00.00	88.02	87.85	86.33
+10.00	88.10	87.93	86.42
+20.00	88.17	88.02	86.52
+22.38	88.21	—	—
+23.00	—	88.04	—
+28.25	—	—	86.60
+30.00	88.27	88.10	86.61
+40.00	88.36	88.19	86.70
+50.00	88.44	88.27	86.80
+60.00	88.52	88.35	86.89
+70.00	88.61	88.44	86.98
+80.00	88.69	88.52	87.08
+90.00	88.78	88.61	87.17
337+00.00	88.86	88.69	87.28
+10.00	88.94	88.77	87.35
+20.00	89.03	88.86	87.49
+25.48	89.08	—	—
+26.26	—	88.91	—
+30.00	89.11	88.94	87.53
+32.60	—	—	87.55
337+40.00	89.20	89.03	87.62

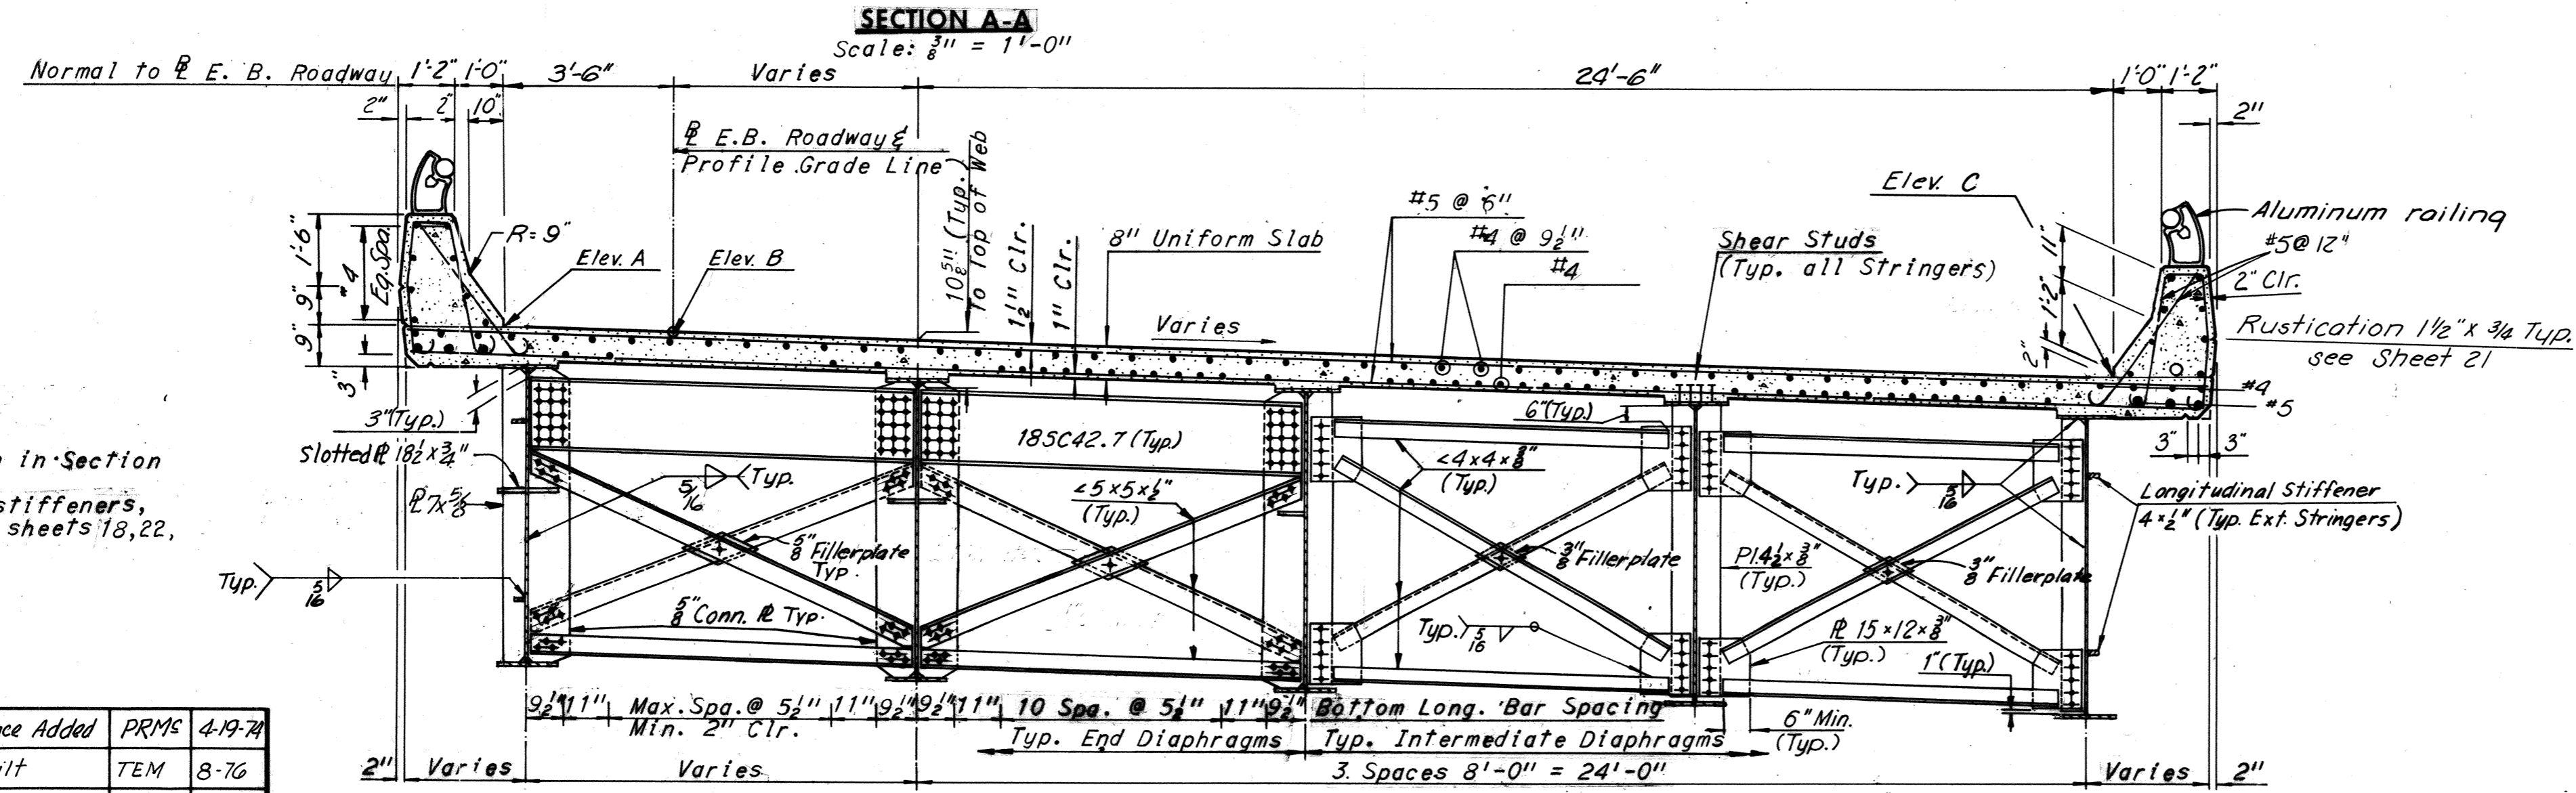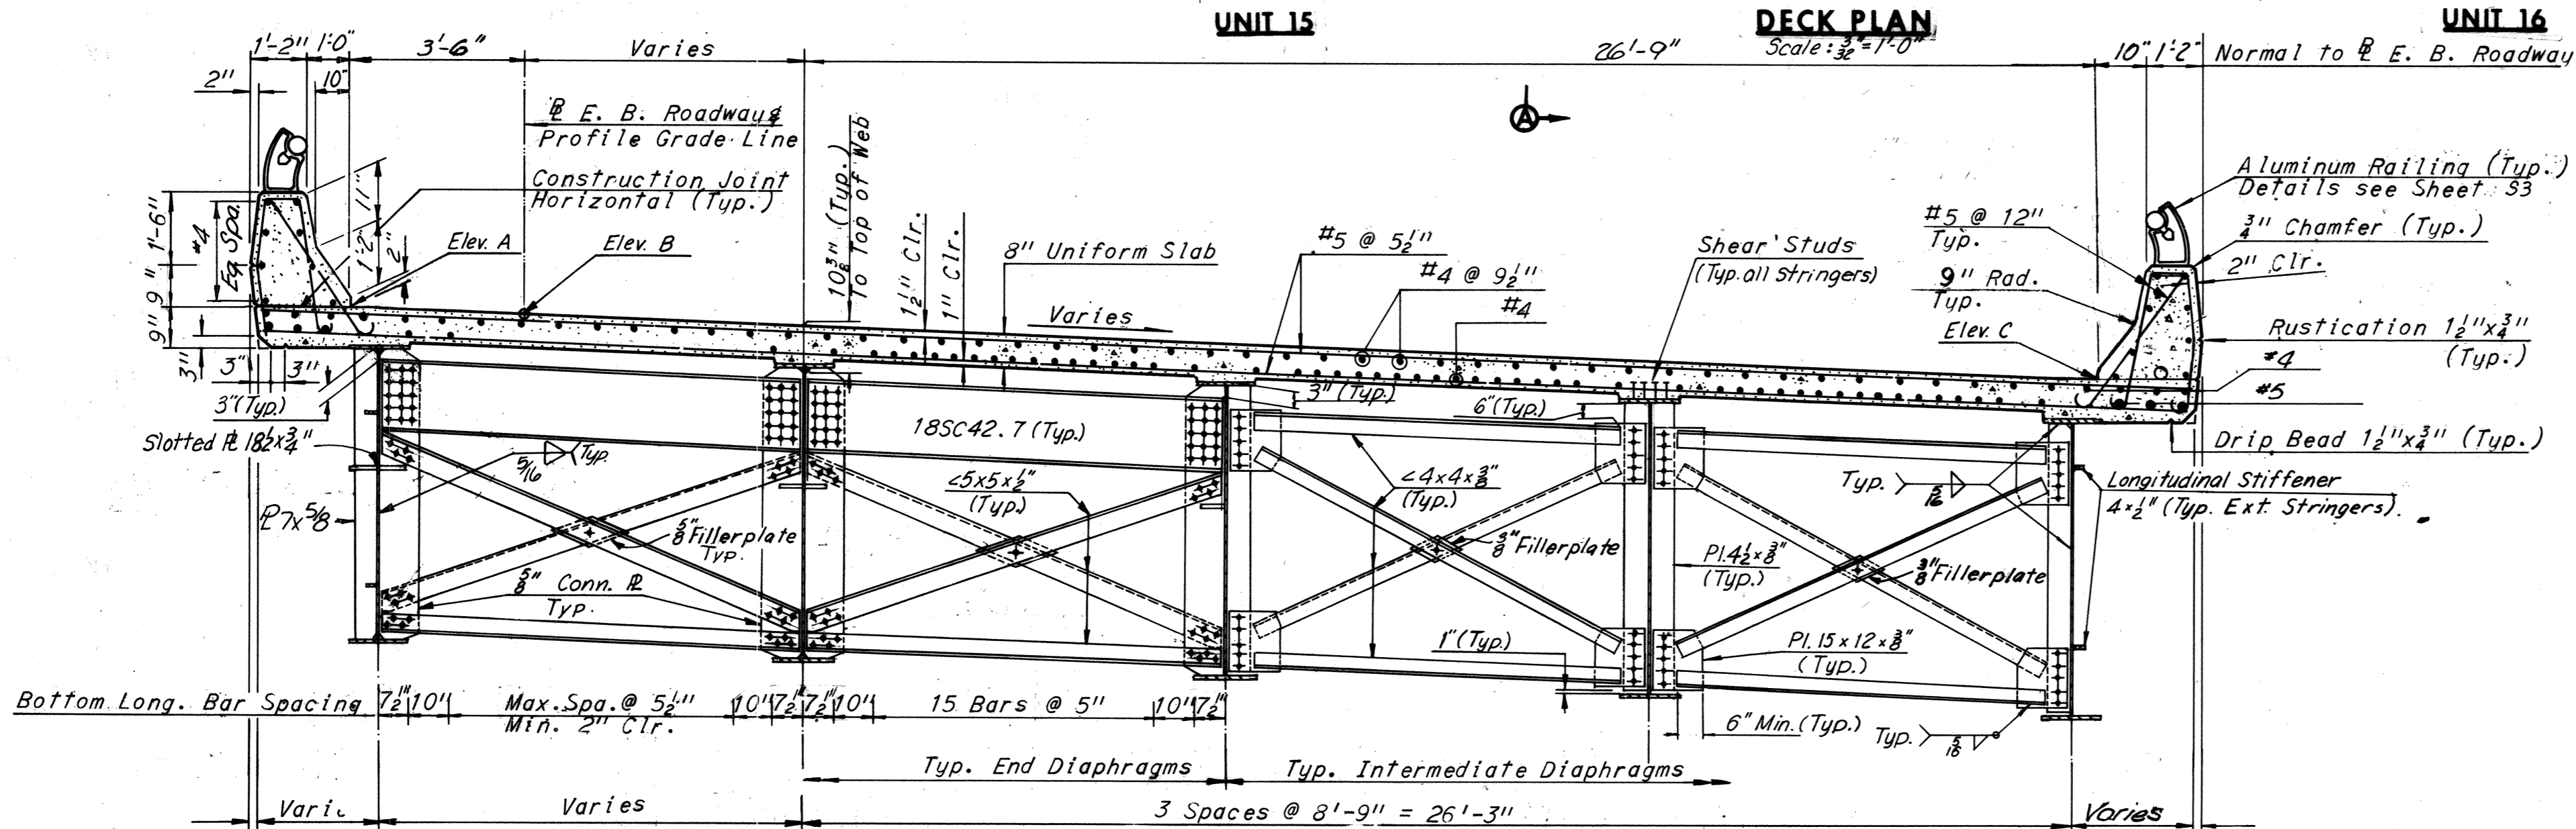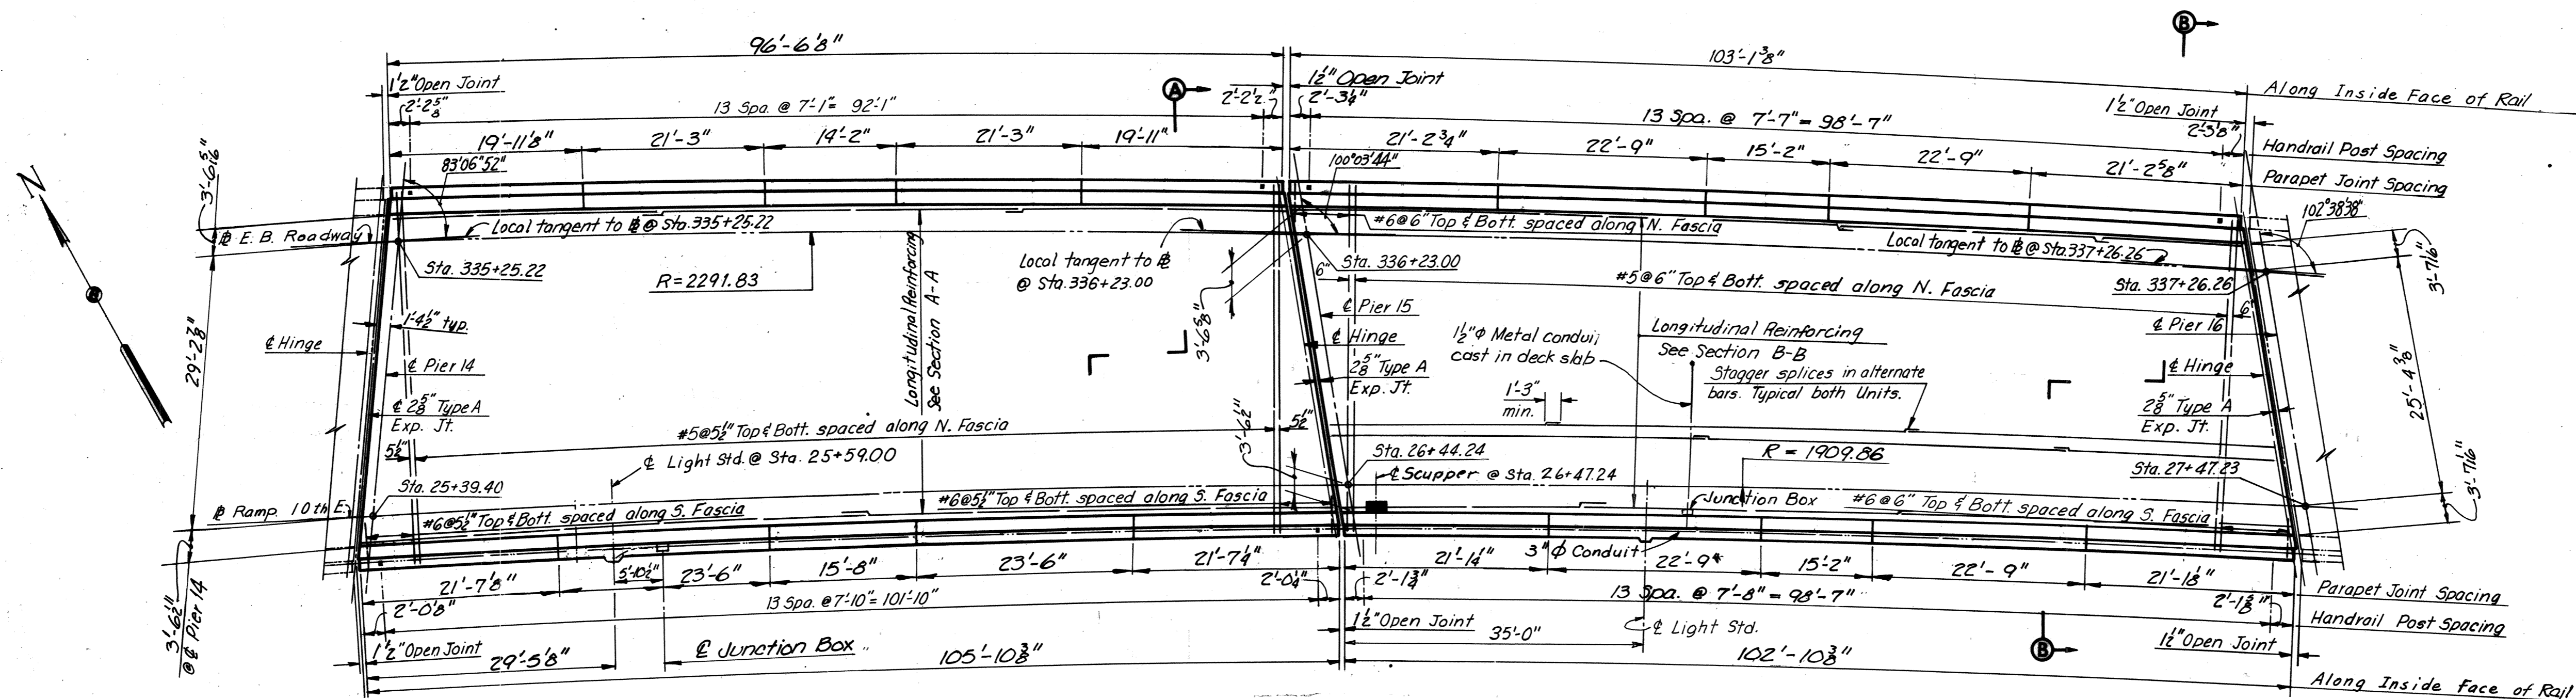

Notes:
 For details not shown in Section B-B, see Section A-A.
 For details of brg. stiffeners, long. stiffeners, see sheets 18, 22, and 23.

Notes:
 For Joint Details, see Sheet 38.
 For Framing Plan, see Sheet 17.
 For Handrail Details, see Sheet 53.
 For Superstructure quantities, see Sheet 2.
 For Standard Drainage Details, see Support Type 2 Sheet 55/56.

BY	DATE	Bar Space Added	PRMS	4-19-78		
MADE	RLM	8-6-68	2	As Built	TEM	8-76
CHECKED	SCC	10-21-68				
IN CHARGE	NO.	REVISION	BY	DATE		

RICHMOND METROPOLITAN AUTHORITY
RICHMOND EXPRESSWAY SYSTEM
DOWNTOWN EXPRESSWAY


BRIDGE NO. 66
EASTBOUND ROADWAY OVER
12TH ST. - R.R. TRACKS AND 16TH ST.
DECK PLAN-UNITS 15 AND 16

HOWARD, NEEDLES, TAMMEN & BERGENDOFF
 consulting engineers
 NEW YORK ALEXANDRIA KANSAS CITY



SCALE: As Noted
 CONTRACT NO. 10
 SHEET NO. 31 OF 46

AS BUILT

RICHMOND EXPRESSWAY SYSTEM			
SECTION	PROJECT	SHEET NO.	TOTAL SHEETS
10	DOWNTOWN EXPRESSWAY	158	265

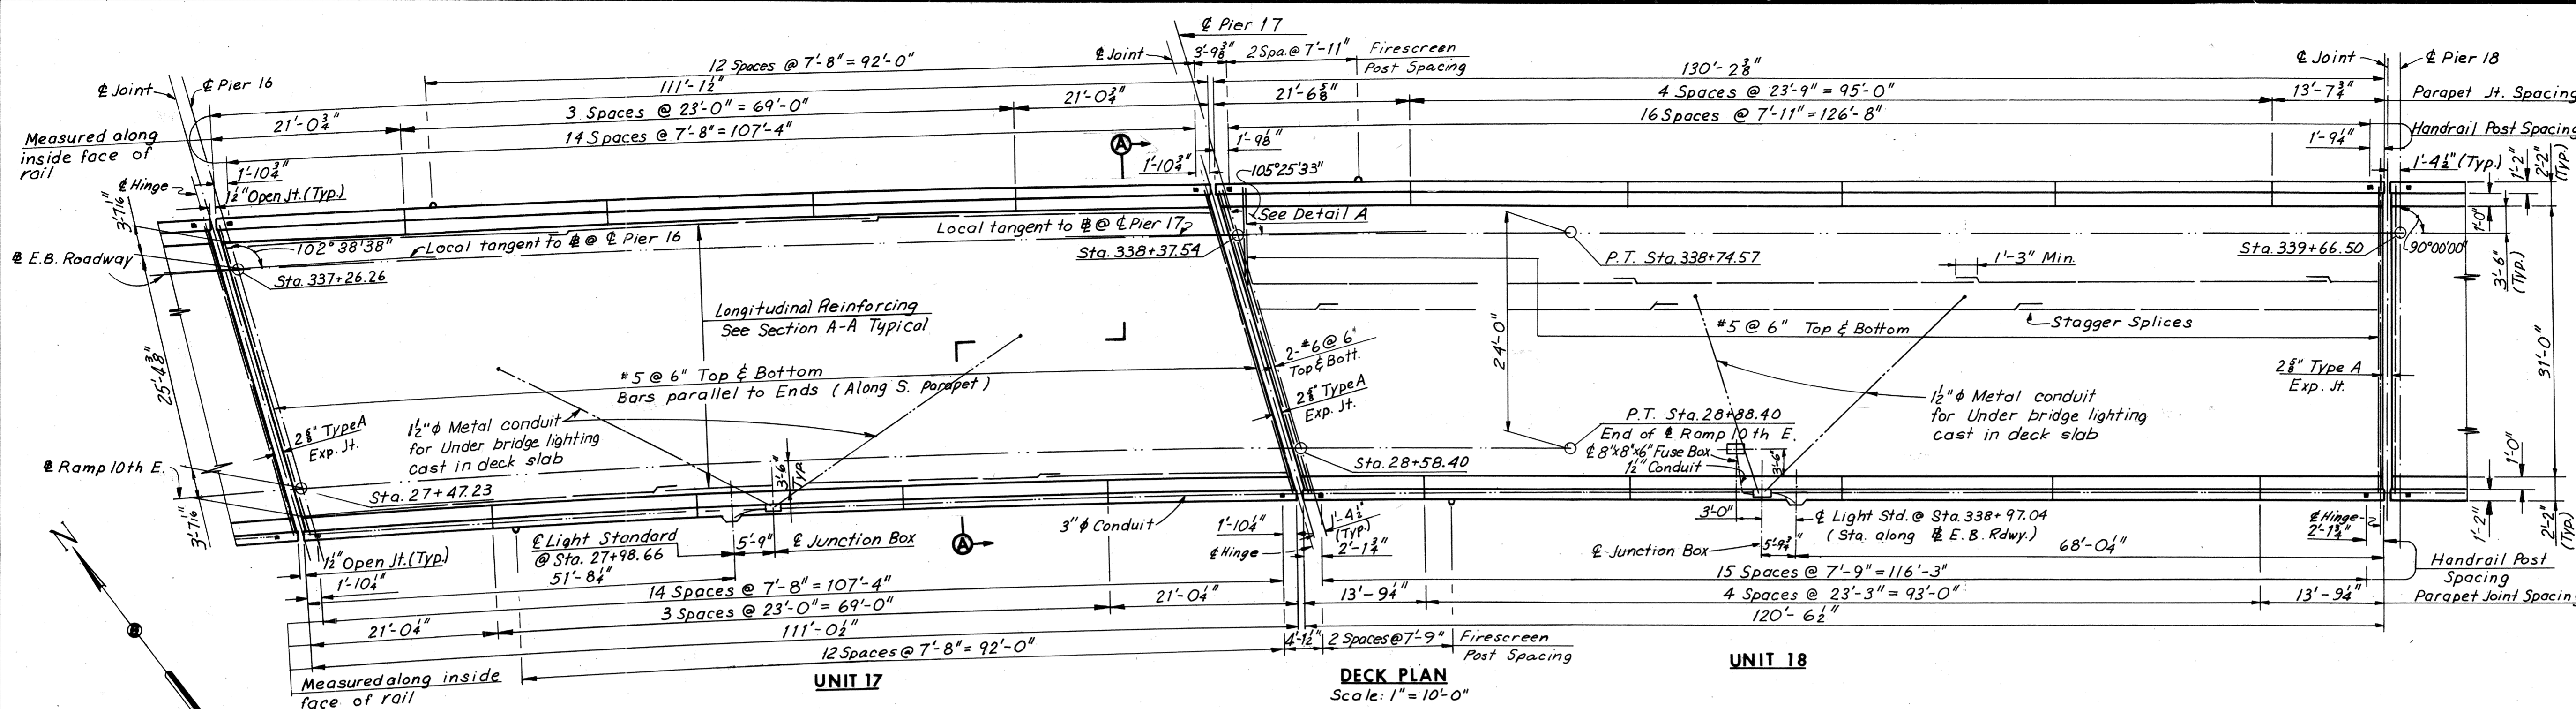

ELEVATION TABLE			
STATION	ELEV. A	ELEV. B	ELEV. C
337+20.00	89.03	88.86	87.44
+25.48	89.08	--	--
+26.26	--	88.91	--
+30.00	89.11	88.94	87.53
+32.60	--	--	87.55
+40.00	89.20	89.03	87.62
+50.00	89.28	89.11	87.71
+60.00	89.36	89.19	87.80
+70.00	89.45	89.28	87.89
+80.00	89.53	89.36	87.98
+90.00	89.62	89.45	88.07
338+00.00	89.70	89.53	88.18
+10.00	89.78	89.61	88.30
+20.00	89.86	89.70	88.43
+30.00	89.93	89.78	88.57
+36.58	89.99	--	--
+37.54	--	89.85	--
+40.00	90.01	89.87	88.71
+45.13	--	--	88.78
+50.00	90.09	89.95	88.85
+60.00	90.17	90.03	88.99
+70.00	90.25	90.12	89.13
+80.00	90.32	90.20	89.26
+90.00	90.40	90.29	89.40
339+00.00	90.48	90.37	89.54
+10.00	90.55	90.45	89.69
+20.00	90.63	90.54	89.83
+30.00	90.70	90.62	89.96
+40.00	90.78	90.71	90.10
+50.00	90.86	90.79	90.24
+60.00	90.94	90.87	90.38
+66.50	90.99	90.93	90.47
+70.00	91.02	90.96	90.52

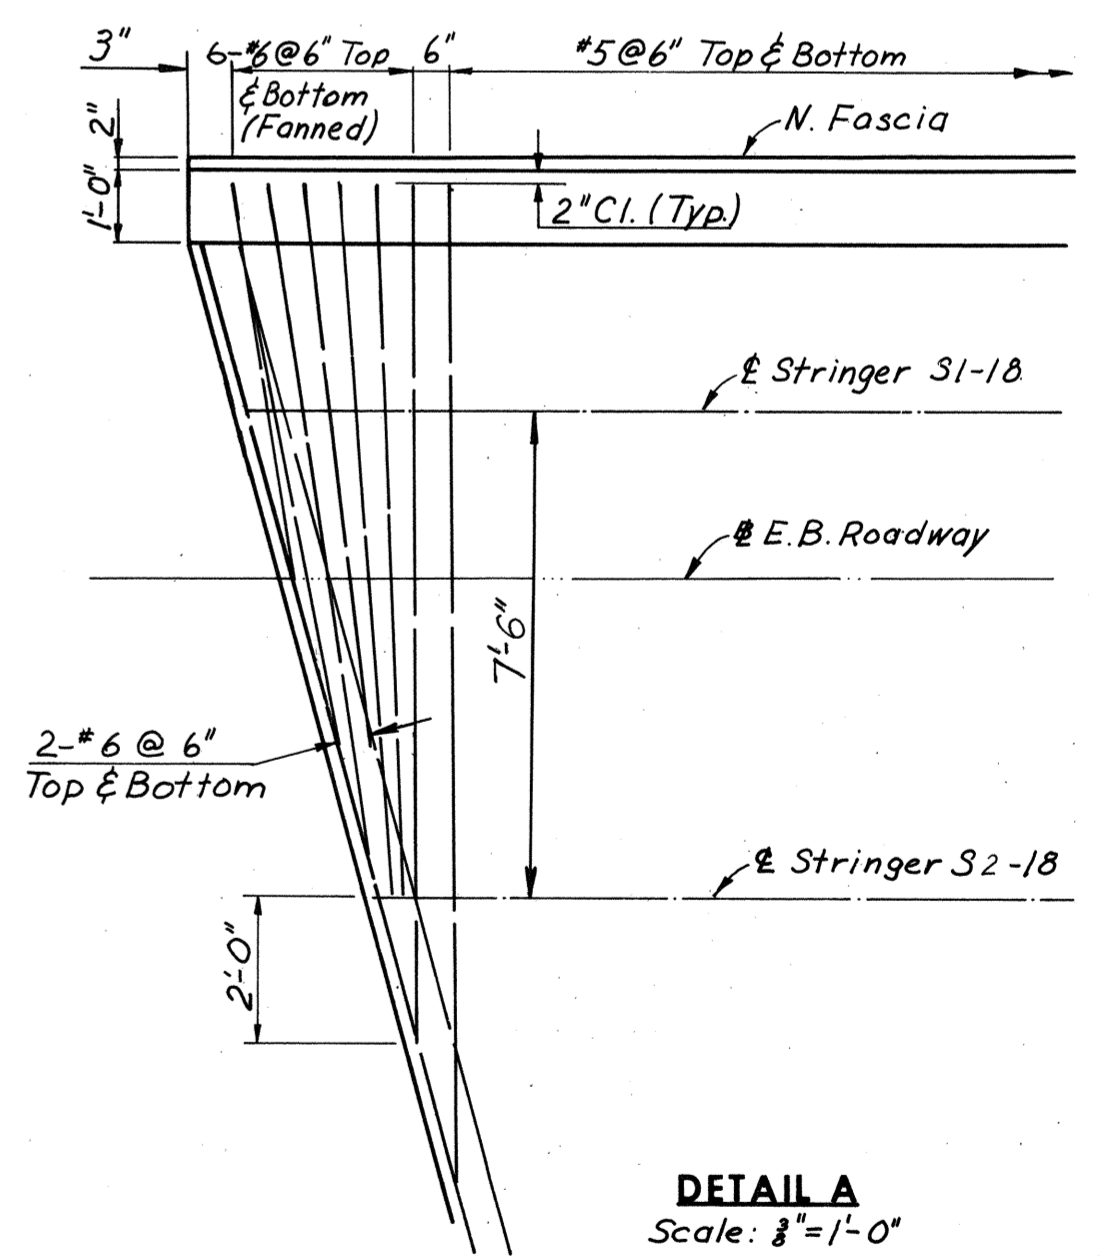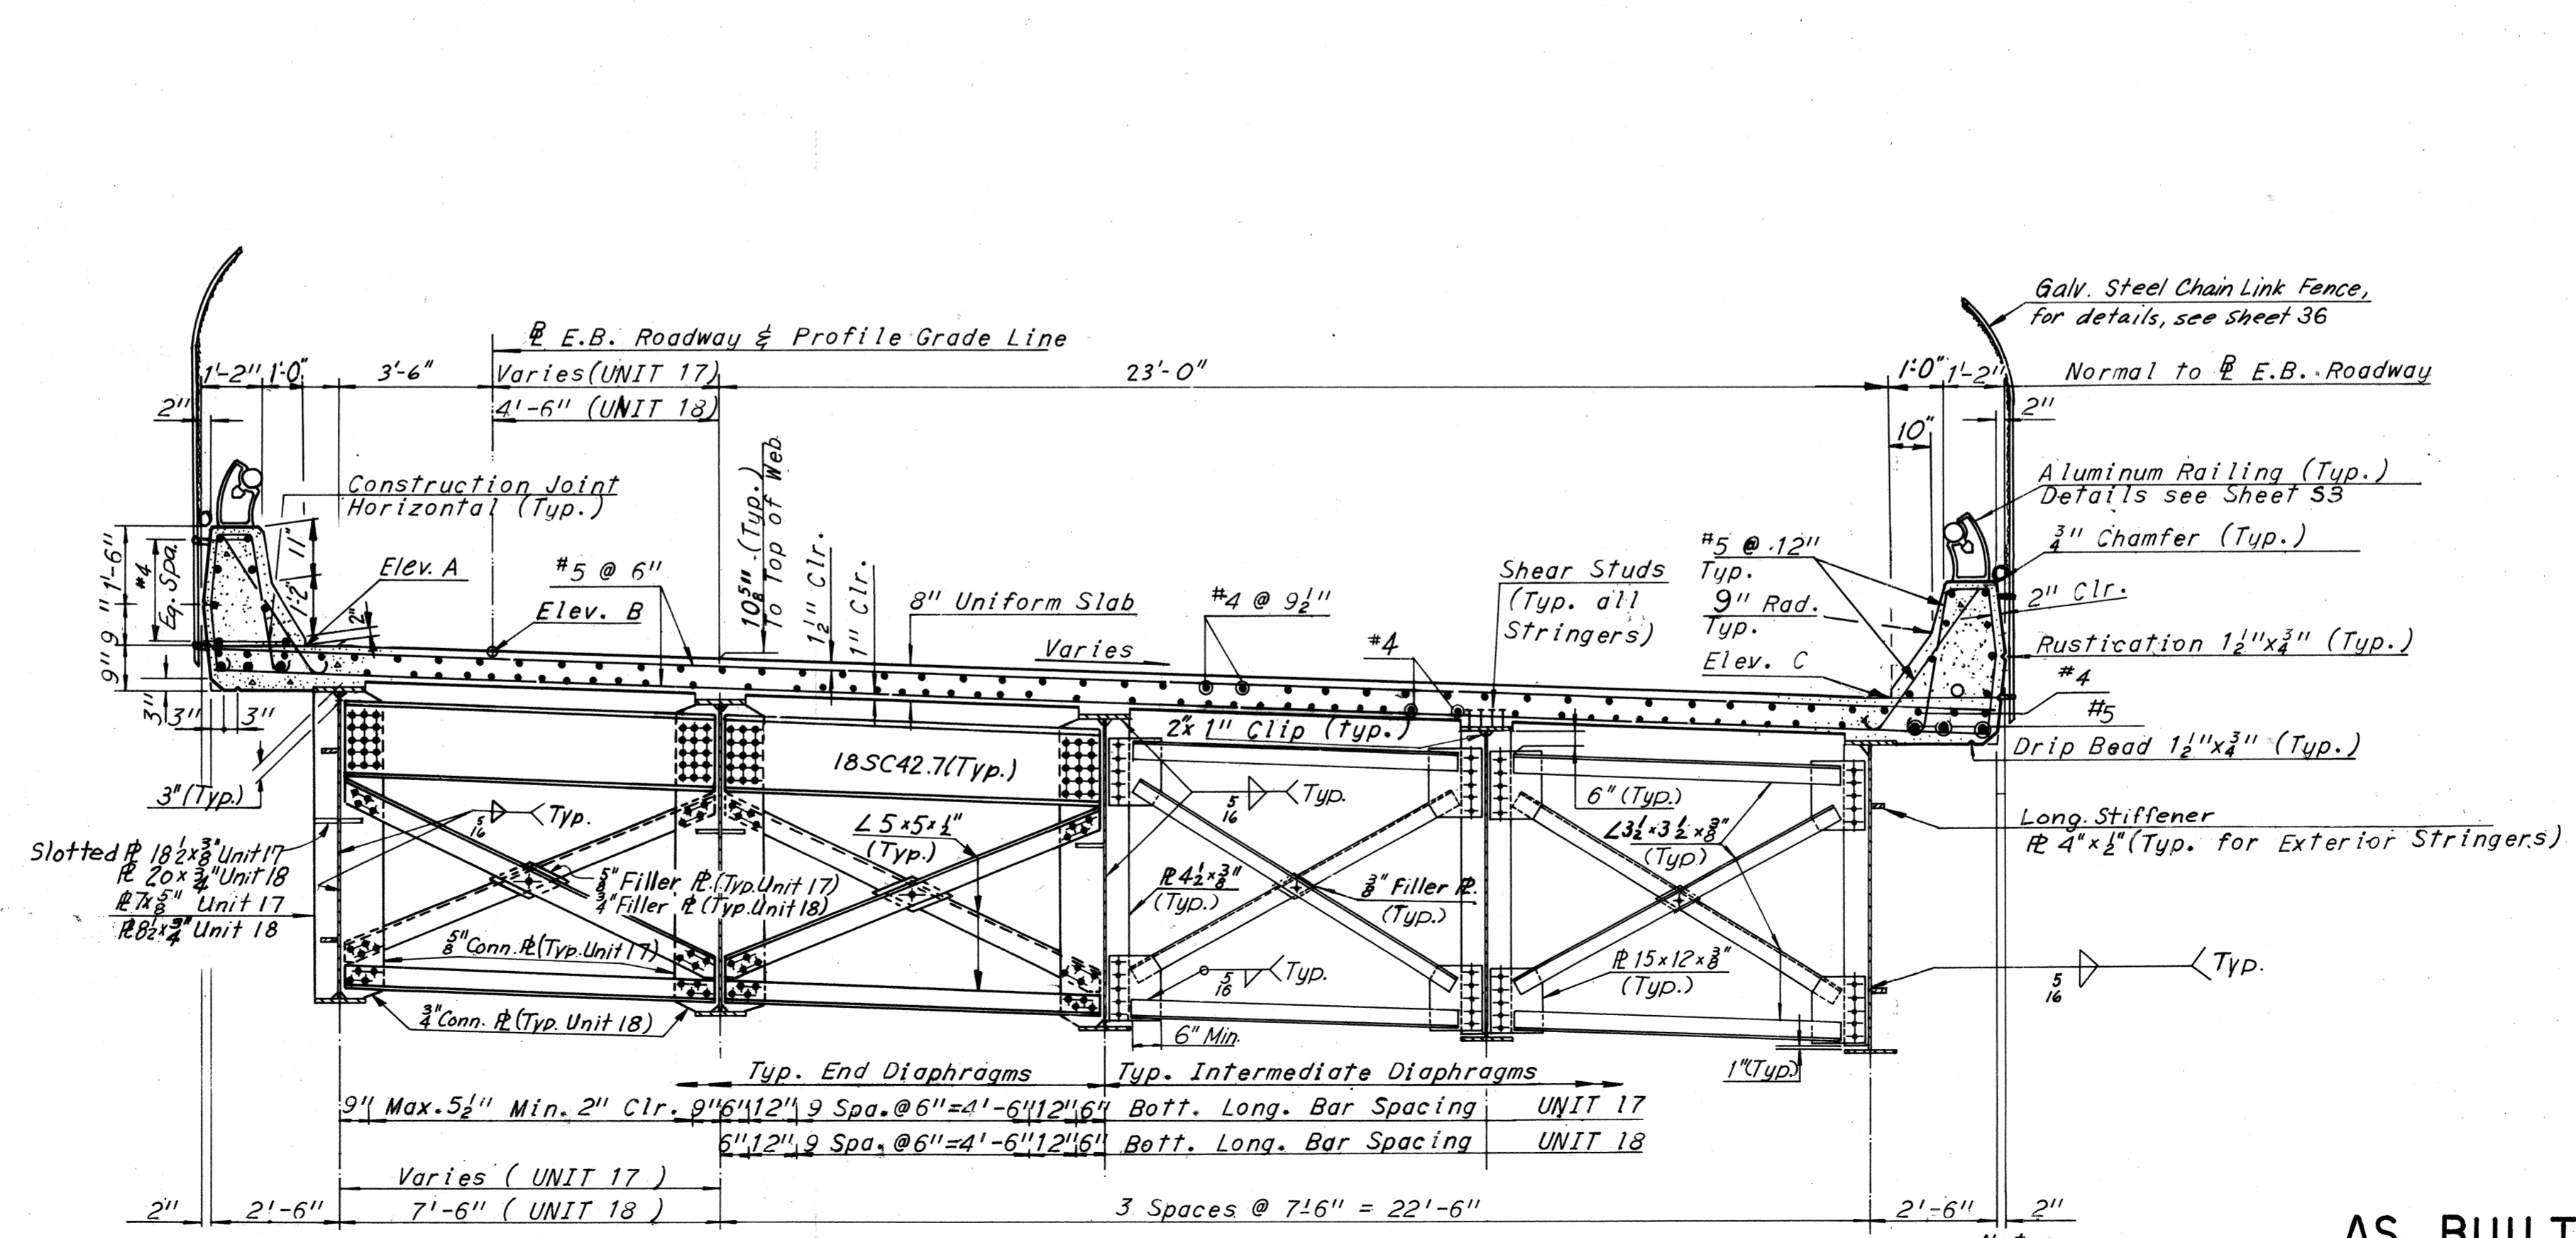

BY	DATE	REVISION	BY	DATE
J.D.	8-9-68			
R.C.	10-18-68	As Built	TEM	8-76

RICHMOND METROPOLITAN AUTHORITY
RICHMOND EXPRESSWAY SYSTEM
DOWNTOWN EXPRESSWAY

BRIDGE NO. 66
EASTBOUND ROADWAY OVER
12TH ST. - R.R. TRACKS AND 16TH ST.
DECK PLAN - UNITS 17 AND 18

HOWARD, NEEDLES, TAMMEN & BERGENDOFF
 consulting engineers
 NEW YORK ALEXANDRIA KANSAS CITY



SCALE: 3/8" = 1'-0"
 CONTRACT NO. 10
 SHEET NO. 32 OF 46

AS BUILT


Notes:
 For Joint Details, see Sheet 38.
 For Framing Plan, see Sheet 18.
 For Handrail Details, see Sheet 93.
 For Superstructure quantities, see Sheet 2.

RICHMOND EXPRESSWAY SYSTEM			
SECTION	PROJECT	SHEET NO.	TOTAL SHEETS
10	DOWNTOWN EXPRESSWAY	159	265


ELEVATION TABLE			
STATION	ELEV. A	ELEV. B	ELEV. C
339+60.00	90.94	90.87	90.38
+66.50	90.99	90.93	90.47
+70.00	91.02	90.96	90.52
+80.00	91.09	91.04	90.65
+90.00	91.17	91.13	90.79
340+00.00	91.24	91.21	90.94
+10.00	91.32	91.29	91.08
+20.00	91.40	91.38	91.22
+30.00	91.47	91.46	91.35
+40.00	91.55	91.55	91.49
+50.00	91.63	91.63	91.63
+60.00	91.71	91.71	91.77
+68.00	91.77	91.78	91.88
+70.00	91.79	91.80	91.91
+80.00	91.86	91.88	92.04
+90.00	91.94	91.97	92.18
341+00.00	92.02	92.05	92.32
+10.00	92.09	92.13	92.47
+20.00	92.17	92.22	92.61
+30.00	92.24	92.30	92.74
+40.00	92.32	92.39	92.87
+50.00	92.40	92.47	92.99
+60.00	92.49	92.55	93.09
+70.00	92.57	92.64	93.19
+75.50	92.61	92.68	93.23
+80.00	92.65	92.72	93.27

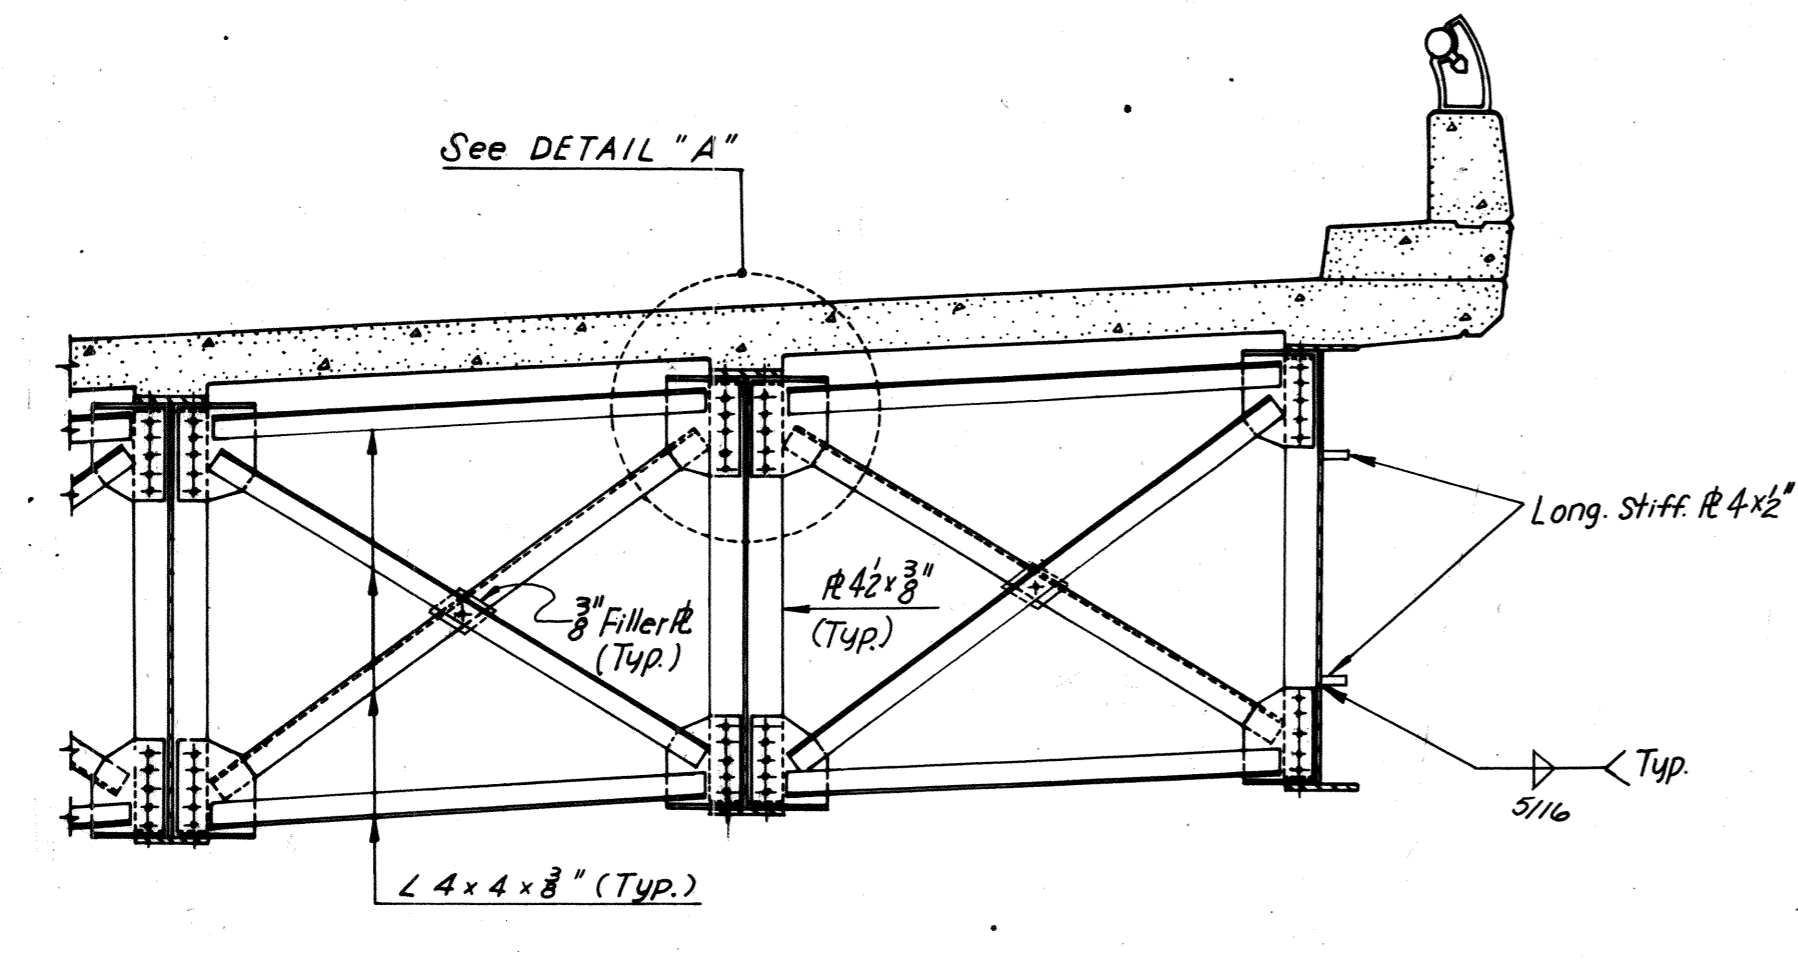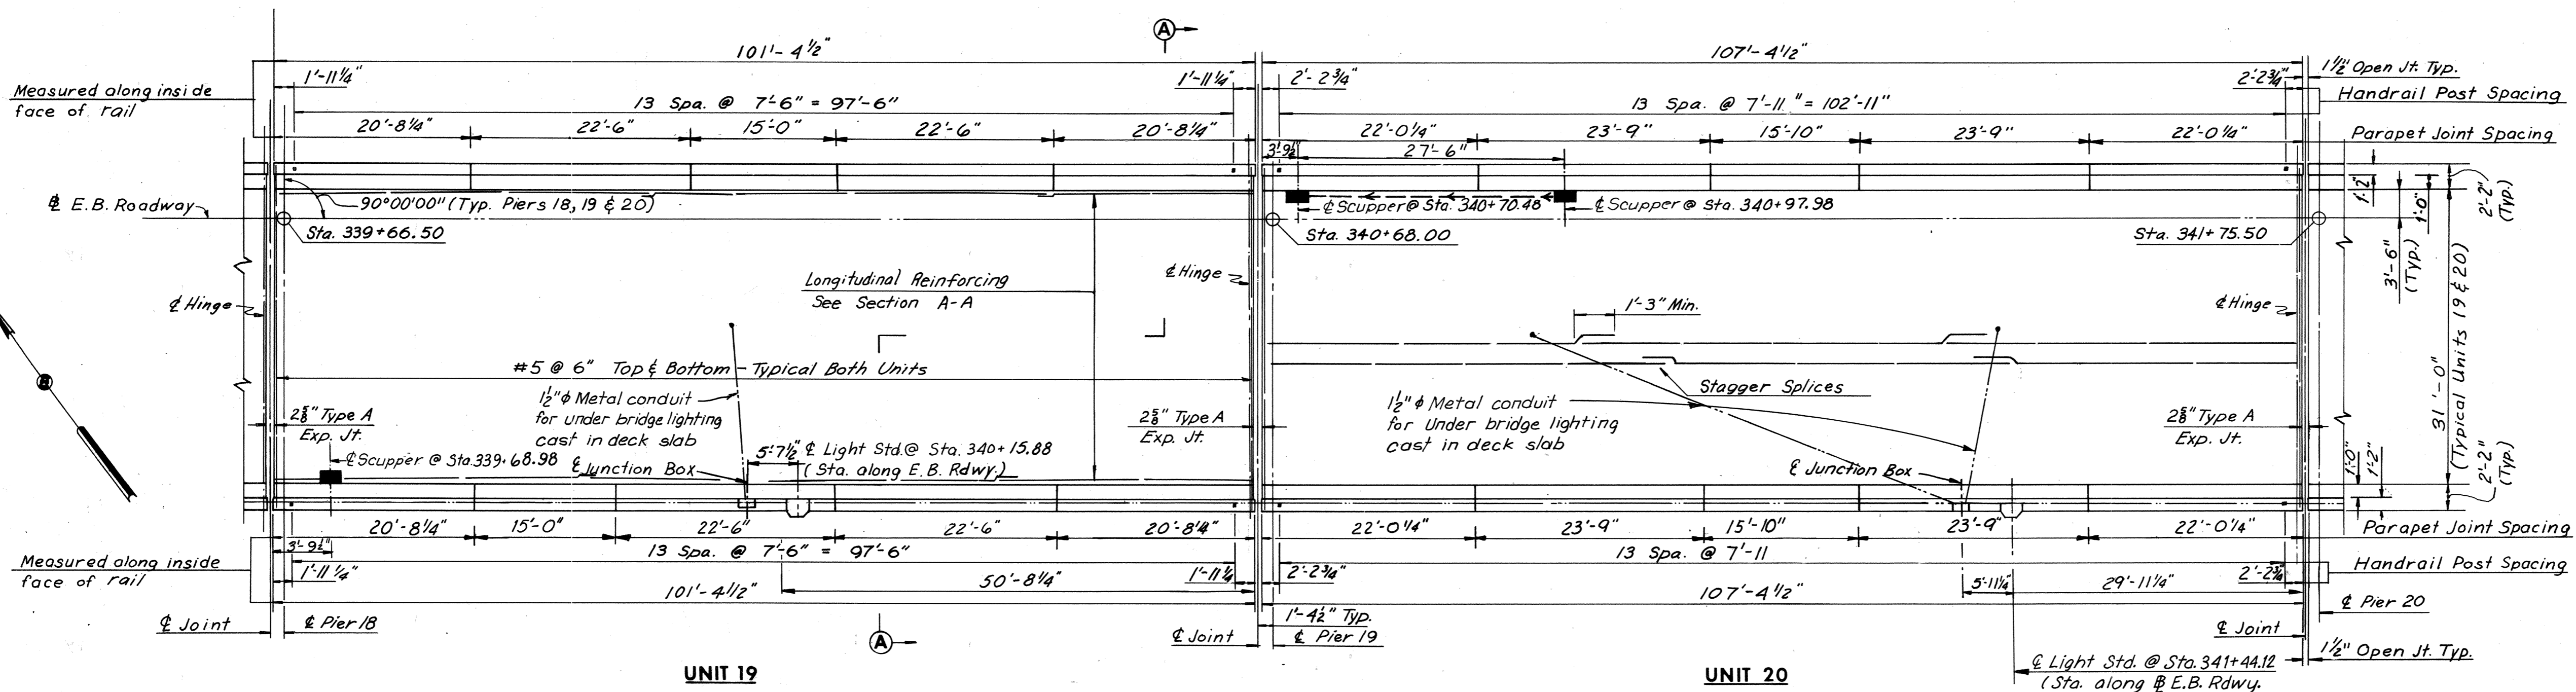


INTERMEDIATE DIAPHRAGM
Scale: 3/8" = 1'-0"

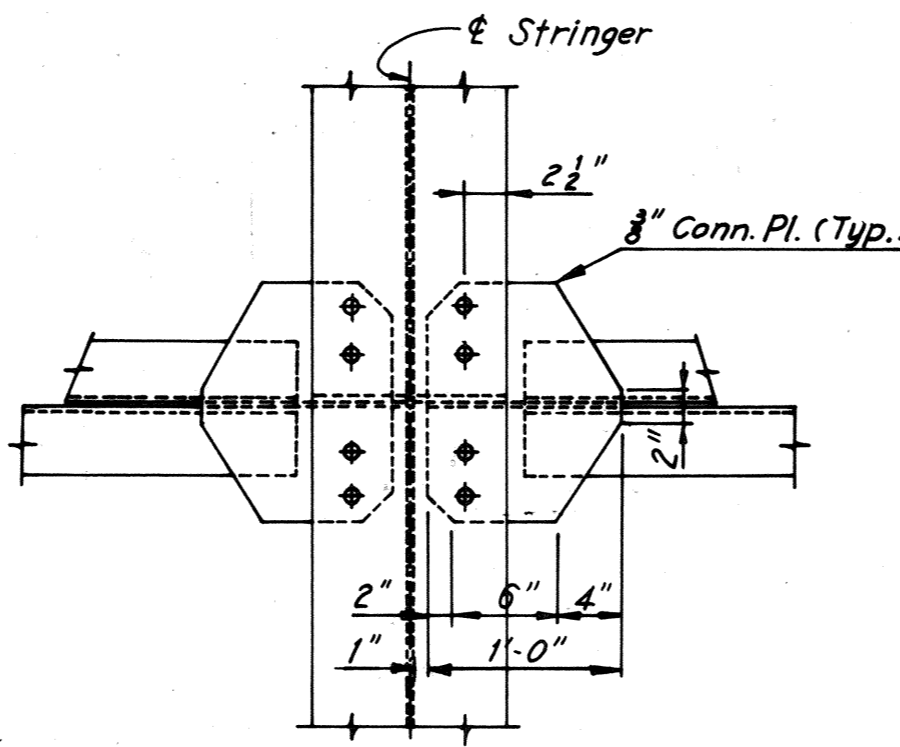


VIEW B-B
Scale: 1" = 1'-0"

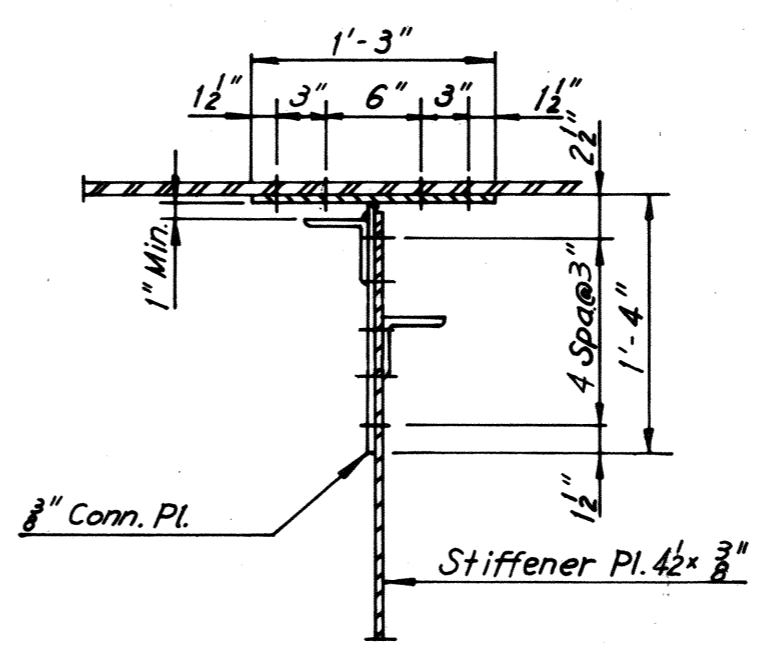

SECTION D-D
Scale: " = "

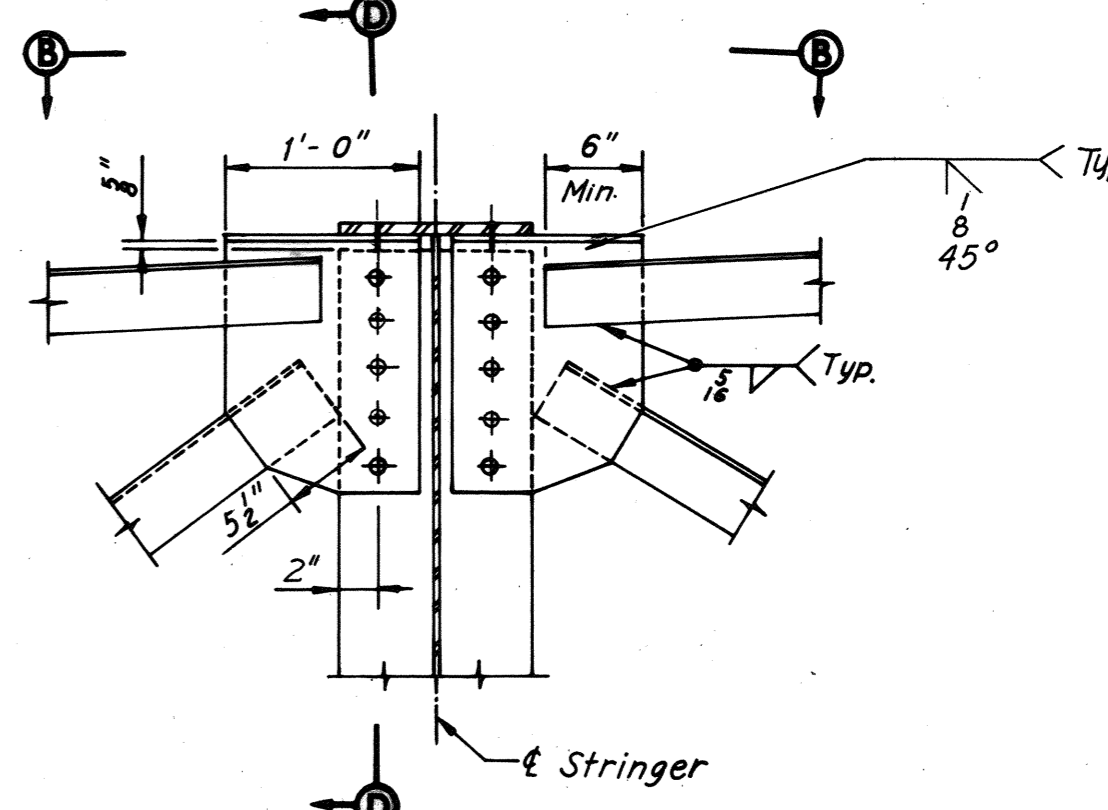

DETAIL A
Scale: 1" = 1'-0"

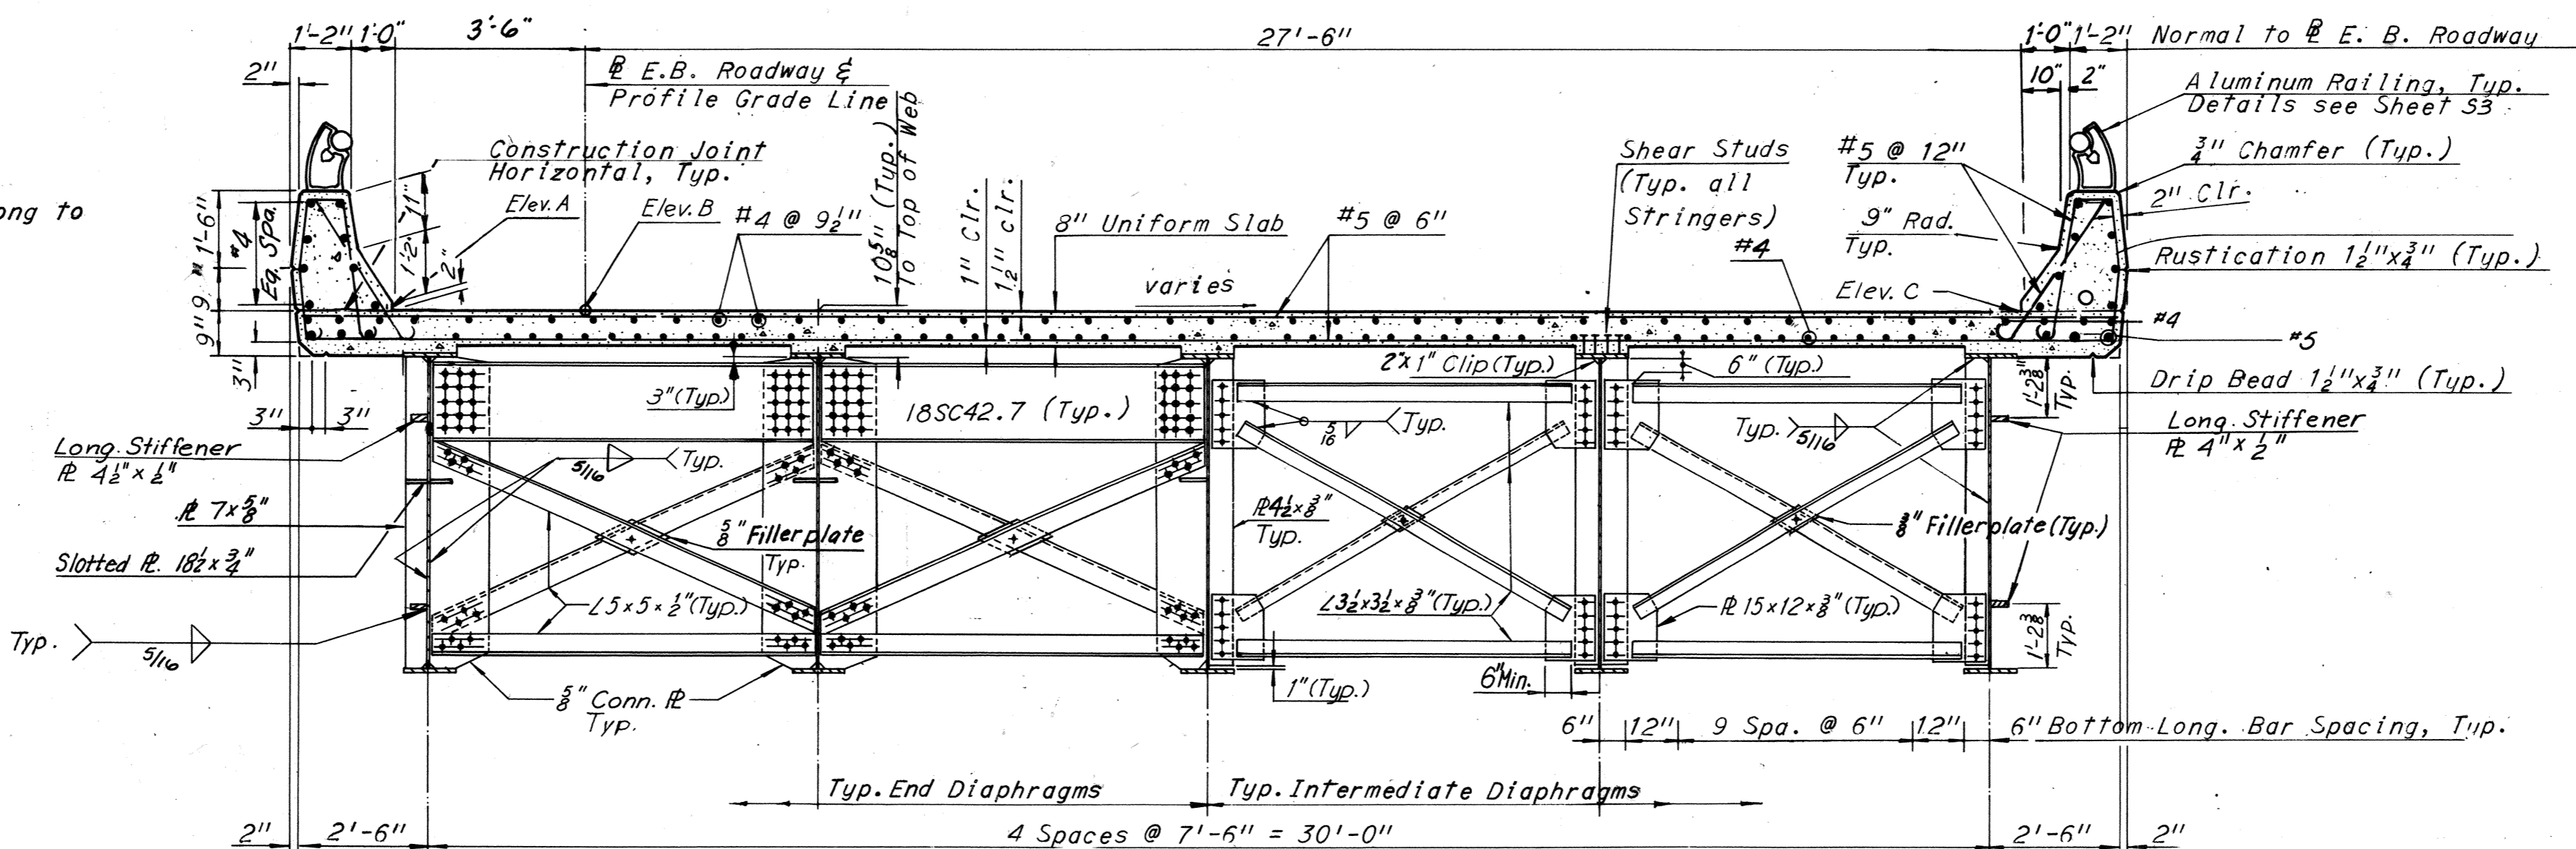

SECTION A-A
Scale: 3/8" = 1'-0"

Note: Intermediate Diaphragm Details belong to Units 21 and 22, see Sheet 34

Note: For details of brg. stiffeners, see sheets 19 & 23

Notes:
For Joint Details, see Sheet 38
For Framing Plan, see Sheet 19
For Handrail Details, see Sheet 53
For Superstructure quantities, see Sheet 2.

BY	DATE	REVISION	BY	DATE
SHS	8-2-68			
R.C.	10-18-68	1	As BuiH	TEM 8-76

RICHMOND METROPOLITAN AUTHORITY
RICHMOND EXPRESSWAY SYSTEM
DOWNTOWN EXPRESSWAY

BRIDGE NO. 66
EASTBOUND ROADWAY OVER
12TH ST. - R.R. TRACKS AND 16TH ST.
DECK PLAN-UNITS 19 AND 20







SCALE: As Noted
HOWARD, NEEDLES, TAMMEN & BERGENDOFF
consulting engineers
NEW YORK ALEXANDRIA KANSAS CITY
CONTRACT NO.: 10
SHEET NO. 33 OF 46

AS BUILT

RICHMOND EXPRESSWAY SYSTEM			
SECTION	PROJECT	SHEET NO.	TOTAL SHEETS
10	DOWNTOWN EXPRESSWAY	160	265

ELEVATION TABLE			
STATION	ELEV. A	ELEV. B	ELEV. C
341+75.50	92.61	92.68	—
+80.00	92.65	92.72	—
+90.00	92.74	92.81	—
342+00.00	92.82	92.89	—
+10.00	92.90	92.97	—
+20.00	92.98	93.06	—
+30.00	93.06	93.15	—
+40.00	93.14	93.24	—
+50.00	93.21	93.32	—
+60.00	93.26	93.38	—
+70.00	93.32	93.45	—
+80.00	93.35	93.49	—
+90.00	93.37	93.52	—
343+00.00	93.39	93.55	—
+10.00	93.40	93.57	—
+20.00	93.38	93.56	—
+30.00	93.35	93.54	—
+40.00	93.30	93.50	—
+50.00	93.22	93.43	—
+60.00	93.14	93.35	94.64
+70.00	93.02	93.23	94.52
+80.00	92.86	93.07	94.36
+90.00	92.66	92.87	94.16

ELEVATION TABLE			
STATION	ELEV. D	ELEV. E	ELEV. F
342+07.56	93.50	93.43	—
+10.00	93.52	93.45	—
+20.00	93.61	93.54	—
+30.00	93.69	93.62	—
+40.00	93.78	93.71	—
+50.00	93.87	93.80	—
+60.00	93.97	93.90	—
+70.00	94.08	94.01	—
+80.00	94.20	94.13	—
+90.00	94.31	94.24	—
343+00.00	94.42	94.35	—
+10.00	94.53	94.46	—
+20.00	94.64	94.57	—
+30.00	94.74	94.67	—
+40.00	94.84	94.77	—
+50.00	94.93	94.86	—
+60.00	95.01	94.94	94.53
+70.00	95.07	95.00	94.59
+80.00	95.14	95.07	94.69
+90.00	95.18	95.12	94.79
344+00.00	95.21	95.16	94.89
+10.00	95.22	95.18	94.96

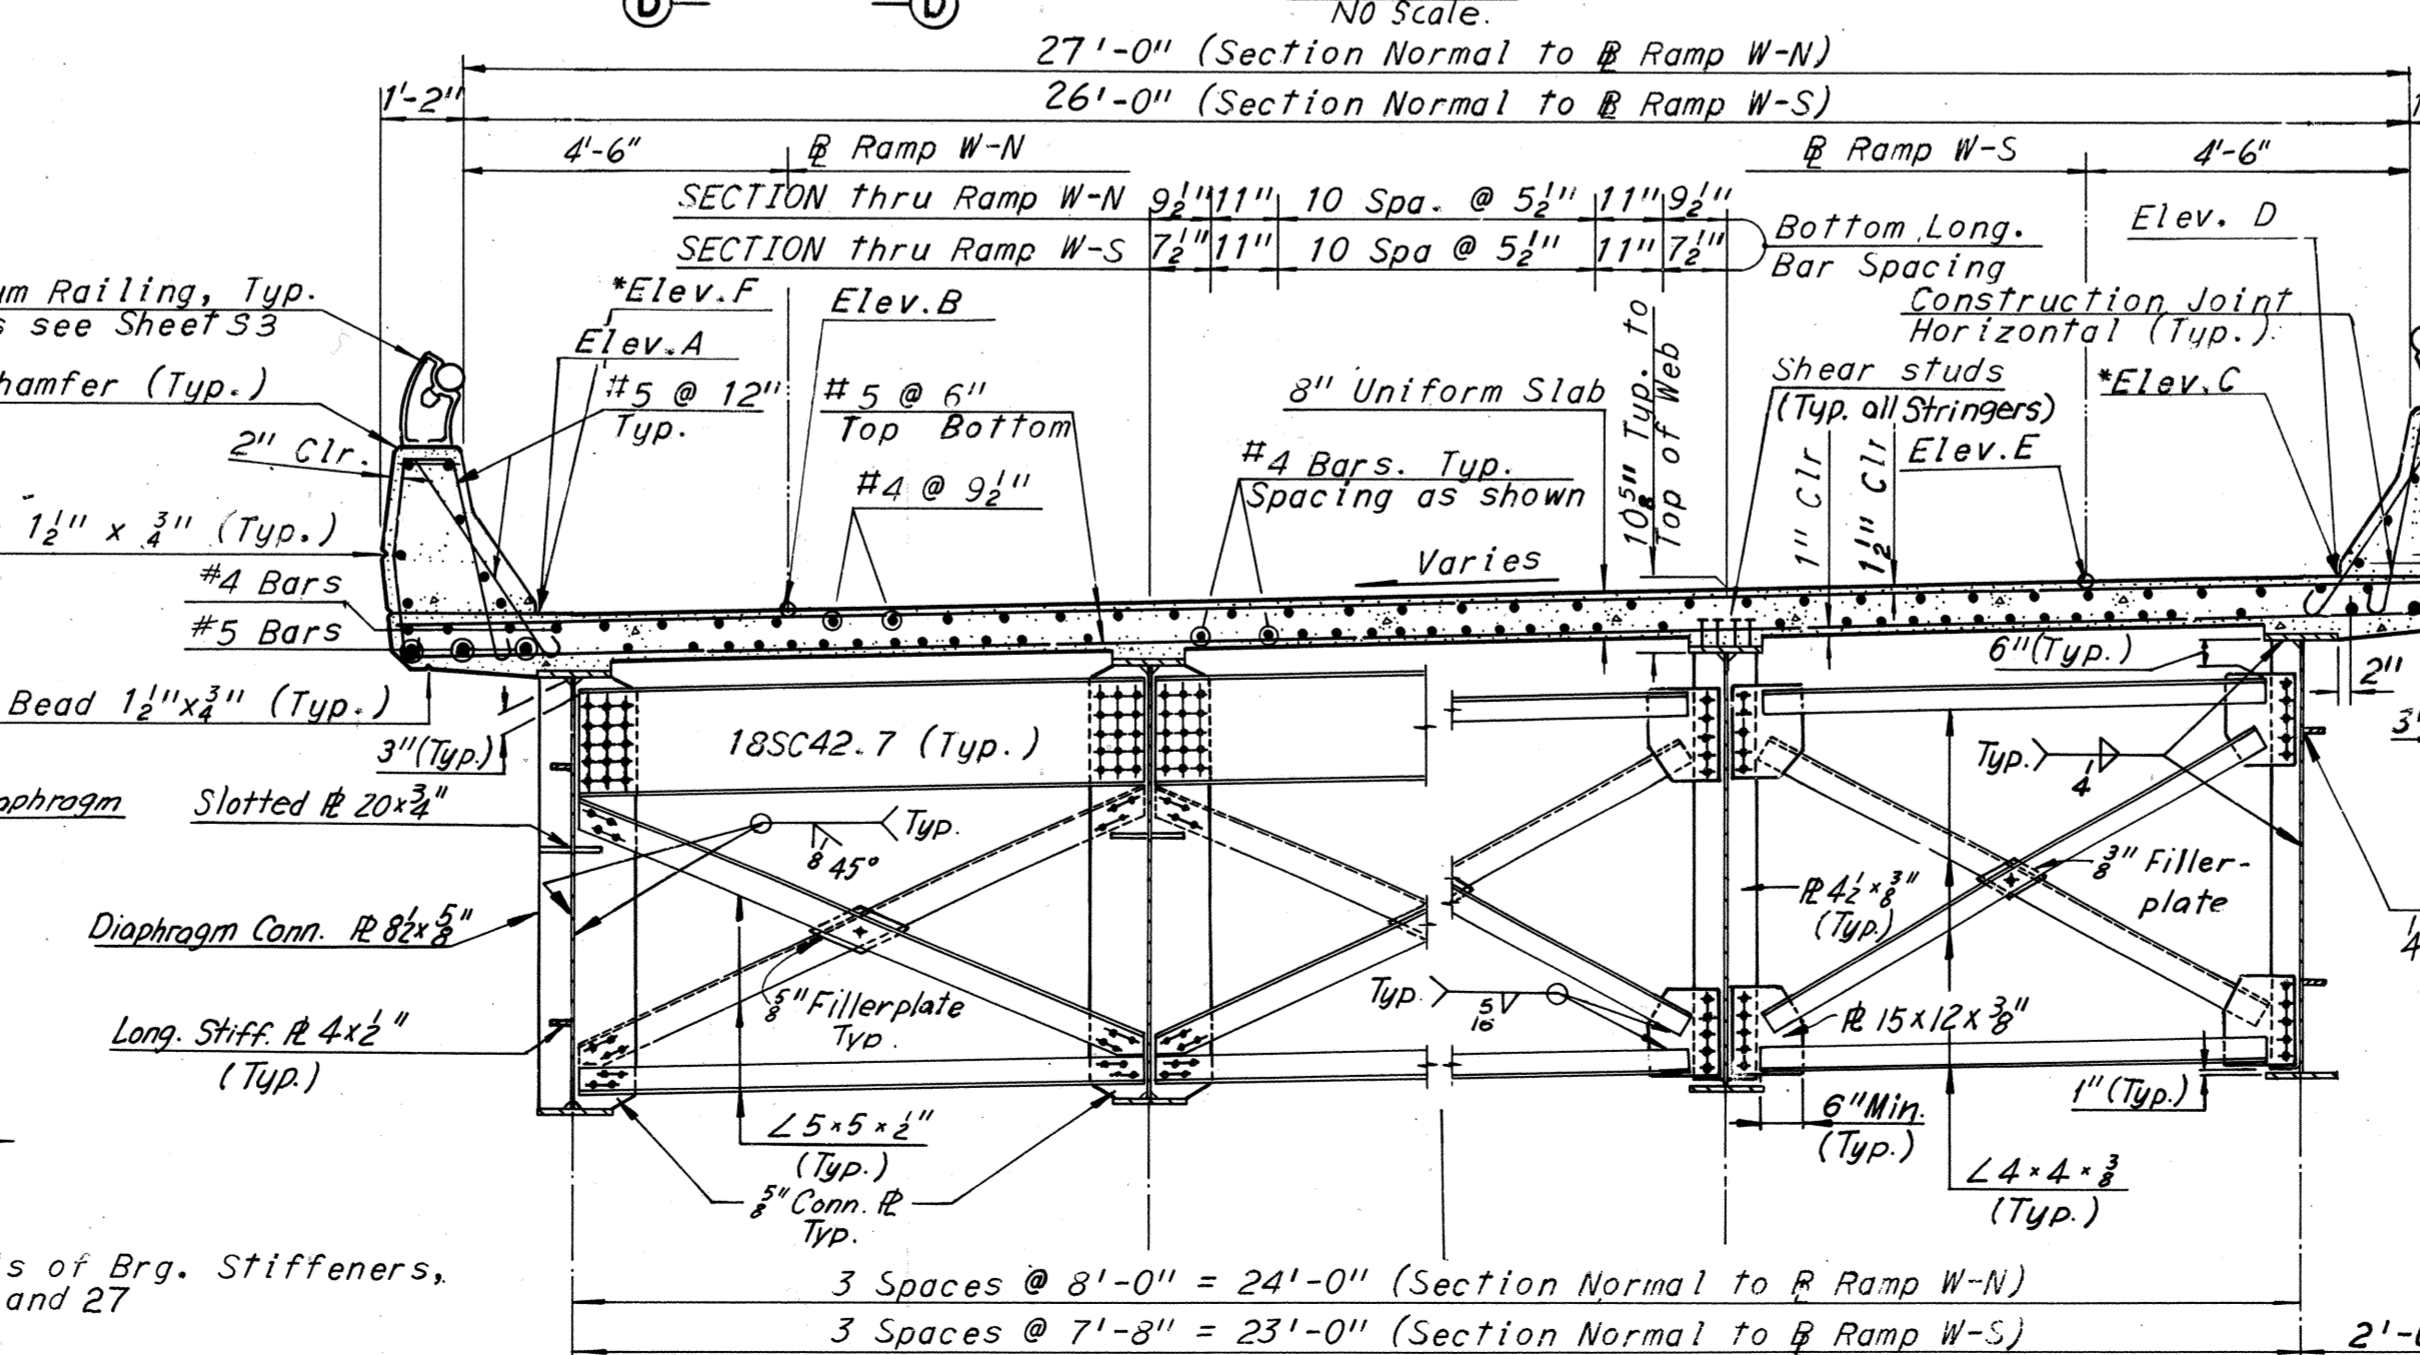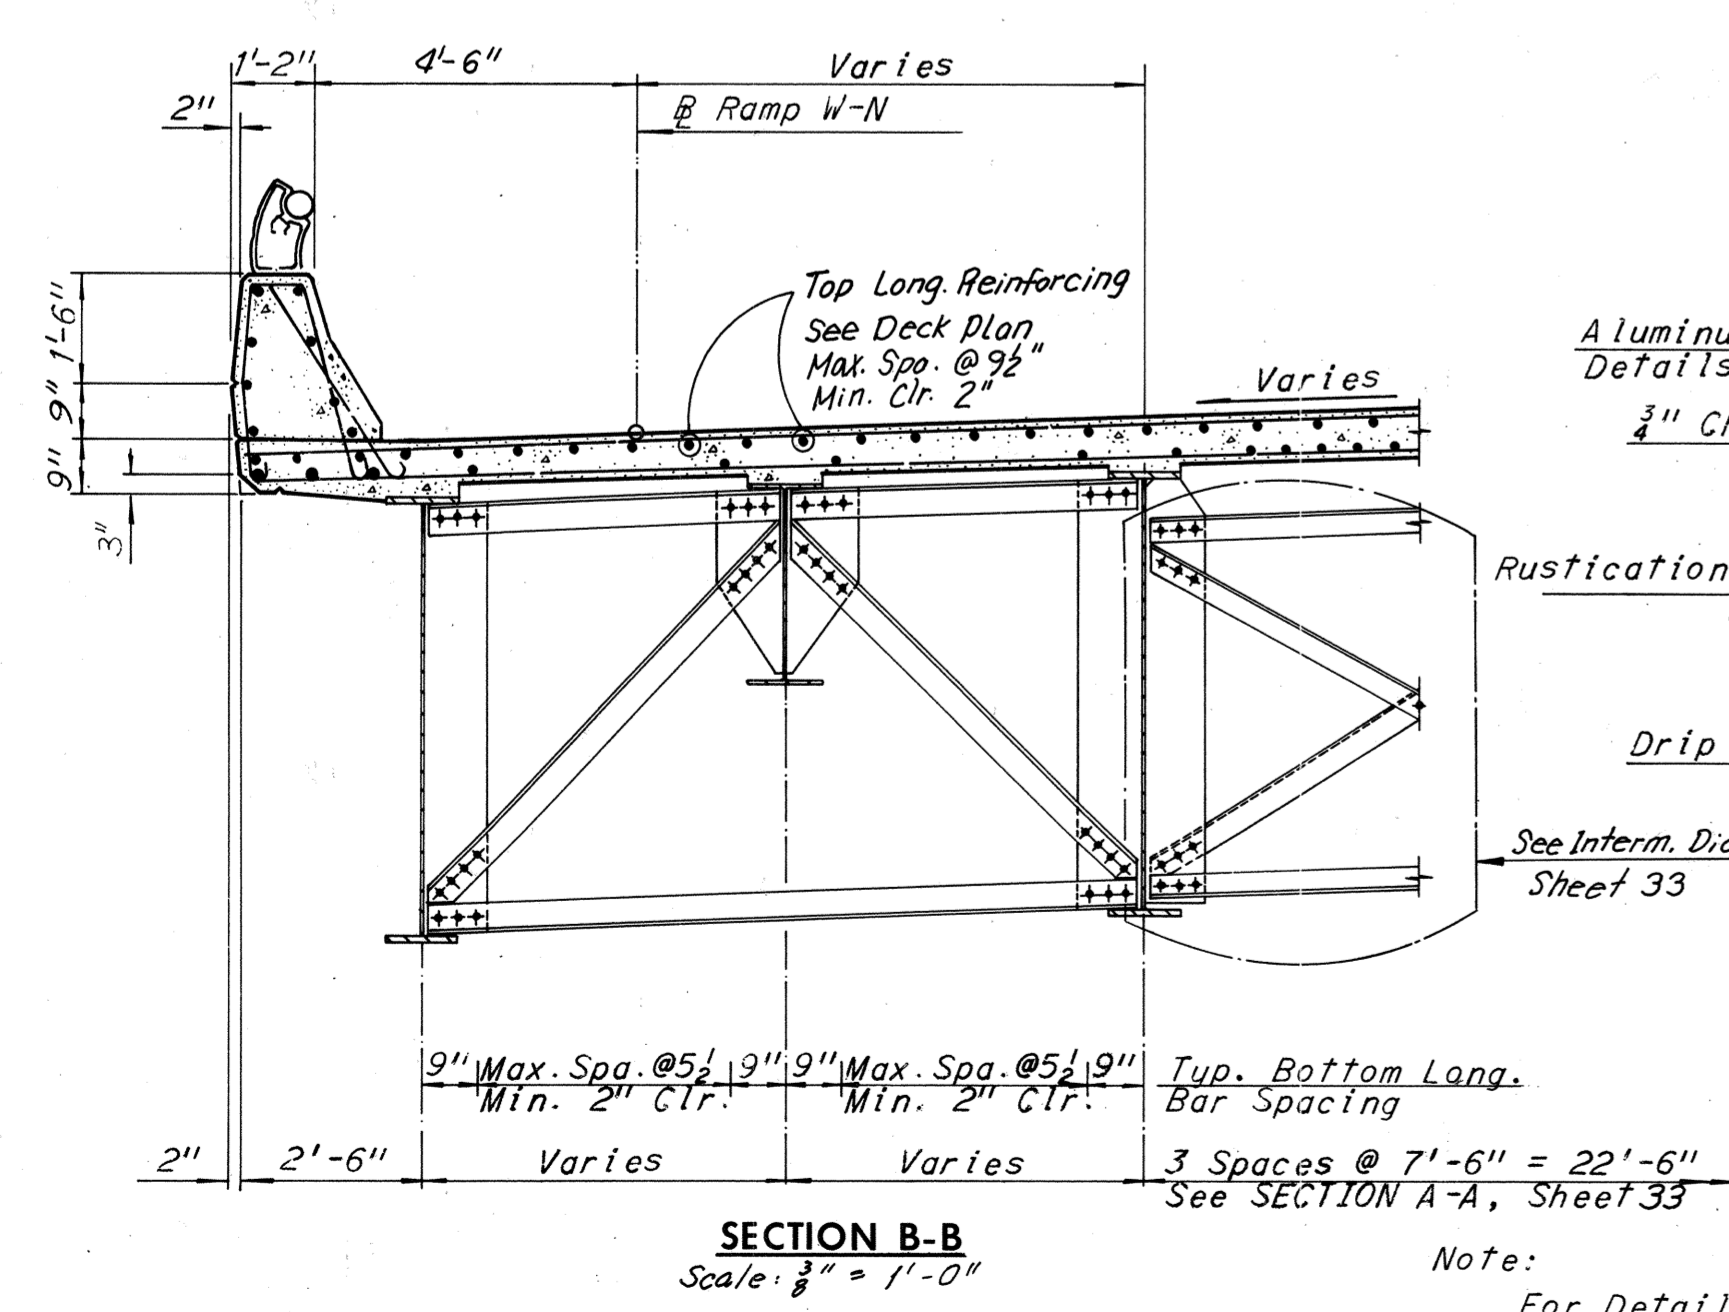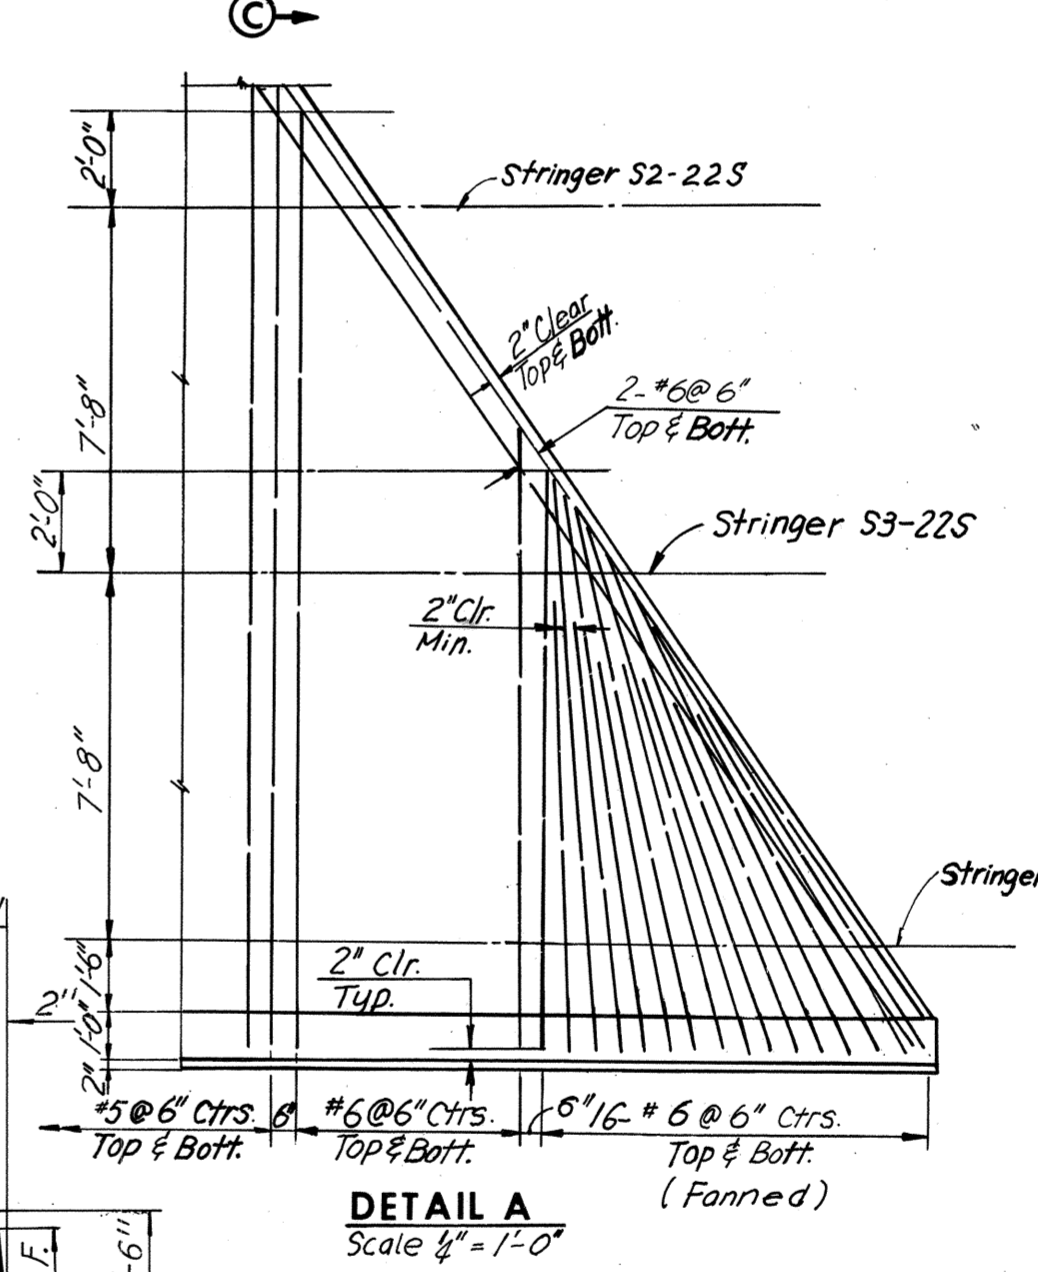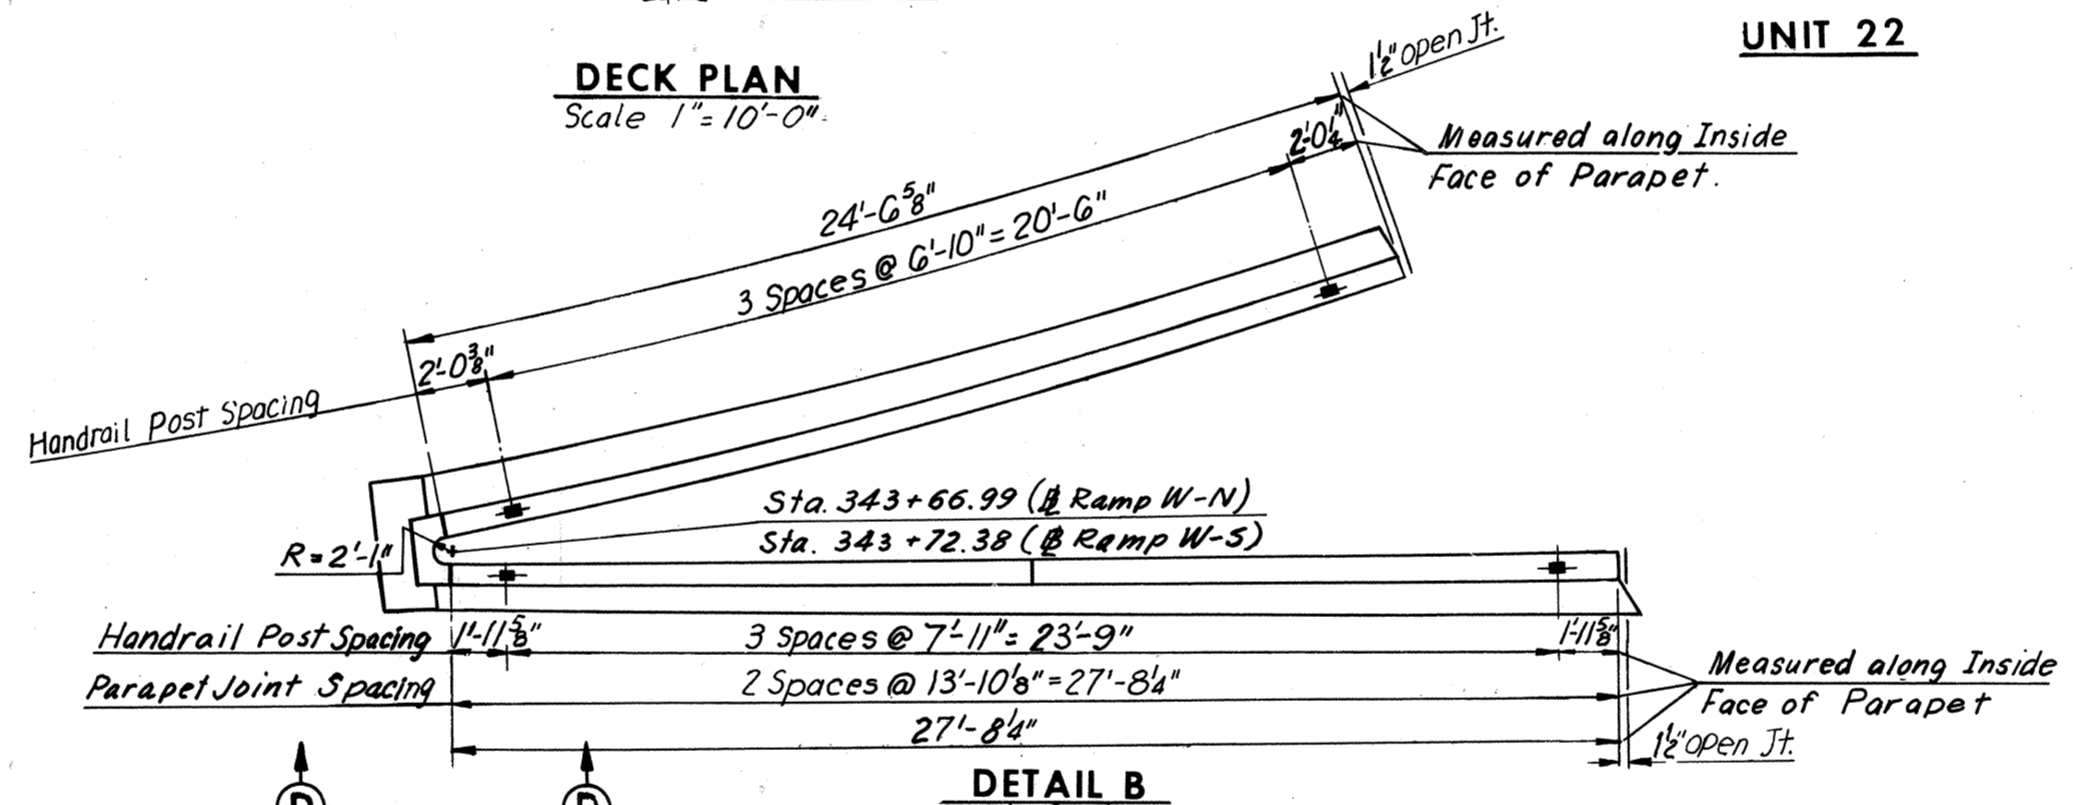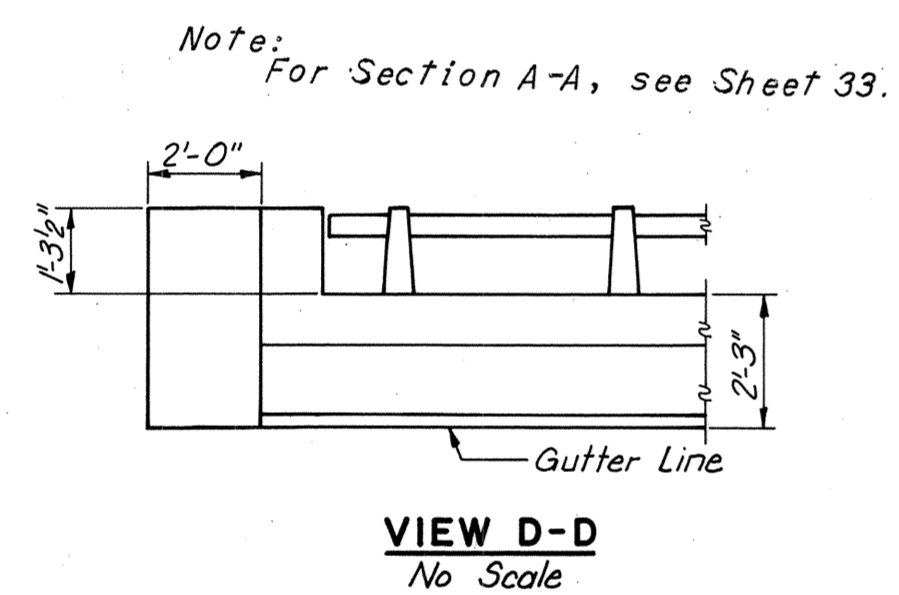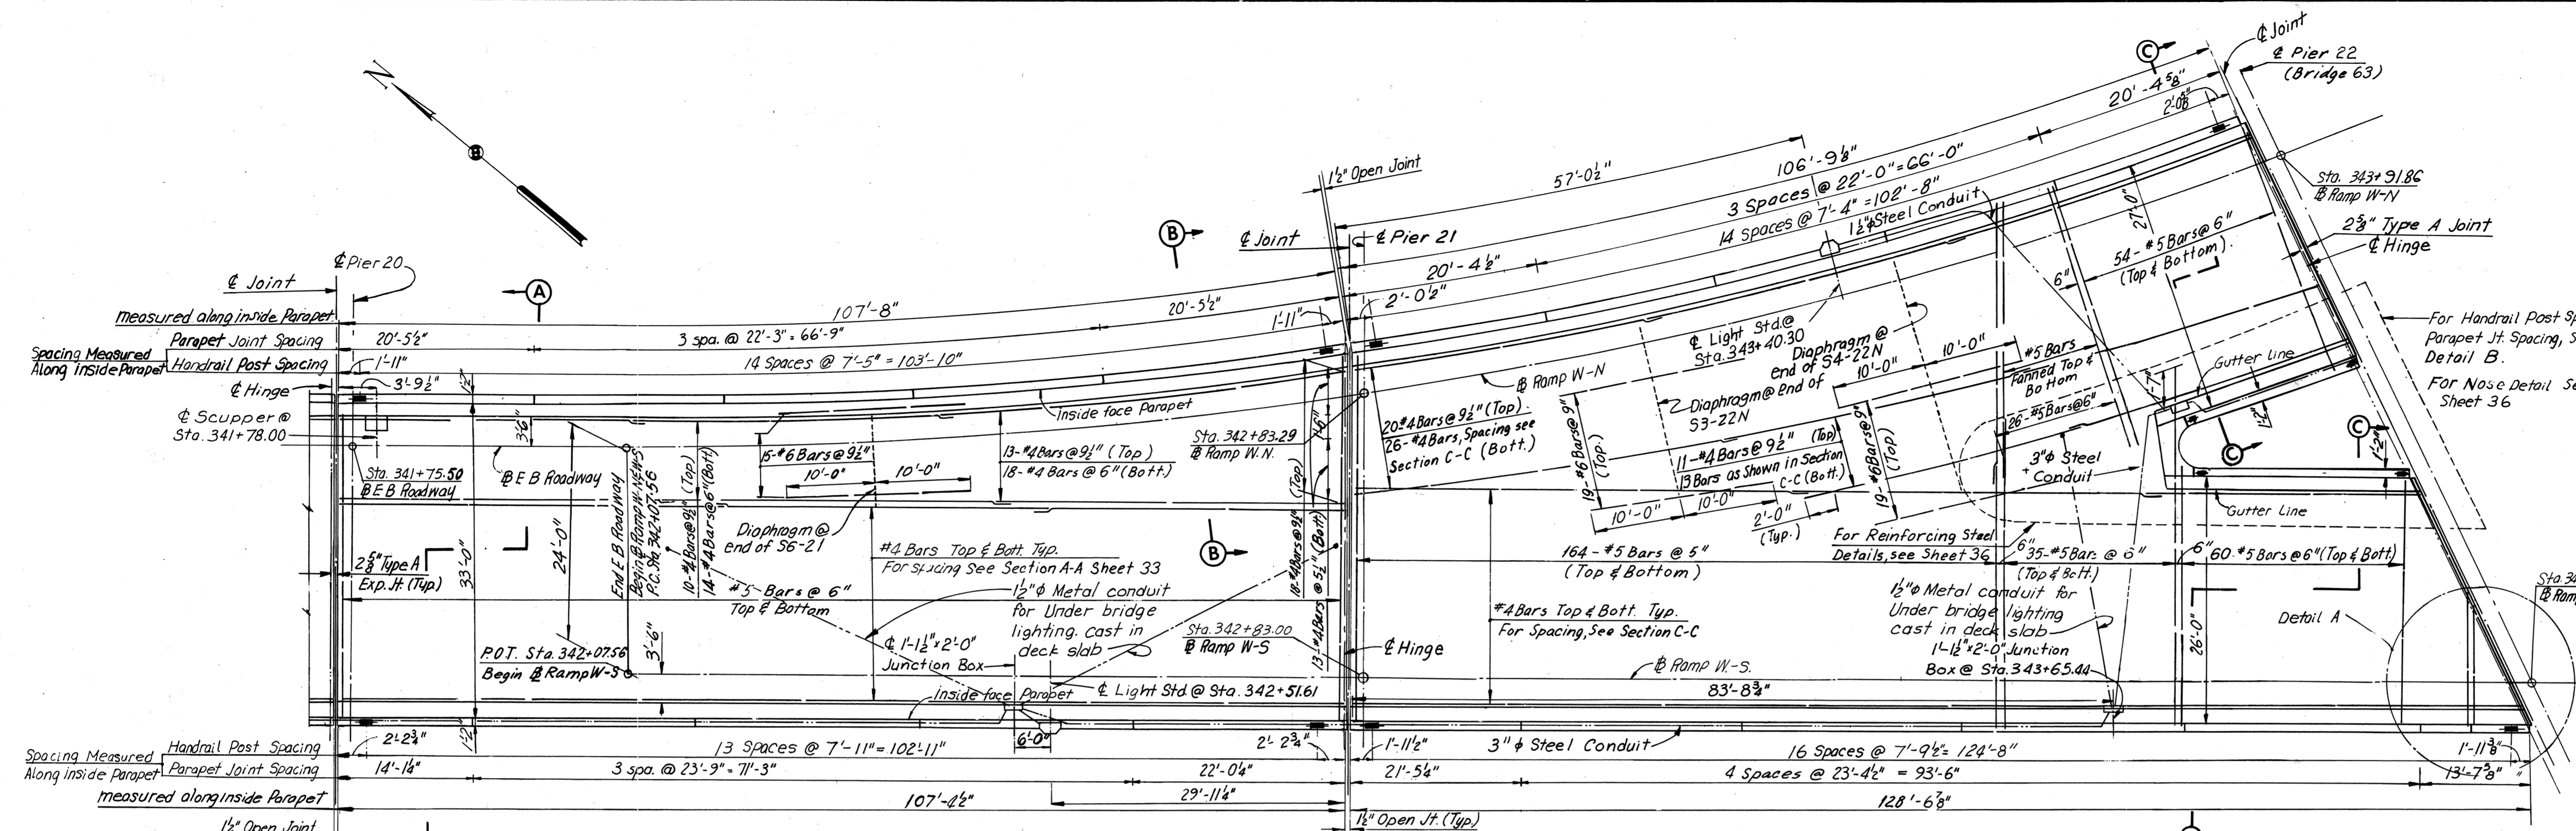

* Elev. C indicates the elevation of nose north gutter line.
* Elev. F indicates the elevation of nose south gutter line.

Notes:
For Superstructure Quantities, see Sheet 2.
For Framing Plan see Sheet 20.
For Framing Details, see Sheets 23 thru 27.
For Joint Details, see Sheet 38.
For Standard Drainage Details, See Support Type 2 Sheet 55&56.

Note:
For Details of Brg. Stiffeners, see Sheets 20 and 27.

Note:
Intermediate Diaphragms shown can only be used where stringers are straight. For Intermediate Diaphragm Details of curved stringers, see Sheet 33.

BY	DATE	NO.	REVISION	BY	DATE
MADE	G.S.H. 08-09-68				
CHECKED	S.C.C. 10-25-68	1	As Built	TEM	8-76
IN CHARGE					

RICHMOND METROPOLITAN AUTHORITY
RICHMOND EXPRESSWAY SYSTEM
DOWNTOWN EXPRESSWAY

BRIDGE NO. 66
EASTBOUND ROADWAY OVER
12TH ST. - R.R. TRACKS AND 16TH ST.
DECK PLAN - UNITS 21 AND 22


HOWARD, NEEDLES, TAMMEN & BERGENDOFF
consulting engineers
NEW YORK ALEXANDRIA KANSAS CITY

SCALE: As Noted
CONTRACT NO.: 10
SHEET NO. 34 OF 46




AS BUILT

RICHMOND EXPRESSWAY SYSTEM			
SECTION	PROJECT	SHEET NO.	TOTAL SHEETS
10	DOWNTOWN EXPRESSWAY	161	265

ELEVATION TABLE			
STATION	ELEV. A	ELEV. B	ELEV. C
344+00.00	95.21	95.16	94.89
+10.00	95.22	95.18	94.96
+20.00	95.21	95.18	95.02
+30.00	95.19	95.17	95.06
+40.00	95.14	95.13	95.08
+50.00	95.08	95.08	95.08
+60.00	95.01	95.02	95.10
+70.00	94.91	94.94	95.10
+80.00	94.81	94.85	95.10
+90.00	94.69	94.75	95.08
345+00.00	94.47	94.06	93.99
+10.00	94.51	94.02	93.94
+20.00	94.55	93.98	93.89
+30.00	94.60	93.94	93.83
+40.00	94.65	93.89	93.76
+50.00	94.65	93.83	93.69
+60.00	94.66	93.76	93.61
+70.00	94.66	93.68	93.52
+73.84	94.66	---	---
+77.08	---	---	93.44
+78.00	---	93.61	---
+80.00	94.66	93.59	93.41
345+90.00	94.62	93.49	93.29
346+00.00	94.56	93.37	93.17
+10.00	94.47	93.25	93.05
+20.00	94.35	93.12	92.91
+30.00	94.20	92.97	92.76
+40.00	94.06	92.82	92.61
+41.63	---	---	92.59
+41.66	94.02	---	---

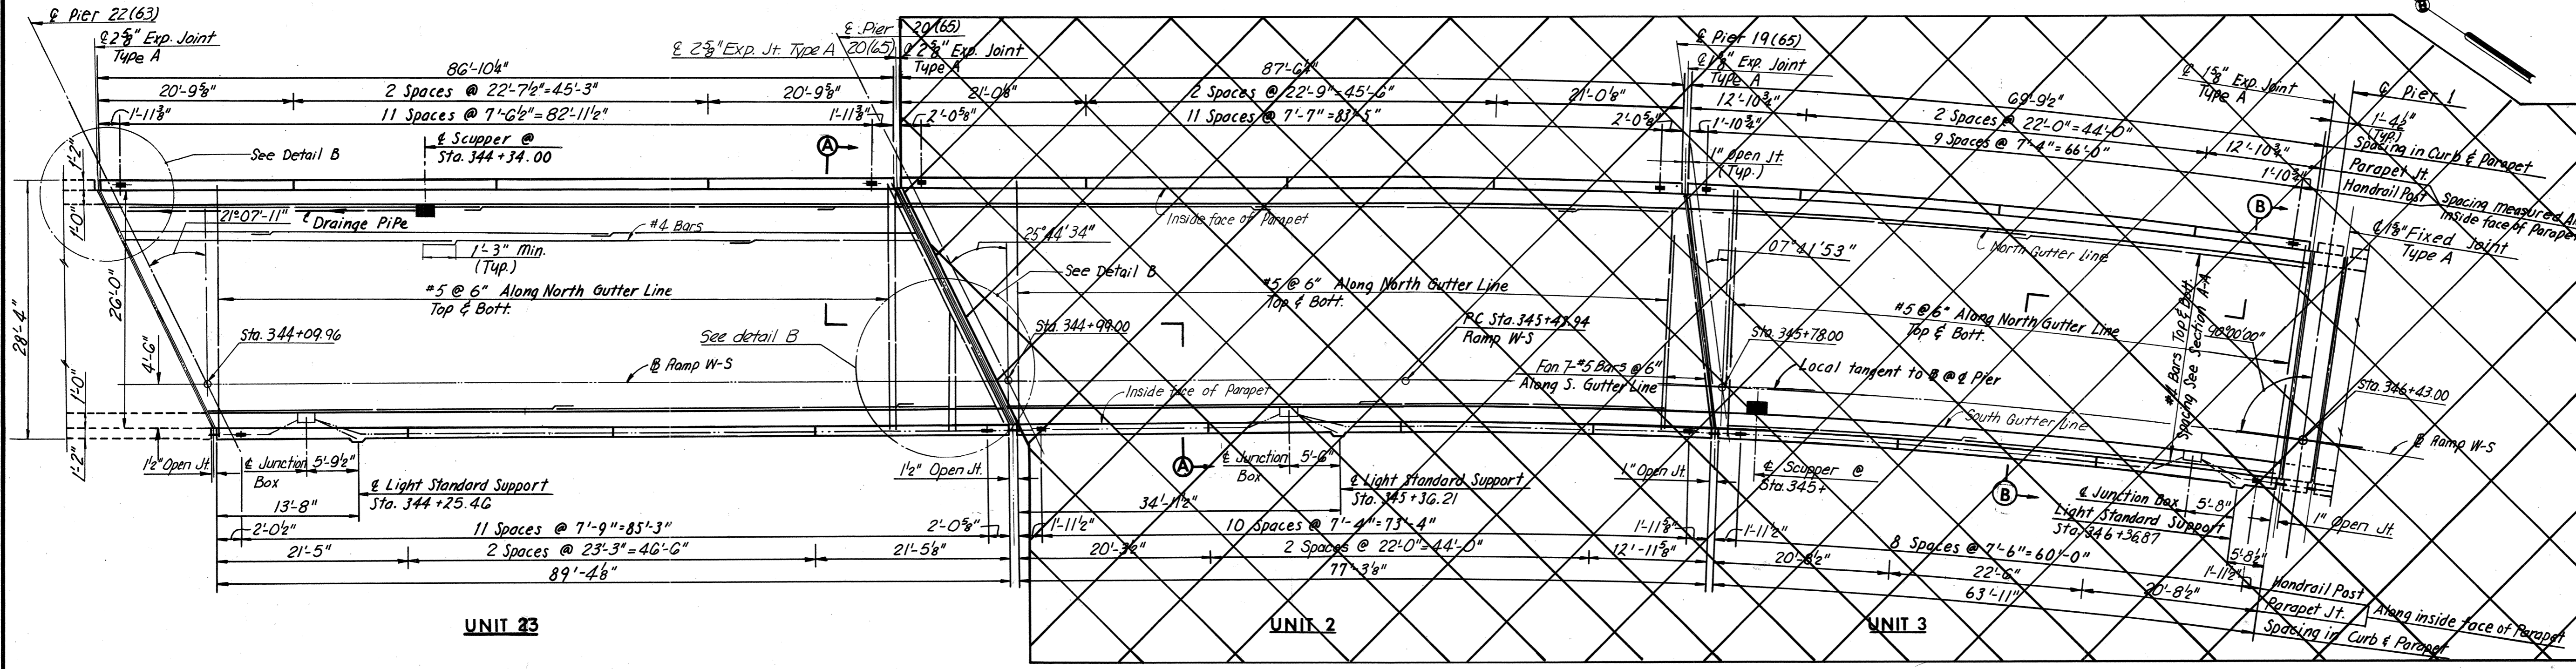

DECK PLAN
Scale: 1"=10'-0"
Note: Section B-B, See Sheet 20.

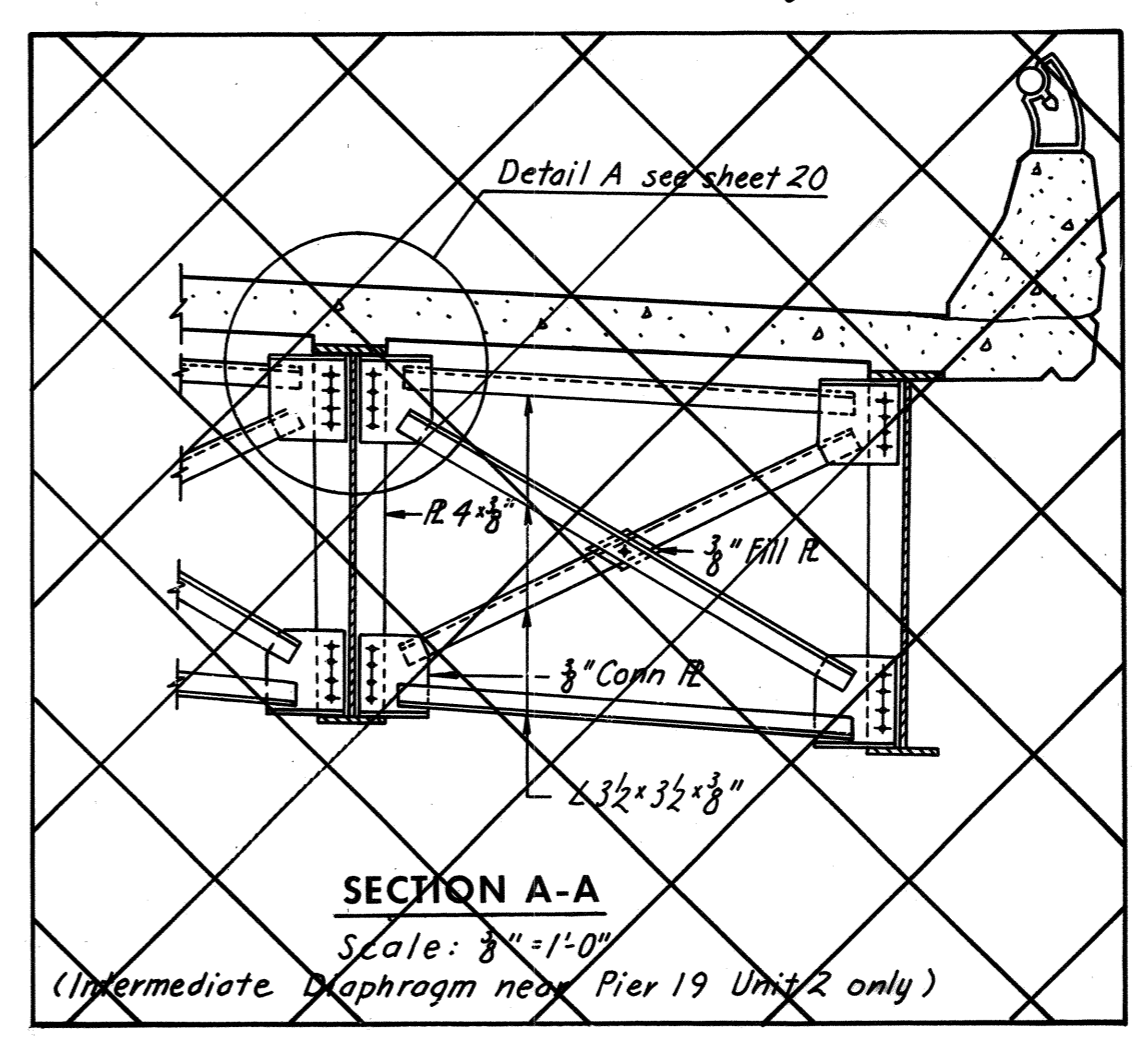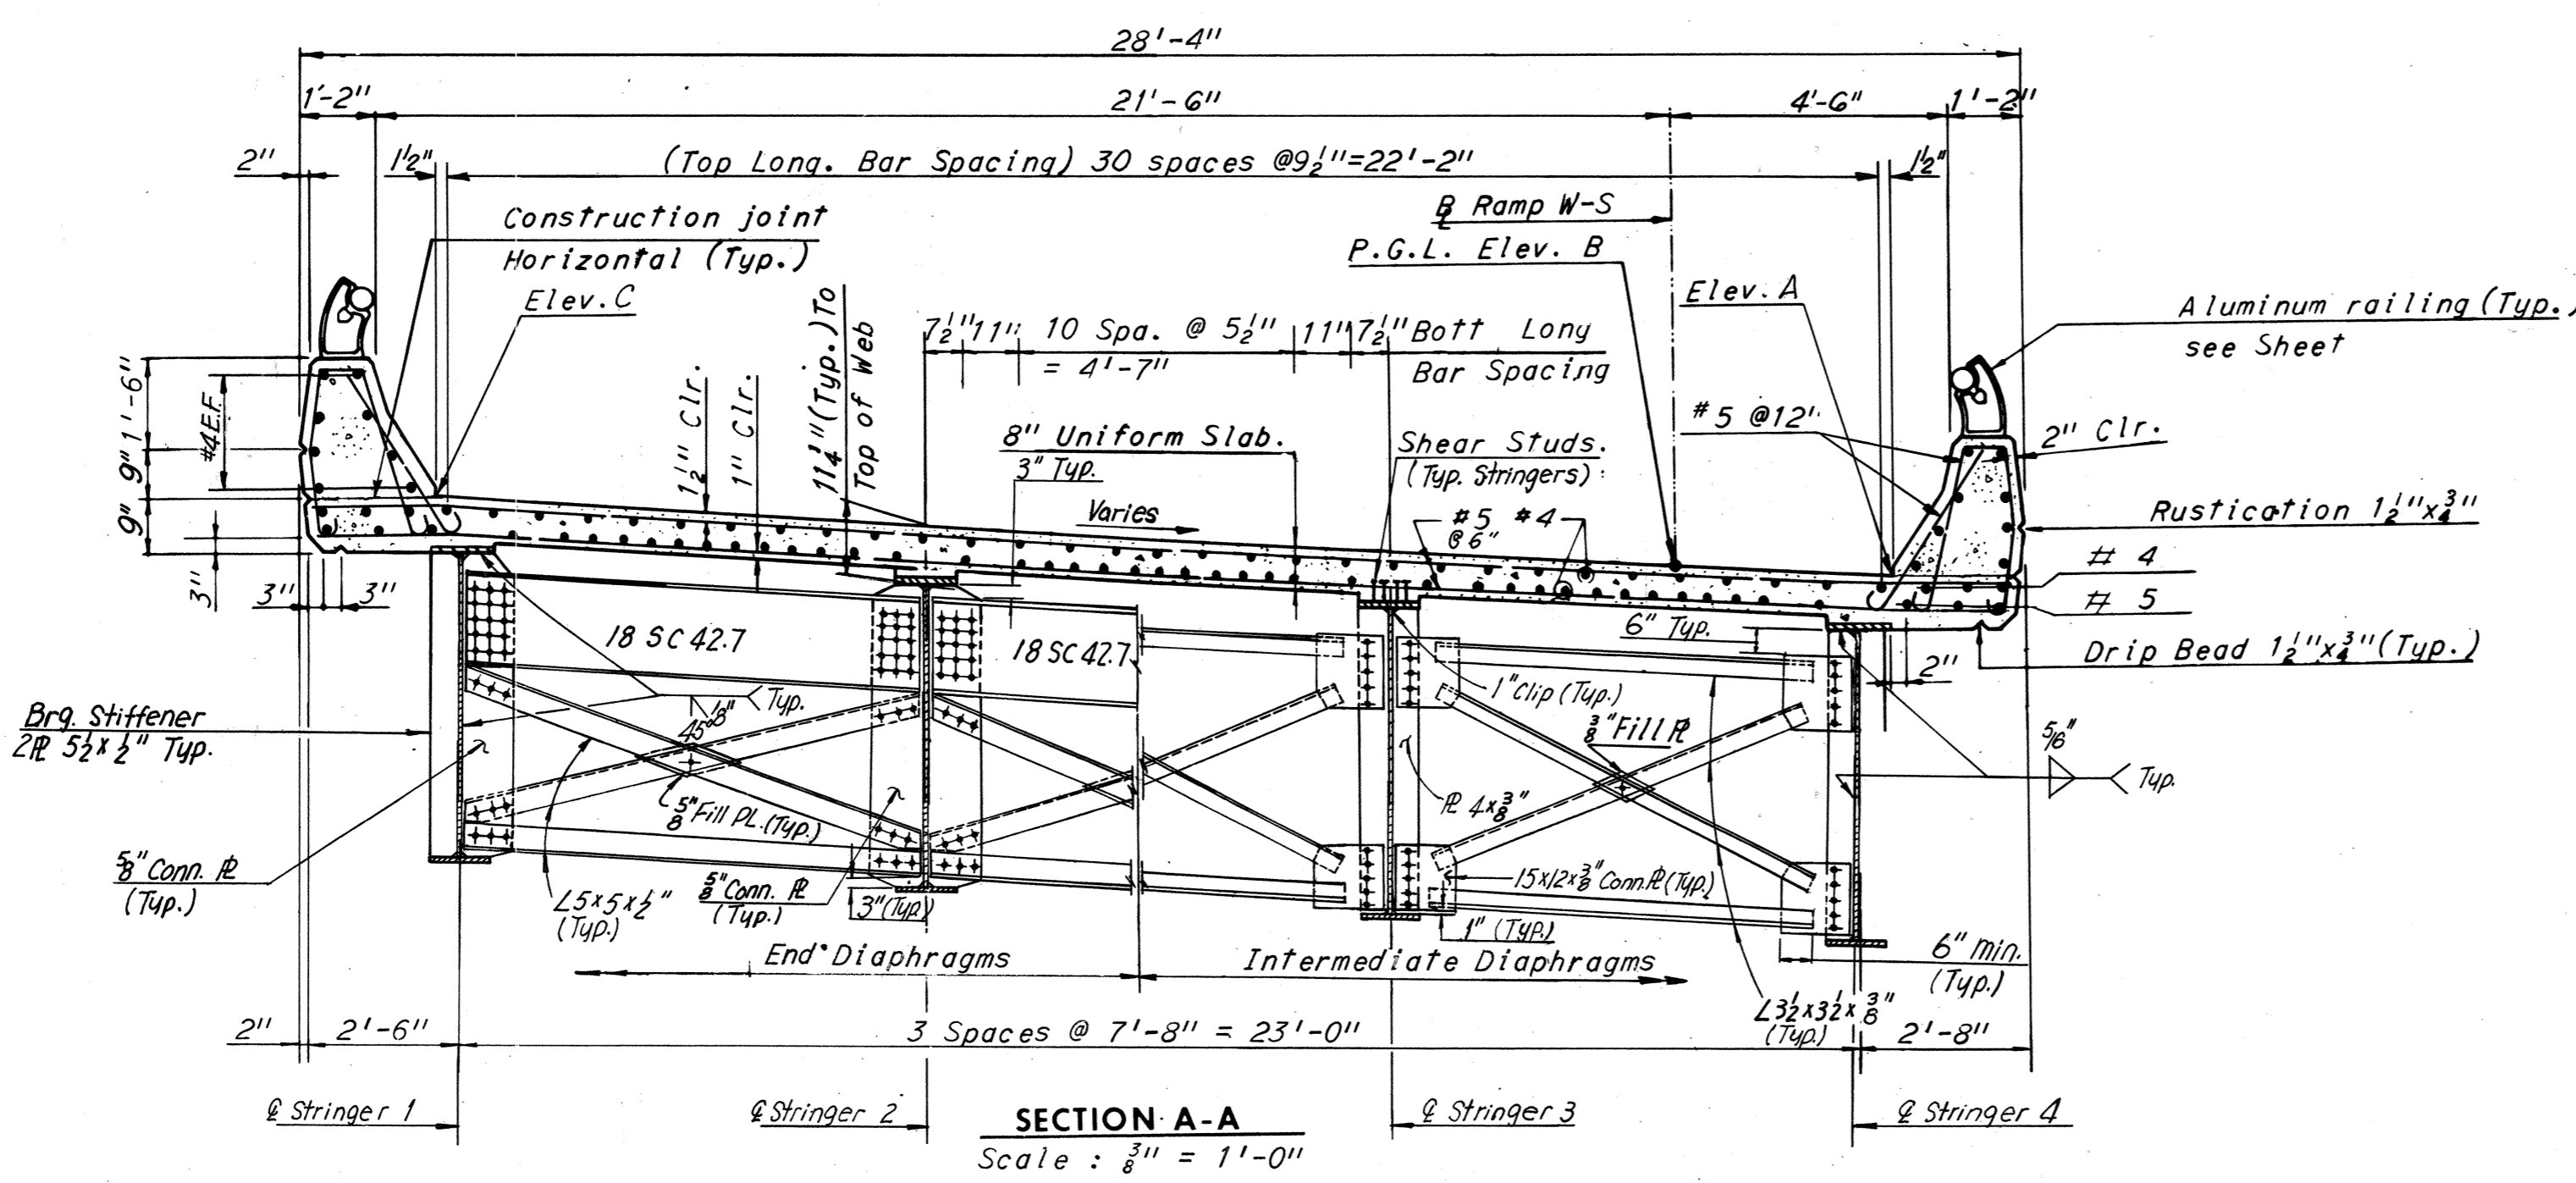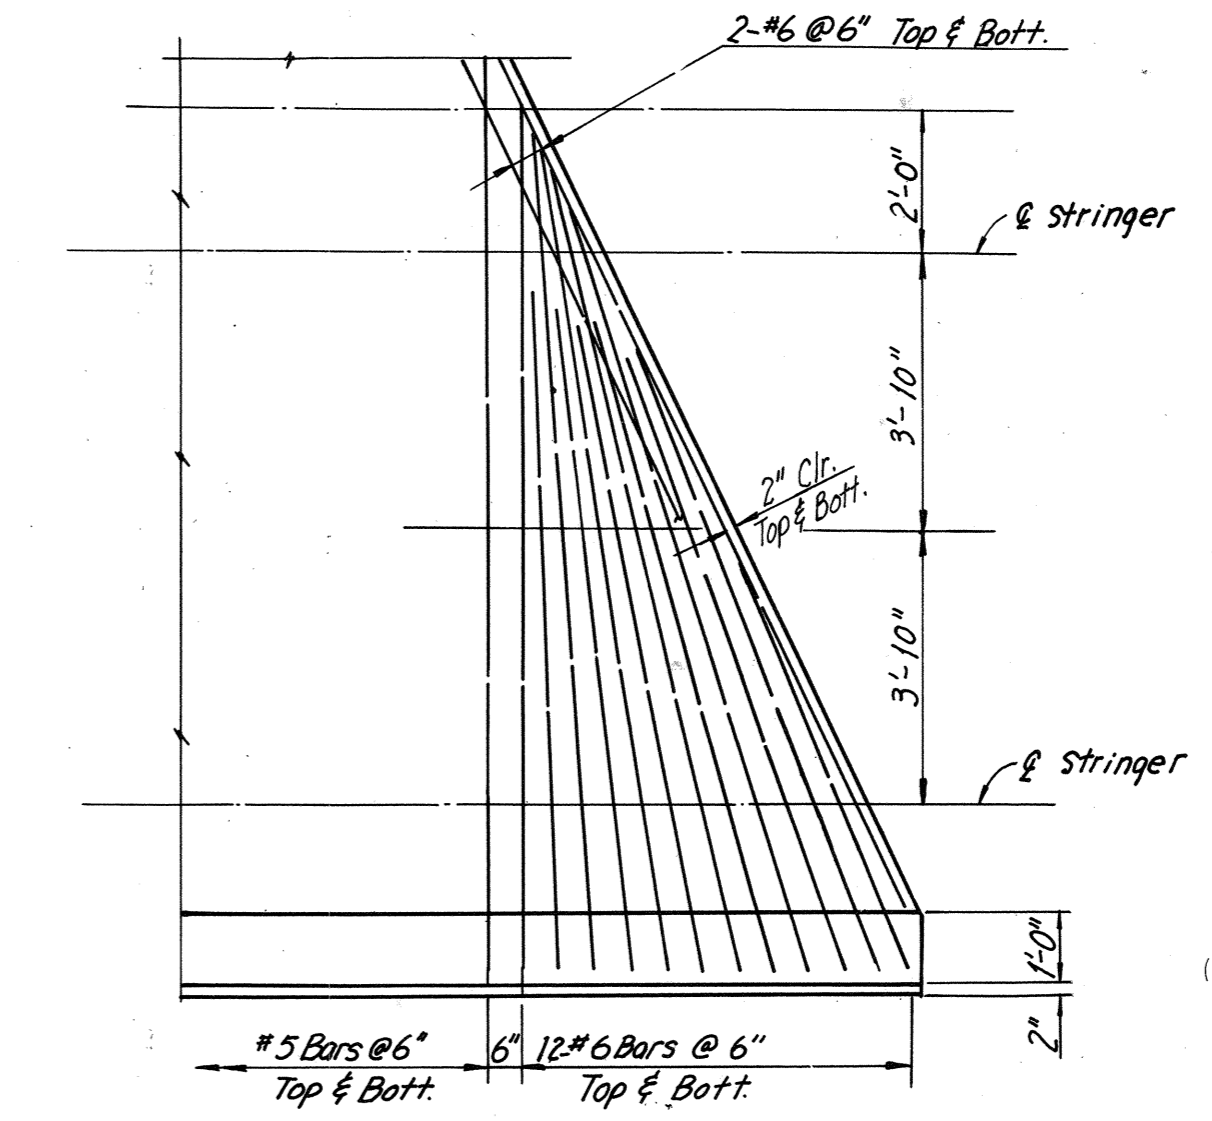

Notes
For Framing Plan, see Sheet 21.
For Standard Lighting Details, see Sheet S4.
For Standard Drainage Details, see Support Type 2 Sheet S5&S6.
For Joint Details, see Sheet 38.
For Standard Handrail Details, see Sheet S3.

RICHMOND METROPOLITAN AUTHORITY
RICHMOND EXPRESSWAY SYSTEM
DOWNTOWN EXPRESSWAY


BRIDGE NO. 66
EASTBOUND ROADWAY OVER
12TH ST.-R.R. TRACKS AND 16TH ST.
DECK PLAN — UNIT 23

HOWARD, NEEDLES, TAMMEN & BERGENDOFF
consulting engineers
NEW YORK ALEXANDRIA KANSAS CITY

SCALE: As Noted
CONTRACT NO. 10
SHEET NO. 35 OF 46


BY	DATE	REVISION	BY	DATE
MADE	G.S.H. 10-29-68	2 As Built	TEM	8-76
CHECKED	A.H.H. 12-13-68			
IN CHARGE				

AS BUILT

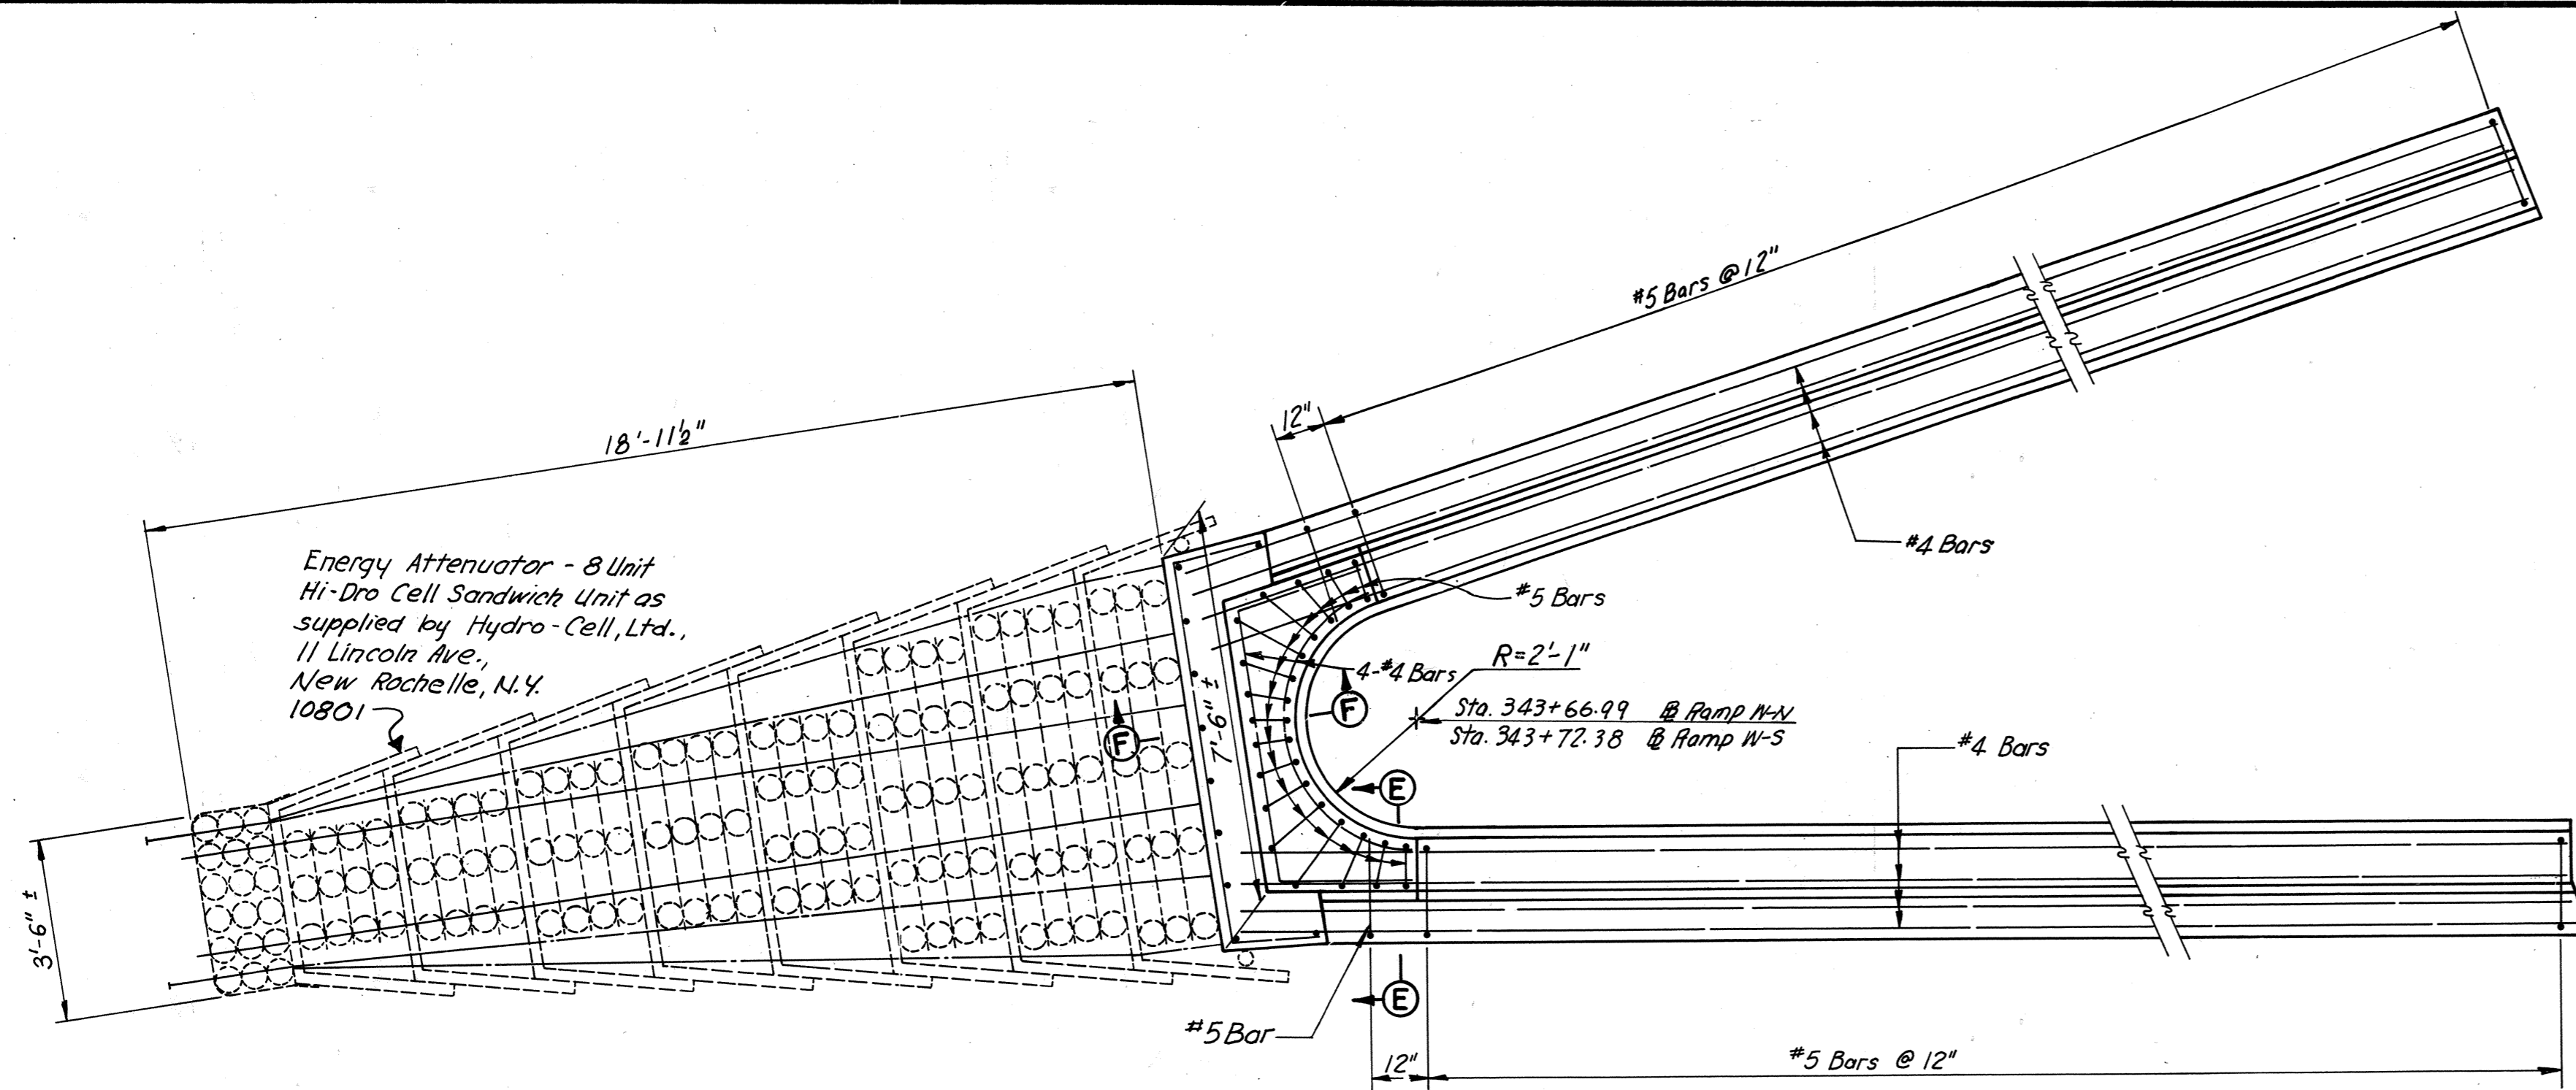


Note: Reinforcing Steel in curb and parapet is shown. For typical section thru curb and parapet, see Section C-C Sheet 34.

CURB AND PARAPET REINFORCING STEEL DETAIL
Scale: 3/8" = 1'-0"

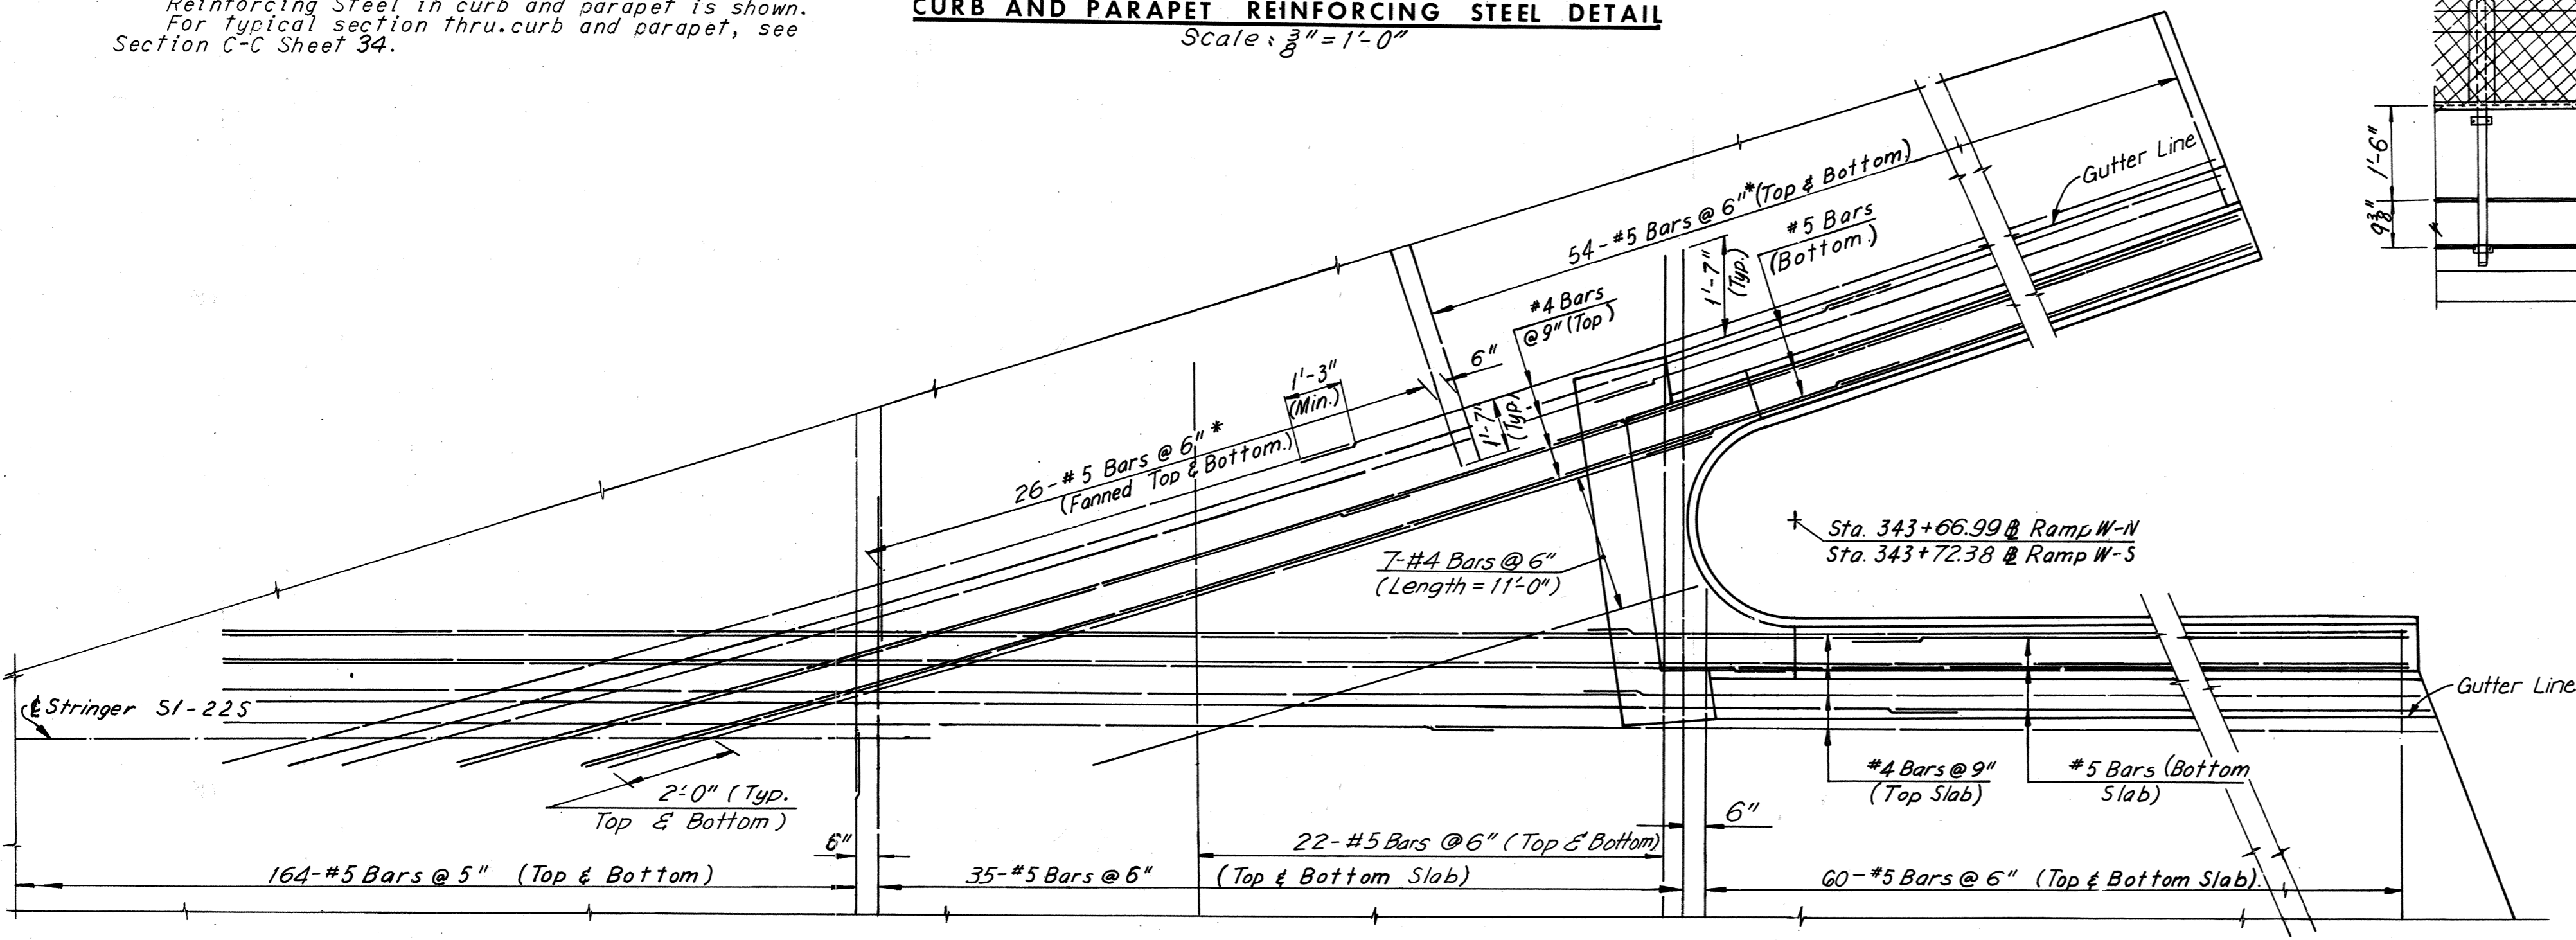


Note: Reinforcing Steel in Slab is shown.
* Spacing measured along north curb of nose.


SLAB REINFORCING STEEL DETAIL
Scale: 3/8" = 1'-0"

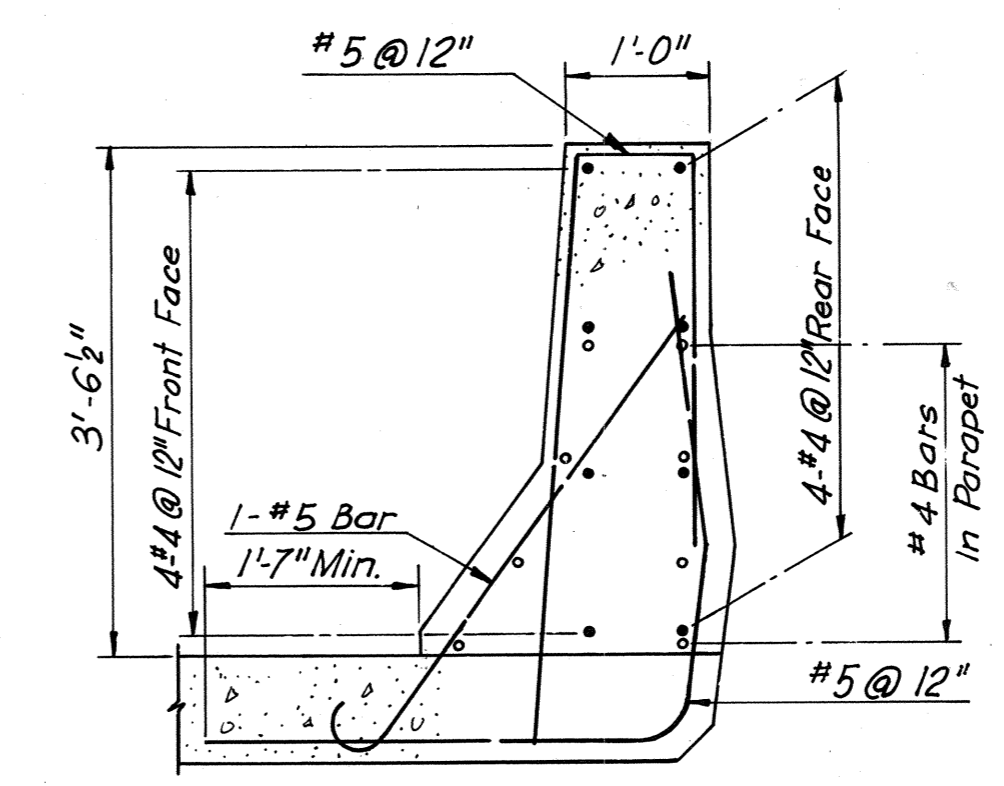


SECTION E-E
(Deck Steel Not Shown)
Scale: 3/4" = 1'-0"

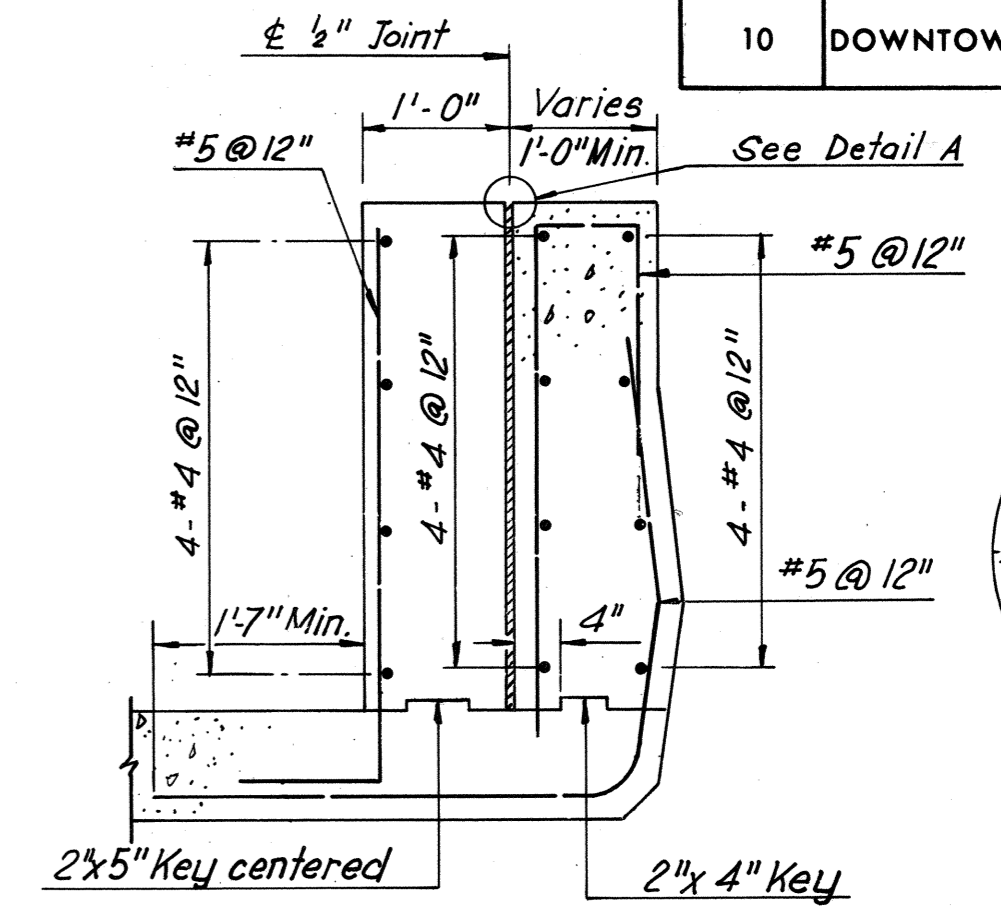


SECTION F-F
(Deck Steel Not Shown)
Scale: 3/4" = 1'-0"

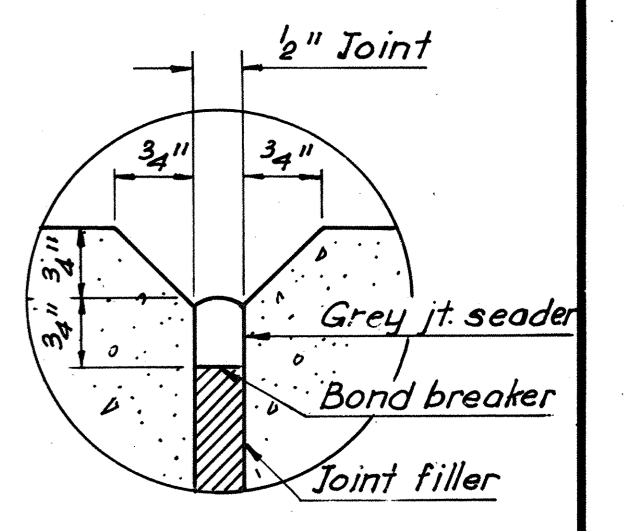


DETAIL A
Scale: Half Size

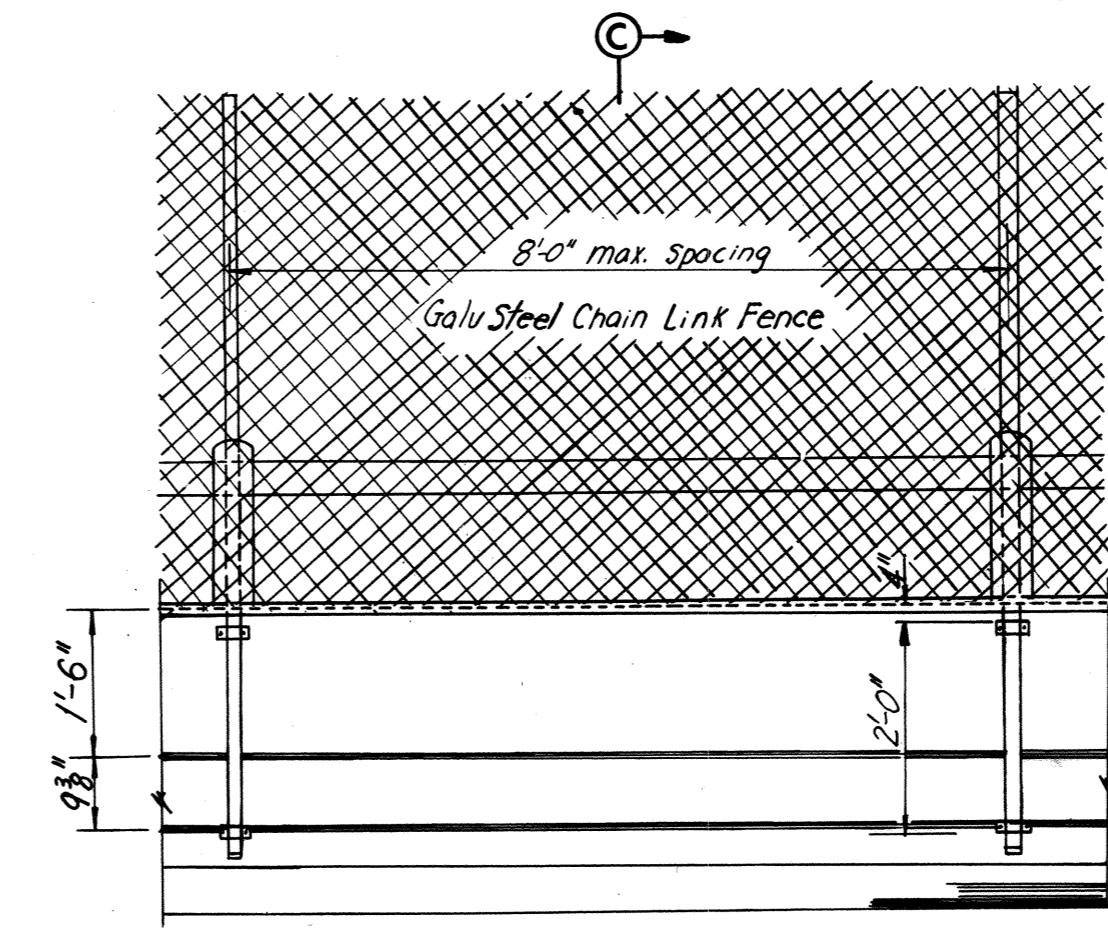

ELEVATION VIEW

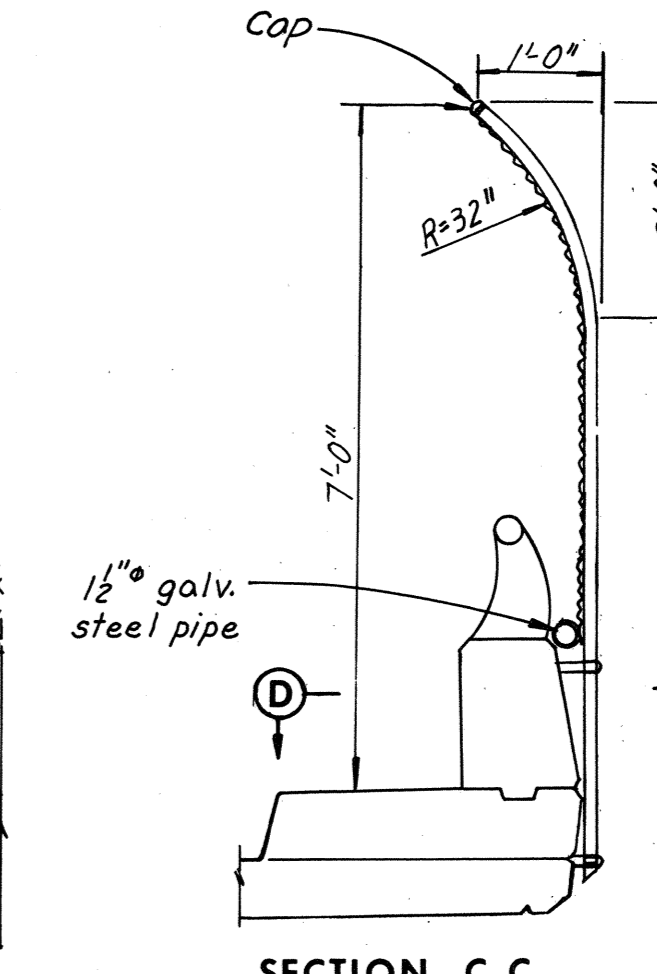

SECTION C-C

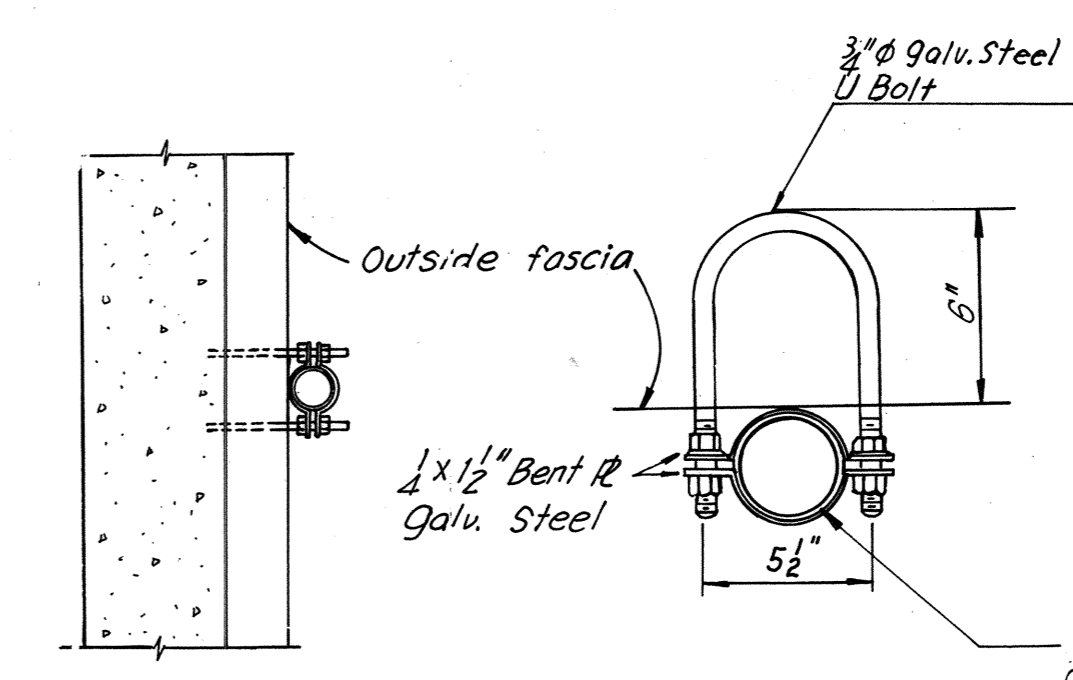

FENCE POST CLAMP

FIRE SCREEN DETAILS
No Scale.
Note: For location of fence, see Sheet 32. For location of nose, see Sheet 34.

ELEVATION TABLE			
STATION	ELEV. D	ELEV. E	ELEV. F
17 + 90.00	76.88	77.20	77.26
+ 57.59	—	—	77.41
18 + 00.00	77.08	77.40	77.46
+ 10.00	77.28	77.60	77.66
+ 12.70	77.33	—	—
+ 20.00	77.48	77.79	77.85
+ 30.00	77.68	77.99	78.05
+ 40.00	77.87	78.18	78.24
+ 50.00	78.07	78.38	78.44
+ 59.82	—	—	78.63
+ 60.00	78.26	78.57	78.63
+ 61.50	—	78.60	—
+ 70.00	78.44	78.74	78.80
+ 70.04	78.44	—	—
+ 80.00	78.60	78.90	78.96
+ 90.00	78.75	79.05	79.11
19 + 00.00	78.88	79.18	79.24
+ 10.00	79.00	79.30	79.36
+ 20.00	79.11	79.40	79.46
+ 30.00	79.20	79.49	79.55
+ 30.20	—	—	79.55
+ 31.40	—	79.50	—
+ 37.22	79.25	—	—
+ 40.00	79.27	79.56	79.62
+ 50.00	79.33	79.62	79.68
+ 60.00	79.39	79.67	79.73
+ 70.00	79.44	79.72	79.78
+ 80.00	79.49	79.78	79.84
+ 87.63	79.53	79.82	79.88
+ 90.00	79.55	79.83	79.89
+ 94.30	79.58	79.85	79.91
20 + 00.00	—	79.88	79.94

Note: See Sheet 28 for Location of Elevations above.

BY	DATE				
MADE	654/PTA	12-14-68			
CHECKED	JD	2-19-69	1	As Built	TEM. 8-76
IN CHARGE					


AS BUILT

RICHMOND METROPOLITAN AUTHORITY
RICHMOND EXPRESSWAY SYSTEM
DOWNTOWN EXPRESSWAY

BRIDGE NO. 66
EASTBOUND ROADWAY OVER
12TH ST. - R.R. TRACKS AND 16TH ST.
SUPERSTRUCTURE DETAILS

HOWARD, NEEDLES, TAMMEN & BERGENDOFF
consulting engineers
NEW YORK ALEXANDRIA KANSAS CITY

SCALE: As Noted
CONTRACT NO. 10
SHEET NO. 36 OF 46

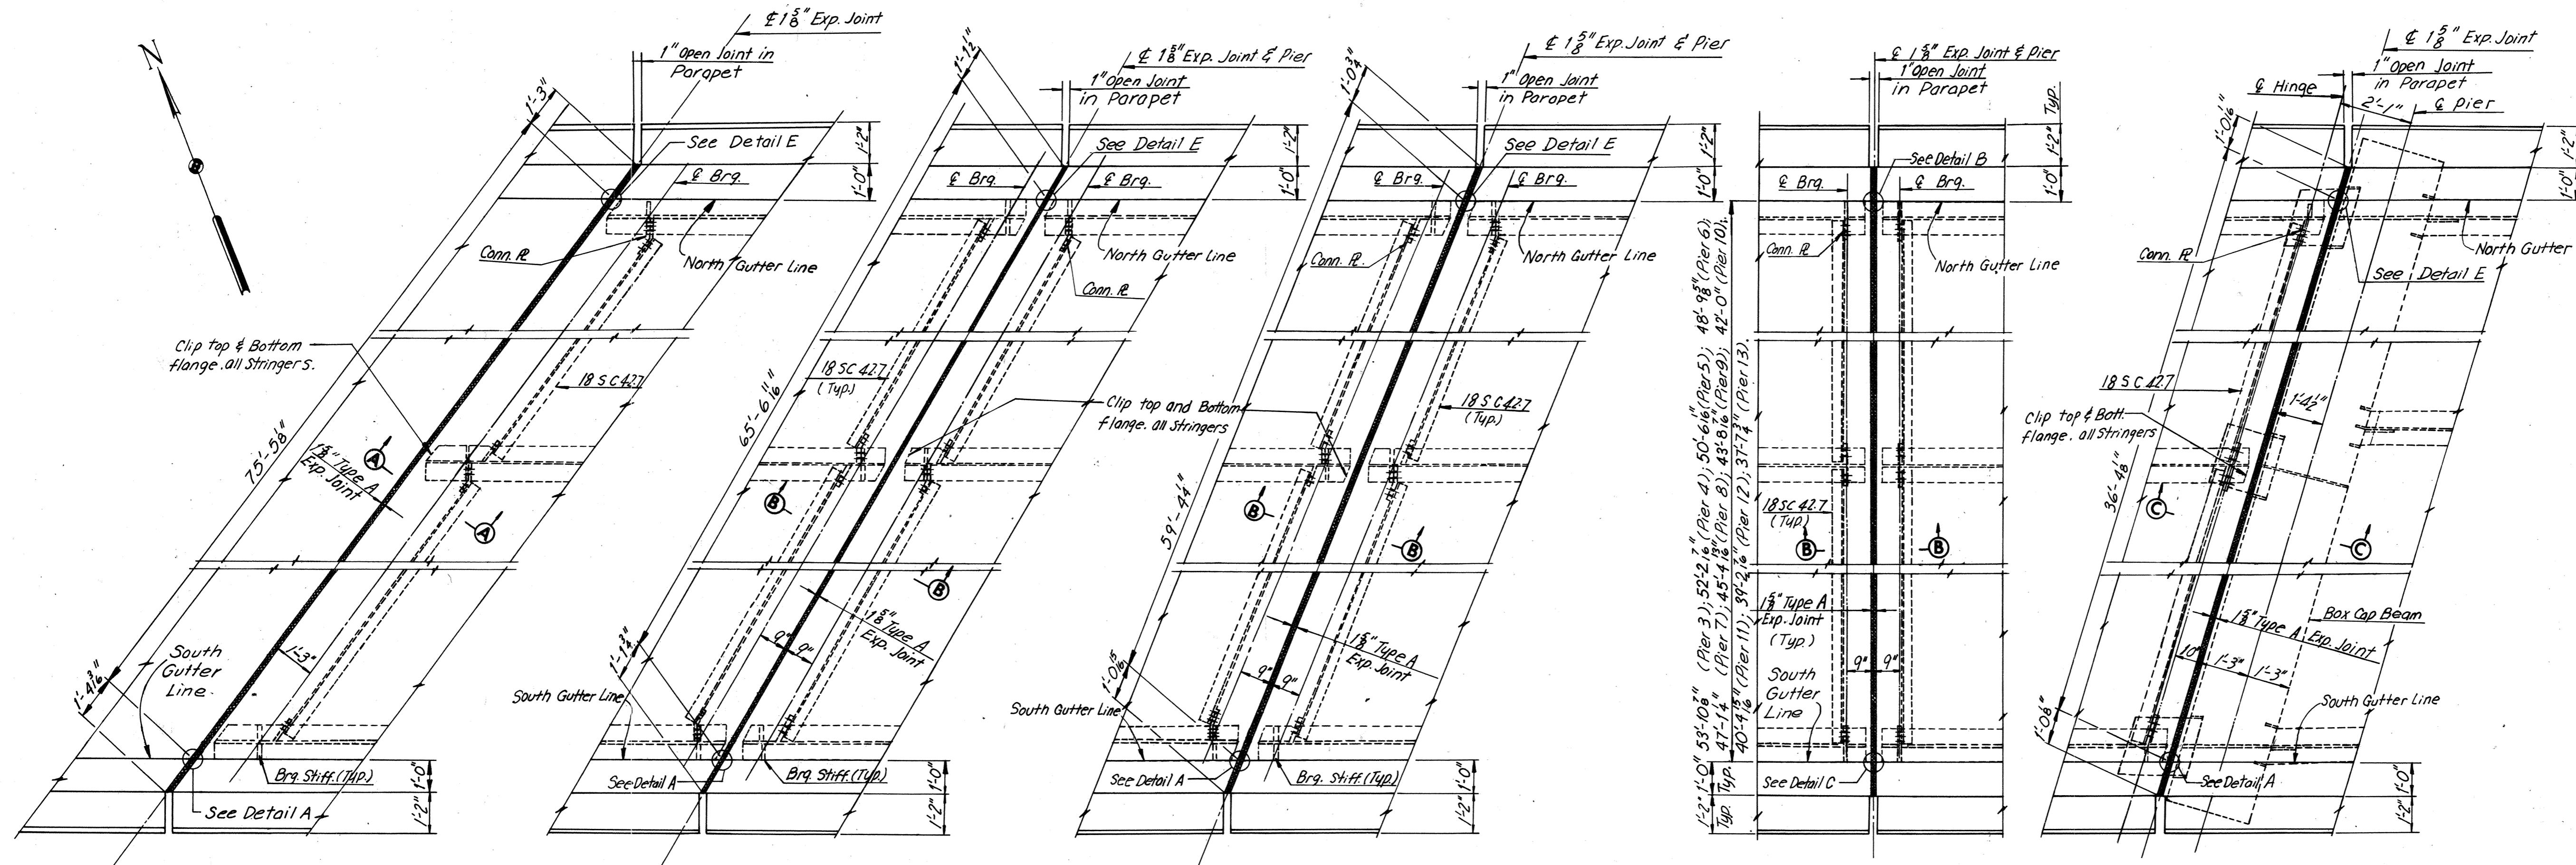


PLAN — JOINT AT WEST ABUTMENT
Scale: 3/8" = 1'-0"

PLAN — JOINT AT PIER 1
Scale: 3/8" = 1'-0"


PLAN — JOINT AT PIER 2
Scale: 3/8" = 1'-0"

PLAN — JOINT AT PIERS 3 THRU. 13
Scale: 3/8" = 1'-0"


PLAN — JOINT AT PIER 14
Scale: 3/8" = 1'-0"

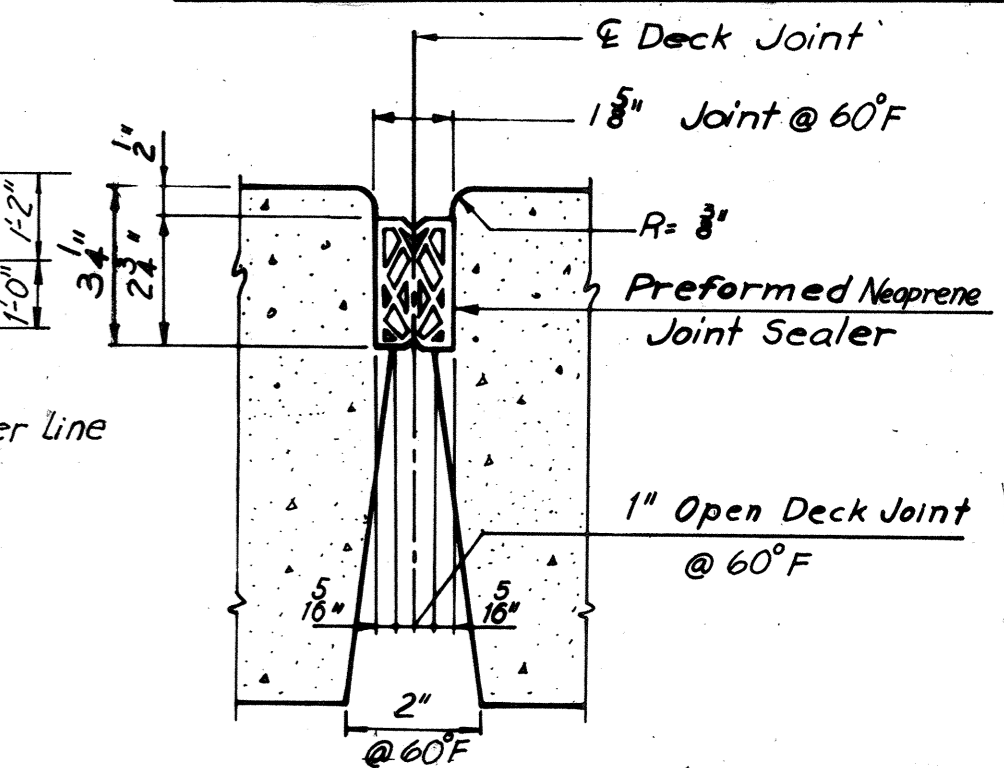


15" TYPE "A" EXPANSION JOINT
Note: For Joint Detail @ Abutment see Detail D.

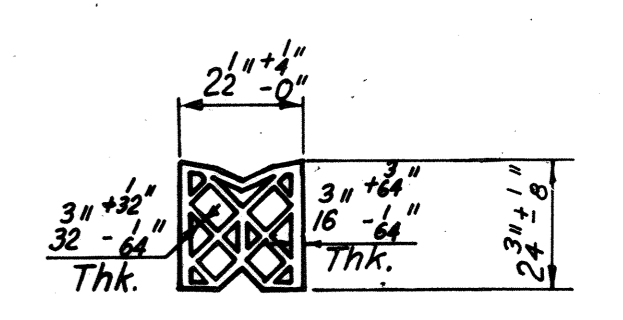


PREFORMED NEOPRENE JOINT SEALER FOR 15" TYPE "A" EXPANSION JOINT

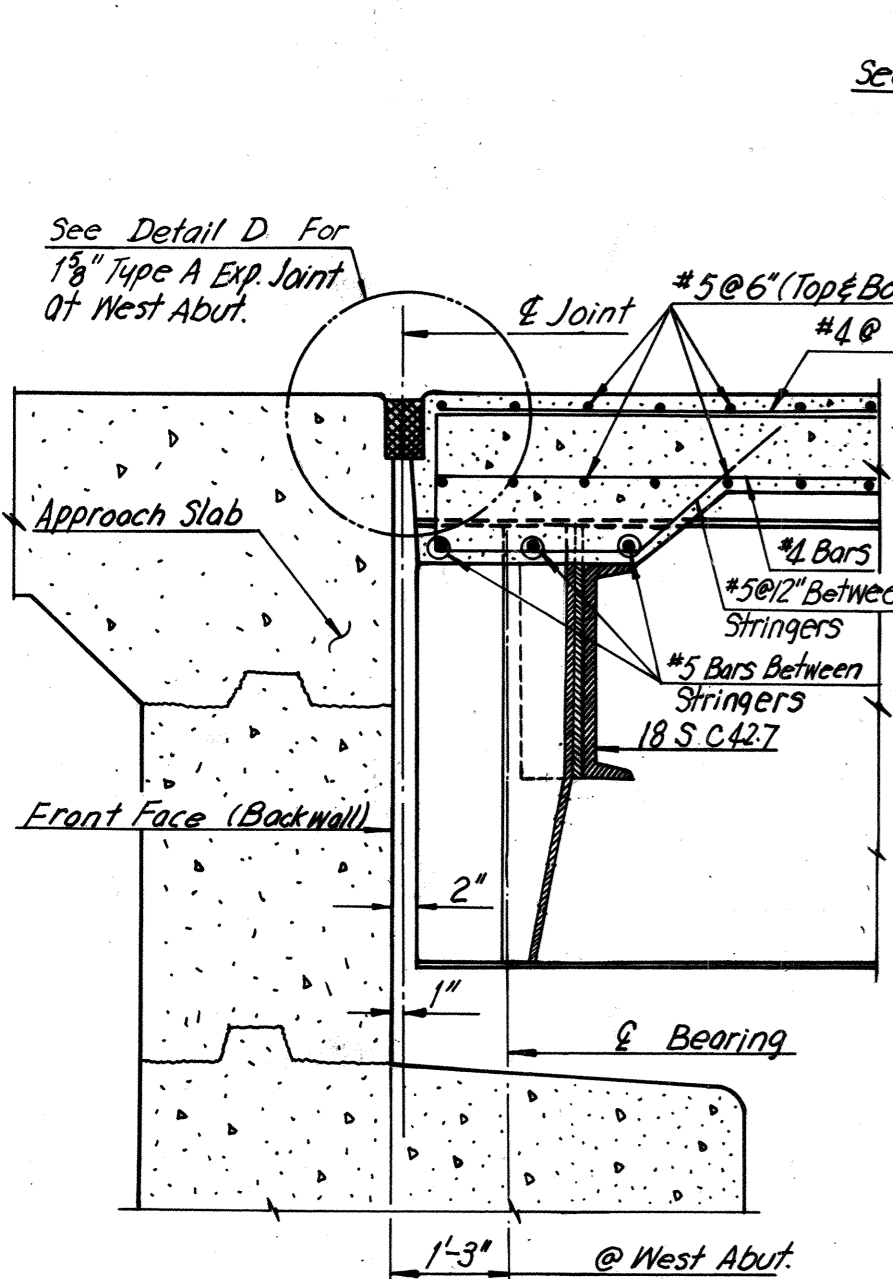


SECTION A-A
Scale: 3/4" = 1'-0"

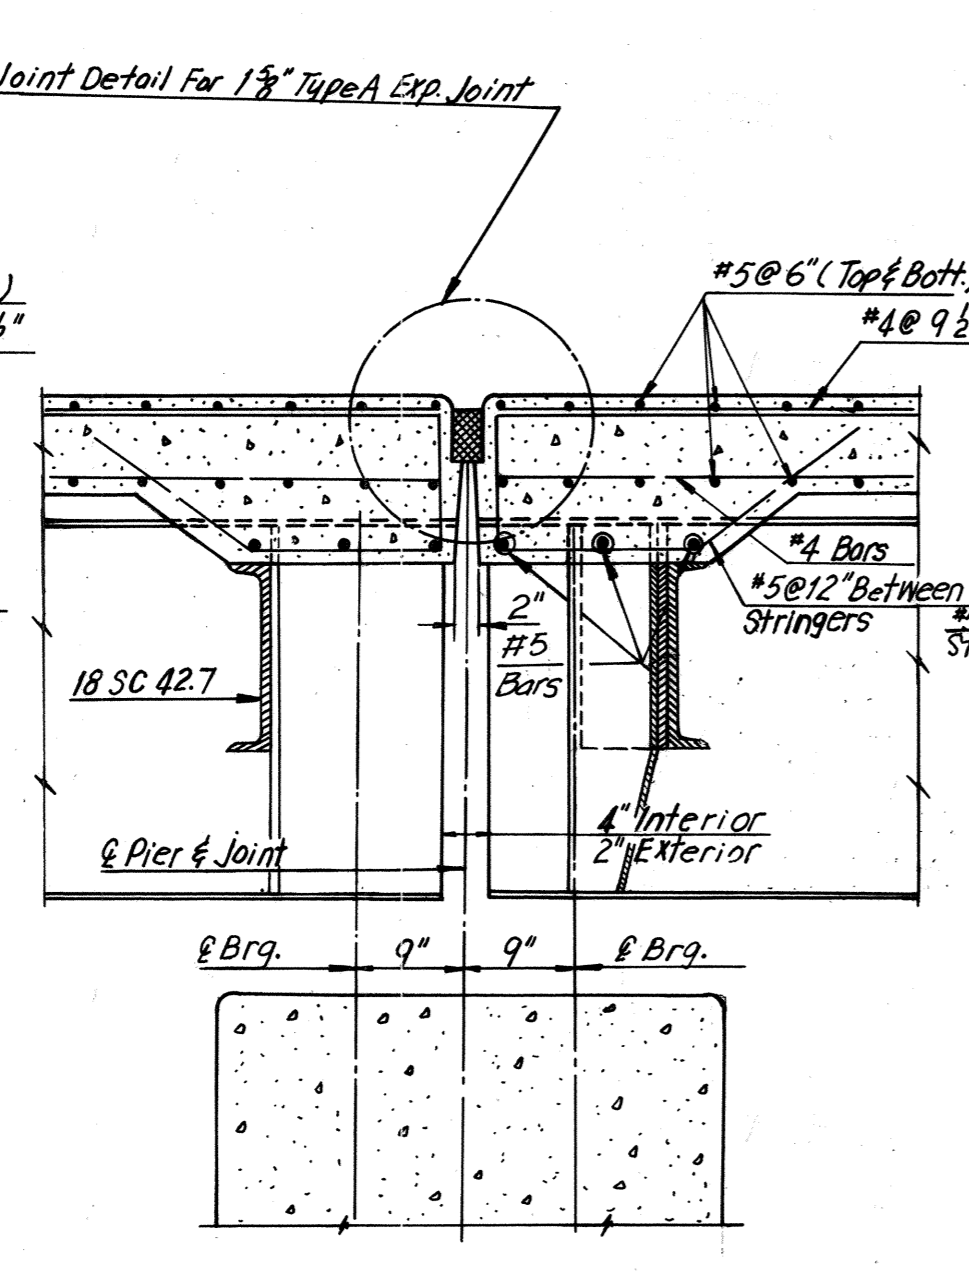


SECTION B-B
Scale: 3/4" = 1'-0"

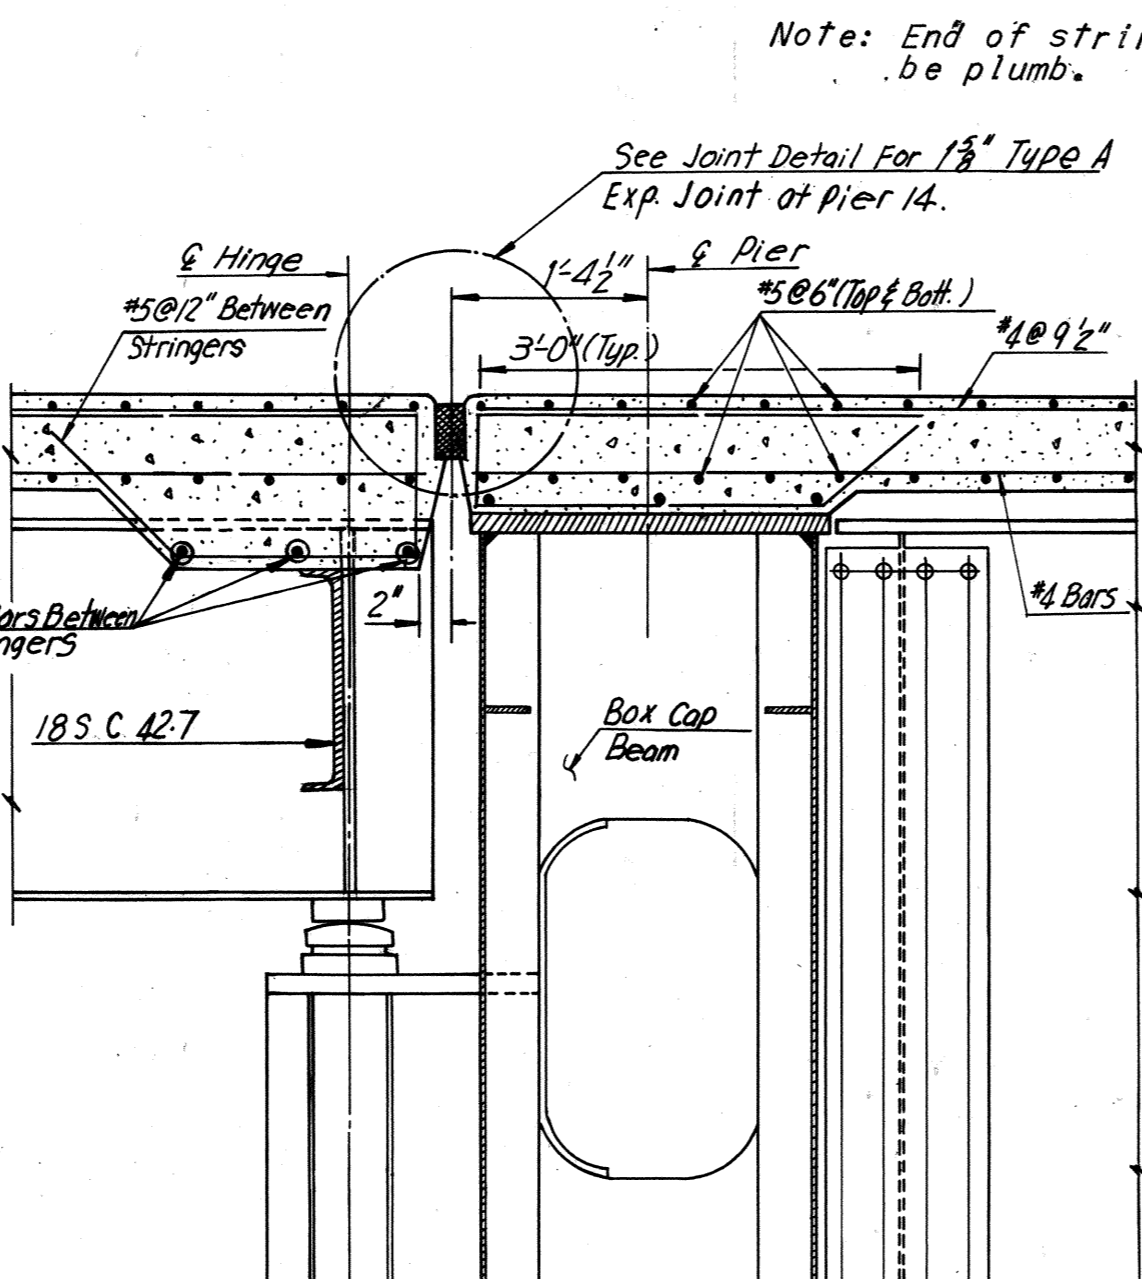


SECTION C-C
Scale: 3/4" = 1'-0"

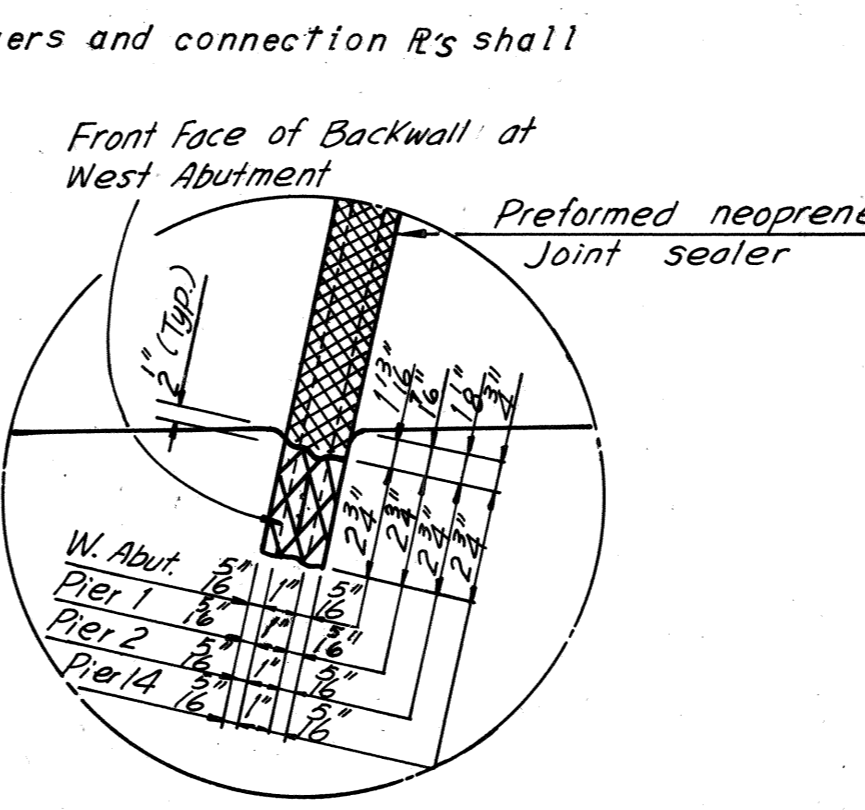


DETAIL A
No Scale

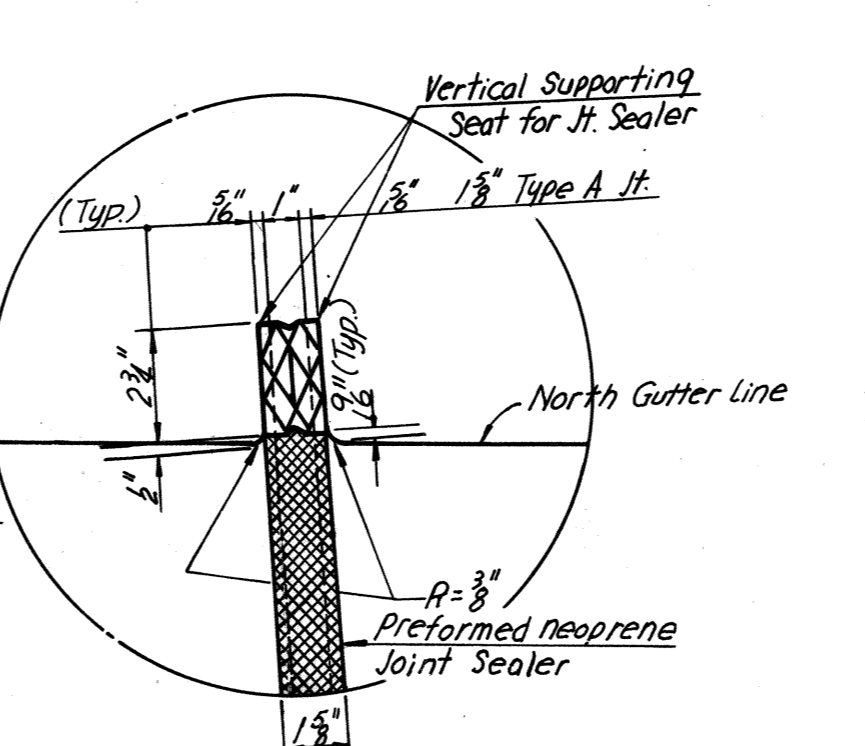


DETAIL B
No Scale
Typical for Piers 3 thru 13.

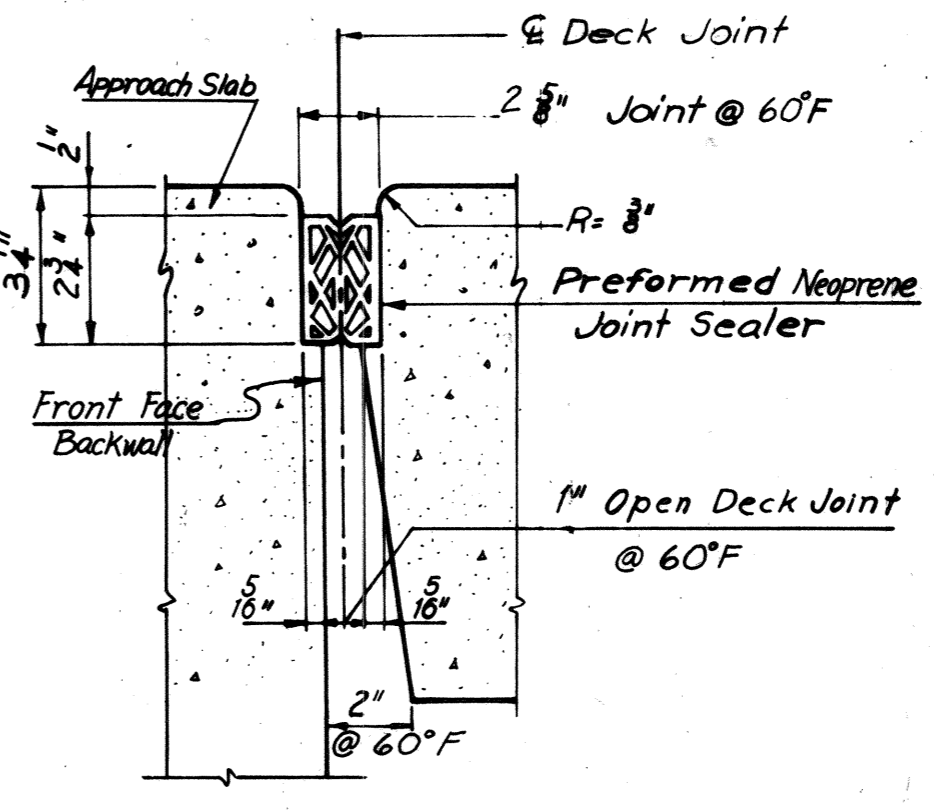

DETAIL D
No Scale

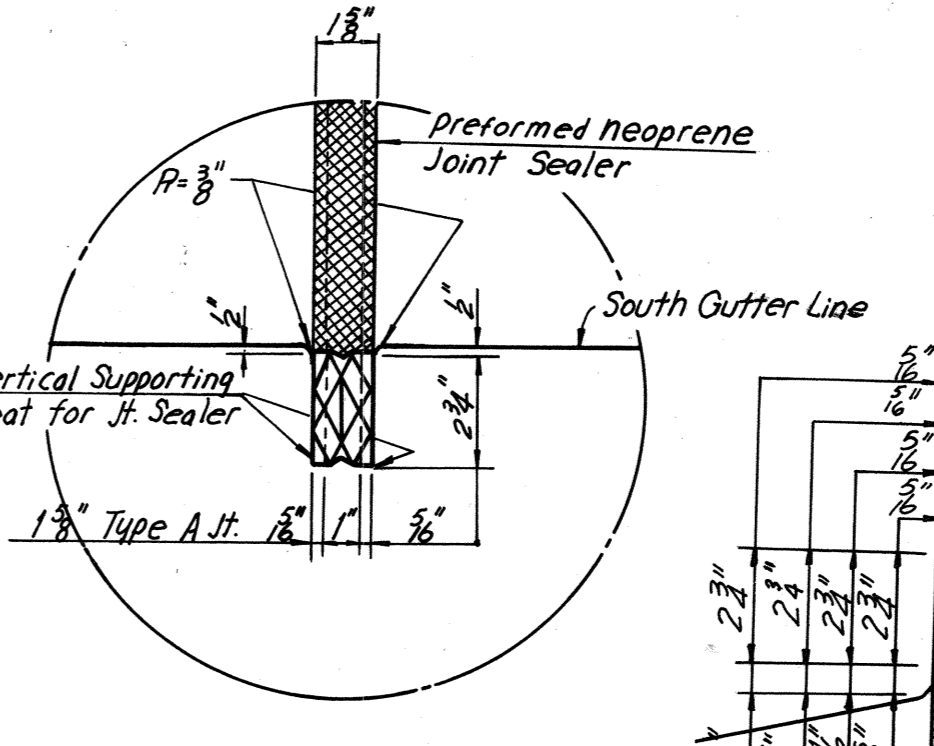

DETAIL C
No Scale
Typical for Piers 3 thru 13.

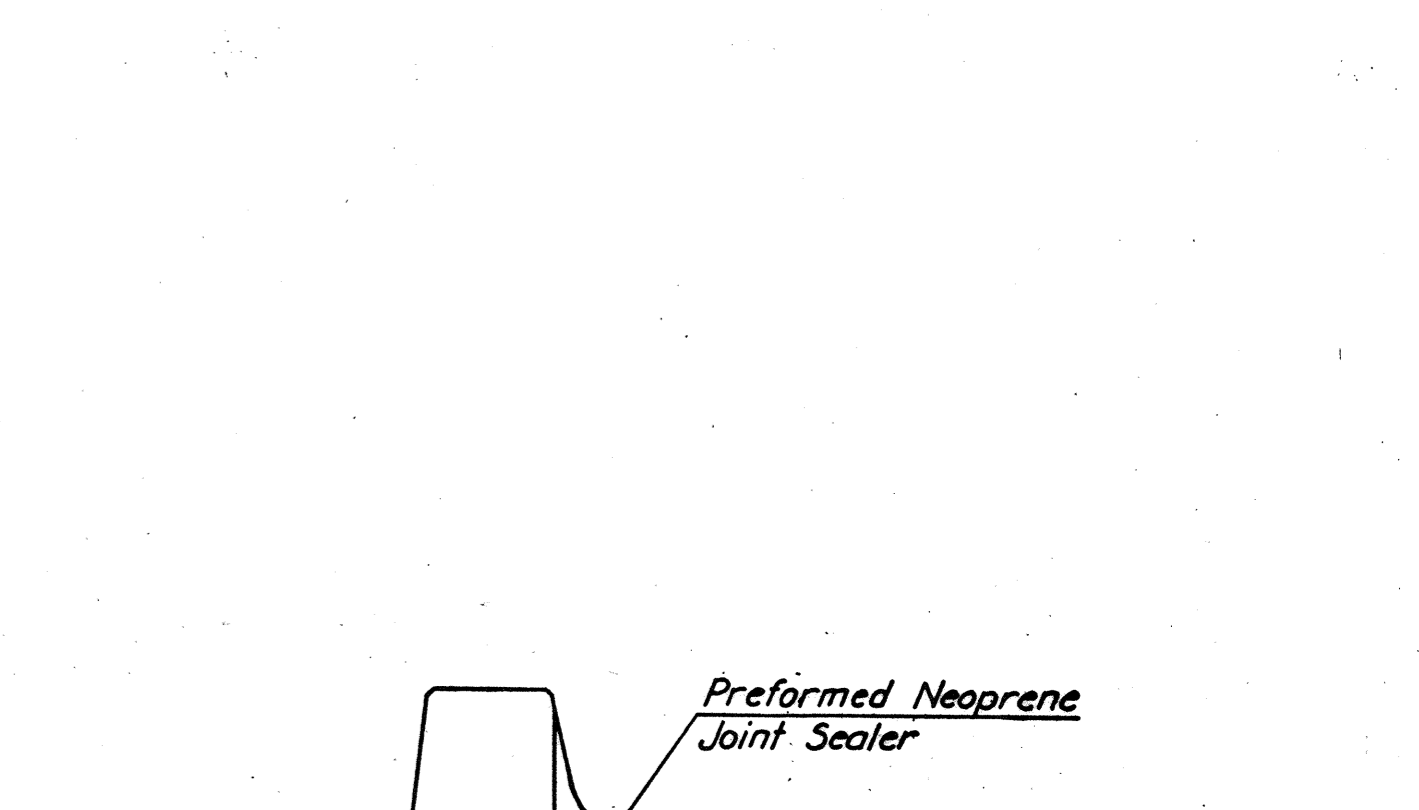

DETAIL E
No Scale

TREATMENT OF TYPE "A" JOINT AT GUTTER

AS BUILT
RICHMOND METROPOLITAN AUTHORITY
RICHMOND EXPRESSWAY SYSTEM
DOWNTOWN EXPRESSWAY

BRIDGE NO. 66
EASTBOUND ROADWAY O.V.
12TH ST. - R.R. TRACKS AND 161
JOINT DETAILS

HOWARD, NEEDLES, TAMMEN & BERGENDOFF
consulting engineers
NEW YORK ALEXANDRIA KANSAS CITY
SCALE: As Noted
CONTRACT NO. 10
SHEET NO. 37 OF 46

MADE	BY	DATE			
CHECKED	C.E.B.	2-5-69	1	As Built	TEM 8-76
IN CHARGE			NO.	REVISION	BY DATE


Note: All horizontal dimensions of Sections shown above are normal to & joint and pier.

Note: For details of bearing stiffeners, see Deck Plan Sheets 28, 29, & 30.


Note: It is absolutely essential that the openings for the preformed neoprene joint sealers be accurately formed and constructed to smooth, straight lines. The size of opening shall be adjusted to allow for anticipated dead load rotation of the ends of the slab and for the temperature at the time of construction.

Note: End of stringers and connection R's shall be plumb.


RICHMOND EXPRESSWAY SYSTEM			
SECTION	PROJECT	SHEET NO.	TOTAL SHEETS
10	DOWNTOWN EXPRESSWAY	164	265

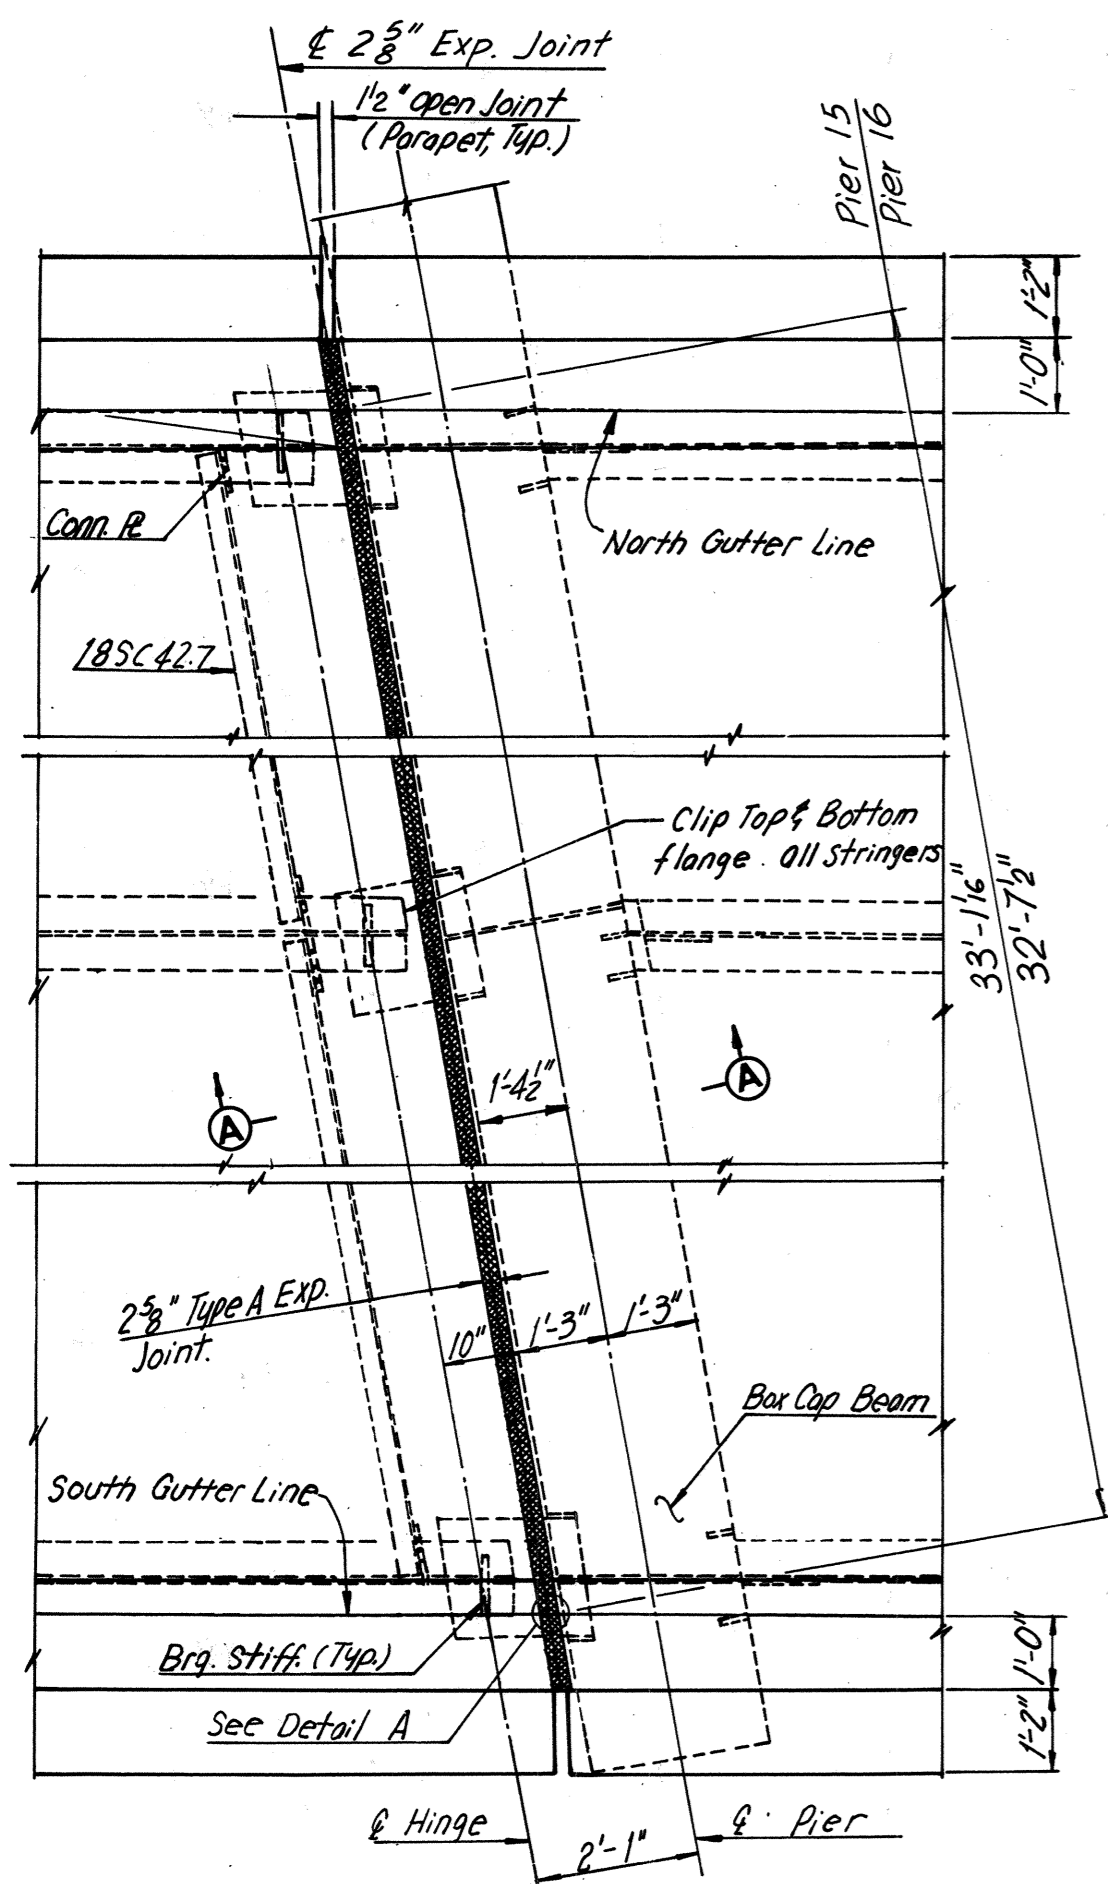


PLAN — JOINT AT PIERS 15 AND 16
Scale 3/8" = 1'-0"

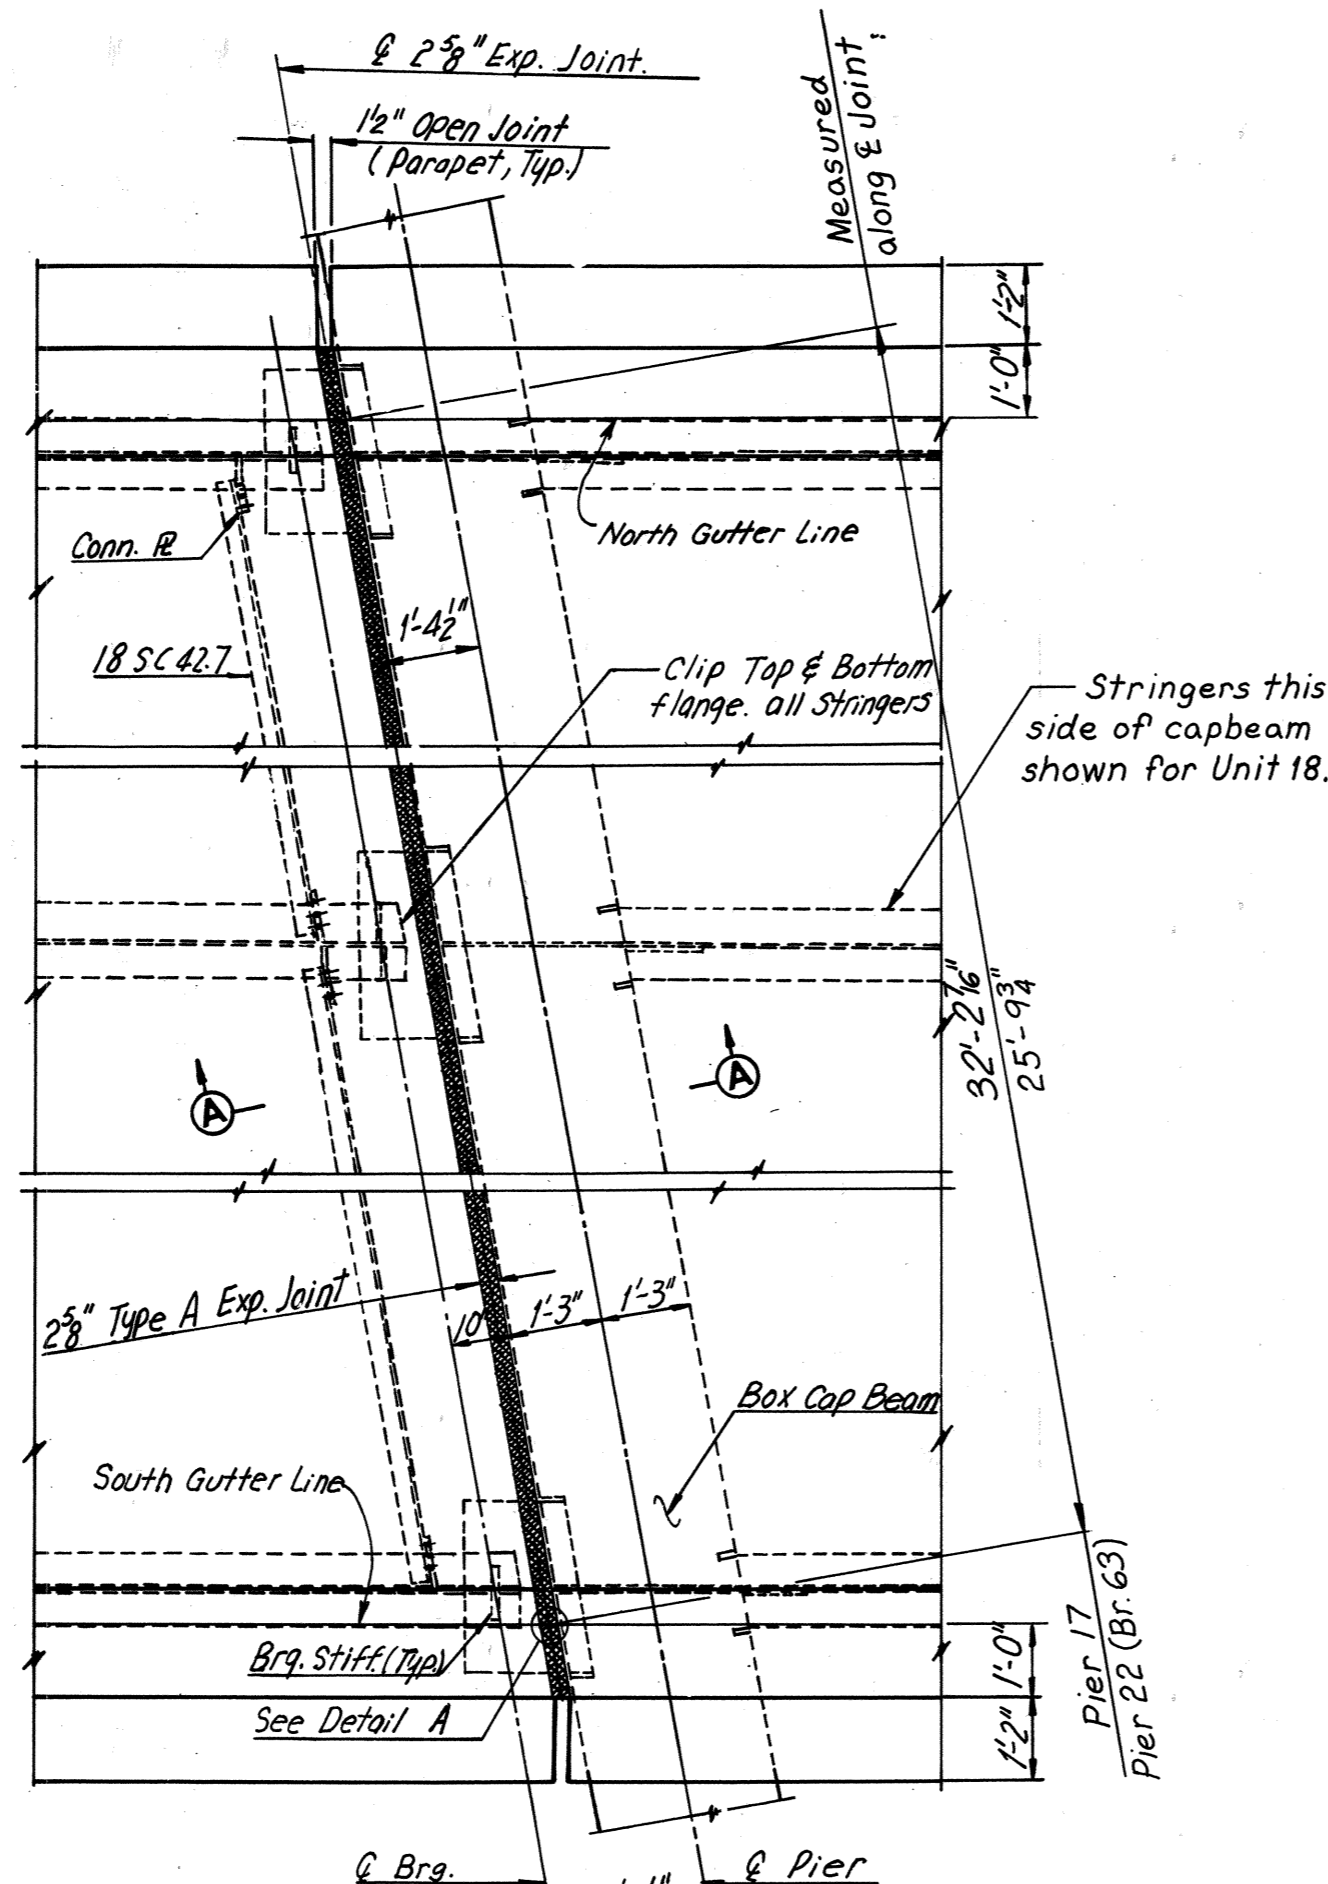


PLAN — JOINT AT PIER 17 AND PIER 22 (BR. 63)
Scale 3/8" = 1'-0"

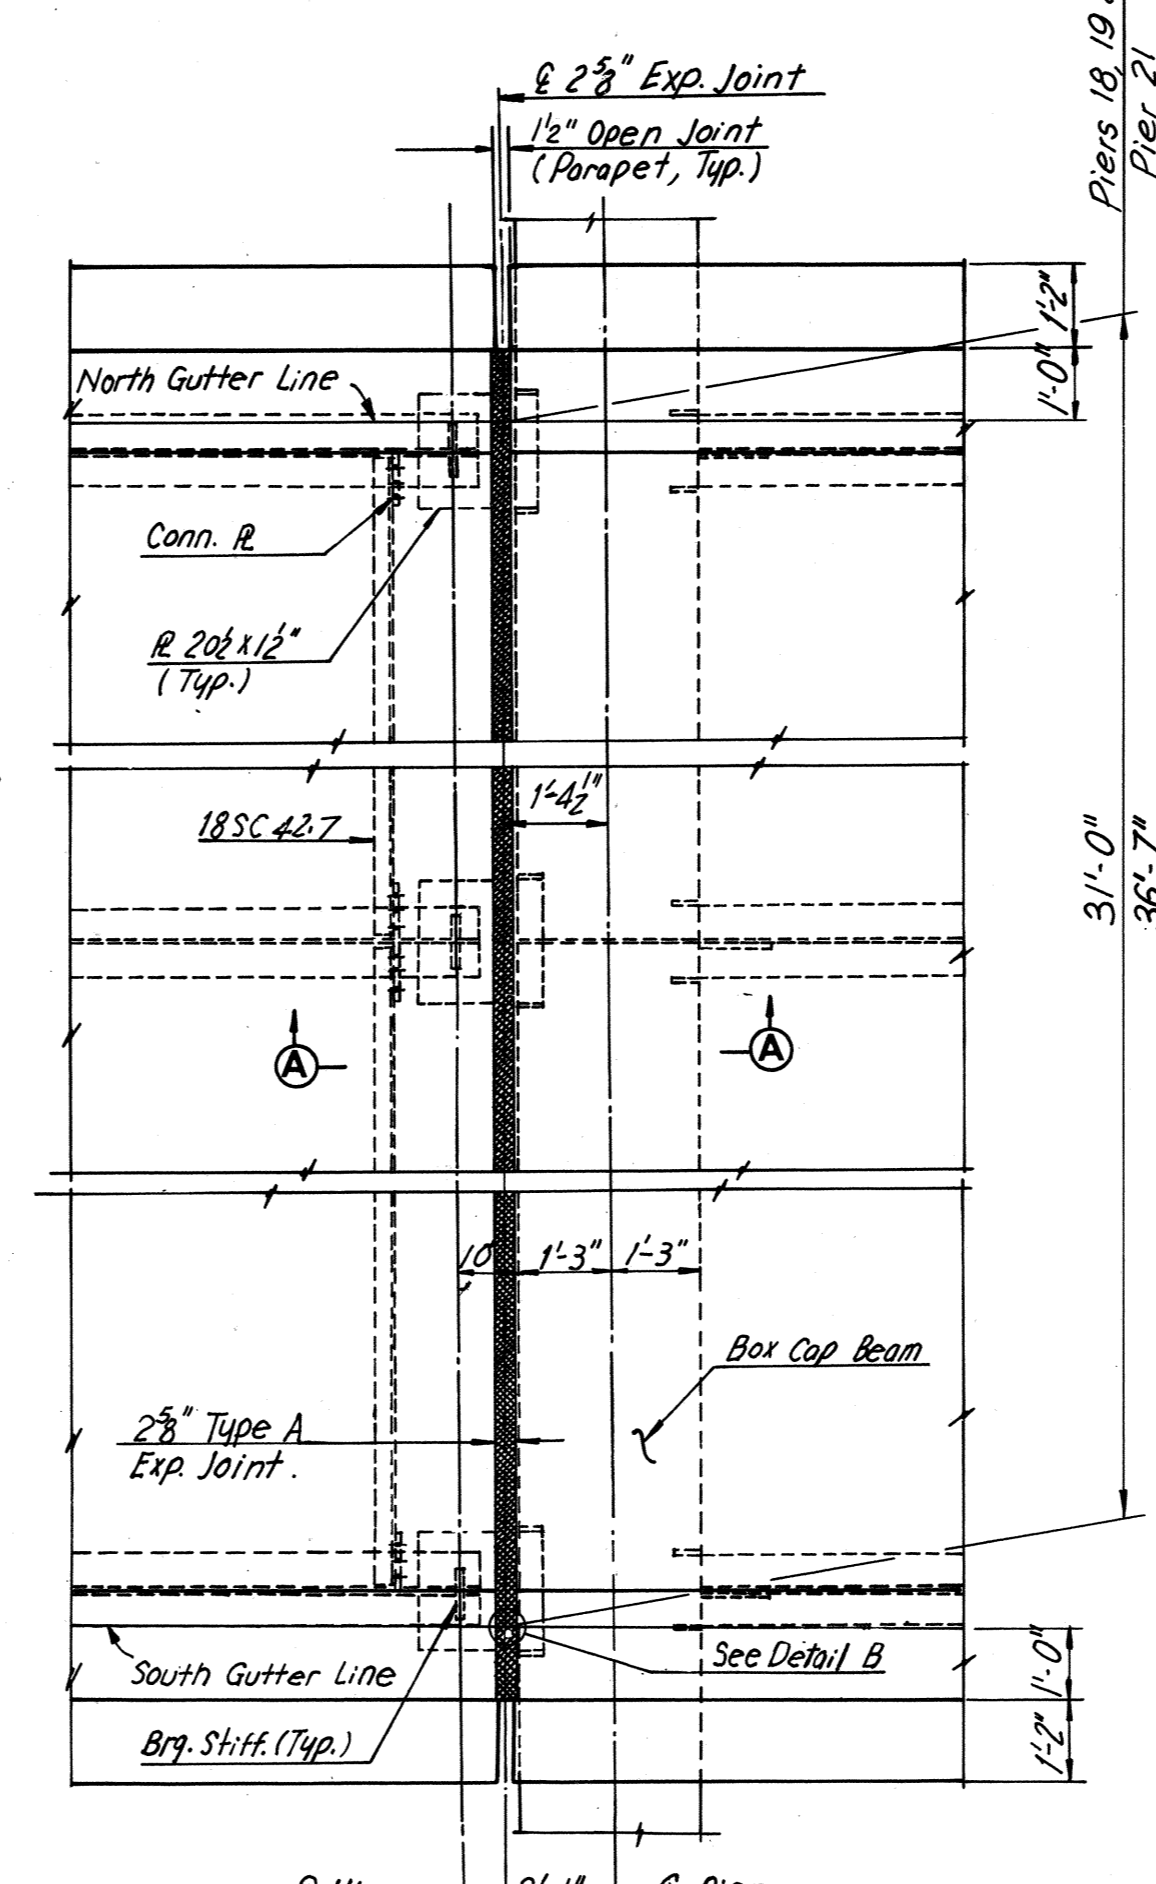

PLAN — JOINT AT PIERS 18, 19, 20 AND 21 (BRIDGE 63)
Scale 3/8" = 1'-0"

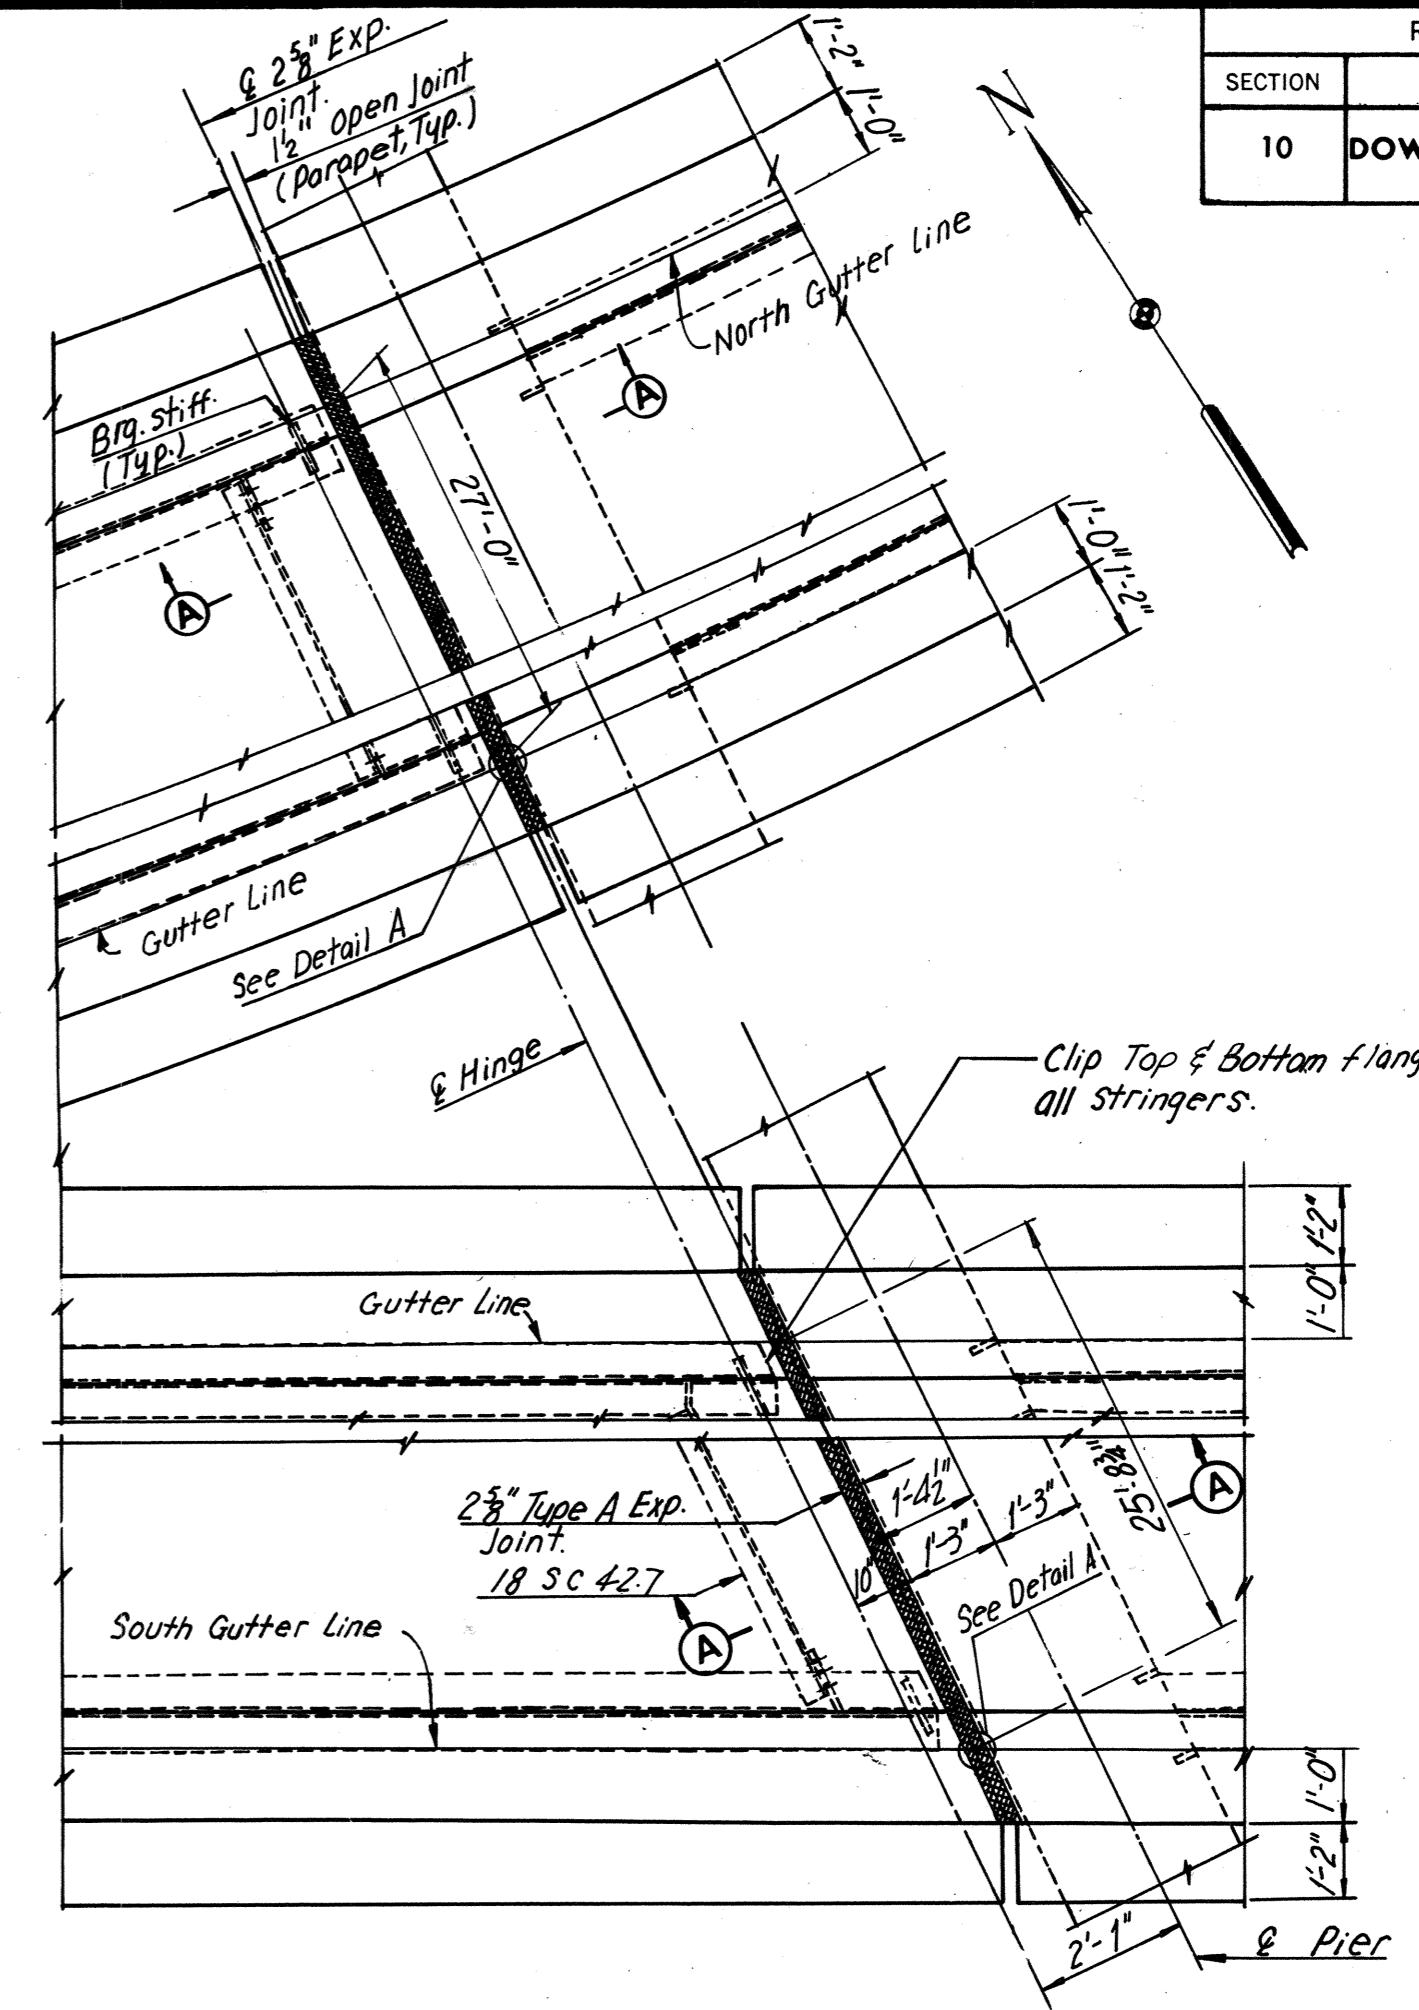


PLAN — JOINT AT PIER 22 (BRIDGE 63)
Scale 3/8" = 1'-0"

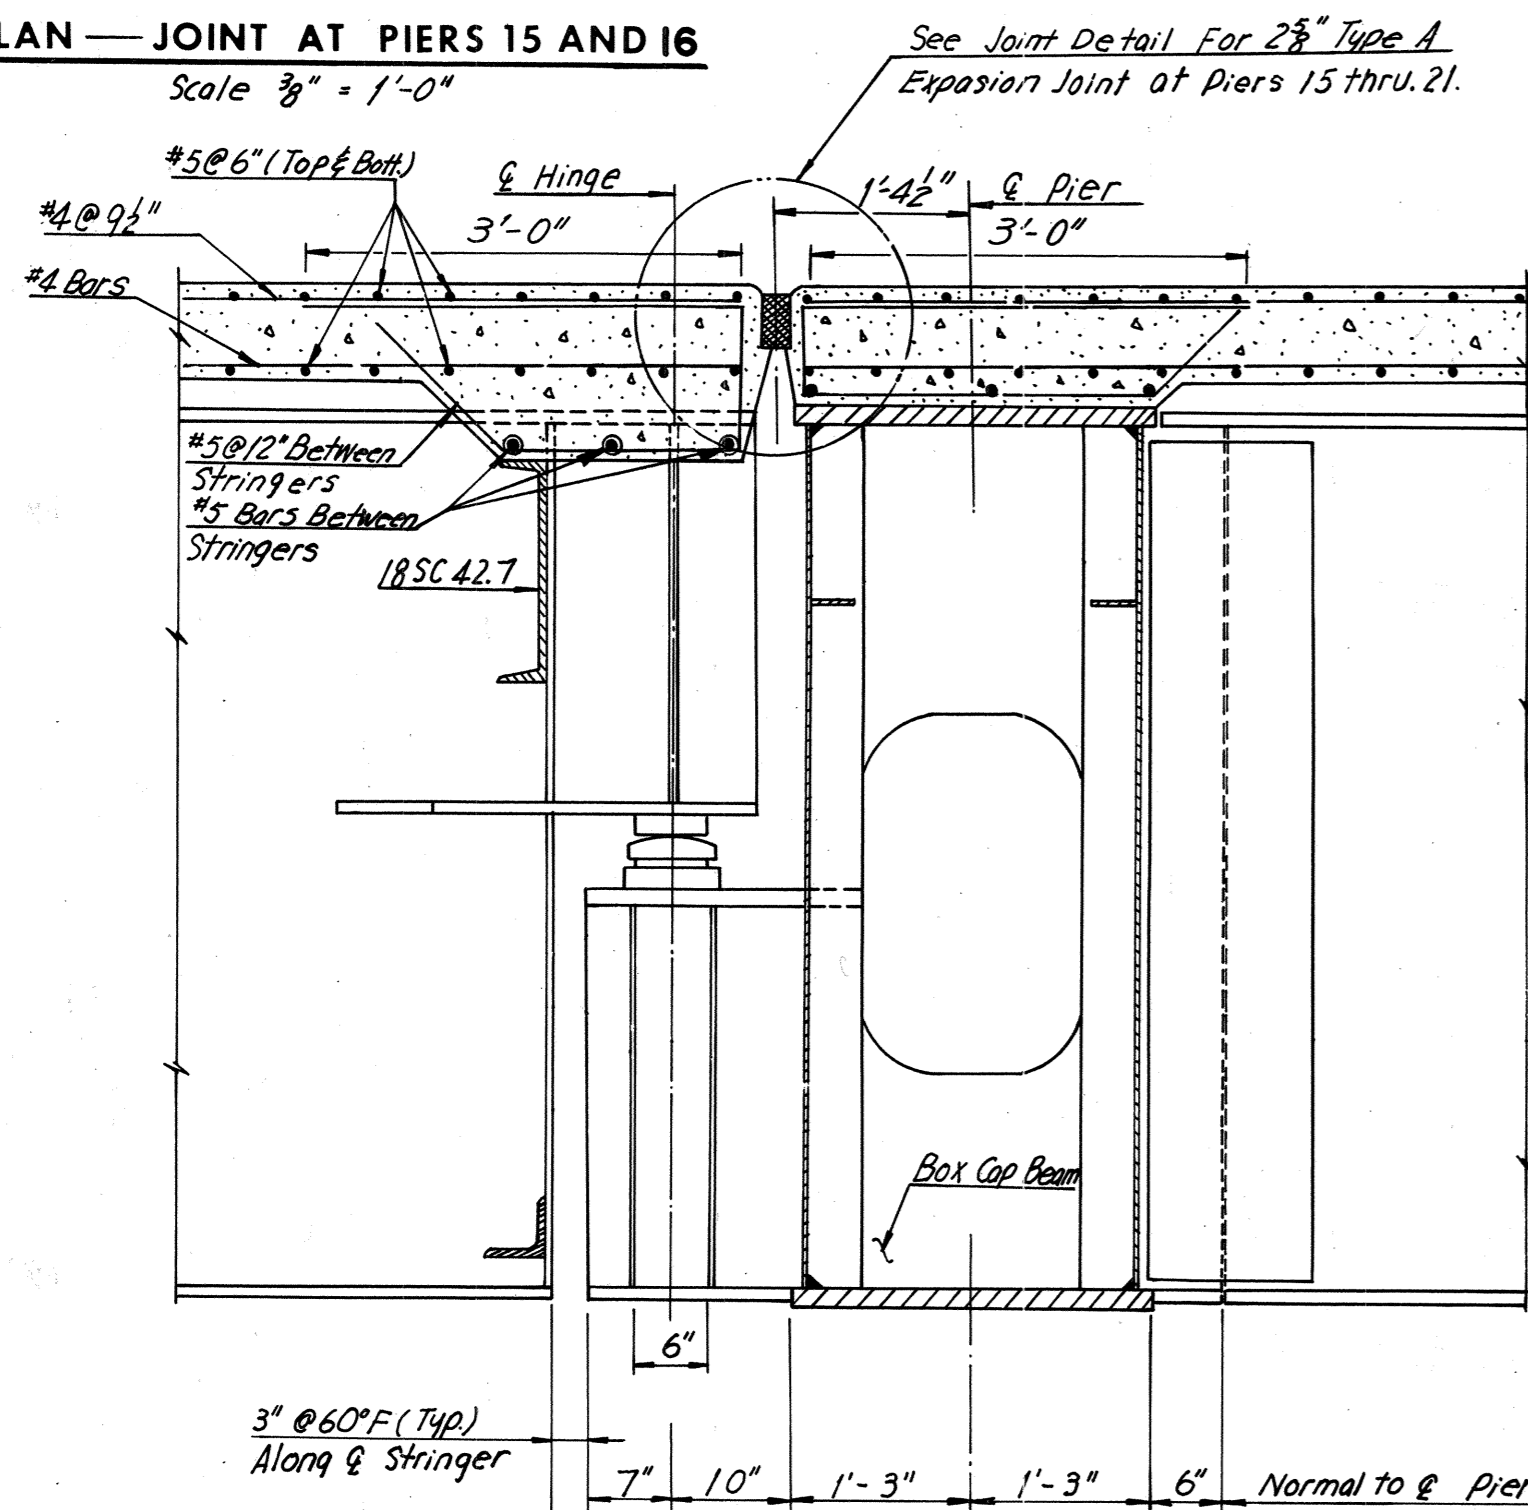


SECTION A-A
Scale 3/4" = 1'-0"


Note: End of stringers and connection R's shall be plumb.

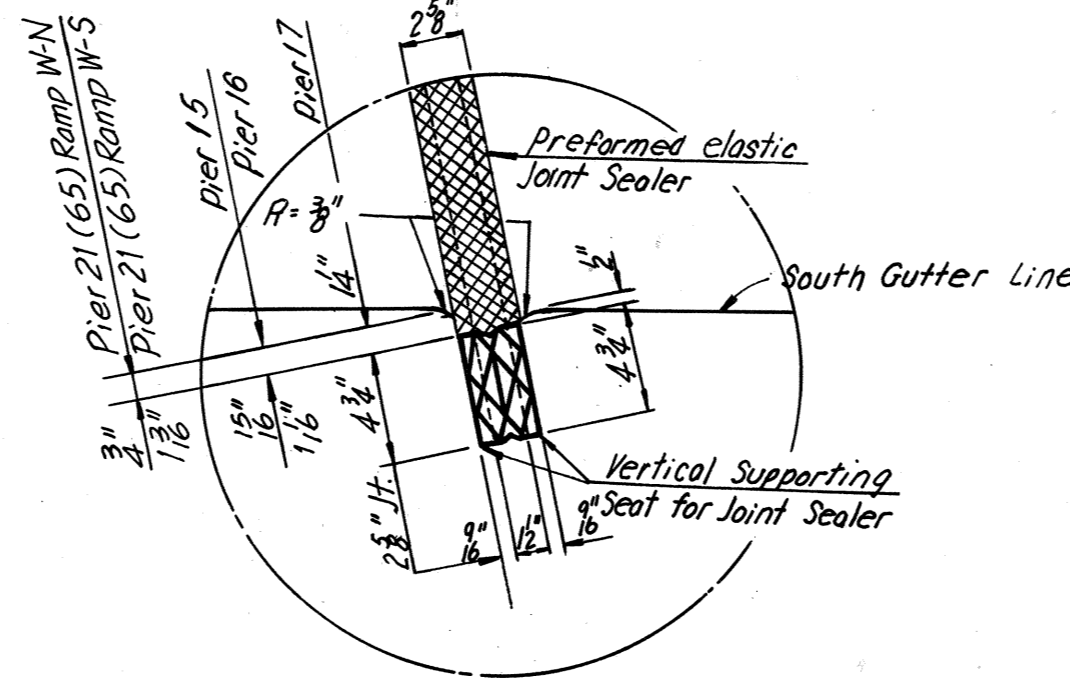

DETAIL A
No Scale
Typical for Piers 15 thru. 17 & Pier 21 (Br. 63)

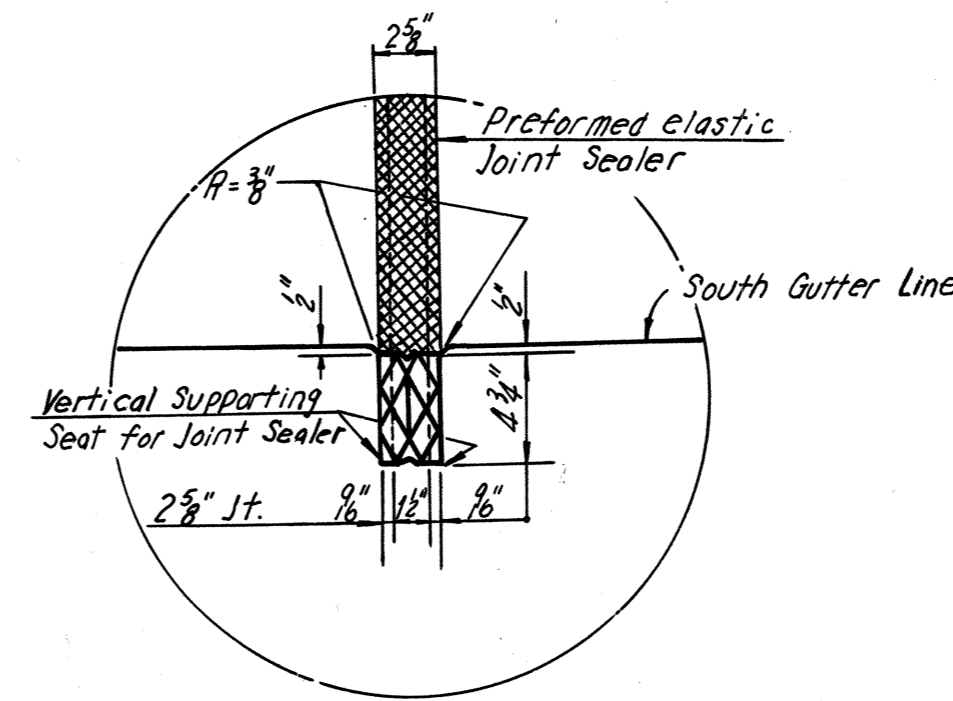

DETAIL B
No Scale
Typical for Piers 18 thru. 20 & Pier 21 (Br. 63)

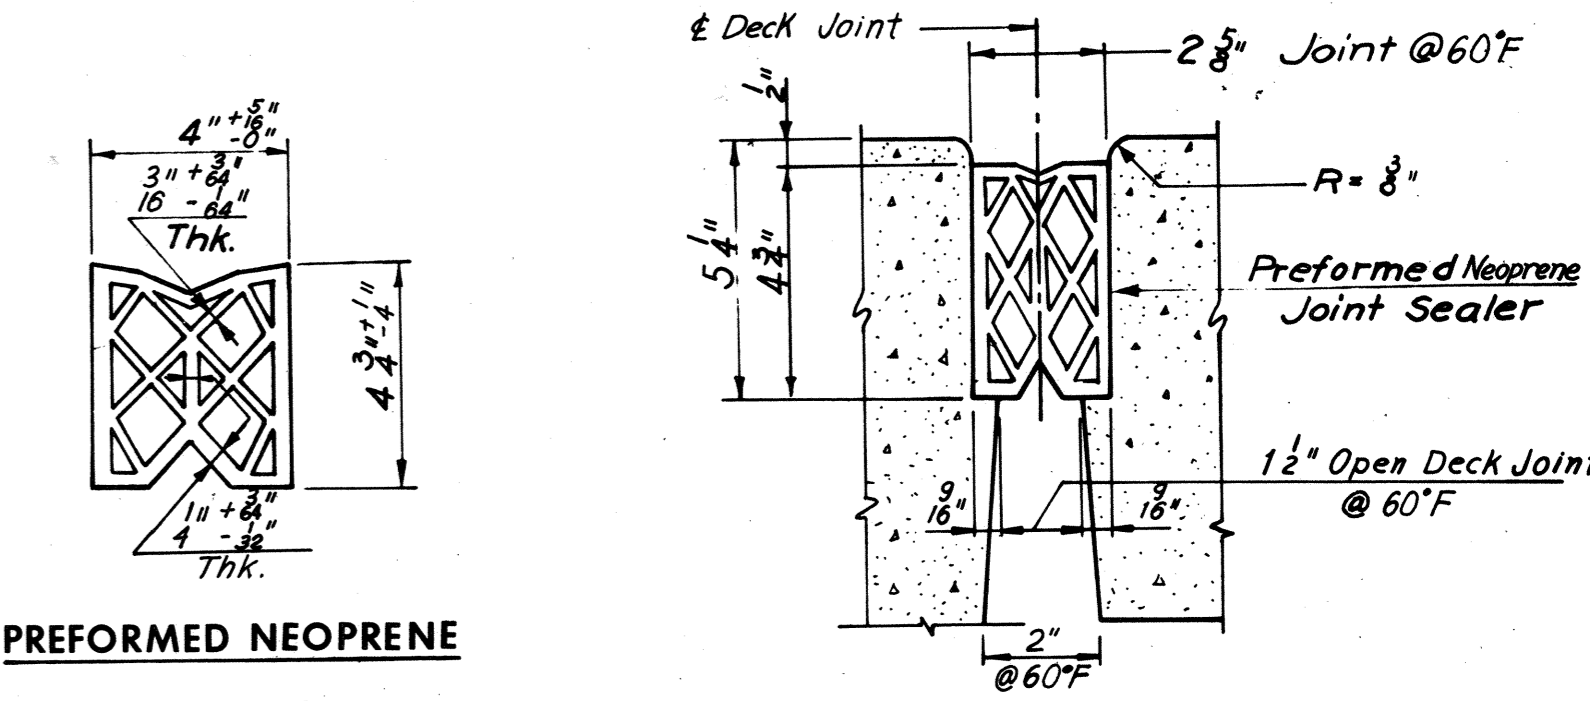

PREFORMED NEOPRENE JOINT SEALER
FOR 2 1/2" TYPE "A" EXPANSION JOINT
No Scale


2 3/8" TYPE "A" EXPANSION JOINT
No Scale

Note: All horizontal dimensions shown above are normal to Q Joint.

Note: All horizontal dimensions of Section shown above are normal to Q joint and pier.

Note: For details of bearing stiffeners, see Framing Plan Sheets 17 thru 21.

Note: It is absolutely essential that the openings for the preformed neoprene joint sealers be accurately formed and constructed to smooth, straight lines. The size of opening shall be adjusted to allow for anticipated dead load rotation of ends of the slab and for the temperature at the time of construction.

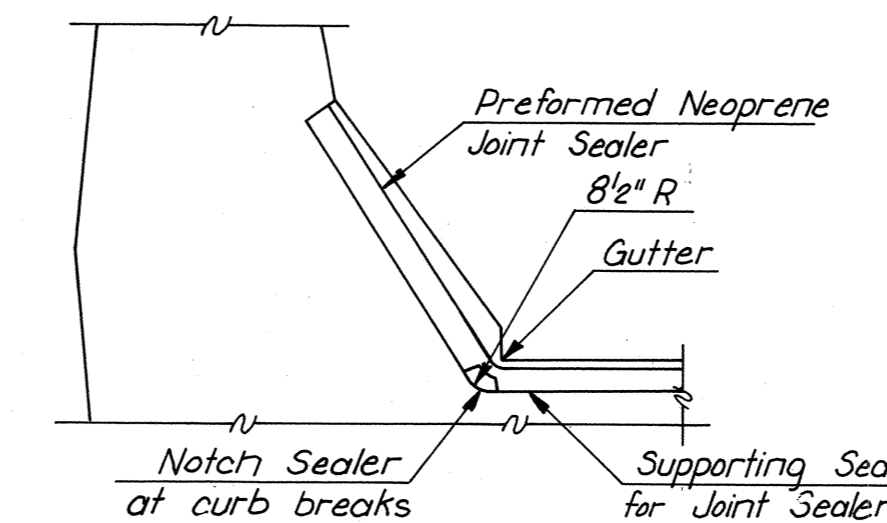

TREATMENT OF TYPE "A" JOINT AT CURB
No Scale

BY	DATE				
MADE	G.S.H.	10-15-68			
CHECKED	C.E.B.	2-5-69	1	As Built	TEM 8-76
IN CHARGE			NO.	REVISION	BY DATE

RICHMOND METROPOLITAN AUTHORITY
RICHMOND EXPRESSWAY SYSTEM
DOWNTOWN EXPRESSWAY

BRIDGE NO. 66
 EASTBOUND ROADWAY OVER
 12TH ST. - R.R. TRACKS AND 16TH ST.












JOINT DETAILS

HOWARD, NEEDLES, TAMMEN & BERGENDOFF
 consulting engineers
 NEW YORK ALEXANDRIA KANSAS CITY

SCALE: As Noted
 CONTRACT NO.: 10
 SHEET NO. 38 OF 46

AS BUILT

PROJECT NO. 7095-127-101	RICHMOND EXPRESSWAY SYSTEM		
SECTION 10	PROJECT DOWNTOWN EXPRESSWAY	SHEET NO. 165	TOTAL SHEETS 265

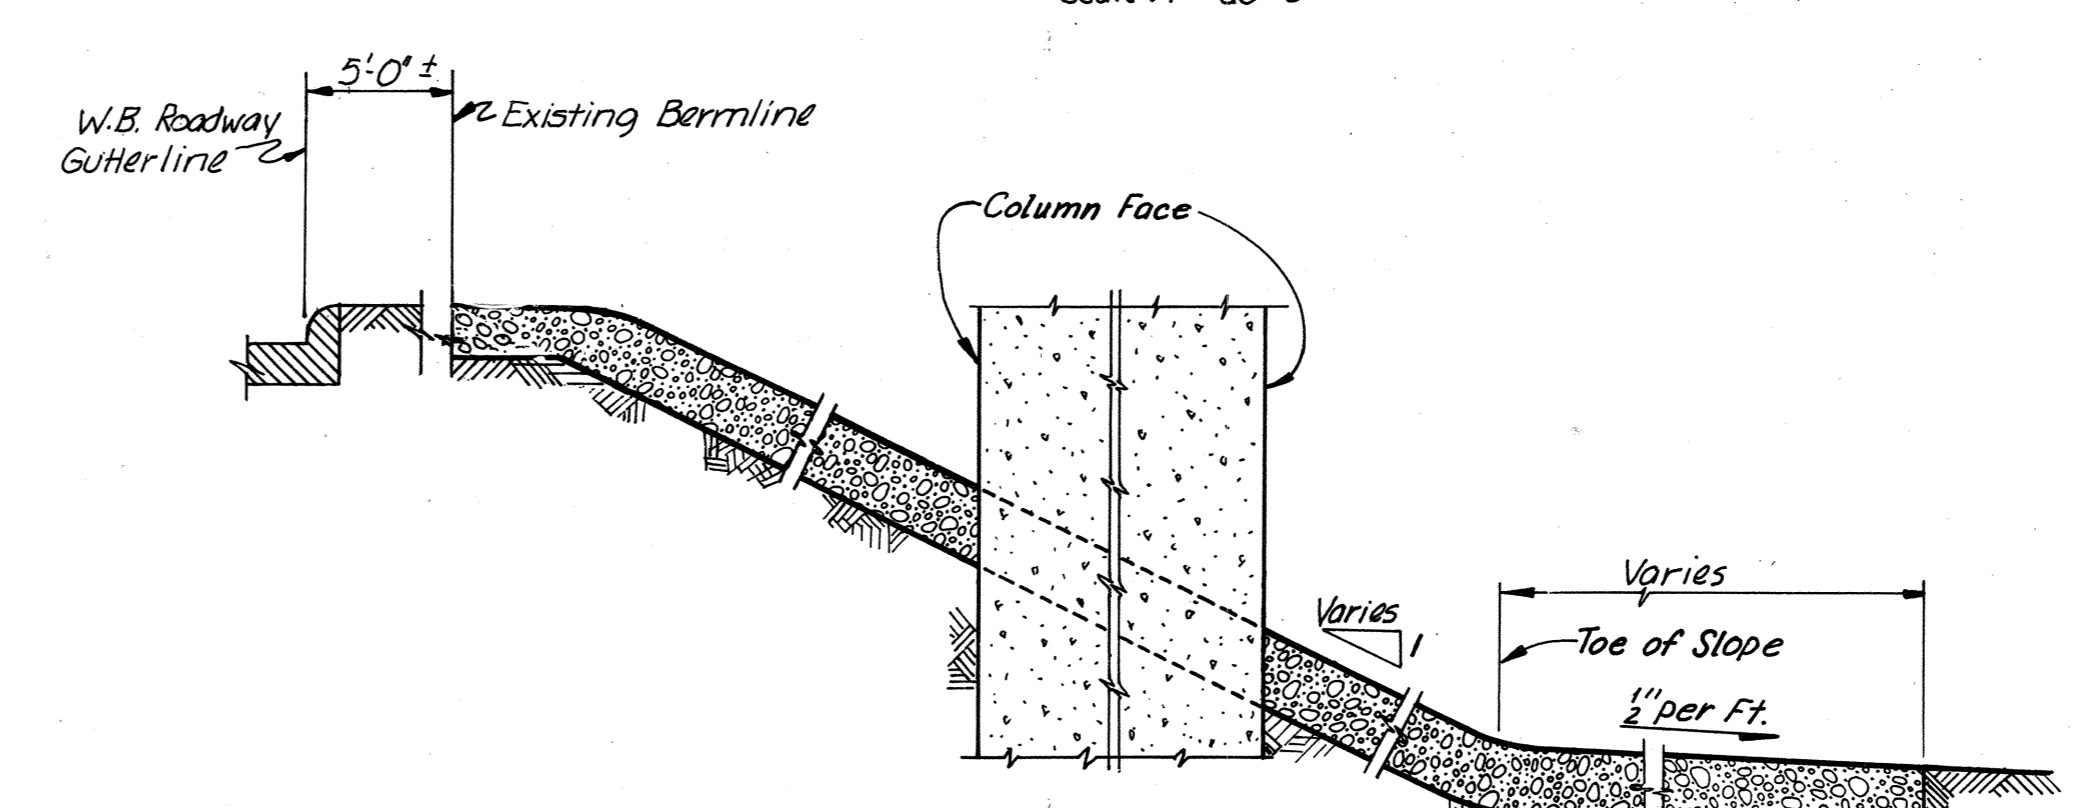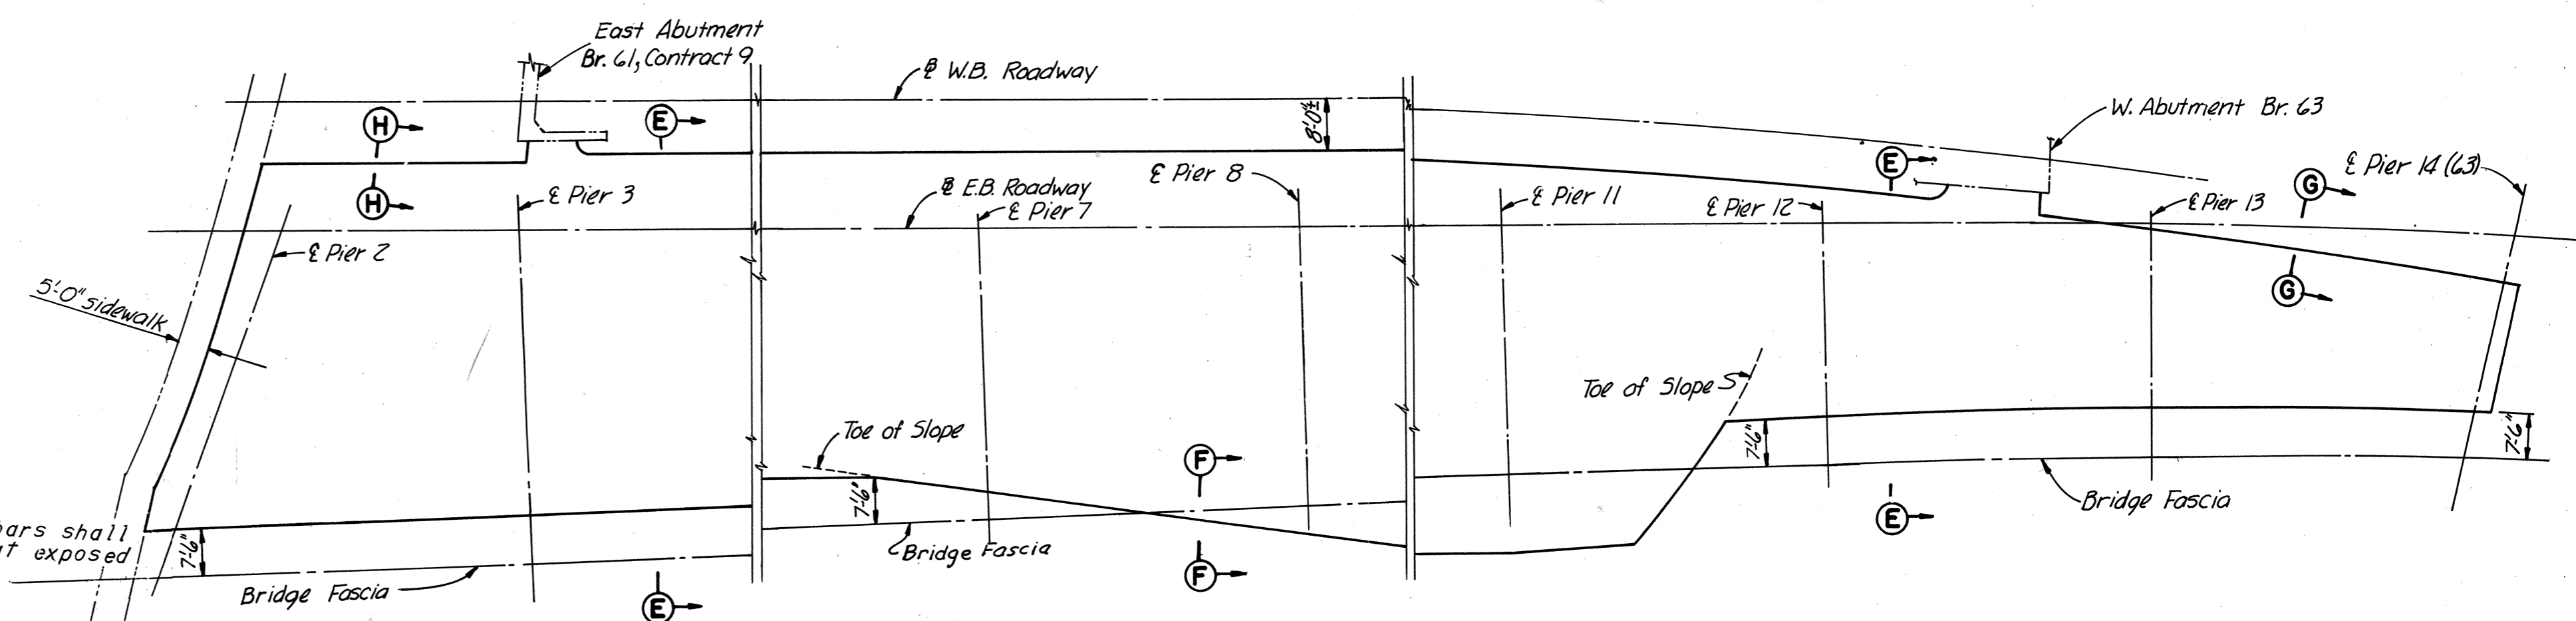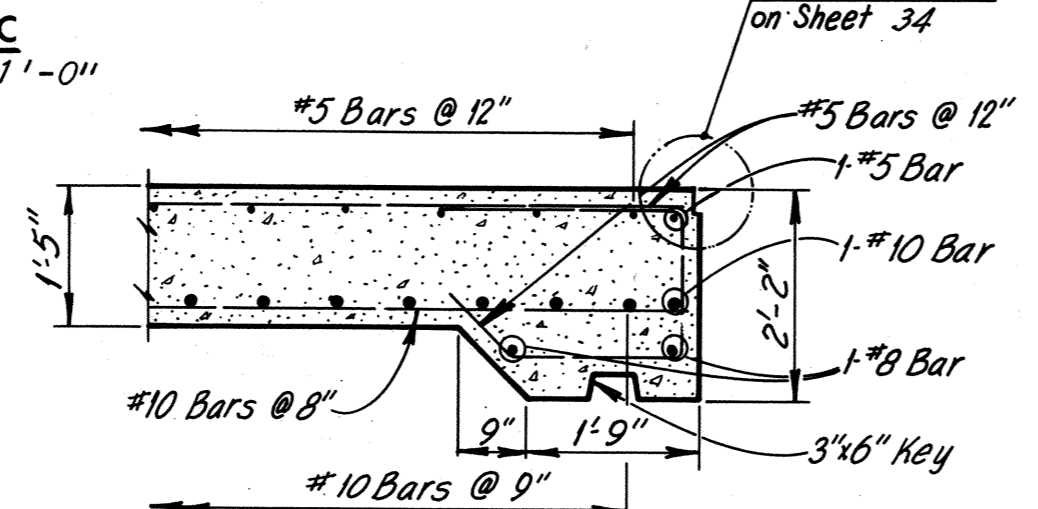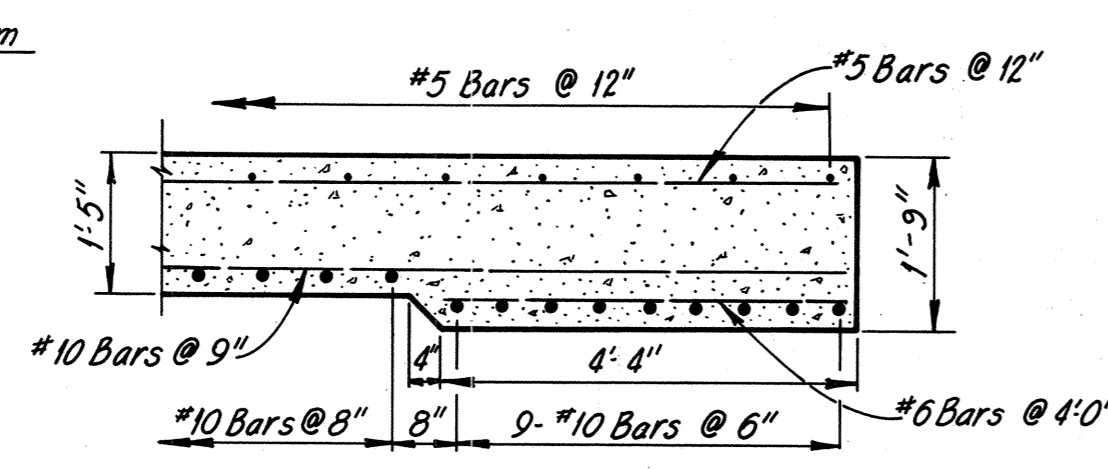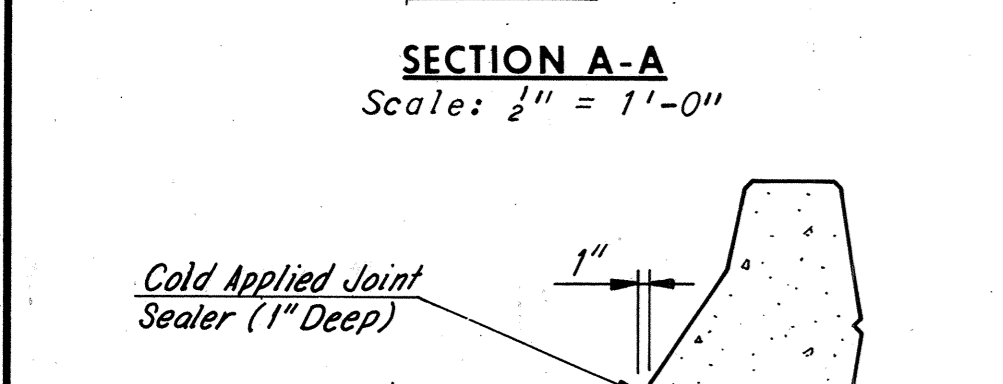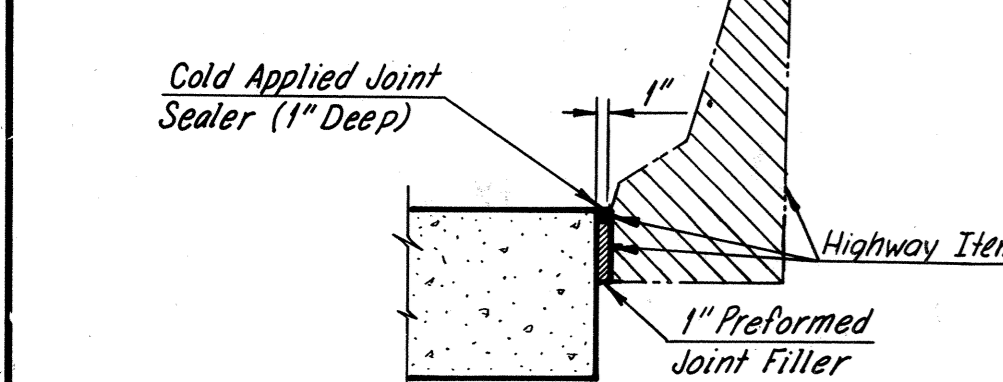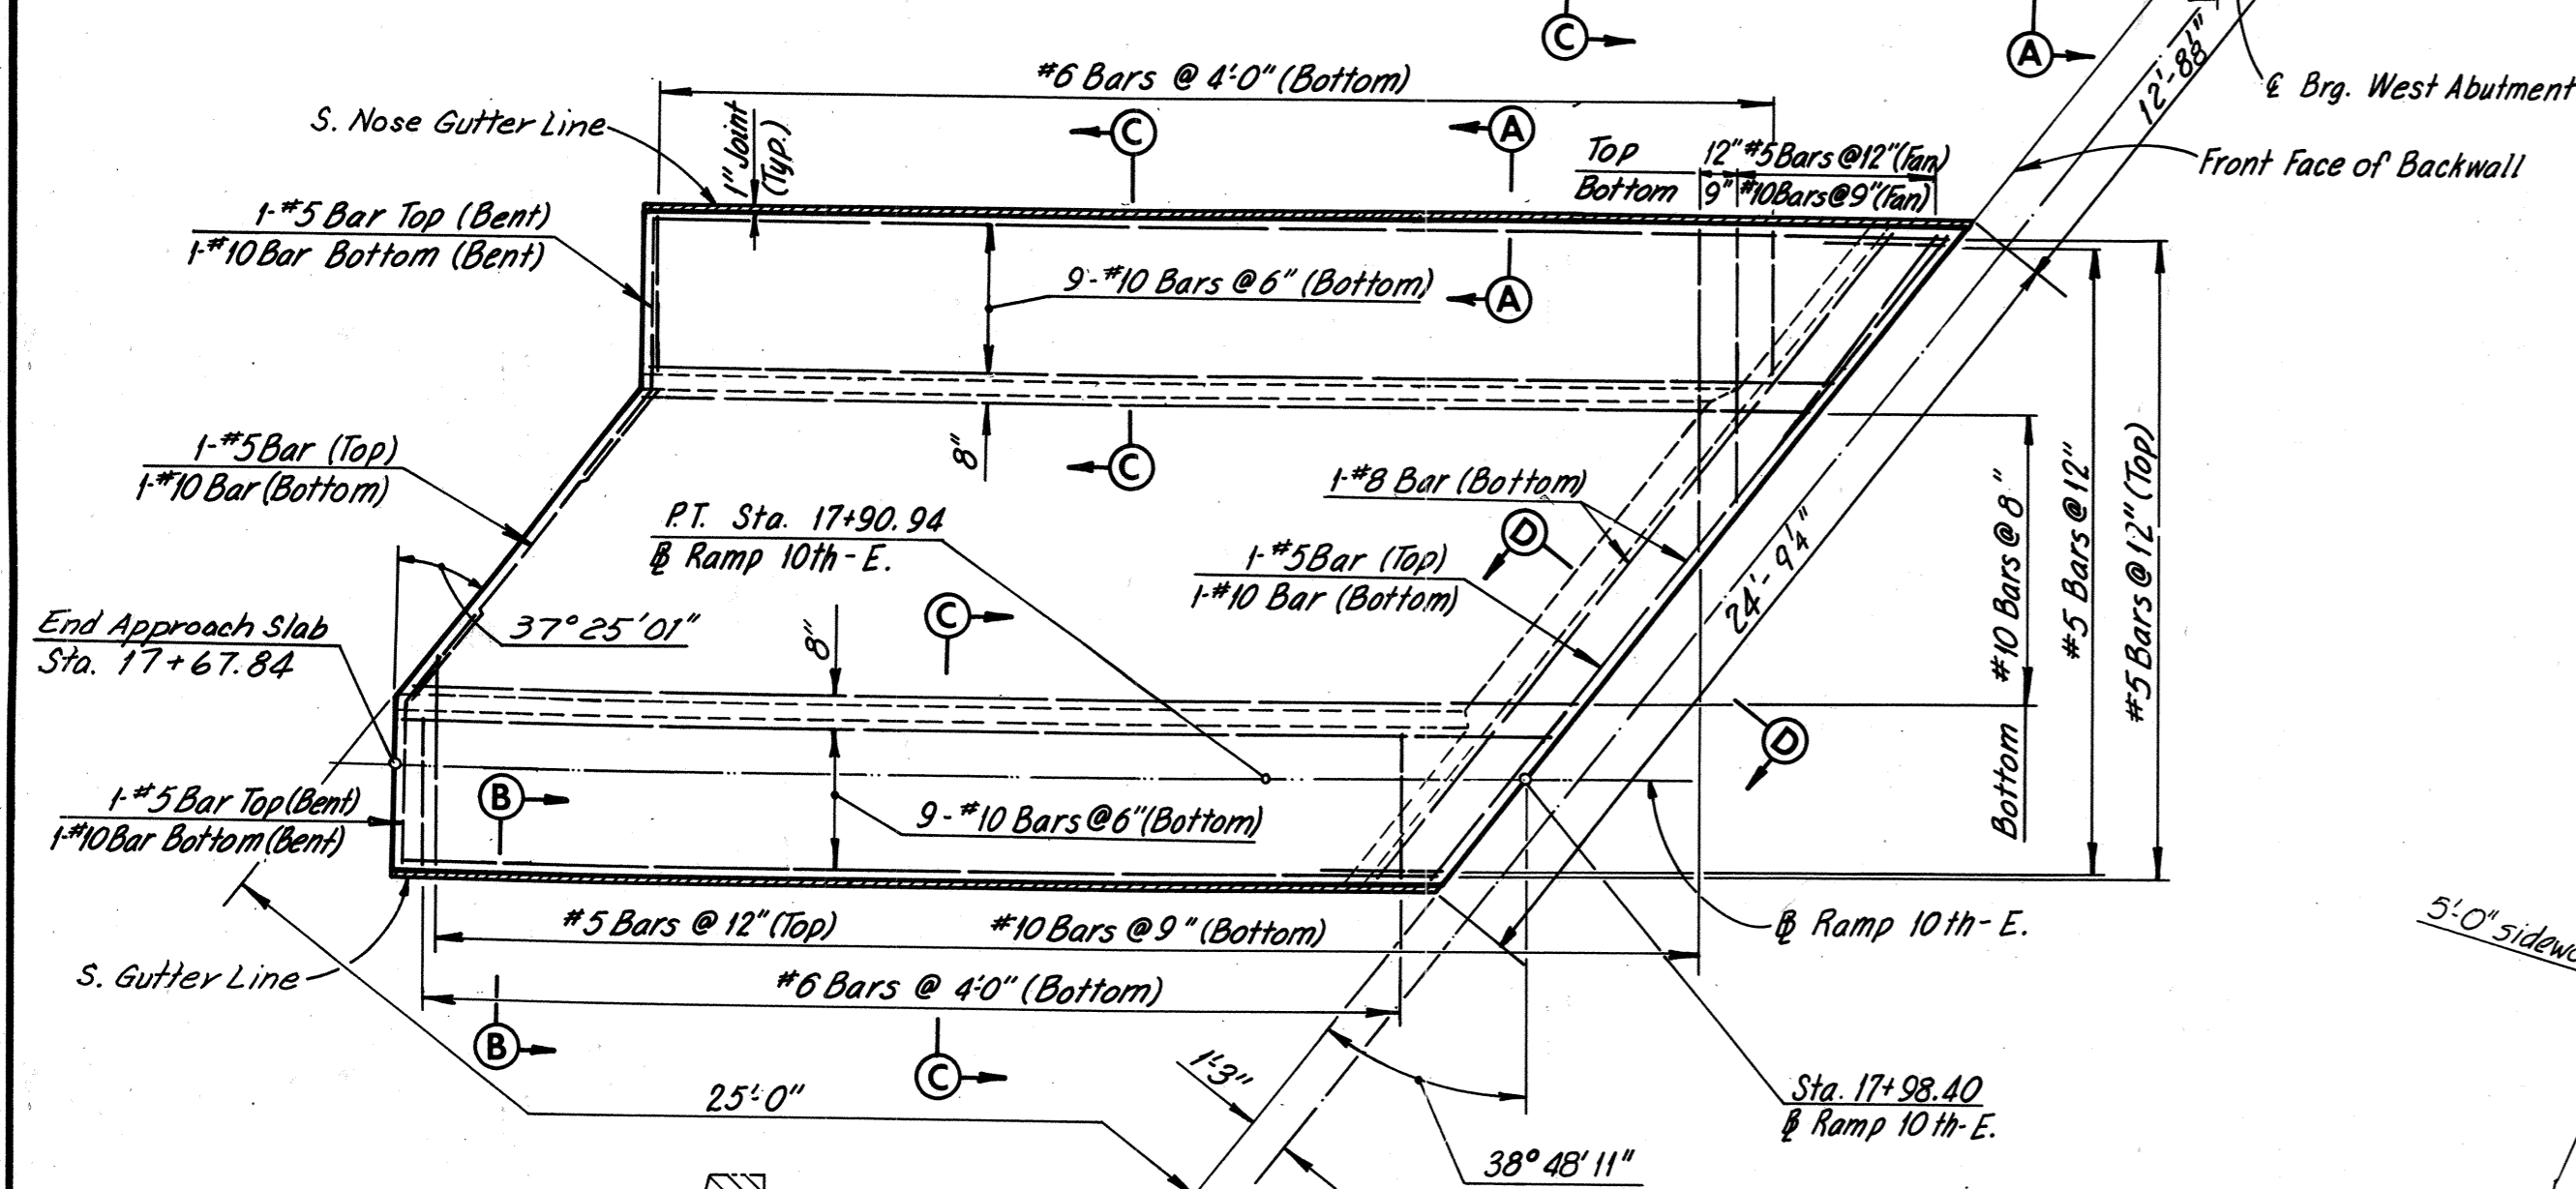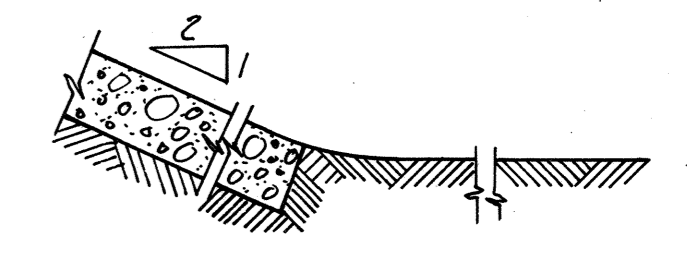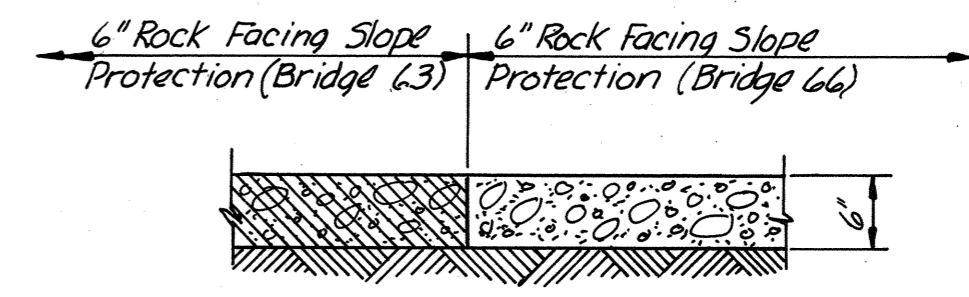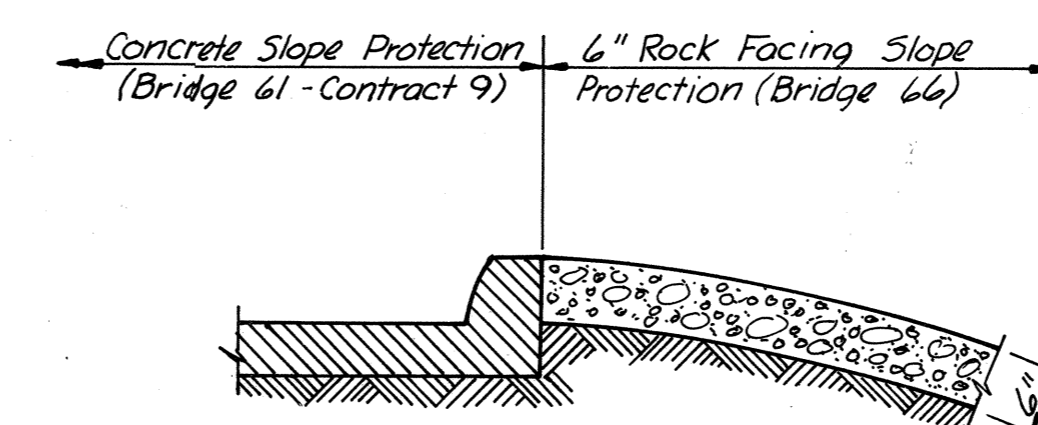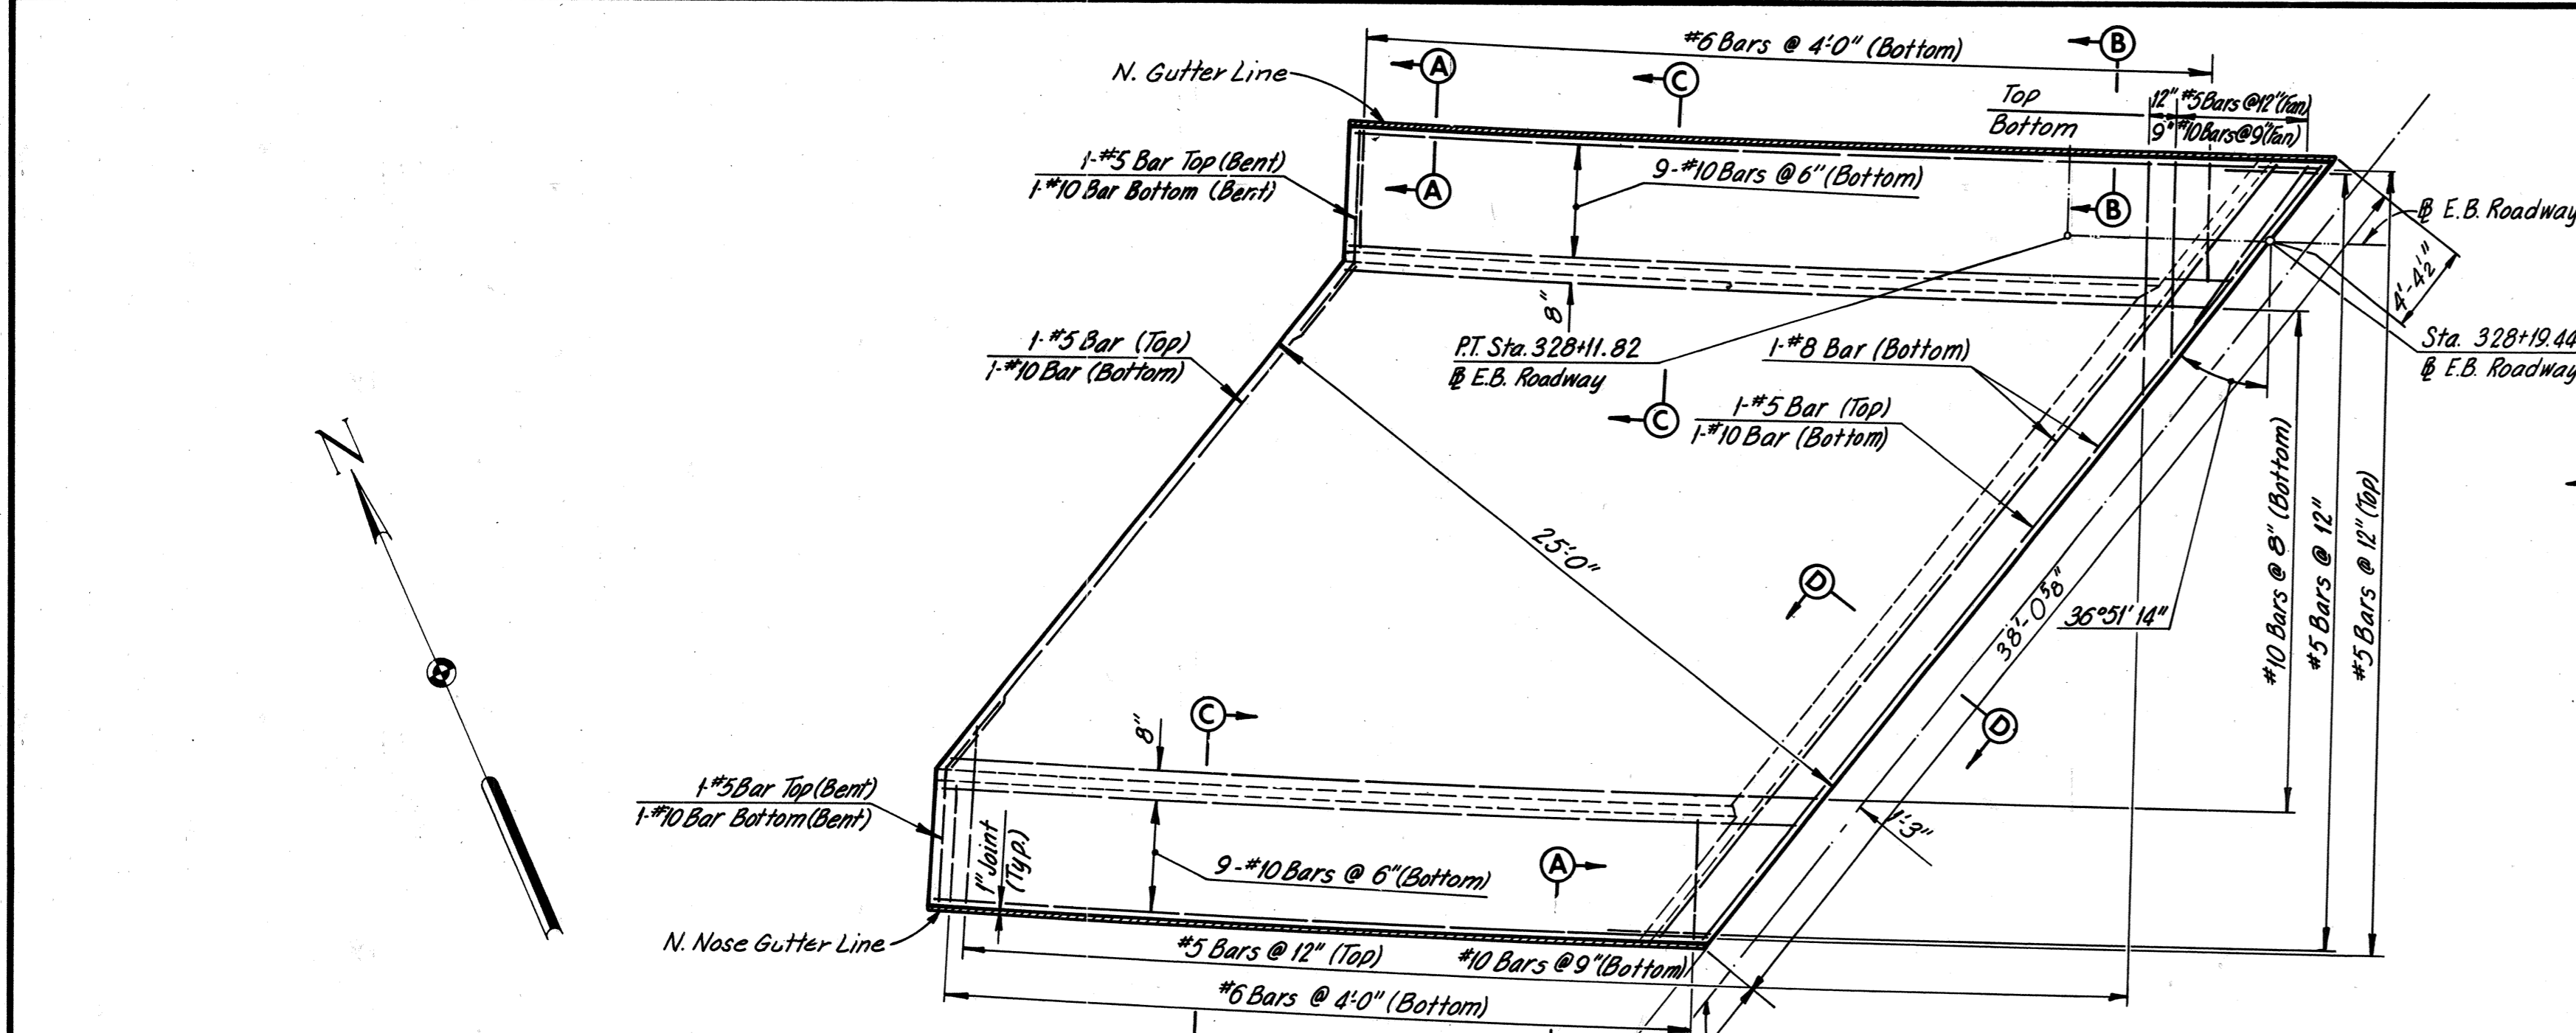

BY	DATE				
MADE	D.E.S.	7-2-68			
CHECKED	HJC	7-9-68	1	As Built	TEM 8-76
IN CHARGE					

RICHMOND METROPOLITAN AUTHORITY
RICHMOND EXPRESSWAY SYSTEM
DOWNTOWN EXPRESSWAY


BRIDGE NO. 66
EASTBOUND ROADWAY OVER
12TH ST. - R.R. TRACKS AND 16TH ST.
APPROACH SLAB AND ROCK FACING
SLOPE PROTECTION DETAILS

SCALE: As Noted
 CONTRACT NO.: 10
 SHEET NO. 39 OF 46


HOWARD, NEEDLES, TAMMEN & BERGENDOFF
 consulting engineers
 NEW YORK ALEXANDRIA KANSAS CITY

AS BUILT


RICHMOND EXPRESSWAY SYSTEM			
SECTION	PROJECT	SHEET NO.	TOTAL SHEETS
10	DOWNTOWN EXPRESSWAY	166	265

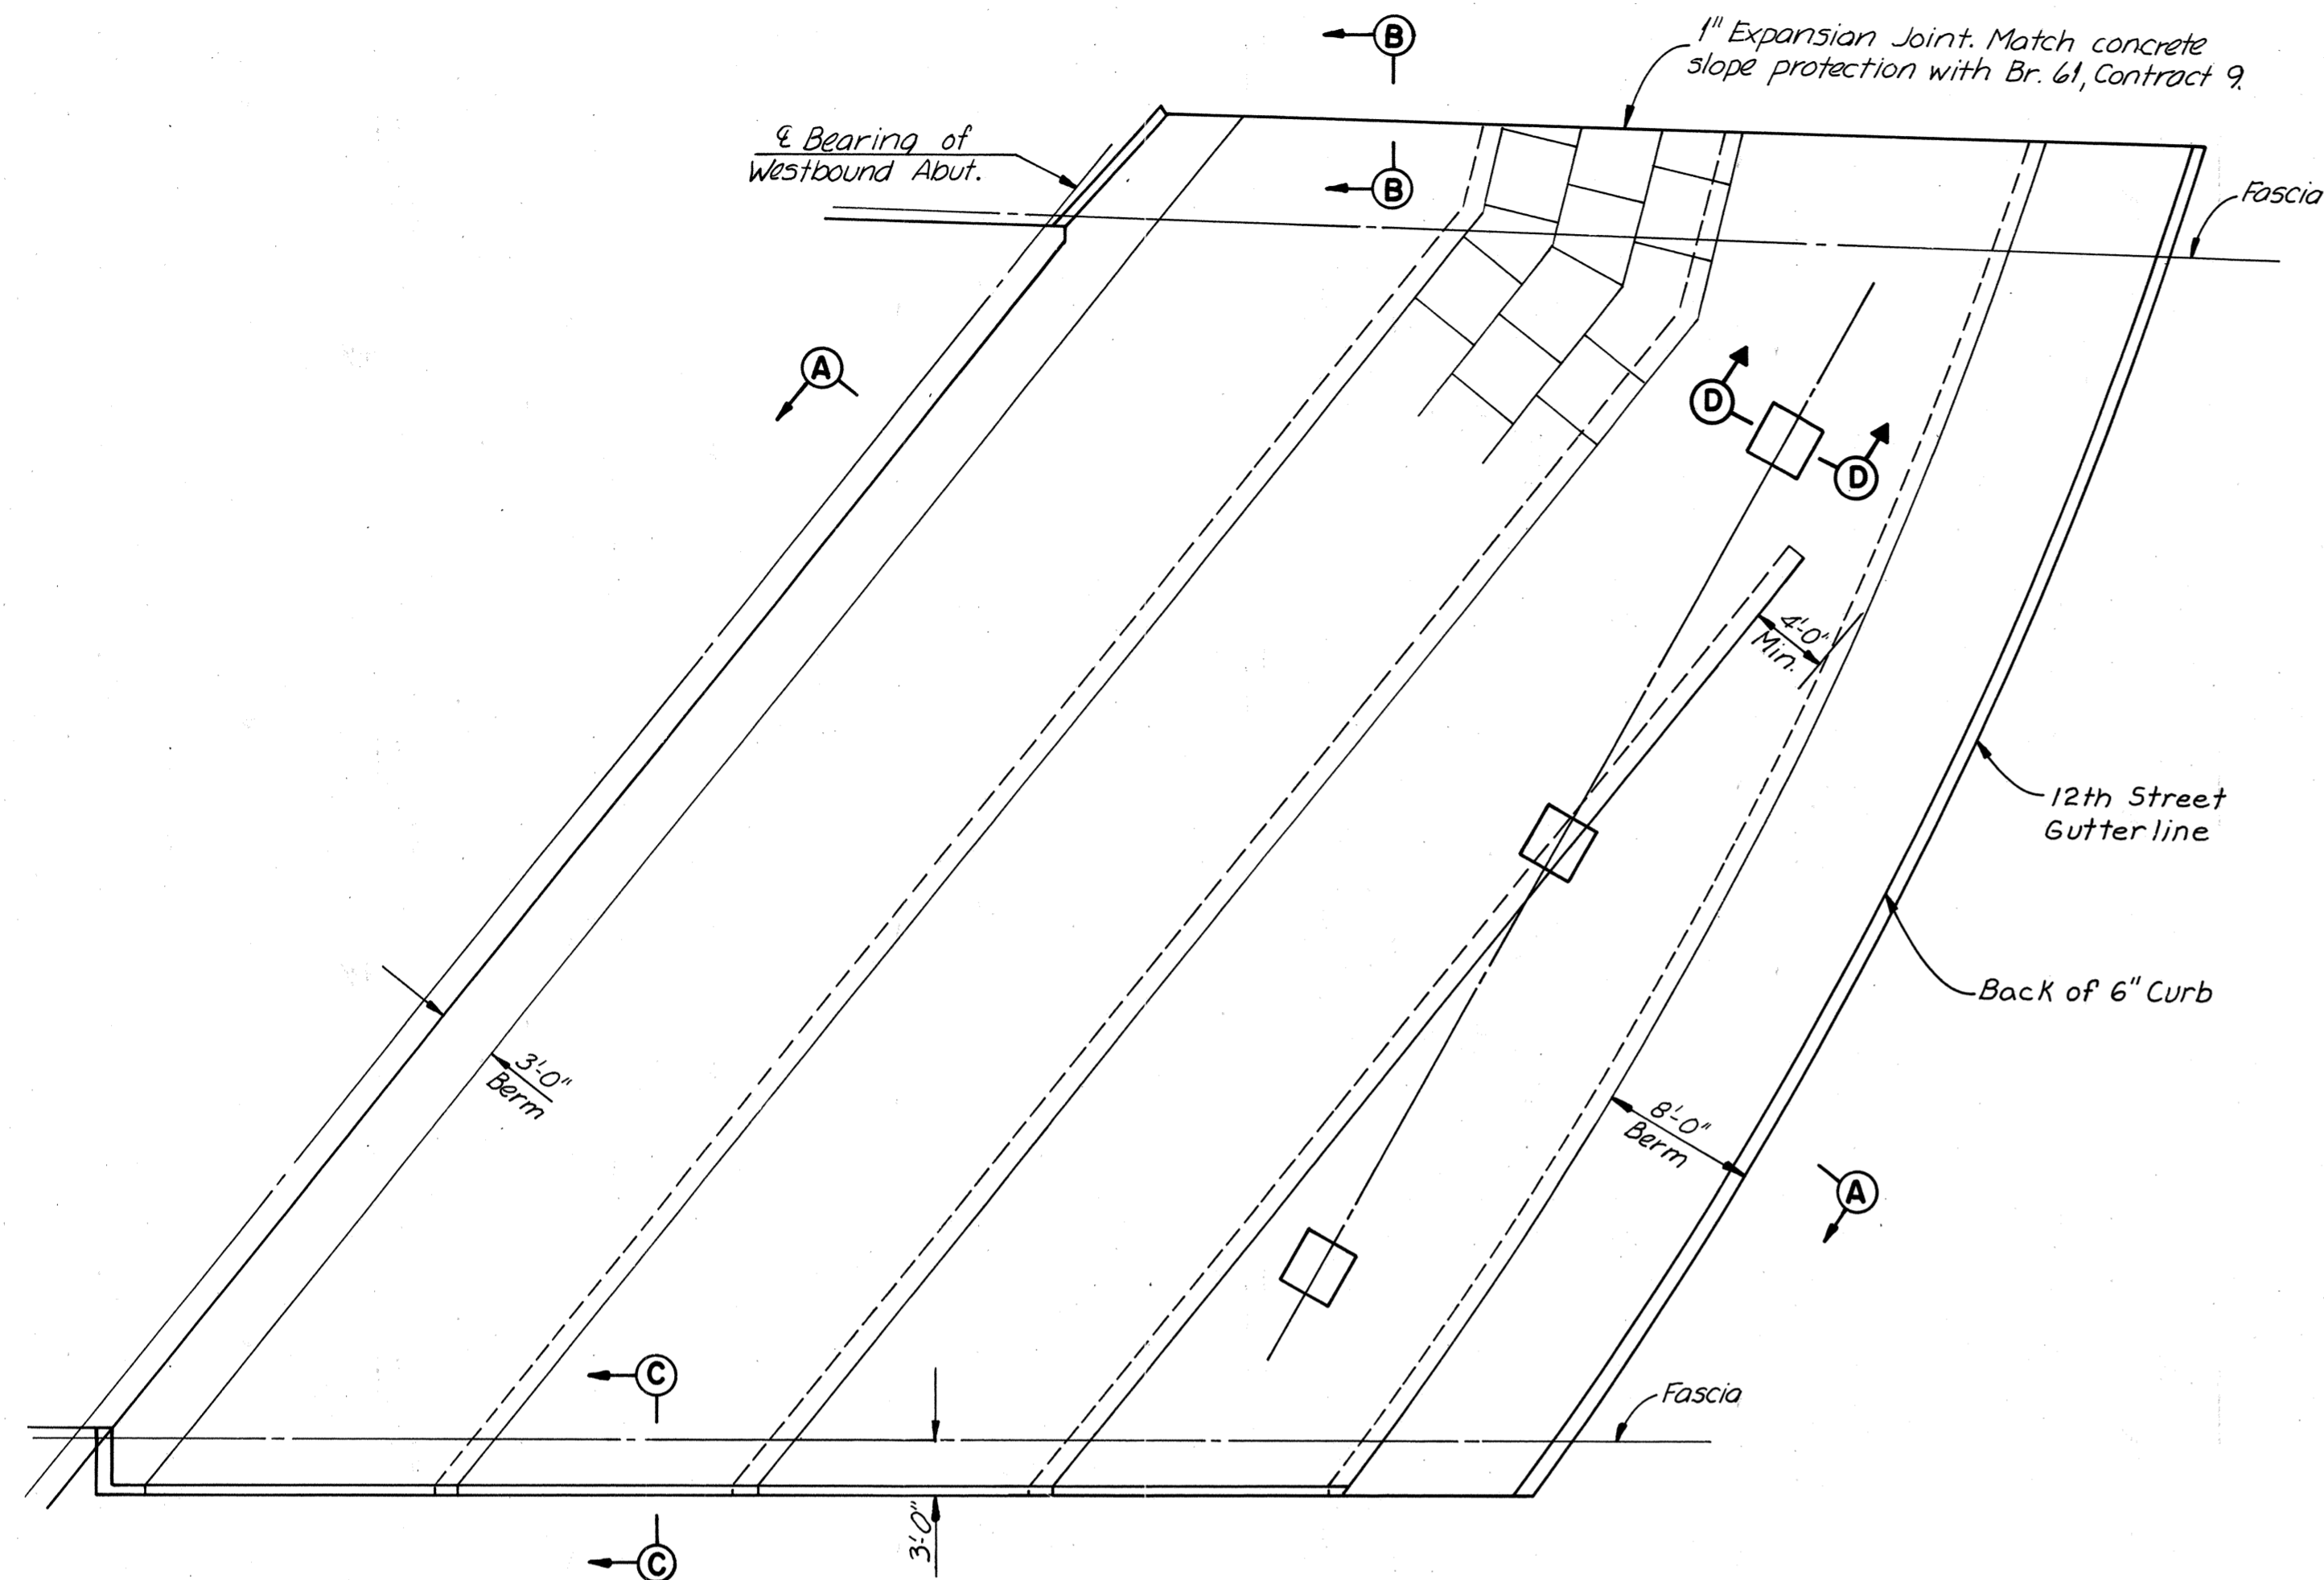


WEST ABUTMENT
Scale: 1/8" = 1'-0"

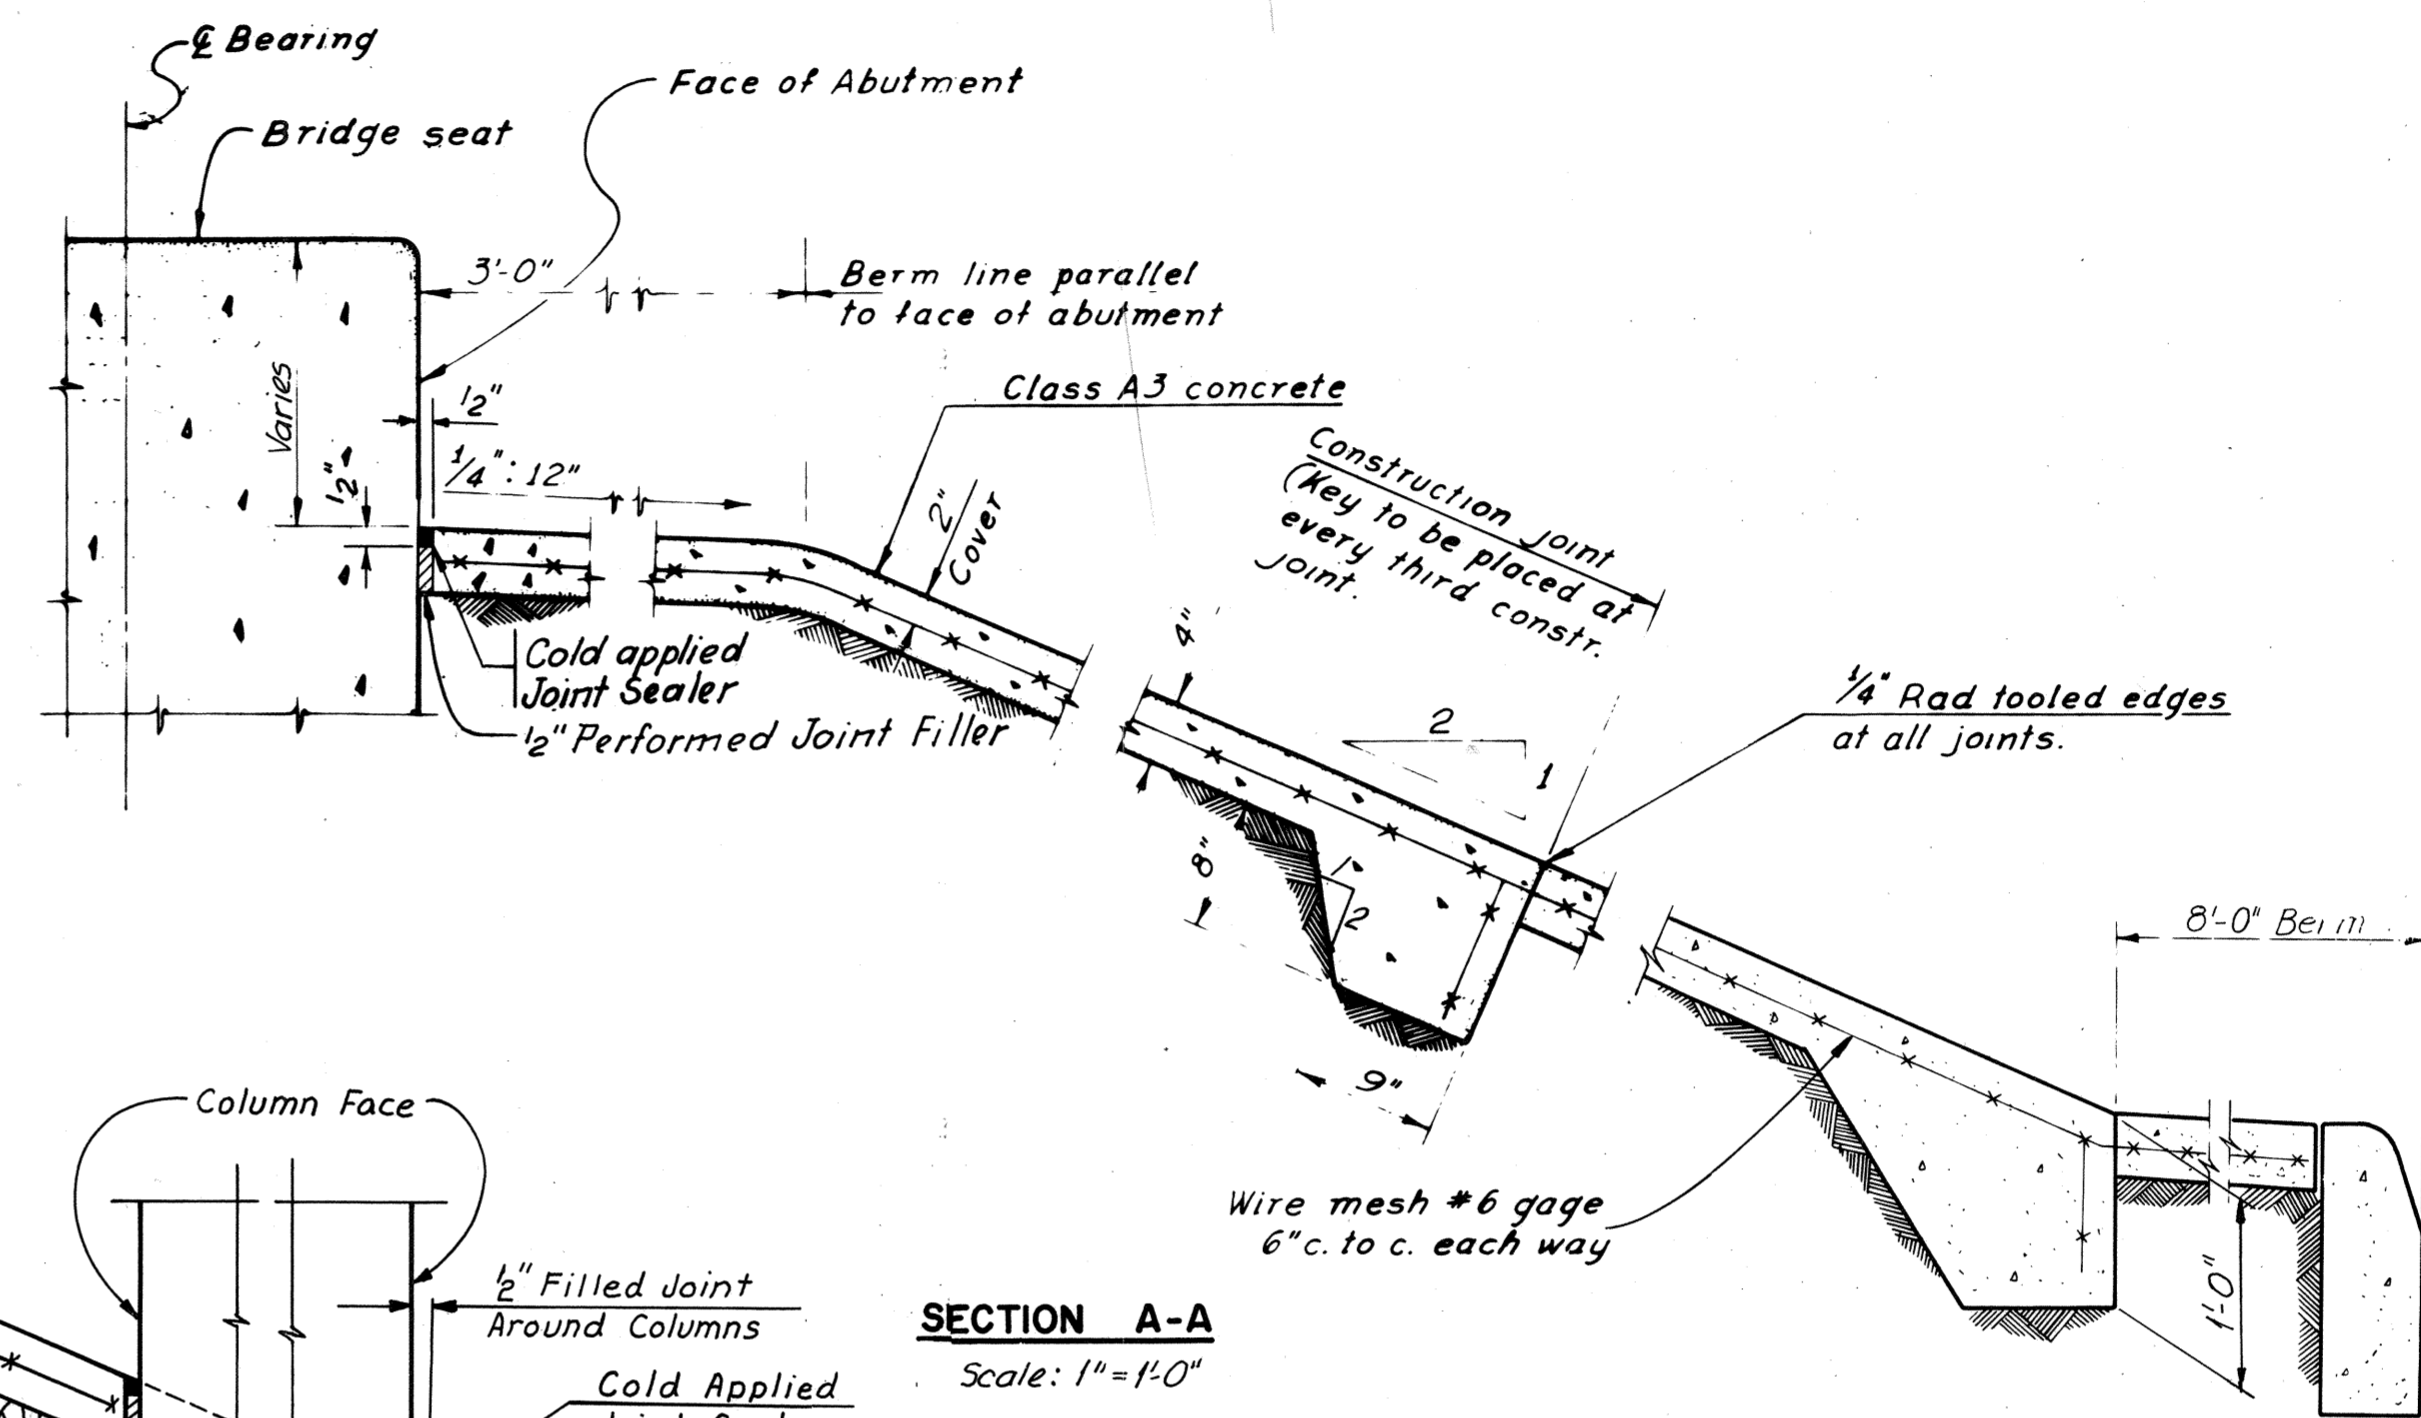


SECTION A-A
Scale: 1" = 1'-0"

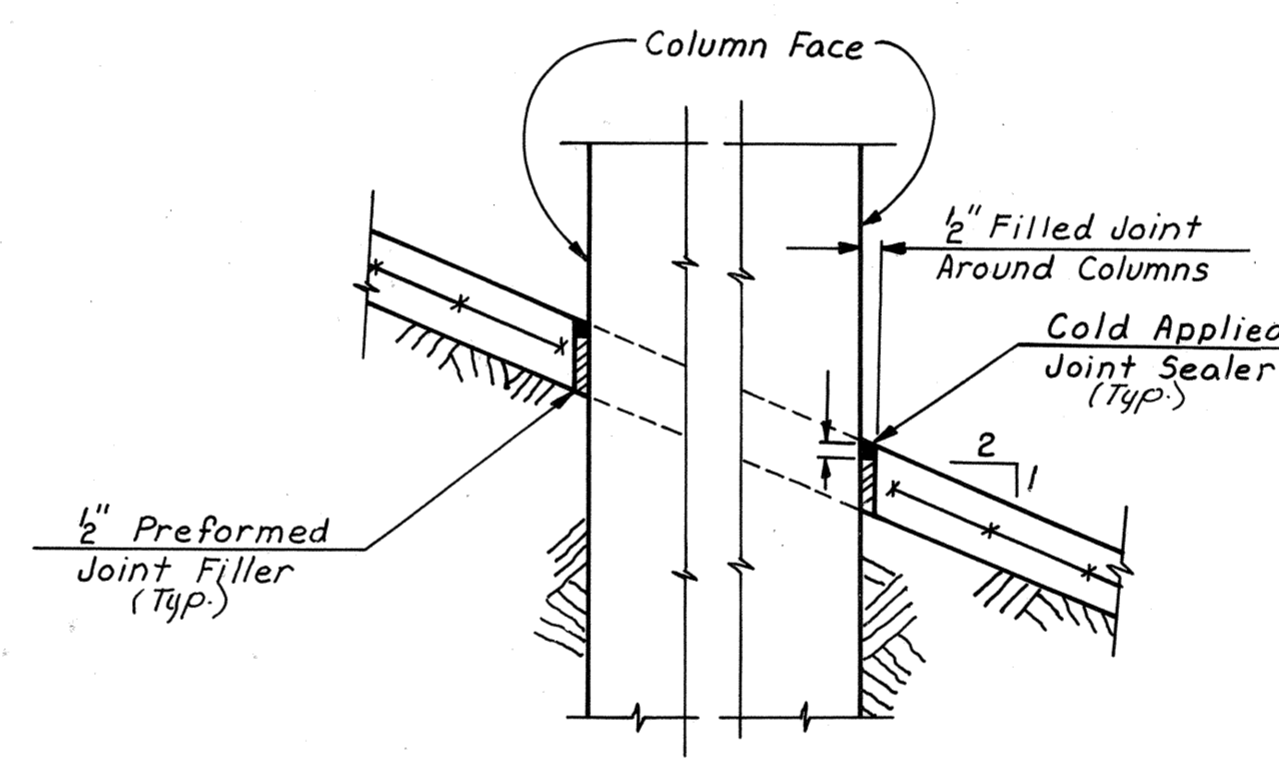

SECTION D-D
Scale: 1" = 1'-0"

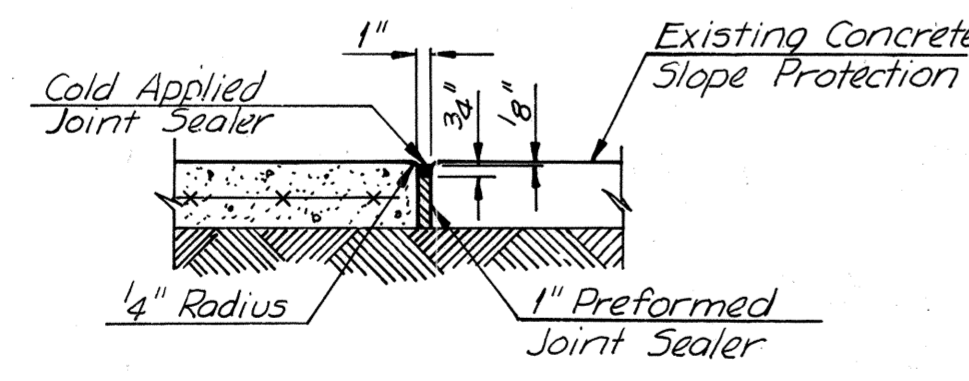

SECTION B-B
Scale: 1" = 1'-0"

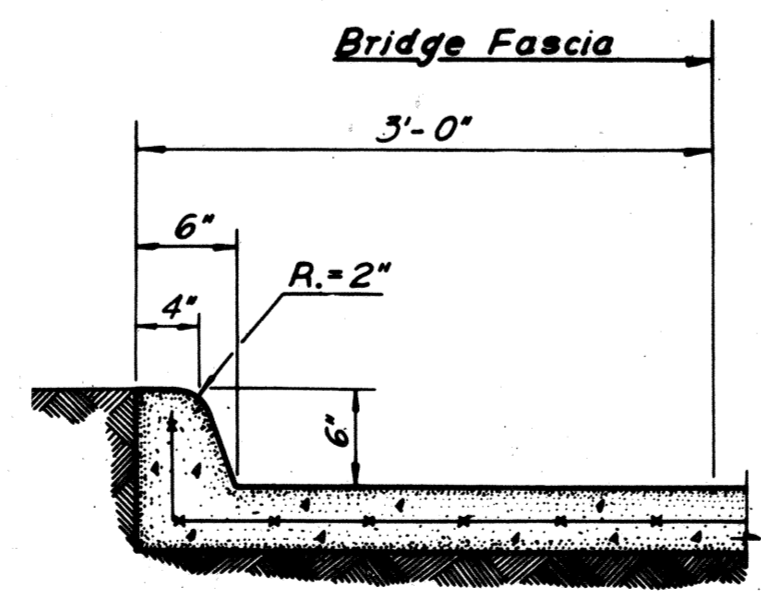

SECTION C-C
Scale 1" = 1'-0"

SLOPE PROTECTION NOTE

The item "Cast-in-place Concrete Slab Slope Protection" shall include the excavation of, or the placing and compaction of any embankment material necessary to bring the surface of the paved slopes to the finished elevations shown on the plans.

"Cast-in Place Concrete Slab Slope Protection shall be paid for at the contract unit price per square yard, which price shall include the concrete slab including wire mesh and joint filler. The slab shall be constructed in 4'-0" x 4'-0" panels, placed in horizontal courses, alternate panels being poured in a staggered pattern, with adjacent panels poured later. The slab shall be Class A3 Concrete of such consistency that it can be placed without the use of top forms, the surface shall be finished with a wood float.

Reinforcing shall consist of wire mesh No. 6 gage, 6" C.C. each way, placed at the center of the slab, and continuous through construction joints.

DESIGNED	D.F.S.	7-68				
DRAWN	J.P.F.	4-74				
CHECKED	L.R.H.	4-74	1	As Built	TEM	8-76
IN CHARGE			NO.	REVISION	BY	DATE

AS BUILT

RICHMOND METROPOLITAN AUTHORITY
RICHMOND EXPRESSWAY SYSTEM
DOWNTOWN EXPRESSWAY

BRIDGE NO. 66
EASTBOUND ROADWAY OVER
12TH ST.-R.R. TRACKS AND 16TH ST.
CONCRETE SLOPE PROTECTION DETAILS

SCALE *As shown*
CONTRACT 10

HOWARD, NEEDLES, TAMMEN & BERGENDOFF
CONSULTING ENGINEERS
Alexandria, Virginia

SHEET 40 OF 46

HNTB



RICHMOND METROPOLITAN TRANSPORTATION AUTHORITY

RICHMOND EXPRESSWAY SYSTEM
CONTRACT NO. PC – 2018
PROTECTIVE COATING OF STRUCTURES


Bridge 67

Downtown Expressway

**Ramp W-N Connection to
Richmond - Petersburg Turnpike**


RECORD SET PLANS (Next 50)

RICHMOND EXPRESSWAY SYSTEM			
SECTION	PROJECT	SHEET NO.	TOTAL SHEETS
10	DOWNTOWN EXPRESSWAY	173	265

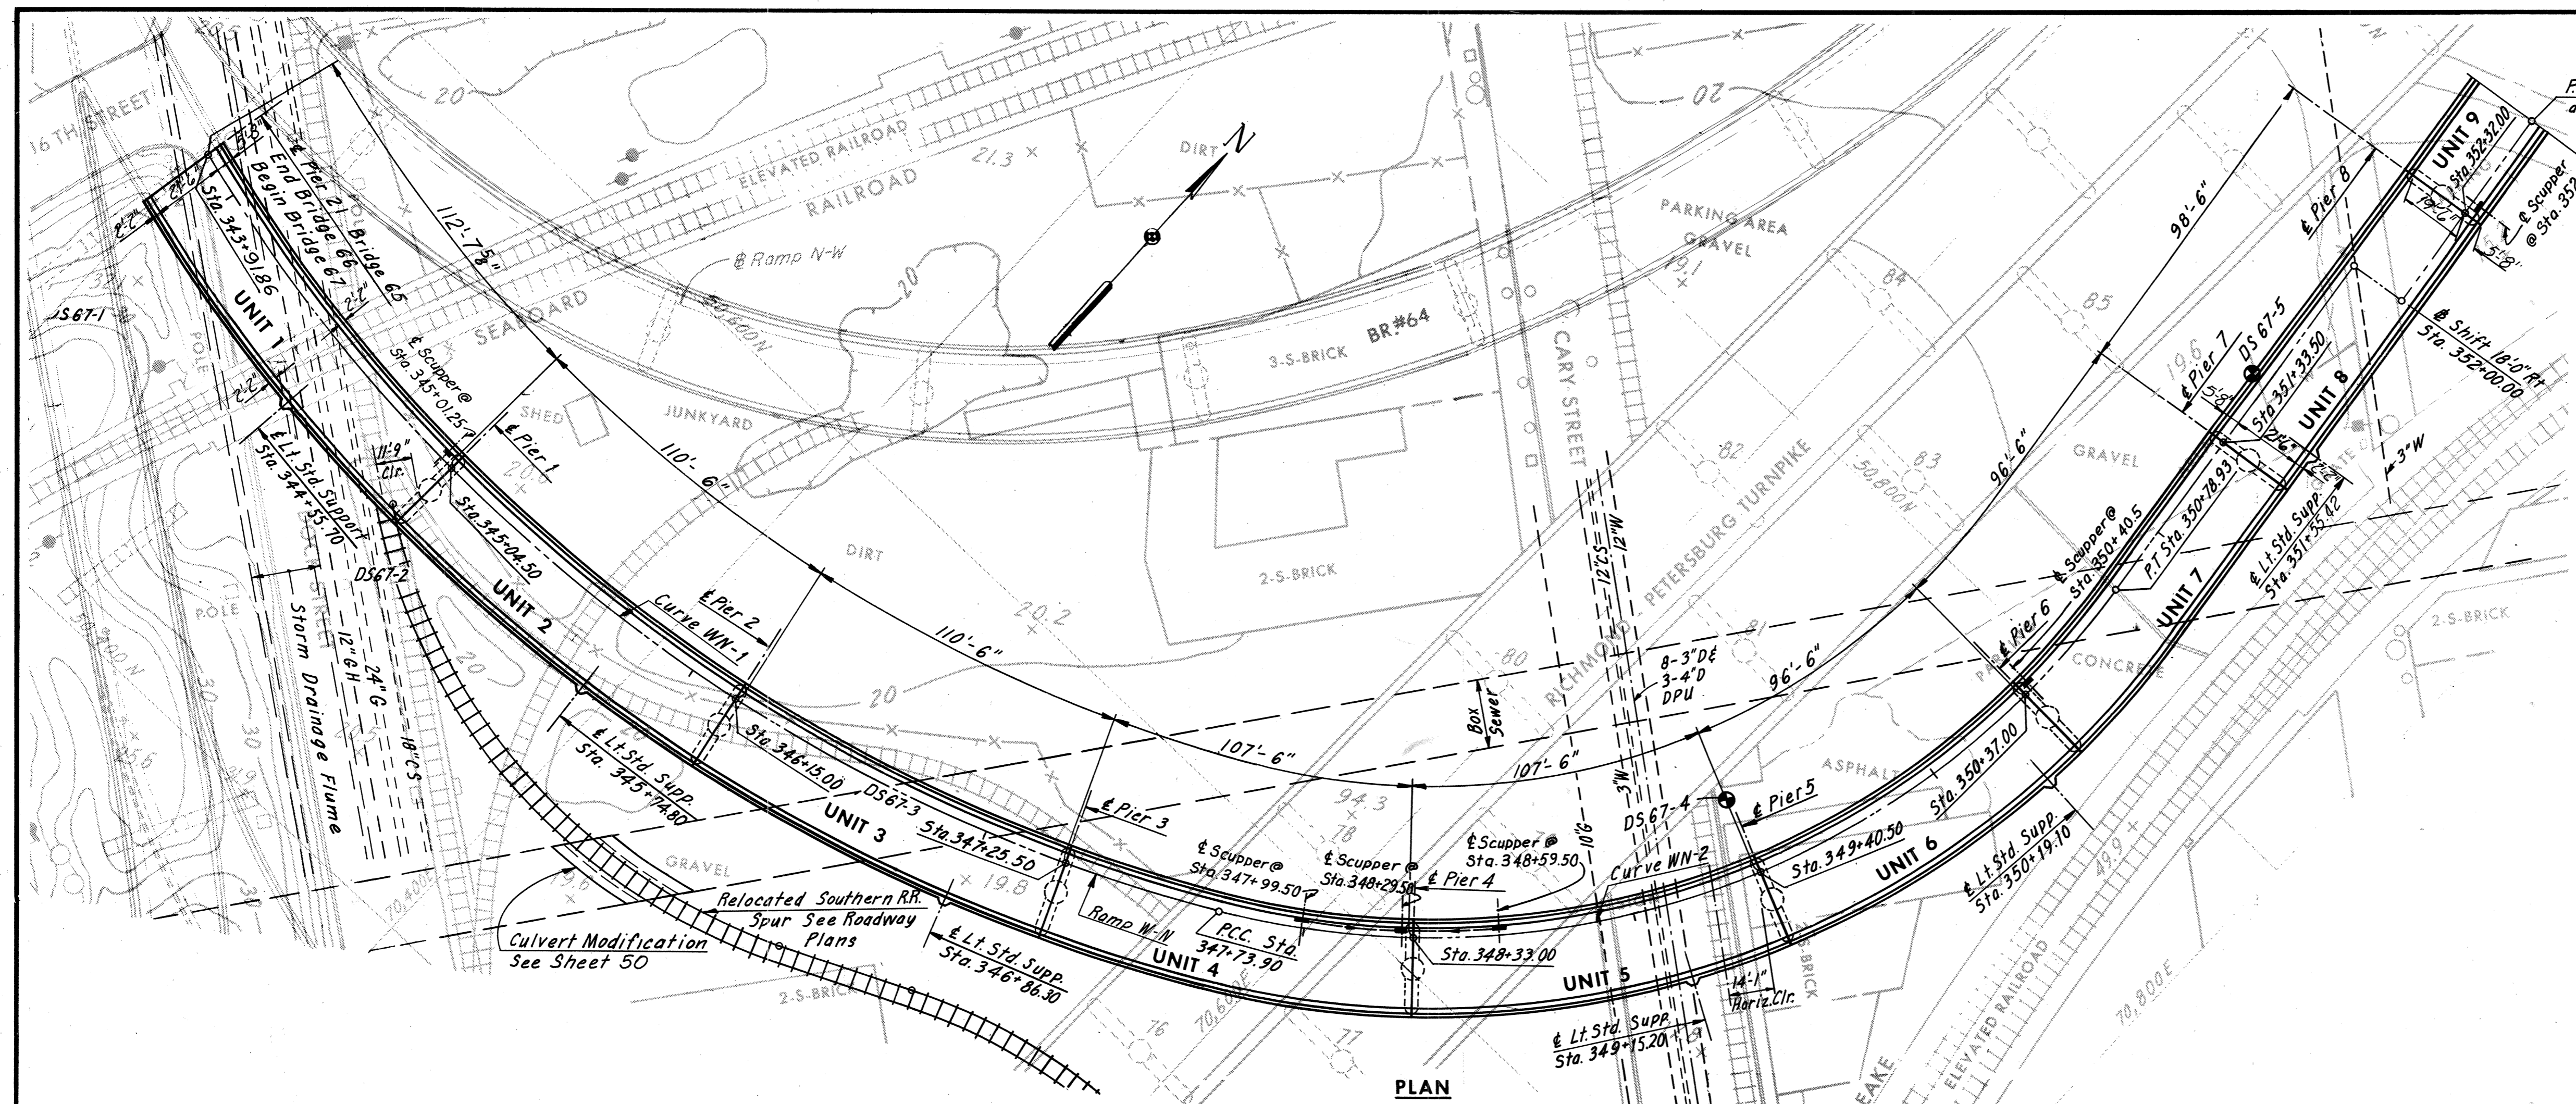

INDEX


GENERAL PLAN AND ELEVATION	1
GENERAL PLAN AND ELEVATION	2
LAYOUT	3
PIERS 1 AND 2	4
PIER 3	5
PIERS 4 AND 5	6
PIER 6	7
PIER 7	8
PIERS 8 AND 9	9
PIER 10E	10
PIERS 11 AND 12E	11
PIER 13E	12
PIERS 10W AND 12W	13
PIERS 13W AND 14	14
NORTH ABUTMENT	15
NORTH ABUTMENT DETAILS	16
NORTH ABUTMENT RETAINING WALL MODIFICATION	17
FRAMING PLAN - UNITS 1 AND 2	18
FRAMING PLAN - UNITS 3 AND 4	19
FRAMING PLAN - UNITS 5 AND 6	20
FRAMING PLAN - UNITS 7 AND 8	21
FRAMING PLAN - UNIT 9 AND FRAMING DETAILS	22
FRAMING PLAN - UNIT 10	23
GIRDER ELEVATIONS - UNIT 10	24
FRAMING PLAN - UNITS 11, 12, 13, 14 AND 15	25
FRAMING PLAN - UNITS 11, 12, 13, 14 AND 15	26
FLOORBEAM 16 AND STEEL COLUMNS	27
DECK PLAN - UNITS 1 AND 2	28
DECK PLAN - UNITS 3 AND 4	29
DECK PLAN - UNITS 5 AND 6	30
DECK PLAN - UNITS 7 AND 8	31
DECK PLAN - UNIT 9 - AND SUPERSTRUCTURE DETAILS	32
DECK PLAN - UNIT 10	33
DECK PLAN - UNITS 11, 12, 13, 14 AND 15	34
STRESS SHEET TRUSS SPAN	35
TOP LATERAL SYSTEM	36
BOTTOM LATERAL SYSTEM	37
TRUSS DETAILS P.P. 0 TO P.P. 6	38
TRUSS DETAILS P.P. 7 TO P.P. 10	39
TRUSS DETAILS P.P. 11 TO P.P. 12	40
FLOORBEAM 0 AND JOINT DETAILS	41
INTERMEDIATE FLOOR BEAMS	42
MISCELLANEOUS DETAILS	43
FLOORBEAM 12 AND JOINT DETAILS	44
DECK PLAN - TRUSS SPAN	45
SHOE DETAILS AND DECK ELEVATIONS	46
JOINT DETAILS	47
SLOPE PROTECTION DETAILS	48 THRU 49
BORING LOGS	50
STANDARD DETAILS	51 THRU 54

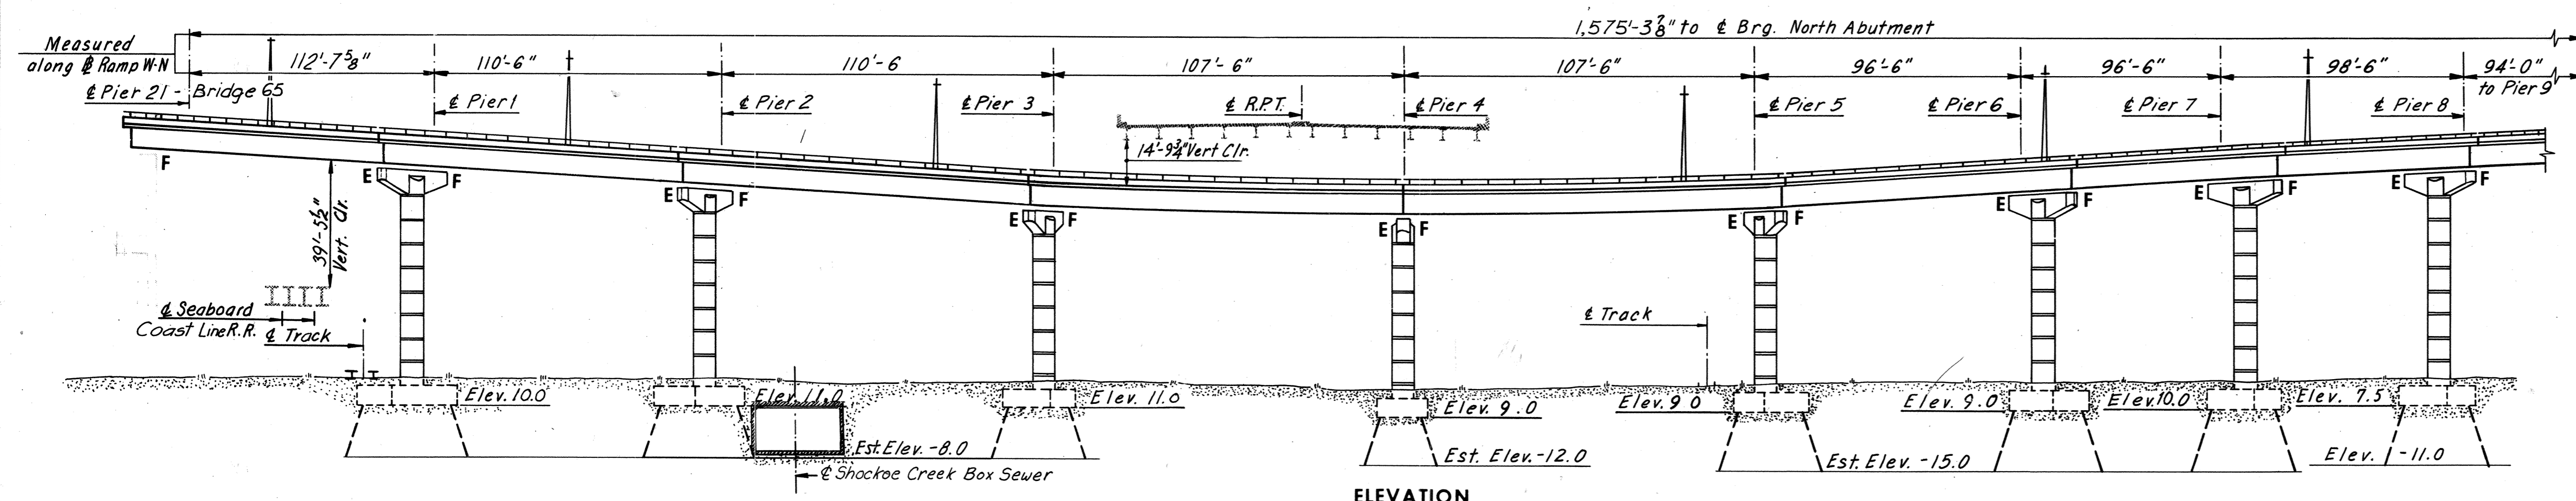

Note:
For General Notes, see Sheet 4.
For Quantity Table, see Sheet 3

CURVE DATA

<p>Curve: R.P.T.-1 P.I. = Sta. 1704+68.83 Δ = 15°03'56" D = 1'00" T = 757.65' L = 1,506.56' R = 5,729.58'</p>	<p>Curve: R.P.T.-2 P.I. = Sta. 1723+07.01 Δ = 35°27'40" D = 4'00" T = 317.90' L = 836.30' R = 1,432.39'</p>	<p>Curve: WN-1 P.I. = Sta. 345+25.47 Δ = 64°53'49" D = 11°27'13.3" T = 317.90' L = 566.33' R = 500.00'</p>	<p>Curve: WN-2 P.I. = Sta. 349+47.64 Δ = 69°32'15" D = 22°28'10.8" T = 173.75' L = 305.03' R = 255.00'</p>	<p>Curve: WN-3 P.I. = Sta. 353+19.15 Δ = 6°23'54" D = 6'00" T = 53.38' L = 106.64' R = 954.93'</p>	<p>Curve: WN-4 P.I. = Sta. 355+39.85 Δ = 5°01'11" D = 1'30" T = 167.43' L = 334.65' R = 3,819.72'</p>	<p>Curve: WN-5 P.I. = Sta. 358+17.39 Δ = 13°10'51" D = 6'00" T = 110.33' L = 219.68' R = 954.93'</p>	<p>Curve: WN-6 P.I. = Sta. 361+67.68 Δ = 19°35'06" D = 4'09'03" T = 238.25' L = 471.85' R = 1,380.39'</p>	<p>Curve: WN-7 P.I. = Sta. 13+42.50 Δ = 32°01'34" D = 5°51'36" T = 426.01' L = 829.72' R = 1,484.39'</p>
---	---	--	--	--	---	--	---	--

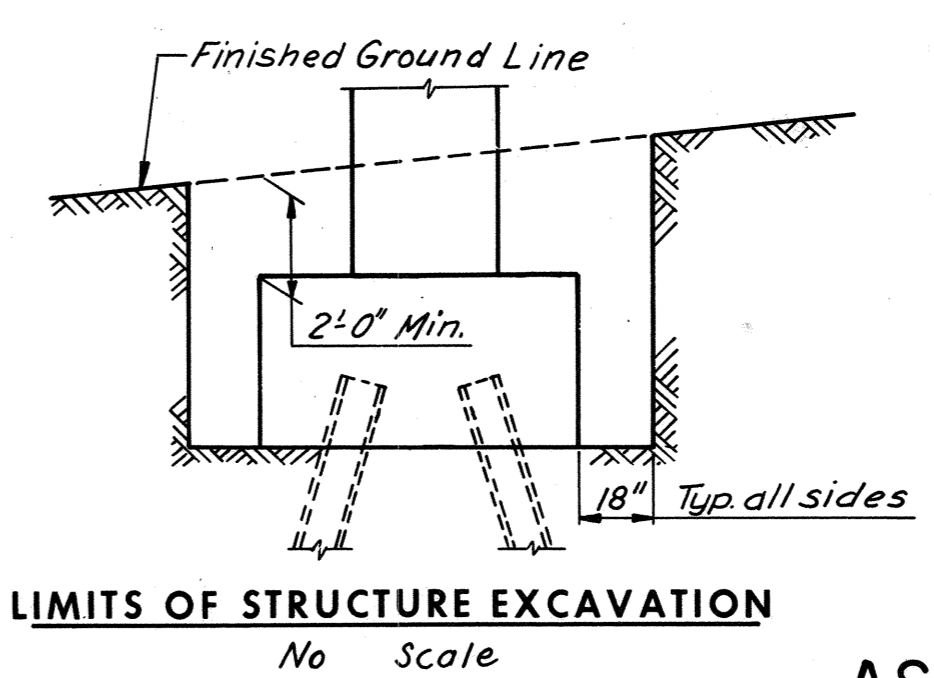

BY	DATE	3	As Built	TEM	6-77
MADE	AMH	3-5-69	Light Sta. Location Unit B	JLK	6-6-75
CHECKED	KC T	5-12-69	Sheets 42 & 45 added	L.B.P.	3-5-75
IN CHARGE					

RICHMOND METROPOLITAN AUTHORITY
RICHMOND EXPRESSWAY SYSTEM
DOWNTOWN EXPRESSWAY





BRIDGE NO. 67
RAMP W-N CONNECTION TO
RICHMOND-PETERSBURG TURNPIKE
GENERAL PLAN AND ELEVATION

HOWARD, NEEDLES, TAMMEN & BERGENDOFF
consulting engineers
NEW YORK ALEXANDRIA KANSAS CITY

SCALE: 1" = 30'-0"
CONTRACT NO.: 10
SHEET NO. 1 OF 54

AS BUILT

RICHMOND EXPRESSWAY SYSTEM			
SECTION	PROJECT	SHEET NO.	TOTAL SHEETS
10	DOWNTOWN EXPRESSWAY	174	265

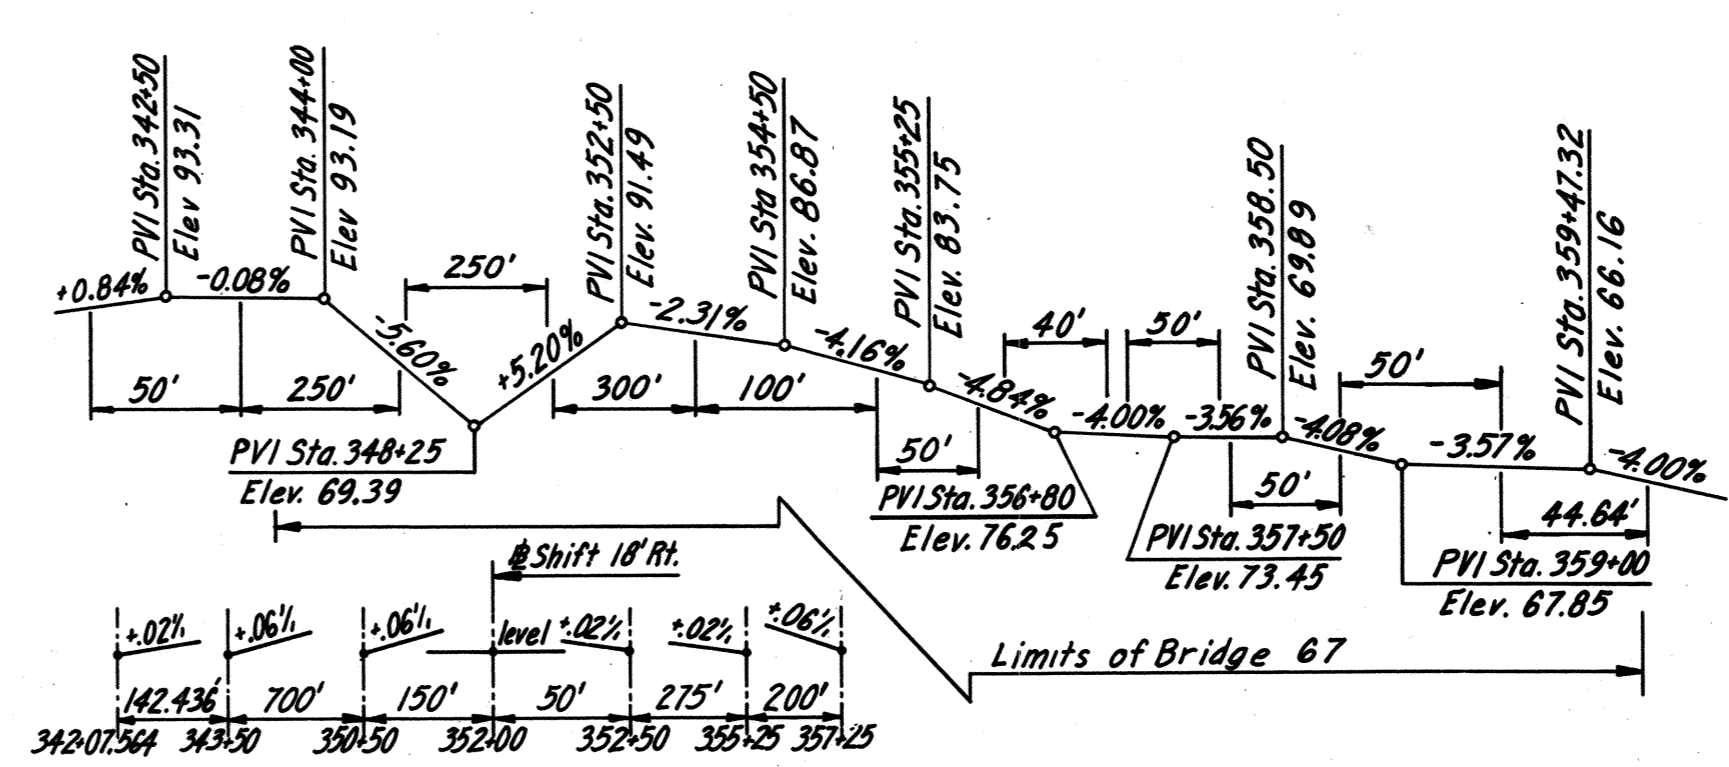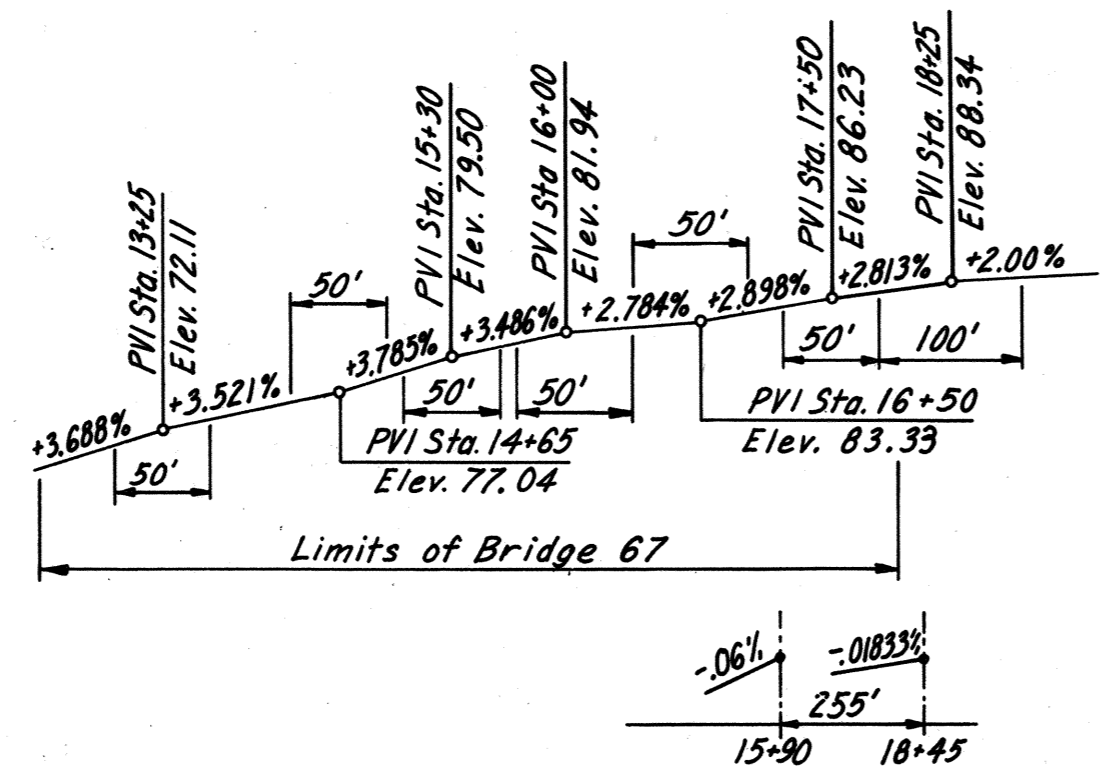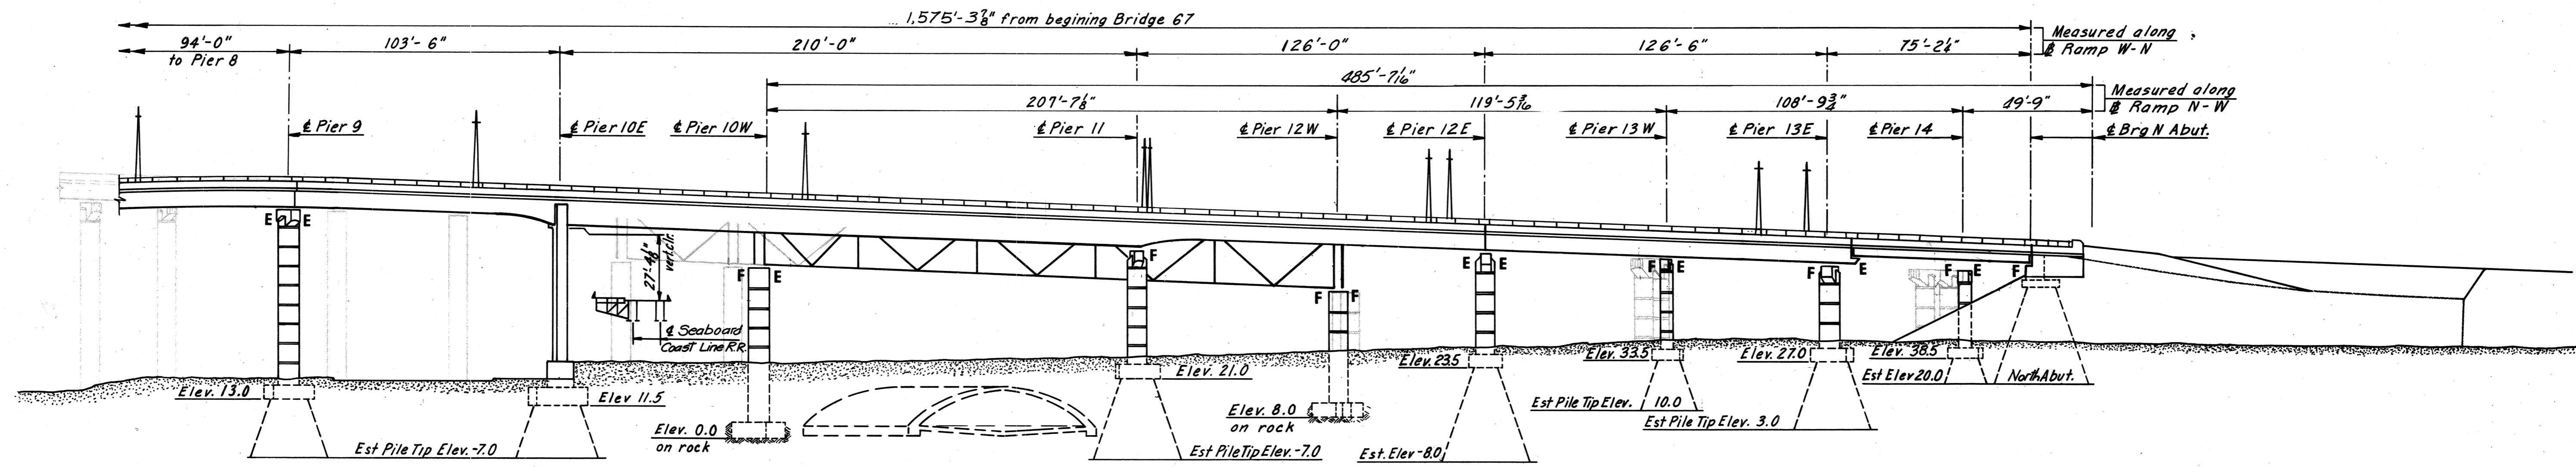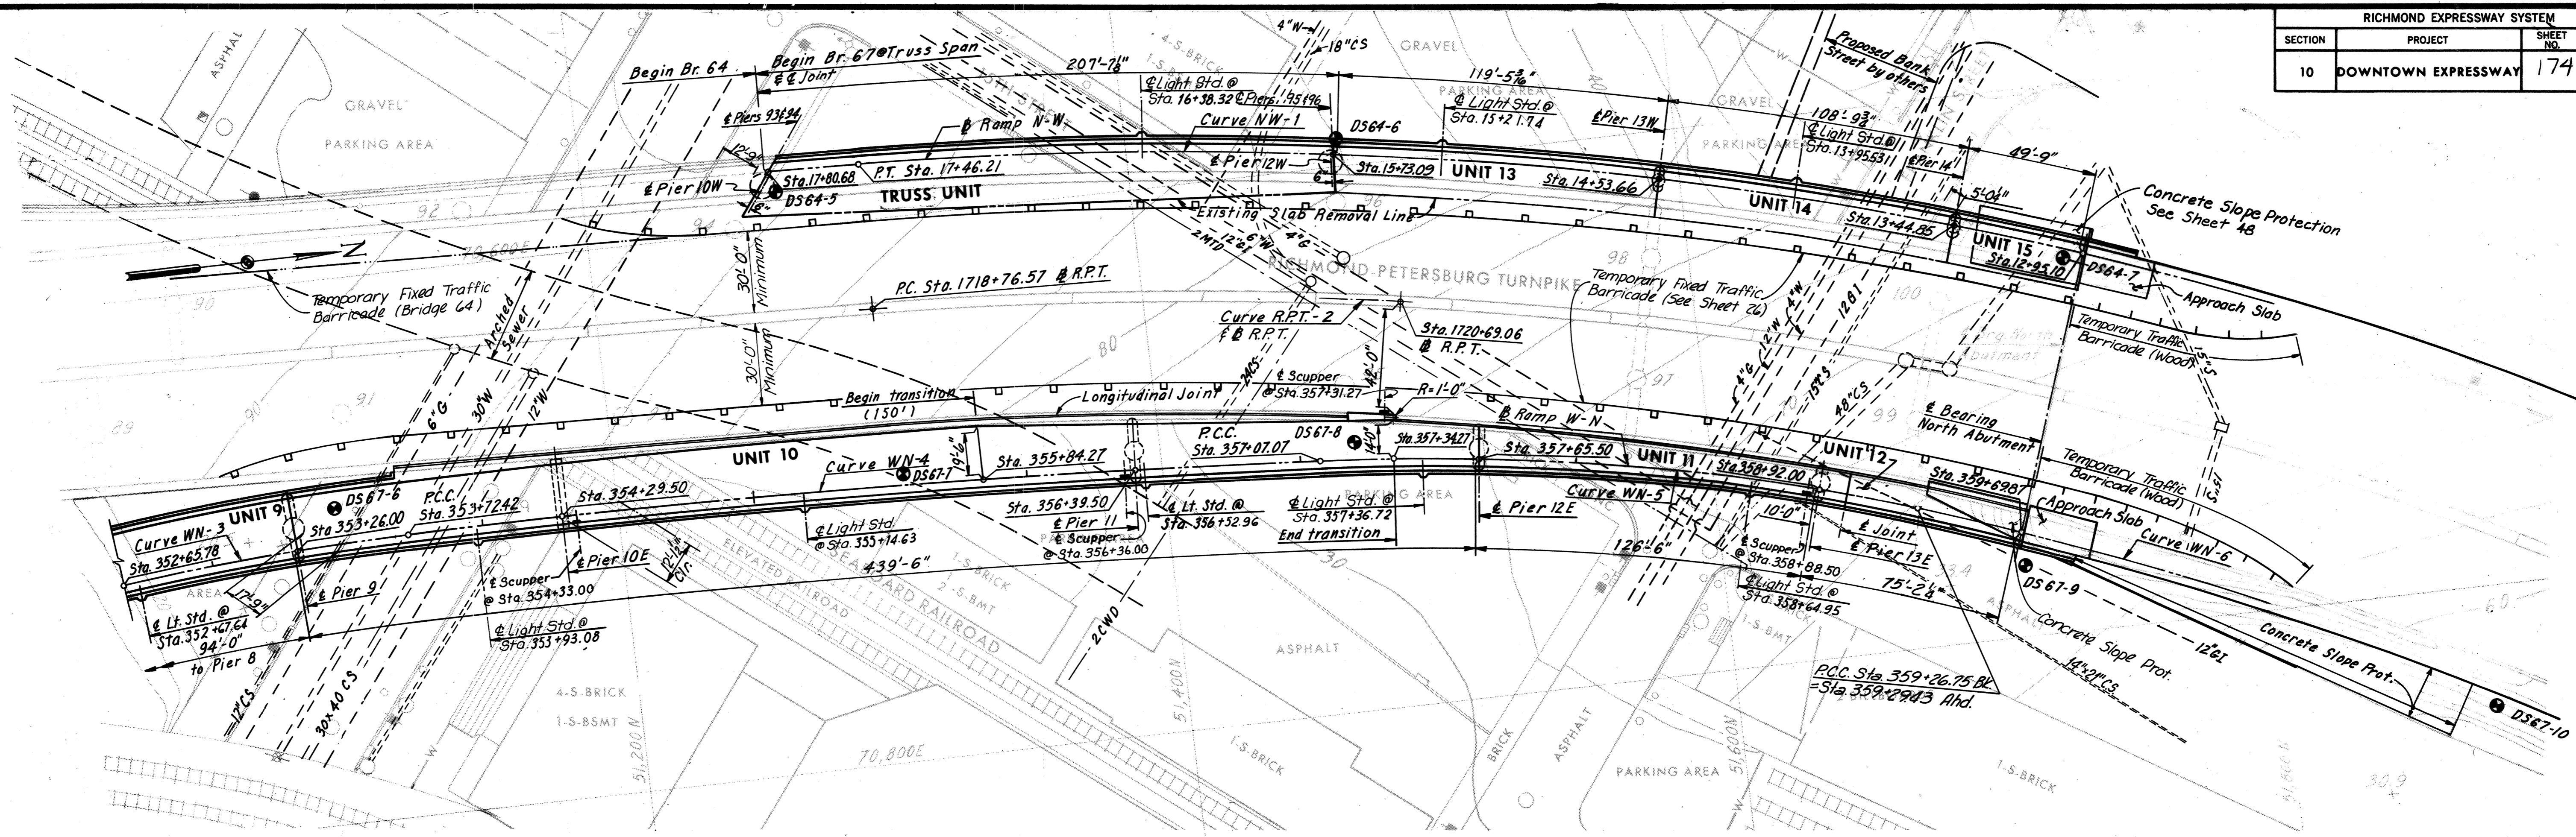

RICHMOND METROPOLITAN AUTHORITY
RICHMOND EXPRESSWAY SYSTEM
DOWNTOWN EXPRESSWAY


BRIDGE NO. 67
RAMP W-N CONNECTION TO
RICHMOND-PETERSBURG TURNPIKE
GENERAL PLAN AND ELEVATION

HOWARD, NEEDLES, TAMMEN & BERGENDOFF
consulting engineers
NEW YORK ALEXANDRIA KANSAS CITY

SCALE: *As Noted*
CONTRACT NO.: 10
SHEET NO. 2 OF 54

BY	DATE	NO.	REVISION	BY	DATE
AMH	12-30-60	2	As Built	TEM	6-77
KCT	5-12-69	1	Revised Plans & Sheet Sta. & Board Length	DWB	1-24-75

RICHMOND EXPRESSWAY SYSTEM			
SECTION	PROJECT	SHEET NO.	TOTAL SHEETS
10	DOWNTOWN EXPRESSWAY	175	265

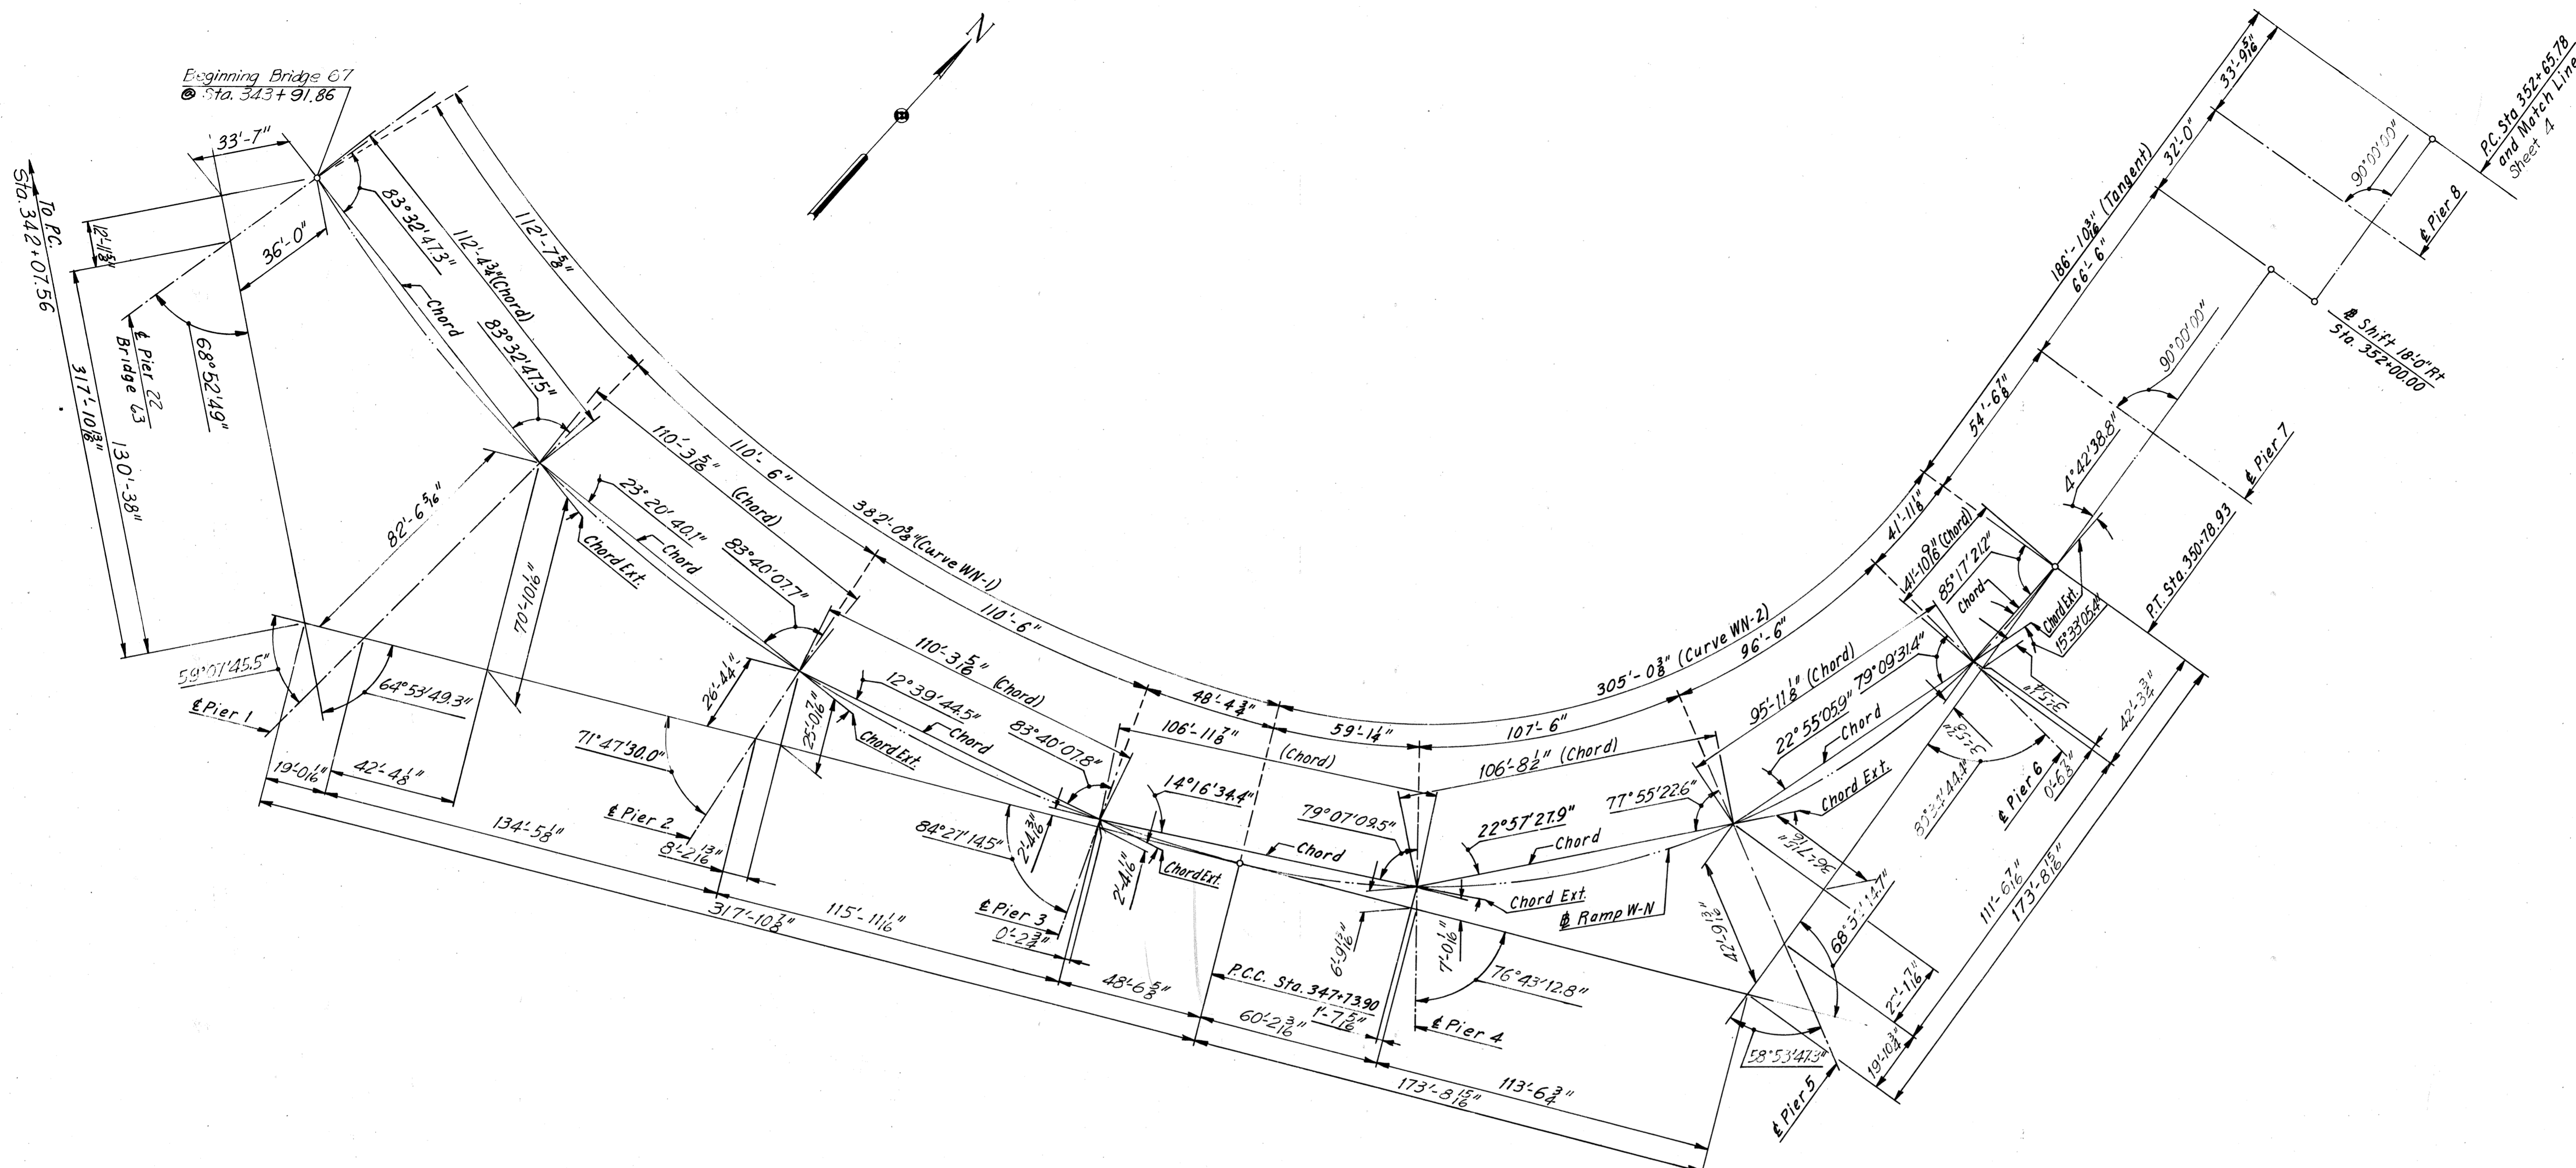

ESTIMATED QUANTITIES

	Structure Excavation	Concrete (#)	Reinforcing Steel	Str. Steel Mild Carbon	Str. Steel High Strength	Aluminum Railing (1-Rail)	Porous Backfill	Underdrain 6" Dia. Pipe	Steel Piles 10BP42	Steel Piles 12BP53
	Cu. Yds.	Cu. Yds.	Lbs.	Lbs.	Lbs.	Lin. Ft.	Cu. Yds.	Lin. Ft.	Lin. Ft.	Lin. Ft.
Superstructure	---	1,729.0	394,000	1,852,700	550,750	2,930	---	---	---	---
Substructure	2,821	2,456.0	376,600	125,200	1,850	---	14	27	630	5,745
Total	2,821	4,185.0 *	770,600	1,977,900	552,600	2,930	14	27	630	5,745

LAYOUT SKETCH
Scale: 1"=30'-0"

	Steel Piles 14BP73	Asphalt Damp proofing	Approach Slab Concrete (#)	Approach Slab Reinforcing Steel	Metal Conduit 3" Dia.	Sheet Piling	Bridge Drainage Metal Work	Concr. Slab Slope Prot.	Modifications To existing Shackoe Creek Box Sewer	Modifications To R.P. Turnpike Bridge	Elastomeric Expansion Dam Type 250	Elastomeric Expansion Dam Type 400A
	Lin. Ft.	Sq. Yds.	Cu. Yds.	Lbs.	Lin. Ft.	Lump Sum	Lbs.	Sq. Yds.	Lump Sum	Lump Sum	Lin. Ft.	Lin. Ft.
Superstructure	---	---	---	---	2,030	--	14,020	---	---	1	18	25
Substructure	760	27	38.0	7900	--	1	---	291	1	-	--	--
Total	760	27	38.0 *	7900	2,030	1	14,020	291	1	1	18	25

* All Concrete for Superstructure shall be Class A4 and for Substructure Class A3.

BY	DATE	REVISION	BY	DATE
MADE	AMH 3-28-69			
CHECKED	KCT 5-5-69	1 As Built	TEM	6-77
IN CHARGE				

**RICHMOND METROPOLITAN AUTHORITY
RICHMOND EXPRESSWAY SYSTEM
DOWNTOWN EXPRESSWAY**



**BRIDGE NO. 67
RAMP W-N CONNECTION TO
RICHMOND-PETERSBURG TURNPIKE
LAYOUT**

HOWARD, NEEDLES, TAMMEN & BERGENDOFF
consulting engineers
NEW YORK ALEXANDRIA KANSAS CITY



SCALE: *As Noted*
CONTRACT NO.: 10
SHEET NO. 3 OF 54

AS BUILT

RICHMOND EXPRESSWAY SYSTEM			
SECTION	PROJECT	SHEET NO.	TOTAL SHEETS
10	DOWNTOWN EXPRESSWAY	176	265

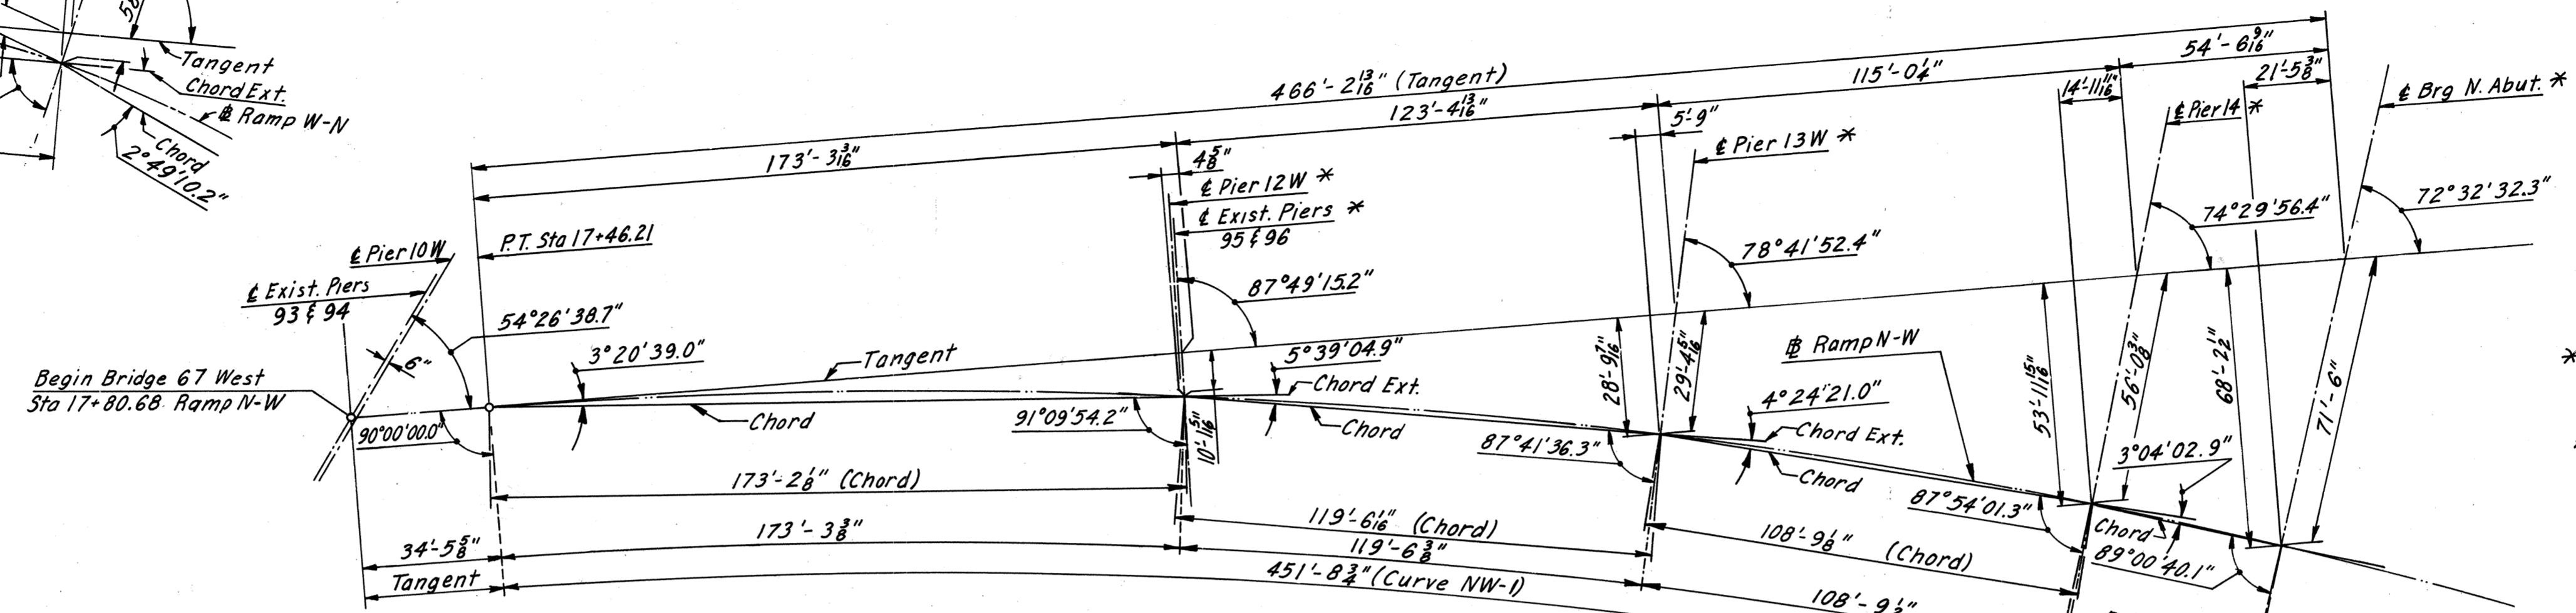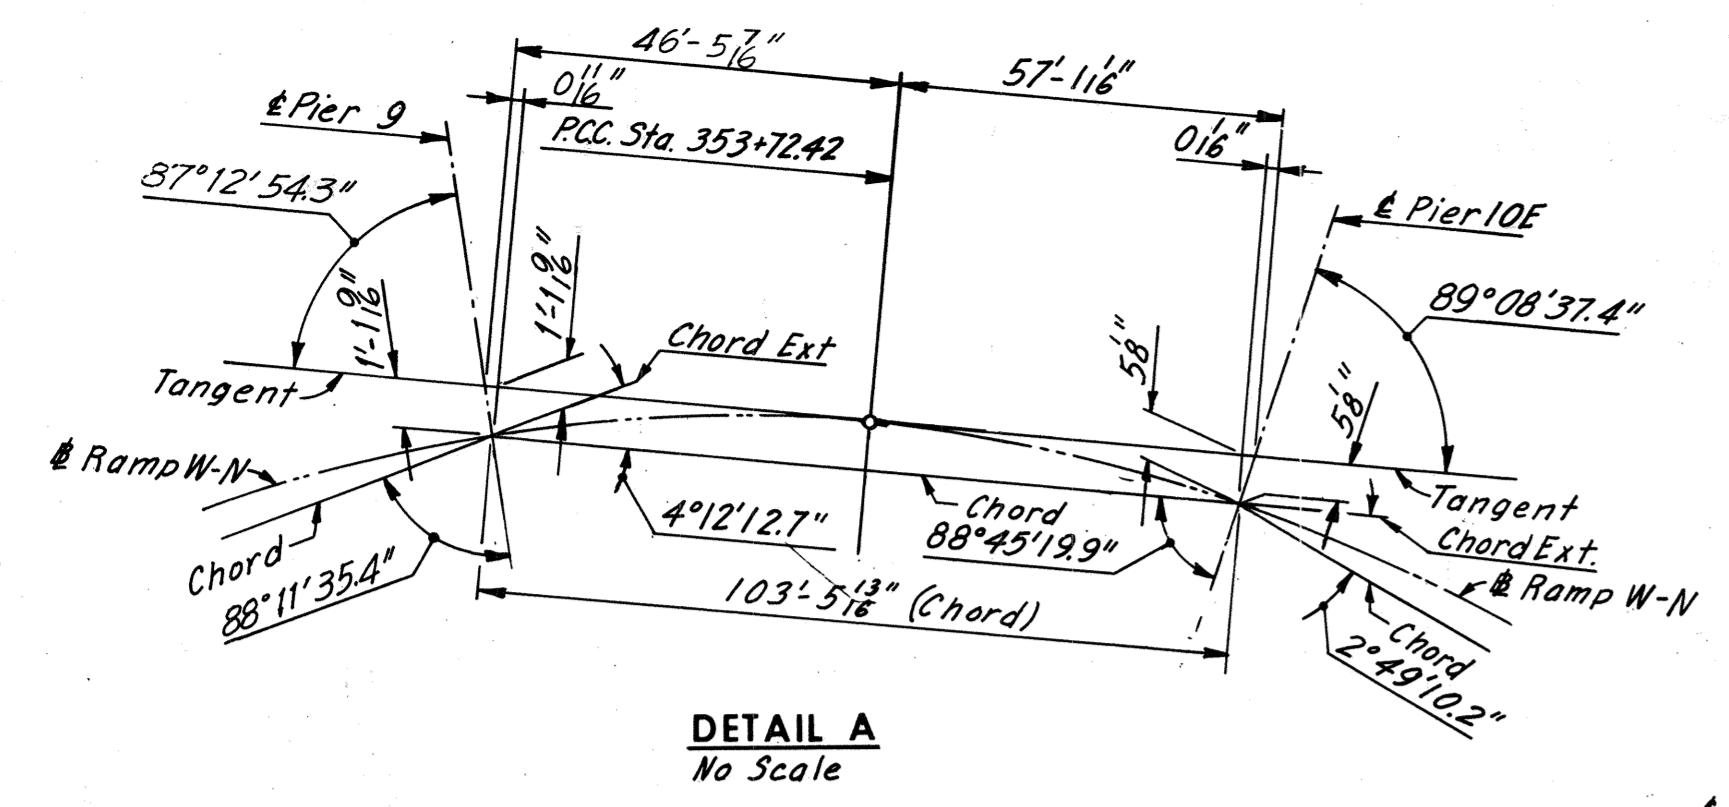

*Note: The centerline shown is for layout only. See abutment and pier drawings for exact locations of columns.

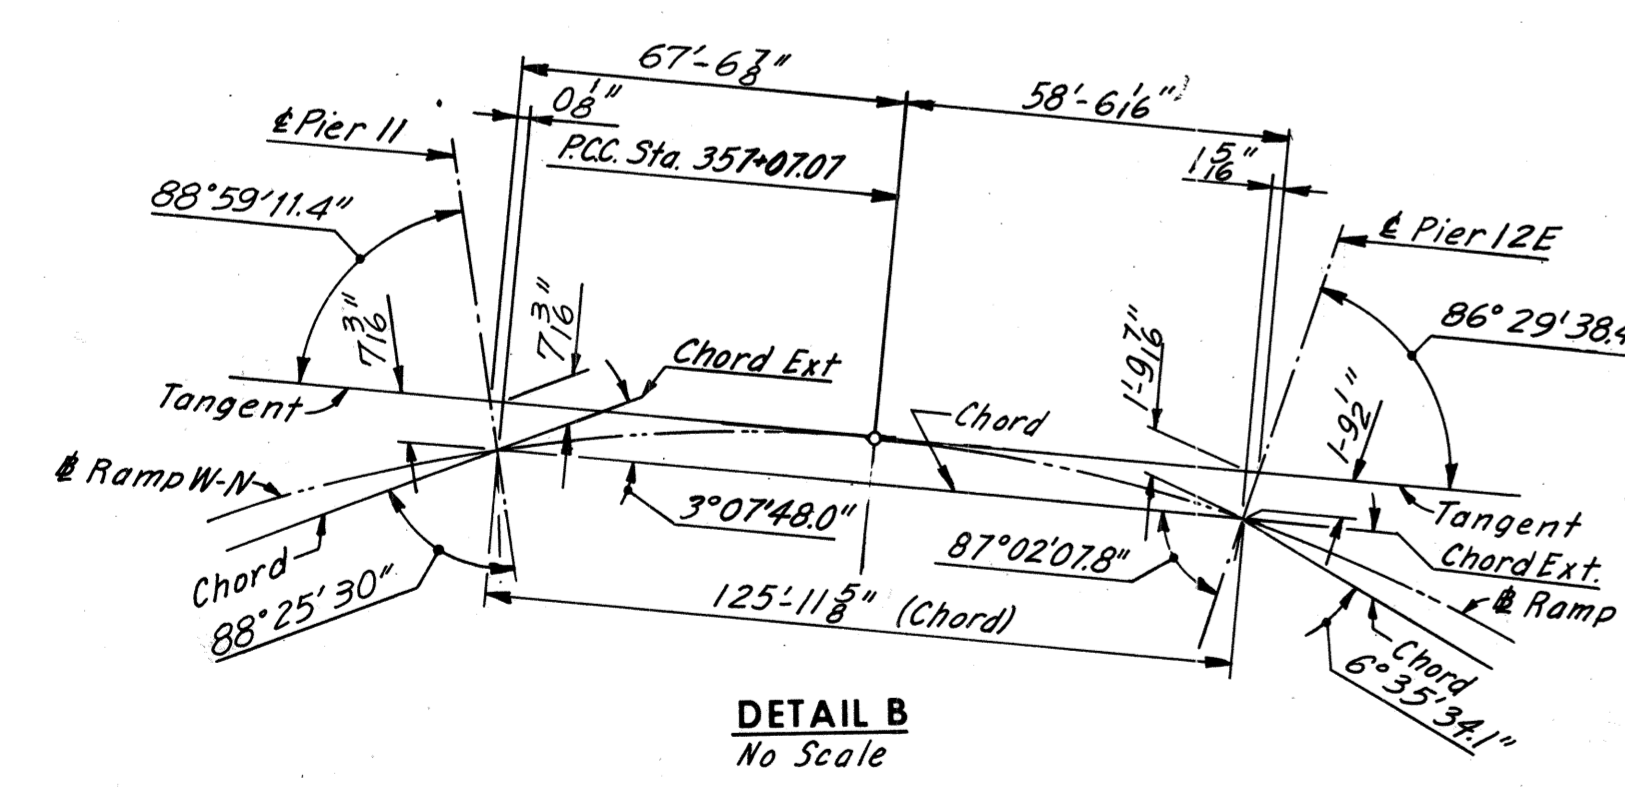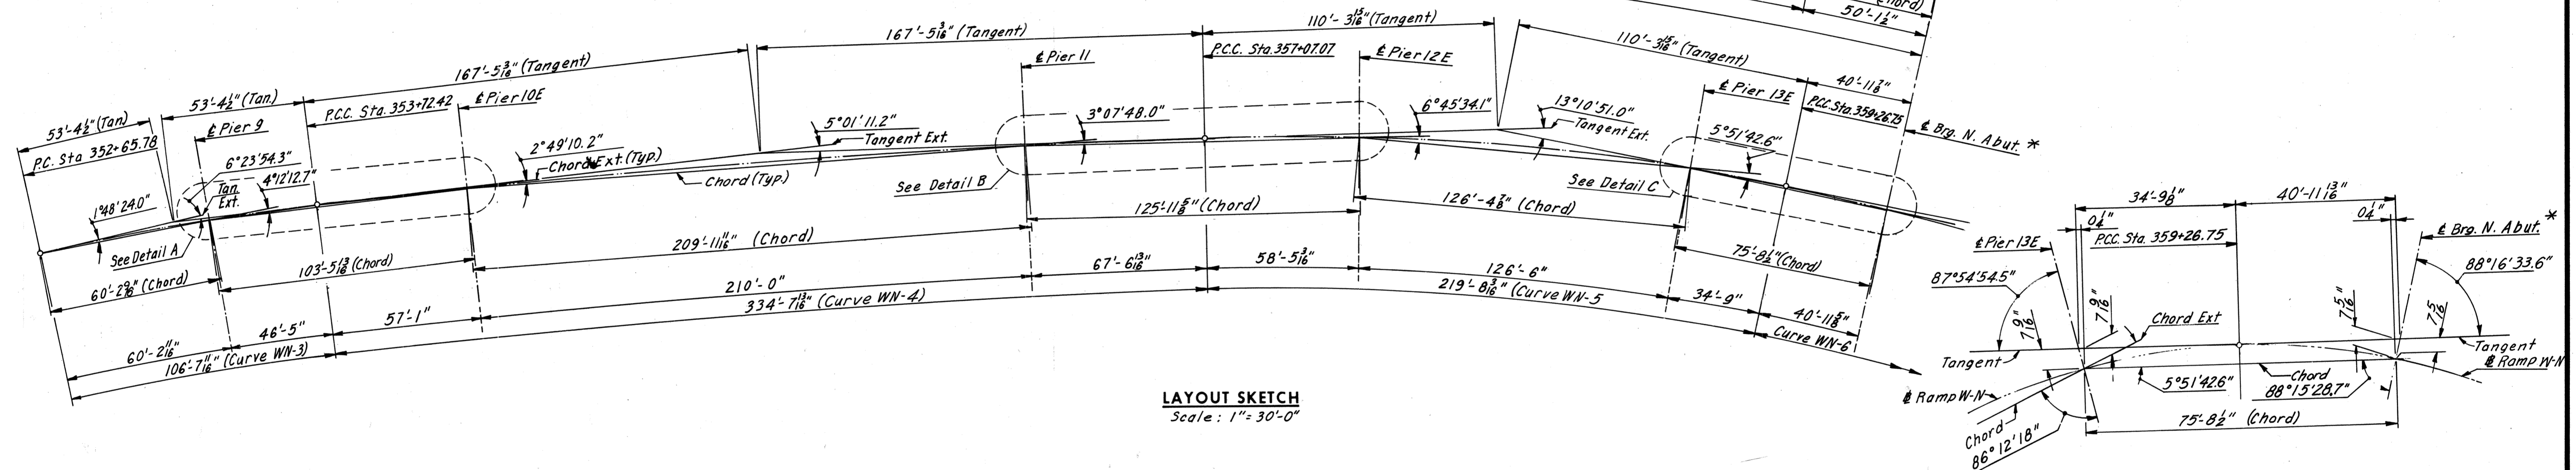

GENERAL NOTES:

ROADWAY: One variable width roadway connecting Br. 66 (E.B. Roadway) with Richmond-Petersburg Turnpike.

face to face of railing is 27'-0" thru the Ramp section, transitioning to 13'-0" widening along Northbound Lanes of the R.P.T. Also included is 13'-0" widening of Southbound Lanes of the R.P.T. from North Abutment to Pier 94.

CAPACITY: Dead load includes 15 lbs. per sq. ft. for future wearing surface. Live load: HS 20-44 loading and alternate military loading.

SPECIFICATIONS:

GENERAL: Virginia Department of Highway Road and Bridge Specifications 1970.

DESIGN: A.A.S.H.O. Standard Specifications for Highway Bridges, 1973, modified by Special Design Provisions.

WELDING: 1972 Standard Specifications for Welded Highway and Railway Bridges of the American Welding Society.

CONTRACT SPECIAL PROVISIONS: Specifications and Contract Special Provisions referred to above are necessary to make these plans complete.

DATUM: City of Richmond

TEMPERATURE: The normal temperature referred to in the plans is 60° F. The temperature range for movement is 0° F. to 120° F.

DIMENSIONS: All dimensions are measured horizontally and vertically unless otherwise noted.

EXCAVATION: Excavation below subgrade and cut slope template shall be classified as Structure Excavation. All excavation above these limits shall be classified as Regular Excavation and is not included in the Structural Quantities.

FOUNDATIONS: Footings shall rest on firm material. Foundation material shall be dry and special attention is called to Section 401.05 of Standard Specifications and to the Contract Special Provisions, concerning preparation of Foundations for footings.

CONCRETE NOTES: Concrete in superstructure shall be Class A-4. All other concrete shall be Class A-3. All exposed edges and corners shall have a 3/4" chamfer or fillet unless otherwise noted. Care in the method of vibration, the use of low-slump concrete, and or other means shall be employed to prevent downgrade movement of newly placed slab concrete. Finishing Concrete Surfaces: See Standard Architectural Detail Sheets and the Contract Special Provisions for types and details. All reinforcing bar dimensions on the detailed drawings are to centers of bars unless otherwise noted. Clear distance between reinforcing steel and face to concrete shall be as noted on the plans. All bar laps shall be 30 diameters of the smaller diameter bar unless otherwise noted. All reinforcing steel shall conform to ASTM 615 Grade 40.

STEEL NOTES: Structural steel shall conform to A.S.T.M. Designations A36, A572 - Grade 50 and A588 as noted. See Special Provisions. All field connections shall be made with high strength bolts. High strength bolts shall be 1/2" diameter unless otherwise noted and shall conform to A.S.T.M. Specification A-325.

**RICHMOND METROPOLITAN AUTHORITY
RICHMOND EXPRESSWAY SYSTEM
DOWNTOWN EXPRESSWAY**

**BRIDGE NO. 67
RAMP W-N CONNECTION TO
RICHMOND-PETERSBURG TURNPIKE
LAYOUT**
















HOWARD, NEEDLES, TAMMEN & BERGENDOFF
consulting engineers
NEW YORK ALEXANDRIA KANSAS CITY

SCALE: As Noted
CONTRACT NO.: 10
SHEET NO. 4 OF 54

BY	DATE	△	Note Added	REV	12-11-74
MADE	AMH	3-27-69	2	As Built	TEM 6-77
CHECKED	KCT	5-6-69			
IN CHARGE			NO.	REVISION	BY DATE

AS BUILT

RICHMOND EXPRESSWAY SYSTEM			
SECTION	PROJECT	SHEET NO.	TOTAL SHEETS
10	DOWNTOWN EXPRESSWAY	177	265

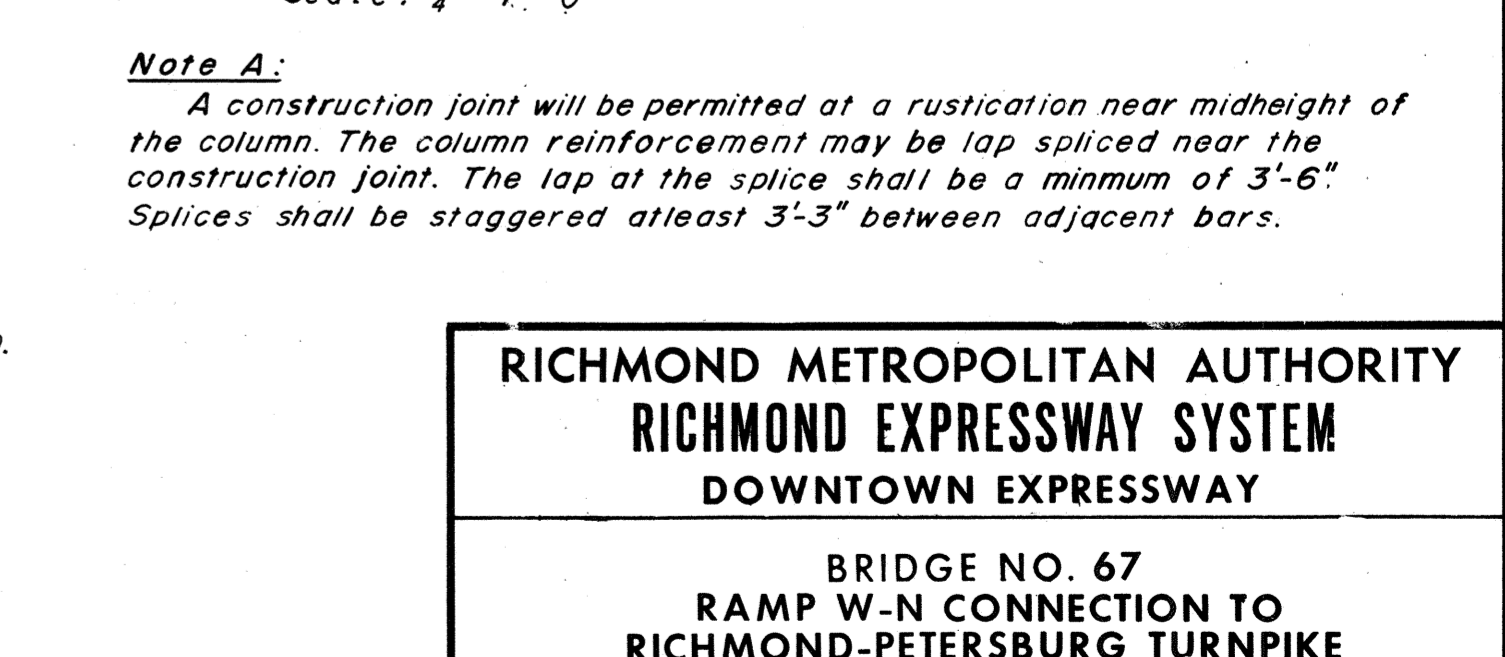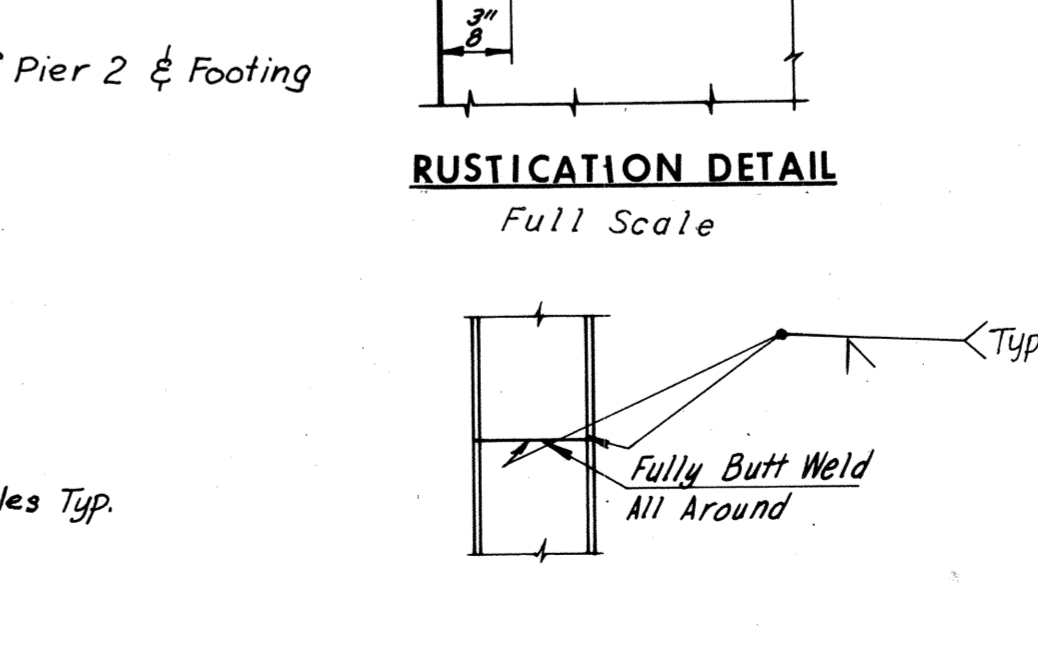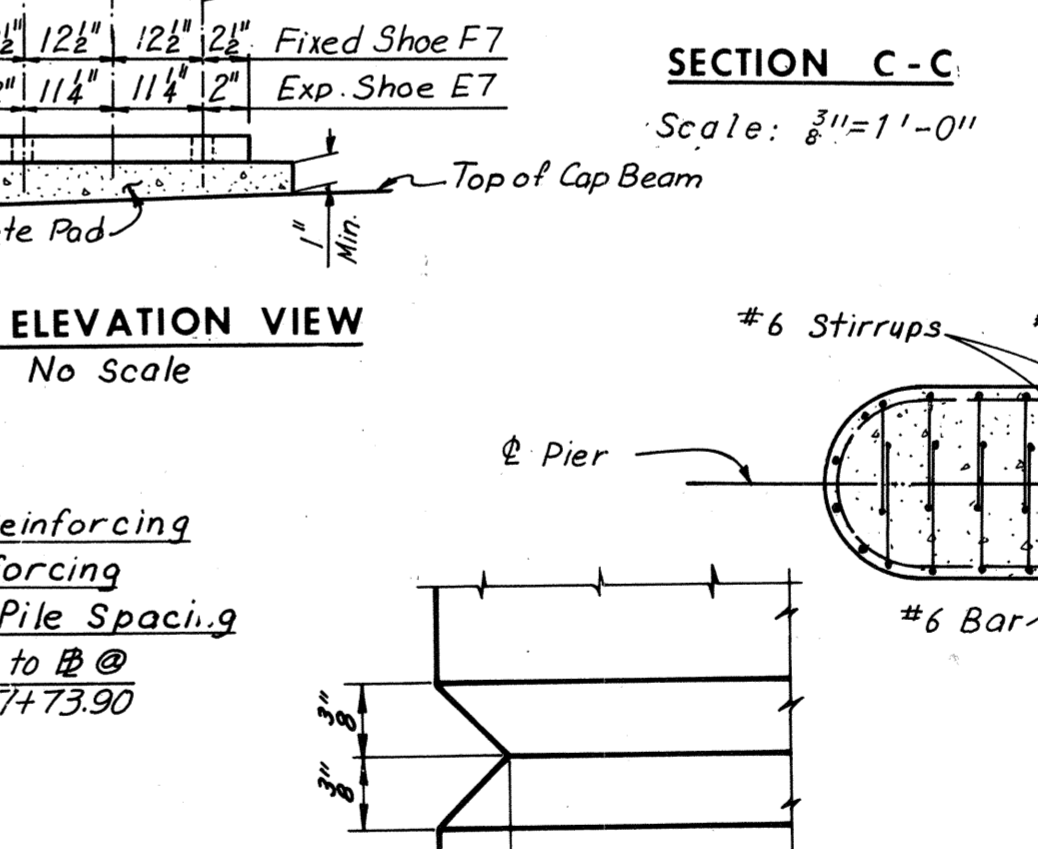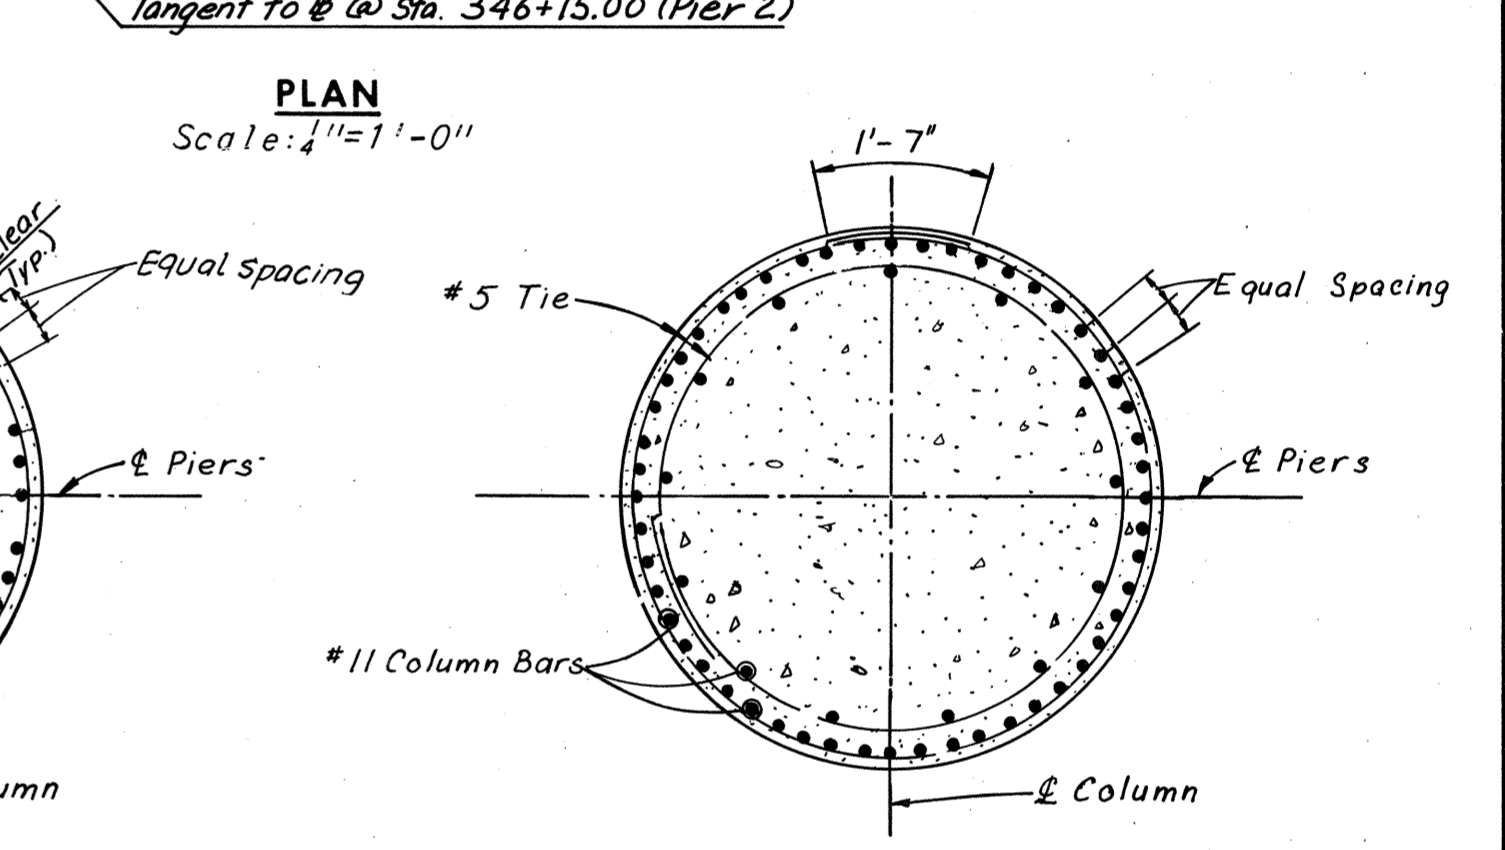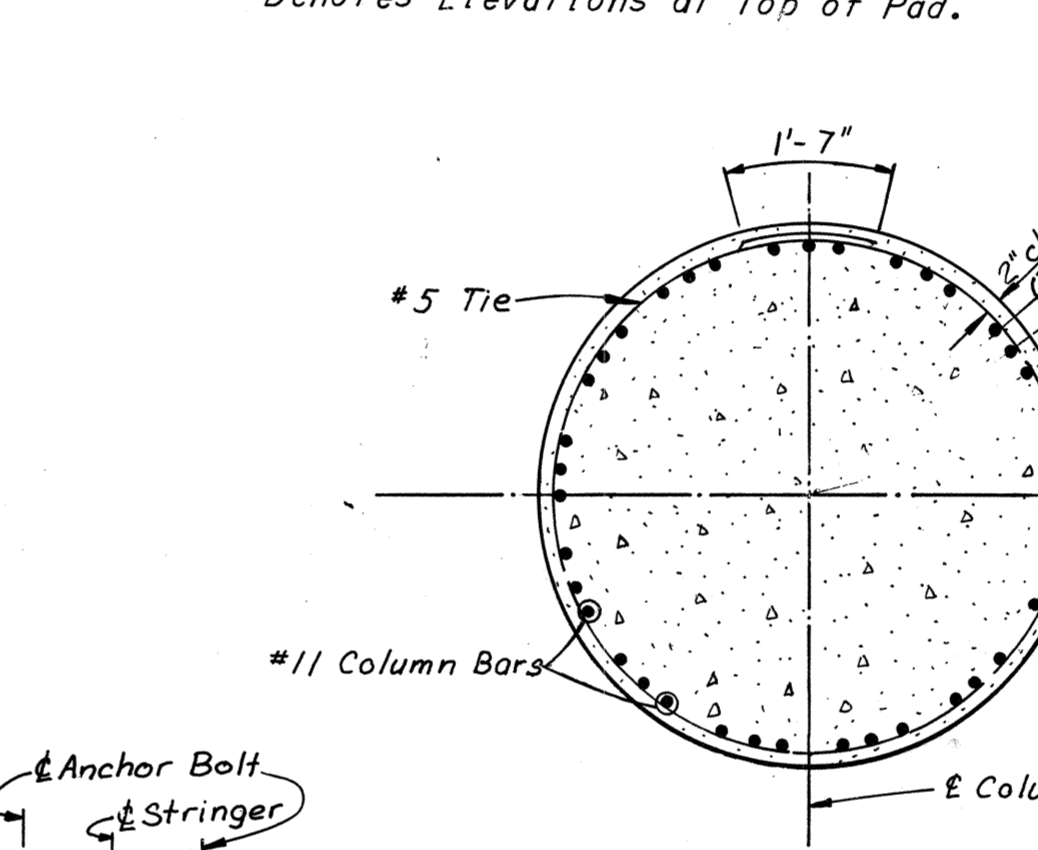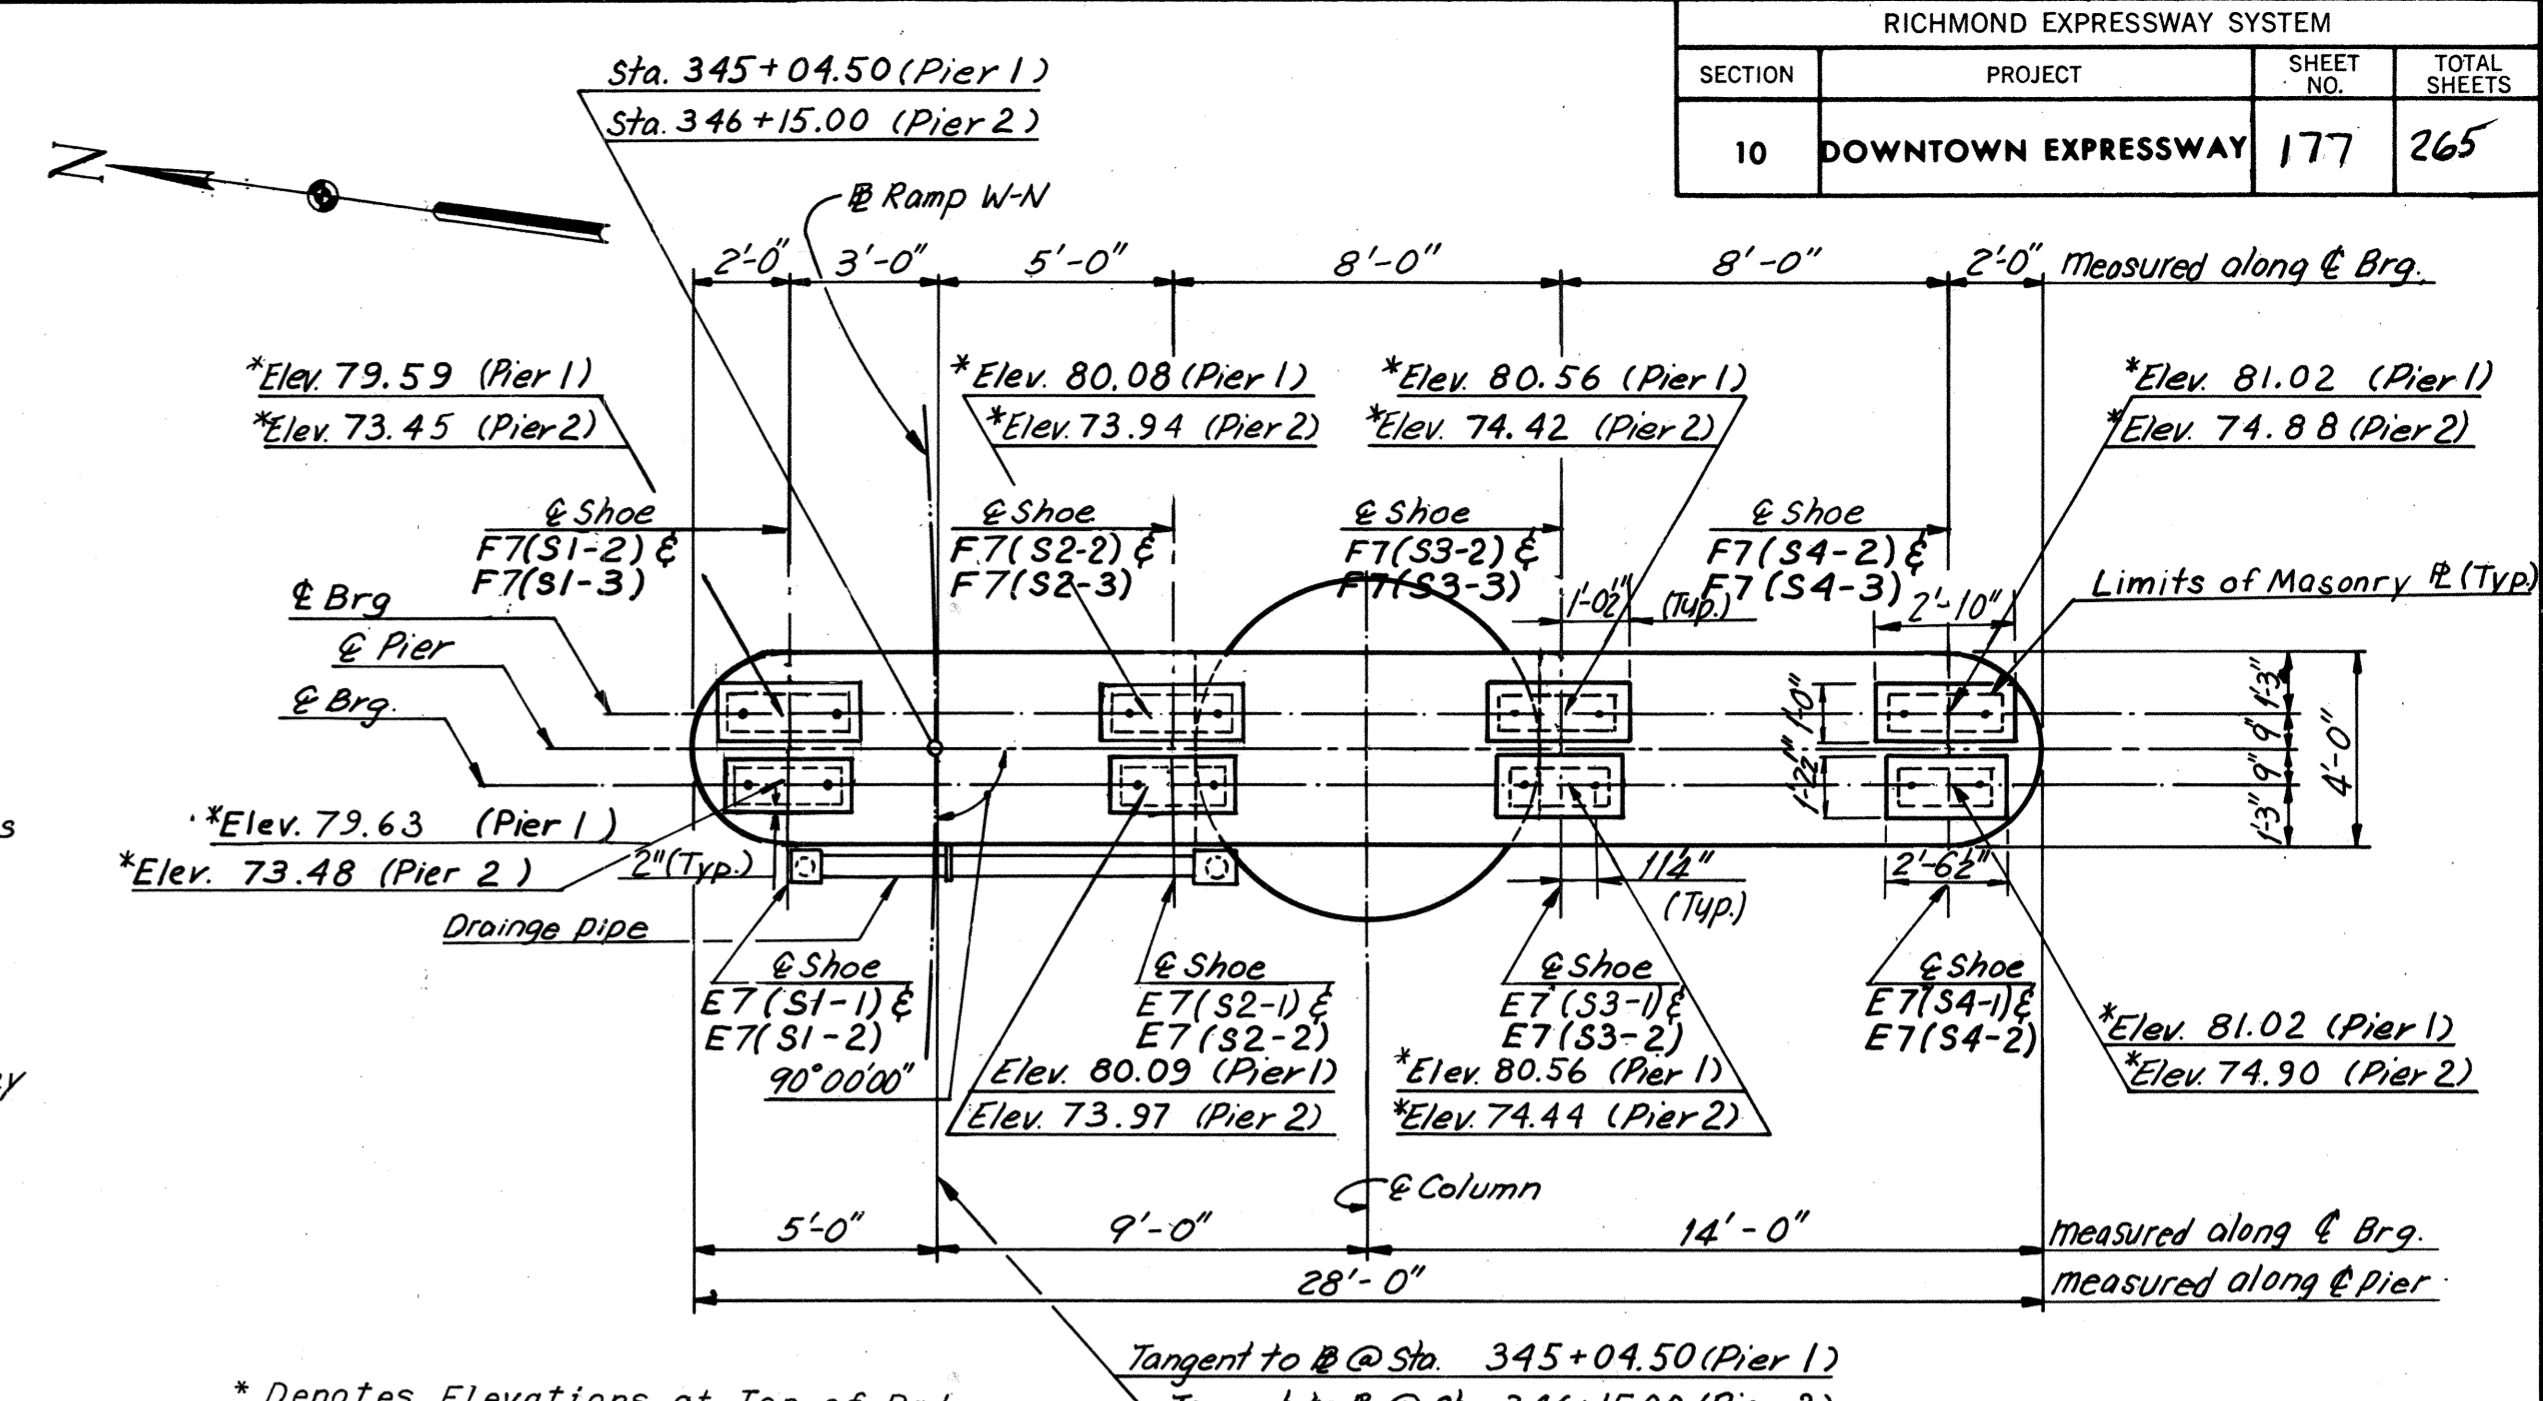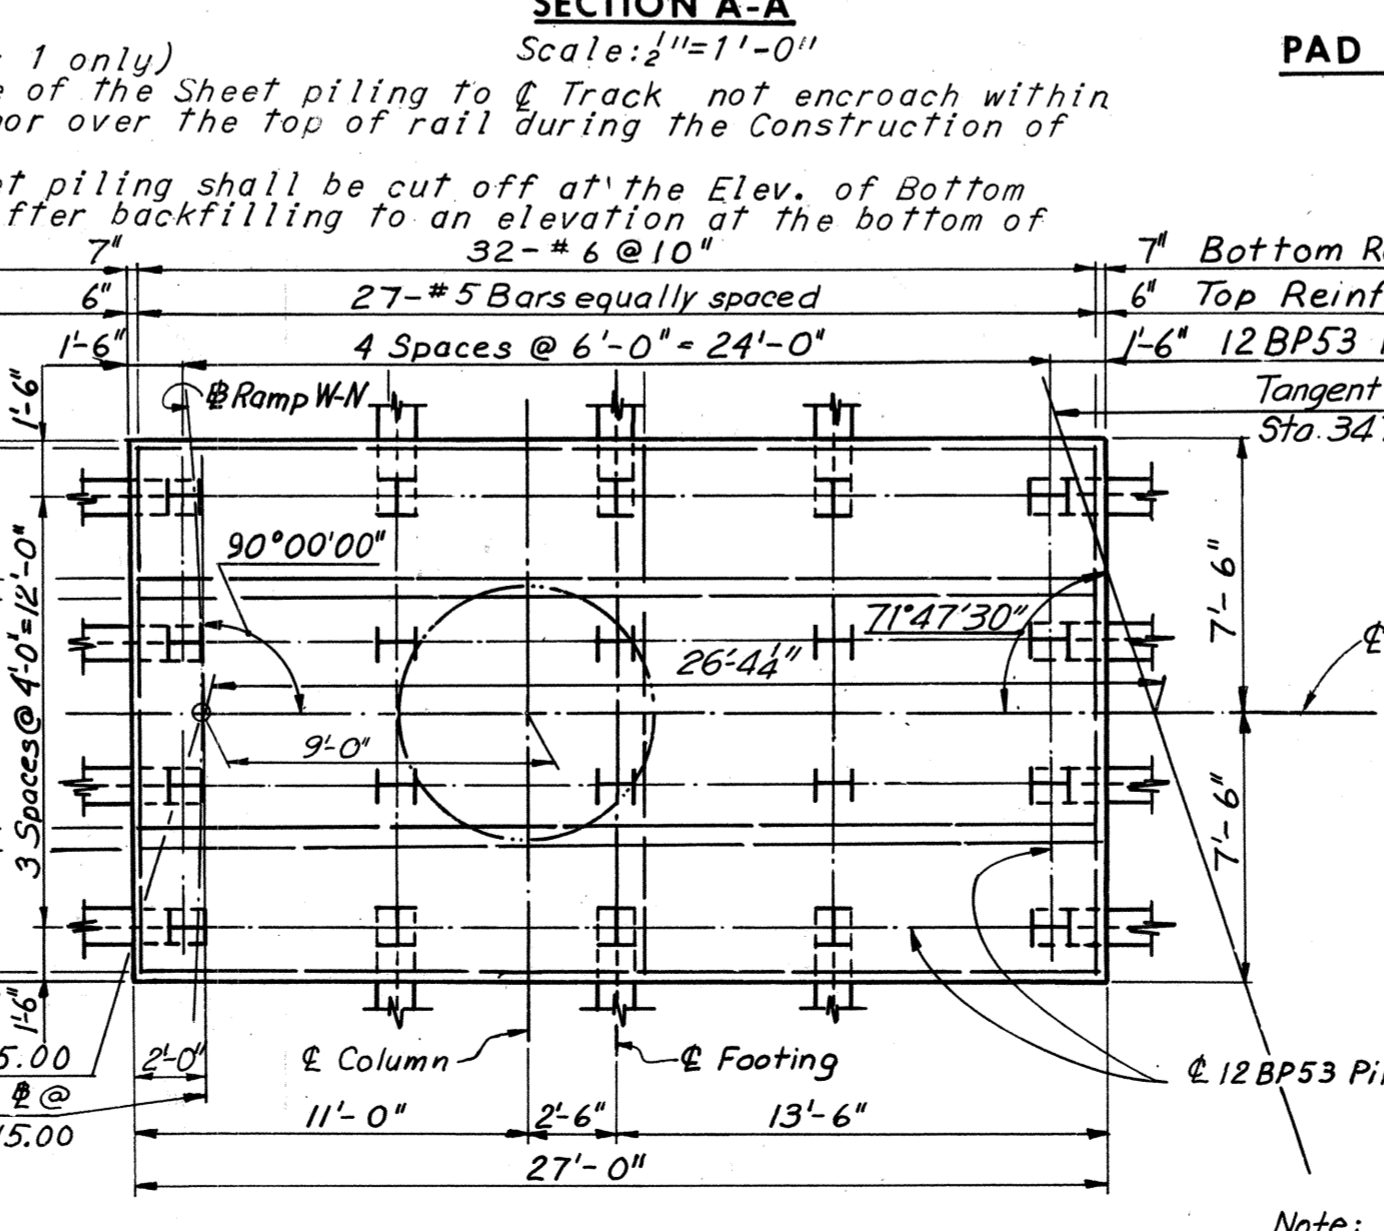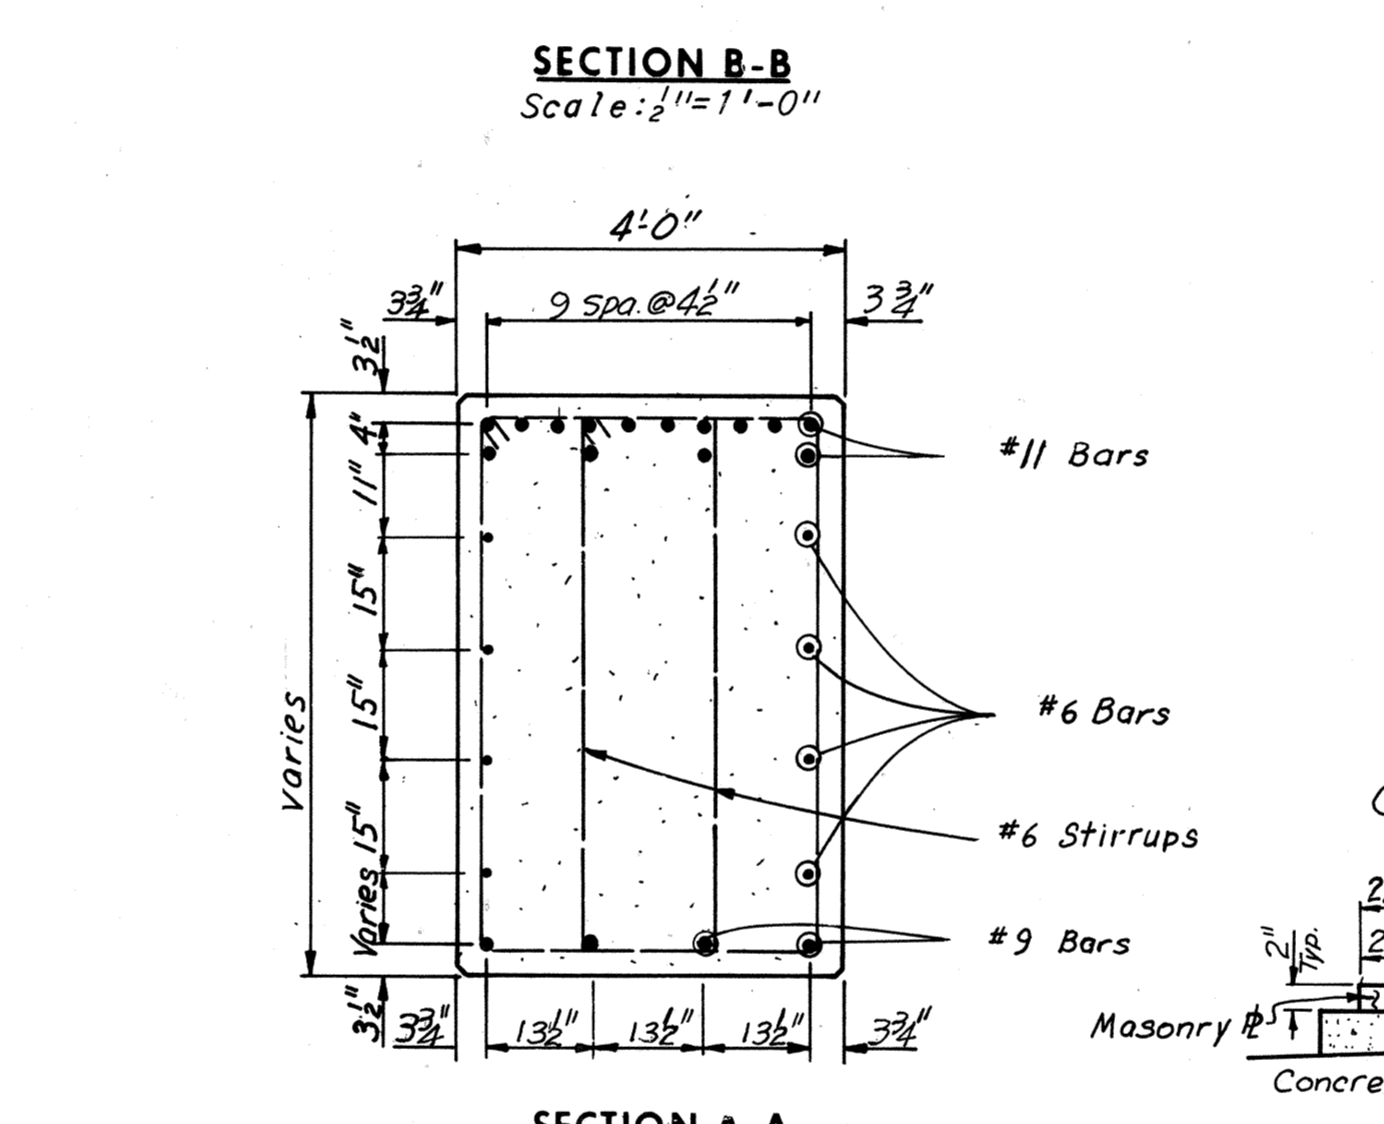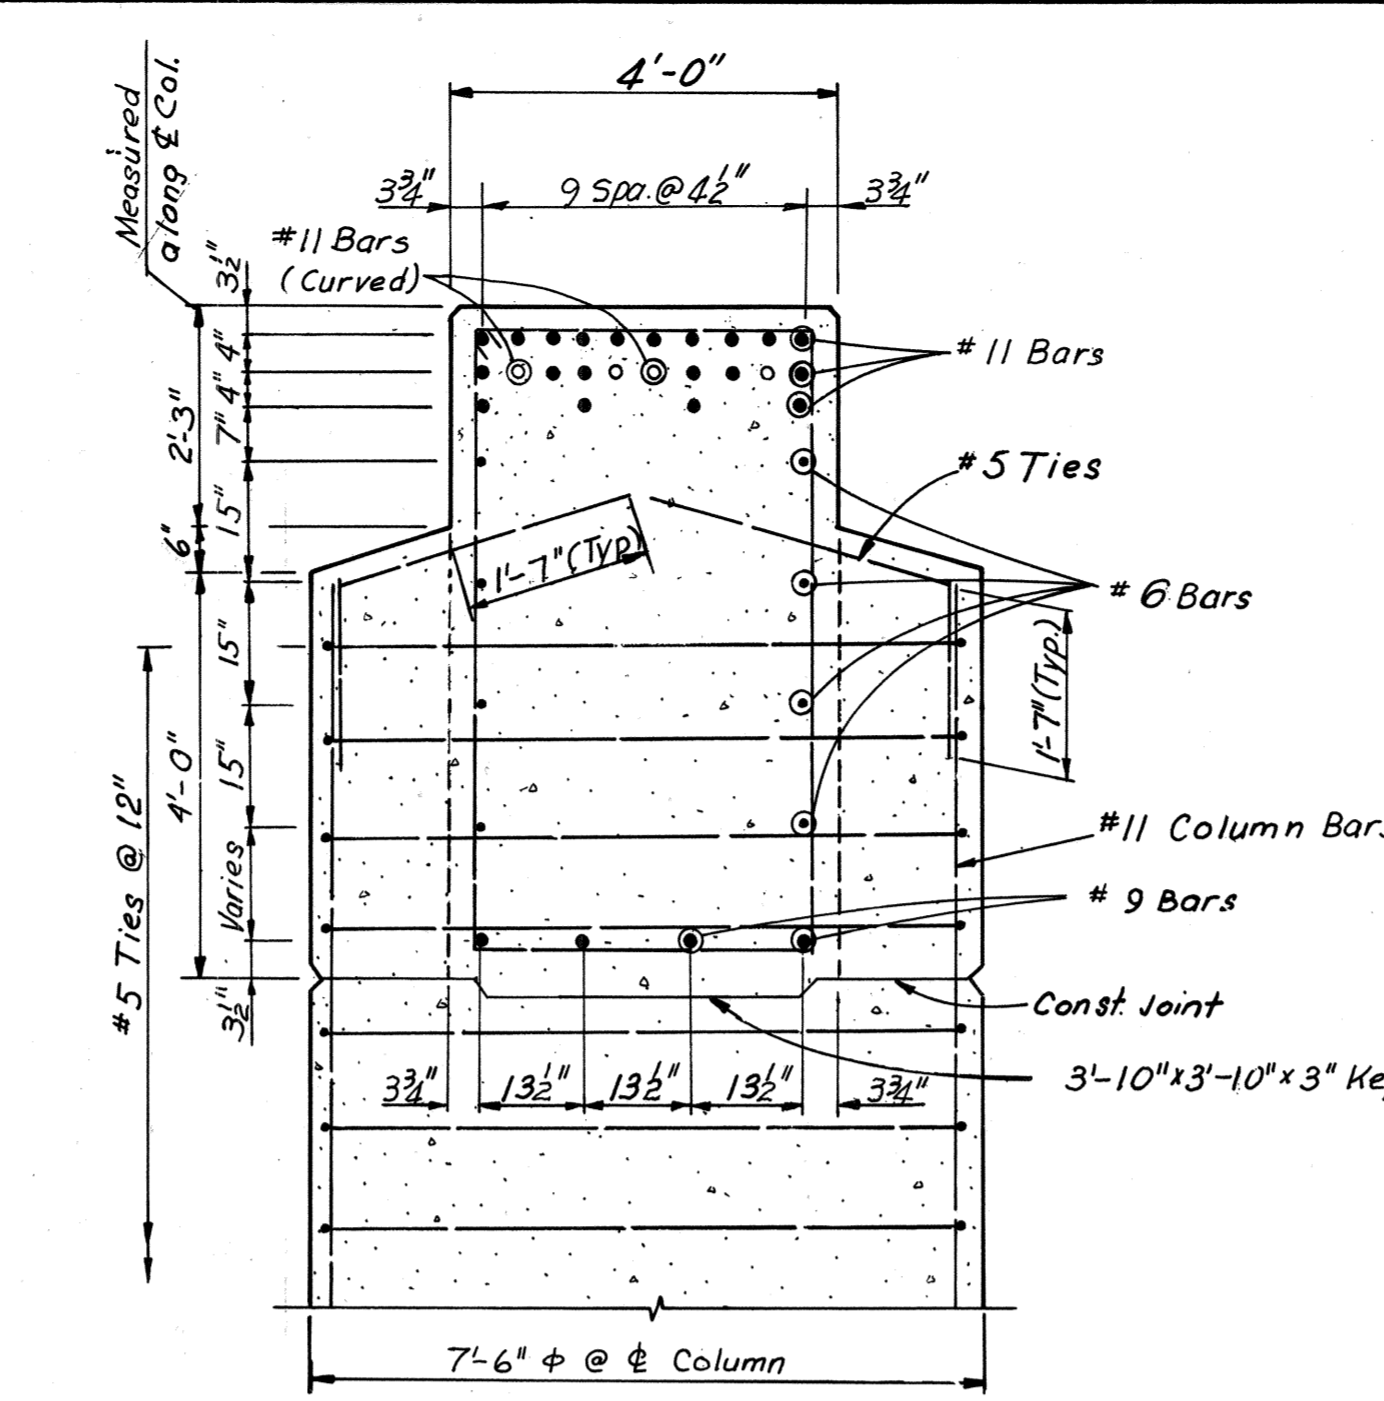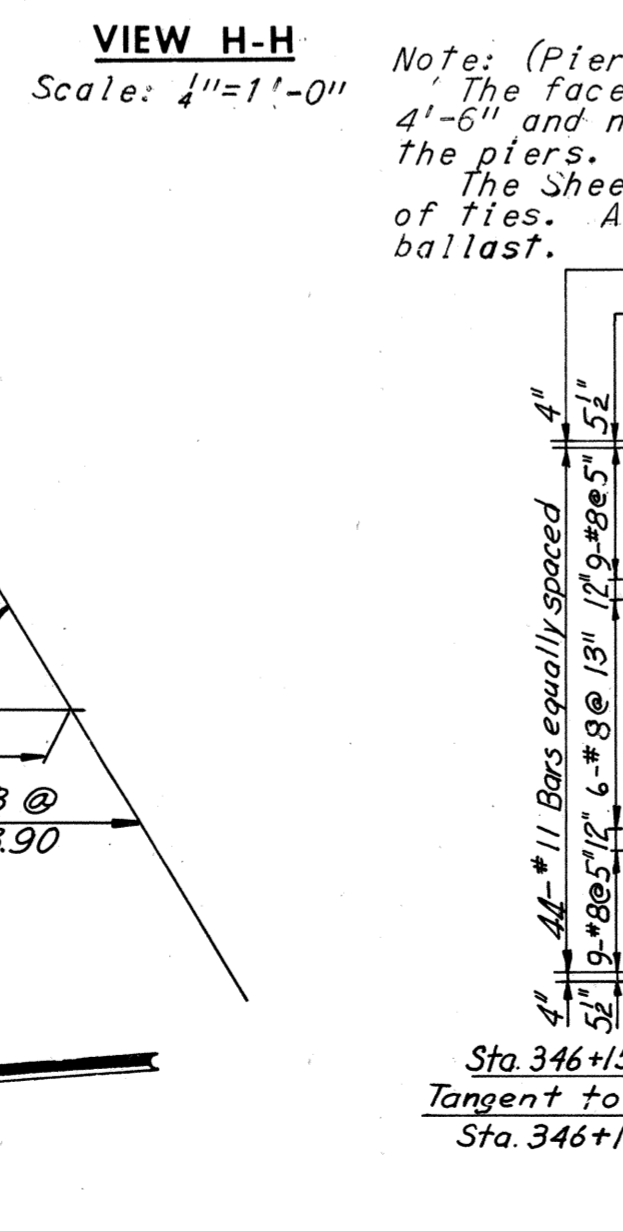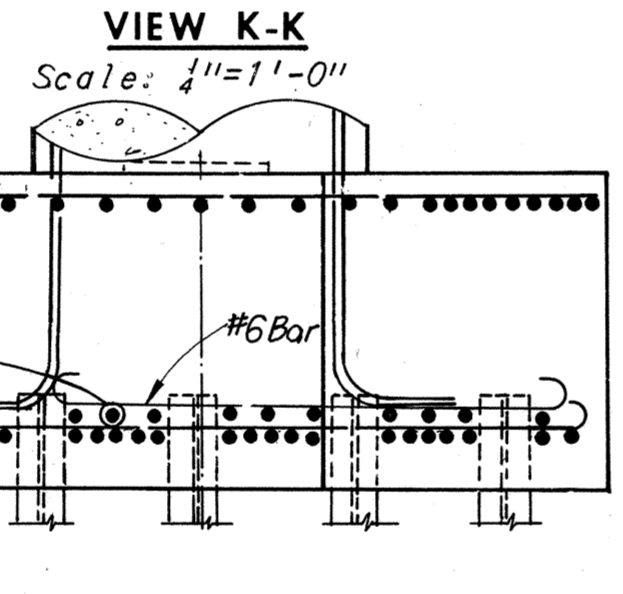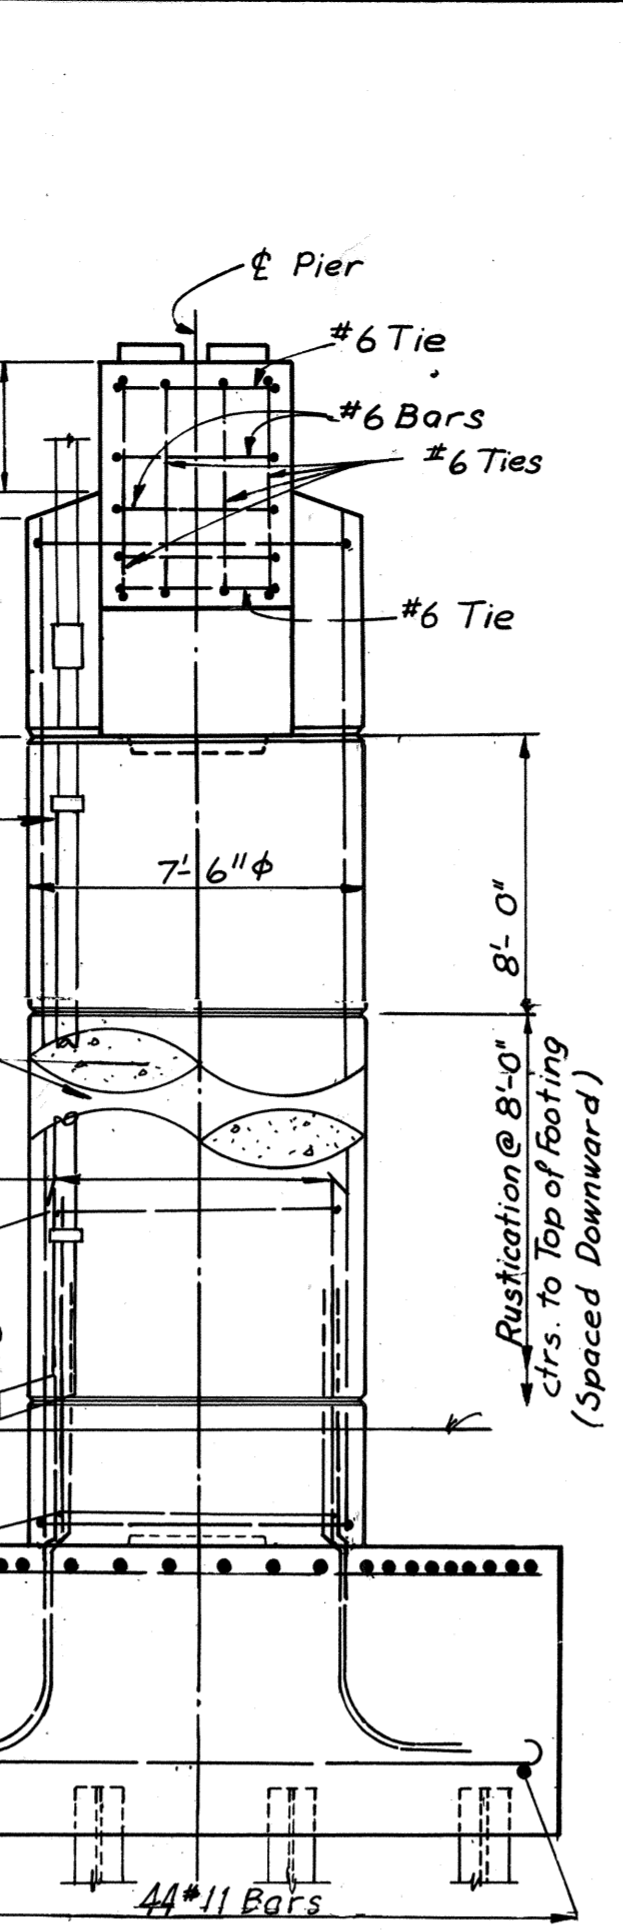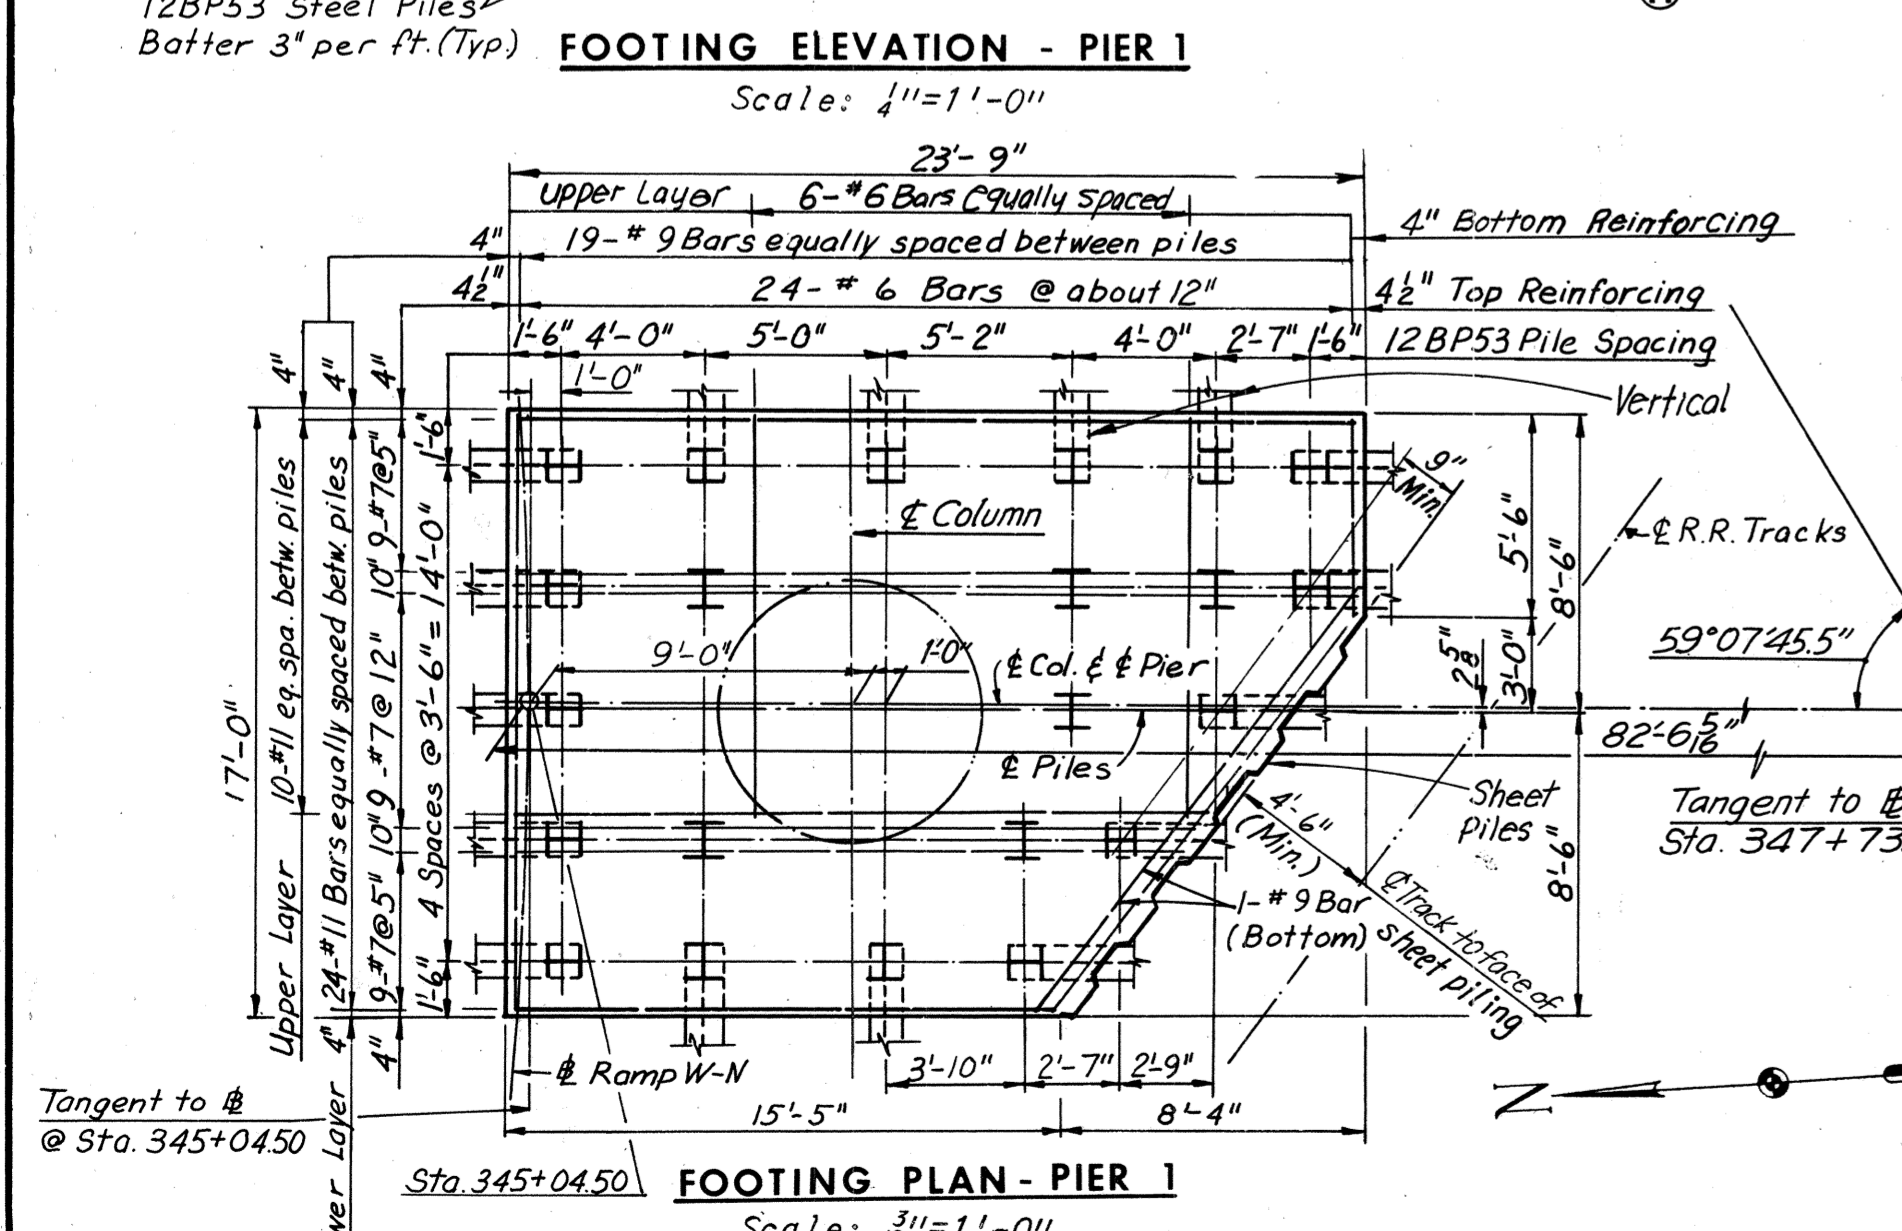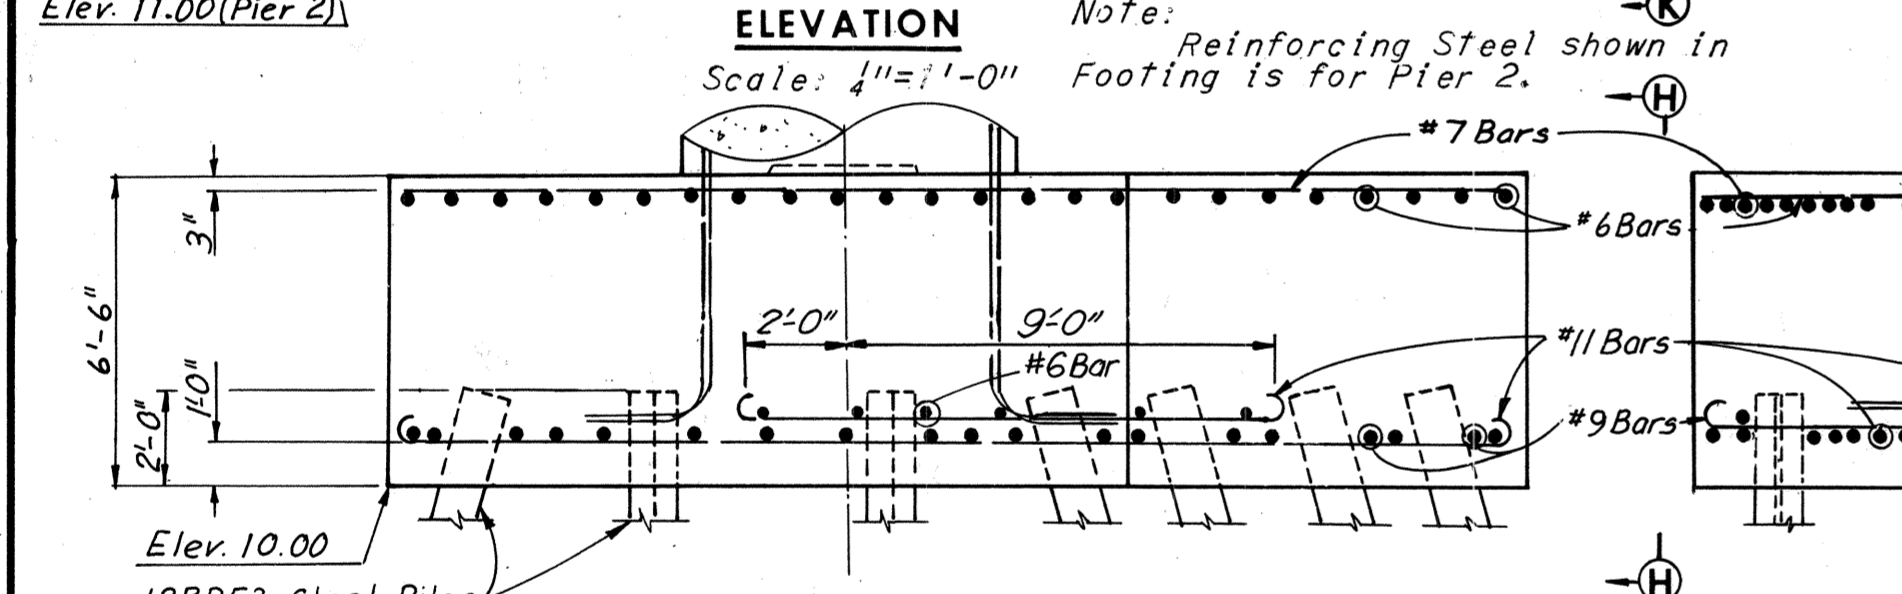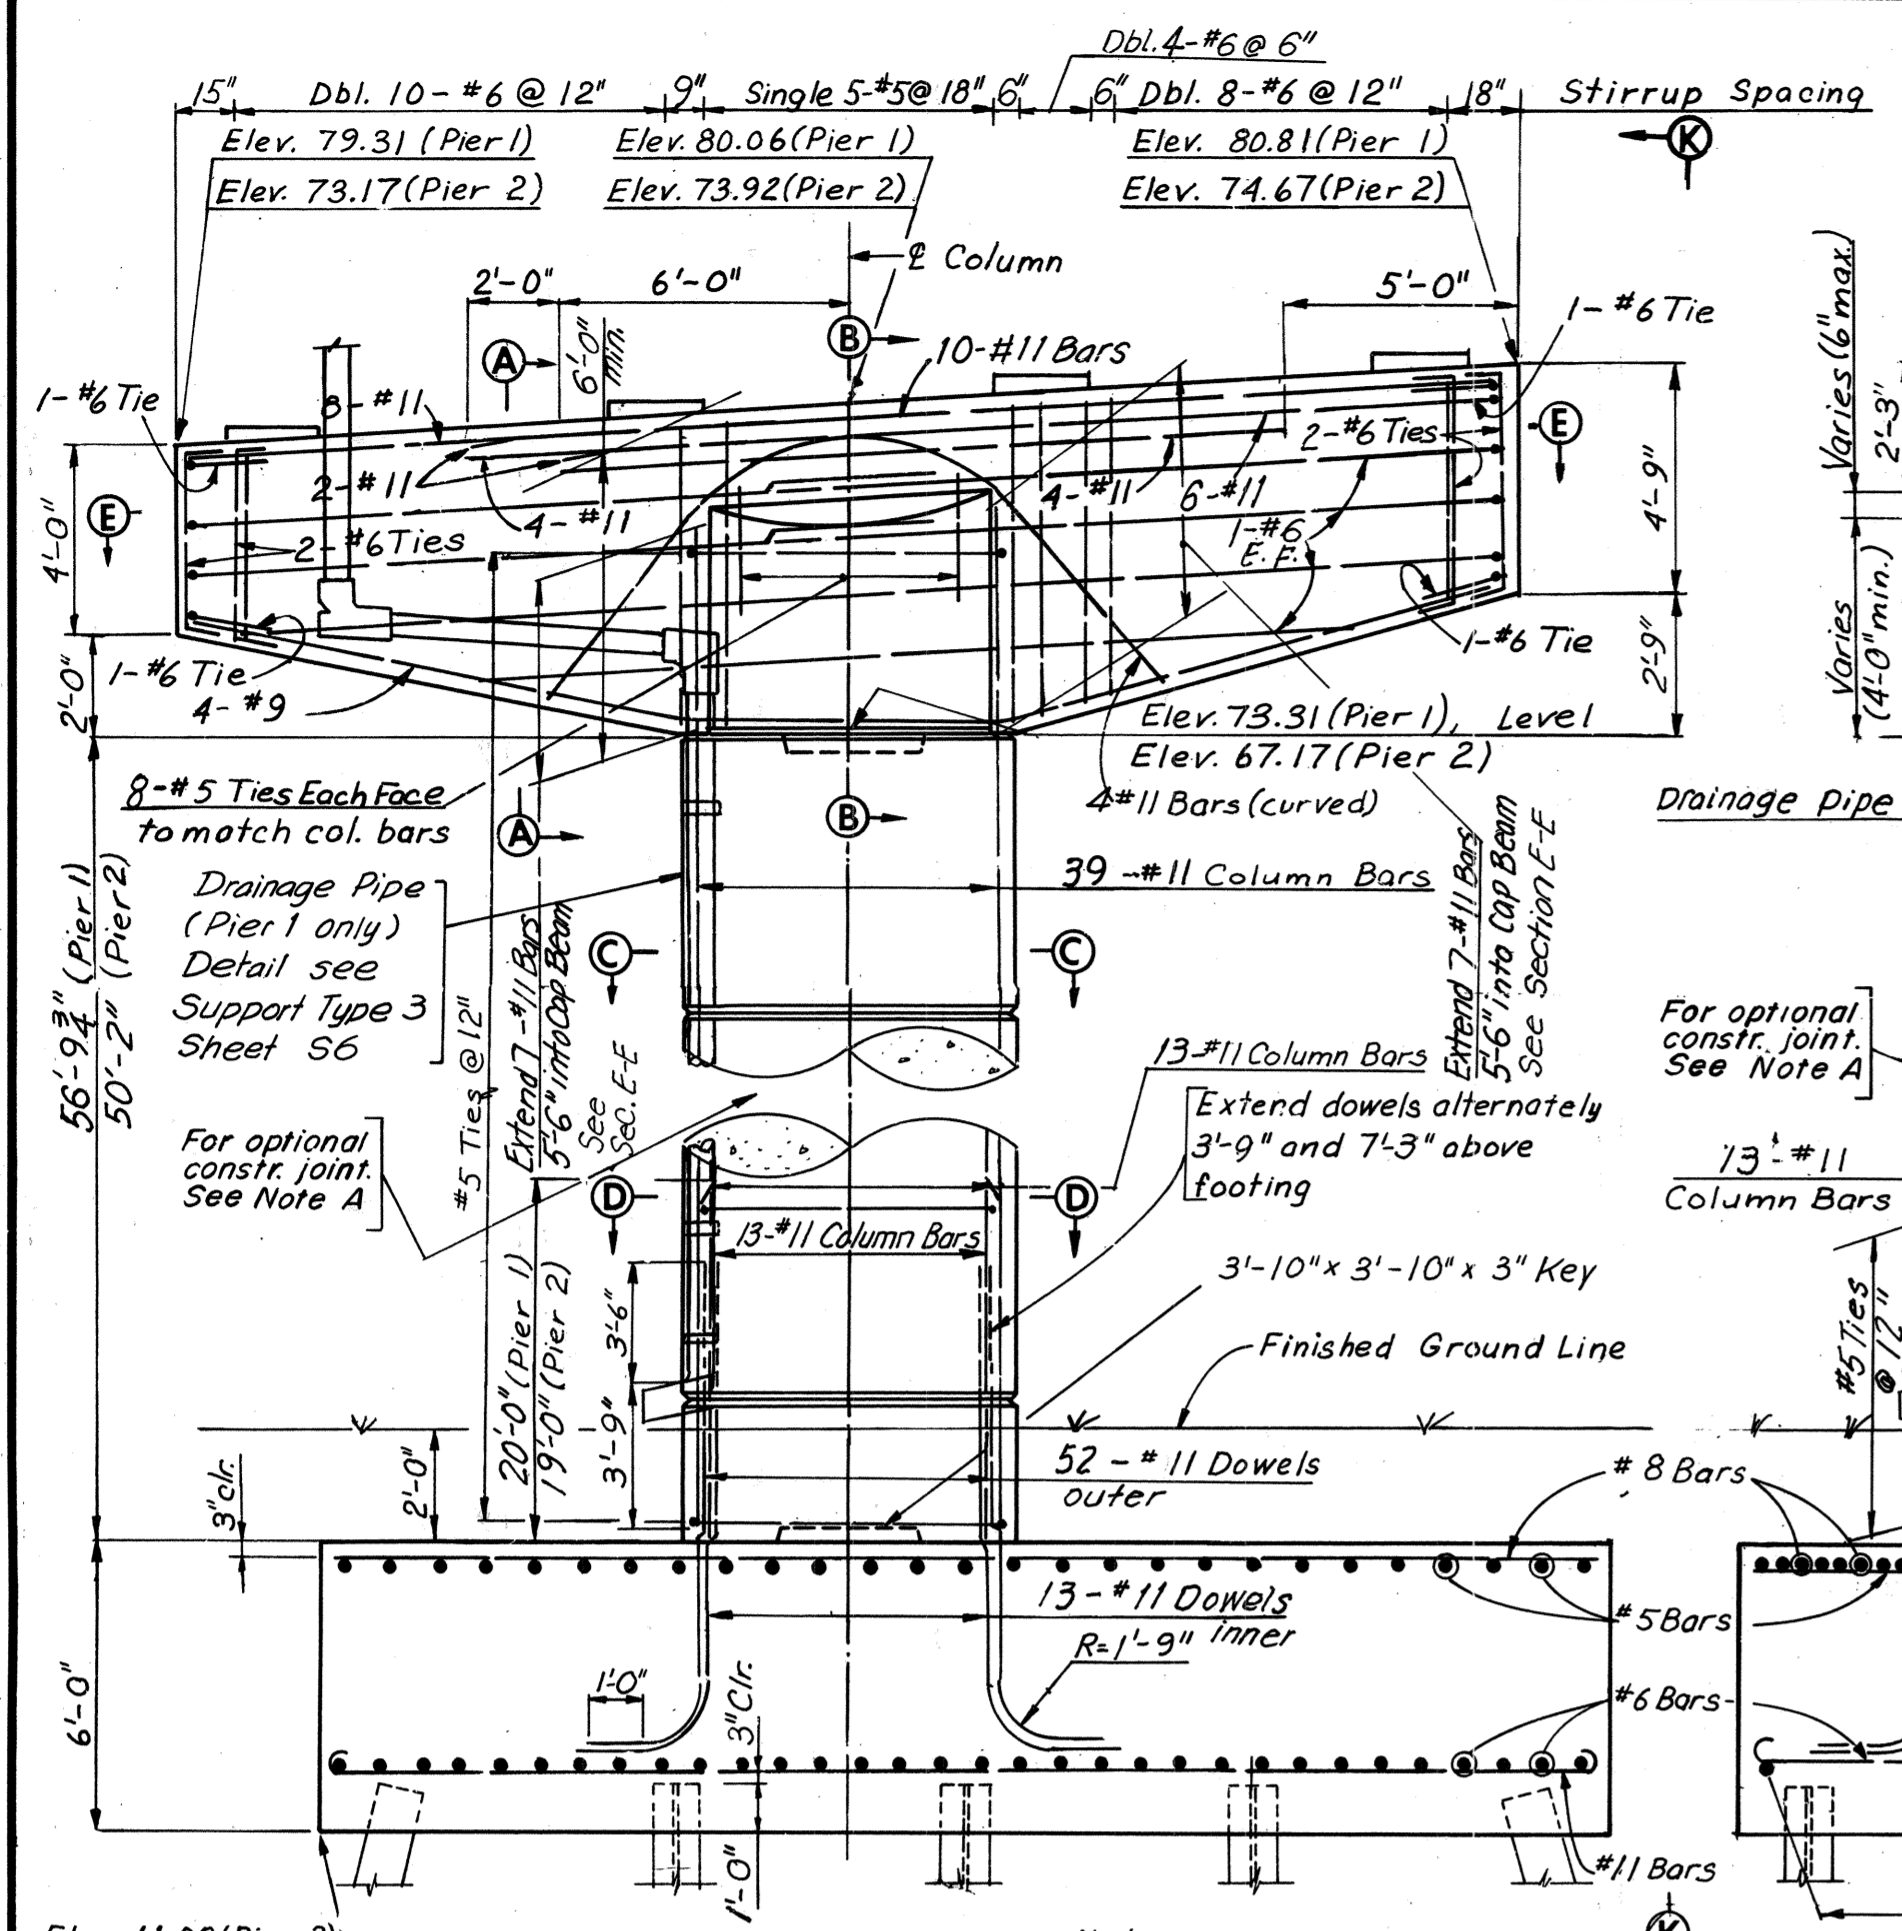

BY	DATE	REVISION	BY	DATE
J.D.	9-16-68			
G.S.H.	4-21-69	1	As Built	TEM 6-77


Note: For 12BP53 Steel Pile Details, see Sheet 6. All piles shall be 12BP53 Steel Piles (Design capacity = 57 tons).
 Note: Footing elevations are approximate only and may be varied to suit field conditions as directed by the Engineer. Vertical shaft reinforcing shall not be cut until these elevations are established. Where elevations change more than 2 ft., redesign will be required.

RICHMOND METROPOLITAN AUTHORITY
RICHMOND EXPRESSWAY SYSTEM
DOWNTOWN EXPRESSWAY
 BRIDGE NO. 67
 RAMP W-N CONNECTION TO
 RICHMOND-PETERSBURG TURNPIKE
 PIERS 1 AND 2
 SCALE: As Noted
 CONTRACT NO. 10
 SHEET NO. 5 OF 54


AS BUILT

FOOTINGS FOR PIERS 1 AND 2 ARE ECCENTRIC AS SHOWN ON FOOTING PLANS ABOVE


RICHMOND EXPRESSWAY SYSTEM			
SECTION	PROJECT	SHEET NO.	TOTAL SHEETS
10	DOWNTOWN EXPRESSWAY	178	265

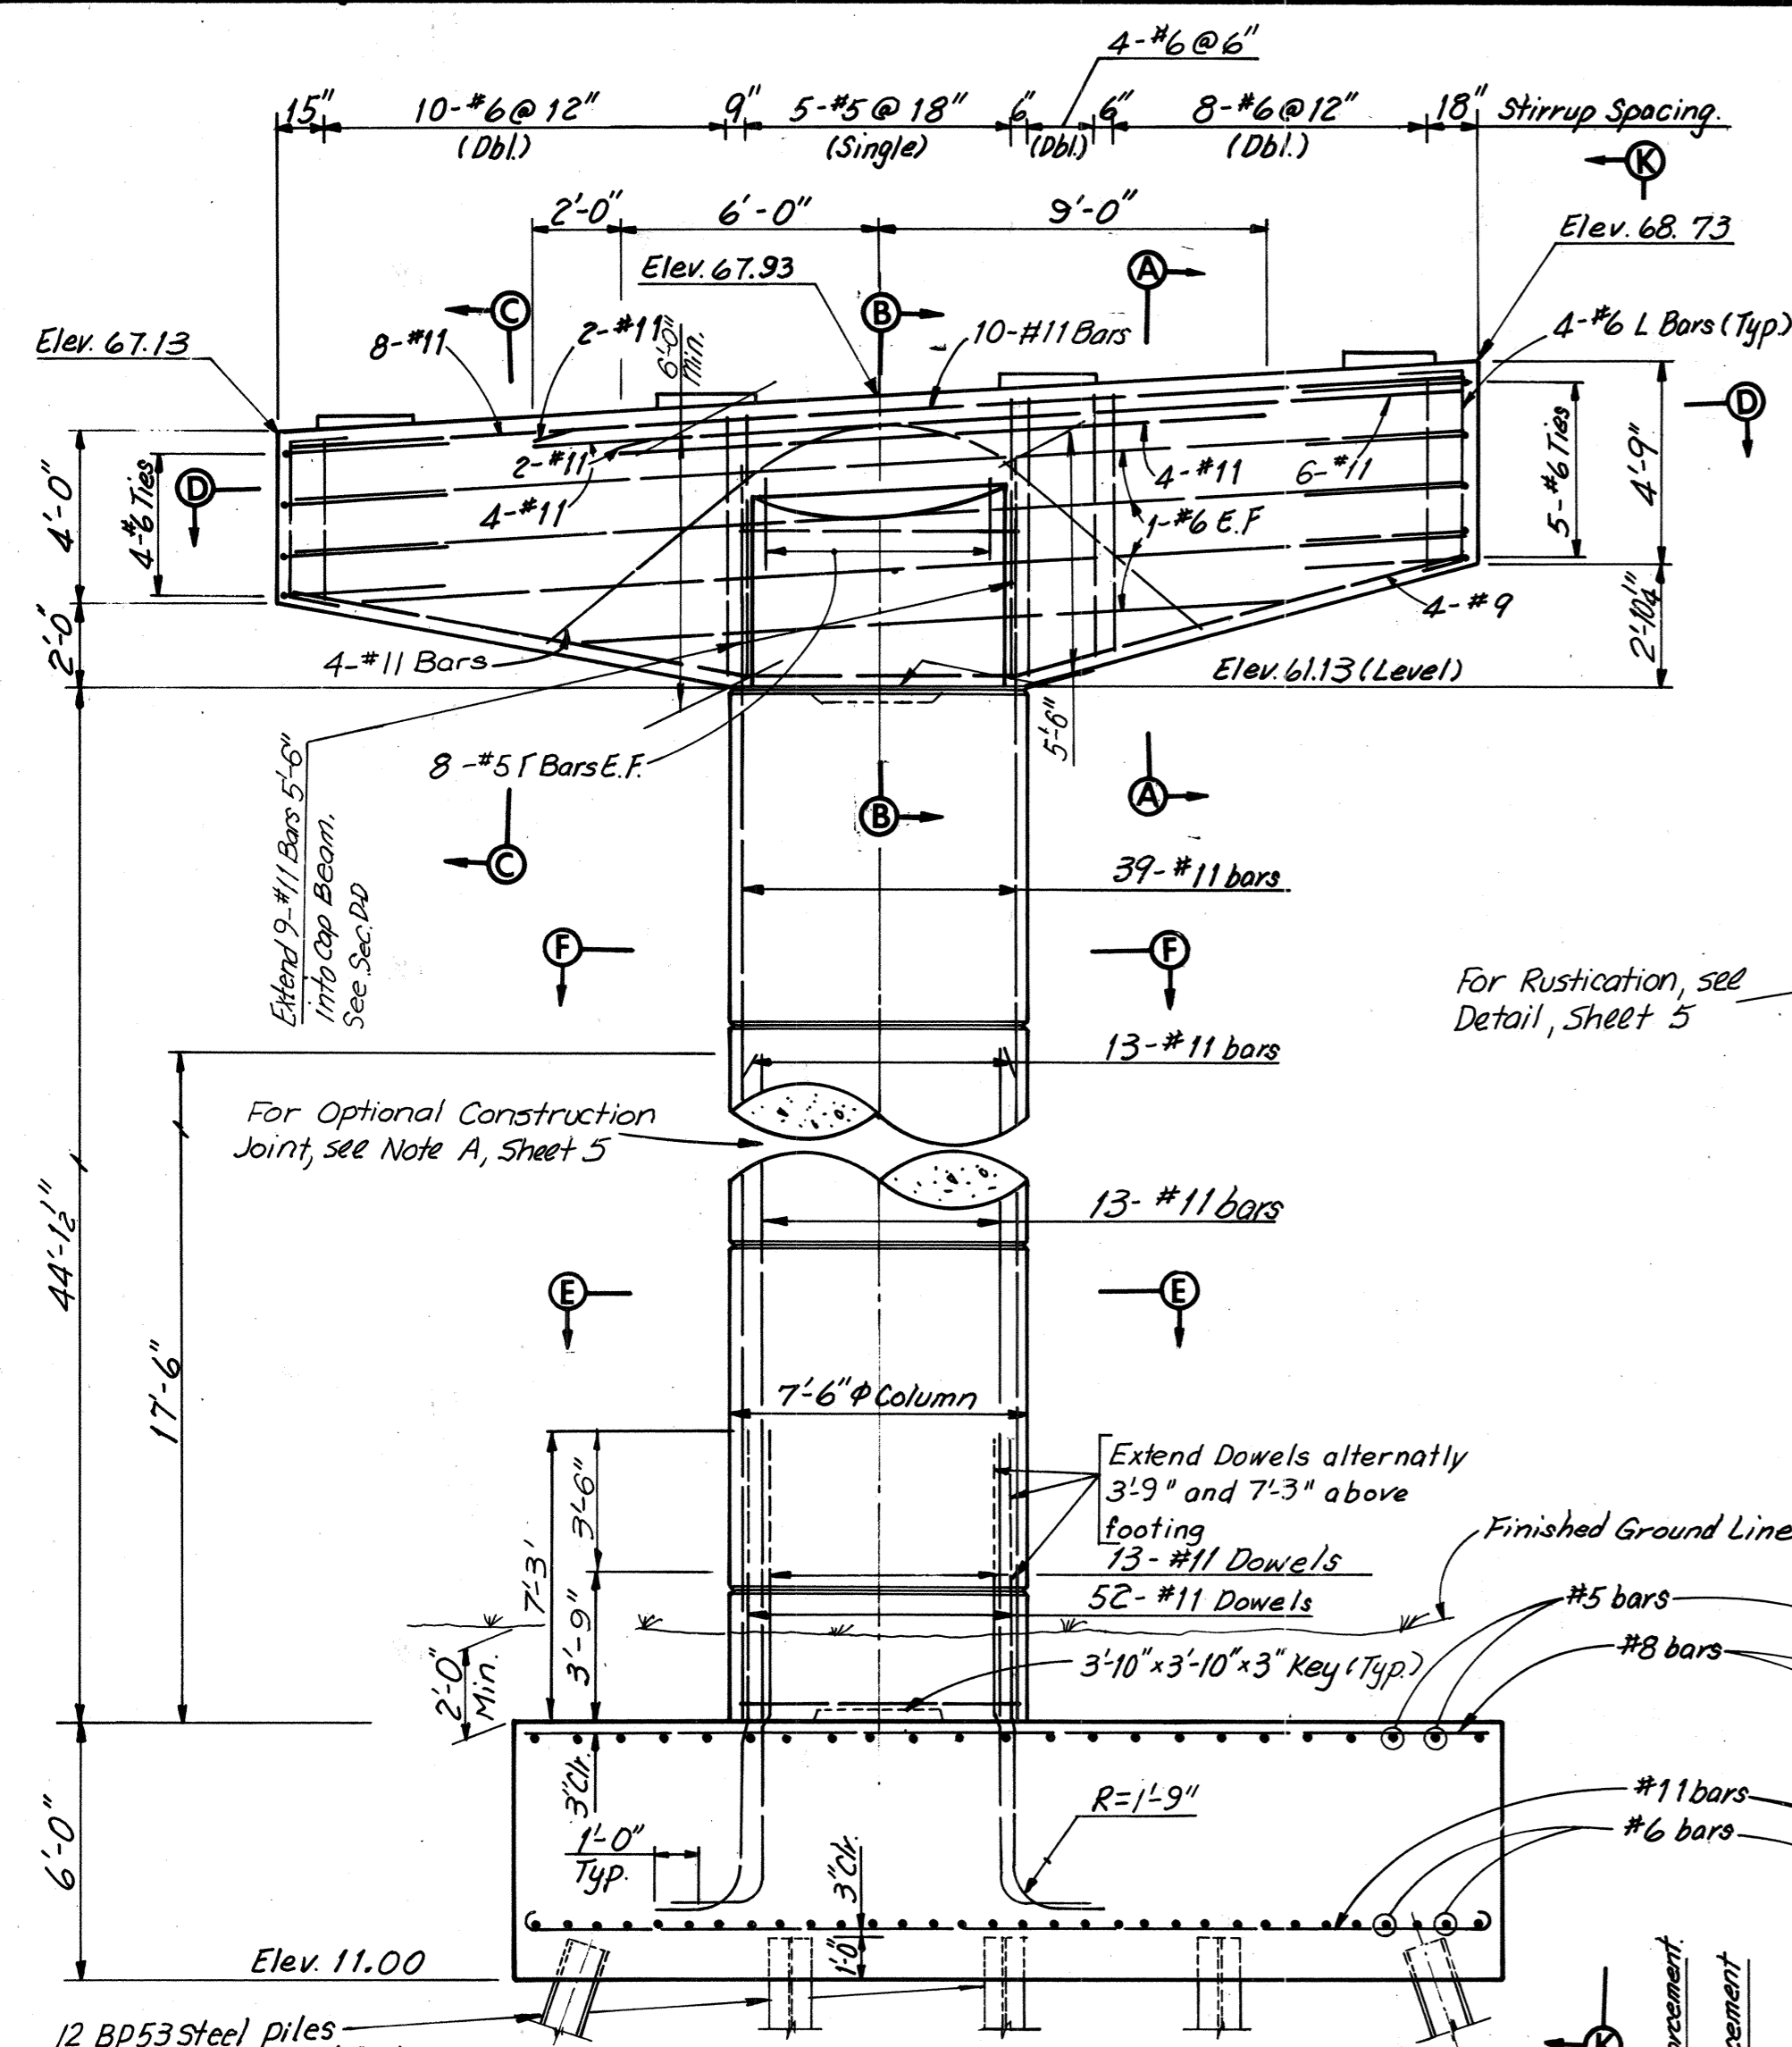


ELEVATION
Scale 1/4"=1'-0"

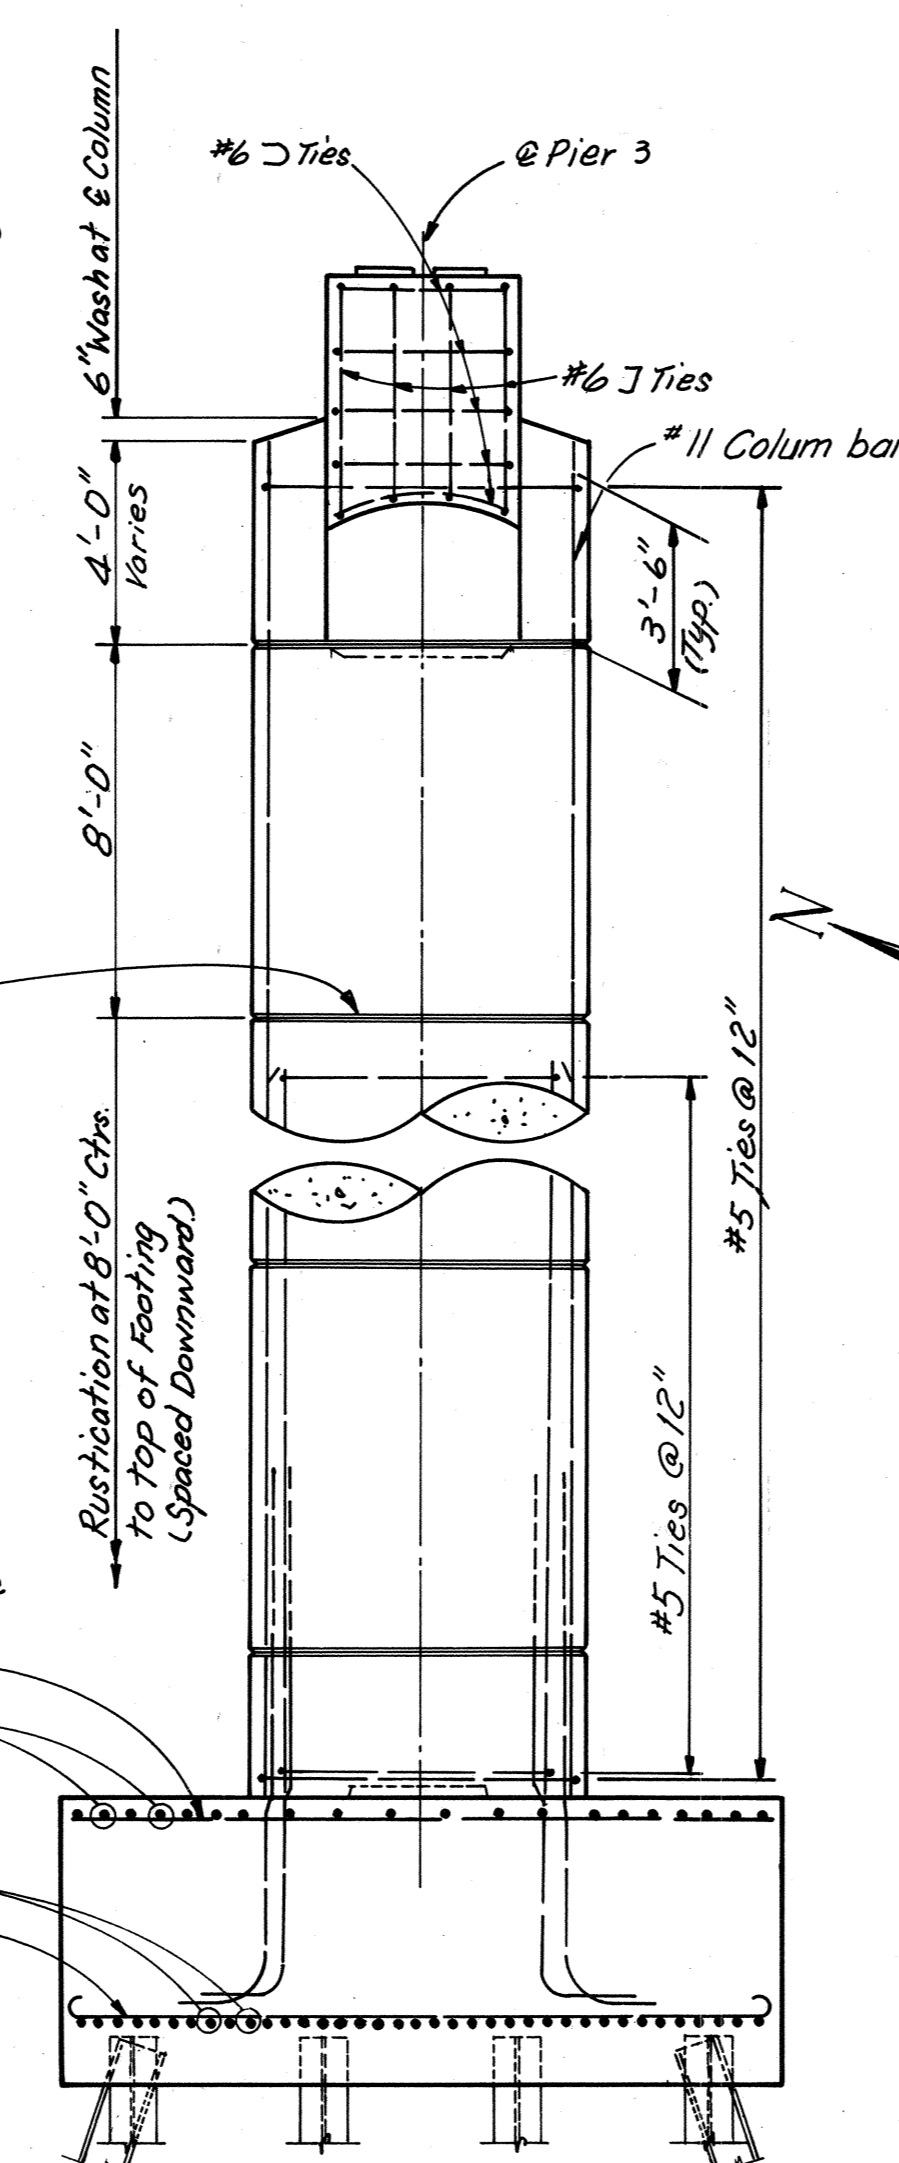

VIEW K-K
Scale 1/4"=1'-0"

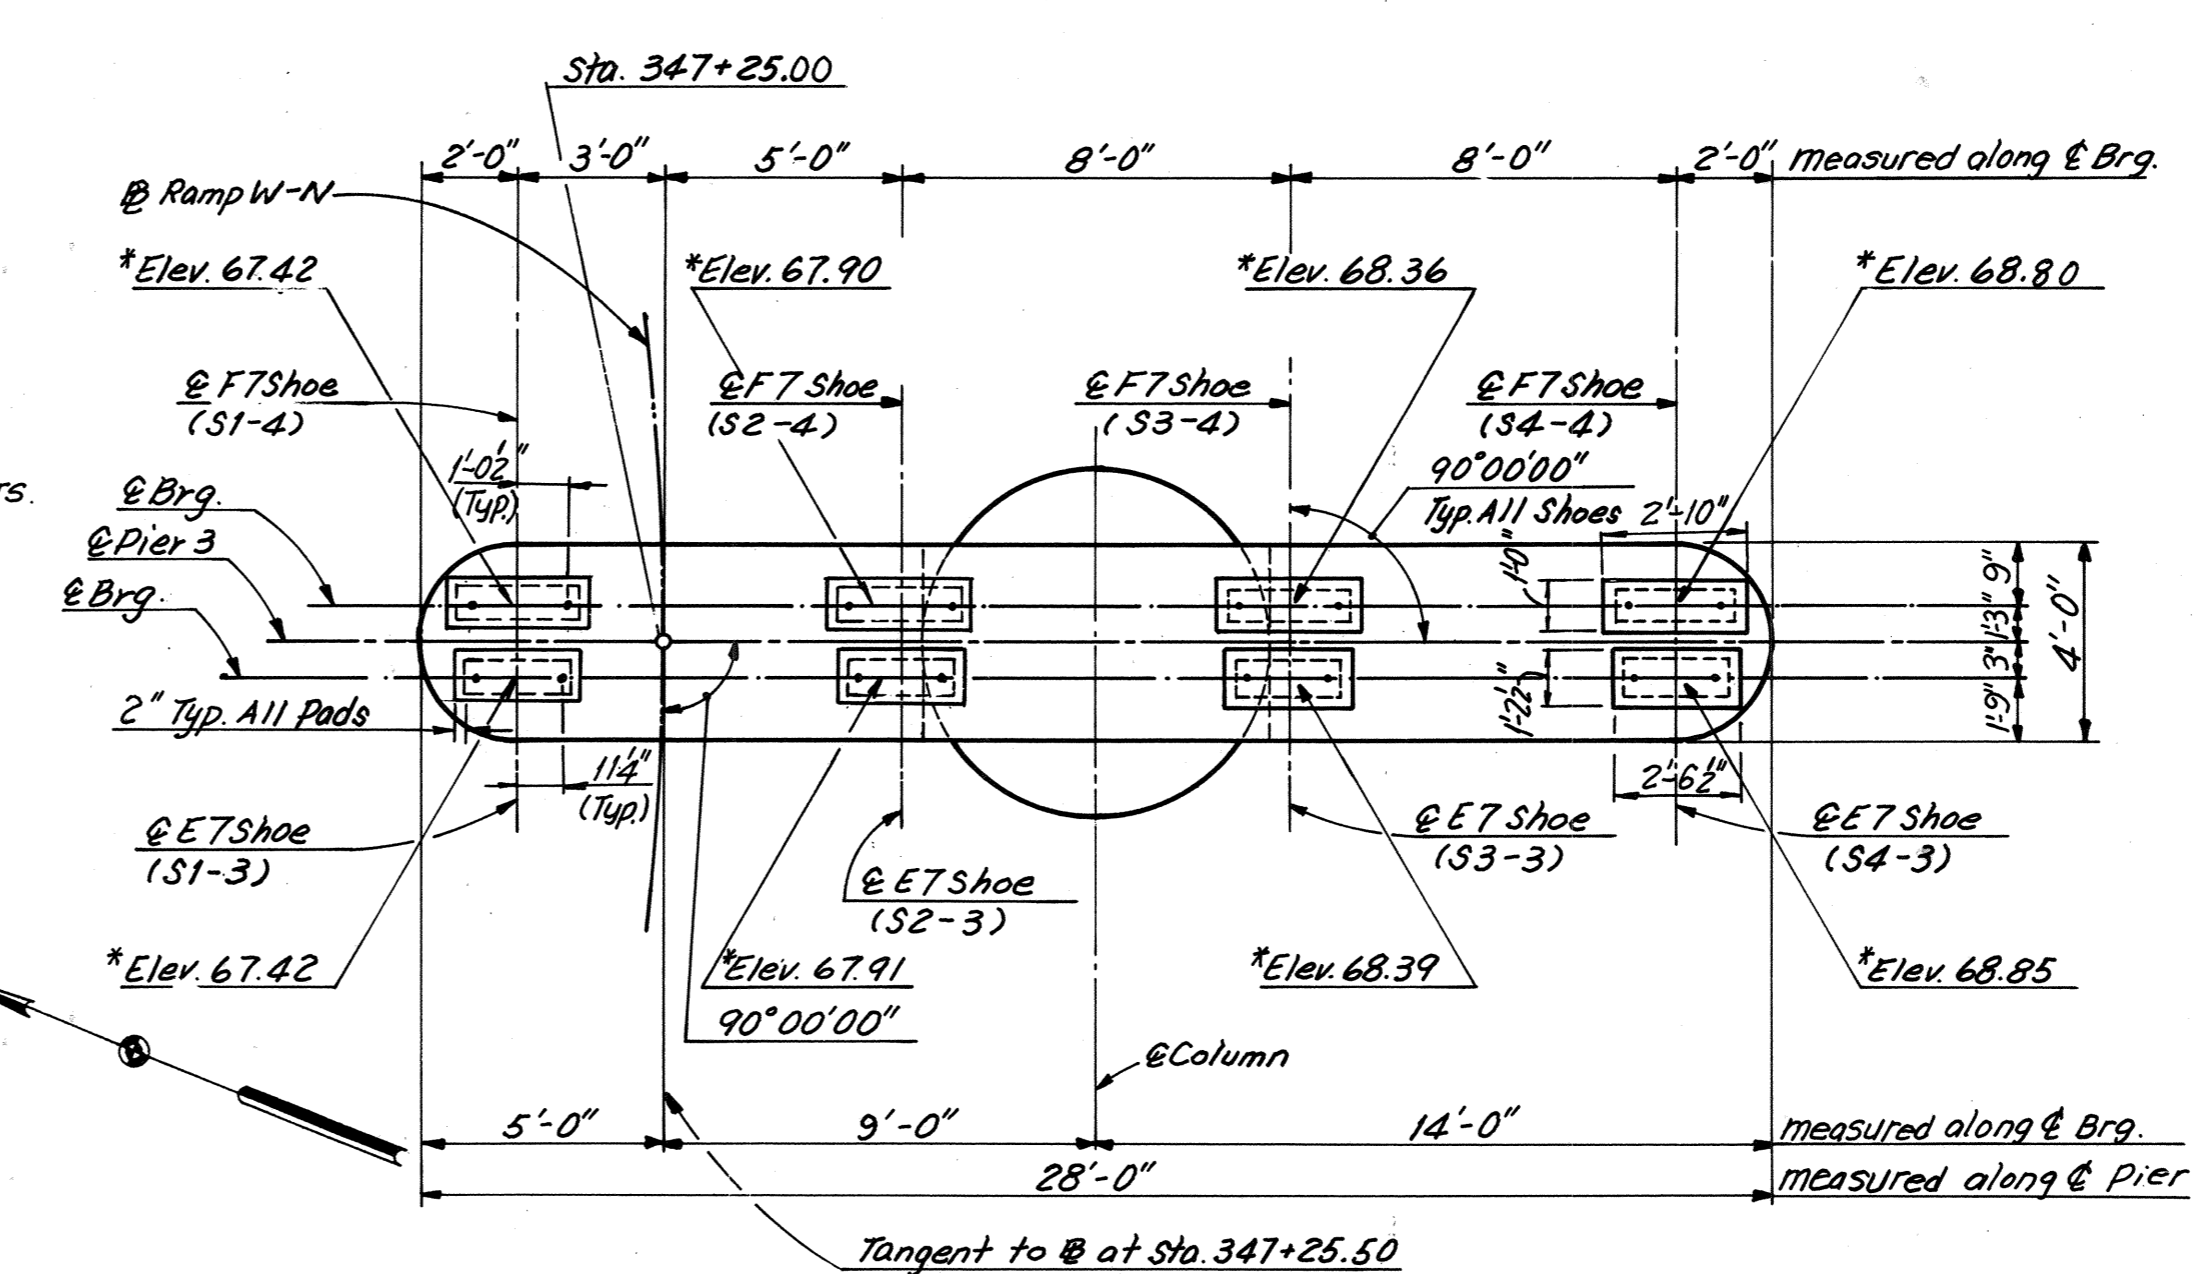


PLAN
Scale 1/4"=1'-0"

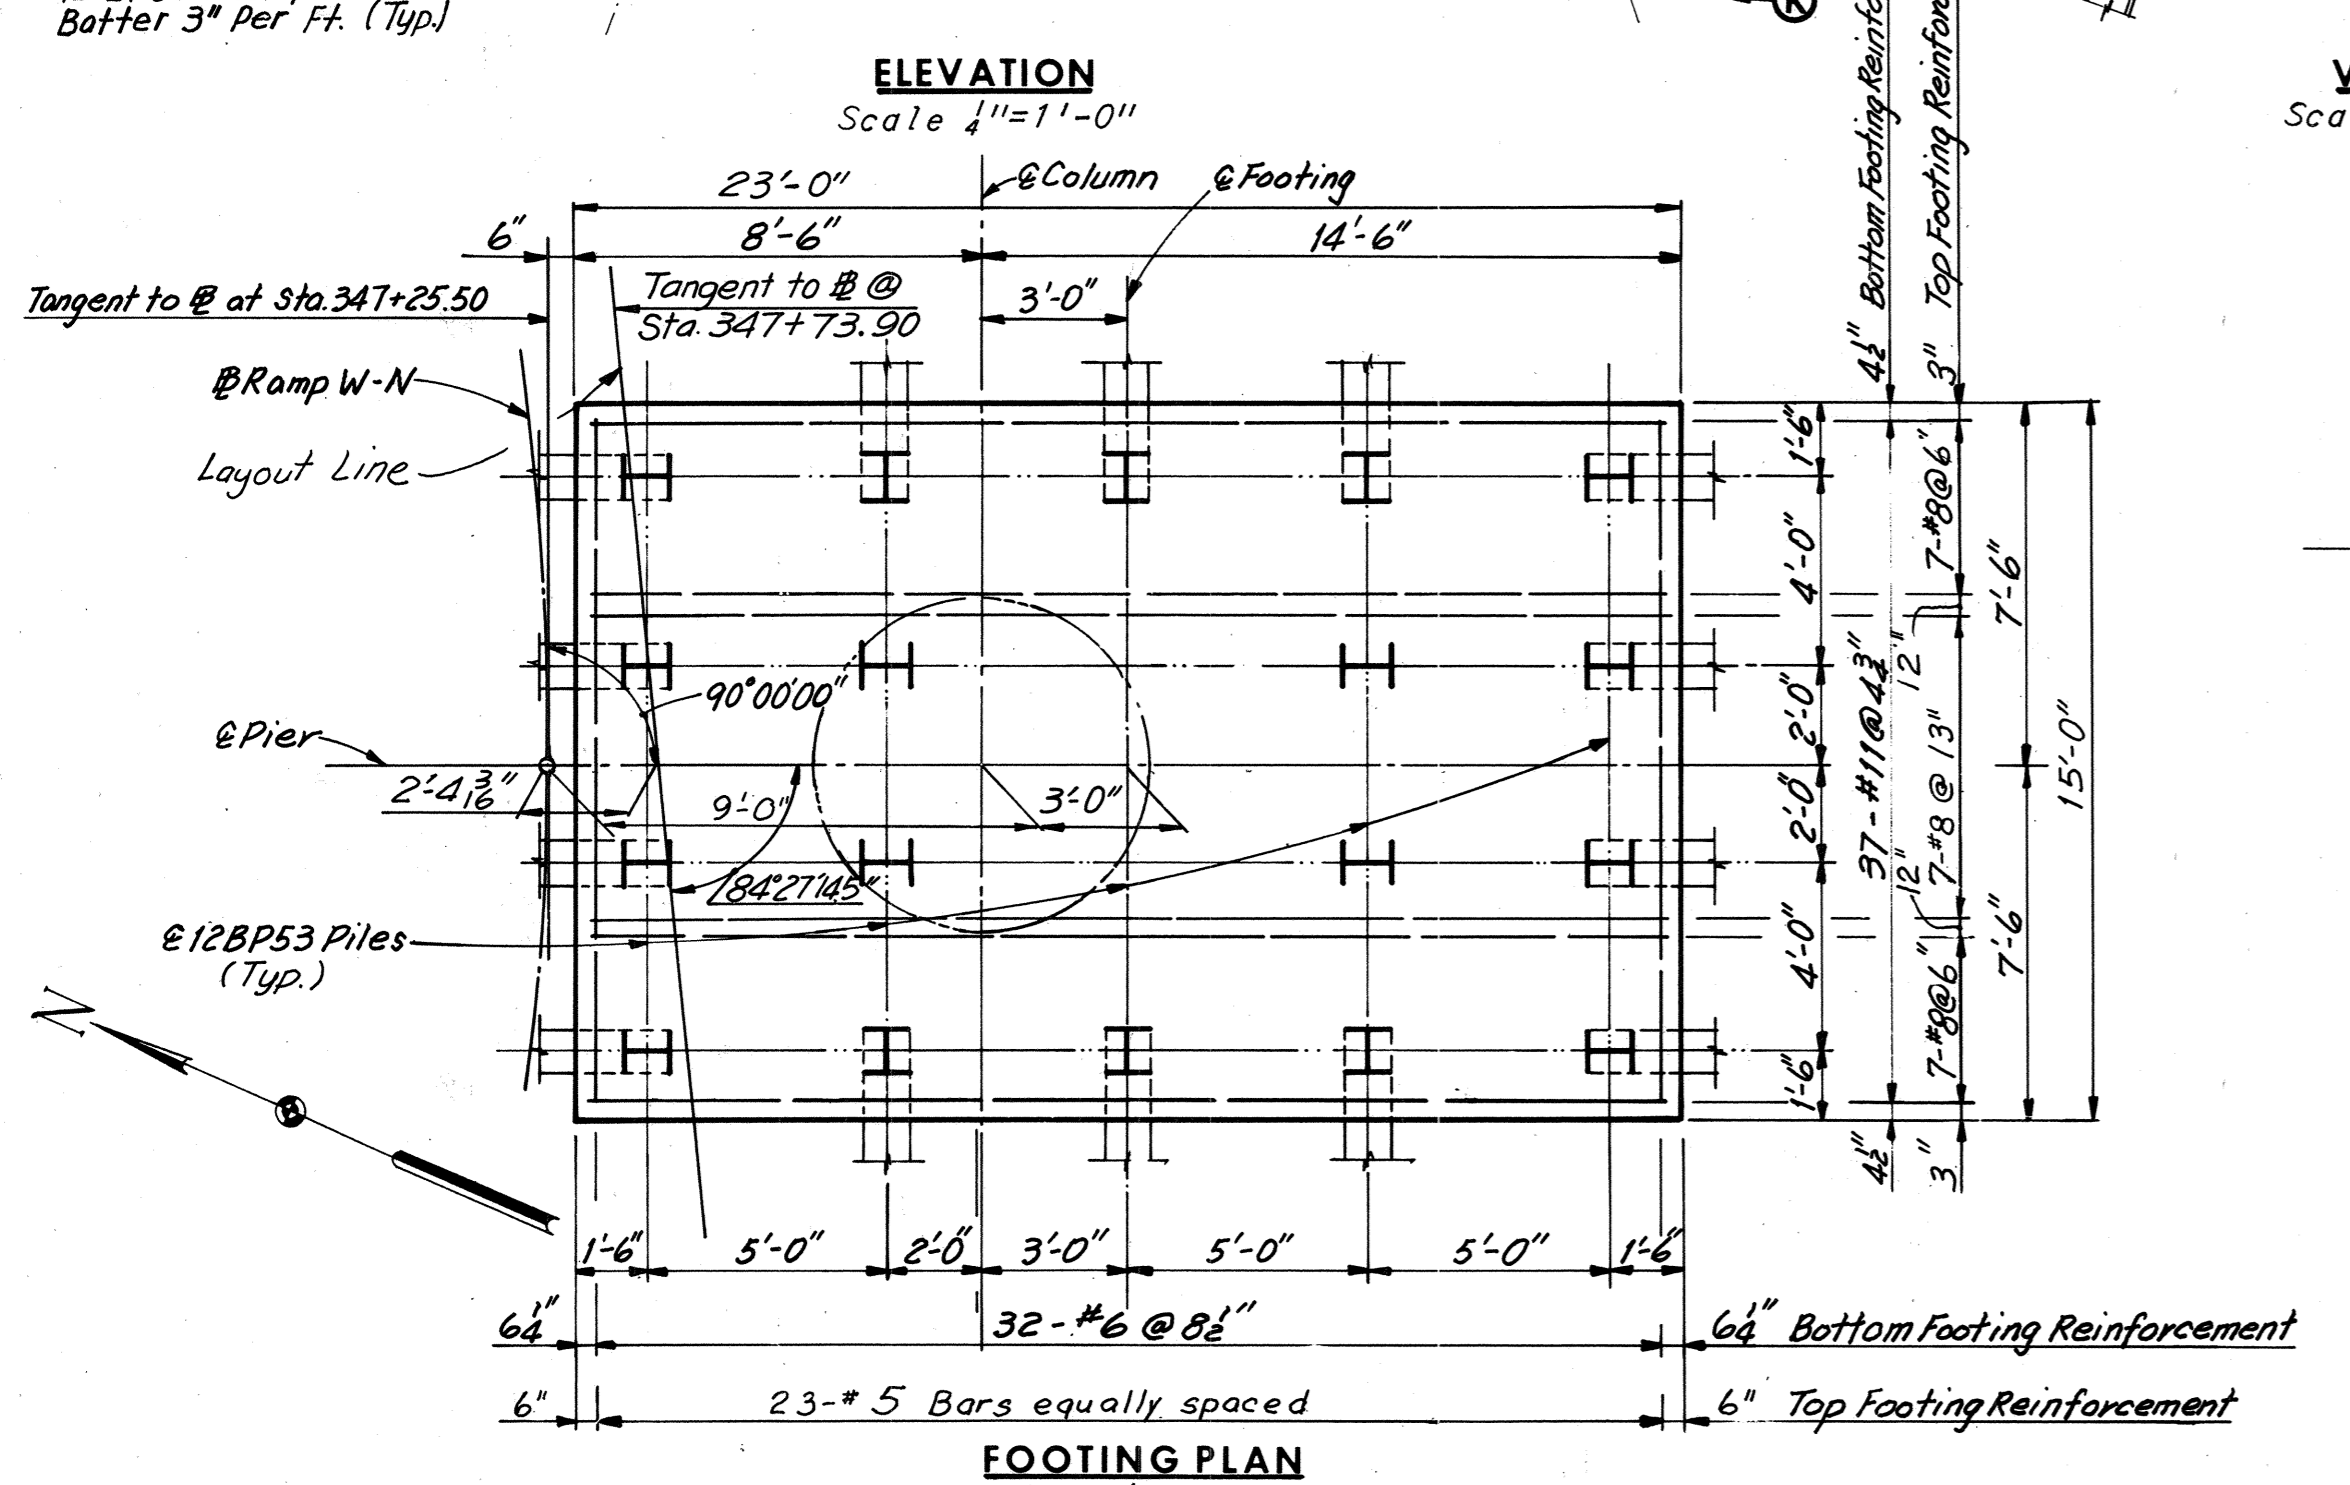


FOOTING PLAN
Scale 1/4"=1'-0"

FOOTING FOR PIER 3 IS ECCENTRIC AS SHOWN ON FOOTING PLAN

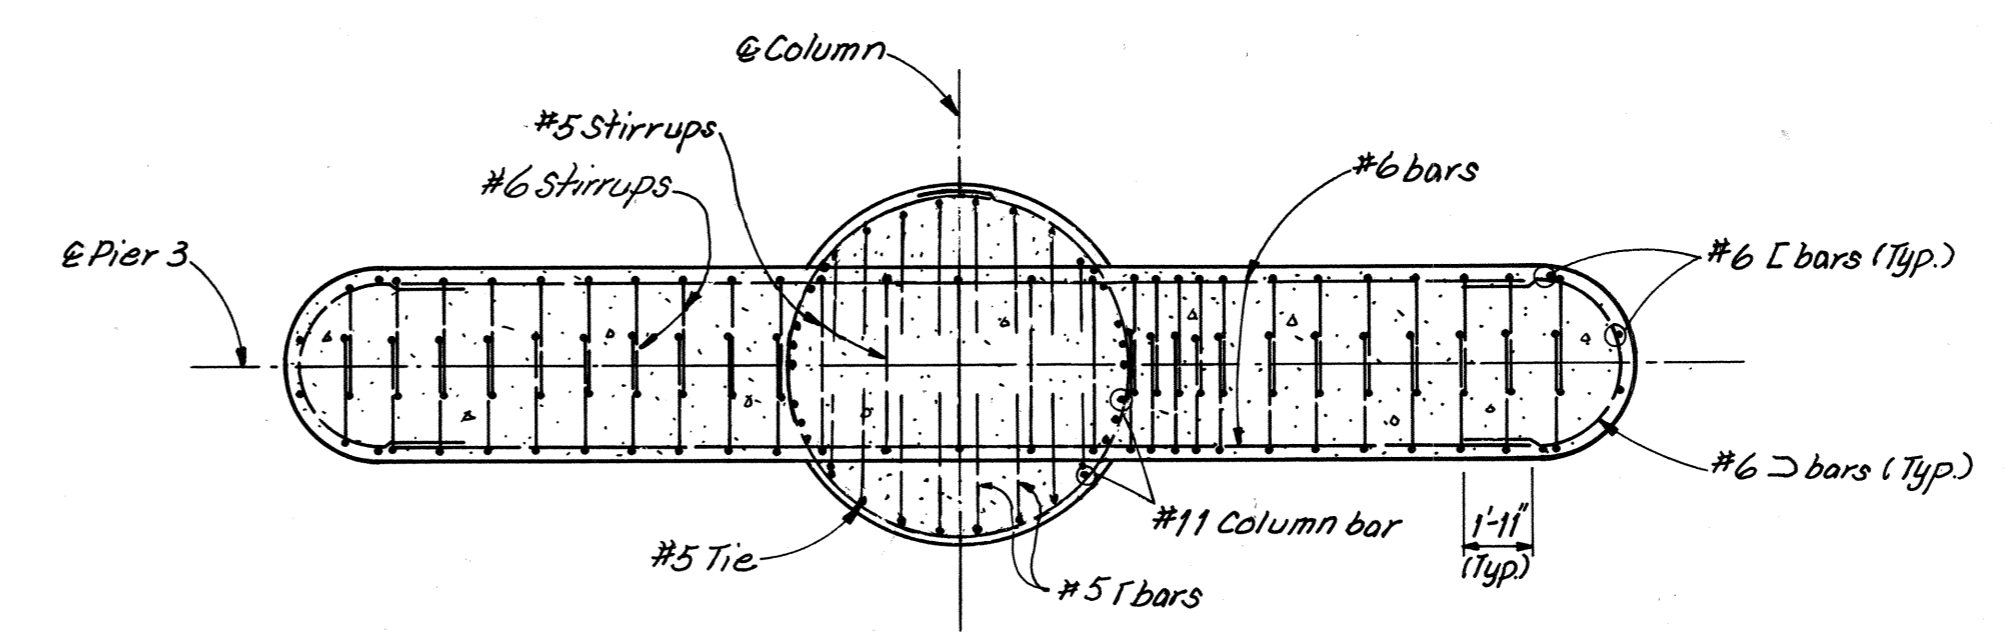


SECTION D-D
Scale 1/4"=1'-0"

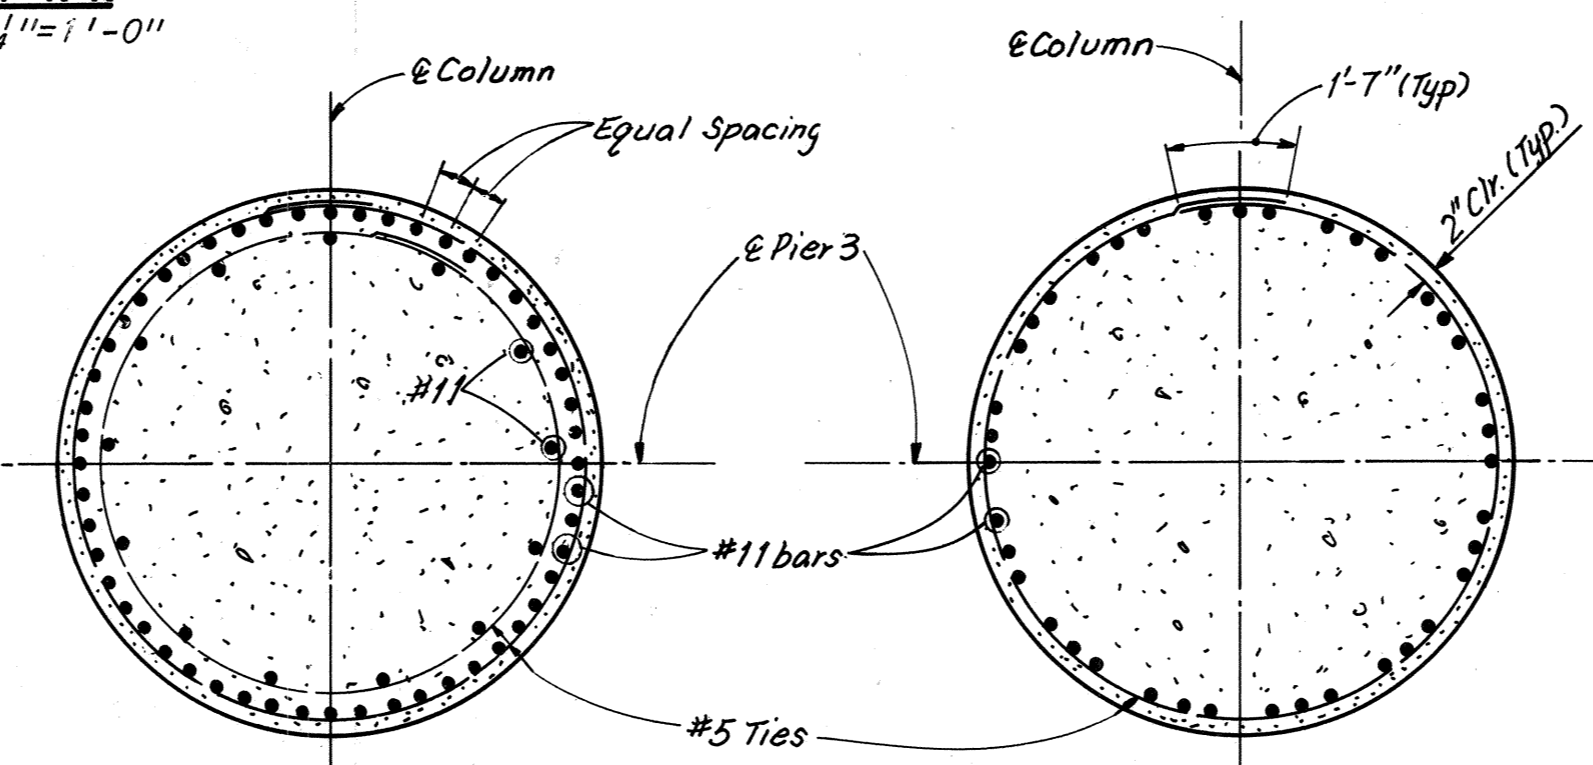


SECTION E-E
Scale 3/8"=1'-0"

SECTION E-F
Scale 3/8"=1'-0"

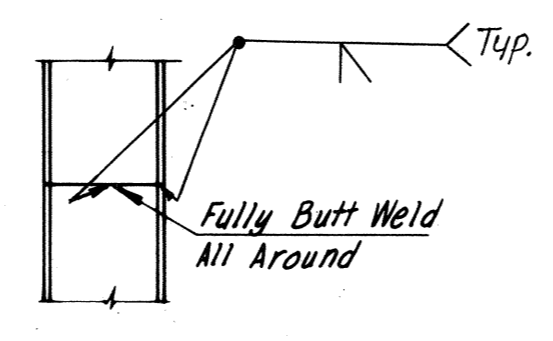

PILE SPICE DETAIL

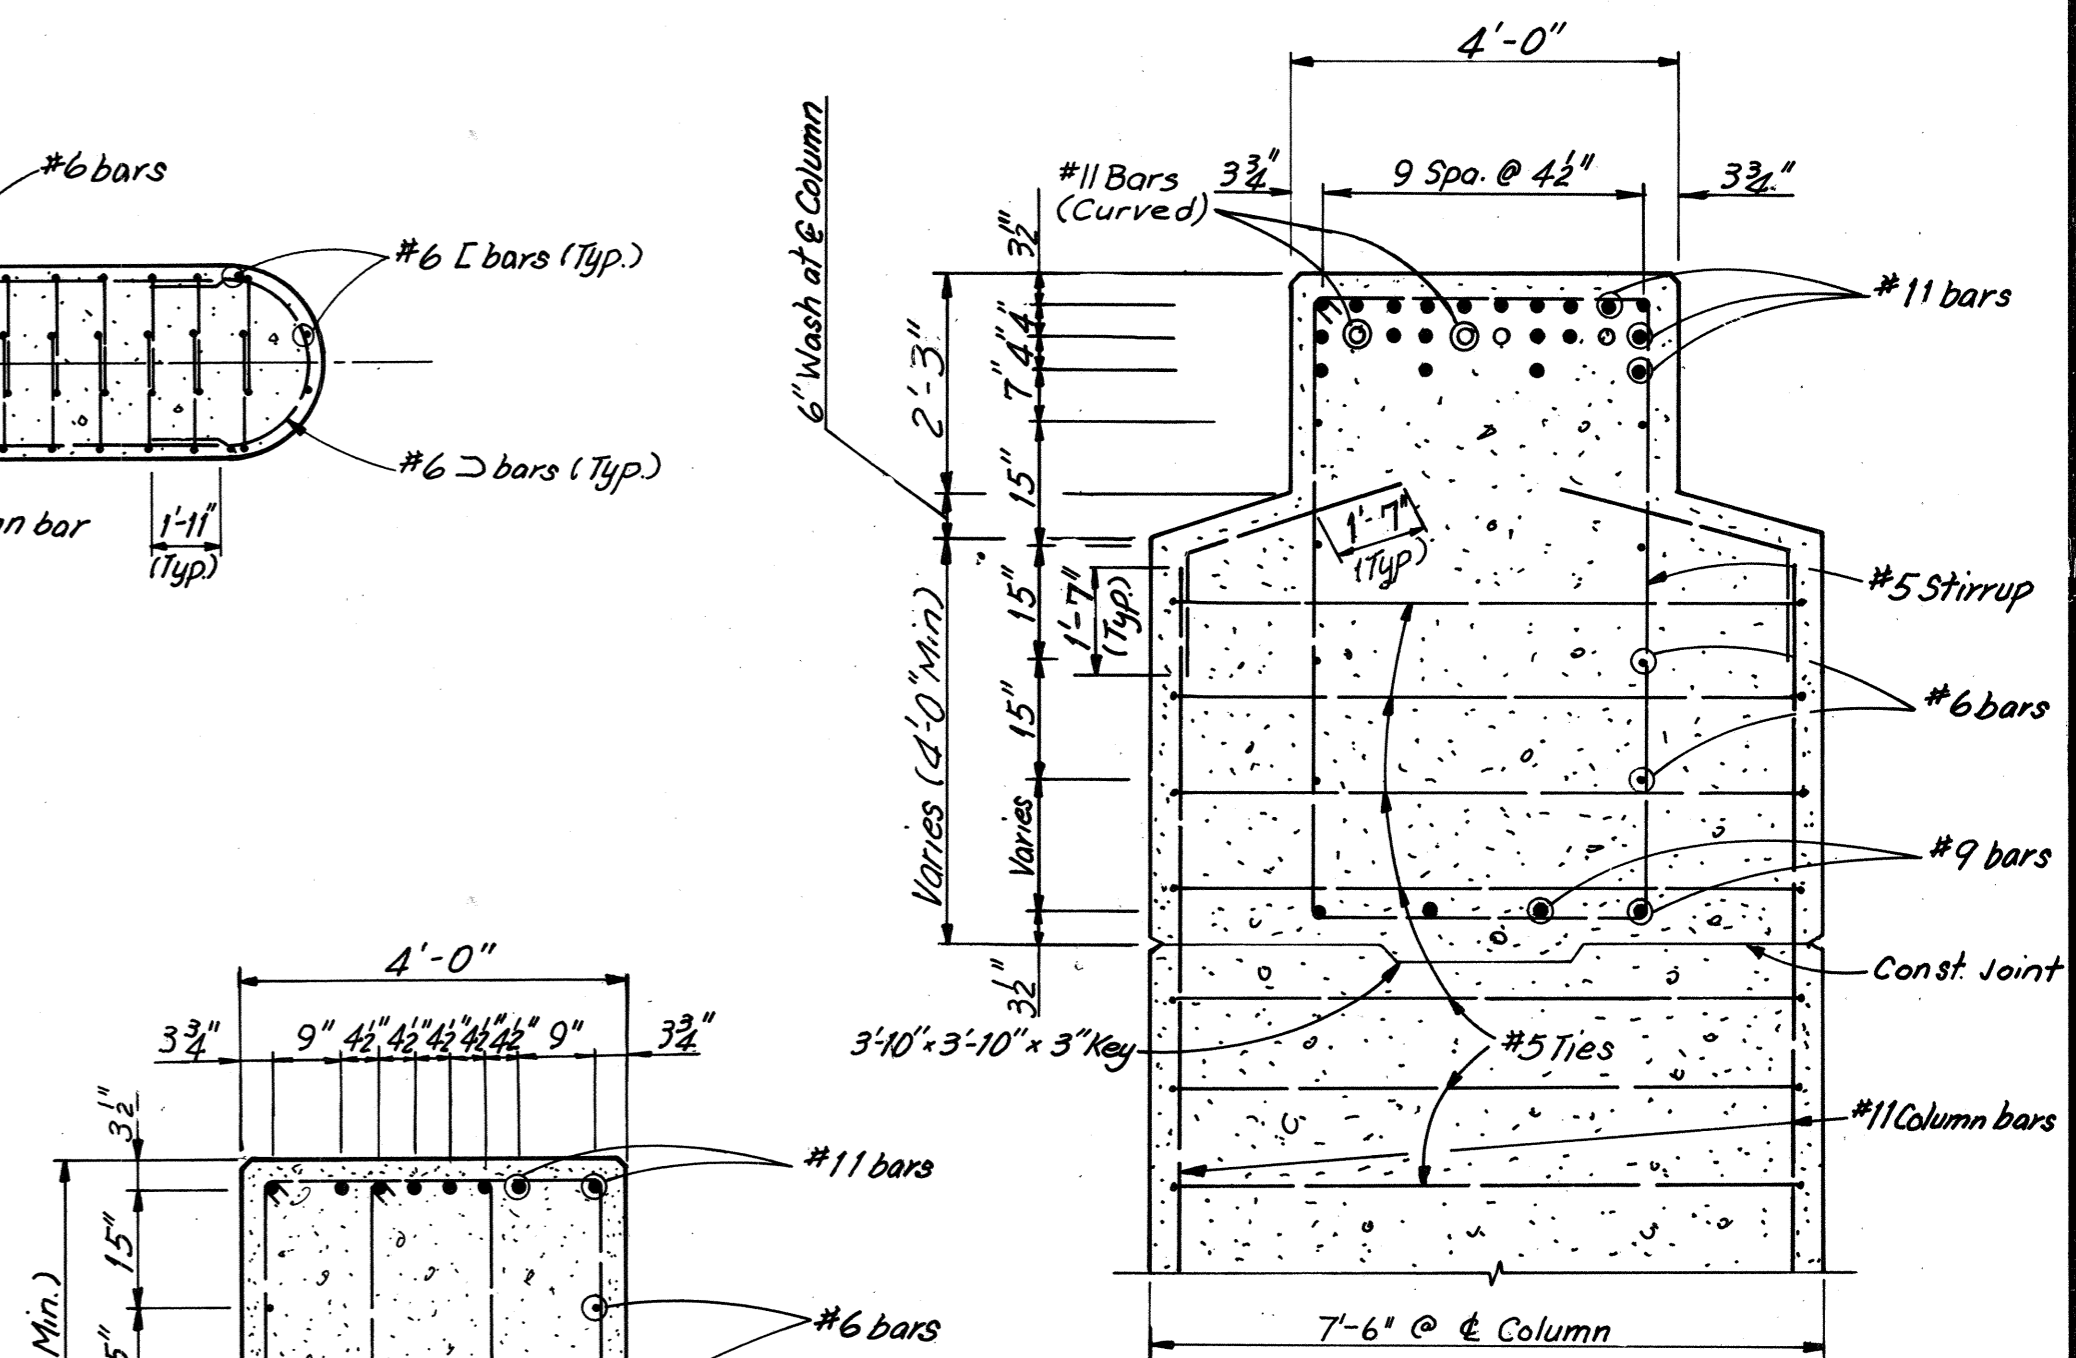

SECTION A-A
Scale 1/2"=1'-0"

SECTION B-B
Scale 1/2"=1'-0"

Note: Footing elevations are approximate only and may be varied to suit field conditions as directed by the Engineer. Vertical shaft reinforcing shall not be cut until these elevations are established. Where elevations change more than 2 ft., redesign will be required.

Note: All piles shall be 12BP53 Steel Piles (Design capacity = 57 tons).
Butter all piles 3" per foot where shown.
For Framing Plan, see Sheet 20.
Estimated Pile Tip Elevation -8.00.
For Standard Shoe details, see Sheets S1&S2.

BY	DATE	Notes Added	LRH	4-19-74		
MADE	G.C.C.	9-17-68	2	As Built	TEM	6-77
CHECKED	PTA	4-21-69				
IN CHARGE						

RICHMOND METROPOLITAN AUTHORITY
RICHMOND EXPRESSWAY SYSTEM
DOWNTOWN EXPRESSWAY







BRIDGE NO. 67
RAMP W-N CONNECTION TO
RICHMOND-PETERSBURG TURNPIKE
PIER 3

HOWARD, NEEDLES, TAMMEN & BERGENDOFF
consulting engineers
NEW YORK ALEXANDRIA KANSAS CITY

SCALE: As Noted
CONTRACT NO.: 10
SHEET NO. 6 OF 54

AS BUILT

RICHMOND EXPRESSWAY SYSTEM			
SECTION	PROJECT	SHEET NO.	TOTAL SHEETS
10	DOWNTOWN EXPRESSWAY	179	265

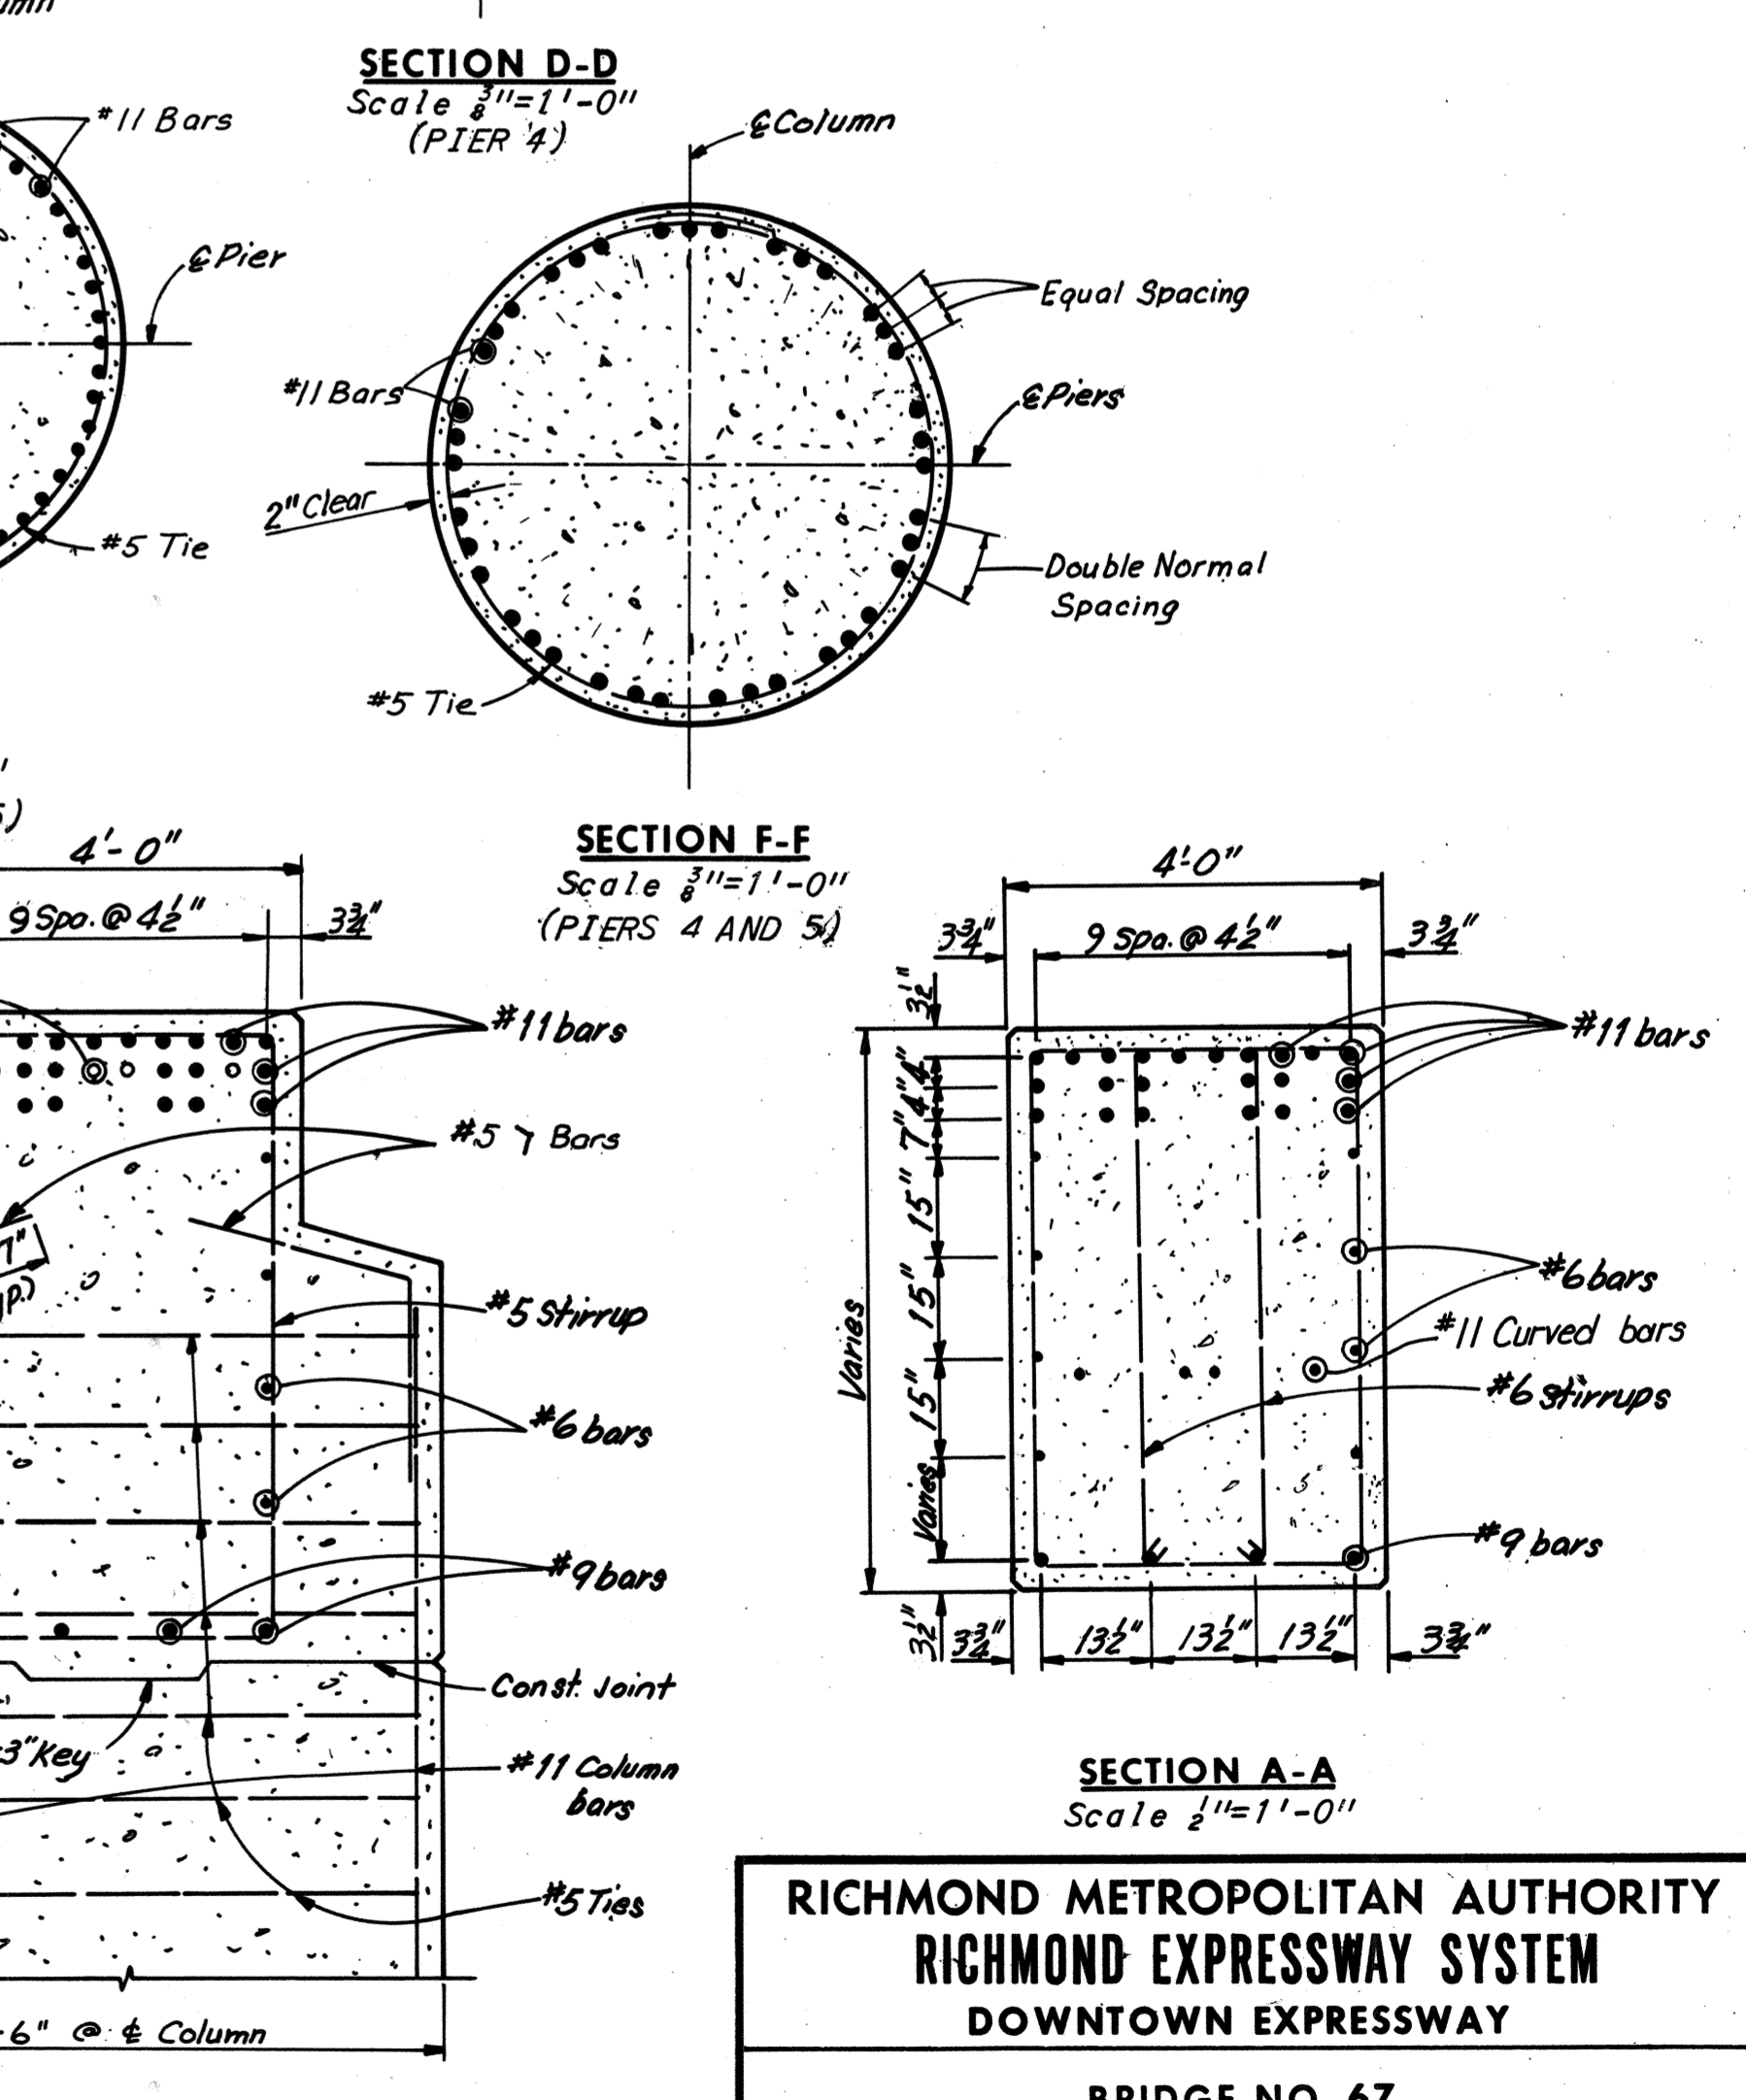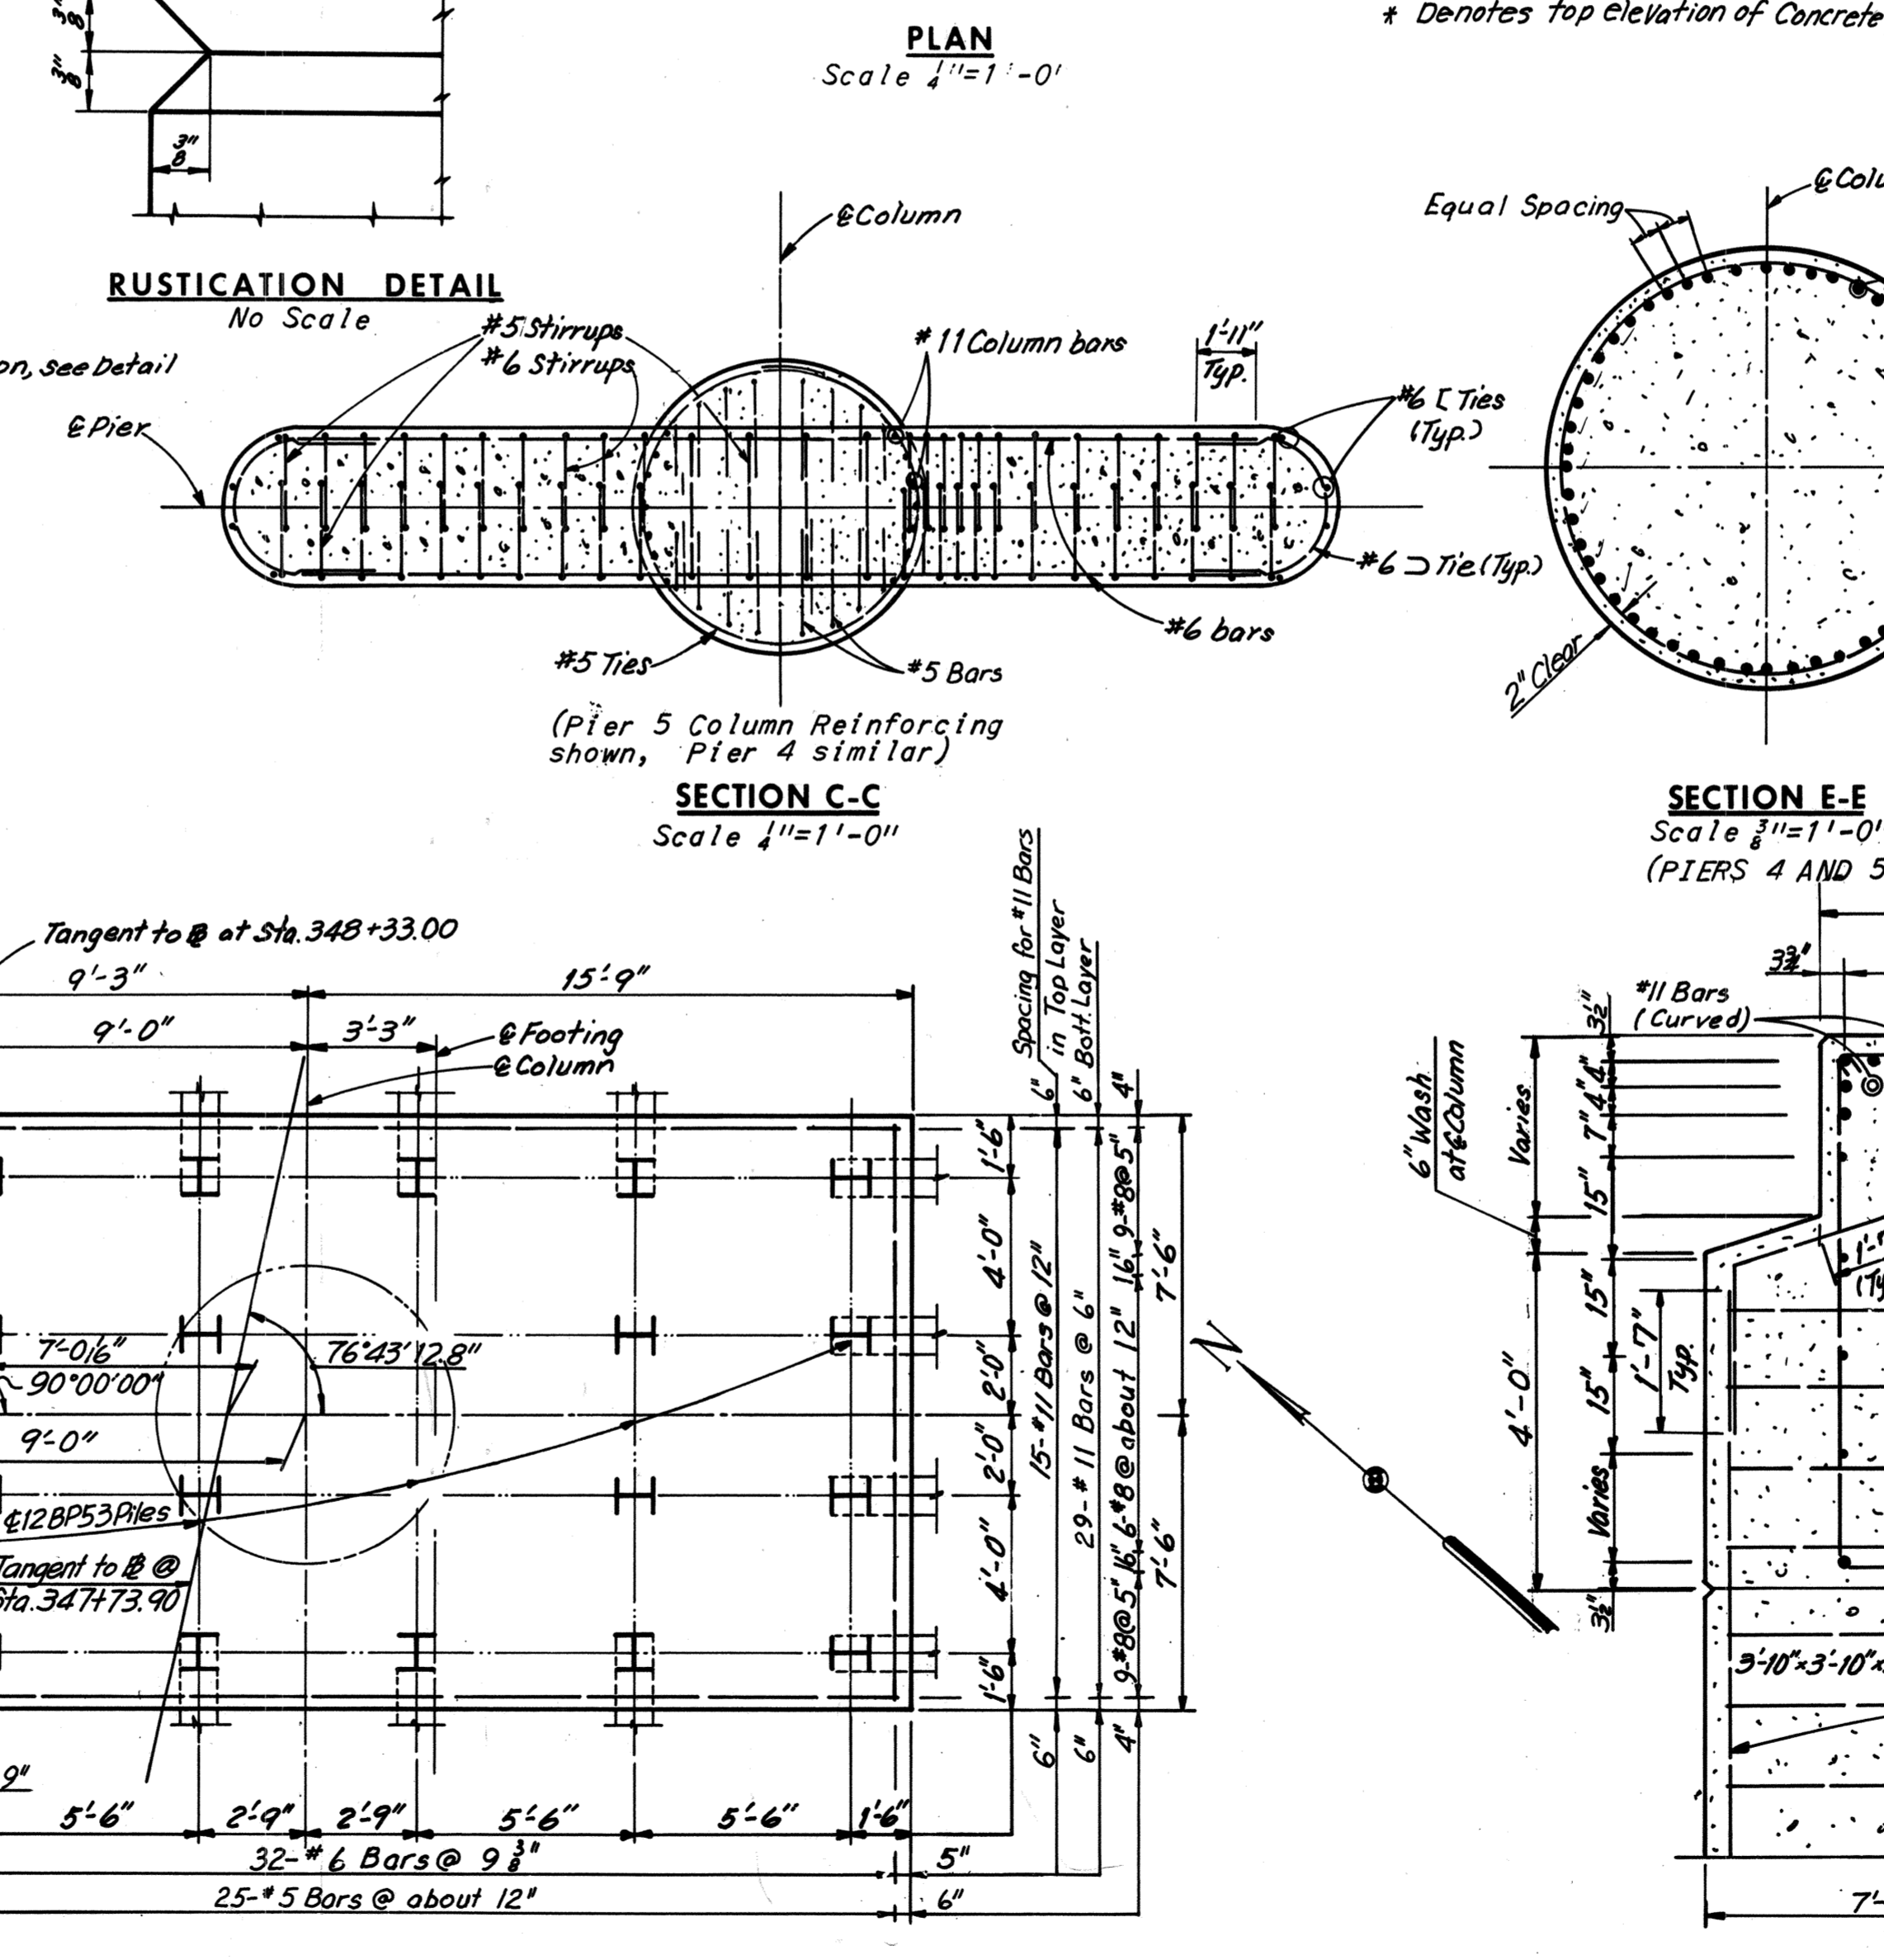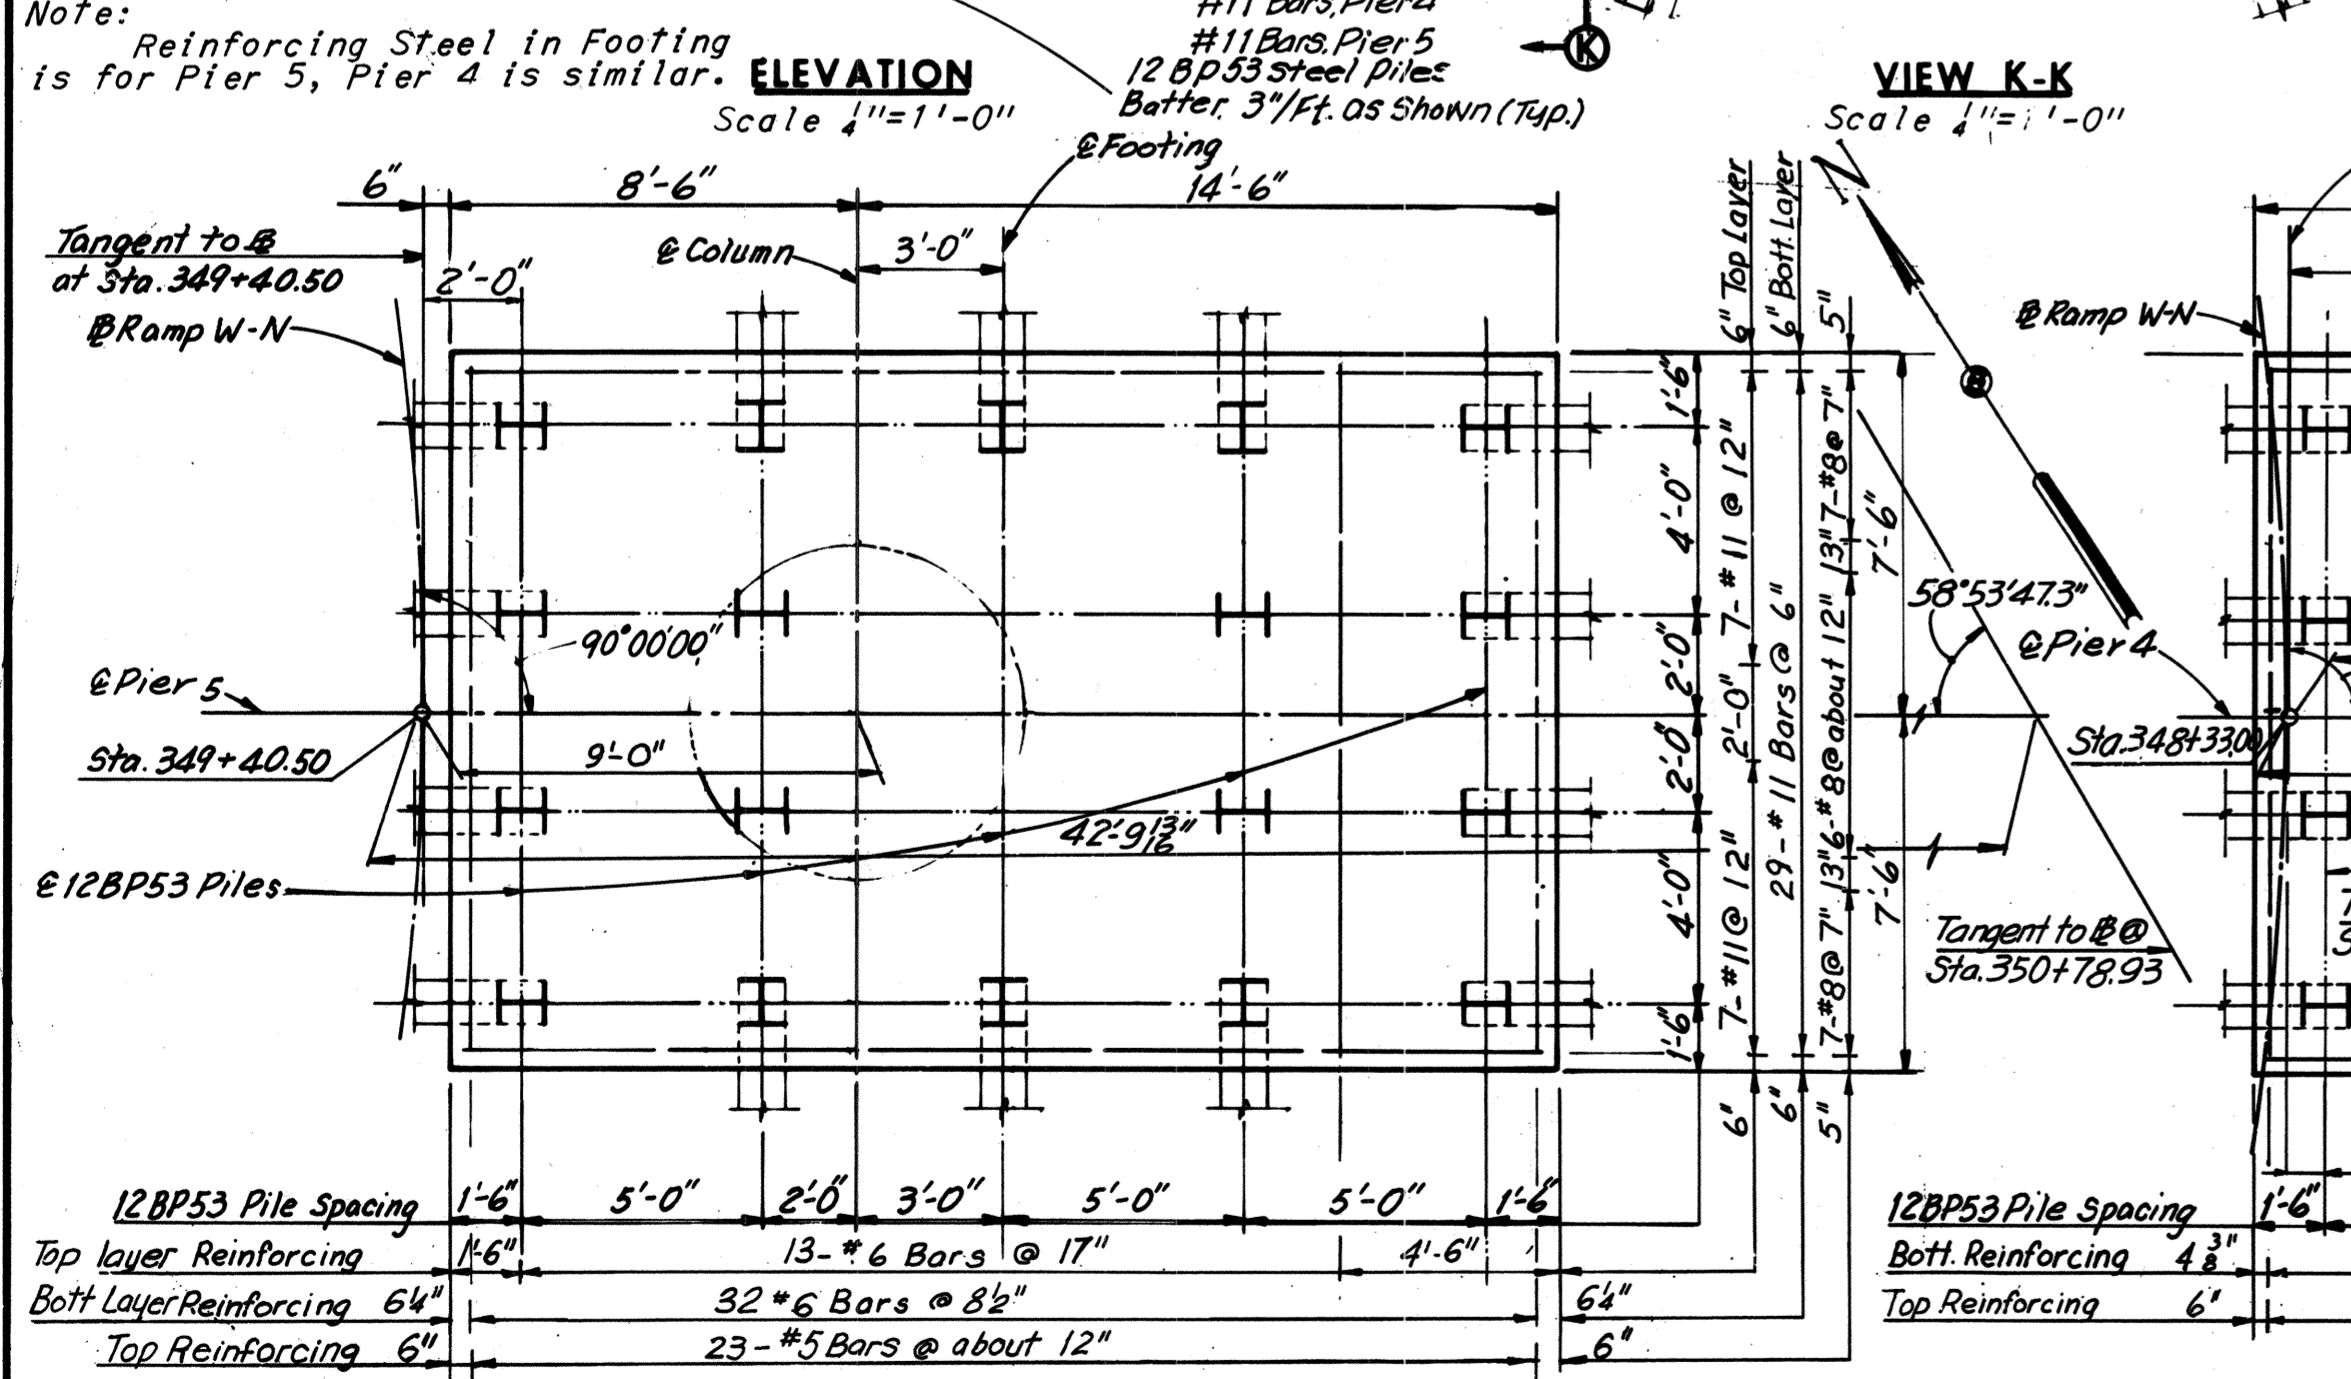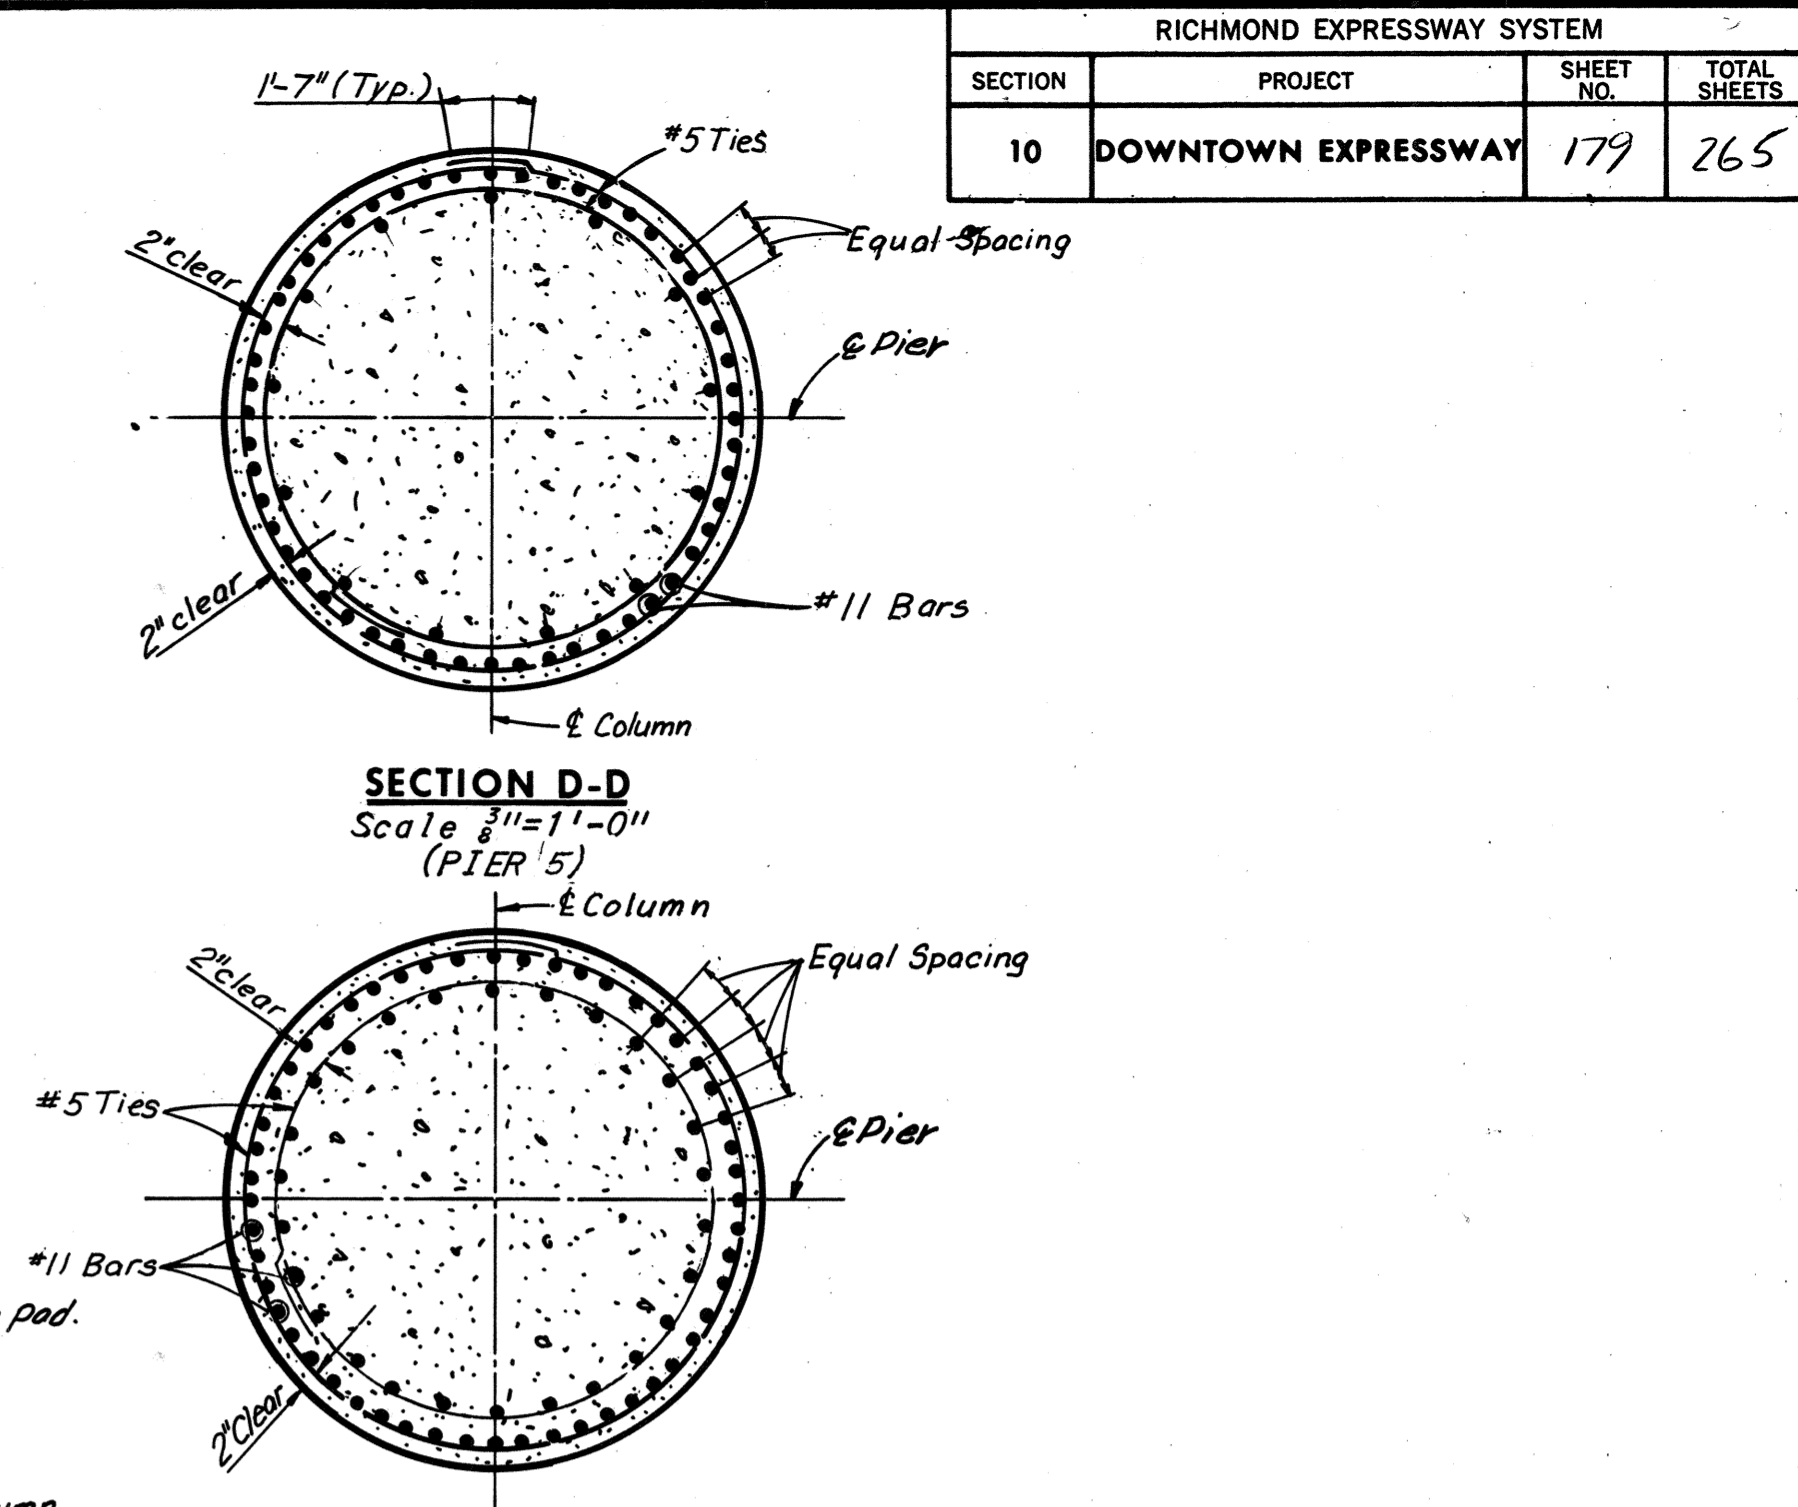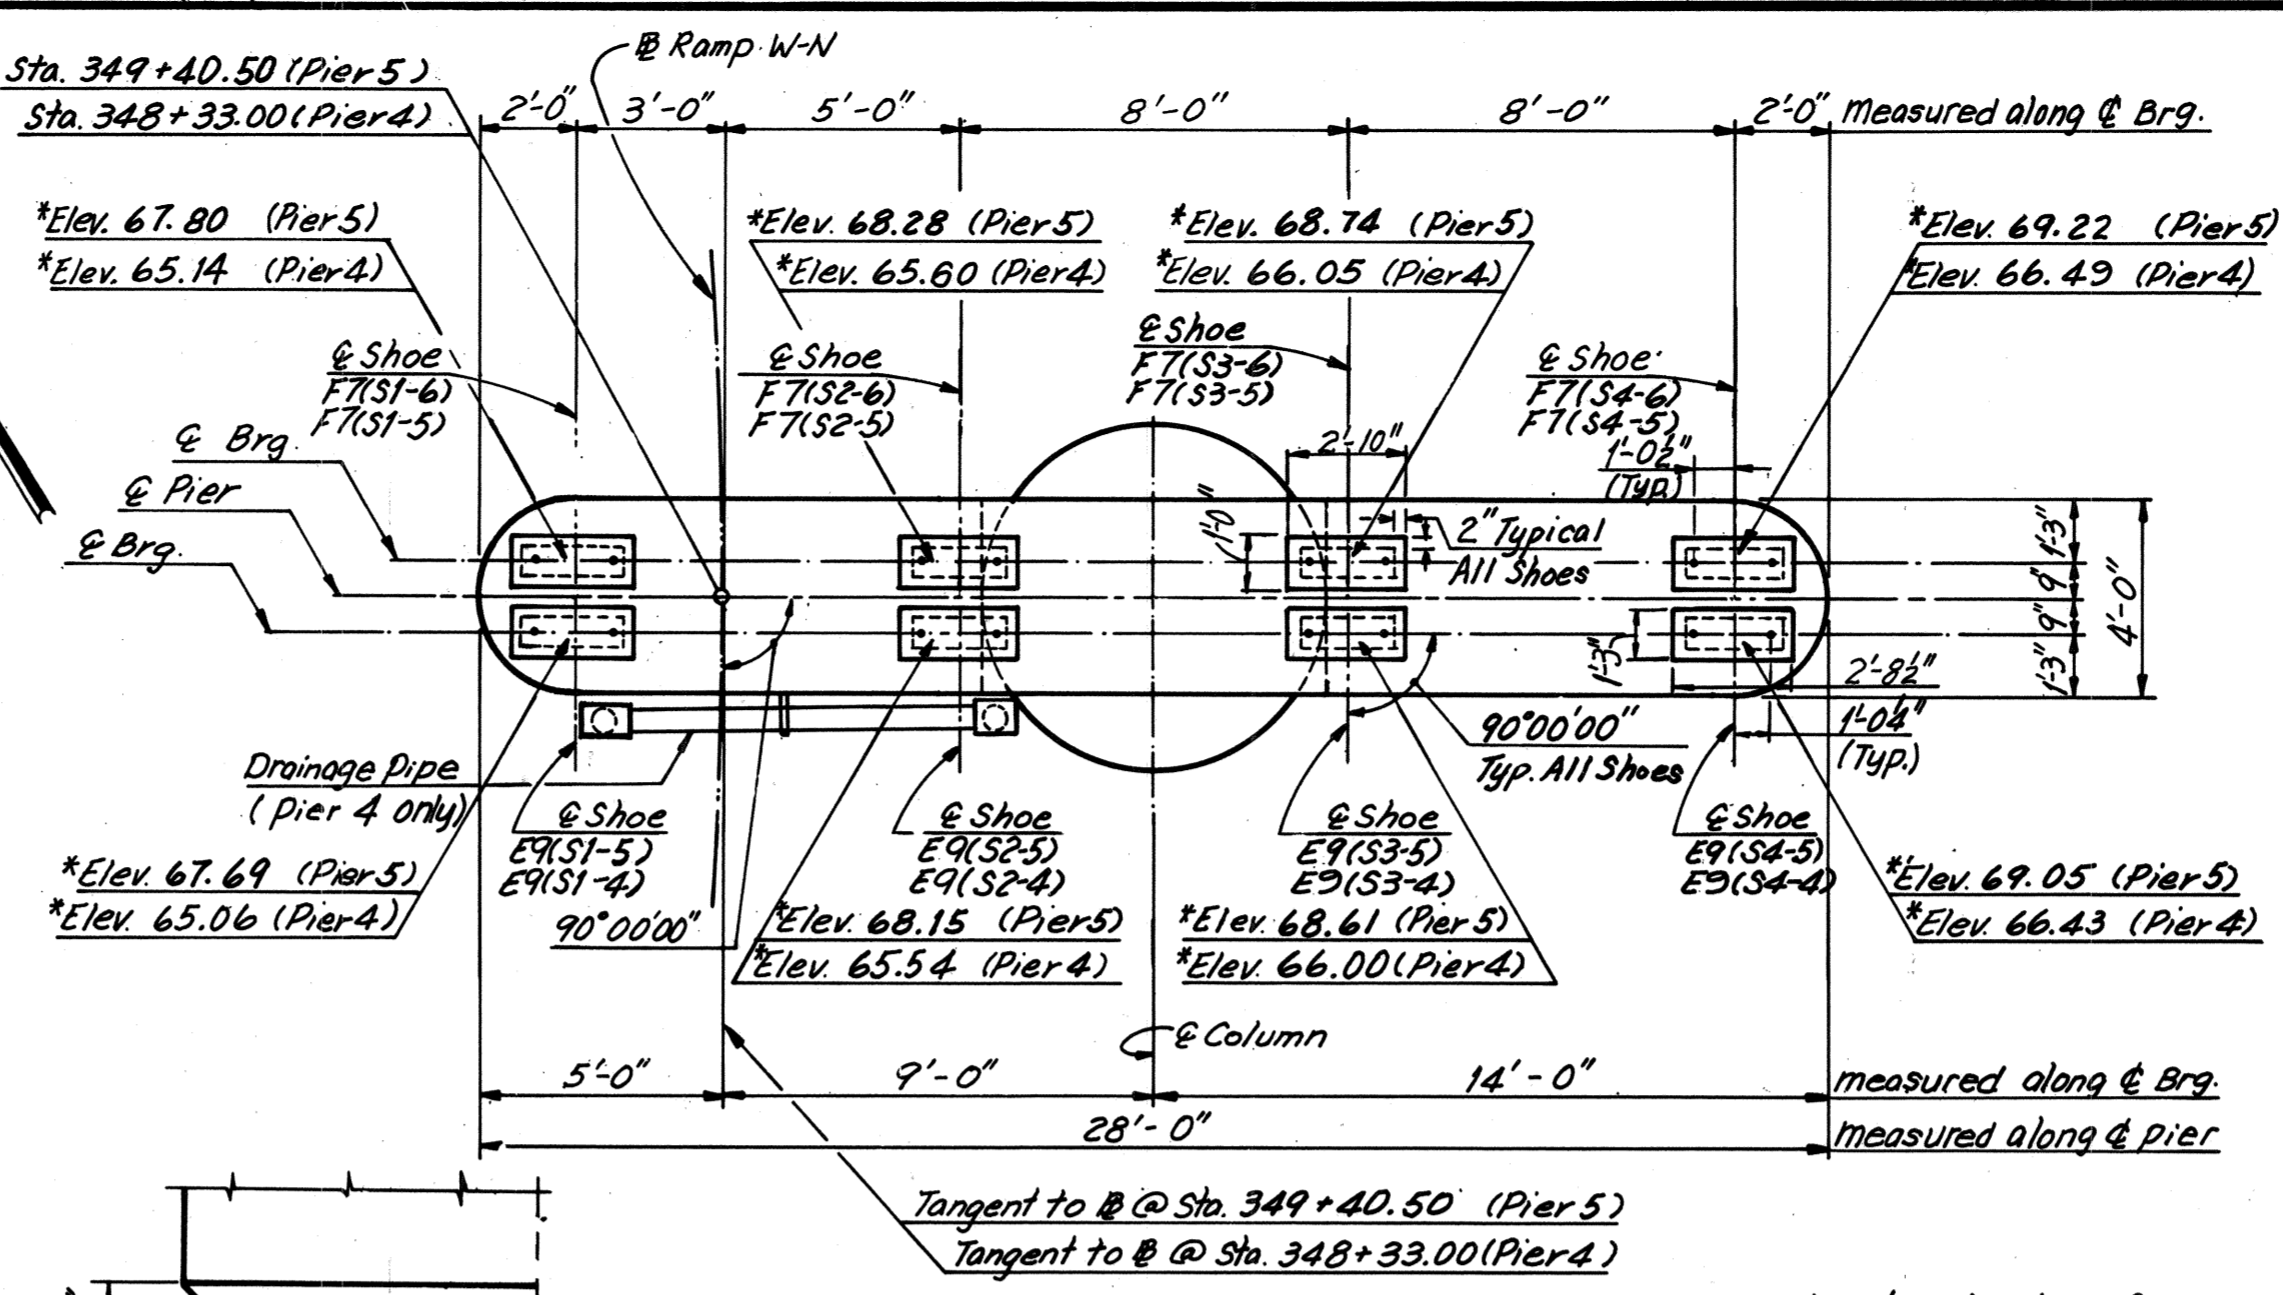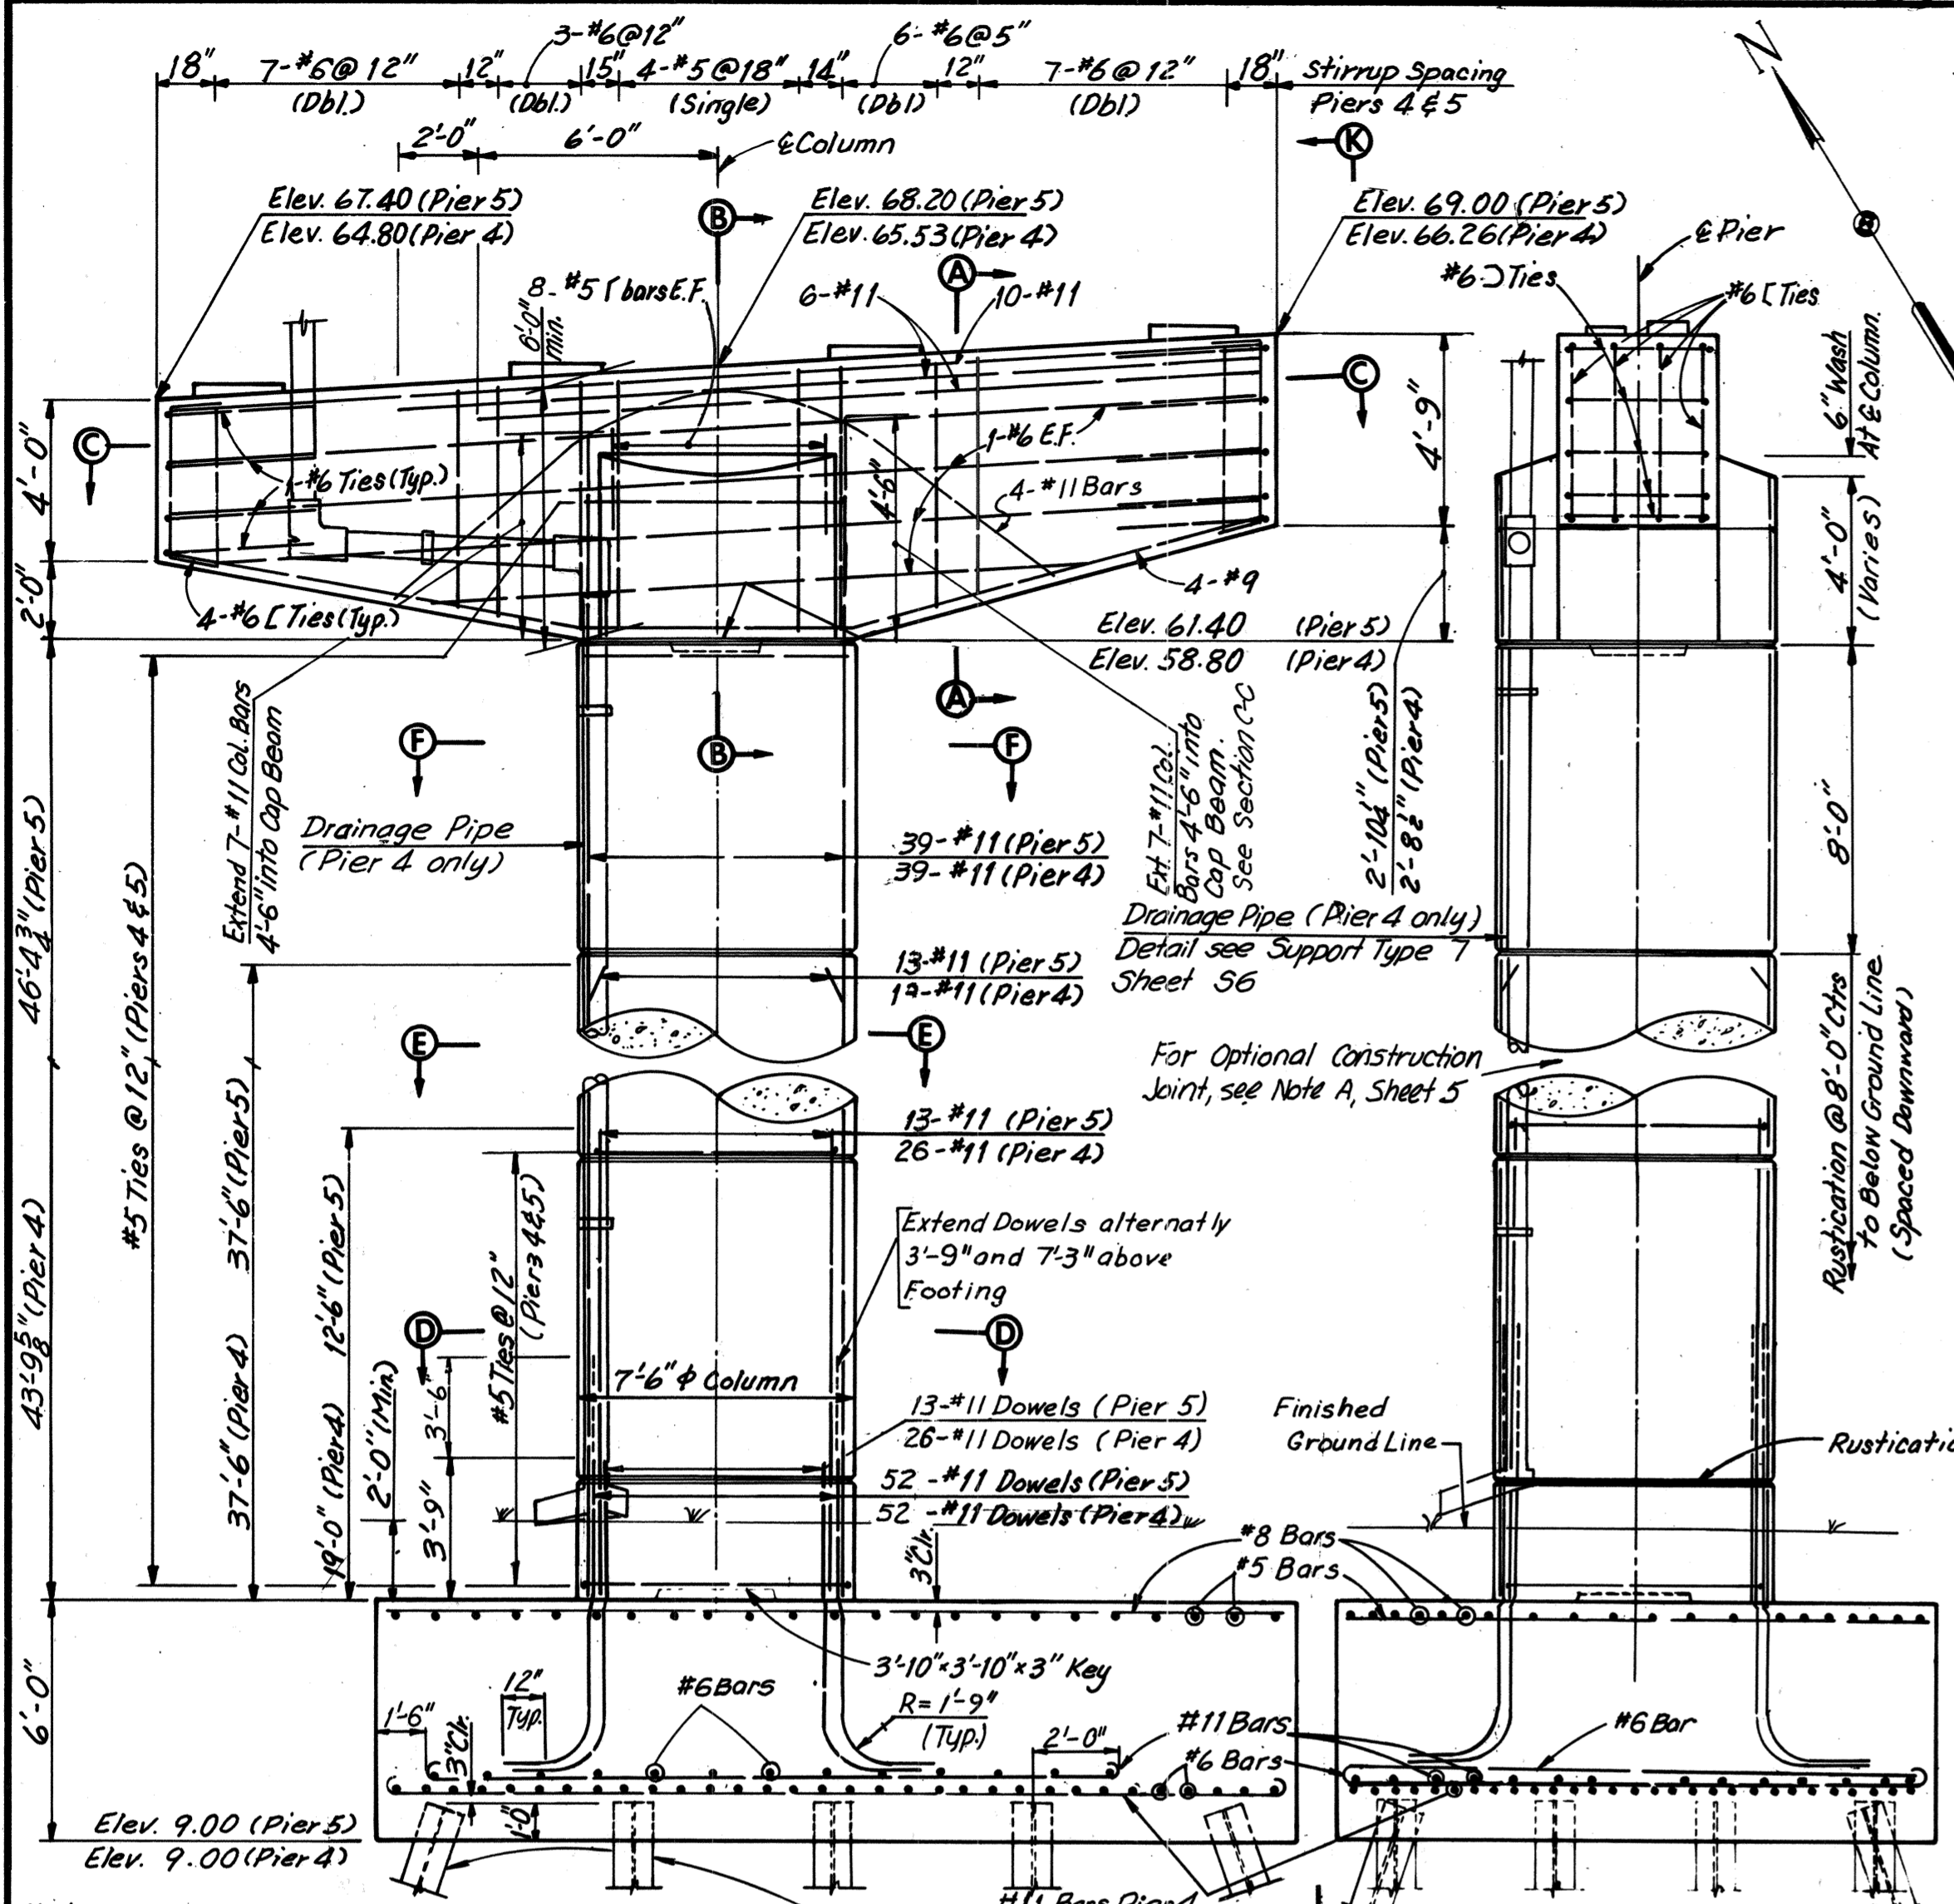

BY	DATE	Note Added	LRH	4-19-74		
MADE	G.C.C.	9-14-68	2	As Built	TEM	6-77
CHECKED	J.D.	9-17-68				
IN CHARGE	NO.	REVISION	BY	DATE		

Note: Footing elevations are approximate only and may be varied to suit field conditions as directed by the Engineer. Vertical shaft reinforcing shall not be cut until these elevations are established. Where elevations change more than 2ft., redesign will be required.

FOOTINGS FOR PIERS 4 AND 5 ARE ECCENTRIC AS SHOWN ON FOOTING PLANS ABOVE

Note: All piles shall be 12BP53 Steel Piles (Design capacity = 57 tons). Batter all piles 3" per foot where shown. For Standard Shoe details, see Sheets S1 & S2. For Framing Plan, see Sheet 20 & 21. Estimated Pile Tip Elevation -12.00 (Pier 4) and -15.00 (Pier 5).

SECTION B-B
Scale 1/2"=1'-0"

AS BUILT



RICHMOND METROPOLITAN AUTHORITY
RICHMOND EXPRESSWAY SYSTEM
DOWNTOWN EXPRESSWAY

BRIDGE NO. 67
RAMP W-N CONNECTION TO
RICHMOND-PETERSBURG TURNPIKE
PIERS 4 AND 5

HOWARD, NEEDLES, TAMMEN & BERGENDOFF
consulting engineers
NEW YORK ALEXANDRIA KANSAS CITY


SCALE: As Noted
CONTRACT NO.: 10
SHEET NO. 7 OF 54

RICHMOND EXPRESSWAY SYSTEM			
SECTION	PROJECT	SHEET NO.	TOTAL SHEETS
10	DOWNTOWN EXPRESSWAY	180	265

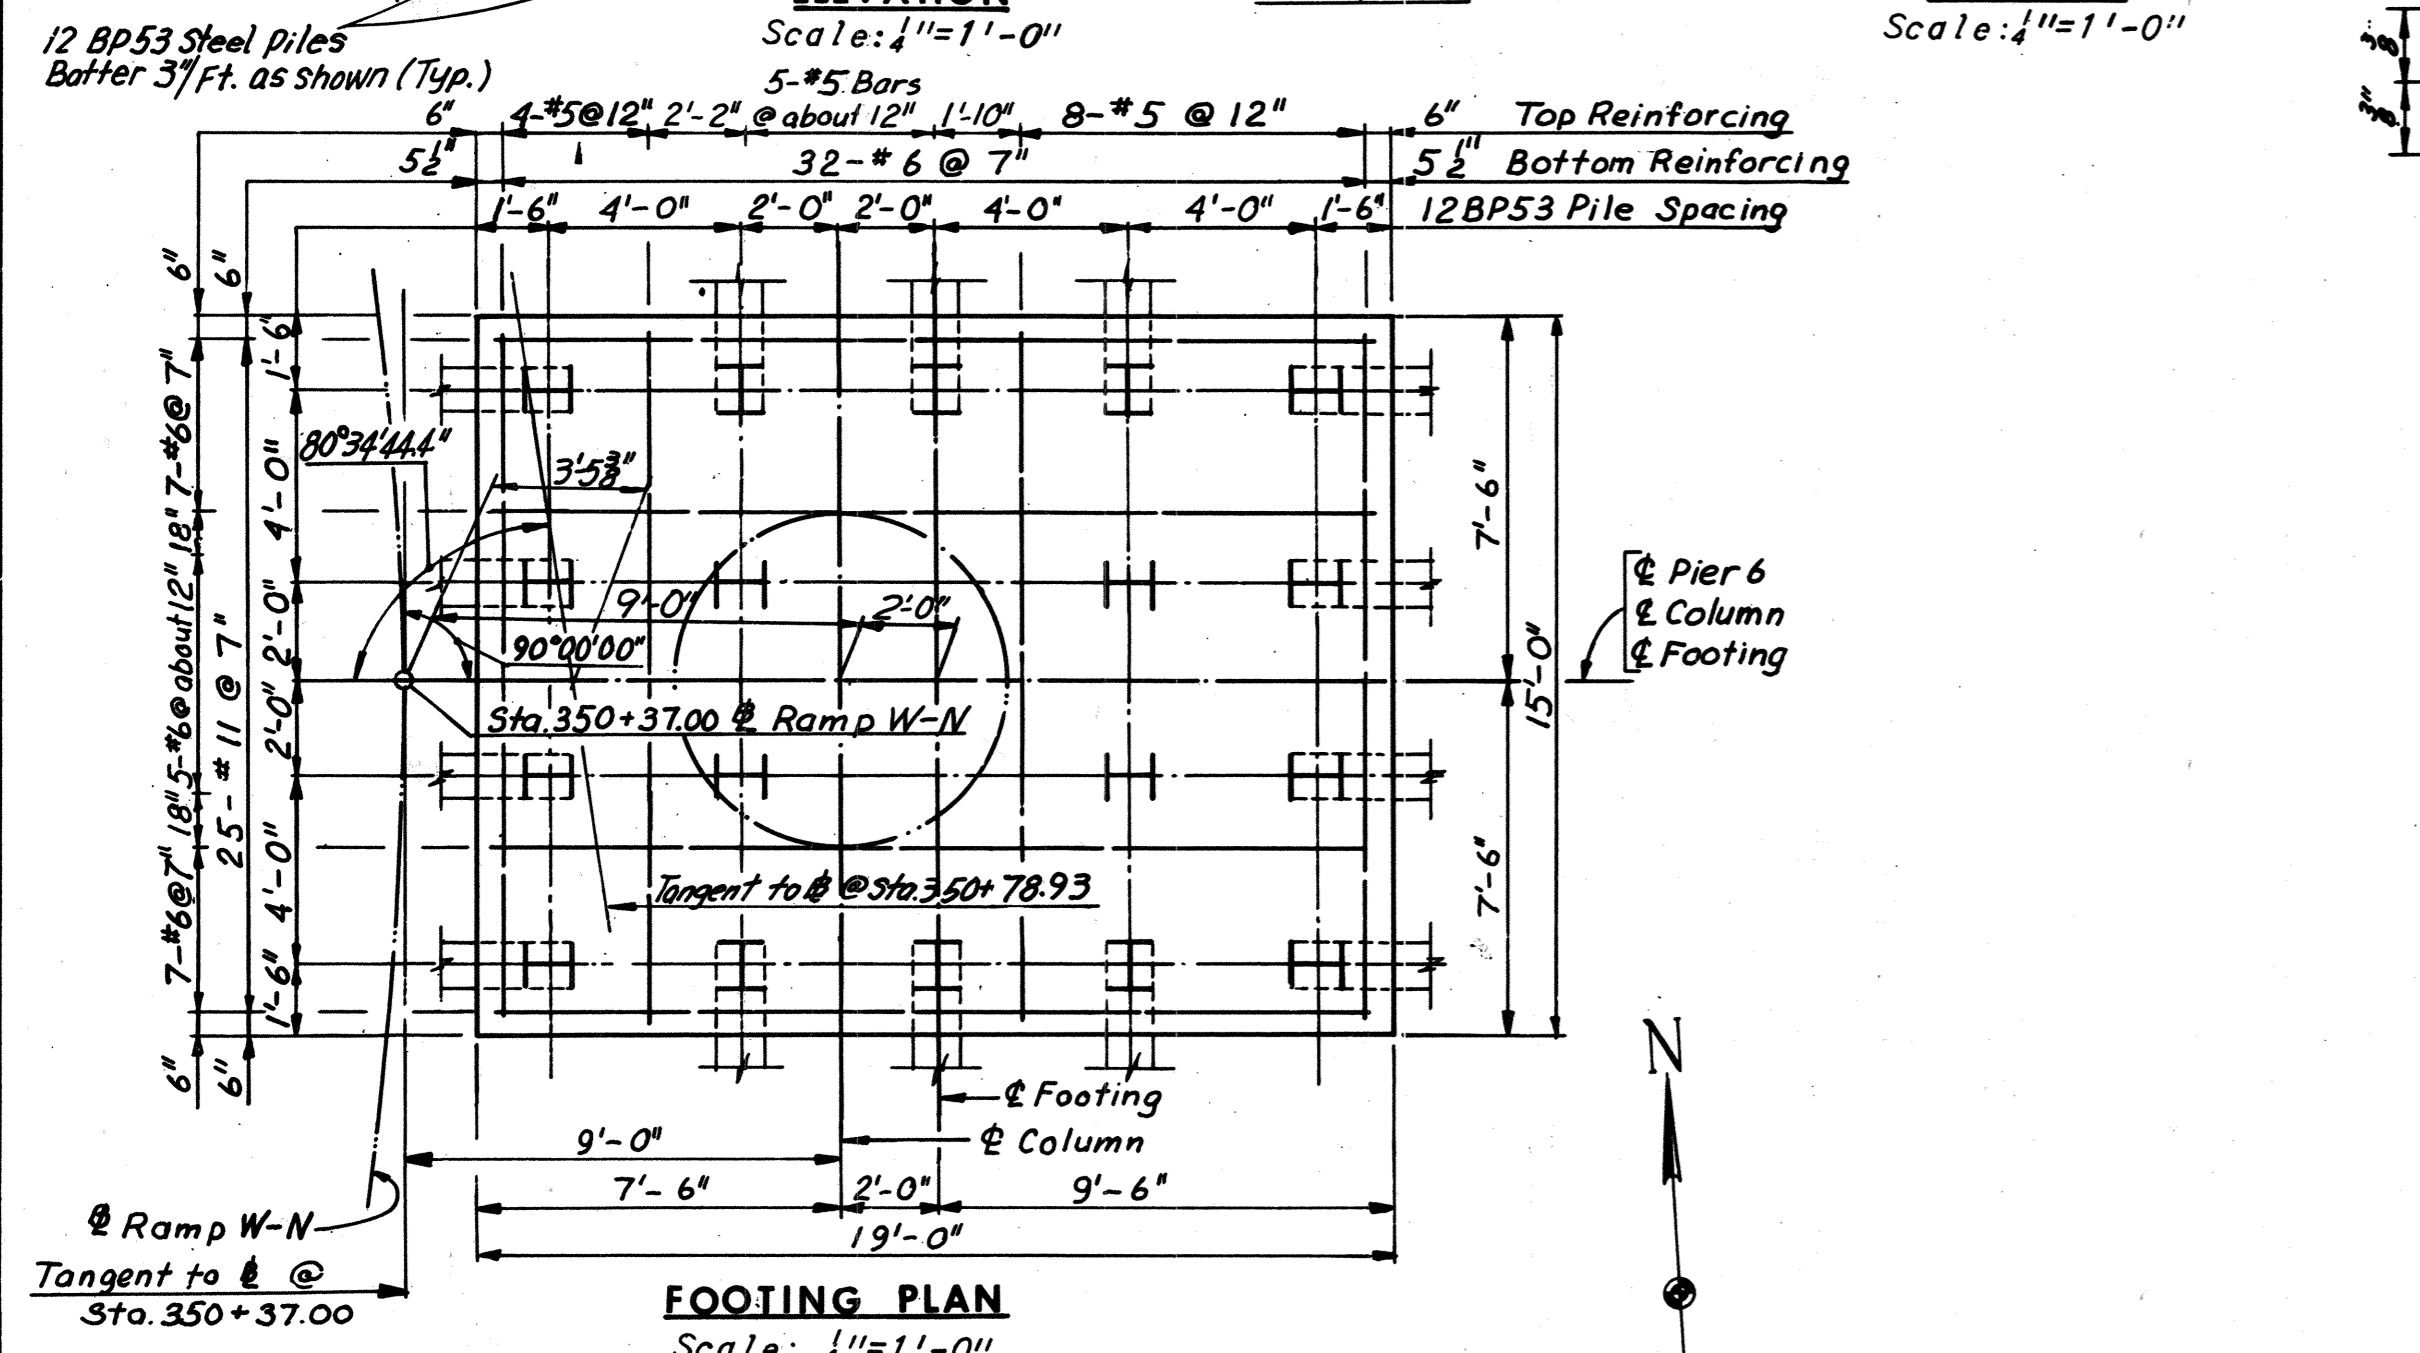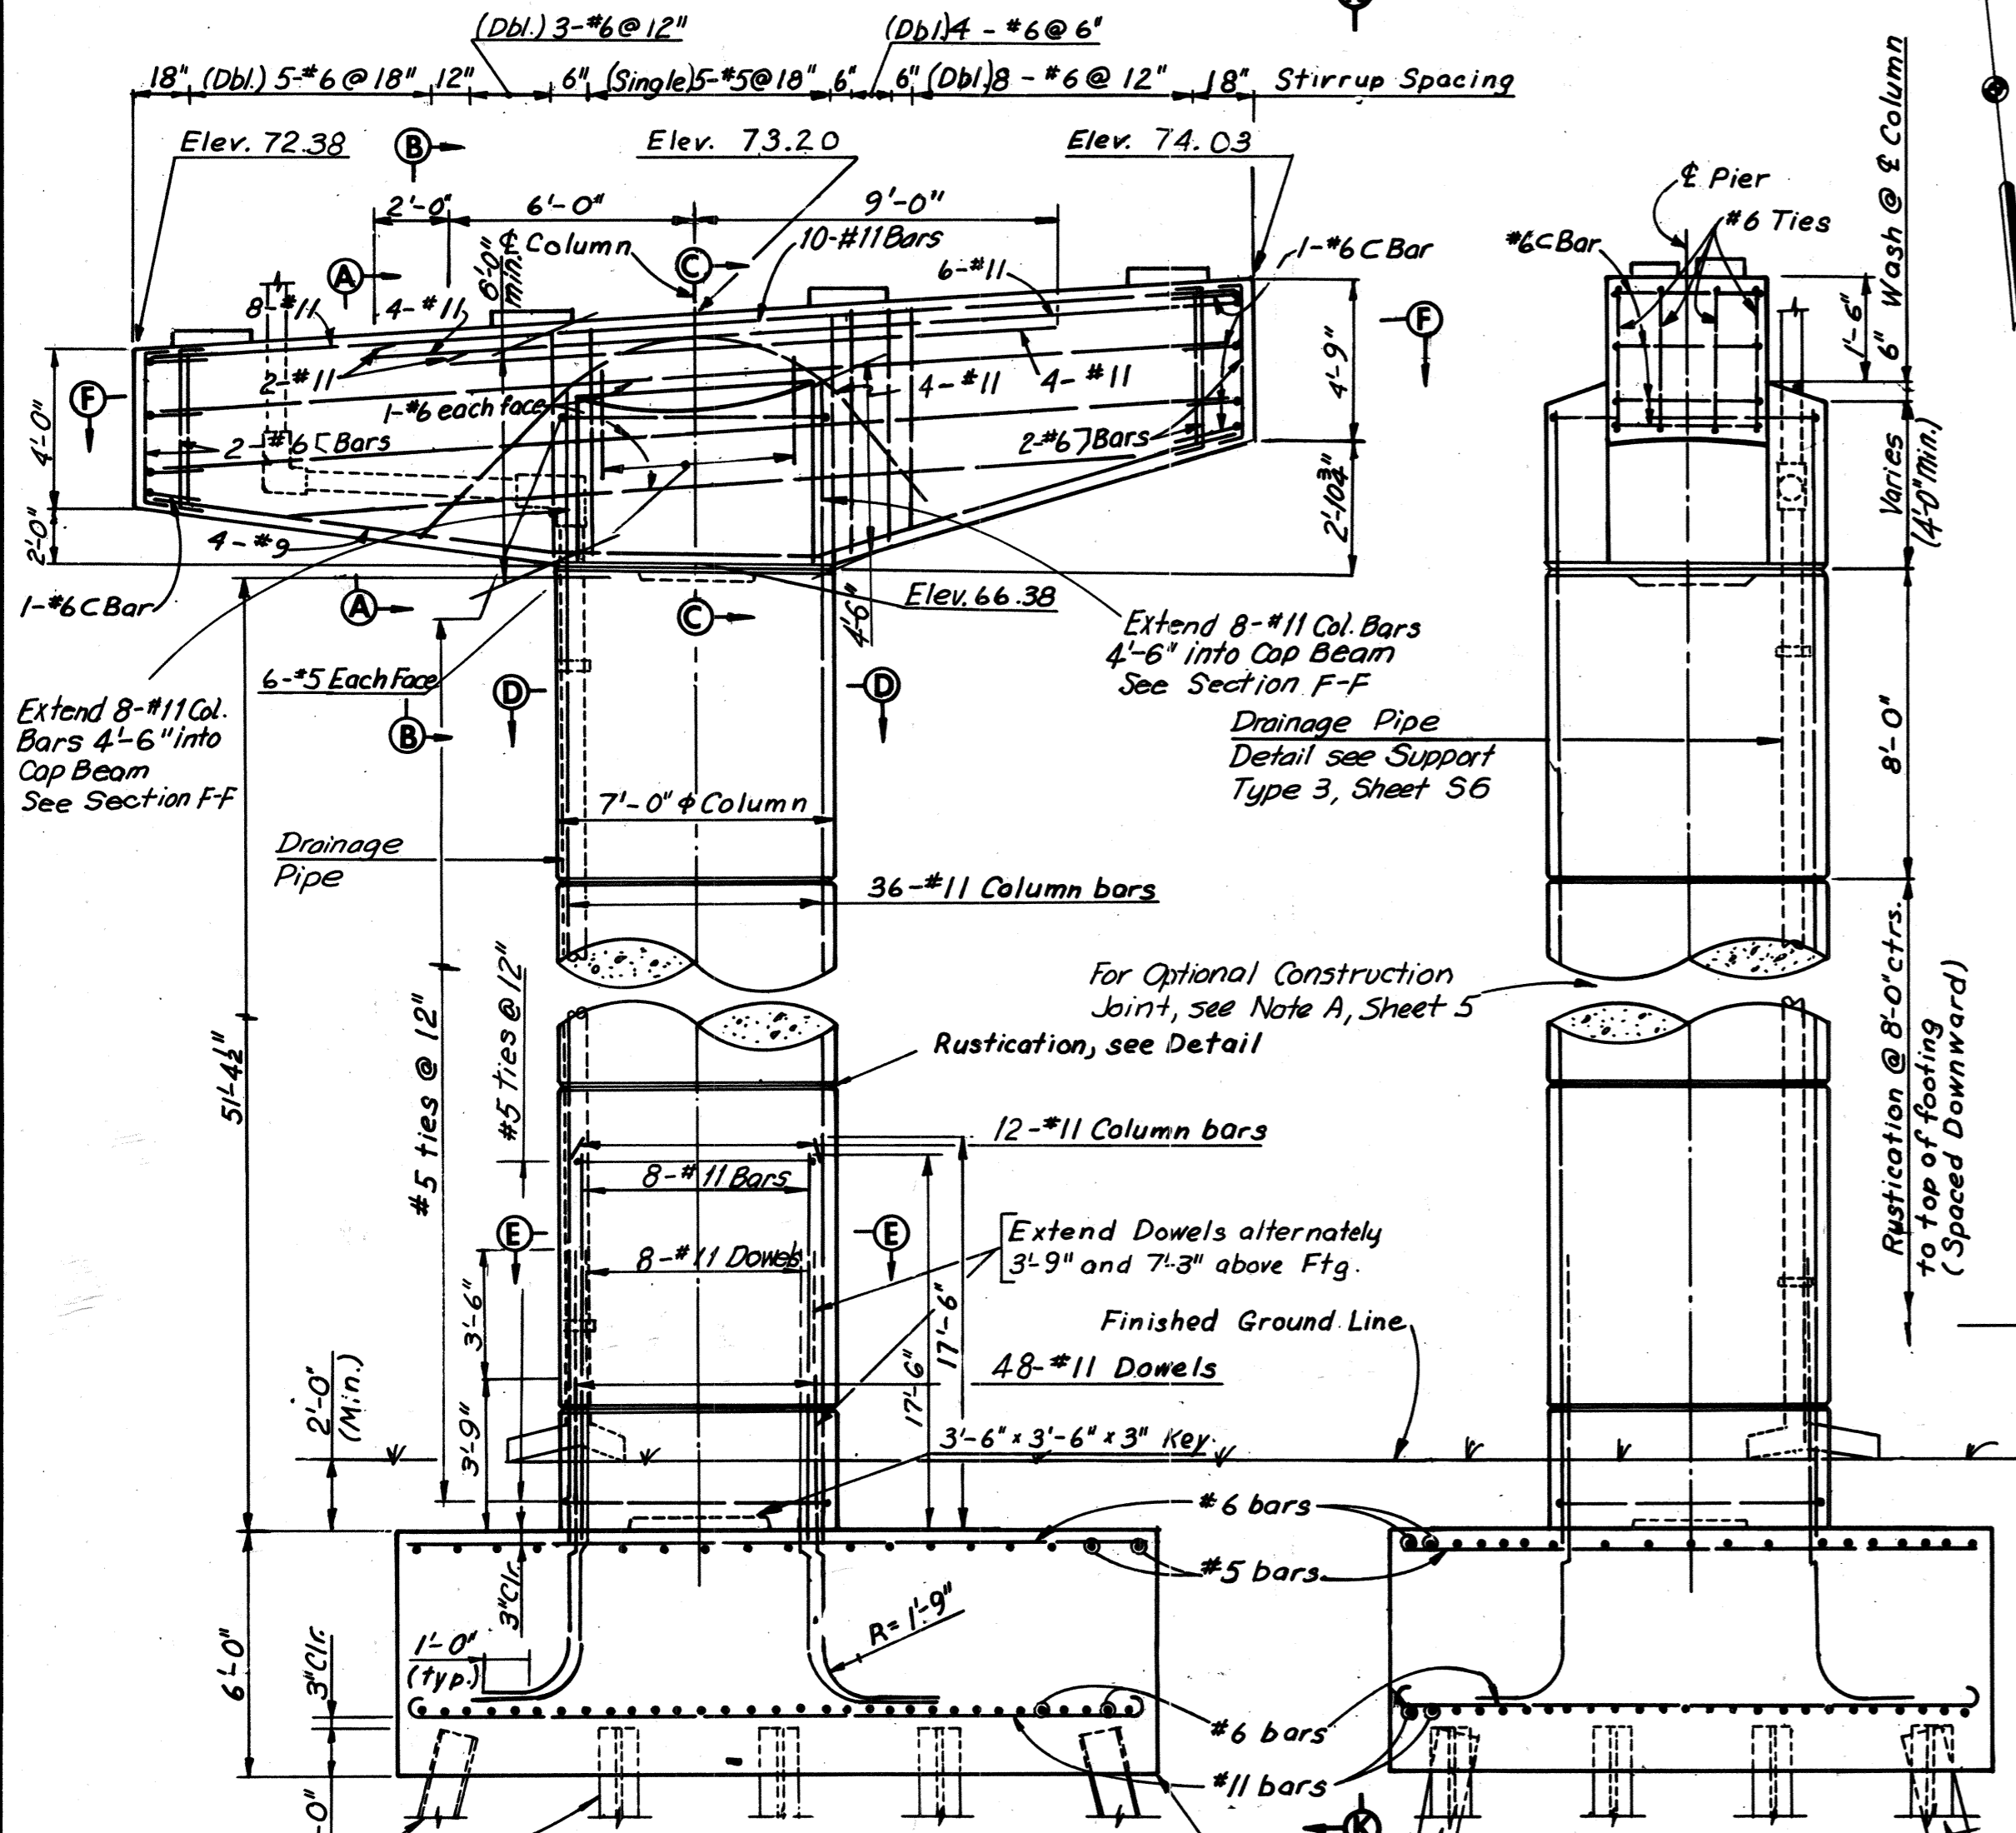


BY	DATE	Note Added	LRH	4-19-74		
MADE	J.D.	9-12-68	2	As Built	TEM	6-77
CHECKED	Y.C.P.	5-15-69				
IN CHARGE	NO.	REVISION	BY	DATE		

FOOTING FOR PIER 6 IS ECCENTRIC AS SHOWN ON FOOTING PLAN

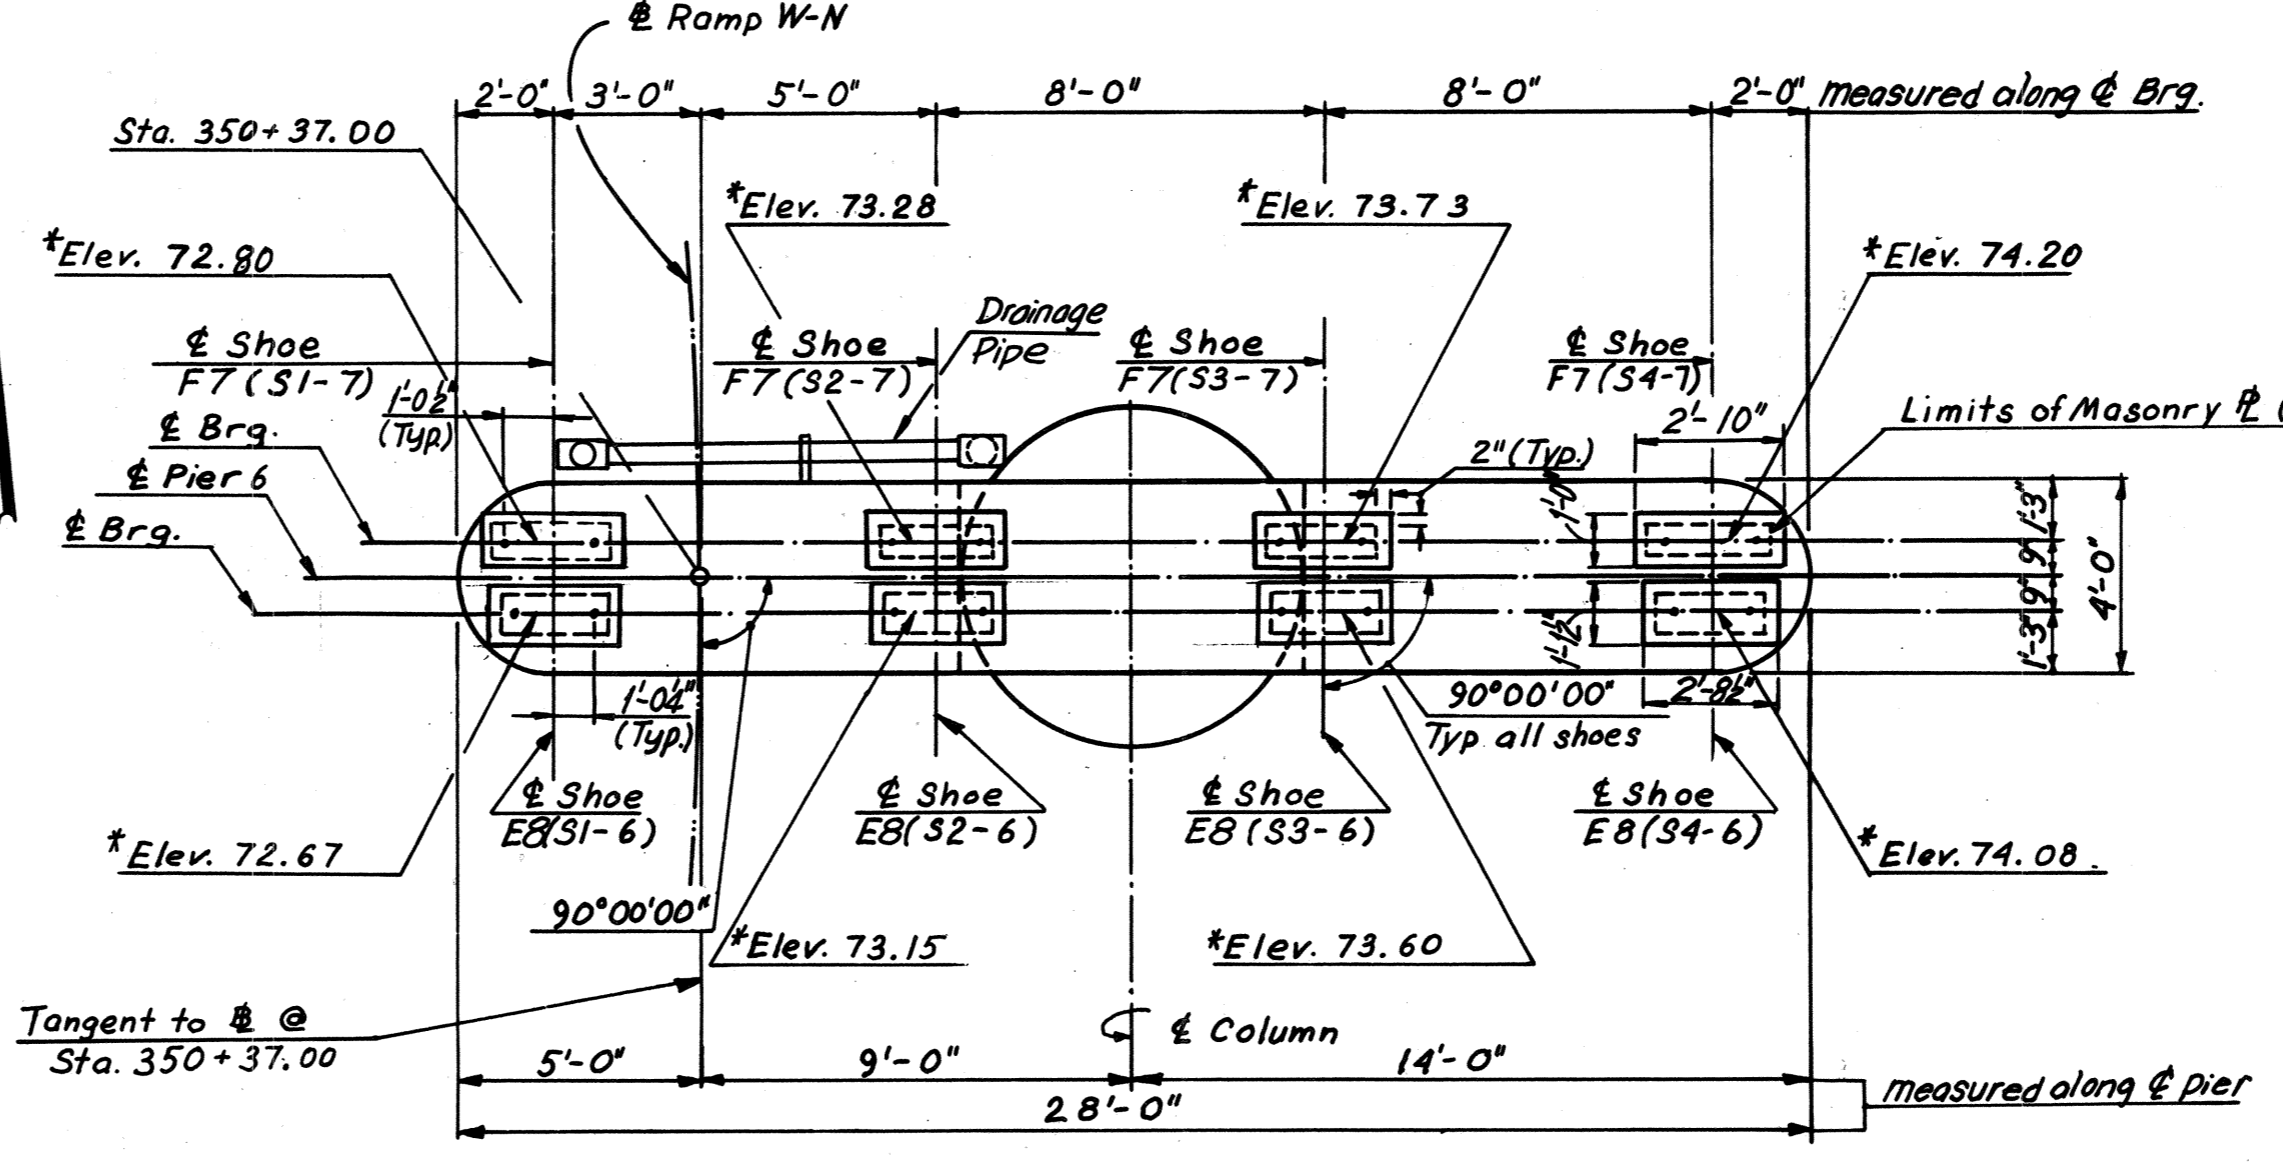


PIER CAP PLAN
Scale: 1/4"=1'-0"

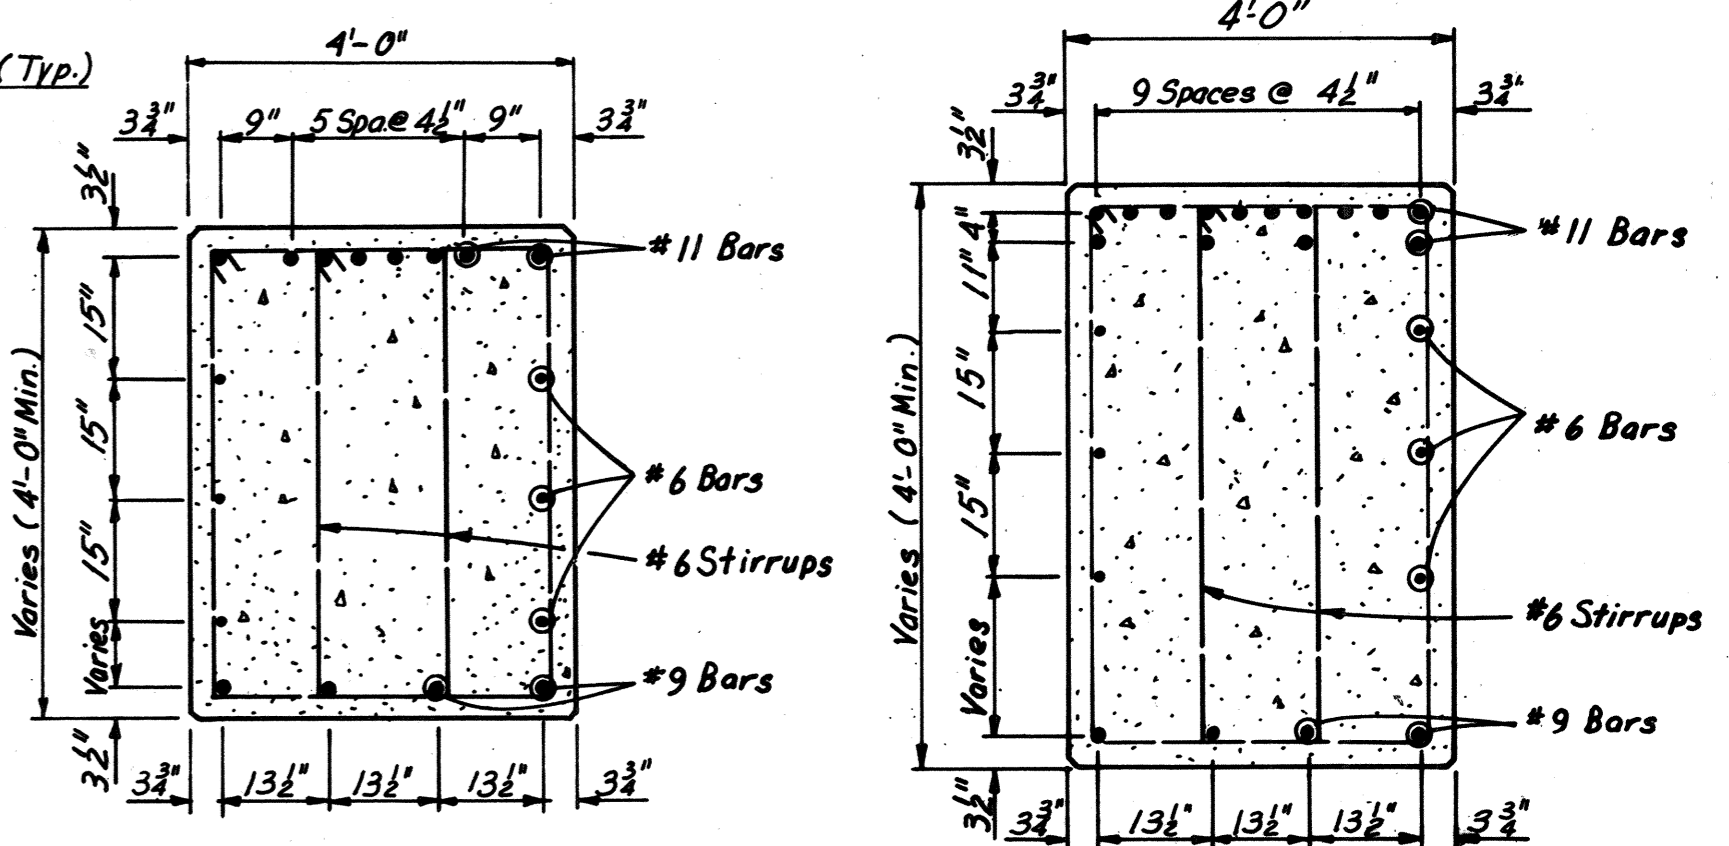


SECTION A-A
Scale: 1/2"=1'-0"


SECTION B-B
Scale: 1/4"=1'-0"

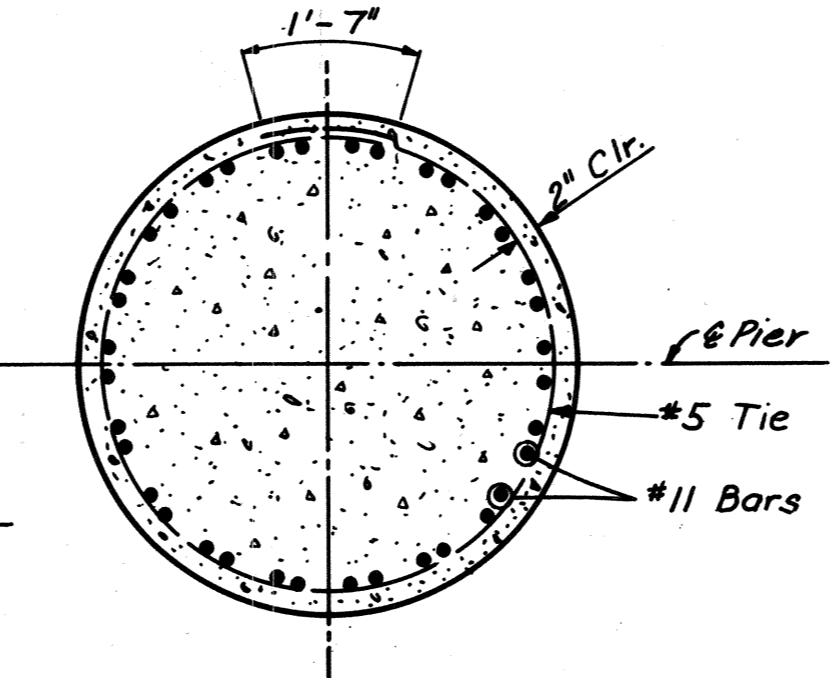


SECTION D-D
Scale: 3/8"=1'-0"

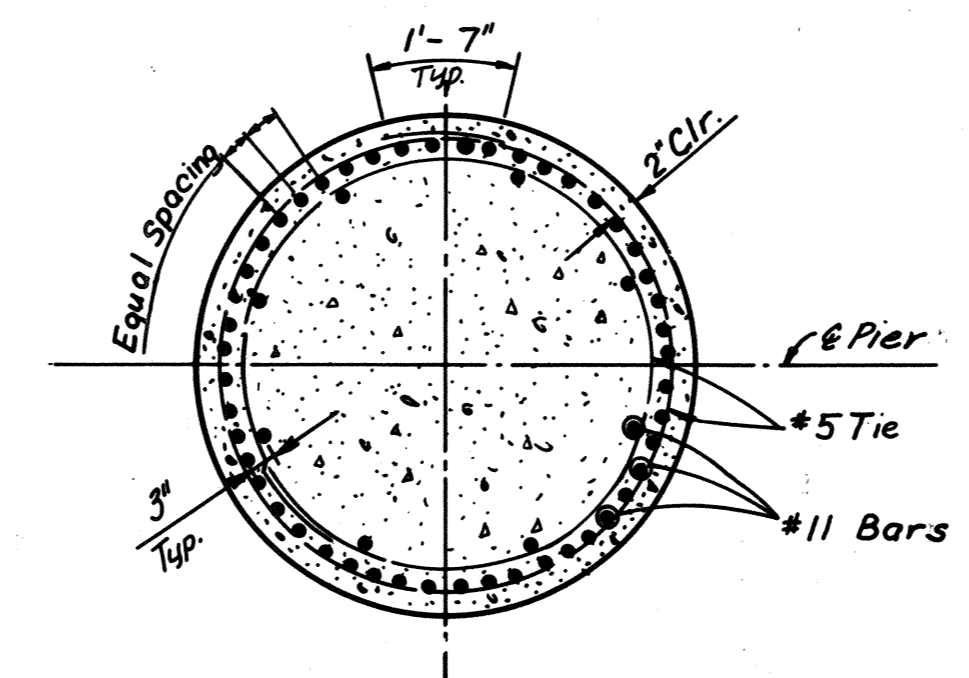


SECTION E-E
Scale: 3/8"=1'-0"

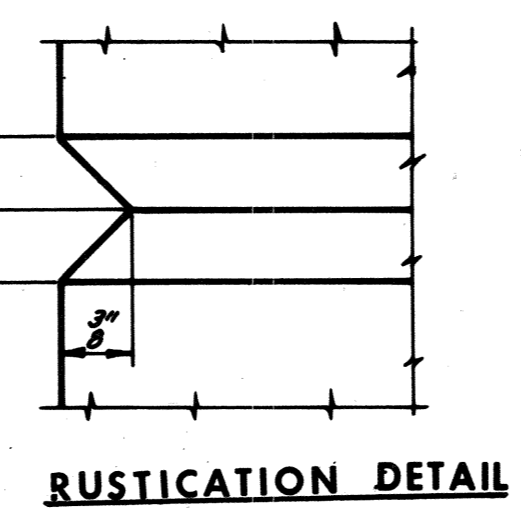


RUSTICATION DETAIL

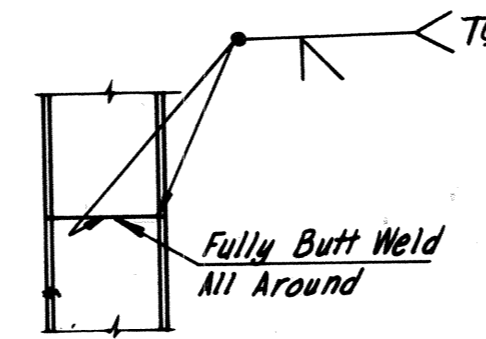


PILE SPICE DETAIL

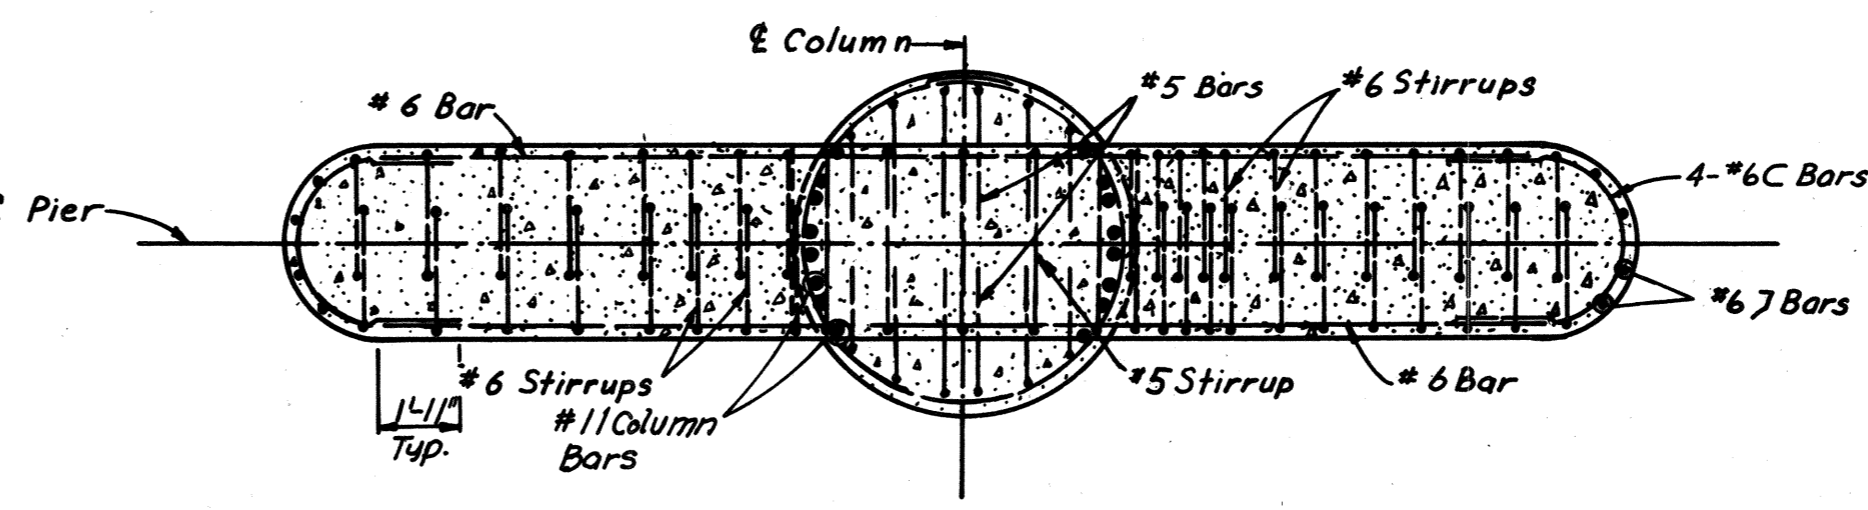

SECTION F-F
Scale: 1/4"=1'-0"

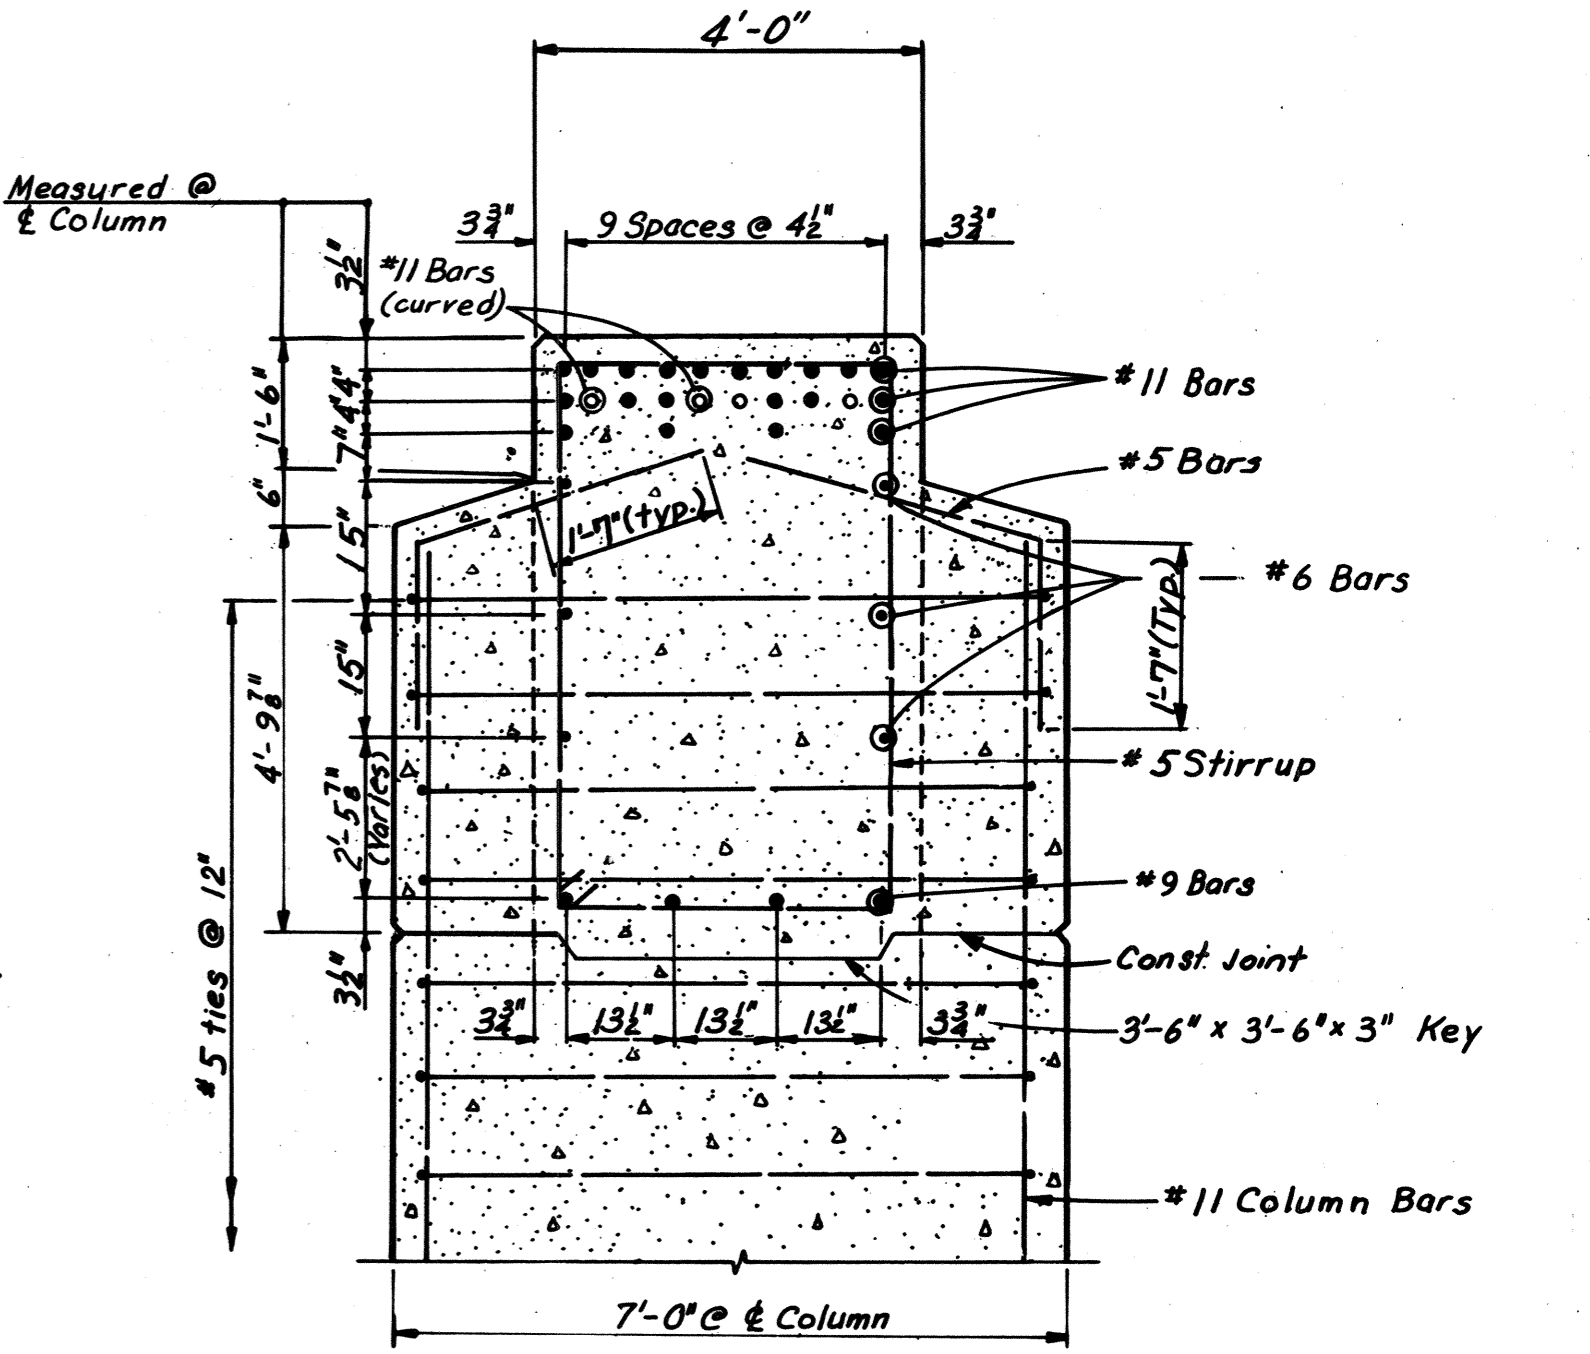

SECTION C-C
Scale: 1/2"=1'-0"

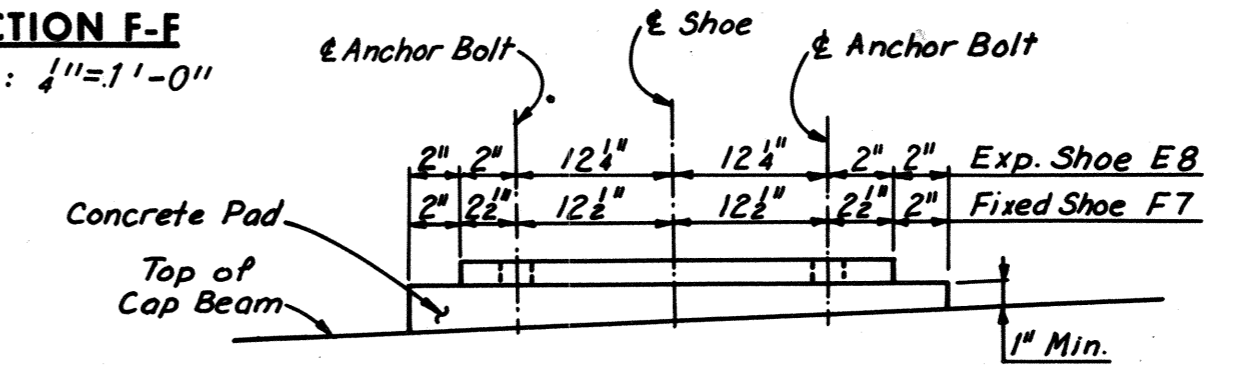

ANCHOR BOLT SETTING PLAN
No Scale

Note: Footing elevations are approximate only and may be varied to suit field conditions as directed by the Engineer. Vertical shaft reinforcing shall not be cut until these elevations are established. Where elevations change more than 2 ft., redesign will be required.

Note: All piles shall be 12BP53 Steel Piles (Design capacity = 57 tons). Batter all piles 3" per foot where shown. For Standard Shoe details, see Sheets S1S2. For Framing Plan, see Sheet 21. Estimated Pile Tip Elevation, -15.00.

RICHMOND METROPOLITAN AUTHORITY
RICHMOND EXPRESSWAY SYSTEM
DOWNTOWN EXPRESSWAY












BRIDGE NO. 67
RAMP W-N CONNECTION TO
RICHMOND-PETERSBURG TURNPIKE
PIER 6

HOWARD, NEEDLES, TAMMEN & BERGENDOFF
consulting engineers
NEW YORK ALEXANDRIA KANSAS CITY

SCALE: As Noted
CONTRACT NO.: 10
SHEET NO. 8 OF 54

AS BUILT

RICHMOND EXPRESSWAY SYSTEM			
SECTION	PROJECT	SHEET NO.	TOTAL SHEETS
10	DOWNTOWN EXPRESSWAY	181	265

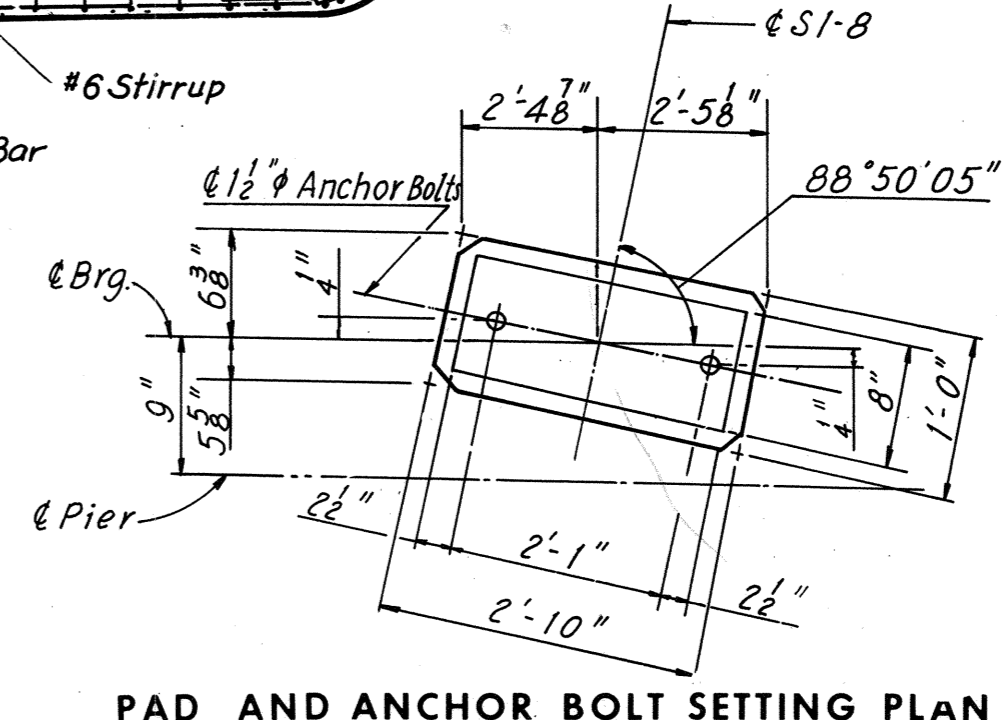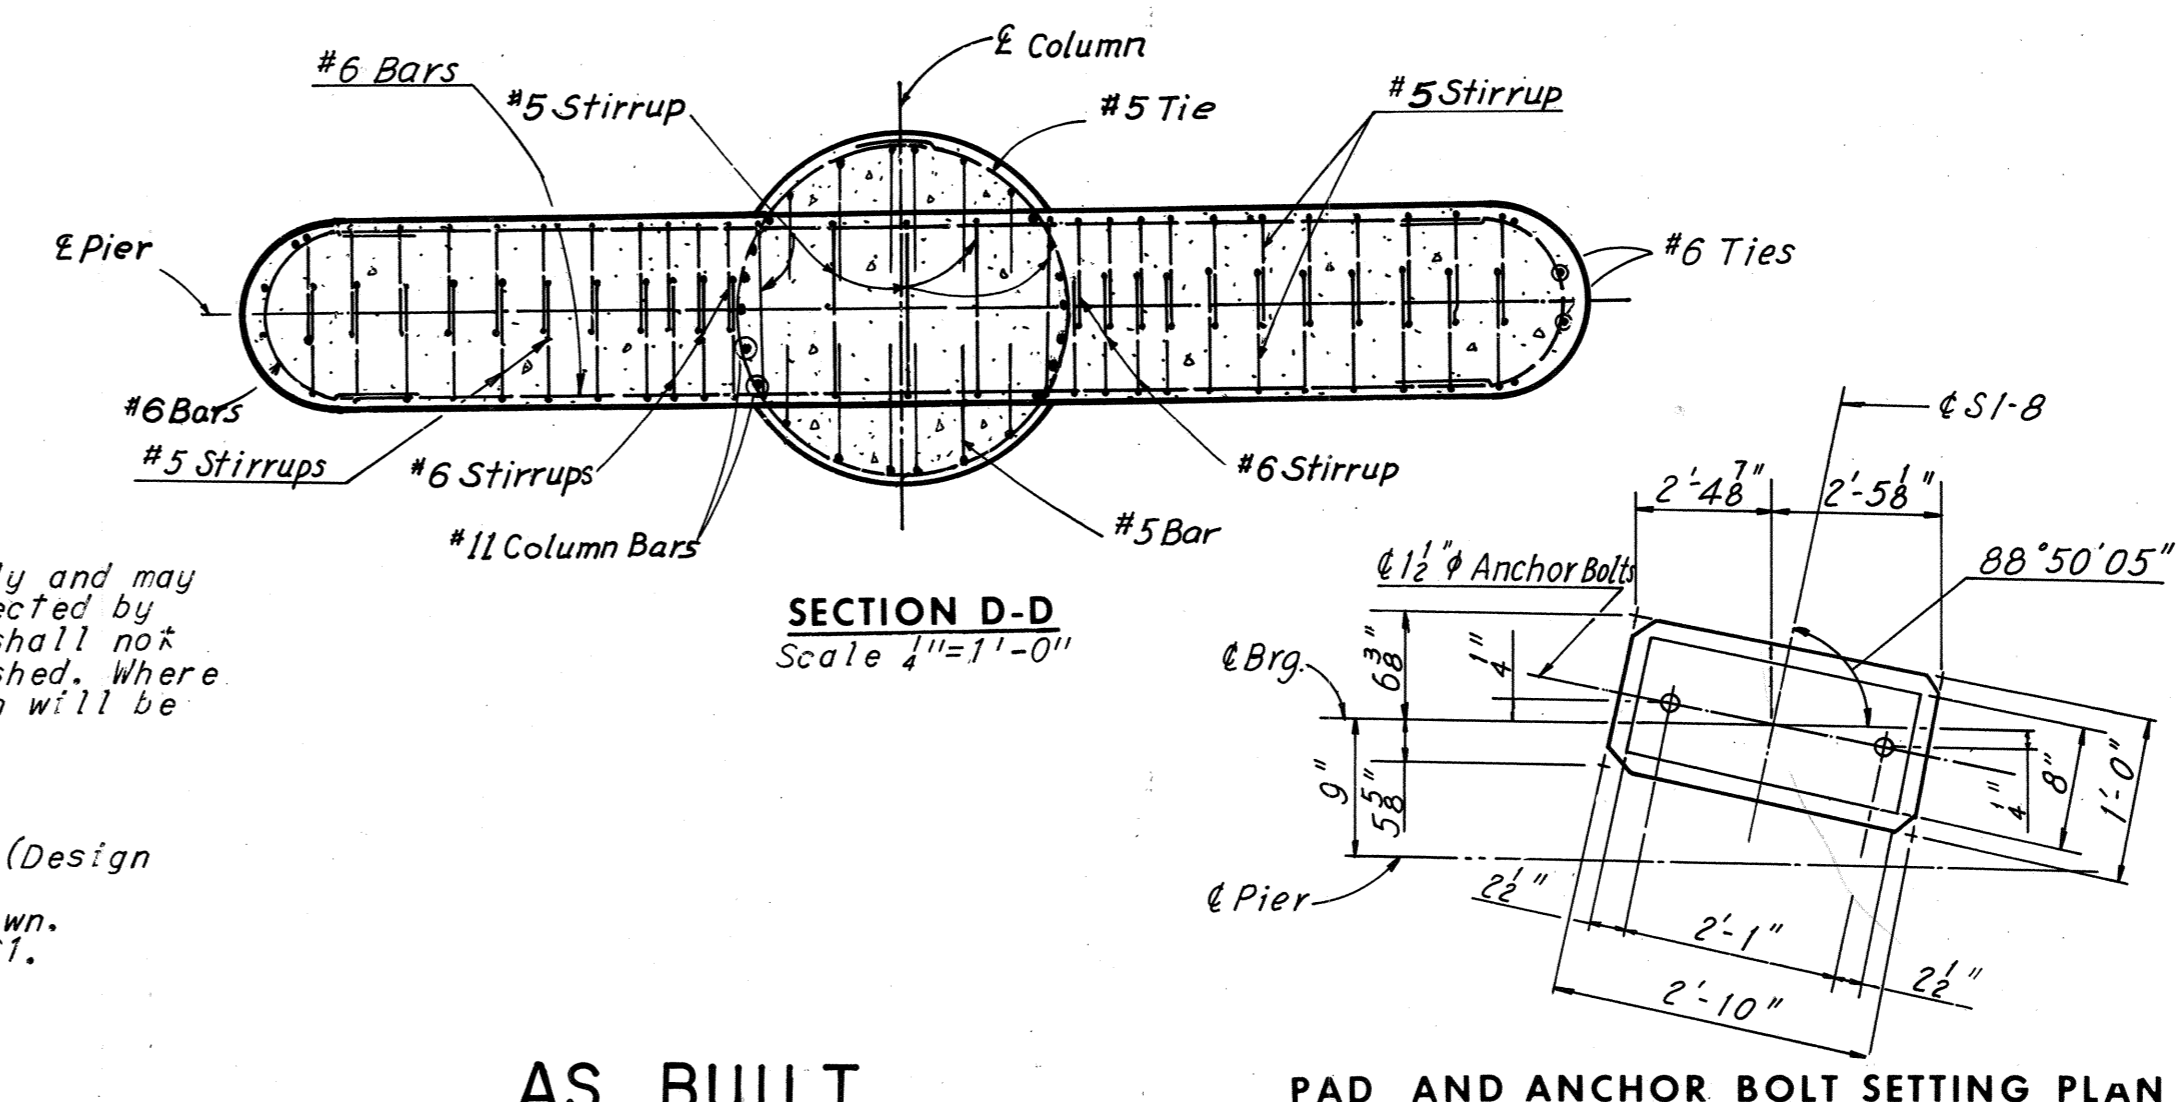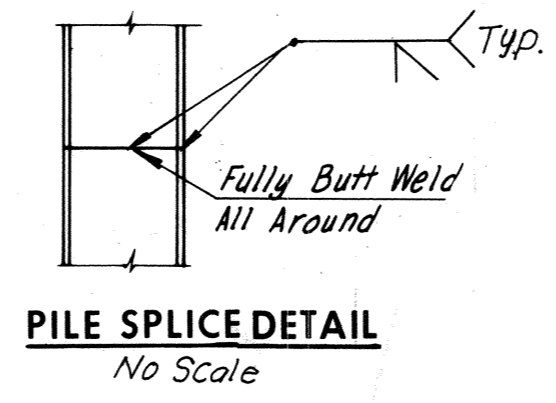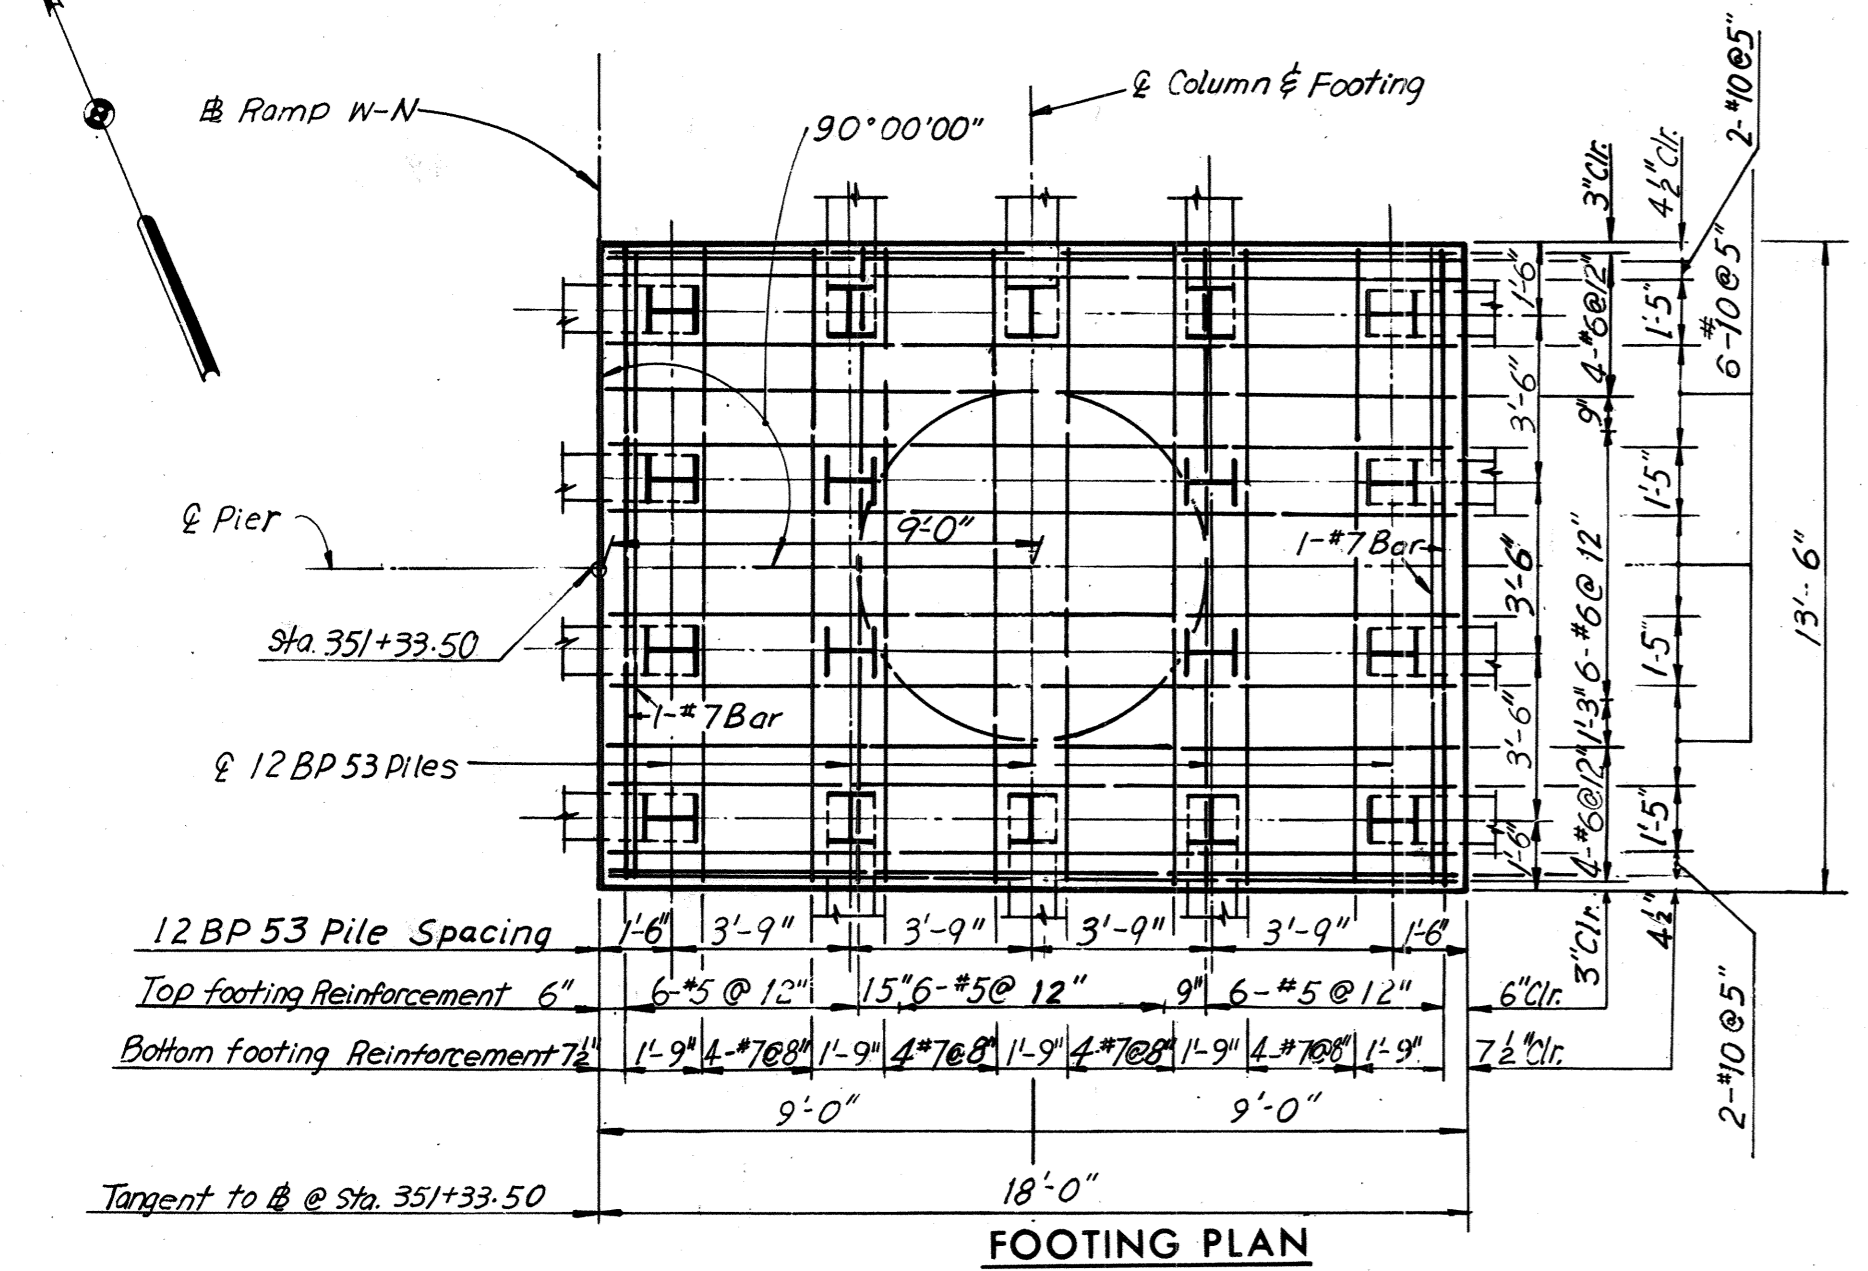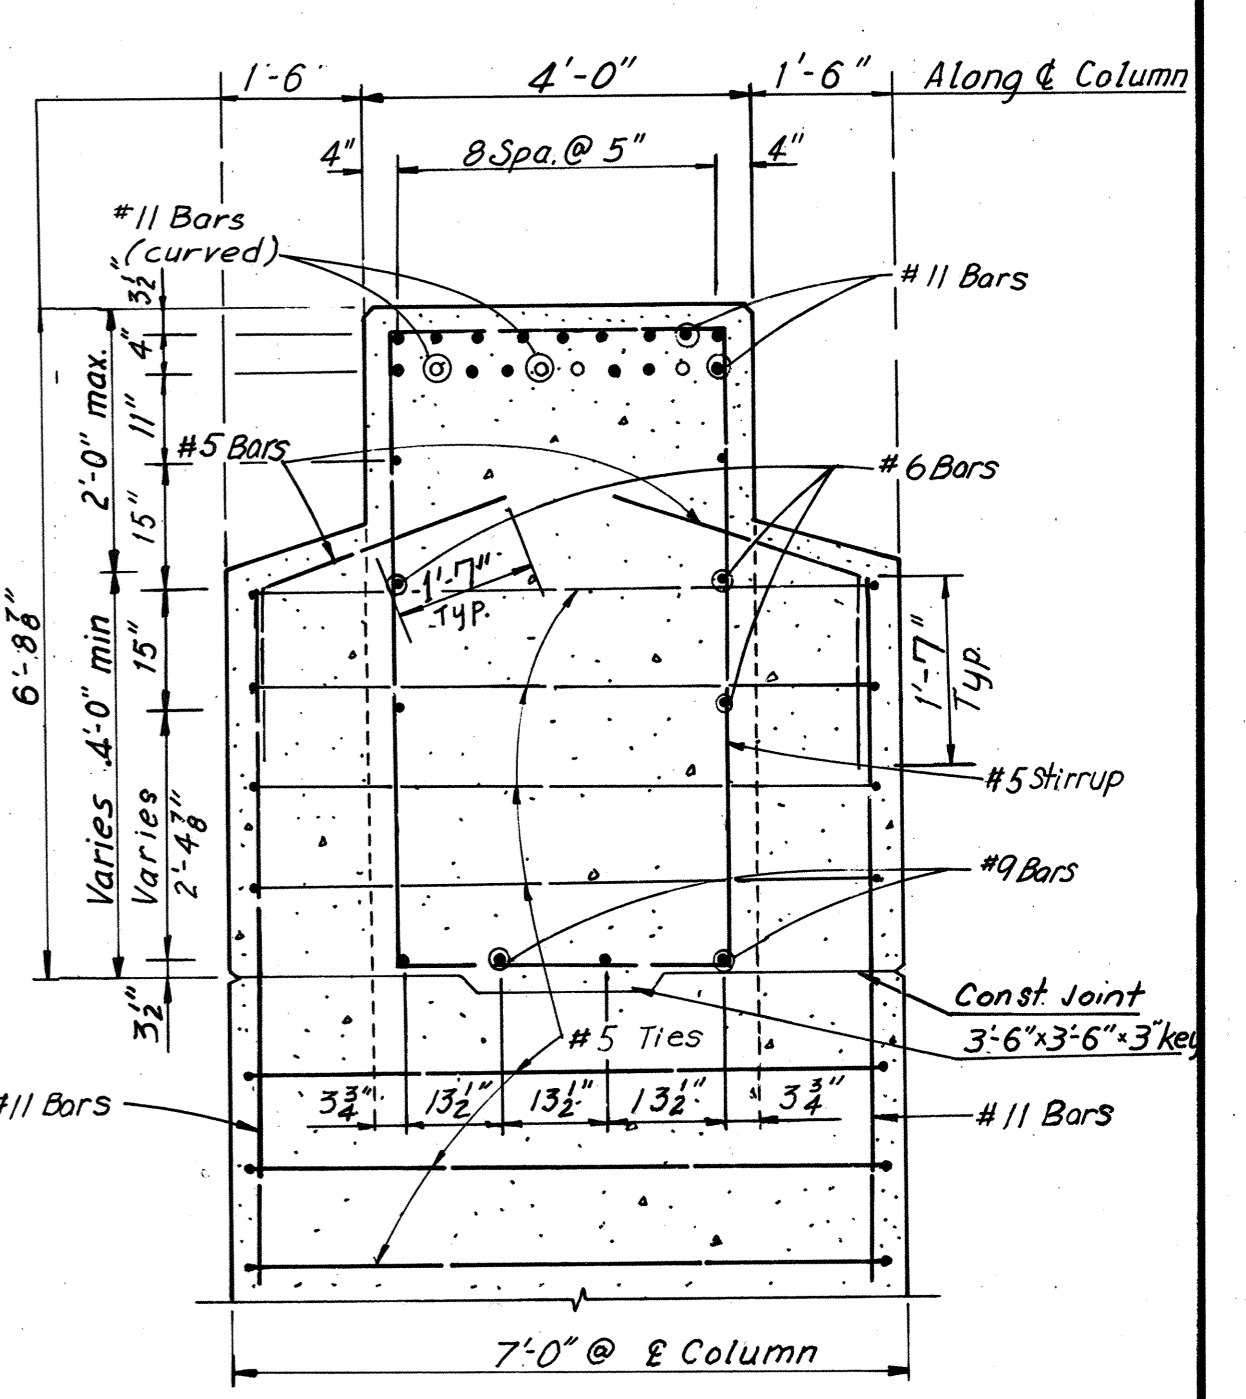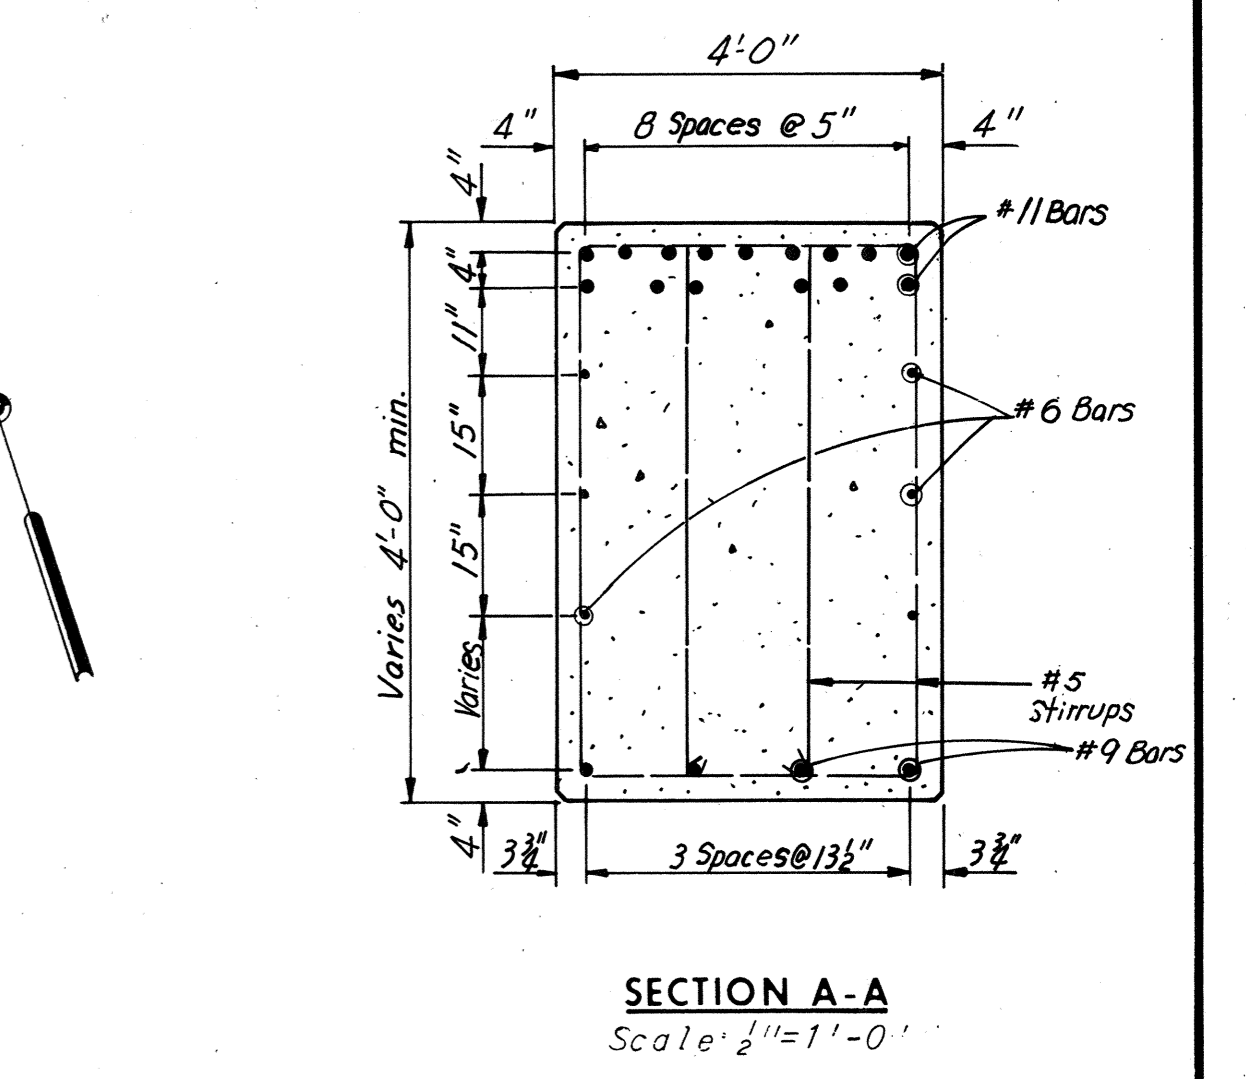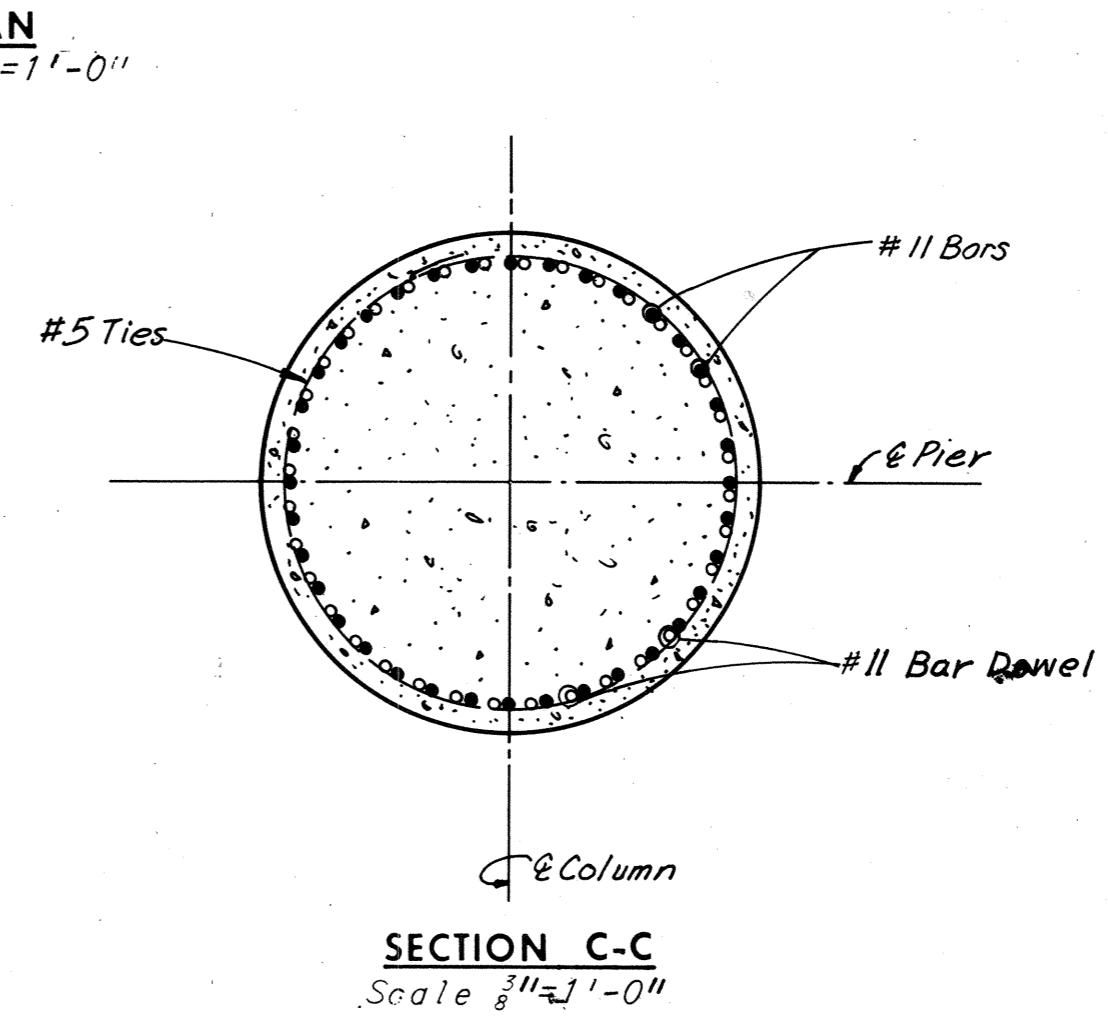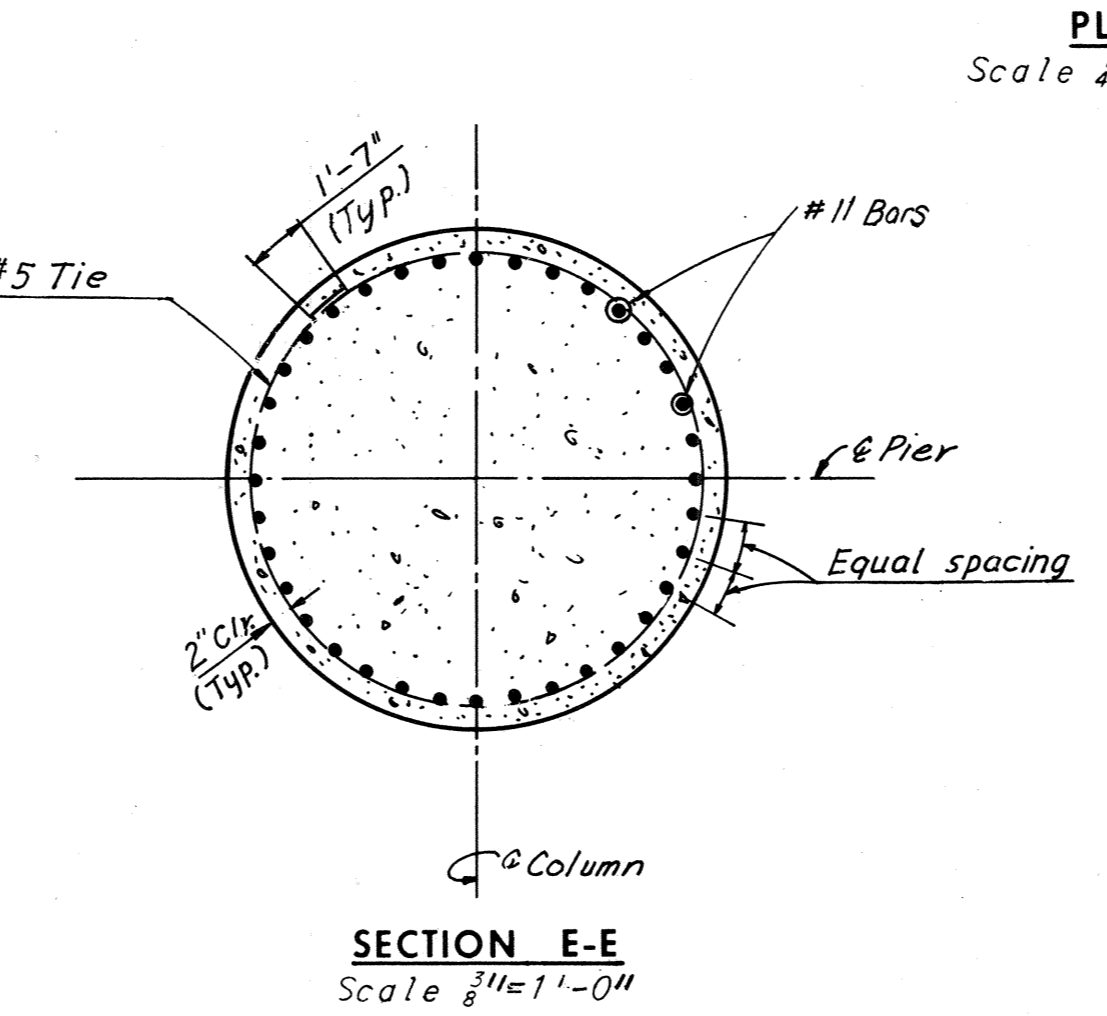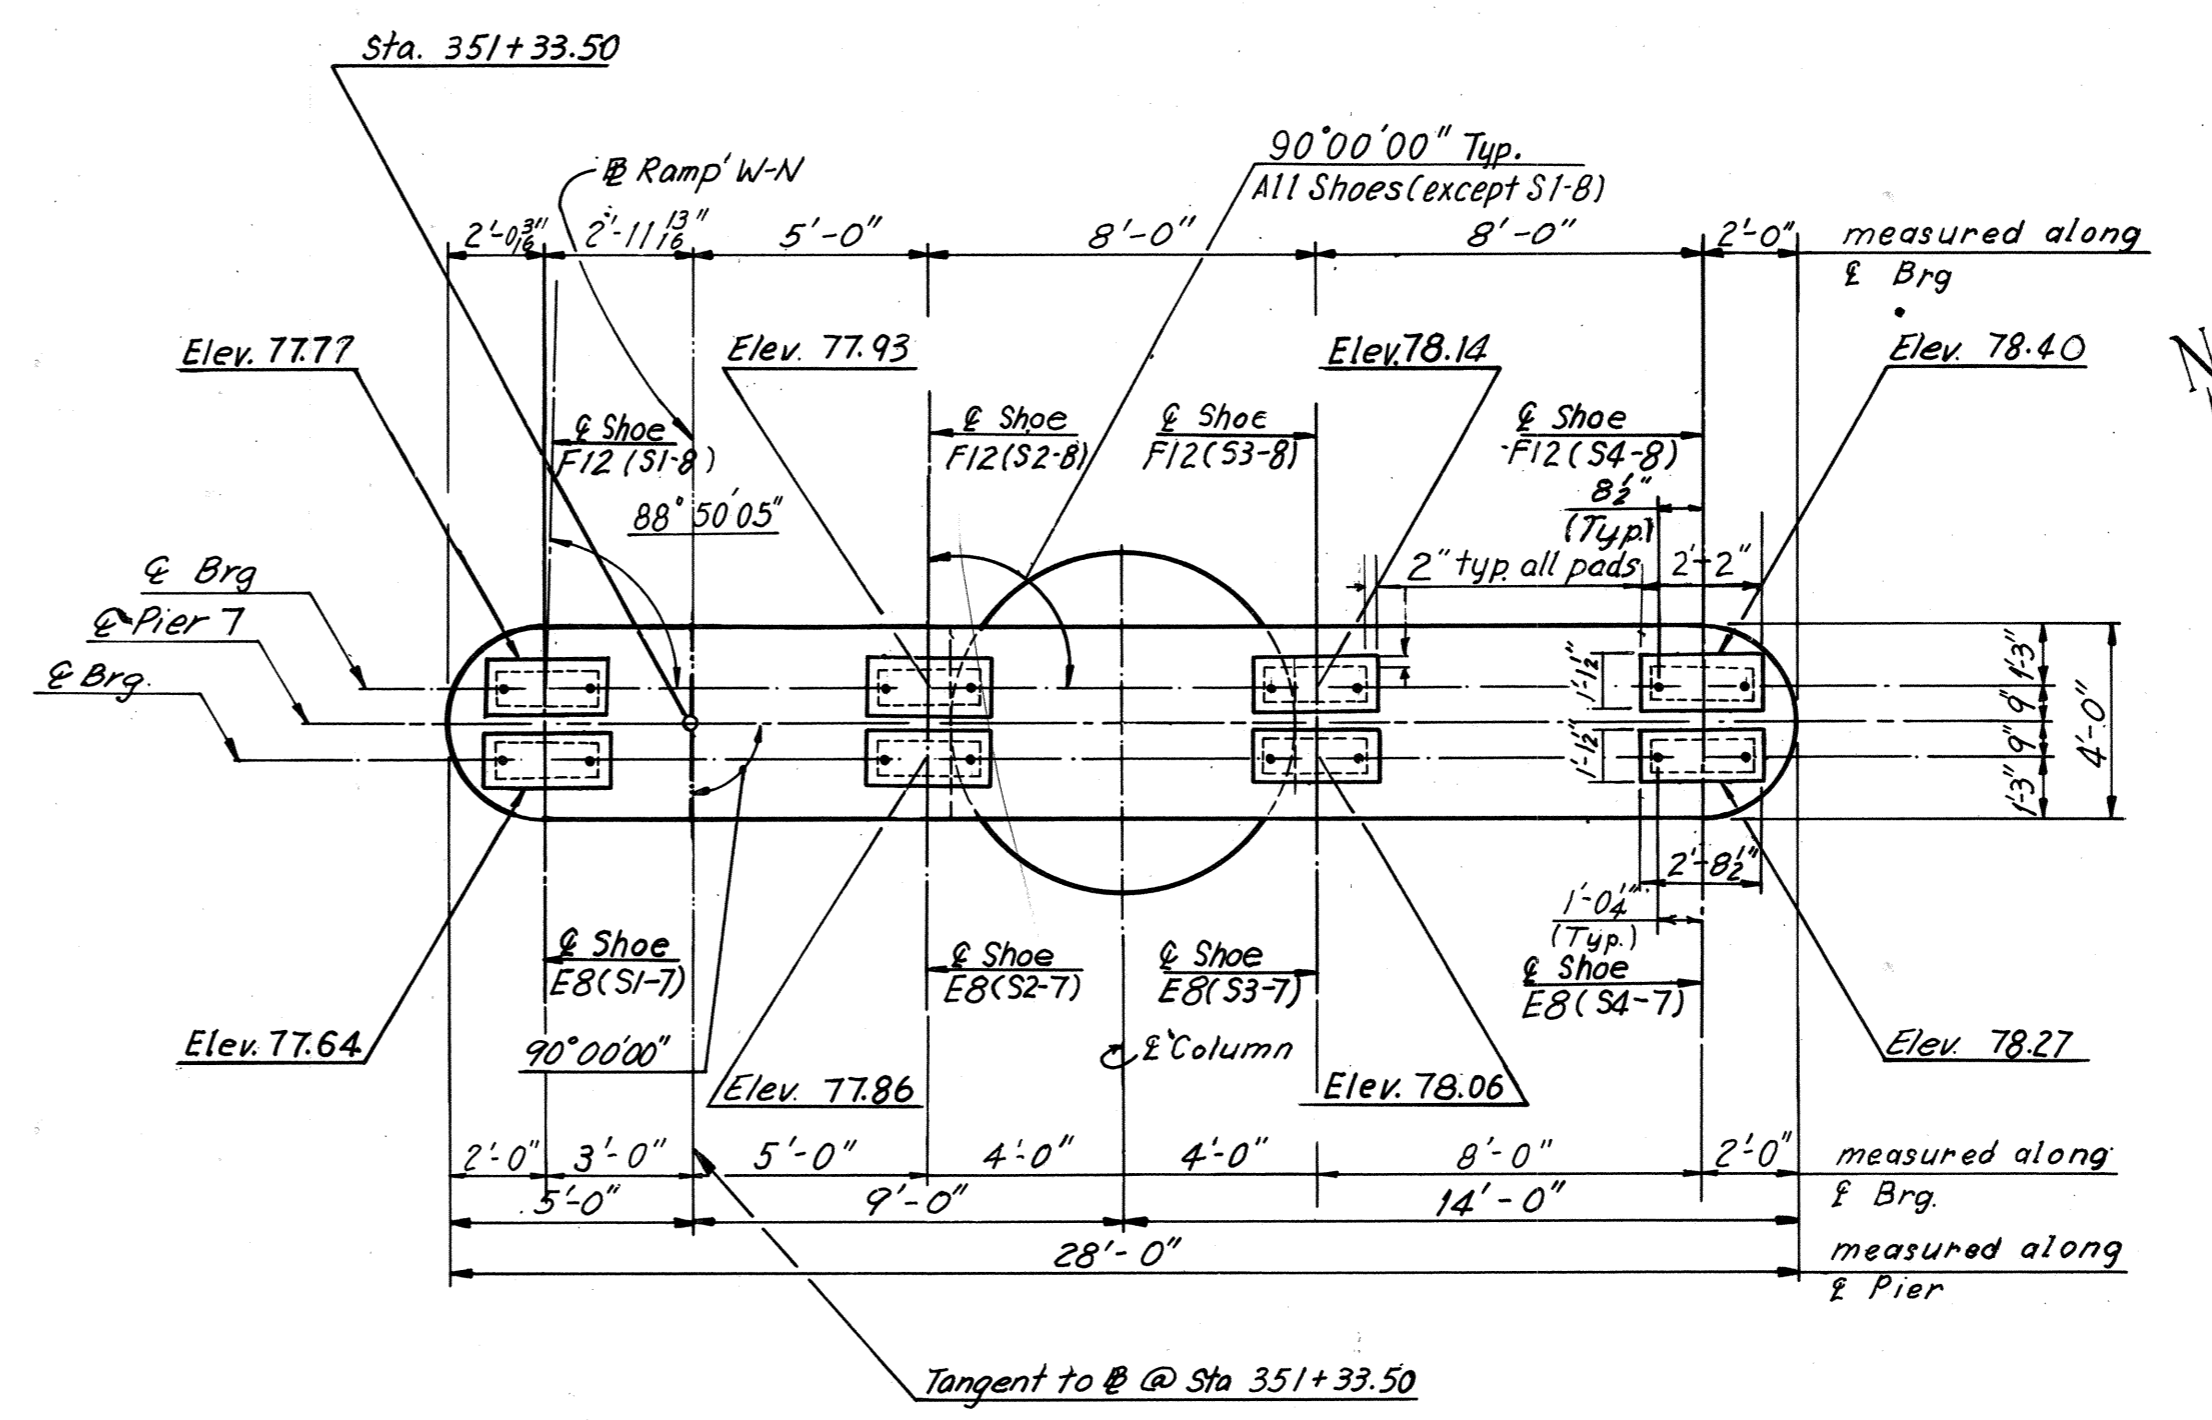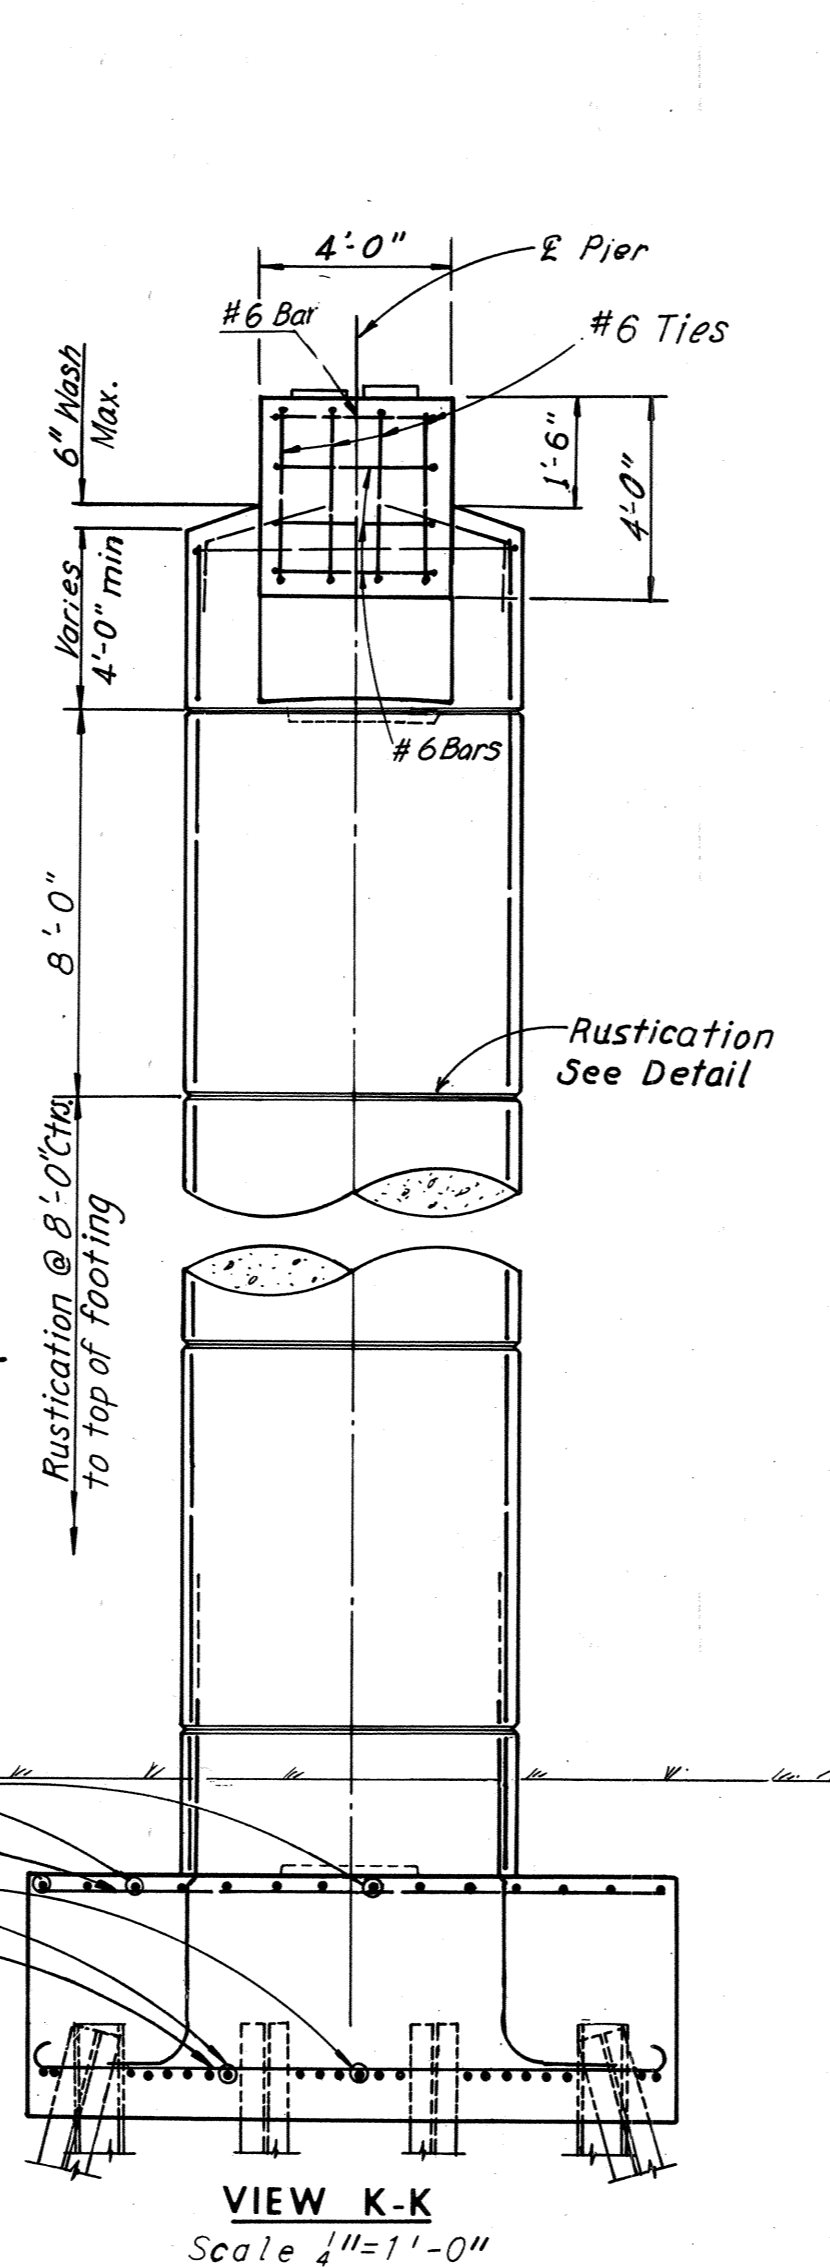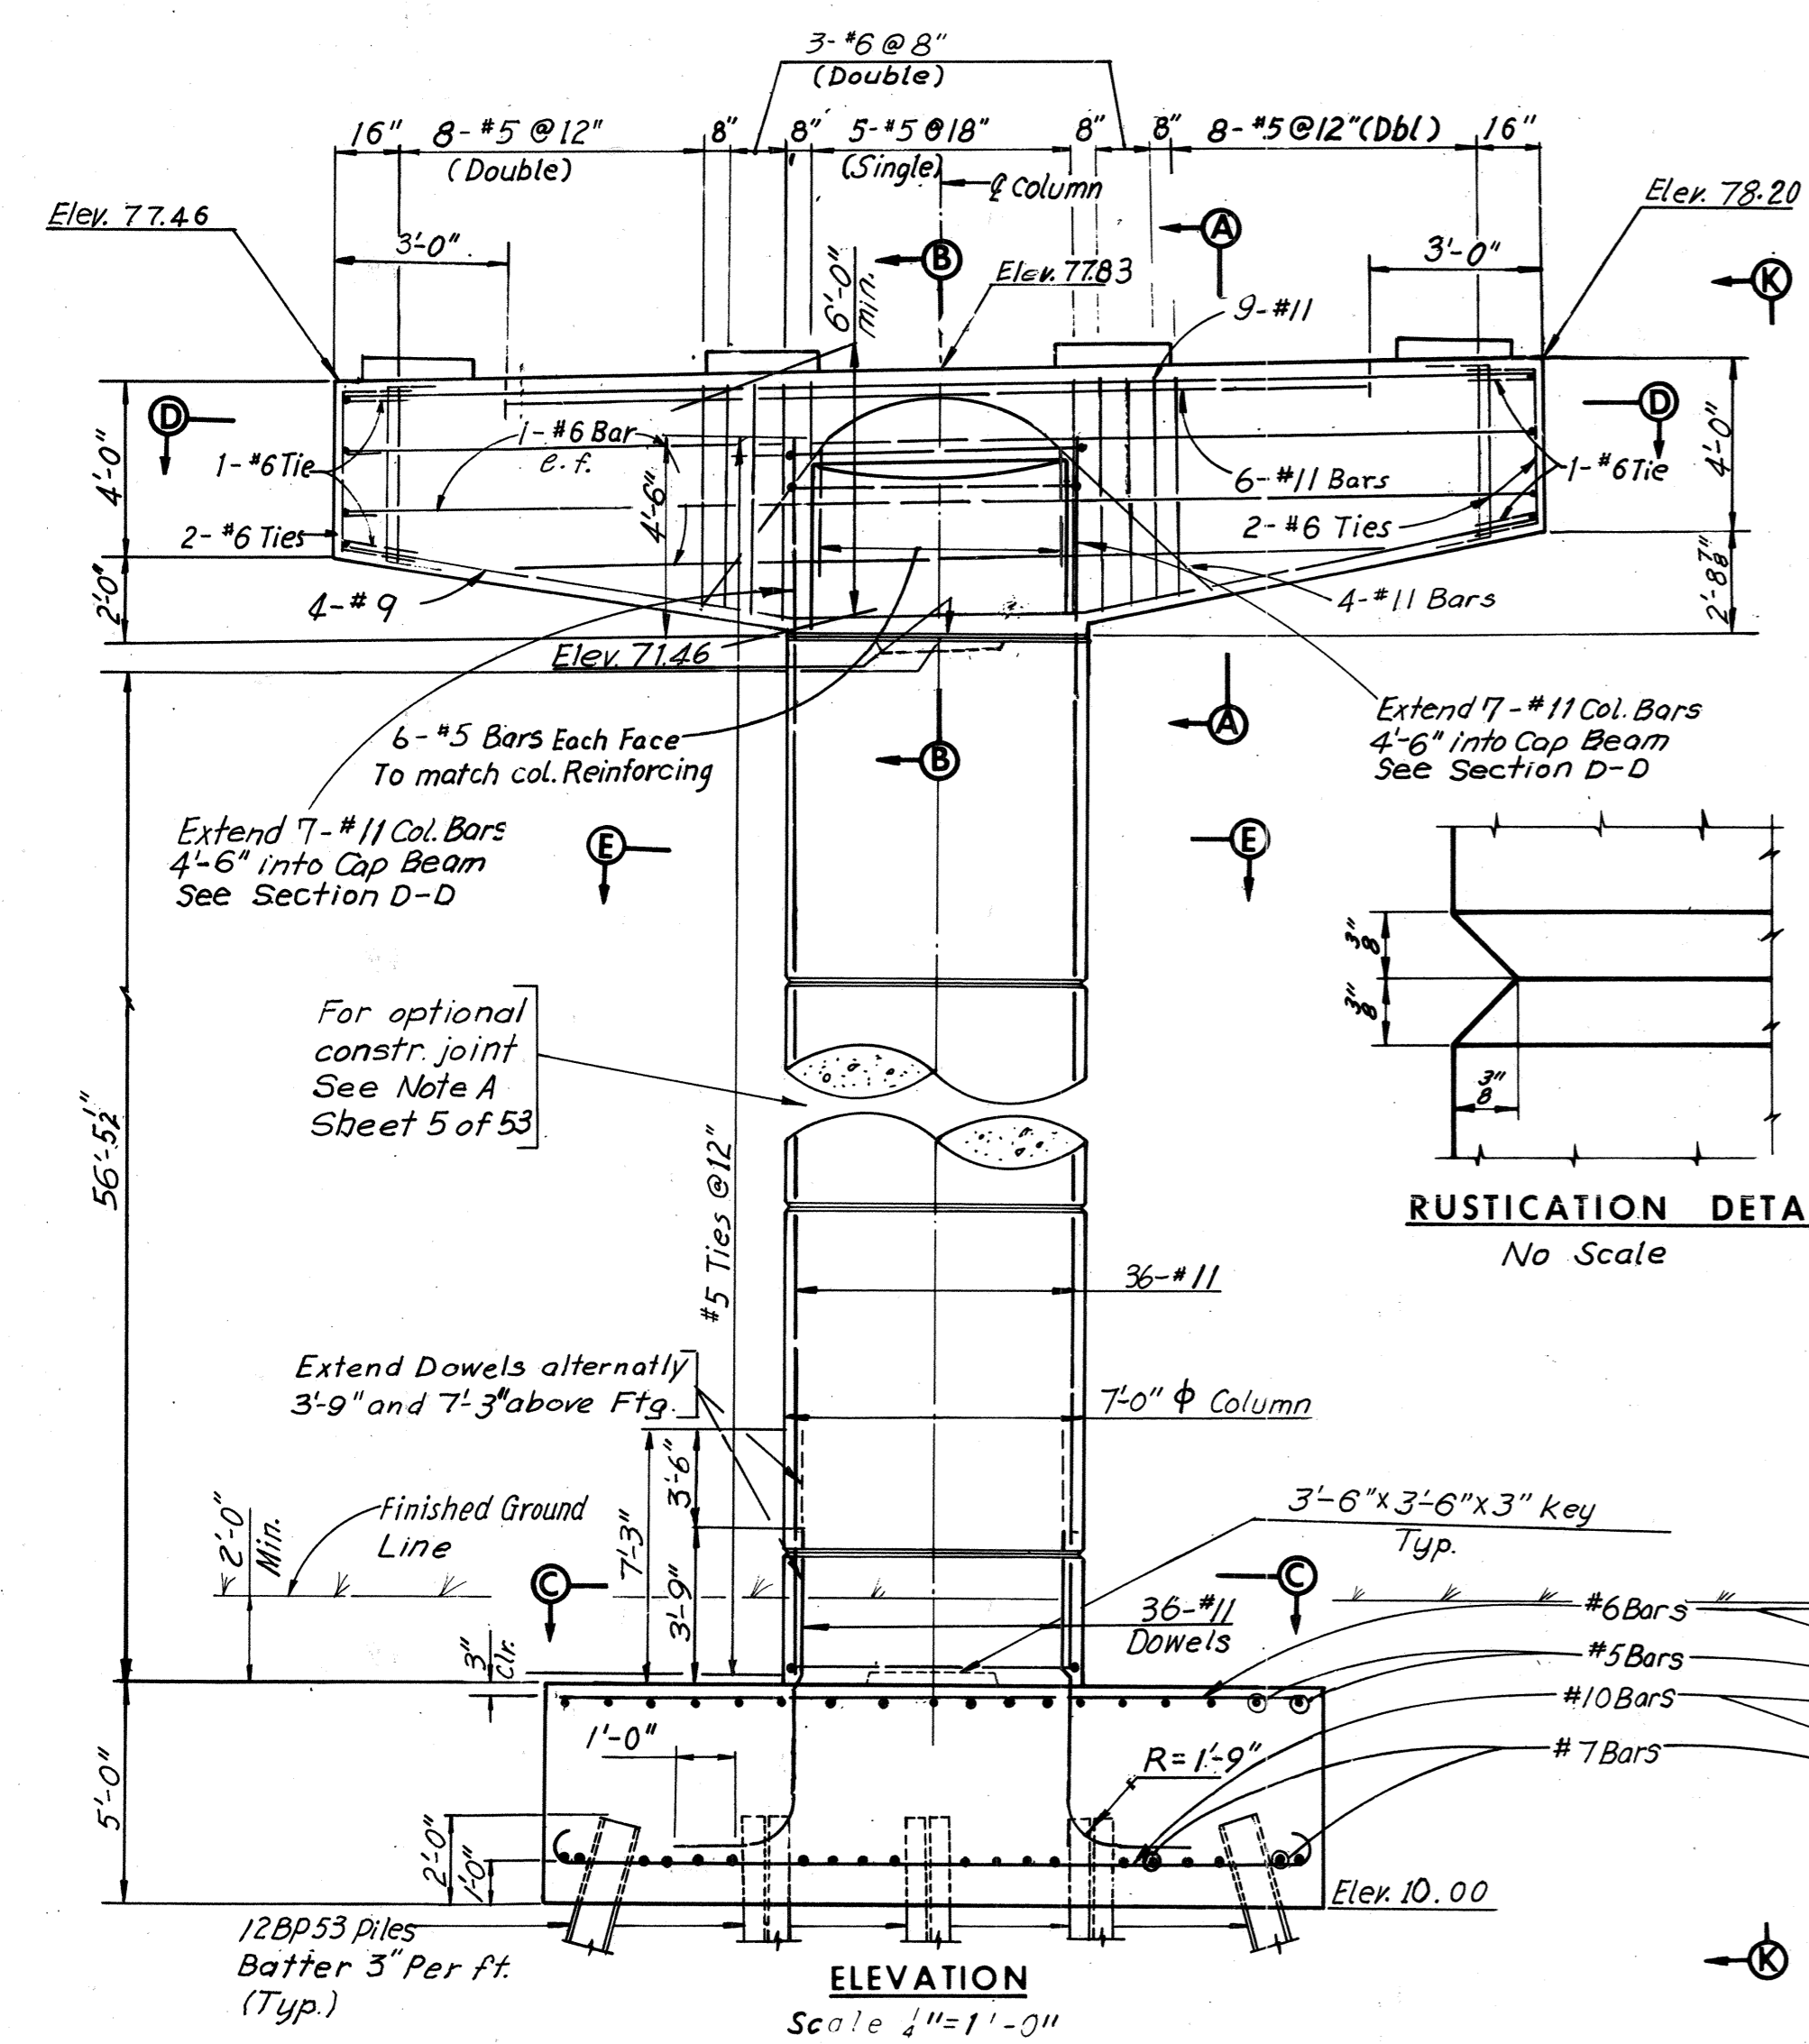

Note: Footing elevations are approximate only and may be varied to suit field conditions as directed by the Engineer. Vertical shaft reinforcing shall not be cut until these elevations are established. Where elevations change more than 2 ft. redesign will be required.

Note: All piles shall be 12BP53 Steel Piles (Design capacity = 57 tons). Batter all piles 3" per foot where shown. For Standard Shoe details, see Sheet S1. For Framing Plan, see Sheet 21 & 22. Estimated pile tip Elevation -15.00.

BY	DATE	REVISION	BY	DATE
MADE	GSH 9-12-68	2 A ₄ Built	TEM	6-77
CHECKED	YCP 5-13-69	Revise Pad Elev. Span B	D.M.R.	2-6-75
IN CHARGE				

AS BUILT











RICHMOND METROPOLITAN AUTHORITY
RICHMOND EXPRESSWAY SYSTEM
DOWNTOWN EXPRESSWAY

BRIDGE NO. 67
 RAMP W-N CONNECTION TO
 RICHMOND-PETERSBURG TURNPIKE
 PIER 7

HOWARD, NEEDLES, TAMMEN & BERGENDOFF
 consulting engineers
 NEW YORK ALEXANDRIA KANSAS CITY

SCALE: As Noted
 CONTRACT NO.: 10
 SHEET NO. 9 OF 54

RICHMOND EXPRESSWAY SYSTEM			
SECTION	PROJECT	SHEET NO.	TOTAL SHEETS
10	DOWNTOWN EXPRESSWAY	182	265

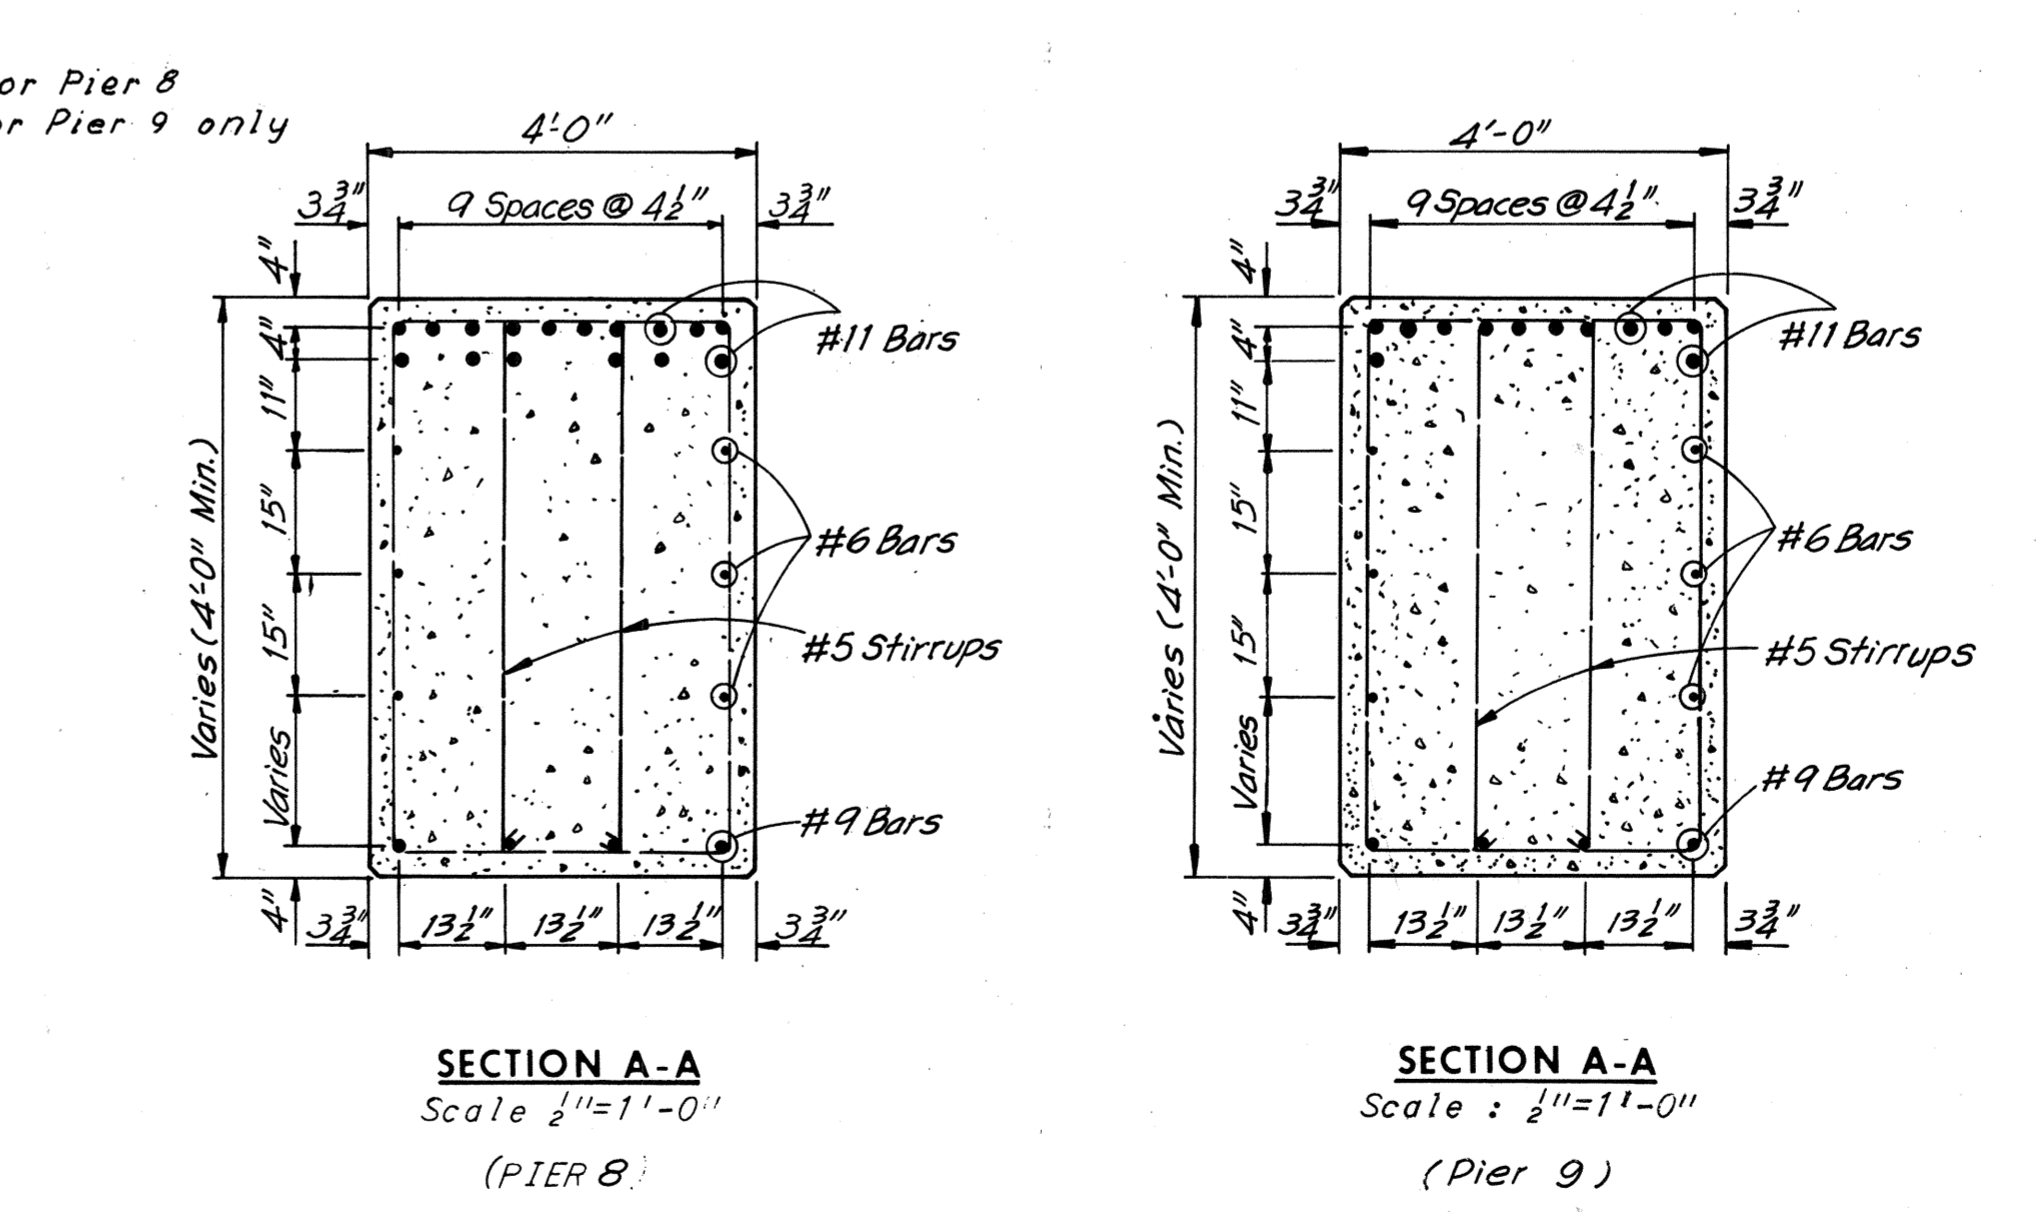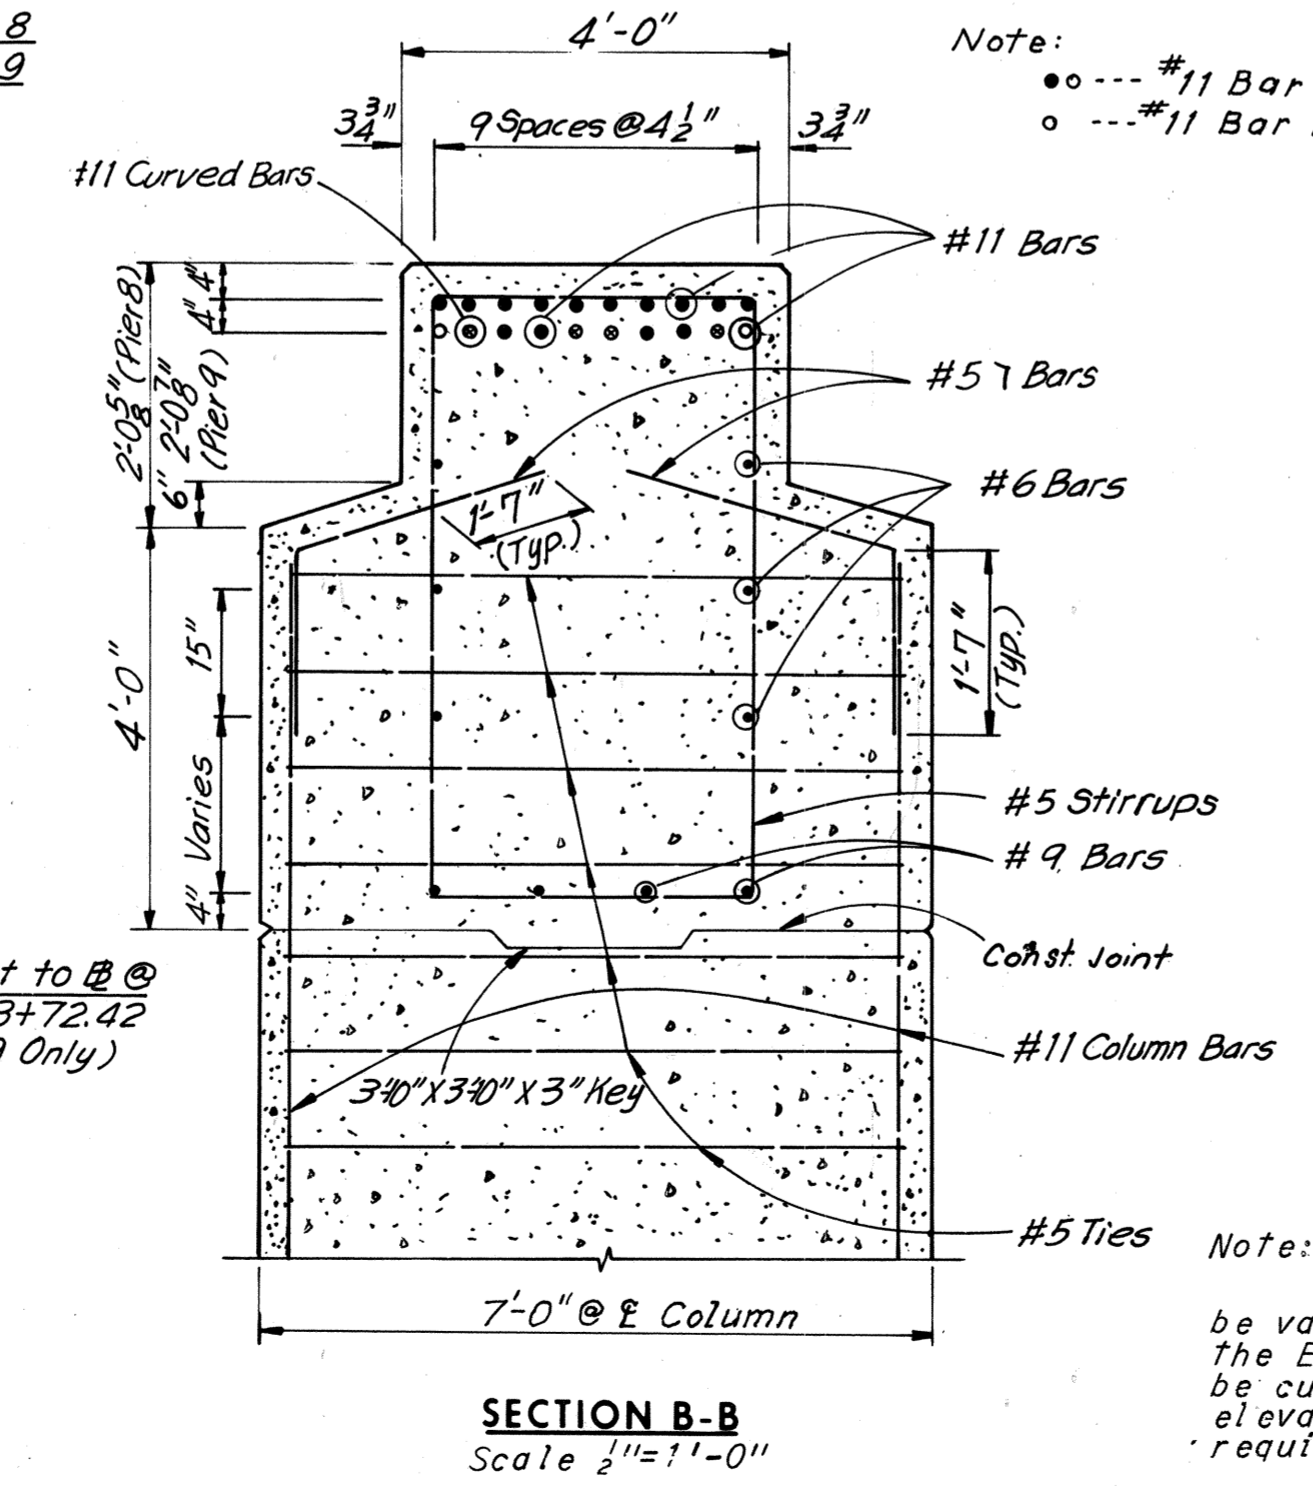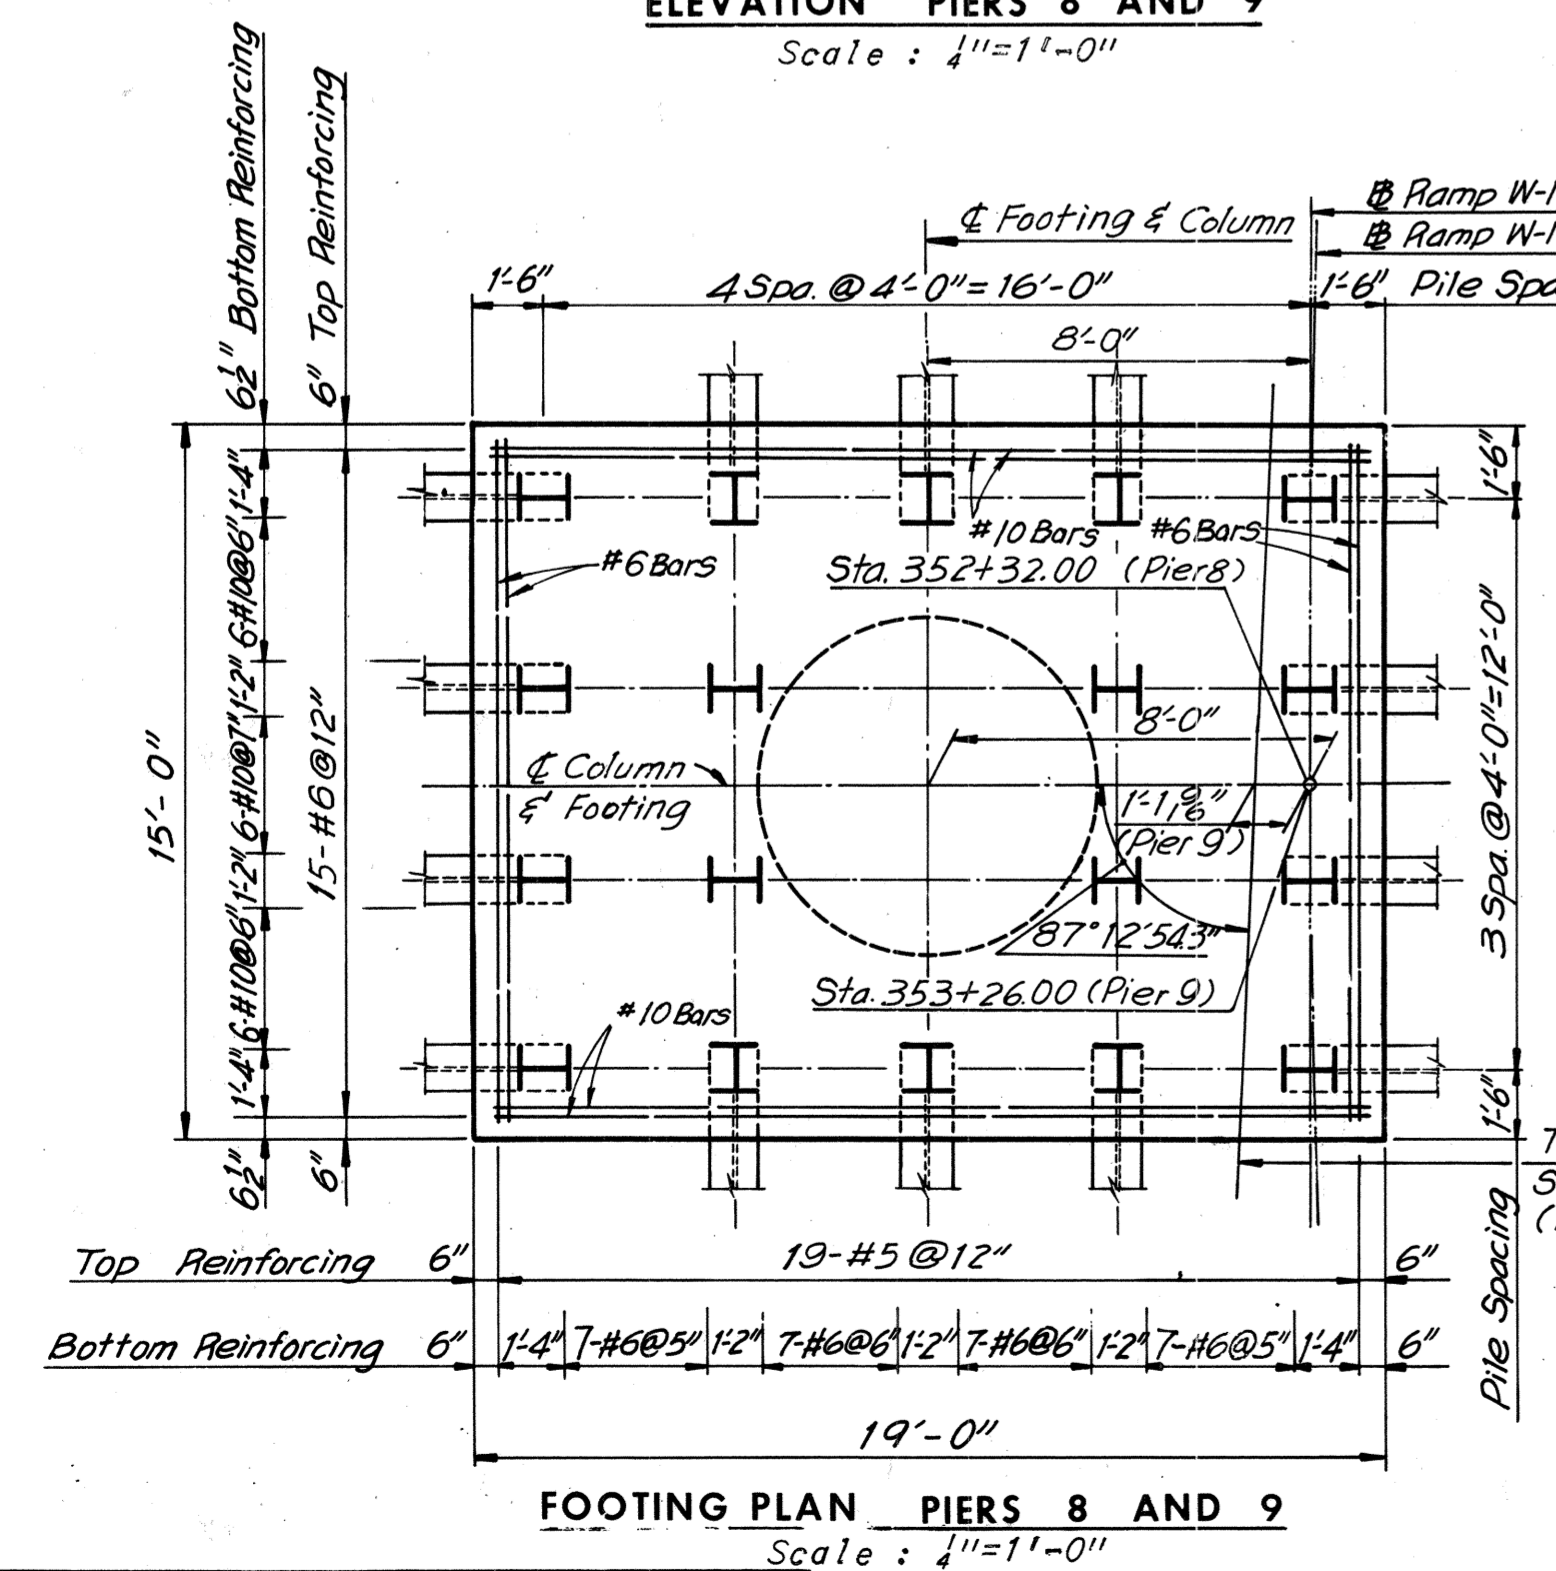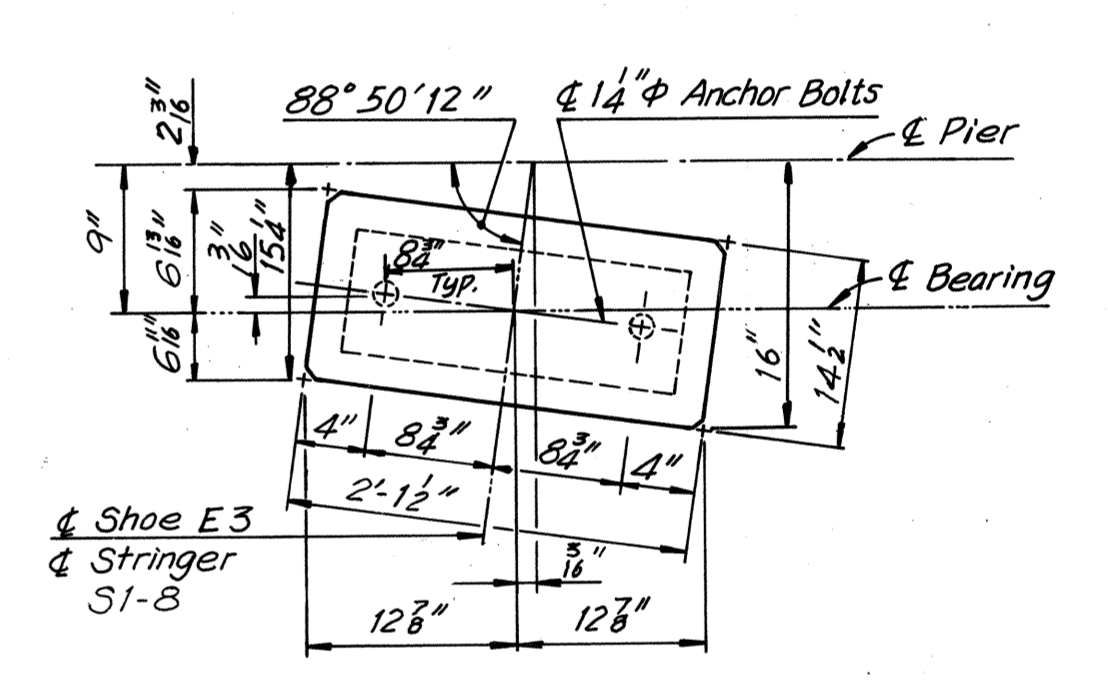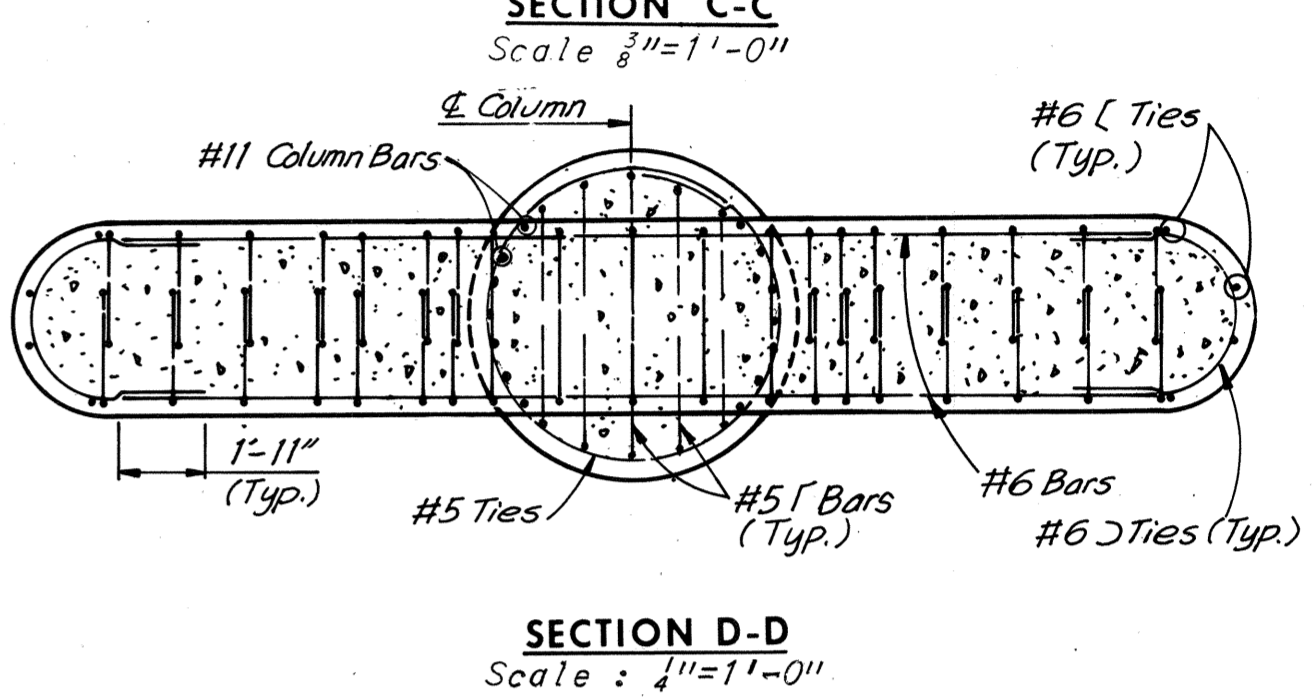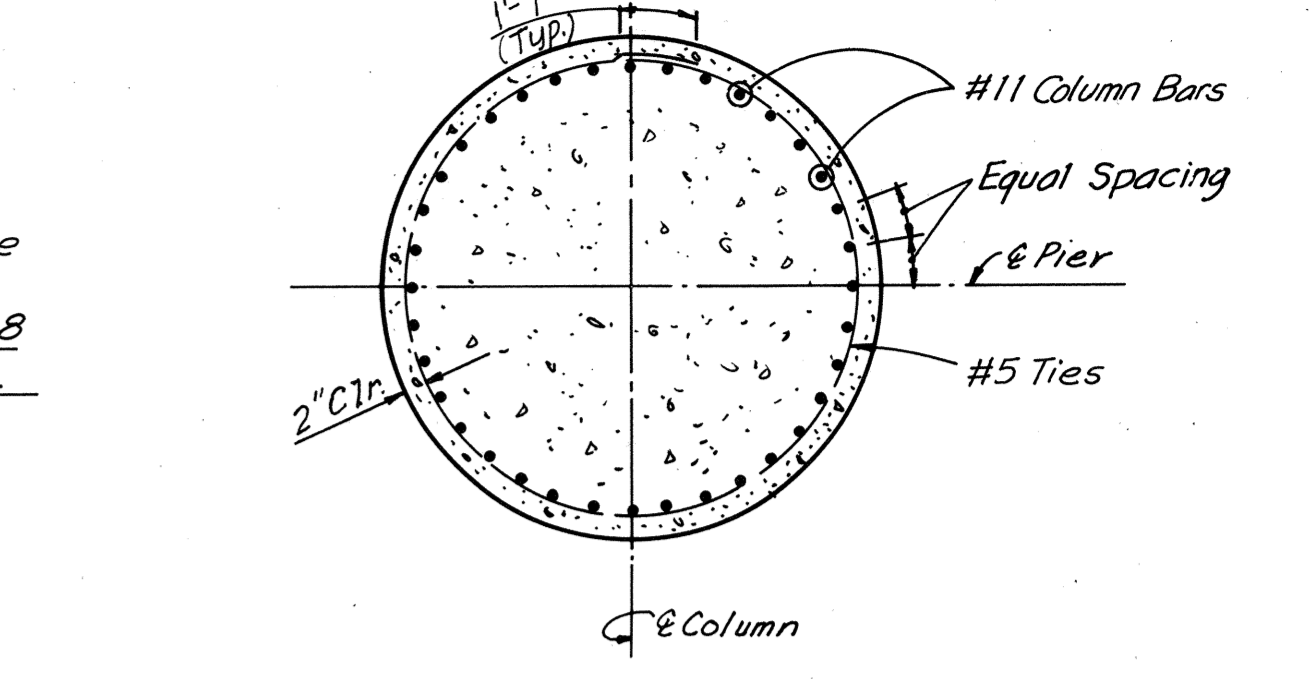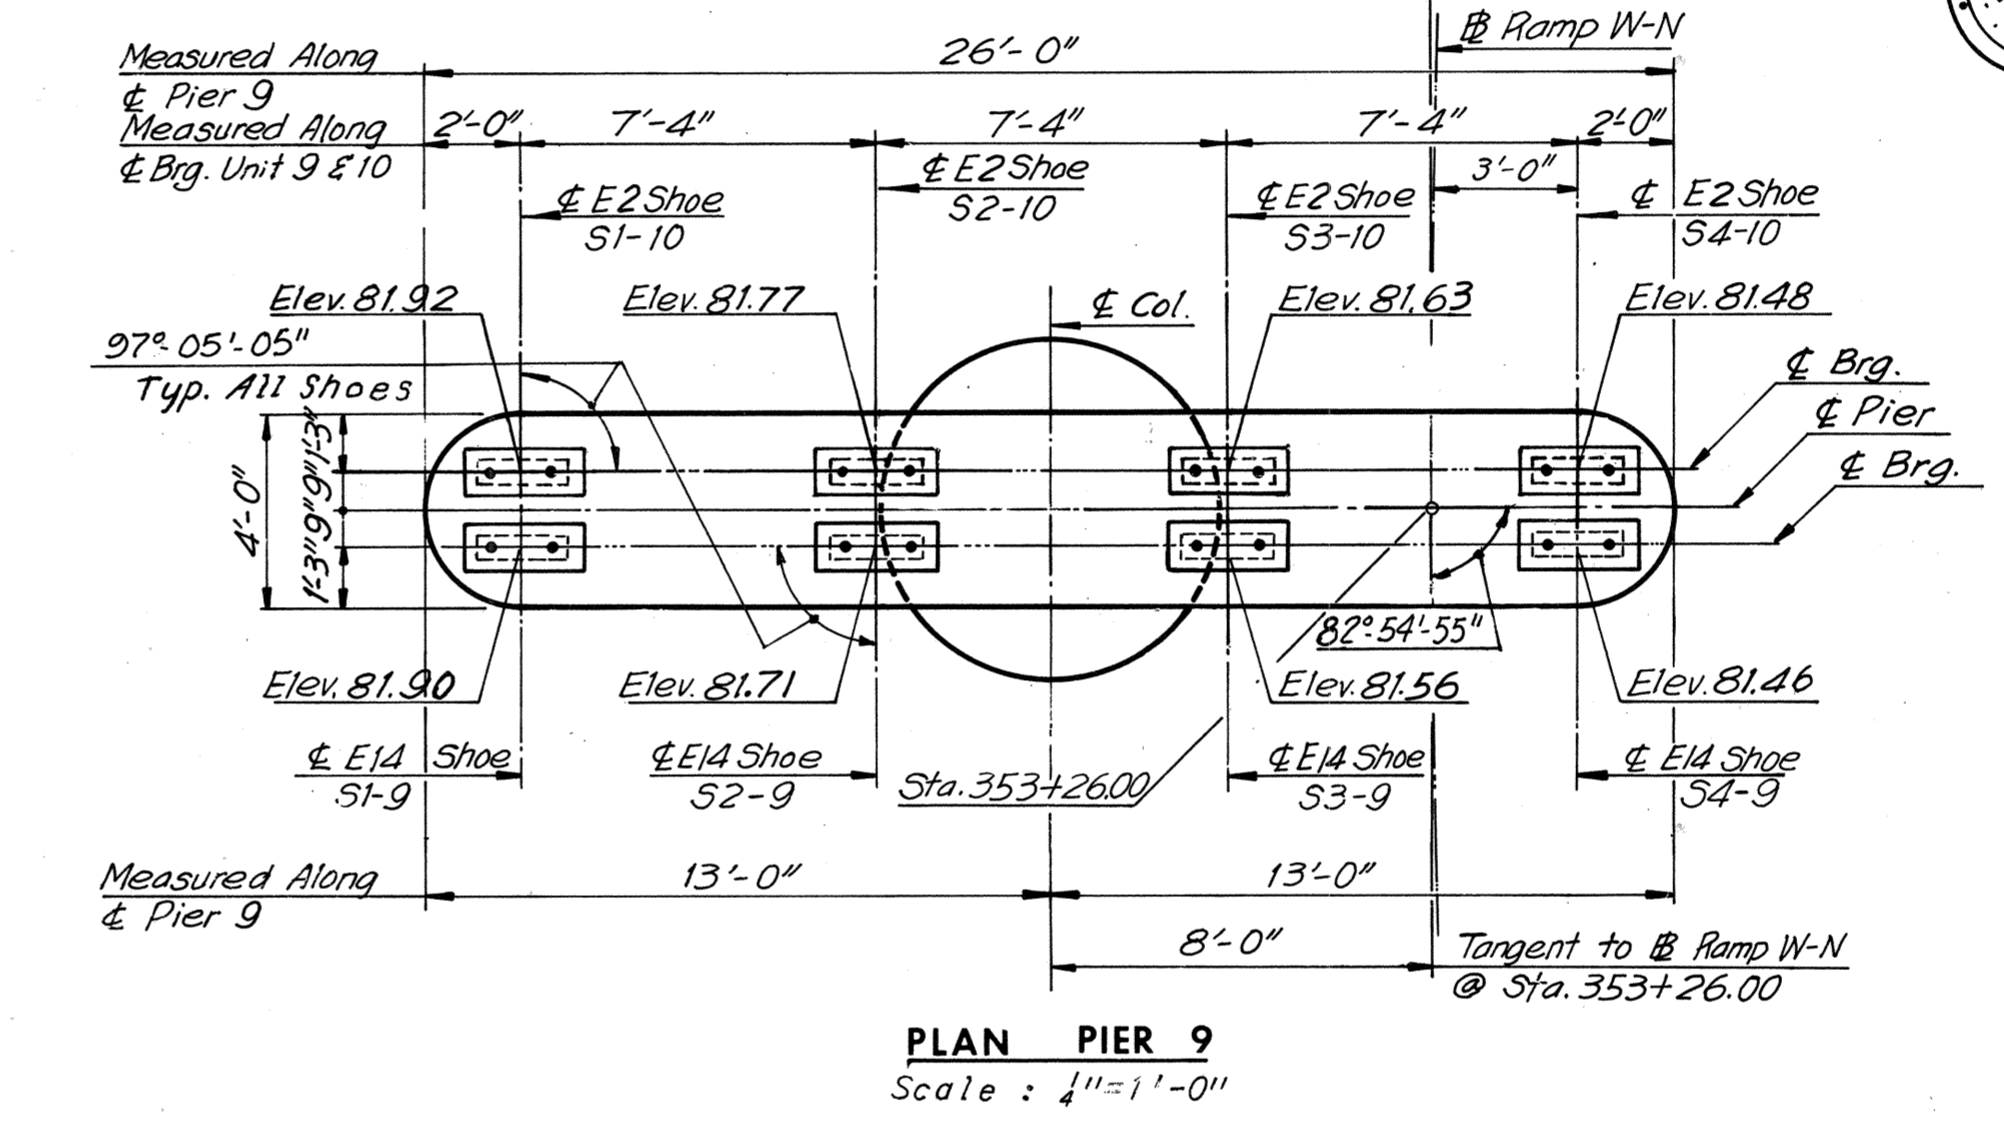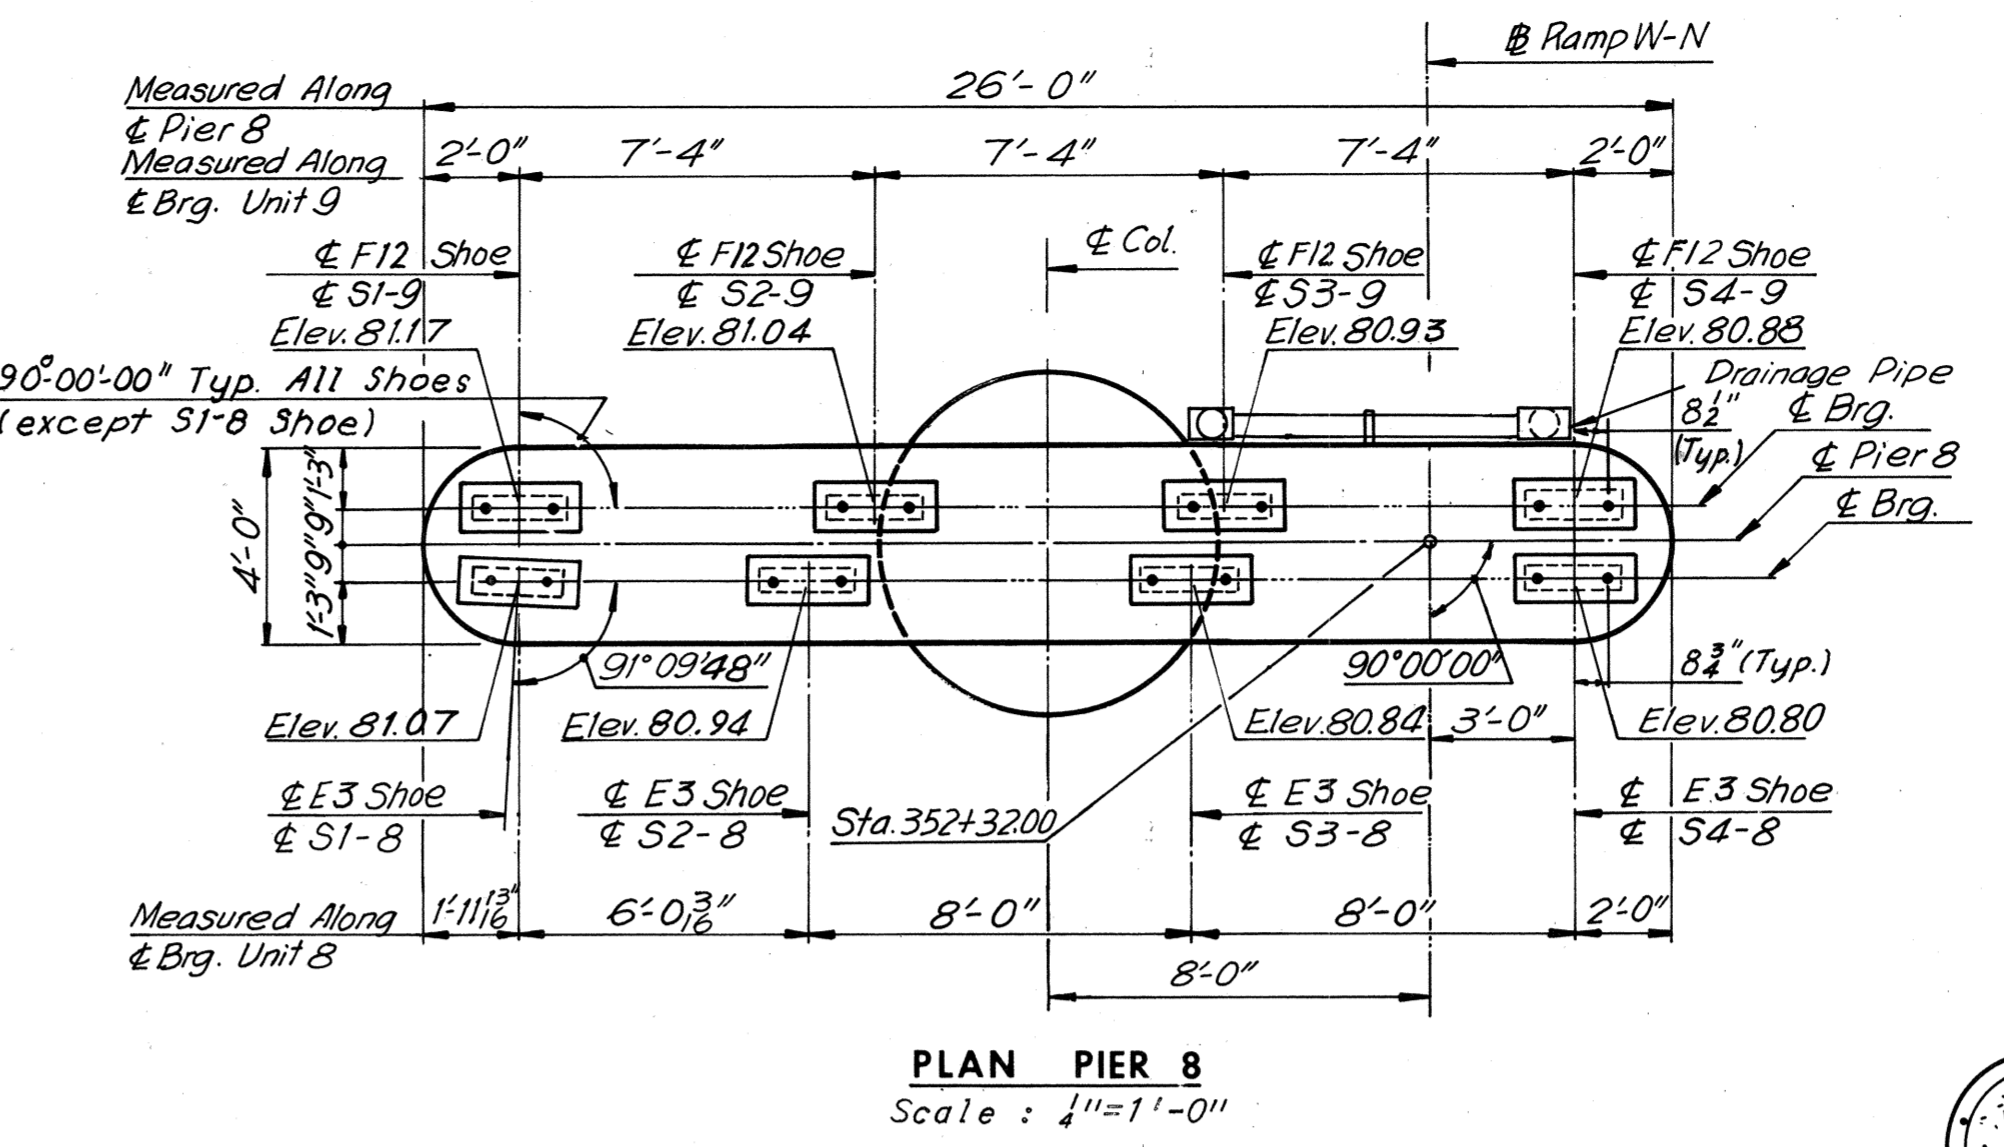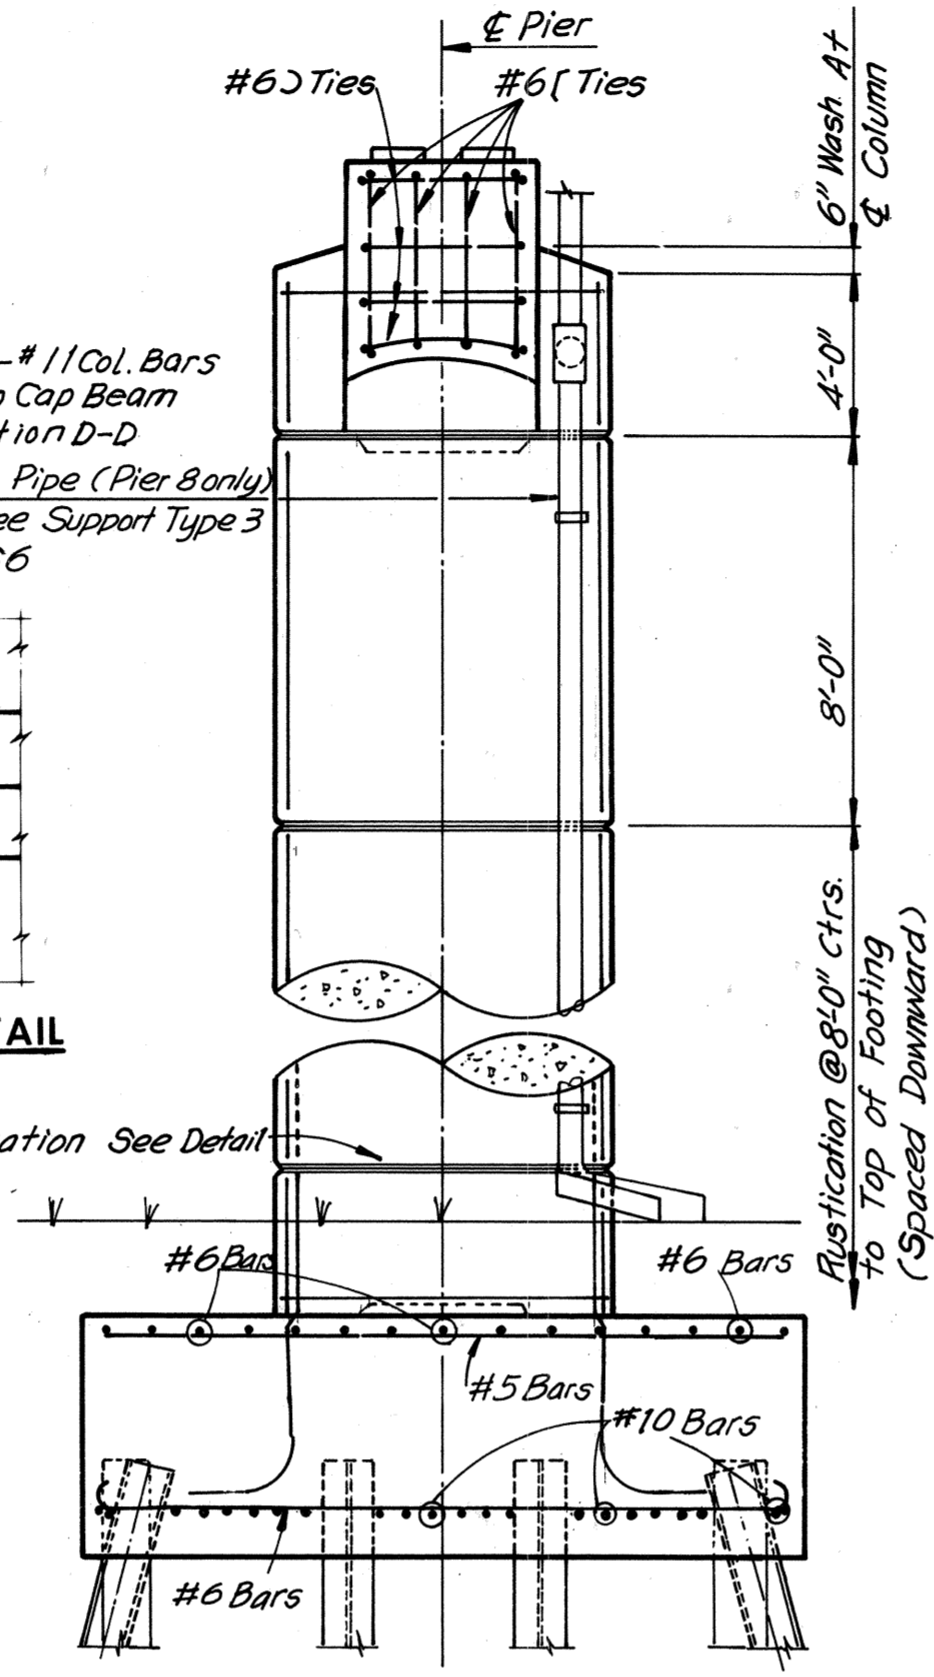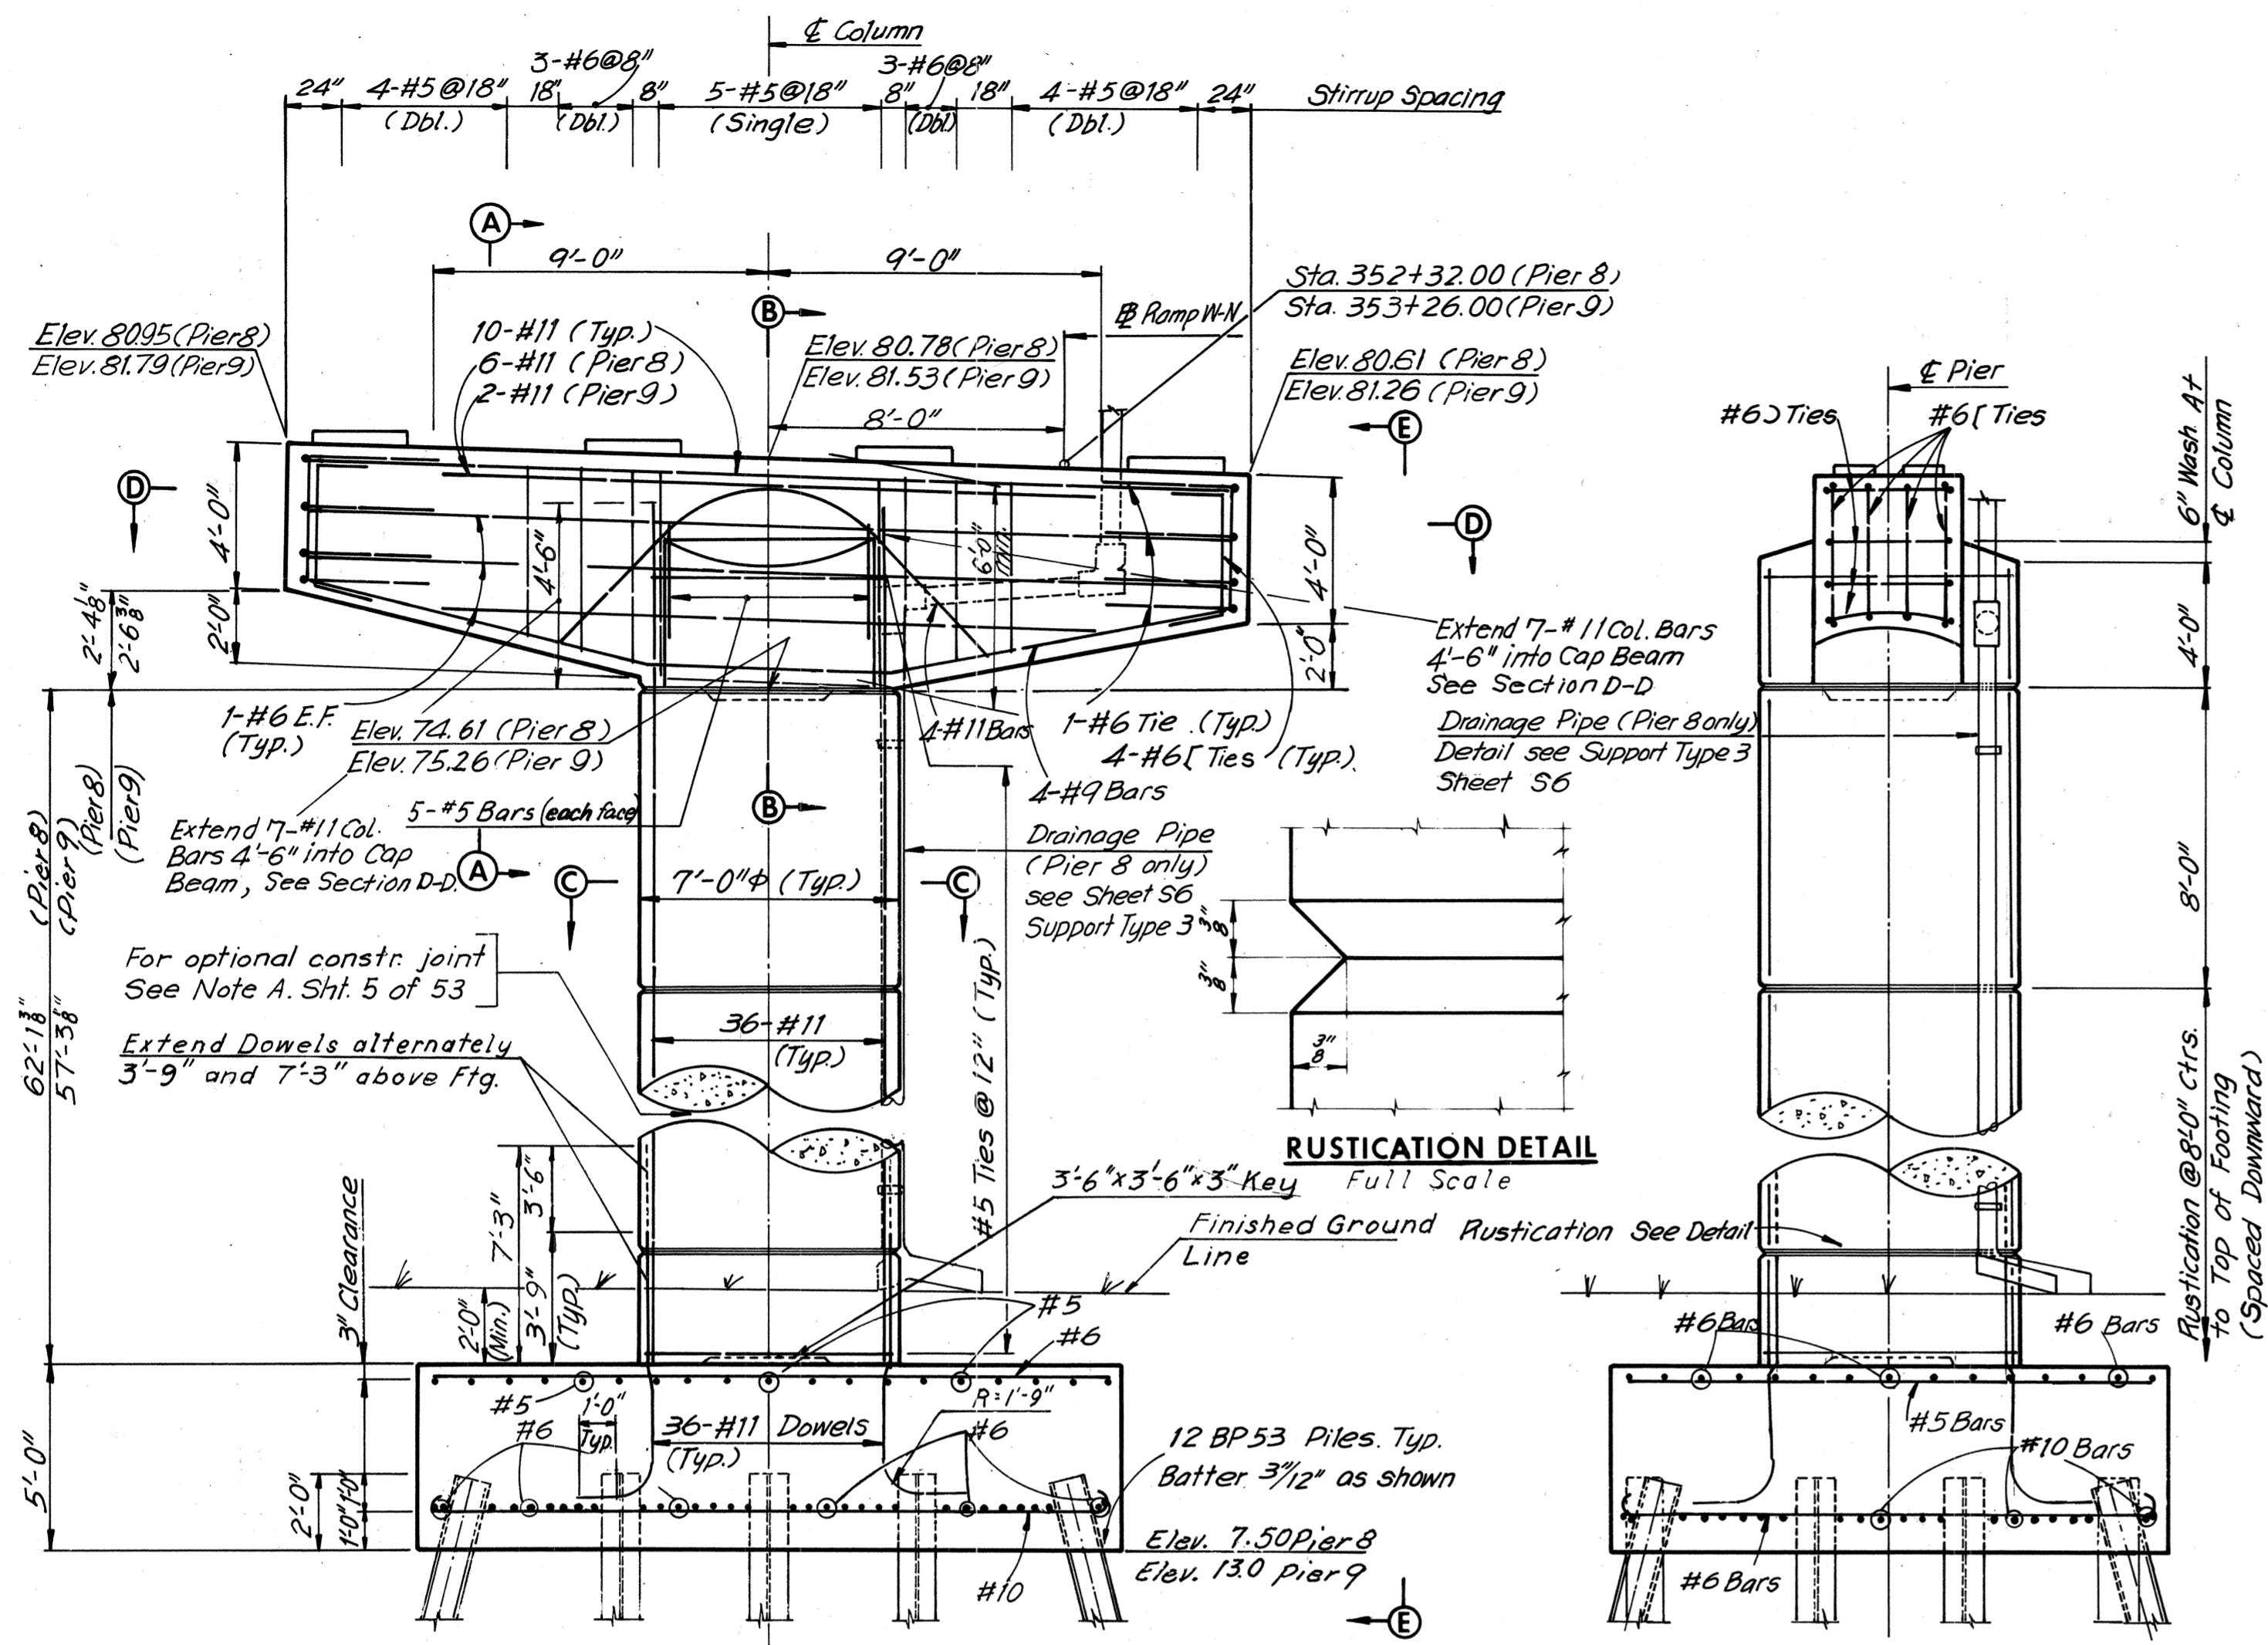

Note: Footing elevations are approximate only and may be varied to suit field conditions as directed by the Engineer. Vertical shaft reinforcing shall not be cut until these elevations are established. Where elevations change more than 2 ft. redesign will be required.

Note: Overexcavation will not be permitted between existing pier and new pier.

Note: All piles shall be 12BP53 Steel Piles. (Design capacity = 57 Tons.) For Standard Shoe Details, see Sheet S1 & S2. For Framing Plans, see Sheet 22 & 23. Estimated pile tip elevations:
Pier 8 = -11
Pier 9 = -7

AS BUILT

BY	DATE	REVISION	BY	DATE
MADE	SCC	2	As Built	6-77
CHECKED	PTA	1	REVISED AND ELEV. S2-B & S3-B	2-4-75
IN CHARGE				

RICHMOND METROPOLITAN AUTHORITY
RICHMOND EXPRESSWAY SYSTEM
DOWNTOWN EXPRESSWAY









BRIDGE NO. 67
RAMP W-N CONNECTION TO
RICHMOND-PETERSBURG TURNPIKE
PIERS 8 AND 9

HOWARD, NEEDLES, TAMMEN & BERGENDOFF
consulting engineers
NEW YORK ALEXANDRIA KANSAS CITY

SCALE: As Noted
CONTRACT NO.: 10
SHEET NO. 10 OF 54

RICHMOND EXPRESSWAY SYSTEM			
SECTION	PROJECT	SHEET NO.	TOTAL SHEETS
10	DOWNTOWN EXPRESSWAY	183	265

Note: All Steel shall be A36 except otherwise shown.
 Pile Tip Elev. -7.00
 Batter exterior piles 2" per foot in direction shown.
 All piles shall be 12BP53 Steel Piles (Design Cap. = 57 Tons).

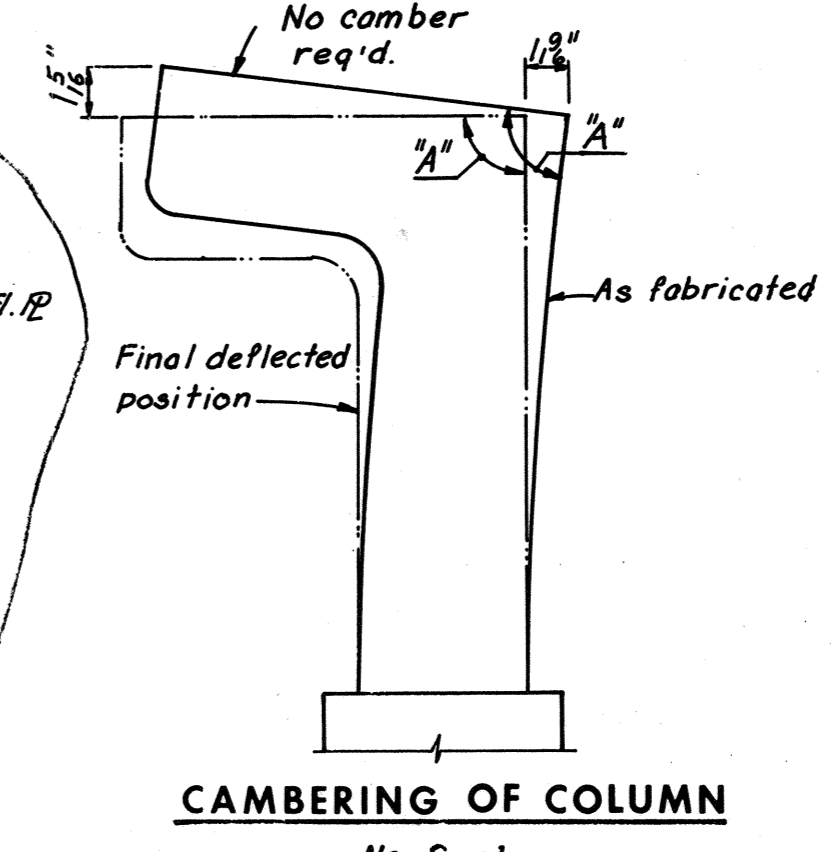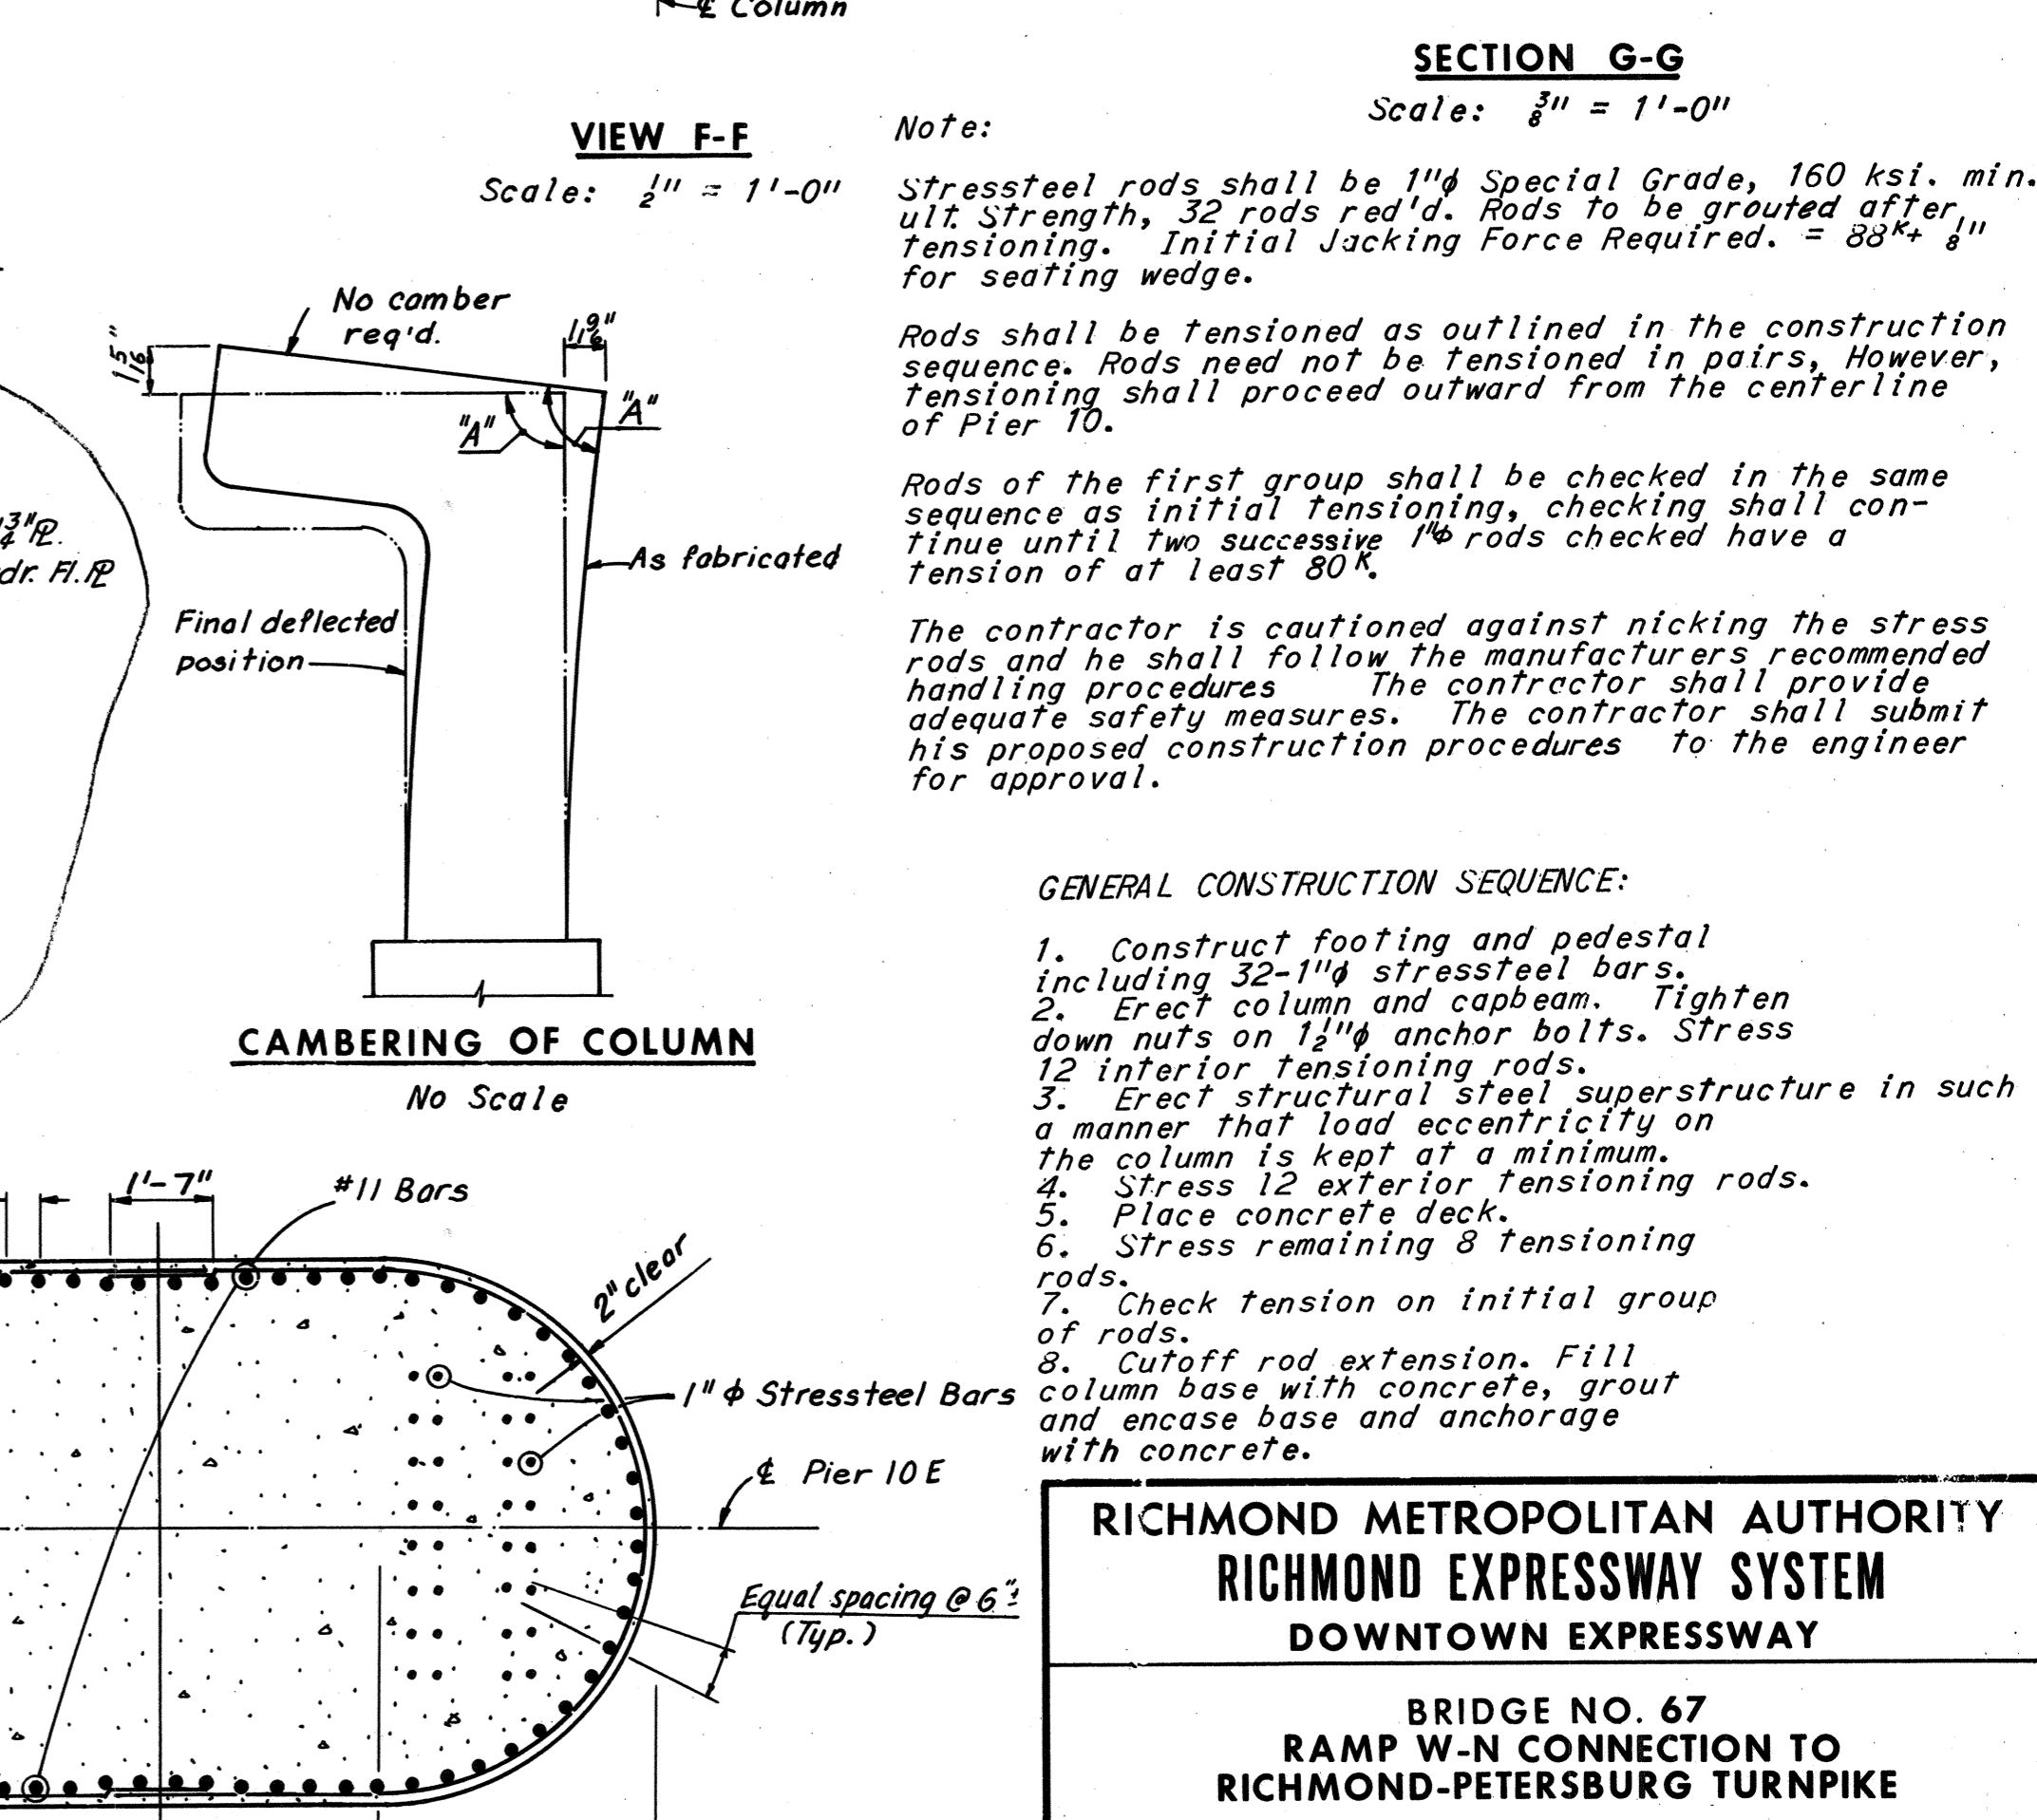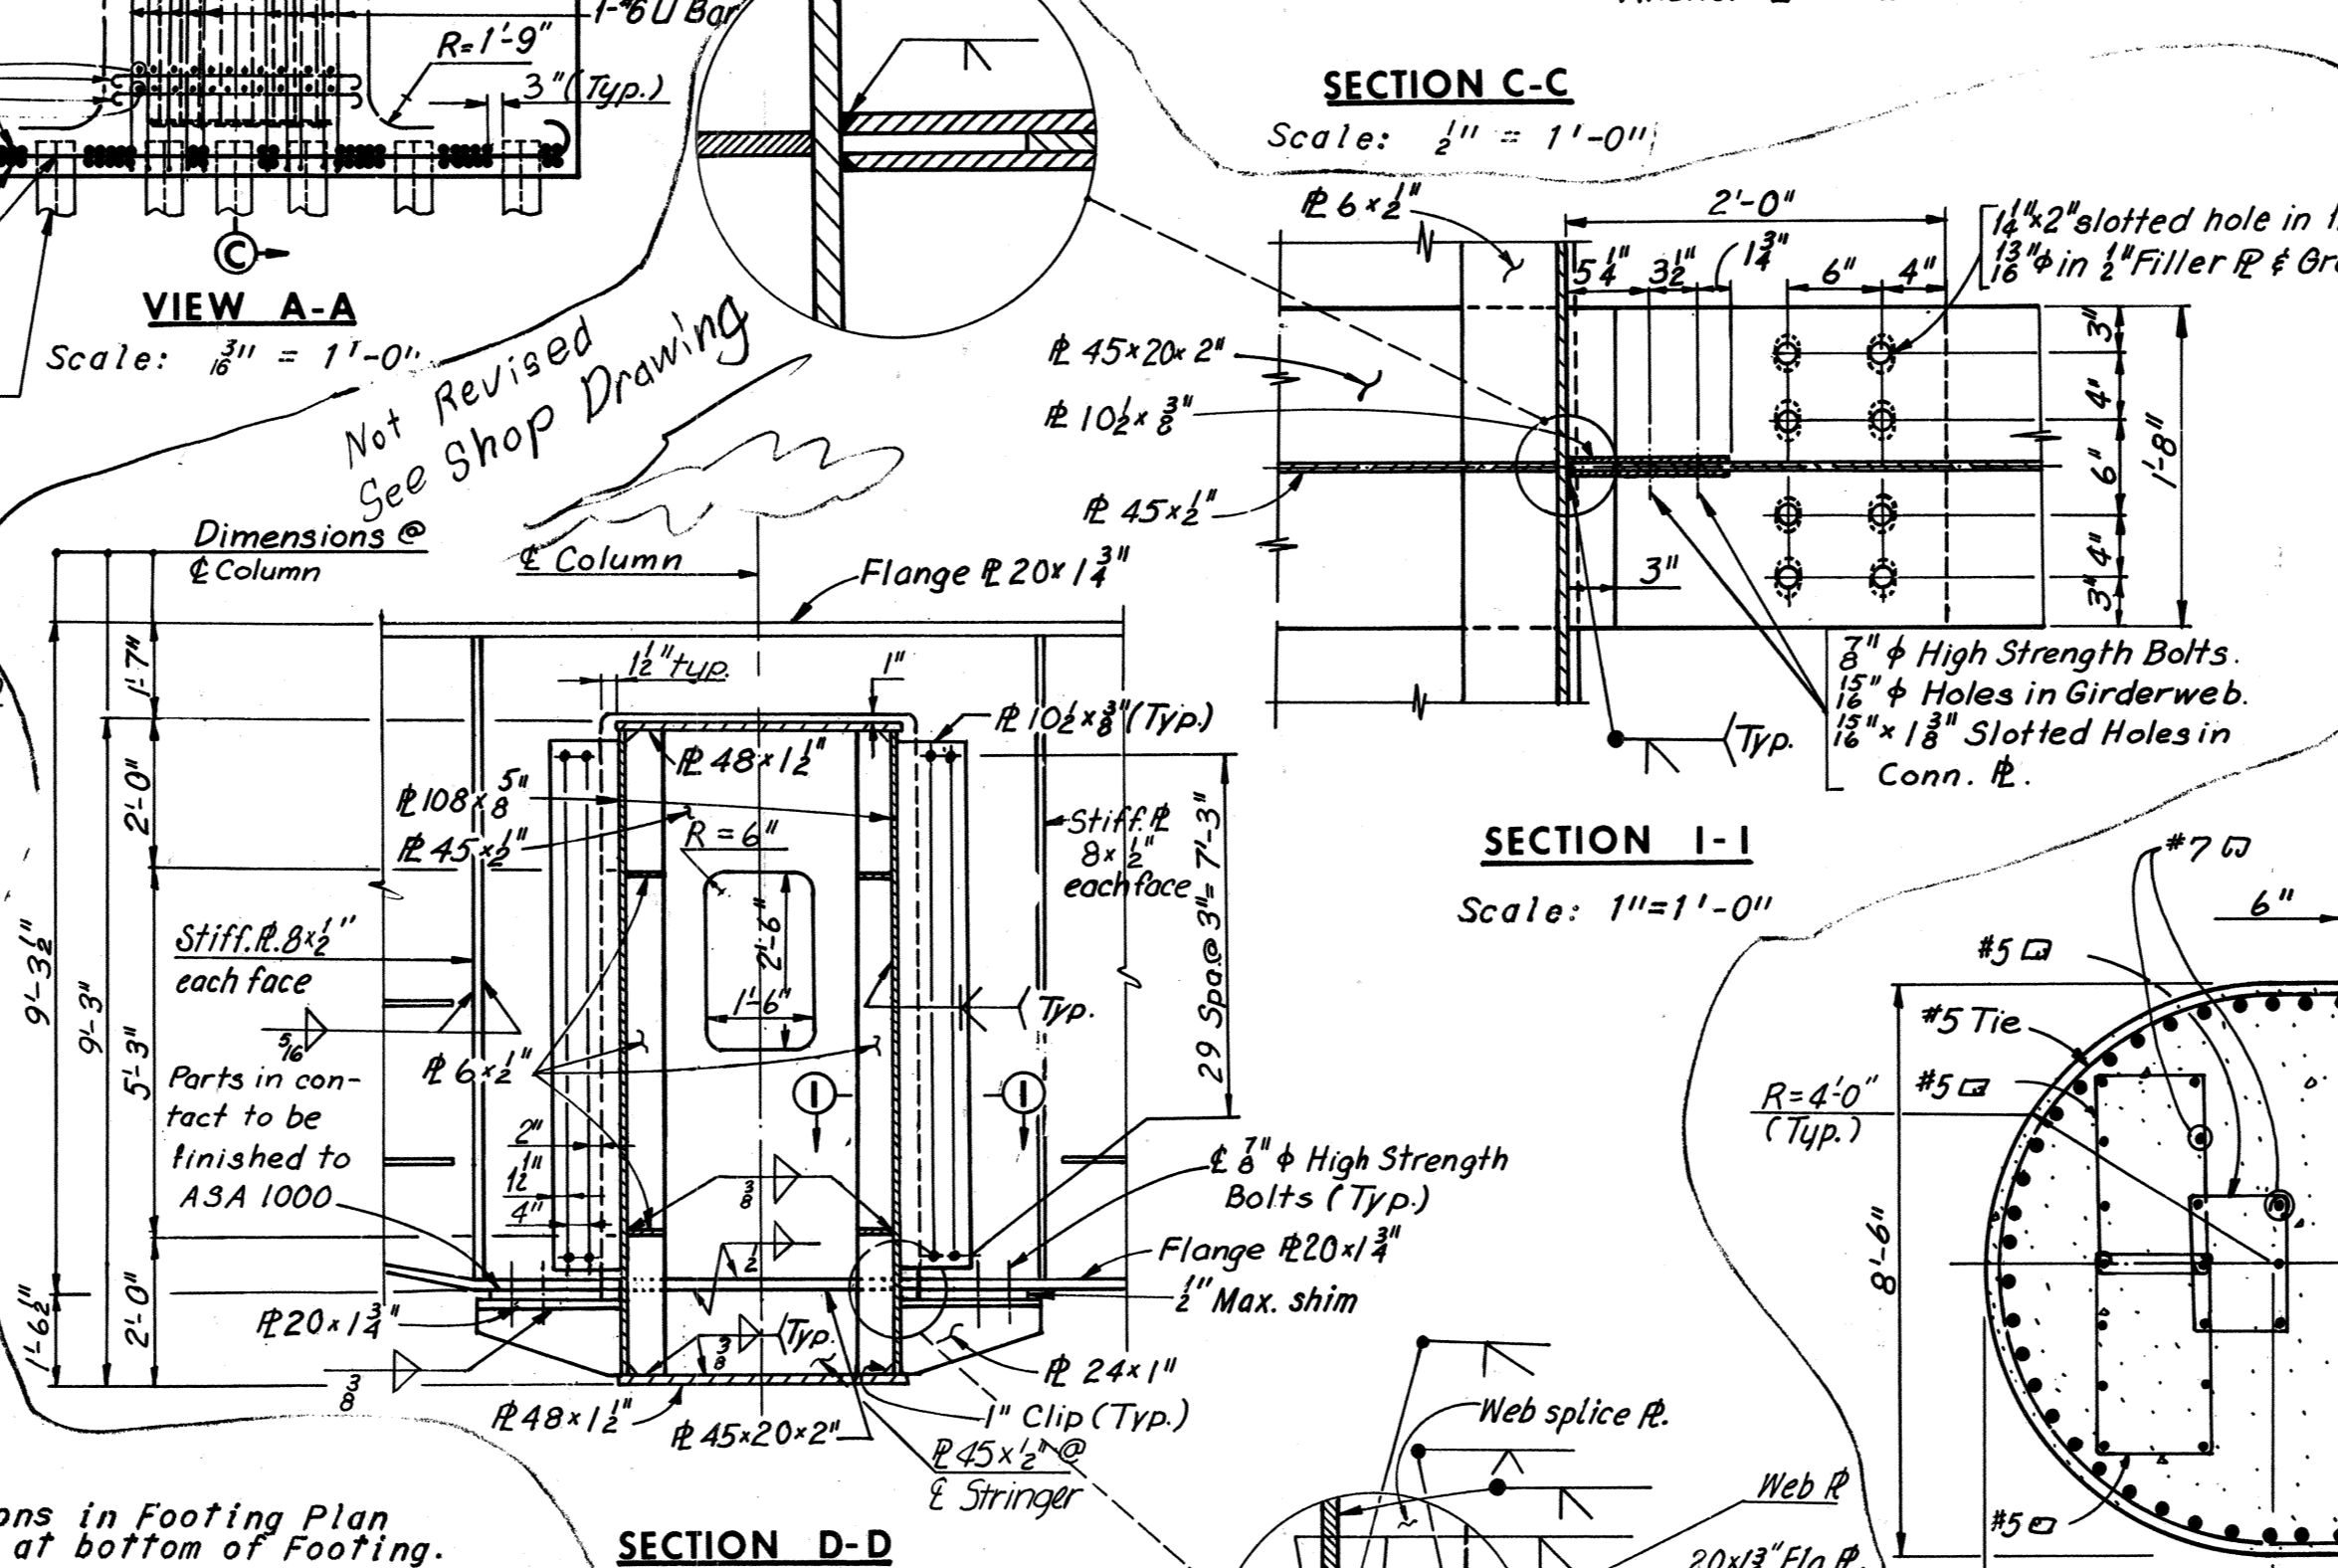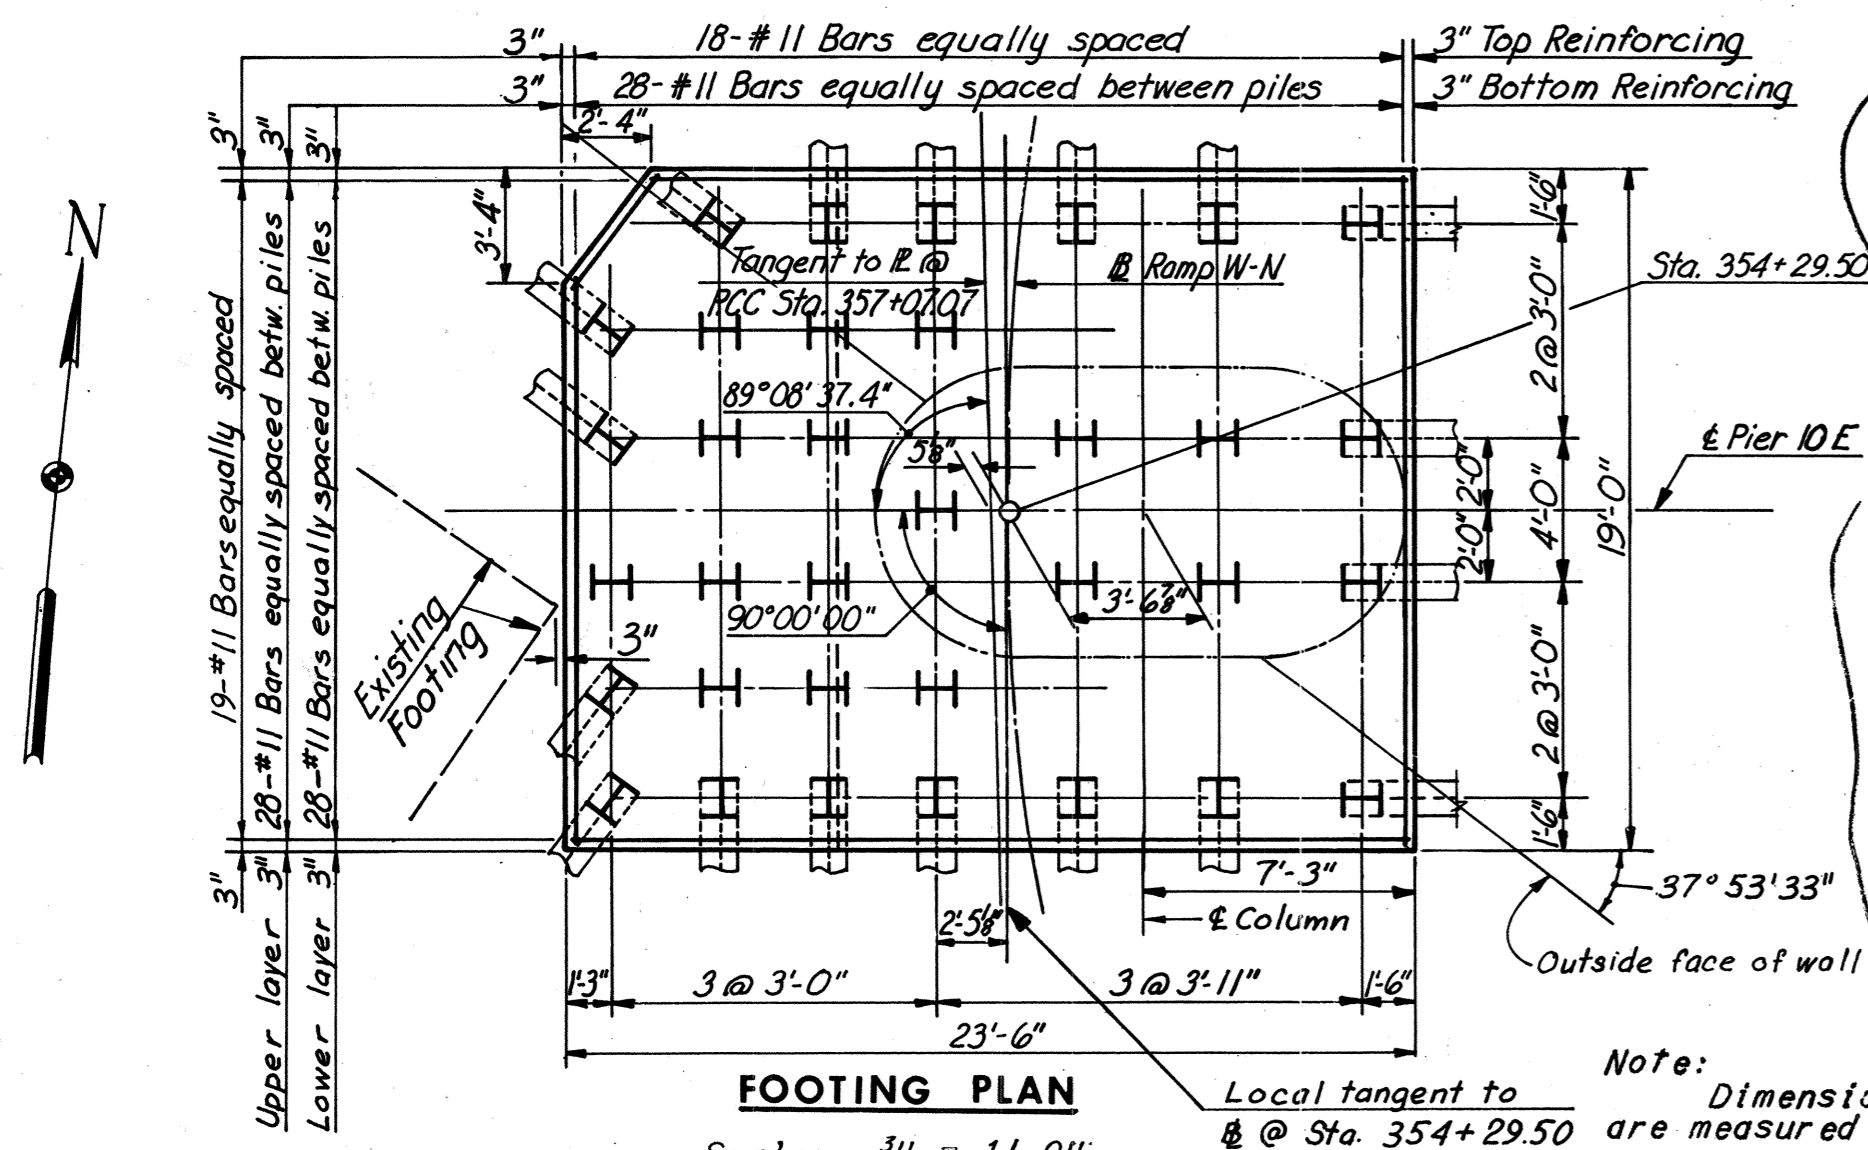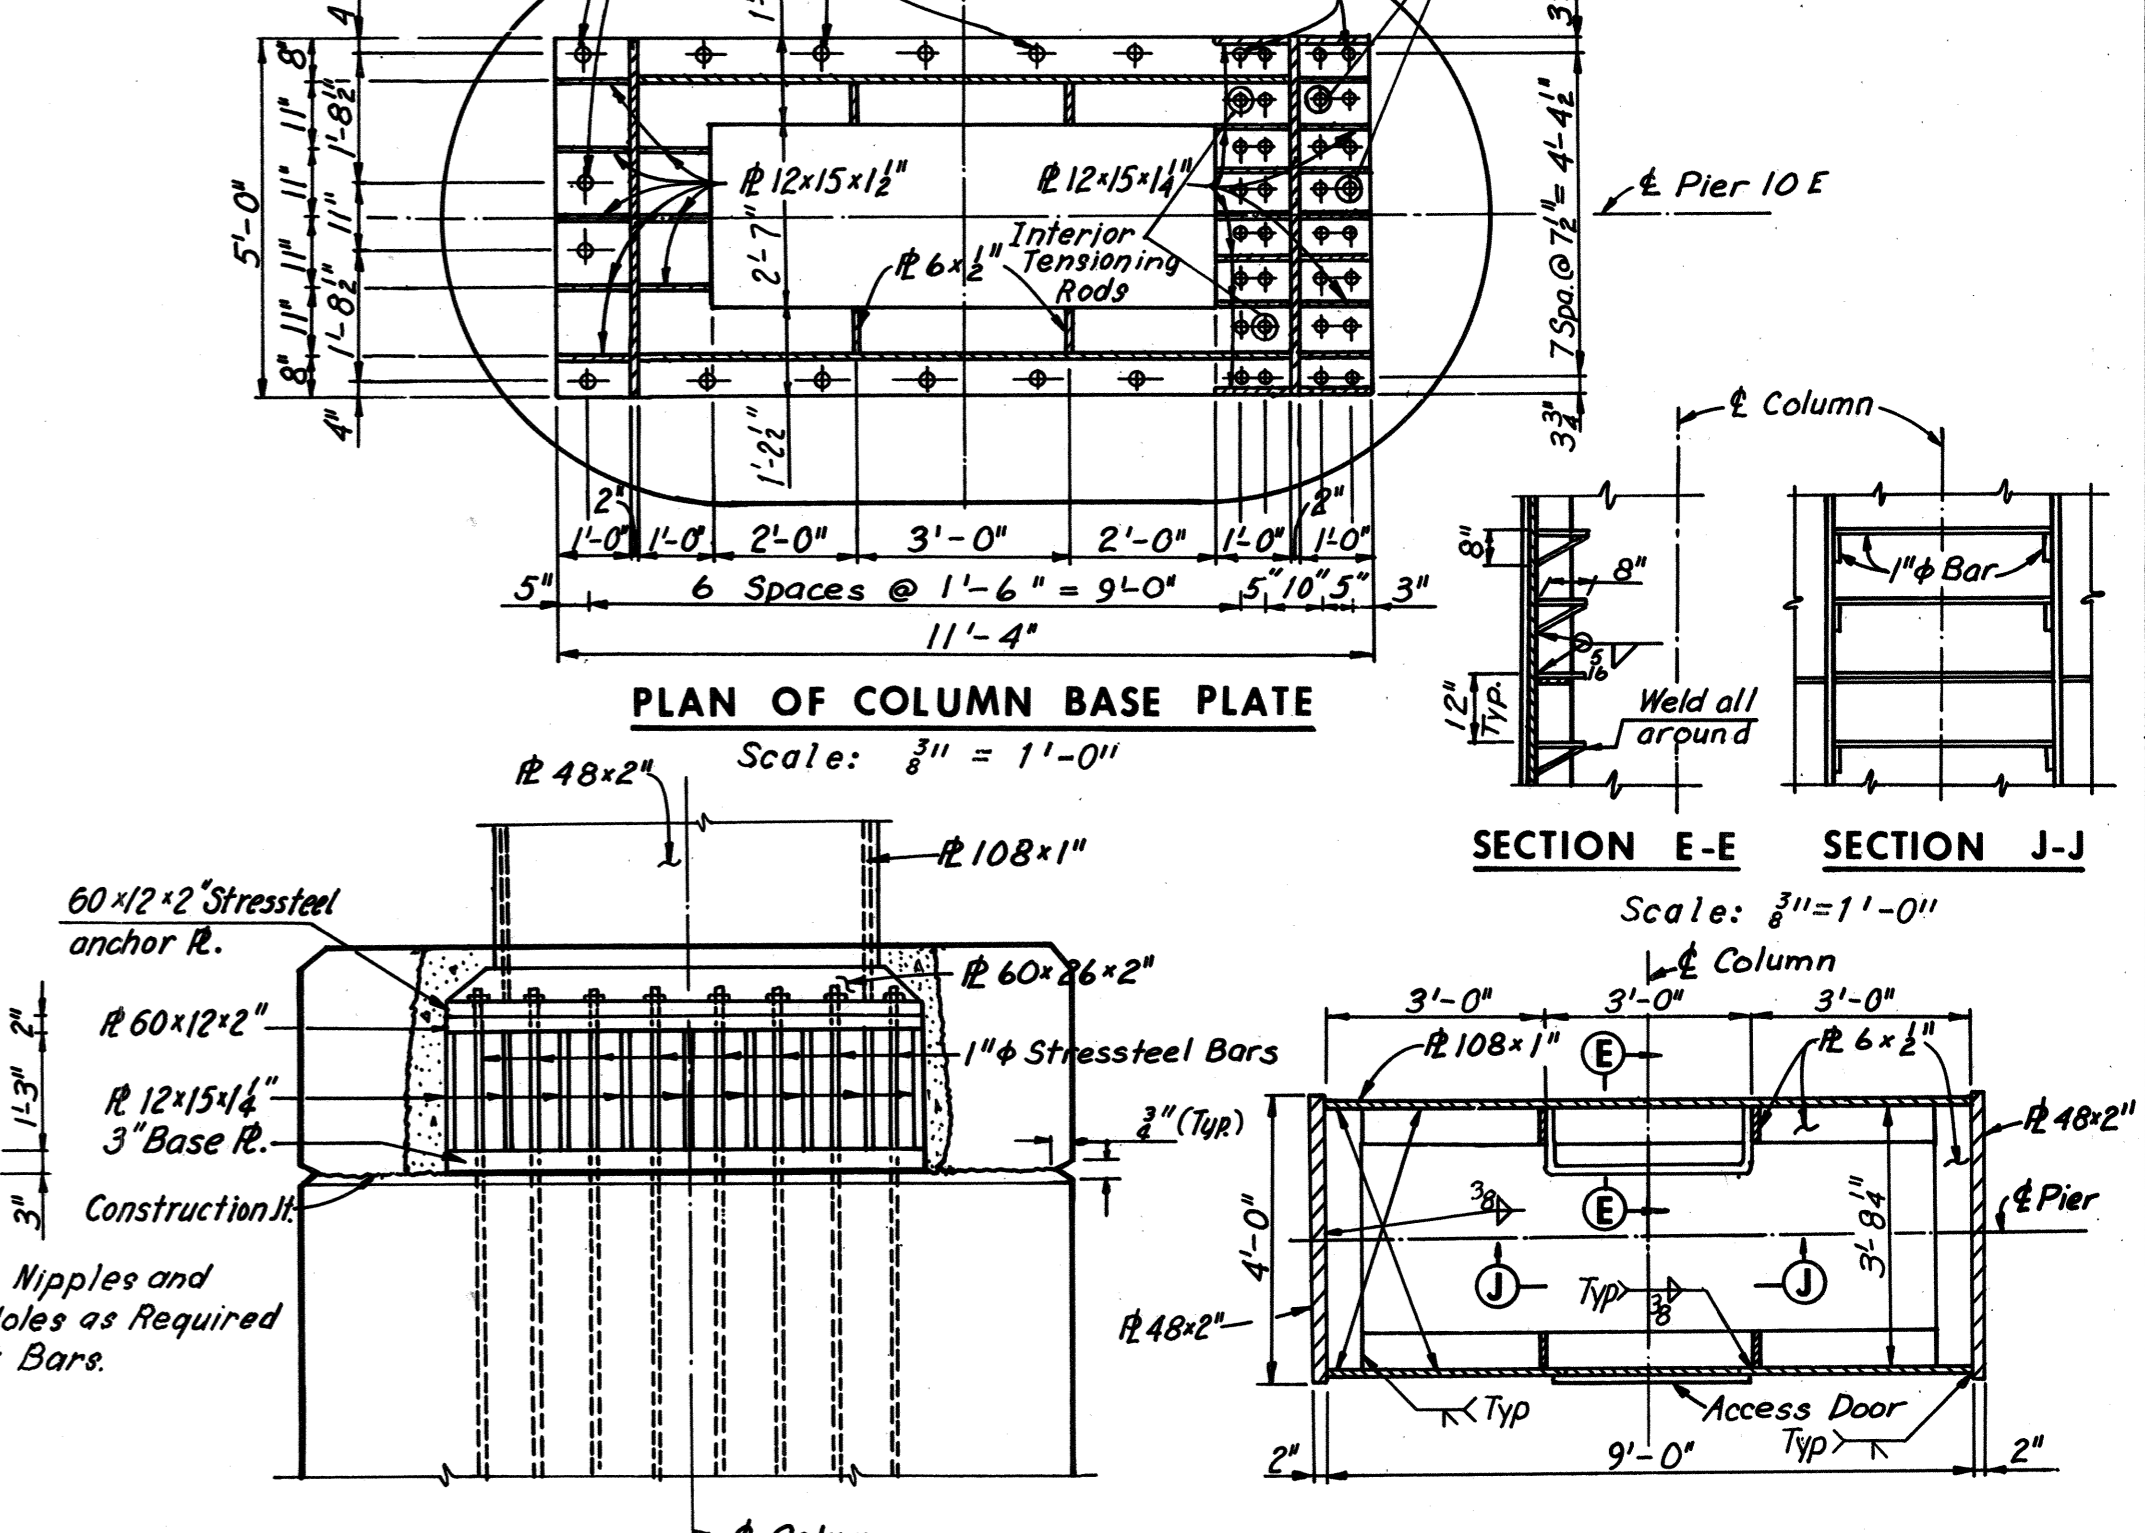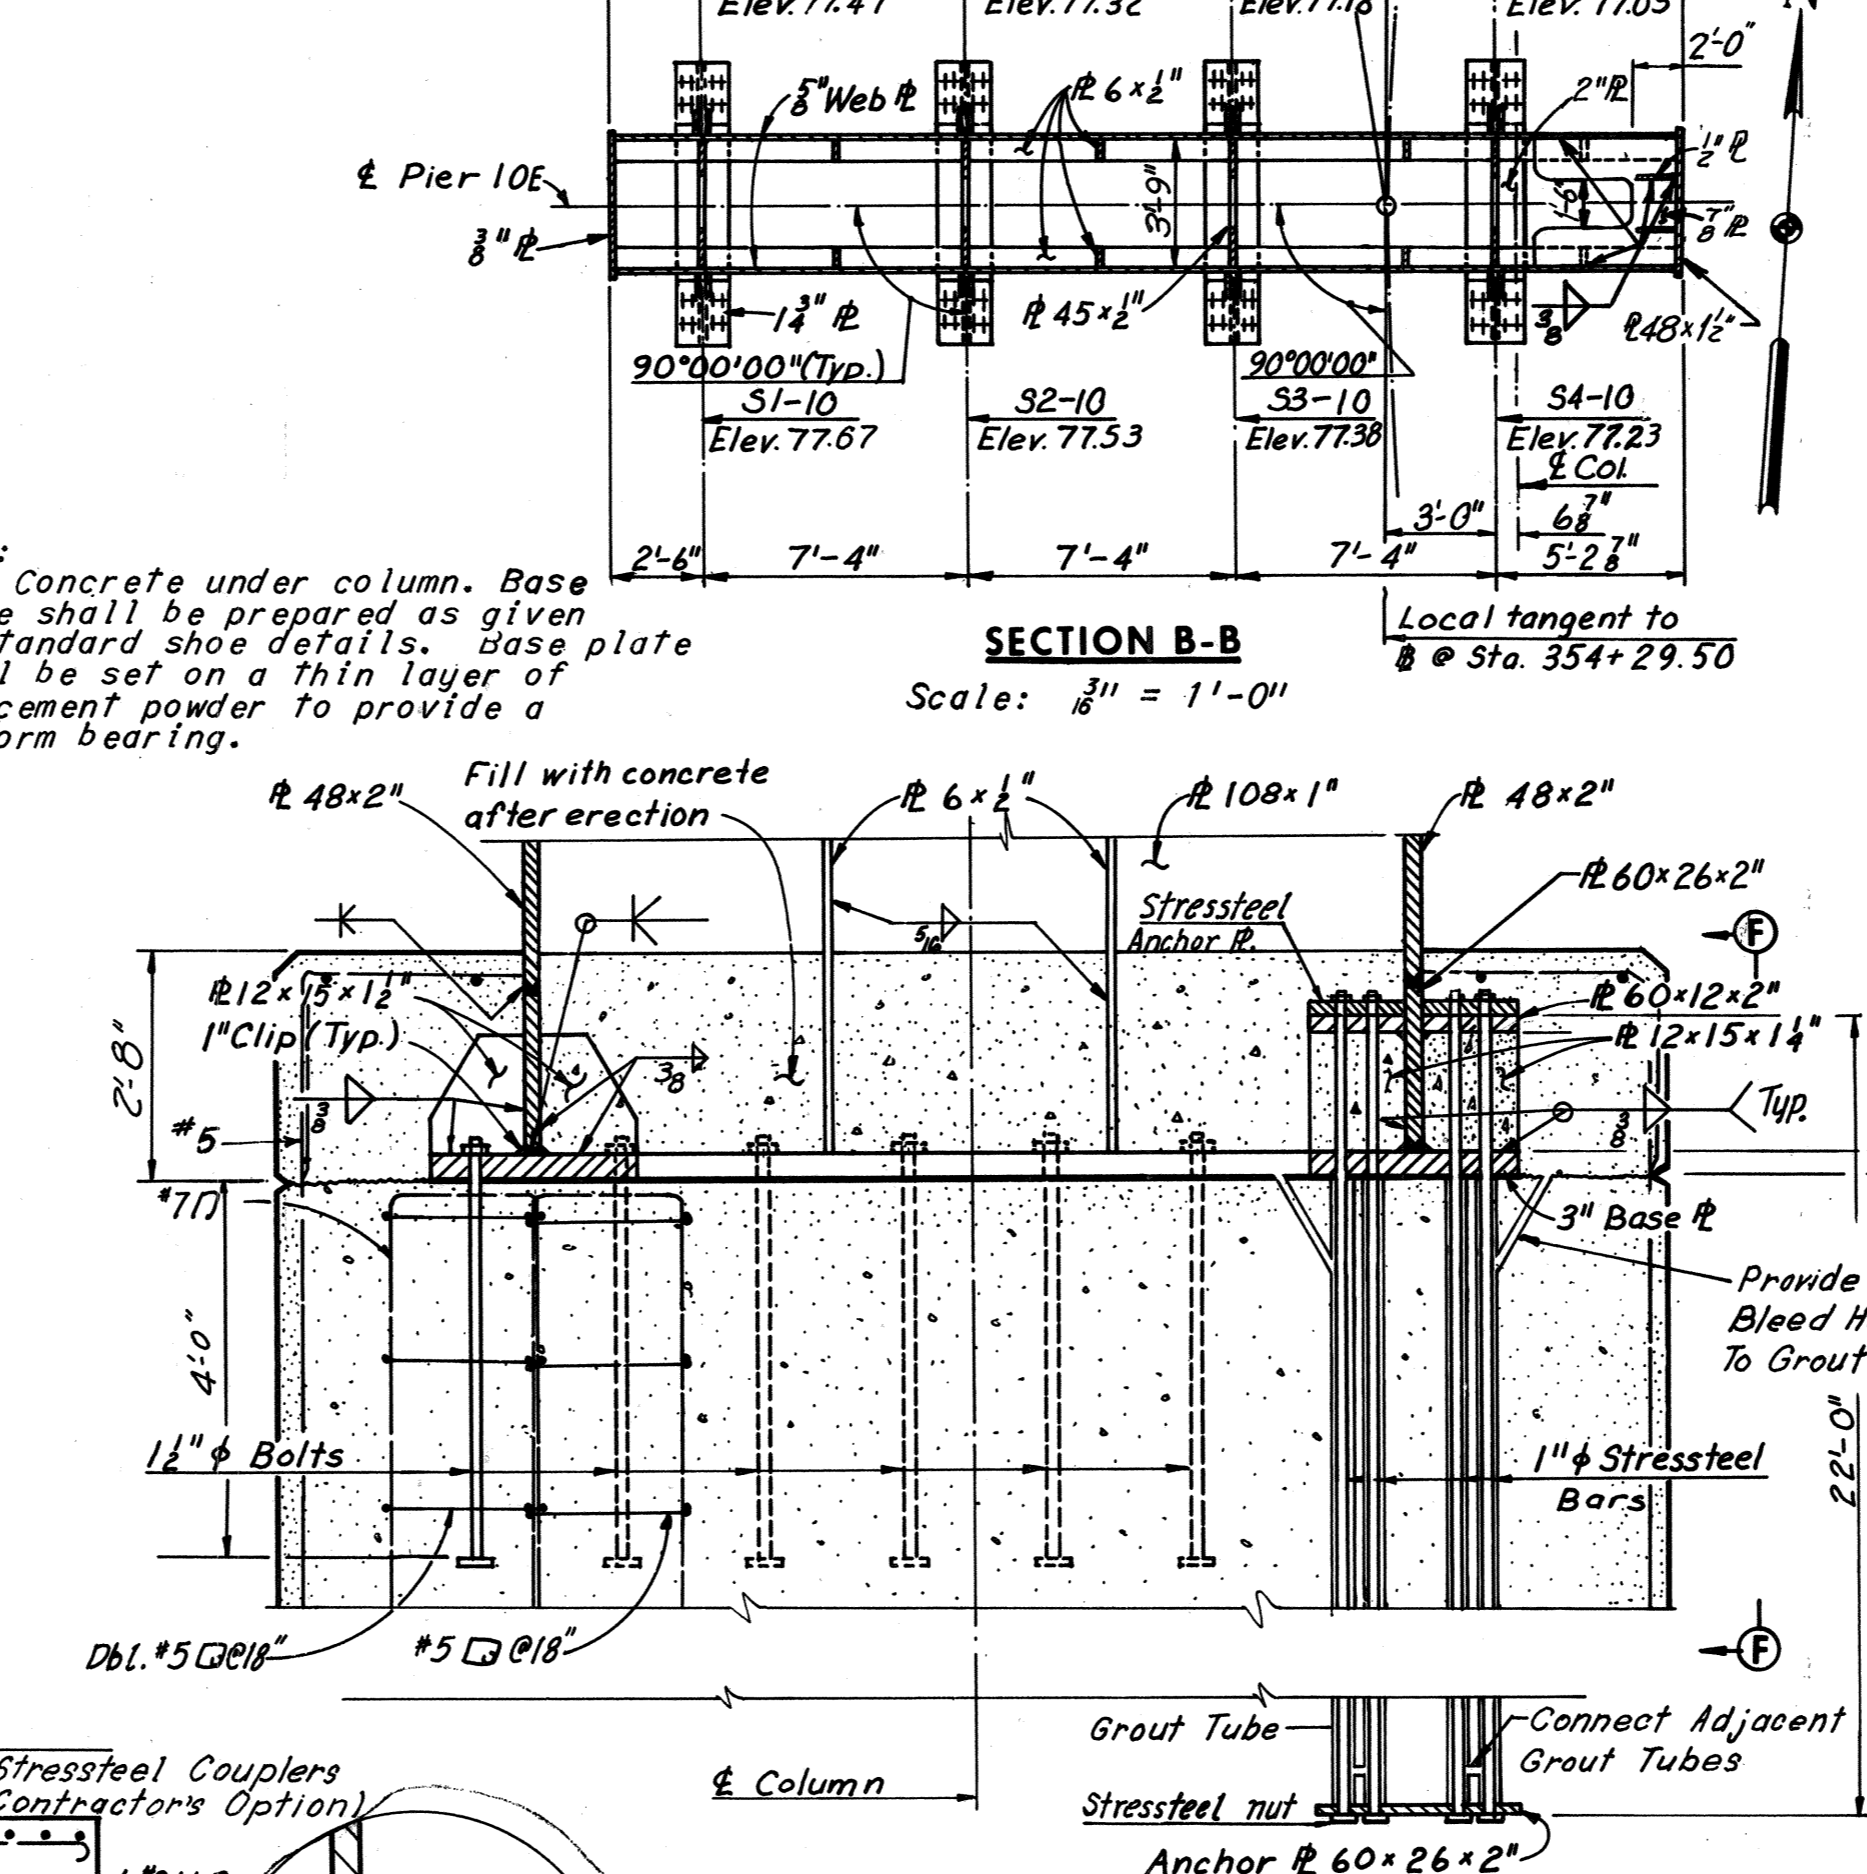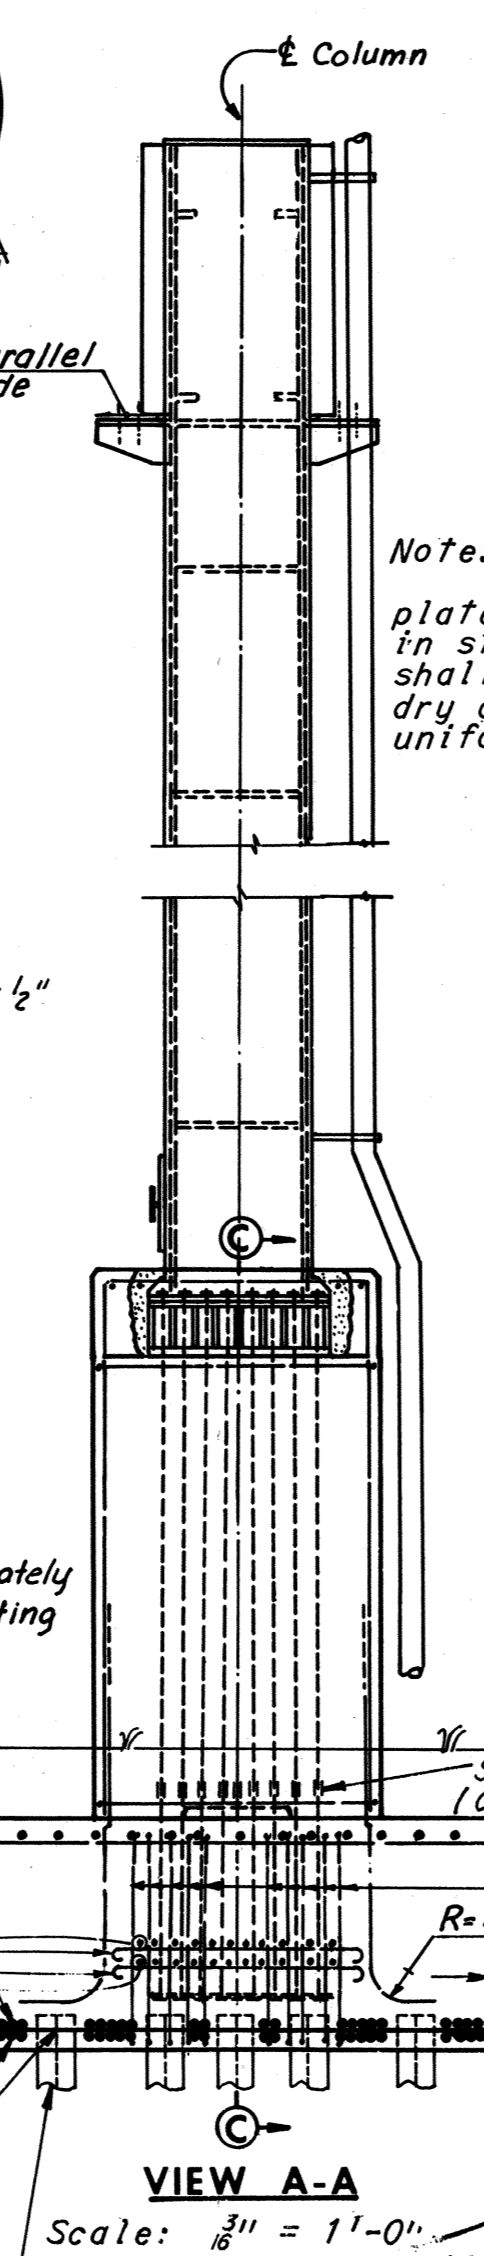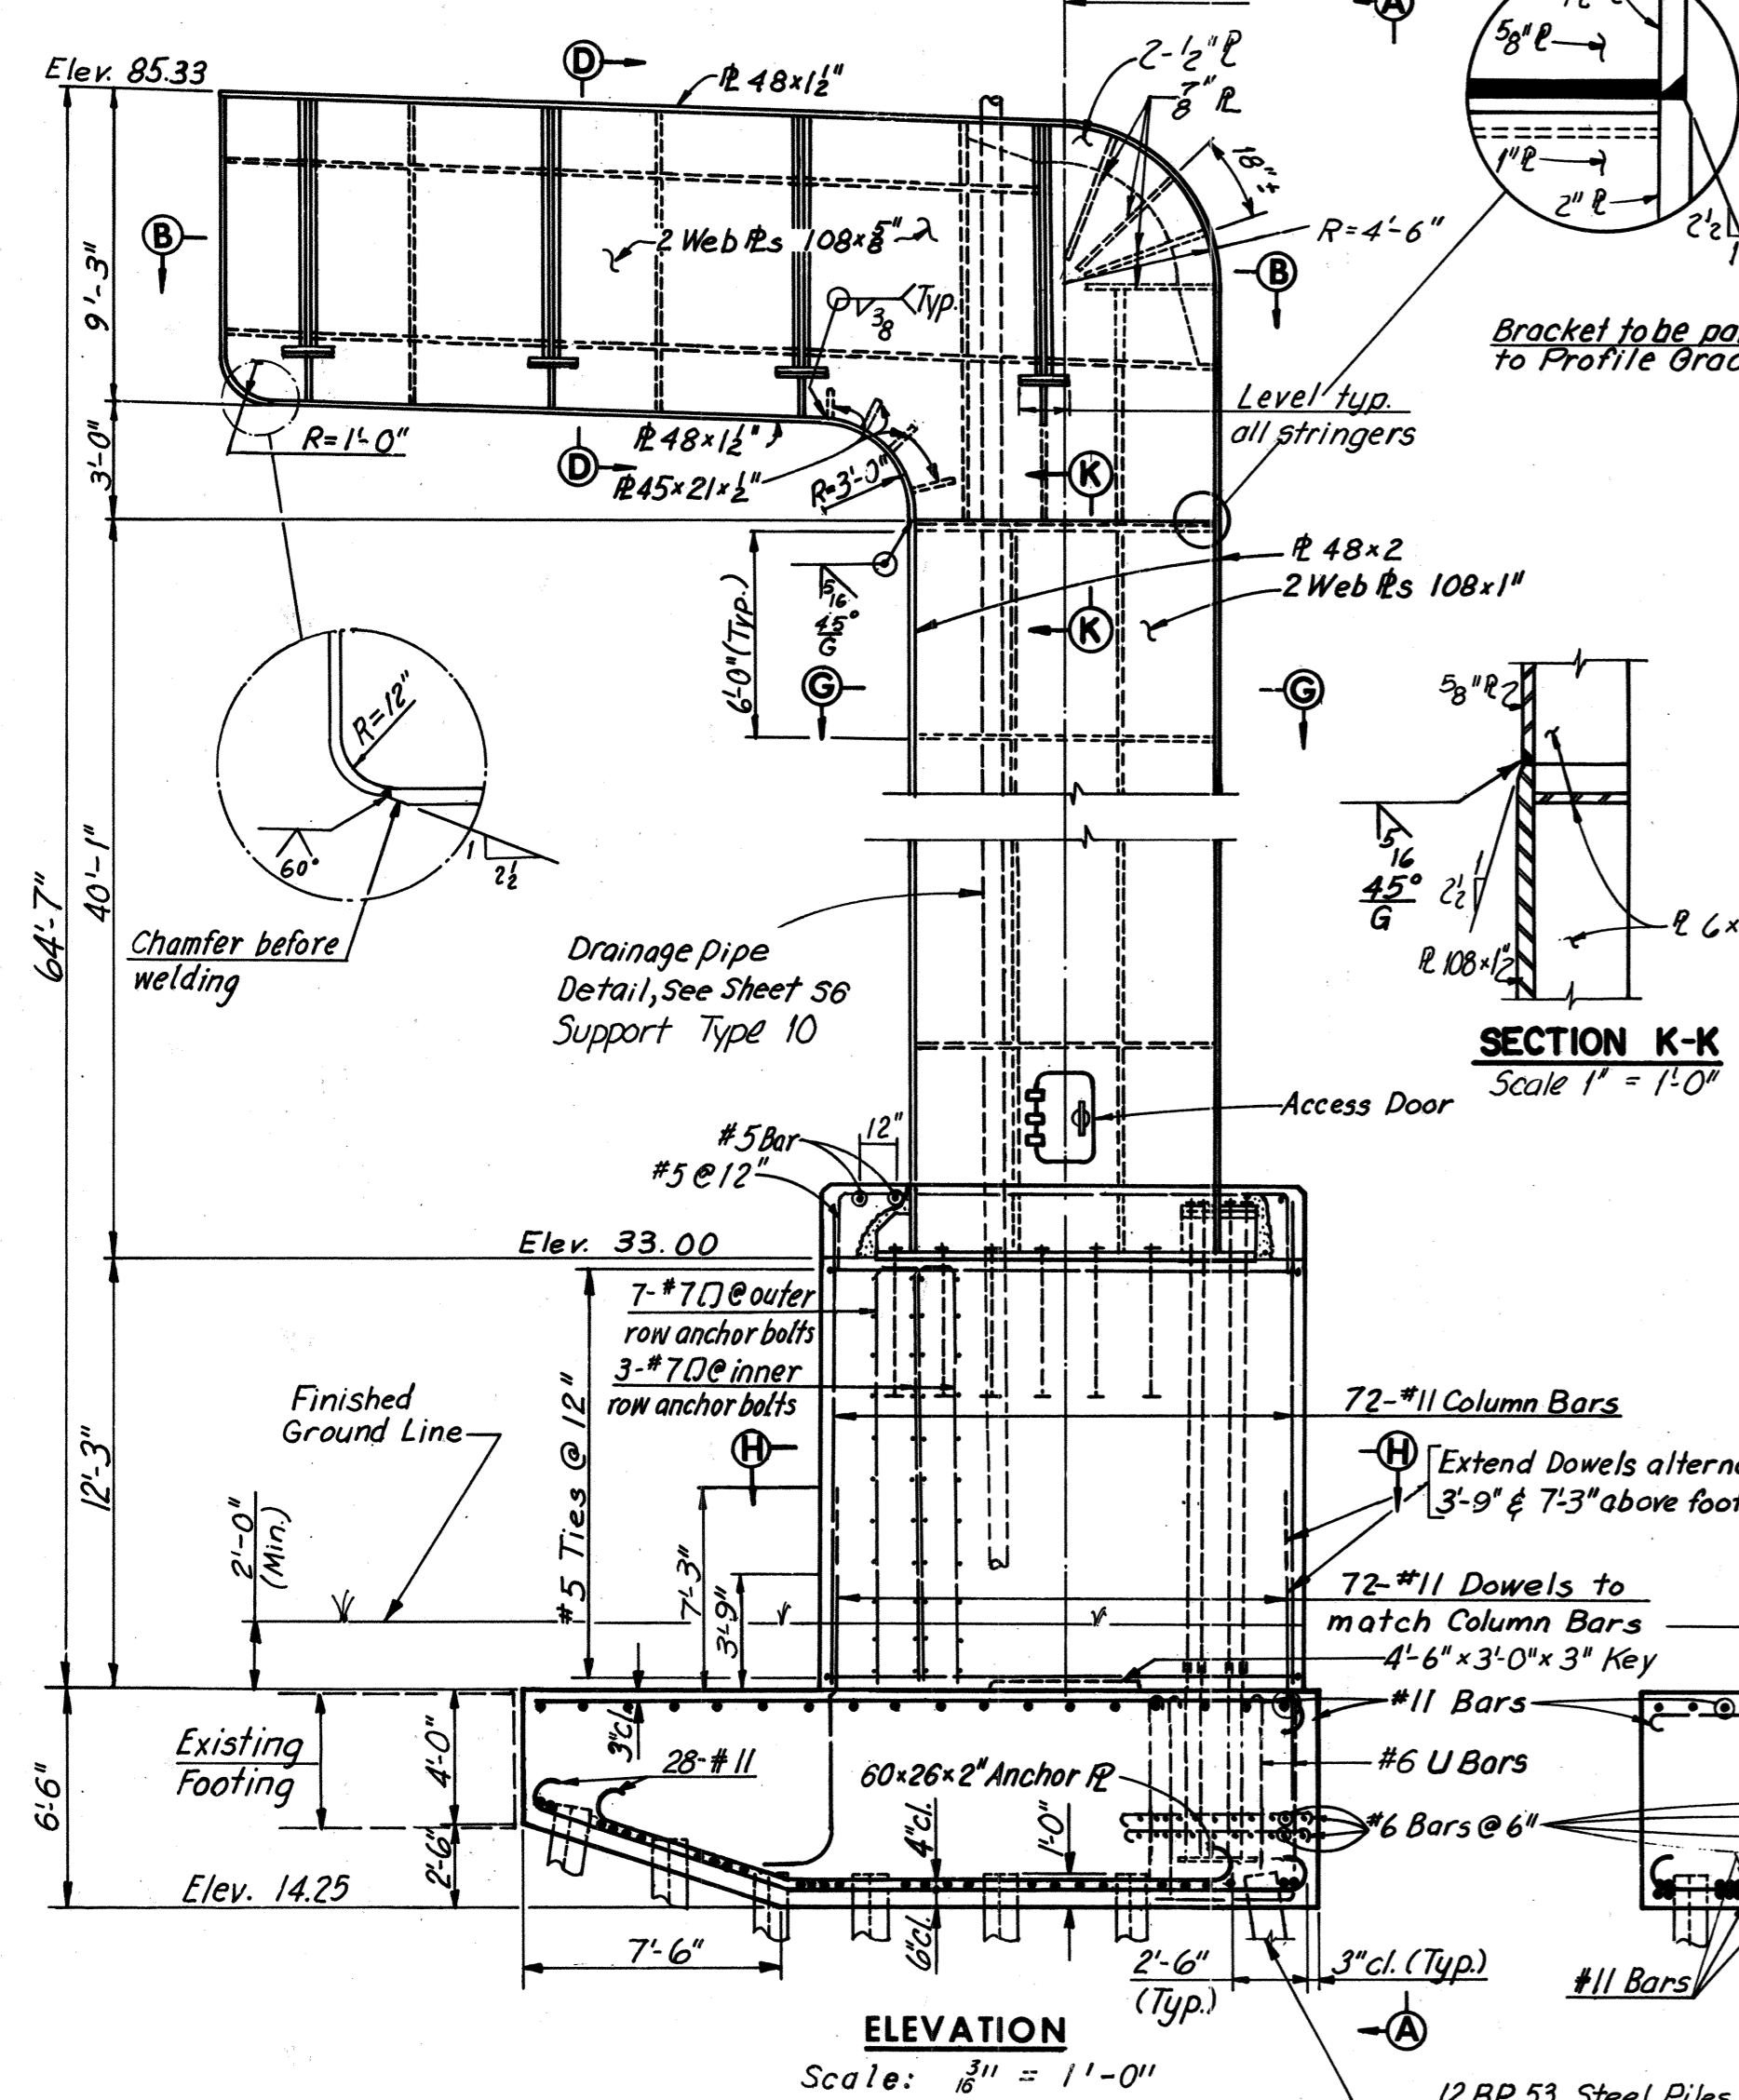

Note: Stresssteel rods shall be 1" Special Grade, 160 ksi. min. ult. strength, 32 rods red'd. Rods to be grouted after tensioning. Initial Jacking Force Required = 88 + 8" for seating wedge.

Rods shall be tensioned as outlined in the construction sequence. Rods need not be tensioned in pairs. However, tensioning shall proceed outward from the centerline of Pier 10.

Rods of the first group shall be checked in the same sequence as initial tensioning, checking shall continue until two successive 1" rods checked have a tension of at least 80k.

The contractor is cautioned against nicking the stress rods and he shall follow the manufacturer's recommended handling procedures. The contractor shall provide adequate safety measures. The contractor shall submit his proposed construction procedures to the engineer for approval.

- GENERAL CONSTRUCTION SEQUENCE:**
1. Construct footing and pedestal including 32-1" stresssteel bars.
 2. Erect column and capbeam. Tighten down nuts on 1/2" anchor bolts. Stress 12 interior tensioning rods.
 3. Erect structural steel superstructure in such a manner that load eccentricity on the column is kept at a minimum.
 4. Stress 12 exterior tensioning rods.
 5. Place concrete deck.
 6. Stress remaining 8 tensioning rods.
 7. Check tension on initial group of rods.
 8. Cutoff rod extension. Fill column base with concrete, grout and encase base and anchorage with concrete.

RICHMOND METROPOLITAN AUTHORITY
RICHMOND EXPRESSWAY SYSTEM
DOWNTOWN EXPRESSWAY

BRIDGE NO. 67
RAMP W-N CONNECTION TO
RICHMOND-PETERSBURG TURNPIKE

PIER 10 E

HOWARD, NEEDLES, TAMMEN & BERGENDOFF
 Consulting Engineers
 NEW YORK ALEXANDRIA KANSAS CITY

SCALE: As Noted
 CONTRACT NO. 10
 SHEET NO. 11 OF 54

BY	DATE	REVISION	BY	DATE
3	As Built	TEM	G-77	
MADE	J.D. 3-11-69	As Plan & Elev. Changed	d.B.P. 7-23-75	
CHECKED	PTA 4-24-69	Changed dim. back to Elev. Sect. B-B	ABJ 1-24-75	
IN CHARGE				
















FOOTING FOR PIER 10E ECCENTRIC AS SHOWN ON FOOTING PLAN

Note: Dimensions in Footing Plan are measured at bottom of Footing.

Note: Footing elevations are approximate only and may be varied to suit field conditions as directed by the Engineer. Vertical shaft reinforcing shall not be cut until these elevations are established. Where elevations change more than 2 ft., redesign will be required.

AS BUILT

RICHMOND EXPRESSWAY SYSTEM			
SECTION	PROJECT	SHEET NO.	TOTAL SHEETS
10	DOWNTOWN EXPRESSWAY	184	265

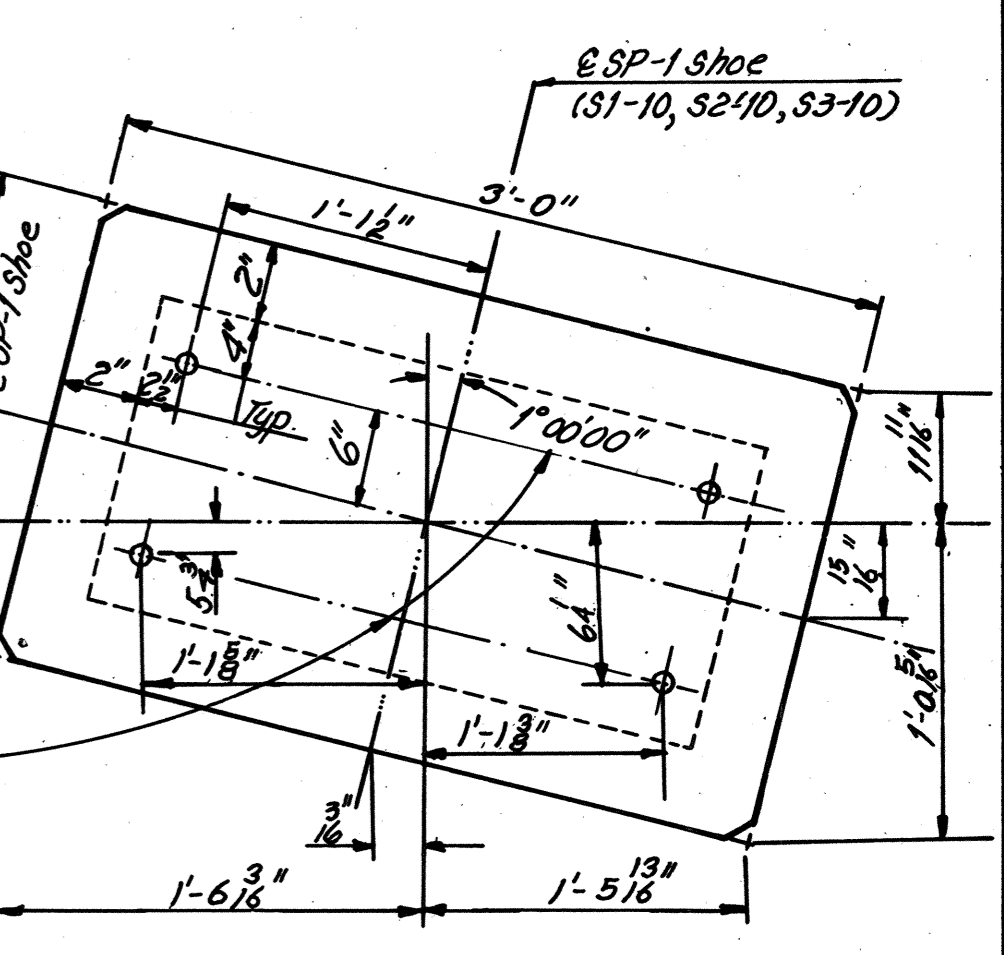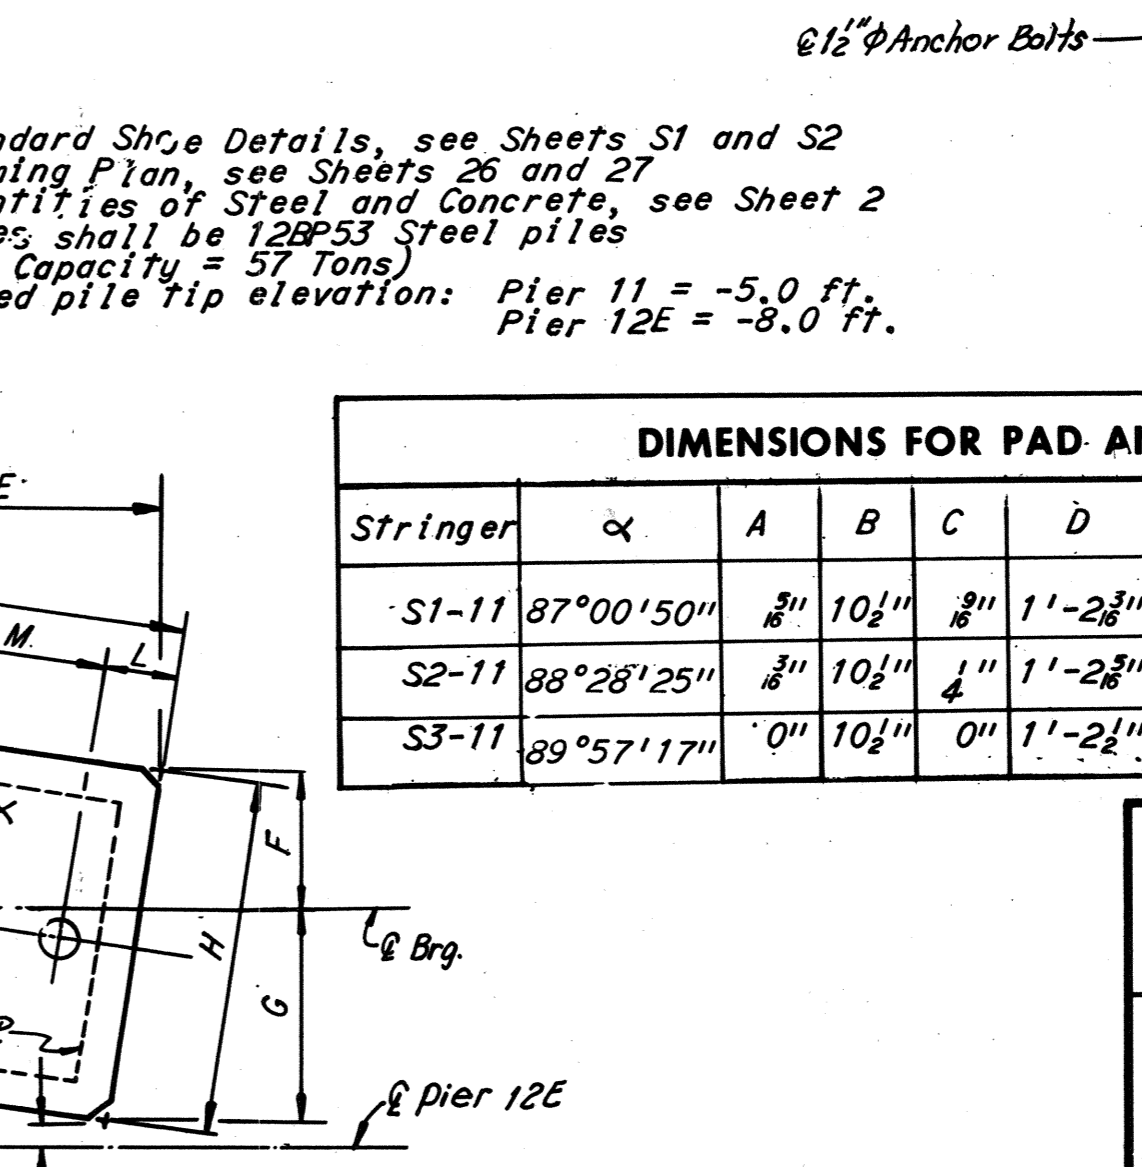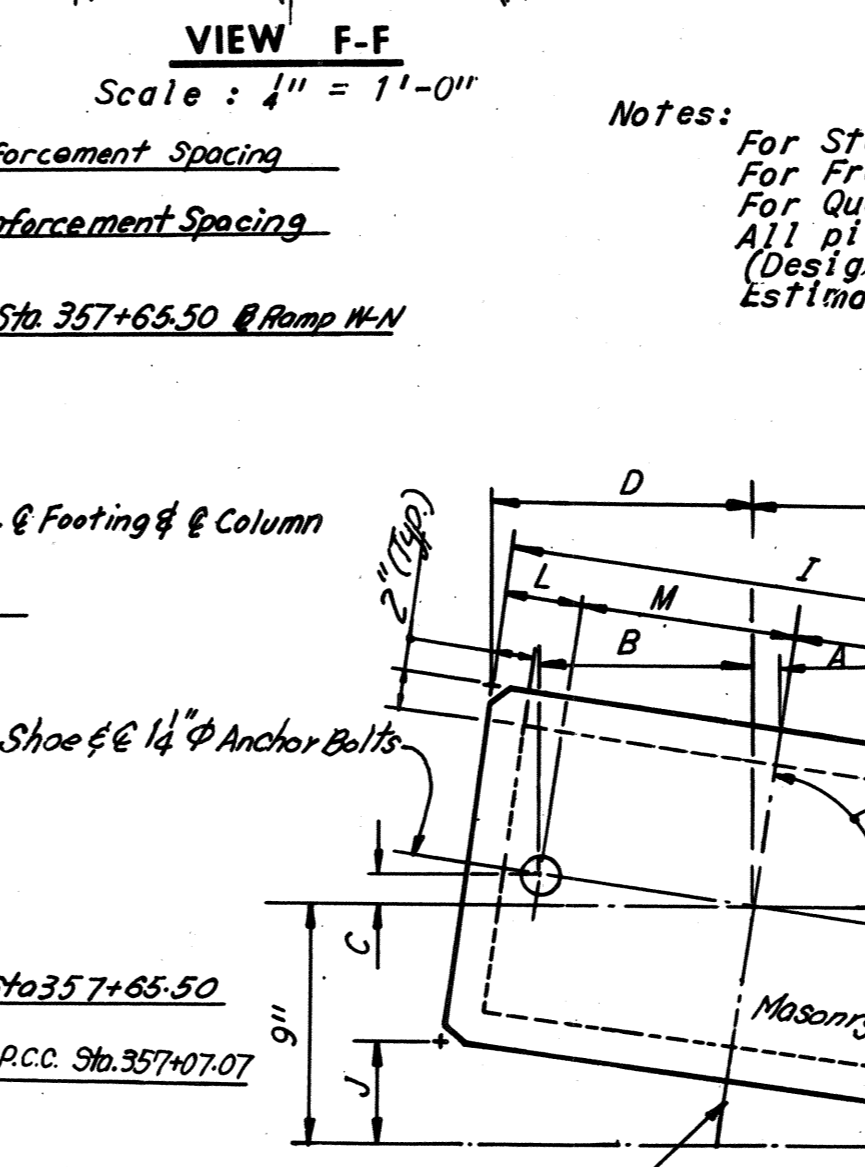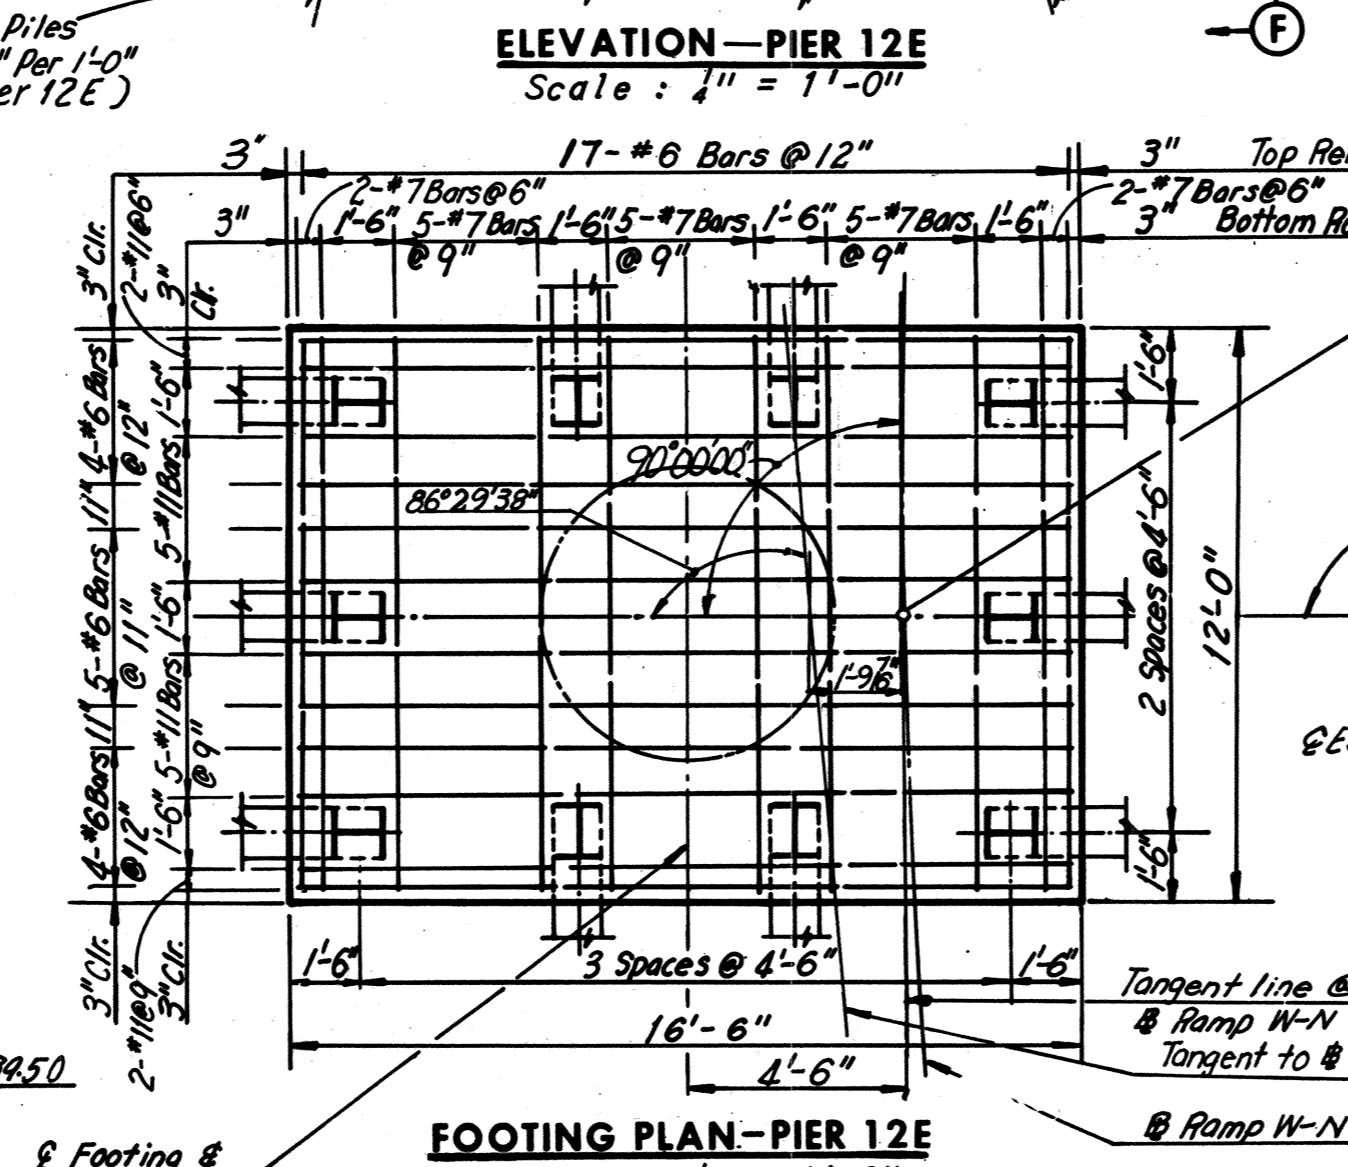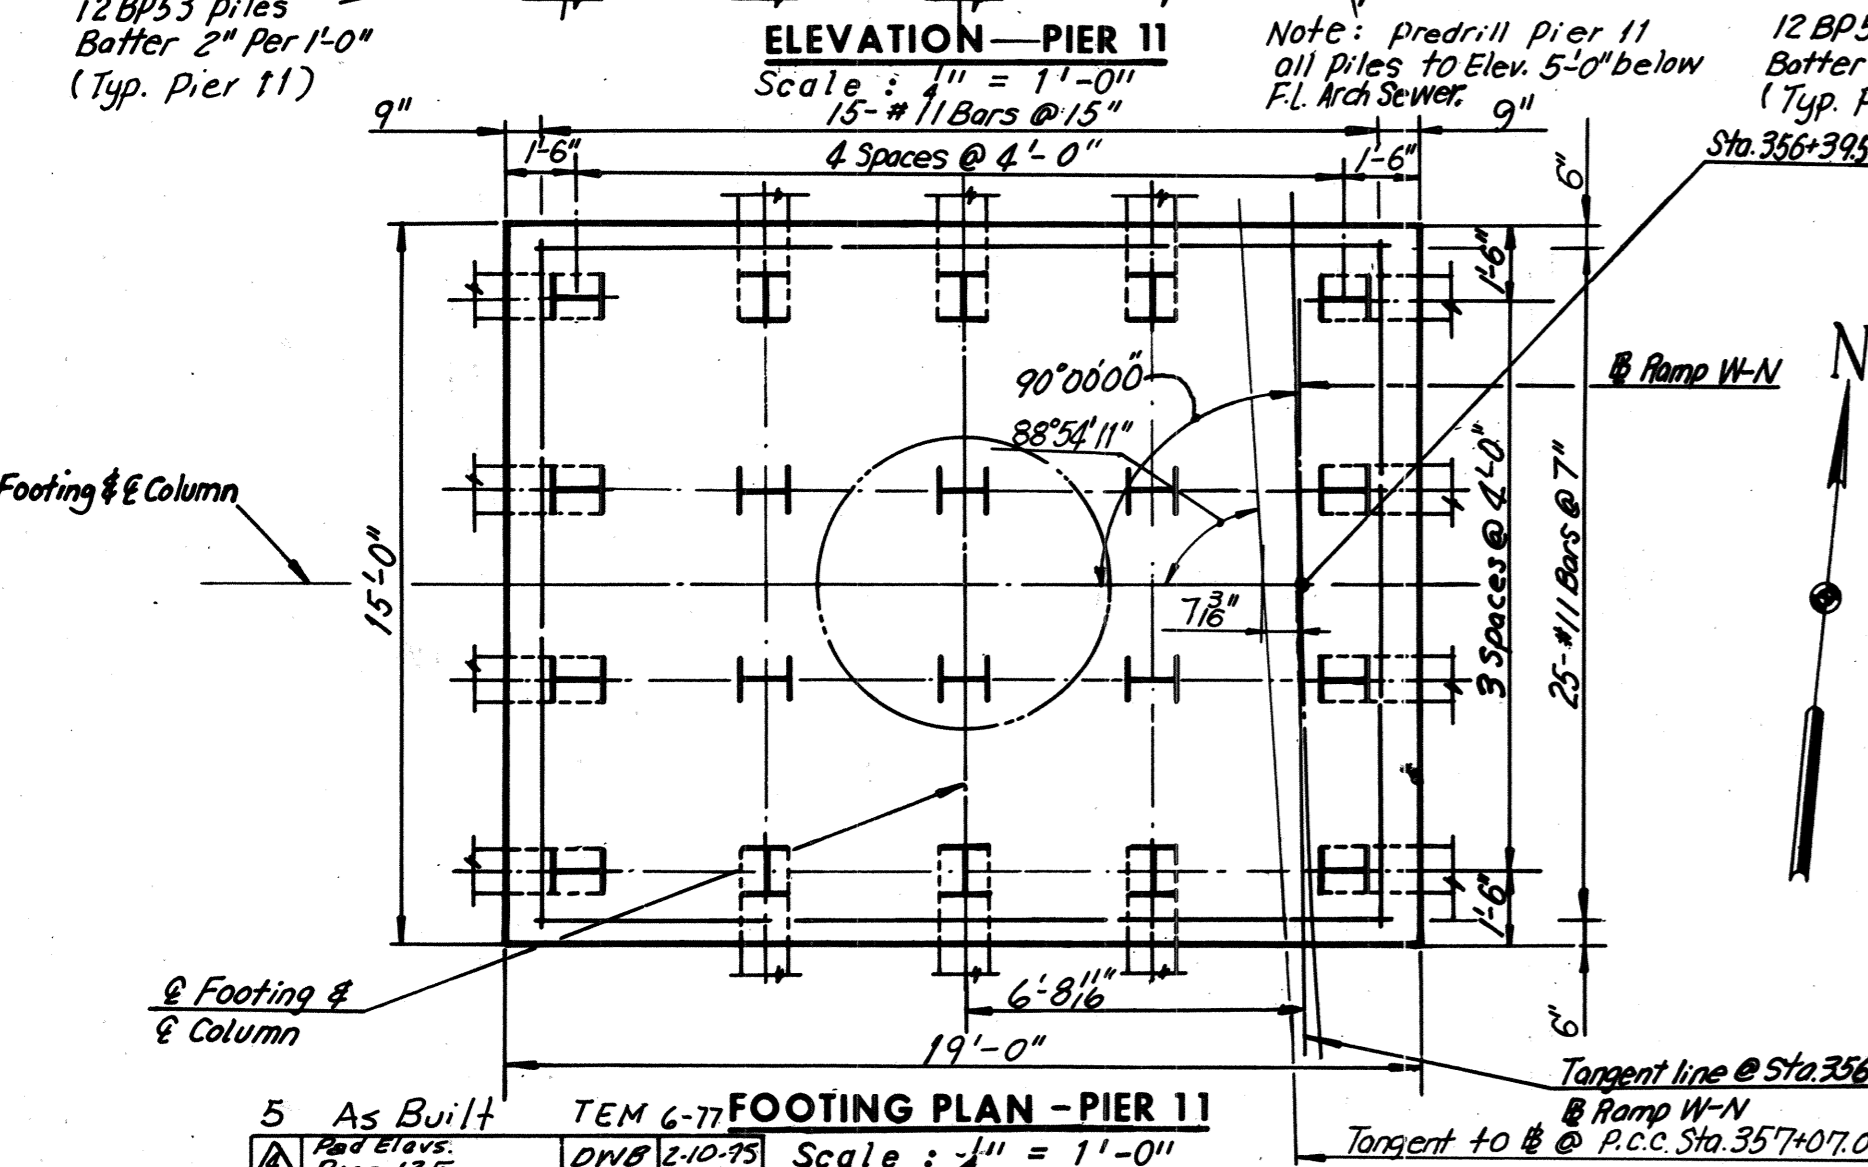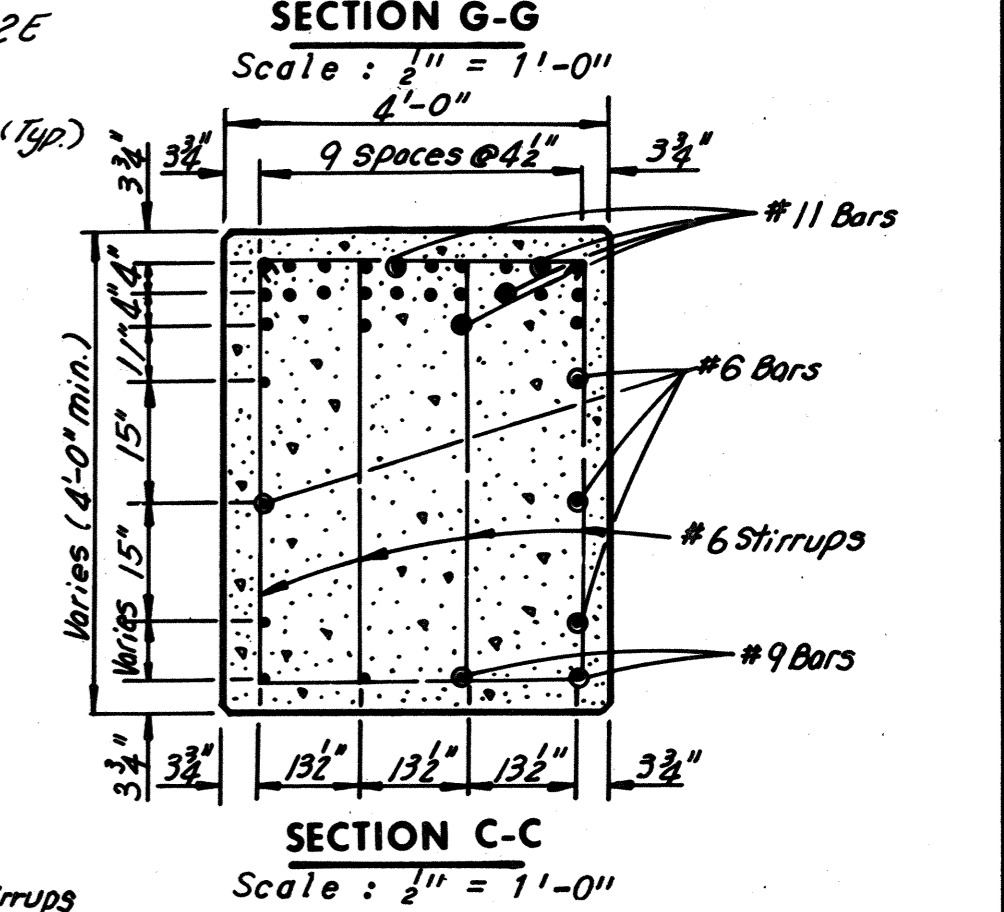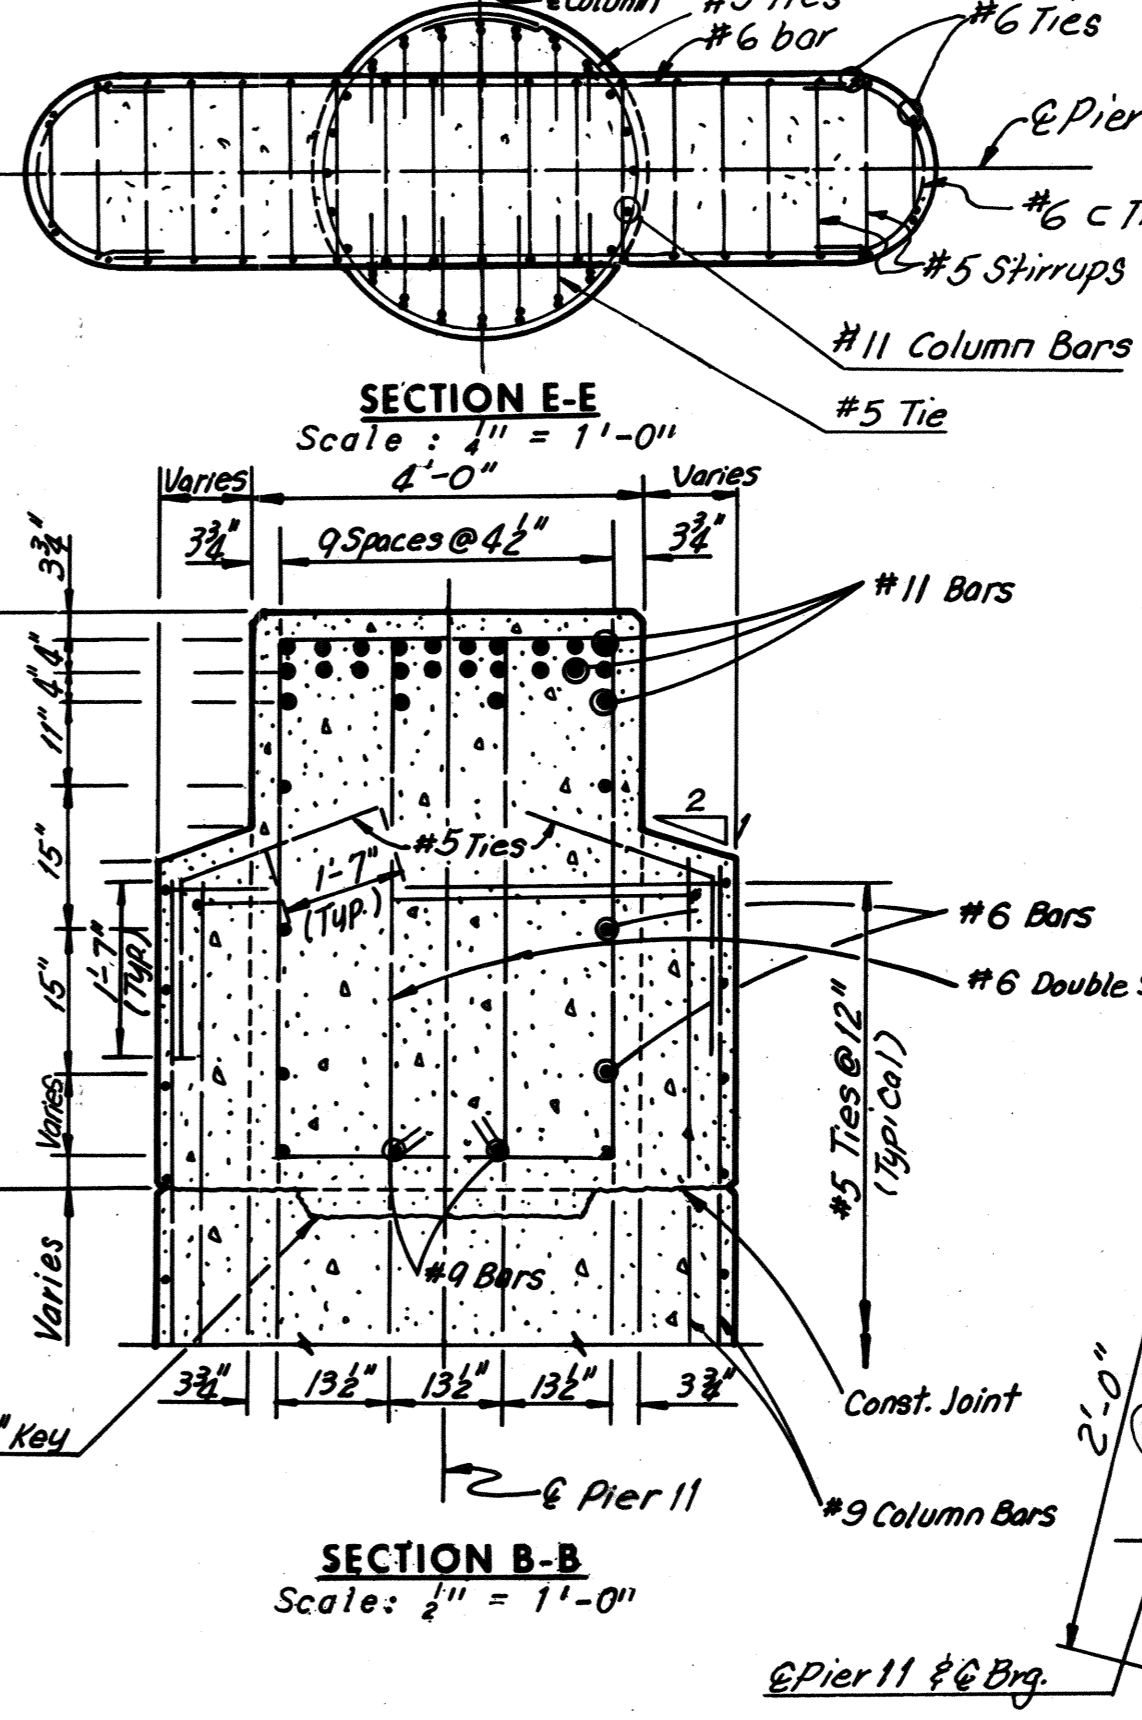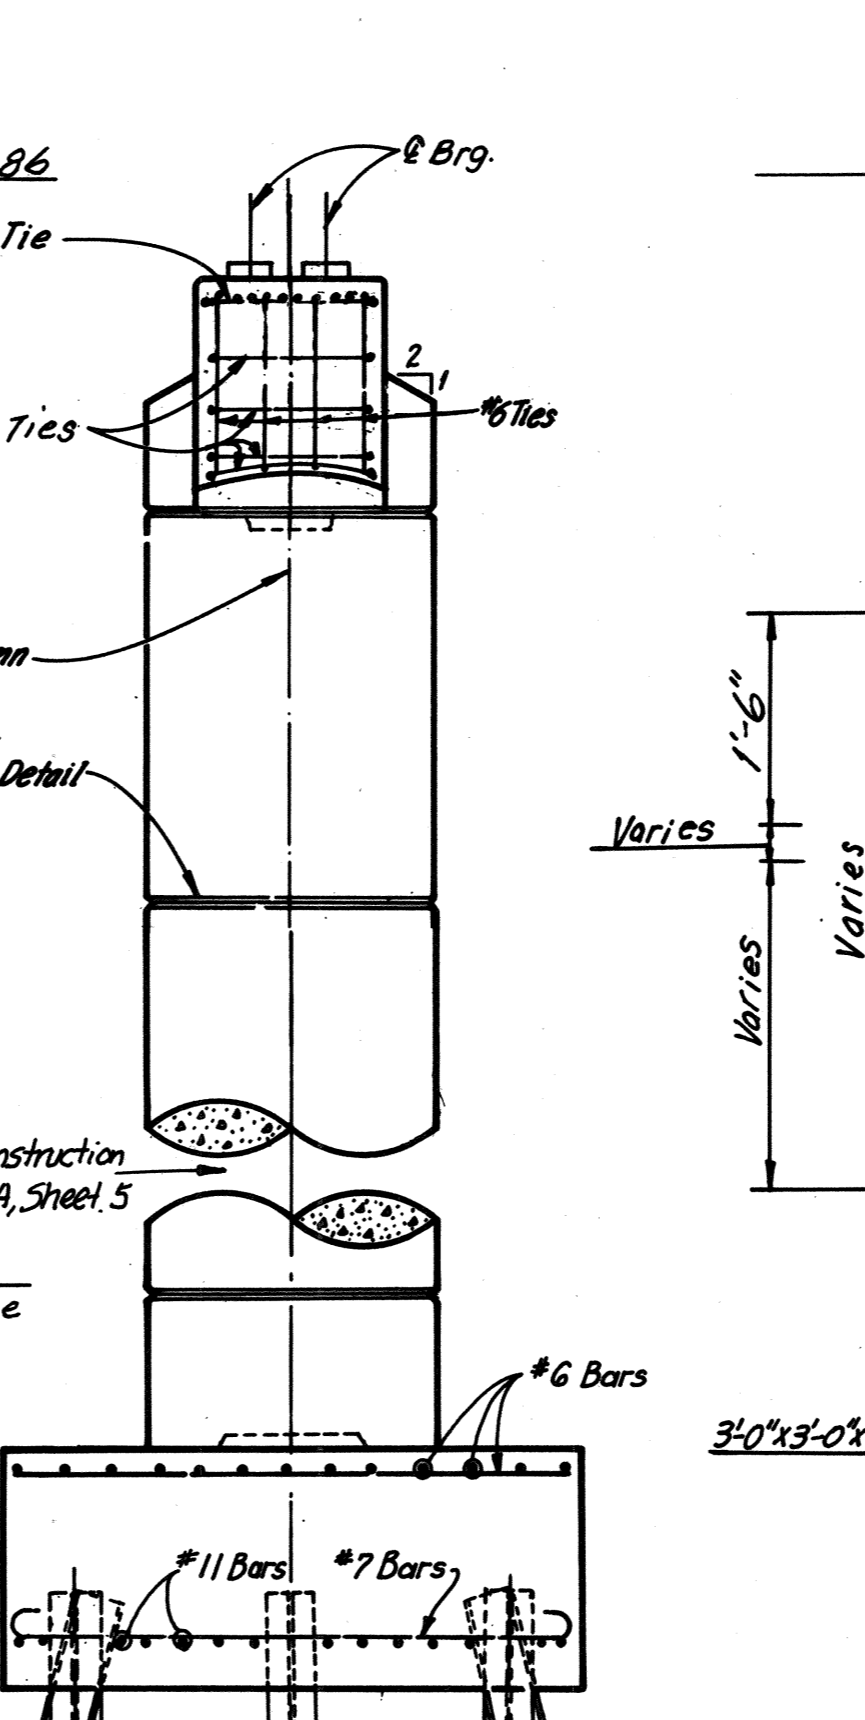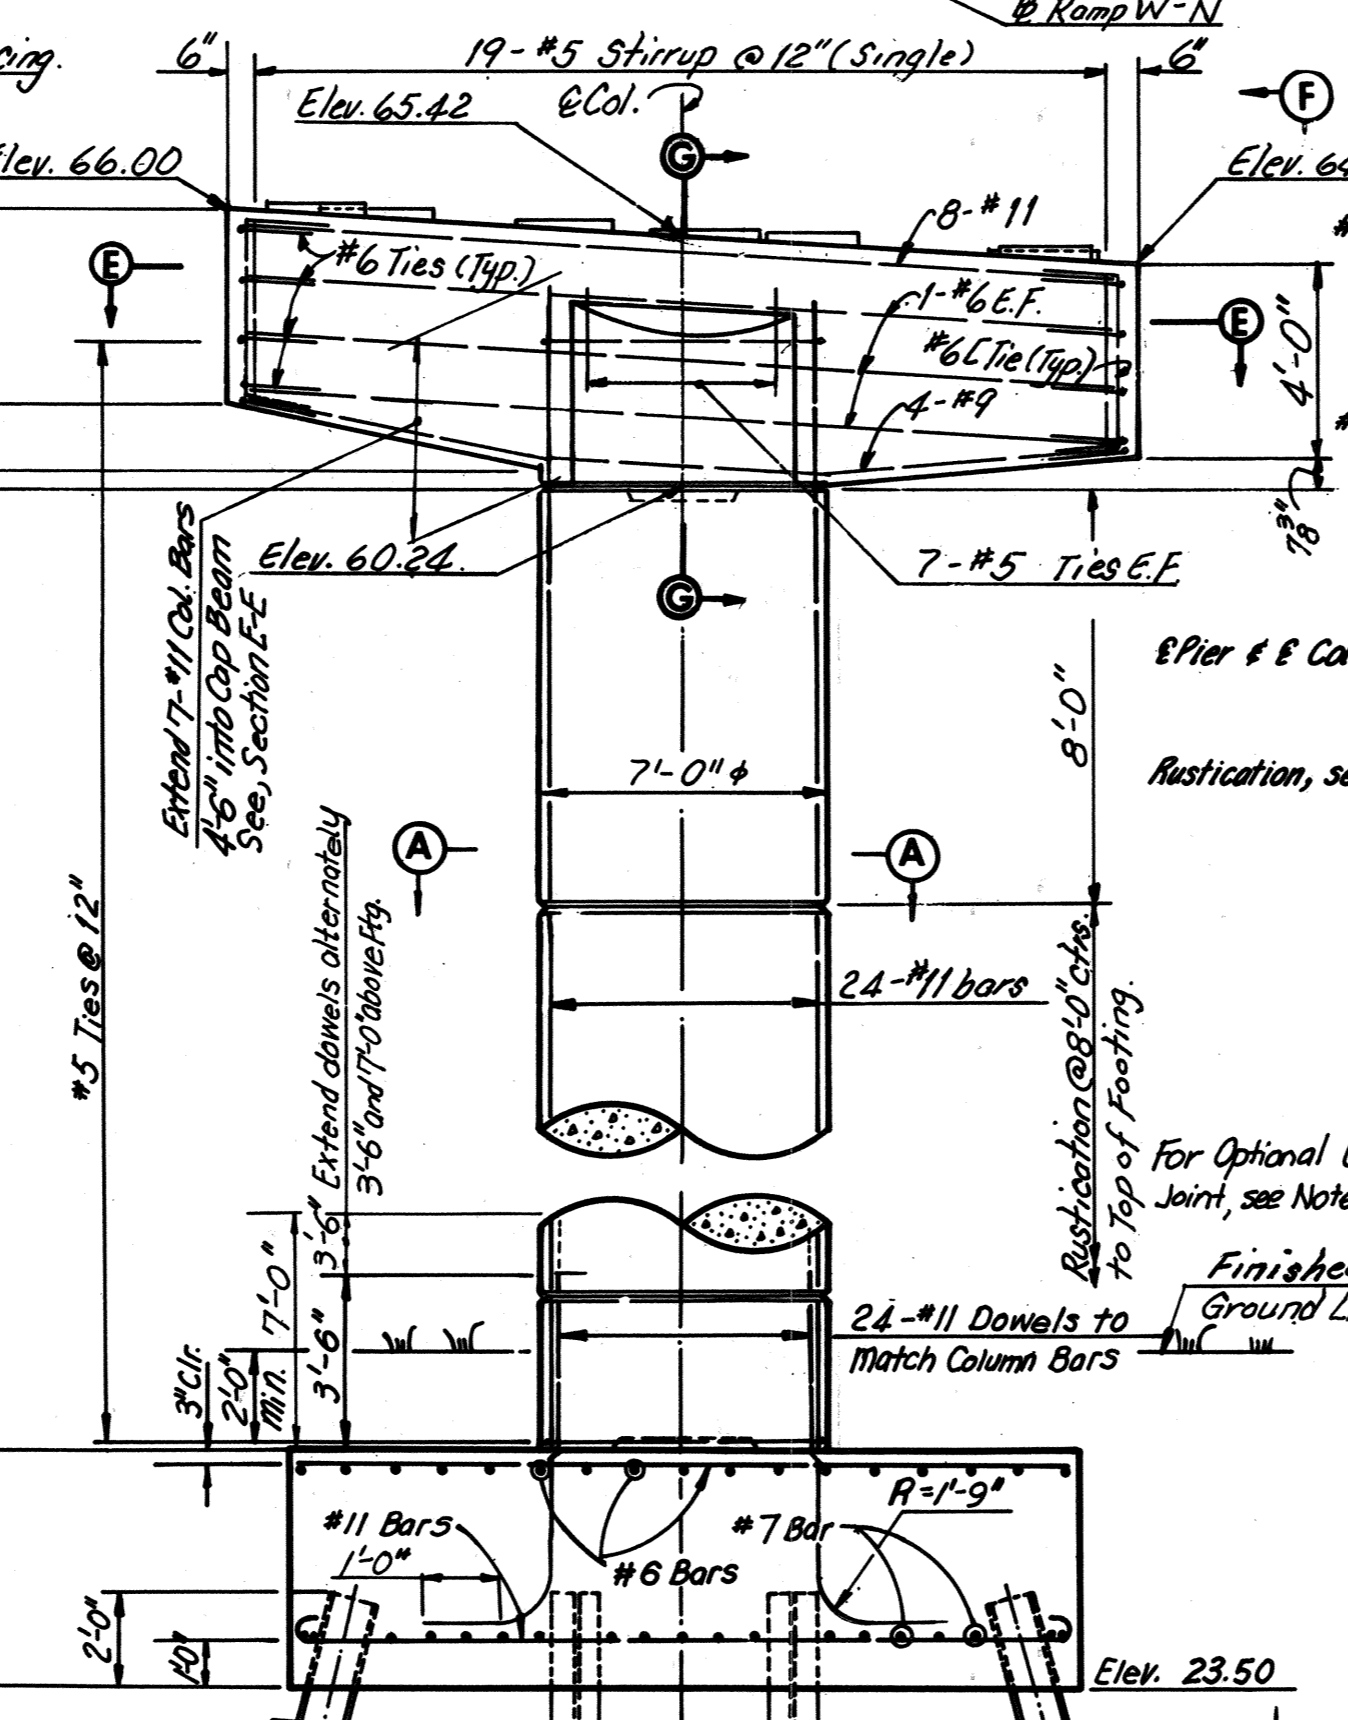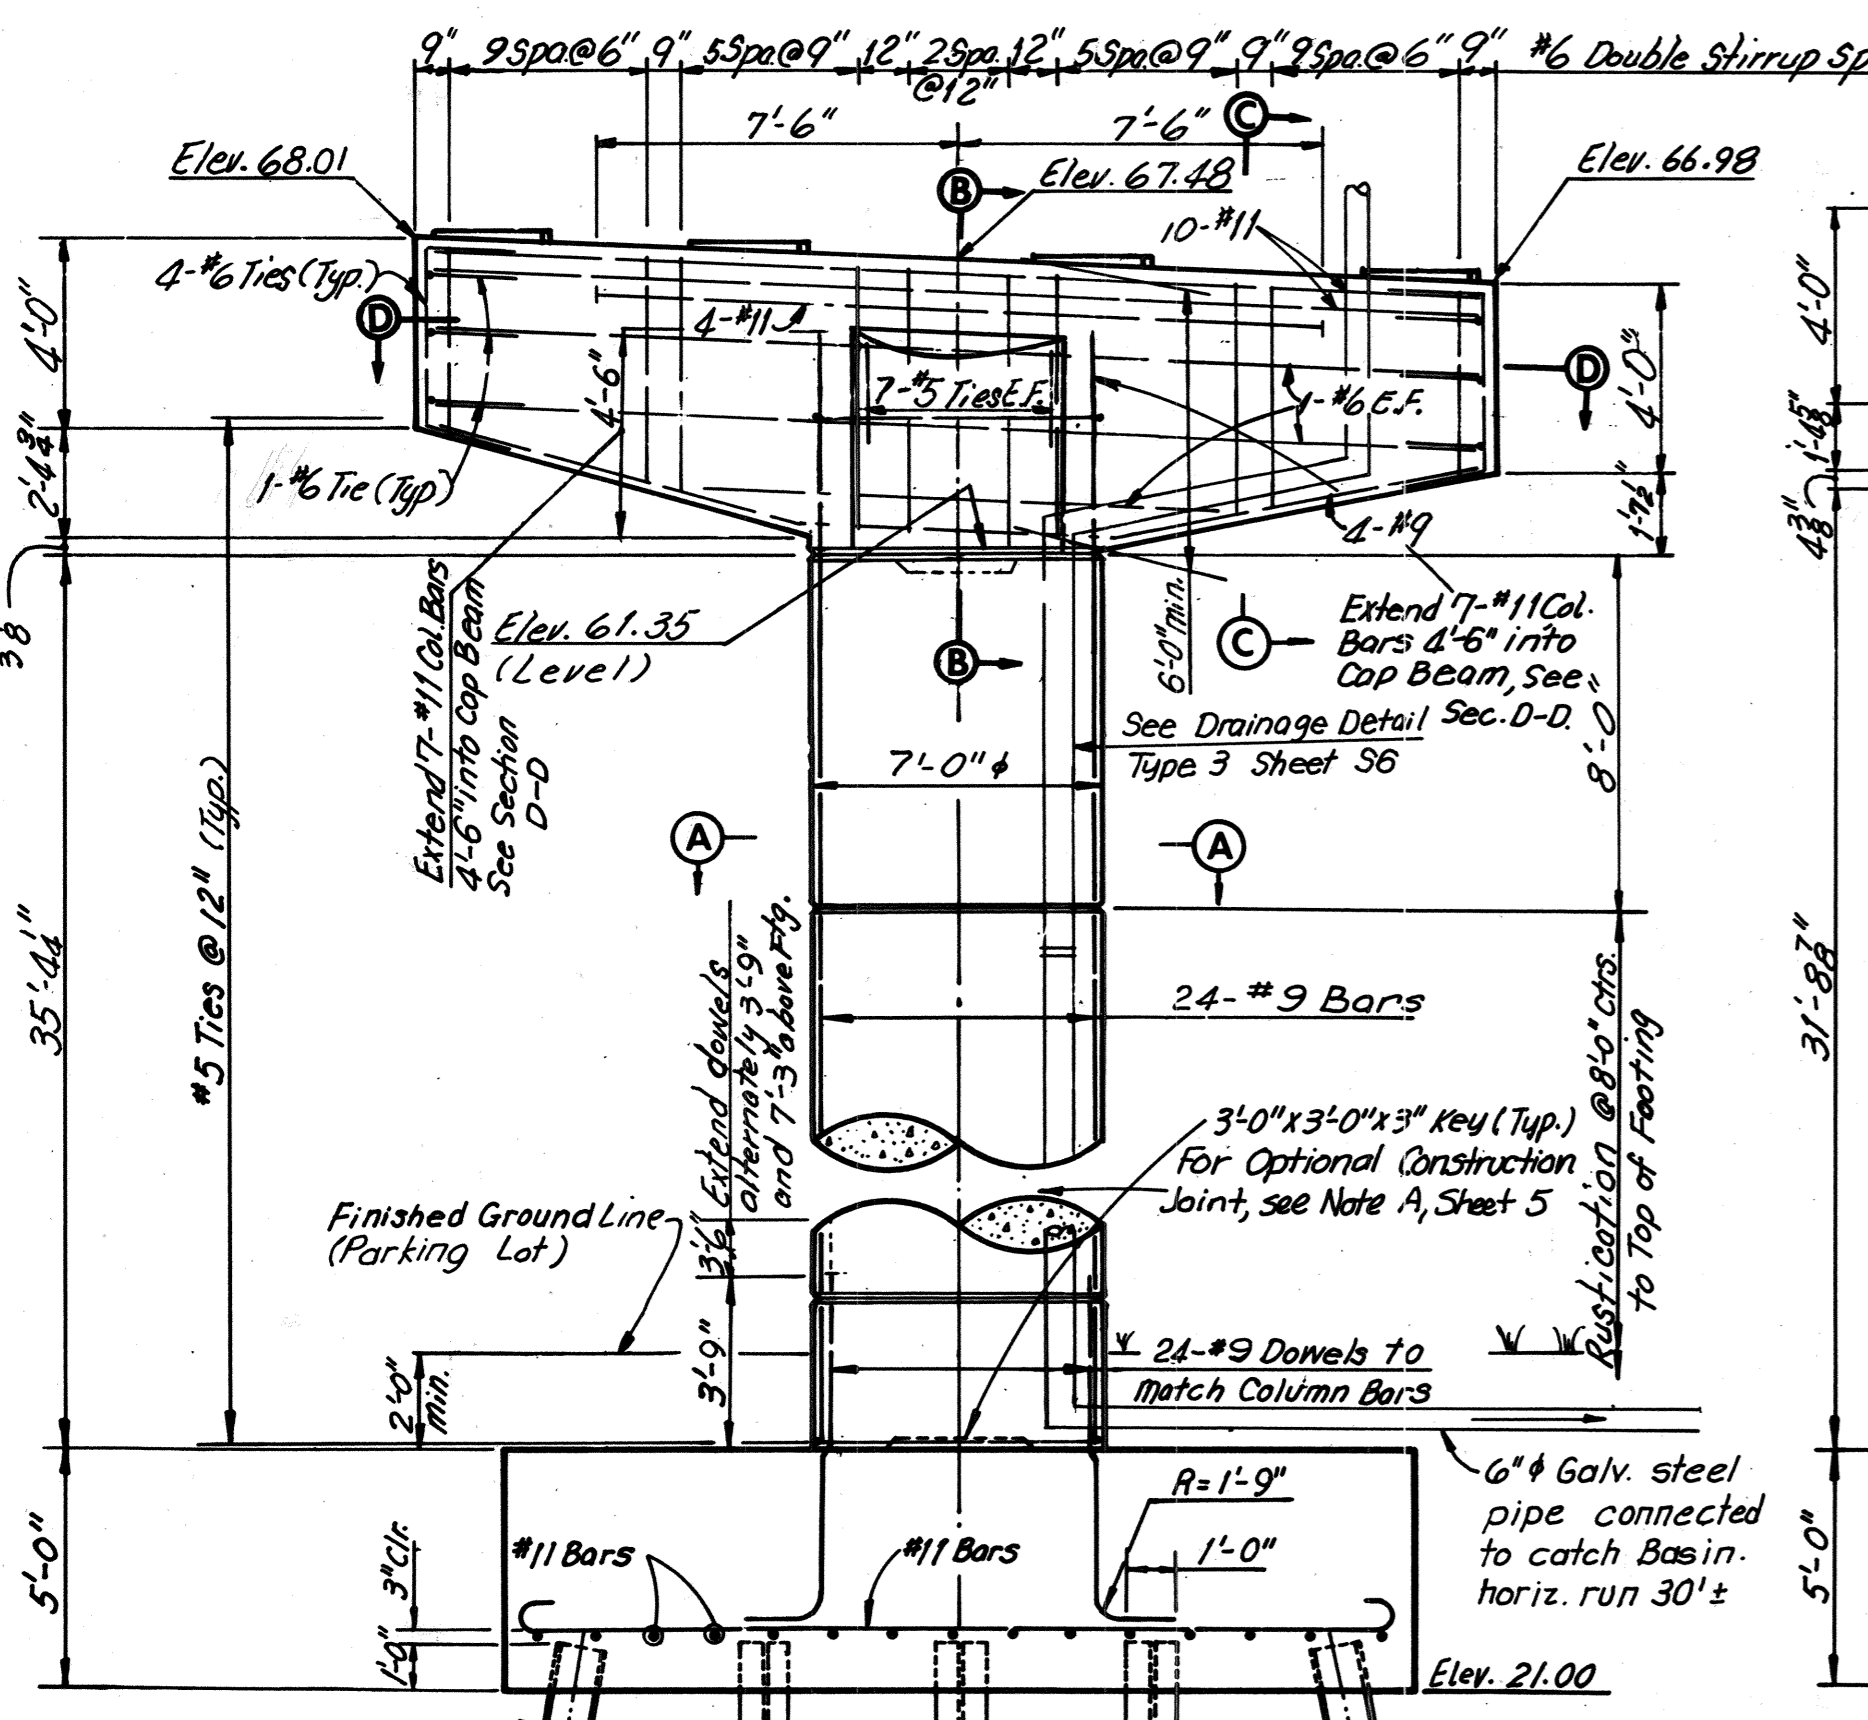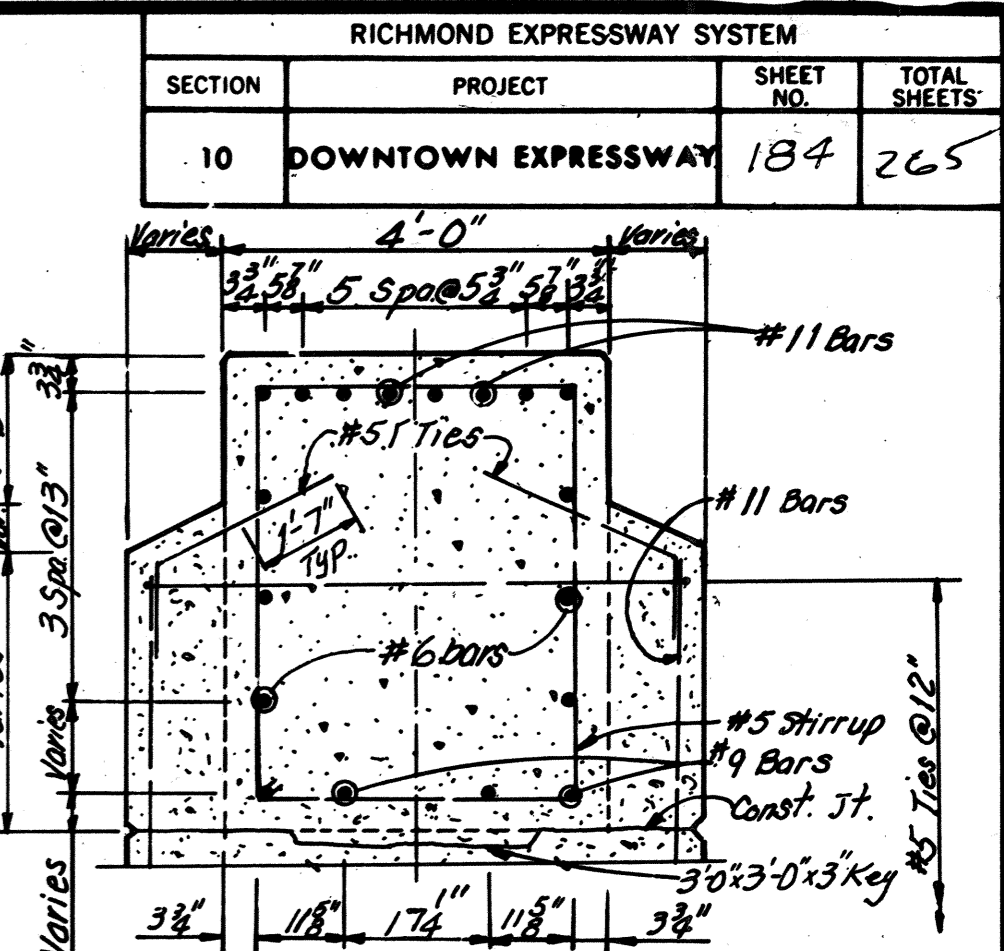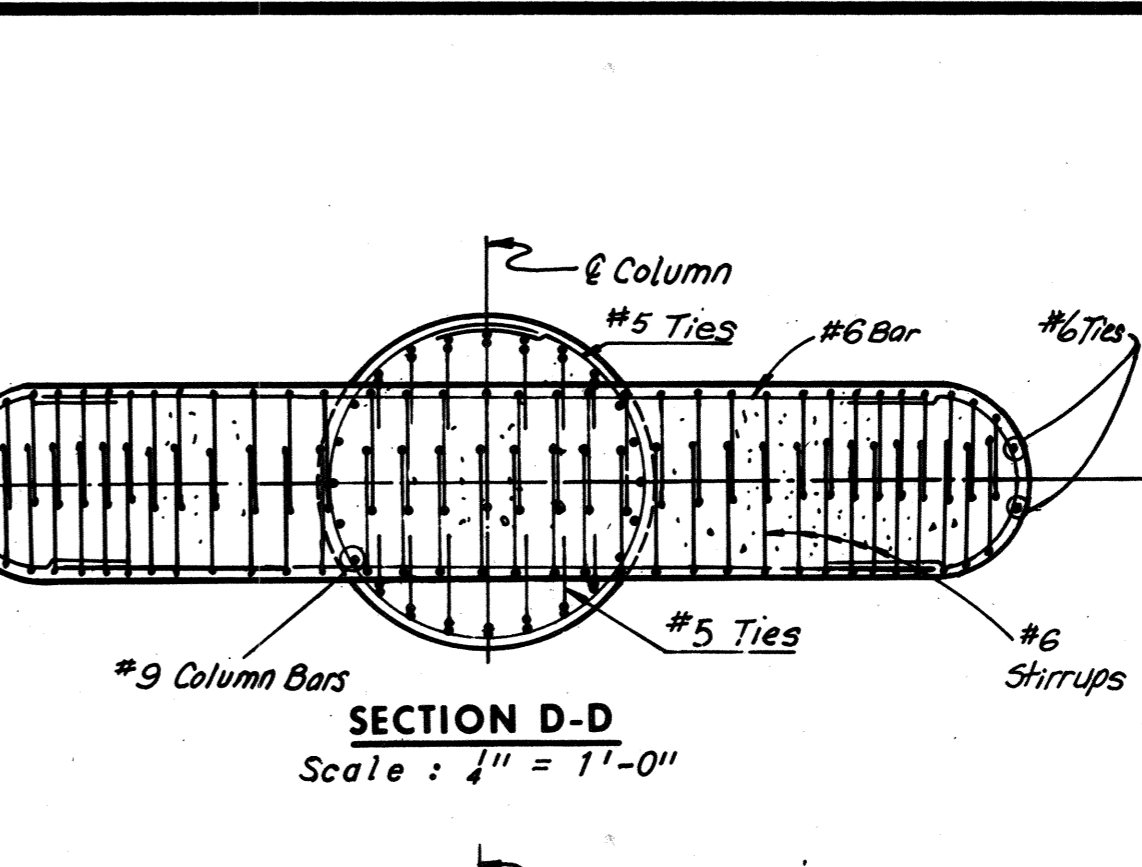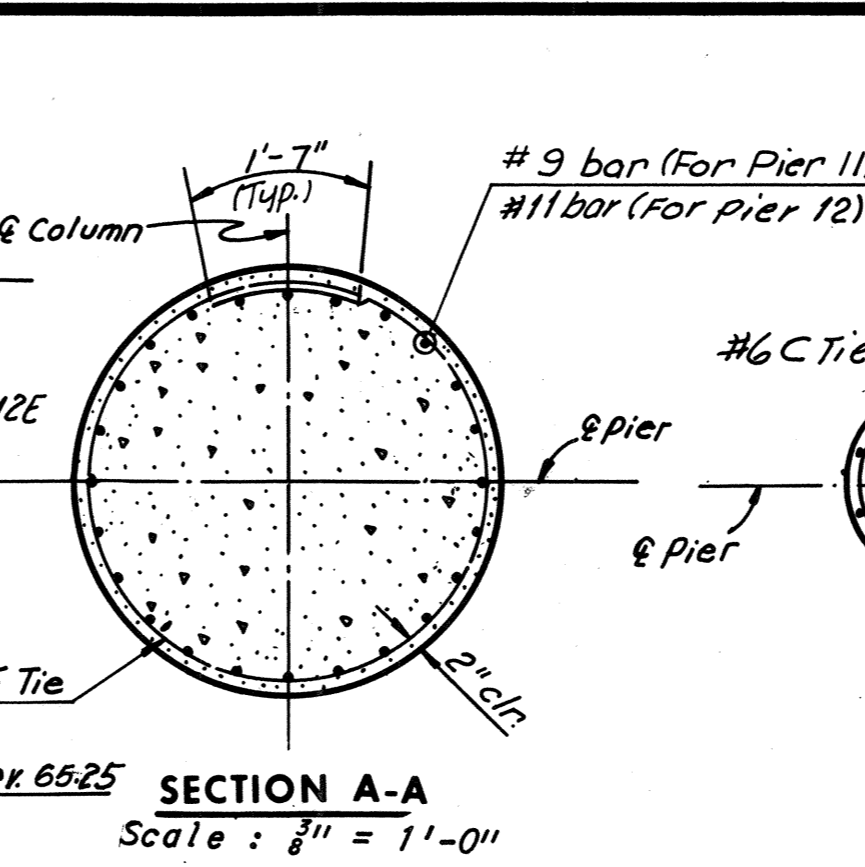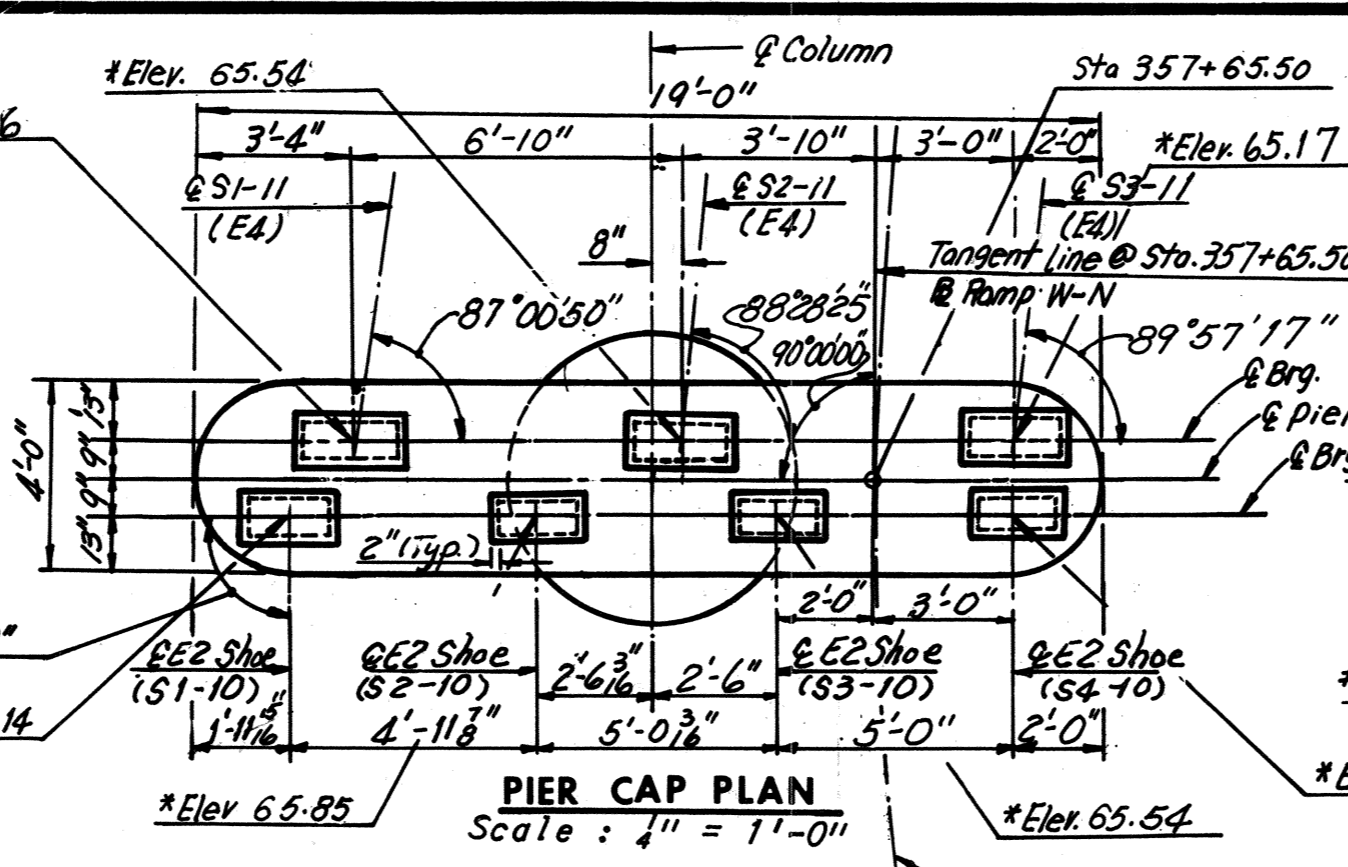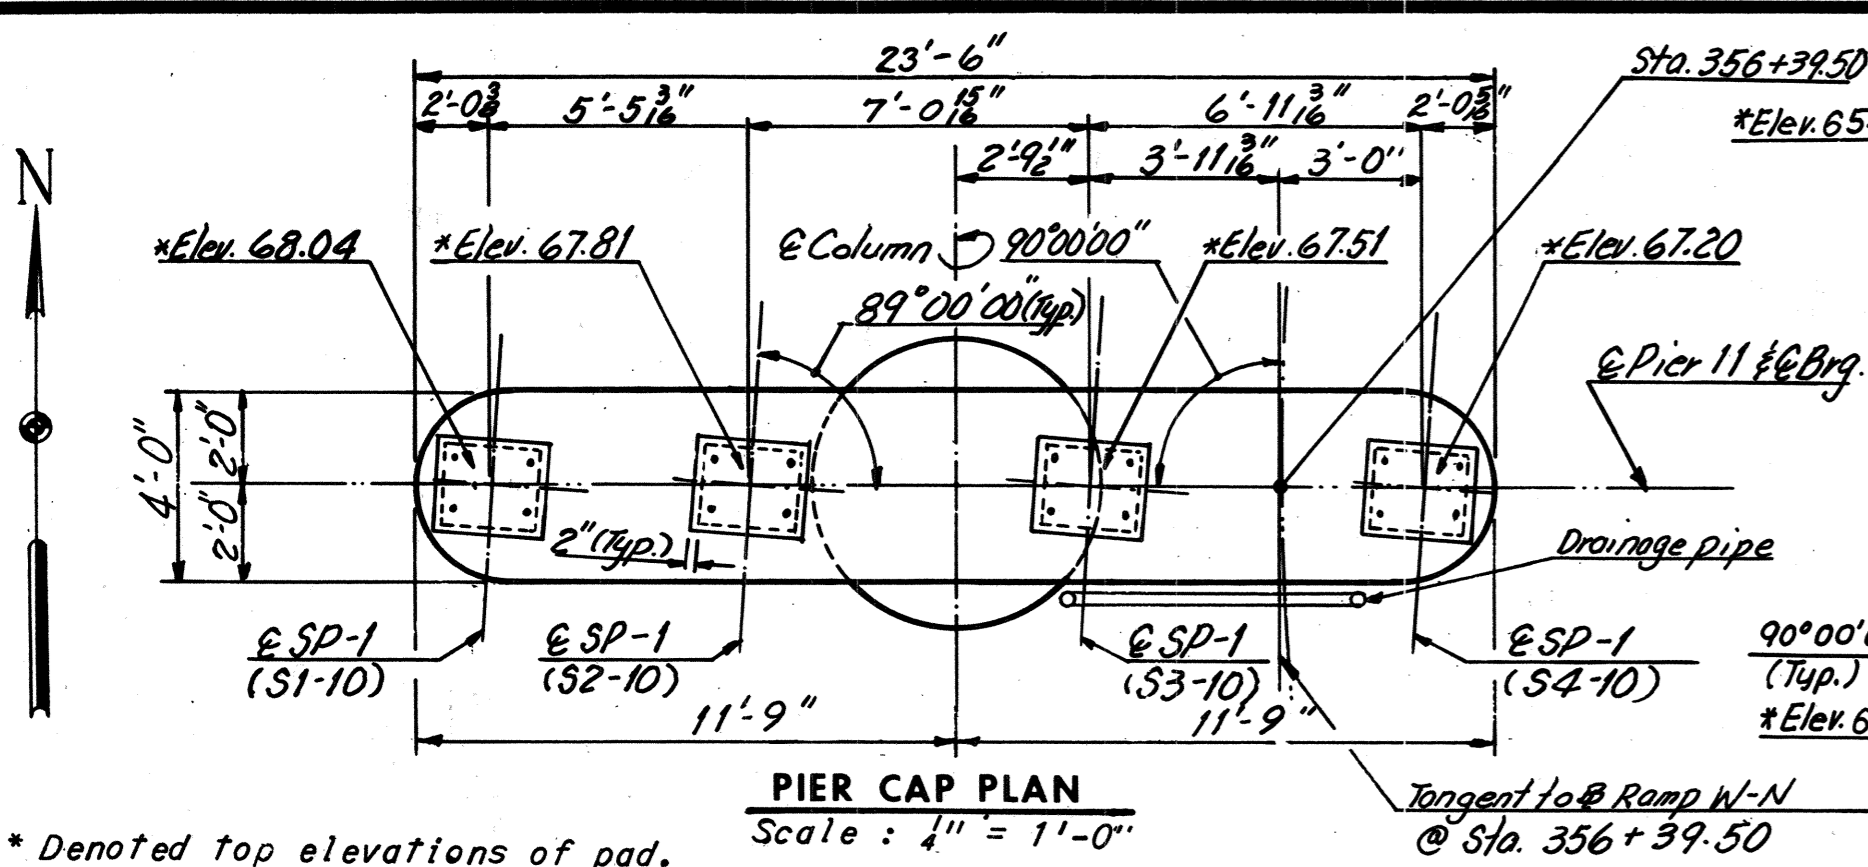

Notes:
For Standard Shoe Details, see Sheets S1 and S2
For Framing Plan, see Sheets 26 and 27
For Quantities of Steel and Concrete, see Sheet 2
All piles shall be 12B53 Steel piles
(Design Capacity = 57 Tons)
Estimated pile tip elevation: Pier 11 = -5.0 ft.
Pier 12E = -8.0 ft.

DIMENSIONS FOR PAD AND ANCHOR BOLT SETTING PLAN														
Stringer	α	A	B	C	D	E	F	G	H	I	J	K	L	M
S1-11	87°00'50"	3 1/2"	10 1/2"	1 1/2"	1'-2 3/4"	1'-2 3/4"	5 1/2"	7"	1'-0 1/2"	2'-5"	3 1/2"	2"	4"	10 1/2"
S2-11	88°28'25"	3 1/2"	10 1/2"	1 1/2"	1'-2 3/4"	1'-2 3/4"	5 1/2"	6 1/2"	1'-0 1/2"	2'-5"	3 1/2"	2 3/4"	4"	10 1/2"
S3-11	89°57'17"	0"	10 1/2"	0"	1'-2 1/2"	1'-2 1/2"	6 1/2"	6 1/2"	1'-0 1/2"	2'-5"	2 3/4"	2 3/4"	4"	10 1/2"

RICHMOND METROPOLITAN AUTHORITY
RICHMOND EXPRESSWAY SYSTEM
DOWNTOWN EXPRESSWAY

BRIDGE NO. 67
RAMP W-N CONNECTION TO
RICHMOND-PETERSBURG TURNPIKE
PIERS 11 AND 12E

HOWARD, NEEDLES, TAMMEN & BERGENDOFF
consulting engineers
NEW YORK ALEXANDRIA KANSAS CITY











SCALE: *As Noted*
CONTRACT NO.: 10
SHEET NO. 12 OF 54

BY	DATE	Notes Added	LRH	4-19-76
MADE	G.S.H.	3-19-69	TEM	9-10-74
CHECKED	PTA	5-7-69	REB	11-13-74
IN CHARGE				

Notes: Footing elevations are approximate only and may be varied to suit field conditions as directed by the Engineer. Vertical shaft reinforcing shall not be cut until these elevations are established. Where elevations change more than 2 ft., redesign will be required.

AS BUILT

RICHMOND EXPRESSWAY SYSTEM			
SECTION	PROJECT	SHEET NO.	TOTAL SHEETS
10	DOWNTOWN EXPRESSWAY	185	265

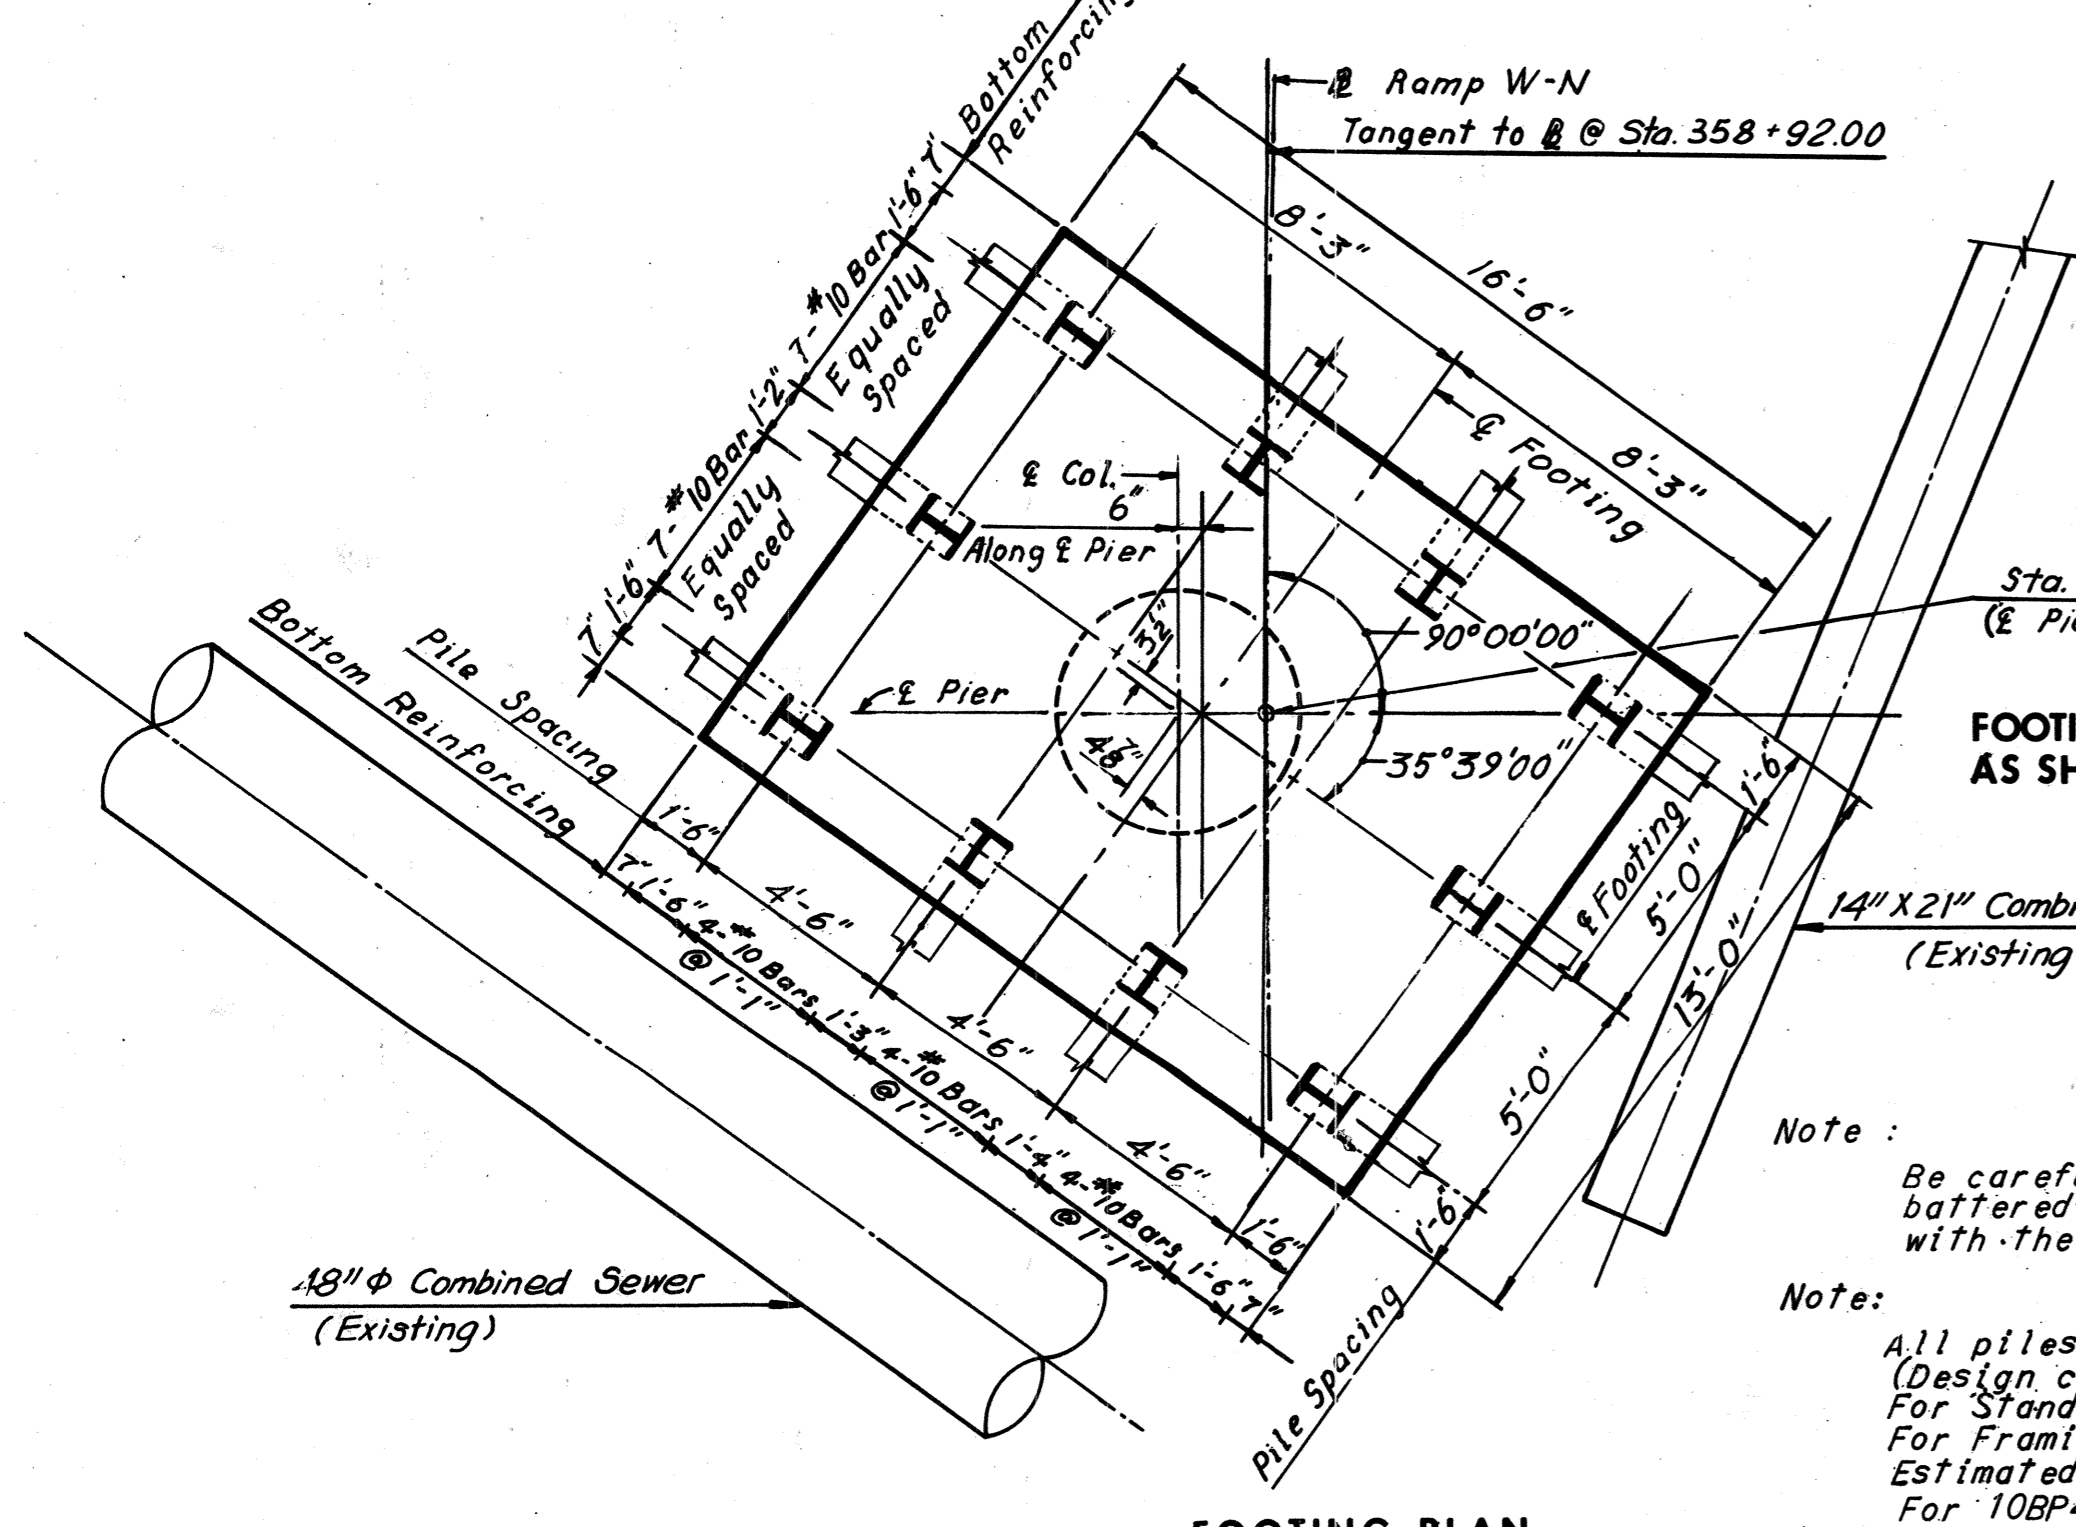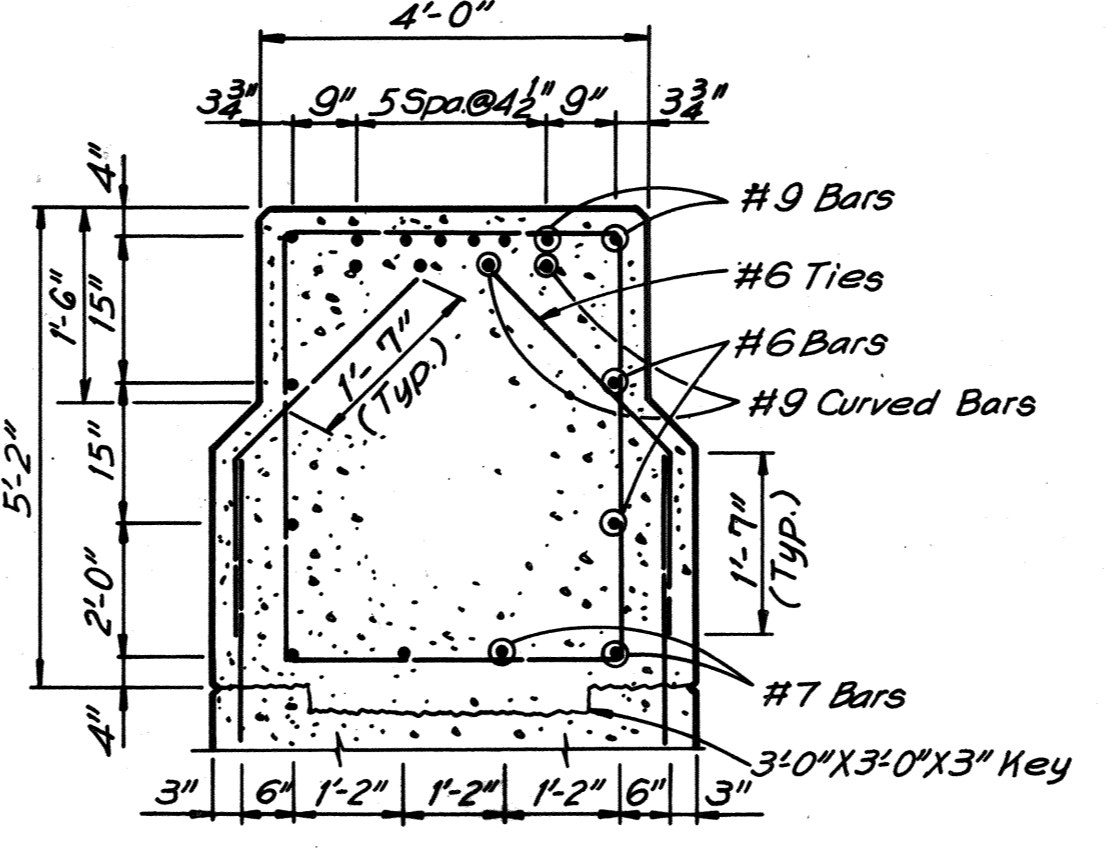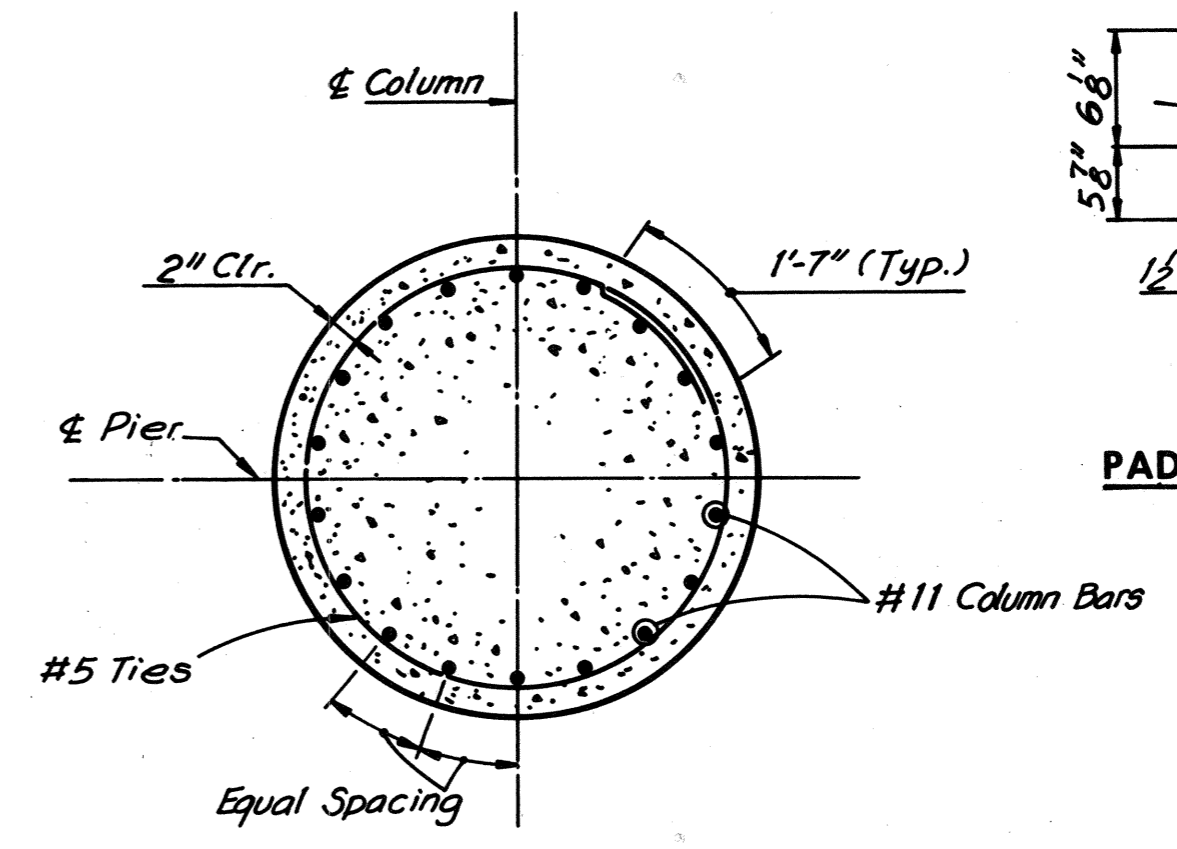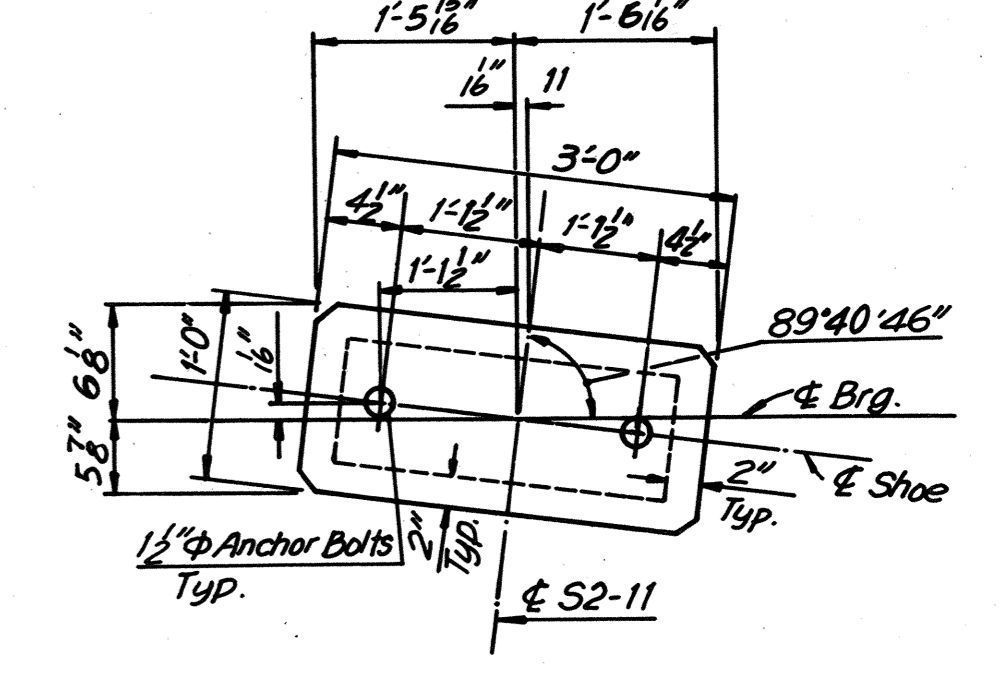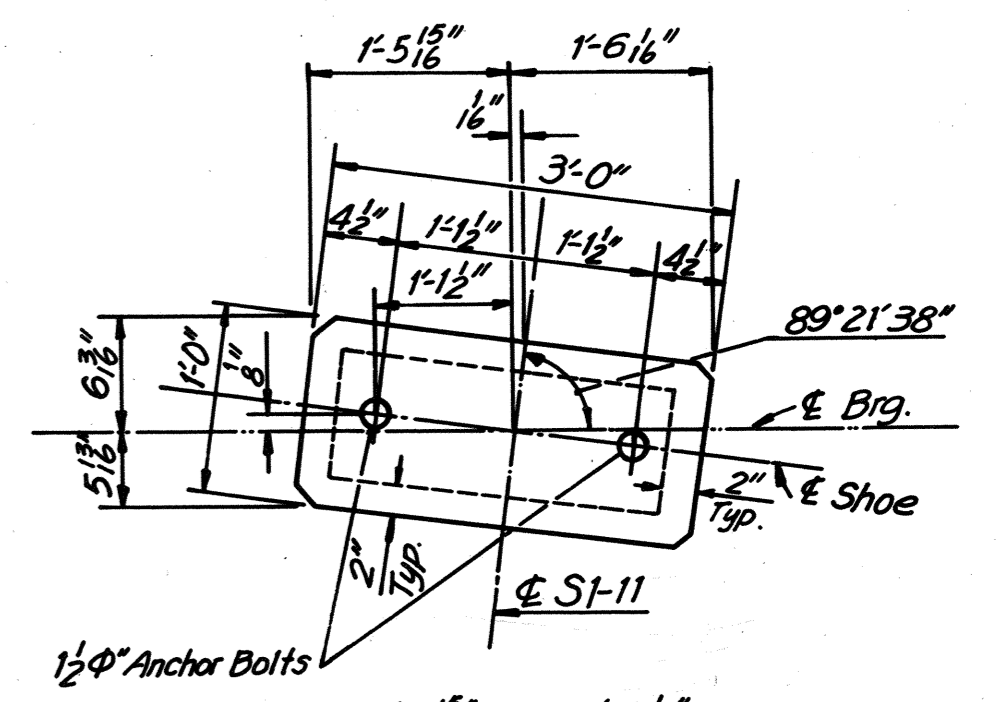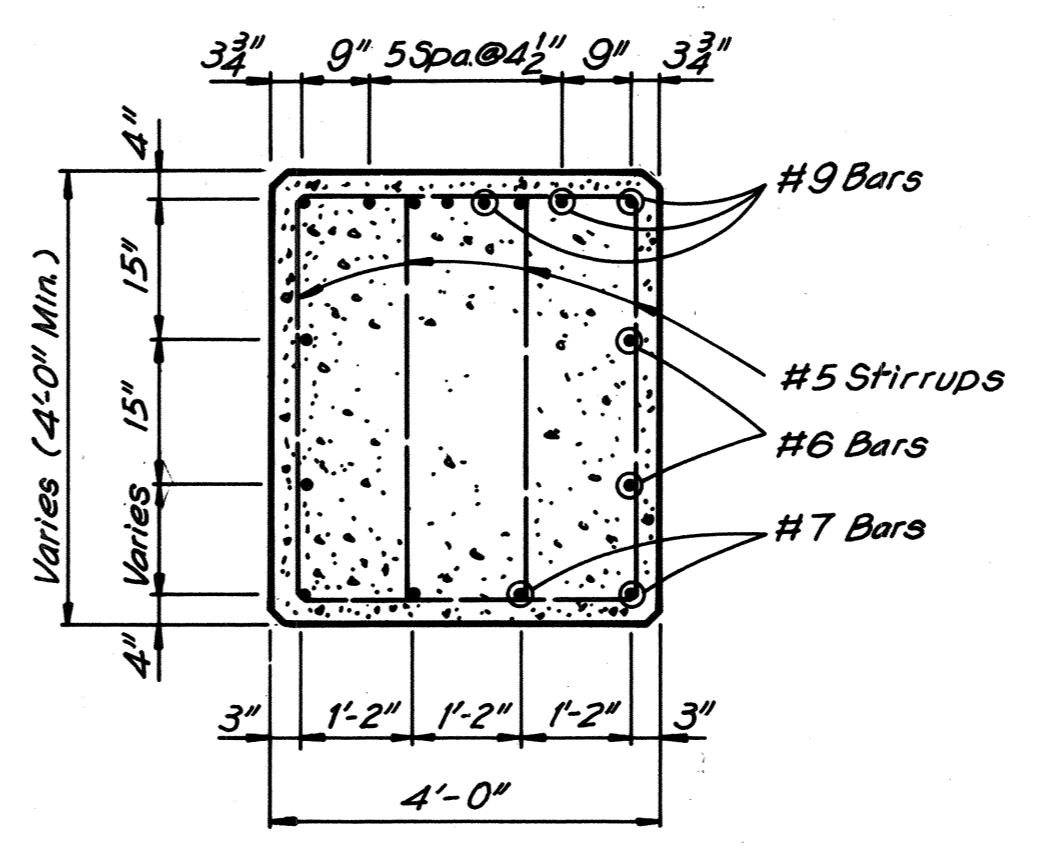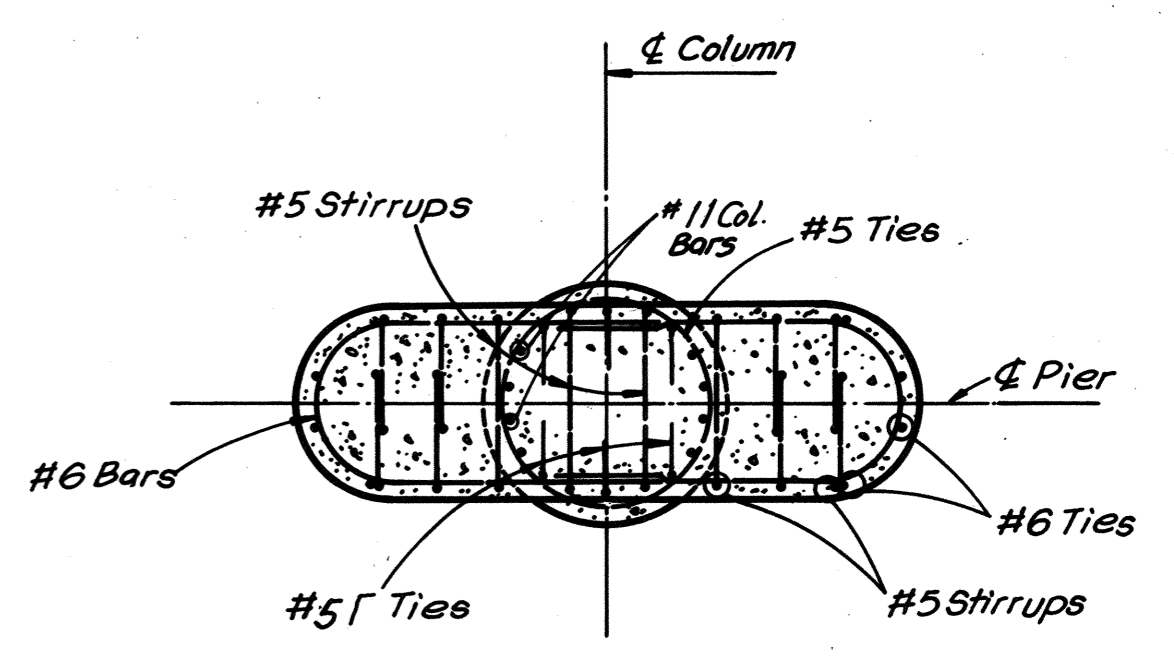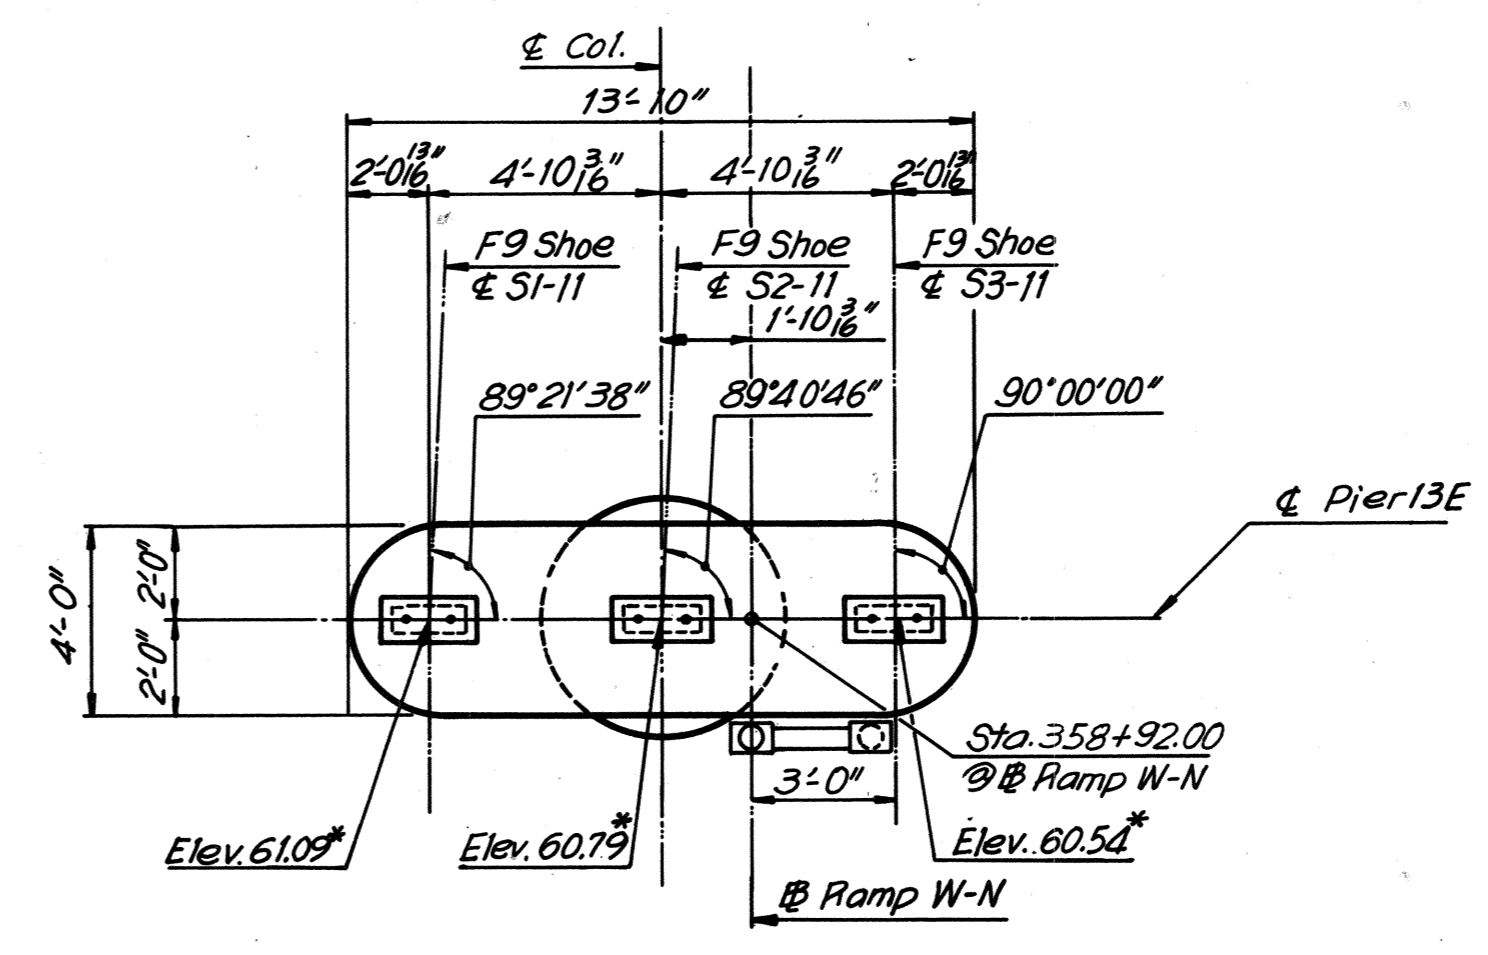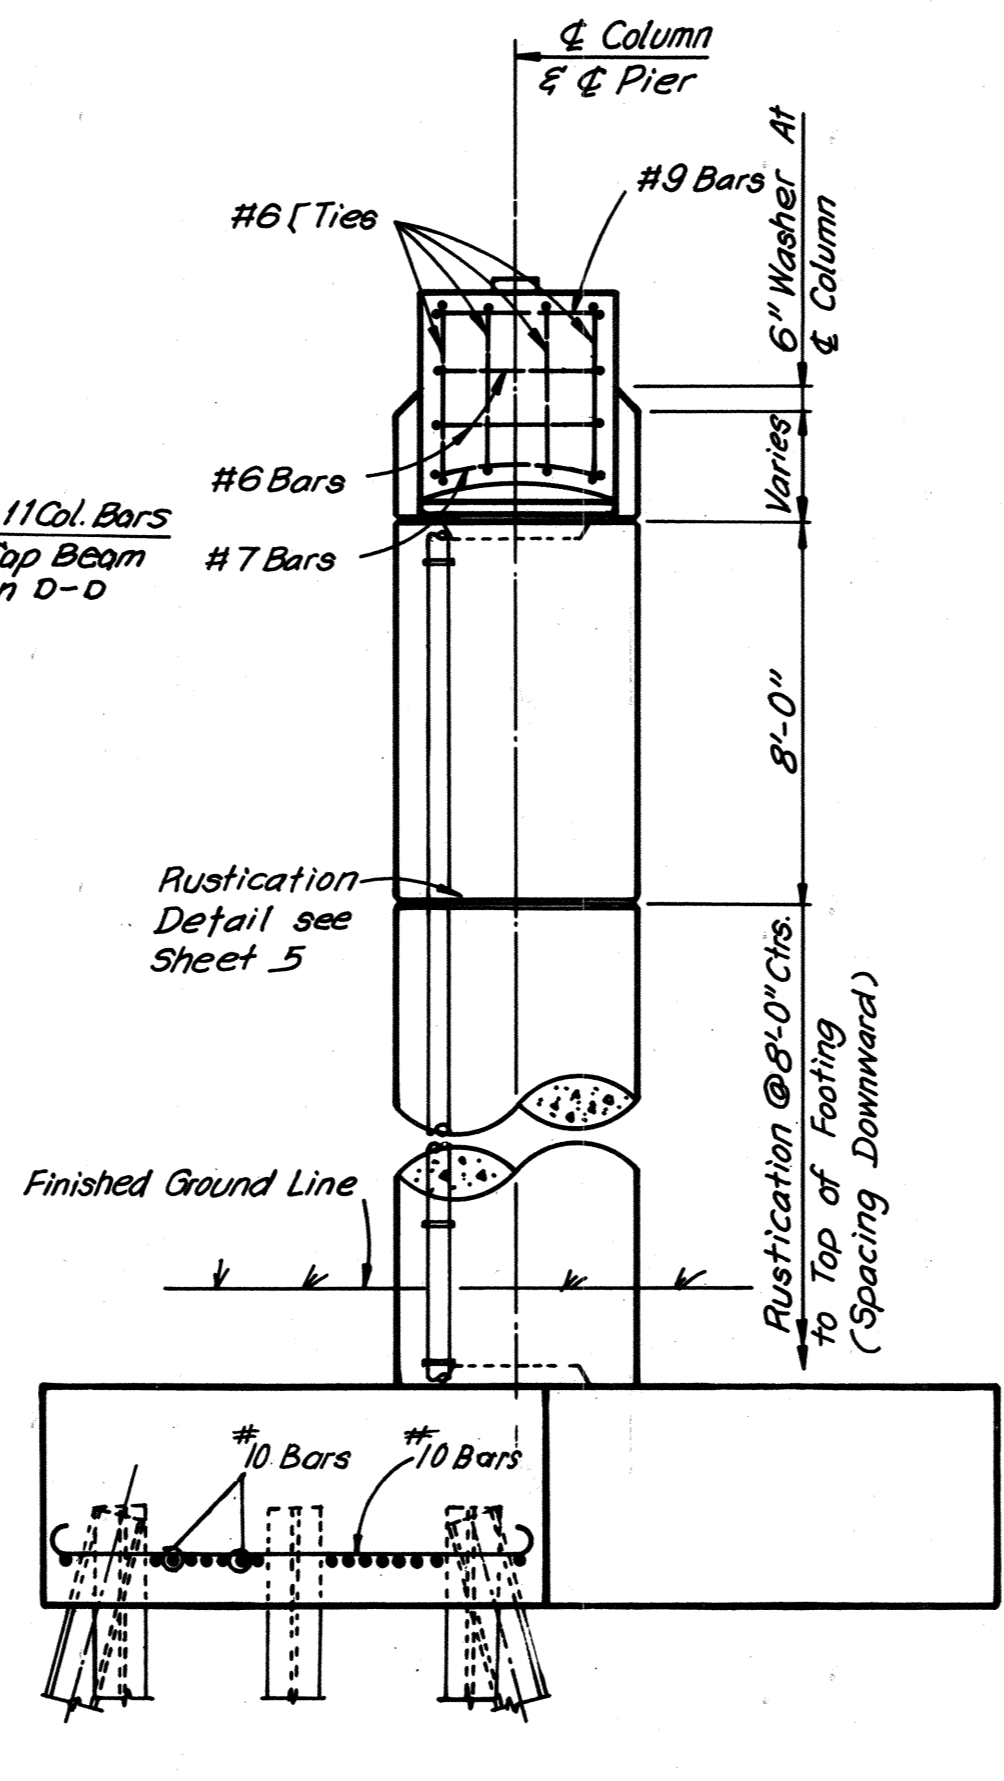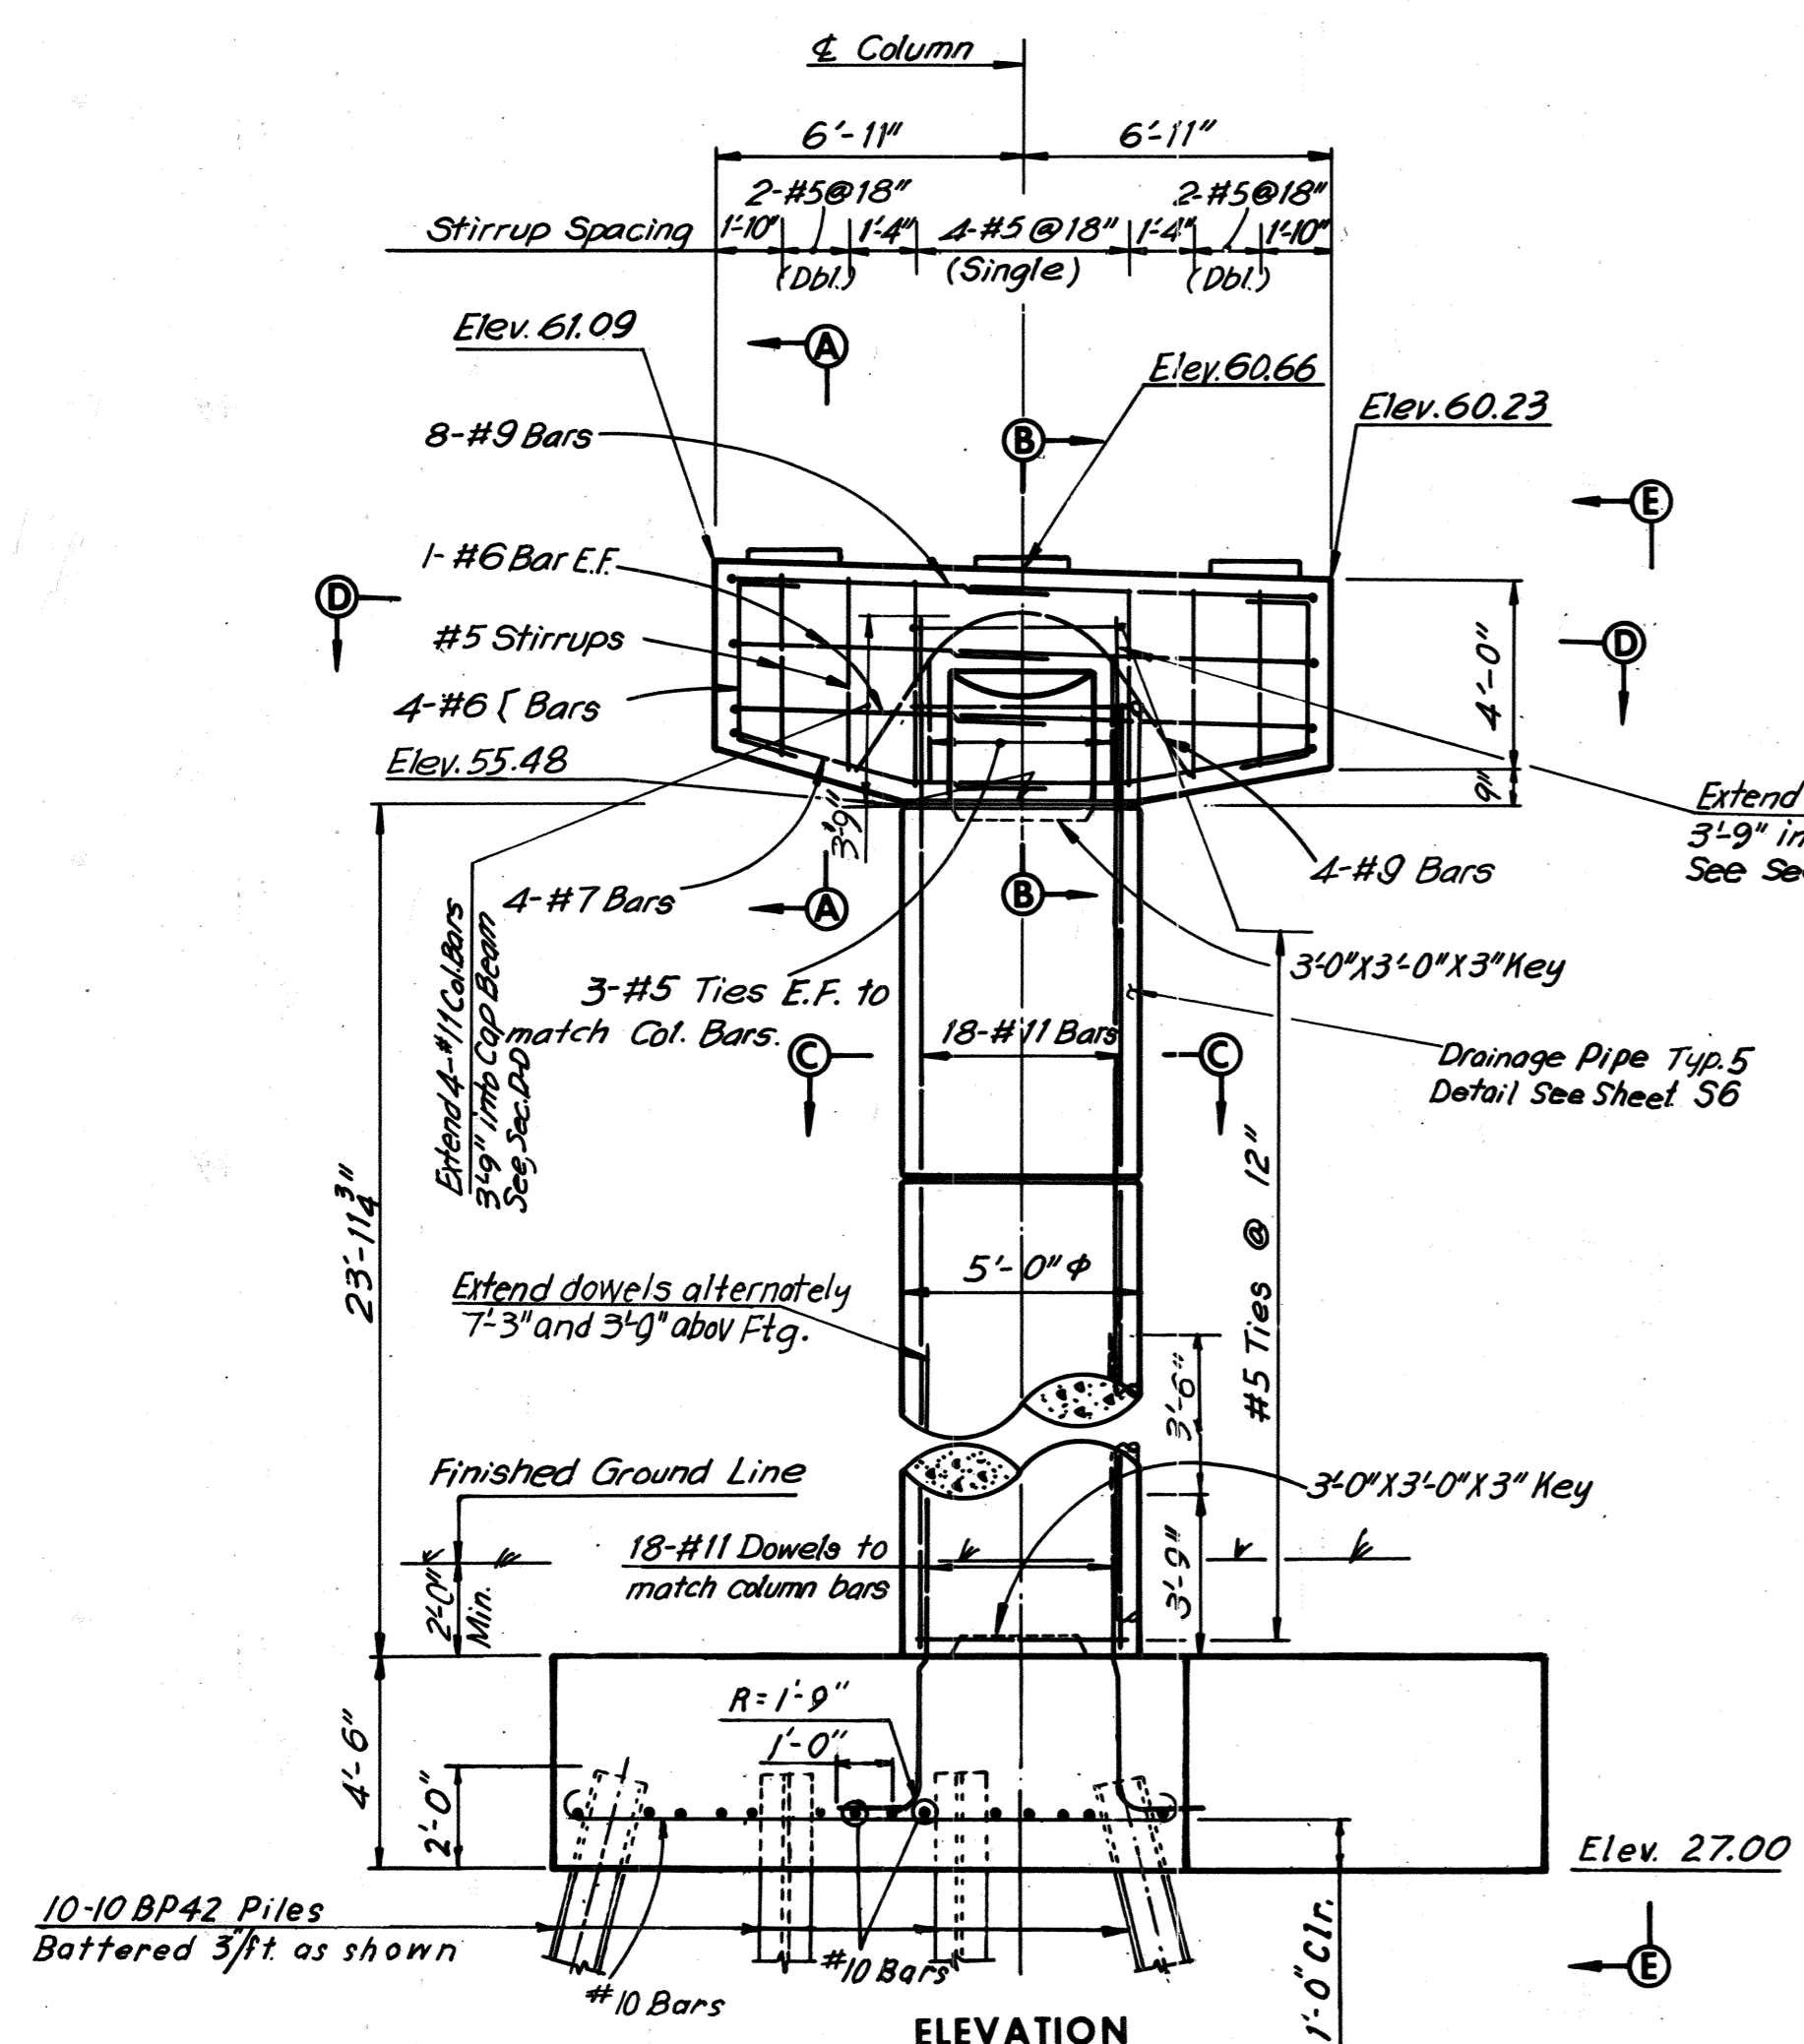

FOOTING FOR PIER 13E IS ECCENTRIC AS SHOWN ON FOOTING PLAN

- Note: Be careful to avoid interference of battered piles and footing excavations with the two existing combined sewers.
- Note: All piles shall be 10BP42 Steel Piles (Design capacity = 45 tons.) For Standard Shoe Details, see Sheet 26 & 27. For Framing Plans, see Sheets 26 & 27. Estimated pile tip elevation, 3.0 For 10BP42 Steel Piles details, see Sheet 5.
- Note: Footing elevations are approximate only and may be varied to suit field conditions as directed by the Engineer. Vertical shaft reinforcing shall not be cut until these elevations are established. Where elevations change more than 2 ft. redesign will be required.

BY	DATE	NO.	REVISION	BY	DATE
MADE	SCC	2.19.69	Z As Built	TEM	6-77
CHECKED	GSH	4.19.69	Δ Pad Elevations	AWB	2-10-75
IN CHARGE					

RICHMOND METROPOLITAN AUTHORITY
RICHMOND EXPRESSWAY SYSTEM
DOWNTOWN EXPRESSWAY









BRIDGE NO. 67
RAMP W-N CONNECTION TO
RICHMOND-PETERSBURG TURNPIKE
PIER 13E

HOWARD, NEEDLES, TAMMEN & BERGENDOFF
consulting engineers
NEW YORK ALEXANDRIA KANSAS CITY




SCALE: As Noted
CONTRACT NO. 10
SHEET NO. 13 OF 54

AS BUILT

RICHMOND EXPRESSWAY SYSTEM			
SECTION	PROJECT	SHEET NO.	TOTAL SHEETS
10	DOWNTOWN EXPRESSWAY	186	265

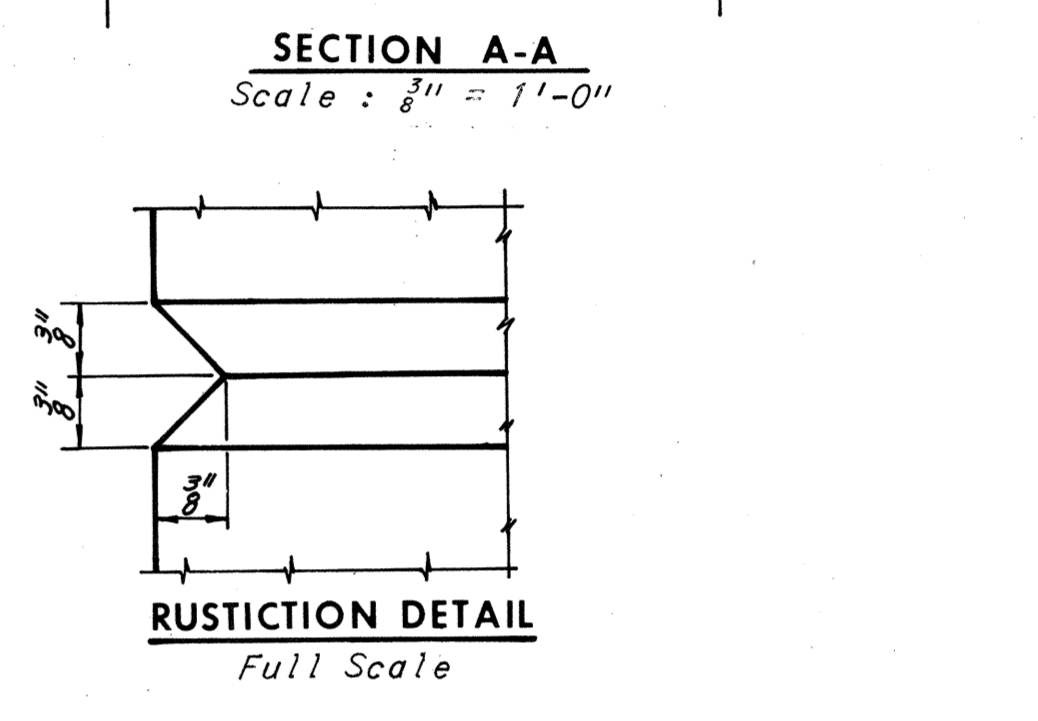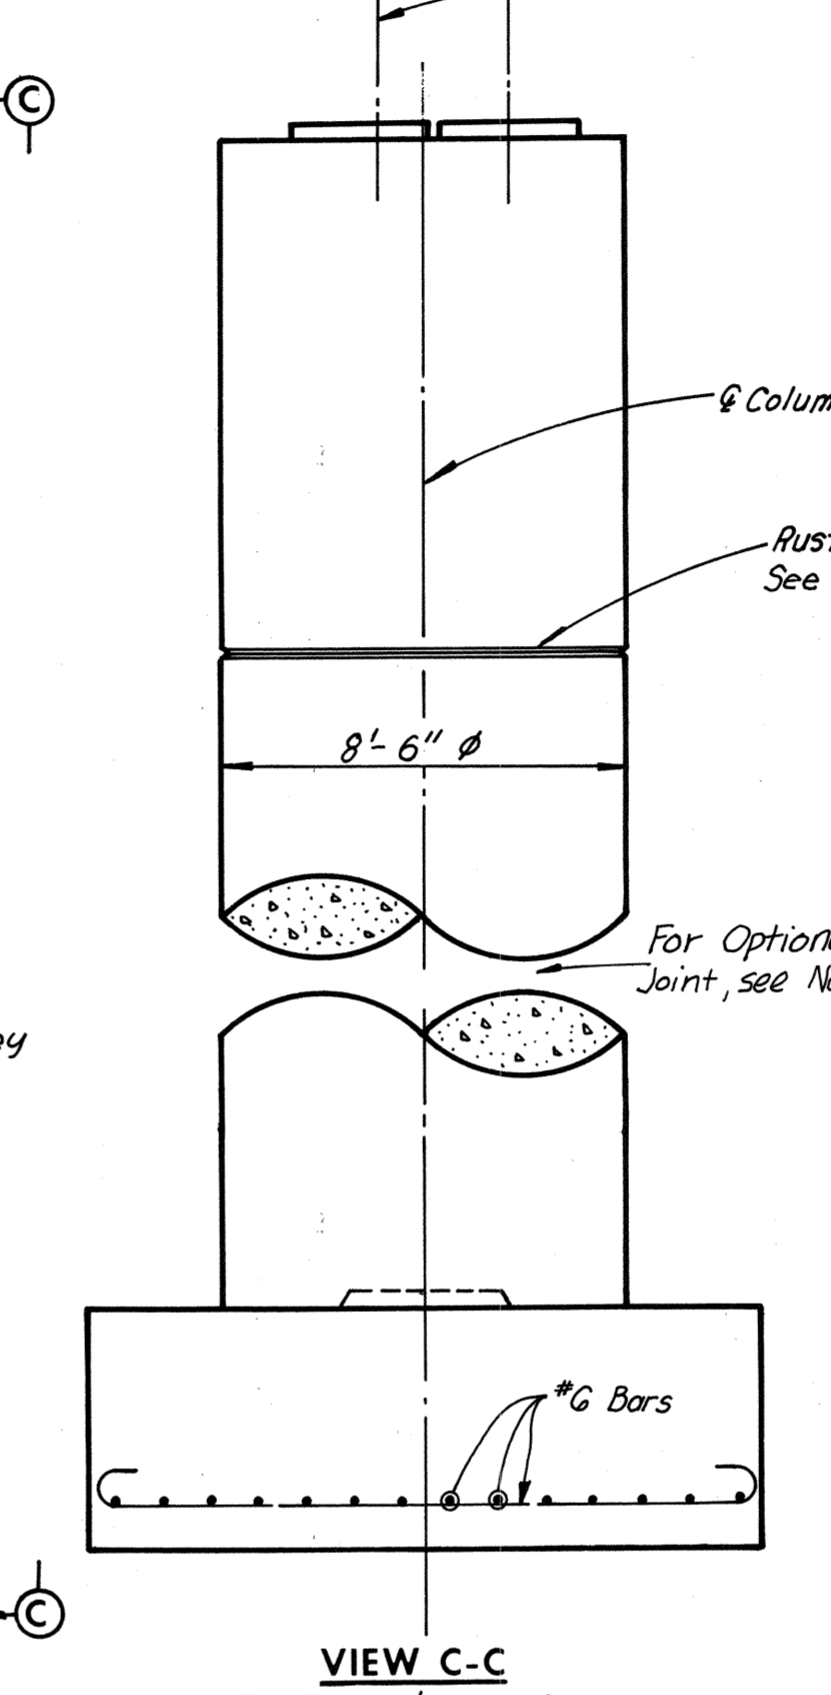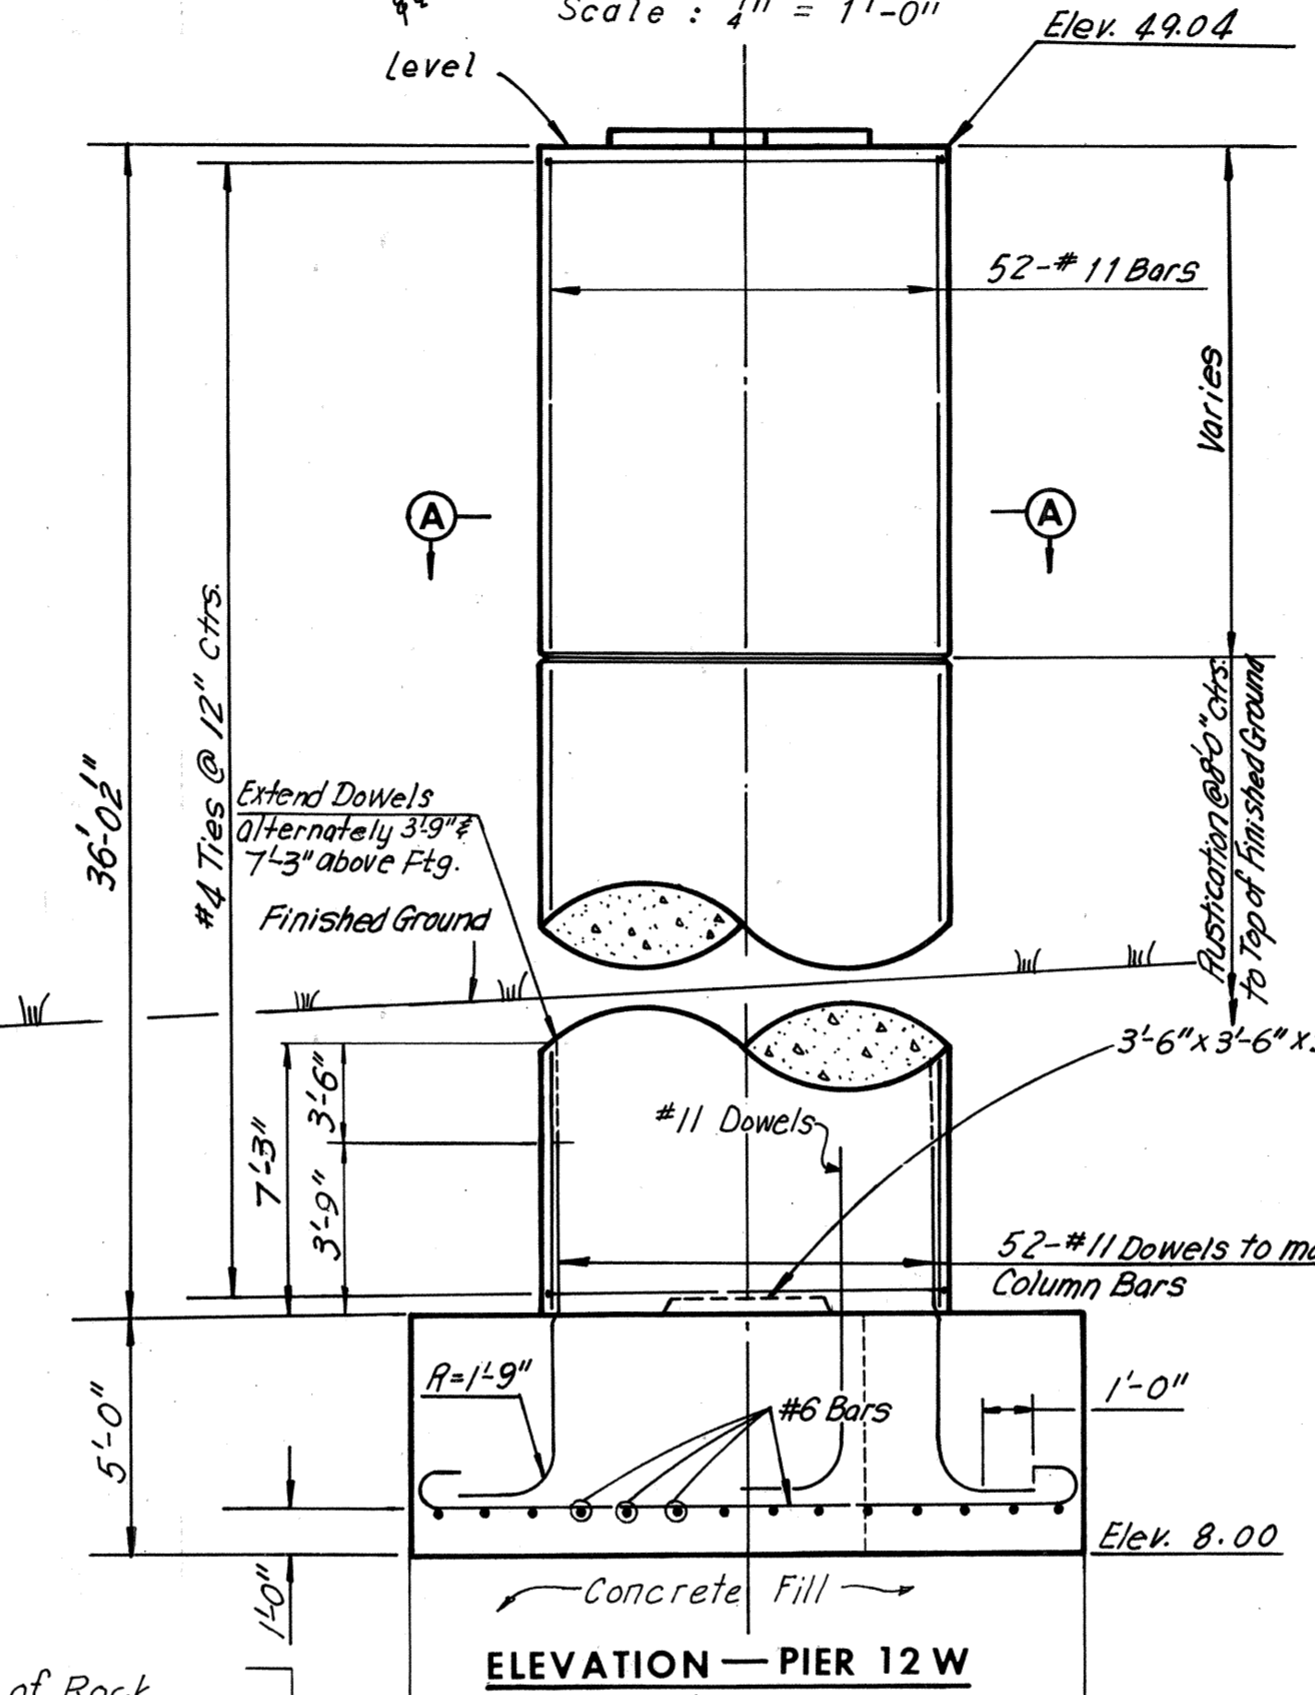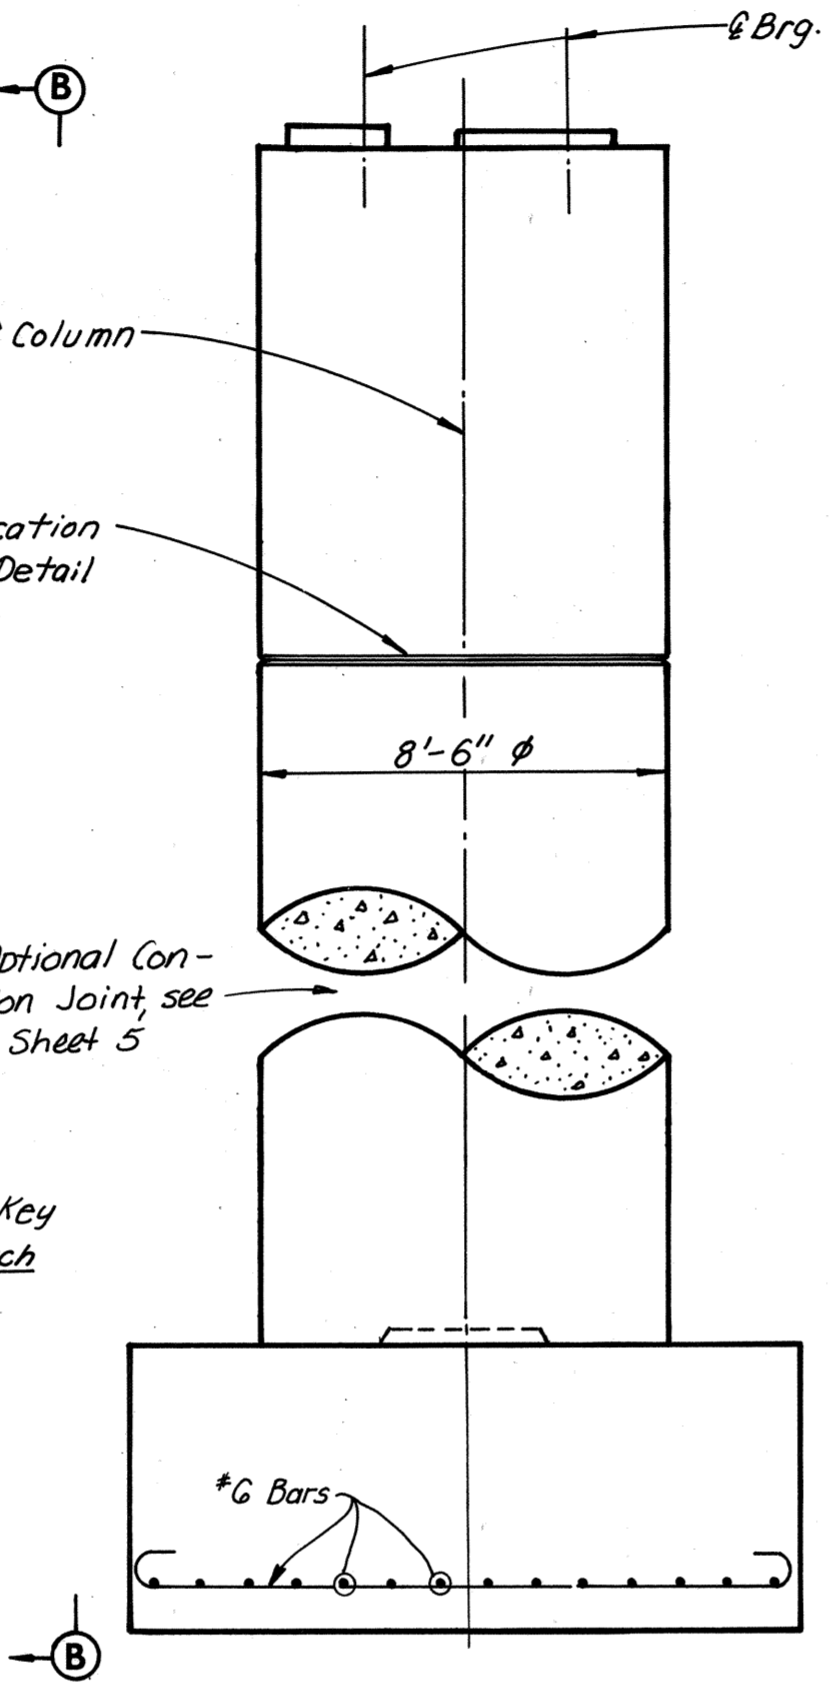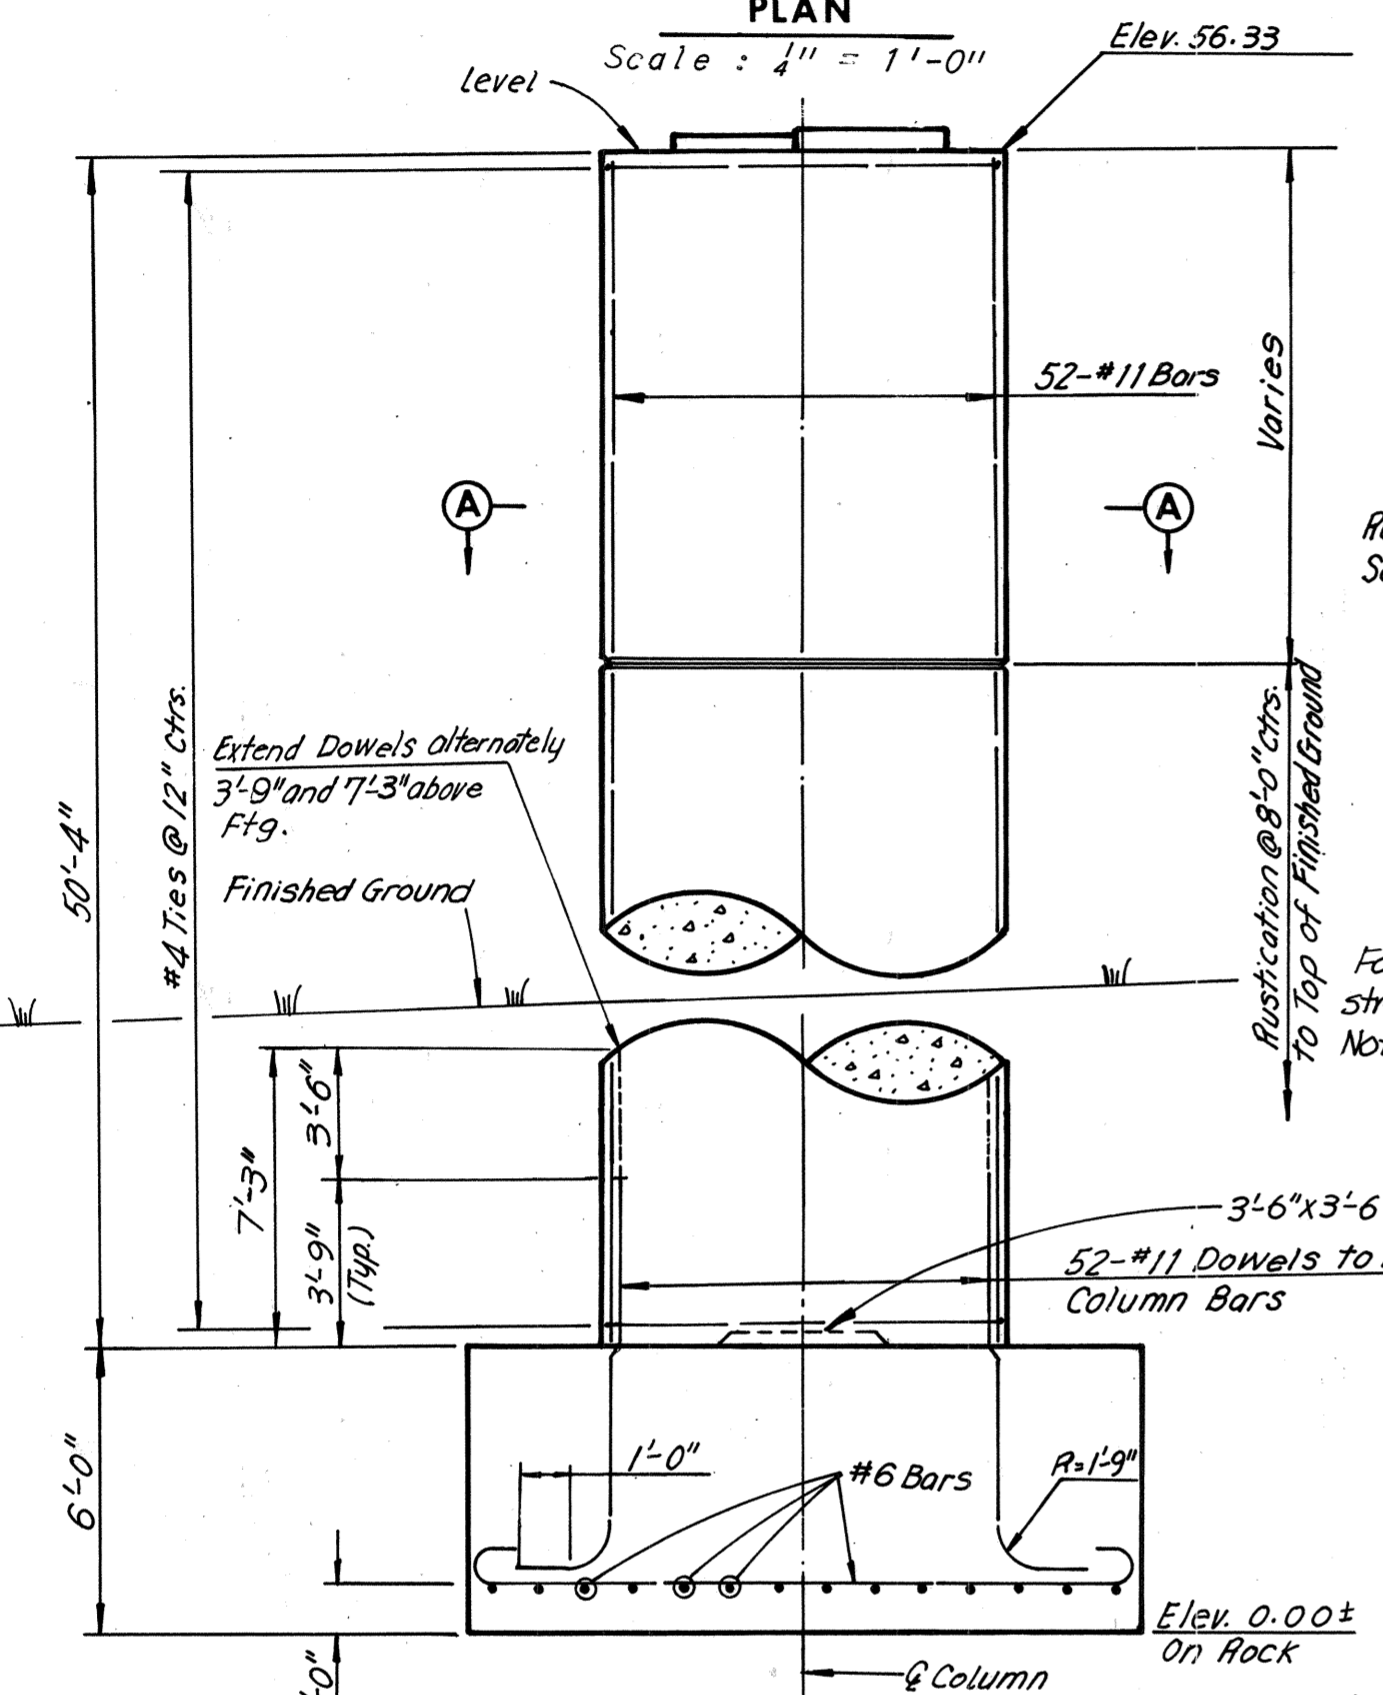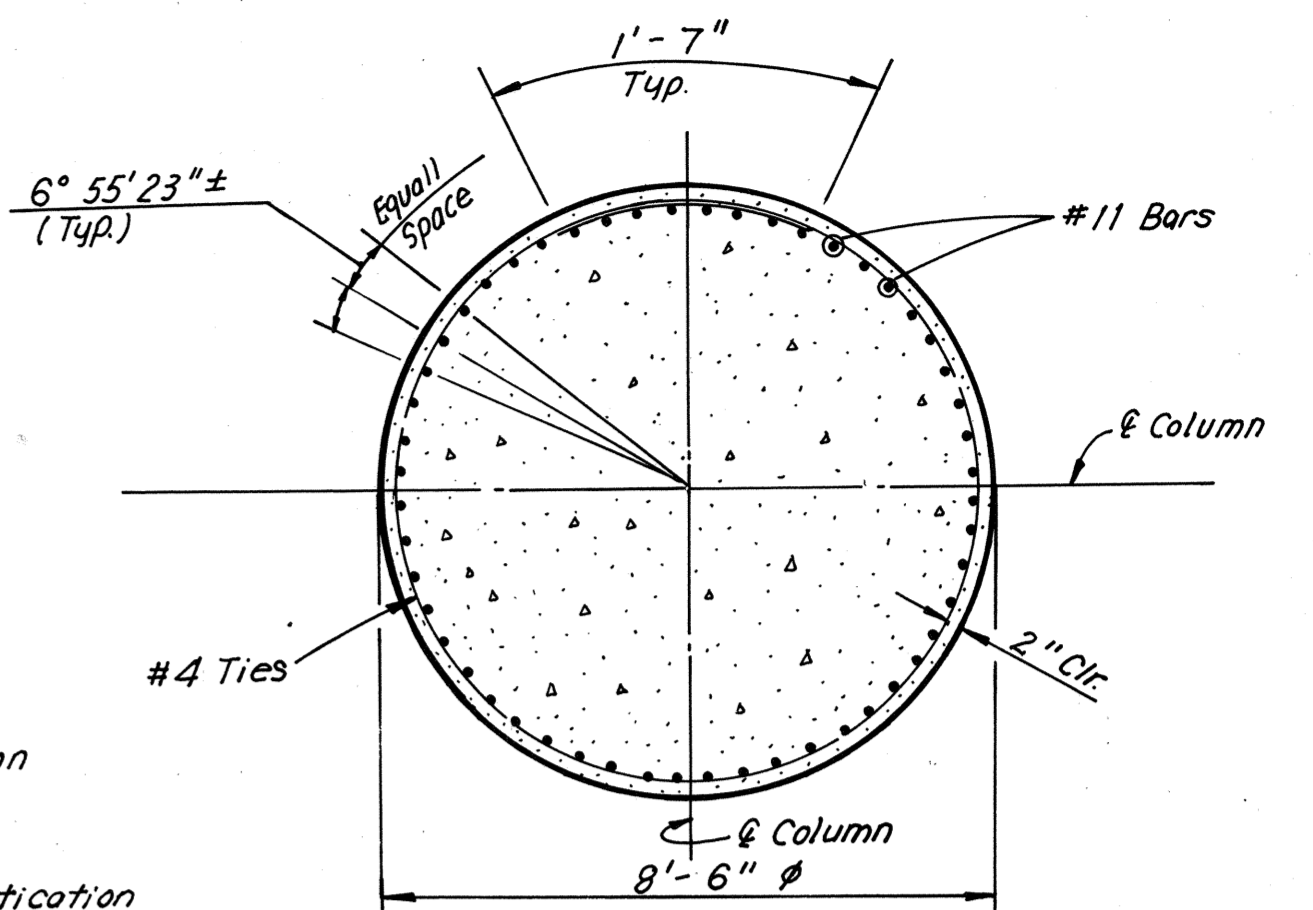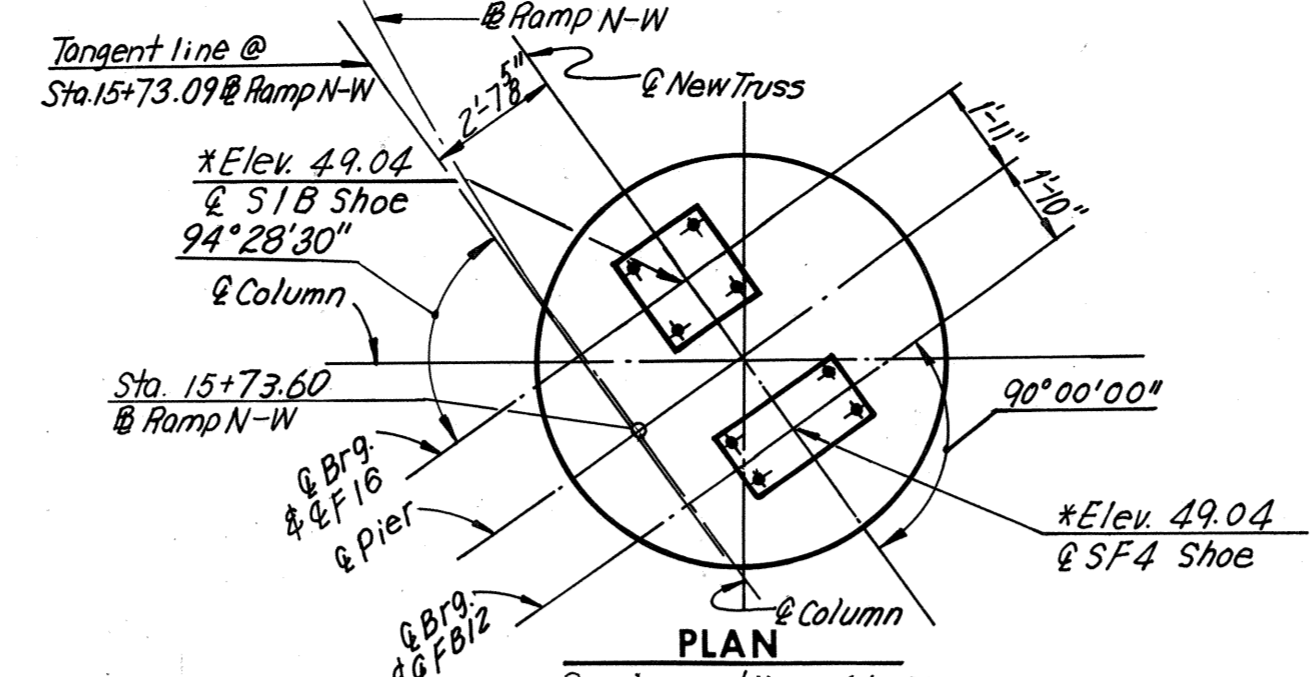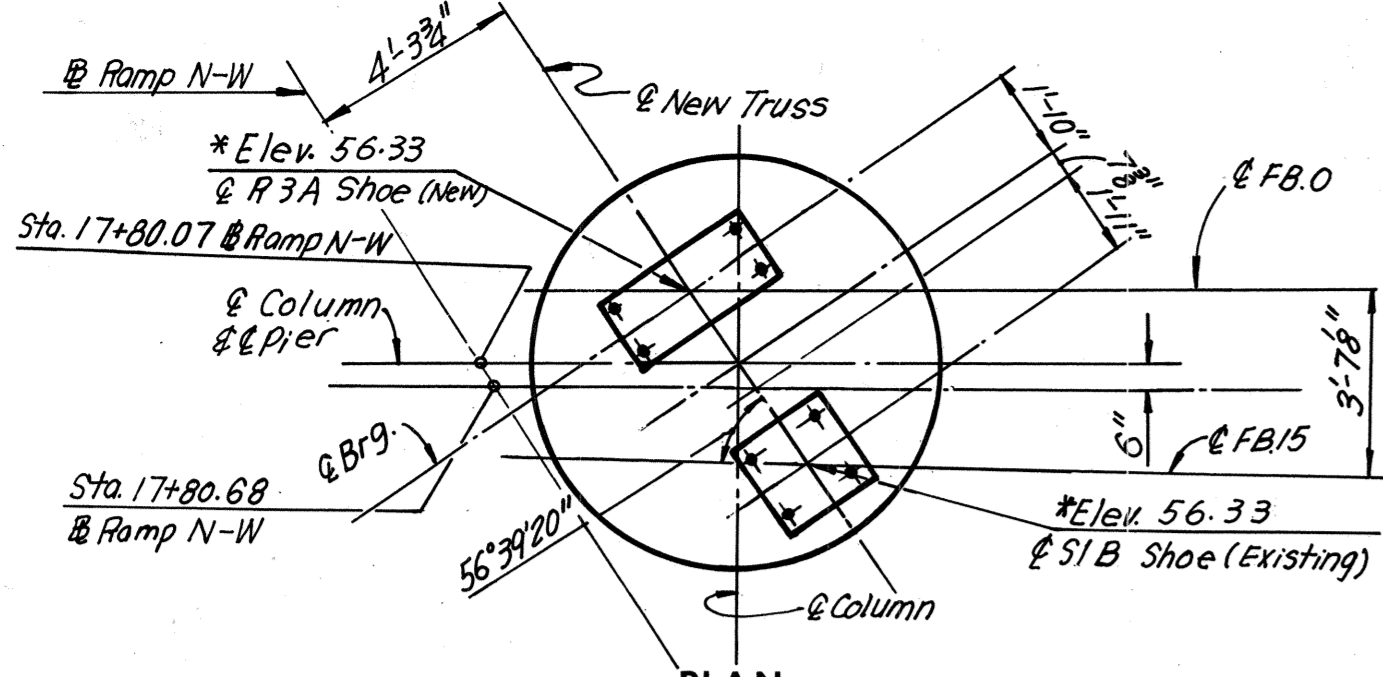

Notes: Footing elevations are approximate only, and may be varied to suit field conditions as directed by the Engineer. Vertical shaft reinforcing shall not be cut until these elevations are established. Where elevations change more than 2 Ft., redesign will be required. For Shoe Details, see Sheet 47. For Framing Plan, see Sheets 26. For Quantities of Steel and Concrete, see Sheet 3.

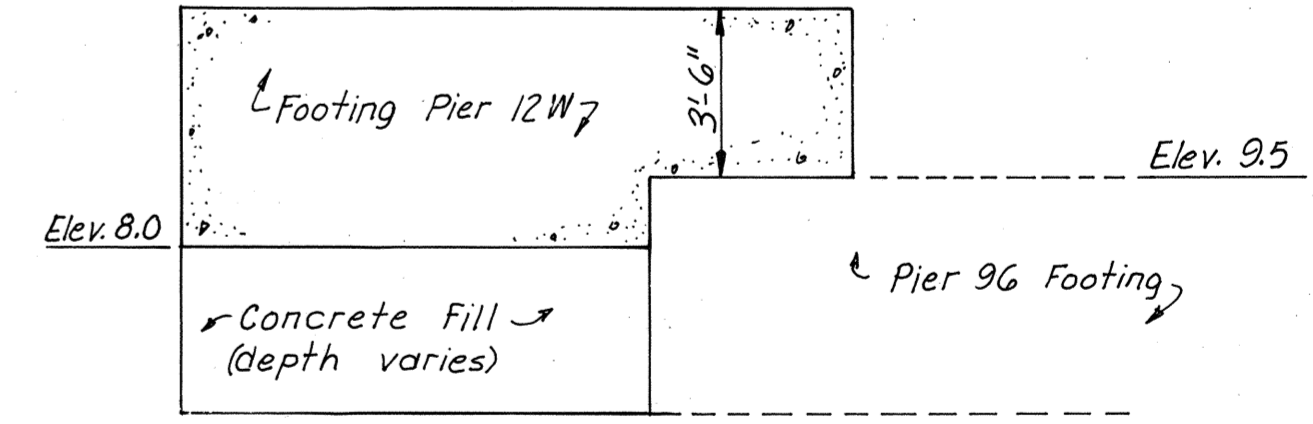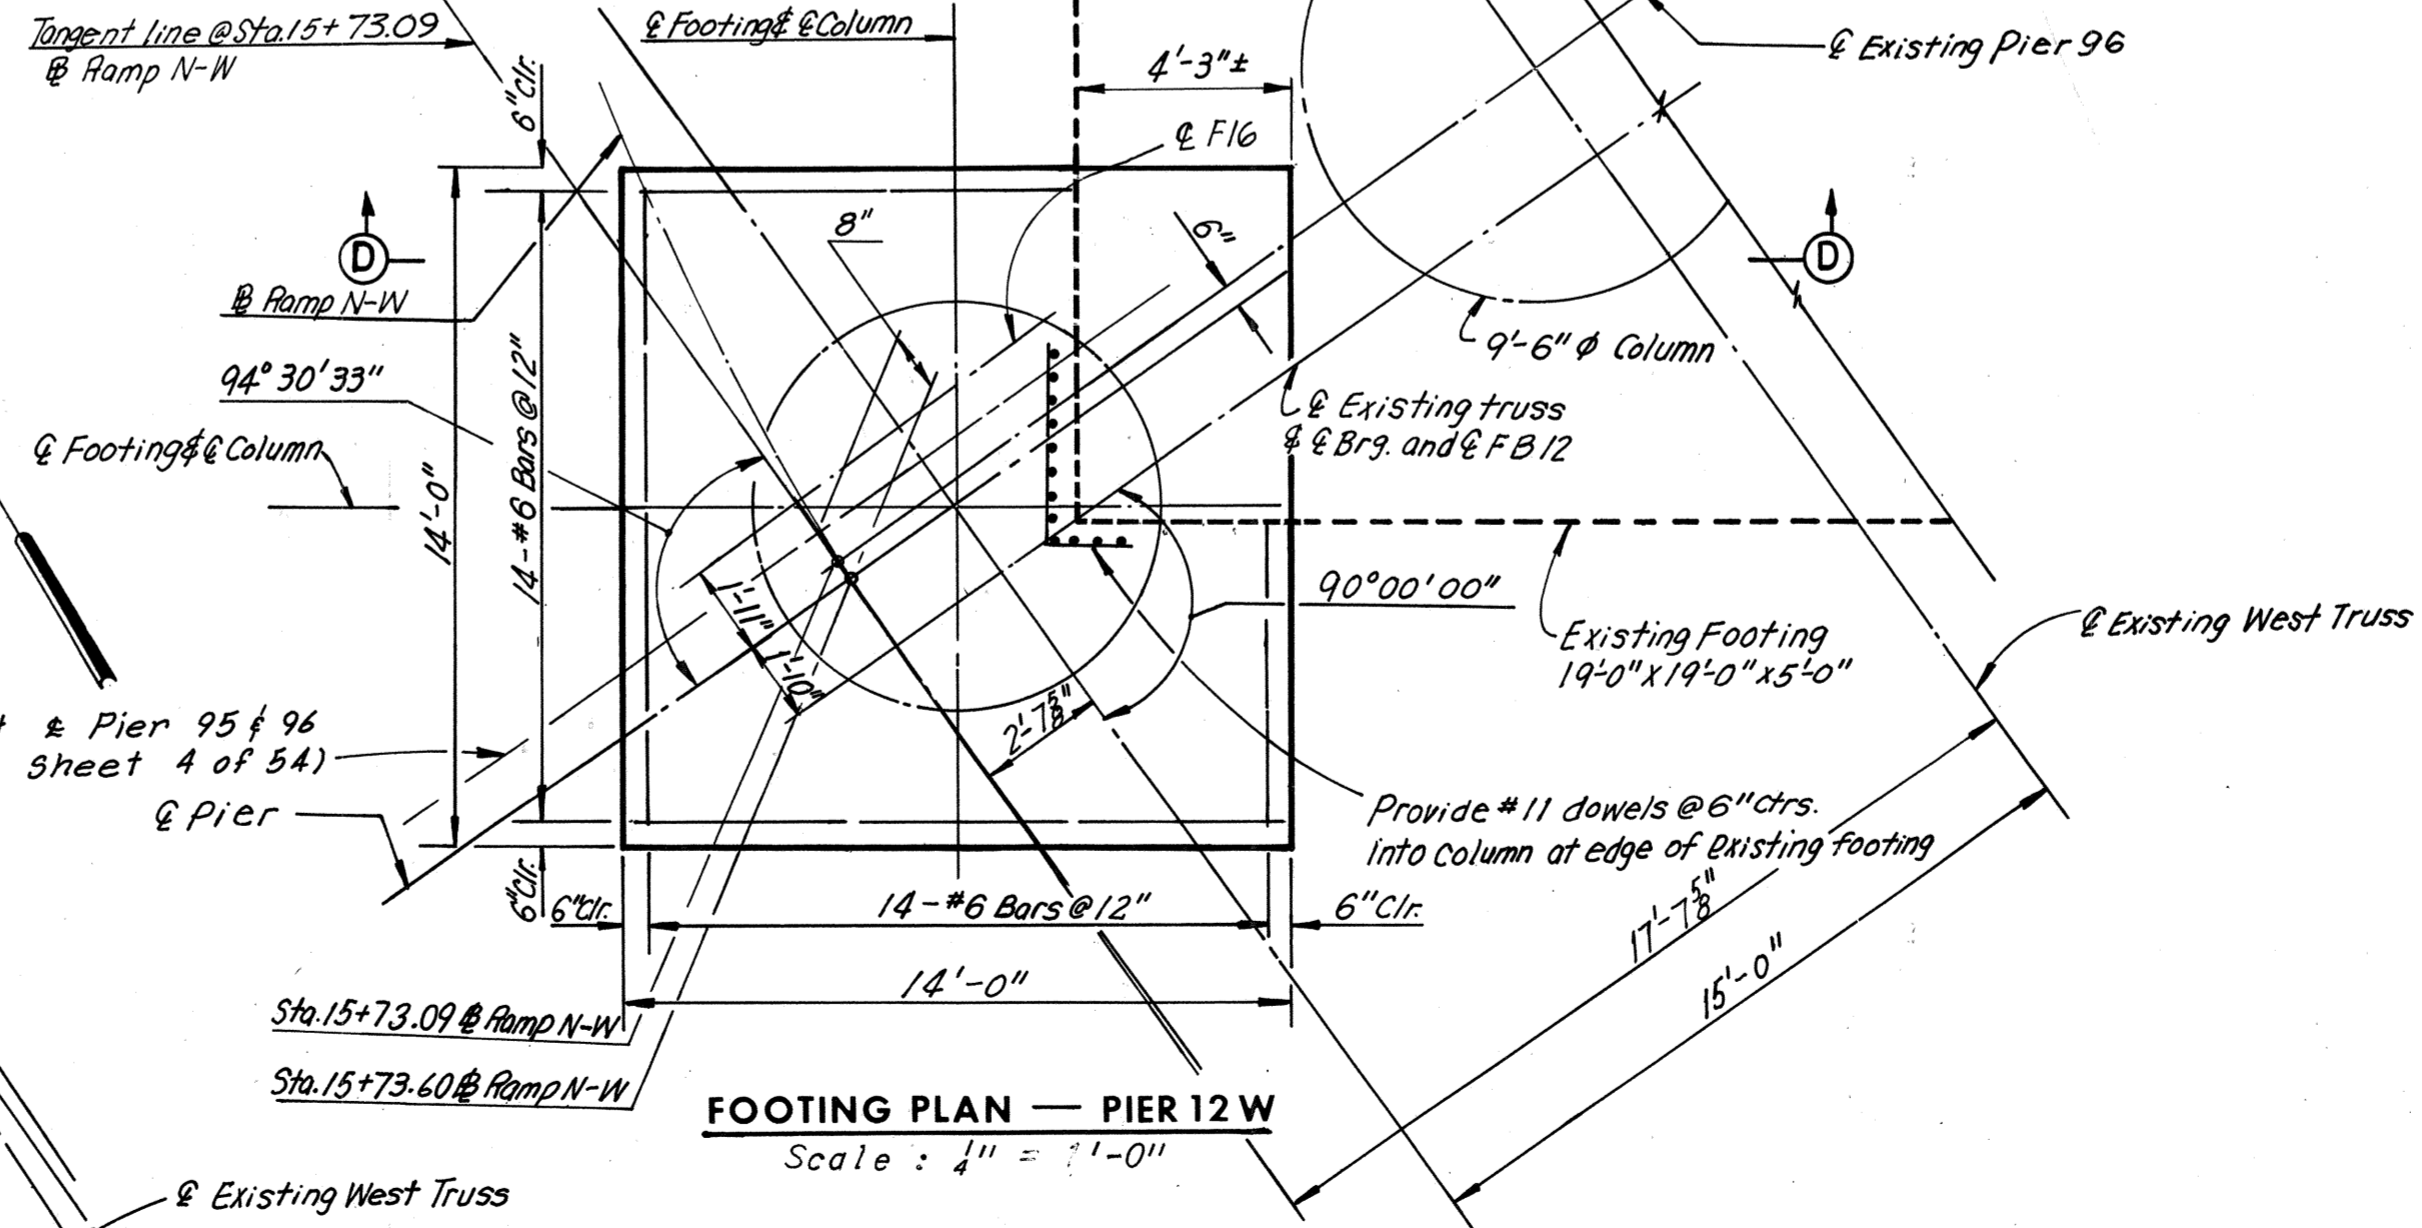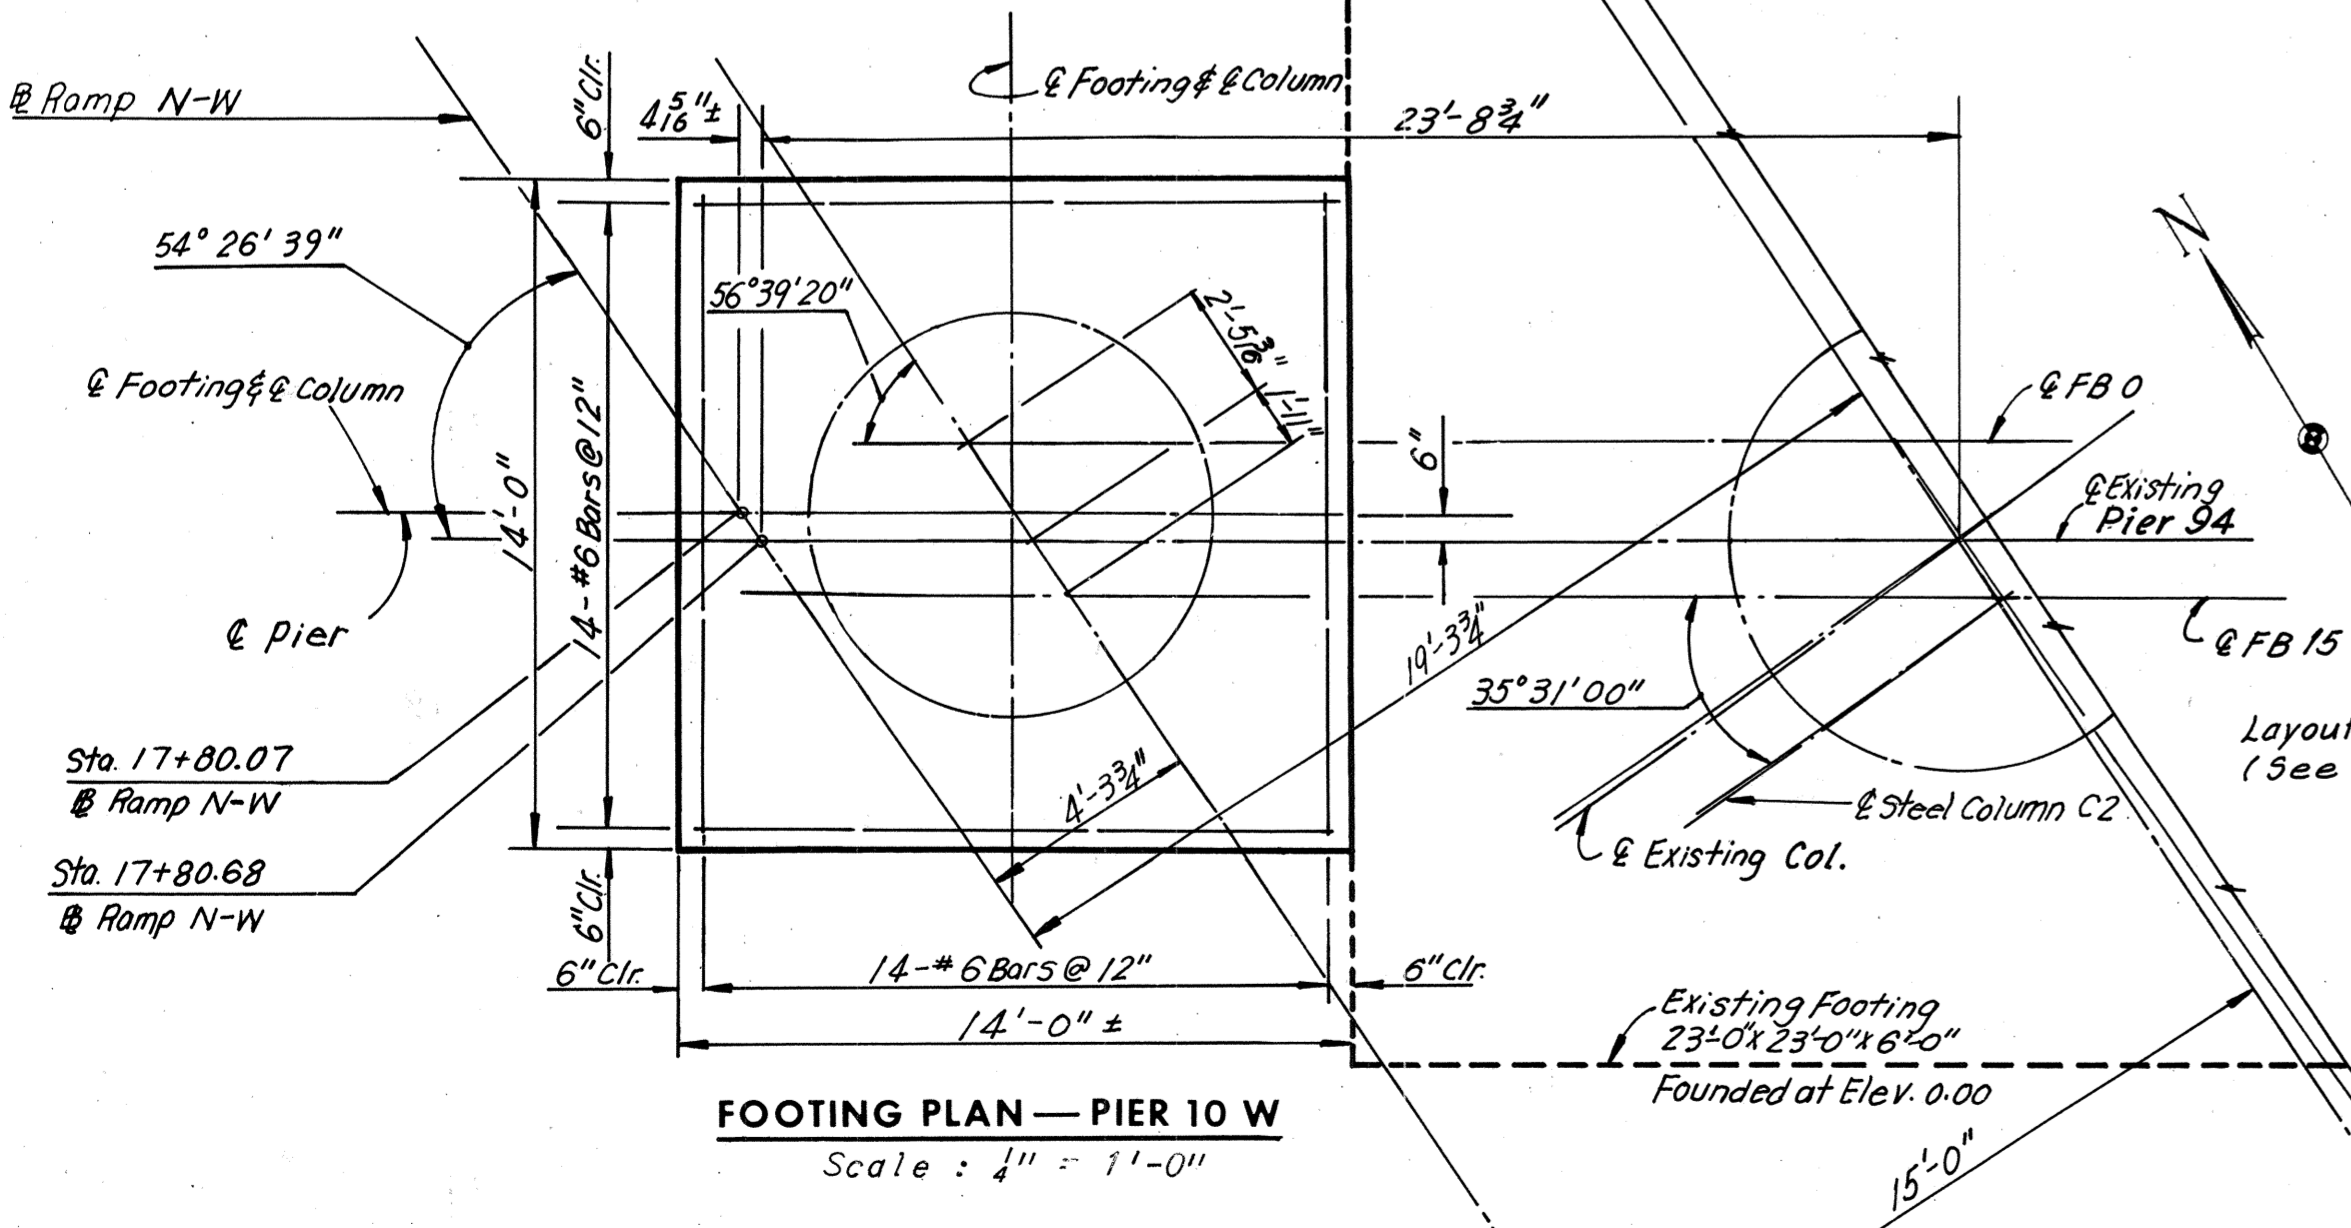


RICHMOND METROPOLITAN AUTHORITY
RICHMOND EXPRESSWAY SYSTEM
 DOWNTOWN EXPRESSWAY

BRIDGE NO. 67
 RAMP W-N CONNECTION TO
 RICHMOND-PETERSBURG TURNPIKE
 PIERS 10 W AND 12 W


NO.	REVISION	BY	DATE
3	As Built	TEM	6-77

AS BUILT


HOWARD, NEEDLES, TAMMEN & BERGENDOFF consulting engineers NEW YORK ALEXANDRIA KANSAS CITY	SCALE: As Noted CONTRACT NO.: 10 SHEET NO. 14 OF 54
---	---

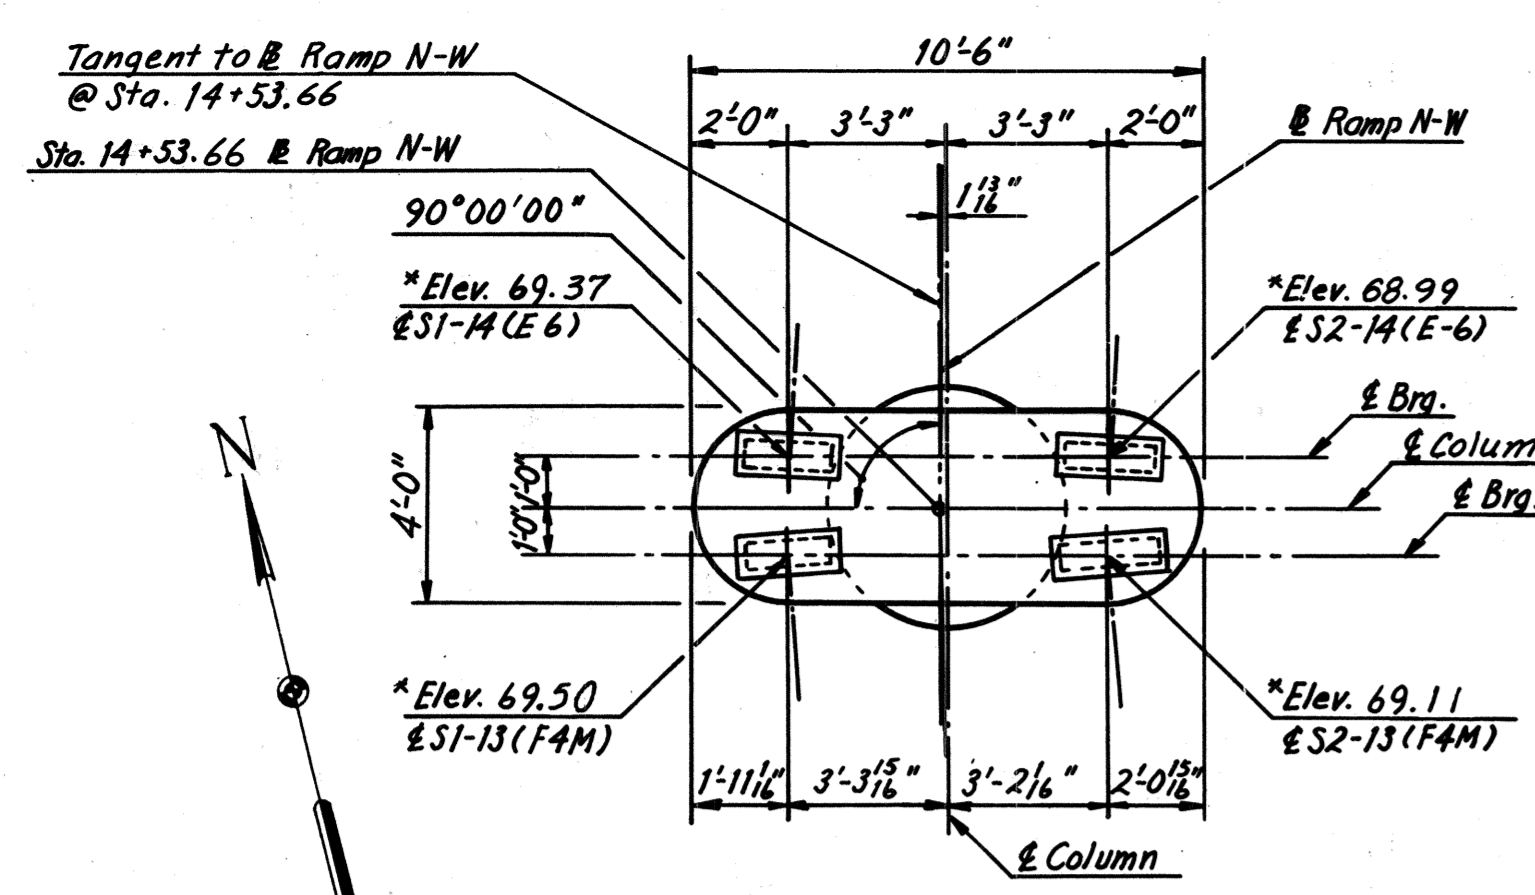


PIER CAP PLAN - PIER 13W
Scale: 1/4" = 1'-0"

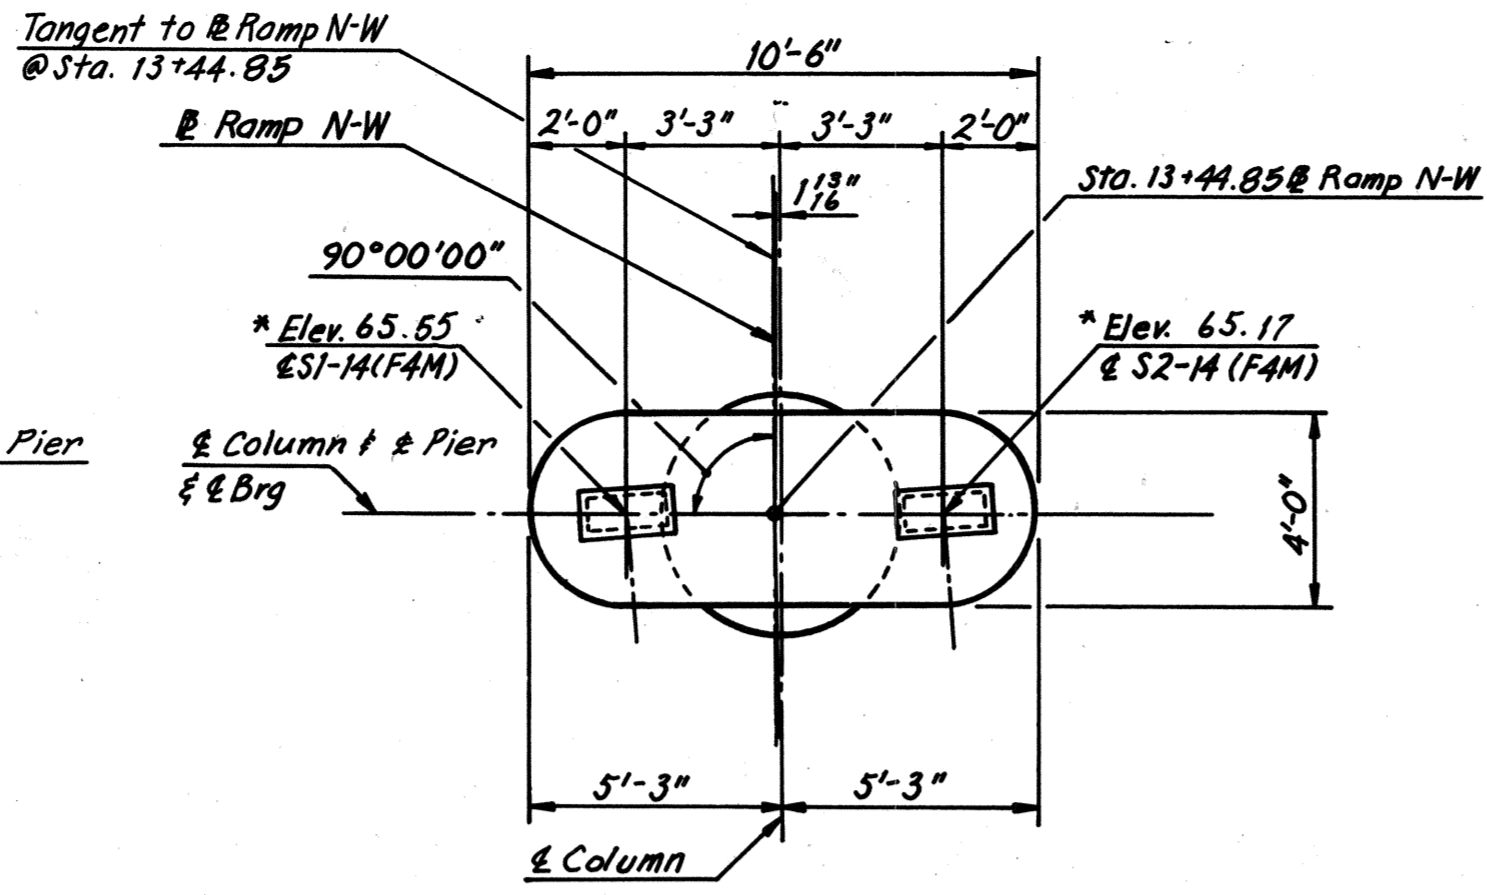


PIER CAP PLAN - PIER 14
Scale: 1/4" = 1'-0"

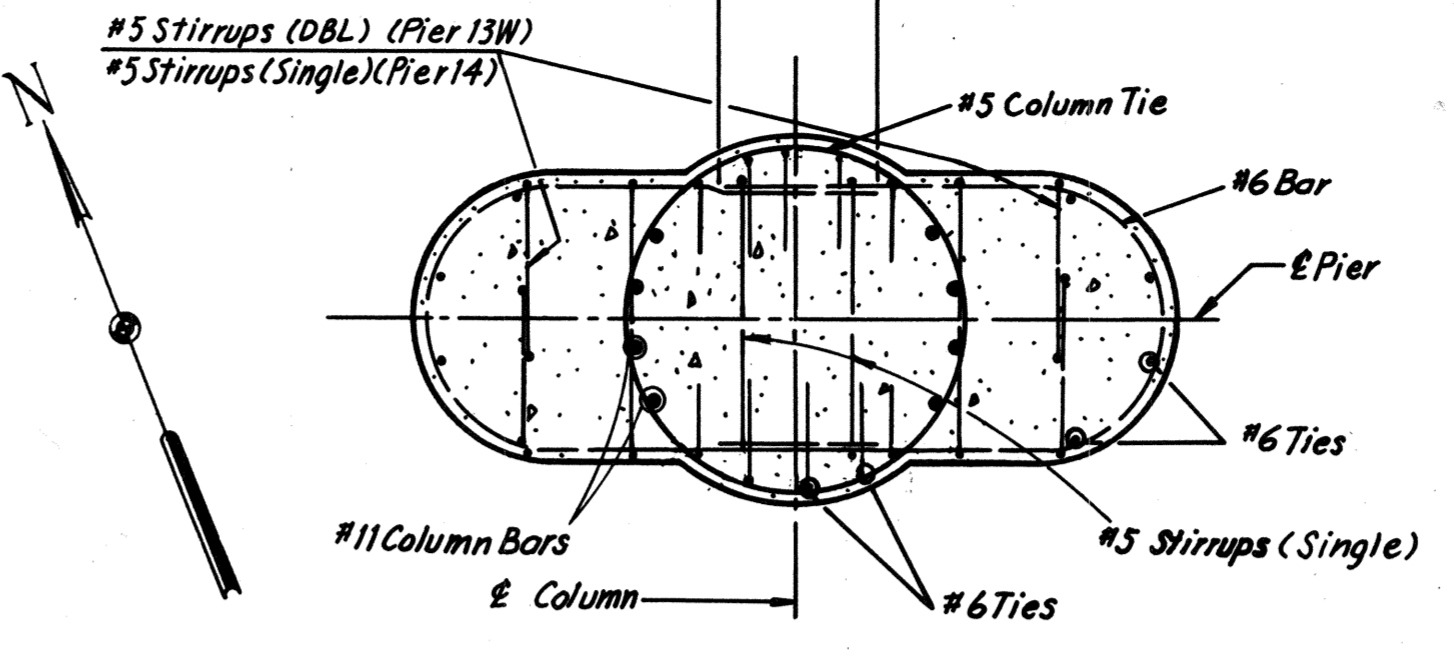


SECTION A-A
Scale: 3/8" = 1'-0"

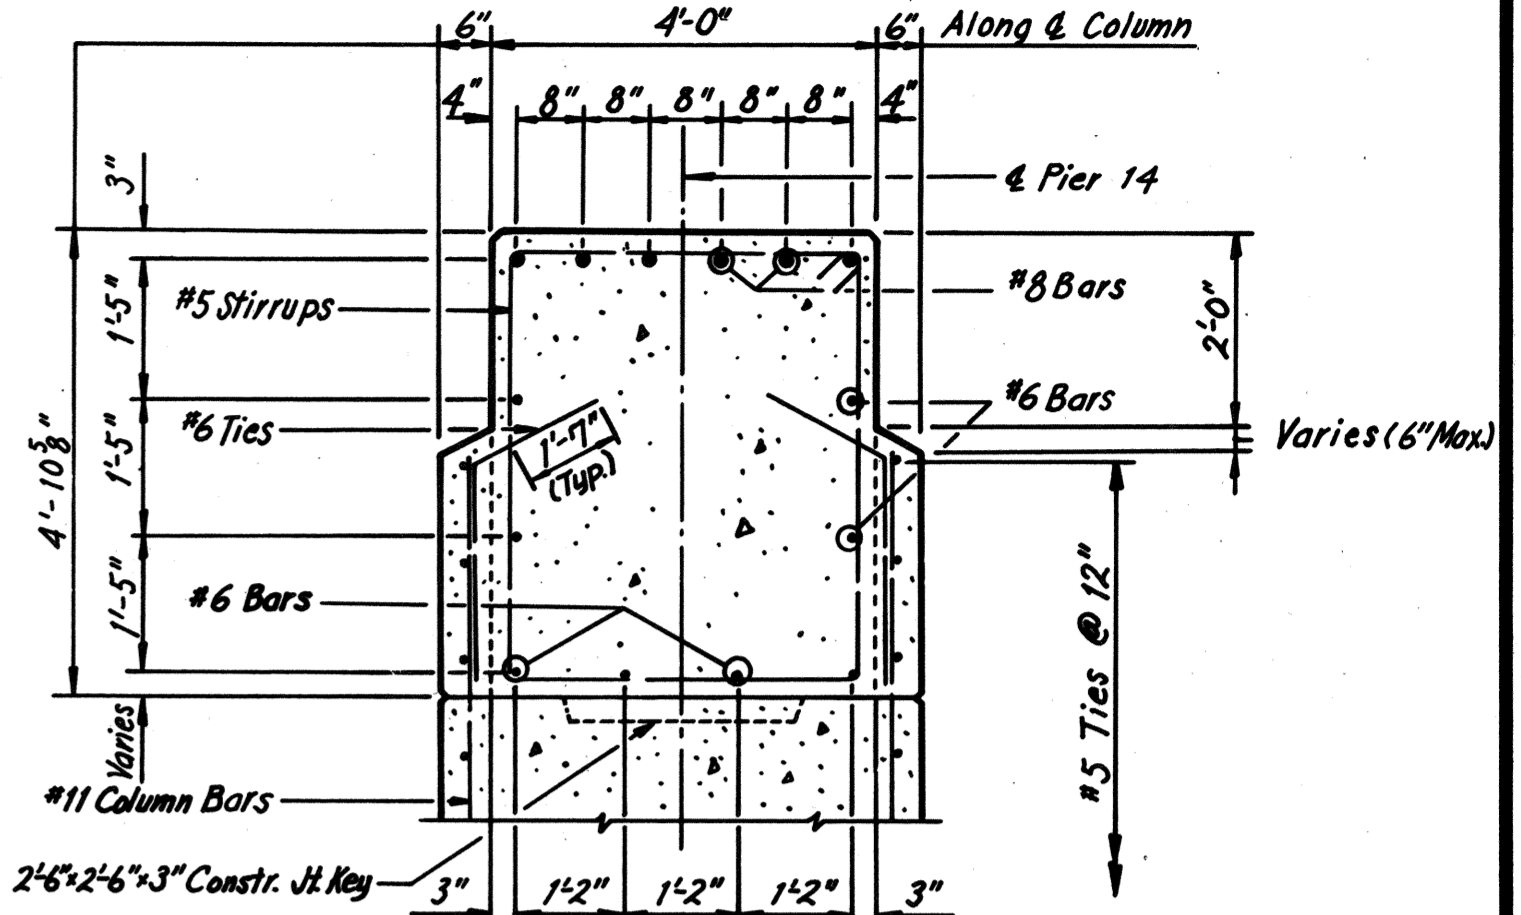


SECTION B-B
Scale: 1/2" = 1'-0"

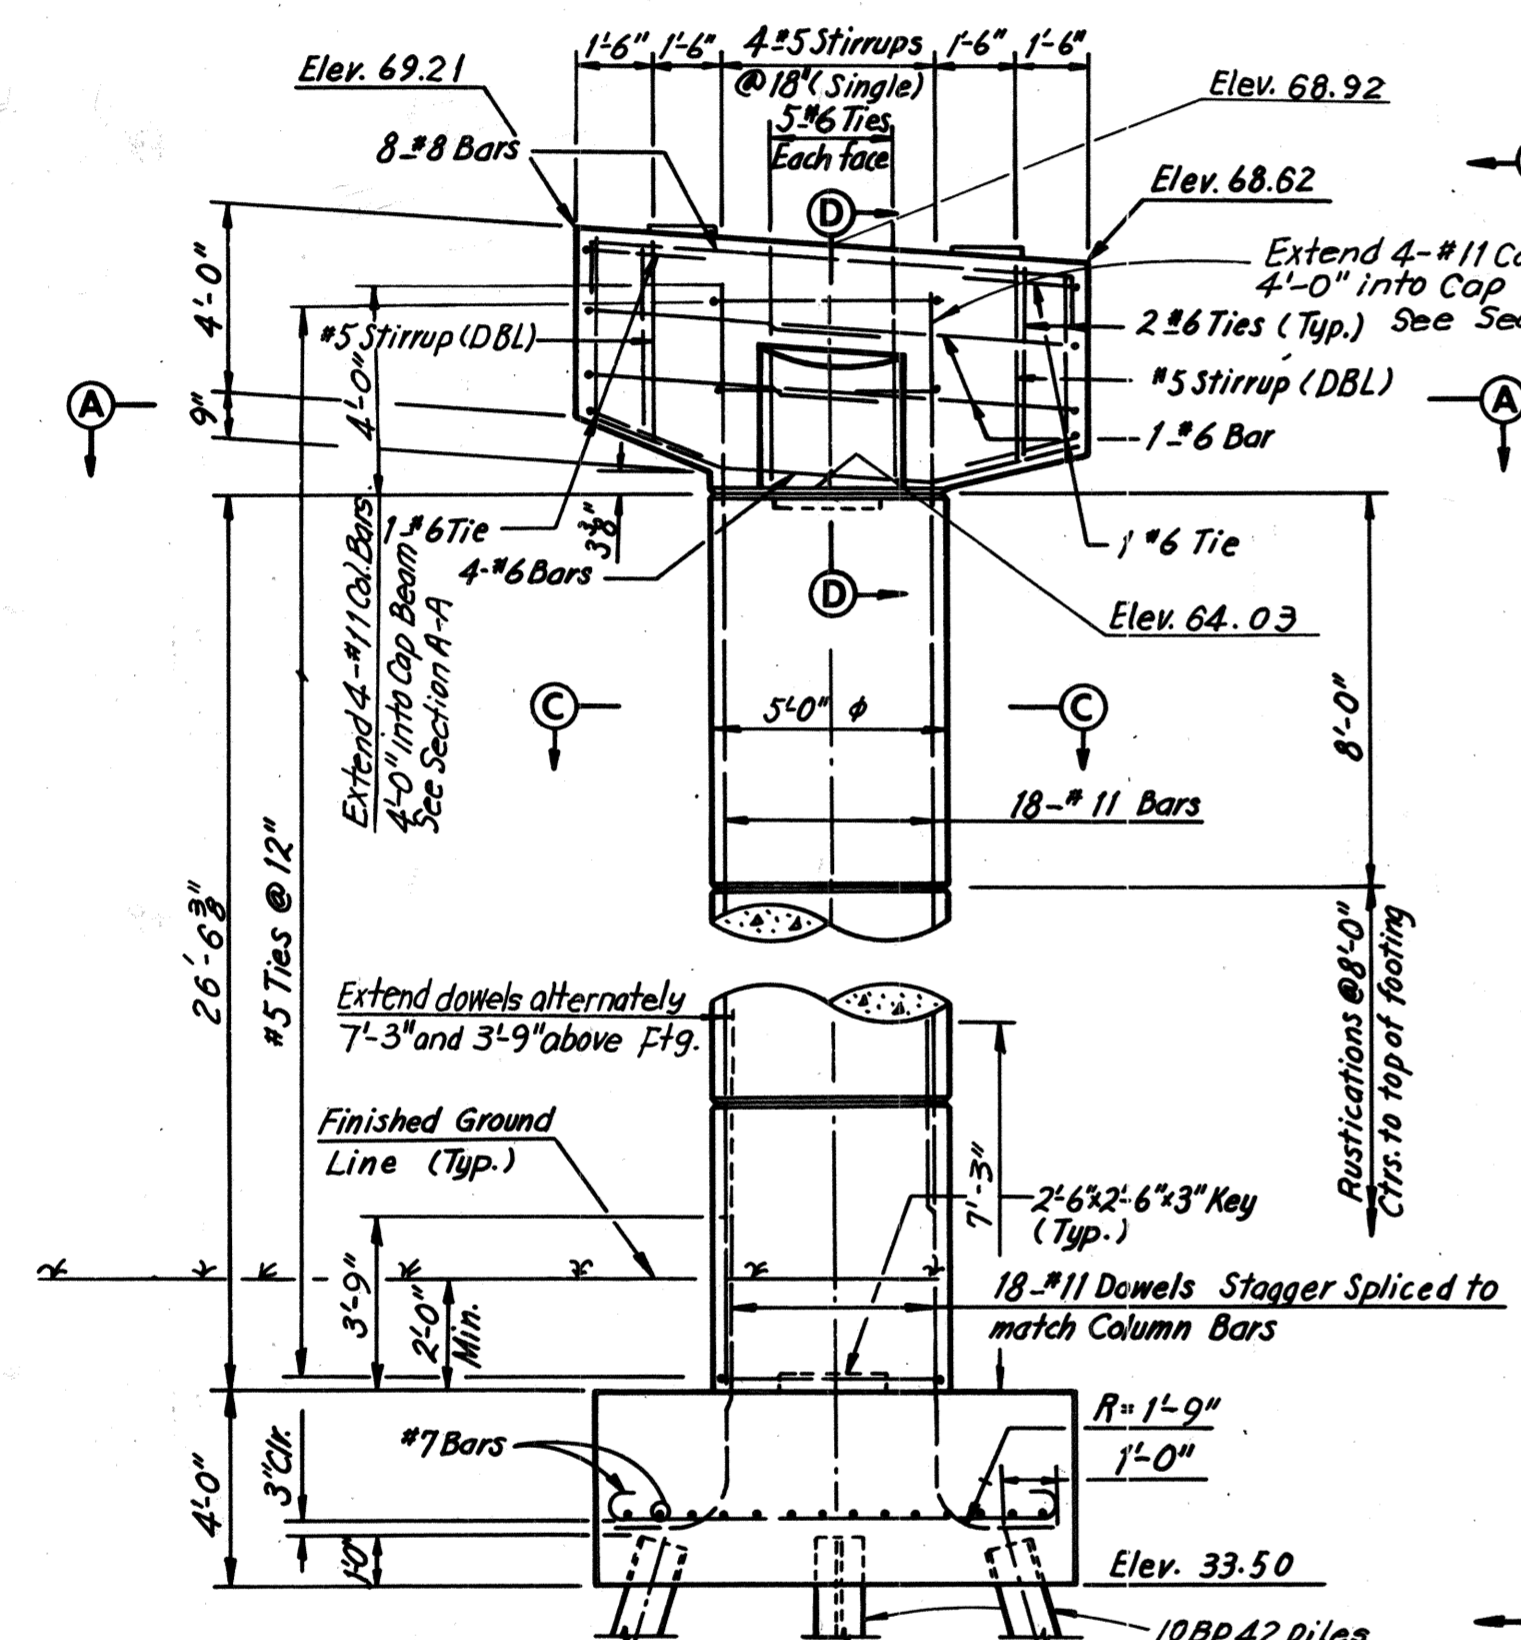


ELEVATION - PIER 13W
Scale: 1/4" = 1'-0"

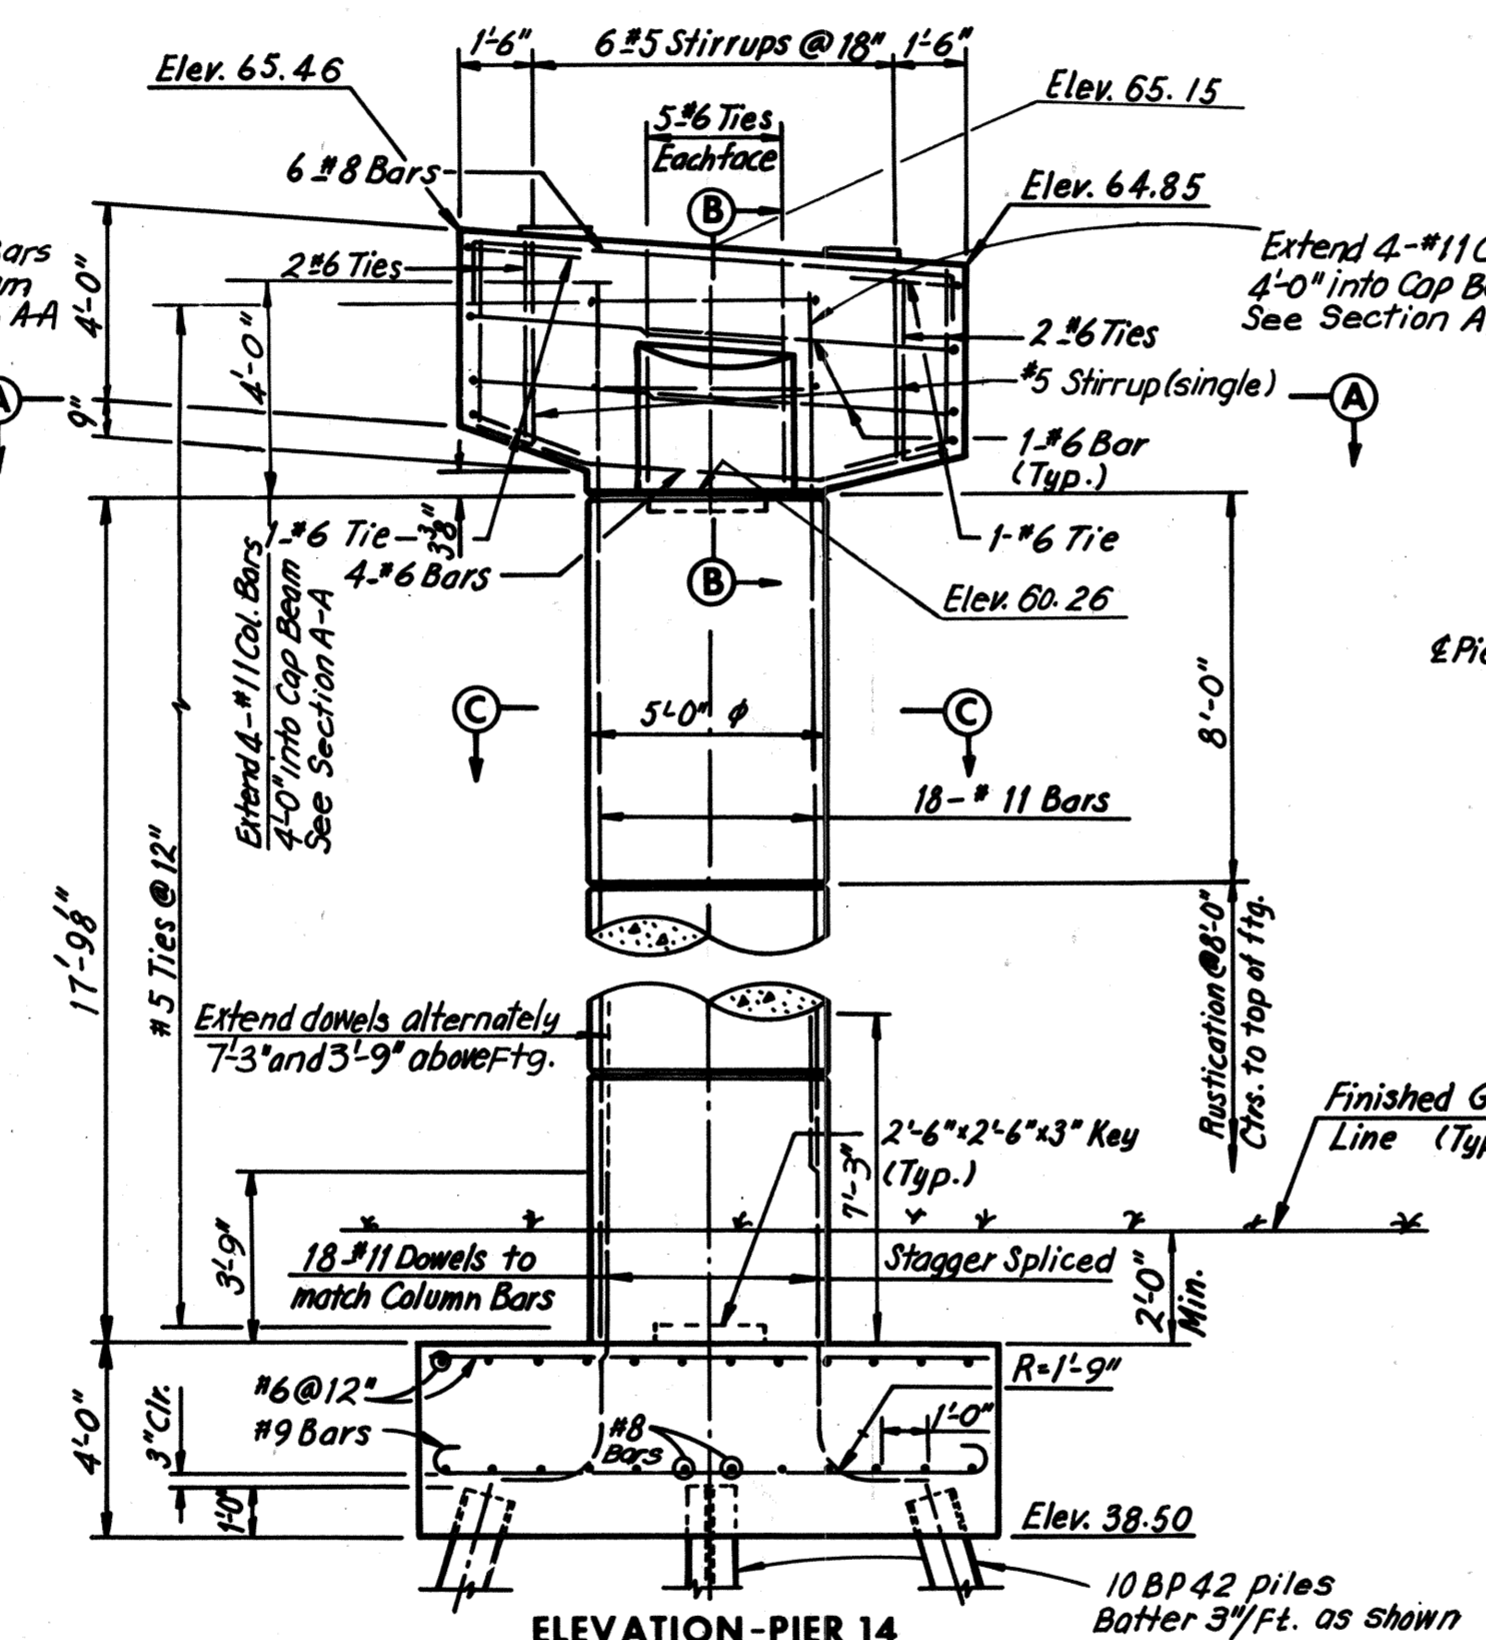


ELEVATION - PIER 14
Scale: 1/4" = 1'-0"

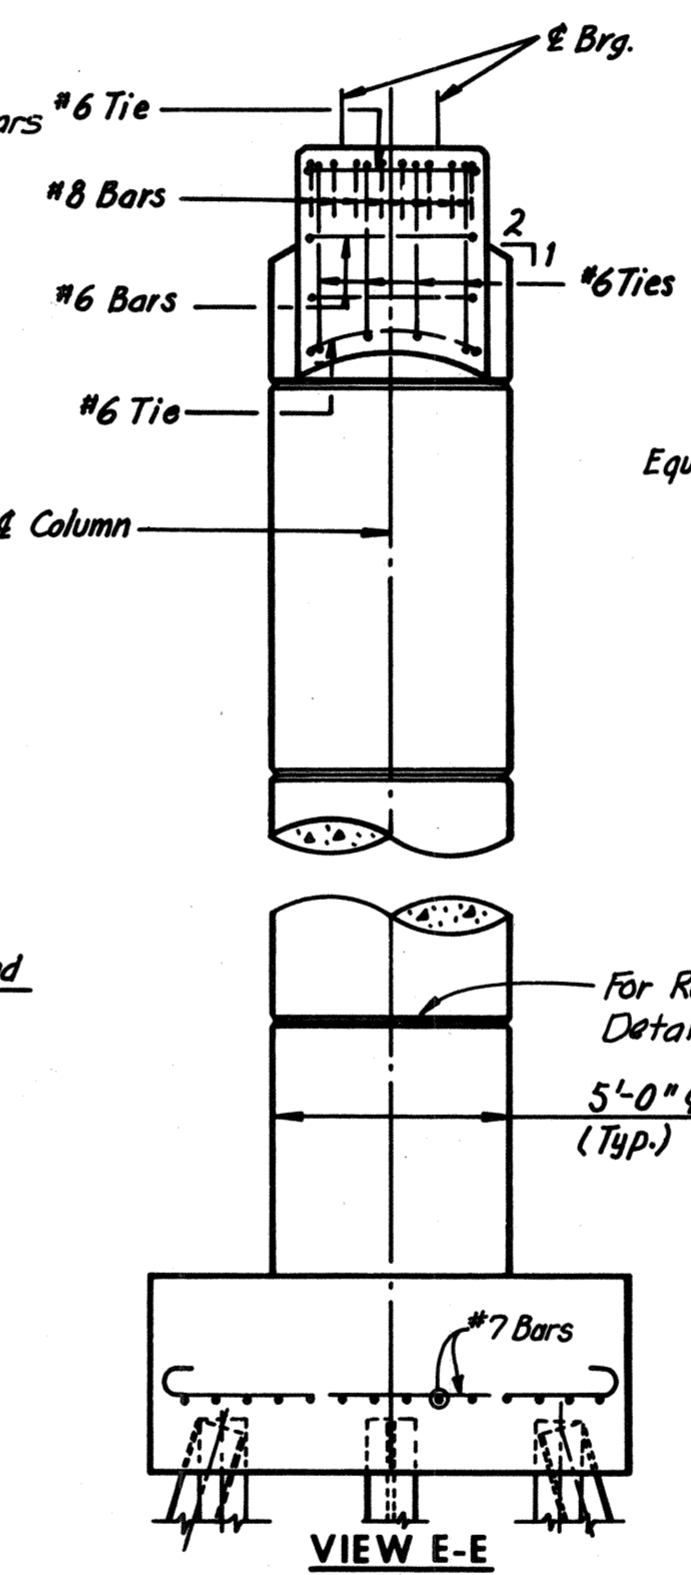

VIEW E-E
Scale: 1/4" = 1'-0"

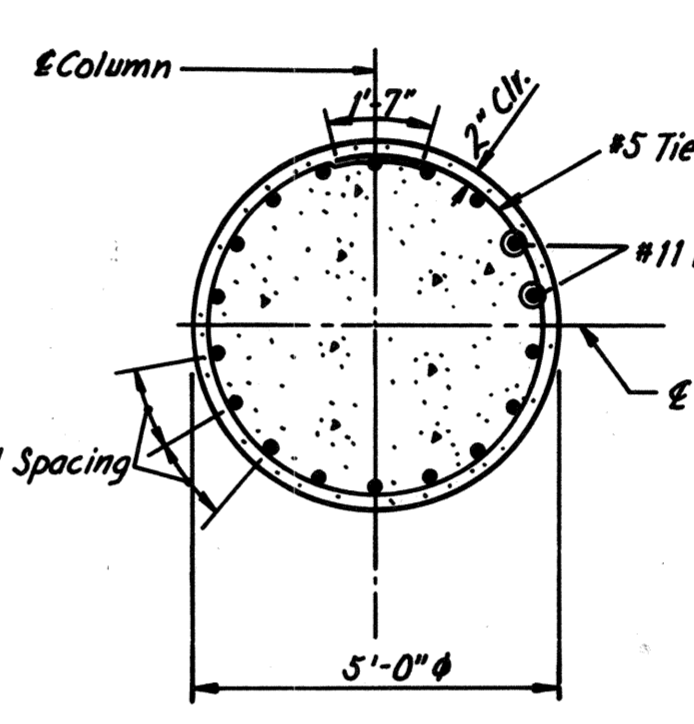

SECTION C-C
Scale: 3/8" = 1'-0"

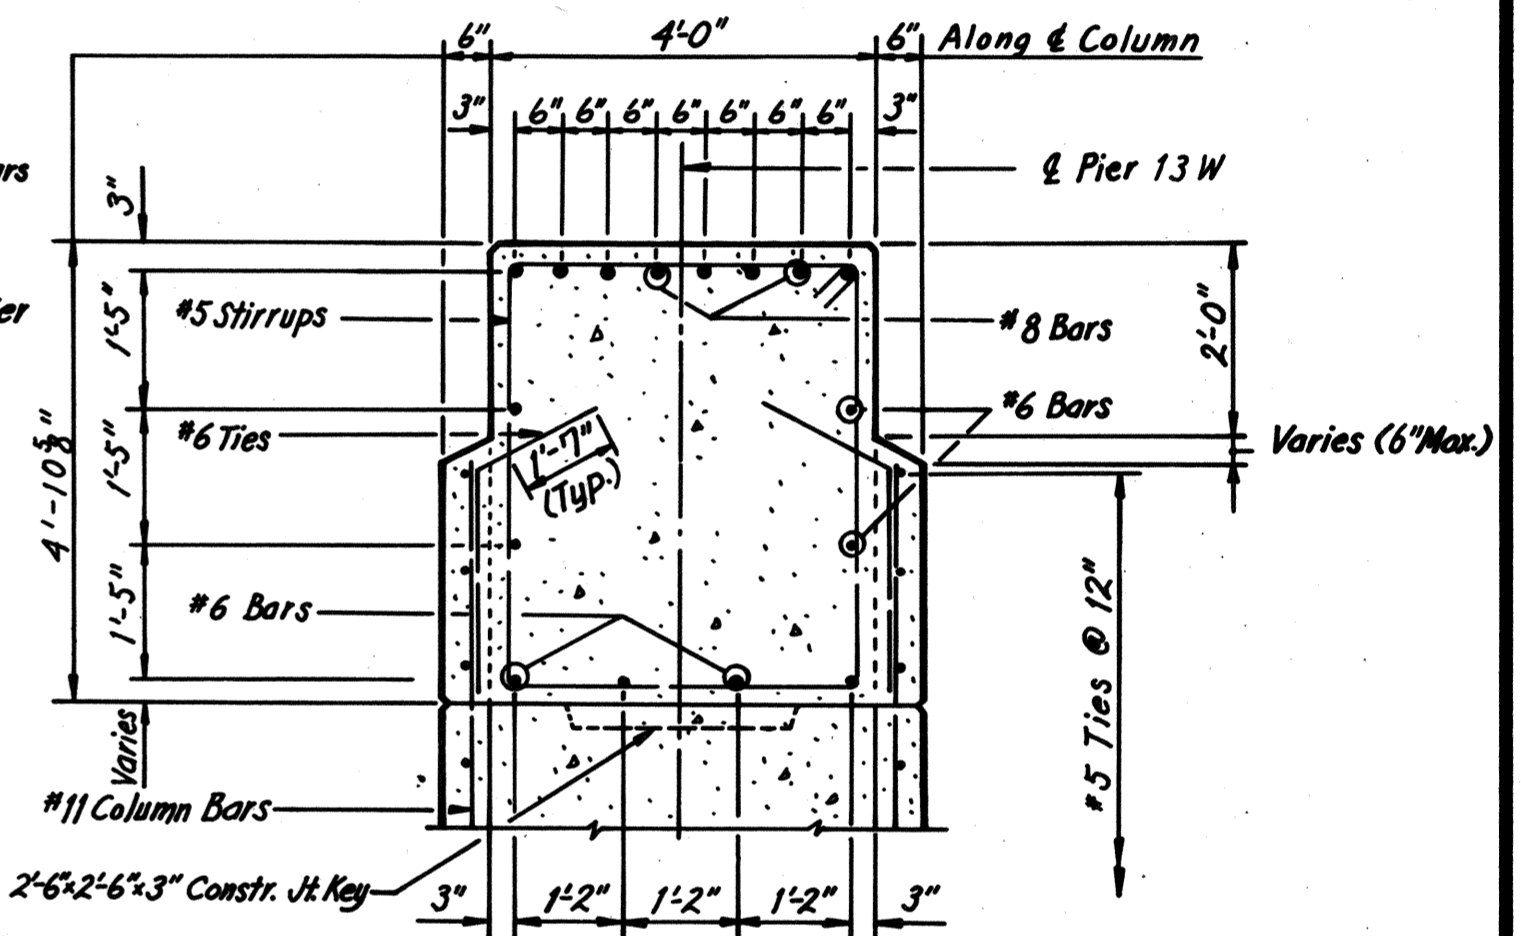


SECTION D-D
Scale: 1/2" = 1'-0"


DIMENSIONS FOR PAD AND ANCHOR BOLT SETTING PLAN														
Pier	Stringer	α	A	B	C	D	E	F	G	H	I	J	K	L
13W	S1-13	87°48'08"	8 1/2"	11 1/2"	11 1/2"	1'-4"	1'-3"	6 1/2"	4 1/2"	2'-8"	11"	11 1/2"	12 1/4"	
	S2-13	87°48'00"	8 1/2"	11 1/2"	11 1/2"	1'-4"	1'-3"	6 1/2"	4 1/2"	2'-8"	11"	11 1/2"	12 1/4"	
	S1-14	87°52'43"	8 1/2"	11 1/2"	11 1/2"	1'-3 1/2"	1'-3"	6 1/2"	5 1/2"	2'-6 1/2"	11'-0 1/2"	11 1/2"	12 1/4"	
14	S1-14	87°55'17"	0"	11 1/2"	11 1/2"	1'-4 1/2"	1'-3 1/2"	6 1/2"	4 1/2"	2'-8"	11"	11 1/2"	0 1/4"	
	S2-14	87°55'17"	0"	11 1/2"	11 1/2"	1'-4 1/2"	1'-3 1/2"	6 1/2"	4 1/2"	2'-8"	11"	11 1/2"	0 1/4"	

Note: Footing elevations are approximate only and may be varied to suit field conditions as directed by the Engineer. Vertical shaft reinforcing shall not be cut until these elevations are established. Where elevations change more than 2 ft., redesign will be required.


Notes: All piles shall be 10BP42 steel piles. (Design Capacity = 45 tons) Batter all piles 3" per foot where shown. For Standard Shoe Details, see Sheet 51. For Framing Plan, see Sheet 26. For Rustication Details, see Sheet 14. For 10BP42 Steel Pile Details, see Sheet 5. Estimated Pile Tip Elevations: Pier 13W = 10.0, Pier 14 = 20.0

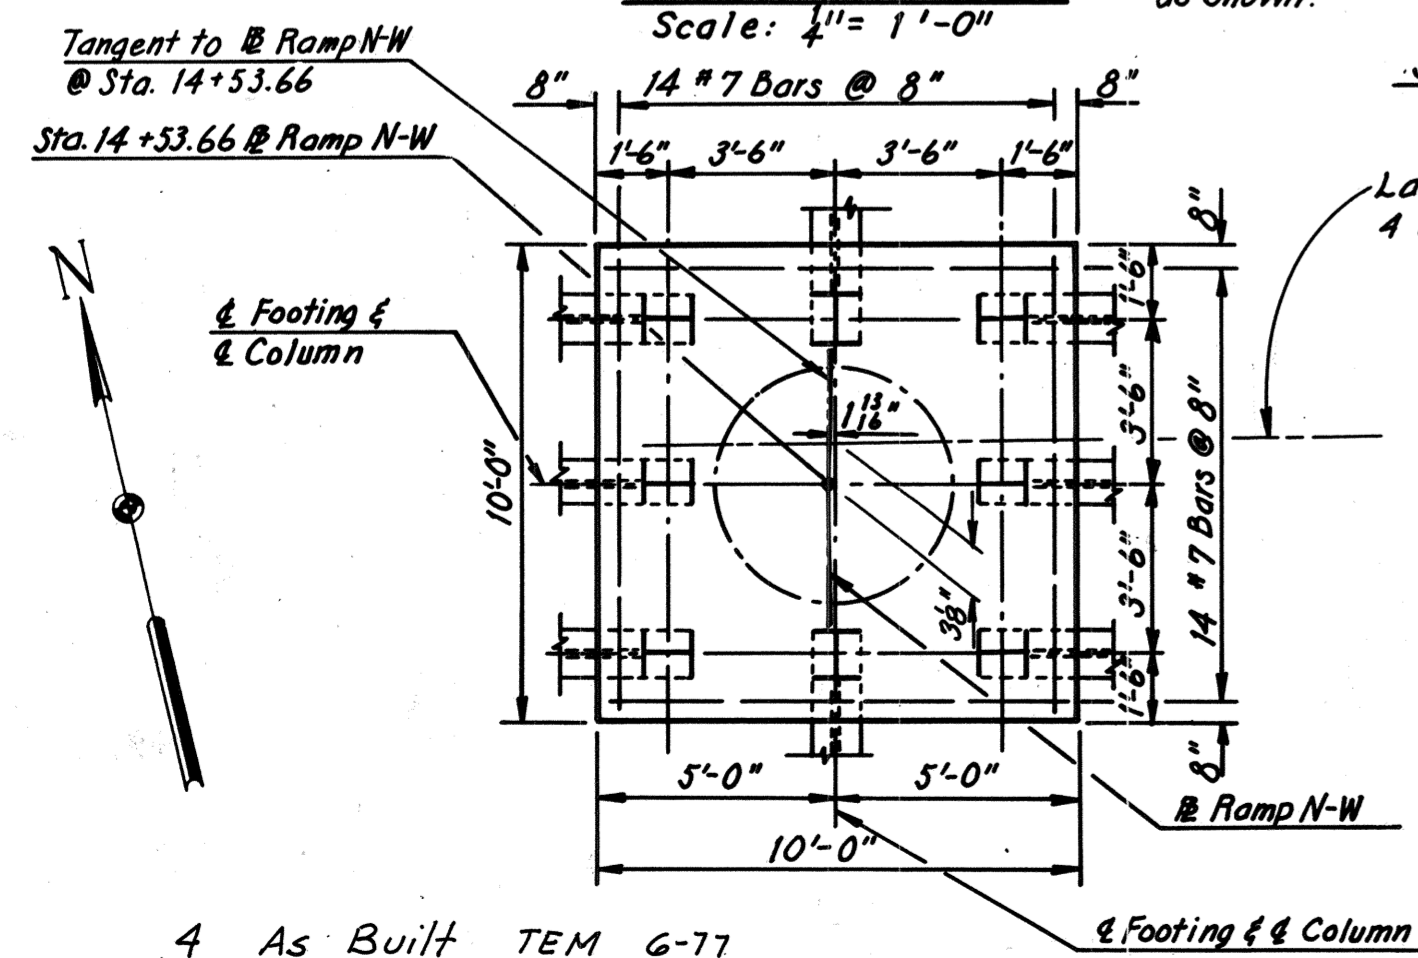

FOOTING PLAN - PIER 13W
Scale: 1/4" = 1'-0"

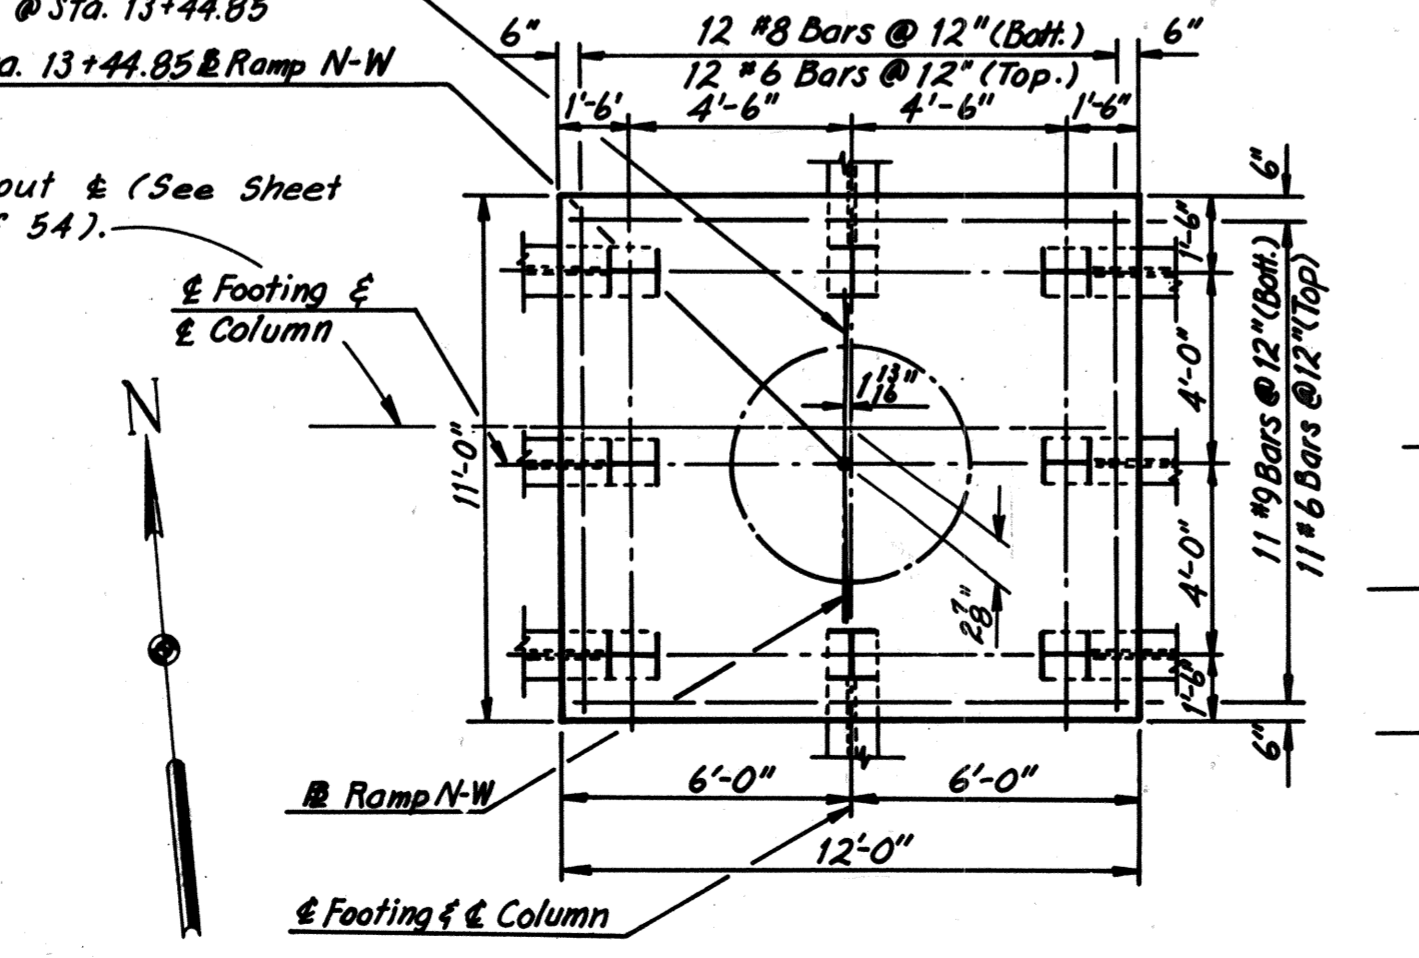

FOOTING PLAN - PIER 14
Scale: 1/4" = 1'-0"

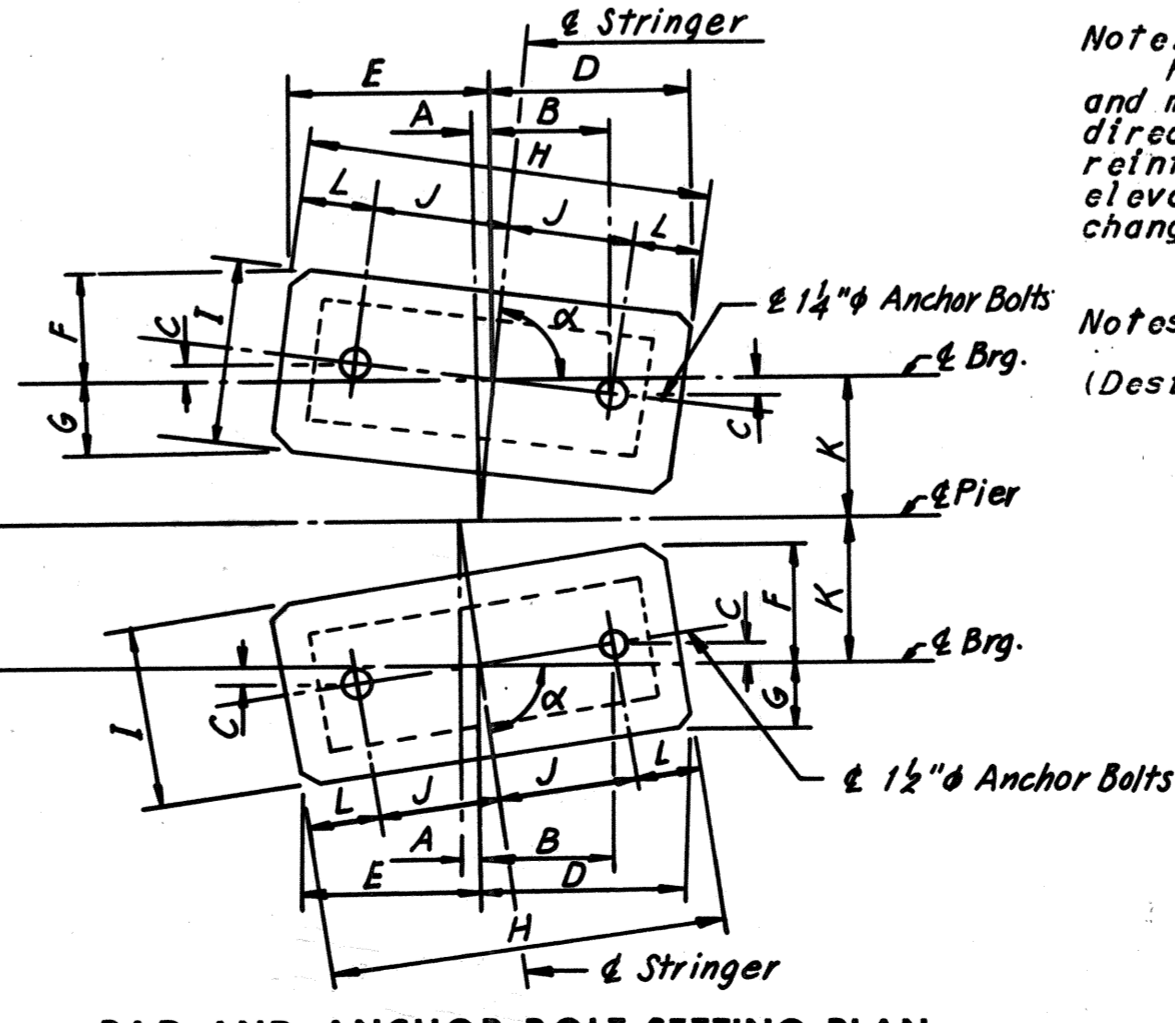

PAD AND ANCHOR BOLT SETTING PLAN
No Scale

4	As Built	TEM	6-77
BY	DATE	REVISION	BY
Y.C.P.	3-5-69	Change of Sta.	LRH
K.C.T.	4-29-69	Pad Elevations Piers 13W & 14	DWB
NO.	REVISION	BY	DATE

FOOTING PLAN	PIER 13W	Scale: 1/4" = 1'-0"
FOOTING PLAN	PIER 14	Scale: 1/4" = 1'-0"

RICHMOND METROPOLITAN AUTHORITY
RICHMOND EXPRESSWAY SYSTEM
DOWNTOWN EXPRESSWAY










BRIDGE NO. 67
 RAMP W-N CONNECTION TO
 RICHMOND-PETERSBURG TURNPIKE
 PIERS 13W AND 14

HOWARD, NEEDLES, TAMMEN & BERGENDOFF
 consulting engineers
 NEW YORK ALEXANDRIA KANSAS CITY

SCALE: As Noted
 CONTRACT NO.: 10
 SHEET NO. 15 OF 54

AS BUILT

RICHMOND EXPRESSWAY SYSTEM			
SECTION	PROJECT	SHEET NO.	TOTAL SHEETS
10	DOWNTOWN EXPRESSWAY	188	265

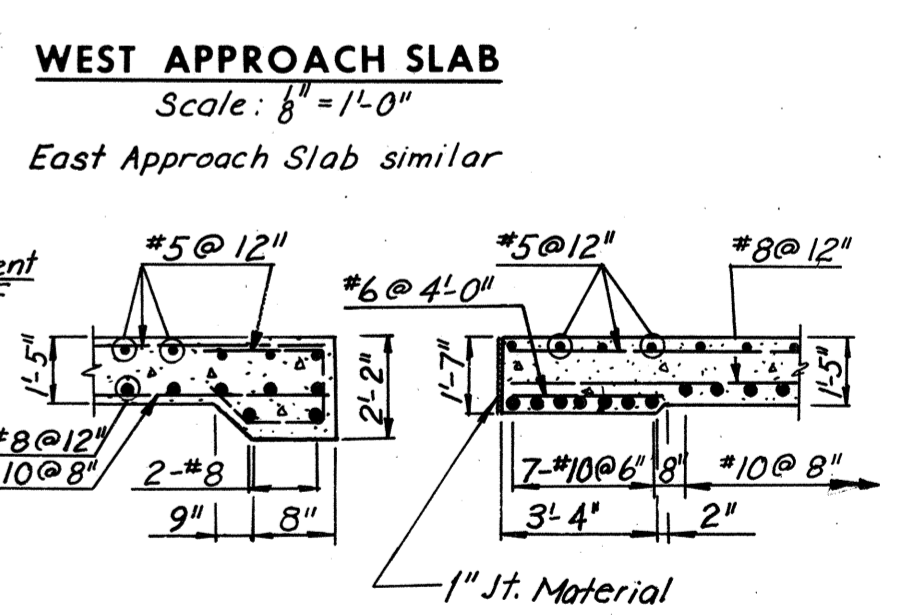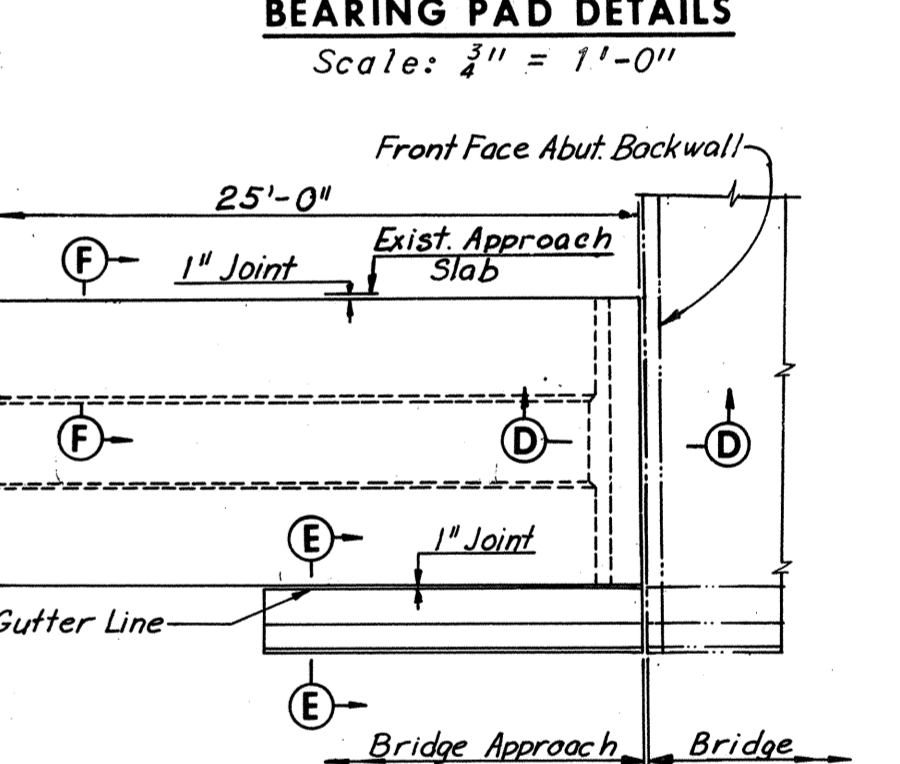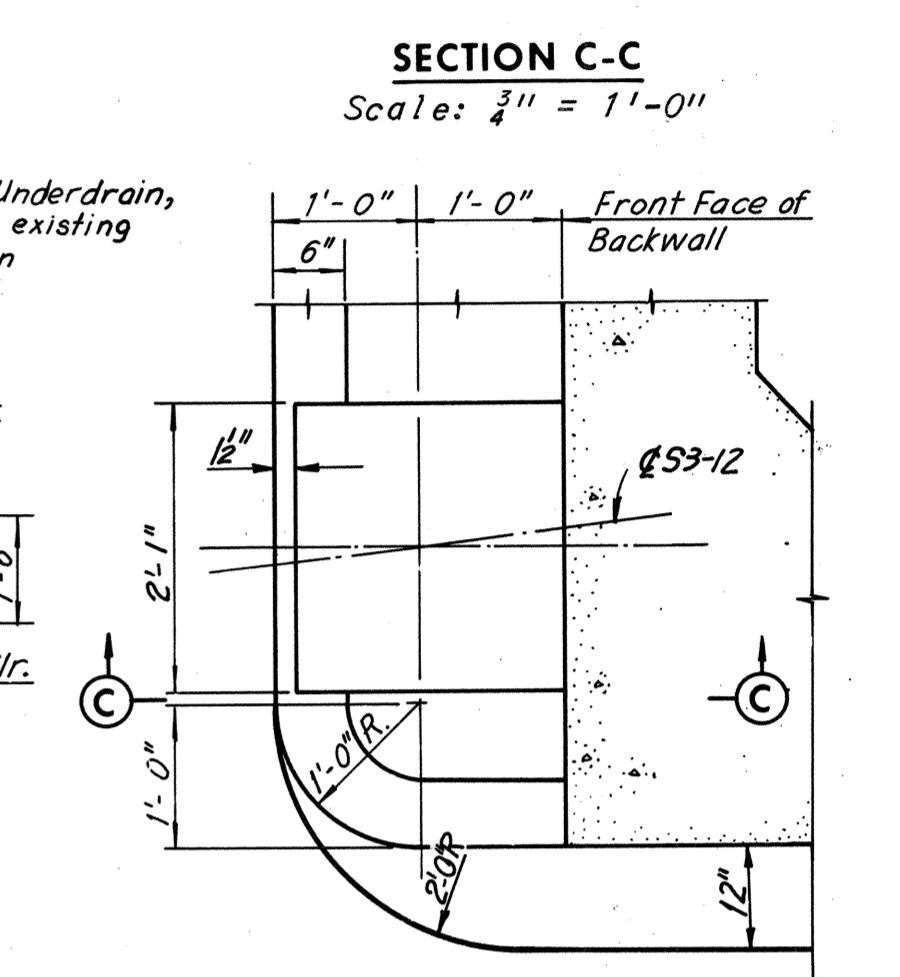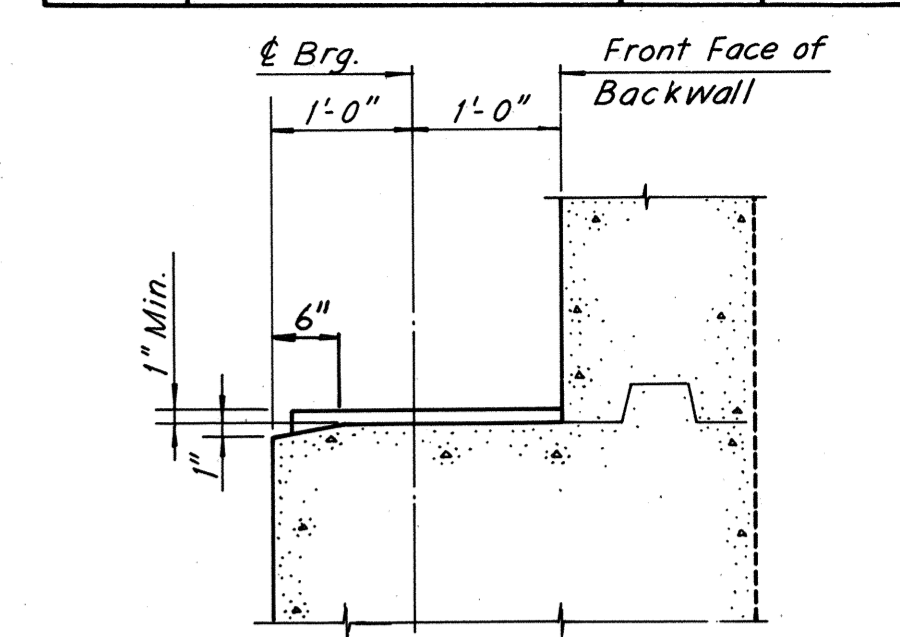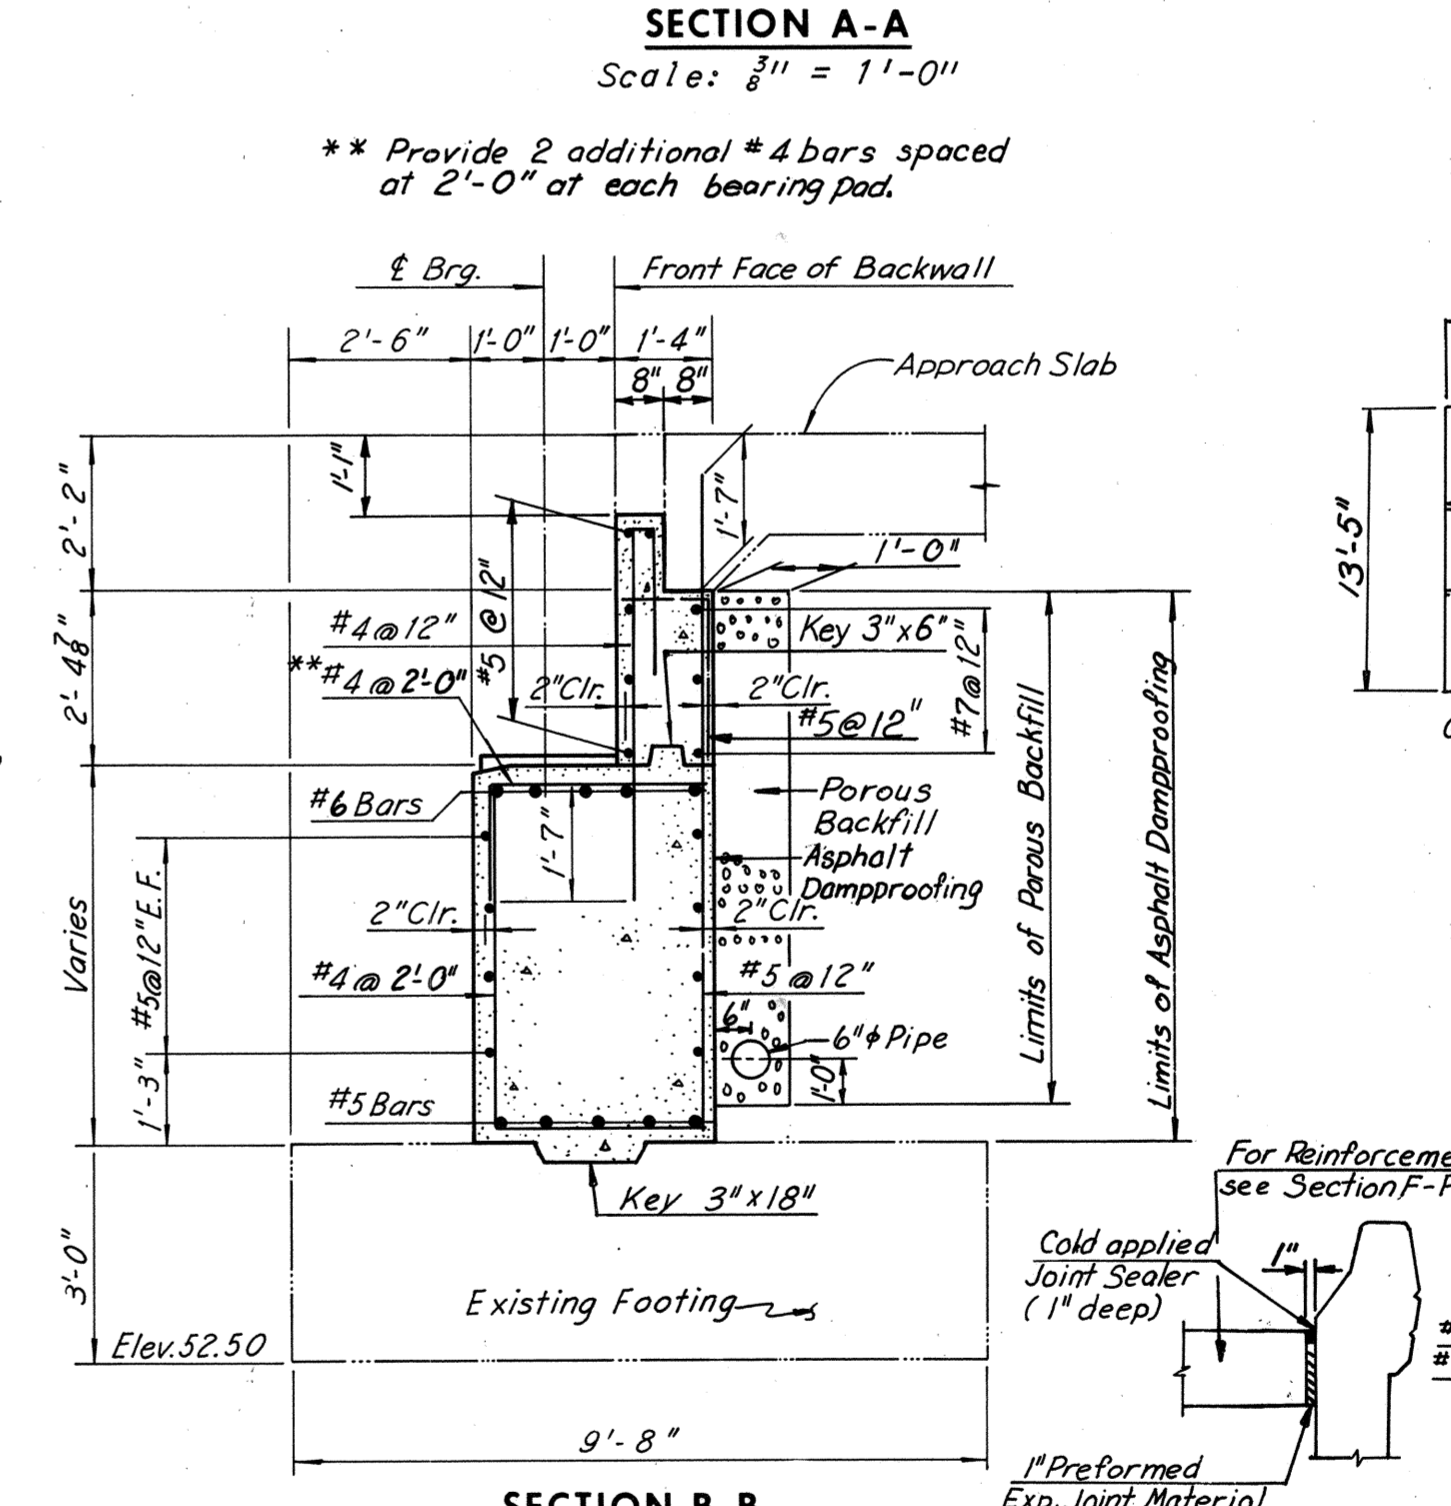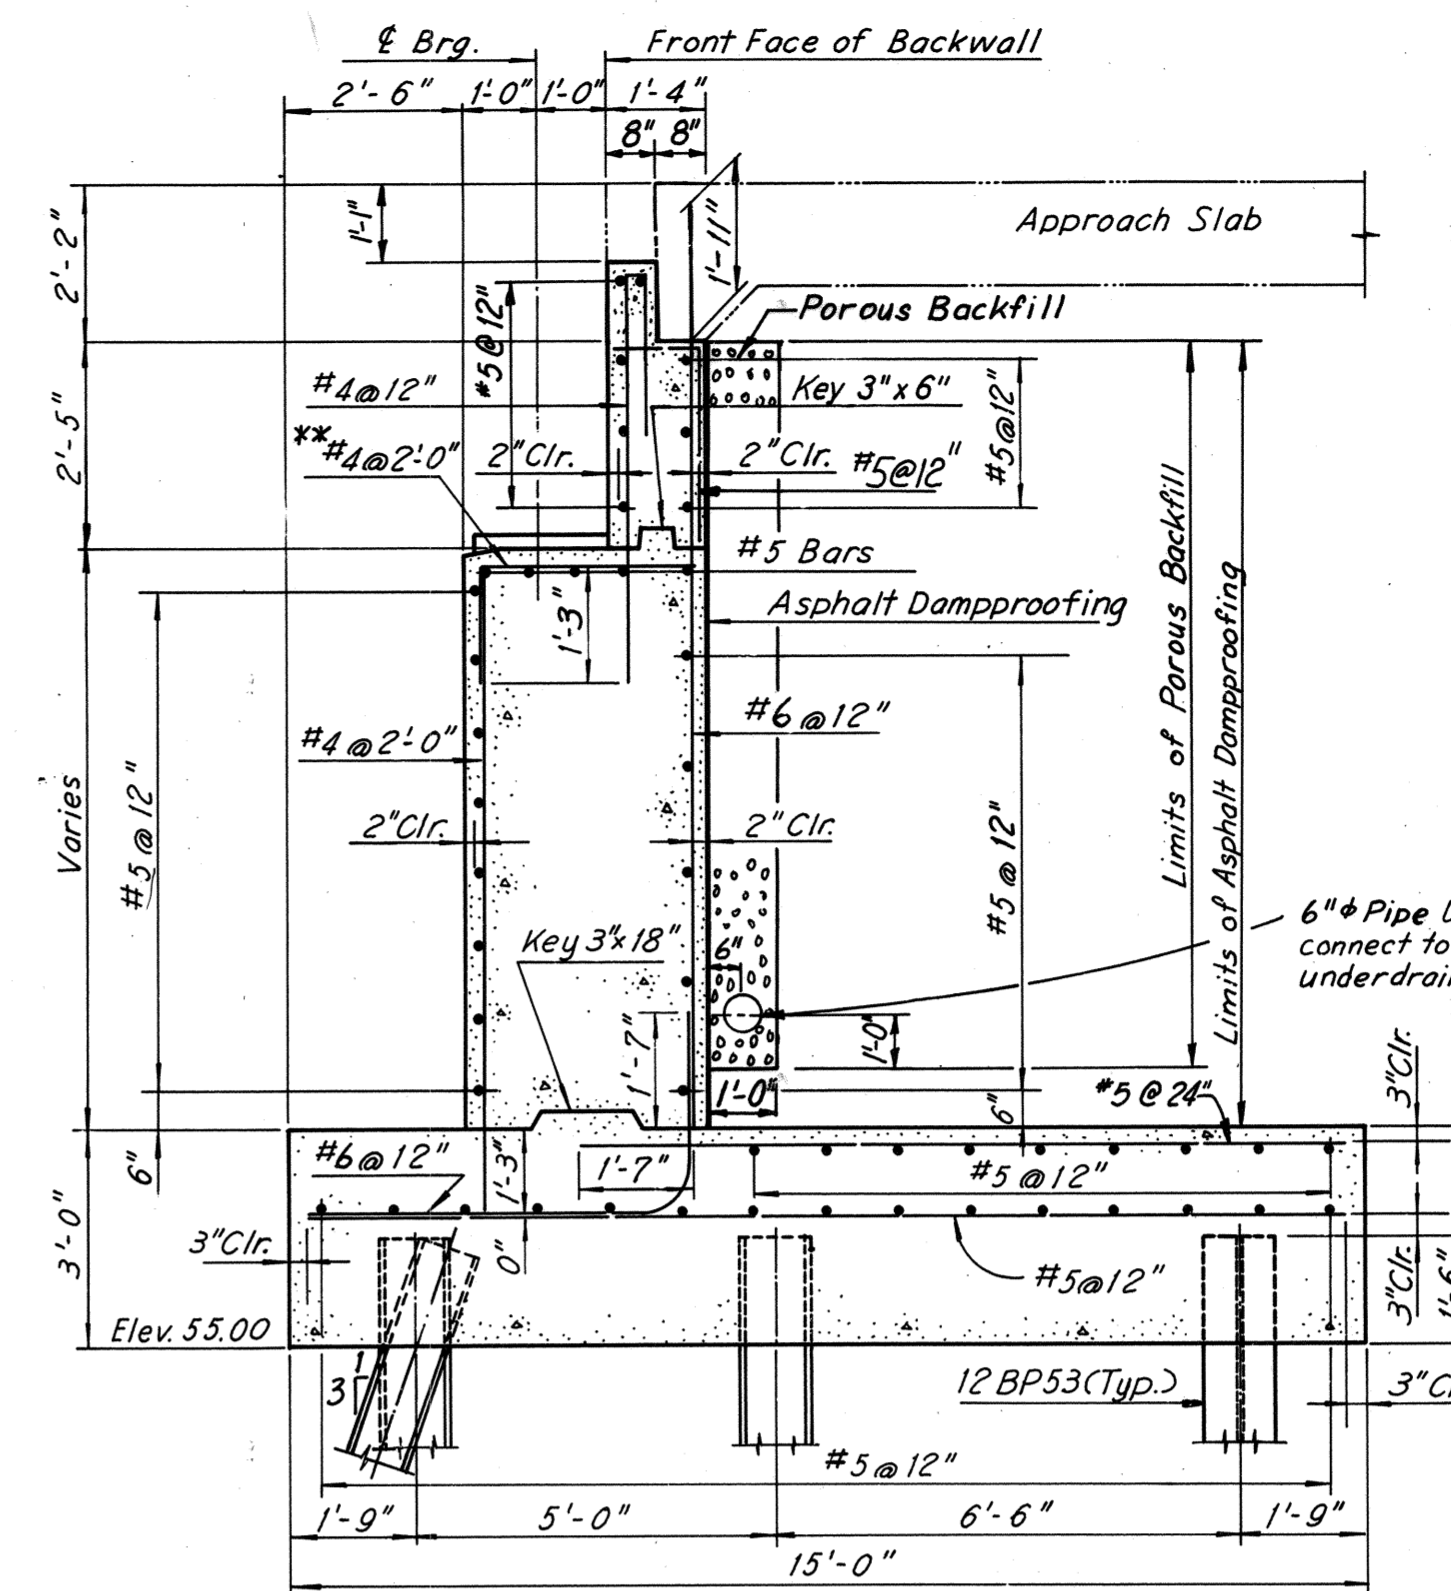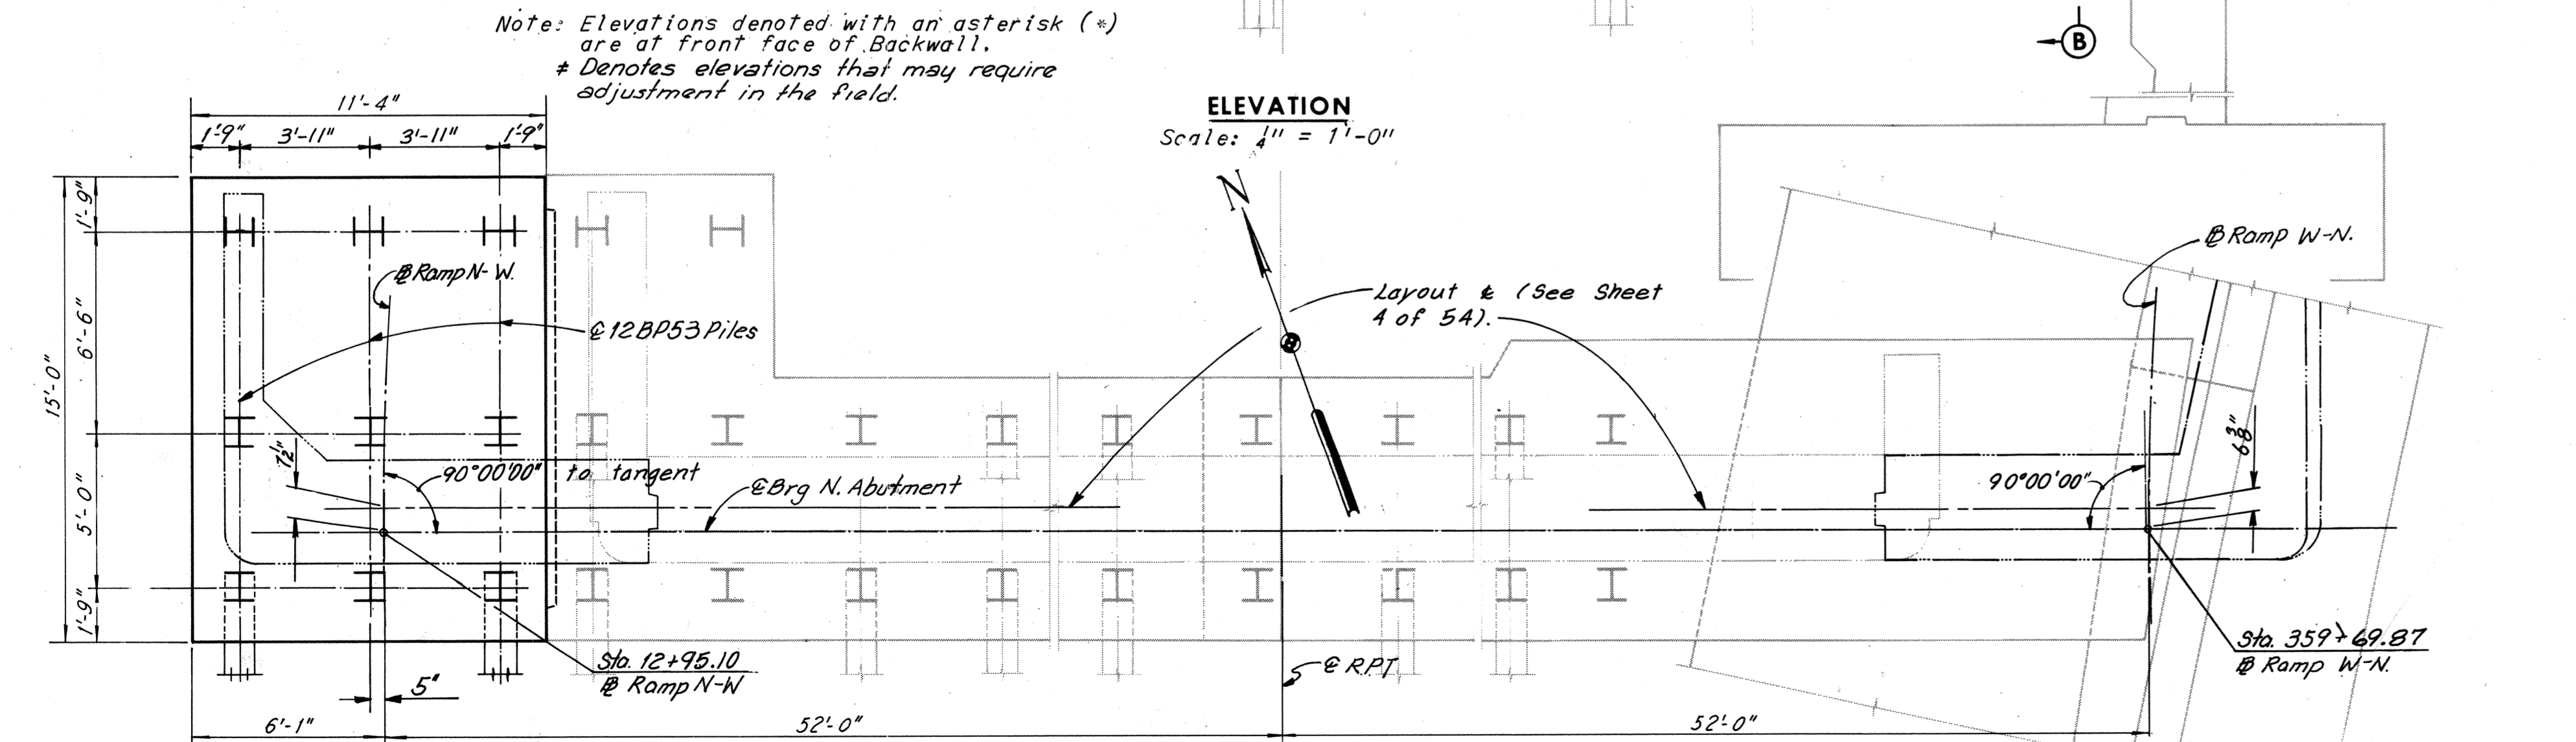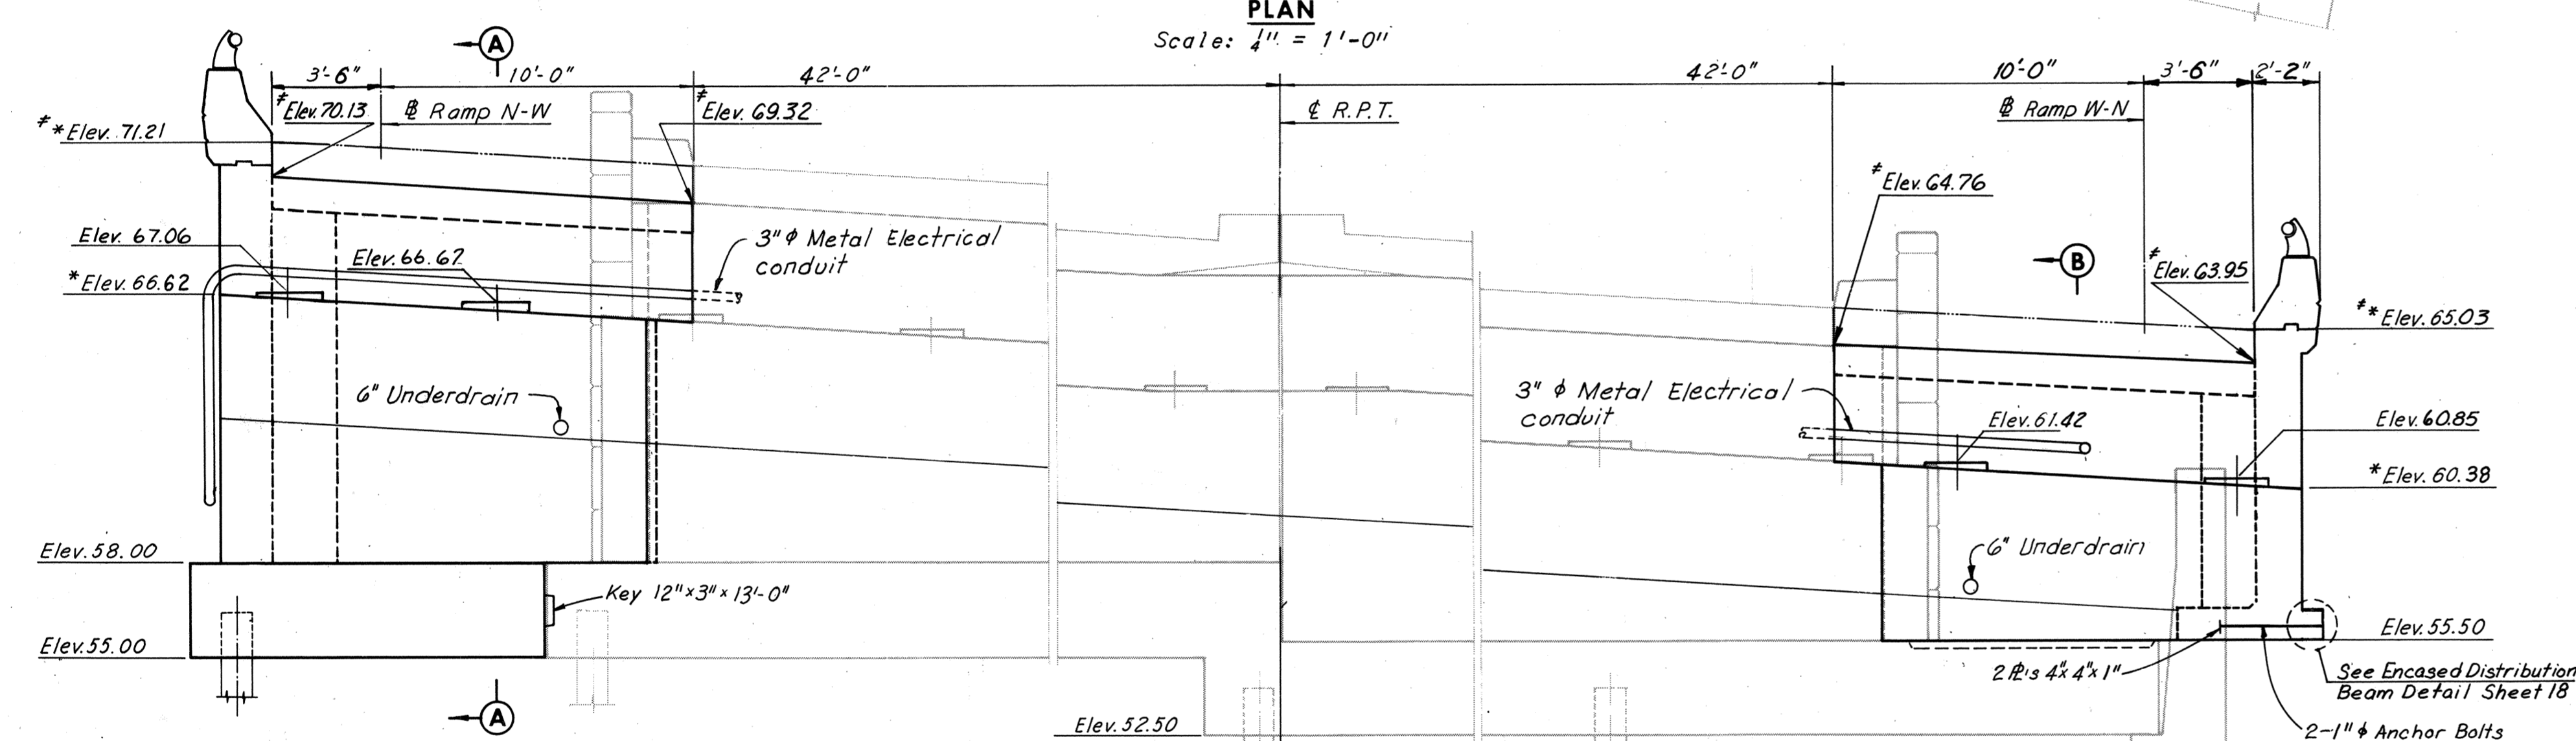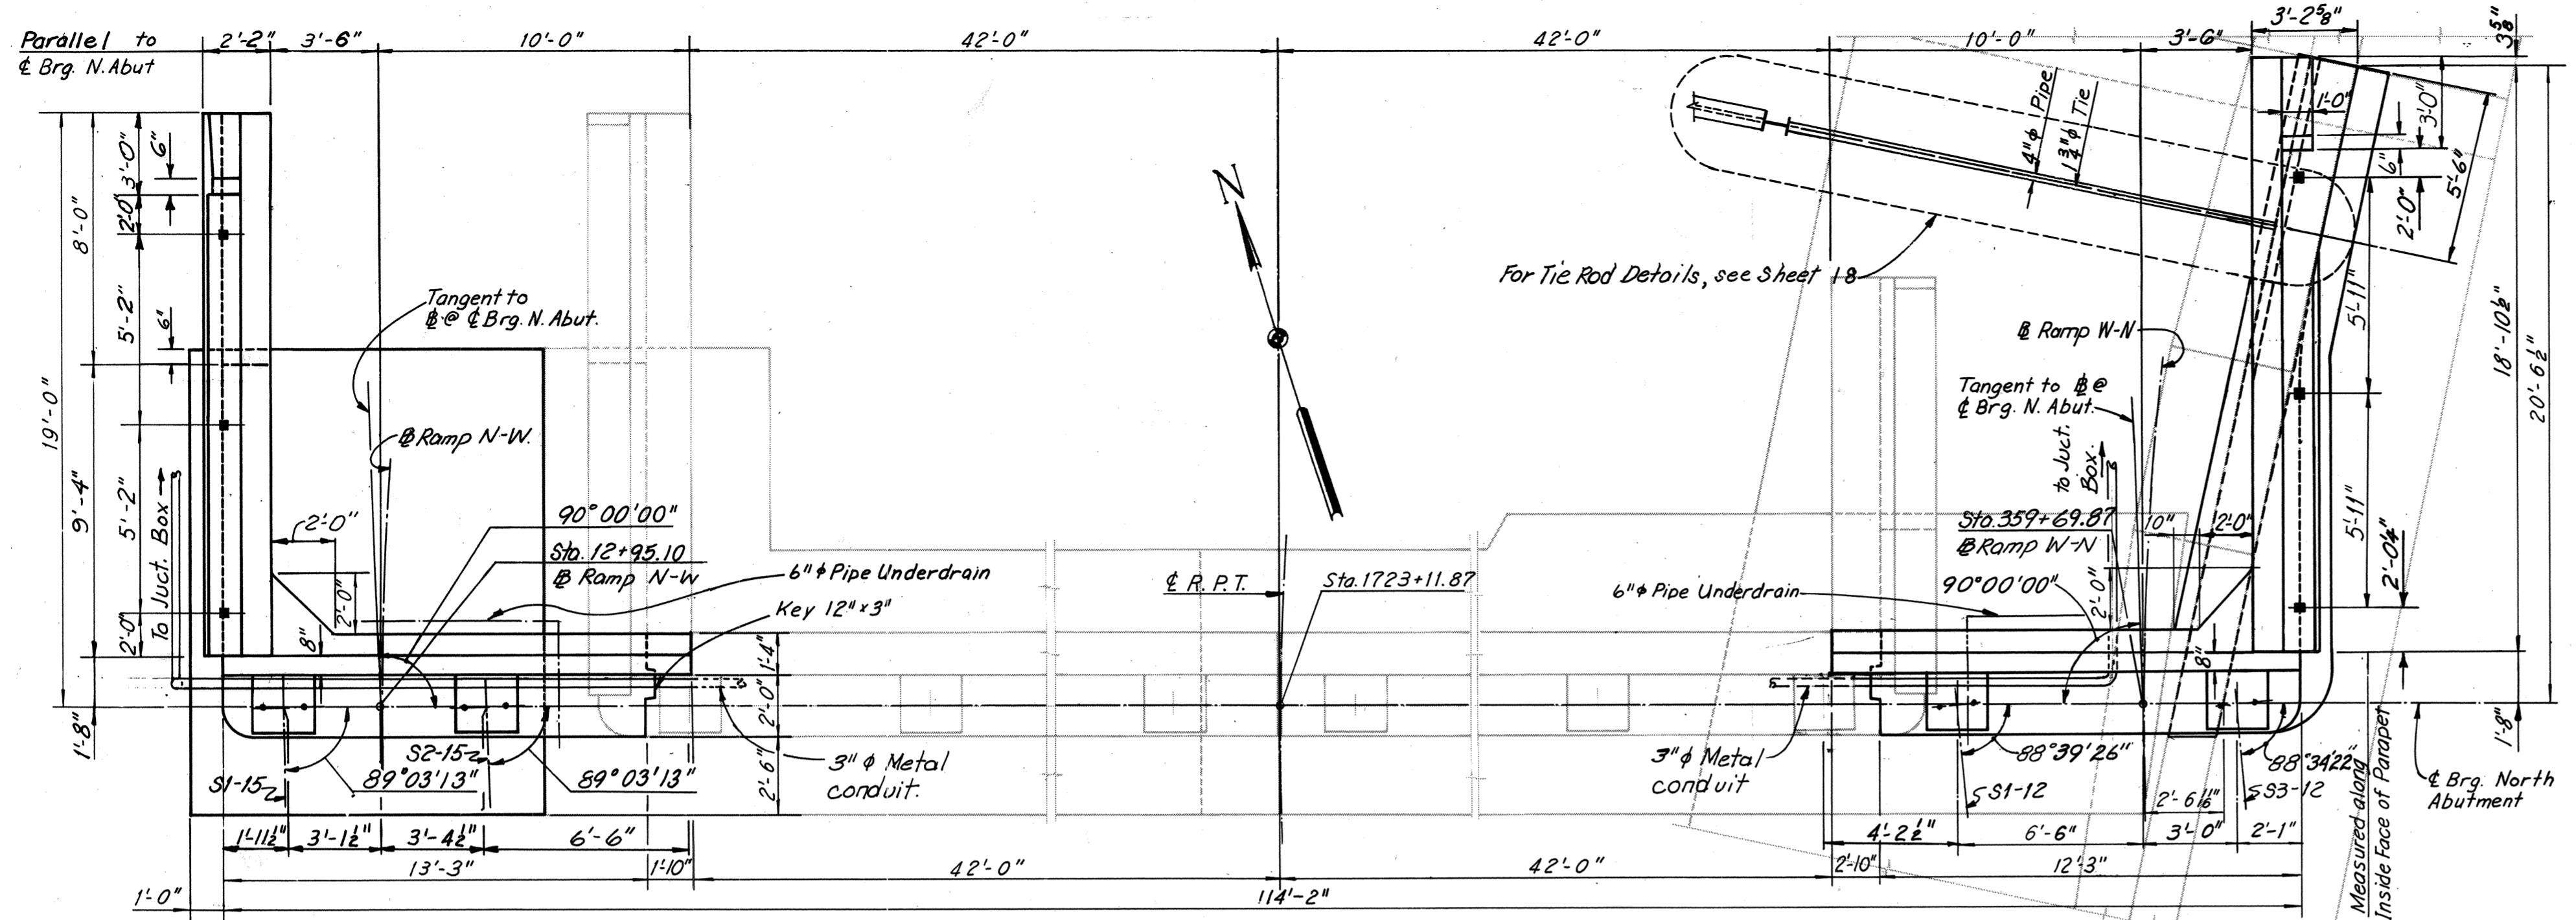

Note: All reinforcement extending from existing barrel, backwall and footing shall be cleaned and extended into new barrel and backwall. The existing wingwall shall be removed to a depth of 2'-0" below the bottom of the approach slabs.

Note: For North Abutment Details see Sheet 17. For Retaining Wall see Sheet 18. For Framing Plan see Sheet 26. All Piles in Footing are 12BP53 Steel Piles (Design Capacity = 57 tons). Estimated Pile Tip Elevation 20.00. The Contractor shall verify all Elevations and Dimensions.

RICHMOND METROPOLITAN AUTHORITY
RICHMOND EXPRESSWAY SYSTEM
DOWNTOWN EXPRESSWAY

BRIDGE NO. 67
RAMP W-N CONNECTION TO
RICHMOND-PETERSBURG TURNPIKE
NORTH ABUTMENT









HOWARD, NEEDLES, TAMMEN & BERGENDOFF
consulting engineers
NEW YORK ALEXANDRIA KANSAS CITY

SCALE: As noted
CONTRACT NO.: 10
SHEET NO. 16 OF 54

AS BUILT

DATE	BY	REVISION	NO.
1-7-69	MHH	Change of Sta. Elevations & Note	1
5-12-69	AMH	As Built	3

RICHMOND EXPRESSWAY SYSTEM			
SECTION	PROJECT	SHEET NO.	TOTAL SHEETS
10	DOWNTOWN EXPRESSWAY	189	265

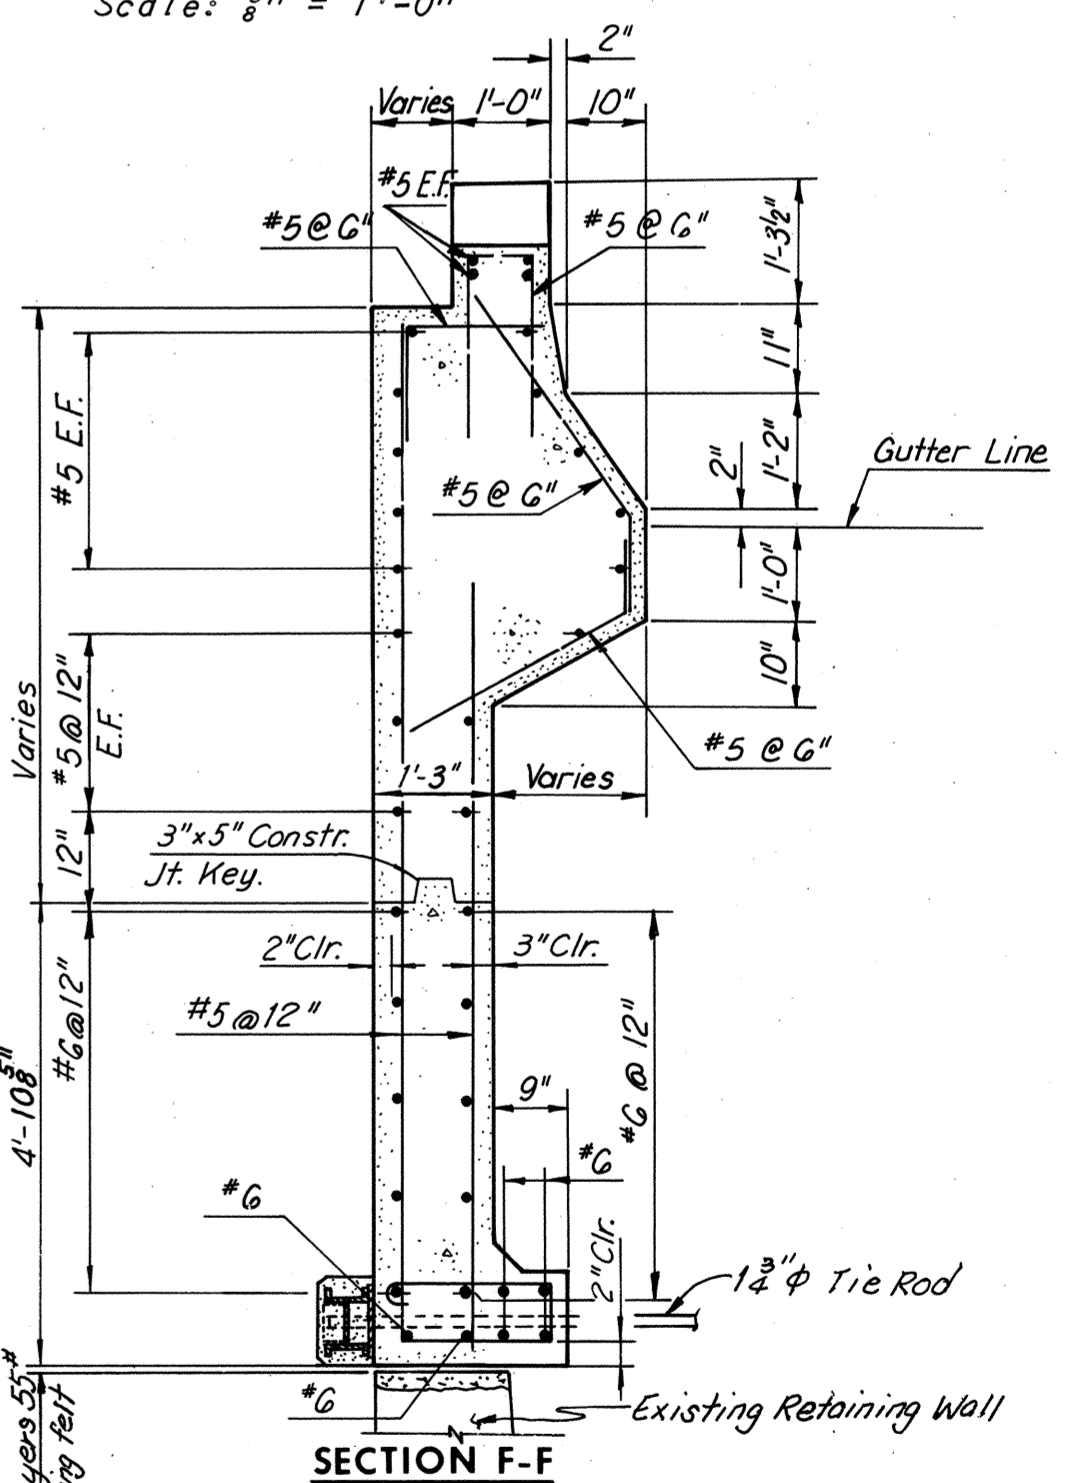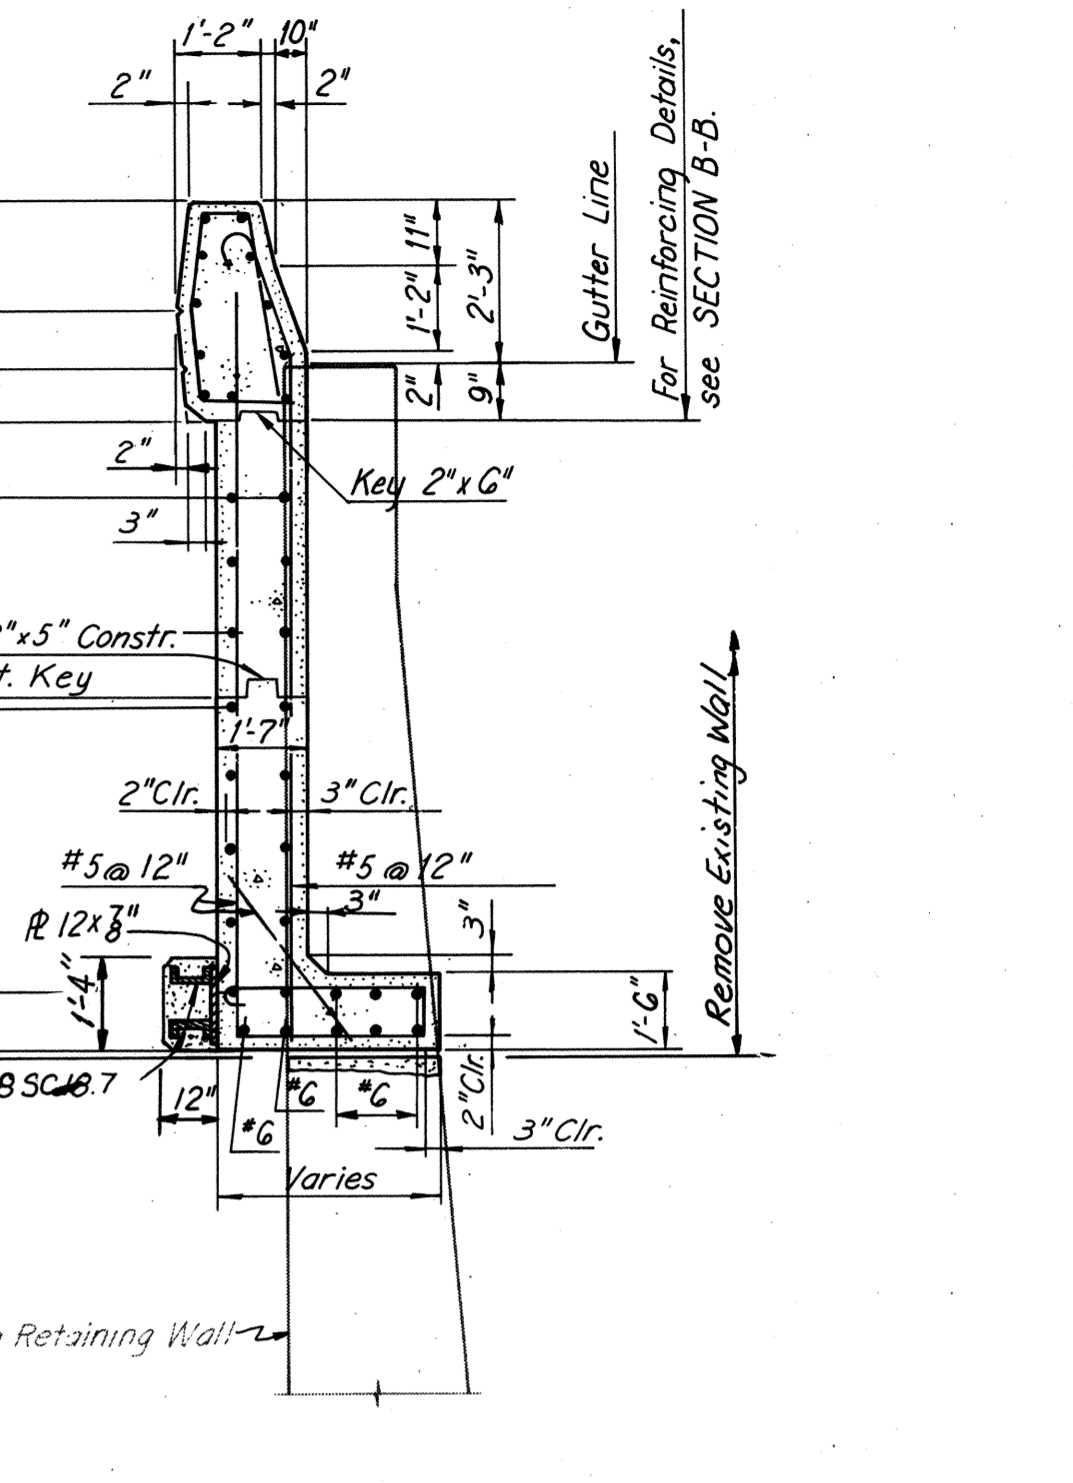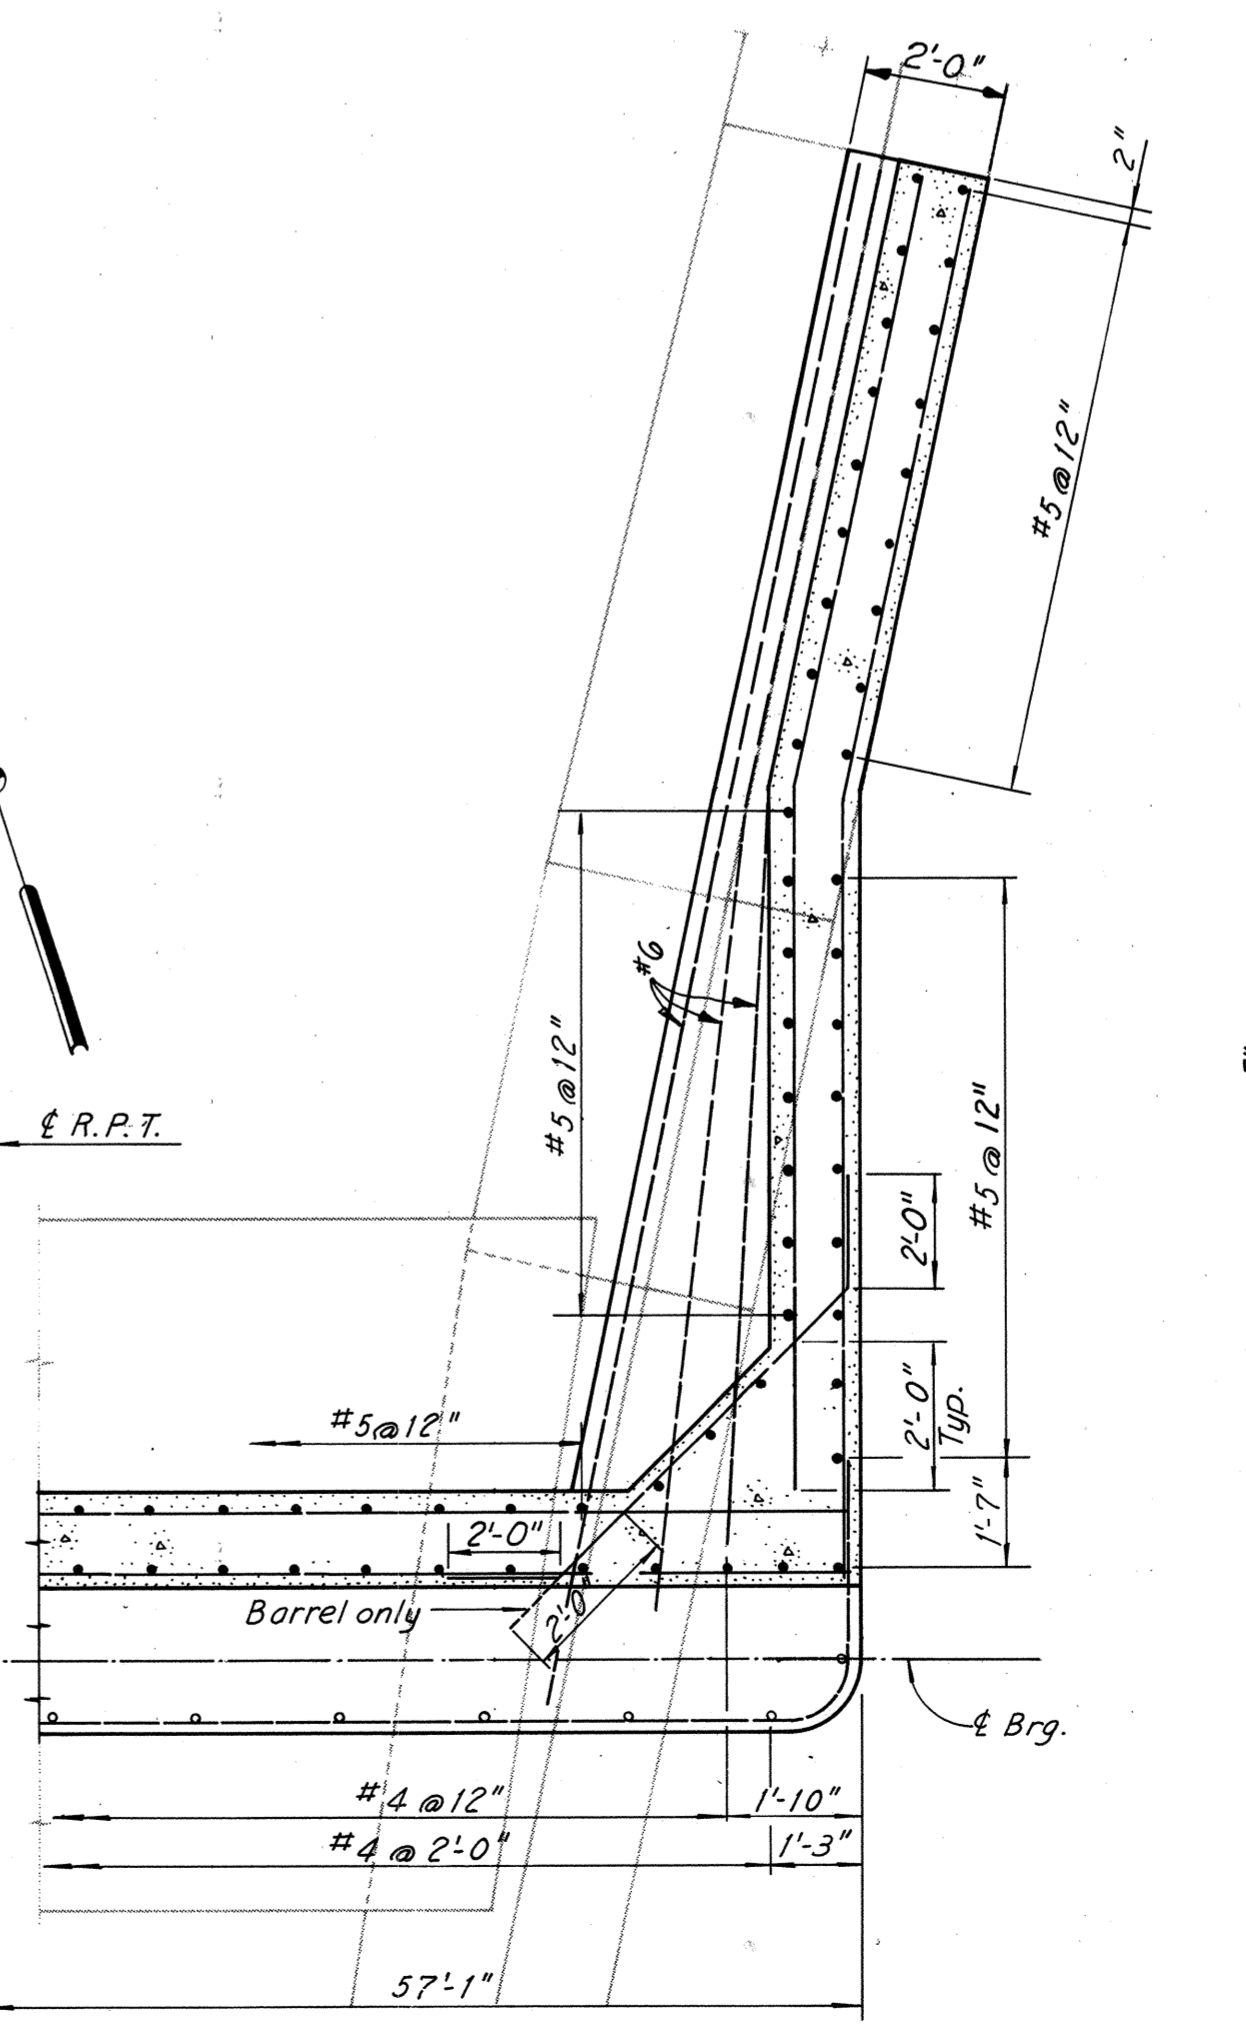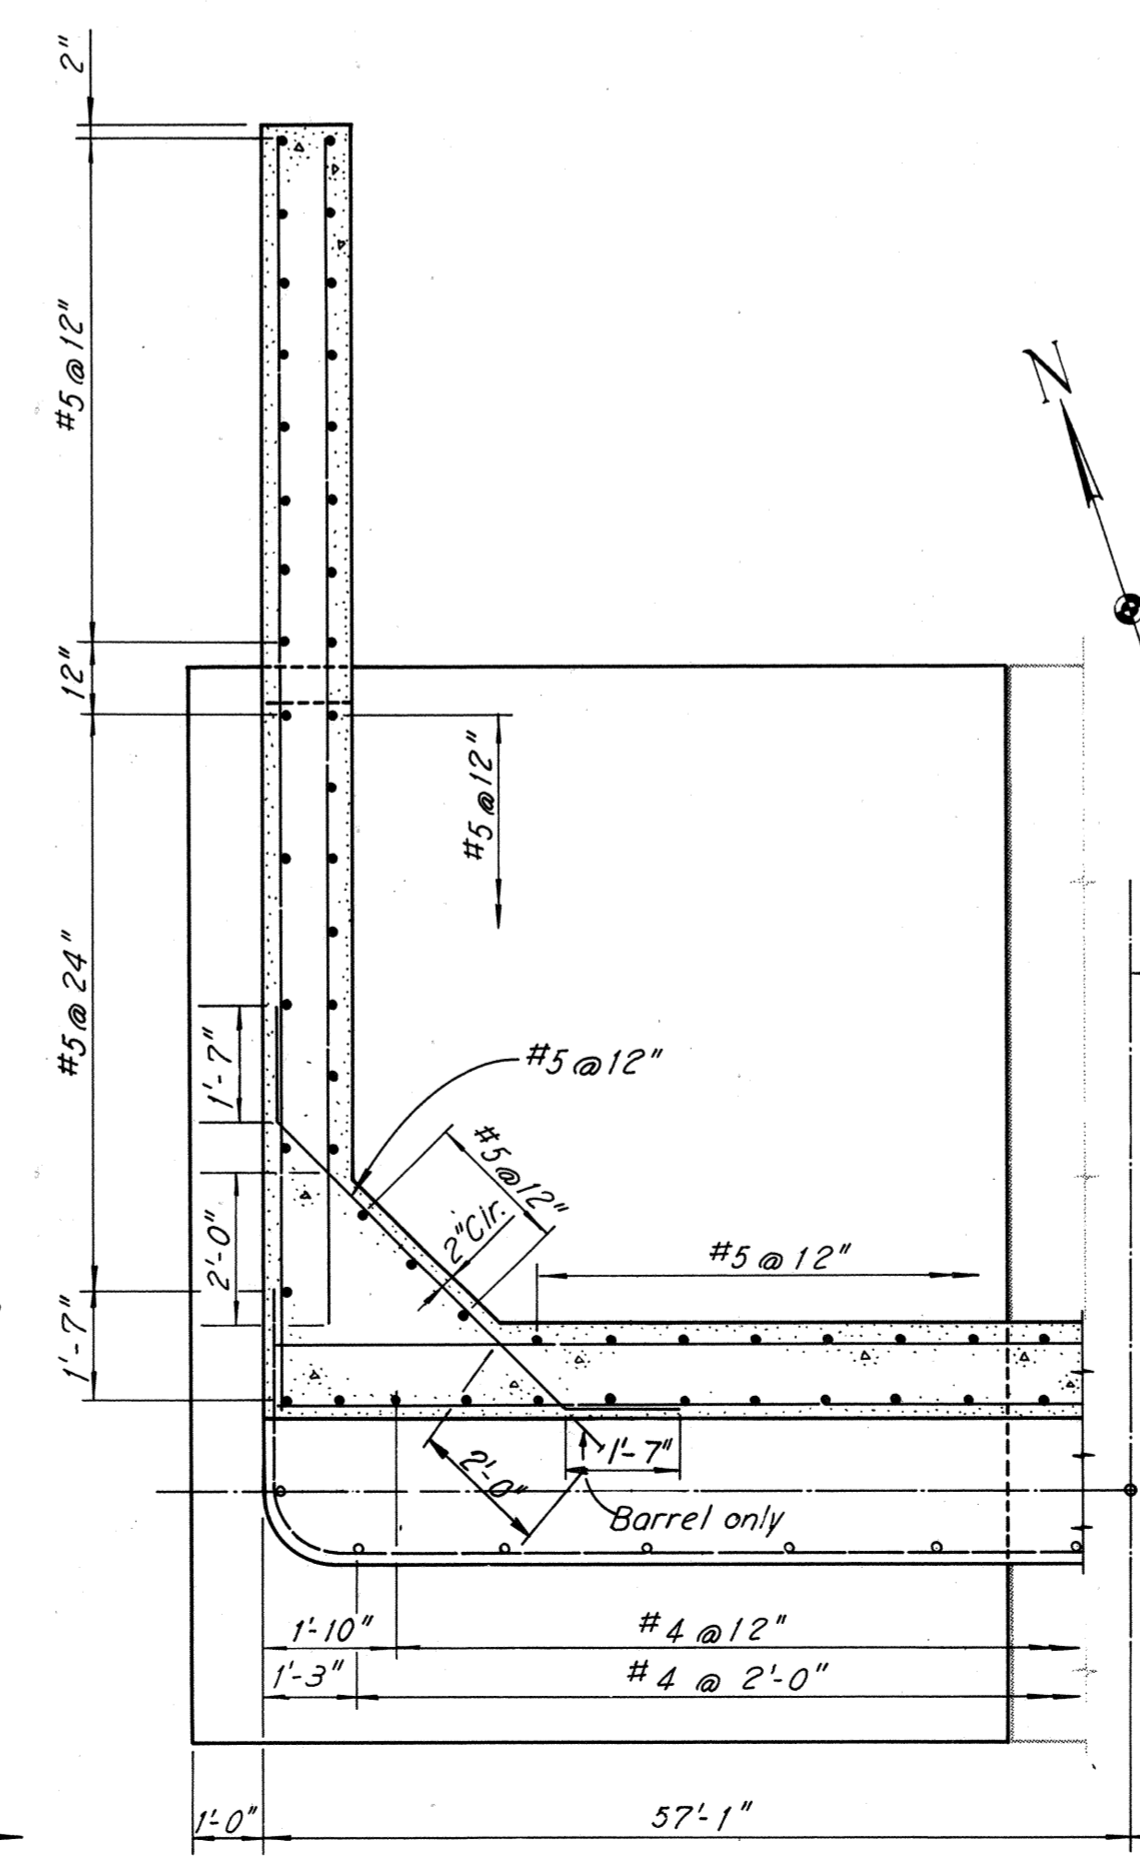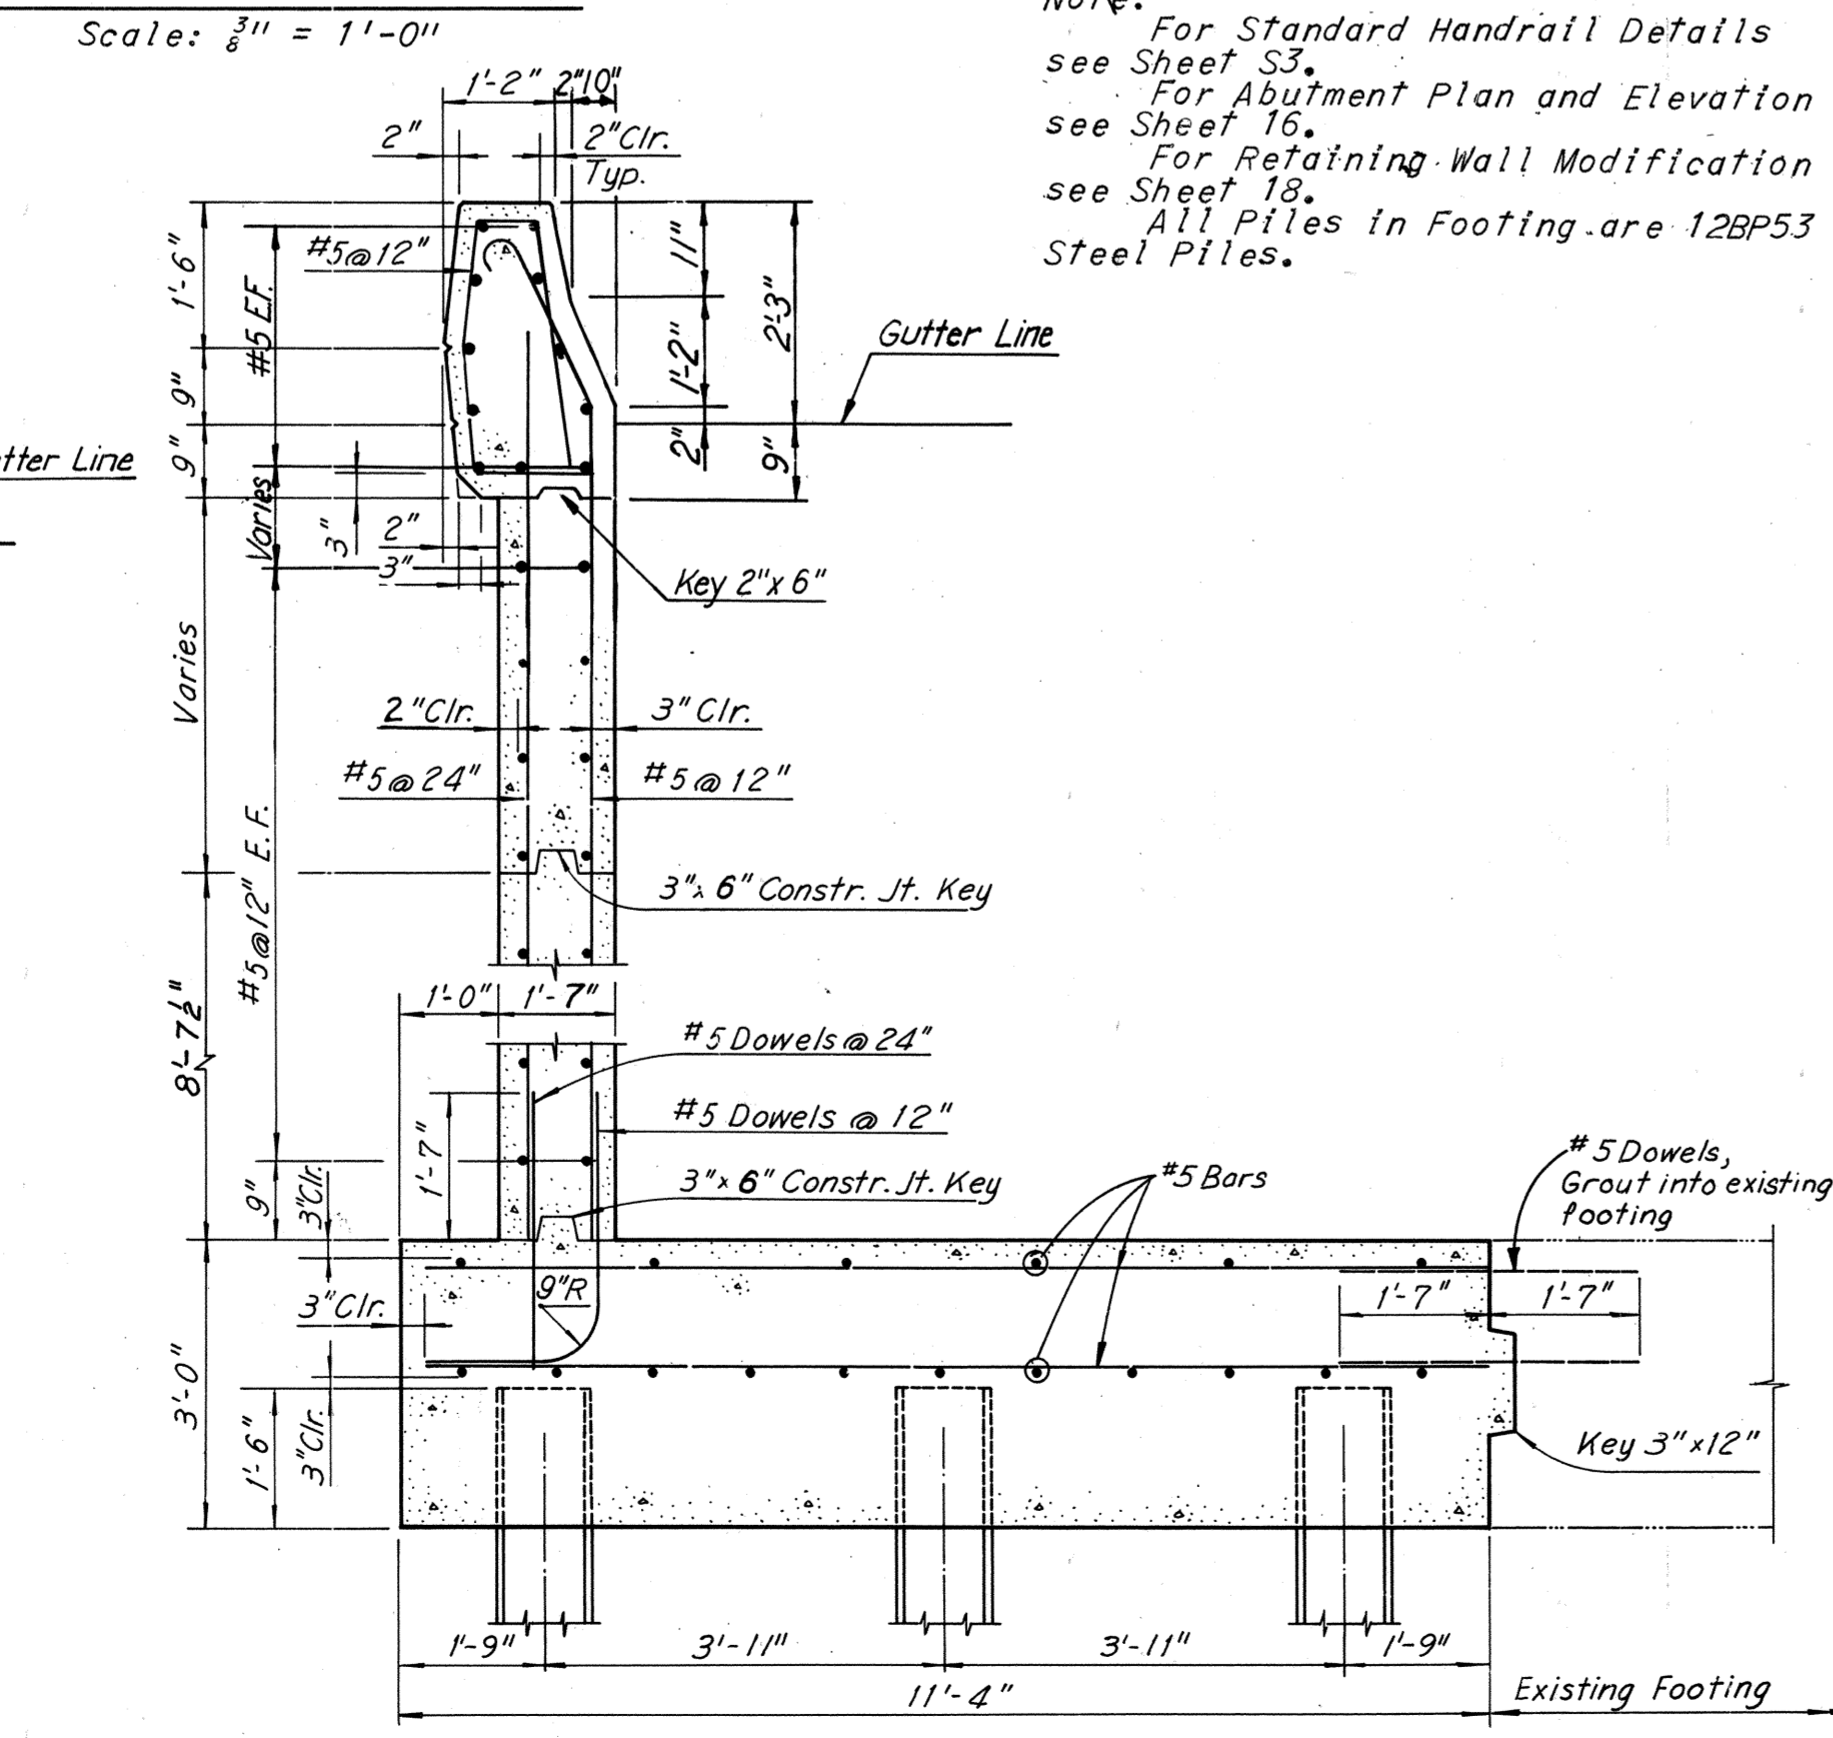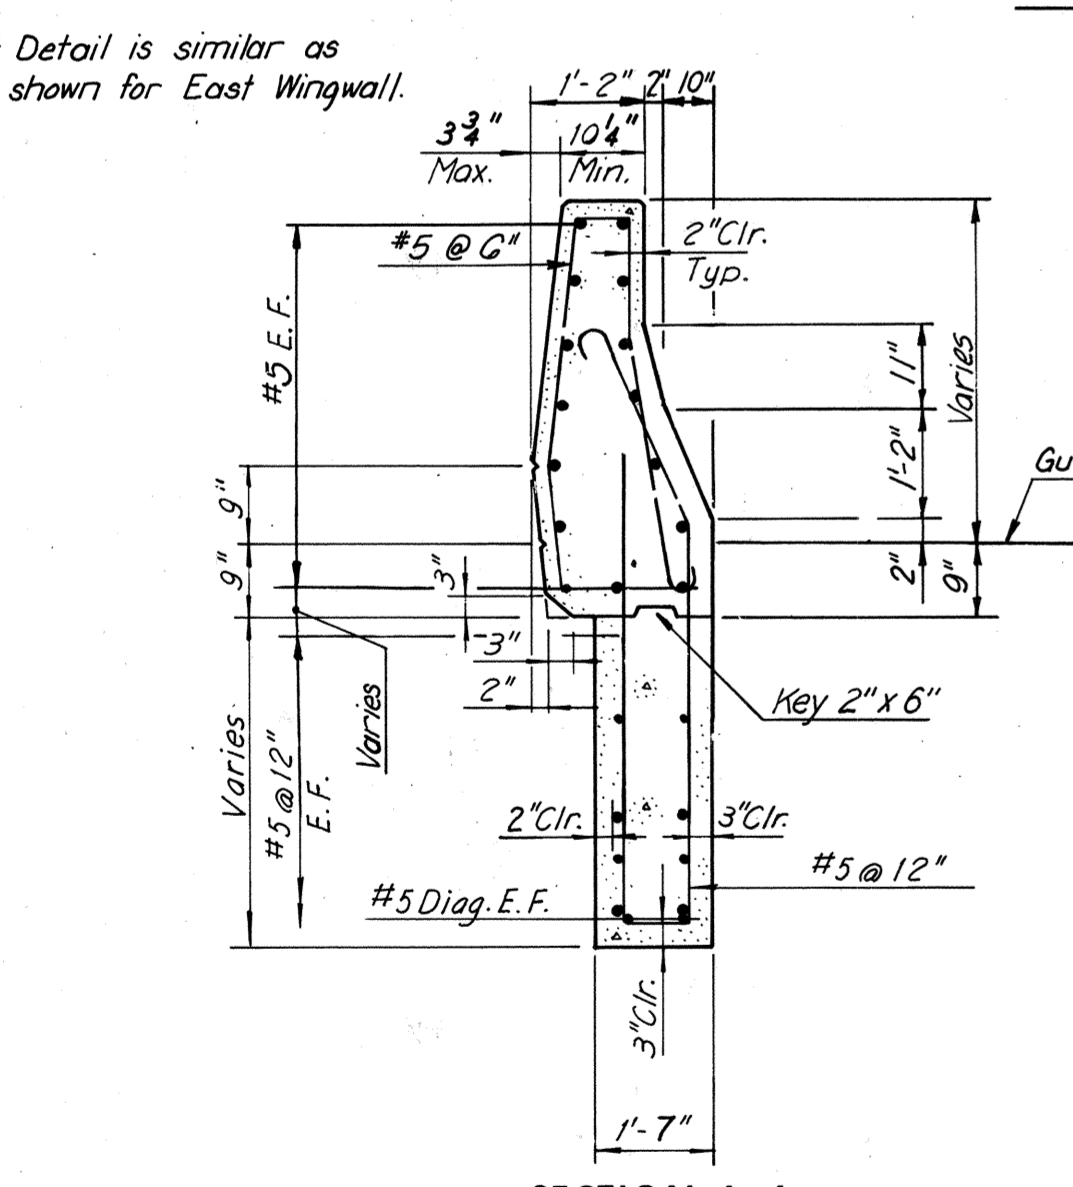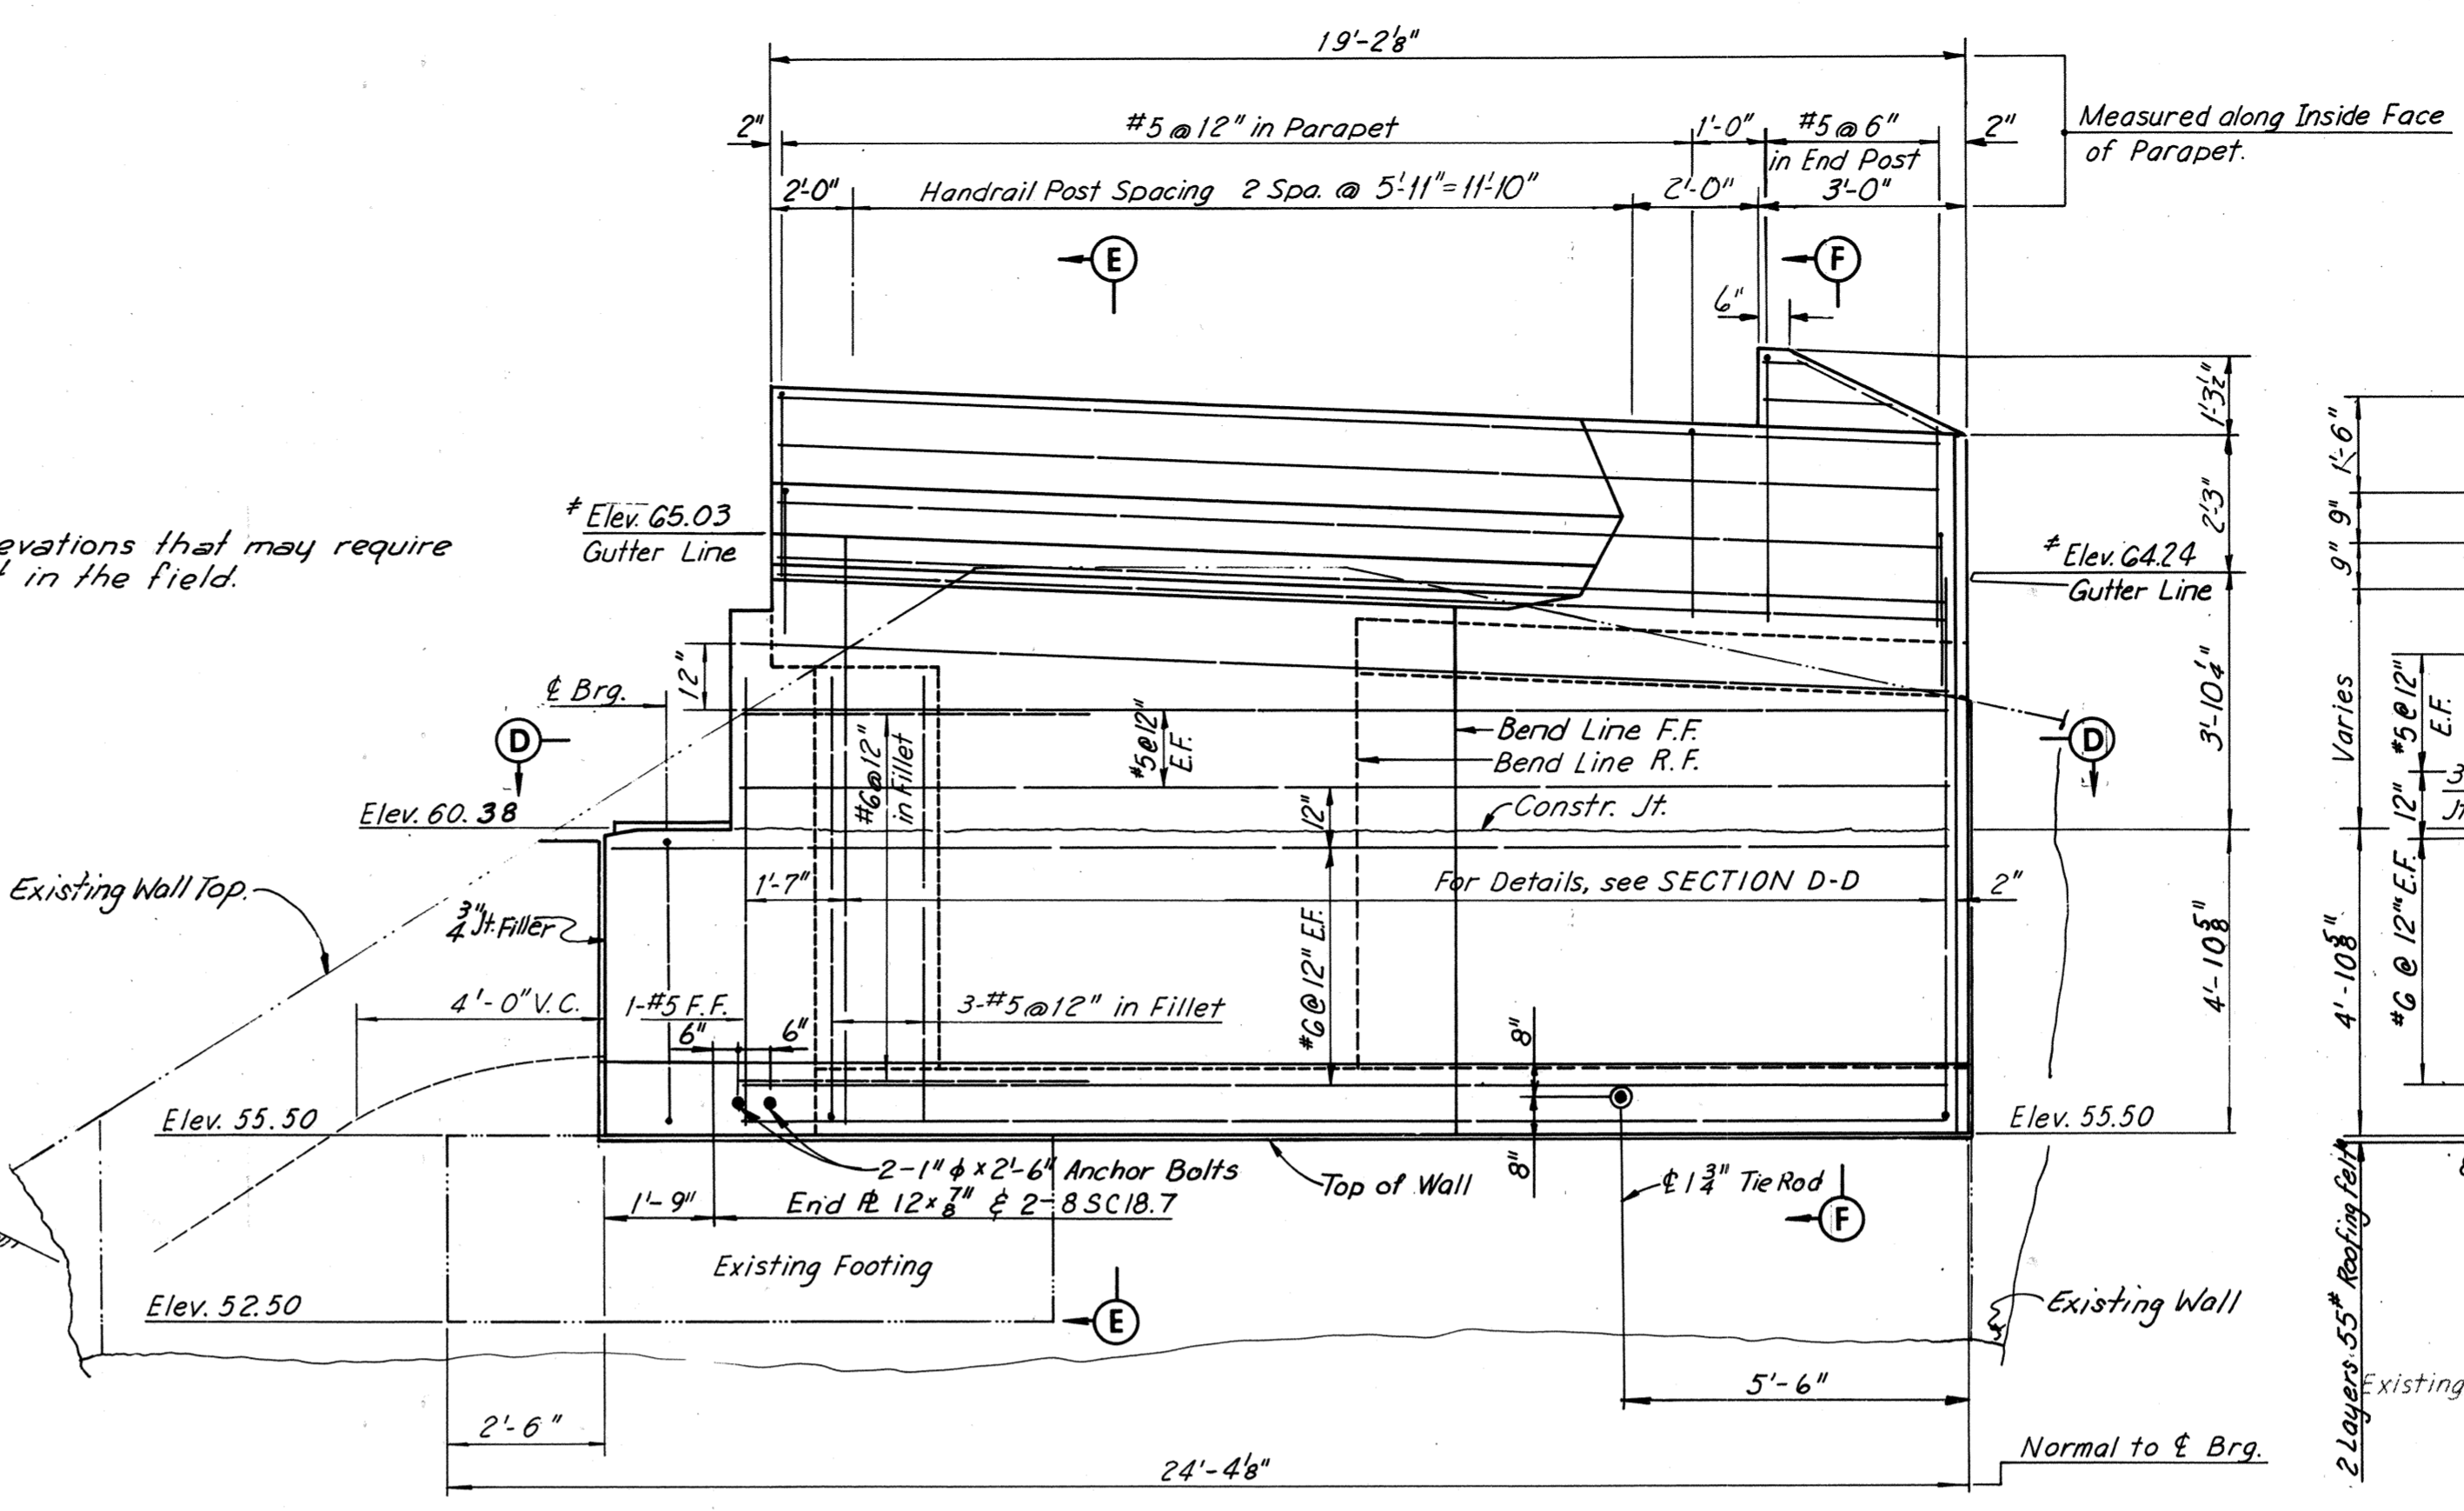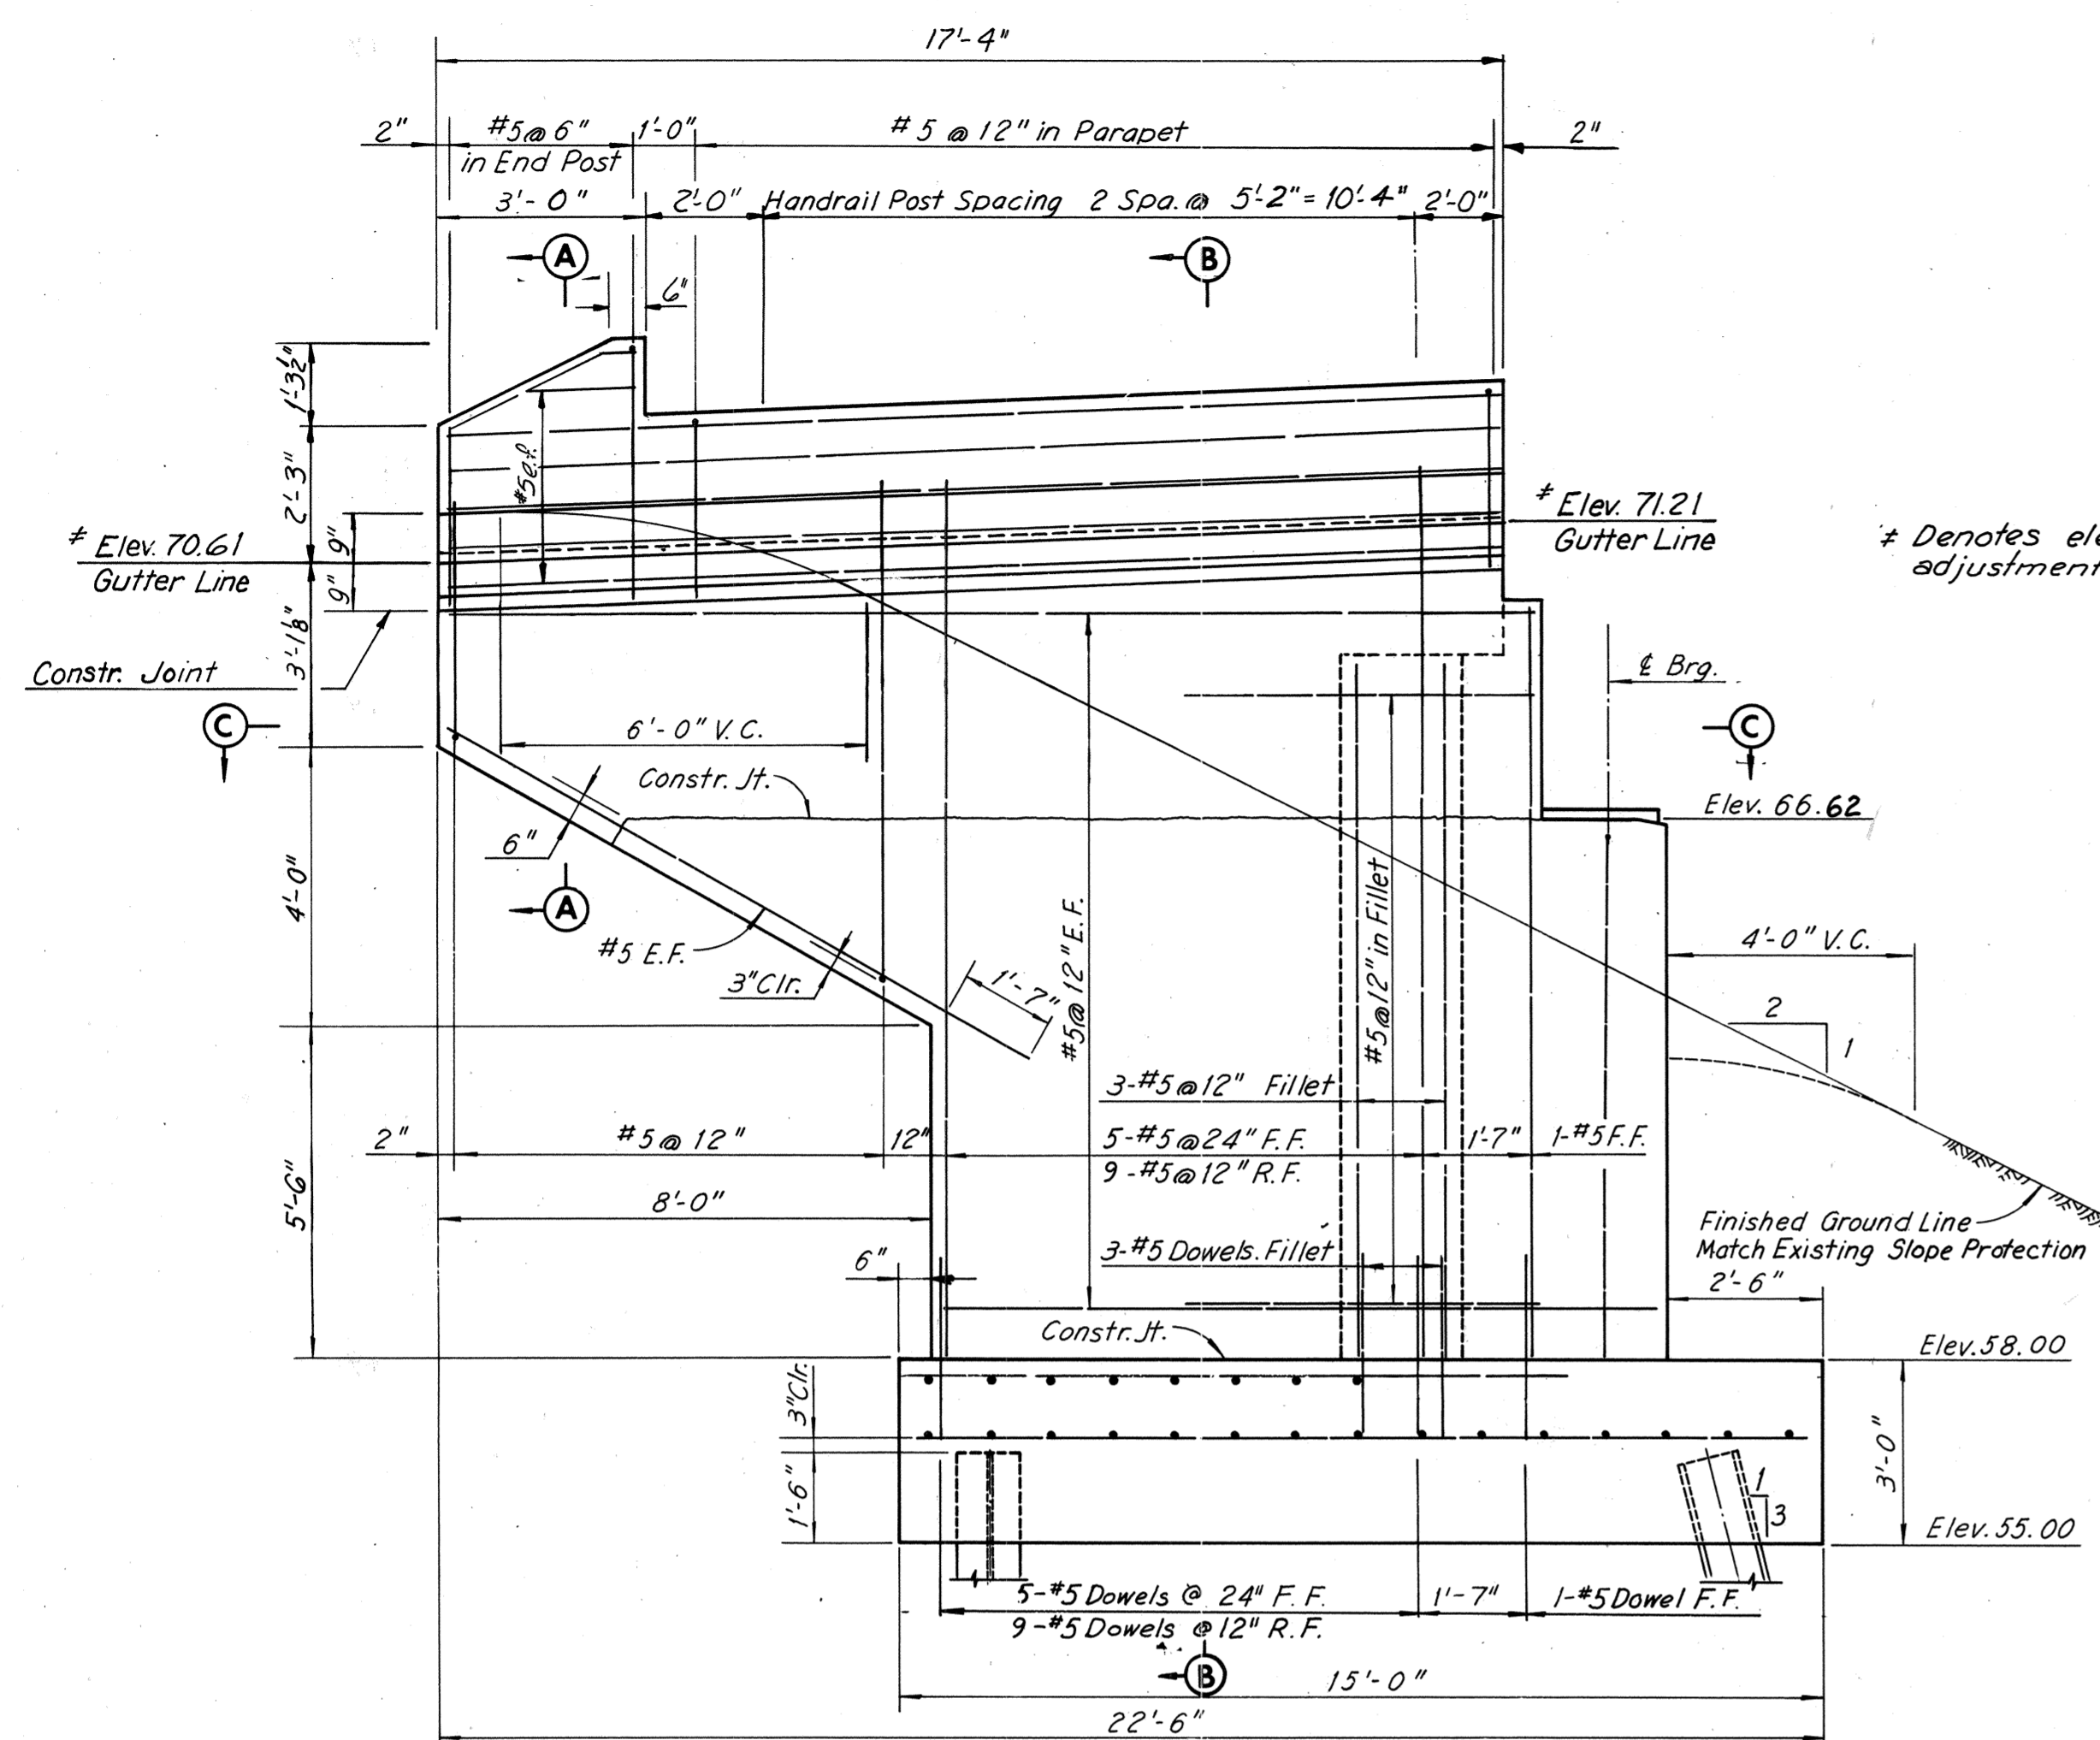

* Denotes elevations that may require adjustment in the field.

Note:
For Standard Handrail Details see Sheet S3.
For Abutment Plan and Elevation see Sheet 16.
For Retaining Wall Modification see Sheet 18.
All piles in Footing are 12BP53 Steel Piles.

LEGEND: E.F. denotes each face.
F.F. denotes front face.
R.F. denotes rear face.

BY	DATE	NO.	REVISION	BY	DATE
MHH	1-14-69	2	As Built	TEN	6-77
AMH	5-13-69	1	Gutter Line Elev. & Note	DWS	8-10-75

RICHMOND METROPOLITAN AUTHORITY
RICHMOND EXPRESSWAY SYSTEM
DOWNTOWN EXPRESSWAY











BRIDGE NO. 67
RAMP W-N CONNECTION TO
RICHMOND-PETERSBURG TURNPIKE
NORTH ABUTMENT DETAILS

HOWARD, NEEDLES, TAMMEN & BERGENDOFF
consulting engineers
NEW YORK ALEXANDRIA KANSAS CITY

SCALE: As Noted
CONTRACT NO.: 10
SHEET NO. 17 OF 54

AS BUILT

RICHMOND EXPRESSWAY SYSTEM			
SECTION	PROJECT	SHEET NO.	TOTAL SHEETS
10	DOWNTOWN EXPRESSWAY	190	265

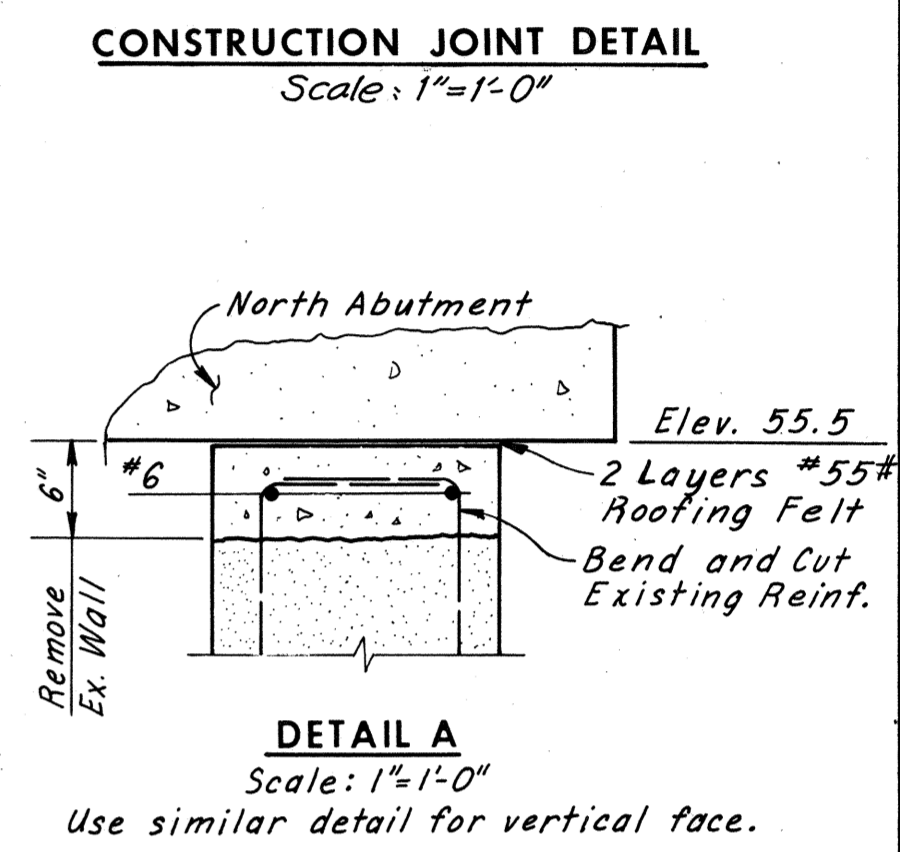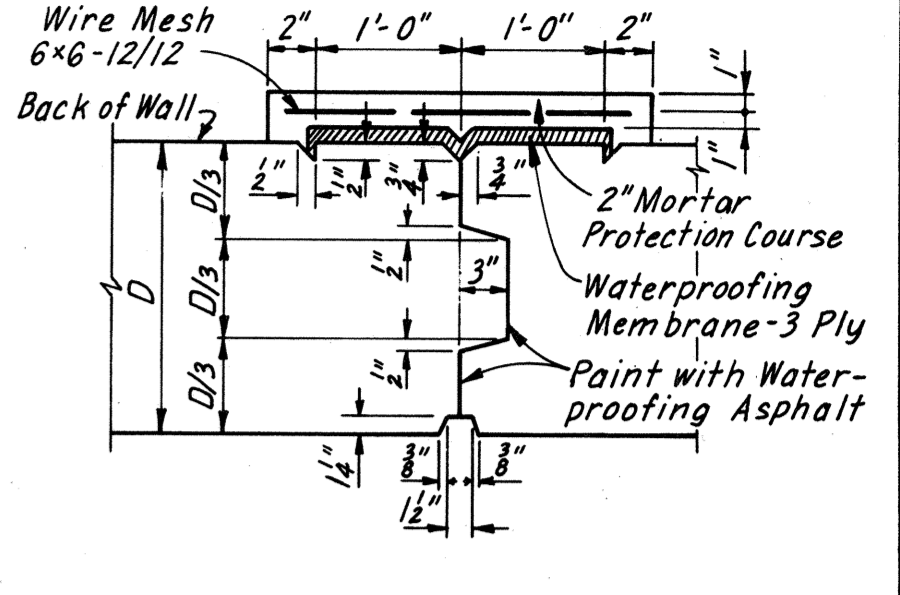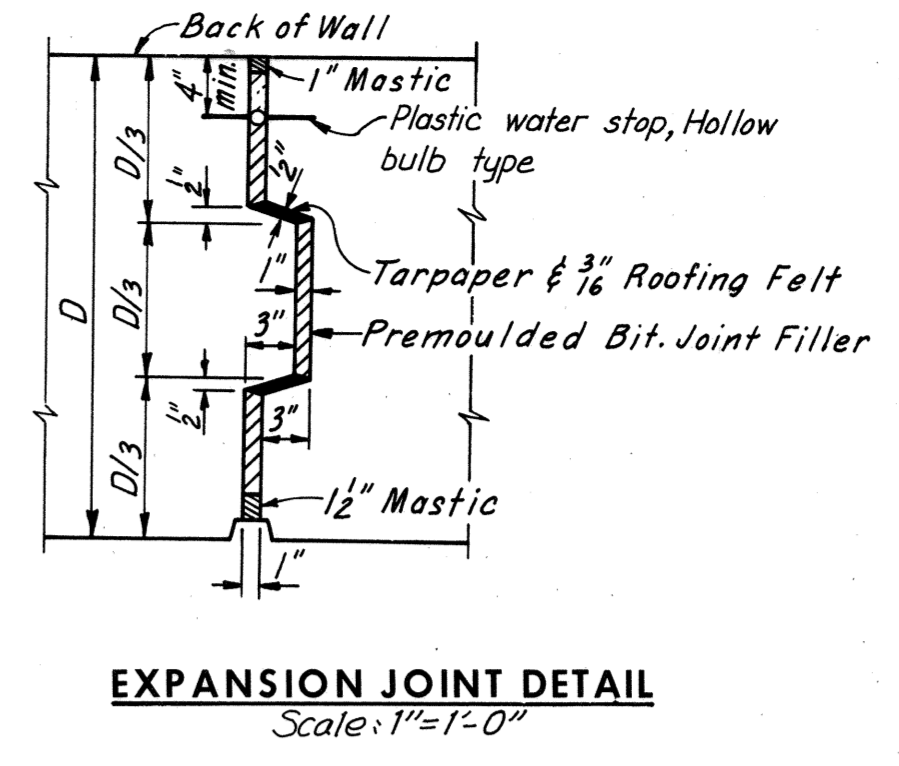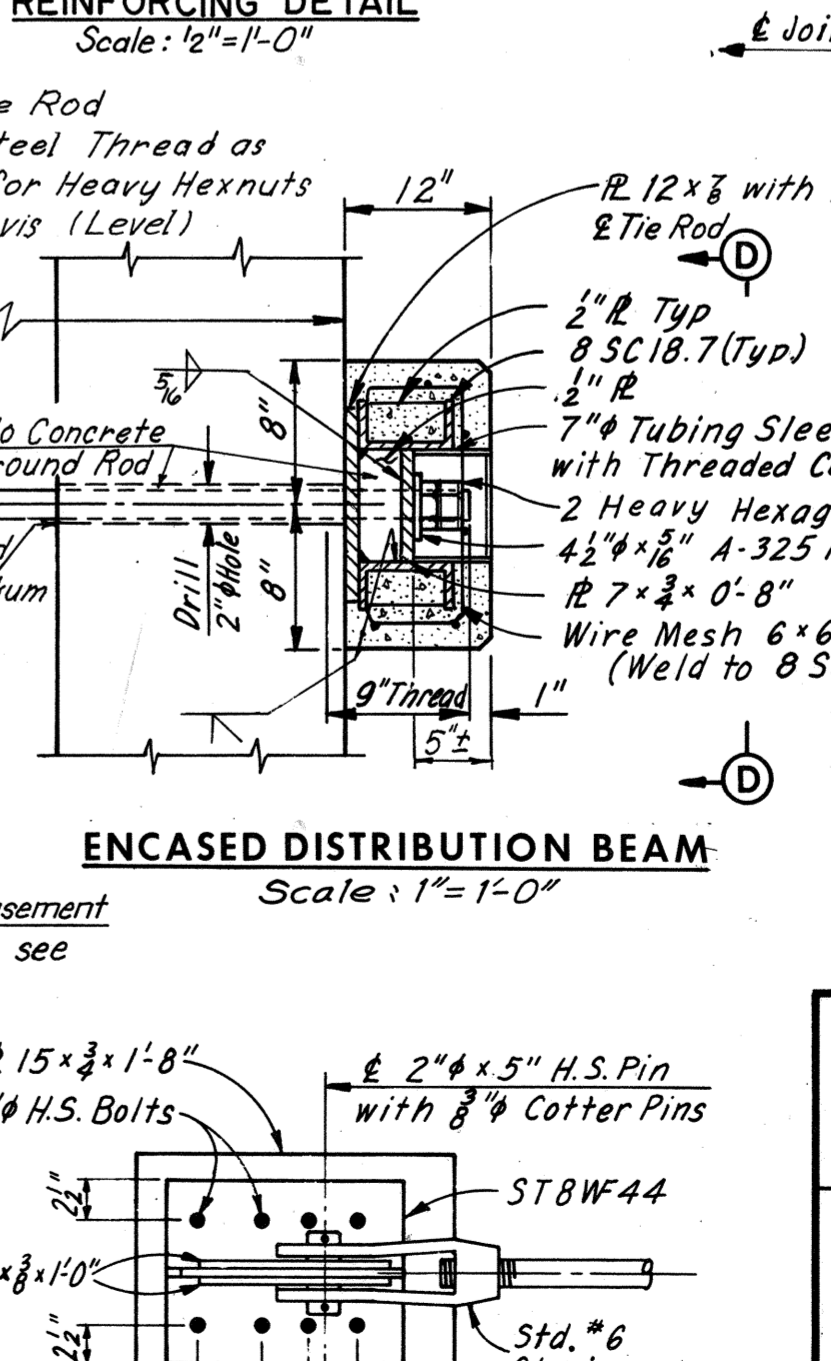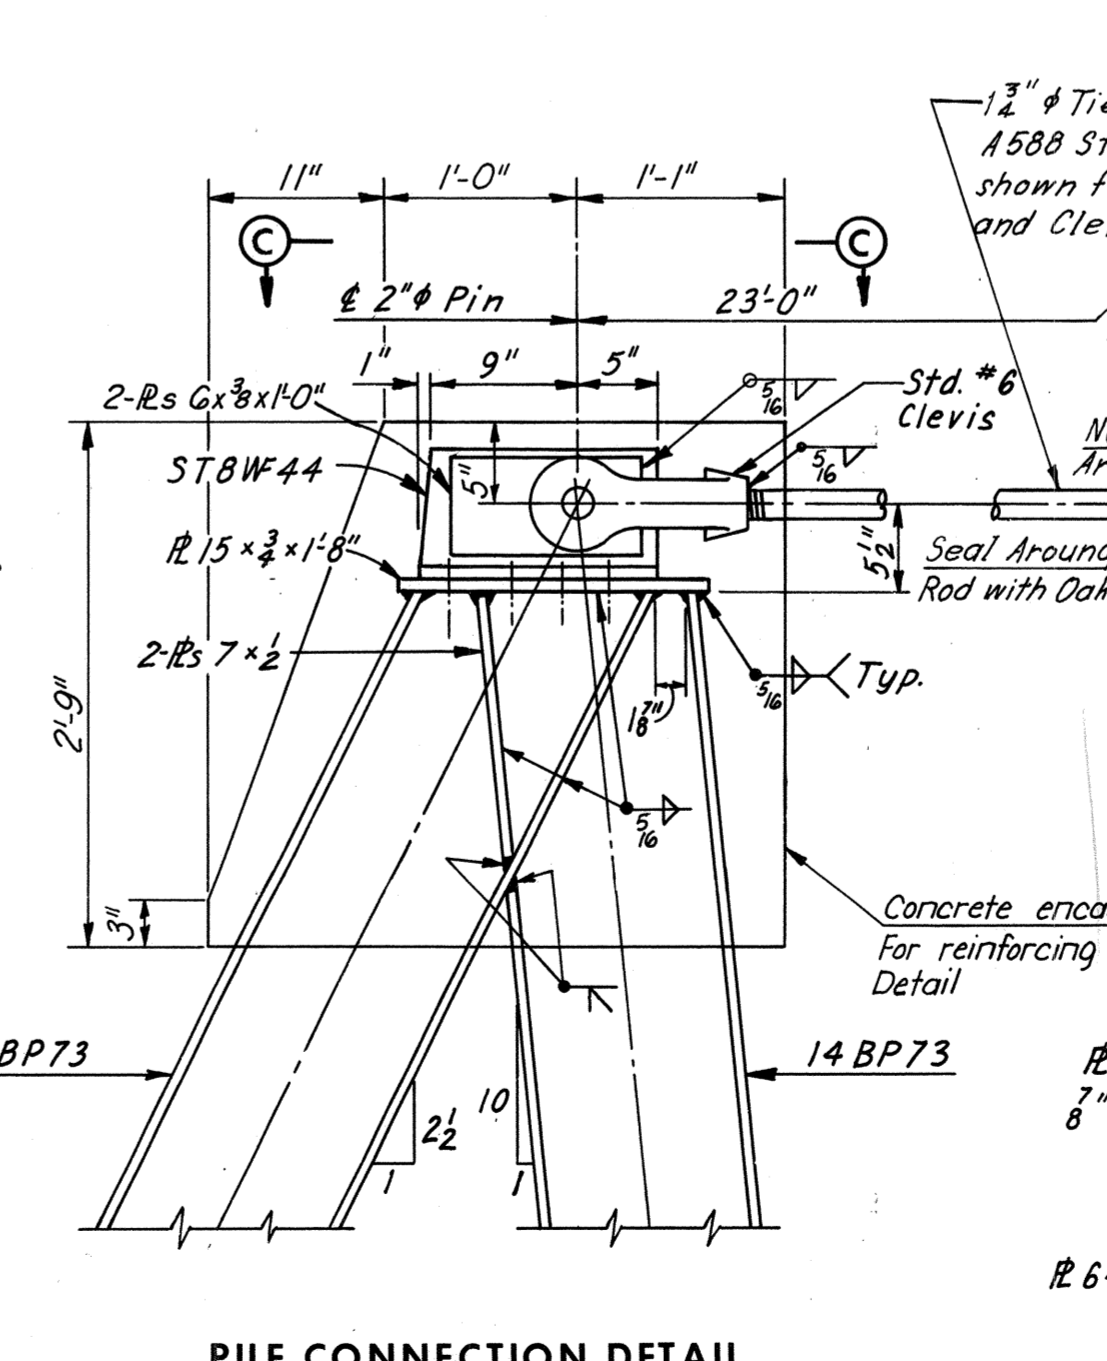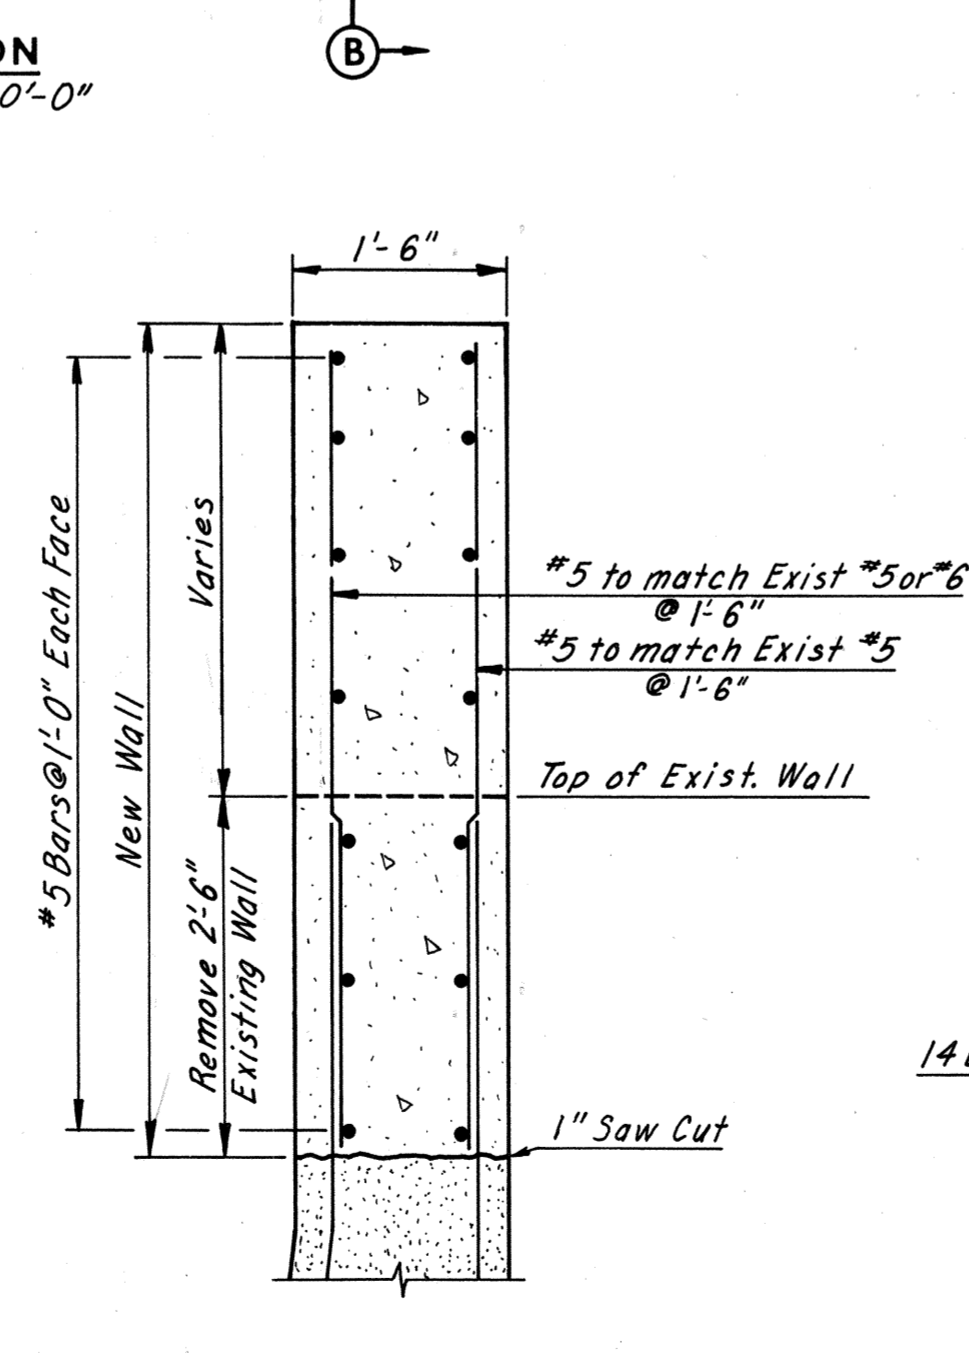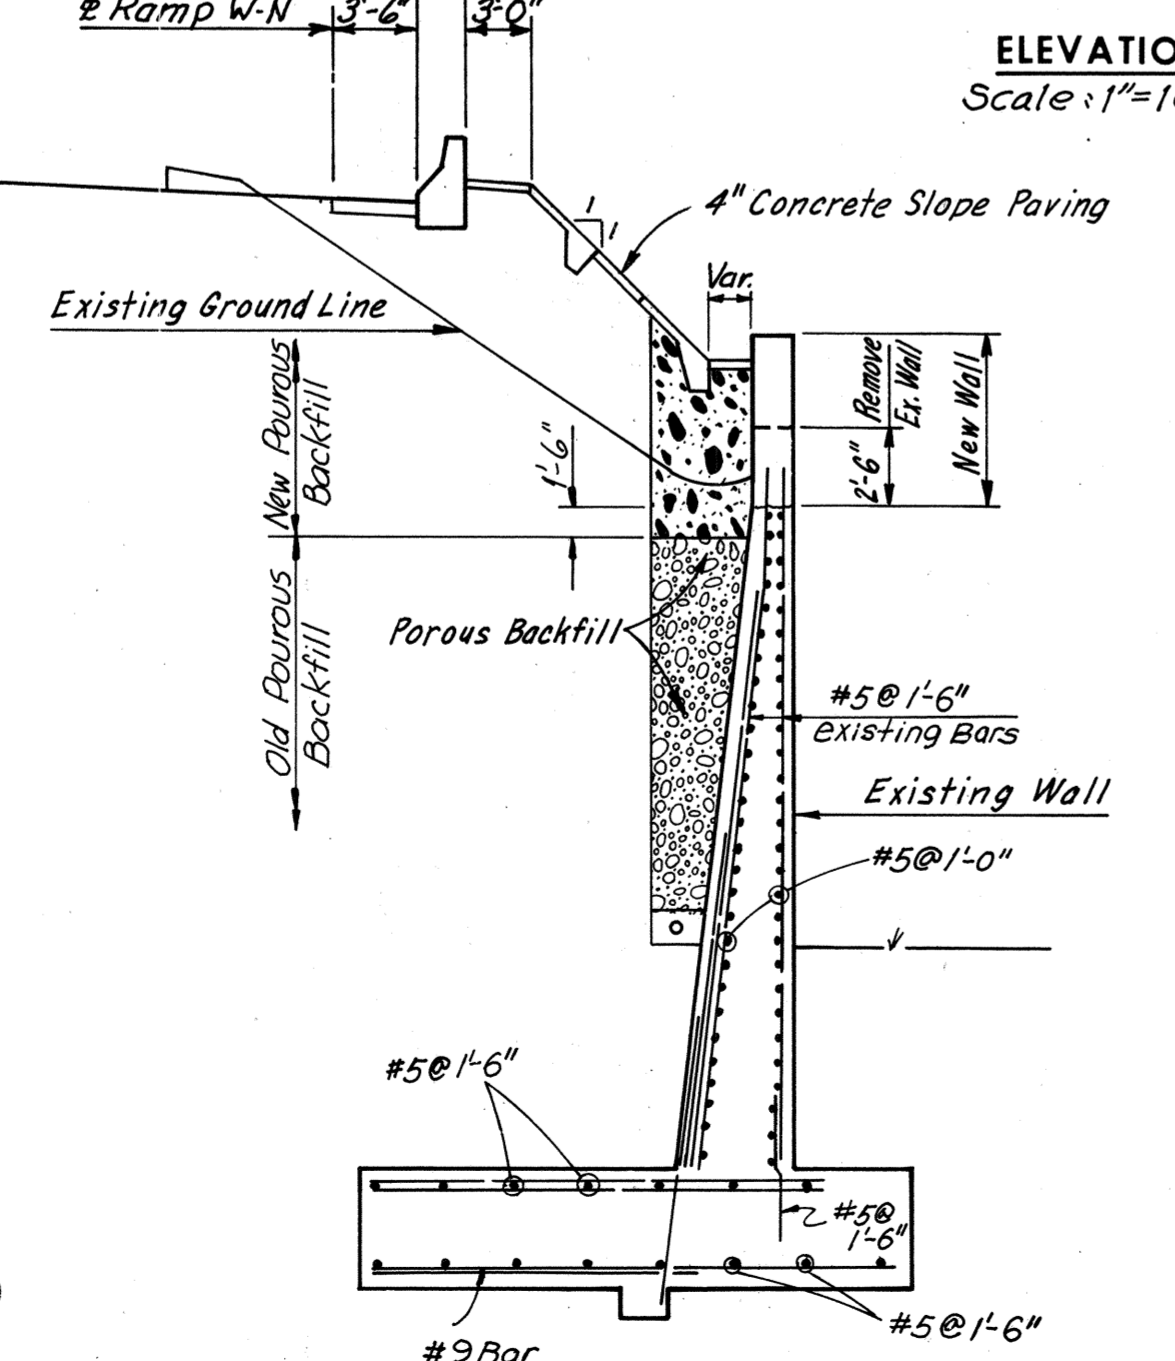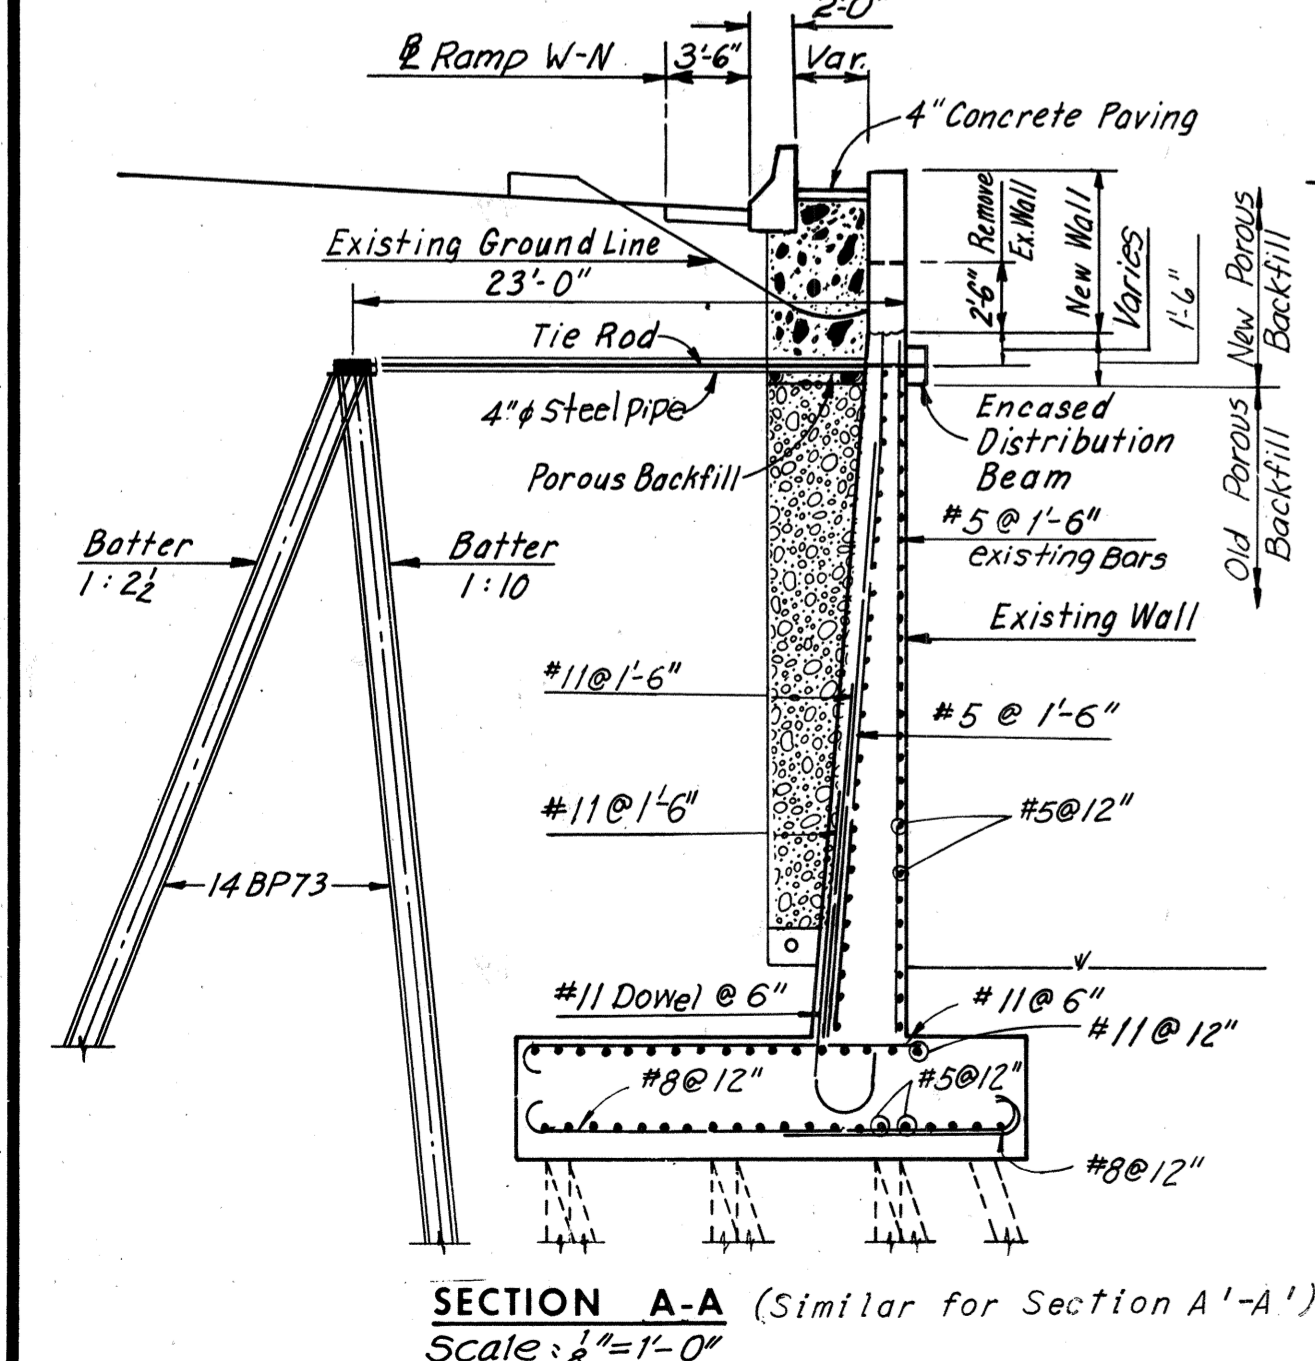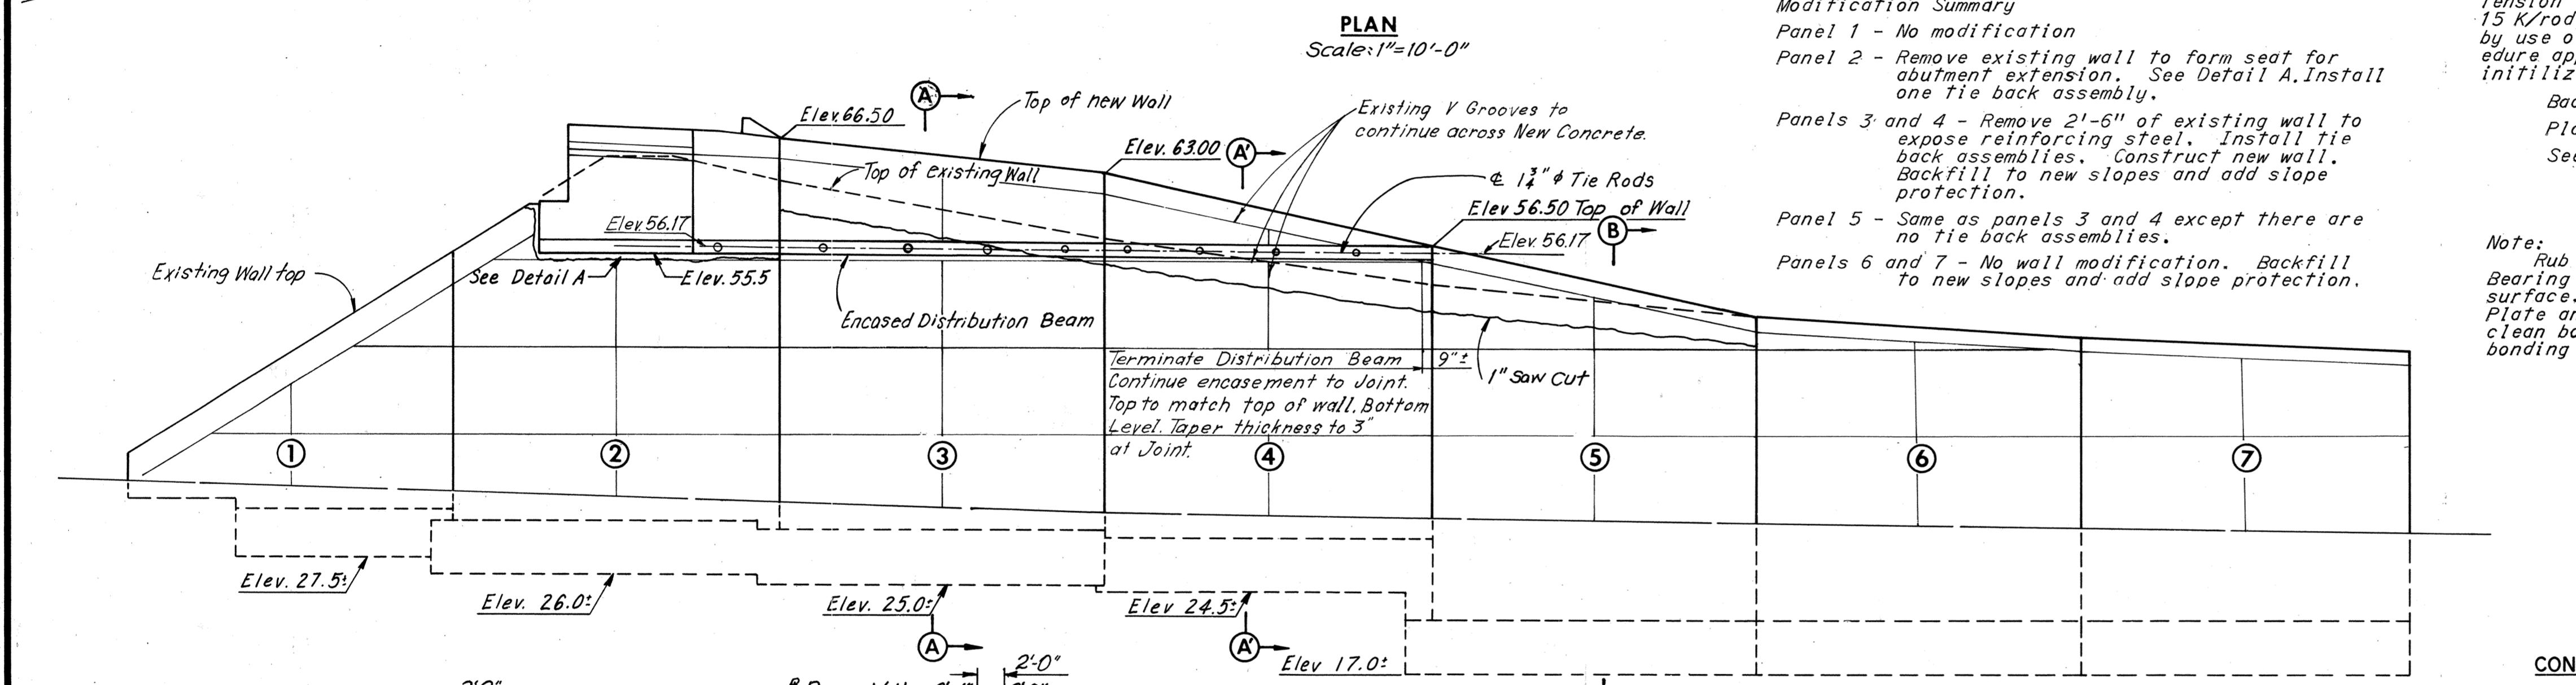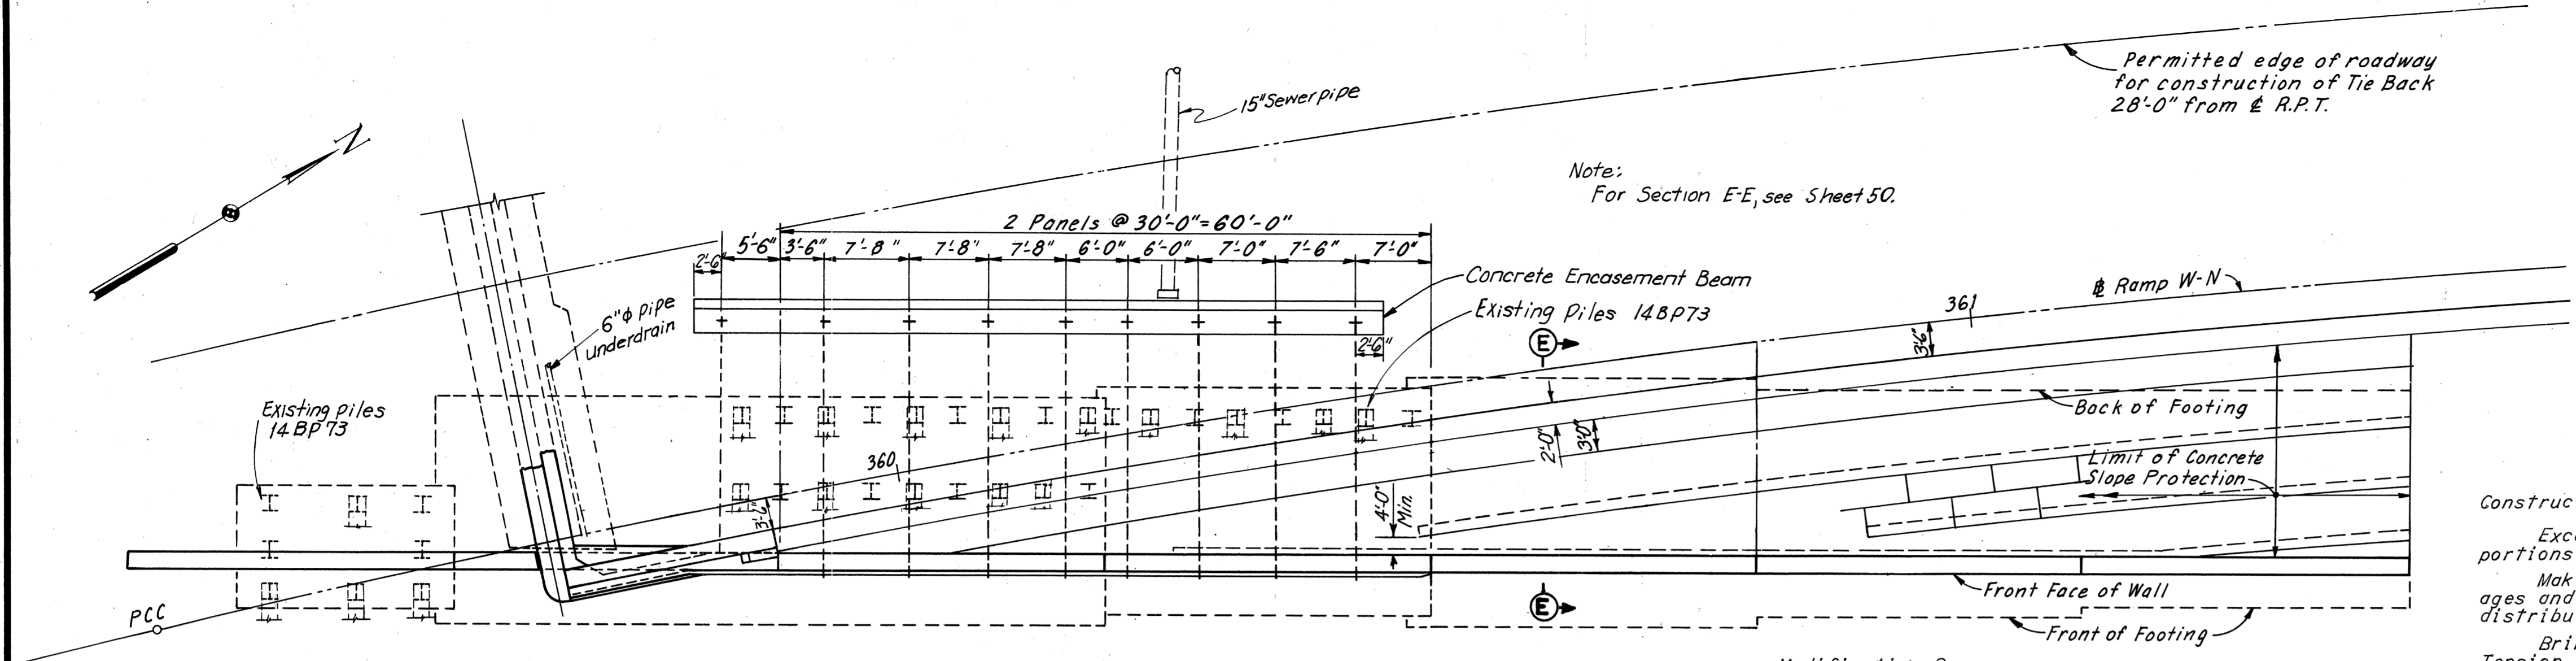

Construction Sequence

Excavate sufficiently to remove required portions of wall. Extend wall to final height.

Make Excavation for placement of pile anchorages and tie rods. Drive piles and install steel distribution beam and tie rods.

Bring tie rod nuts to "finger tight" condition. Tension tie rods to 18 K/rod, Panels 2 and 3; and 15 K/rod, Panel 4. Tension shall be determined by use of a Whitmore strain gage or other procedure approved by the Engineer. Gages shall be initialized after tie rod nuts are "finger tight"

Backfill wall to final slope.

Place concrete slope protection

See Special Provision

Note: Rub wall with neat cement paste under 12"x8" Bearing Plate to provide reasonably smooth bearing surface. Roughen area between edge of Bearing Plate and limits of concrete encasement to provide clean bonding surface. See Special Provisions for bonding new concrete to existing.

Modification Summary

Panel 1 - No modification

Panel 2 - Remove existing wall to form seat for abutment extension. See Detail A. Install one tie back assembly.

Panels 3 and 4 - Remove 2'-6" of existing wall to expose reinforcing steel. Install tie back assemblies. Construct new wall. Backfill to new slopes and add slope protection.

Panel 5 - Same as panels 3 and 4 except there are no tie back assemblies.

Panels 6 and 7 - No wall modification. Backfill to new slopes and add slope protection.

BY	DATE	NO.	REVISION	BY	DATE
AMH	3-12-69				
KCT	6-24-69	1	As Bui/H	TEM	6-77

AS BUILT

RICHMOND METROPOLITAN AUTHORITY
RICHMOND EXPRESSWAY SYSTEM
DOWNTOWN EXPRESSWAY

BRIDGE NO. 67
 RAMP W-N CONNECTION TO
 RICHMOND-PETERSBURG TURNPIKE
 NORTH ABUTMENT RETAINING WALL
 MODIFICATION






HOWARD, NEEDLES, TAMMEN & BERGENDOFF
 consulting engineers
 NEW YORK ALEXANDRIA KANSAS CITY

SCALE: As Noted


CONTRACT NO.: 10

SHEET NO. 18 OF 54

RICHMOND EXPRESSWAY SYSTEM			
SECTION	PROJECT	SHEET NO.	TOTAL SHEETS
10	DOWNTOWN EXPRESSWAY	191	265

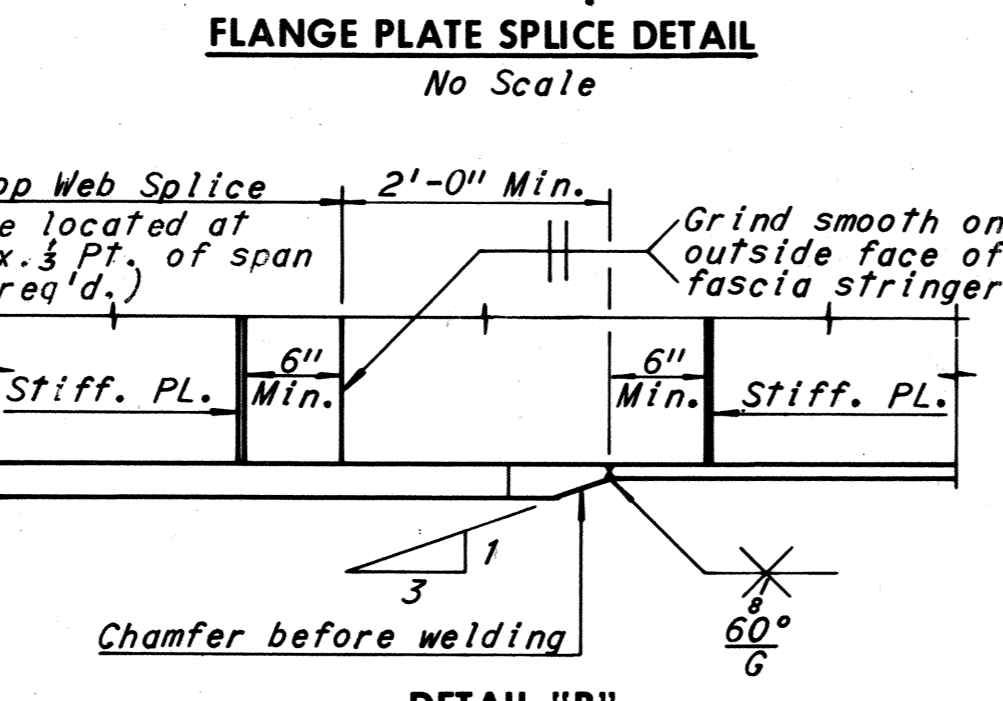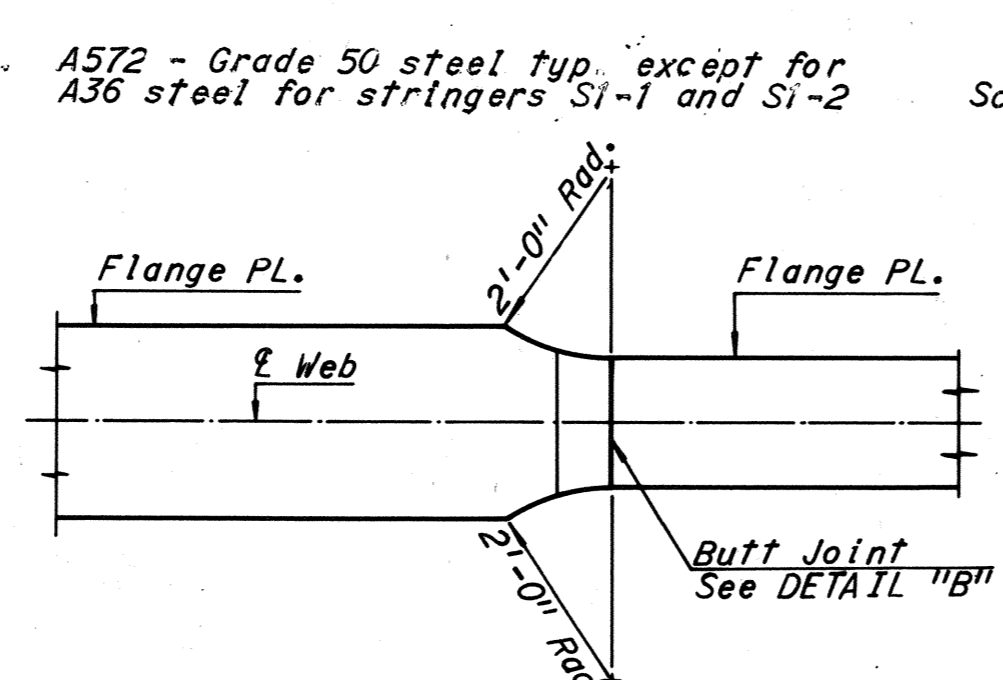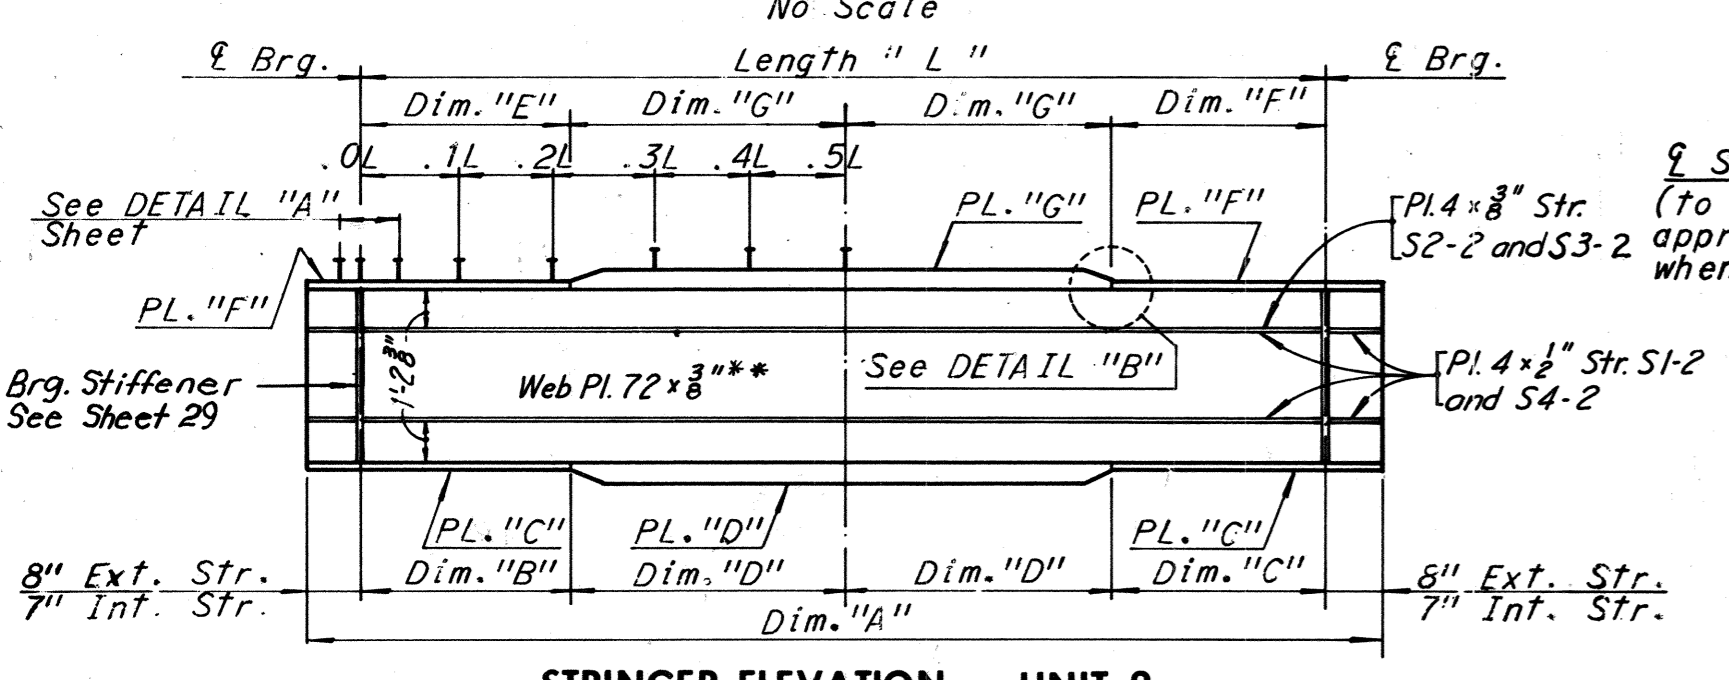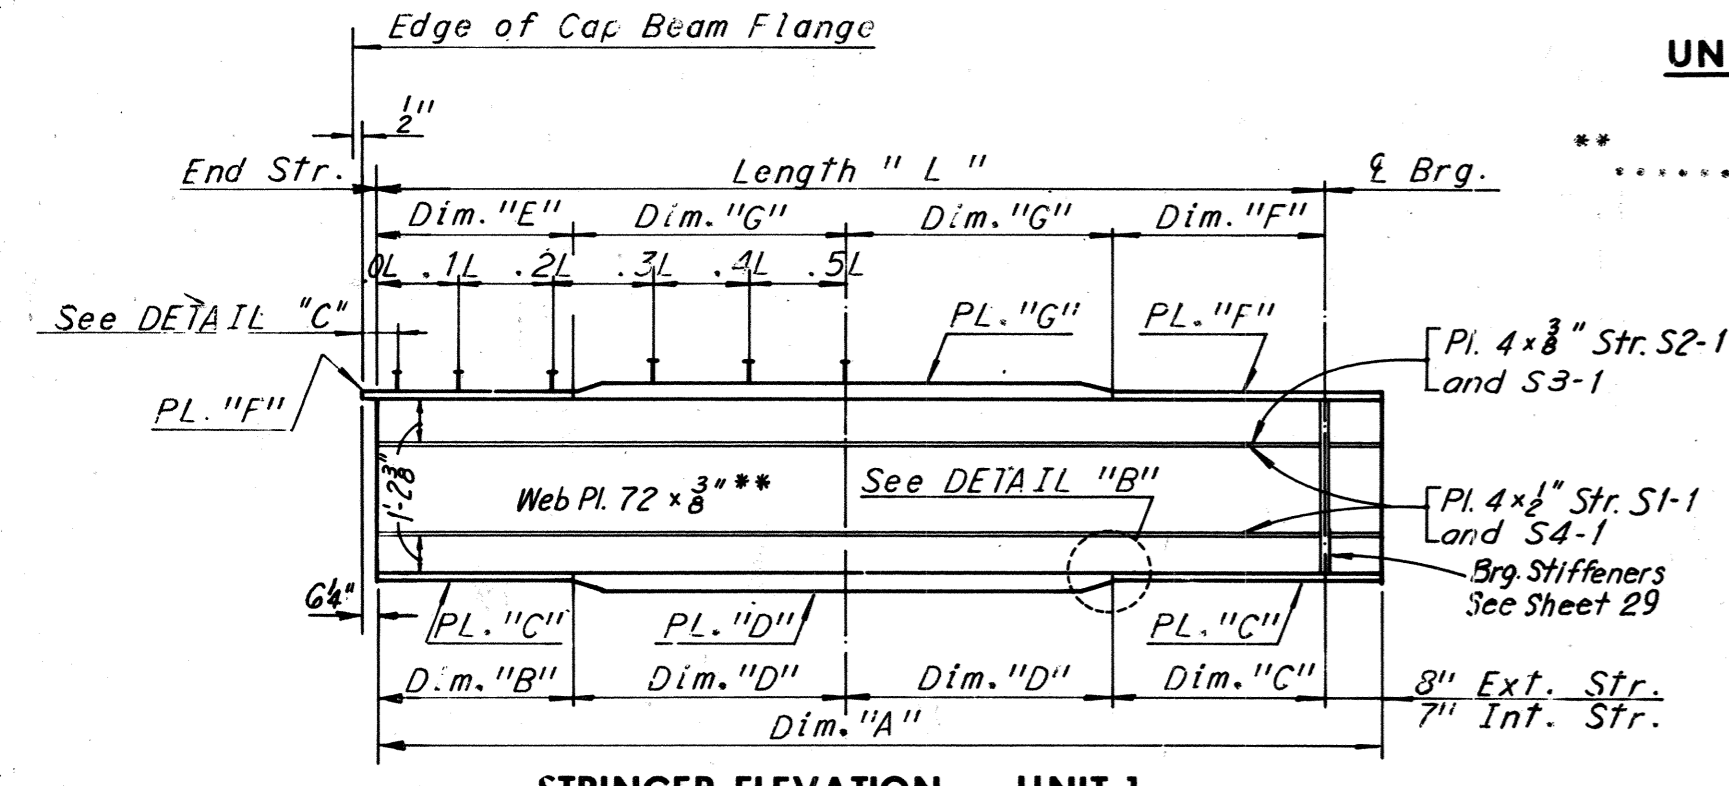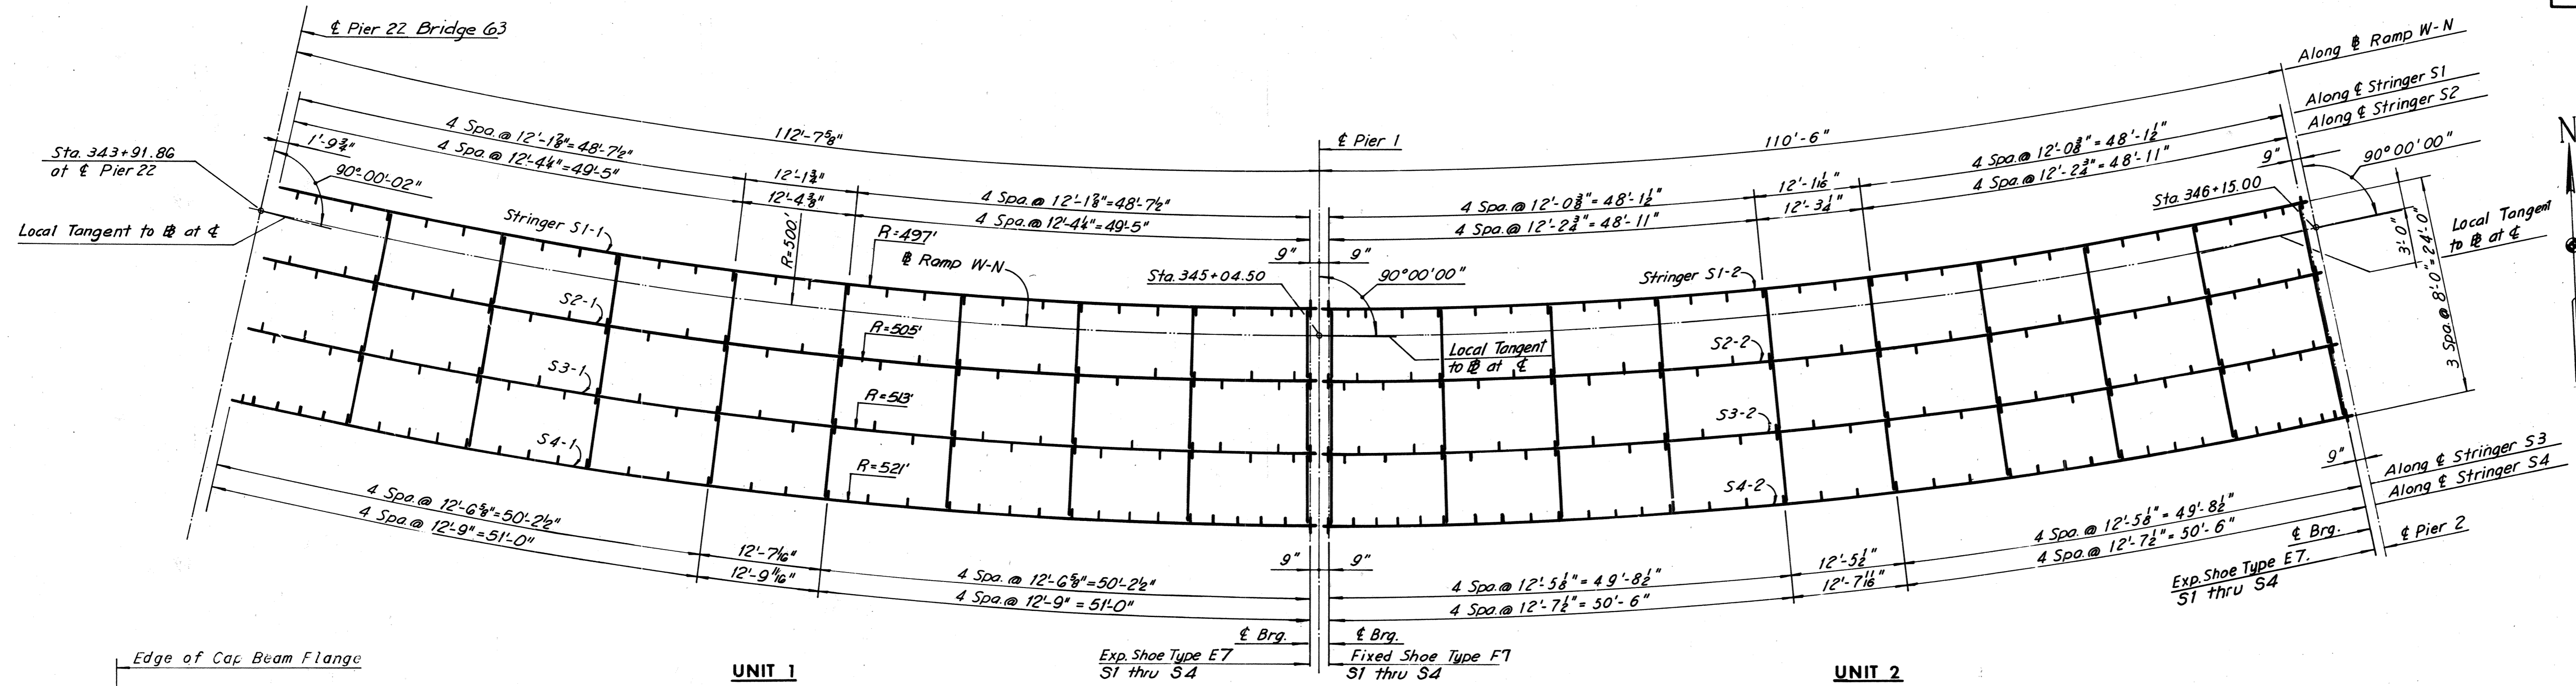


FRAMING PLAN
Scale: 1" = 10'-0"

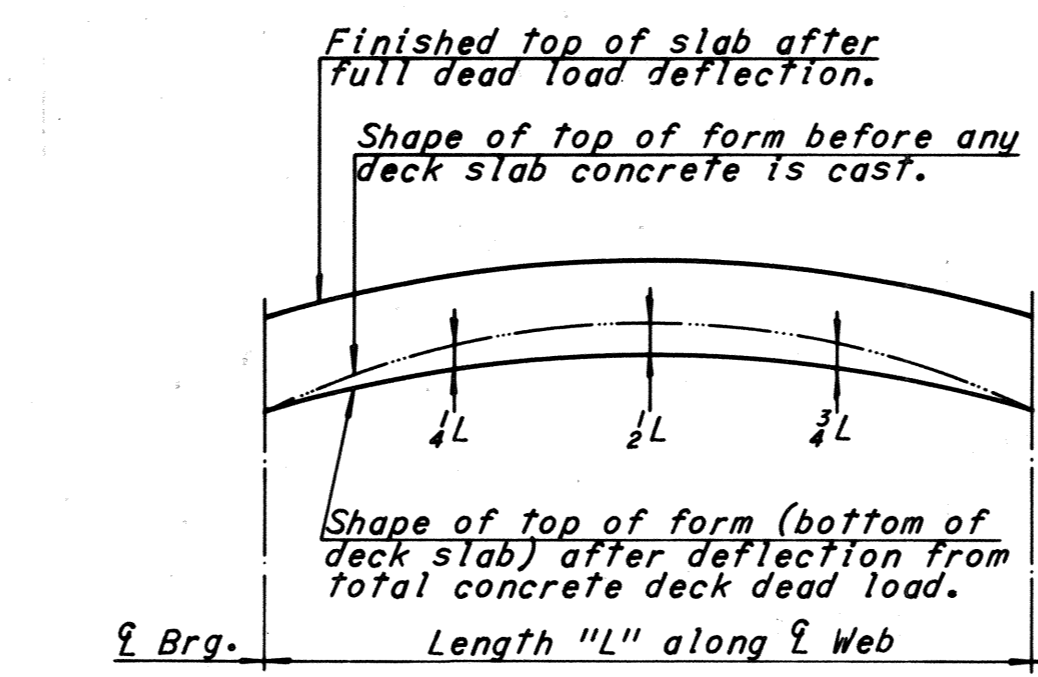

DEAD LOAD DEFLECTION DIAGRAM

NOTE TO CONTRACTOR
Deflections given are those anticipated to occur in the stringer upon placement of the total concrete deck dead load.
In practice, the stringers in place are not likely to have the exact camber to compensate for these deflections during construction. The residual amounts shall be provided by adjusting forms to vary the thickness of the concrete haunch between the bottom of the slab and the top of stringer without altering the slab thickness.



UNIT 2

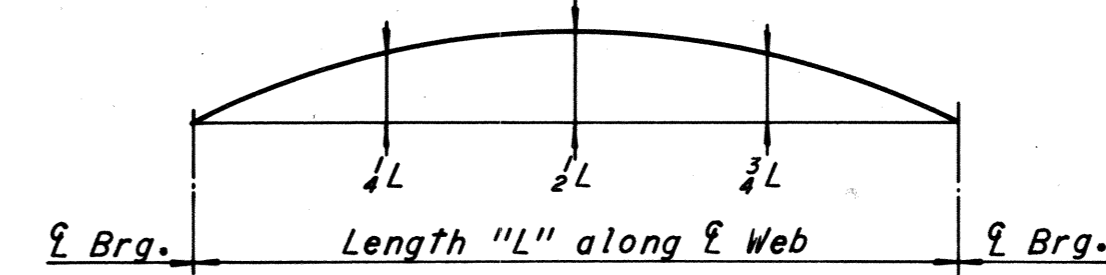

CAMBER DIAGRAM

NOTE TO FABRICATOR
The stringers shall be fabricated with an upward camber amounting to the tabulated value. This will provide approximate compensation for deflection under full dead load and for conformity with finished grade.

EXPANSION SHOES		FIXED SHOES	
TYPE	NO. REQD.	TYPE	NO. REQD.
E7	8	F7	4

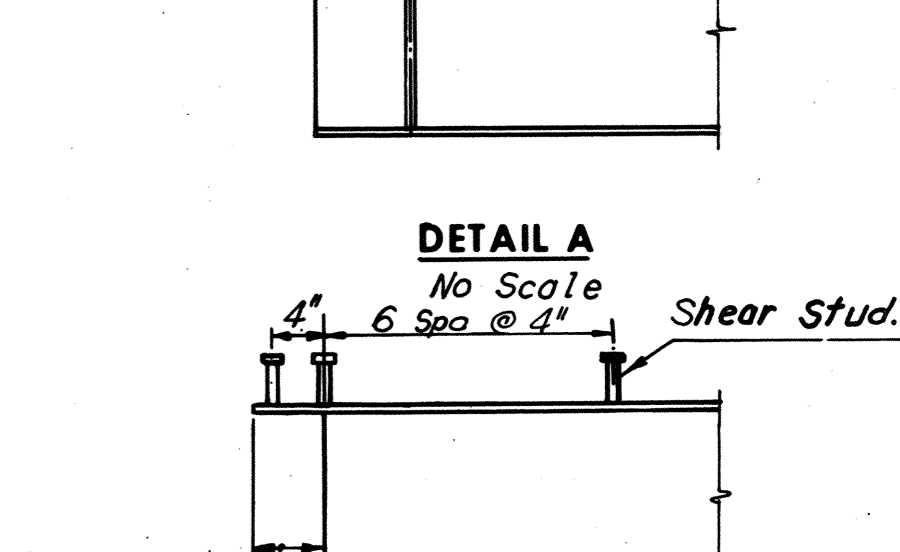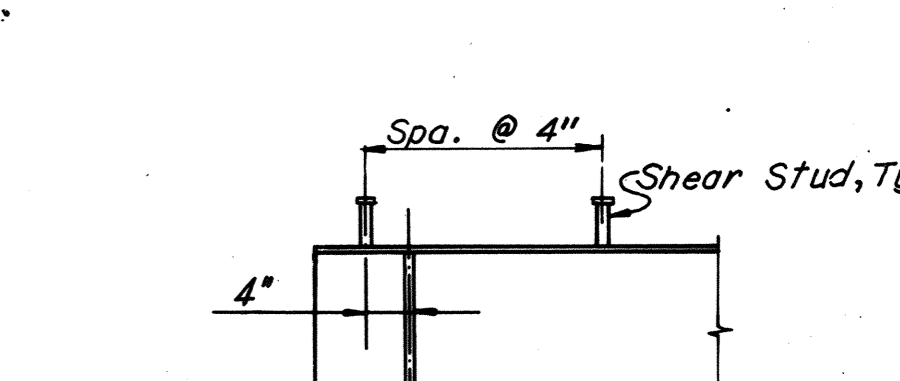

UNIT	STRINGER	STRINGER SCHEDULE												DEAD LOAD DEFLECTION (CONCRETE ONLY)					DEAD LOAD DEFLECTIONS (STEEL ONLY)			CAMBER SCHEDULE					
		Dim. "A"	Dim. "B"	Dim. "C"	Dim. "D"	Dim. "E"	Dim. "F"	Dim. "G"	PL "C"	PL "D"	PL "E"	PL "F"	PL "G"	0.0L-0.1L	0.1L-0.2L	0.2L-0.3L	0.3L-0.4L	0.4L-0.5L	1/4L	1/2L	3/4L	1/4L	1/2L	3/4L			
		LENGTH	Dim. "B"	Dim. "C"	Dim. "D"	Dim. "E"	Dim. "F"	Dim. "G"	PL "C"	PL "D"	PL "E"	PL "F"	PL "G"	MAX. SHEAR STUD SPACING	MAX. SHEAR STUD SPACING	MAX. SHEAR STUD SPACING	MAX. SHEAR STUD SPACING	MAX. SHEAR STUD SPACING	1/4L	1/2L	3/4L	1/4L	1/2L	3/4L			
1	S1-1	110'-0 1/2"	109'-4 3/8"	19'-8 3/8"	19'-8 3/8"	35'-0"	54'-8 3/8"	54'-8 3/8"	-	16x3/8"	16x1 1/8"	12x3/4"	-	16 1/2"	19"	24"	24"	24"	7 3/8"	1 3/8"	7 3/8"	1 3/8"	3 3/8"	1 3/8"	4 1/8"	5 1/2"	4 1/8"
	S2-1	111'-9 3/8"	111'-2 3/8"	20'-4 1/8"	20'-4 1/8"	35'-3"	55'-7 3/8"	55'-7 3/8"	-	16x1 1/8"	16x1 1/8"	12x1 1/8"	-	12 1/2"	15 1/2"	20"	24"	24"	1 1/8"	1 3/8"	1 1/8"	1 3/8"	1 3/8"	1 3/8"	4 1/8"	6 1/8"	4 1/8"
	S3-1	113'-7 1/8"	113'-0 1/8"	20'-3"	20'-3 1/8"	36'-3"	19'-3"	19'-3 1/8"	37'-3"	20x1 1/4"	20x1 1/8"	12x1"	16x1 1/4"	10 1/2"	12 1/2"	16 1/2"	21 1/2"	24"	1 3/8"	1 1/8"	1 3/8"	3 3/8"	1 1/2"	3 3/8"	4 3/8"	6 1/2"	4 3/8"
	S4-1	115'-5 1/8"	114'-9 1/8"	20'-7 3/8"	20'-7 3/8"	36'-9"	20'-7 3/8"	20'-7 3/8"	36'-9"	20x1 1/2"	24x1 1/2"	16x1"	20x1 1/4"	8 1/2"	10"	14"	19 1/2"	24"	1 3/8"	1 3/8"	1 3/8"	3 3/8"	3 3/8"	3 3/8"	4 3/8"	6 1/2"	4 3/8"
2	S1-2	109'-8 1/8"	108'-4 1/8"	21'-2"	21'-2 1/8"	33'-0"	54'-2"	54'-2 1/8"	-	12x1 1/8"	16x1 1/4"	12x3/4"	-	16"	18 1/2"	24"	24"	24"	7 3/8"	1 3/8"	7 3/8"	1 3/8"	3 3/8"	1 3/8"	1 3/8"	1 3/8"	1 3/8"
	S2-2	111'-3 1/8"	110'-1 1/8"	21'-9 3/8"	21'-9 3/8"	33'-3"	55'-0 3/8"	55'-0 3/8"	-	16x1"	16x1 3/8"	12x1"	-	12 1/2"	15 1/2"	19 1/2"	24"	24"	1 3/8"	1 1/8"	1 3/8"	1 3/8"	1 3/8"	1 3/8"	1 3/8"	2 3/8"	1 3/8"
	S3-2	113'-0 1/8"	111'-10 1/8"	22'-2 1/8"	22'-2 1/8"	33'-9"	22'-2 1/8"	22'-2 1/8"	33'-9"	20x1"	20x1 1/8"	12x3/4"	16x1"	10"	12 1/2"	16 1/2"	21 1/2"	24"	1 3/8"	1 1/8"	1 3/8"	3 3/8"	1 1/2"	3 3/8"	2 3/8"	2 1/8"	1 3/8"
	S4-2	114'-11 1/8"	113'-7 1/8"	22'-6 3/8"	22'-6 3/8"	34'-3"	22'-6 3/8"	22'-6 3/8"	34'-3"	20x1 1/4"	20x1 1/8"	16x3/4"	16x1 1/4"	8 1/2"	10"	14"	19 1/2"	24"	1 1/2"	2 1/8"	1 1/2"	3 3/8"	1 1/2"	3 3/8"	2 3/8"	2 3/8"	2"

Notes:
 * Spacing begins at termination of 6 spaces @ 4".
 † Denotes A572-Grade 50 steel for thicknesses of 1/2" and under and A588 steel for thicknesses over 1/2".
 All steel shall be A36 unless otherwise shown.
 Exterior stringer longitudinal stiffeners shall be located on the exterior face of the stringer.
 Intermediate stiffener plates shall be equally spaced between diaphragms as shown. The first two stiffener spaces at the ends of stringers shall be one-half the normal spacing within the panel.
 All intermediate stiffeners shall be R5x3".

RICHMOND METROPOLITAN AUTHORITY
RICHMOND EXPRESSWAY SYSTEM
DOWNTOWN EXPRESSWAY


BRIDGE NO. 67
 RAMP W-N CONNECTION TO
 RICHMOND-PETERSBURG TURNPIKE

FRAMING PLAN - UNITS 1 AND 2

HOWARD, NEEDLES, TAMMEN & BERGENDOFF
 consulting engineers
 NEW YORK ALEXANDRIA KANSAS CITY

SCALE: As Noted
 CONTRACT NO.: 10
 SHEET NO. 19 of 54

AS BUILT

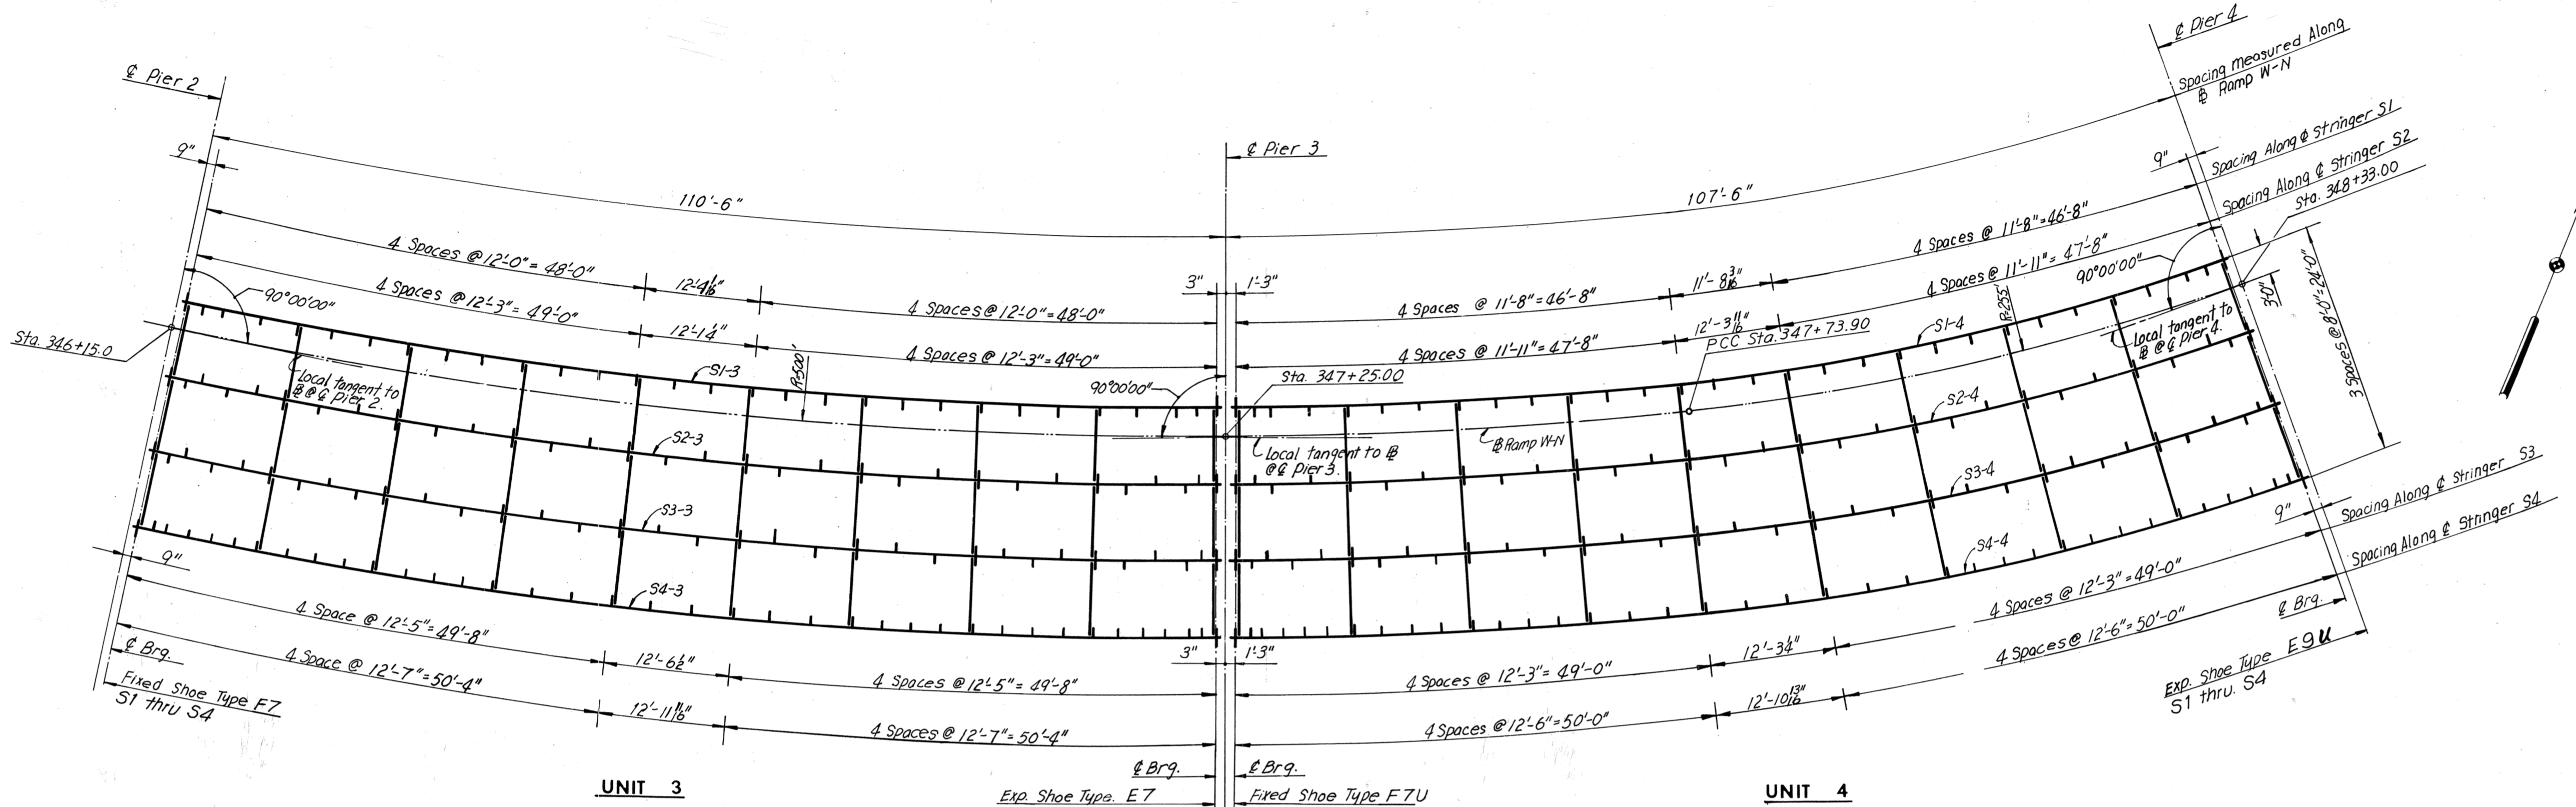


Note: For size of bearing stiffeners located on the outside face of exterior stringers see Sheet 29.

UNIT 3

UNIT 4


***** A572 - Grade 50 steel type, except for A36 steel for stringers-S1-3 and S1-4

FRAMING PLAN
Scale: 1" = 10'-0"

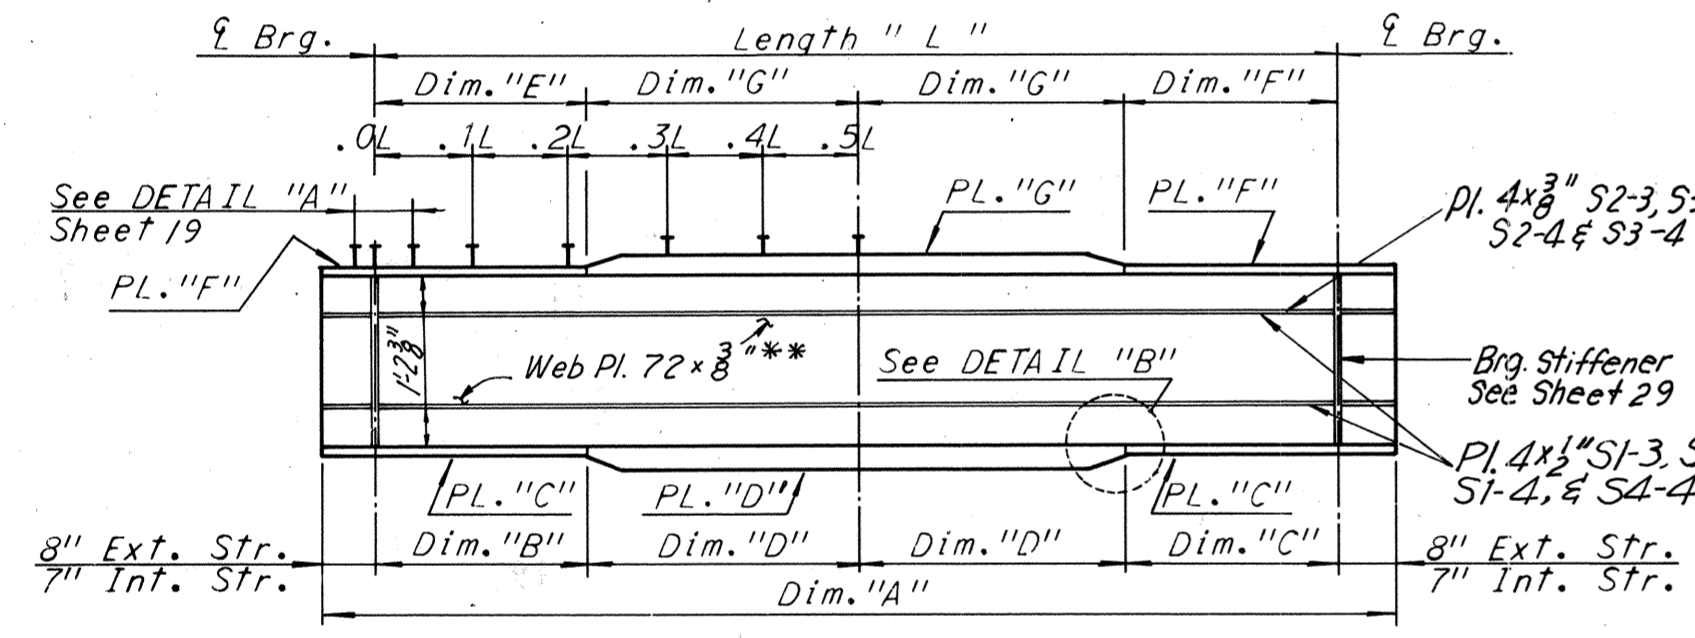


STRINGER ELEVATION
No Scale


Note: All horizontal dimensions are measured along \bar{x} Web.
Notes:
All steel shall be A36 unless otherwise shown.
Exterior stringer longitudinal stiffeners shall be located on the exterior face of the stringer.
Intermediate stiffener plates shall be equally spaced between diaphragms as shown.
The first two stiffener spaces at the ends of stringers shall be one-half the normal spacing within the panel.
All intermediate stiffeners shall be of $R25 \times 3\frac{1}{2}$.

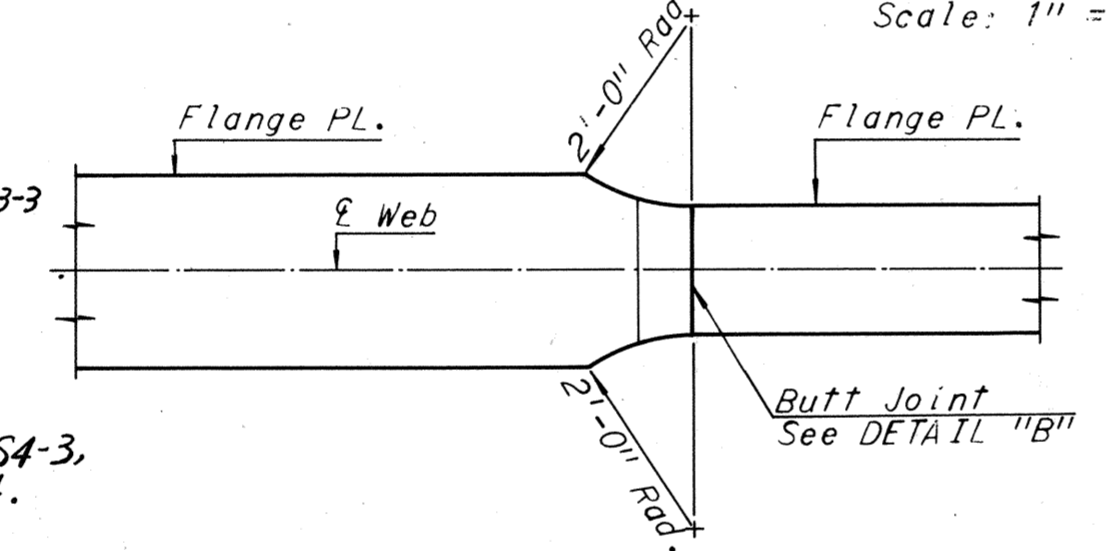

FLANGE PLATE SPLICE DETAIL
No Scale

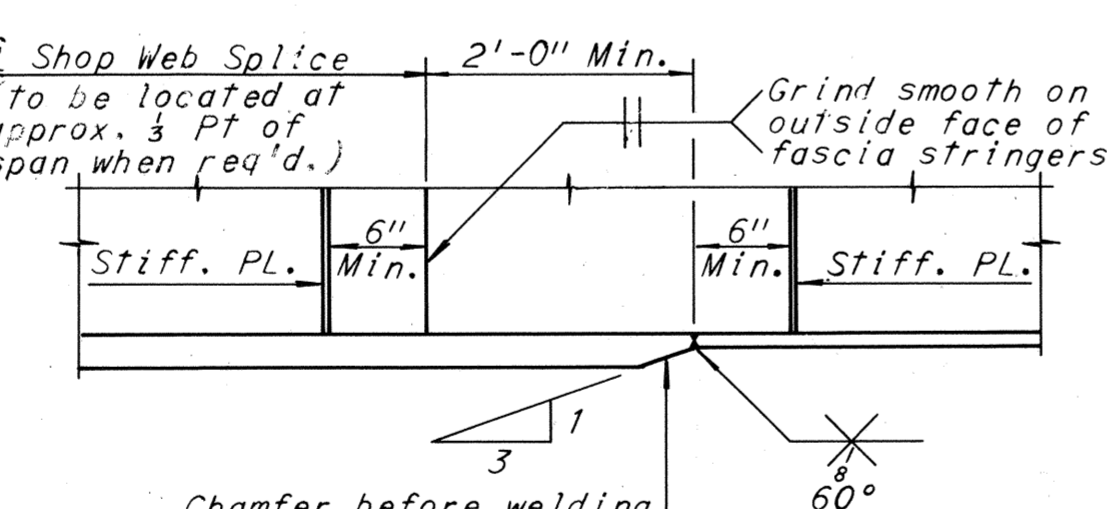


DETAIL "B"
No Scale

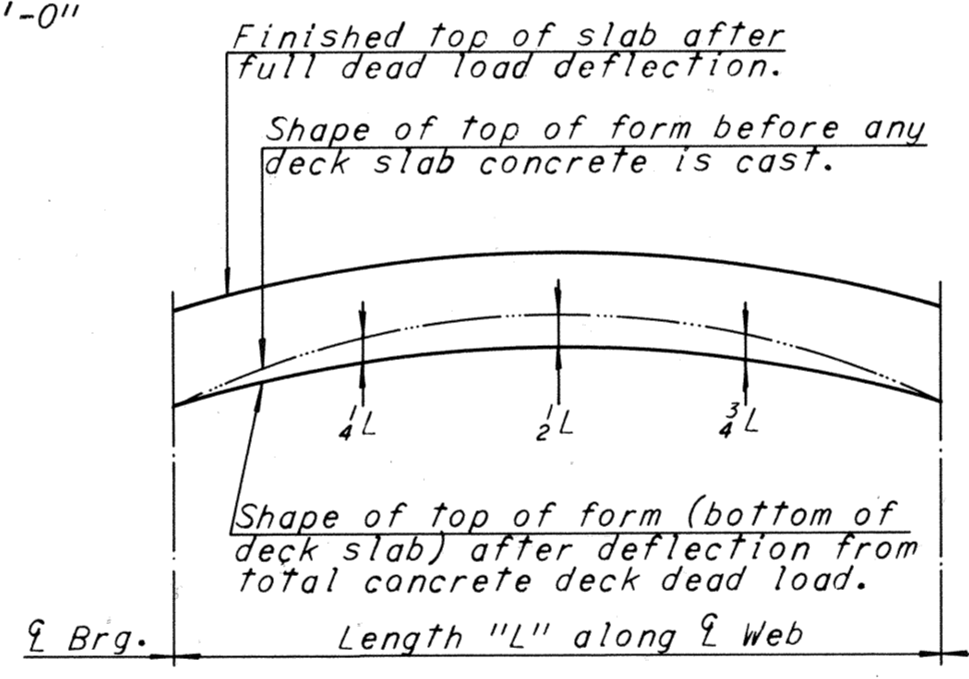

DEAD LOAD DEFLECTION DIAGRAM

NOTE TO CONTRACTOR


Deflections given are those anticipated to occur in the stringer upon placement of the total concrete deck dead load.
In practice, the stringers in place are not likely to have the exact camber to compensate for these deflections during construction. The residual amounts shall be provided by adjusting forms to vary the thickness of the concrete haunch between the bottom of the slab and the top of stringer without altering the slab thickness.

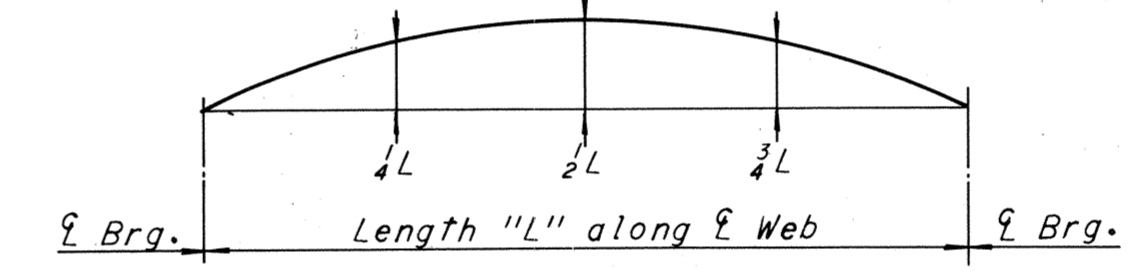

CAMBER DIAGRAM

NOTE TO FABRICATOR

The stringers shall be fabricated with an upward camber amounting to the tabulated value. This will provide approximate compensation for deflection under full dead load and for conformity with finished grade.

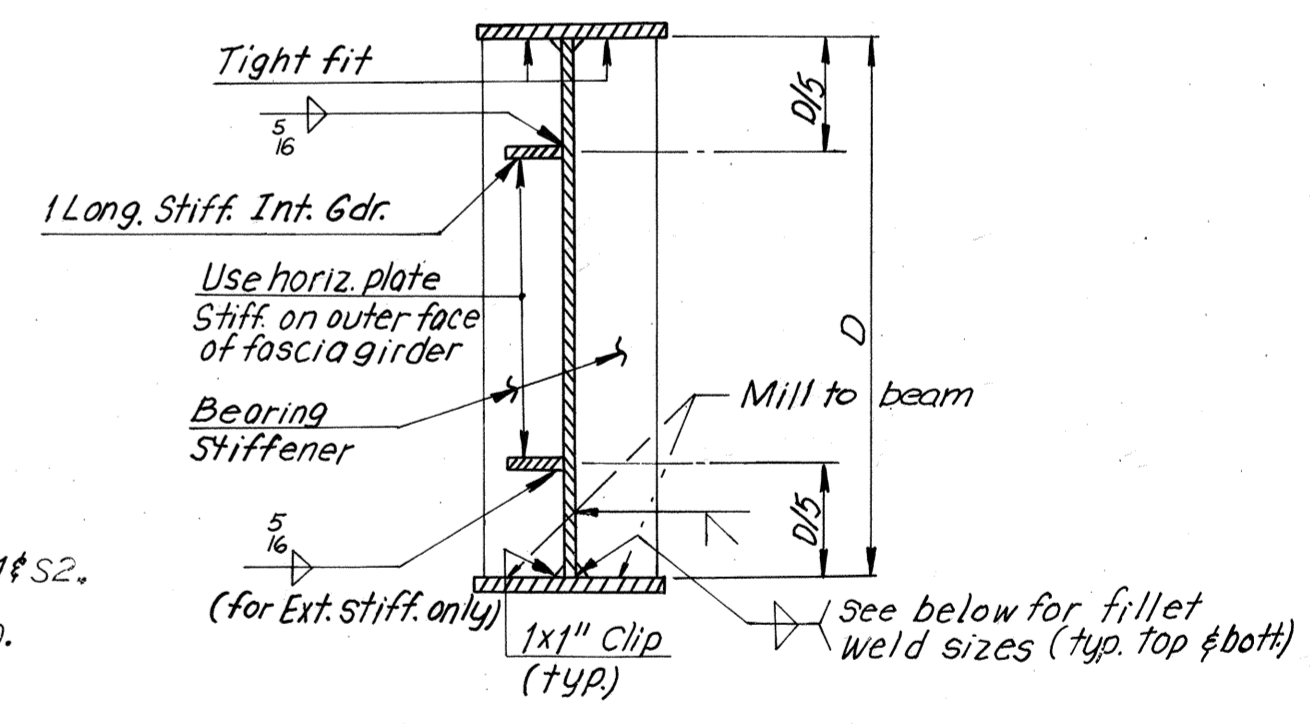

WEB TO FLANGE WELDS AND LONGITUDINAL STIFFENER WELD DETAILS

Note: Minus (-) sign in camber denotes downward camber.

Note: Web to flange weld size shall be determined by flange thickness as follows:
over 1/2" to 1 1/2"..... 5/8" weld
over 1 1/2" to 2 1/4"..... 3/4" weld

UNIT	STRINGER	Dim. "A"	LENGTH "L"	Dim. "B"	Dim. "C"	Dim. "D"	Dim. "E"	Dim. "F"	Dim. "G"	PL. "C"	PL. "D"	PL. "F"	PL. "G"	MAX. SHEAR STUD SPACING					DEAD LOAD DEFLECTIONS (STEEL ONLY)			CAMBER SCHEDULE						
														DEAD LOAD DEFLECTION (CONCRETE ONLY)					1/4L	1/2L	3/4L	1/4L	1/2L	3/4L				
														0.0L-0.1L	0.1L-0.2L	0.2L-0.3L	0.3L-0.4L	0.4L-0.5L							1/4L	1/2L	3/4L	
3	S1-3	109'-8 1/8"	108'-4 1/8"	21'-2"	21'-2 1/2"	33'-0"	54'-2"	54'-2 1/2"	-	12x1 1/2"	16x1 1/4"	12x 3/4"	-	16 1/2"	18 1/2"	24"	24"	24"	7/8"	1 1/4"	7/8"	1/8"	3/8"	1/8"	5/8"	5/8"	-3/8"	
	S2-3	111'-3 1/4"	110'-1 1/4"	21'-9 3/4"	21'-9 3/4"	33'-3"	55'-0 3/8"	55'-0 3/8"	-	16x1 1/2"	16x1 3/8"	12x1 1/2"	-	12 1/2"	15 1/2"	19 1/2"	24"	24"	1 1/4"	1 1/8"	1 1/4"	1/4"	3/8"	1/4"	1 1/4"	1 1/4"	5/8"	
	S3-3	113'-0 1/2"	111'-10 1/2"	22'-2 1/4"	22'-2 1/4"	33'-9"	22'-2 1/4"	22'-2 1/4"	33'-9"	20x1 1/4"	20x1 3/8"	12x 3/4"	16x1 1/4"	10"	12 1/2"	16 1/2"	21 1/2"	24"	1 3/8"	1 5/8"	1 3/8"	3/8"	1/2"	3/8"	1 3/4"	1 3/8"	9/8"	
	S4-3	114'-11 1/8"	113'-7 1/8"	22'-6 3/4"	22'-6 3/4"	34'-3"	22'-6 3/4"	22'-6 3/4"	34'-3"	20x1 1/4"	20x1 3/8"	16x 3/4"	16x1 1/4"	8 1/2"	10"	14"	19 1/2"	24"	1 1/2"	2 1/4"	1 1/2"	3/8"	1/2"	3/8"	1 1/2"	1 1/8"	1 1/2"	
4	S1-4	106'-4 3/8"	105'-0 3/8"	20'-9 1/4"	20'-9 1/4"	31'-9"	51'-9 1/4"	51'-9 1/4"	-	12x1 1/2"	16x1 1/4"	12x 3/4"	-	16 1/2"	18 1/2"	24"	24"	24"	1 1/8"	1 3/8"	1 1/8"	1/2"	3/8"	1/2"	3/8"	-4 1/8"	-6 3/8"	-4 1/8"
	S2-4	108'-9 1/8"	107'-7 1/8"	21'-0 3/4"	21'-0 3/4"	32'-9"	53'-9 1/8"	53'-9 1/8"	-	16x1 1/2"	16x1 3/8"	12x1 1/2"	-	13"	15 1/2"	19 1/2"	24"	24"	1 1/2"	1 7/8"	1 1/2"	3/8"	1/2"	3/8"	-4 1/4"	-5 3/8"	-4 1/4"	
	S3-4	111'-5 1/4"	110'-3 1/4"	21'-7 3/4"	21'-7 3/4"	33'-6"	21'-7 3/4"	21'-7 3/4"	33'-6"	20x1 1/4"	20x1 3/8"	16x 3/4"	16x1 1/4"	10"	12 1/2"	16"	20 1/2"	24"	1 3/8"	1 5/8"	1 3/8"	3/8"	1/2"	3/8"	-4 3/8"	-5 1/8"	-4 1/8"	
	S4-4	114'-2 1/8"	112'-10 1/8"	21'-8 3/4"	21'-8 3/4"	34'-9"	21'-8 3/4"	21'-8 3/4"	34'-9"	20x1 1/4"	24x1 3/8"	16x1 1/4"	20x1 1/2"	8"	9 1/2"	13"	18"	24"	1 1/4"	1 1/2"	1 1/4"	3/8"	1/2"	3/8"	-4 1/8"	-5 1/4"	-3 7/8"	

* Spacing begins at termination of 6 spaces @ 4".

* Denotes A572-Grade 50 steel for thickness of 3/8" and under and A588 steel for thickness over 3/8".

Note: Shear lug spacing as shown is typical for both halves of the stringer.

BY	DATE	Shops Revised, Camber & Note Added	LRH	4-19-77
MADE	G.S.H.	Dead Load Defl. Steel Added	REJ	11-14-74
CHECKED	R.T.A.	As Built	TEM	6-77
IN CHARGE	NO.	REVISION	BY	DATE


AS BUILT

RICHMOND METROPOLITAN AUTHORITY
RICHMOND EXPRESSWAY SYSTEM
DOWNTOWN EXPRESSWAY

BRIDGE NO. 67
 RAMP W-N CONNECTION TO
 RICHMOND-PETERSBURG TURNPIKE
FRAMING PLAN-UNITS 3 AND 4

SCALE: As Noted
 HOWARD, NEEDLES, TAMMEN & BERGENDOFF
 consulting engineers
 NEW YORK ALEXANDRIA KANSAS CITY
 CONTRACT NO. 10
 SHEET NO. 20 OF 54

SHOE SCHEDULE			
EXPANSION SHOES		FIXED SHOES	
TYPE	NO. REQD.	TYPE	NO. REQD.
E8U	4	F7U	8
E9U	4		

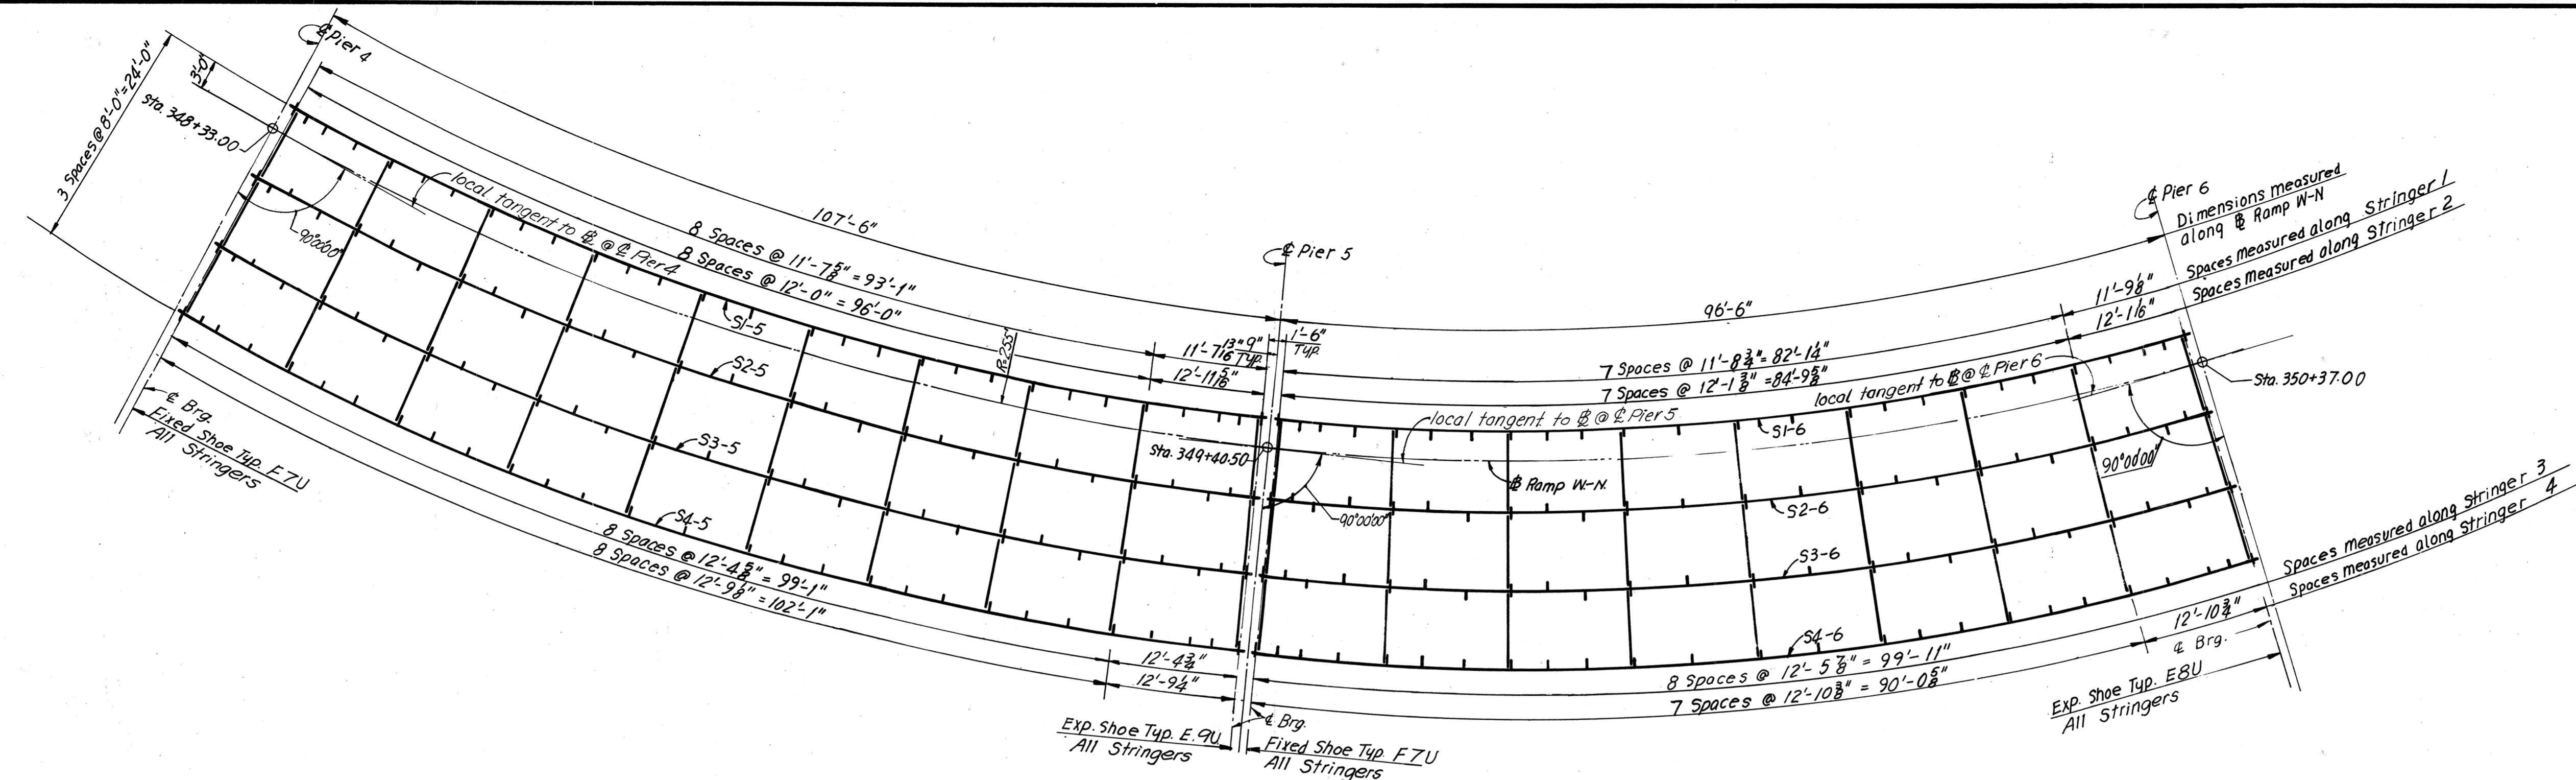


UNIT 5

UNIT 6

Note: For size of bearing stiffeners located on the outside face of exterior stringers see Sheet 29.

** A572 - Grade 50 steel typ. except for A36 steel for stringers S1-5 and S1-6

FRAMING PLAN
Scale 1" = 10'-0"

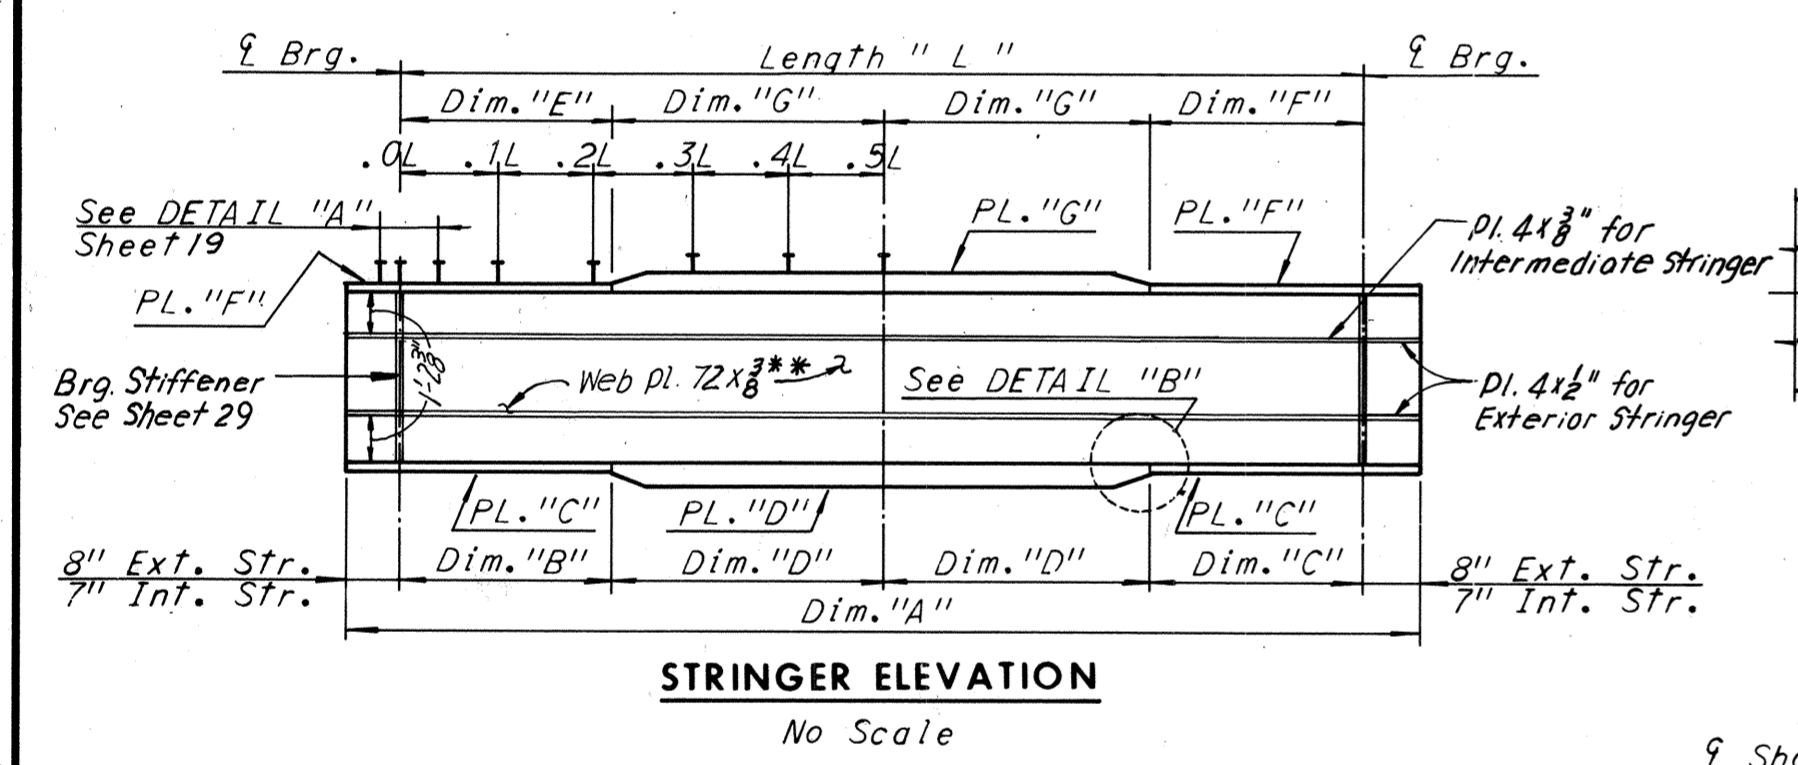


STRINGER ELEVATION

No Scale


Note: All horizontal dimensions are measured along \bar{L} Web.

Notes:
All steel shall be A36 unless otherwise shown.
Exterior stringer longitudinal stiffeners shall be located on the exterior face of the stringer.
Intermediate stiffener plates shall be equally spaced between diaphragms as shown.
The first two stiffener spaces at the ends of stringers shall be one-half the normal spacing within the panel.
All intermediate stiffeners shall be of $\bar{R} 5 \times \bar{3}$.

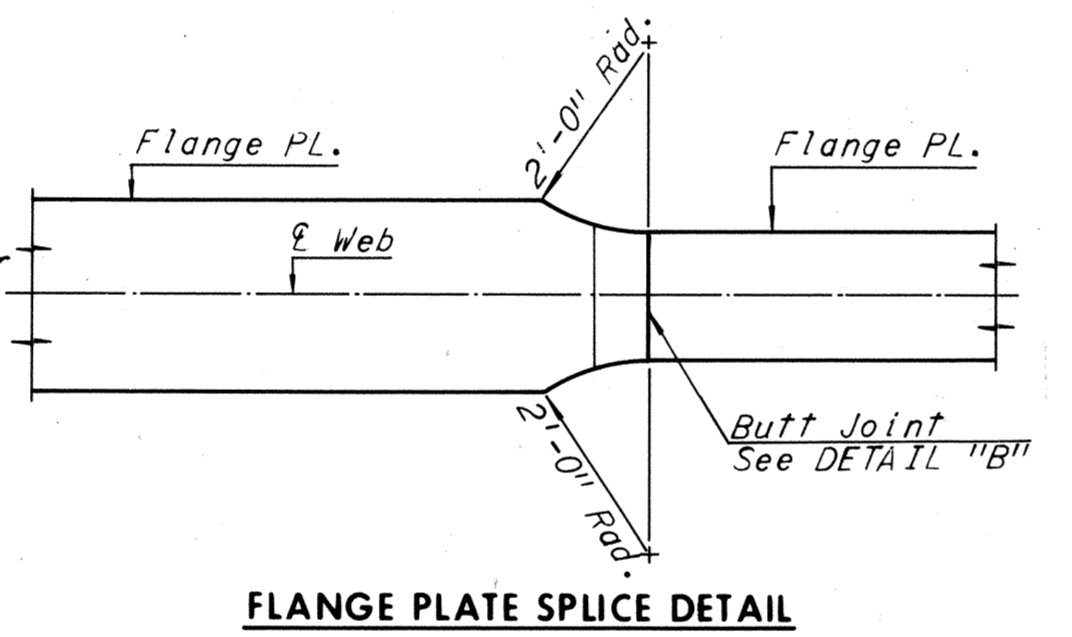


FLANGE PLATE SPICE DETAIL

No Scale

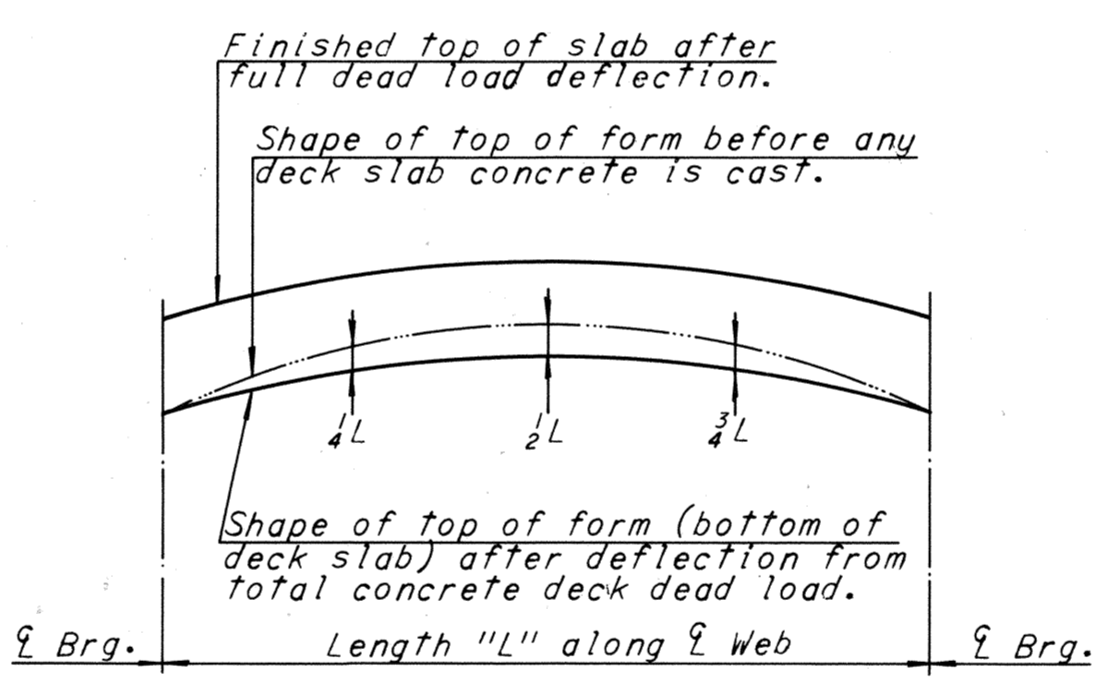

DEAD LOAD DEFLECTION DIAGRAM

Note:
Falsework supports will be required under Units 5 and 6 until all stringers and tie-down bearings are in place.

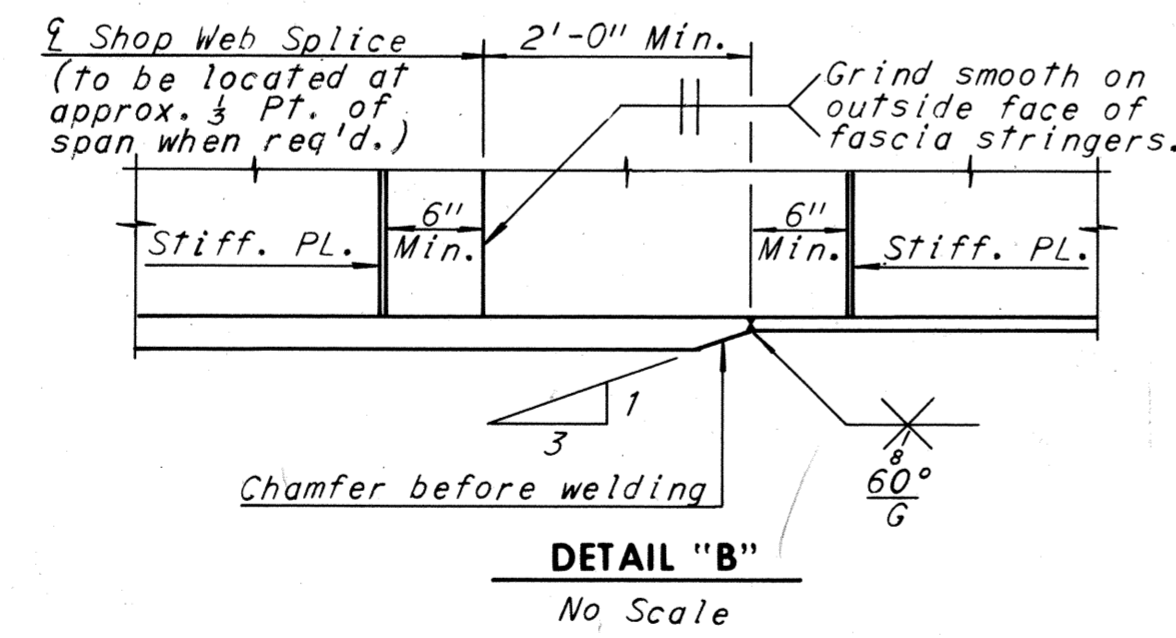

DETAIL "B"

No Scale

NOTE TO CONTRACTOR

Deflections given are those anticipated to occur in the stringer upon placement of the total concrete deck dead load.
In practice, the stringers in place are not likely to have the exact camber to compensate for these deflections during construction. The residual amounts shall be provided by adjusting forms to vary the thickness of the concrete haunch between the bottom of the slab and the top of stringer without altering the slab thickness.

Note:
Minus (-) sign in camber denotes downward camber

UNIT	STRINGER	Dim. "A"	LENGTH	Dim. "B"	Dim. "C"	Dim. "D"	Dim. "E"	Dim. "F"	Dim. "G"	PL. "C"	PL. "D"	PL. "F"	PL. "G"	MAX. SHEAR STUD SPACING					DEAD LOAD DEFLECTION (CONCRETE ONLY)			DEAD LOAD DEFLECTIONS (STEEL ONLY)			CAMBER SCHEDULE			
														0.0L-0.1L	0.1L-0.2L	0.2L-0.3L	0.3L-0.4L	0.4L-0.5L	1/4	1/2	3/4	1/4	1/2	3/4	1/4	1/2	3/4	
														0.0L-0.1L	0.1L-0.2L	0.2L-0.3L	0.3L-0.4L	0.4L-0.5L	1/4	1/2	3/4	1/4	1/2	3/4	1/4	1/2	3/4	
5	S1-5	106'-0 1/2"	104'-8 1/2"	52'-4 1/2"	52'-4 3/4"	—	52'-4 3/4"	52'-4 3/8"	—	12x3/4"	—	12x3/4"	—	22 1/2"	24"	24"	24"	24"	24"	7 1/2"	9 1/2"	7 1/2"	1/8"	3/8"	1/8"	-5 1/8"	-6 1/4"	-5 1/8"
	S2-5	109'-3 3/8"	108'-1 1/2"	21'-3 3/8"	21'-3 3/8"	32'-9"	54'-0 1/8"	54'-0 3/8"	—	16x1 1/4"	16x1 1/4"	16x1 1/4"	—	13 1/2"	16 1/2"	20 1/2"	24"	24"	1 1/2"	1 1/2"	1 1/2"	1/4"	3/8"	1/4"	-4 3/8"	-5 1/2"	-4 3/8"	
	S3-5	112'-7 3/4"	111'-5 3/4"	22'-2 3/4"	22'-2 3/4"	33'-6"	22'-2 3/4"	22'-2 3/4"	33'-6"	20x1 1/4"	20x1 1/4"	16x1 1/4"	16x1 1/4"	9 1/2"	12"	16"	20 1/2"	24"	1 1/4"	1 1/2"	1 1/4"	5/8"	1/2"	5/8"	-3 7/8"	-5 1/2"	-3 7/8"	
	S4-5	116'-2 1/2"	114'-10 1/4"	22'-8 1/2"	22'-8 1/2"	34'-9"	22'-8 1/2"	22'-8 1/2"	34'-9"	20x1 1/4"	24x1 1/4"	16x1 1/4"	20x1 1/2"	7 1/2"	9 1/2"	13"	18"	24"	1 1/2"	2"	1 1/2"	5/8"	5/8"	5/8"	-3 3/8"	-4 3/8"	-3 3/8"	
6	S1-6	95'-2 3/8"	93'-10 3/8"	46'-11 1/4"	46'-11 1/4"	0	45'-11 1/4"	45'-11 1/4"	—	12x1 1/4"	—	12x3/4"	—	20"	23 1/2"	24"	24"	24"	3 3/8"	9 1/2"	3 3/8"	1/8"	1 1/8"	1/8"	1 1/8"	1 1/8"	1 1/8"	1 1/8"
	S2-6	98'-0 1/2"	96'-10 1/2"	19'-2 3/8"	19'-2 3/8"	29'-3"	48'-5 3/8"	48'-5 3/8"	—	12x1 1/4"	12x1 1/4"	12x3/4"	—	13 1/2"	16 1/2"	19 1/2"	24"	24"	1 3/8"	1 3/8"	1 3/8"	1/8"	3/8"	1/8"	1 3/8"	1 3/8"	1 3/8"	
	S3-6	101'-1 1/2"	99'-11 1/2"	20'-2 1/2"	20'-2 1/2"	29'-9"	49'-11 1/2"	49'-11 1/2"	—	16x1 1/4"	20x1 1/4"	16x3/4"	—	10"	12"	16"	20"	24"	1"	1 3/8"	1"	1/4"	5/8"	1/4"	1 1/8"	1 3/8"	1 1/4"	
	S4-6	104'-3 3/8"	102'-11 3/8"	20'-8 1/8"	20'-8 1/8"	30'-9"	20'-8 1/8"	20'-8 1/8"	30'-9"	20x1 1/4"	20x1 1/4"	16x3/4"	16x1 1/4"	8"	9 1/2"	13"	17 1/2"	24"	1 3/8"	1 3/8"	1 3/8"	5/8"	5/8"	5/8"	1 3/8"	2"	1 1/2"	

BY	DATE	Notes added, shoe Revision, Camber	LRH	4-19-74
MADE	GSH	08-16-68	REB	11-14-74
CHECKED	SCC	10-21-68	TEM	6-77
IN CHARGE	NO.	REVISION	BY	DATE

Note: Shear lug spacing as shown is typical for both halves of the stringer.

* Spacing begins at termination of 6 spaces @ 4".
Denotes A572-Grade 50 steel for thickness of 3/4" and under and A588 steel for thickness over 3/4"

Notes:
For Standard Shoe details see Sheets S1 S2.
For Deck Plan see, Sheet 31.
For Details of diaphragms, see Sheet 31.
For Joint details, see Sheet 49.
For Web to Flange Weld size, see note, Sheet 20.


AS BUILT

RICHMOND METROPOLITAN AUTHORITY
RICHMOND EXPRESSWAY SYSTEM
DOWNTOWN EXPRESSWAY


BRIDGE NO. 67
RAMP W-N CONNECTION TO
RICHMOND-PETERSBURG TURNPIKE
FRAMING PLAN - UNITS 5 AND 6

HOWARD, NEEDLES, TAMMEN & BERGENDOFF
consulting engineers
NEW YORK ALEXANDRIA KANSAS CITY


SCALE: As Noted
CONTRACT NO.: 10
SHEET NO. 21 OF 54

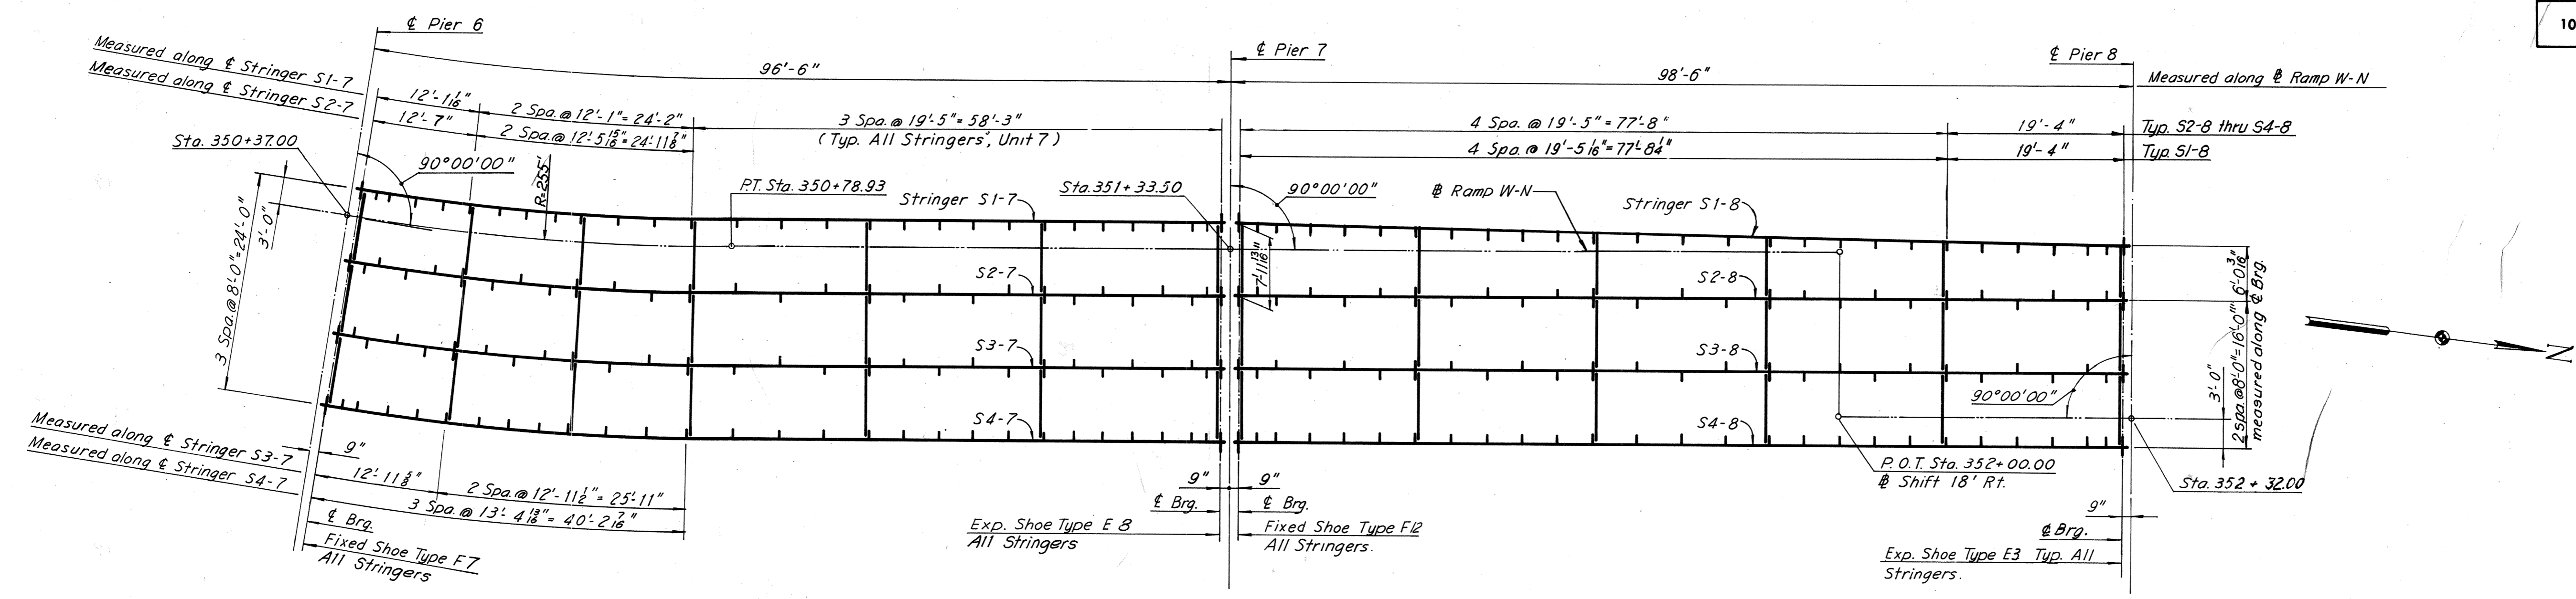


FRAMING PLAN
Scale: 1" = 10'-0"

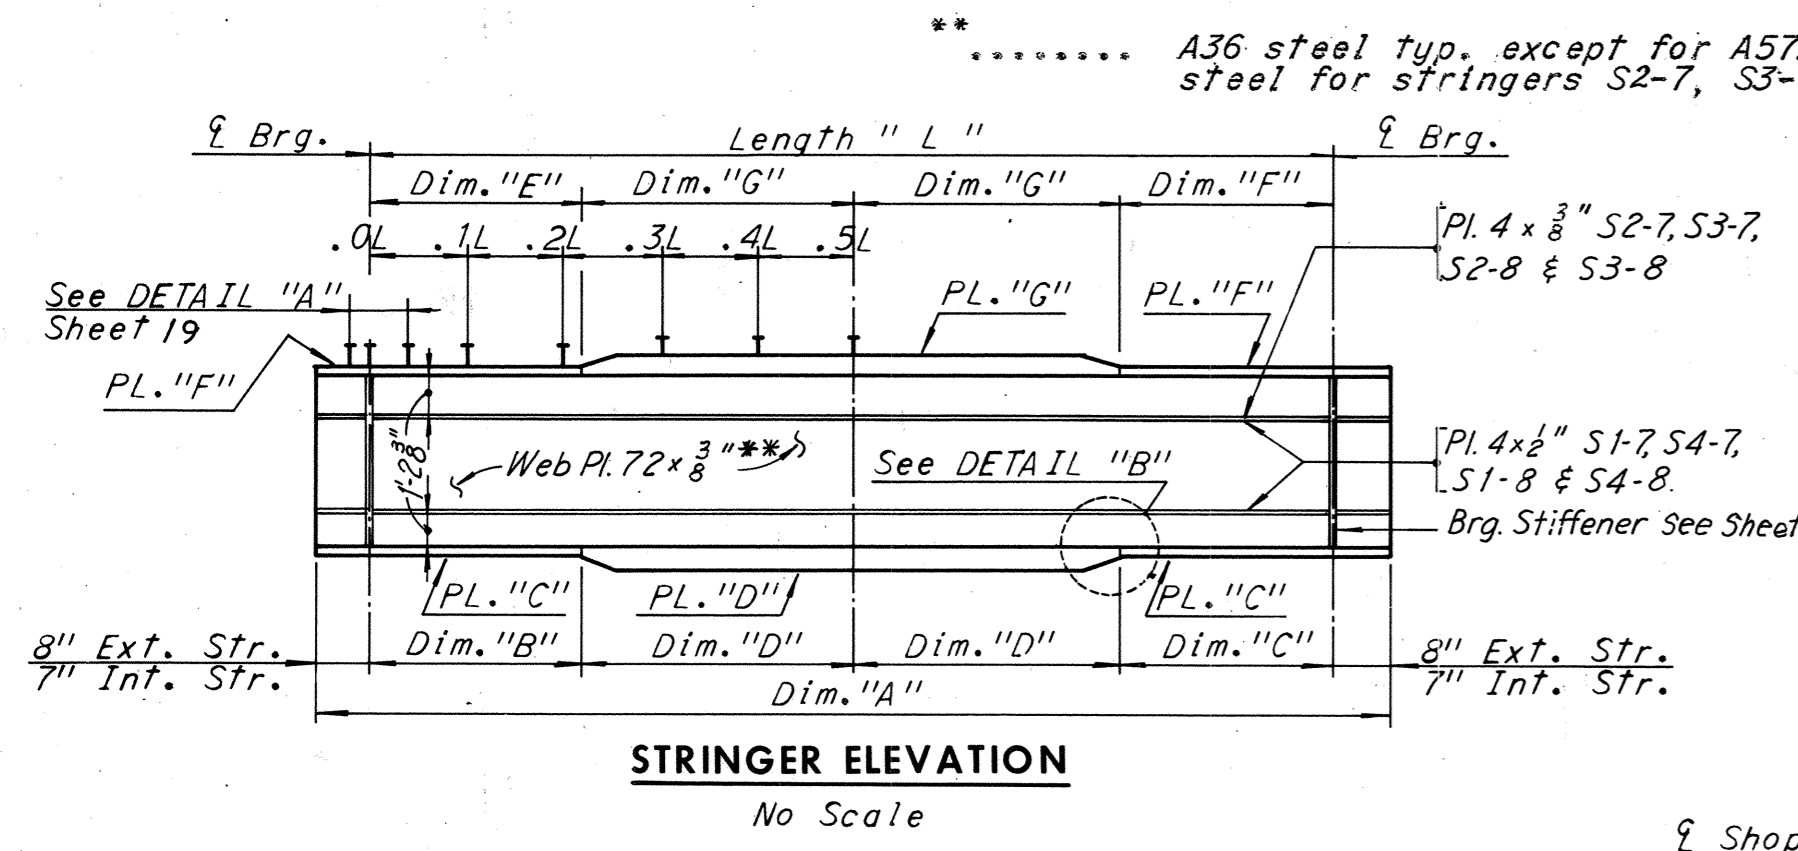


STRINGER ELEVATION
No Scale

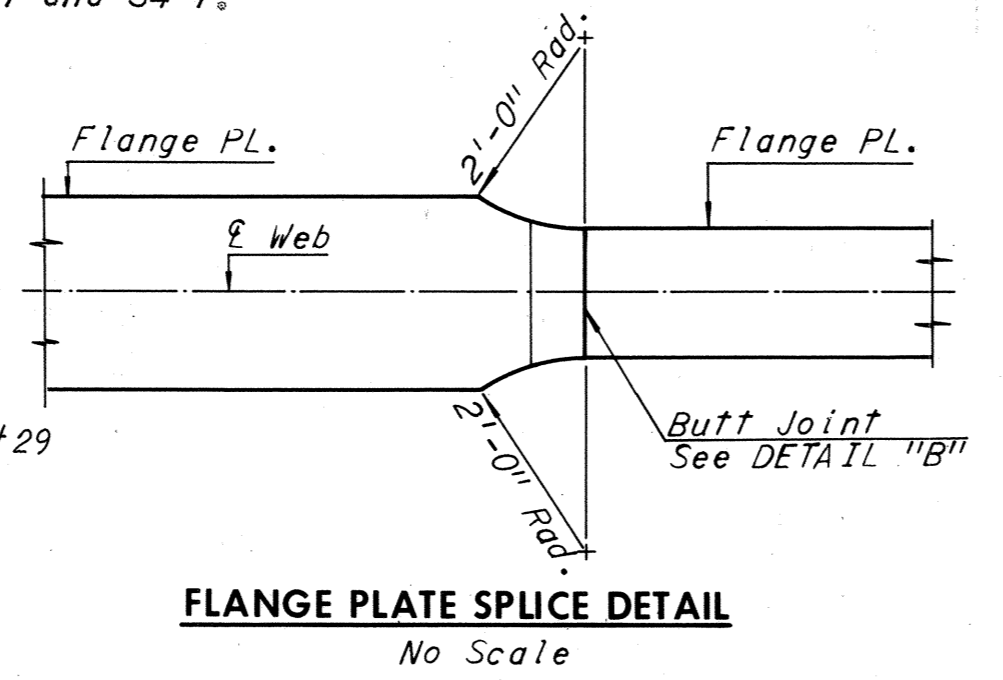

FLANGE PLATE SPICE DETAIL
No Scale

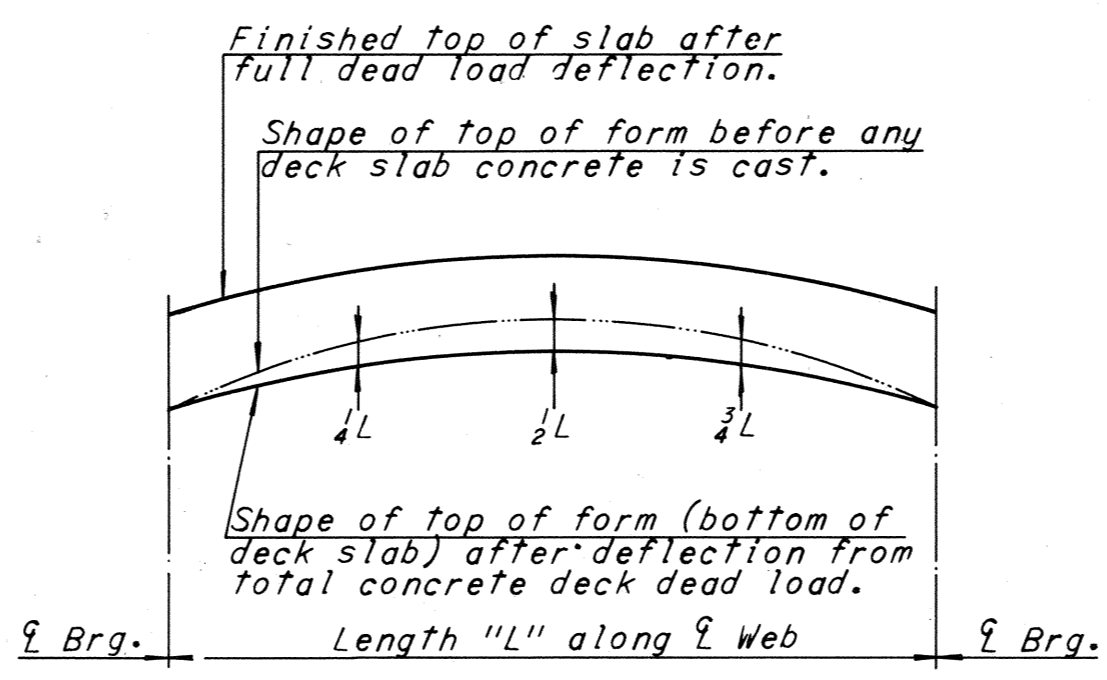

DEAD LOAD DEFLECTION DIAGRAM

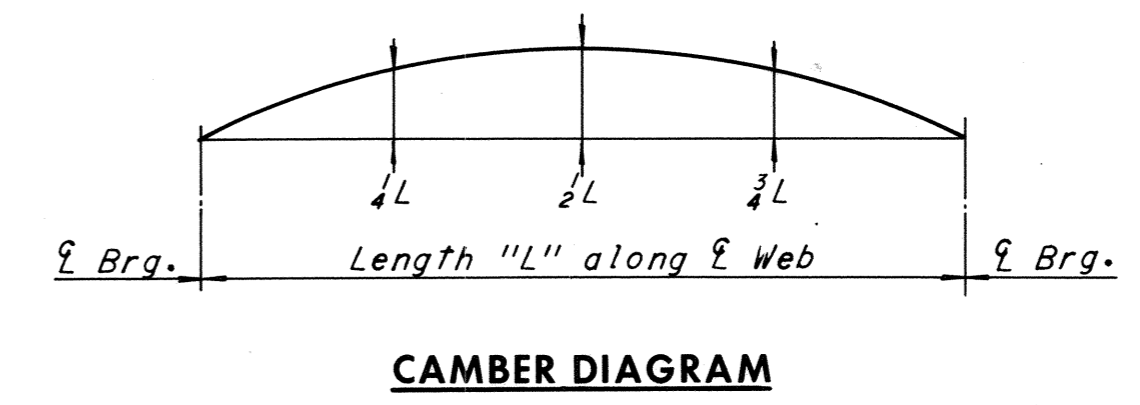

CAMBER DIAGRAM

NOTE TO CONTRACTOR
Deflections given are those anticipated to occur in the stringer upon placement of the total concrete deck dead load.
In practice, the stringers in place are not likely to have the exact camber to compensate for these deflections during construction. The residual amounts shall be provided by adjusting forms to vary the thickness of the concrete haunch between the bottom of the slab and the top of stringer without altering the slab thickness.

NOTE TO FABRICATOR
The stringers shall be fabricated with an upward camber amounting to the tabulated value. This will provide approximate compensation for deflection under full dead load and for conformity with finished grade.

SHOE SCHEDULE			
EXPANSION SHOES		FIXED SHOES	
TYPE	NO. REQD.	TYPE	NO. REQD.
E3	4	F7	4
E8	4	F12	4

Notes:
All steel shall be A36 steel unless denoted otherwise.
Exterior stringer longitudinal stiffeners shall be located on the exterior face of the stringer.
Intermediate stiffener plates shall be equally spaced between diaphragms as shown.
The first two stiffener spaces at the ends of stringers shall be one-half the normal spacing within the panel.
All intermediate stiffeners shall be of $\phi 5 \times 3/8$.

Note: For size of bearing stiffeners located on the outside face of exterior stringers see Sheet 29.

UNIT	STRINGER	Dim. "A"	LENGTH	Dim. "B"	Dim. "C"	Dim. "D"	Dim. "E"	Dim. "F"	Dim. "G"	PL. "C"	PL. "D"	PL. "F"	PL. "G"	DEAD LOAD DEFLECTION (CONCRETE ONLY)				DEAD LOAD DEFLECTIONS (STEEL ONLY)			CAMBER SCHEDULE					
														0.0L-0.1L	0.1L-0.2L	0.2L-0.3L	0.3L-0.4L	0.4L-0.5L	1/4L	1/2L	3/4L	1/4L	1/2L	3/4L		
7	S1-7	95'-10 1/2"	94'-6 1/2"	18'-9"	18'-9 1/2"	28'-6"	47'-3"	47'-3 1/2"	-	12x1 1/4"	16x1 1/4"	12x 3/4"	-	15 1/2"	18"	23"	24"	24"	5 3/8"	7 1/8"	9"	1 1/8"	3 1/8"	1 1/8"	1 1/8"	1 1/8"
	S2-7	96'-11 1/2"	95'-9 1/2"	18'-7 1/2"	18'-7 1/2"	29'-3"	47'-10 1/2"	47'-10 1/2"	-	16x1 1/4"	16x1 1/4"	12x 3/4"	-	13 1/2"	16 1/2"	20 1/2"	24"	24"	3 3/4"	1 1/4"	3 1/4"	1 1/8"	2"	1 1/8"	1 1/8"	
	S3-7	98'-3 1/2"	97'-1 1/2"	18'-9 1/2"	18'-9 1/2"	29'-9"	48'-6 1/2"	48'-6 1/2"	-	16x1 1/4"	20x1 1/4"	16x 3/4"	-	9 1/2"	12"	16"	20"	24"	13 1/8"	1 1/8"	13 1/8"	3 1/8"	1 1/8"	2 1/8"	2"	
	S4-7	99'-9 1/2"	98'-5 1/2"	18'-5 1/2"	18'-5 1/2"	30'-9"	48'-5 1/2"	48'-5 1/2"	30'-9"	20x1 1/4"	20x1 1/4"	16x 3/4"	16x1 1/4"	7 1/2"	9 1/2"	13"	17 1/2"	24"	3 1/4"	1 1/4"	3 1/4"	1 1/8"	1 1/8"	1 1/8"	1 1/8"	
8	S1-8	98'-4 1/2"	97'-0 1/2"	19'-0 1/2"	19'-0 1/2"	29'-6"	48'-6 1/2"	48'-6 1/2"	-	12x1 1/4"	12x1 1/4"	12x 3/4"	-	10 1/2"	12"	16 1/2"	24"	24"	7 3/8"	1 3/8"	7 3/8"	3 1/4"	1 1/4"	3 1/4"	1 1/8"	2 1/8"
	S2-8	98'-2"	97'-0"	18'-6"	18'-6"	-	48'-6"	48'-6"	-	12x1 1/4"	-	12x 3/4"	-	11 1/2"	13 1/2"	18"	23"	24"	7 1/8"	1 1/8"	7 1/8"	3 1/8"	1 1/8"	3 1/8"	2 1/8"	
	S3-8	98'-2"	97'-0"	18'-6"	18'-6"	-	48'-6"	48'-6"	-	12x1 1/4"	-	12x 3/4"	-	11 1/2"	13 1/2"	18"	23"	24"	7 1/8"	1 1/8"	7 1/8"	3 1/8"	1 1/8"	3 1/8"	2 1/8"	
	S4-8	98'-4 1/2"	97'-0 1/2"	19'-0 1/2"	19'-0 1/2"	29'-6"	48'-6 1/2"	48'-6 1/2"	-	12x1 1/4"	12x1 1/4"	12x 3/4"	-	10 1/2"	12"	16 1/2"	24"	24"	7 3/8"	1 3/8"	7 3/8"	3 1/4"	1 1/4"	3 1/4"	2 1/8"	

Note: Shear lug spacing as shown is typical for both halves of the stringer.
* Spacing begins at termination of 6 spaces @ 4".
* Denotes A572-Grade 50 steel for thickness of 3/4" and under and A588 steel for thickness over 3/4".

Notes:
For Standard Shoe details, see Sheets S1 & S2.
For Deck Plan see Sheet 32.
For Details of diaphragms, see Sheet 32.
For Joint Details, see Sheet 49.
For Web to Flange Weld size, see Note, Sheet 20.

BY	DATE	Notes & Camber Added	LRH	4-19-74
MADE	MHH	8-26-68	dead load Def. of steel added	11-14-74
CHECKED	SCC	10-22-68	3 As Built	TEM 6-77
IN CHARGE	NO.	REVISION	BY	DATE

AS BUILT


RICHMOND METROPOLITAN AUTHORITY
RICHMOND EXPRESSWAY SYSTEM
DOWNTOWN EXPRESSWAY

BRIDGE NO. 67
RAMP W-N CONNECTION TO
RICHMOND-PETERSBURG TURNPIKE
FRAMING PLAN-UNITS 7 AND 8


HOWARD, NEEDLES, TAMMEN & BERGENDOFF
consulting engineers
NEW YORK ALEXANDRIA KANSAS CITY

SCALE: As Noted.
CONTRACT NO.: 10
SHEET NO. 22 OF 54


SHOE SCHEDULE			
EXPANSION SHOES		FIXED SHOES	
TYPE	NO. REQD.	TYPE	NO. REQD.
E14	4	F12	4

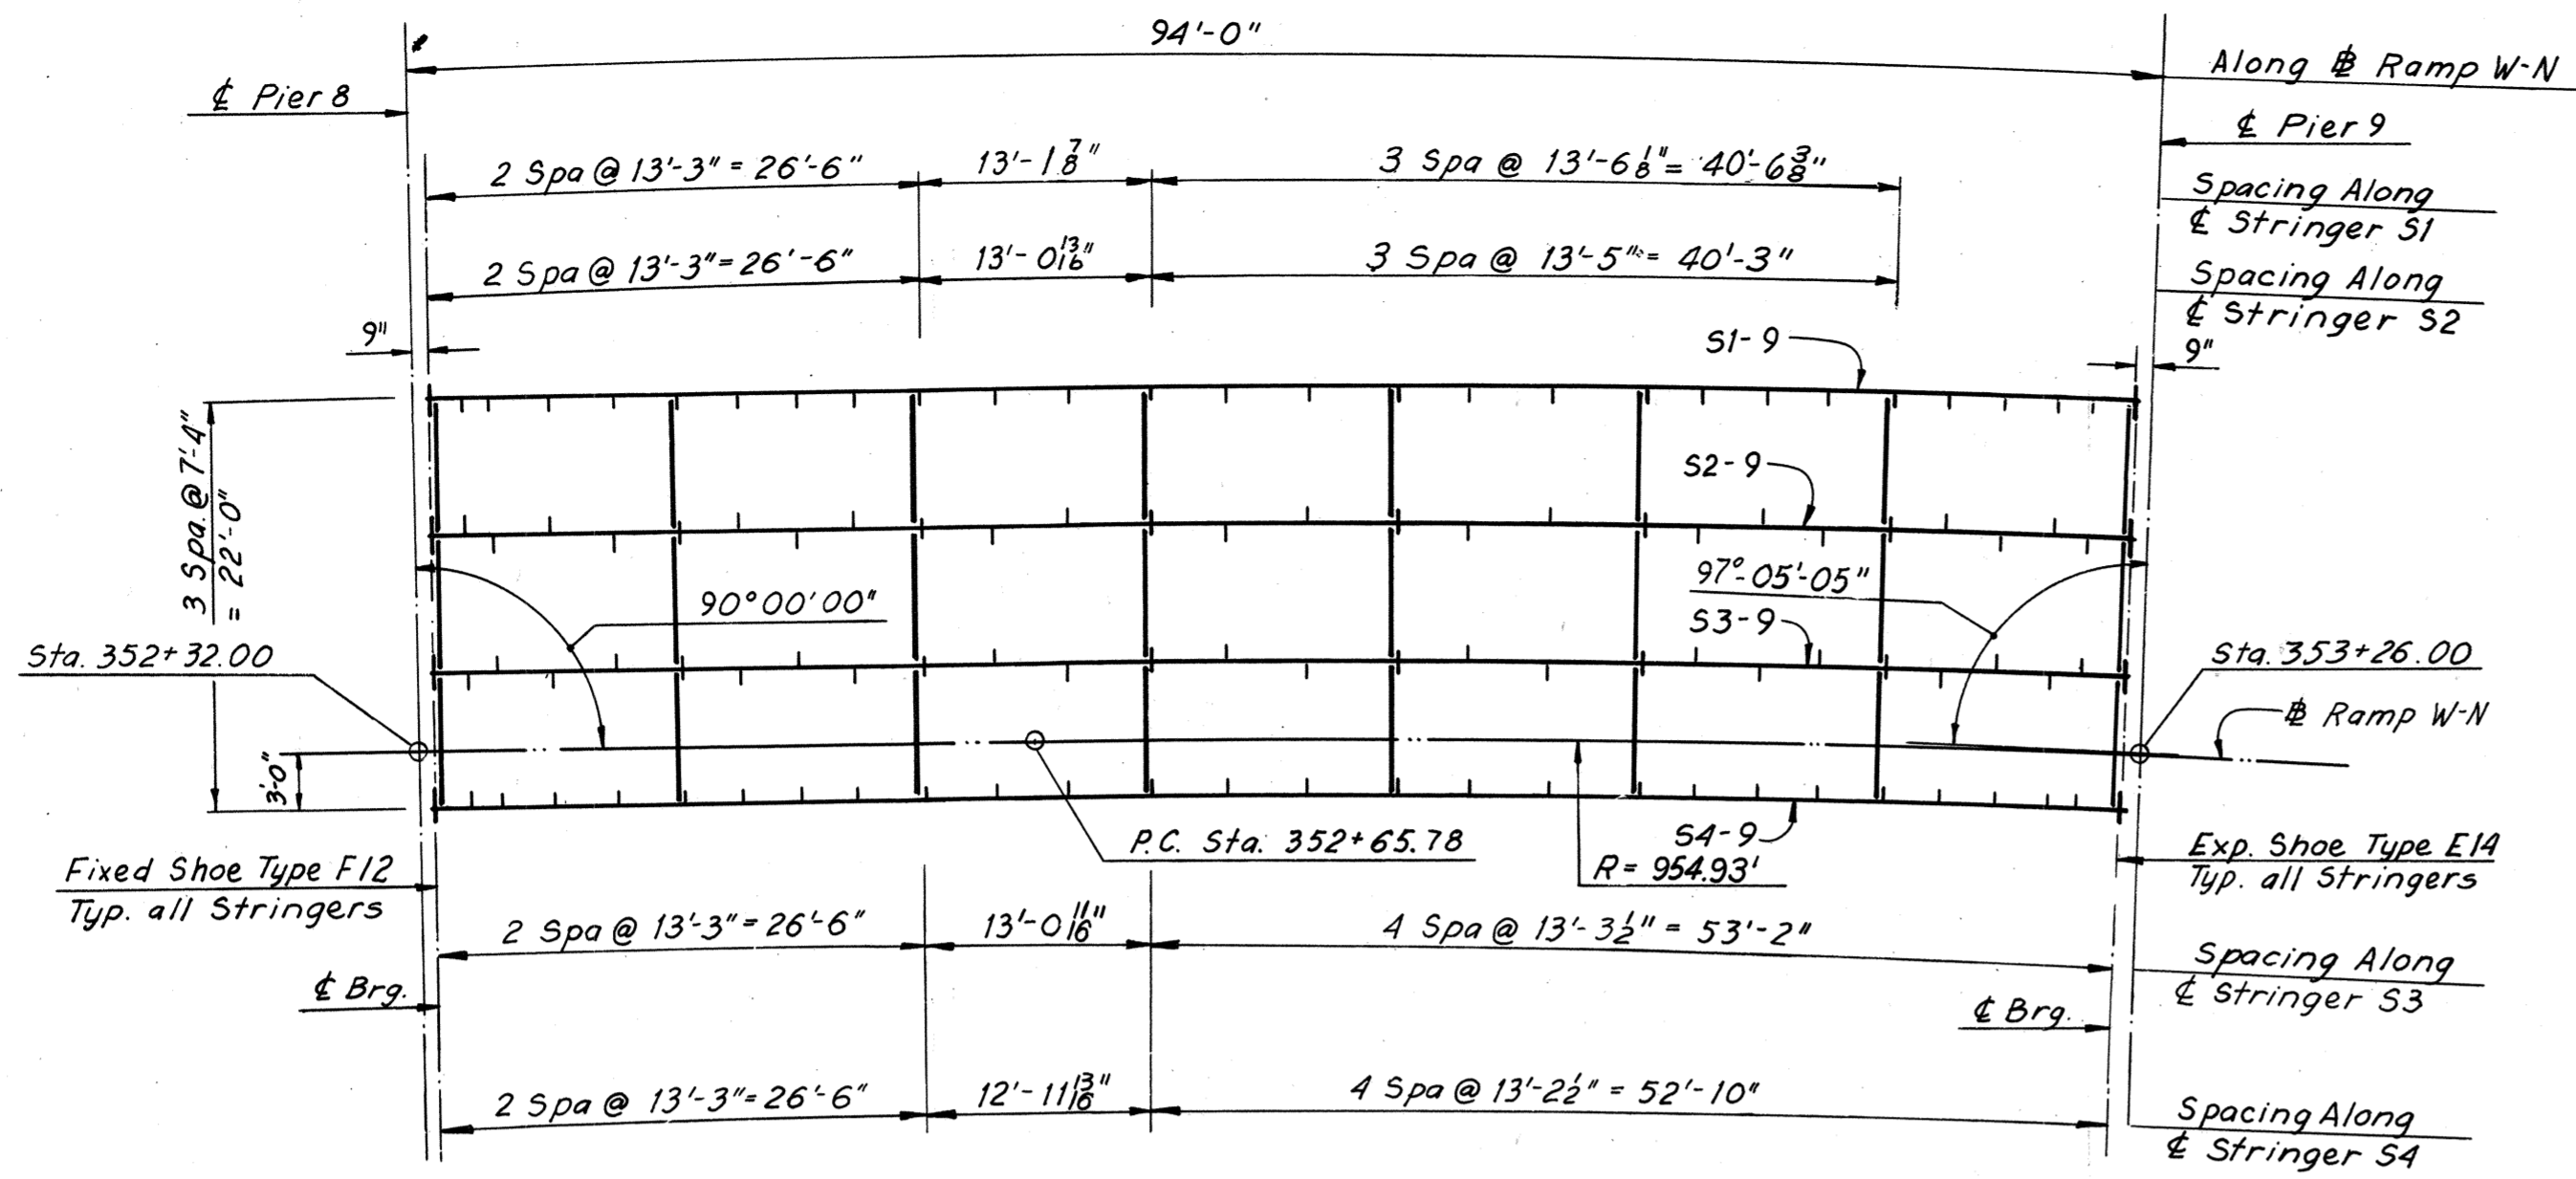

UNIT 9
FRAMING PLAN
Scale: 1" = 10'-0"

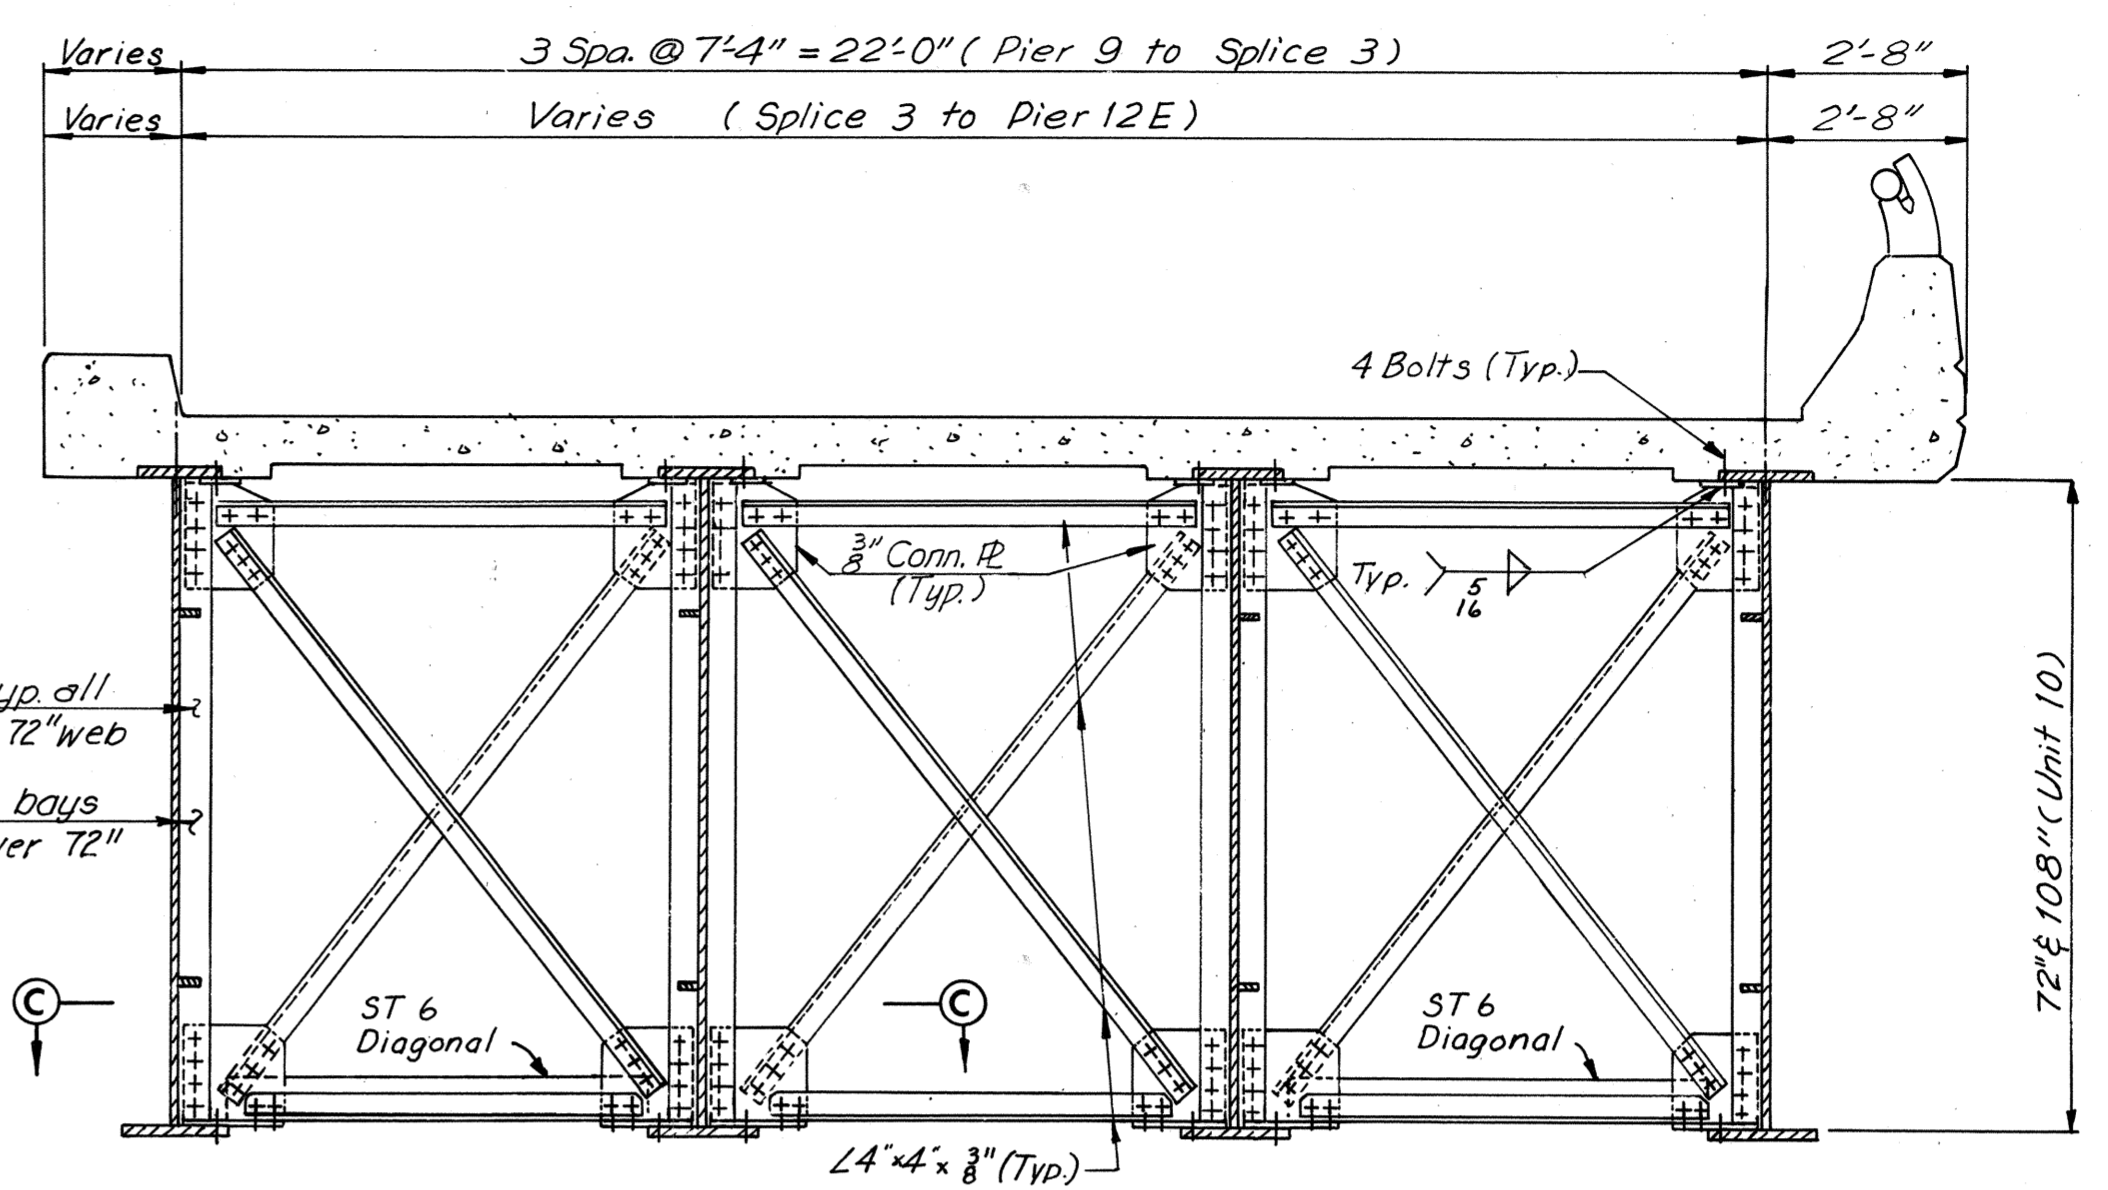


TYPICAL INTERMEDIATE DIAPHRAGM-UNIT 10
Scale: 3/8" = 1'-0"

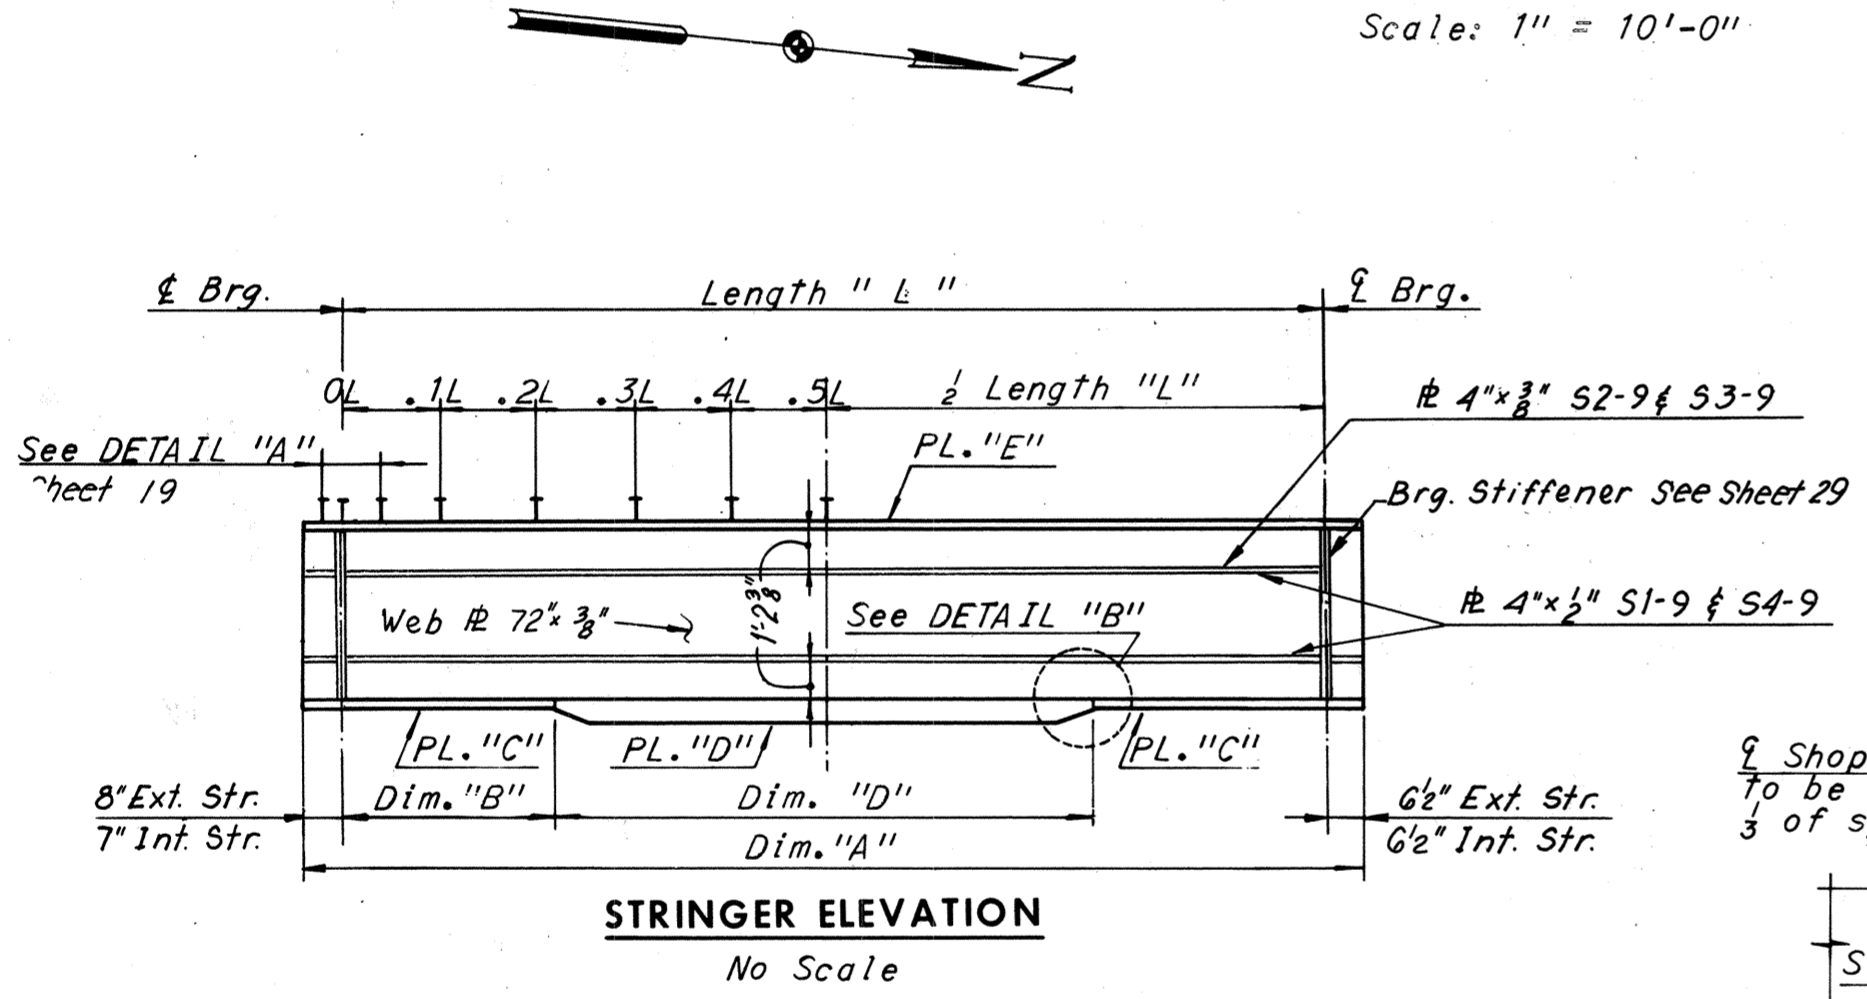


STRINGER ELEVATION
No Scale


Note: All horizontal dimensions are measured along \bar{x} Web.
Note: For size of bearing stiffeners located on the outside face of exterior stringers see Sheet 20.

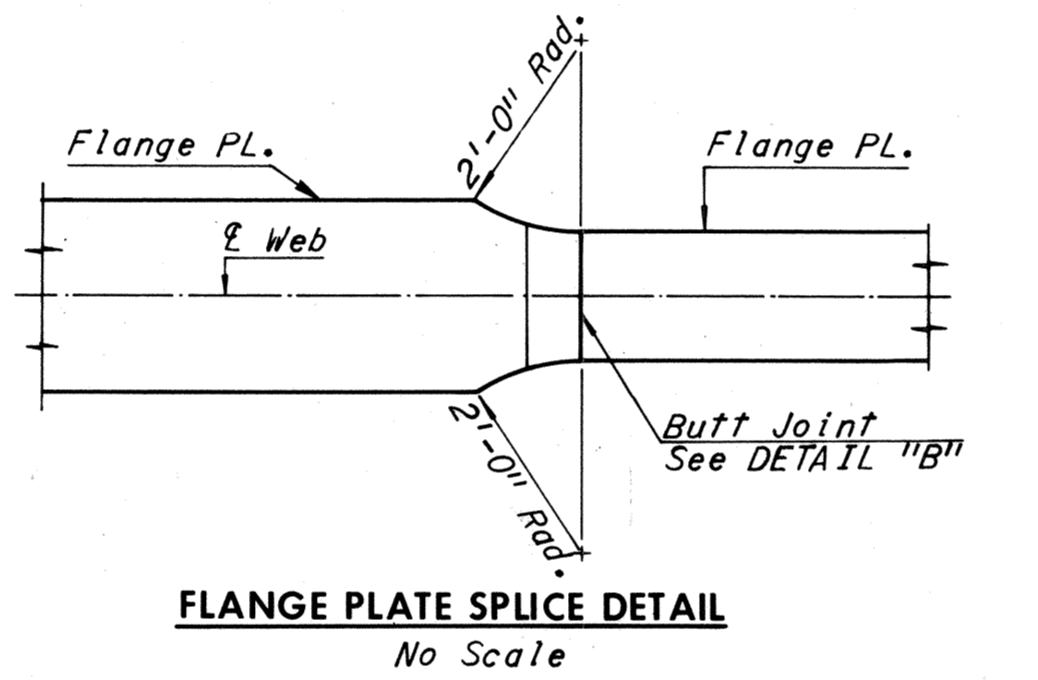

FLANGE PLATE SPICE DETAIL
No Scale

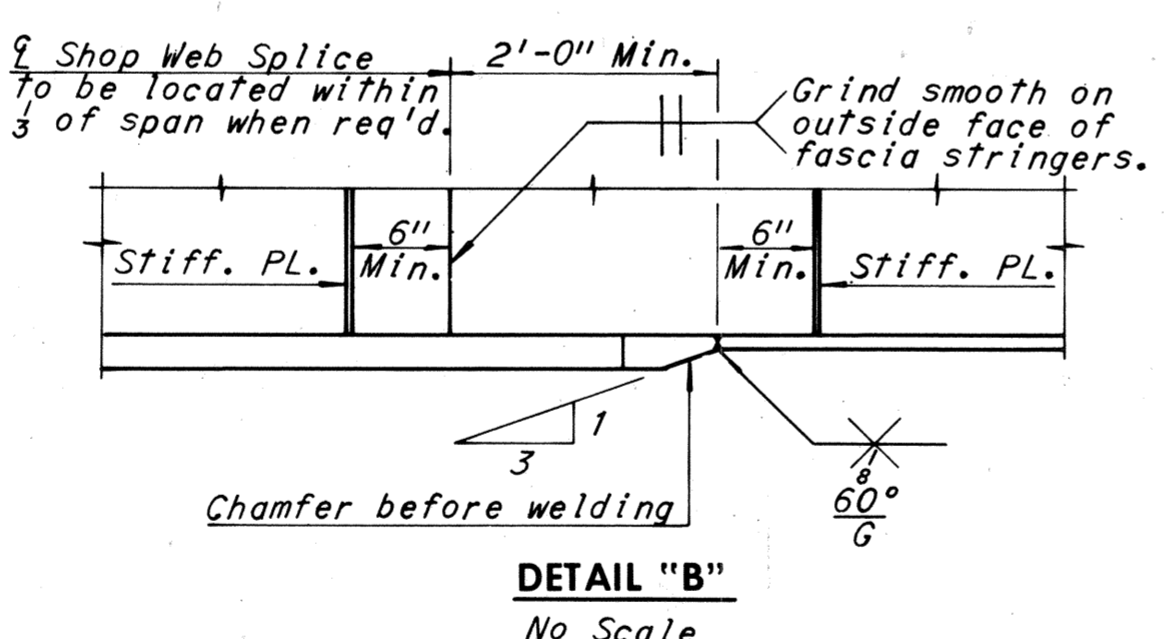


DETAIL "B"
No Scale

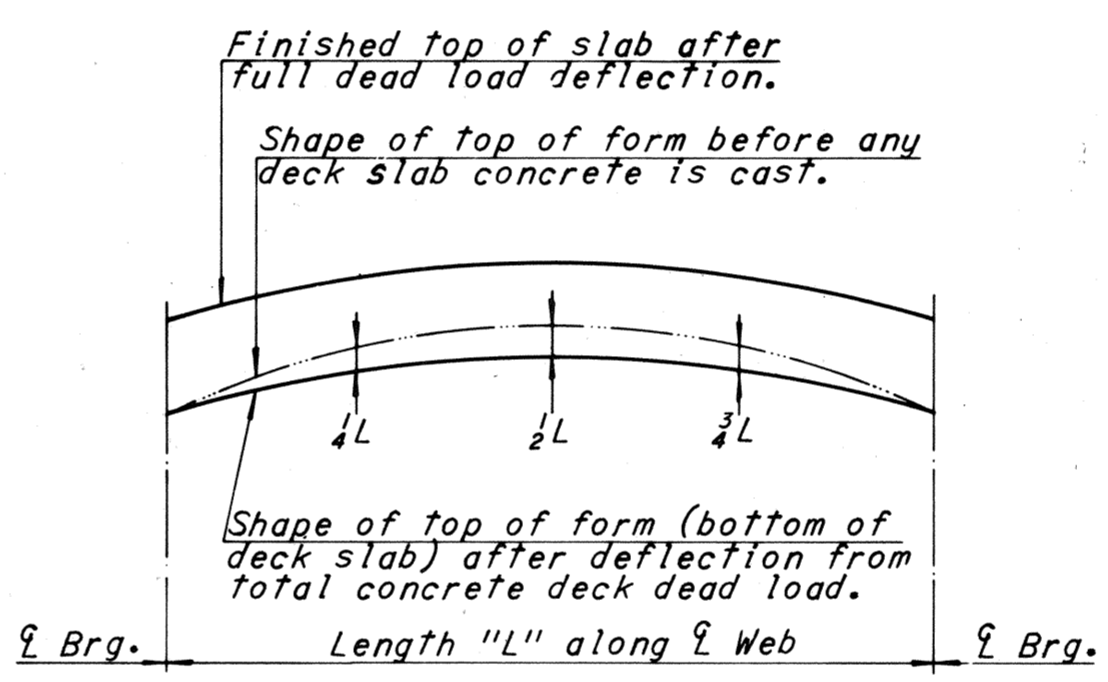

DEAD LOAD DEFLECTION DIAGRAM
NOTE TO CONTRACTOR

Deflections given are those anticipated to occur in the stringer upon placement of the total concrete deck dead load. In practice, the stringers in place are not likely to have the exact camber to compensate for these deflections during construction. The residual amounts shall be provided by adjusting forms to vary the thickness of the concrete haunch between the bottom of the slab and the top of stringer without altering the slab thickness.

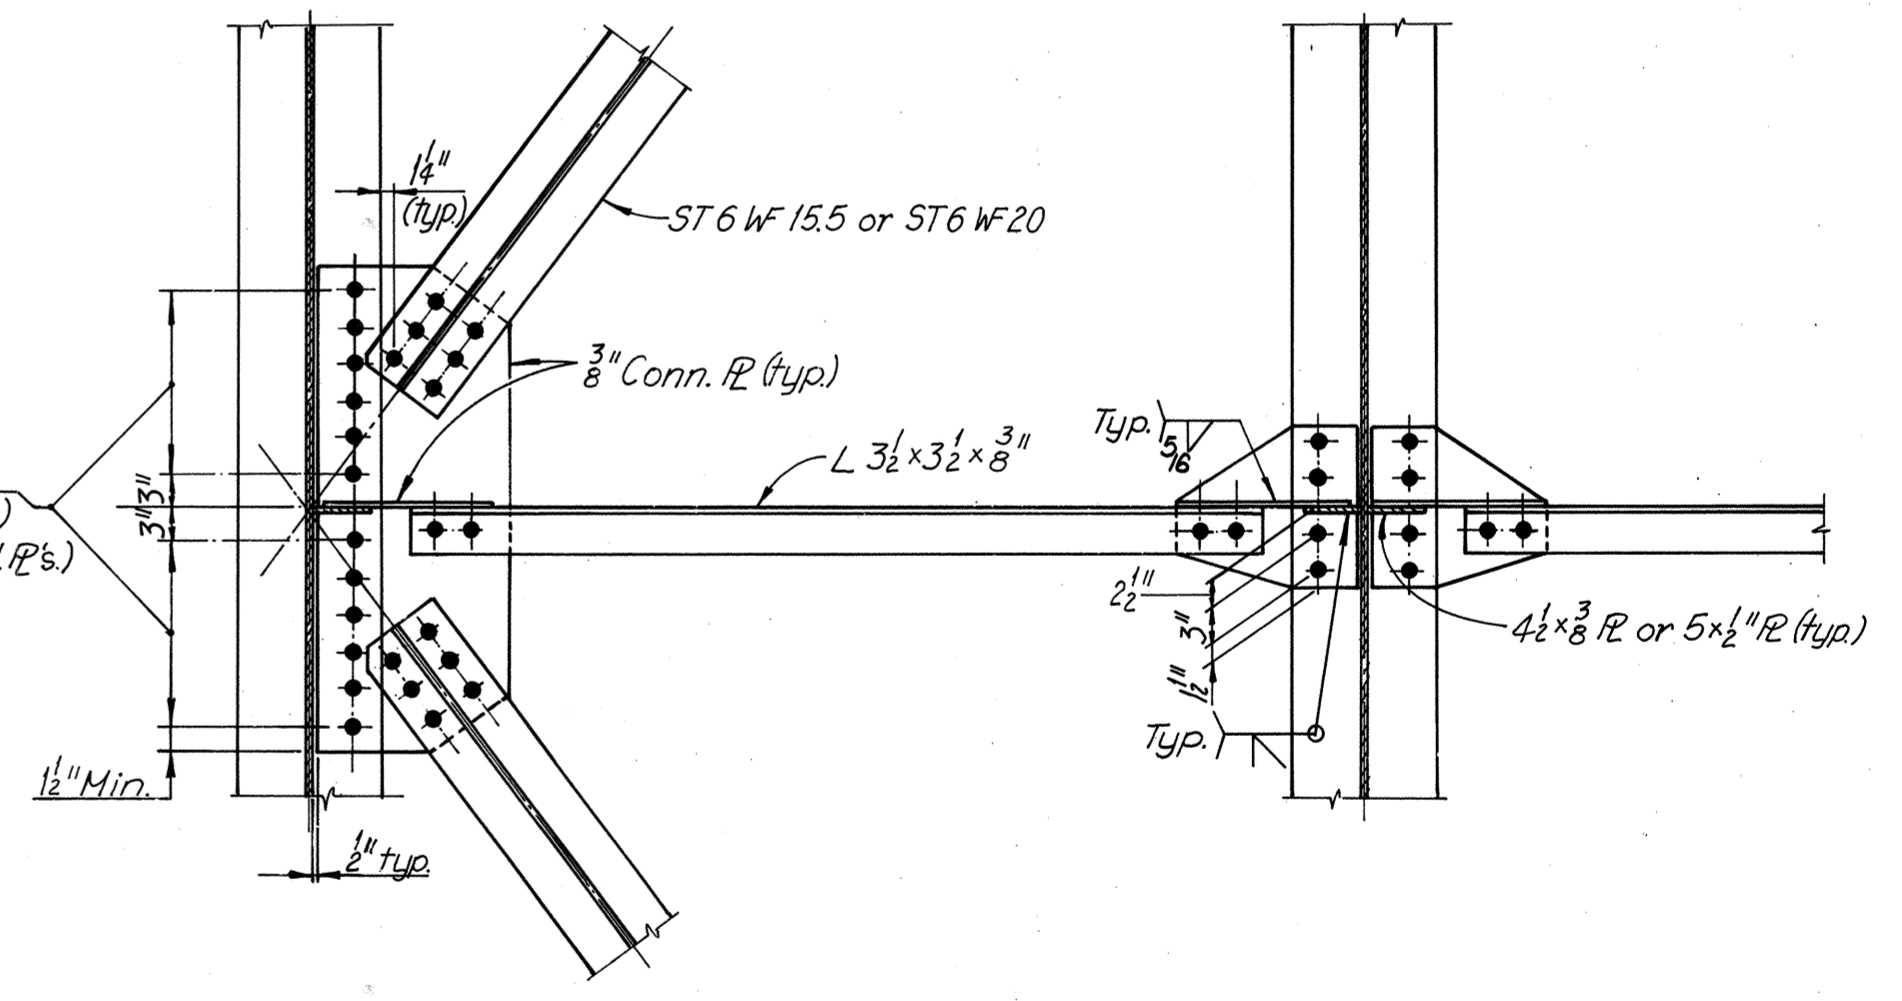

SECTION C-C
Scale: 3/4" = 1'-0"

UNIT	STRINGER	Dim. "A"	LENGTH "L"	Dim. "B"	Dim. "C"	Dim. "D"	PL "C"	PL "D"	PL "E"	MAX. SHEAR STUD SPACING					DEAD LOAD DEFLECTION (CONCRETE ONLY)			DEAD LOAD DEFLECTIONS (STEEL ONLY)			CAMBER SCHEDULE		
										0.0L-0.1L	0.1L-0.2L	0.2L-0.3L	0.3L-0.4L	0.4L-0.5L	1/4L	1/2L	3/4L	1/4L	1/2L	3/4L	1/4L	1/2L	3/4L
										0.1L	0.2L	0.3L	0.4L	0.5L	1/2	1/4	1/2	3/4	1/4	1/2	3/4	1/4	1/2
9	S1-9	97'-2 1/8"	96'-0 3/8"	19'-0"	55'-8 3/8"	12'x11"	12'x1 1/2"	12'x3 1/2"	10 1/2"	12"	16 1/2"	24"	24"	13 1/4"	1 1/8"	13 1/4"	3 1/2"	4"	3 1/2"	4"	5 1/2"	3 1/2"	
	S2-9	95'-9 1/8"	94'-8 3/8"	-	93'-2 1/8"	-	12'x1 1/2"	12'x3 1/2"	13 1/2"	15 1/2"	20 1/2"	24"	24"	13 1/4"	1 1/8"	13 1/4"	3 1/2"	4"	3 1/2"	3 3/4"	5 1/2"	3 1/2"	
	S3-9	94'-4 1/8"	93'-3 1/8"	-	92'-8 1/8"	-	12'x1 1/2"	12'x3 1/2"	11 1/2"	13 1/2"	18"	23"	24"	11 1/4"	1"	11 1/4"	3 1/2"	4"	3 3/4"	3 3/4"	4 5/8"	3 3/8"	
	S4-9	93'-1 1/8"	91'-11 1/8"	19'-0"	54'-3 1/8"	12'x11"	12'x1 1/2"	12'x3 1/2"	10 1/2"	12"	16 1/2"	22"	24"	5 1/8"	3/8"	5 1/8"	1 1/8"	3 1/8"	1 1/8"	3 1/8"	4 1/8"	3 1/8"	

* Spacing begins at termination of 6 spaces @ 4".

Note: Shear lug spacing as shown is typical for both halves of the stringer.

Notes: All steel shall be A36 steel unless denoted otherwise. Exterior stringer longitudinal stiffeners shall be located on the exterior face of the stringer. Intermediate stiffener plates shall be equally spaced between diaphragms as shown. The first two stiffener spaces at the ends of stringers shall be one-half the normal spacing within the panel. All intermediate stiffeners shall be of # 5x3".

Notes: For Standard Shoe details see Sheets S1 & S2. For Deck Plan see, Sheet 33. For Details of diaphragms, see Sheet 33. For Joint details, see Sheet 49. For Web to Flange Weld size, see Note, Sheet 20.

BY	DATE	REVISION	BY	DATE
MADE	C.E.B. 3-13-69	1	LRH	4-19-74
CHECKED	AMH 4-18-69	3	TEM	6-77
IN CHARGE				

RICHMOND METROPOLITAN AUTHORITY
RICHMOND EXPRESSWAY SYSTEM
DOWNTOWN EXPRESSWAY

BRIDGE NO. 67
RAMP W-N CONNECTION TO
RICHMOND-PETERSBURG TURNPIKE
FRAMING PLAN AND DETAILS
UNIT 9



HOWARD, NEEDLES, TAMMEN & BERGENDOFF
consulting engineers
NEW YORK ALEXANDRIA KANSAS CITY

SCALE: As Noted
CONTRACT NO.: 10
SHEET NO. 23 OF 54


AS BUILT

RICHMOND EXPRESSWAY SYSTEM			
SECTION	PROJECT	SHEET NO.	TOTAL SHEETS
10	DOWNTOWN EXPRESSWAY	196	265

SHOE SCHEDULE			
EXP. SHOE	FIXED SHOE		
TYPE	NO.	TYPE	NO.
E2	8	SP-1	4

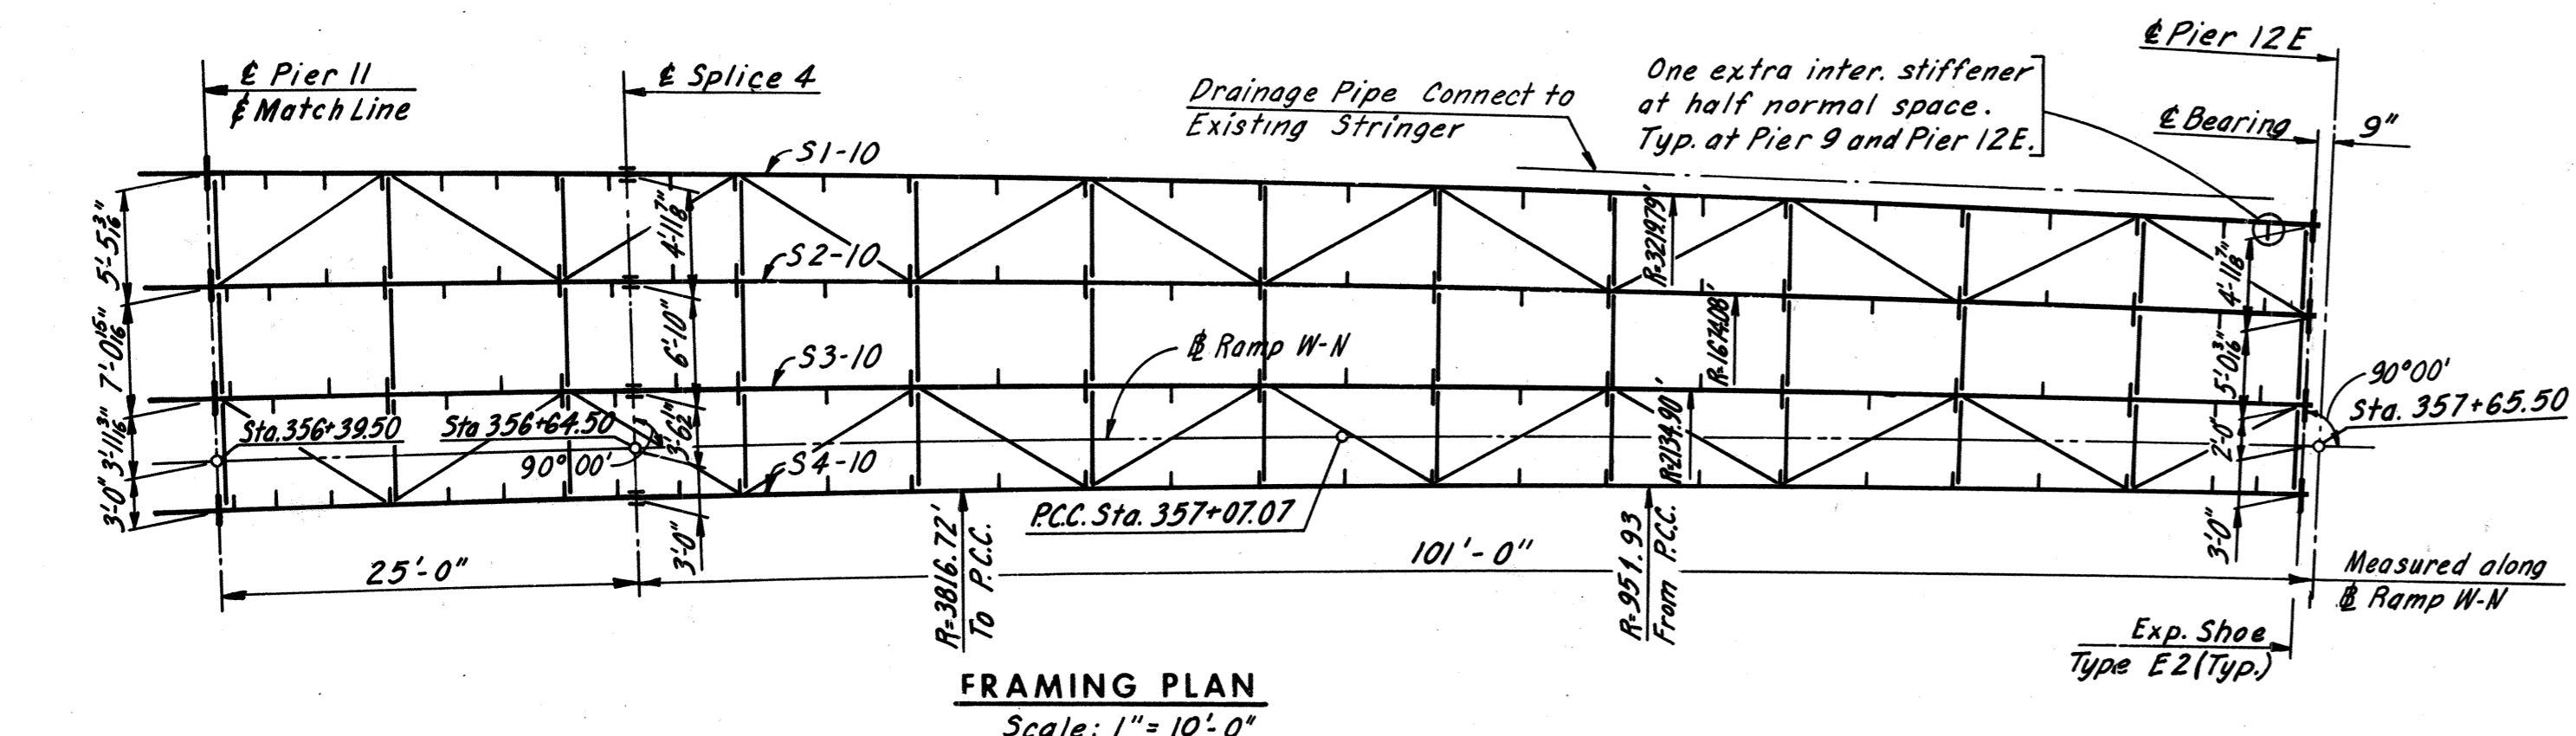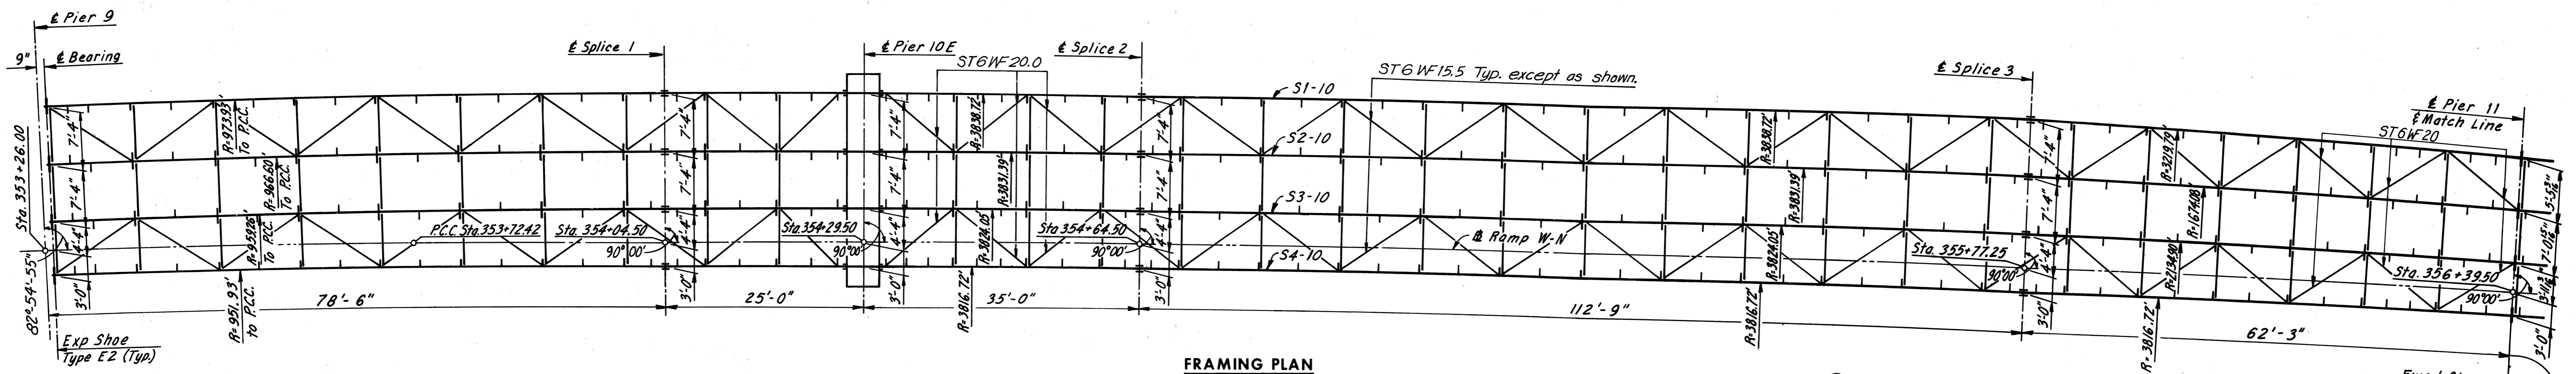


FRAMING PLAN
Scale: 1" = 10'-0"

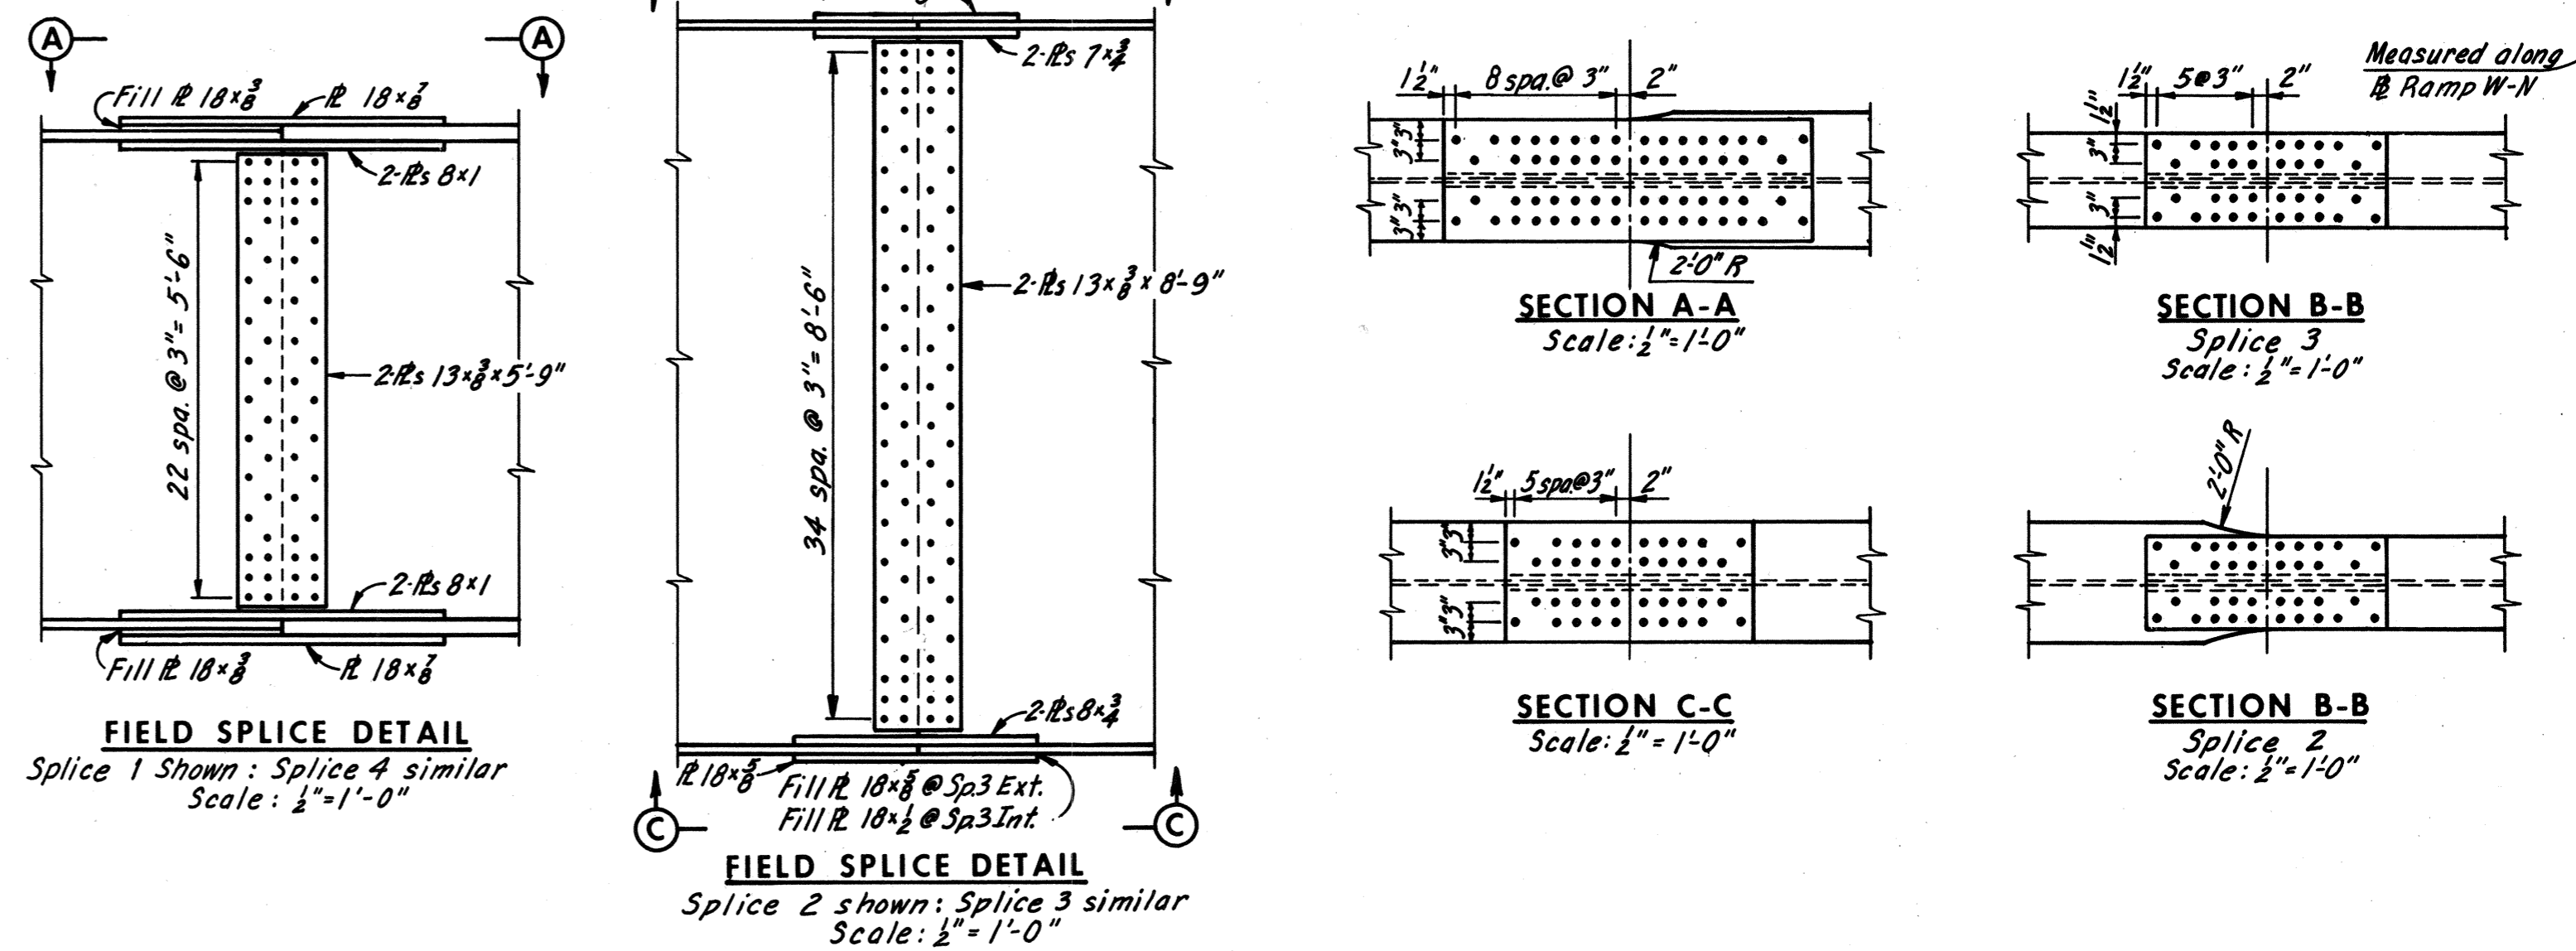


FIELD SPICE DETAIL
Splice 1 Shown: Splice 4 similar
Scale: 1/2" = 1'-0"


FIELD SPICE DETAIL
Splice 2 Shown: Splice 3 similar
Scale: 1/2" = 1'-0"

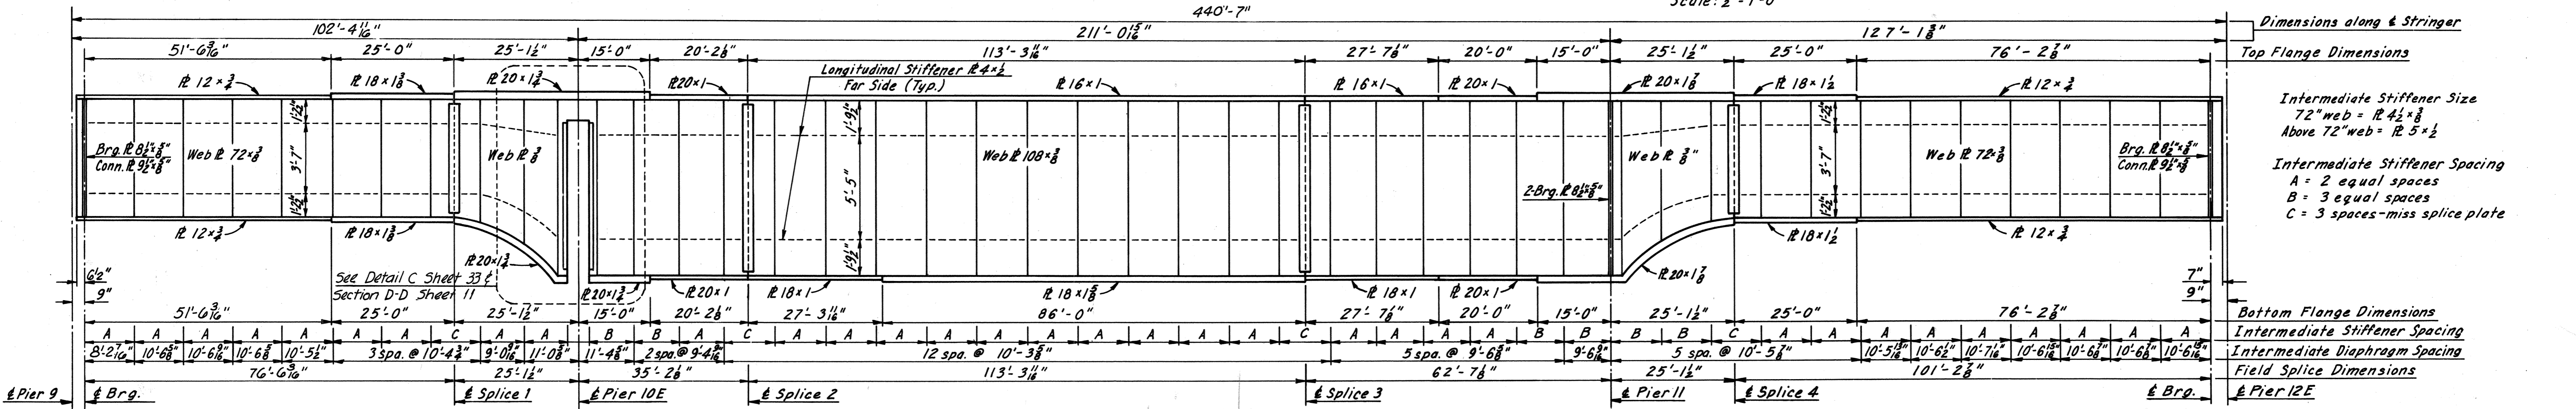

ELEVATION S1-10
No Scale

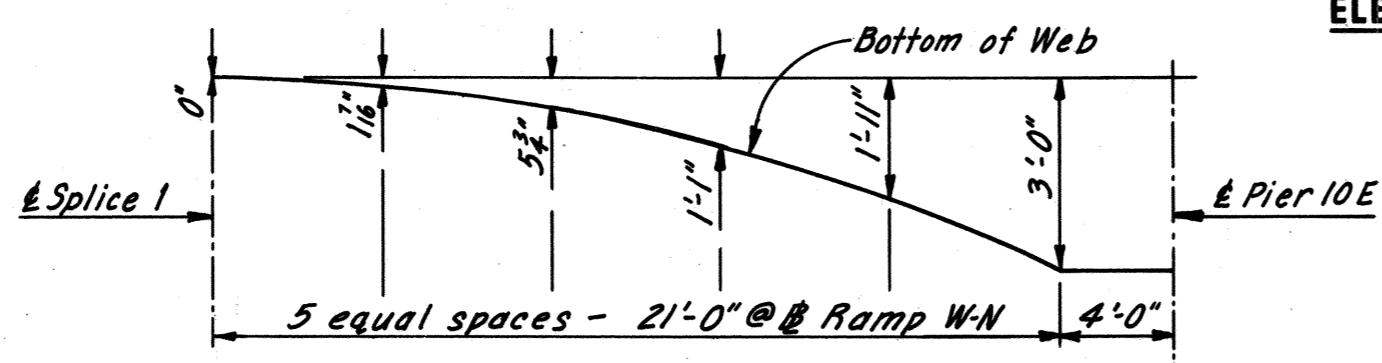

HAUNCH DETAIL
No Scale

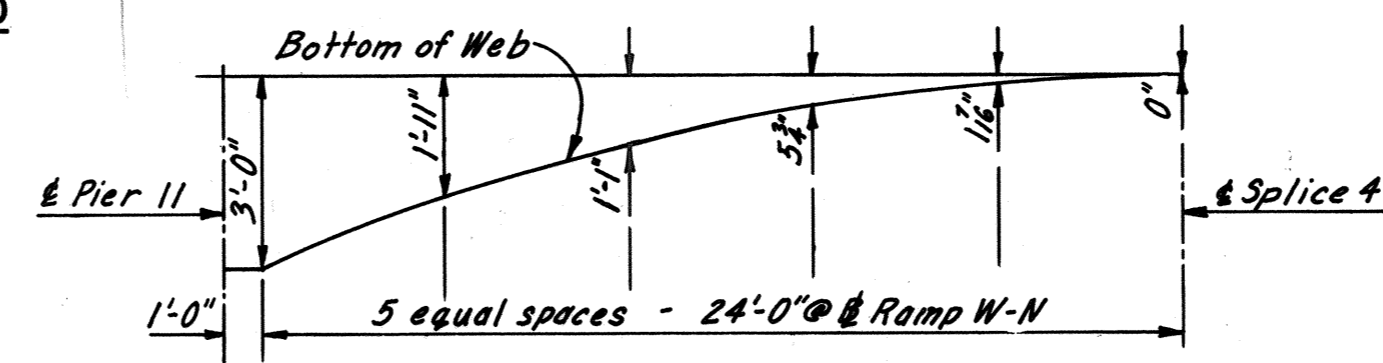

HAUNCH DETAIL
No Scale

Notes:
For Deck Plan, see Sheet 34.
For Shoe Details, see Sheet S2.
For Details of Intermediate Diaphragms, see Sheet 23.
For Details of End Diaphragms, see Section D-D Sheet 33.
For Details of Lateral Bracing, see Sheet 23.
All steel is A36 unless otherwise noted.
For Joint Details, see Sheet 49.
For Web to Flange Weld, see Note, Sheet 20.

RICHMOND METROPOLITAN AUTHORITY
RICHMOND EXPRESSWAY SYSTEM
DOWNTOWN EXPRESSWAY

BRIDGE NO. 67
RAMP W-N CONNECTION TO
RICHMOND-PETERSBURG TURNPIKE
FRAMING PLAN- UNIT 10




HOWARD, NEEDLES, TAMMEN & BERGENDOFF
consulting engineers
NEW YORK ALEXANDRIA KANSAS CITY

SCALE: As Noted
CONTRACT NO.: 10
SHEET NO. 24 OF 54

BY	DATE	REVISION	BY	DATE
AMH	2-28-69	2 As Built	TEM	6-77
JD	4-26-69			

AS BUILT

RICHMOND EXPRESSWAY SYSTEM			
SECTION	PROJECT	SHEET NO.	TOTAL SHEETS
10	DOWNTOWN EXPRESSWAY	197	265

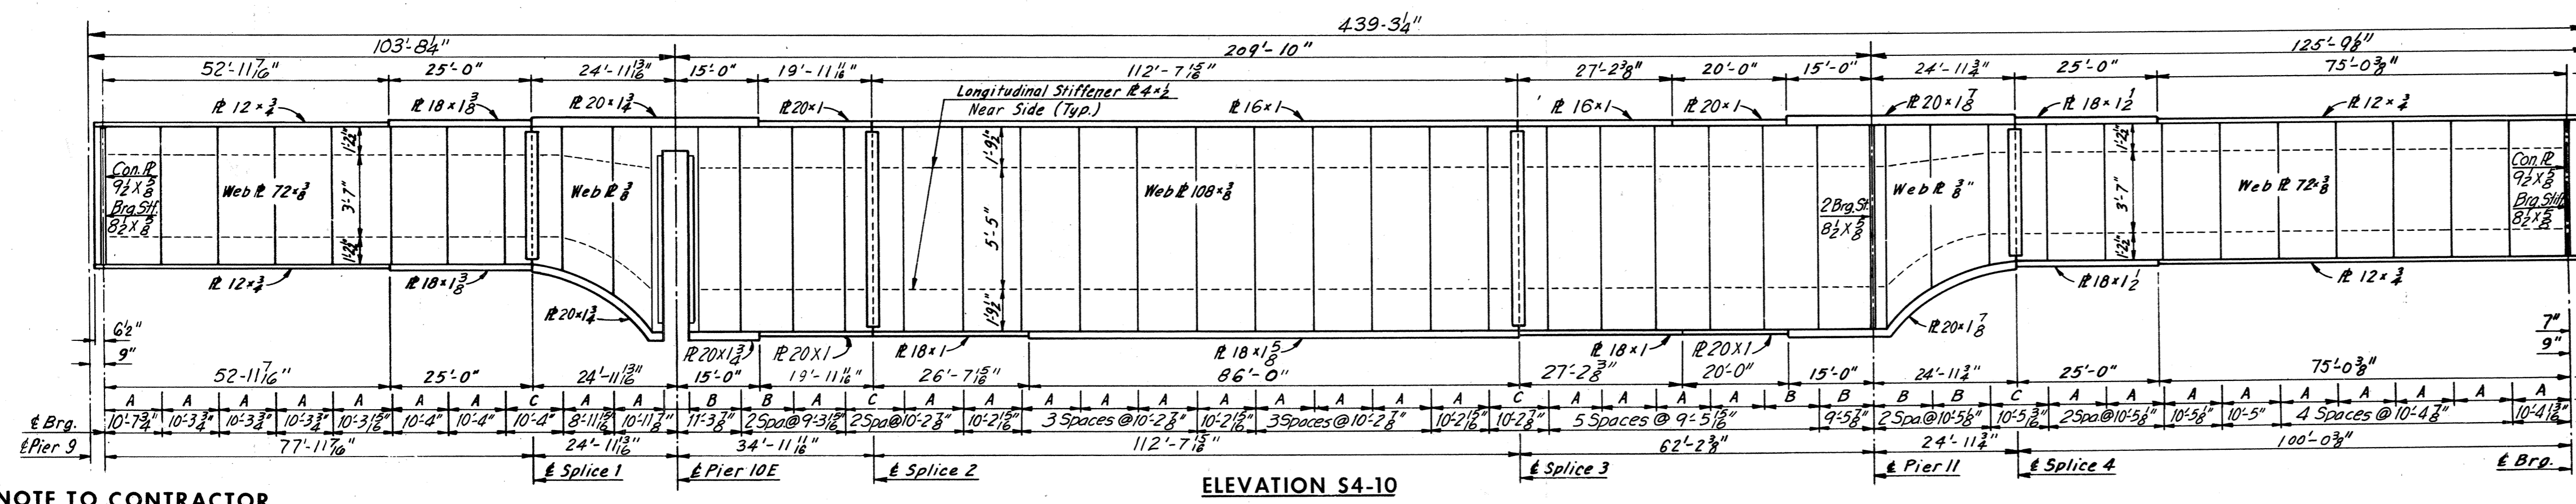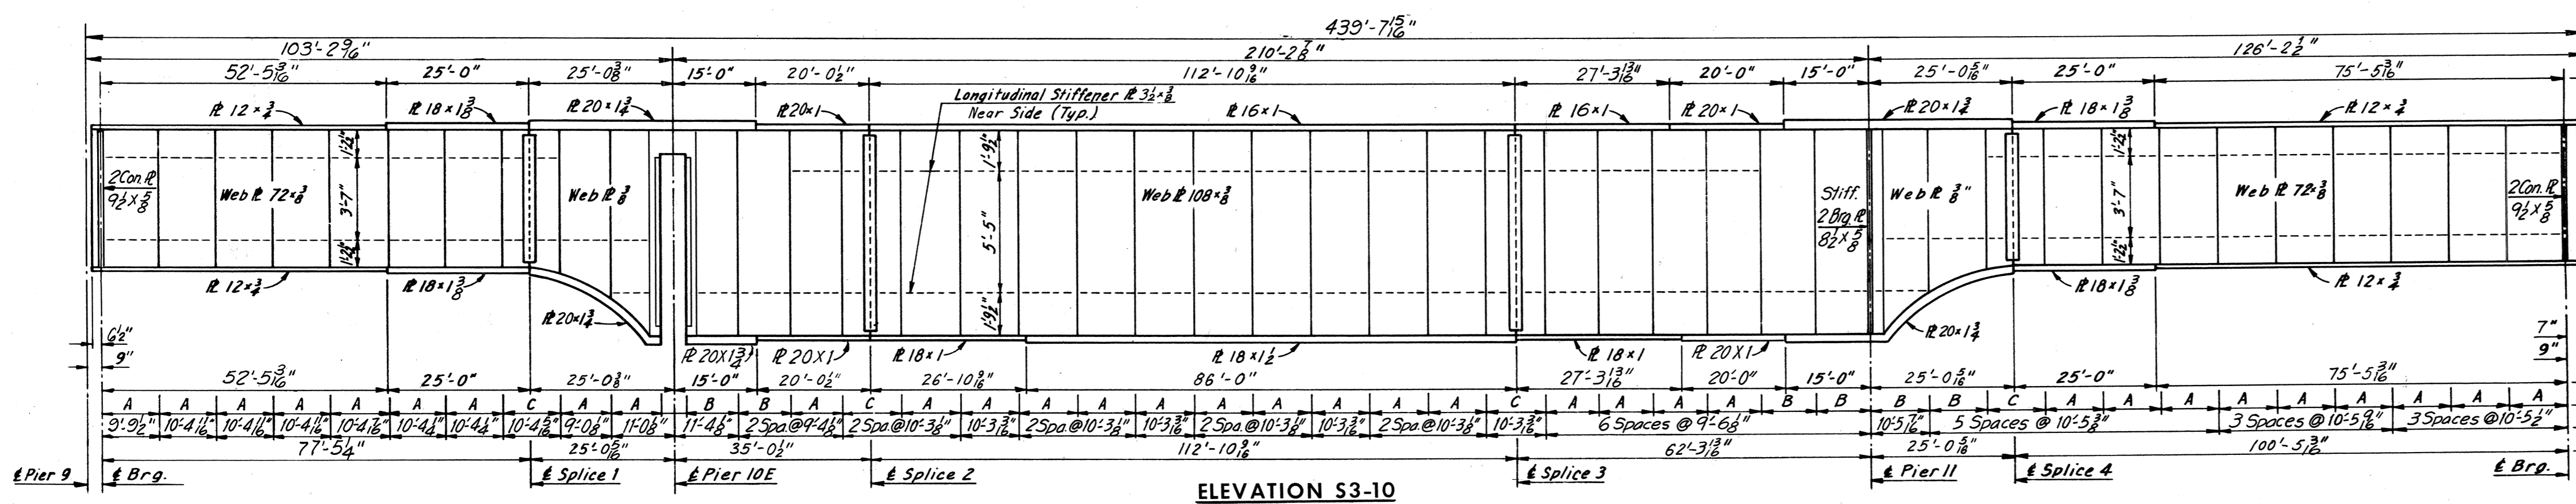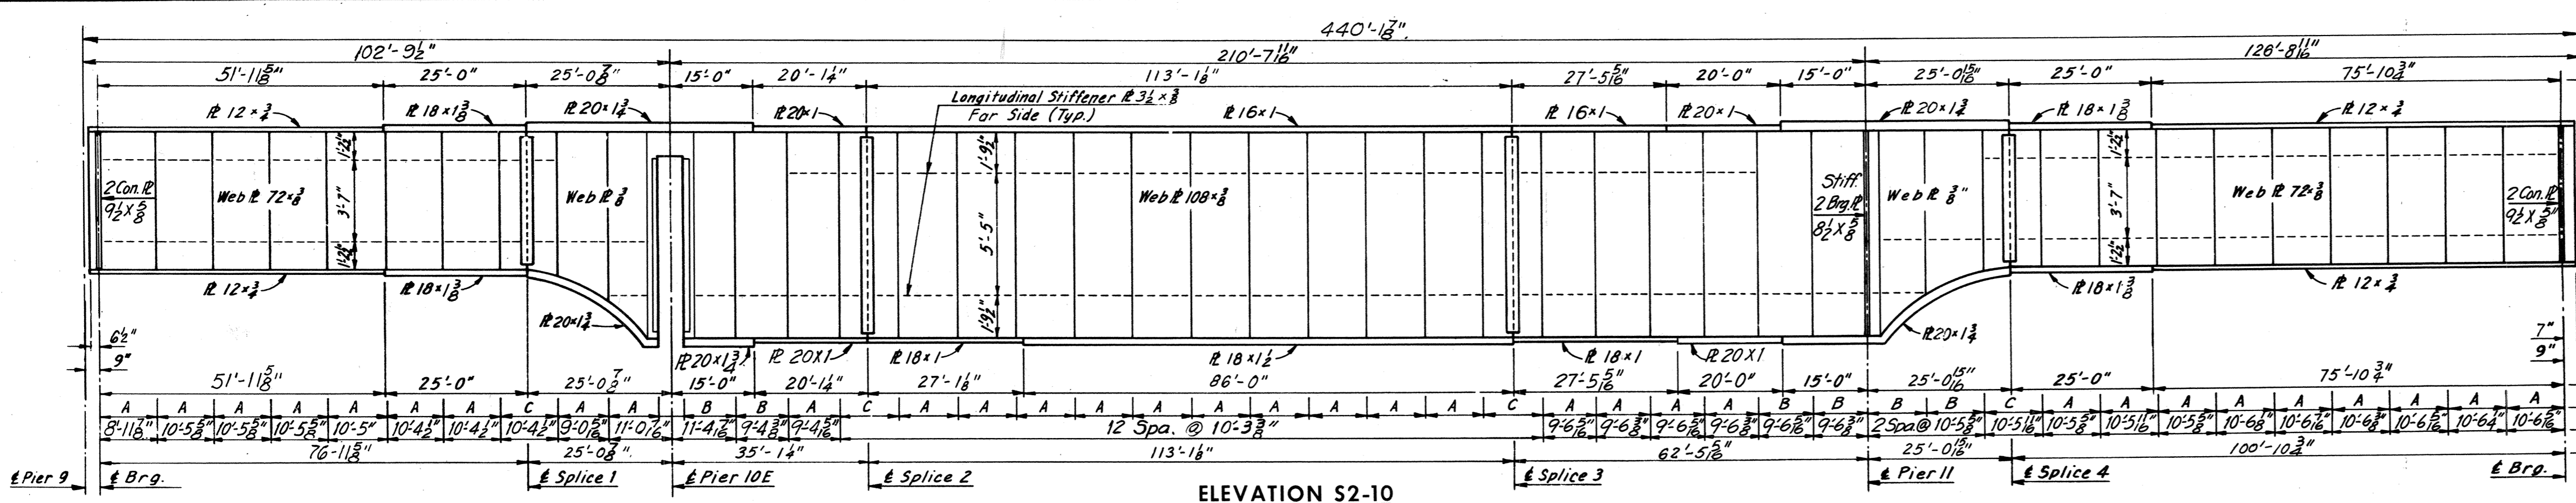

STRINGER	ELEV. A	ELEV. B	ELEV. C	ELEV. D	ELEV. E	ELEV. F
S1-10	88.50	87.37	85.60	80.87	76.81	72.72
S2-10	88.35	87.23	85.46	80.65	76.57	72.42
S3-10	88.21	87.08	85.31	80.43	76.24	72.12
S4-10	88.06	86.93	85.16	80.20	75.93	71.82

NOTE TO CONTRACTOR

Deflections given are those anticipated to occur in the stringer upon placement of the total concrete deck dead load. In practice, the stringers in place are not likely to have the exact camber to compensate for these deflections during construction. The residual amounts shall be provided by adjusting forms to vary the thickness of the concrete haunch between the bottom of the slab and the top of stringer without altering the slab thickness.


NOTE TO FABRICATOR

The stringers shall be fabricated with an upward camber amounting to the tabulated value. This will provide approximate compensation for deflection under full dead load and for conformity with finished grade.


DEAD LOAD DEFLECTION DIAGRAM

Exterior Stringer S1-10
Interior Stringer S2-10 & S3-10
Exterior Stringer S4-10

DEAD LOAD DEFLECTION DIAGRAM

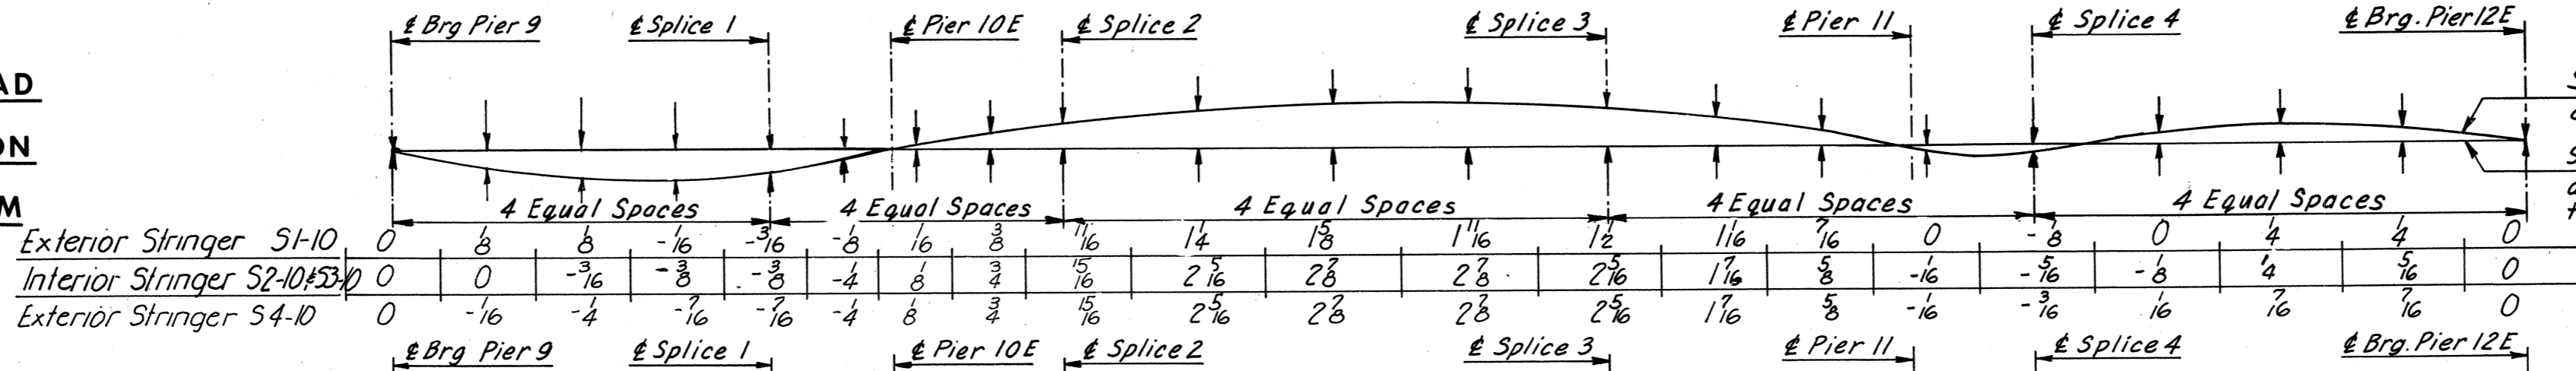

CAMBER DIAGRAM

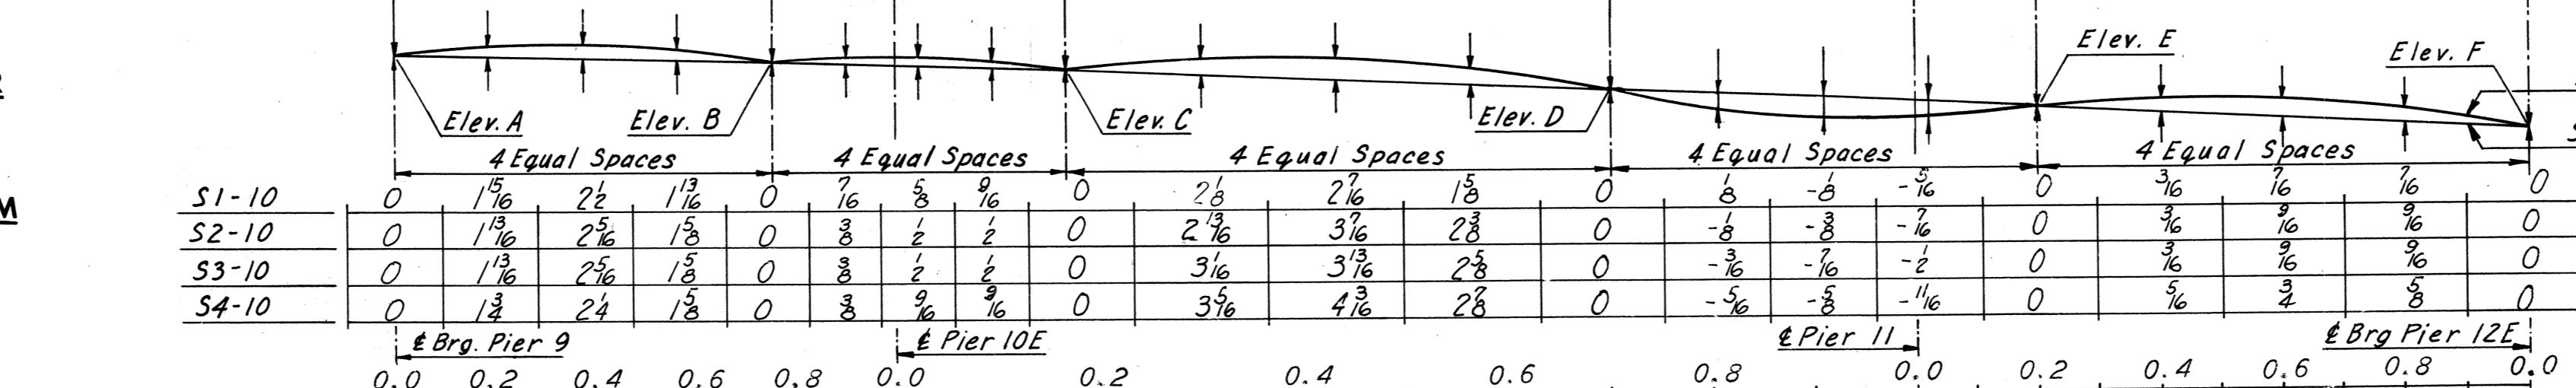

MAX. SHEAR STUD SPACING

Stringer	0.0	0.2	0.4	0.6	0.8	0.0	0.2	0.4	0.6	0.8	0.0	0.2	0.4	0.6	0.8	0.0
Exterior Stringers	21	24	24	24	24	24	24	24	24	24	24	24	24	24	24	24
Interior Stringers	21	24	24	24	24	24	24	24	24	24	24	24	24	24	24	20

Note: For Deck Plan, see Sheet 34. All Steel shall be A36 unless otherwise noted. For Details not shown, see Section D-D, sheet 11, and Detail C, sheet 33. For Web to Flange Weld size, see Note, Sheet 20.

RICHMOND METROPOLITAN AUTHORITY
RICHMOND EXPRESSWAY SYSTEM
DOWNTOWN EXPRESSWAY

BRIDGE NO. 67
 RAMP W-N CONNECTION TO
 RICHMOND-PETERSBURG TURNPIKE
GIRDER ELEVATIONS - UNIT 10


HOWARD, NEEDLES, TAMMEN & BERGENDOFF
 consulting engineers
 NEW YORK ALEXANDRIA KANSAS CITY

SCALE: No Scale
 CONTRACT NO.: 10
 SHEET NO. 25 OF 54

AS BUILT

BY	DATE	Note Added	LRH	4-19-74
MADE	AMH	Z 288-69	TEM	6-77
CHECKED	JD	4-29-69		
IN CHARGE				

RICHMOND EXPRESSWAY SYSTEM			
SECTION	PROJECT	SHEET NO.	TOTAL SHEETS
10	DOWNTOWN EXPRESSWAY	198	265

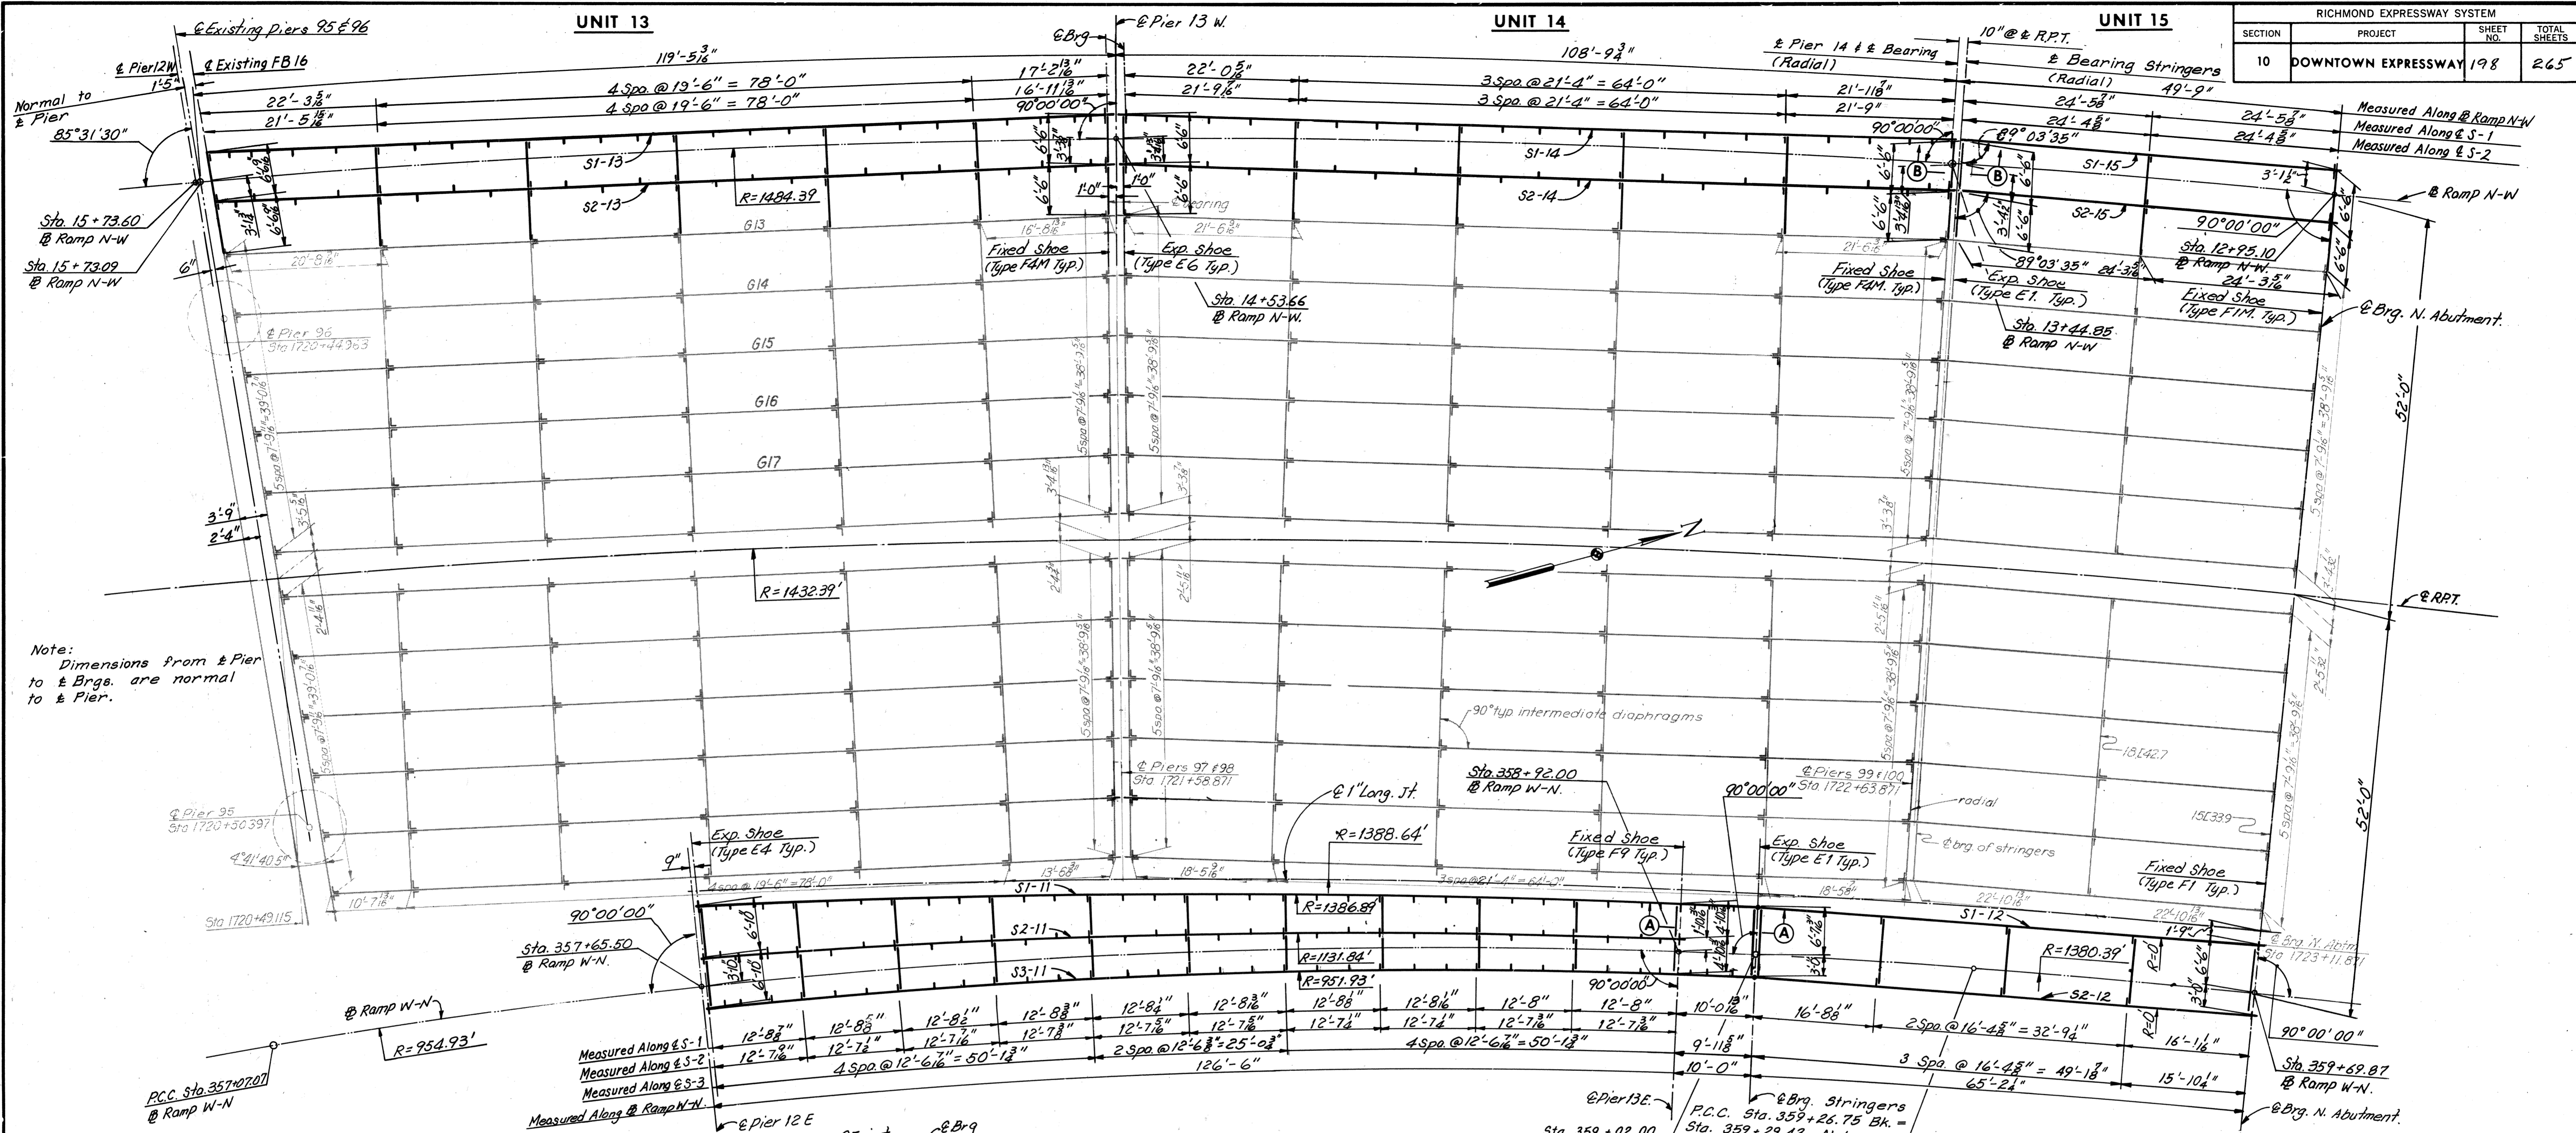


Note:
Dimensions from Pier to Brgs. are normal to Pier.

Note:
For Stringer Elevation, see Sheet 27.
For Stringer Schedule, see Sheet 27.
For Camber Schedule, see Sheet 27.
For FB 16 Details, see Sheet 28.
For Deck Plan, see Sheet 35.
For Shoe Details, see Sheets 51 & 52.


Note:
Dimensions shown on the plans for existing structural metalwork are in accordance with drawings prepared for the original construction. The Contractor shall verify all necessary dimensions of existing structural metalwork prior to fabrication of new metalwork.
New Diaphragms are to match Existing Diaphragms, in Units 13, 14 and 15.

BY	DATE	REVISION	BY	DATE
Y.C.P.	2-24-69	1	DWB	12-11-74
K.C.T.	4-26-69	3	TEM	6-77

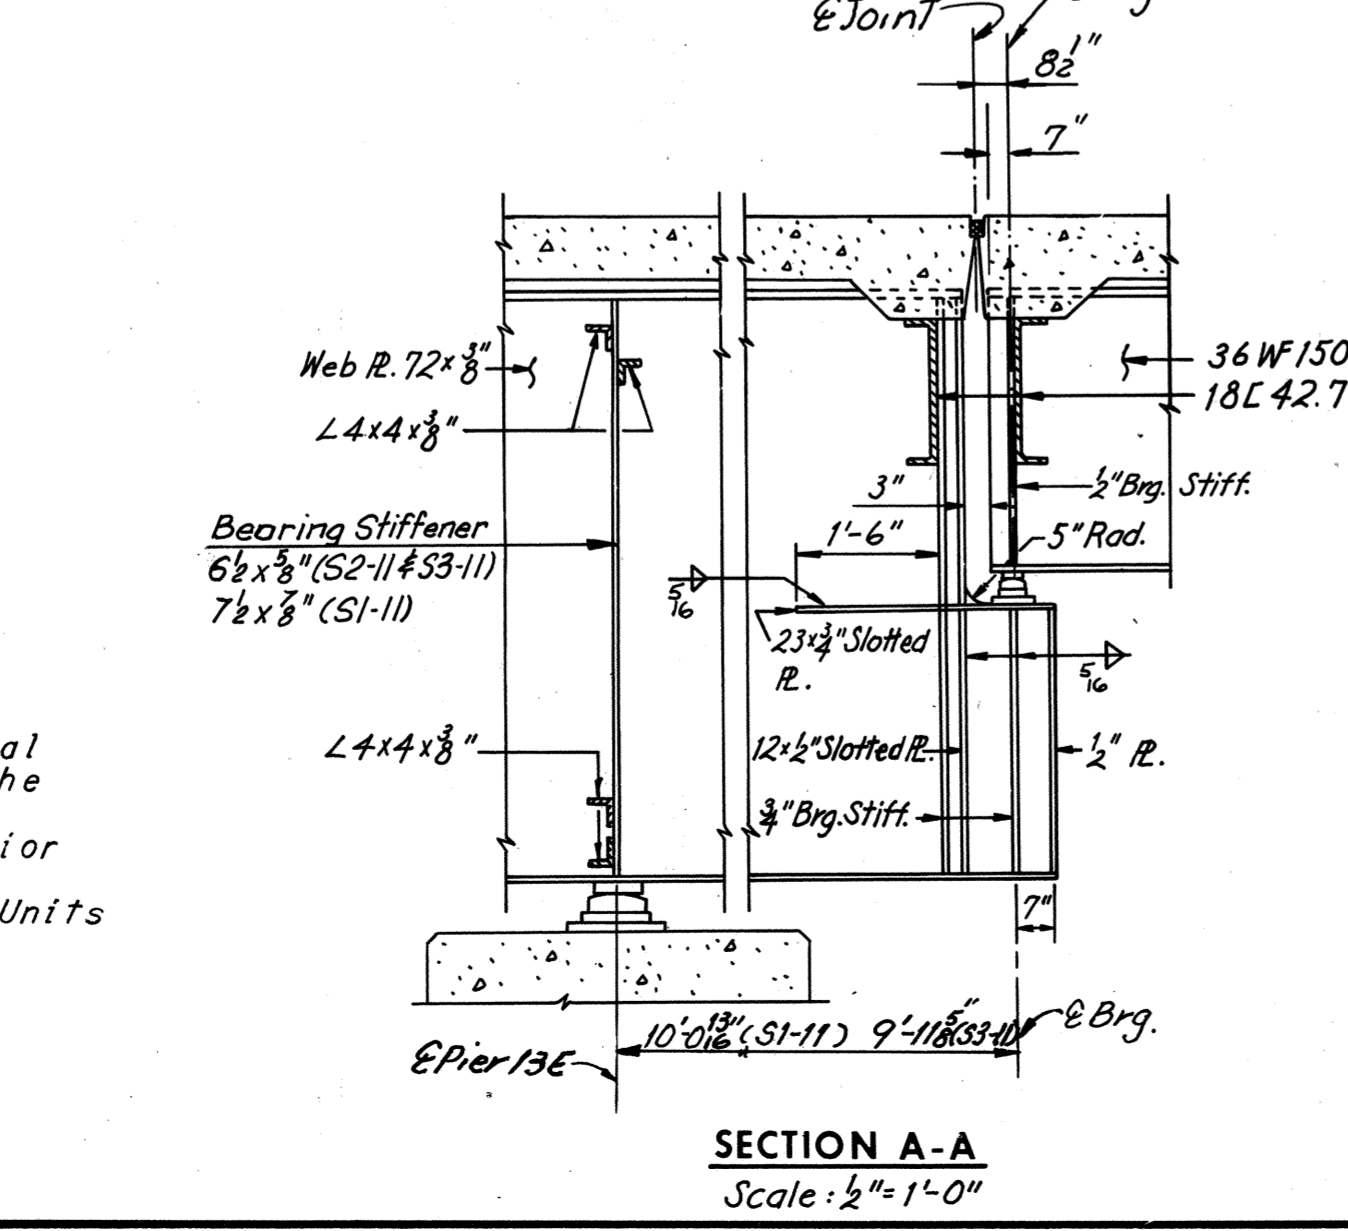

FRAMING PLAN
Scale: 1"=10'-0"

Note:
Intermediate stiffener PIs. 4x3/8 shall be equally spaced between diaphragms as shown. The first two stiffener spaces at the end of stringers shall be one-half the normal spacing within the panel.

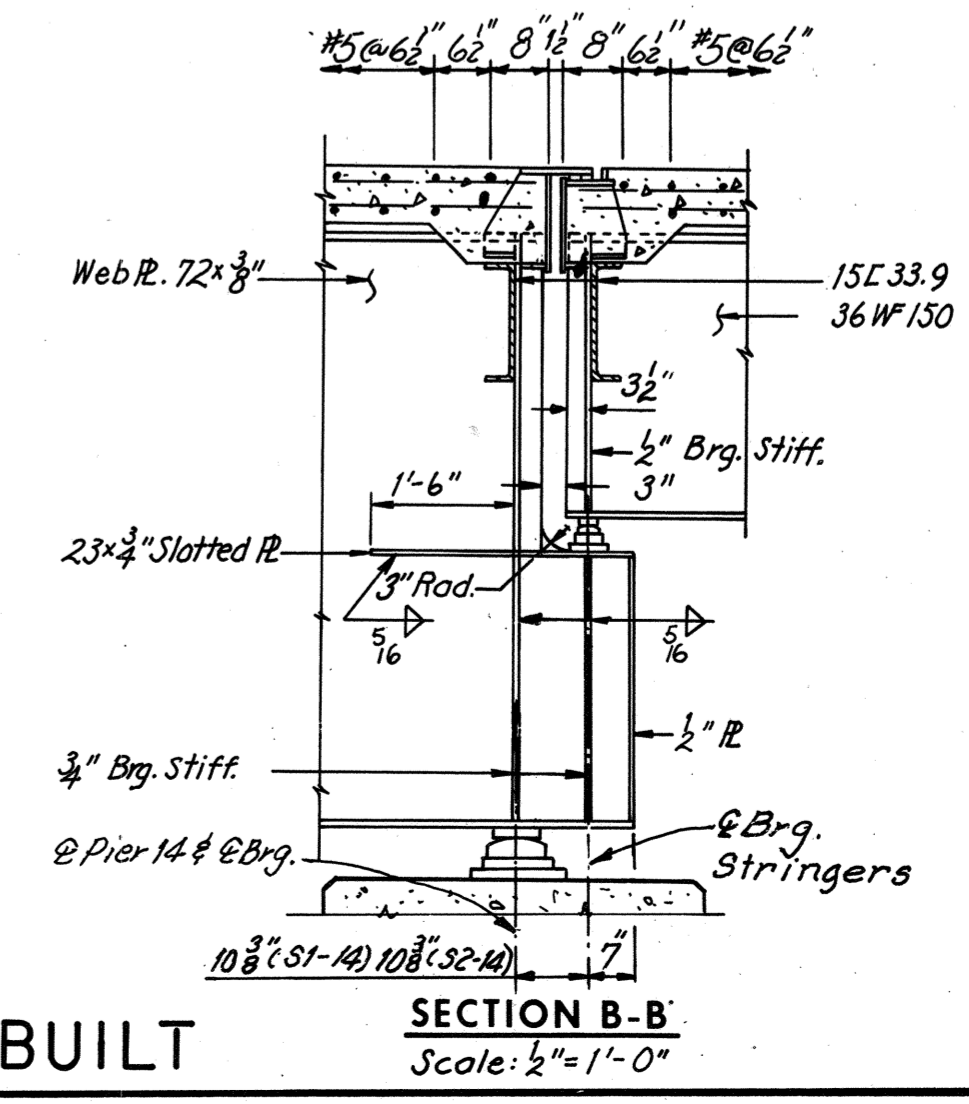

AS BUILT

SECTION B-B
Scale: 1/2"=1'-0"


SHOE SCHEDULE			
FIXED SHOES		EXPANSION SHOES	
TYPE	NO. REQD.	TYPE	NO. REQD.
F1	2	E1	4
F1M	2	E4	3
F4M	4	E6	2
F9	3	-	-

RICHMOND METROPOLITAN AUTHORITY
RICHMOND EXPRESSWAY SYSTEM
DOWNTOWN EXPRESSWAY

BRIDGE NO. 67
RAMP W-N CONNECTION TO
RICHMOND-PETERSBURG TURNPIKE
FRAMING PLAN - UNITS 11, 12, 13, 14 AND 15

HOWARD, NEEDLES, TAMMEN & BERGENDOFF
consulting engineers
NEW YORK ALEXANDRIA KANSAS CITY


SCALE: As Noted
CONTRACT NO.: 10
SHEET NO. 26 OF 54

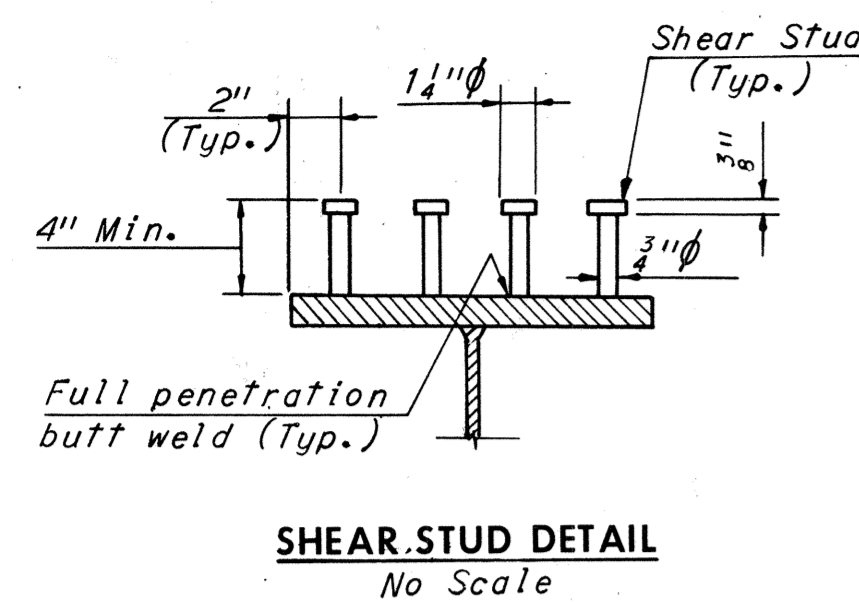

SHEAR STUD DETAIL
No Scale

SHEAR STUD NOTE


Capacity = 3,400 lbs. per stud.
The Contractor may, if he elects, use three 1/2" diameter studs at the same longitudinal spacing in lieu of the four 3/4" diameter studs shown.
Stud rows shall be placed parallel to the main deck reinforcing.
Shear stud spacing shown is maximum spacing.

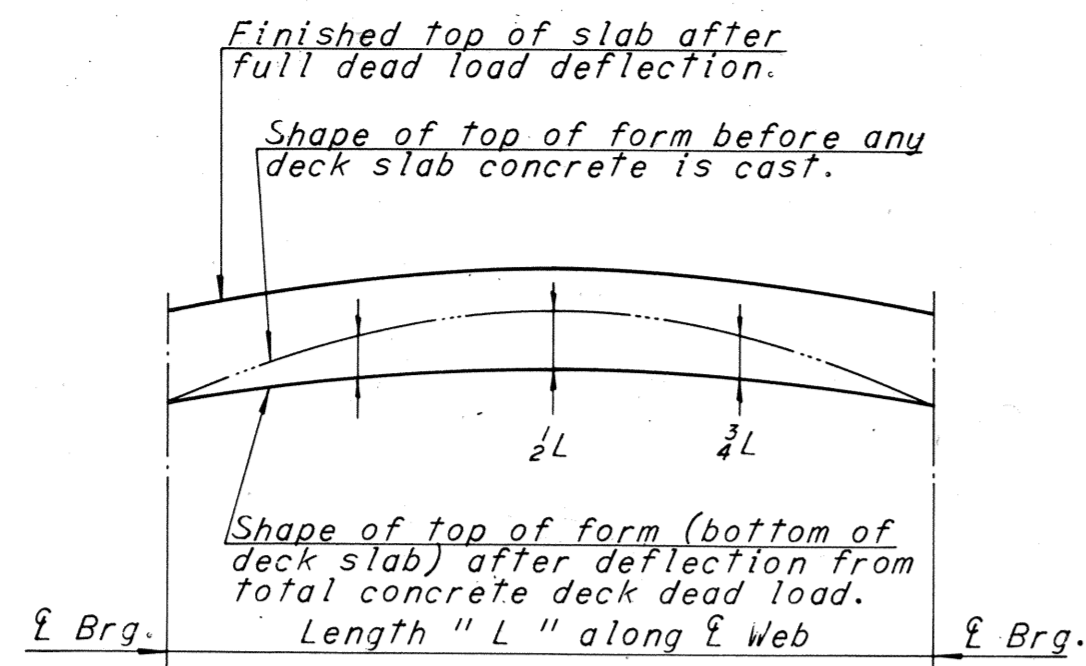

DEAD LOAD DEFLECTION DIAGRAM

NOTE TO CONTRACTOR

Deflections given are those anticipated to occur in the stringer upon placement of the total concrete deck dead load.
In practice, the stringers in place are not likely to have the exact camber to compensate for these deflections during construction. The residual amounts shall be provided by adjusting forms to vary the thickness of the concrete haunch between the bottom of the slab and the top of stringer without altering the slab thickness.

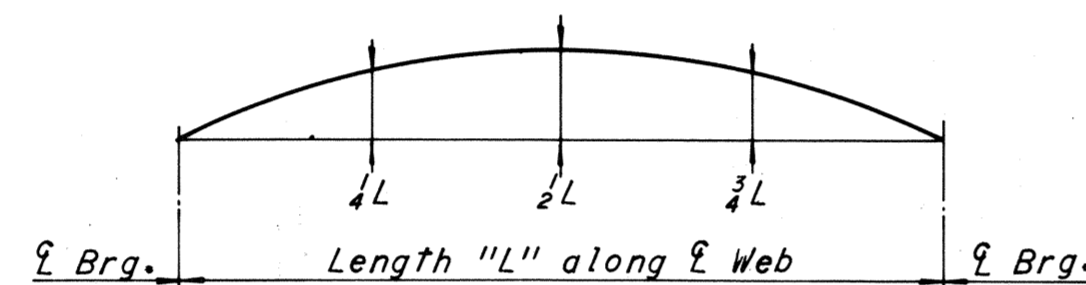


CAMBER DIAGRAM


NOTE TO FABRICATOR

The stringers shall be fabricated with an upward camber amounting to the tabulated value. This will provide approximate compensation for deflection under full dead load and for conformity with finished grade.


Note:
Stringers having a total camber of less than 1" are not required to be shop cambered, but should be turned so that any mill tolerance deviation from straightness will be in the direction shown by the Camber Diagram.
If stringers are not cambered, distance top of stringers to top of slab will vary along the stringer in accordance with the offset dimensions shown in the Camber Diagram, and with minimum distance as shown in Cross-Section on Sheet

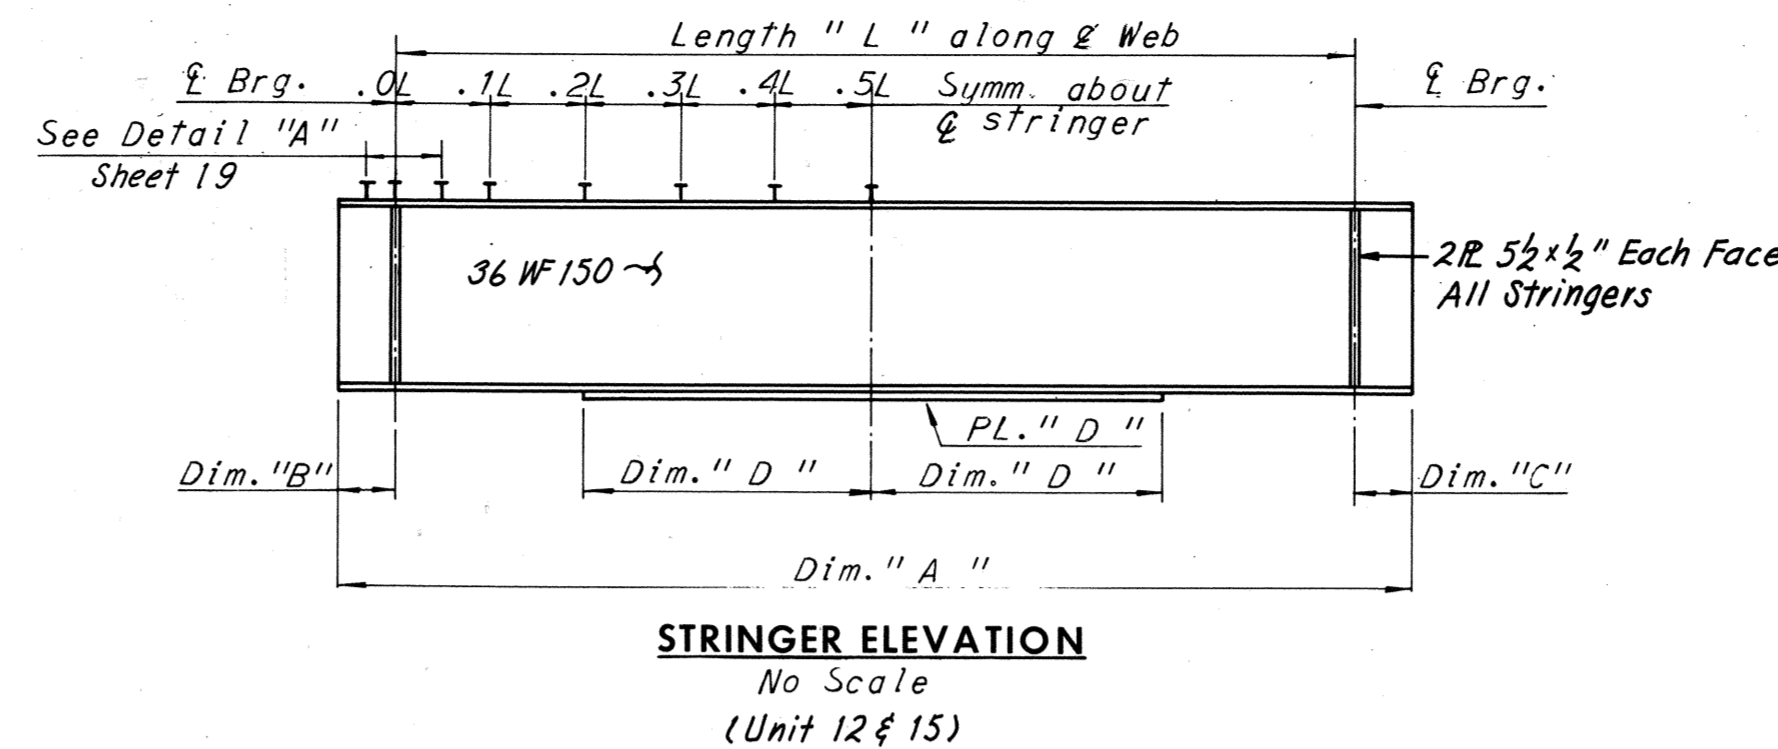


STRINGER ELEVATION
No Scale
(Unit 12 & 15)

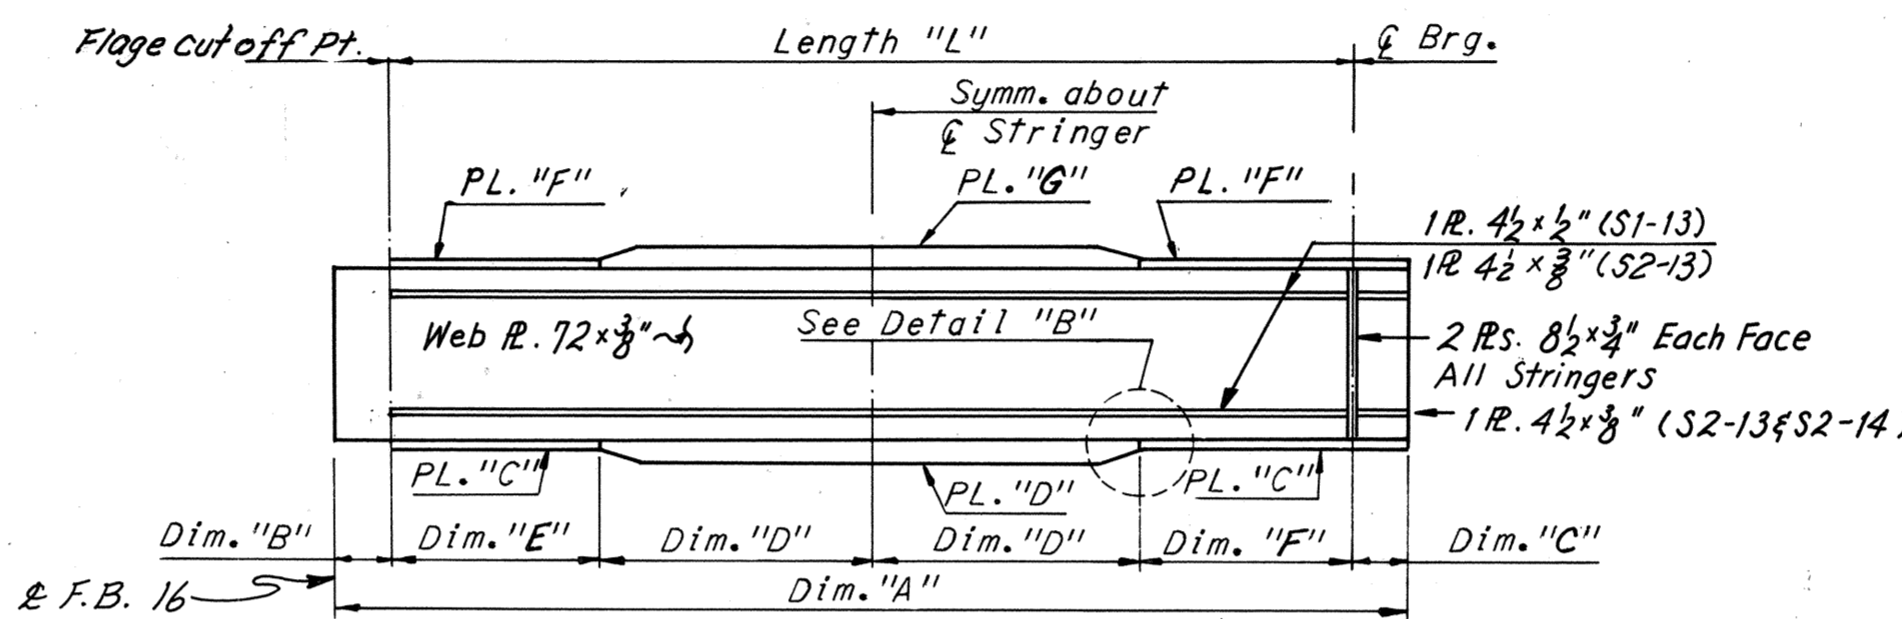


STRINGER ELEVATION
No Scale
(Unit 13)

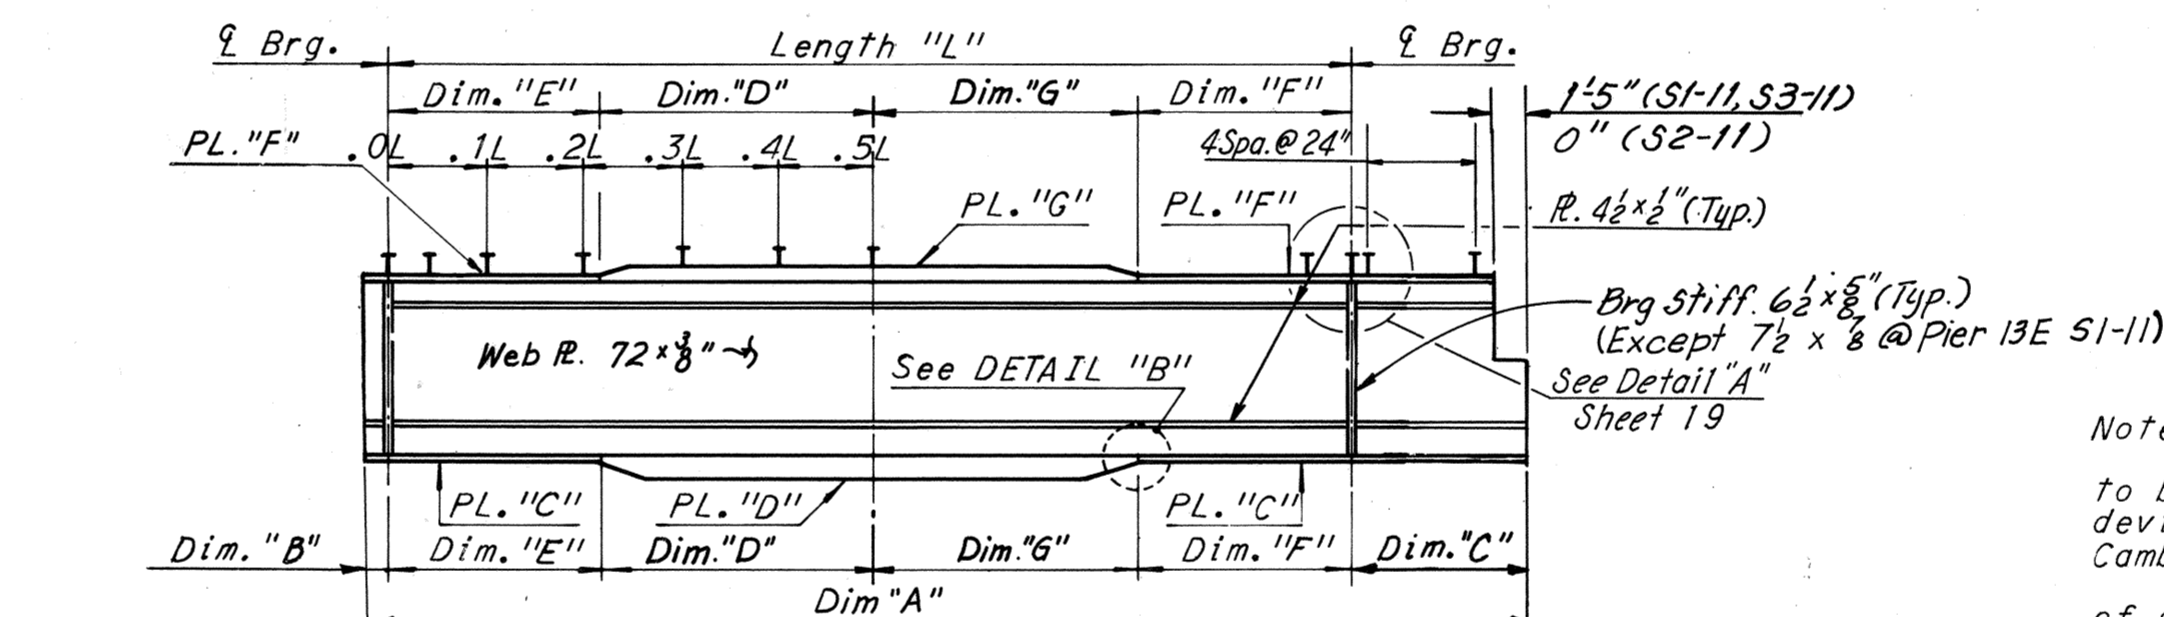

STRINGER ELEVATION
No Scale
(Unit 11)

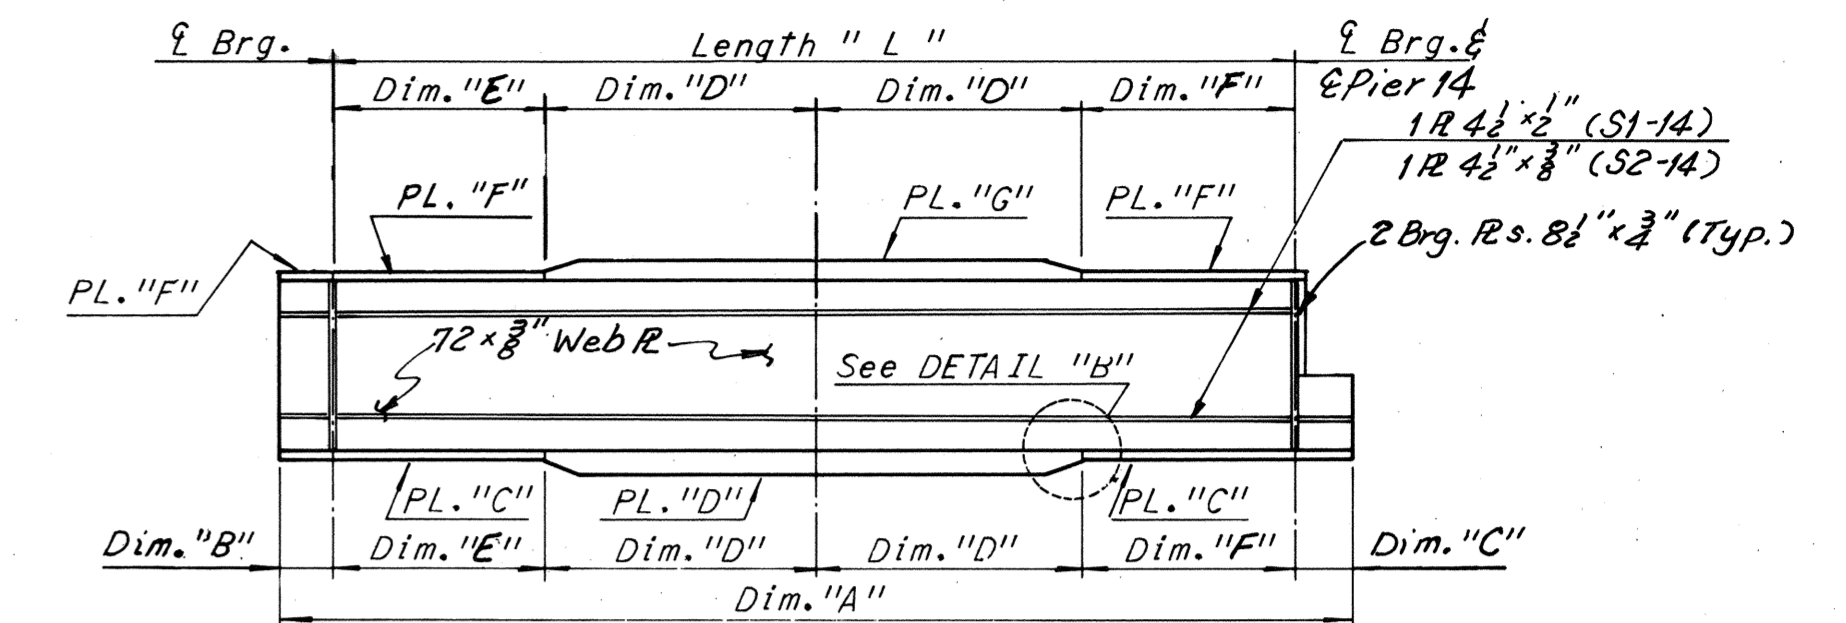


STRINGER ELEVATION
No Scale
(Unit 14)

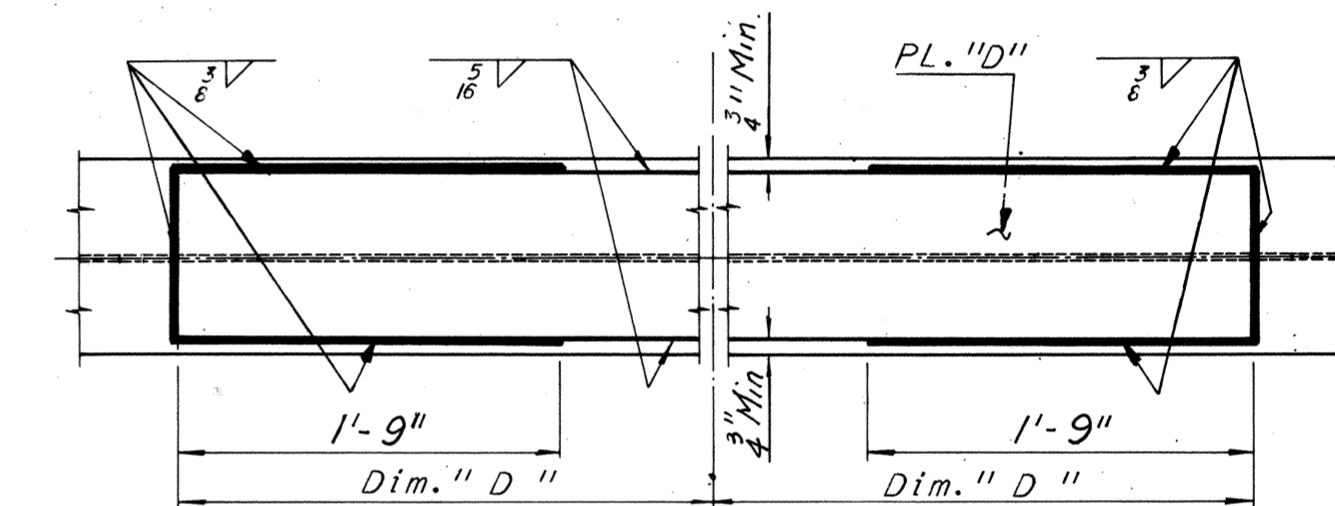

COVER PLATE DETAIL
No Scale

Note:
Stringers having a total camber of less than 1" are not required to be shop cambered, but should be turned so that any mill tolerance deviation from straightness will be in the direction shown by the Camber Diagram.
If stringers are not cambered, distance top of stringers to top of slab will vary along the stringer in accordance with the offset dimensions shown in the Camber Diagram, and with minimum distance as shown in cross-section on Sheet 35.

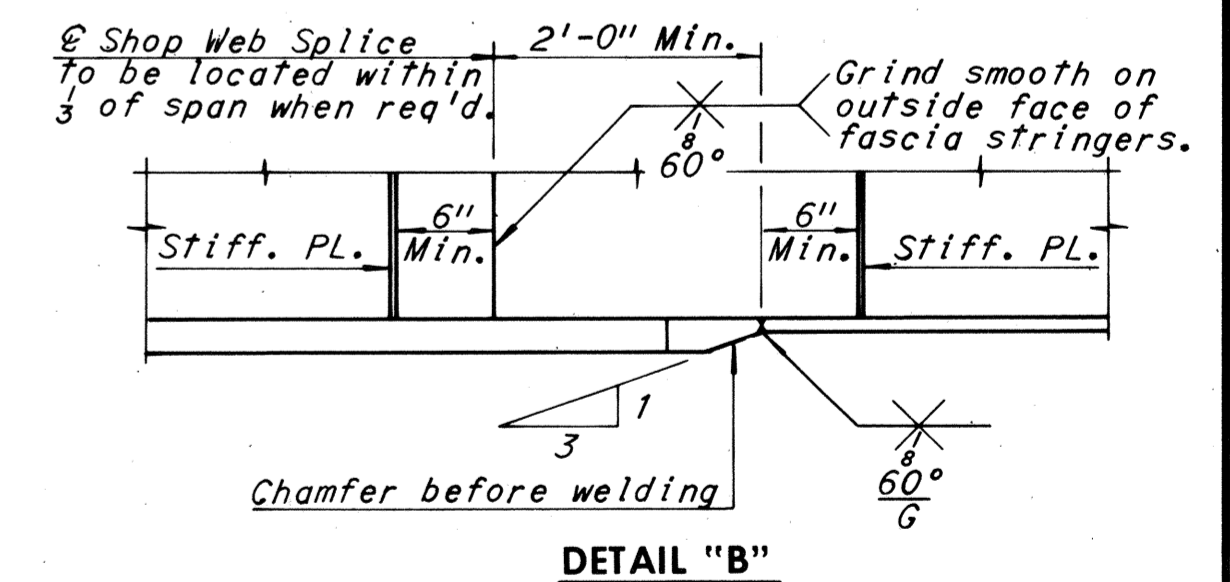

DETAIL "B"
No Scale
NOTE: Web to flange weld size see sheet 20.

UNIT	STRINGER	Dim. "A"	LENGTH "L"	Dim. "B"	Dim. "C"	Dim. "D"	Dim. "E"	Dim. "F"	Dim. "G"	PL. "C"	PL. "D"	PL. "F"	PL. "G"	MAX. SHEAR STUD SPACING					DEAD LOAD DEFLECTION SCHEDULE			CAMBER SCHEDULE			
														0.0L-0.1L*	0.1L-0.2L	0.2L-0.3L	0.3L-0.4L	0.4L-0.5L	1/4L	1/2L	3/4L	1/4L	1/2L	3/4L	
11	S1-11	138'-1 1/2"	126'-11"	7"	10'-7 1/2"	38'-0"	25'-5 1/2"	25'-5 1/2"	38'-0"	16'-1 3/8"	18 x 2"	12 x 1"	16 x 1"	17"	19"	24"	24"	24"	24"	1 1/2	1 3/4	1 1/2	2 3/4	3 3/8	2 9/8
	S2-11	127'-3 3/8"	126'-1 1/2"	7"	7"	31'-6 1/8"	31'-6 1/8"	31'-6 1/8"	31'-6"	14 x 1 1/2"	16 x 2"	12 x 1"	18 x 1"	18"	20 1/2"	24"	24"	24"	24"	1 1/2	2 1/2	1 1/2	2 1/2	4 3/8	3 3/8
	S3-11	136'-5 7/8"	125'-4 1/2"	7"	10'-6 3/8"	37'-8"	25'-0 1/8"	18'-6 1/8"	44'-2"	14 x 1"	14 x 2"	12 x 3/4"	12 x 1 1/2"	22"	24"	24"	24"	24"	24"	1 3/4	2 1/2	1 1/2	2 5/8	4	2 1/2
12	S1-12	66'-9 1/2"	65'-6 1/2"	7"	8"	24'-0"	-	-	-	36W 150	10 1/2 x 3/4"	-	-	8"	9"	11"	12 1/2"	15"	9"	3/4	3/4	3/4	1	1 1/4	1 1/4
	S3-12	66'-5 1/2"	65'-0 1/2"	7"	10"	23'-9"	-	-	-	36W 150	10 1/2 x 3/4"	-	-	10"	11"	14 1/2"	17 1/2"	24"	1 3/4	1 1/2	1 3/4	1	1 1/4	1 1/4	
	S1-13	118'-4 1/2"	116'-7 1/2"	11"	10 1/2"	37'-0"	21'-3 3/8"	21'-3 3/8"	-	18 x 1"	18 x 1 1/2"	18 x 1"	18 x 1 1/2"	-	-	-	-	-	1 3/4	1 3/8	1 3/4	1 3/4	1 3/4	2 3/4	1 3/4
13	S2-13	117'-4 1/2"	115'-6 3/8"	11"	10 1/2"	36'-0"	21'-9 3/8"	21'-9 3/8"	-	18 x 1"	18 x 1 1/2"	18 x 1"	18 x 1 1/2"	-	-	-	-	-	1 1/2	1 1/2	1 1/2	1 1/2	2 1/4	1 1/2	
	S1-14	110'-4 1/2"	108'-0 3/8"	10 1/2"	1'-5 3/8"	35'-0"	19'-0 1/8"	19'-0 1/8"	-	18 x 1"	18 x 1 1/2"	18 x 1"	18 x 1 1/2"	-	-	-	-	-	1	1 3/8	1	1 1/2	1 3/4	1 3/4	
	S2-14	109'-10 3/8"	107'-6 1/2"	10 1/2"	1'-5 3/8"	35'-0"	18'-9 1/4"	18'-9 1/4"	-	18 x 1"	18 x 1 1/2"	18 x 1"	18 x 1 1/2"	-	-	-	-	-	7/8	1 1/2	7/8	1 1/4	1 3/8	1 1/2	
14	S1-15	50'-1 1/2"	48'-11 3/8"	3 1/2"	10"	-	-	-	-	36W 150	-	-	-	-	-	-	-	-	5/8	7/8	5/8	3/4	1/2	3/8	
	S2-15	49'-8 1/2"	48'-9 3/8"	3 1/2"	8"	-	-	-	-	36W 150	-	-	-	-	-	-	-	-	5/8	3/8	5/8	5/8	1/2	5/8	

* Spacing begins at termination of 6 spaces @ 4".

NOTE:
All steel shall be A36 unless otherwise shown.
Longitudinal stiffeners of exterior stringer shall be located on the exterior face of the stringer.

BY	DATE	REVISION	DATE
MADE	K.C.P. 2-26-69	2 As Built	TEM 6-77
CHECKED	K.C.T. 4-28-69		
IN CHARGE			

AS BUILT










RICHMOND METROPOLITAN AUTHORITY
RICHMOND EXPRESSWAY SYSTEM
DOWNTOWN EXPRESSWAY

BRIDGE NO. 67
RAMP W-N CONNECTION TO
RICHMOND-PETERSBURG TURNPIKE
FRAMING PLAN - UNITS 11,12,13,14 AND 15

HOWARD, NEEDLES, TAMMEN & BERGENDOFF
consulting engineers
NEW YORK ALEXANDRIA KANSAS CITY

SCALE: No Scale
CONTRACT NO.: 10
SHEET NO. 27 OF 54

RICHMOND EXPRESSWAY SYSTEM			
SECTION	PROJECT	SHEET NO.	TOTAL SHEETS
10	DOWNTOWN EXPRESSWAY	200	265

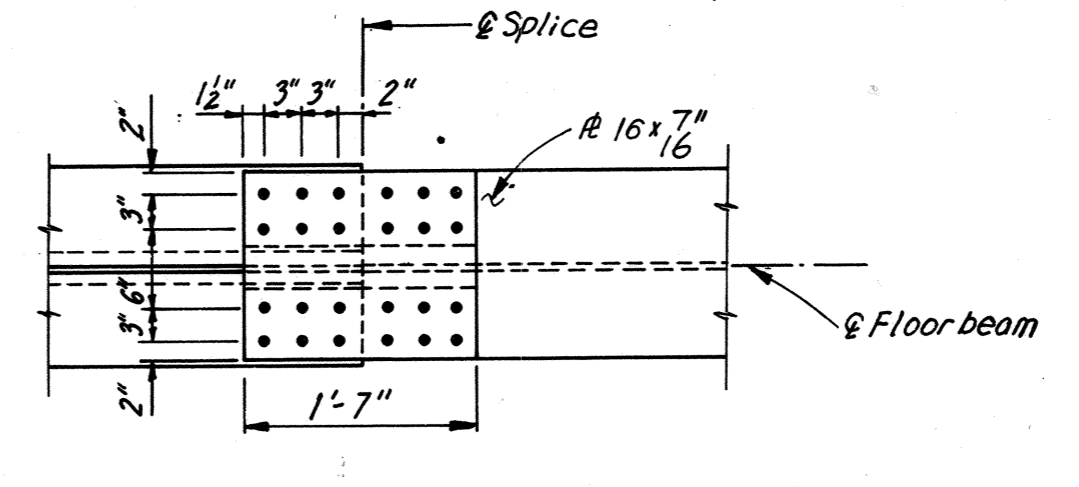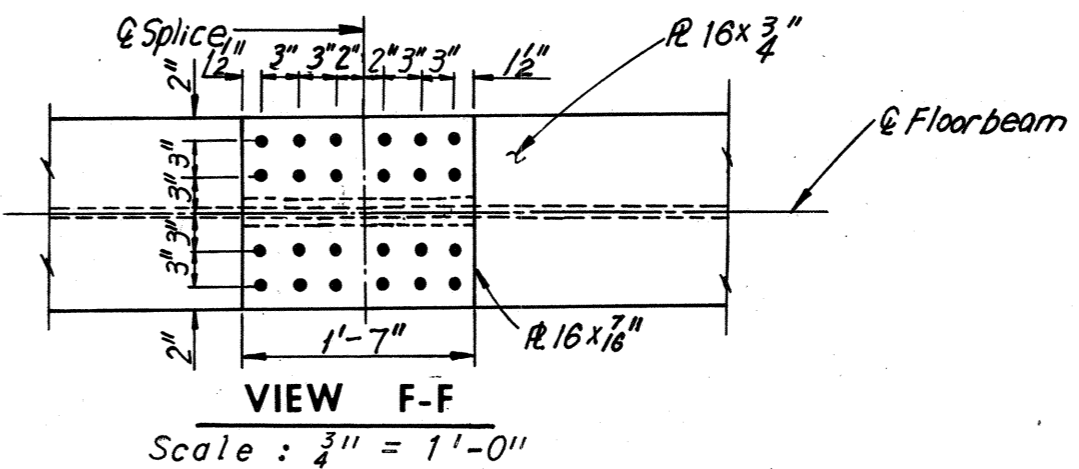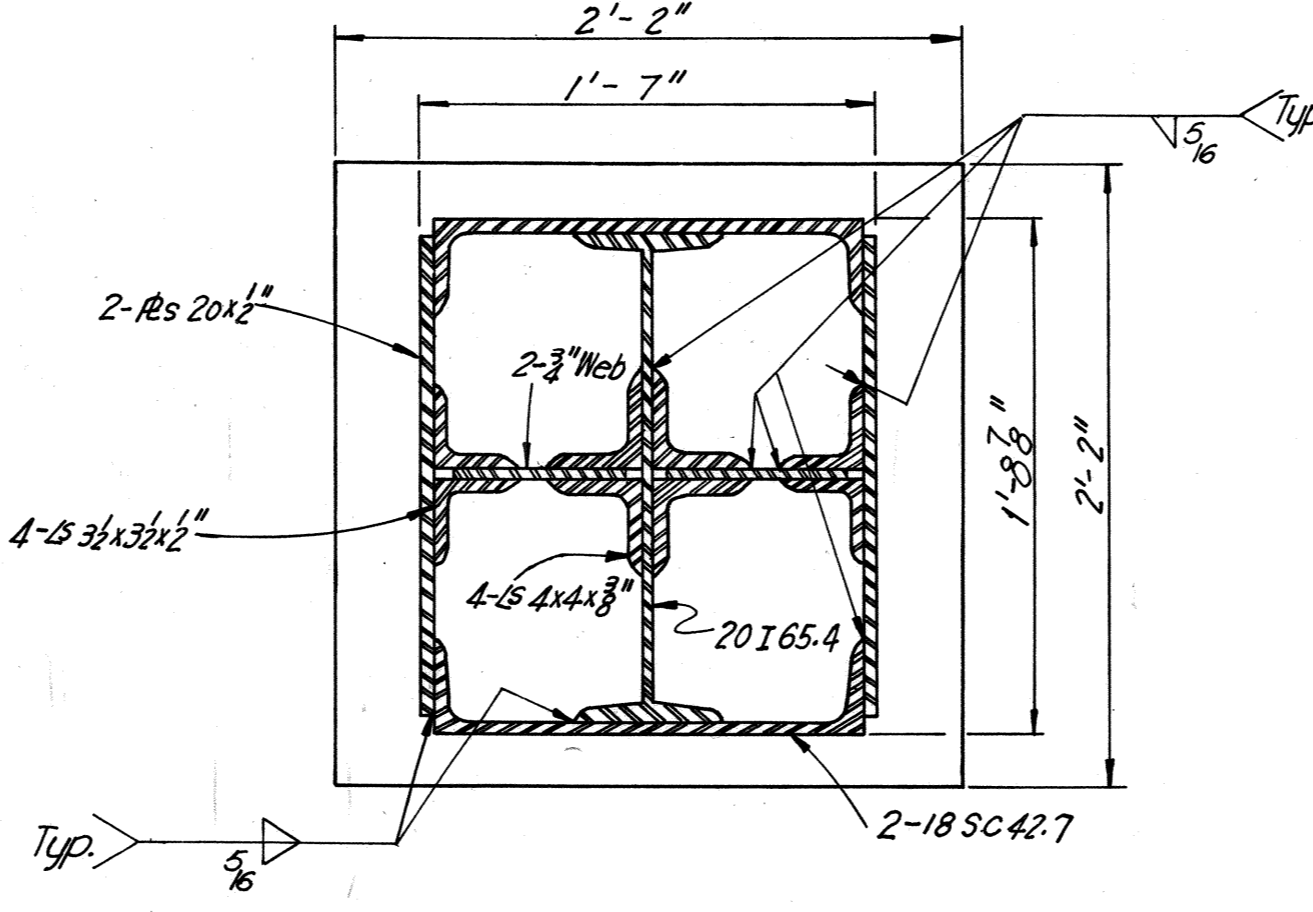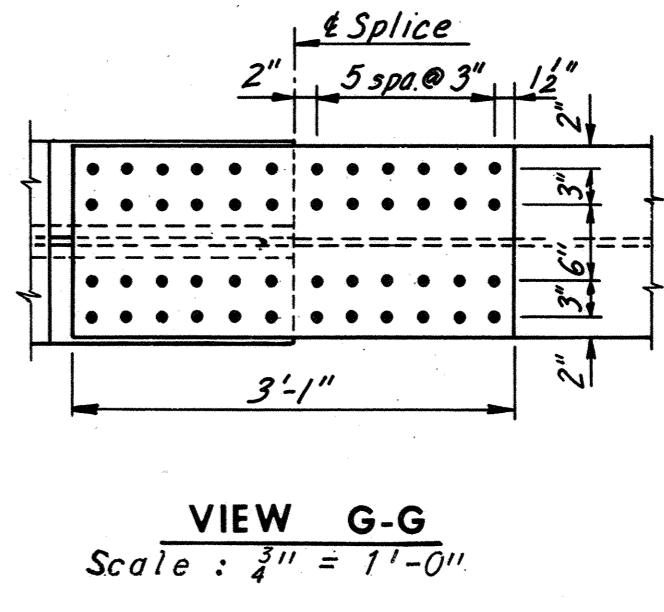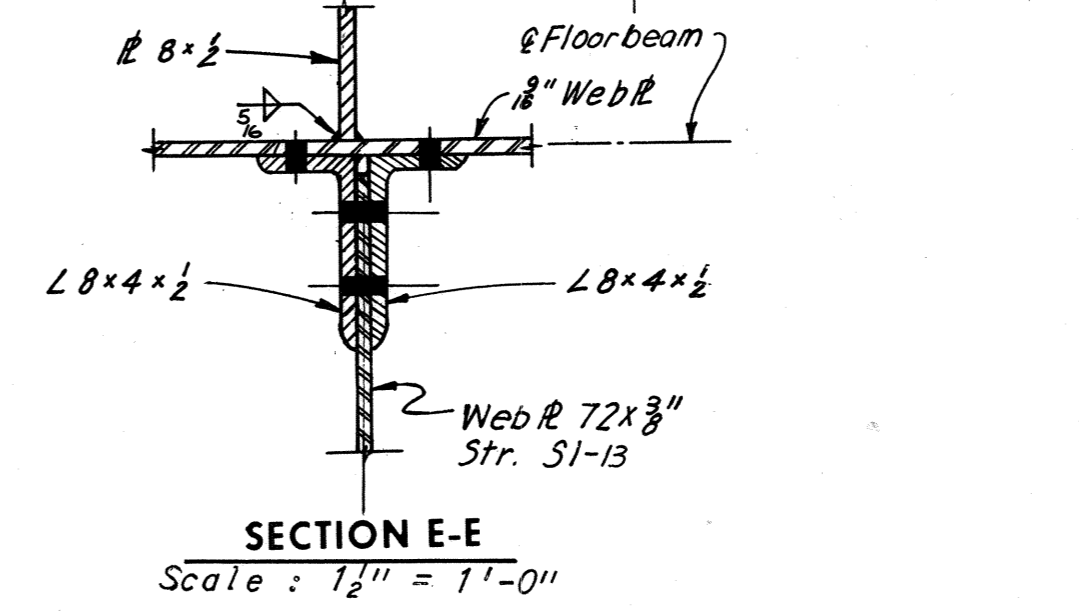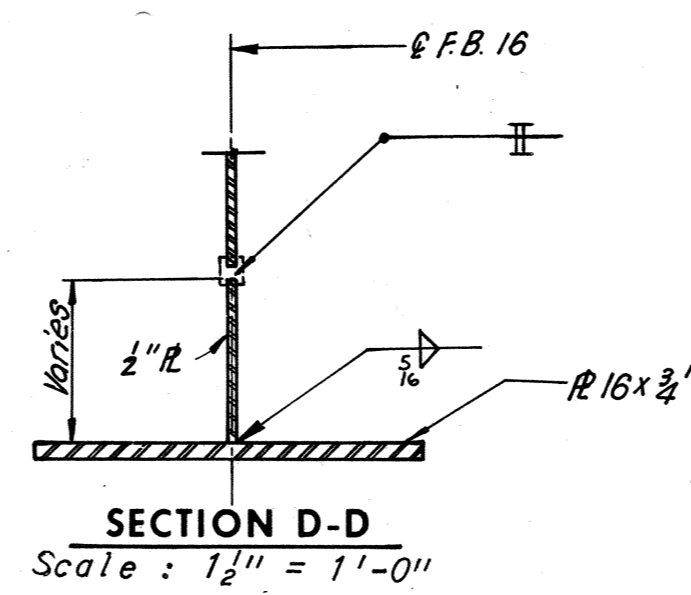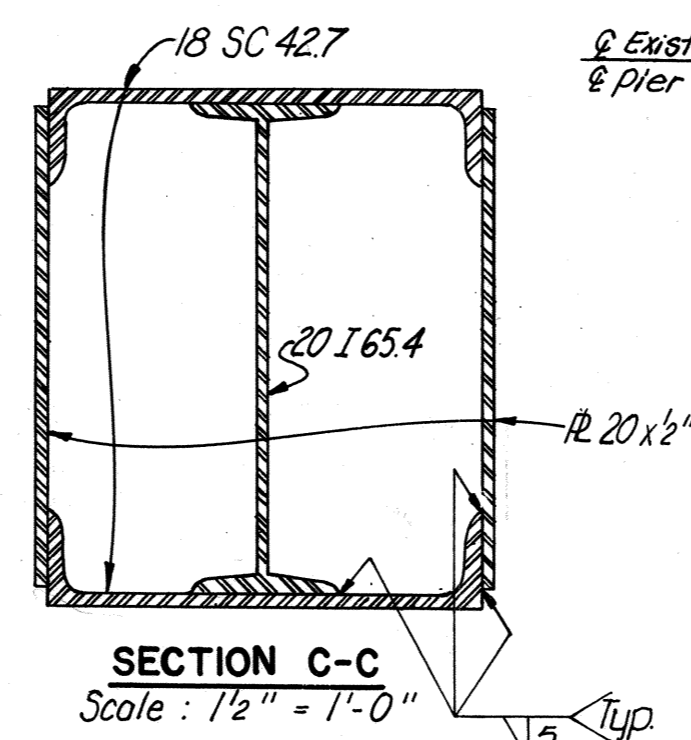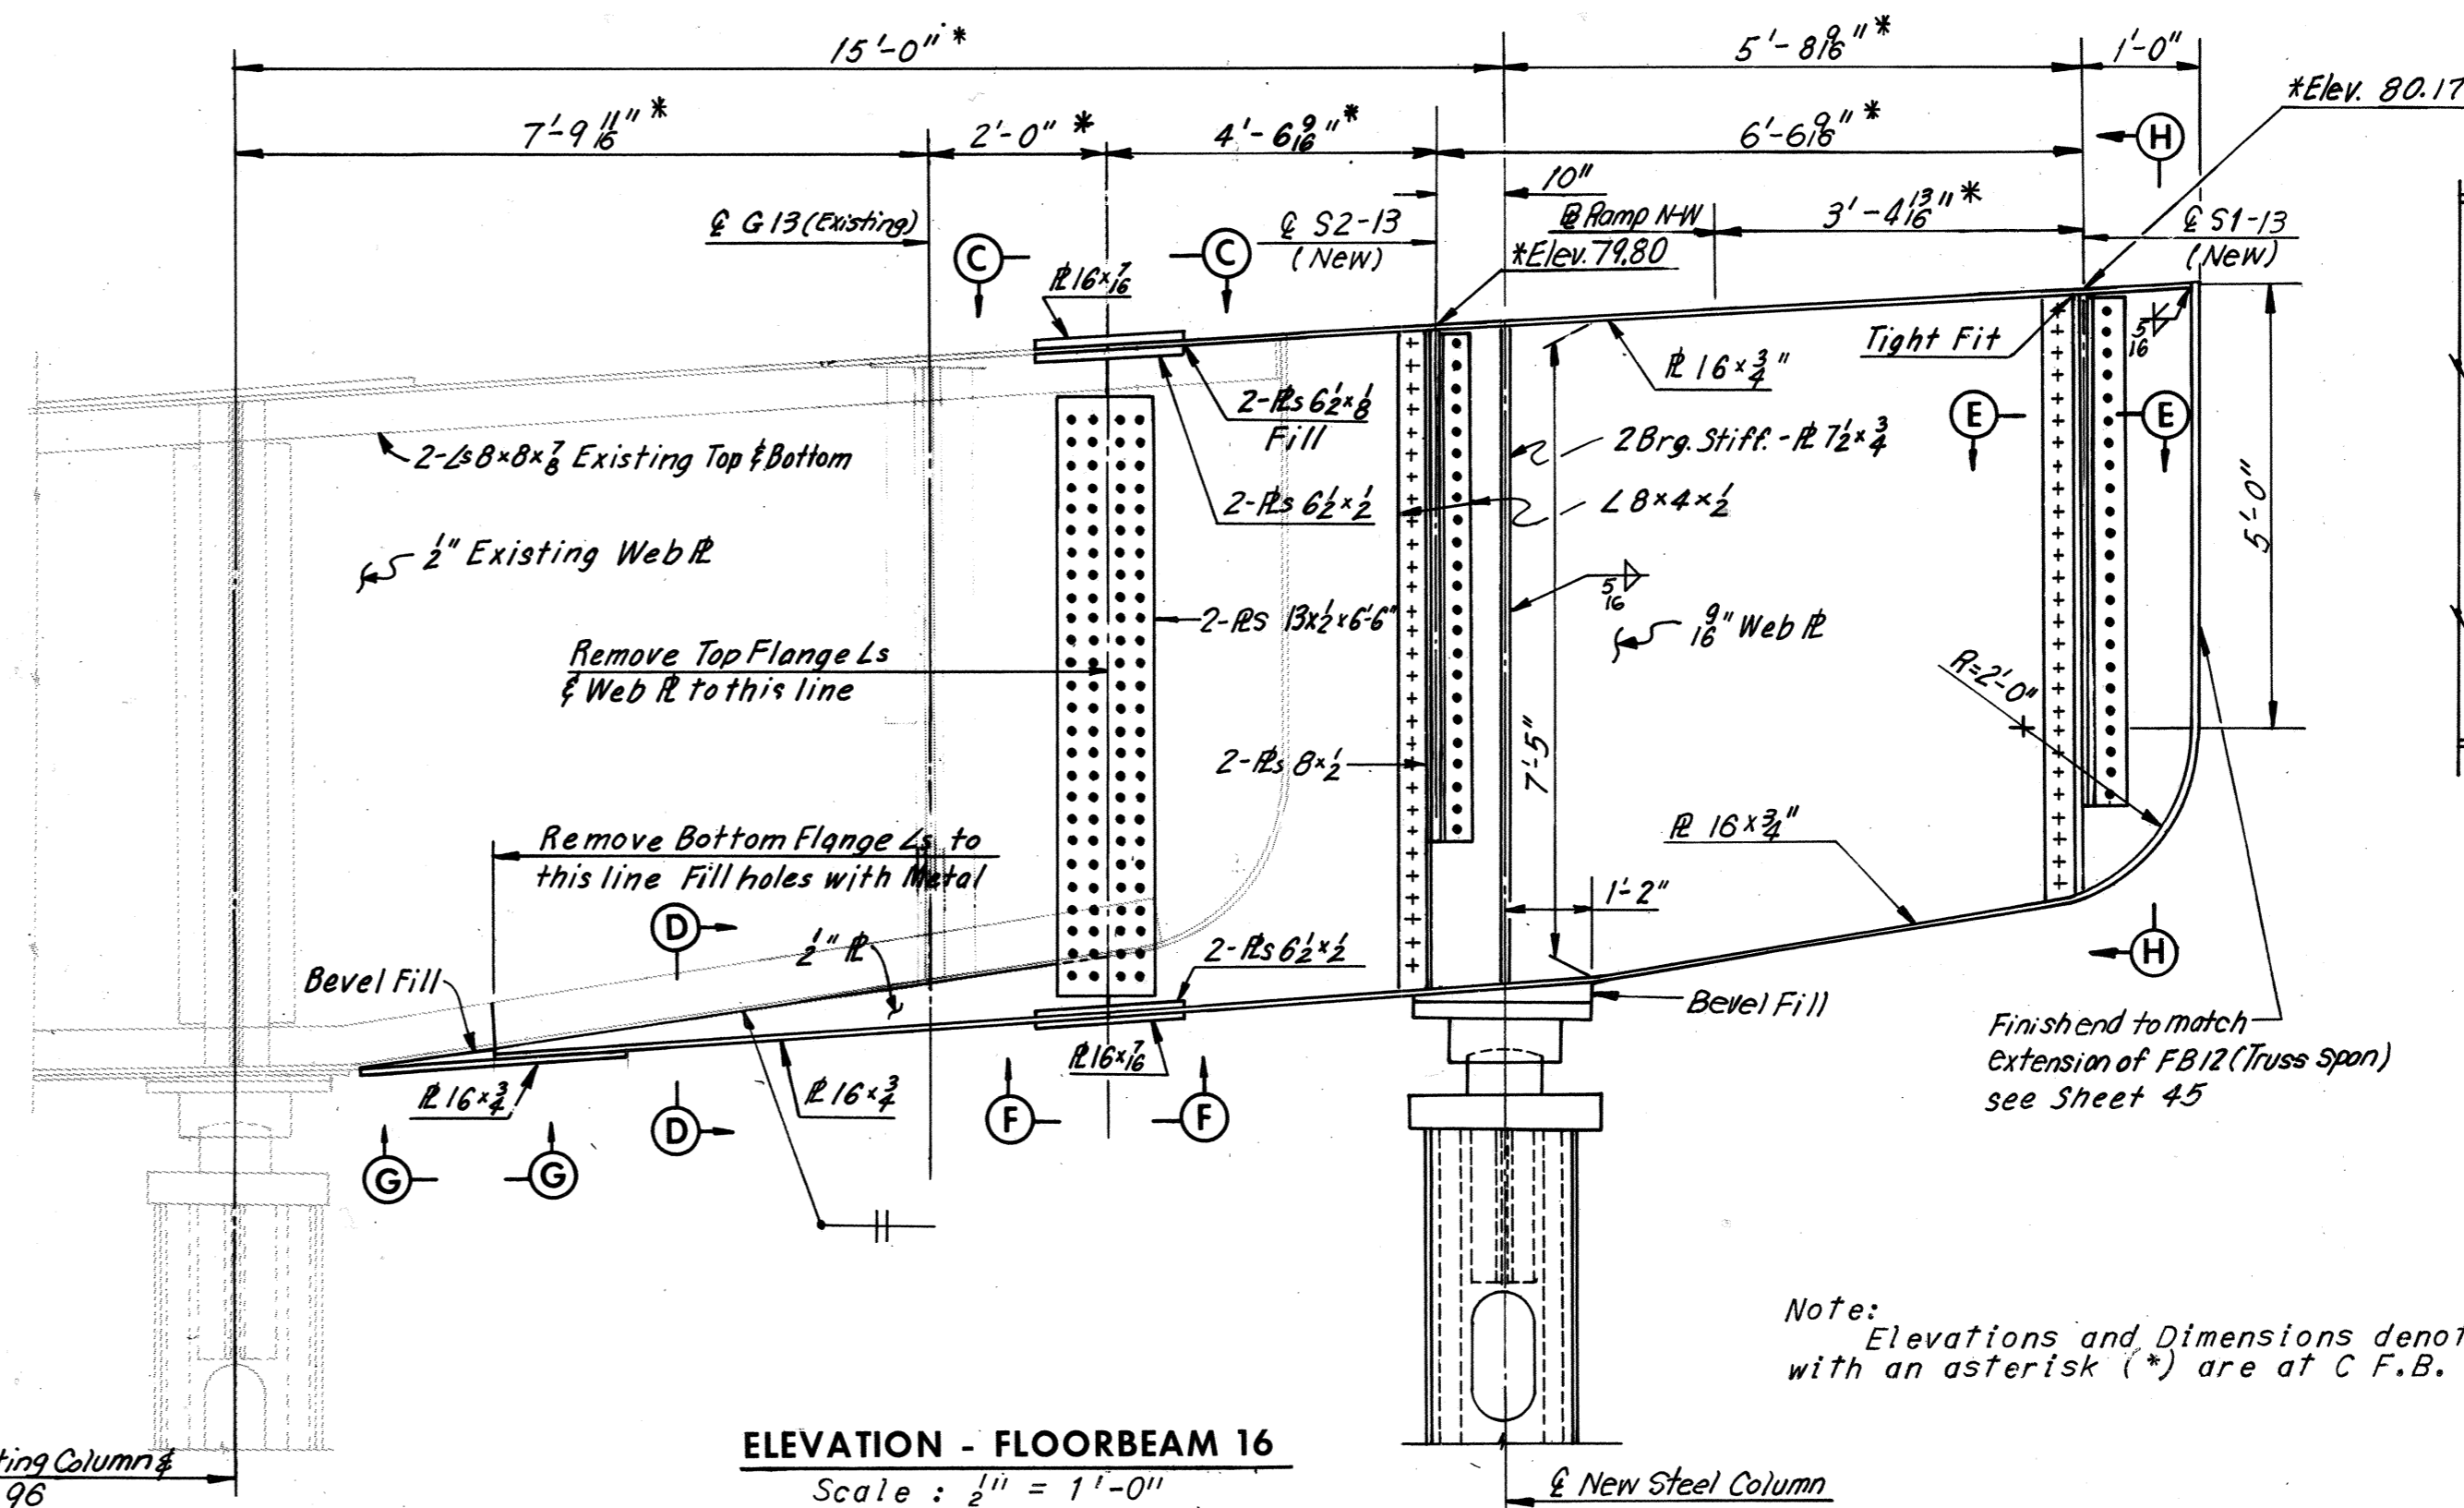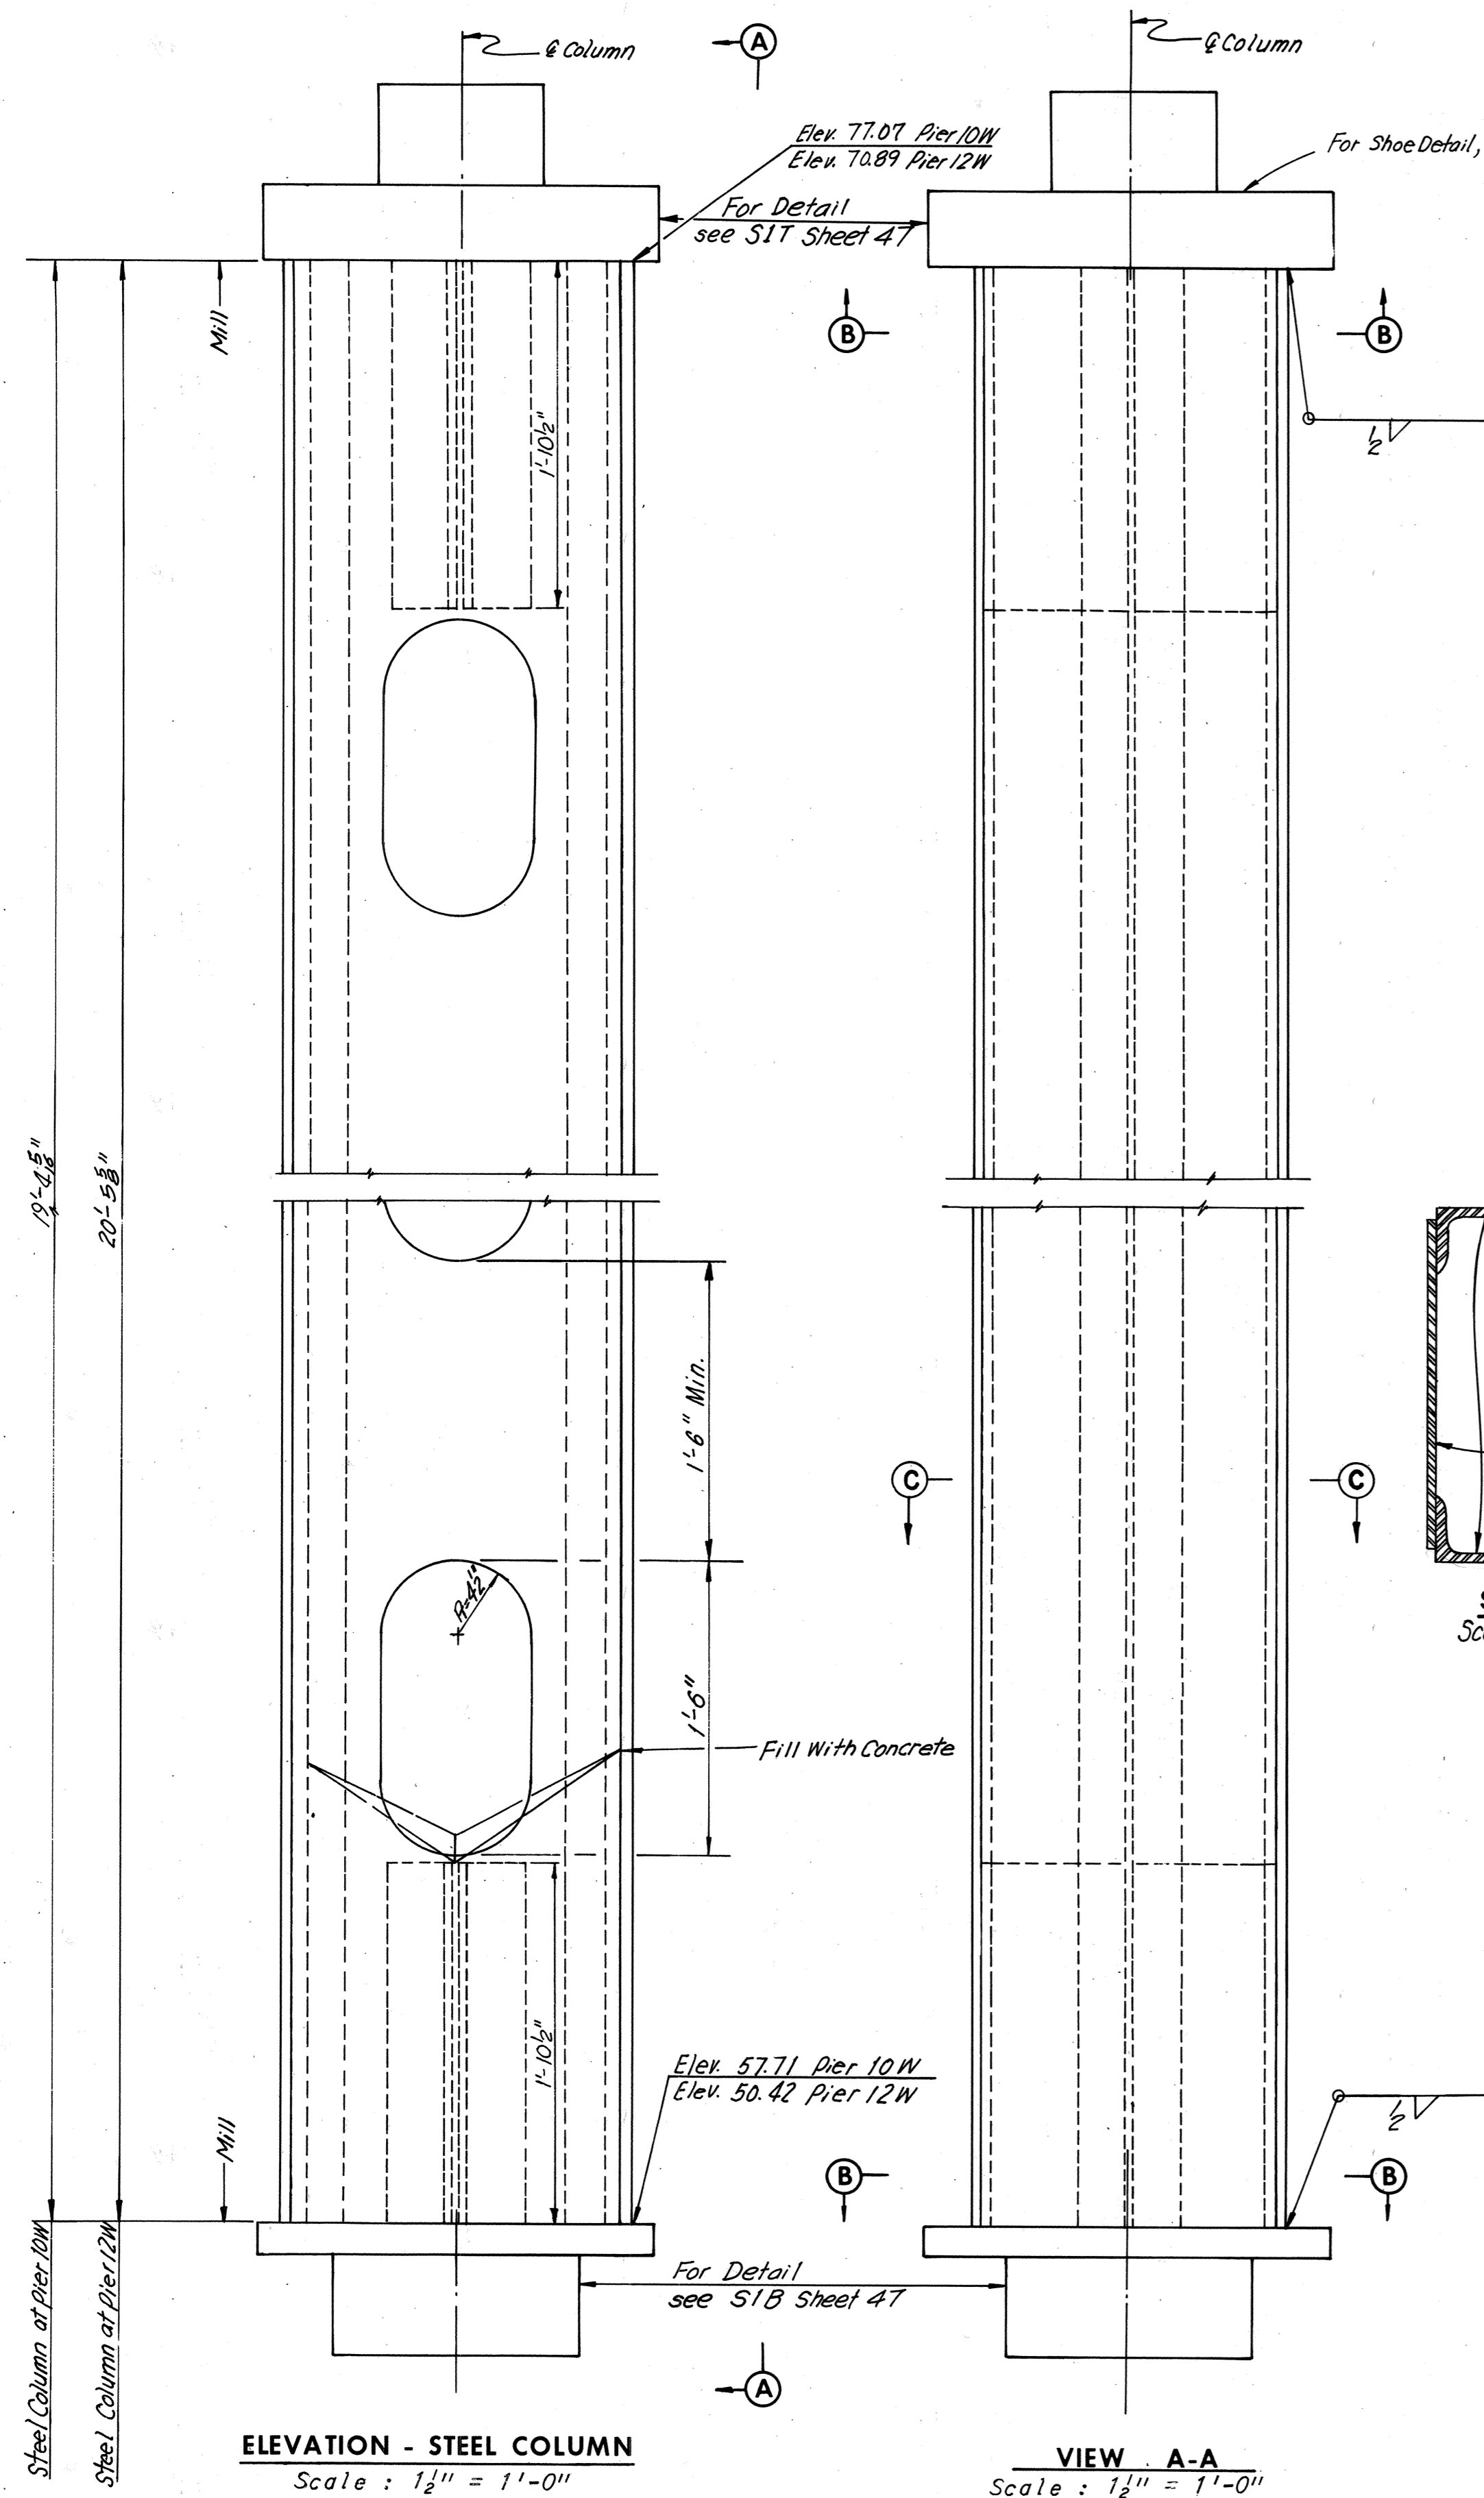

SECTION H-H
Scale: 1/2" = 1'-0"

Note: Elevations and Dimensions denoted with an asterisk (*) are at C.F.B. 16.

NO.	REVISION	BY	DATE
3	As Built	TEM	6-77
	Revised Elev.	RJP	1-24-75
	Bolts Deleted	T.E.M.	10-74
	Webbed Corn.		

RICHMOND METROPOLITAN AUTHORITY
RICHMOND EXPRESSWAY SYSTEM
DOWNTOWN EXPRESSWAY

BRIDGE NO. 67
RAMP W-N CONNECTION TO
RICHMOND-PETERSBURG TURNPIKE
FLOORBEAM 16 AND STEEL COLUMNS






HOWARD, NEEDLES, TAMMEN & BERGENDOFF
consulting engineers
NEW YORK ALEXANDRIA KANSAS CITY

SCALE: *As Noted*
CONTRACT NO.: 10
SHEET NO. 28 OF 54

AS BUILT

RICHMOND EXPRESSWAY SYSTEM			
SECTION	PROJECT	SHEET NO.	TOTAL SHEETS
'0	DOWNTOWN EXPRESSWAY	201	265

ELEVATION TABLE			
STATION	ELEV. A	ELEV. B	ELEV. C
343+80.00	92.86	93.07	94.36
90.00	92.66	92.87	94.16
90.43	92.65	92.86	94.15
91.86	92.61	92.82	94.11
344+00.00	92.40	92.61	93.90
10.00	92.09	92.30	93.59
20.00	91.73	91.94	93.28
30.00	91.32	91.53	92.82
40.00	90.86	91.07	92.36
50.00	90.34	90.55	91.84
60.00	89.79	90.00	91.29
70.00	89.26	89.47	90.76
80.00	88.72	88.93	90.22
90.00	88.14	88.35	89.64
345+00.00	87.55	87.76	89.05
04.50	87.28	87.49	88.72
10.00	86.94	87.15	88.44
20.00	86.35	86.56	87.85
30.00	85.75	85.96	87.25
40.00	85.17	85.38	86.67
50.00	84.58	84.79	86.08
60.00	84.02	84.23	85.52
70.00	83.46	83.67	84.96
80.00	82.90	83.11	84.40
90.00	82.34	82.55	83.84
346+00.00	81.78	81.99	83.28
10.00	81.22	81.43	82.72
15.00	80.94	81.15	82.44
20.00	80.66	80.87	82.16

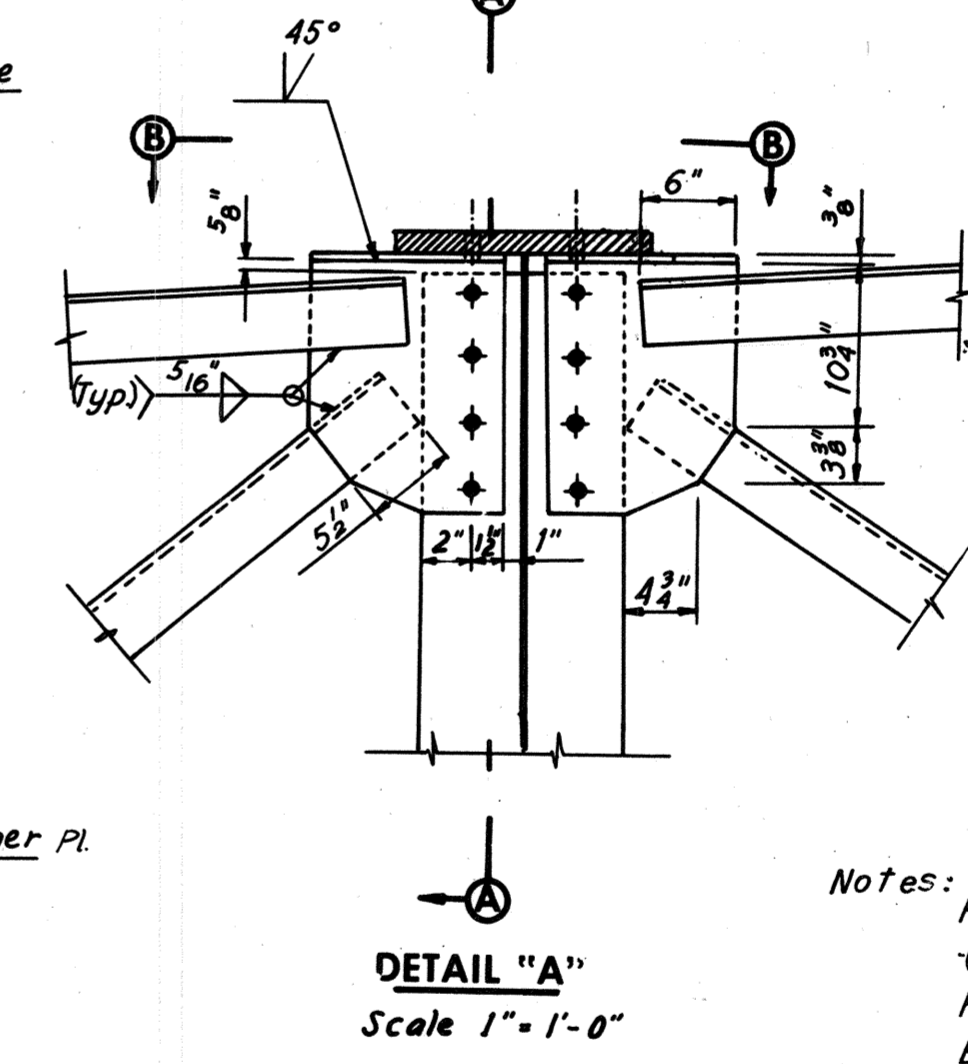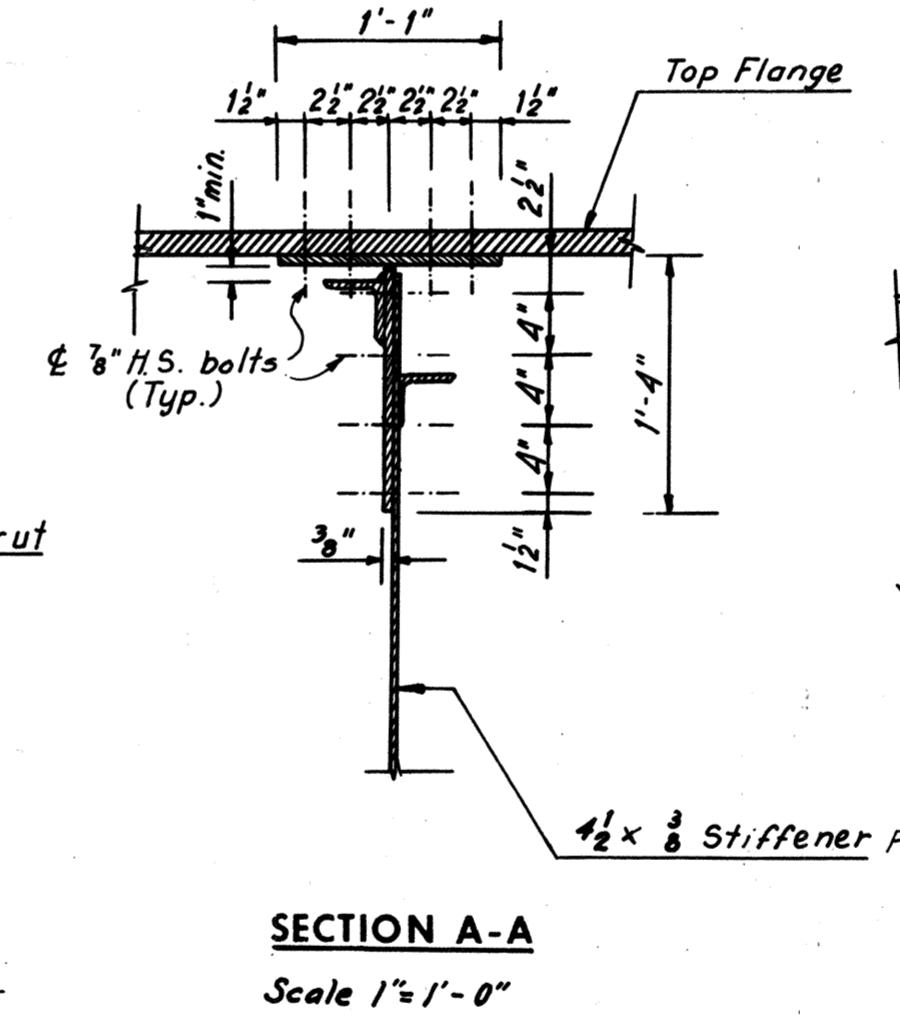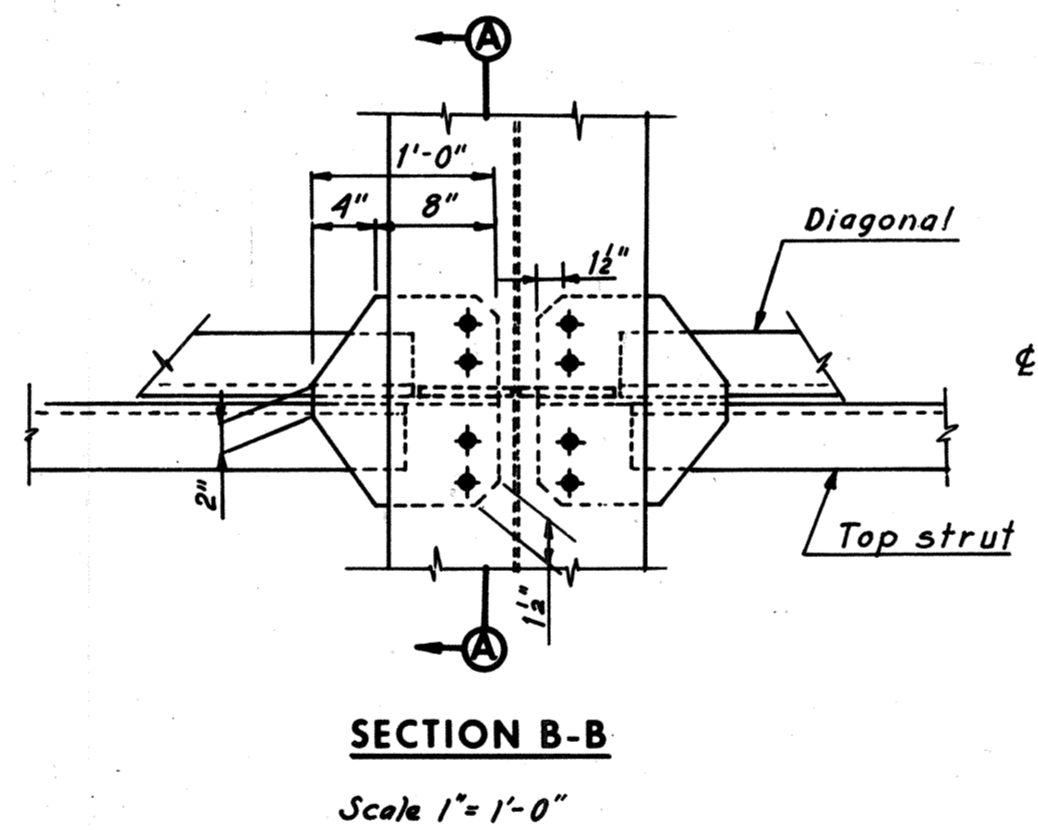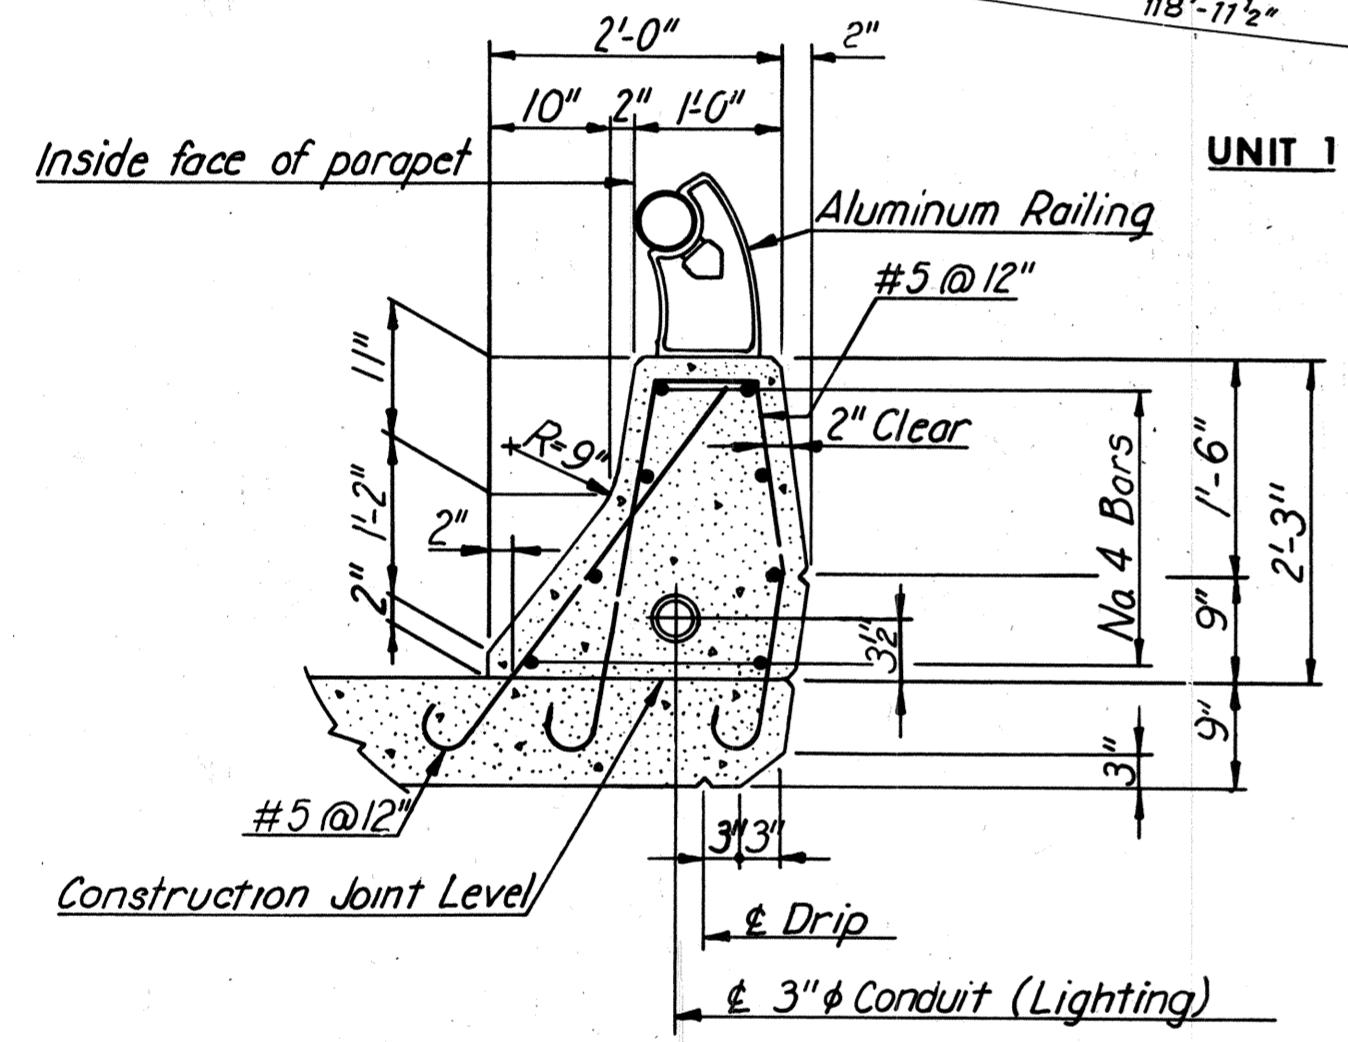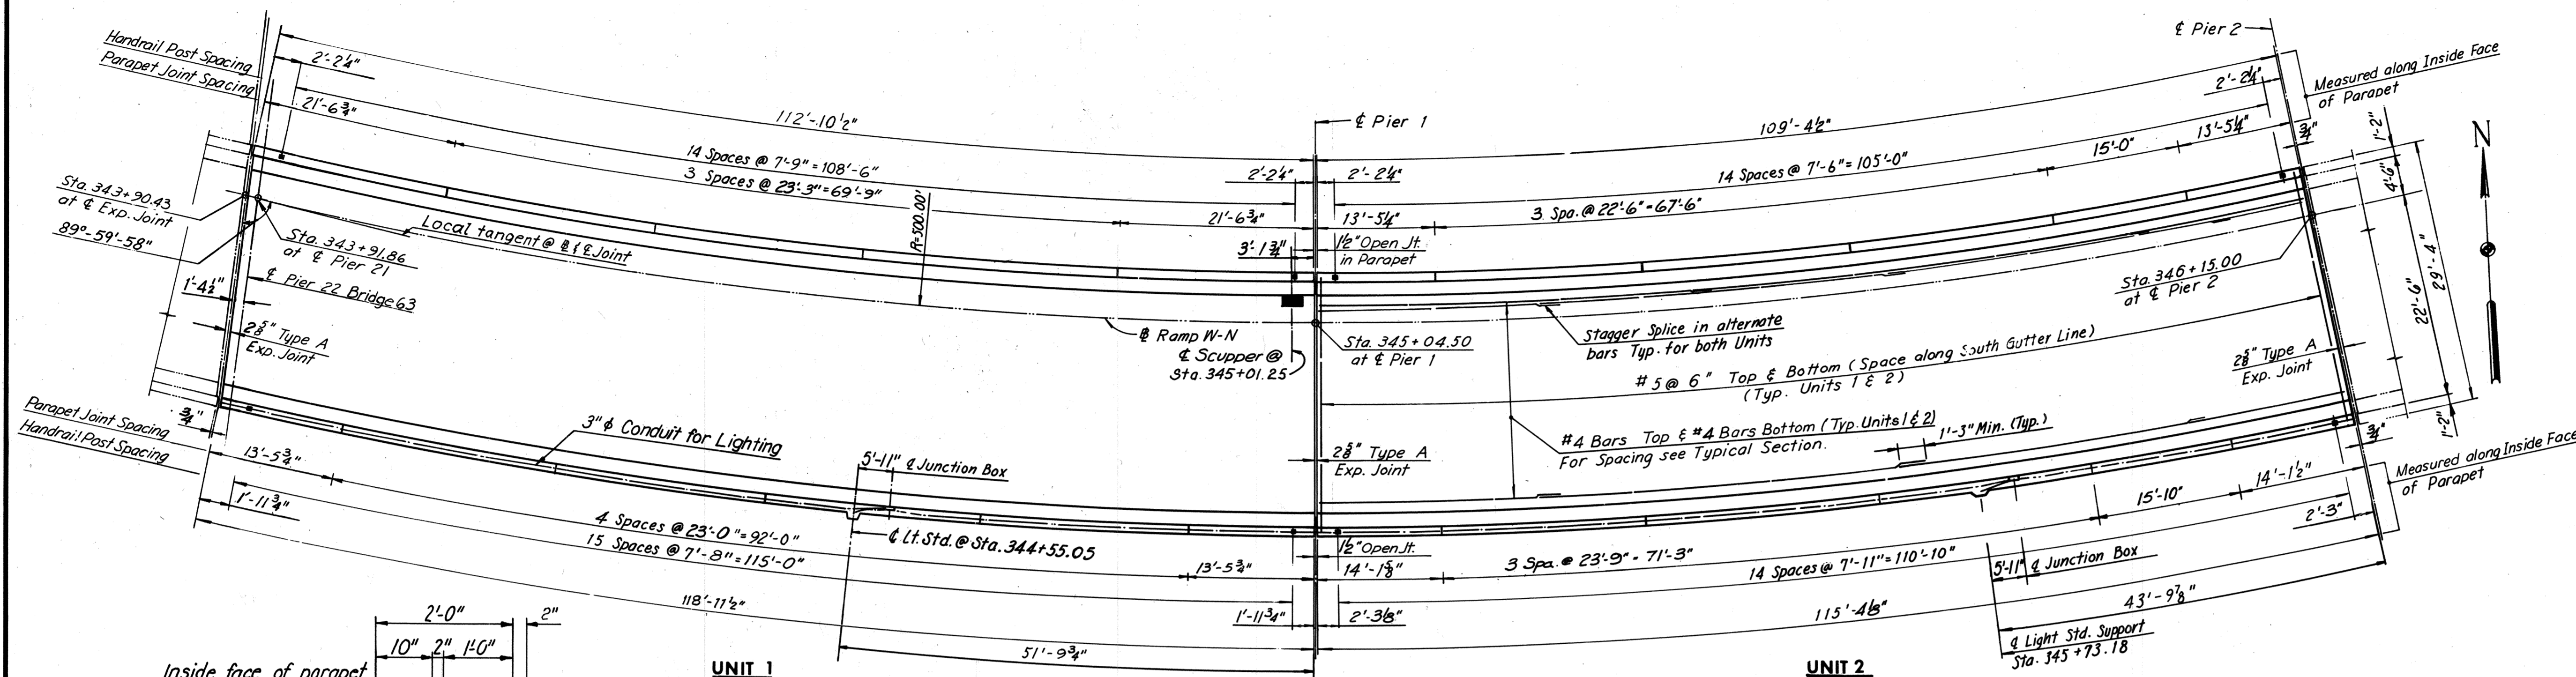



TYPICAL PARAPET DETAIL
Scale: 3/4"=1'-0"

SECTION B-B
Scale: 1"=1'-0"

SECTION A-A
Scale: 1"=1'-0"

DETAIL 'A'
Scale: 1"=1'-0"

Notes:
 For Layout of Pier 21 see Sheet 2 of Bridge #65 (Ramp S-W).
 For Framing Details of Pier 21 see Sheet 20 of Bridge #66 (E.B. Roadway).
 Piers 1 and 2 both are radial to @ Ramp N-W (Curve NW-1).
 For intermediate diaphragm and transverse stiffener spacing see Sheet 19.
 For Handrail Details see Sheet 53.
 For Lighting Details see Sheet 54.
 For Standard Drainage Details see Support Type 3 Sheet 56.
 For Joint Details see Sheet 48.

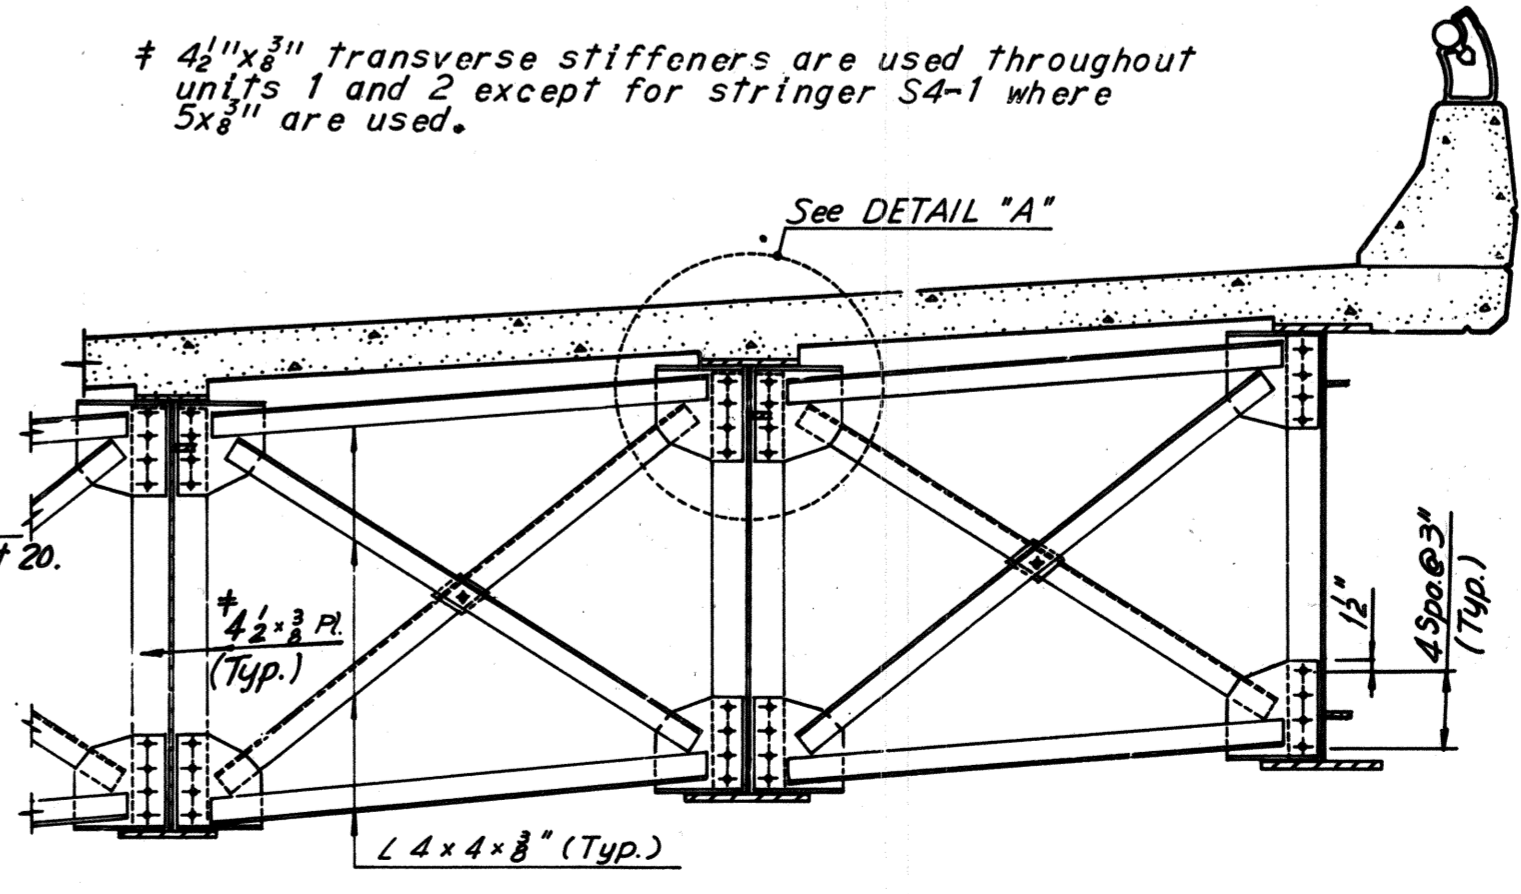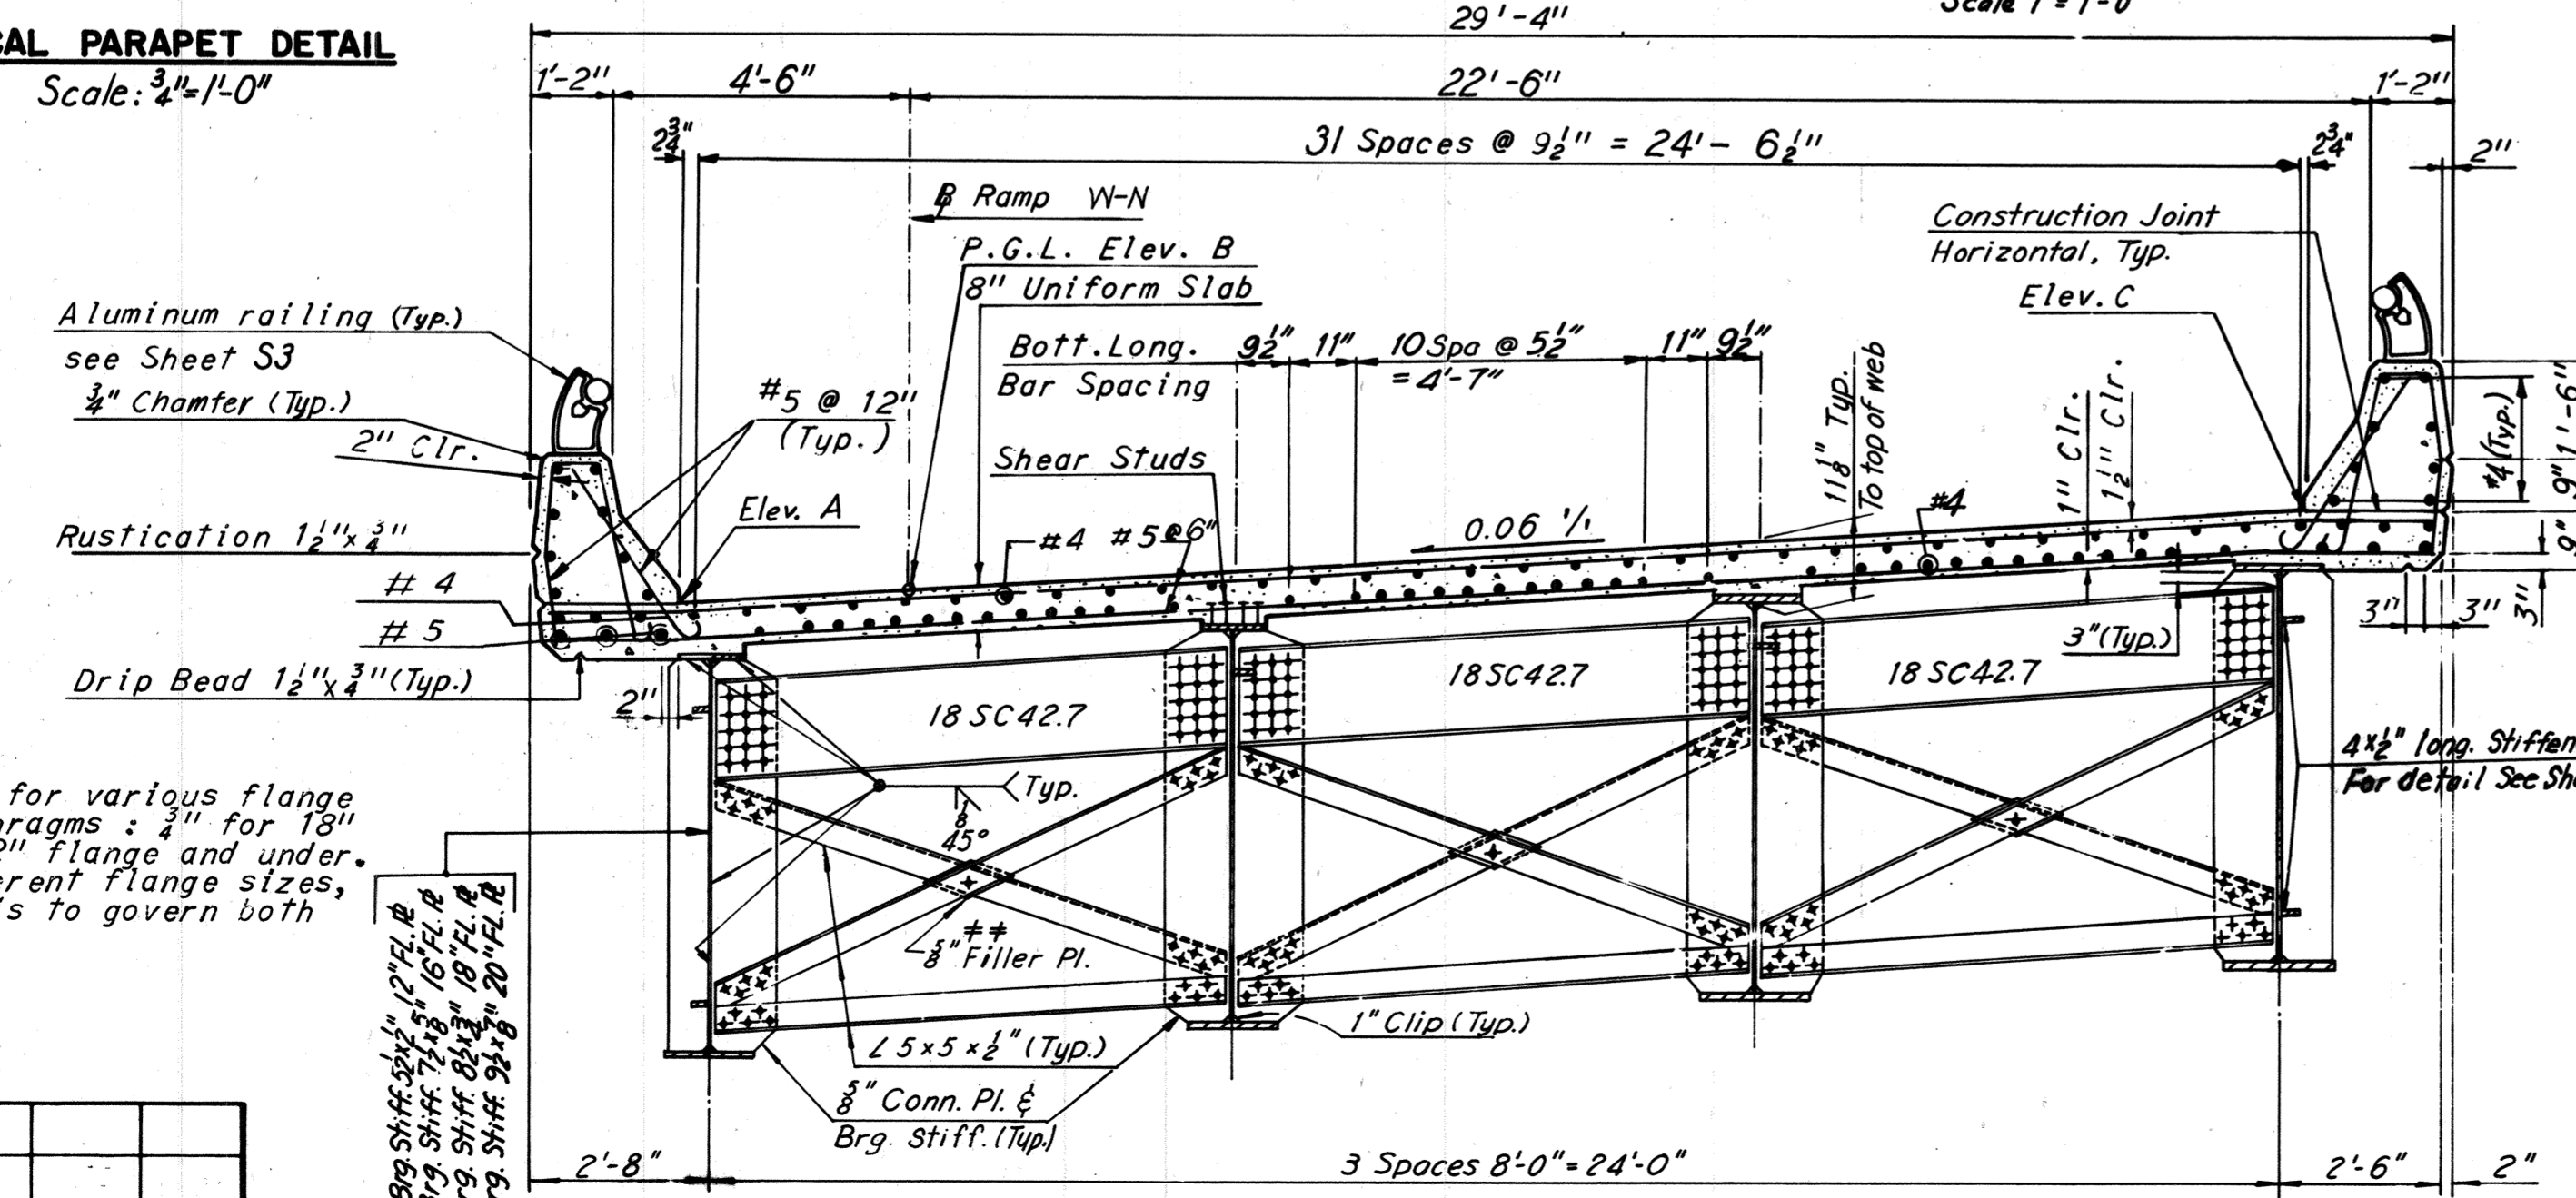

TYPICAL SECTION-END DIAPHRAGM
Scale: 3/8"=1'-0"

INTERMEDIATE DIAPHRAGM
Scale: 3/8"=1'-0"

AS BUILT

** The following conn. & thickness for various flange sizes shall be used at end diaphragms: 3/4" for 18" flange, 5/8" for 15" and 2" for 12" flange and under. In bays where girders have different flange sizes, the conn. & for the bigger one is to govern both conn. &'s.

BY	DATE	NO.	REVISION	BY	DATE
MADE	M.H.H. 8-17-68				
CHECKED	S.C.C. 11-4-68	1	As Built	TEM	G-77
IN CHARGE					

RICHMOND METROPOLITAN AUTHORITY
RICHMOND EXPRESSWAY SYSTEM
DOWNTOWN EXPRESSWAY


BRIDGE NO. 67
 RAMP W-N CONNECTION TO
 RICHMOND-PETERSBURG TURNPIKE
 DECK PLAN - UNITS 1 AND 2

HOWARD, NEEDLES, TAMMEN & BERGENDOFF
 consulting engineers
 NEW YORK ALEXANDRIA KANSAS CITY

SCALE: As Noted
 CONTRACT NO.: 10
 SHEET NO. 29 OF 54

RICHMOND EXPRESSWAY SYSTEM			
SECTION	PROJECT	SHEET NO.	TOTAL SHEETS
10	DOWNTOWN EXPRESSWAY	202	265

ELEVATION TABLE			
STATION	ELEV. A	ELEV. B	ELEV. C
346+10.00	81.22	81.43	82.72
+15.00	80.94	81.15	82.44
+20.00	80.66	80.87	82.16
+30.00	80.10	80.31	81.60
+40.00	79.54	79.75	81.04
+50.00	78.98	79.19	80.48
+60.00	78.42	78.63	79.92
+70.00	77.86	78.07	79.36
+80.00	77.30	77.51	78.80
347+00.00	76.18	76.39	77.68
+10.00	75.64	75.85	77.14
+20.00	75.15	75.36	76.65
+25.50	74.89	75.10	76.39
+30.00	74.69	74.90	76.19
+40.00	74.29	74.50	75.79
+50.00	73.92	74.13	75.42
+60.00	73.60	73.81	75.10
+70.00	73.32	73.53	74.82
+80.00	73.08	73.29	74.58
+90.00	72.89	73.10	74.39
348+00.00	72.74	72.95	74.24
+10.00	72.63	72.84	74.13
+20.00	72.57	72.78	74.07
+30.00	72.55	72.76	74.05
+33.00	72.55	72.76	74.05
+40.00	72.57	72.78	74.07

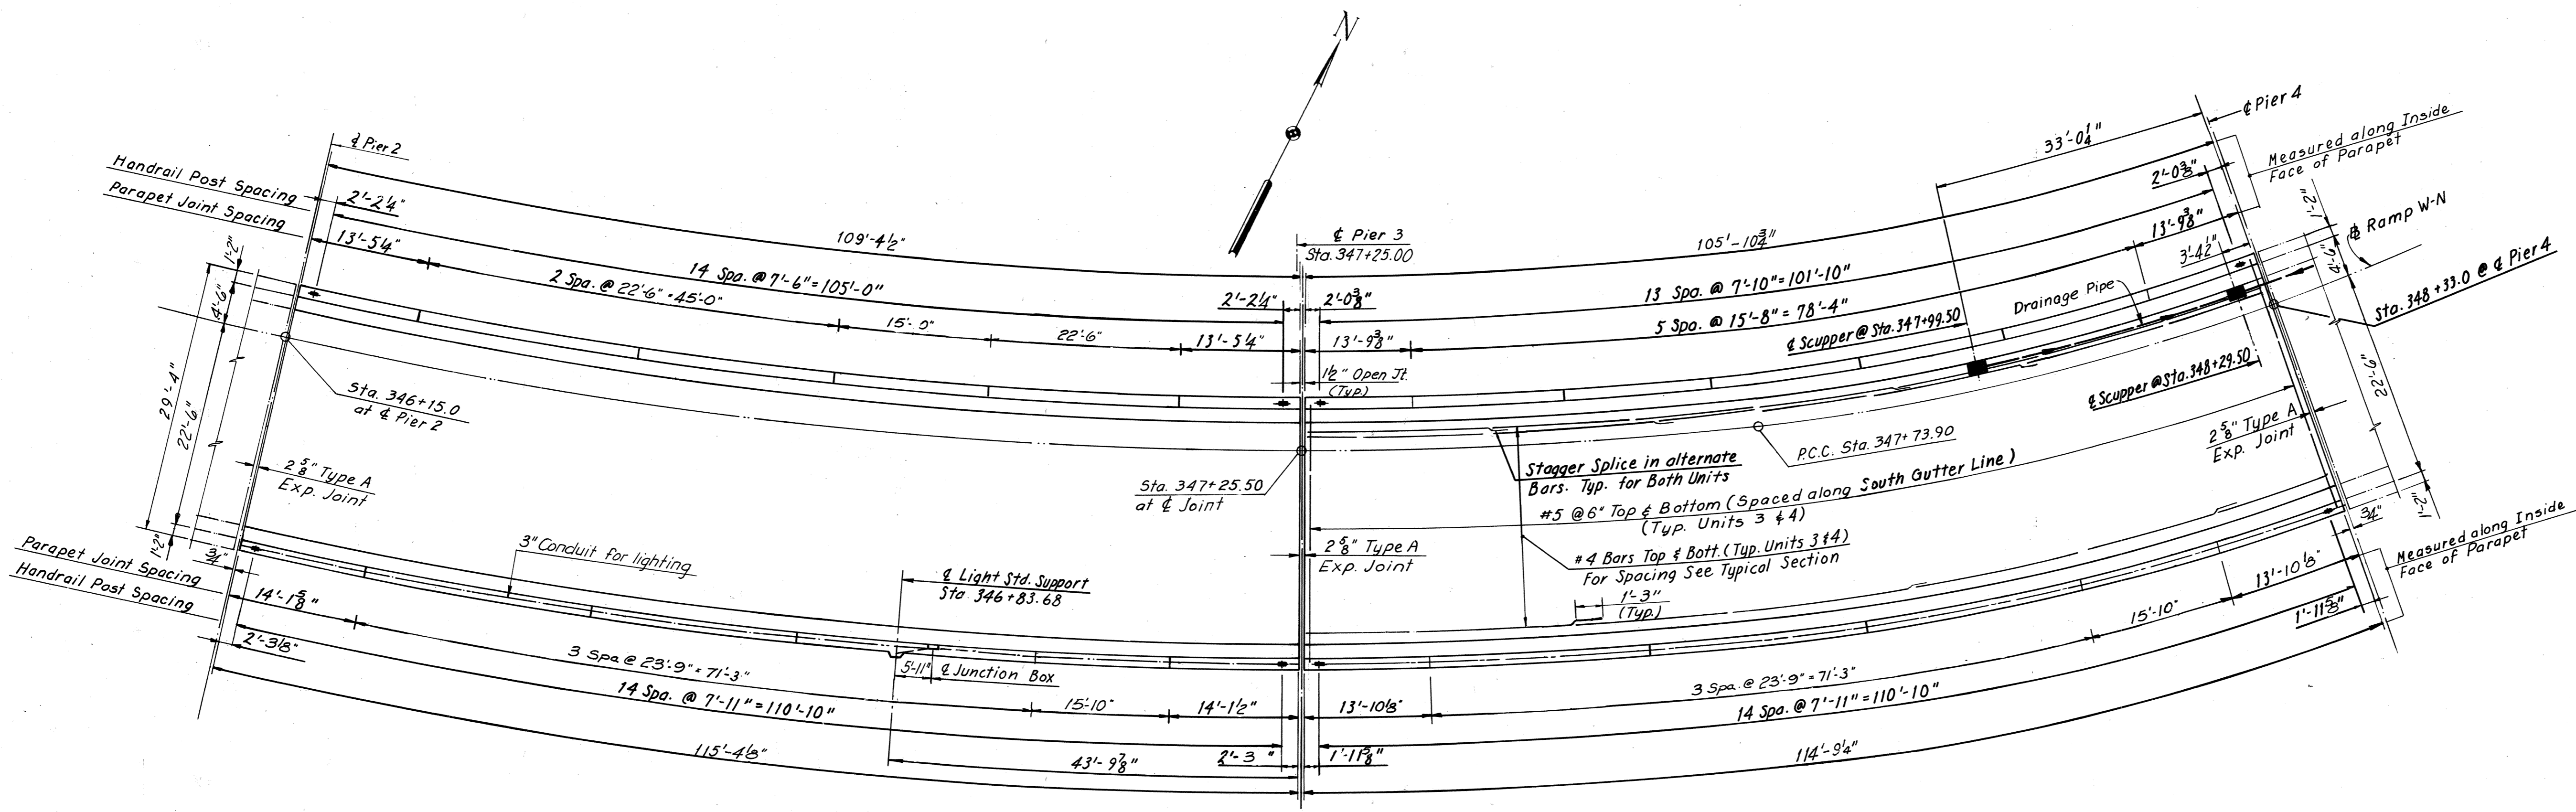


UNIT 3

UNIT 4


DECK PLAN
Scale: 1"=10'-0"

Notes:
 Piers 2, 3 and 4 are all radial to Ramp W-N (Curves WN-1 and WN-2).
 For intermediate diaphragm and transverse stiffener spacing see Sheet 20.
 For Details of diaphragm connections to top and bottom flanges of stringers see Sheet 29.
 For Handrail Details see Sheet 53.
 For Lighting Details see Sheet 54.
 For Standard Drainage Details see Support Type 3, Sheet 56.
 (Pipes between Scuppers in Unit 4 to be connected as shown for Support Type 7, Sheet 56.)
 For Typical Parapet Detail, see Sheet 29.
 For Joint Details see Sheet 48.

* All intermediate diaphragms in Unit 3 and the first three in Unit 4 consist of L5x4x1/2. Last five intermediate diaphragms in Unit 4 consist of L5x5x7/8.

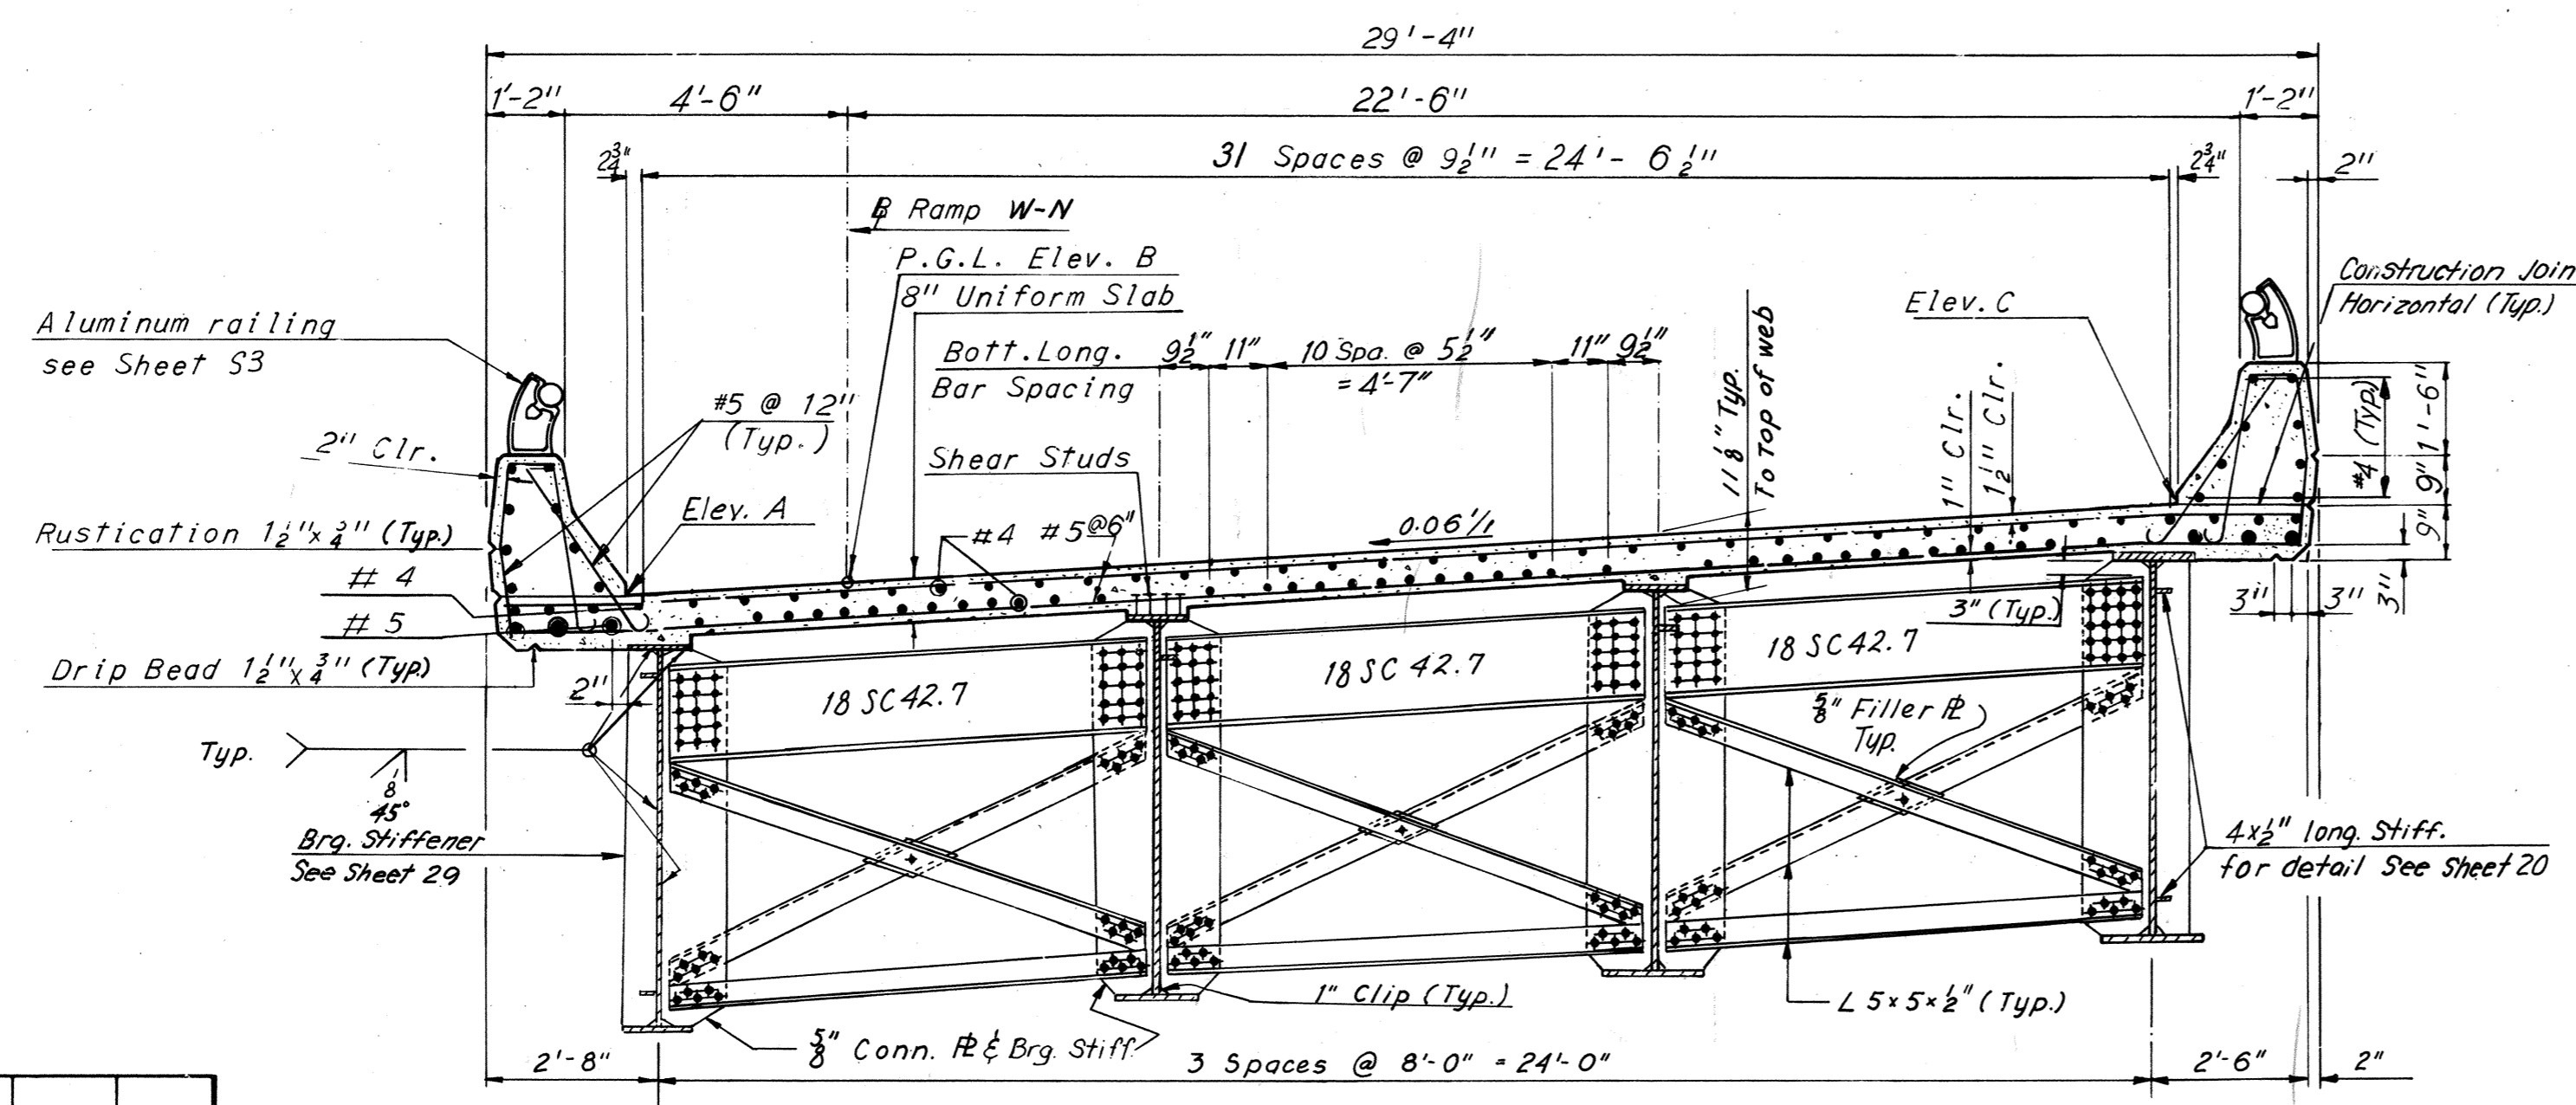

TYPICAL SECTION-END DIAPHRAGM
Scale: 3/8"=1'-0"

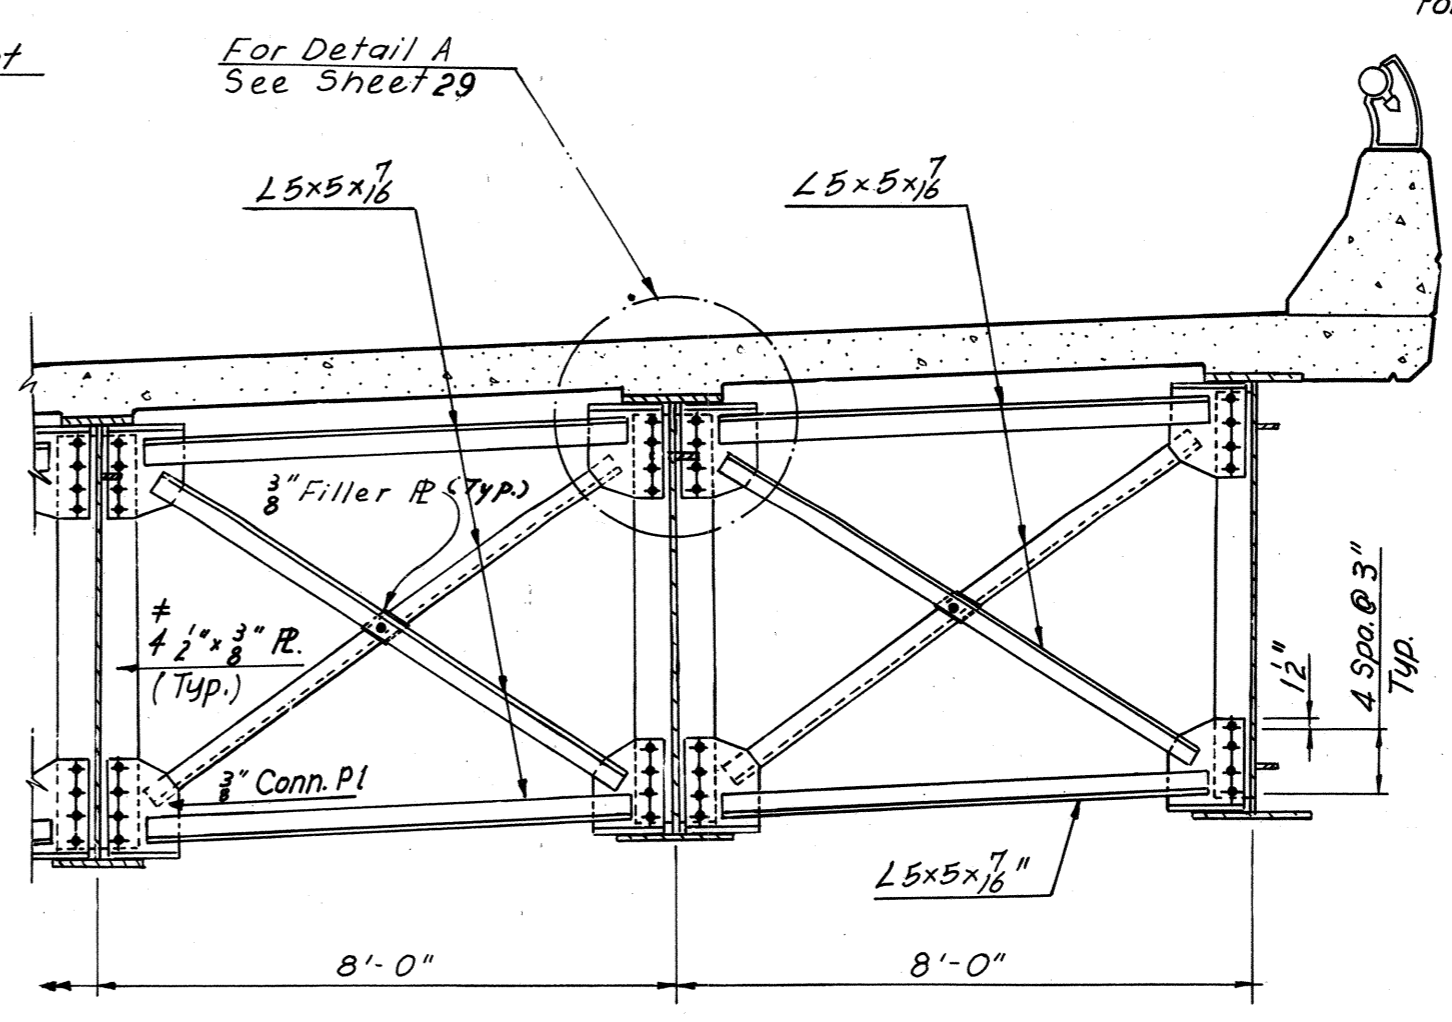

INTERMEDIATE DIAPHRAGM
Scale: 3/8"=1'-0"

BY	DATE	REVISION	BY	DATE
MADE	C.E.B.	2 As Built	TEM	6-77
CHECKED	KCT	11-4-68	Revised angle size Intermediate Diap.	1-24-75
IN CHARGE				

RICHMOND METROPOLITAN AUTHORITY
RICHMOND EXPRESSWAY SYSTEM
 DOWNTOWN EXPRESSWAY

BRIDGE NO. 67
 RAMP W-N CONNECTION TO
 RICHMOND-PETERSBURG TURNPIKE
 DECK PLAN UNITS 3 AND 4


HOWARD, NEEDLES, TAMMEN & BERGENDOFF
 consulting engineers
 NEW YORK ALEXANDRIA KANSAS CITY

SCALE: As noted
 CONTRACT NO. 10
 SHEET NO. 30 OF 54

AS BUILT

RICHMOND EXPRESSWAY SYSTEM			
SECTION	PROJECT	SHEET NO.	TOTAL SHEETS
10	DOWNTOWN EXPRESSWAY	2.03	265

ELEVATION TABLE			
STATION	ELEV. A	ELEV. B	ELEV. C
348+33.00	72.55	72.76	74.05
+40.00	72.57	72.78	74.07
+50.00	72.64	72.85	74.14
+60.00	72.75	72.96	74.25
+70.00	72.90	73.11	74.40
+80.00	73.10	73.31	74.60
+90.00	73.34	73.55	74.84
349+00.00	73.62	73.83	75.12
+10.00	73.95	74.16	75.45
+20.00	74.31	74.52	75.81
+30.00	74.73	74.94	76.23
+40.00	75.18	75.39	76.68
+40.50	75.21	75.42	76.71
+50.00	75.68	75.89	77.18
+60.00	76.20	76.41	77.70
+70.00	76.72	76.93	78.22
+80.00	77.24	77.45	78.74
+90.00	77.76	77.97	79.27
350+00.00	78.28	78.49	79.78
+10.00	78.80	79.01	80.30
+20.00	79.32	79.53	80.82
+30.00	79.84	80.05	81.34
+37.00	80.21	80.41	81.69
+40.00	80.36	80.57	81.84

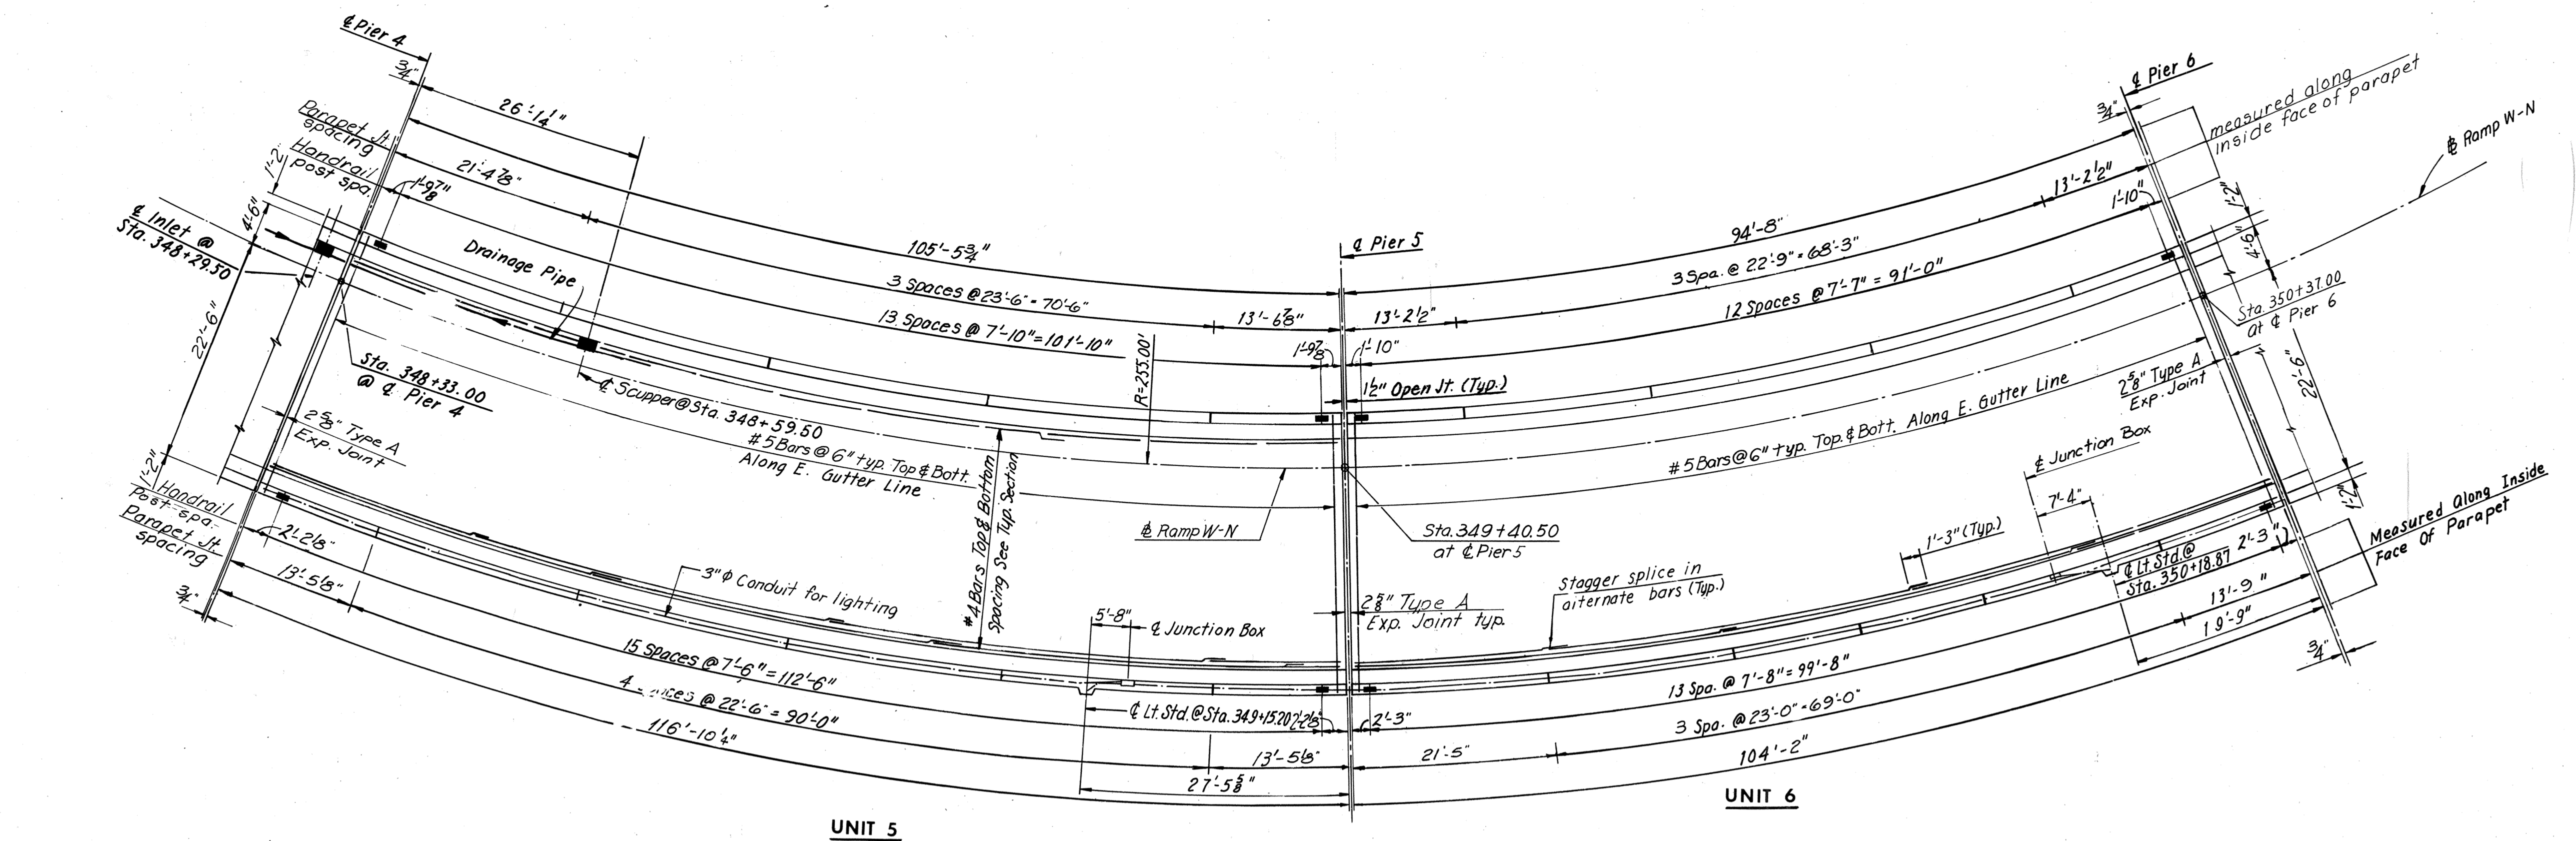


UNIT 5


UNIT 6

DECK PLAN

Scale: 1" = 10'-0"

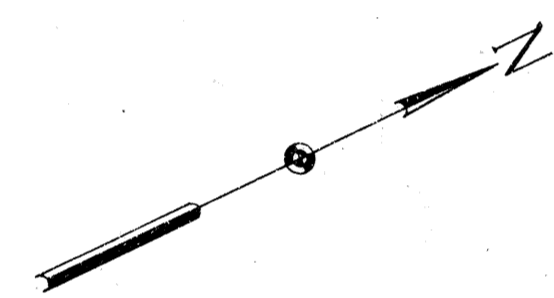


Notes:
 Piers 4, 5 and 6 are all radial to Ramp W-N (Curve WN-2)
 For Details of diaphragm connections to top and bottom flanges of stringers see Sheet 29.
 For intermediate diaphragm and transverse stiffener spacings see Sheet 21.
 For Handrail Details see Sheet 53.
 For Lighting Details see Sheet 54.
 For Standard Drainage Details see Support Type 7 Sheet 50.
 For Typical Parapet Detail, see Sheet 29.
 For Joint Details see Sheet 48.

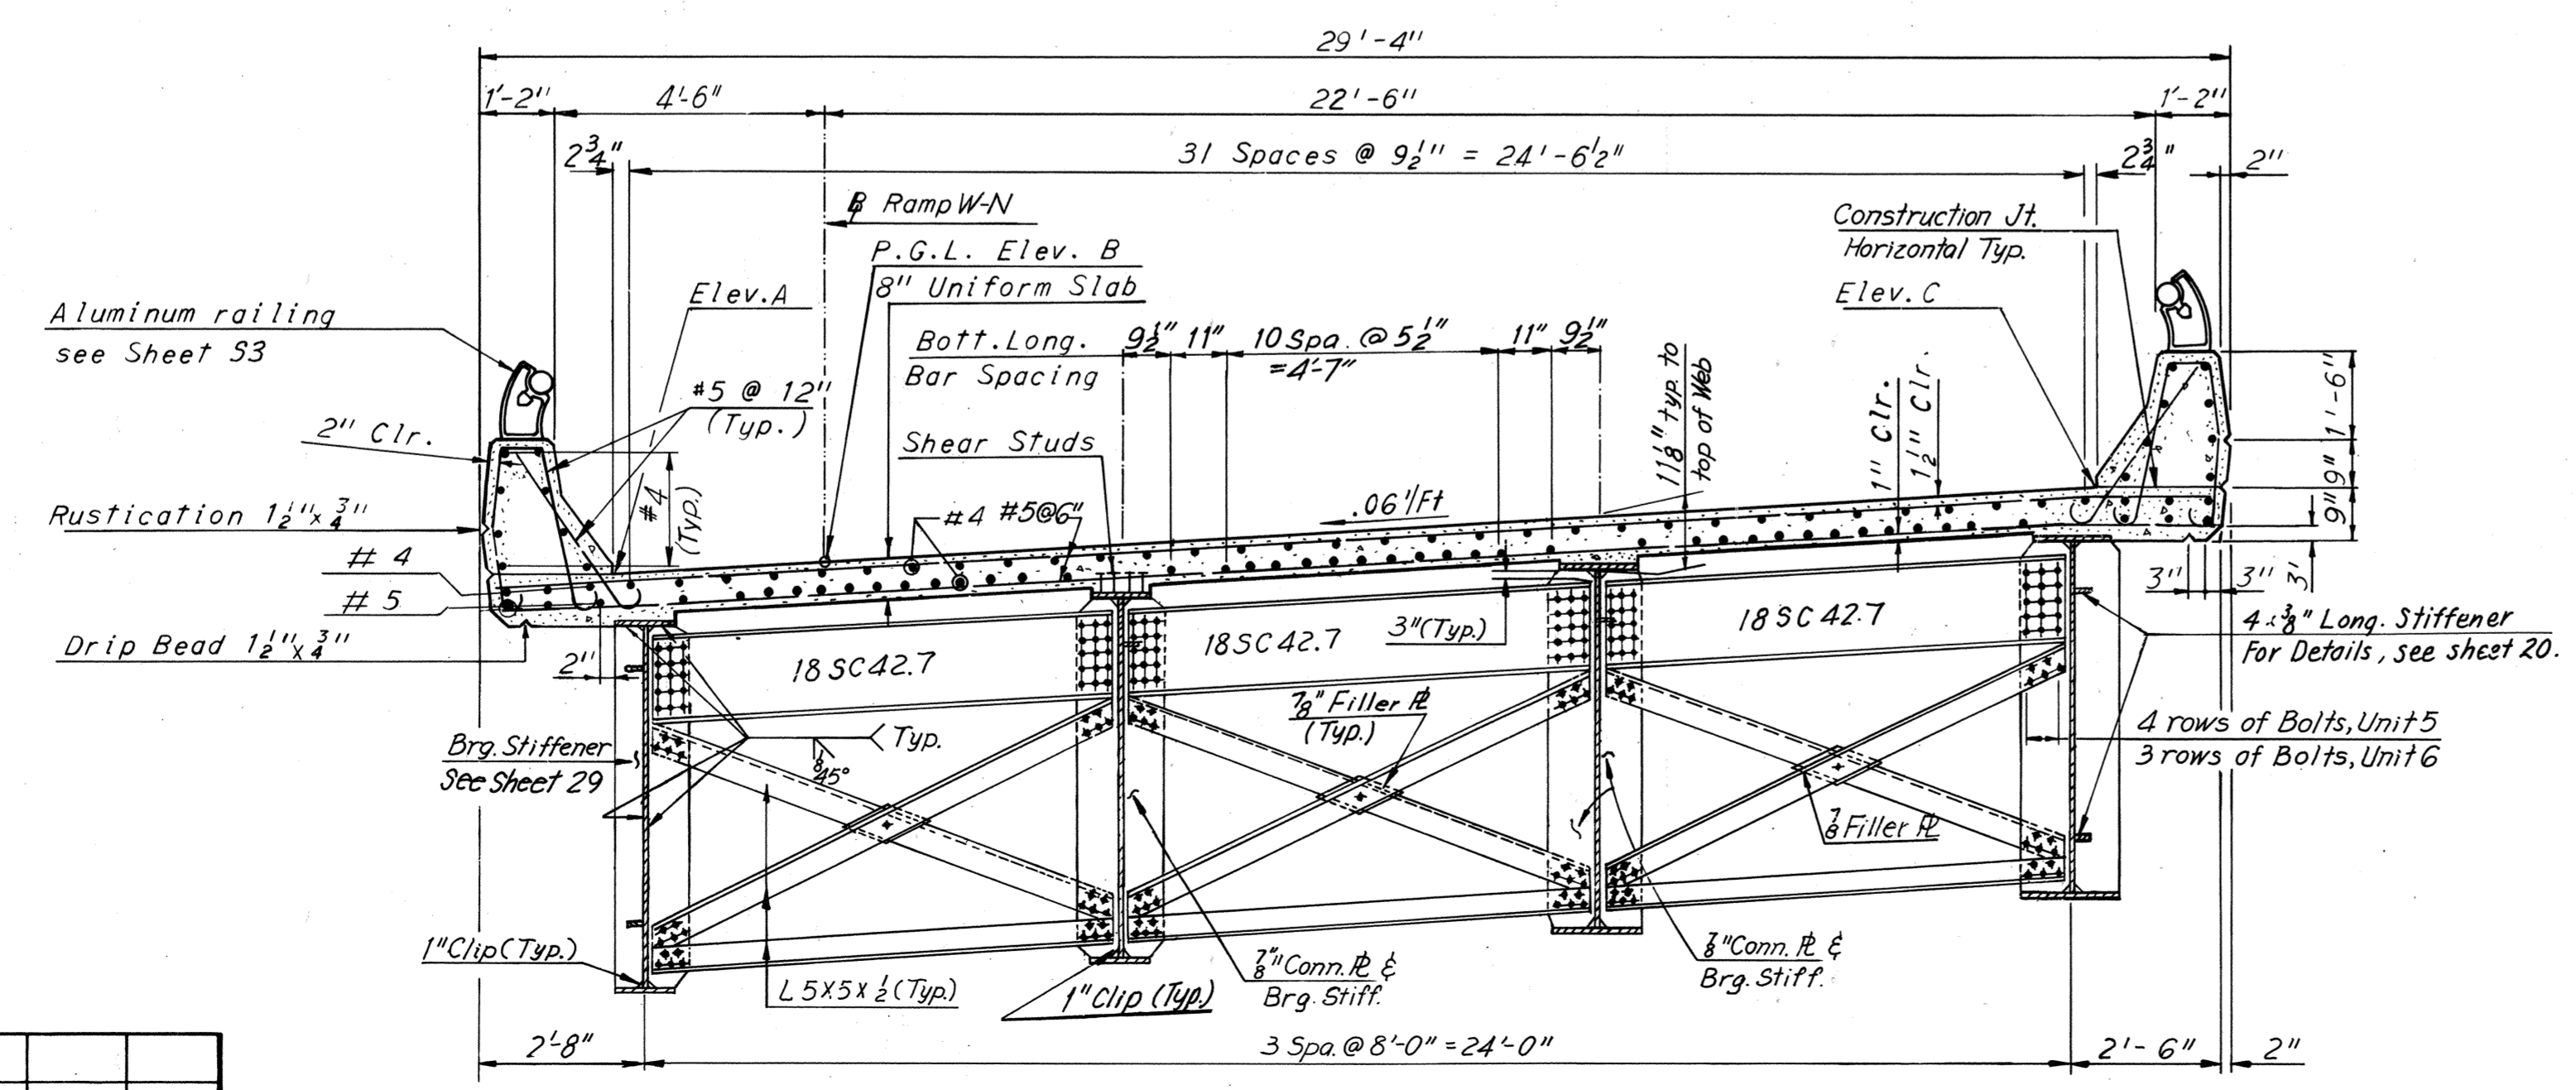

TYPICAL SECTION - END DIAPHRAGM

Scale: 3/8" = 1'-0"

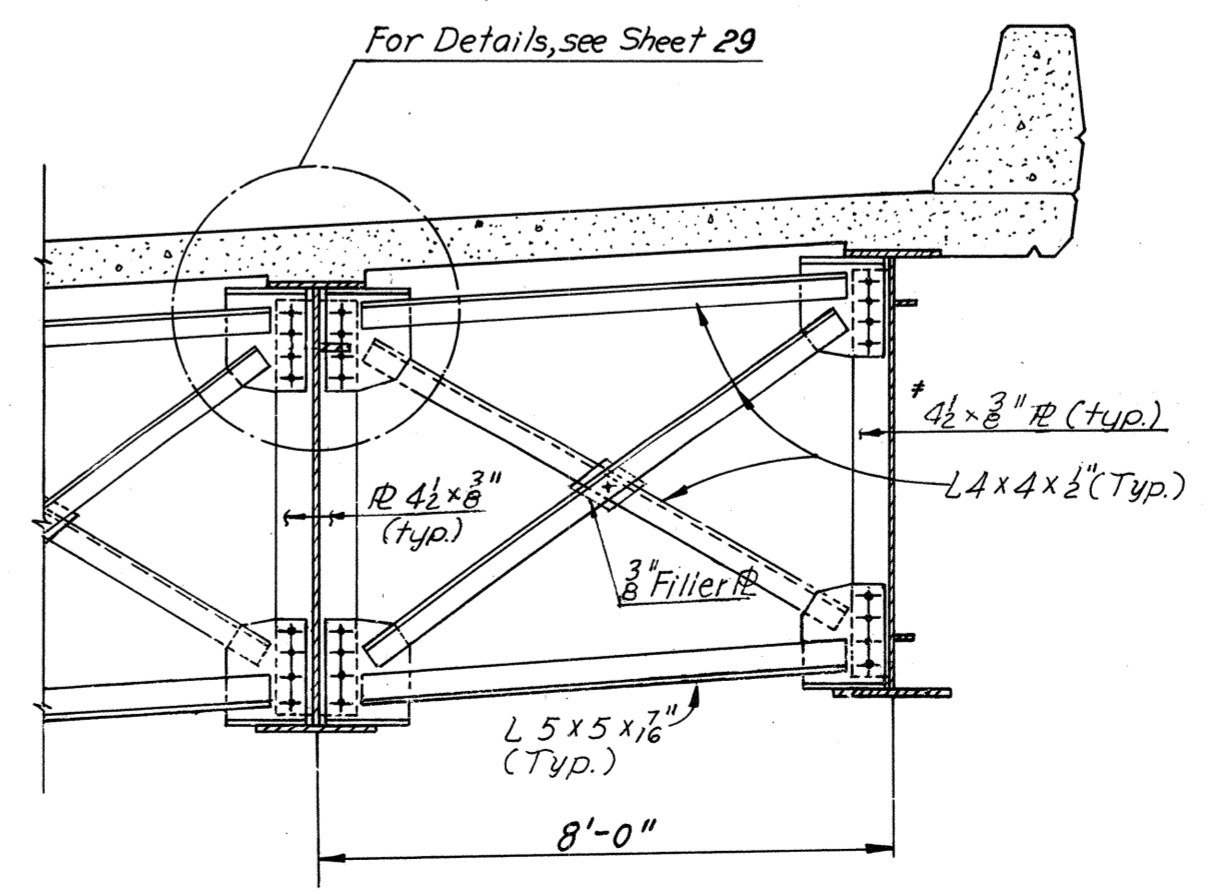

INTERMEDIATE DIAPHRAGM

Scale: 3/8" = 1'-0"

4x3/8 transverse stiffeners are used throughout Units 5 and 6 except for Stringer S4-5 where 5x3/8 are used.

BY	DATE	NO.	REVISION	BY	DATE
MADE	AHH 8-26-68				
CHECKED	KCT 11-1-68	1	As Built	TEM	6-77
IN CHARGE					

RICHMOND METROPOLITAN AUTHORITY
 RICHMOND EXPRESSWAY SYSTEM
 DOWNTOWN EXPRESSWAY

BRIDGE NO. 67
 RAMP W-N CONNECTION TO
 RICHMOND-PETERSBURG TURNPIKE
 DECK PLAN - UNITS 5 AND 6




HOWARD, NEEDLES, TAMMEN & BERGENDOFF
 consulting engineers
 NEW YORK ALEXANDRIA KANSAS CITY

AS BUILT

SCALE: As Noted
 CONTRACT NO.: 10
 SHEET NO. 31 OF 54

RICHMOND EXPRESSWAY SYSTEM			
SECTION	PROJECT	SHEET NO.	TOTAL SHEETS
10	DOWNTOWN EXPRESSWAY	204	265

ELEVATION TABLE			
STATION	ELEV. A	ELEV. B	ELEV. C
350+37.00	80.21	80.41	81.69
+40.00	80.36	80.57	81.84
+50.00	80.89	81.09	82.33
+60.00	81.41	81.61	82.80
+70.00	81.94	82.13	83.25
+80.00	82.49	82.65	83.68
+90.00	83.02	83.17	84.11
351+00.00	83.55	83.69	84.55
+10.00	84.07	84.20	84.97
+20.00	84.56	84.68	85.37
+30.00	85.04	85.13	85.73
+33.50	85.20	85.29	85.86
+40.00	85.49	85.57	86.08
+50.00	85.91	85.97	86.40
+60.00	86.31	86.36	86.70
+70.00	86.69	86.71	86.97
+80.00	87.03	87.05	87.22
+90.00	87.35	87.35	87.44
352+00.00	87.64	87.64	87.64
+10.00	87.97	87.89	87.88
+20.00	88.28	88.13	88.10
+30.00	88.56	88.33	88.30
+32.00	88.62	88.37	88.34

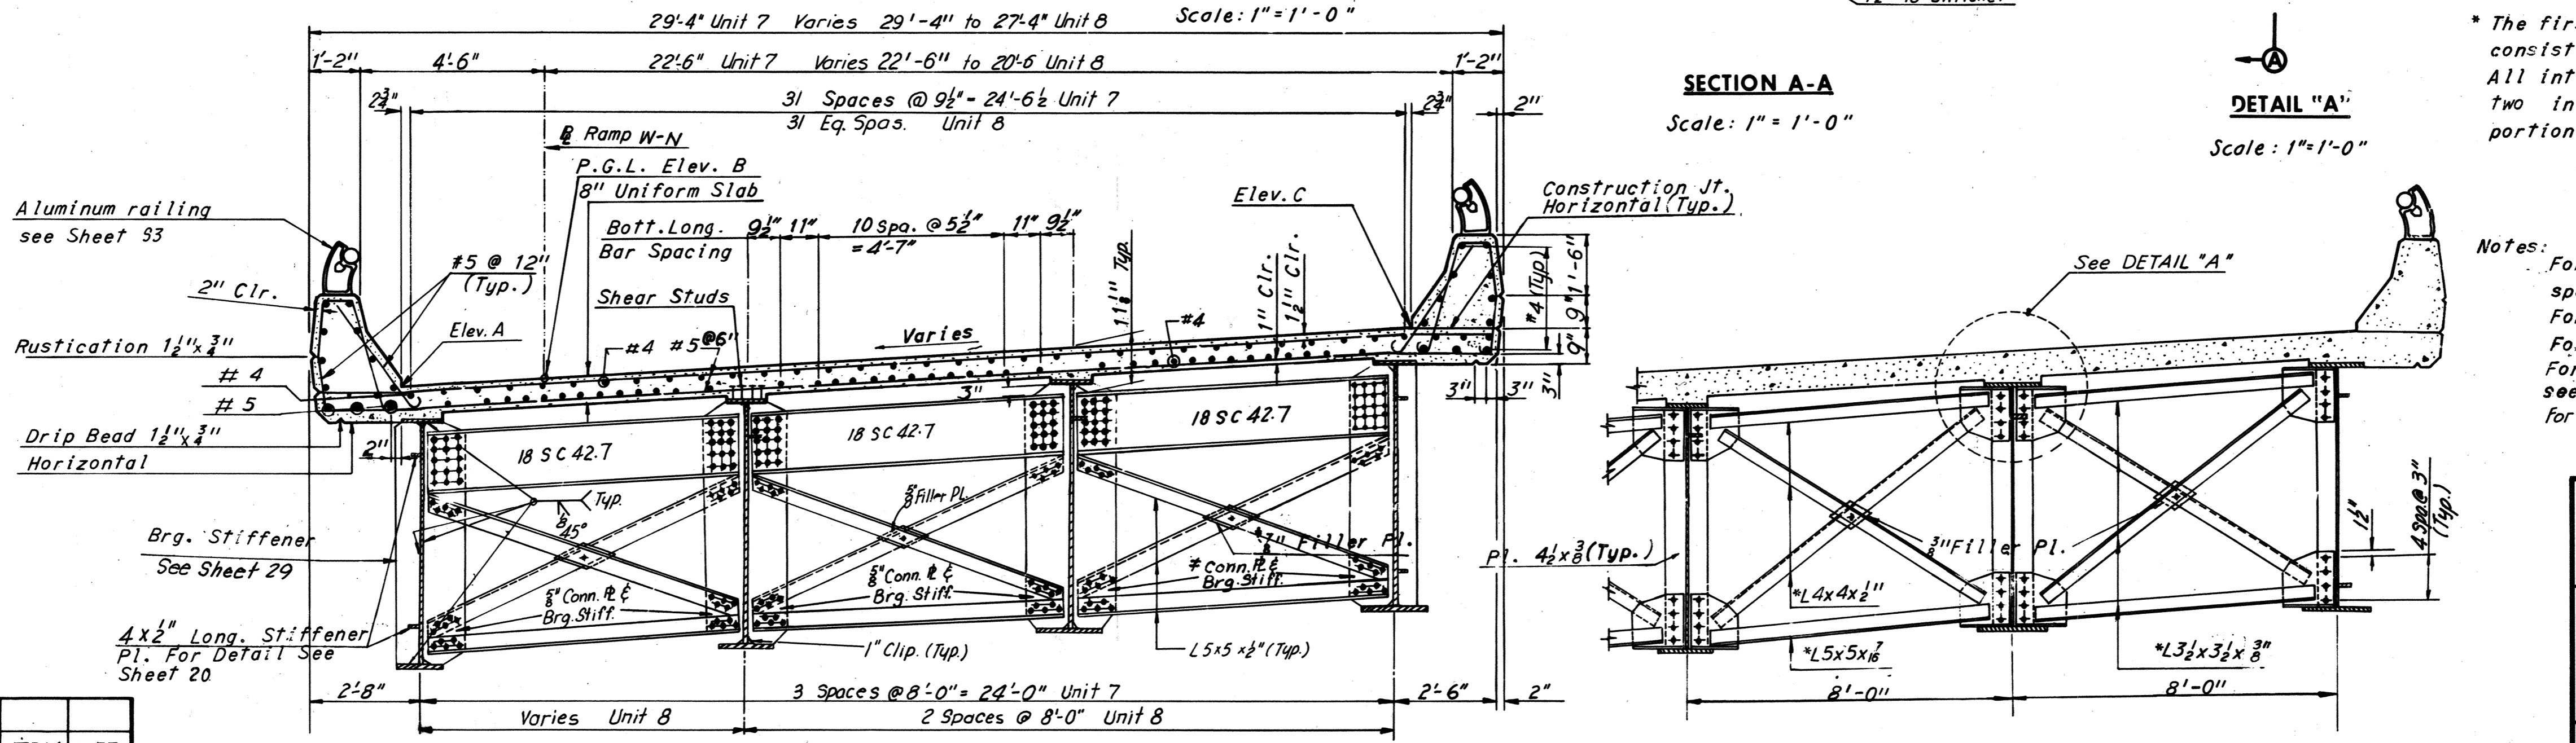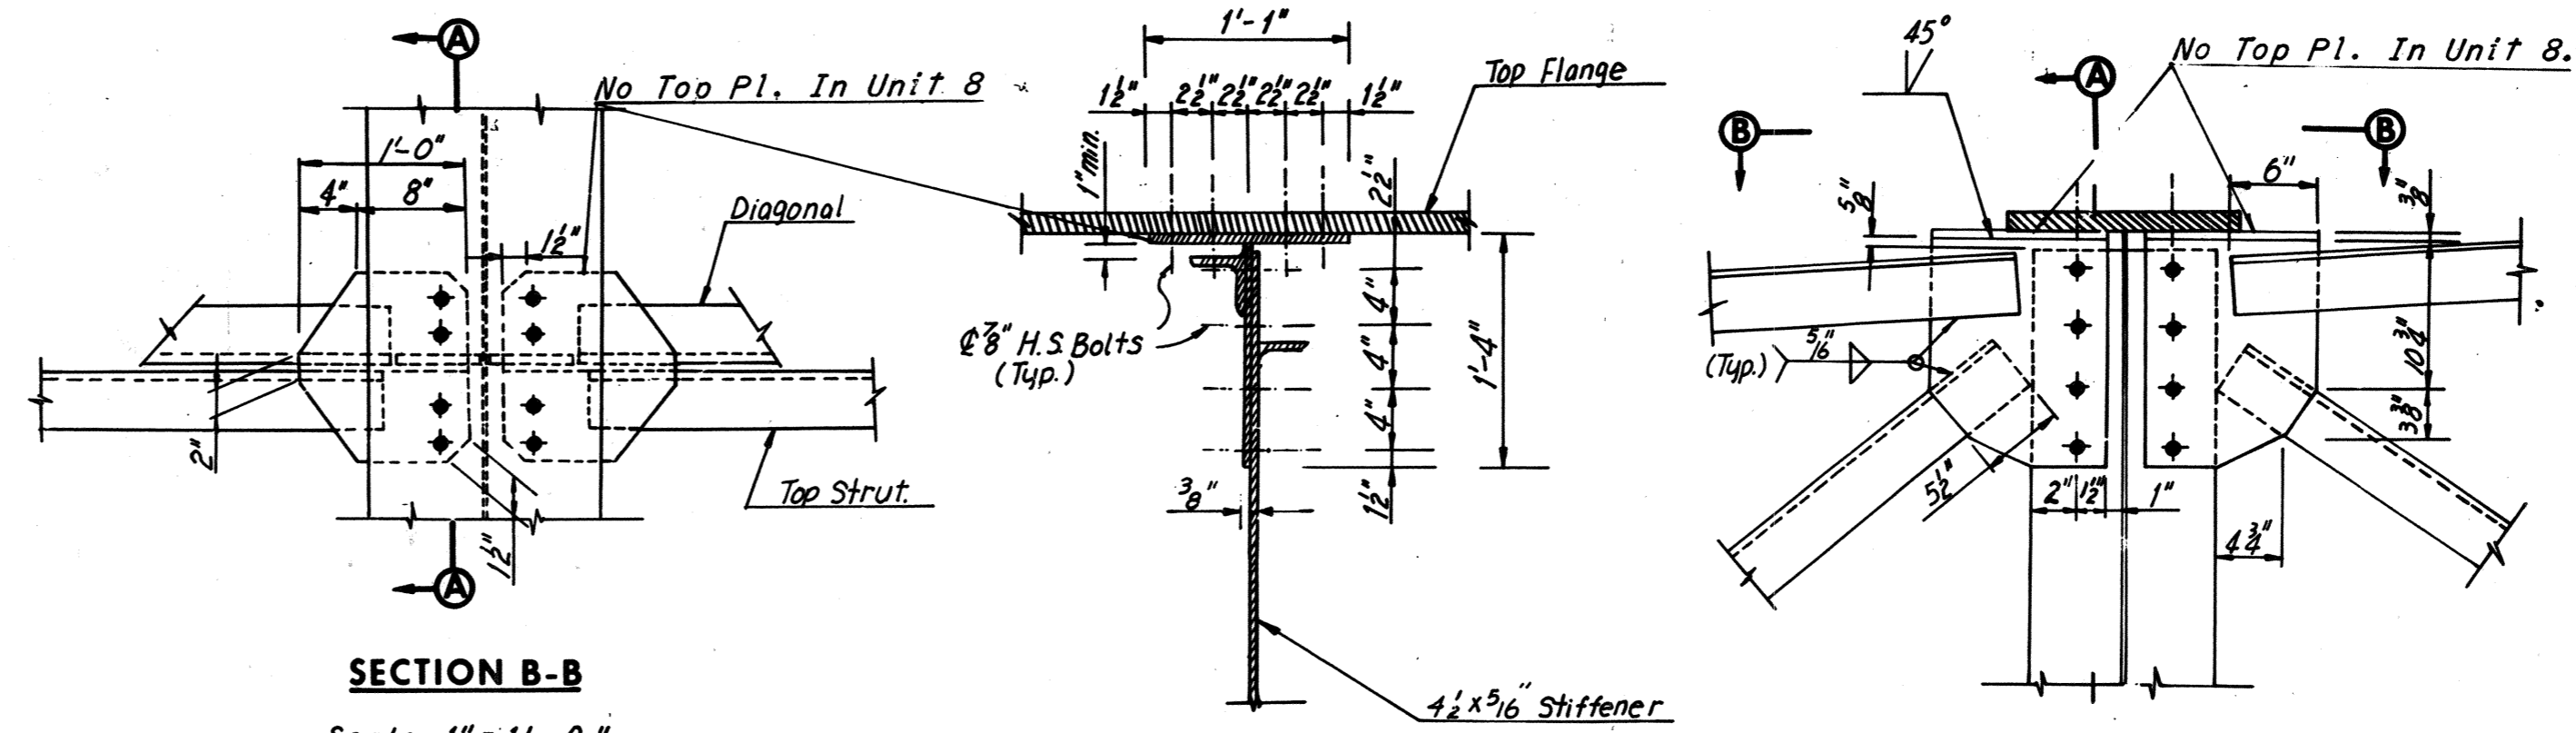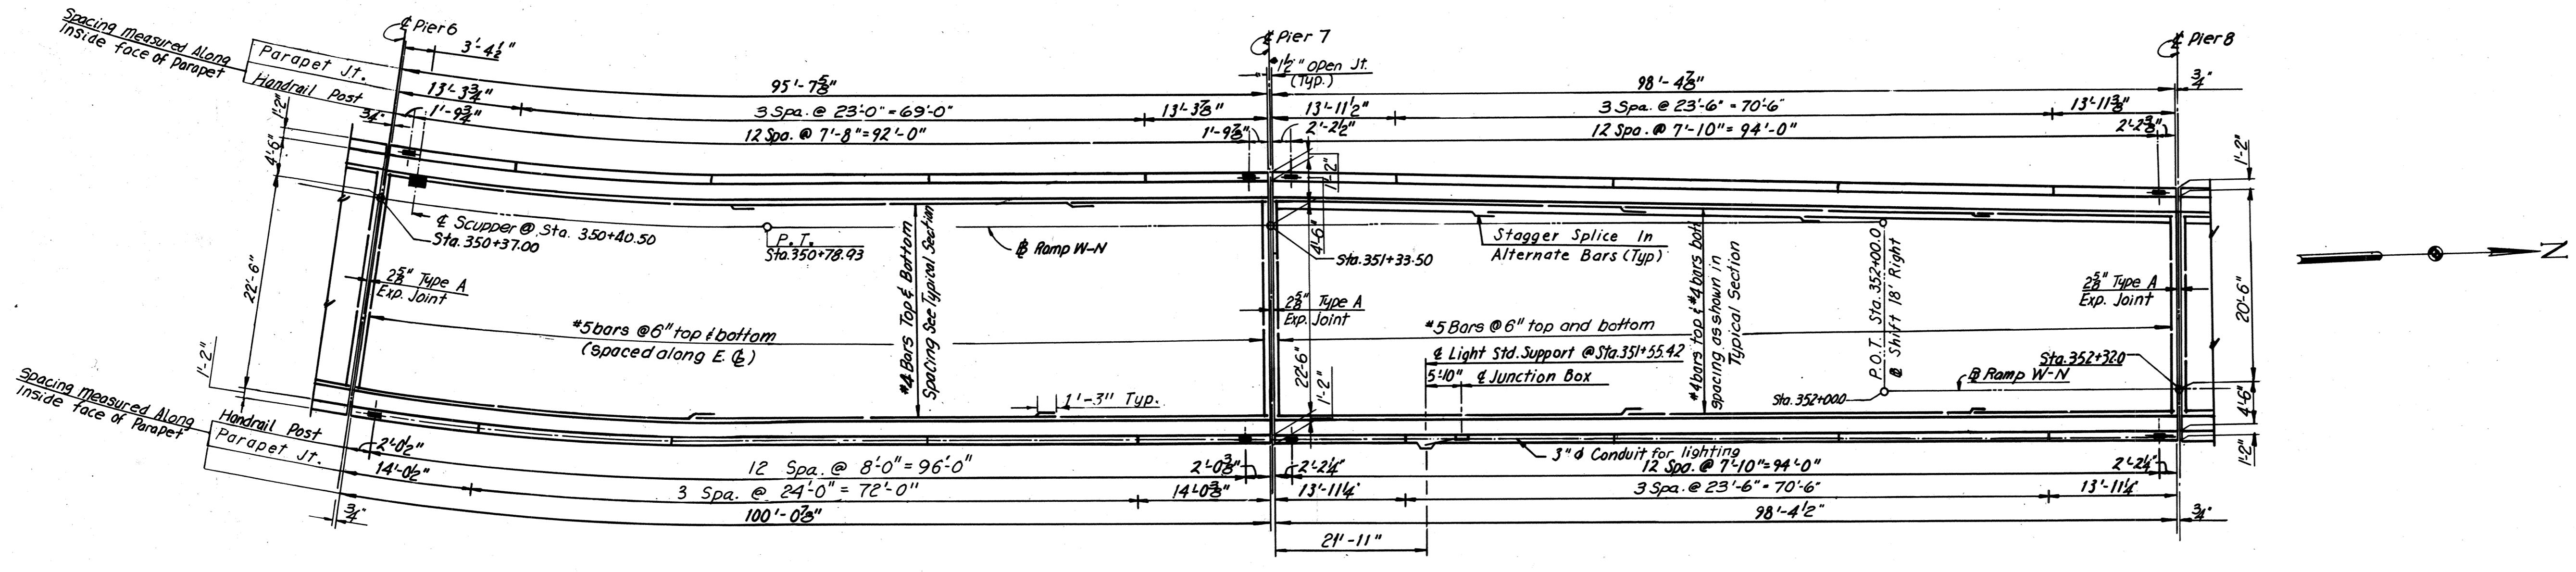

* The first three intermediate diaphragms in Unit 7 consist of Ls4x4x2 (curved portion of roadway). All intermediate diaphragms in Unit 8 and the last two in Unit 7 consist of Ls3 1/2 x 3 1/2 x 8 (tangent portion of roadway).

Notes:
 For intermediate diaphragm and transverse stiffener spacings see Sheet 22.
 For Handrail Details see Sheet 53.
 For Lighting Details see Sheet 54.
 For Standard Drainage Details see Support Type 3 Sheet 36.
 For Typical Parapet Details, see Sheet 29

BY	DATE	REVISION	BY	DATE
MADE	GSH 09-22-68	2 As Built	TEM	6-77
CHECKED	KCT 11-1-68	Light Sta. Location	JLK	6-6-75
IN CHARGE				

RICHMOND METROPOLITAN AUTHORITY
RICHMOND EXPRESSWAY SYSTEM
DOWNTOWN EXPRESSWAY

BRIDGE NO. 67
RAMP W-N CONNECTION TO
RICHMOND-PETERSBURG TURNPIKE
DECK PLAN UNITS - 7 AND 8

HOWARD, NEEDLES, TAMMEN & BERGENDOFF
 consulting engineers
 NEW YORK ALEXANDRIA KANSAS CITY


SCALE: As Noted
 CONTRACT NO. 10
 SHEET NO. 32 OF 54

AS BUILT

RICHMOND EXPRESSWAY SYSTEM			
SECTION	PROJECT	SHEET NO.	TOTAL SHEETS
10	DOWNTOWN EXPRESSWAY	205	265



ELEVATION TABLE			
STATION	ELEV A	ELEV B	ELEV C
352+30.00	88.57	88.33	88.22
32.00	88.63	88.37	88.33
40.00	88.83	88.52	88.46
50.00	89.06	88.67	88.60
60.00	89.20	88.81	88.74
70.00	89.30	88.91	88.84
80.00	89.39	89.00	88.93
90.00	89.44	89.05	88.98
353+00.00	89.47	89.08	89.01
10.00	89.48	89.09	89.02
20.00	89.46	89.07	89.00
26.00	89.44	89.05	88.98
30.00	89.42	89.03	88.96

Note: Connect Lighting Conduit in existing structure with Junction Box at nose of new part of structure.

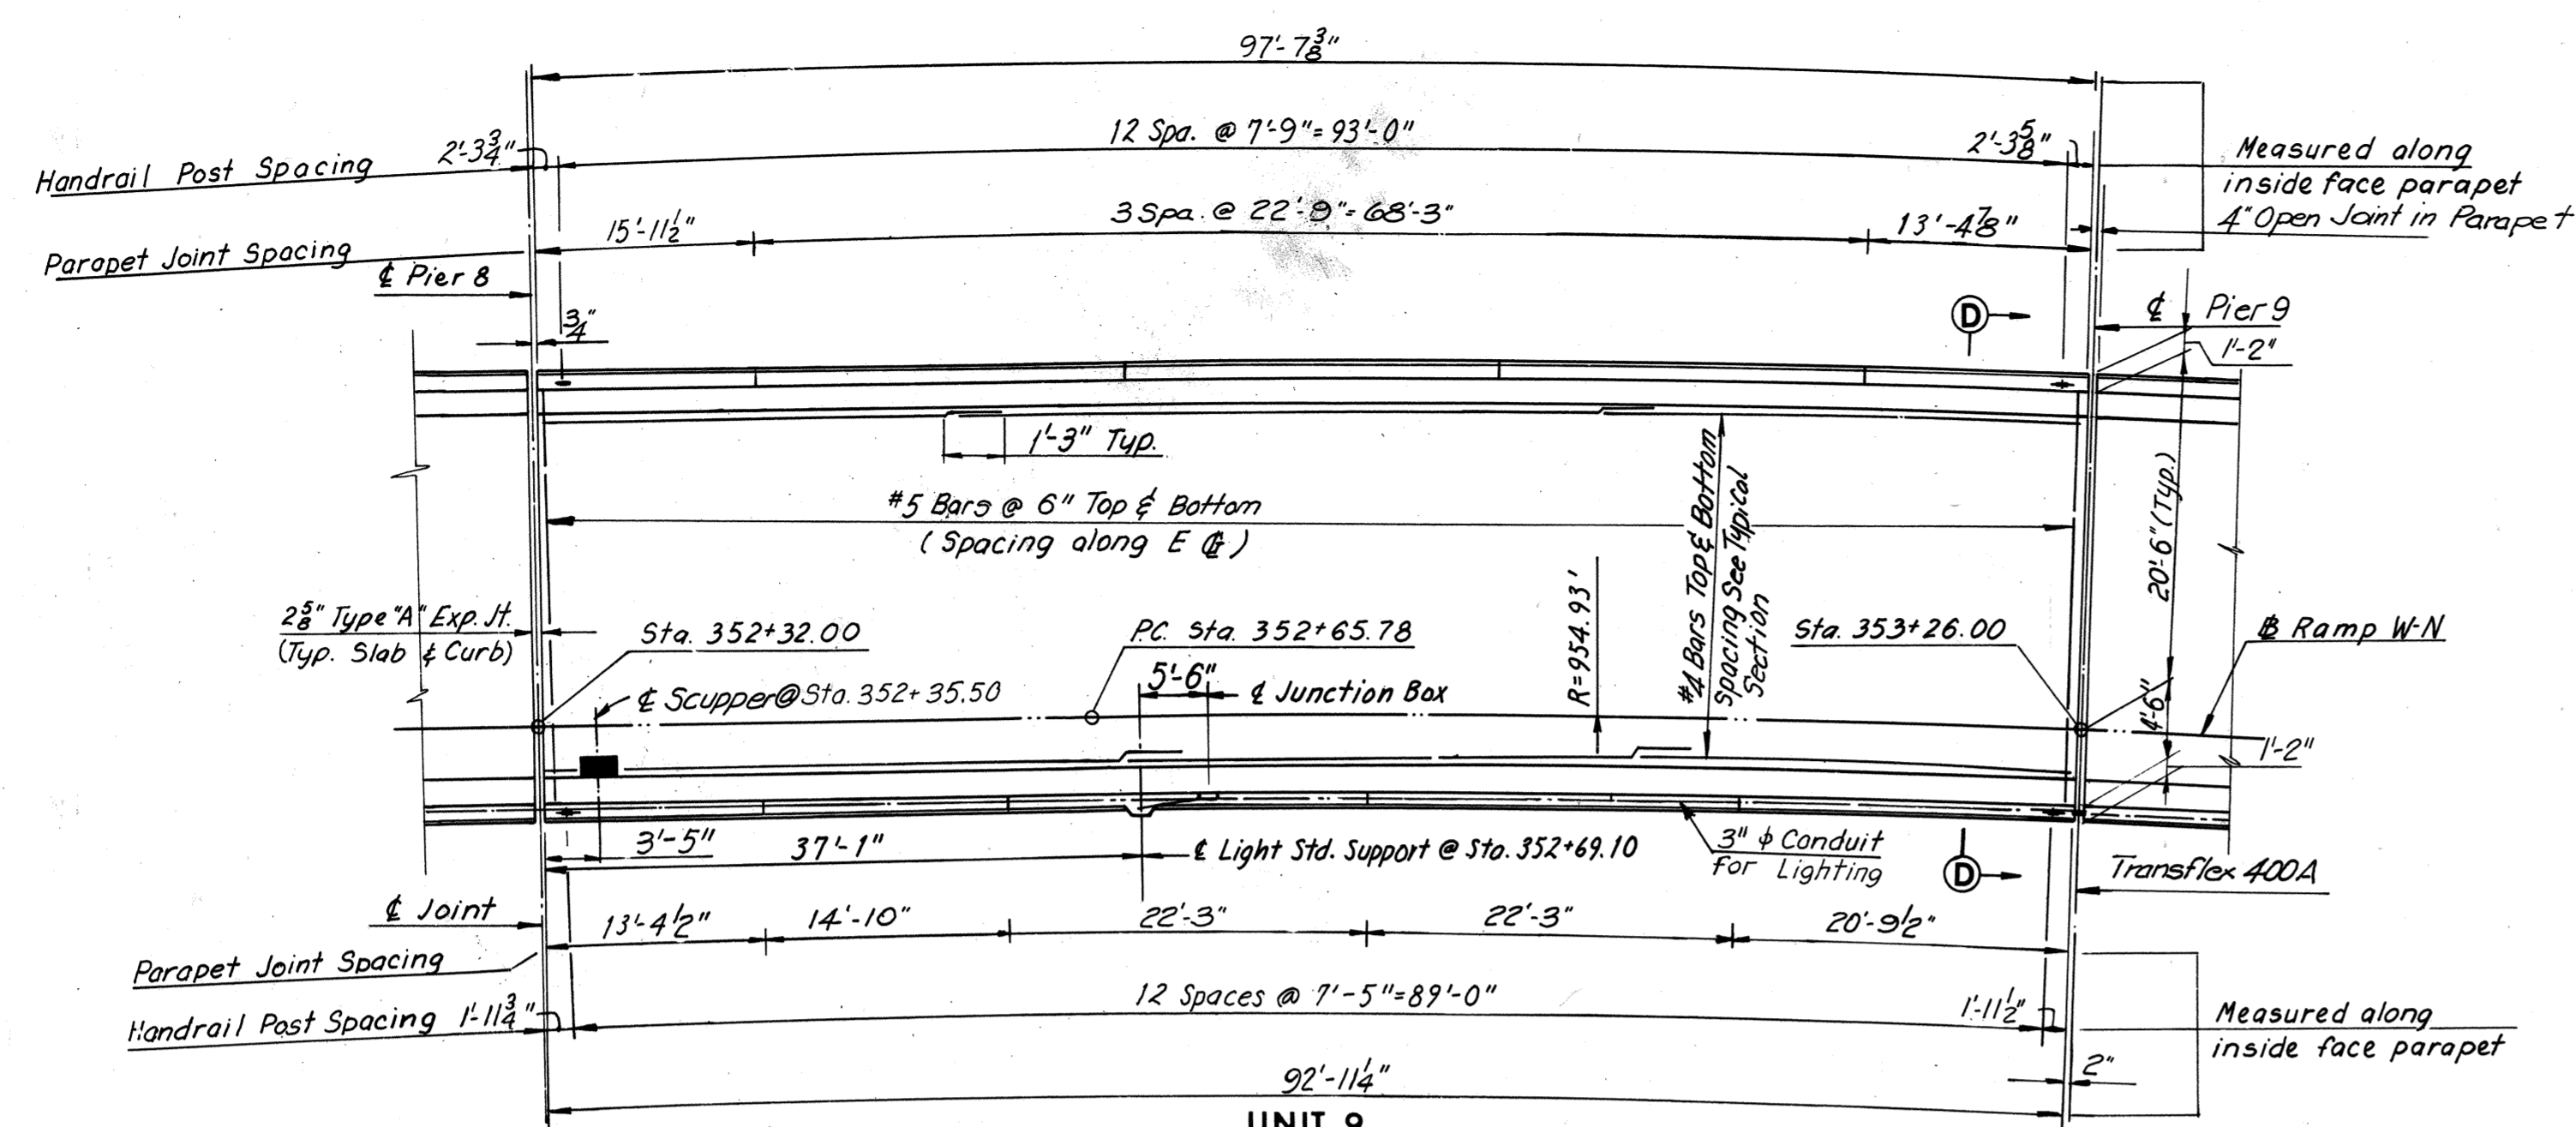


UNIT 9

Scale: 1" = 10'-0"

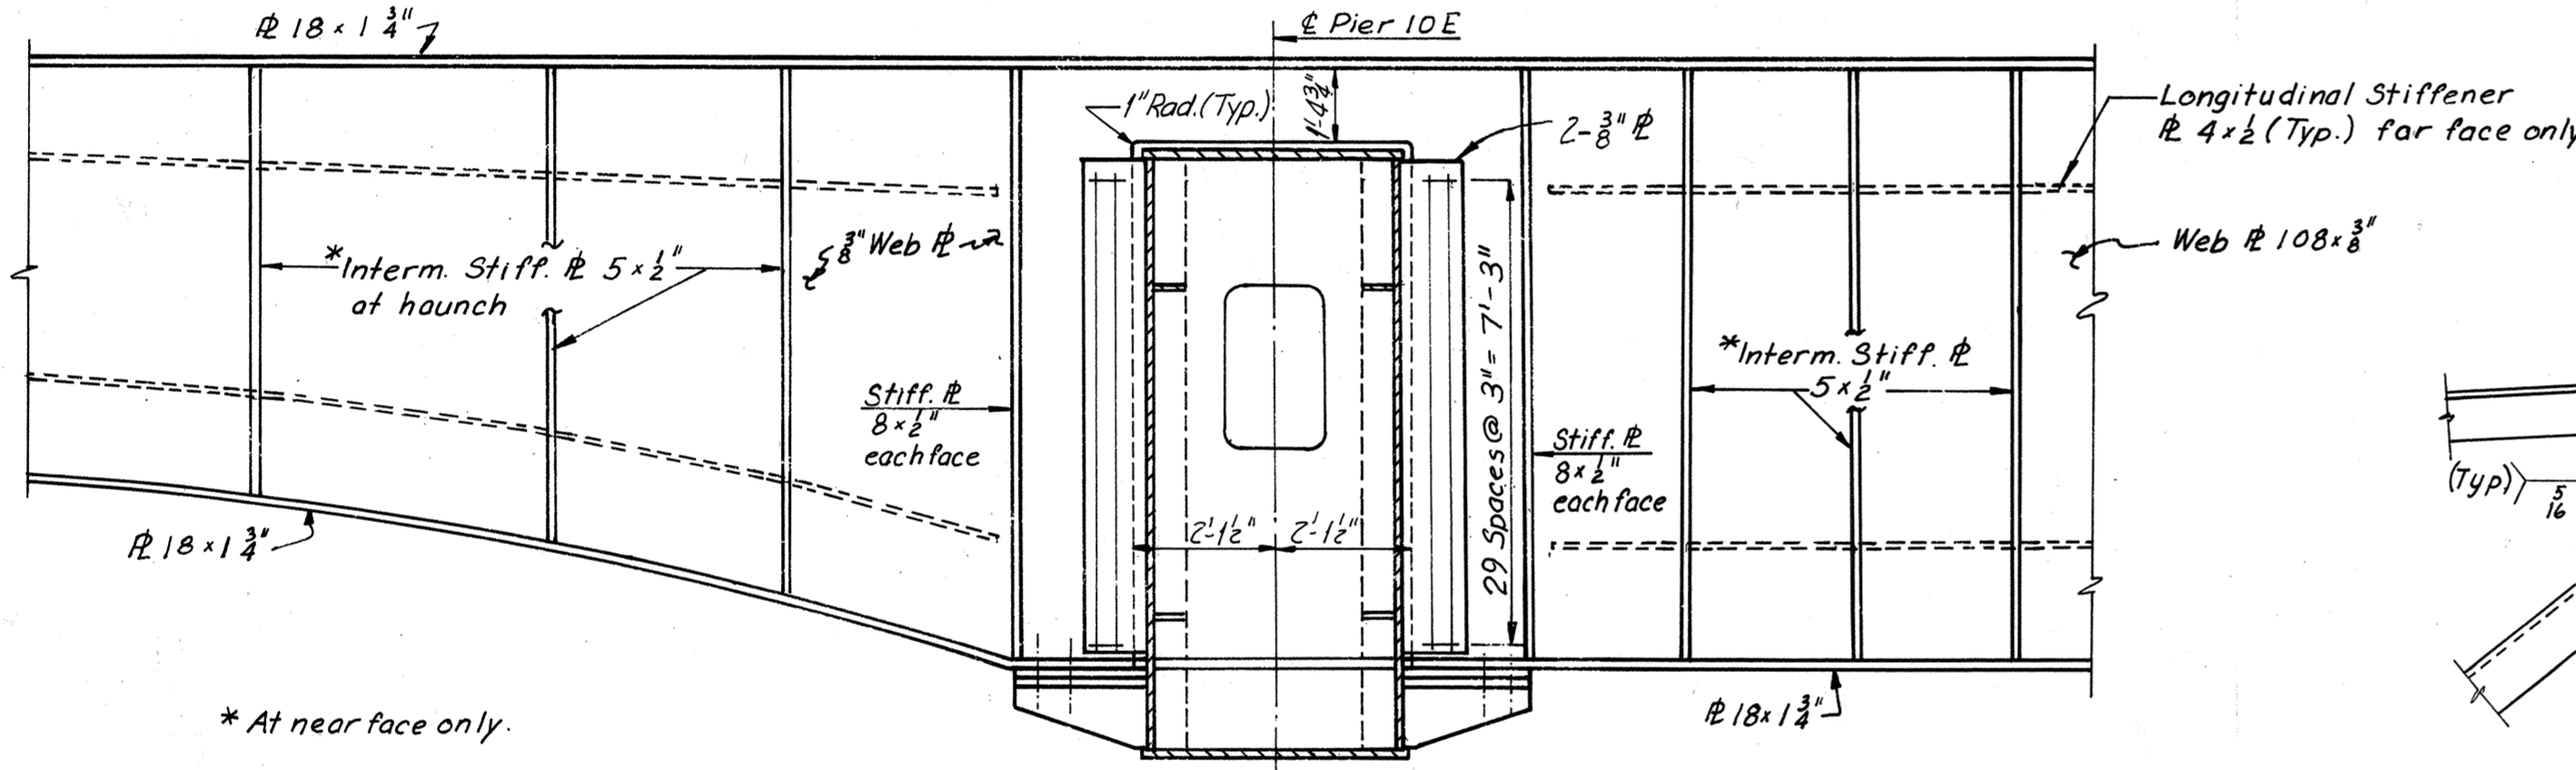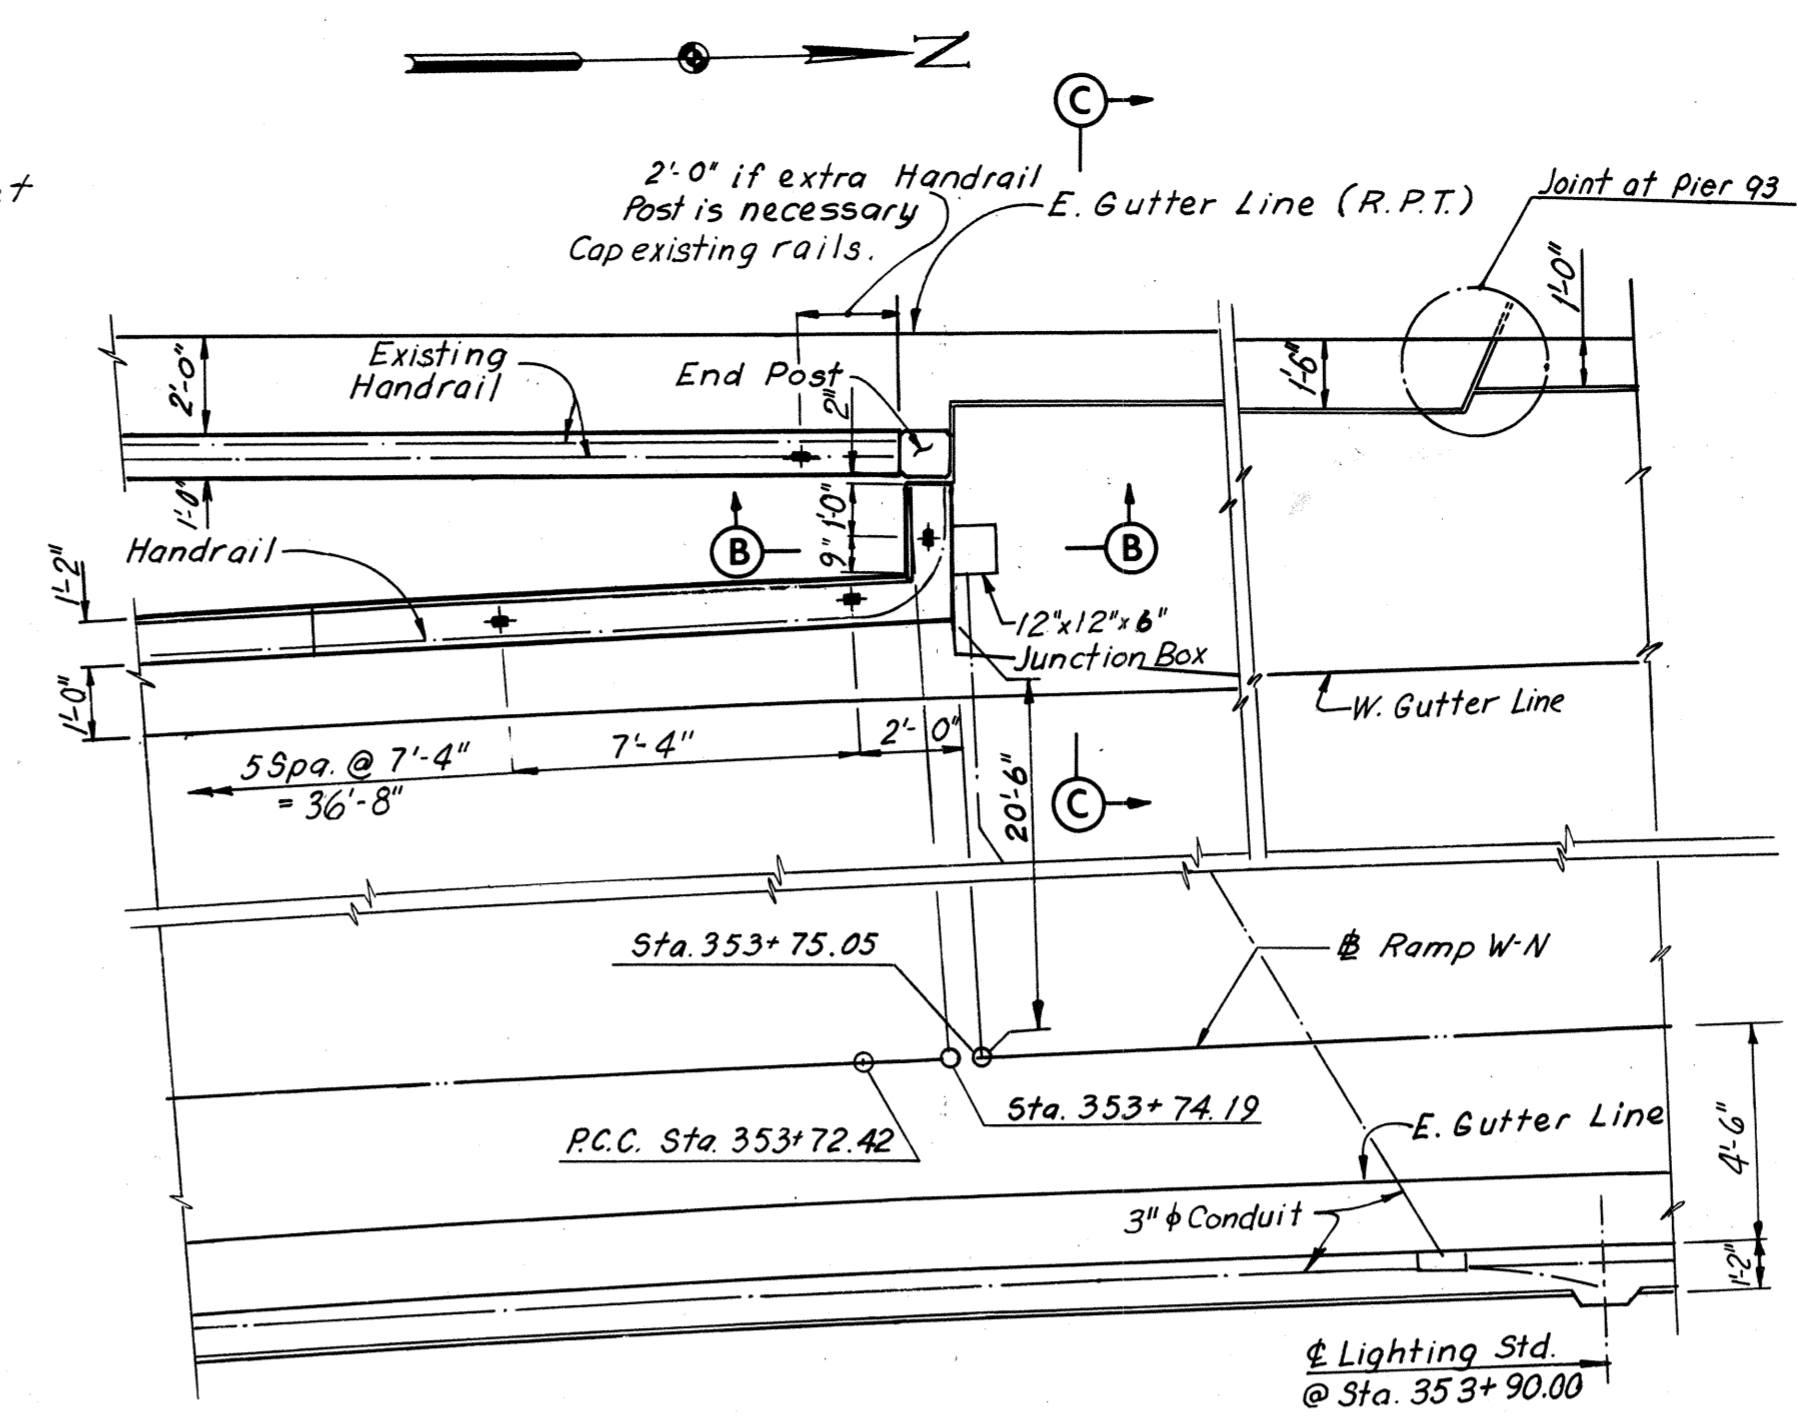


DETAIL C

Scale: 3/8" = 1'-0"

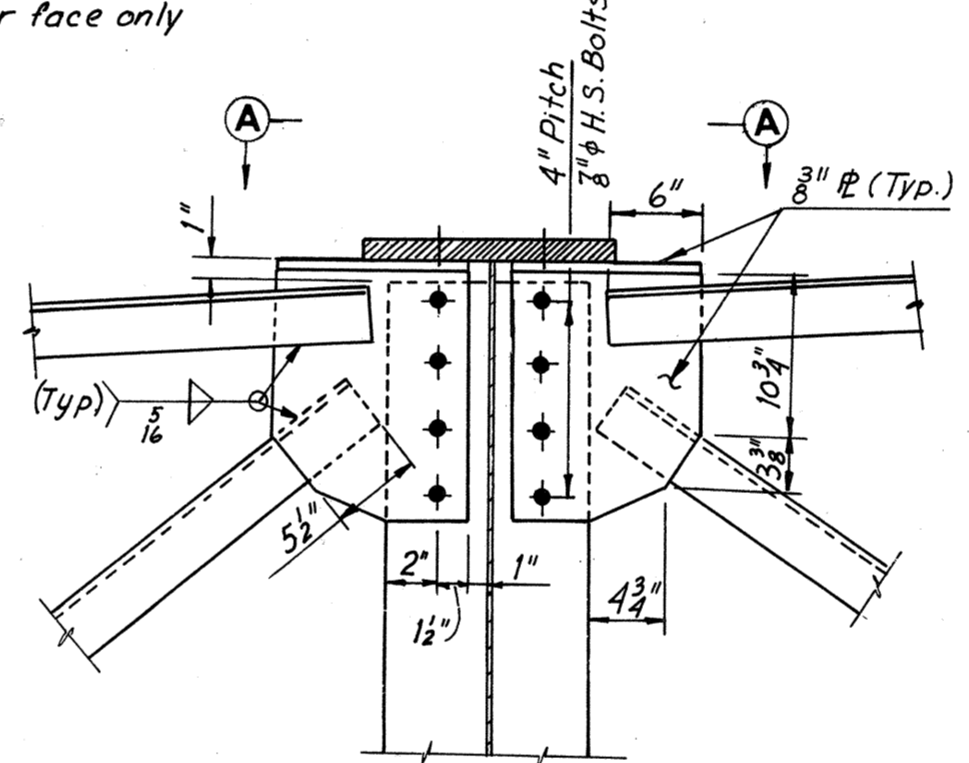


DETAIL A

Scale: 1" = 1'-0"

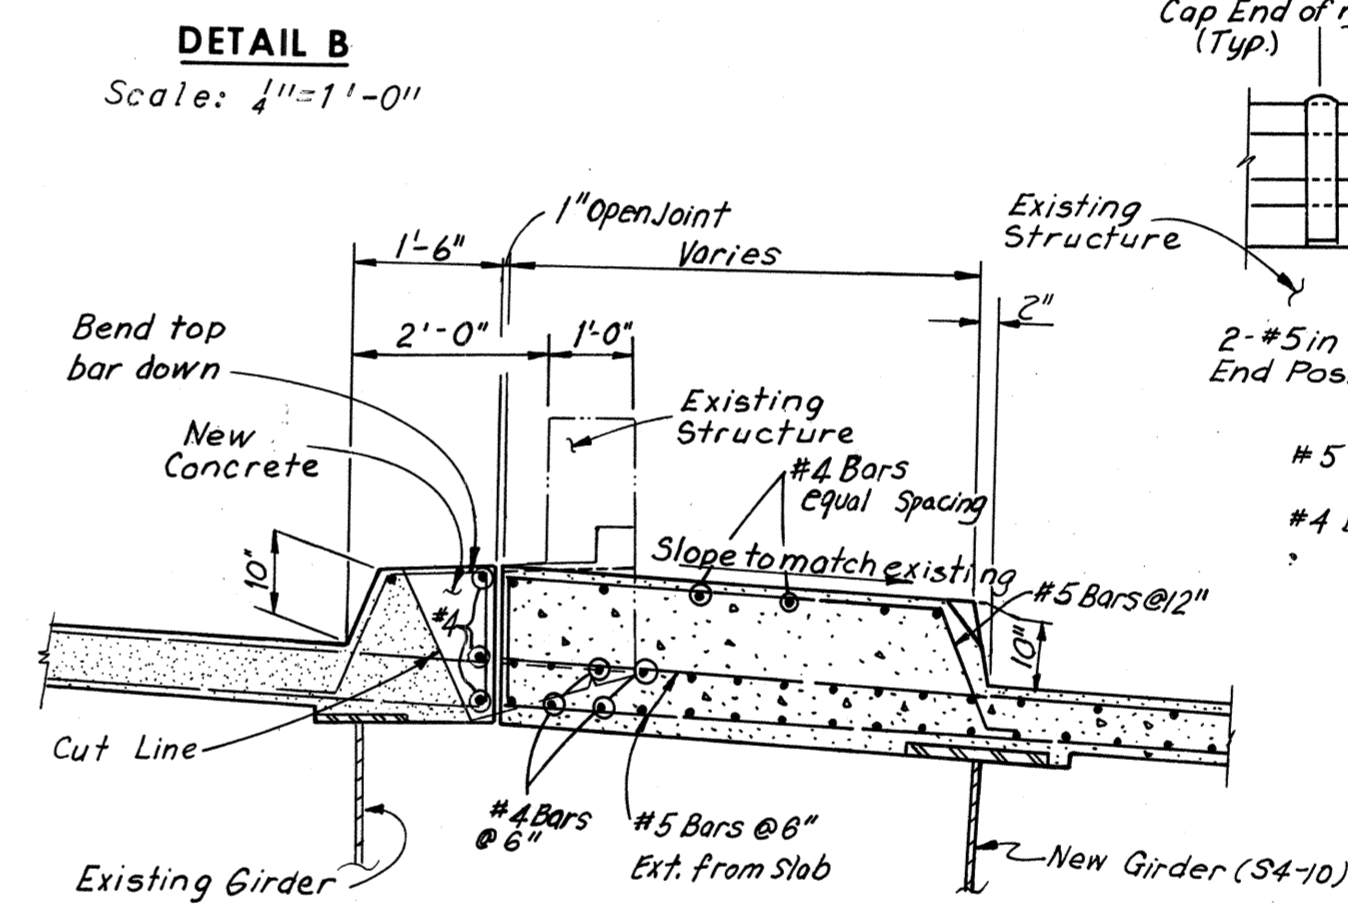


SECTION C-C

Scale: 1/2" = 1'-0"

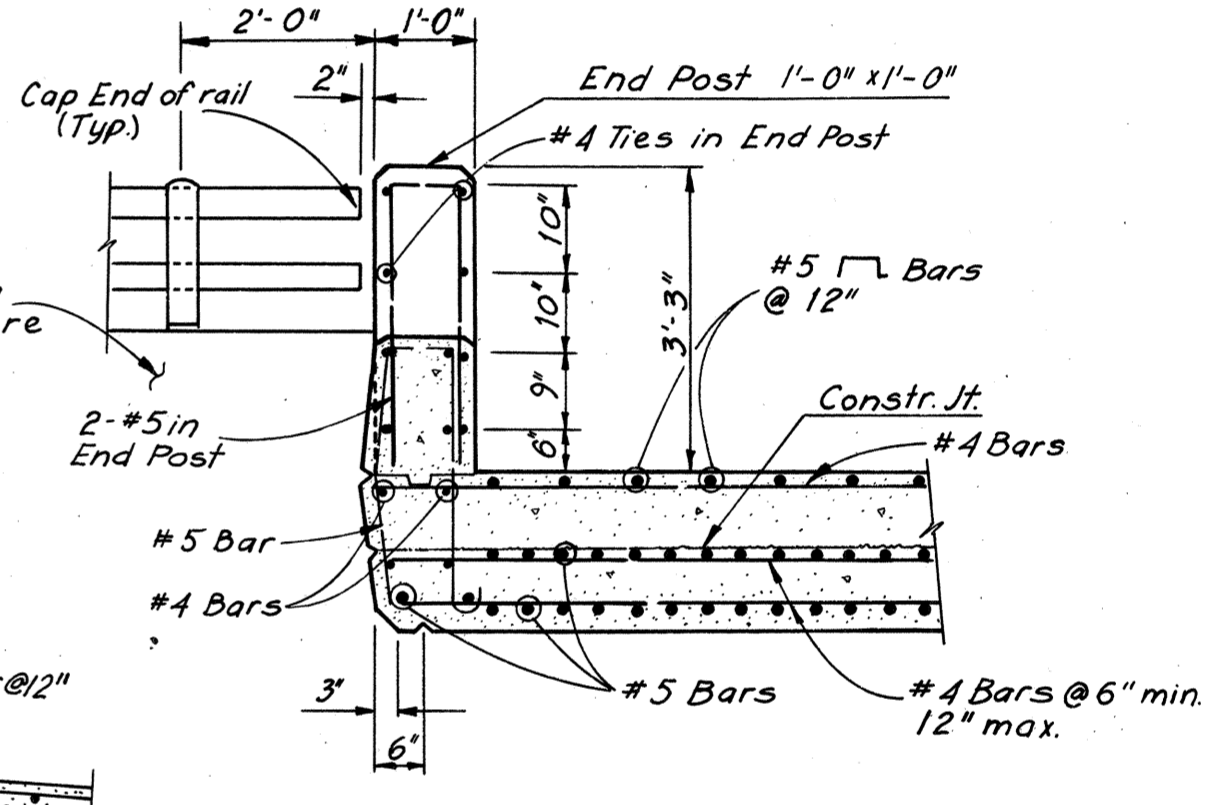

SECTION B-B


Scale: 1/2" = 1'-0"

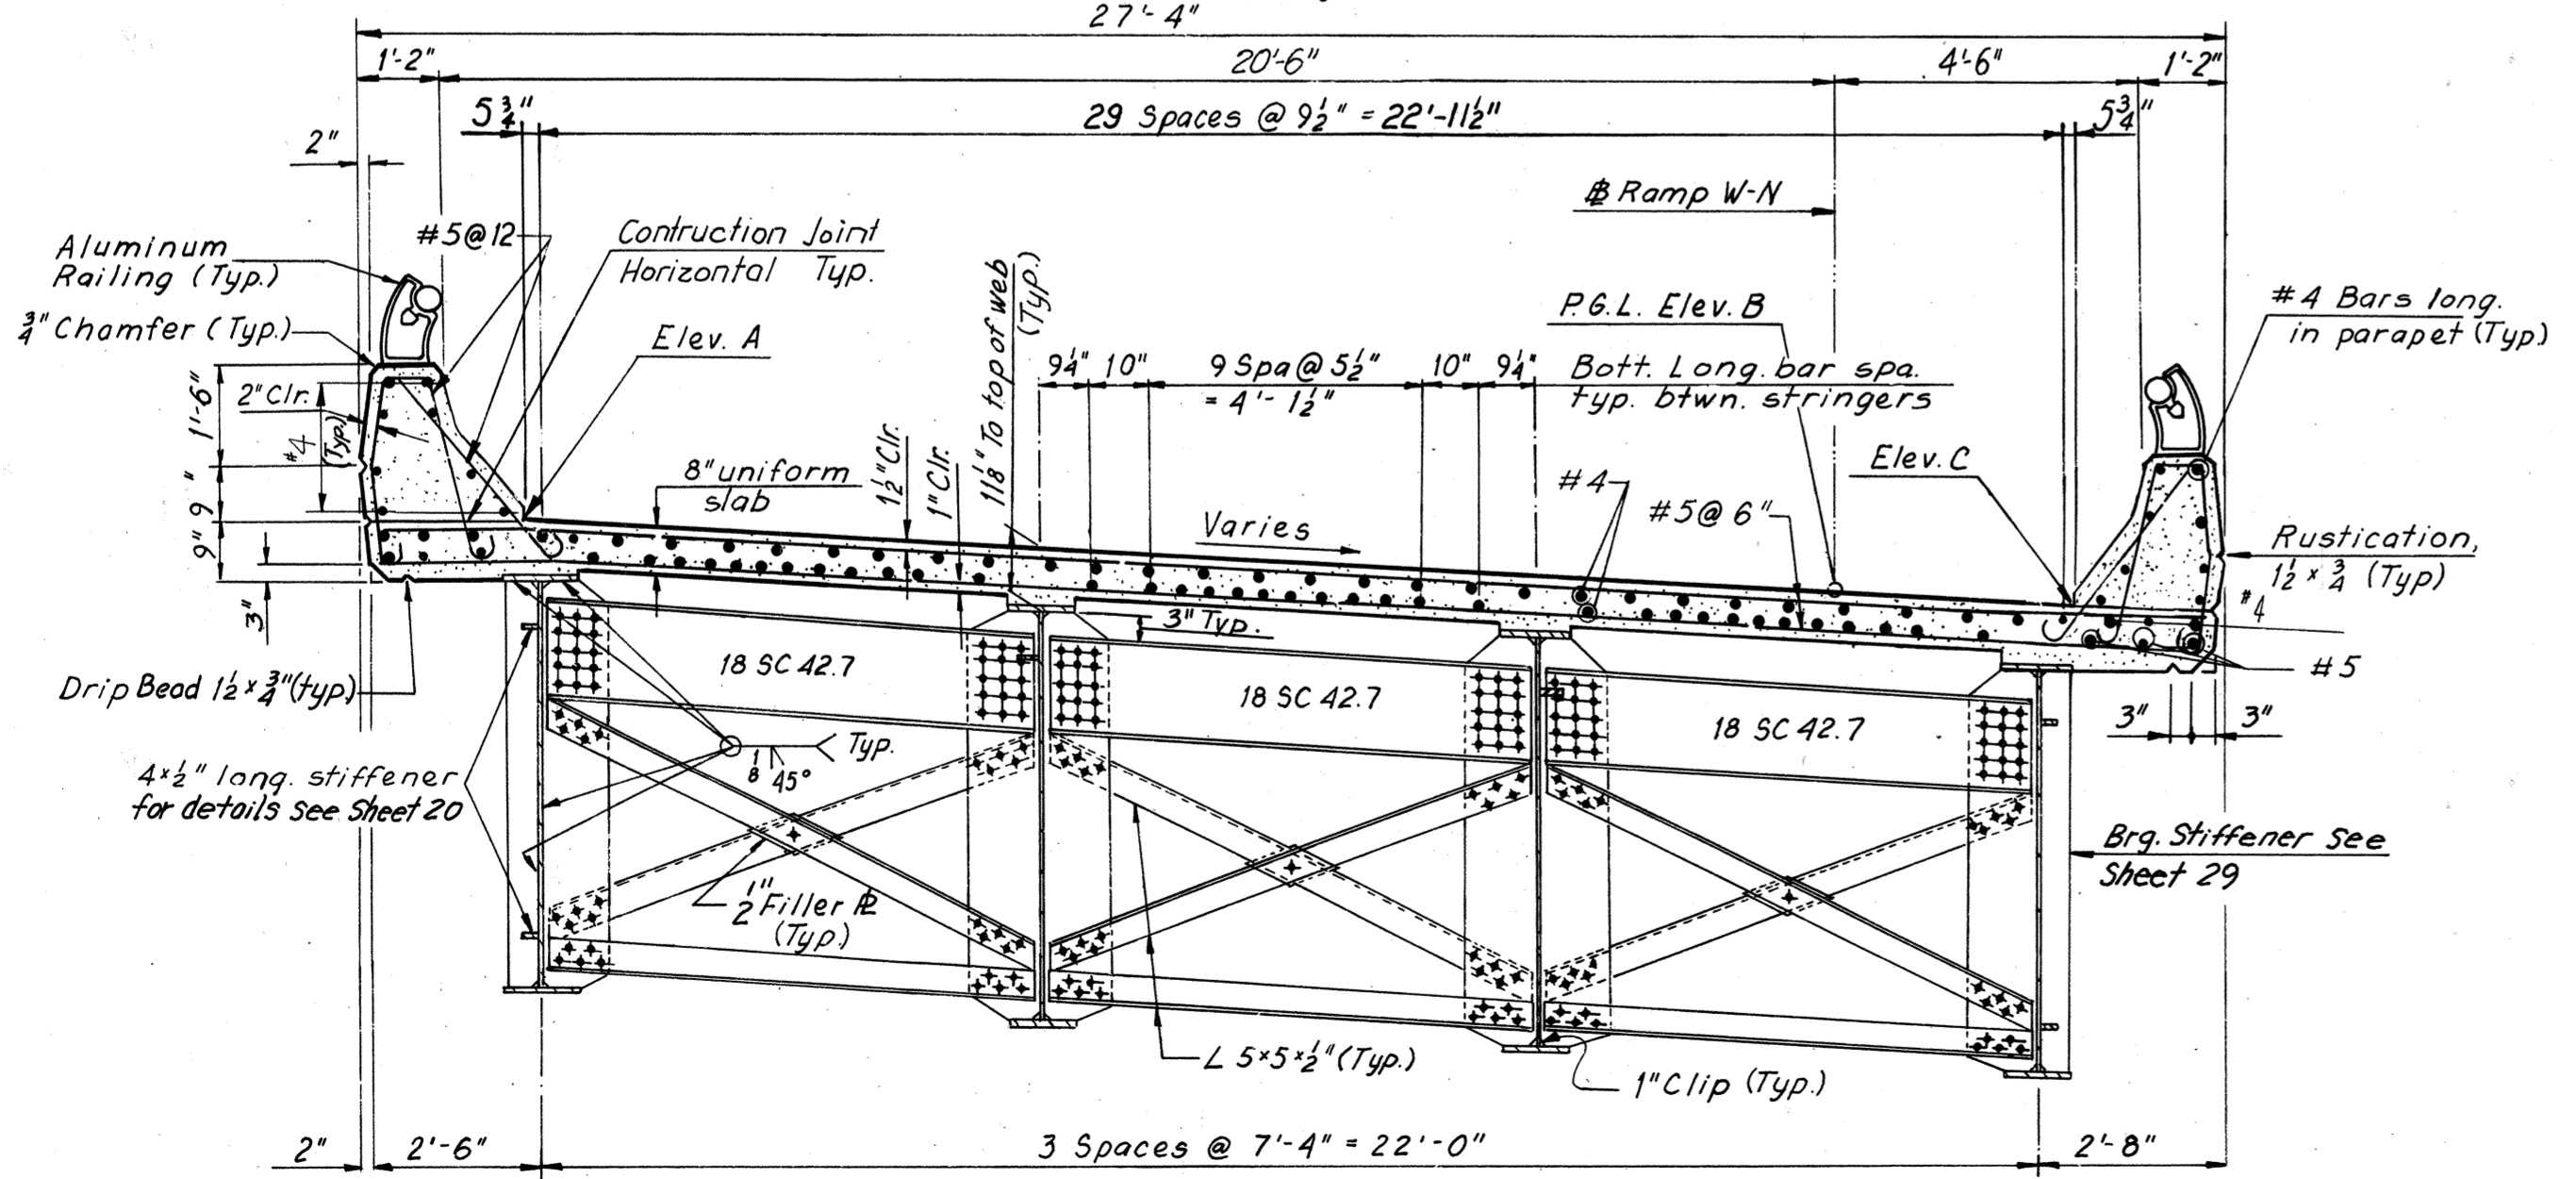

SECTION D-D - END DIAPHRAGM

Scale: 3/8" = 1'-0"


Unit 9 shown, Unit 10 Diaphragm similar

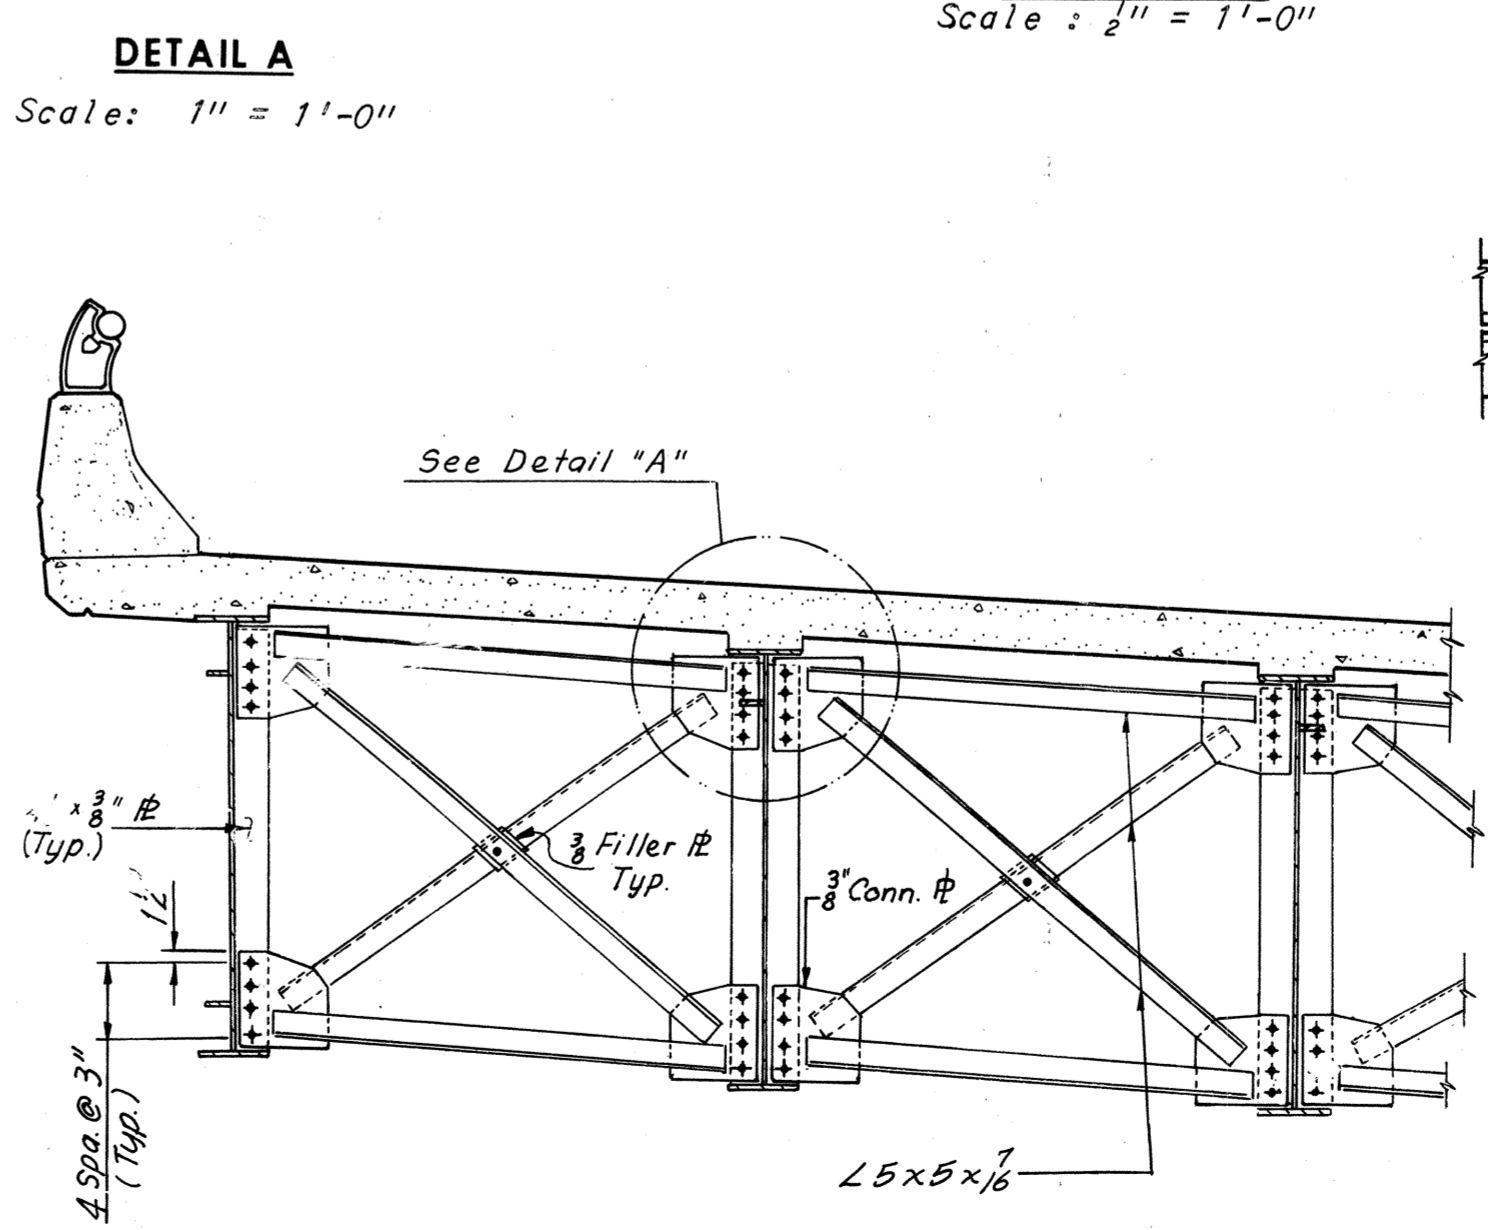

INTERMEDIATE DIAPHRAGM-UNIT 9

Scale: 3/8" = 1'-0"

AS BUILT

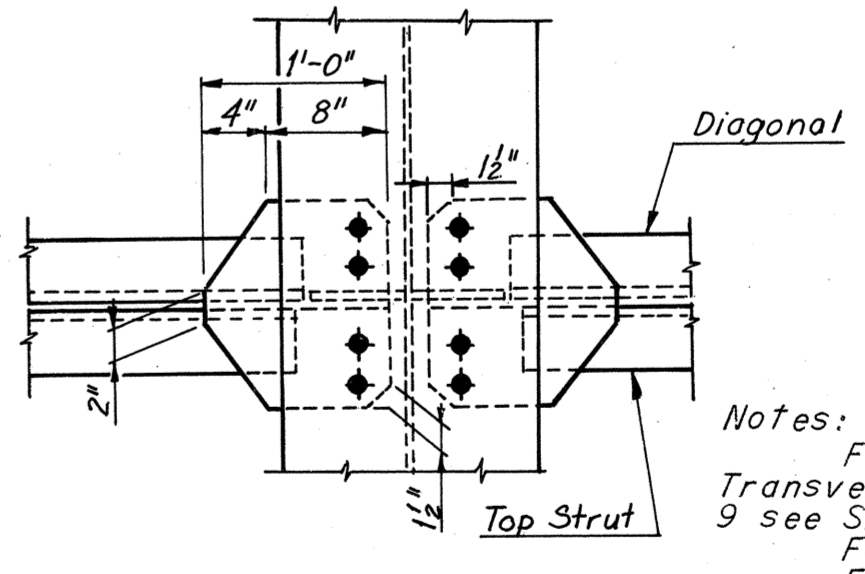

VIEW A-A

Scale: 1" = 1'-0"

Notes:
 For Intermediate Diaphragm and Transverse Stiffener Spacing for Unit 9 see Sheet 23.
 For Handrail Details see Sheet 53.
 For Lighting Details see Sheet 54.
 For Location of Detail B see Sheet 34.
 For Standard Drainage Details see Support Type 3 Sheet 56.
 For Location of Detail C see Stringer S1-10 Sheet 24.
 For Typical Parapet Detail, see Sheet 29.

RICHMOND METROPOLITAN AUTHORITY
 RICHMOND EXPRESSWAY SYSTEM
 DOWNTOWN EXPRESSWAY

BRIDGE NO. 67
 RAMP W-N CONNECTION TO
 RICHMOND-PETERSBURG TURNPIKE
 DECK PLAN AND SUPERSTRUCTURE DETAILS
 UNIT 9






HOWARD, NEEDLES, TAMMEN & BERGENDOFF
 consulting engineers
 NEW YORK ALEXANDRIA KANSAS CITY

SCALE: As Noted
 CONTRACT NO.: 10
 SHEET NO. 33 OF 54

BY	DATE	REVISION	BY	DATE
MADE	C.E.B.	3-7-69	2 As Built	TEM 6-77
CHECKED	A.M.H.	4-21-69	Revised 2 size, Intermediate Diaphragm	R.P. 1-24-75
IN CHARGE				

RICHMOND EXPRESSWAY SYSTEM			
SECTION	PROJECT	SHEET NO.	TOTAL SHEETS
10	DOWNTOWN EXPRESSWAY	206	265

ELEVATION TABLE			
STATION	ELEV. A	ELEV. B	ELEV. C
353+26.00	88.98	89.05	89.43
+30.00	88.96	89.03	89.41
+40.00	88.89	88.96	89.34
+50.00	88.80	88.87	89.25
+60.00	88.68	88.75	89.13
+70.00	88.54	88.61	88.99
+80.00	88.37	88.44	88.82
+90.00	88.17	88.24	88.62
354+00.00	87.96	88.03	88.41
+10.00	87.72	87.79	88.17
+20.00	87.46	87.53	87.91
+29.50	87.19	87.26	87.64
+30.00	87.17	87.24	87.62
+40.00	86.88	86.95	87.33
+50.00	86.57	86.64	87.02
+60.00	86.24	86.31	86.69
+70.00	85.89	85.96	86.34
+80.00	85.52	85.59	85.97
+90.00	85.13	85.20	85.58
355+00.00	84.72	84.79	85.17
+10.00	84.30	84.37	84.75
+20.00	83.86	83.93	84.33
+30.00	83.41	83.48	83.90
+40.00	82.94	83.02	83.46
+50.00	82.45	82.54	83.02
+60.00	81.97	82.06	82.57
+70.00	81.48	81.57	82.12
+80.00	80.99	81.09	81.68
+90.00	80.49	80.61	81.23
356+00.00	80.00	80.12	80.77
+10.00	79.51	79.64	80.31
+20.00	79.02	79.15	79.85
+30.00	78.53	78.67	79.39
+39.50	78.06	78.21	78.95
+40.00	78.04	78.19	78.92
+50.00	77.55	77.70	78.46
+60.00	77.06	77.22	77.99
+70.00	76.58	76.74	77.53
+80.00	76.11	76.29	77.10
+90.00	75.67	75.86	76.68
357+00.00	75.25	75.45	76.28
+10.00	74.85	75.05	75.88
+20.00	74.44	74.65	75.48
+30.00	74.04	74.25	75.09
+40.00	73.65	73.86	—
+50.00	73.27	73.48	—
+60.00	72.89	73.10	—
+65.50	72.69	72.90	—

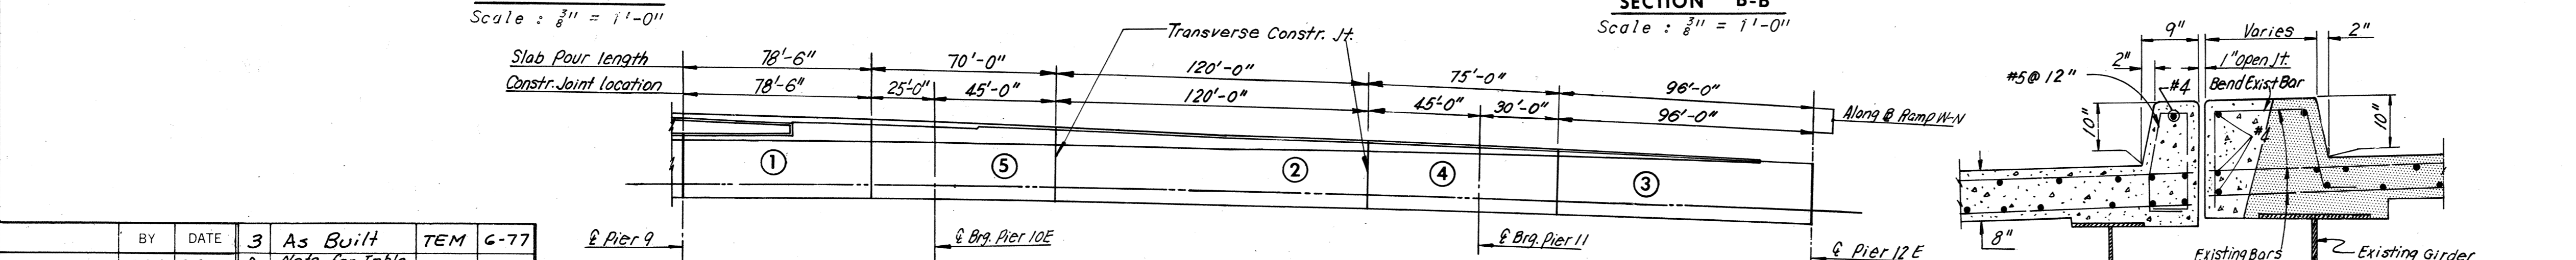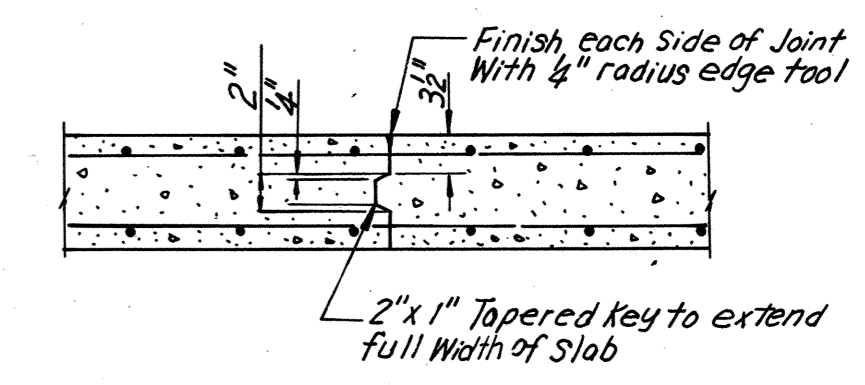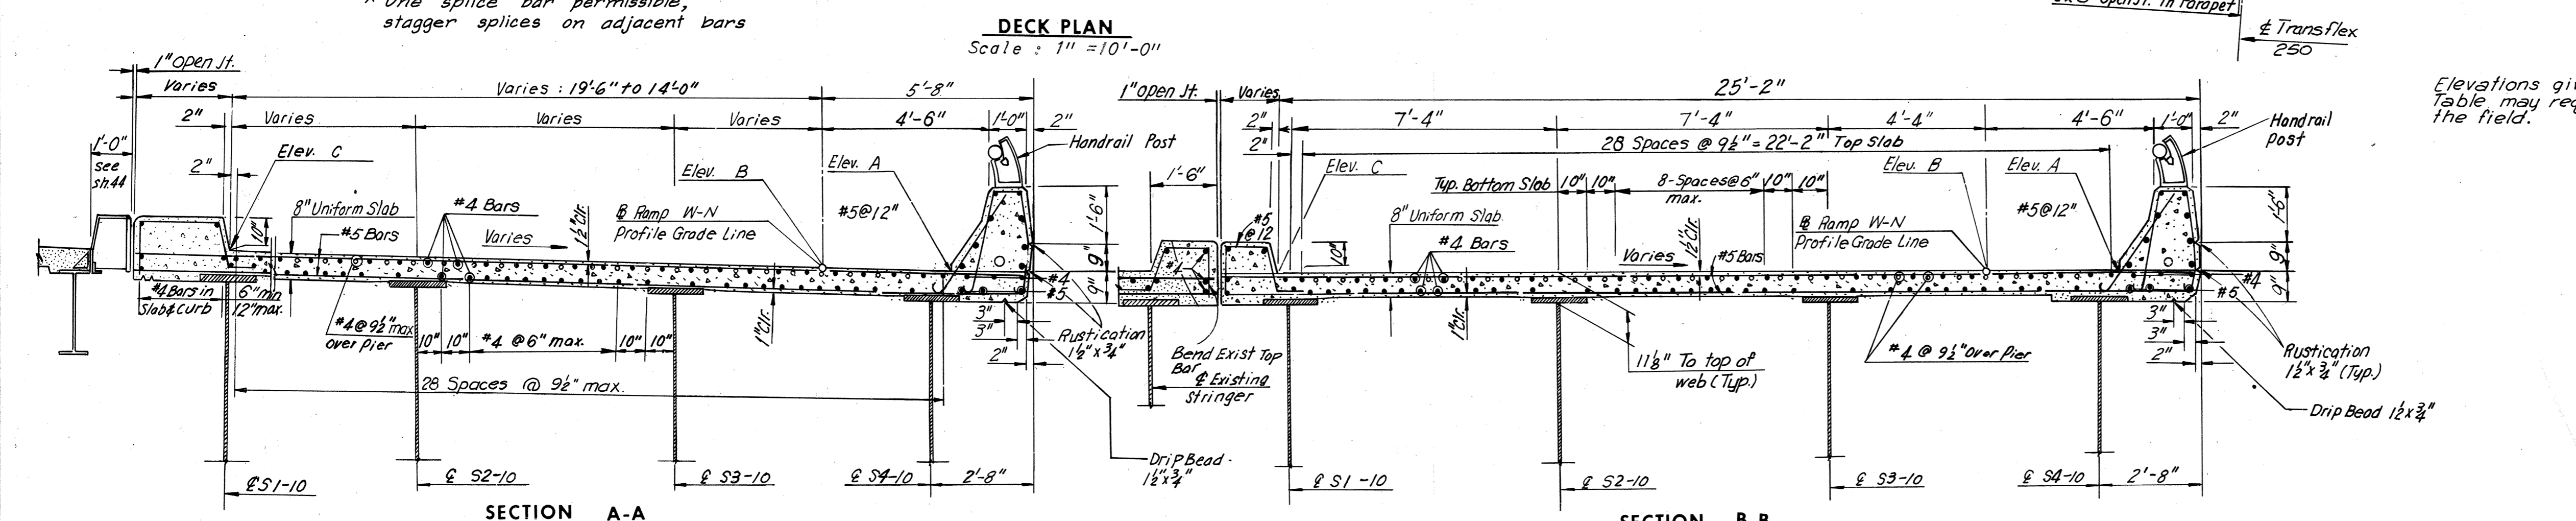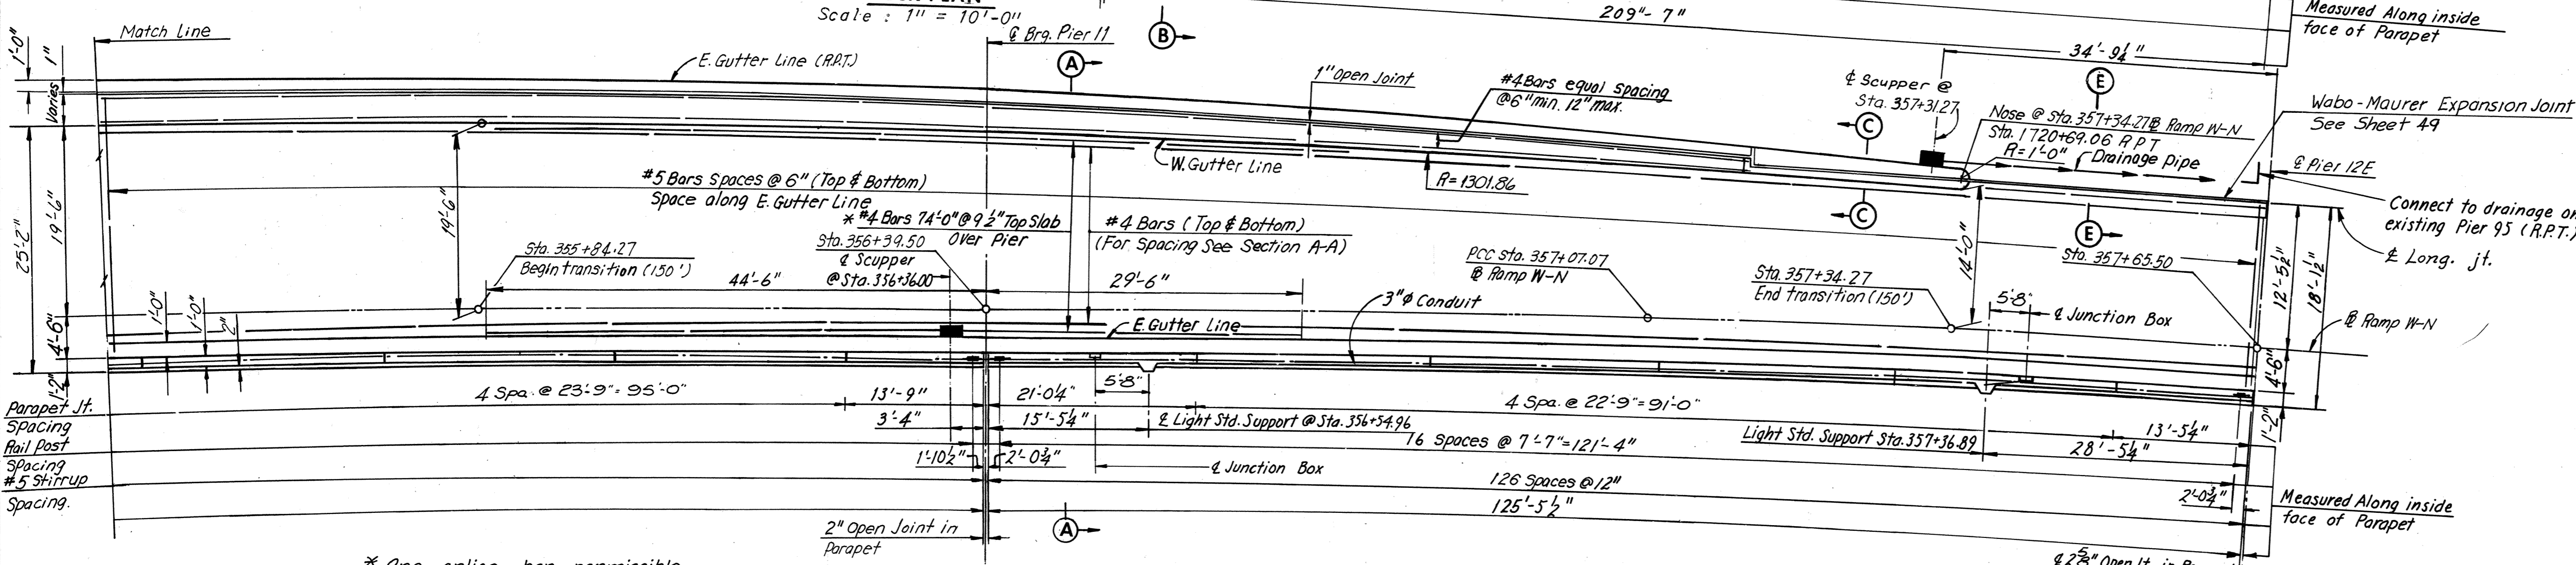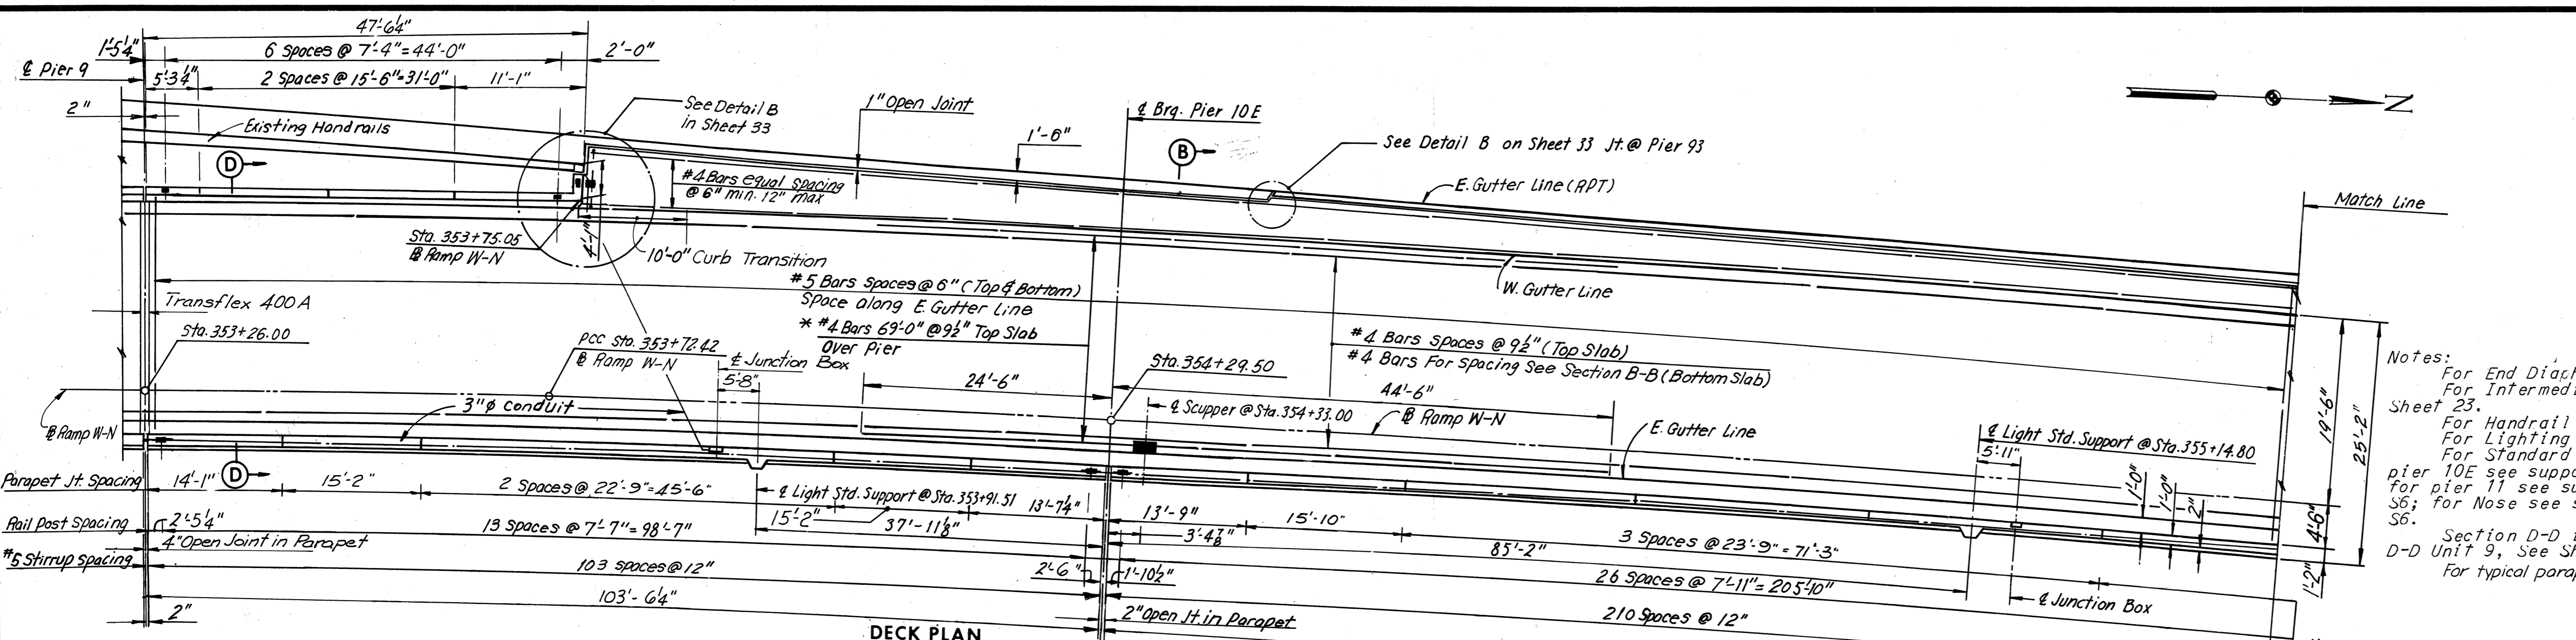

Notes:
 For End Diaphragms see, Sheet 33.
 For Intermediate Diaphragms see, Sheet 23.
 For Handrail Details see, Sheet 33.
 For Lighting Details see, Sheet 34.
 For Standard Drainage Details for pier 10E see support Type 10, sheet S6; for pier 11 see support Type 9, sheet S6; for Nose see support Type 9, sheet S6.
 Section D-D is similar to Section D-D Unit 9, See Sheet 33.
 For typical parapet Details, see Sheet 29.

Elevations given in the Elevation Table may require adjustment in the field.

BY	DATE	3	As Built	TEM	G-77
MADE	G.S.H	2-26-69		DWB	1-28-75
CHECKED	AMH	4-23-69		RJF	1-24-75
IN CHARGE					

AS BUILT


RICHMOND METROPOLITAN AUTHORITY
 RICHMOND EXPRESSWAY SYSTEM
 DOWNTOWN EXPRESSWAY

BRIDGE NO. 67
 RAMP W-N CONNECTION TO
 RICHMOND-PETERSBURG TURNPIKE
 DECK PLAN — UNIT 10

HOWARD, NEEDLES, TAMMEN & BERGENDOFF
 consulting engineers
 NEW YORK ALEXANDRIA KANSAS CITY

SCALE: As Noted
 CONTRACT NO.: 10
 SHEET NO. 34 OF 54

RICHMOND EXPRESSWAY SYSTEM			
SECTION	PROJECT	SHEET NO.	TOTAL SHEETS
10	DOWNTOWN EXPRESSWAY	207	265

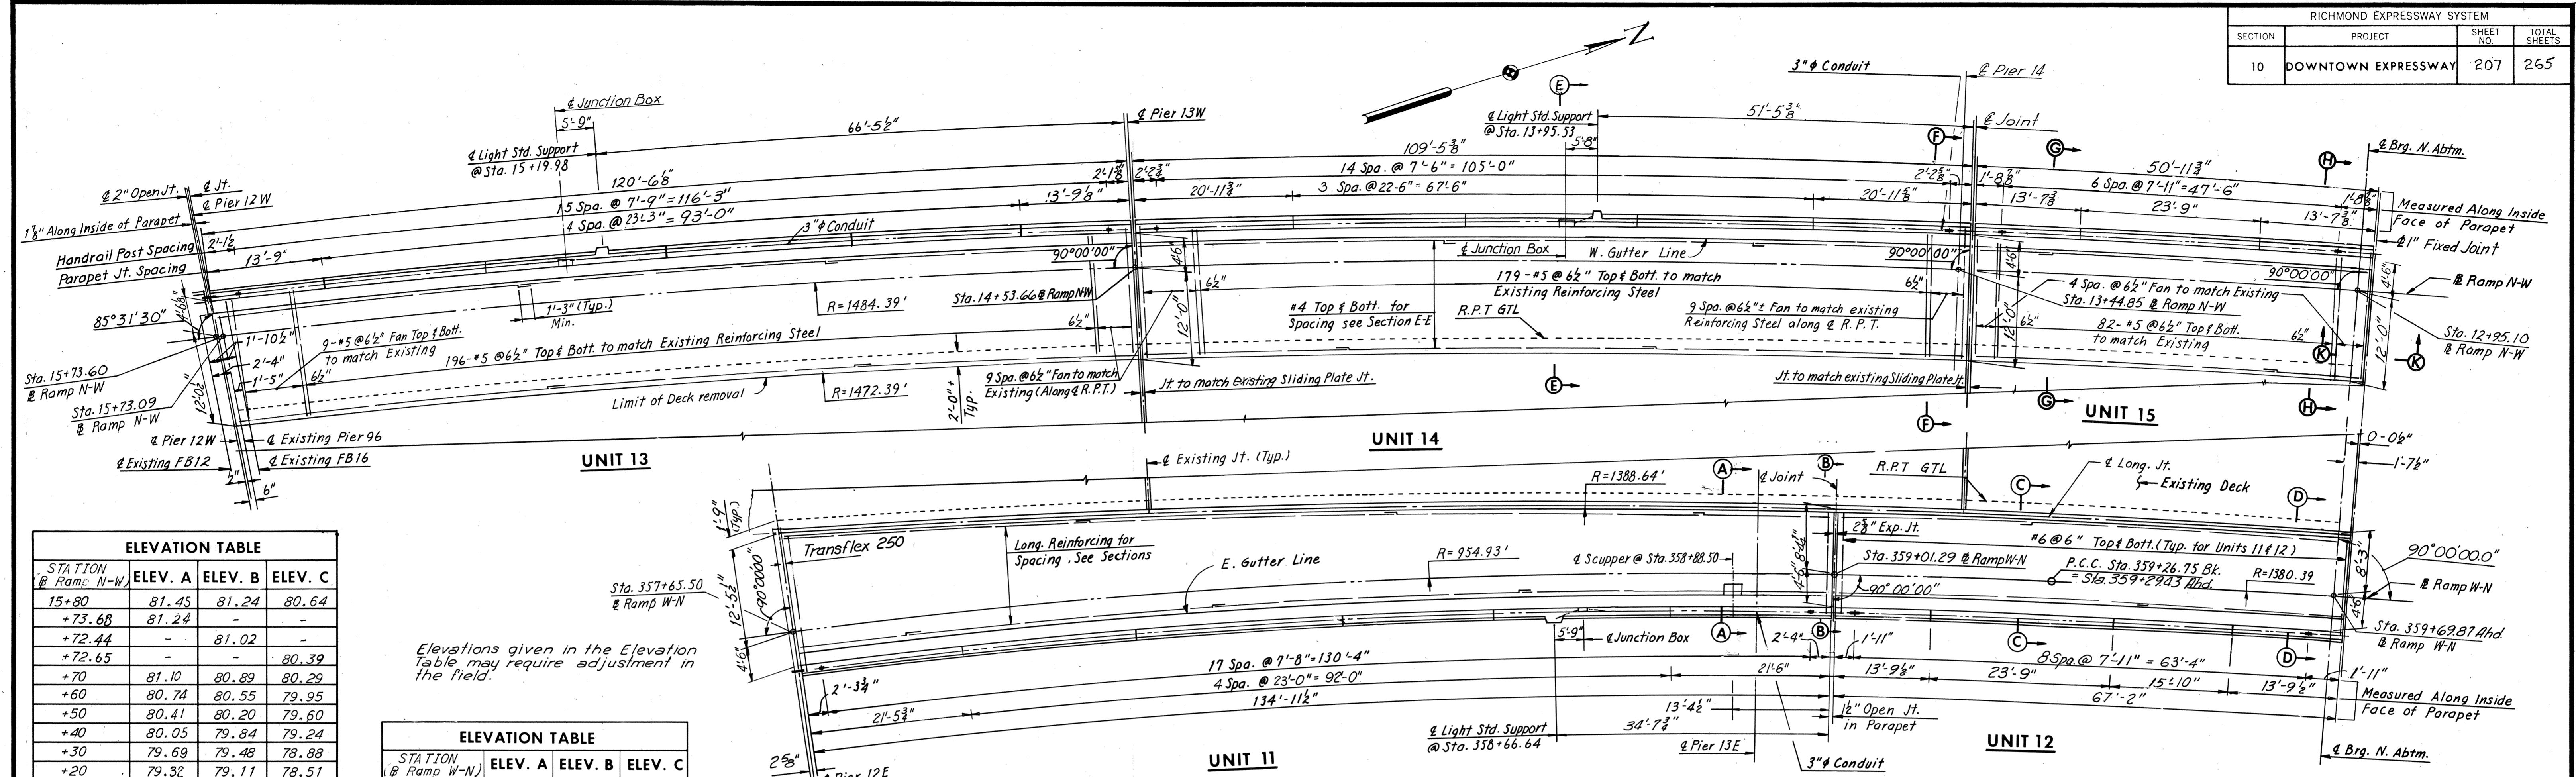


STATION @ Ramp N-W	ELEV. A	ELEV. B	ELEV. C
15+80	81.45	81.24	80.64
+73.68	81.24	-	-
+72.44	-	81.02	-
+72.65	-	-	80.39
+70	81.10	80.89	80.29
+60	80.74	80.55	79.95
+50	80.41	80.20	79.60
+40	80.05	79.84	79.24
+30	79.69	79.48	78.88
+20	79.32	79.11	78.51
+10	78.95	78.74	78.14
15+00	78.57	78.36	77.76
14+90	78.20	77.99	77.39
+80	77.82	77.61	77.01
+70	77.45	77.24	76.64
+60	77.08	76.87	76.27
+53.40	76.85	76.64	76.04
+50	76.72	76.51	75.91
+40	76.37	76.16	75.56
+30	76.02	75.81	75.21
+20	75.67	75.46	74.86
+10	75.31	75.10	74.50
14+00	74.96	74.75	74.15
13+90	74.61	74.40	73.80
+80	74.26	74.05	73.45
+70	73.91	73.70	73.10
+60	73.55	73.34	72.74
+50	73.20	72.99	72.39
+44.61	73.01	72.80	72.20
+40	72.85	72.64	72.04
+30	72.49	72.28	71.68
+20	72.13	71.92	71.32
+10	71.77	71.56	70.96
13+00	71.40	71.19	70.59
12+92.81	71.12	70.91	70.31

STATION @ Ramp W-N	ELEV. A	ELEV. B	ELEV. C
357+60	72.89	73.10	74.28
+65.50	72.69	72.90	73.65
+70	72.53	72.74	73.48
+80	72.17	72.38	73.09
+90	71.82	72.03	72.70
358+00	71.46	71.67	72.32
+10	71.10	71.31	71.94
+20	70.75	70.96	71.56
+30	70.39	70.60	71.19
+40	70.02	70.23	70.80
+50	69.65	69.86	70.41
+60	69.26	69.47	70.01
+70	68.86	69.07	69.60
+80	68.46	68.67	69.18
+90	68.06	68.27	68.78
+92	67.98	68.19	68.70
359+00	67.67	67.88	68.38
+02.00	67.60	67.81	68.31
+10	67.24	67.50	68.00
+20	66.93	67.14	67.63
+30	66.57	66.78	67.27
+40	66.20	66.41	66.91
+50	65.82	66.03	66.53
+60	65.44	65.65	66.14
+69.39	65.06	65.27	65.78
+70	65.04	65.25	65.75

Note:
 For Sections E-E, F-F, G-G and H-H, see Sheet 47.
 For Framing Plan, see Sheet 26.
 For Joint Details, see Sheet 48 and 49.
 Elevation C is to be confirmed by Contractor.
 For Handrail Details, see Sheet 33.
 For Typical Parapet Details, see Sheet 28.

BY	DATE	3	As Built	TEM	G-77
MADE	Y.C.P. G.C.C.	2-27-69		DWB	1-28-75
CHECKED	K.C.T.	5-1-69		DWB	1-17-75
IN CHARGE	NO.	REVISION	BY	DATE	

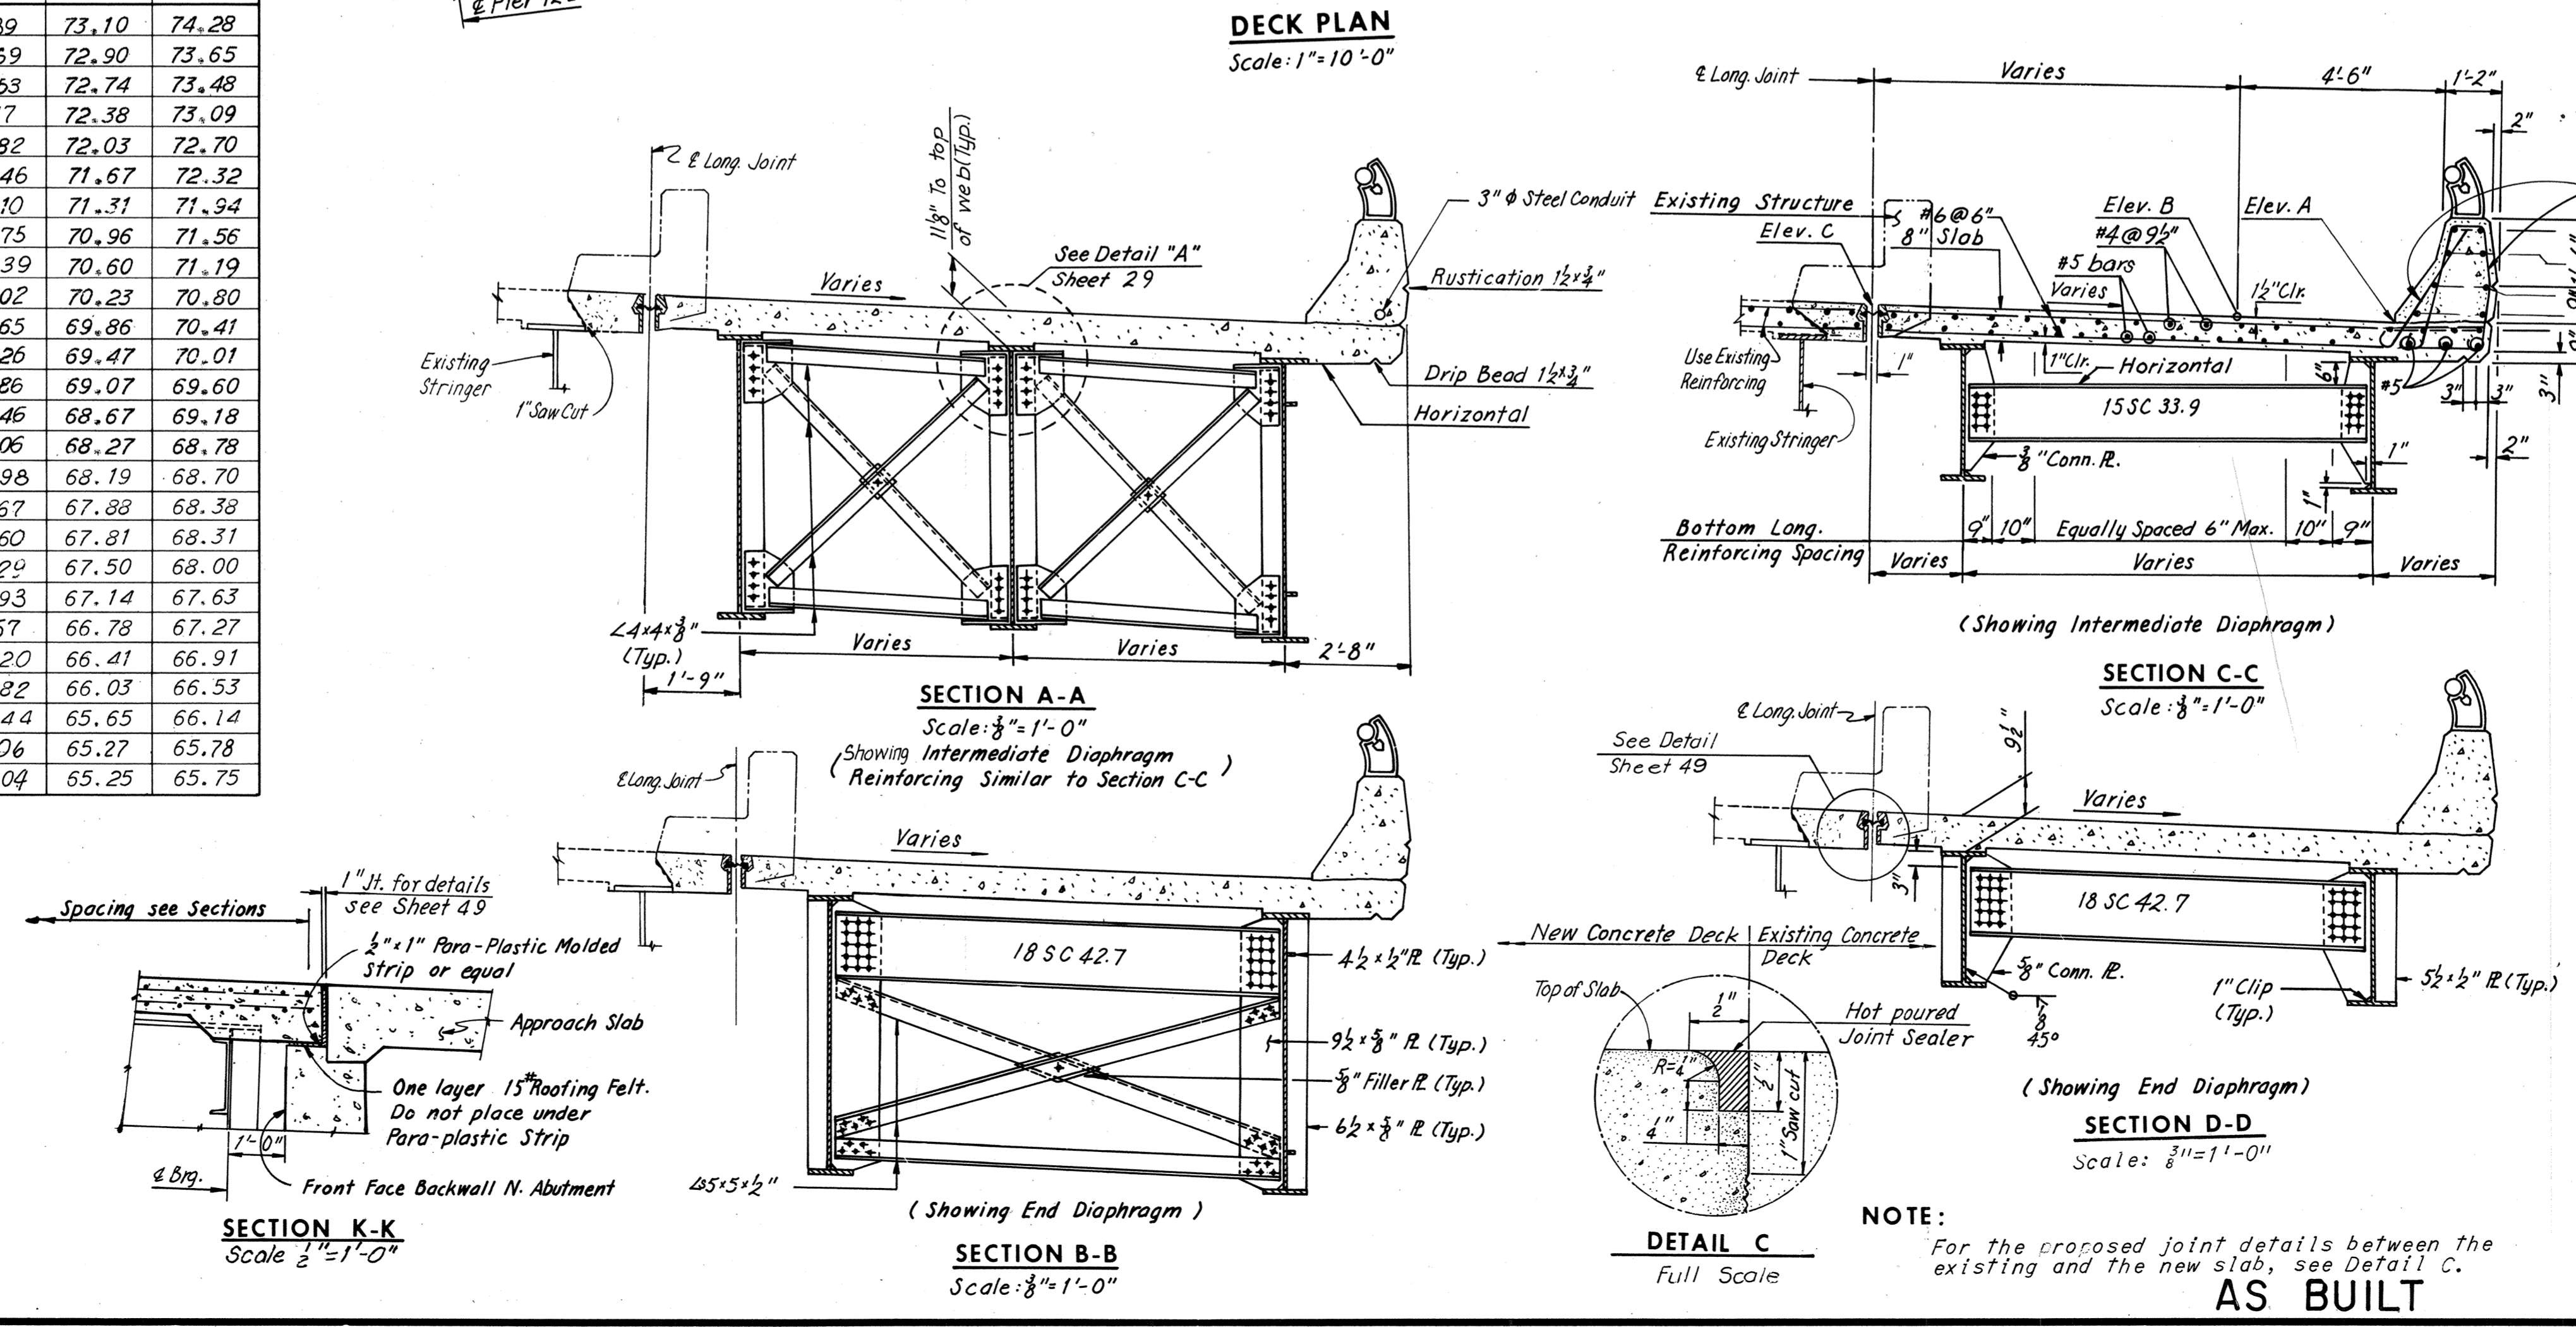

Note:
 For Standard Drainage Details for Unit 11 see Support Type 3 Sheet 36.

NOTE:
 For the proposed joint details between the existing and the new slab, see Detail C.
AS BUILT

RICHMOND METROPOLITAN AUTHORITY
RICHMOND EXPRESSWAY SYSTEM
 DOWNTOWN EXPRESSWAY


BRIDGE NO. 67
 RAMP W-N CONNECTION TO
 RICHMOND-PETERSBURG TURNPIKE
DECK PLAN-UNITS 11, 12, 13, 14 AND 15

HOWARD, NEEDLES, TAMMEN & BERGENDOFF
 consulting engineers
 NEW YORK ALEXANDRIA KANSAS CITY


SCALE: As Noted
 CONTRACT NO.: 10
 SHEET NO. 35 OF 54

MEMBER	STRESSES					L	AREA REQUIRED		SECTION	AREA PROVIDED	
	DEAD LOAD	LIVE LOAD	IMPACT	DESIGN LOAD	ALLOWABLE STRESS		GROSS	NET		GROSS	NET
	T	T	T	T	T		T	T		T	T
TOP CHORDS											
U0WN-U4WN	213C	68	10	296C	15.43	43.4	19.2	—	1-Top R 24x ³ / ₈ 2-Web R 24x ³ / ₈	58.50	—
U4WN-U6WN	649C	183	28	860C	15.02	57.1	57.3	—	1-Top R 24x ³ / ₈ 2-Web R 24x ³ / ₈	64.50	—
U6WN-U8WN	780C	228	35	1043C	14.96	59.0	69.7	—	1-Top R 24x ³ / ₈ 2-Web R 24x ³ / ₈	76.50	—
U8WN-U10WN	644C	194	30	868C	15.02	57.1	57.8	—	1-Top R 24x ³ / ₈ 2-Web R 24x ³ / ₈	64.50	—
U10WN-U12WN	257C	79	12	348C	15.06	56.0	23.1	—	1-Top R 24x ³ / ₈ 2-Web R 24x ³ / ₈	58.50	—
BOTTOM CHORDS											
L0WN-L3AWN	0	0	0	0	20.00	—	—	—	1-Top R 24x ³ / ₈ 2-Web R 24x ³ / ₈	58.50	51.00
L3AWN-L5WN	506T	134	20	660T	20.00	—	33.0	—	1-Top R 24x ³ / ₈ 2-Web R 24x ³ / ₈	64.50	55.75
L5WN-L7WN	777T	224	34	1035T	20.00	—	51.8	—	1-Top R 24x ³ / ₈ 2-Web R 24x ³ / ₈	64.50	55.75
L7WN-L9WN	777T	240	36	1047T	20.00	—	52.4	—	1-Top R 24x ³ / ₈ 2-Web R 24x ³ / ₈	64.50	55.75
L9WN-L11WN	508T	160	24	692T	20.00	—	34.6	—	1-Top R 24x ³ / ₈ 2-Web R 24x ³ / ₈	64.50	55.75
L11WN-L12WN	0	0	0	0	20.00	—	—	—	1-Top R 24x ³ / ₈ 2-Web R 24x ³ / ₈	58.50	51.00
DIAGONALS											
U0WN-L3AWN	394T	132	20	546T	20.00	48.9	—	27.3	1-Top R 24x ⁹ / ₁₆ 2-Web R 18x ⁹ / ₁₆	40.50	36.00
L3AWN-U4WN	380C	134	20	534C	15.32	47.6	34.9	—	1-Top R 24x ⁹ / ₁₆ 2-Web R 18x ⁹ / ₁₆	40.50	—
U4WN-L5WN	226T	100	15	341T	20.00	65.7	—	17.1	2-Web R 15x ⁹ / ₁₆ 2-Perf. R 24x ⁹ / ₁₆	30.38	25.88
L5WN-U6WN	212C	101	15	328C	14.78	63.8	22.2	—	2-Web R 15x ⁹ / ₁₆ 2-Perf. R 24x ⁹ / ₁₆	30.38	—
U6WN-L7WN	17T	46C	7	36C	14.67	66.5	2.5	—	2-Web R 15x ⁹ / ₁₆ 2-Perf. R 24x ⁹ / ₁₆	30.38	25.88
L7WN-U8WN	17T	55C	8	62C	14.74	64.7	4.2	—	2-Web R 15x ⁹ / ₁₆ 2-Perf. R 24x ⁹ / ₁₆	30.38	25.88
U8WN-L9WN	188C	87	13	288C	14.64	67.4	19.7	—	2-Web R 15x ⁹ / ₁₆ 2-Perf. R 24x ⁹ / ₁₆	30.38	—
L9WN-U10WN	210T	88	13	311T	20.00	65.6	—	15.6	2-Web R 15x ⁹ / ₁₆ 2-Perf. R 24x ⁹ / ₁₆	30.38	25.88
U10WN-L11WN	390C	138	21	549C	15.03	56.8	36.5	—	1-Top R 24x ⁹ / ₁₆ 2-Web R 18x ⁹ / ₁₆	40.50	—
L11WN-U12WN	416T	141	21	578T	20.00	55.2	—	28.9	1-Top R 24x ⁹ / ₁₆ 2-Web R 18x ⁹ / ₁₆	40.50	36.00
U0WN-L0WN	394C	137	20	551C	15.50	40.7	35.5	—	2-Web R 18x ⁹ / ₁₆ 2-Perf. R 24x ⁹ / ₁₆	37.50	—
U4WN-L4WN TO U10WN-L10WN	0	0	0	0	20.00	—	—	—	2-12[25.0 Intermediate Stay R 15x ⁹ / ₁₆ x1'-11 ¹ / ₂ " End Stay R 26x ⁹ / ₁₆ x1'-11 ¹ / ₂ "	14.64	11.09
U12WN-L12WN	394C	137	20	551C	15.38	45.4	35.8	—	2-Web R 18x ⁹ / ₁₆ 2-Perf. R 24x ⁹ / ₁₆	37.50	—

MEMBER	SECTION	L	T	ALLOWABLE STRESS	GROSS AREA
END SWAY AT P.P. 0	U0WN-L2W	14WF 61	93.1	13.40	17.94
	L0WN-L2W	14WF 61			17.94
INTERMEDIATE SWAYS	U4WN-M4N	12BP 53	67.1	14.65	15.58
	M4N-M4N				
	L4WN-L4W	14WF 61	53.0		17.94
END SWAY AT P.P. 12	U12WN-L12W	14WF 61	88.2	13.67	17.94
	L12WN-L12W	14WF 61	53.0		17.94
CENTER POST	SEE TYPICAL SECTION		58.7	14.97	15.58

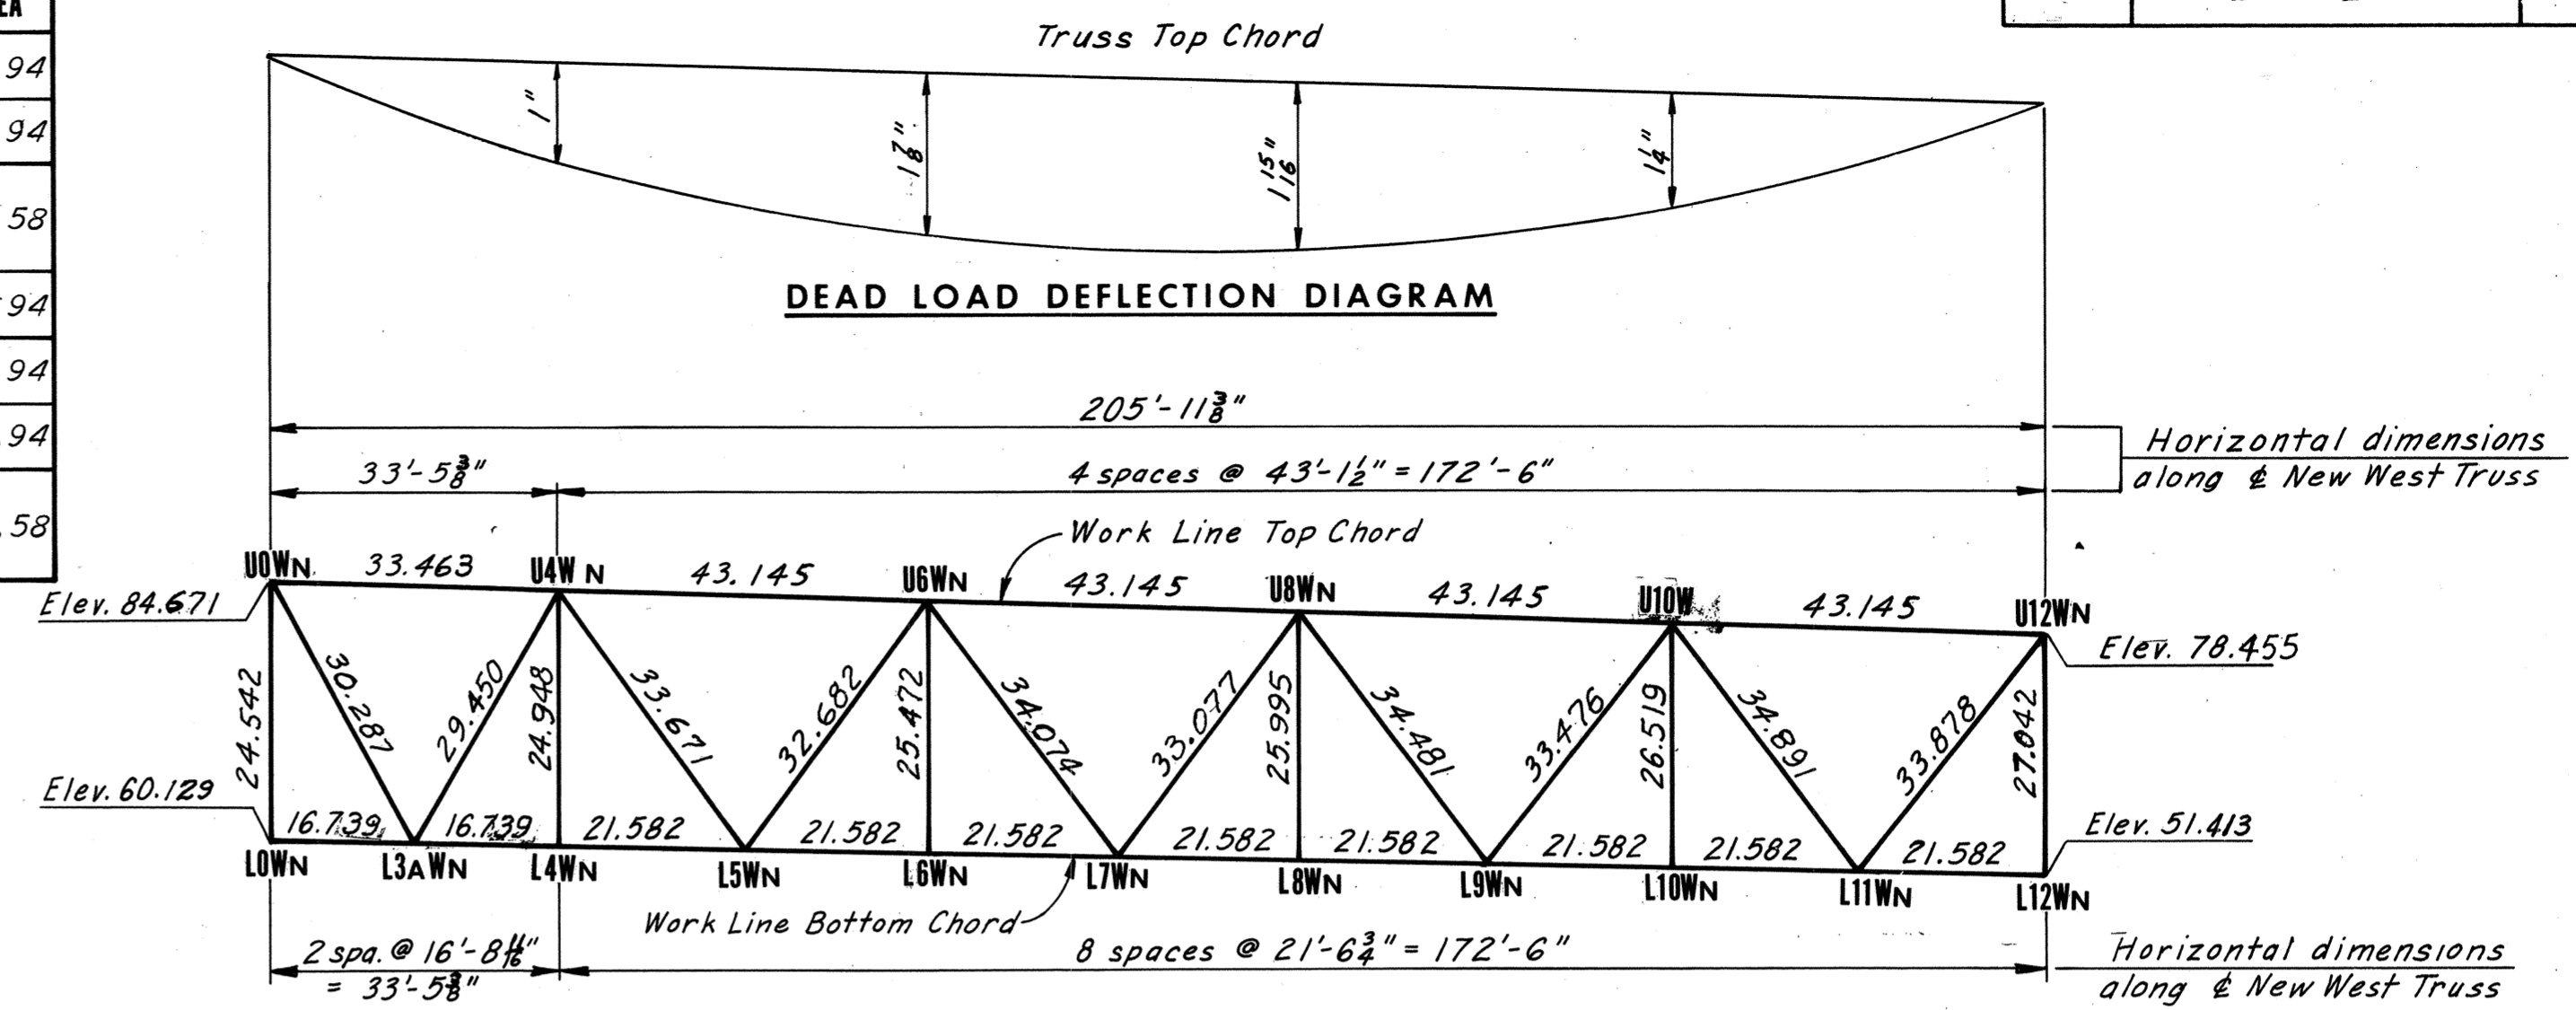

NEW WEST TRUSS DIMENSIONS
No Scale

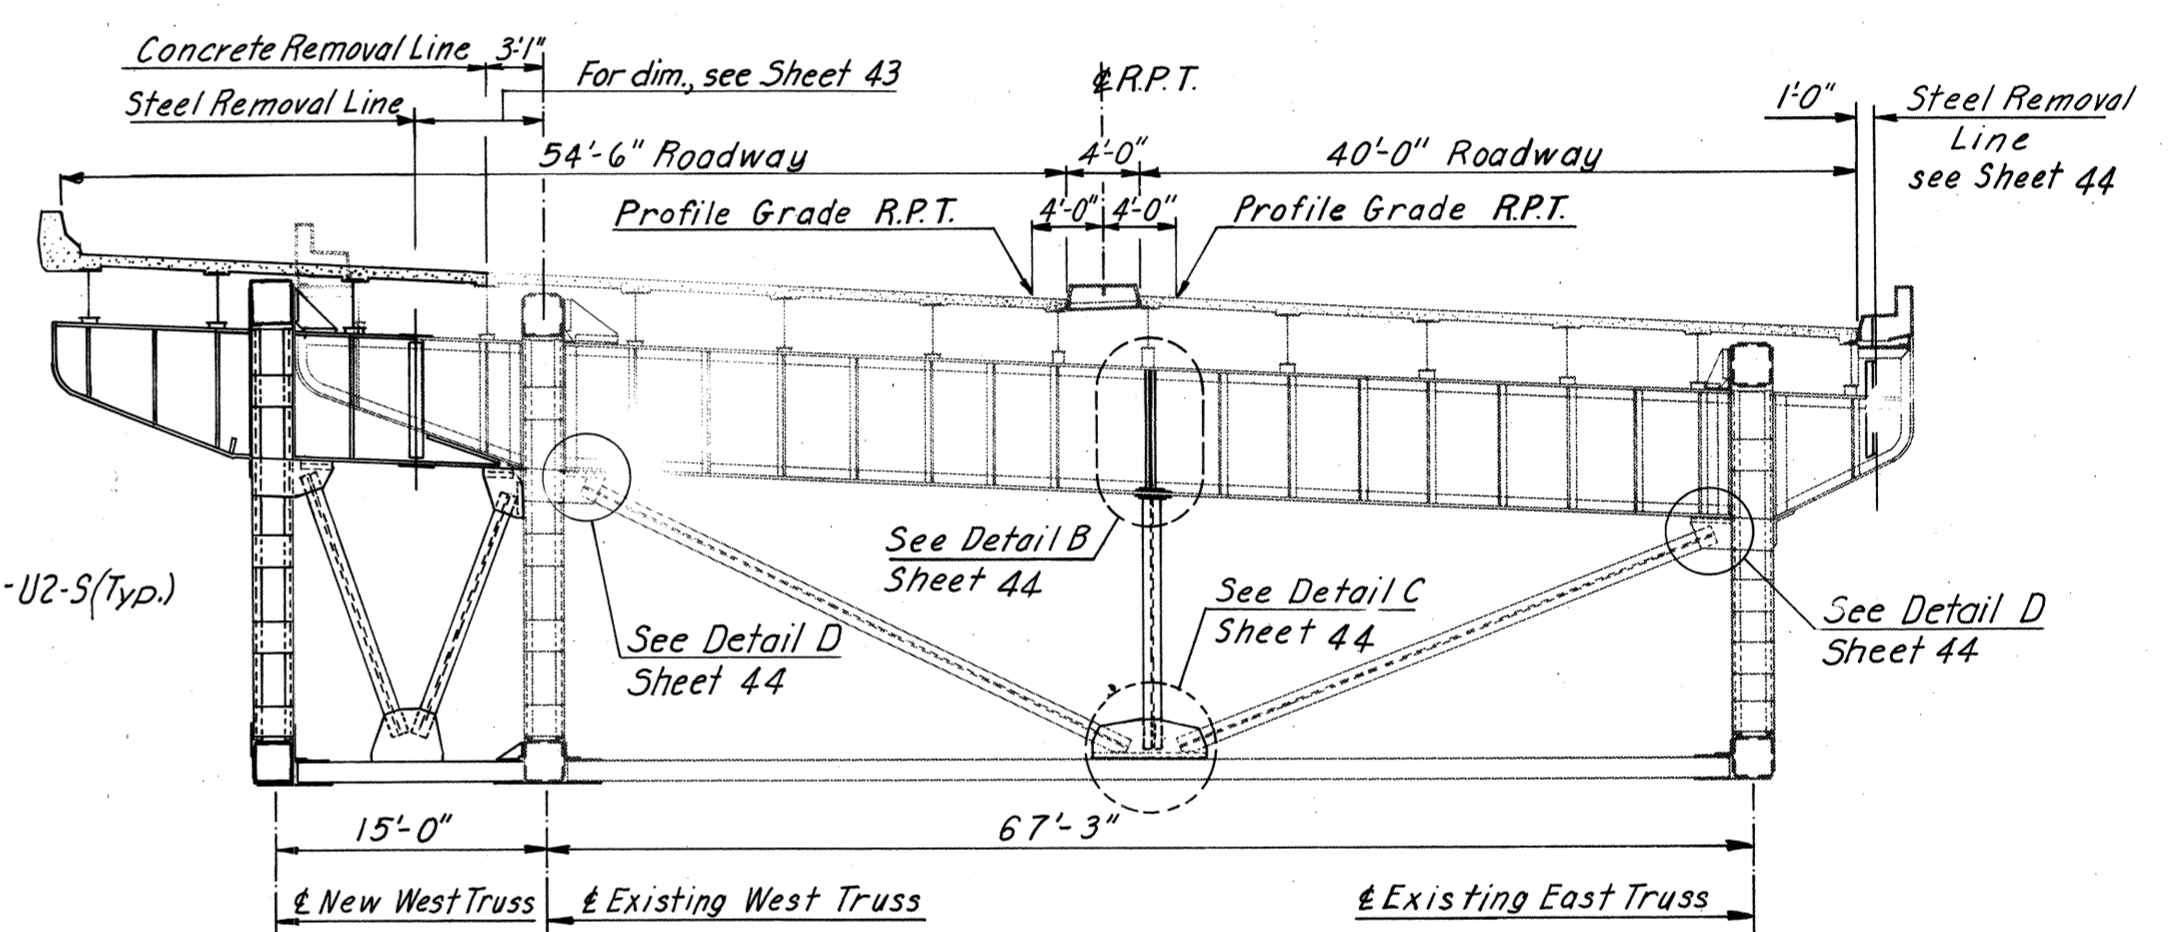

TYPICAL SECTION
Scale: 1/2" = 1'-0"

GENERAL NOTES FOR TRUSS SPAN

For General Design Notes, see Sheet 4.
Truss and floorbeams shall be cambered for full dead load.
All truss joints shall be detailed to make axes of members conform to full dead load layout of truss. Reaming or drilling of connections shall be done with chords assembled in that position. Reaming of connections for web members shall be made to carefully set metal templates. All chords shall be milled to bear at both ends. All truss verticals and floorbeams shall lie in truly vertical planes under full dead load.
Prior to removal of any existing structure, the existing floorbeams and sway frames are to be modified by adding posts and strengthening connections. (See Details B, C & D, Sheet 44.) No modification required at Floorbeam O.
Sway frame connection modifications shall be restricted as follows:
a. Adjacent sway frames shall not be modified simultaneously.
b. Connections in a sway frame are to be modified one at a time. A minimum of one-half the existing connection must be maintained at all times.
c. Holes 3/16" oversize are permitted for connection modifications provided a hardened washer is used under both the head and nut.
d. Traffic on Richmond-Petersburg Turnpike within the truss span shall be limited to 25 MPH during the sway frame modifications.
e. Post connections shall be made after all other sway frame connections at that floorbeam are completed.







The new truss has been designed to carry all the added dead load resulting from the widened roadway.
The new truss shall be temporarily loaded to simulate full dead load prior to making permanent connections to the existing structure.
The concrete deck to be placed after the permanent connections are made and the temporary loads removed.

	STRINGERS									FLOORBEAMS					
	A			B			C			FB 0		FB 4,6,8,10		FB 12	
	MOMENT	REACTION	SHEAR	MOMENT	REACTION	SHEAR	MOMENT	REACTION	SHEAR	MOMENT	SHEAR	MOMENT	SHEAR	MOMENT	SHEAR
DEAD LOAD	188	48	26	225	56	31	175	61	32	123	28	546	106	105	33
LIVE LOAD	245	44	17	265	48	19	275	40	20	233	51	321	68	154	50
IMPACT	74	13	5	80	14	6	83	12	6	70	15	96	20	46	15
TOTAL	407	105	48	570	118	56	533	113	58	426	94	963	194	305	98
REQ'D. SEC. MOD.	244			342			320			254		577		183	
SECTION	33 WF 118*			33 WF 130*			33 WF 130*			Web 82 ¹ / ₂ x 1/2"		Web 83 x 1/2"		Web 82 ¹ / ₂ x 1/2"	
PROV. SEC. MOD.	358.3			404.8			404.8			1,227		1,103		1,227	

* Live Load Deflection governs design.

Notes: Cross-section area of the structural members shown in the tables are in square inches, applied loads, reactions and shears are all given in kips, allowable stresses in kips per square inch and section moduli in inches cubed. C and T in the stress columns denotes respectively compression and tension.

MADE	D.E.S.	12-17-68	3 As Built	TEM 6-77
CHECKED	JV	5-15-69	Notes Added	E.J.M. 3-5-75
IN CHARGE			Detail C & D added, notes removed, FB Web R size & truss dims. rev.	d.B.P. 2-7-75

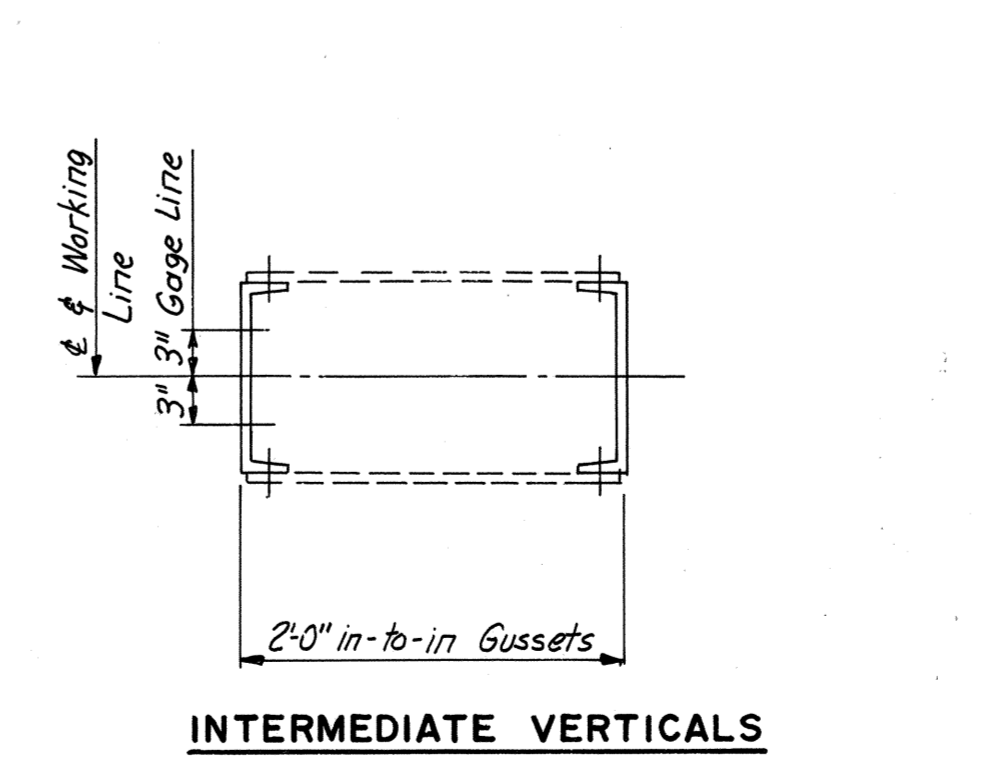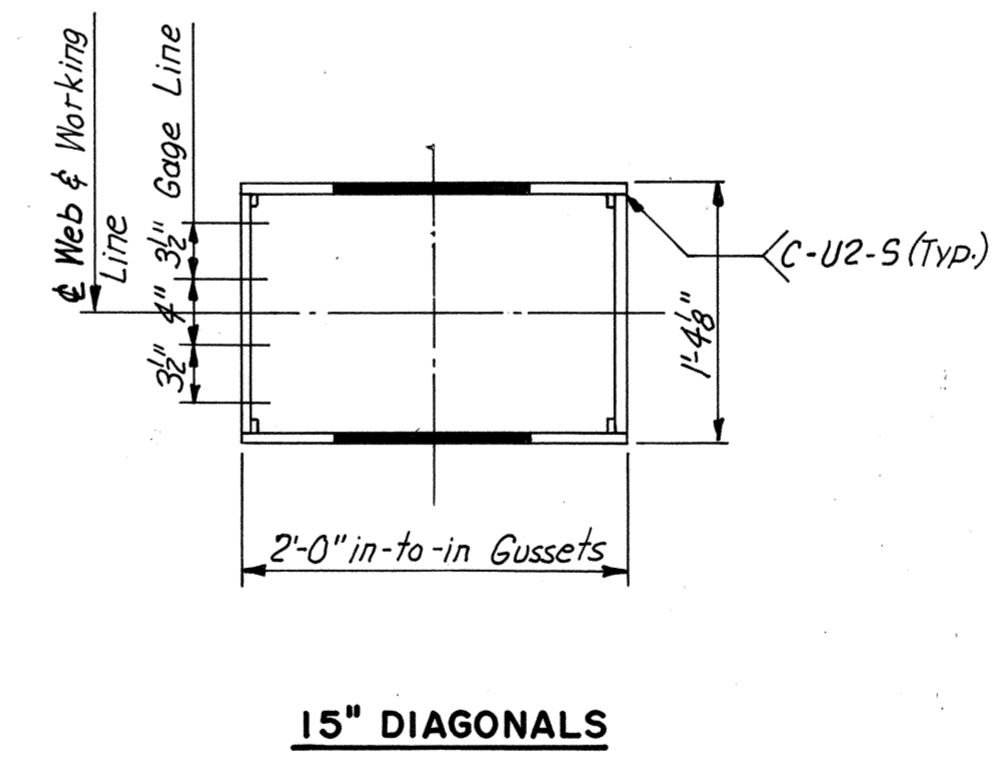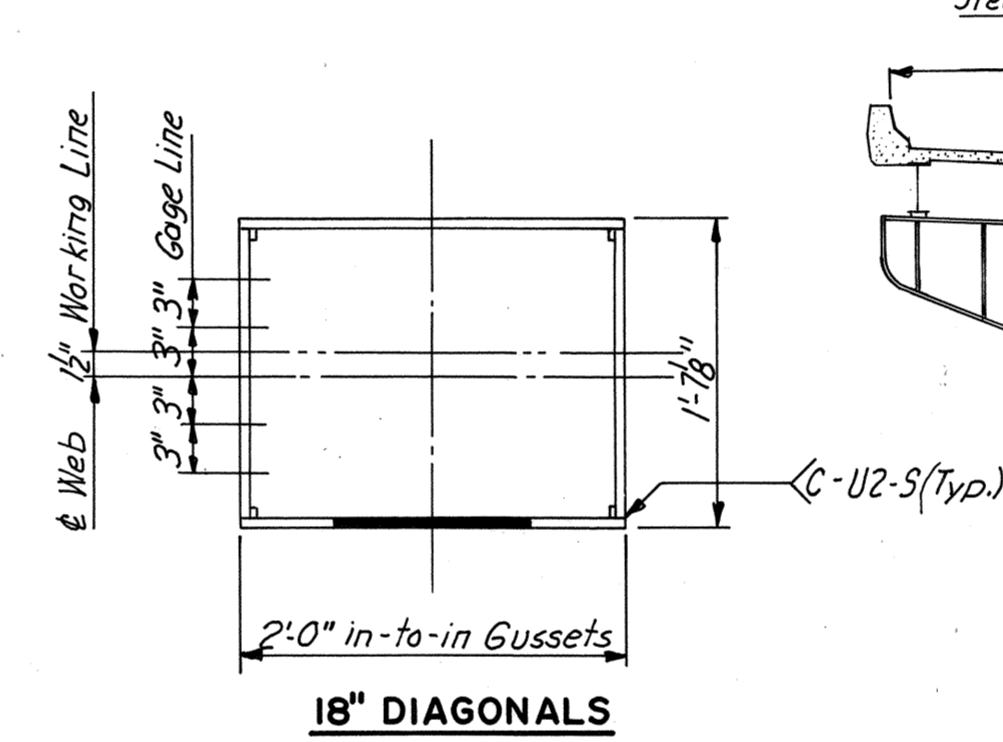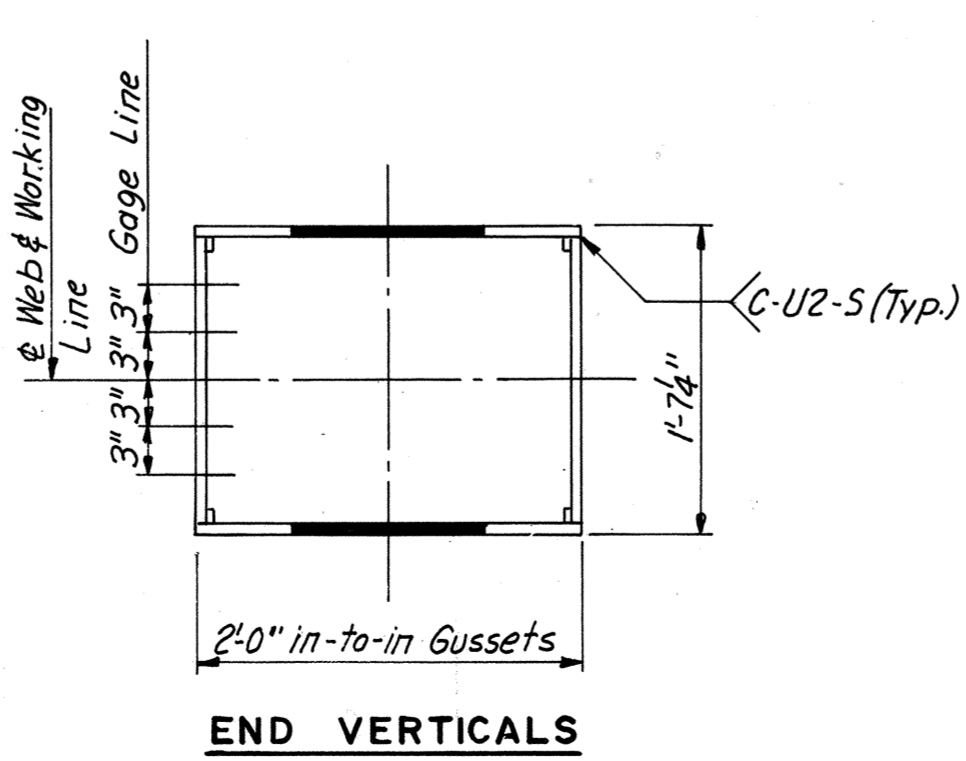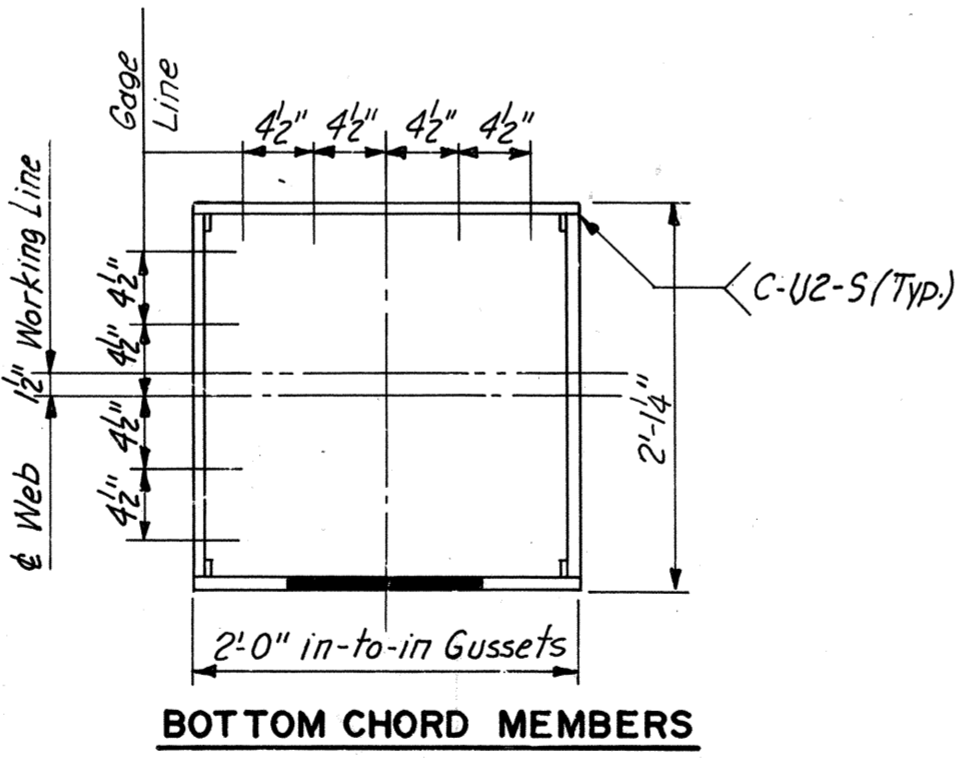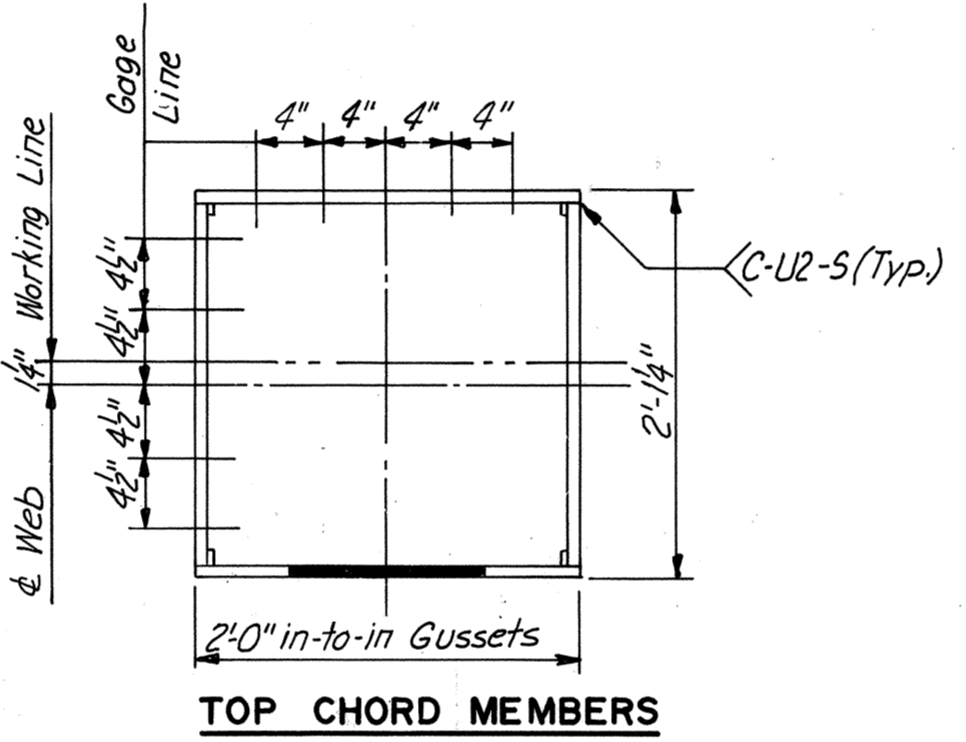

RICHMOND METROPOLITAN AUTHORITY
RICHMOND EXPRESSWAY SYSTEM
DOWNTOWN EXPRESSWAY




BRIDGE NO. 67
RAMP W-N CONNECTION TO RICHMOND-PETERSBURG TURNPIKE
STRESS SHEET TRUSS SPAN

HOWARD, NEEDLES, TAMMEN & BERGENDOFF
 consulting engineers
 NEW YORK ALEXANDRIA KANSAS CITY


SCALE: As Noted
 CONTRACT NO. 10
 SHEET NO. 36 OF 54

AS BUILT






RICHMOND EXPRESSWAY SYSTEM			
SECTION	PROJECT	SHEET NO.	TOTAL SHEETS
10	DOWNTOWN EXPRESSWAY	209	265

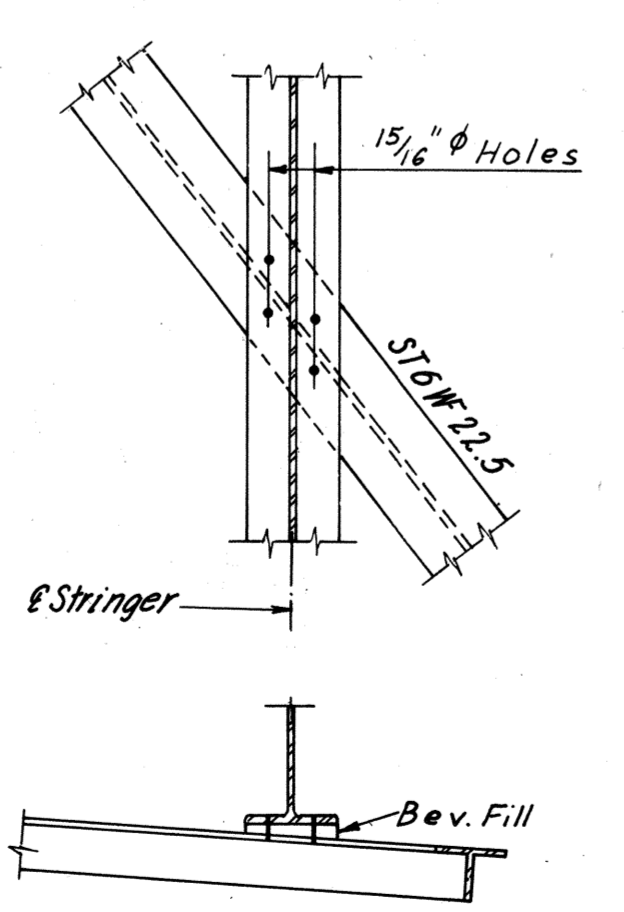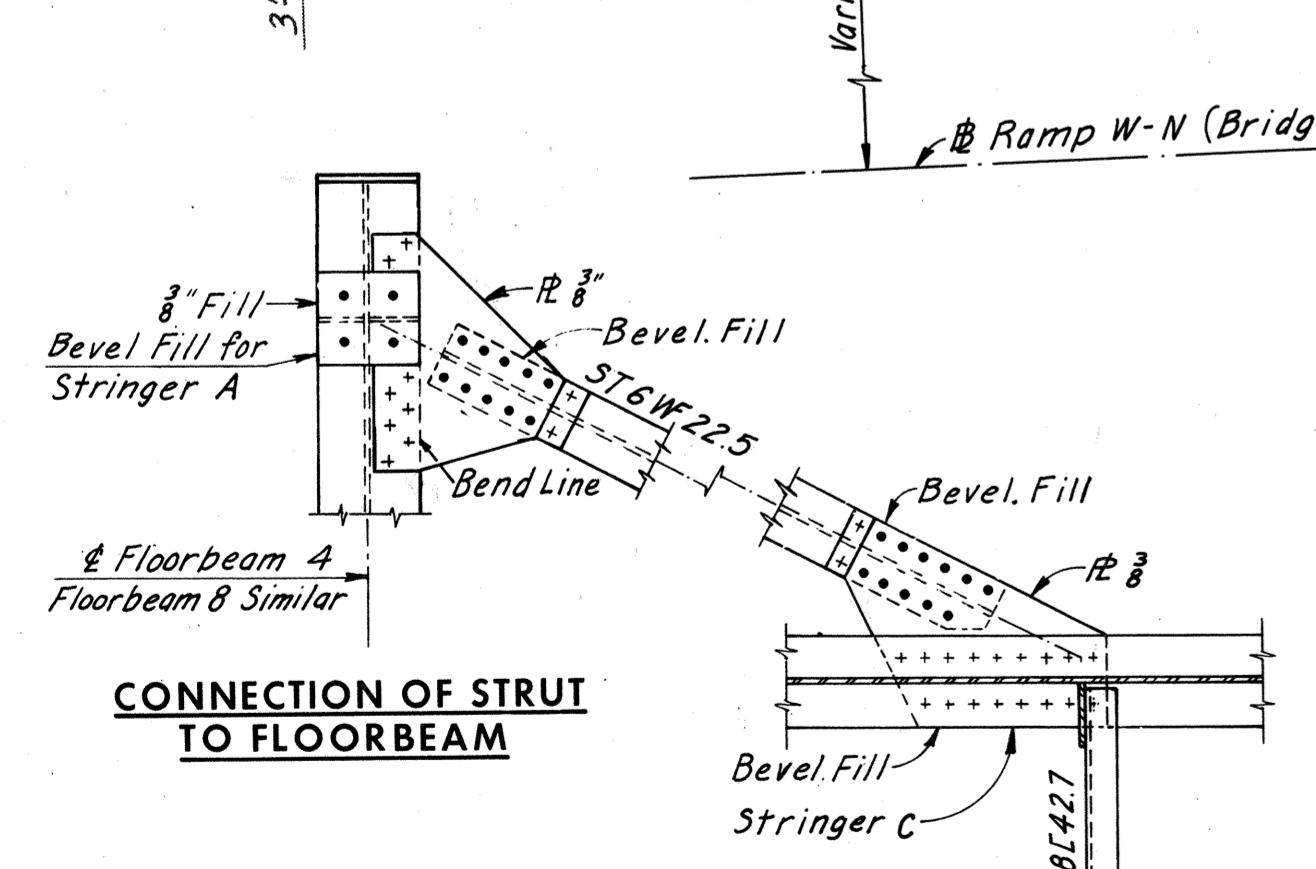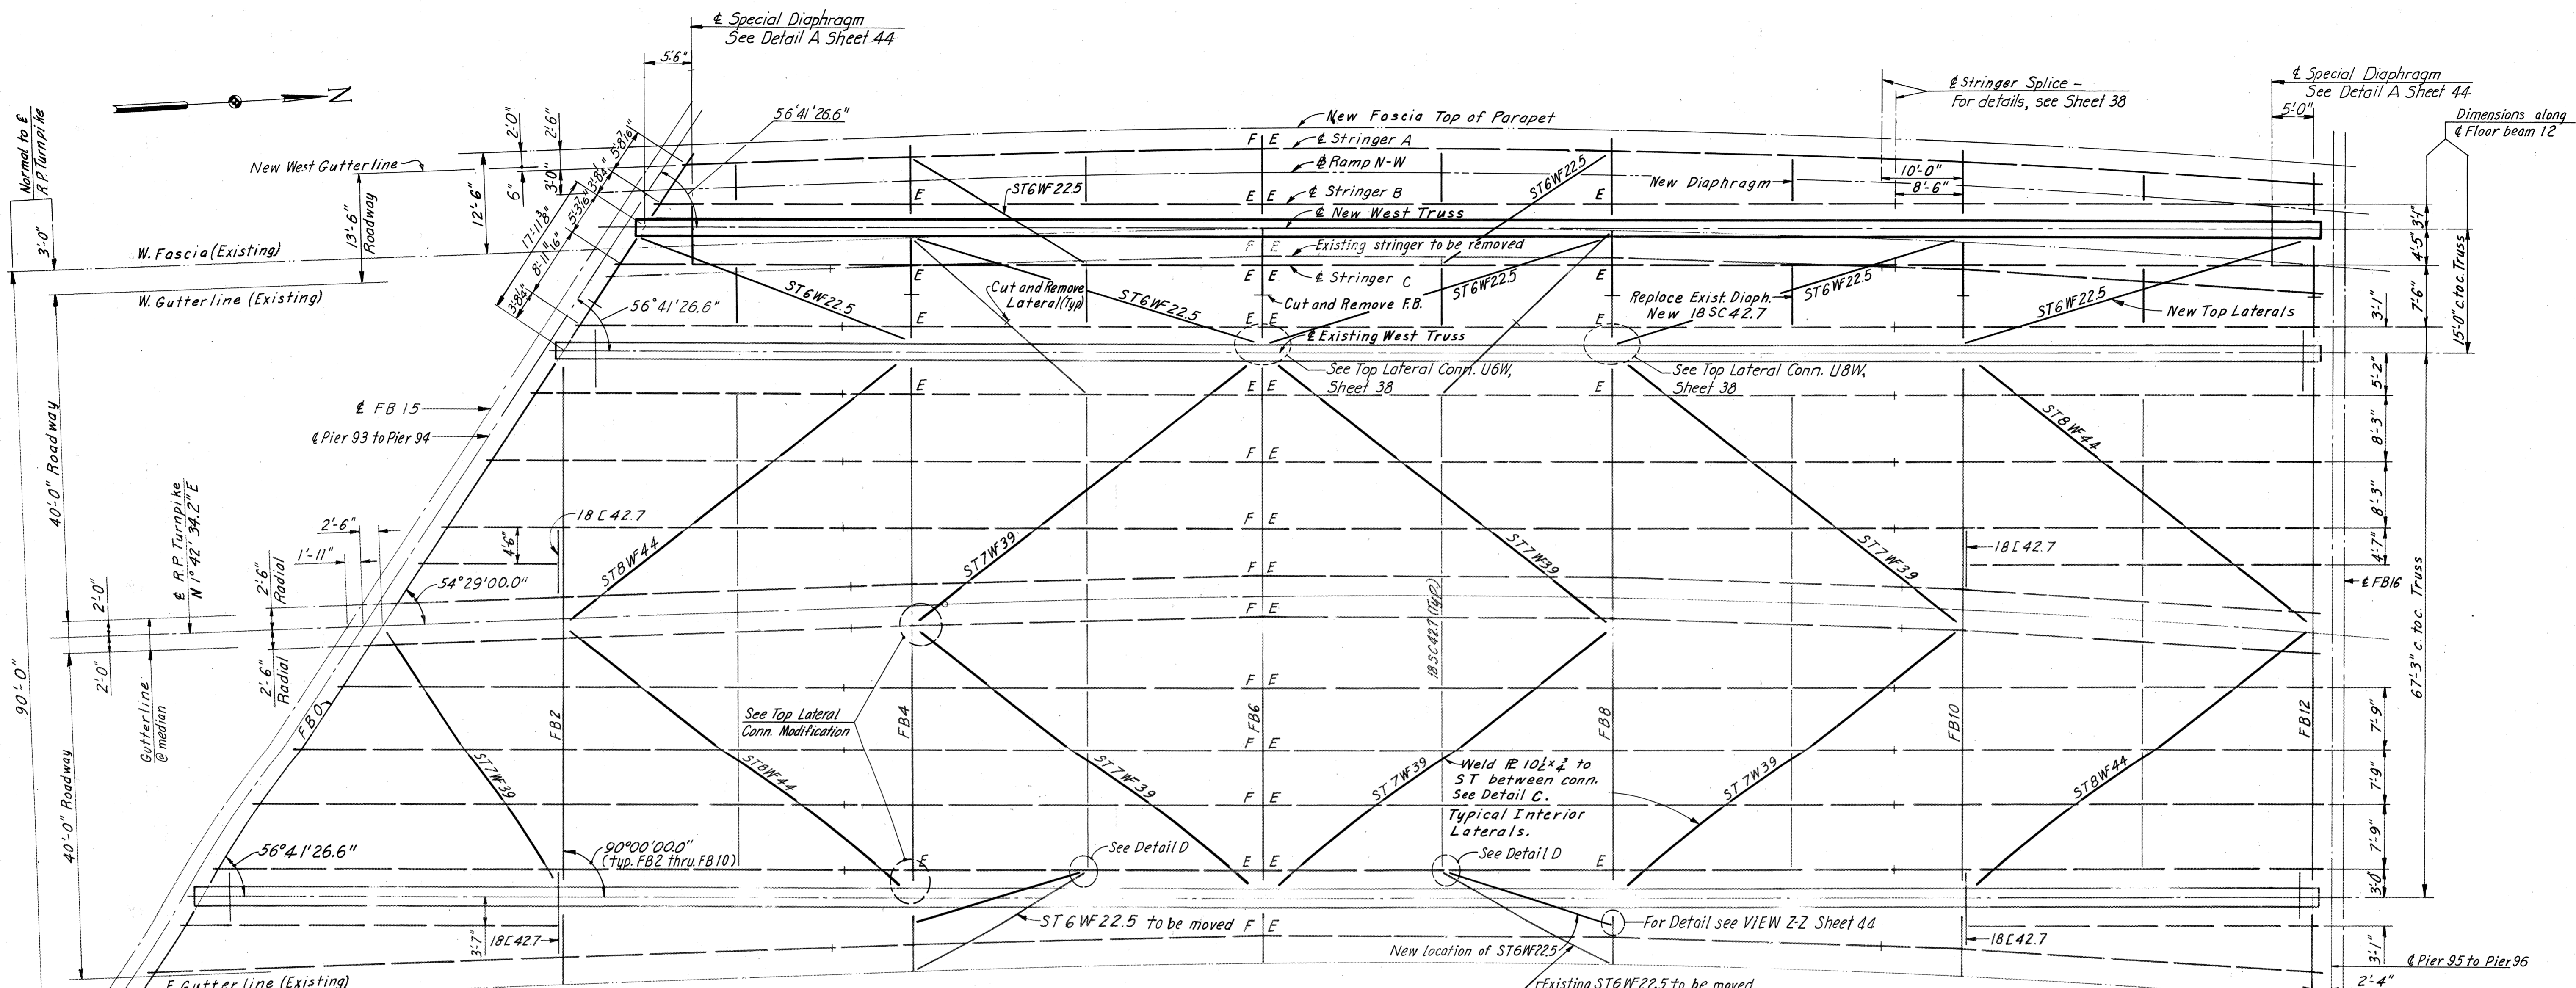

TYPICAL STRINGER TO LATERAL CONNECTION
 Bolt with hand tightened 5/16" erection bolts. Replace erection bolts with 7/8" bolts after concrete has been poured.

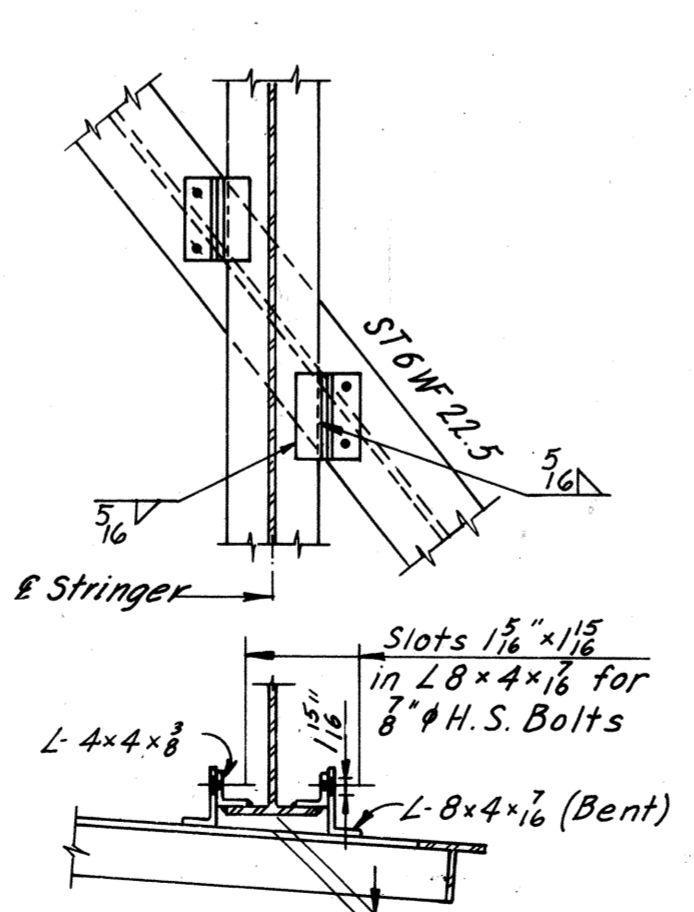

ALTERNATE CONNECTION
 May be used where 't' is greater than 1". Bolt with hand tightened 7/8" H.S. Bolts during erection. Tighten bolts with torque wrench after concrete has been poured.

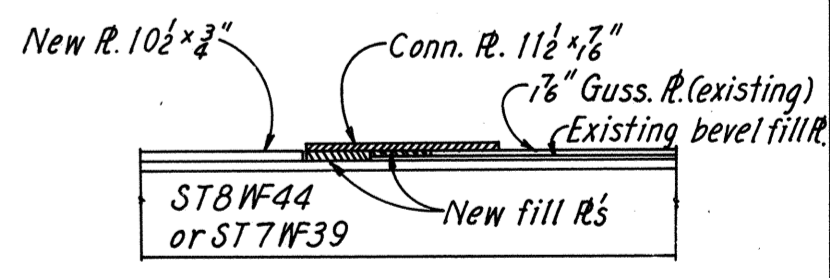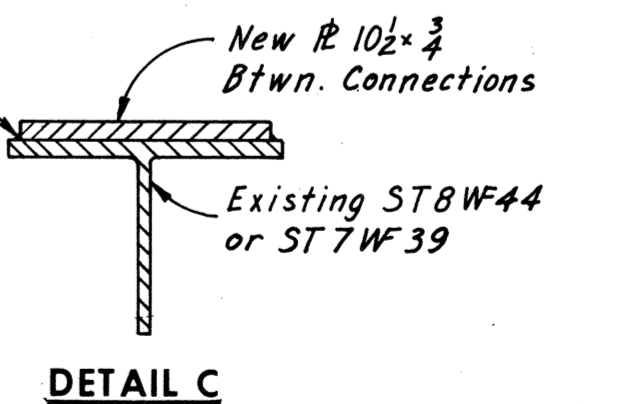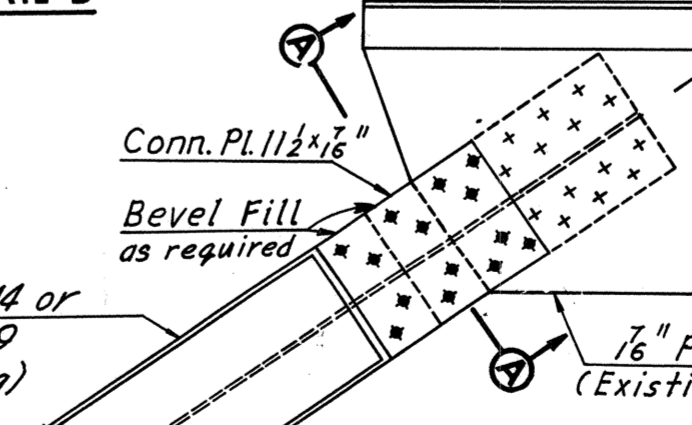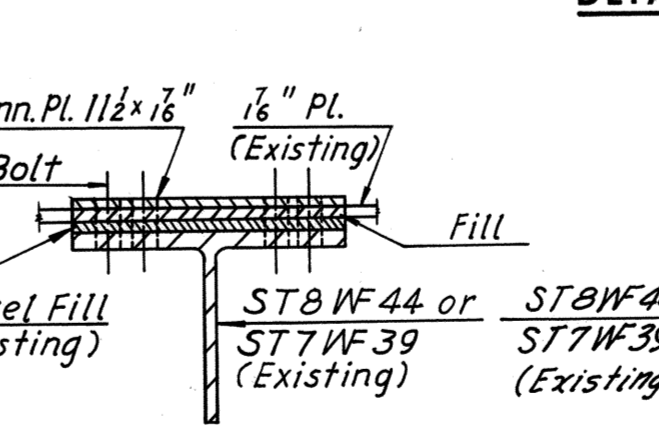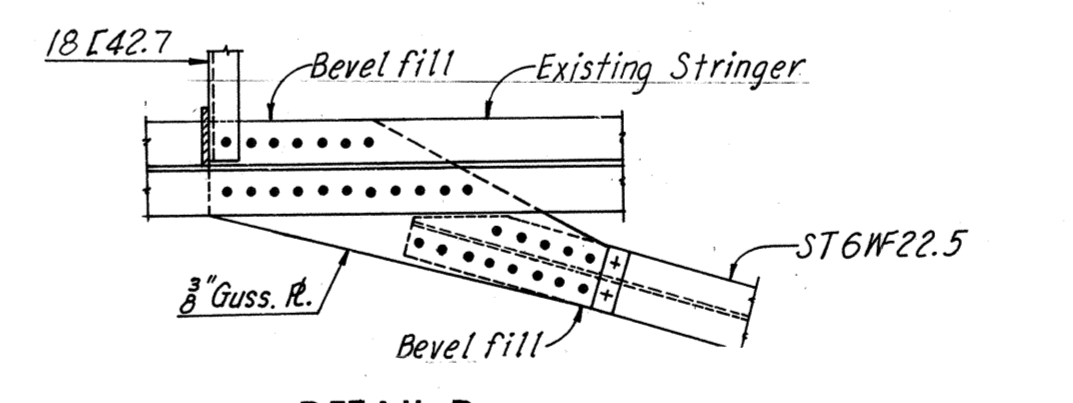

SECTION B-B
No Scale

RICHMOND METROPOLITAN AUTHORITY
RICHMOND EXPRESSWAY SYSTEM
DOWNTOWN EXPRESSWAY

BRIDGE NO. 67
RAMP W-N CONNECTION TO
RICHMOND-PETERSBURG TURNPIKE
TOP LATERAL SYSTEM

HOWARD, NEEDLES, TAMMEN & BERGENDOFF
 consulting engineers
 NEW YORK ALEXANDRIA KANSAS CITY


SCALE: 1/8" = 1'-0" or As Noted
 CONTRACT NO.: 10
 SHEET NO. 37 OF 54

MADE	BY	DATE	NO.	REVISION	BY	DATE
AMH	JV	12-2-68	2	As Built	TEM	6-77
CHECKED		5-15-69		Dim's & angles revised	d.B.P.	2-7-75
IN CHARGE						


TOP LATERAL CONN. MODIFICATION

AS BUILT


RICHMOND EXPRESSWAY SYSTEM			
SECTION	PROJECT	SHEET NO.	TOTAL SHEETS
10	DOWNTOWN EXPRESSWAY	210	265

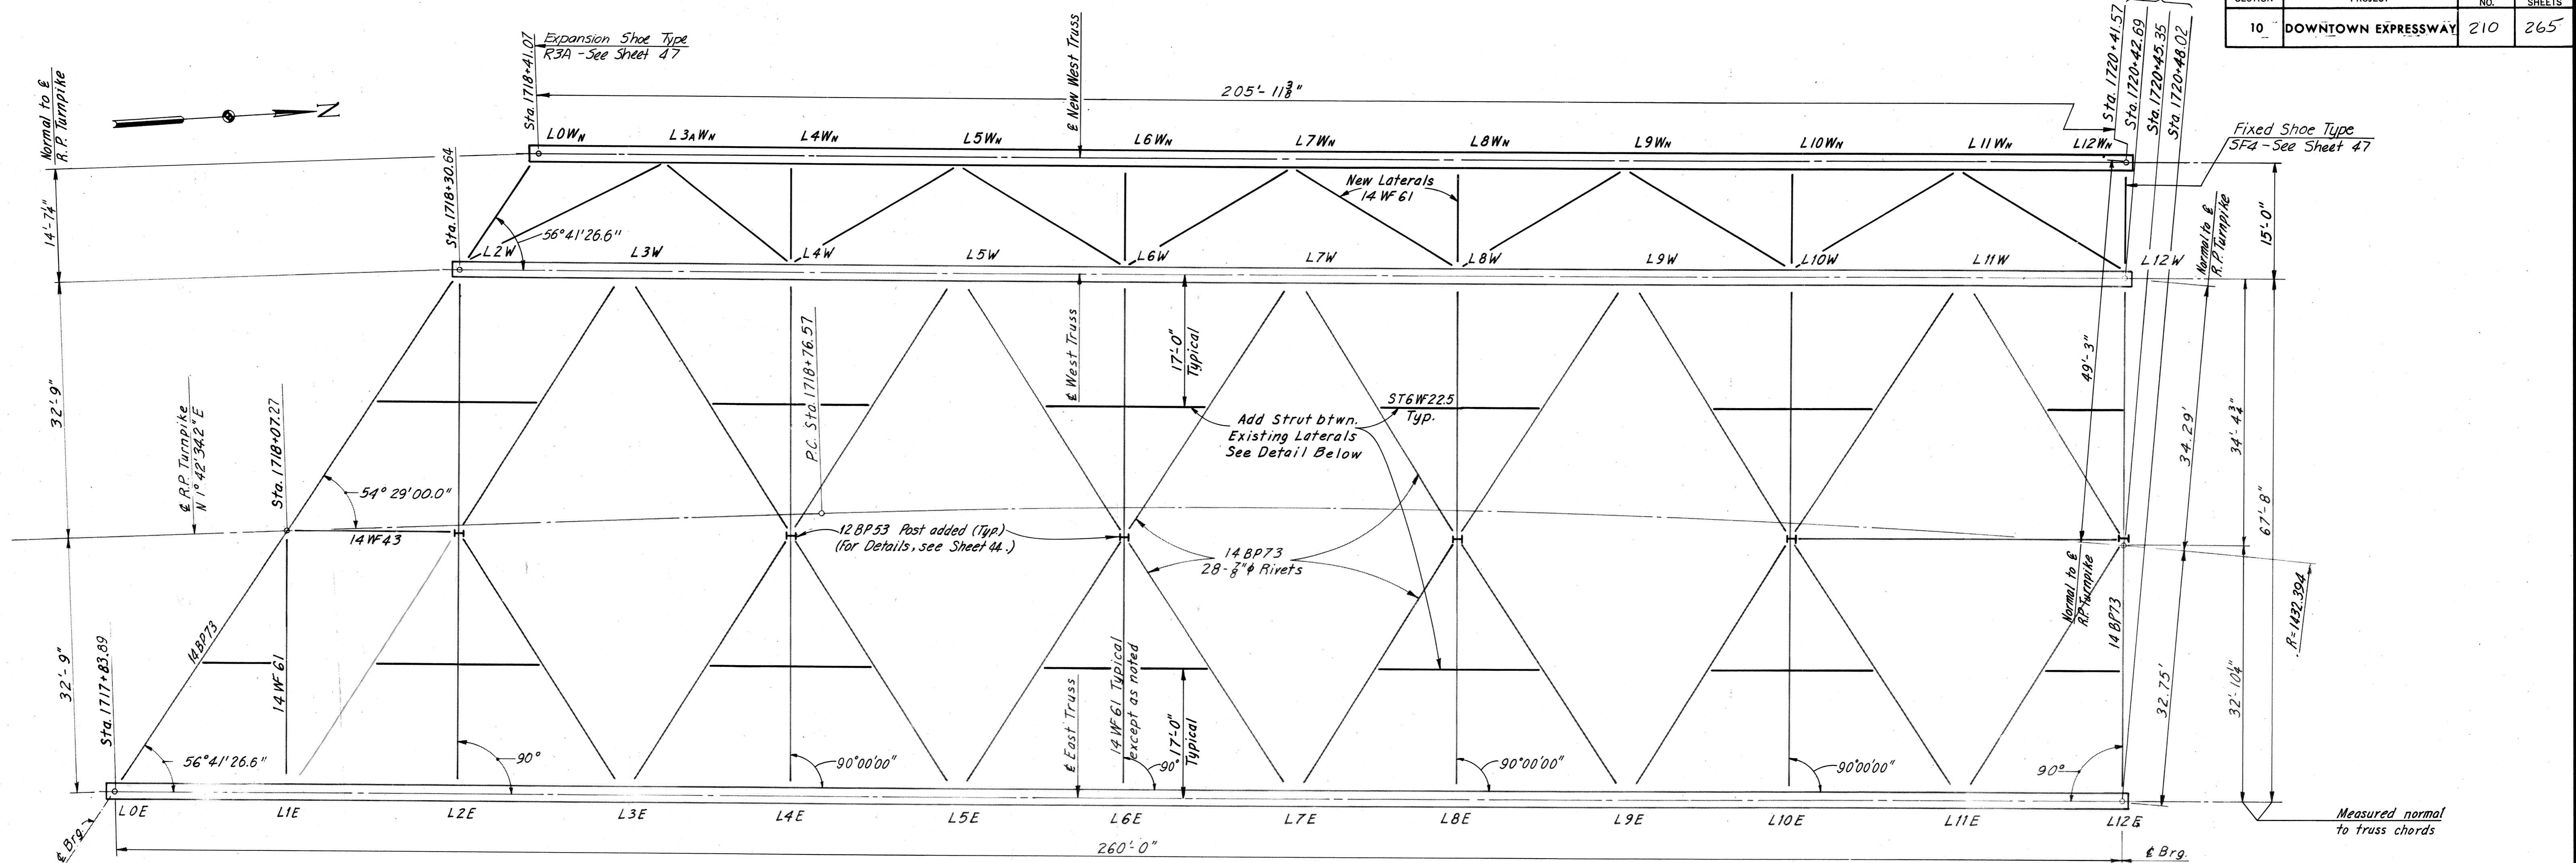


PLAN OF BOTTOM LATERAL SYSTEM AND TRUSS GEOMETRY
Scale: 1" = 10'-0"

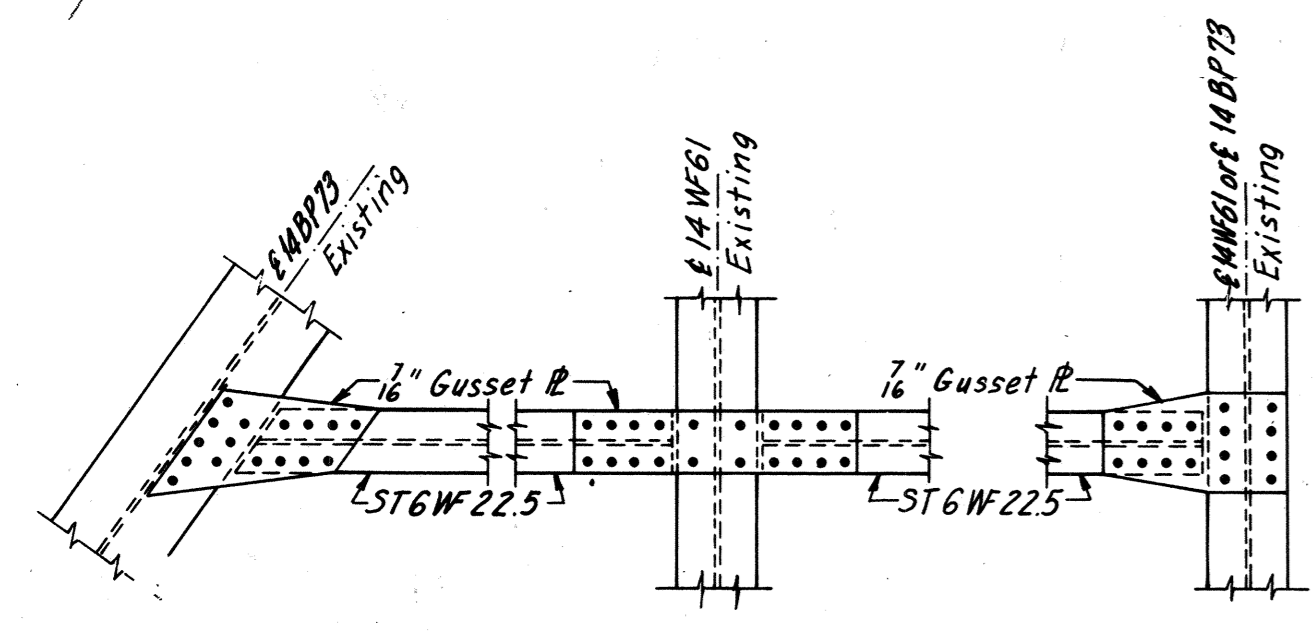


CONNECTION OF STRUT TO BOTTOM LATERAL

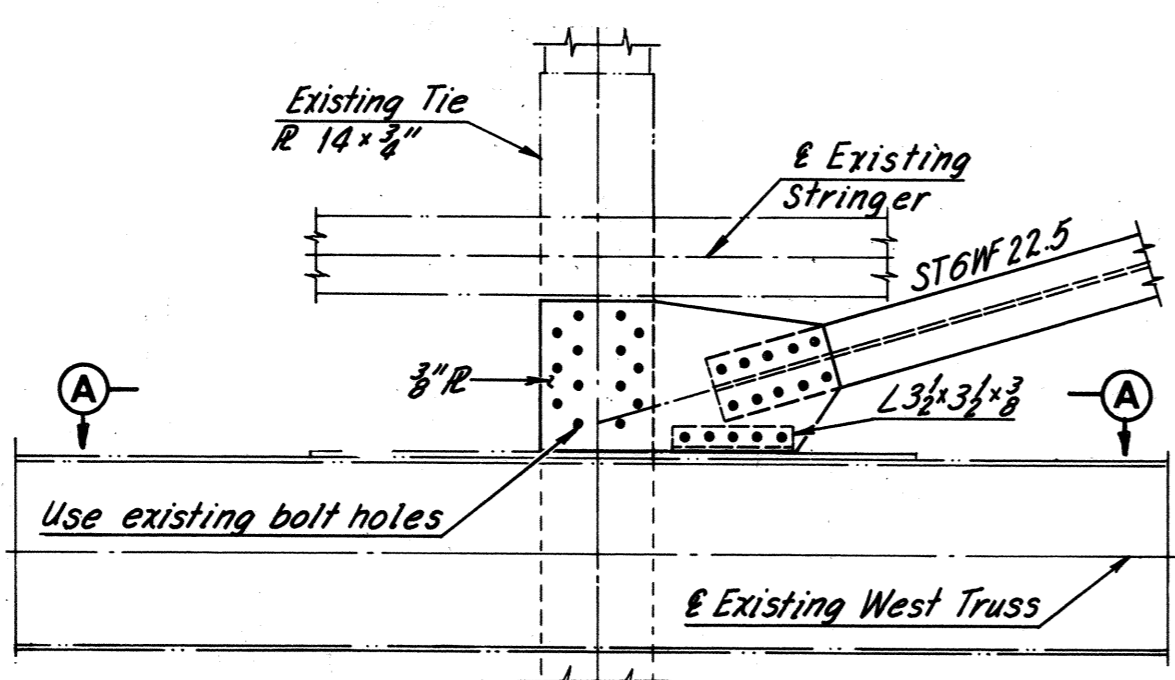


TOP LATERAL CONNECTION U8W
(U10W Typical, U4W Similar)

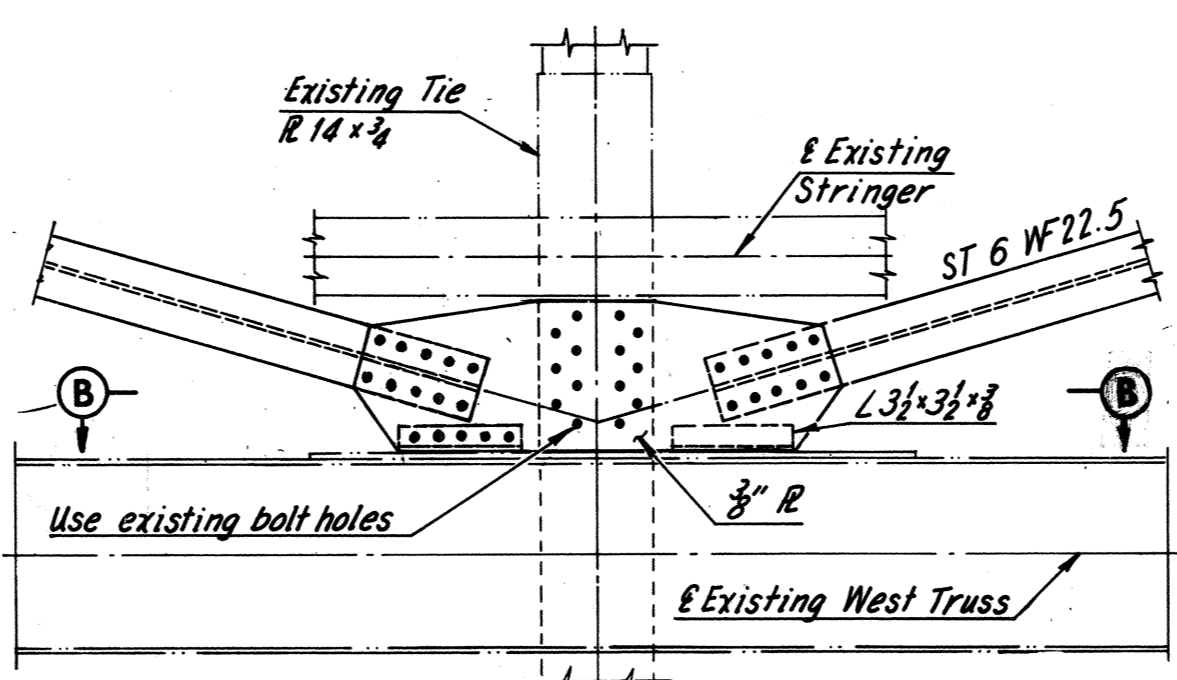


TOP LATERAL CONNECTION U6W

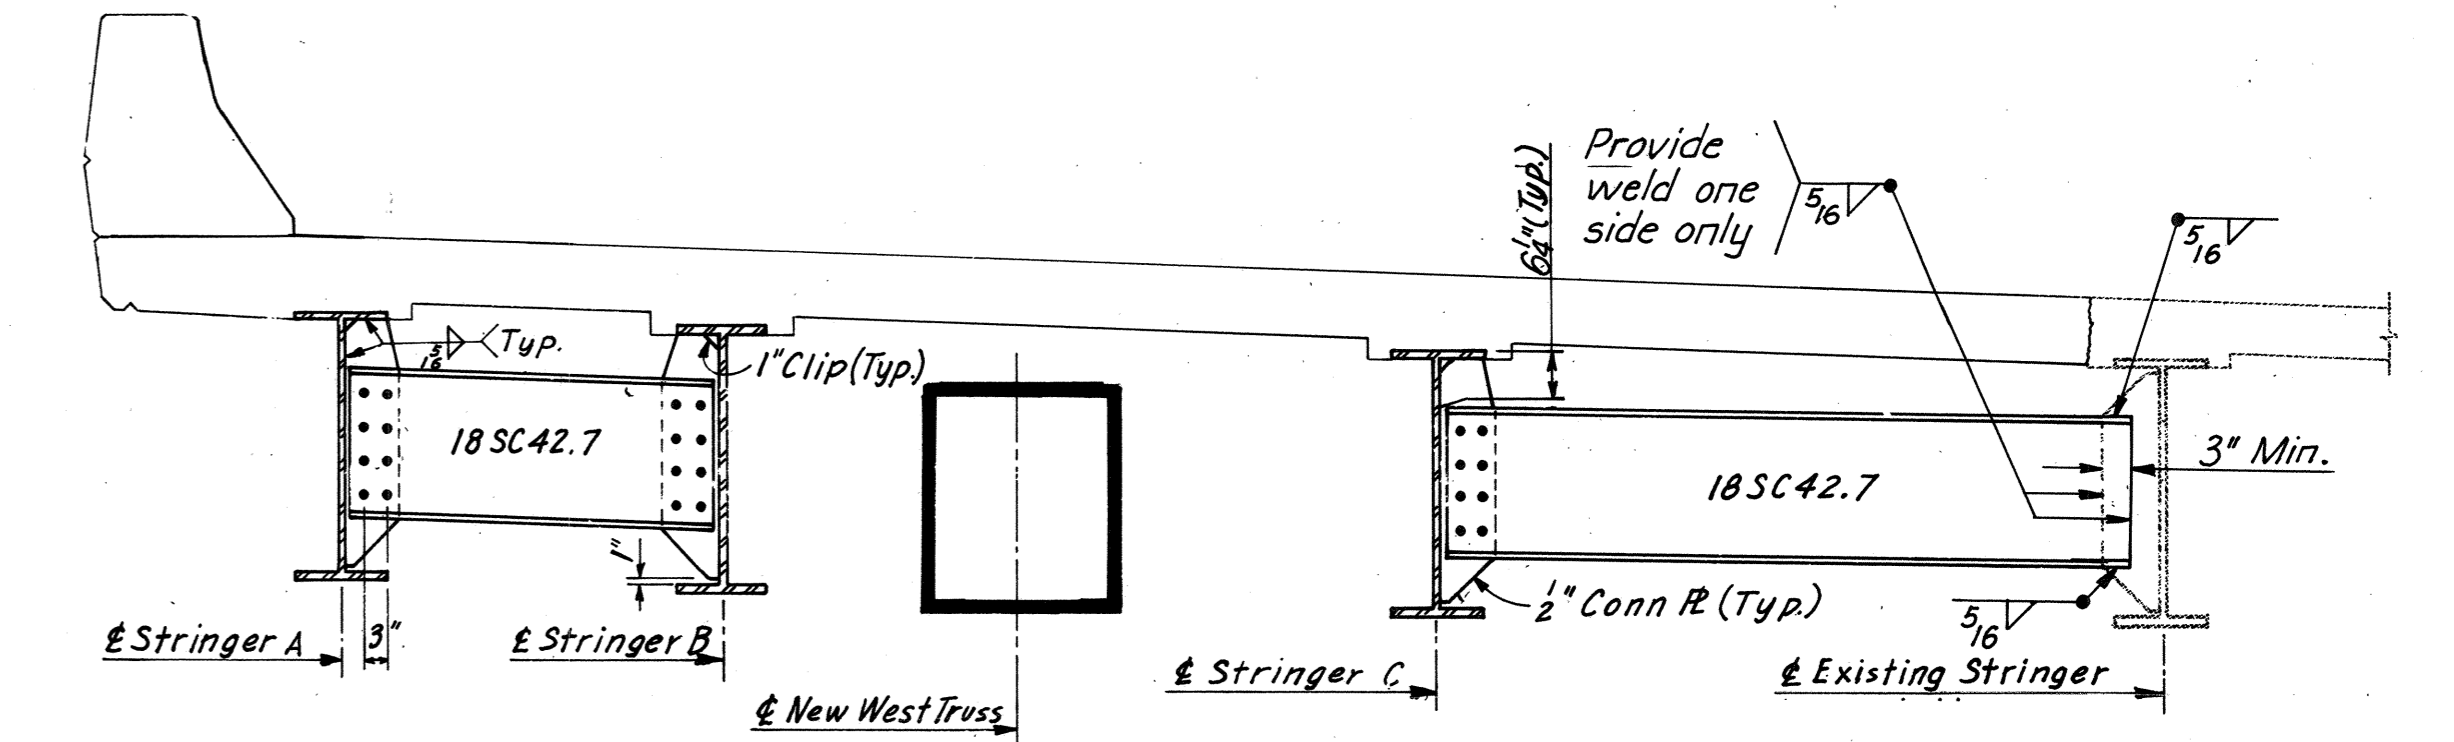


INTERMEDIATE STRINGER DIAPHRAGM

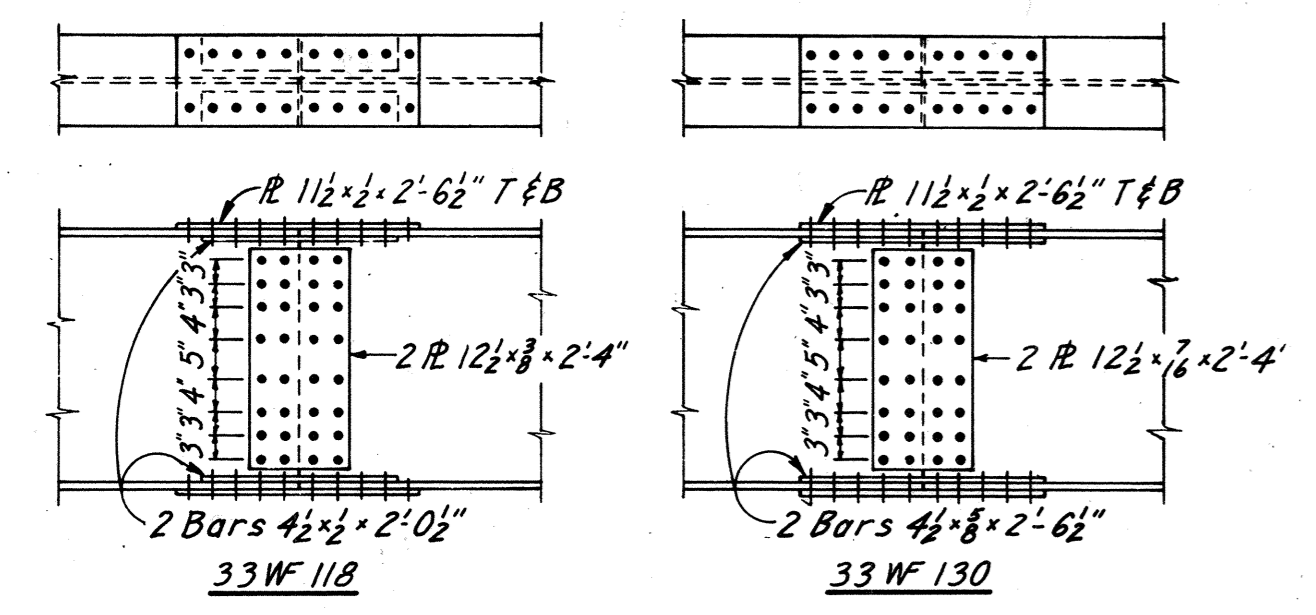

DETAILS OF STRINGER SPLICES

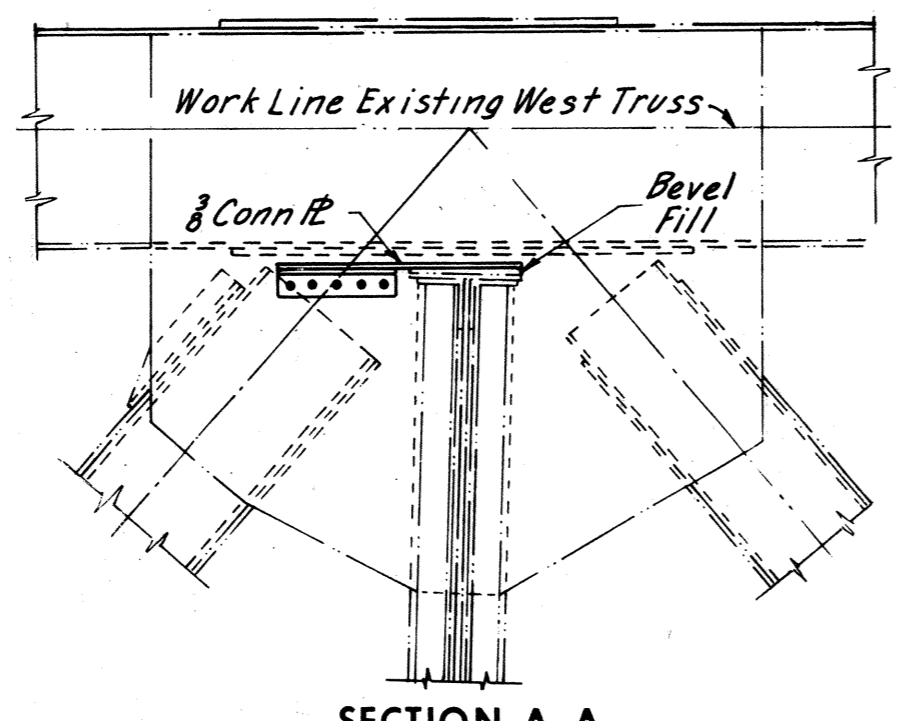

SECTION A-A

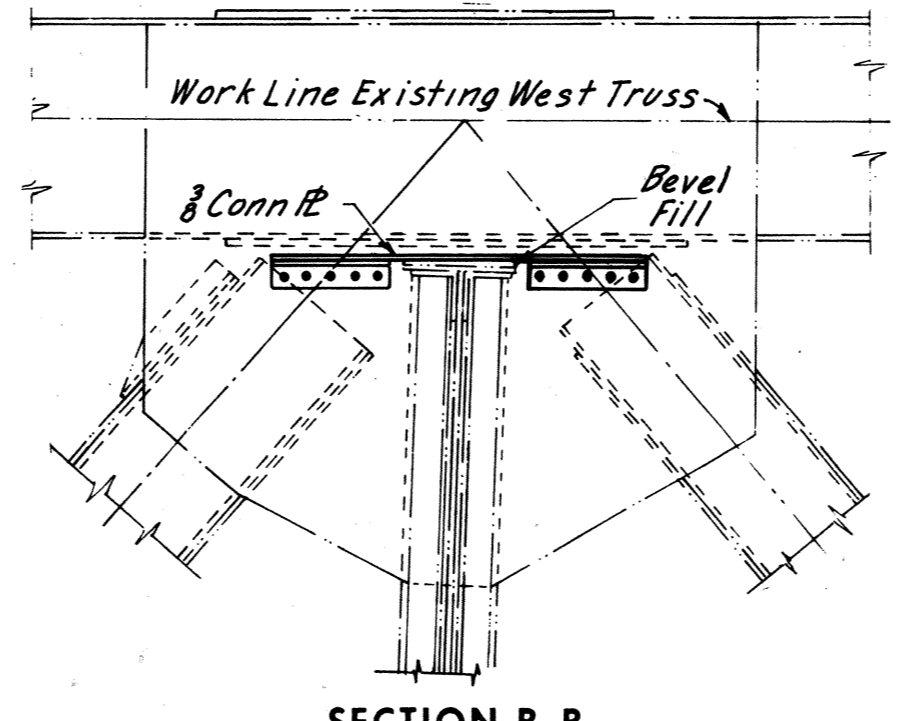

SECTION B-B

4 As Built TEM 6-77			
BY	DATE	REVISION	BY
AMH	12-4-68	Shoes Added	LRH 4-19-74
JV	5-15-69	Station, angle, gusset & diaphragm conn. Post of 150 deleted	d.B.P. 2-7-75
			d.B.P. 3-5-75
NO.	REVISION	BY	DATE

RICHMOND METROPOLITAN AUTHORITY
RICHMOND EXPRESSWAY SYSTEM
DOWNTOWN EXPRESSWAY


BRIDGE NO. 67
RAMP W-N CONNECTION TO
RICHMOND-PETERSBURG TURNPIKE
BOTTOM LATERAL SYSTEM

HOWARD, NEEDLES, TAMMEN & BERGENDOFF
consulting engineers
NEW YORK ALEXANDRIA KANSAS CITY

SCALE: 1/2" = 1'-0" or As Noted
CONTRACT NO. 10
SHEET NO. 38 OF 54

AS BUILT

RICHMOND EXPRESSWAY SYSTEM			
SECTION	PROJECT	SHEET NO.	TOTAL SHEETS
10	DOWNTOWN EXPRESSWAY	211	265

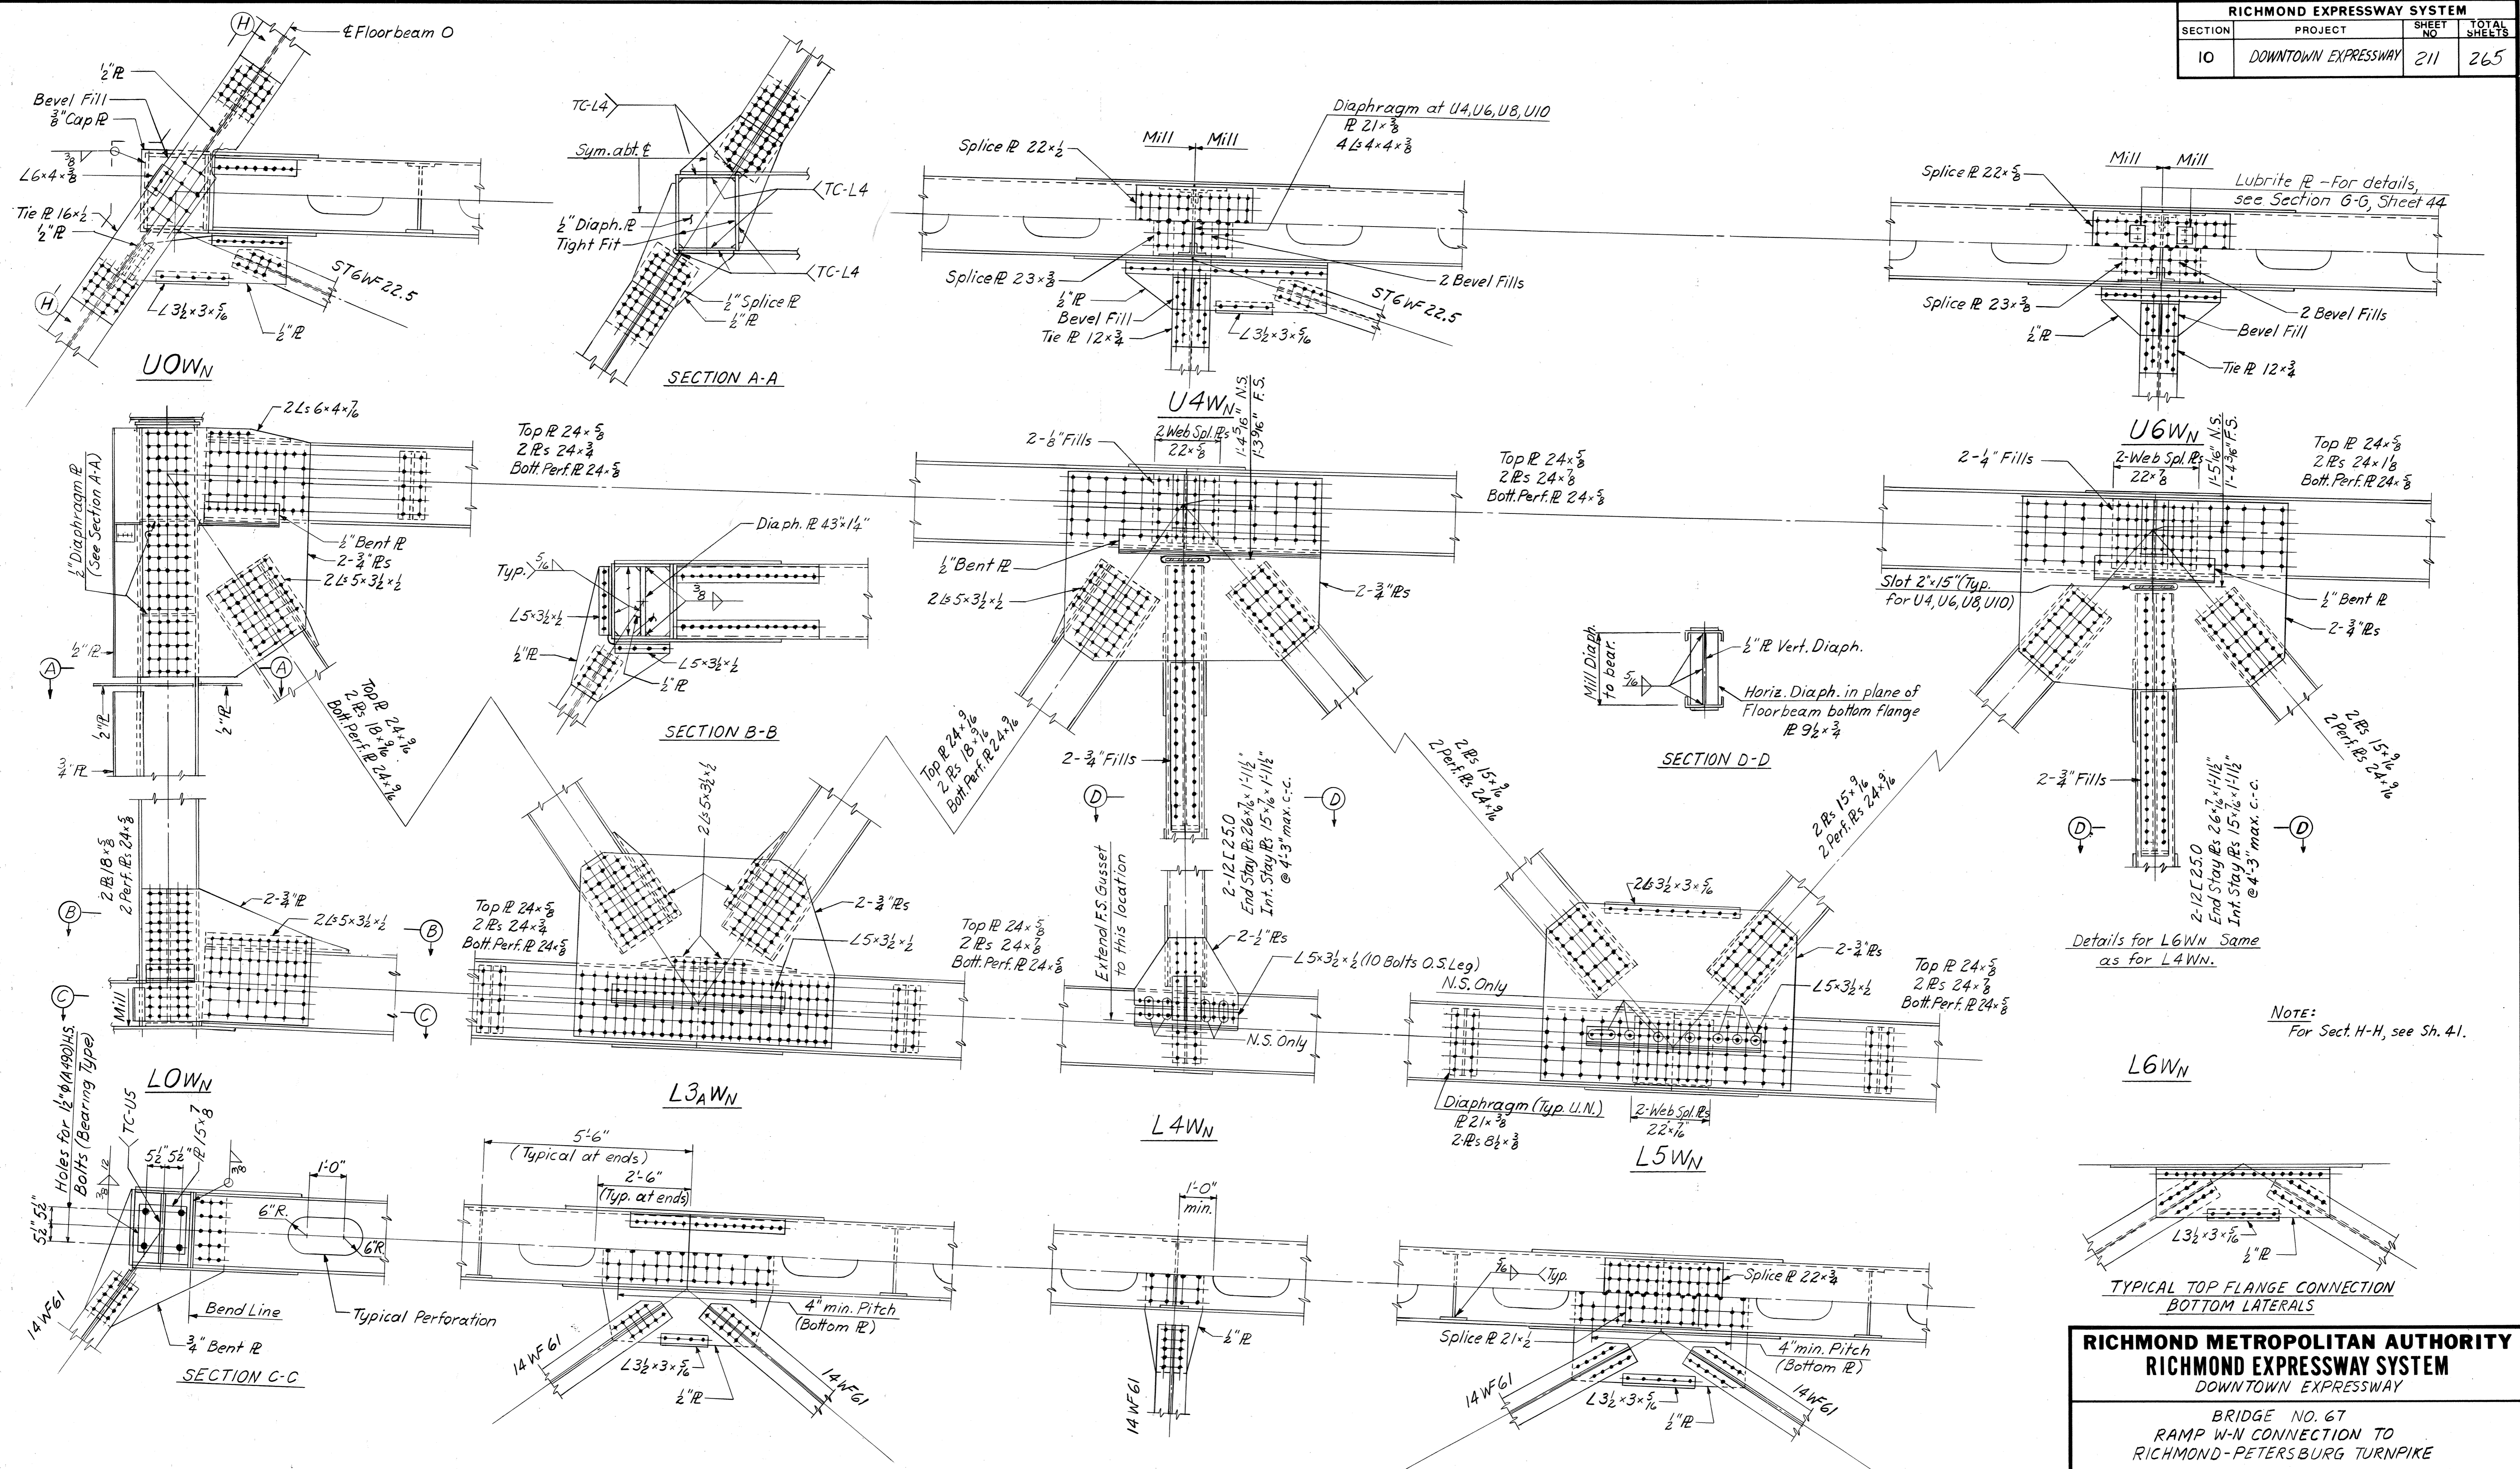

NOTE:
For Sect. H-H, see Sh. 41.

DESIGNED	DRAWN	CHECKED	IN CHARGE	NO.	REVISION	BY	DATE
	PRY		PRY				
	1-74						
	2						
	As Built						

RICHMOND METROPOLITAN AUTHORITY
RICHMOND EXPRESSWAY SYSTEM
 DOWNTOWN EXPRESSWAY

BRIDGE NO. 67
 RAMP W-N CONNECTION TO
 RICHMOND-PETERSBURG TURNPIKE
 TRUSS DETAILS - P.P.O TO P.P.6

SCALE 1/2" = 1'-0"
 DATE





HOWARD, NEEDLES, TAMMEN & BERGENDOFF
 CONSULTING ENGINEERS
 Alexandria, Virginia

HNTB




SHEET 39 OF 54

AS BUILT


RICHMOND EXPRESSWAY SYSTEM			
SECTION	PROJECT	SHEET NO.	TOTAL SHEETS
10	DOWNTOWN EXPRESSWAY	212	265

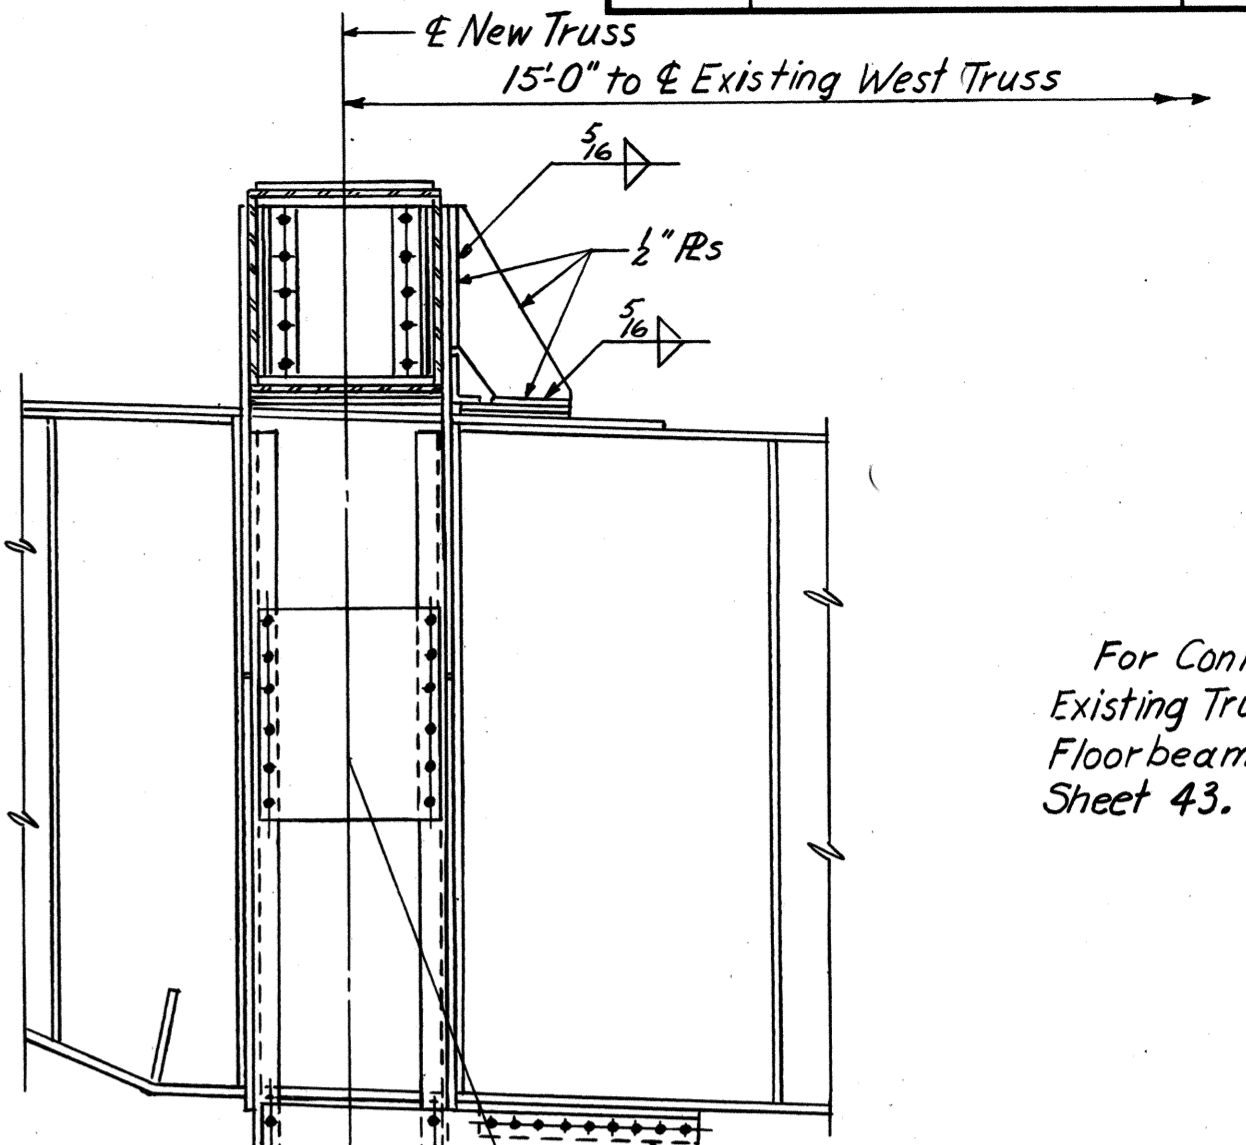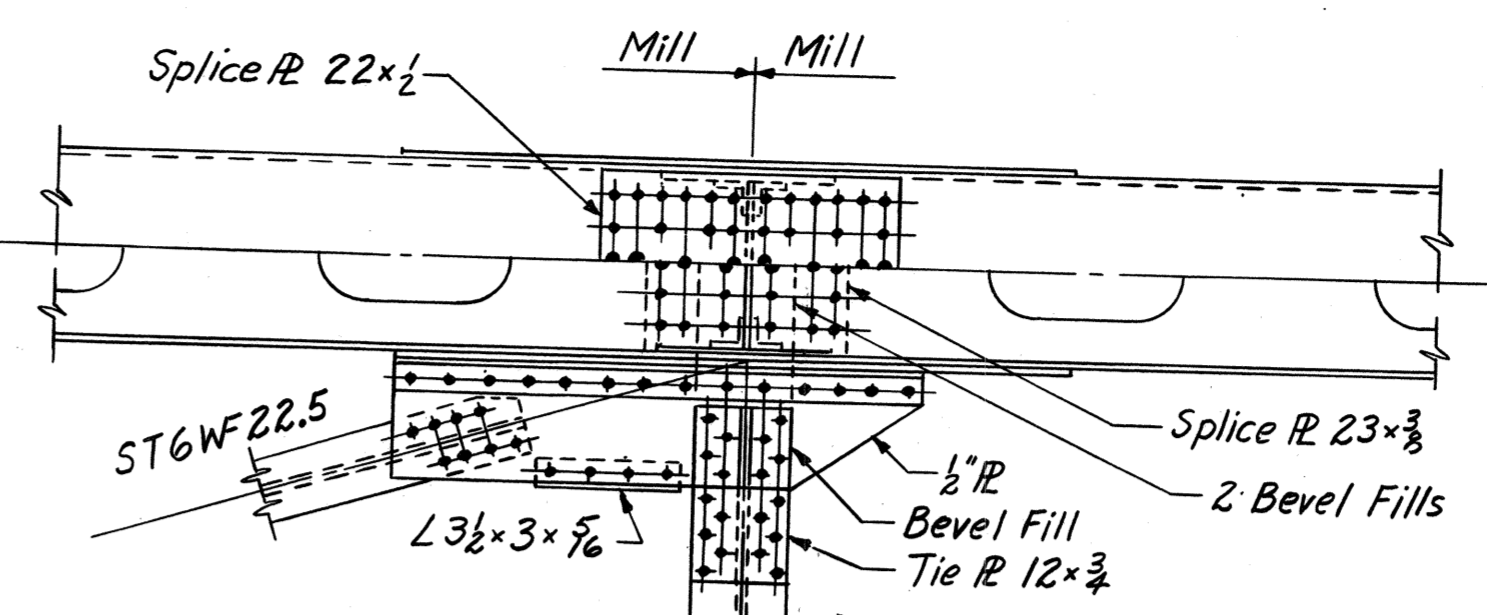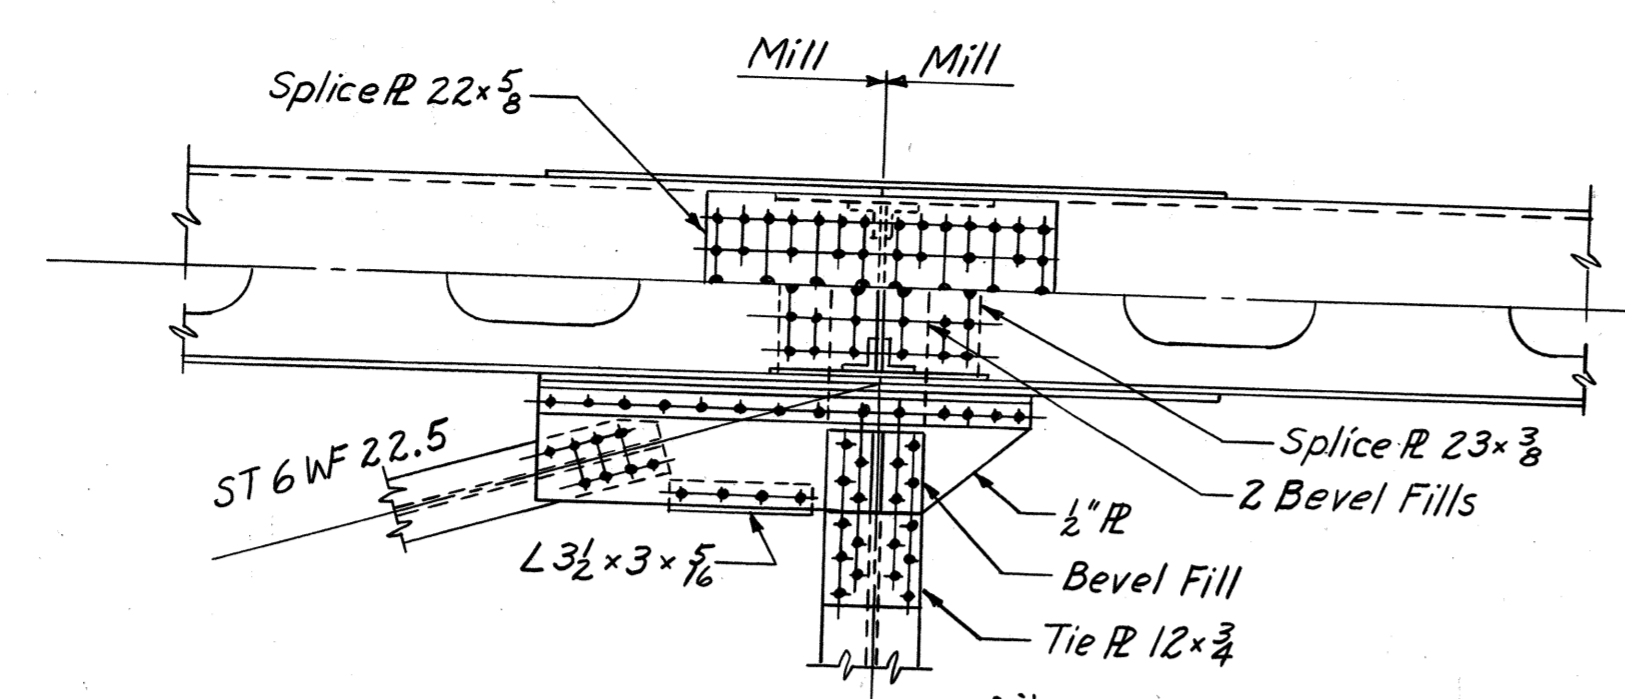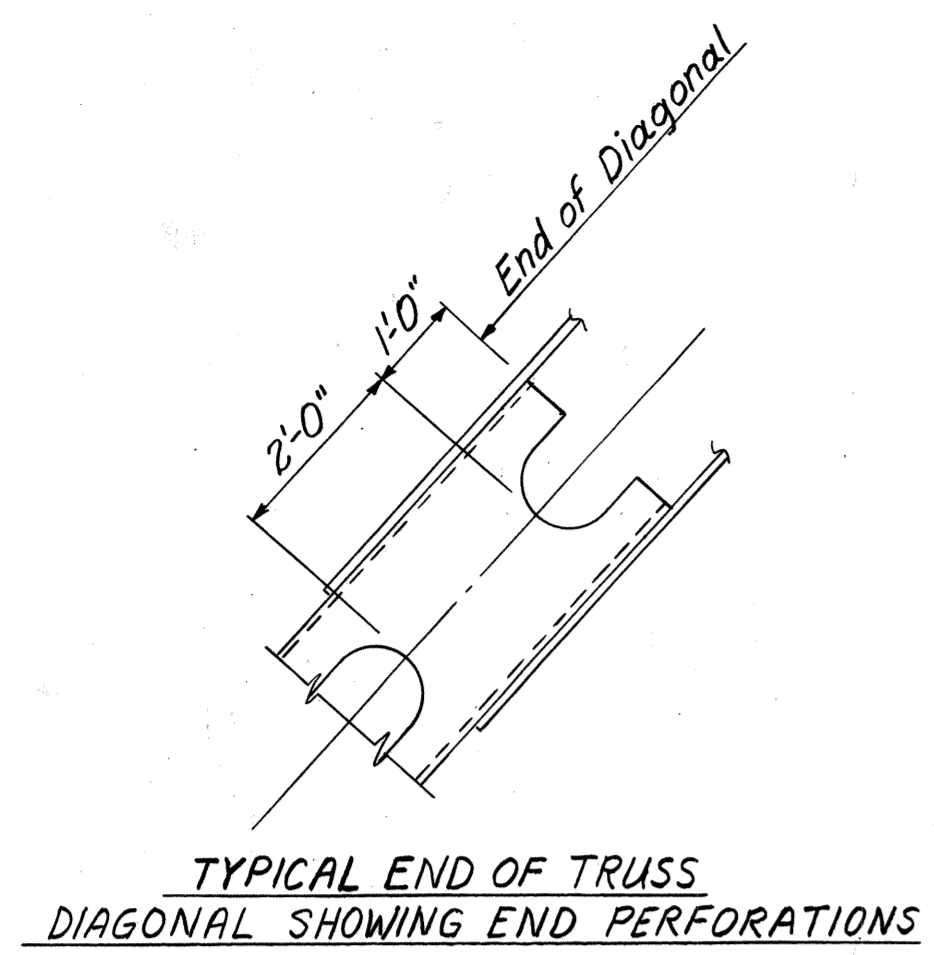


For Connections to Existing Truss see Floor beam Details, Sheet 43.

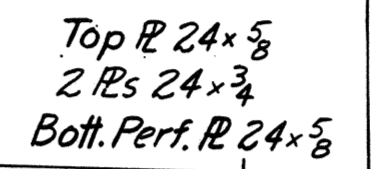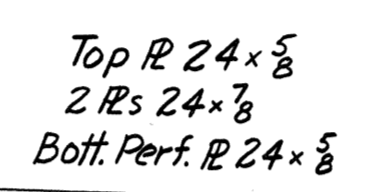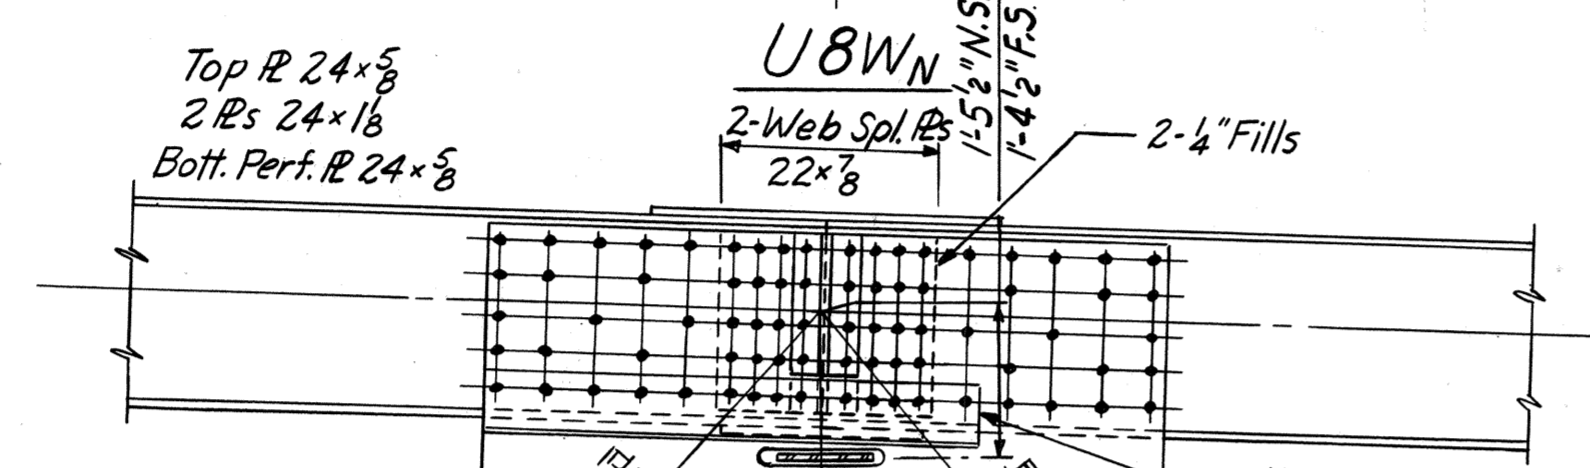


For Connections to Existing Truss see Details E-low.

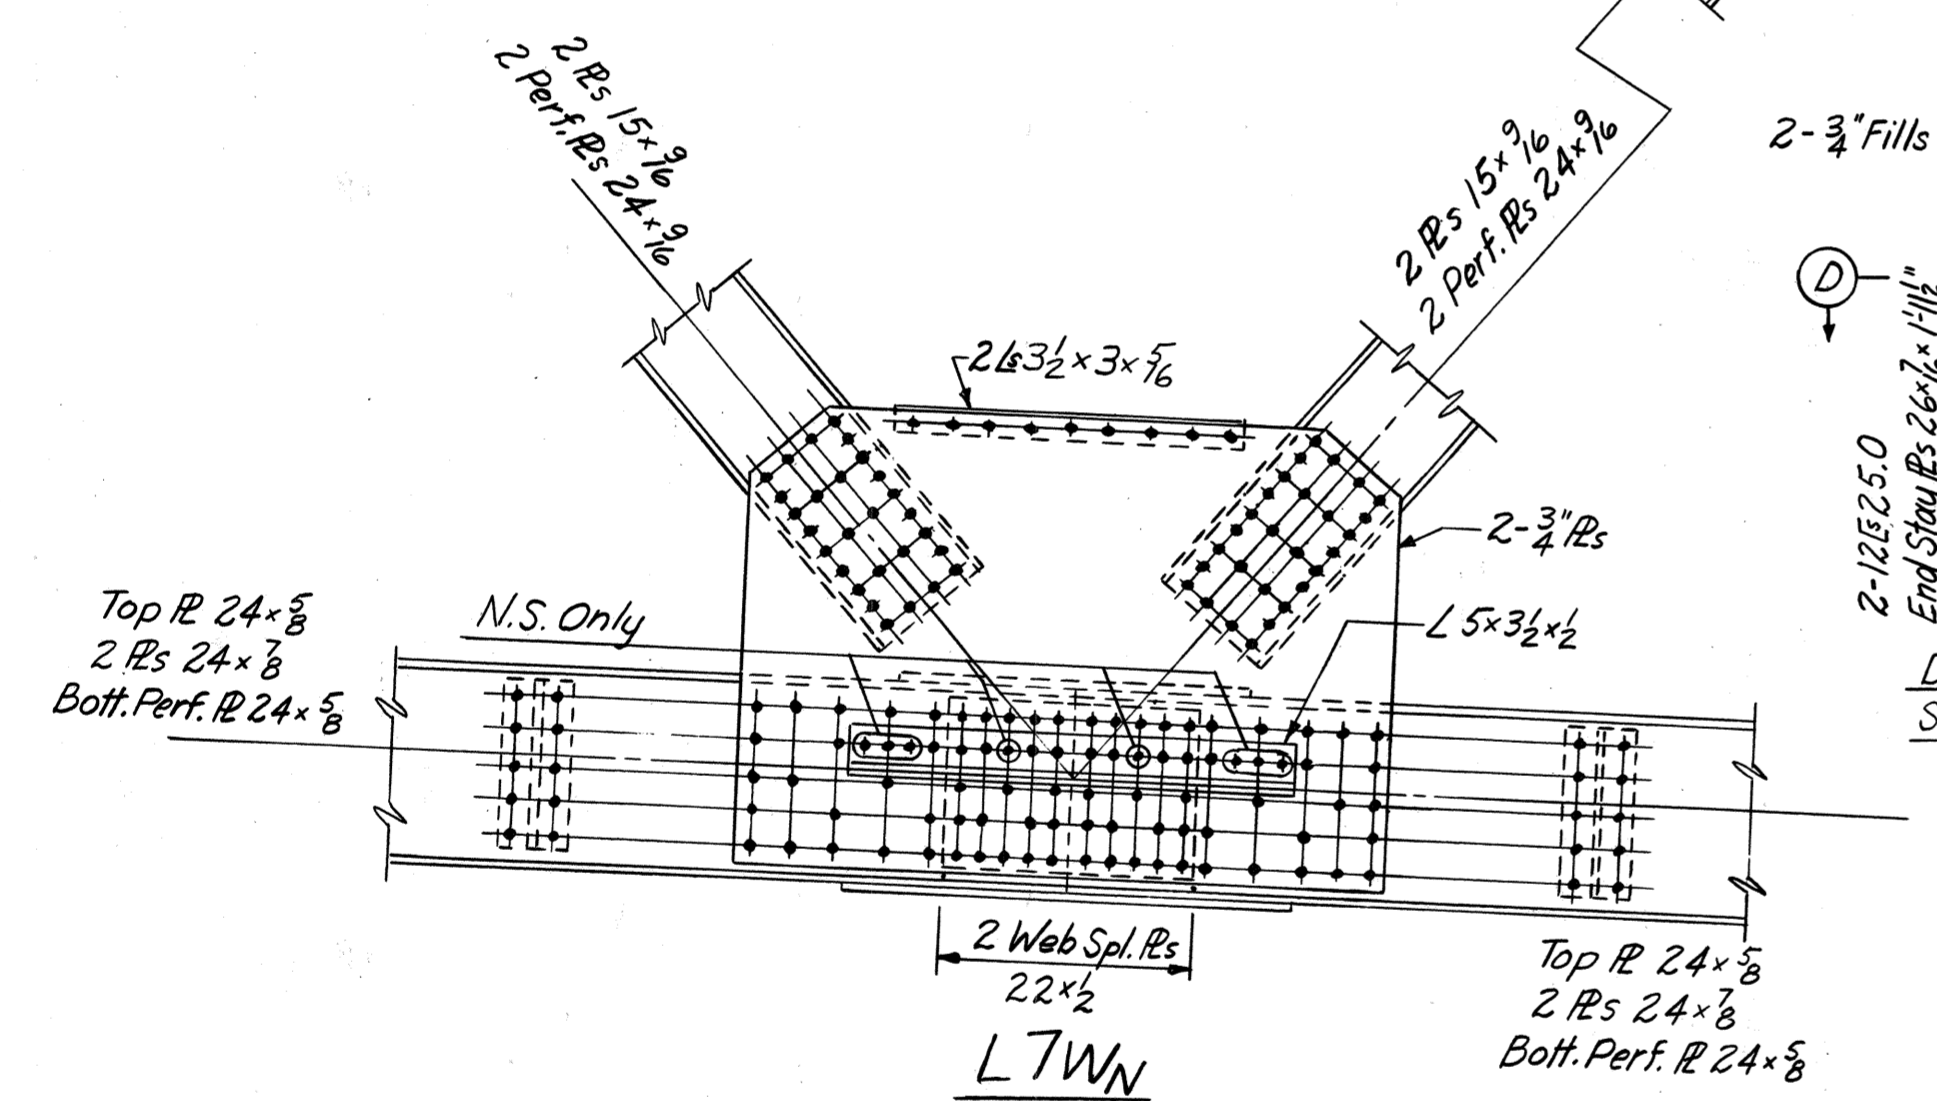



Details for L8WN
Same as for L4WN.

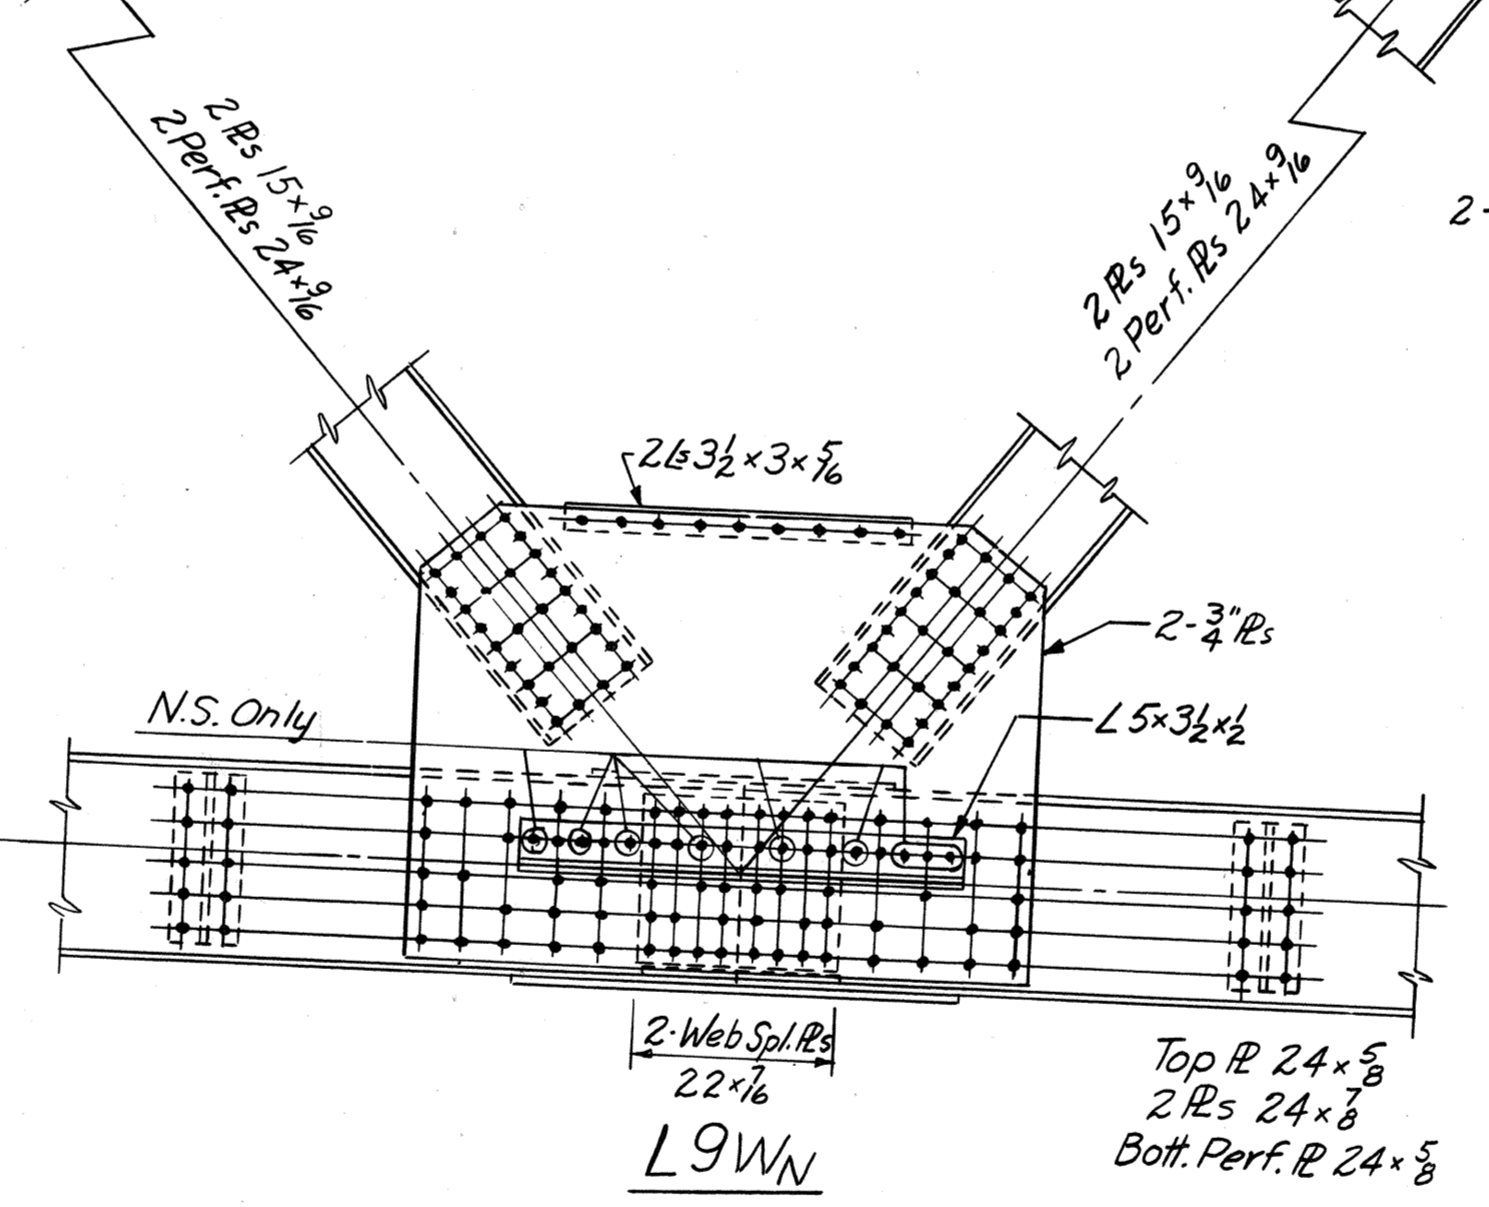

Details for L10WN
Same as for L4WN

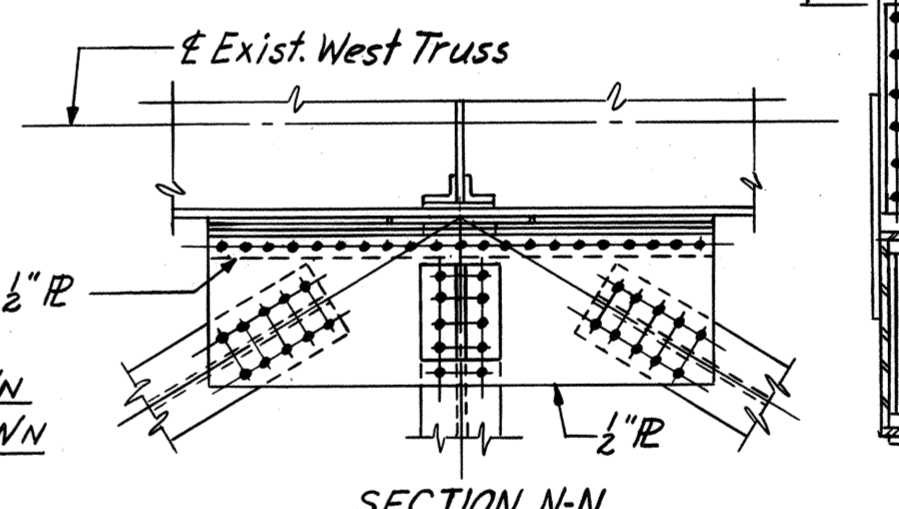

INTERMEDIATE SWAYS
AT P.P.s 4, 6, 8 & 10

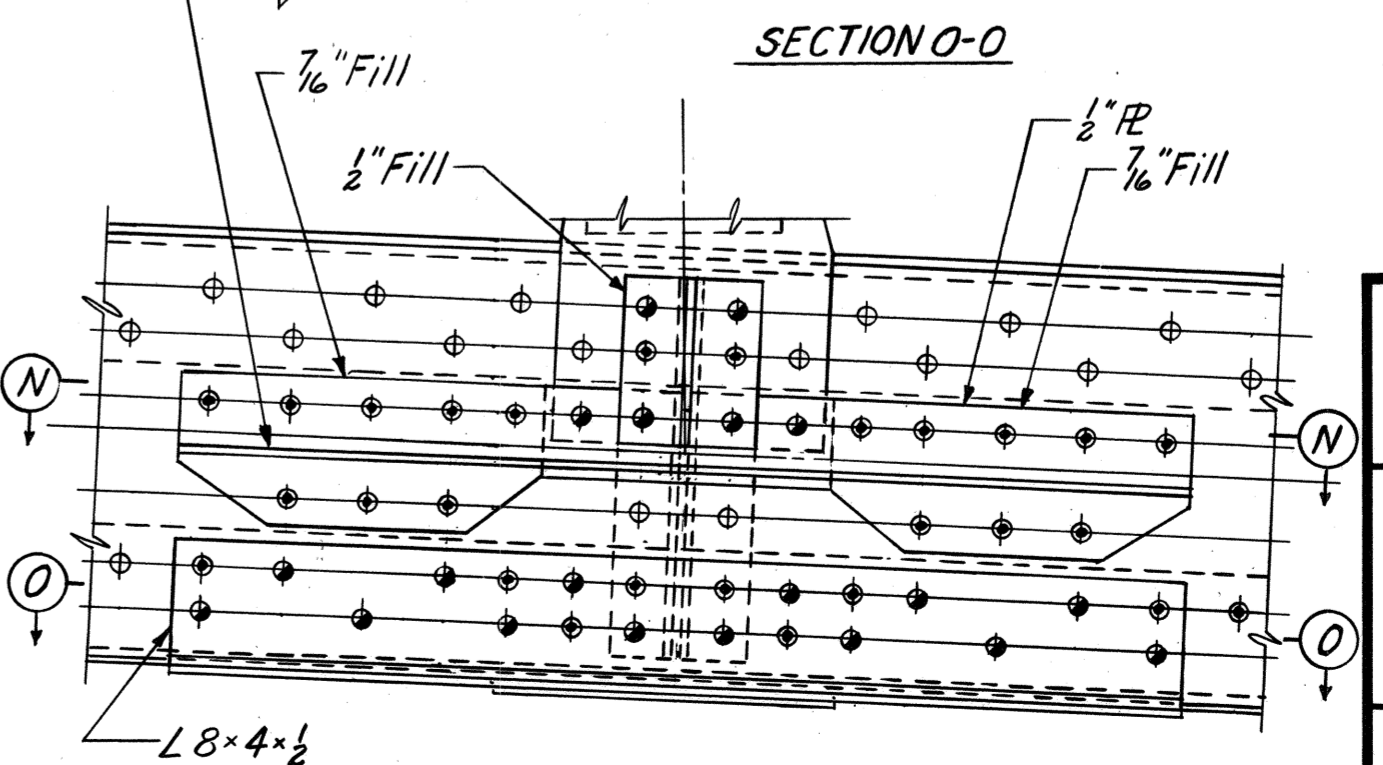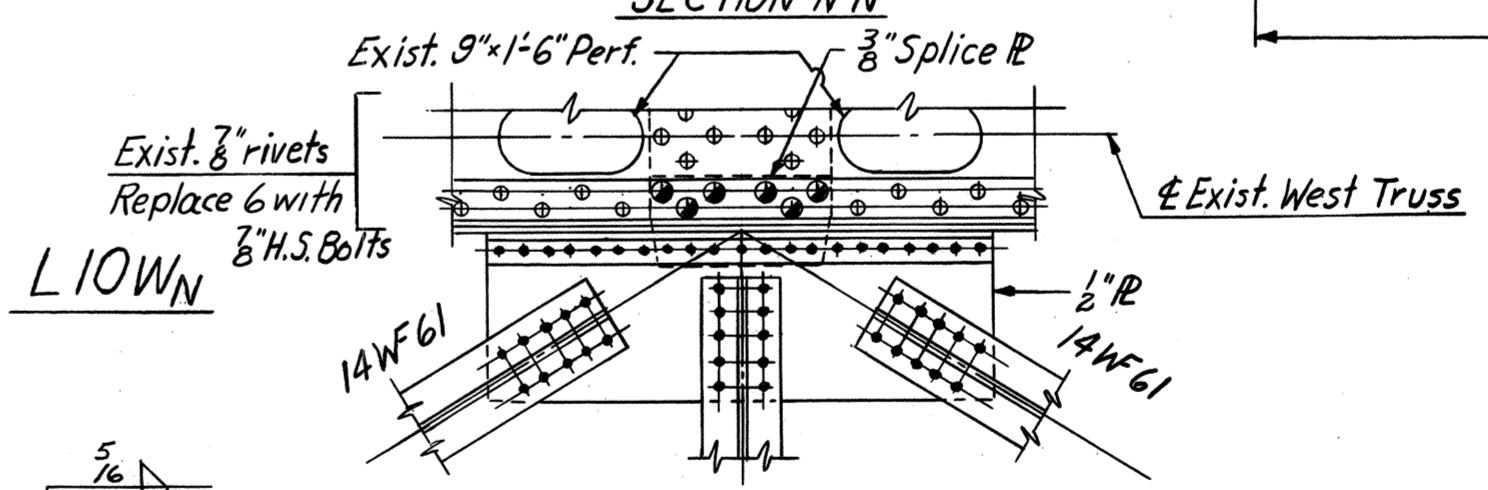

INT. SWAY CONN. TO EXIST. BOTTOM CHORD

RICHMOND METROPOLITAN AUTHORITY
RICHMOND EXPRESSWAY SYSTEM
DOWNTOWN EXPRESSWAY

BRIDGE NO. 67
RAMP W-N CONNECTION TO
RICHMOND-PETERSBURG TURNPIKE
TRUSS DETAILS - P.P.7 TO P.P.10


SCALE 1/2" = 1'-0" UN
DATE _____ SHEET 40 OF 54

HOWARD, NEEDLES, TAMMEN & BERGENDOFF
CONSULTING ENGINEERS
Alexandria, Virginia

HNTB

DESIGNED	DRAWN	CHECKED	IN CHARGE	NO.	REVISION	BY	DATE
	PRY 1-74		PRY				
					Slot location	d.B.P.	2-7-75

SECTION M-M
1" = 1'-0"
For Legend see Sheet 41. AS BUILT

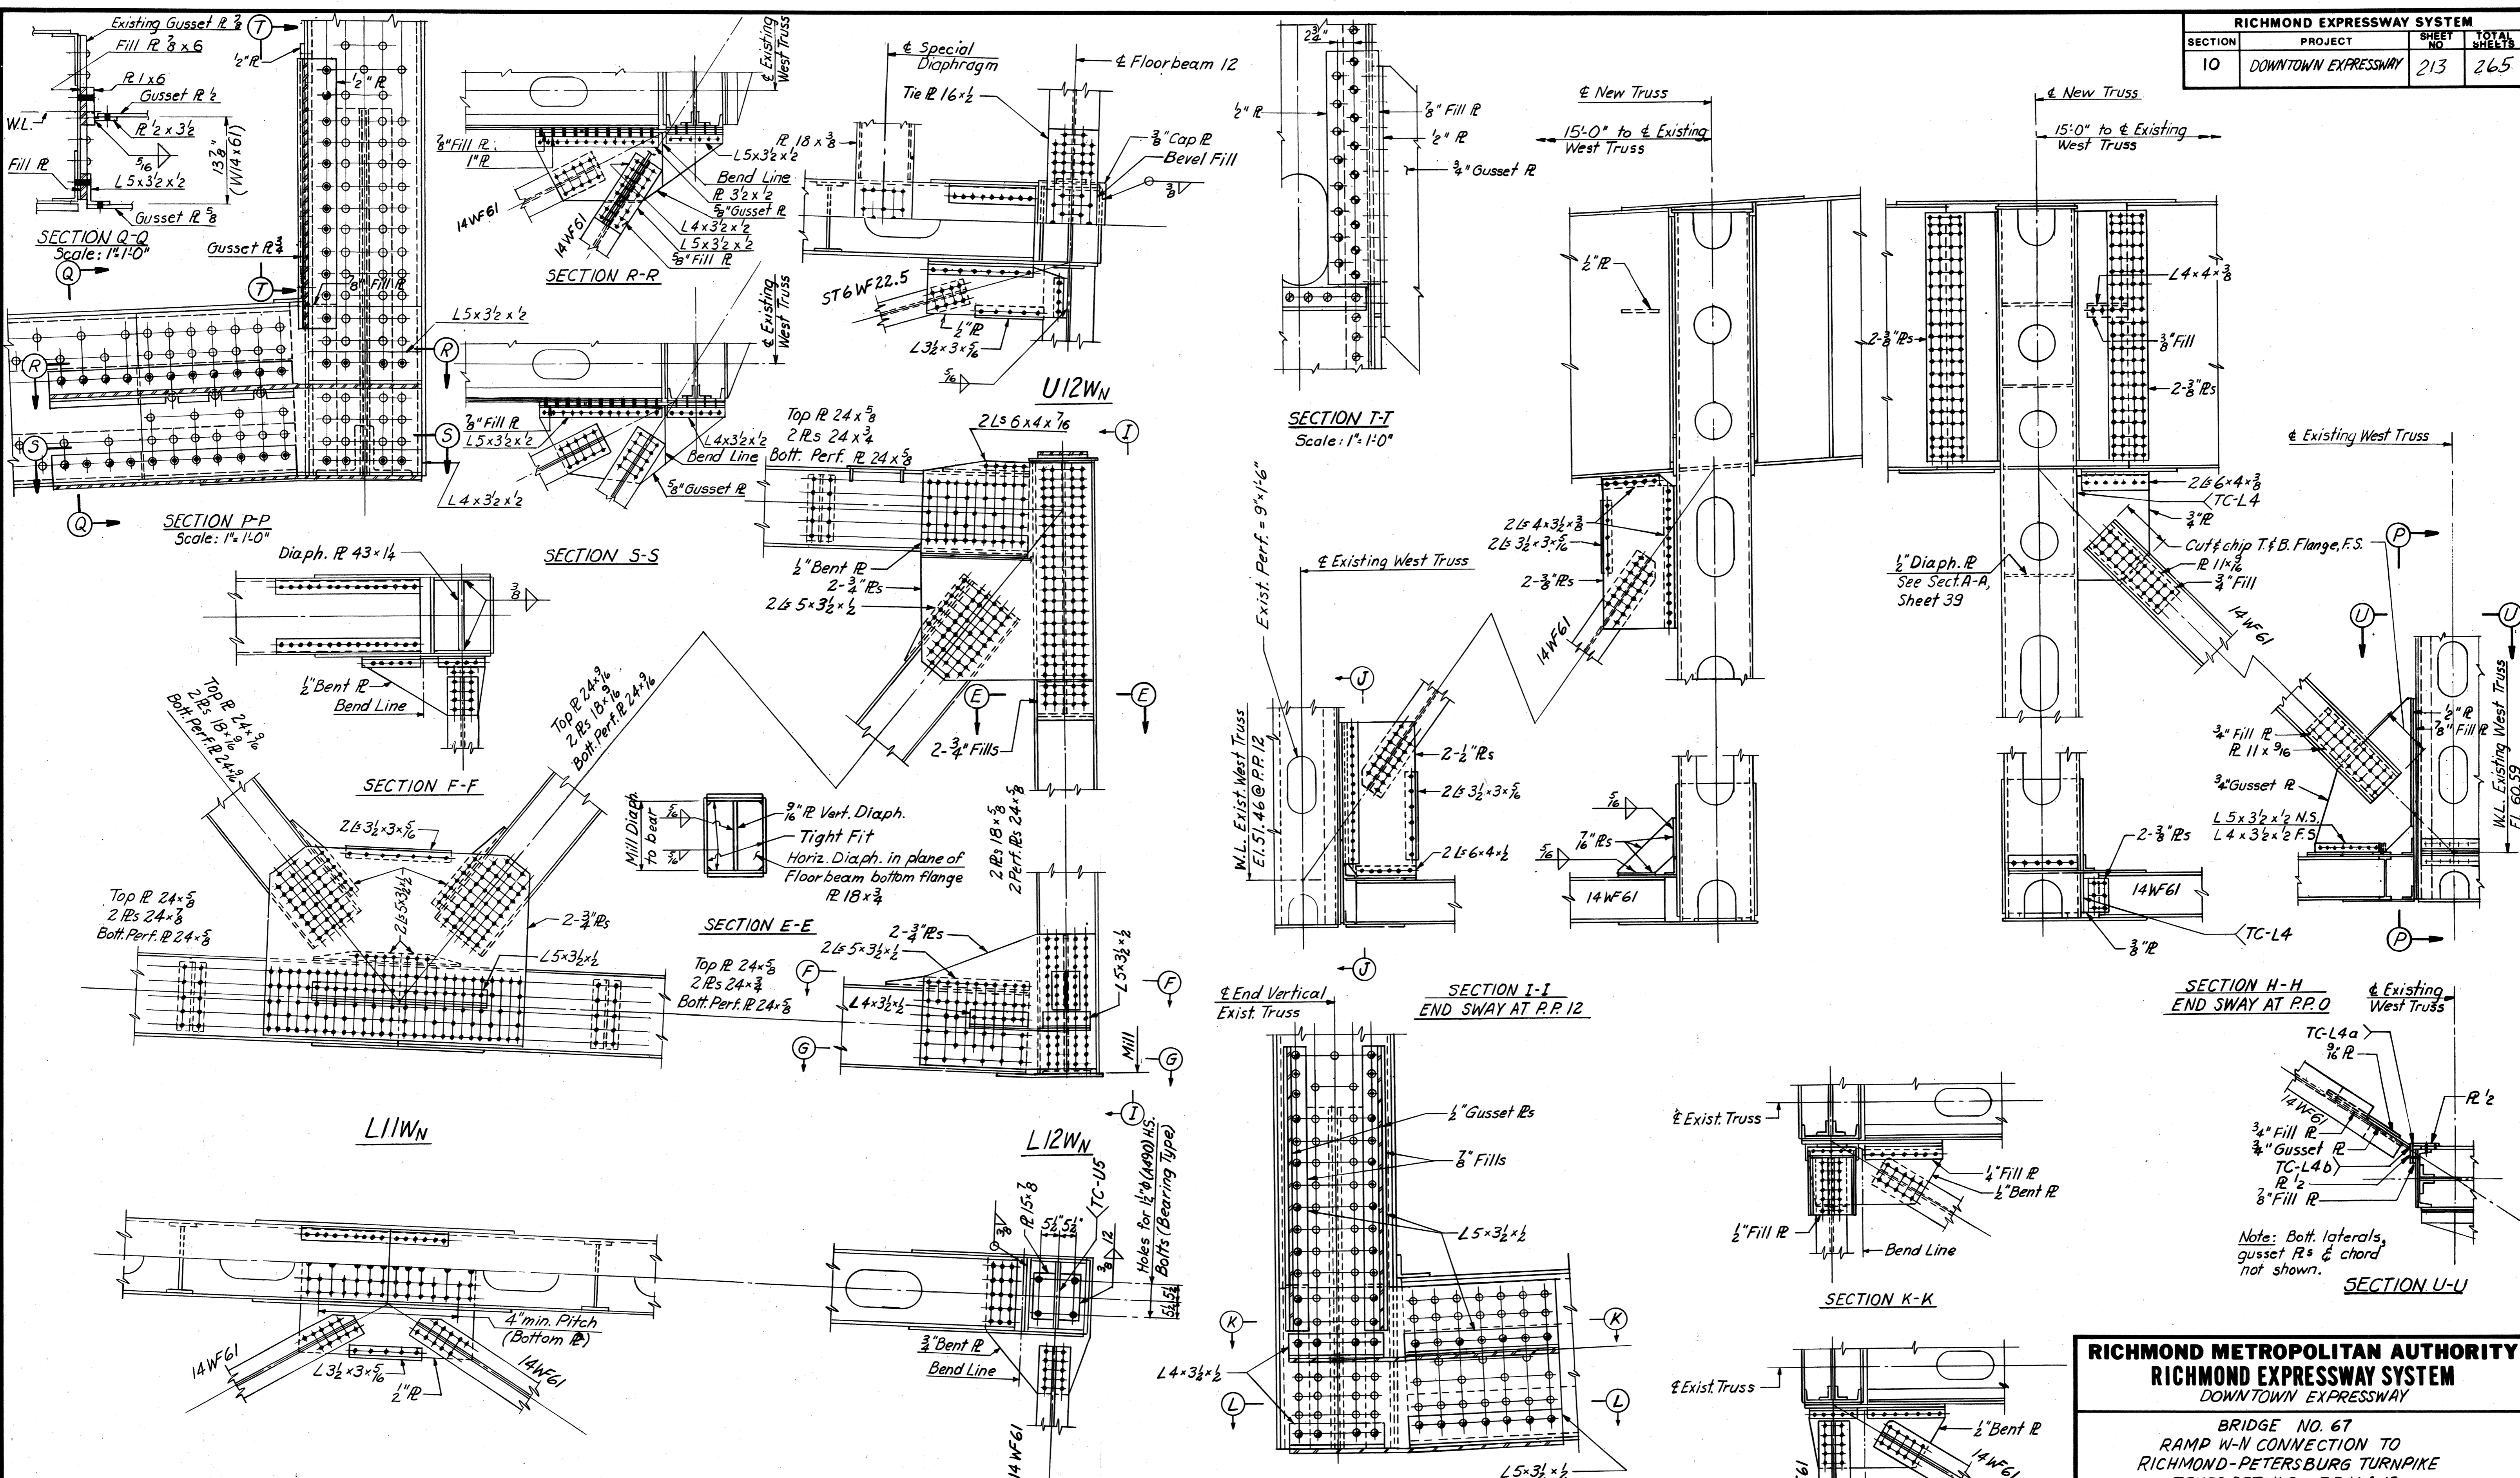

DESIGNED	DRAWN	CHECKED	IN CHARGE	NO.	REVISION	BY	DATE
	PRY		PRY				

NO.	REVISION	BY	DATE
2	As Built	TEM	G-77
1	Connections to Exist. Truss at P.P.O. added, Depth of Floor Beam rev. & spec. Diaph. add.	d.B.P.	2-7-75

⚡ Indicates existing 3/8" rivets to remain in place.
 ⚡ Indicates existing 3/8" rivets to be replaced with 3/8" H.S. Bolts.
 ⚡ Indicates new holes to be drilled for 3/8" H.S. Bolts

⚡ Indicates existing 1" rivets to remain in place.
 ⚡ Indicates existing 1" rivets to be replaced with 1" H.S. Bolts.
 ⚡ Indicates new holes to be drilled for 1" H.S. Bolts.

RICHMOND METROPOLITAN AUTHORITY
RICHMOND EXPRESSWAY SYSTEM
 DOWNTOWN EXPRESSWAY

BRIDGE NO. 67
 RAMP W-N CONNECTION TO
 RICHMOND-PETERSBURG TURNPIKE
 TRUSS DETAILS - P.P. 11 & 12



SCALE 1/2" = 1'-0" U.M.
 DATE _____ SHEET 41 OF 54

HOWARD, NEEDLES, TAMMEN & BERGENDOFF
 CONSULTING ENGINEERS
 Alexandria, Virginia

HNTB

AS BUILT


RICHMOND EXPRESSWAY SYSTEM			
SECTION	PROJECT	SHEET NO.	TOTAL SHEETS
10	DOWNTOWN EXPRESSWAY	214	265

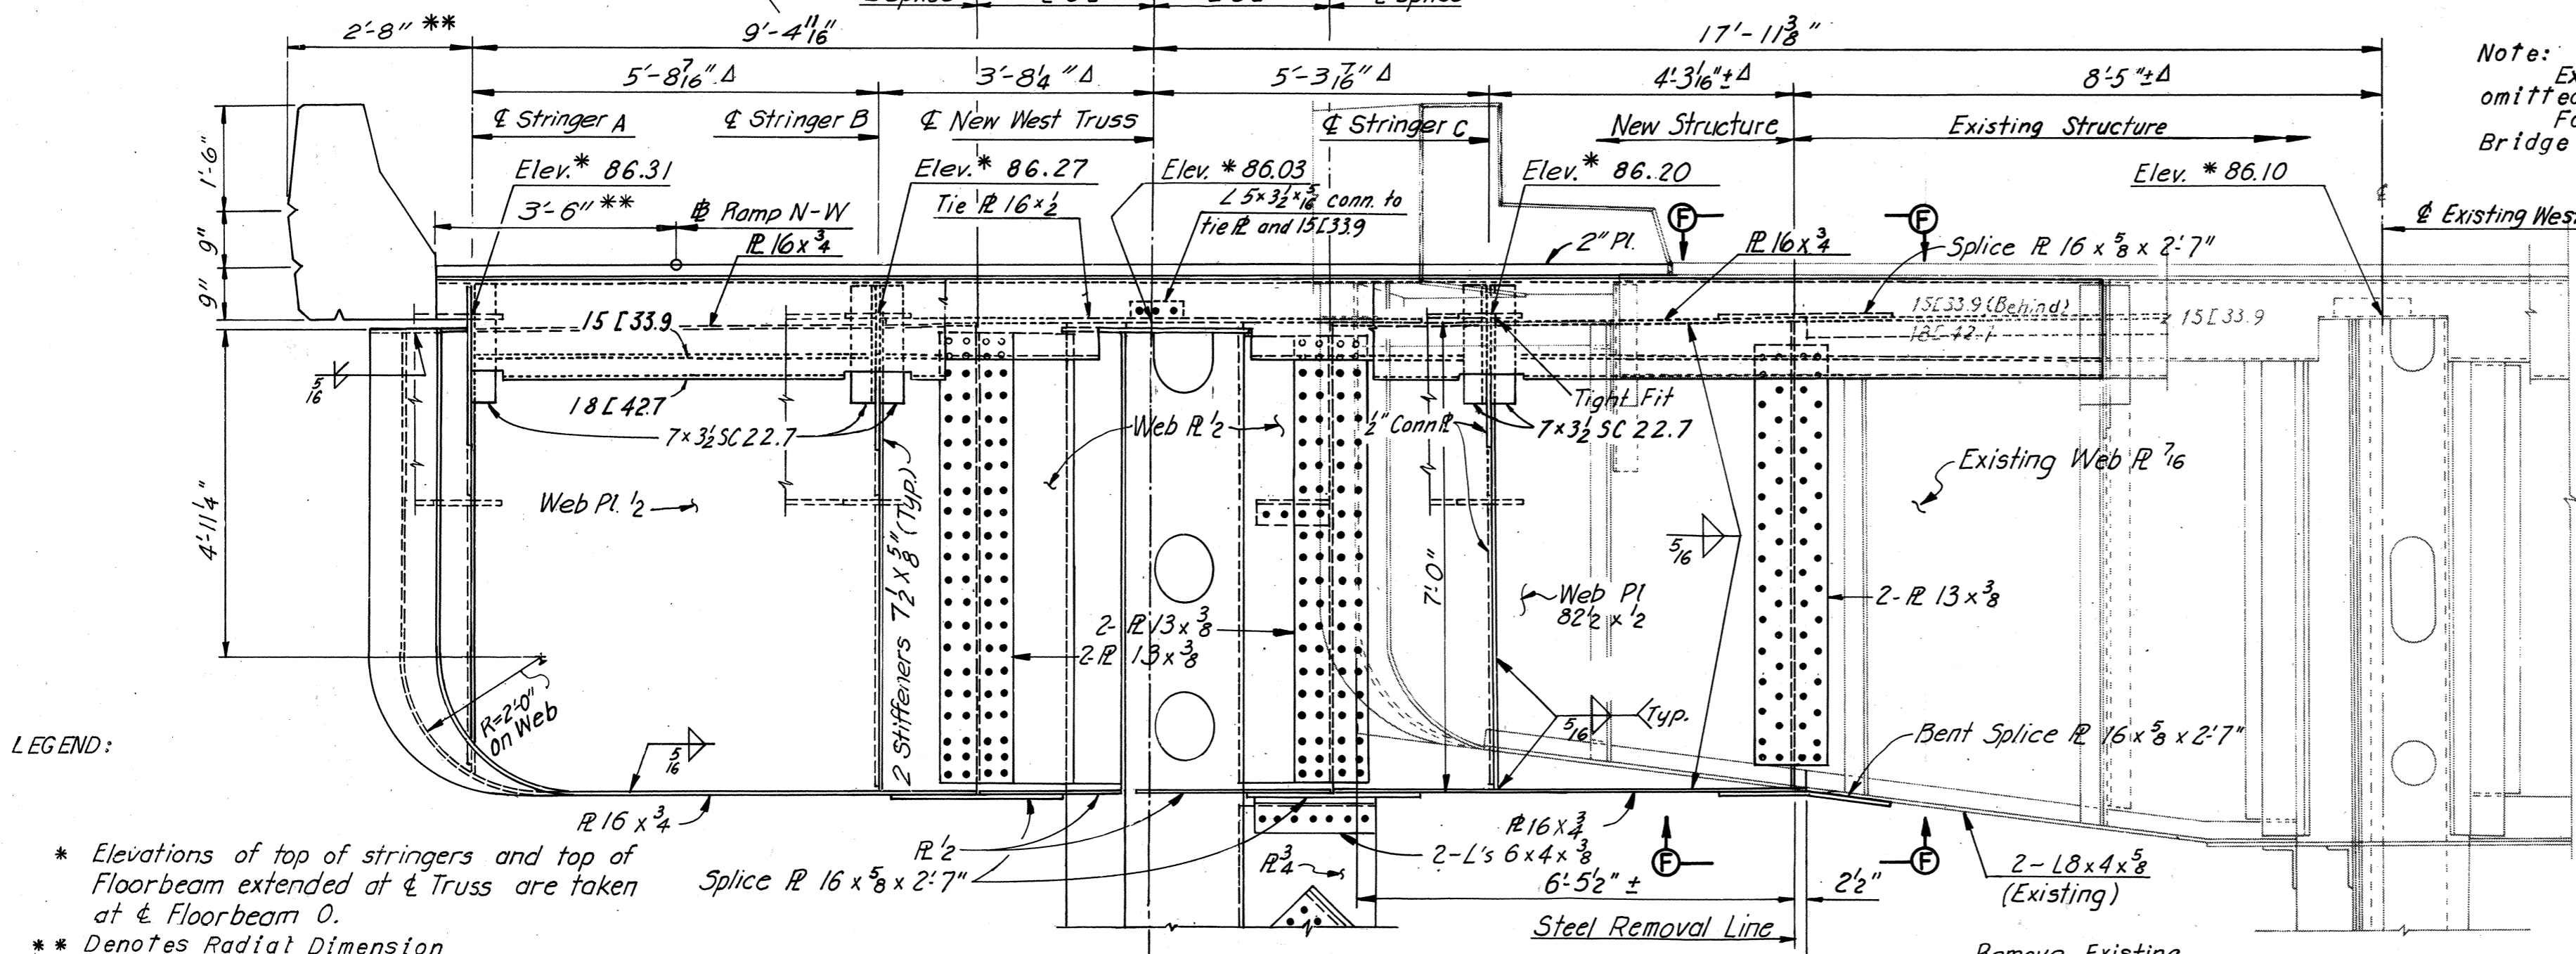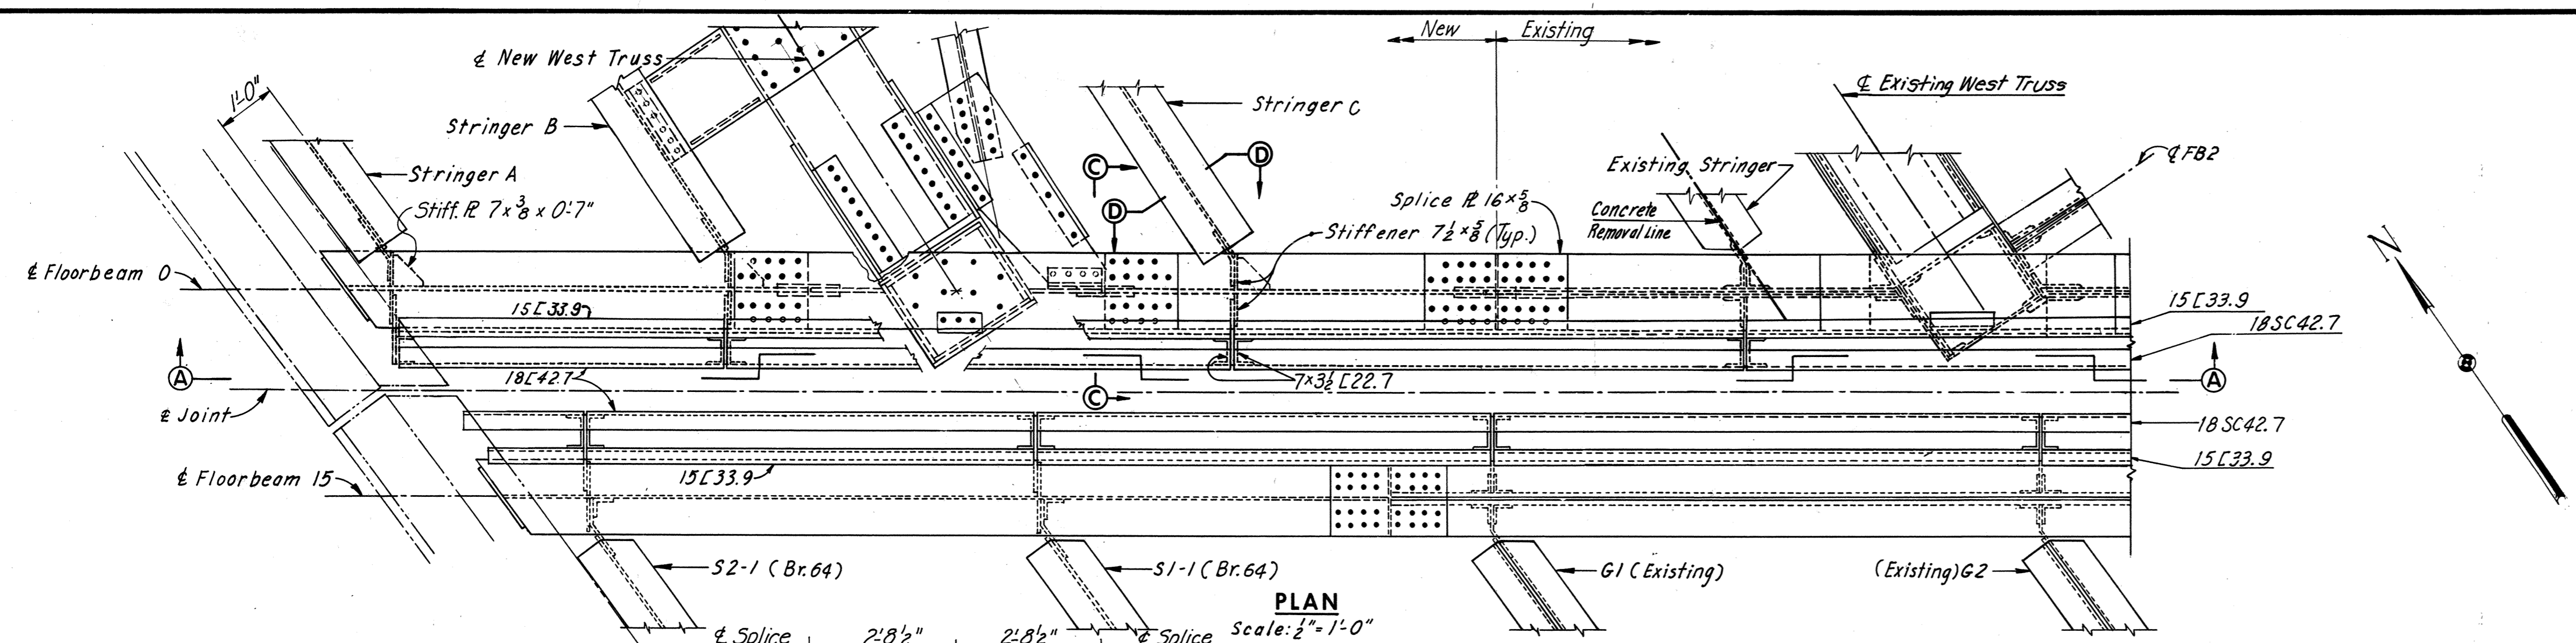

LEGEND:


- * Elevations of top of stringers and top of floorbeam extended at Truss are taken at Floorbeam 0.
- ** Denotes Radial Dimension
- Δ Dimensions are to projected Stringer at Floorbeam. Connection - Stiffener Plate shall be located by the Fabricator.

Note: Expansion plates and curb plates are omitted from Plan. For Elevation of Floorbeam 15, see Bridge 64 Sheet 18.

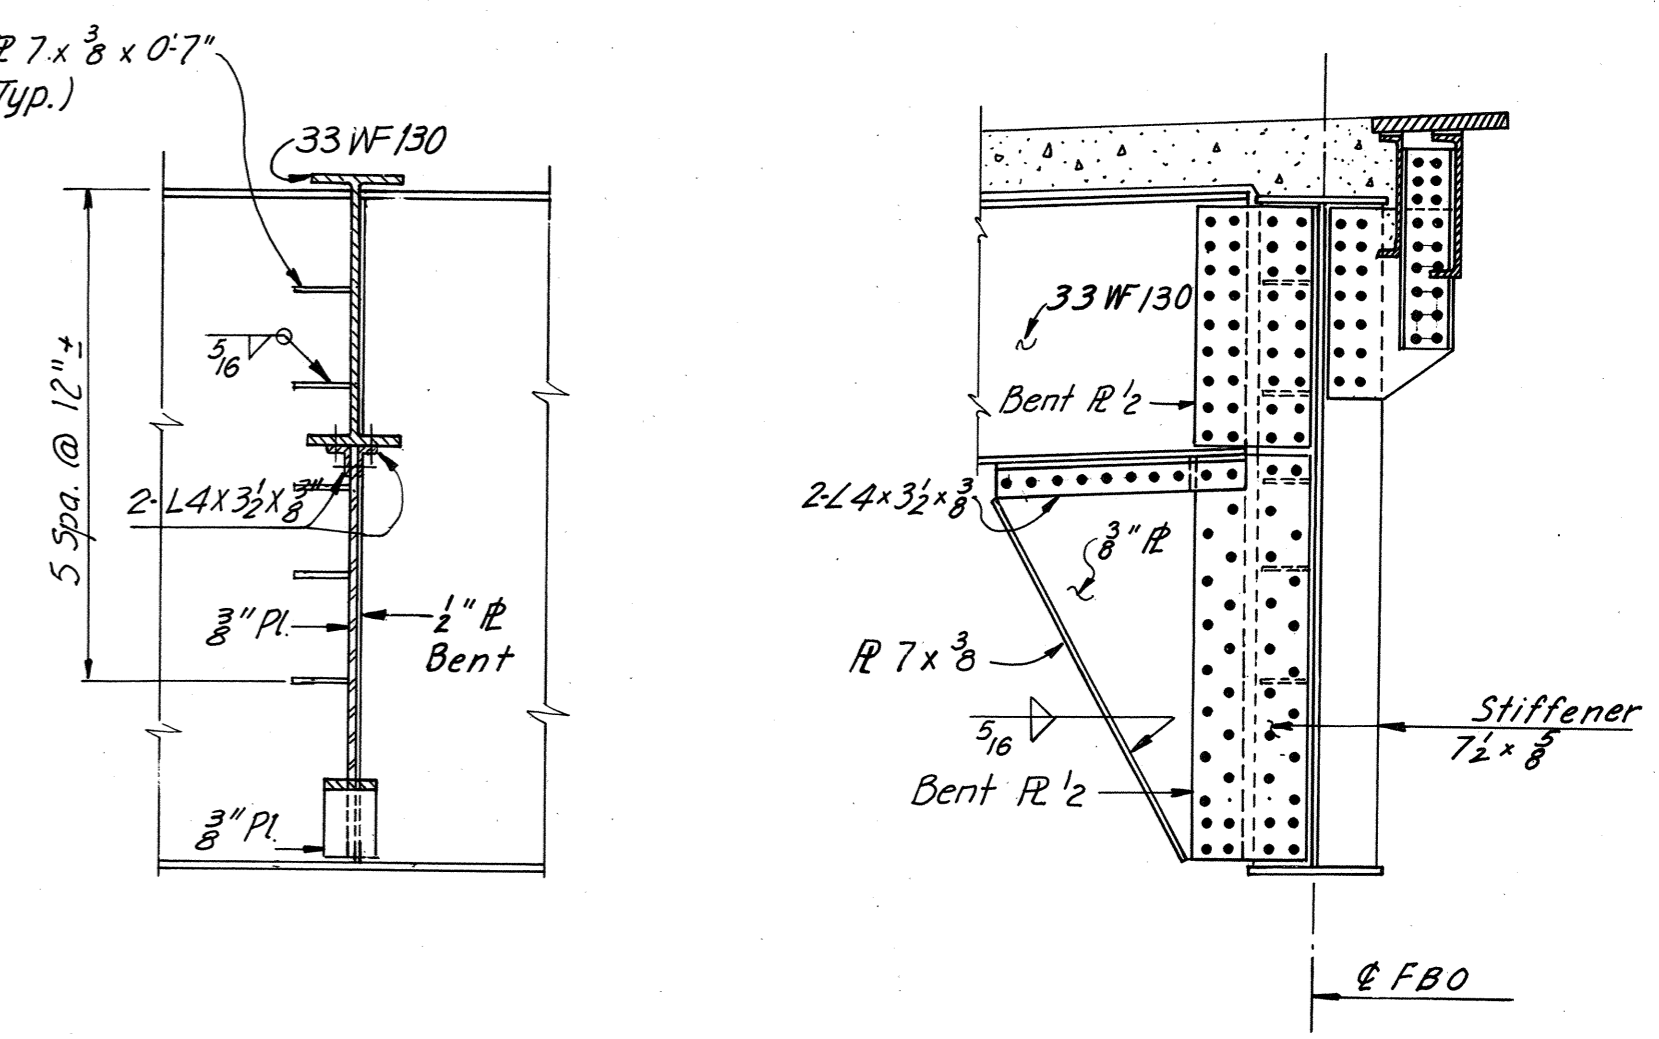


SECTION D-D Scale: 1/2" = 1'-0"

SECTION C-C Scale: 1/2" = 1'-0"

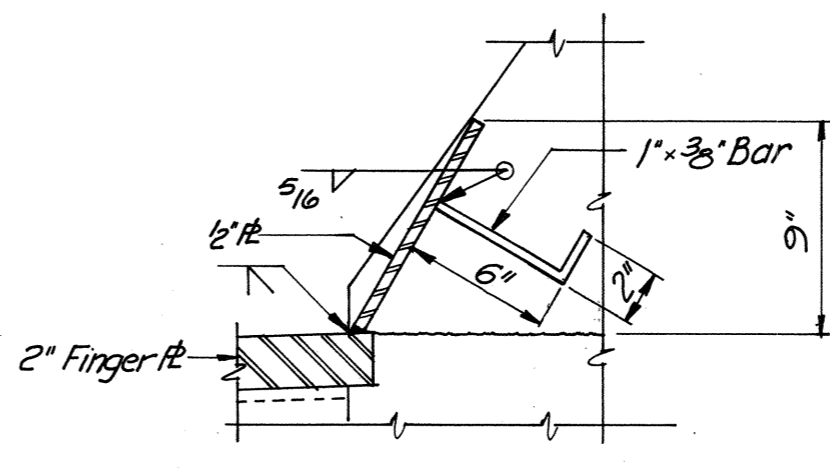


SECTION E-E Scale: 1/2" = 1'-0"

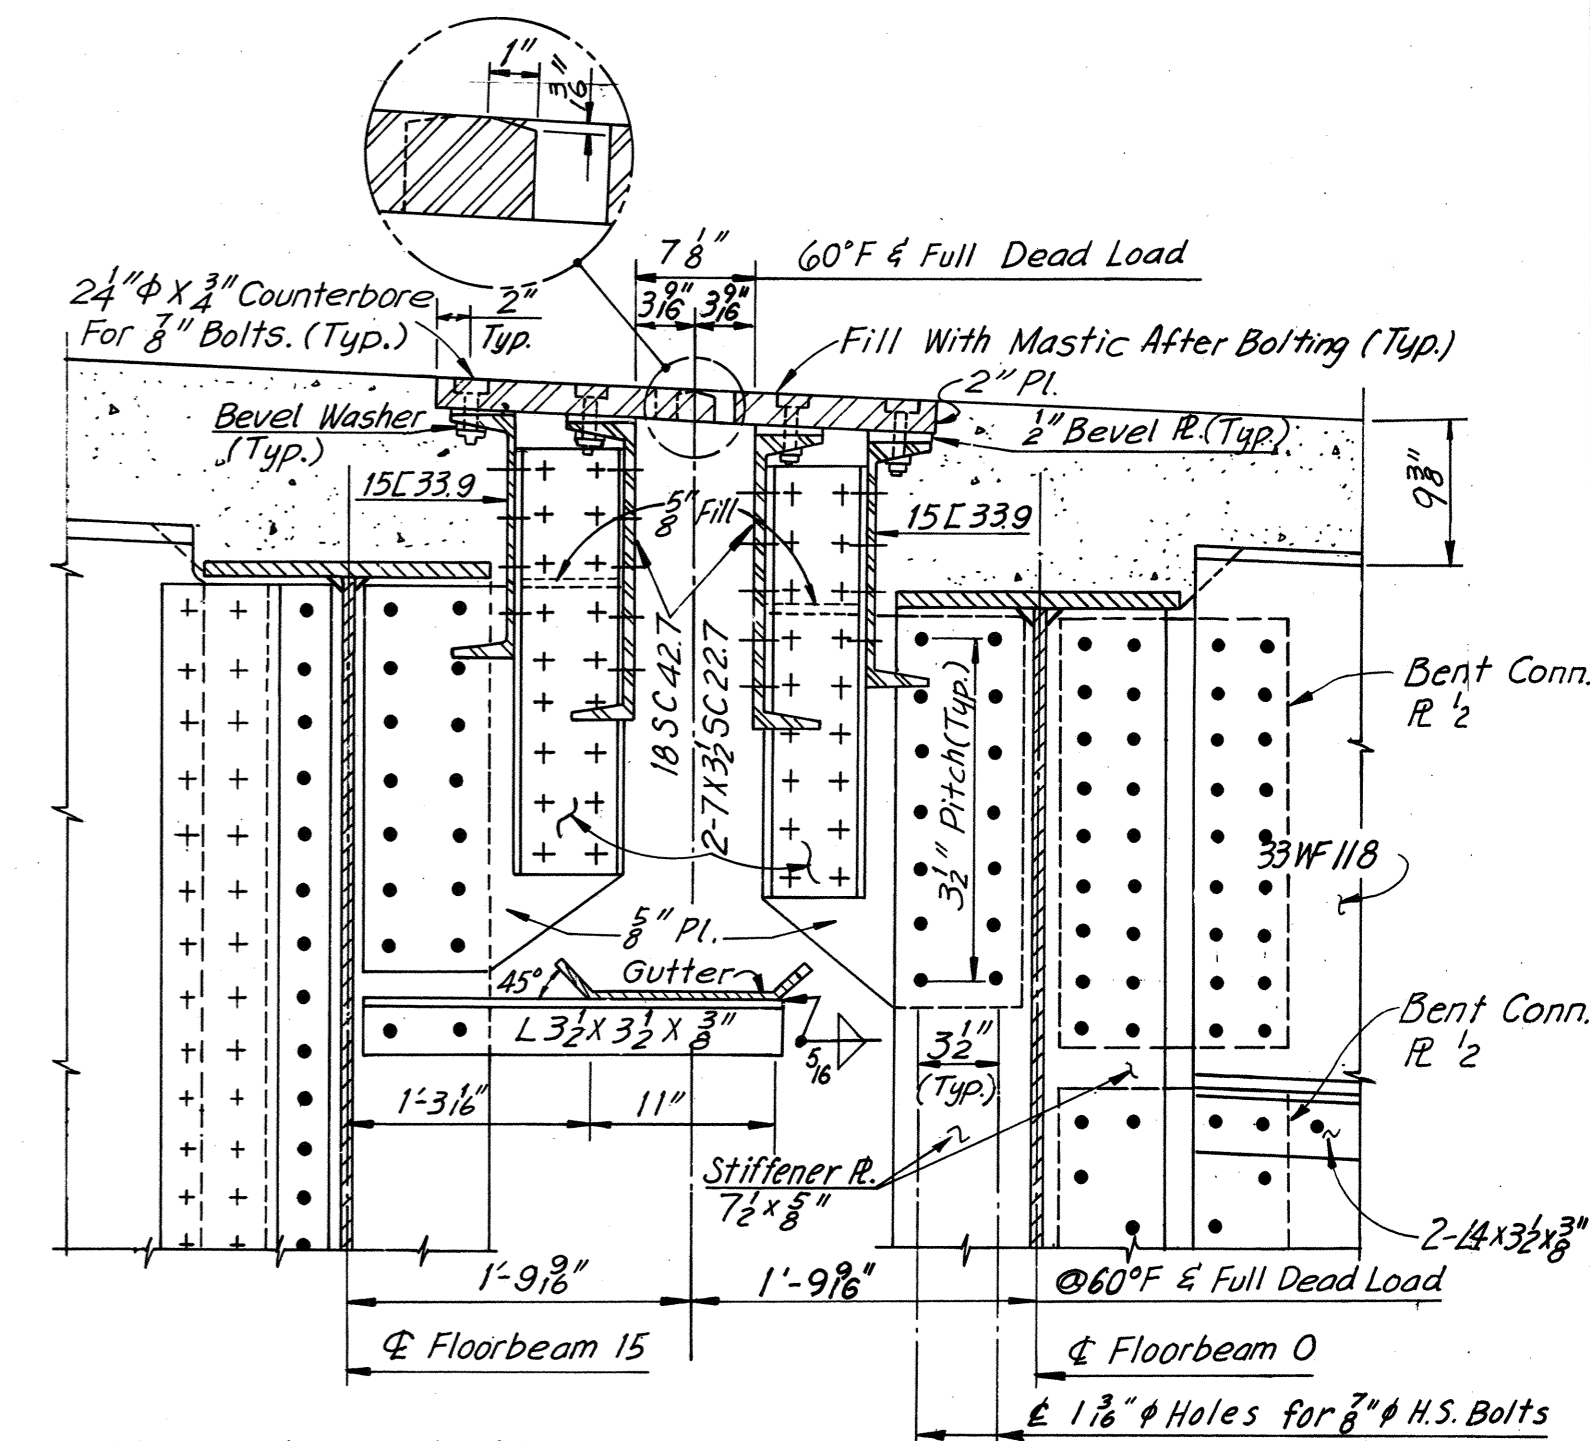


SECTION B-B Scale: 1" = 1'-0"

Note: Cut existing gutter on the west side of the existing stringer and set the new gutter into the existing gutter. Bolt the two together with existing bolts. Provide an 8" lap.

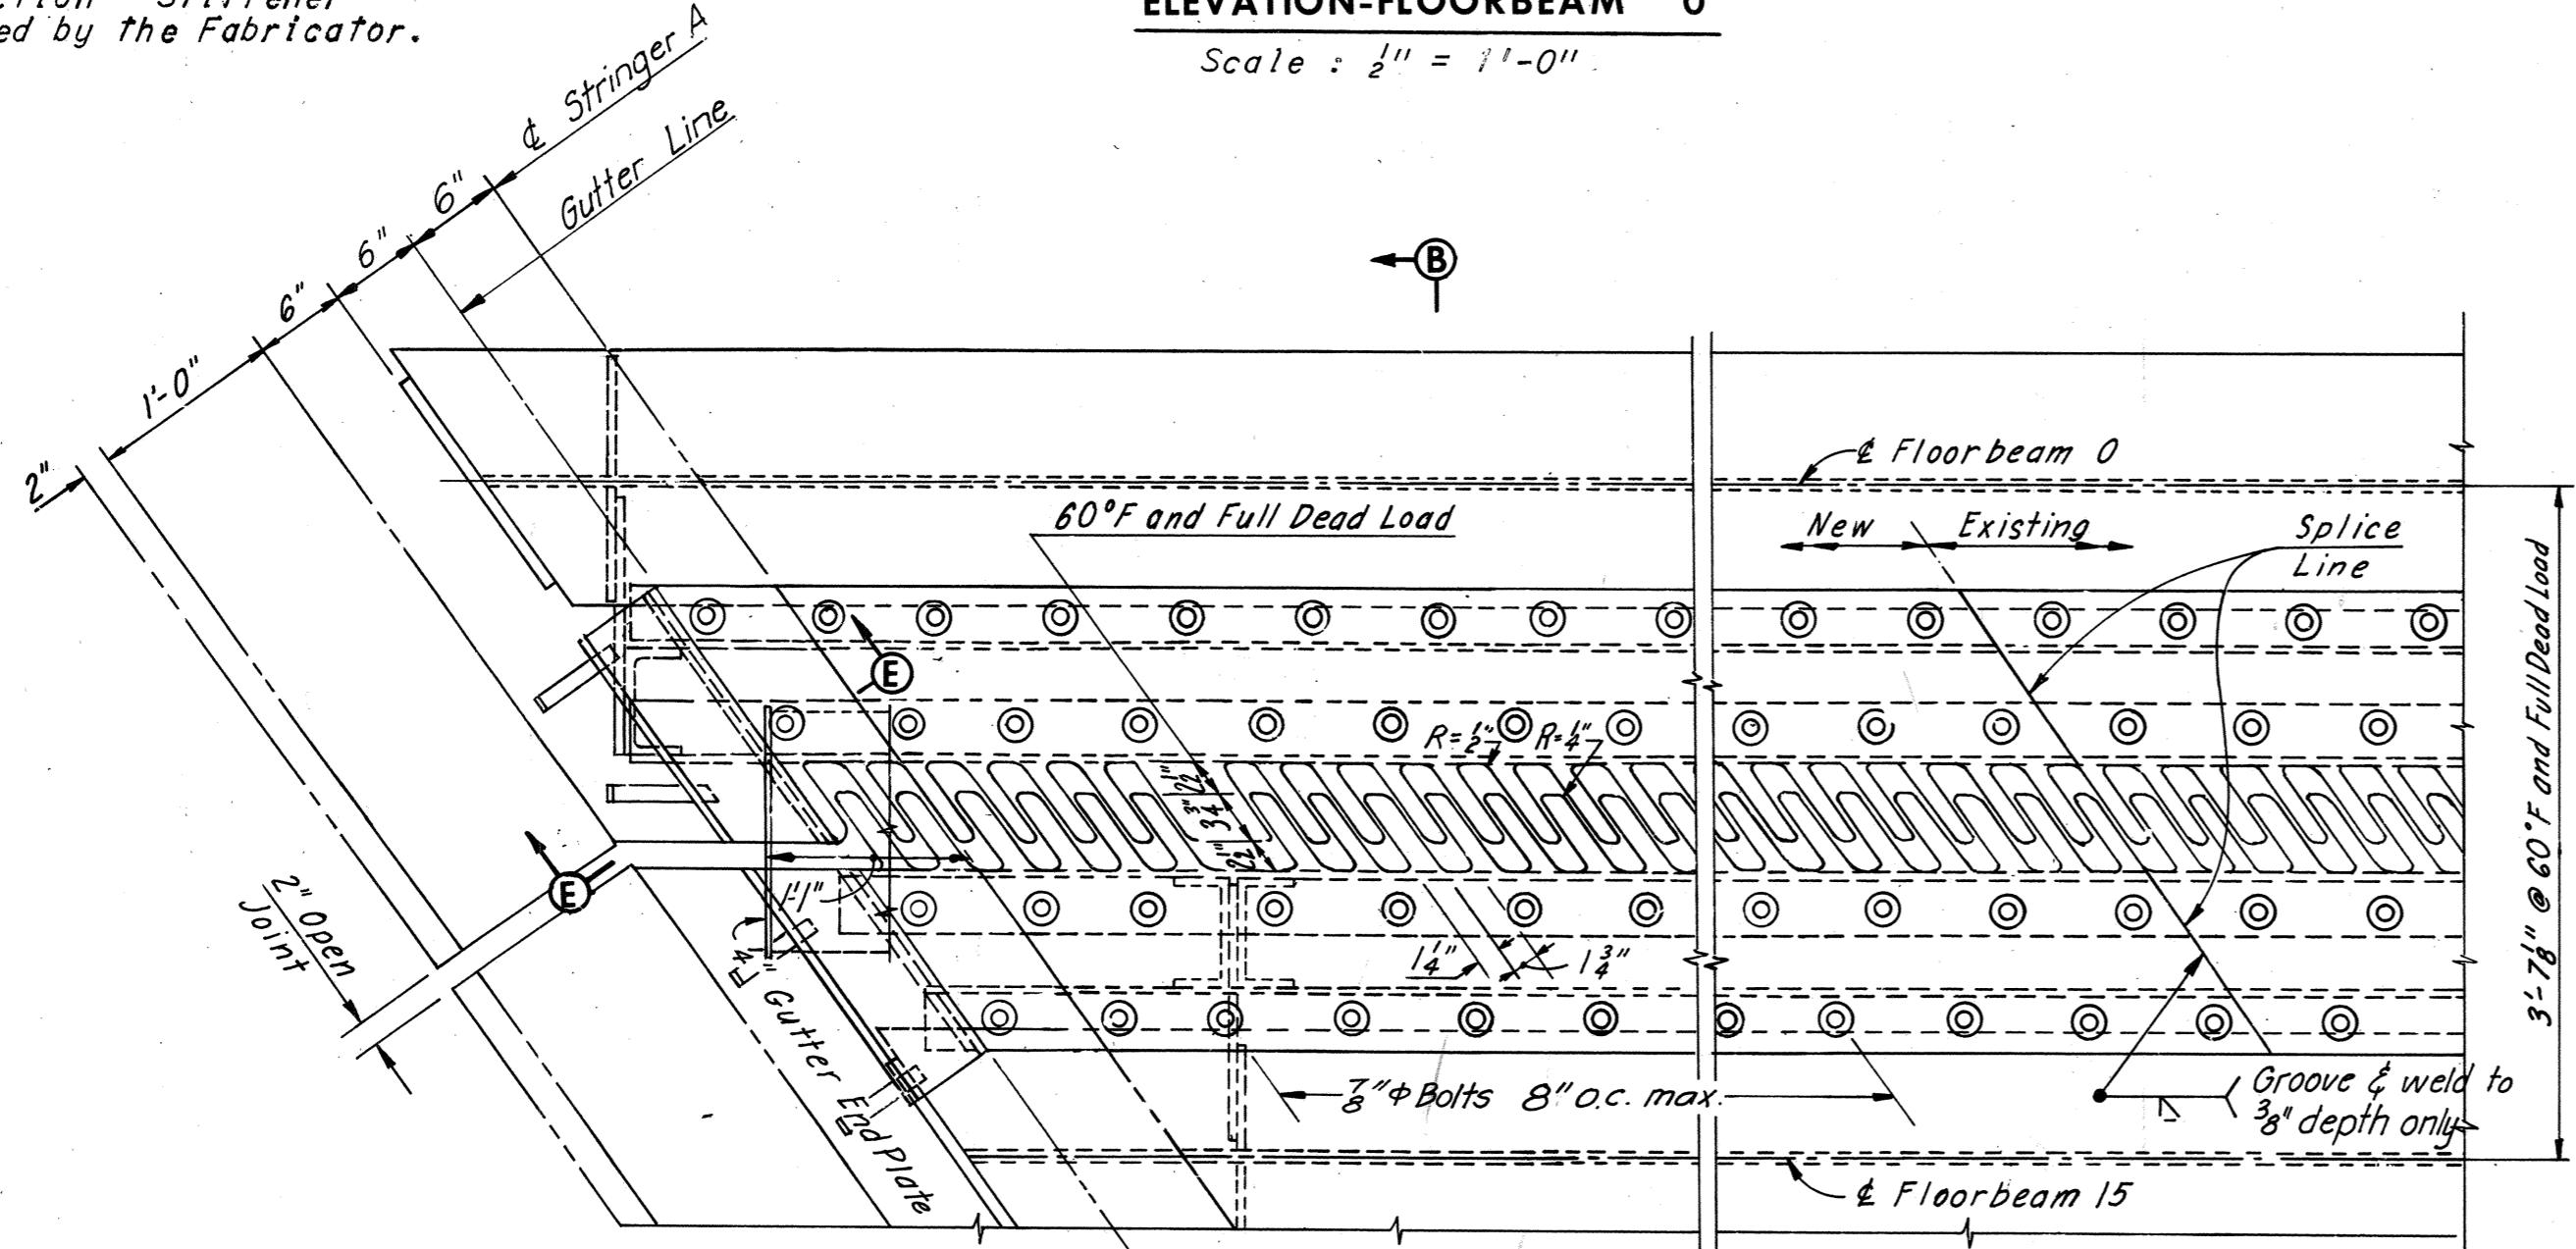

PART PLAN OF EXPANSION DEVICE Scale: 1" = 1'-0"

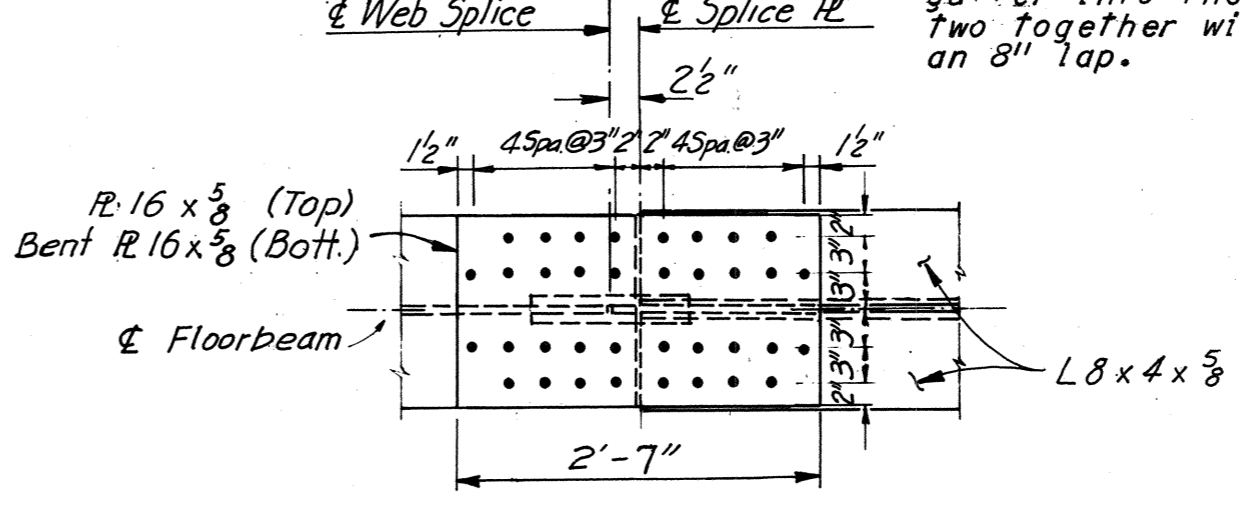

VIEW E-F Scale: 3/4" = 1'-0" bottom Splice Similar

Note: Cut existing finger plate as close to the existing gutter line as possible. New plate shall be provided long & cut to exact length after existing plate is cut.

BY	DATE	NO.	REVISION	BY	DATE
MADE	1-75	2	As Built	TEM	6-77
CHECKED			New sheet added	d.B.P.	2-7-75
IN CHARGE					

**RICHMOND METROPOLITAN AUTHORITY
RICHMOND EXPRESSWAY SYSTEM**




BRIDGE NO. 67
RAMP W-N CONNECTION TO
RICHMOND-PETERSBURG TURNPIKE
FLOORBEAM 0 AND JOINT DETAILS

HOWARD, NEEDLES, TAMMEN & BERGENDOFF consulting engineers NEW YORK ALEXANDRIA KANSAS CITY	SCALE: As Noted CONTRACT NO.: 10 SHEET NO. 42 OF 54
---	---

AS BUILT


* 6'-11 1/4" @ FB6
 * 6'-9 7/8" @ FB8
 * 5'-4 7/8" @ FB10

** 8'-4 3/8" @ FB6
 ** 8'-0" @ FB8
 ** 7'-9 3/8" @ FB10

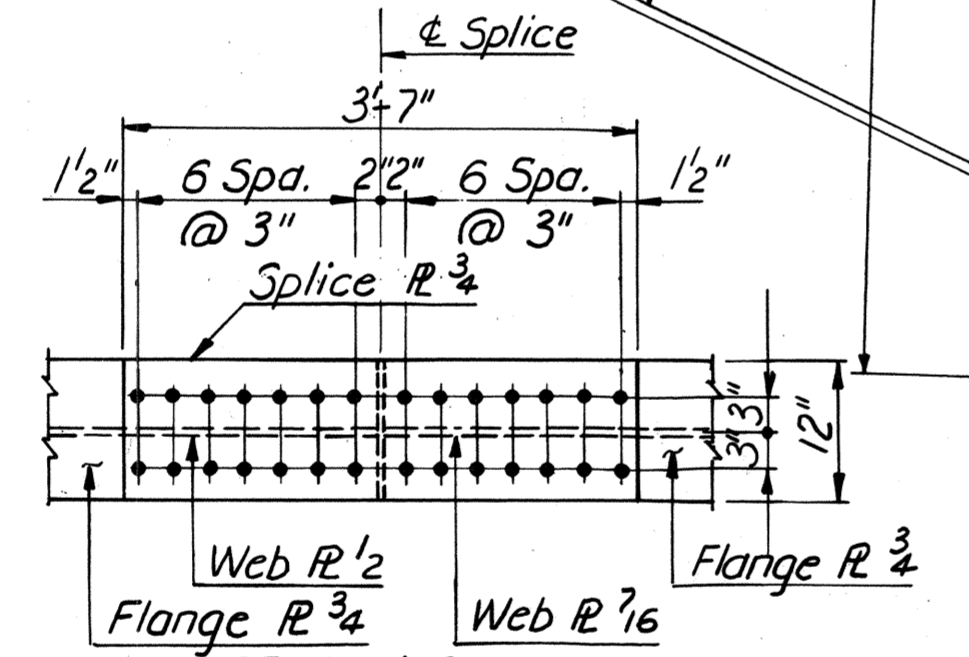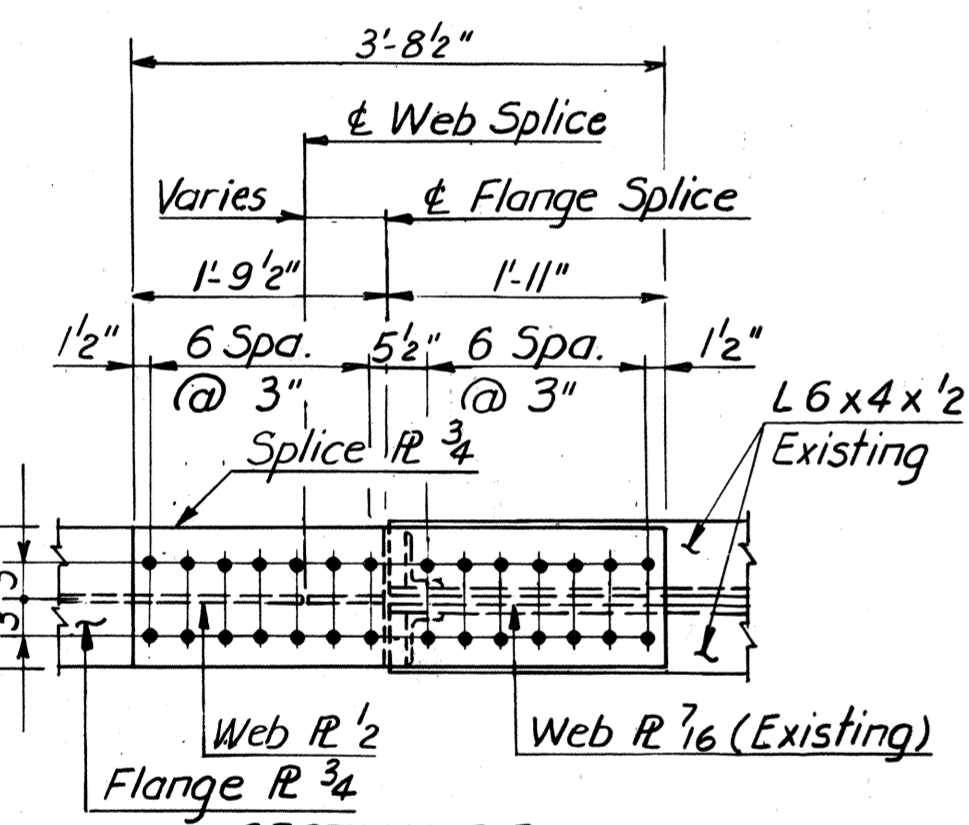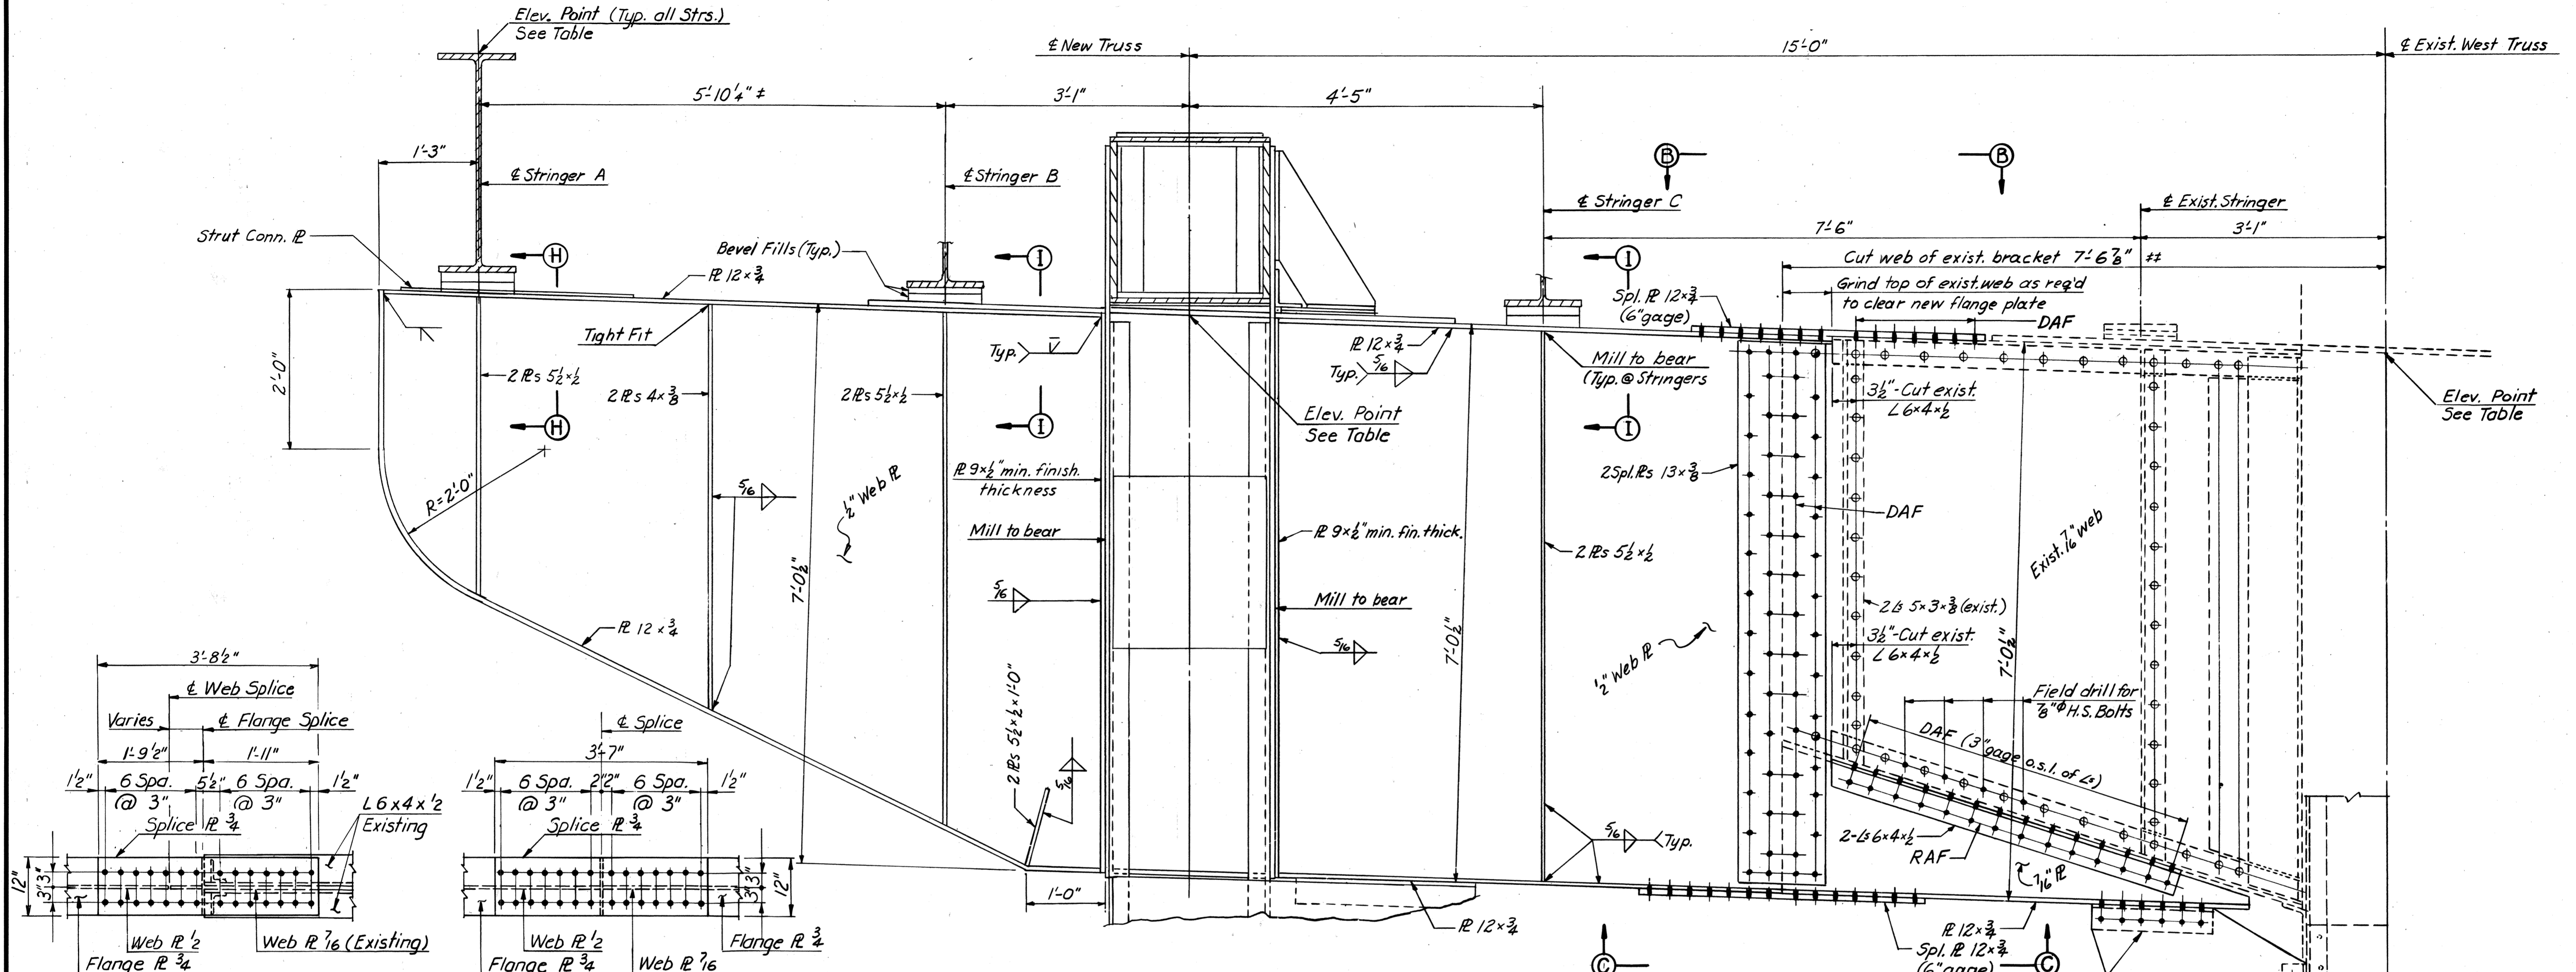

FLOORBEAM FB4
 Details for FB6, FB8 & FB10 Similar
 Scale: 1/2" = 1'-0"
 Dims. along & Floorbeam

NOTES:
 Holes marked RAF are to be subpunched and reamed assembled in the field.
 Holes marked DAF are to be drilled in the field with pieces assembled.
 Existing shop drawings are available upon request.
 For Sections E-E, F-F and G-G see Sheet 44.

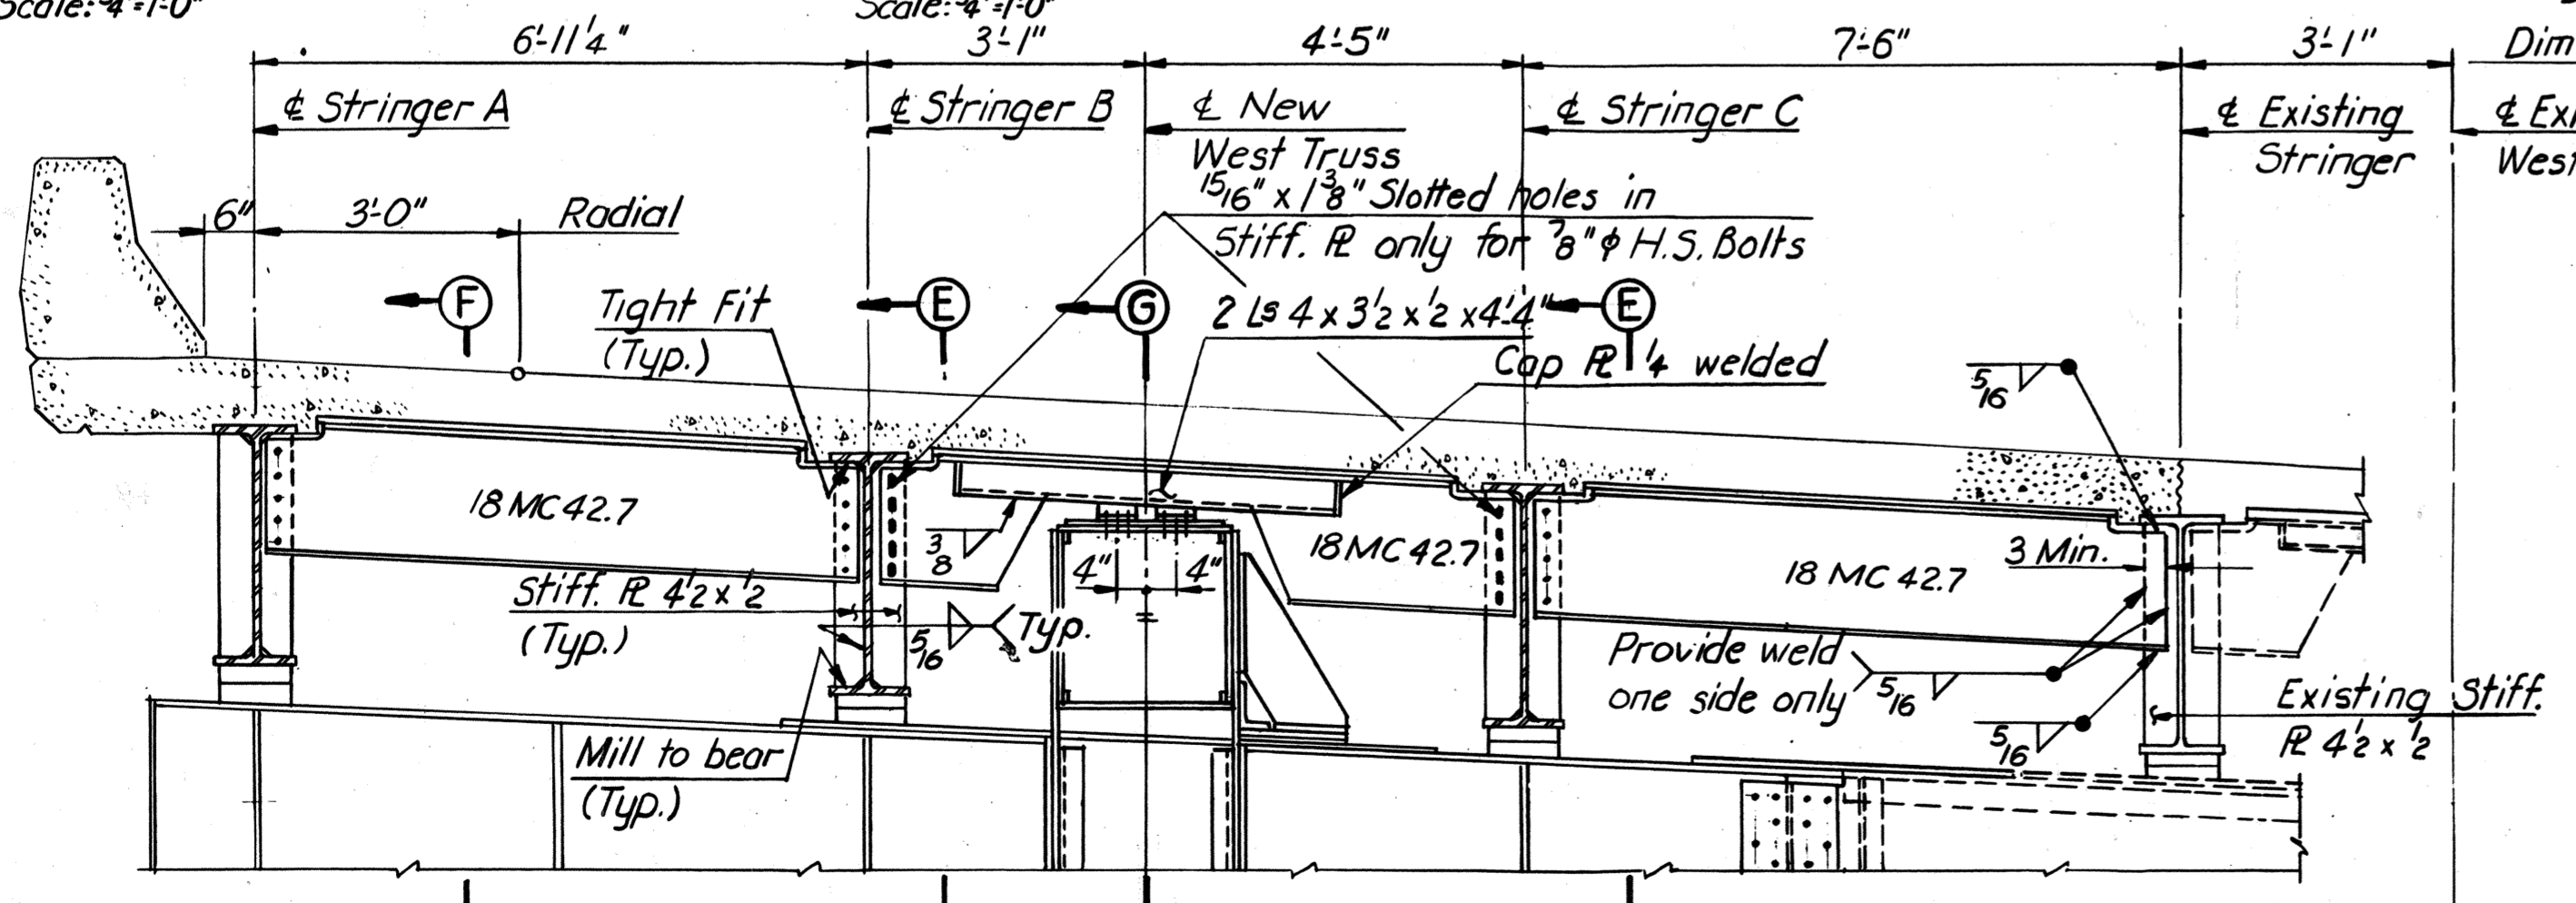

LOCATION	STR. A	STR. B	STR. C	New TRUSS	EXISTING TRUSS
FB4	85.53	85.33	85.08	82.30	81.85
FB6	84.32	84.04	83.73	80.94	80.41
FB8	83.12	82.79	82.42	79.61	78.97
FB10	81.92	81.62	81.19	78.37	77.62

Note: Elevations shown are taken at & Floorbeam.

DESIGNED				
DRAWN	PRY	4-74		
CHECKED				
IN CHARGE	PRY	NO.	REVISION	BY DATE

Table of Elev. & Diaph. Det. added, FB Web R thick. rev. notes removed & connection added.
 C.B.P. 2-7-75

RICHMOND METROPOLITAN AUTHORITY
RICHMOND EXPRESSWAY SYSTEM
 DOWNTOWN EXPRESSWAY

BRIDGE NO. 67
 RAMP W-N CONNECTION TO
 RICHMOND-PETERSBURG TURNPIKE
 INTERMEDIATE FLOORBEAMS


SCALE: As Noted
 DATE: _____ SHEET 43 OF 54

HOWARD, NEEDLES, TAMMEN & BERGENDOFF
 CONSULTING ENGINEERS
 Alexandria, Virginia

HNTB


AS BUILT

RICHMOND EXPRESSWAY SYSTEM			
SECTION	PROJECT	SHEET NO.	TOTAL SHEETS
10	DOWNTOWN EXPRESSWAY	216	265

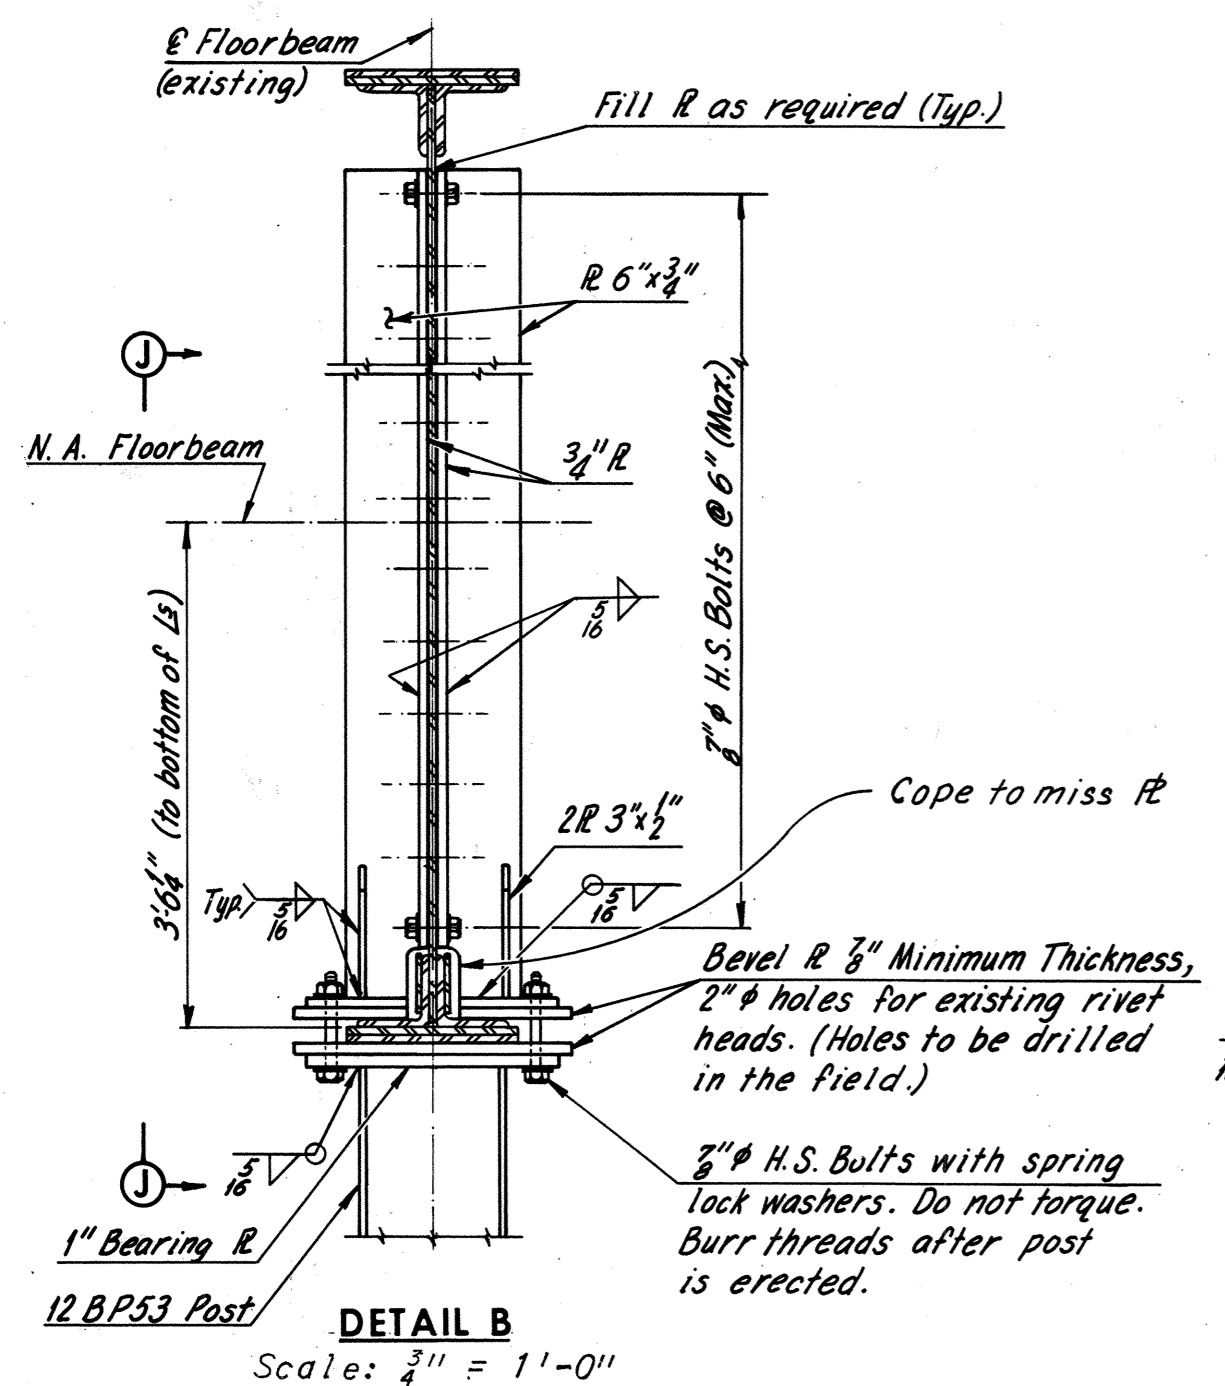


DETAIL B
Scale: 3/4" = 1'-0"


Note:
New bearing stiffeners (also includes 1" and 3/4" Min. bevel R) are to be set with full bearing on the bottom flange angles before drilling holes in existing web. If existing rivets are removed, holes in new stiffeners shall be drilled to match present holes while in bearing on the bottom flange.
The post shall then be drawn into full contact with the bottom of floorbeam by means of the erection bolts.
No welding or cutting will be permitted on existing alloy material.

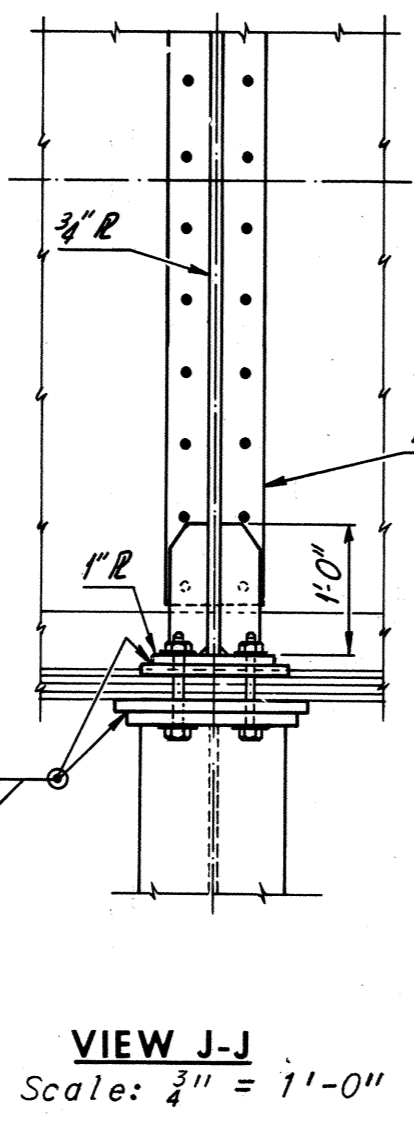


VIEW J-J
Scale: 3/4" = 1'-0"

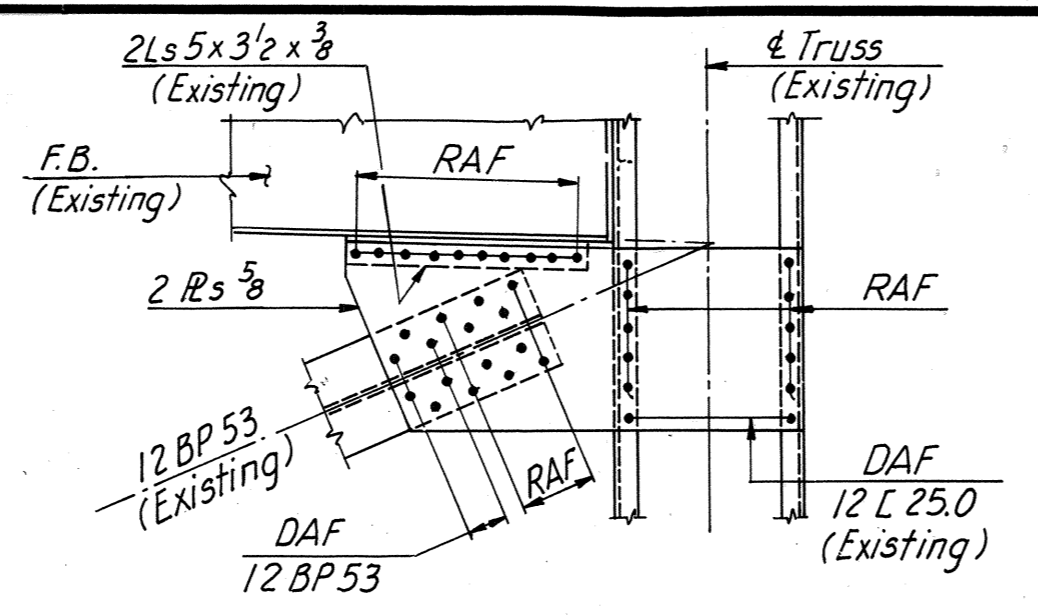

DETAIL D
AT FB2E, FB4E, FB6E, FB8E, FB10E, FB4W & FB6W
Scale: 1/2" = 1'-0"

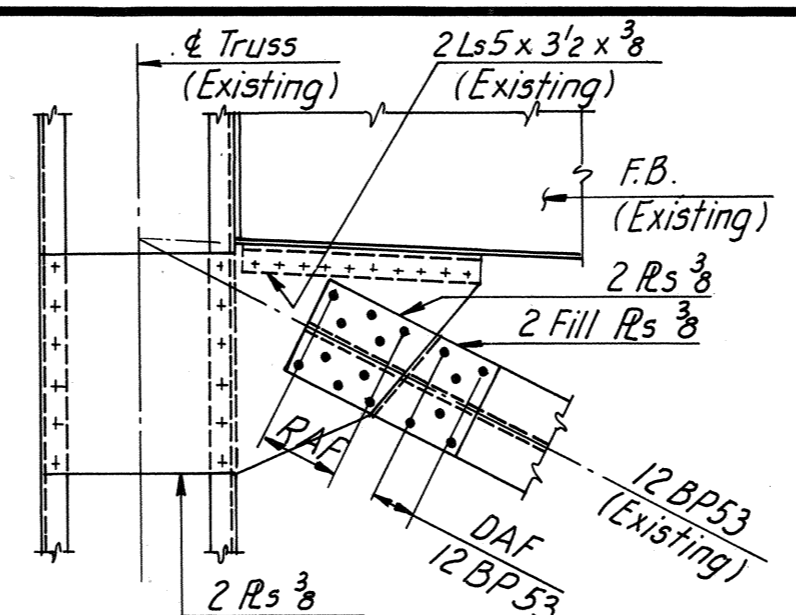


DETAIL D
AT FB8W & FB10W
Scale: 1/2" = 1'-0"

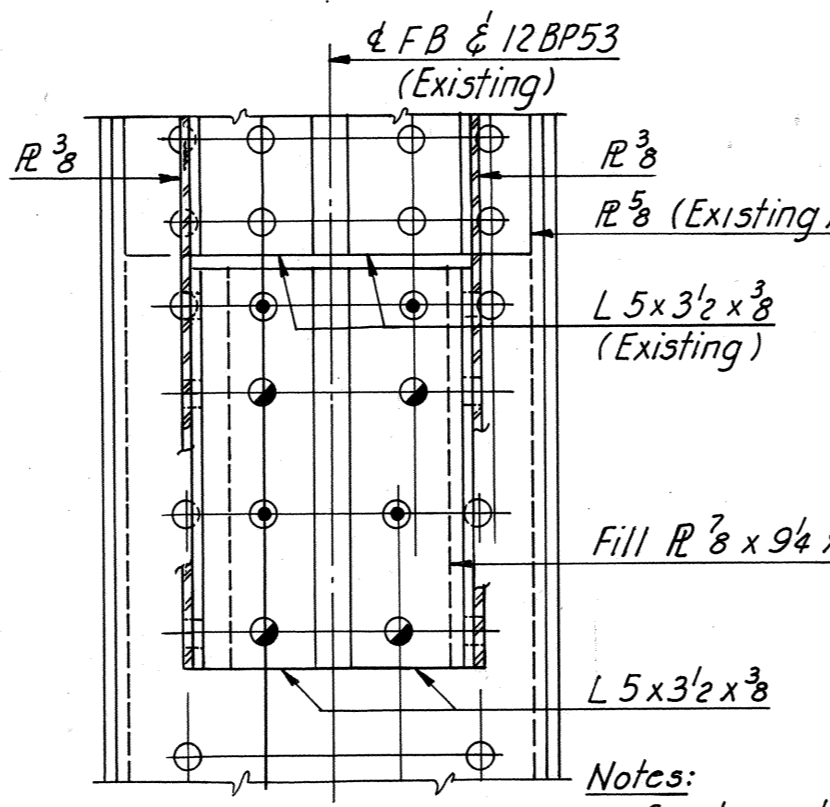


SECTION M-M
Scale: 1/2" = 1'-0"


Notes:
See Legend, Sheet 41.
Indicates RAF for 1" H.S. Bolts.
Indicates DAF for 1" H.S. Bolts.

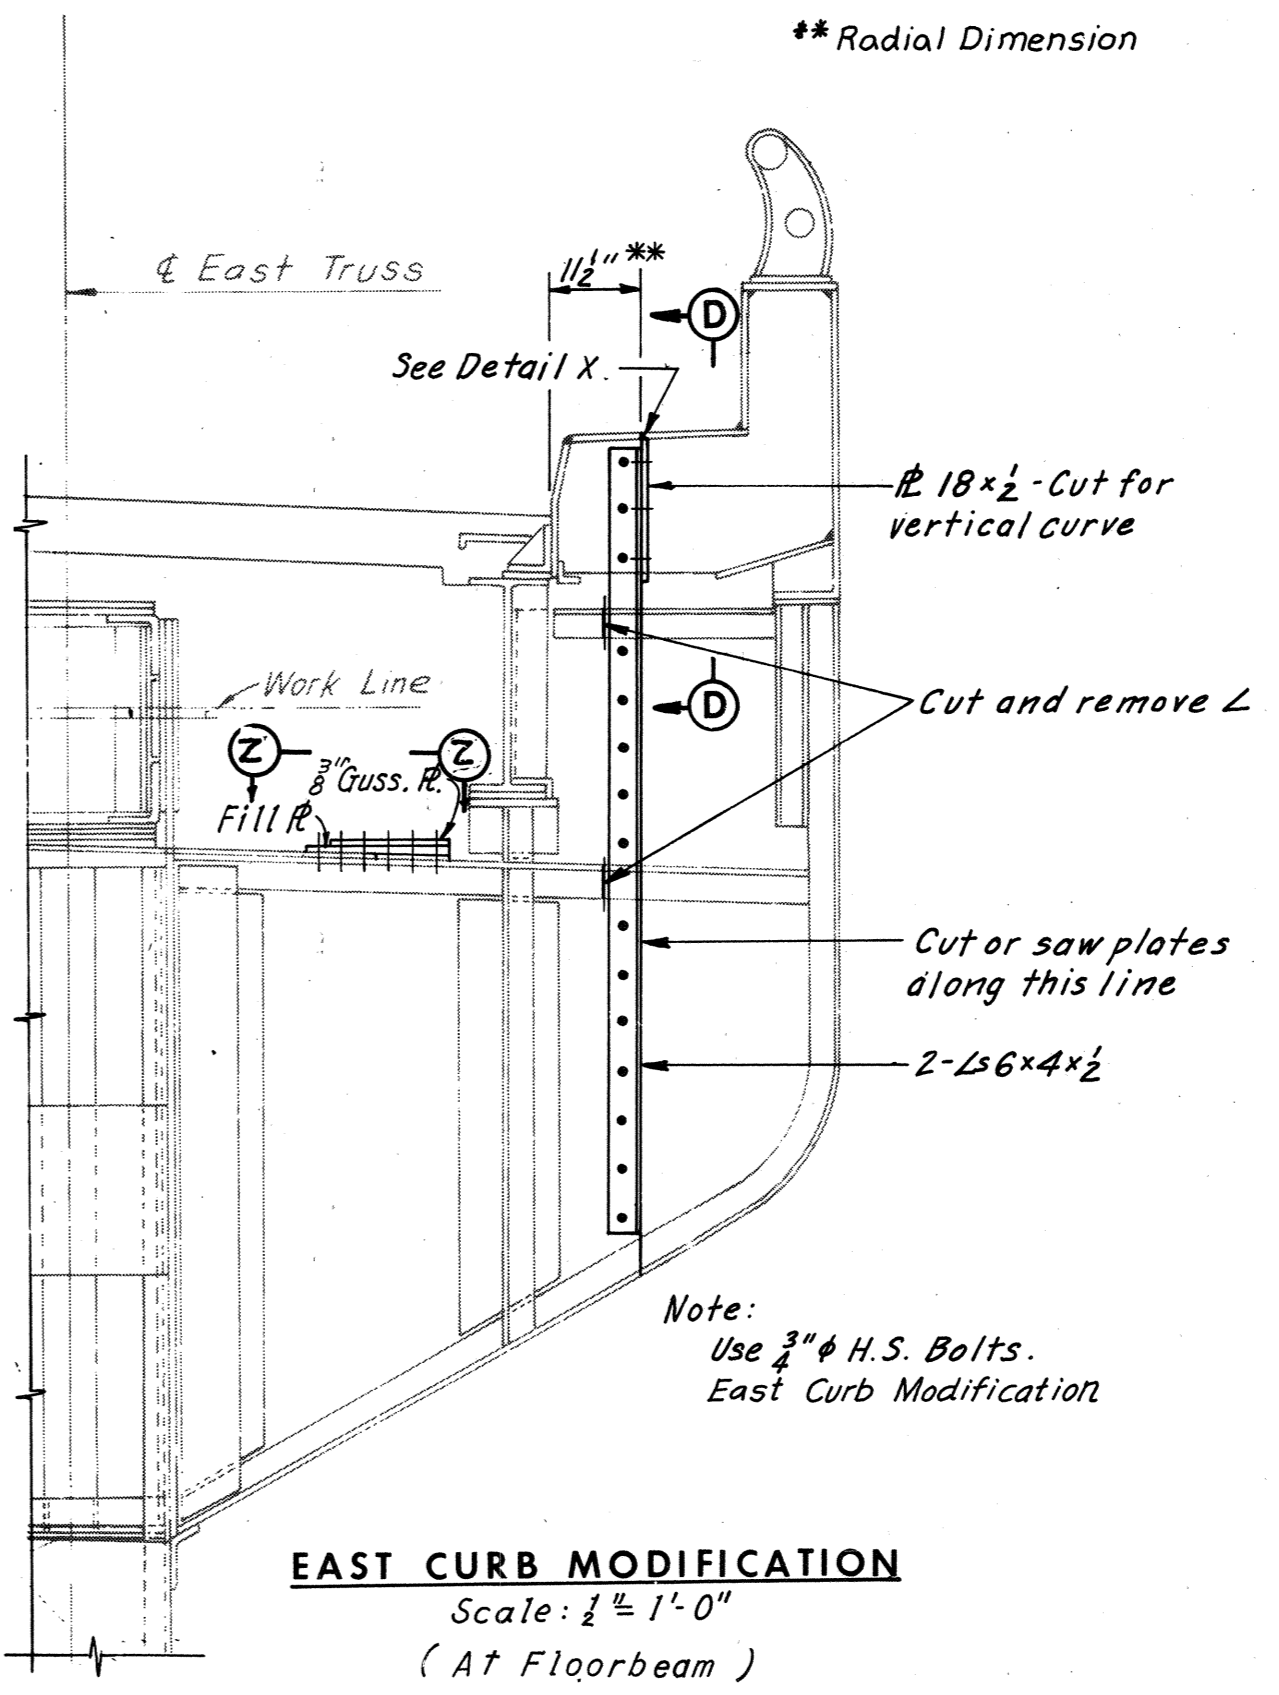

EAST CURB MODIFICATION
Scale: 1/2" = 1'-0"
(At Floorbeam)

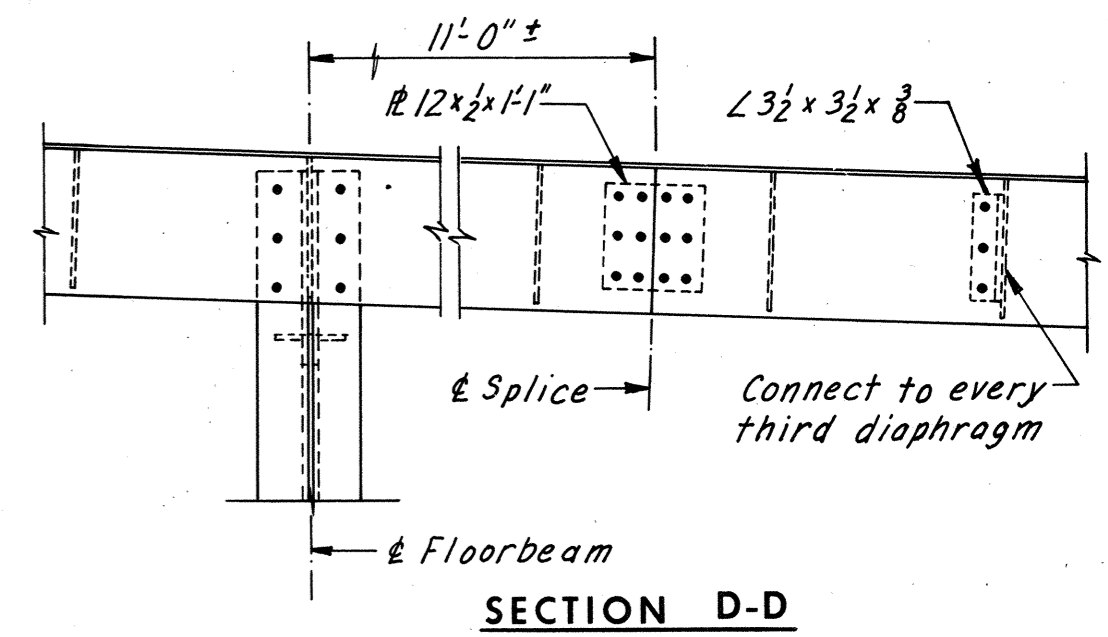


SECTION D-D

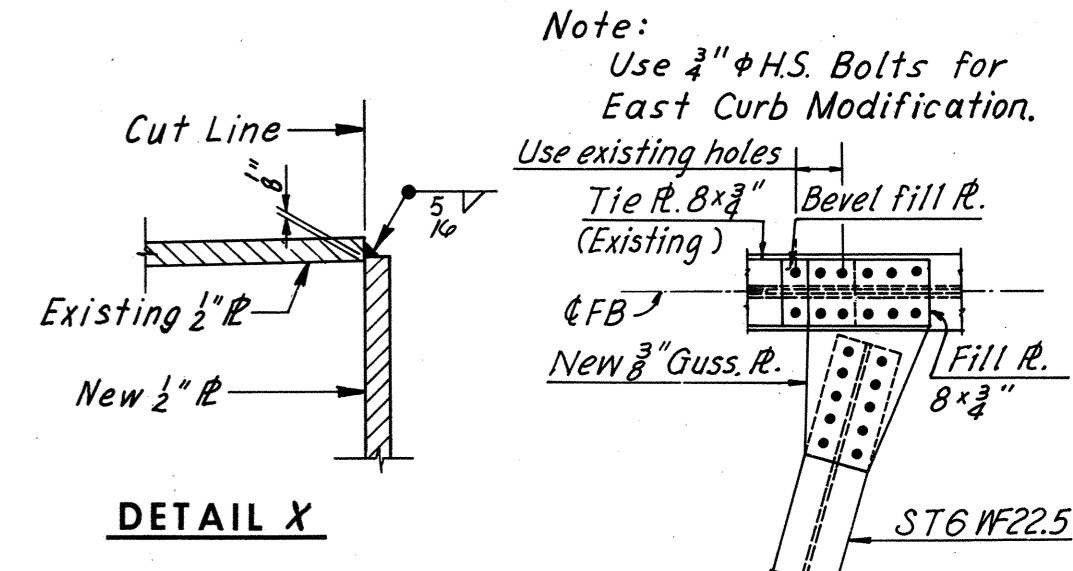


DETAIL X


VIEW Z-Z
Scale: 1/2" = 1'-0"

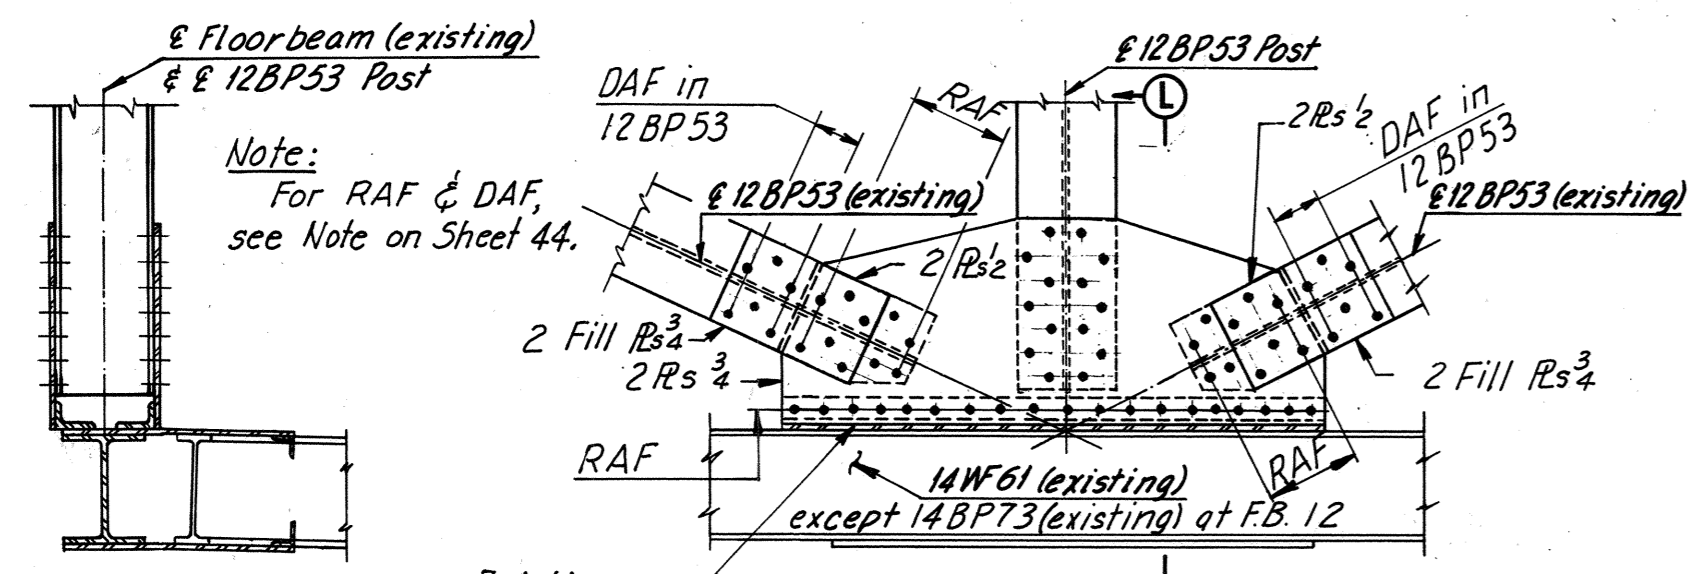


SECTION L-L
Scale: 1/2" = 1'-0"

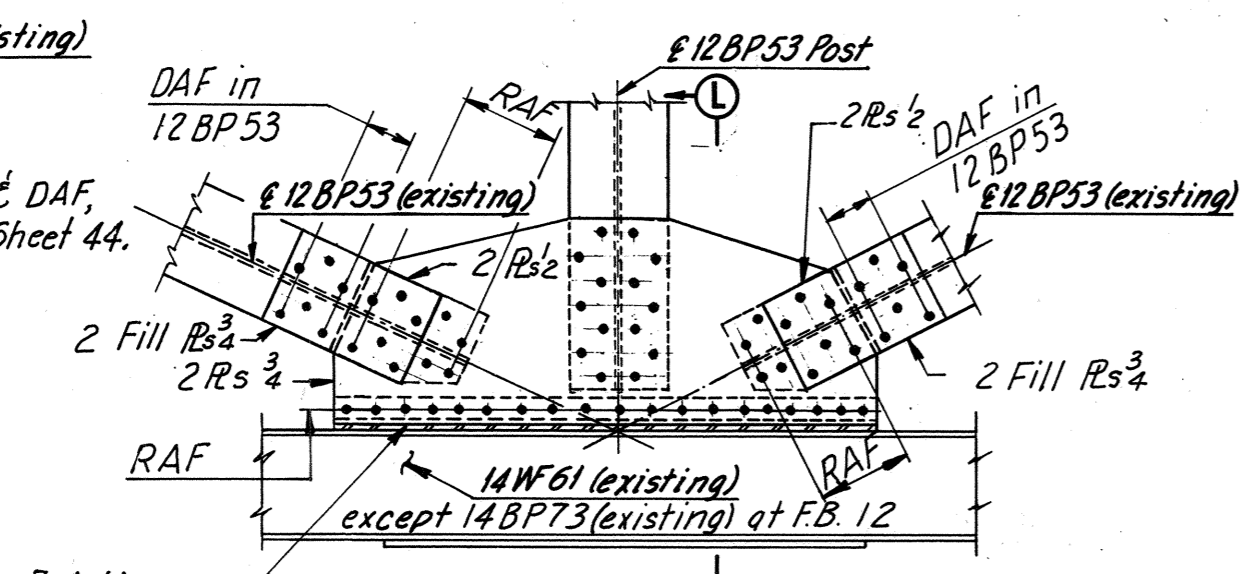

DETAIL C
Scale: 1/2" = 1'-0"

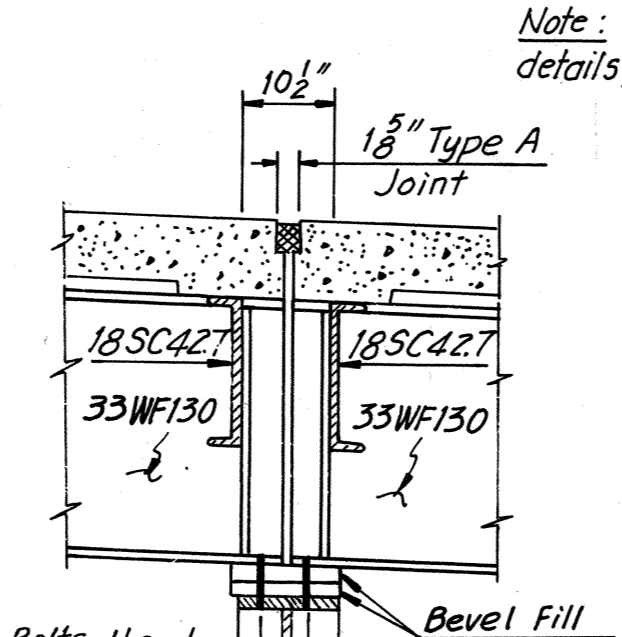

SECTION E-E
Scale: 1/2" = 1'-0"

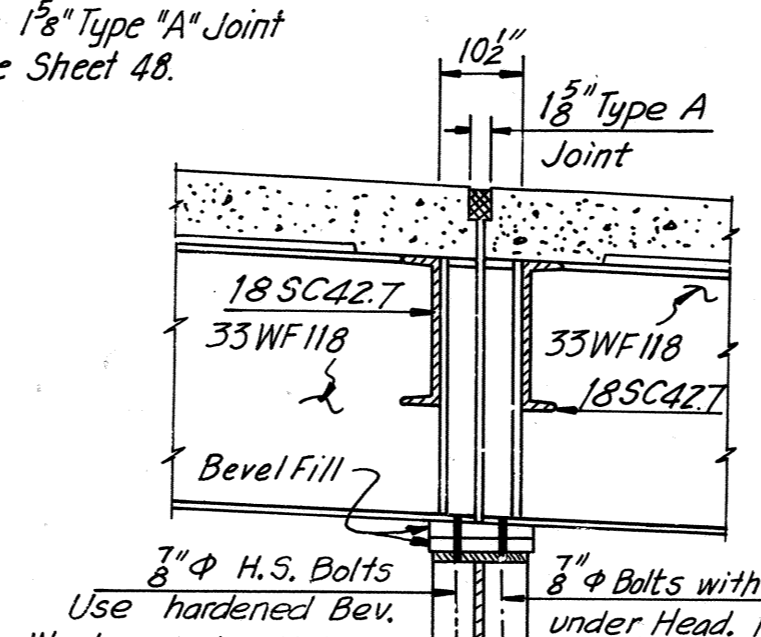


SECTION F-F
Scale: 1/2" = 1'-0"


Note: For 1 1/8" Type "A" Joint details, see Sheet 48.

7/8" H.S. Bolts
Use hardened Bev. Washer under Nut and apply Torque to Nut. Std round hardened Washer under Head.


7/8" Bolts with Head up, Std. Washer under Head. Hand tighten Nut and nick thread. 15" Hole in F.B. and Bevel Fills on F.B. 15" x 1 1/8" Slotted Holes in Stringer Flange only.

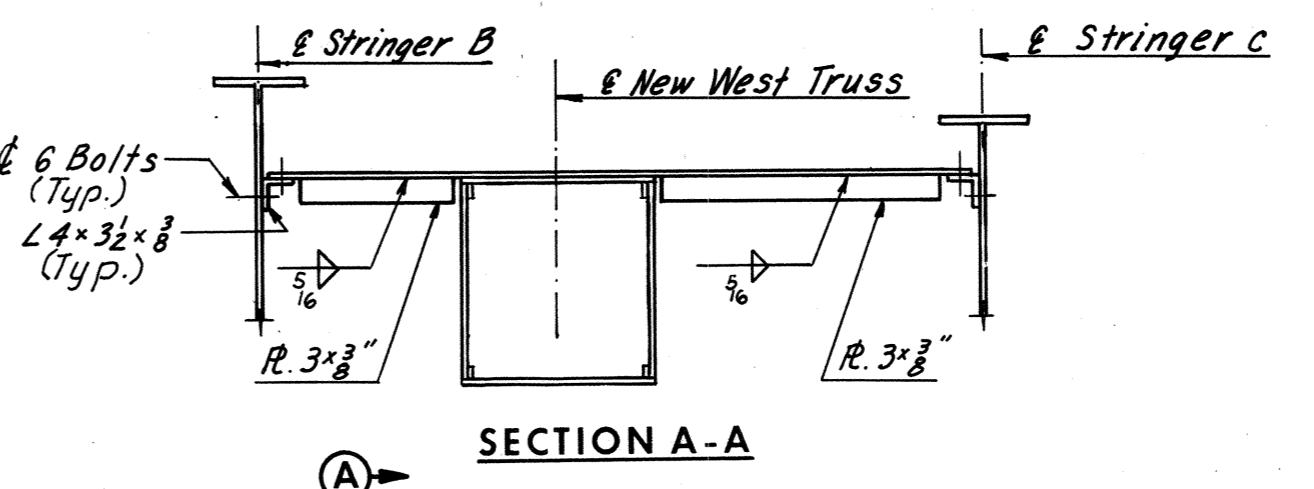

SECTION A-A

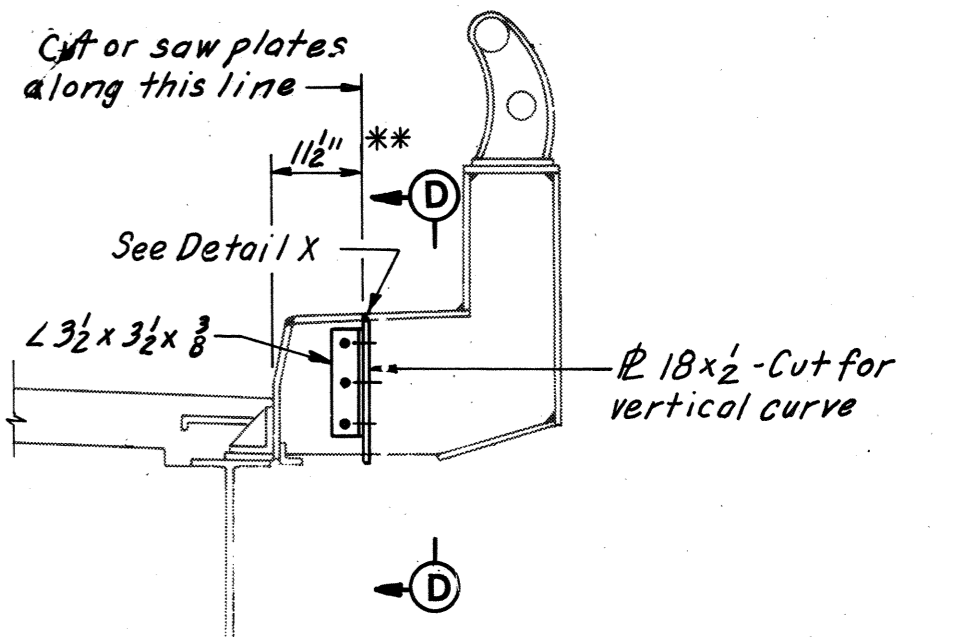


EAST CURB MODIFICATION
Scale: 1/2" = 1'-0"
(At Diaphragm)

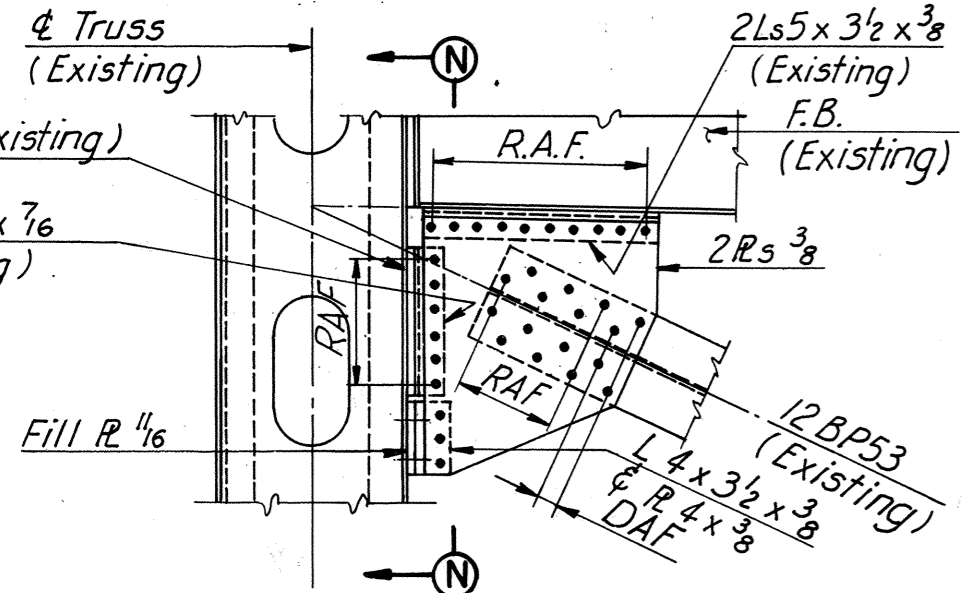


DETAIL D
AT FB2W
Scale: 1/2" = 1'-0"


Notes:
See Legend, Sheet 41.
Indicates RAF for 1" H.S. Bolts.
Indicates DAF for 1" H.S. Bolts.

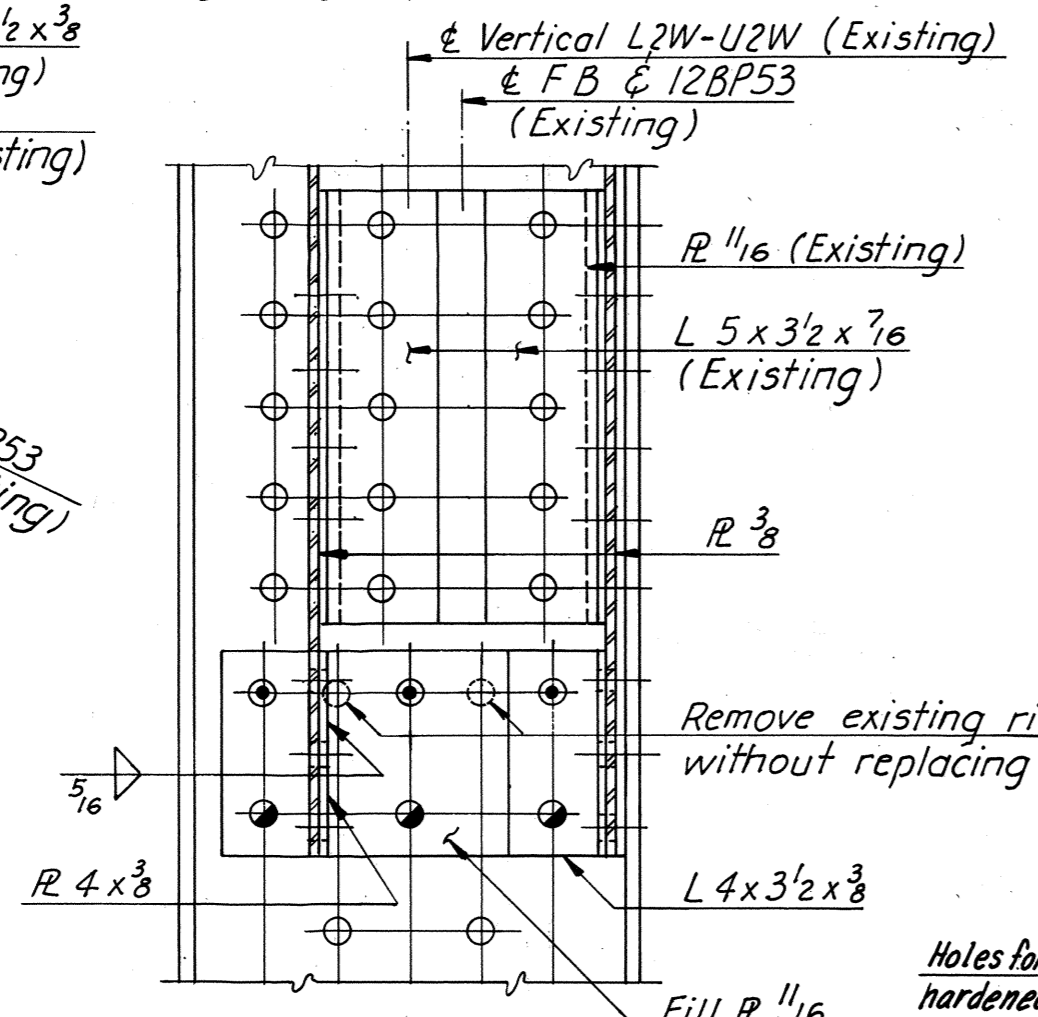


SECTION N-N
Scale: 1/2" = 1'-0"

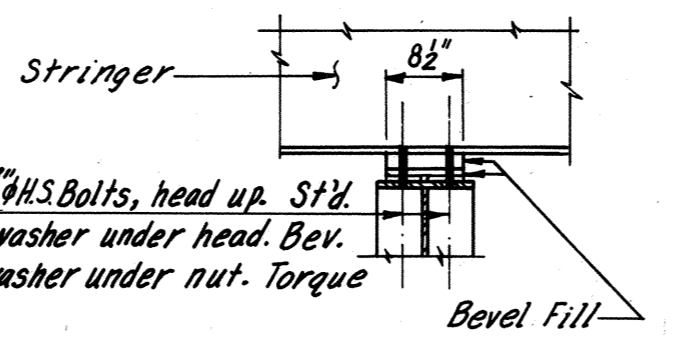

SECTION H-H
Scale: 1/2" = 1'-0"

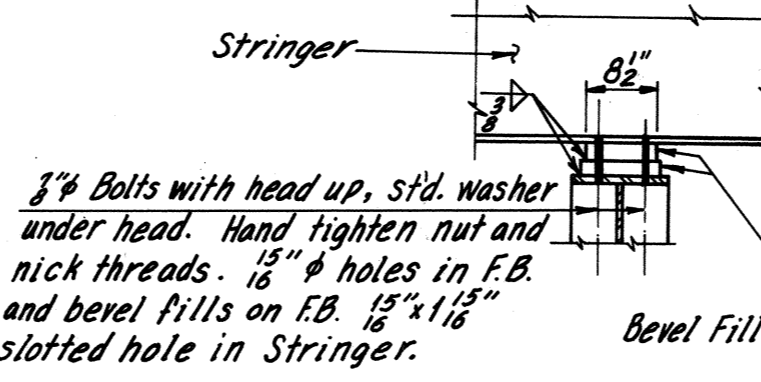

SECTION I-I
Scale: 1/2" = 1'-0"

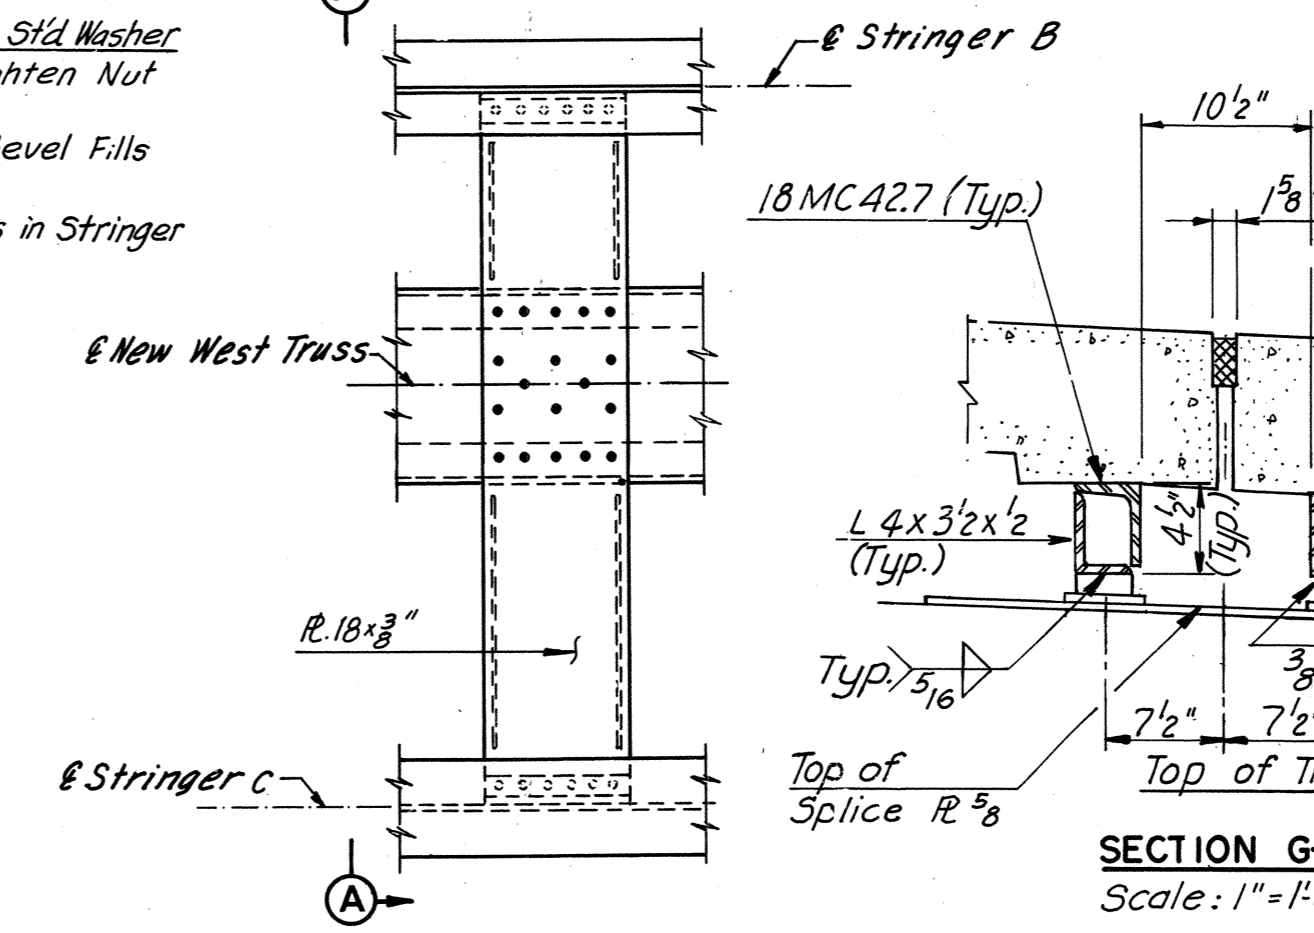

SECTION G-G
Scale: 1" = 1'-0"

(For location of Section G-G see Sheet 43.)

DETAIL A

(For location of Detail A see sheet 37.)

DESIGNED	DRAWN	CHECKED	IN CHARGE	NO.	REVISION	BY	DATE

NO.	REVISION	BY	DATE
1	Details B, C & D & Sections J-J, L-L, M-M & N-N added	A.B.P.	3-5-75
2	Post & 1 1/8" Joint Det deleted	L.B.P.	2-7-75
3	Detail A & Section A-A revised	A.B.P.	2-7-75

RICHMOND METROPOLITAN AUTHORITY
RICHMOND EXPRESSWAY SYSTEM
DOWNTOWN EXPRESSWAY

BRIDGE NO. 67
RAMP W-N CONNECTION TO
RICHMOND-PETERSBURG TURNPIKE
MISCELLANEOUS DETAILS

SCALE As Noted
DATE


HOWARD, NEEDLES, TAMMEN & BERGENDOFF
CONSULTING ENGINEERS
Alexandria, Virginia

HNTB


SHEET 44 OF 54

AS BUILT


RICHMOND EXPRESSWAY SYSTEM			
SECTION	PROJECT	SHEET NO.	TOTAL SHEETS
10	DOWNTOWN EXPRESSWAY	217	265

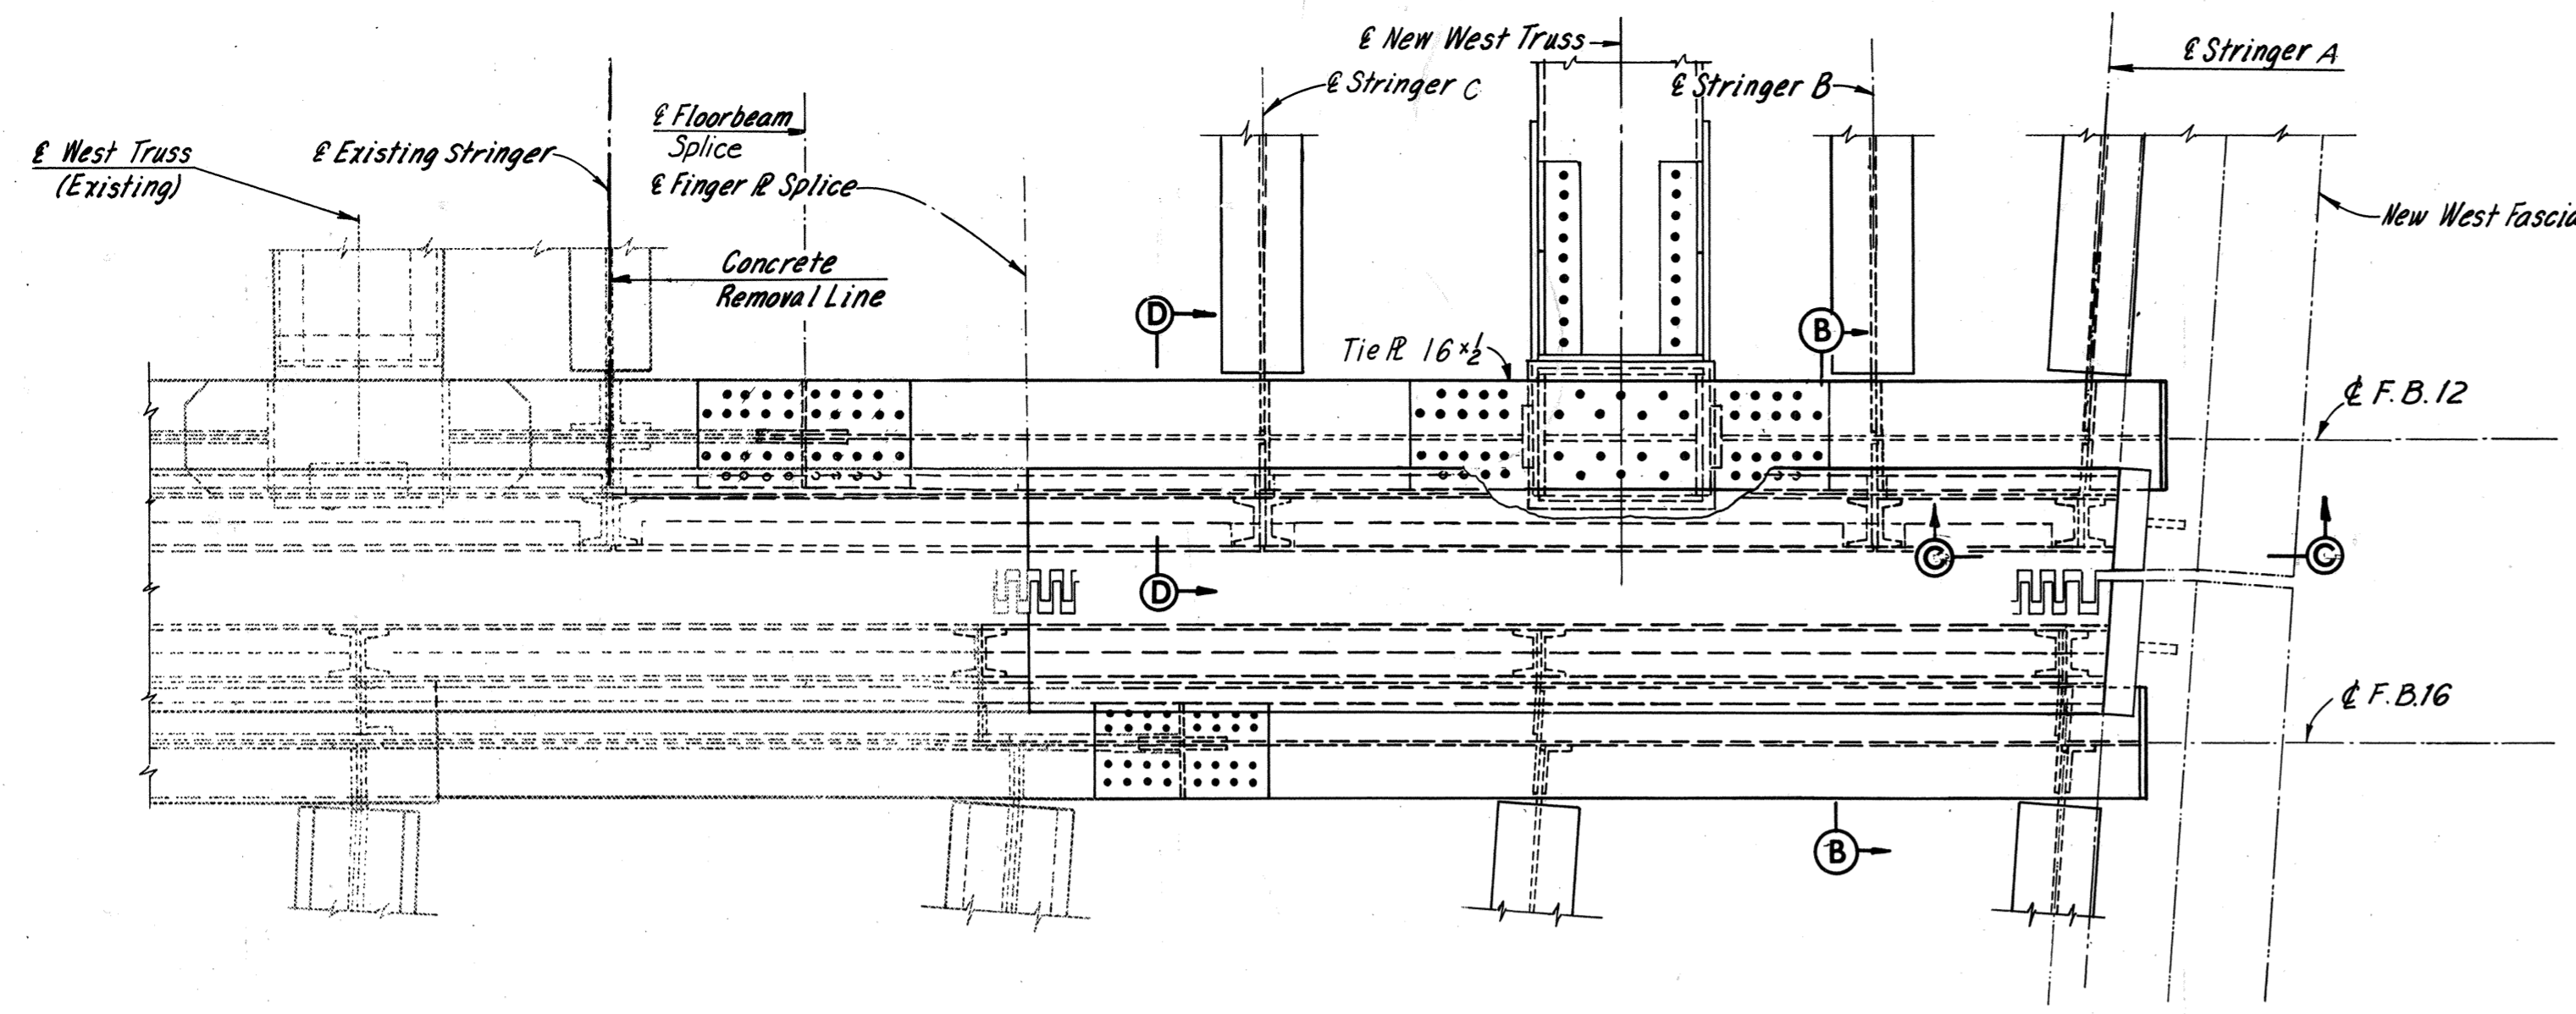

PLAN
Scale: 1/2" = 1'-0"

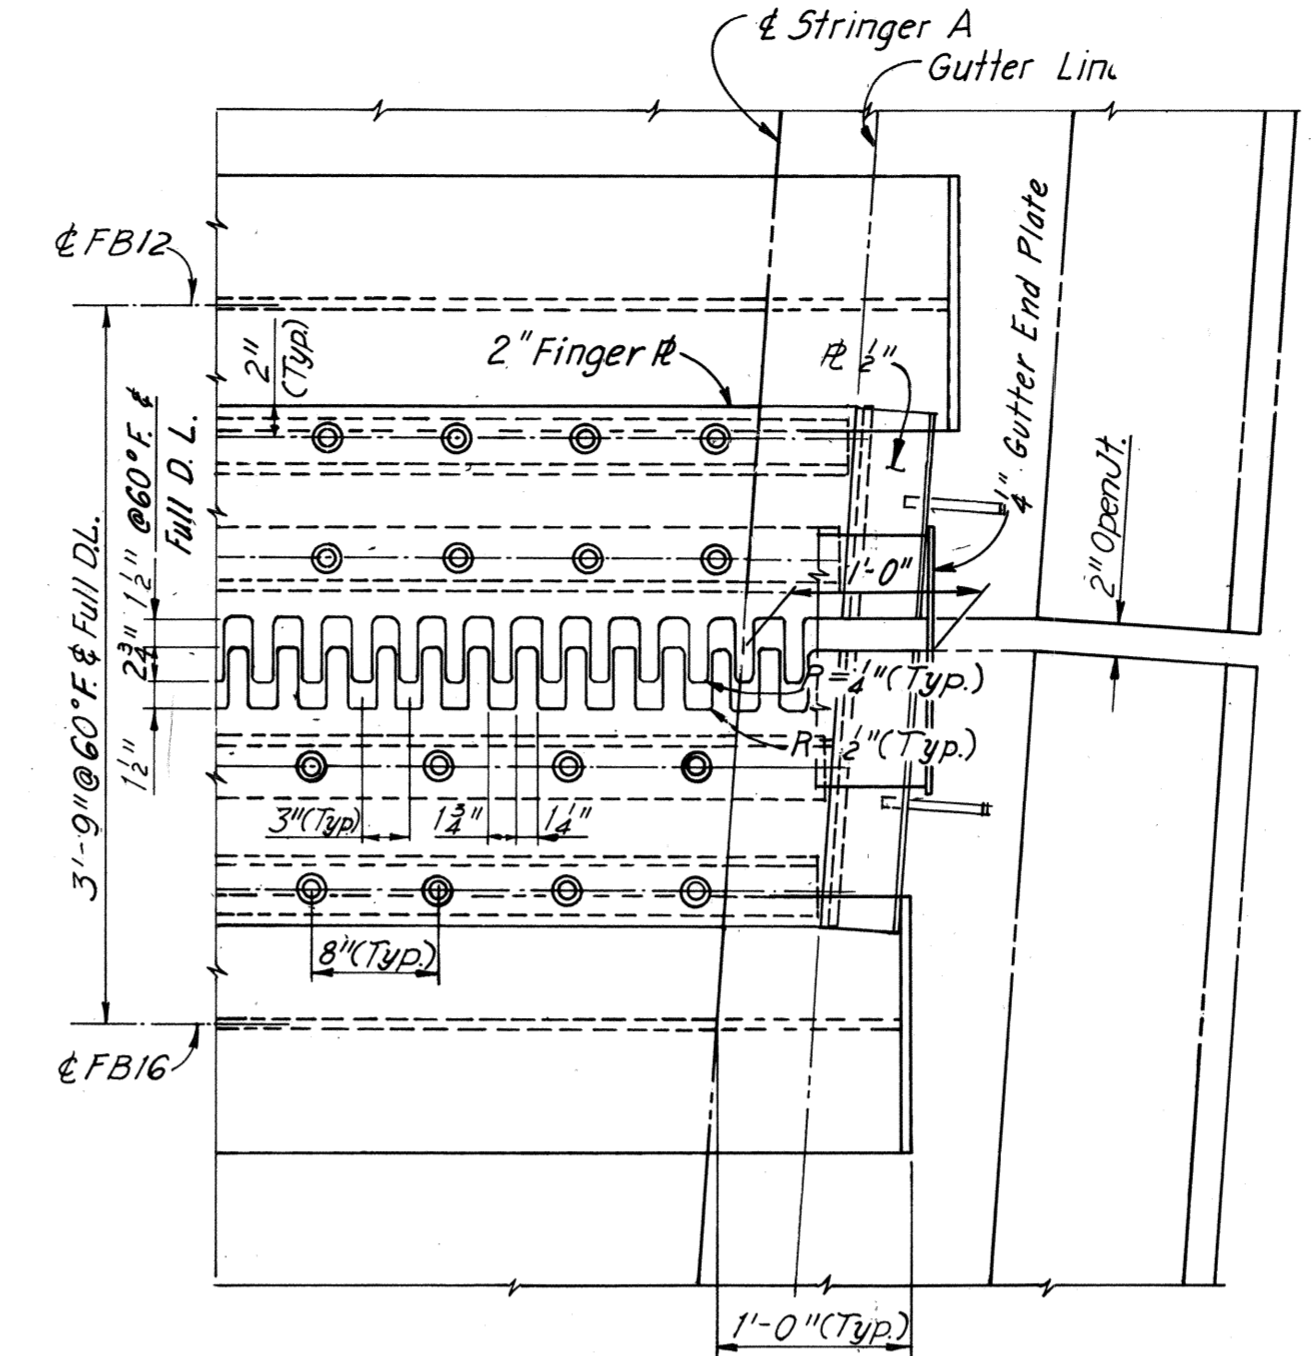


PART PLAN OF EXPANSION DEVICE
Scale: 1" = 1'-0"

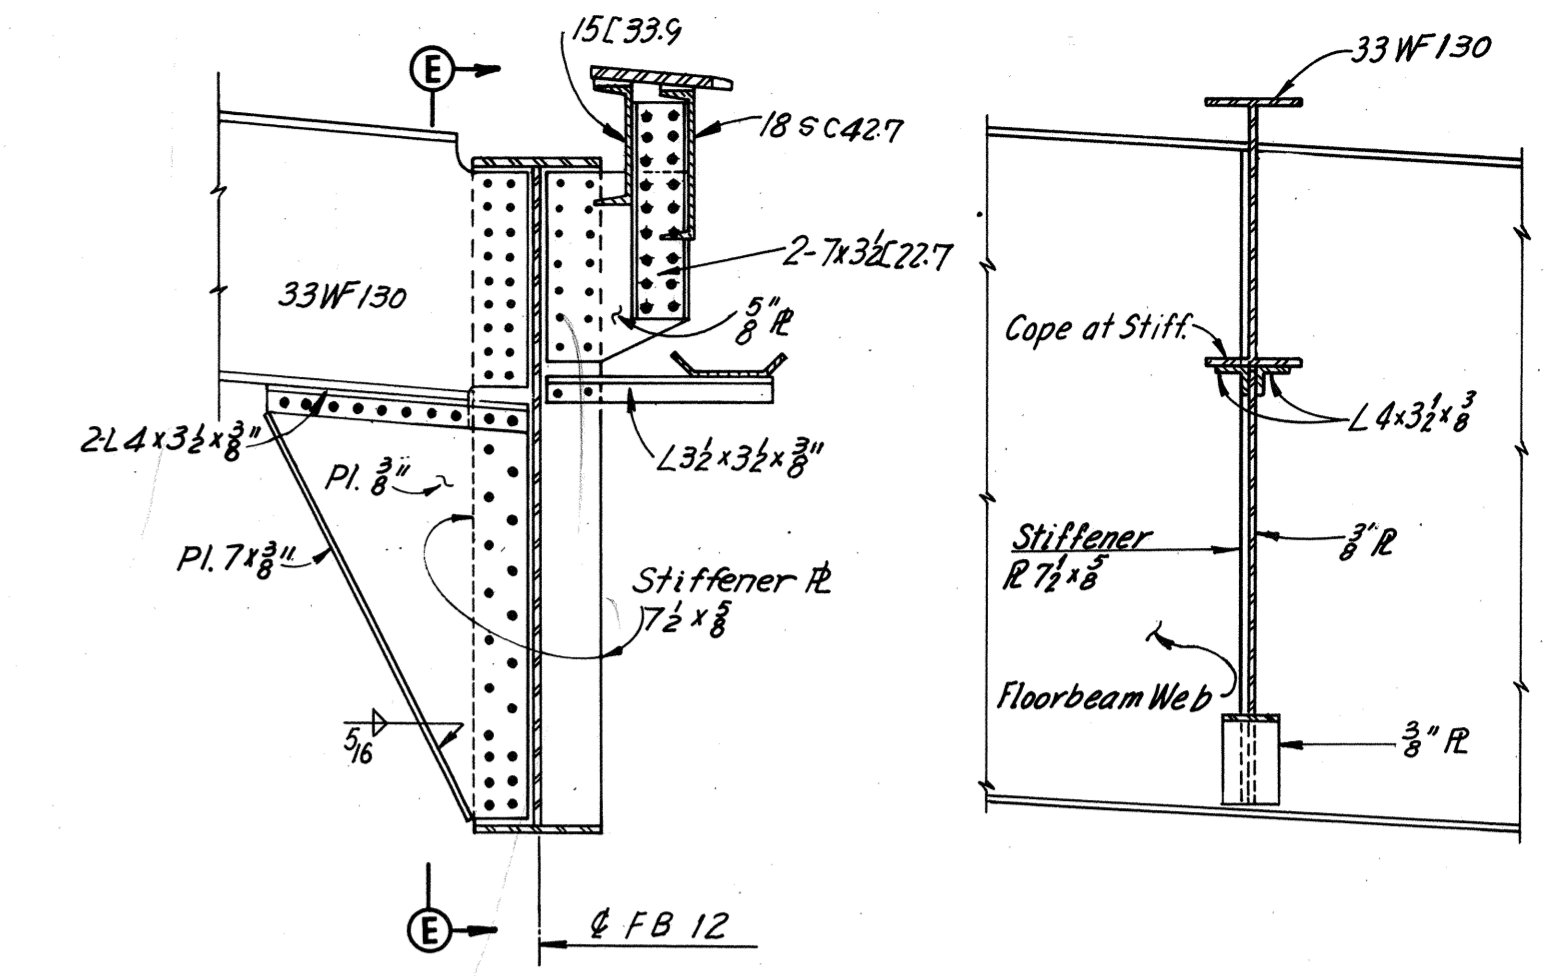


SECTION D-D
Scale: 1/2" = 1'-0"

SECTION E-E
Scale: 1/2" = 1'-0"

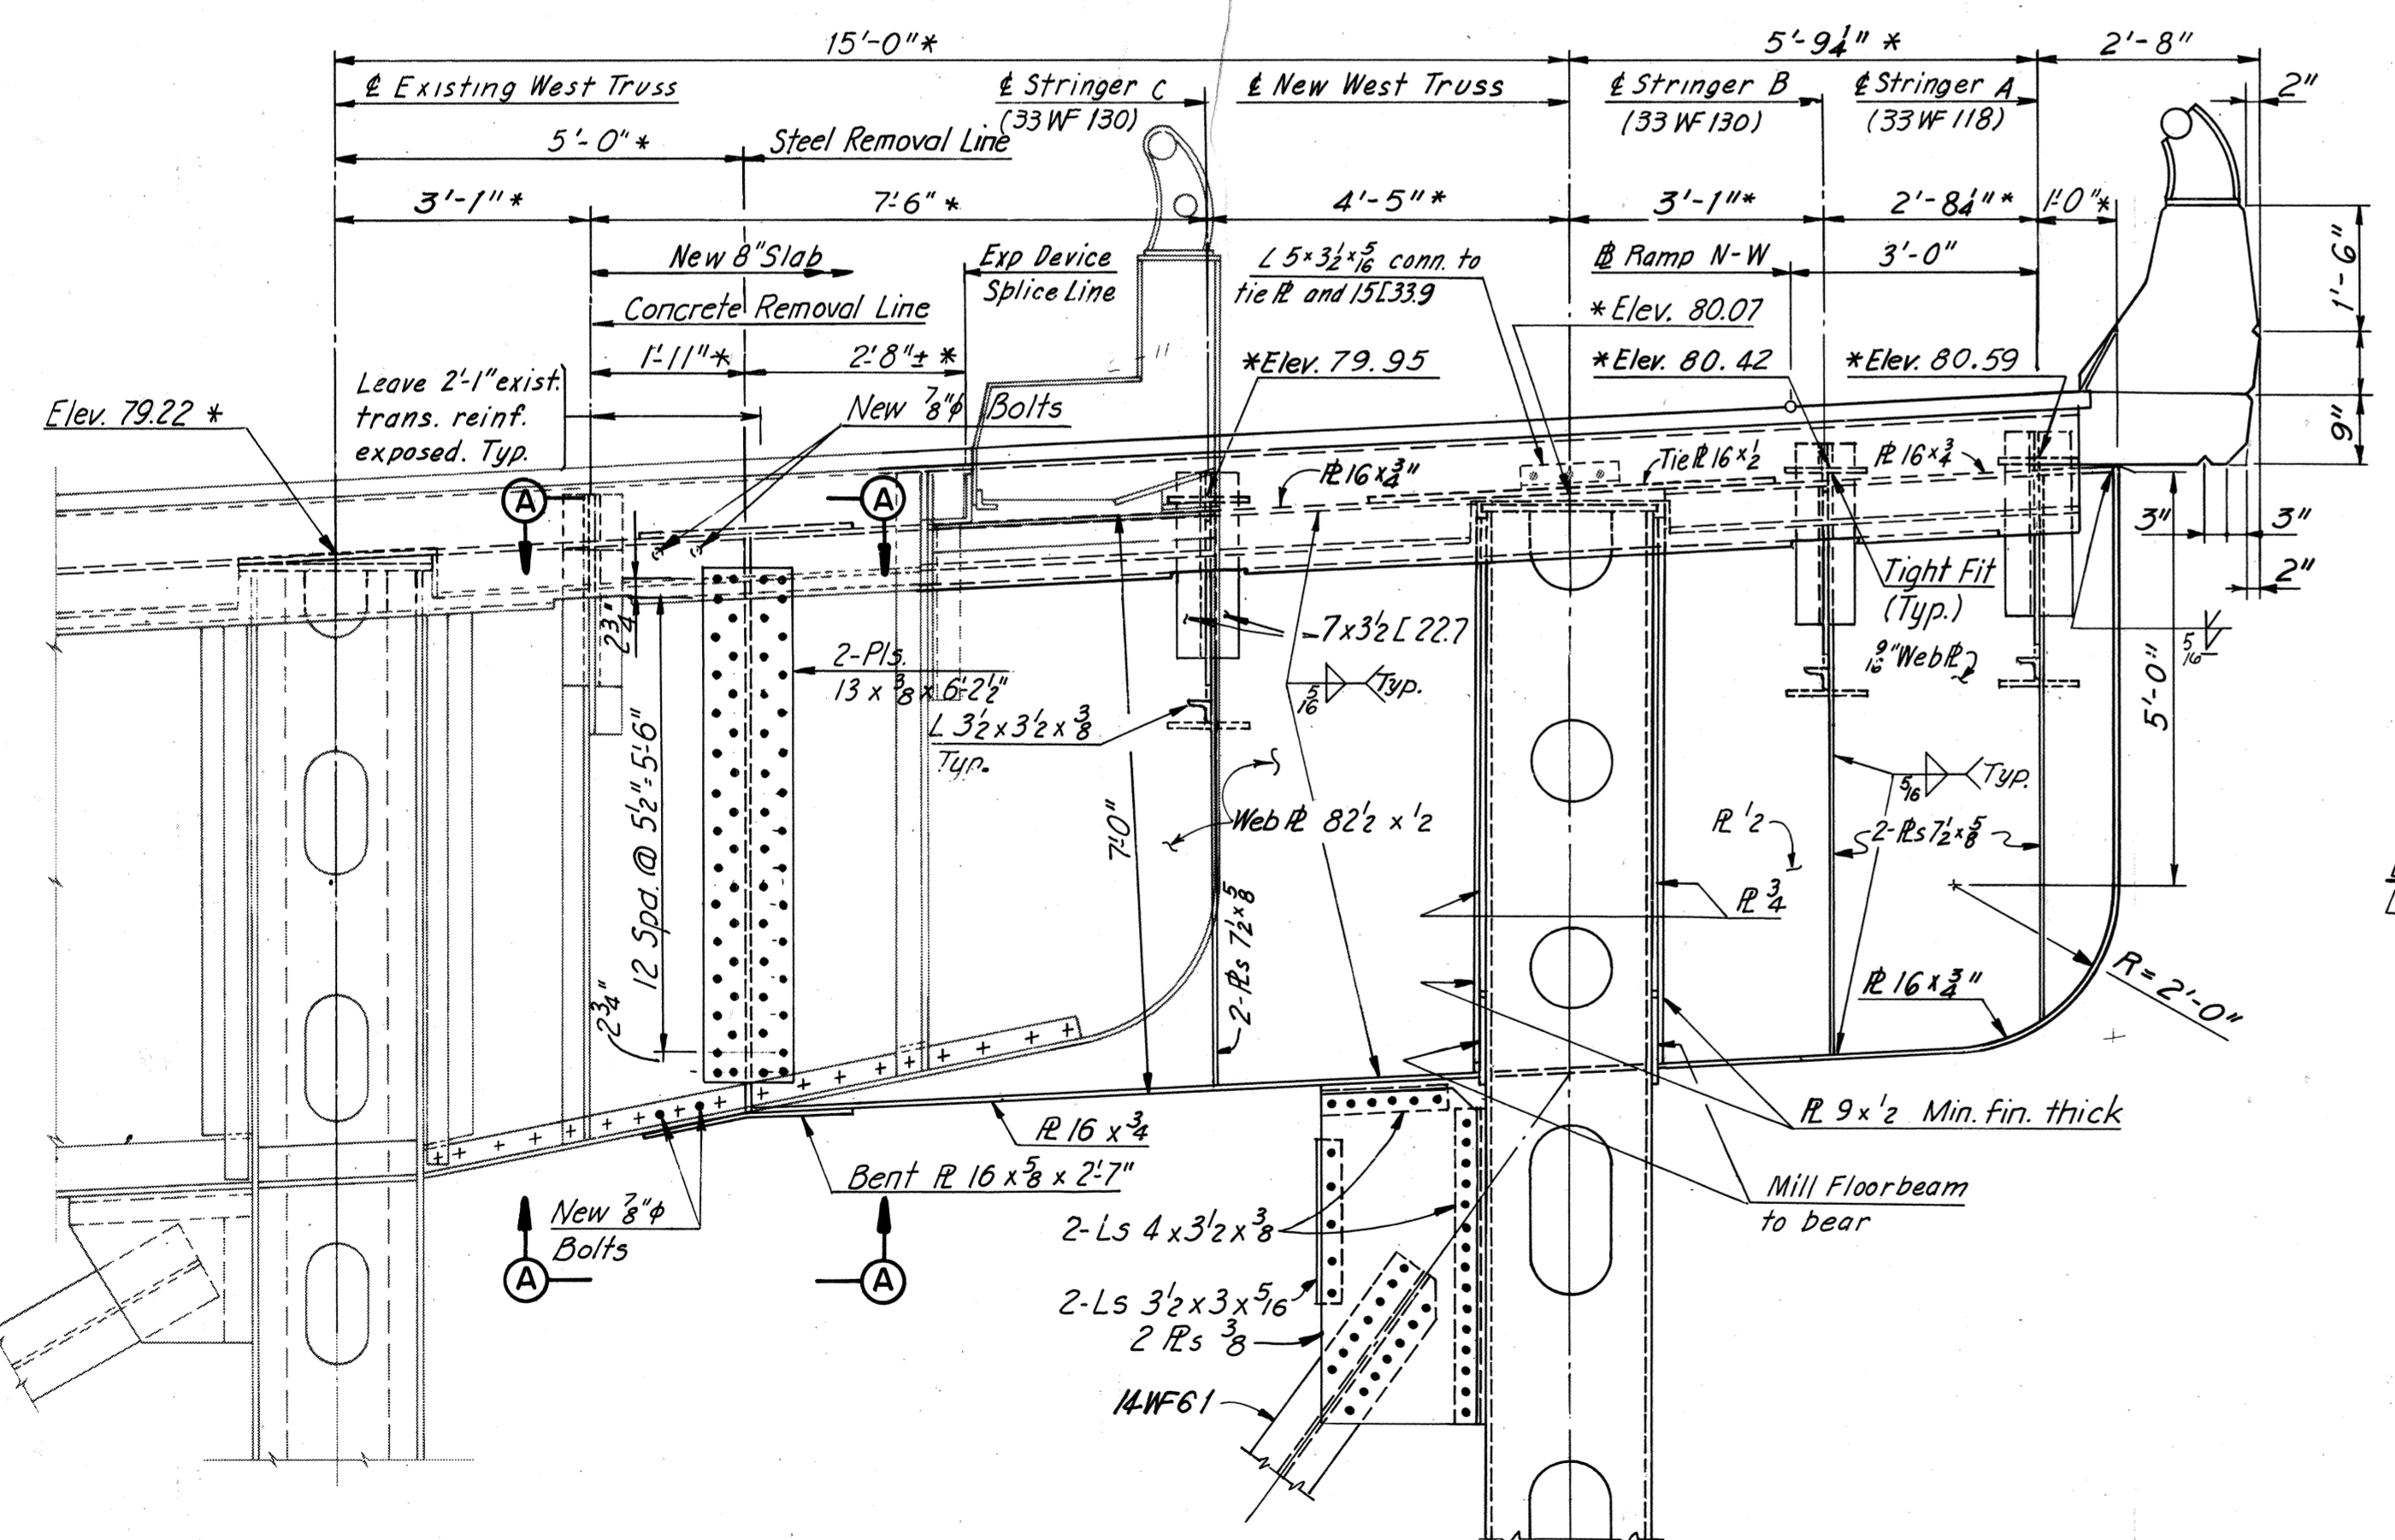


SECTION A-A - FLOORBEAM 12
Scale: 1/2" = 1'-0"

LEGEND:
* Indicates Elevations of top of stringers and top of floorbeam extended at & Truss are taken at & Floorbeam 12.
or • Indicates new 8" H.S. Bolts. For connection to New West Truss, see Sh. 41.

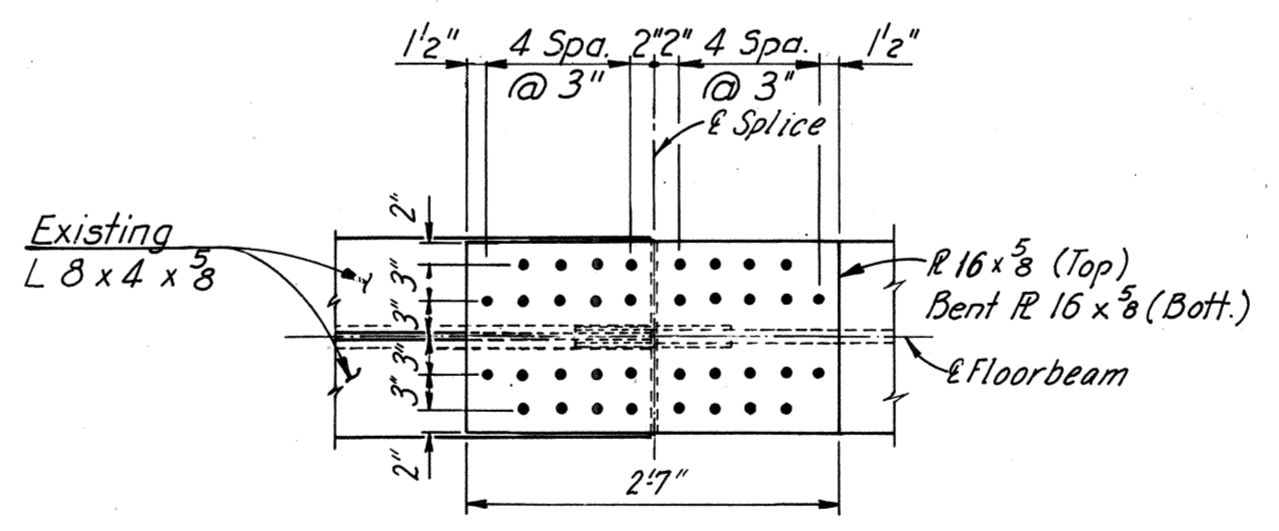

SECTION A-A
Scale: 1/2" = 1'-0"

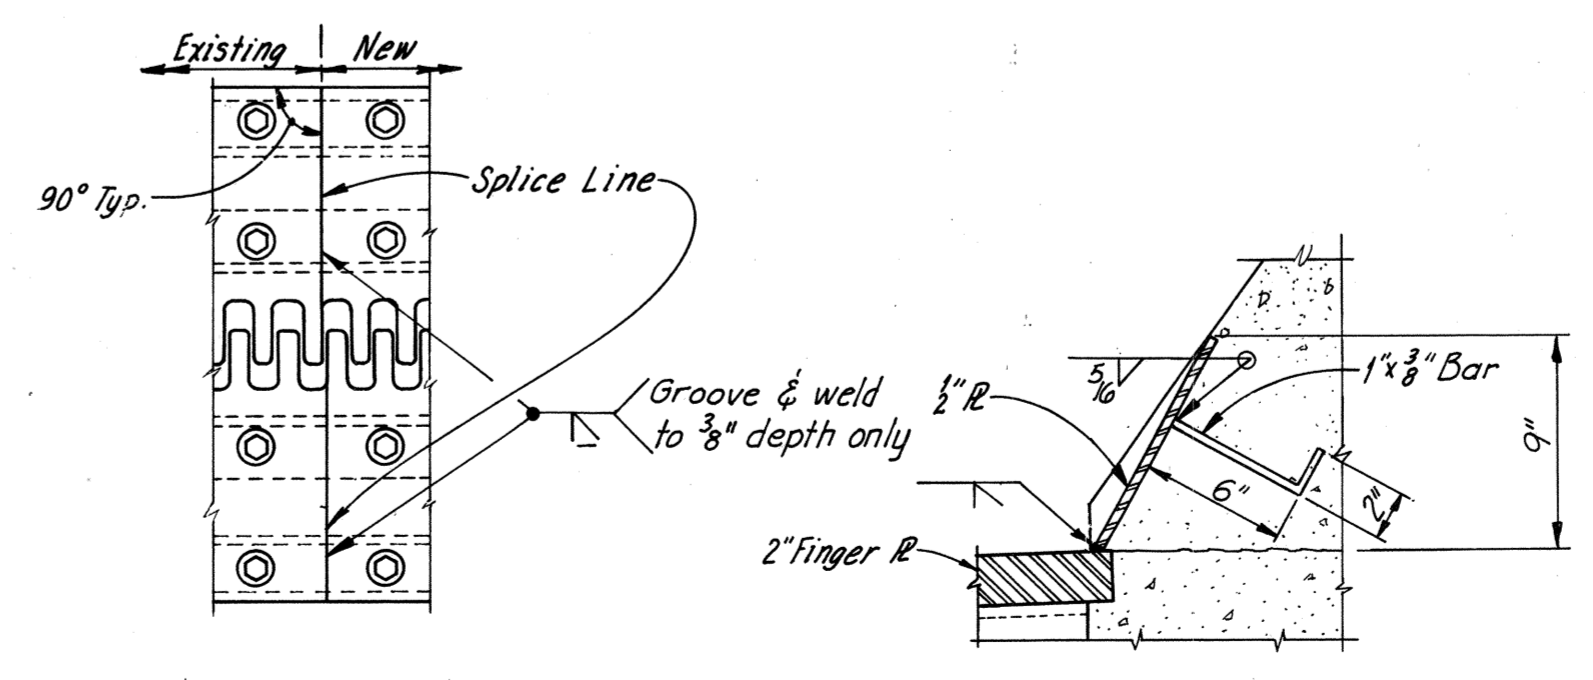

SECTION B-B
Scale: 1" = 1'-0"

SECTION C-C
Scale: 1 1/2" = 1'-0"

EXPANSION DEVICE SPLICE DETAIL
Scale: 1" = 1'-0"
Note: Cut existing finger plate as close to the existing gutter line as possible. New plate shall be provided long & cut to exact length after exist. plate is cut.

Note: Cut existing gutter on the west side of the existing stringer and set the new gutter into the existing gutter. Bolt the two together with existing bolts. Provide an 8" lap.

BY	DATE	REVISION	BY	DATE
MADE	A.B.P. 1-75	2 As Built	TEM	G-77
CHECKED		New sheet added	A.B.P.	2-75
IN CHARGE				

RICHMOND METROPOLITAN AUTHORITY
RICHMOND EXPRESSWAY SYSTEM
DOWNTOWN EXPRESSWAY



BRIDGE NO. 67
RAMP W-N CONNECTION TO
RICHMOND-PETERSBURG TURNPIKE
FLOORBEAM 12 AND JOINT DETAILS

HOWARD, NEEDLES, TAMMEN & BERGENDOFF
consulting engineers
NEW YORK ALEXANDRIA KANSAS CITY

SCALE: As Noted
CONTRACT NO. 10
SHEET NO. 45 OF 54

AS BUILT

RICHMOND EXPRESSWAY SYSTEM			
SECTION	PROJECT	SHEET NO.	TOTAL SHEETS
10	DOWNTOWN EXPRESSWAY	218	265

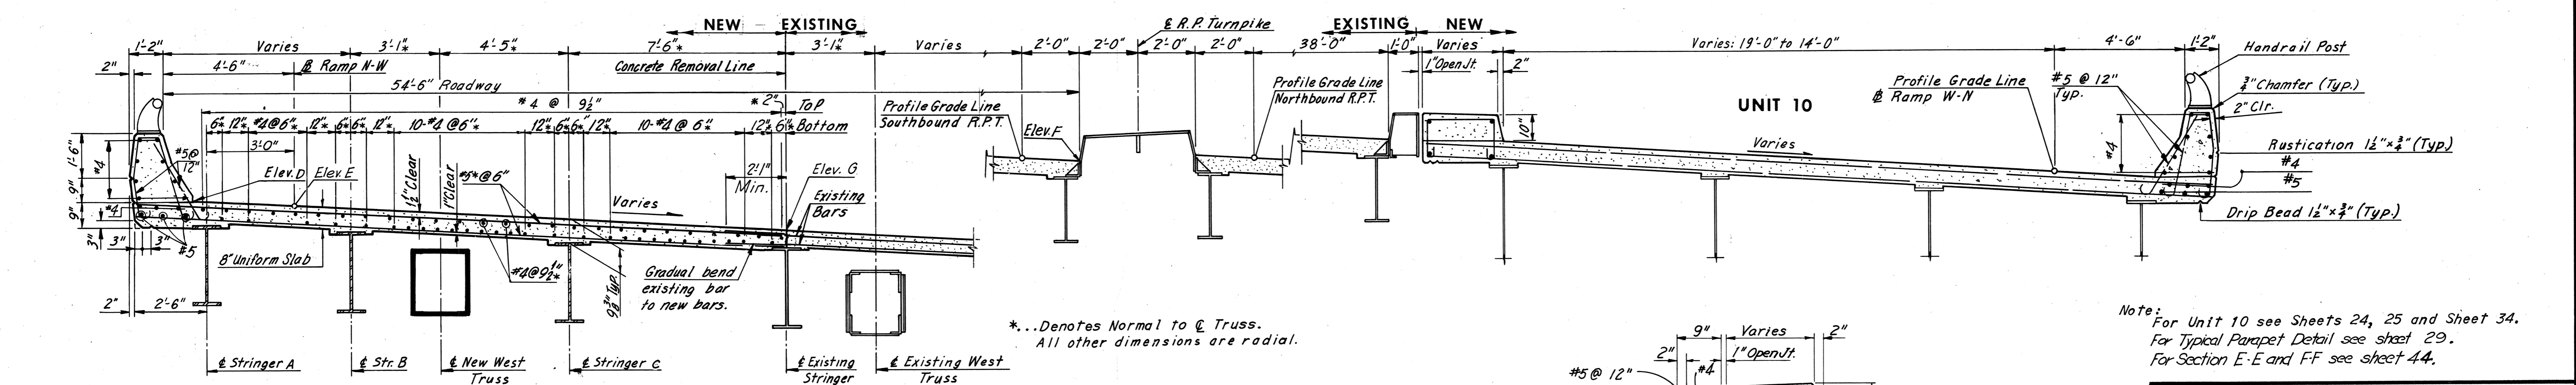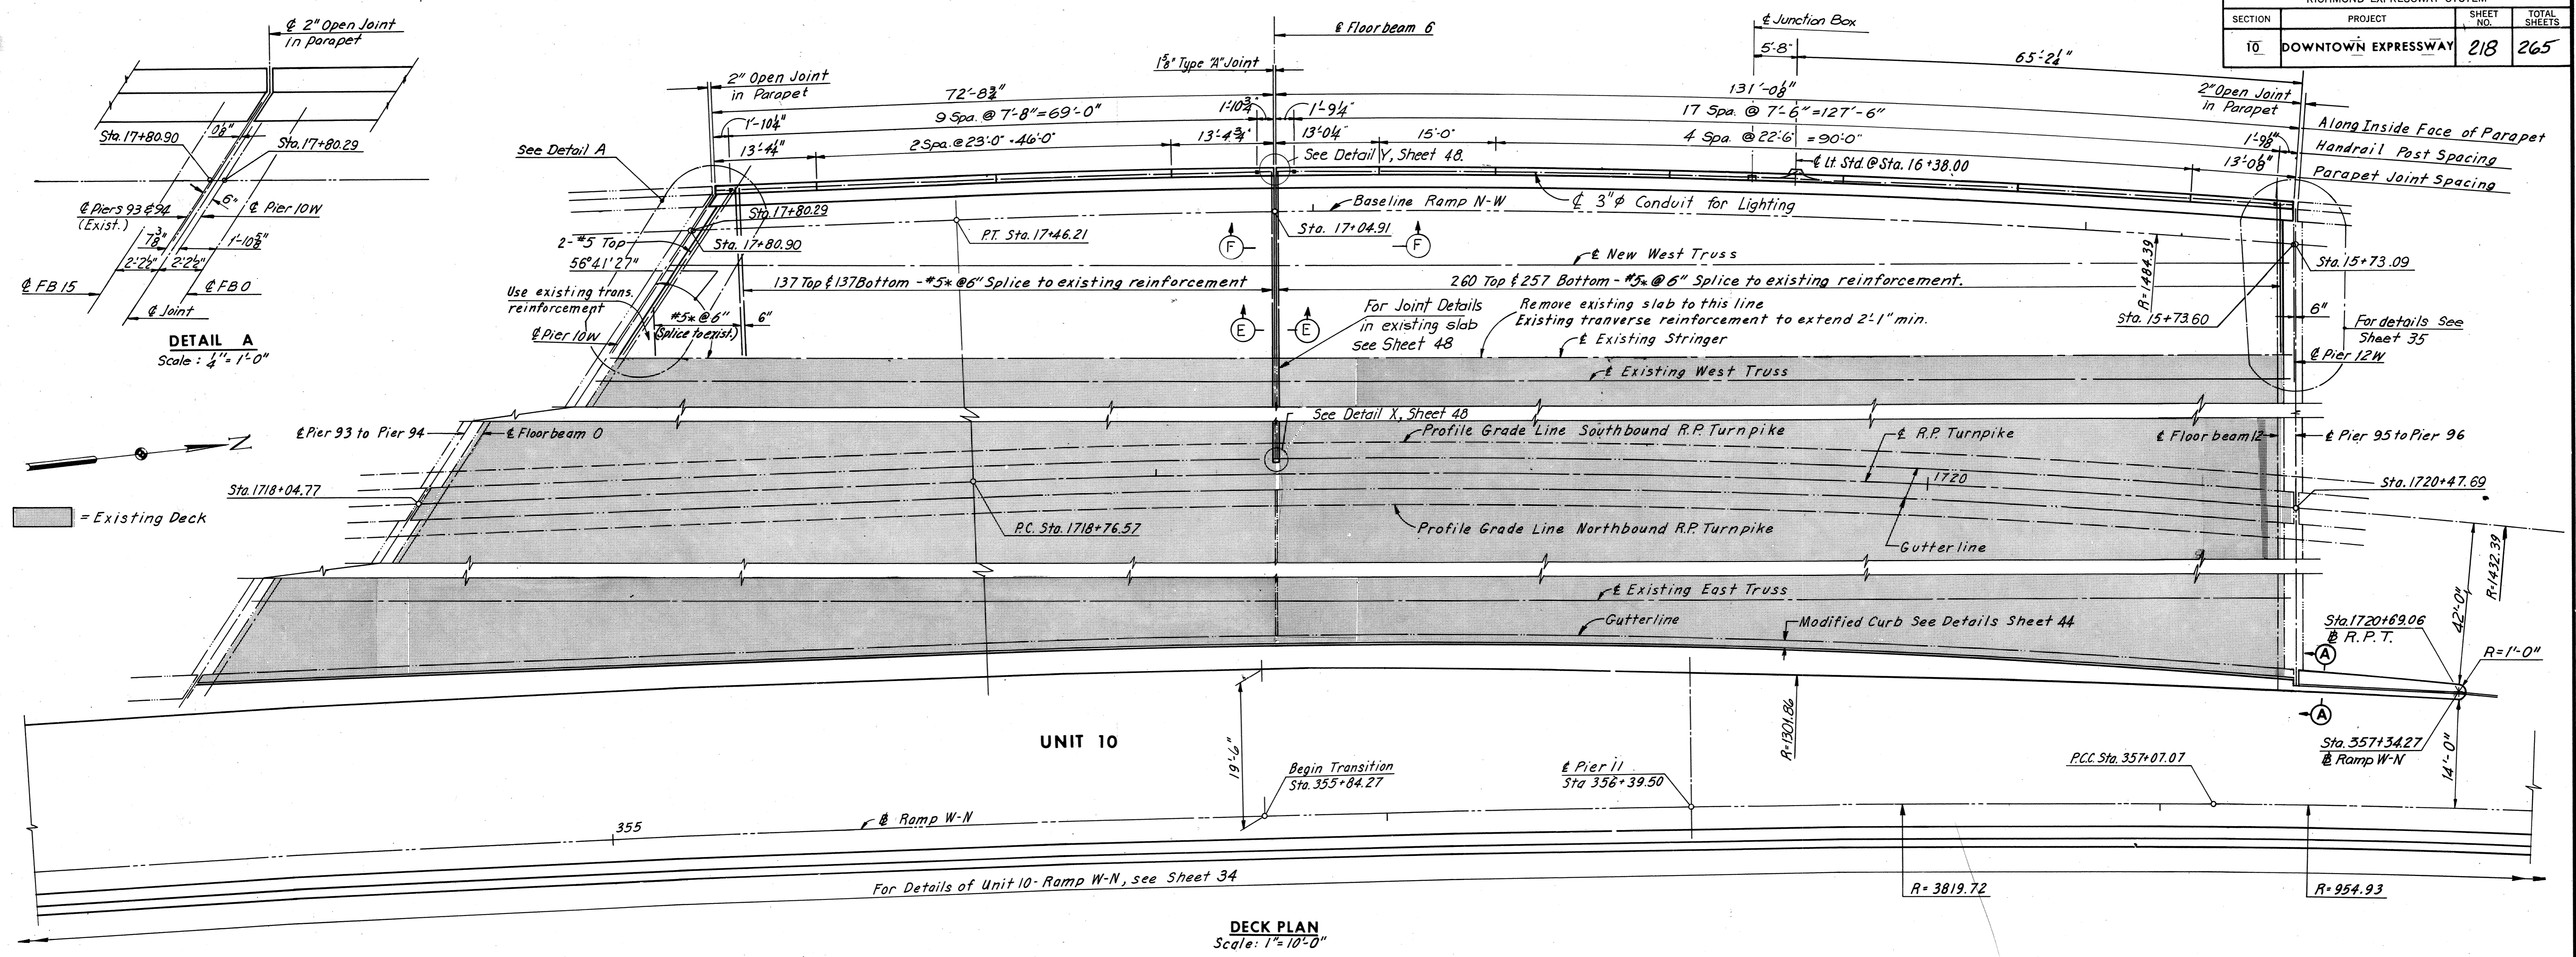

Note: For Elev. D, Elev. E, Elev. F and Elev. G see Sheet 47.

Note: For Unit 10 see Sheets 24, 25 and Sheet 34. For Typical Parapet Detail see sheet 29. For Section E-E and F-F see sheet 44.


RICHMOND METROPOLITAN AUTHORITY
RICHMOND EXPRESSWAY SYSTEM
DOWNTOWN EXPRESSWAY

BRIDGE NO. 67
 RAMP W-N CONNECTION TO
 RICHMOND-PETERSBURG TURNPIKE
DECK PLAN - TRUSS SPAN


BY	DATE	3	As Built	TEM	G-77
MADE	A.M.H.	2-11-69	Joint details at P.B. & rev.	C.B.P.	2-25-75
CHECKED	K.C.T.	6-25-69	Stations, angle & conc. rem. line rev.	C.B.P.	2-7-75
IN CHARGE	NO.	REVISION	BY	DATE	

AS BUILT


RICHMOND EXPRESSWAY SYSTEM			
SECTION	PROJECT	SHEET NO.	TOTAL SHEETS
10	DOWNTOWN EXPRESSWAY	220	265

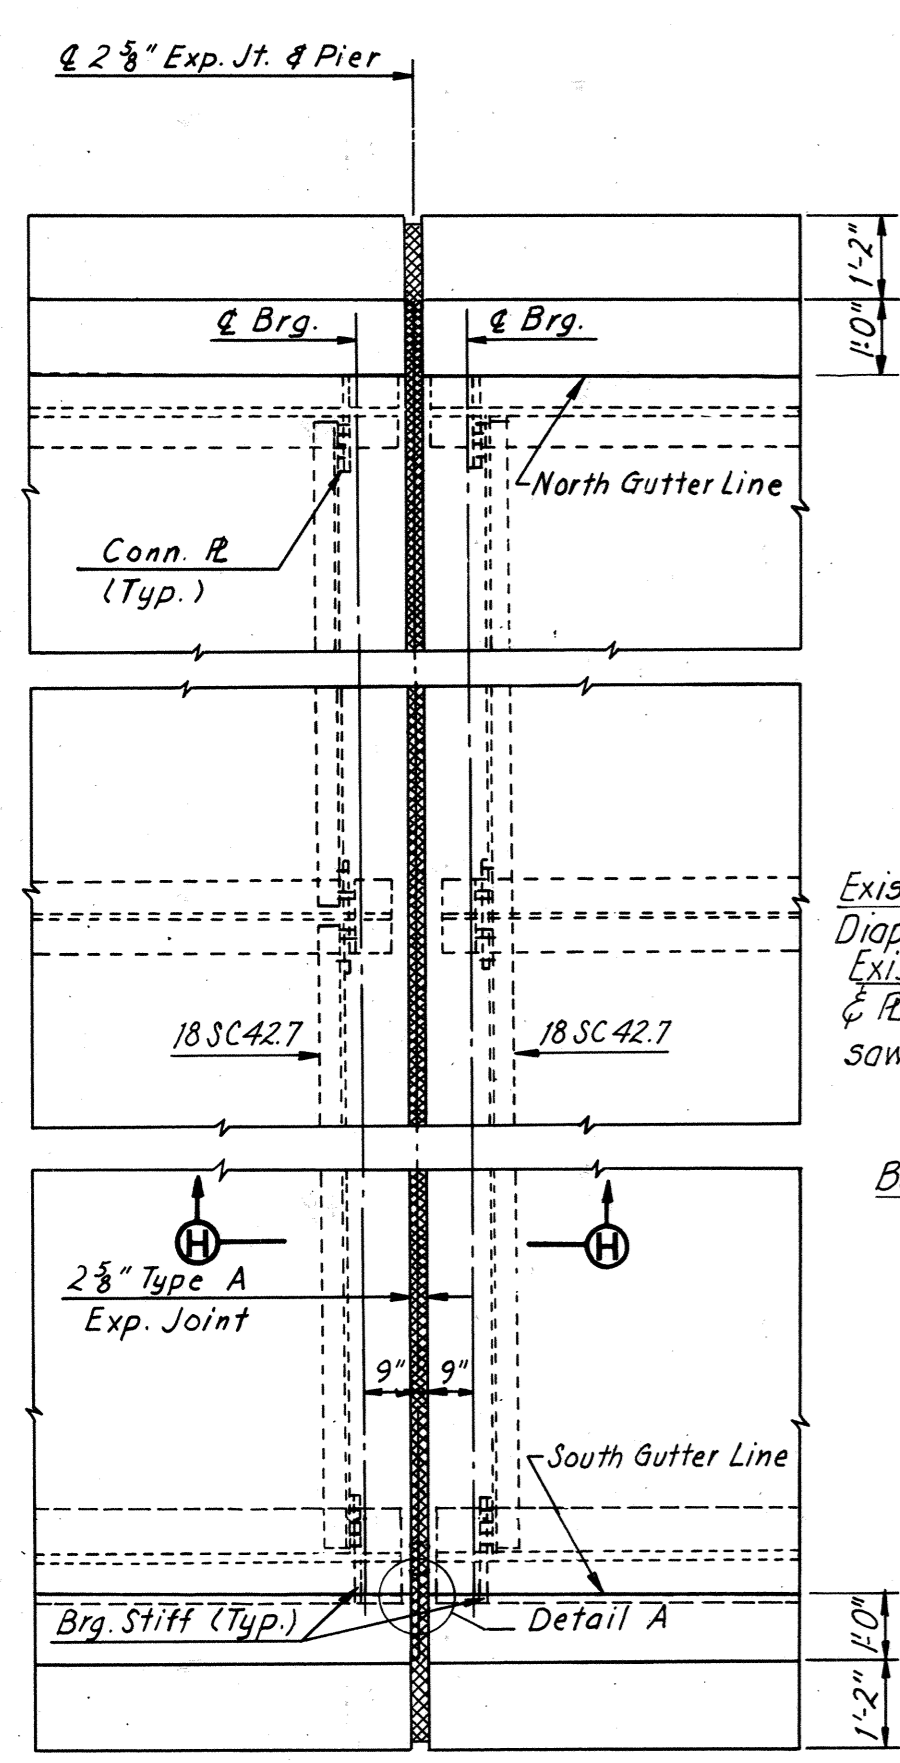

PLAN - JOINT AT PIERS 1 THRU 8
Scale: 3/8" = 1'-0"

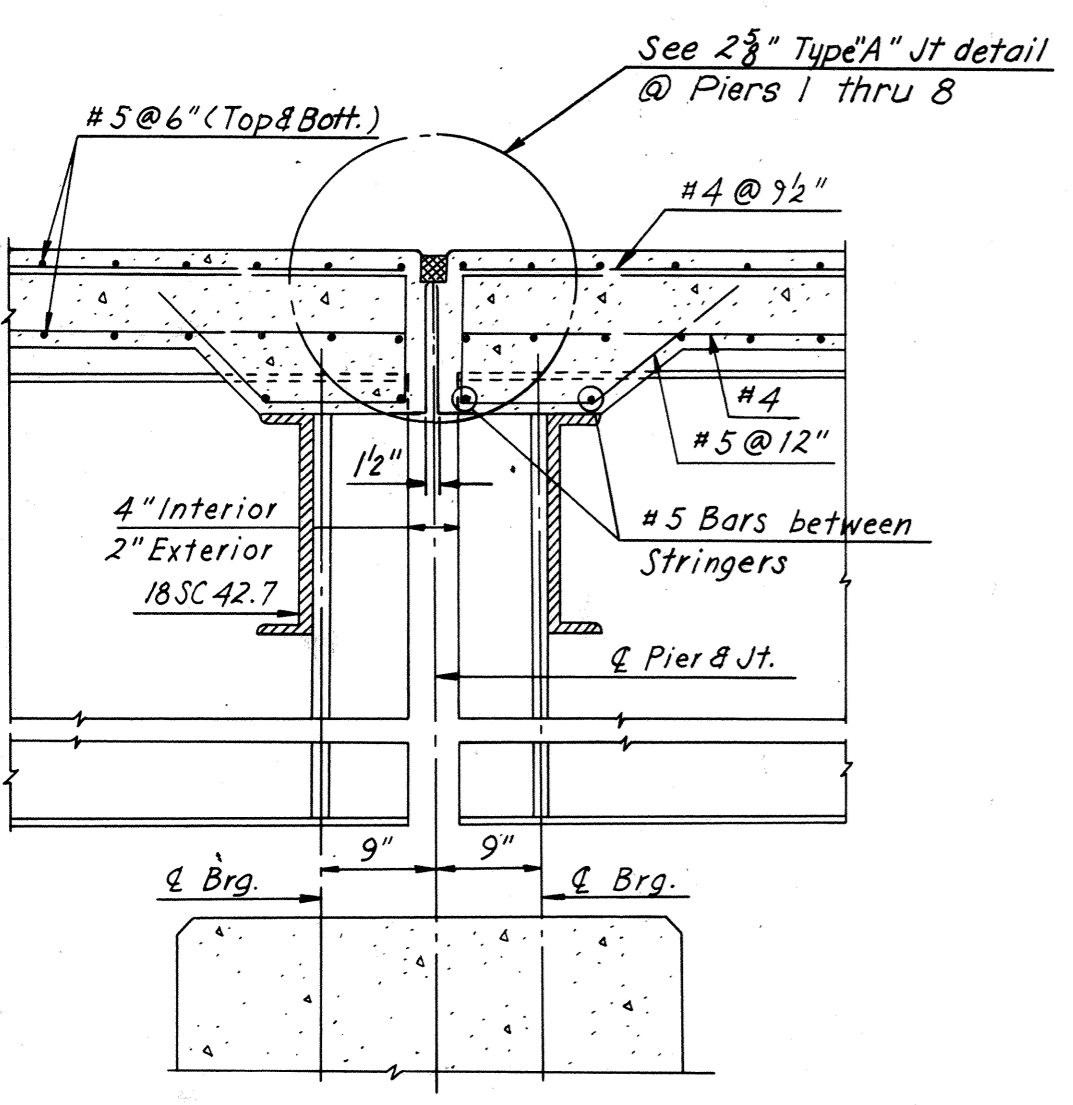


SECTION H-H
Scale: 1/4" = 1'-0"

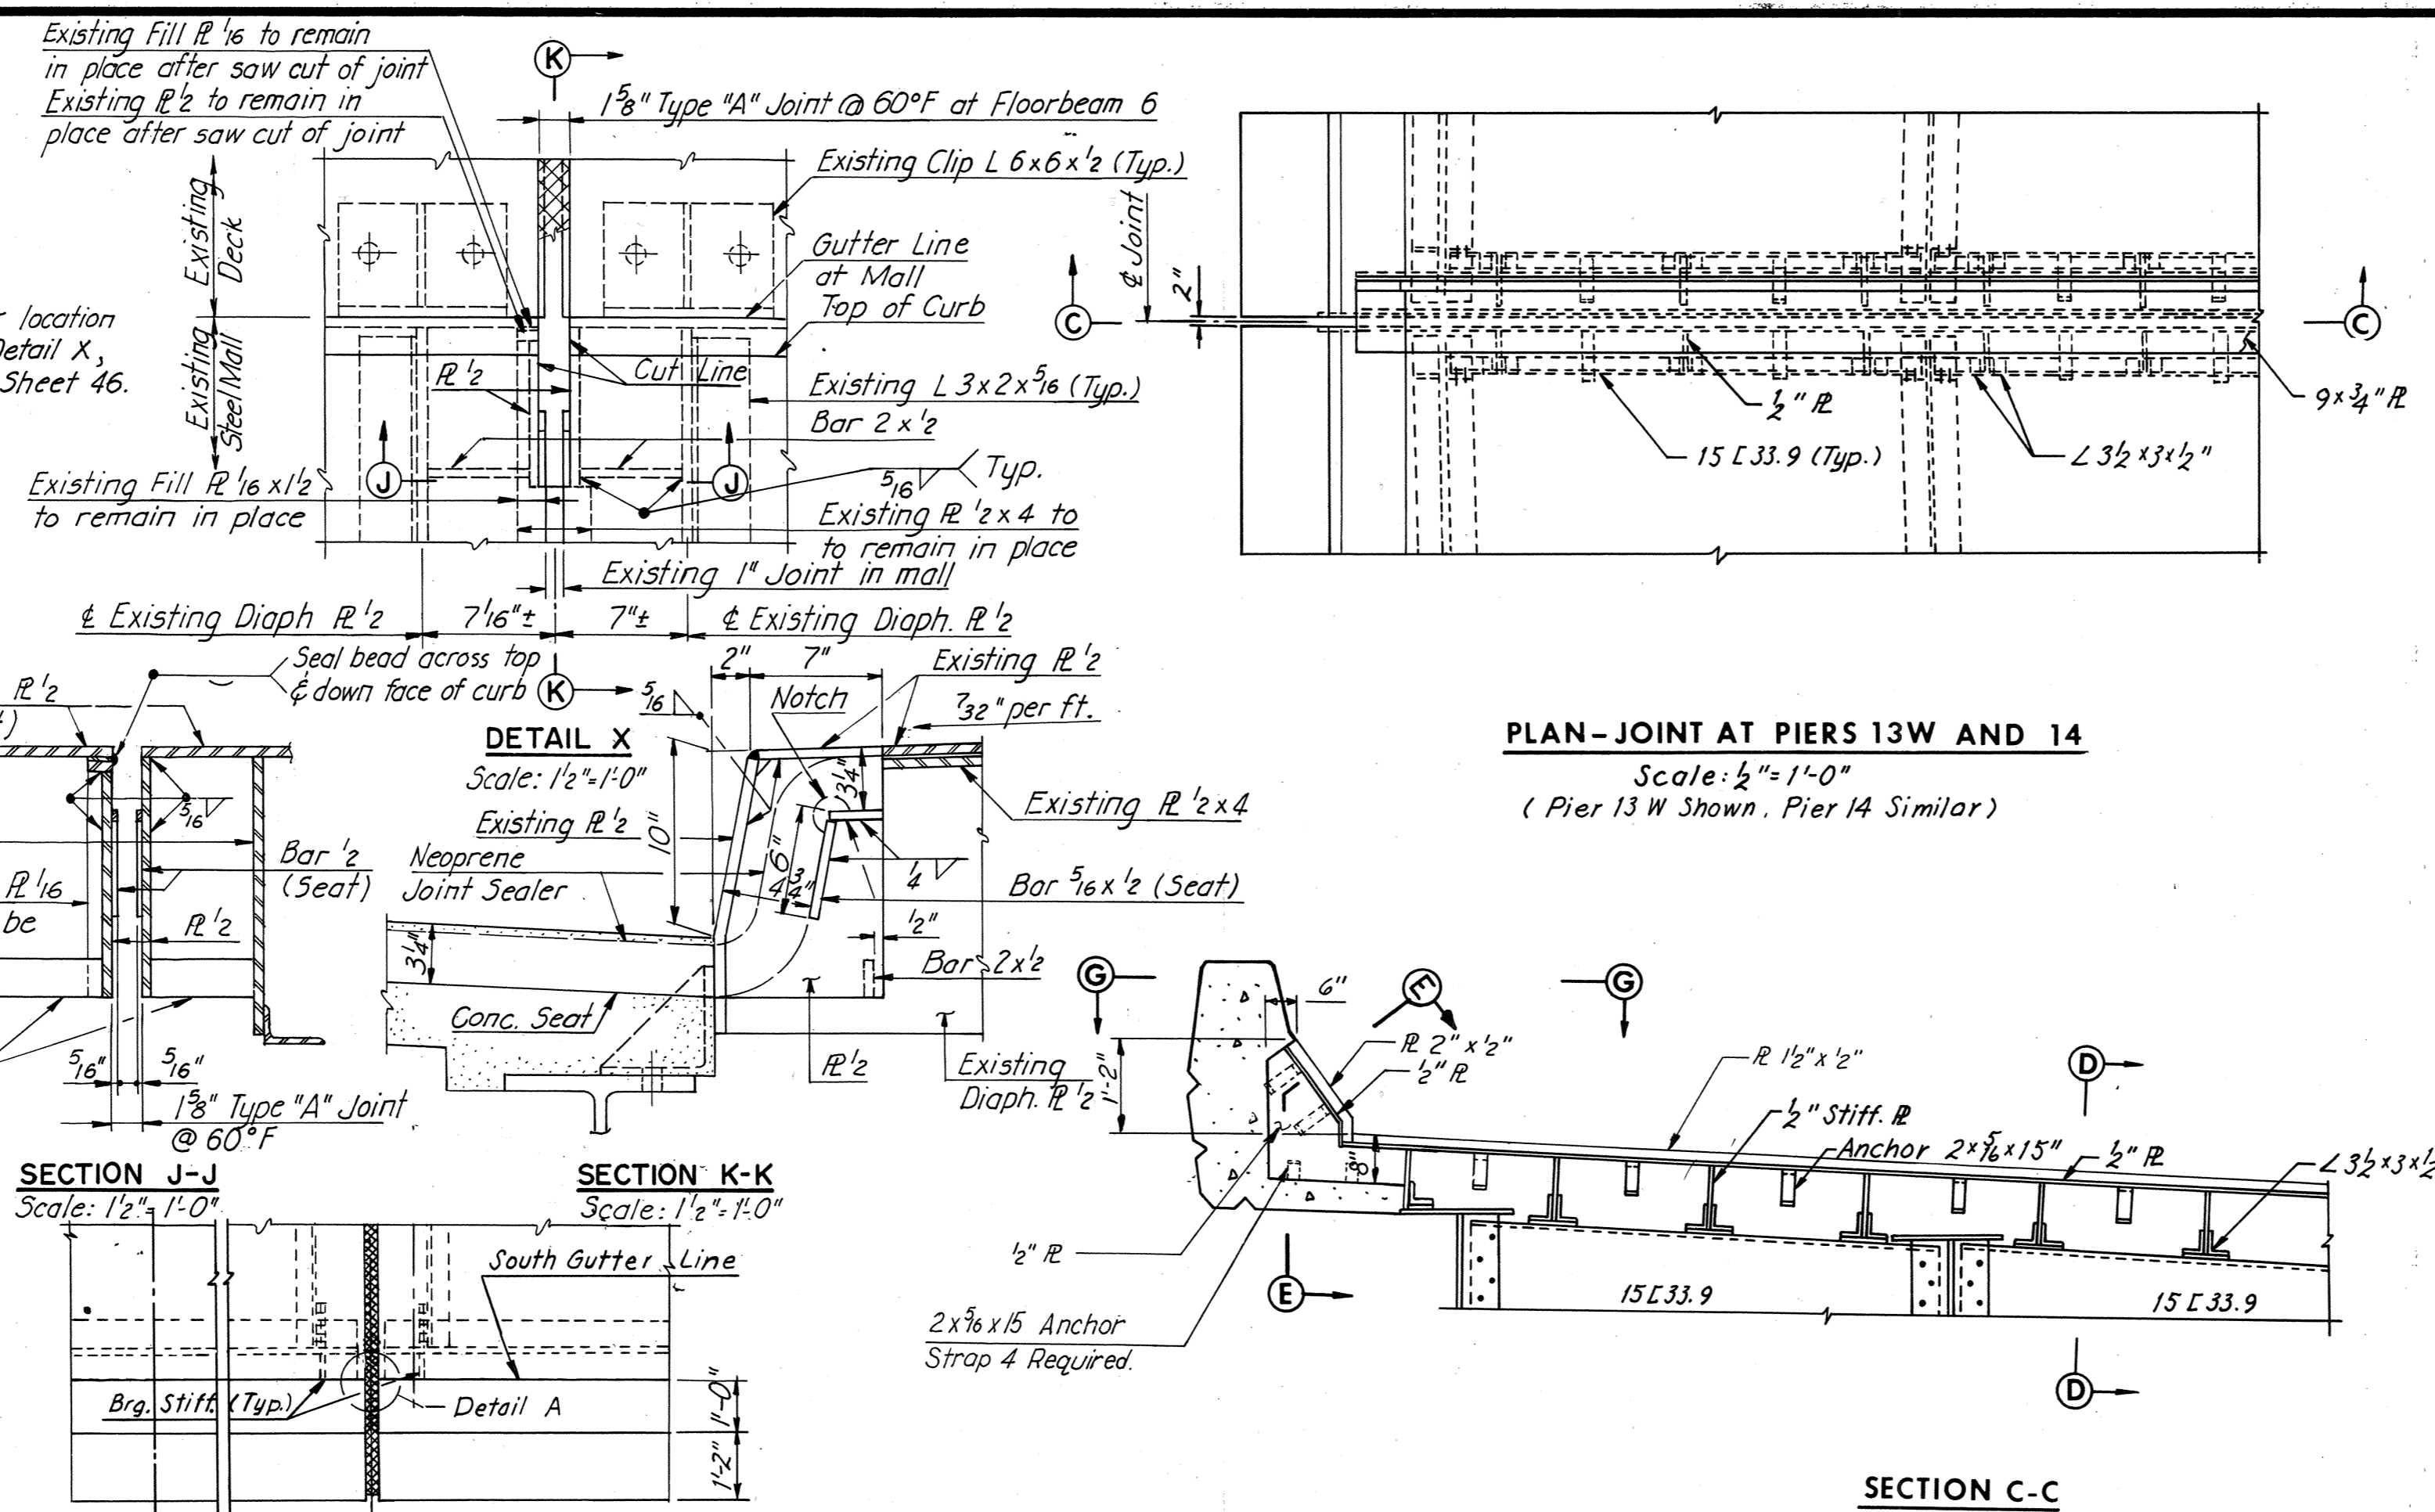


PLAN - JOINT AT PIERS 13W AND 14
Scale: 1/2" = 1'-0"
(Pier 13 W Shown, Pier 14 Similar)

PLAN - JOINT AT PIER 13 E
Scale: 3/8" = 1'-0"

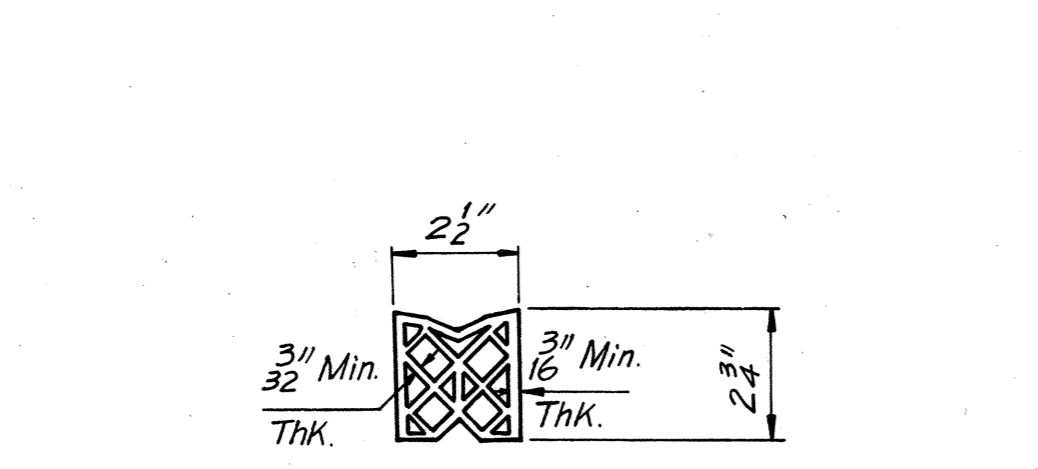


SECTION J-J
Scale: 1/2" = 1'-0"

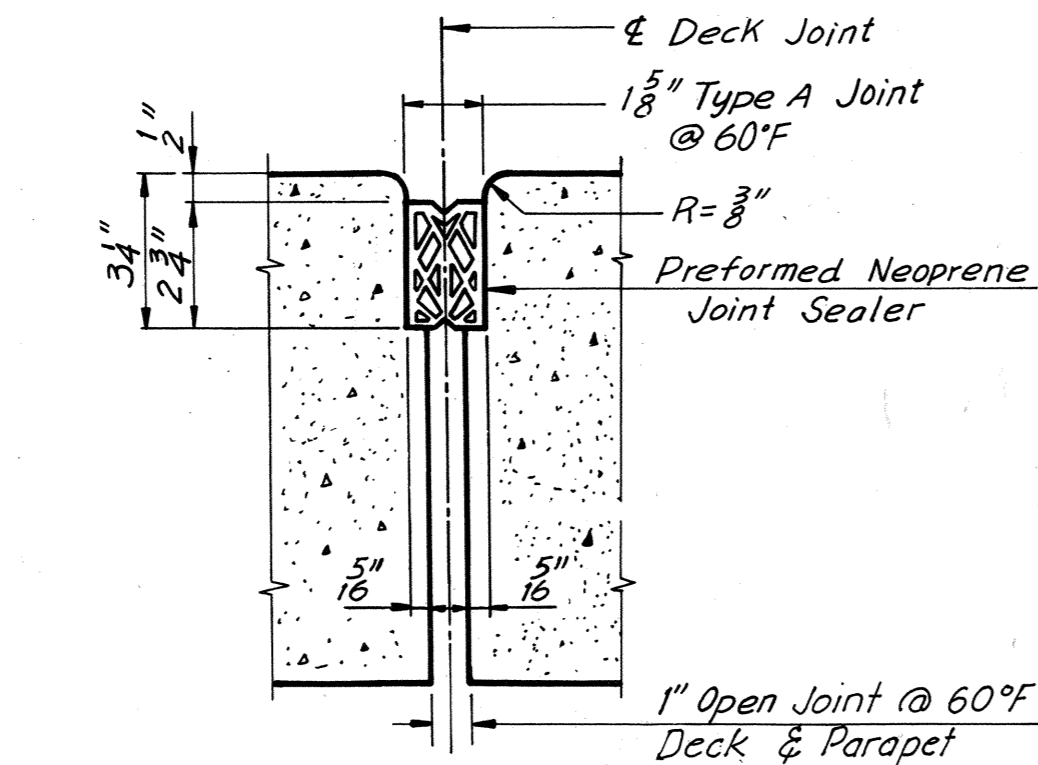


SECTION K-K
Scale: 1/2" = 1'-0"


1 1/2" TYPE "A" JOINT
Scale: 3" = 1'-0"

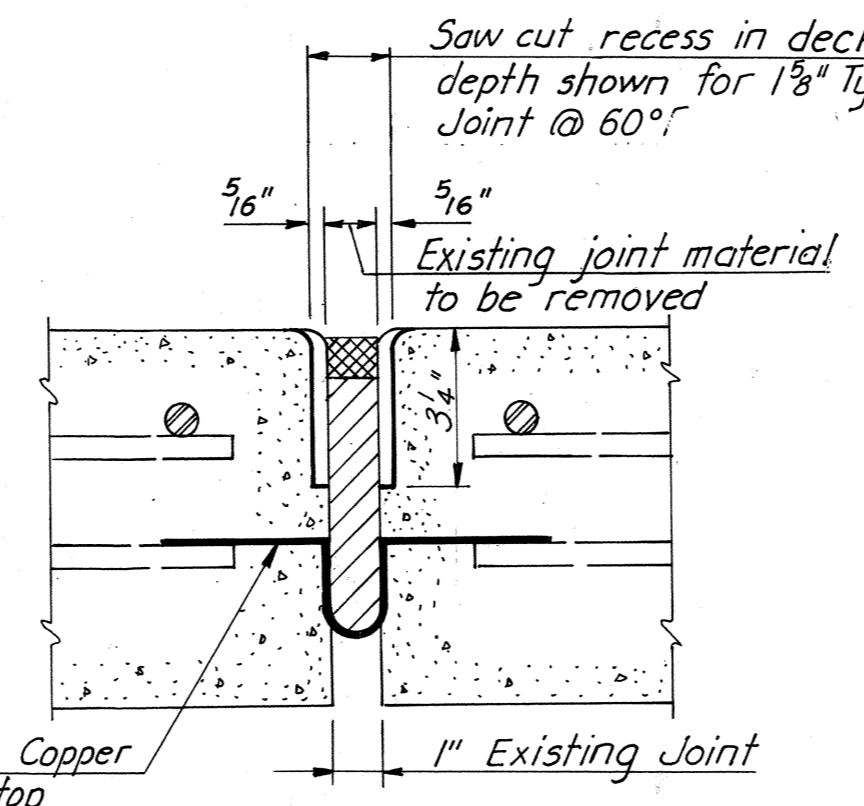


TYPICAL SECTION THRU EXISTING DECK JOINT AT FLOORBEAM 6
Scale: 3" = 1'-0"

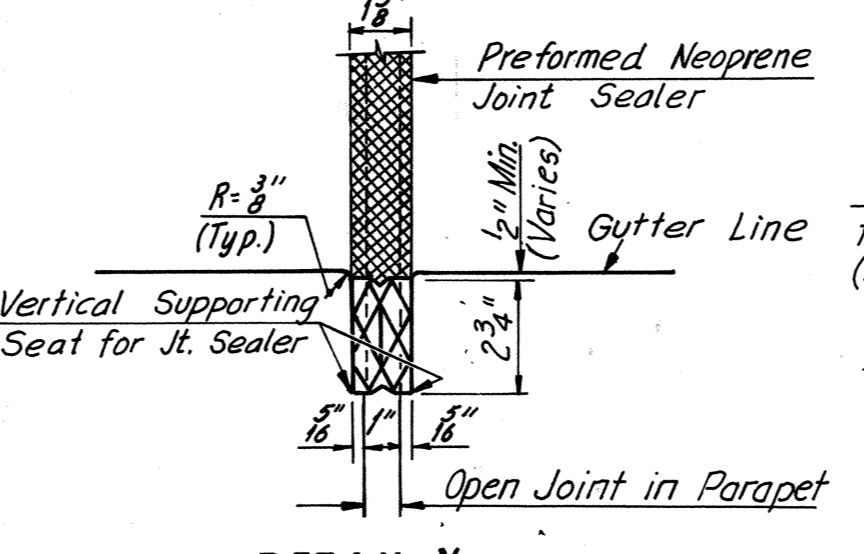


DETAIL Y
No Scale

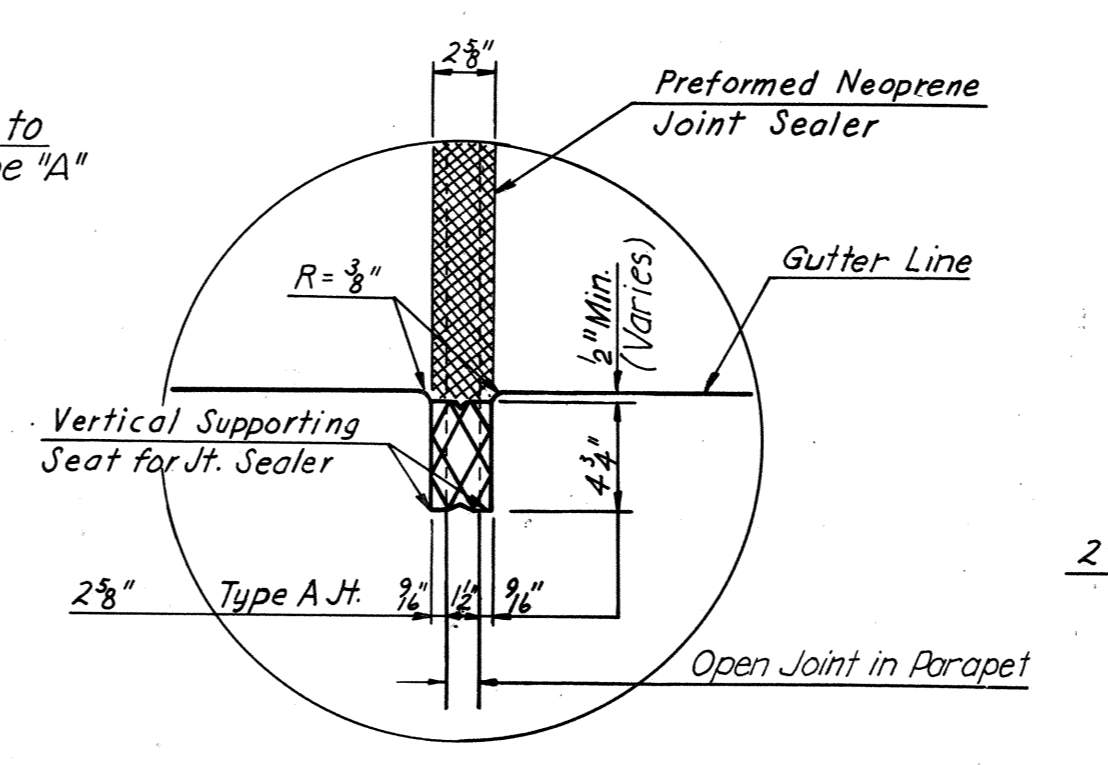

DETAIL A
No Scale

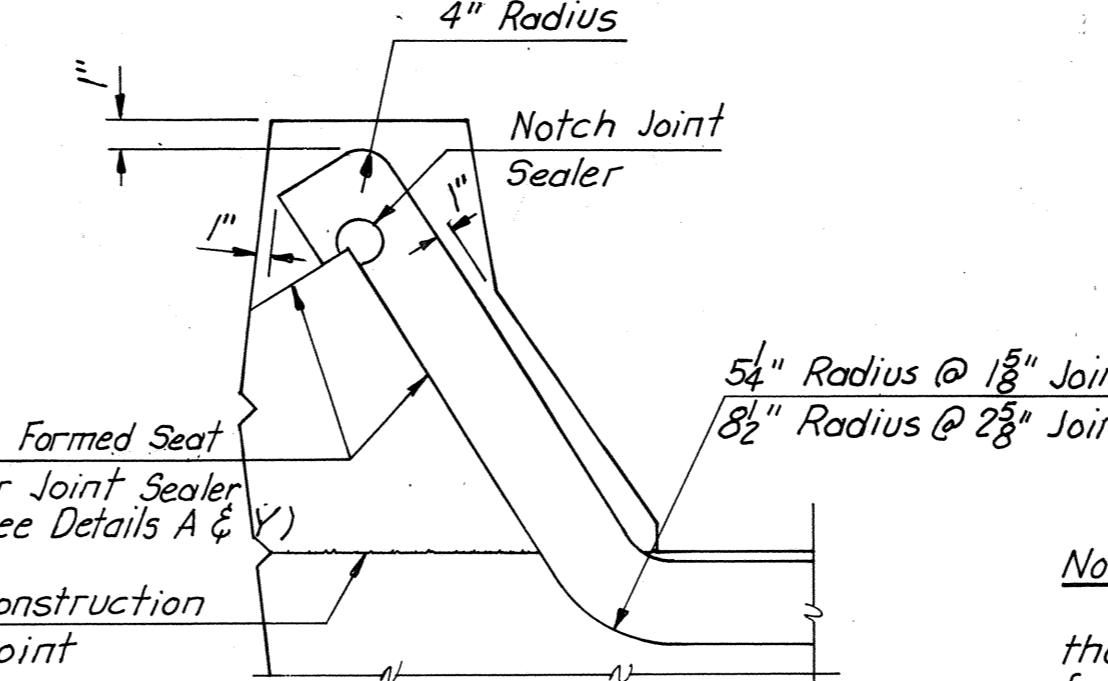


TREATMENT OF TYPE "A" JOINT AT CURB
No Scale

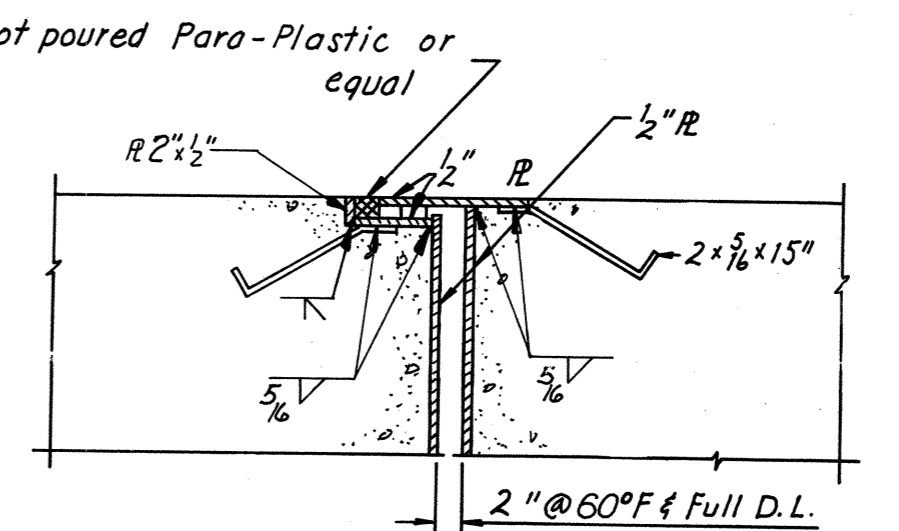


SECTION C-C
Scale: 1/2" = 1'-0"

SECTION E-E
Scale: 1" = 1'-0"

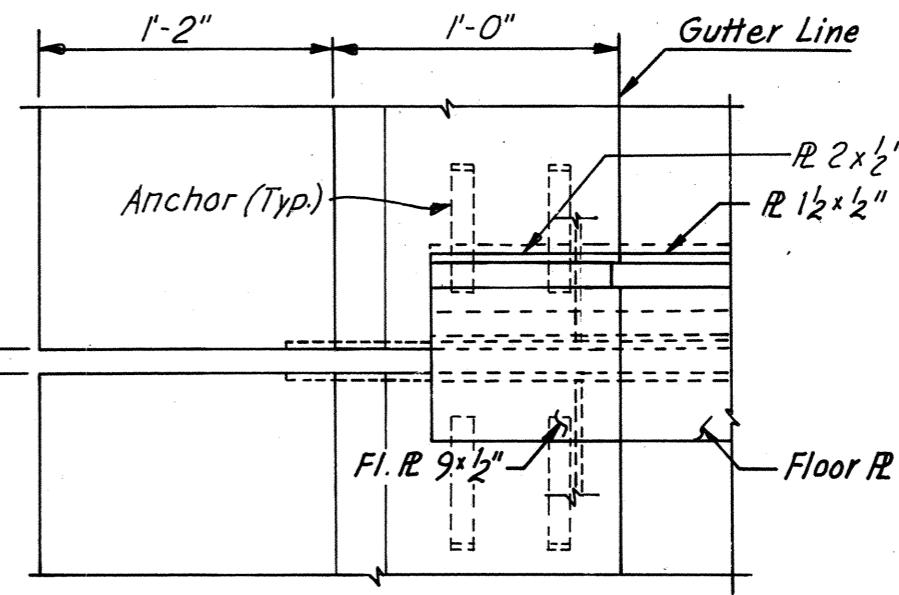


SECTION E-E
Scale: 1" = 1'-0"


VIEW G-G
No Scale

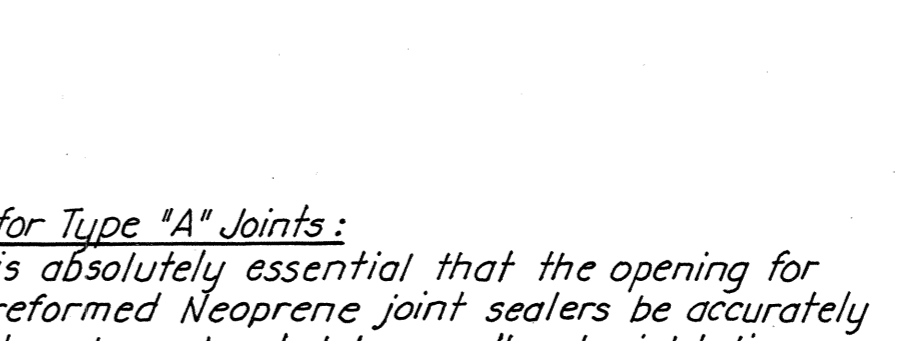


VIEW G-G
No Scale

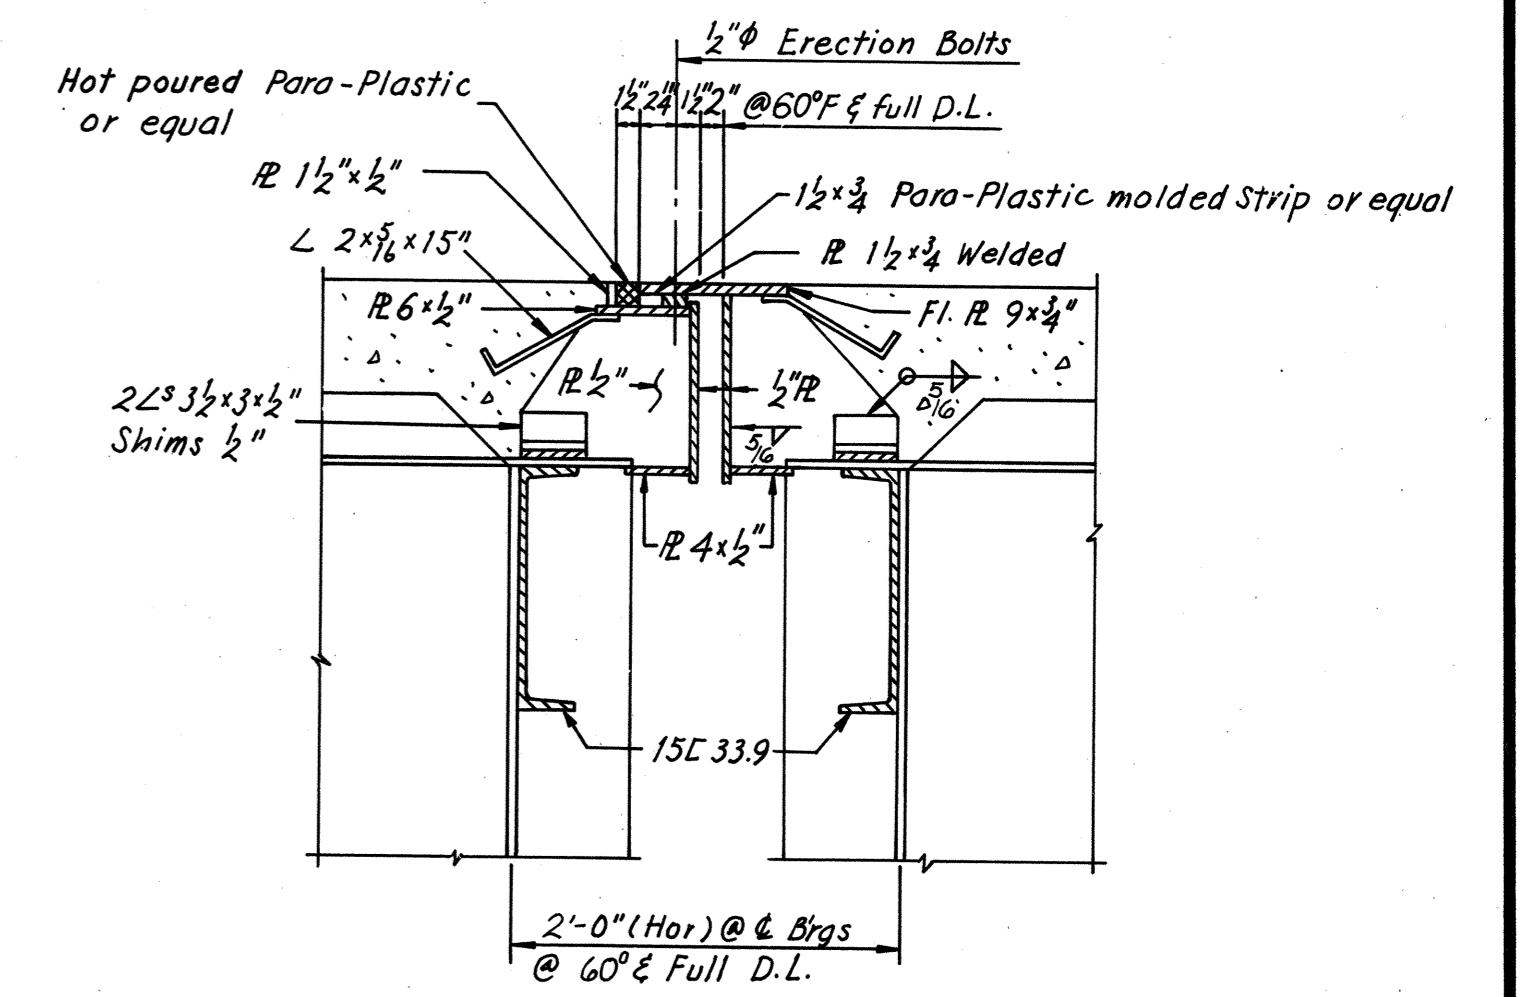

SECTION D-D
Scale: 1" = 1'-0"
(Pier 13 W shown, Pier 14 similar)

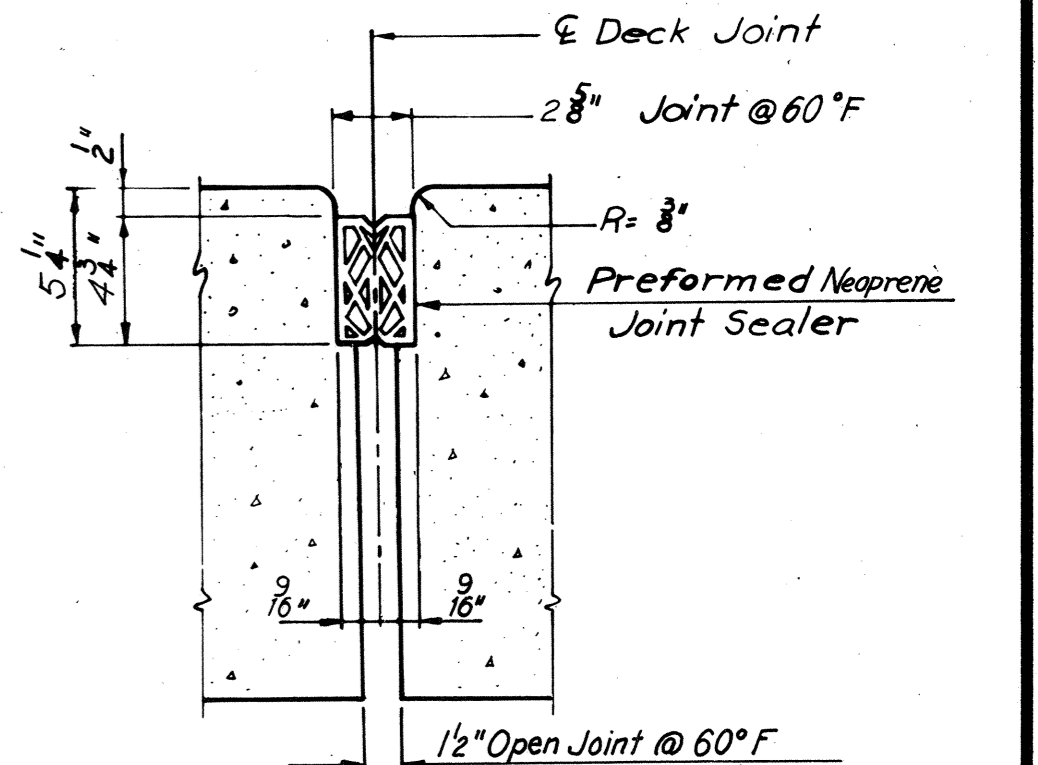

2 5/8" TYPE "A" JOINT
No Scale

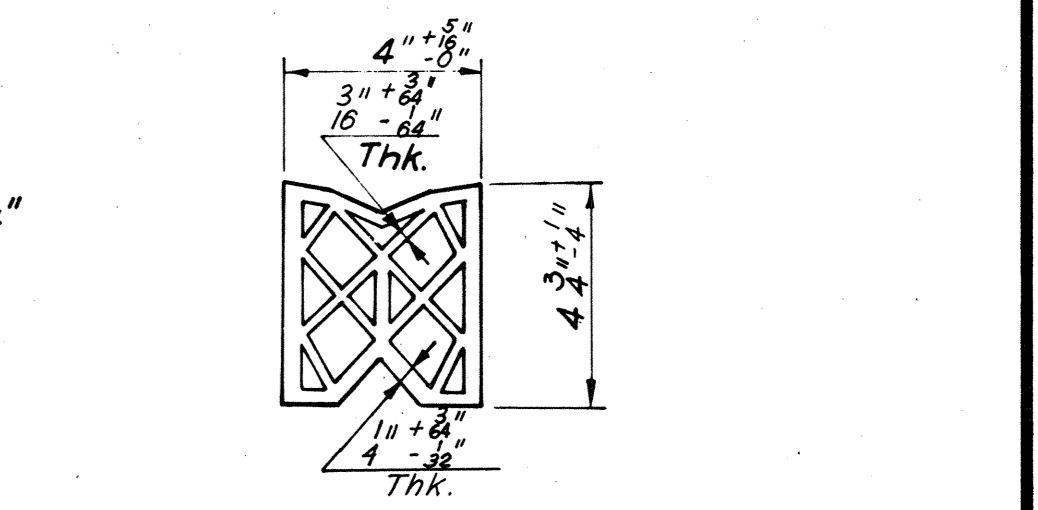

PREFORMED NEOPRENE JOINT SEALER
No Scale

FOR 2 5/8" TYPE "A" JOINT
No Scale

Note for Type "A" Joints:
It is absolutely essential that the opening for the preformed Neoprene joint sealers be accurately formed and constructed to smooth, straight lines. The size of opening shall be adjusted to allow for anticipated dead load rotation of the ends of the slab and for the temperature of the time of construction.

AS BUILT

BY	DATE	3	As Built	TEM	G-77
MADE	Y.C.P.	3-25-69	Joint Det. for exist. joint & Mall. added	d.B.P.	2-25-75
CHECKED	G.S.H.	7-10-69	1 1/2" Type "A" Joint details added	d.B.P.	2-7-75
IN CHARGE	NO.	REVISION	BY	DATE	


RICHMOND METROPOLITAN AUTHORITY
RICHMOND EXPRESSWAY SYSTEM
DOWNTOWN EXPRESSWAY

BRIDGE NO. 67
RAMP W-N CONNECTION TO RICHMOND-PETERSBURG TURNPIKE
JOINT DETAILS


SCALE: *As Noted*
CONTRACT NO.: 10
SHEET NO. 48 OF 54

HOWARD, NEEDLES, TAMMEN & BERGENDOFF
consulting engineers
NEW YORK ALEXANDRIA KANSAS CITY


RICHMOND EXPRESSWAY SYSTEM			
SECTION	PROJECT	SHEET NO.	TOTAL SHEETS
10	DOWNTOWN EXPRESSWAY	221	265

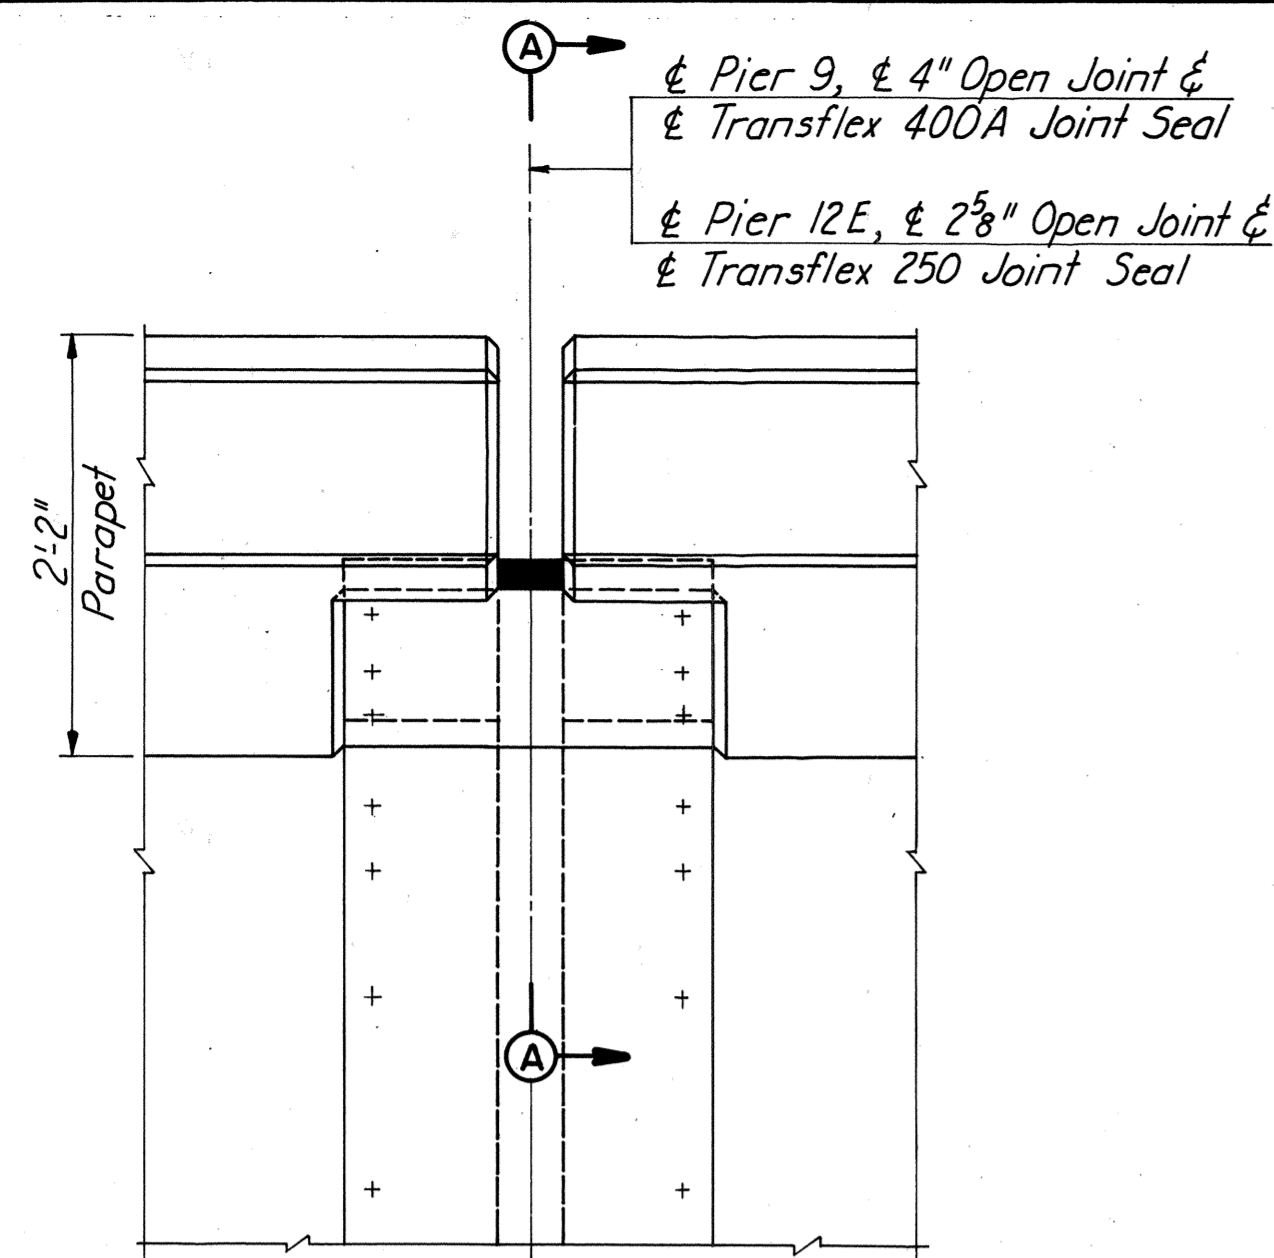

PARTIAL PLAN OF JOINTS AT PIERS 9 & 12E
Scale: 1/4"=1'-0"

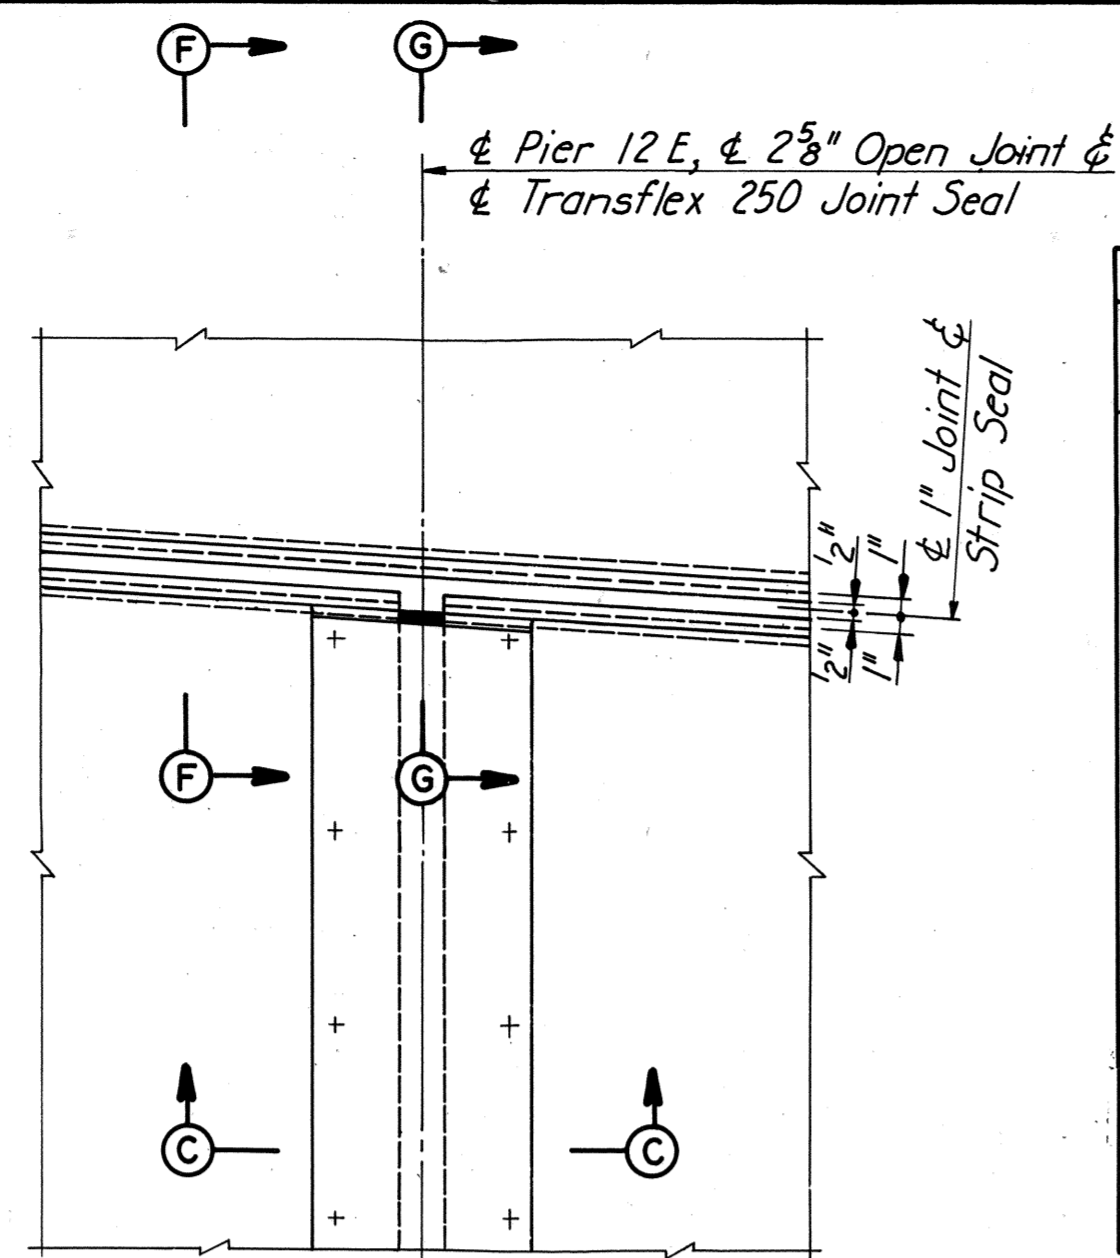

PARTIAL PLAN OF JOINT AT PIER 12E
Scale: 1/4"=1'-0"

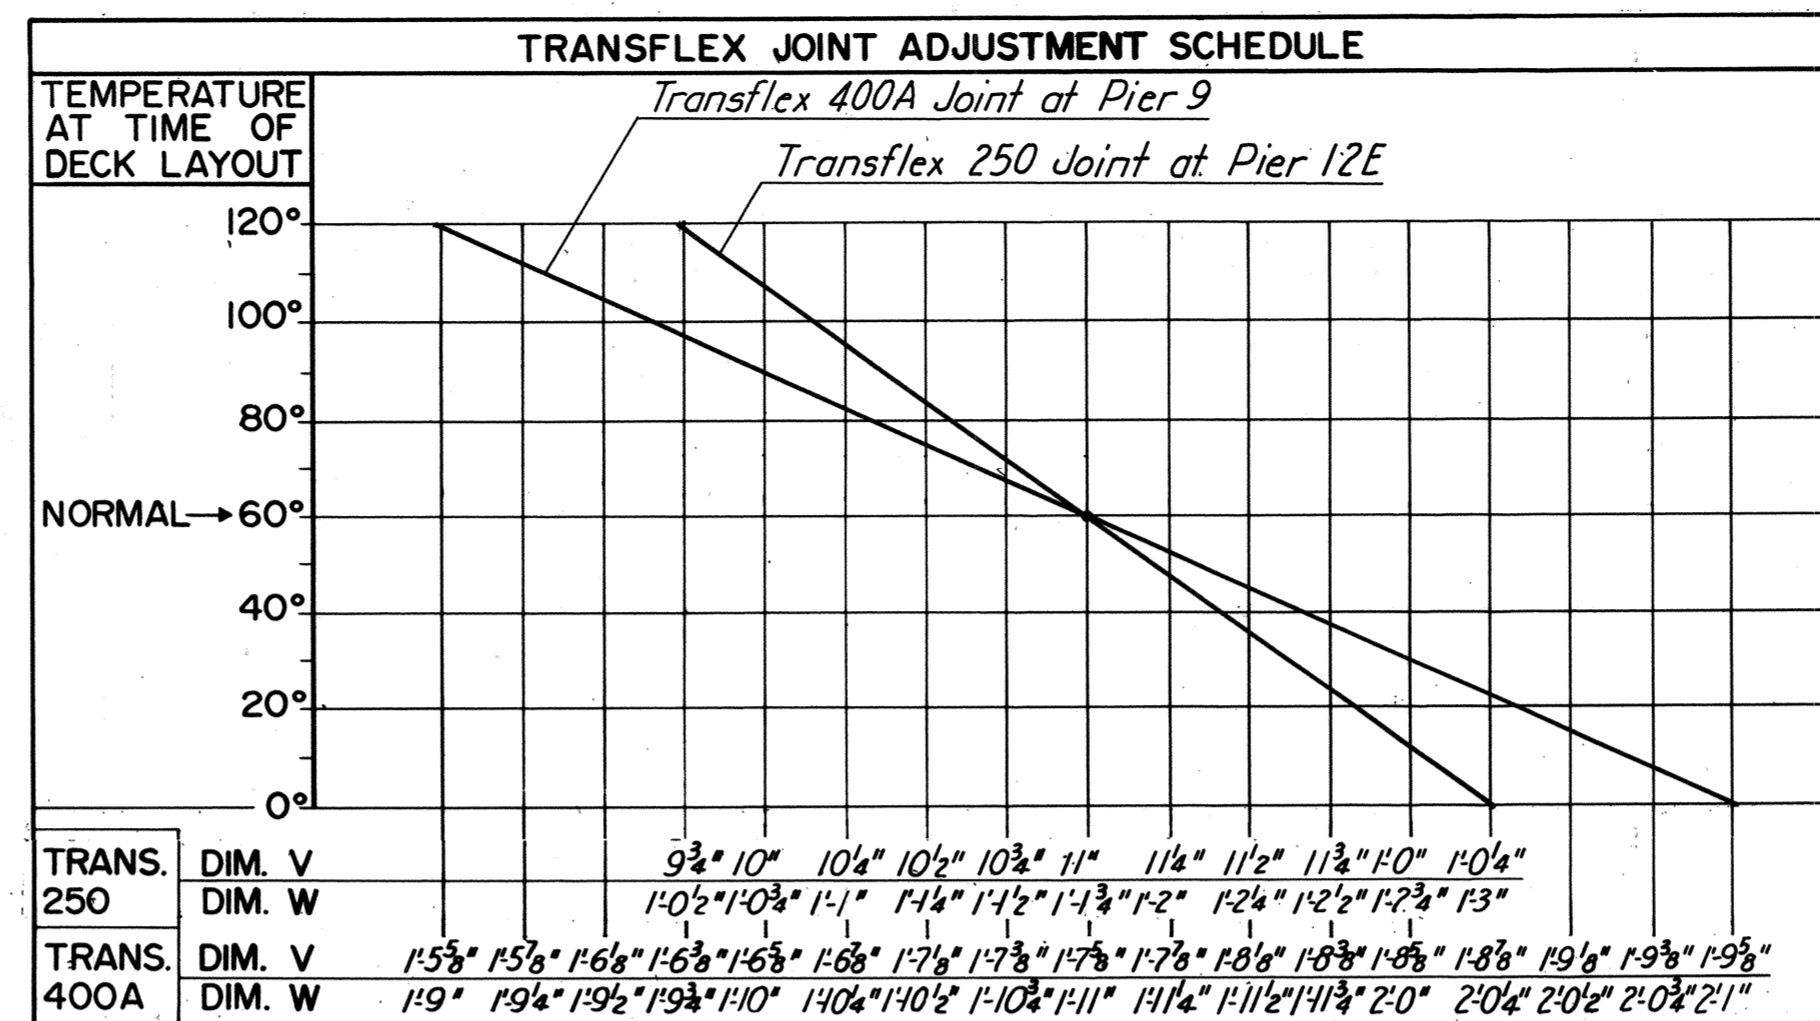


NOTES FOR FILLED JOINTS:

Joints shall be free of cracked and spalled areas and their faces shall be free of all foreign matter, curing compound, oils, greases and dirt. All faces must be sandblasted or brushed with a mechanical rotary wire brush. Just prior to sealing, the joint shall be blown out with oil-free and water-free compressed air.


NOTES FOR WABO-MAURER JOINTS:

Do not use steel extrusions as screed support. Steel extrusion shall conform to ASTM A36. Structural steel shall conform to ASTM A588. Steel assembly shall be shop welded to convenient lengths and butt welded in the field to desired length. Joint shall conform to grade of deck slab. Steel assembly shall be sandblasted in the shop prior to painting.


Steel assembly shall receive one shop coat of epoxy zinc paint. Neoprene extrusion shall be roughened with a wire brush before bonding to steel extrusion with Bon Lastic Adhesive. Groove in steel extrusion to be blown out with oil-free and water-free compressed air prior to installation of Neoprene extrusion. The Wabo-Maurer joint assembly shall be installed in accordance with manufacturer's recommended construction methods.

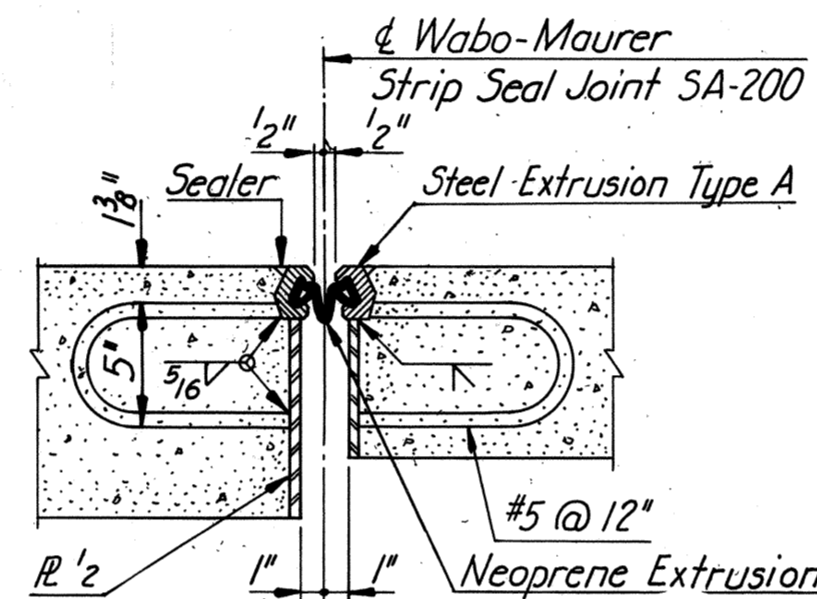


SECTION F-F
Scale: 1/2"=1'-0"

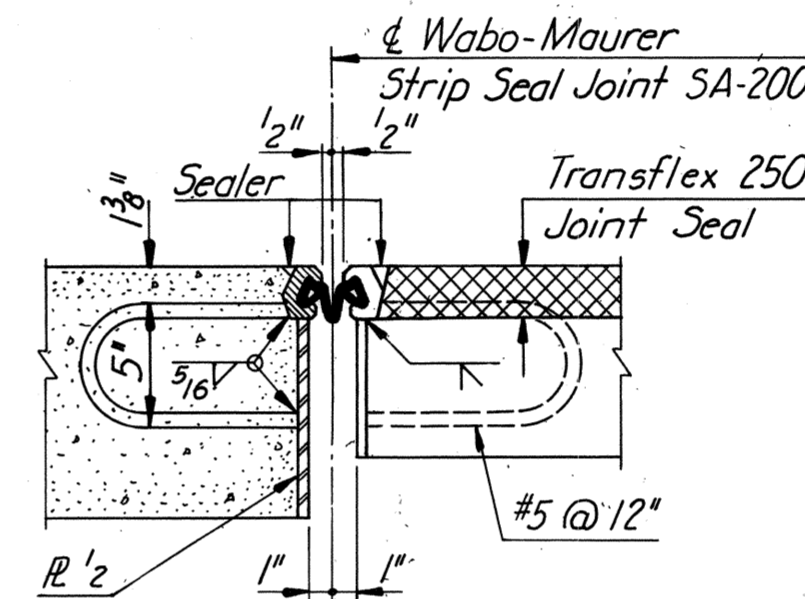


SECTION G-G
Scale: 1/2"=1'-0"

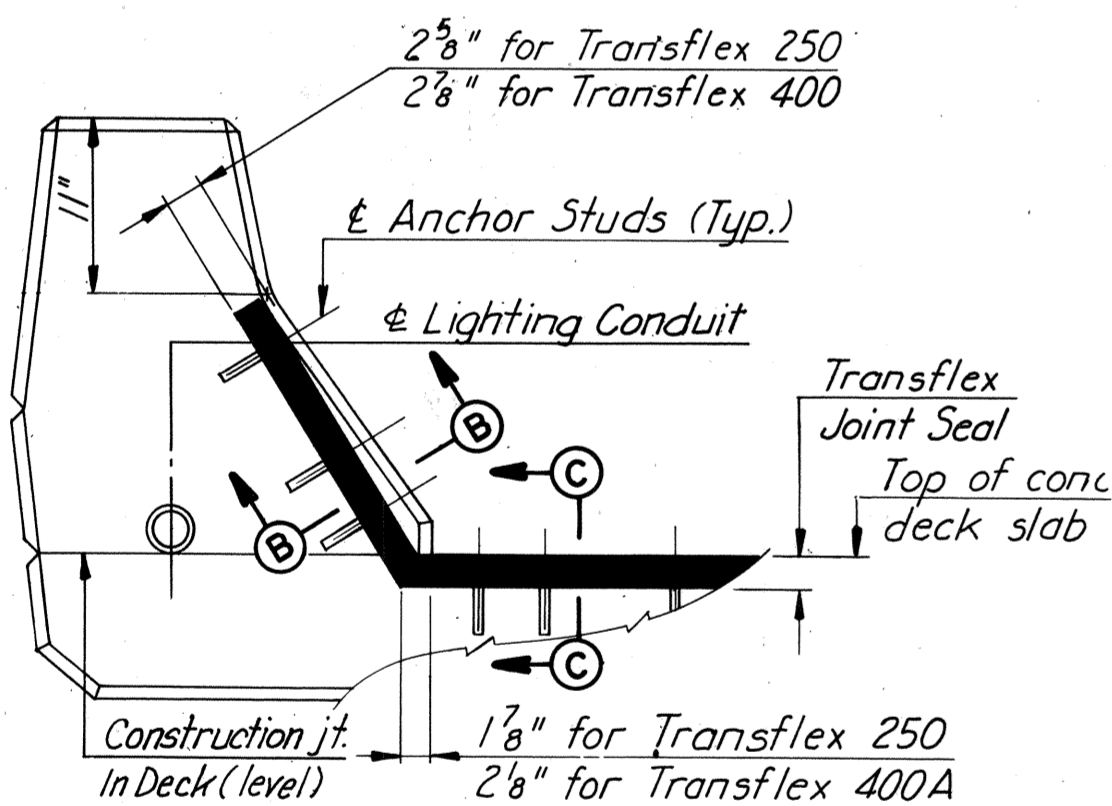


SECTION A-A
Scale: 1/4"=1'-0"

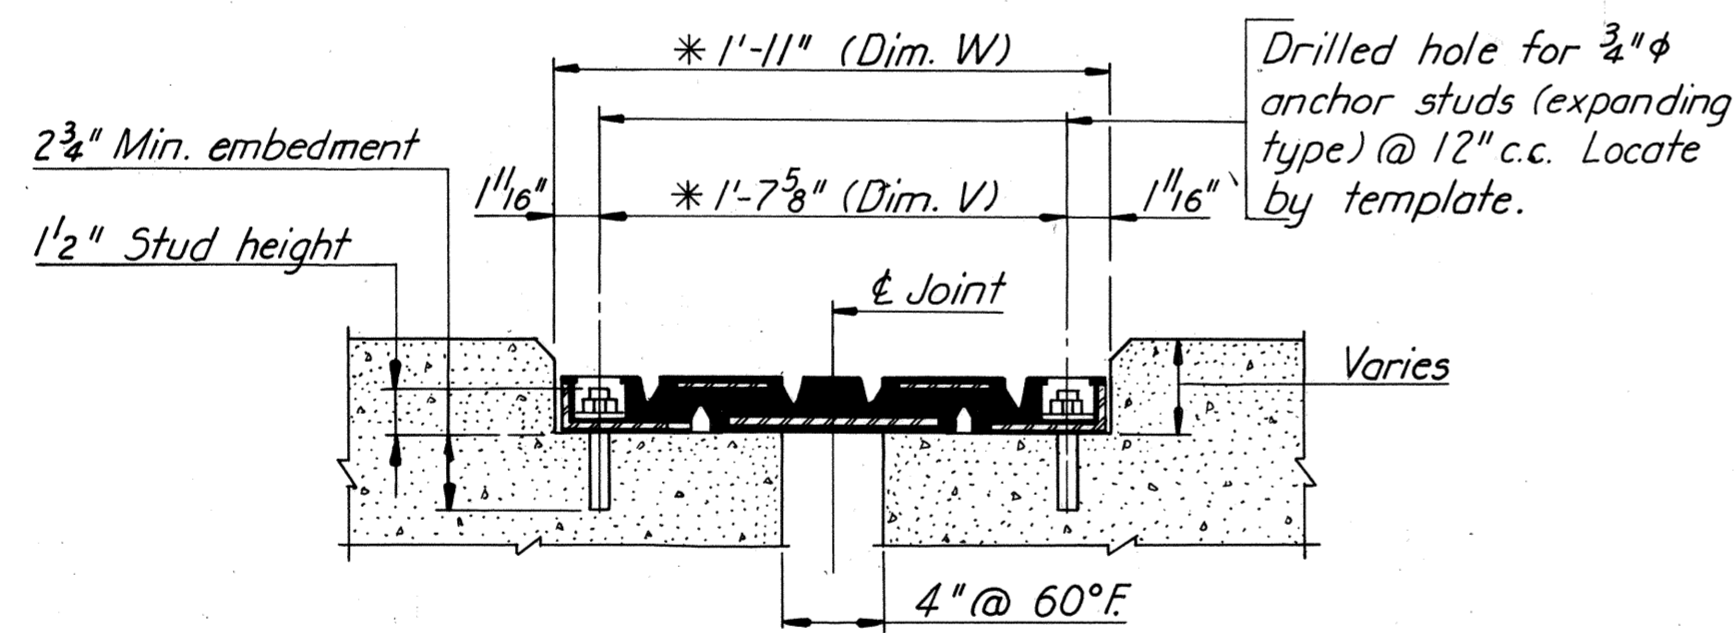


SECTION B-B TRANSFLEX 400A JOINT
Scale: 1/2"=1'-0"

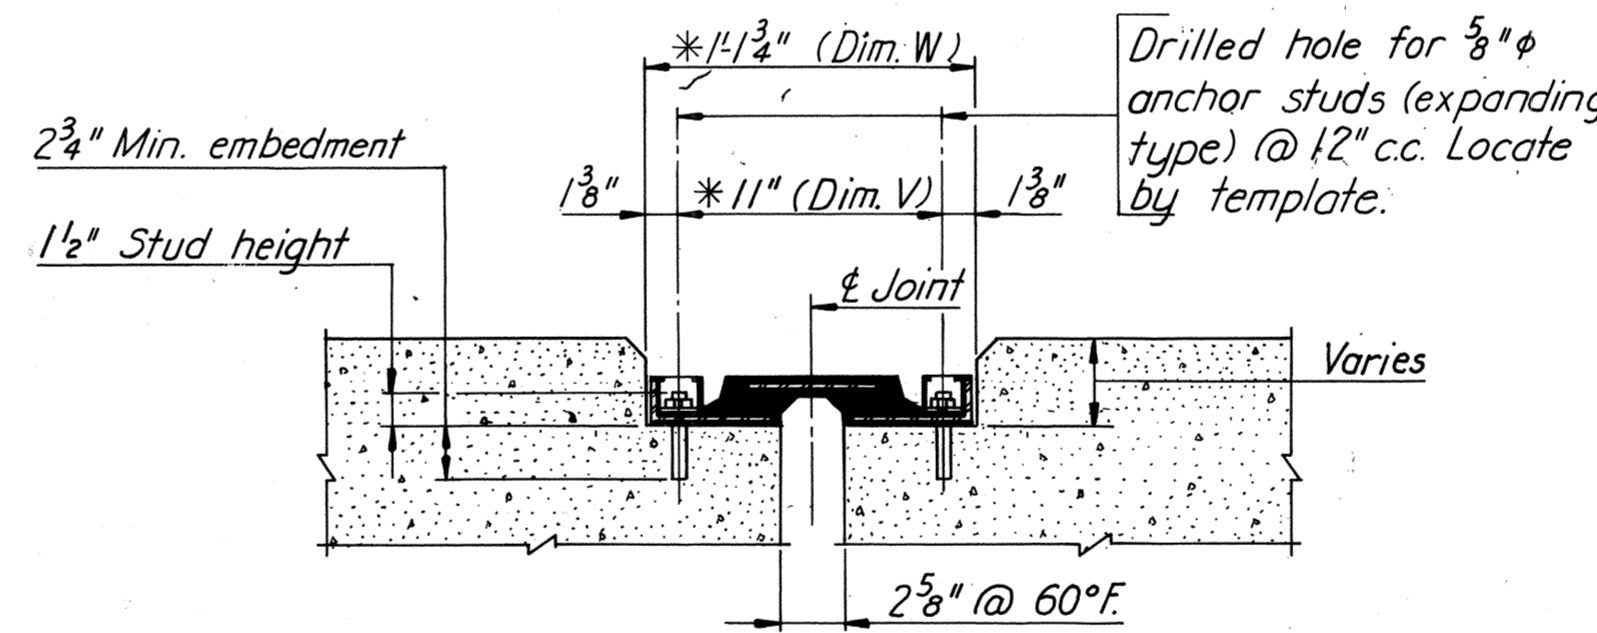


SECTION B-B TRANSFLEX 250 JOINT
Scale: 1/2"=1'-0"

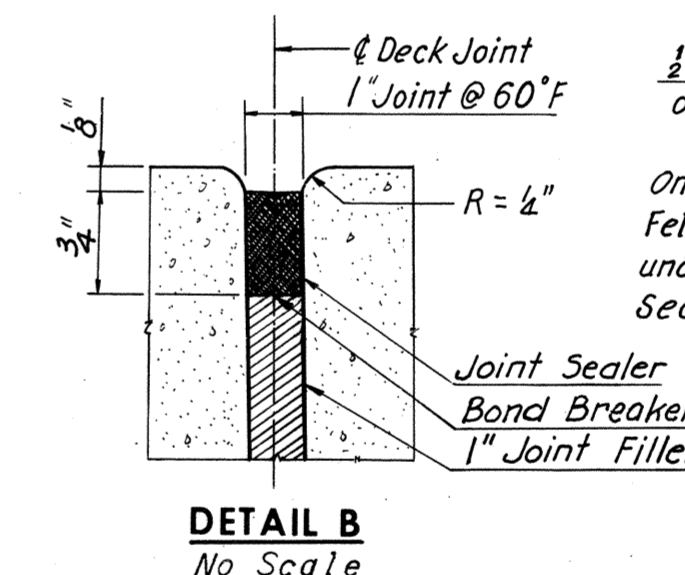

DETAIL B
No Scale

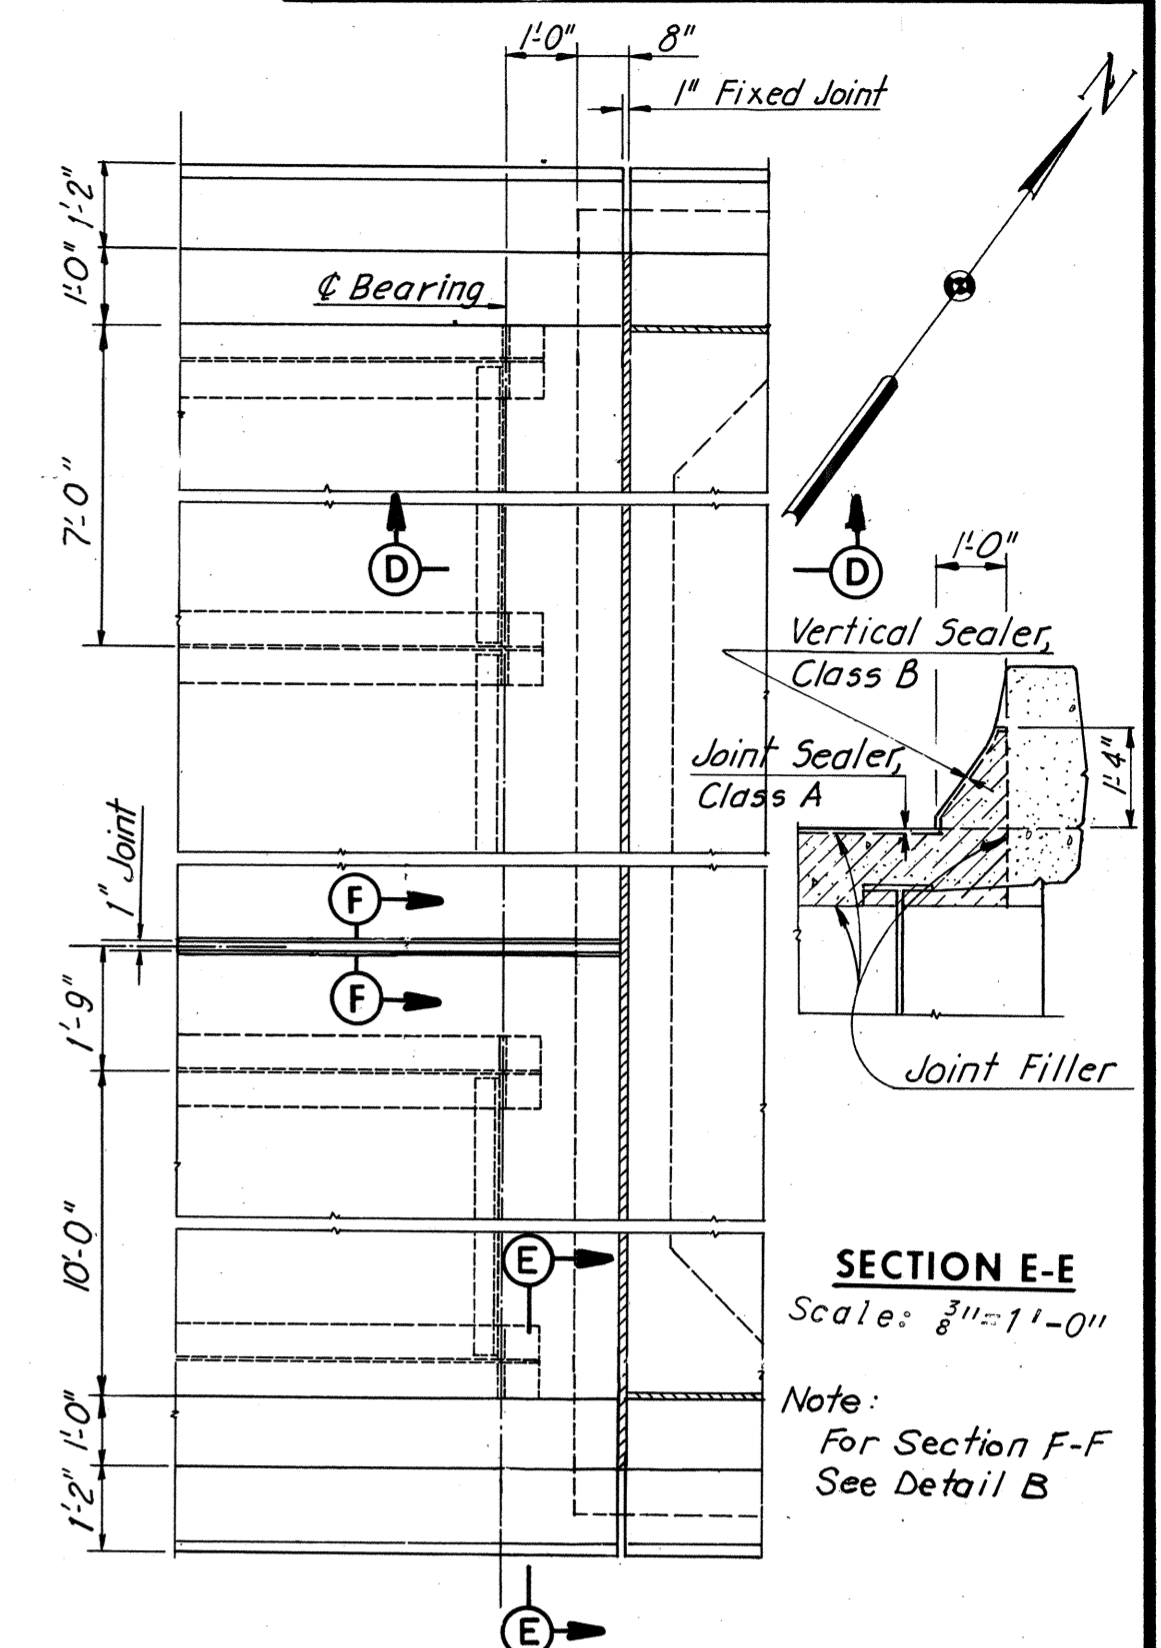


PLAN JOINT AT NORTH ABUTMENT
Scale: 3/8"=1'-0"

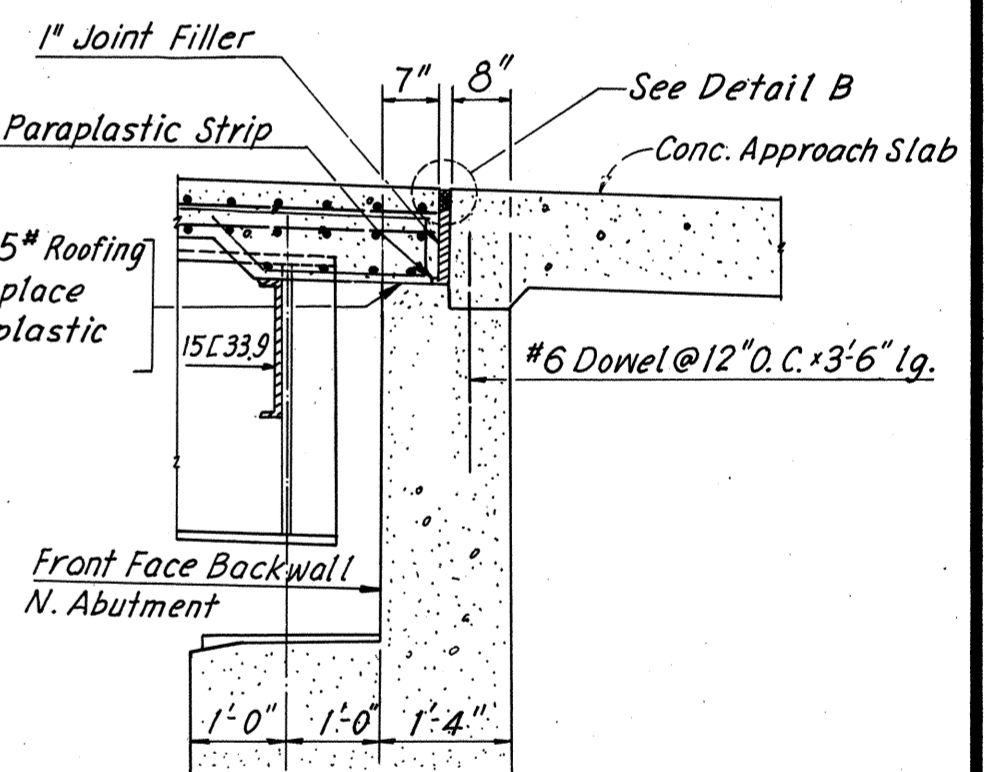


SECTION D-D
Scale: 1/2"=1'-0"

NOTES FOR TRANSFLEX JOINTS:

* Dimension shown is at 60°F. For Dim. V and W adjustment due to temperature change, see Joint Adjustment Schedule. Anchors may be drilled in as shown, or cast-in-place Swedge bolts, 6" long. If they are drilled in, care shall be exercised in placing the deck reinf. steel so that the bars will not interfere with the drilling. Transflex Seals shall be installed in accordance with manufacturer's recommendations.

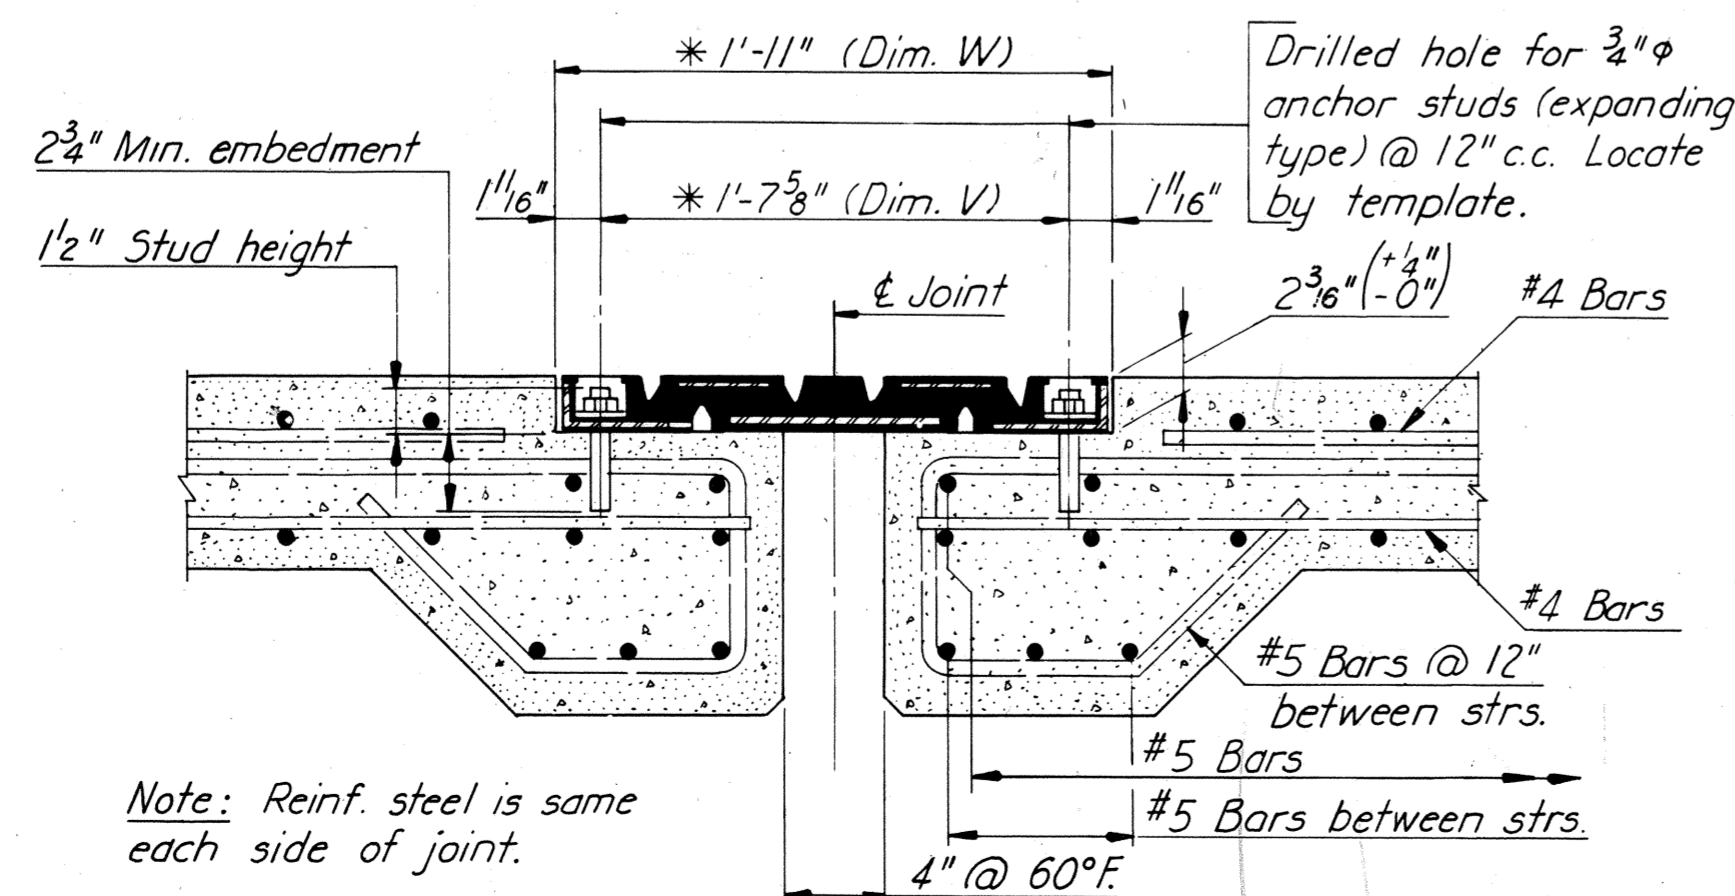

SECTION C-C TRANSFLEX 400A JOINT
Scale: 1/2"=1'-0"

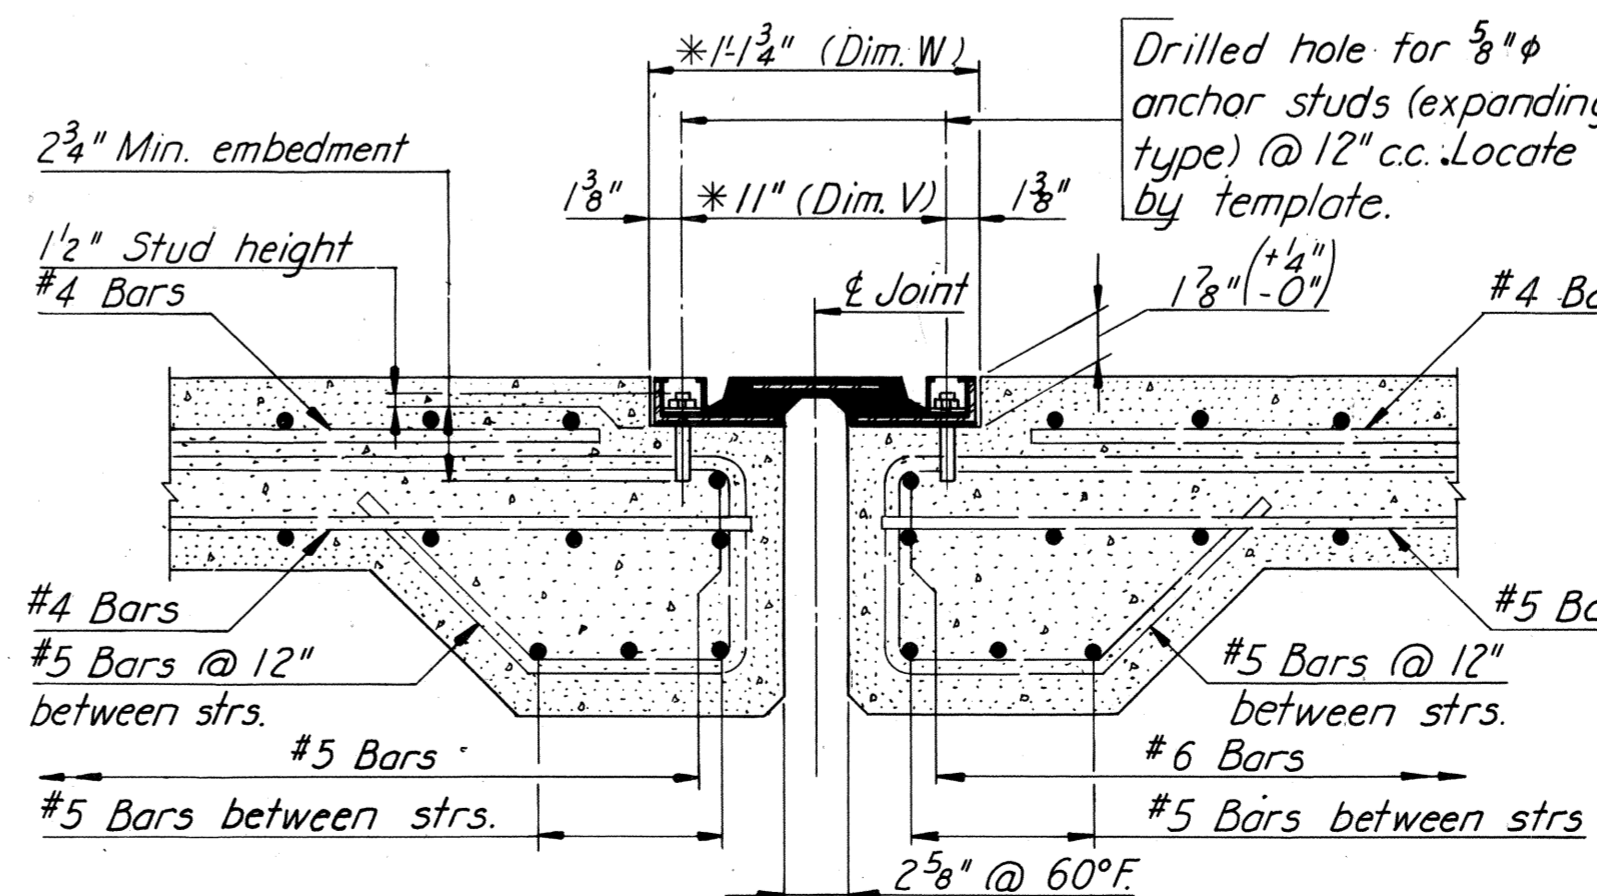

SECTION C-C TRANSFLEX 250 JOINT
Scale: 1/2"=1'-0"

Note: Transflex 250 Joints and Transflex 400A Joints shall be paid for as Elastomeric Expansion Dams, Type 250 and Elastomeric Expansion Dams, Type 400A respectively. The neoprene and the steel be considered a incidental pay item to the bridge structural steel.

BY	DATE			
MADE	K.C.T.	4-3-69		
CHECKED	G.S.H.	7-17-69	As Built	TEM 6-77
IN CHARGE				

AS BUILT

RICHMOND METROPOLITAN AUTHORITY
RICHMOND EXPRESSWAY SYSTEM
DOWNTOWN EXPRESSWAY


BRIDGE NO. 67
RAMP W-N CONNECTION TO
RICHMOND-PETERSBURG TURNPIKE

JOINT DETAILS


SCALE: As Noted
CONTRACT NO.: 10
SHEET NO. 49 OF 54

HOWARD, NEEDLES, TAMMEN & BERGENDOFF
consulting engineers
NEW YORK ALEXANDRIA KANSAS CITY


RICHMOND EXPRESSWAY SYSTEM			
SECTION	PROJECT	SHEET NO.	TOTAL SHEETS
10	DOWNTOWN EXPRESSWAY	222	265

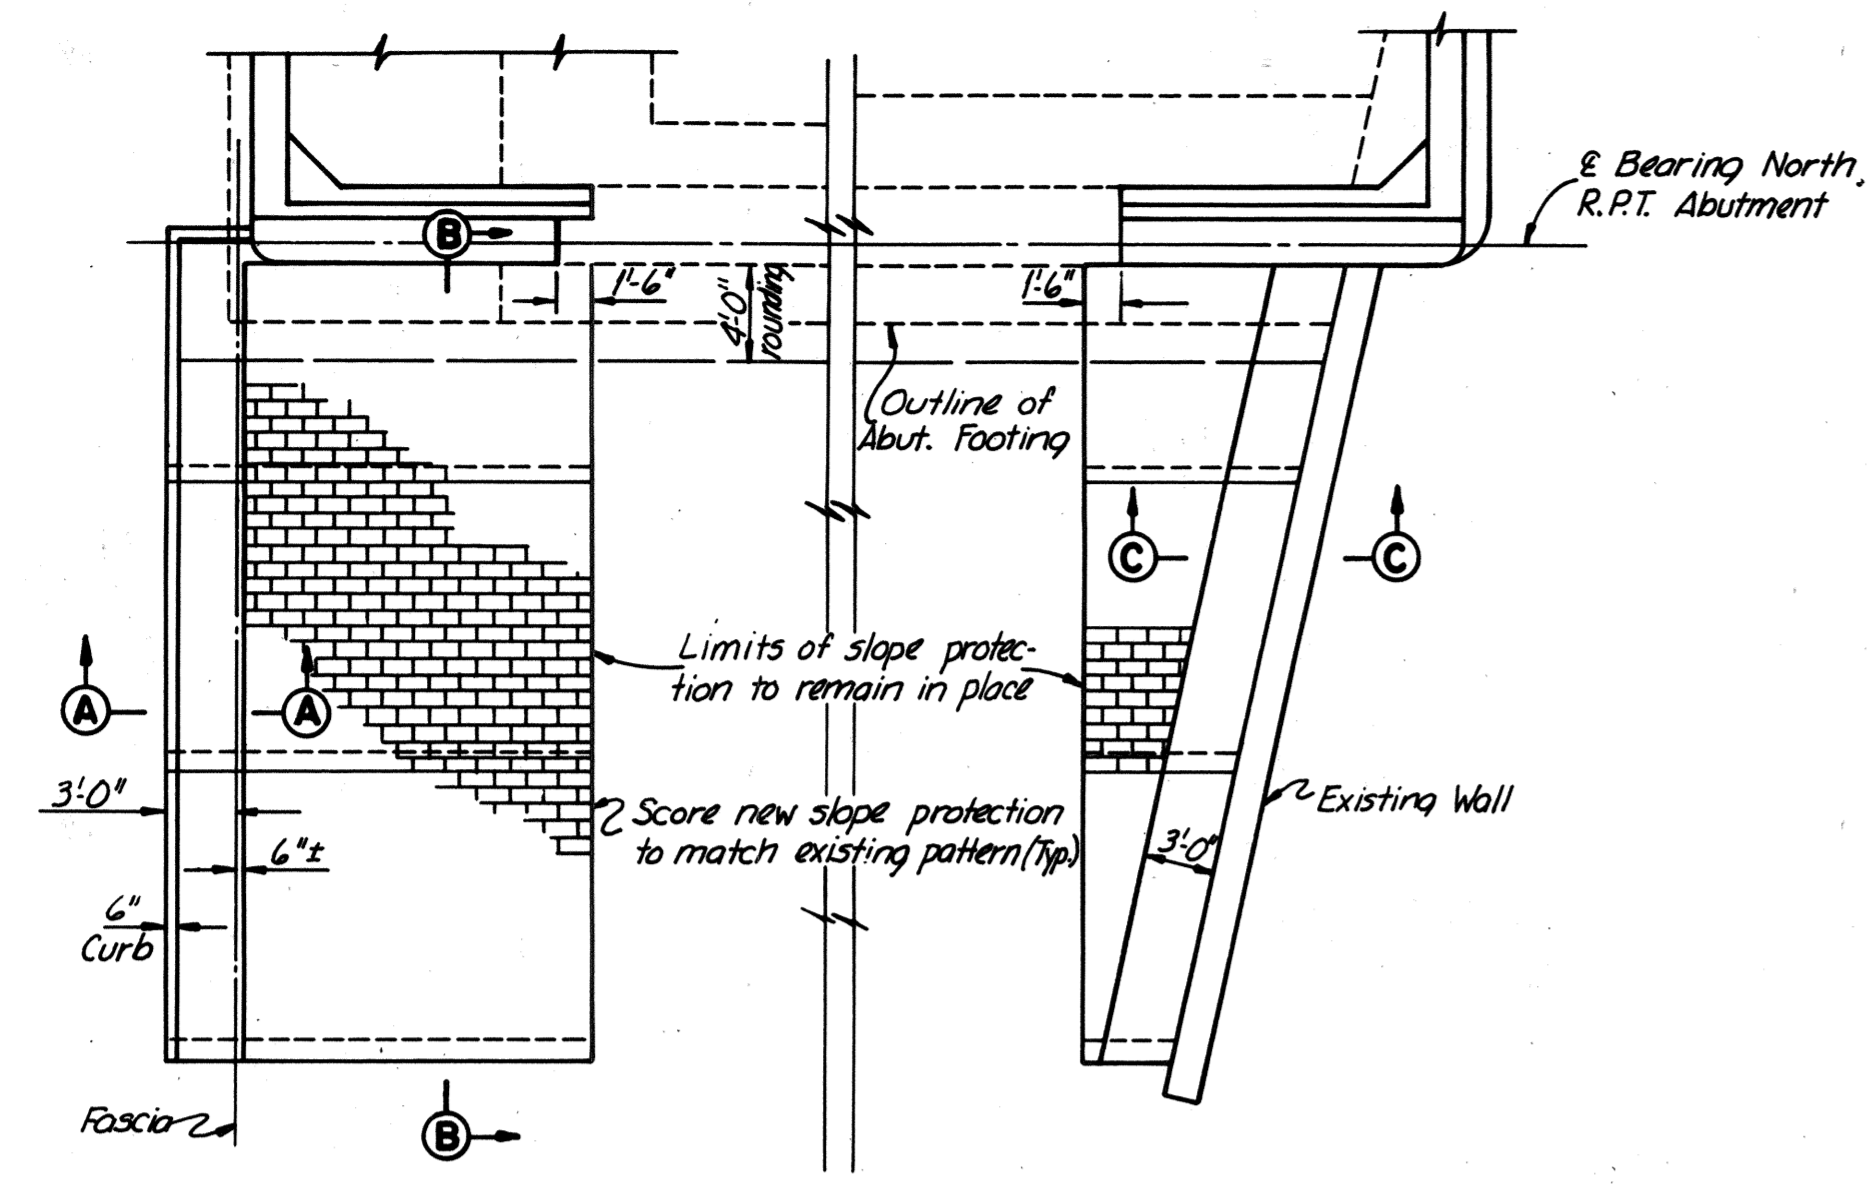

**PLAN OF SLOPE PROTECTION
NORTH ABUTMENT**
Scale: 1/8" = 1'-0"

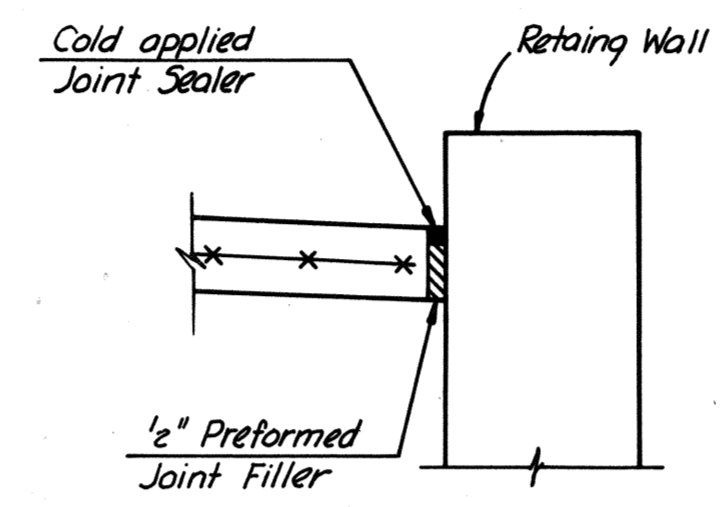


SECTION A-A
Scale: 1" = 1'-0"


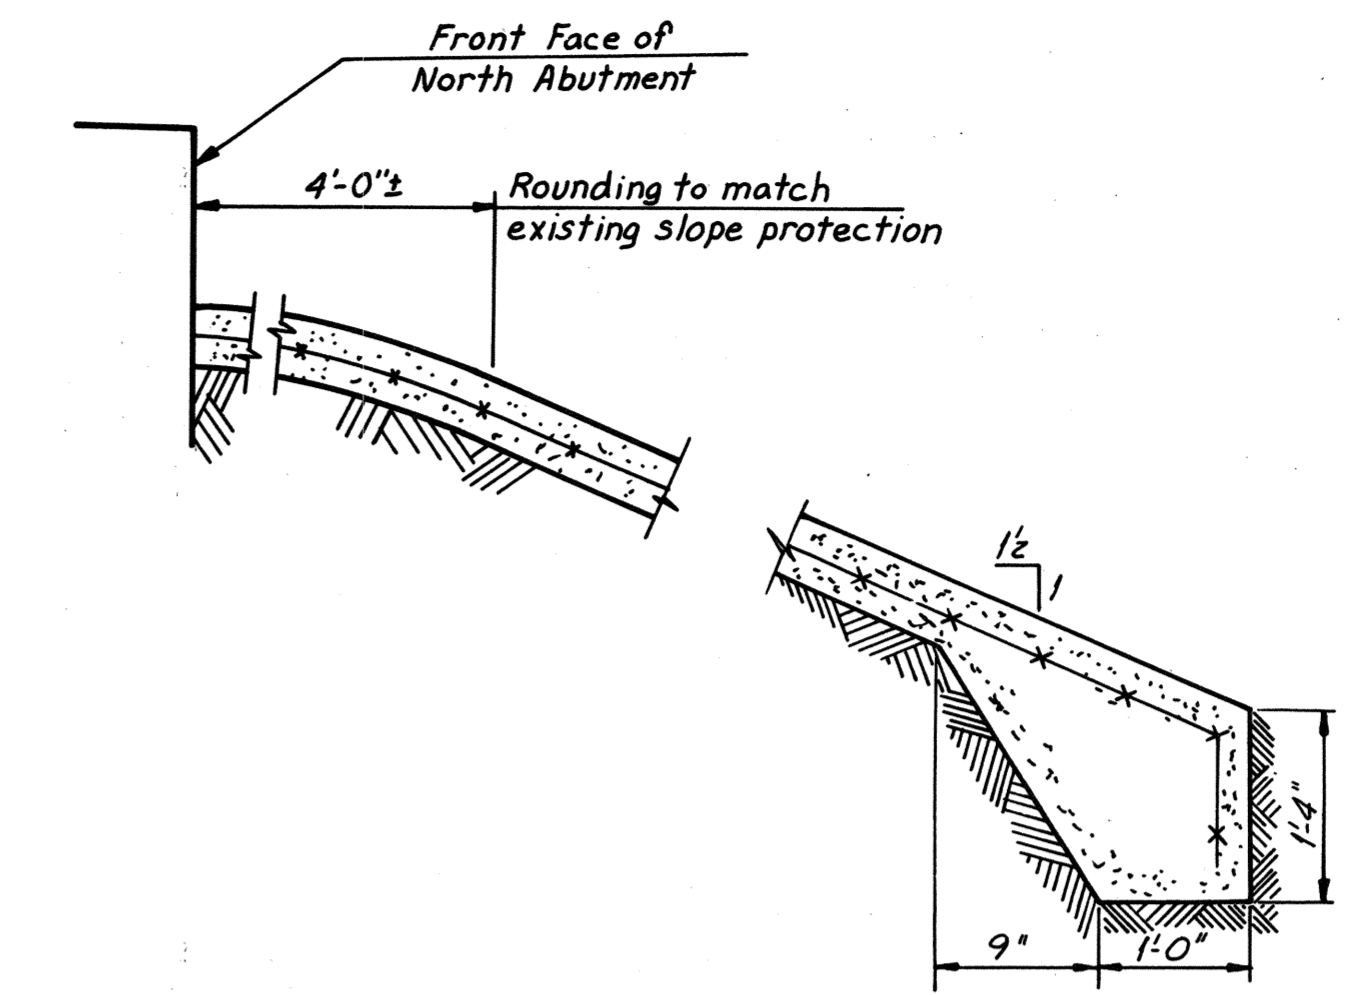


SECTION B-B
Scale: 1" = 1'-0"
See Section E-E this sheet for details not shown, except place keys every third construction joint.


SLOPE PROTECTION NOTE
The item "Cast-in-place Concrete Slab Slope Protection" shall include the excavation of, or the placing and compaction of any embankment material necessary to bring the surface of the paved slopes to the finished elevations shown on the plans.
"Cast-in-place Concrete Slab Slope Protection" shall be paid for at the contract unit price per square yard, which price shall include the concrete slab including wire mesh and joint filler. The slab shall be constructed in 4'-0" x 4'-0" panels, placed in horizontal courses, alternate panels being poured in a staggered pattern with adjacent panels poured later. The slab shall be Class A3 Concrete of such consistency that it can be placed without the use of top forms, the surface shall be finished with a wood float.
Reinforcing shall consist of wire mesh No. 6 gage, 6" C.C. each way, placed at the center of the slab, and continuous through construction joints.

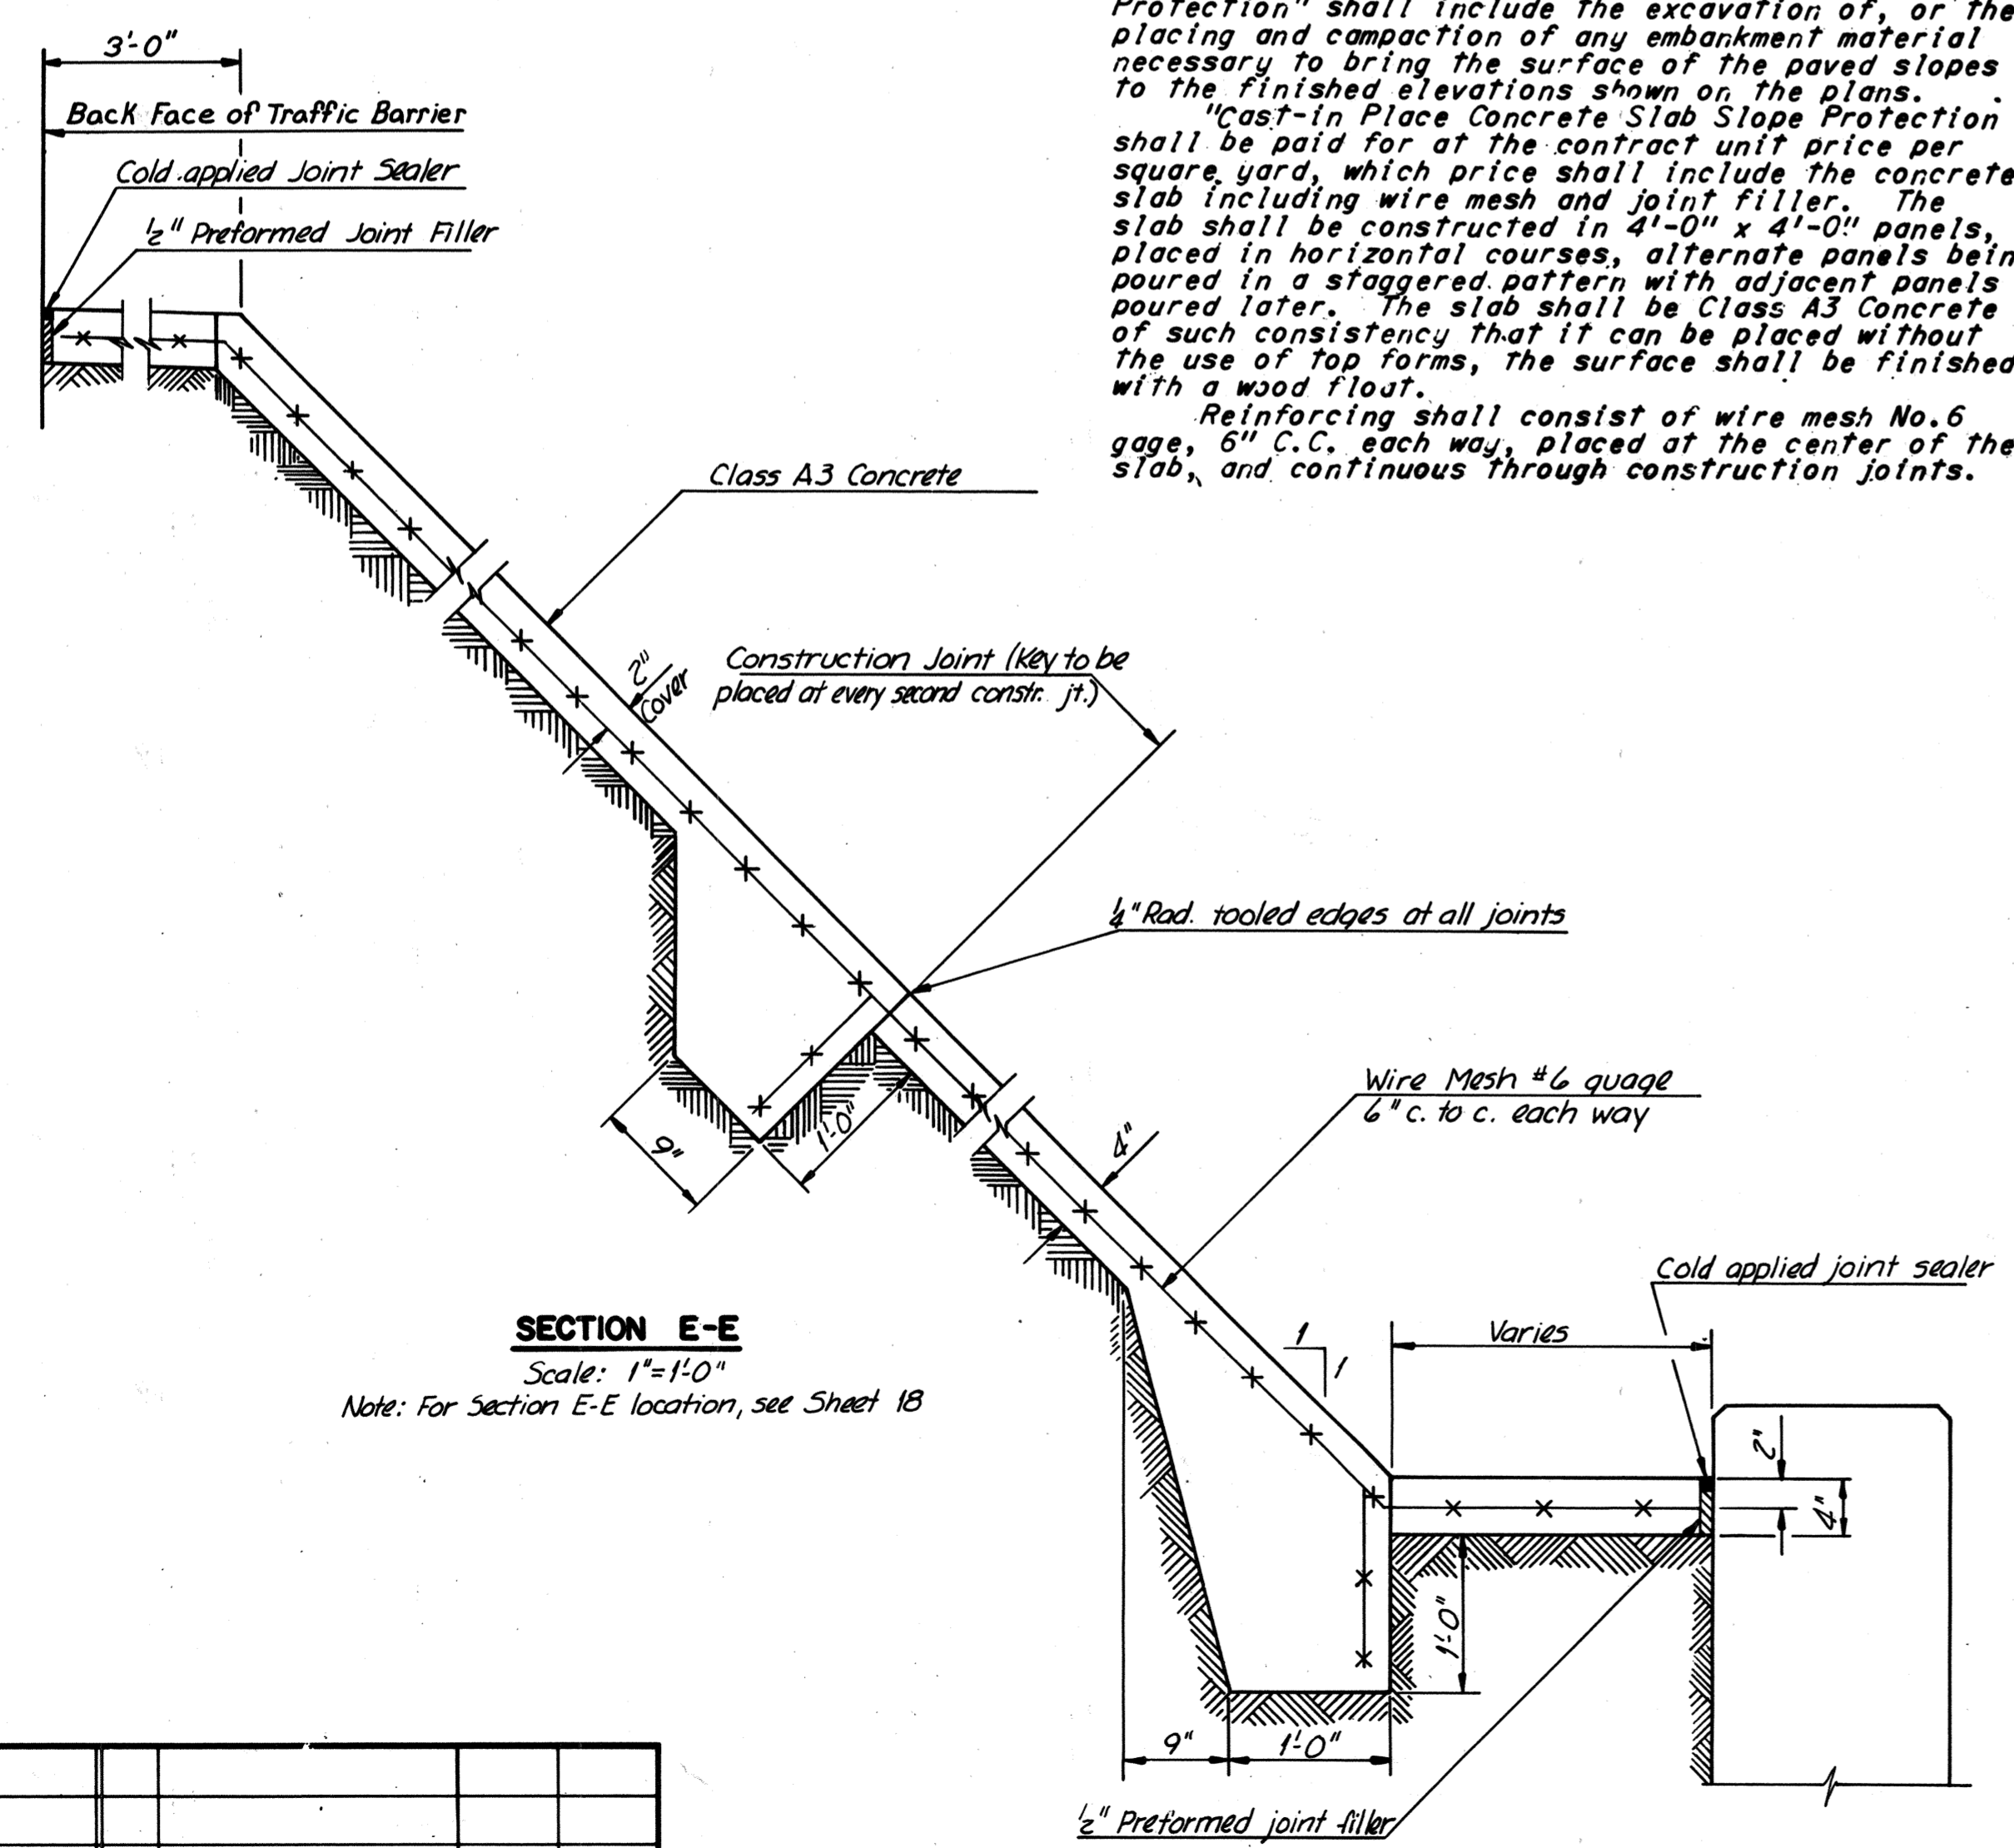


SECTION E-E
Scale: 1" = 1'-0"
Note: For Section E-E location, see Sheet 18

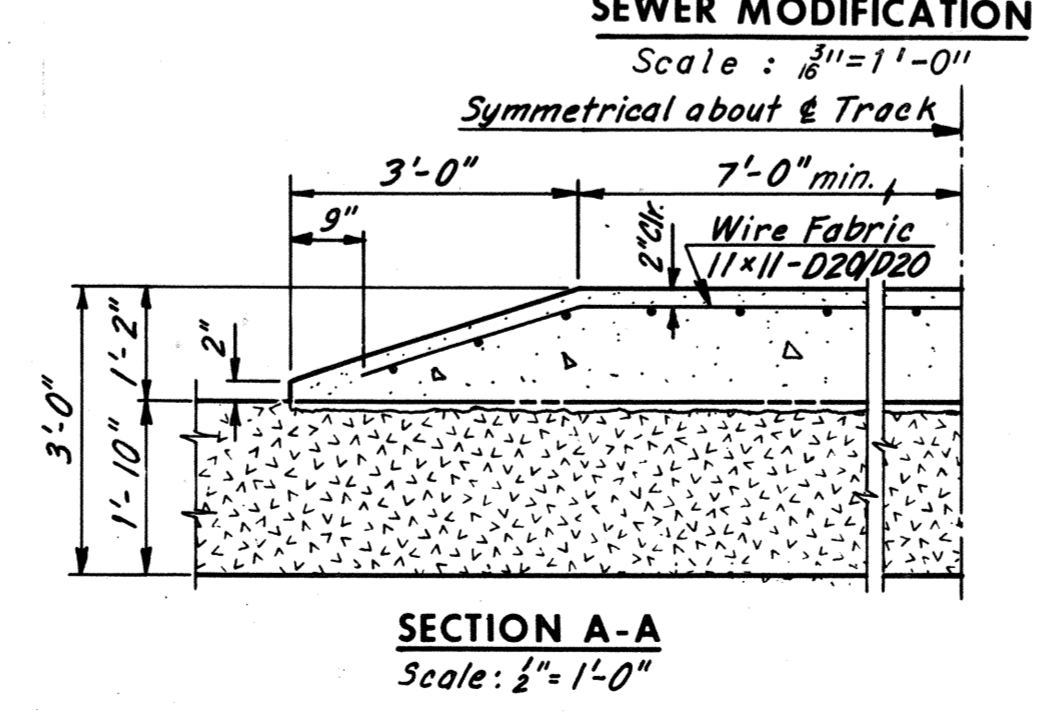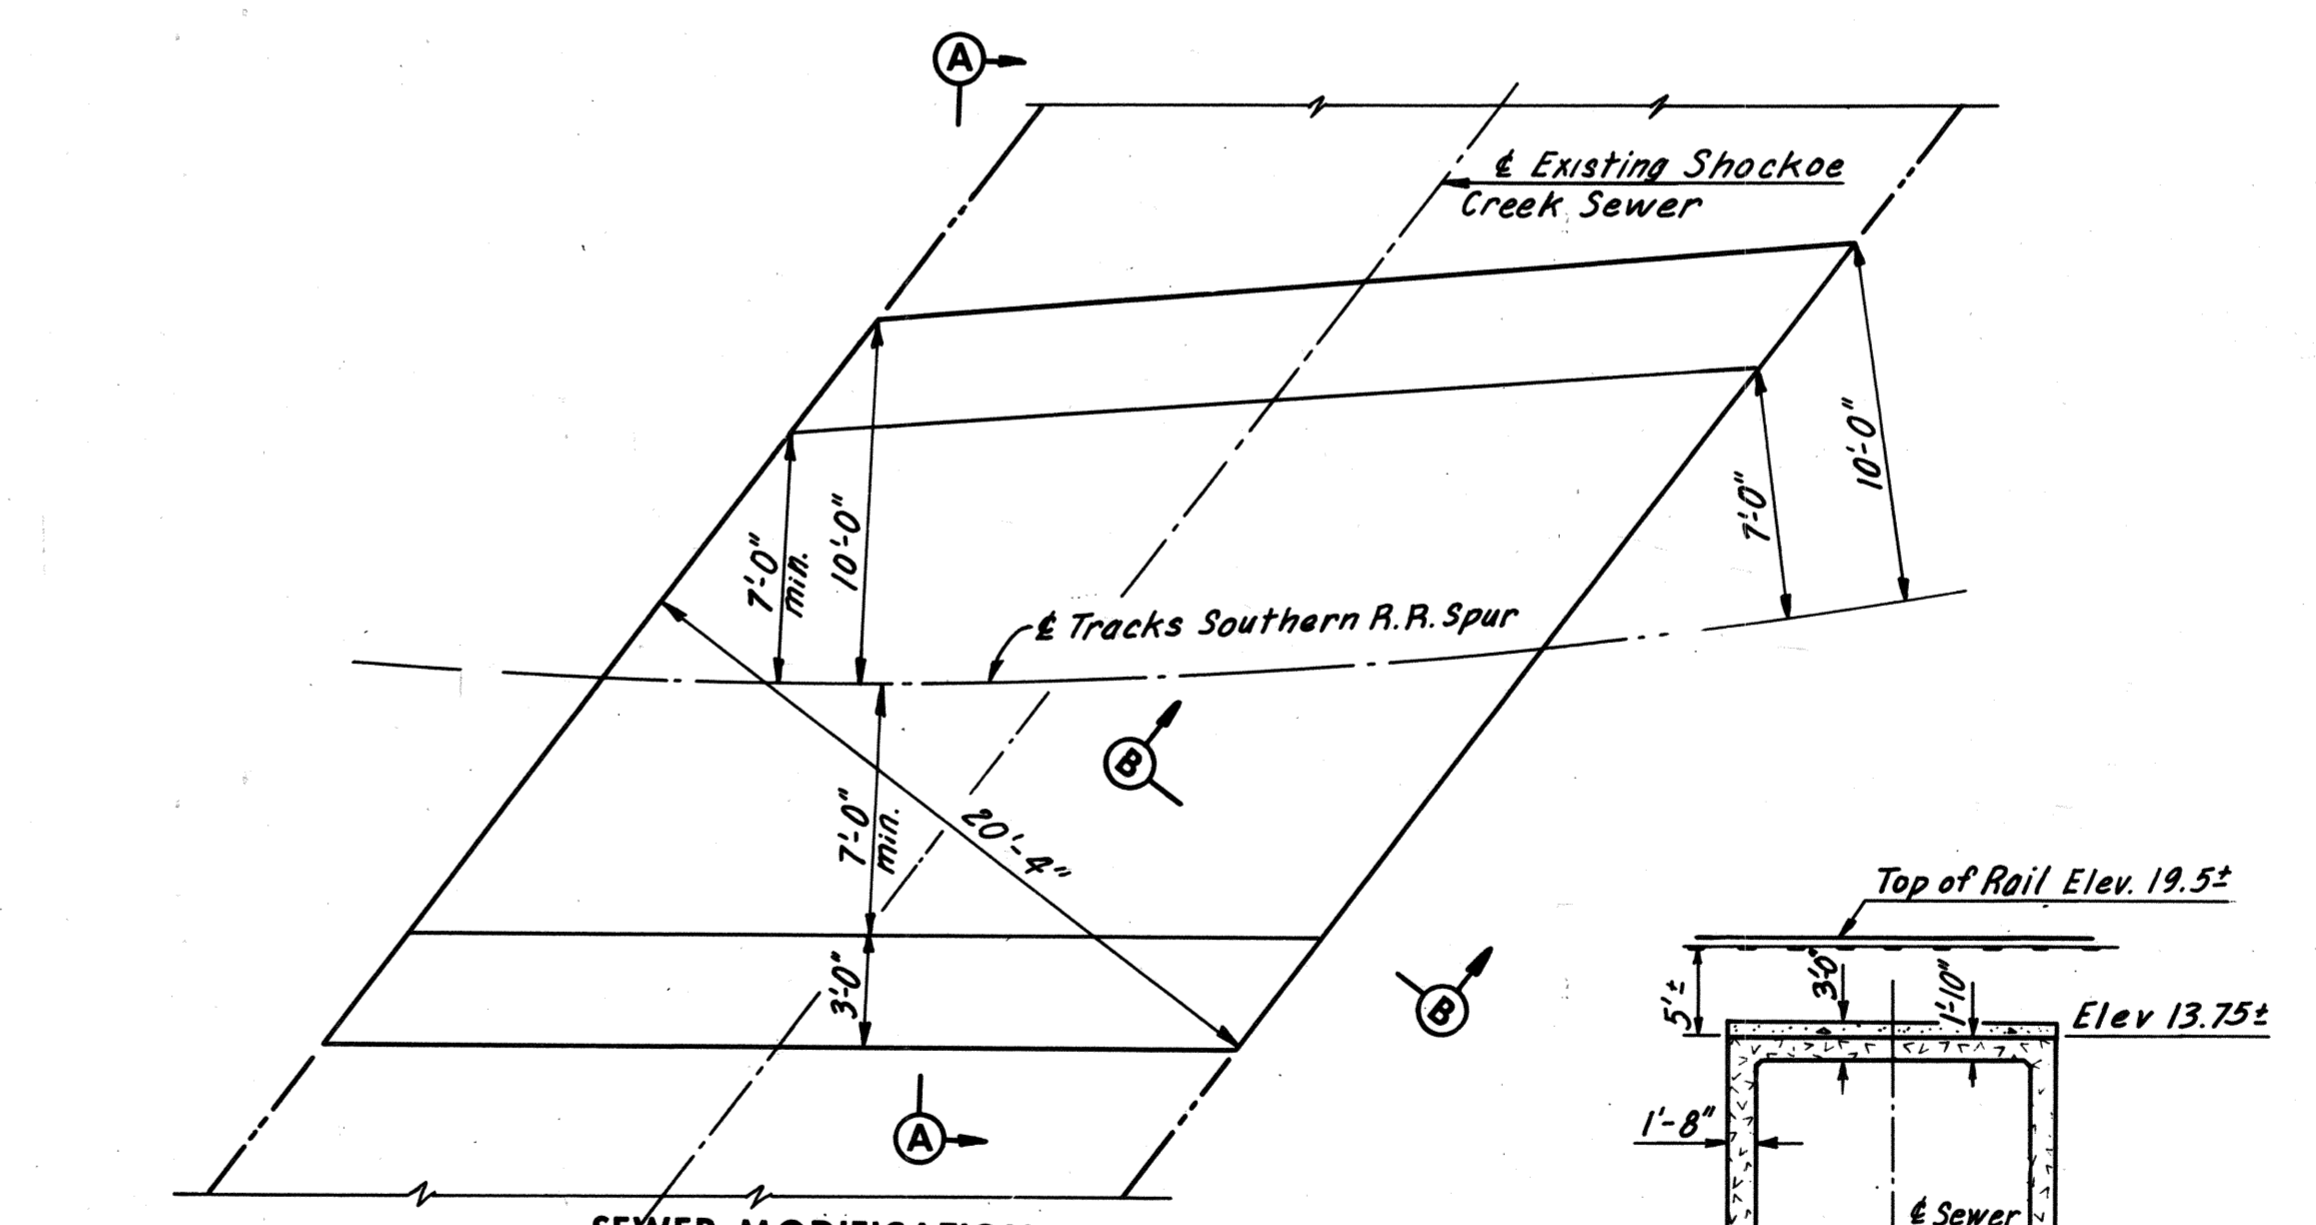

SECTION A-A
Scale: 1/2" = 1'-0"

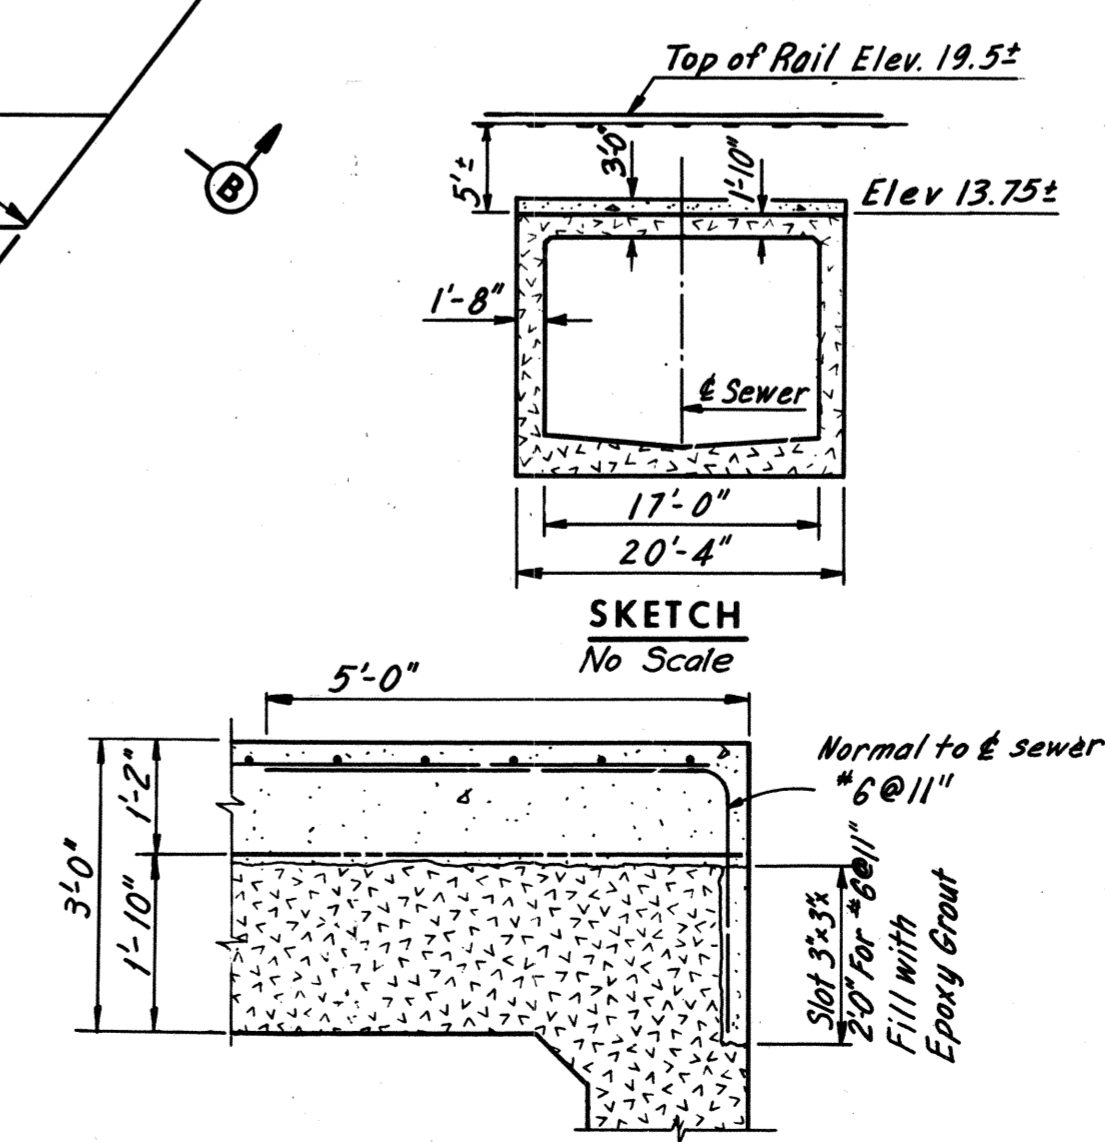

SECTION B-B
Scale: 1/2" = 1'-0"

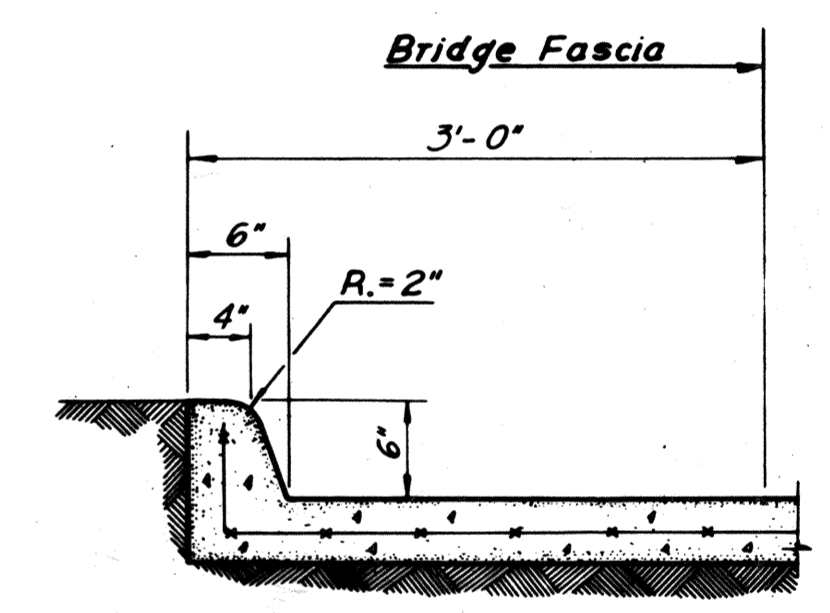

SECTION C-C
Scale: 1" = 1'-0"

DESIGNED	DRAWN	CHECKED	IN CHARGE	NO.	REVISION	BY	DATE
	JPE 4-74				As Built	TEM	6-77

**RICHMOND METROPOLITAN AUTHORITY
RICHMOND EXPRESSWAY SYSTEM**
DOWNTOWN EXPRESSWAY
BRIDGE NO. 67
RAMP W-N CONNECTION TO
RICHMOND - PETERSBURG TURNPIKE
SLOPE PROTECTION DETAILS

SCALE: As shown
CONTRACT 10 SHEET 50 OF 54

HOWARD, NEEDLES, TAMMEN & BERGENDOFF
CONSULTING ENGINEERS
Alexandria, Virginia

HNTB

AS BUILT



RICHMOND METROPOLITAN TRANSPORTATION AUTHORITY

RICHMOND EXPRESSWAY SYSTEM
CONTRACT NO. PC – 2018
PROTECTIVE COATING OF STRUCTURES

Bridge 68


Downtown Expressway

Ramp W-S Connection to
Richmond - Petersburg Turnpike

RECORD SET PLANS (Next 36)

RICHMOND EXPRESSWAY SYSTEM			
SECTION	PROJECT	SHEET NO.	TOTAL SHEETS
11	DOWNTOWN EXPRESSWAY	64	97

INDEX	SHEET
GENERAL PLAN AND ELEVATION	1
GENERAL PLAN AND ELEVATION	2
LAYOUT	3
PIERS 1 AND 2	4 AND 4A
PIER 3	5
PIER 4	6
PIER 5	7
PIERS 6 AND 7	8
PIERS 8, 9 AND 10	9
PIERS 11 AND 12	10
PIERS 13 AND 14	11
FRAMING PLAN UNITS 2 AND 3	12
FRAMING PLAN UNITS 4, 5 AND 6	13
FRAMING PLAN UNITS 7, 8, AND 9	14
FRAMING PLAN UNITS 10, 11 AND 12	15
FRAMING PLAN UNITS 13 THRU 18	16 AND 16A
FRAMING DETAILS	17
FRAMING DETAILS 2 AND 3	18
DECK PLAN UNITS 4, 5 AND 6	19
DECK PLAN UNITS 7, 8 AND 9	20
DECK PLAN UNITS 10, 11 AND 12	21
DECK PLAN UNITS 13 THRU 18	22
SUPERSTRUCTURE DETAILS	23
JOINT DETAILS	24
BORING LOGS	25 AND 26
STANDARD SHEETS	27 AND 28
EXISTING PIERS 42 & 44 MODIFICATIONS	51 THRU 56
	11A

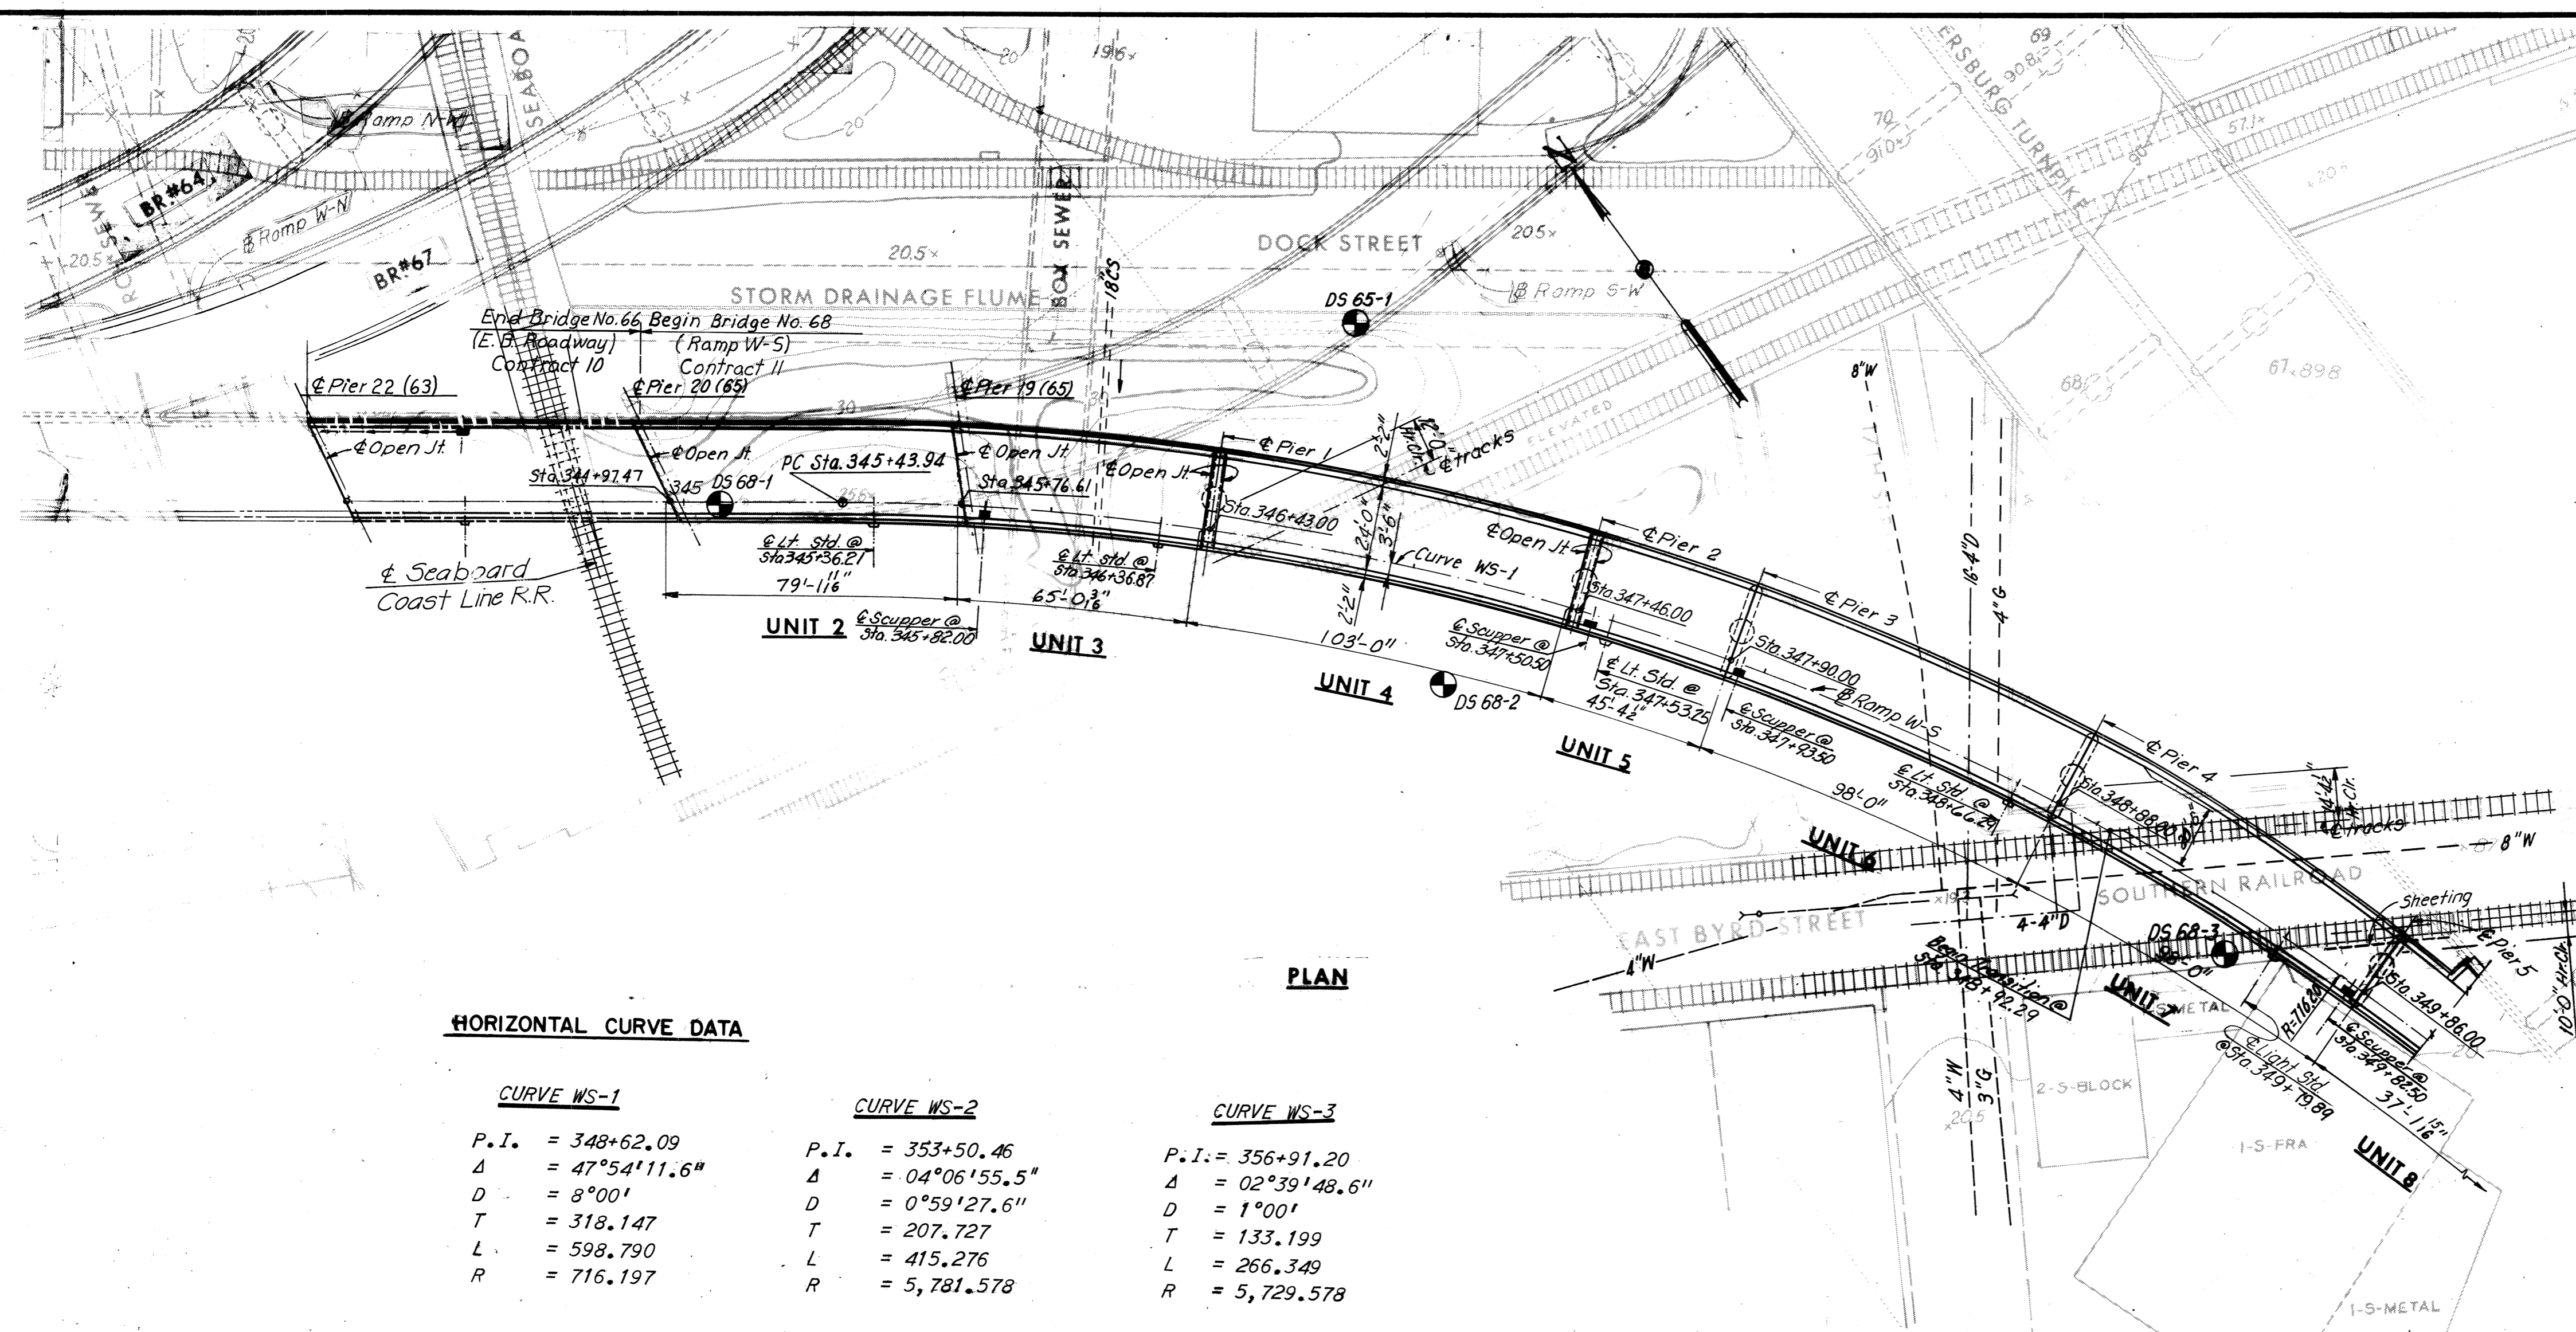

HORIZONTAL CURVE DATA

CURVE WS-1		CURVE WS-2		CURVE WS-3	
P.I.	= 348+62.09	P.I.	= 353+50.46	P.I.	= 356+91.20
Δ	= 47°54'11.6"	Δ	= 04°06'55.5"	Δ	= 02°39'48.6"
D	= 8°00'	D	= 0°59'27.6"	D	= 1°00'
T	= 318.147	T	= 207.727	T	= 133.199
L	= 598.790	L	= 415.276	L	= 266.349
R	= 716.197	R	= 5,781.578	R	= 5,729.578

GENERAL NOTES

- ROADWAY:** One 24'-0" clear roadway transitioning into a 13'-6" widening of existing Richmond-Petersburg Turnpike.
- CAPACITY:** Dead load includes 15lbs. per sq.ft. for future wearing surface. Live load HS 20-44 loading and alternate military loading.
- SPECIFICATIONS:**
 - GENERAL:** Virginia Department of Highway Road and Bridge Specifications 1970.
 - DESIGN:** A.A.S.H.O. Standard Specifications for Highway Bridges 1973, modified by Special Design provisions.
 - WELDING:** 1972 Structural Welding Code of the American Welding Society.

DATUM:

City of Richmond

EXCAVATION:

Excavation below subgrade and cut slope template shall be classified as Regular Excavation. All excavation above these limits shall be classified as Regular Excavation and is not included in the Structural Quantities.

FOUNDATIONS:


Footings shall rest on firm material. Foundation material shall be dry and special attention is called to Section 401.05 of General Specifications and to the Contract Special Provisions, concerning preparation of foundations for footings.

CONCRETE NOTES:

Concrete in superstructure shall be Class A-4. All other concrete shall be Class A-3. All exposed edges and corners shall have a 3" chamfer or fillet unless otherwise noted. Care in the method of vibration, the use of low-slump concrete, and or other means shall be employed to prevent downgrade movement of newly placed slab concrete. Finishing Concrete Surfaces: See Standard Architectural Detail Sheets and the Contract Special Provisions for types and details. All reinforcing steel shall be deformed bars conforming to ASTM A615 Grade 40. All reinforcing bar dimensions on the detailed drawings are to centers of bars unless otherwise noted. Clear distance between reinforcing steel and face of concrete shall be as noted on the plans. All bar laps shall be 30 diameters of the smaller diameter bar unless otherwise noted.

STEEL NOTES:

Structural steel shall conform to A.S.T.M. Designations A36, A572-Grade 50 and A588 as noted. See Special Provisions. All field connections shall be made with high strength bolts. High strength bolts shall be 1" diameter unless otherwise noted and shall conform to A.S.T.M. Specification A-325.

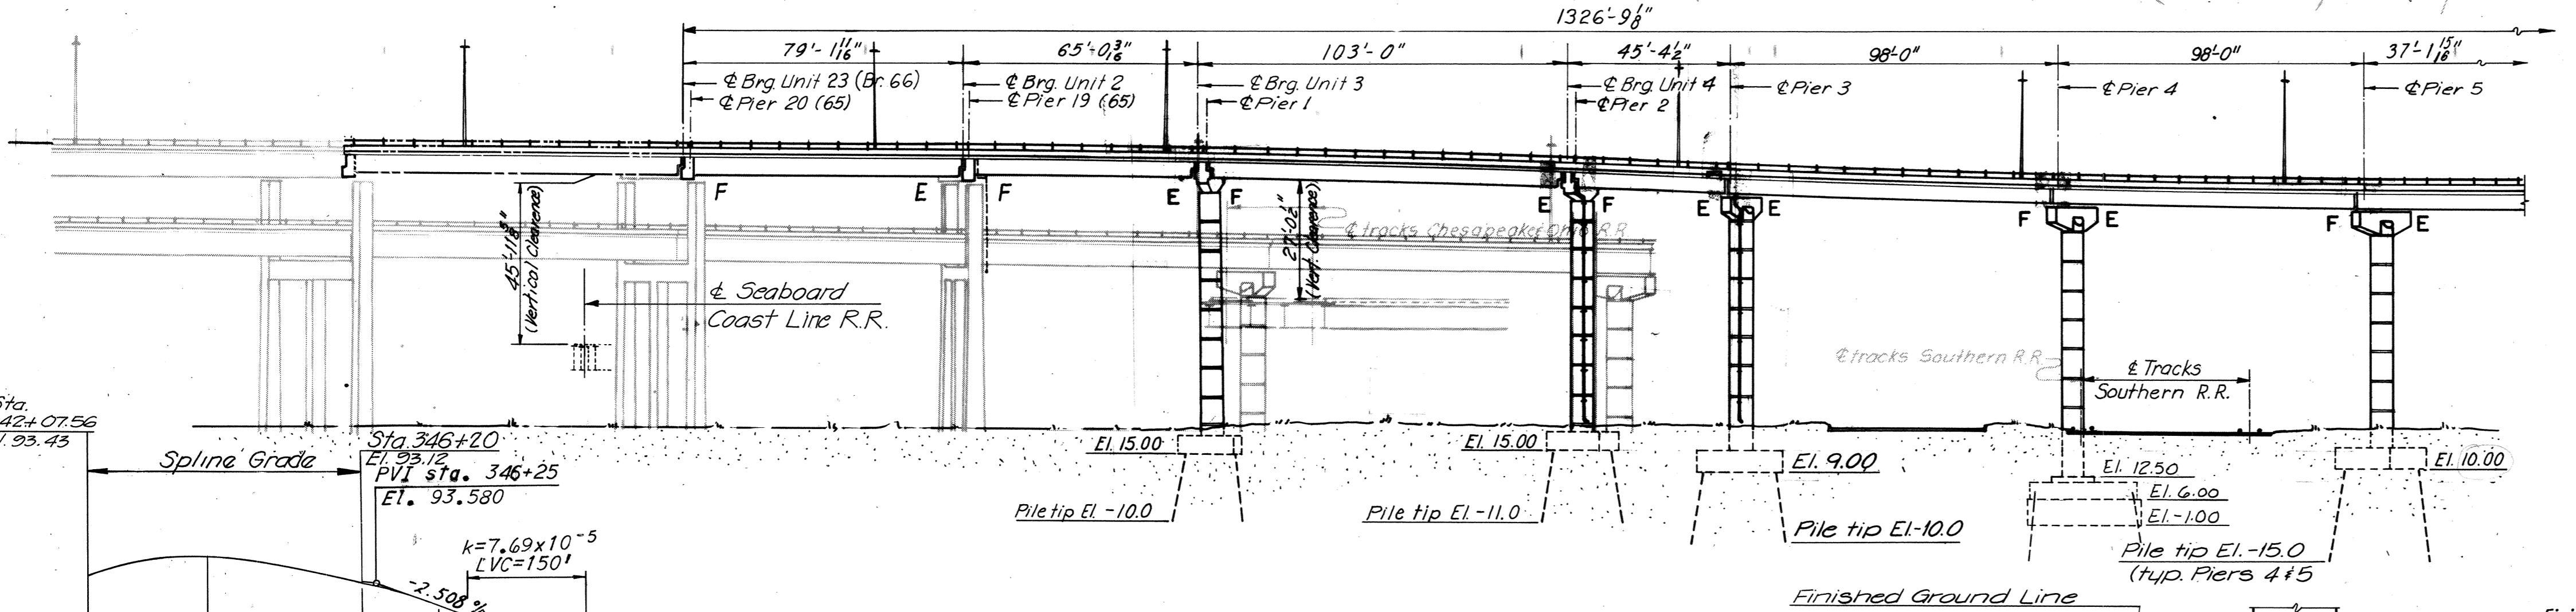


ELEVATION

BY	DATE	REVISION	BY	DATE
J.V.	4-2-69	Profile Grade W-5, Index	TEM	8-26-75
G.S.H.	7-16-69	Seaboard Coast Line Added	TEM	6-74

△ PROFILE GRADE B RAMP W-5


LIMITS OF STRUCTURE EXCAVATION

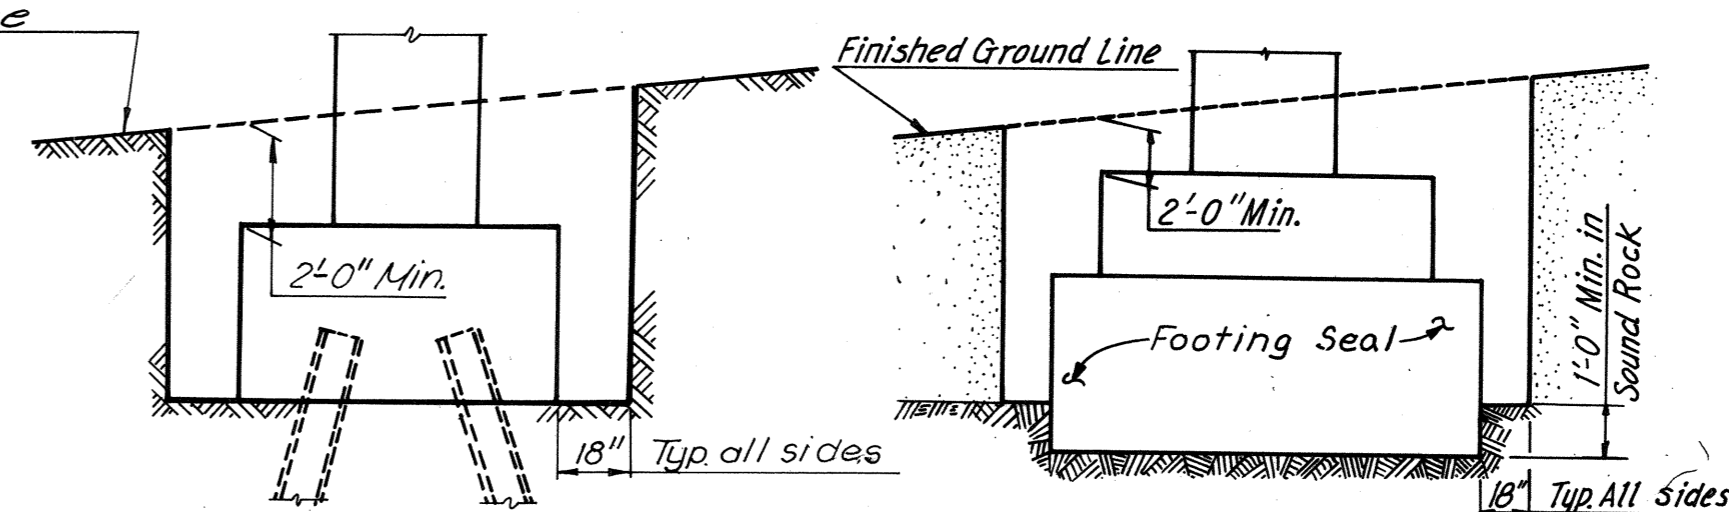


AS BUILT
RICHMOND METROPOLITAN AUTHORITY
RICHMOND EXPRESSWAY SYSTEM
DOWNTOWN EXPRESSWAY
BRIDGE NO. 68
RAMP W-5 CONNECTION TO
RICHMOND-PETERSBURG TURNPIKE
GENERAL PLAN AND ELEVATION

HOWARD, NEEDLES, TAMMEN & BERGENOFF consulting engineers NEW YORK ALEXANDRIA KANSAS CITY	SCALE: 1"=30' CONTRACT NO. 11 SHEET NO. 1 OF 28
--	---

RICHMOND EXPRESSWAY SYSTEM			
SECTION	PROJECT	SHEET NO.	TOTAL SHEETS
11	DOWNTOWN EXPRESSWAY	65	97

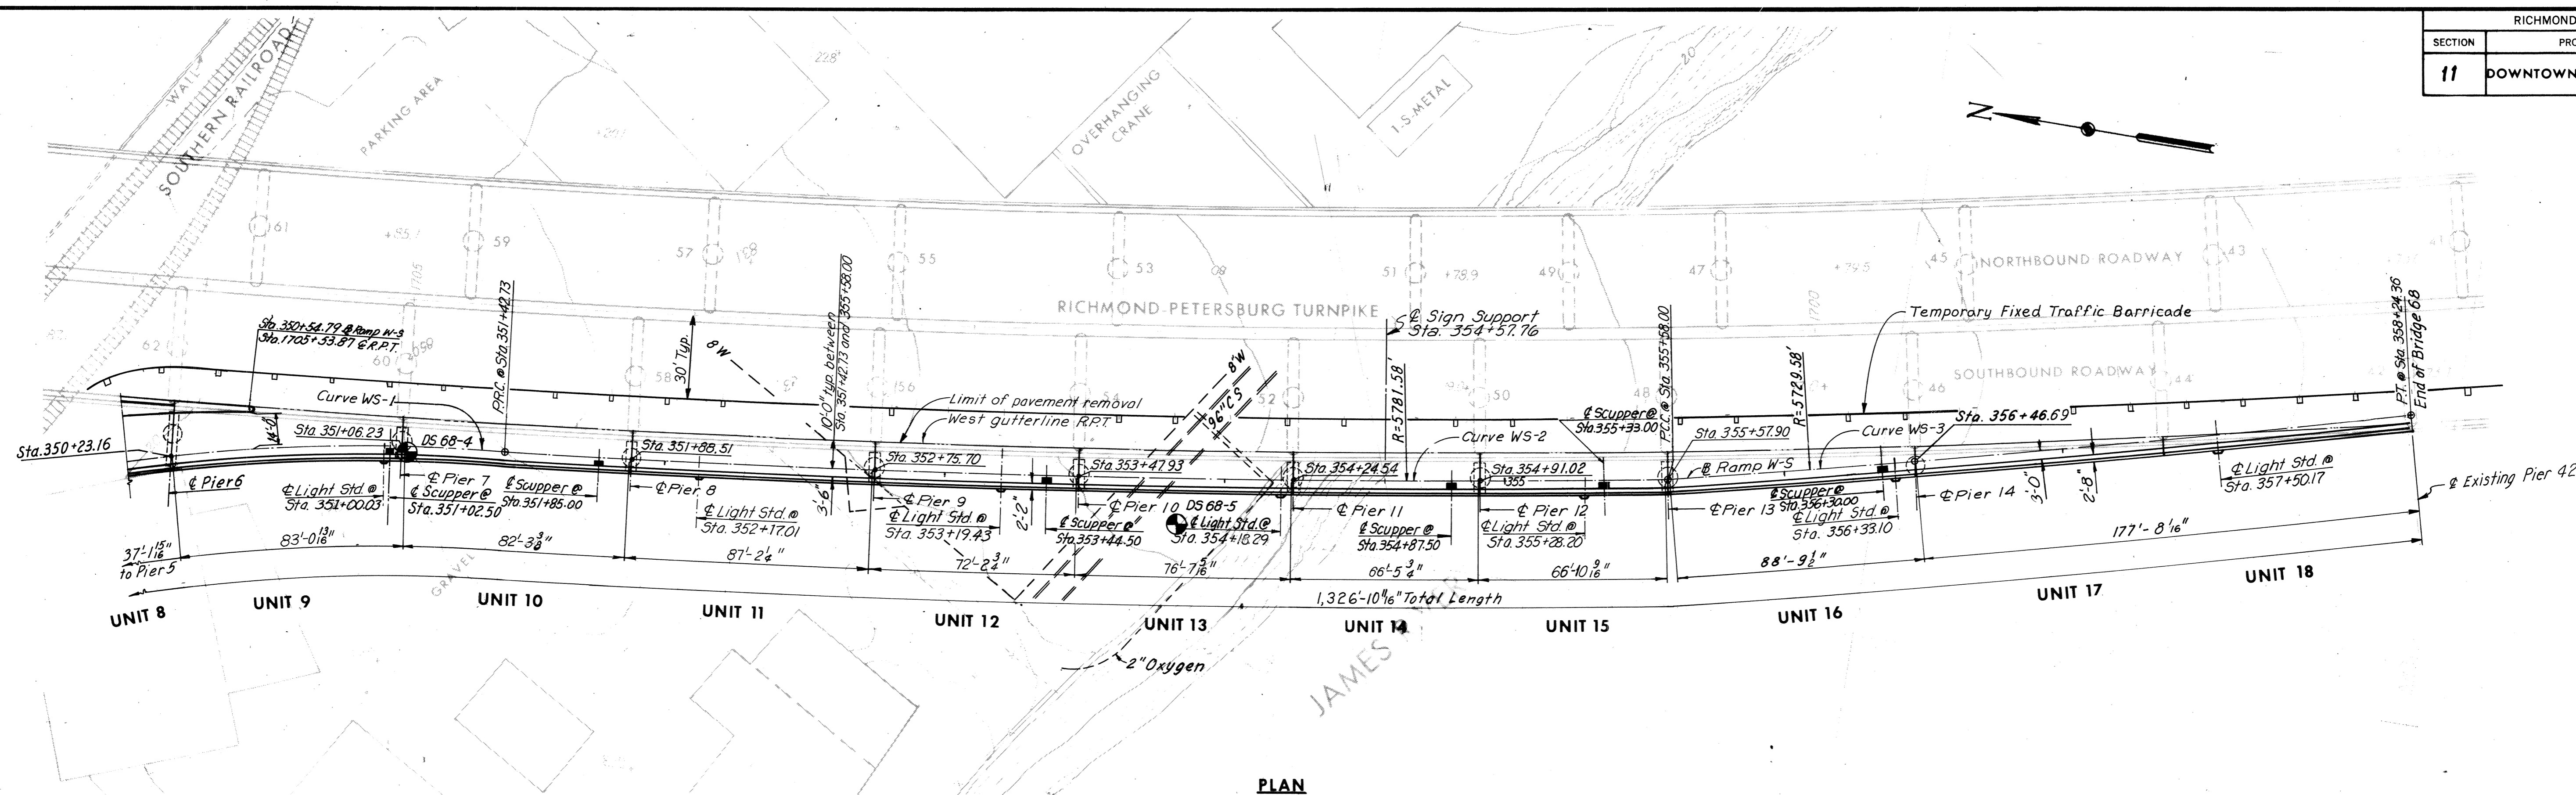

PLAN

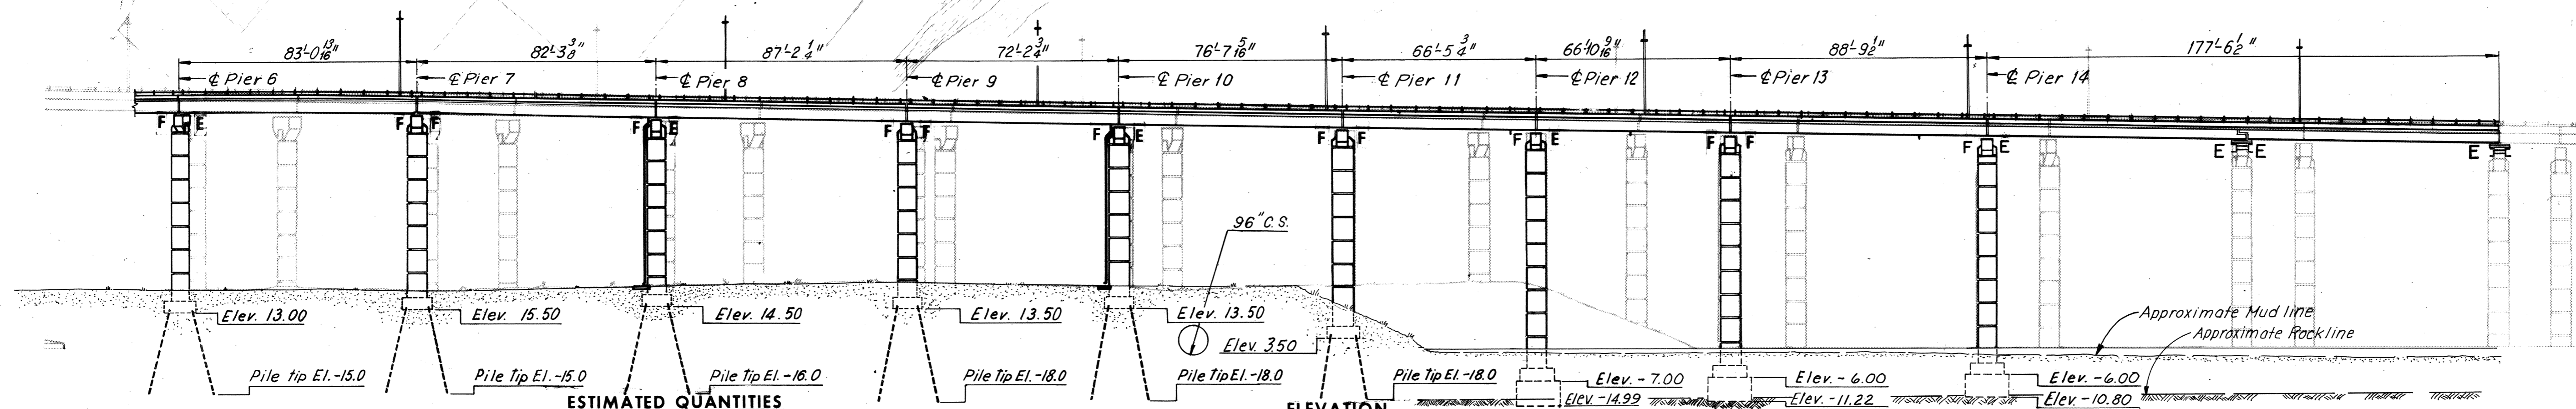

ELEVATION

ESTIMATED QUANTITIES

	Structure Excavation	Concrete	Reinforcing Steel	Str. Steel Mild carbon	Str. Steel High Strength	Aluminum Railing (1-rail)	Steel Piles 10BP42
	Cu. Yds.	Cu. Yds.	Lbs.	Lbs.	Lbs.	Lin. Ft.	Lin. Ft.
Superstructure	----	888.7	215,200	600,400	255,600	1,849	-----
Substructure	1,415*	1,751.0	245,300	31,600	8,400	---	2,630
Total	1,415*	2,639.7	460,500	632,000	264,000	1,849	2,630

	Steel Piles 12BP53	Tremie Concrete Class T3	Sheeting Pier 5	Metal Conduit	Bridge Drainage	Modifications to R.P. Turnpike Bridge	Modifications to Existing Retaining Wall	Temporary Barricade
	Lin. Ft.	Cu. Yds.	Lump Sum	Lin. Ft.	metal work Lbs.	Lump Sum	Cu. Yds.	Lin. Ft.
Superstructure	---	---		1,310	11,450	1	50	
Substructure	1,412	173.3	1	---	---	---	---	
Total	1,412	173.3	1	1,310	11,450	1	50	990

* Including 365 Cu. Yds. of "Underwater" Excavation for Piers 12, 13 and 14.
 * All concrete for Superstructure shall be Class A4 and for Substructure Class A3. Concrete for Footing Seals shall be Tremie Concrete, Class T3 and is listed separately.

BY	DATE	REVISION	BY	DATE
MADE	J.V. 4-3-69			
CHECKED	G.S.H. 7-16-69	At Pier 44 # 42	T.E.M. 8-26-75	
IN CHARGE				

AS BUILT


RICHMOND METROPOLITAN AUTHORITY
RICHMOND EXPRESSWAY SYSTEM
DOWNTOWN EXPRESSWAY

BRIDGE NO. 68
RAMP W-S CONNECTION TO
RICHMOND-PETERSBURG TURNPIKE
GENERAL PLAN AND ELEVATION

HOWARD, NEEDLES, TAMMEN & BERGENDOFF
 consulting engineers
 NEW YORK ALEXANDRIA KANSAS CITY


SCALE: 1"=30'
 CONTRACT NO. 11
 SHEET NO. 2 OF 28

RICHMOND EXPRESSWAY SYSTEM			
SECTION	PROJECT	SHEET NO.	TOTAL SHEETS
11	DOWNTOWN EXPRESSWAY	66	97

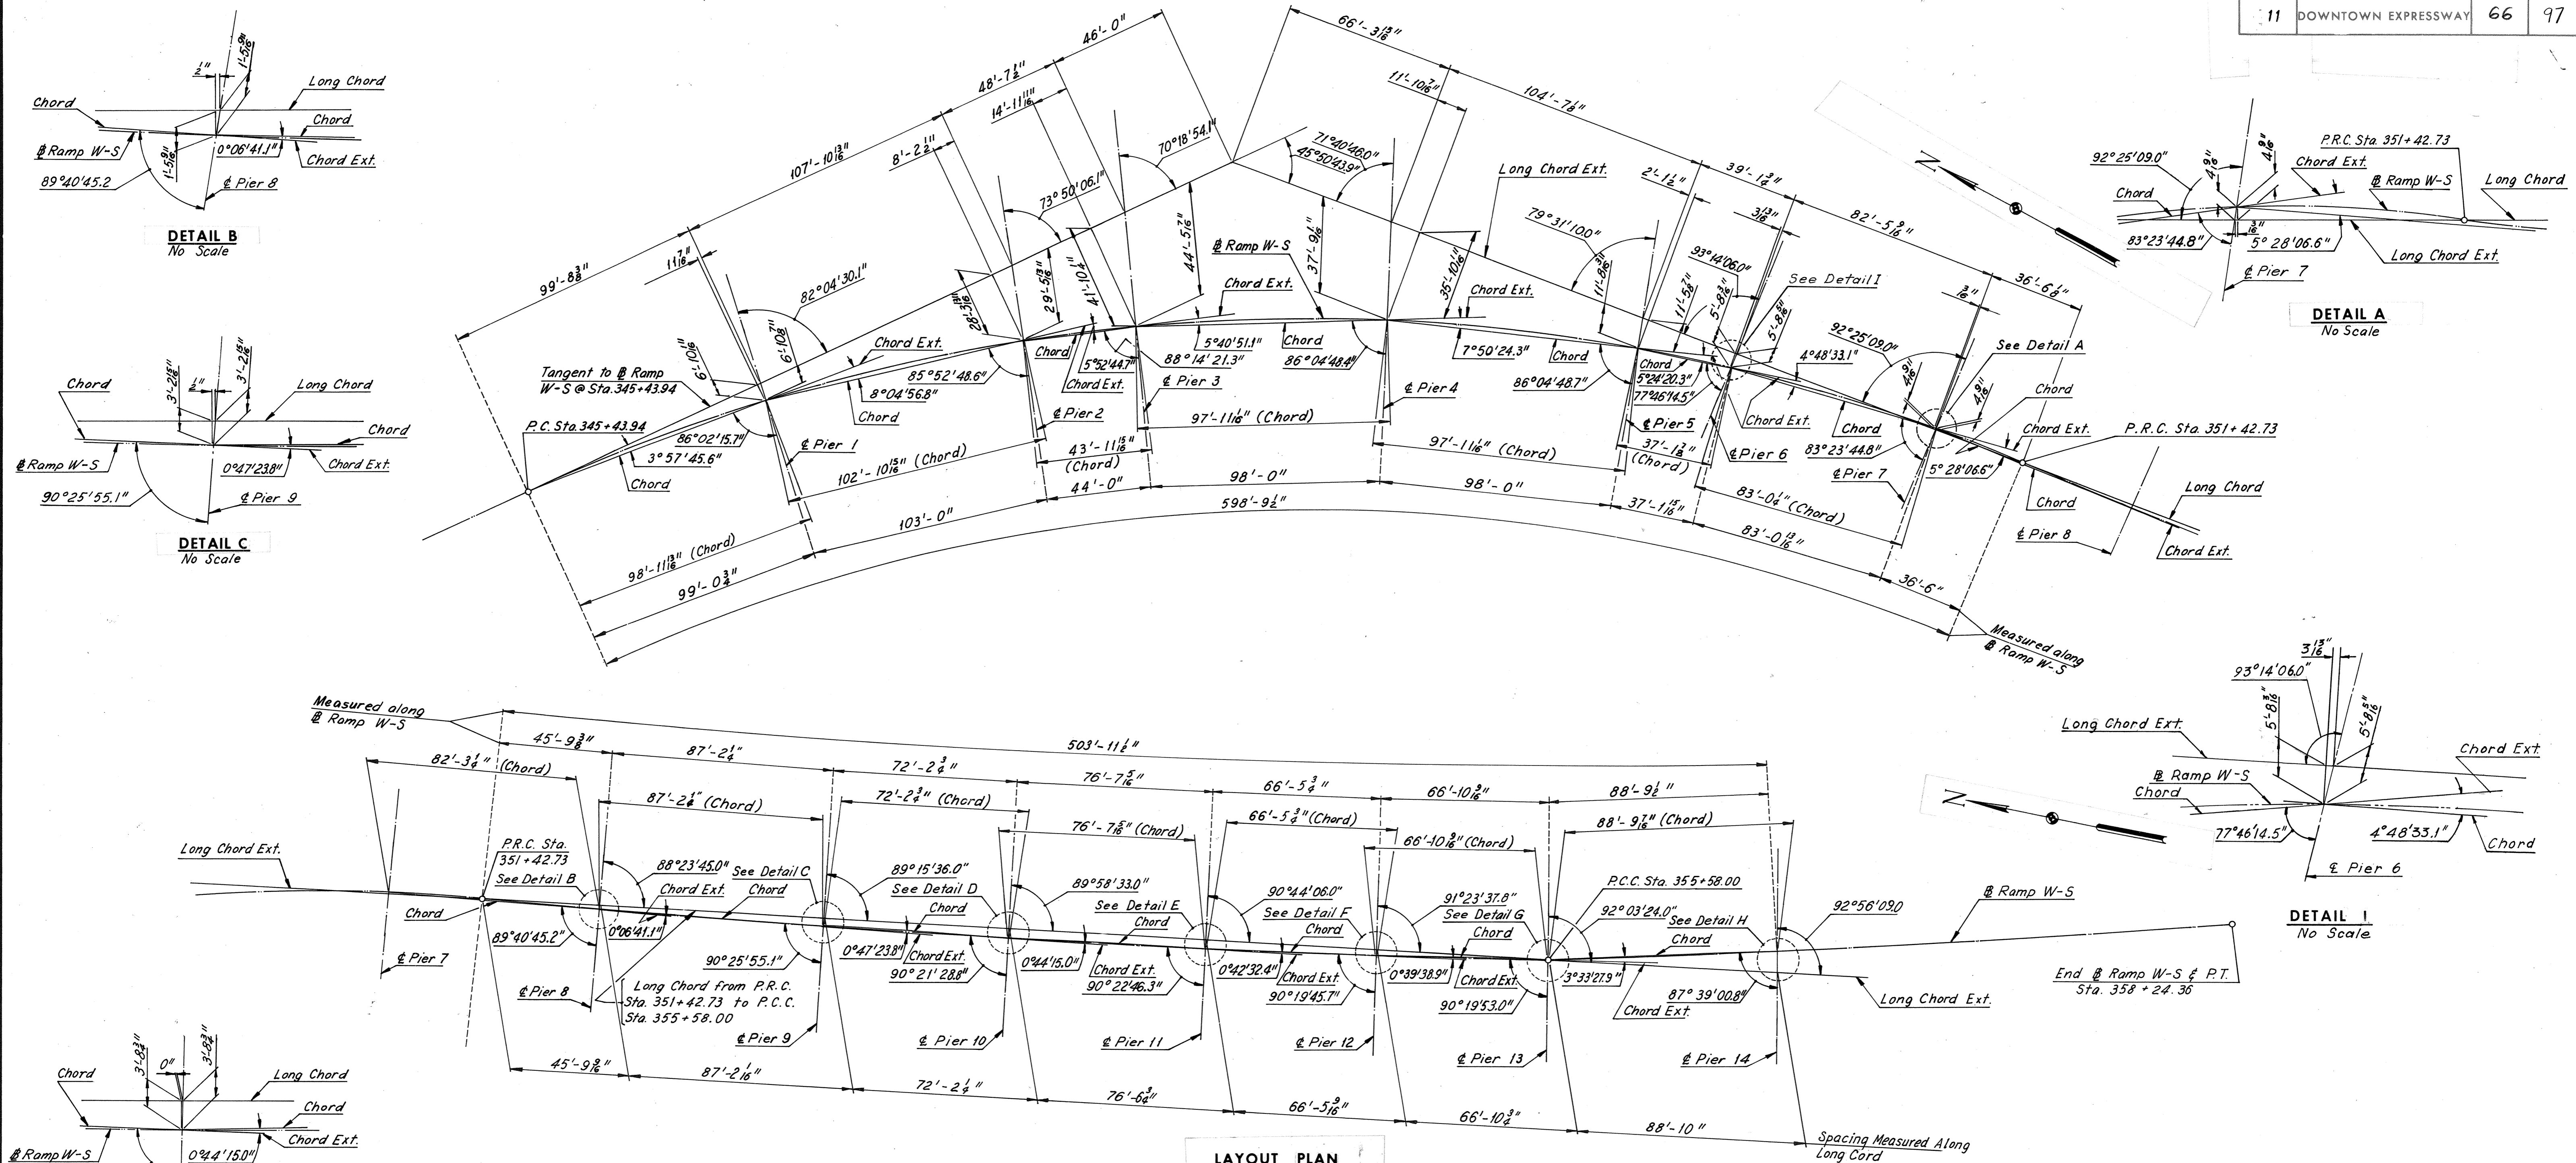


LAYOUT PLAN
Scale: 1" = 30'-0"


DETAIL B
No Scale

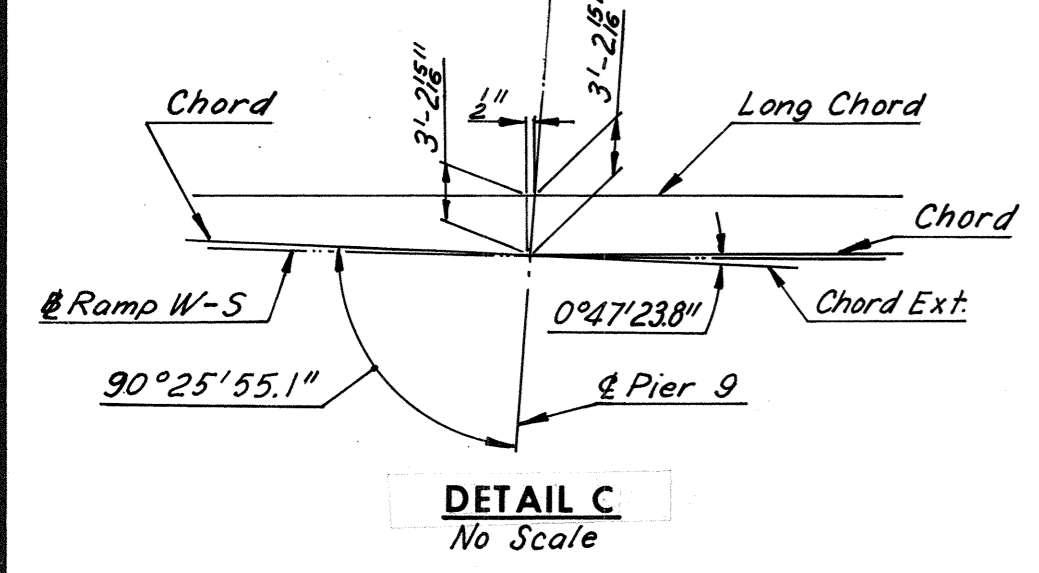



DETAIL A
No Scale

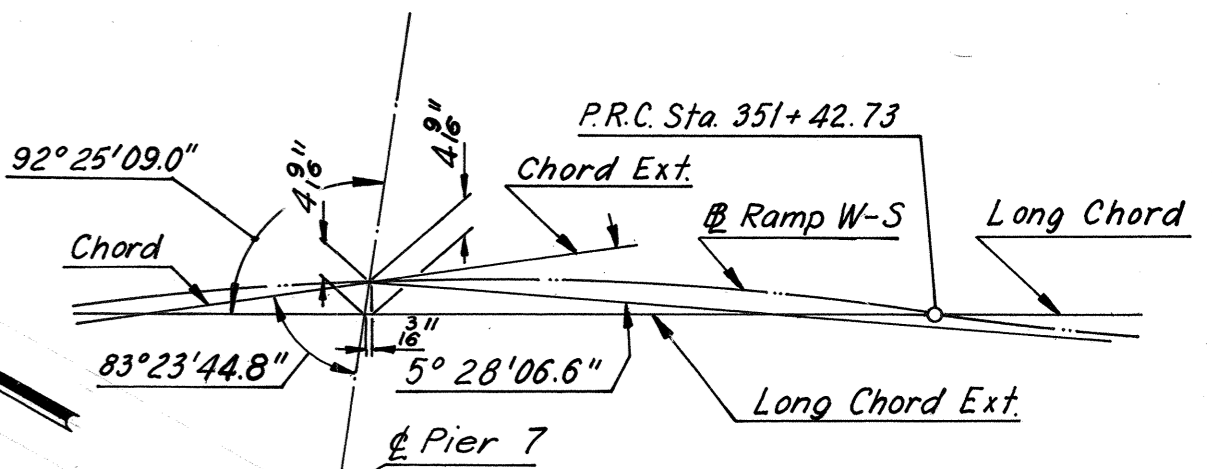


DETAIL C
No Scale

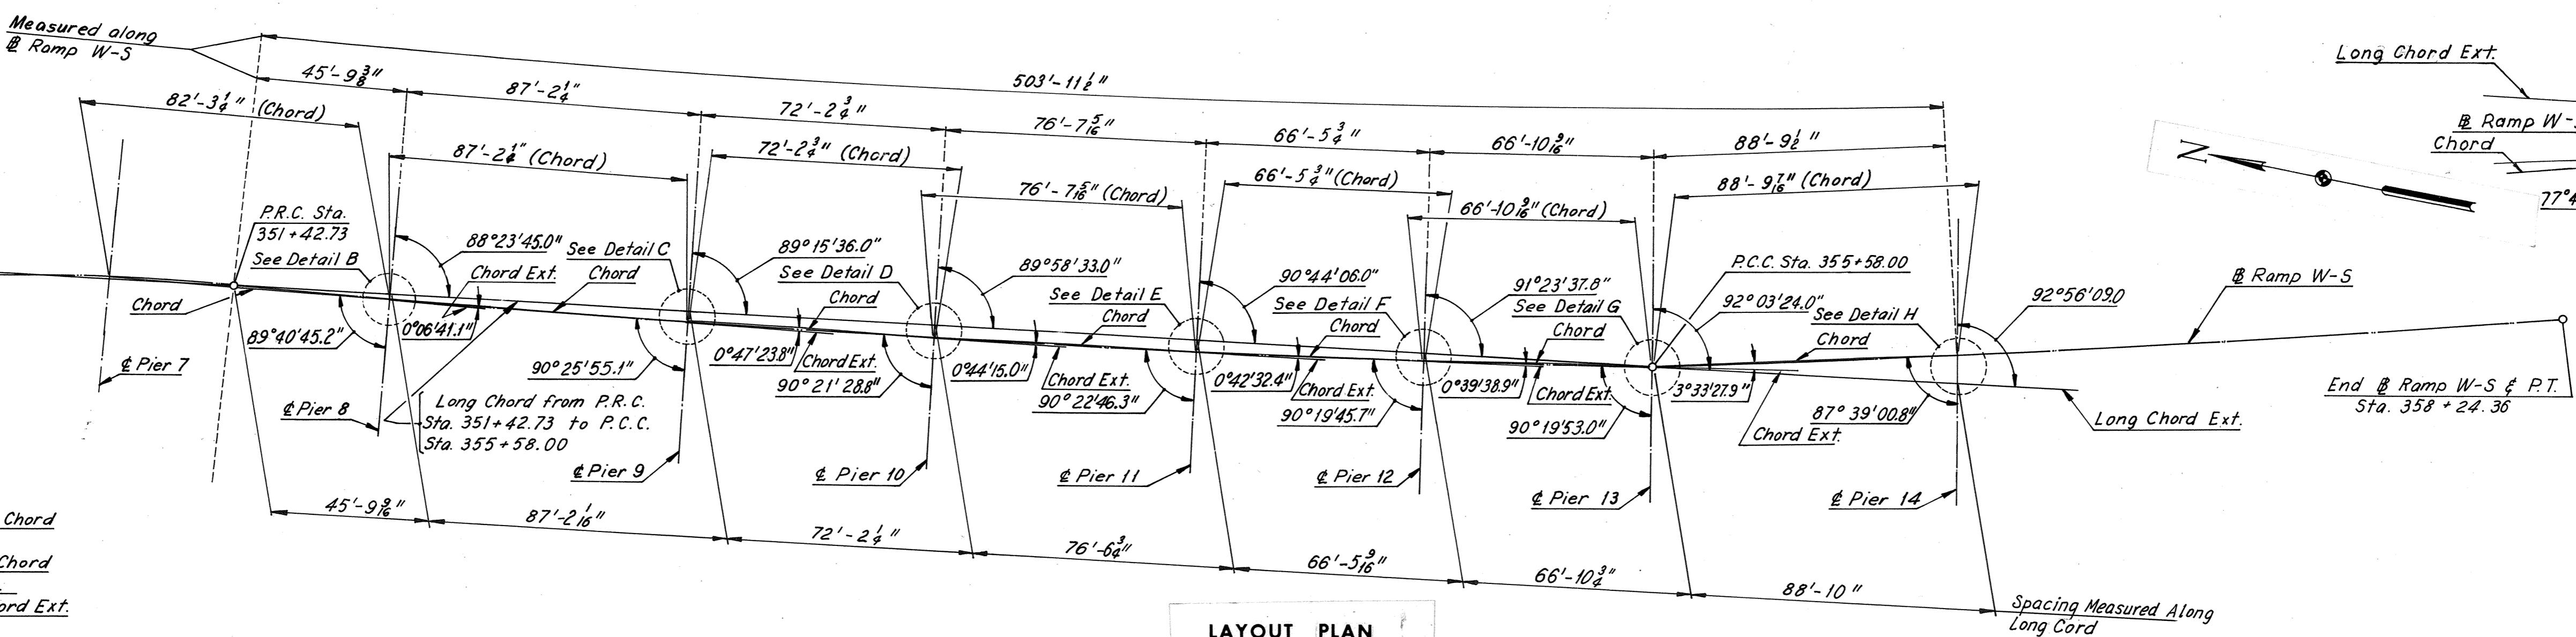


DETAIL I
No Scale

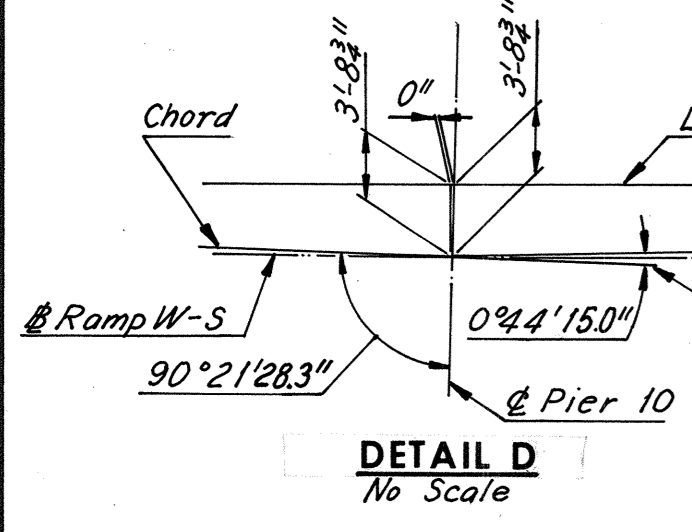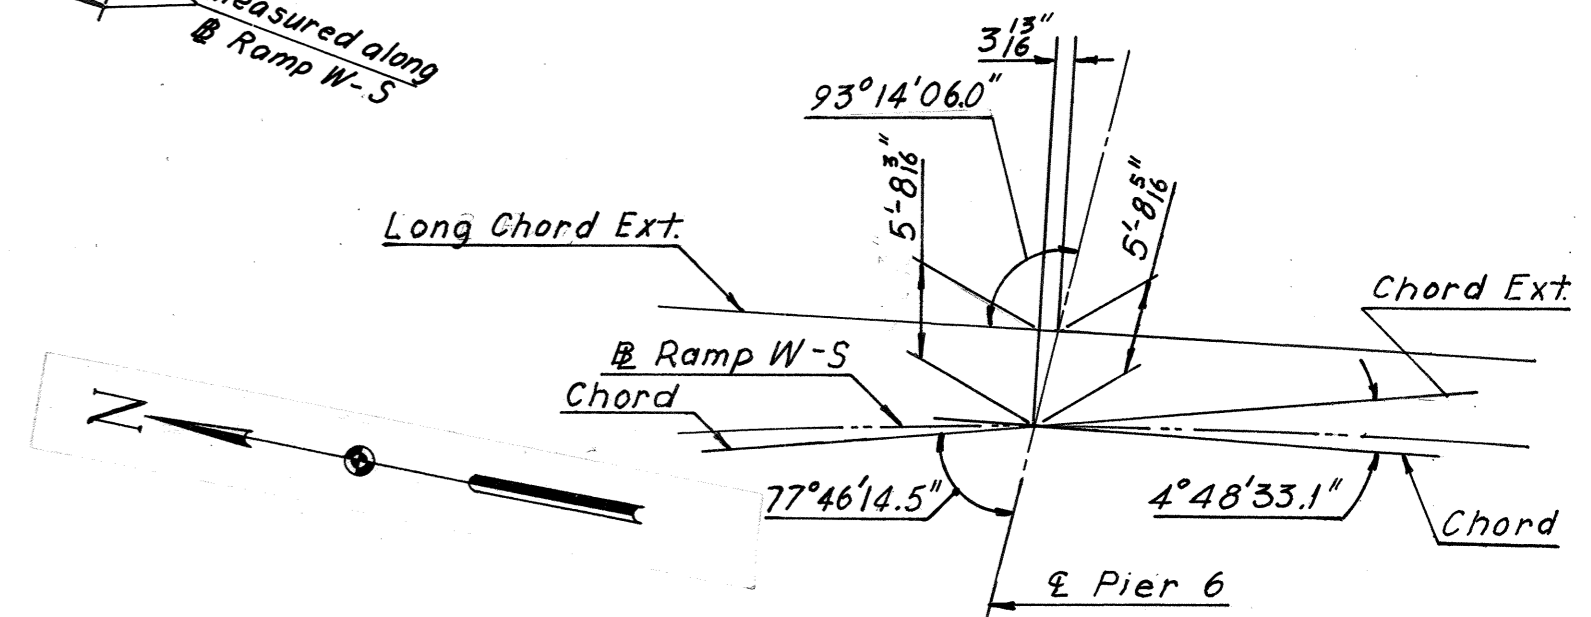


DETAIL D
No Scale

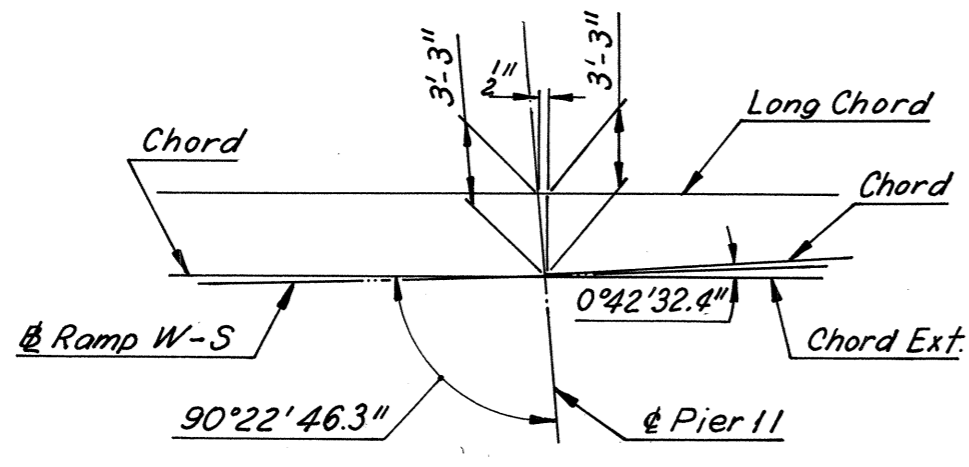


DETAIL E
No Scale

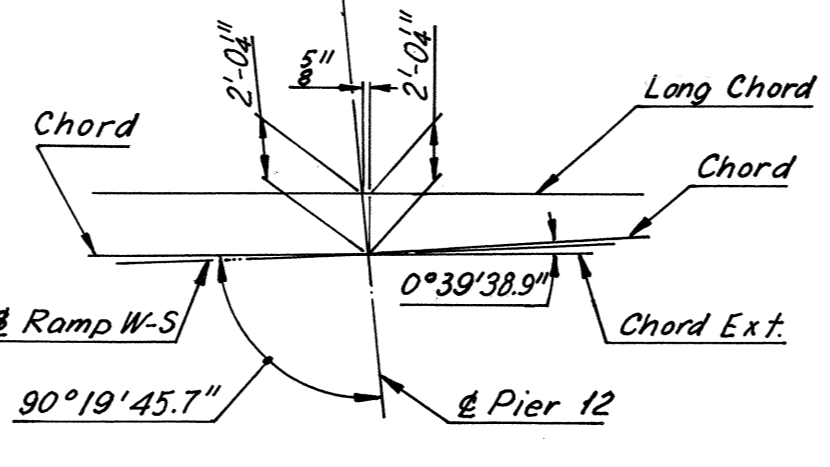

DETAIL F
No Scale

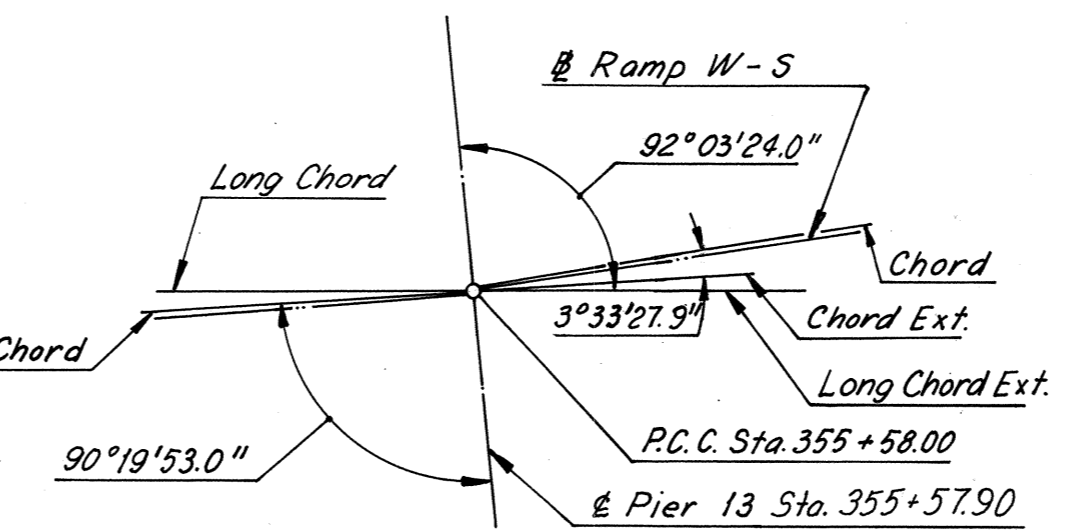

DETAIL G
No Scale

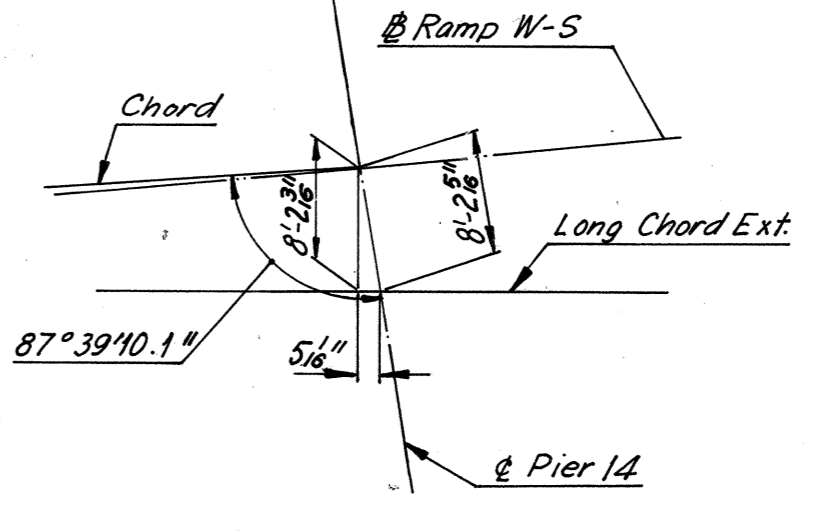

DETAIL H
No Scale

BY	DATE	NO.	REVISION	BY	DATE
MADE	PTA	3-24-69			
CHECKED	JD	4-22-69			
IN CHARGE					

AS BUILT

RICHMOND METROPOLITAN AUTHORITY
RICHMOND EXPRESSWAY SYSTEM
DOWNTOWN EXPRESSWAY

BRIDGE NO. 68
RAMP W-5 CONNECTION TO
RICHMOND-PETERSBURG TURNPIKE


LAYOUT

SCALE: *As Noted*


HOWARD, NEEDLES, TAMMEN & BERGENDOFF
consulting engineers
NEW YORK ALEXANDRIA KANSAS CITY

CONTRACT NO. 11
SHEET NO. 3 OF 28

RICHMOND EXPRESSWAY SYSTEM			
SECTION	PROJECT	SHEET NO.	TOTAL SHEETS
11	DOWNTOWN EXPRESSWAY	67	97

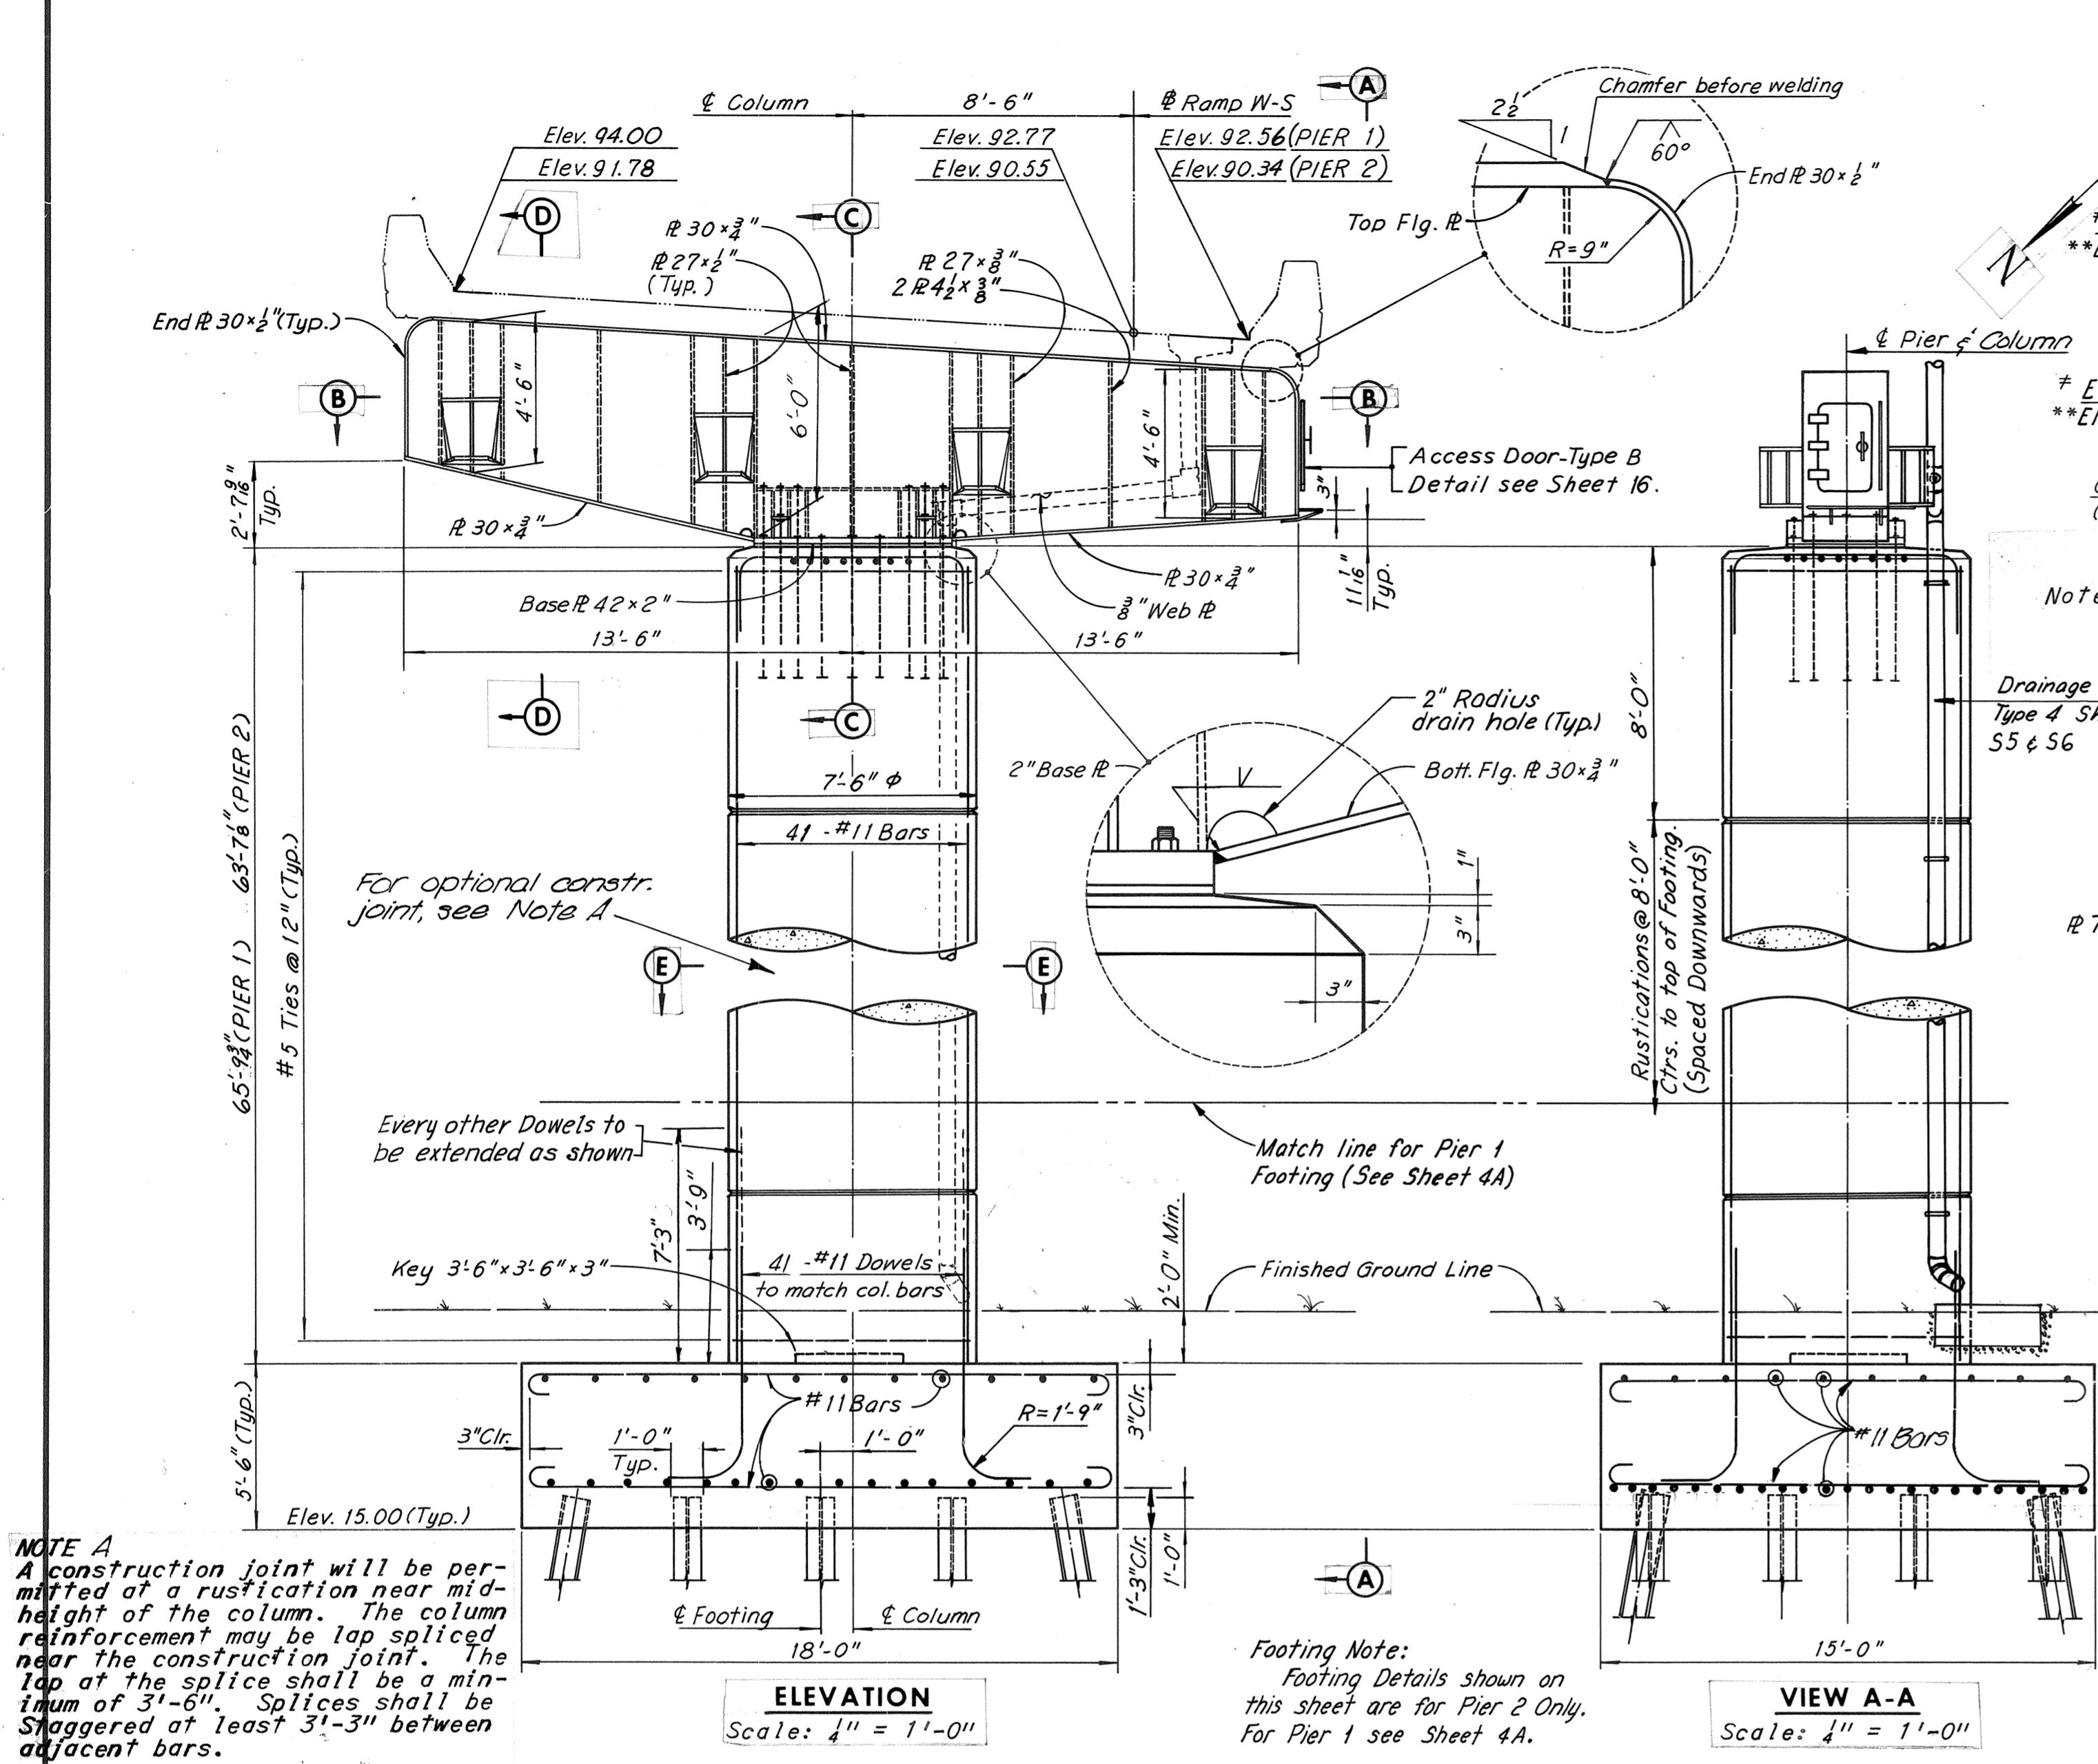

NOTE A
A construction joint will be permitted at a rustication near mid-height of the column. The column reinforcement may be lap spliced near the construction joint. The lap at the splice shall be a minimum of 3'-6". Splices shall be staggered at least 3'-3" between adjacent bars.






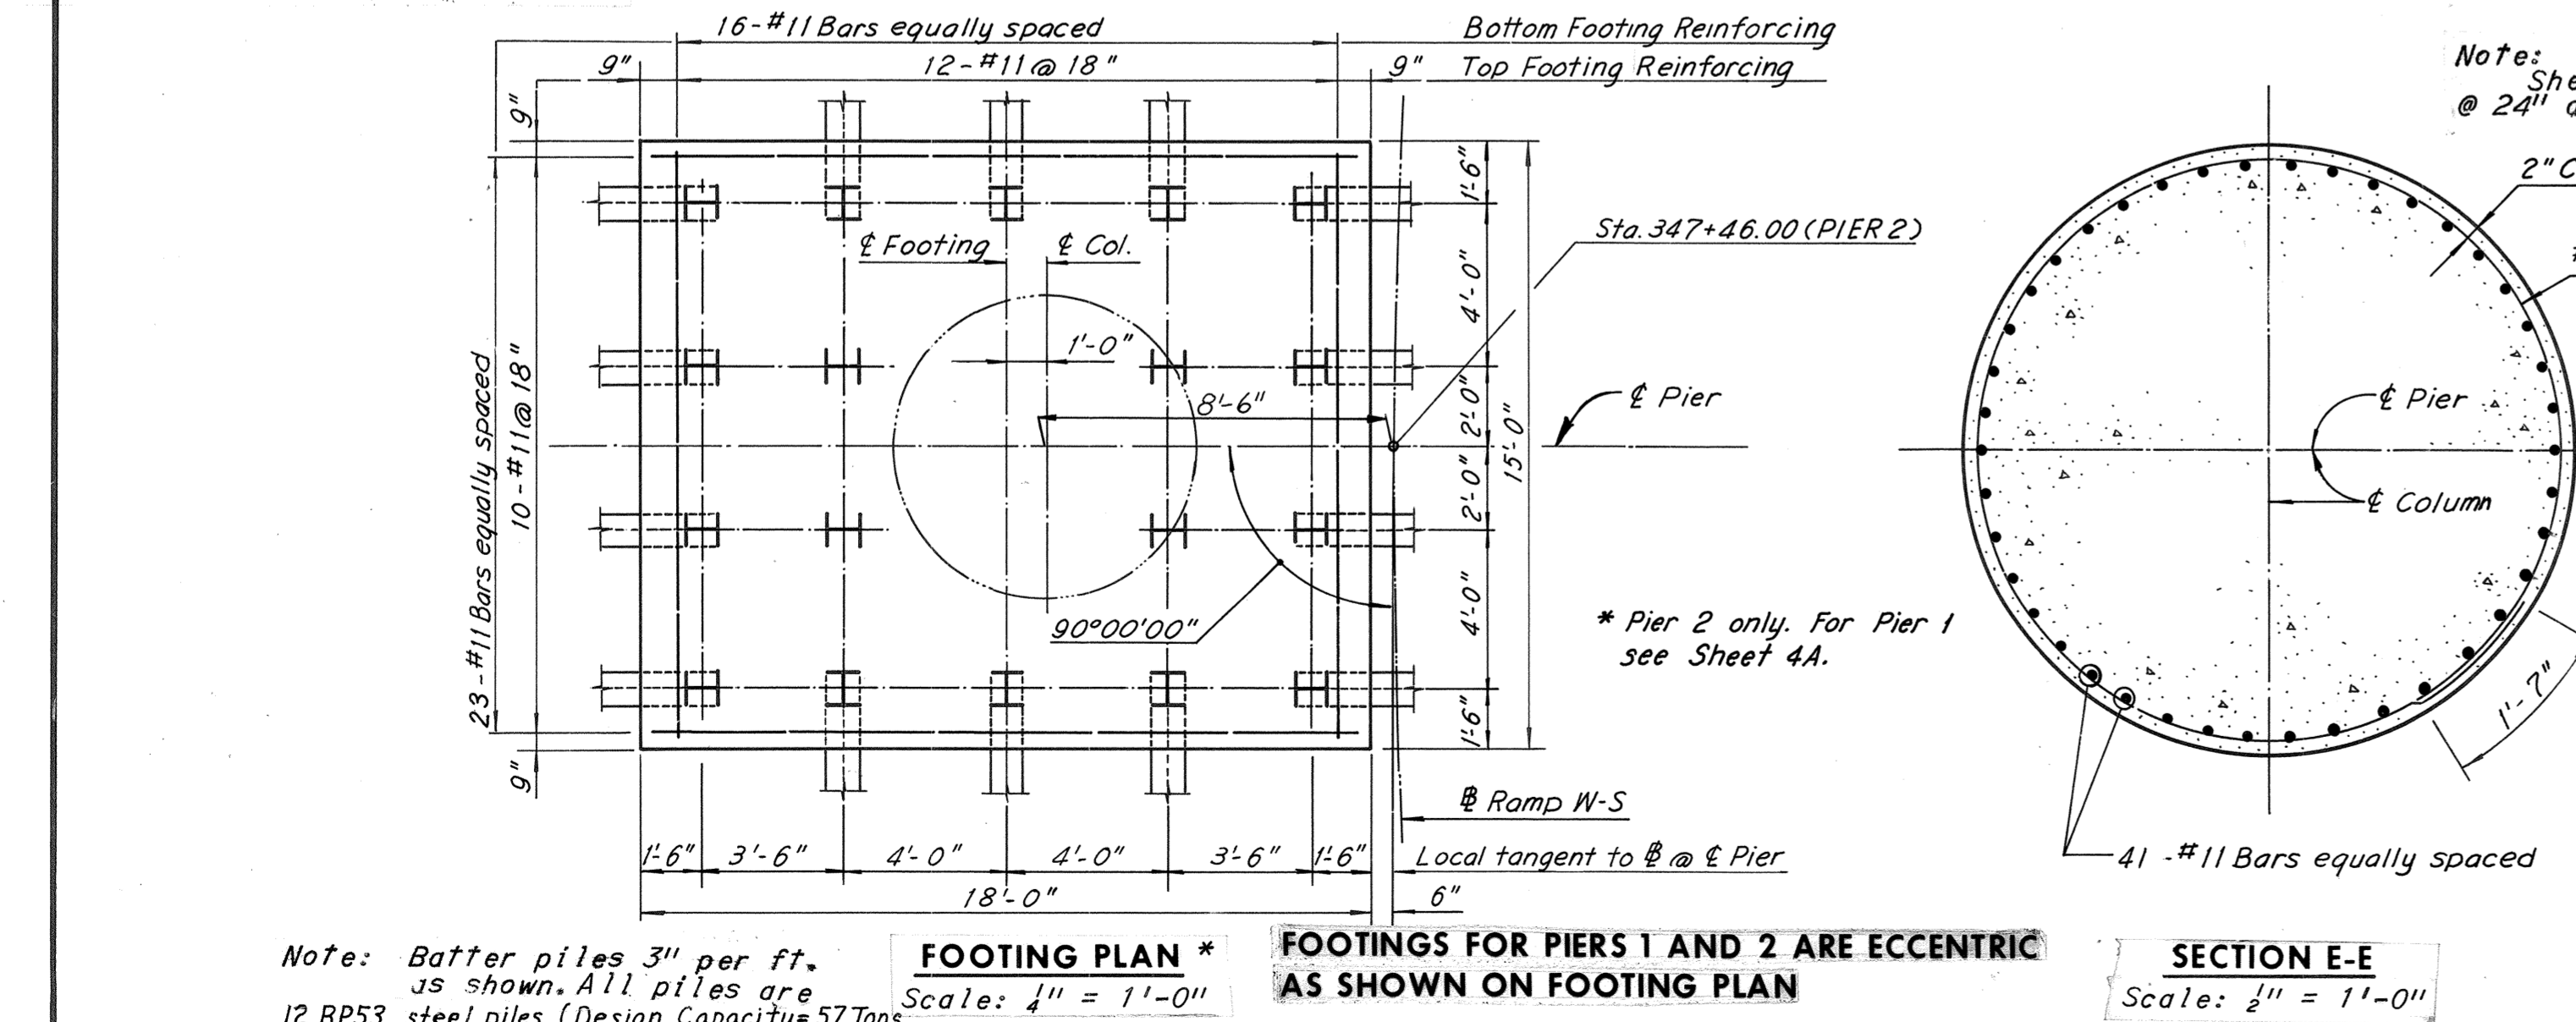


BY	DATE	REVISION	BY	DATE
MADE	MHH 1-17-69	Deleted and Dim added, sect. D-D Footing Details	TEM	8-76
CHECKED	JD 2-13-69	Pier 1 Deleted	MSD	3-13-75
IN CHARGE				

FOOTINGS FOR PIERS 1 AND 2 ARE ECCENTRIC AS SHOWN ON FOOTING PLAN

NOTE: Footing elevations are approximate only and may be varied to suit field conditions as directed by the Engineer. Vertical shaft reinforcement shall not be cut until these elevations are established. Where elevations change more than 2 ft., redesign will be required.

NOTE: All Structural Steel for Piers 1 and 2 shall be A36. Steel Cap Beams need not be cambered.

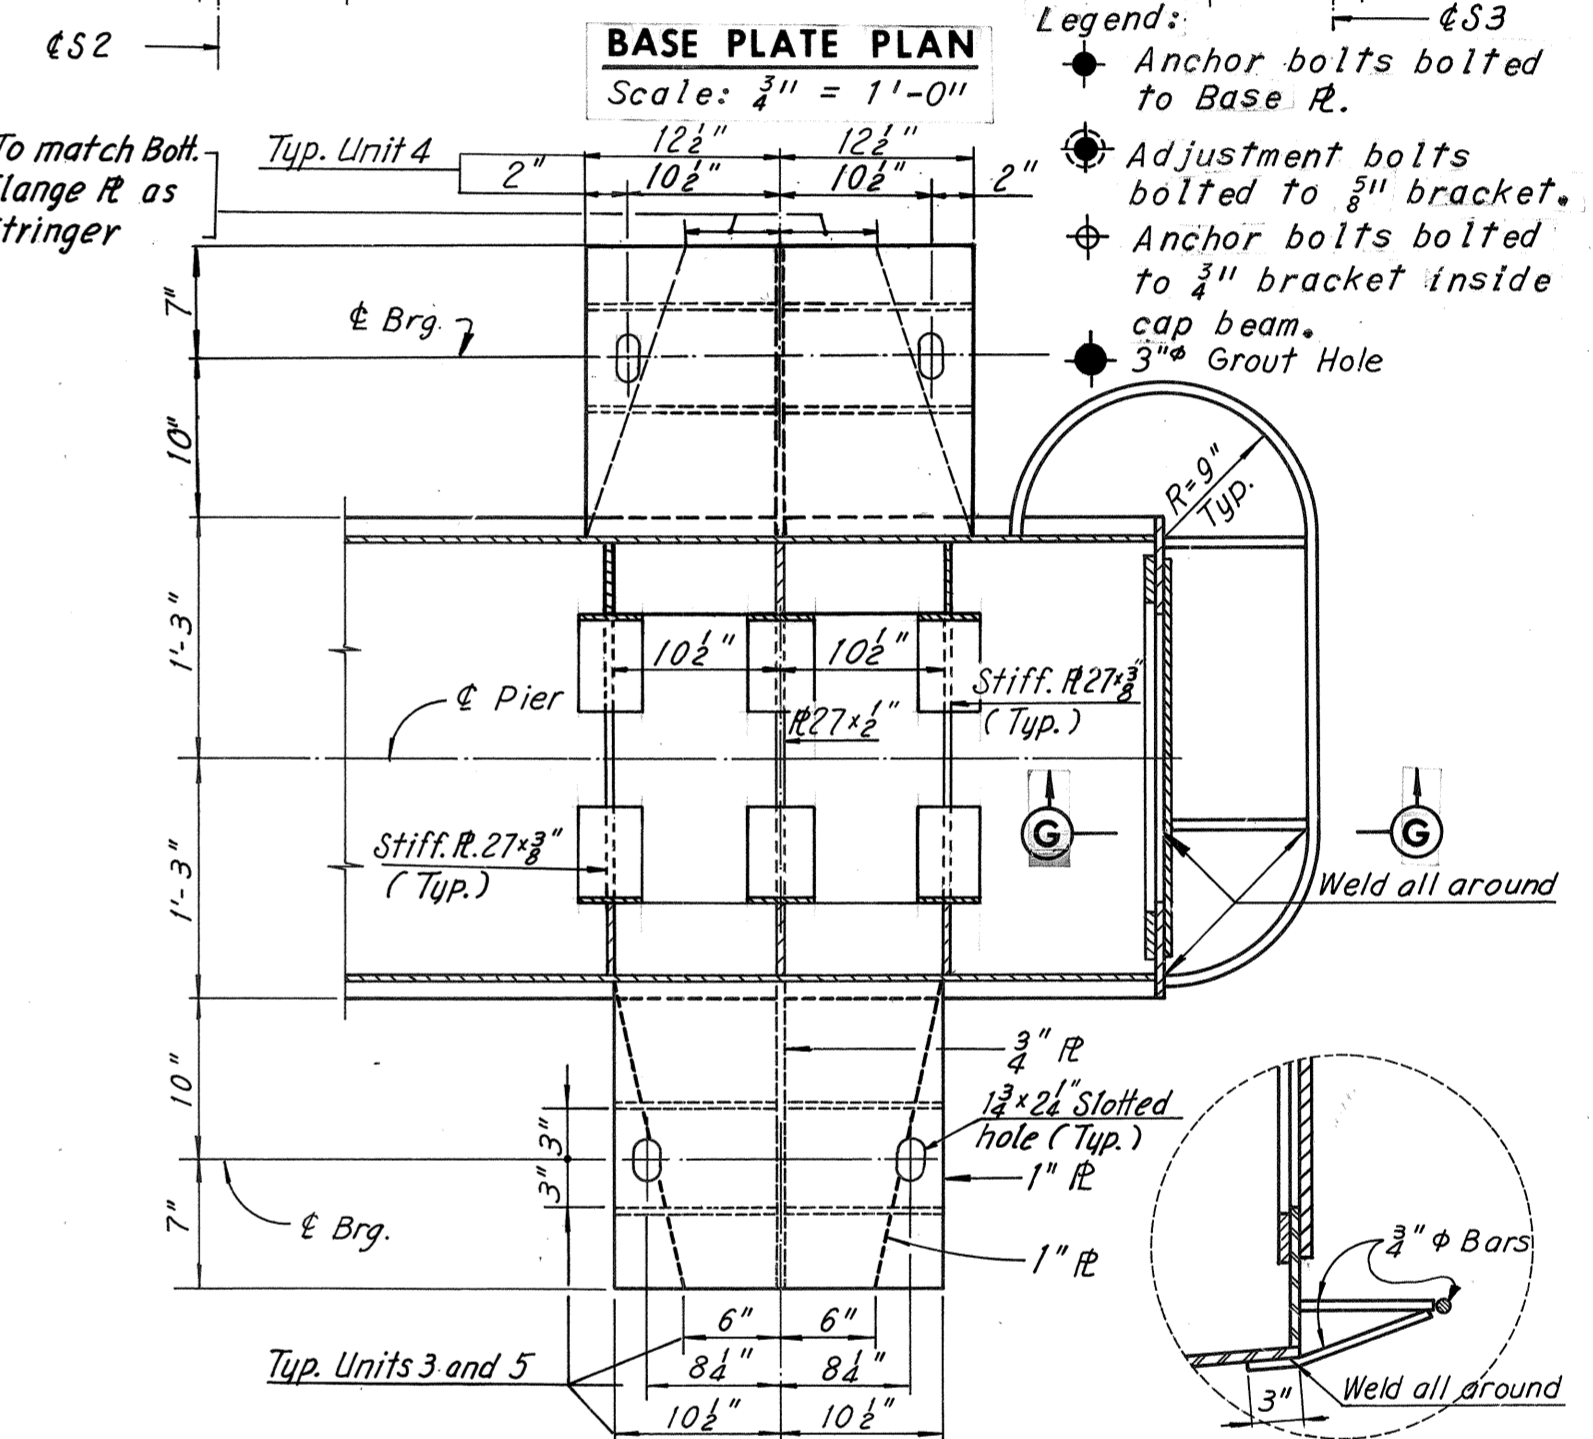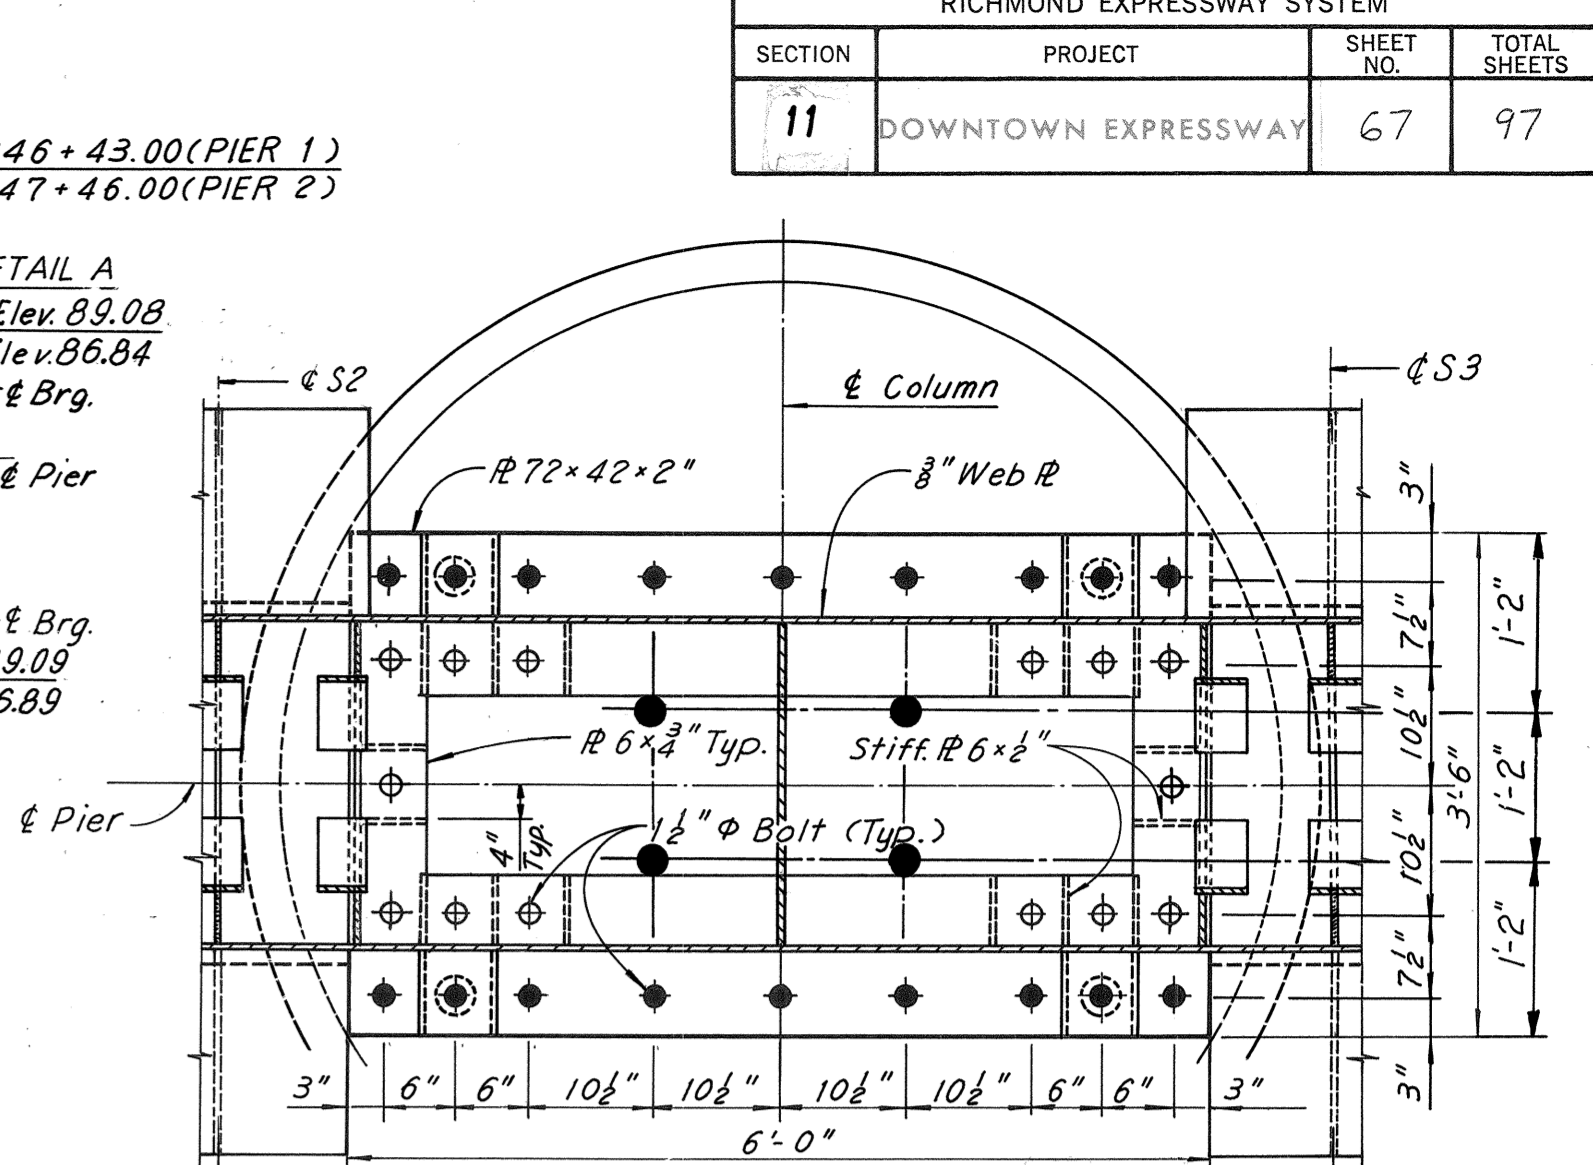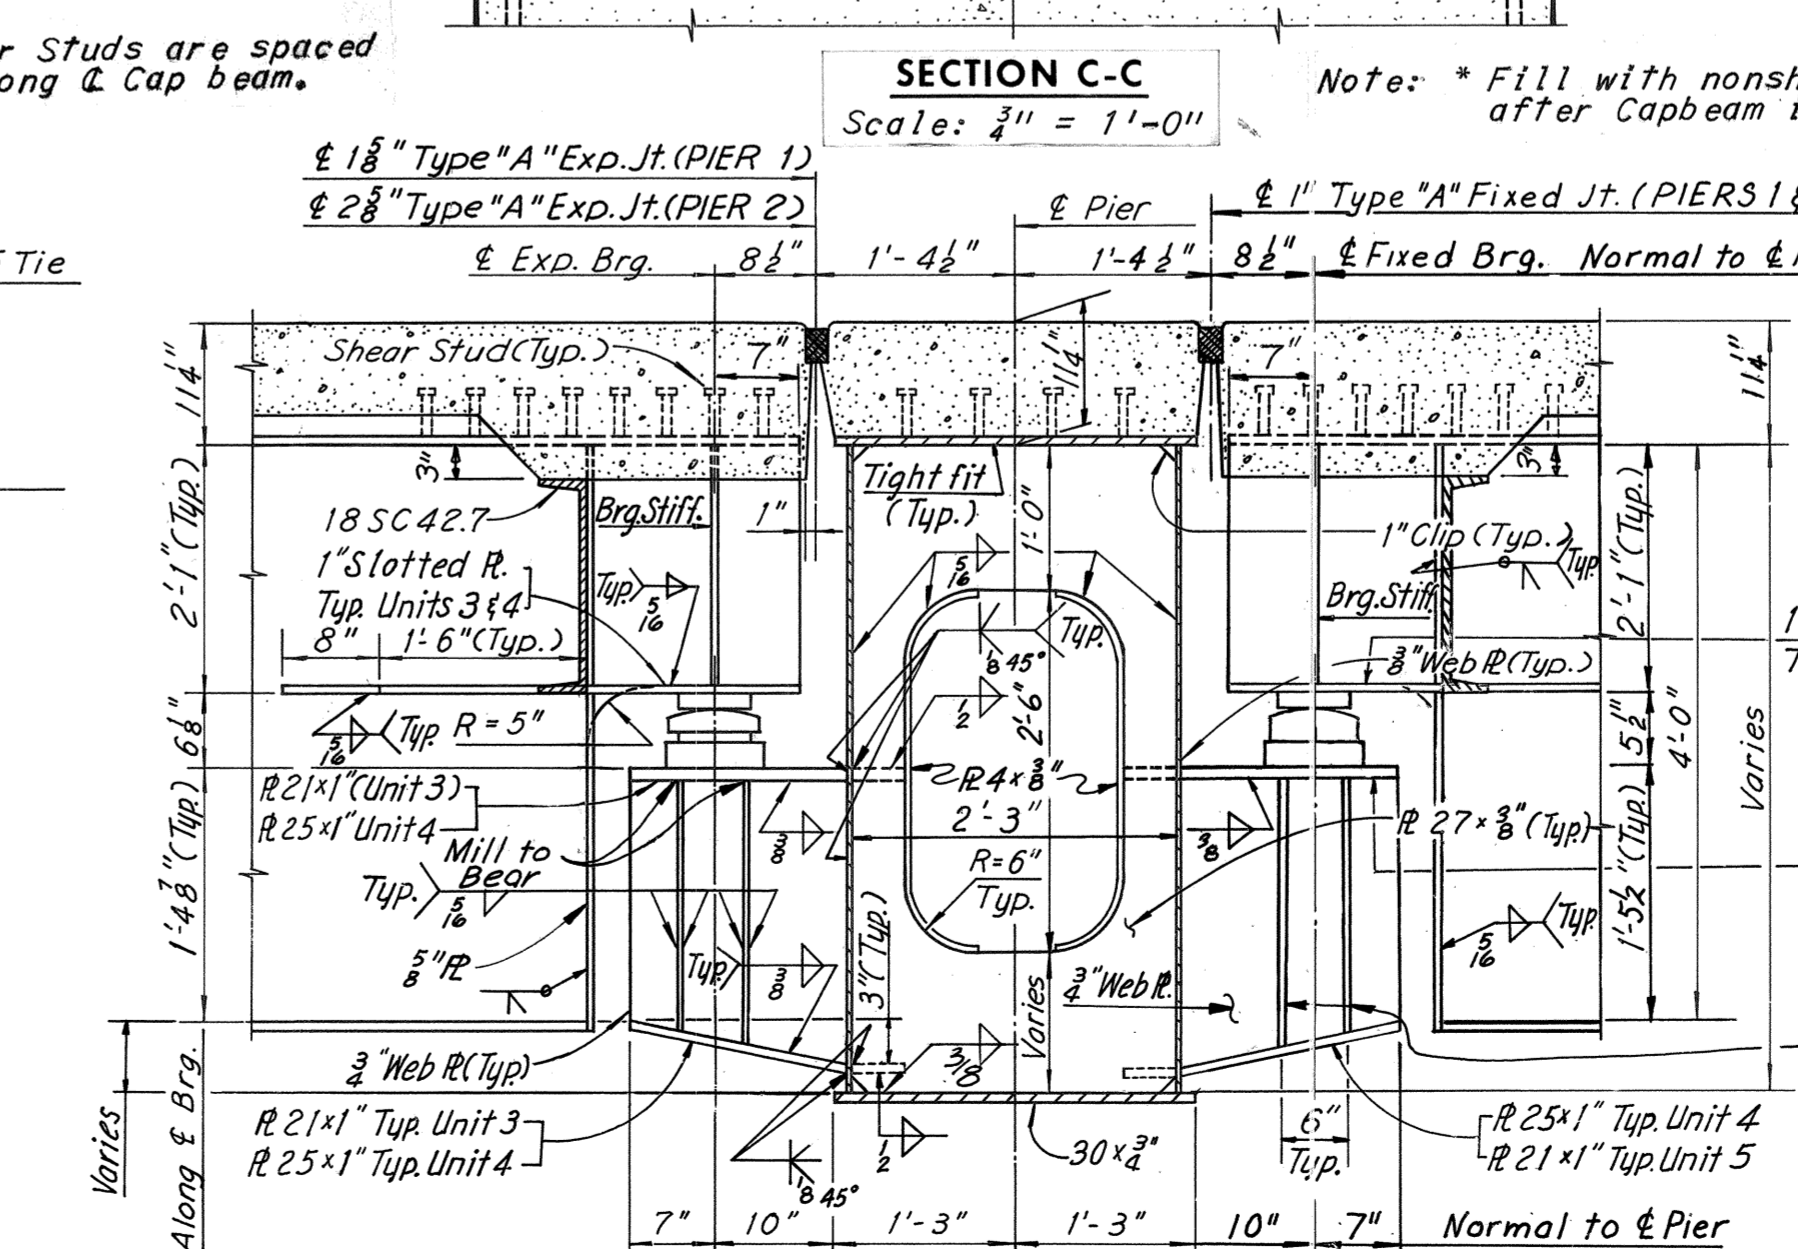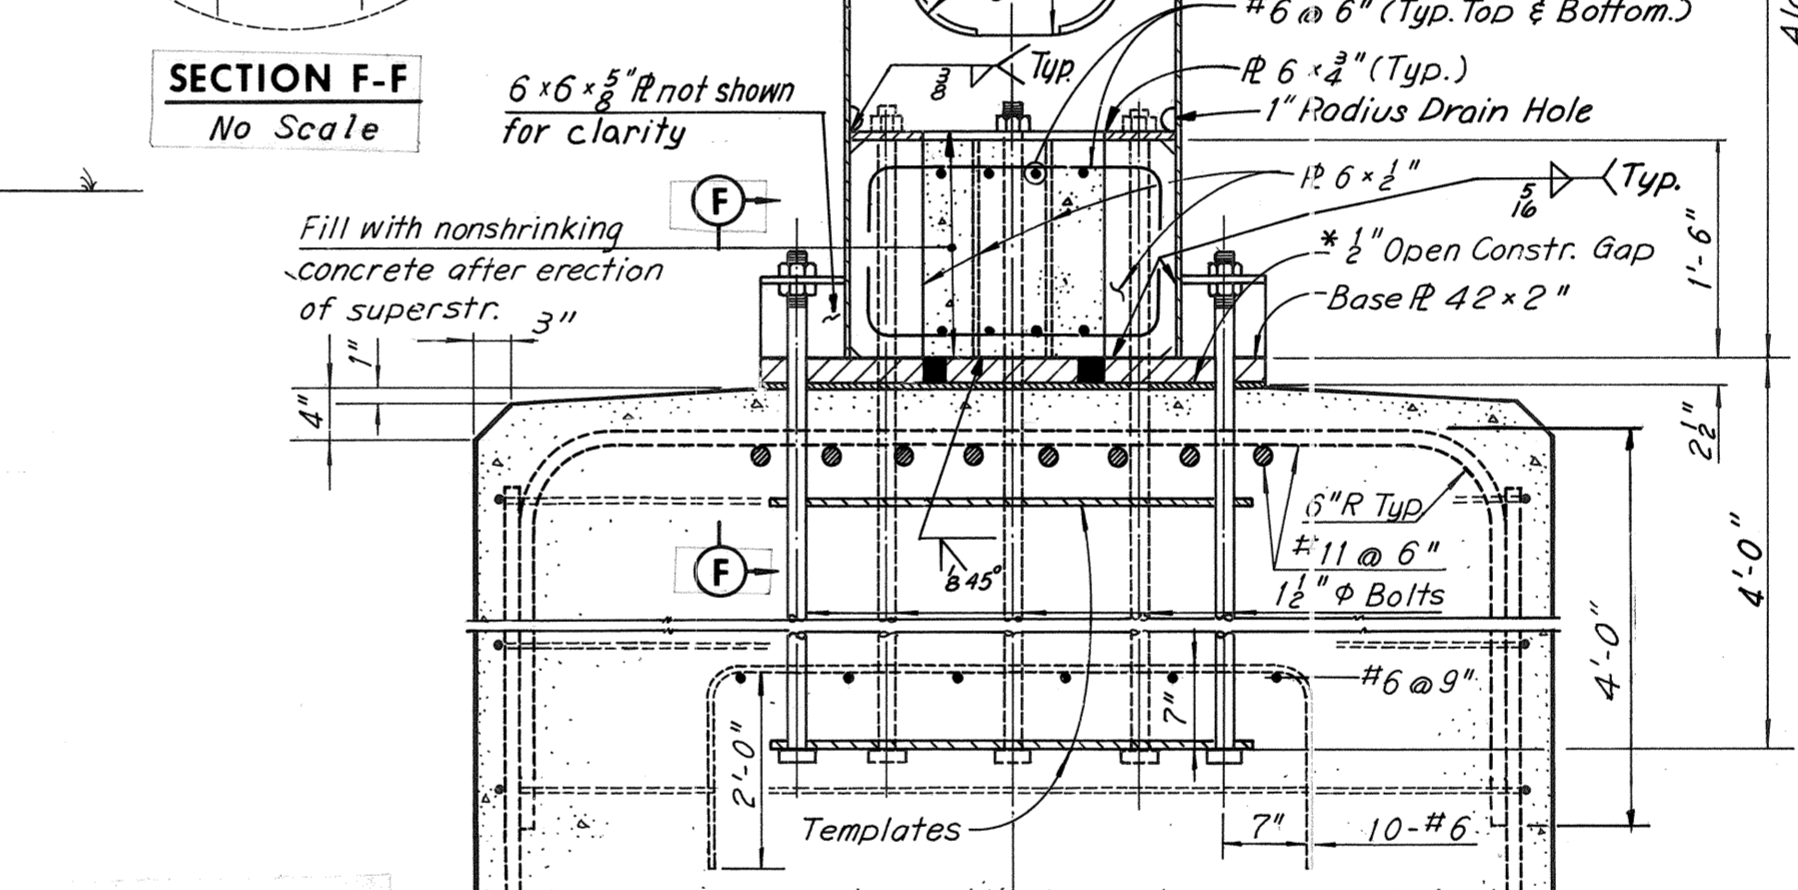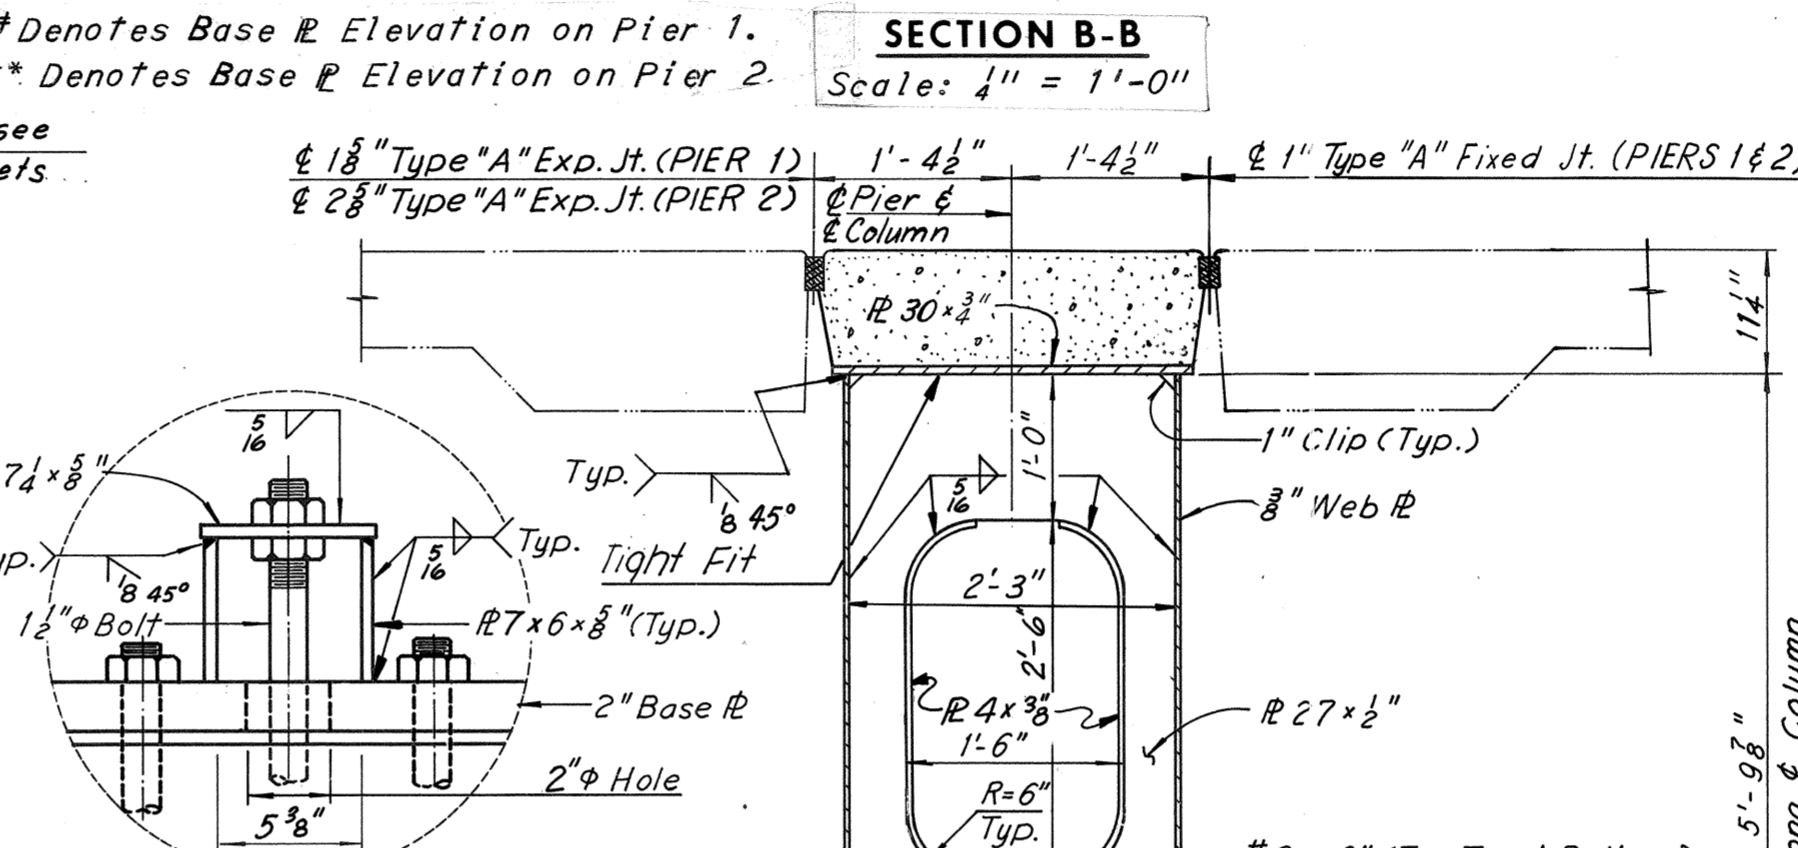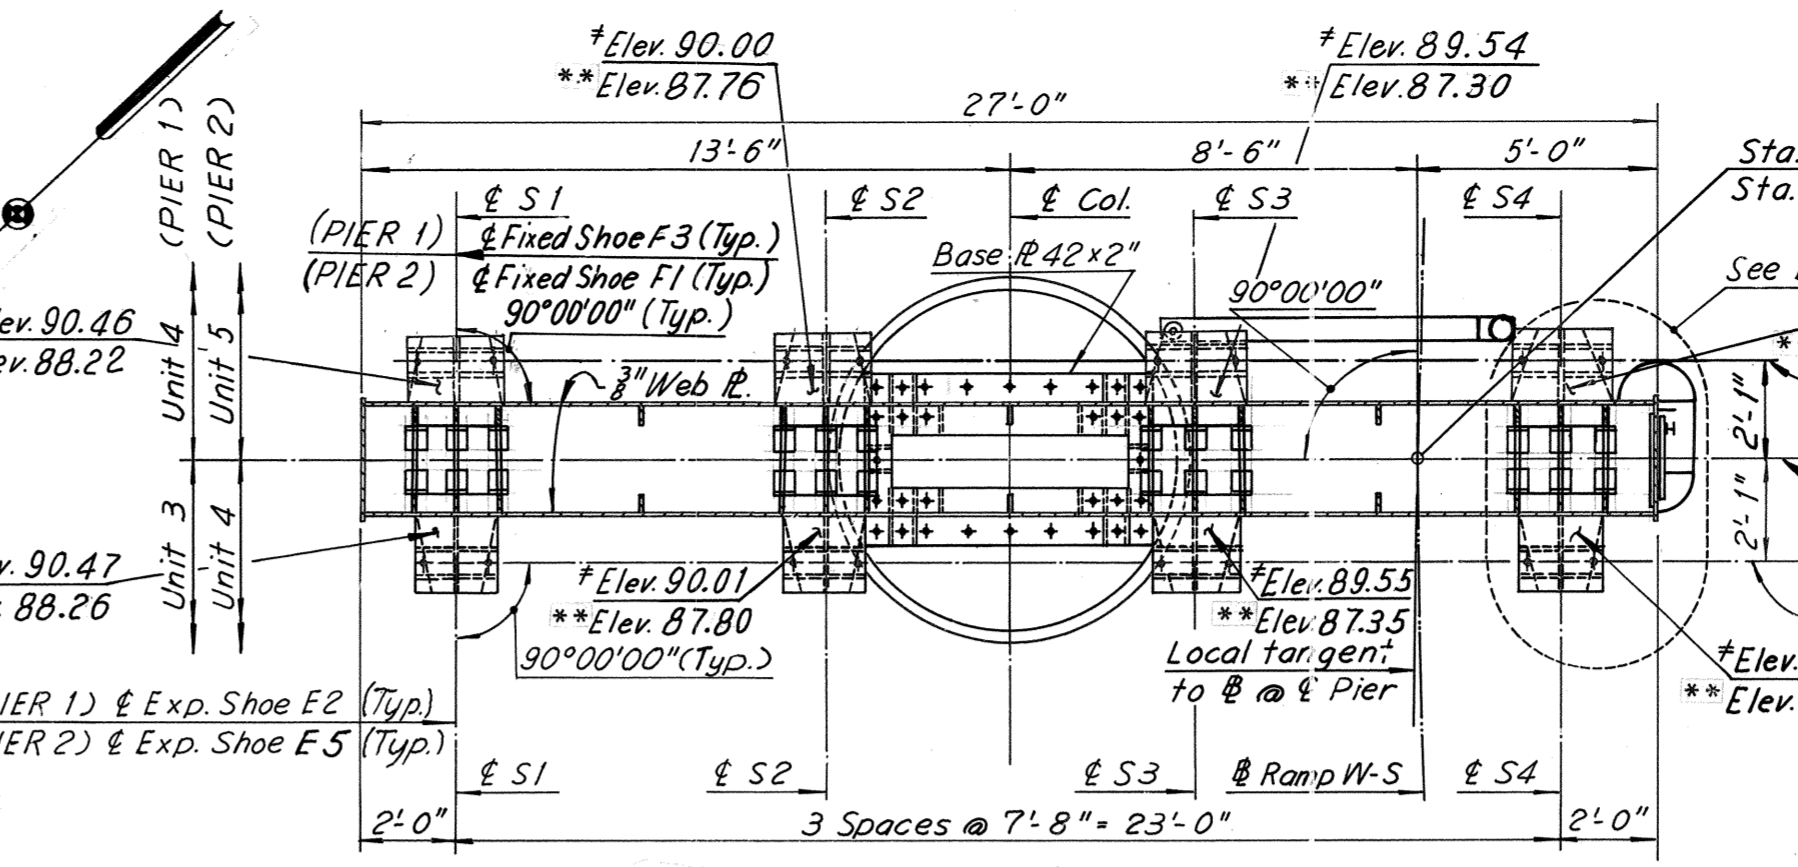

SECTION G-G
Scale: 1/4" = 1'-0"

NOTE: All holes in base R and bracket R's for 1/2" dia. anchor bolts shall be 2" in dia.

NOTES:
For Framing Plan, see Sheet 13.
For Joint Details, see Sheet 25.
For Shear Stud Details, see Sheet 12.
For Shoe Details, see Sheets S1 and S2.
For Bearing pile Details, see Sheet 9.
Estimated pile tip elevation -10.00 for Pier 1 and -11.00 for Pier 2.

NOTE: All anchor bolts connecting cap beam to column shall be 1/2" dia., and each nut shall have washer (not shown on details).
For Rustication Detail, see Sheet 5.

RICHMOND METROPOLITAN AUTHORITY
RICHMOND EXPRESSWAY SYSTEM
DOWNTOWN EXPRESSWAY


BRIDGE NO. 68
RAMP W-S CONNECTION TO
RICHMOND-PETERSBURG TURNPIKE
PIERS 1 AND 2

HOWARD, NEEDLES, TAMMEN & BERGENDOFF
consulting engineers
NEW YORK ALEXANDRIA KANSAS CITY


SCALE: As Noted
CONTRACT NO. 11
SHEET NO. 4 OF 28

AS BUILT

RICHMOND EXPRESSWAY SYSTEM			
SECTION	PROJECT	SHEET NO.	TOTAL SHEETS
11	DOWNTOWN EXPRESSWAY	67A	97

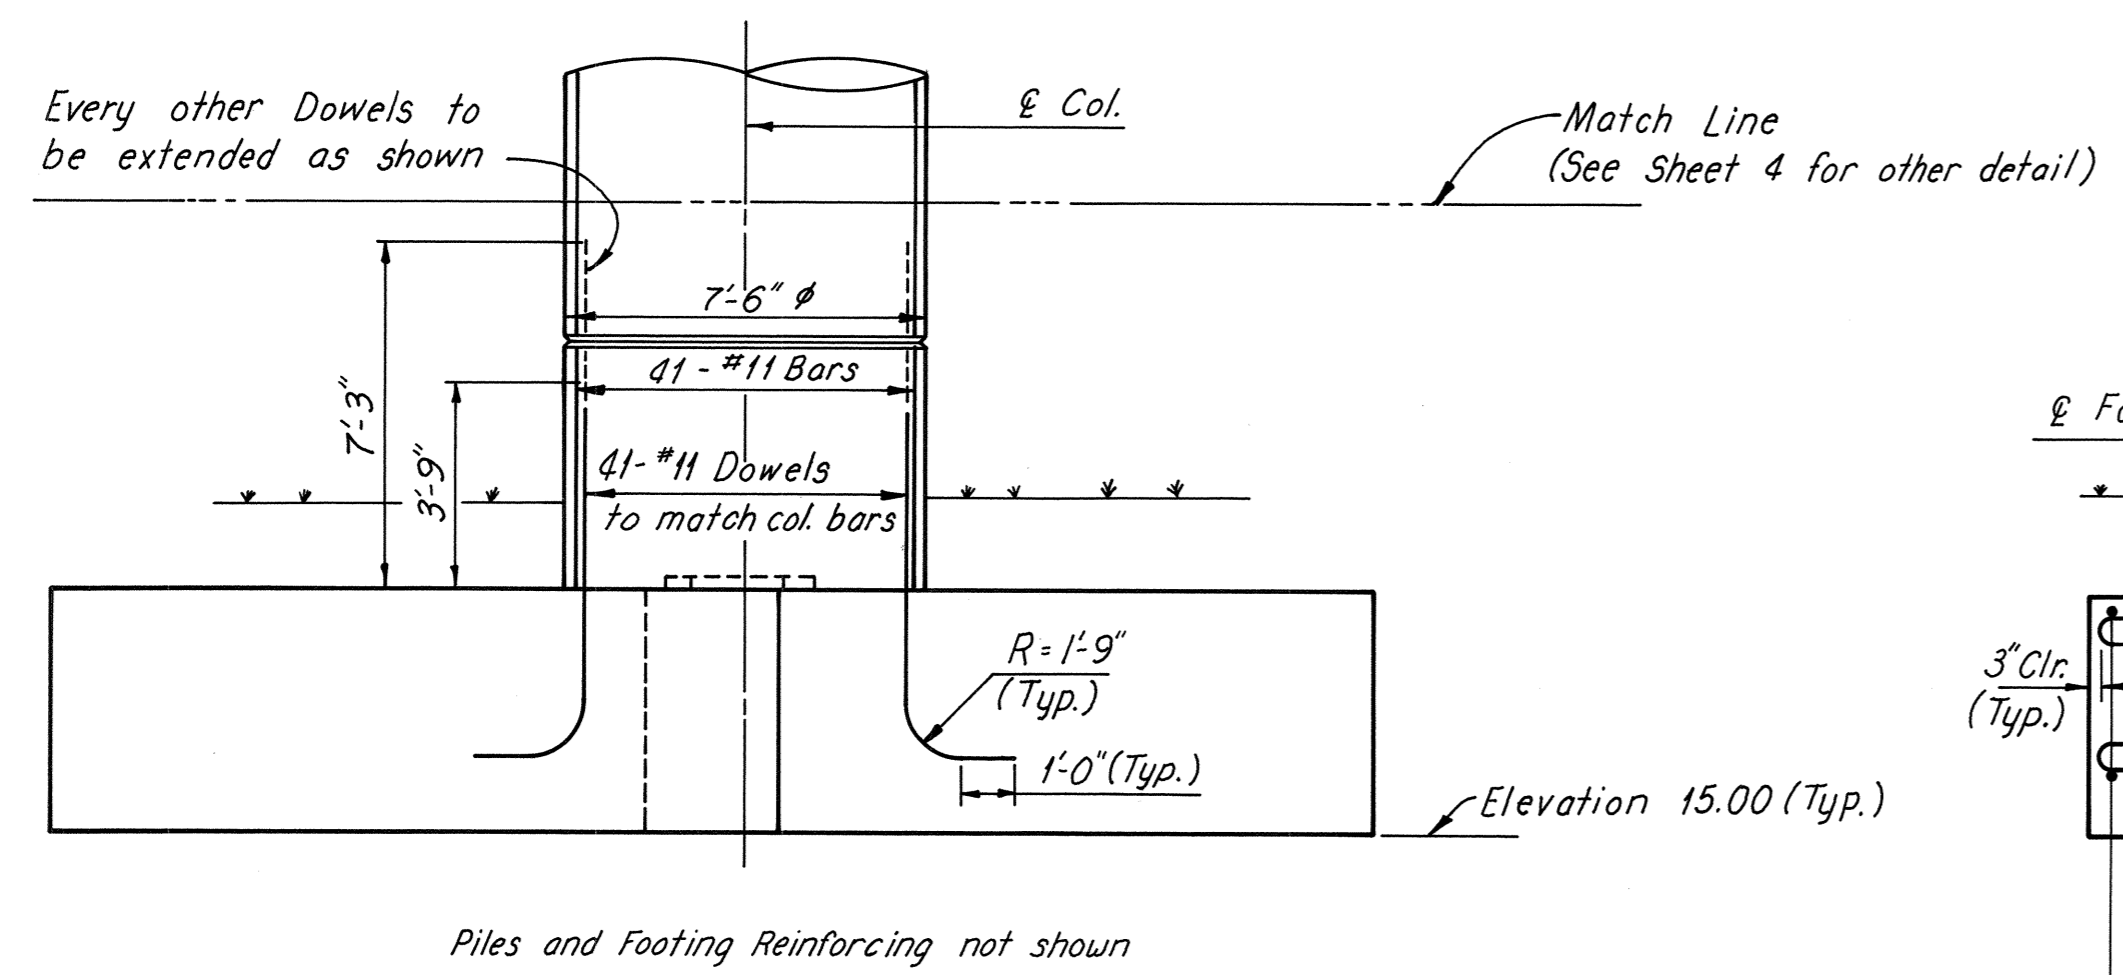


ELEVATION
Scale: 1/4" = 1'-0"

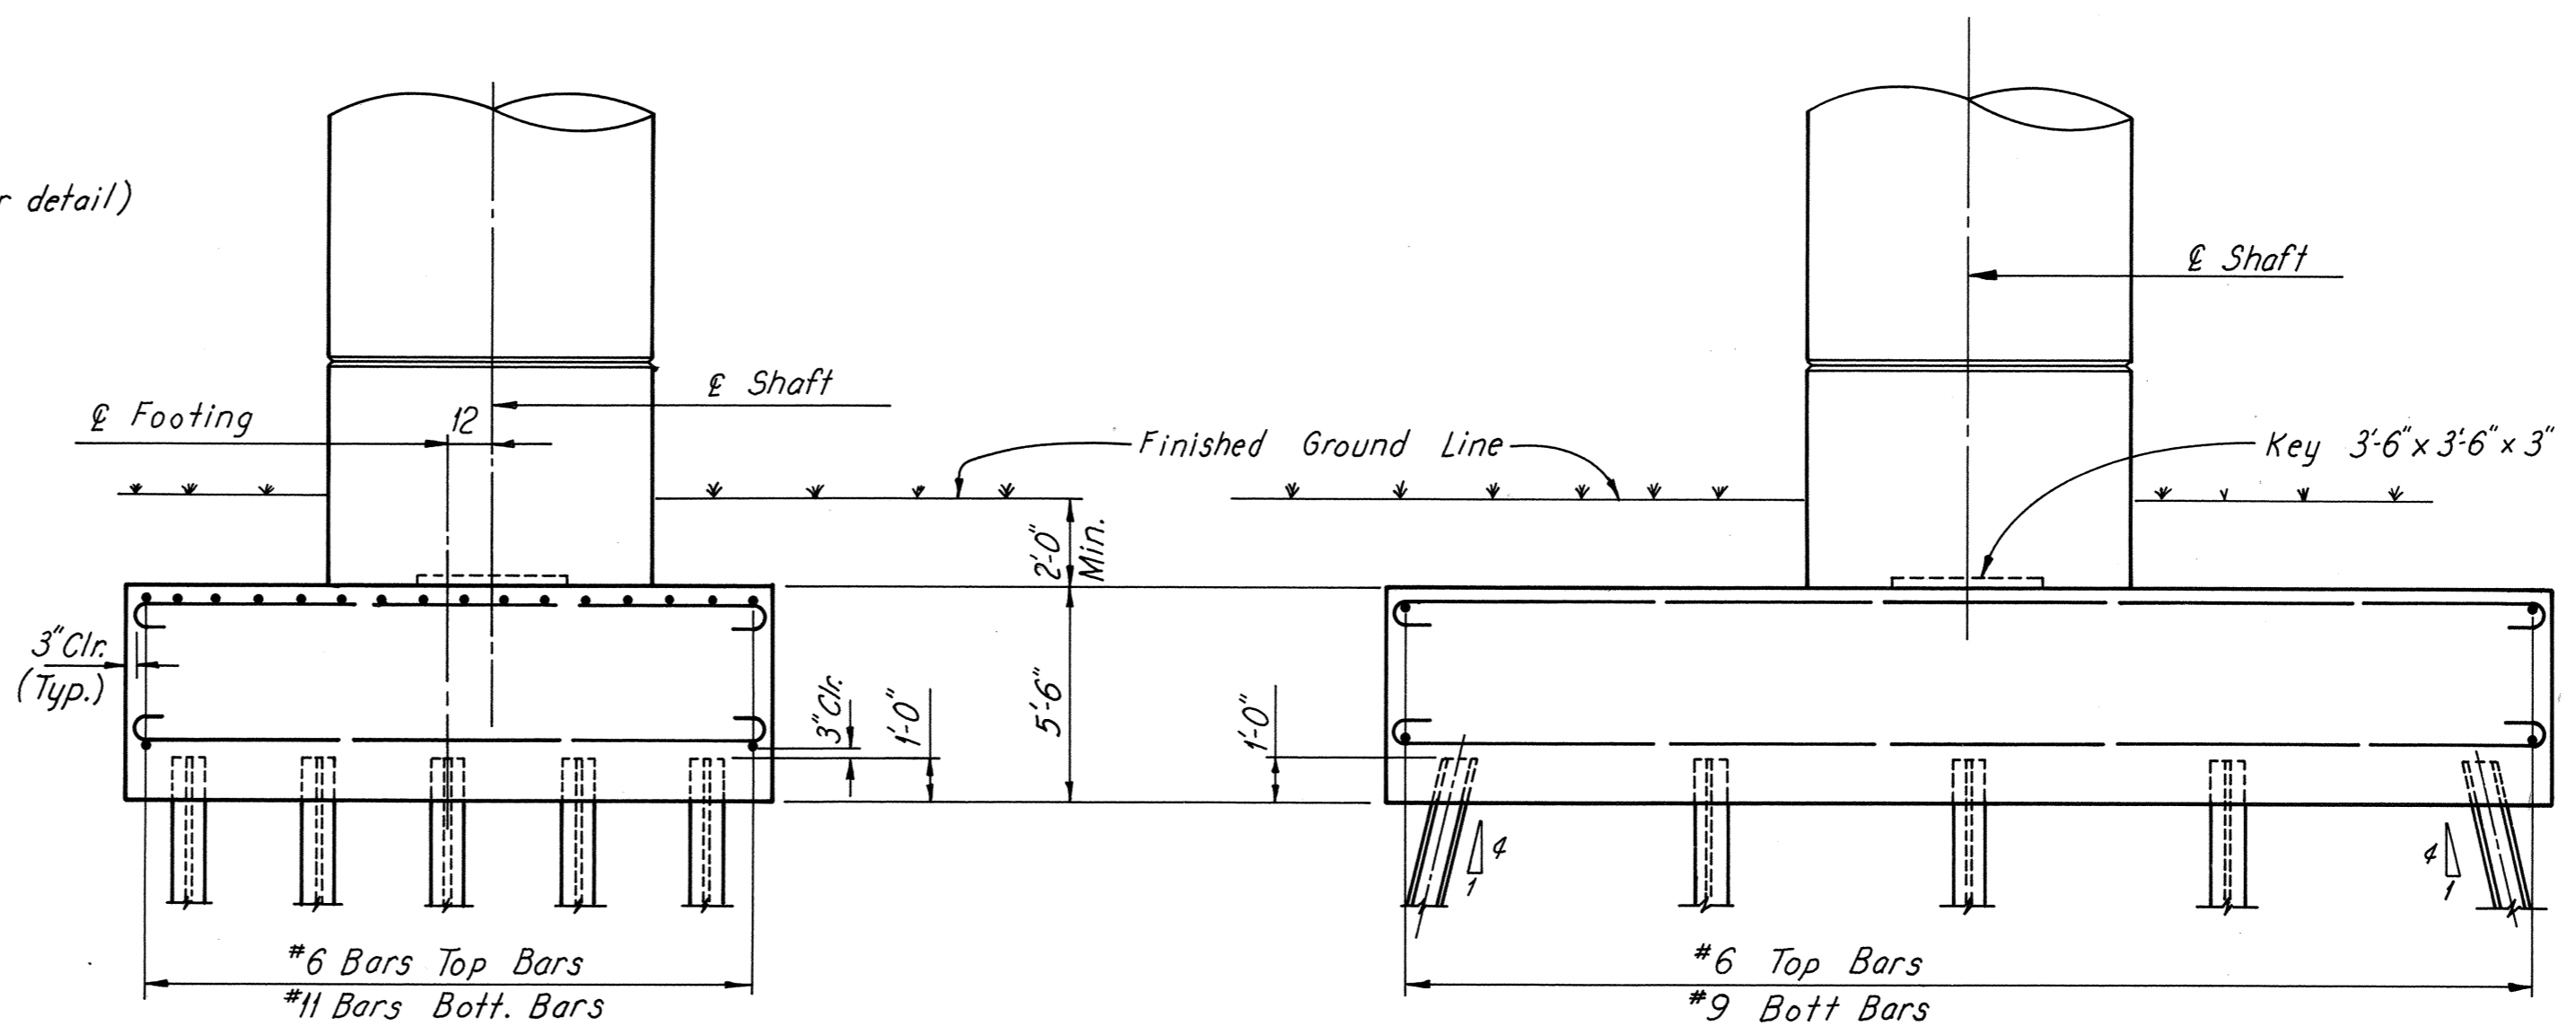

VIEW A-A
Scale: 1/4" = 1'-0"

VIEW B-B
Scale: 1/4" = 1'-0"

Note:
Footing elevations are approximate only and may be varied to suit field conditions as directed by the Engineer. Vertical shaft reinforcement shall not be cut until these elevations are established. Where elevations change more than 2 ft., redesign will be required.

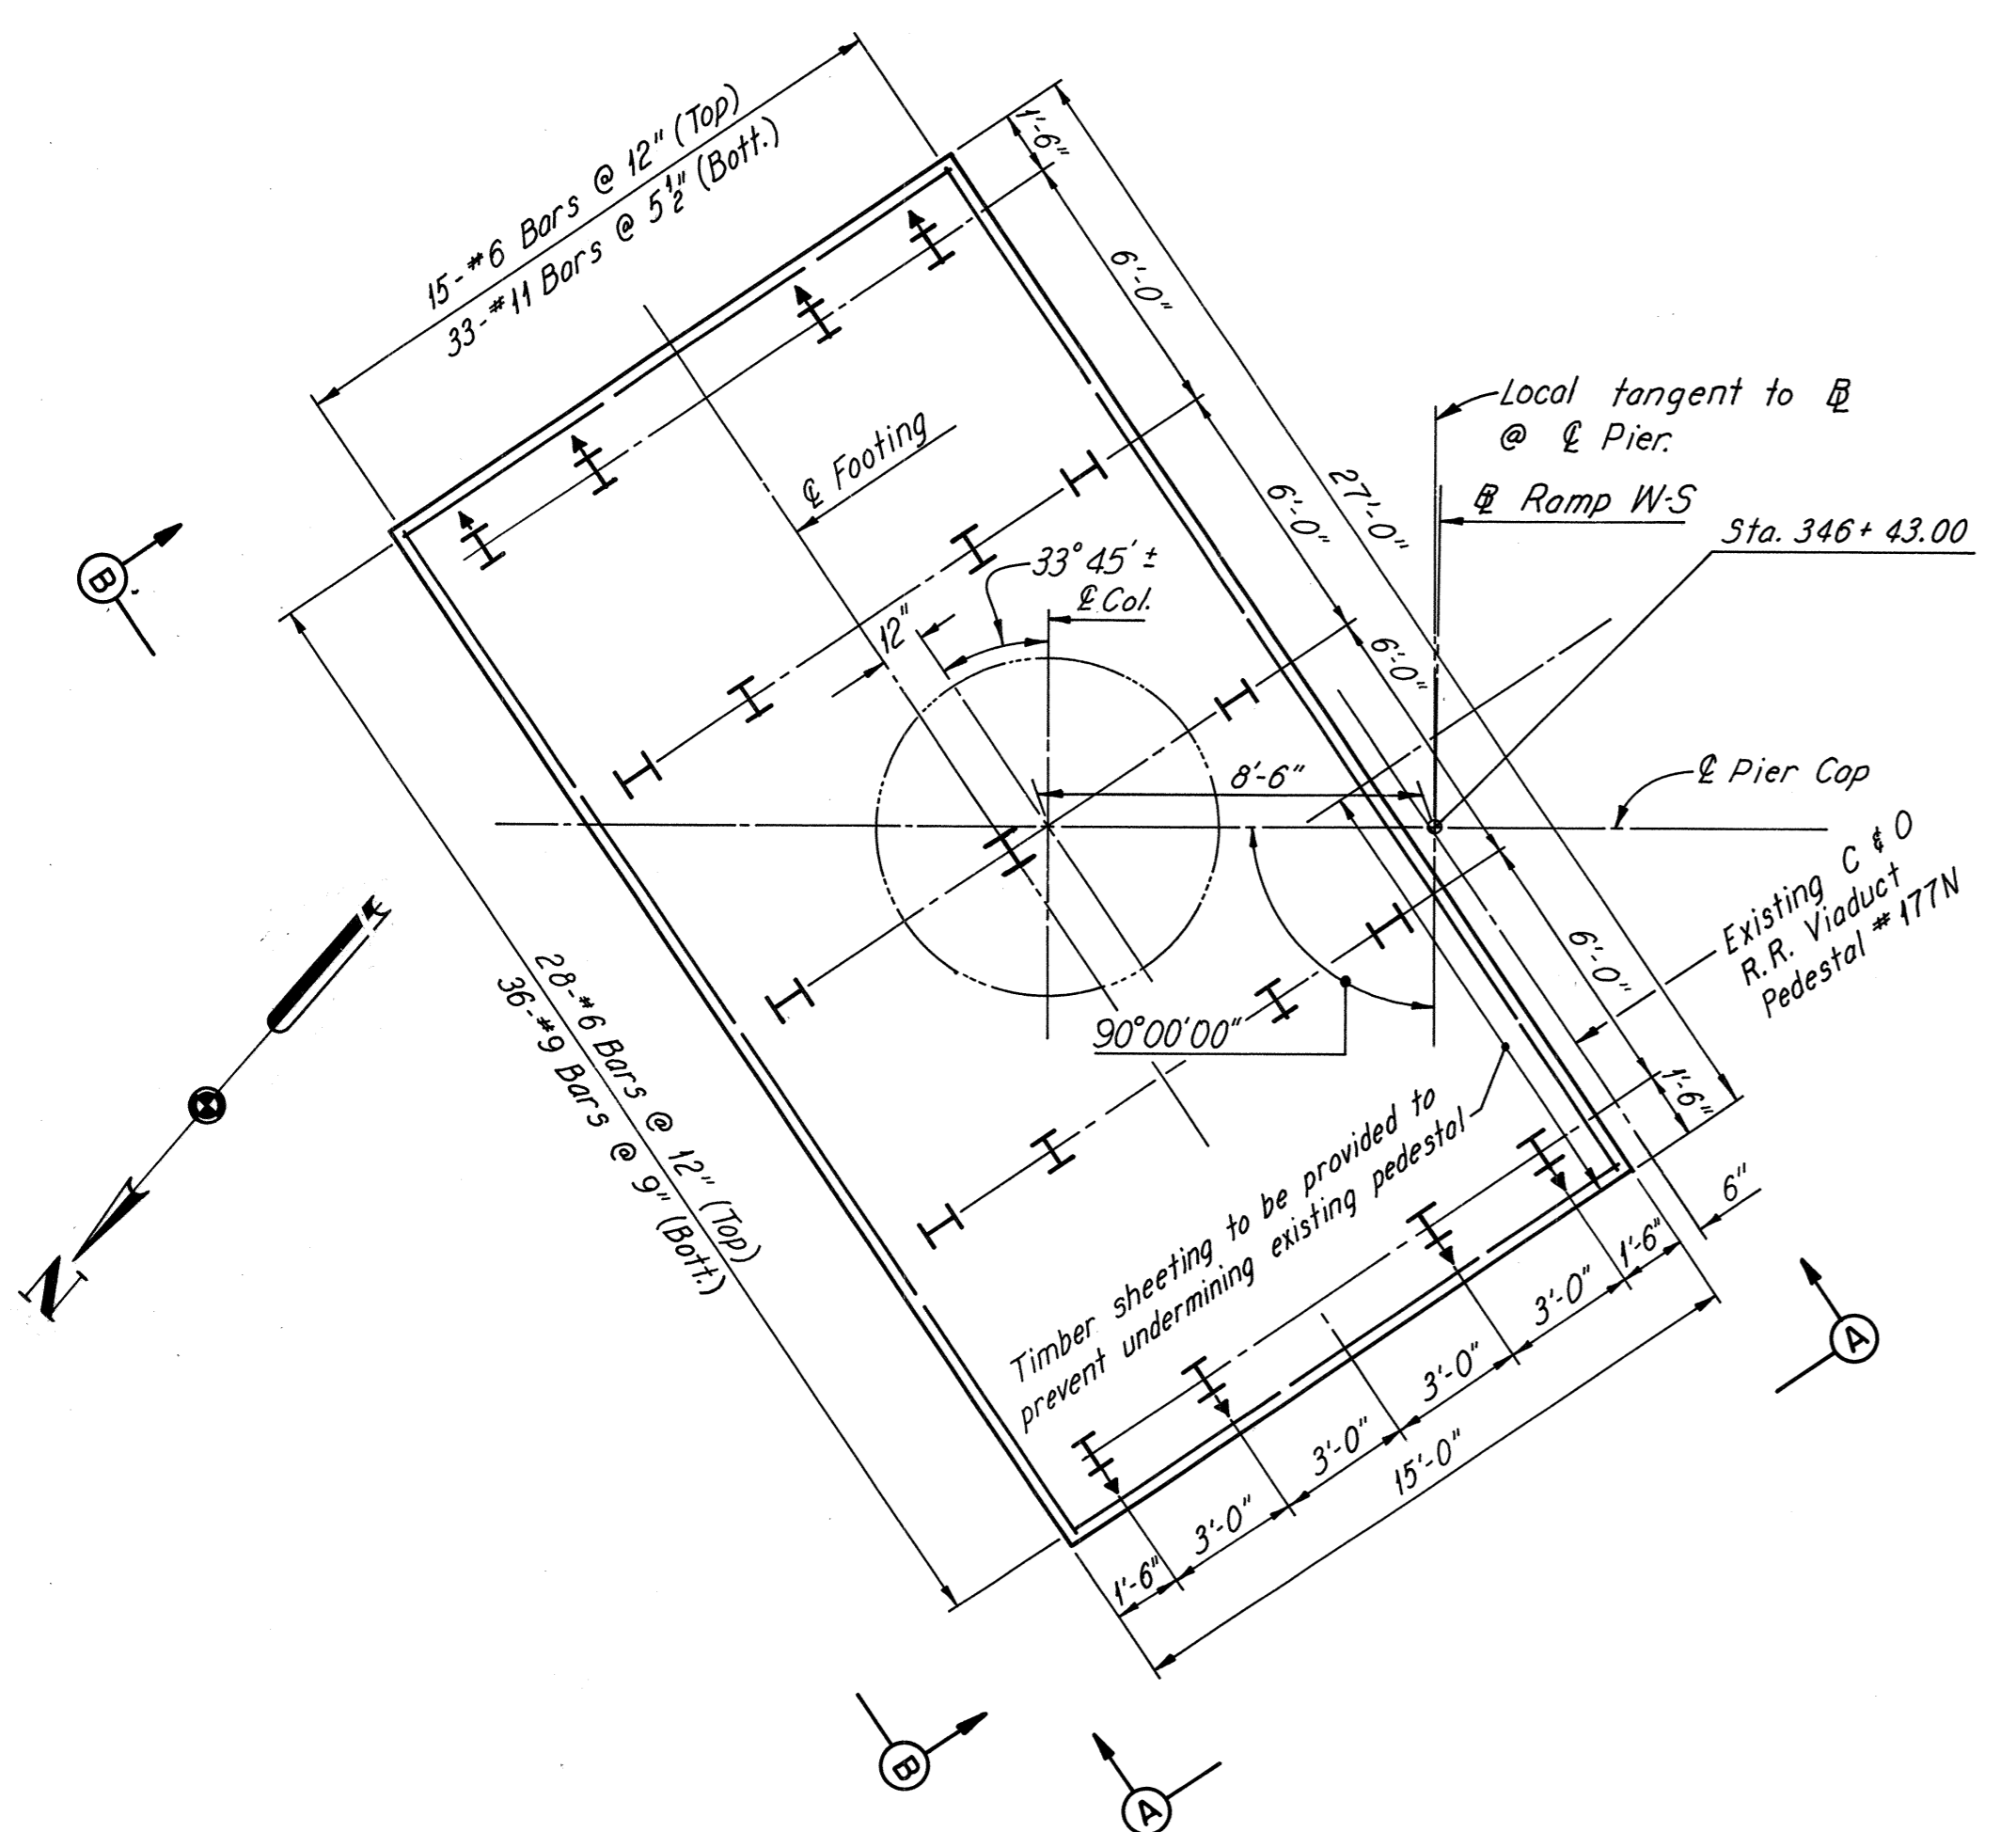

FOOTING PLAN
Scale: 1/4" = 1'-0"

Note:
Batter Piles 3" per foot as shown. All piles are 12BP53 steel piles (Pile design capacity = 57 Tons).

FOOTING FOR PIER 1 IS ECCENTRIC AS SHOWN ON FOOTING PLAN & VIEW A-A.

MADE	BY	DATE	NO.	REVISION	BY	DATE
JLK	JLK	7-17-75				
DWB	DWB	7-21-75	1	Pile Added	TEM	8-26-75

AS BUILT

RICHMOND METROPOLITAN AUTHORITY
RICHMOND EXPRESSWAY SYSTEM
DOWNTOWN EXPRESSWAY

BRIDGE NO. 68
RAMP W-S CONNECTION TO
RICHMOND-PETERSBURG TURNPIKE
PIER I FOOTING

HOWARD, NEEDLES, TAMMEN & BERGENDOFF
consulting engineers
NEW YORK ALEXANDRIA KANSAS CITY




SCALE: As Noted

CONTRACT NO.: 11


SHEET NO. 4A OF 28

RICHMOND EXPRESSWAY SYSTEM			
SECTION	PROJECT	SHEET NO.	TOTAL SHEETS
11	DOWNTOWN EXPRESSWAY	68	97


NOTE: A
 A construction joint will be permitted at a rustication near mid-height of the column. The column reinforcement may be lap spliced near the construction joint. The lap of the splice shall be a minimum of 3'-6". Splices shall be staggered at least 3'-3" between adjacent bars.

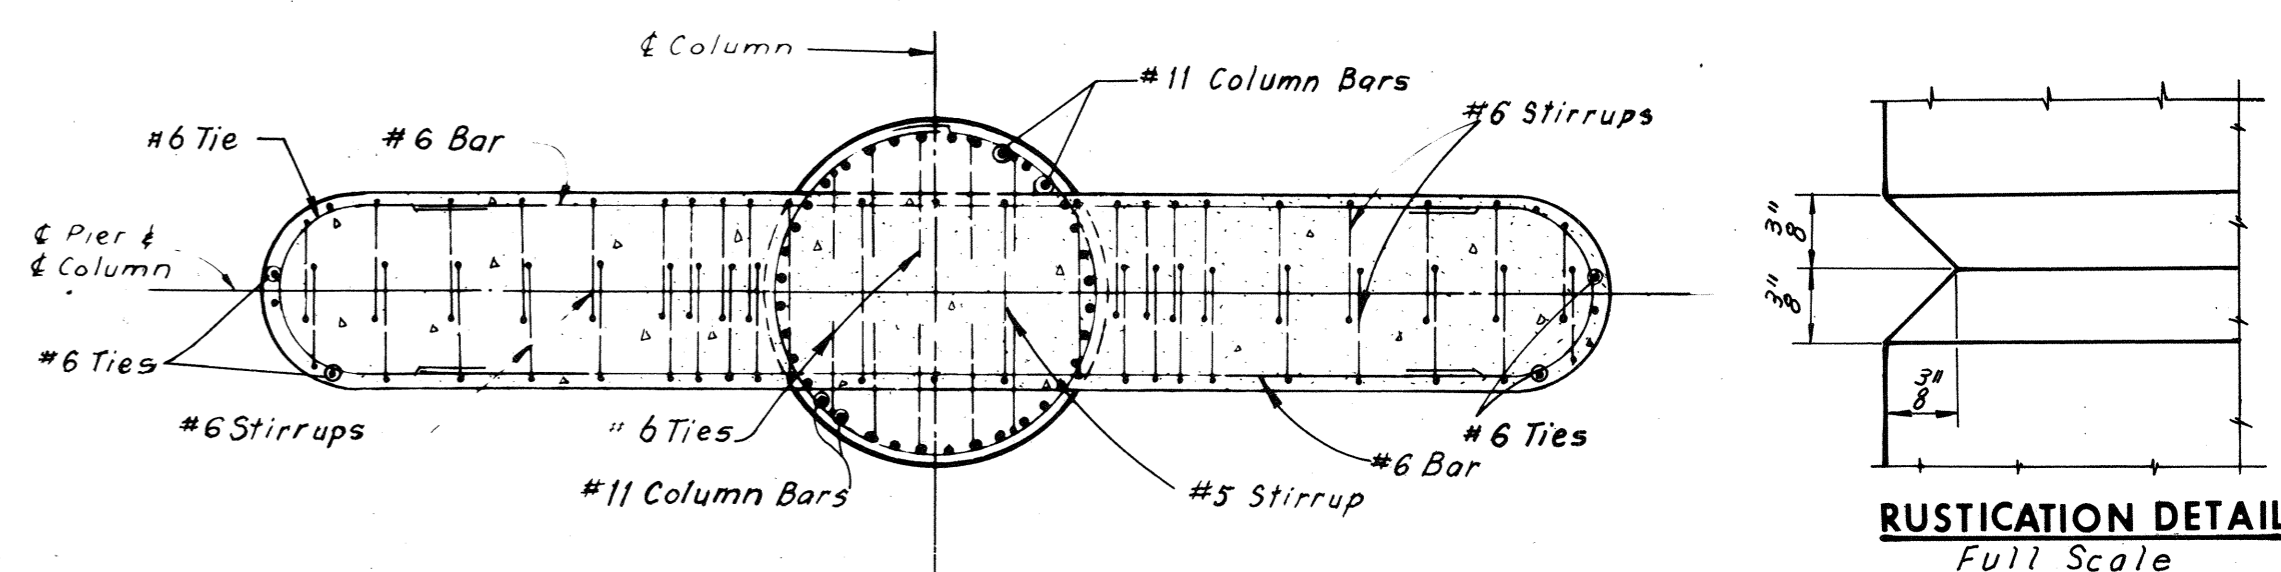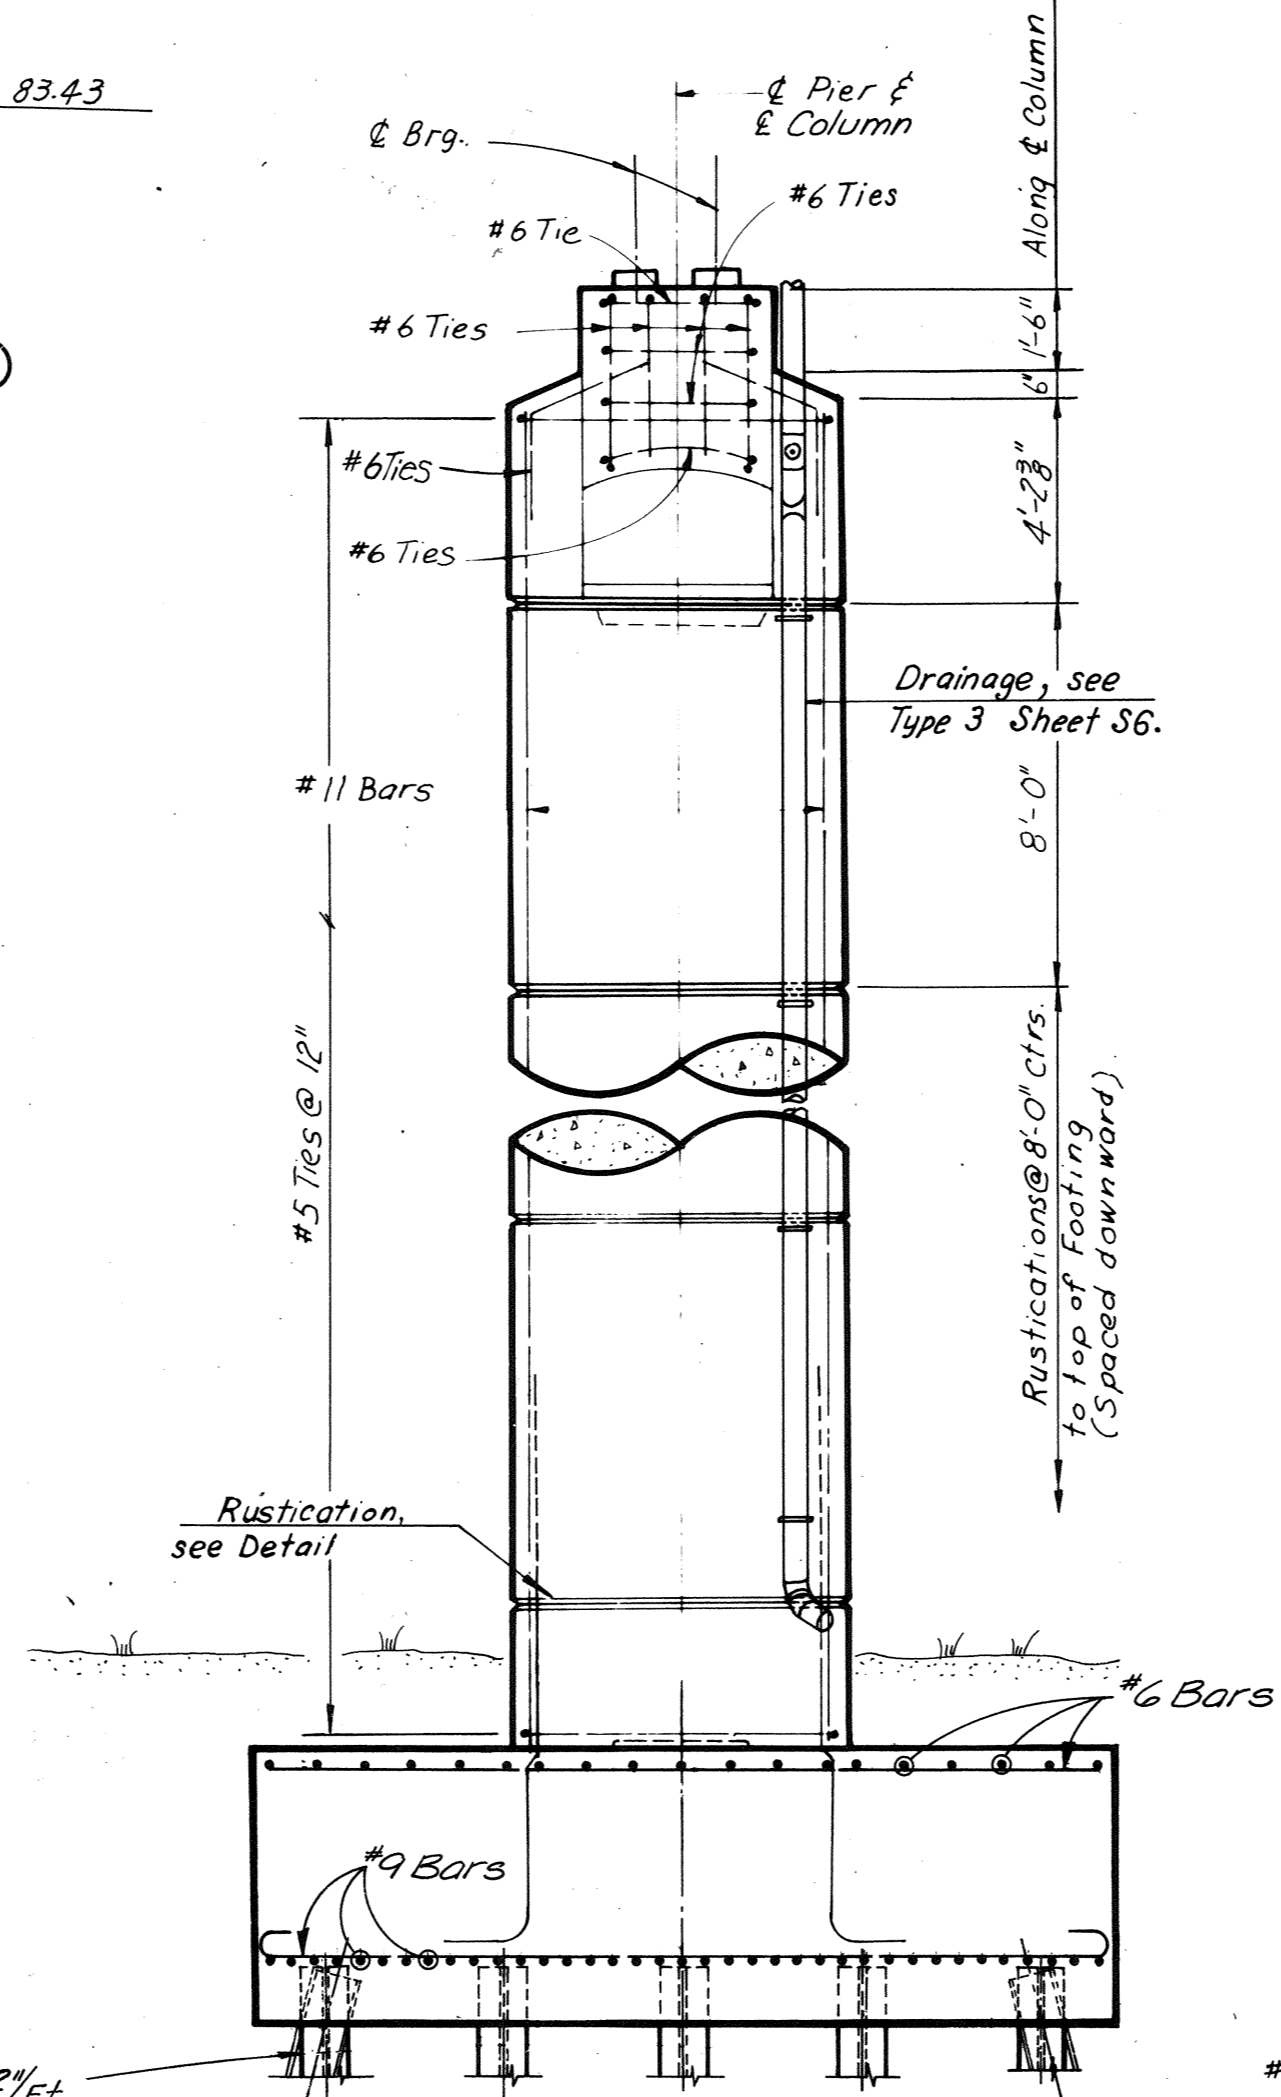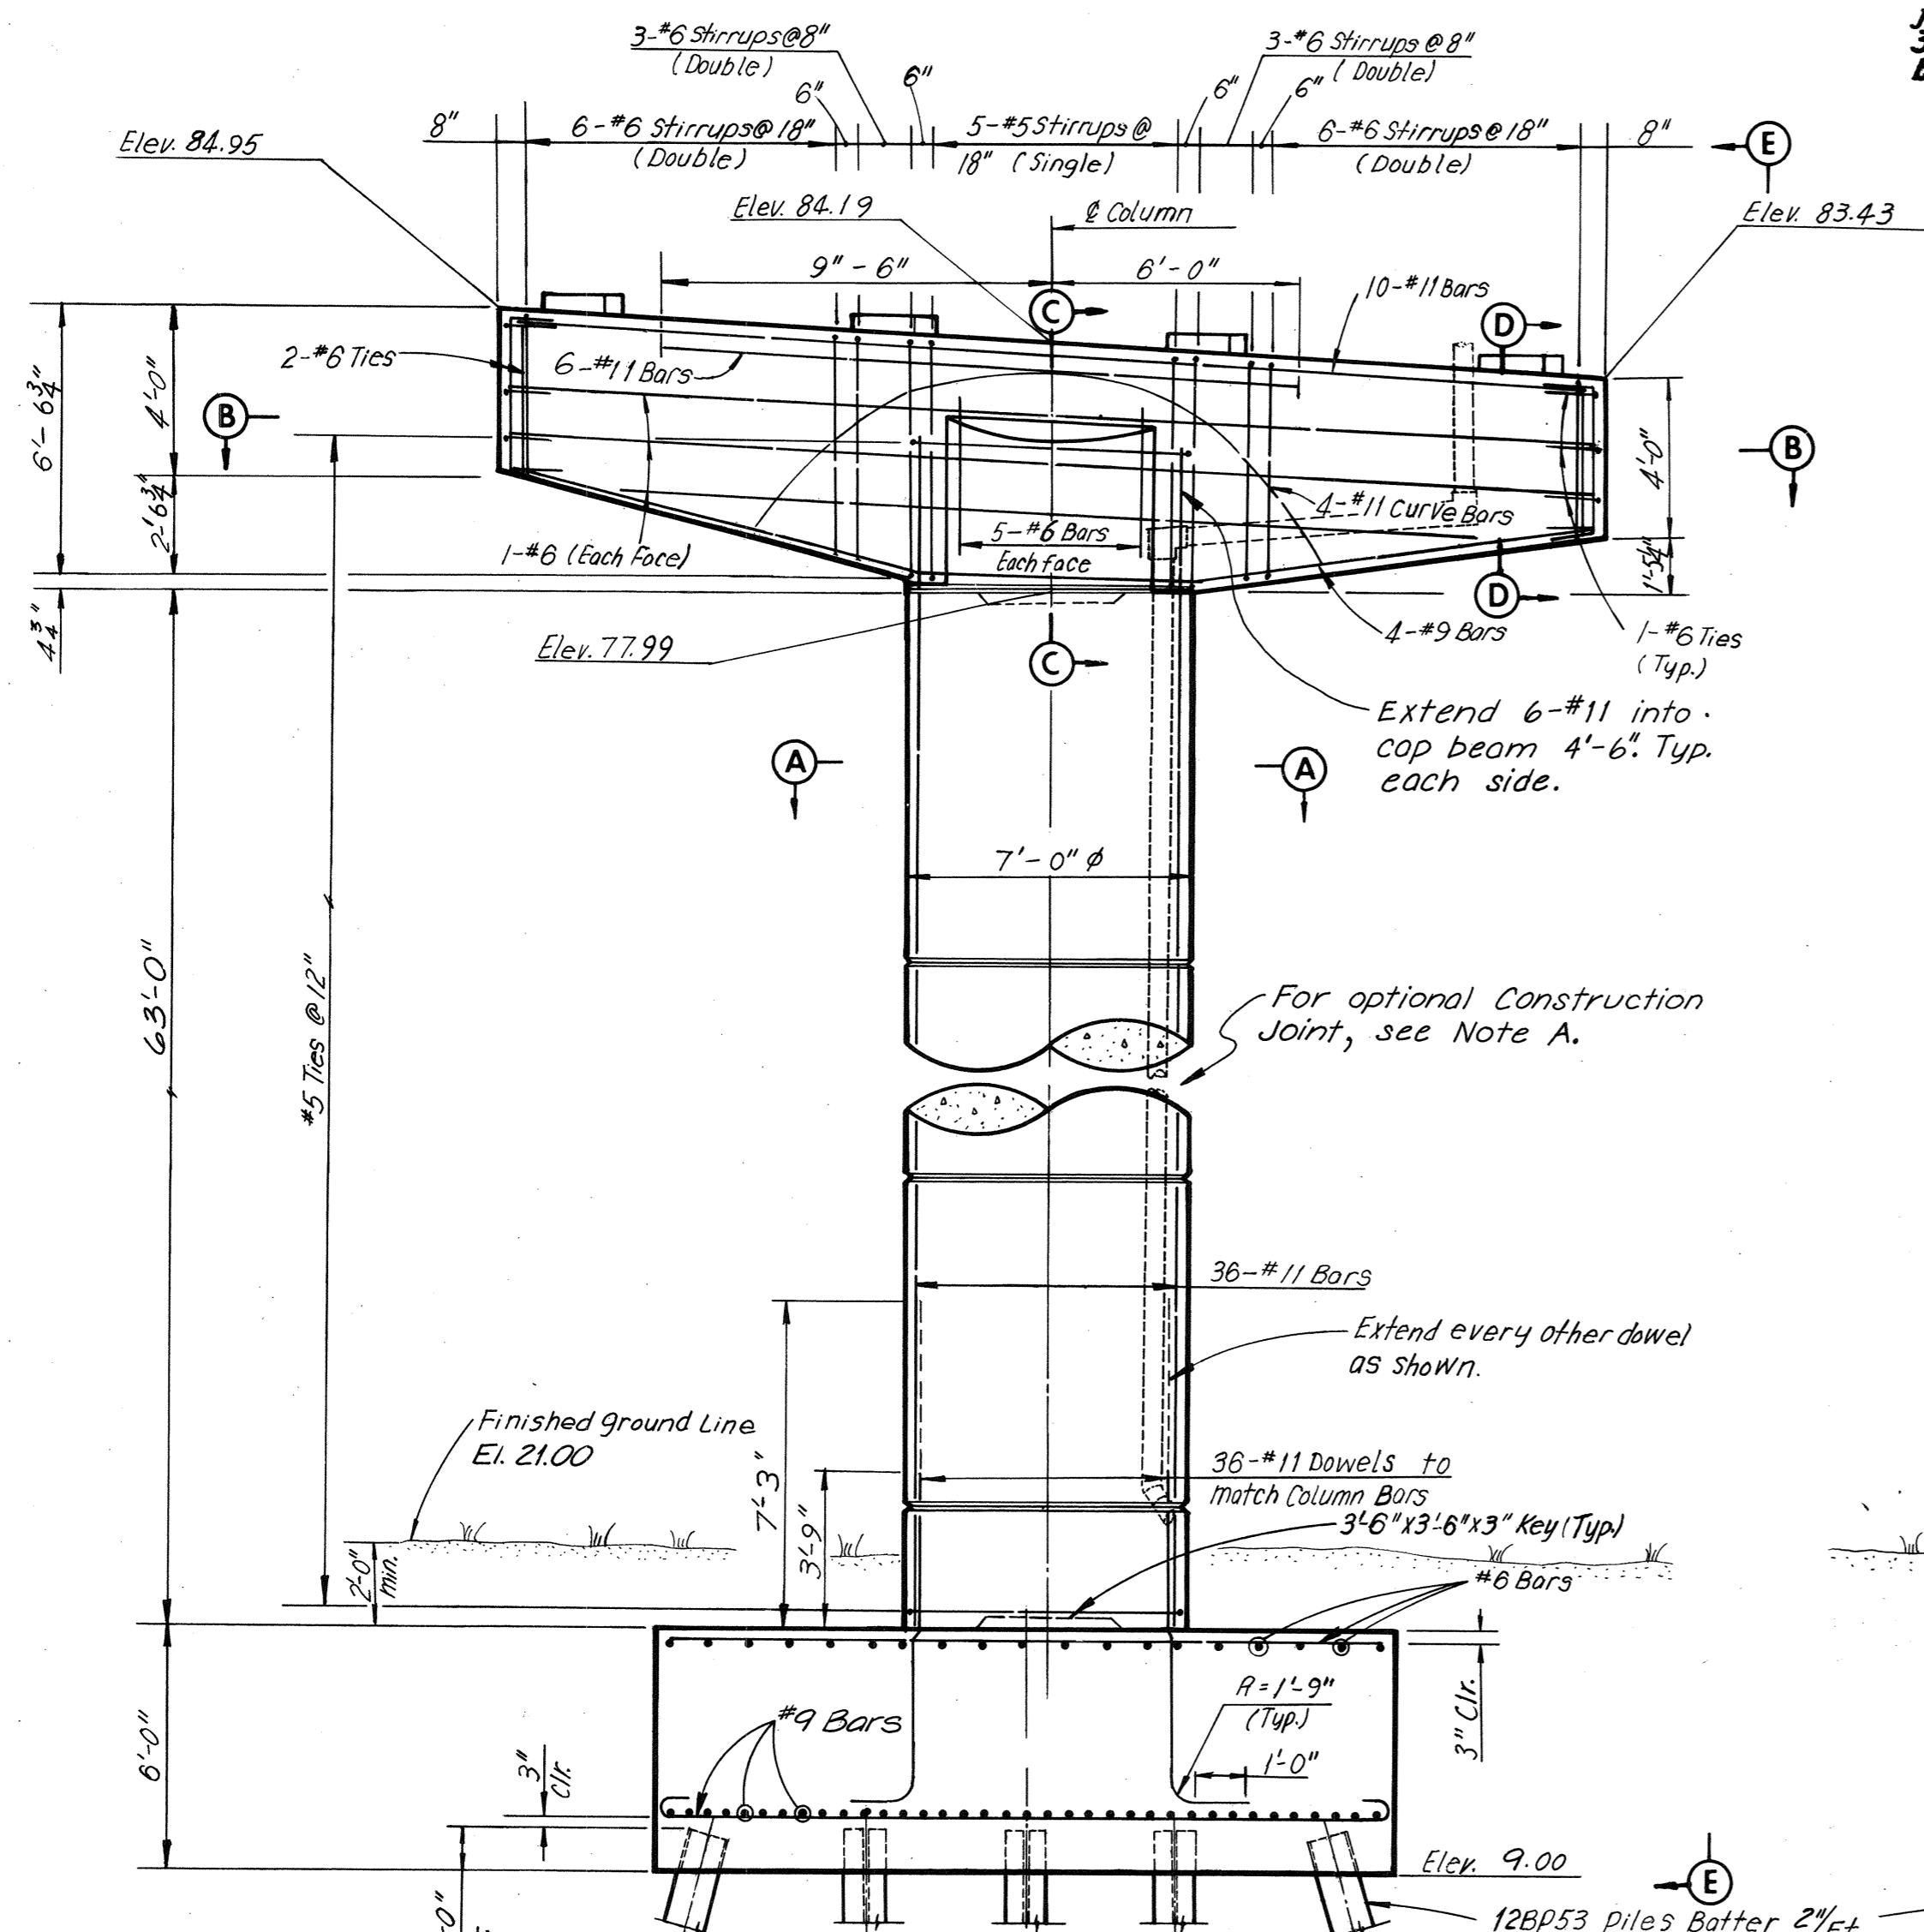


SECTION B-B
 Scale: 1/4" = 1'-0"
 Note: Typical dimensions of concrete pad for E1 shoe is 2'-0" x 1'-0" and for E5 shoe is 2'-5" x 1'-12".

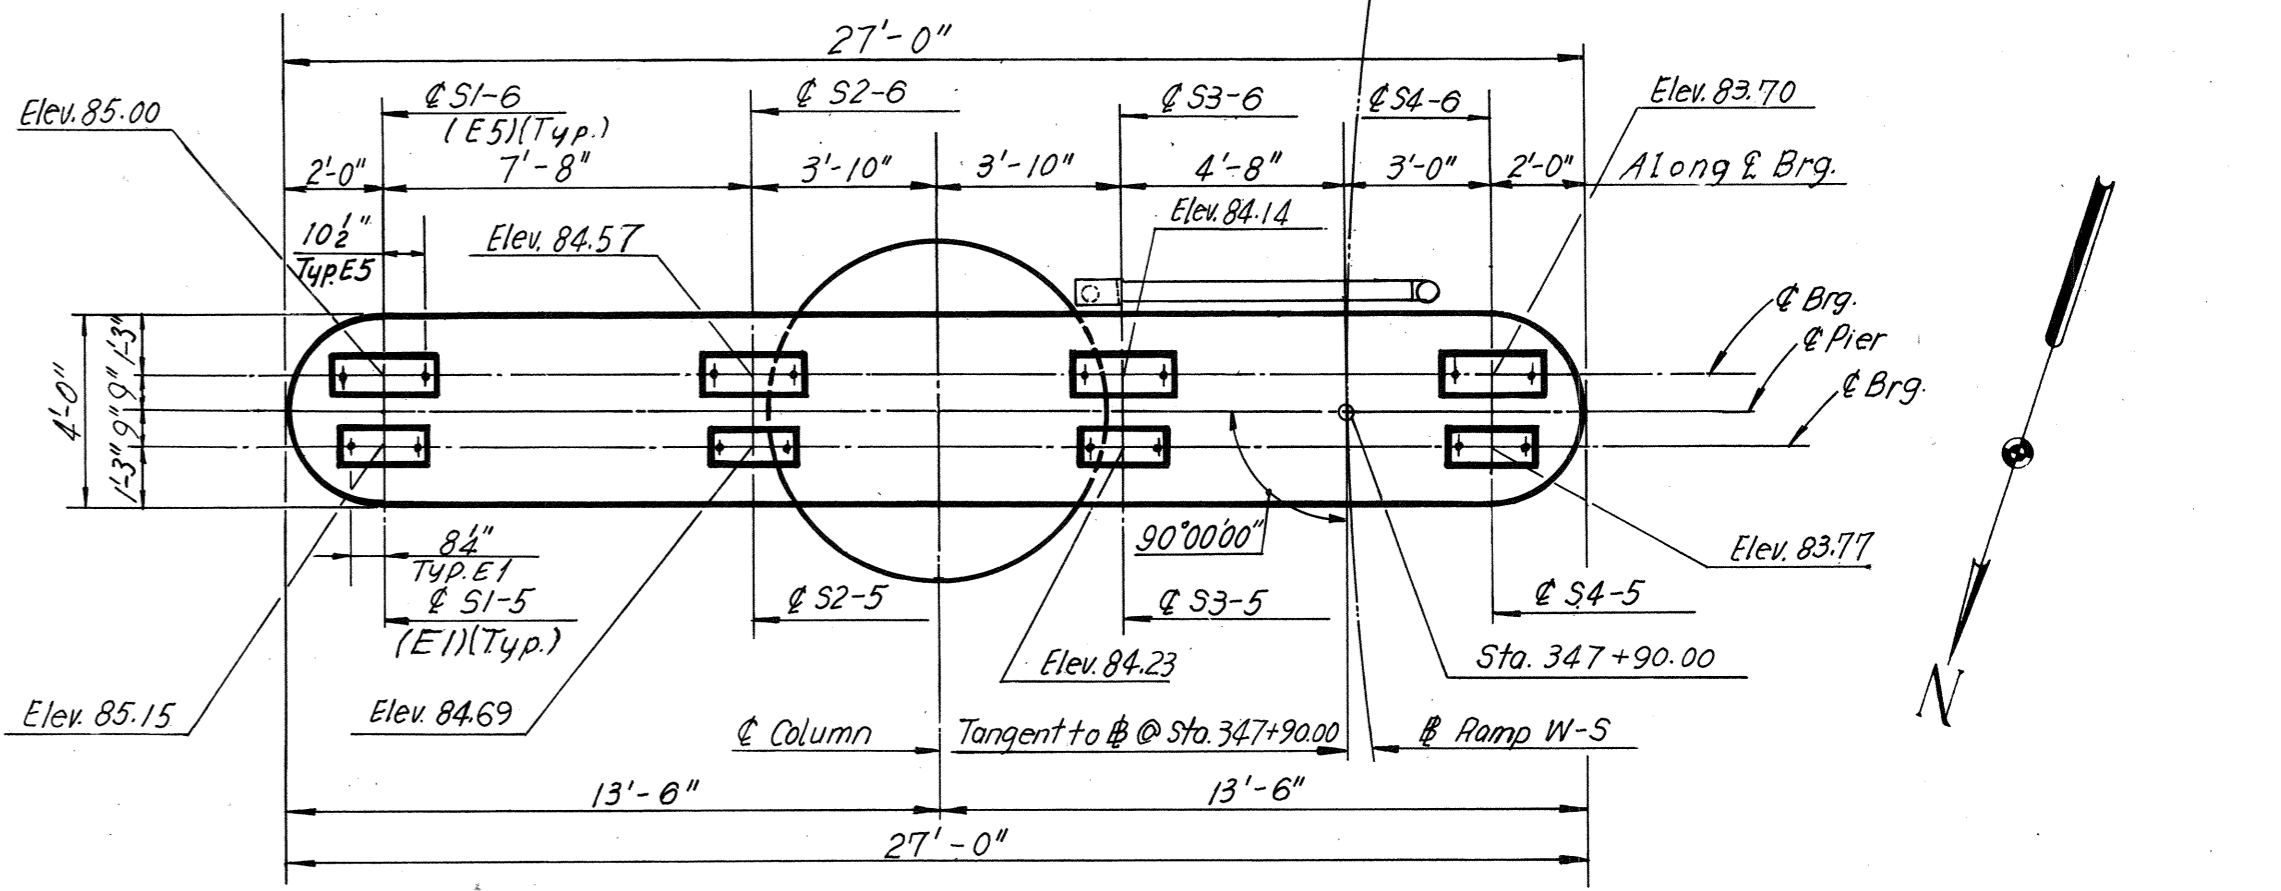


PLAN
 Scale: 1/4" = 1'-0"
 Note: All elevations are @ top of Concrete Pad.

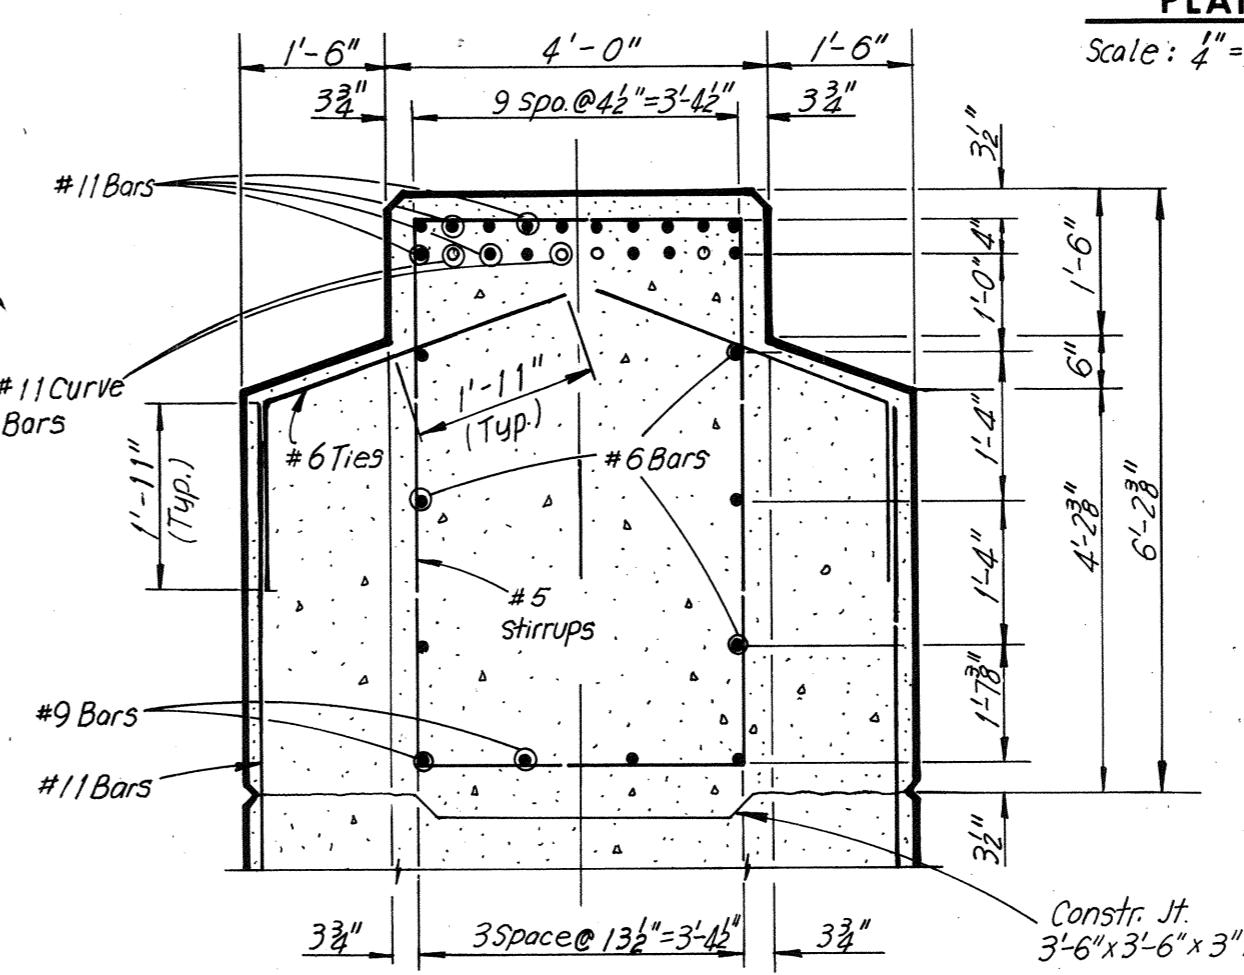


SECTION C-C
 Scale: 1/2" = 1'-0"

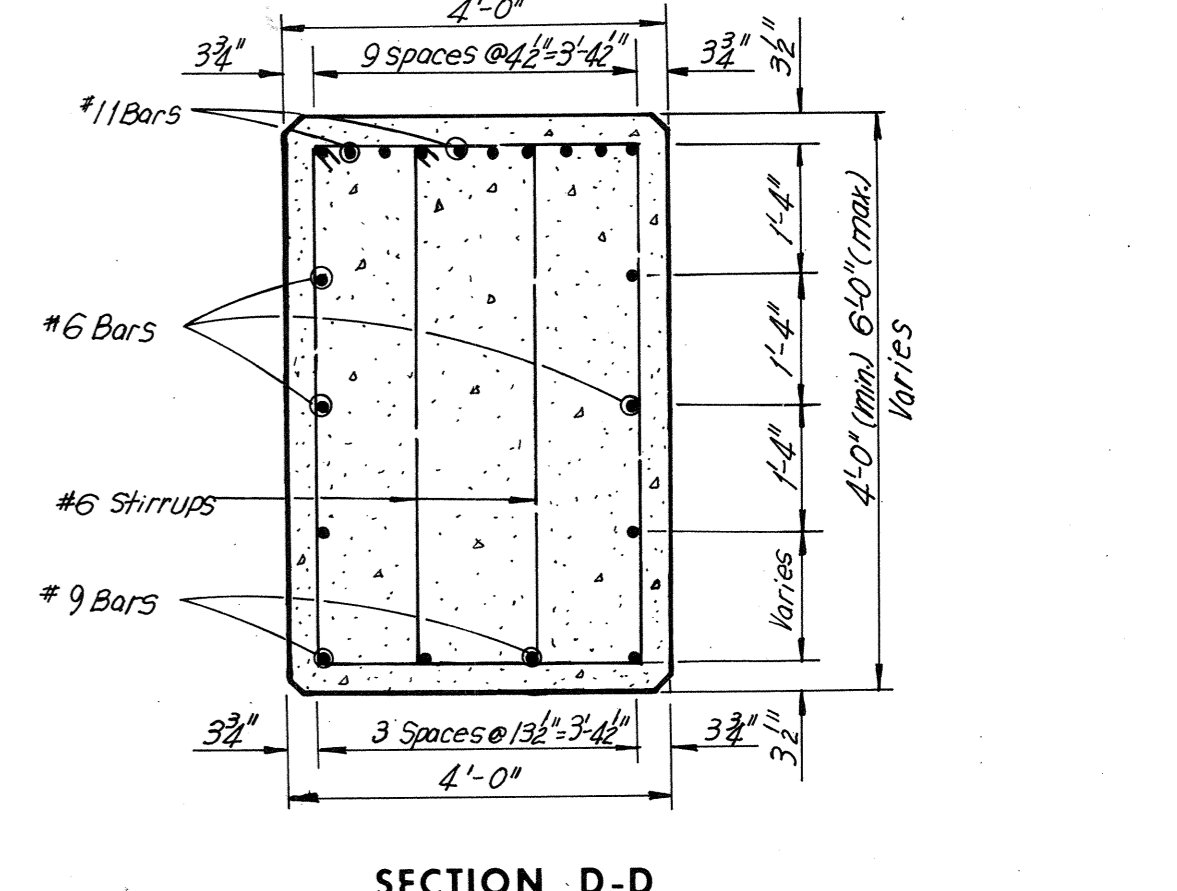


SECTION D-D
 Scale: 1/4" = 1'-0"

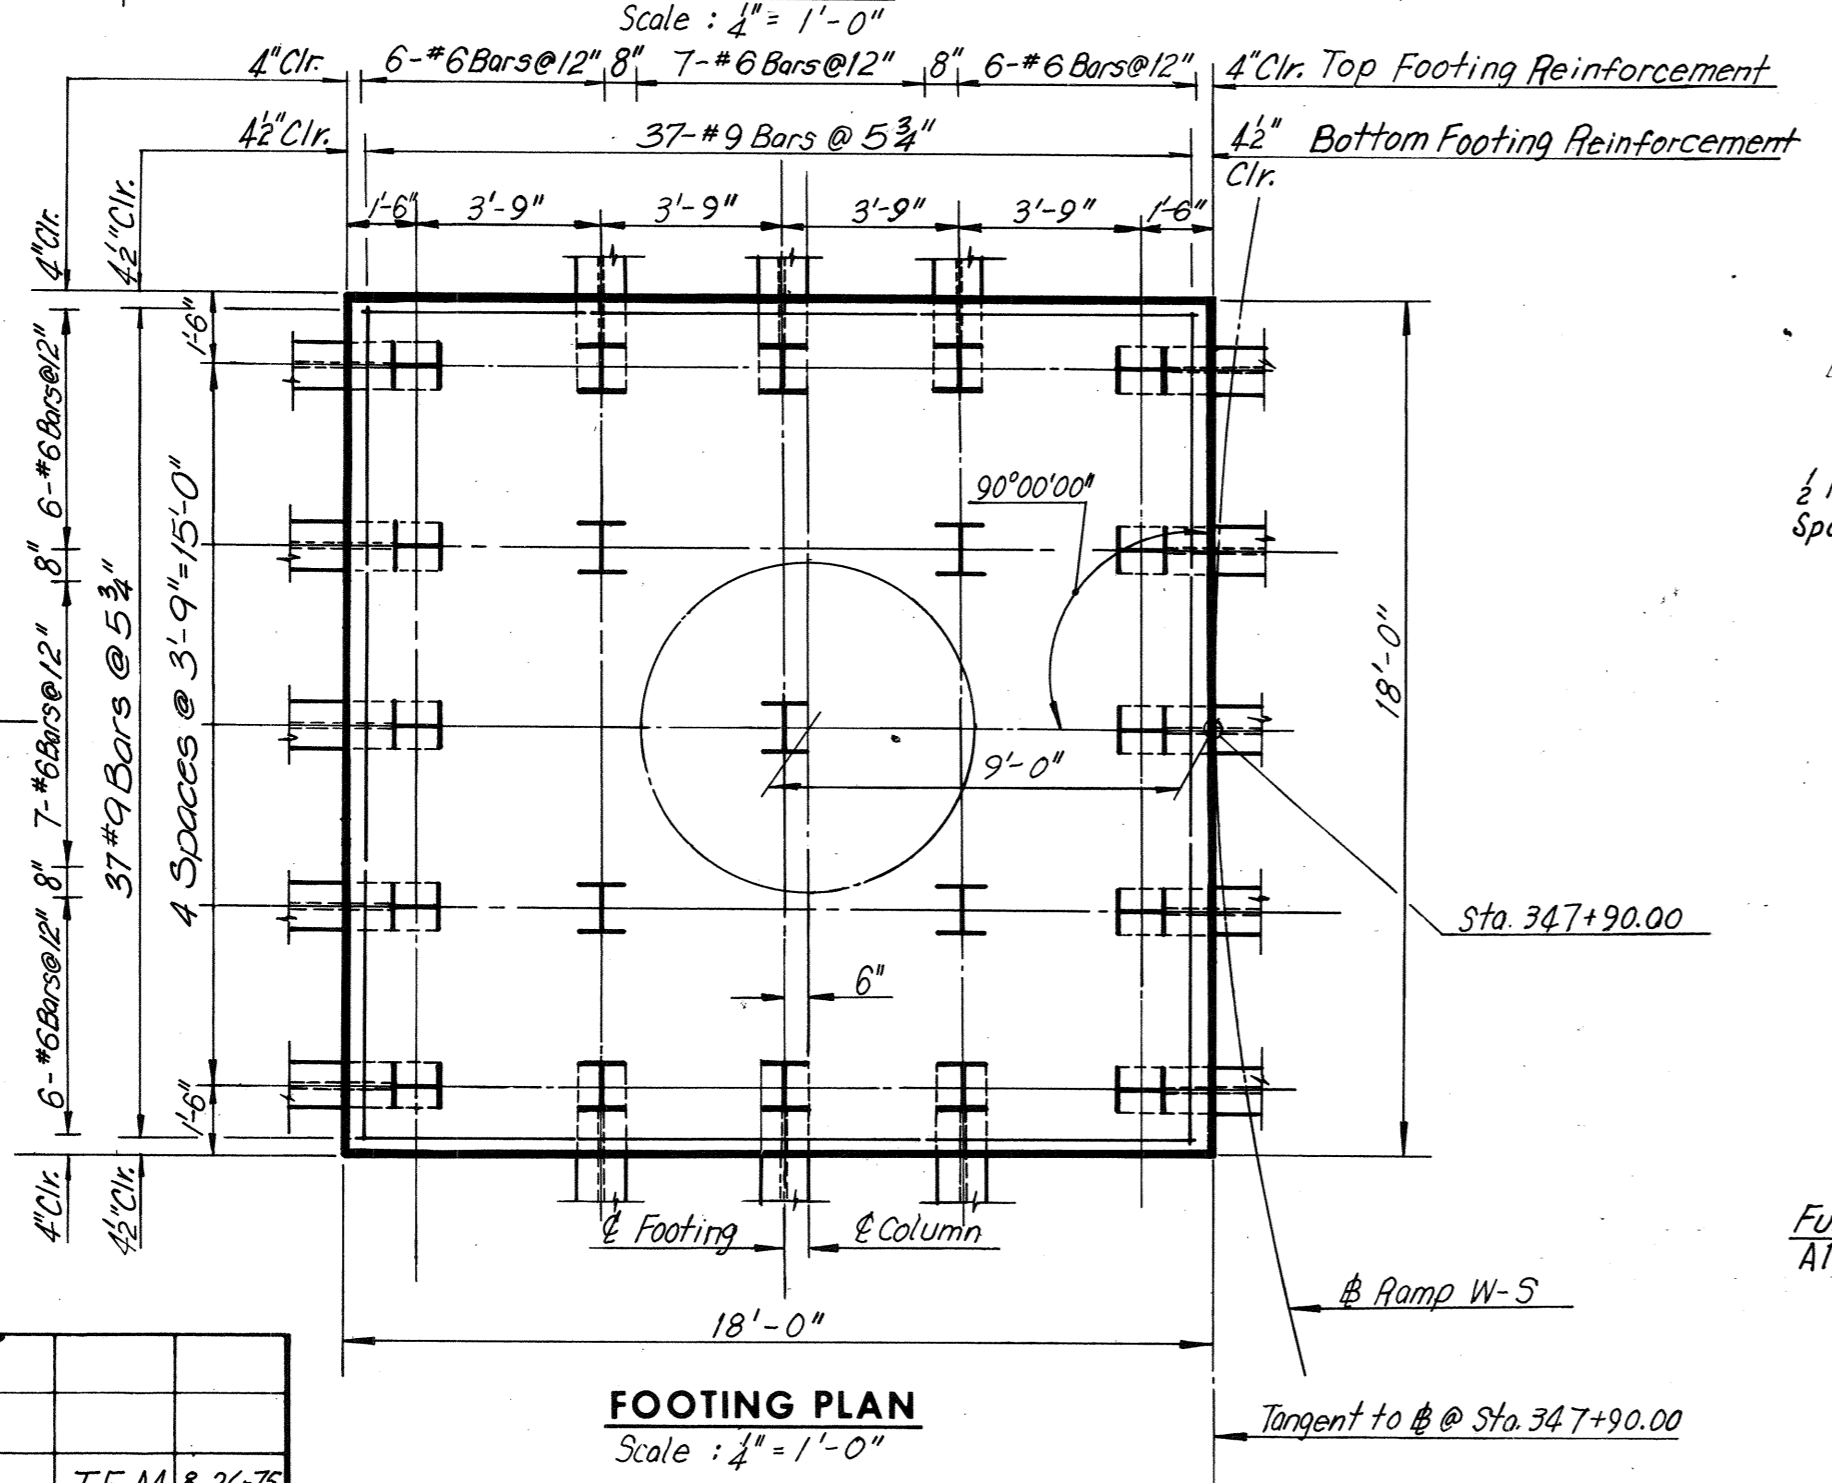

FOOTING PLAN
 Scale: 1/4" = 1'-0"

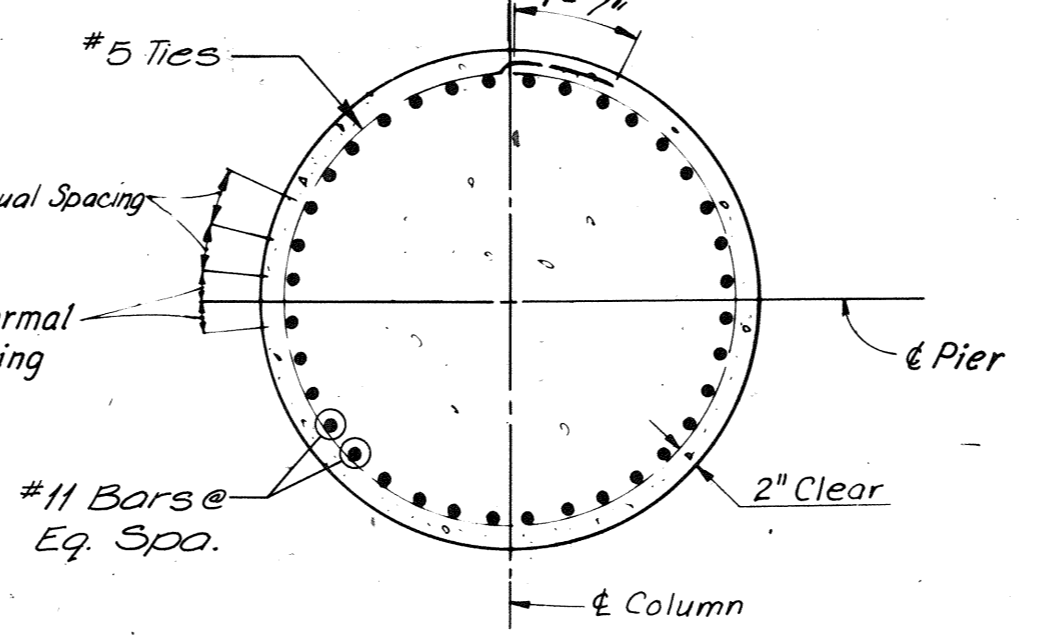

SECTION A-A
 Scale: 3/8" = 1'-0"

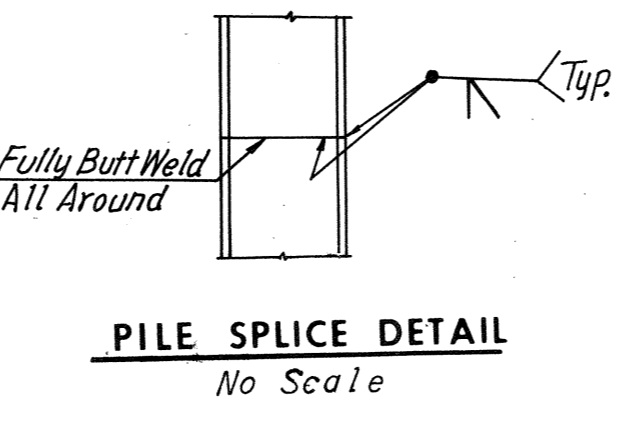

PILE SPLICE DETAIL
 No Scale

Note: Footing Elevations are approximate only and maybe varied to suit field conditions as directed by the Engineer. Vertical shaft reinforcing shall not be cut until these elevations are established. Where elevations change more than 2ft., redesign will be required.

Notes: All piles shall be 12BP53 Steel Piles (design capacity = 57tons)

For Standard Shoe Detail, see sheets S1 and S2.
 For Framing Plan, see Sheet 13.
 For Quantities of concrete and Steel see Sheet 2.
 Estimated pile tip elevation is -10.0.

FOOTING FOR PIER 3 IS ECCENTRIC AS SHOWN ON FOOTING PLAN

BY	DATE	NO.	REVISION	BY	DATE
MADE	G.S.H.	6-10-89			
CHECKED	Y.C.P.	6-14-89	Notes	T.E.M.	8-26-75
IN CHARGE					

AS BUILT

RICHMOND METROPOLITAN AUTHORITY
RICHMOND EXPRESSWAY SYSTEM
DOWNTOWN EXPRESSWAY


BRIDGE NO. 68
RAMP W-S CONNECTION TO
RICHMOND-PETERSBURG TURNPIKE
PIER 3

HOWARD, NEEDLES, TAMMEN & BERGENDOFF
 Consulting Engineers
 NEW YORK ALEXANDRIA KANSAS CITY


SCALE: As Noted
 CONTRACT NO.: 11
 SHEET NO.: 5 OF 28

RICHMOND EXPRESSWAY SYSTEM			
SECTION	PROJECT	SHEET NO.	TOTAL SHEETS
11	DOWNTOWN EXPRESSWAY	69	97


NOTE A:
 A construction joint will be permitted at a rustication near mid-height of the column. The column reinforcement may be lap spliced near the construction joint. The lap at the splice shall be a minimum of 3'-6". Splices shall be staggered at least 3'-3" between adjacent bars.

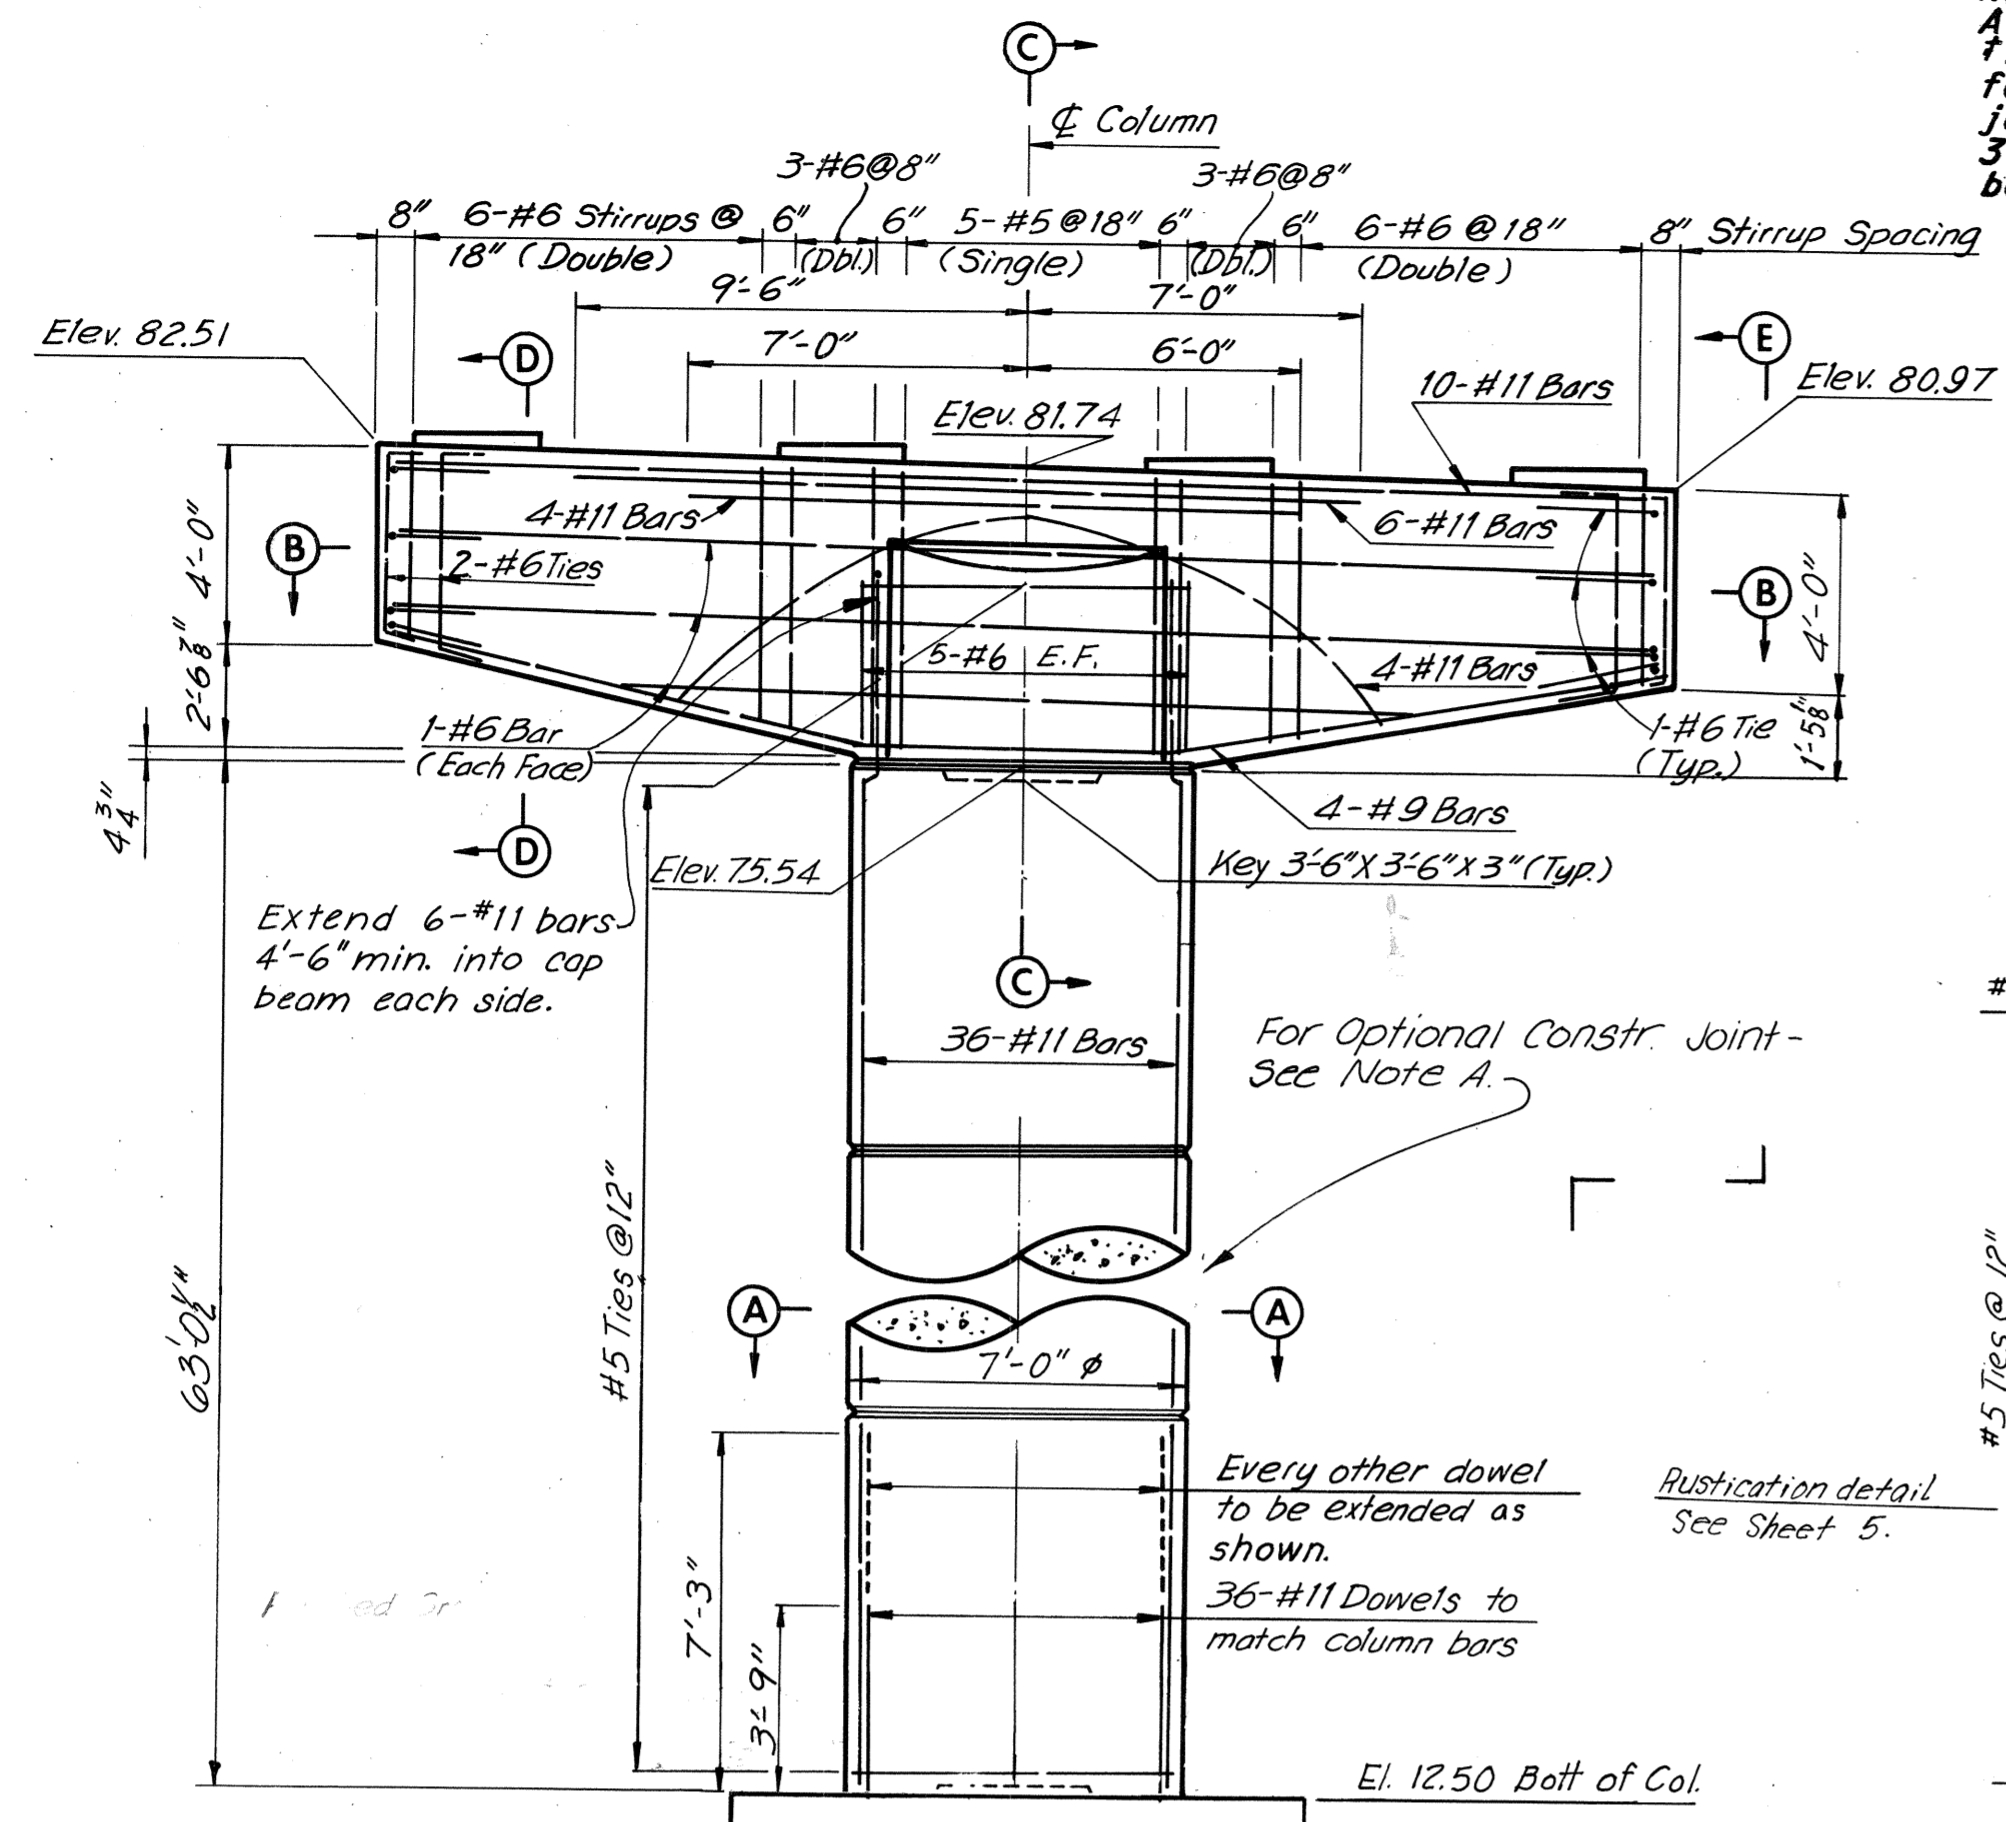


ELEVATION
 Scale: 1/4" = 1'-0"

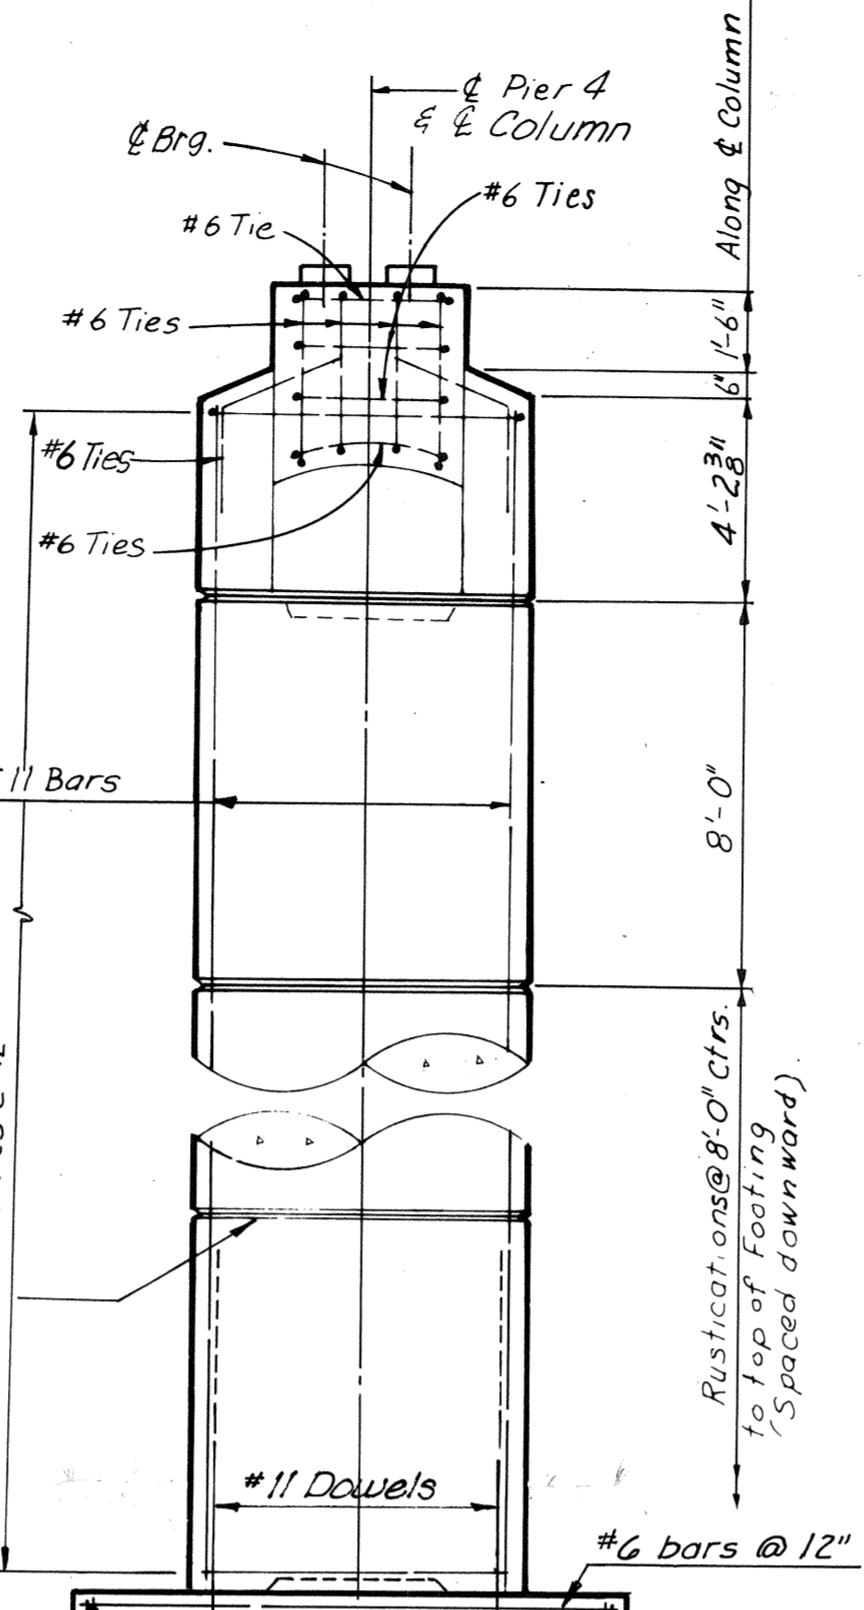

Rustication detail
 See Sheet 5.

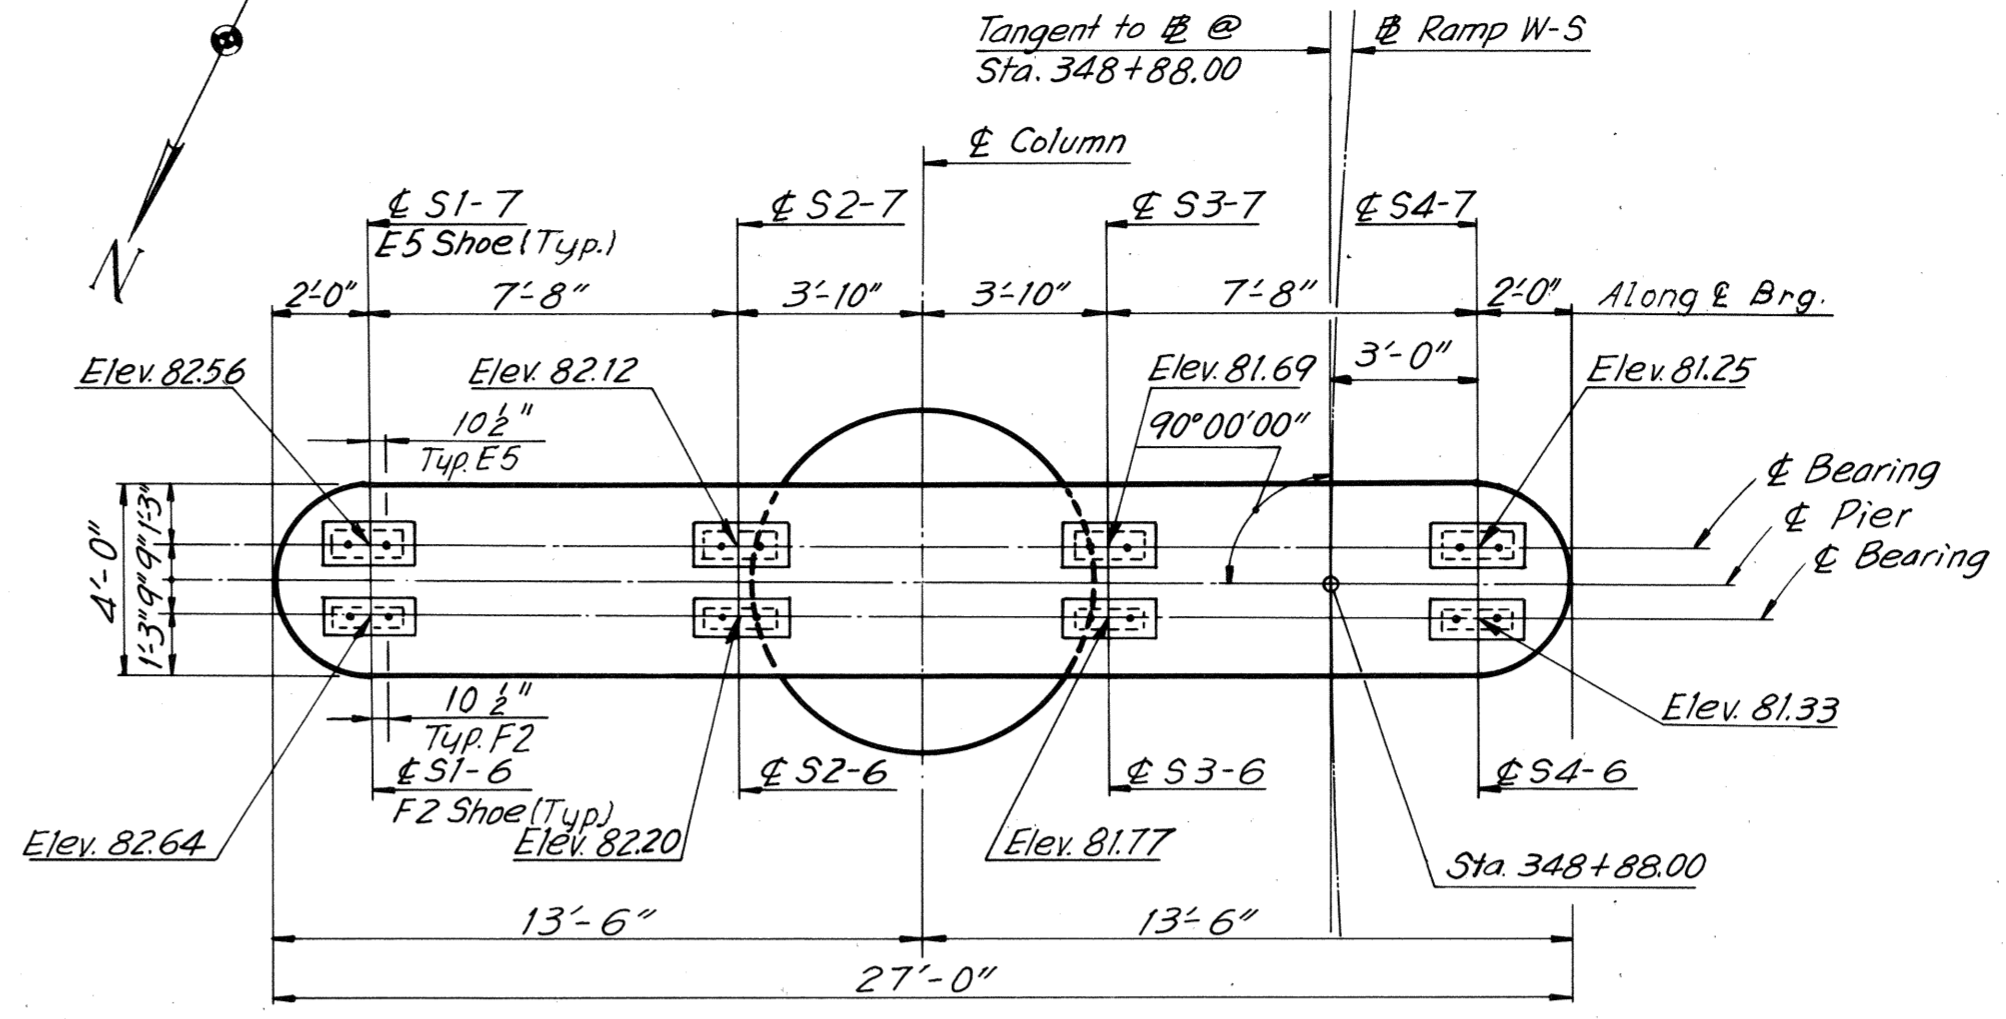


PLAN
 Scale: 1/4" = 1'-0"

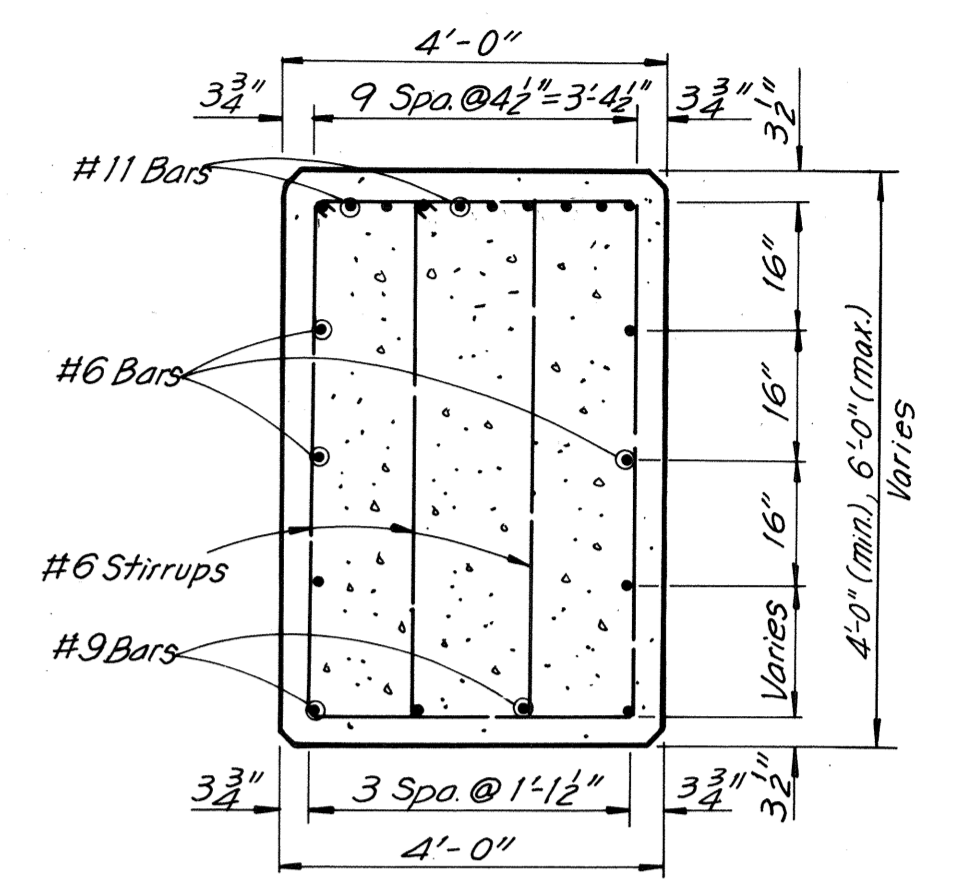


SECTION D-D
 Scale: 1/2" = 1'-0"

Note: Typical dimensions of concrete pad for E5 shoe is 2'-5 1/2" x 1'-1 1/2" and for F2 shoe is 2'-6" x 11".

Note: All elevations are @ top of concrete pad at bearing.

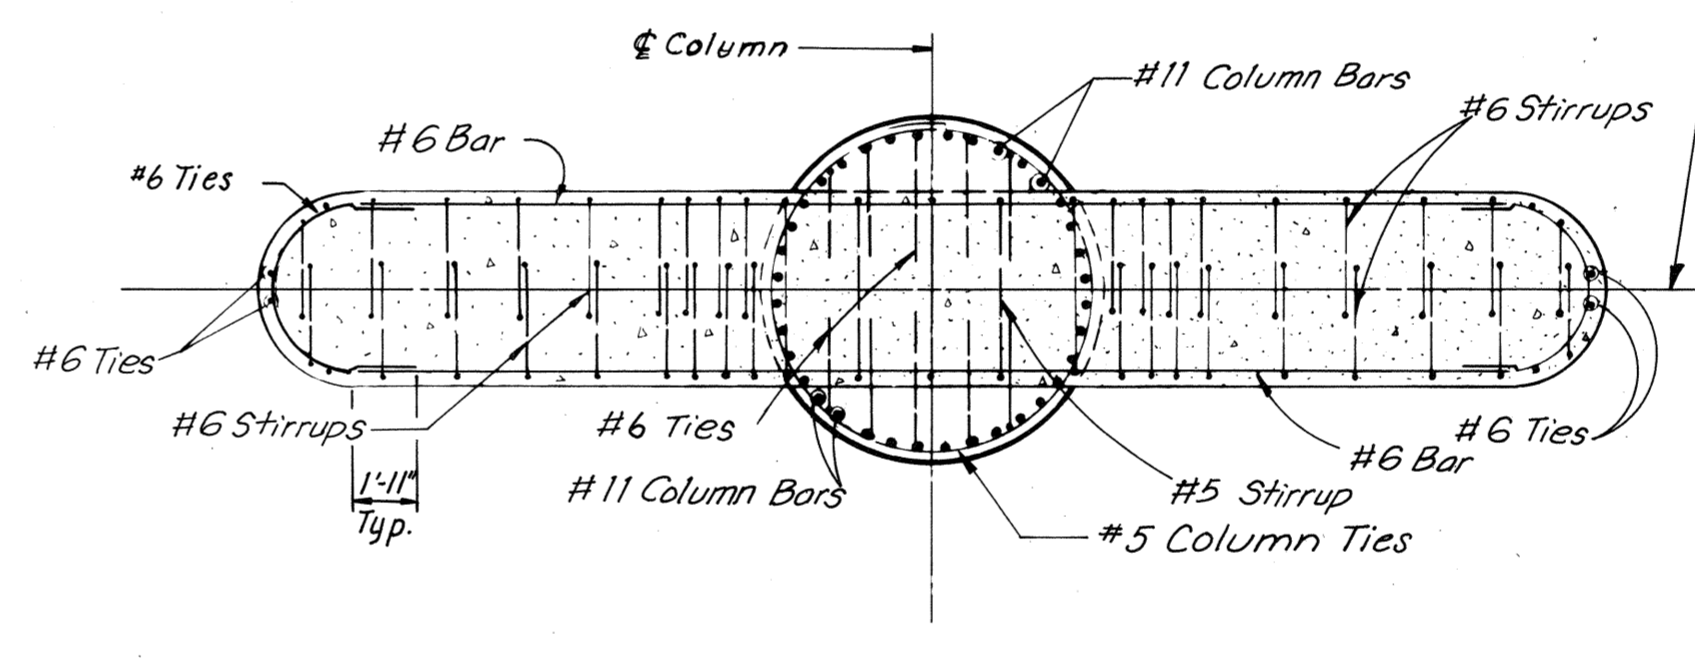


SECTION B-B
 Scale: 1/4" = 1'-0"

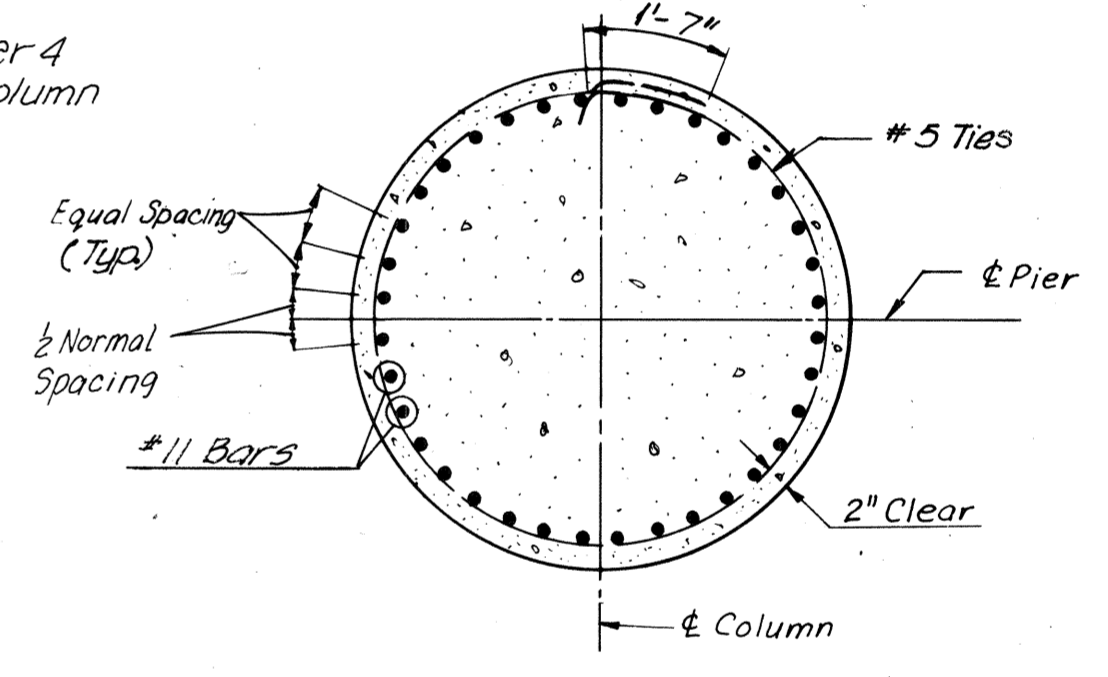

SECTION A-A
 Scale: 3/8" = 1'-0"


Note: Footing elevations are approximate only and may be varied to suit field conditions as directed by the Engineer. Vertical shaft reinforcing shall not be cut until these elevations are established. Where elevations change more than 2 ft., redesign will be required.

Notes:
 All piles shall be 12BP53 steel piles (Design Capacity = 57 Tons)
 Batter piles 1' per foot where shown.
 For Standard Shoe Detail, see Sheets S1 and S2.
 For Framing Plan, see Sheets 13 and 14.
 For Rustication Detail, see Sheet 5.
 For 12BP53 Steel Pile Details, see Sheet 5.
 For Quantities of concrete and steel, see Sheet 2.
 Estimated pile Tip Elevation is - 15.0.

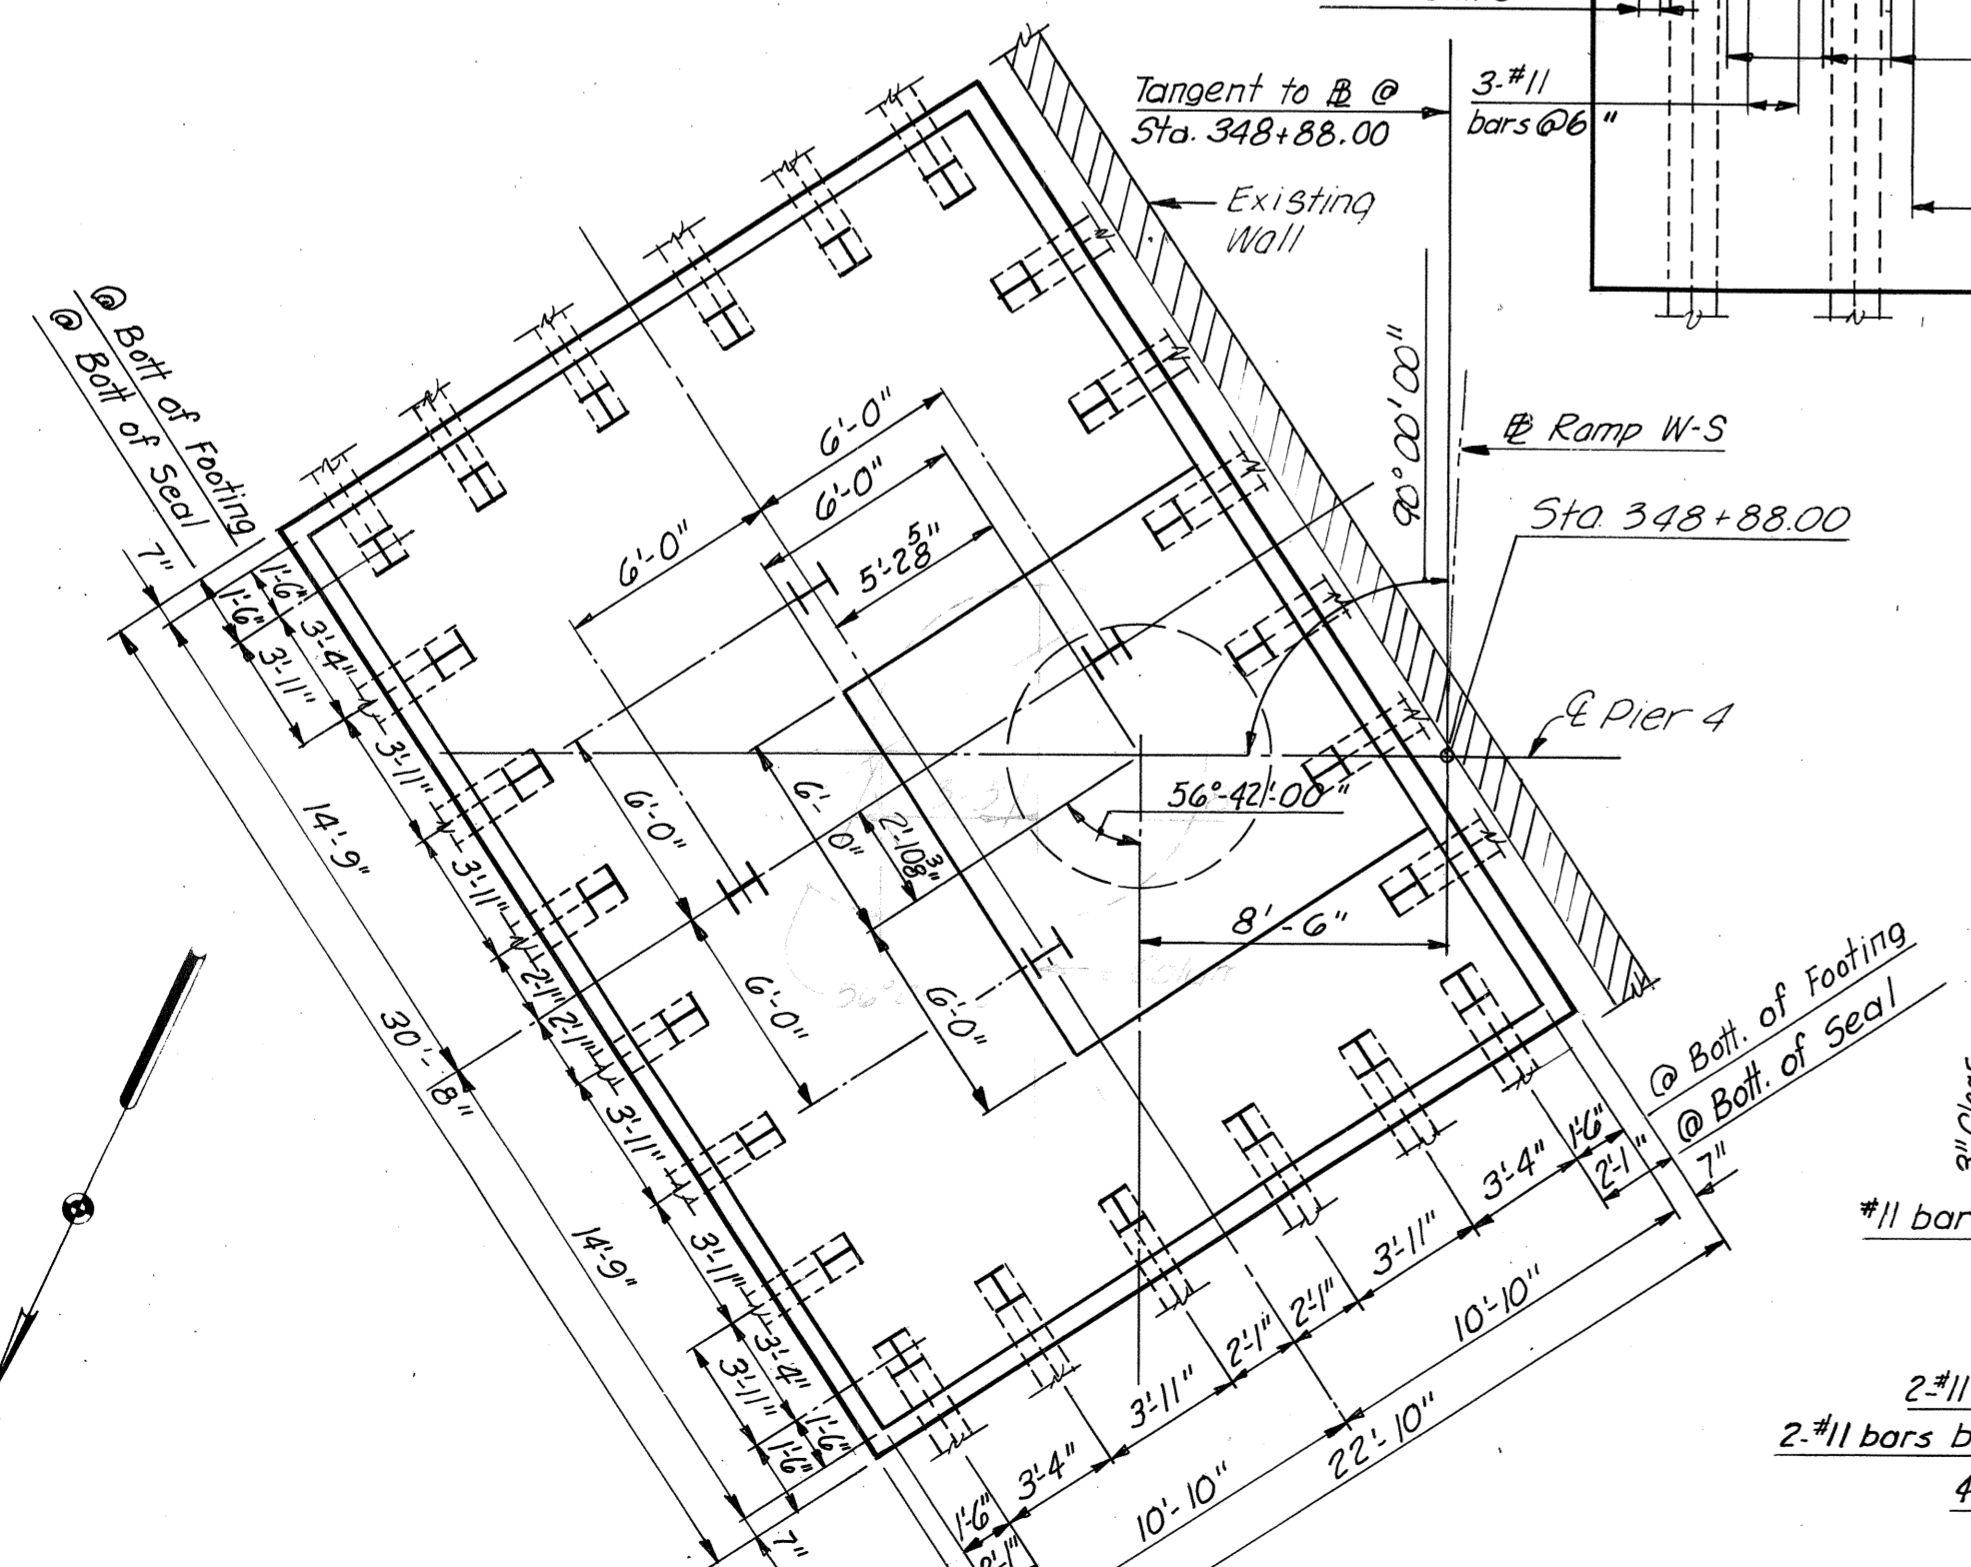


FOOTING FOR PIER 4 IS ECCENTRIC AS SHOWN ON FOOTING PLAN


FOOTING PLAN
 Scale: 1/8" = 1'-0"

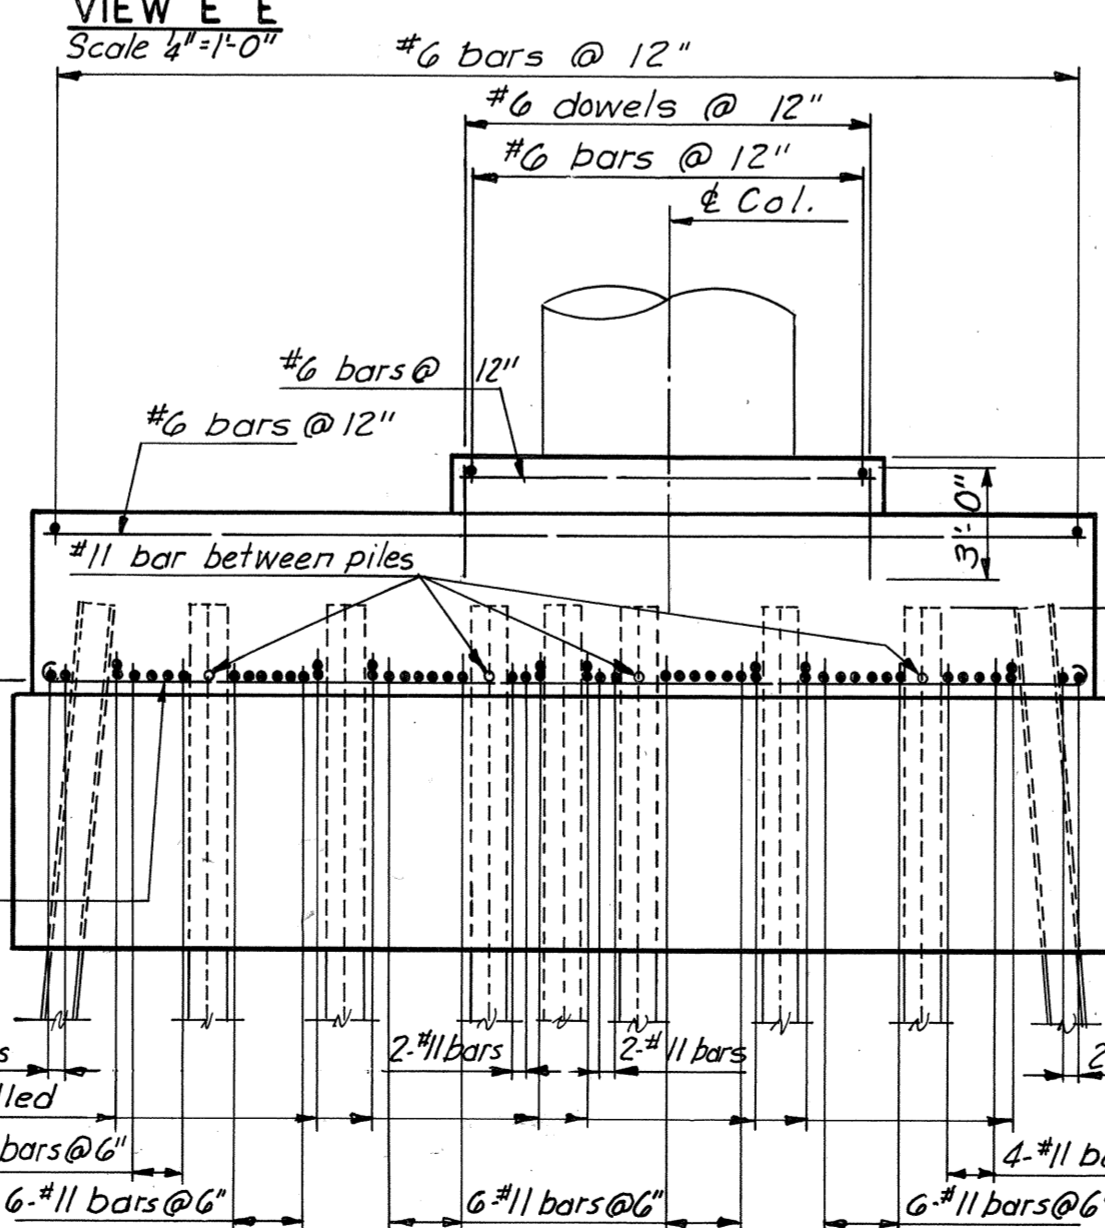

VIEW E-E
 Scale: 1/4" = 1'-0"

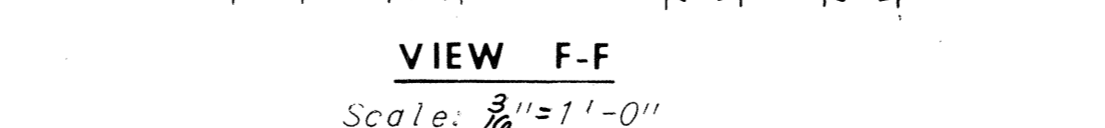

VIEW F-F
 Scale: 3/8" = 1'-0"






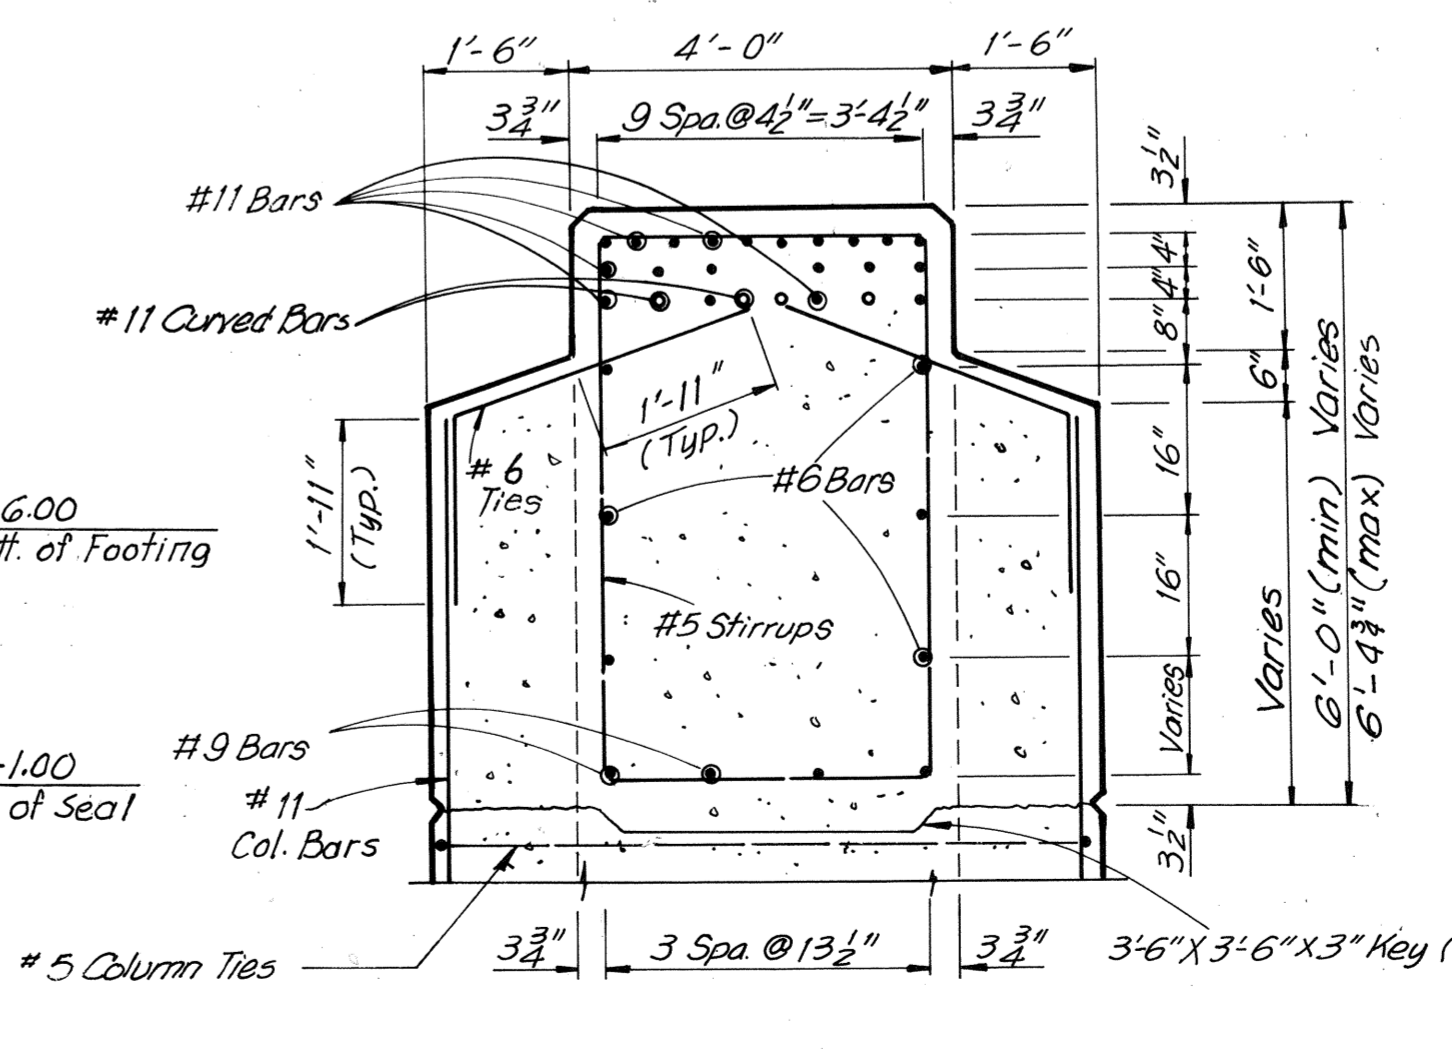


SECTION C-C
 Scale: 1/2" = 1'-0"

AS BUILT
RICHMOND METROPOLITAN AUTHORITY
RICHMOND EXPRESSWAY SYSTEM
DOWNTOWN EXPRESSWAY
BRIDGE NO. 68
RAMP W-S CONNECTION TO
RICHMOND-PETERSBURG TURNPIKE
PIER 4

BY	DATE	NO.	REVISION	BY	DATE
SCC	6-10-69				
G.S.H.	6-14-69	1	Note deleted	T.E.M.	8-26-75

RICHMOND EXPRESSWAY SYSTEM			
SECTION	PROJECT	SHEET NO.	TOTAL SHEETS
11	DOWNTOWN EXPRESSWAY	70	97

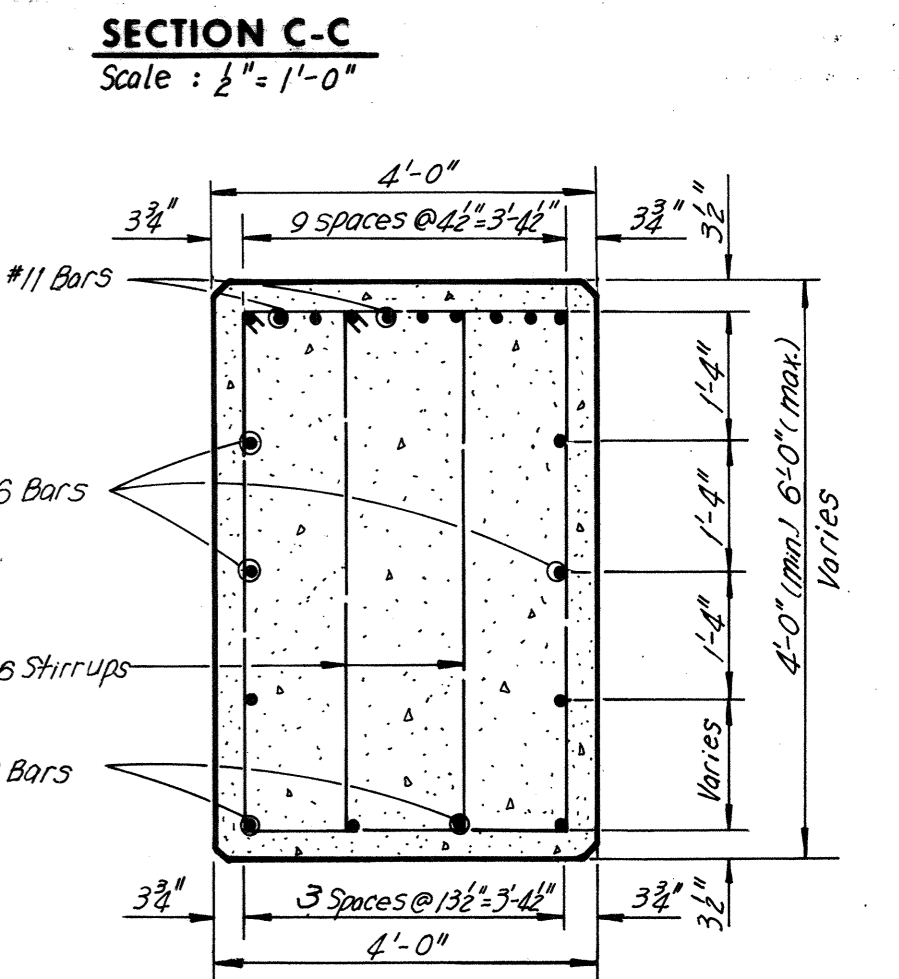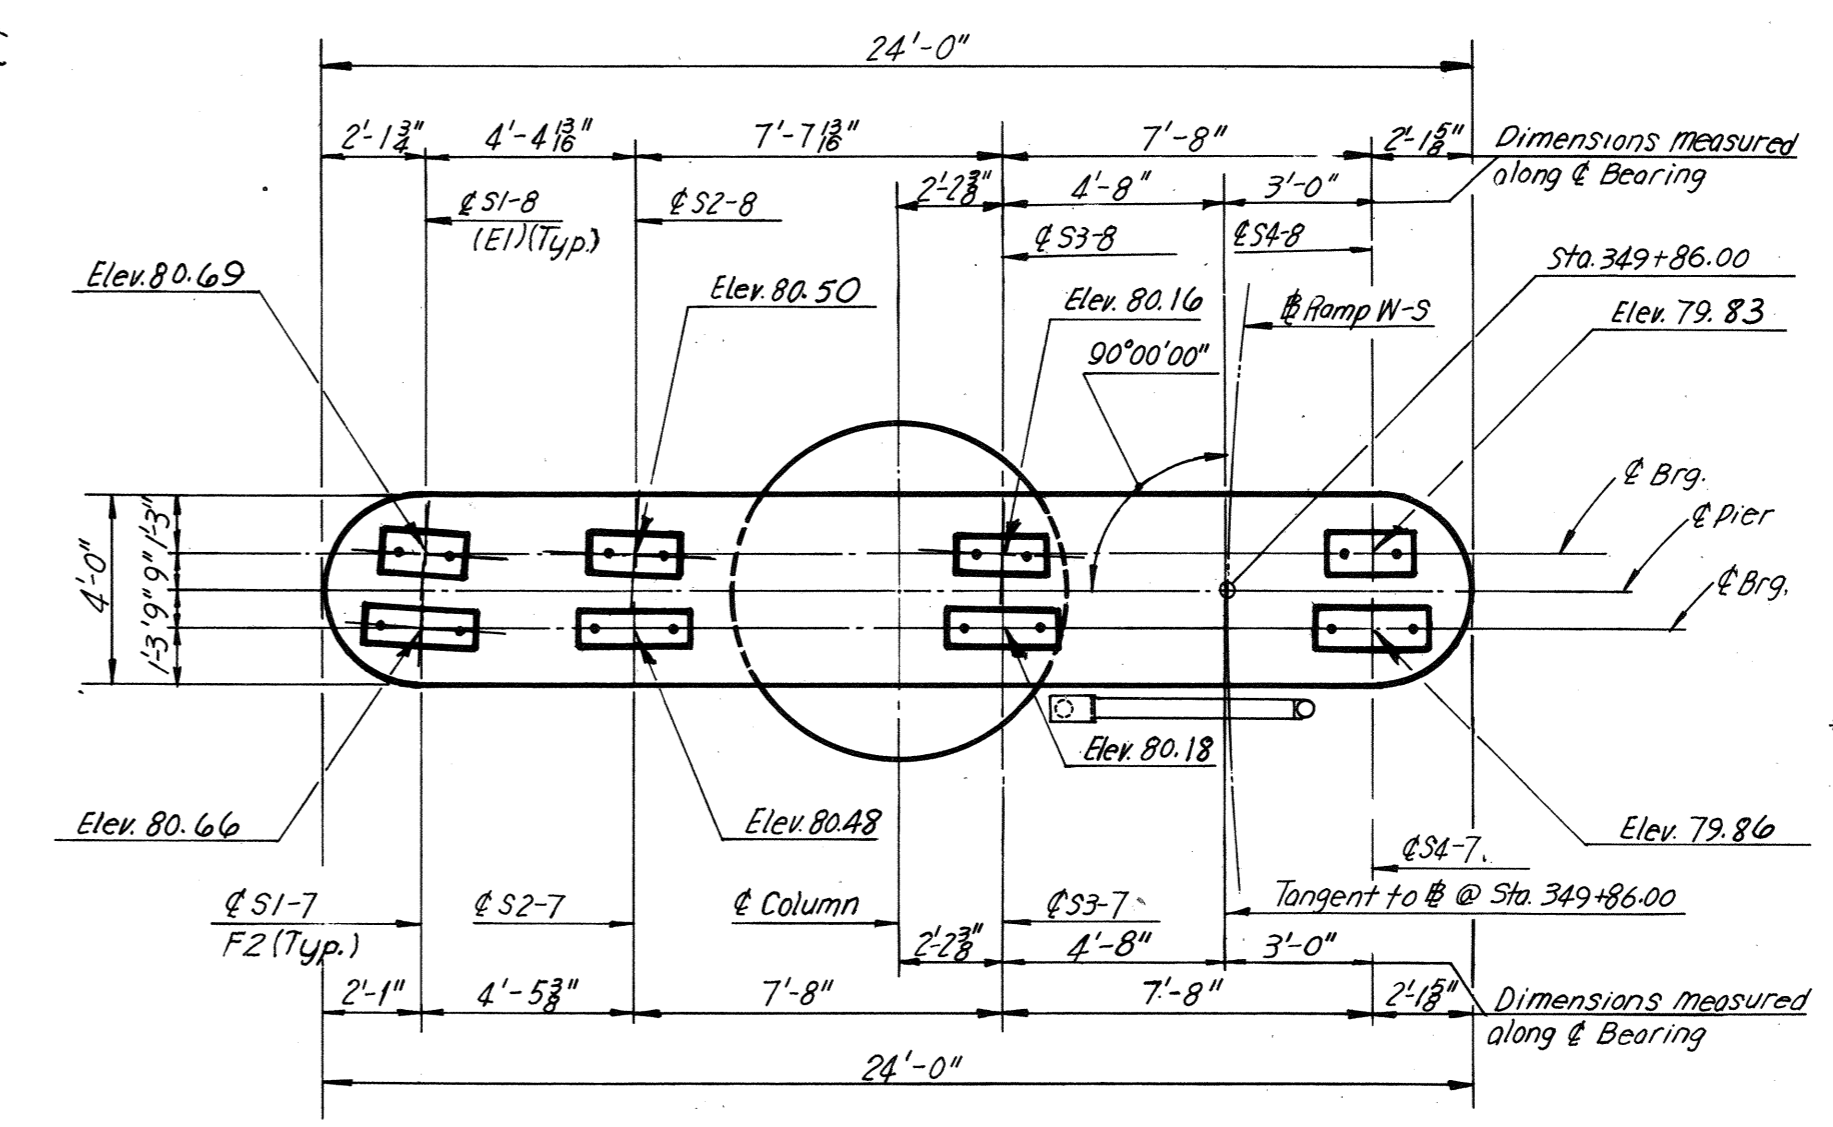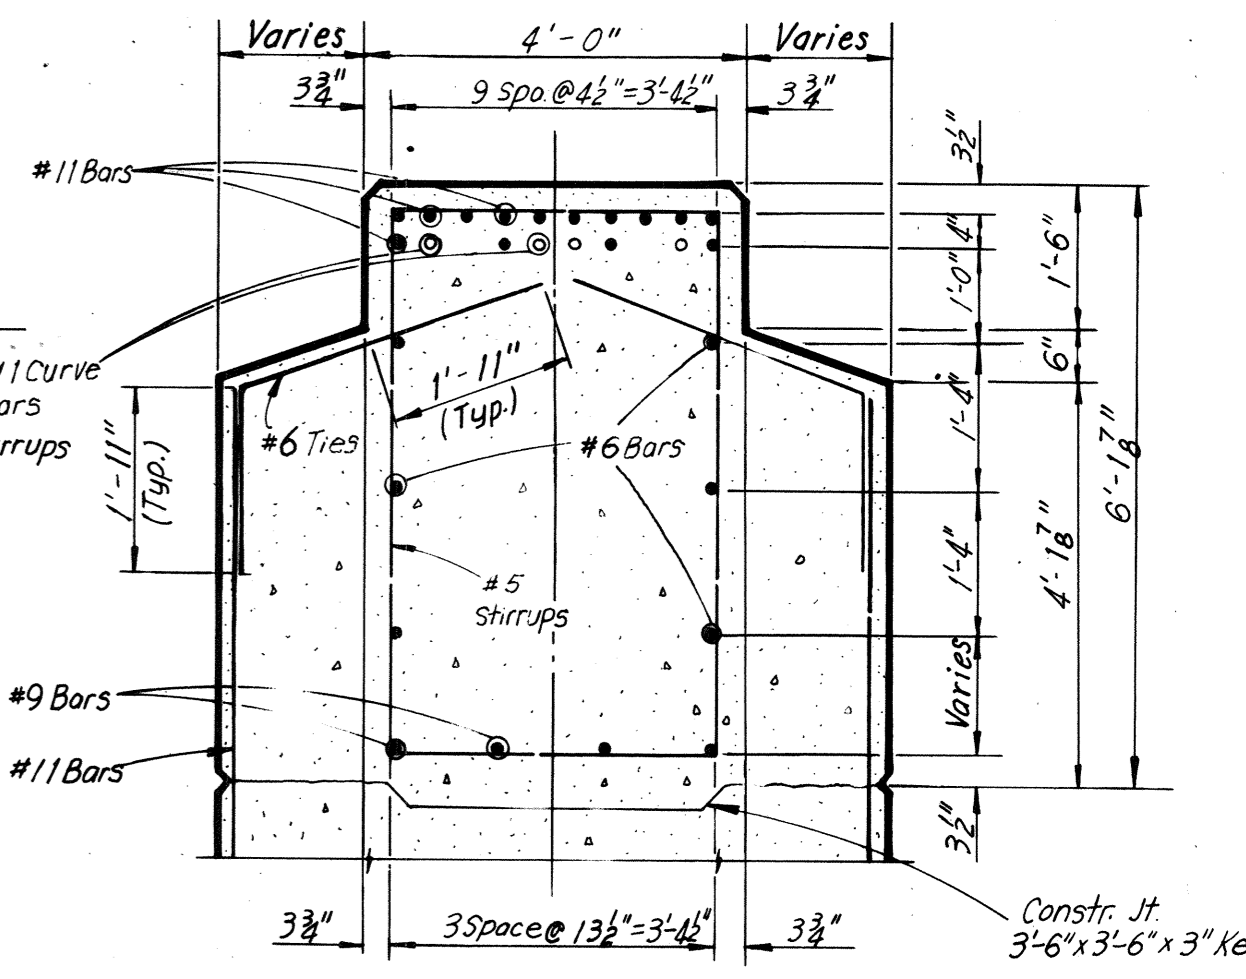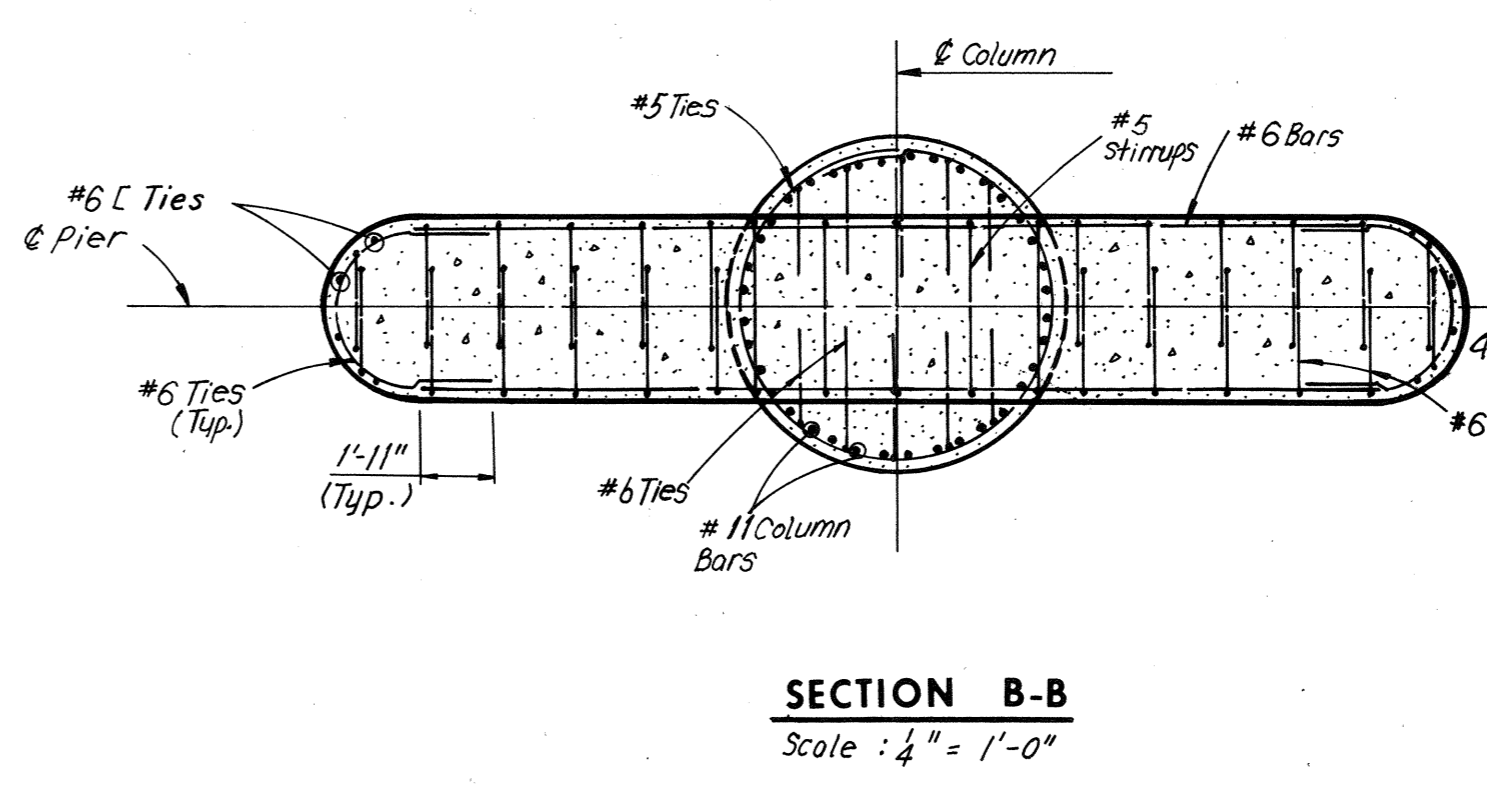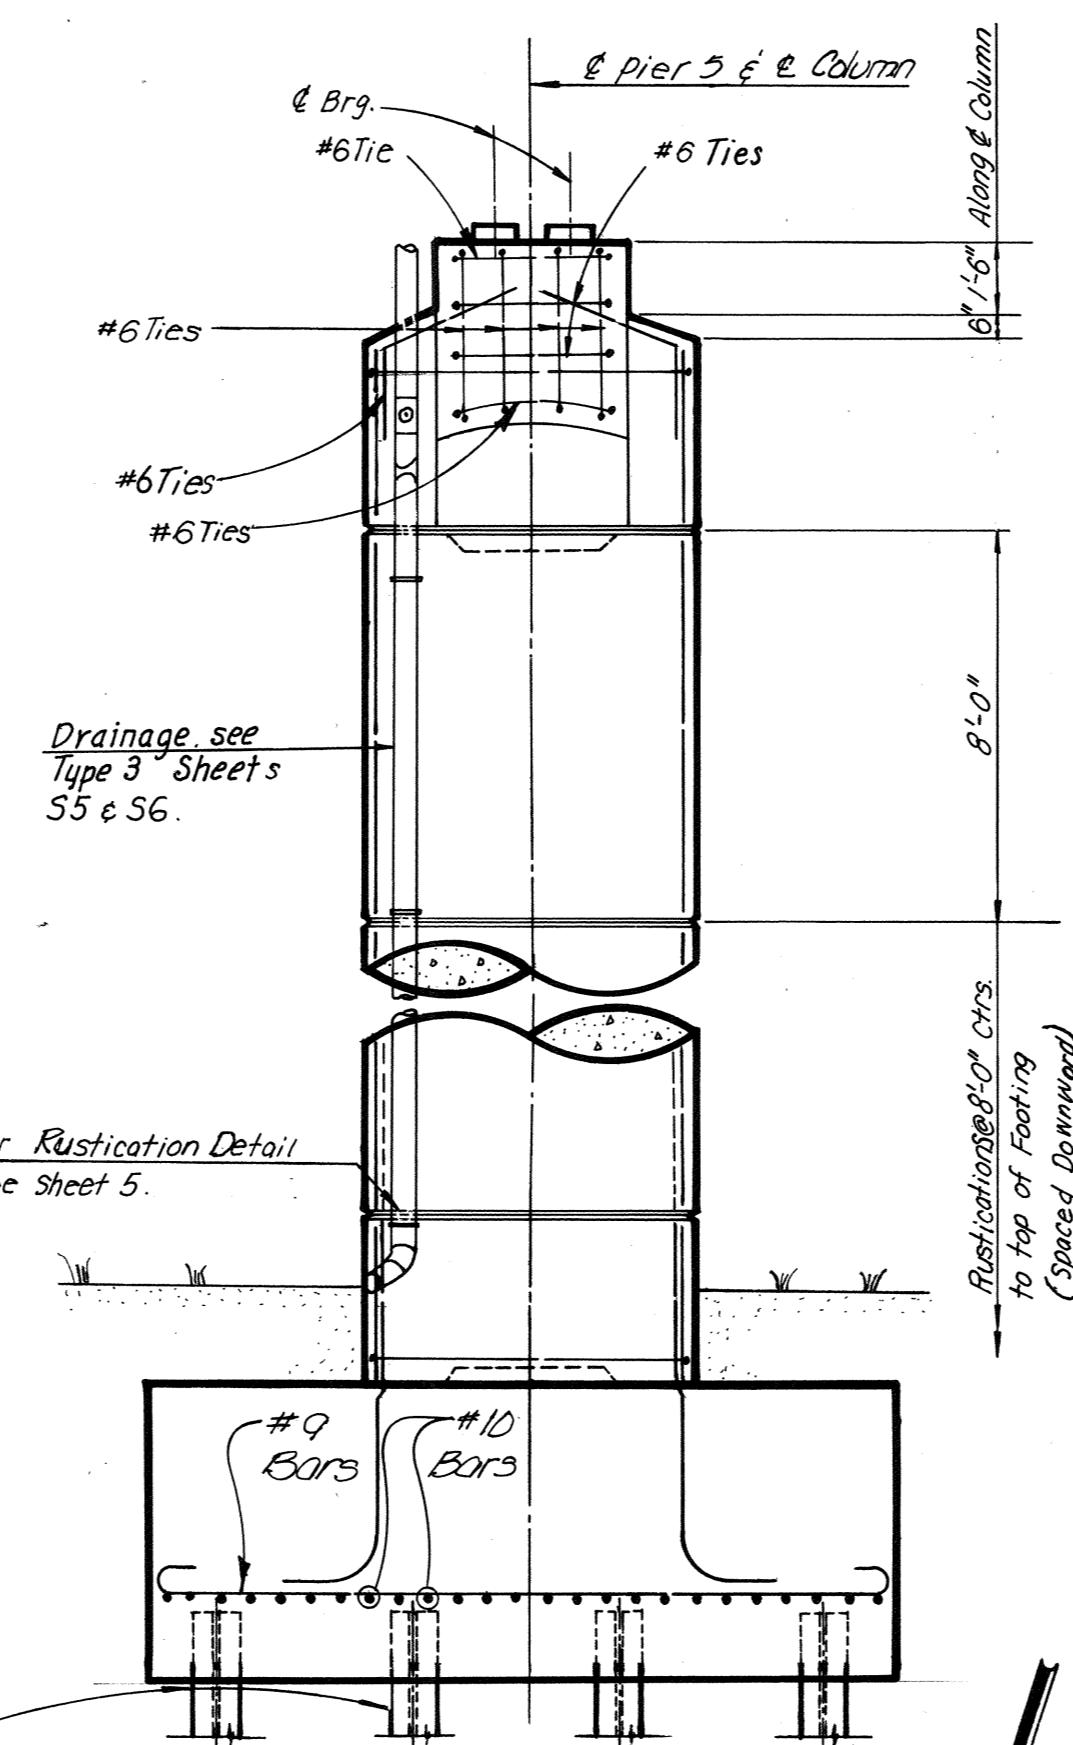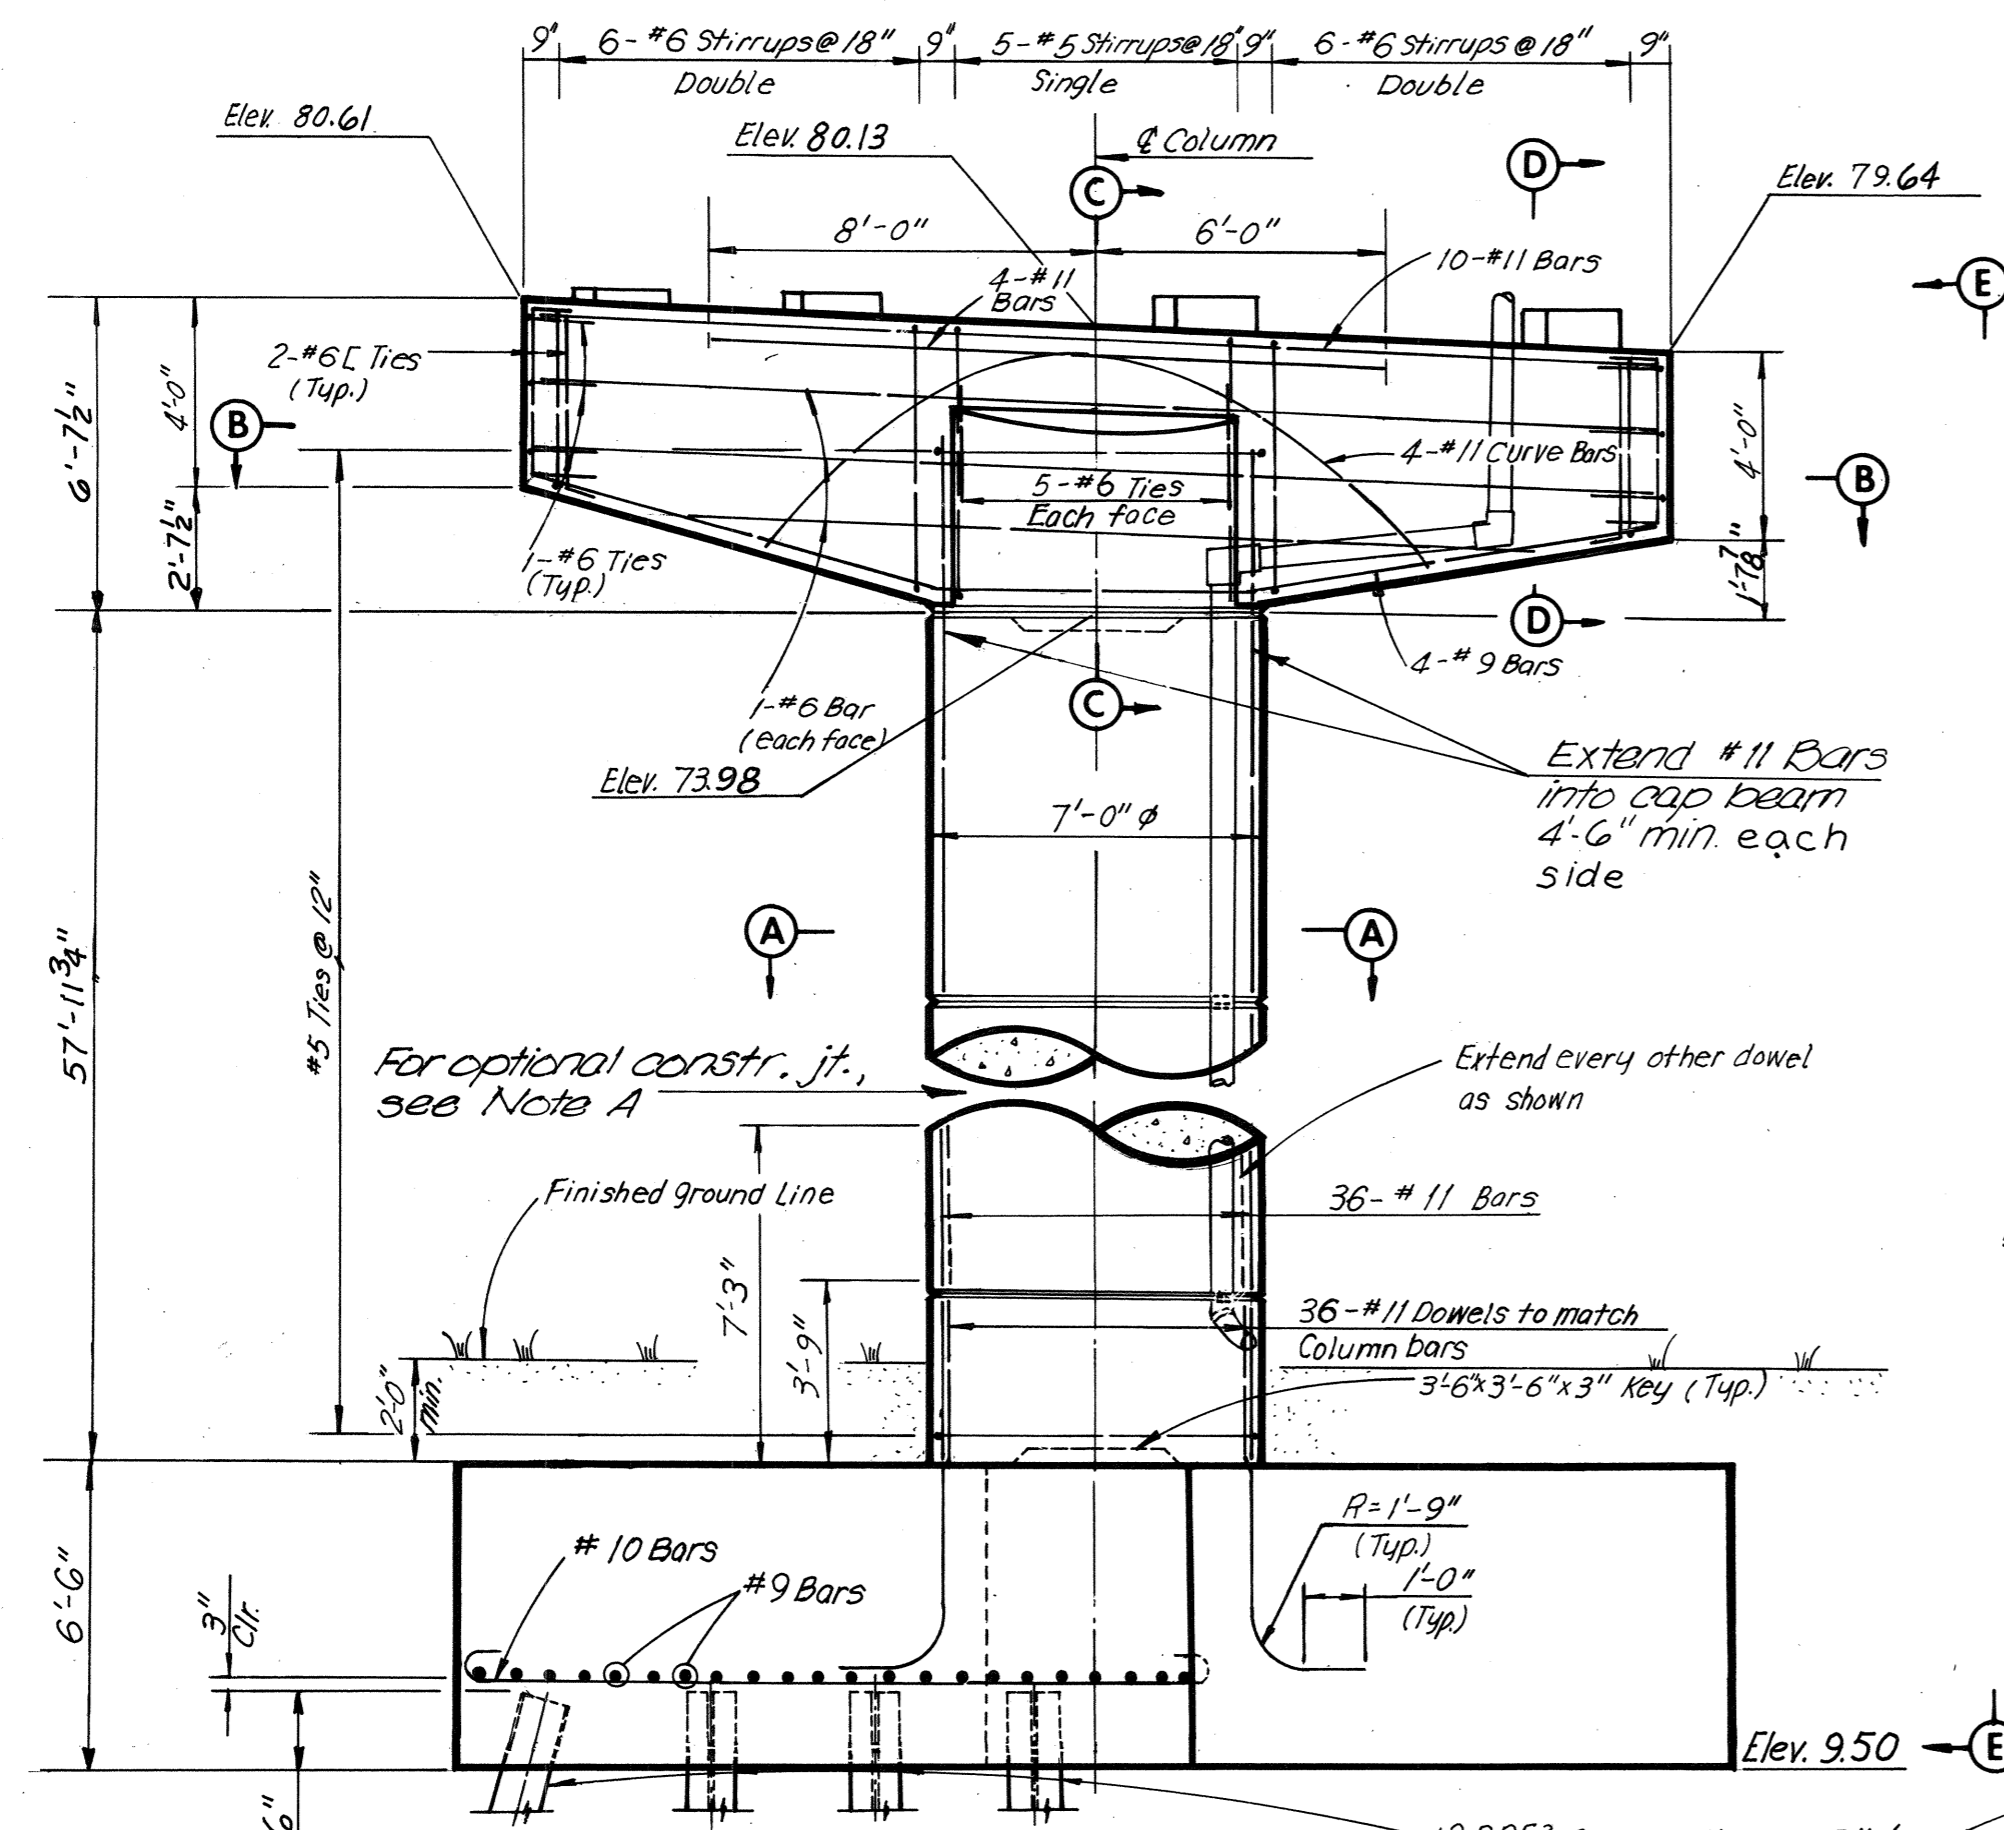


NOTE A:
A construction joint will be permitted at a rustication near mid-height of the column. The column reinforcement may be lap spliced near the construction joint. The top of the splice shall be a minimum of 3'-6". Splices shall be staggered at least 3'-3" between adjacent bars.

ELEVATION
Scale: 1/4" = 1'-0"


VIEW E-E
Scale: 1/4" = 1'-0"

PLAN
Scale: 1/4" = 1'-0"


SECTION D-D
Scale: 1/4" = 1'-0"

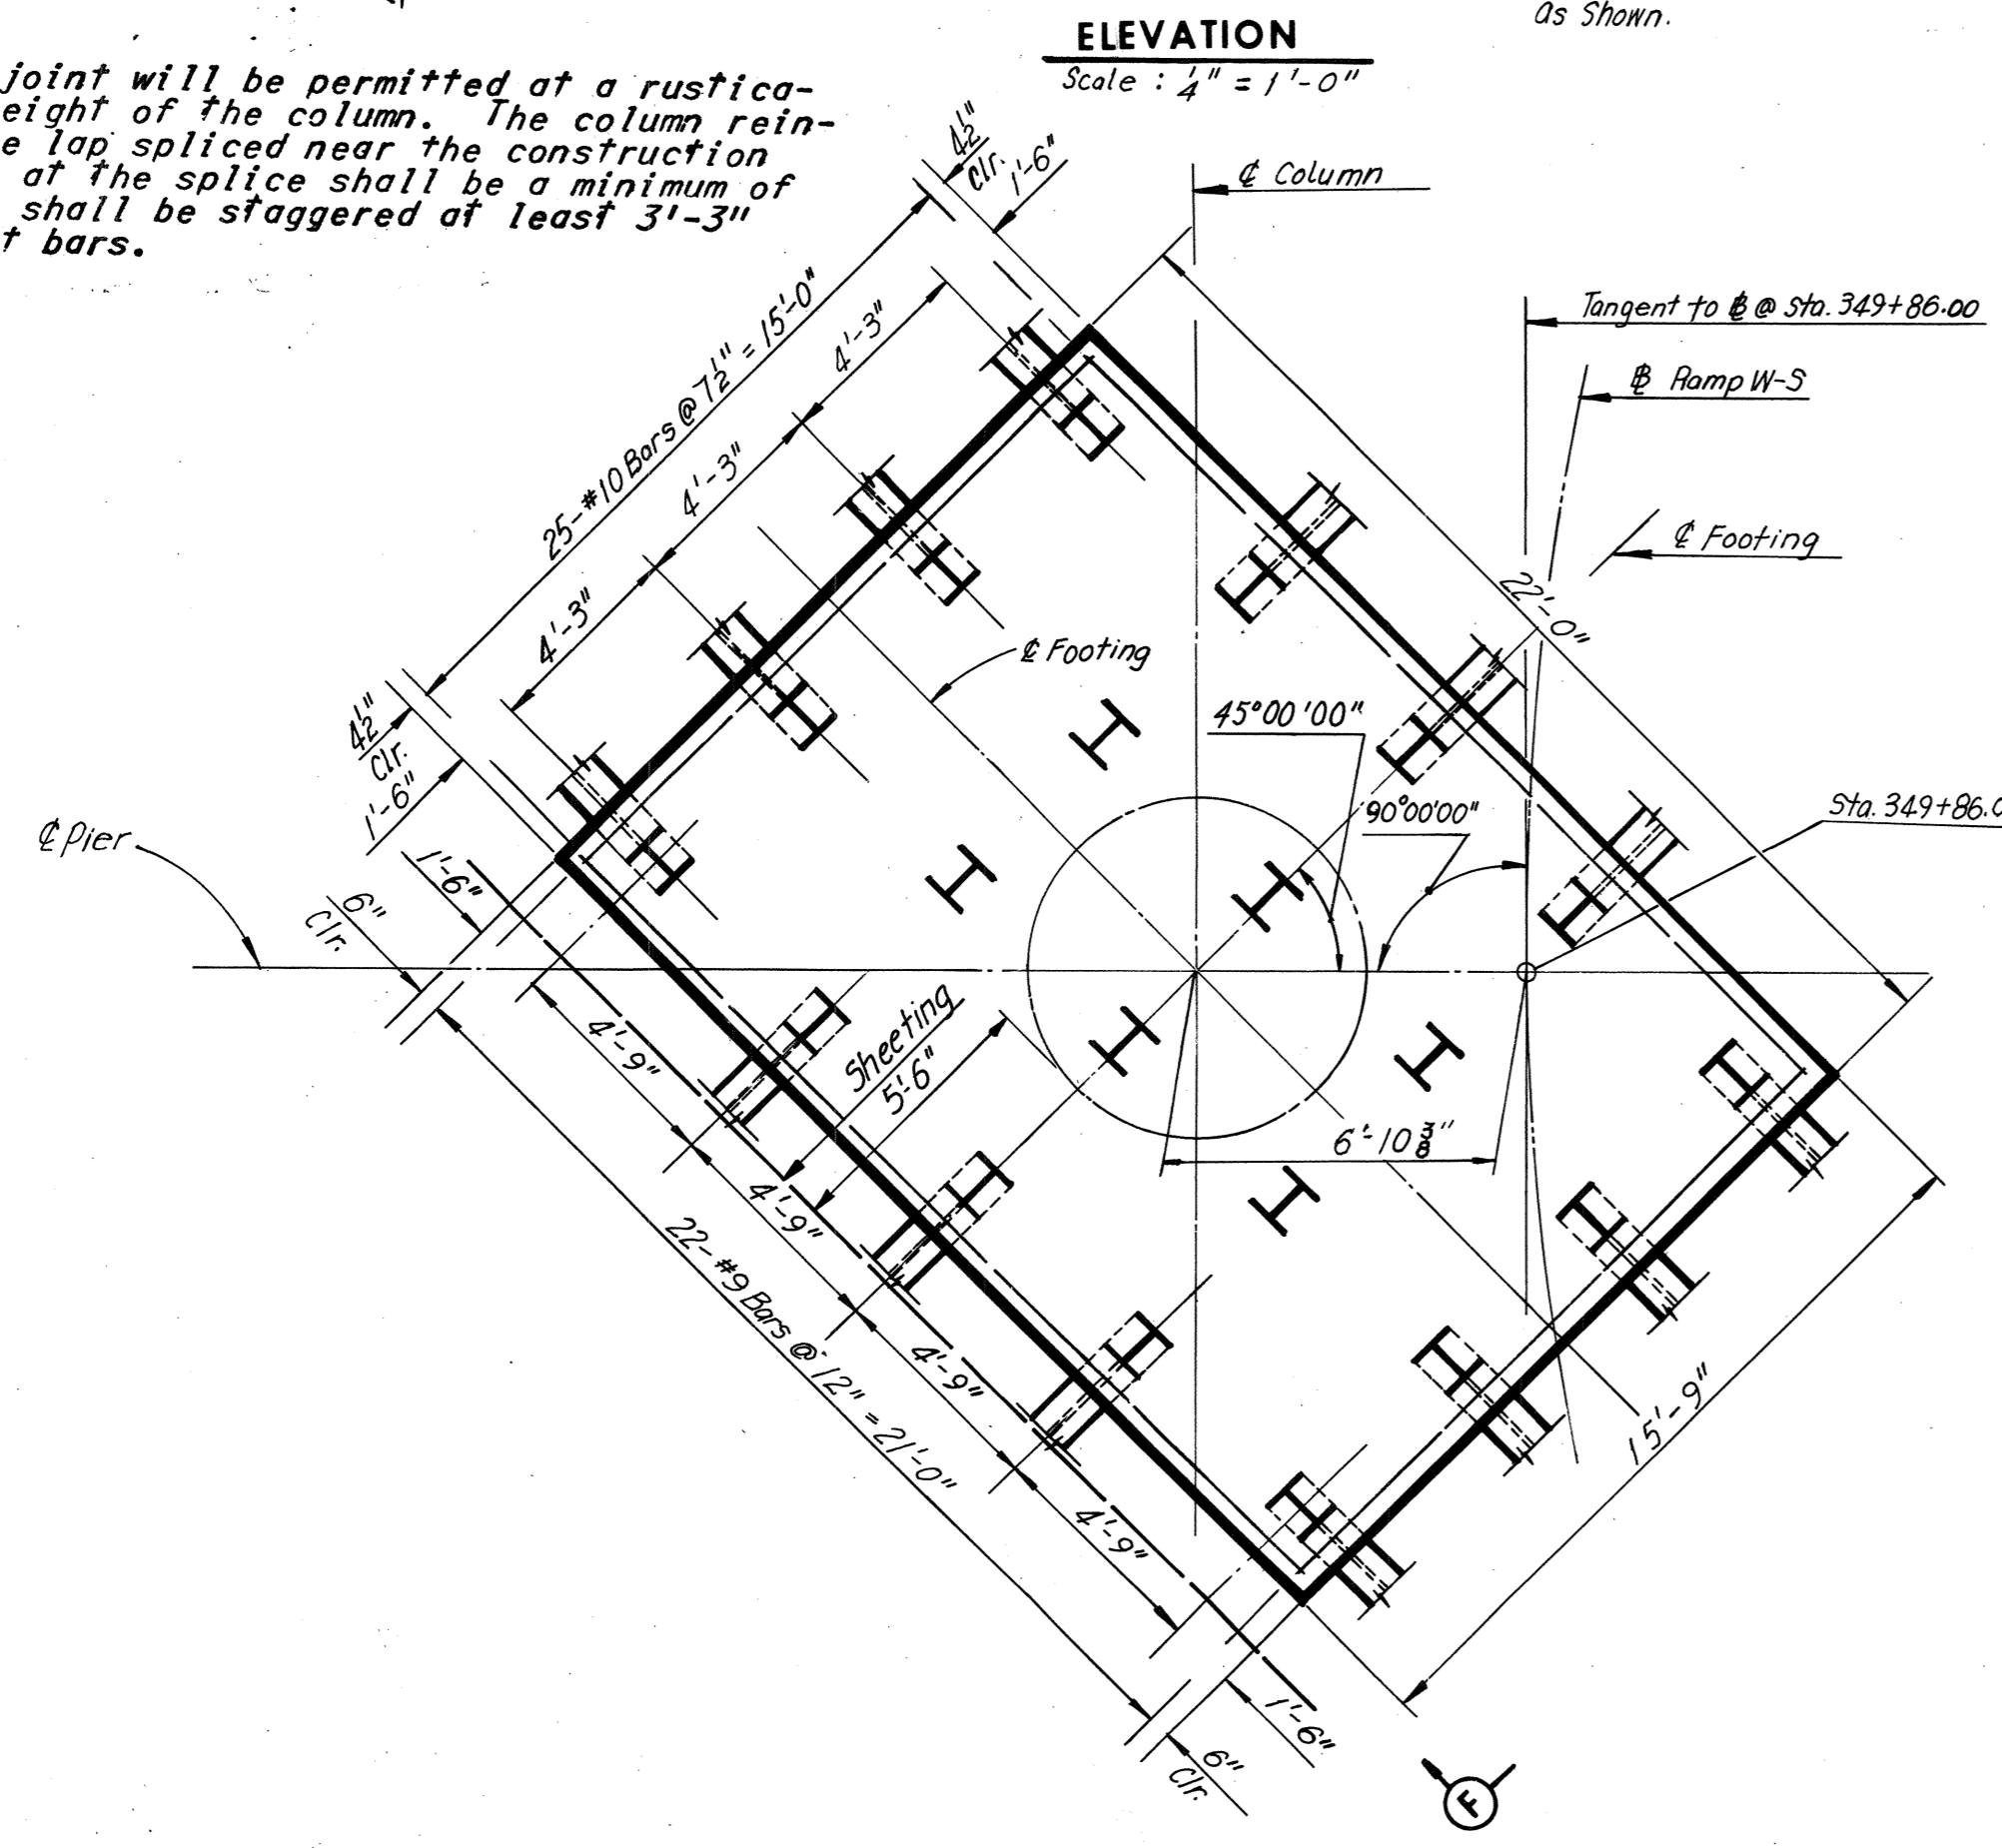

FOOTING PLAN
Scale: 1/4" = 1'-0"

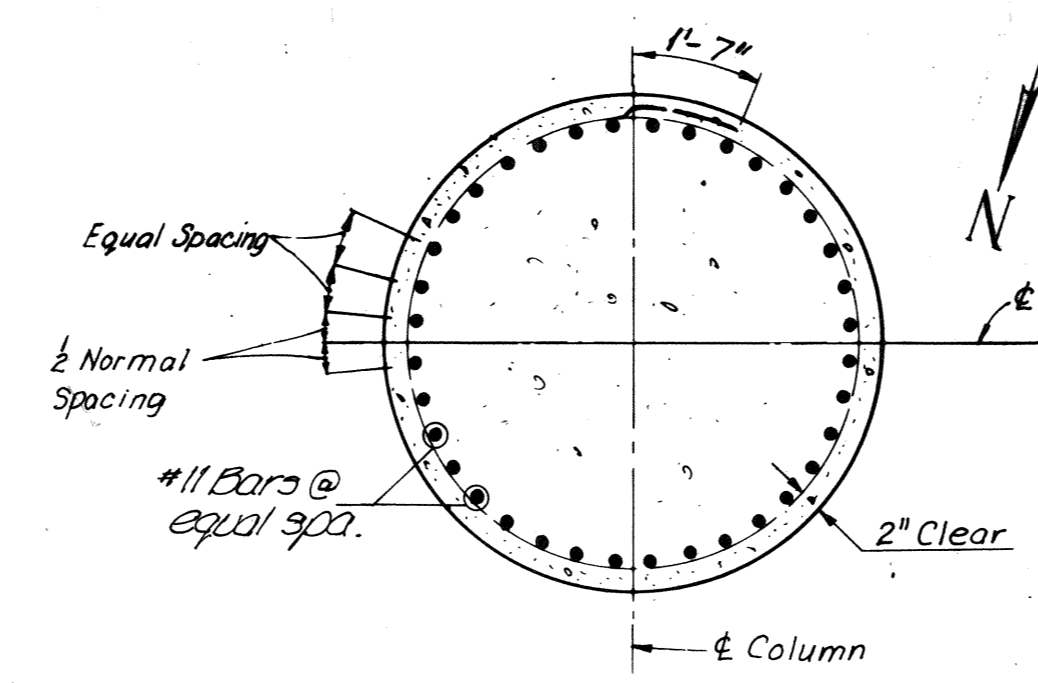

SECTION A-A
Scale: 3/8" = 1'-0"

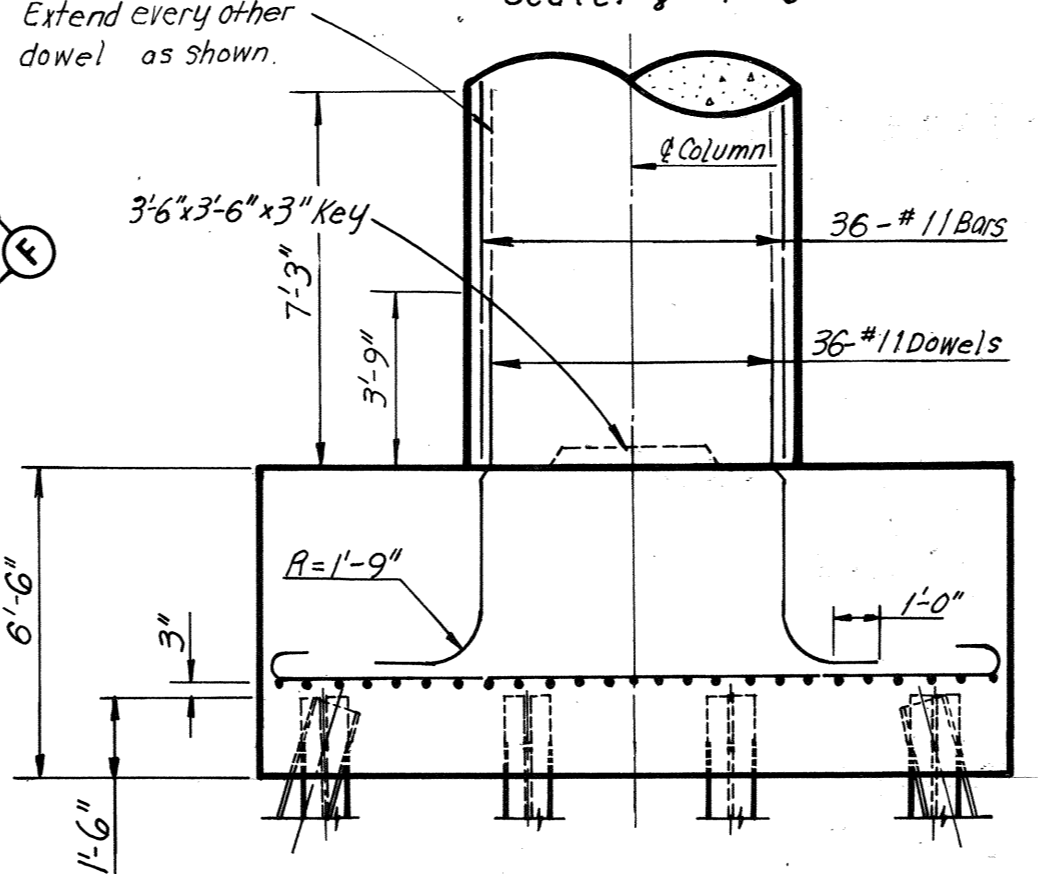


VIEW F-F
Scale: 1/4" = 1'-0"

DIMENSIONS FOR PAD AND ANCHOR BOLT SETTING PLAN													
Stringers	d	β	A	B	C	D	E	F	G	H	I	J	K
S1-7	-	87°45'28"	3 1/2"	10 1/2"	8 1/2"	15 3/8"	14 3/8"	6 1/8"	4 1/8"	11"	2'-6"	10 1/2"	2 1/2"
S2-7	-	90°00'00"	0"	10 1/2"	0"	15"	15"	5 1/2"	5 1/2"	11"	2'-6"	10 1/2"	2 1/2"
S3-7	-	90°00'00"	0"	10 1/2"	0"	15"	15"	5 1/2"	5 1/2"	11"	2'-6"	10 1/2"	2 1/2"
S4-7	-	90°00'00"	0"	10 1/2"	0"	15"	15"	5 1/2"	5 1/2"	11"	2'-6"	10 1/2"	2 1/2"
S1-8	93°50'24"	-	5 1/8"	8 1/8"	12 5/8"	11 7/8"	6 1/8"	5 3/8"	1'-0"	2'-0 1/2"	8 1/2"	2"	
S2-8	92°38'34"	-	5 1/8"	8 1/8"	12 5/8"	12"	6 1/8"	5 3/8"	1'-0"	2'-0 1/2"	8 1/2"	2"	
S3-8	91°27'44"	-	4 1/8"	8 1/8"	12 5/8"	12 1/2"	6 1/8"	5 3/8"	1'-0"	2'-0 1/2"	8 1/2"	2"	
S4-8	91°27'44"	-	4 1/8"	8 1/8"	12 5/8"	12 1/2"	6 1/8"	5 3/8"	1'-0"	2'-0 1/2"	8 1/2"	2"	

Note: Footing Elevations are approximate only and maybe varied to suit field conditions as directed by the Engineer. Vertical shaft reinforcing shall not be cut until these elevations are established. Where elevations change more than 2 ft., redesign will be required.

Notes:
All piles shall be 12BP53 steel piles (Design Capacity = 57 tons).
Batter all piles 3" per foot where shown.
For Standard Shoe Detail, see Sheets S1 and S2.
For Framing Plan, see Sheet 14.
For Rustication Detail, see Sheet 5.
For 12BP53 Steel Pile Detail, see Sheet 5.
For Quantities of concrete and steel, see Sheet 2.
Estimated Pile tip elevations are -15.0

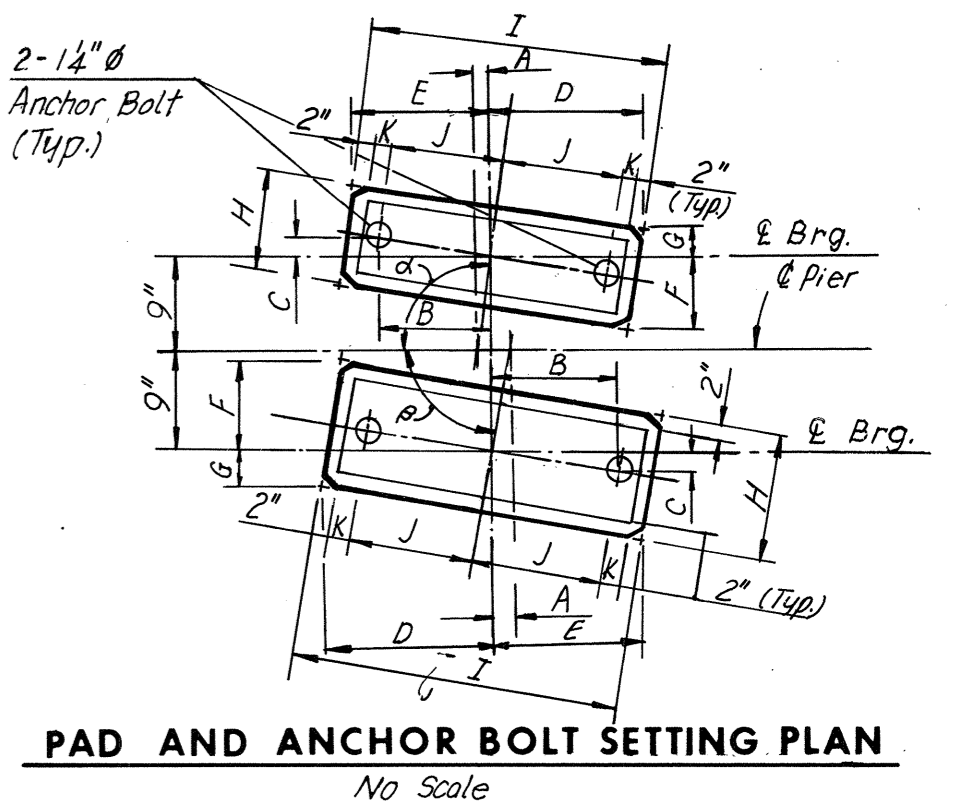

PAD AND ANCHOR BOLT SETTING PLAN
No Scale

BY	DATE	NO.	REVISION	BY	DATE
MADE	G.S.H. 6-10-69				
CHECKED	S.C.C. 6-17-69	1	Rad Elevations	TEM	8-26-75
IN CHARGE					

AS BUILT

RICHMOND METROPOLITAN AUTHORITY
RICHMOND EXPRESSWAY SYSTEM
DOWNTOWN EXPRESSWAY

BRIDGE NO. 68
RAMP W-S CONNECTION TO
RICHMOND-PETERSBURG TURNPIKE
PIER 5


HOWARD, NEEDLES, TAMMEN & BERGENDOFF
consulting engineers
NEW YORK ALEXANDRIA KANSAS CITY

SCALE: As Noted
CONTRACT NO.: 11
SHEET NO. 7 OF 28


DIMENSIONS FOR PAD AND ANCHOR BOLT SETTING PLAN

Stringer	a	B	C	D	E	F	G	H	I	J	K	L
*S1-9	88°31'17"	8 1/2	7 1/2	13 1/2	12 1/2	15	2'-2 1/2"	8 1/2	5	10	4	
*S2-9	85°33'46"	9	6 1/2	13 1/2	13 1/2	15	2'-2 1/2"	8 1/2	5	10	4	
*S3-9	79°16'37"	10 1/2	9 1/2	16 1/2	16 1/2	15	2'-2 1/2"	8 1/2	5	10	4	
S1-10	89°35'33"	8 1/2	5 1/2	12 1/2	12 1/2	11 1/2	2'-1"	8	4 1/2	9		
S2-10	88°51'44"	8 1/2	5 1/2	12 1/2	12 1/2	11 1/2	2'-1"	8	4 1/2	9		
S1-8	80°07'28"	9 1/2	8 1/2	15 1/2	10 1/2	13 1/2	2'-3"	8	5 1/2	8	1 1/2	
S2-8	78°55'37"	9 1/2	8 1/2	16 1/2	10 1/2	13 1/2	2'-3"	8	5 1/2	8	1 1/2	
S3, 4-8	77°44'47"	9 1/2	8 1/2	16 1/2	10 1/2	13 1/2	2'-3"	8	5 1/2	8	1 1/2	
**S1-9	89°20'16"	8 1/2	5 1/2	12 1/2	12 1/2	11 1/2	2'-1"	8	4 1/2	9		
**S2-9	86°22'45"	8 1/2	4 1/2	13 1/2	11 1/2	11 1/2	2'-1"	8	4 1/2	9		
**S3-9	86°38'50"	8 1/2	5 1/2	13 1/2	11 1/2	11 1/2	2'-1"	8	4 1/2	9		


NOTE: Dimensions are in inches unless shown otherwise. Stringers denoted with * are at Pier 6 and with ** are at Pier 7.

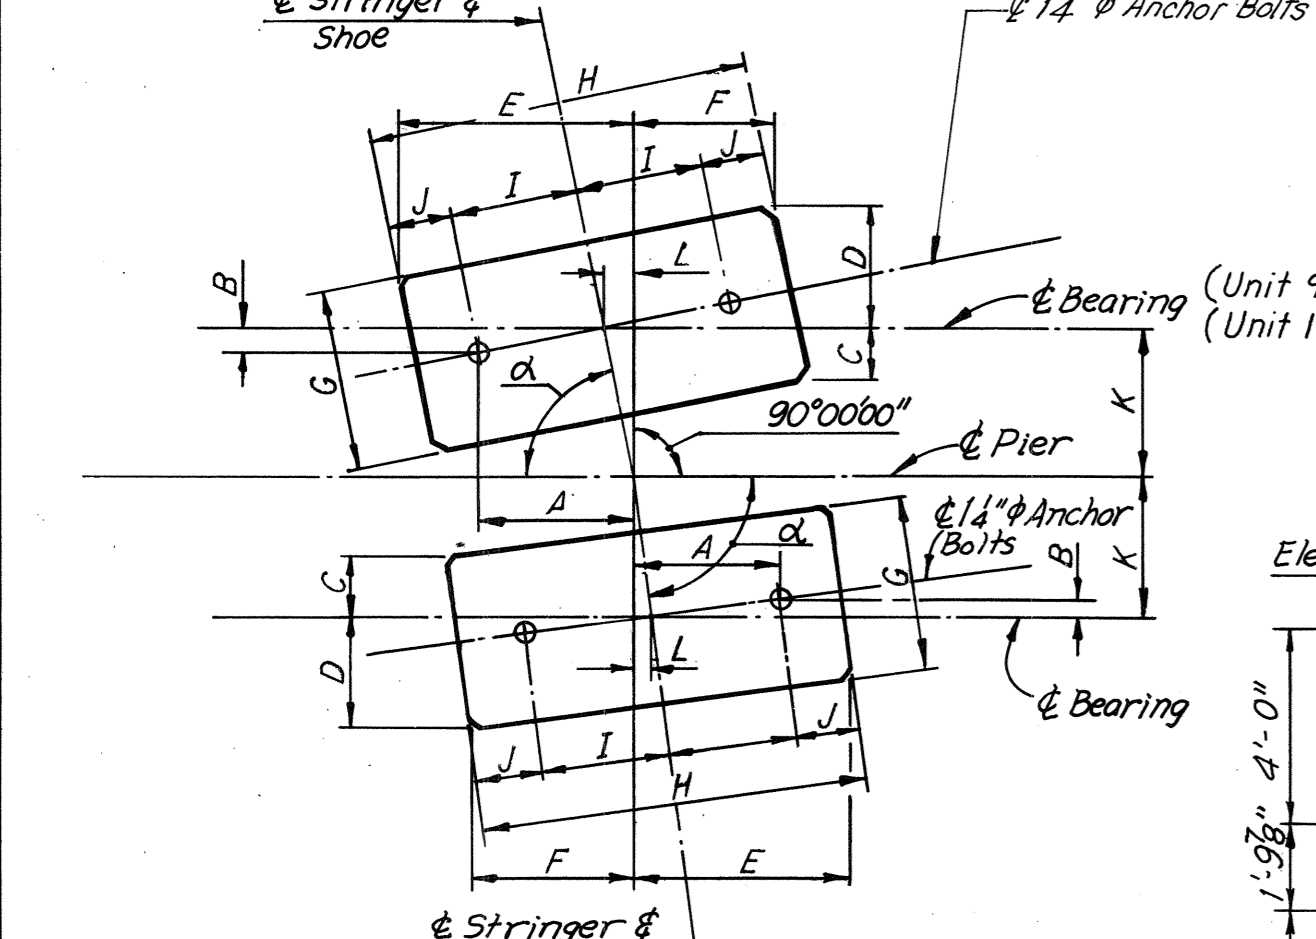

PAD AND ANCHOR BOLT SETTING PLAN
No Scale

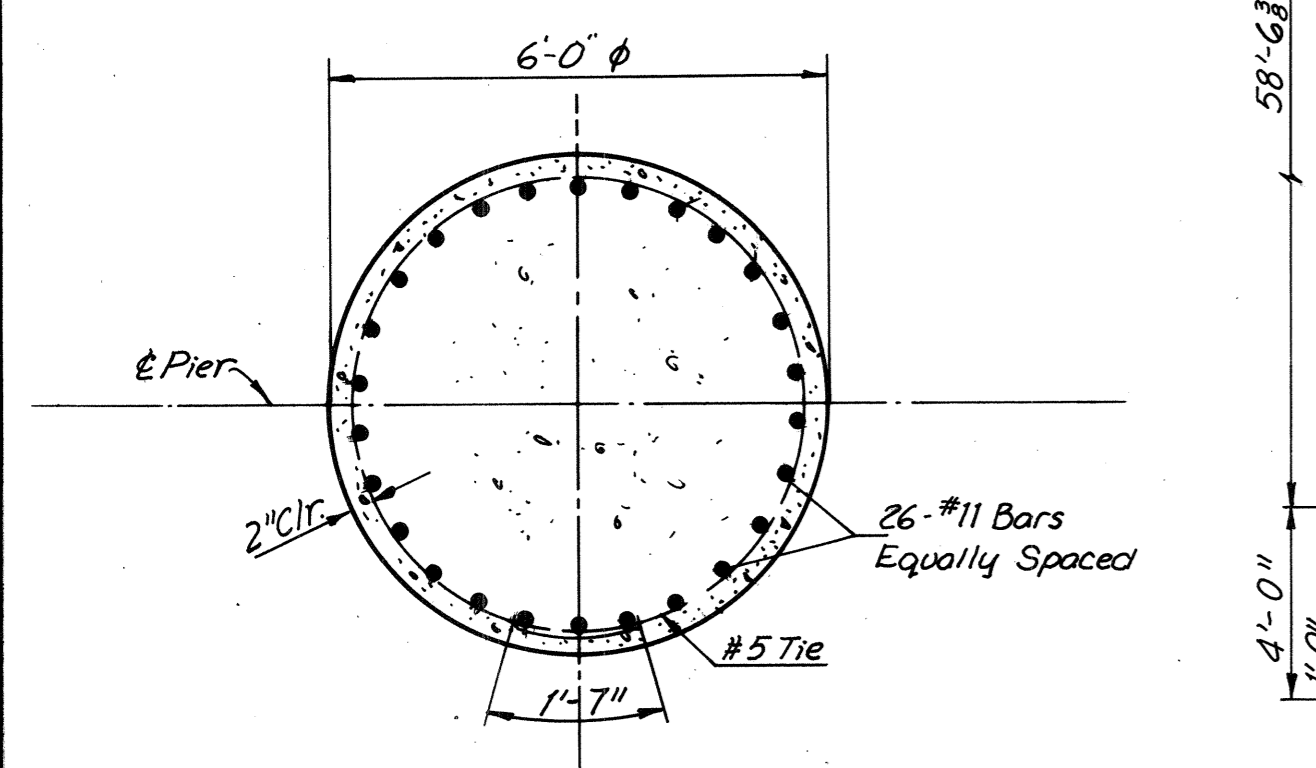


SECTION G-G
No Scale

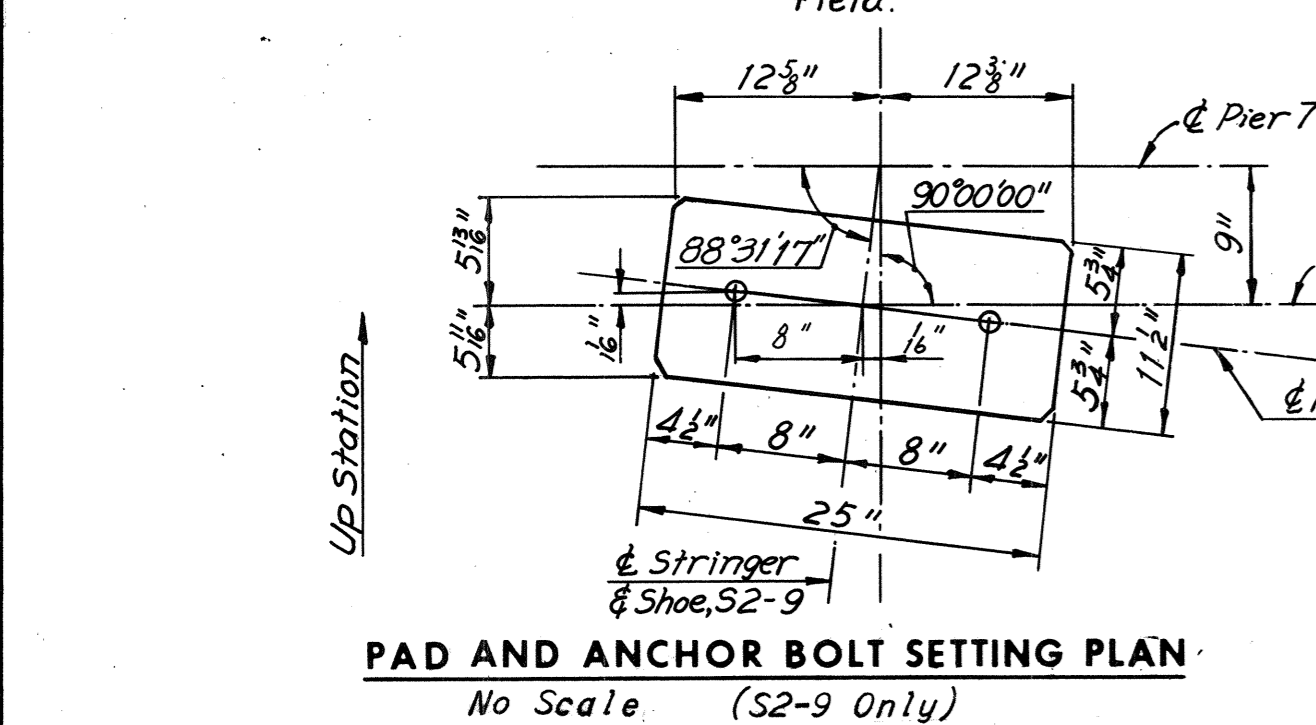


PAD AND ANCHOR BOLT SETTING PLAN
No Scale (S2-9 Only)


BY	DATE	FOOTING DOWEL PIER 7	TEM	8-26-75
MADE	AHH	01-27-69	YCP	8-26-75
CHECKED	YCP	2-5-69	NO.	REVISION
IN CHARGE				

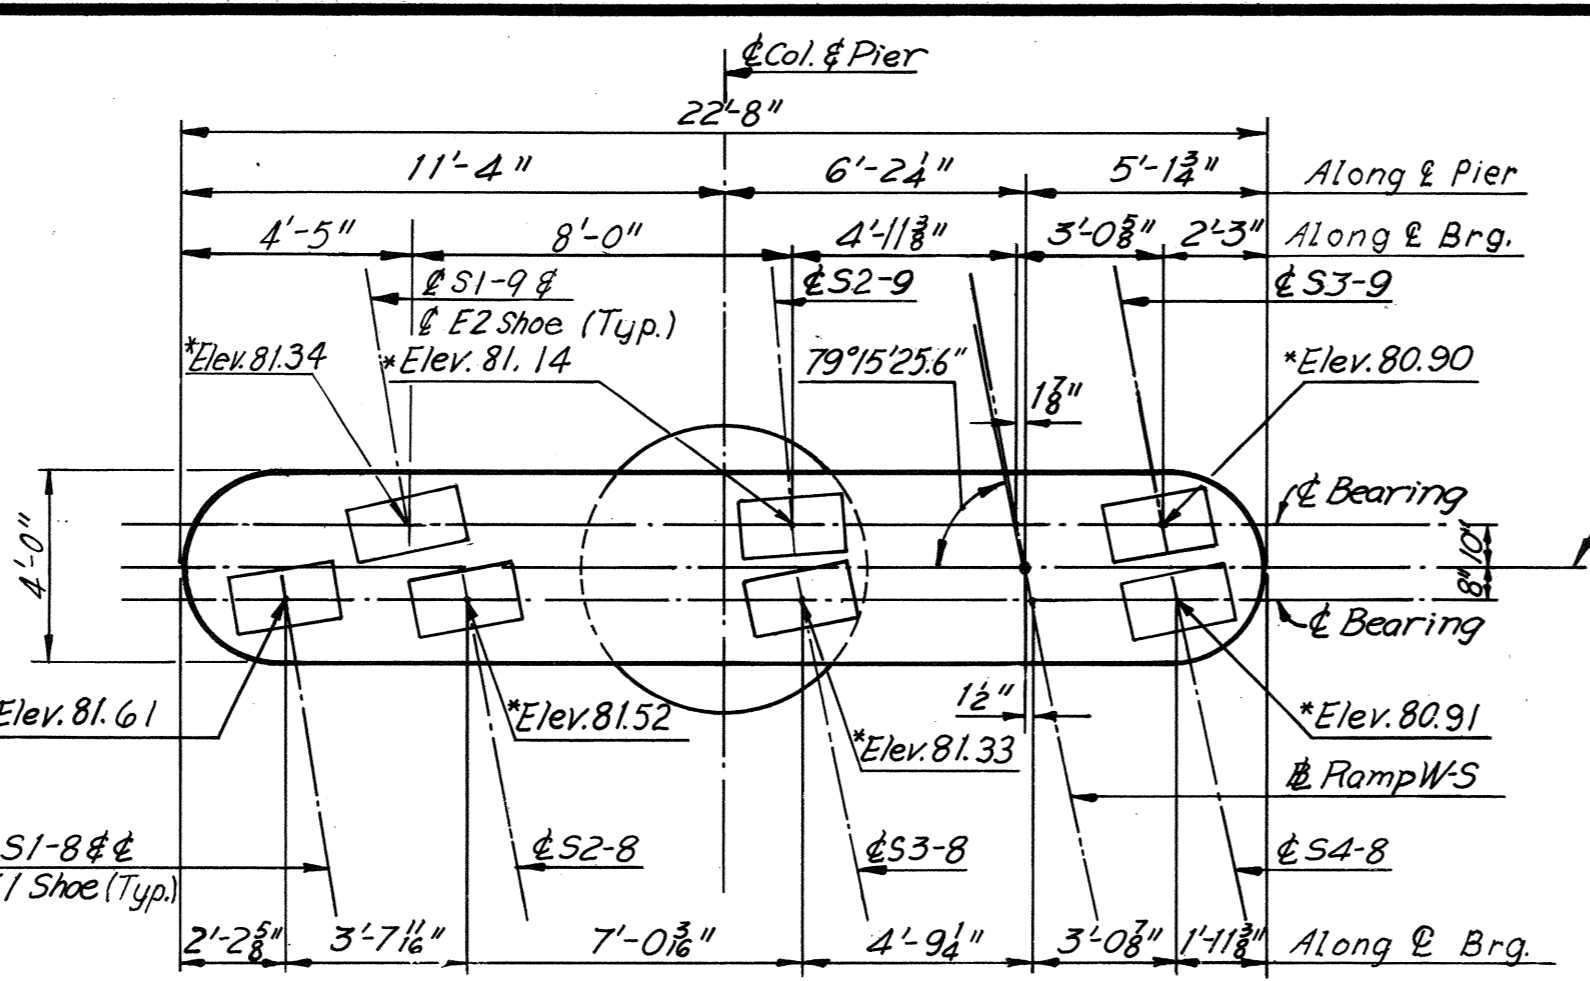


PLAN-PIER 6
Scale: 1/4" = 1'-0"

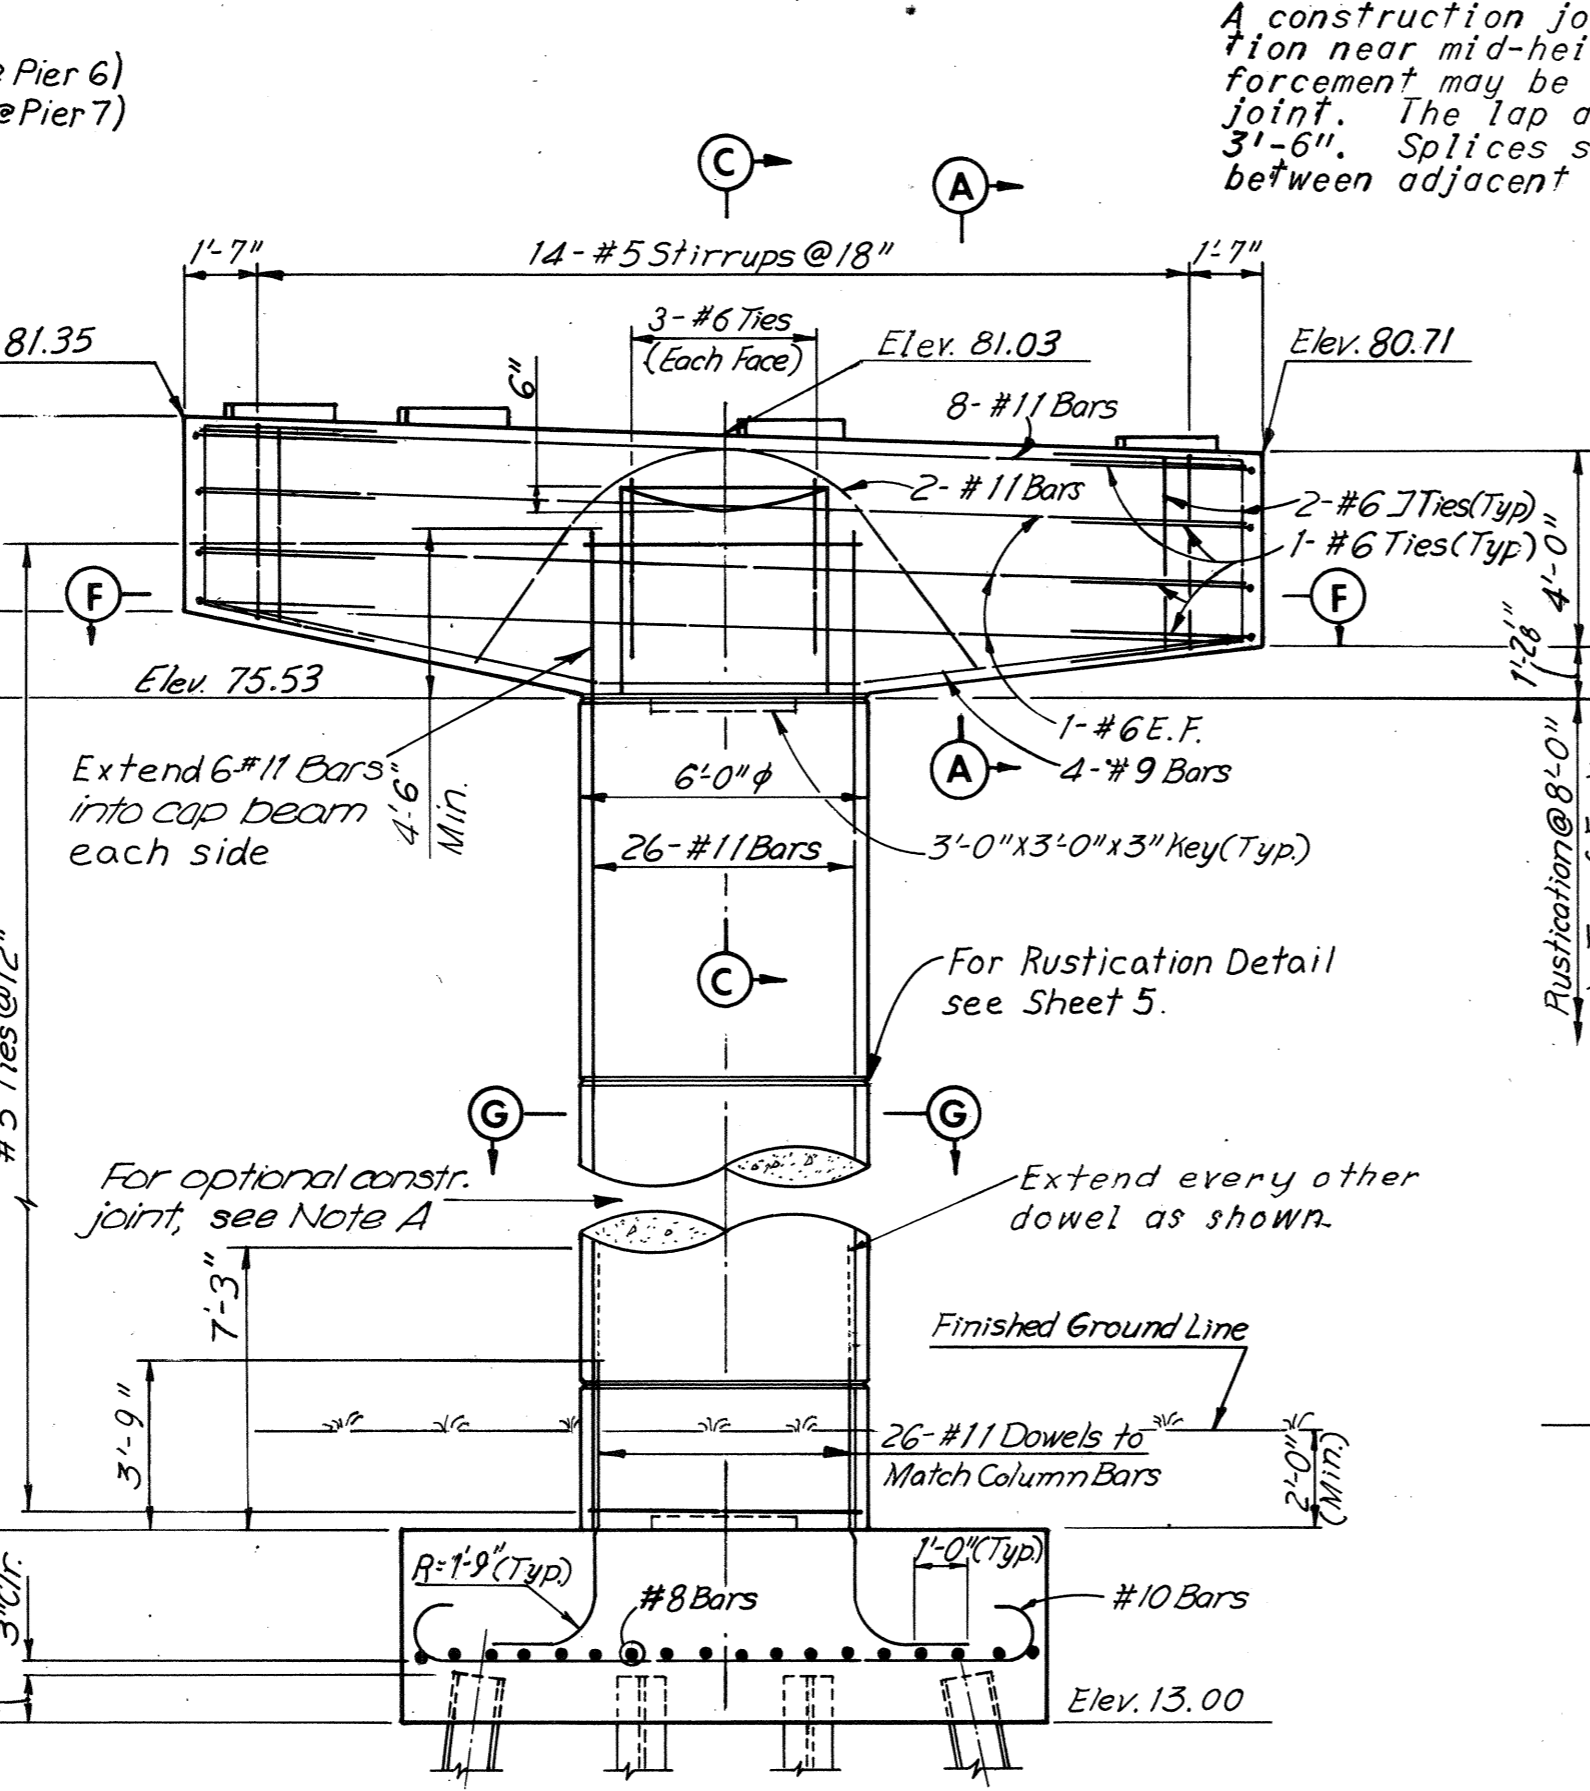


ELEVATION-PIER 6
Scale: 1/4" = 1'-0"

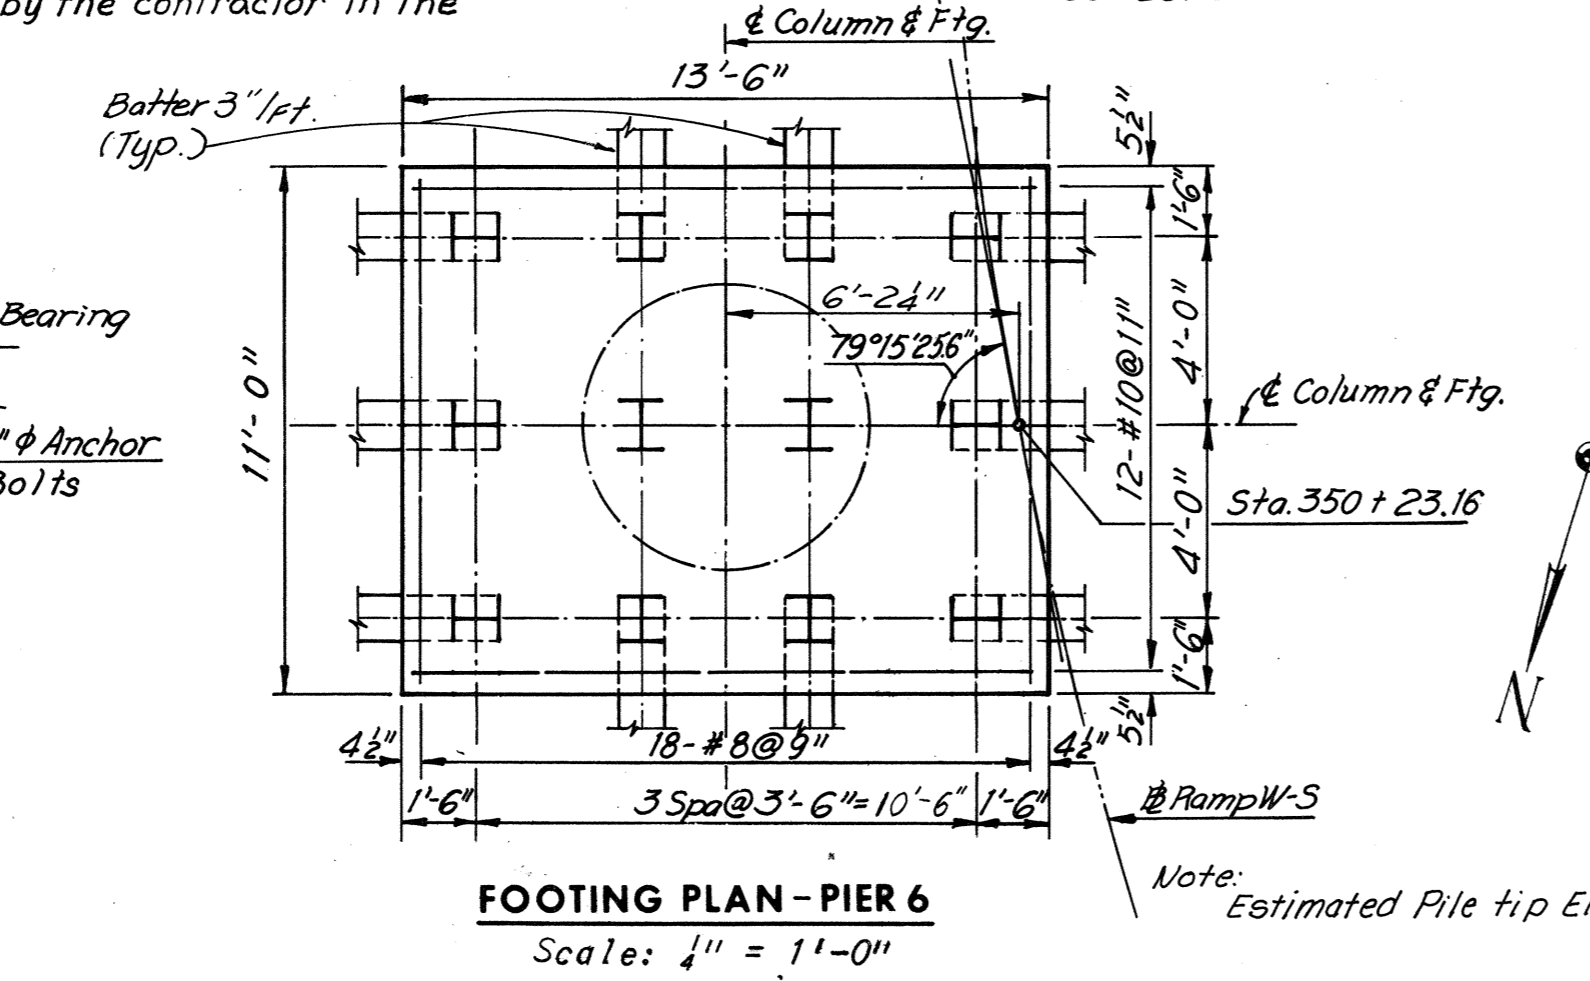


FOOTING PLAN-PIER 6
Scale: 1/4" = 1'-0"

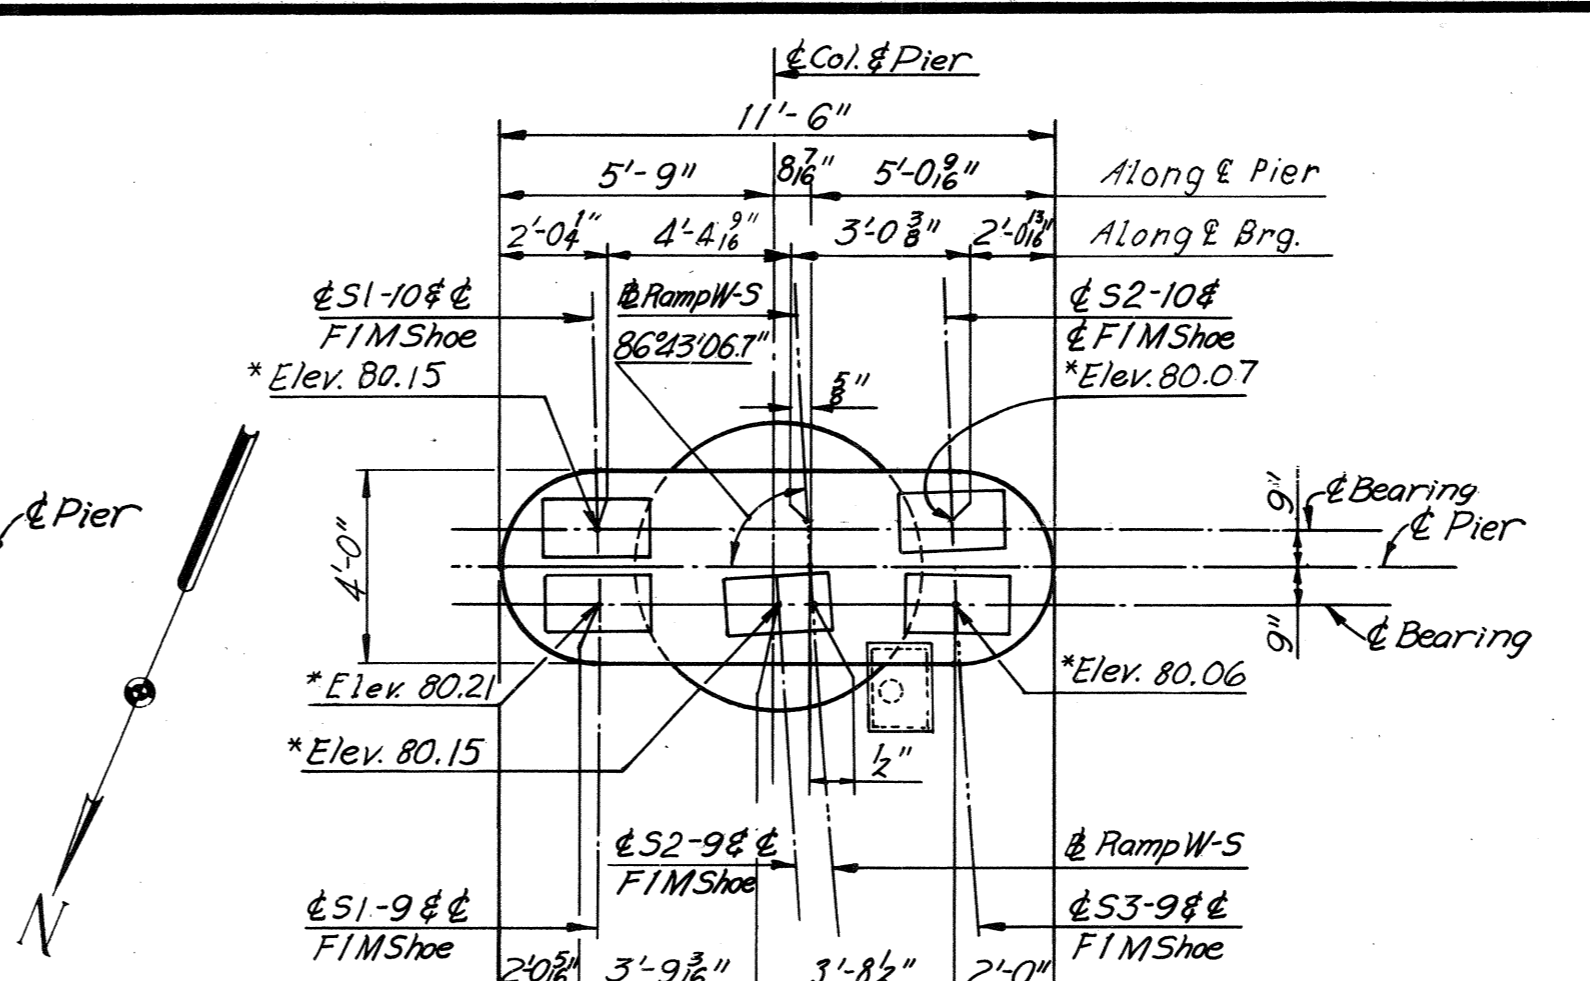


PLAN-PIER 7
Scale: 1/4" = 1'-0"

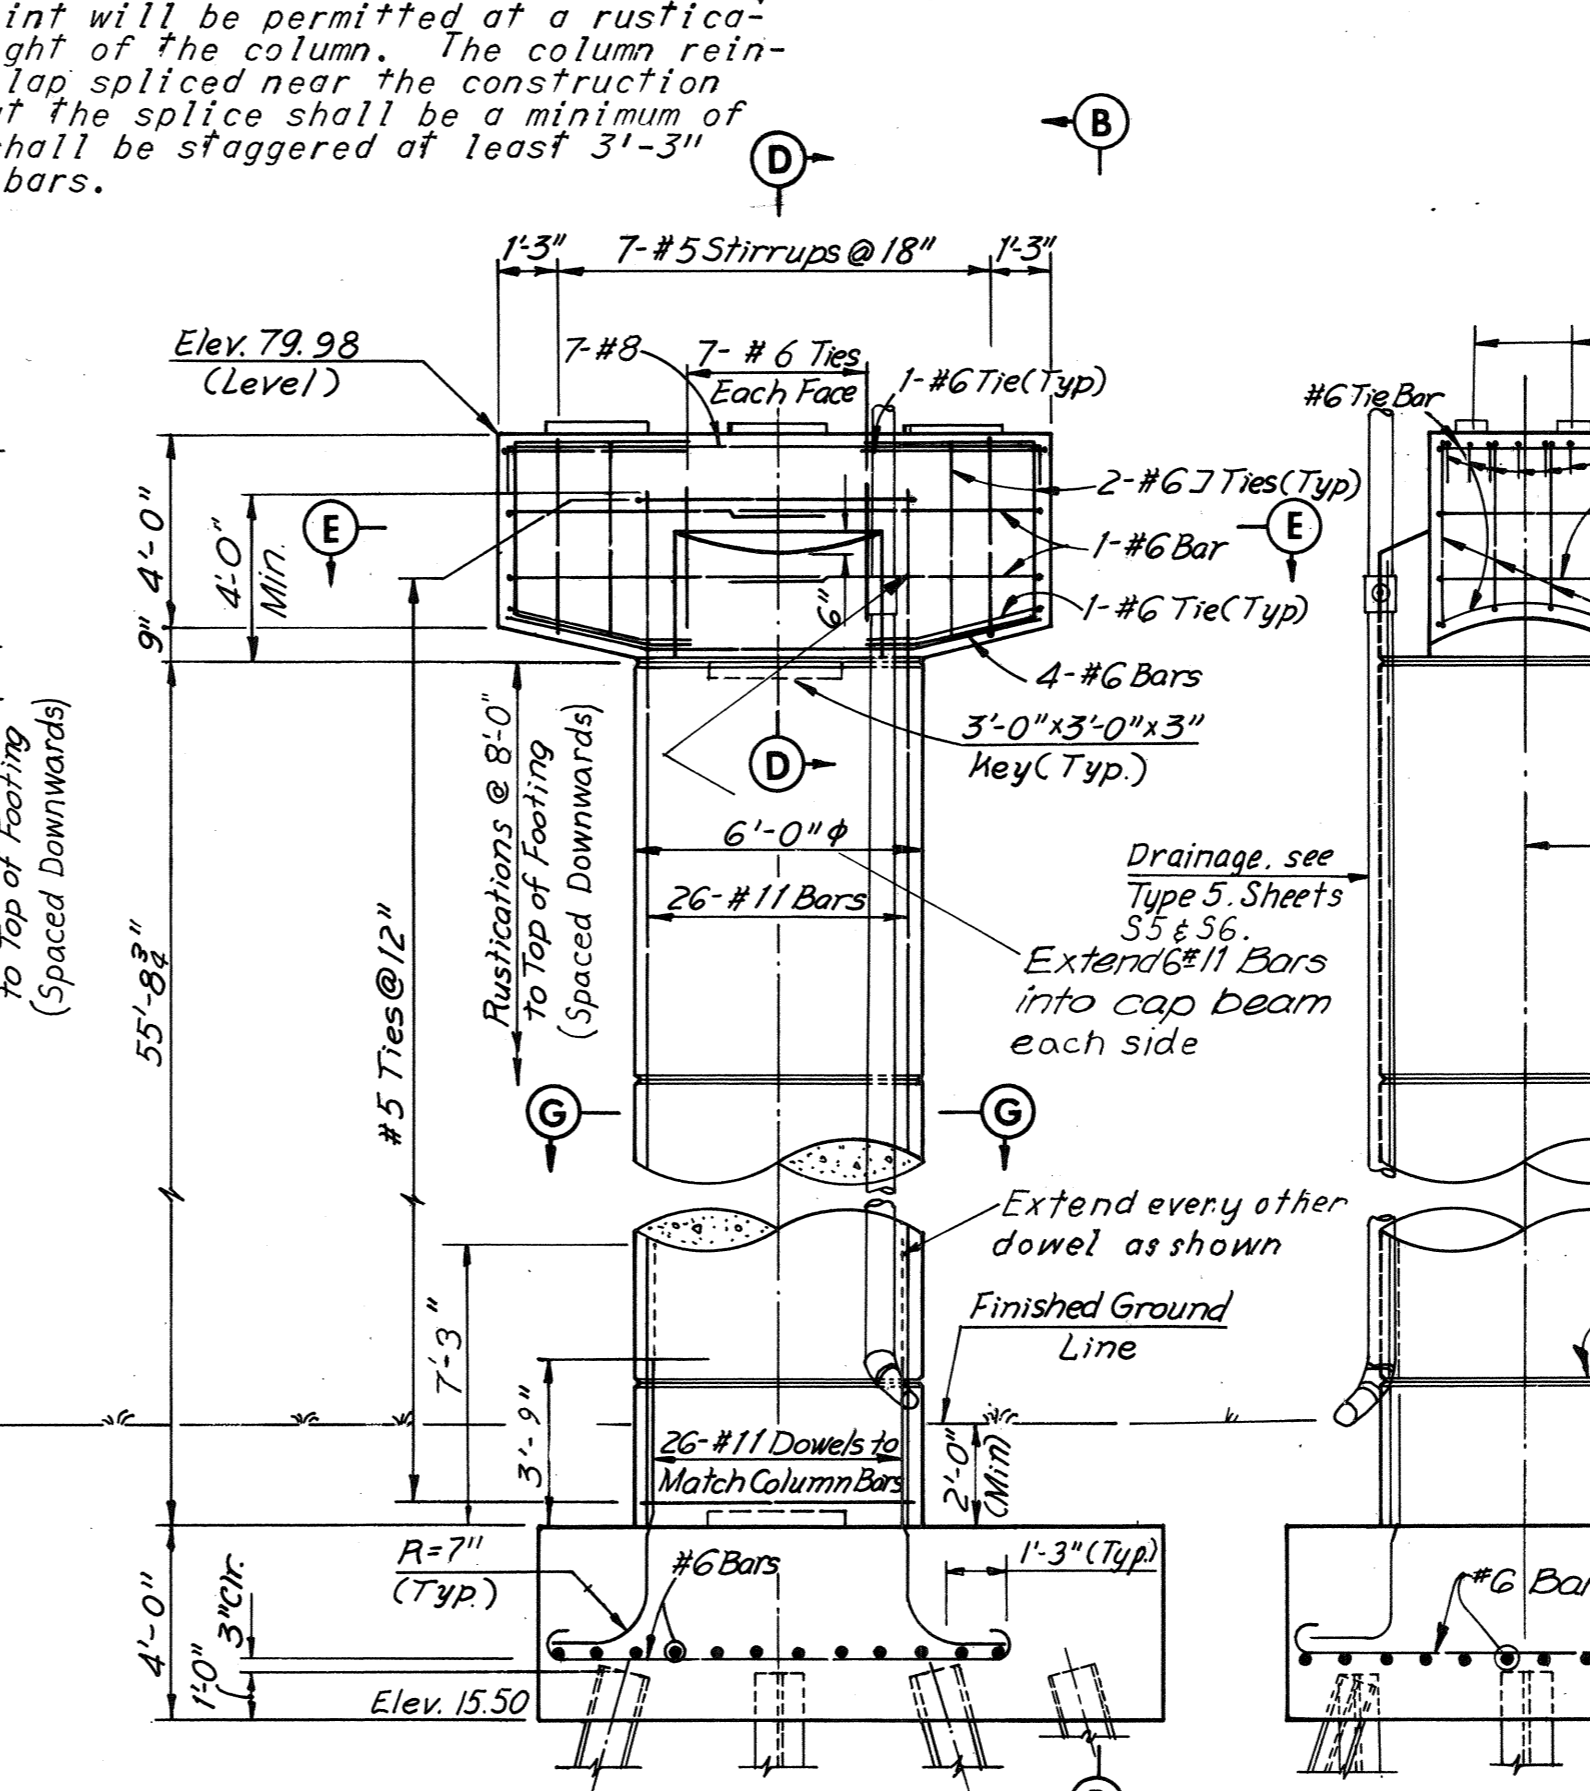


ELEVATION-PIER 7
Scale: 1/4" = 1'-0"

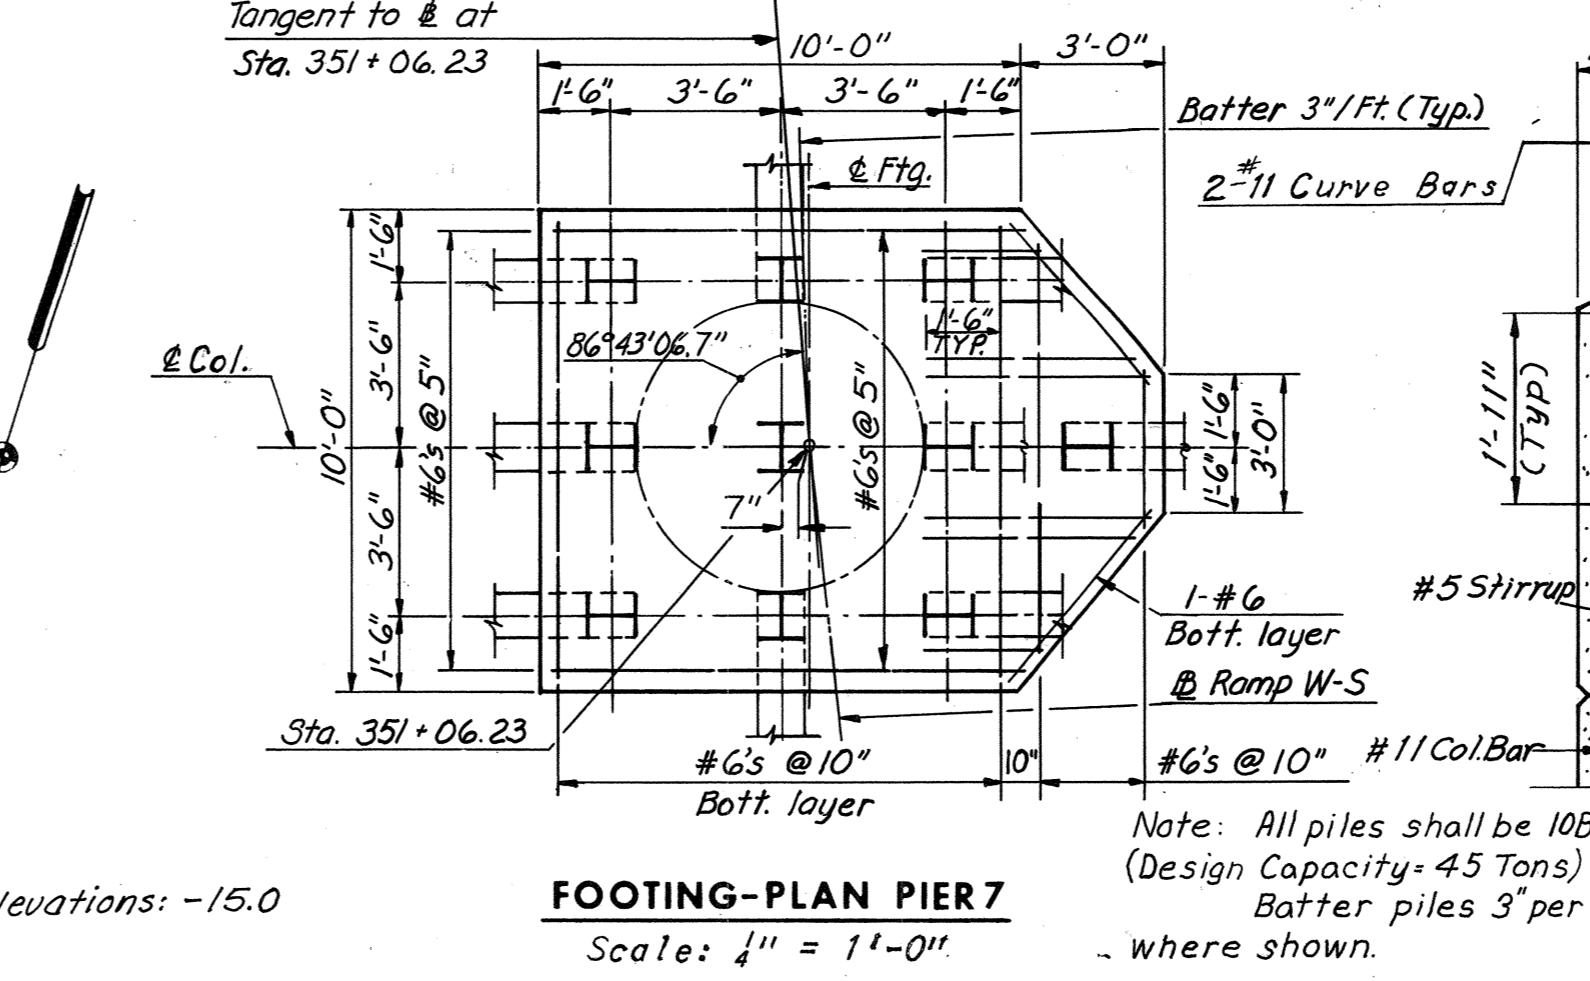


FOOTING PLAN-PIER 7
Scale: 1/4" = 1'-0"

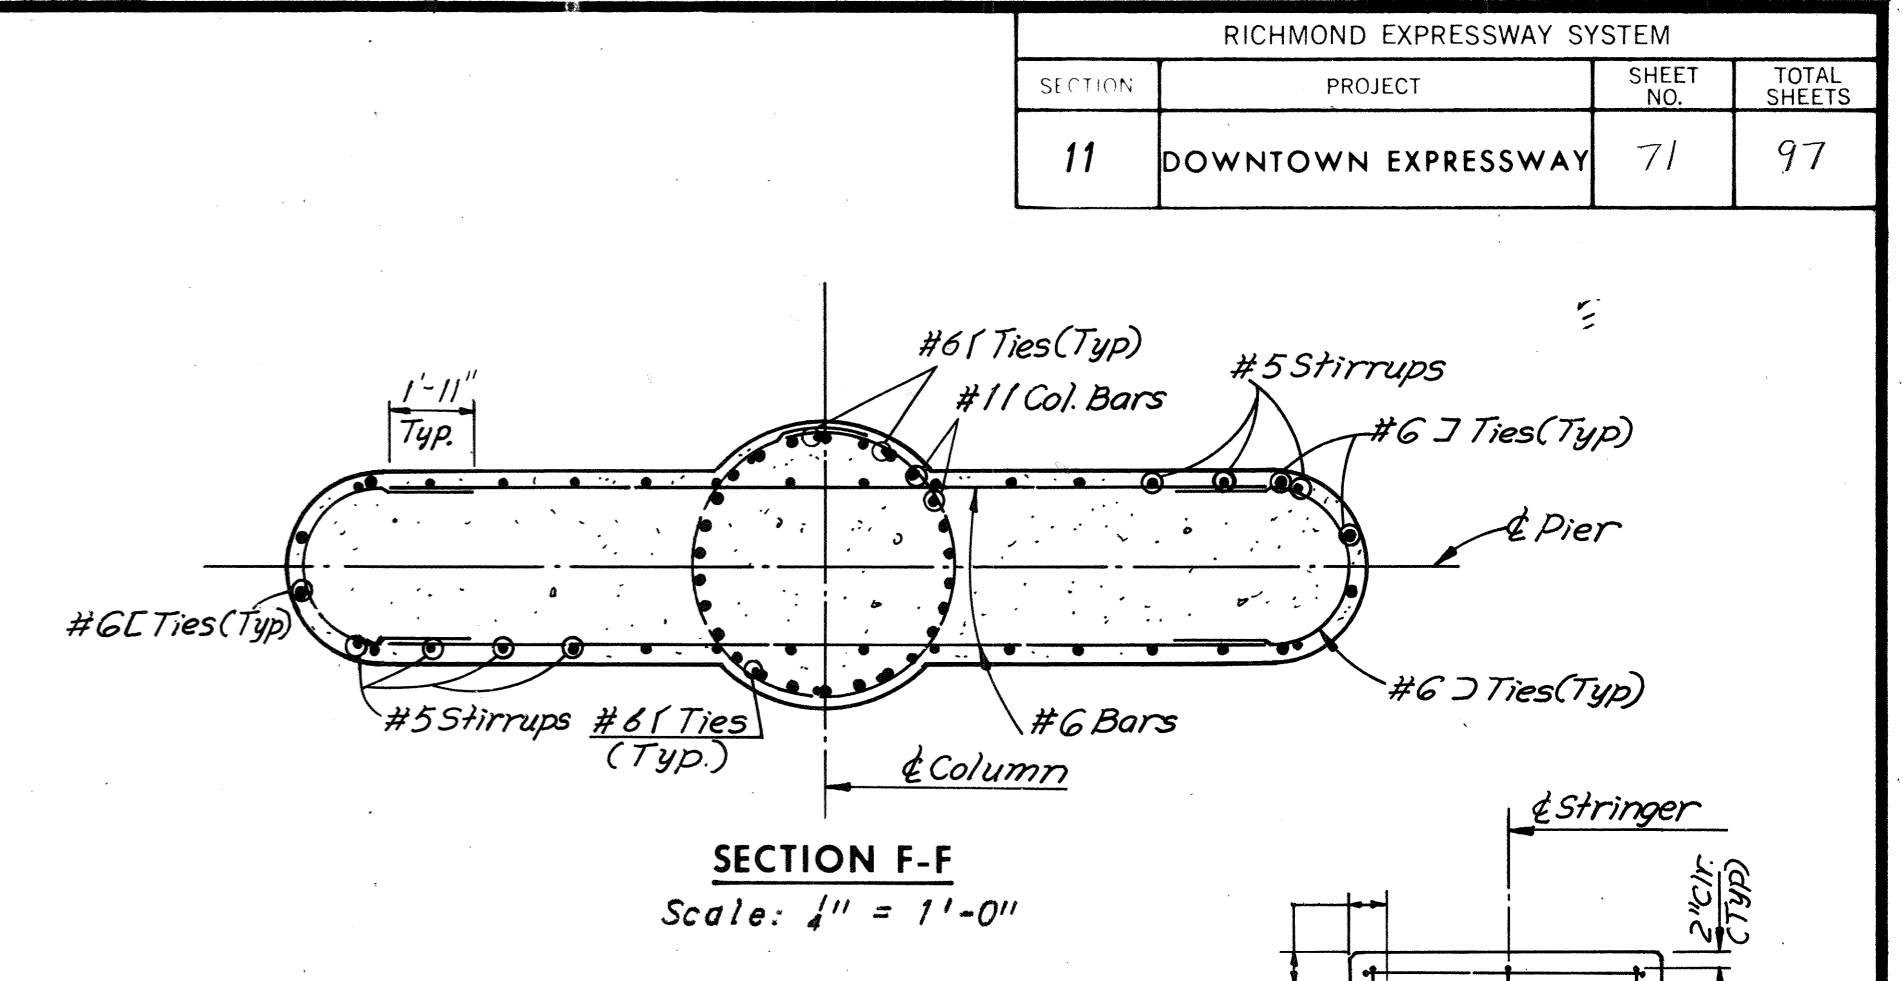


SECTION F-F
Scale: 1/4" = 1'-0"

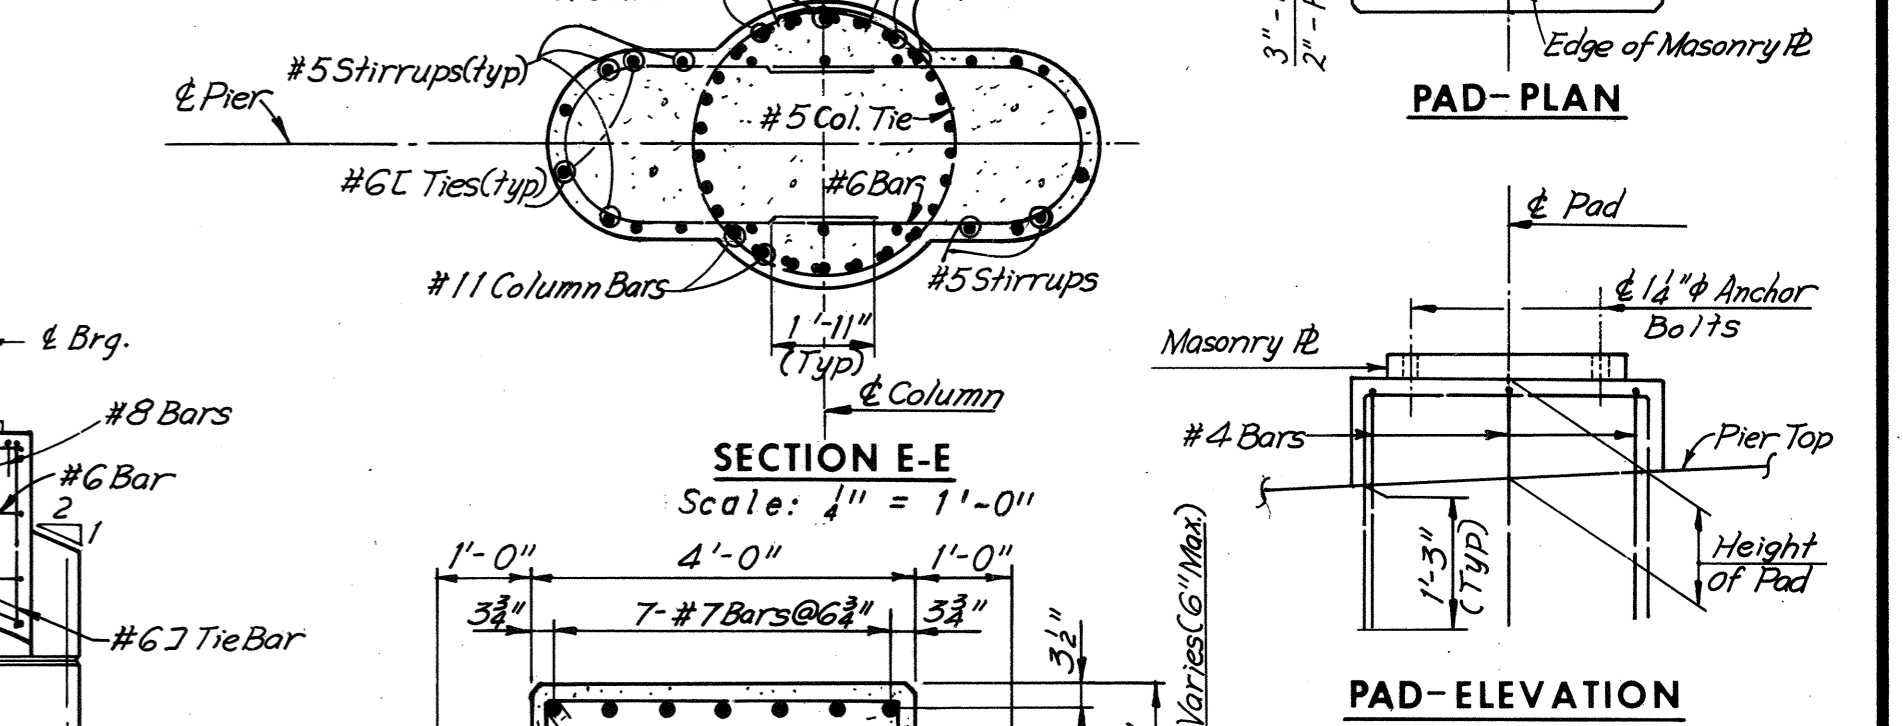


SECTION E-E
Scale: 1/4" = 1'-0"

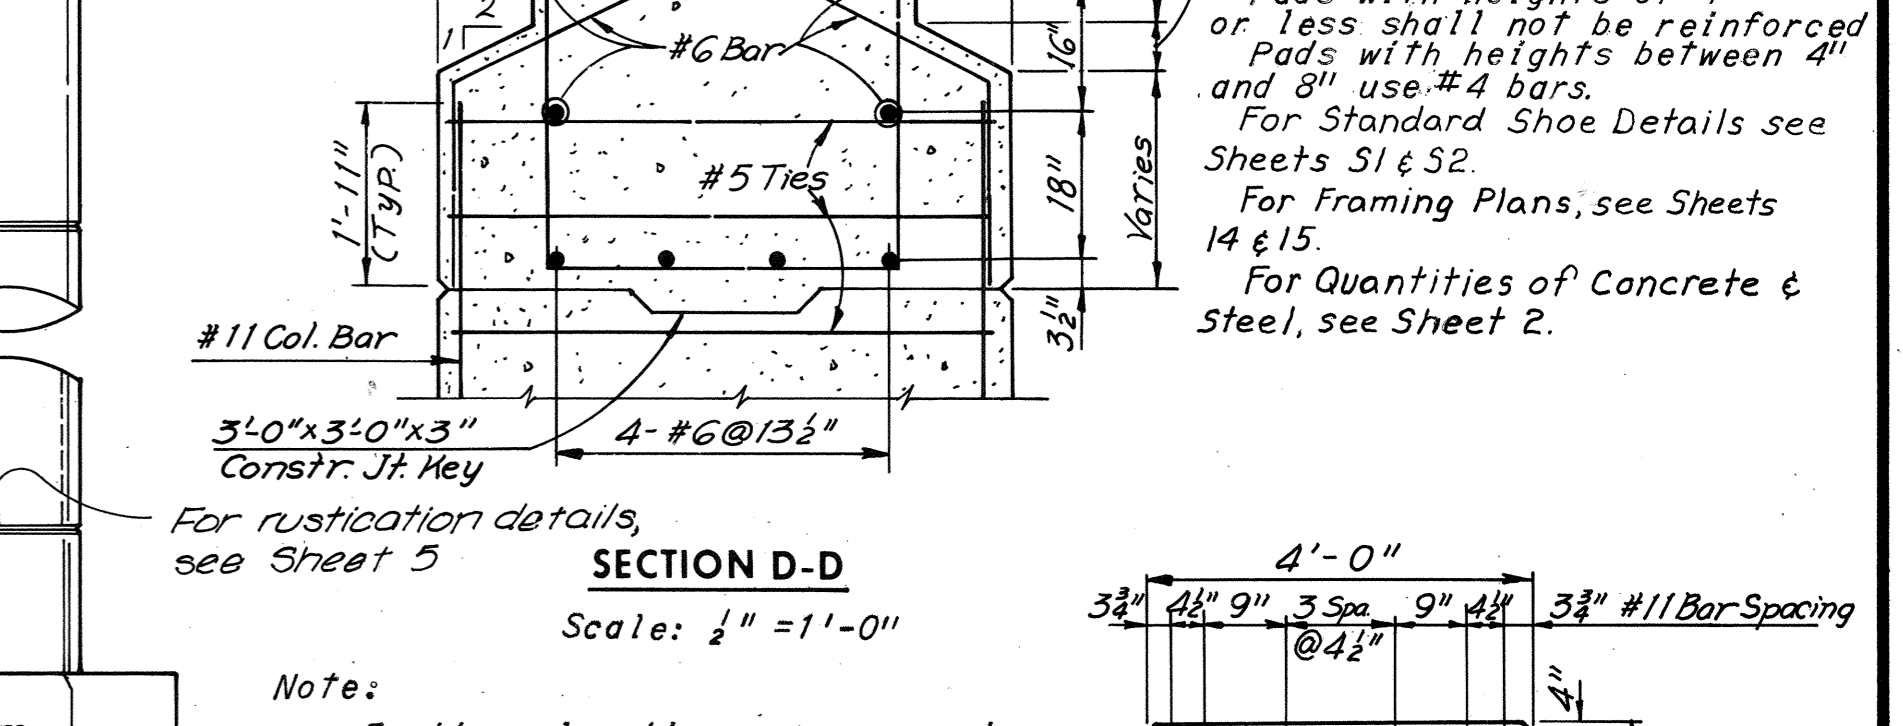

SECTION D-D
Scale: 1/4" = 1'-0"

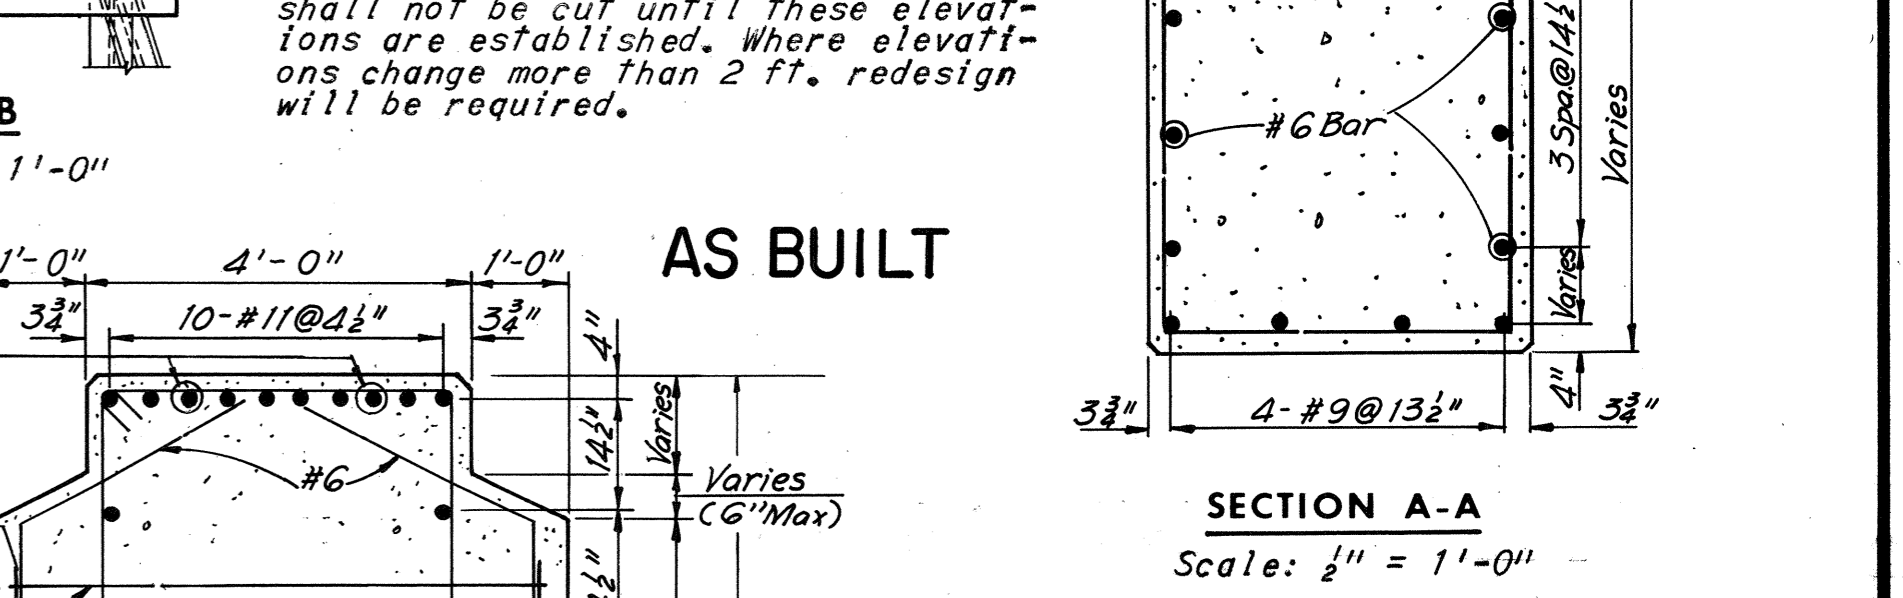

SECTION A-A
Scale: 1/4" = 1'-0"

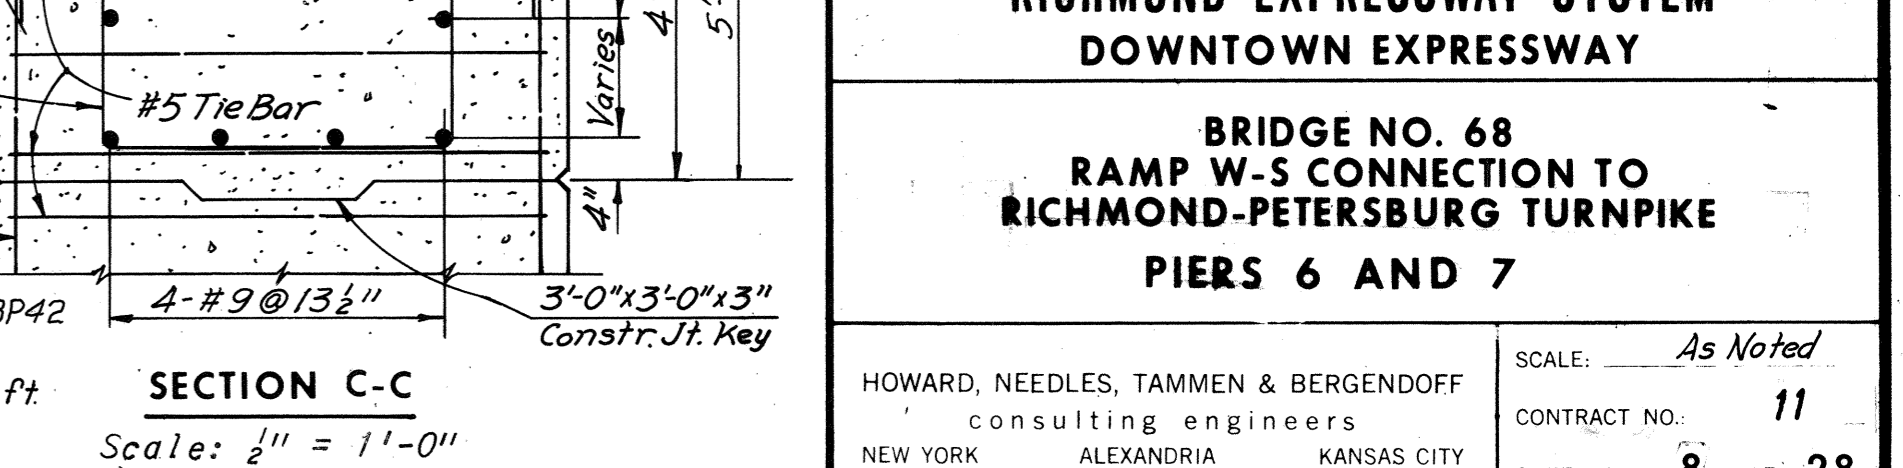


AS BUILT
Scale: 1/4" = 1'-0"

RICHMOND METROPOLITAN AUTHORITY
RICHMOND EXPRESSWAY SYSTEM
DOWNTOWN EXPRESSWAY


BRIDGE NO. 68
RAMP W-S CONNECTION TO
RICHMOND-PETERSBURG TURNPIKE
PIERS 6 AND 7

HOWARD, NEEDLES, TAMMEN & BERGENDOFF
consulting engineers
NEW YORK ALEXANDRIA KANSAS CITY


SCALE: As Noted
CONTRACT NO. 11
SHEET NO. 8 OF 28

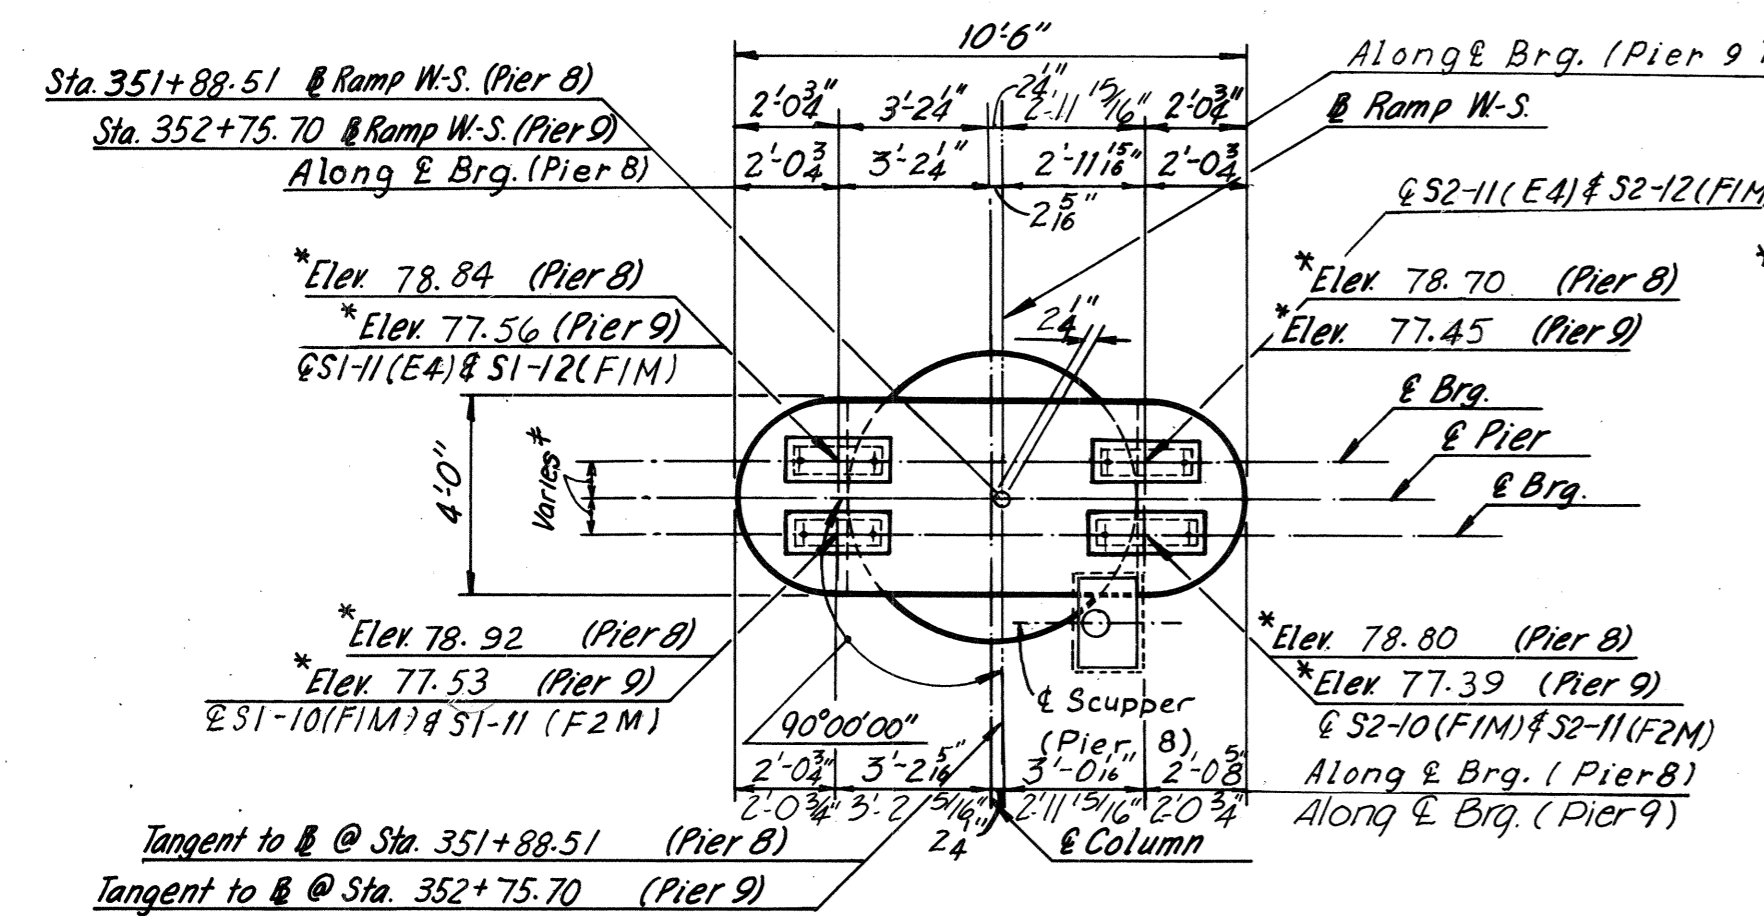


PIER CAP PLAN-PIERS 8 AND 9
Scale: 1/4" = 1'-0"

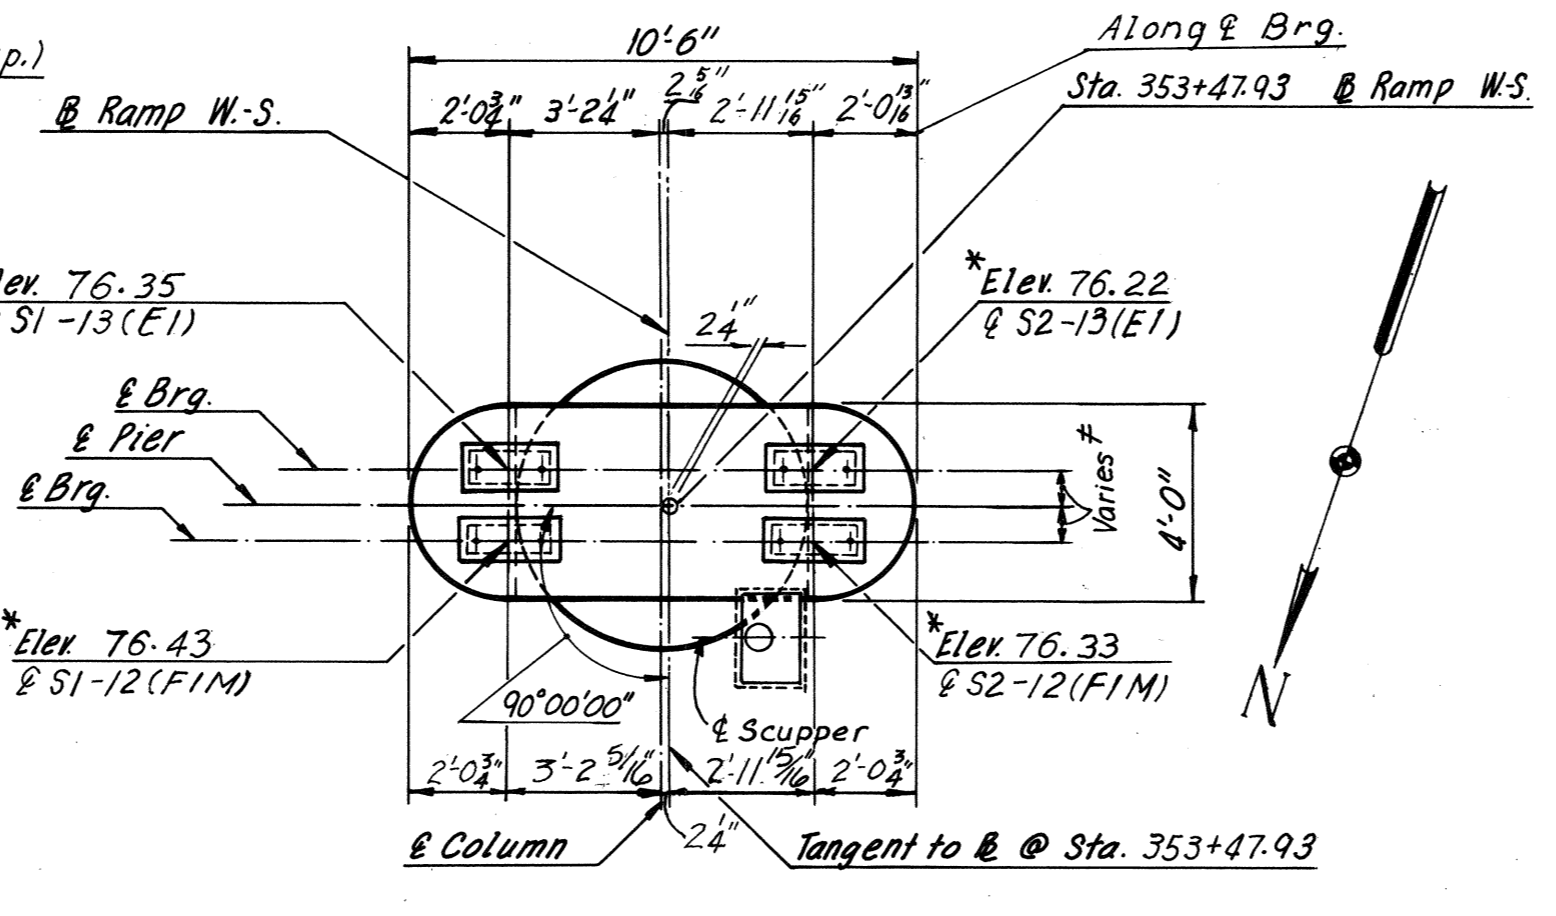


PIER CAP PLAN-PIER 10
Scale: 1/4" = 1'-0"

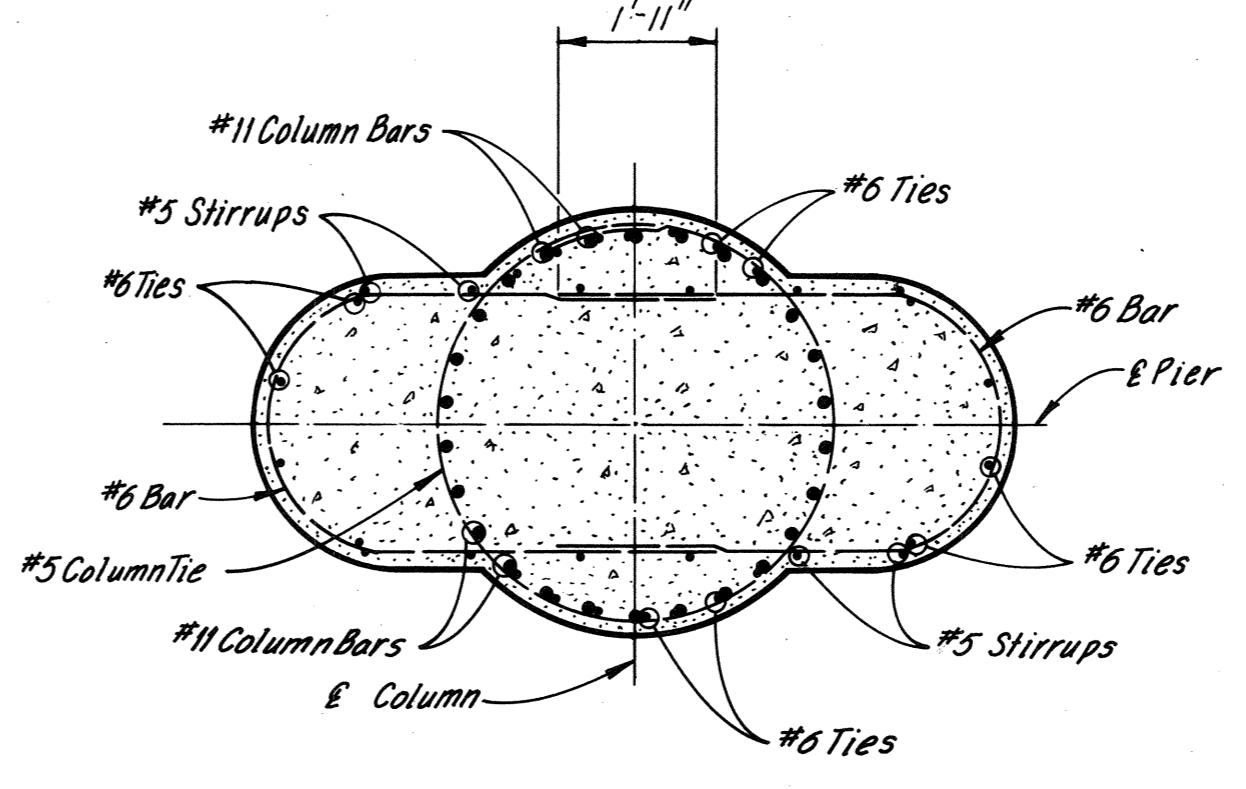


SECTION A-A
Scale: 3/8" = 1'-0"

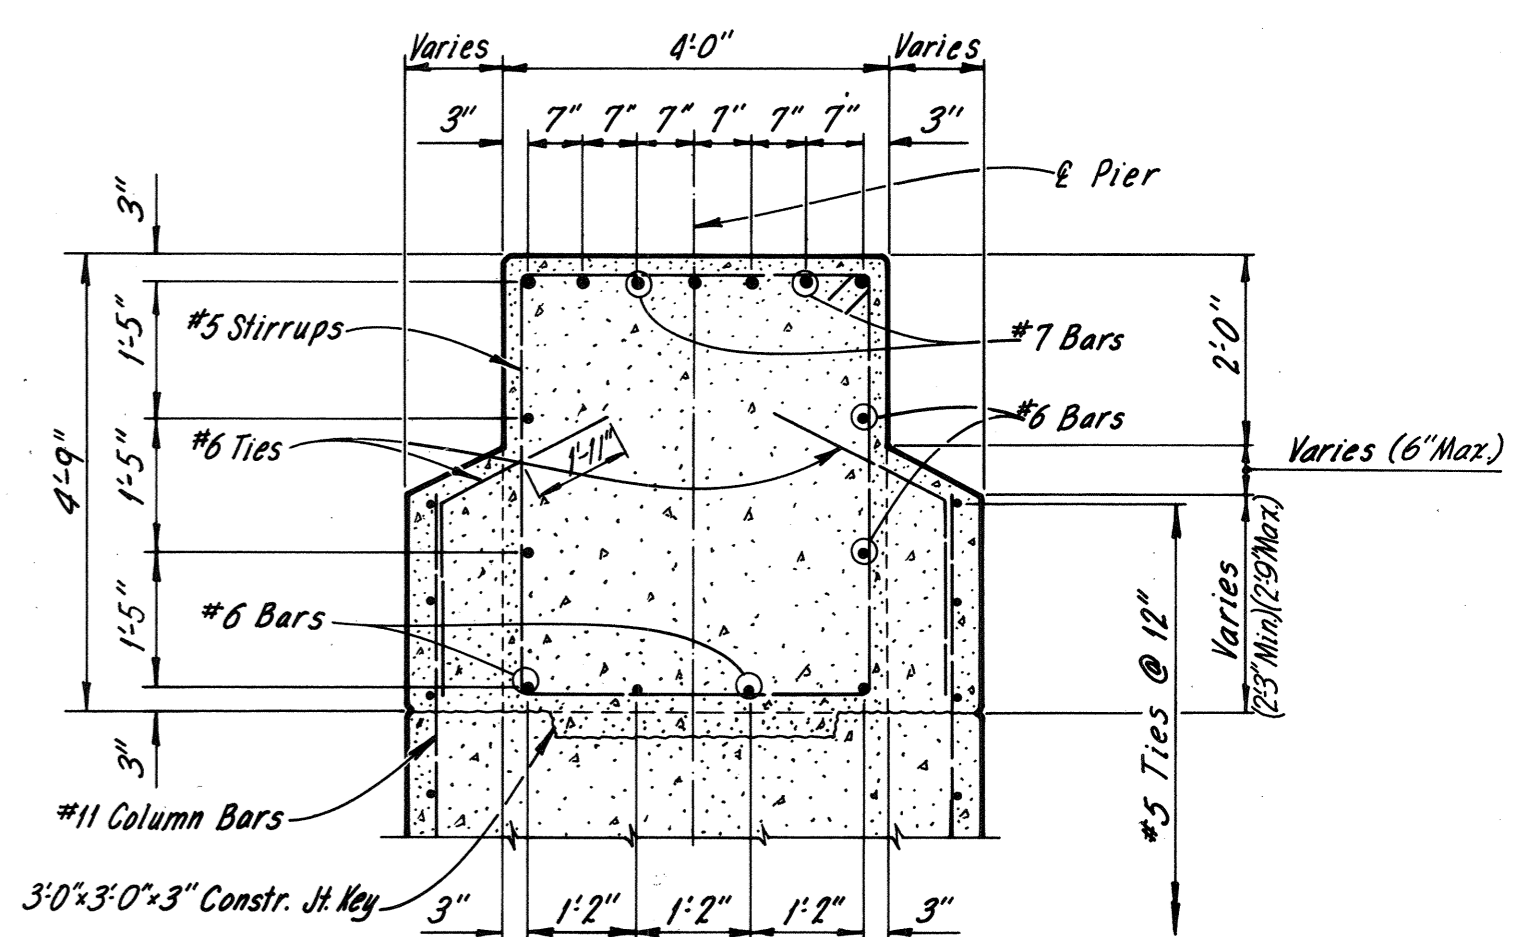


SECTION B-B
Scale: 2" = 1'-0"

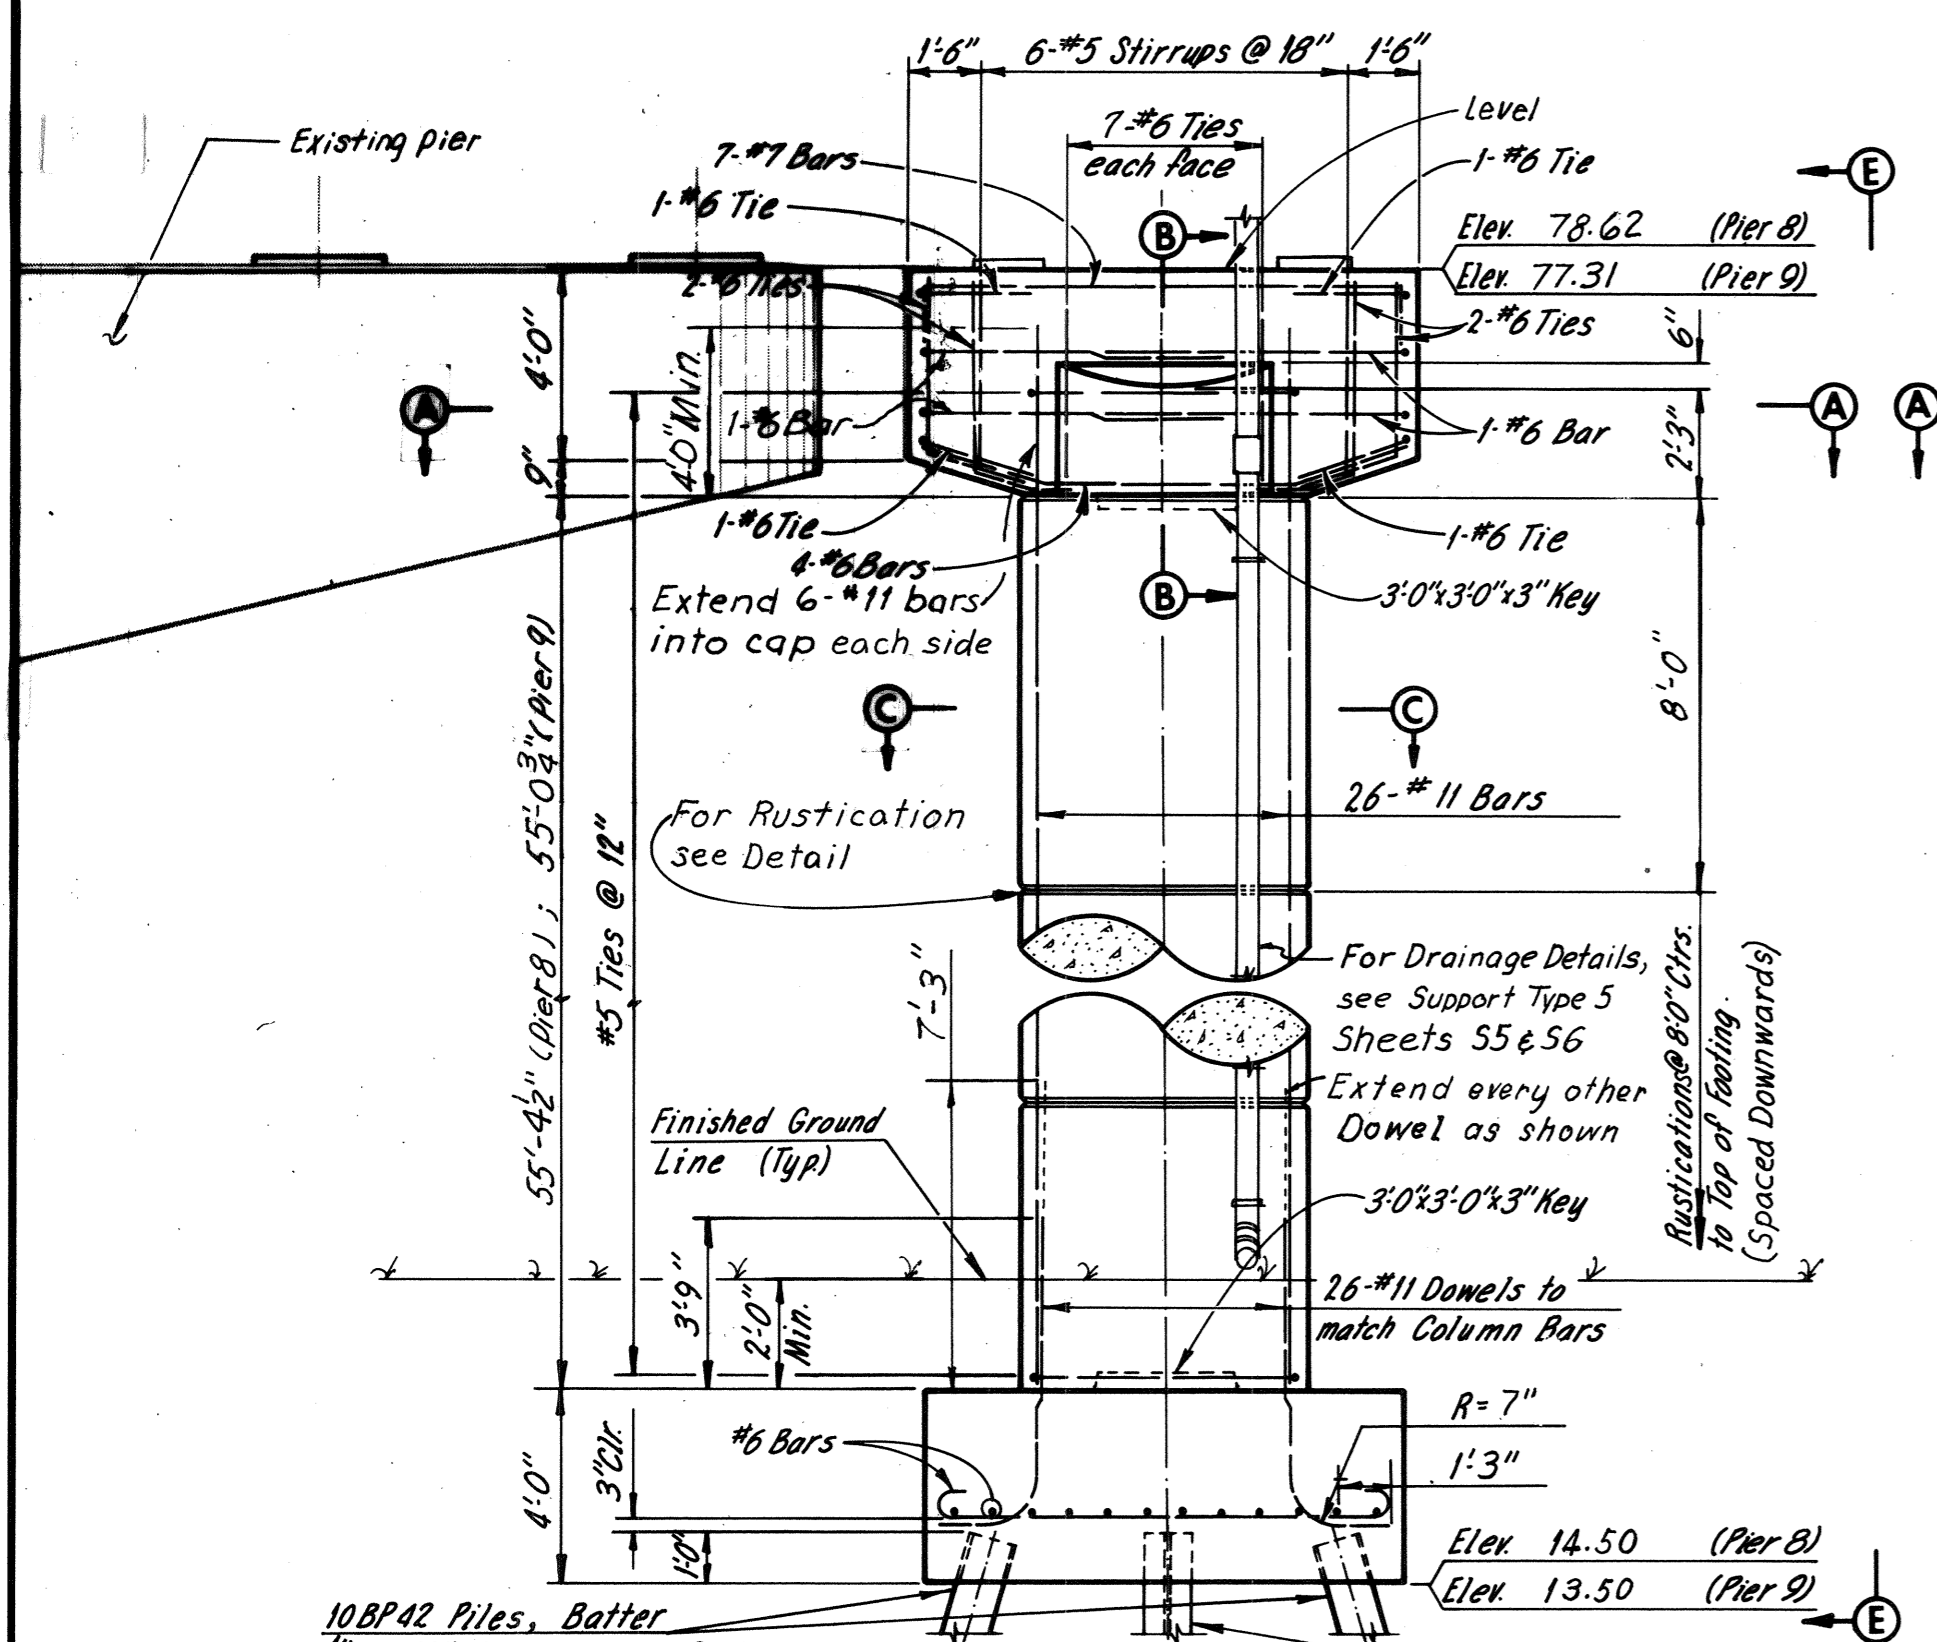


ELEVATION-PIERS 8 AND 9
Scale: 1/4" = 1'-0"

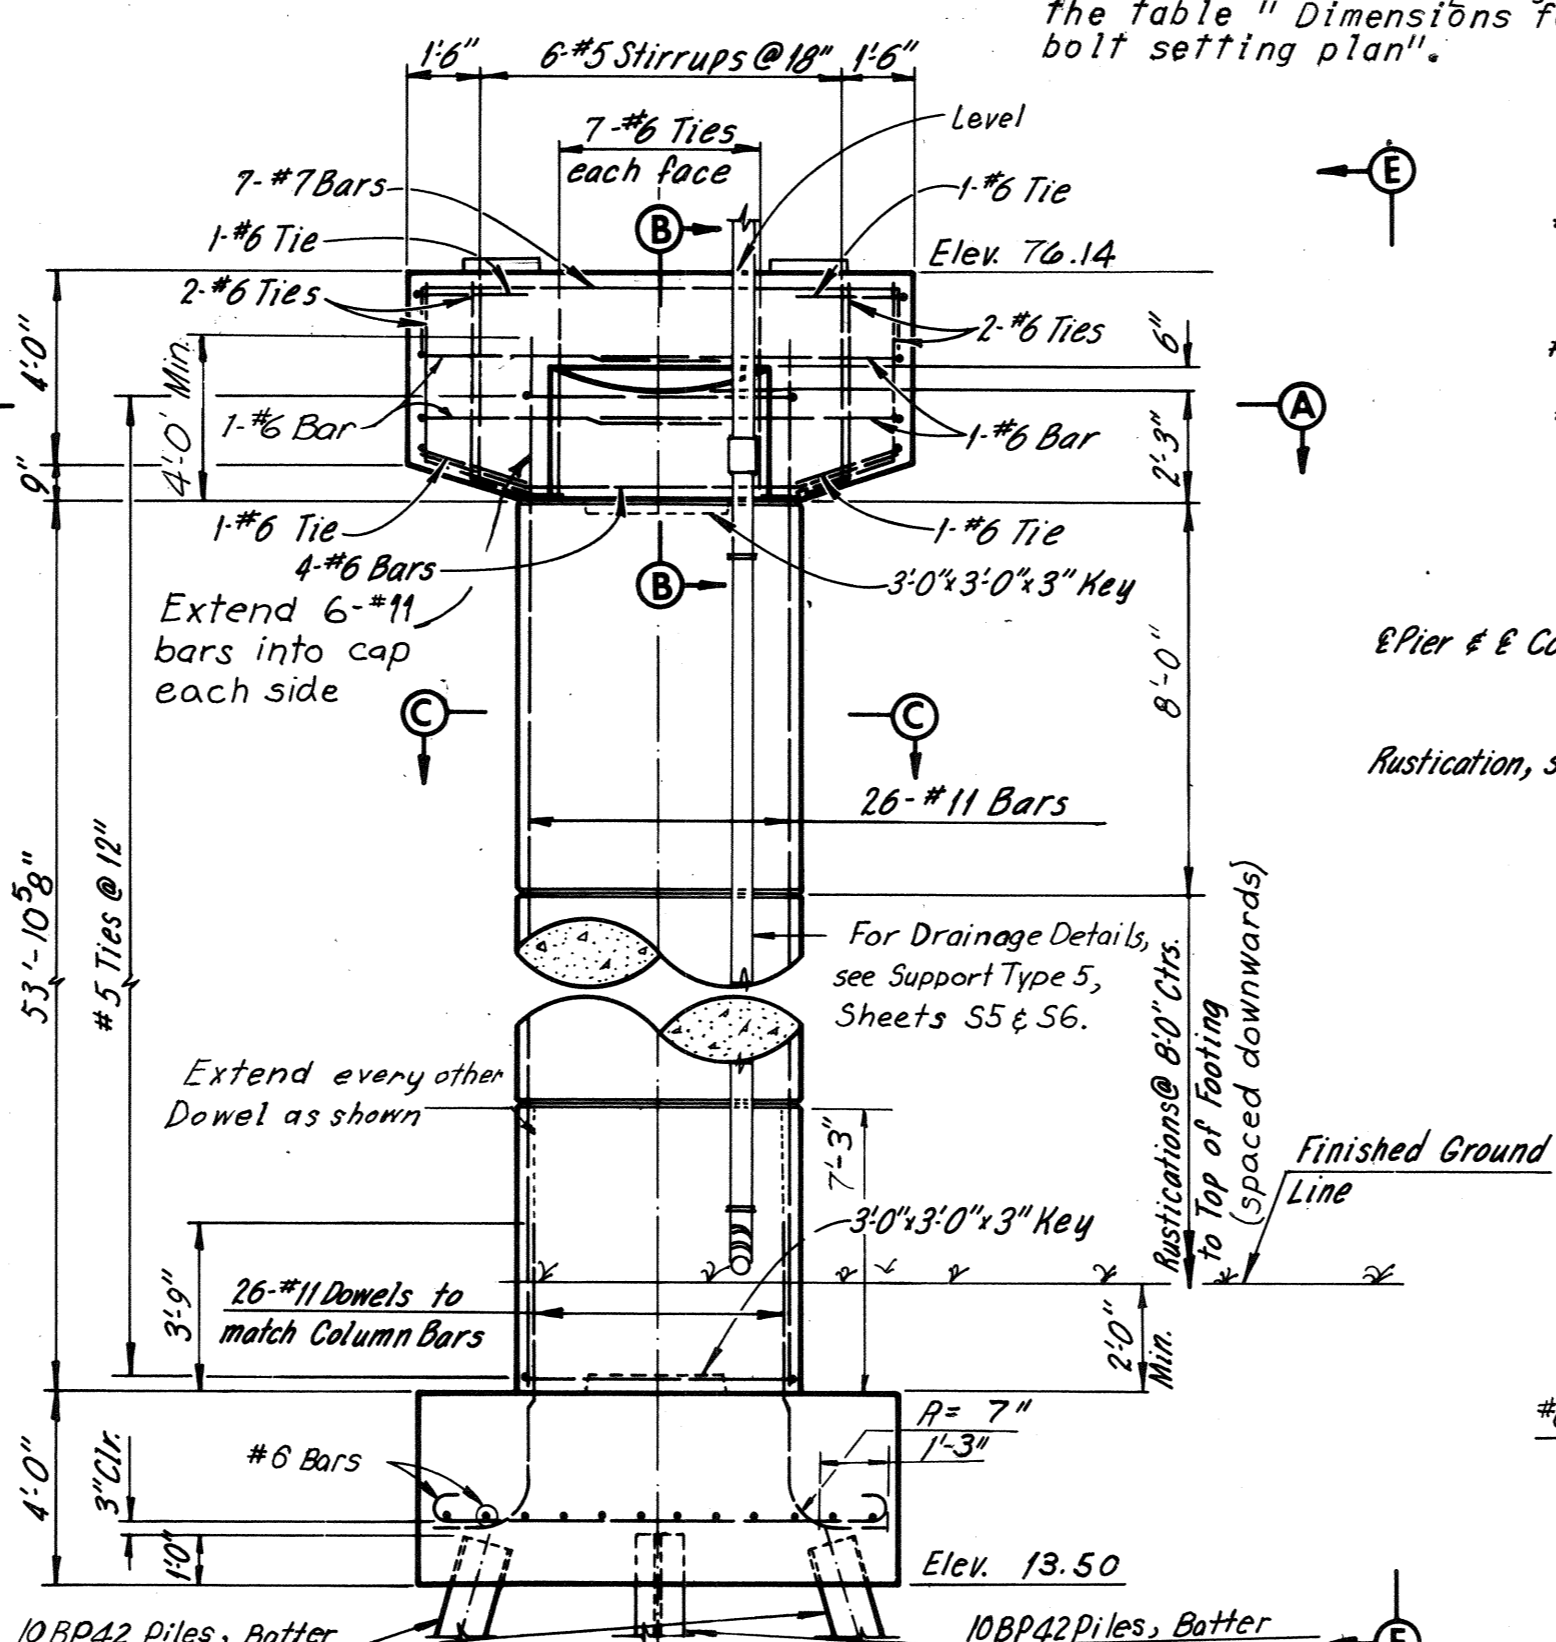

ELEVATION-PIER 10
Scale: 1/4" = 1'-0"

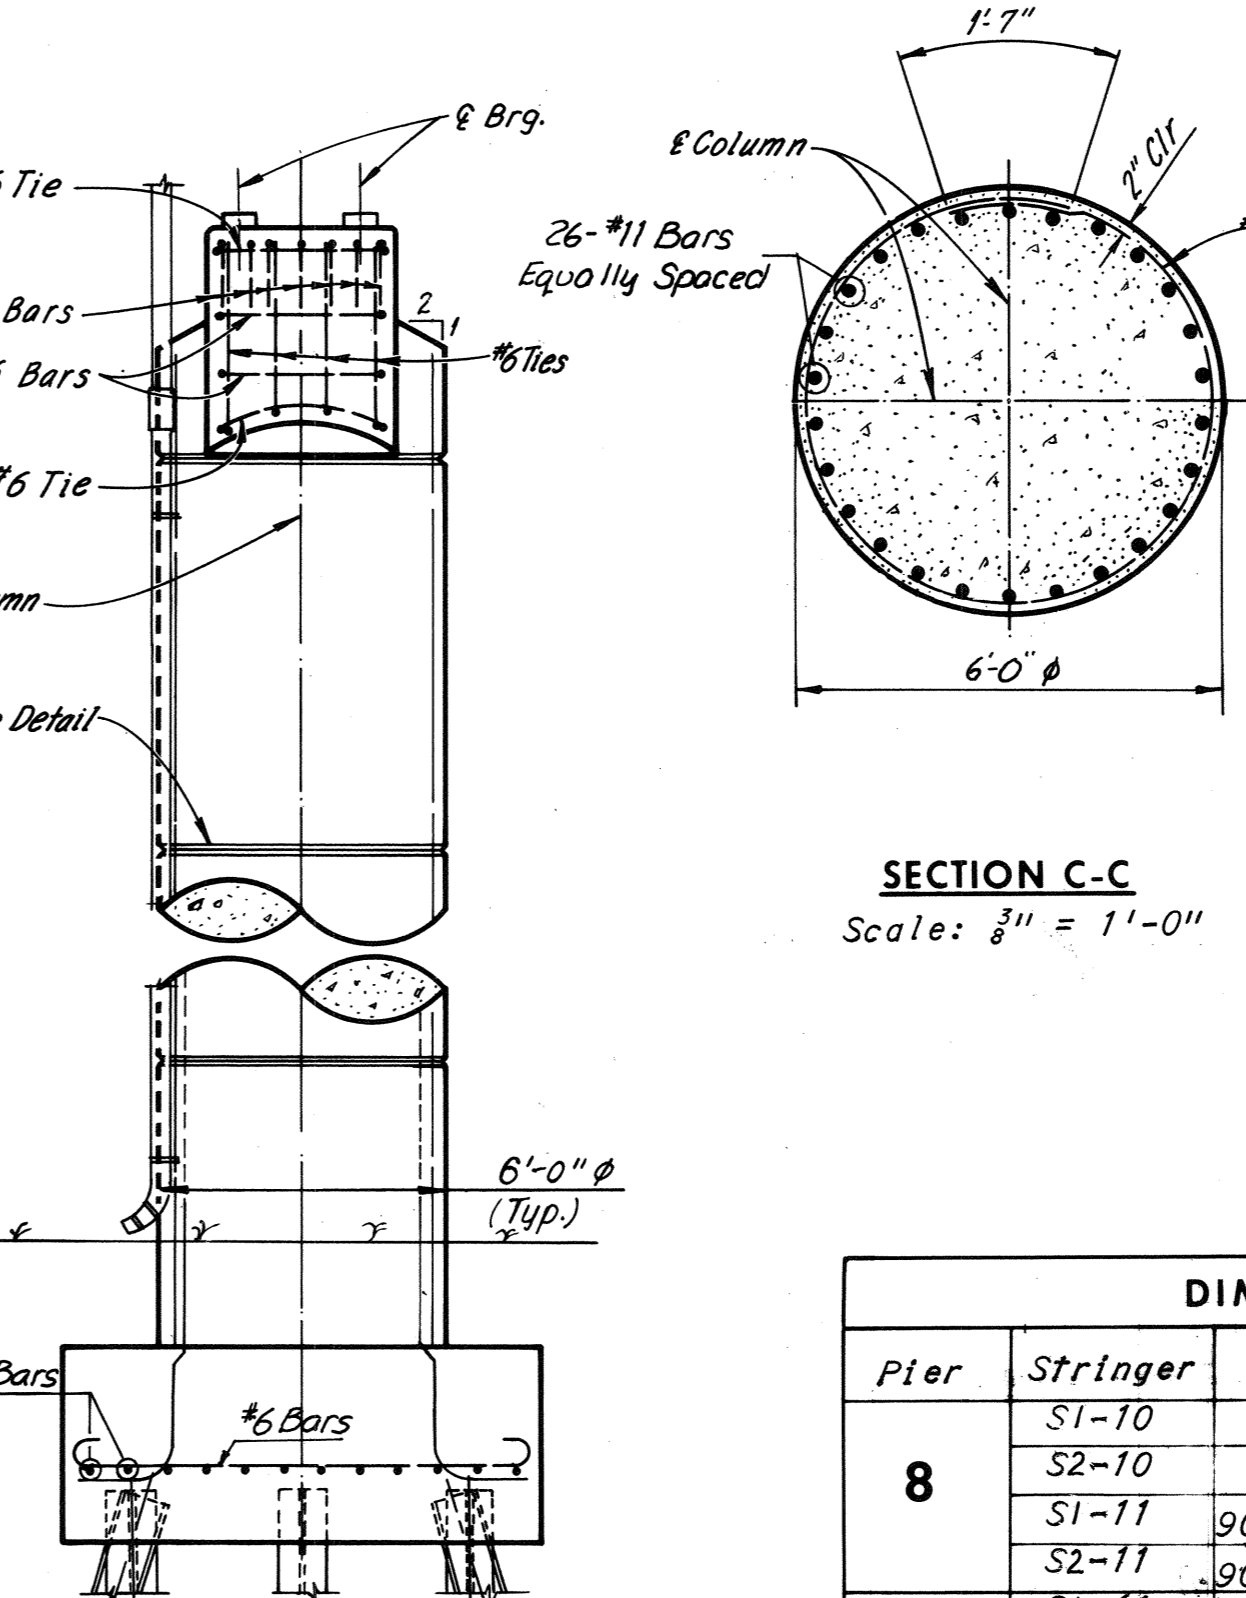


VIEW E-E
Scale: 1/4" = 1'-0"

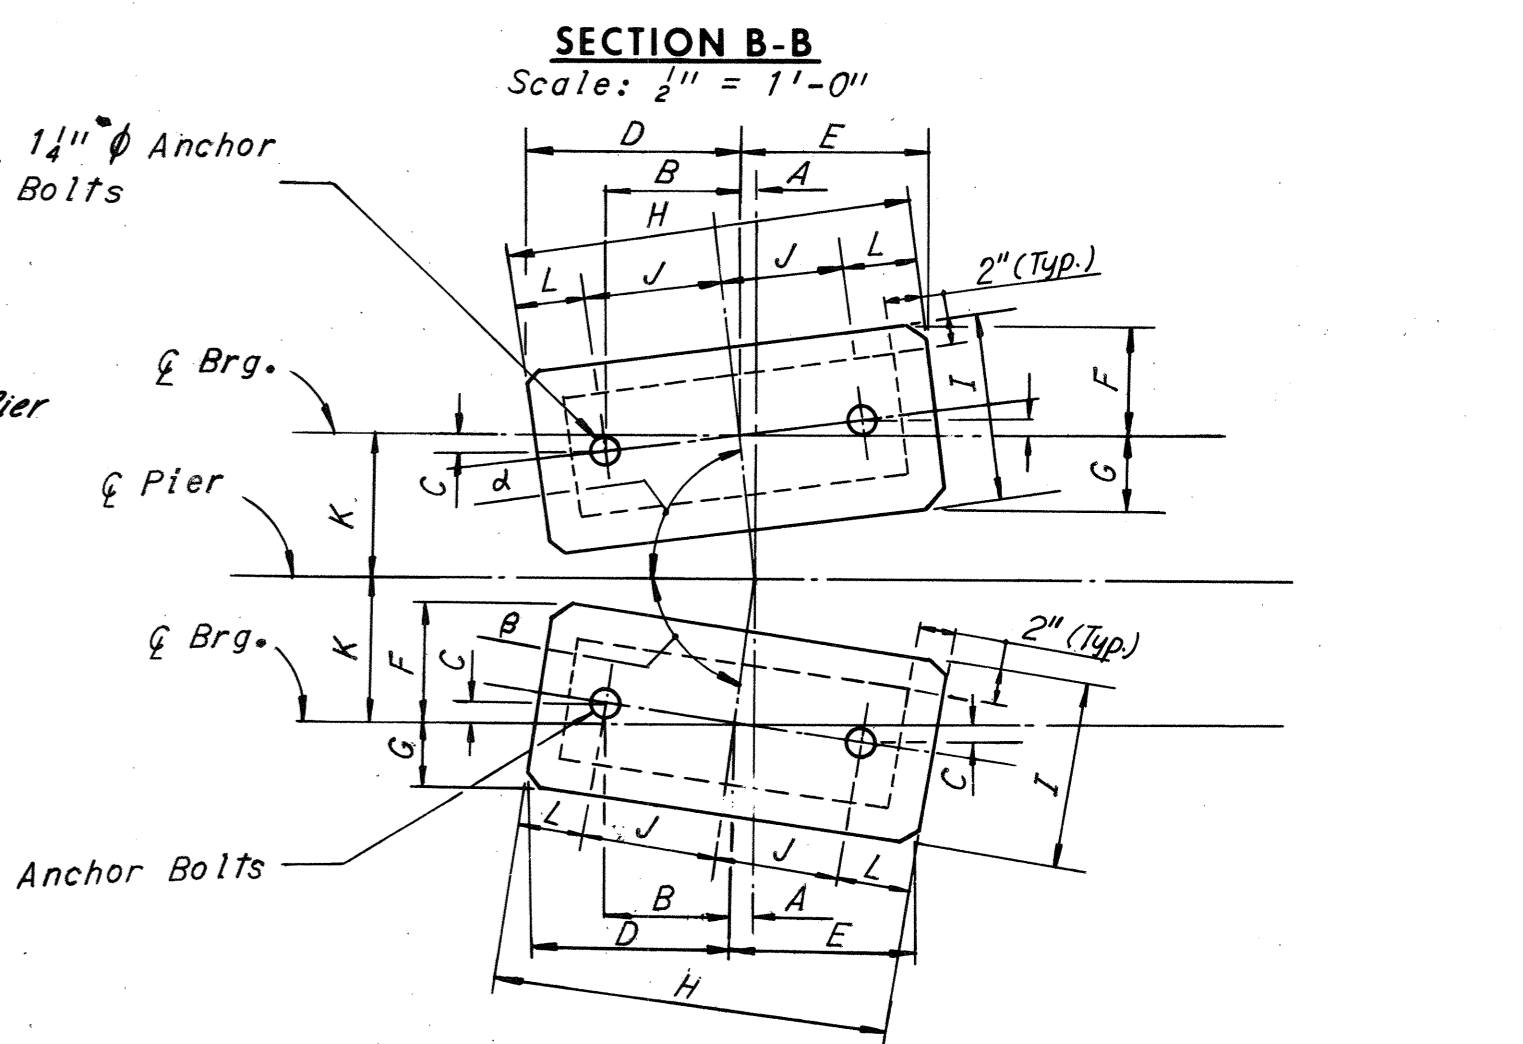


PAD AND ANCHOR BOLT SETTING PLAN
NO Scale


DIMENSIONS FOR PAD AND ANCHOR BOLT SETTING PLAN															
Pier	Stringer	α	β	A	B	C	D	E	F	G	H	I	J	k	L
8	S1-10	-	89°36'33"	11"	8"	11"	11-0 1/2"	11-0 1/2"	5 1/2"	5 1/2"	21-1"	11 1/2"	8"	9"	4 1/2"
	S2-10	-	90°19'22"	11"	8"	11"	11-0 1/2"	11-0 1/2"	5 1/2"	5 1/2"	21-1"	11 1/2"	8"	9"	4 1/2"
9	S1-11	90°25'55"	-	11"	10 1/2"	11"	11-2 1/2"	11-2 1/2"	6 3/4"	6 3/4"	21-5"	11-0 1/2"	10 1/2"	9"	4"
	S2-11	90°25'55"	-	11"	10 1/2"	11"	11-2 1/2"	11-2 1/2"	6 3/4"	6 3/4"	21-5"	11-0 1/2"	10 1/2"	9"	4"
10	S1-12	-	89°34'05"	11"	10 1/2"	11"	11-3"	11-3"	5 1/2"	5 1/2"	21-6"	11"	10 1/2"	8"	4 1/2"
	S2-12	90°21'29"	-	11"	8"	11"	11-0 1/2"	11-0 1/2"	5 1/2"	5 1/2"	21-1"	11 1/2"	8"	10"	4 1/2"
10	S1-13	-	90°21'29"	11"	8"	11"	11-0 1/2"	11-0 1/2"	5 1/2"	5 1/2"	21-1"	11 1/2"	8"	9"	4 1/2"
	S2-13	89°38'31"	-	11"	8 1/2"	11"	11-0 1/2"	11-0 1/2"	5 1/2"	5 1/2"	21-0 1/2"	11-0"	8 1/2"	9"	4"

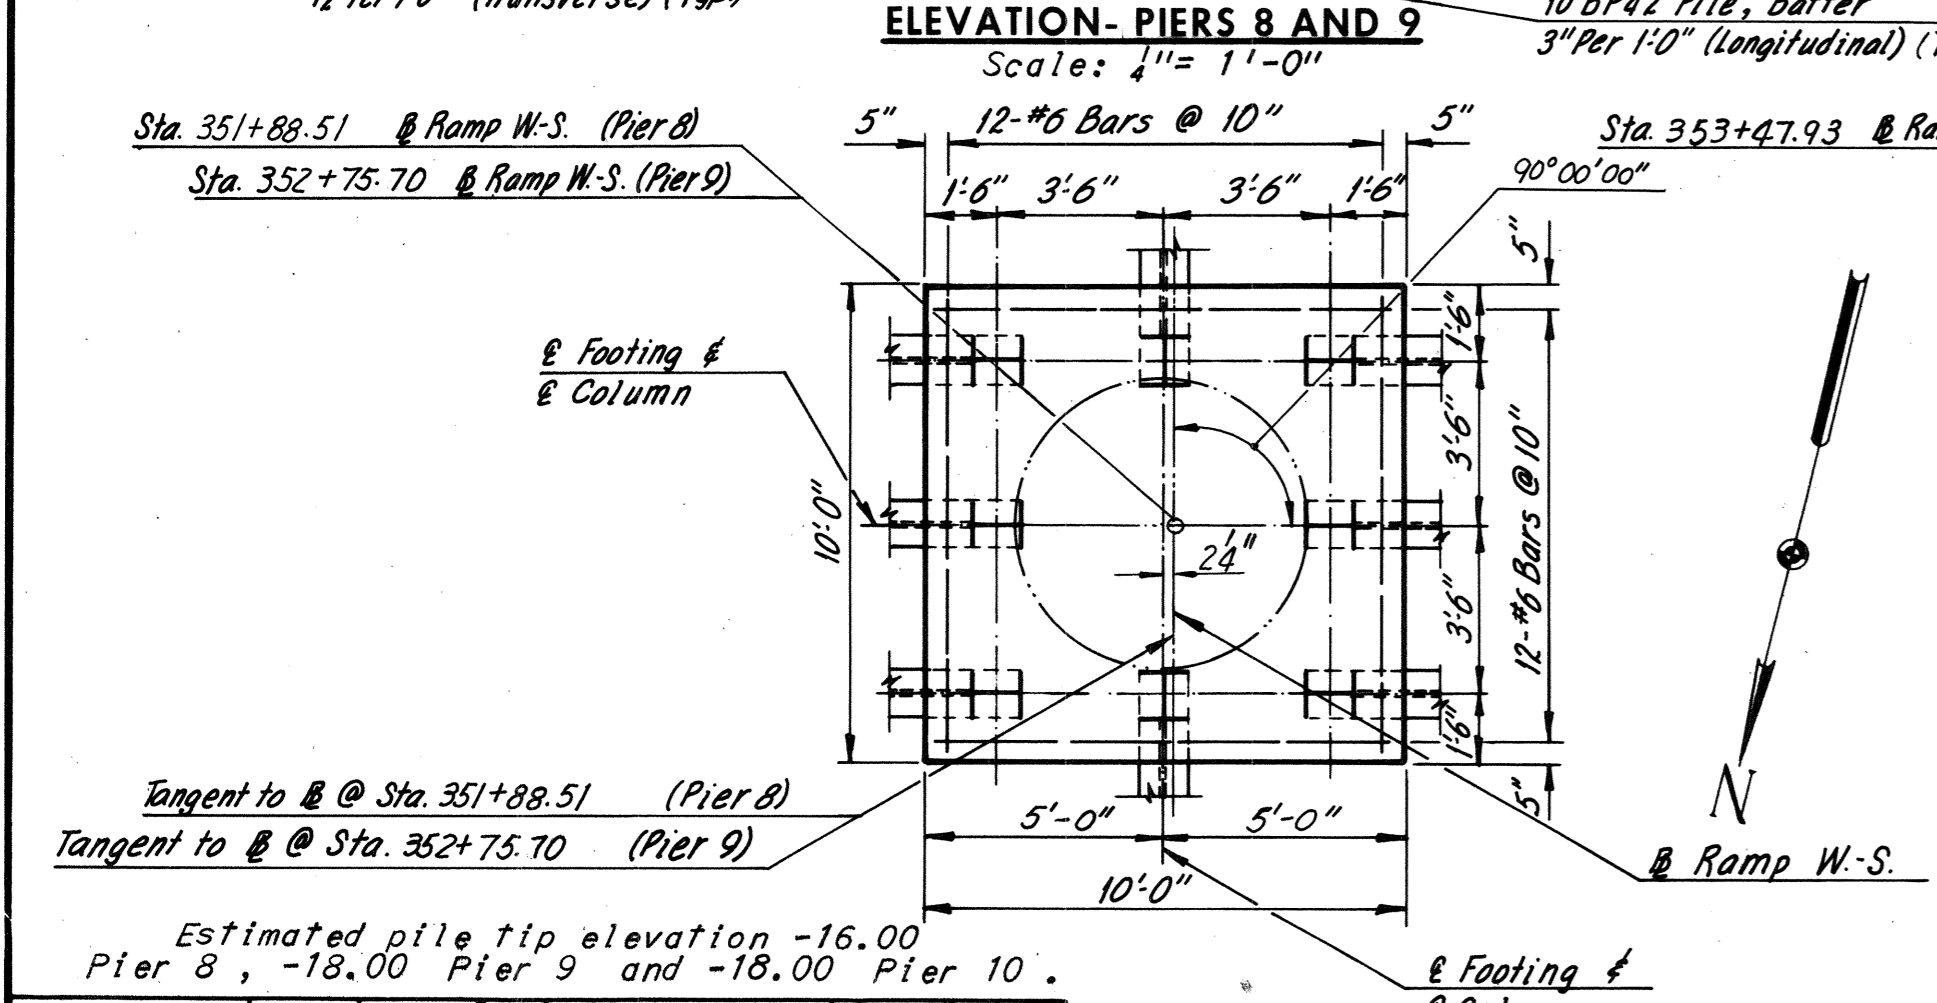


FOOTING PLAN-PIERS 8 AND 9
Scale: 1/4" = 1'-0"

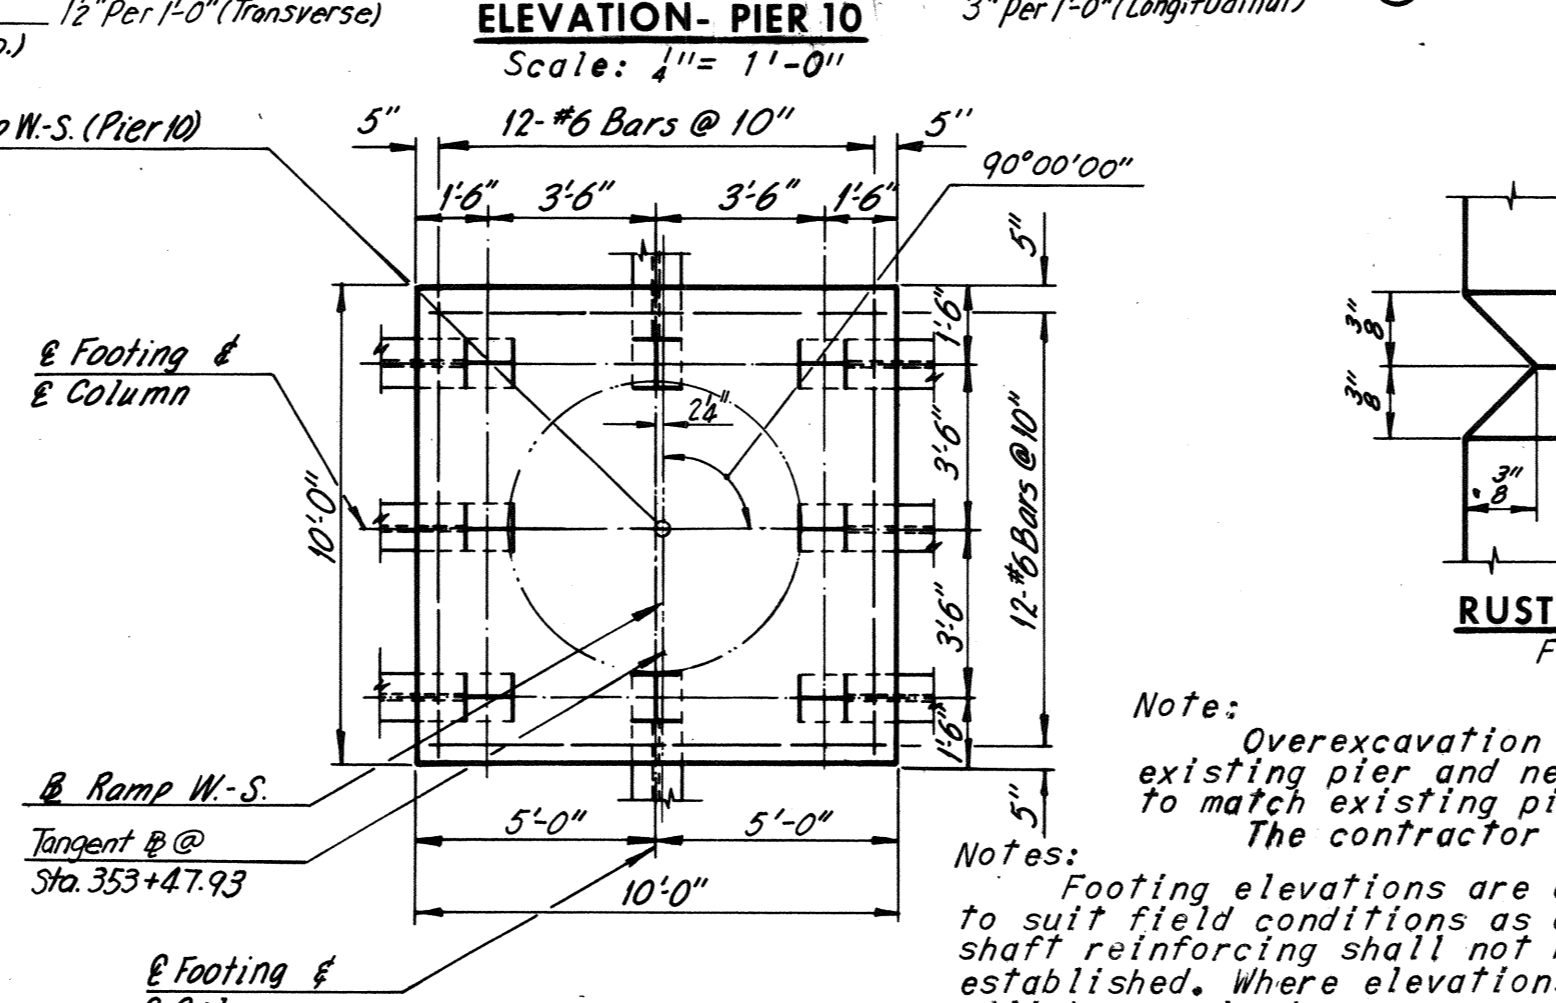

FOOTING PLAN-PIER 10
Scale: 1/4" = 1'-0"

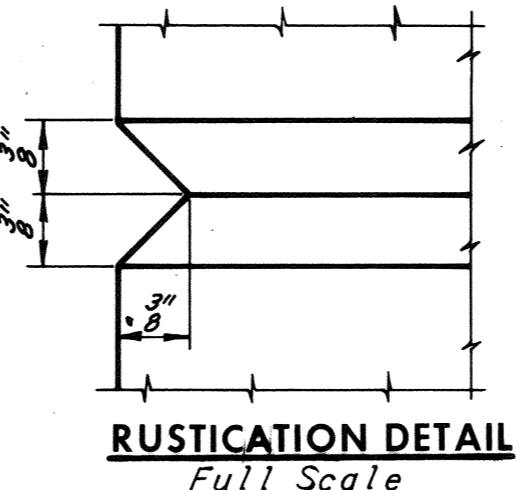

RUSTICATION DETAIL
Full Scale

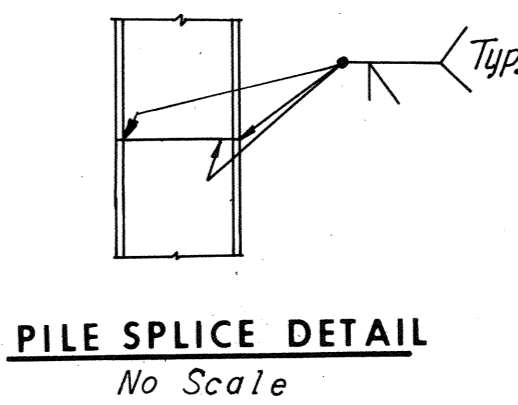

PILE SPLICE DETAIL
No Scale

Note: Overexcavation will not be permitted between existing piers 8, 9 and 10, and to match existing piers 53, 56 and 54 respectively. The contractor shall verify the stations in the field.

Notes: Footing elevations are approximate only and may be varied to suit field conditions as directed by Engineer. Vertical shaft reinforcing shall not be cut until these elevations are established. Where elevations change more than 2 ft. redesign will be required.

All piles shall be 10BP42 Steel Piles. (Design capacity = 45 Tons.) For Standard Shoe Details, see Sheets S1 & S2. For Framing Plans, see Sheets 15 and 16. For quantities of concrete and steel, see Sheet 2.

BY	DATE	REVISION	BY	DATE
D.E.S.	1-28-89	Footings Dowels	TEM	8-26-76
G.S.H.	2-4-69	Pad Elevations	TEM	8-26-75
K.C.T.	2-4-69	Pad Elevations	TEM	8-26-75
IN CHARGE	NO.	REVISION	BY	DATE

AS BUILT


RICHMOND METROPOLITAN AUTHORITY
RICHMOND EXPRESSWAY SYSTEM
DOWNTOWN EXPRESSWAY

BRIDGE NO. 68
RAMP W-S CONNECTION TO
RICHMOND-PETERSBURG TURNPIKE
PIERS 8, 9 AND 10


HOWARD, NEEDLES, TAMMEN & BERGENDOFF
consulting engineers
NEW YORK ALEXANDRIA KANSAS CITY

SCALE: As Noted
CONTRACT NO. 11
SHEET NO. 9 OF 28

RICHMOND EXPRESSWAY SYSTEM			
SECTION	PROJECT	SHEET NO.	TOTAL SHEETS
11	DOWNTOWN EXPRESSWAY	73	97

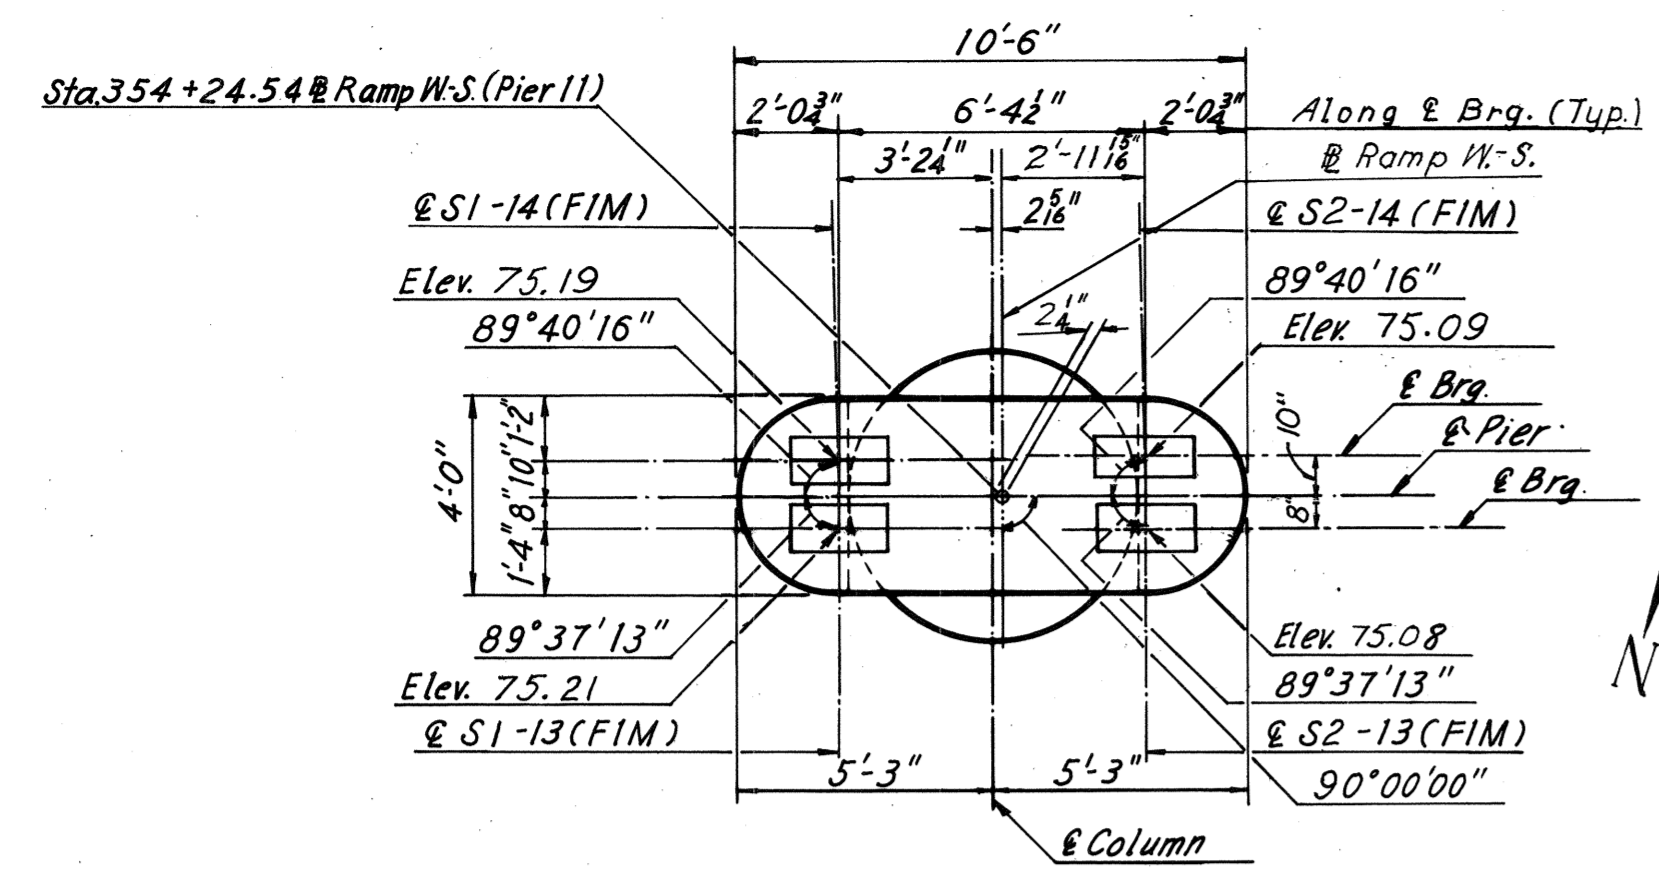


PIER CAP PLAN-PIER 11
Scale: 4" = 1'-0"

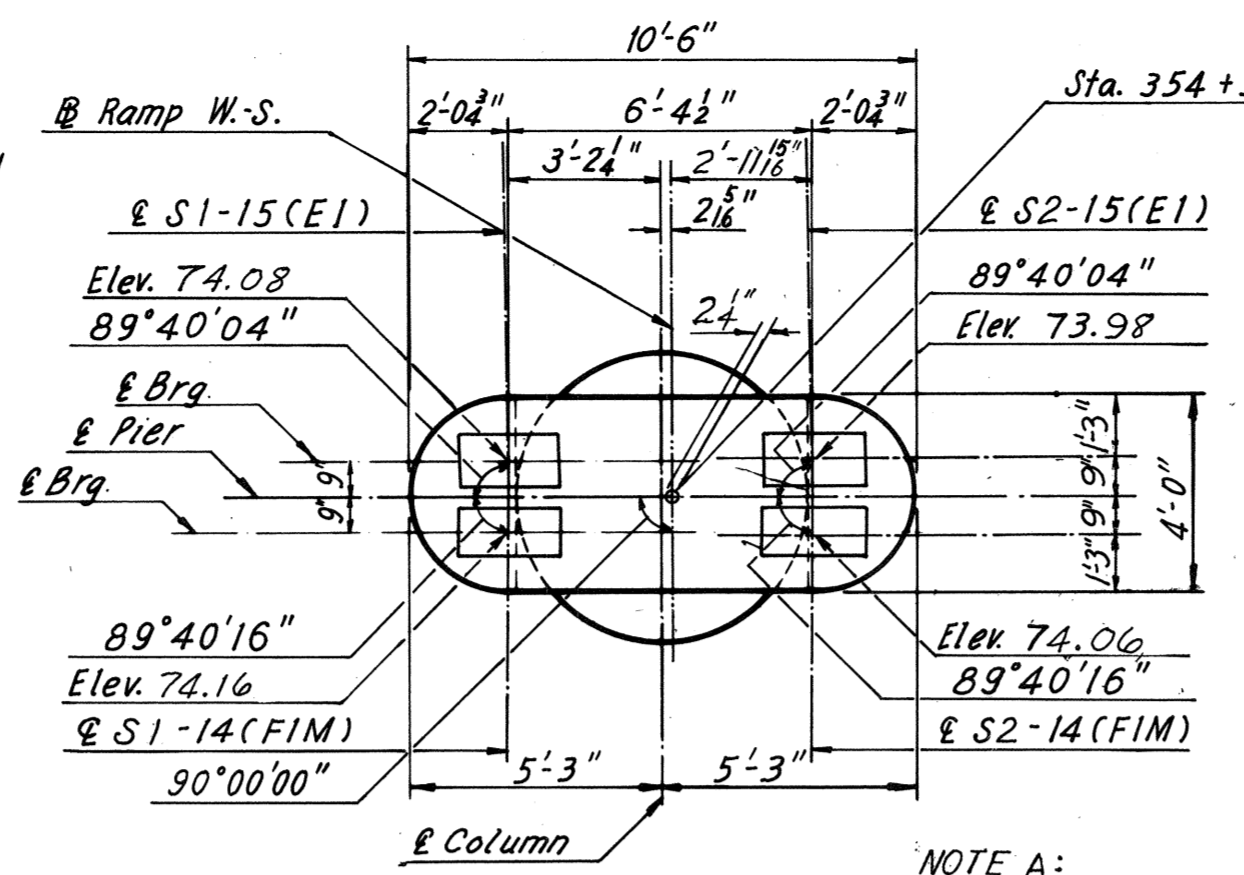


PIER CAP PLAN-PIER 12
Scale: 4" = 1'-0"


NOTE A:
A construction joint will be permitted at a rustication near mid-height of the column. The column reinforcement may be lap spliced near the construction joint. The lap at the splice shall be a minimum of 3'-6". Splices shall be staggered at least 3'-3" between adjacent bars.

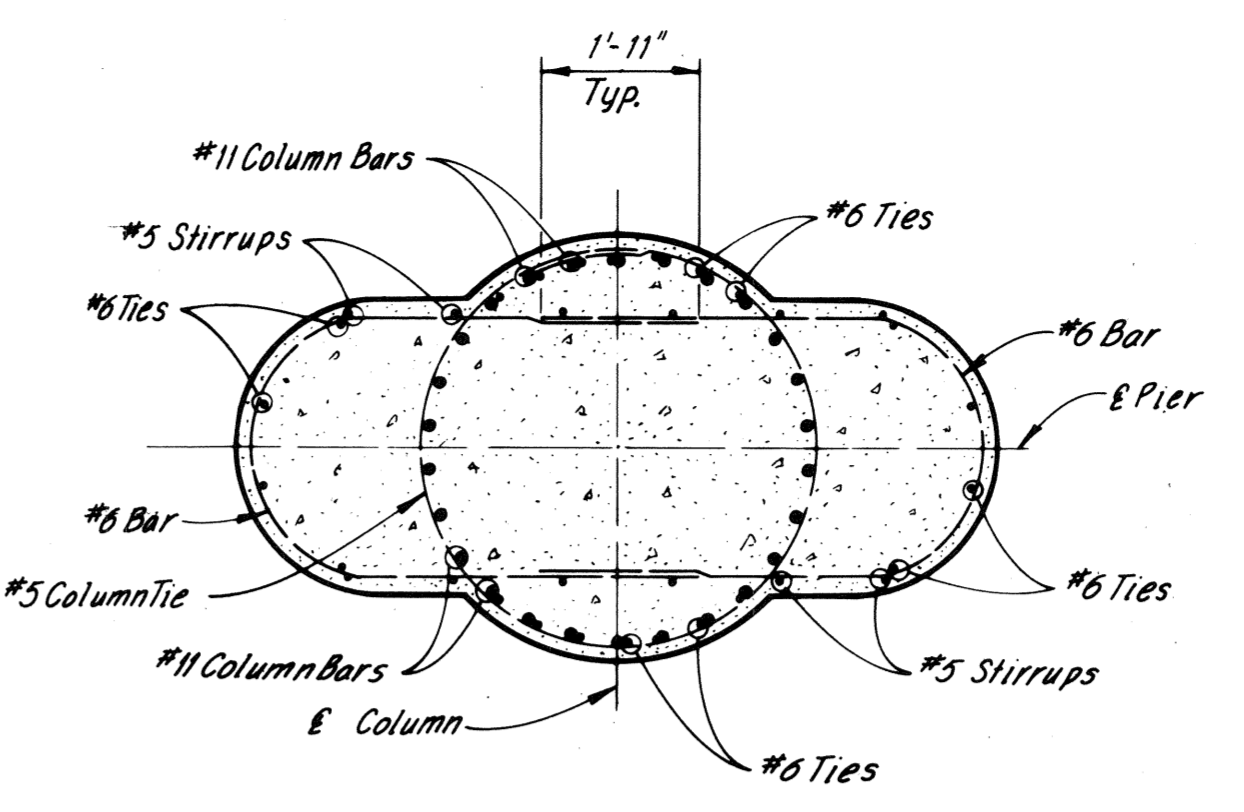


SECTION A-A
Scale: 3/8" = 1'-0"

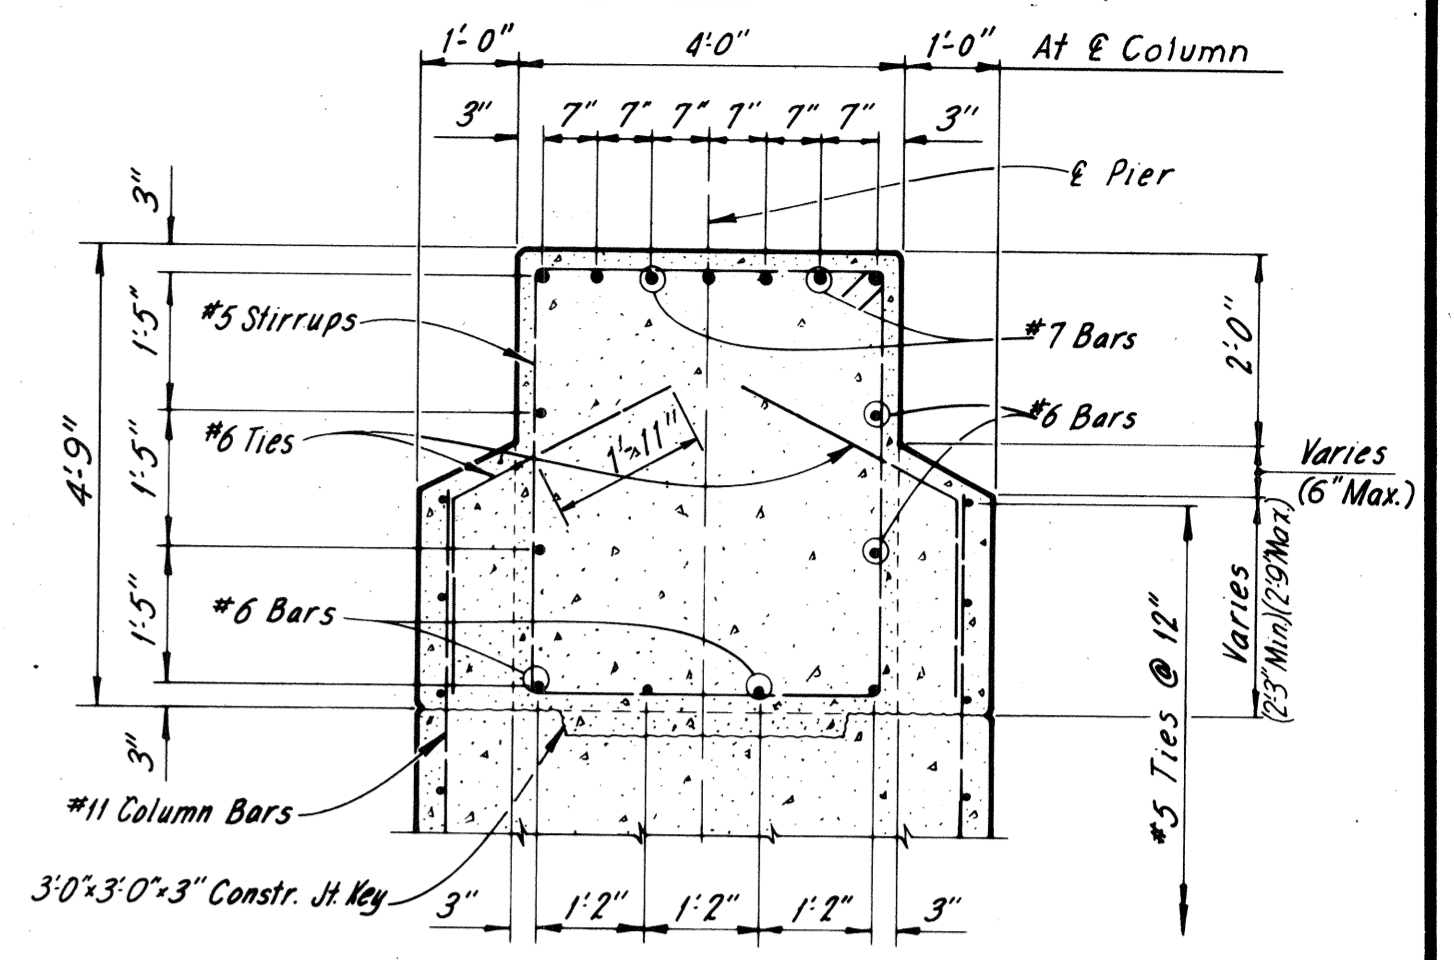


SECTION B-B
Scale: 2" = 1'-0"

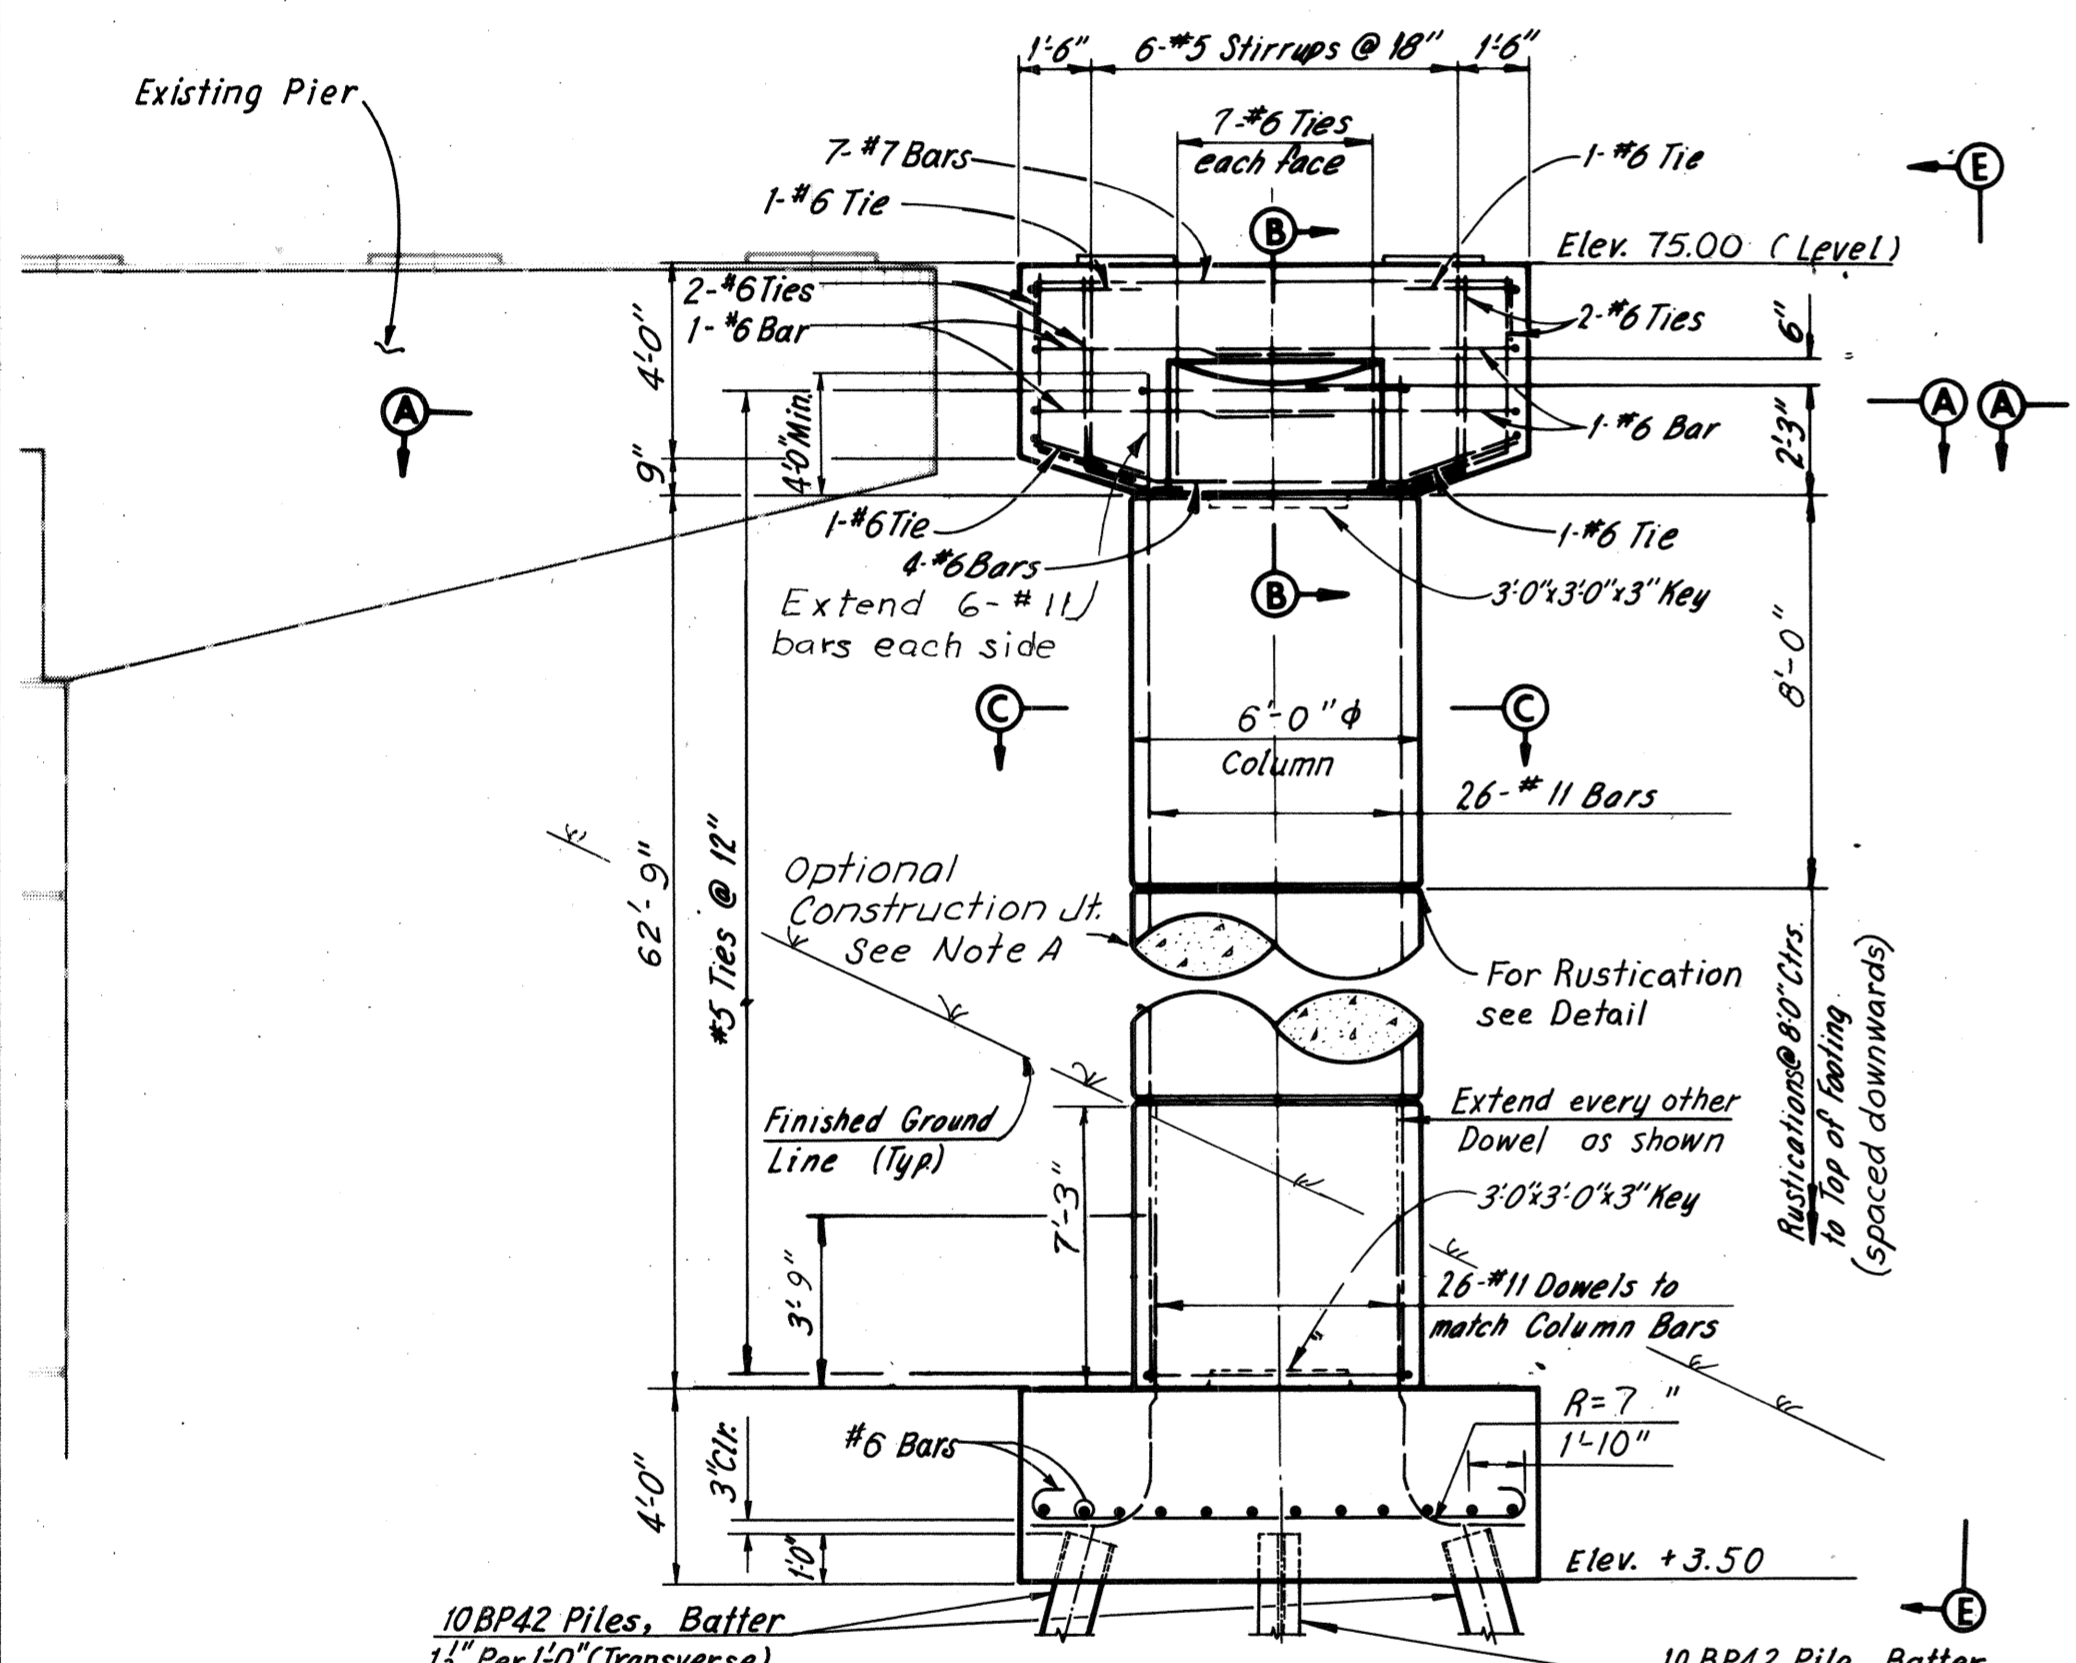


ELEVATION - PIER 11
Scale: 4" = 1'-0"

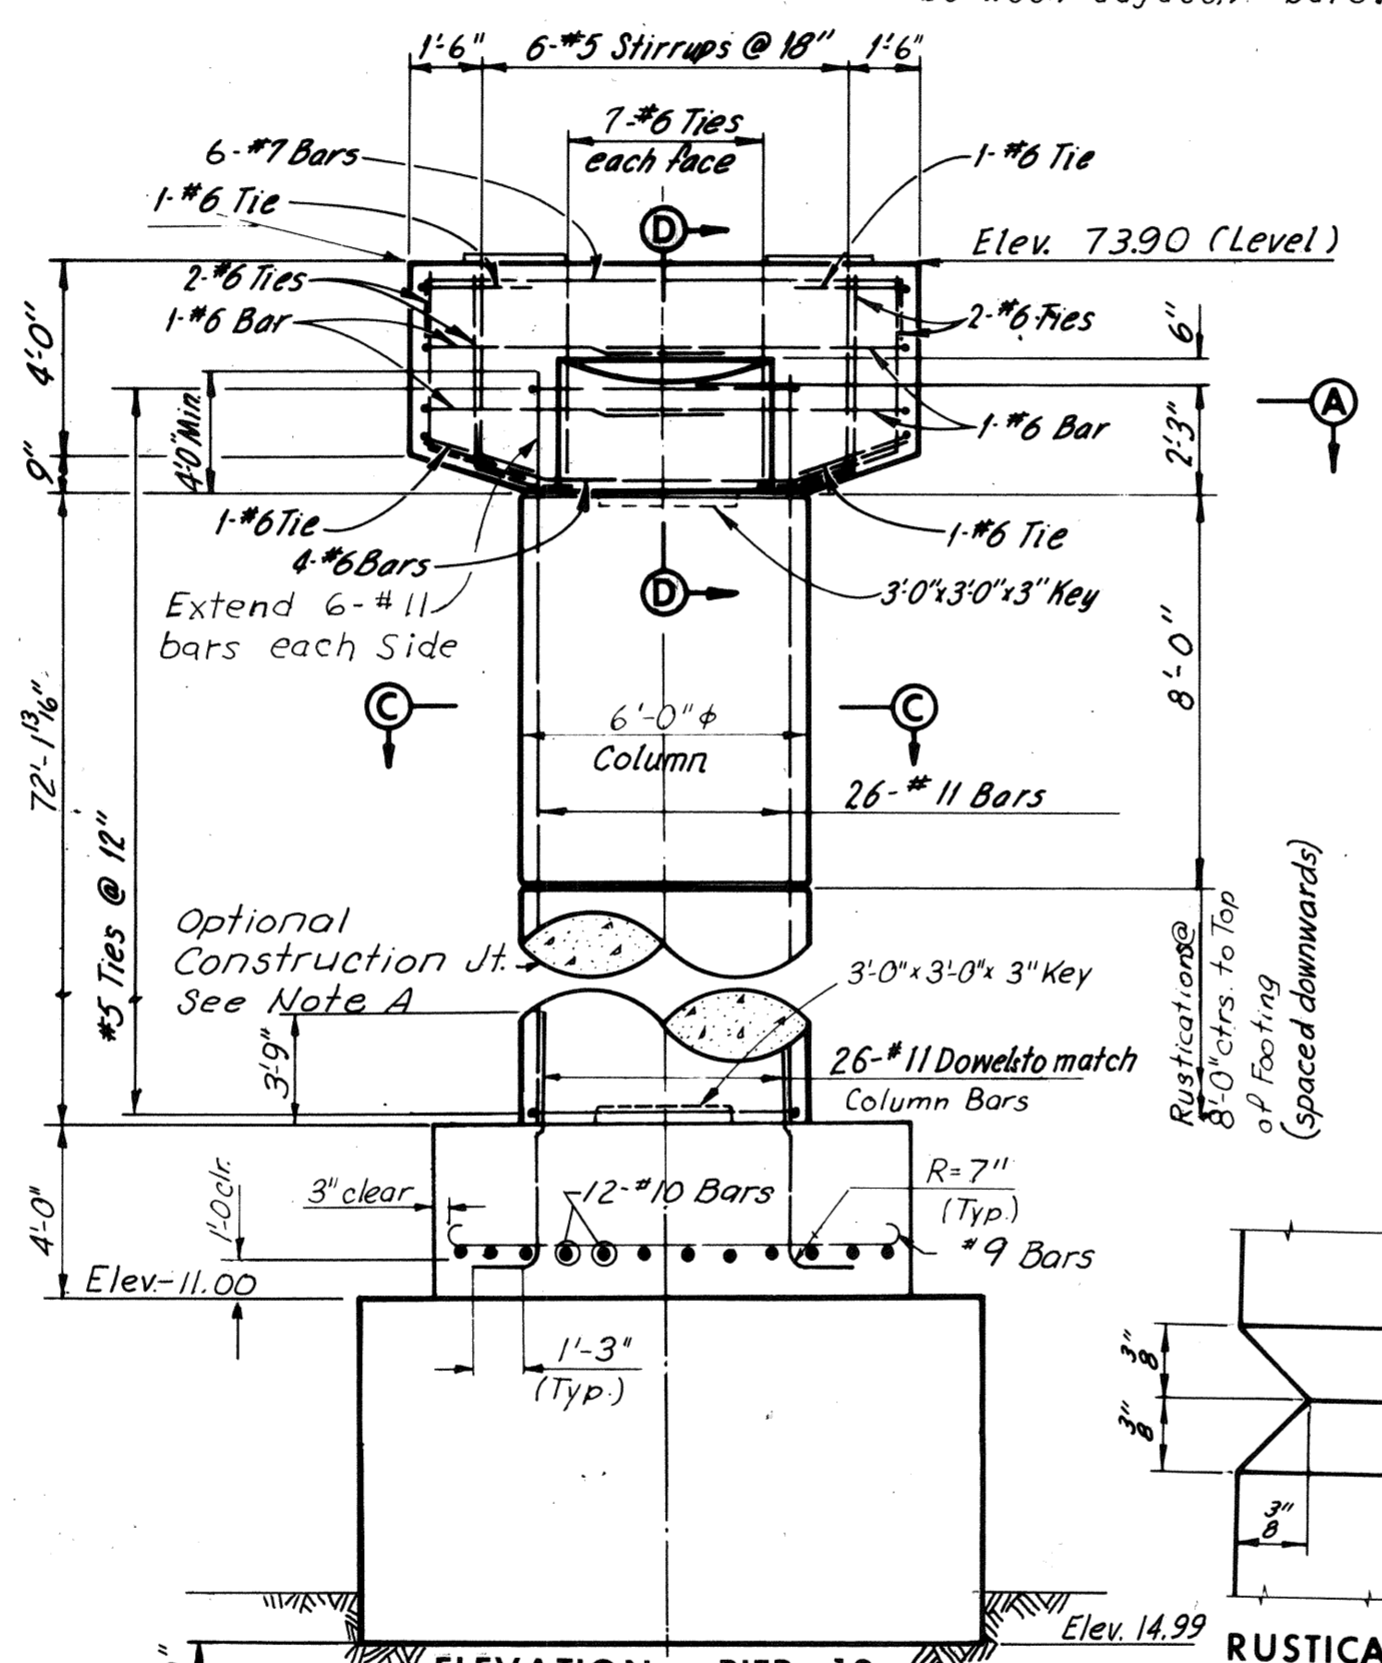


ELEVATION - PIER 12
Scale: 4" = 1'-0"

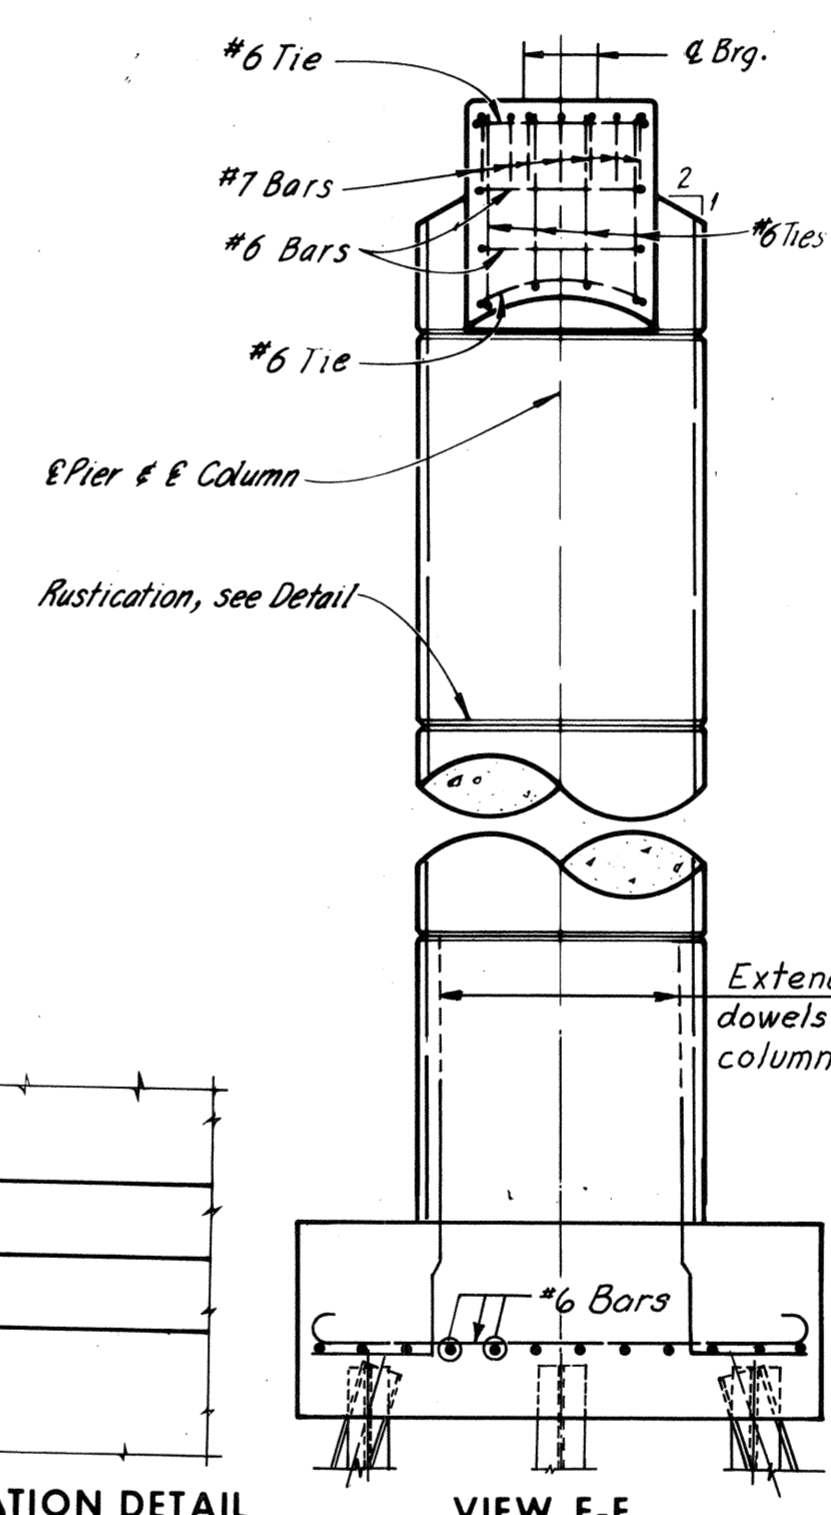


VIEW E-E
Scale: 4" = 1'-0"

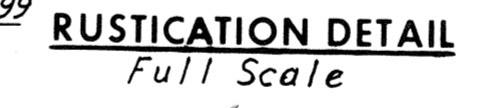

RUSTICATION DETAIL
Full Scale

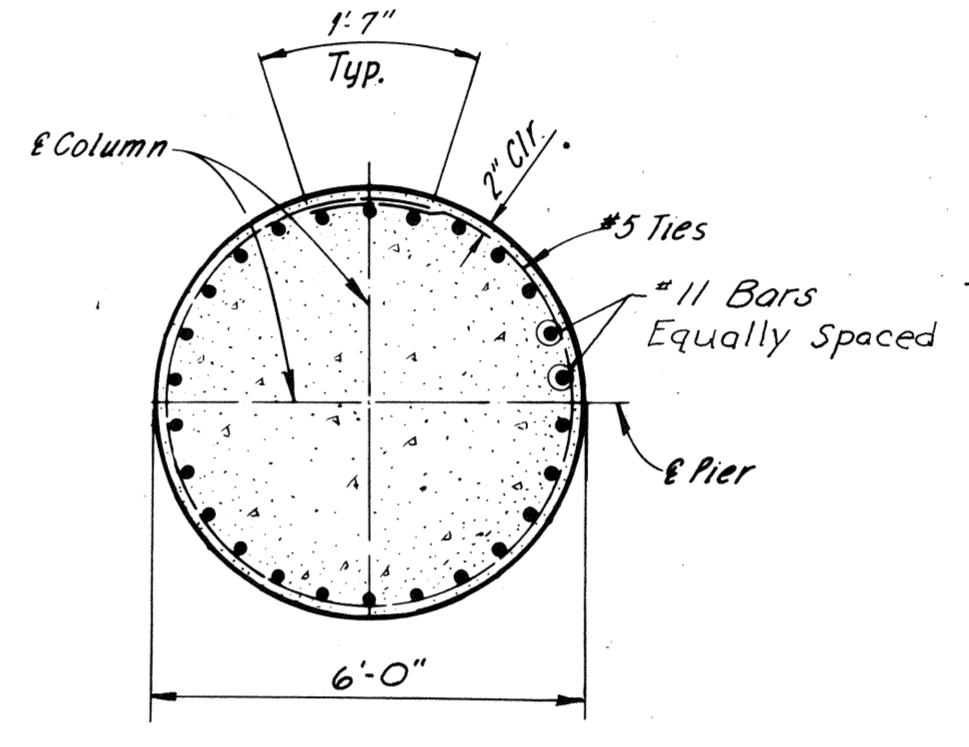


SECTION C-C
Scale: 3/8" = 1'-0"

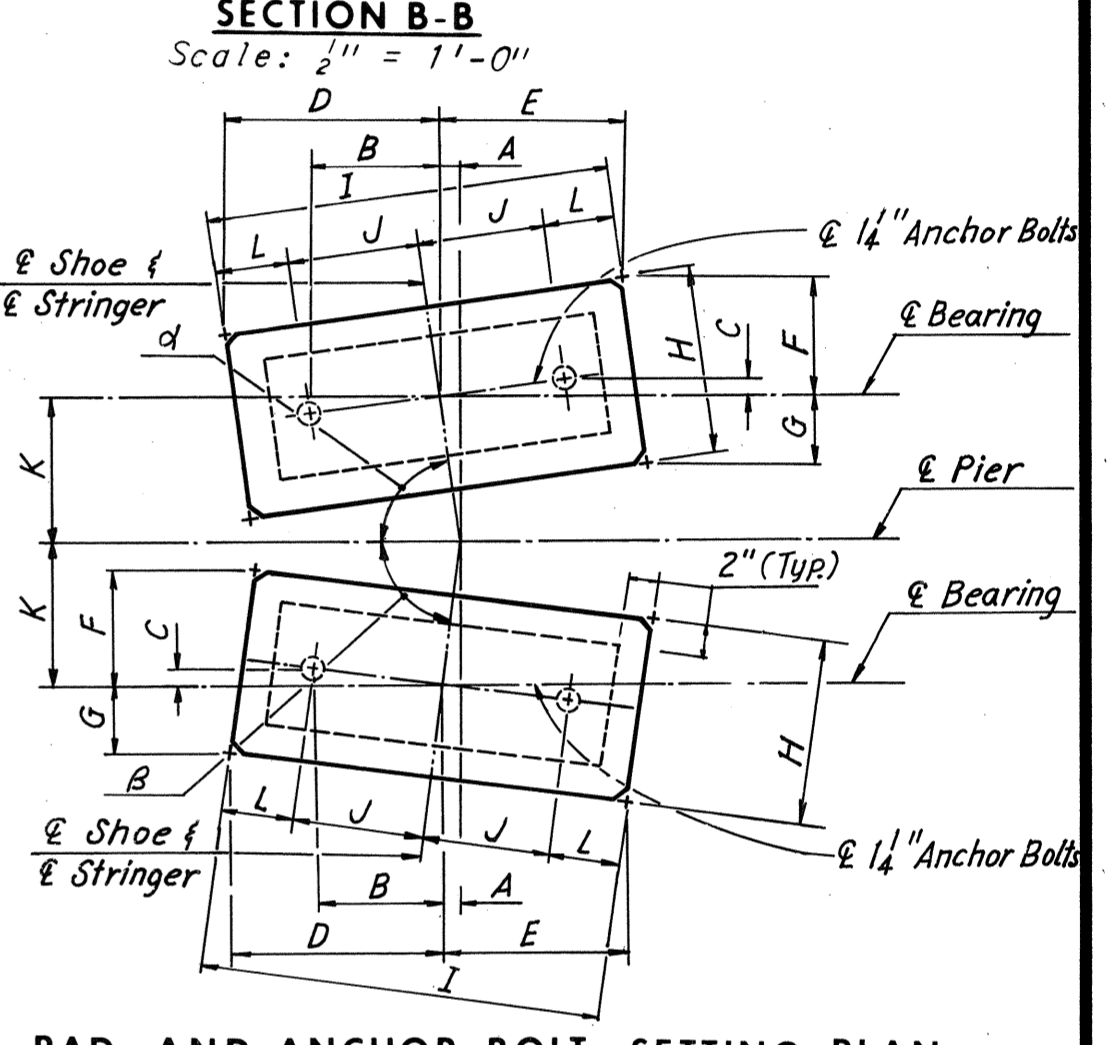


PAD AND ANCHOR BOLT SETTING PLAN
No Scale

DIMENSIONS FOR PAD AND ANCHOR BOLT SETTING PLAN															
Pier	Stringer	d	β	A	B	C	D	E	F	G	H	I	J	K	L
11	S1-13	—	89° 37' 13"	8"	8"	12 1/2"	12 1/2"	5 3/4"	5 3/4"	11 1/2"	2'-1"	8"	8"	4 1/2"	4 1/2"
	S2-13	—	89° 37' 13"	8"	8"	12 1/2"	12 1/2"	5 3/4"	5 3/4"	11 1/2"	2'-1"	8"	8"	4 1/2"	4 1/2"
	S1-14	89° 40' 16"	—	8"	8"	12 1/2"	12 1/2"	5 3/4"	5 3/4"	11 1/2"	2'-1"	8"	10"	4 1/2"	4 1/2"
	S2-14	89° 40' 16"	—	8"	8"	12 1/2"	12 1/2"	5 3/4"	5 3/4"	11 1/2"	2'-1"	8"	10"	4 1/2"	4 1/2"
12	S1-14	—	89° 40' 16"	8"	8"	12 1/2"	12 1/2"	5 3/4"	5 3/4"	11 1/2"	2'-1"	8"	9"	4 1/2"	4 1/2"
	S2-14	—	89° 40' 16"	8"	8"	12 1/2"	12 1/2"	5 3/4"	5 3/4"	11 1/2"	2'-1"	8"	9"	4 1/2"	4 1/2"
	S1-15	89° 40' 04"	—	8 1/2"	8 1/2"	12 1/2"	12 1/2"	6 3/4"	6 3/4"	12"	2'-0 1/2"	8 1/2"	9"	4 1/2"	4 1/2"
S2-15	89° 40' 04"	—	8 1/2"	8 1/2"	12 1/2"	12 1/2"	6 3/4"	6 3/4"	12"	2'-0 1/2"	8 1/2"	9"	4 1/2"	4 1/2"	


Note:
Footing elevations are approximate only and may be varied to suit field conditions as directed by the Engineer. Vertical shaft reinforcing shall not be cut until these elevations are established. Where elevations change more than 2 ft. redesign will be required.
Overexcavation will not be permitted between existing pier and new pier.
Pier 11 and pier 12 are to match existing pier 52 and pier 50 respectively. The Contractor shall verify the stations in the field.
All piles shall be 10BP42 Steel Piles.
(Design capacity = 45 Tons.)
For Steel and Concrete quantities, see Sheet 2.

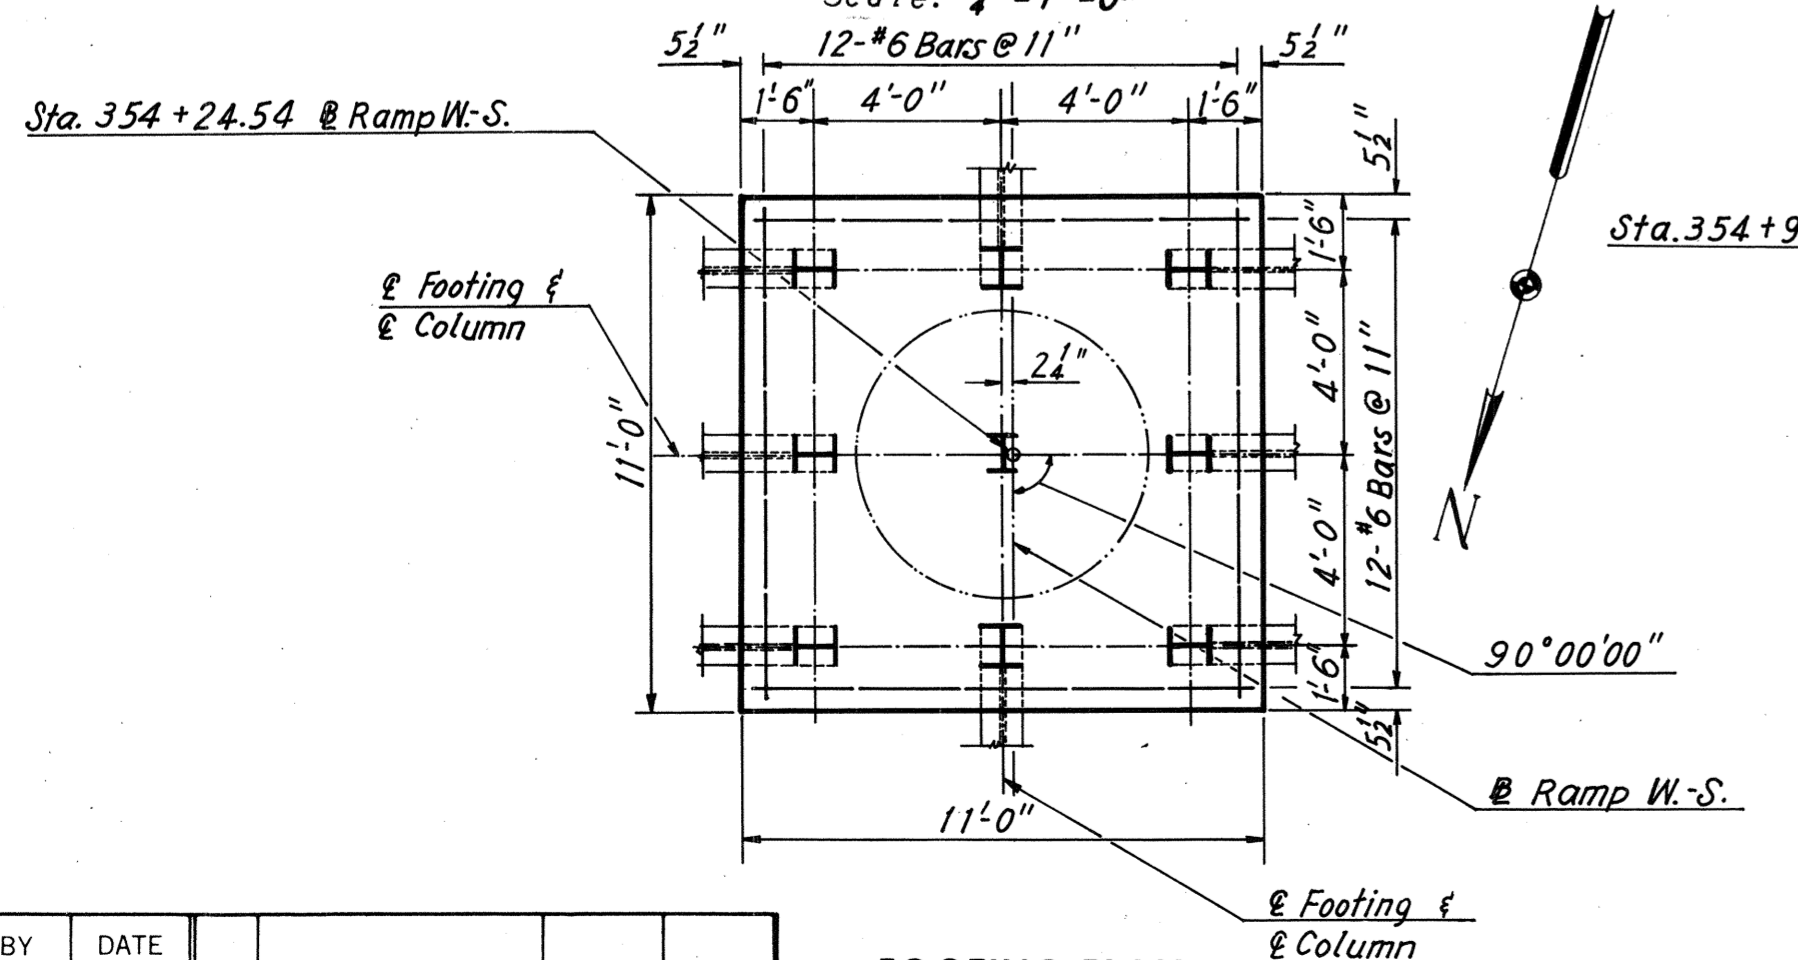

FOOTING PLAN - PIER 11
Scale: 4" = 1'-0"

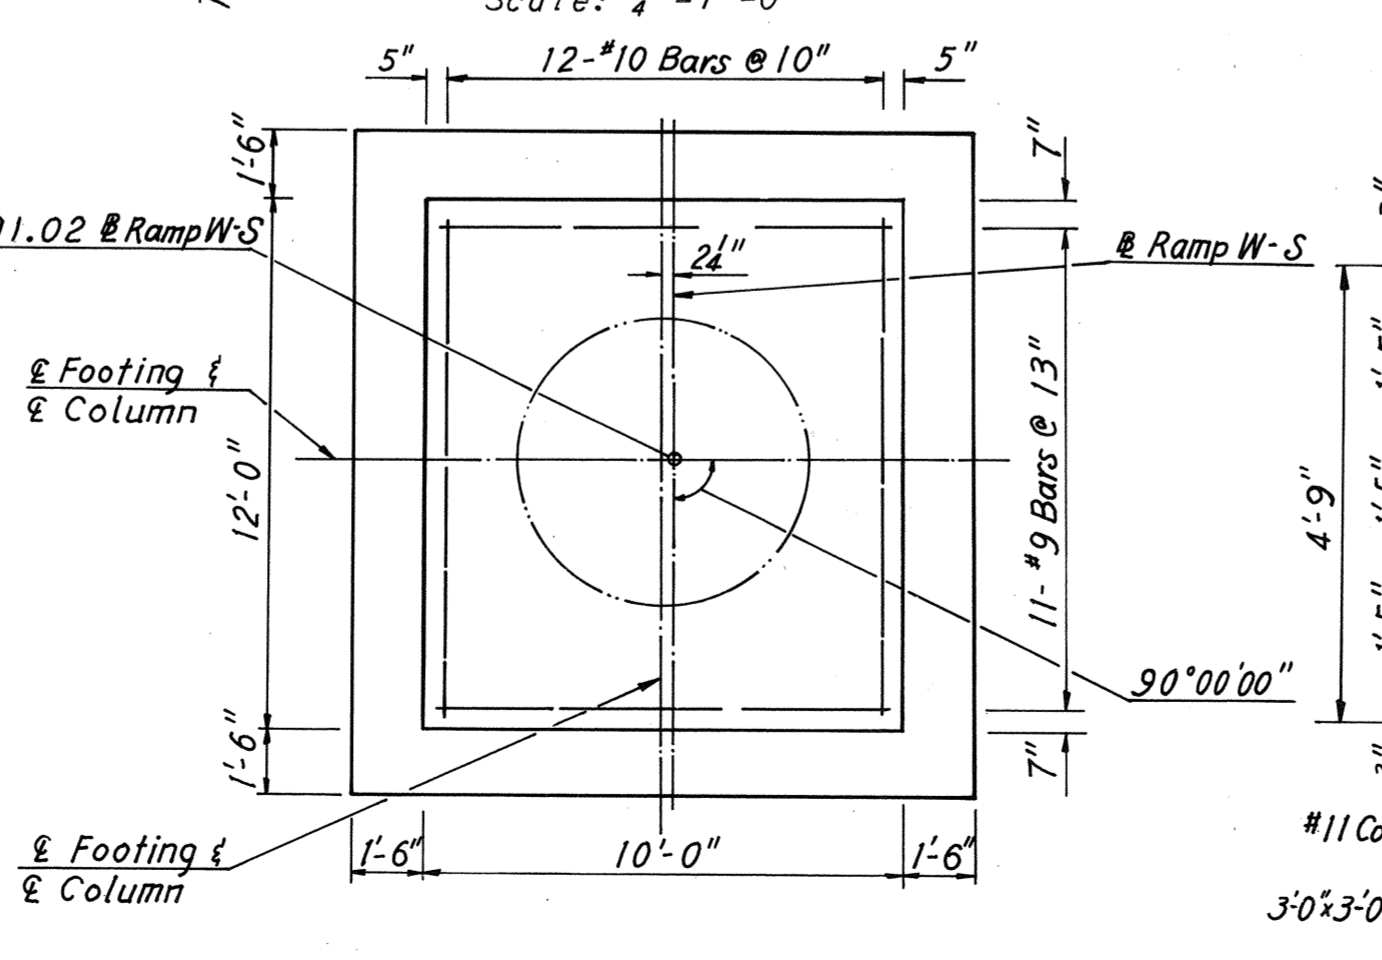

FOOTING PLAN - PIER 12
Scale: 4" = 1'-0"

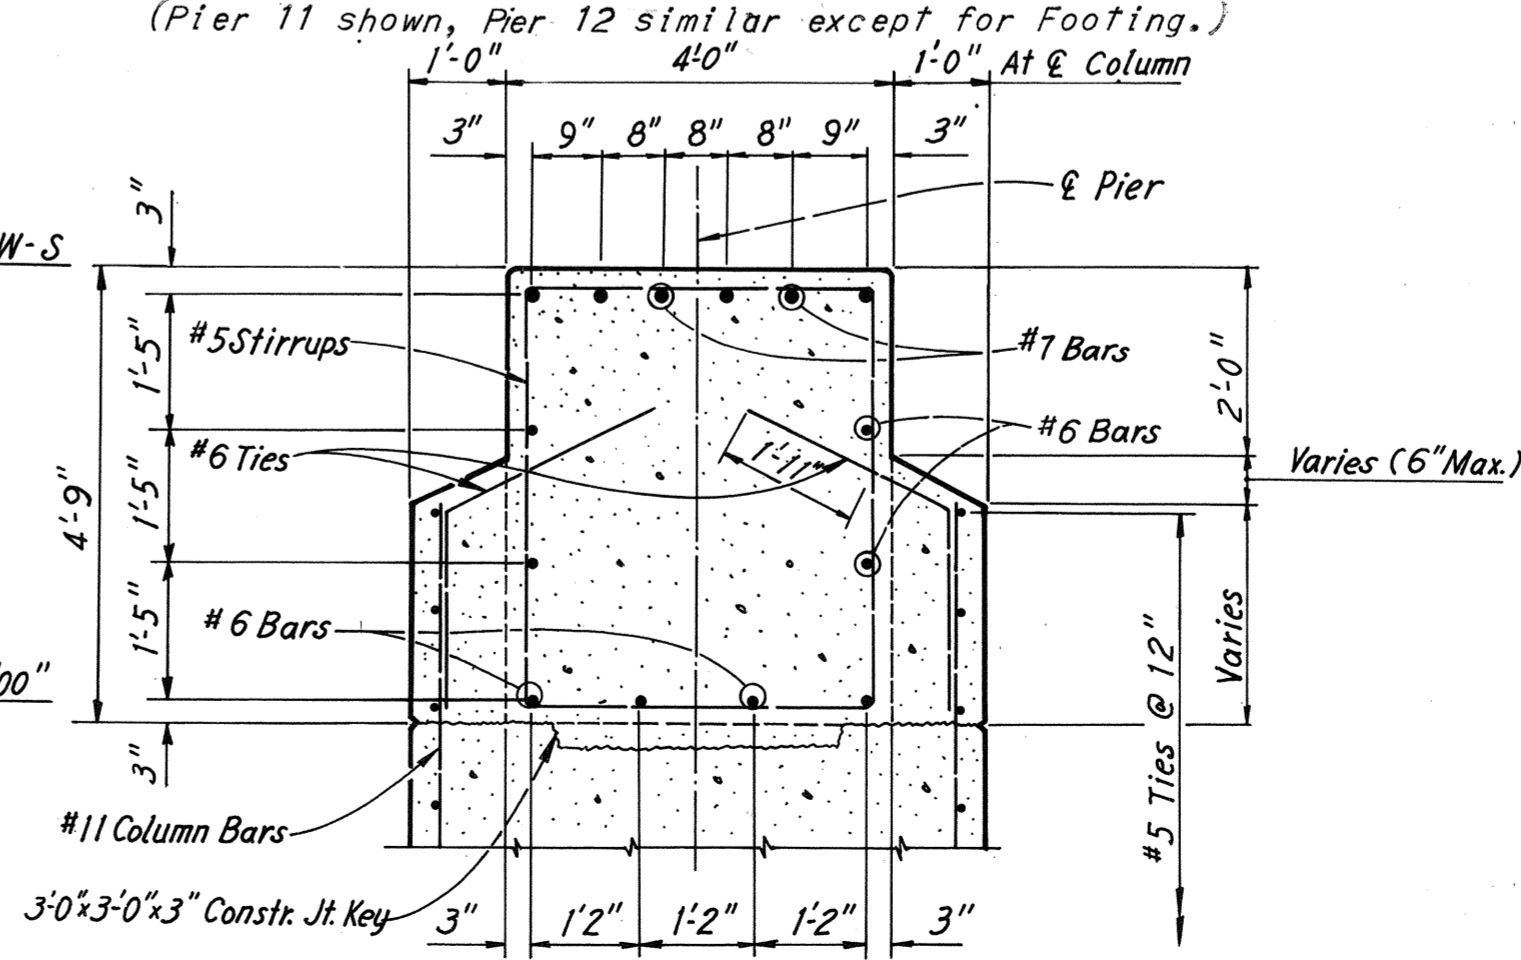

SECTION D-D
Scale: 2" = 1'-0"

Note:
For Standard Shoe Details see Sheets S1 and S2
For Framing Plans see Sheet 16.
Estimated Pile Tip Elevation -18.00 for Pier 11.

AS BUILT











BY	DATE	REVISION	BY	DATE	
MADE	KCT	1-22-69	Footings Dowels	TEM	8-26-76
CHECKED	R C	2-1-69	Pad Elevations	TEM	8-26-75
IN CHARGE					

RICHMOND METROPOLITAN AUTHORITY
RICHMOND EXPRESSWAY SYSTEM
DOWNTOWN EXPRESSWAY

BRIDGE NO. 68
RAMP W-S CONNECTION TO
RICHMOND-PETERSBURG TURNPIKE
PIERS 11 AND 12

HOWARD, NEEDLES, TAMMEN & BERGENDOFF
consulting engineers
NEW YORK ALEXANDRIA KANSAS CITY

SCALE: As Noted
CONTRACT NO. 11
SHEET NO. 10 OF 28

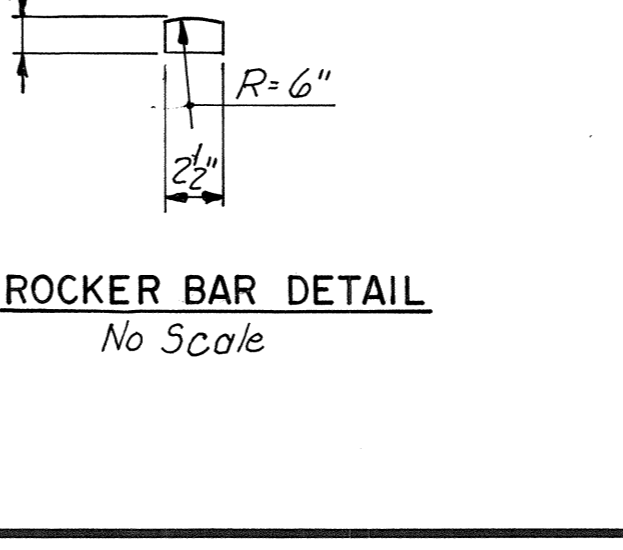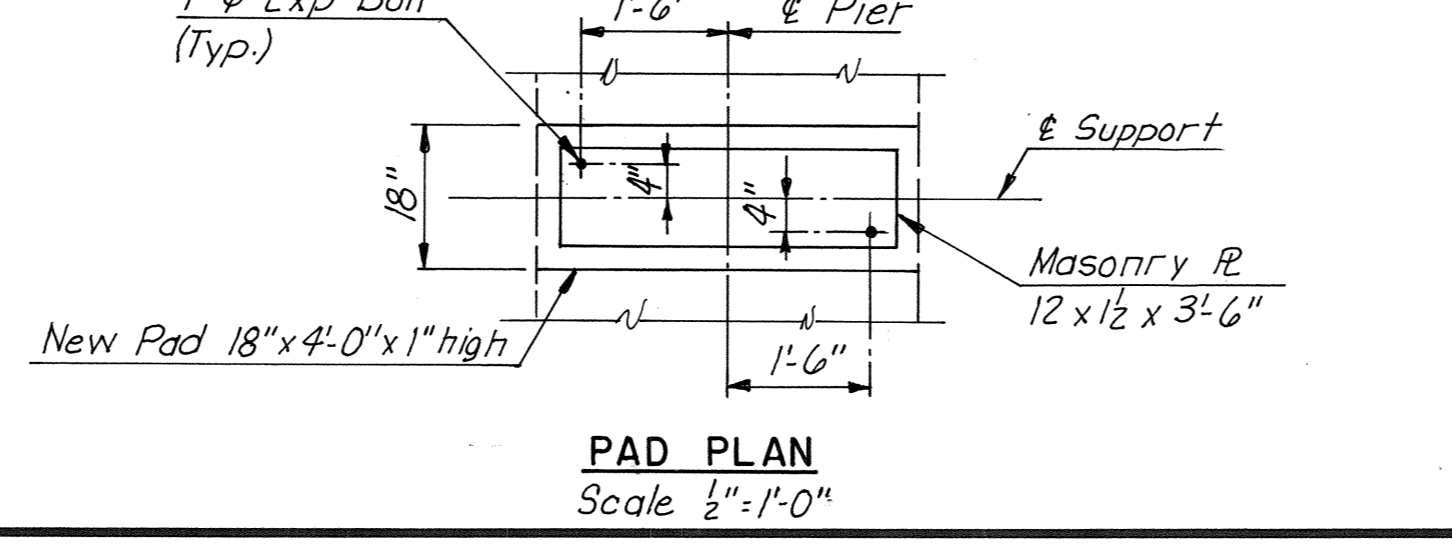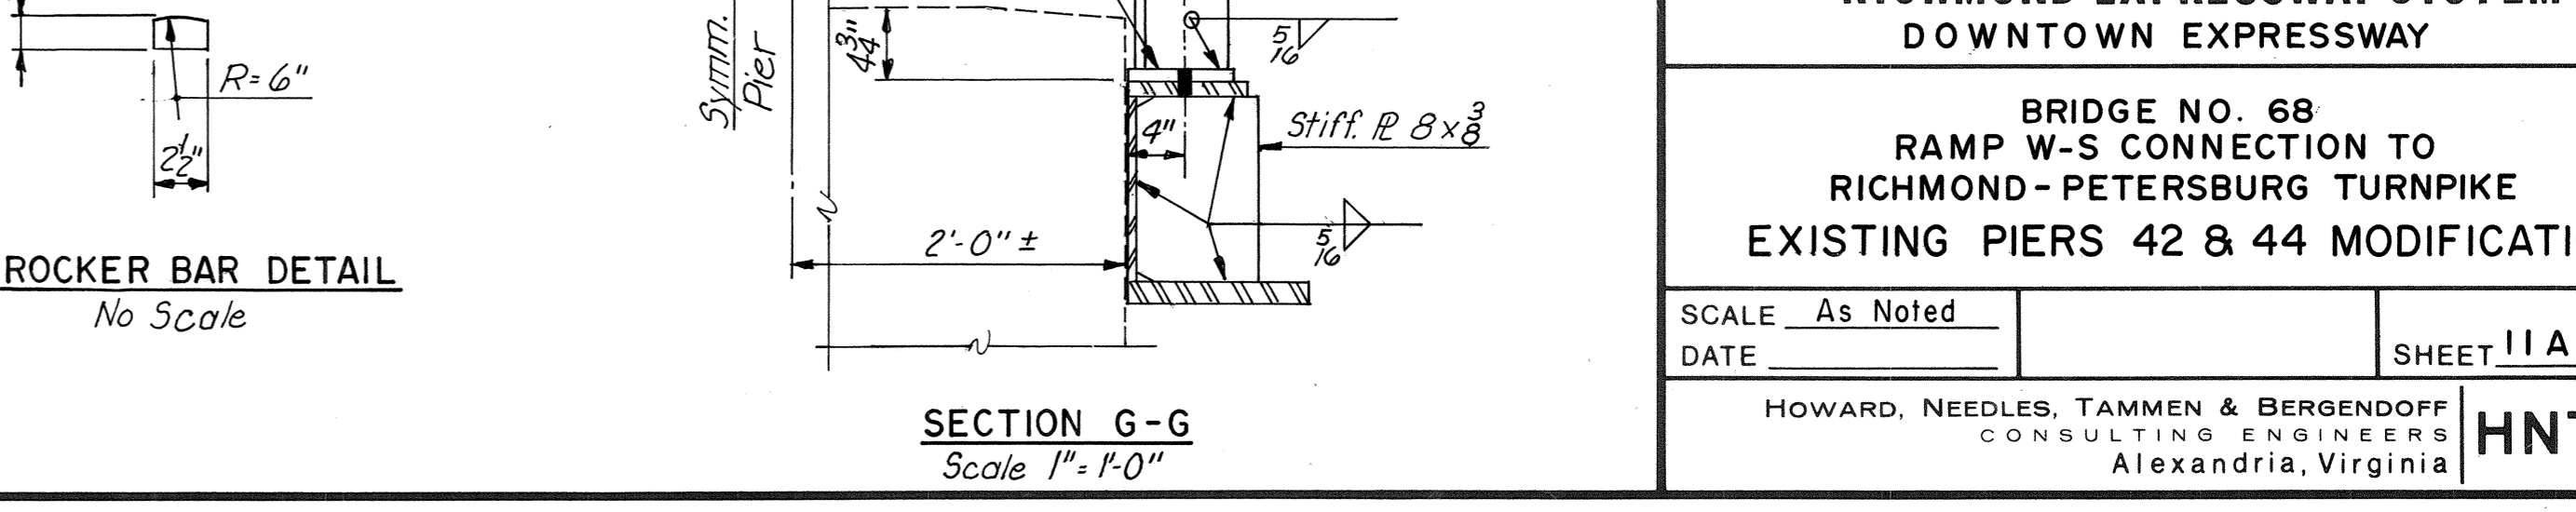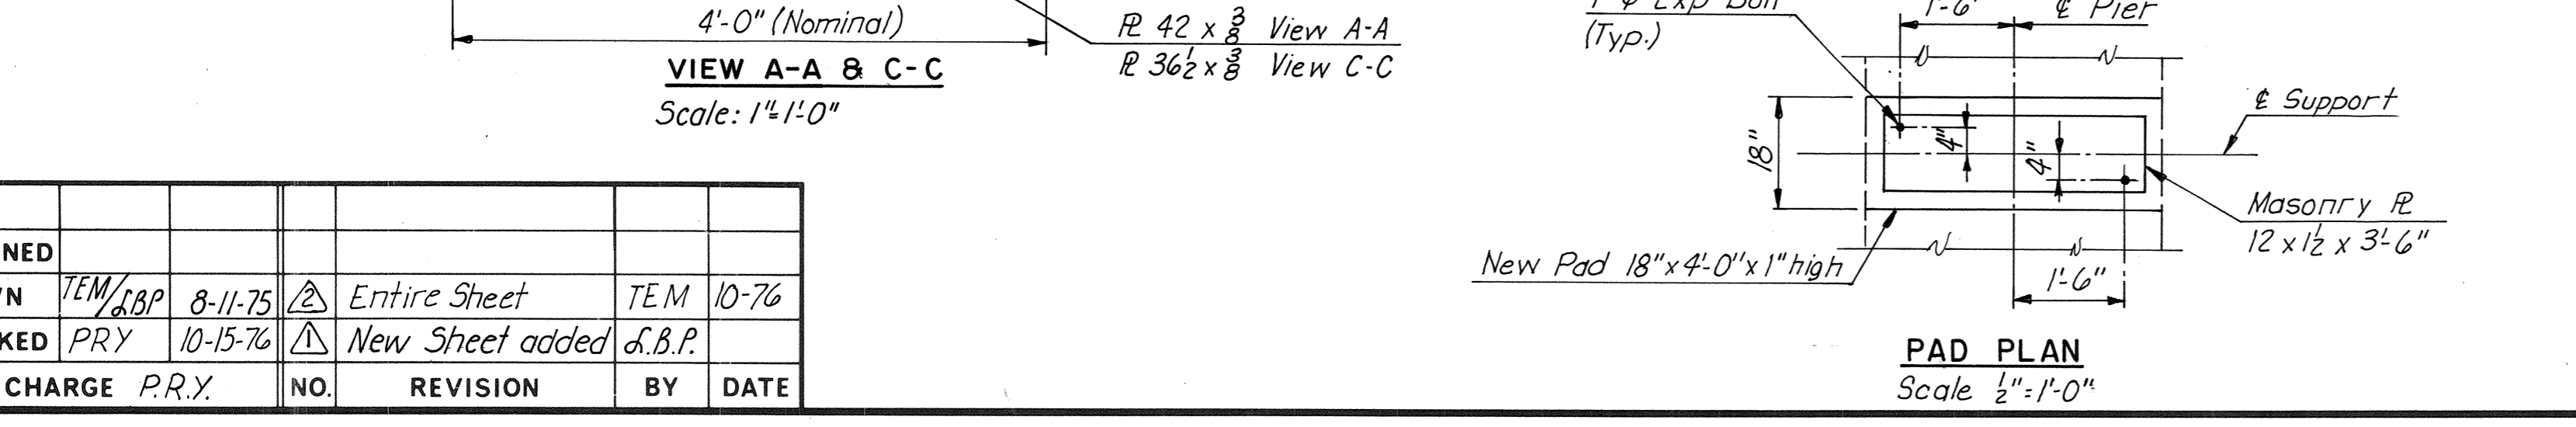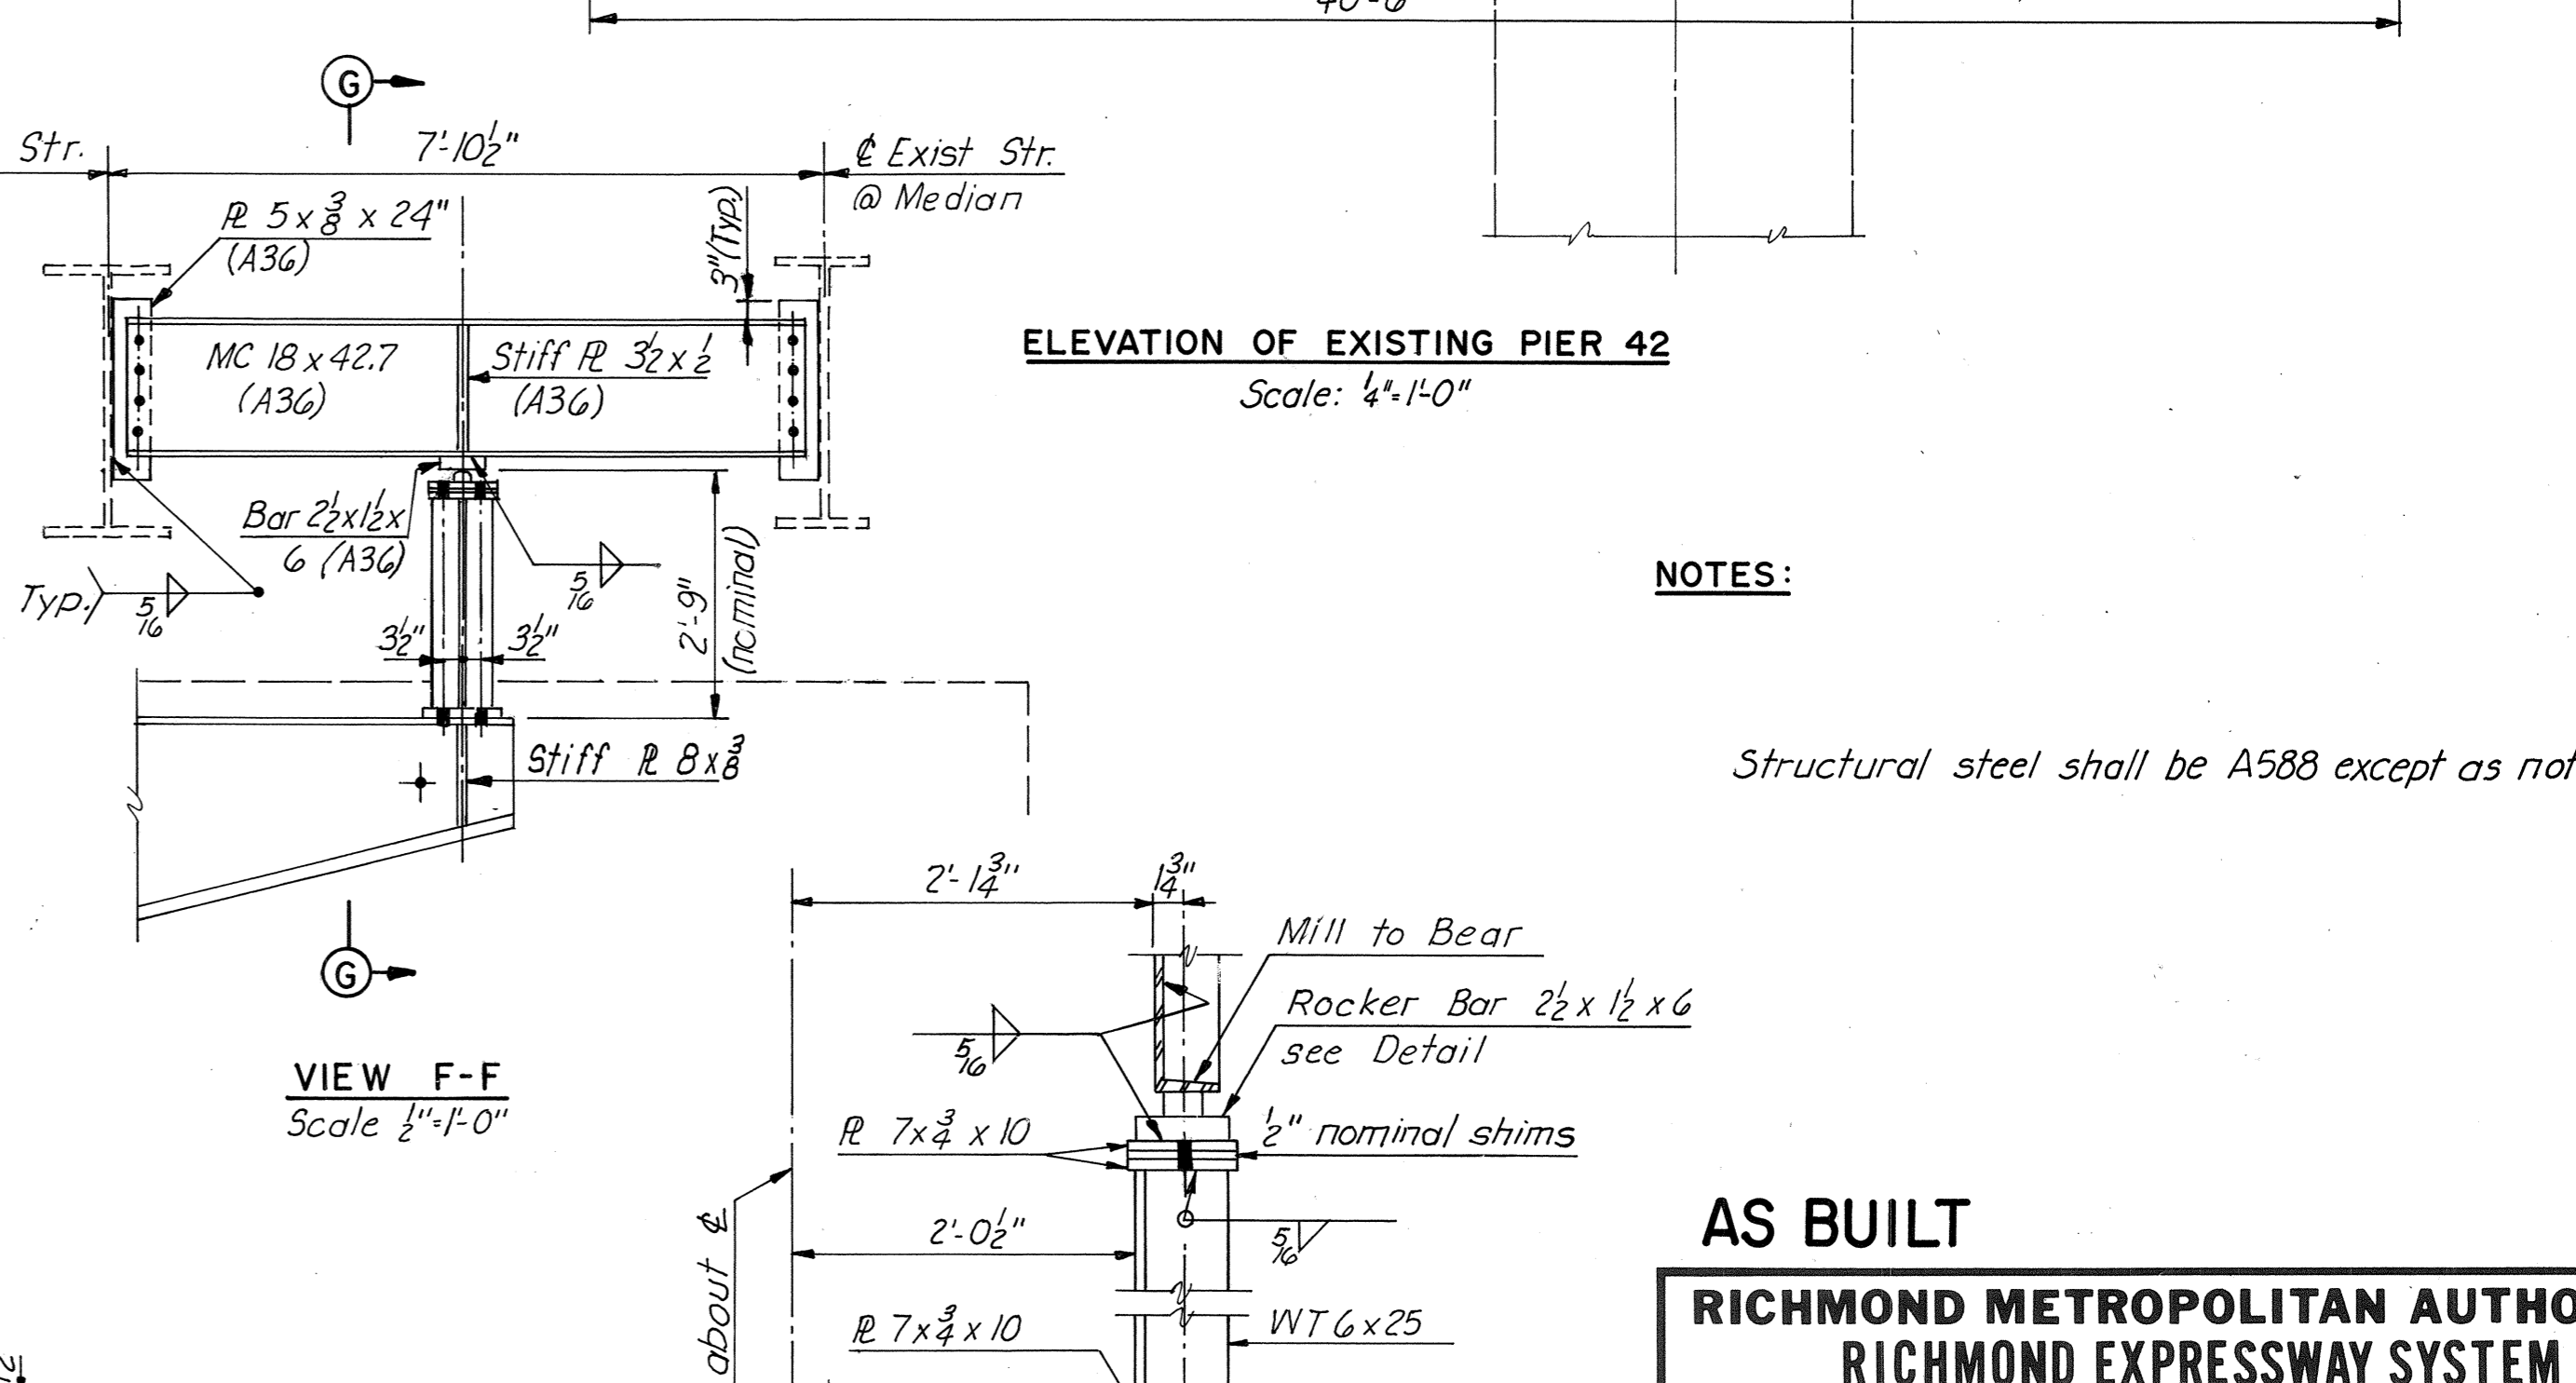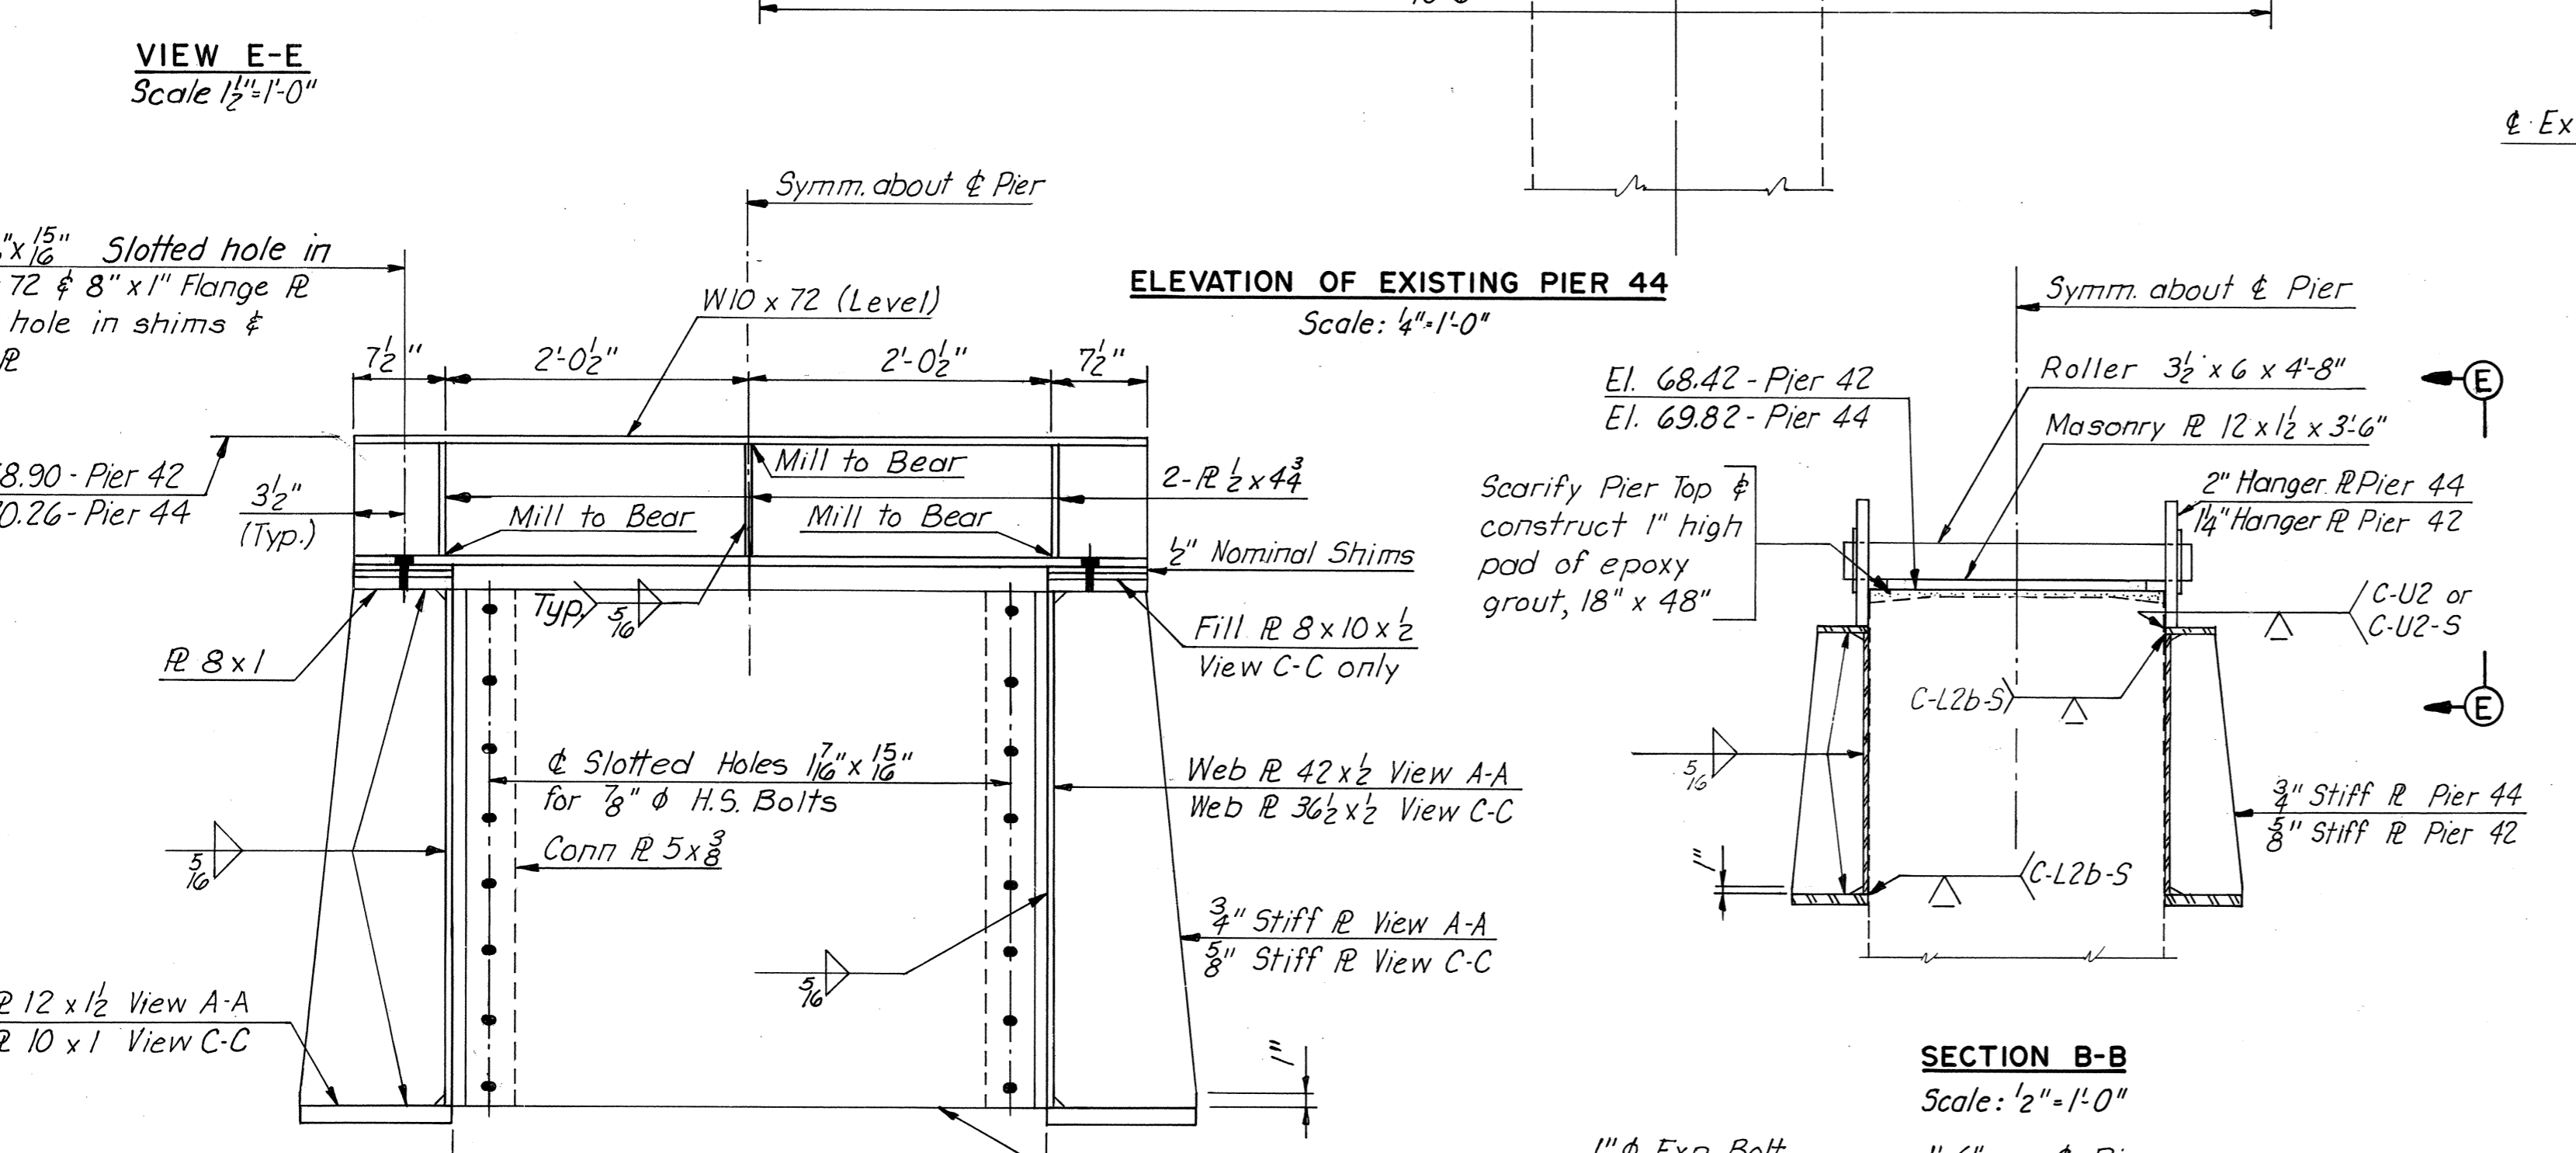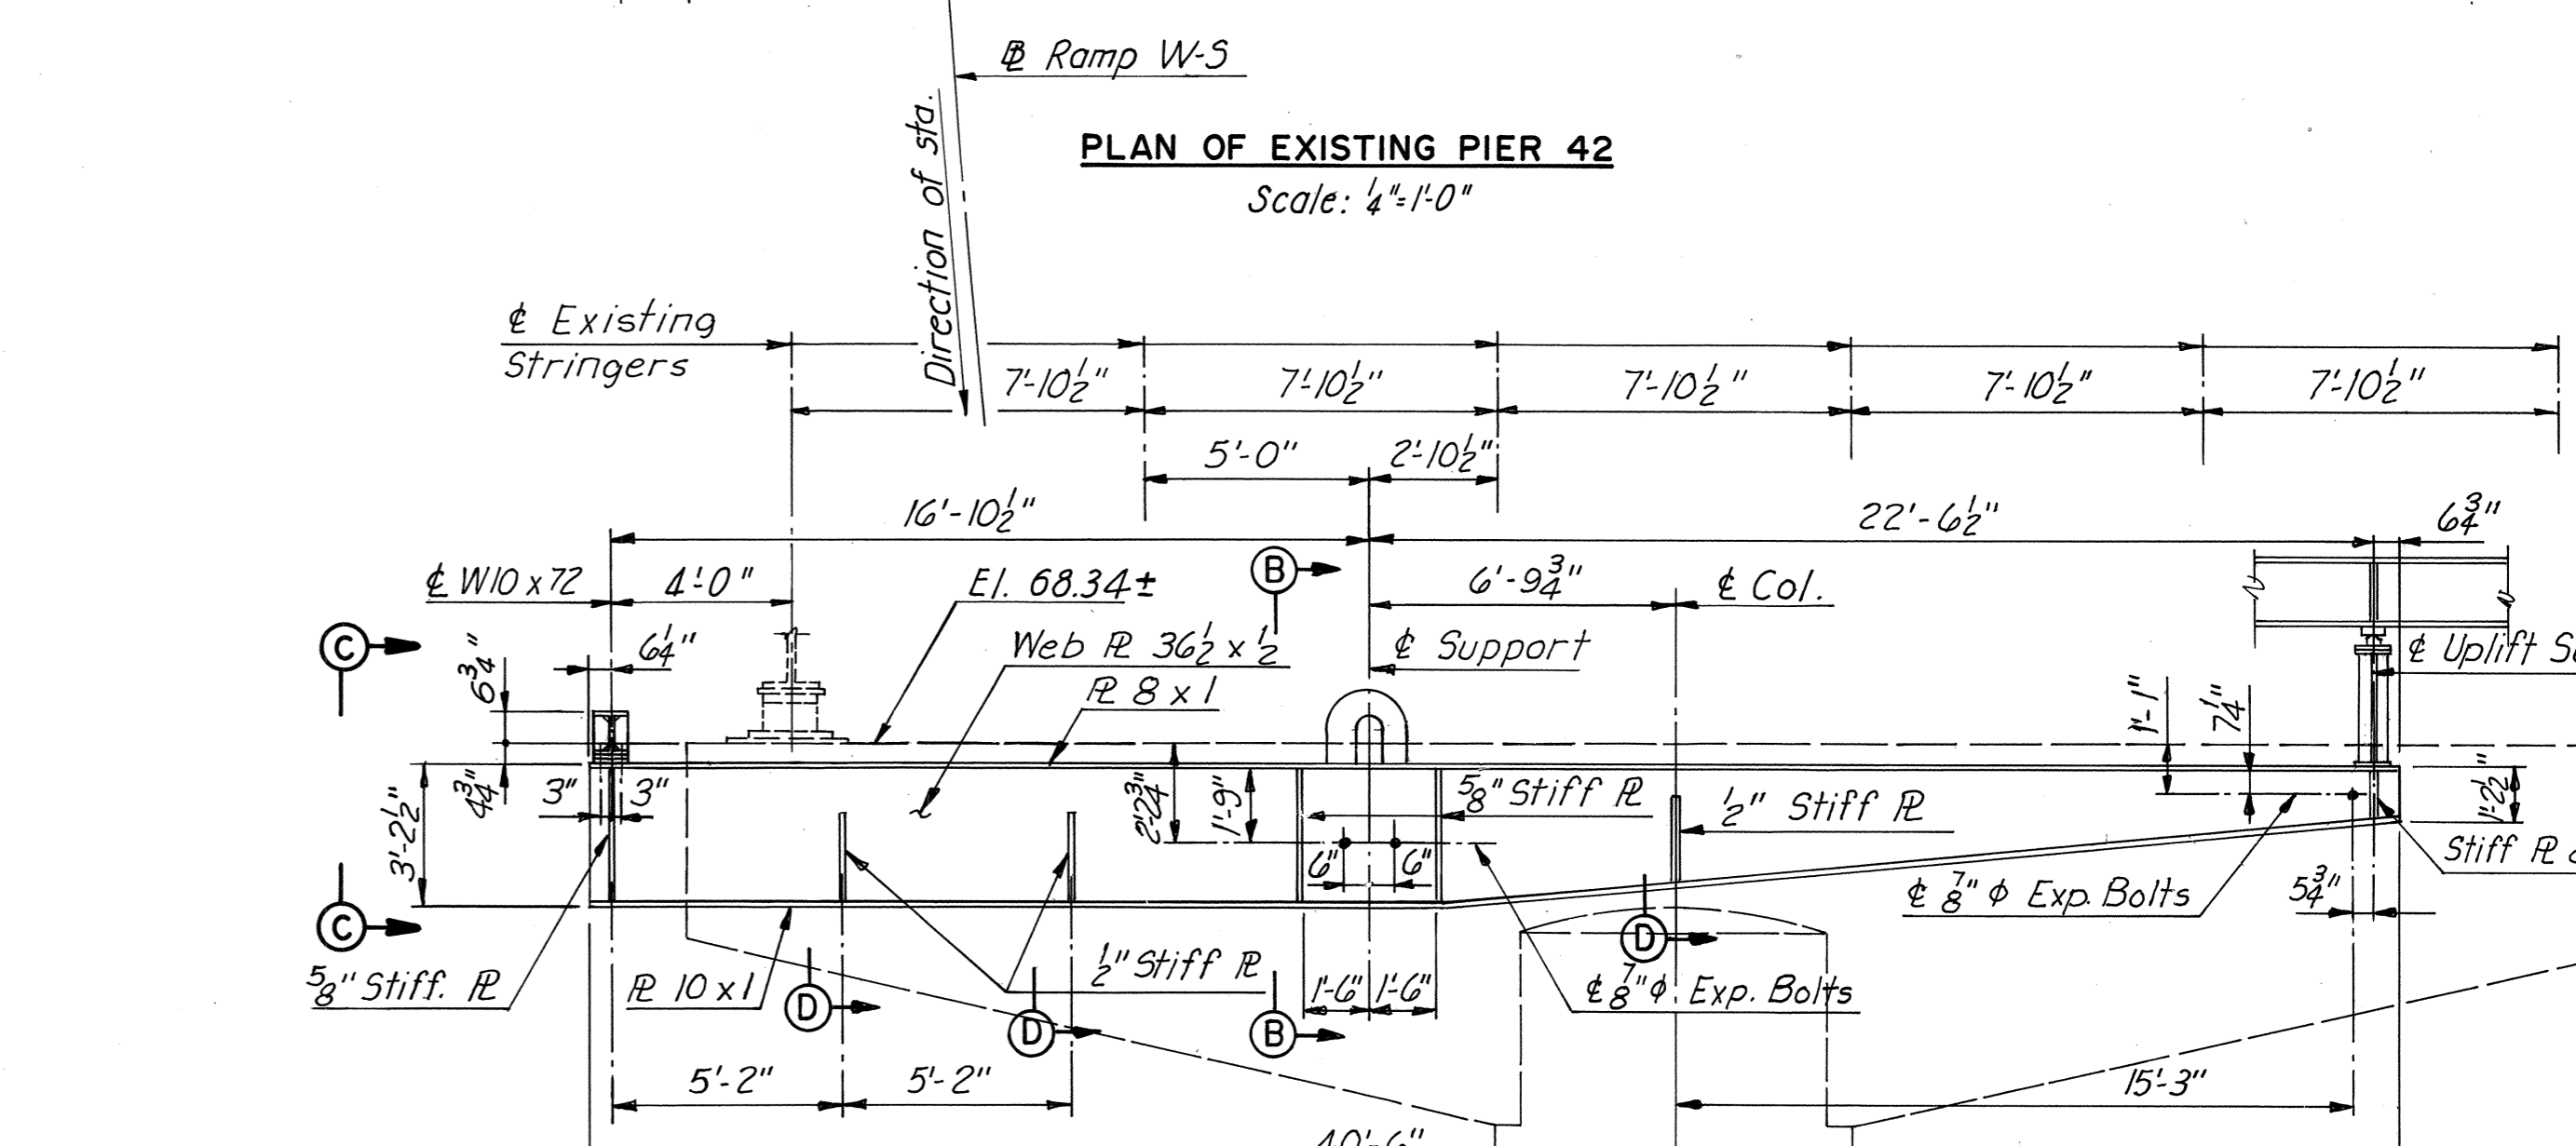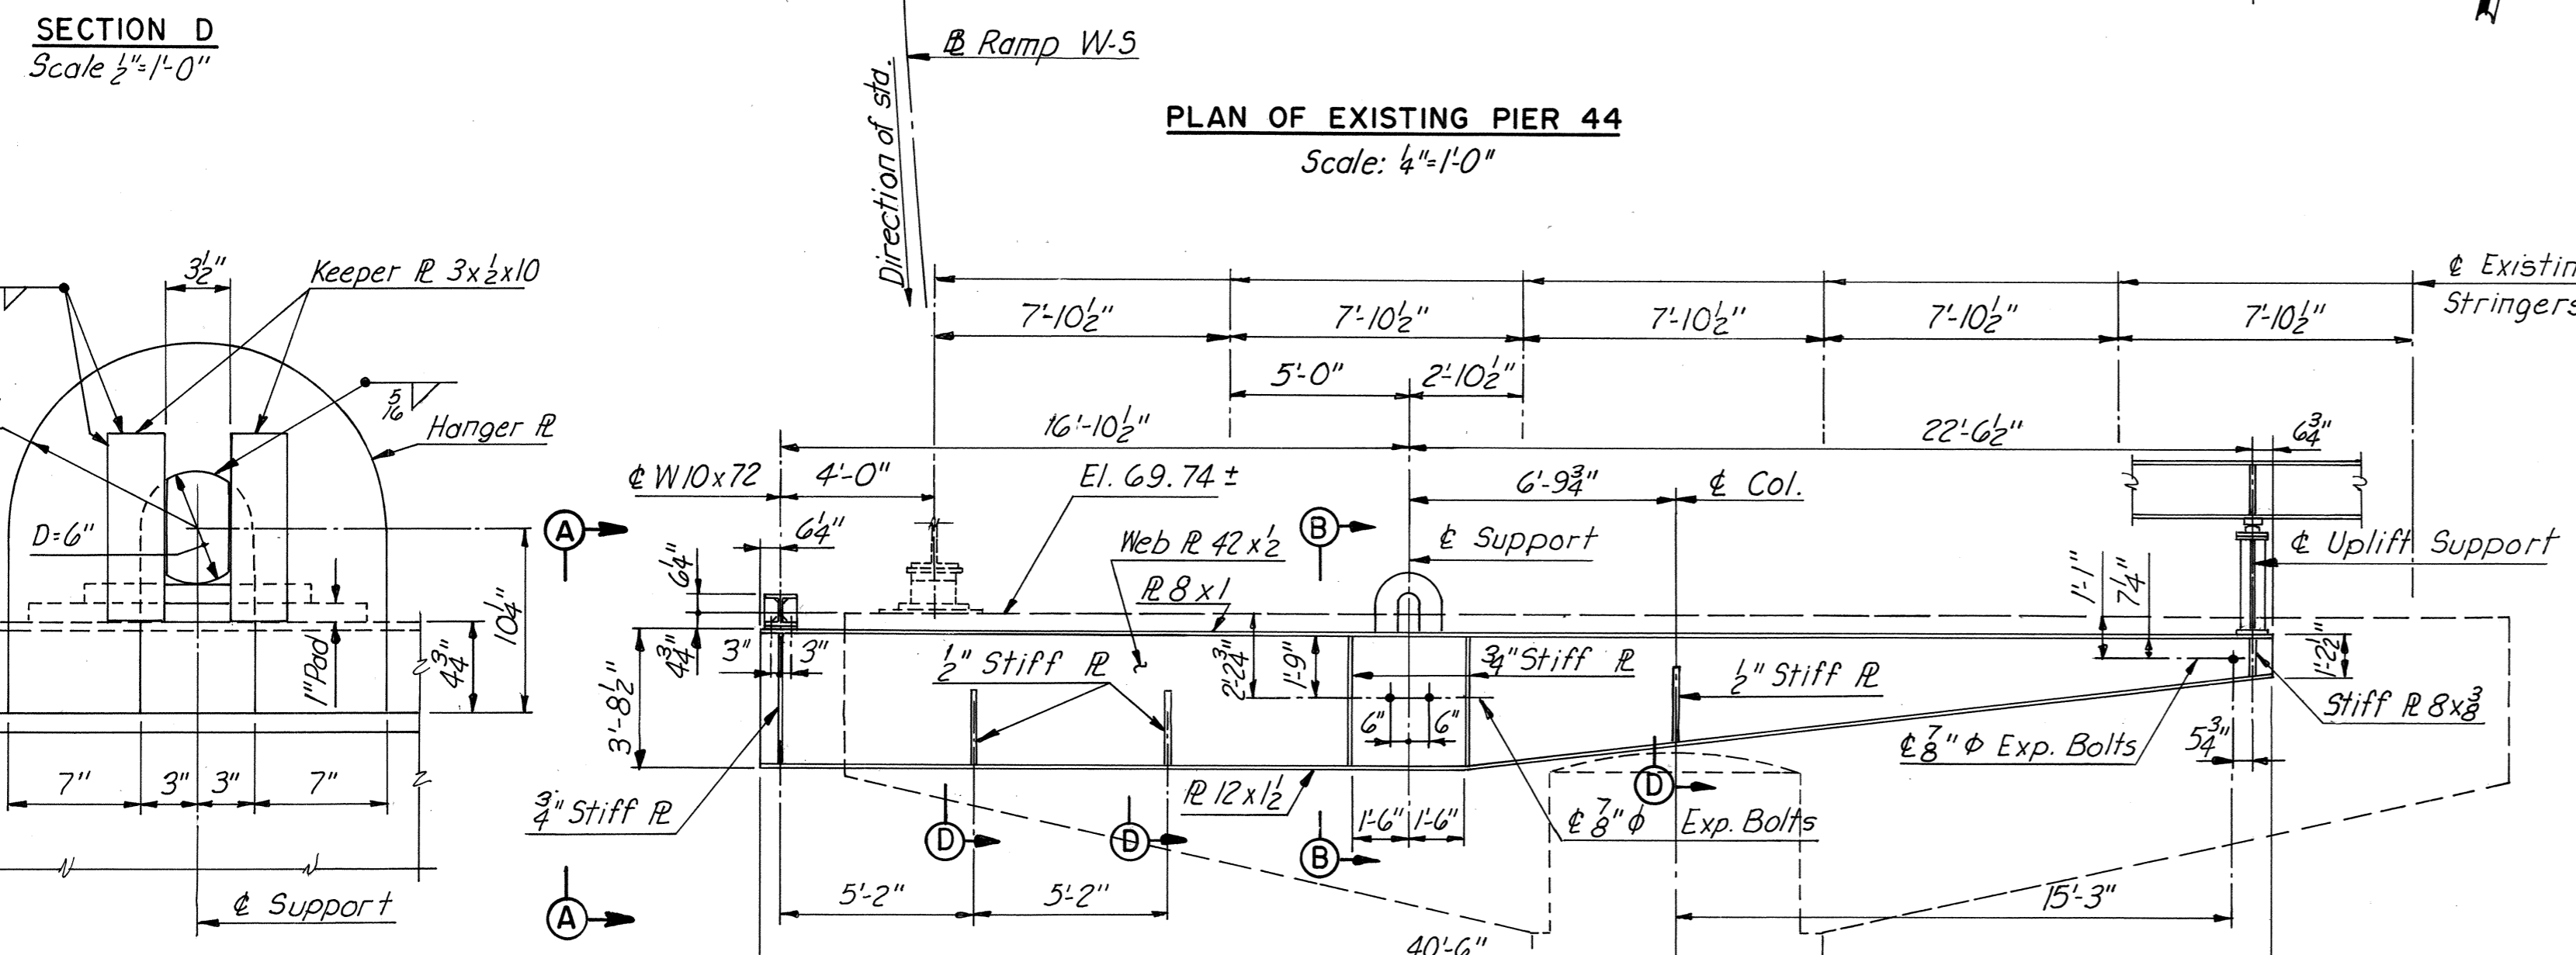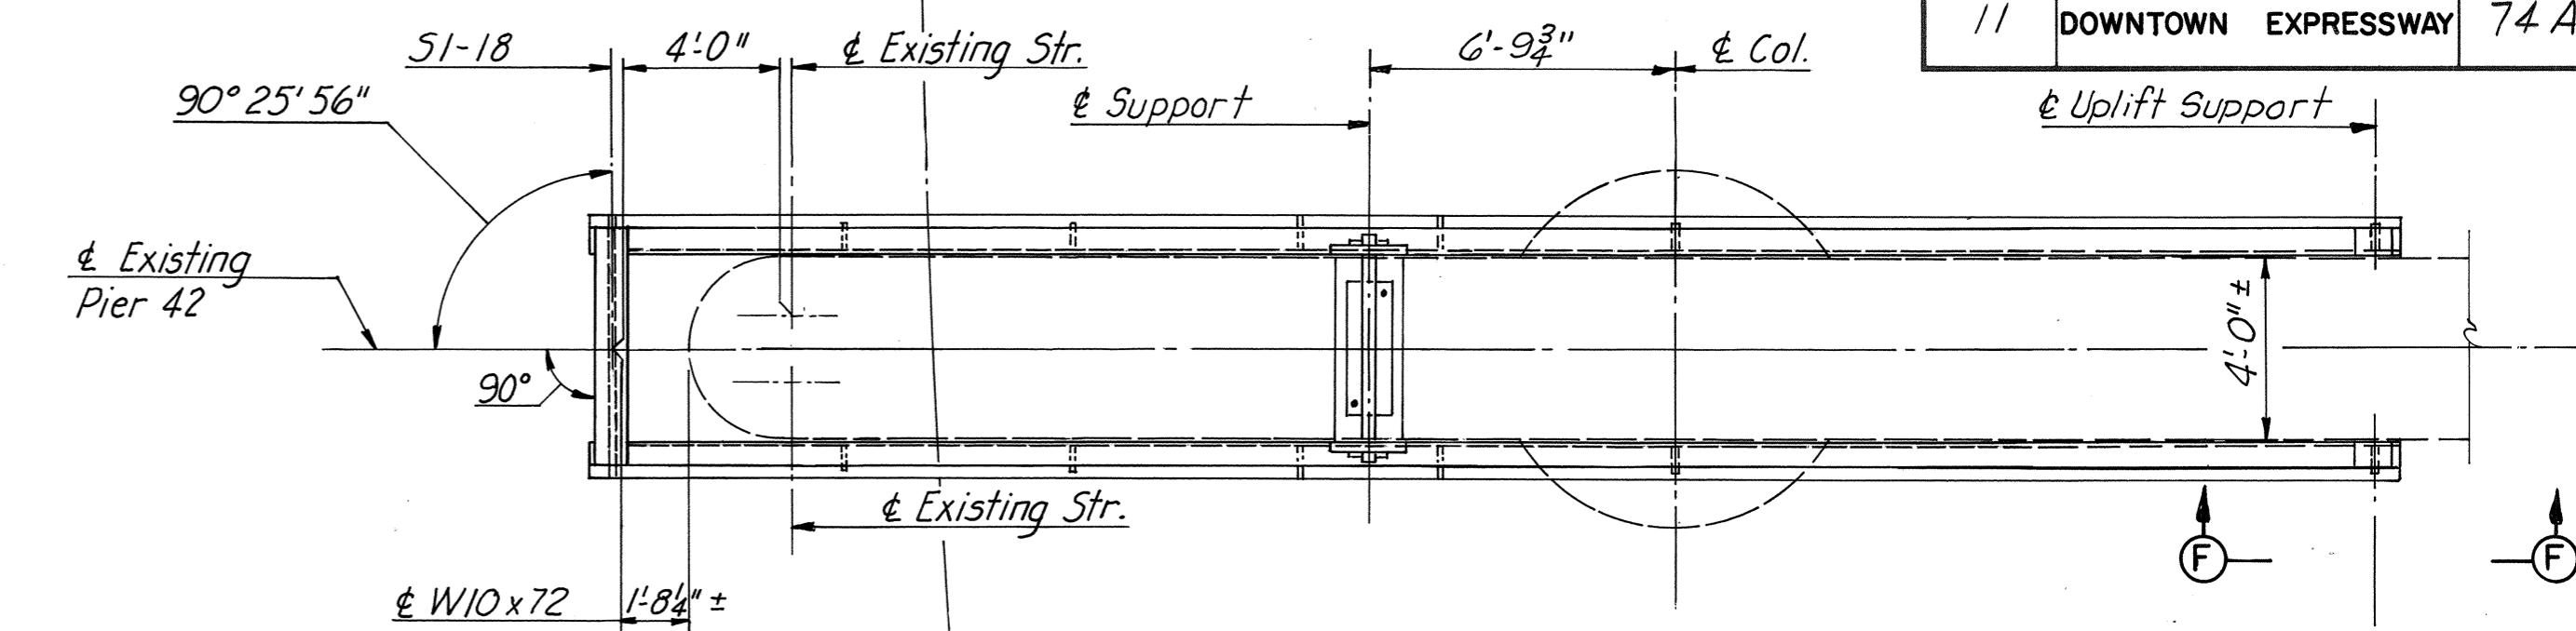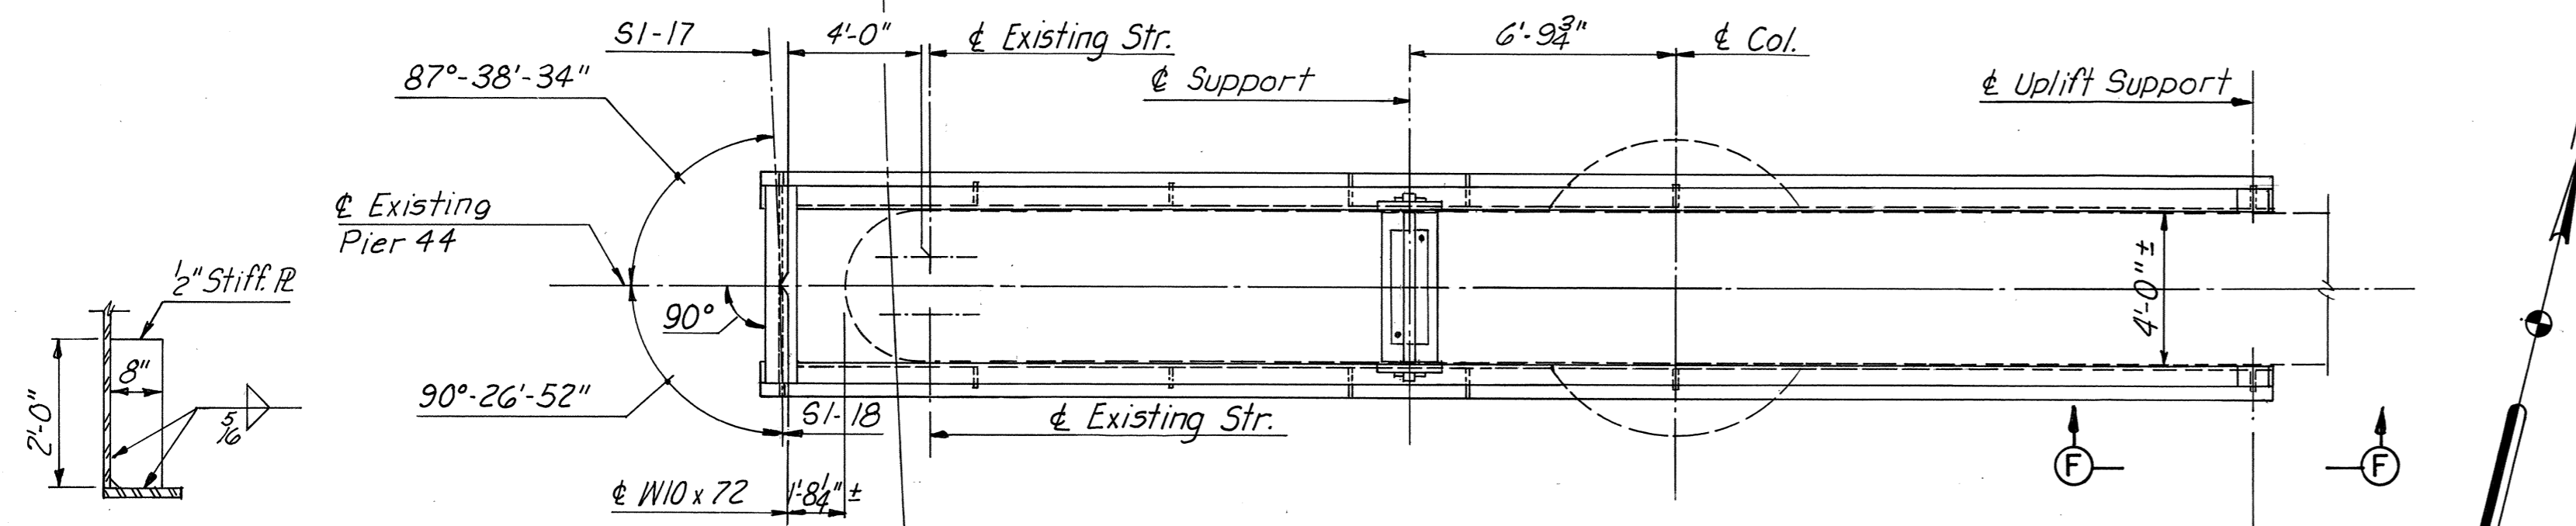

NOTES:
Structural steel shall be A588 except as noted.

AS BUILT

RICHMOND METROPOLITAN AUTHORITY
RICHMOND EXPRESSWAY SYSTEM
DOWNTOWN EXPRESSWAY



BRIDGE NO. 68
RAMP W-S CONNECTION TO
RICHMOND-PETERSBURG TURNPIKE
EXISTING PIERS 42 & 44 MODIFICATIONS

SCALE: As Noted
DATE: _____ SHEET 11A OF 28

HOWARD, NEEDLES, TAMMEN & BERGENDOFF
CONSULTING ENGINEERS
Alexandria, Virginia

HNTB

DESIGNED					
DRAWN	TEM/ABP	8-11-75	Entire Sheet	TEM	10-76
CHECKED	PRY	10-15-76	New Sheet added	d.B.P.	
IN CHARGE	P.R.Y.		NO. REVISION	BY	DATE

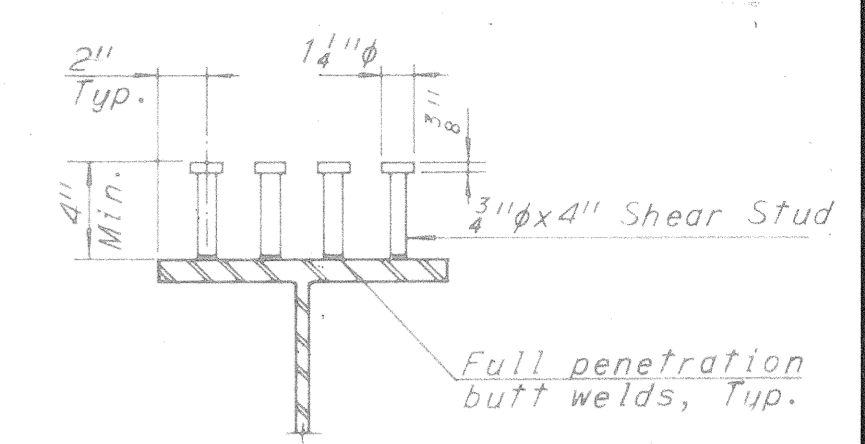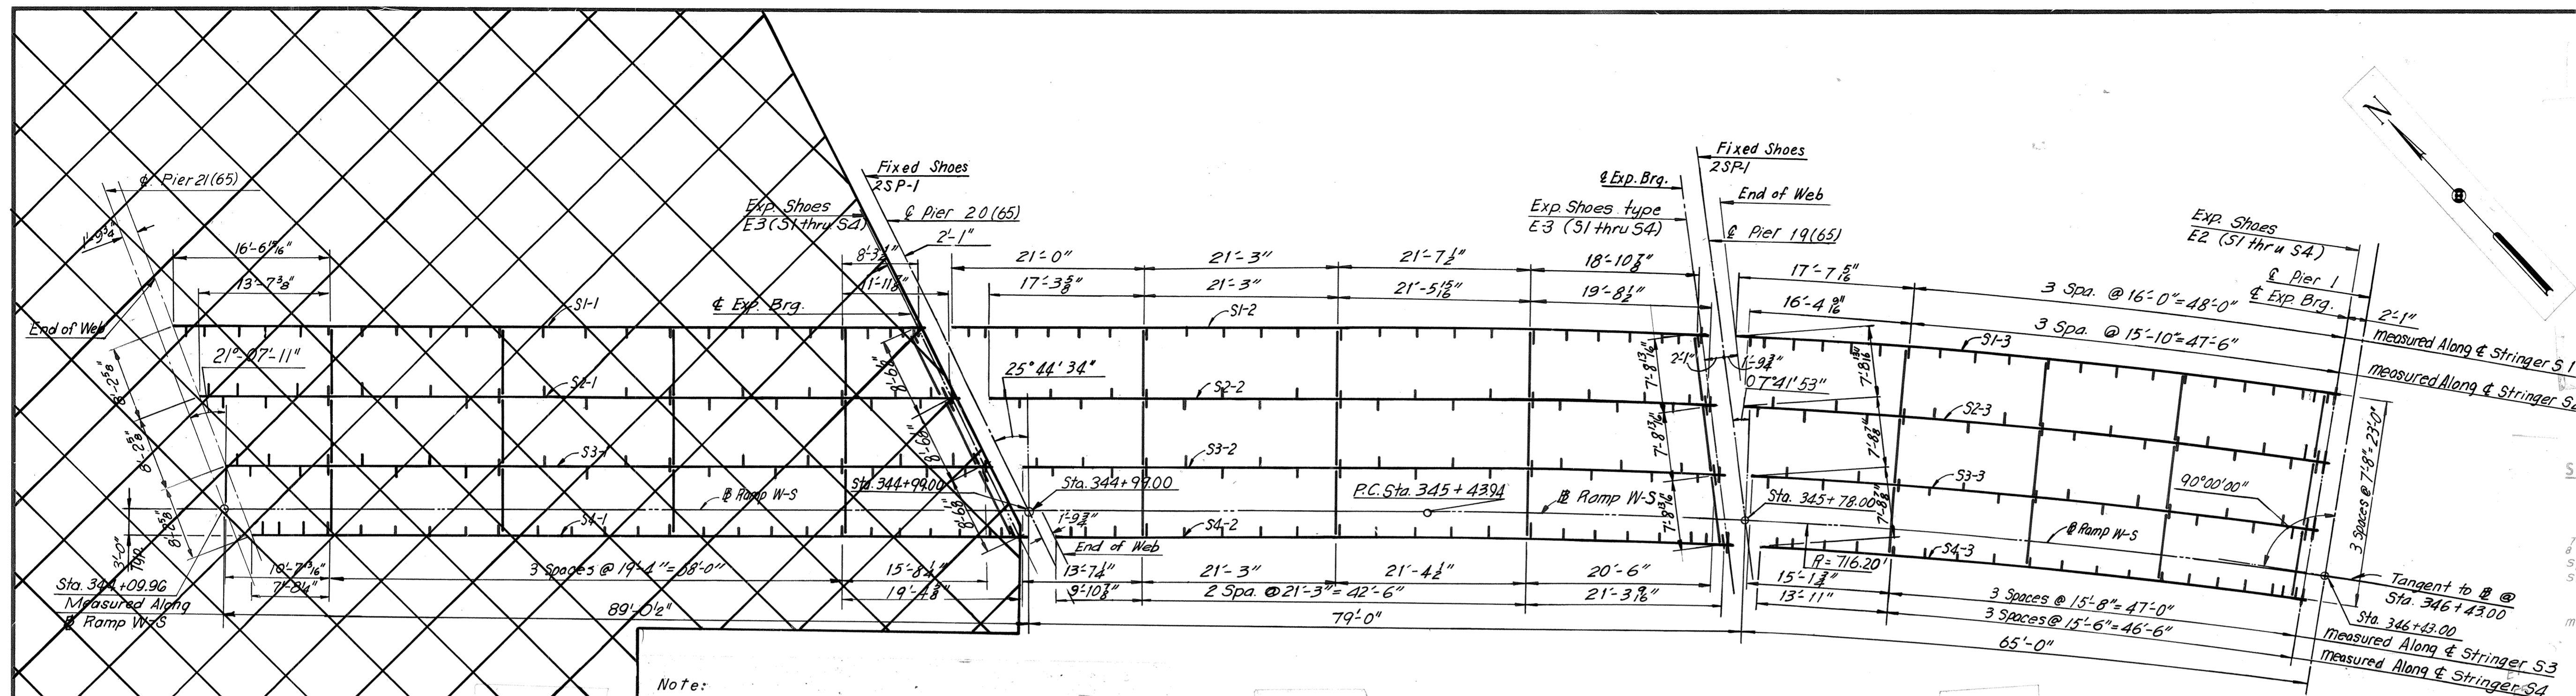


SHEAR STUD DETAIL
No Scale

SHEAR STUD NOTE


Contractor may, if he elects, use three 1/2" diameter studs at the same longitudinal spacing in lieu of the four 3/4" diameter studs shown.
Stud rows shall be placed parallel to the main deck reinforcement.

Note: Pier 20(65) and 19(65) denotes piers 20 and 19 of Bridge 65(Ramp S-W).

UNIT 2
FRAMING PLAN
Scale 1" = 10'-0"

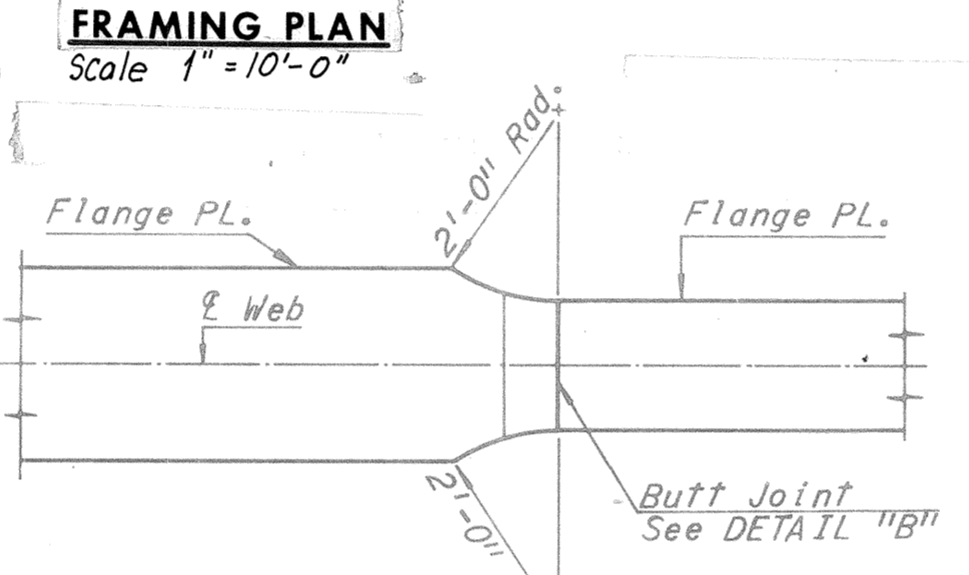


FLANGE PLATE SPLICE DETAIL
No Scale

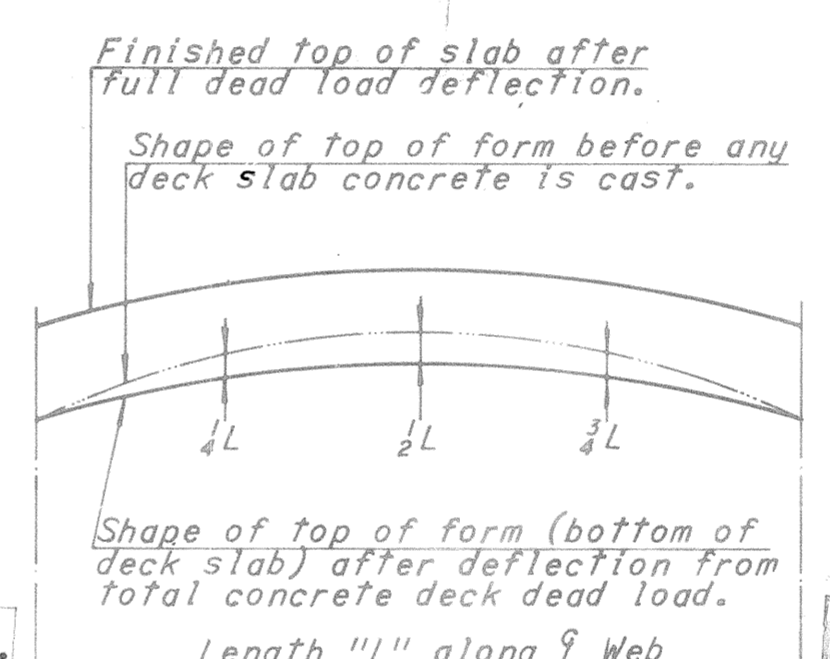


DEAD LOAD DEFLECTION DIAGRAM

NOTE TO CONTRACTOR
Deflections given are those anticipated to occur in the stringer upon placement of the total concrete deck dead load.
In practice, the stringers in place are not likely to have the exact camber to compensate for these deflections during construction. The residual amounts shall be provided by adjusting forms to vary the thickness of the concrete haunch between the bottom of the slab and the top of stringer without altering the slab thickness.

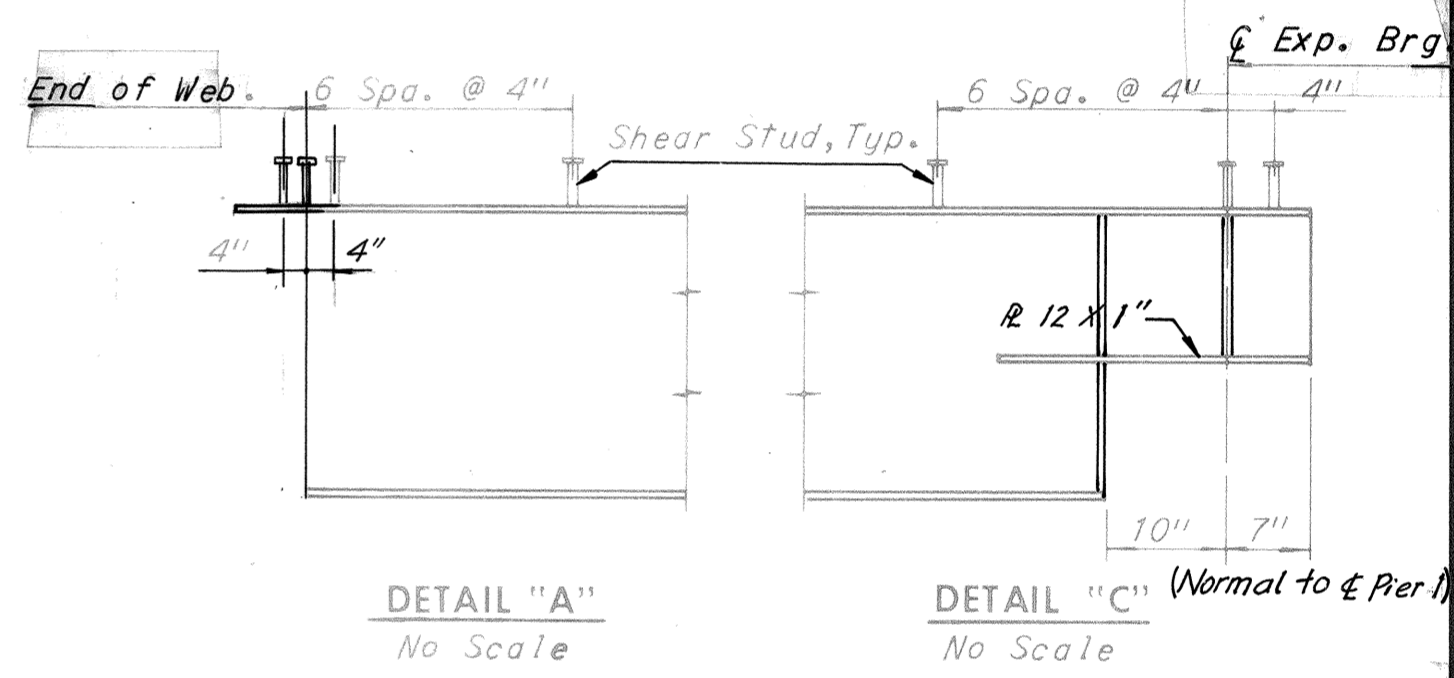


DETAIL "A" No Scale
DETAIL "C" (Normal to Exp. Brg.) No Scale

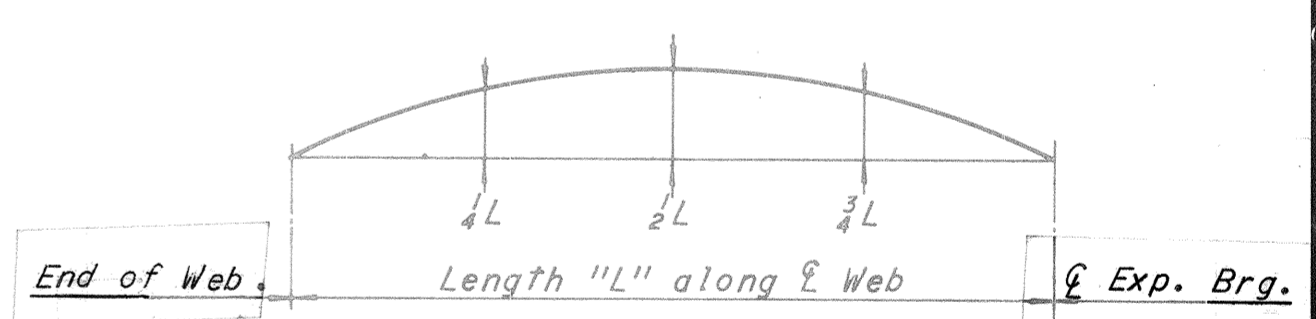

CAMBER DIAGRAM

NOTE TO FABRICATOR
The stringers shall be fabricated with an upward camber amounting to the tabulated value. This will provide approximate compensation for deflection under full dead load and for conformity with finished grade.
Dimensions are in inches.

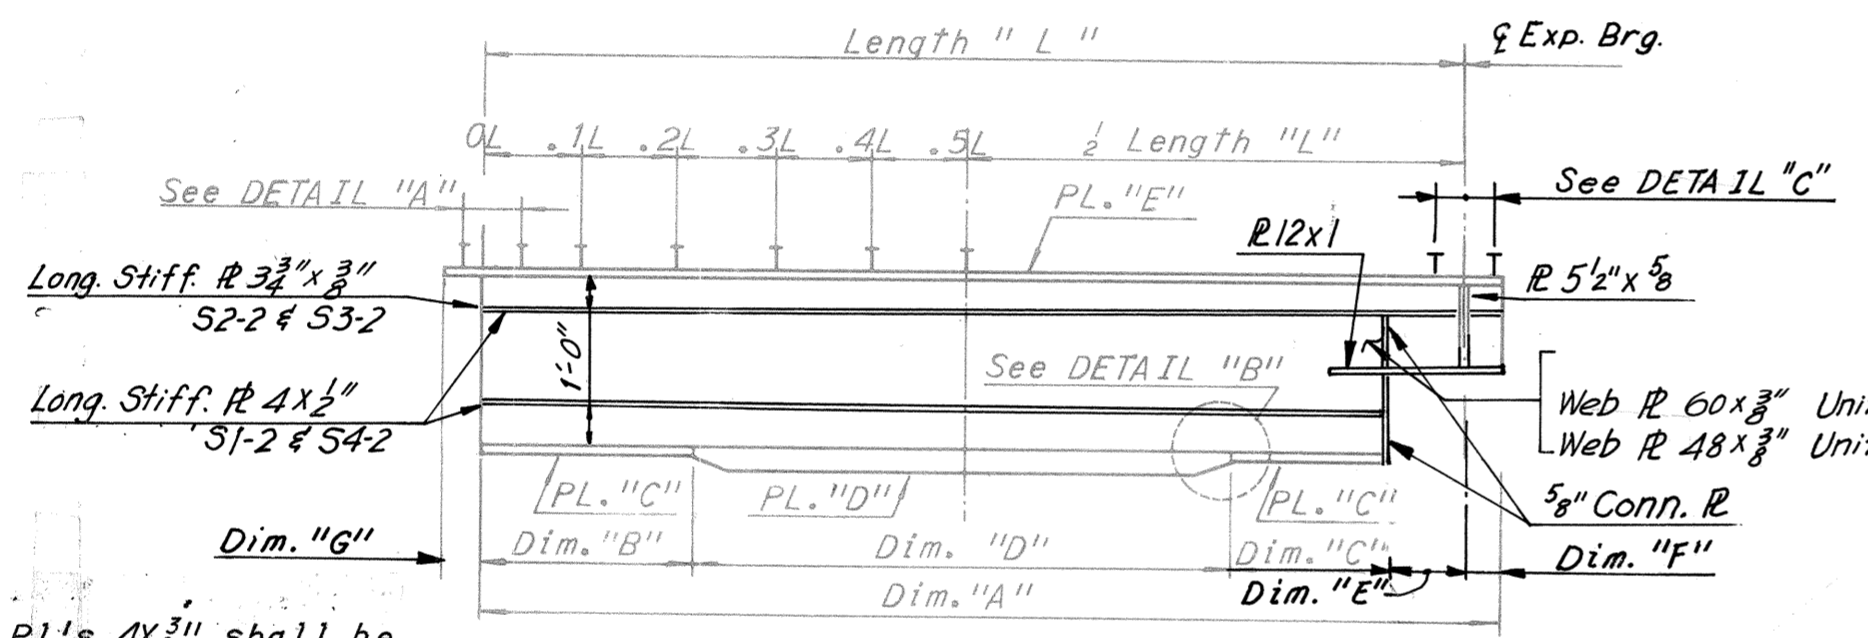

STRINGER ELEVATION
No Scale

Note: Intermediate stiffener PL's 4x3/8" shall be equally spaced between diaphragms as shown. The first two stiffener spaces at the ends of stringers shall be one-half the normal spacing within the panel.

Note: All horizontal dimensions are measured along Exp. Brg.

SHOE SCHEDULE			
EXPANSION SHOES		FIXED SHOES	
TYPE	NO. REQD.	TYPE	NO. REQD.
E2	4	Sp-1	4
E3	4		

Notes:
For Framing Details @ piers 19(65) and 1, see Sheet 17.
For Diaphragm connections see Sheet 19.
For Shoe Details, see Sheet S1 and S2.
For superstructure steel quantities, see sheet 2.
For joint details, see Sheet 25.
Exterior stringer longitudinal stiffeners shall be located on the exterior face of the stringer.
Longitudinal stiffeners not to be used in Unit 3.

UNIT	STRINGER	Dim. "A"	LENGTH	Dim. "B"	Dim. "C"	Dim. "D"	Dim. "E"	Dim. "F"	Dim. "G"	PL "C"	PL "D"	PL "E"	MAX. SHEAR STUD SPACING						DEAD LOAD DEFLECTION SCHEDULE			CAMBER SCHEDULE				
													0.0L-0.1L	0.1L-0.2L	0.2L-0.3L	0.3L-0.4L	0.4L-0.5L	1/4L	1/2L	3/4L	1/4L	1/2L	3/4L			
1	S1-1	83'-6 3/4"	82'-10 3/4"	9'-5 1/4"	8'-6 1/4"	6'-11 1/4"	11 1/2"	7 3/4"	6 1/2"	12 x 3/4"	12 x 1 1/4"	12 x 3/4"	11 1/2"	13 1/2"	17"	20 1/2"	24"	1"	1 3/8"	1"	1 3/8"	1 3/8"	1 3/8"	1 3/8"	1 3/8"	
	S2-1	84'-3"	83'-1 1/4"	11'-3 3/8"	10'-4 1/2"	6'-11 3/8"	11 1/2"	7 3/4"	6 1/2"	12 x 3/4"	12 x 1 1/4"	12 x 3/4"	11 1/2"	13 1/2"	17"	20 1/2"	24"	1 1/8"	1 3/8"	1 1/8"	1 3/8"	1 3/8"	1 3/8"	1 3/8"	1 3/8"	
	S3-1	84'-11 3/16"	84'-4 1/16"	11'-8 1/8"	10'-8 3/8"	6'-11 1/8"	11 1/2"	7 3/4"	6 1/2"	12 x 3/4"	12 x 1 1/4"	12 x 3/4"	11 1/2"	13 1/2"	17"	20 1/2"	24"	1 1/8"	1 3/8"	1 1/8"	1 3/8"	1 3/8"	1 3/8"	1 3/8"	1 3/8"	1 3/8"
	S4-1	85'-8 3/8"	85'-0 7/8"	10'-6 3/8"	9'-7 3/8"	6'-11 1/8"	11 1/2"	7 3/4"	6 1/2"	12 x 3/4"	12 x 1 1/4"	12 x 3/4"	11 1/2"	13 1/2"	17"	20 1/2"	24"	1 1/8"	1 3/8"	1 1/8"	1 3/8"	1 3/8"	1 3/8"	1 3/8"	1 3/8"	1 3/8"
2	S1-2	83'-4 1/8"	82'-9 3/8"	12'-10 1/8"	12'-0 3/8"	5'-11 1/8"	10 1/2"	7 1/2"	6 1/2"	12 x 3/4"	12 x 1 1/2"	12 x 3/4"	12 1/2"	14 1/2"	17 1/2"	21 1/2"	24"	3/4"	1 1/8"	3/4"	1 5/8"	2 1/8"	1 5/8"	1 5/8"	1 5/8"	
	S2-2	80'-4 1/2"	79'-9 1/2"	14'-4 1/2"	13'-6 1/2"	5'-11 1/2"	10 1/2"	7 1/2"	6 1/2"	12 x 3/4"	12 x 1 1/2"	12 x 3/4"	13"	14 1/2"	18"	21 1/2"	24"	1 1/8"	1"	1 1/8"	1 3/8"	1 3/8"	1 3/8"	1 3/8"	1 3/8"	
	S3-2	77'-3 3/8"	76'-8 3/8"	—	—	7'-10 3/8"	10 1/2"	7 1/2"	6 1/2"	—	12 x 1 1/2"	12 x 3/4"	13 1/2"	15 1/2"	17 1/2"	20 1/2"	24"	5/8"	7/8"	5/8"	1 3/8"	1 3/8"	1 3/8"	1 3/8"	1 3/8"	
	S4-2	74'-3 1/2"	73'-8 1/2"	—	—	7'-10 3/8"	10 1/2"	7 1/2"	6 1/2"	—	12 x 1 1/2"	12 x 3/4"	13"	15"	17 1/2"	21"	24"	1/2"	1 1/8"	1/2"	1 3/8"	1 3/8"	1 3/8"	1 3/8"	1 3/8"	
3	S1-3	66'-2 3/8"	65'-7 3/8"	10'-3 3/8"	9'-5 3/8"	4'-11 1/8"	10"	7"	6 1/2"	12 x 1"	16 x 1 1/4"	12 x 3/4"	10"	11 1/2"	14"	17"	22"	1/2"	1 1/8"	1/2"	1 3/8"	2 3/8"	1 3/8"	1 3/8"	1 3/8"	
	S2-3	64'-5 3/8"	63'-10 3/8"	9'-11 3/8"	9'-1 3/8"	4'-11 1/8"	10"	7"	6 1/2"	12 x 1"	16 x 1 1/4"	12 x 3/4"	10 1/2"	12"	14"	16"	19 1/2"	7/8"	5/8"	7/8"	1 3/8"	2 1/8"	1 3/8"	1 3/8"		
	S3-3	62'-8 3/8"	62'-1 3/8"	11'-0 3/8"	10'-2 3/8"	4'-11 1/8"	10"	7"	6 1/2"	12 x 1"	16 x 1 1/4"	12 x 3/4"	12"	13 1/2"	16"	18 1/2"	22"	3/8"	9/8"	3/8"	1 1/8"	1 1/8"	1 1/8"	1 1/8"	1 1/8"	
	S4-3	61'-0"	60'-5"	—	—	5'-7 1/8"	10"	7"	6 1/2"	—	12 x 1 1/4"	12 x 3/4"	12"	14"	16"	19 1/2"	24"	5/16"	7/16"	5/16"	3/4"	1"	3/4"	3/4"	3/4"	

Note: All steel shall be A36 unless shown otherwise.
* Spacing begins at termination of 6 spaces @ 4"
Denotes A572-Grade 50 Steel for thickness of 1/2" and under and A588 Steel for thickness over 1/2".

BY	DATE				
MADE	GSH	12-10-68			
CHECKED	JD	4-28-69	Stringer Elev. Diaphragm locat. Unit 3	T.E.M.	82675
IN CHARGE					

AS BUILT


RICHMOND METROPOLITAN AUTHORITY
RICHMOND EXPRESSWAY SYSTEM
DOWNTOWN EXPRESSWAY

BRIDGE NO. 68
RAMP W-5 CONNECTION TO
RICHMOND-PETERSBURG TURNPIKE









FRAMING PLAN UNITS 1, 2 AND 3

HOWARD, NEEDLES, TAMMEN & BERGENDOFF
consulting engineers
NEW YORK ALEXANDRIA KANSAS CITY

SCALE: As Noted
CONTRACT NO. 11
SHEET NO. 12 OF 28

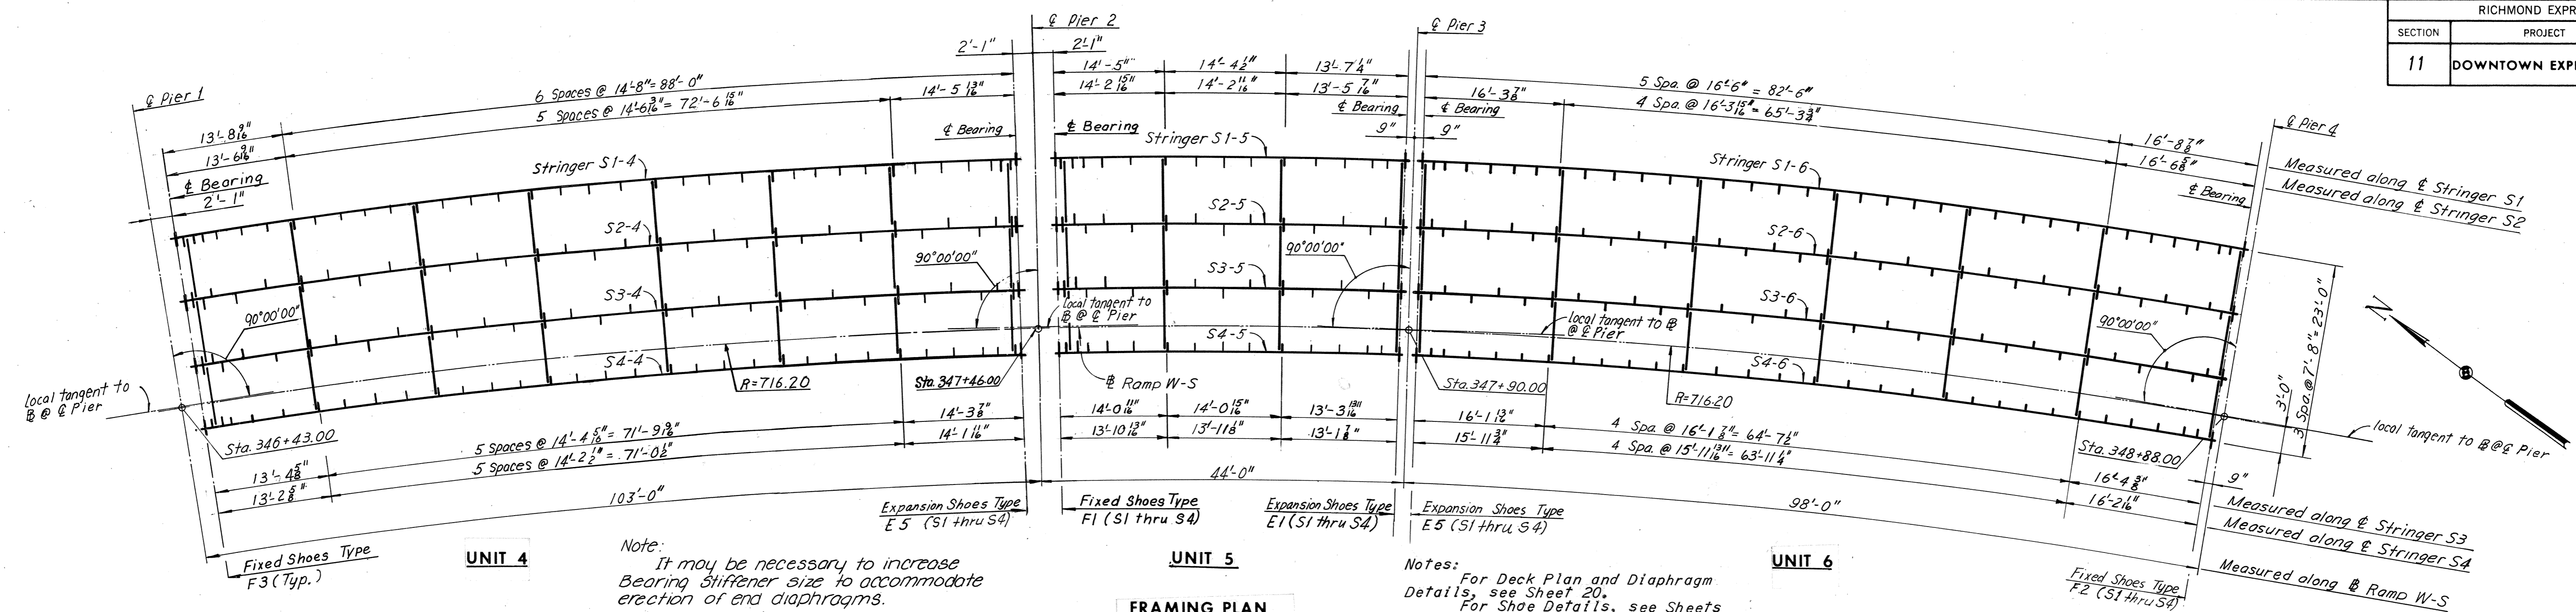


EXPANSION SHOES		FIXED SHOES	
TYPE	NO. REQD.	TYPE	NO. REQD.
-	4	-	4
-	8	-	4
-	-	F3	4
-	-	-	-

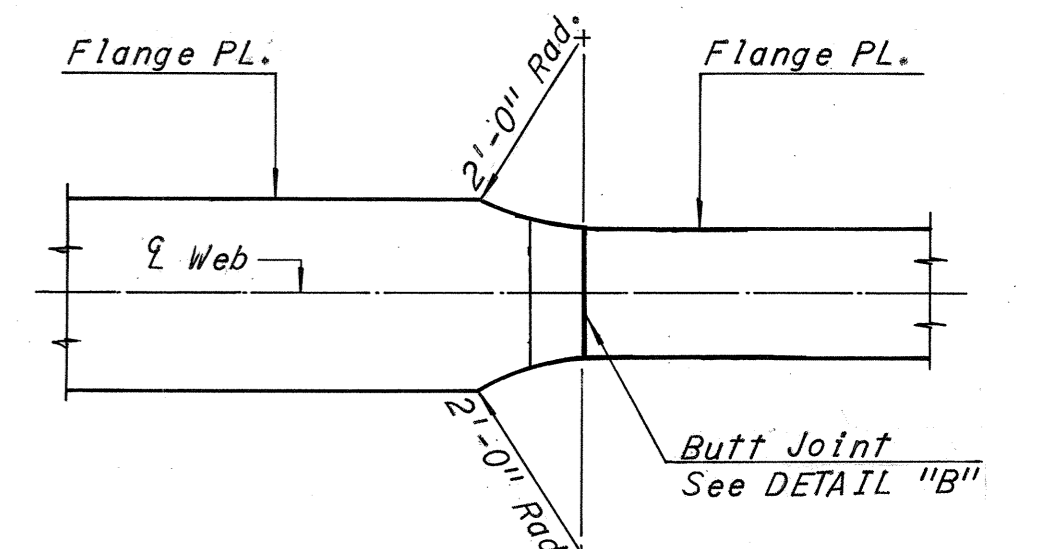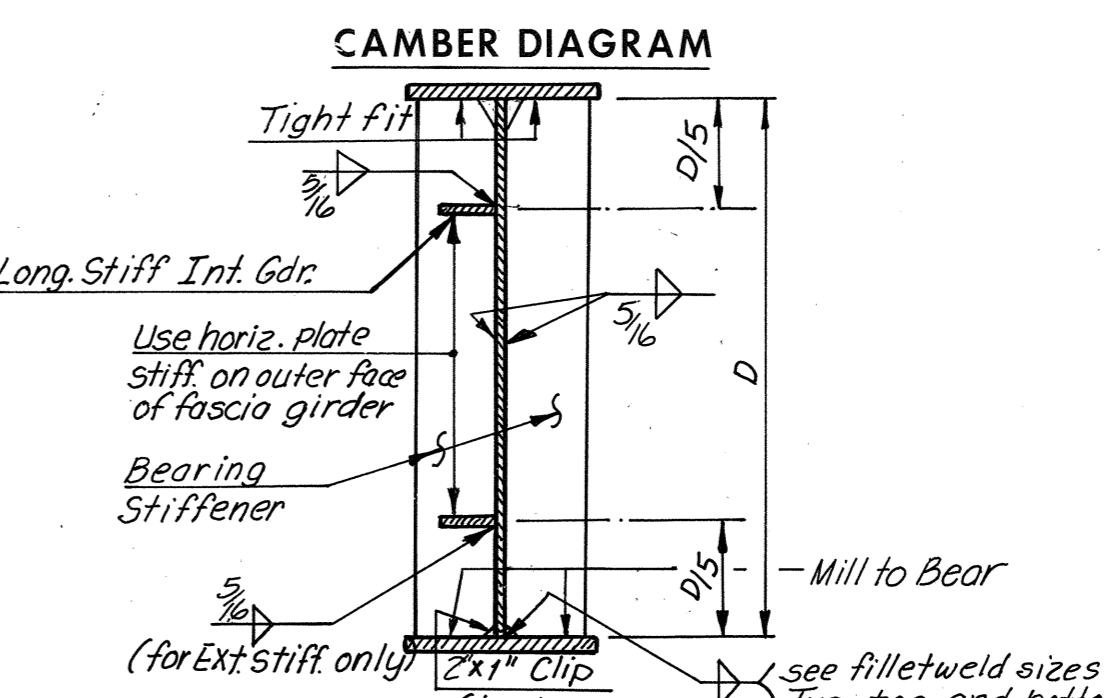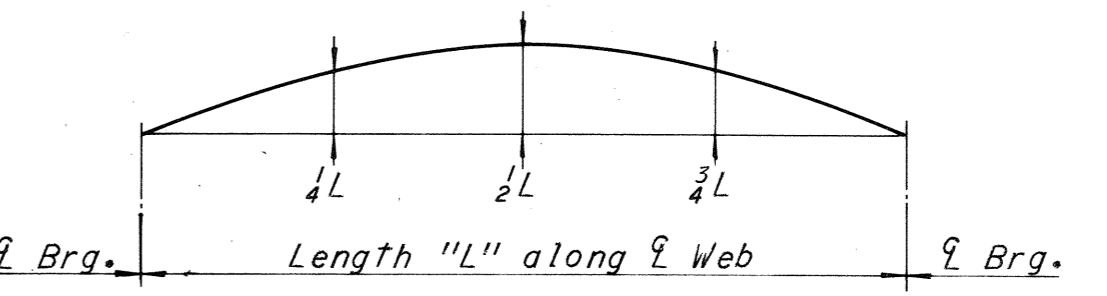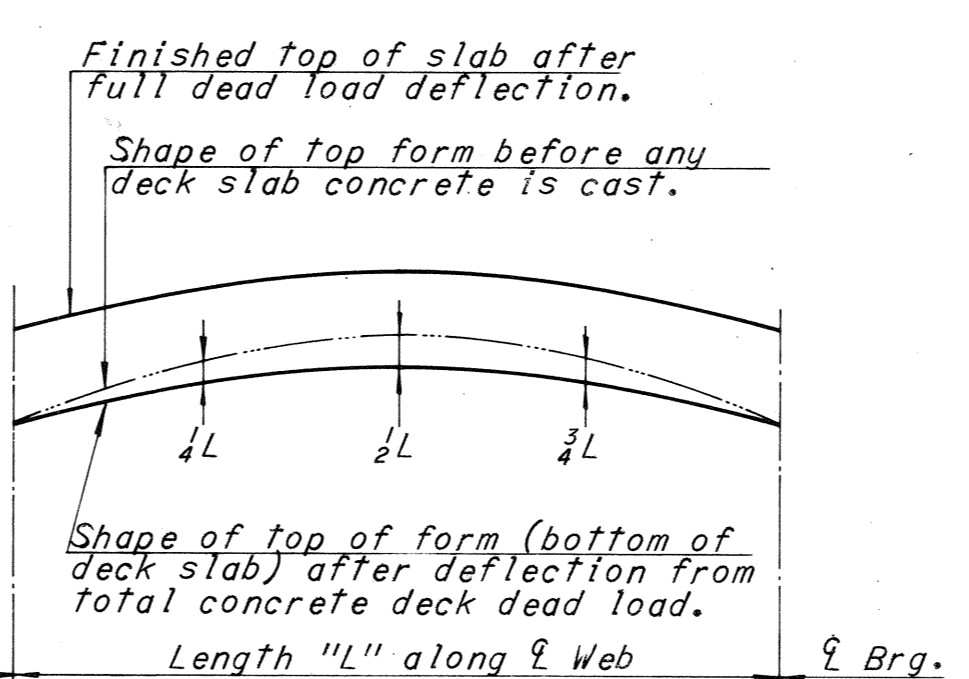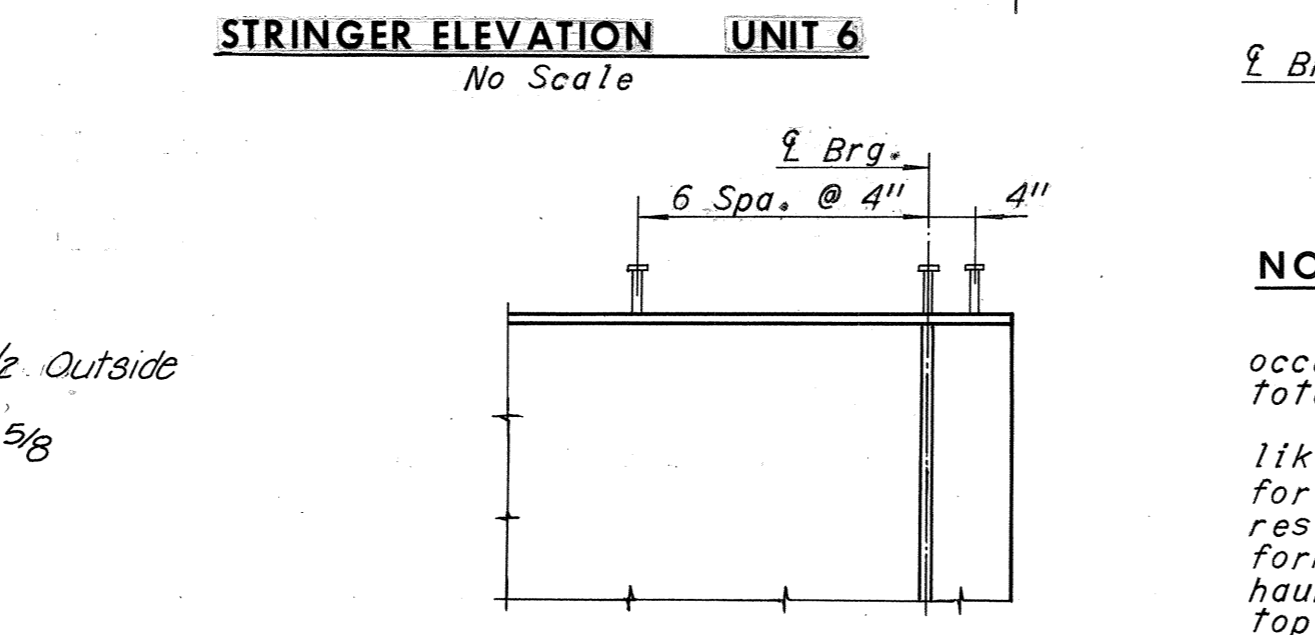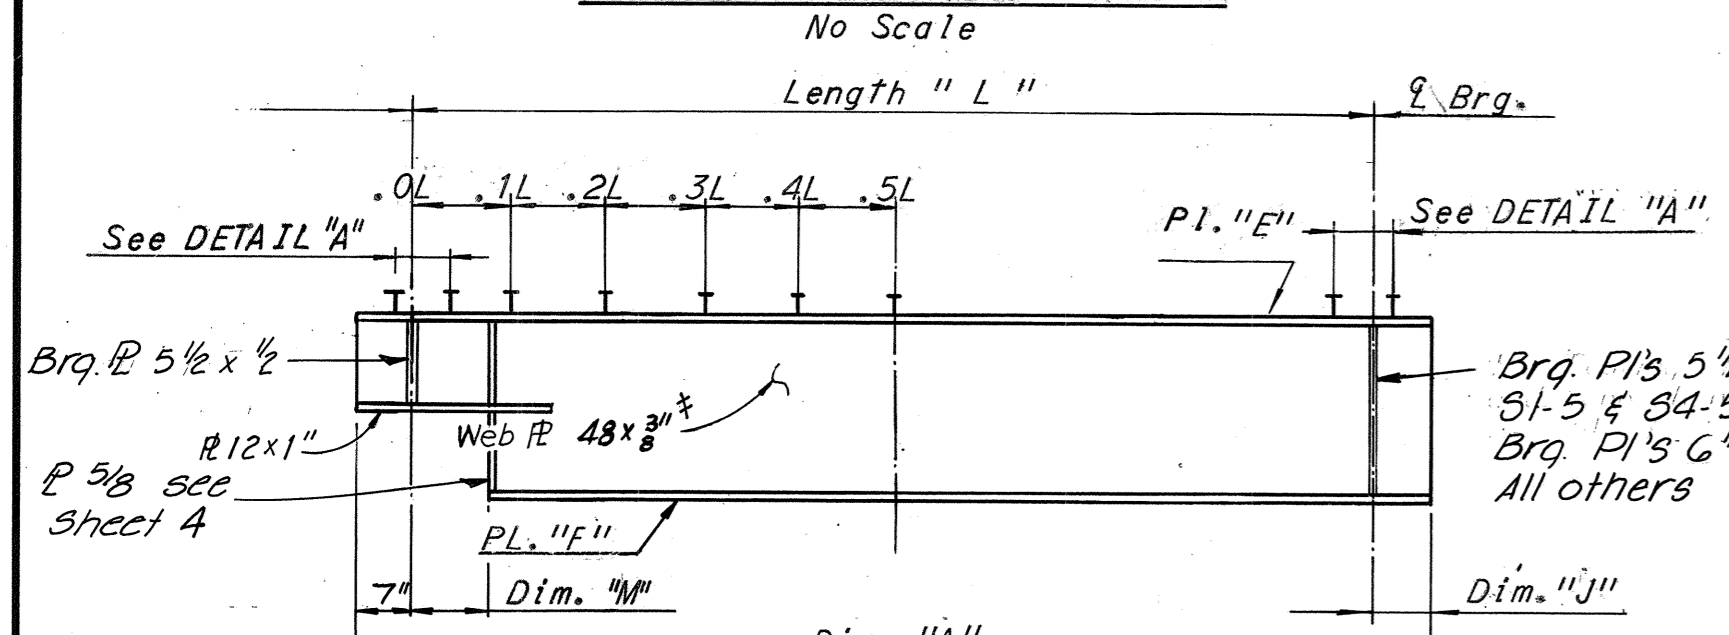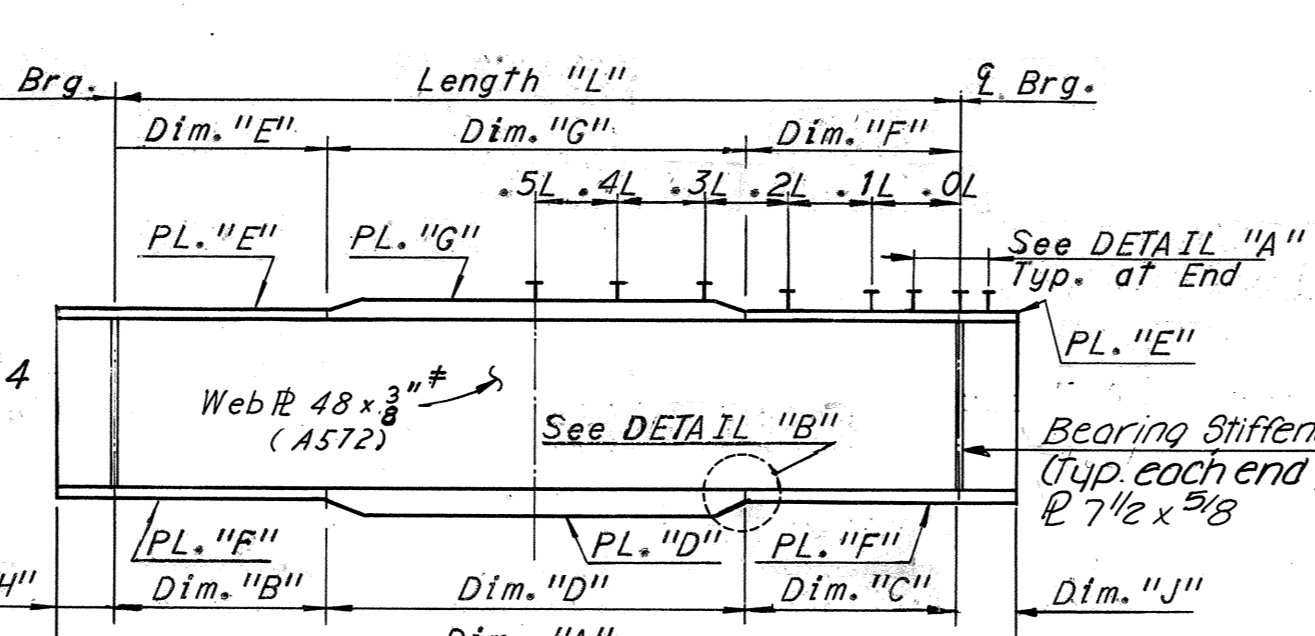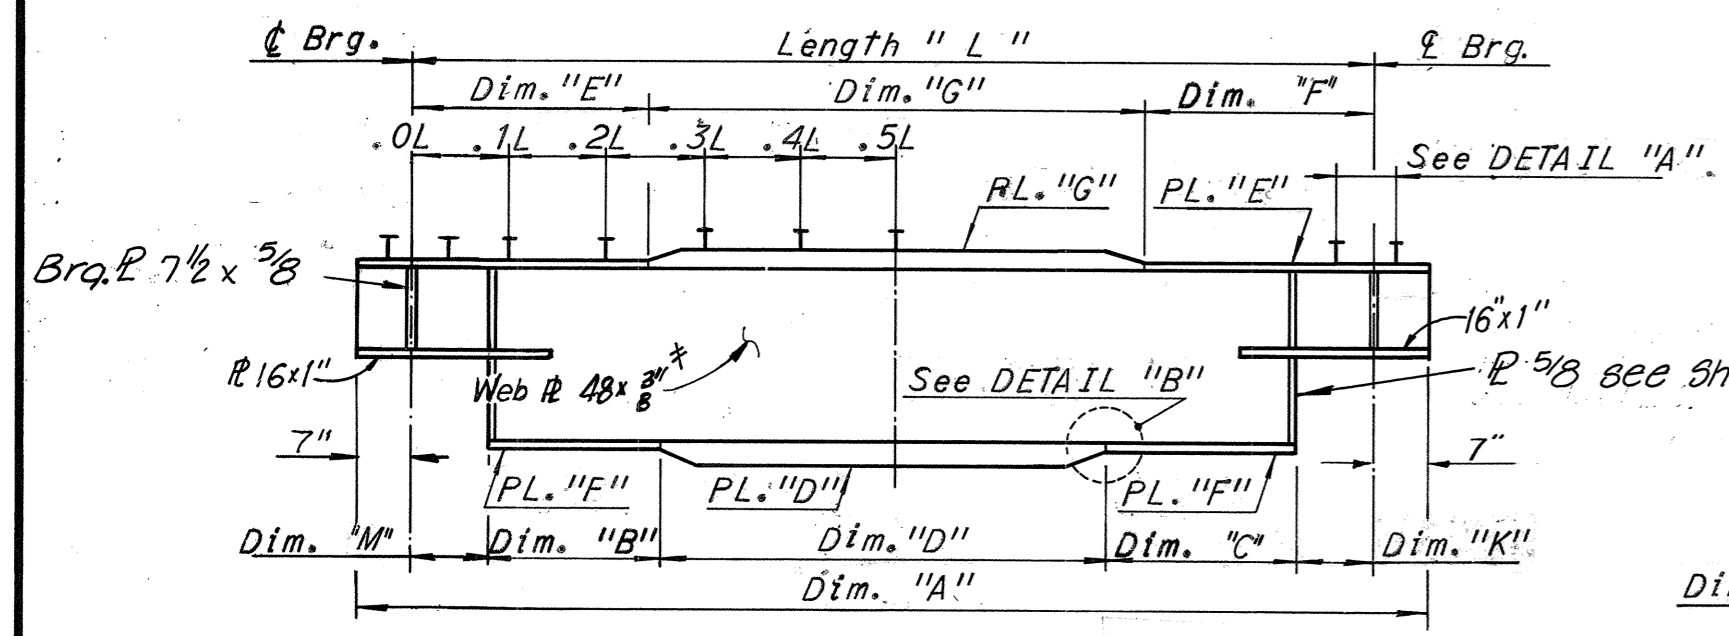

NOTE TO CONTRACTOR
 Deflections given are those anticipated to occur in the stringer upon placement of the total concrete deck dead load. In practice, the stringers in place are not likely to have the exact camber to compensate for these deflections during construction. The residual amounts shall be provided by adjusting forms to vary the thickness of the concrete haunch between the bottom of the slab and the top of stringer without altering the slab thickness.
 Note: For "Note to Fabricator" see Sheet 12.

WEB TO FLANGE WELDS AND LONGITUDINAL STIFFENER WELD DETAILS
 (No scale)
 Note: Web to flange weld size shall be determined by flange thickness as follows:
 To 1/2" 5/8" weld
 over 1/2" to 2 1/4" 3/4" weld
 over 2 1/4" 1" weld

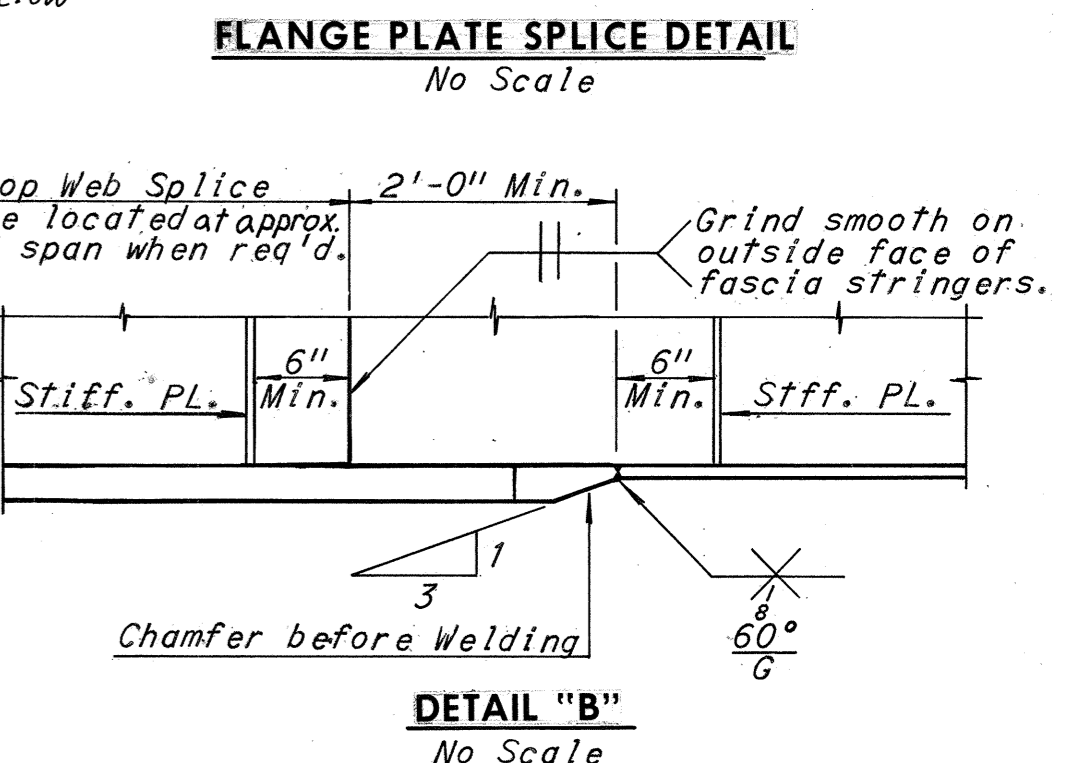

UNIT	STRINGER	Dim. "A"	LENGTH "L"	Dim. "B"	Dim. "C"	Dim. "D"	Dim. "E"	Dim. "F"	Dim. "G"	Dim. "H"	Dim. "J"	Dim. "K"	Dim. "M"	PL. "D"	PL. "E"	PL. "F"	PL. "G"	DEAD LOAD DEFLECTION SCHEDULE					CAMBER SCHEDULE					
																		0.0L-0.1L	0.1L-0.2L	0.2L-0.3L	0.3L-0.4L	0.4L-0.5L	1/4L	1/2L	3/4L	1/4L	1/2L	3/4L
4	S1-4	102'-10 3/8"	101'-8 3/8"	19'-0 1/2"	19'-0 3/8"	62'-0"	19'-10 1/4"	19'-10 3/8"	62'-0"	-	-	10"	10"	24 x 1 1/2"	16 x 1 1/2"	20 x 1 3/8"	16 x 1 1/2"	9 1/2"	11"	13 1/2"	17"	22"	1 3/4"	2 1/2"	1 3/4"	3 3/16"	4 1/16"	3 5/16"
	S2-4	101'-9 3/8"	100'-7 3/8"	18'-5 1/8"	18'-5 3/8"	62'-0"	19'-3 1/8"	19'-3 3/8"	62'-0"	-	-	10"	10"	20 x 1 1/2"	12 x 3/4"	16 x 1 3/8"	16 x 3/4"	11"	11 1/2"	14"	17"	21"	2 1/16"	2 7/8"	2 1/16"	3 13/16"	5 3/16"	3 1/16"
	S3-4	100'-8 3/8"	99'-6 3/8"	18'-11 1/8"	18'-11"	60'-0"	49'-9 1/8"	49'-9"	-	-	10"	10"	16 x 1 1/2"	12 x 3/4"	16 x 1 1/2"	-	-	11"	12 1/2"	15 1/2"	18 1/2"	22 1/2"	2 1/8"	3"	2 1/8"	3 3/8"	5 1/4"	3 3/4"
	S4-4	99'-6 3/8"	98'-4 3/8"	20'-4 3/8"	20'-4 3/8"	56'-0"	49'-2 7/8"	49'-2 3/8"	-	-	10"	10"	16 x 1 1/2"	12 x 3/4"	12 x 1"	-	-	10"	13"	16 1/2"	19 1/2"	24"	1 13/16"	2 1/16"	1 13/16"	3 7/16"	4 1/16"	3 3/8"
5	S1-5	43'-7 3/8"	42'-4 3/8"	-	-	-	-	-	-	8"	-	10"	-	12 x 3/4"	12 x 3/4"	-	-	24"	24"	24"	24"	24"	1 3/8"	1 3/8"	1 3/8"	1 3/8"	1 3/8"	1 3/8"
	S2-5	43'-1 3/8"	41'-11 1/8"	-	-	-	-	-	-	7"	-	10"	-	12 x 3/4"	12 x 3/4"	-	-	24"	24"	24"	24"	24"	1 3/8"	1 3/8"	1 3/8"	1 3/8"	1 3/8"	1 3/8"
	S3-5	42'-7 3/8"	41'-5 3/8"	-	-	-	-	-	-	7"	-	10"	-	12 x 3/4"	12 x 3/4"	-	-	24"	24"	24"	24"	24"	1 3/8"	1 3/8"	1 3/8"	1 3/8"	1 3/8"	1 3/8"
	S4-5	42'-2 3/8"	40'-11 3/8"	-	-	-	-	-	-	8"	-	10"	-	12 x 3/4"	12 x 3/4"	-	-	24"	24"	24"	24"	24"	1 3/8"	1 3/8"	1 3/8"	1 3/8"	1 3/8"	1 3/8"
6	S1-6	100'-6 3/8"	99'-2 1/8"	22'-7 3/8"	22'-7 3/8"	54'-0"	18'-1 3/8"	18'-1 3/8"	63'-0"	8"	8"	-	-	16 x 2 3/8"	12 x 1 1/4"	16 x 2"	12 x 1 7/8"	7 1/2"	9"	12"	16"	21 1/2"	1 1/2"	2 1/8"	1 1/2"	2"	2 3/4"	2"
	S2-6	99'-4 1/8"	98'-2 1/8"	24'-1 3/8"	24'-1 3/8"	50'-0"	22'-1 3/8"	22'-1 3/8"	54'-0"	7"	7"	-	-	16 x 2 3/8"	12 x 1 1/4"	16 x 1 3/4"	12 x 1 3/8"	9"	10"	13 1/2"	17"	22"	1 1/2"	2 1/8"	1 1/2"	1 13/16"	2 3/4"	1 13/16"
	S3-6	98'-3 1/8"	97'-1 1/8"	20'-0 3/8"	20'-0 3/8"	57'-0"	48'-6 3/8"	48'-6 3/8"	-	7"	7"	-	-	16 x 1 3/8"	12 x 1 1/4"	16 x 1 3/8"	-	9 1/2"	11"	14 1/2"	18"	23"	1 1/2"	2 1/16"	1 1/2"	1 7/8"	2 5/8"	1 7/8"
	S4-6	97'-5 3/8"	96'-1 3/8"	22'-0 3/8"	22'-0 3/8"	52'-0"	48'-0 3/8"	48'-0 3/8"	-	8"	8"	-	-	16 x 1 1/2"	12 x 3/4"	16 x 1 1/2"	-	9 1/2"	11 1/2"	14 1/2"	19"	24"	1 3/8"	2 1/4"	1 3/8"	1 13/16"	1 13/16"	

BY	DATE				
MADE	GSN	12-09-68			
CHECKED	PTA	4-29-69	Diaph. locat Unit 4 & 5	TEM	82675
IN CHARGE					

* Spacing begins at termination of 6 spaces @ 4".
 * Denotes A572-Grade 50 steel for thickness of 3/4" and under and A588 steel for thickness over 3/4".

Notes:
 All horizontal dimensions are measured along & of web.
 All steel shall be A36 unless otherwise shown.
 All intermediate stiffeners shall be 4x8 unless where the width of top flange plate is 20 or over, Pts 5x8 shall be used.

The intermediate stiffeners shall be equally spaced between diaphragms as shown. The first two intermediate stiffener spaces at the ends of stringers shall be one-half the normal spacing within the panel.

AS BUILT

RICHMOND METROPOLITAN AUTHORITY
RICHMOND EXPRESSWAY SYSTEM
DOWNTOWN EXPRESSWAY


BRIDGE NO. 68
 RAMP W-S CONNECTION TO
 RICHMOND-PETERSBURG TURNPIKE

FRAMING PLAN - UNITS 4, 5 AND 6

HOWARD, NEEDLES, TAMMEN & BERGENDOFF
 consulting engineers
 NEW YORK ALEXANDRIA KANSAS CITY







SCALE: As Noted
 CONTRACT NO. 11
 SHEET NO. 13 OF 28

RICHMOND EXPRESSWAY SYSTEM			
SECTION	PROJECT	SHEET NO.	TOTAL SHEETS
11	DOWNTOWN EXPRESSWAY	77	97

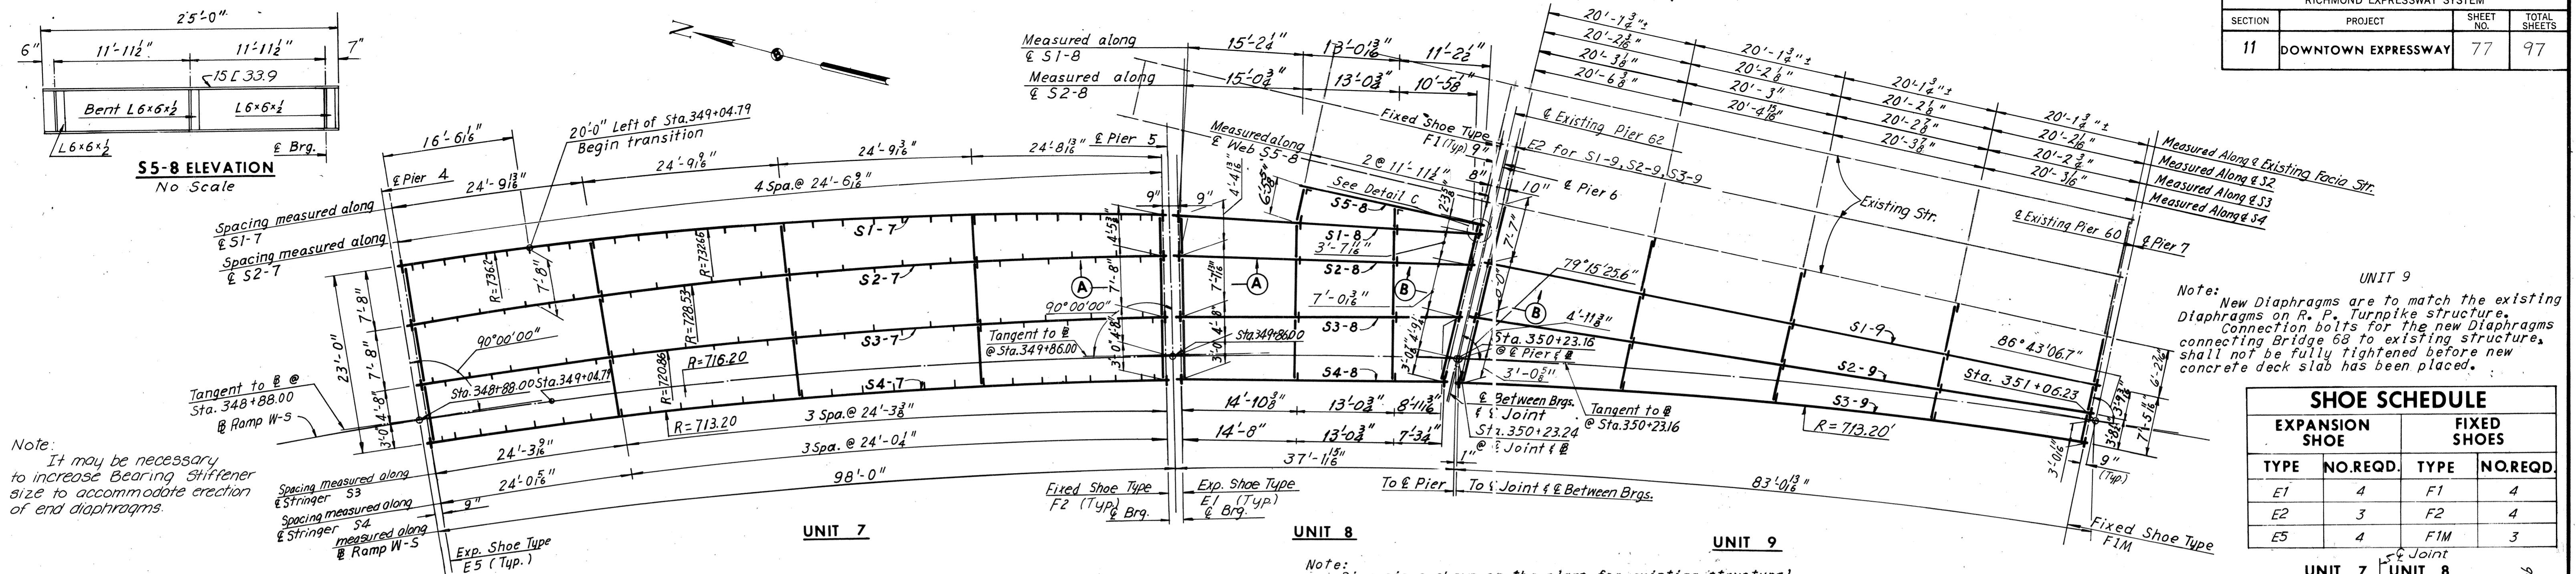


SHOE SCHEDULE

EXPANSION SHOE		FIXED SHOES	
TYPE	NO. REQD.	TYPE	NO. REQD.
E1	4	F1	4
E2	3	F2	4
E5	4	F1M	3

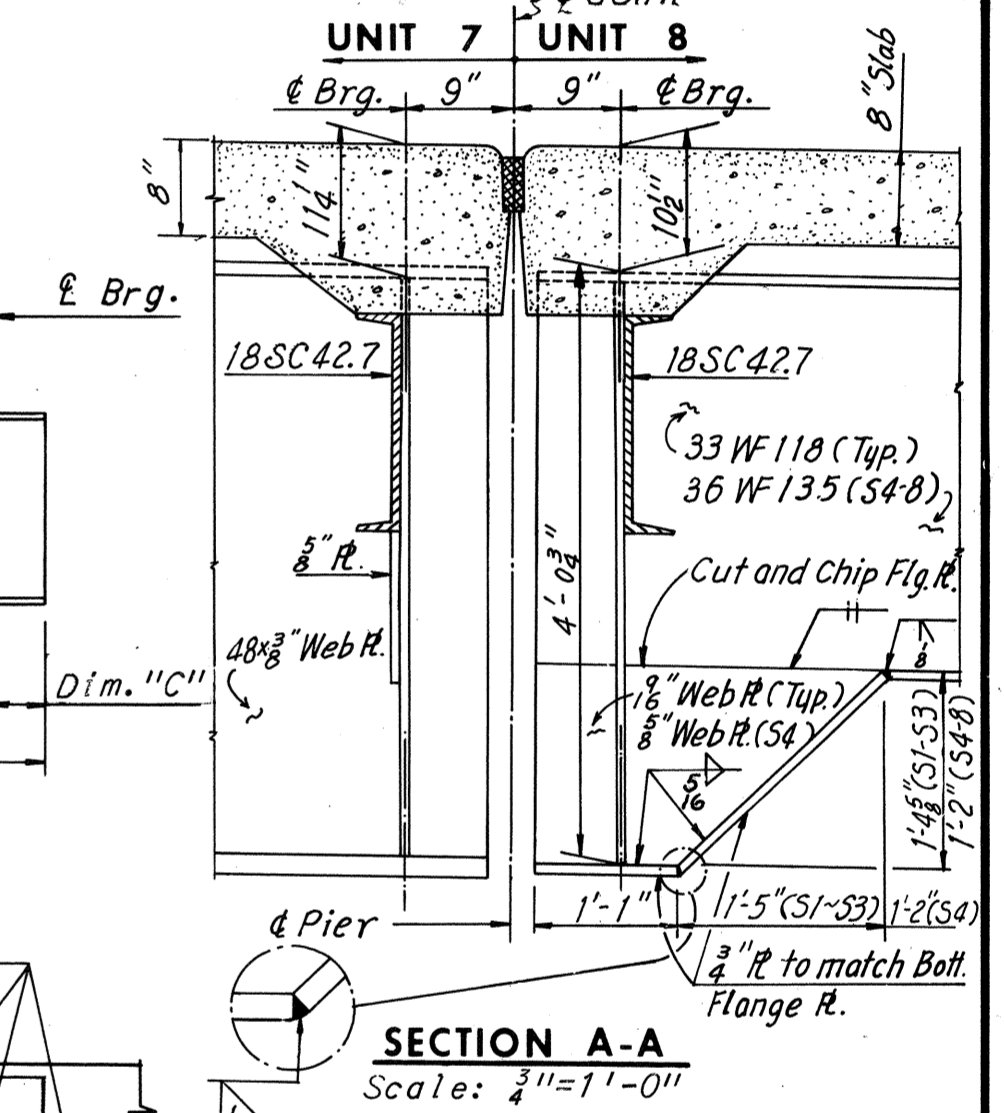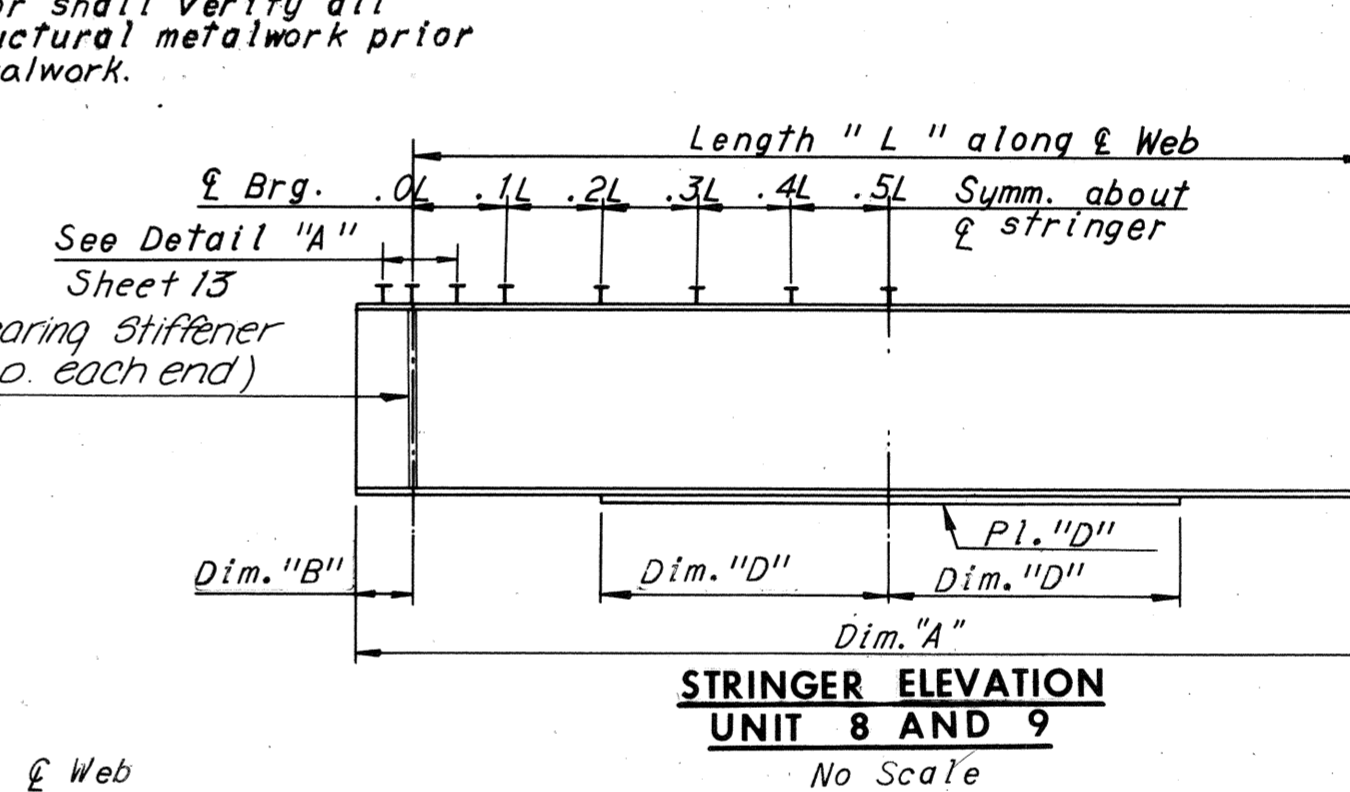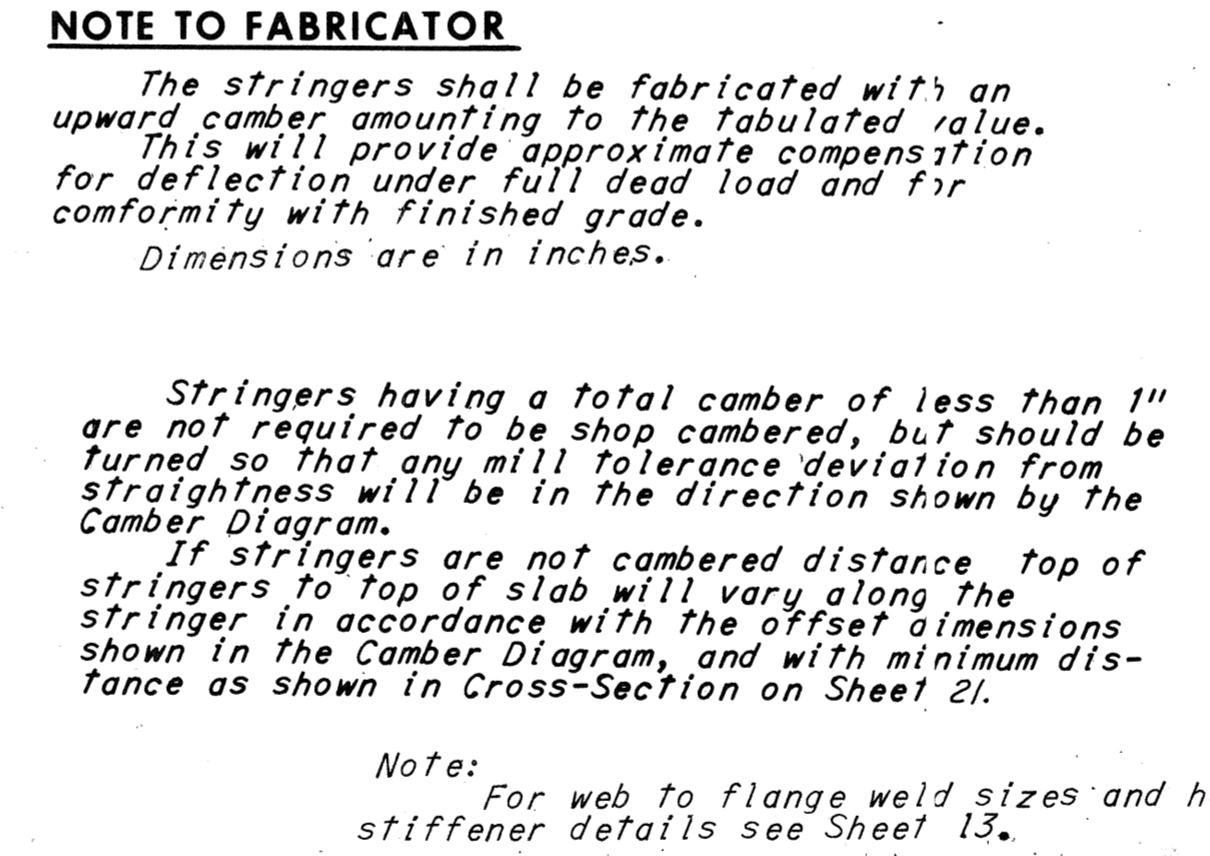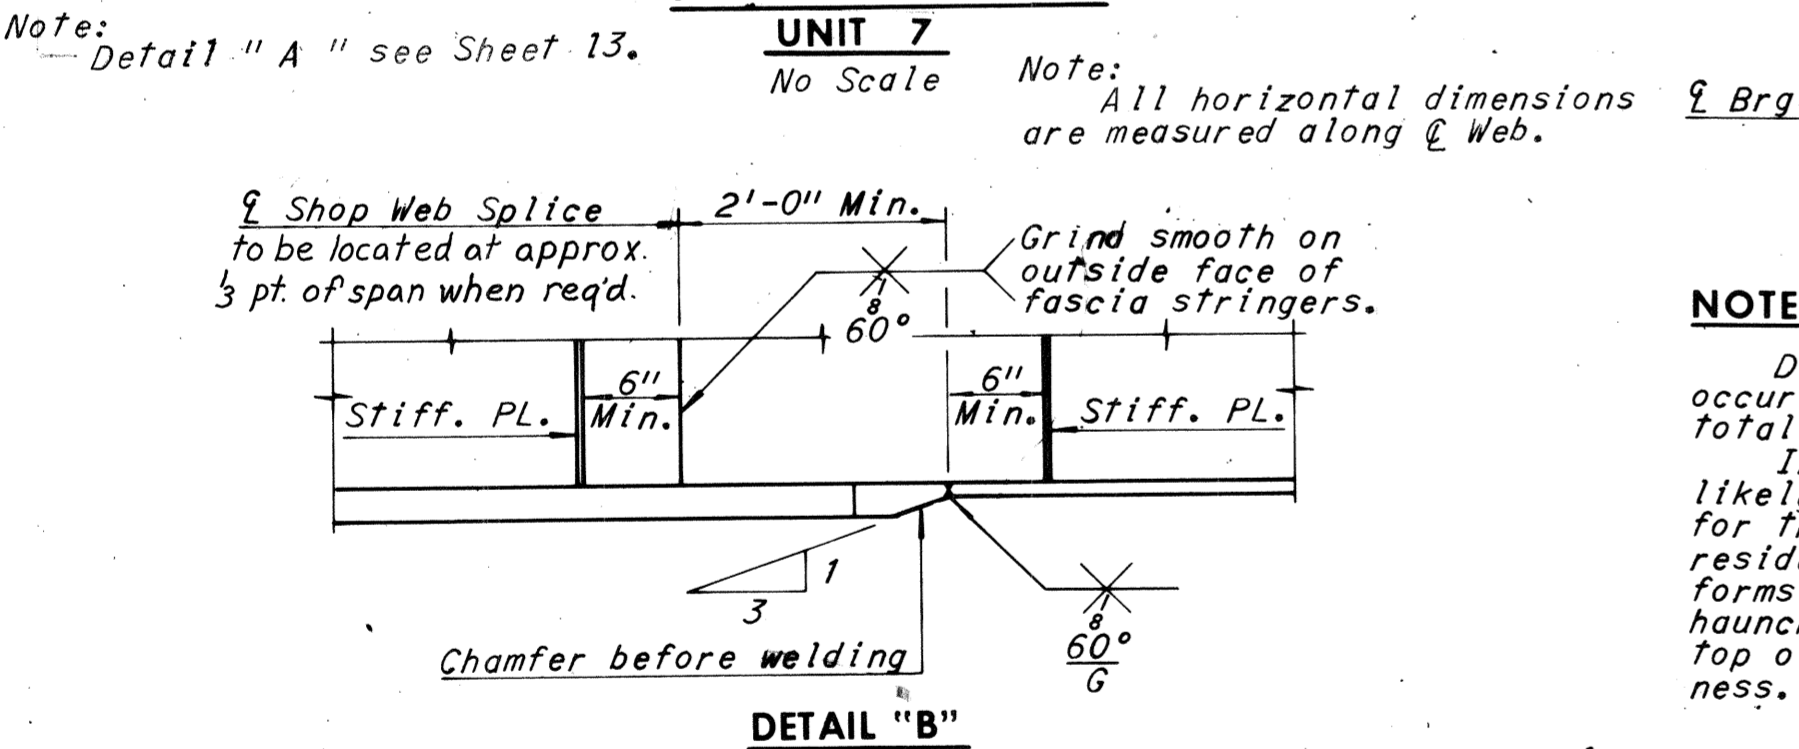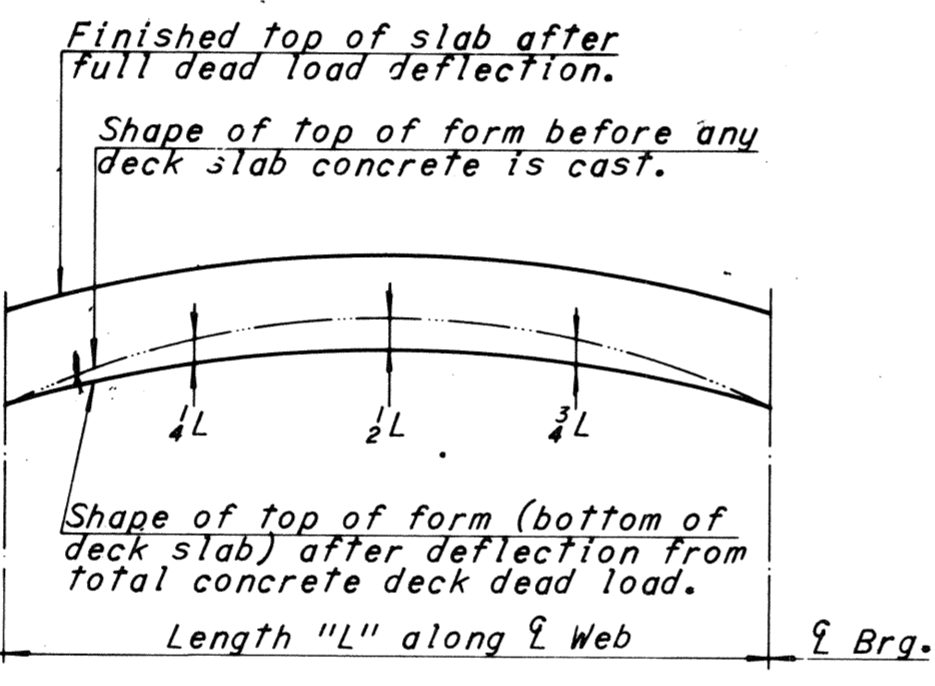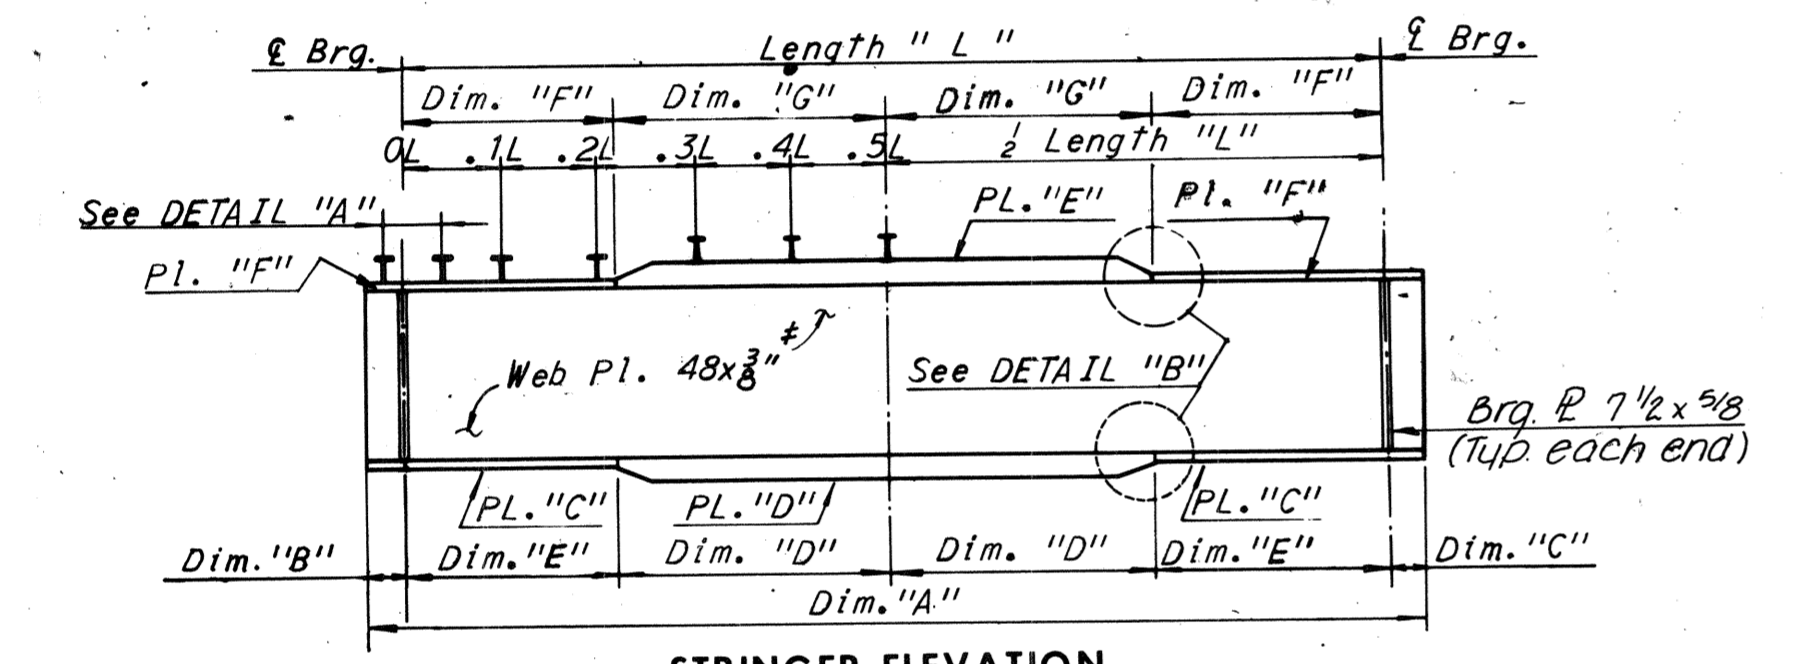

UNIT	STRINGER	Dim. "A"	LENGTH "L"	Dim. "B"	Dim. "C"	Dim. "D"	Dim. "E"	Dim. "F"	Dim. "G"	PL. "C" or Rolled Sect.	PL. "D"	PL. "E"	PL. "F"	DEAD LOAD DEFLECTION SCHEDULE					CAMBER SCHEDULE		
														0.0L-0.1L	0.1L-0.2L	0.2L-0.3L	0.3L-0.4L	0.4L-0.5L	1/4L	1/2L	3/4L
7	S1-7	100'-5 3/4"	99'-1 3/4"	8"	8"	27'-0"	22'-6 3/4"	18'-0 1/2"	31'-6"	16x2 1/2"	16x2 1/2"	12x1 1/2"	12x1 1/2"	7 1/2"	12"	1 3/8"	1 7/8"	1 5/16"	1 1/16"	2 1/16"	1 7/16"
	S2-7	99'-4 1/2"	98'-2 1/2"	7"	7"	25'-0"	24'-1 1/8"	22'-1 1/8"	27'-0"	16x2 1/2"	16x2 1/2"	12x1 1/2"	12x1 1/2"	9"	10"	1 1/16"	2"	1 3/8"	1"	1 3/8"	1 1/8"
	S3-7	98'-3 1/2"	97'-1 1/2"	7"	7"	28'-6"	20'-0 1/8"	48'-6 1/2"	—	16x1 1/2"	16x1 1/2"	—	12x1 1/2"	9 1/2"	11"	1 1/2"	2 1/16"	1 1/2"	1 1/16"	1 1/16"	3/4"
	S4-7	97'-5 1/2"	96'-1 1/2"	8"	8"	26'-0"	22'-0 1/2"	48'-0 1/2"	—	16x1 1/2"	16x1 1/2"	—	12x1 1/2"	9 1/2"	11 1/2"	1 1/2"	2 1/16"	1 1/2"	1 1/16"	1 1/16"	1 1/2"
	S1-8	40'-9 1/2"	39'-5 1/2"	8"	8"	—	—	—	—	—	33WF118	—	—	—	24"	24"	3/16"	3/16"	3/16"	1/4"	3/8"
8	S2-8	39'-8 1/2"	38'-6 1/2"	7"	7"	—	—	—	—	33WF118	—	—	—	24"	24"	1/8"	3/16"	1/8"	3/16"	1/4"	3/16"
	S3-8	38'-0 1/2"	36'-10 1/2"	7"	7"	—	—	—	—	33WF118	—	—	—	24"	24"	1/8"	3/16"	1/8"	3/16"	1/4"	3/16"
	S4-8	36'-4 3/8"	35'-0"	8"	8"	—	—	—	—	36WF135	—	—	—	24"	24"	1/16"	1/8"	1/16"	1/8"	1/8"	1/8"
	S5-8	25'-0"	—	—	—	—	—	—	—	15L 33.9	—	—	—	—	—	1/16"	1/8"	1/16"	1/4"	1/16"	3/16"
9	S1-9	81'-10 1/2"	80'-8 1/2"	7"	7"	32'-0"	—	—	—	36WF170	10 1/2 x 1"	—	—	10"	11 1/2"	1 3/16"	1 5/8"	1 3/16"	1 9/16"	2 5/16"	1 3/4"
	S2-9	82'-1 3/4"	80'-11 3/4"	7"	7"	32'-0"	—	—	—	36WF170	10 1/2 x 1"	—	—	10"	11 3/4"	1 1/16"	1 1/16"	1 3/16"	2"	2 7/8"	2 1/8"
	S3-9	82'-10 3/4"	81'-6 1/4"	8"	8"	32'-0"	—	—	—	36WF194	10 1/2 x 1 1/4"	—	—	12"	13 1/2"	1 1/16"	1 1/16"	1 3/16"	2 1/16"	3 3/4"	2 3/4"

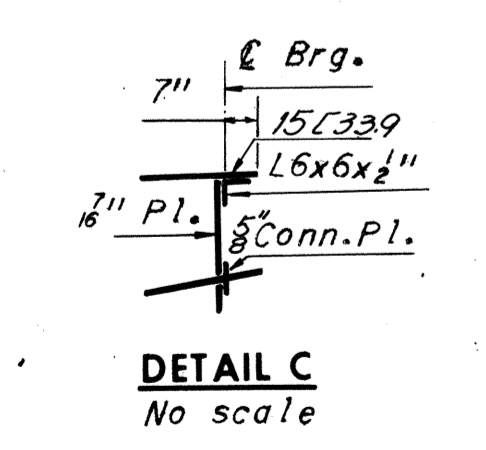

BY	DATE		
MADE	K.C.T.	11-12-68	
CHECKED	D.E.S.	1-13-69	
IN CHARGE			

Note: Intermediate stiffener Pls. 4x3/8" shall be equally spaced between diaphragms as shown. The first two stiffener spaces at the end of stringers shall be one-half the normal spacing within the panel.

Note: All Steel shall be A-36 unless denoted otherwise.

Note: Spacing begins at termination of 6 spaces @ 4".

Note: # Denotes A572-Grade 50 steel for thicknesses of 3/8" and under and A588 Steel for thicknesses over 3/8".

Notes: For Superstructure Steel Quantities, see Sheet 2.
For Joint Details, see Sheet 25.
For Shoe Details, see Sheet S1 and S2.
For Diaphragm Details, see Sheet 21.
For Shear Stud Details, see Sheet 12.



AS BUILT

RICHMOND METROPOLITAN AUTHORITY
RICHMOND EXPRESSWAY SYSTEM
DOWNTOWN EXPRESSWAY


BRIDGE NO. 68
RAMP W-S CONNECTION TO
RICHMOND-PETERSBURG TURNPIKE
FRAMING PLAN - UNITS 7, 8 AND 9

HOWARD, NEEDLES, TAMMEN & BERGENDOFF
consulting engineers
NEW YORK ALEXANDRIA KANSAS CITY


SCALE: As Noted
CONTRACT NO.: 11
SHEET NO. 14 OF 28

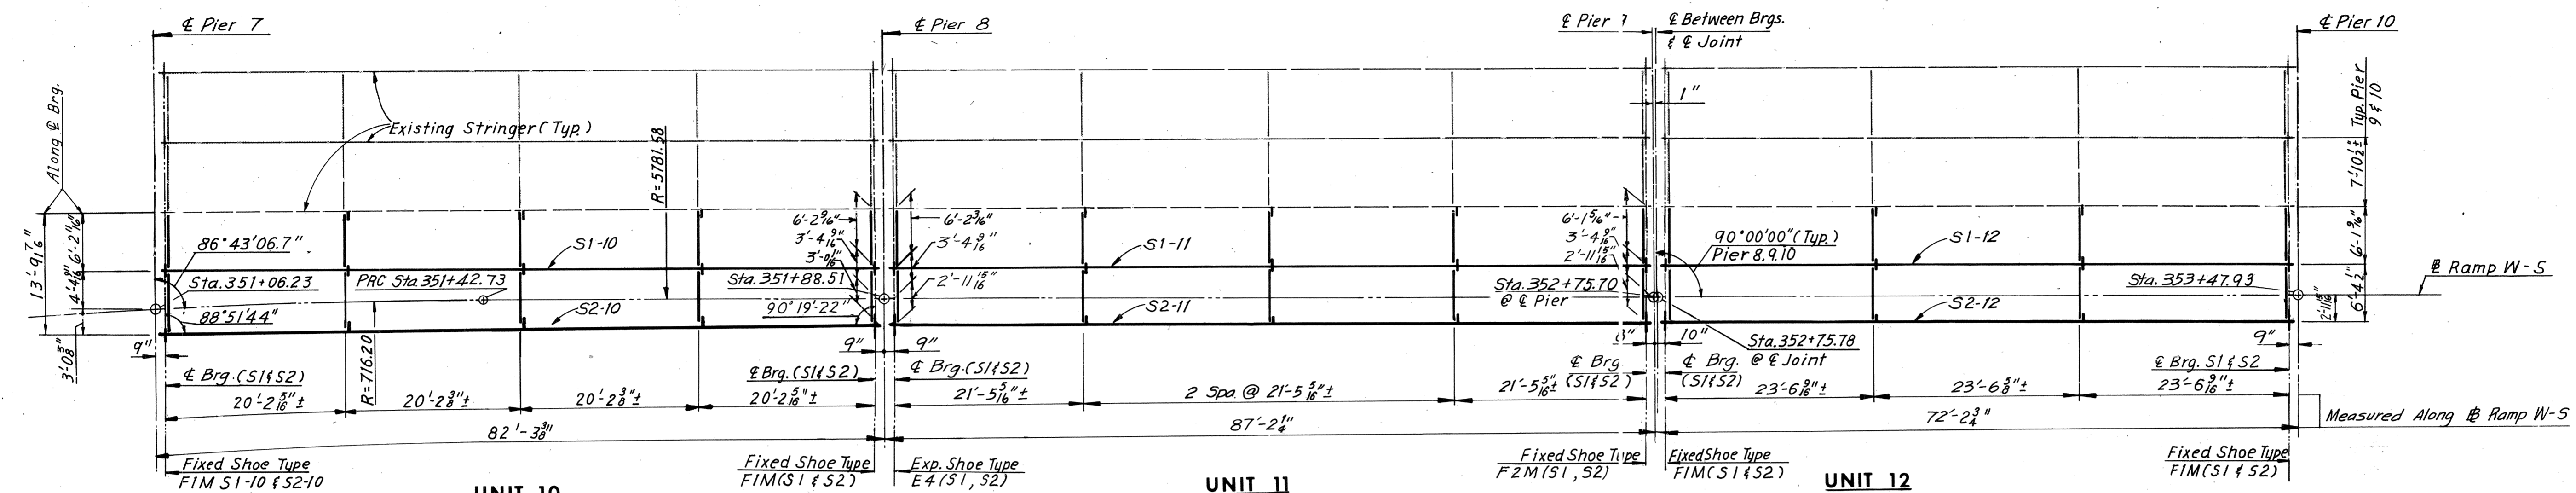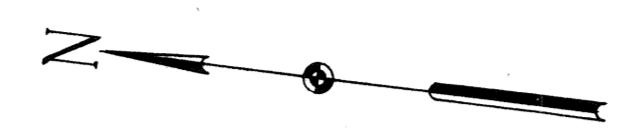


UNIT 11 FRAMING PLAN
Scale: 1" = 10'-0"

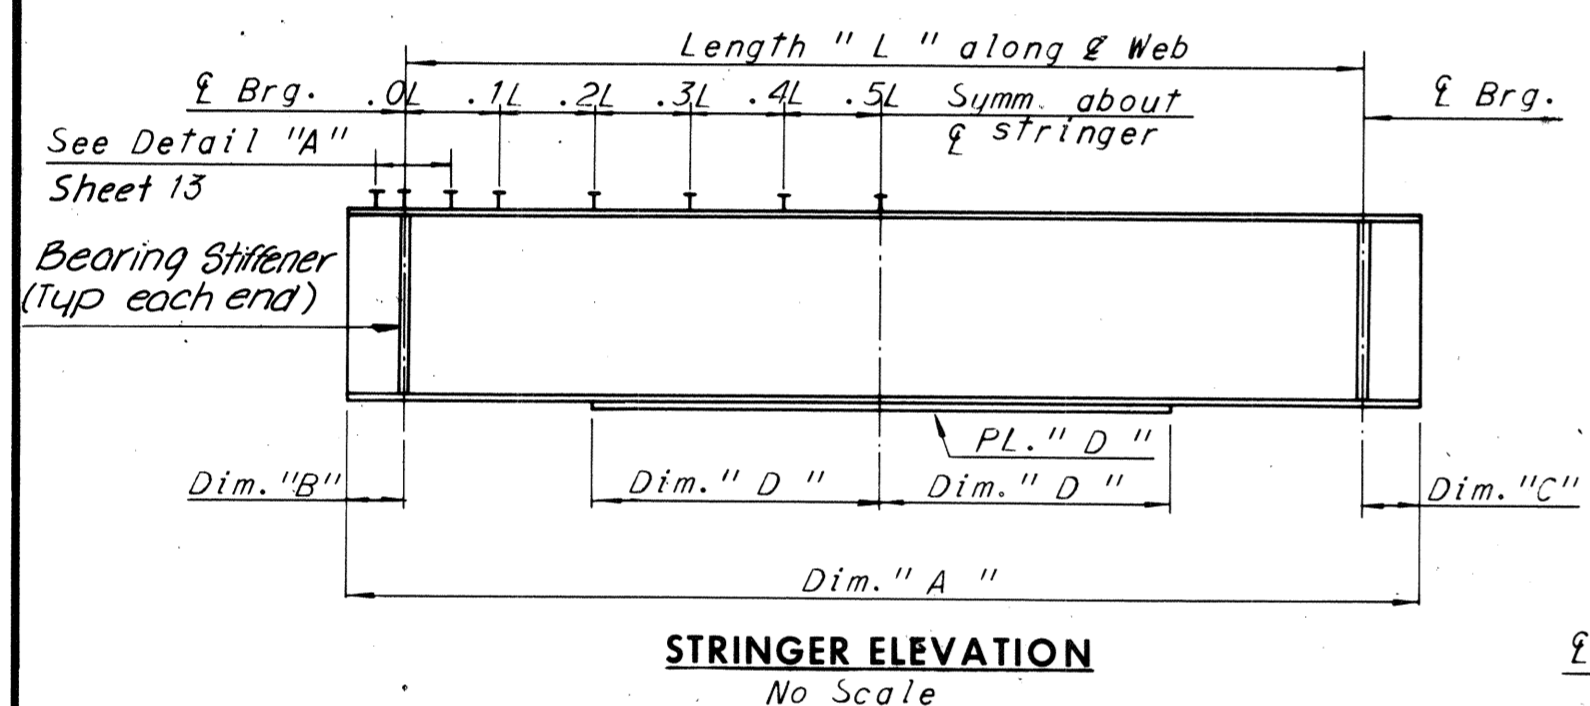

STRINGER ELEVATION
No Scale

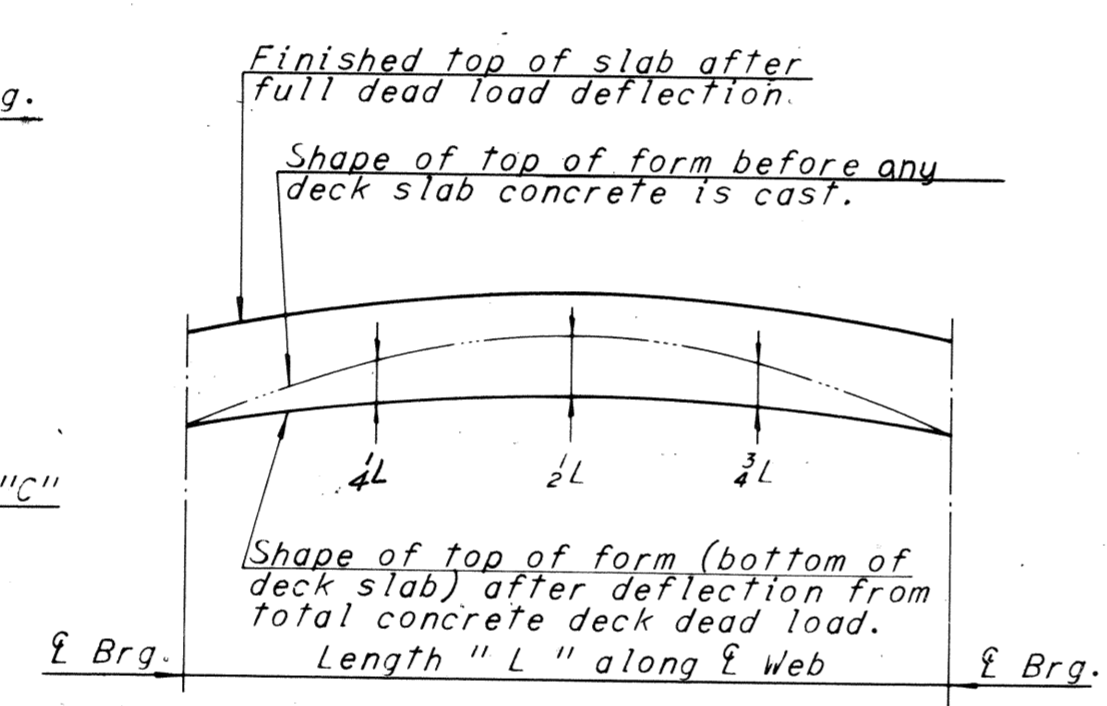


DEAD LOAD DEFLECTION DIAGRAM

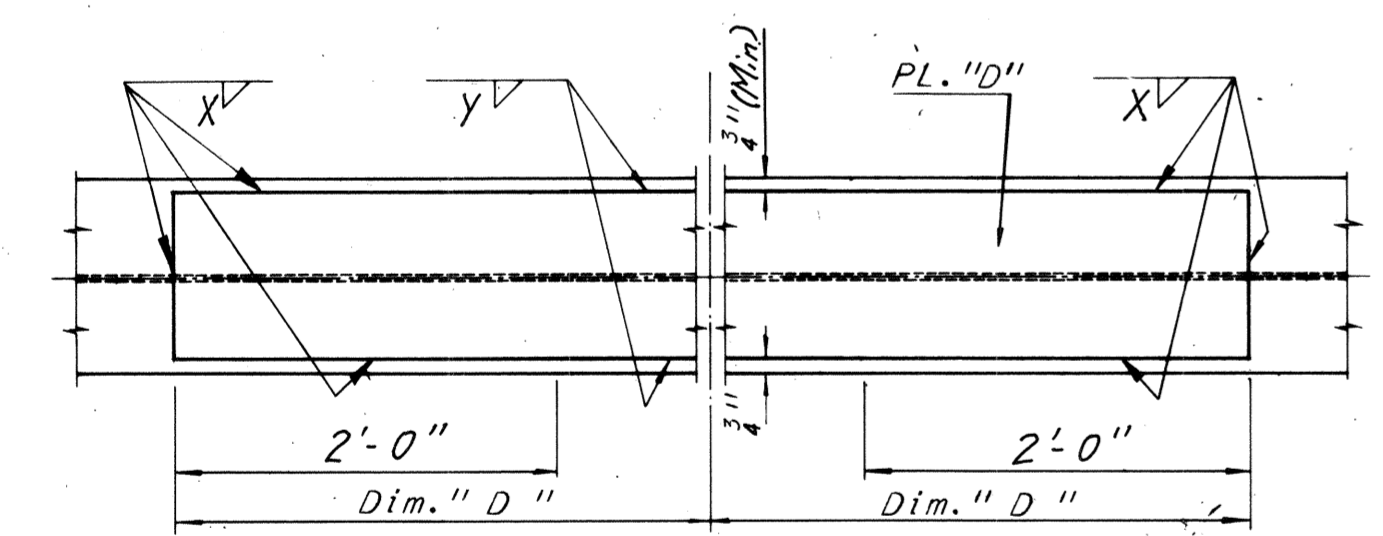

COVER PLATE DETAIL
No Scale

NOTE TO CONTRACTOR
Deflections given are those anticipated to occur in the stringer upon placement of the total concrete deck dead load. In practice, the stringers in place are not likely to have the exact camber to compensate for these deflections during construction. The residual amounts shall be provided by adjusting forms to vary the thickness of the concrete haunch between the bottom of the slab and the top of stringer without altering the slab thickness.

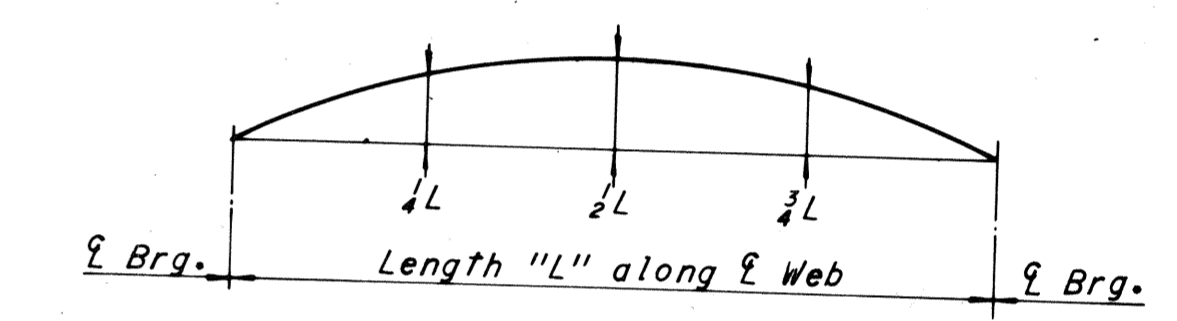

CAMBER DIAGRAM

NOTE TO FABRICATOR
The stringers shall be fabricated with an upward camber amounting to the tabulated value. This will provide approximate compensation for deflection under full dead load and for conformity with finished grade.

Stringers having a total camber of less than 1" are not required to be shop cambered, but should be turned so that any mill tolerance deviation from straightness will be in the direction shown by the Camber Diagram. If stringers are not cambered, distance top of stringers to top of slab will vary along the stringer in accordance with the offset dimensions shown in the Camber Diagram, and with minimum distance as shown in Cross-Section on Sheet 22.

Unit	Stringer	X	Y
10	S1-10	1/2	5/16
	S2-10	3/8	3/8
11	S1-11	3/8	5/16
	S2-11	3/8	3/8
12	S1-12	3/8	5/16
	S2-12	1/8	3/16

UNIT	STRINGER	STRINGER SIZE	Dim. "A"	LENGTH "L"	Dim. "B"	Dim. "C"	Dim. "D"	PL. "D"	MAX. SHEAR STUD SPACING					DEAD LOAD DEFLECTION SCHEDULE			CAMBER SCHEDULE		
									0.0L-0.1L	0.1L-0.2L	0.2L-0.3L	0.3L-0.4L	0.4L-0.5L	1/4L	1/2L	3/4L	1/4L	1/2L	3/4L
									19"	20"	24"	24"	24"	1 1/4"	1 3/4"	1 1/4"	1 1/16"	2 3/8"	1 3/8"
10	S1-10	36 W 150	81'-10 1/2"	80'-8 1/2"	7"	7"	28'-9"	10 1/2 x 1 3/8"	19"	20"	24"	24"	24"	1 1/4"	1 3/4"	1 1/4"	1 1/16"	2 3/8"	1 3/8"
	S2-10	36 W 170	81'-11 3/4"	80'-9 3/4"	7"	7"	28'-9"	10 1/2 x 1 3/8"	20"	21"	24"	24"	24"	1 1/4"	1 3/4"	1 1/4"	1 1/8"	2 3/8"	1 3/8"
11	S1-11	36 W 160	86'-10 5/8"	85'-8 5/8"	7"	7"	30'-6"	10 1/2 x 1 1/2"	21"	22"	24"	24"	24"	1 1/4"	2"	1 1/4"	1 3/16"	2 3/4"	2"
	S2-11	36 W 194	86'-11 1/4"	85'-9 3/4"	7"	7"	29'-0"	10 1/2 x 1 3/8"	23"	24"	24"	24"	24"	1 3/8"	1 13/16"	1 3/8"	1 1/8"	2 5/8"	1 3/8"
12	S1-12	36 W 135	71'-9 1/4"	70'-7 1/4"	7"	7"	23'-6"	10 1/2 x 3/8"	20"	22"	23"	24"	24"	3/8"	1 1/4"	3/8"	1 3/16"	1 3/8"	1 3/16"
	S2-12	36 W 135	71'-10 3/16"	70'-8 3/16"	7"	7"	24'-6"	10 1/2 x 1 1/8"	21"	22"	24"	24"	24"	1"	1 3/8"	1"	1 3/16"	1 1/16"	1 3/16"

SHOE SCHEDULE			
EXPANSION SHOES		FIXED SHOES	
TYPE	NO. REQD.	TYPE	NO. REQD.
E4	2	FIM	8
-	-	F2M	2

* Spacing begins at termination of 6 spaces @ 4".

Note: Dimensions shown on the plans for existing structural metalwork are in accordance with drawings prepared for the original construction. The Contractor shall verify all necessary dimensions of existing structural metalwork prior to preparing shop drawings for new metalwork.

Notes: All steel shall be A-36 unless denoted otherwise. For Superstructure Steel Quantities, see Sheet 2. For Joint Details, see Sheet 25. For New Shoe Details, see Sheet S1 and S2. For Diaphragm Details, see Sheet 22. For Shear Stud Detail, see Sheet 12.

Note: New Diaphragms are to match the existing Diaphragms on R. P. Turnpike structure. Connection bolts for the new Diaphragms connecting Bridge 68 to the existing structure, shall not be fully tightened before new concrete deck slab has been placed.

BY	DATE	REVISION	BY	DATE
MADE	SCC 11-12-68			
CHECKED	D.E.S. 1-15-69	Deleted end diaph. conn. @ exist. str.	TEM	8-26-75
IN CHARGE				

AS BUILT

RICHMOND METROPOLITAN AUTHORITY
RICHMOND EXPRESSWAY SYSTEM
DOWNTOWN EXPRESSWAY

BRIDGE NO. 68
RAMP W-S CONNECTION TO
RICHMOND-PETERSBURG TURNPIKE
FRAMING PLAN - UNITS 10, 11 AND 12




HOWARD, NEEDLES, TAMMEN & BERGENDOFF
consulting engineers
NEW YORK ALEXANDRIA KANSAS CITY

SCALE: As Noted
CONTRACT NO.: 11
SHEET NO. 15 OF 28


RICHMOND EXPRESSWAY SYSTEM			
SECTION	PROJECT	SHEET NO.	TOTAL SHEETS
11	DOWNTOWN EXPRESSWAY	79	97

SHOE SCHEDULE			
EXPANSION SHOES		FIXED SHOES	
TYPE	NO REQD	TYPE	NO REQD
E1	4	F1M	8
E4	1	F2M	4
E1M	3		


Note: New Diaphragms are to match the existing Diaphragms on R. P. Turnpike structure. Connection bolts for the new Diaphragms connecting Bridge 68 to existing structure, shall not be fully tightened before new concrete deck slab has been placed.

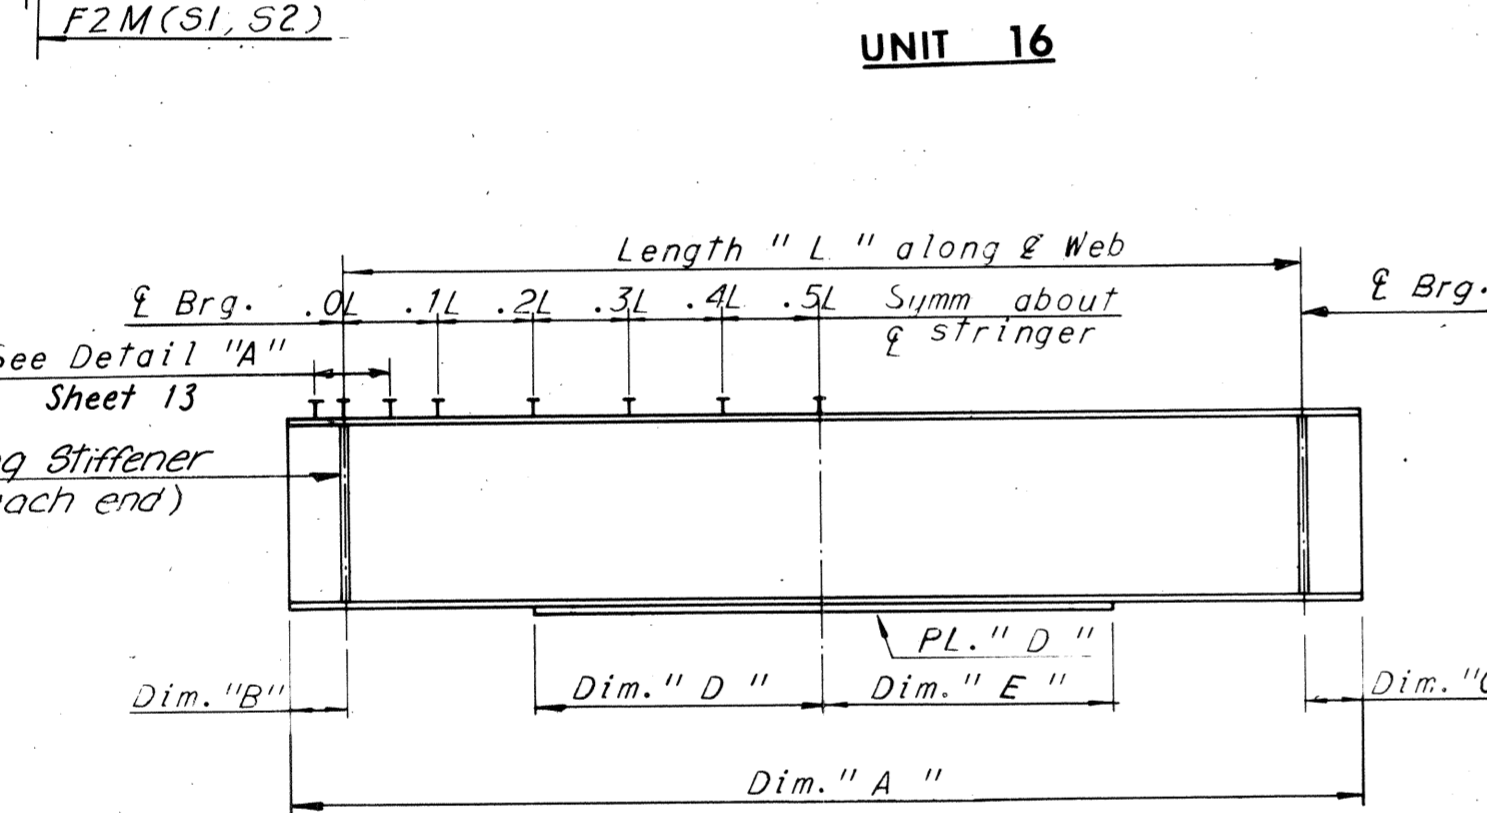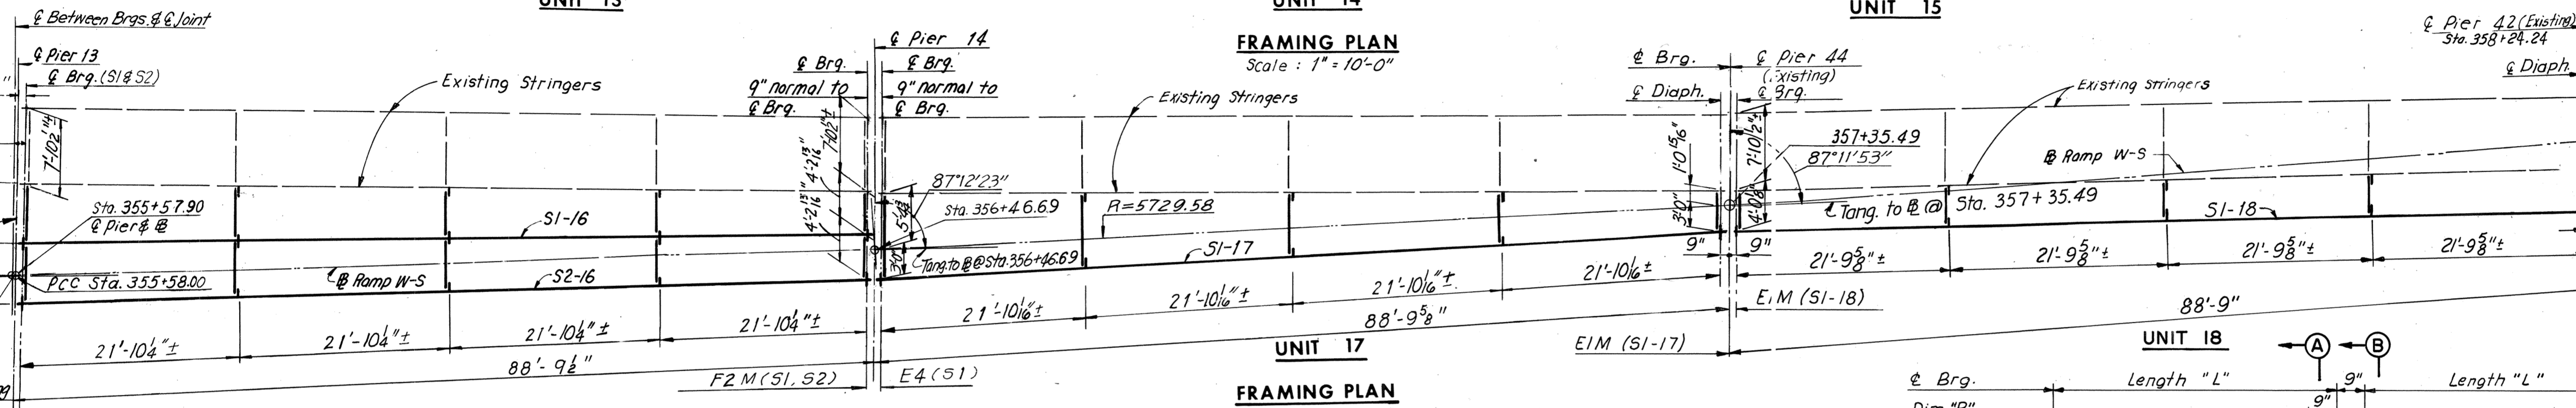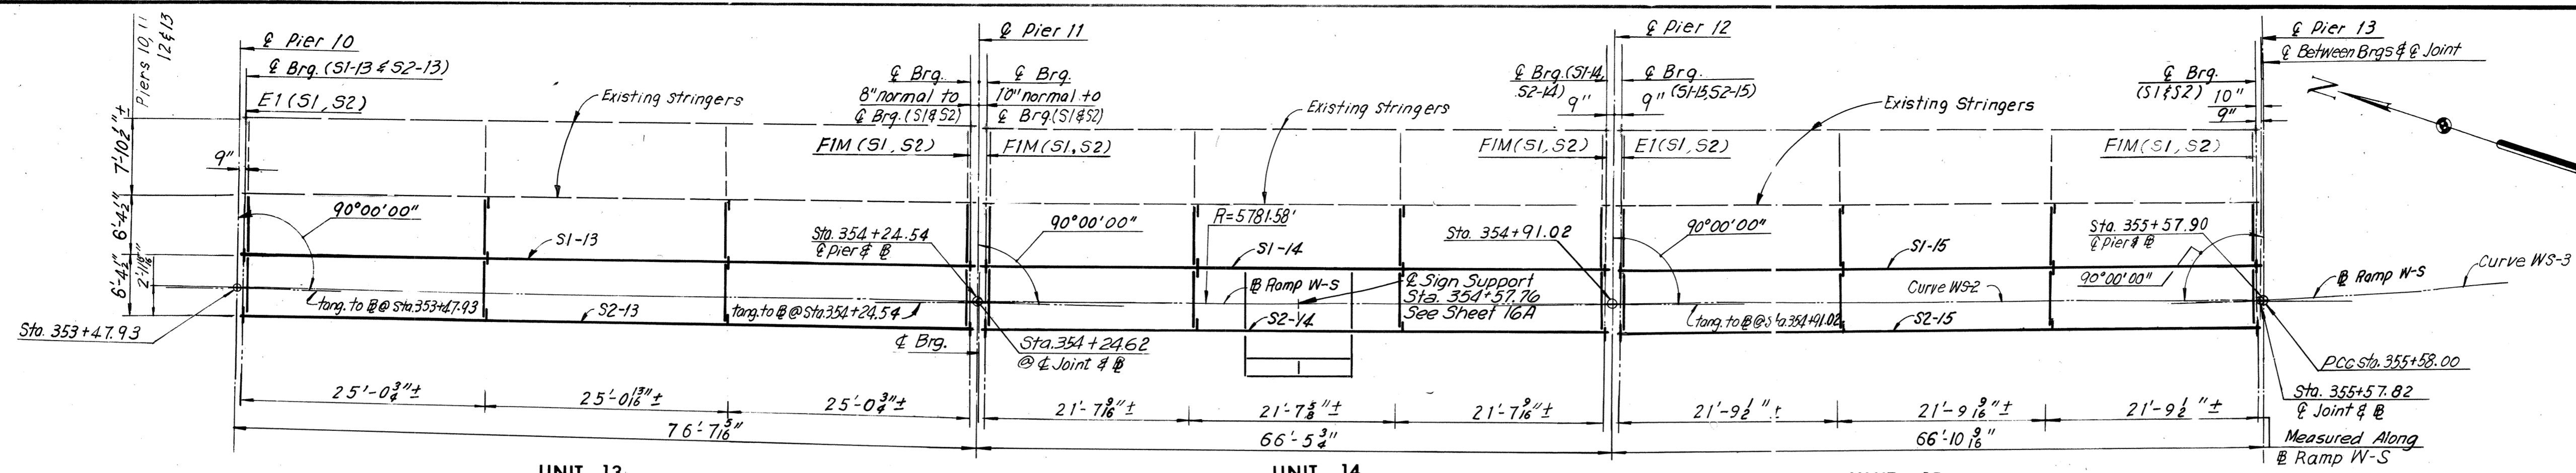

Unit	Stringer	X	Y
13	S1-13	7/16	5/16
	S2-13	7/16	5/16
14	S1-14	5/16	5/16
	S2-14	5/16	5/16
15	S1-15	5/16	5/16
	S2-15	5/16	5/16
16	S1-16	1/2	5/16
	S2-16	5/8	3/8
17	S1-17	3/8	3/8
	S1-18	3/8	5/16


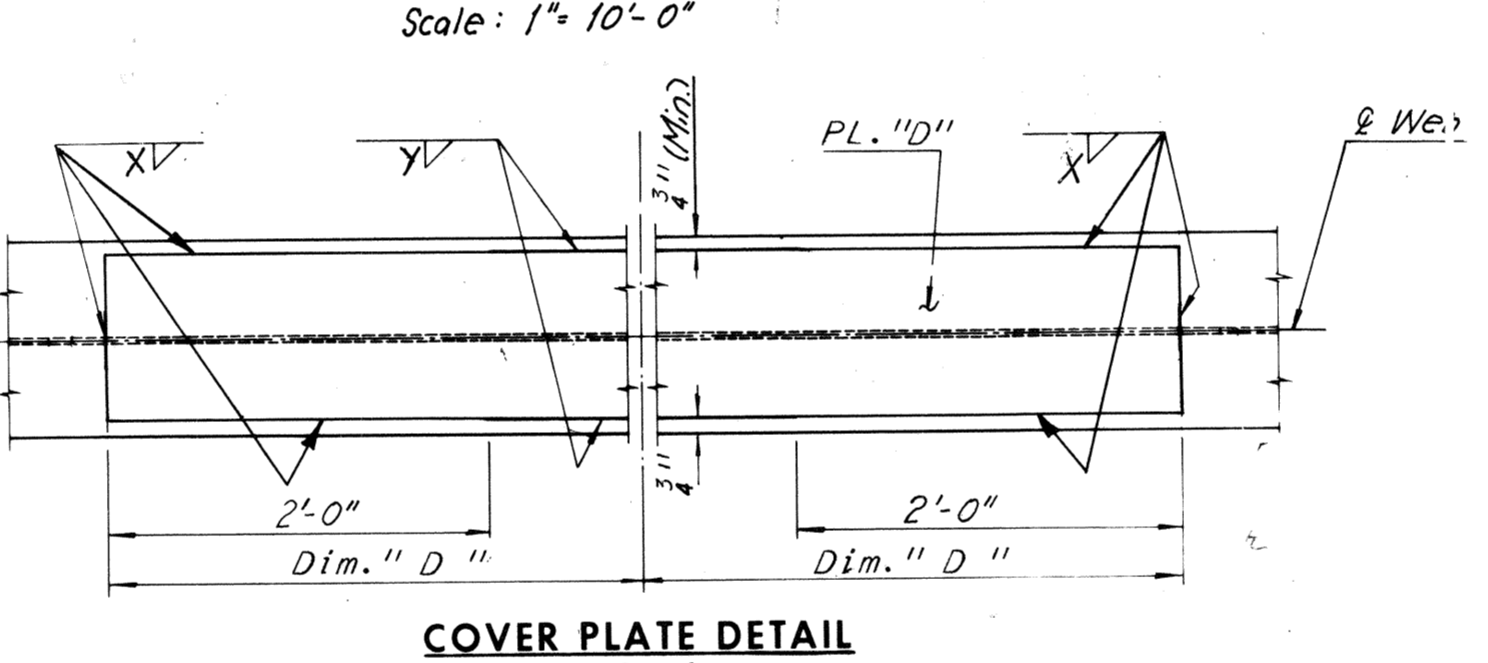


Note: Stringers having a total camber of less than 1" are not required to be shop cambered, but should be turned so that any mill tolerance deviation from straightness will be in the direction shown by the Camber Diagram. If stringers are not cambered, distance top of stringers to top of slab will vary along the stringer in accordance with the offset dimensions shown in the Camber Diagram, and with minimum distance as shown in cross-section on Sheet 23. (Typical all A36 WF except as shown otherwise.)

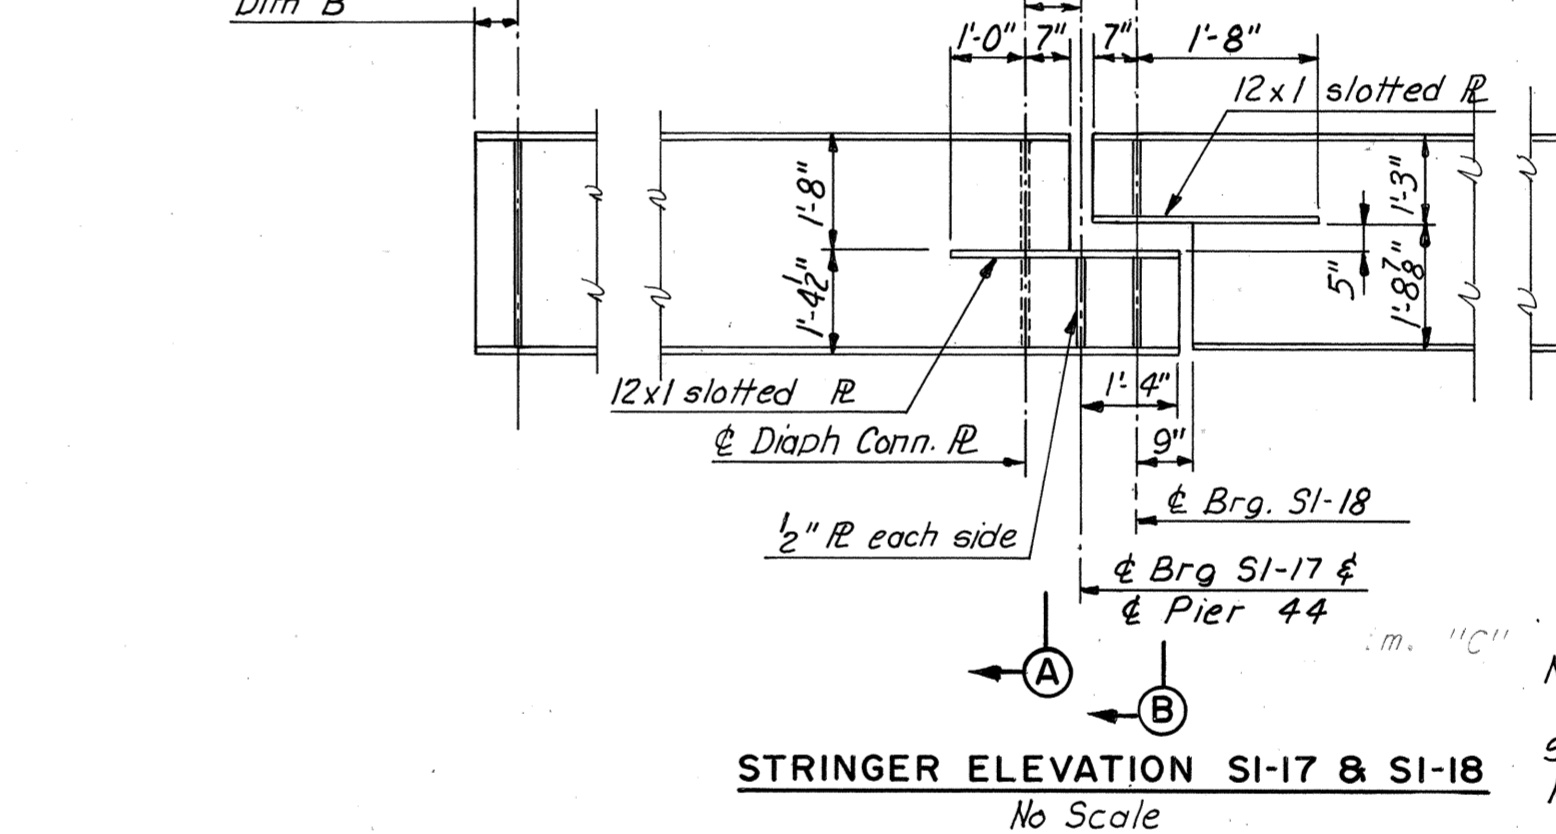

Note: For Details not shown see Stringer Elevation Unit 13 thru 16.

UNIT	STRINGER	STRINGER SIZE	Dim. "A"	LENGTH "L"	Dim. "B"	Dim. "C"	Dim. "D"	Dim. "E"	PL. "D"	DEAD LOAD DEFLECTION SCHEDULE					CAMBER SCHEDULE					
										MAX. SHEAR STUD SPACING					1/4L	1/2L	3/4L	1/4L	1/2L	3/4L
										0.0L-0.1L	0.1L-0.2L	0.2L-0.3L	0.3L-0.4L	0.4L-0.5L						
13	S1-13	36 WF 135	76'-3 13/16"	75'-11 1/16"	7"	7"	26'-3"	26'-3"	10 1/2 x 1 1/2"	20"	21"	24"	24"	24"	1 1/2"	1 1/2"	1 1/2"	1 3/8"	1 5/16"	1 3/8"
	S2-13	36 WF 150	76'-4 13/16"	75'-2 13/16"	7"	7"	26'-0"	26'-0"	10 1/2 x 1 1/4"	22"	23"	24"	24"	24"	1 1/2"	1 1/2"	1 1/2"	1 3/8"	1 5/16"	1 3/8"
14	S1-14	36 WF 135	66'-0 5/16"	64'-10 5/16"	7"	7"	18'-6"	18'-6"	10 1/2 x 3/4"	20"	22"	23"	24"	24"	3/4"	1"	3/4"	1 5/16"	1 5/16"	1 5/16"
	S2-14	36 WF 135	66'-1 3/16"	64'-11 3/16"	7"	7"	20'-6"	20'-6"	10 1/2 x 3/4"	21"	22"	24"	24"	24"	3/4"	1 1/16"	3/4"	1"	1 5/16"	1"
15	S1-15	36 WF 135	66'-5 1/8"	65'-3 1/8"	7"	7"	18'-6"	18'-6"	10 1/2 x 3/8"	20"	22"	23"	24"	24"	3/4"	1"	3/4"	1 5/16"	1 5/16"	1 5/16"
	S2-15	36 WF 135	66'-6"	65'-4"	7"	7"	20'-6"	20'-6"	10 1/2 x 3/4"	21"	22"	24"	24"	24"	3/4"	1 1/16"	3/4"	1 5/16"	1 5/16"	1 5/16"
16	S1-16	36 WF 150	88'-5 1/8"	87'-3 1/8"	7"	7"	31'-3"	31'-3"	10 1/2 x 1 1/2"	21"	23"	24"	24"	24"	1 1/2"	2"	1 1/2"	2"	2 3/4"	2"
	S2-16	36 WF 182	88'-7"	87'-5"	7"	7"	30'-6"	30'-6"	10 1/2 x 1 1/2"	23"	24"	24"	24"	24"	1 1/2"	2 1/2"	1 1/2"	2"	2 3/4"	2"
17	S1-17	36 WF 194	90'-0 7/16"	88'-1 3/16"	7"		43'-1 1/2"	31'-6"	10 1/2 x 1 1/2"	20"	21"	24"	24"	24"	1 1/2"	2 1/6"	1 1/2"	2"	2 3/4"	2"
	S1-18	36 WF 150	89'-1 9/16"	87'-11 9/16"			28'-6"	28'-6"	10 1/2 x 1"	24"	24"	24"	24"	24"	1 1/2"	2 1/6"	1 1/2"	2 1/6"	2 7/8"	2 1/6"

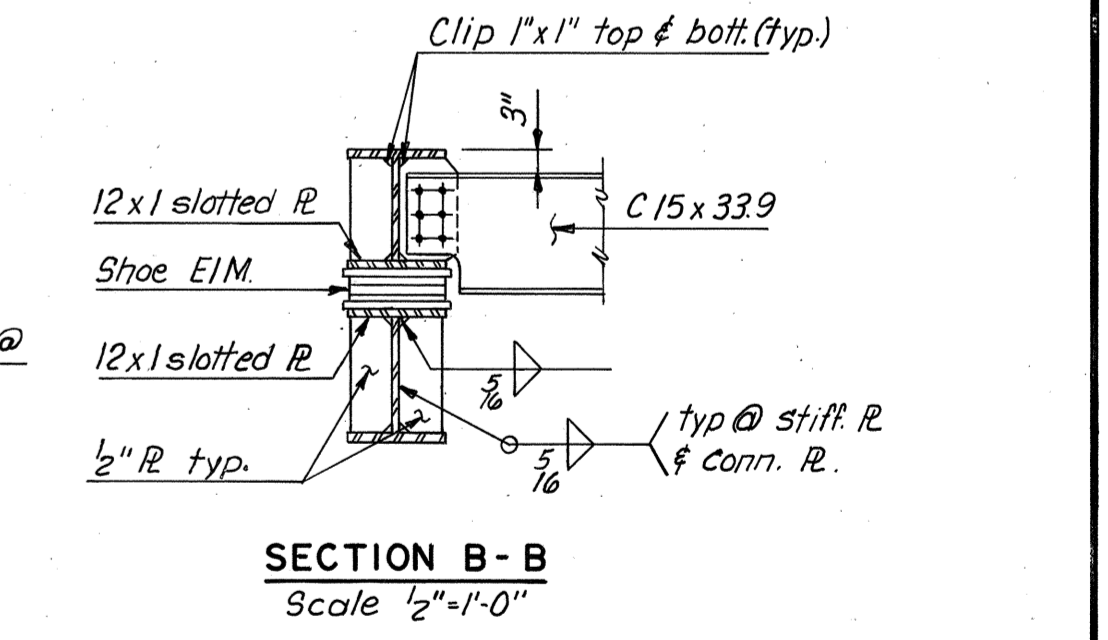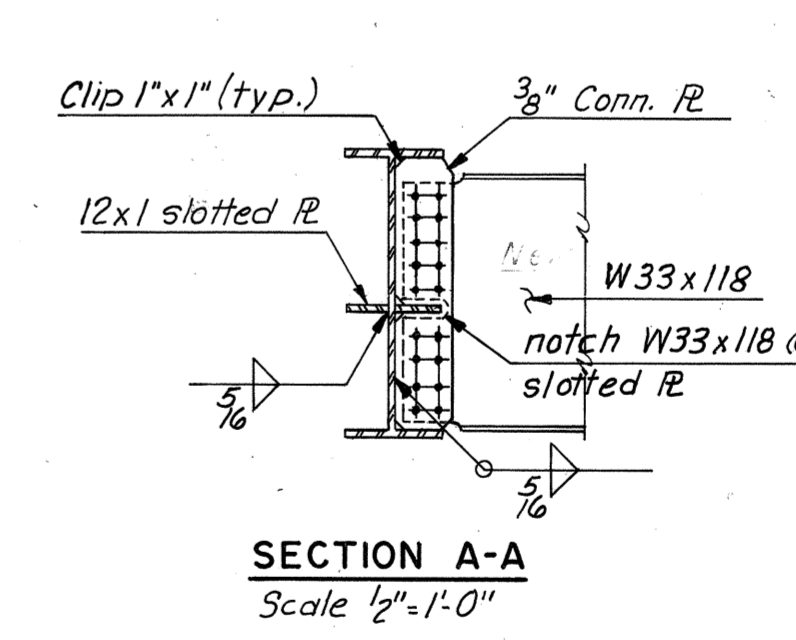

AS BUILT

RICHMOND METROPOLITAN AUTHORITY
RICHMOND EXPRESSWAY SYSTEM
DOWNTOWN EXPRESSWAY

BRIDGE NO. 68
RAMP W-5 CONNECTION TO
RICHMOND-PETERSBURG TURNPIKE
FRAMING PLAN — UNITS 13 THRU 18

HOWARD, NEEDLES, TAMMEN & BERGENDOFF
 consulting engineers
 NEW YORK ALEXANDRIA KANSAS CITY

SCALE: As Noted
 CONTRACT NO.: 11
 SHEET NO. 16 28




MADE	GSH	11-18-88	Deleted end diaphragm conn. R @ exist str.	T.E.M.	8-18-75
CHECKED	SCC	1-17-69	Diaphragm sp. Unit 16 Str. & Diaphragm Units 17 & 18	TEM.	8-18-75
IN CHARGE					

Note: Dimensions shown on the plans for existing structural metalwork are in accordance with drawings prepared for the original construction. The Contractor shall verify all necessary dimensions of existing structural metalwork prior to preparing shop drawings for new metalwork.

Note: All Steel shall be A-36 unless denoted otherwise. * Denotes A572 - Grade 50 Steel for thickness of 3/4" and under and A588 Steel for thickness over 3/4"

Note: For Camber Diagram and Dead Load Deflection Diagram see Sheet 12. * Spacing begins at termination of 6 spaces @ 4".

RICHMOND EXPRESSWAY SYSTEM			
SECTION	PROJECT	SHEET NO.	TOTAL SHEETS
11	DOWNTOWN EXPRESSWAY	79A	97

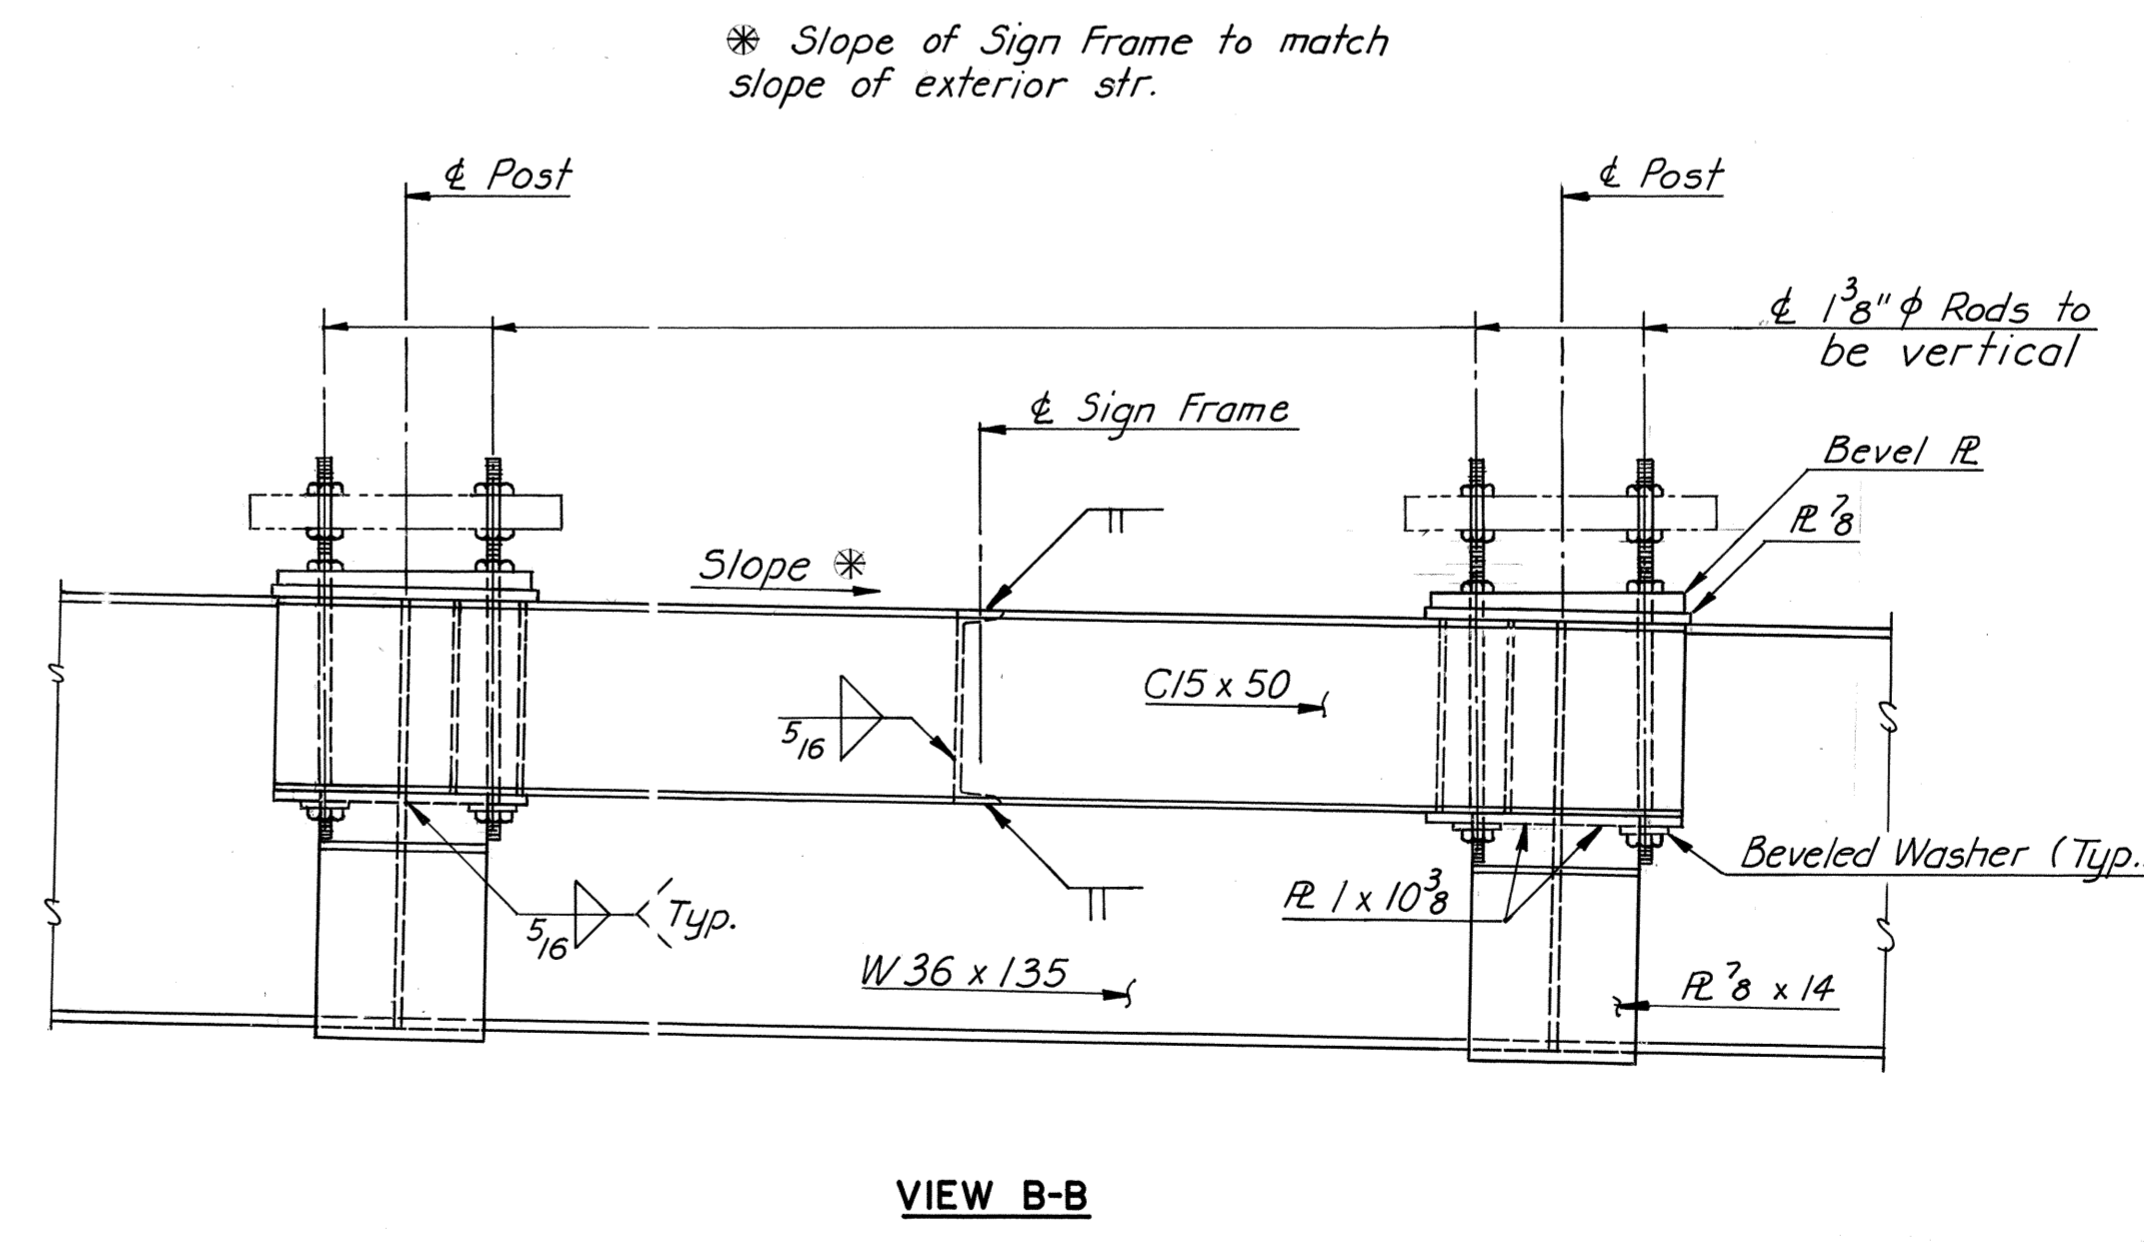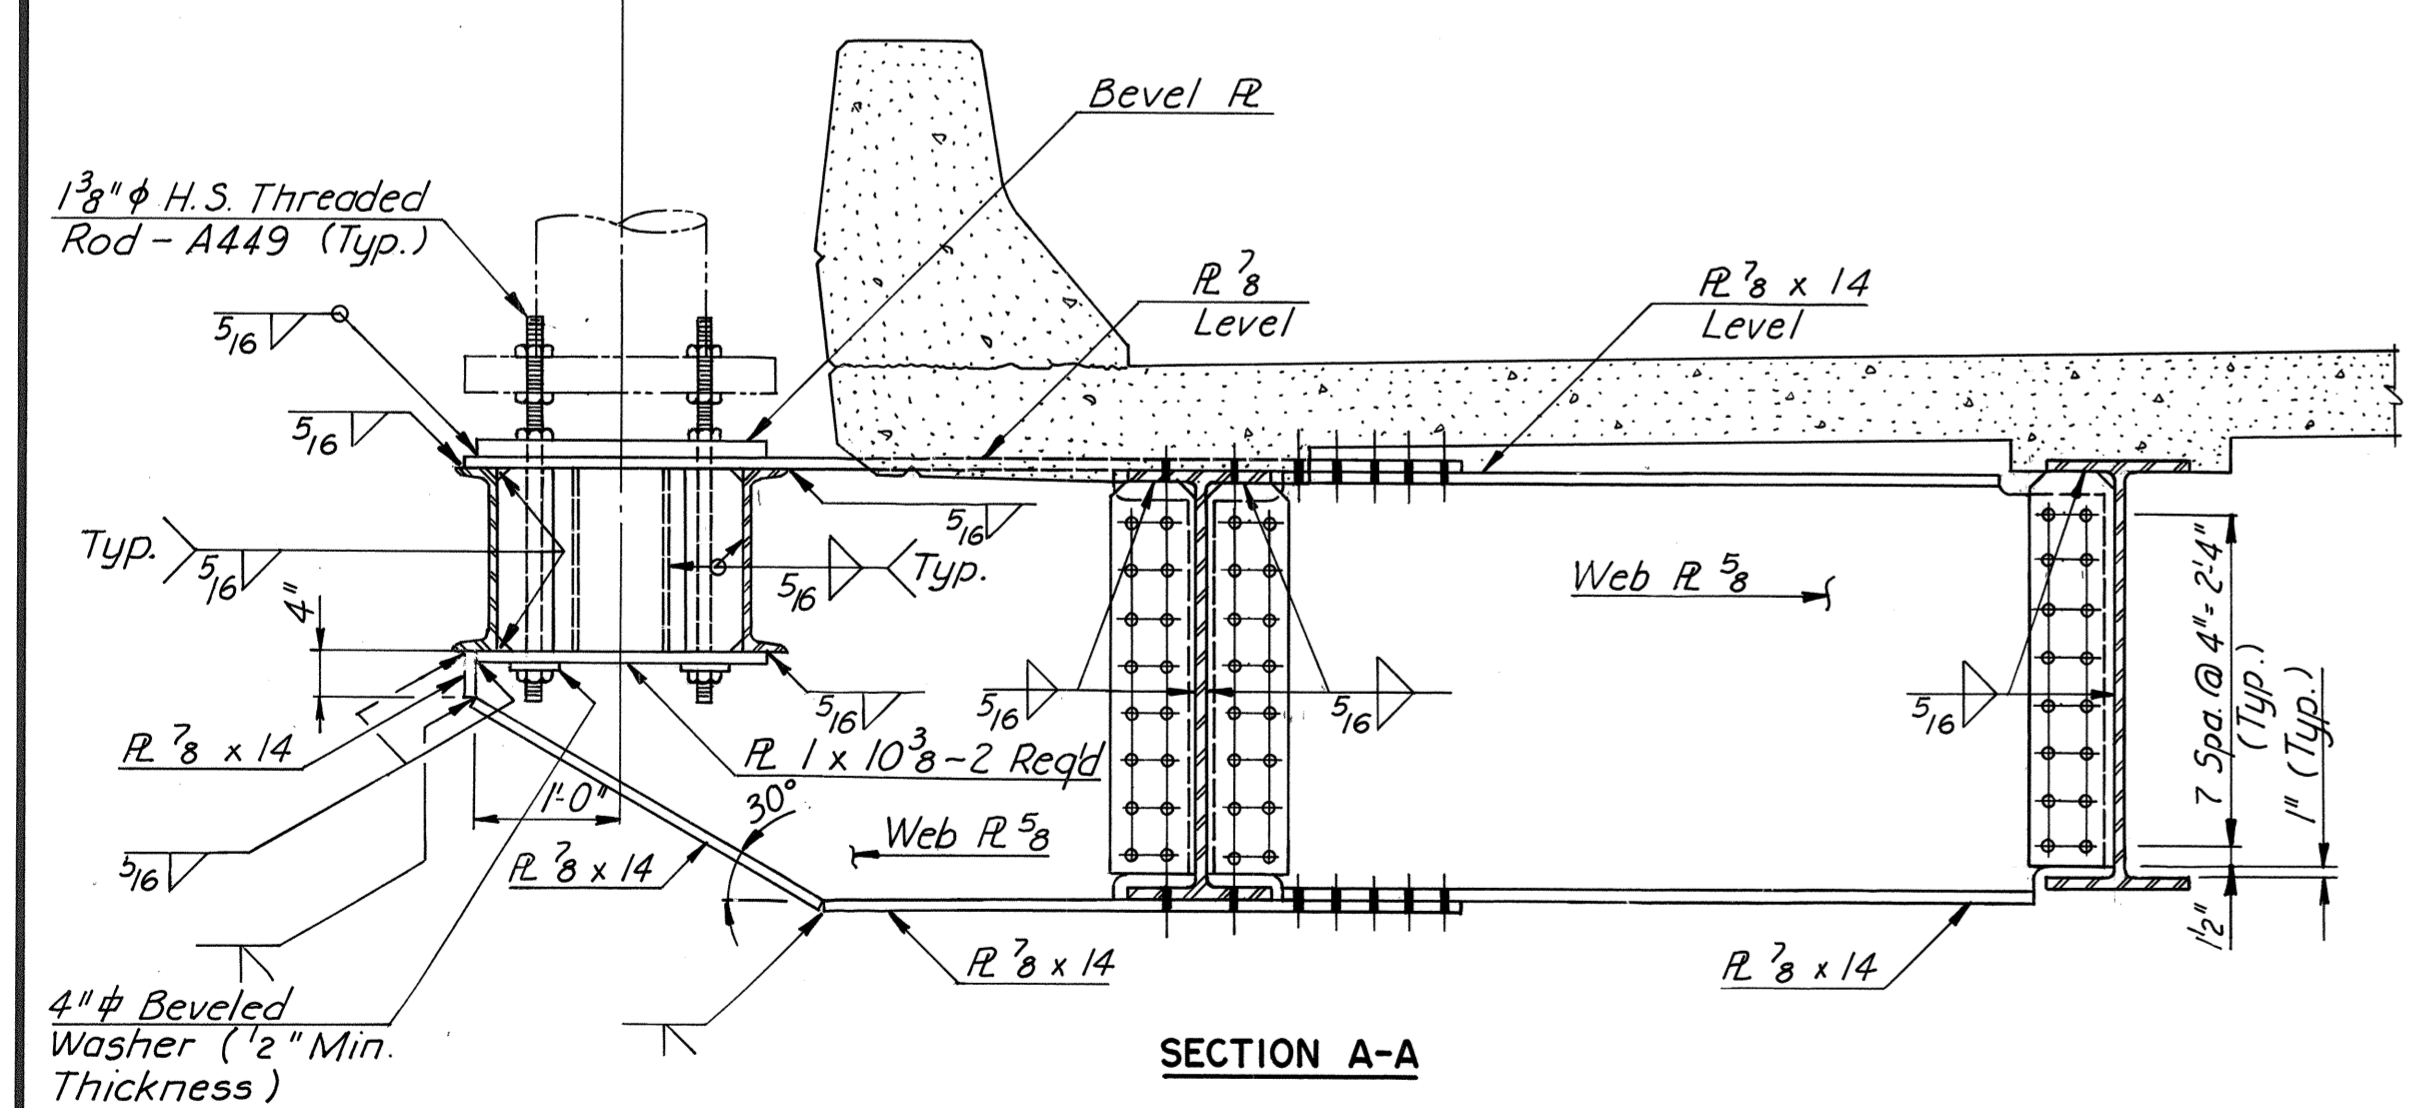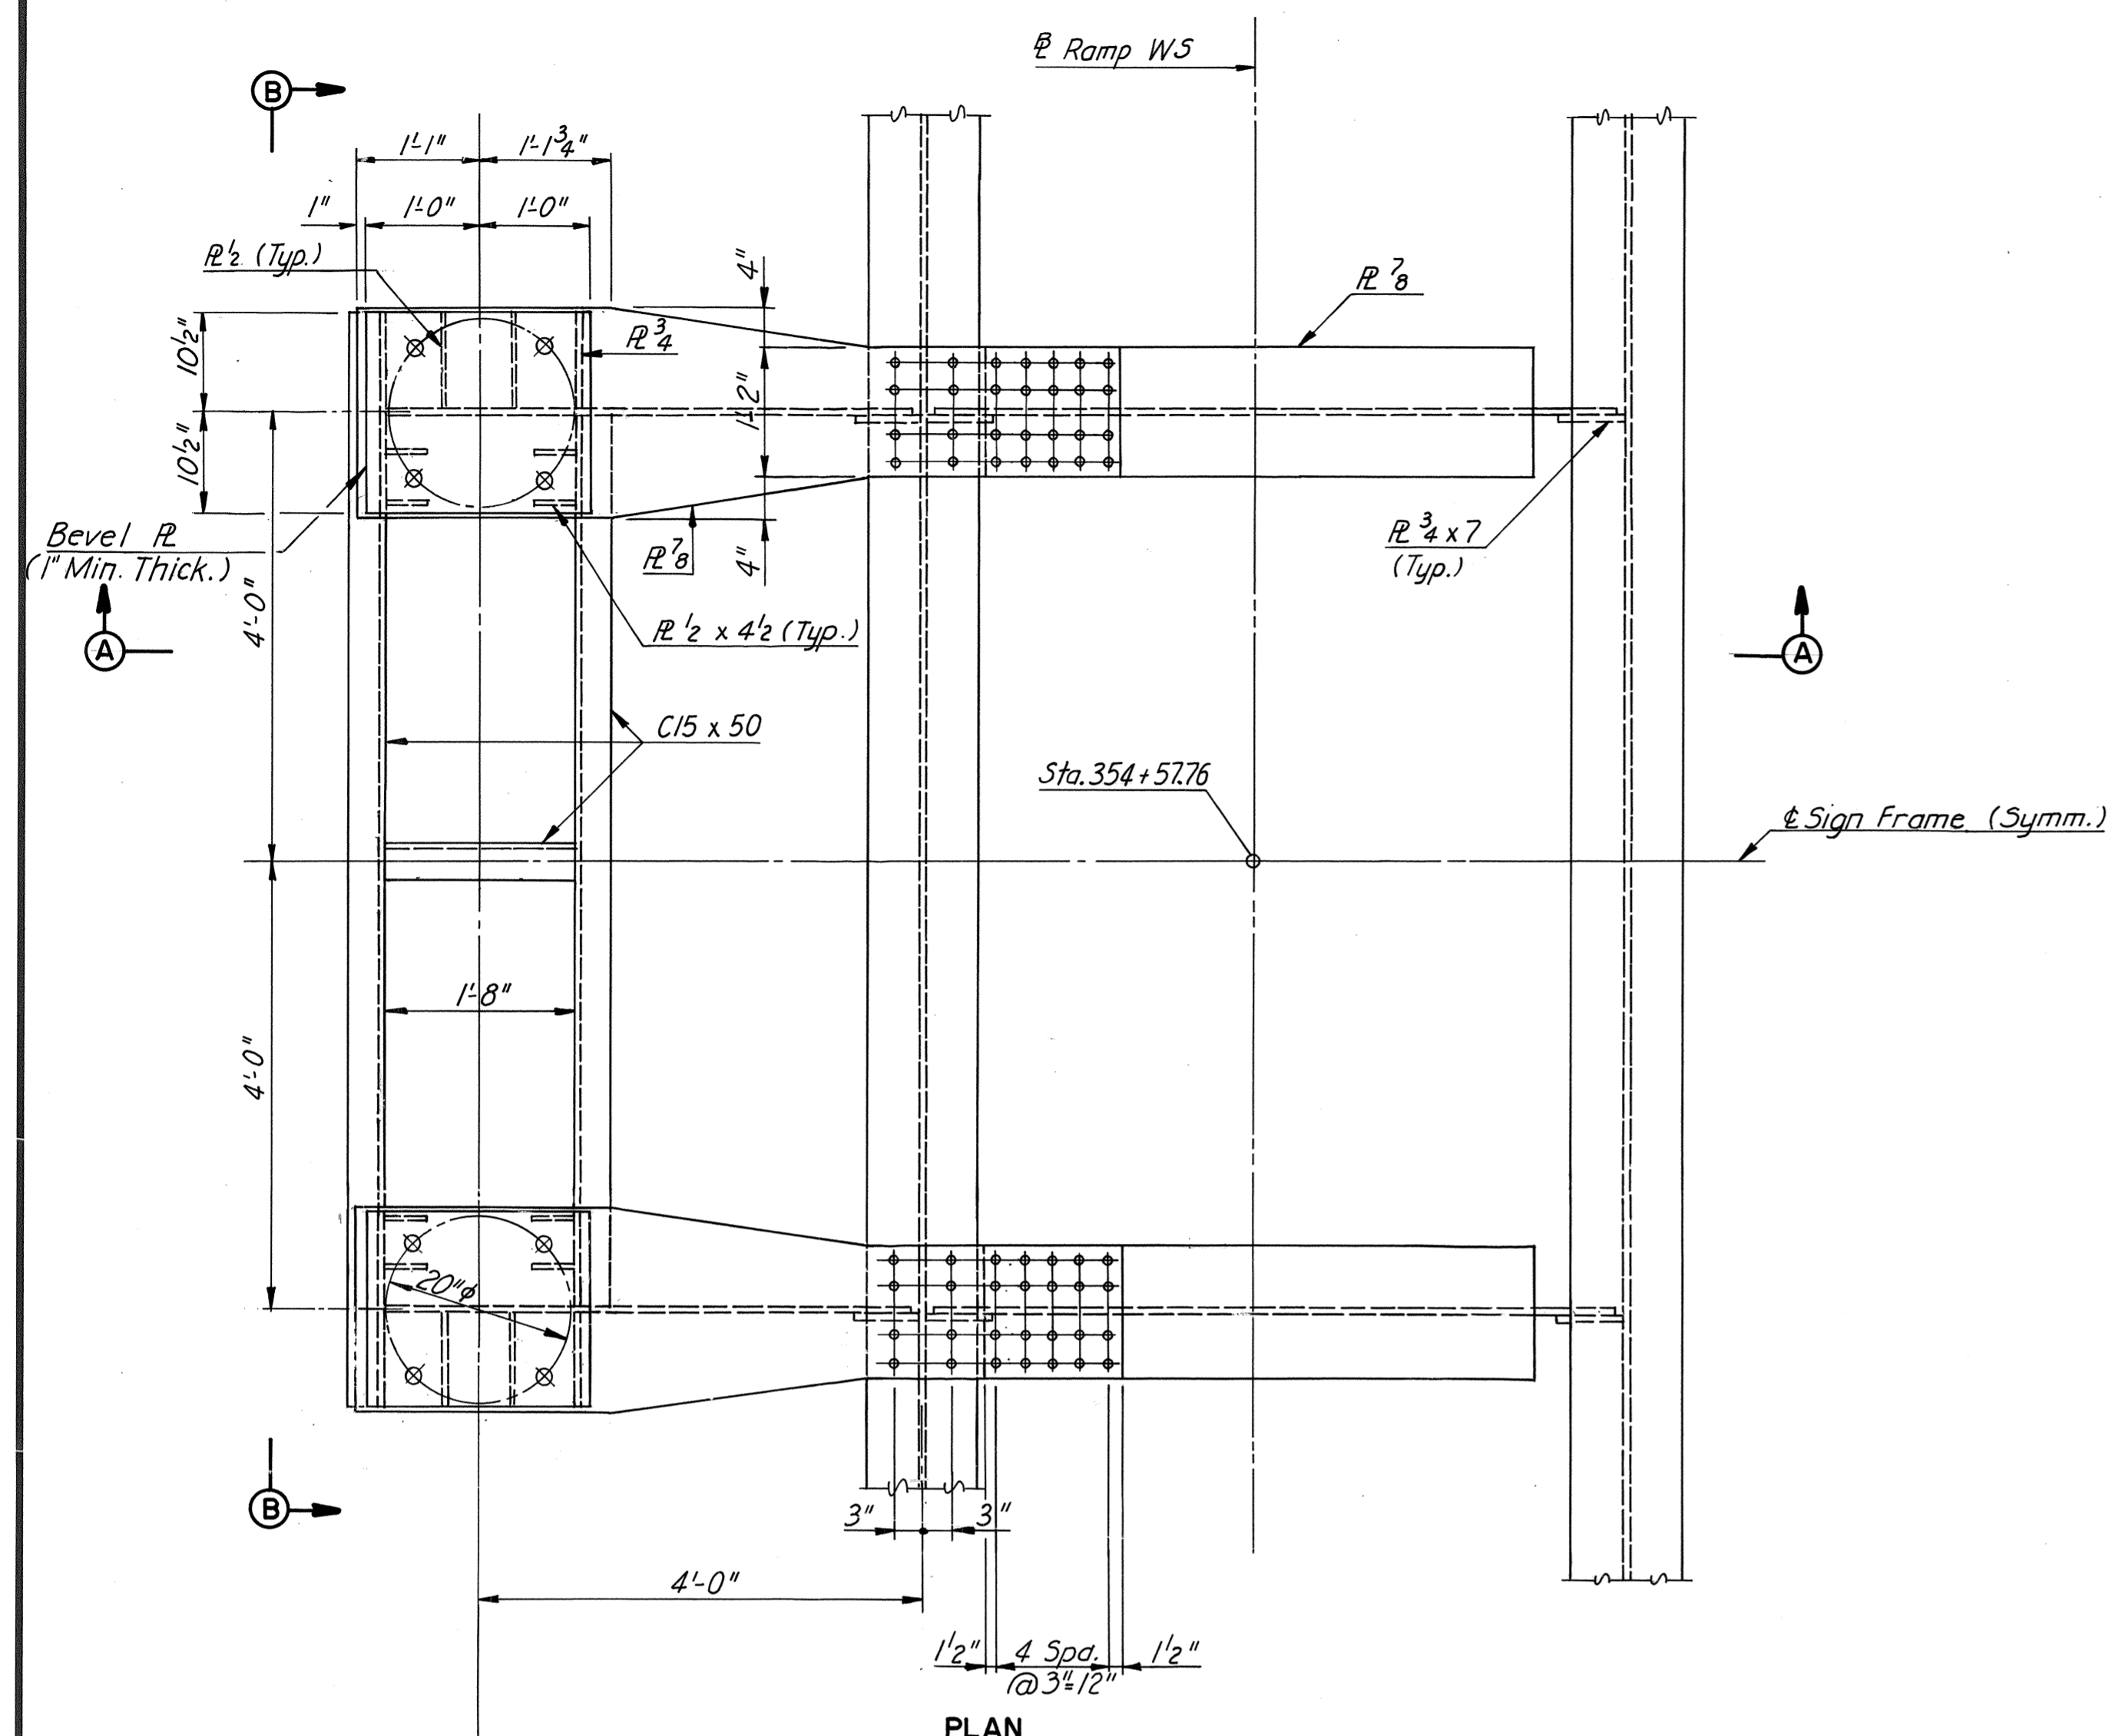

- Notes:
1. See Framing Plan Sheet 16 for location of sign support diaphragms.
 2. All material shall be ASTM A36 steel, except anchor bolt assemblies.
 3. Care shall be taken to ensure vertical alignment of the anchor rods.
 4. For signing and sign pole details, see Roadway Plans.
 5. All bolts to be 7/8" H.S. unless noted otherwise.

DESIGNED	T.E.M.	3-76			
DRAWN	d.B.P.	3-76			
CHECKED	T.E.M.	3-76	1	New Sheet added	d.B.P. 3-76
IN CHARGE			NO.	REVISION	BY DATE

AS BUILT


RICHMOND METROPOLITAN AUTHORITY
RICHMOND EXPRESSWAY SYSTEM
 DOWNTOWN EXPRESSWAY

BRIDGE NO. 68
 RAMP W-S CONNECTION FROM
 RICHMOND-PETERSBURG TURNPIKE
 SIGN SUPPORT BRACKET DETAILS-UNIT 14


SCALE 3/4" = 1'-0"
 DATE _____ CONTRACT NO. 11
 SHEET 16A OF 28

HOWARD, NEEDLES, TAMMEN & BERGENDOFF
 CONSULTING ENGINEERS
 Alexandria, Virginia **HNTB**



RICHMOND EXPRESSWAY SYSTEM			
SECTION	PROJECT	SHEET NO.	TOTAL SHEETS
11	DOWNTOWN EXPRESSWAY	80	97

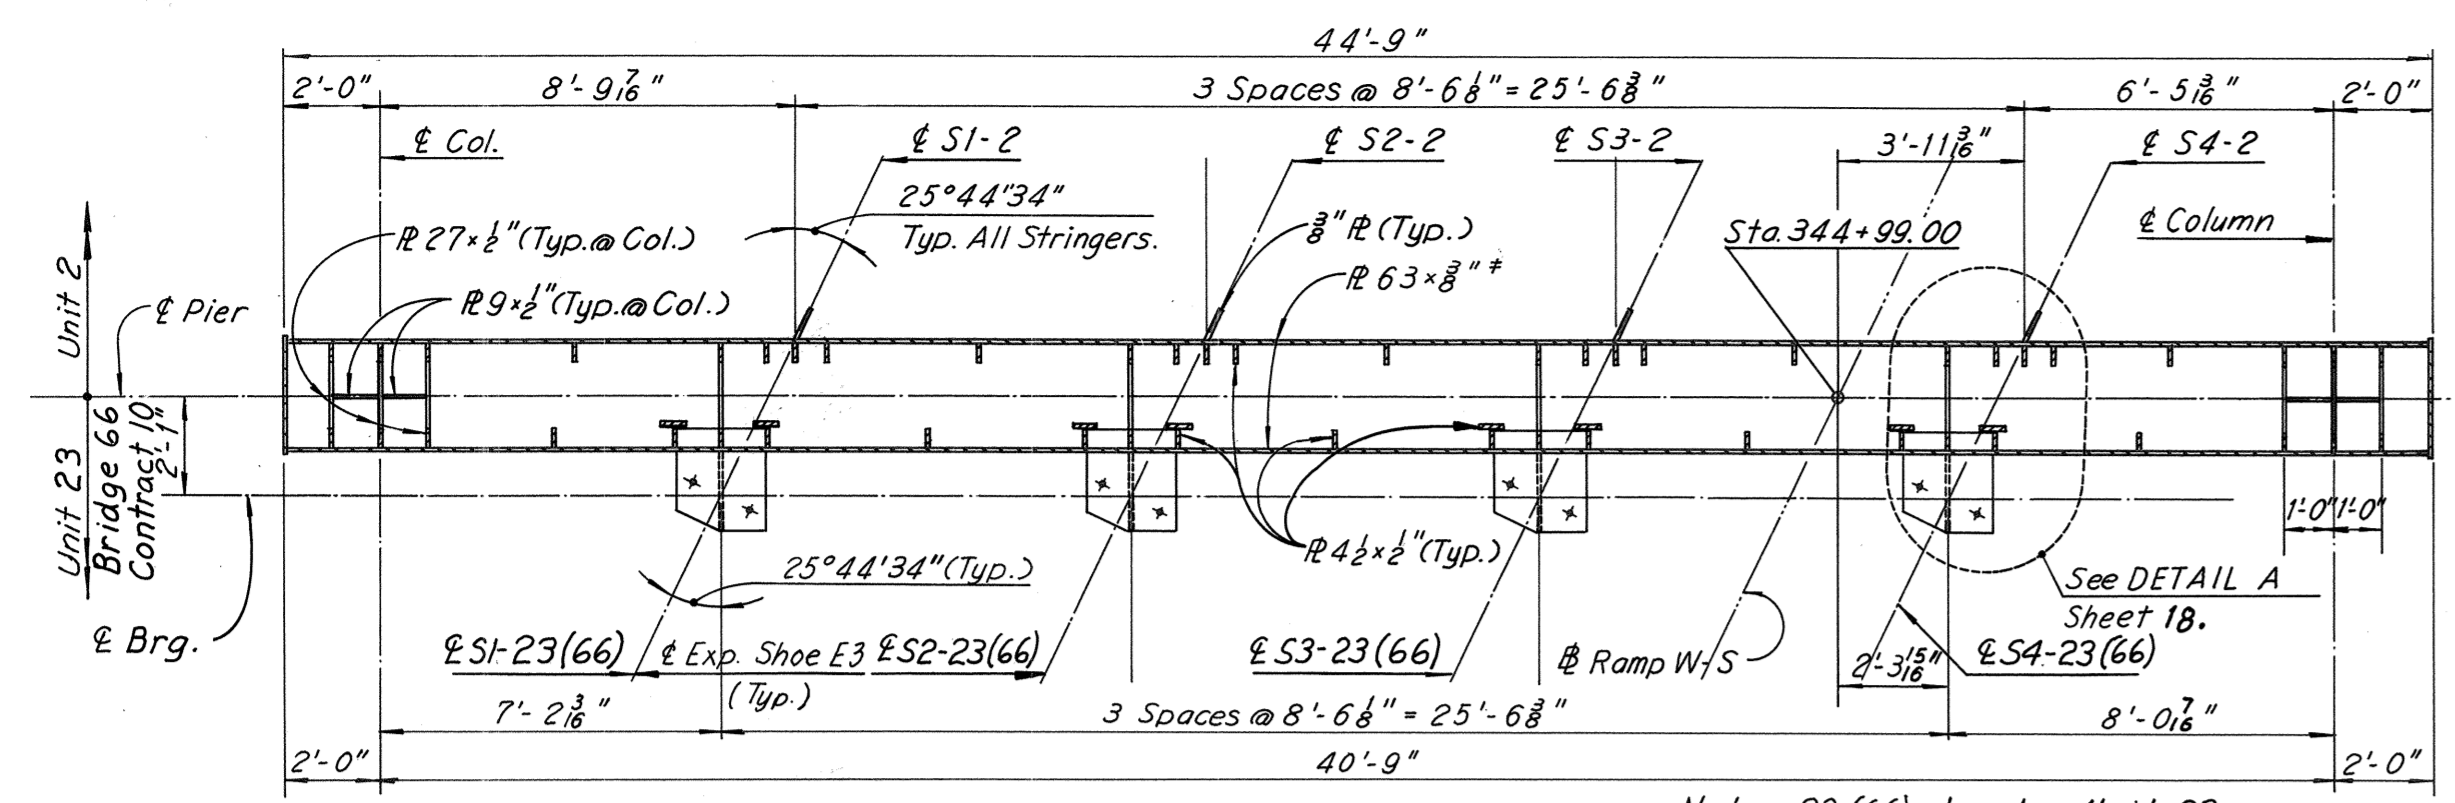


SECTION B-B
Scale: 1/4" = 1'-0"

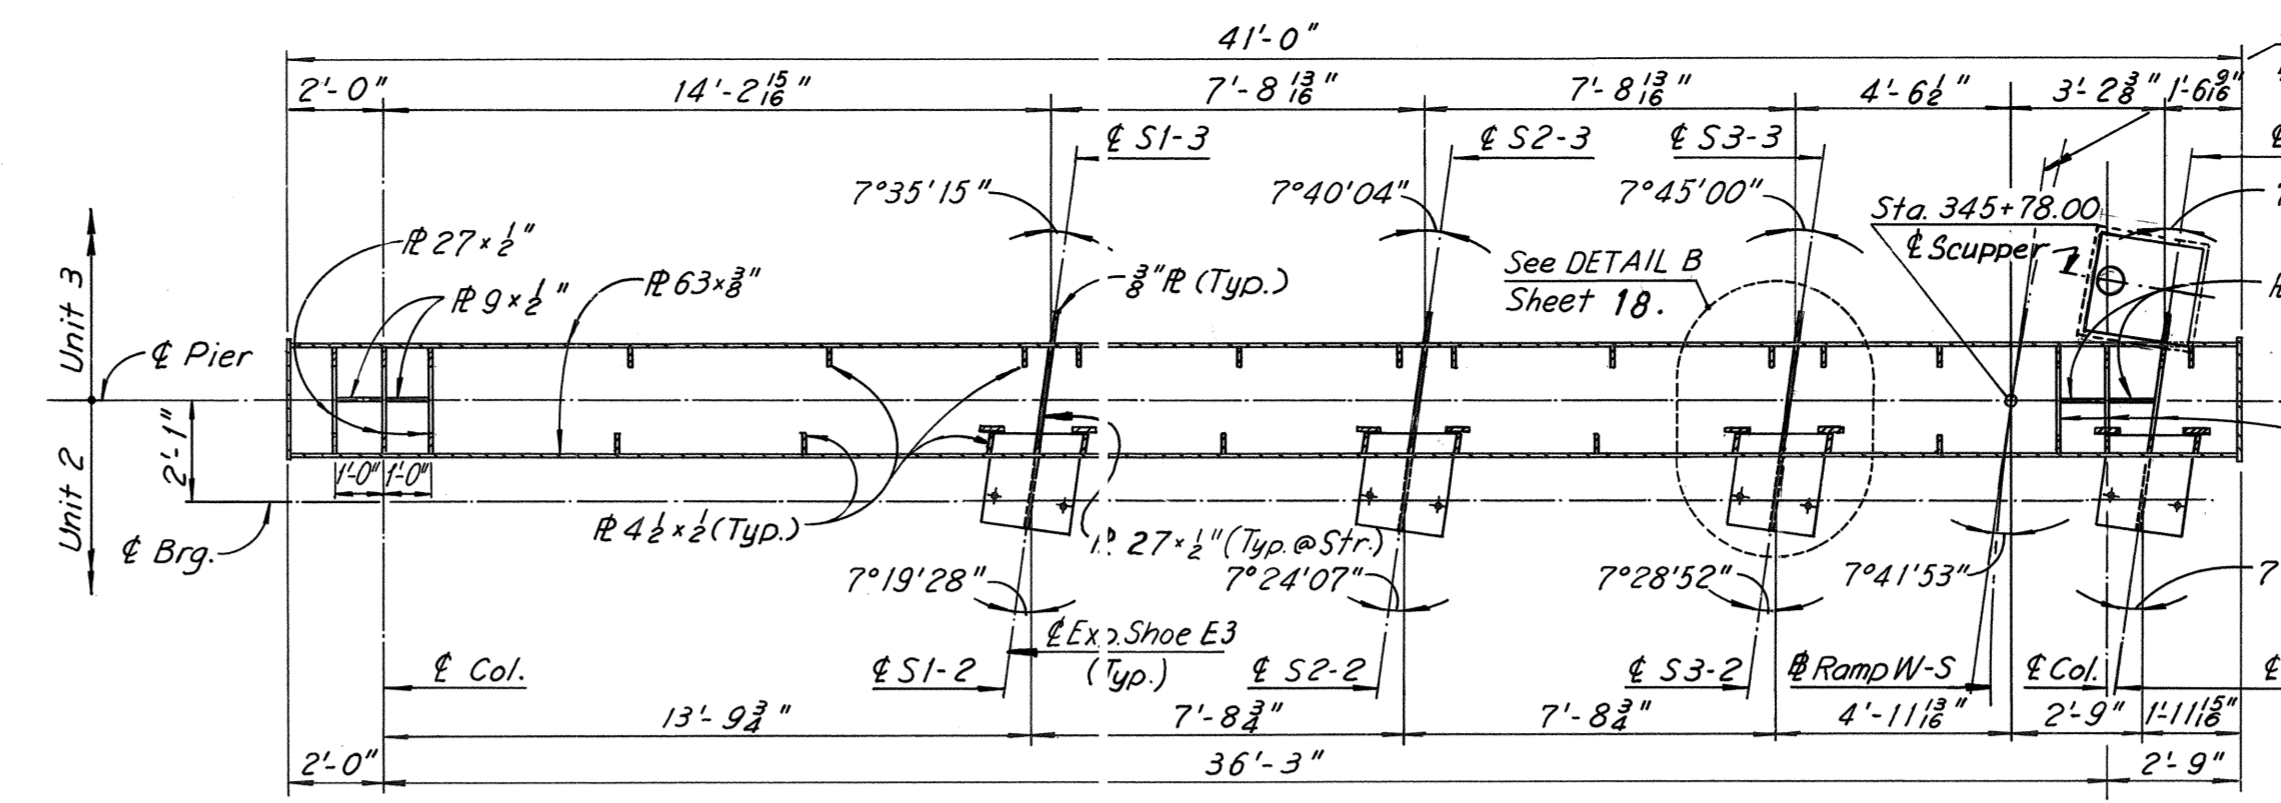



SECTION C-C
Scale: 1/4" = 1'-0"

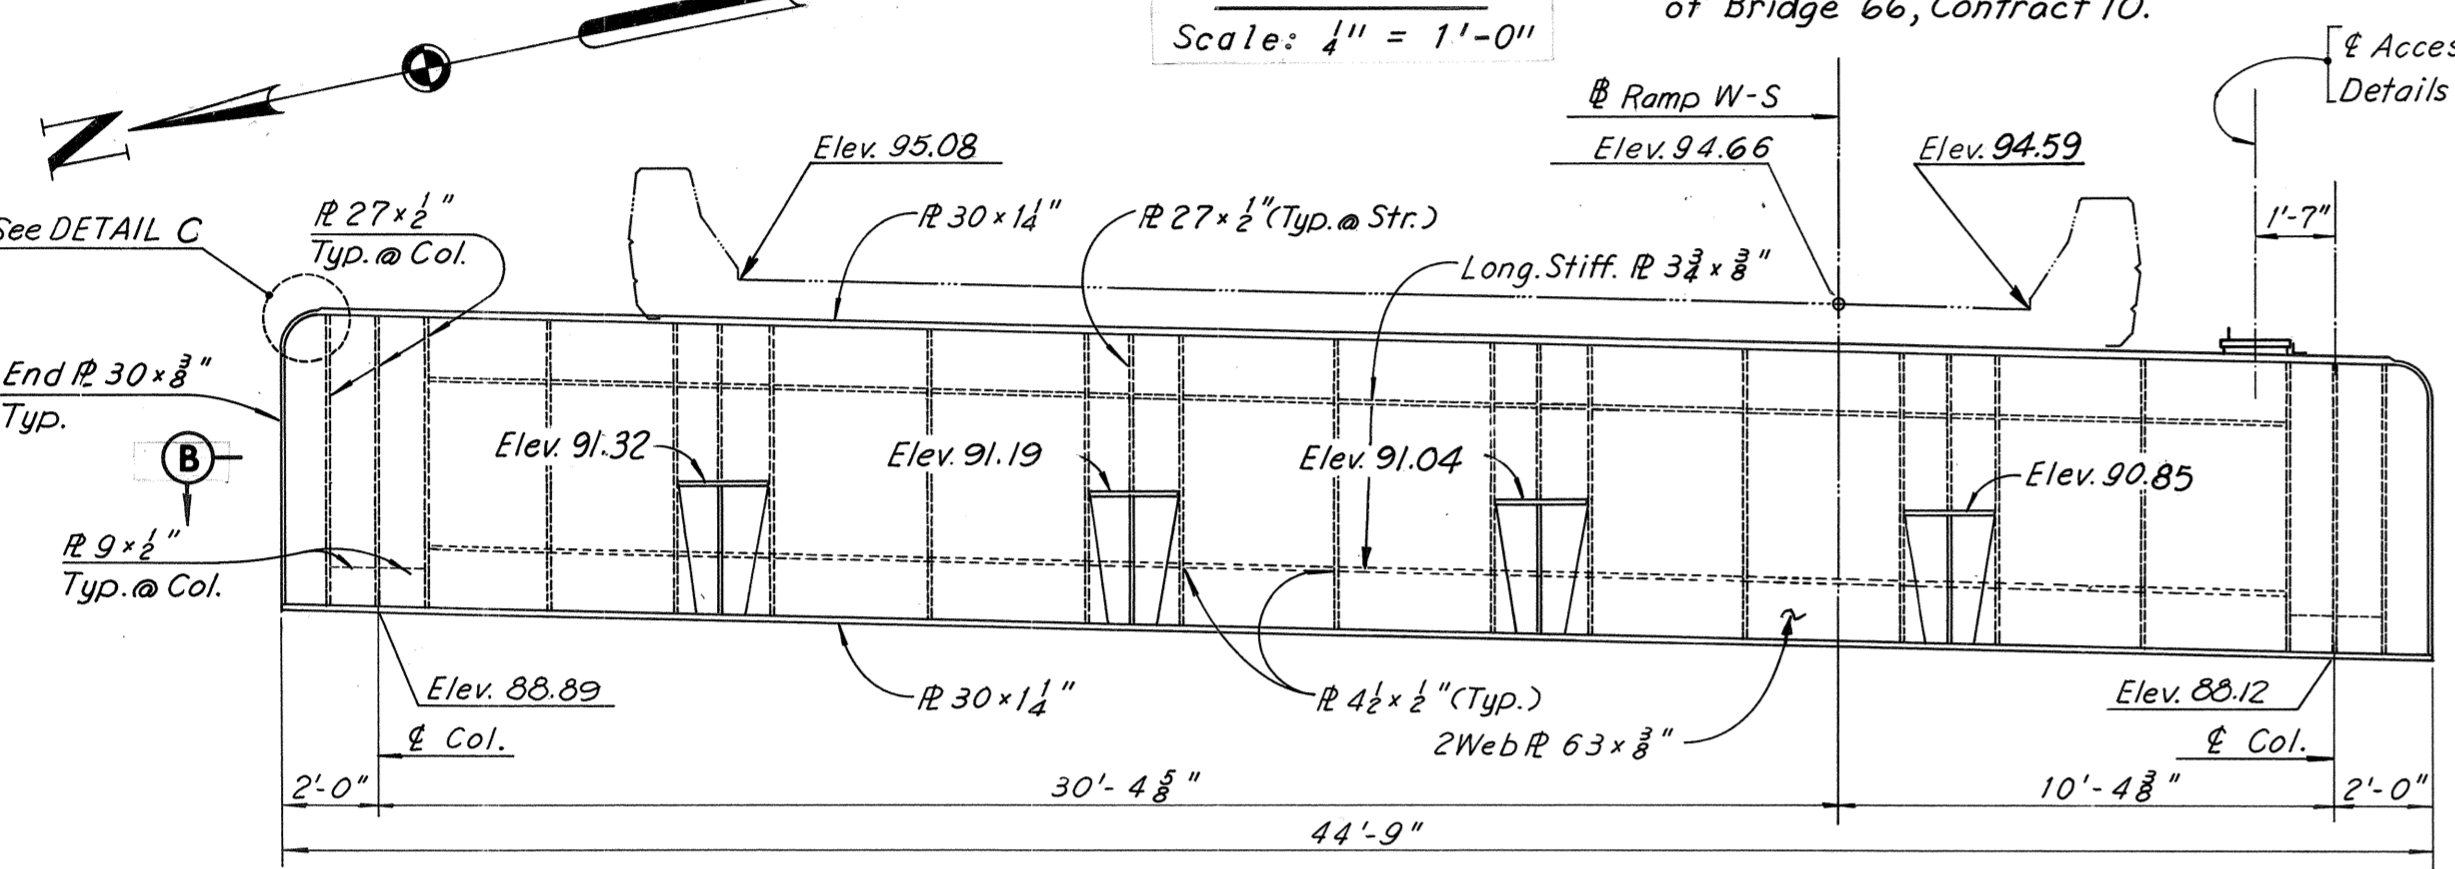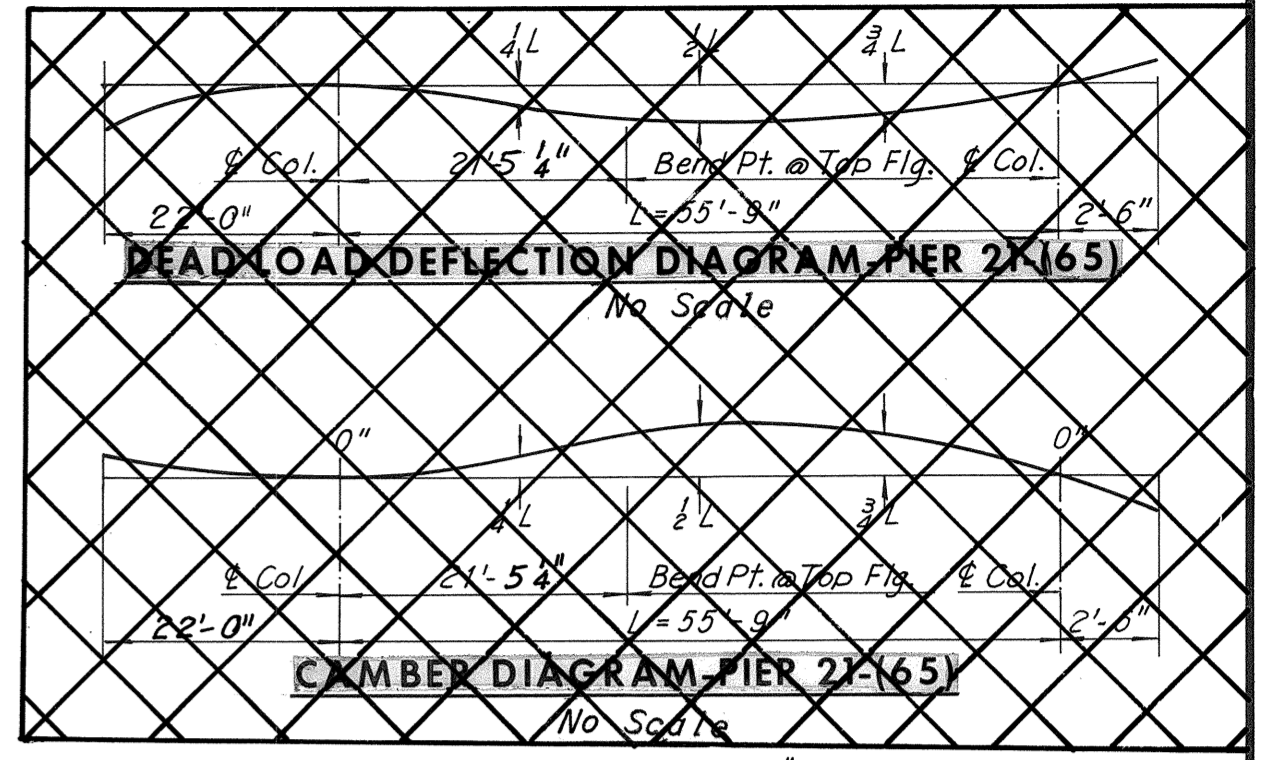

CAP BEAM ELEVATION - PIER 20-(65)
Scale: 1/4" = 1'-0"

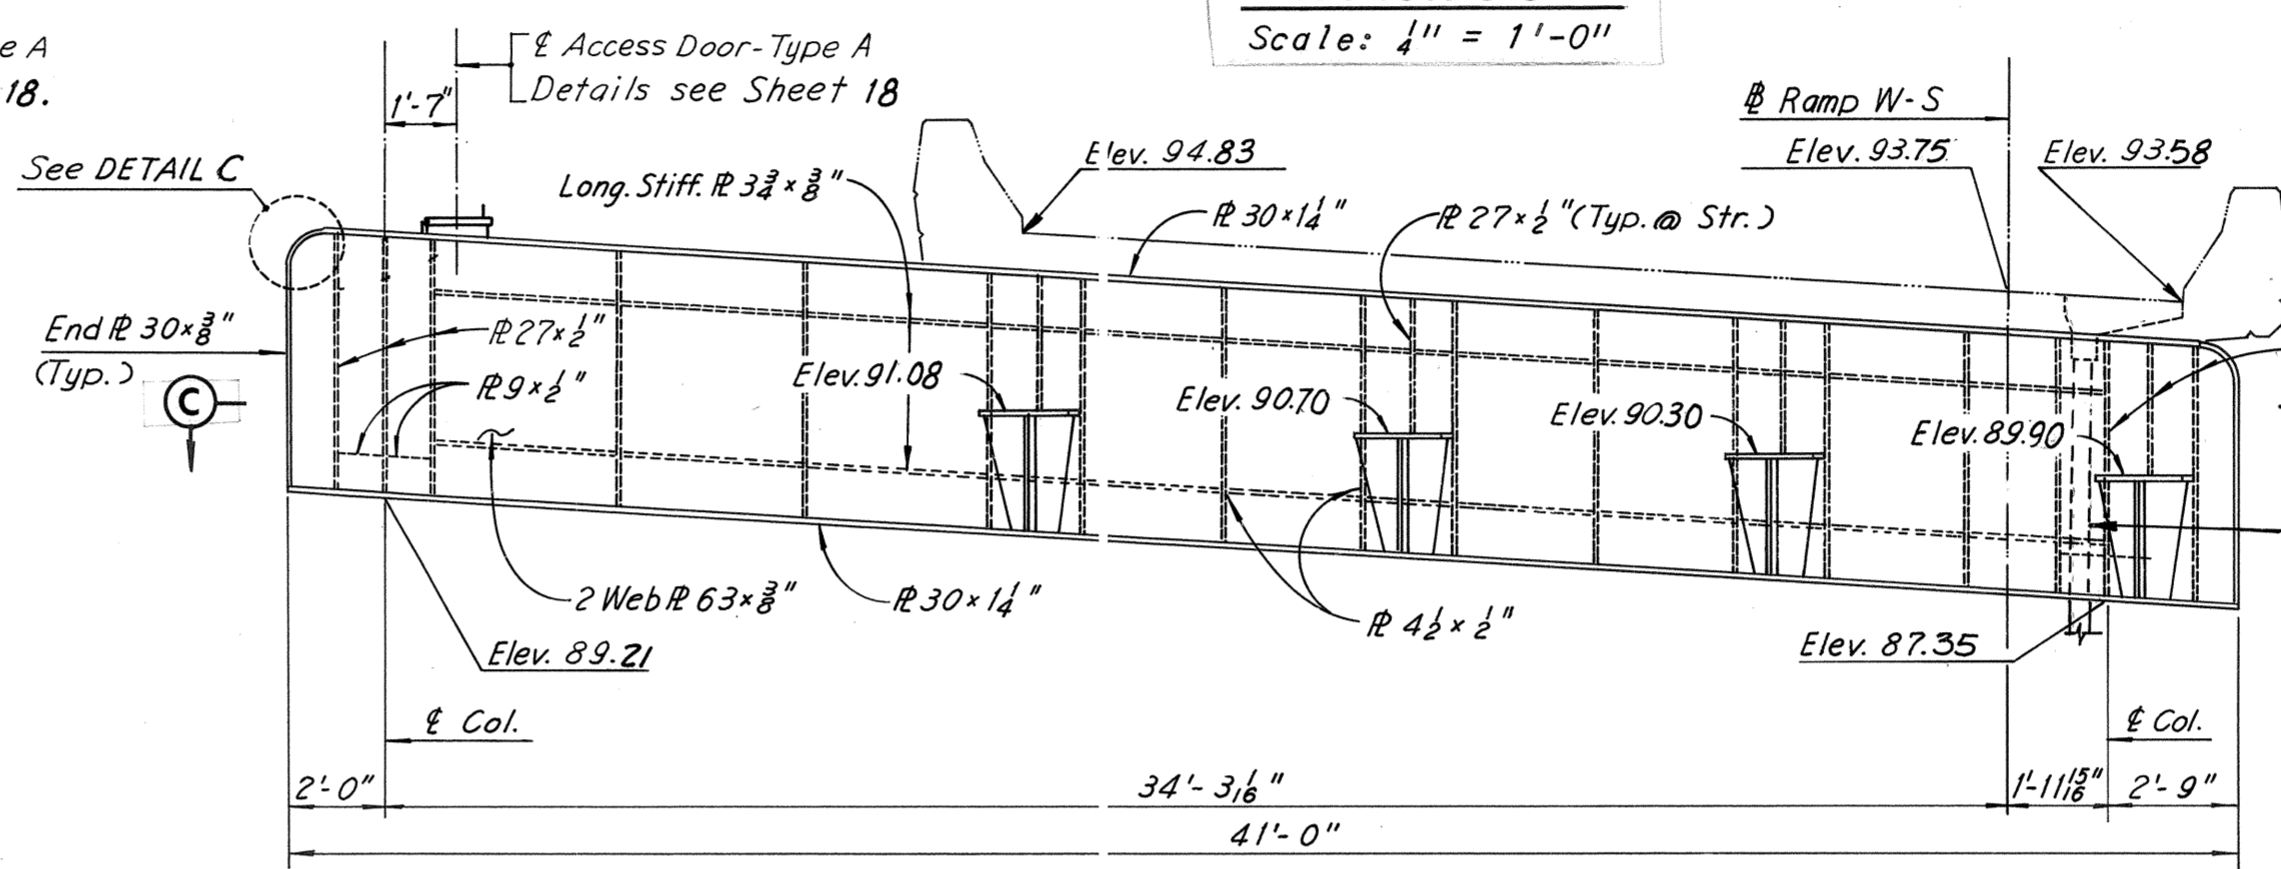


CAP BEAM ELEVATION - PIER 19-(65)
Scale: 1/4" = 1'-0"

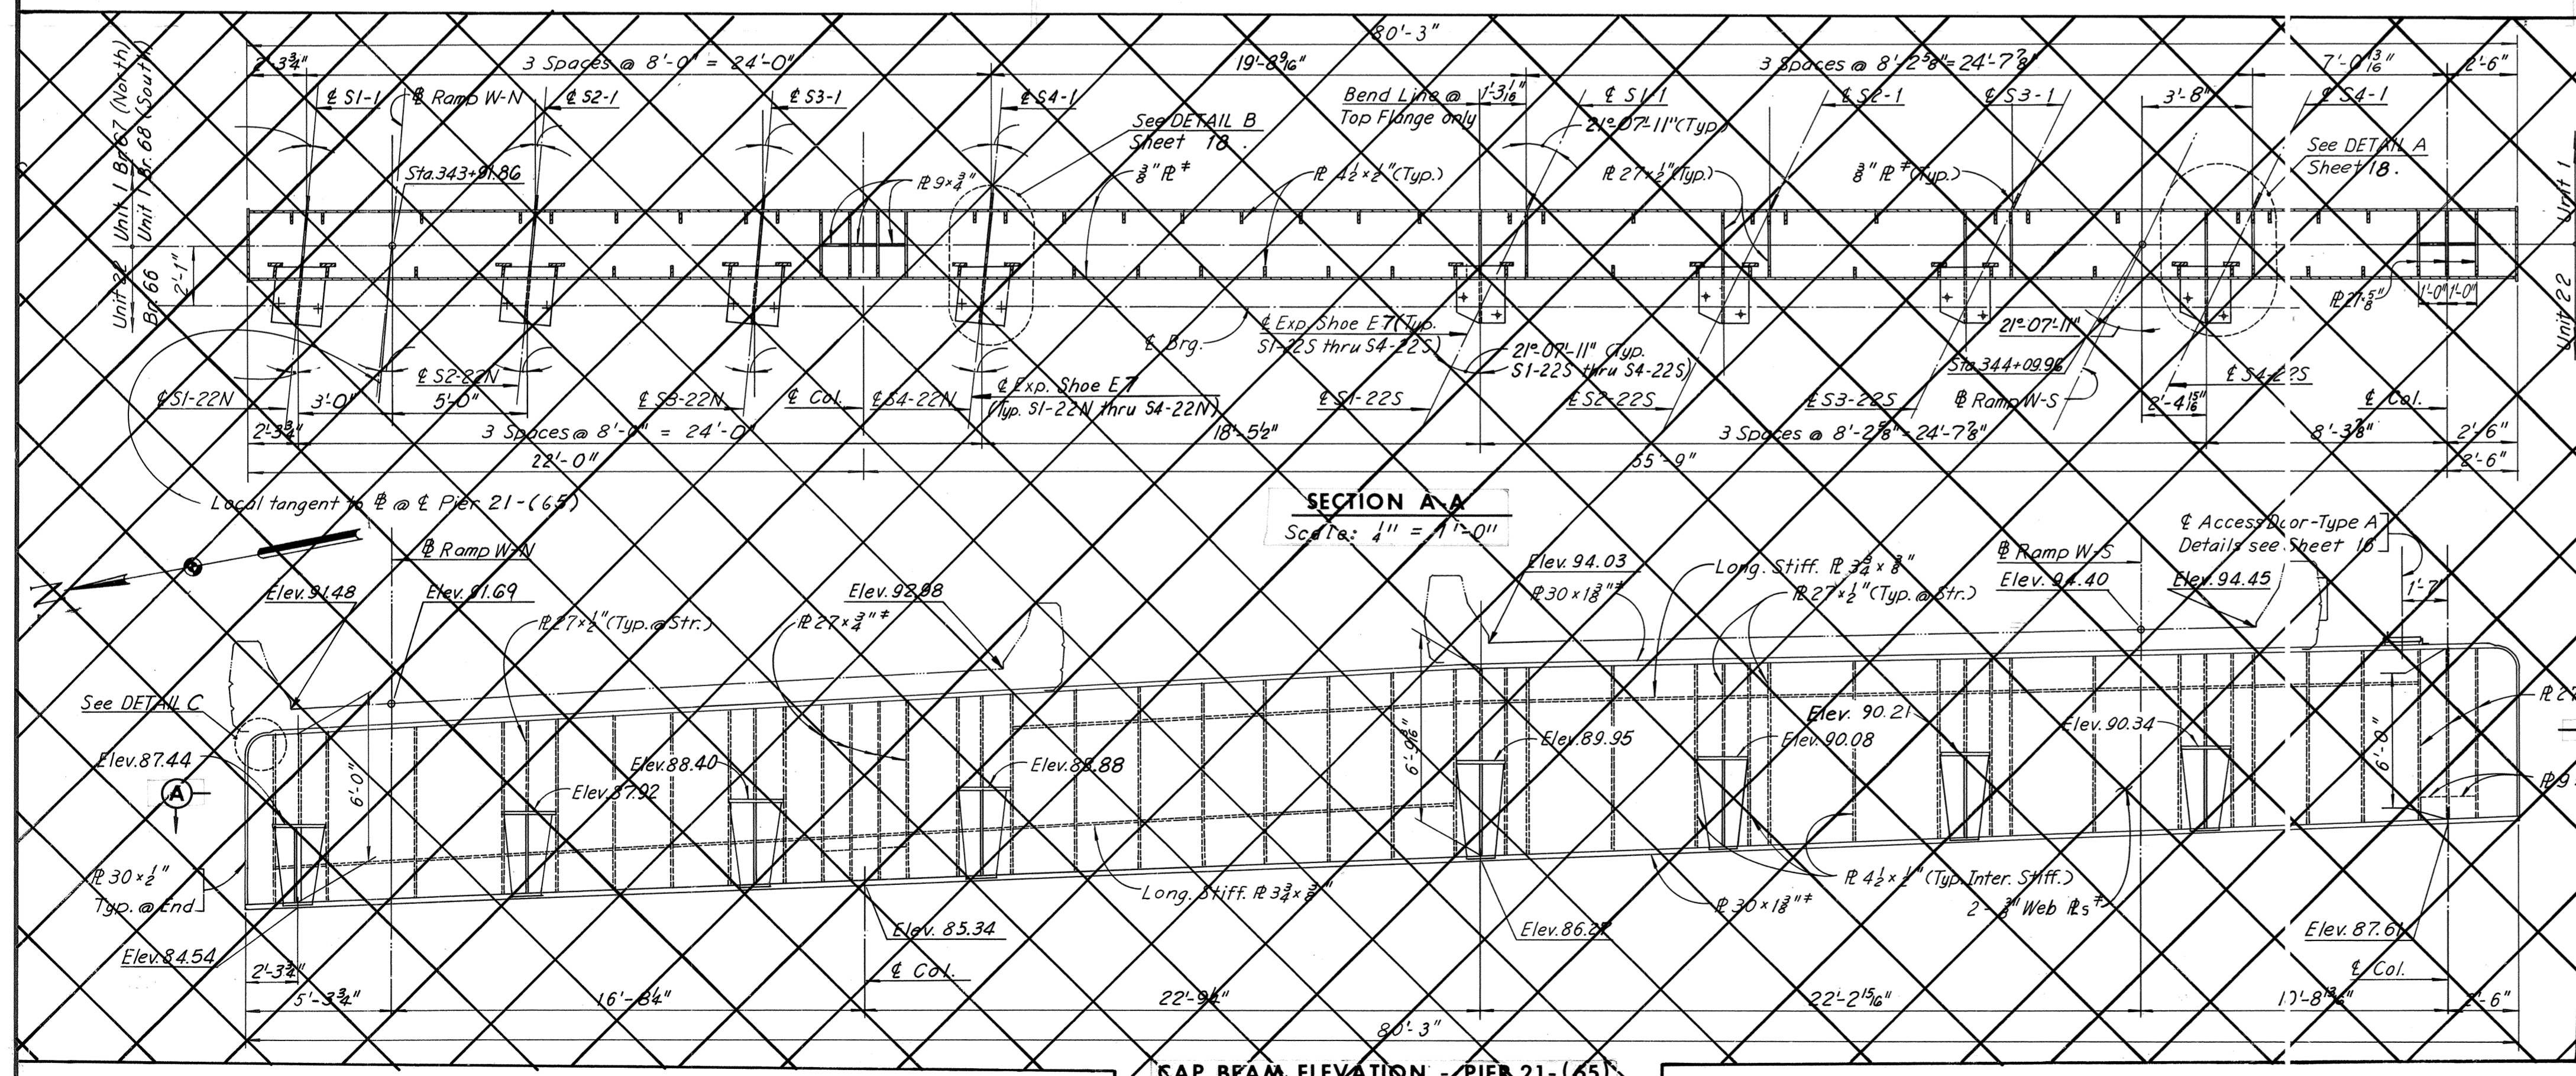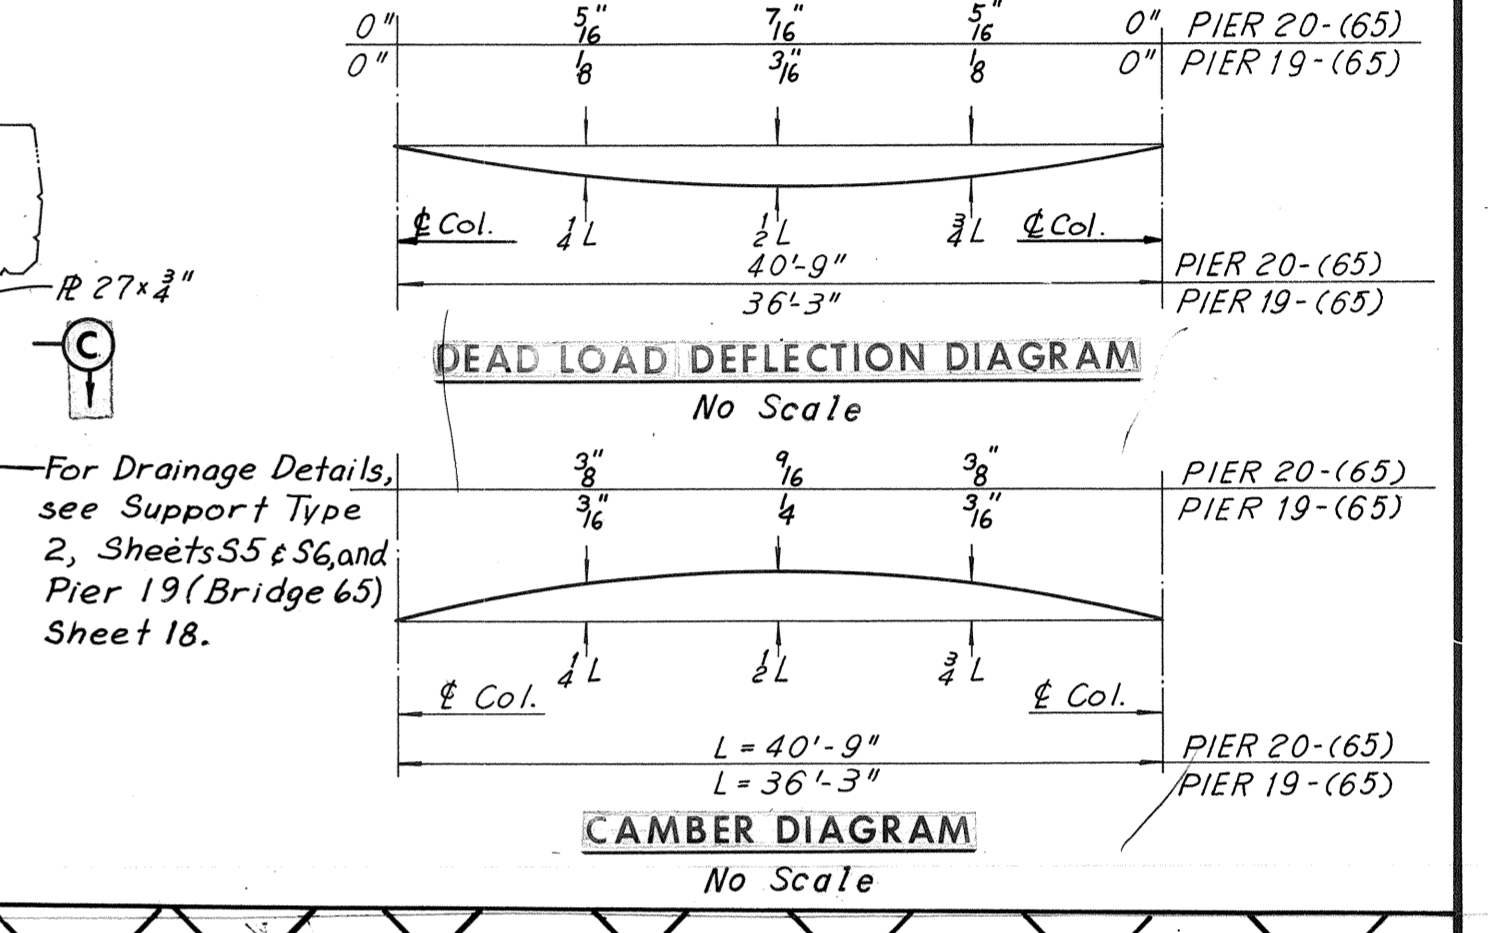


SECTION A-A
Scale: 1/4" = 1'-0"

CAP BEAM ELEVATION - PIER 21-(65)
Scale: 1/4" = 1'-0"

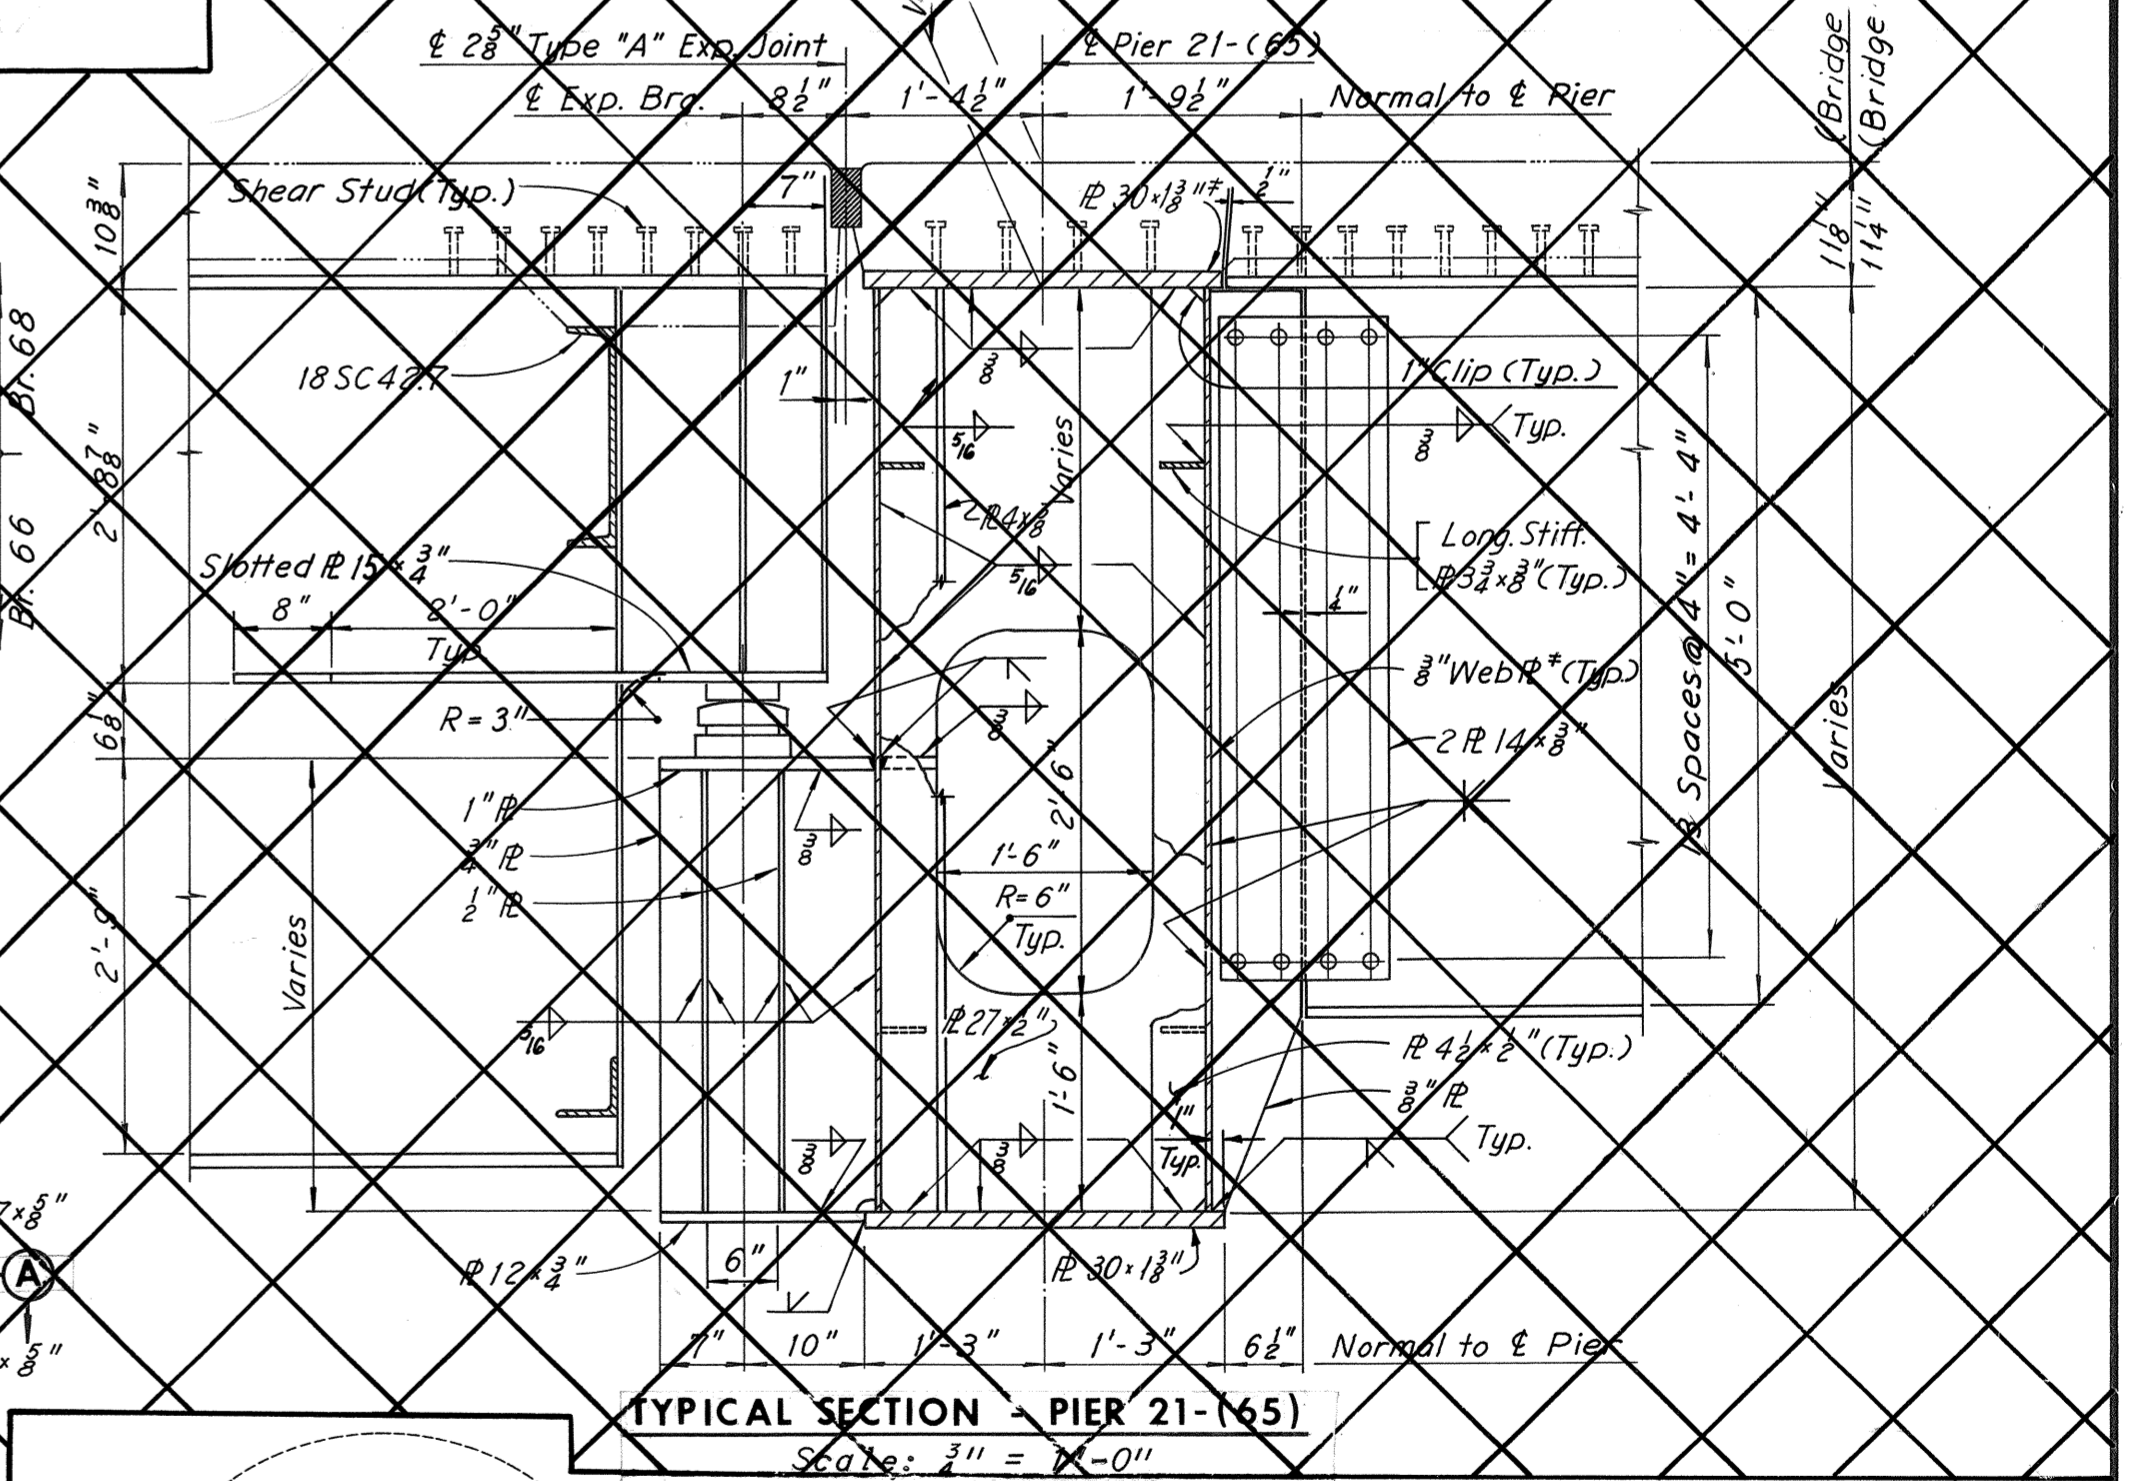

TYPICAL SECTION - PIER 21-(65)
Scale: 3/8" = 1'-0"

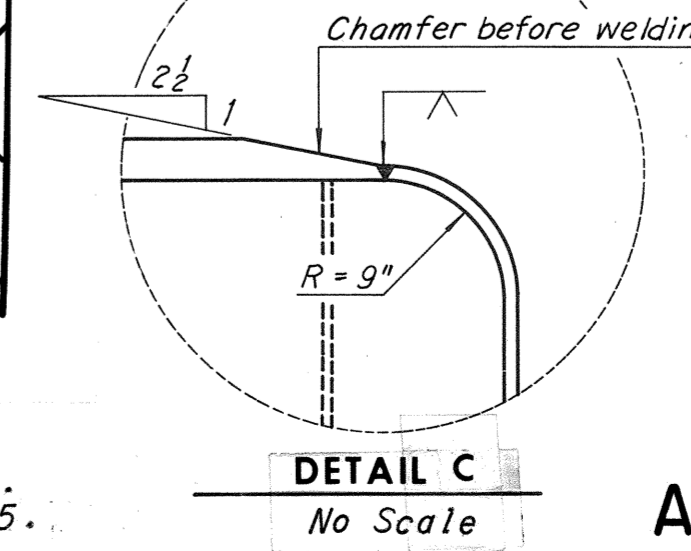

BY	DATE	NO.	REVISION	BY	DATE
MADE	MHH 2-1-69	1	Pad & Deck Elev.	TEM	3-76
CHECKED	JD 6-6-69	2	Rev. Elevations	SSS	12-75
IN CHARGE					

Notes:
 All steel shall be A36 unless denoted otherwise.
 * Denotes A572-Grade 50 steel for thickness of 3/4" and under and A588 steel for thickness over 3/4".
 Provide Drain Holes at lower end.
 All elevations shown are final elevations.

Notes:
 For Framing Plan, see Sheet 12.
 For Joint Details, see Sheet 25.

RICHMOND METROPOLITAN AUTHORITY
RICHMOND EXPRESSWAY SYSTEM
 DOWNTOWN EXPRESSWAY

BRIDGE NO. 68
 RAMP W-S CONNECTION TO
 RICHMOND-PETERSBURG TURNPIKE


FRAMING DETAILS

HOWARD, NEEDLES, TAMMEN & BERGENDOFF
 consulting engineers
 NEW YORK ALEXANDRIA KANSAS CITY


SCALE: As Noted
 CONTRACT NO.: 11
 SHEET NO. 17 OF 28

AS BUILT


RICHMOND EXPRESSWAY SYSTEM			
SECTION	PROJECT	SHEET NO.	TOTAL SHEETS
11	DOWNTOWN EXPRESSWAY	81	97

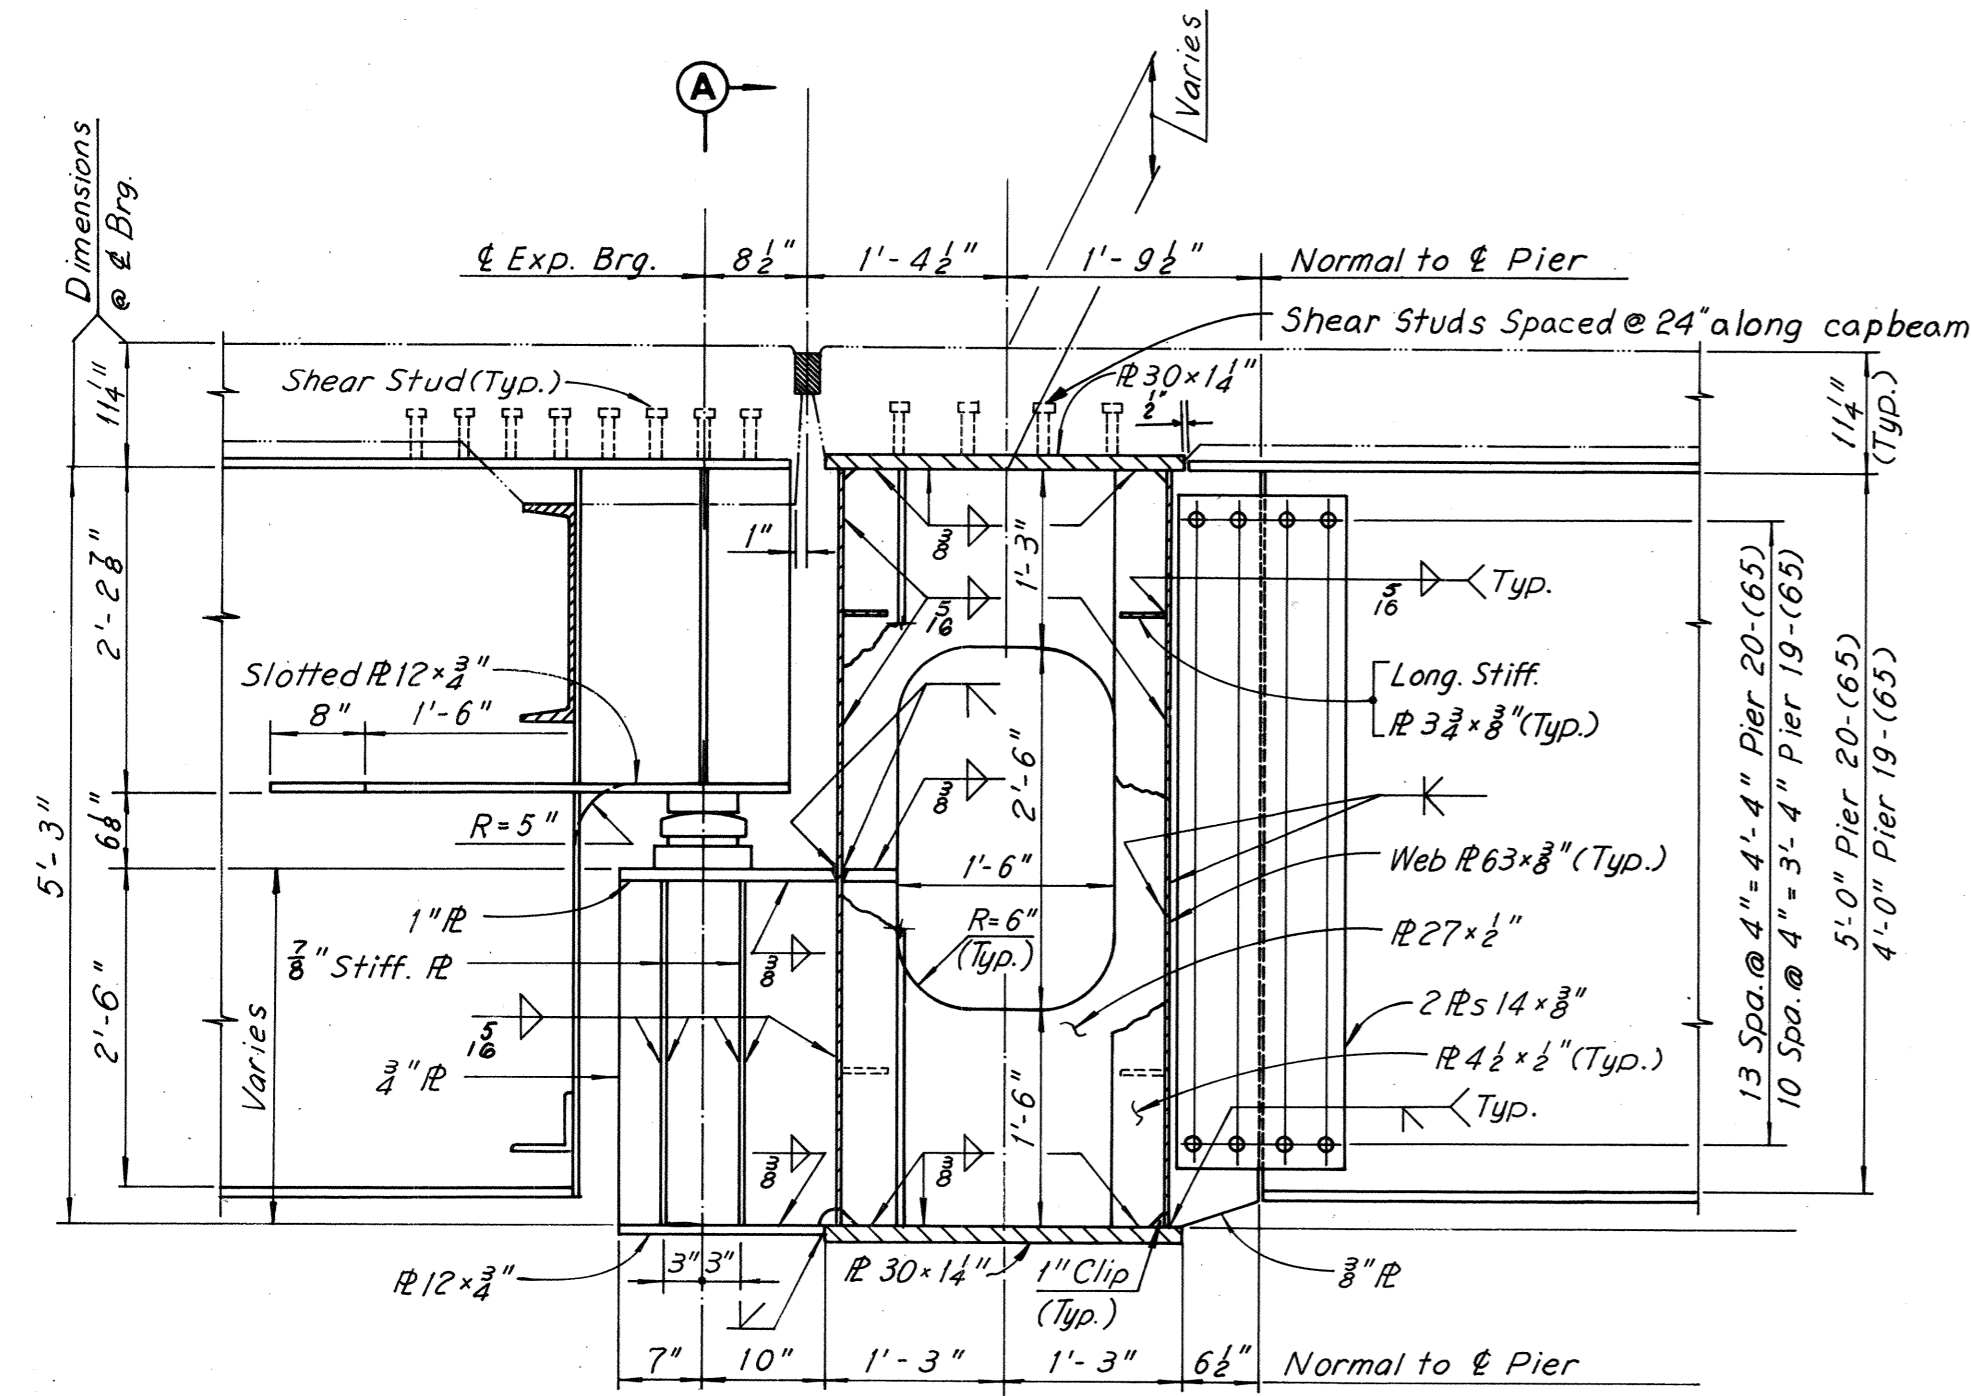

TYPICAL SECTION
Scale: 3/4" = 1'-0"

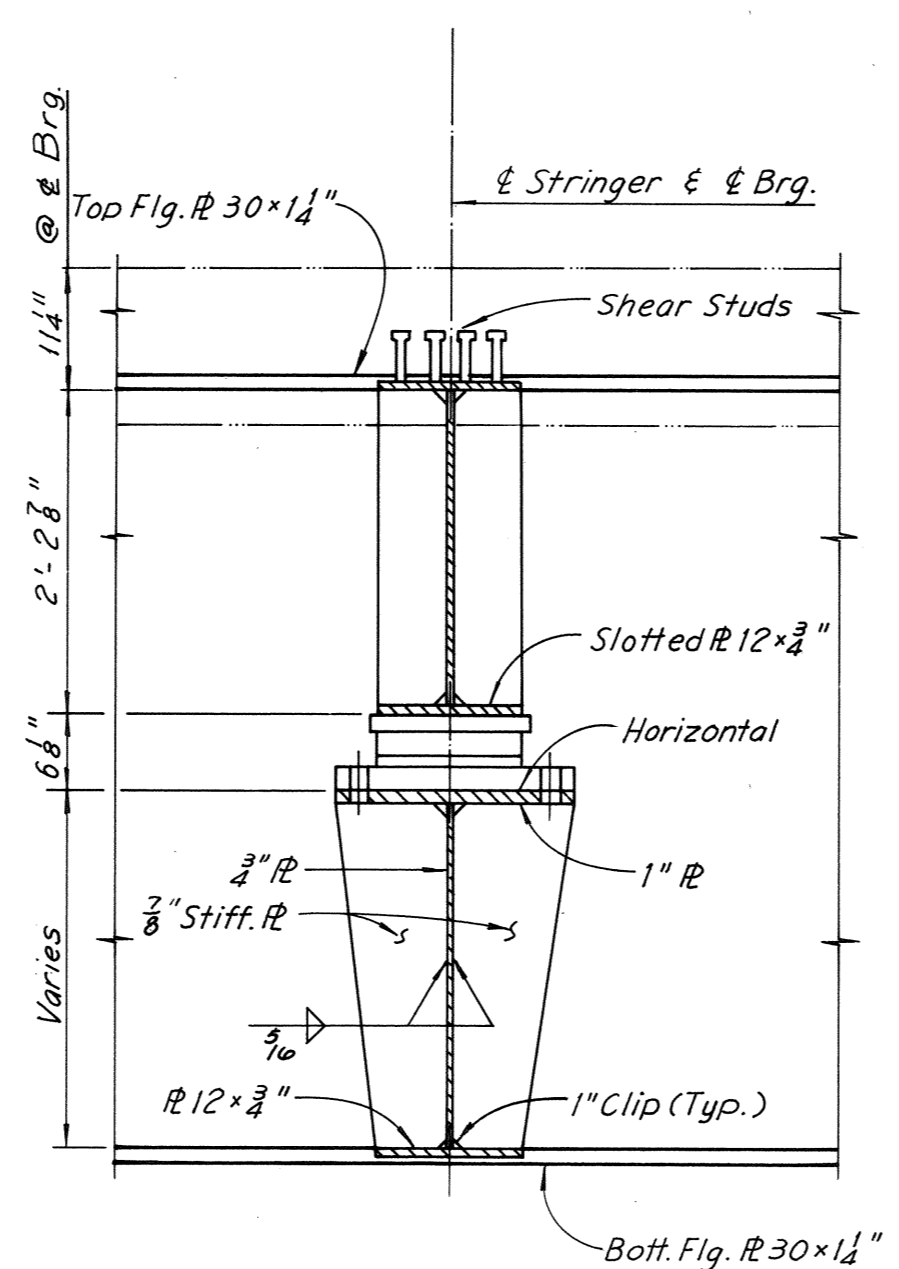


SECTION A-A
Scale: 3/4" = 1'-0"

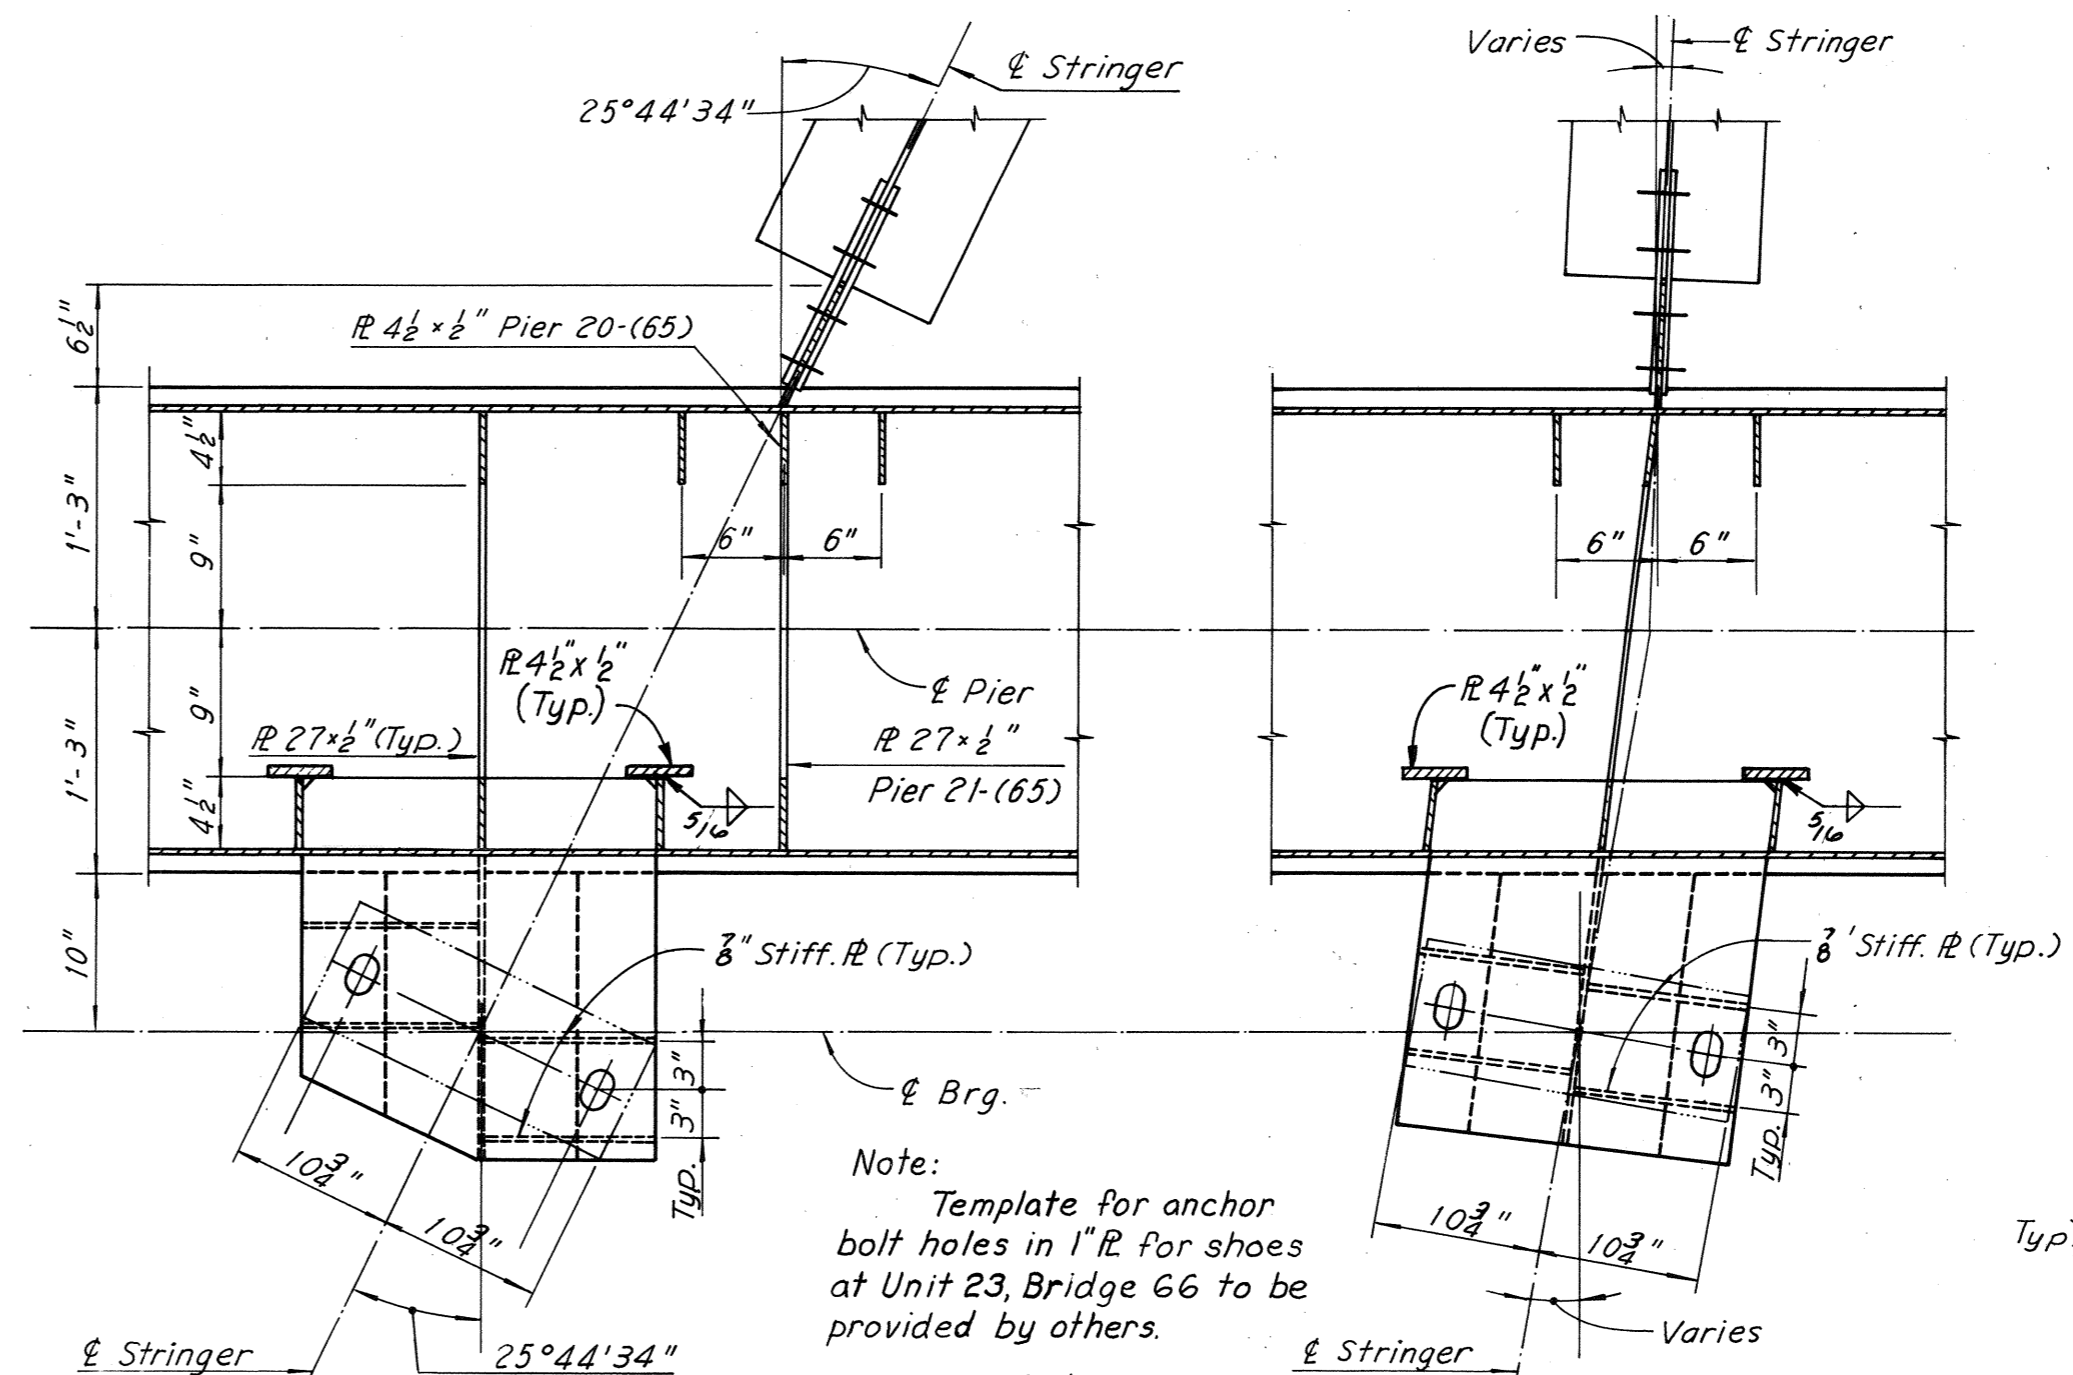


DETAIL A
Scale: 1" = 1'-0"


DETAIL B
Scale: 1" = 1'-0"

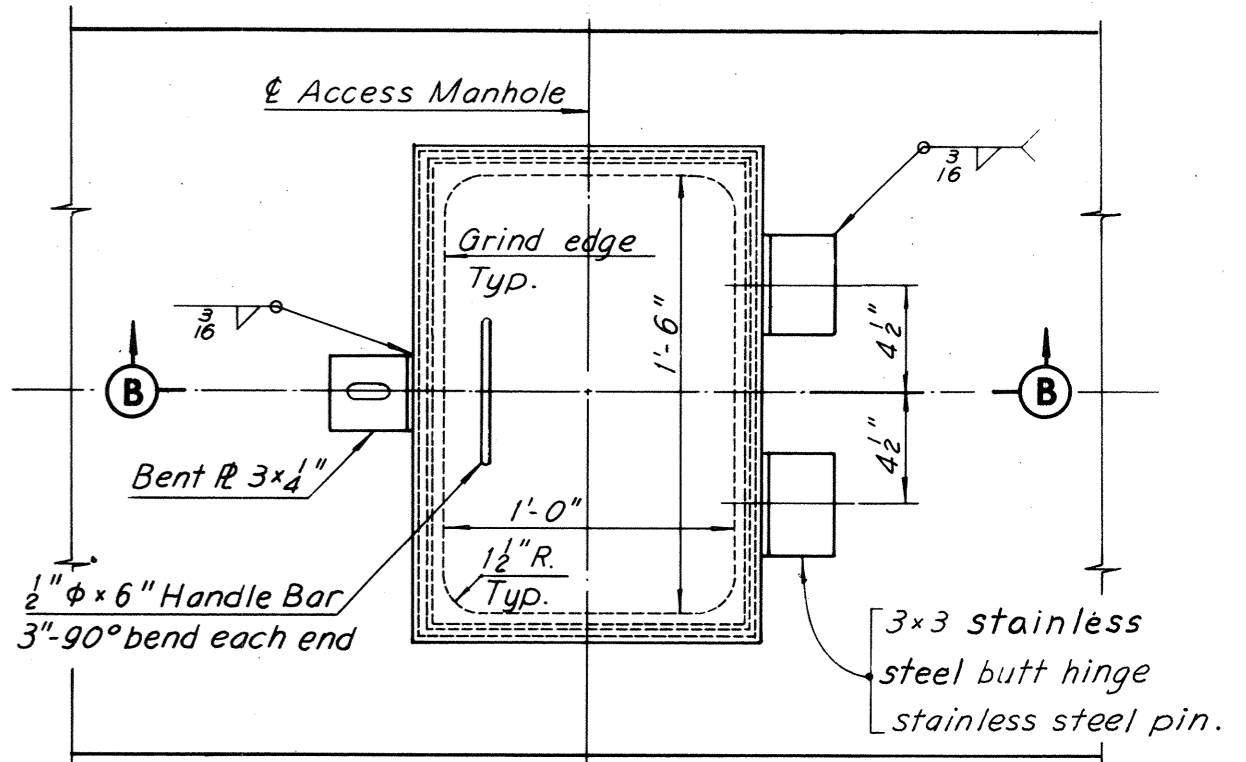


ACCESS DOOR - TYPE A
Scale: 1/2" = 1'-0"

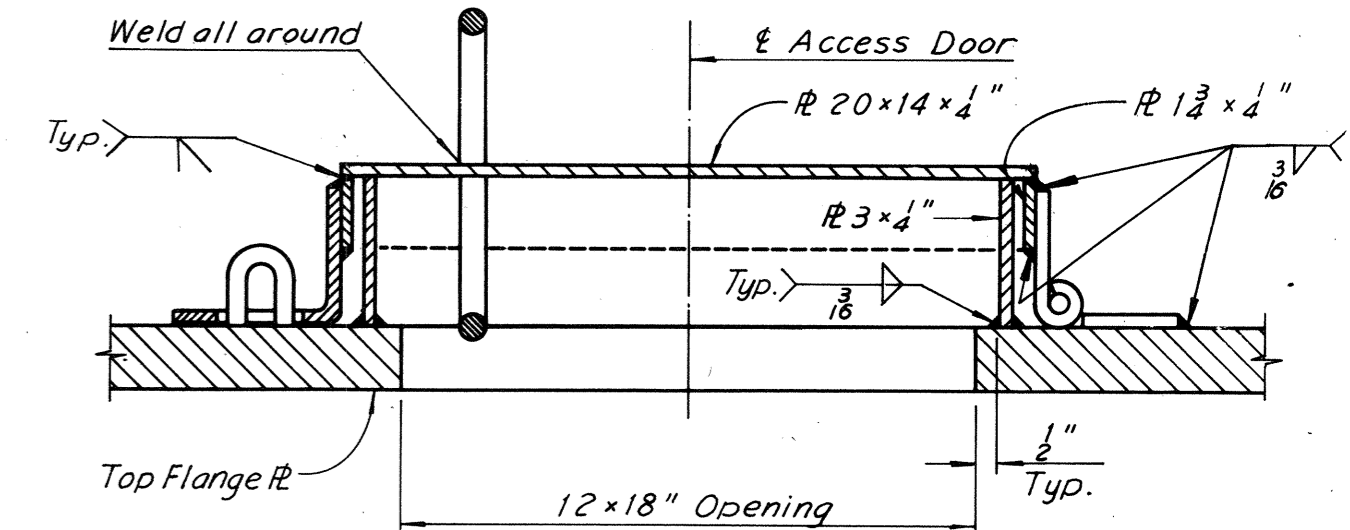


SECTION B-B
No Scale

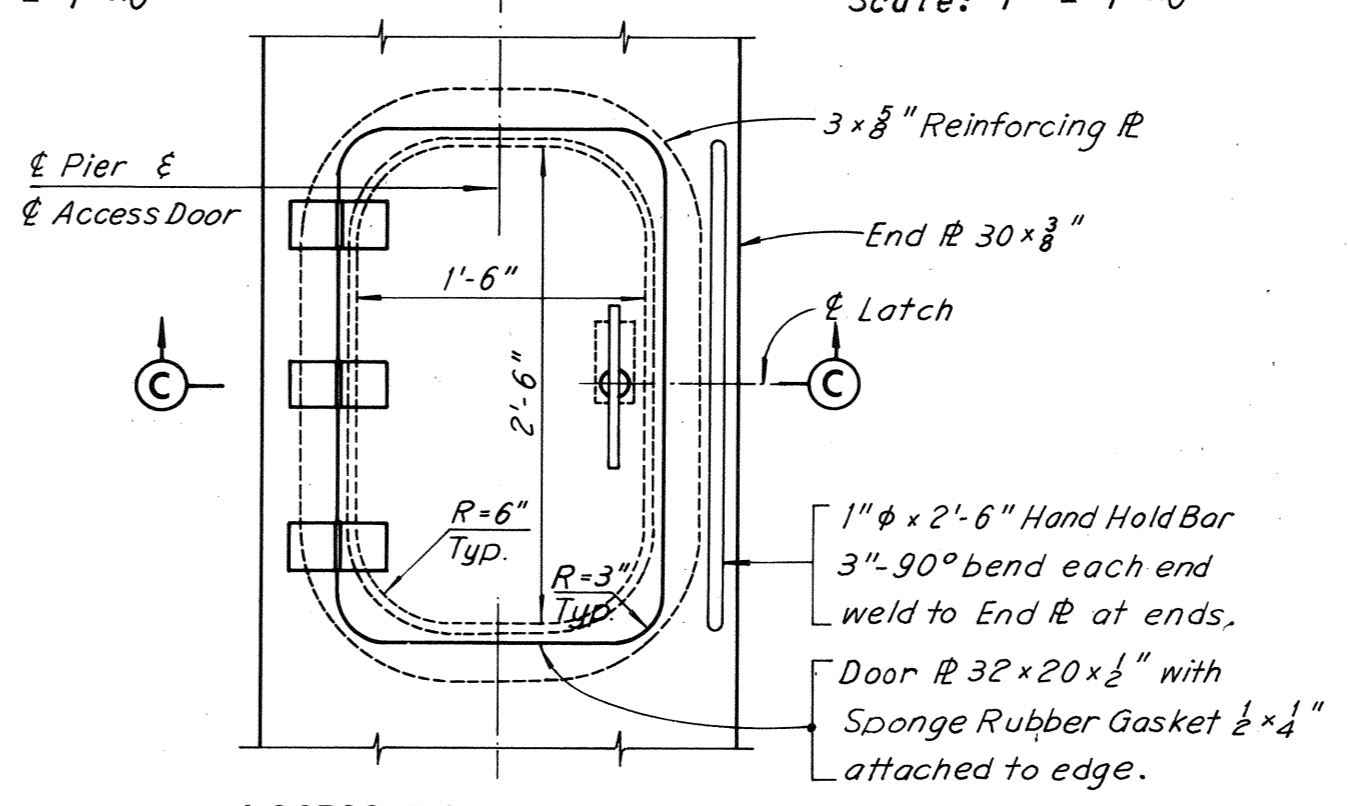

ACCESS DOOR - TYPE B
Scale: 1" = 1'-0"

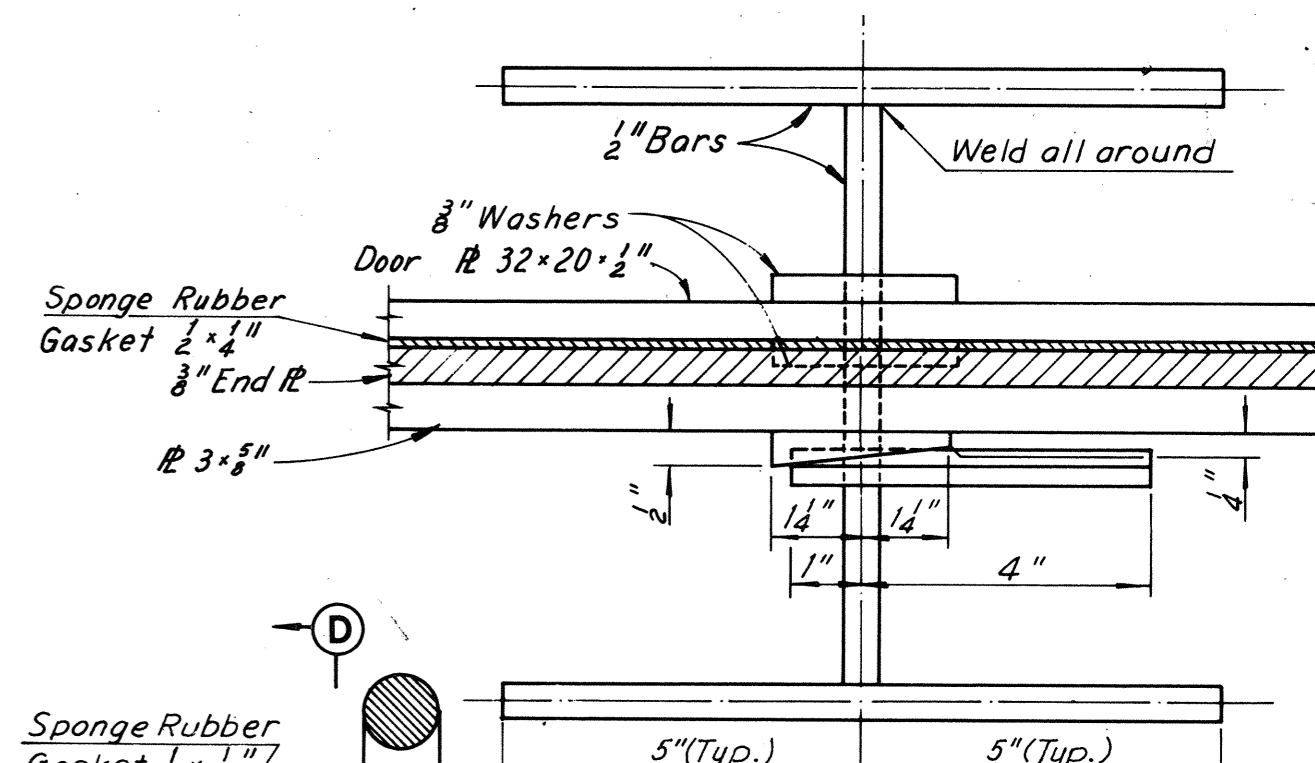

SECTION D-D
No Scale

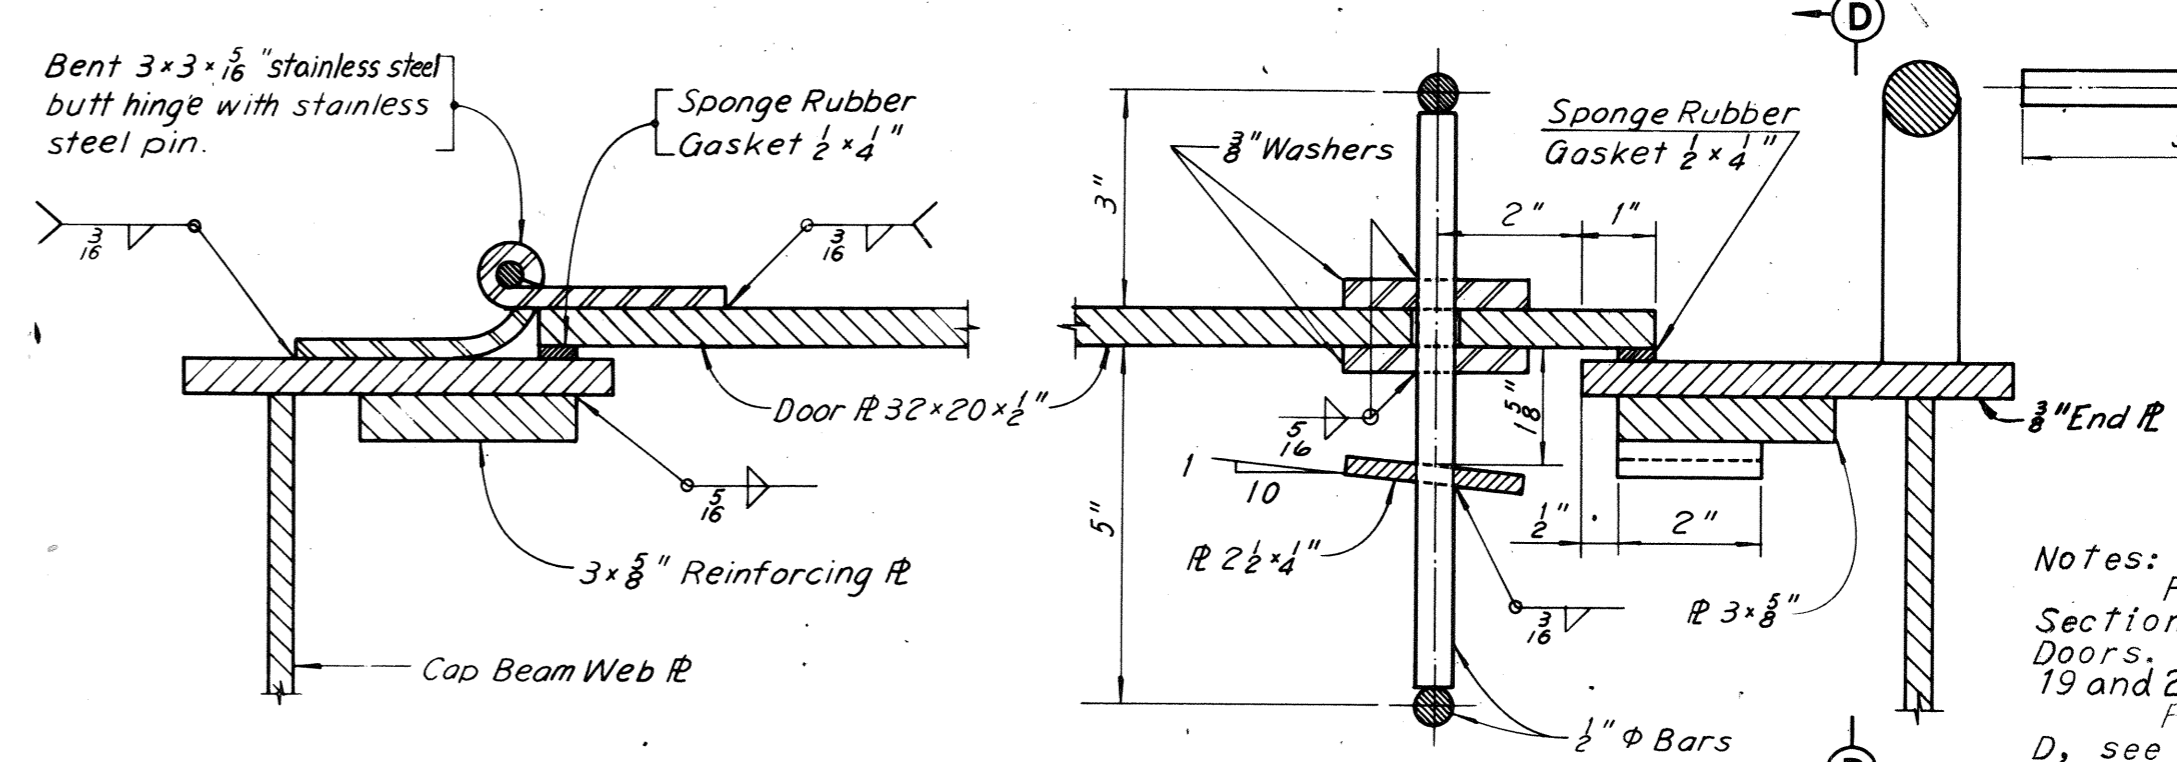

SECTION C-C
No Scale

Notes:
For location of Typical Section, Details A and B, and Access Doors, see Framing Details for Piers 19 and 20, Sheet 17.
For location of Details C and D, see Framing Plan Units 17 and 18, Sheet 16.

BY	DATE	REVISION	BY	DATE
MADE	MHH 1-31-69			
CHECKED	JD 5-2-69	Dim and weld size	TEM	9-30-76
IN CHARGE				


AS BUILT

RICHMOND METROPOLITAN AUTHORITY
RICHMOND EXPRESSWAY SYSTEM
DOWNTOWN EXPRESSWAY

BRIDGE NO. 68
RAMP W-S CONNECTION TO
RICHMOND-PETERSBURG TURNPIKE
FRAMING DETAILS

HOWARD, NEEDLES, TAMMEN & BERGENDOFF
consulting engineers
NEW YORK ALEXANDRIA KANSAS CITY

SCALE: As Noted
CONTRACT NO. 11
SHEET NO. 18 OF 28

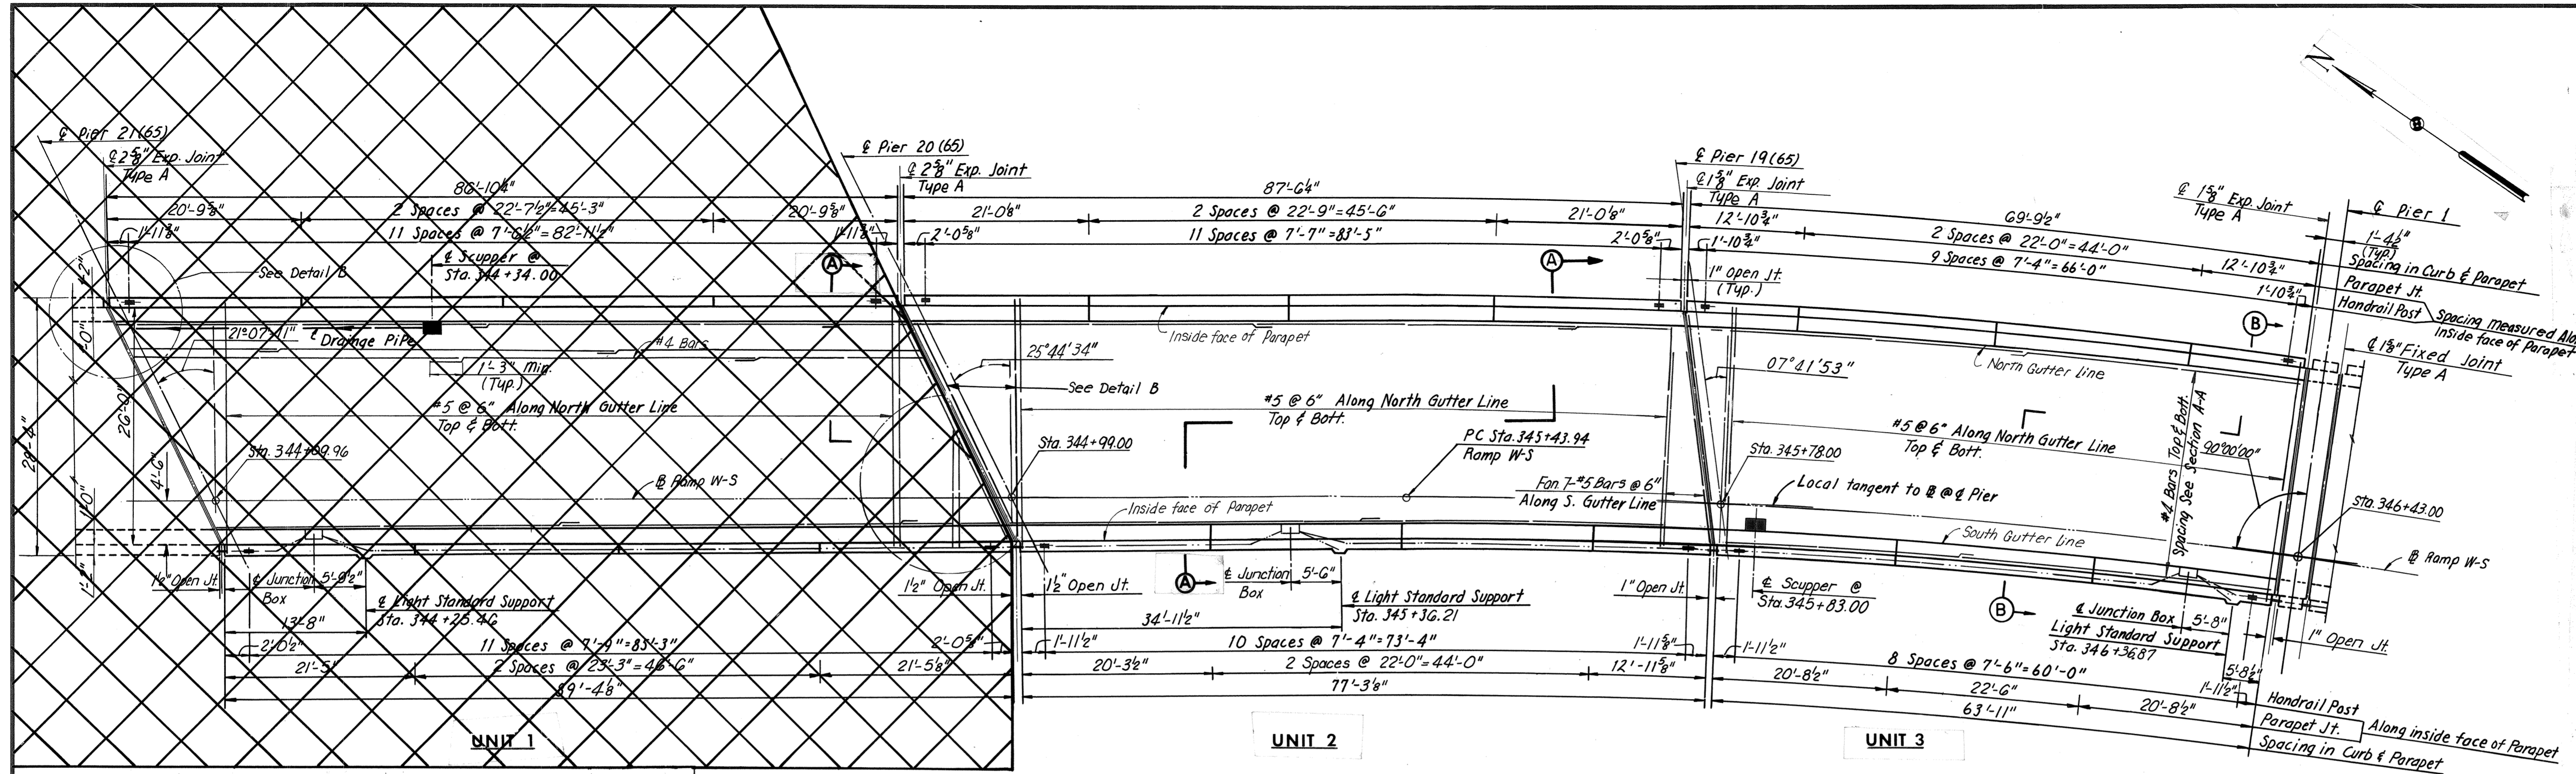



ELEVATION TABLE

STATION	ELEV. A	ELEV. B	ELEV. C
344+00.57	94.89	---	---
344+00.00	94.89	95.16	95.21
+09.84	---	---	95.22
+09.96	---	95.18	---
+10.00	94.96	95.18	95.22
+20.00	95.02	95.18	95.21
+30.00	95.06	95.17	95.19
+40.00	95.08	95.13	95.14
+50.00	95.08	95.08	95.08
+60.00	95.10	95.02	95.01
+70.00	95.10	94.94	94.91
+80.00	95.10	94.85	94.81
+87.57	95.08	---	---
+90.00	95.08	94.75	94.69
+99.16	---	---	94.59
344+99.00	---	94.66	---
345+00.00	95.06	94.65	94.58
+10.00	95.03	94.54	94.46
+20.00	95.01	94.44	94.34
+30.00	94.99	94.33	94.22
+40.00	94.96	94.22	94.09
+50.00	94.92	94.10	93.96
+60.00	94.88	93.98	93.84
+70.00	94.84	93.86	93.69
+73.84	94.82	---	---
+77.08	---	---	93.58
+78.00	---	93.75	---
+80.00	94.79	93.72	93.54
345+90.00	94.74	93.59	93.39
346+00.00	94.67	93.44	93.73
+10.00	94.51	93.28	93.07
+20.00	94.35	93.12	92.91
+30.00	94.20	92.97	92.76
+40.00	94.05	92.82	92.61
+41.63	---	---	92.59
+41.66	94.02	---	---


Note:
 Pier 20(65) and Pier 19(65)
 denotes Piers 21, 20 and 19 of Bridge 65(Ramp S-W).

DECK PLAN
 Scale: 1/8" = 1'-0"

Note:
 Section B-B, See Sheet 20.

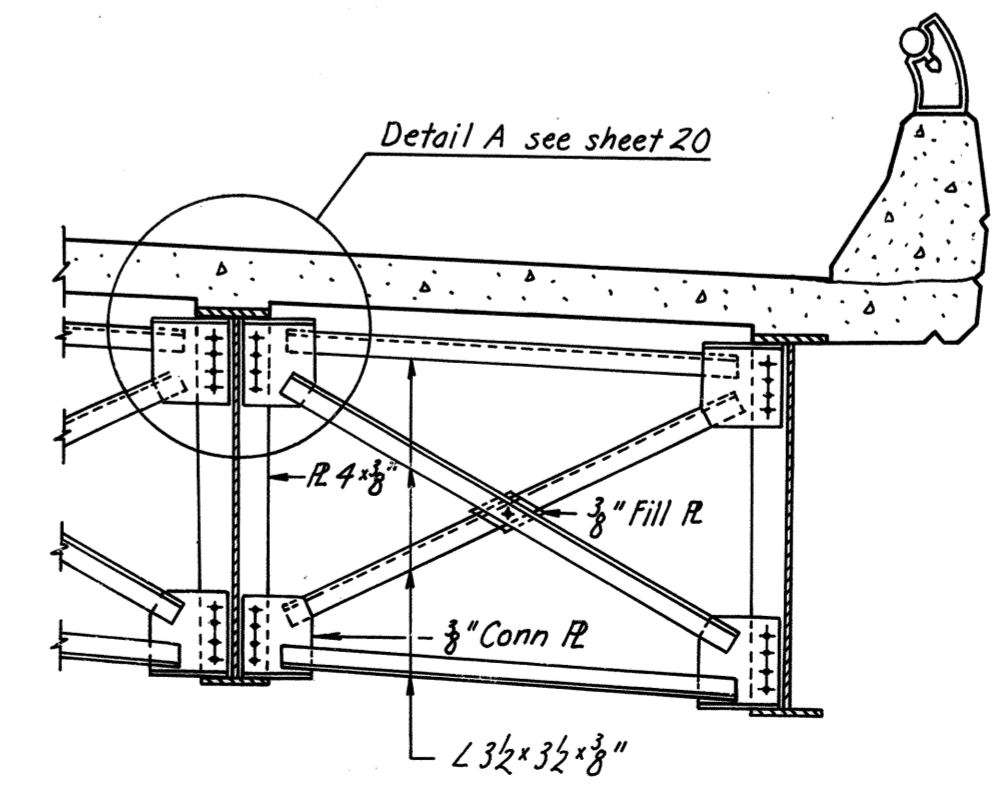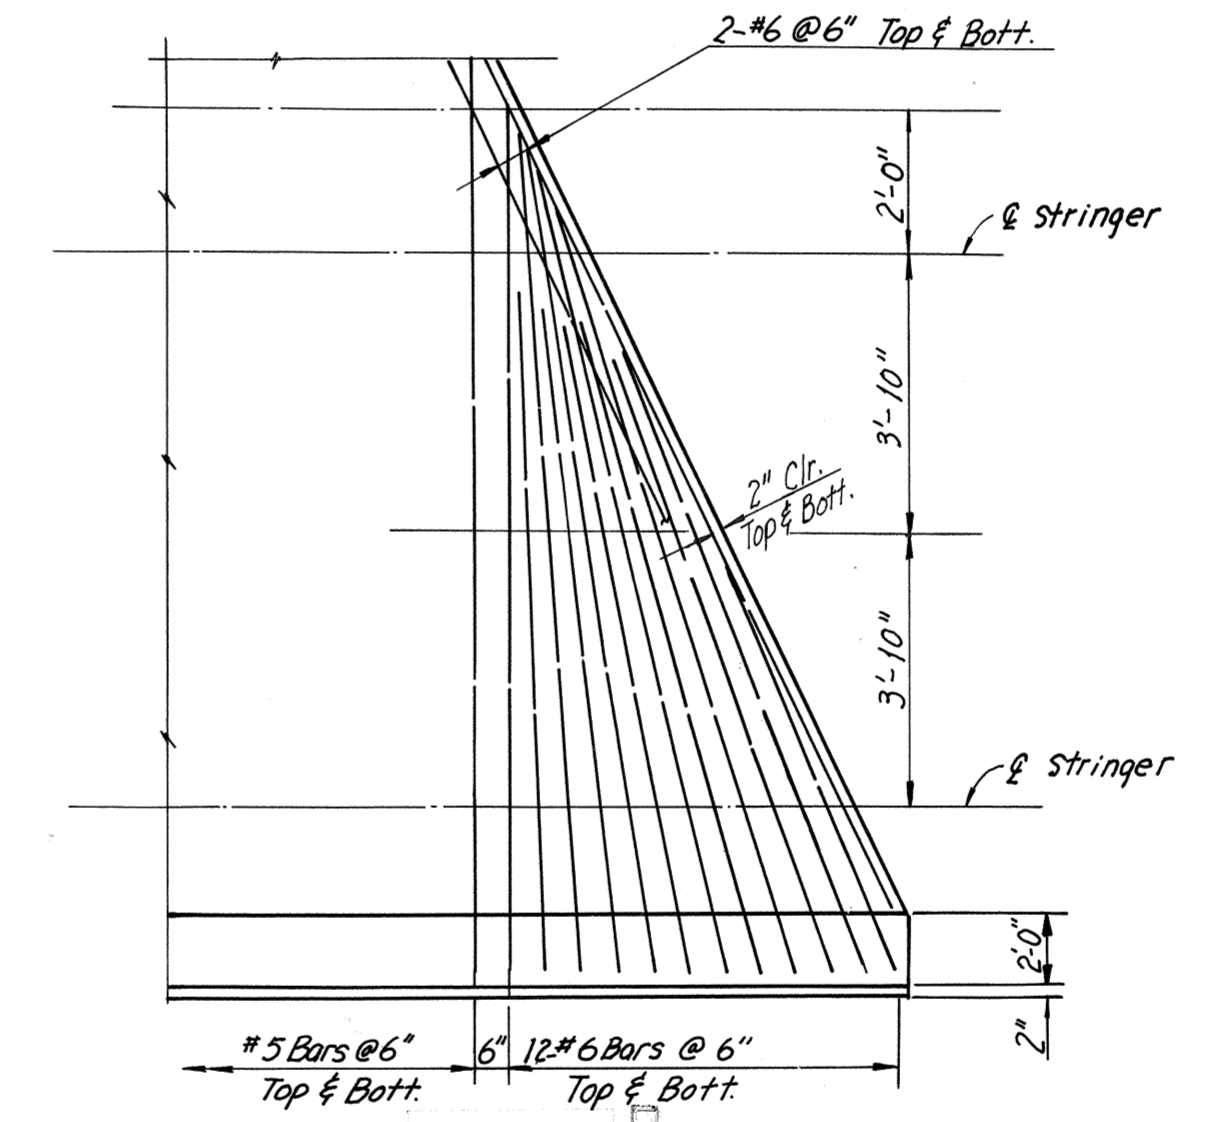

SECTION A-A
 Scale: 3/8" = 1'-0"
 (Intermediate Diaphragm near Pier 19 Unit 2 only)

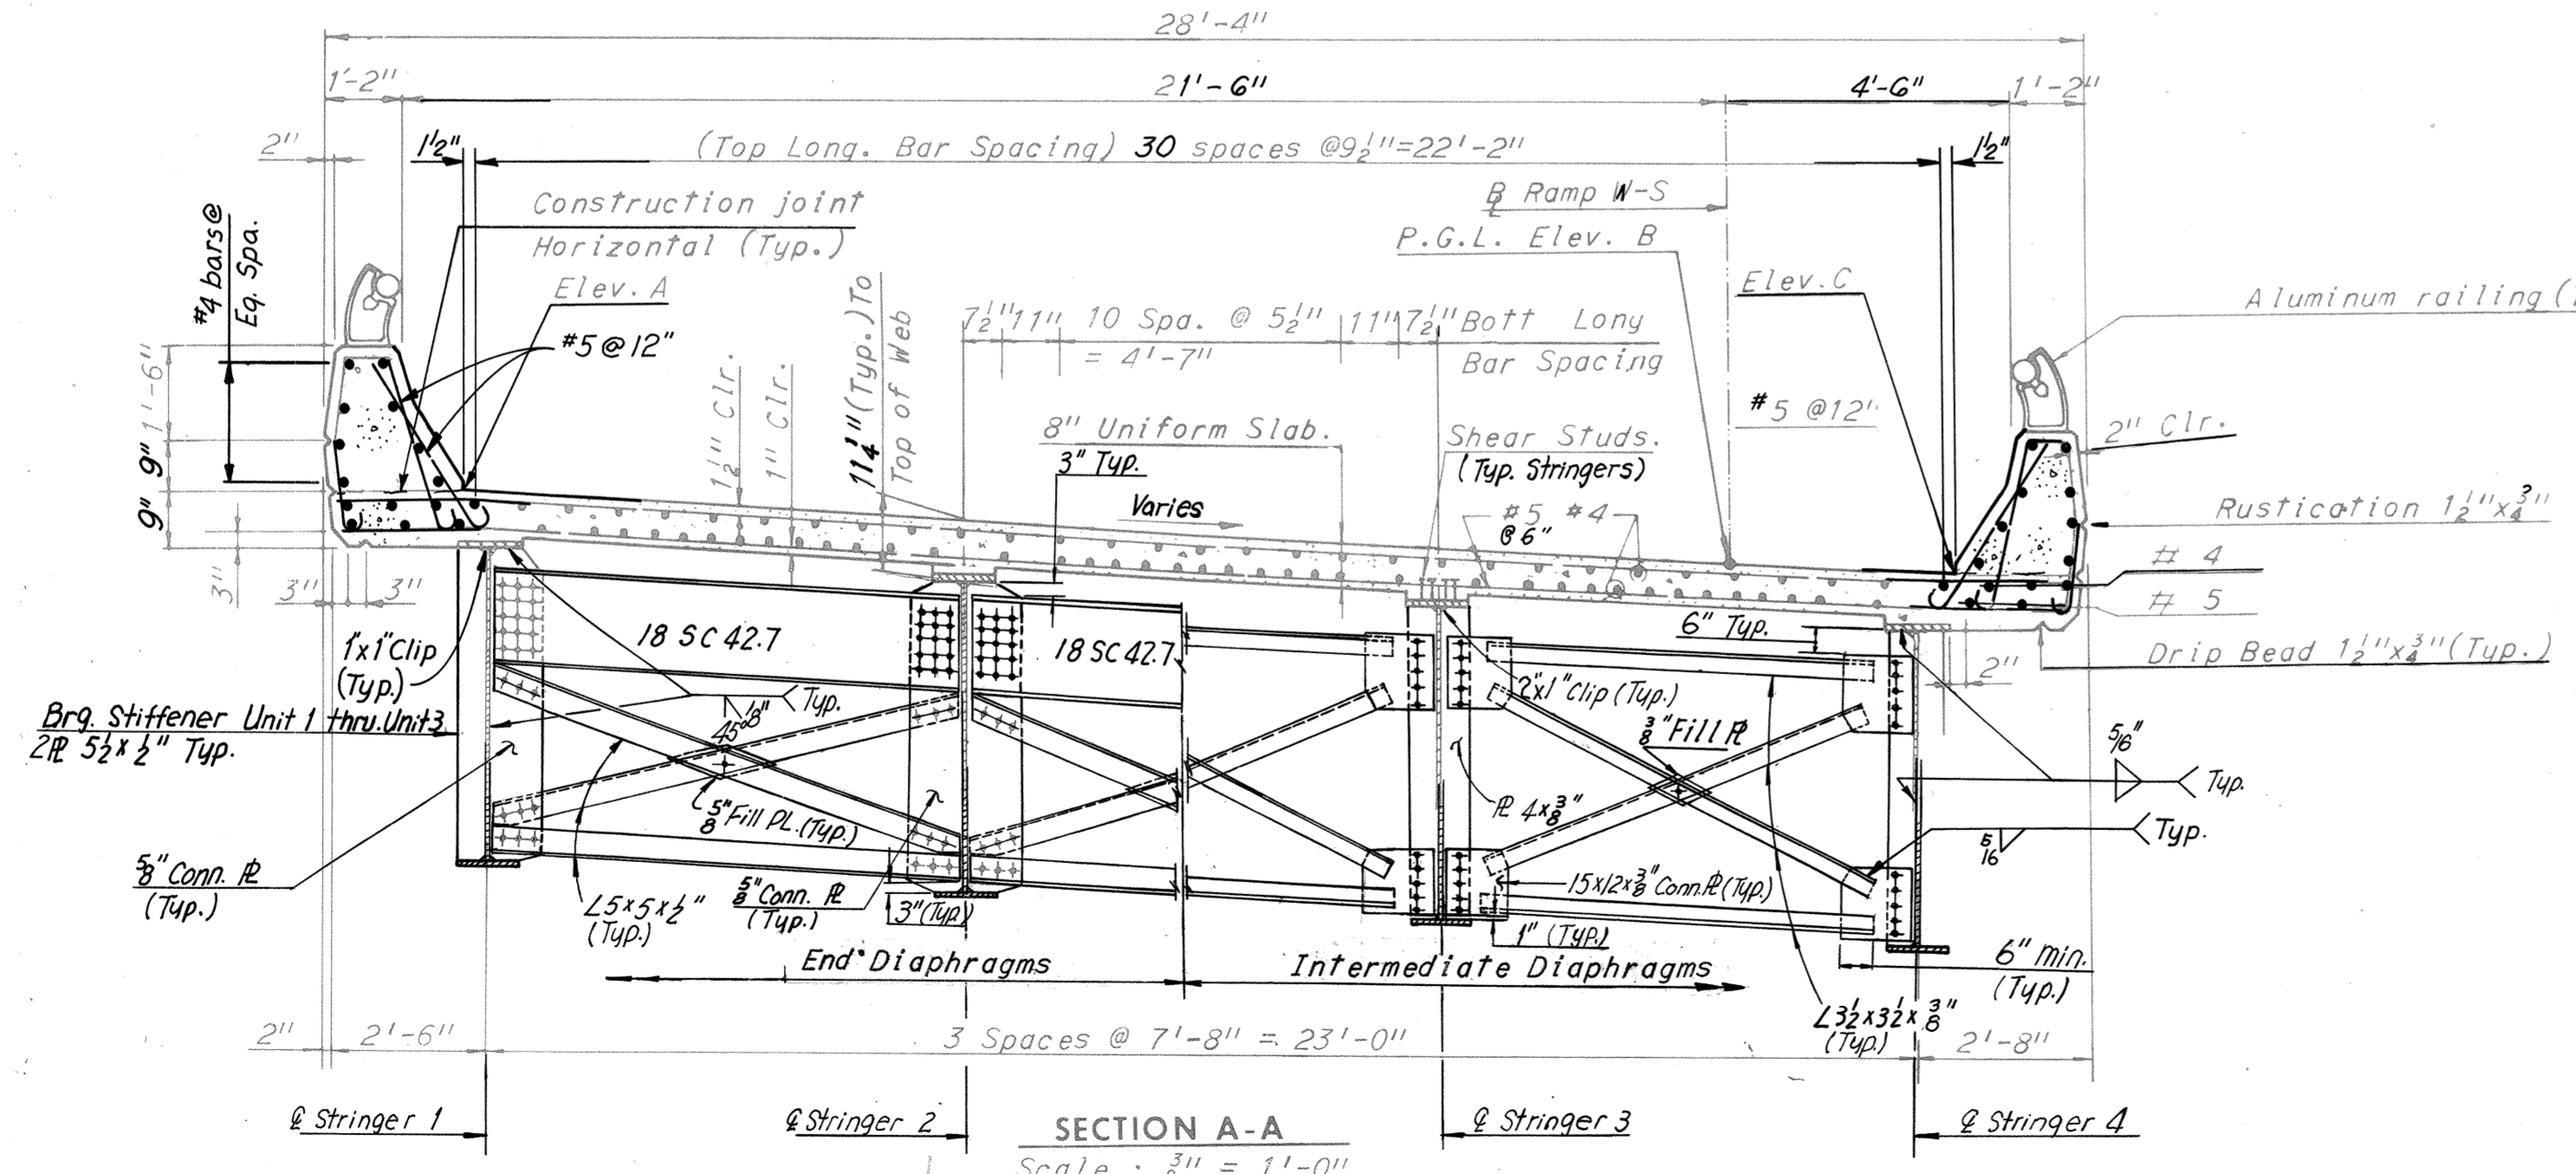

SECTION A-A
 Scale: 3/8" = 1'-0"

Note:
 End Diaphragm for Unit 3, see Sheet 20.

Notes
 For Framing Plan, see Sheet 12.
 For Standard Lighting Details, see Sheet S4.
 For Standard Drainage Details, see Support
 Type 2 Sheets S5 and S6.
 For Joint Details, see Sheet 25.
 For Standard Handrail Details, see Sheet S3.

AS BUILT
 RICHMOND METROPOLITAN AUTHORITY
 RICHMOND EXPRESSWAY SYSTEM
 DOWNTOWN EXPRESSWAY

BRIDGE NO. 68
 RAMP W-5 CONNECTION TO
 RICHMOND-PETERSBURG TURNPIKE


DECK PLAN — UNITS 1, 2 AND 3

HOWARD, NEEDLES, TAMMEN & BERGENDOFF
 consulting engineers
 NEW YORK ALEXANDRIA KANSAS CITY






SCALE: As Noted
 CONTRACT NO. 11
 SHEET NO. 19 OF 28

MADE	BY	DATE	NO.	REVISION	BY	DATE
	GSH	10-24-68		Elev. Table	TEM	3-76
	AHH	12-13-68		Rev. Elev. Table	SSS	12-75

RICHMOND EXPRESSWAY SYSTEM			
SECTION	PROJECT	SHEET NO.	TOTAL SHEETS
11	DOWNTOWN EXPRESSWAY	83	97

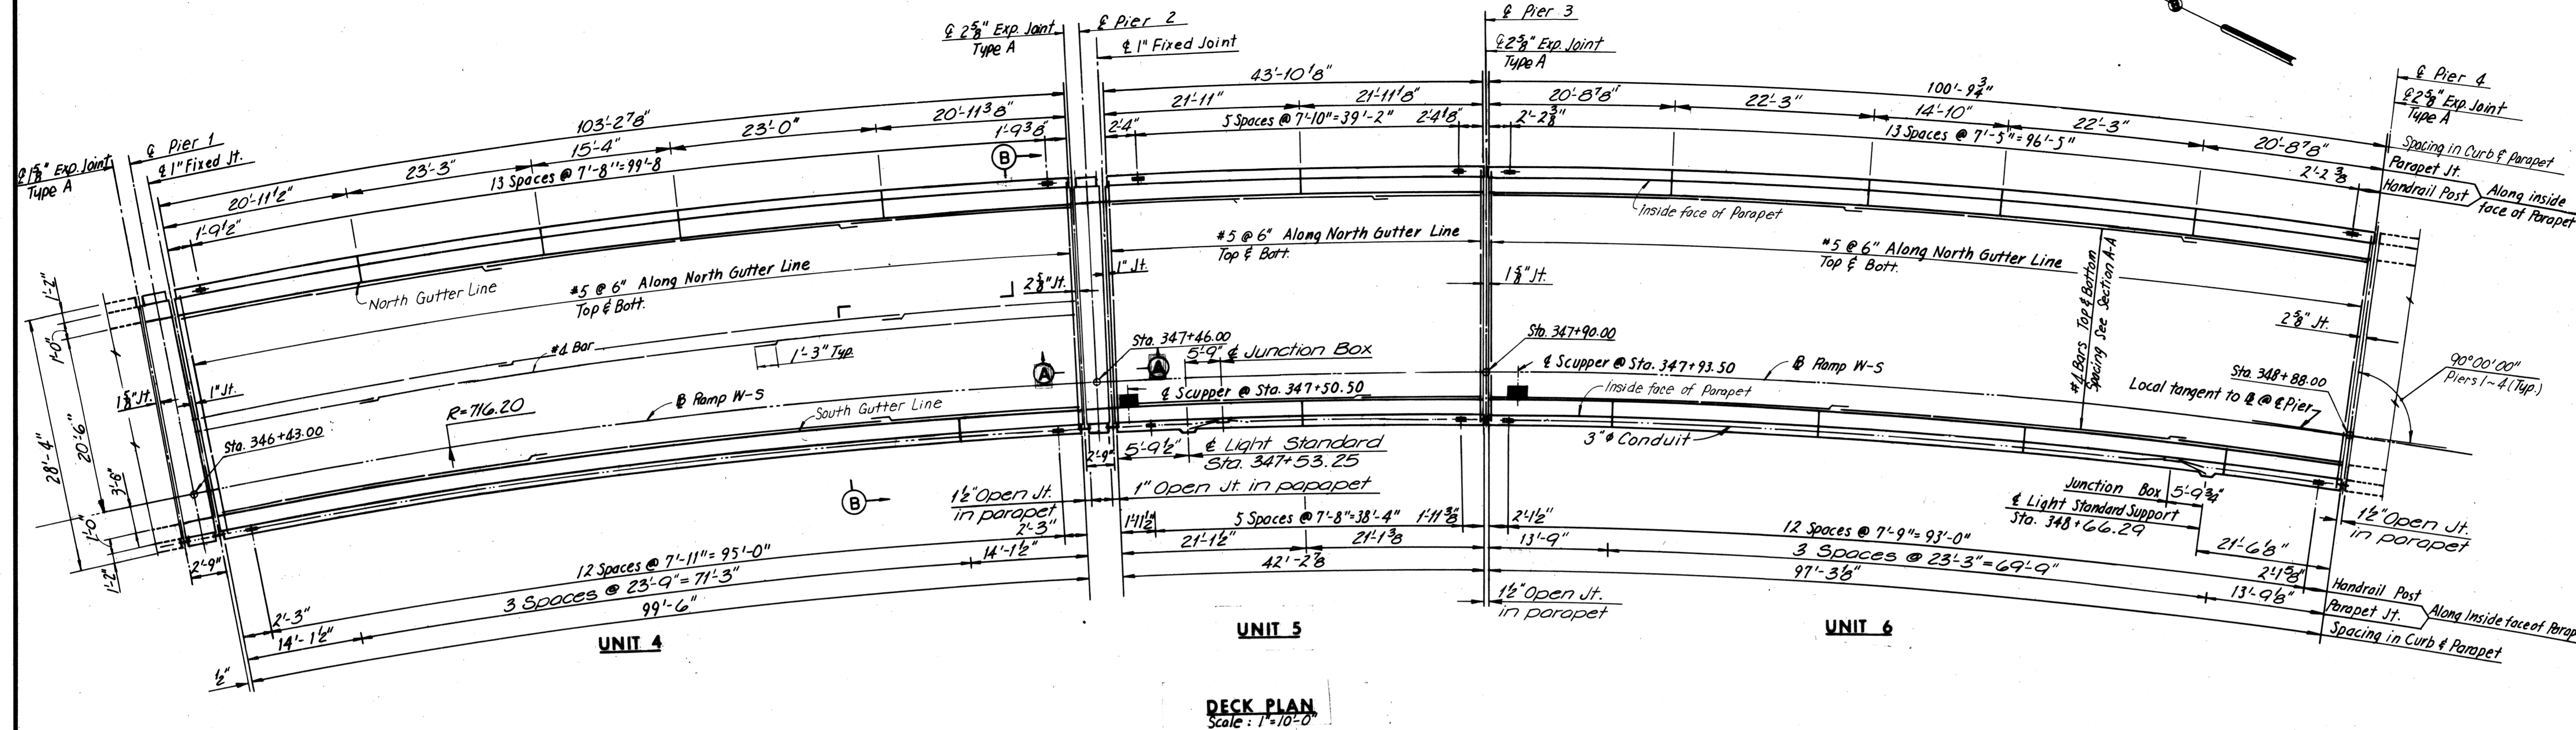

ELEVATION TABLE			
STATION	ELEV. A	ELEV. B	ELEV. C
346+43.00	94.00	92.77	92.56
+50.00	93.88	92.65	92.44
+60.00	93.71	92.48	92.27
+70.00	93.32	92.29	92.08
+80.00	93.32	92.09	91.88
346+90.00	93.11	91.88	91.67
347+00.00	92.90	91.67	91.46
+10.00	92.67	91.44	91.23
+20.00	92.43	91.20	90.99
+30.00	92.18	90.95	90.74
+40.00	91.93	90.70	90.49
+44.62	---	---	90.37
+44.66	91.81	---	---
+46.00	91.78	90.55	90.34
+50.00	91.68	90.45	90.24
+60.00	91.42	90.19	89.98
+70.00	91.17	89.94	89.73
+80.00	90.92	89.69	89.48
347+90.00	90.67	89.44	89.23
348+00.00	90.42	89.19	88.98
+10.00	90.17	88.94	88.73
+20.00	89.92	88.69	88.48
+30.00	89.67	88.44	88.23
+40.00	89.42	88.19	87.98
+50.00	89.17	87.94	87.73
+60.00	88.92	87.69	87.48
+70.00	88.67	87.44	87.23
+80.00	88.42	87.19	86.98
348+88.00	88.23	87.00	86.79

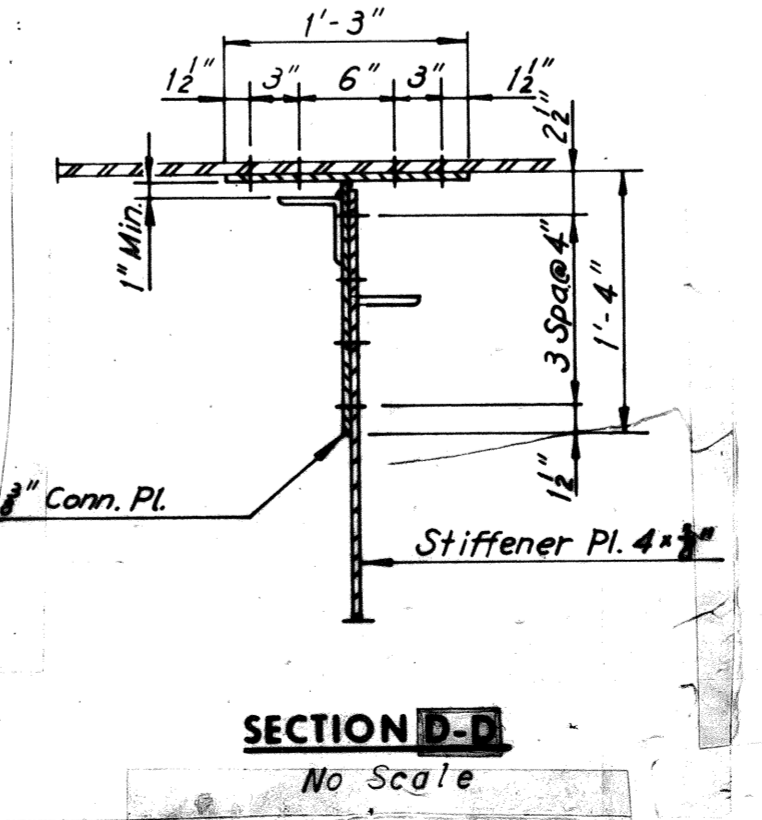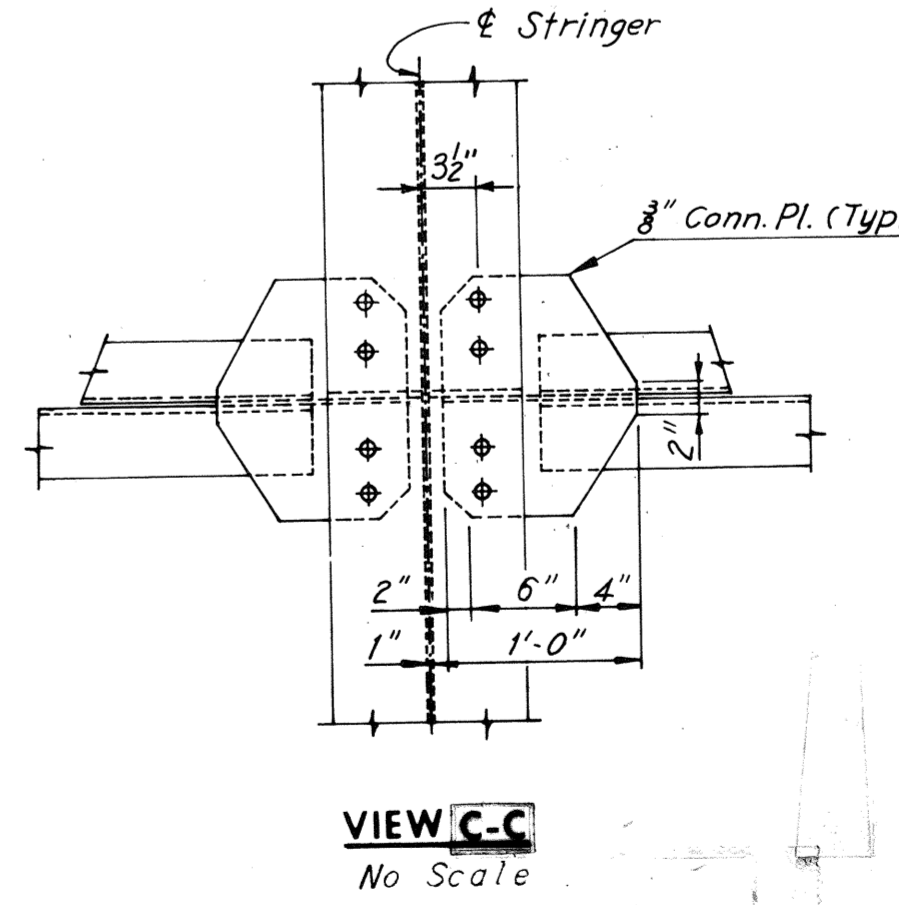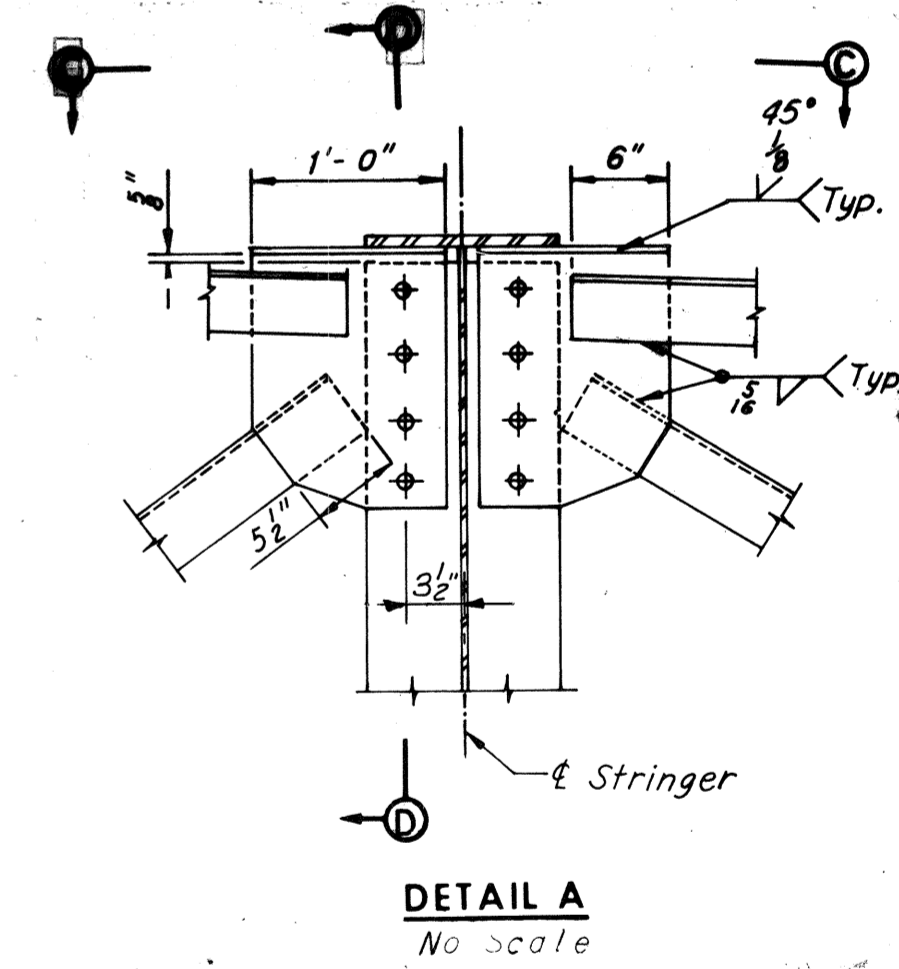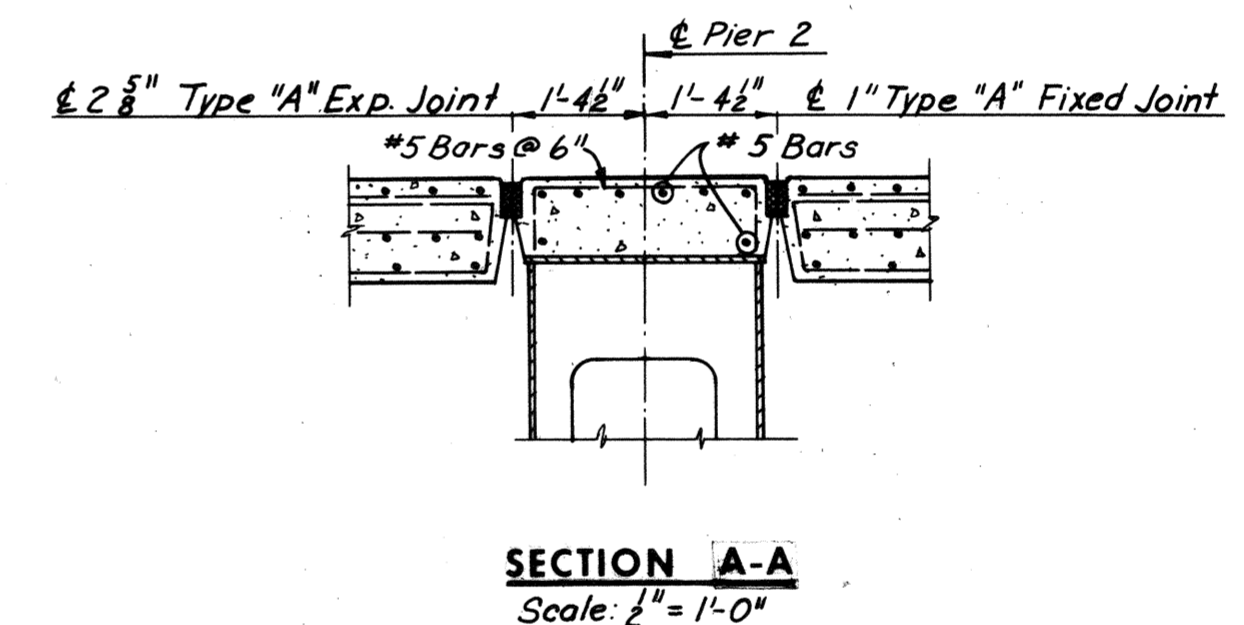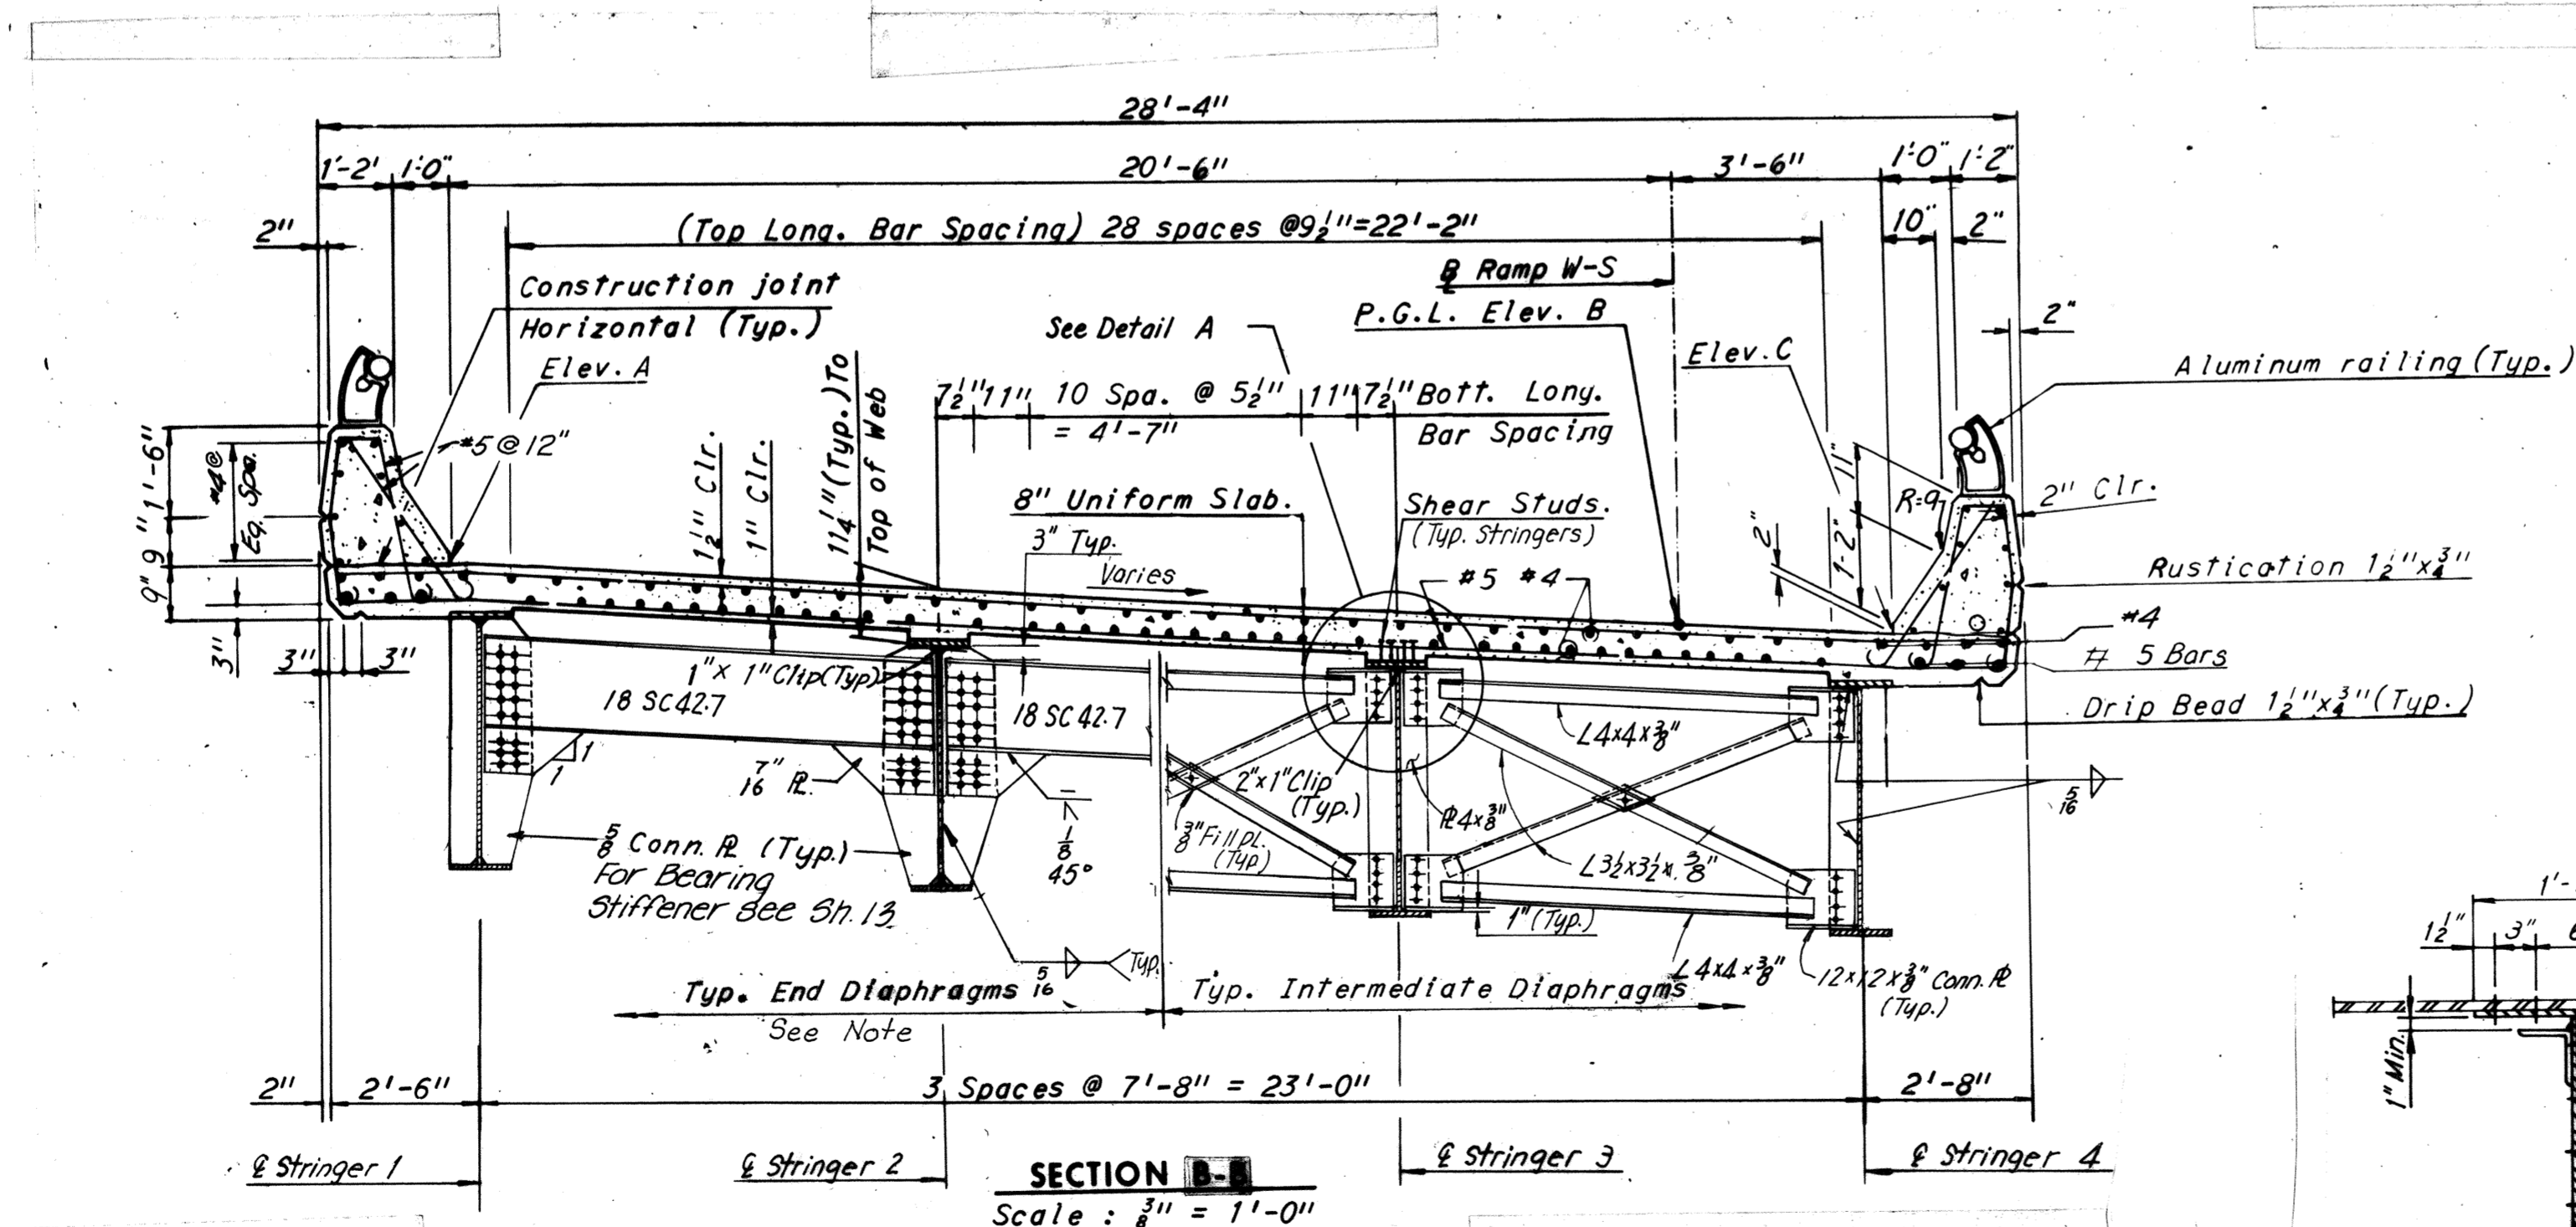

Notes
For Framing Plan see Sheet 13.
For Joint Details see Sheet 25.
For Standard Lighting Details see Sheet 54.
For Standard Handrail Details see Sheet 53.
For Standard Drainage Details see Support Type 4 Sheets 55 & 56.

AS BUILT
RICHMOND METROPOLITAN AUTHORITY
RICHMOND EXPRESSWAY SYSTEM
DOWNTOWN EXPRESSWAY
BRIDGE NO. 68
RAMP W-S CONNECTION TO
RICHMOND-PETERSBURG TURNPIKE
DECK PLAN - UNITS 4, 5 AND 6

BY	DATE	NO.	REVISION	BY	DATE
MADE	G.S.H. 10-31-68	1	Dim. in Det. A and view C-C	TEM	8-76
CHECKED	A.H.H. 12-13-68	2	Corrected dimension	SSS	12-75
IN CHARGE					

HOWARD, NEEDLES, TAMMEN & BERGENDOFF consulting engineers NEW YORK ALEXANDRIA KANSAS CITY	SCALE: As Noted CONTRACT NO. 11 SHEET NO. 20 OF 28
---	--

RICHMOND EXPRESSWAY SYSTEM			
SECTION	PROJECT	SHEET NO.	TOTAL SHEETS
11	DOWNTOWN EXPRESSWAY	84	97

ELEVATION TABLE

STATION	ELEV. A	ELEV. B	ELEV. C
348+88.00	88.20	87.00	86.79
+90	88.18	86.95	86.74
349+00.00	87.94	86.73	86.52
+10	87.72	86.53	86.32
+20	87.50	86.34	86.13
+30	87.30	86.16	85.95
+40	87.12	86.01	85.80
+50	86.95	85.86	85.65
+60	86.72	85.74	85.54
+70	86.51	85.62	85.44
+80	86.32	85.53	85.36
+86	86.21	85.48	85.32
+90	86.15	85.44	85.30
350+00.00	85.99	85.38	85.25
+10	85.85	85.33	85.21
+20	85.74	85.29	84.19
+22.57			85.18
+23.24		85.28	
+26.05	85.76		
+30	85.72	85.26	85.15
+40	85.49	85.18	85.10
+50	85.32	85.05	84.94
+54.79	85.25	85.03	84.94
+60	85.17	84.88	84.81
+70	84.99	84.71	84.64
+80	84.85	84.60	84.52
+90	84.69	84.45	84.37
351+00.00	84.51	84.29	84.21
+06.23	84.40	84.31	84.29

Note: New Diaphragms are to match the existing Diaphragms on R. P. Turnpike structure. Connection bolts for the new Diaphragms connecting Bridge 68 to existing structure, shall not be fully tightened before new concrete deck slab has been placed.

Note A: Elev. A between Sta. 348+88 and 350+54.79 is given along the East Gutter Line Ramp W-5 and are radial to the Base Line Ramp W-5 at the respective stations. Elev. A from Sta. 350+54.79 to the End of Bridge is given along existing Gutter Line R.P.T. and are radial to the existing Base Line R.P.T. at the respective stations as given along the Base Line Ramp W-5. Cross Slope is radial to the Base Line R.P.T. Elev. A is to be field verified. Minor adjustments may be required.

Note: Existing No.5 transverse steel top & bottom to remain in place and be cleaned of concrete. Existing steel shall extend a minimum of 2'-0" into new concrete. Bottom reinf. shall be straightened.

Notes: For Framing Plan Details see Sheet 14. For Intermediate Diaphragm Details, Conn. R. Details and Reinforcement in Unit 7, see Section A-A of Sheet 20. For Standard Handrail Details, see Sheet S3. For Standard Lighting Details, see Sheet S4. For Joint Details, see Sheet 25. For Standard Drainage Details for Unit 7 see Support Type 3 and for Unit 9 see Support Type 5, both on Sheets S5 & S6. End Diaphragms for Unit 7 @ pier 4 and-5 see Section A-A Sheet 20.






**RICHMOND METROPOLITAN AUTHORITY
RICHMOND EXPRESSWAY SYSTEM
DOWNTOWN EXPRESSWAY**

**BRIDGE NO. 68
RAMP W-5 CONNECTION TO
RICHMOND-PETERSBURG TURNPIKE
DECK PLAN-UNITS 7, 8 AND 9**

HOWARD, NEEDLES, TAMMEN & BERGENDOFF
consulting engineers
NEW YORK ALEXANDRIA KANSAS CITY

SCALE: As Noted
CONTRACT NO.: 11
SHEET NO. 21 OF 28

AS BUILT

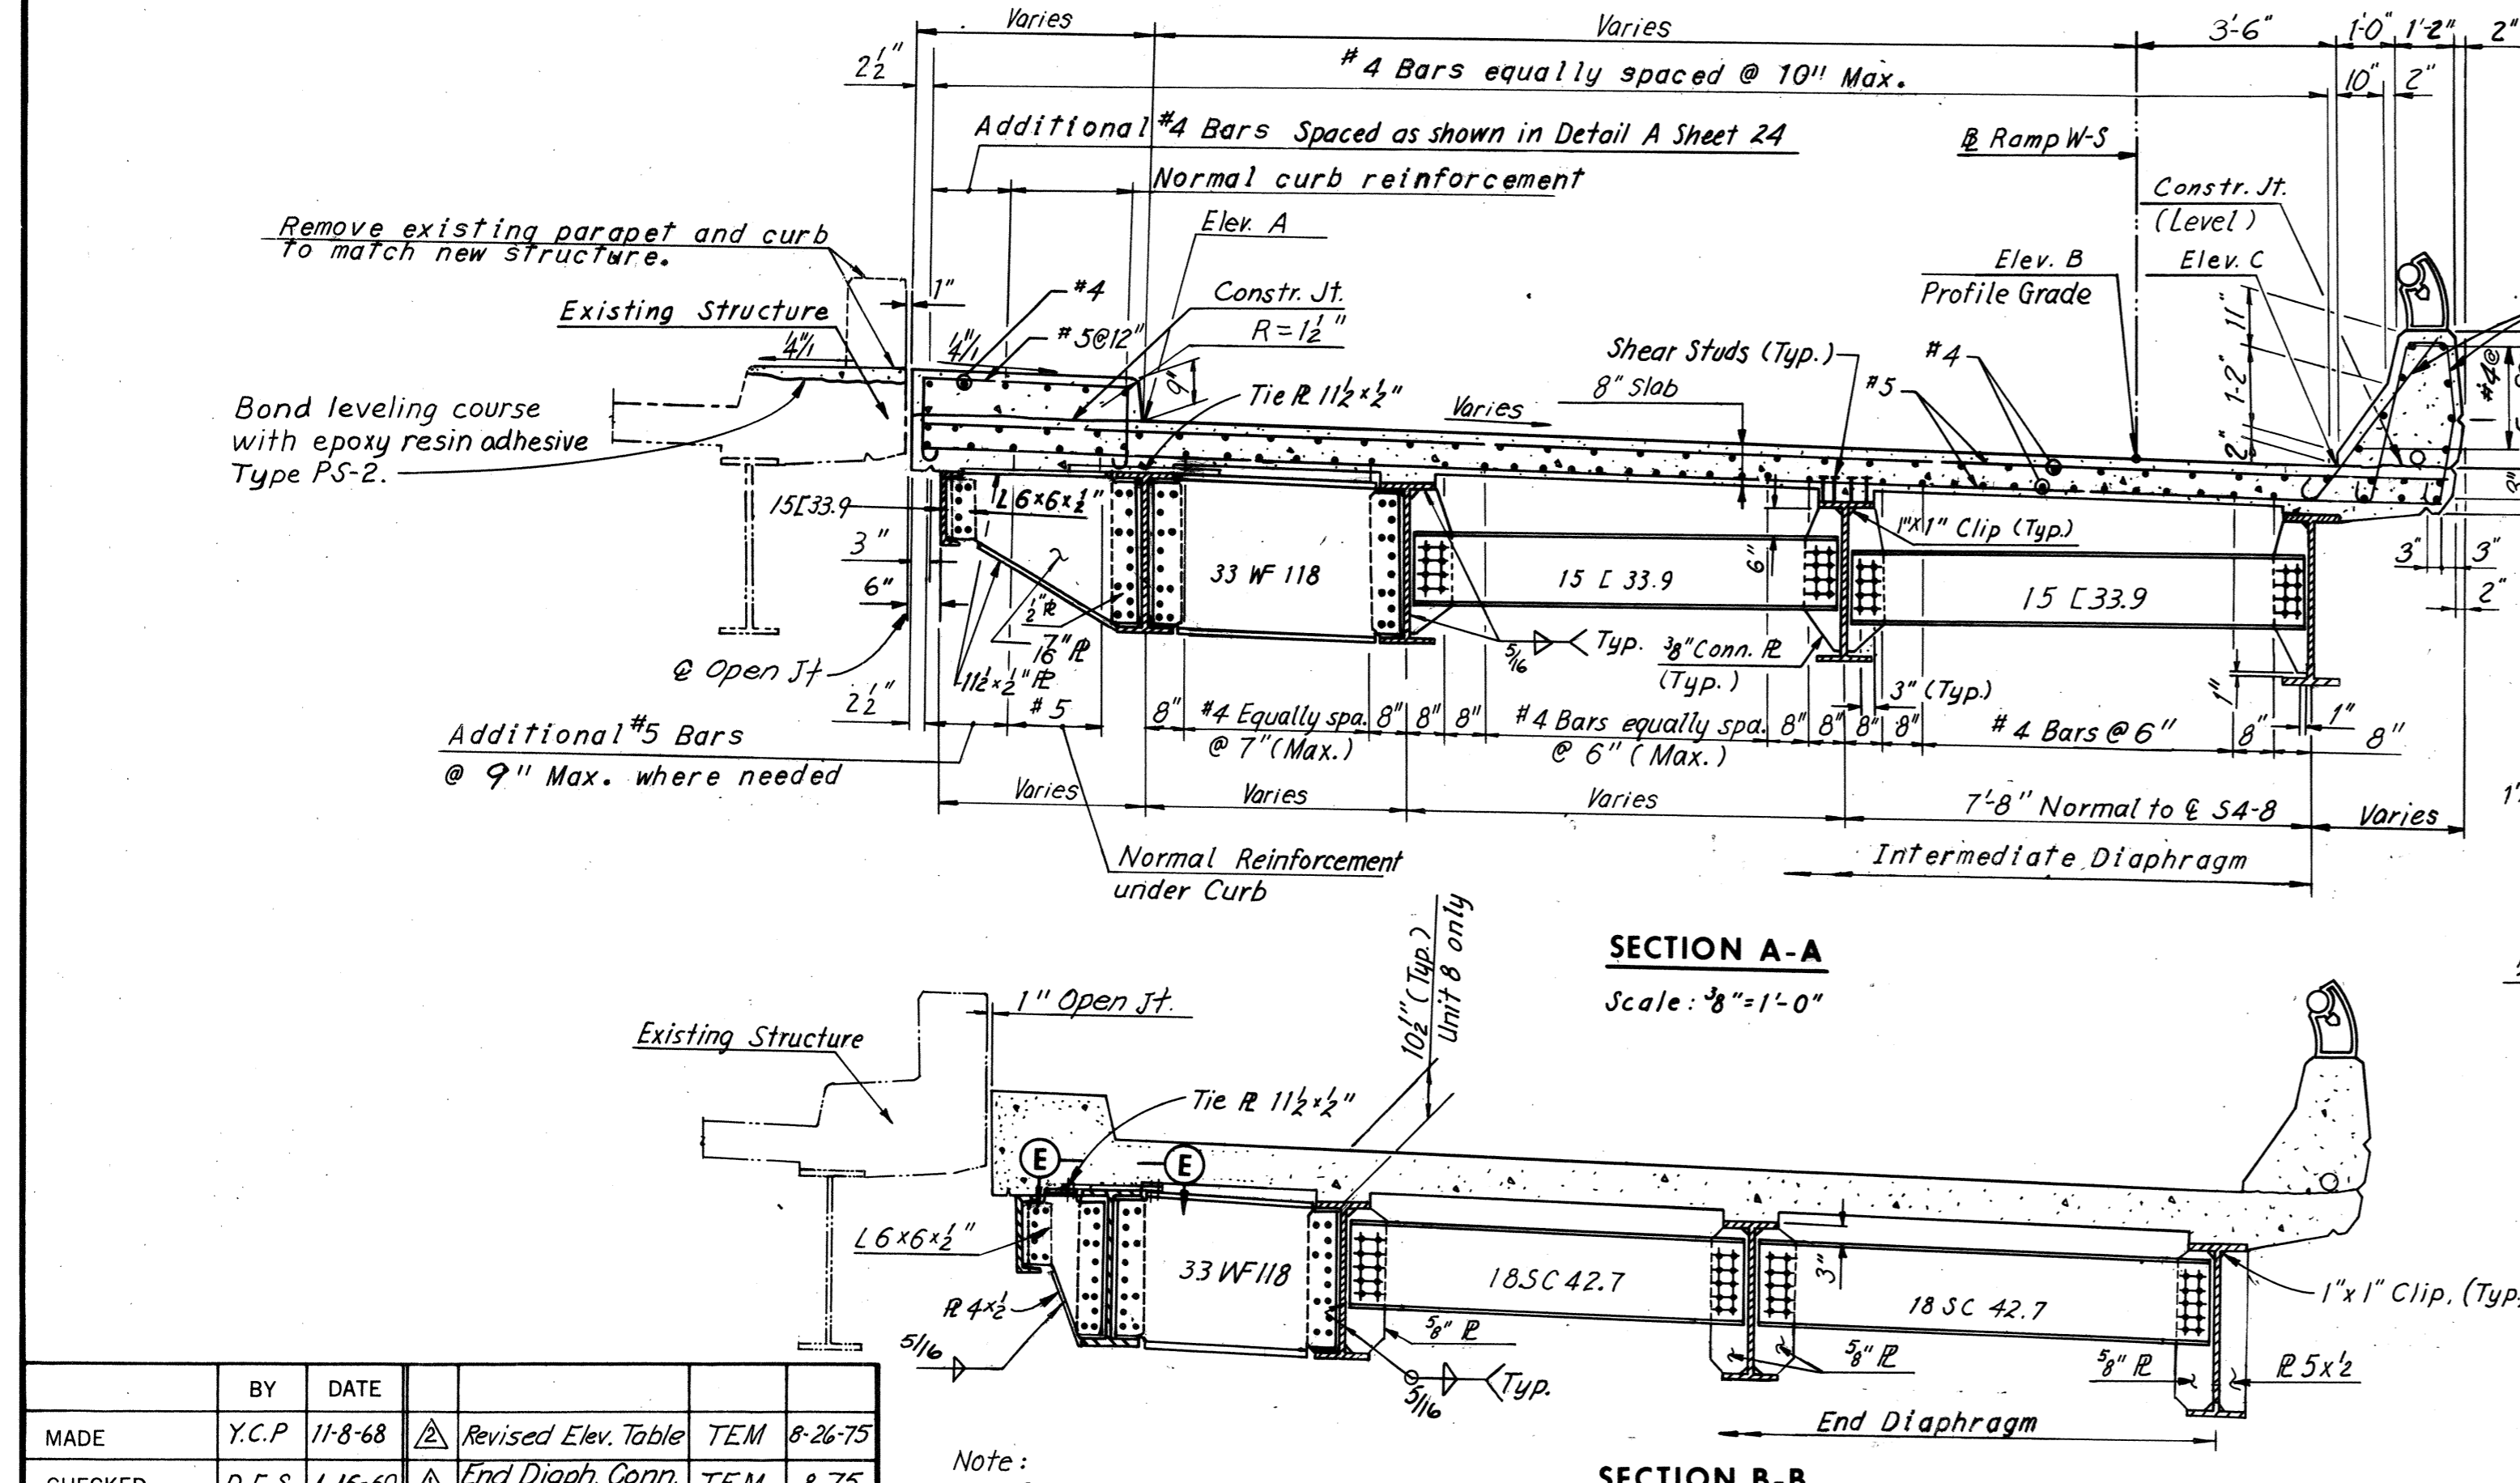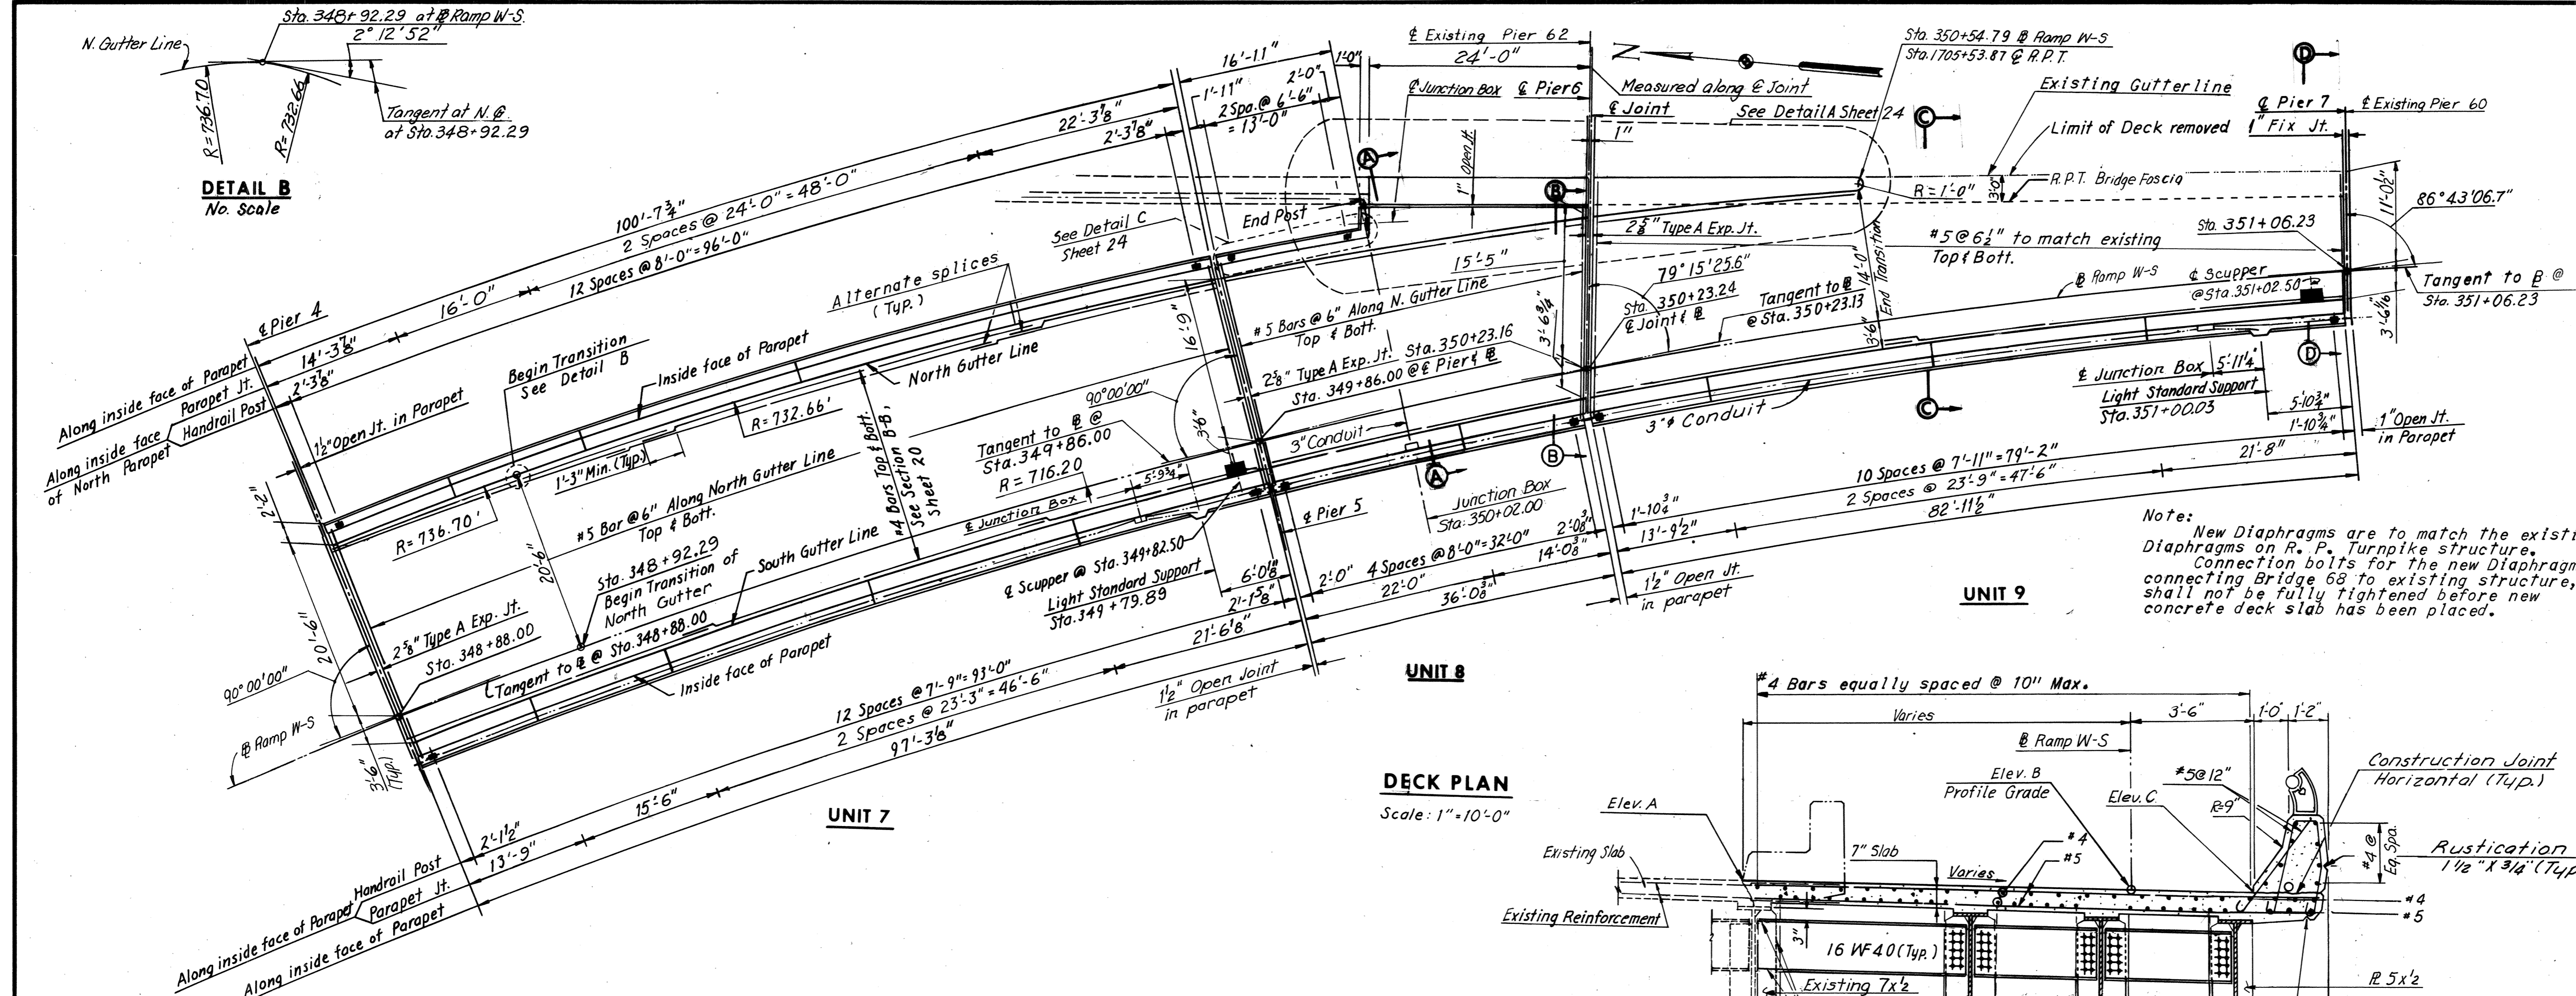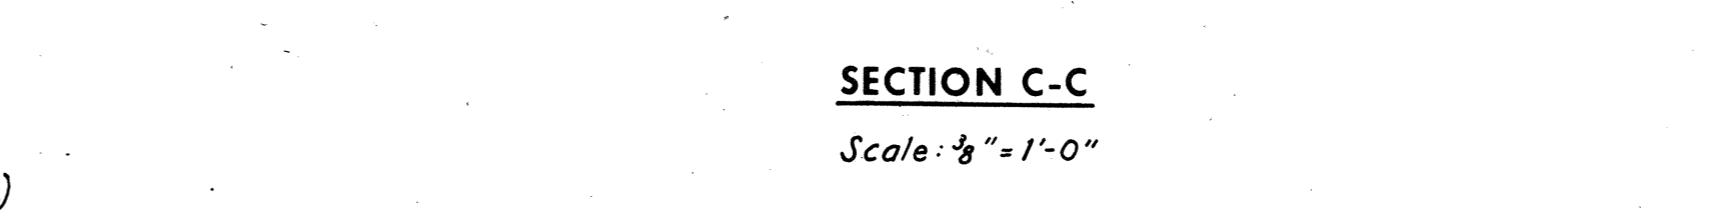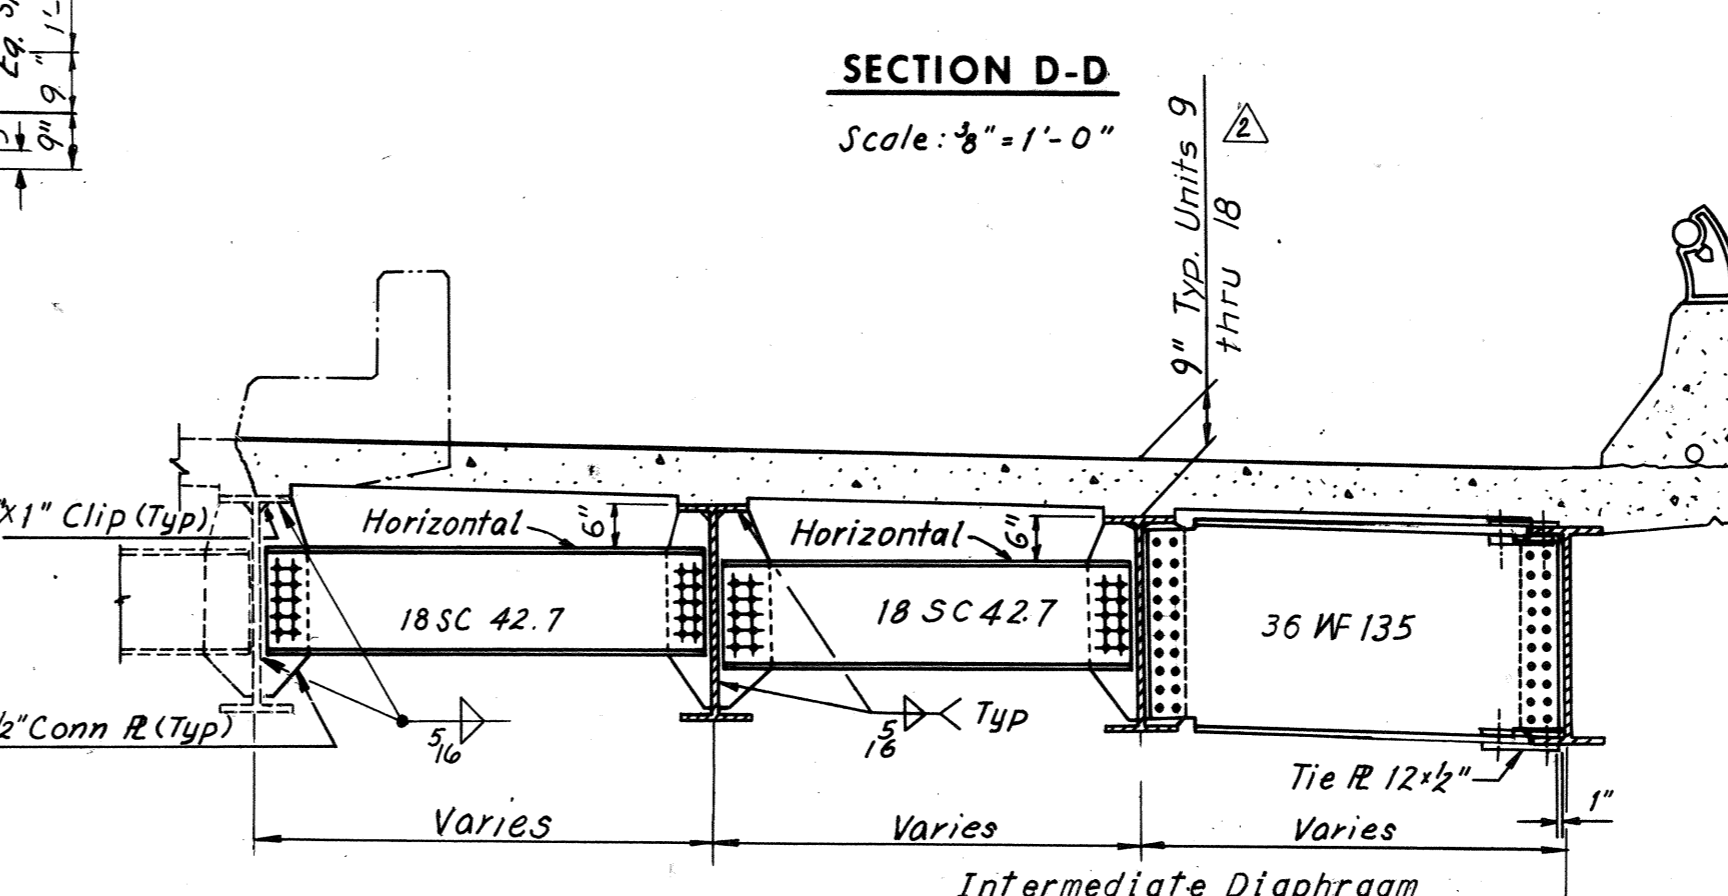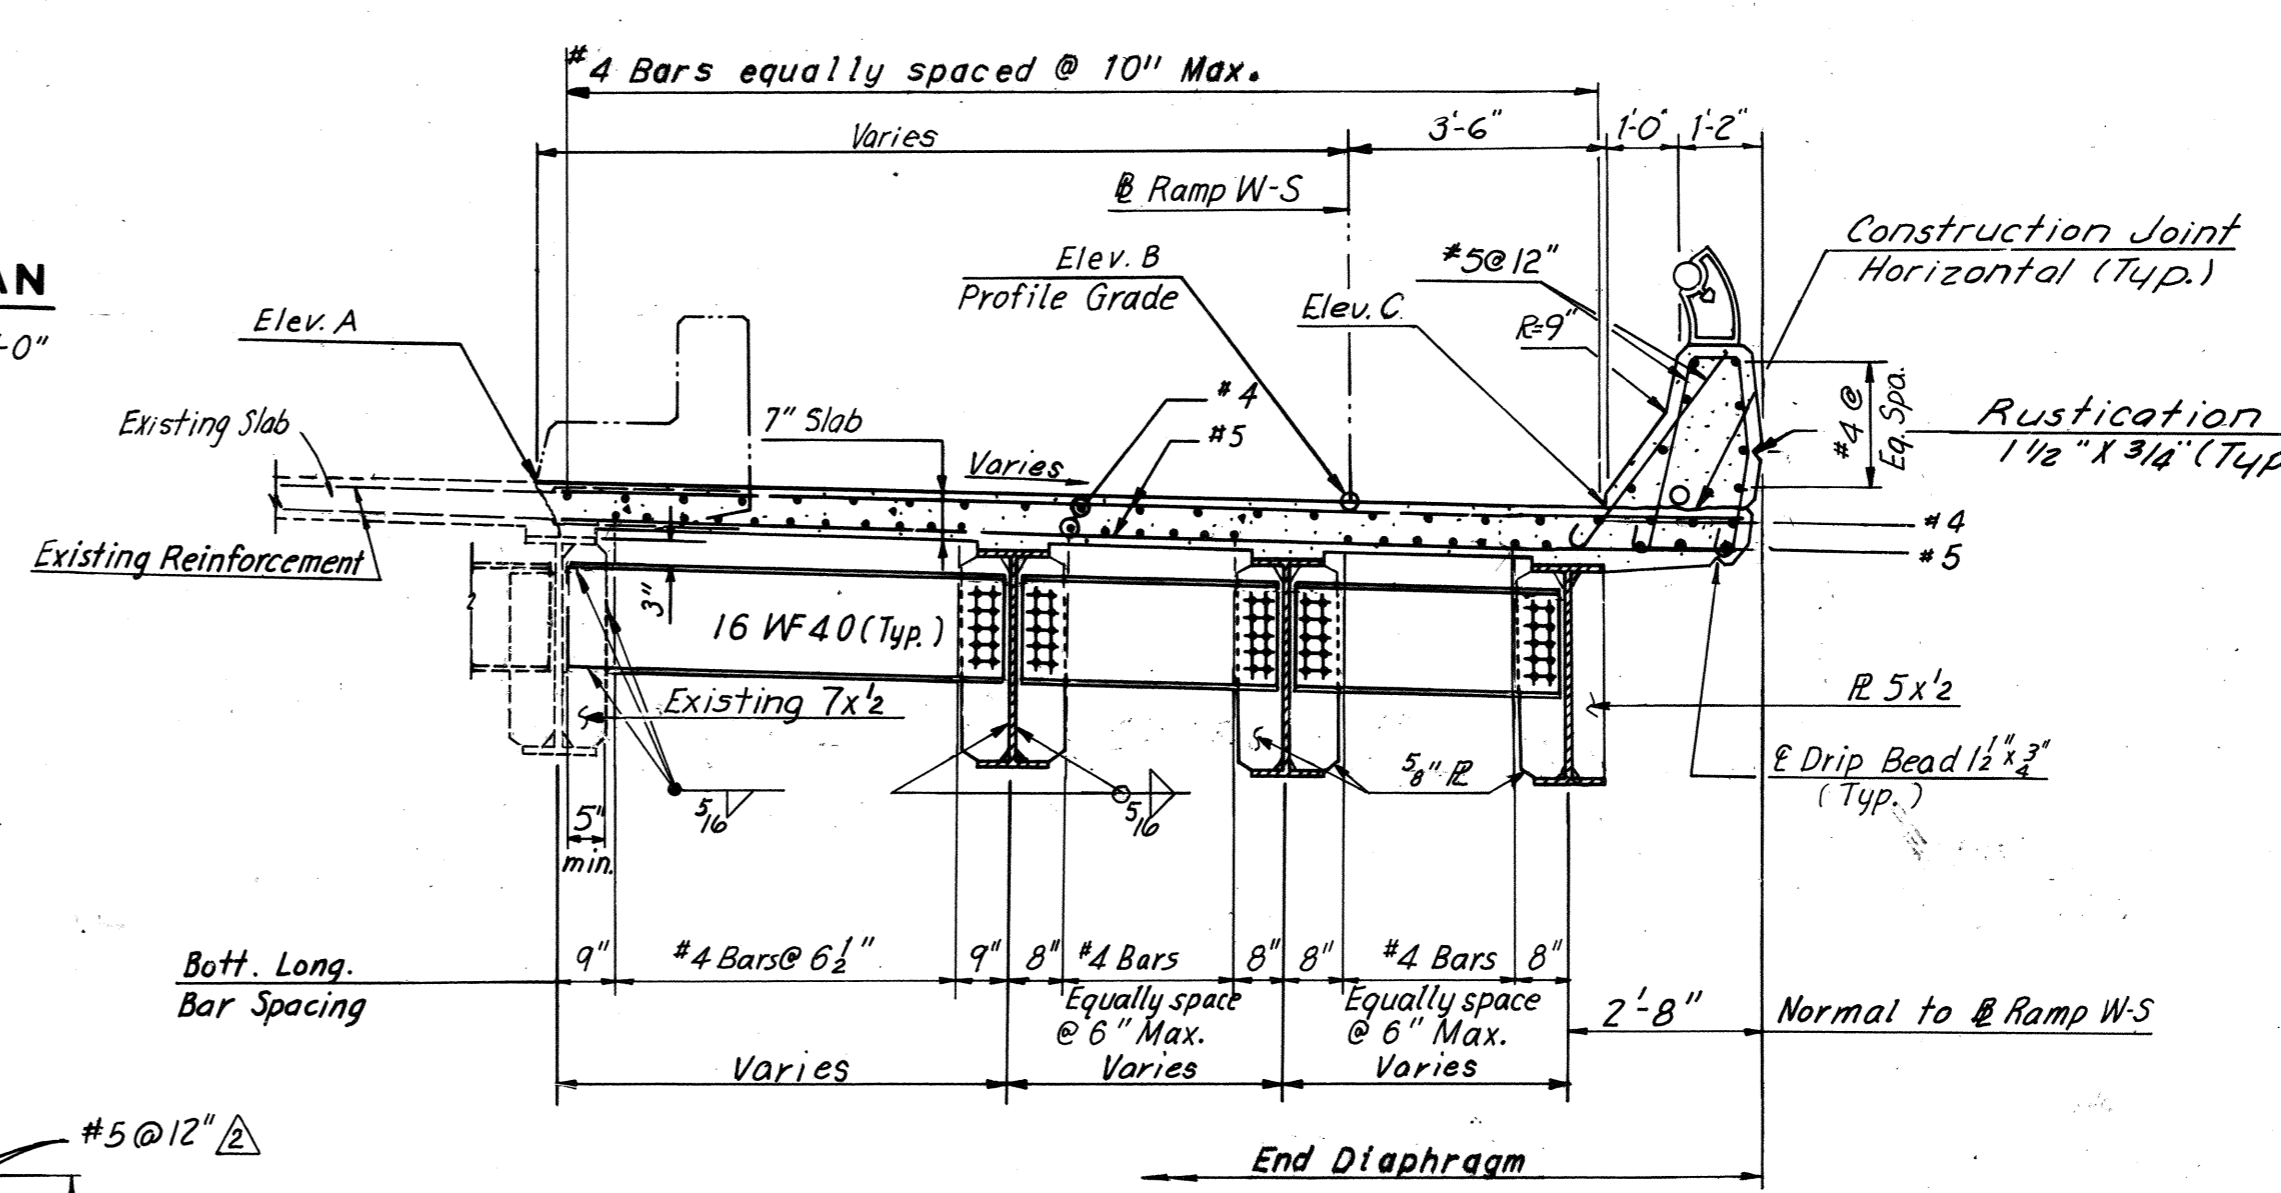


BY	DATE	REVISION	BY	DATE
Y.C.P	11-8-68	Revised Elev. Table	TEM	8-26-75
D.E.S	1-16-69	End Diaph. Conn. at exist. string	TEM	8-75
NO.				

Note: Section E-E, See Section G-G on Sheet 24.

SECTION B-B
Scale: 3/8" = 1'-0"

MADE	BY	DATE	REVISION	BY	DATE
Y.C.P	11-8-68		Revised Elev. Table	TEM	8-26-75
D.E.S	1-16-69		End Diaph. Conn. at exist. string	TEM	8-75

RICHMOND EXPRESSWAY SYSTEM			
SECTION	PROJECT	SHEET NO.	TOTAL SHEETS
11	DOWNTOWN EXPRESSWAY	85	97

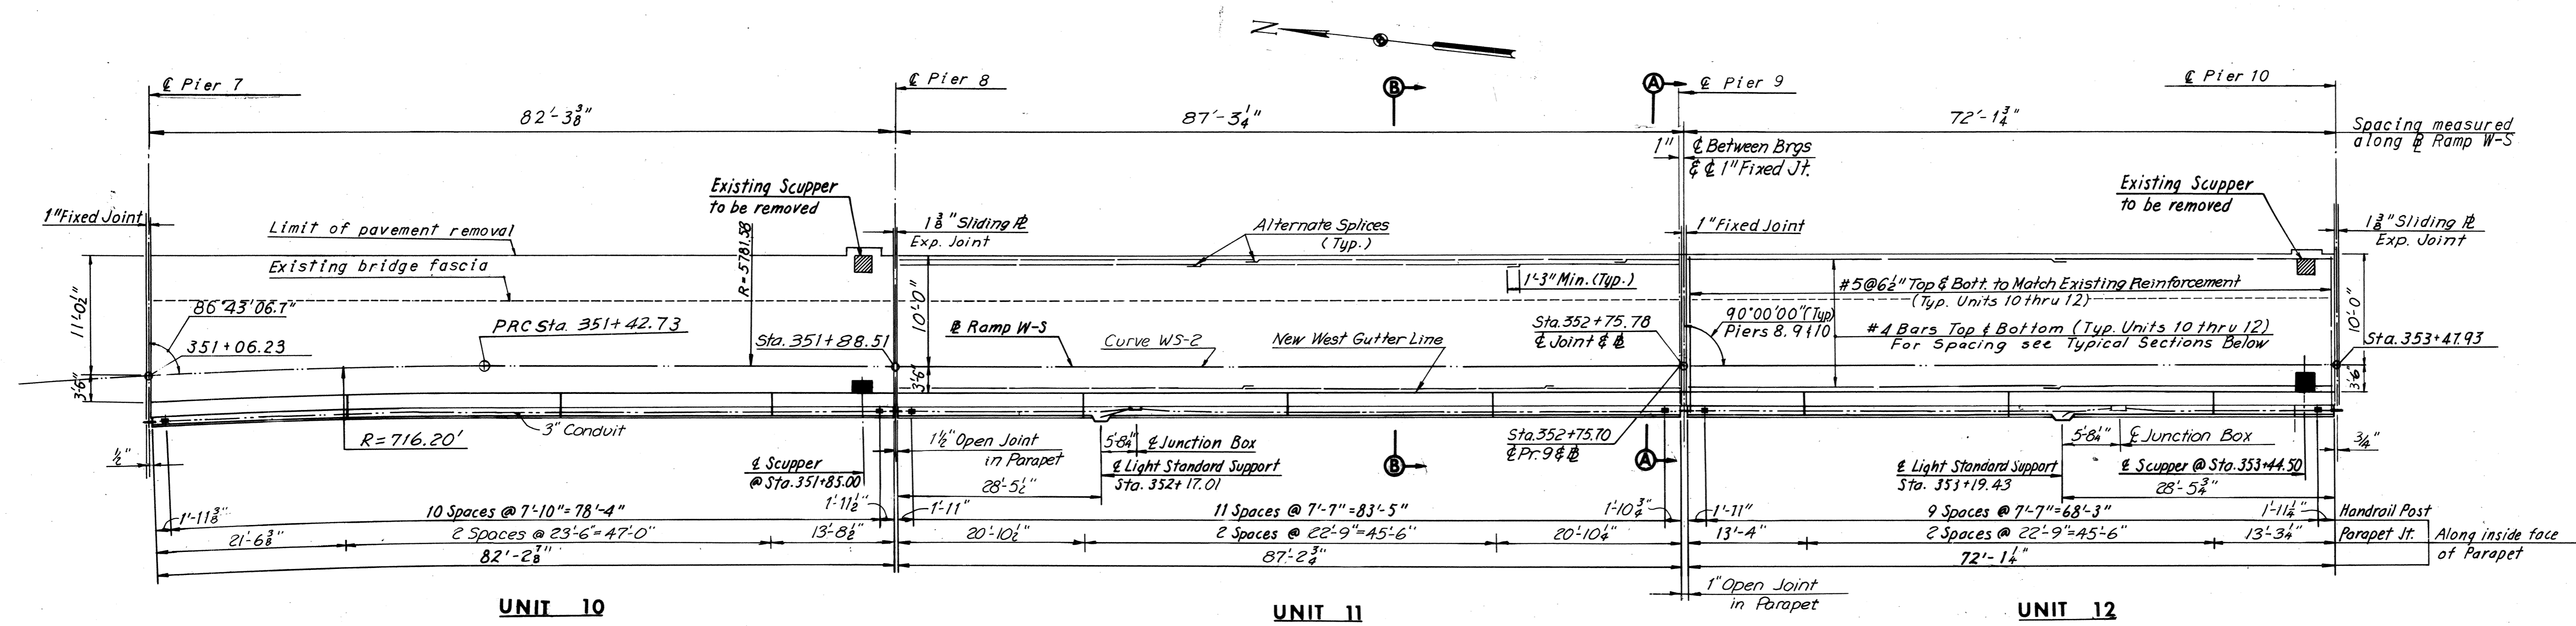


DECK PLAN
Scale: 1"=10'-0"


Note:
New Diaphragms are to match the existing Diaphragms on R. P. Turnpike structure. Connection bolts for the new Diaphragms connecting Bridge 68 to existing structure, shall not be fully tightened before new concrete deck slab has been placed.

ELEVATION TABLE			
STATION	ELEV. A	ELEV. B	ELEV. C
+06.23	84.52	84.34	84.29
+10	84.39	84.18	84.10
+20	84.23	84.02	83.94
+30	84.07	83.85	83.78
+40	83.90	83.70	83.62
+50	83.77	83.57	83.49
+60	83.56	83.36	83.28
+70	83.42	83.21	83.15
+80	83.26	83.05	82.99
+88.51	83.13	83.03	82.99
+90	83.12	83.01	82.98
352+00	82.94	82.85	82.82
+10	82.76	82.69	82.66
+20	82.60	82.53	82.50
+30	82.45	82.37	82.34
+40	82.29	82.21	82.19
+50	82.17	82.06	82.03
+60	82.01	81.90	81.87
+70	81.85	81.74	81.71
+75.78	81.81	81.67	81.62
+80	81.73	81.60	81.55
+90	81.56	81.44	81.39
353+00	81.41	81.28	81.23
+10	81.25	81.12	81.08
+20	81.04	80.95	80.92
+30	80.93	80.80	80.76
+40	80.75	80.64	80.60
+47.93	80.65	80.52	80.48

Note:
See Note A Sheet 21 of this set.

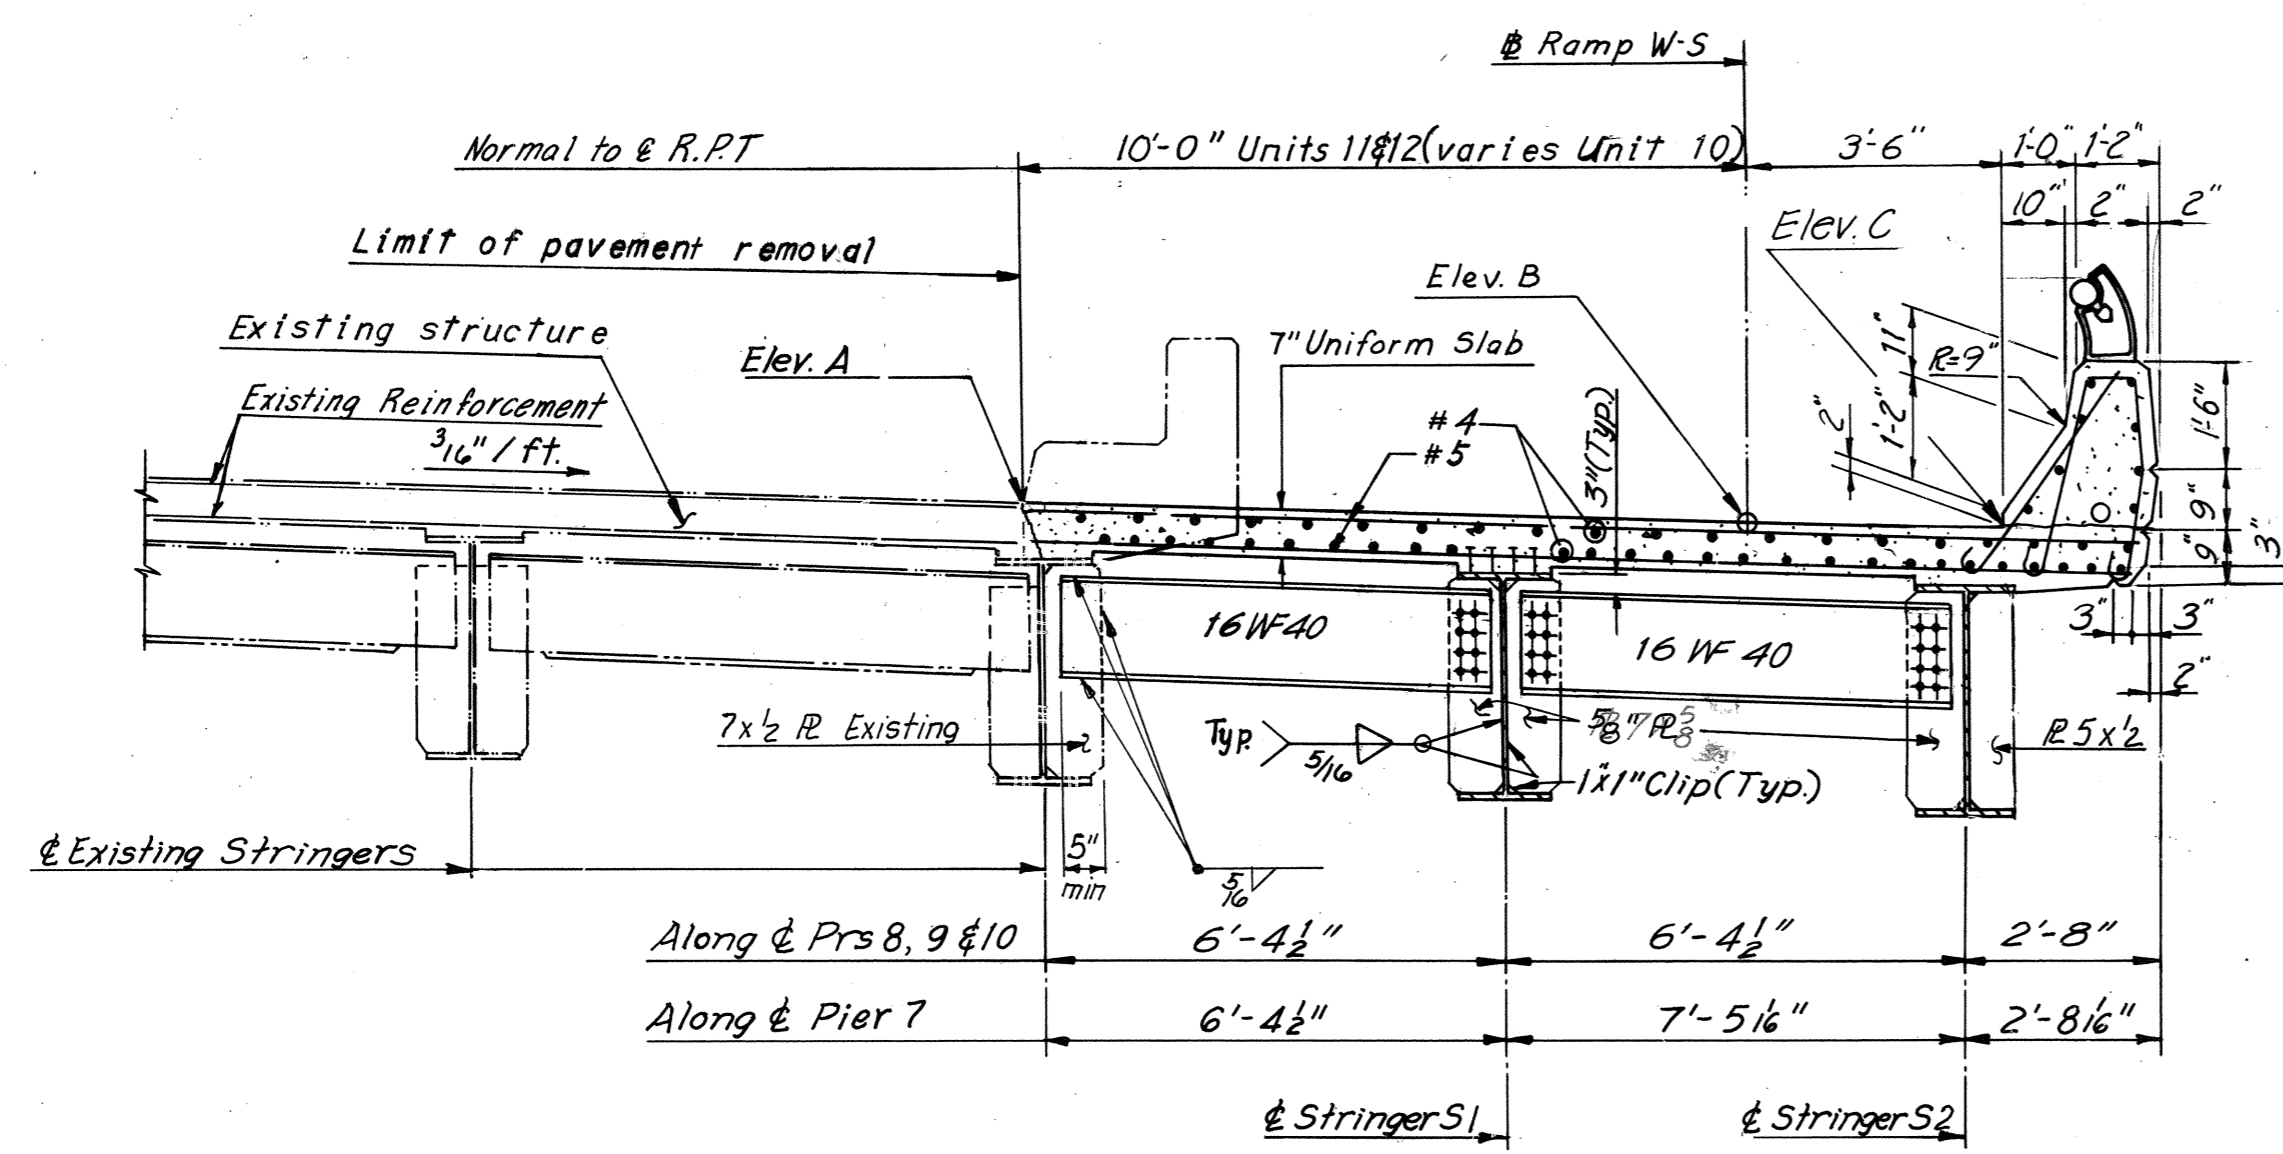


END DIAPHRAGM TYPICAL SECTION A-A
Scale: 3/8" = 1'-0"

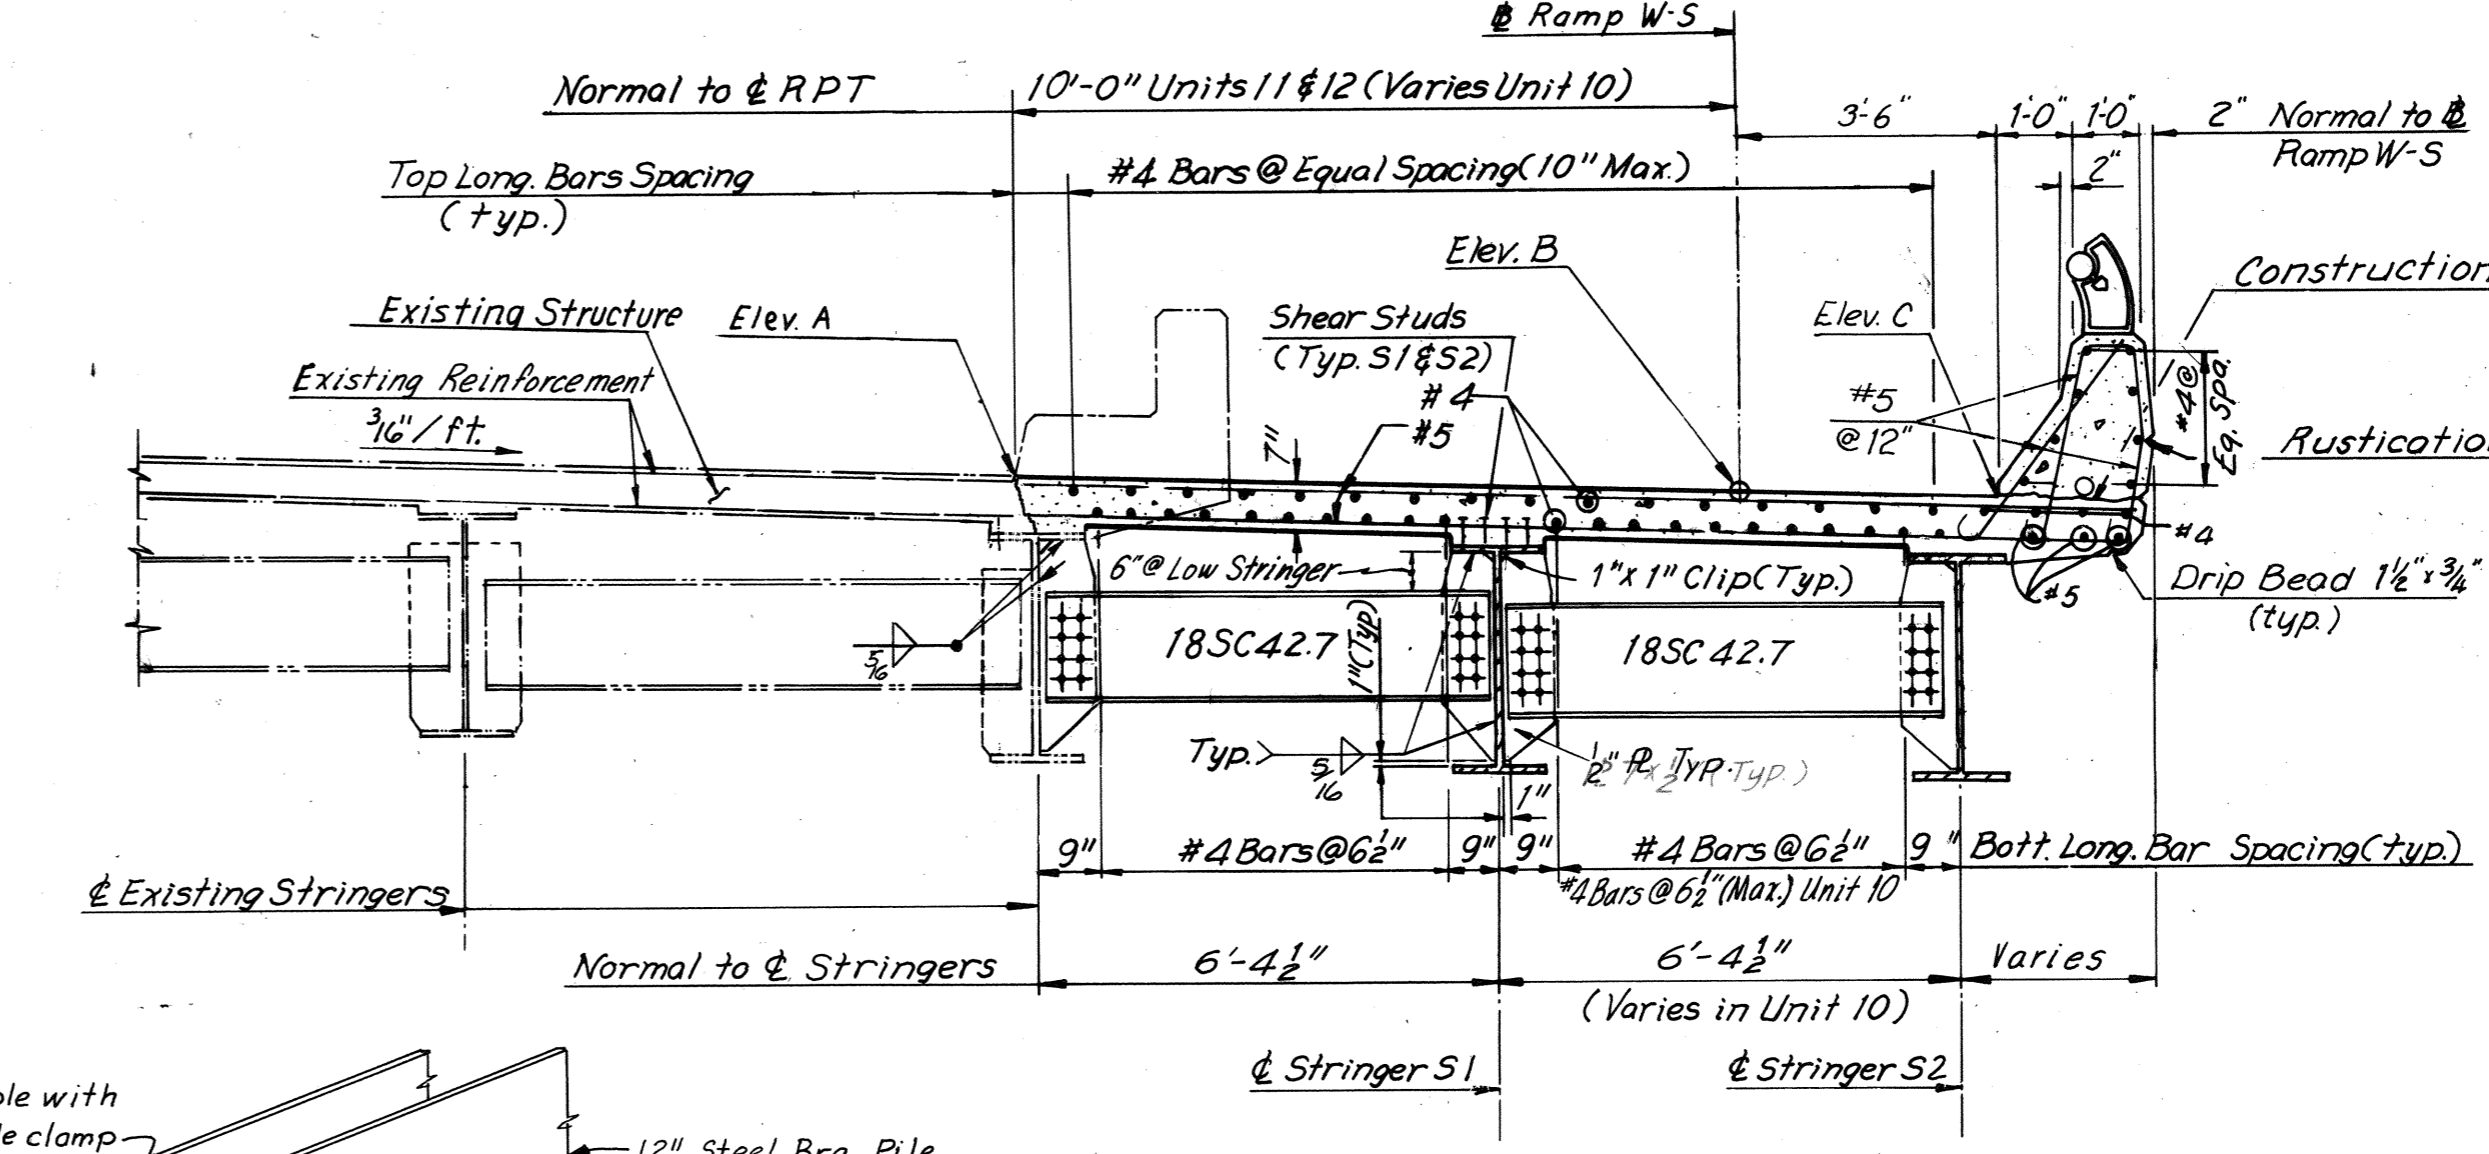

INTERMEDIATE DIAPHRAGM TYPICAL SECTION B-B
Scale: 3/8" = 1'-0"

Note:
Existing No. 5 transverse steel to remain in place and be cleared of concrete. Existing steel shall extend a minimum of 2'-0" into new concrete. Bottom reinf. shall be straightened.

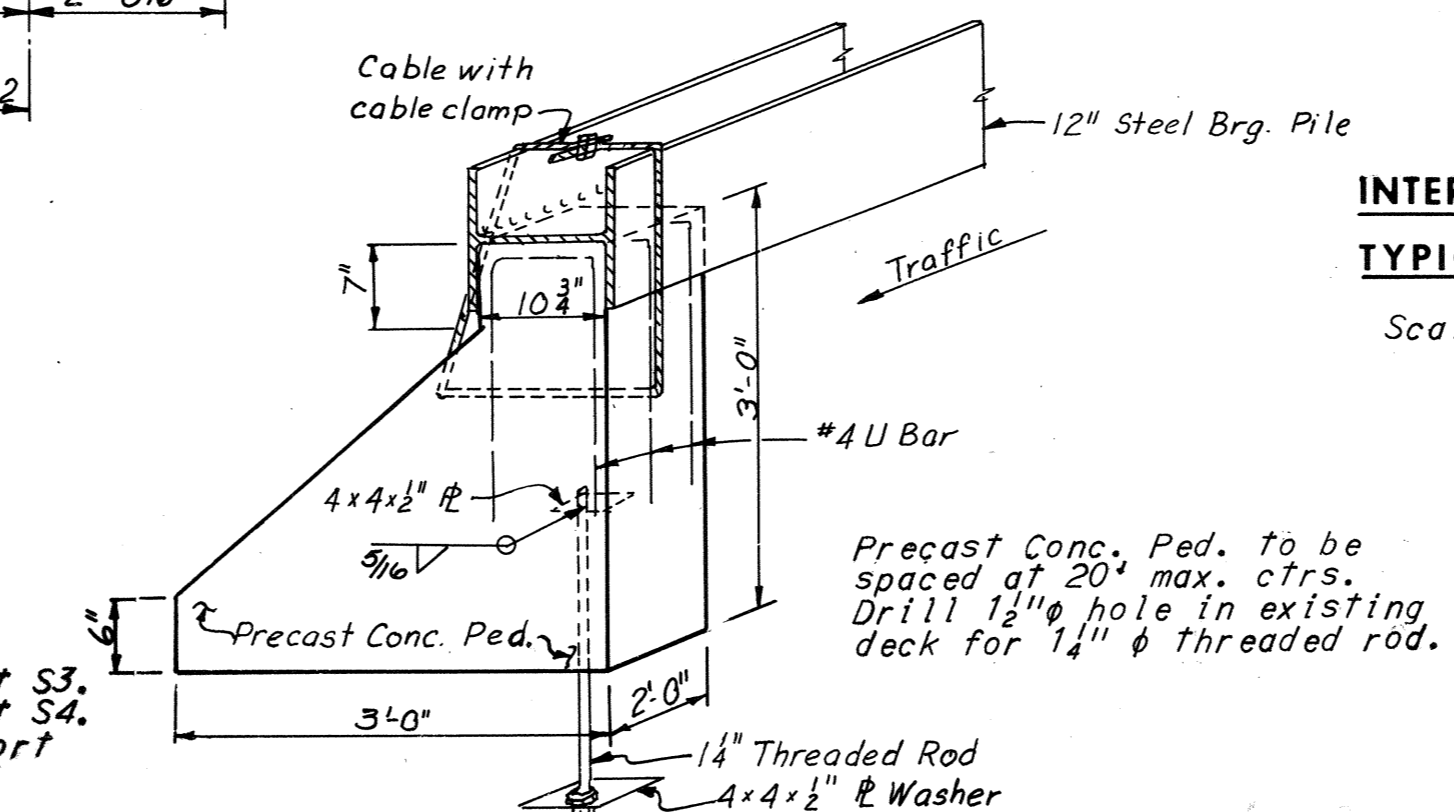

PROPOSED TEMPORARY FIXED TRAFFIC BARRICADE
Scale: 3/4" = 1'-0"

Notes
For Framing Plan Details see Sheet 15
For Joint Details see Sheet 25
For Quantities see Sheet 2
For Standard Handrail Details, see Sheet S3.
For Standard Lighting Details, see Sheet S4.
For Standard Drainage Details, see Support Type 9 on Sheets S5 & S6.

MADE	CHECKED	IN CHARGE	BY	DATE	NO.	REVISION	BY	DATE
C.E.B.	D.E.S.		TEM	12-3-68		Revised Elev. Table & Note Deleted		8-26-75
			TEM	1-15-69		End Diaph. Conn. at exist. String.		8-26-75

AS BUILT

RICHMOND METROPOLITAN AUTHORITY
RICHMOND EXPRESSWAY SYSTEM
DOWNTOWN EXPRESSWAY

BRIDGE NO. 68
RAMP W-S CONNECTION TO
RICHMOND-PETERSBURG TURNPIKE
DECK PLAN - UNITS 10, 11 AND 12




HOWARD, NEEDLES, TAMMEN & BERGENDOFF
consulting engineers
NEW YORK ALEXANDRIA KANSAS CITY

SCALE: As Noted
CONTRACT NO. 11
SHEET NO. 22 OF 28

RICHMOND EXPRESSWAY SYSTEM			
SECTION	PROJECT	SHEET NO.	TOTAL SHEETS
11	DOWNTOWN EXPRESSWAY	86	97

ELEVATION TABLE			
STATION	ELEV. A	ELEV. B	ELEV. C
353+47.93	80.65	80.52	80.48
+50	80.63	80.49	80.44
+60	80.43	80.32	80.28
+70	80.29	80.17	80.12
+80	80.11	80.00	79.97
+90	79.97	79.85	79.81
354+00.00	79.82	79.69	79.65
+10	79.64	79.53	79.49
+20	79.48	79.37	79.33
+24.62	79.43	79.30	79.26
+30	79.33	79.22	79.17
+40	79.18	79.06	79.01
+50	79.00	78.89	78.86
+60	78.85	78.74	78.70
+70	78.69	78.58	78.54
+80	78.51	78.41	78.38
354+90	78.35	78.25	78.22
+91.02	78.34	78.24	78.21
355+00.00	78.18	78.09	78.06
+10	78.06	77.95	77.90
+20	77.85	77.77	77.75
+30	77.67	77.61	77.59
+40	77.54	77.46	77.43
+50	77.36	77.29	77.27
+57.82	77.27	77.17	77.15
+60	77.22	77.14	77.11
+70	77.03	76.98	76.96
+80	76.85	76.82	76.81
+90	76.66	76.66	76.66
356+00.00	76.50	76.51	76.51
+10	76.34	76.35	76.36
+20	76.17	76.20	76.21
+30	76.03	76.05	76.06
+40	75.87	75.90	75.91
+46.69	75.80	75.80	75.81
+50	75.71	75.74	75.76
+60	75.73	75.66	75.60
+70	75.35	75.40	75.45
+80	75.24	75.27	75.30
+90	75.11	75.13	75.15
357+00.00	74.94	74.96	75.00
+10	74.78	74.81	74.85
+20	74.65	74.67	74.70
+30	74.52	74.53	74.55
+35.49	74.44	74.45	74.47
+40	74.35	74.36	74.40
+50	74.17	74.18	74.25
+60	74.01	74.01	74.10
+70	—	74.00	73.94
+80	—	73.85	73.79
+90	—	73.70	73.64
358+00.00	—	73.55	73.49
+10	—	73.39	73.33
+20	—	73.24	73.19
+24.24	—	73.18	73.13

Note: See Note A Sheet 21.

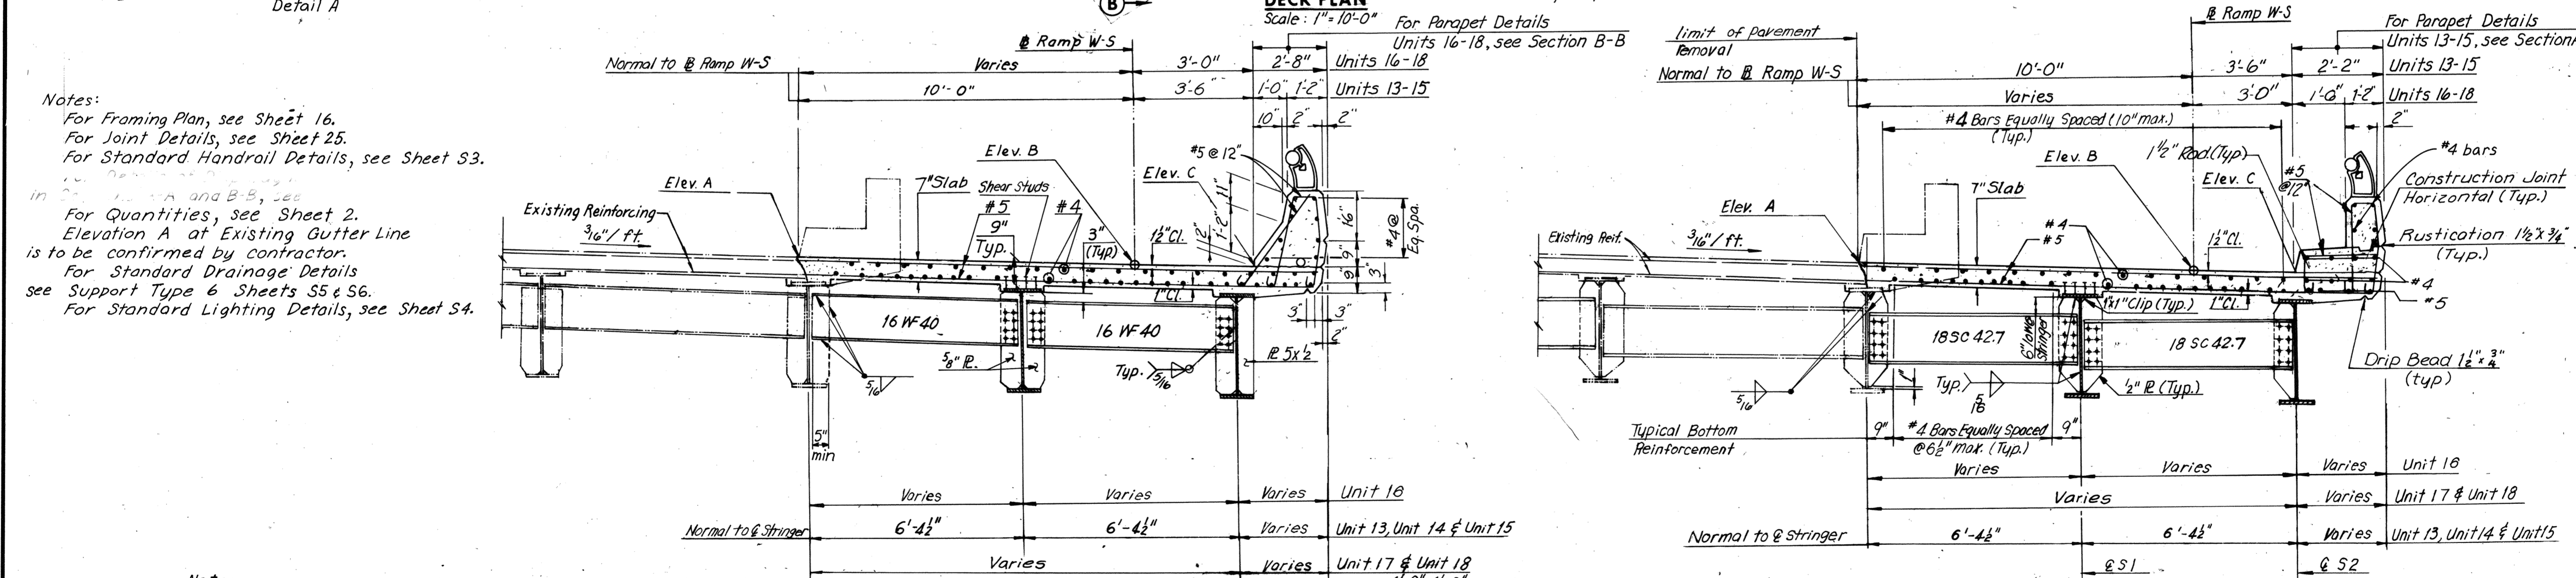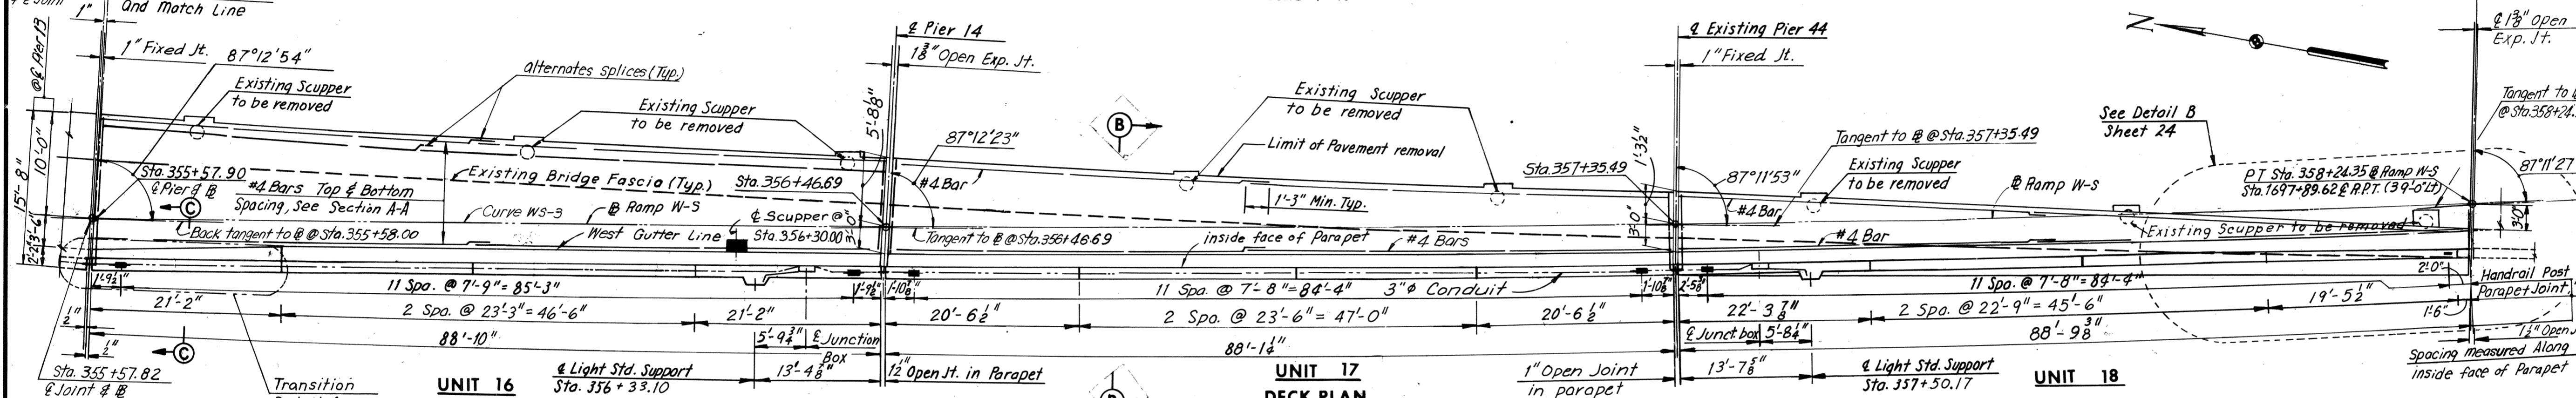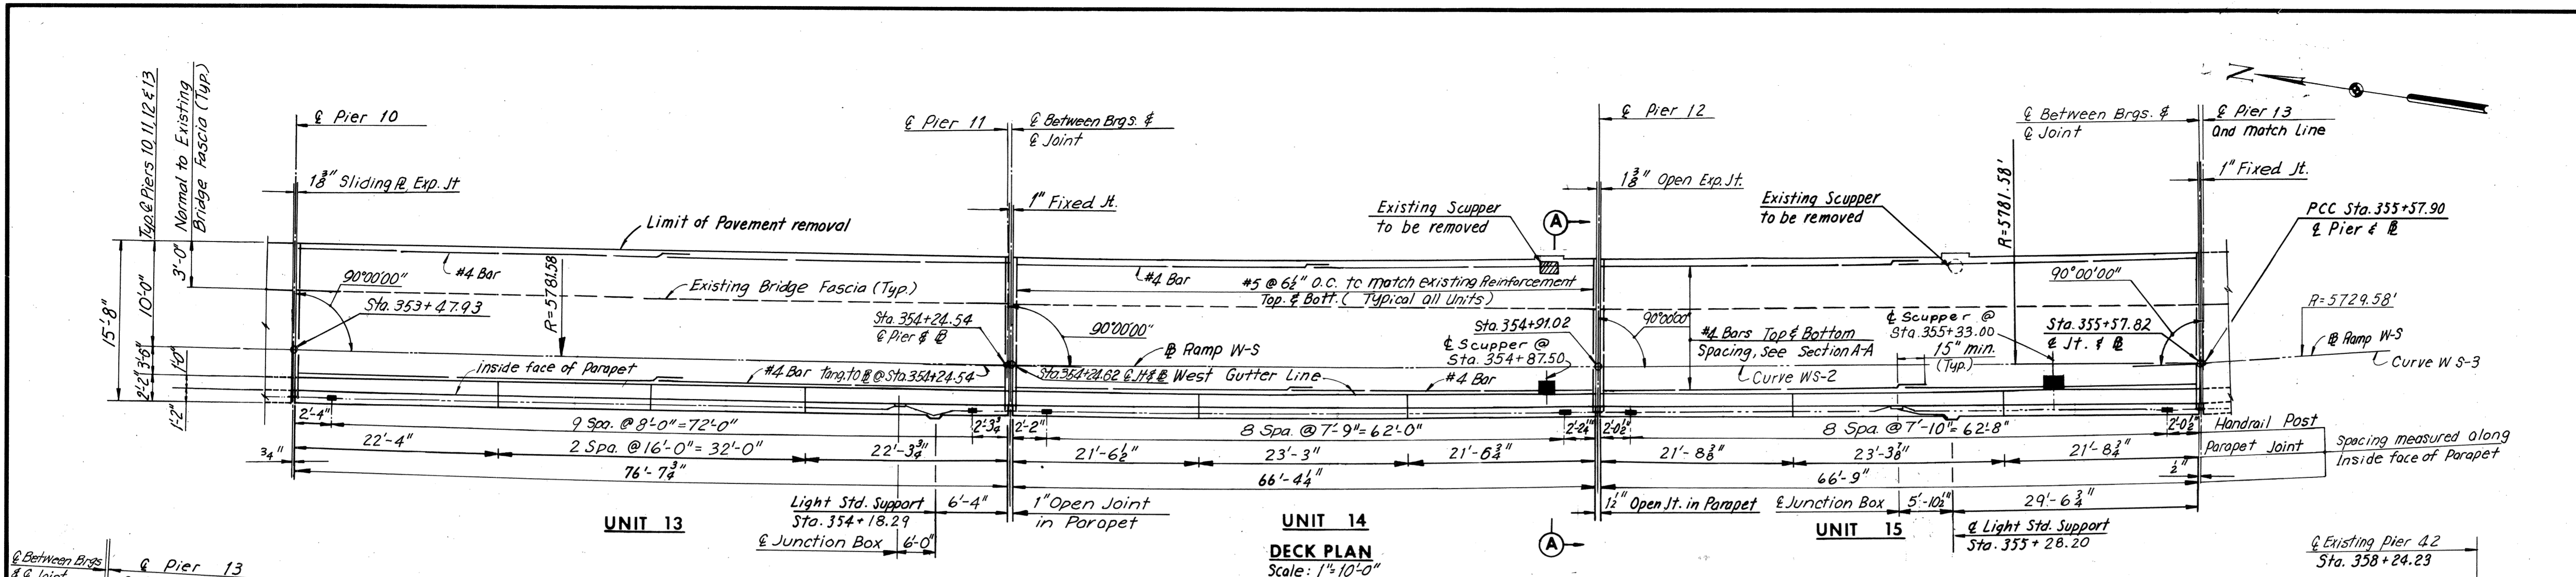

Notes:
 For Framing Plan, see Sheet 16.
 For Joint Details, see Sheet 25.
 For Standard Handrail Details, see Sheet S3.
 in Section A and B-B, see
 For Quantities, see Sheet 2.
 Elevation A at Existing Gutter Line
 is to be confirmed by contractor.
 For Standard Drainage Details,
 see Support Type 6 Sheets S5 & S6.
 For Standard Lighting Details, see Sheet S4.

Note:
 New Diaphragms are to match the existing
 Diaphragms on R. P. Turnpike structure.
 Connection bolts for the new Diaphragms
 connecting Bridge 68 to existing structure,
 shall not be fully tightened before new
 concrete deck slab has been placed.

Note: Cross Slope in Units 16, 17 and 18
 should be normal to R.P.T.

BY	DATE	NO.	REVISION	BY	DATE
MADE	GSH	11-12-68	Revised Elev. Table	TEM	8-26-75
CHECKED	D.E.S.	1-17-69	End Diaph. Conn. at exist. String	TEM	8-26-75
IN CHARGE					

AS BUILT











RICHMOND METROPOLITAN AUTHORITY
RICHMOND EXPRESSWAY SYSTEM
DOWNTOWN EXPRESSWAY

BRIDGE NO. 68
RAMP W-S CONNECTION TO
RICHMOND-PETERSBURG TURNPIKE
DECK PLAN — UNITS 13 THRU. 18

HOWARD, NEEDLES, TAMMEN & BERGENDOFF
 consulting engineers
 NEW YORK ALEXANDRIA KANSAS CITY

SCALE: As Noted
 CONTRACT NO.: 11
 SHEET NO. 23 OF 28

RICHMOND EXPRESSWAY SYSTEM			
SECTION	PROJECT	SHEET NO.	TOTAL SHEETS
11	DOWNTOWN EXPRESSWAY	87	97

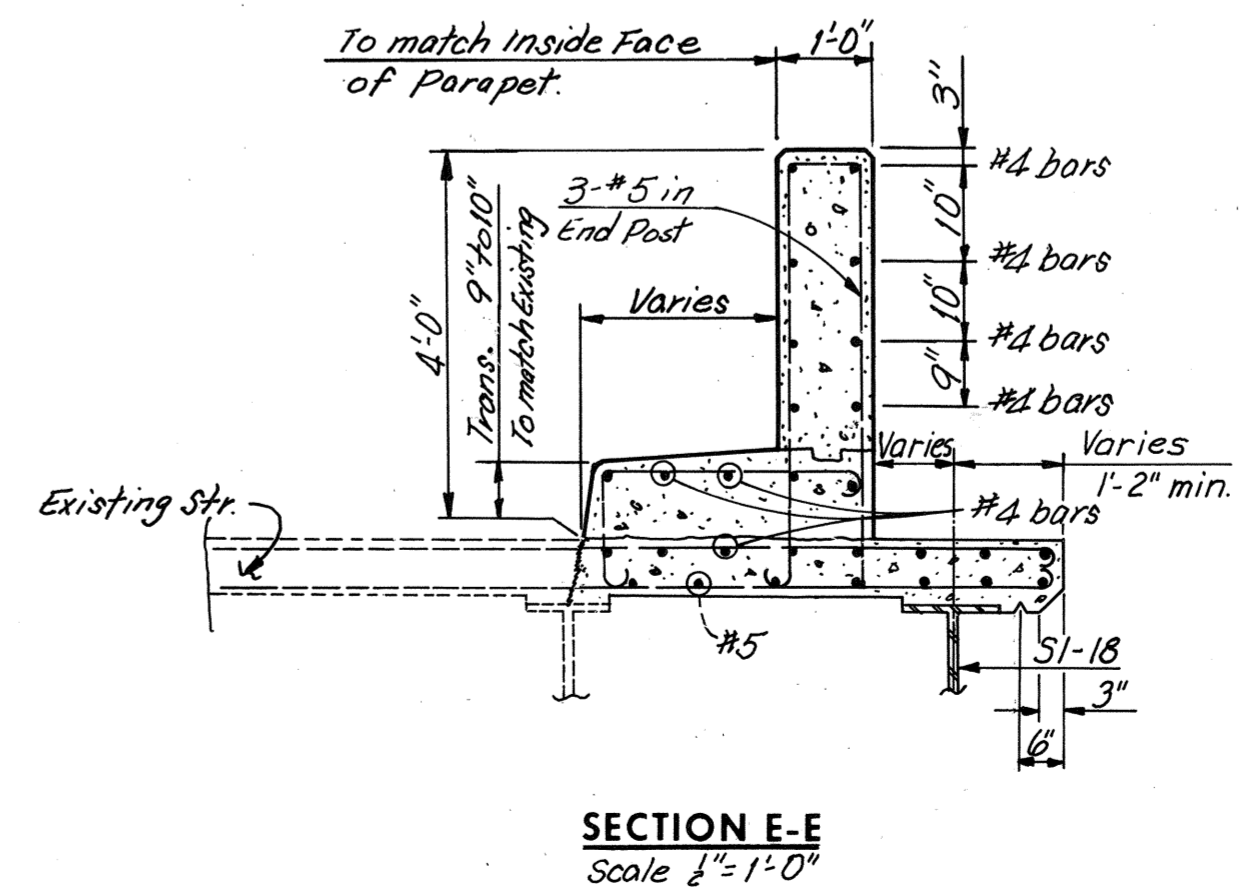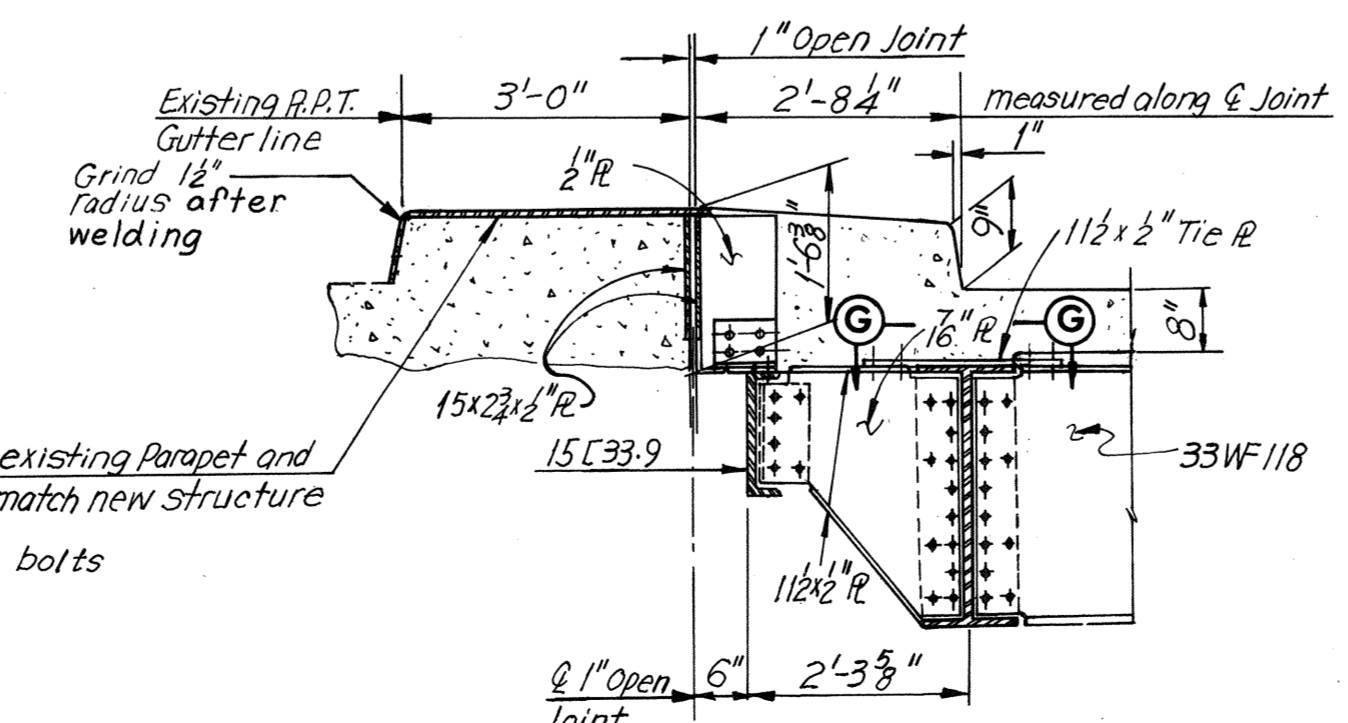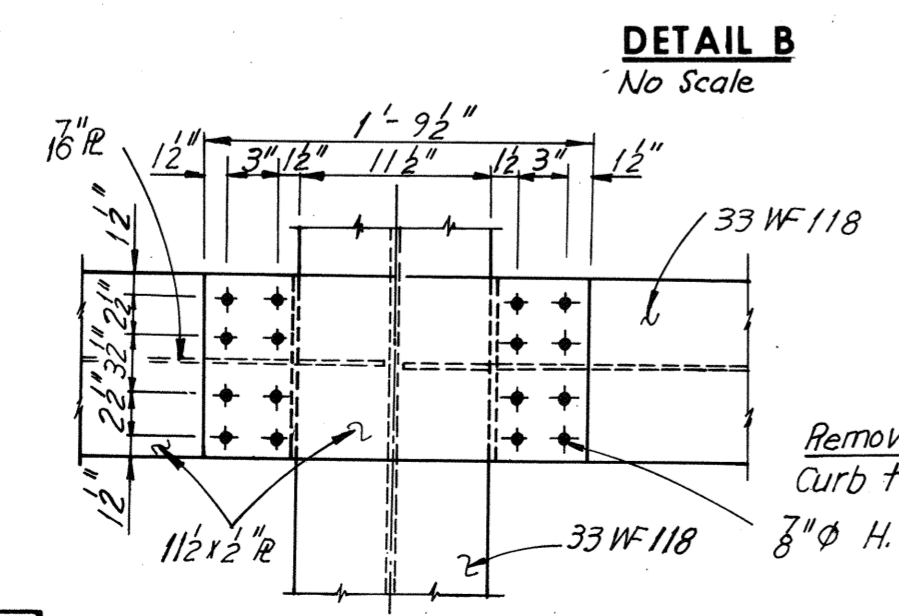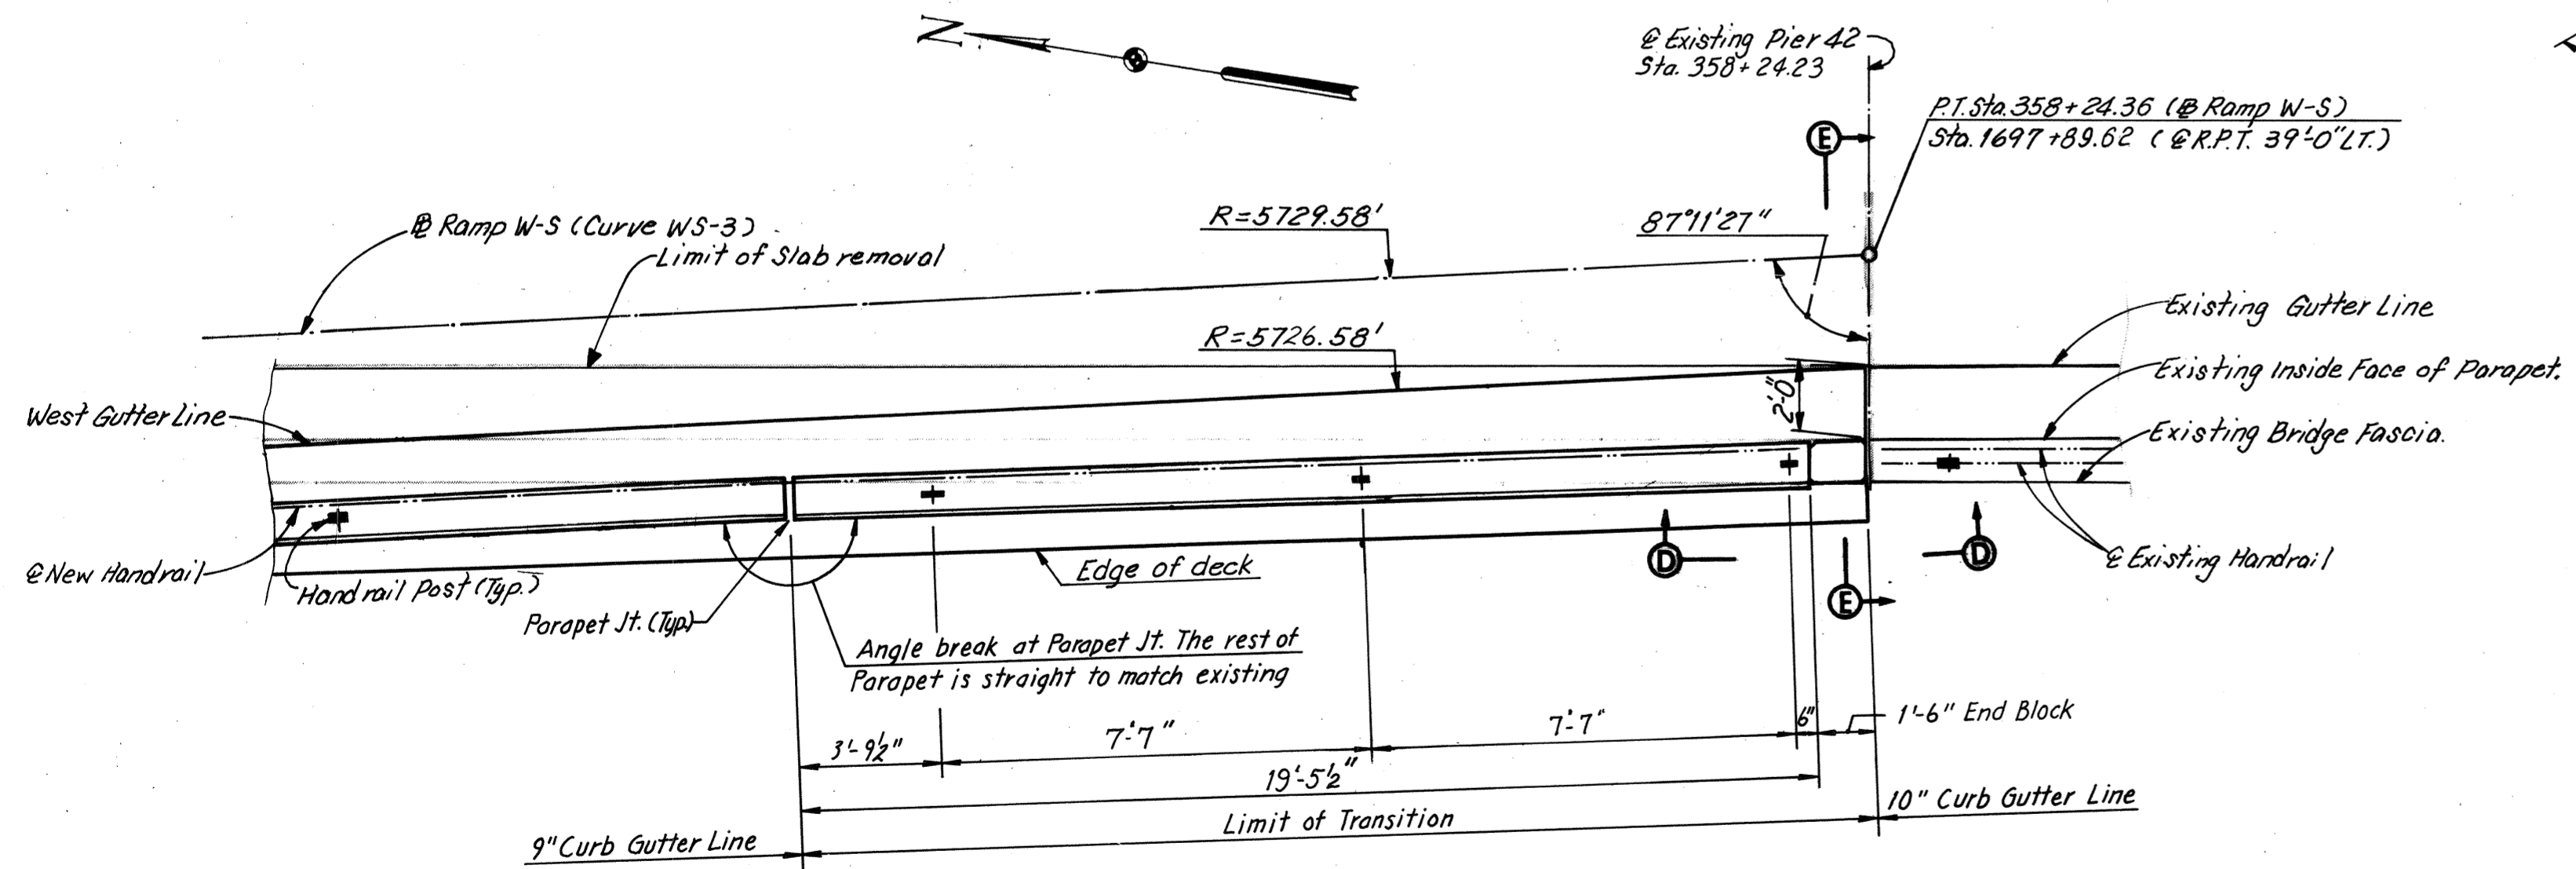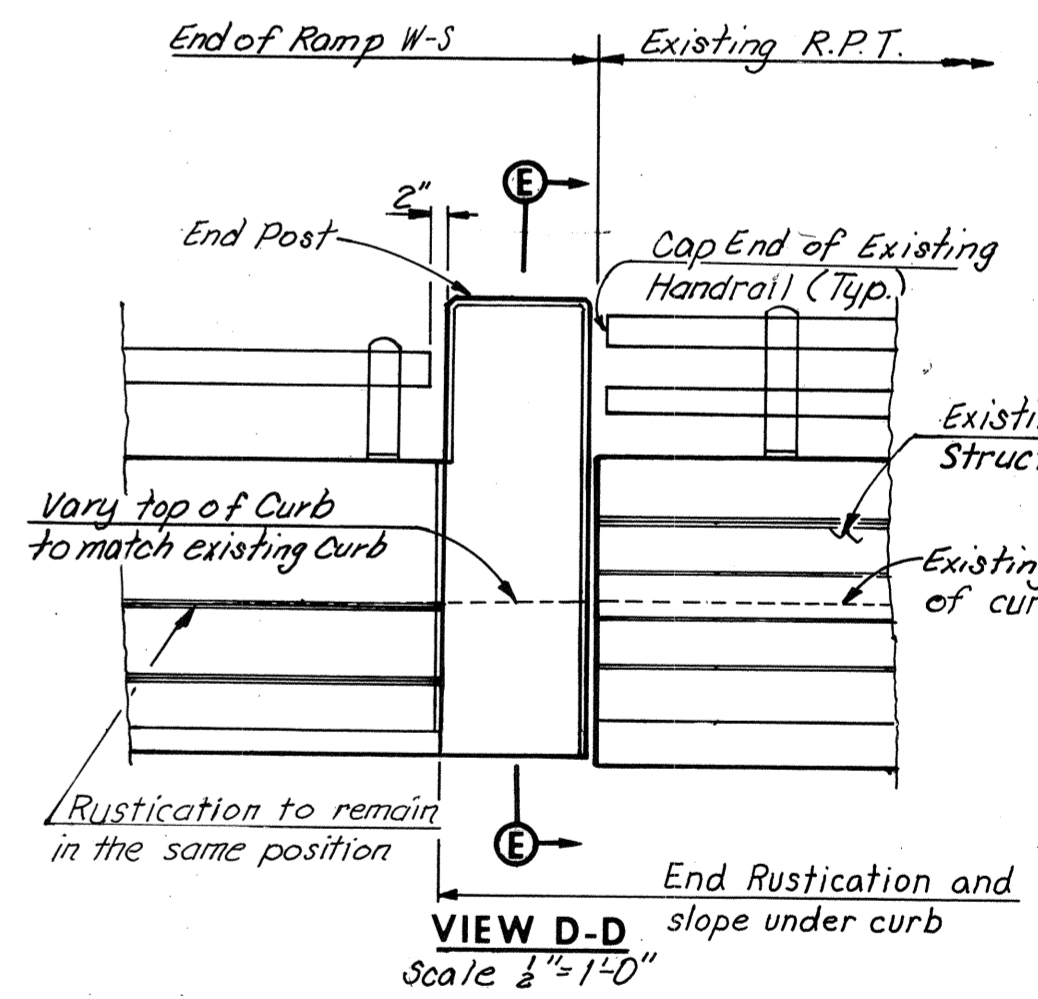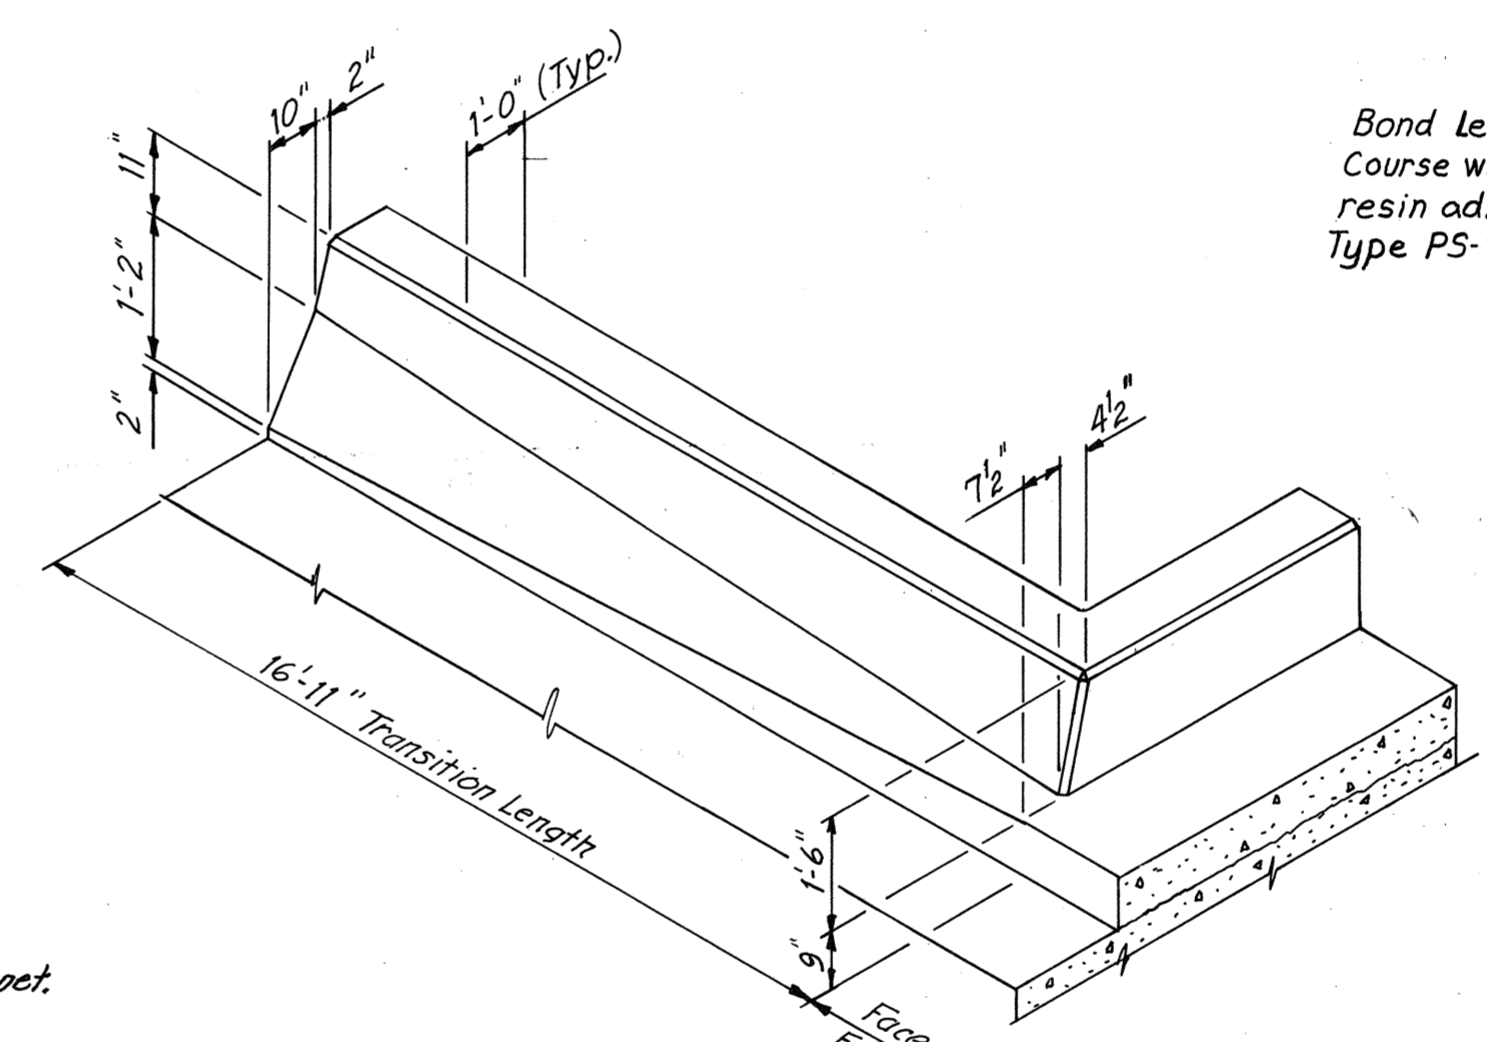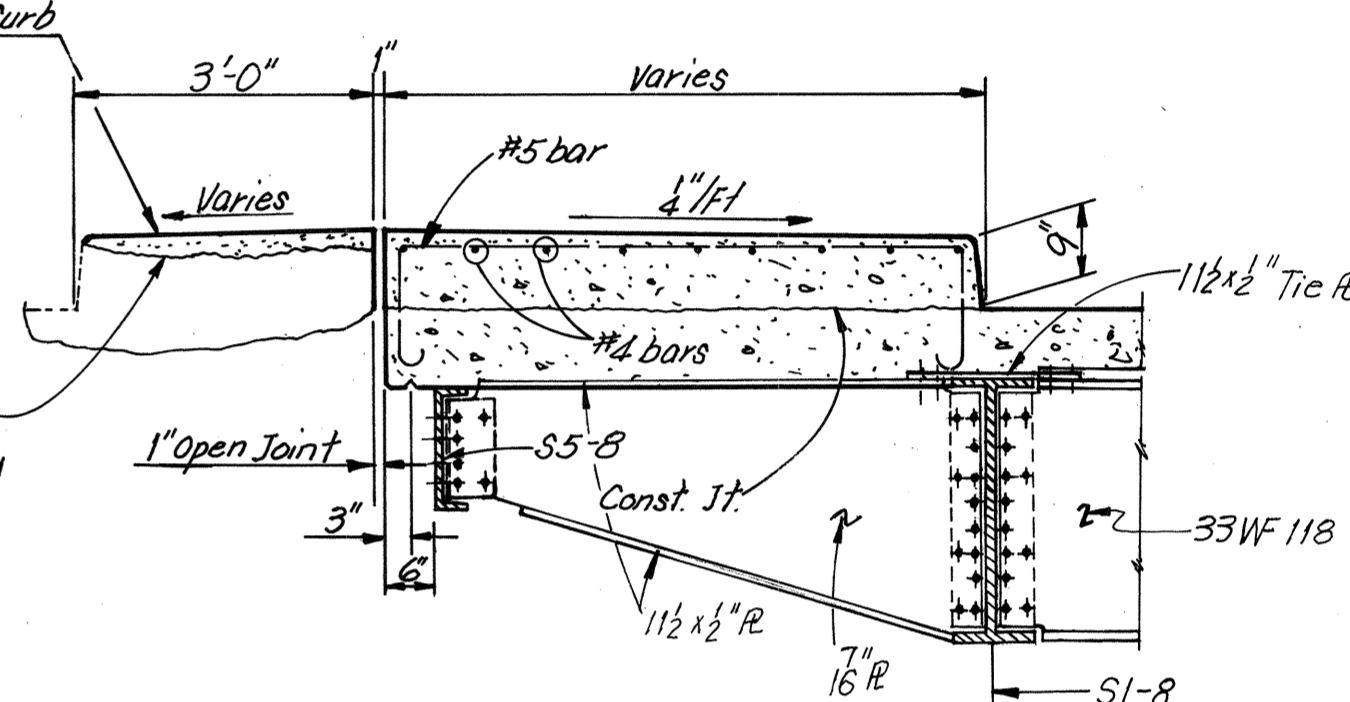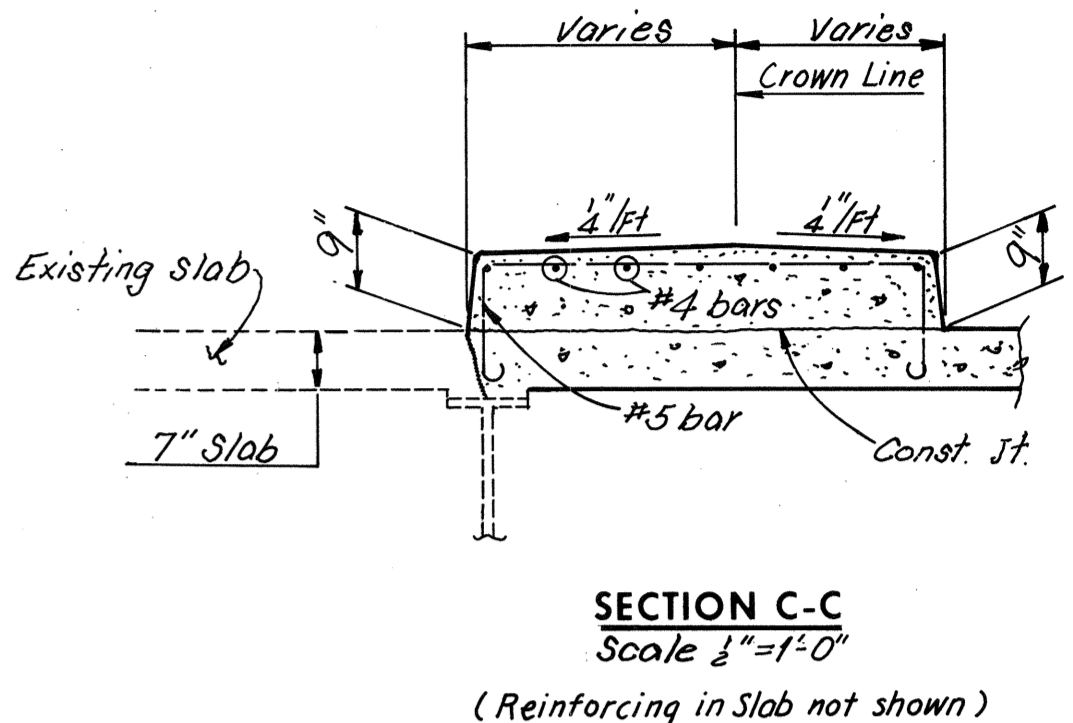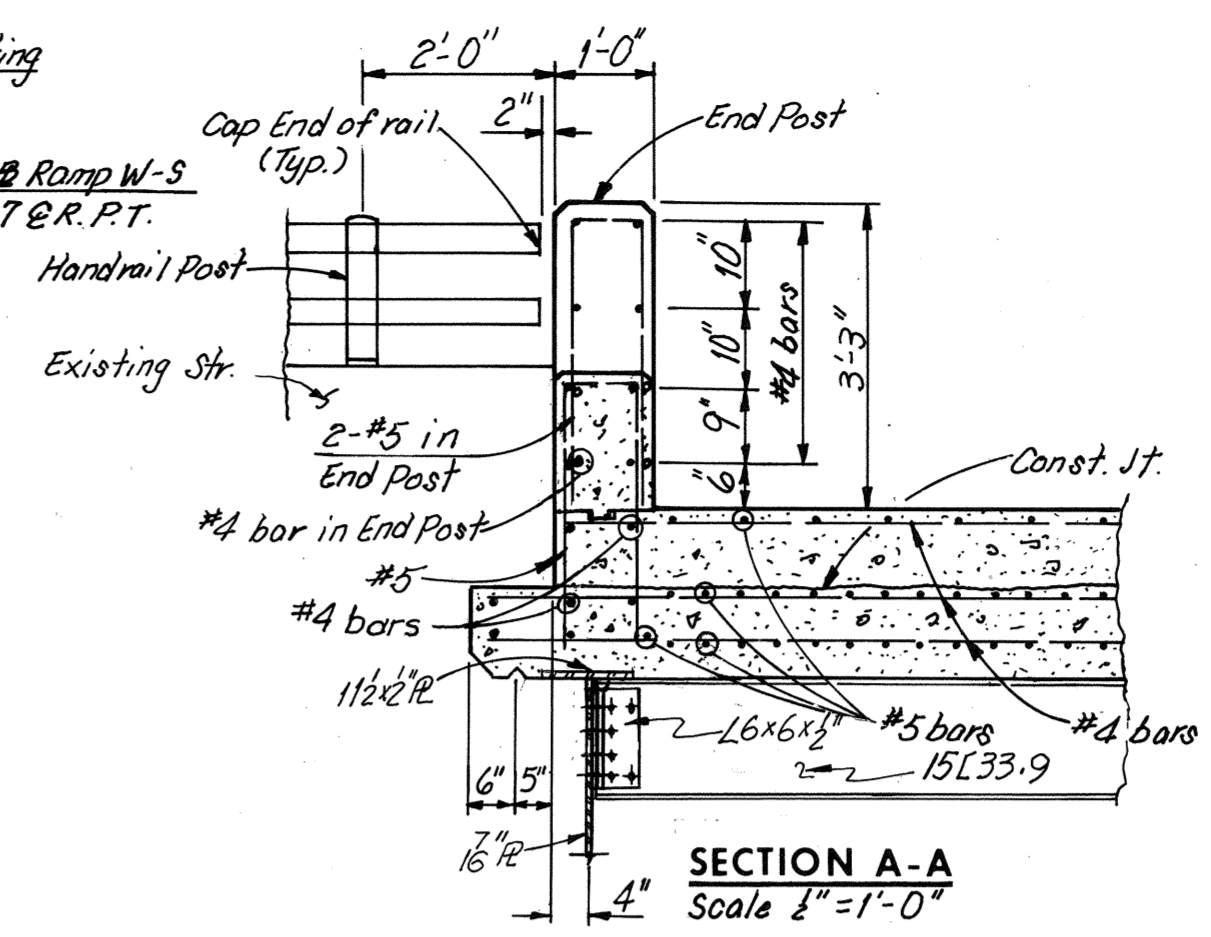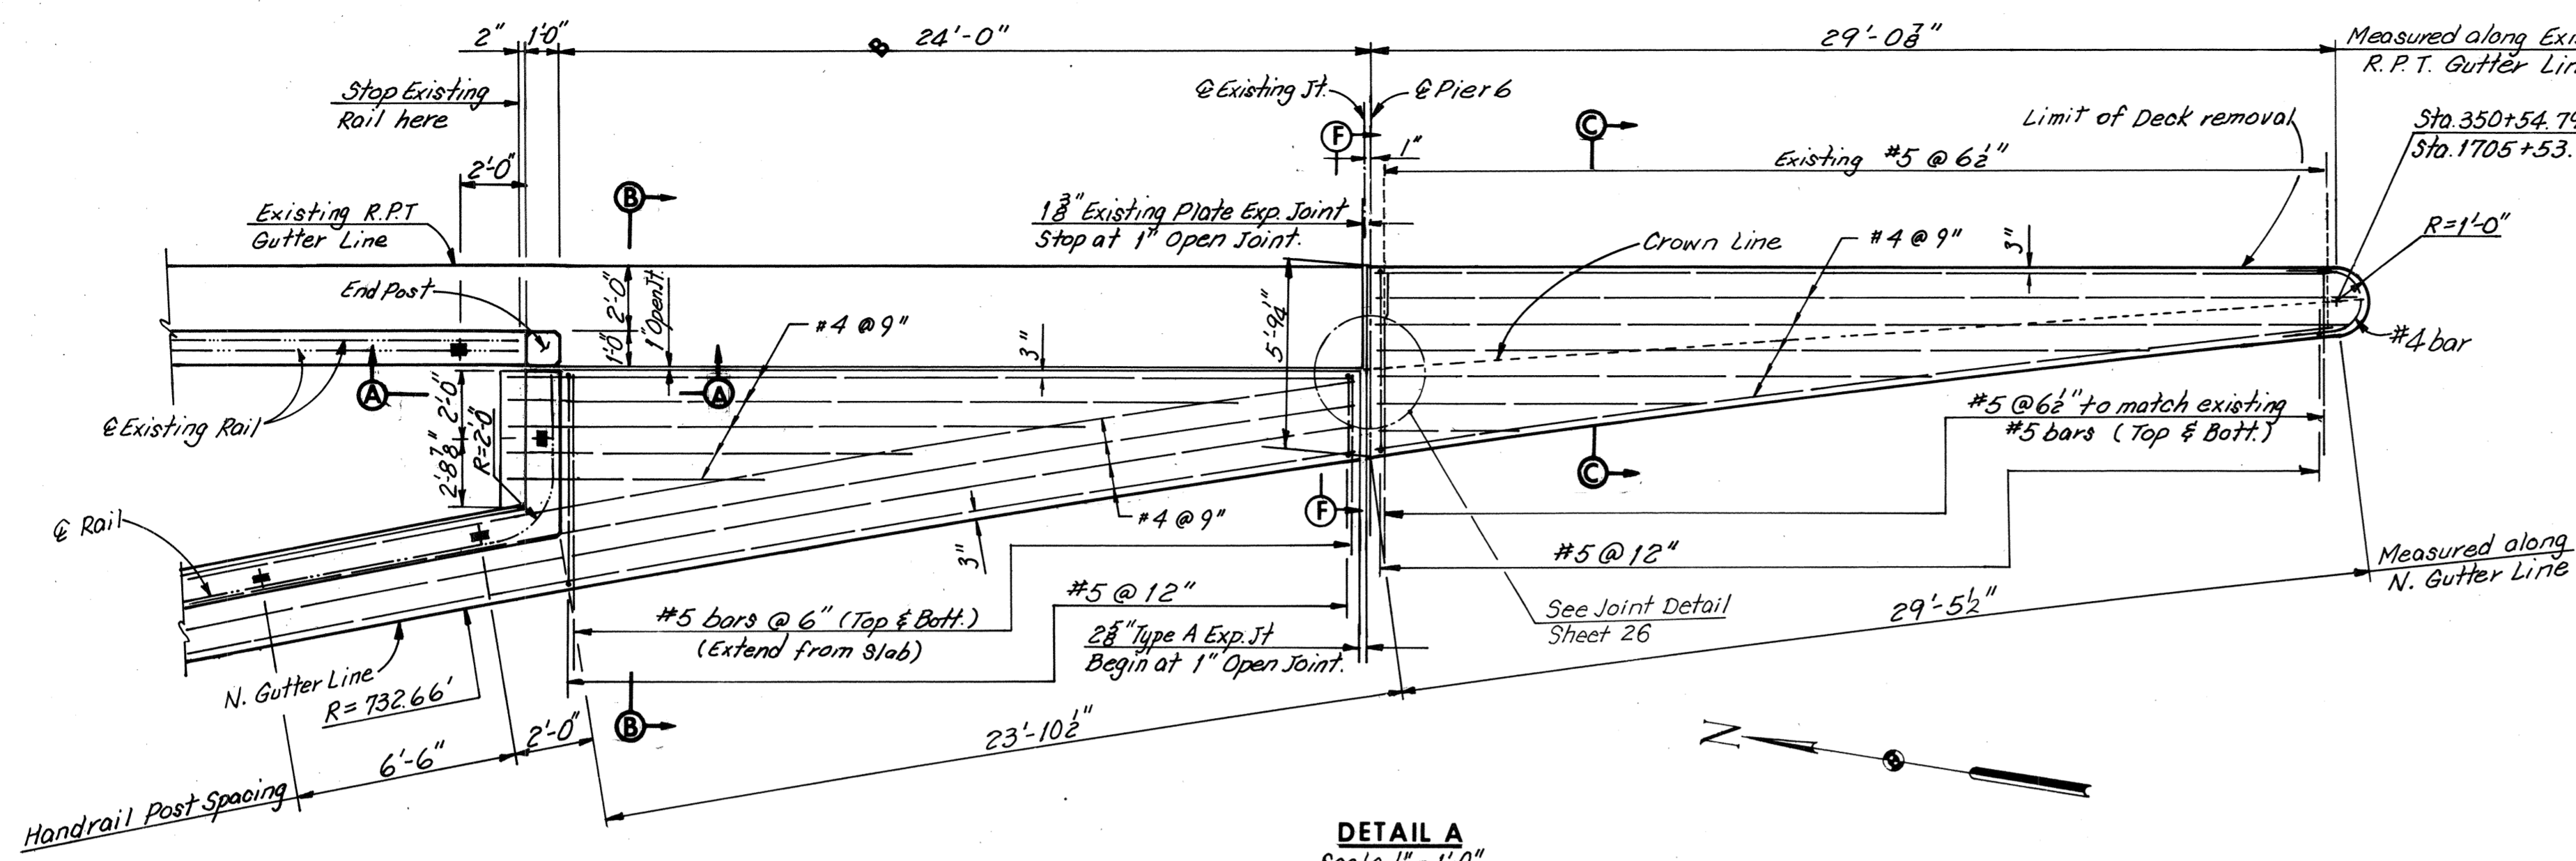

Notes:
For location of Details A and C, see Sheet 21.
For location of Detail B, see Sheet 23.

AS BUILT
RICHMOND METROPOLITAN AUTHORITY
RICHMOND EXPRESSWAY SYSTEM
DOWNTOWN EXPRESSWAY
BRIDGE NO. 68
RAMP W-S CONNECTION TO
RICHMOND-PETERSBURG TURNPIKE
SUPERSTRUCTURE DETAILS

HOWARD, NEEDLES, TAMMEN & BERGENDOFF
consulting engineers
NEW YORK ALEXANDRIA KANSAS CITY
SCALE: As Noted
CONTRACT NO. 11
SHEET NO. 24 OF 28


BY	DATE	NO.	REVISION	BY	DATE
MADE	G.C.C. 1-29-69	1	Det. A & Sect. A-A	TEM	4-76
CHECKED	Y.C.P. 2-3-69	2	Section E-E	TEM	8-26-75
IN CHARGE					

SECTION G-G
Scale: 1" = 1'-0"


SECTION F-F
Scale: 1/2" = 1'-0"

SECTION E-E
Scale 1/4" = 1'-0"


RICHMOND EXPRESSWAY SYSTEM			
SECTION	PROJECT	SHEET NO.	TOTAL SHEETS
11	DOWNTOWN EXPRESSWAY	88	97

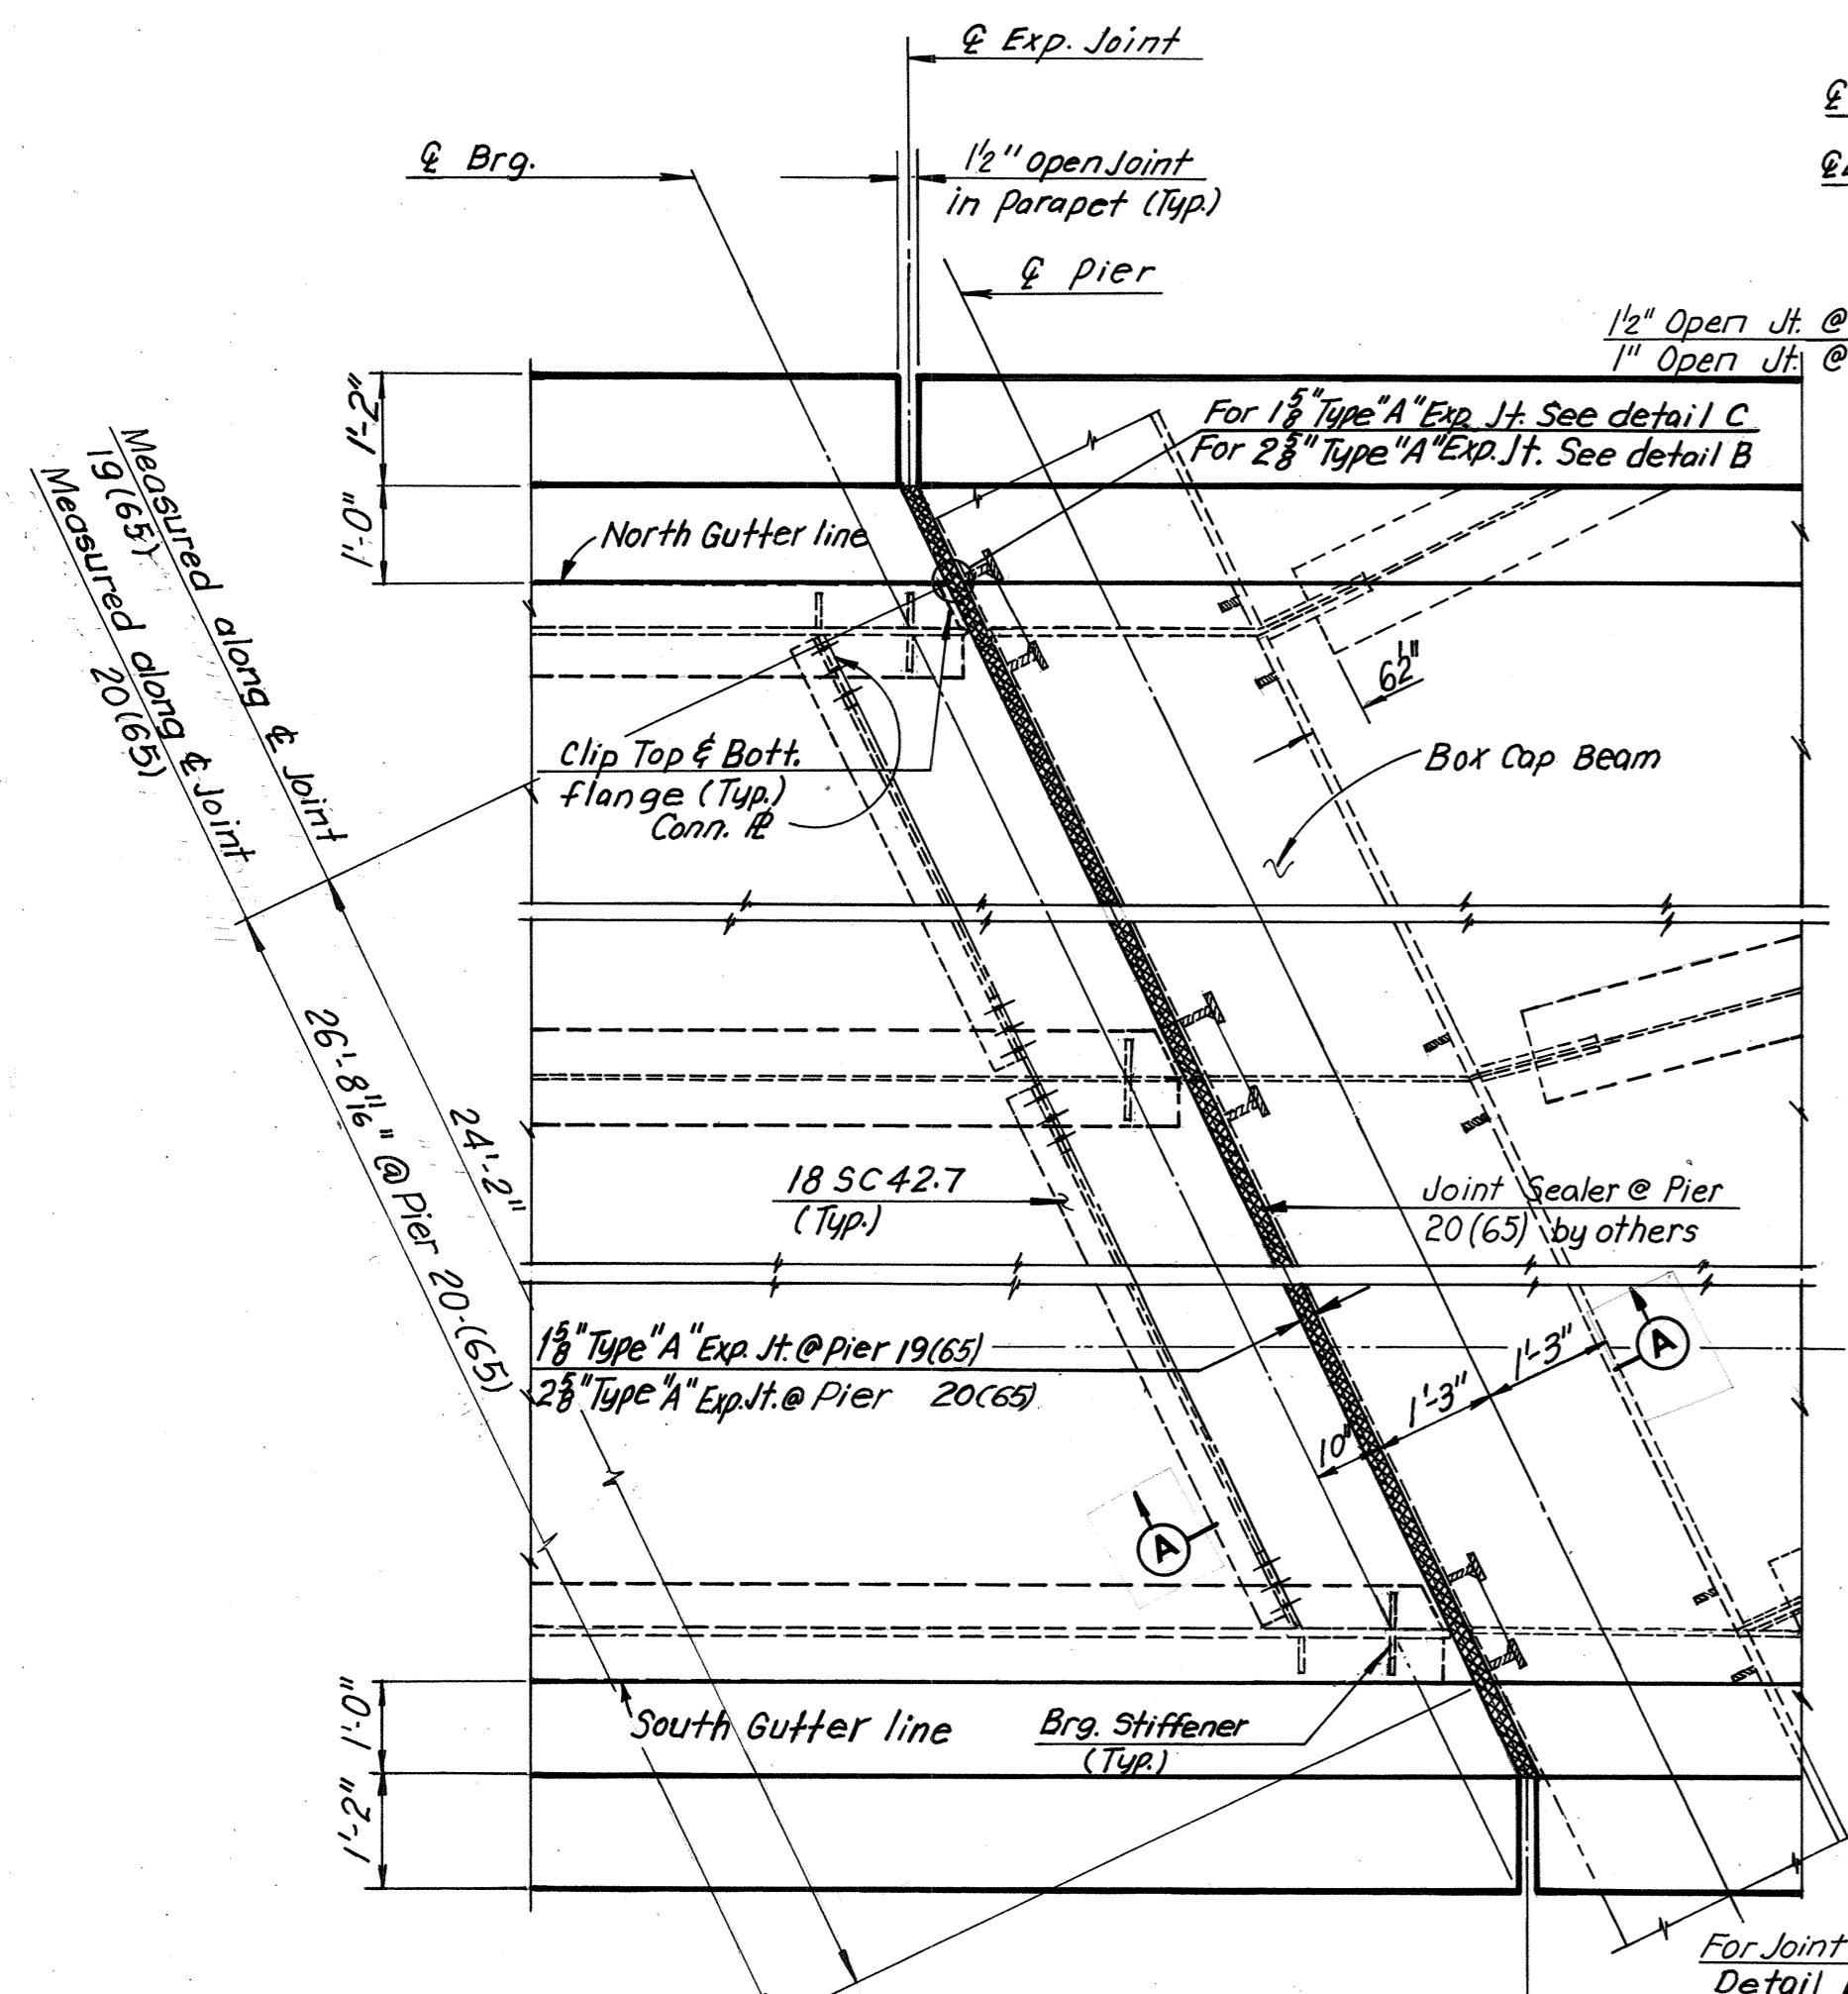


PLAN - JOINT AT PIERS 19 (65) AND 20(65)
Scale: 1/2" = 1'-0"

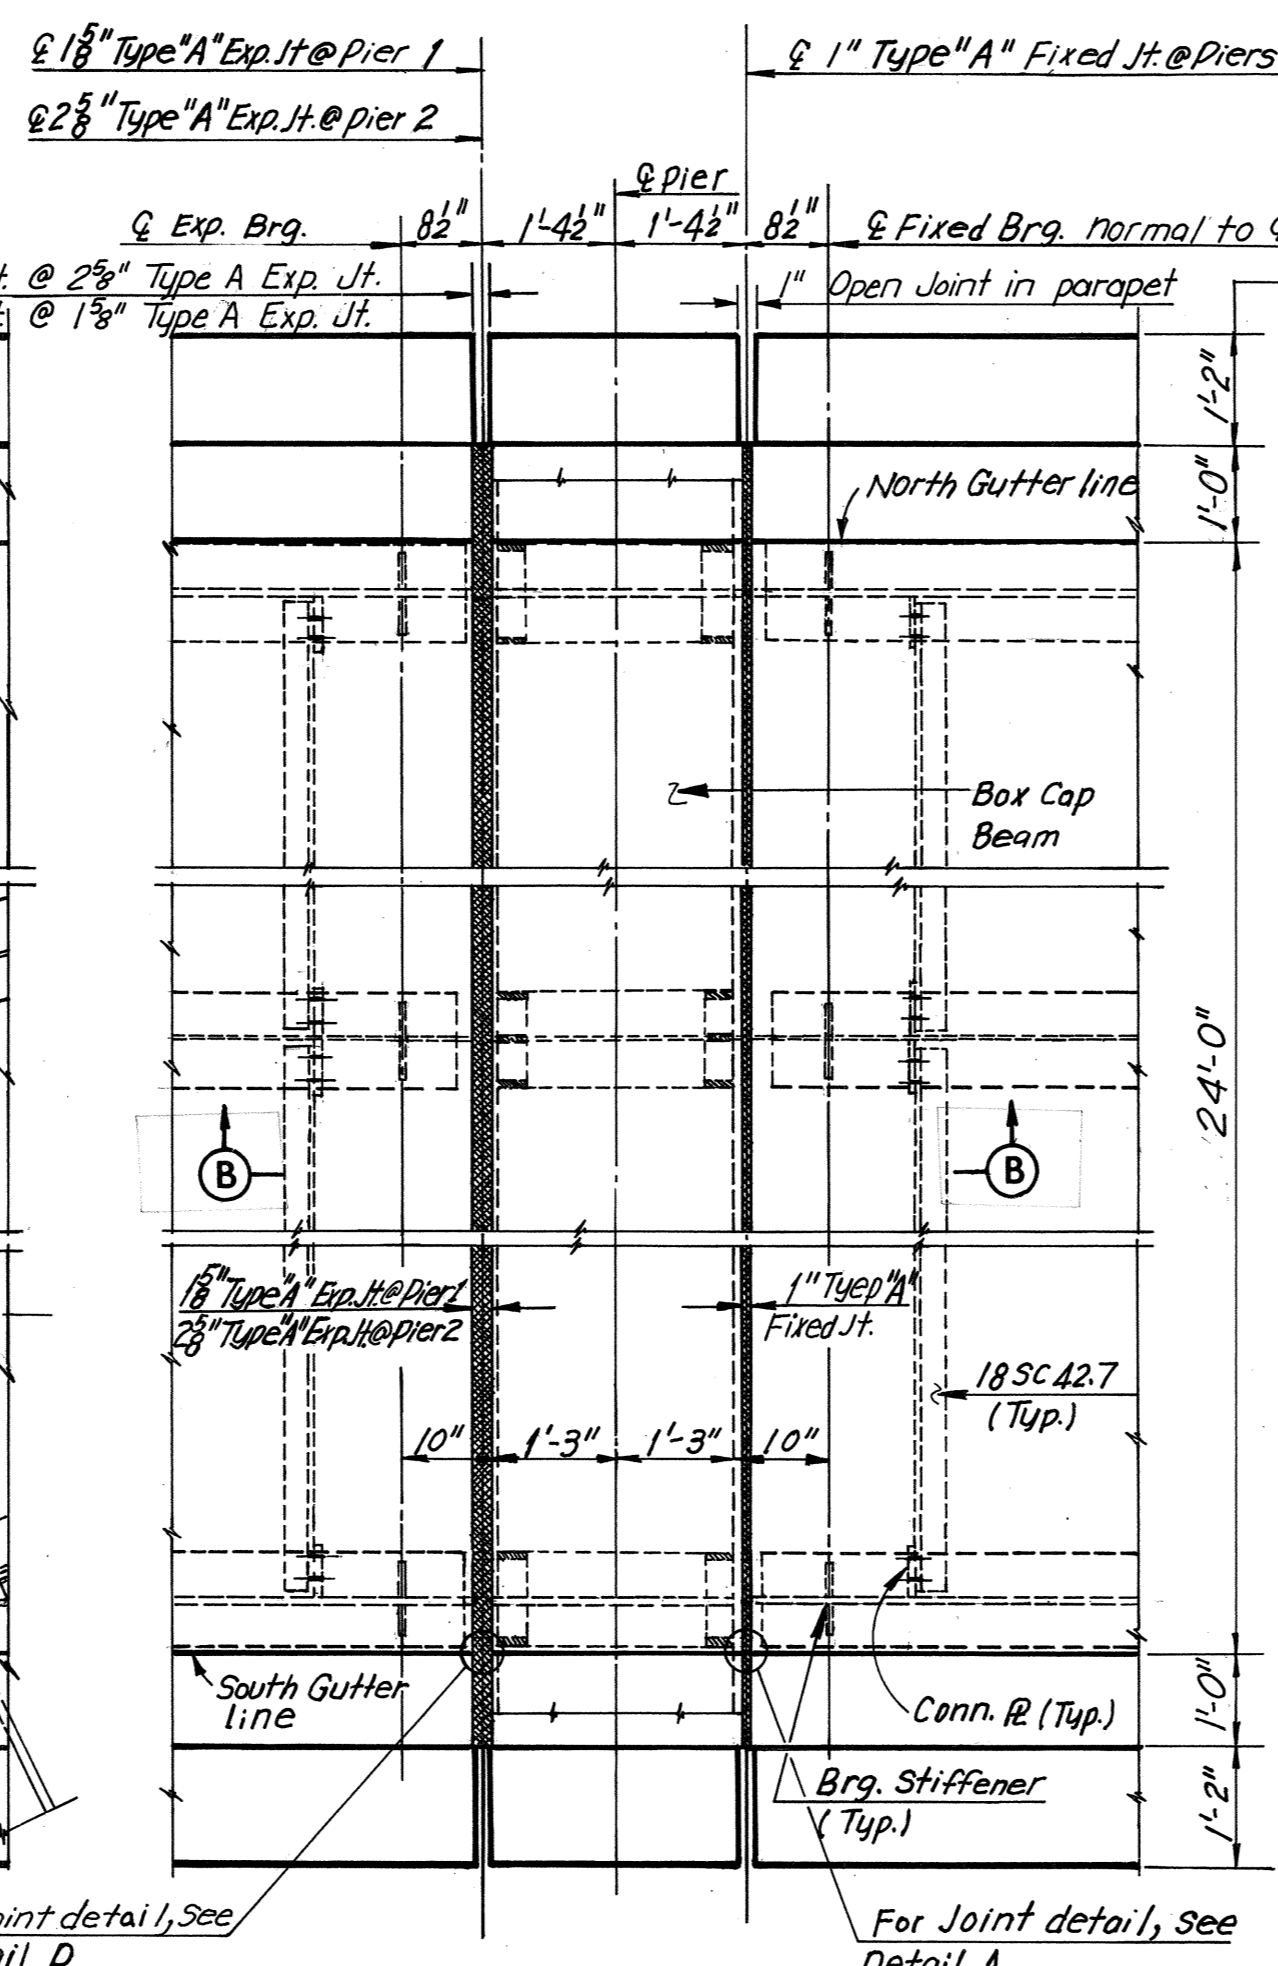


PLAN - JOINT AT PIERS 1 AND 2
Scale: 1/2" = 1'-0"

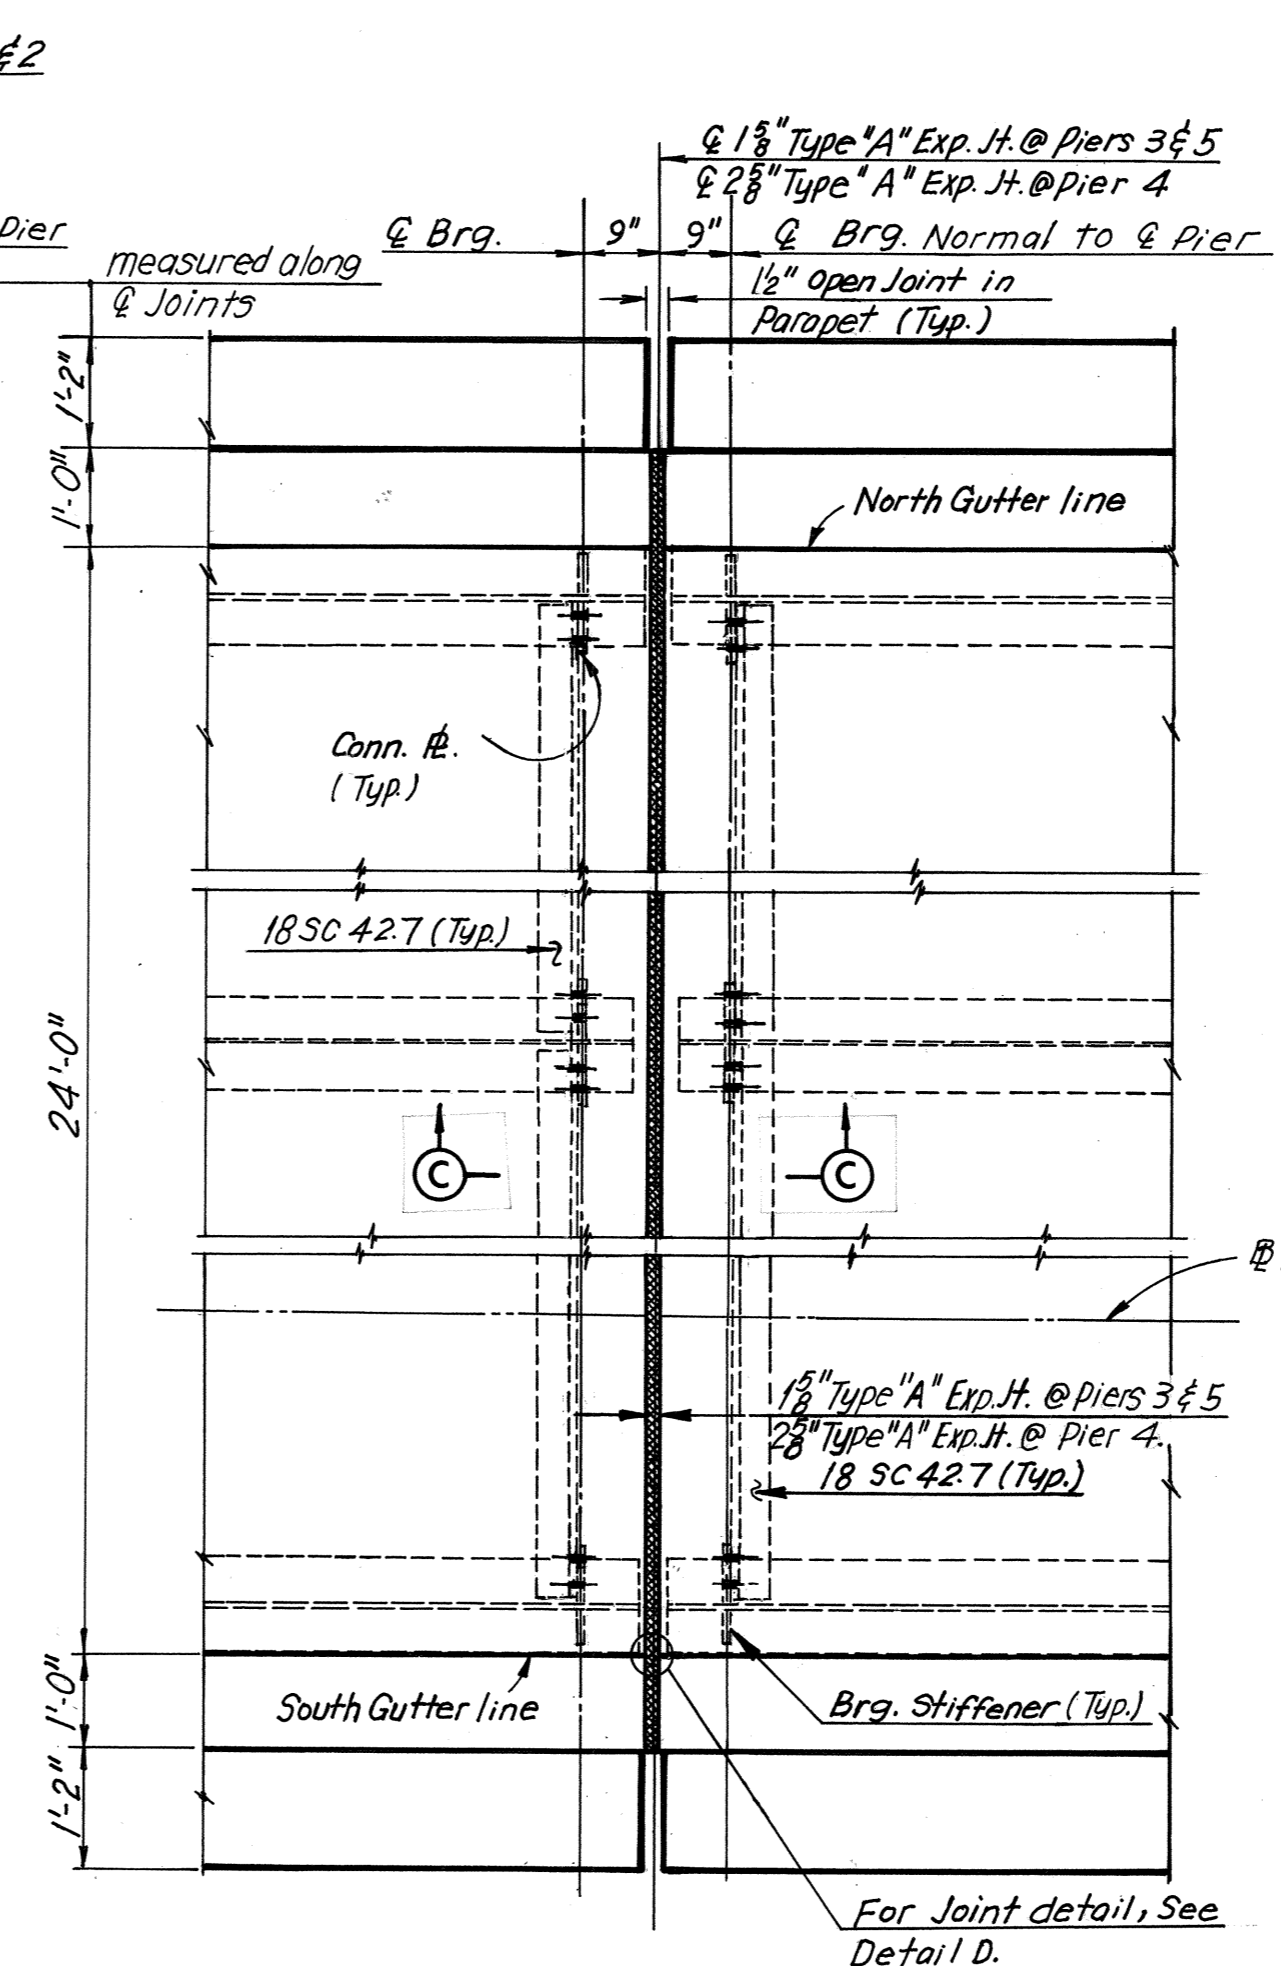


PLAN - JOINT AT PIERS 3, 4 AND 5
Scale: 1/2" = 1'-0"

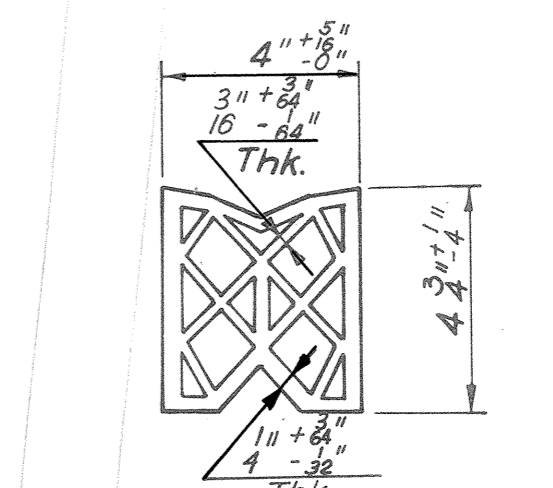


PREFORMED NEOPRENE JOINT SEALER FOR 2 3/8" TYPE "A" JOINT

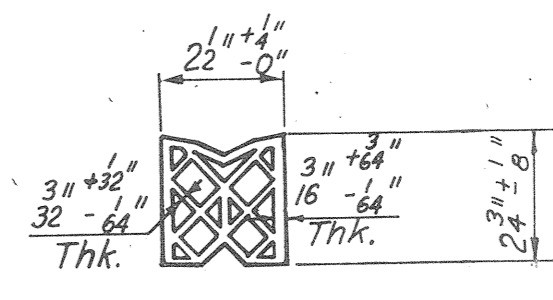


PREFORMED NEOPRENE JOINT SEALER FOR 1 5/8" TYPE "A" JOINT

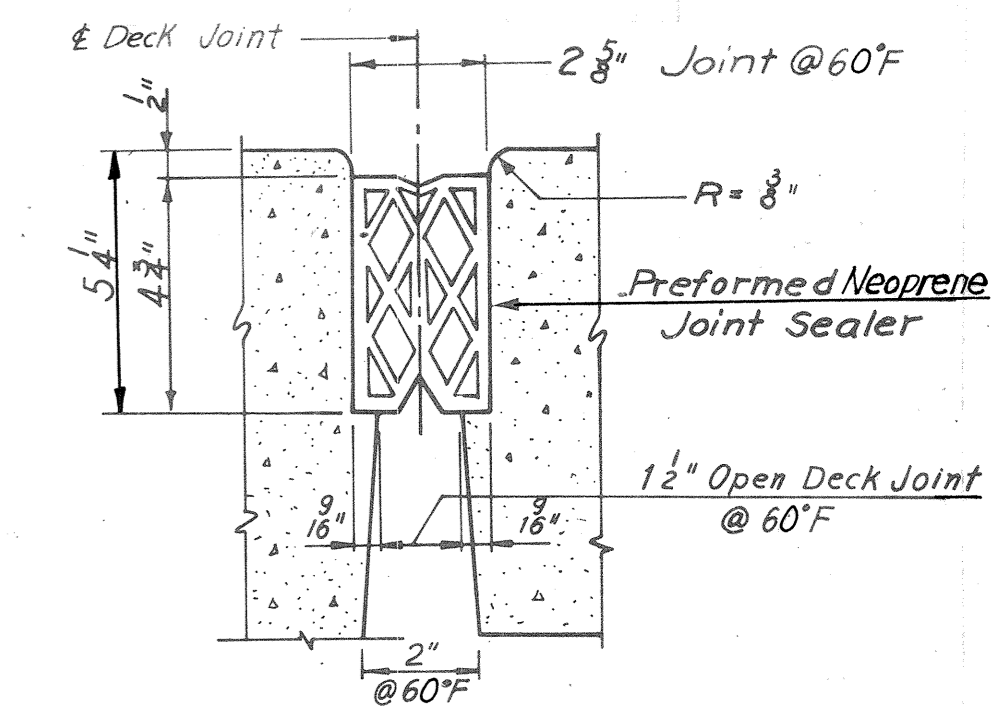


2 3/8" TYPE "A" JOINT

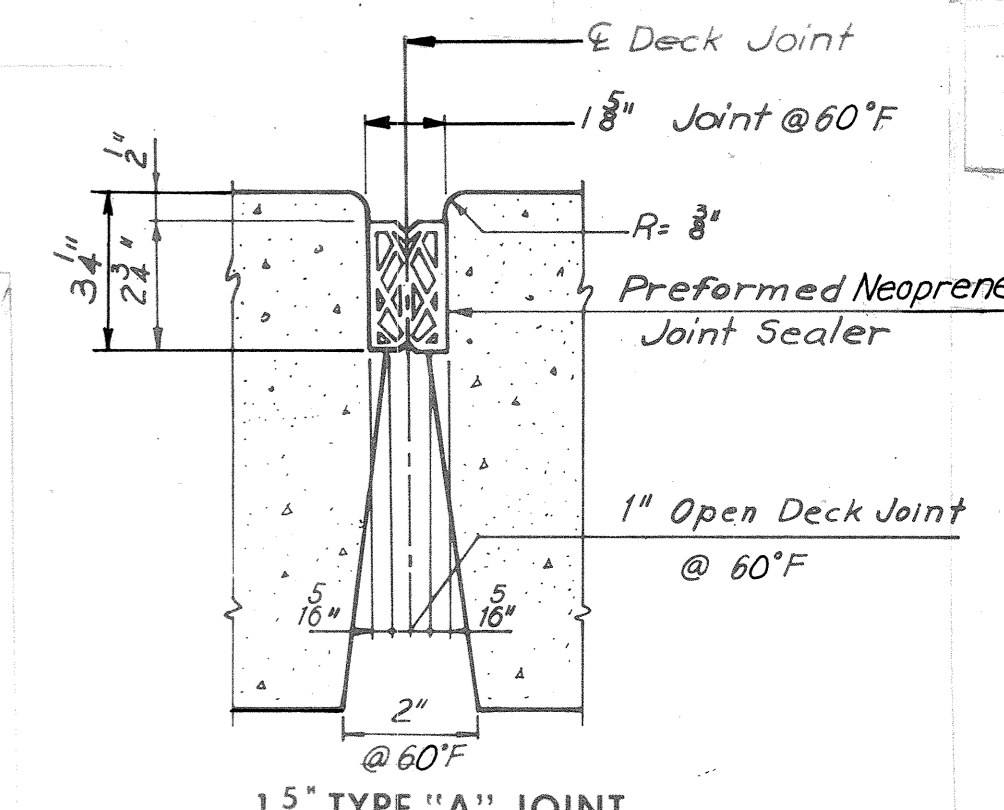


1 5/8" TYPE "A" JOINT

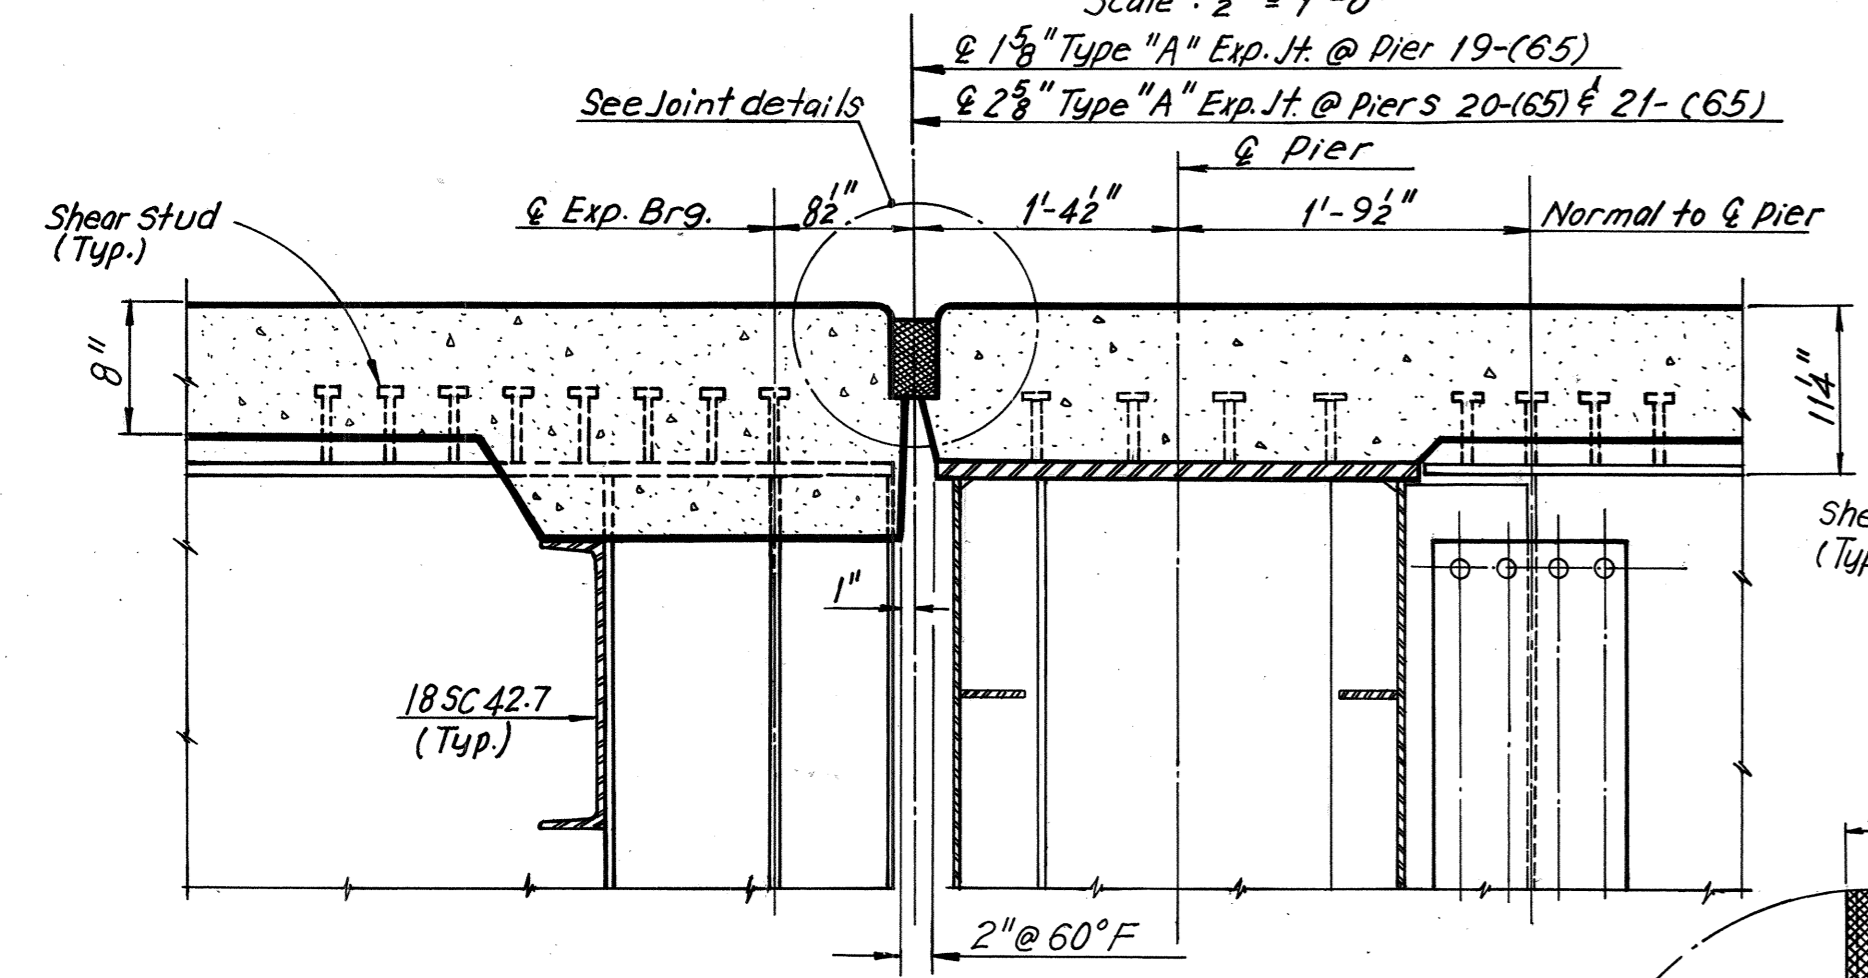


SECTION A-A
Scale: 1" = 1'-0"

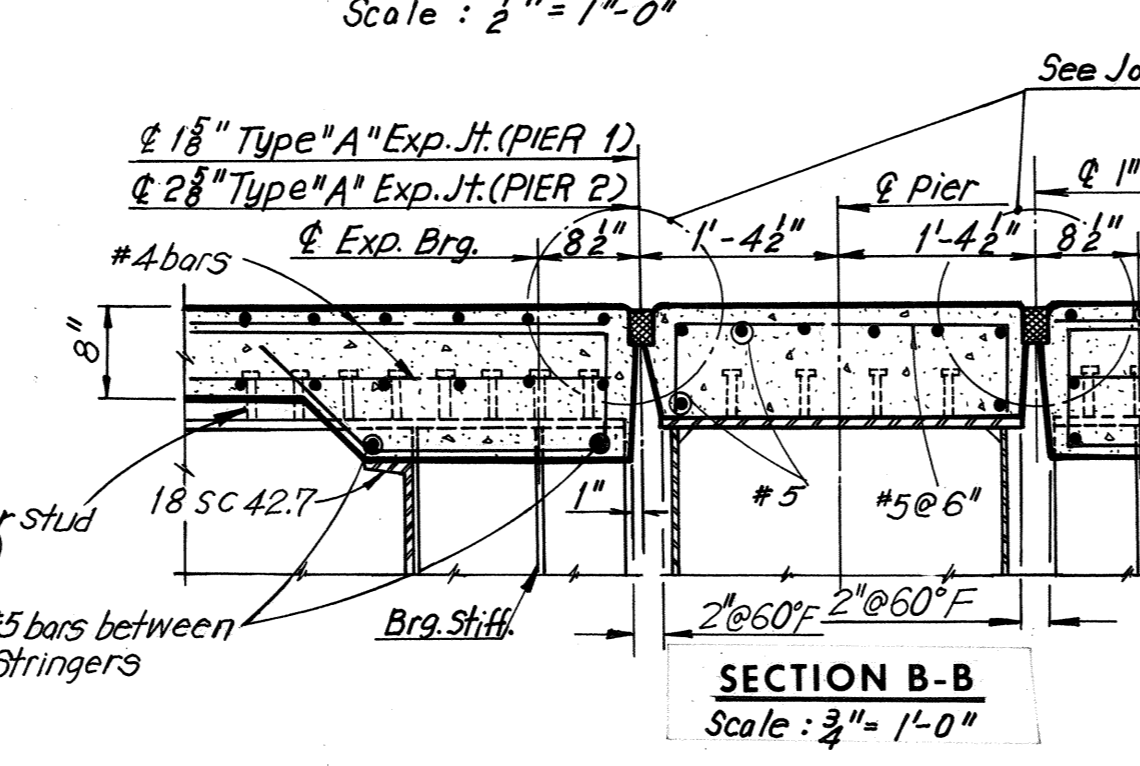


SECTION B-B
Scale: 3/4" = 1'-0"

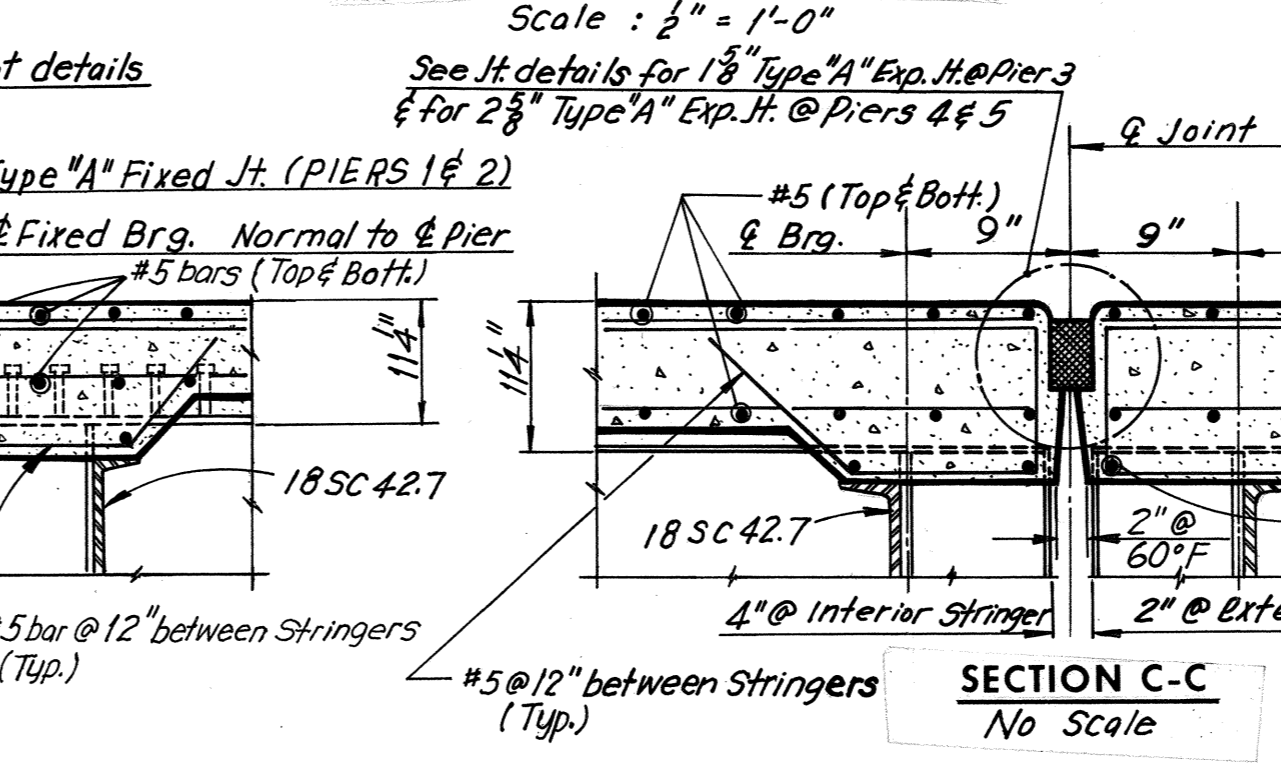


SECTION C-C
No Scale

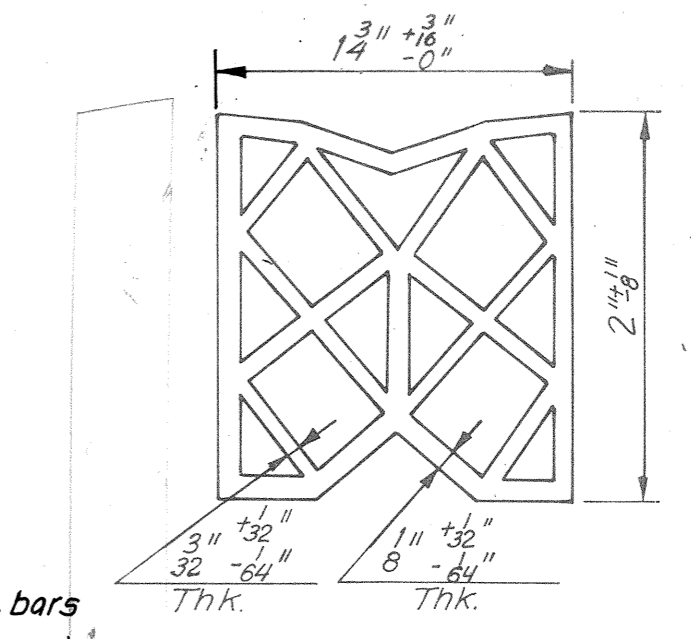


PREFORMED NEOPRENE JOINT SEALER FOR 1" TYPE "A" JOINT

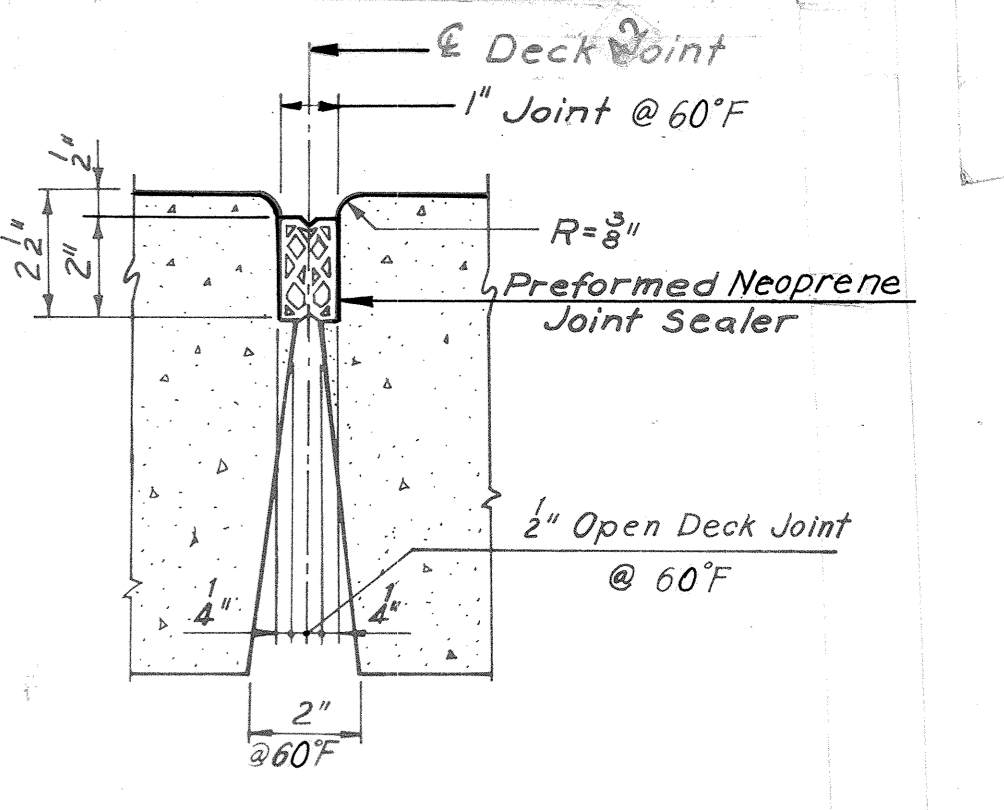


1" TYPE "A" JOINT

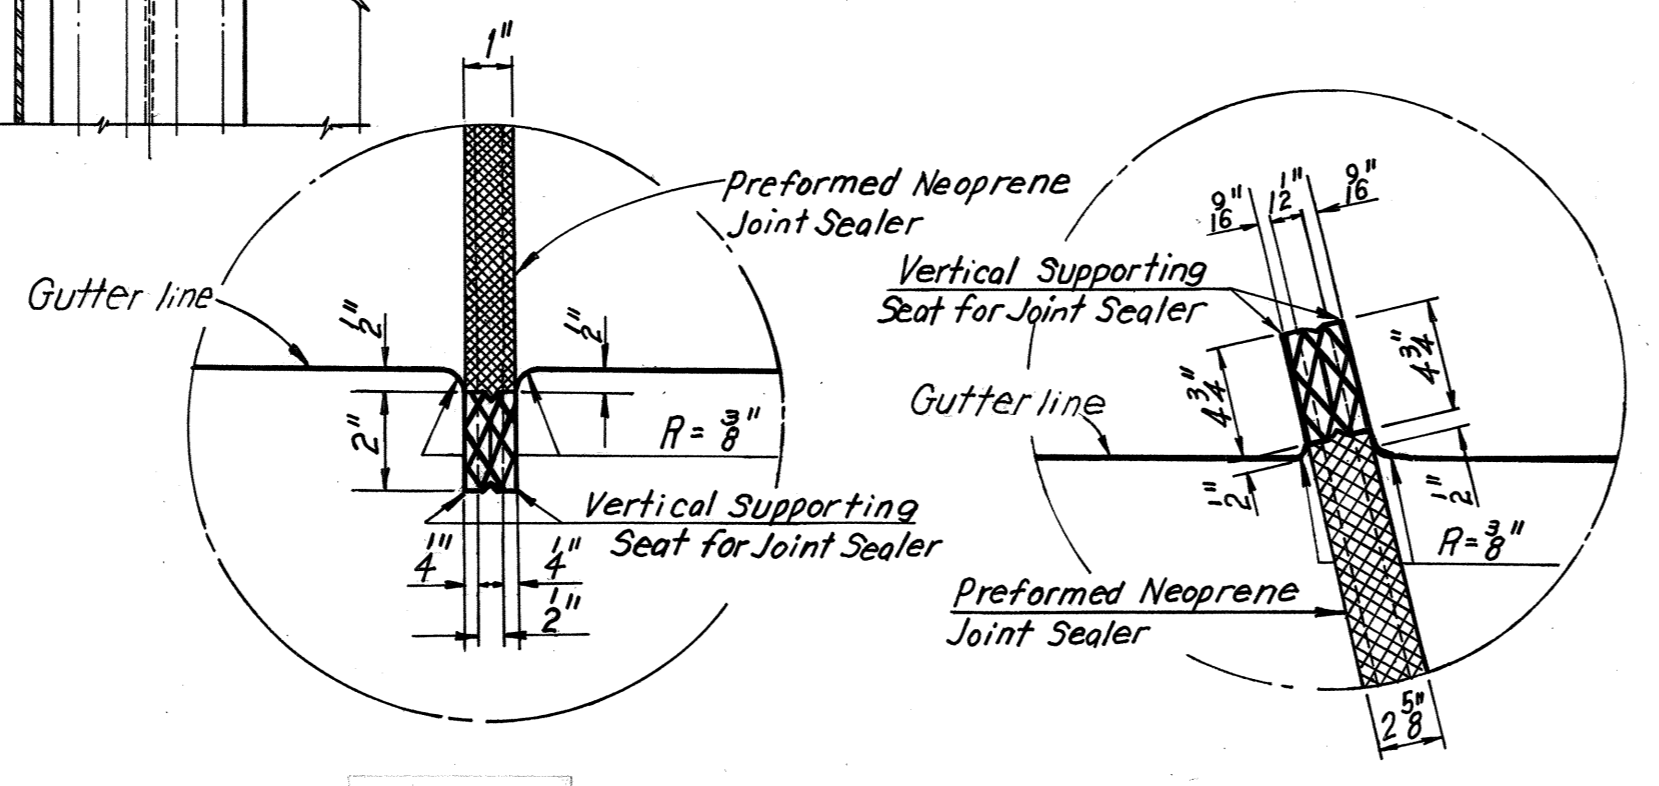


DETAIL A
Scale: 3" = 1'-0"

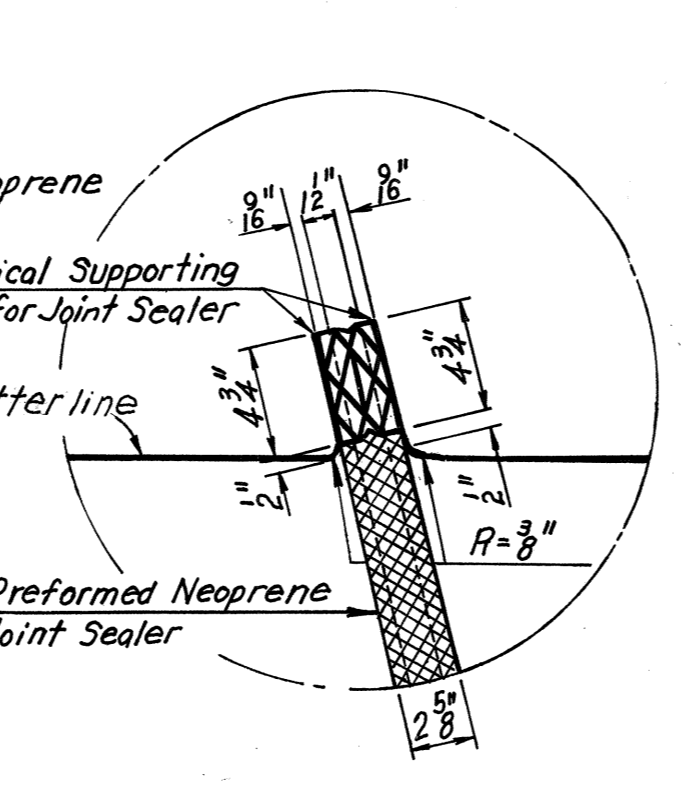


DETAIL B
Scale: 1 1/2" = 1'-0"

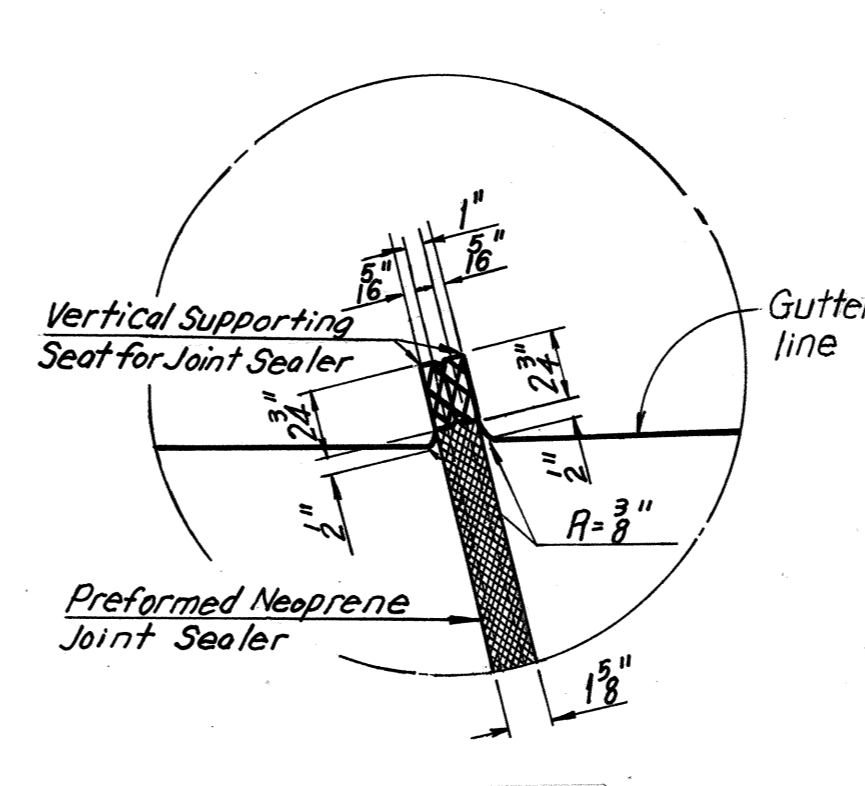

DETAIL C
Scale: 1 1/2" = 1'-0"

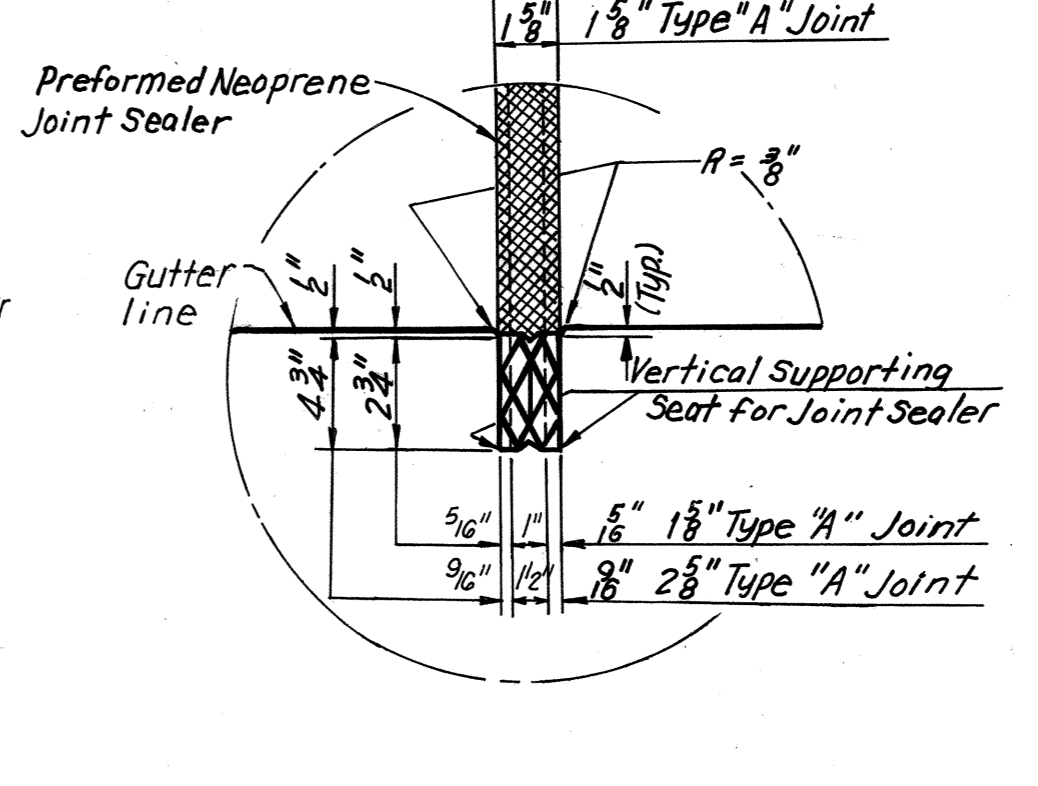

DETAIL D
No Scale

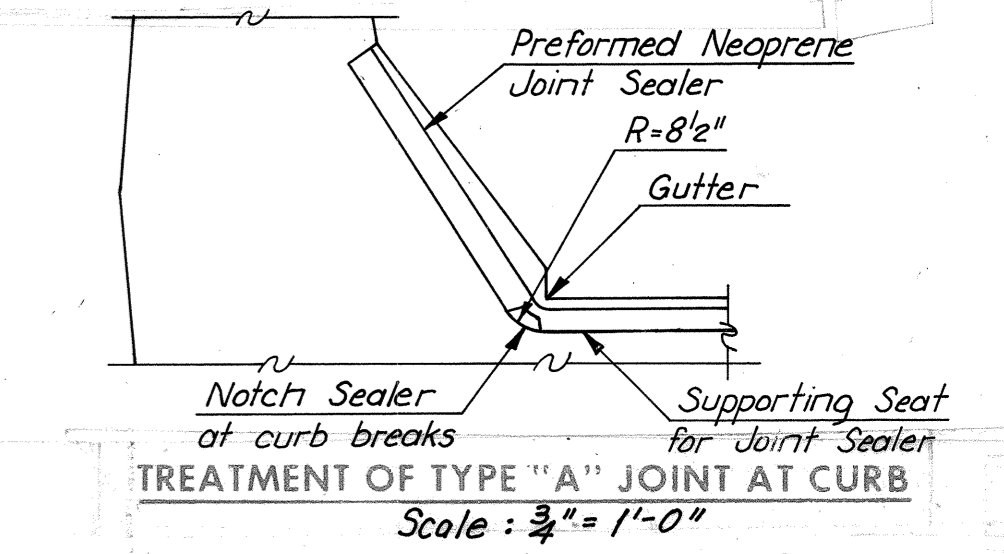

TREATMENT OF TYPE "A" JOINT AT CURB
Scale: 3/4" = 1'-0"

Note: Reinforcings of Section A-A are similar to Section B-B.
Note: Horizontal dimensions as shown in the cross sections are normal to ξ joint.

BY	DATE	REVISION	BY	DATE
MADE	G.S.H.	9-26-69		
CHECKED	V.C.P.	10-1-69	Diaph conn. R @ Piers 3, 4 & 5	TEM. 8-26-75
IN CHARGE				

RICHMOND METROPOLITAN AUTHORITY
RICHMOND EXPRESSWAY SYSTEM
DOWNTOWN EXPRESSWAY













BRIDGE NO. 68
RAMP W-S CONNECTION TO
RICHMOND-PETERSBURG TURNPIKE

JOINT DETAILS

HOWARD, NEEDLES, TAMMEN & BERGENDOFF
consulting engineers
NEW YORK ALEXANDRIA KANSAS CITY

SCALE: As Noted
CONTRACT NO. 11
SHEET NO. 25 OF 28

AS BUILT

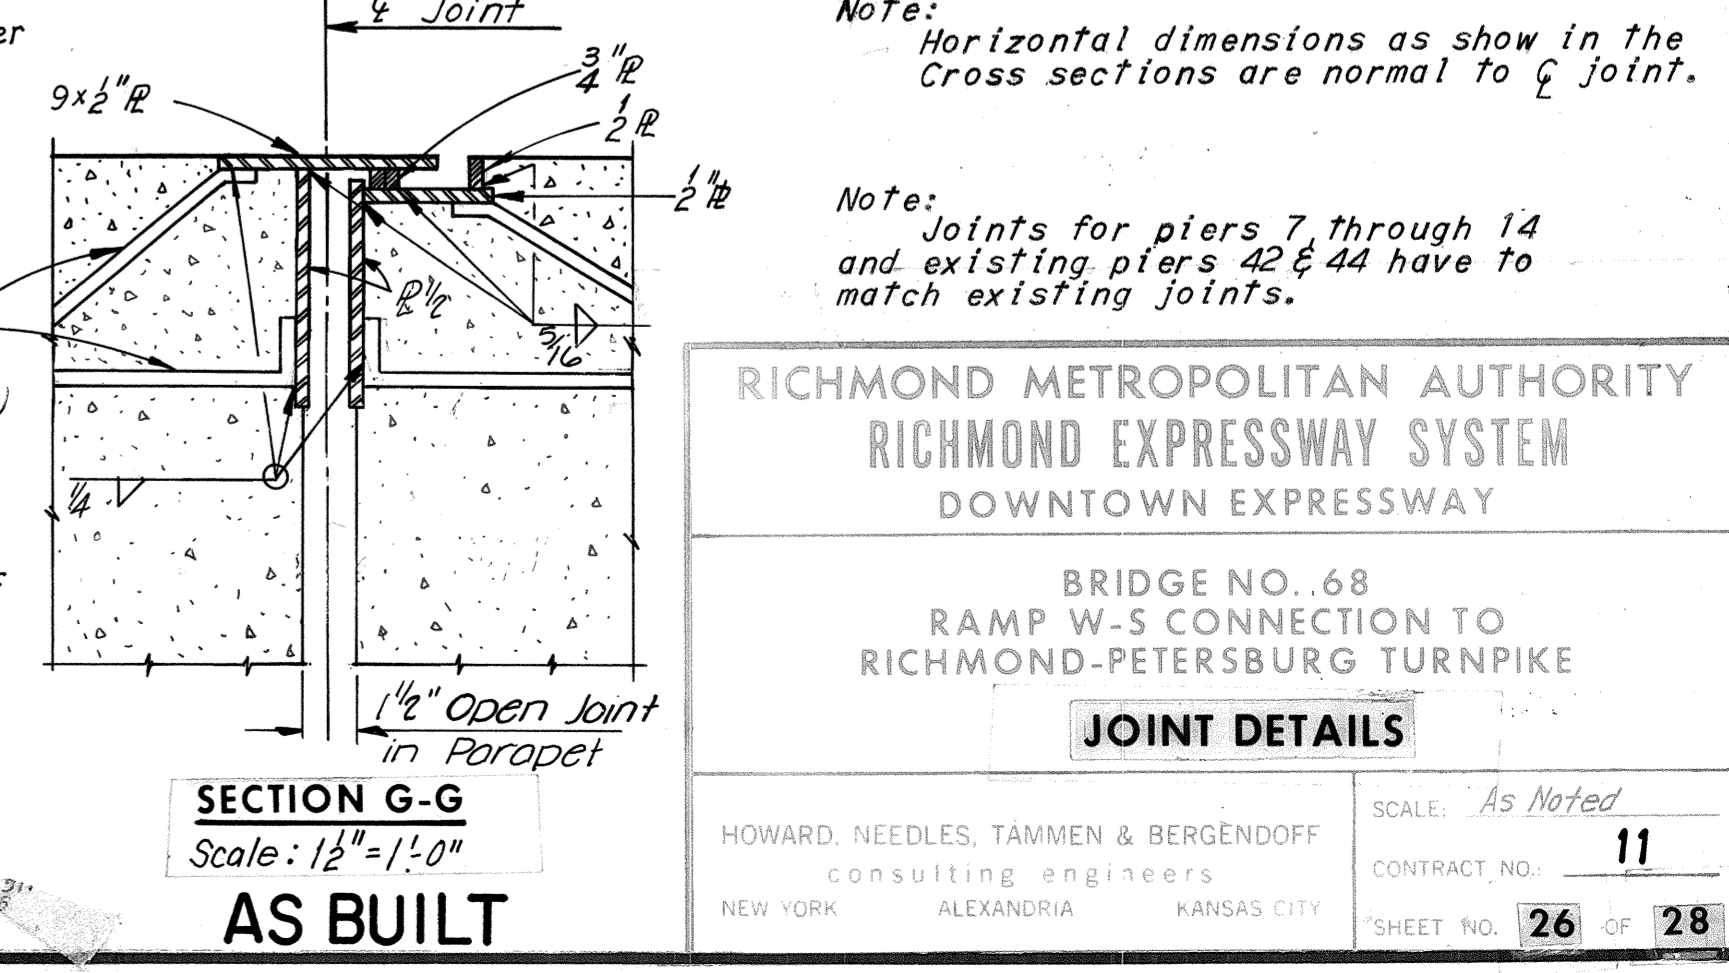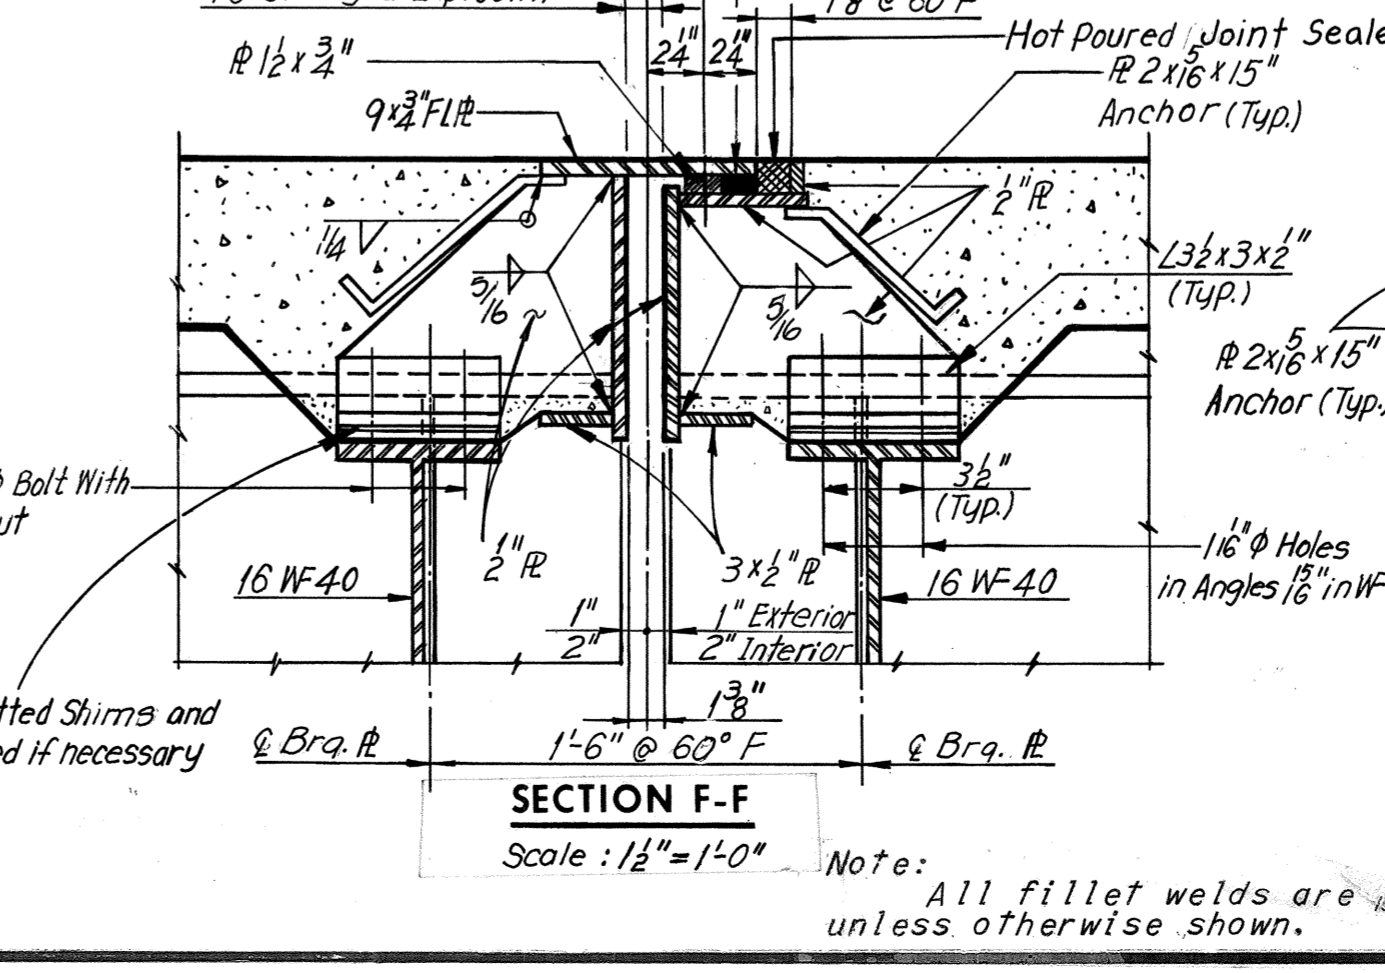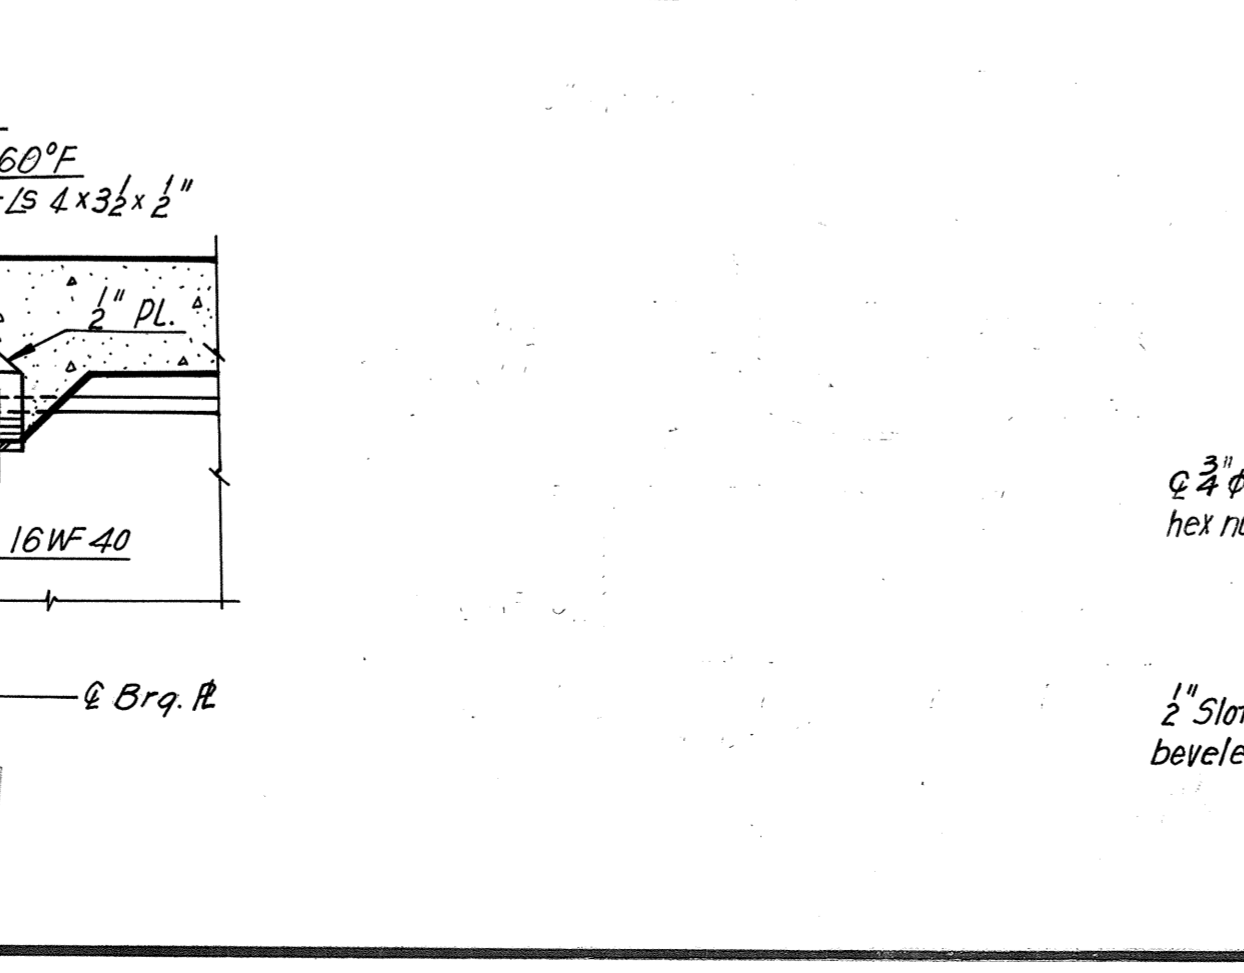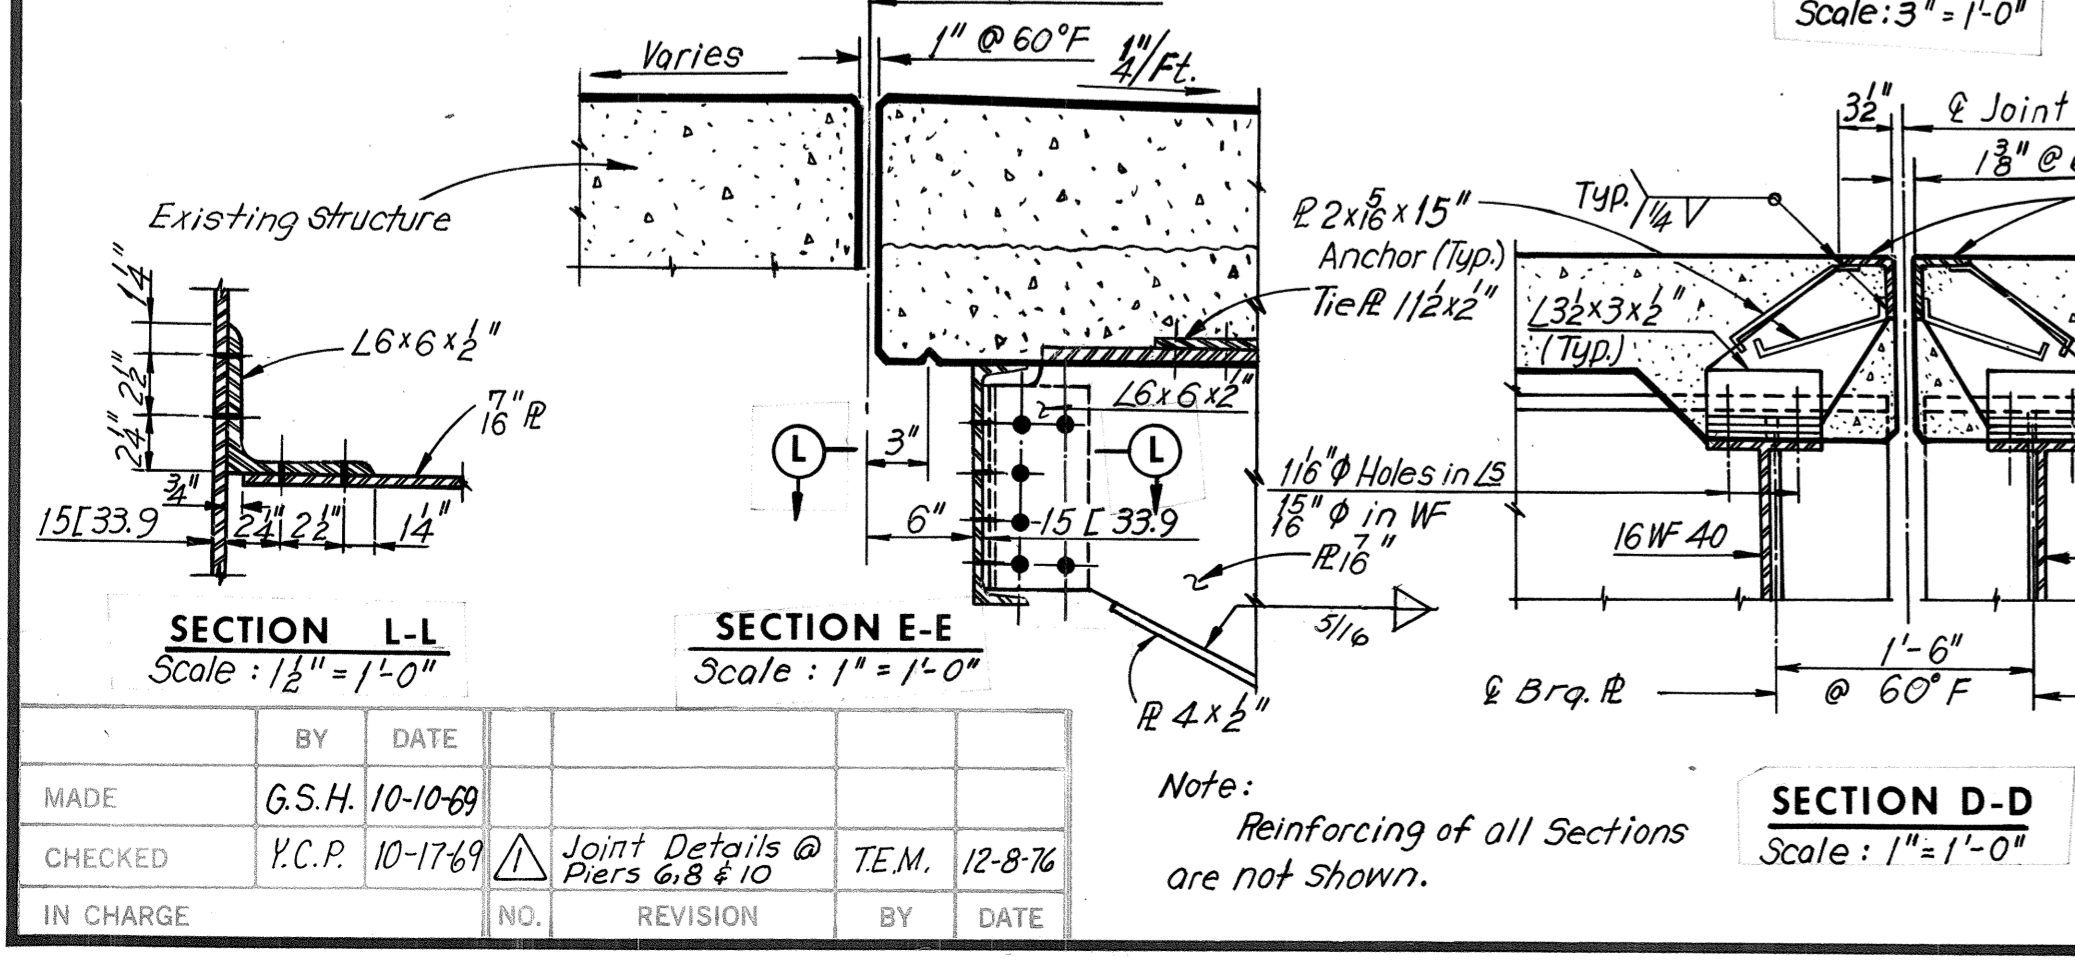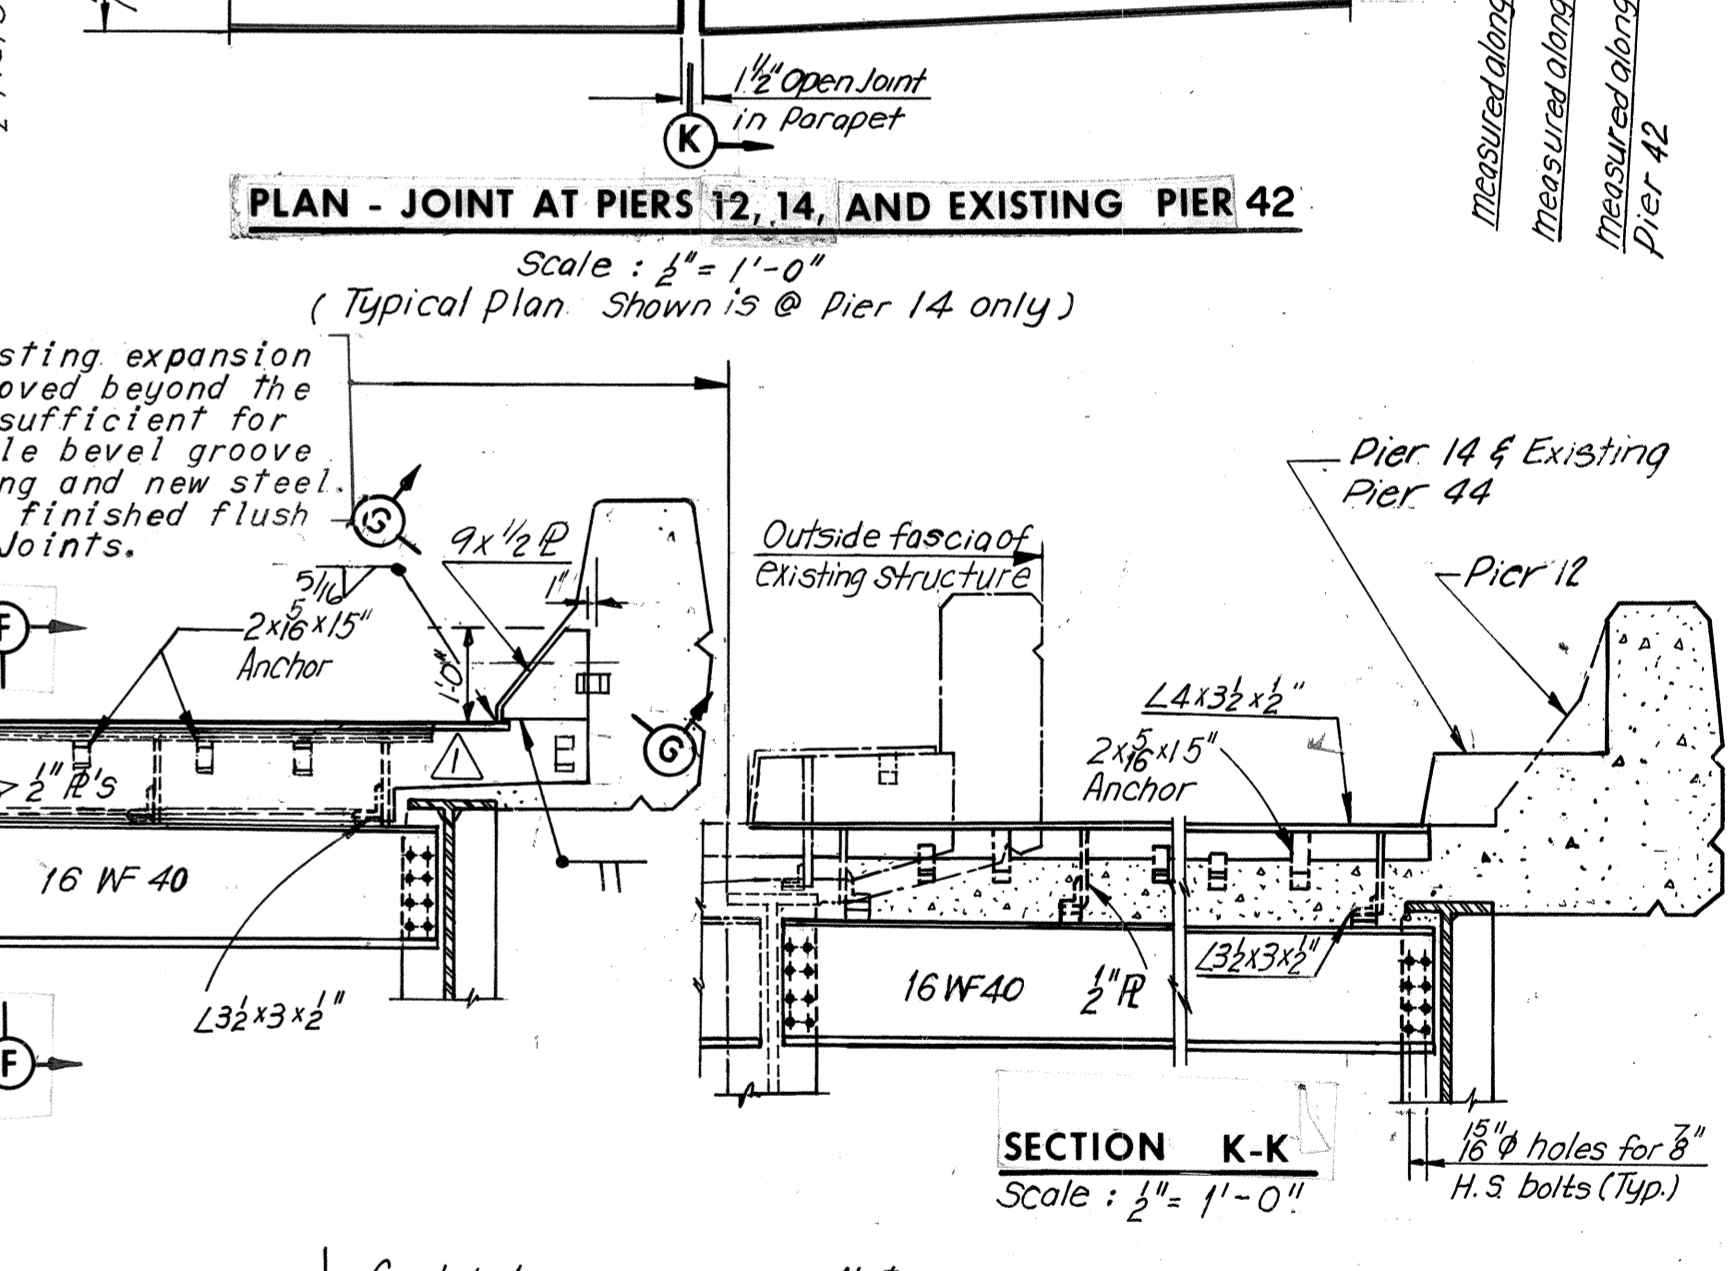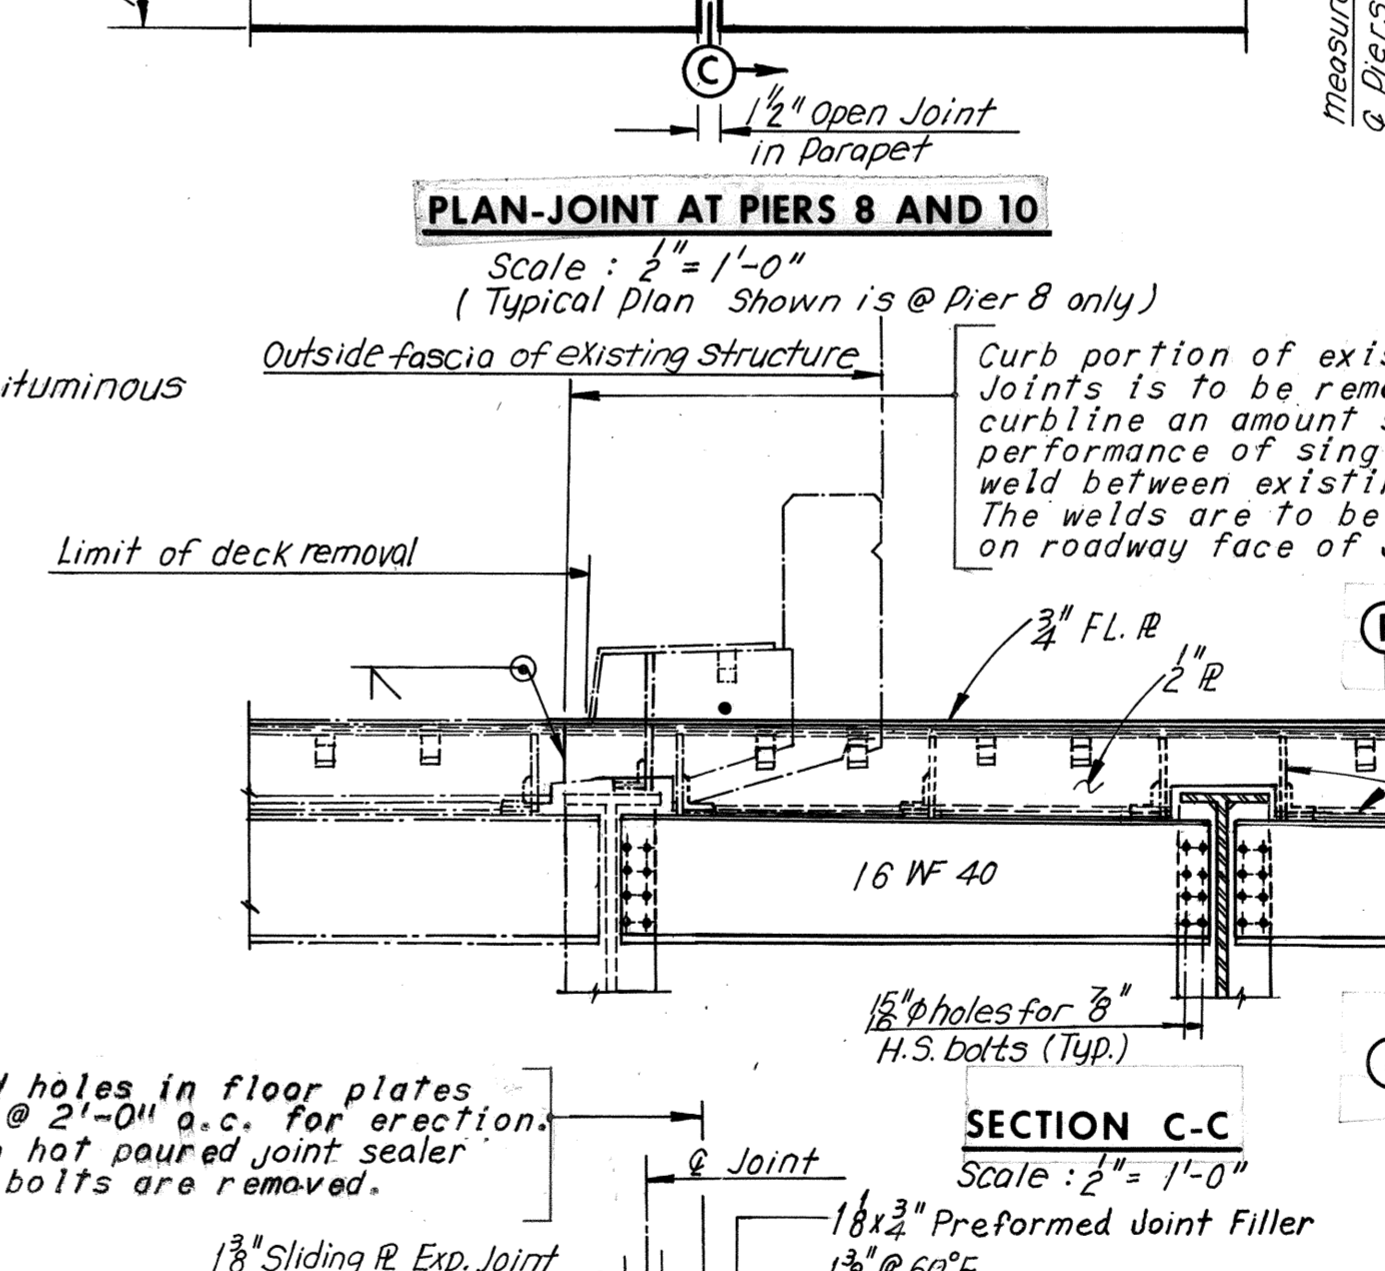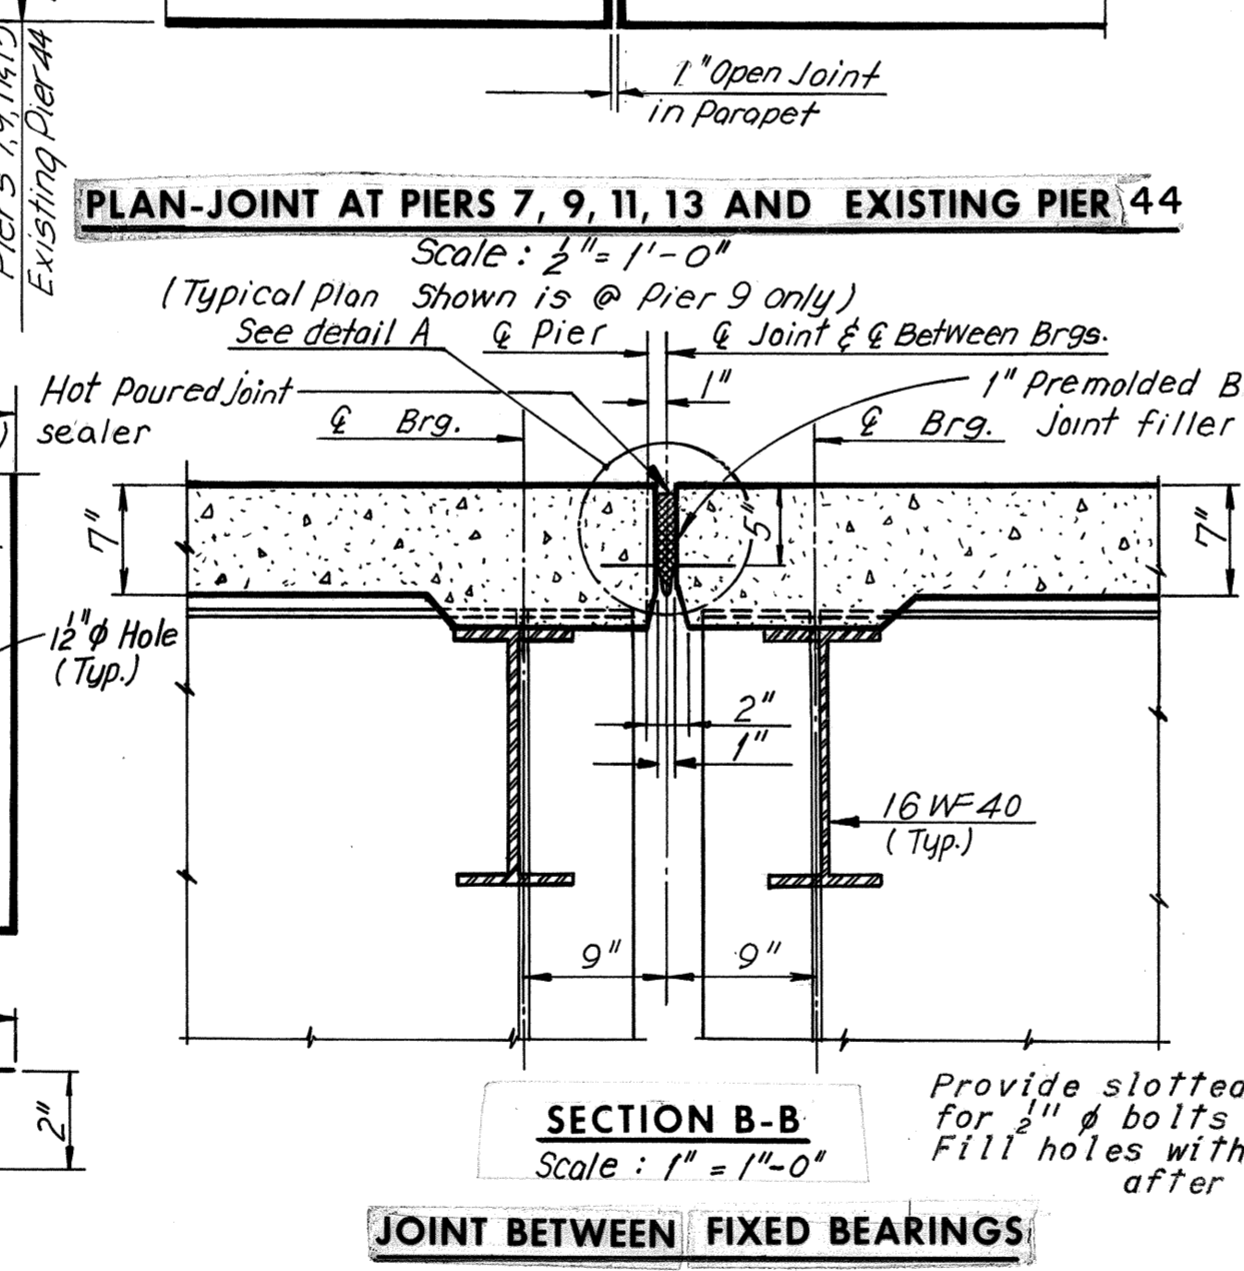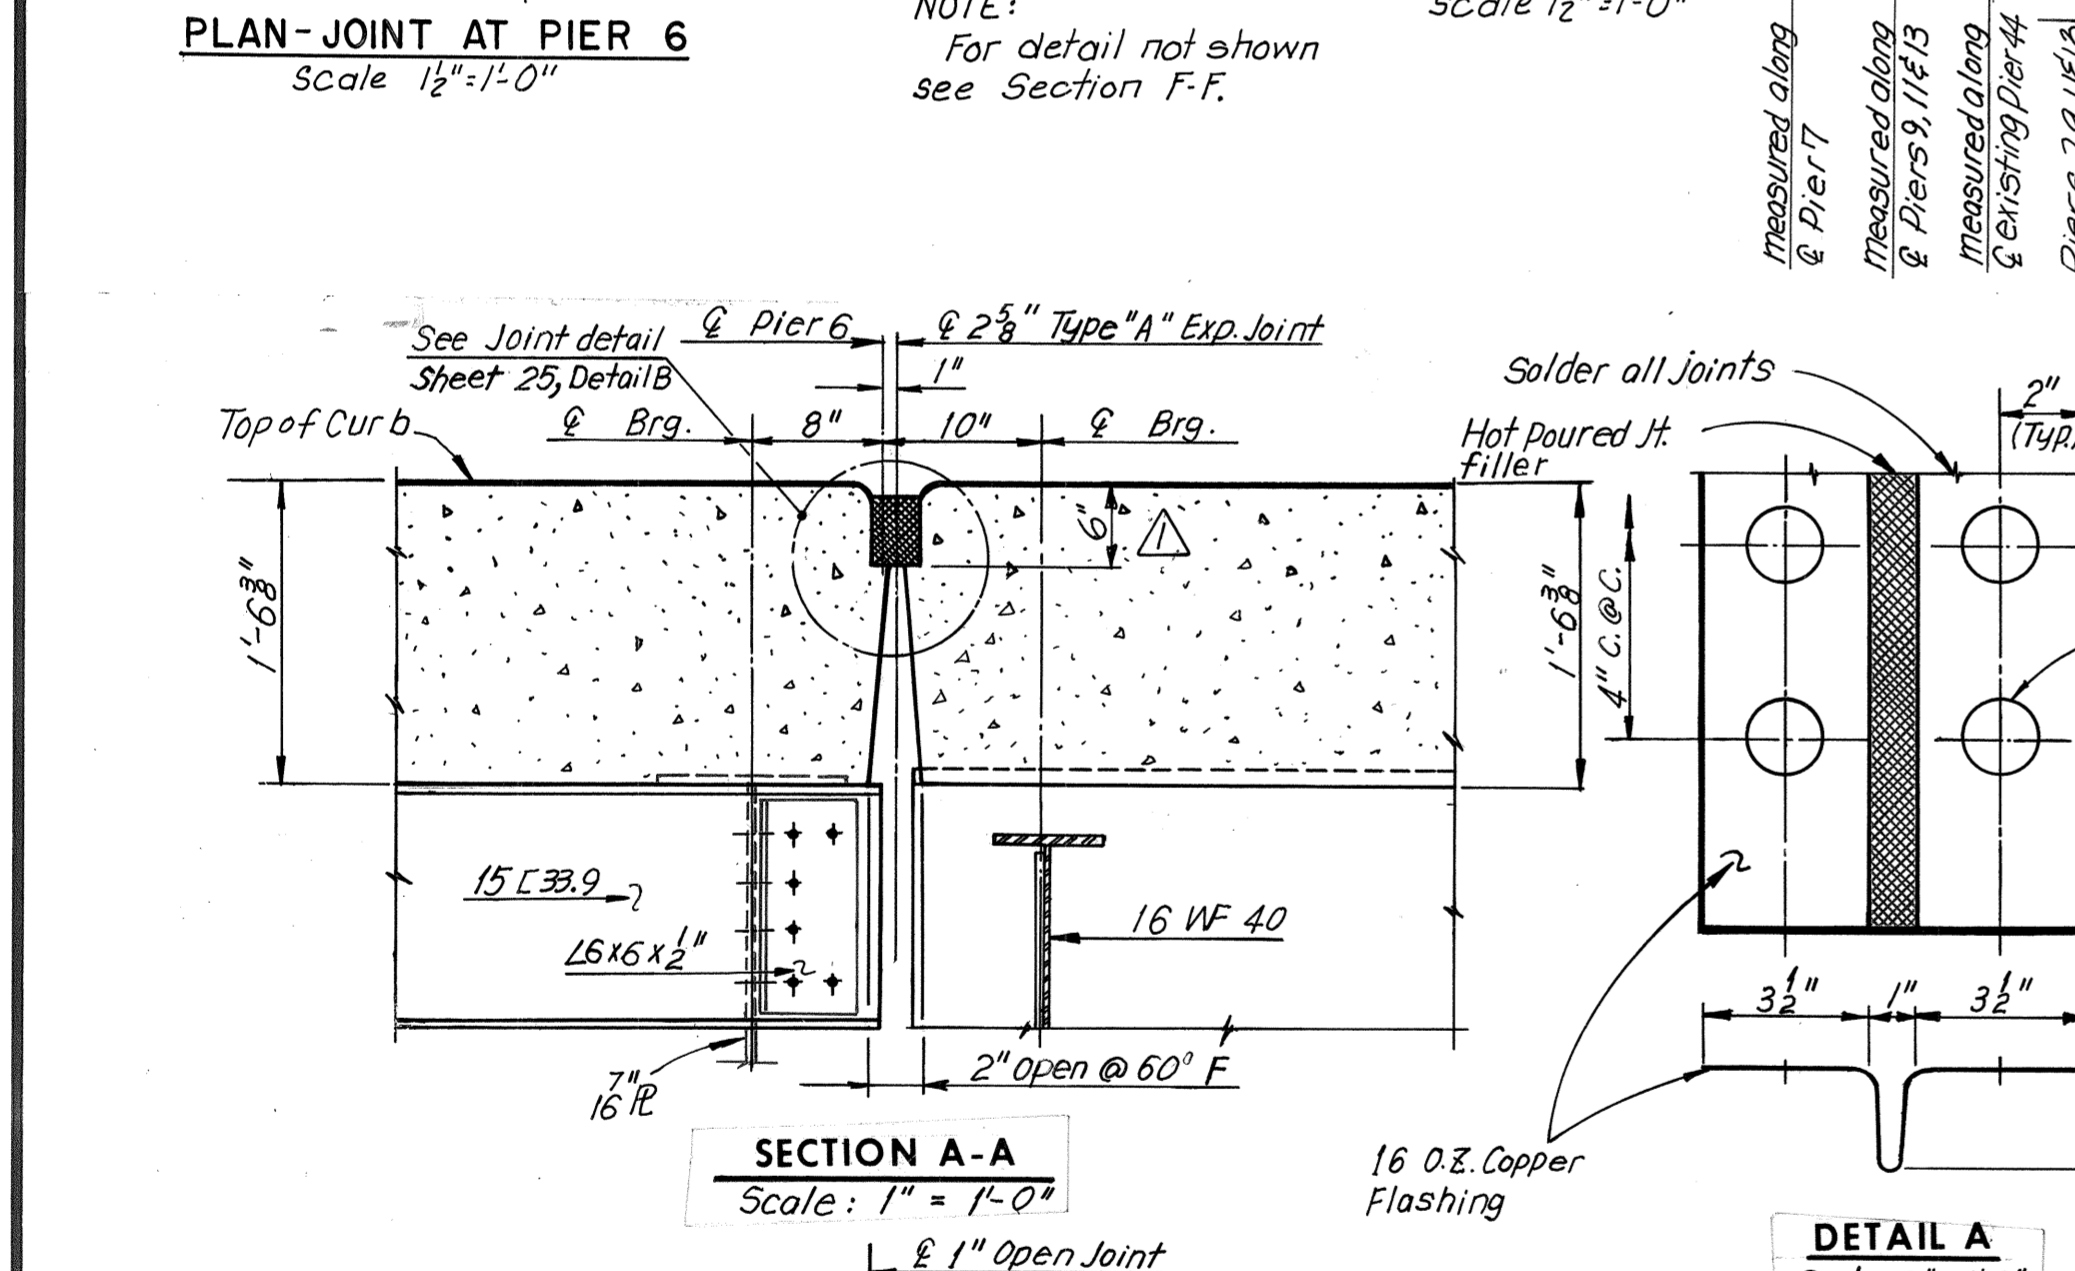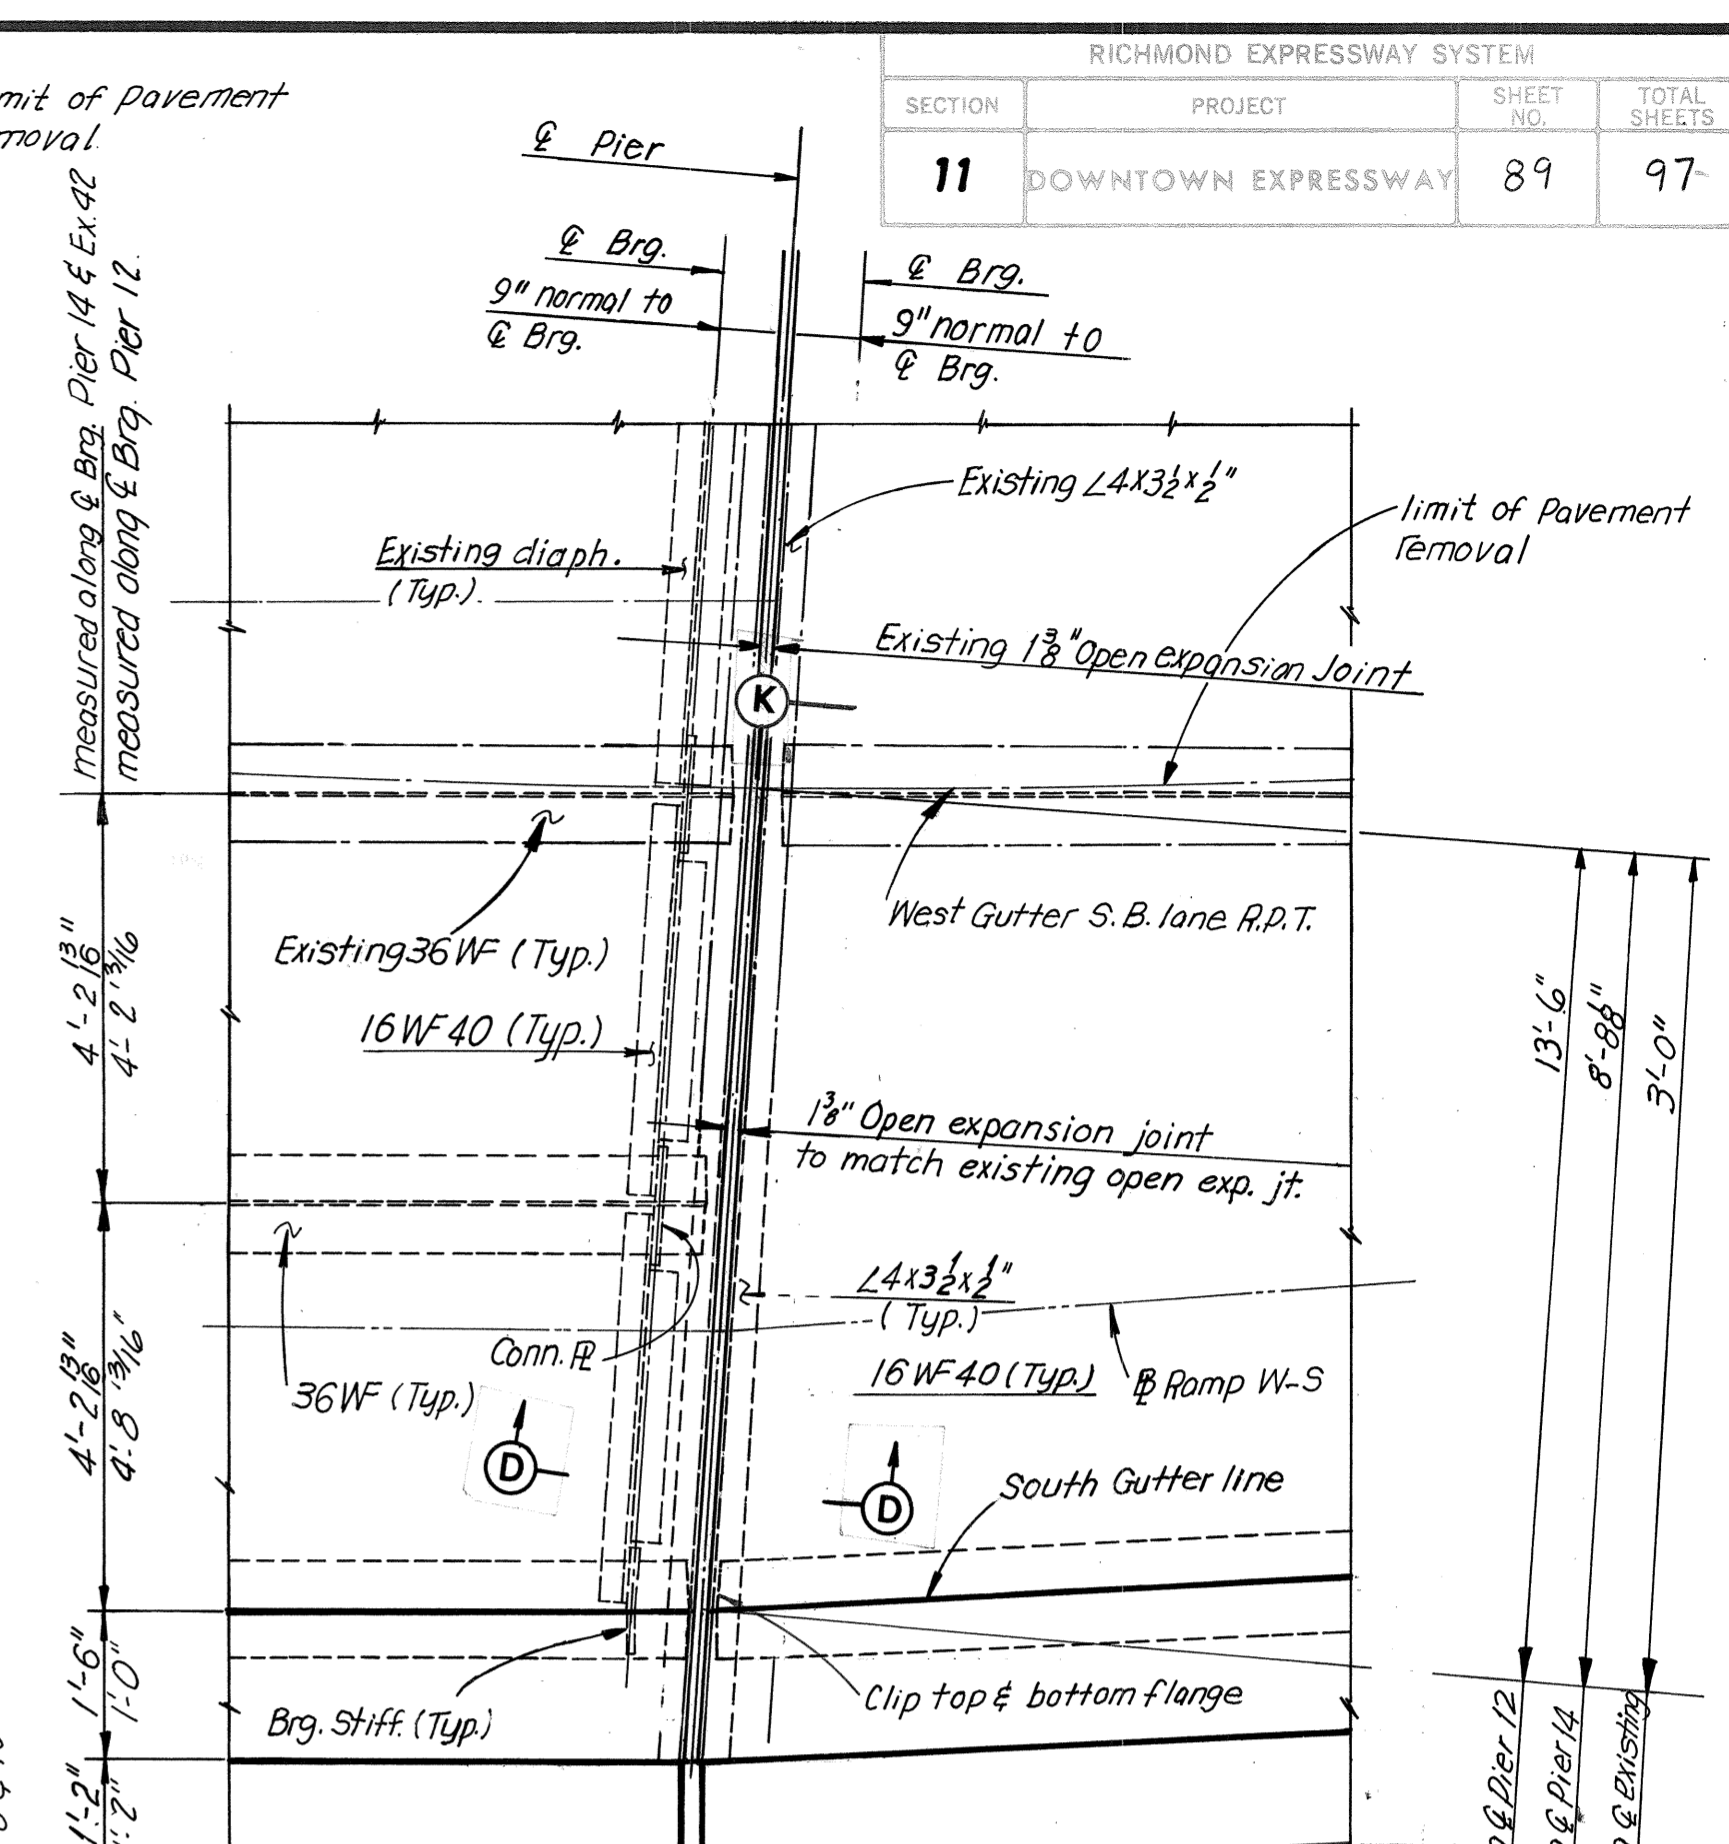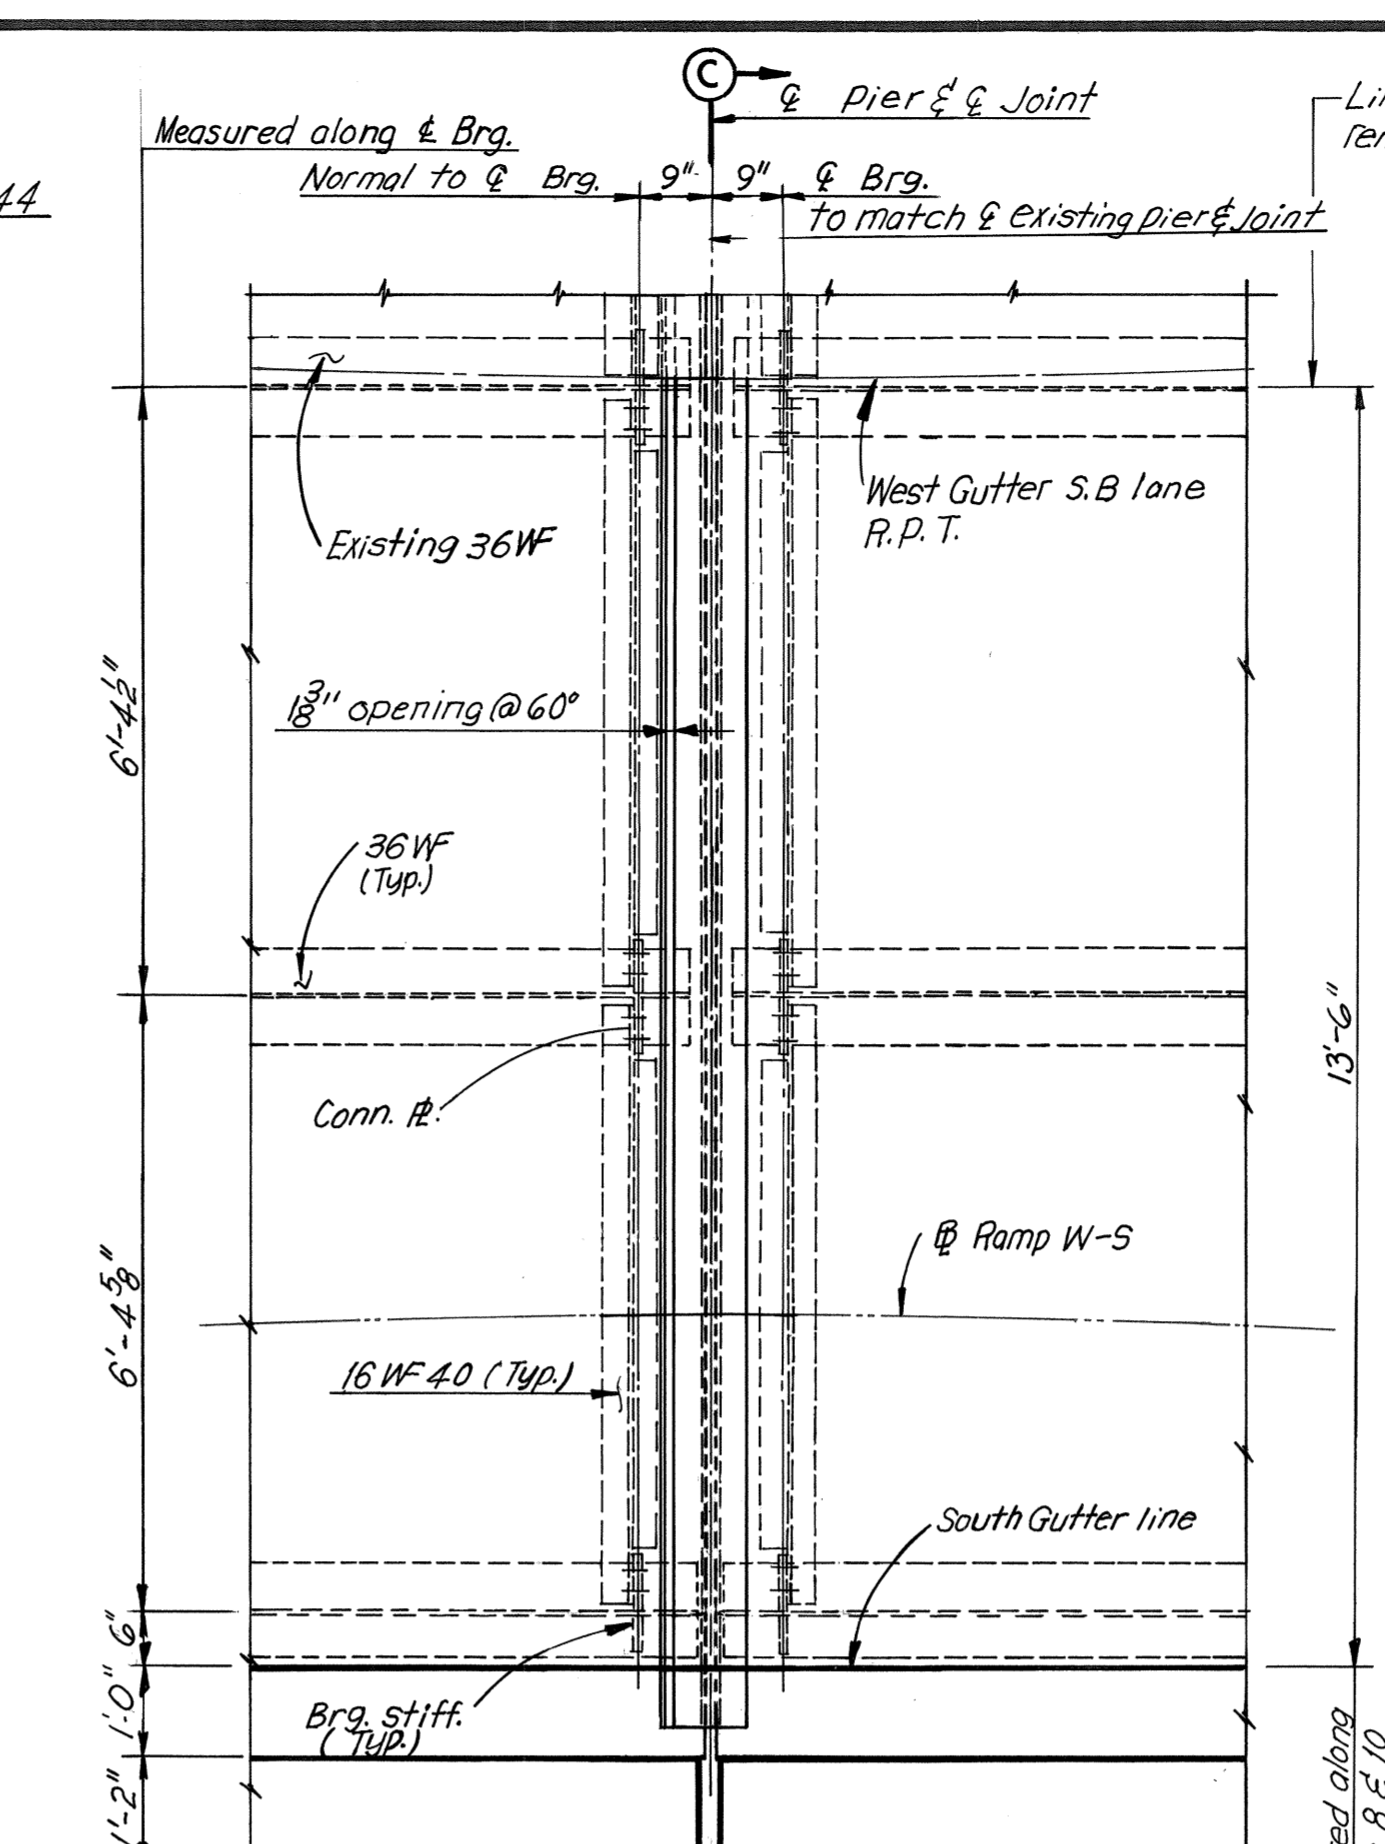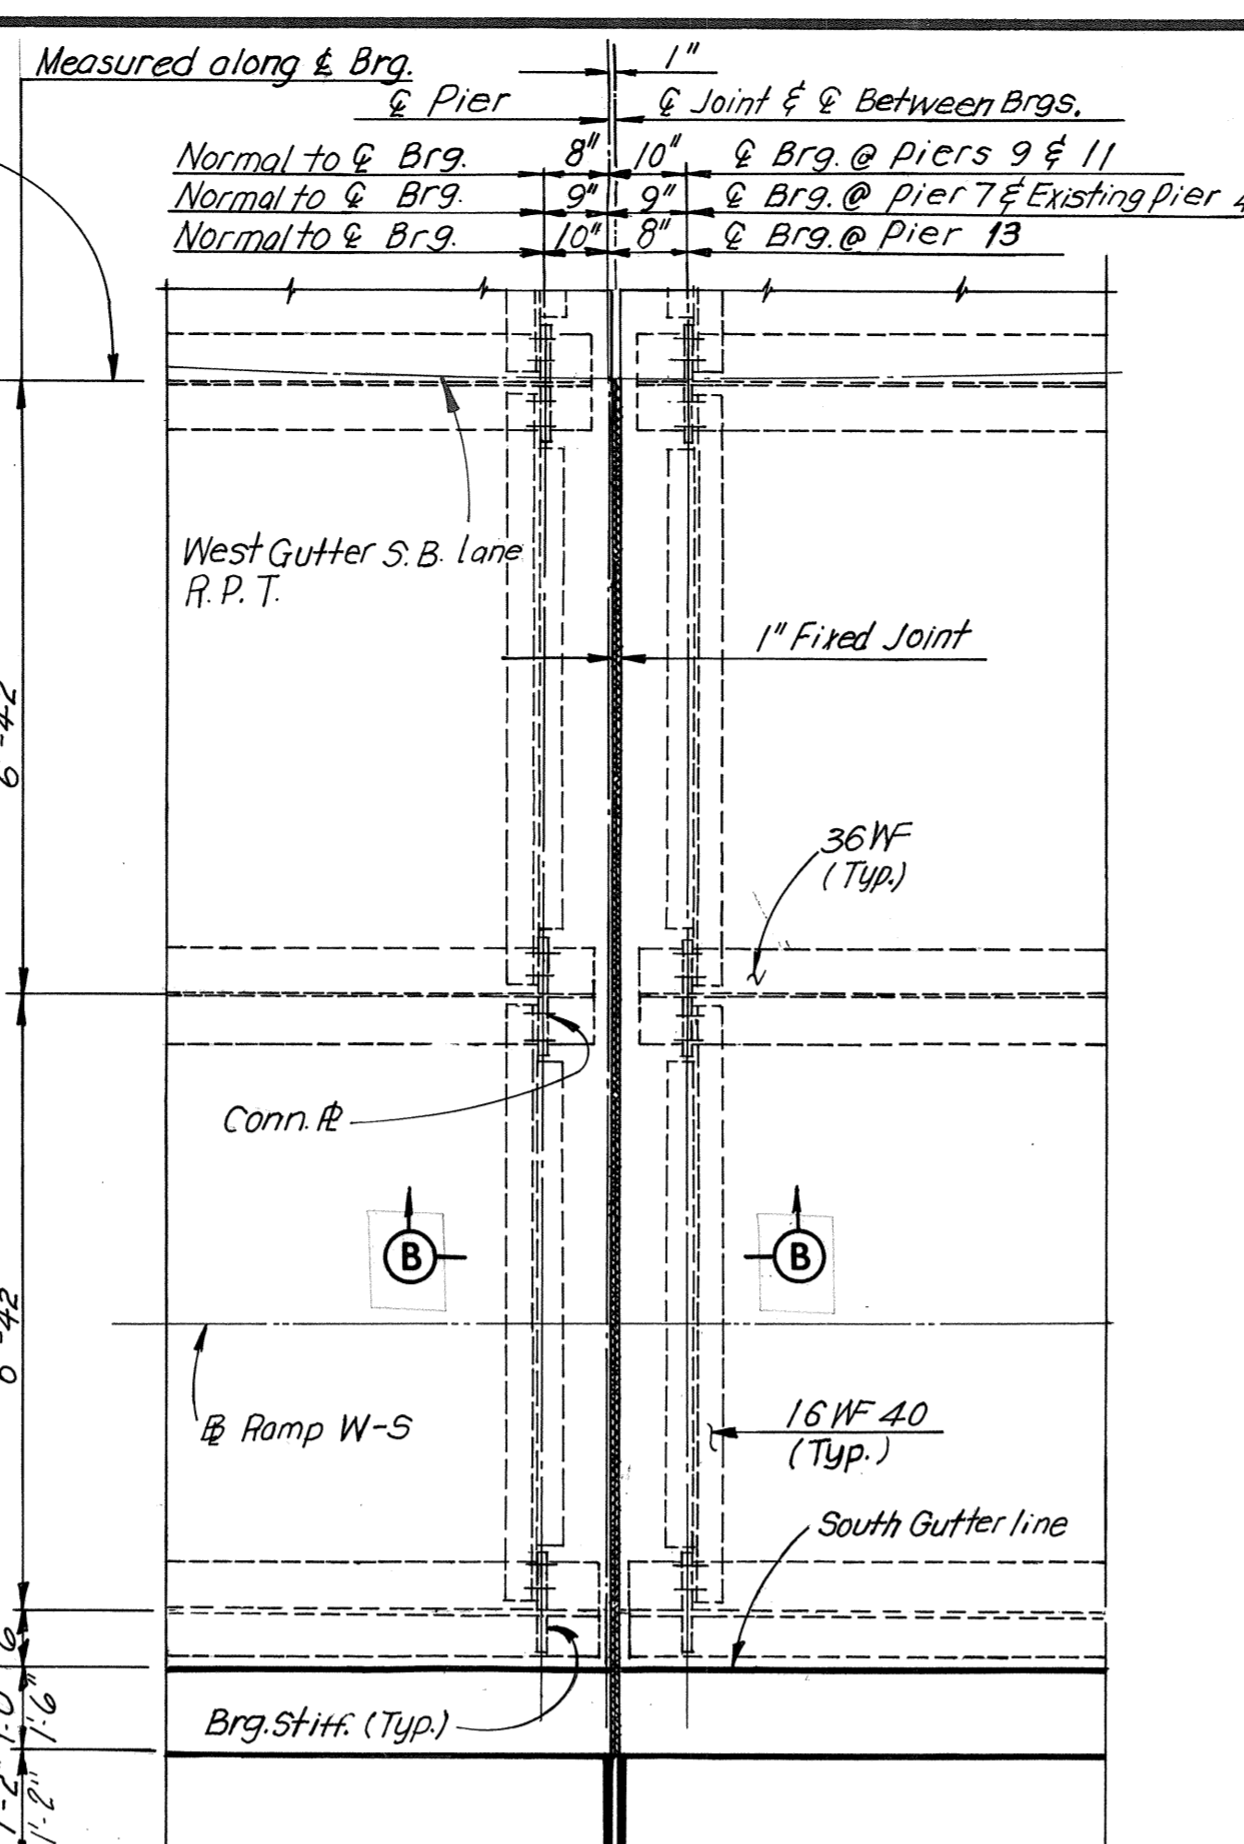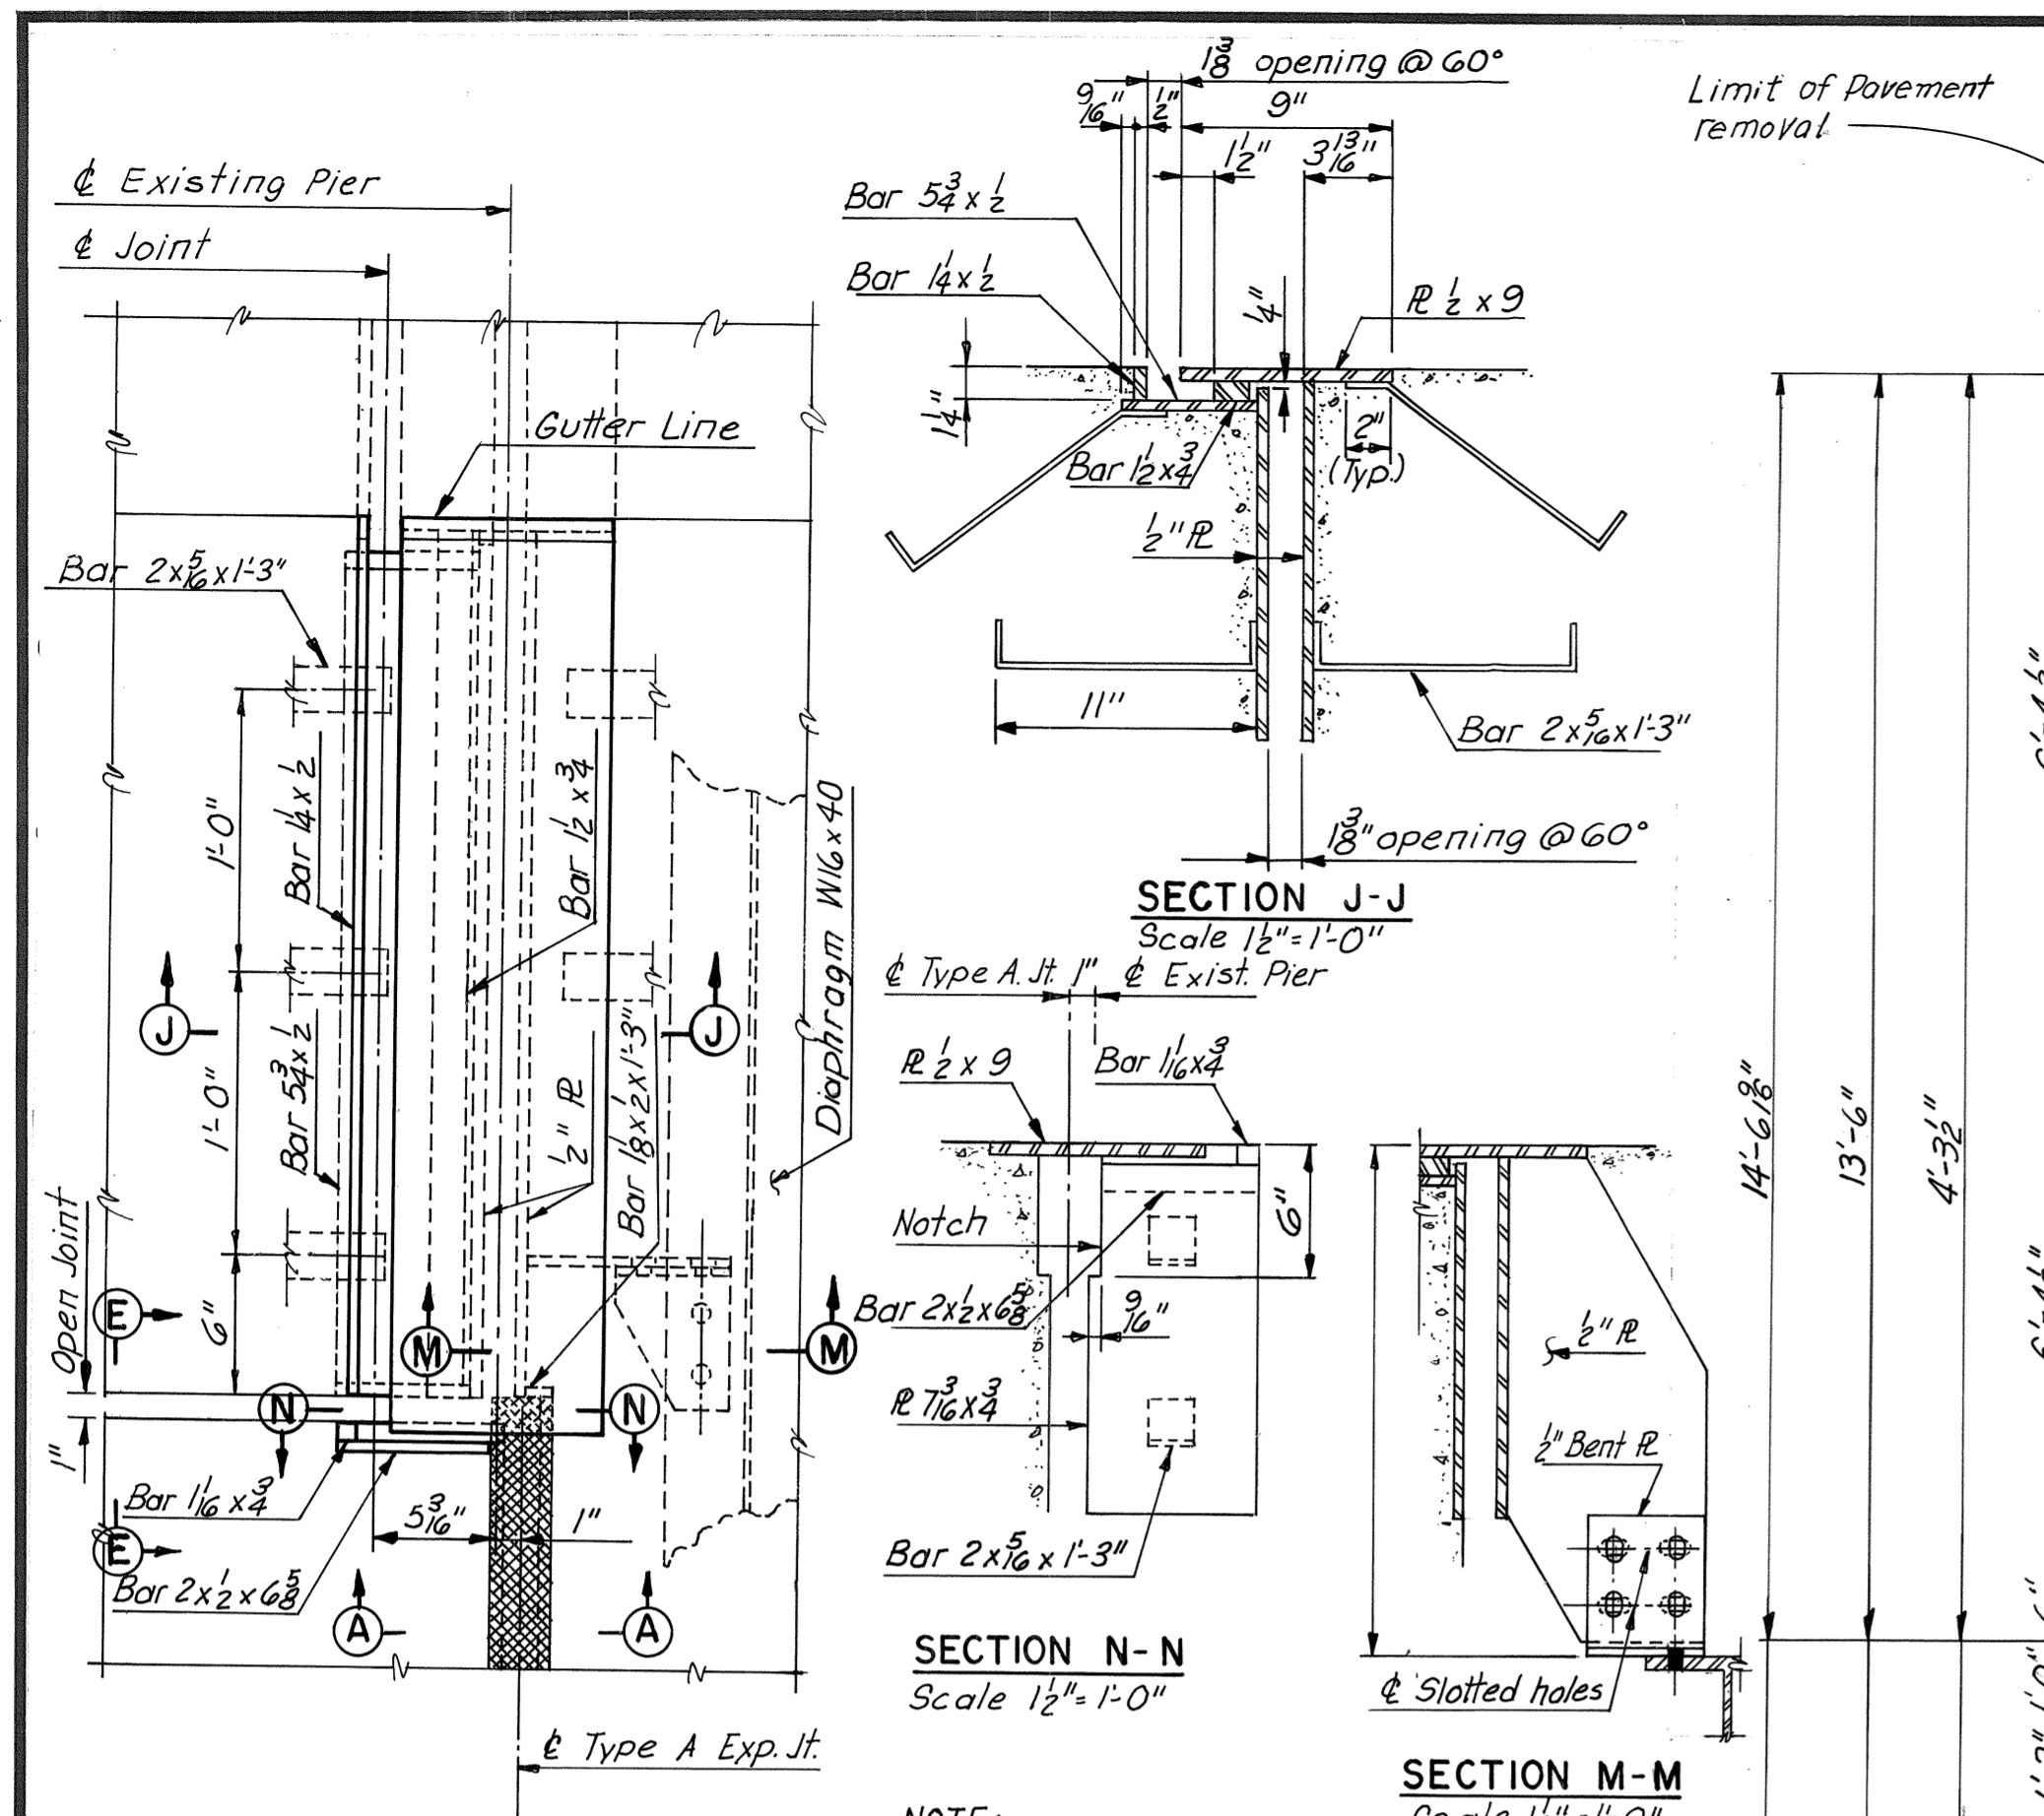

RICHMOND METROPOLITAN AUTHORITY
RICHMOND EXPRESSWAY SYSTEM
DOWNTOWN EXPRESSWAY


BRIDGE NO. 68
RAMP W-S CONNECTION TO
RICHMOND-PETERSBURG TURNPIKE

JOINT DETAILS


HOWARD, NEEDLES, TAMMEN & BERGENDOFF
CONSULTING ENGINEERS
NEW YORK ALEXANDRIA KANSAS CITY

SCALE: As Noted
CONTRACT NO. 11
SHEET NO. 26 OF 28


RICHMOND EXPRESSWAY SYSTEM			
SECTION	PROJECT	SHEET NO.	TOTAL SHEETS
11	DOWNTOWN EXPRESSWAY	92	97

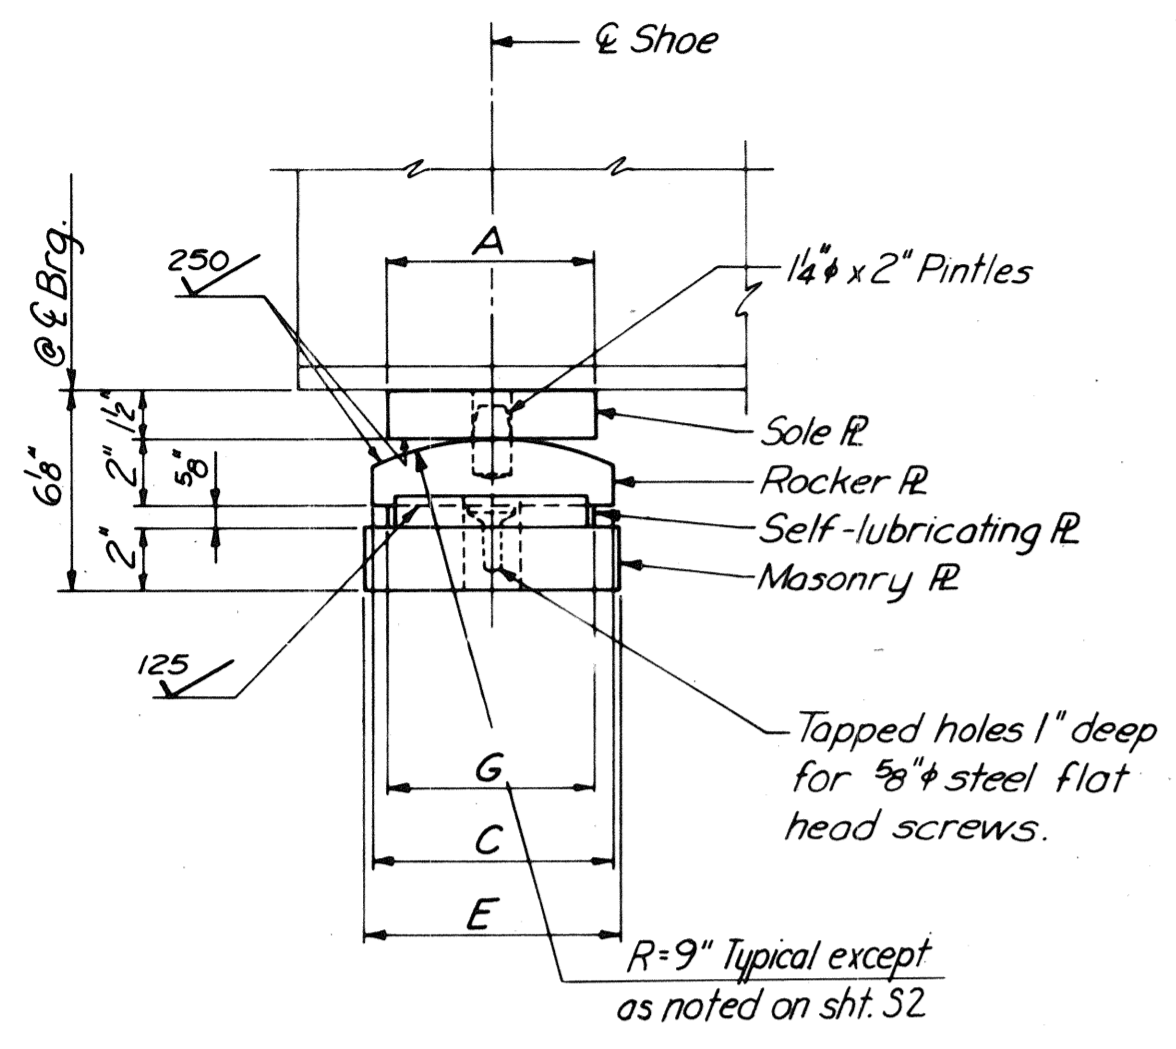


SIDE ELEVATION

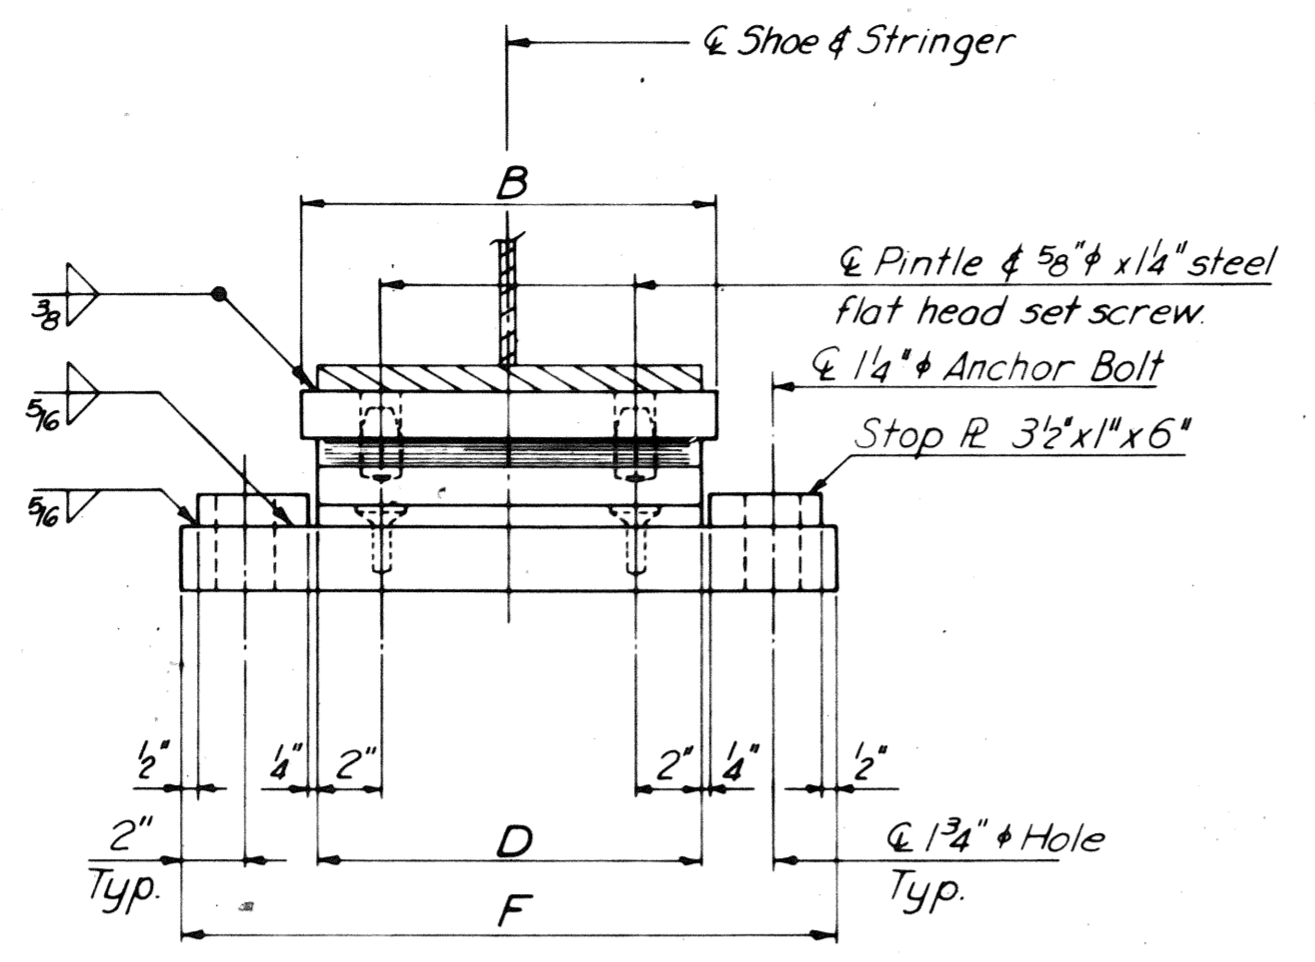


END ELEVATION

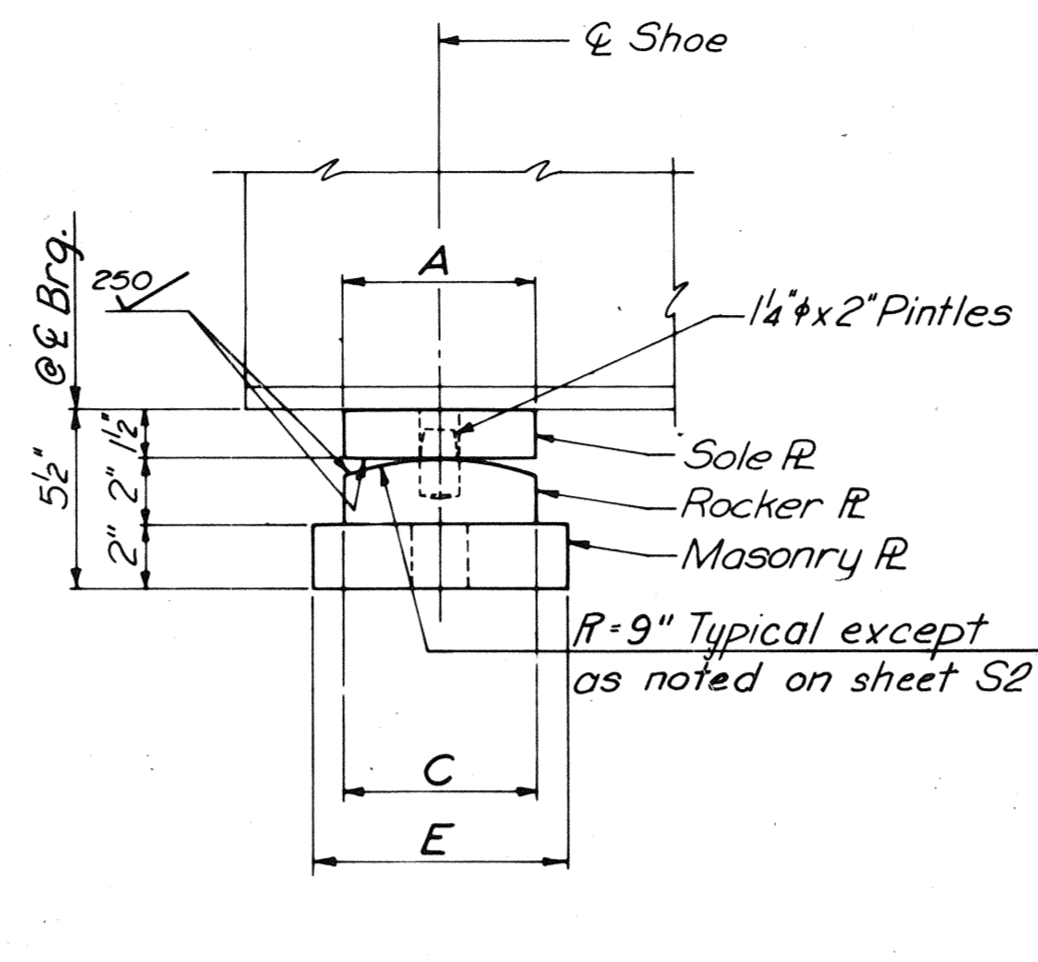

SIDE ELEVATION

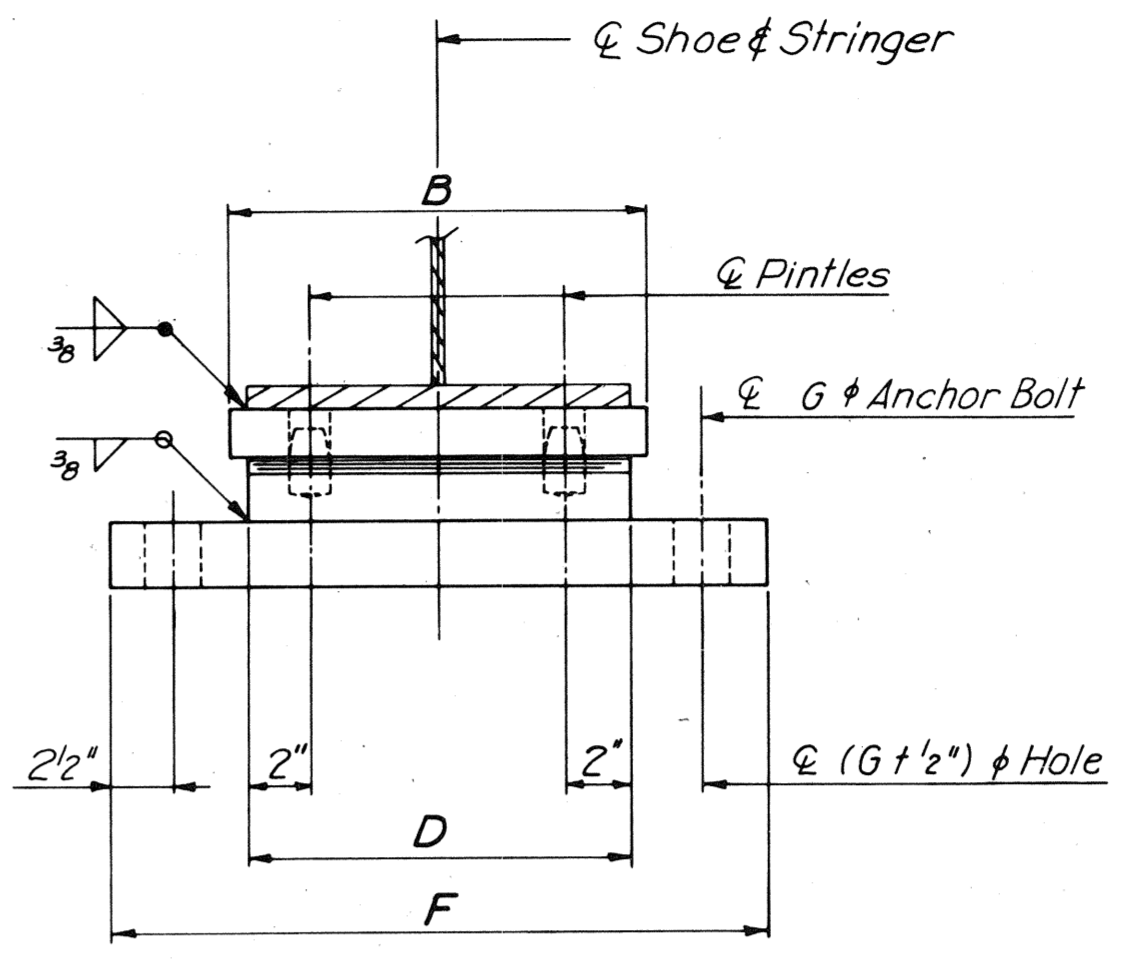


END ELEVATION

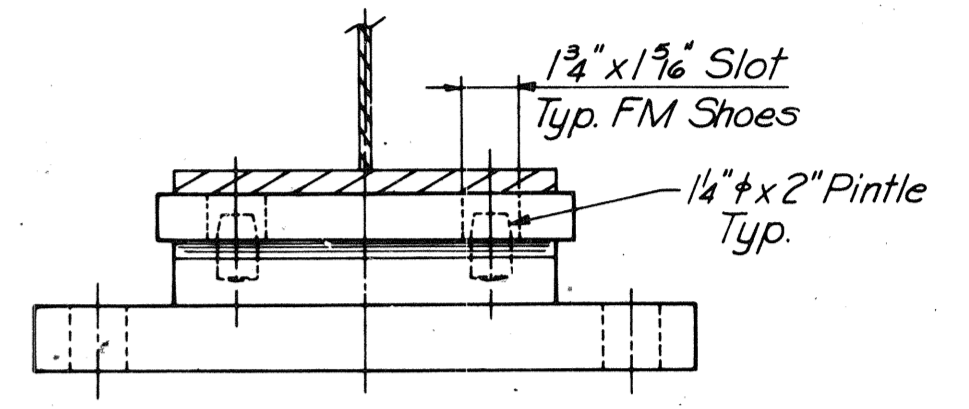


END ELEVATION


Note:
Fixed Modified Shoes same as Fixed Shoes except as shown.

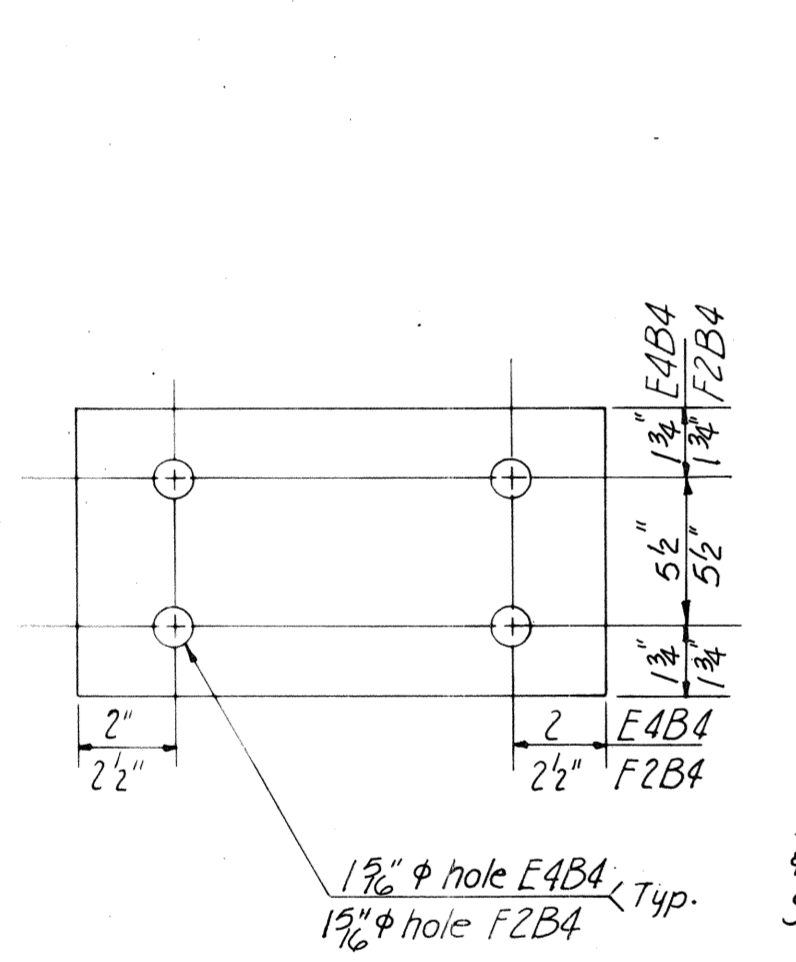


MASONRY PLATE DETAIL
E4B4 & F2B4

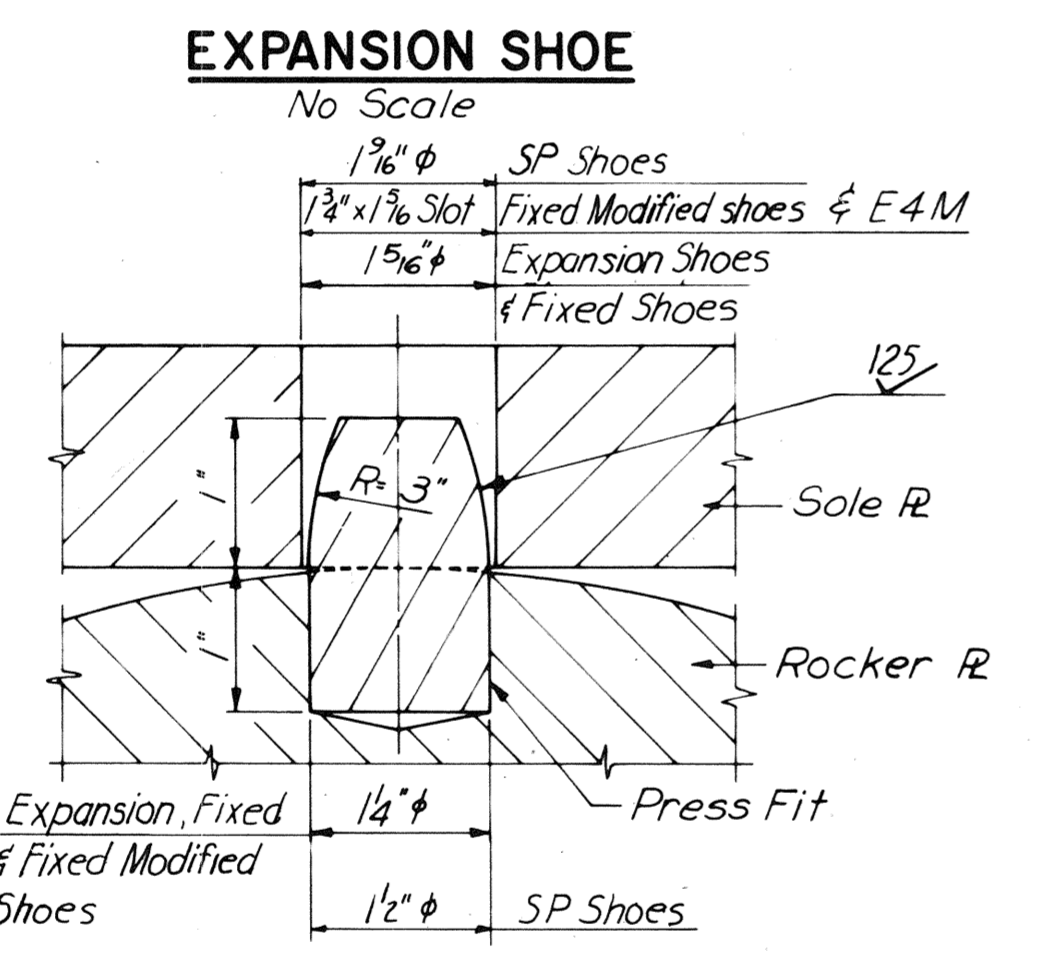

PINTLE DETAIL
Scale: 3/4"=1"

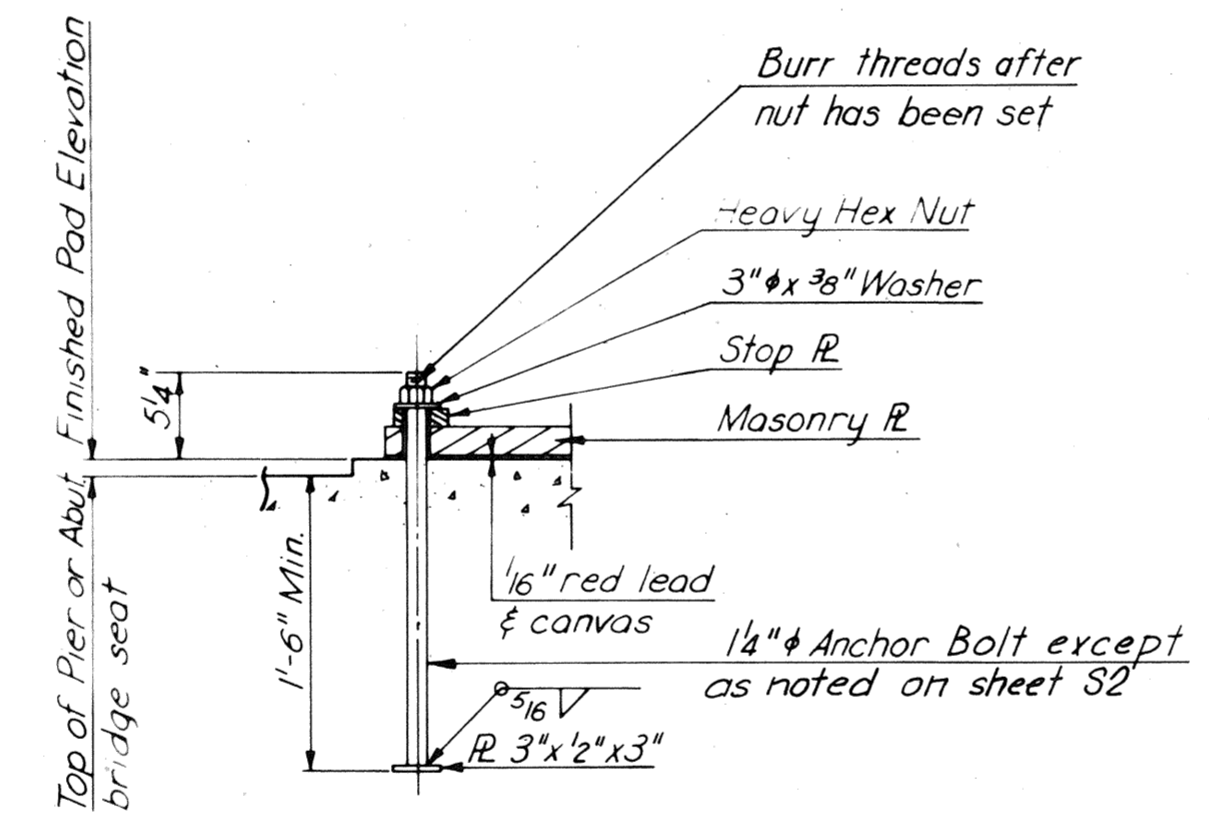


EXPANSION SHOE

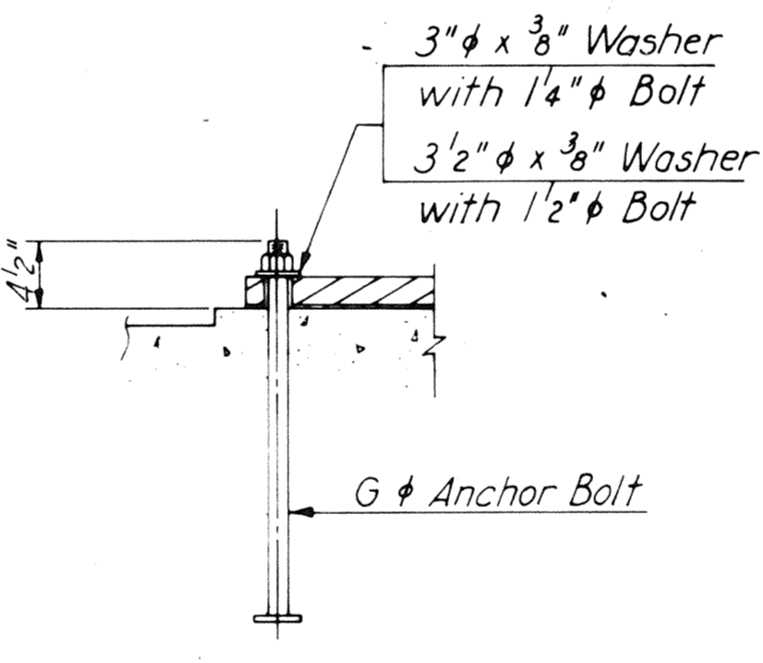


FIXED SHOE

Note:
Anchor Bolt for Fixed Shoes & SP Shoes same as Anchor Bolt for Exp Shoes except as shown.

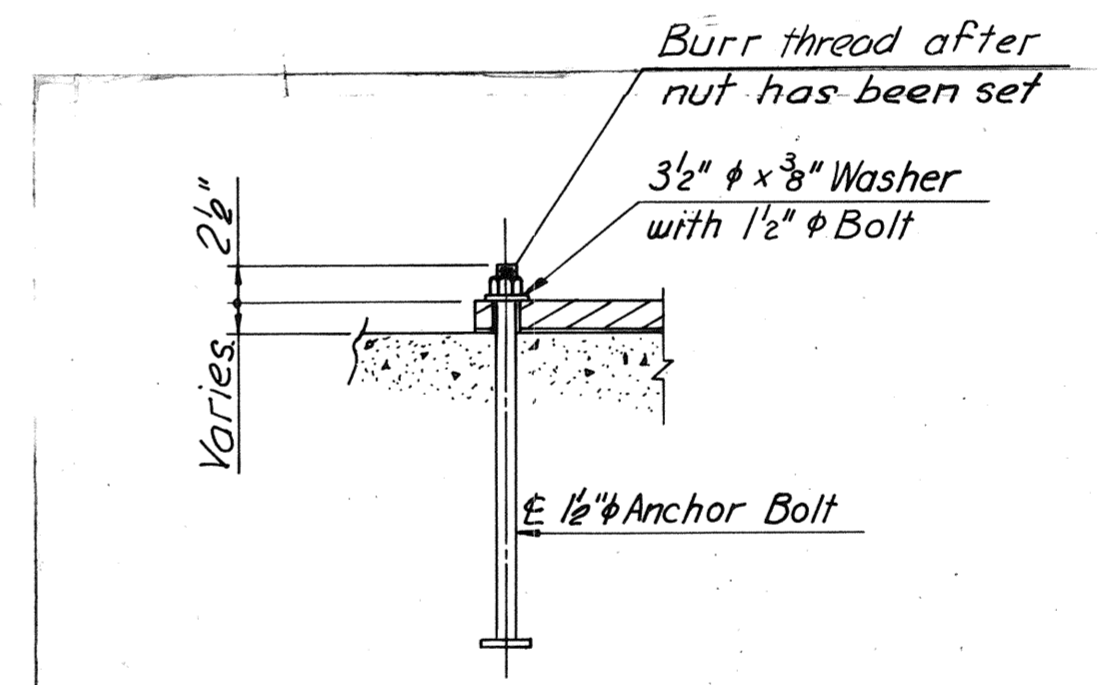


SP SHOE


FIXED MODIFIED SHOE
No Scale

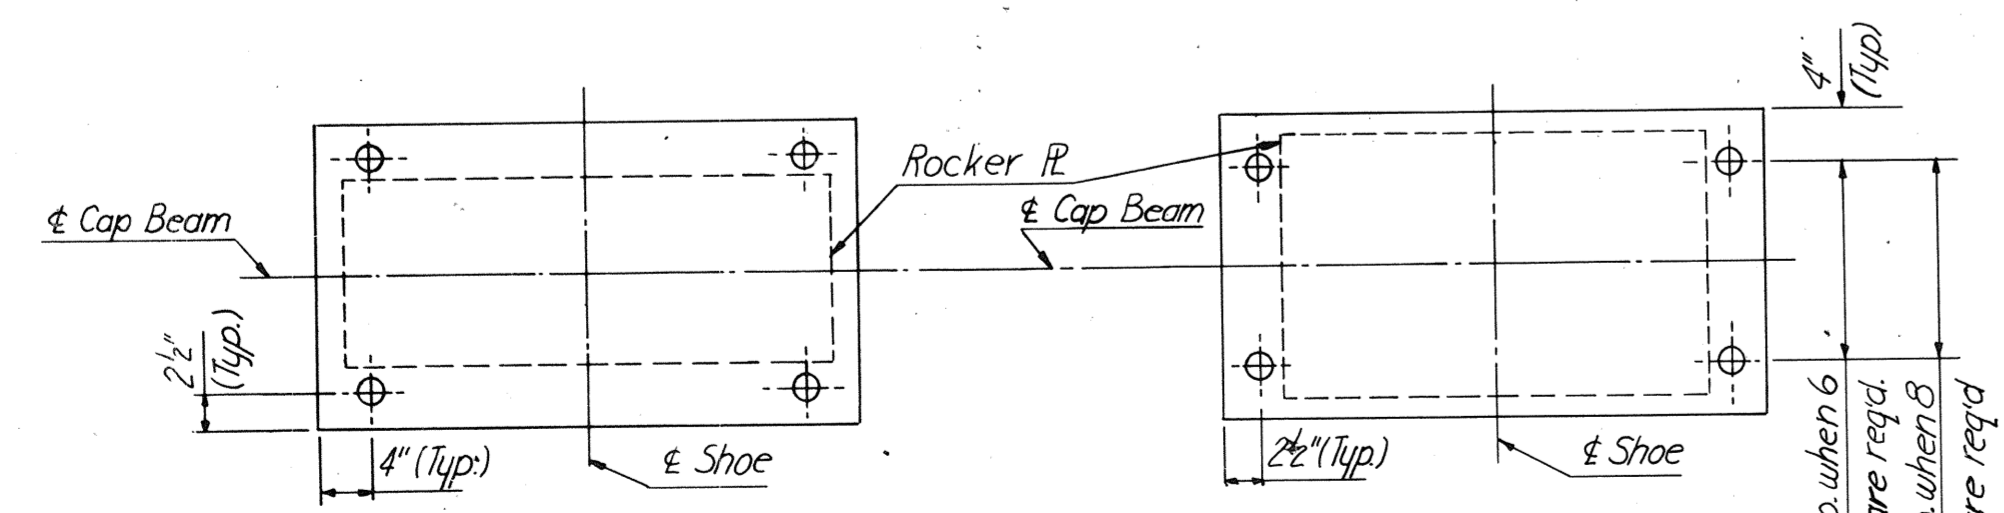

BOLT SETTING FOR SP-2 ONLY

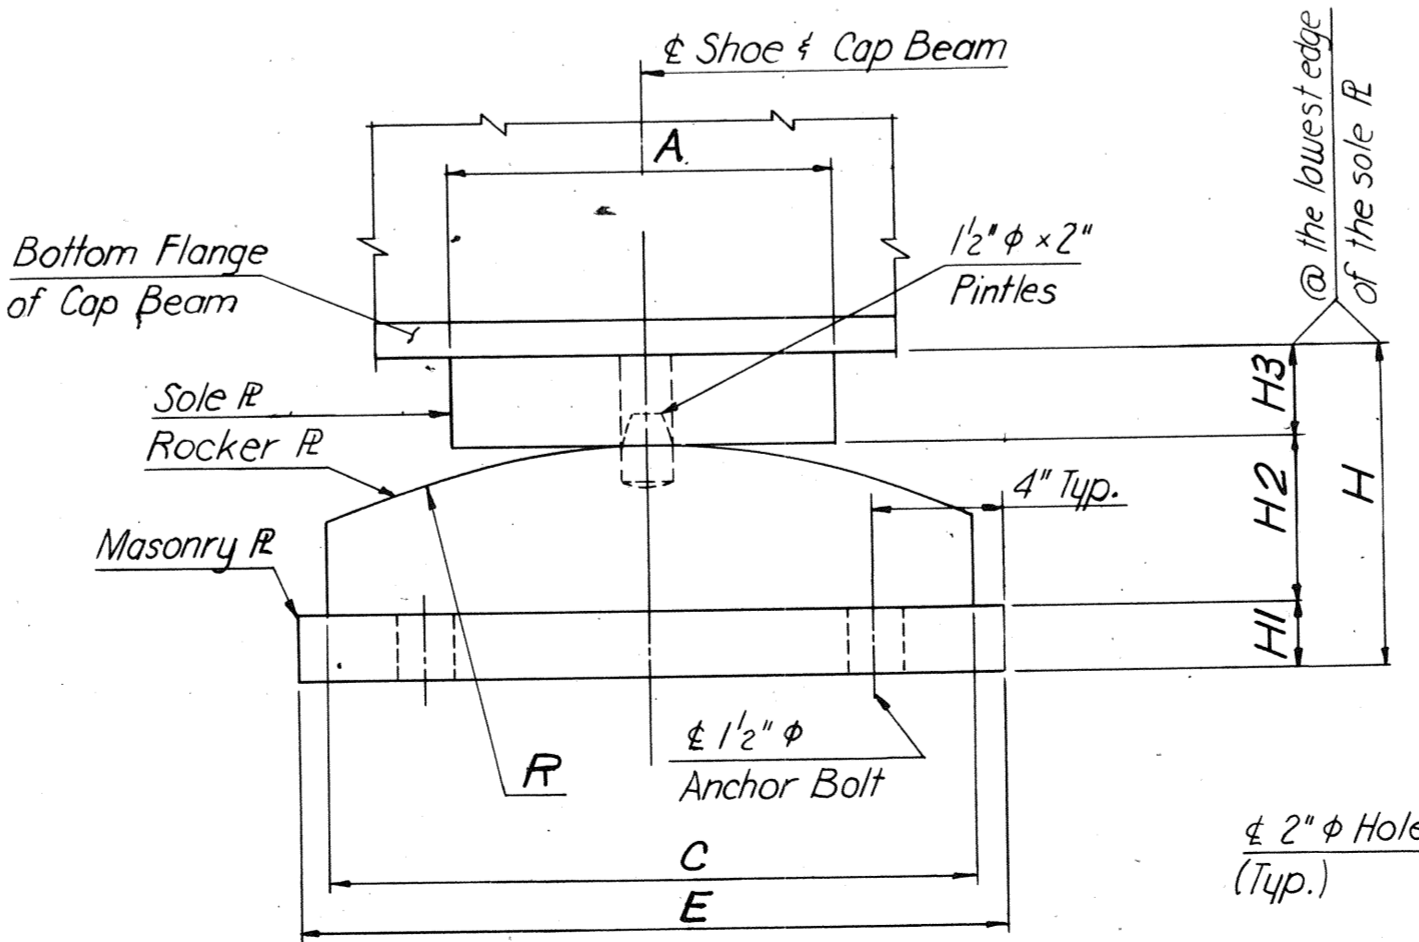

SIDE ELEVATION

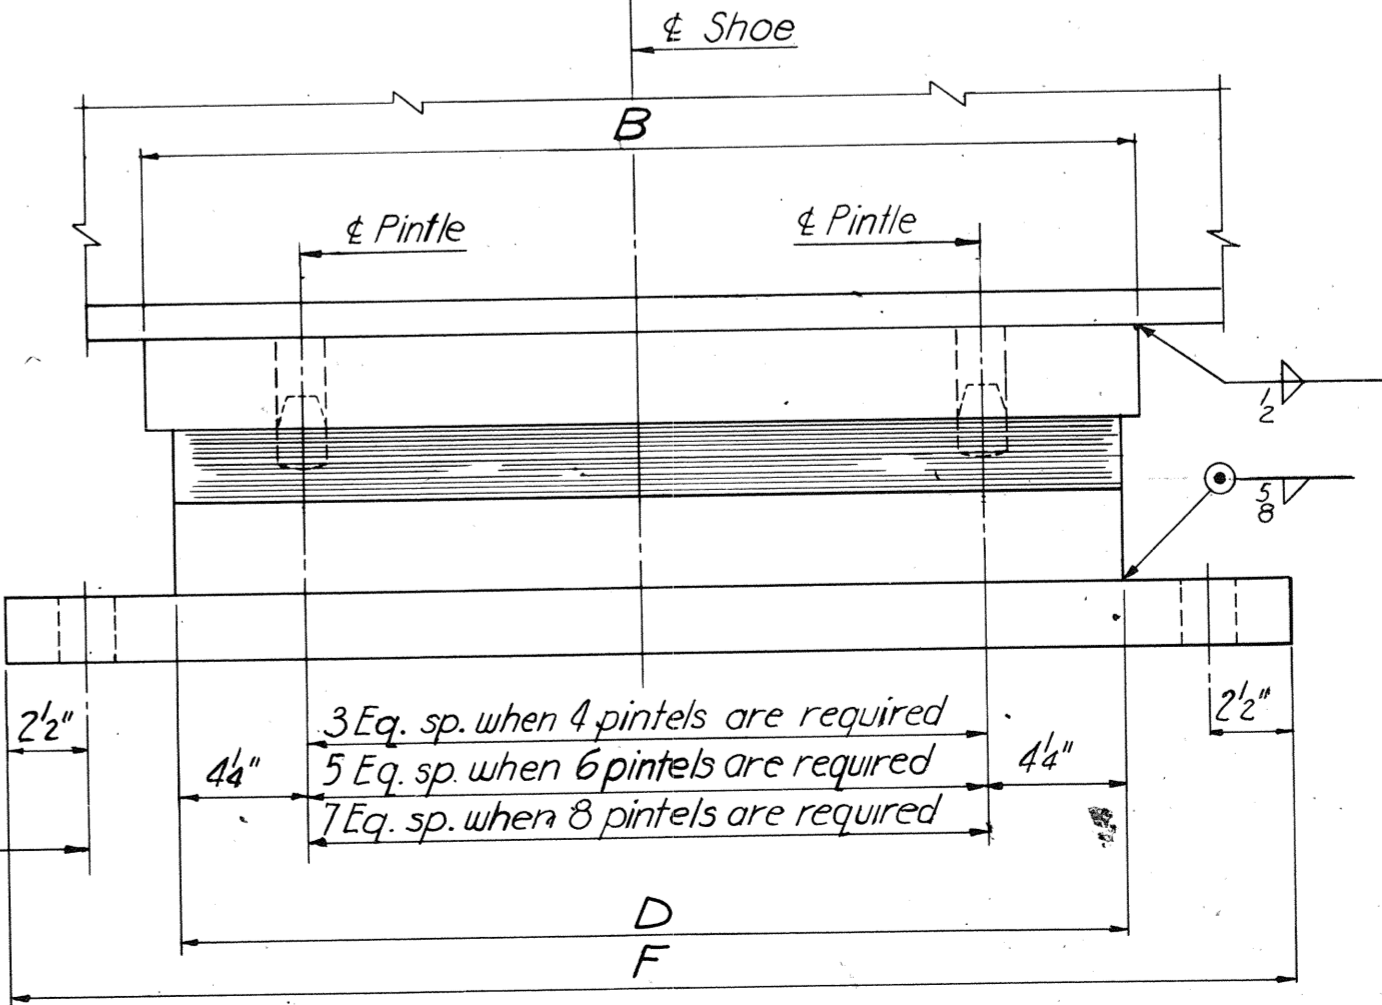

END ELEVATION

Note:
For shoe schedules, see sheet S2.
For shoe notes, see sheet S2.

RICHMOND METROPOLITAN AUTHORITY
RICHMOND EXPRESSWAY SYSTEM


STANDARD
SHOE DETAILS

BY	DATE			
MADE	HBW	7-68		
CHECKED	FGC	7-68	Dimension Changes	TEM. 5/76
IN CHARGE	FXH			

MASONRY PLATE PLAN
SP SHOE

EXPANSION SHOE DIMENSIONS								
TYPE	A	B	C	D	E	F	G	REMARKS
E1	6"	1'-1"	7 1/2"	1'-0"	8"	1'-8 1/2"	6"	
E2	6"	1'-1"	8 1/2"	1'-0"	9"	1'-8 1/2"	6 1/2"	
E3	6"	1'-1"	9"	1'-1"	9 1/2"	1'-9 1/2"	7"	
E4	6"	1'-5 1/2"	8"	1'-4 1/2"	8 1/2"	2'-1"	6"	
E4B4	6"	1'-5 1/2"	8"	1'-4 1/2"	9"	2'-1"	6"	4 Bolts in Masonry R
E5	6"	1'-5 1/2"	9"	1'-4 1/2"	9 1/2"	2'-1"	7"	
E9	6"	1'-9"	10"	1'-8"	11"	2'-4 1/2"	7 1/2"	
E15	6"	1'-5"	10"	1'-4"	11 1/2"	2'-4 1/2"	7 1/2"	R=12"
E1M	6"	1'-1"	7 1/2"	1'-0"	8"	1'-1"	6"	
E1K	6"	1'-1"	7 1/2"	1'-0"	8"	1'-8 1/2"	6"	
E6	6"	1'-7"	8"	1'-6"	8 1/2"	2'-2 1/2"	6"	

SHOE SCHEDULE							
TYPE	EXPANSION SHOES			FIXED SHOES			
	BRIDGE B-65	BRIDGE B-68	TOTAL	TYPE	BRIDGE B-65	BRIDGE B-68	TOTAL
E1	10	12	22	F1		8	8
E2	2	7	9	F1M	16	19	35
E3		4	4	F2	32	8	40
E4	26	3	29	F2M	4	6	10
E4B4	6	12	18	F2B4	6		6
E5	12		12	F3	8	4	12
E9	8		8	F7	8		8
E15	4		4	SP-1		4	4
E1M	4	3	7				
E1K	1		1				
E6	1		1				

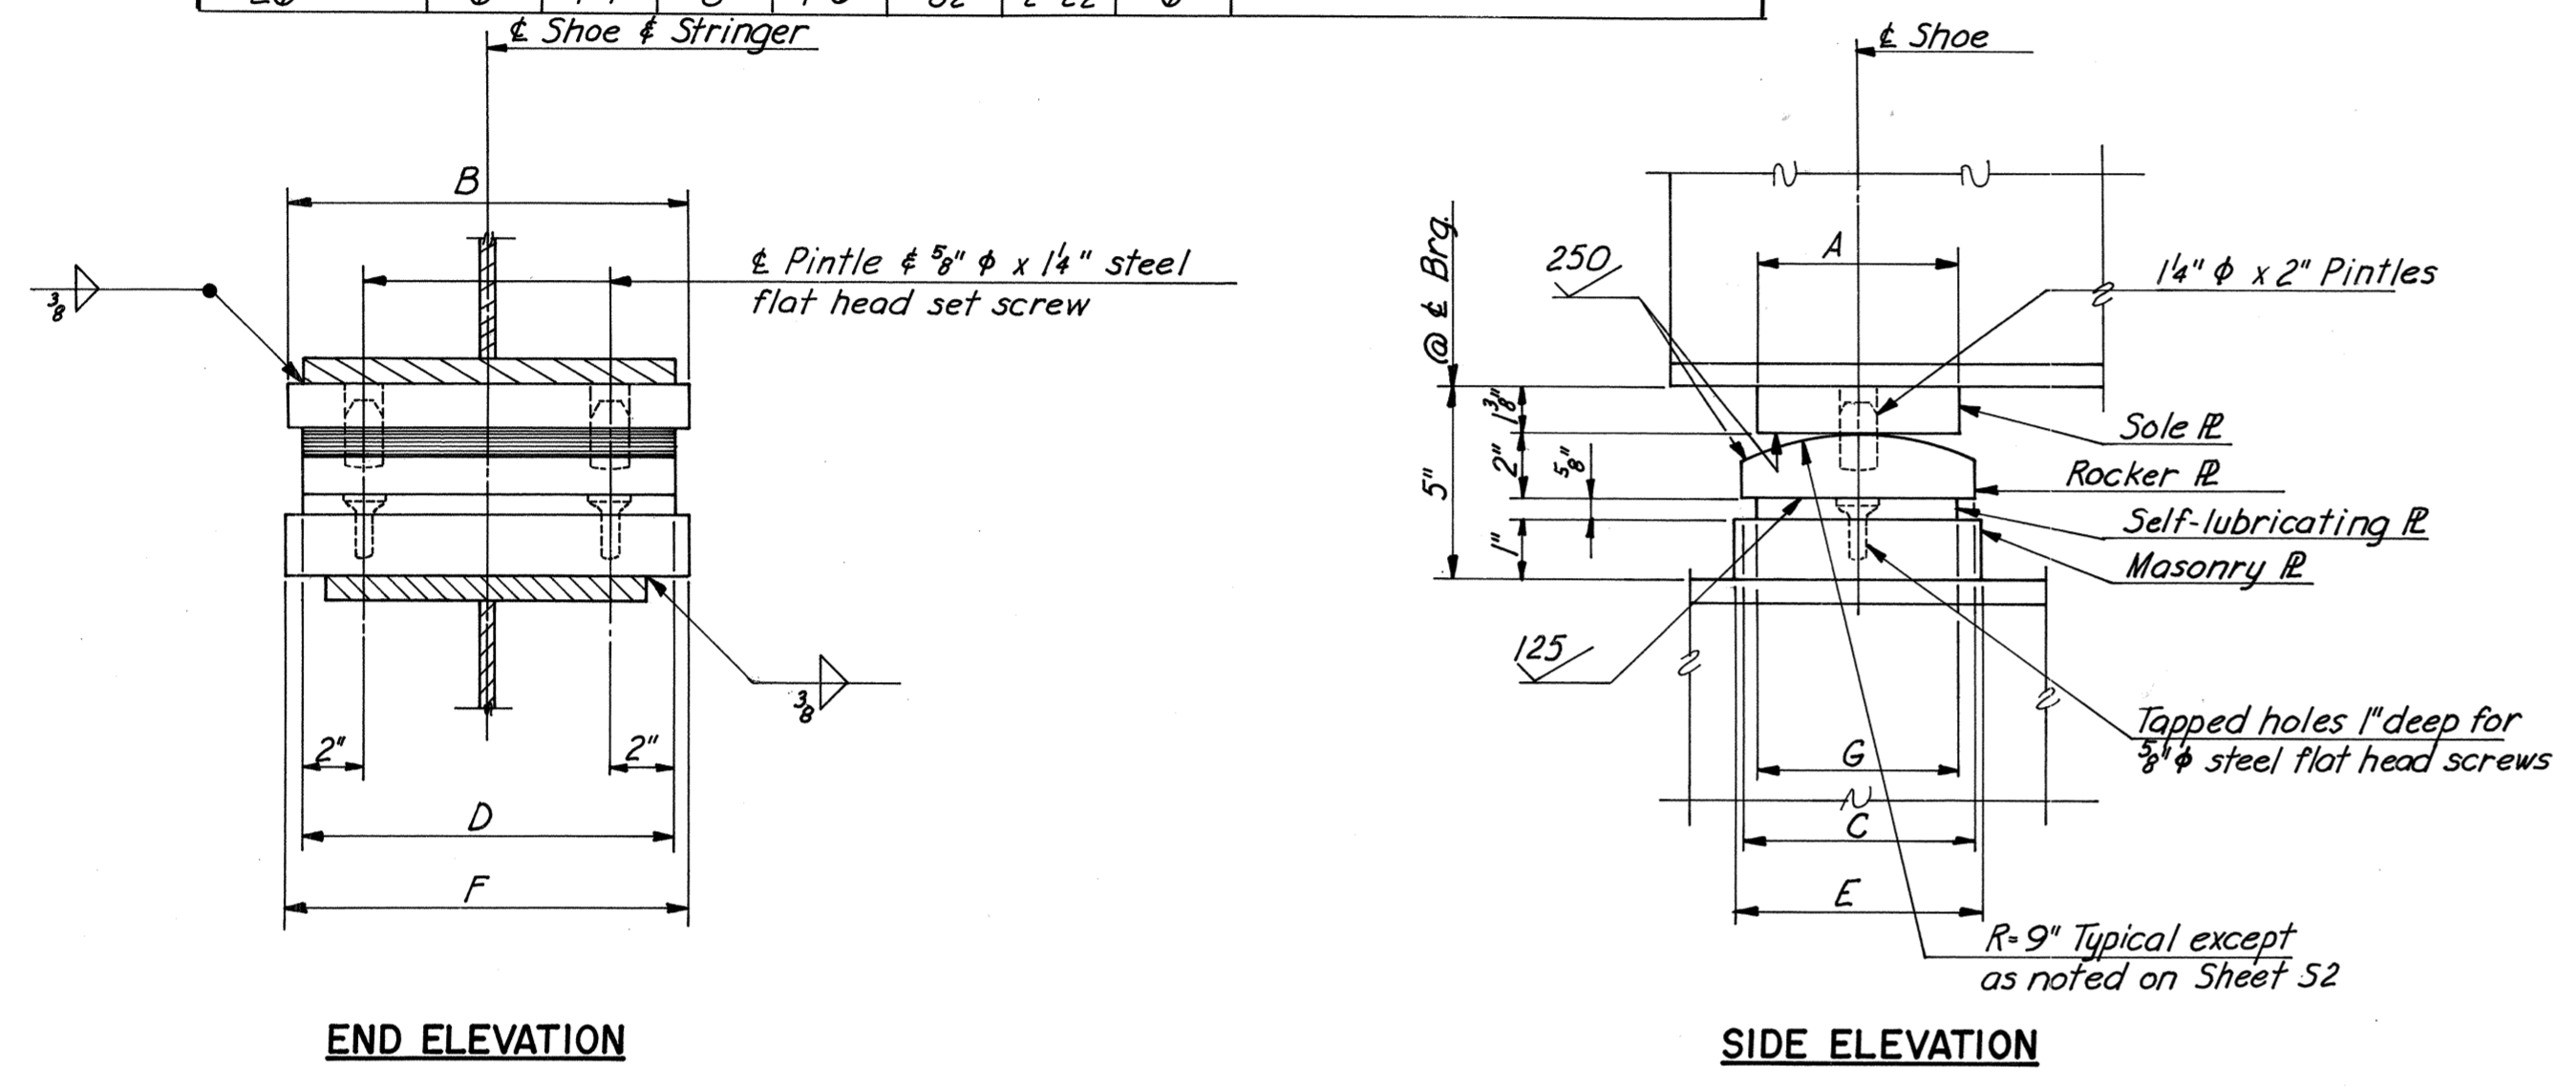


EXPANSION SHOE E1M


Shoe Notes:
 Material for shoes (exclusive of self-lubricating plates) shall be high strength, low alloy structural steel conforming to ASTM specification A-588.
 Top of masonry plates, bottom of rocker plates and top and bottom of sole plates shall be planed, straightened or otherwise treated to secure true level surfaces.
 Contact surfaces noted on the plans with finish symbols shall be finished in accordance with the American Standards Association surface roughness requirement as defined in ASA B46.1-55, Surface Roughness, Waviness and Lay, Part I.
 The plates comprising the expansion shoes shall be set so as to be truly centered under full dead load at a temperature of 60°F.
 Concrete pads shall be formed integral with abutment or pier and not less than 6" or more than 4" above finished elevation. Dress down pads by rubbing, grinding or as otherwise approved by the Engineer, to true level surfaces of the finished elevation.
 Anchor bolt assemblies shall conform to ASTM A-307-66 and shall be hot-dip galvanized conforming to A.S.T.M. A-153-66.
 Templates shall be used to accurately set the anchor bolts.

FIXED SHOE DIMENSIONS								
TYPE	A	B	C	D	E	F	G	REMARKS
F1	6"	1'-1"	6"	1'-0"	7 1/2"	1'-9"	1 1/4"	
F1M	6"	1'-1"	6"	1'-0"	7 1/2"	1'-9"	1 1/4"	
F2	6"	1'-5 1/2"	6"	1'-4 1/2"	7"	2'-2"	1 1/4"	
F2M	6"	1'-5 1/2"	6"	1'-4 1/2"	7"	2'-2"	1 1/4"	
F2B4	6"	1'-5 1/2"	6"	1'-4 1/2"	9"	2'-2"	1 1/4"	
F3	6"	1'-5 1/2"	6"	1'-4 1/2"	8"	2'-2"	1 1/4"	
F7	6"	1'-9"	6"	1'-8"	8"	2'-6"	1 1/2"	

SPECIAL SHOE DIMENSIONS												
TYPE	A	B	C	D	E	F	H1	H2	H3	H	R	NO. OF BOLTS OR PINTLES
SP-1	1'-0"	1'-11"	1'-6"	1'-11"	1'-8"	2'-8"	2"	4 1/2"	3"	9 1/2"	1'-6"	4

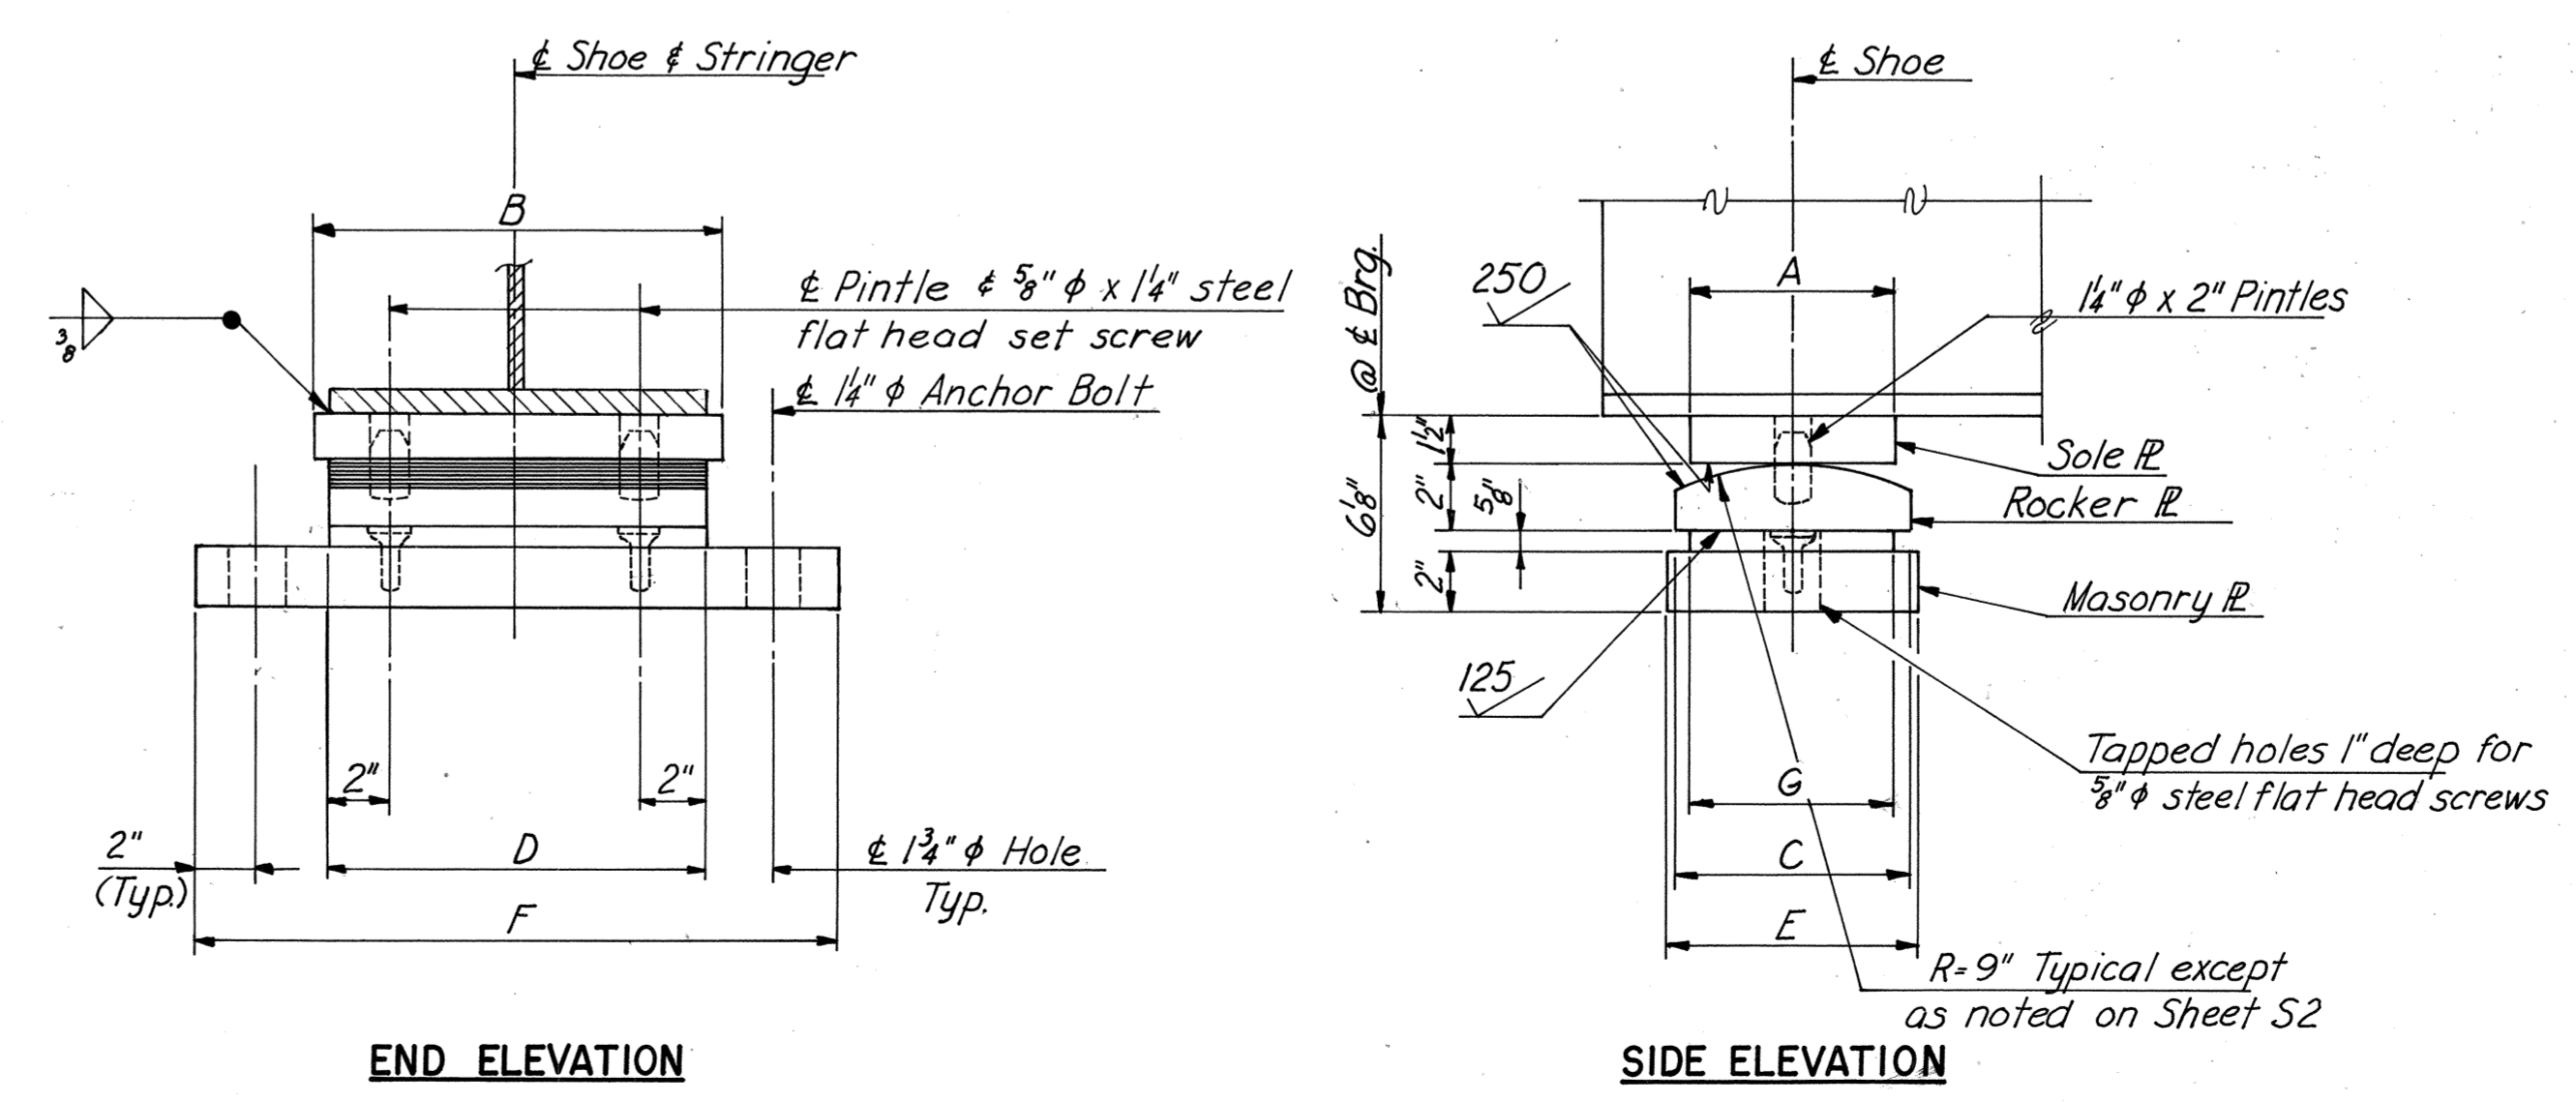

EXPANSION SHOE E1K

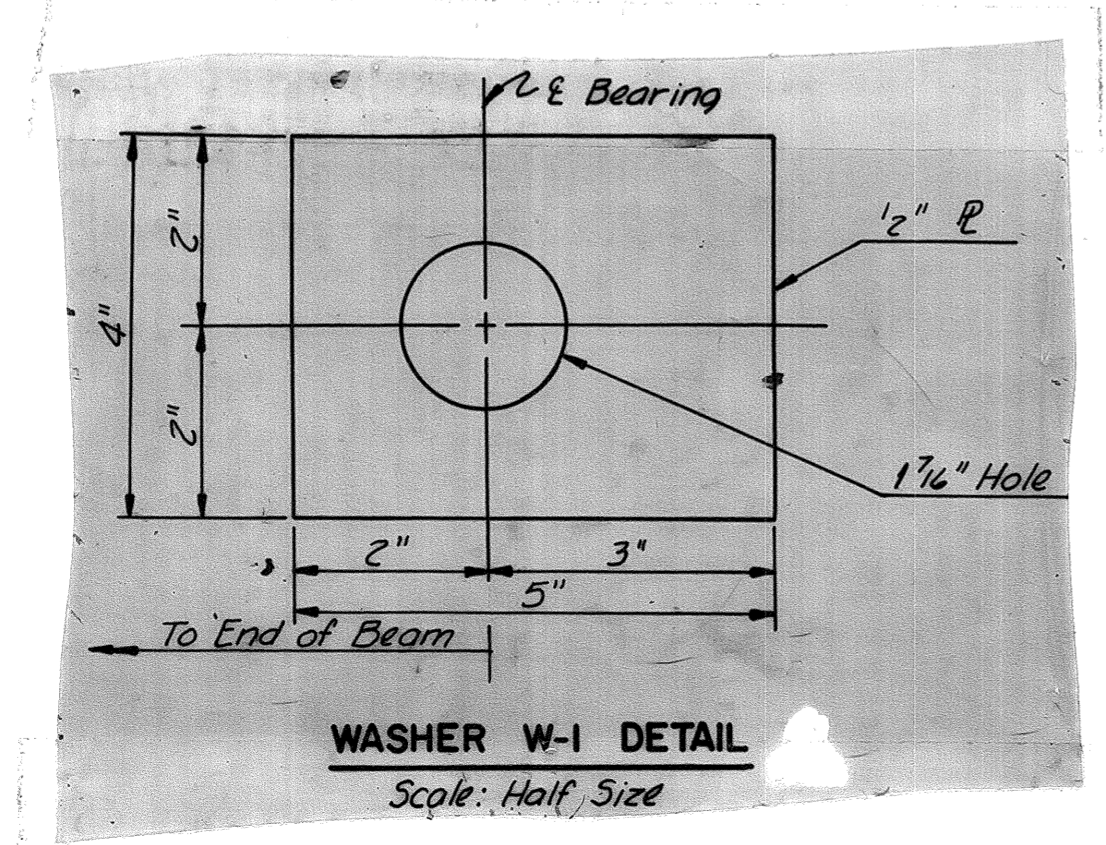

RICHMOND METROPOLITAN AUTHORITY
RICHMOND EXPRESSWAY SYSTEM
 DOWNTOWN EXPRESSWAY

STANDARD SHOE DETAILS


SCALE As shown
 CONTRACT 11 SHEET S2 OF 6

HOWARD, NEEDLES, TAMMEN & BERGENDOFF
 CONSULTING ENGINEERS
 Alexandria, Virginia


HNTB

DESIGNED		Shoe Type E6 added	T.E.M.	7-76
DRAWN		Dim. E Shoes E4B4 & F2B4	TEM	5-76
CHECKED		Shoe Schedule B65	TEM	4-76
		Shoe SP-1	T.E.M.	3-76
		Shoe Schedule rev.	T.E.M.	8-25-75
IN CHARGE	NO.	REVISION	BY	DATE


RICHMOND EXPRESSWAY SYSTEM			
SECTION	PROJECT	SHEET NO.	TOTAL SHEETS
11	DOWNTOWN EXPRESSWAY	94	97

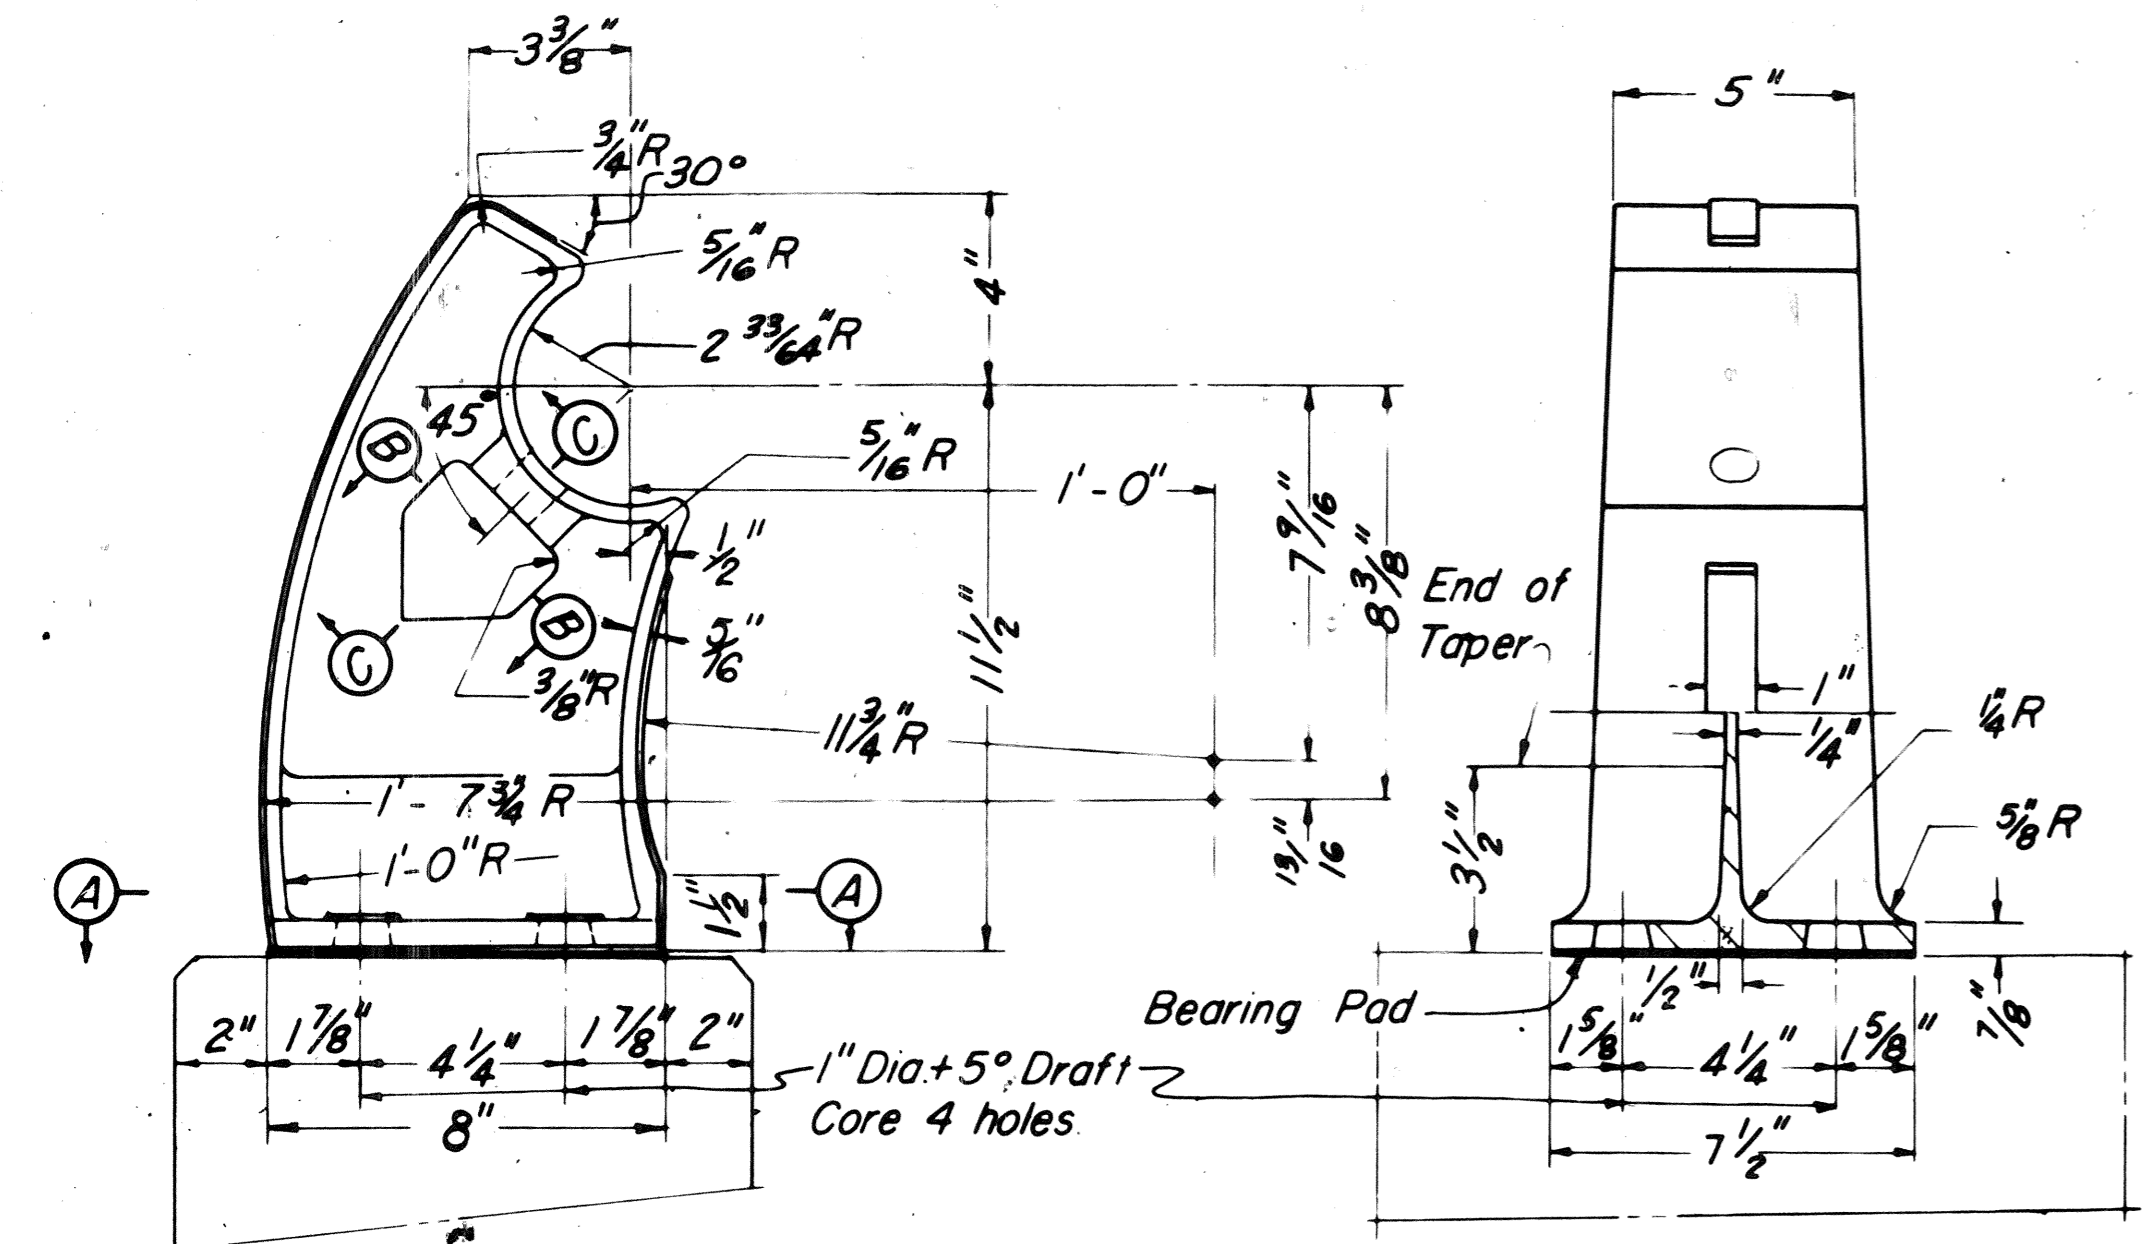


SIDE ELEVATION
Scale: 3"=1'-0"

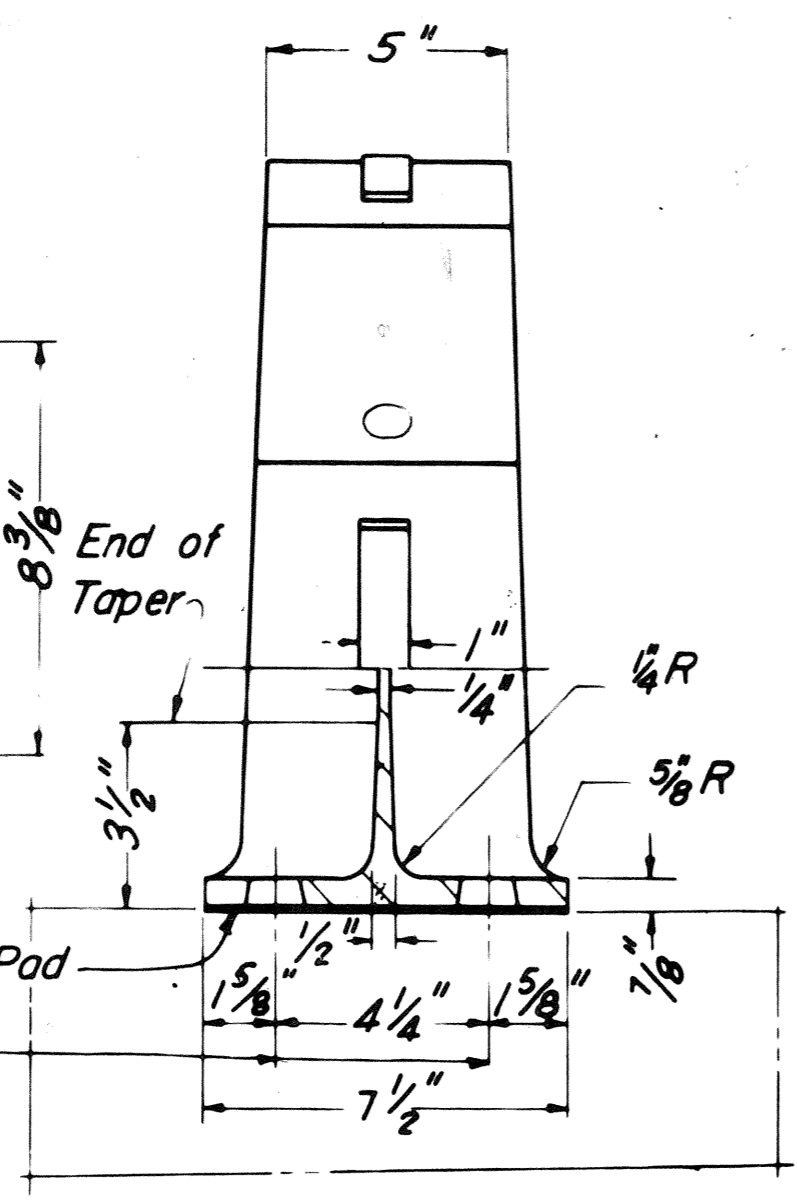


FRONT ELEVATION
Scale: 3"=1'-0"

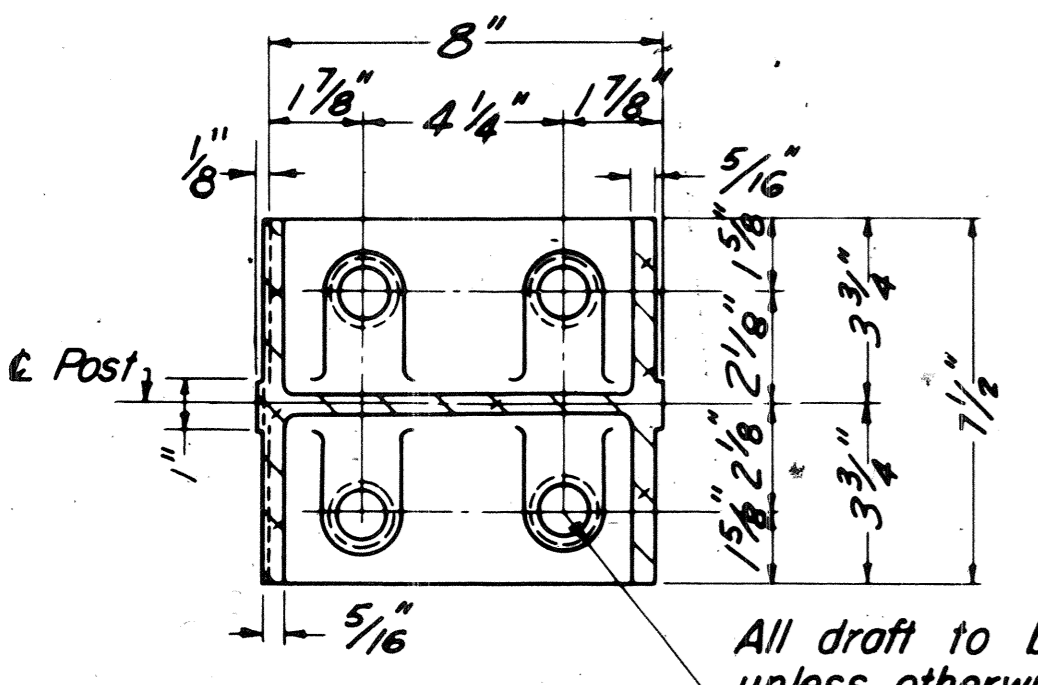


SECTION A-A
Scale: 3"=1'-0"

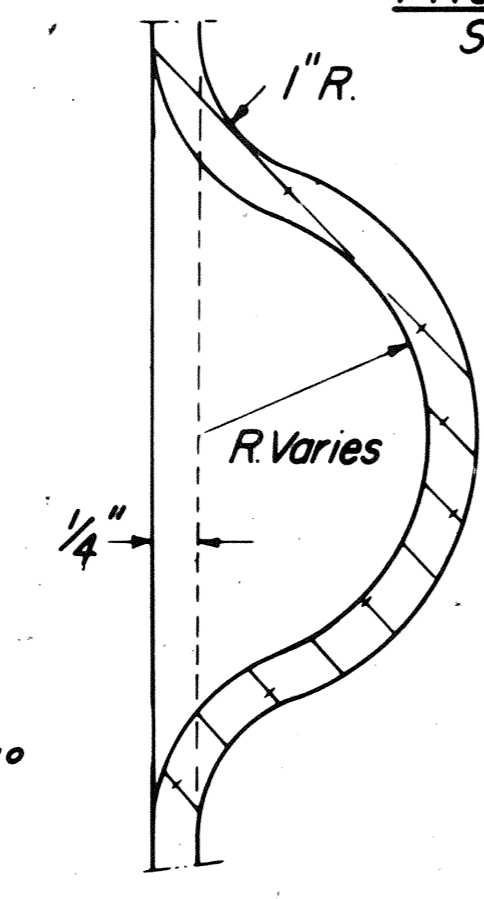

SECTION B-B

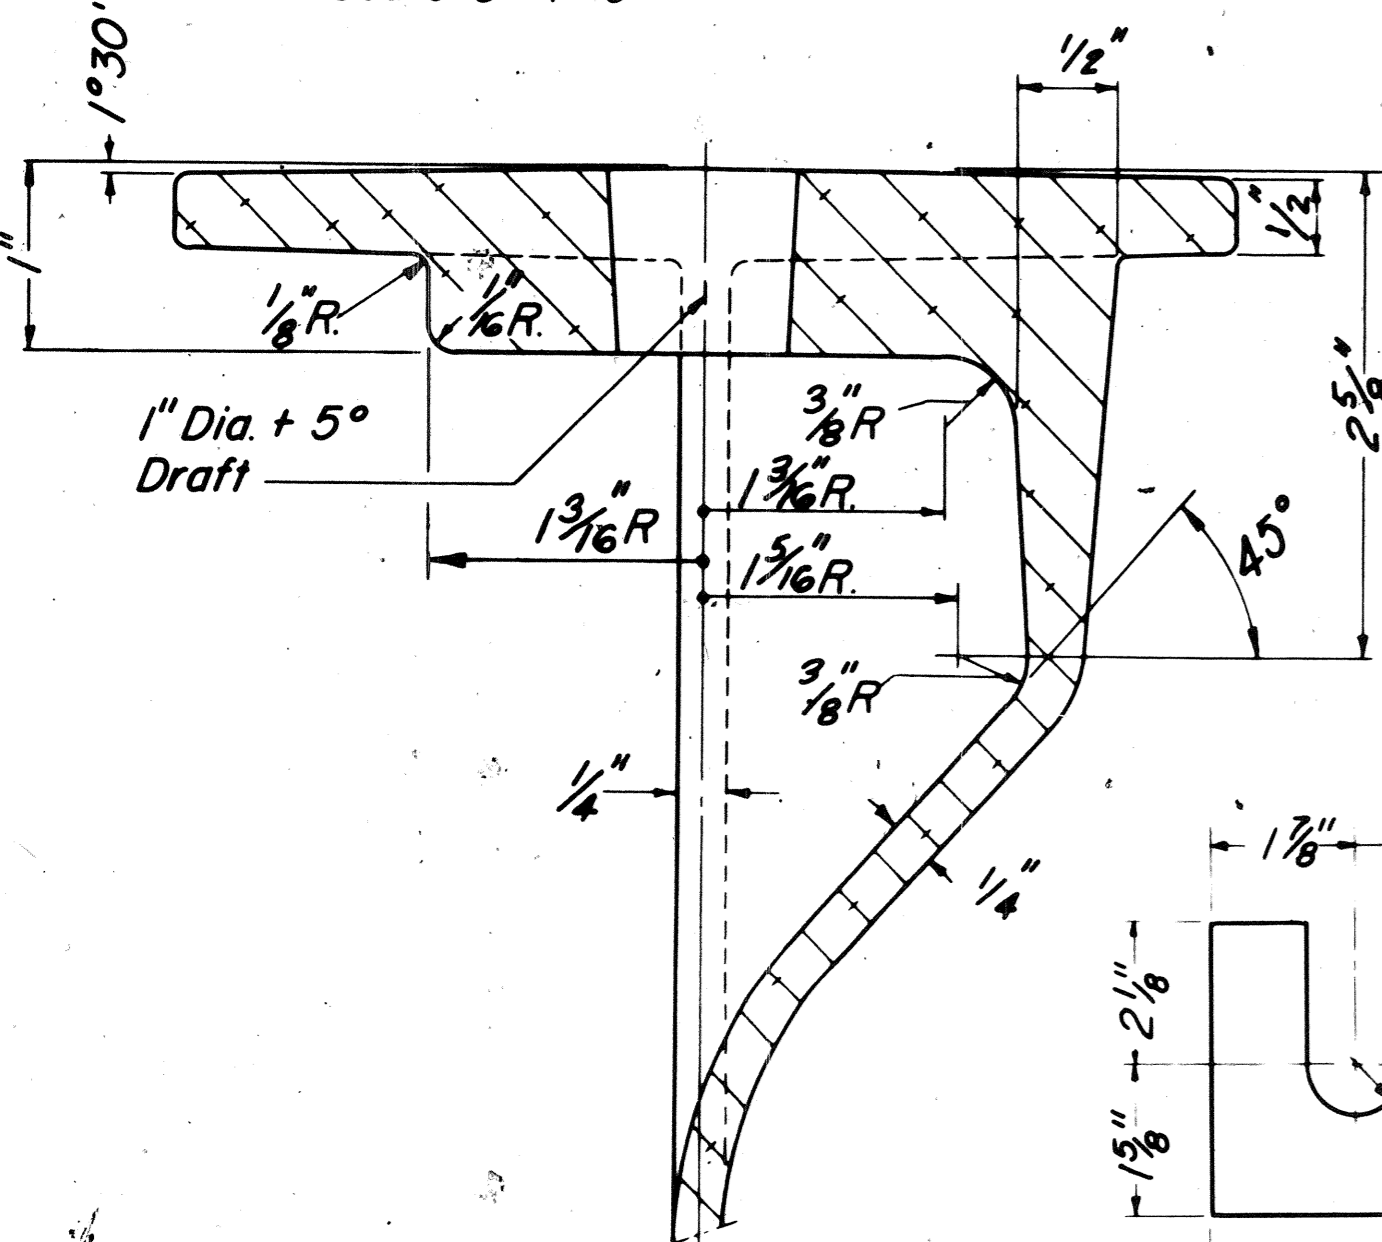


SECTION C-C
Scale: 1"=1"

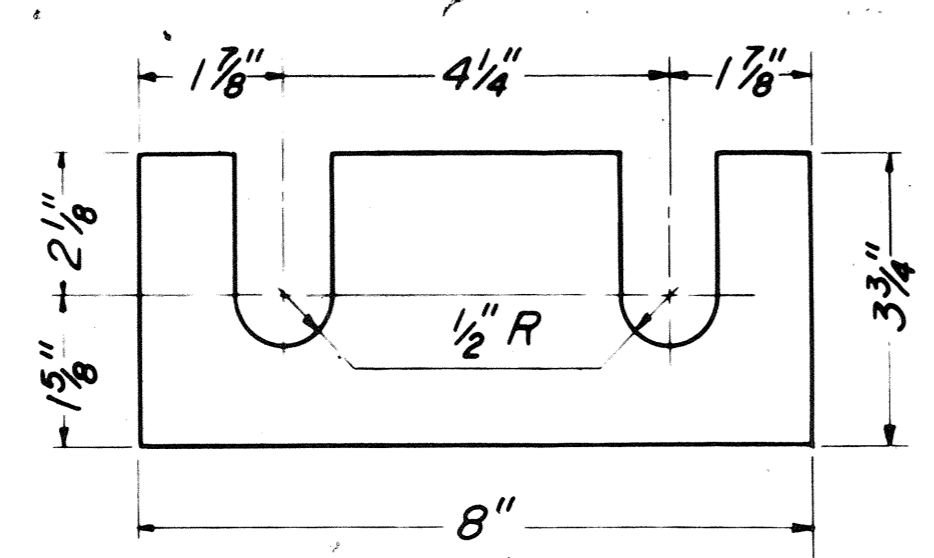


SHIM DETAIL

Shims to be made from 1/16 or 1/8 material. Shims shall not project outside of post base.

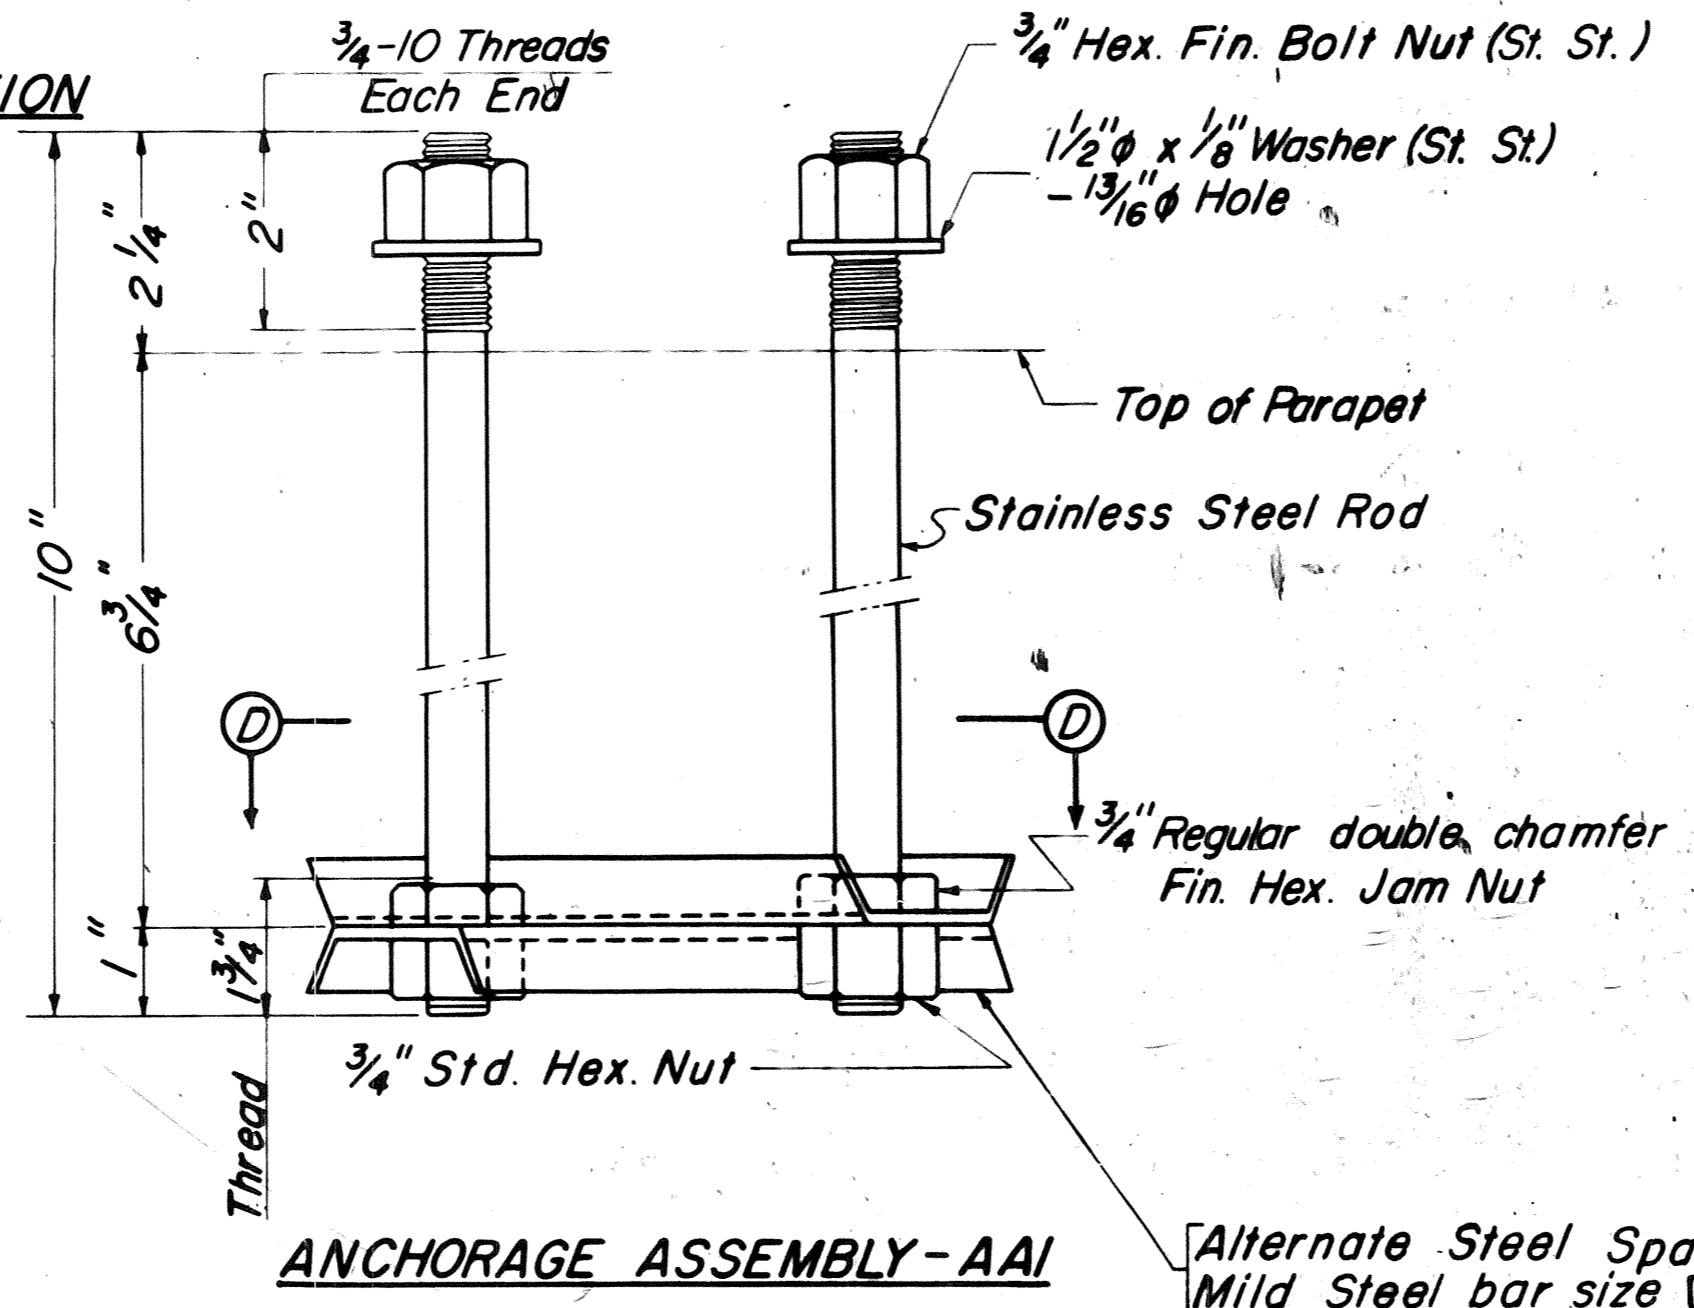


ANCHORAGE ASSEMBLY-AAI

- AAI - Steel Spacer - ASTM A425, or A36 (As shown)
- Nuts (Top) - ASTM A276, Type 304
- Top Washers - Stainless Steel
- Rods - ASTM A-276, Type 304 Annealed, Hot-finished
- Nuts (Bottom) - ASTM A307
- Threads on all rods may be rolled or cut.

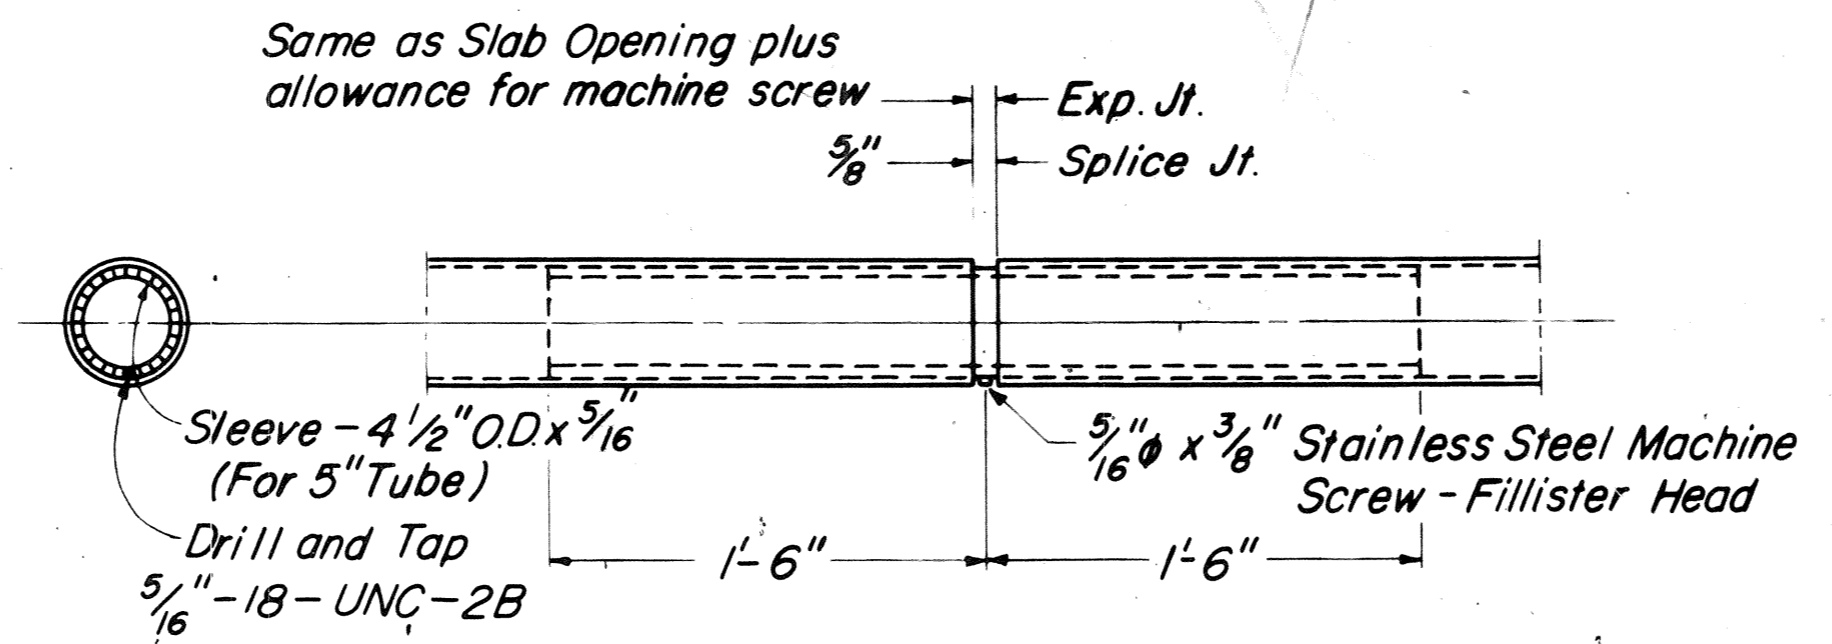


RAIL SPLICE & EXP. JOINT

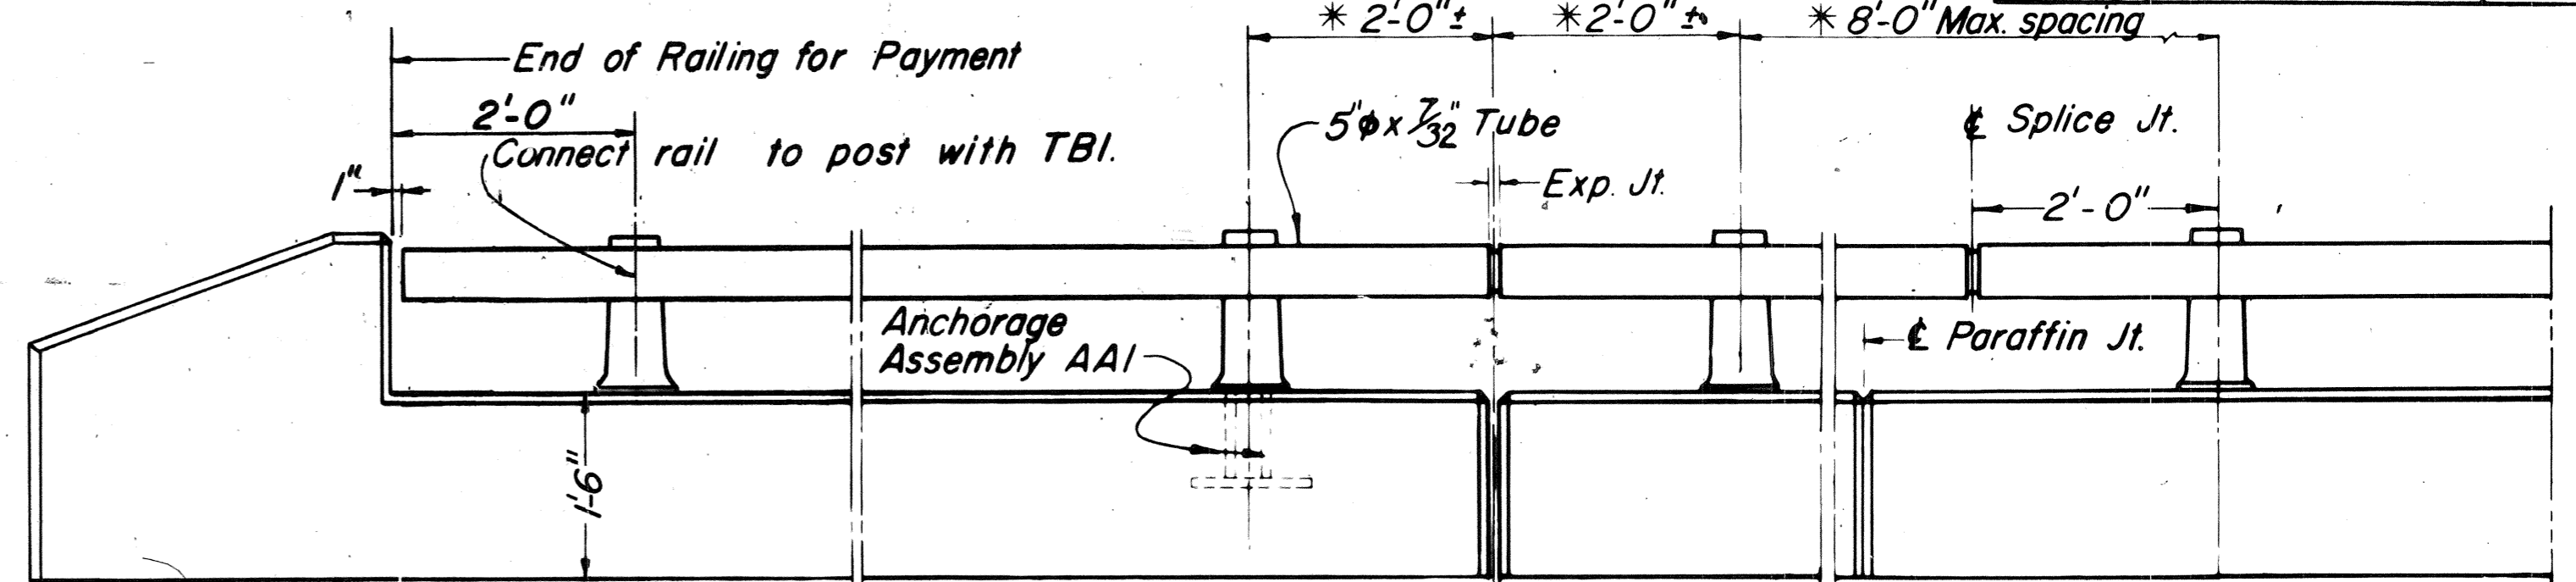


ELEVATION
Scale: 3/4"=1'-0"

2" Open joint in parapet @ Pier or front face of Abutment Backwall

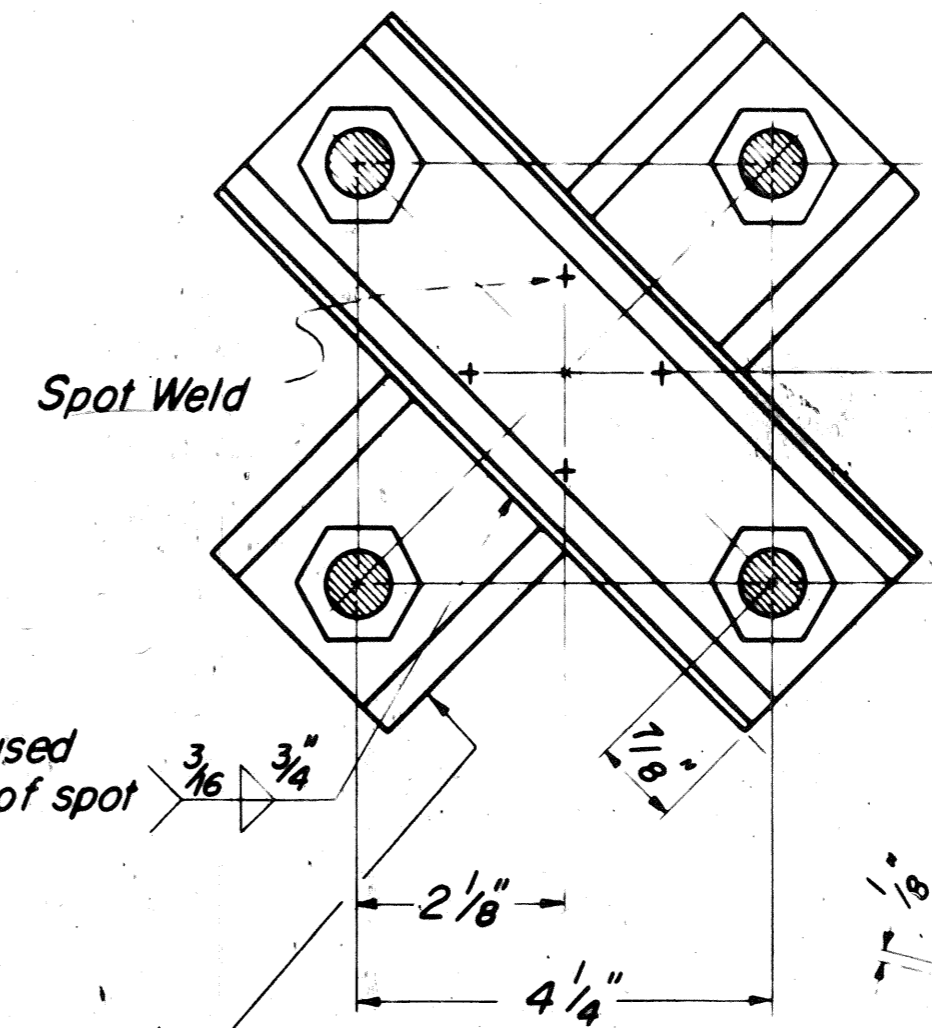


SECTION D-D

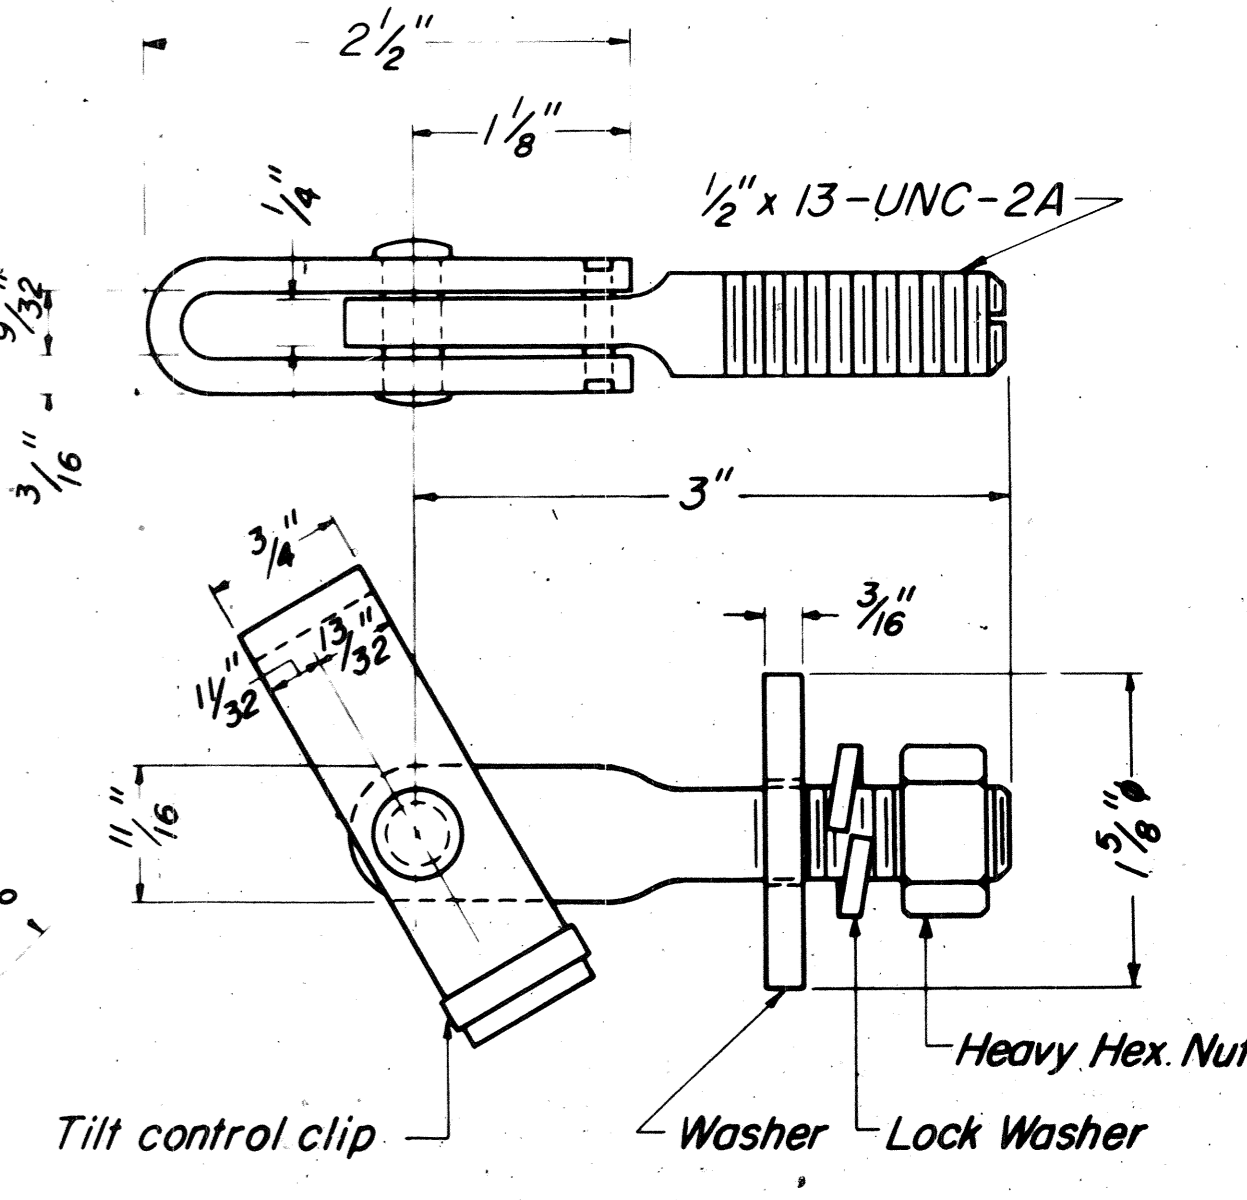

TOGGLE BOLT ASSEMBLY-TBI
TRAFFIC RAIL

Material for toggle bolt assembly TBI shall be carbon or stainless steel having a minimum elongation of 12%. Any non stainless component to be either galvanized to ASTM-A153 or cadmium plated to ASTM-A165, Type NS. Required minimum tensile load to equal 9000 lbs. when in an open position and tested thru a 1 inch hole.

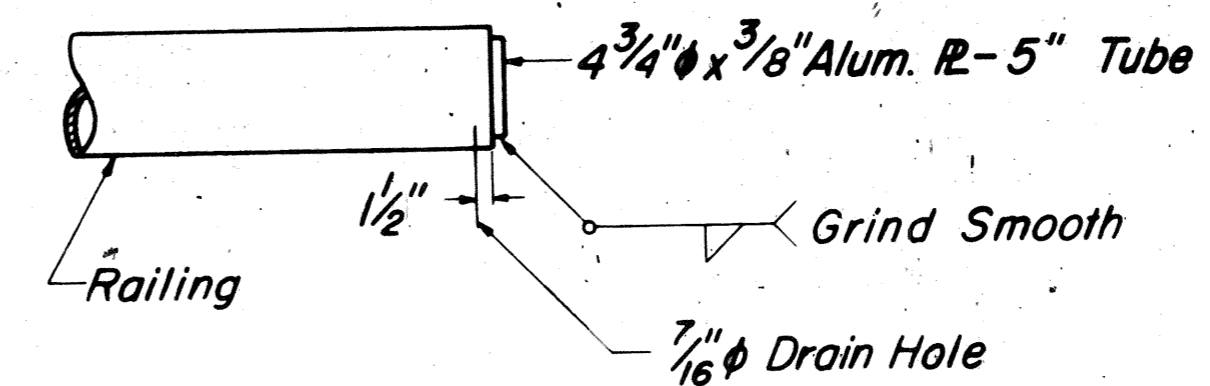

RAIL END CAP

NOTES:

- Posts shall be seated on neoprene bearing pads 1/16 minimum thickness, having a nominal durometer hardness of 70. Pads shall conform to post base dimensions.
- Aluminum shims may be used for adjusting post alignment, maximum thickness of shim build-up not to exceed 1/8.
- Where more tilting of the post is required, the concrete area shall be ground down.
- Posts shall be cast aluminum.
- Rail members shall be aluminum extruded tube.
- Anchor bolts may be set normal to profile grade.
- Bi-metallic anchor rods may be used as an alternate for the stainless steel rods. See Special Provisions.


RICHMOND METROPOLITAN AUTHORITY
RICHMOND EXPRESSWAY SYSTEM
DOWNTOWN EXPRESSWAY

STANDARD ALUMINUM RAILING DETAILS
(1 RAIL)


HOWARD NEEDLES TAMMEN & BERGENDOFF
consulting engineers
NEW YORK ALEXANDRIA KANSAS CITY
SCALE AS SHOWN
CONTRACT NO 11
SHEET NO 53 OF 6

MADE	BY	DATE	NO.	REVISION	BY	DATE
	ABP	8-67				
	AVS	8-67				
	PRY					


RICHMOND EXPRESSWAY SYSTEM			
SECTION	PROJECT	SHEET NO.	TOTAL SHEETS
11	DOWNTOWN EXPRESSWAY	95	97

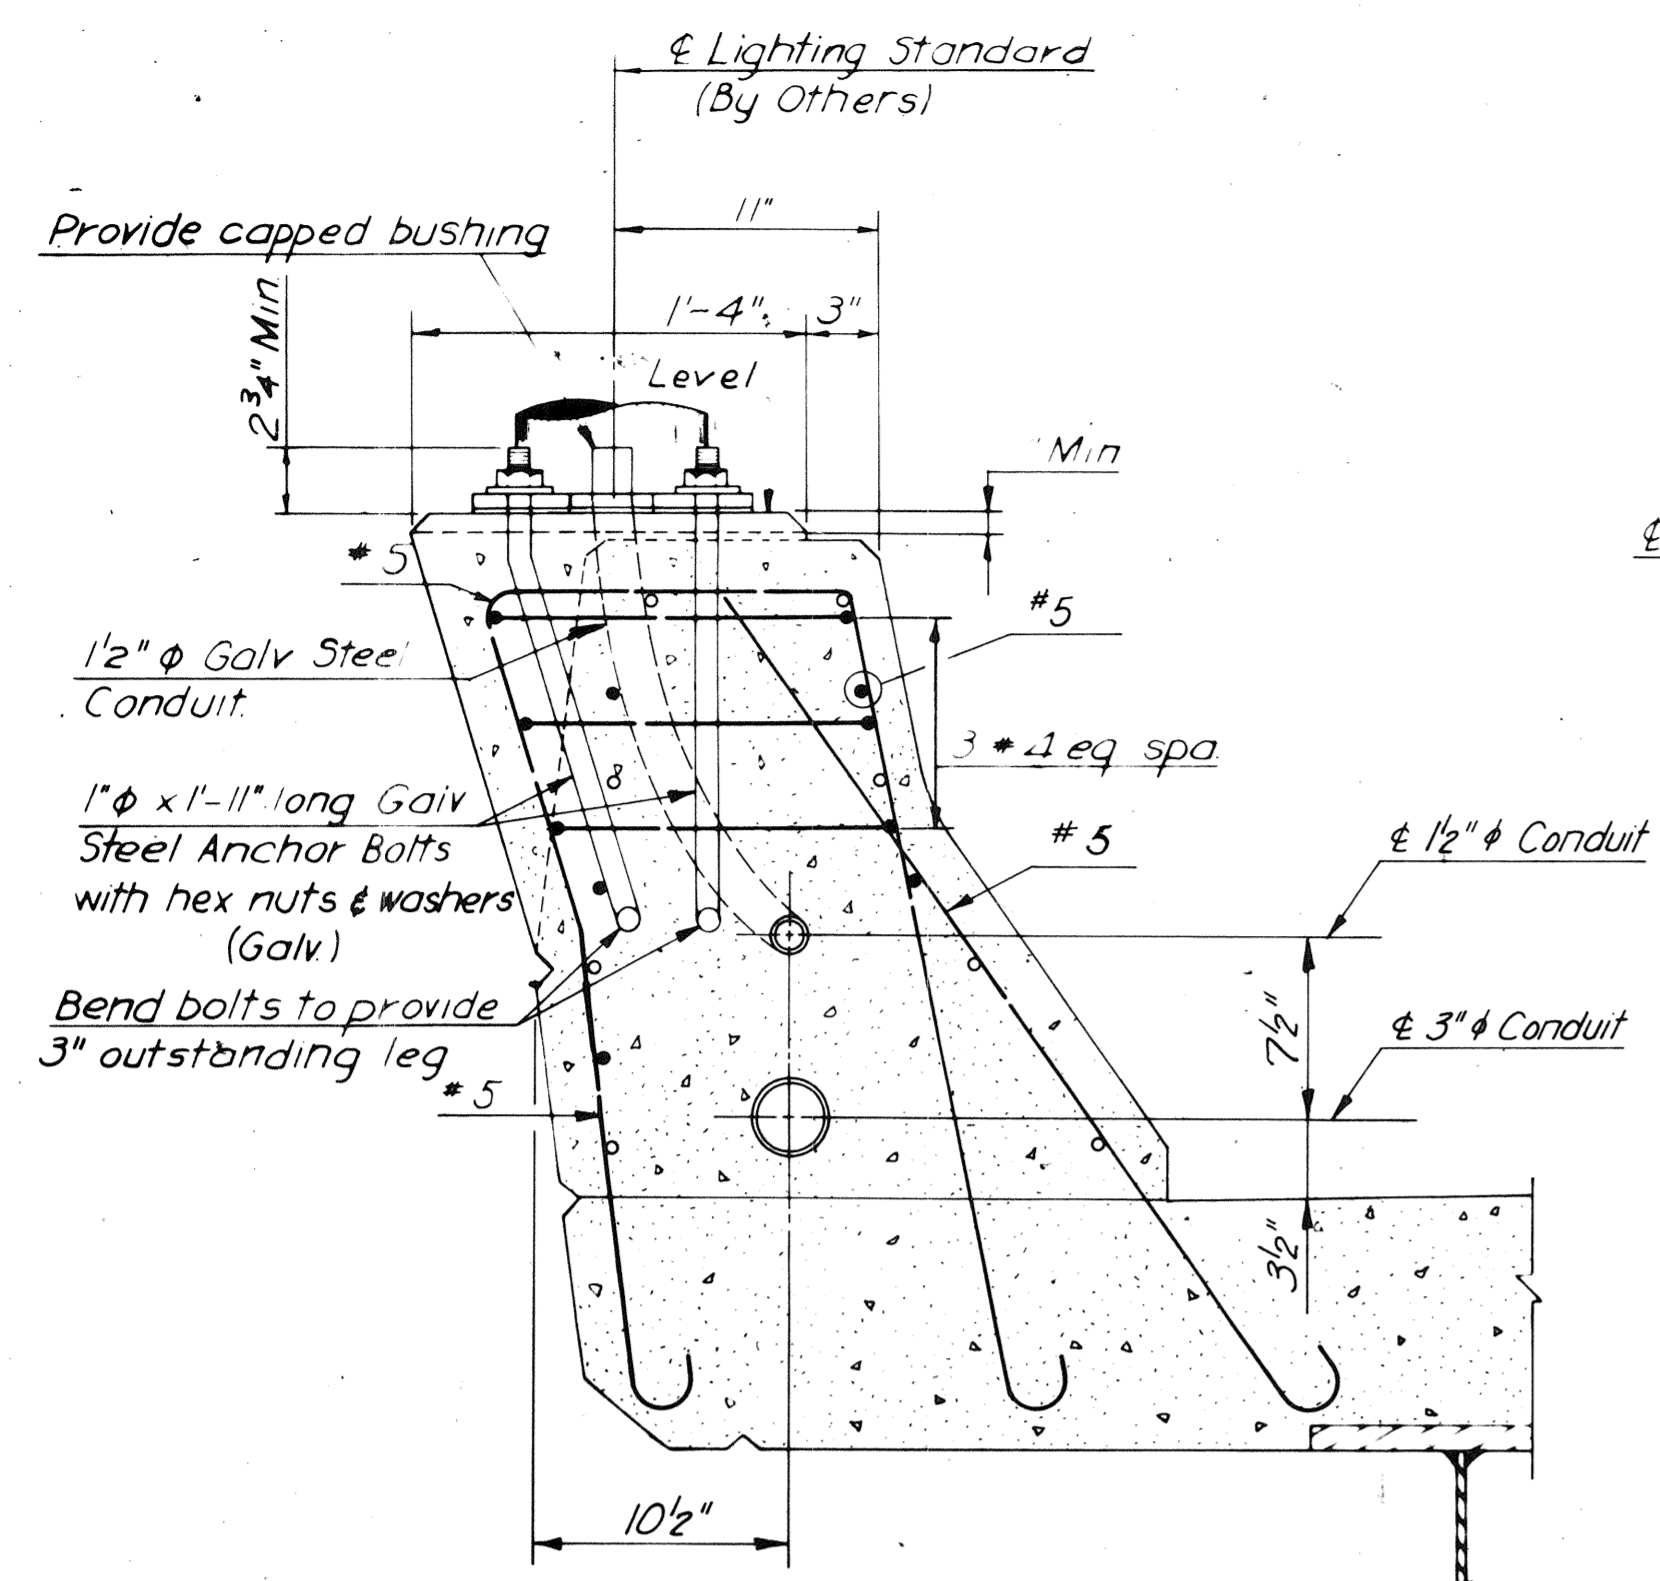


SECTION A-A
Scale 1/2"=1'-0"

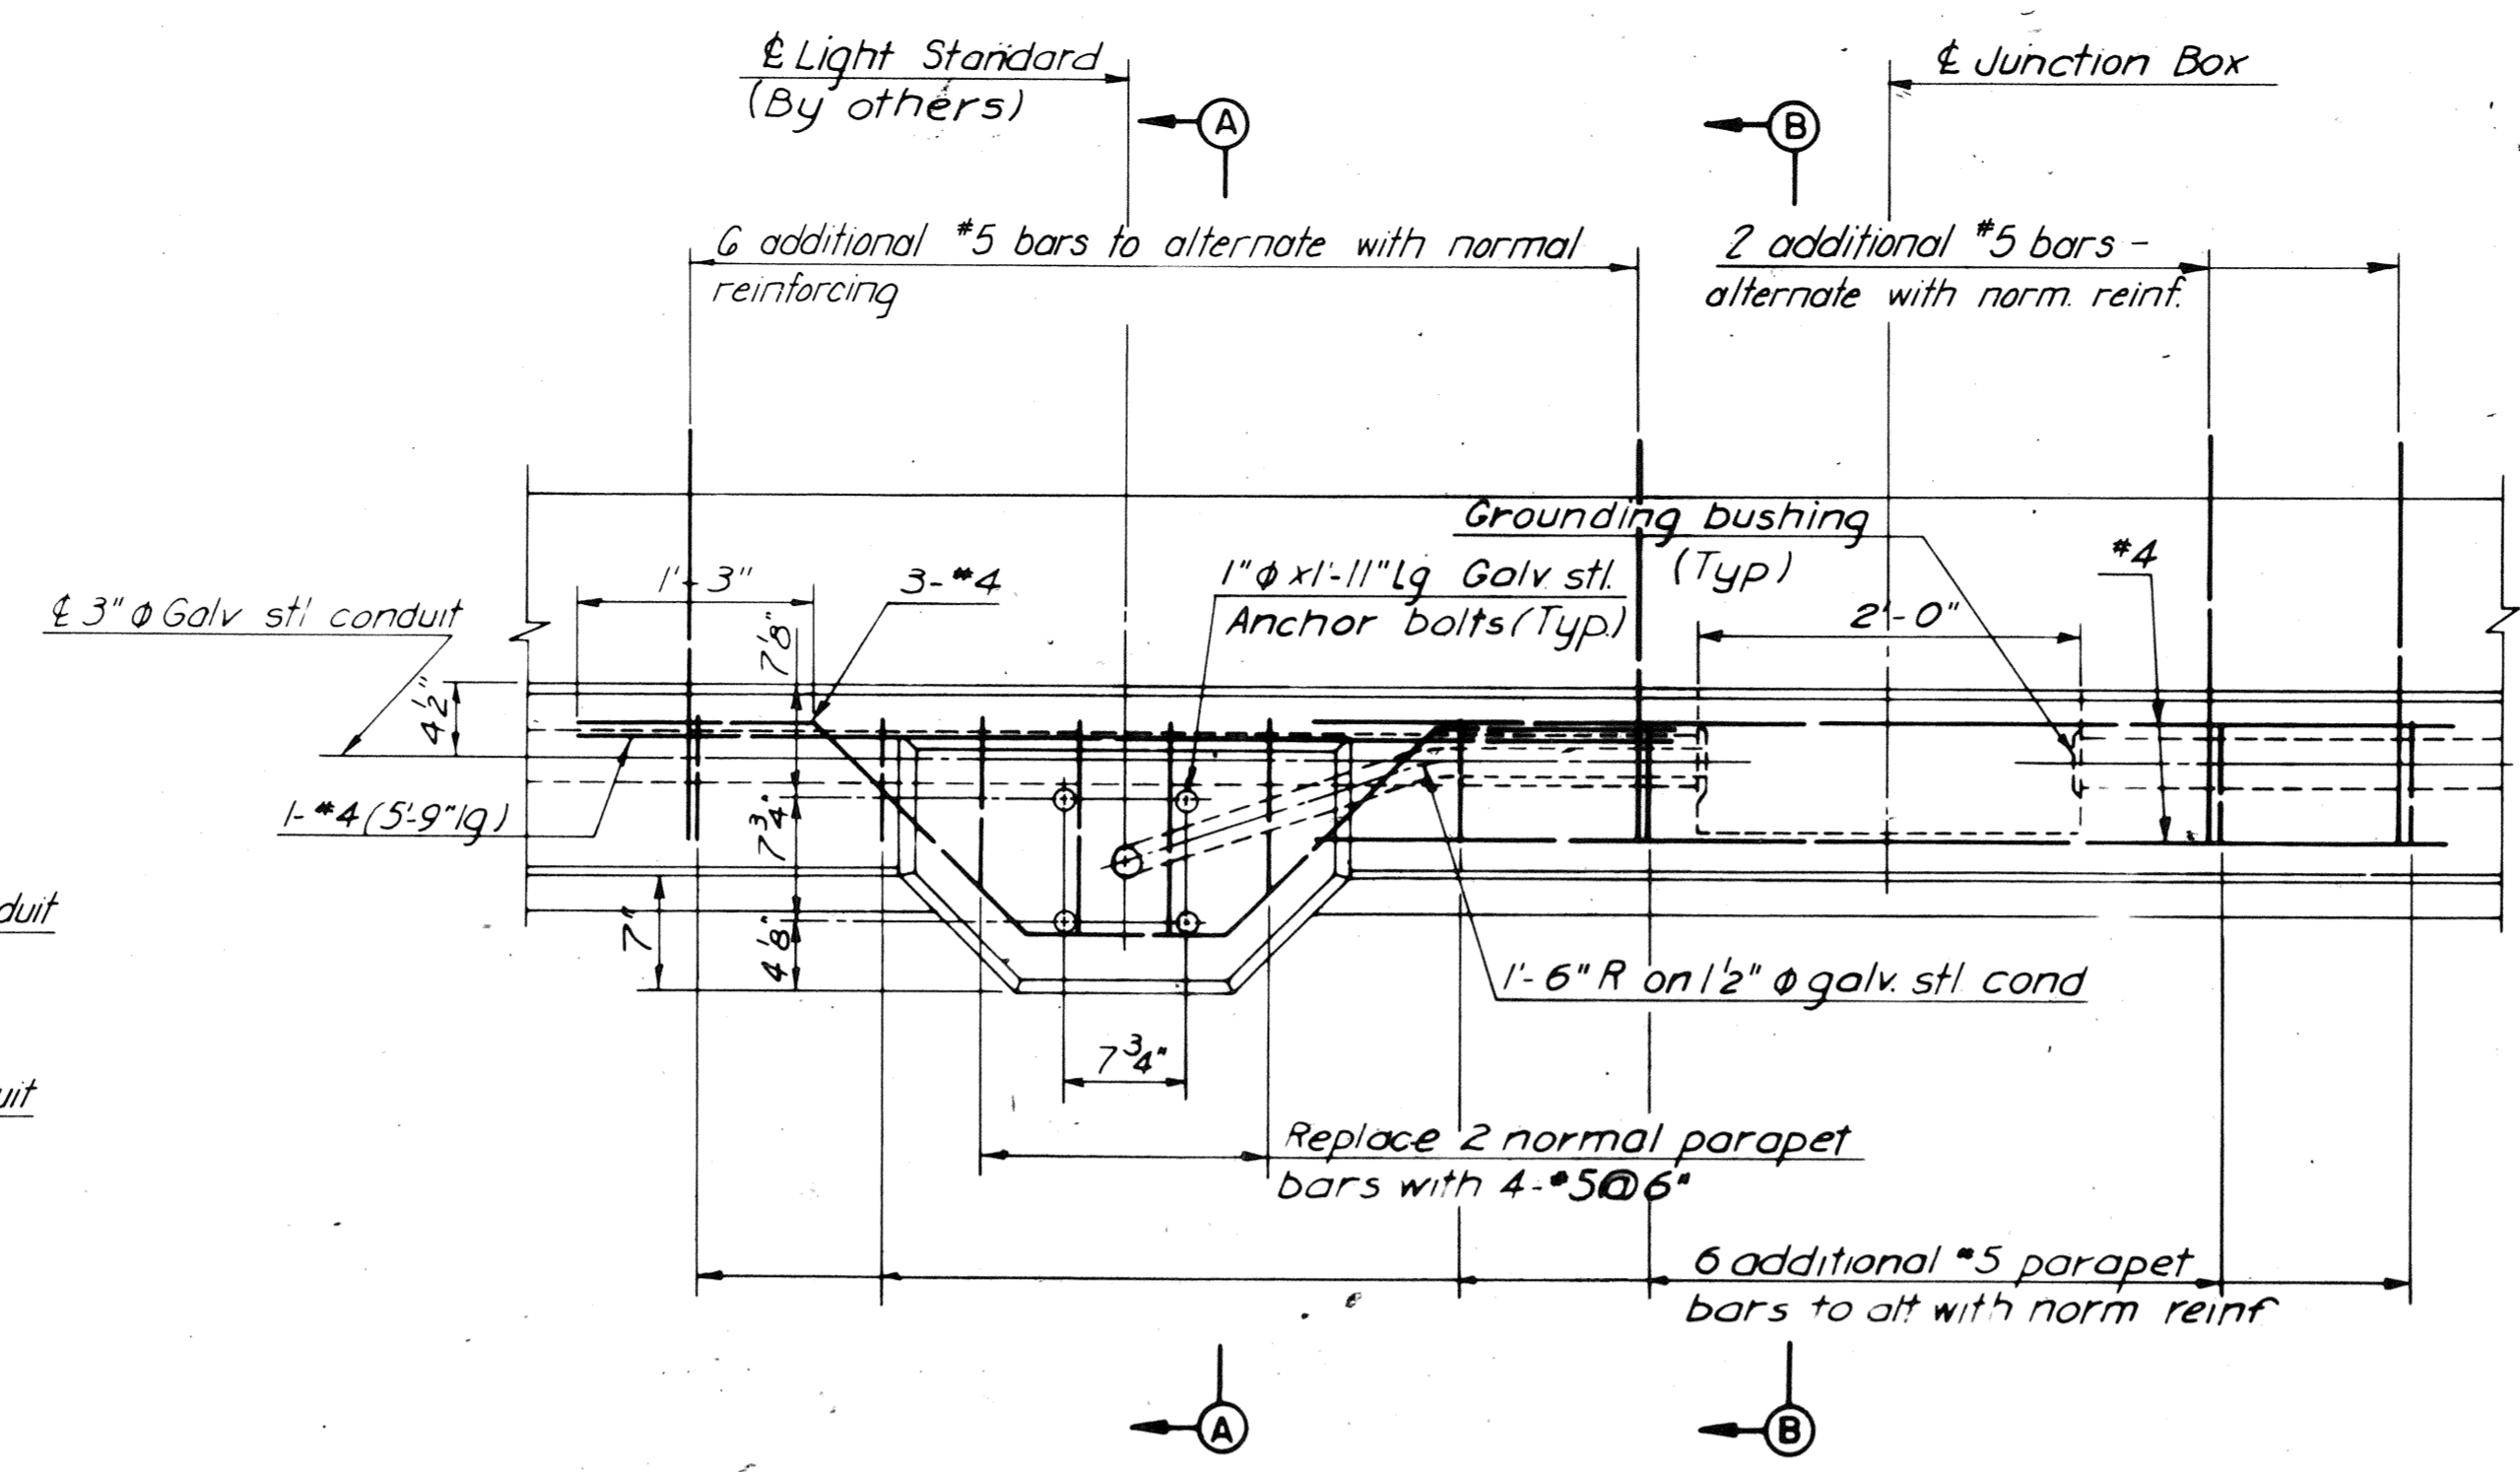


PLAN AT LIGHT STANDARD
Scale 1"=1'-0"

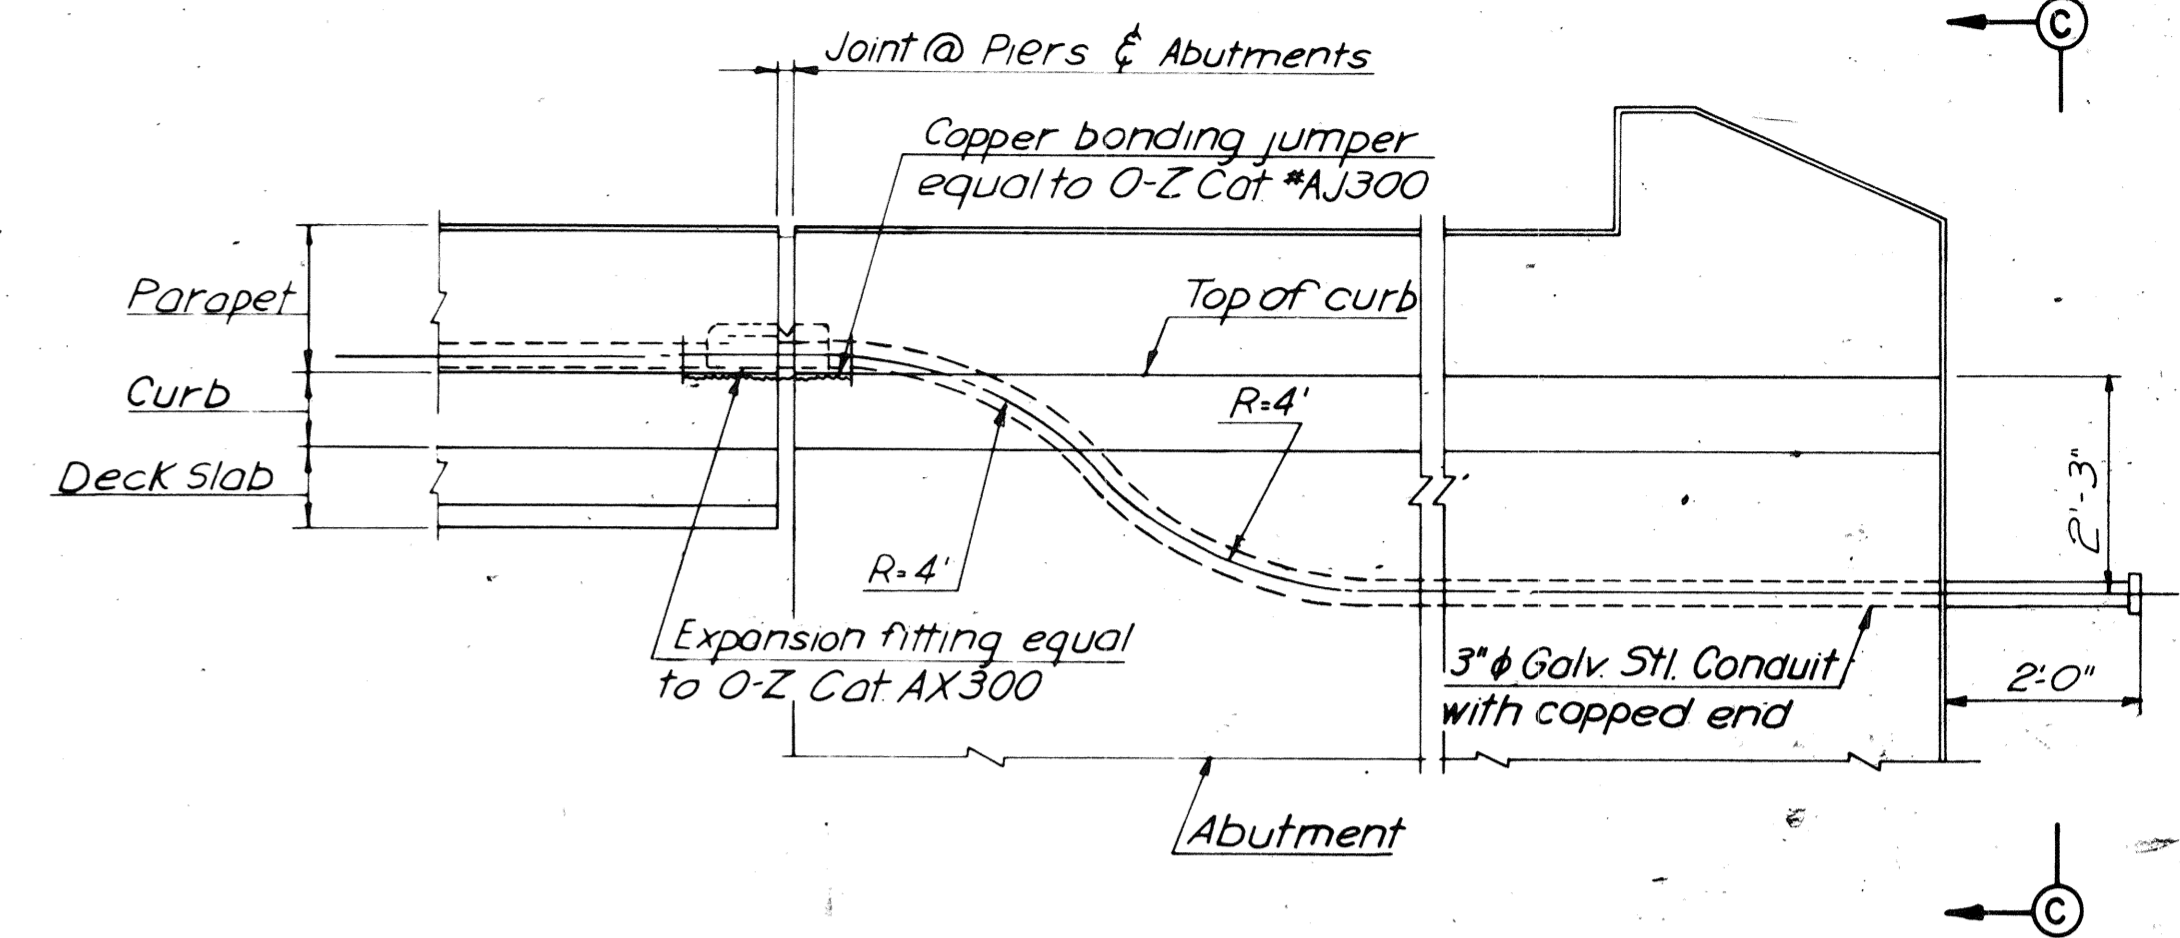


TYPICAL CONDUIT INSTALLATION DETAILS AT DECK JOINTS AND ABUTMENT WINGWALL
No Scale

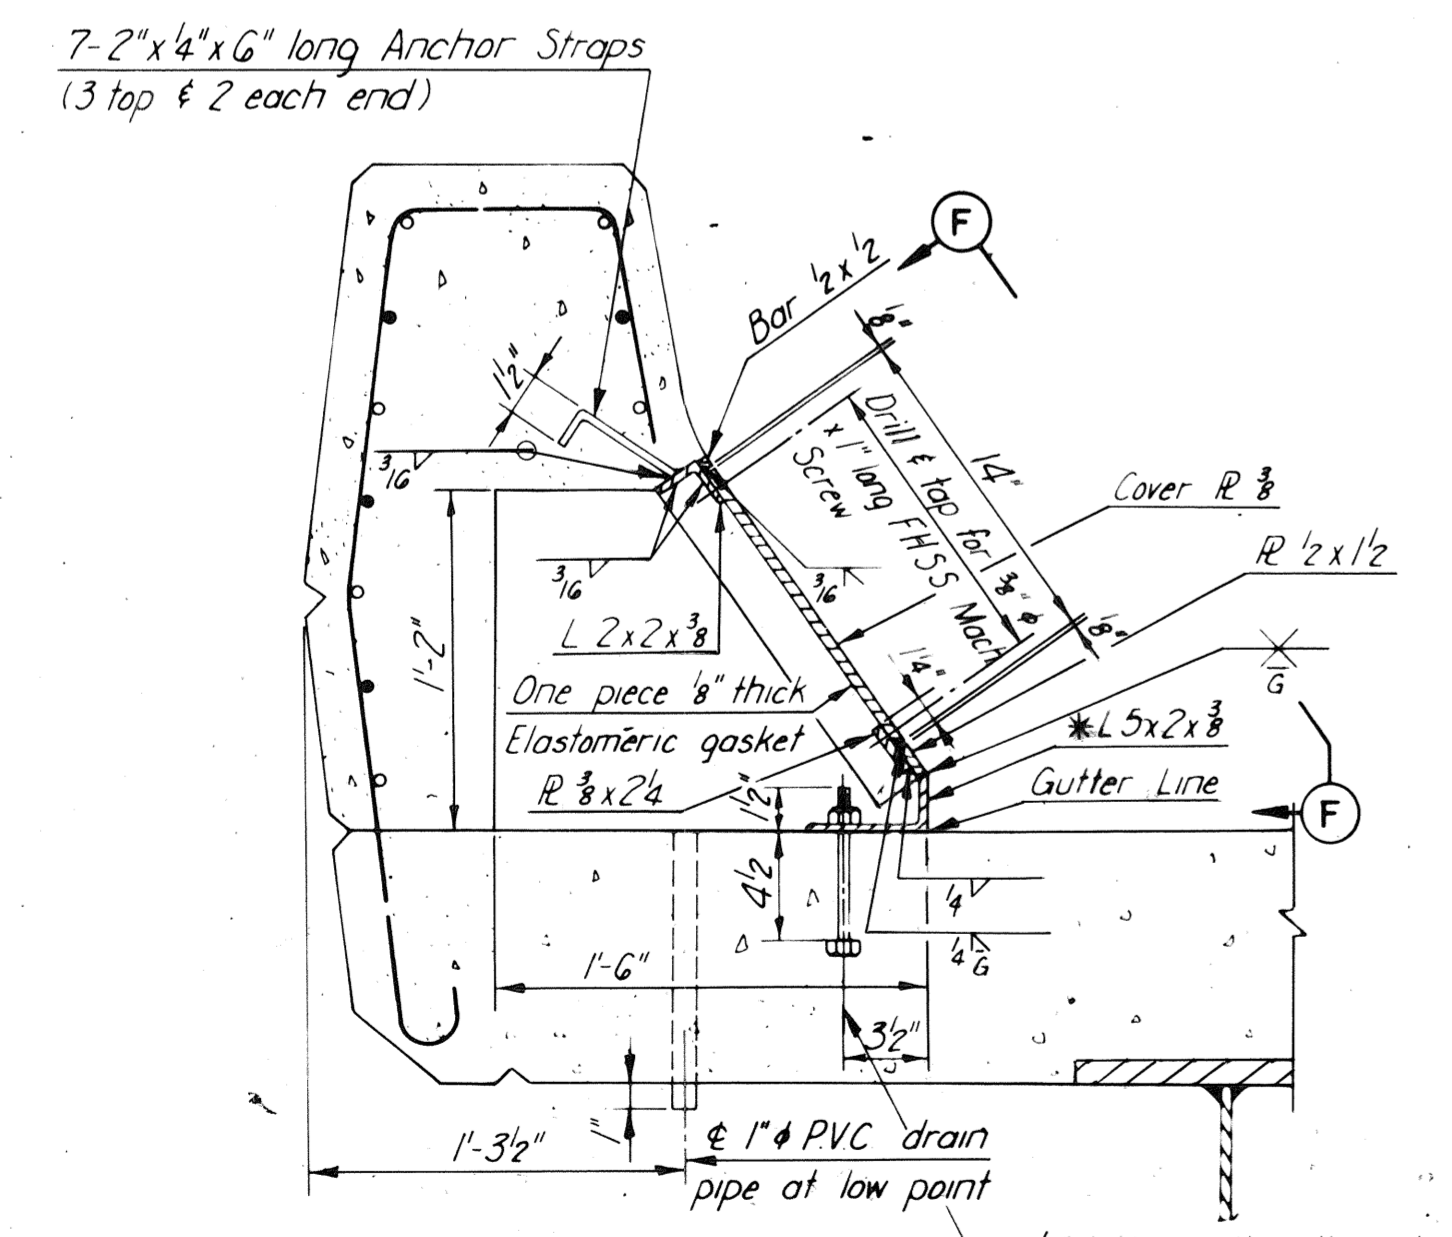


SECTION B-B
Scale 1/2"=1'-0"

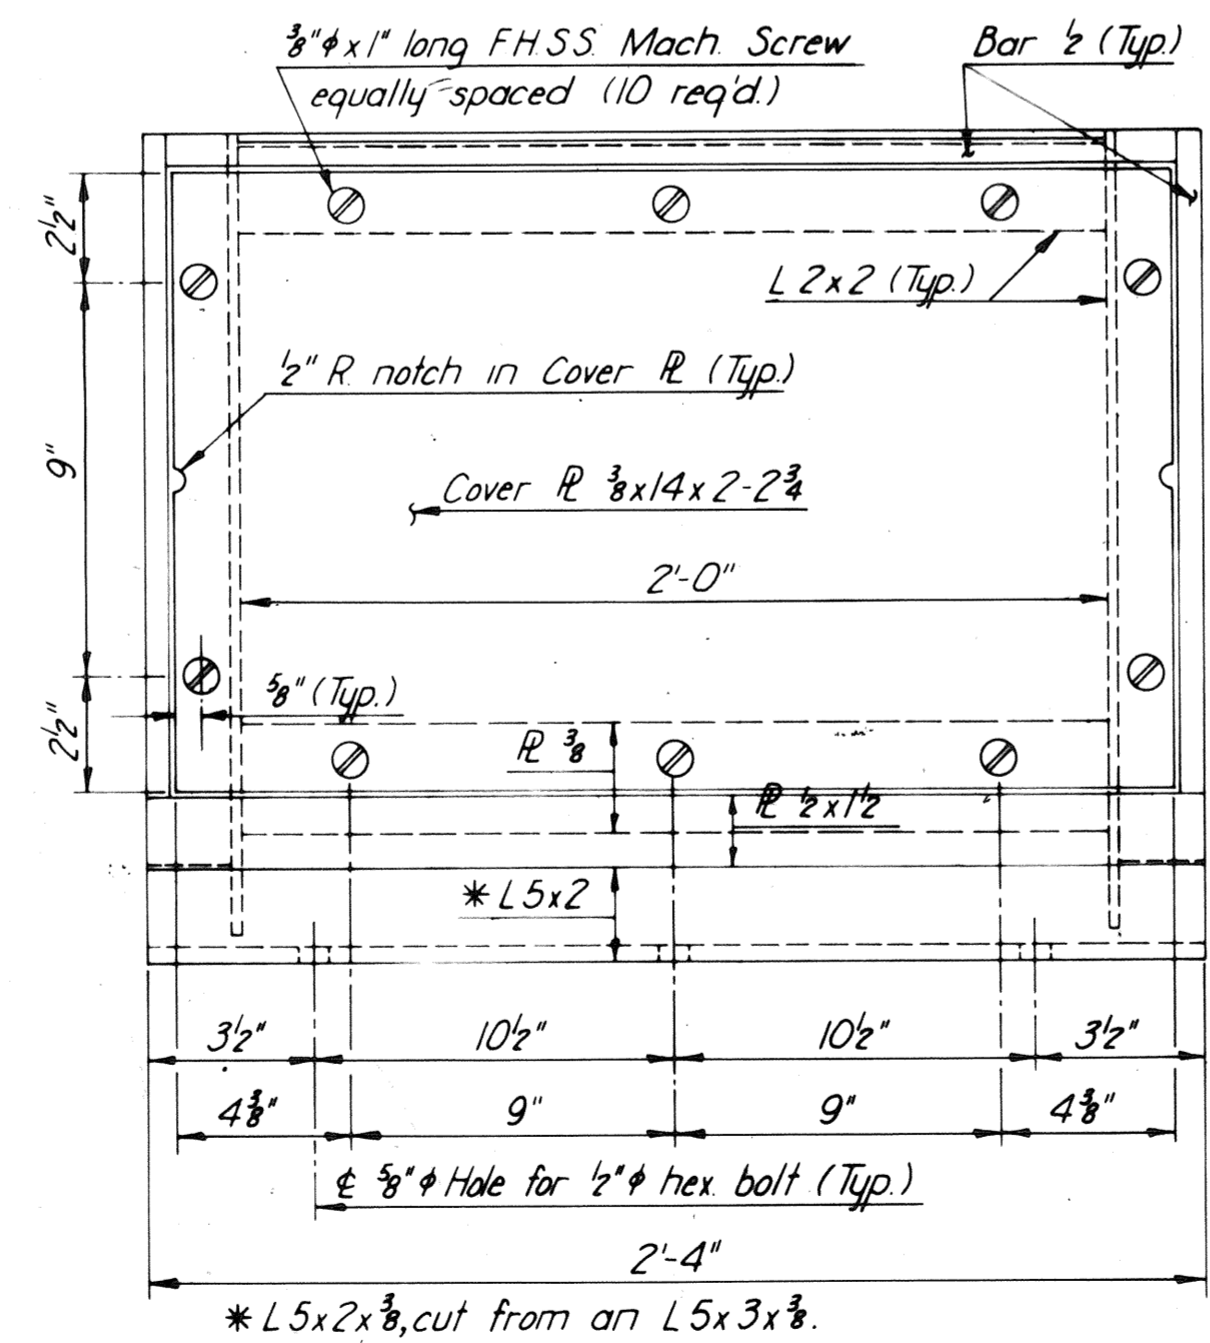

VIEW F-F
No Scale

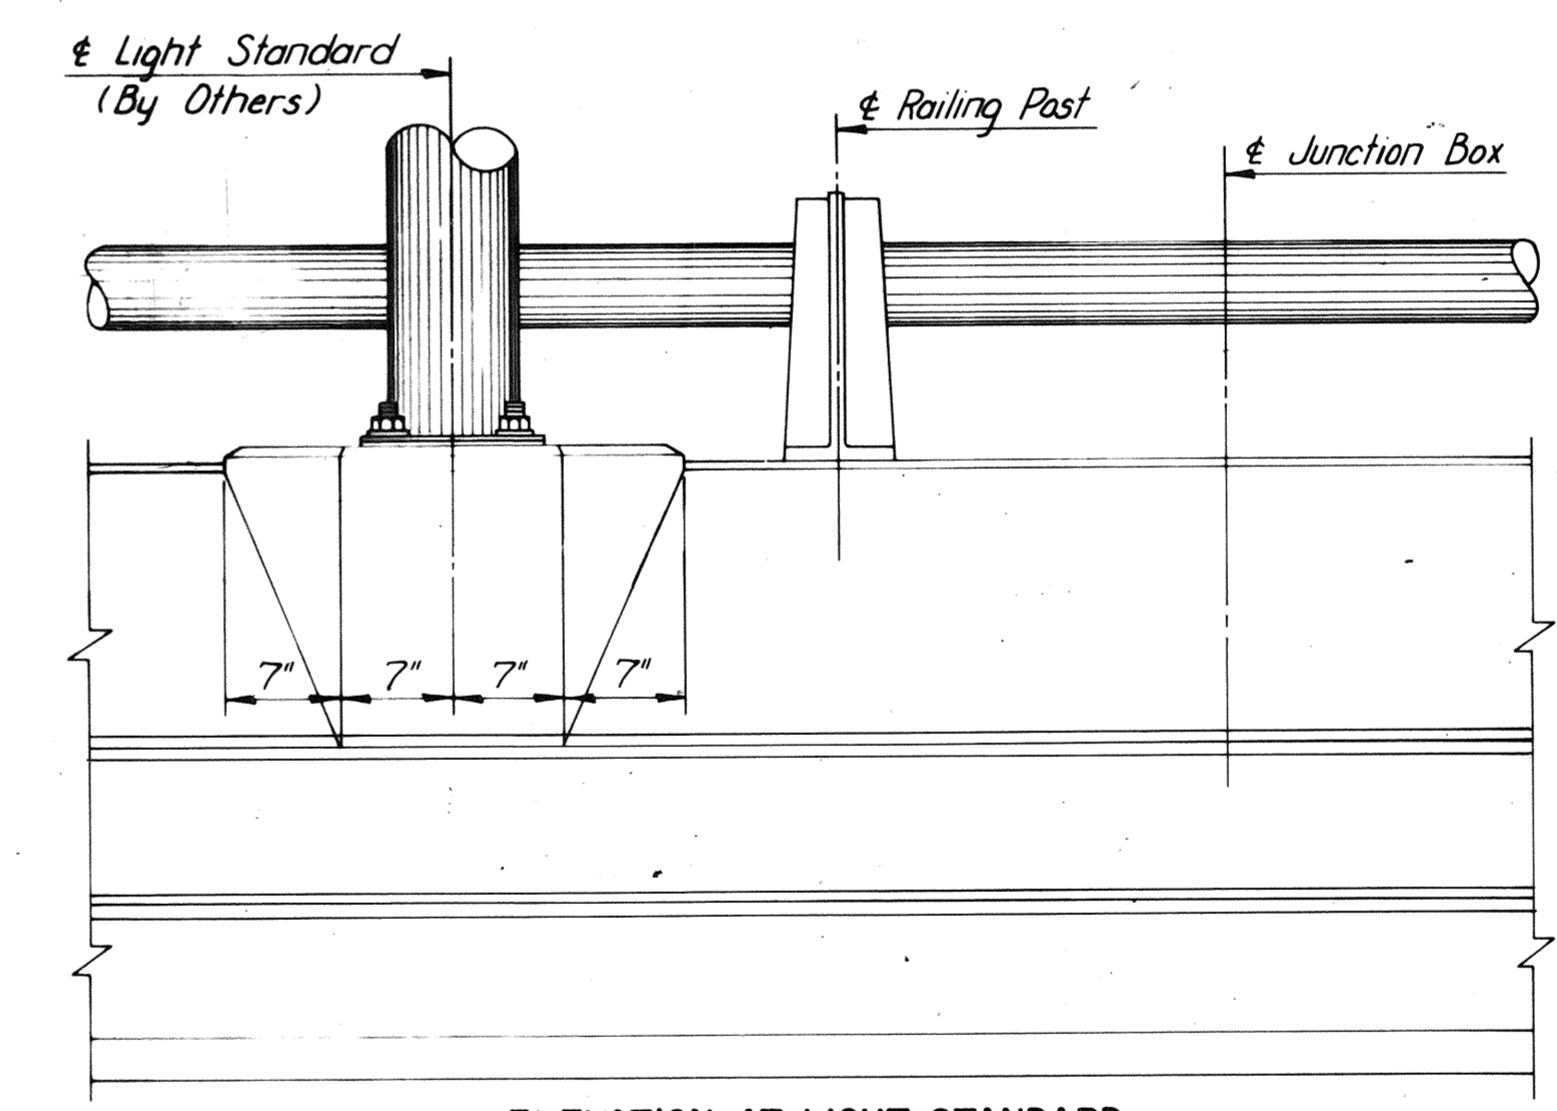


ELEVATION AT LIGHT STANDARD
Scale 1"=1'-0"

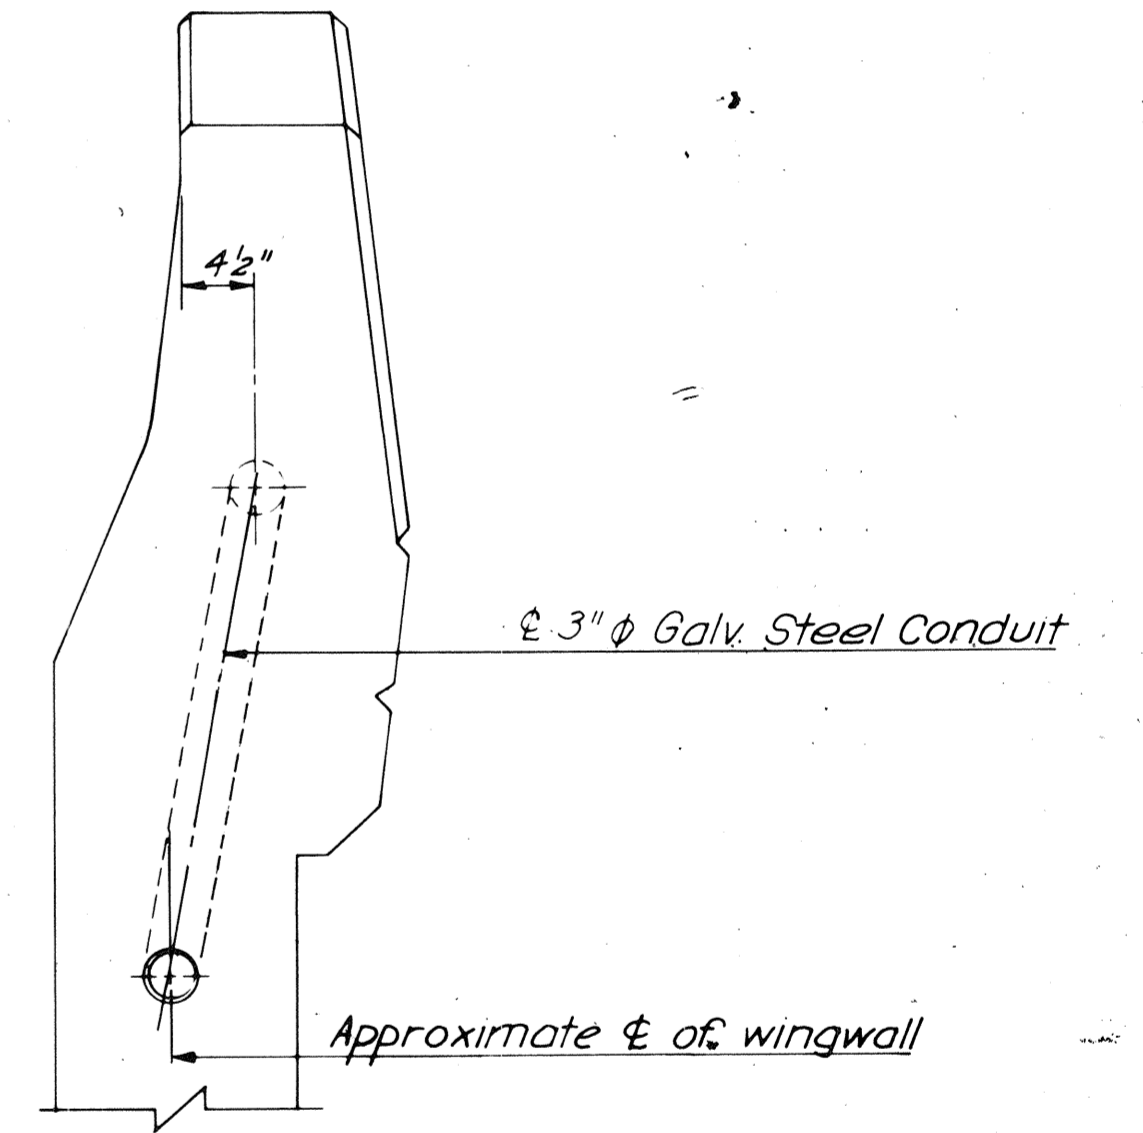

VIEW C-C
No Scale

NOTES:
 All conduits shall be terminated in Junction Boxes with grounding bushings equal to O-Z type 1GB.
 Anchor bolt assemblies shall conform to ASTM A307 and shall be hot dip galv after fabrication in accordance with ASTM A153.
 Junction Box and cover shall be hot galvanized after fabrication in accordance with ASTM A123.
 Only additional or replacement reinf is shown on this sheet for normal reinf see individual bridge Cross Section and Deck Plan sheets.

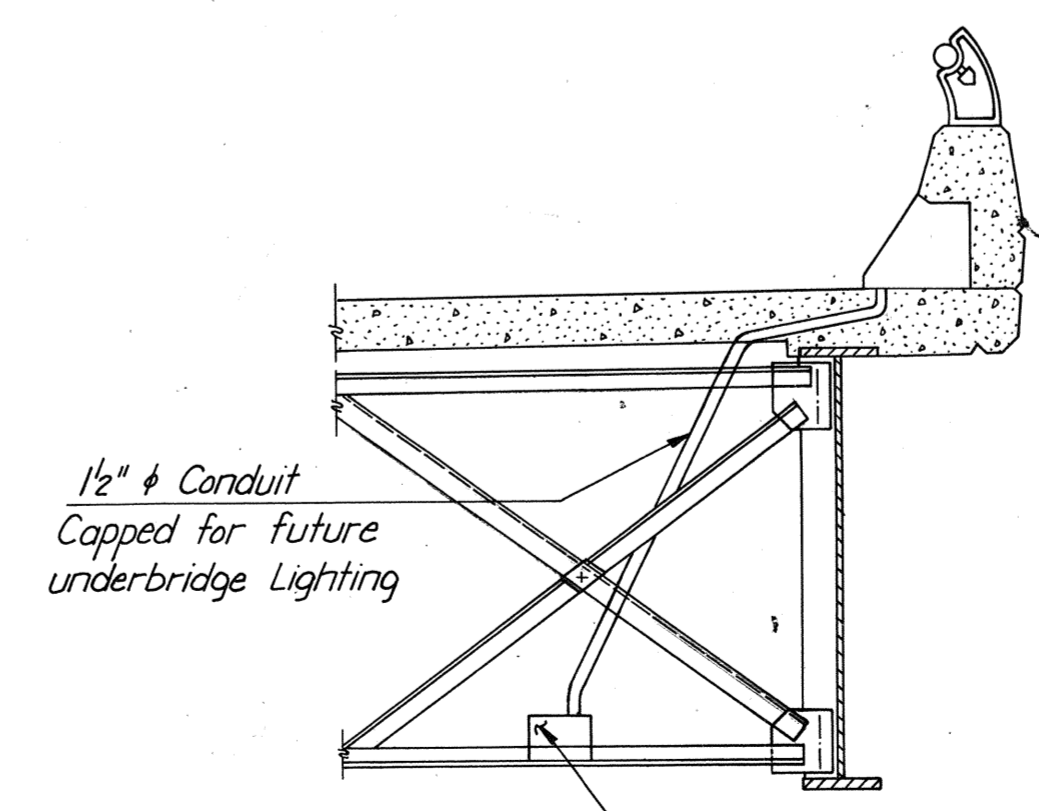

DETAIL FOR FUSE BOX FOR UNDERDECK LIGHTING
No Scale


BY	DATE	NO.	REVISION	BY	DATE
MADE	DLA 3-68				
CHECKED	PRY 3-68				
IN CHARGE	PRY				

RICHMOND METROPOLITAN AUTHORITY
RICHMOND EXPRESSWAY SYSTEM
 DOWNTOWN EXPRESSWAY


STANDARD ELECTRICAL DETAILS
 (BRIDGES CARRYING EXP SYSTEM)

HOWARD, NEEDLES, TAMMEN & BERGENDOFF
 consulting engineers
 NEW YORK ALEXANDRIA KANSAS CITY


SCALE:
 CONTRACT No. 11
 SHEET No. 94 OF 97

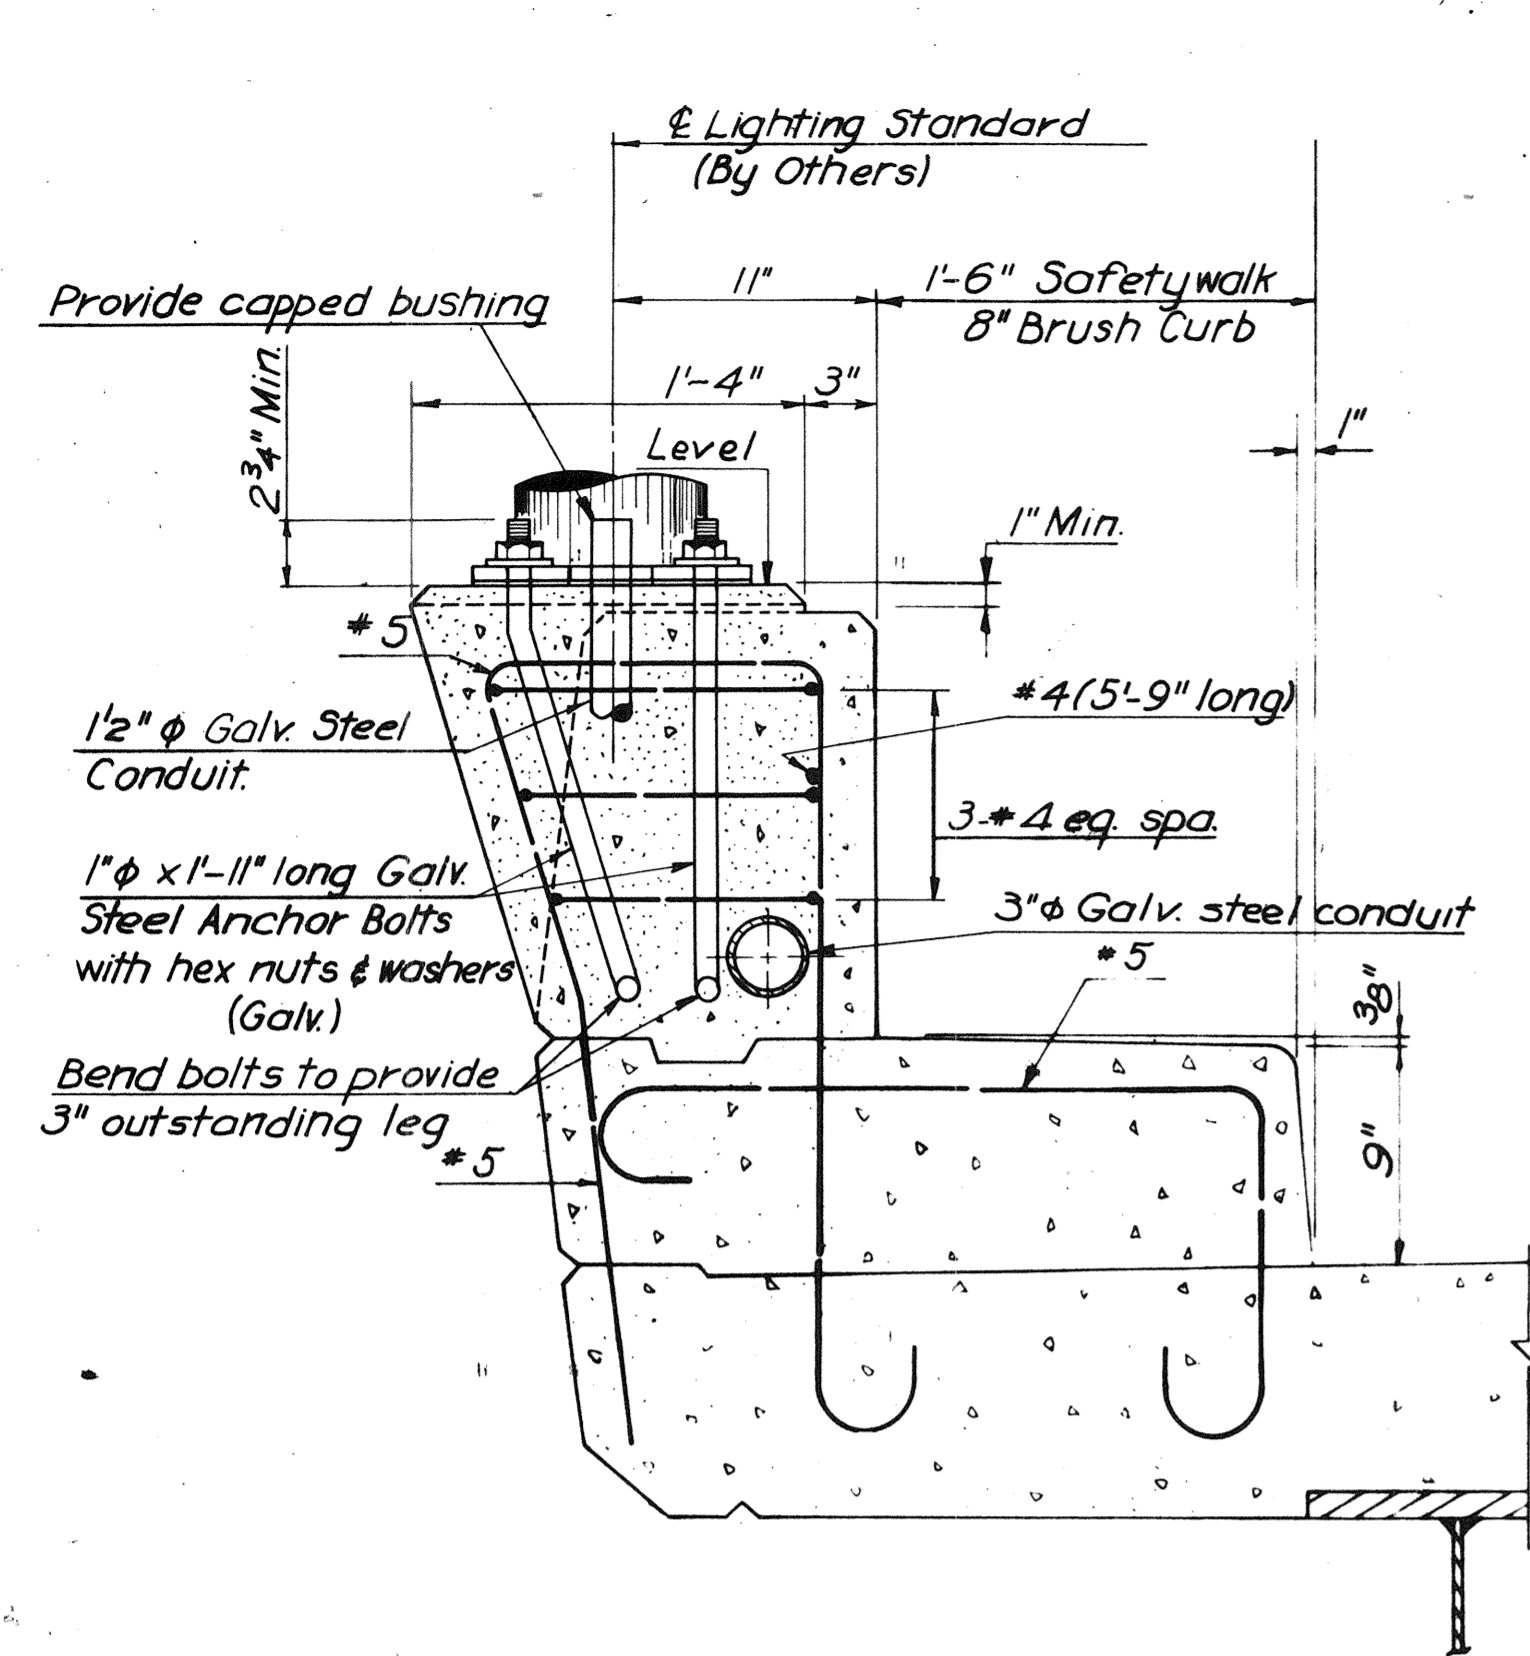


SECTION A-A
Scale: 1/2" = 1'-0"

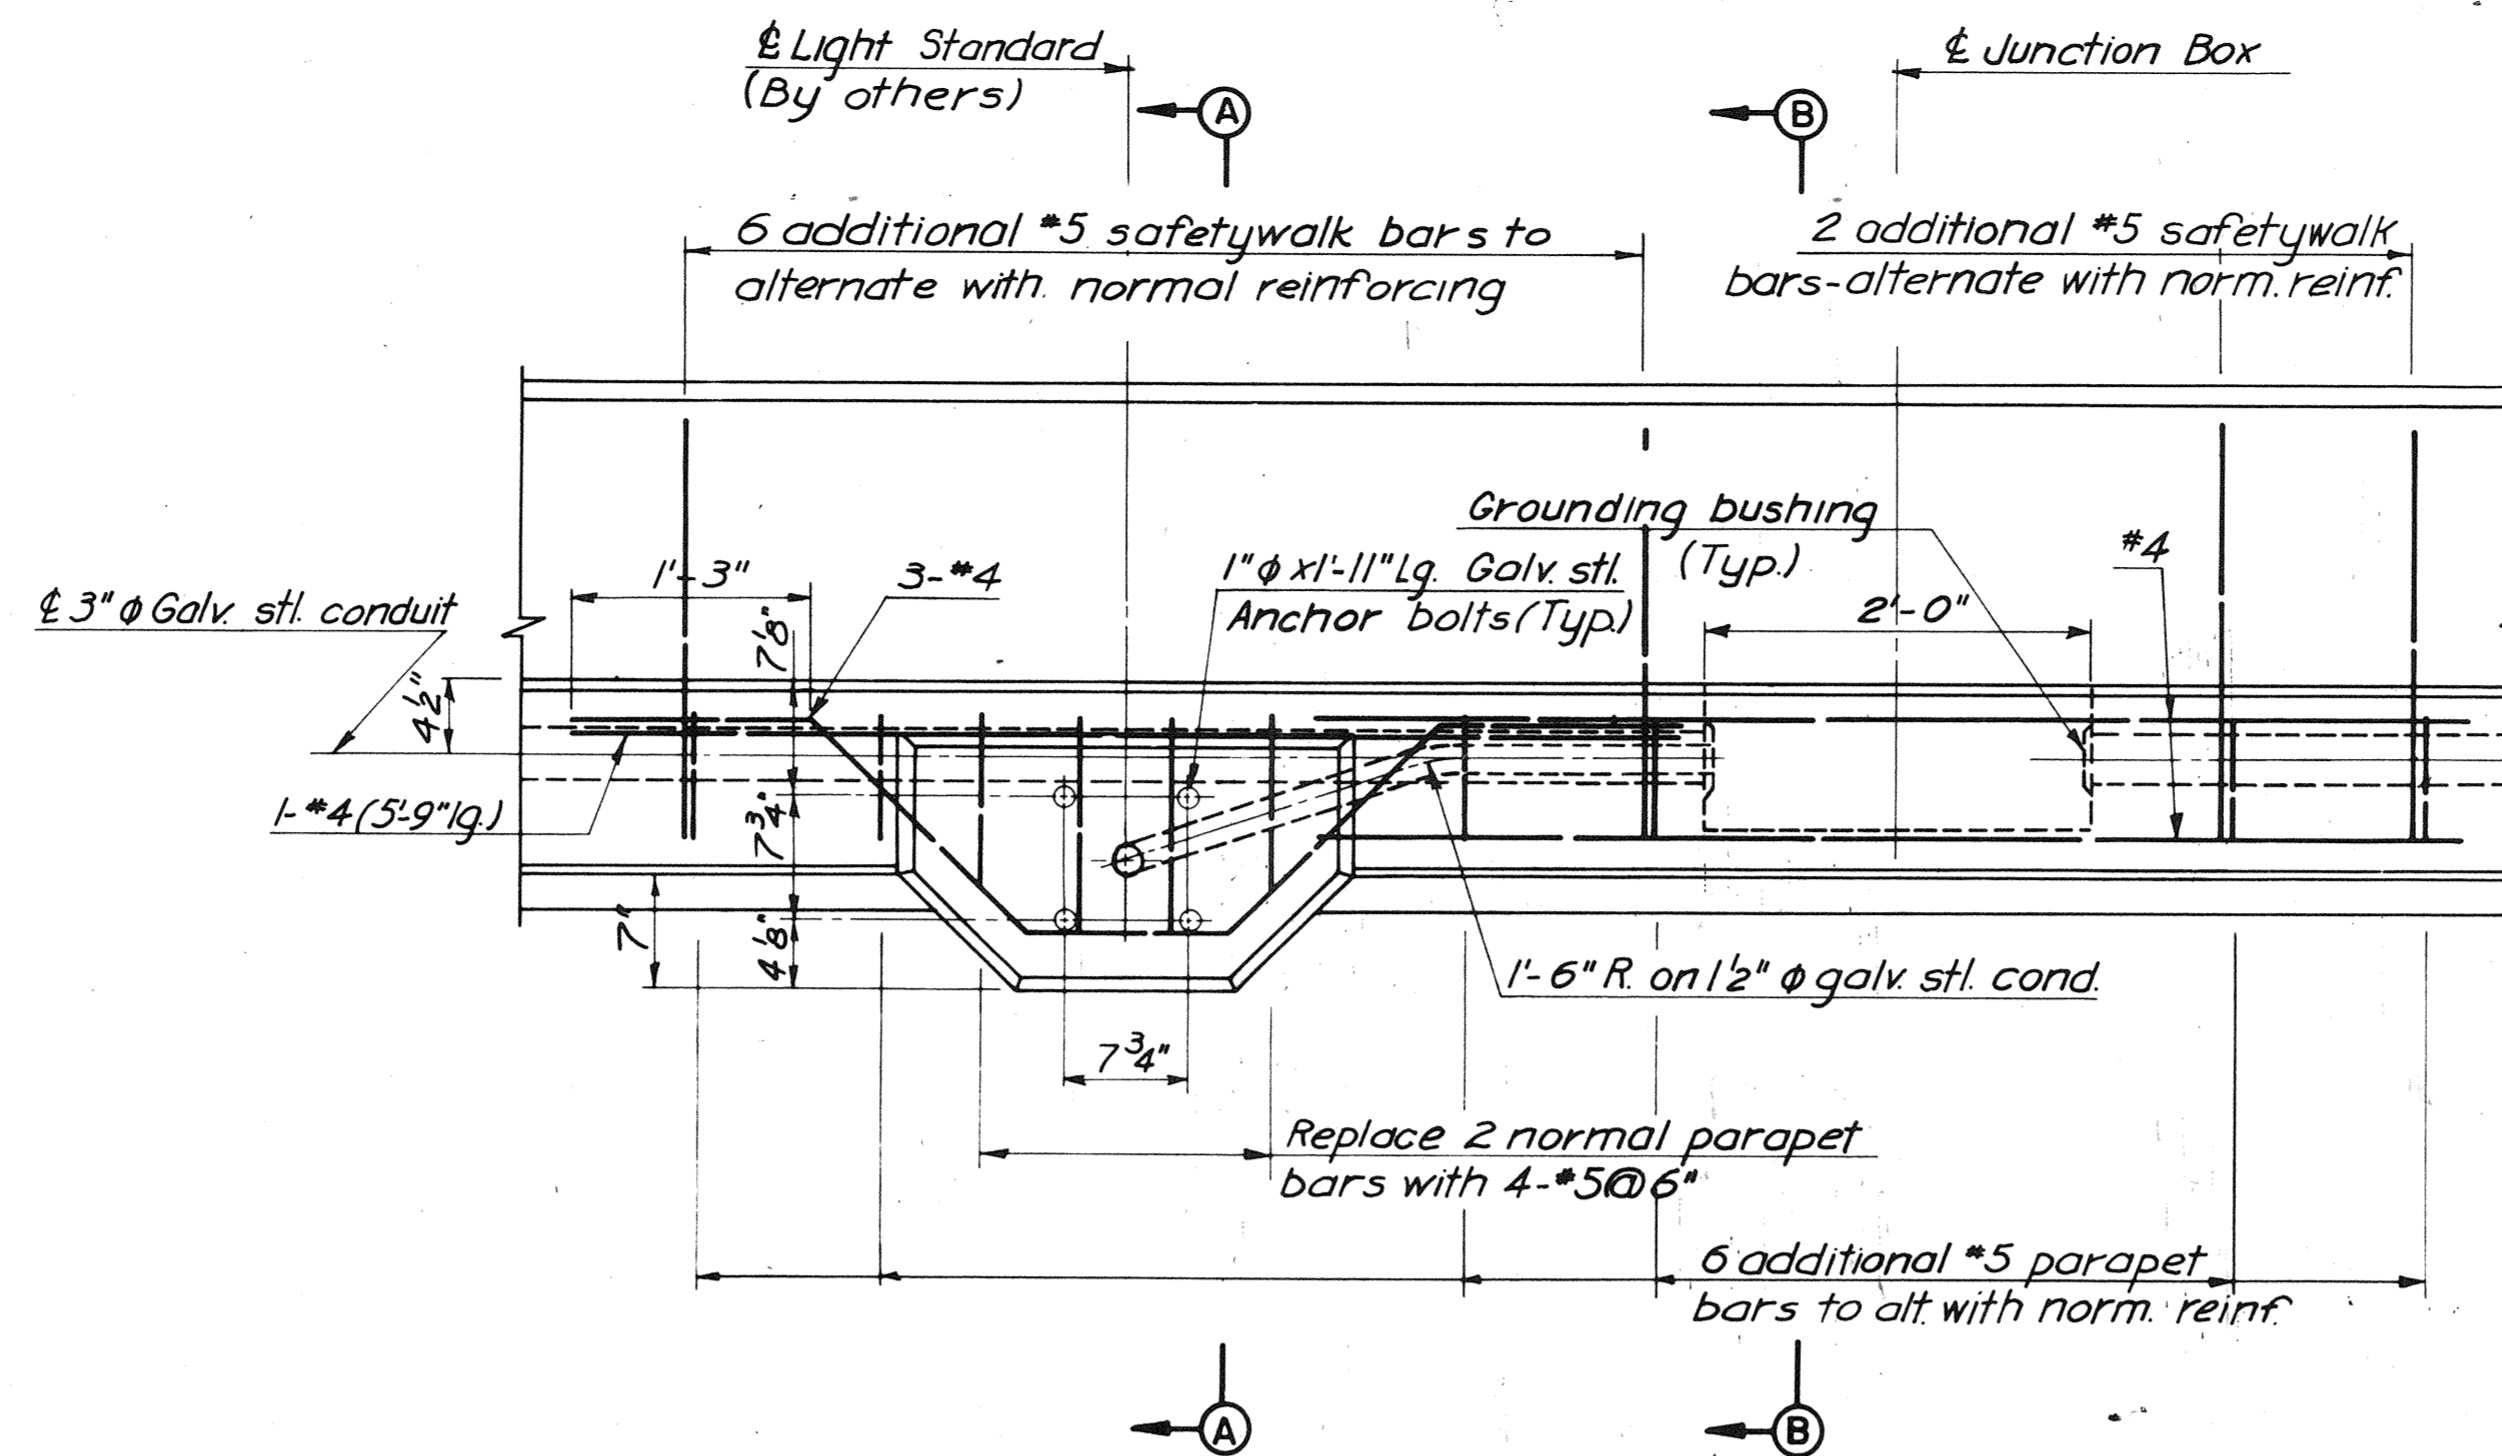


PLAN AT LIGHT STANDARD
Scale: 1" = 1'-0"

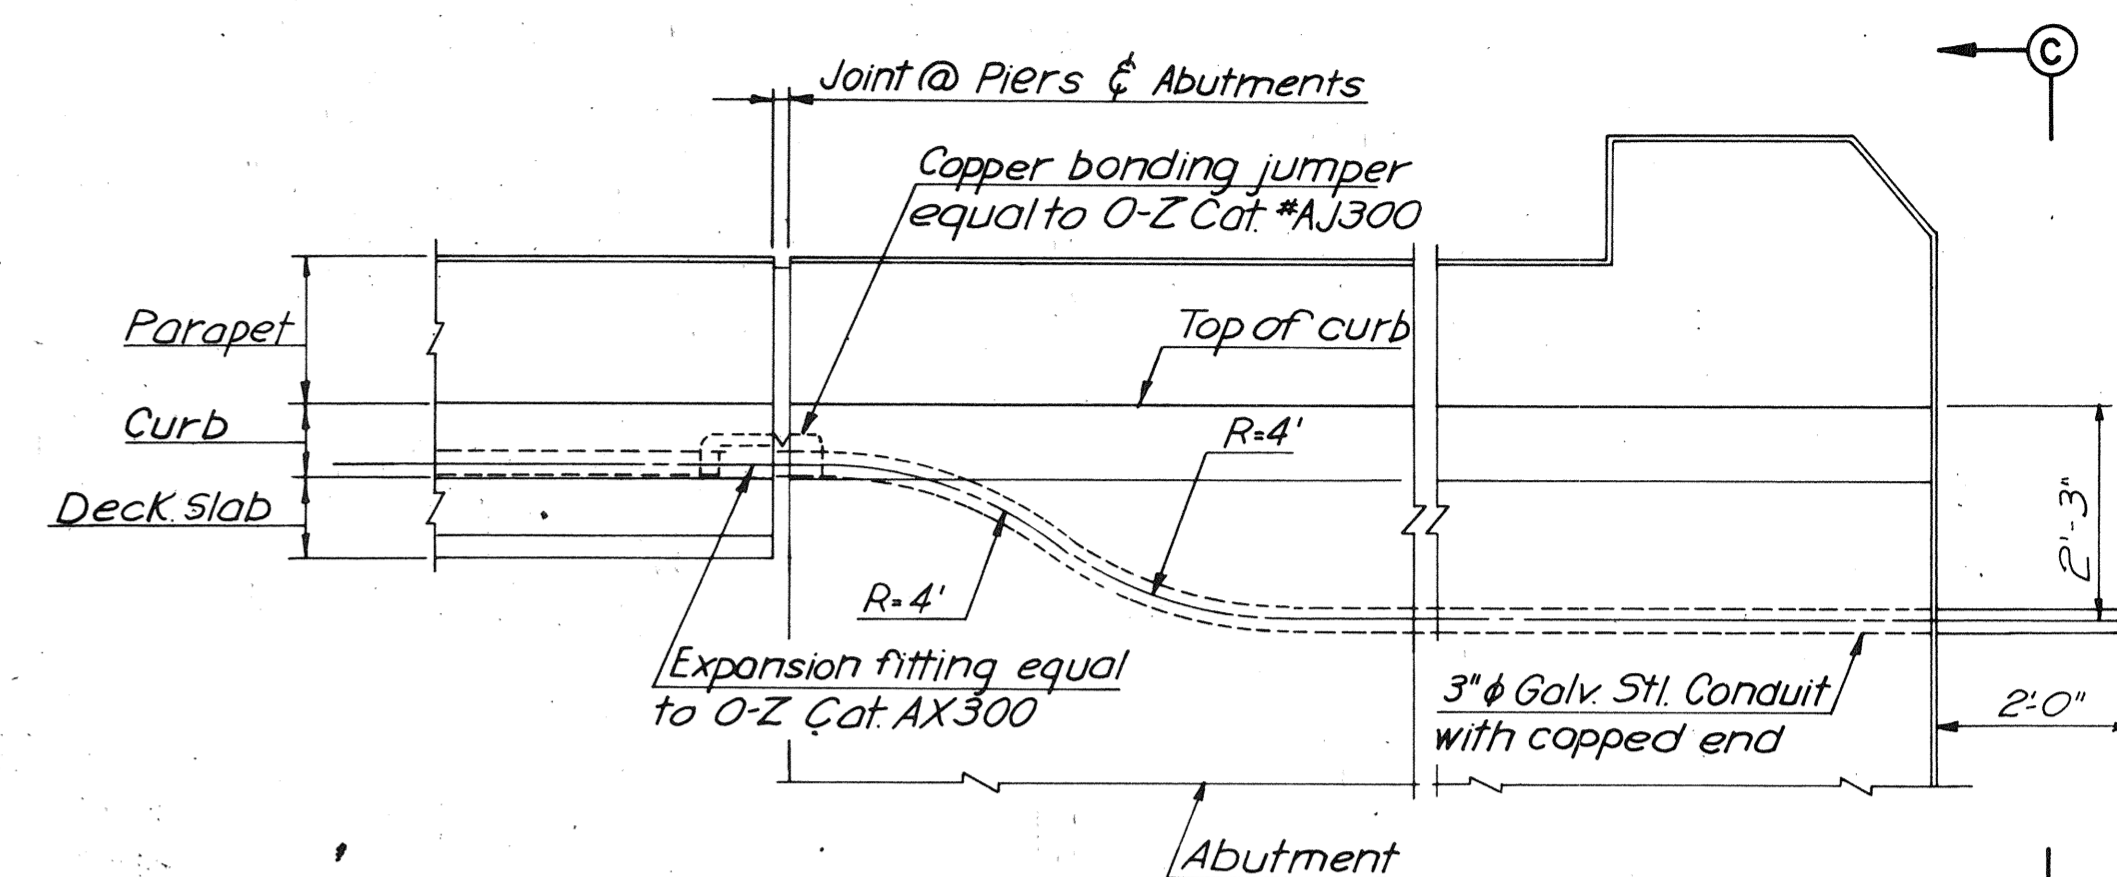


TYPICAL CONDUIT INSTALLATION DETAILS AT DECK JOINTS AND ABUTMENT WINGWALL
No Scale

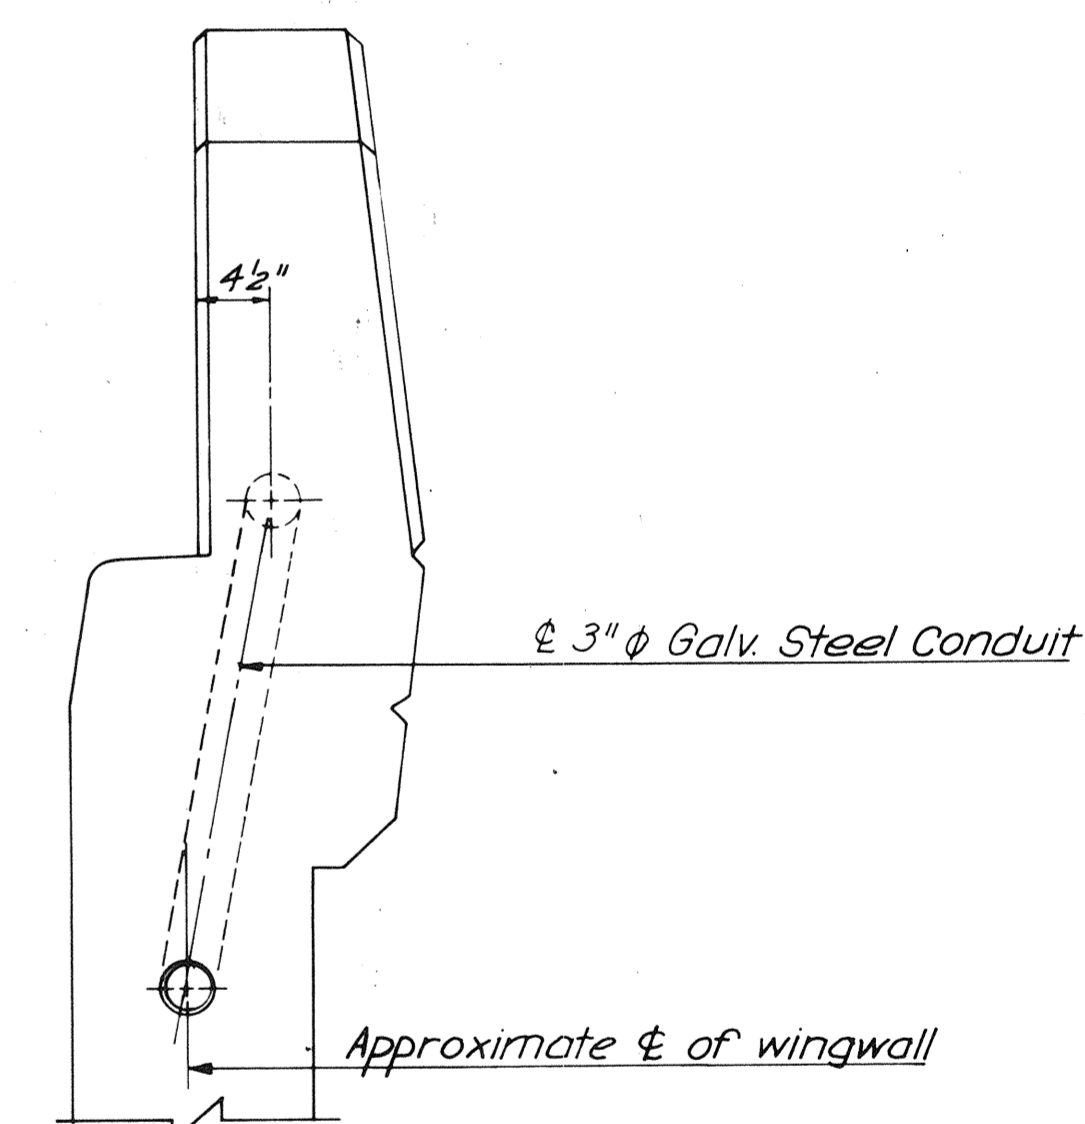

VIEW C-C
Scale: 1/2" = 1'-0"

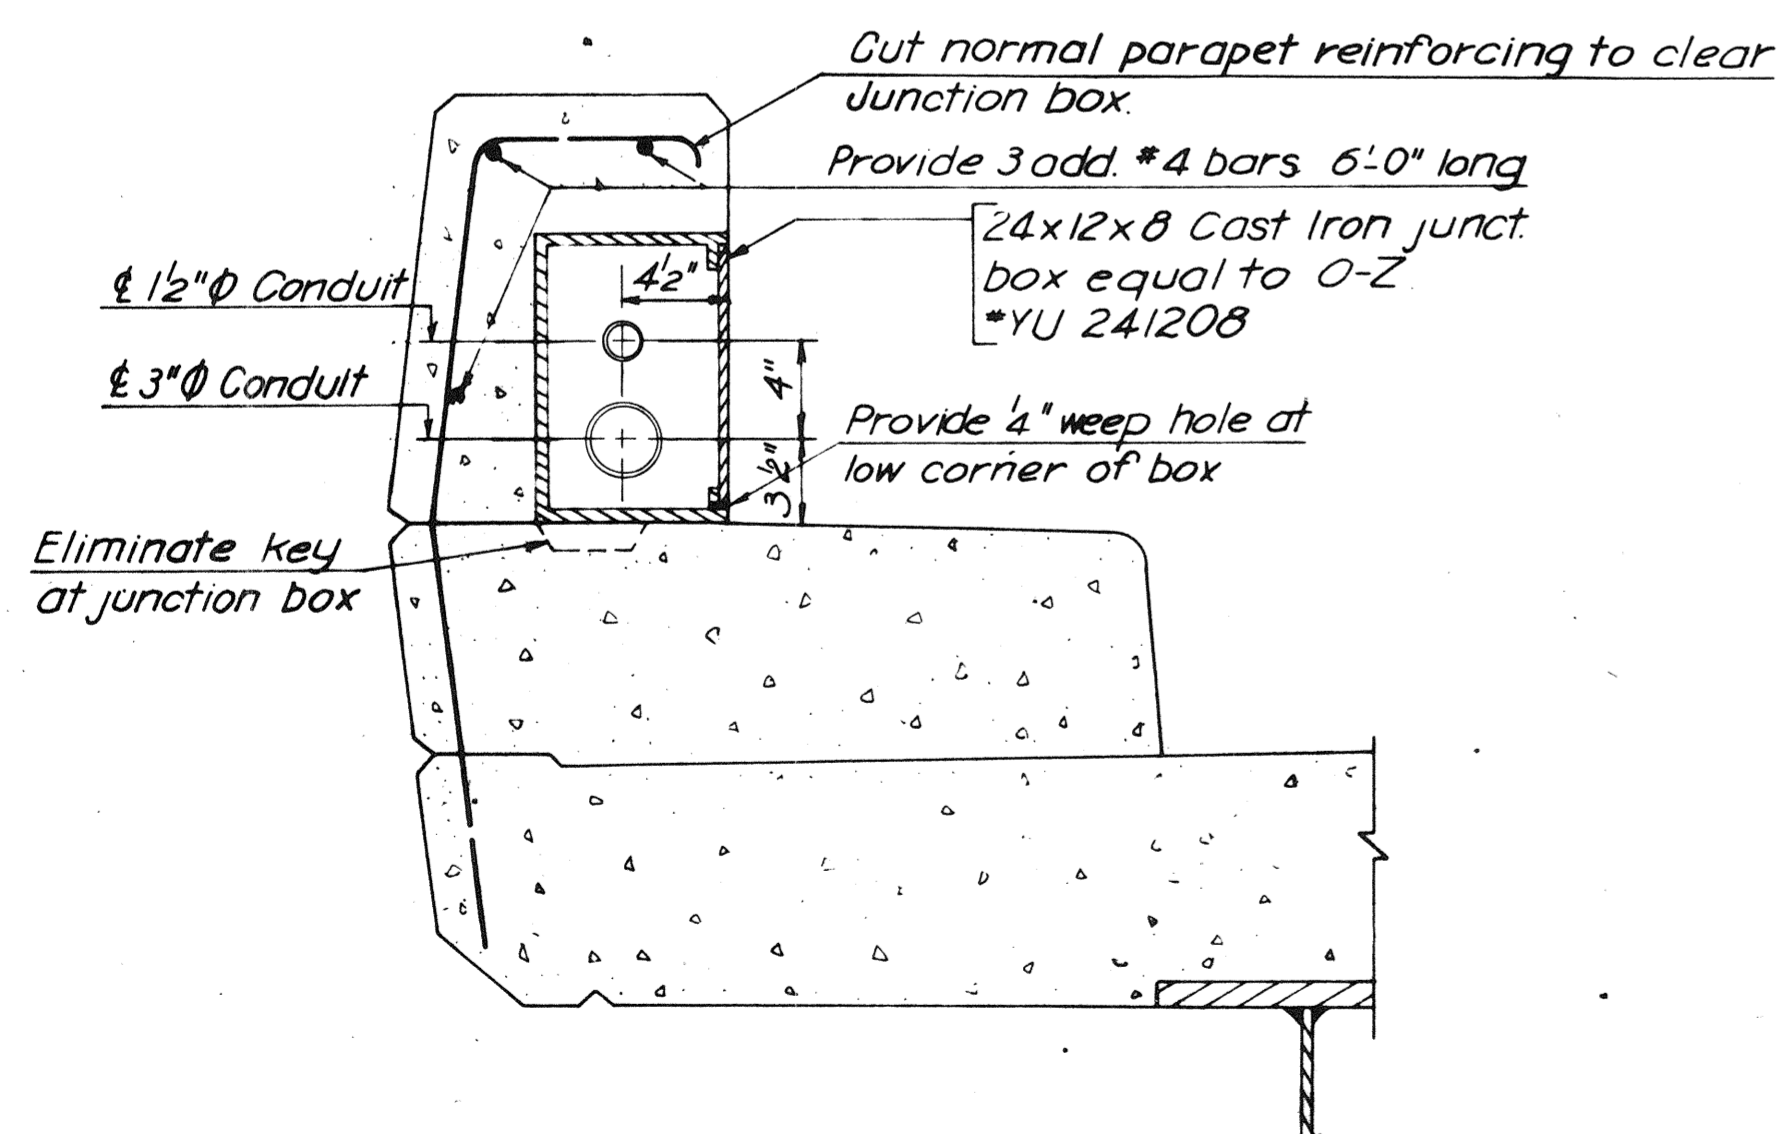

SECTION B-B
Scale: 1/2" = 1'-0"

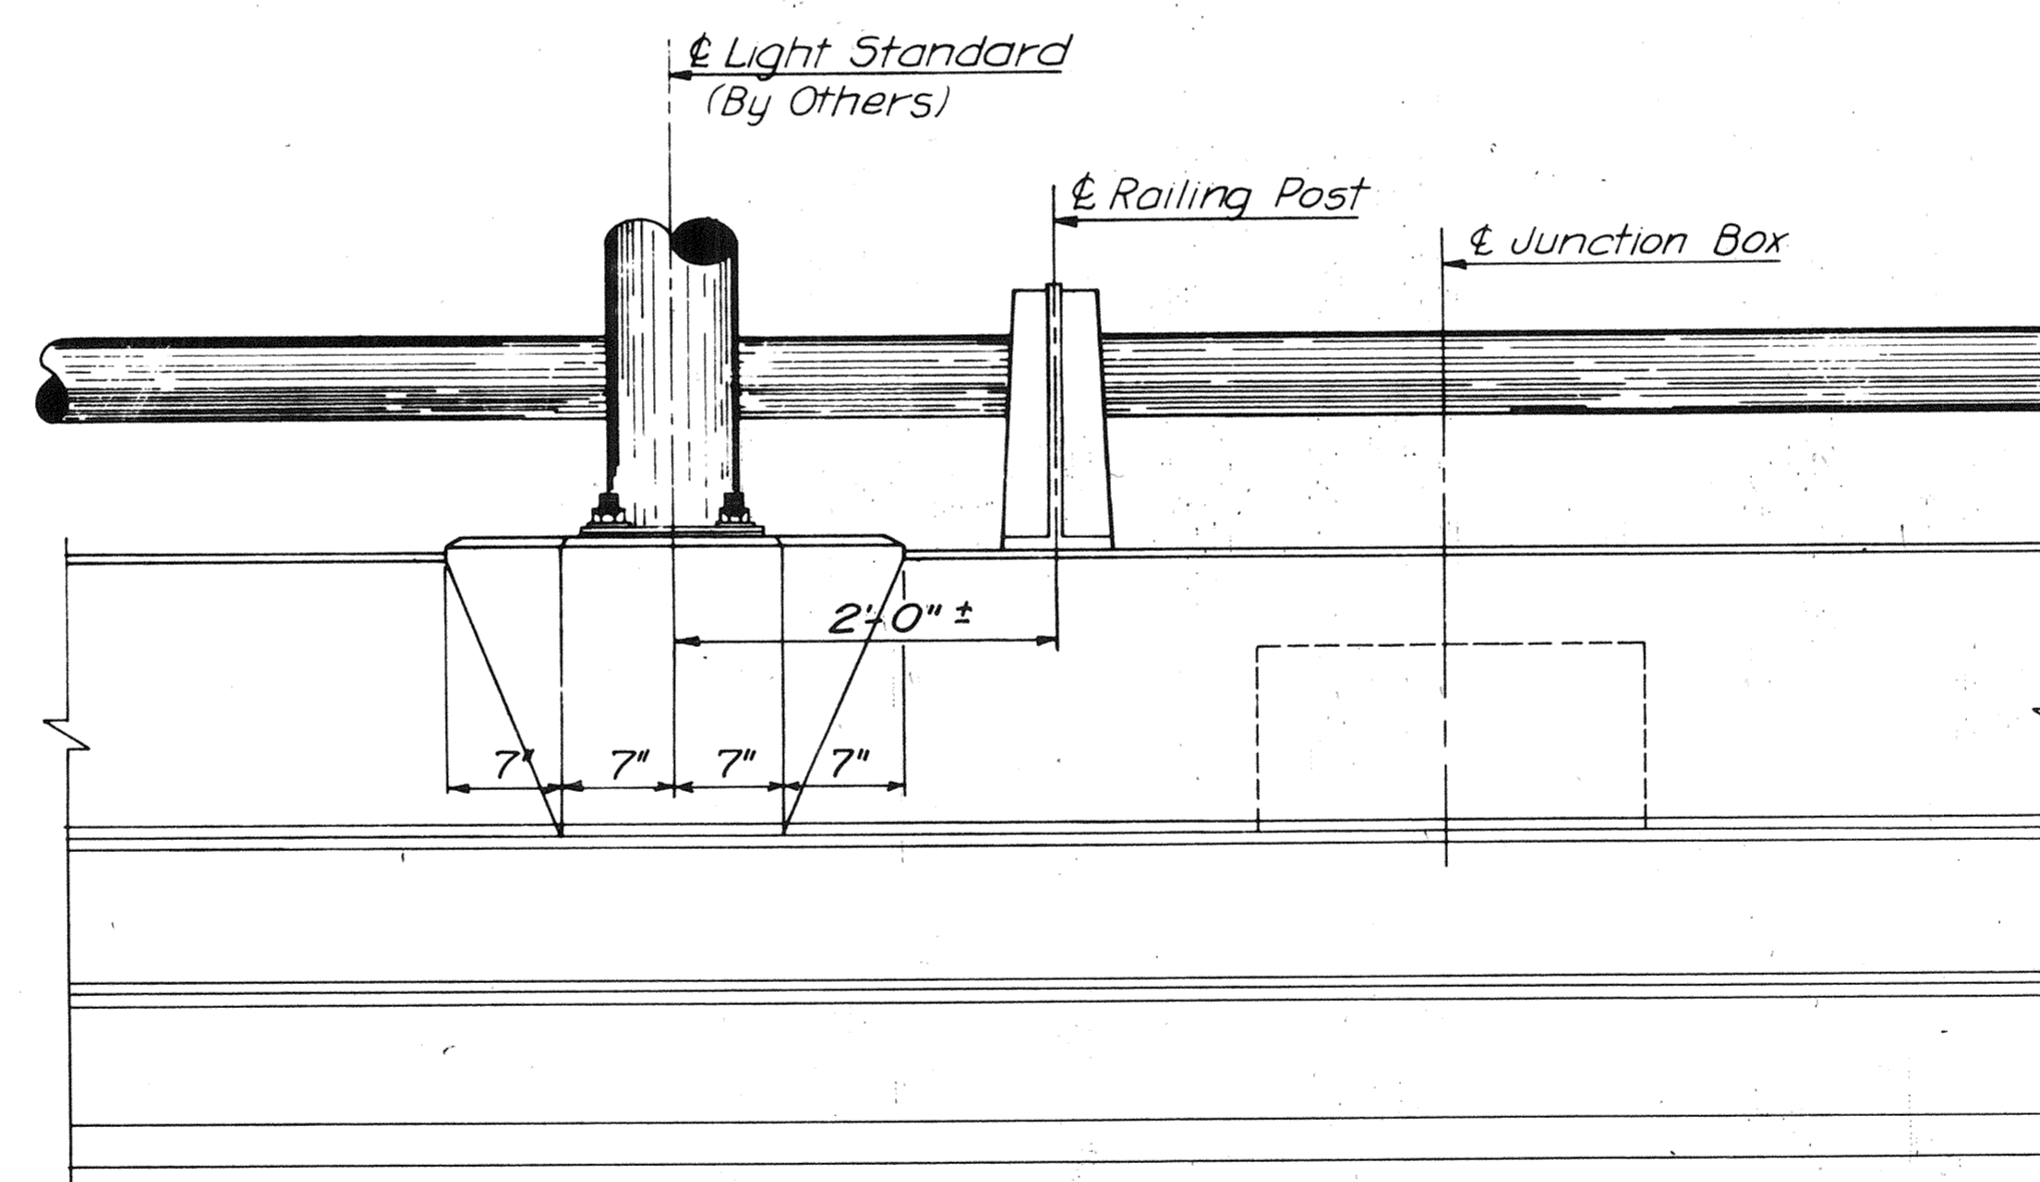

ELEVATION AT LIGHT STANDARD
Scale: 1" = 1'-0"

NOTES:
 All conduits shall be terminated in Junction Boxes with grounding bushings equal to O-Z type 1GB.
 Anchor bolt assemblies shall conform to ASTM A307 and shall be hot-dip galv after fabrication in accordance with ASTM A153.
 Junction Box and cover shall be hot-galvanized after fabrication in accord with ASTM A123.
 Only additional or replacement reinf. is shown on this sheet. For normal reinf. see individual bridge Cross Section and Deck Plan sheets.

Typical for Unit 2 B65
 Units 16 & 18 B68

BY	DATE				
MADE	D.L.A.	3-68			
CHECKED	P.R.Y.	3-68	New Sheet	TEM	9-29-76
IN CHARGE	P.R.Y.				


RICHMOND METROPOLITAN AUTHORITY
 RICHMOND EXPRESSWAY SYSTEM

STANDARD
 ELECTRICAL DETAILS
 (BRIDGES CARRYING EXP SYSTEM)

HOWARD, NEEDLES, TAMMEN & BERGENDOFF
 consulting engineers
 NEW YORK ALEXANDRIA KANSAS CITY


SCALE: AS SHOWN
 CONTRACT NO.:
 SHEET NO. S4B OF

RICHMOND EXPRESSWAY SYSTEM			
SECTION	PROJECT	SHEET NO.	TOTAL SHEETS
11	DOWNTOWN EXPRESSWAY	96	97

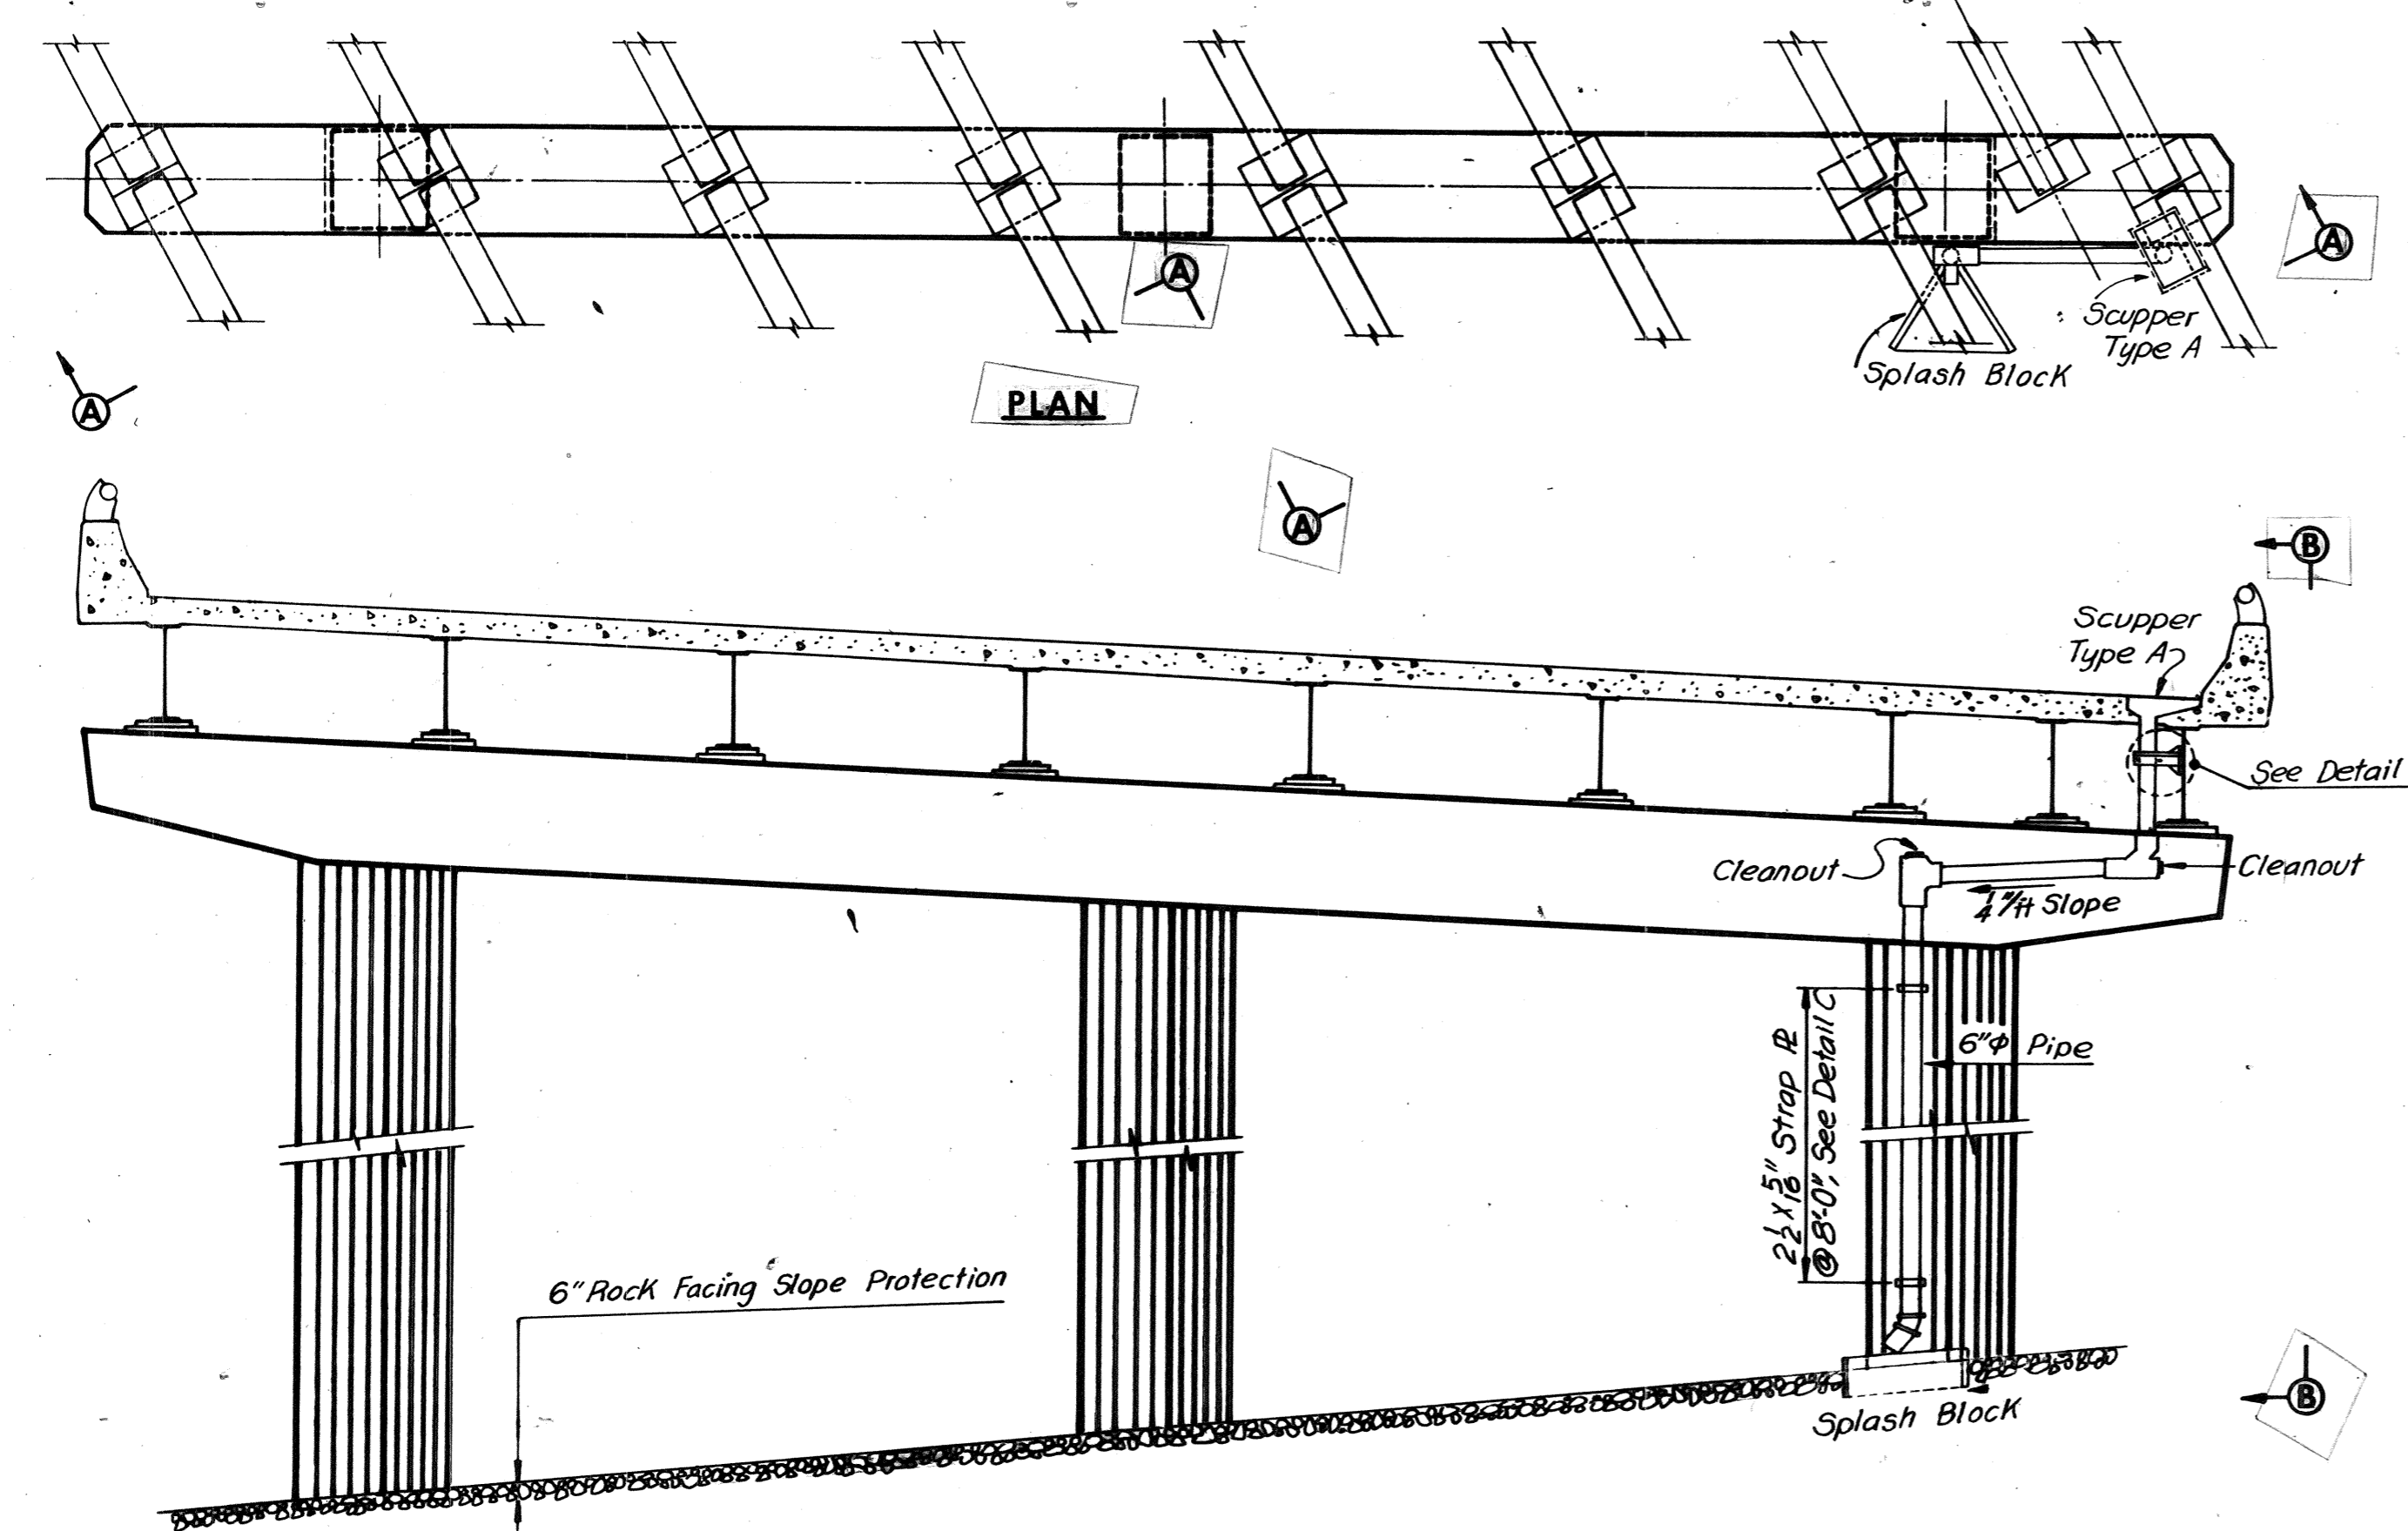

PLAN

VIEW A-A ELEVATION SUPPORT TYPE 1
Scale: 1/8" = 1'-0"

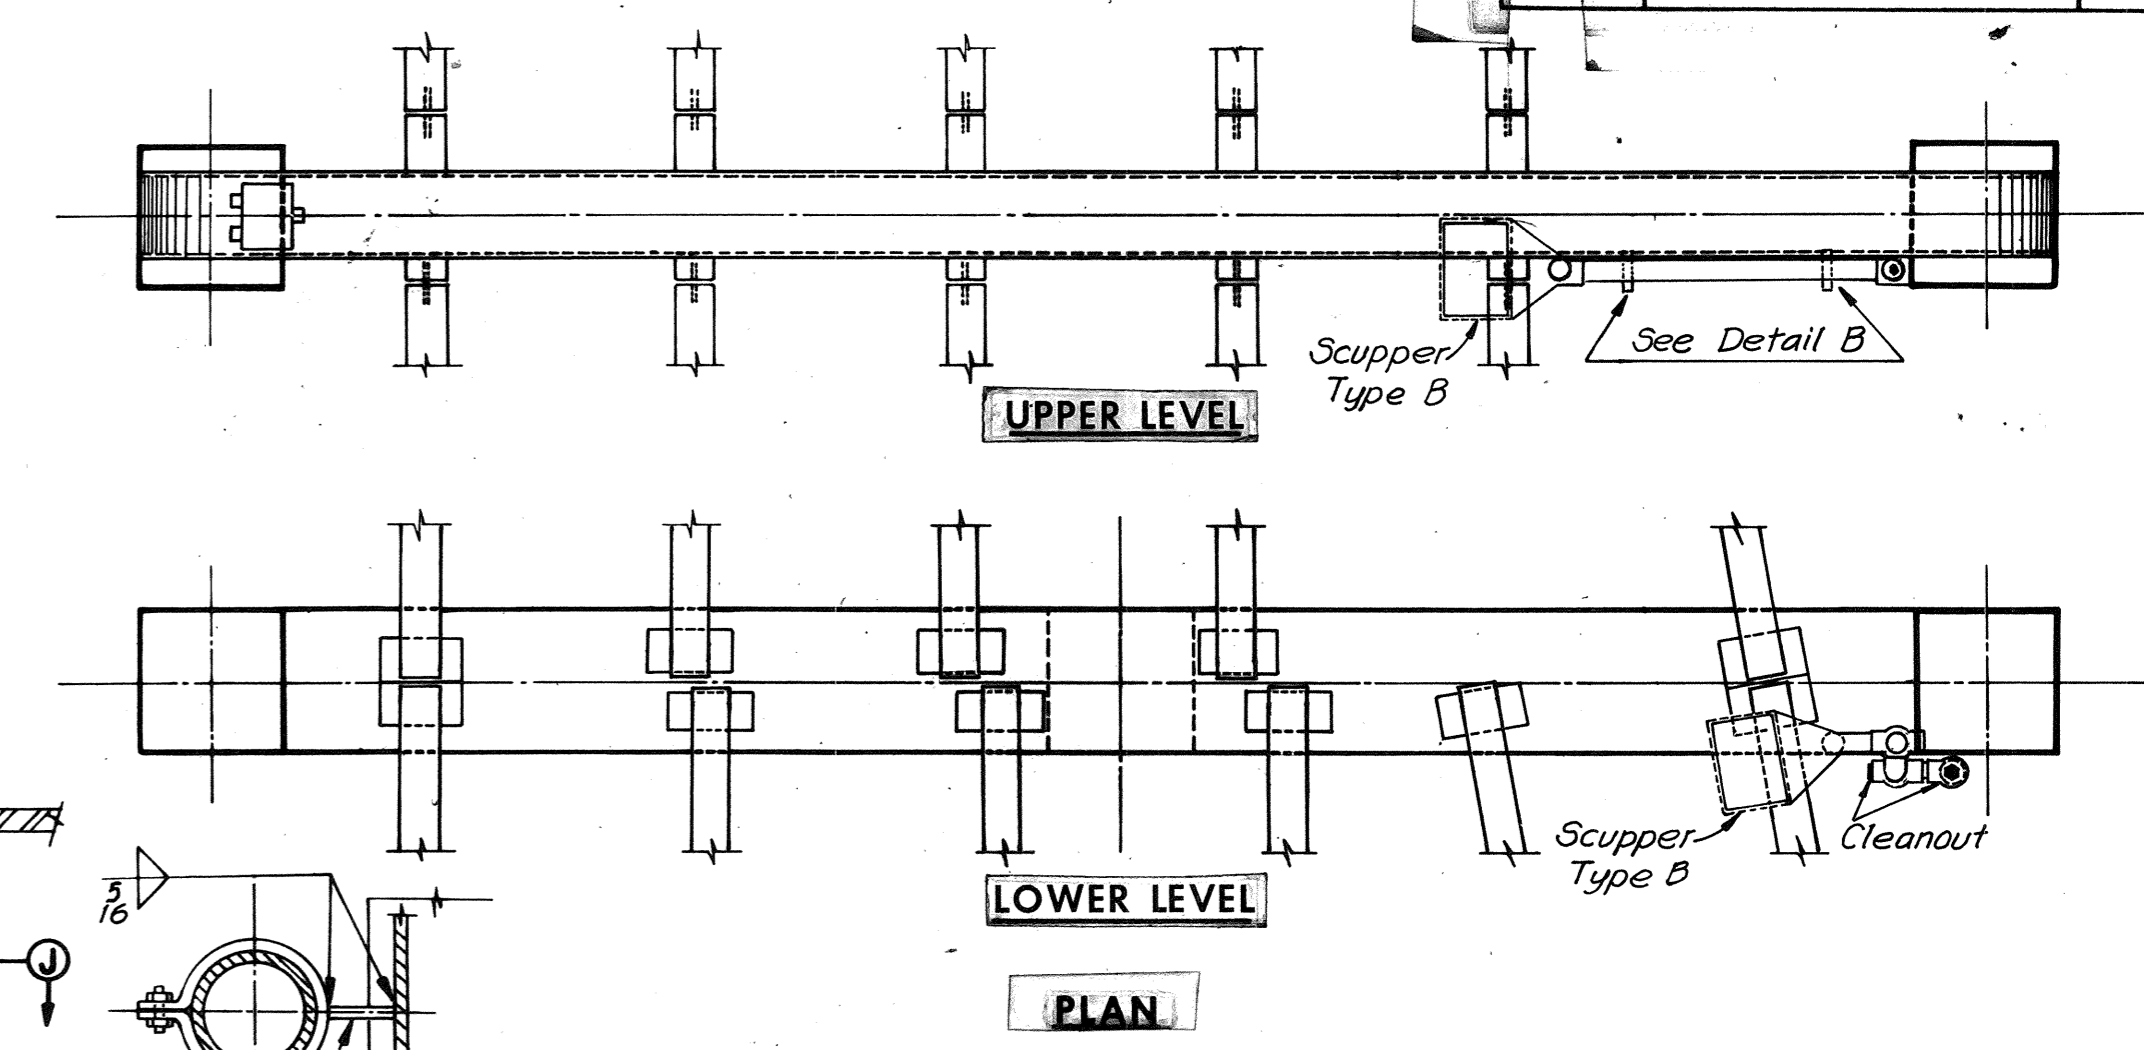


UPPER LEVEL

LOWER LEVEL


PLAN

Note: Remove existing scuppers at widening portions. Also remove enough concrete around these scuppers to provide required bond length (about 2'-0").

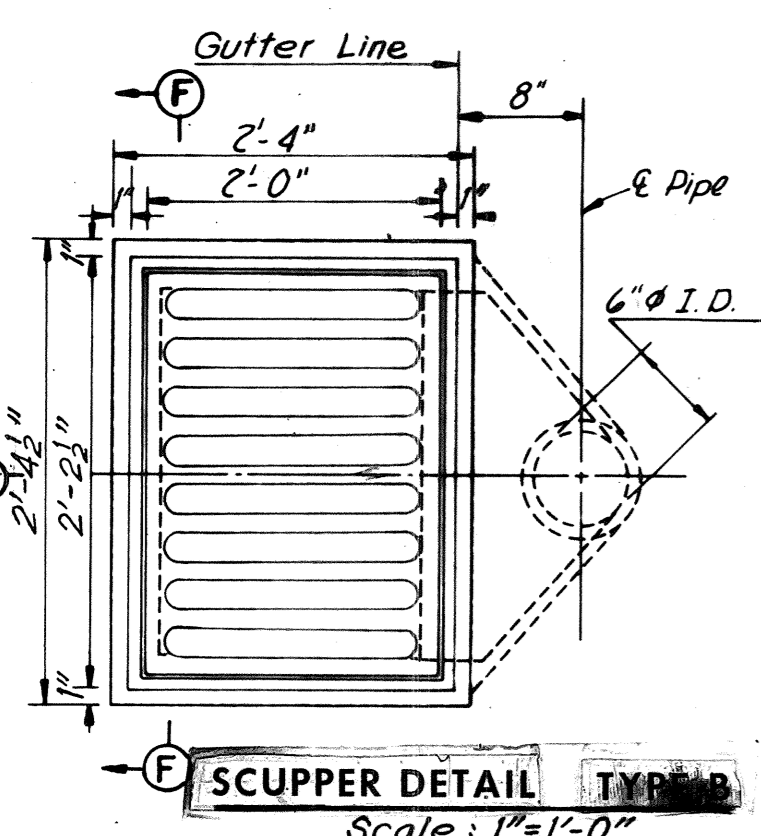


SCUPPER DETAIL TYPE B
Scale: 1" = 1'-0"


Note: For dimensions not given, see Scupper Detail, Type A.

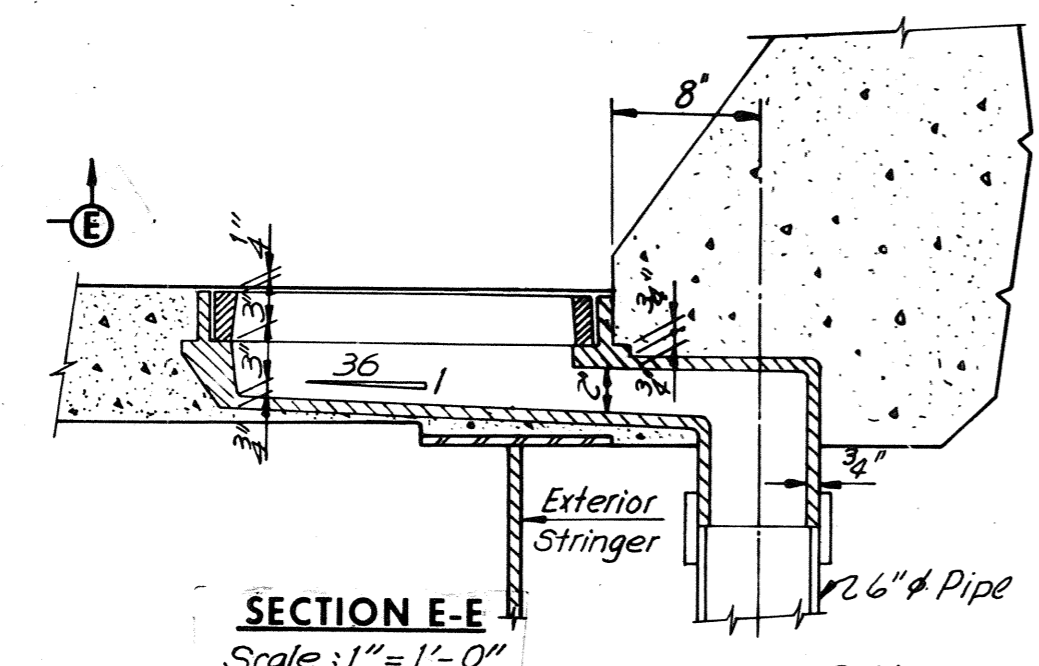


SECTION E-E
Scale: 1" = 1'-0"

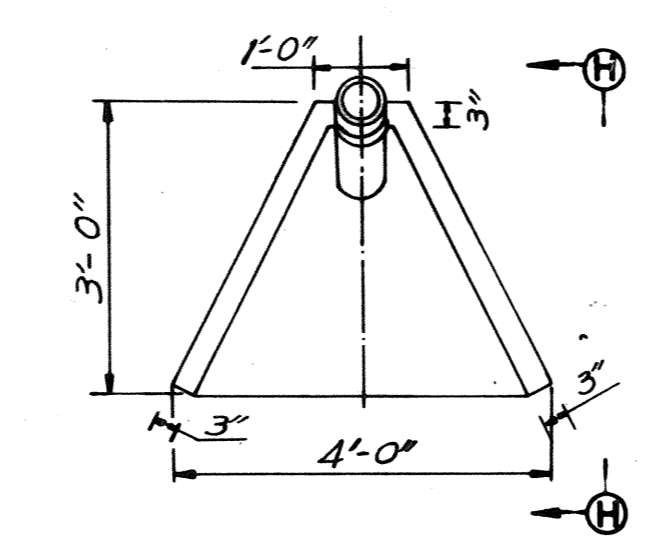


VIEW H-H
Scale: 1" = 1'-0"

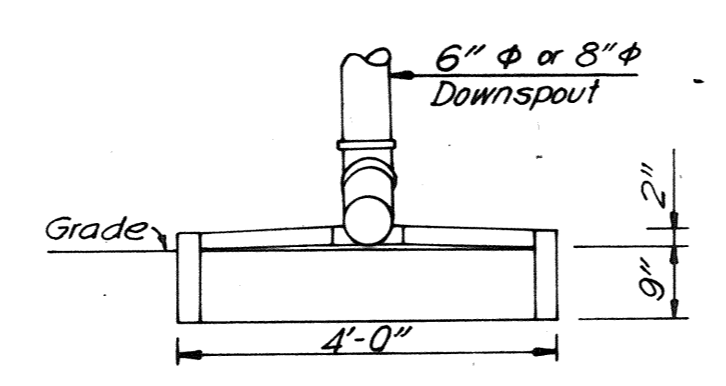


SPLASH BLOCK DETAIL
Scale: 1" = 1'-0"

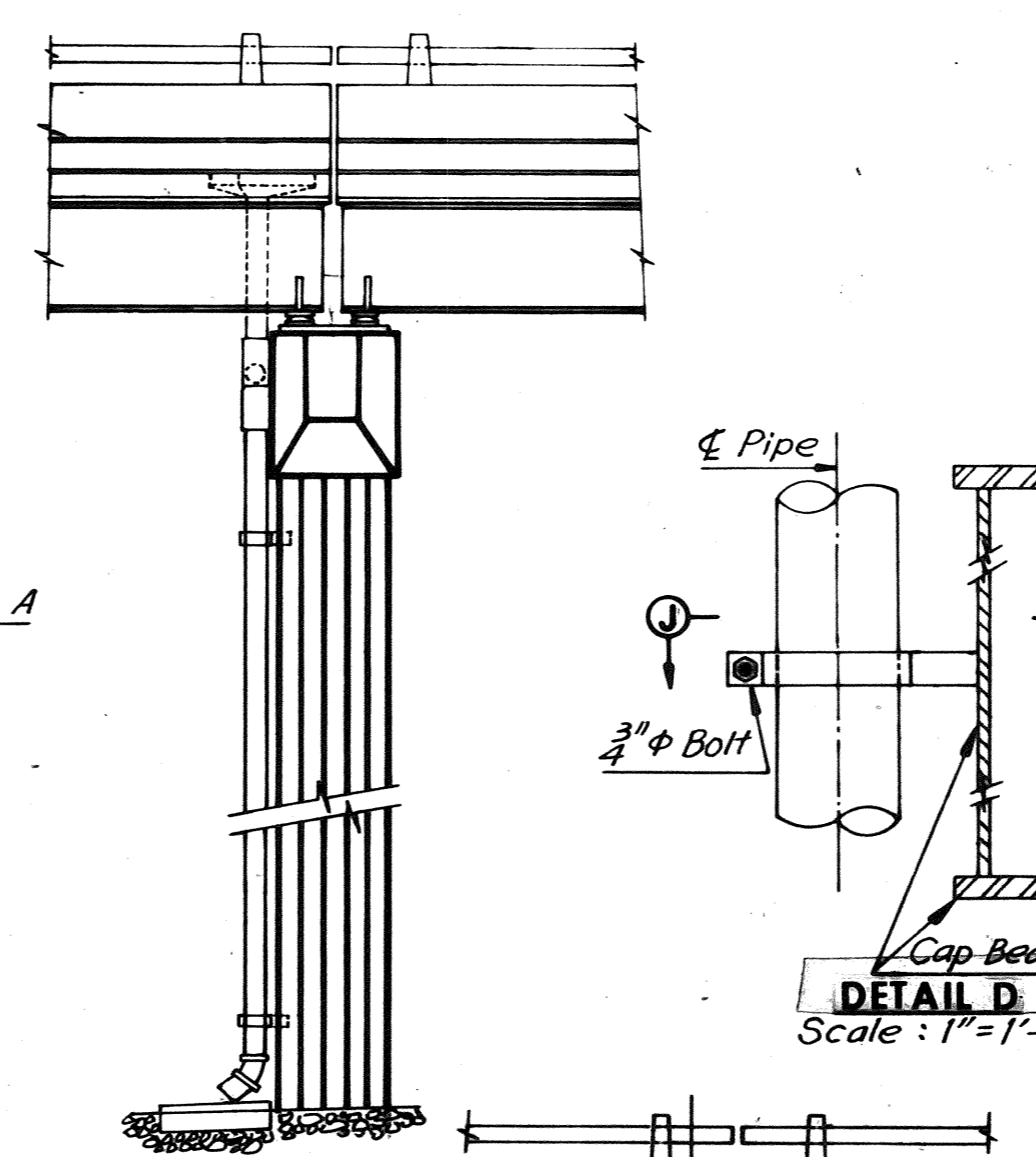


VIEW B-B
Scale: 1/8" = 1'-0"

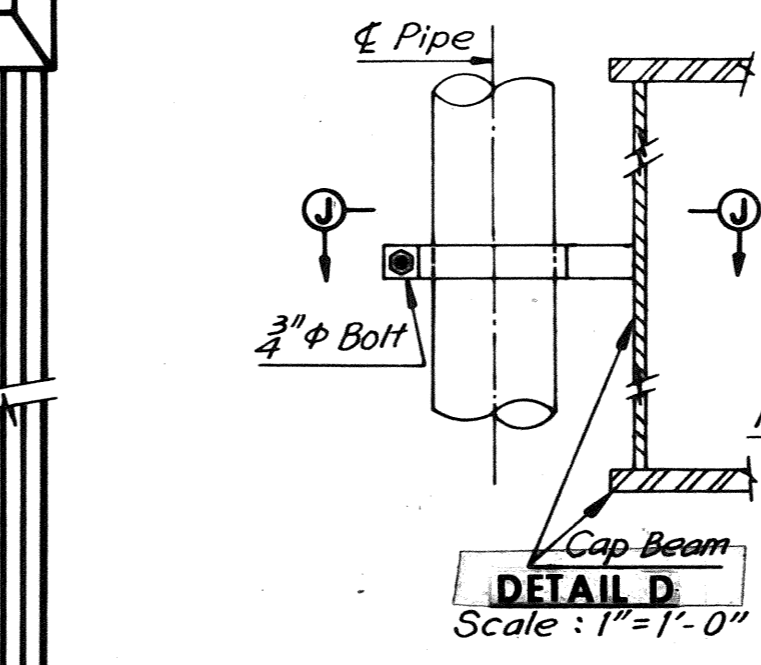


DETAIL D
Scale: 1" = 1'-0"

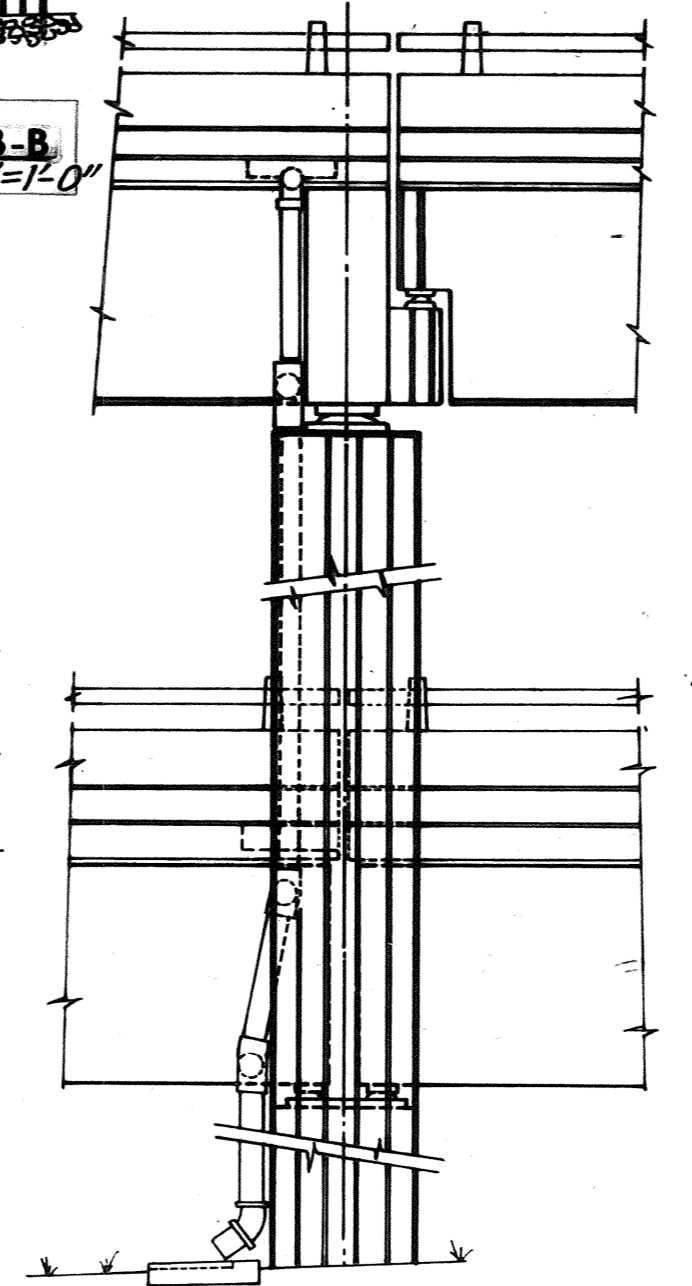


VIEW G-G
Scale: 3/8" = 1'-0"

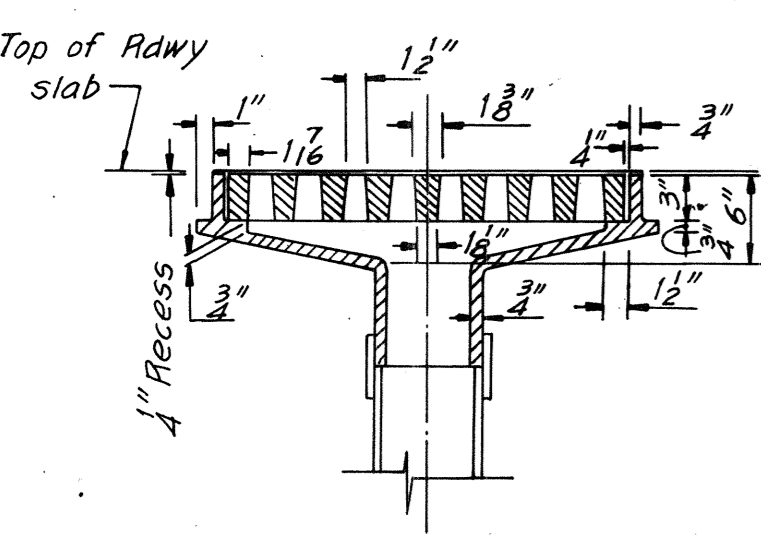

SECTION D-D
Scale: 1" = 1'-0"

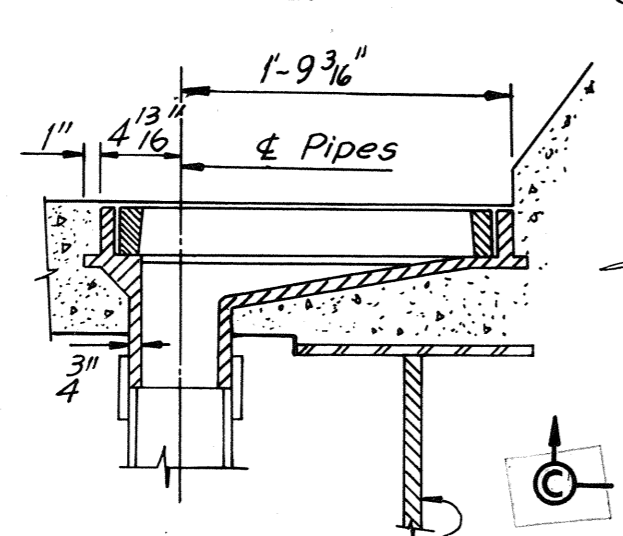


SECTION C-C
Scale: 1" = 1'-0"

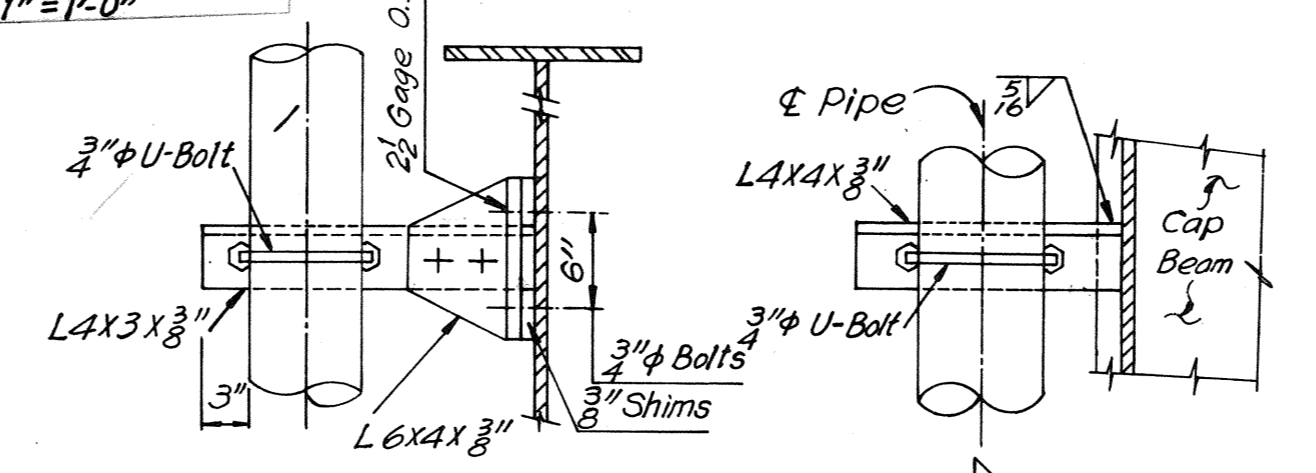


DETAIL A
Scale: 1" = 1'-0"

DETAIL B
Scale: 1" = 1'-0"

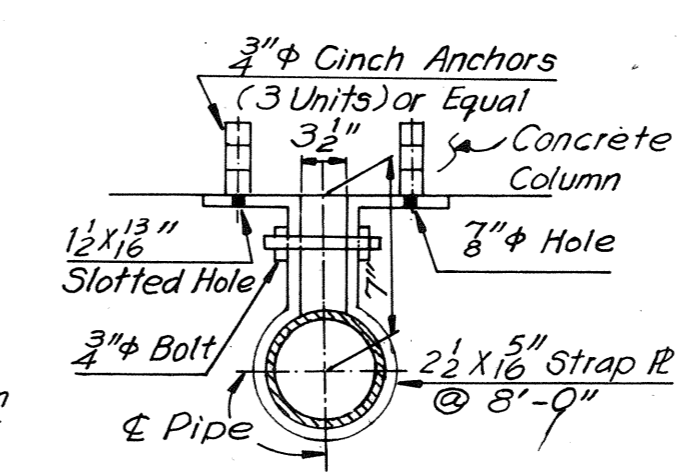

DETAIL C
Scale: 1" = 1'-0"

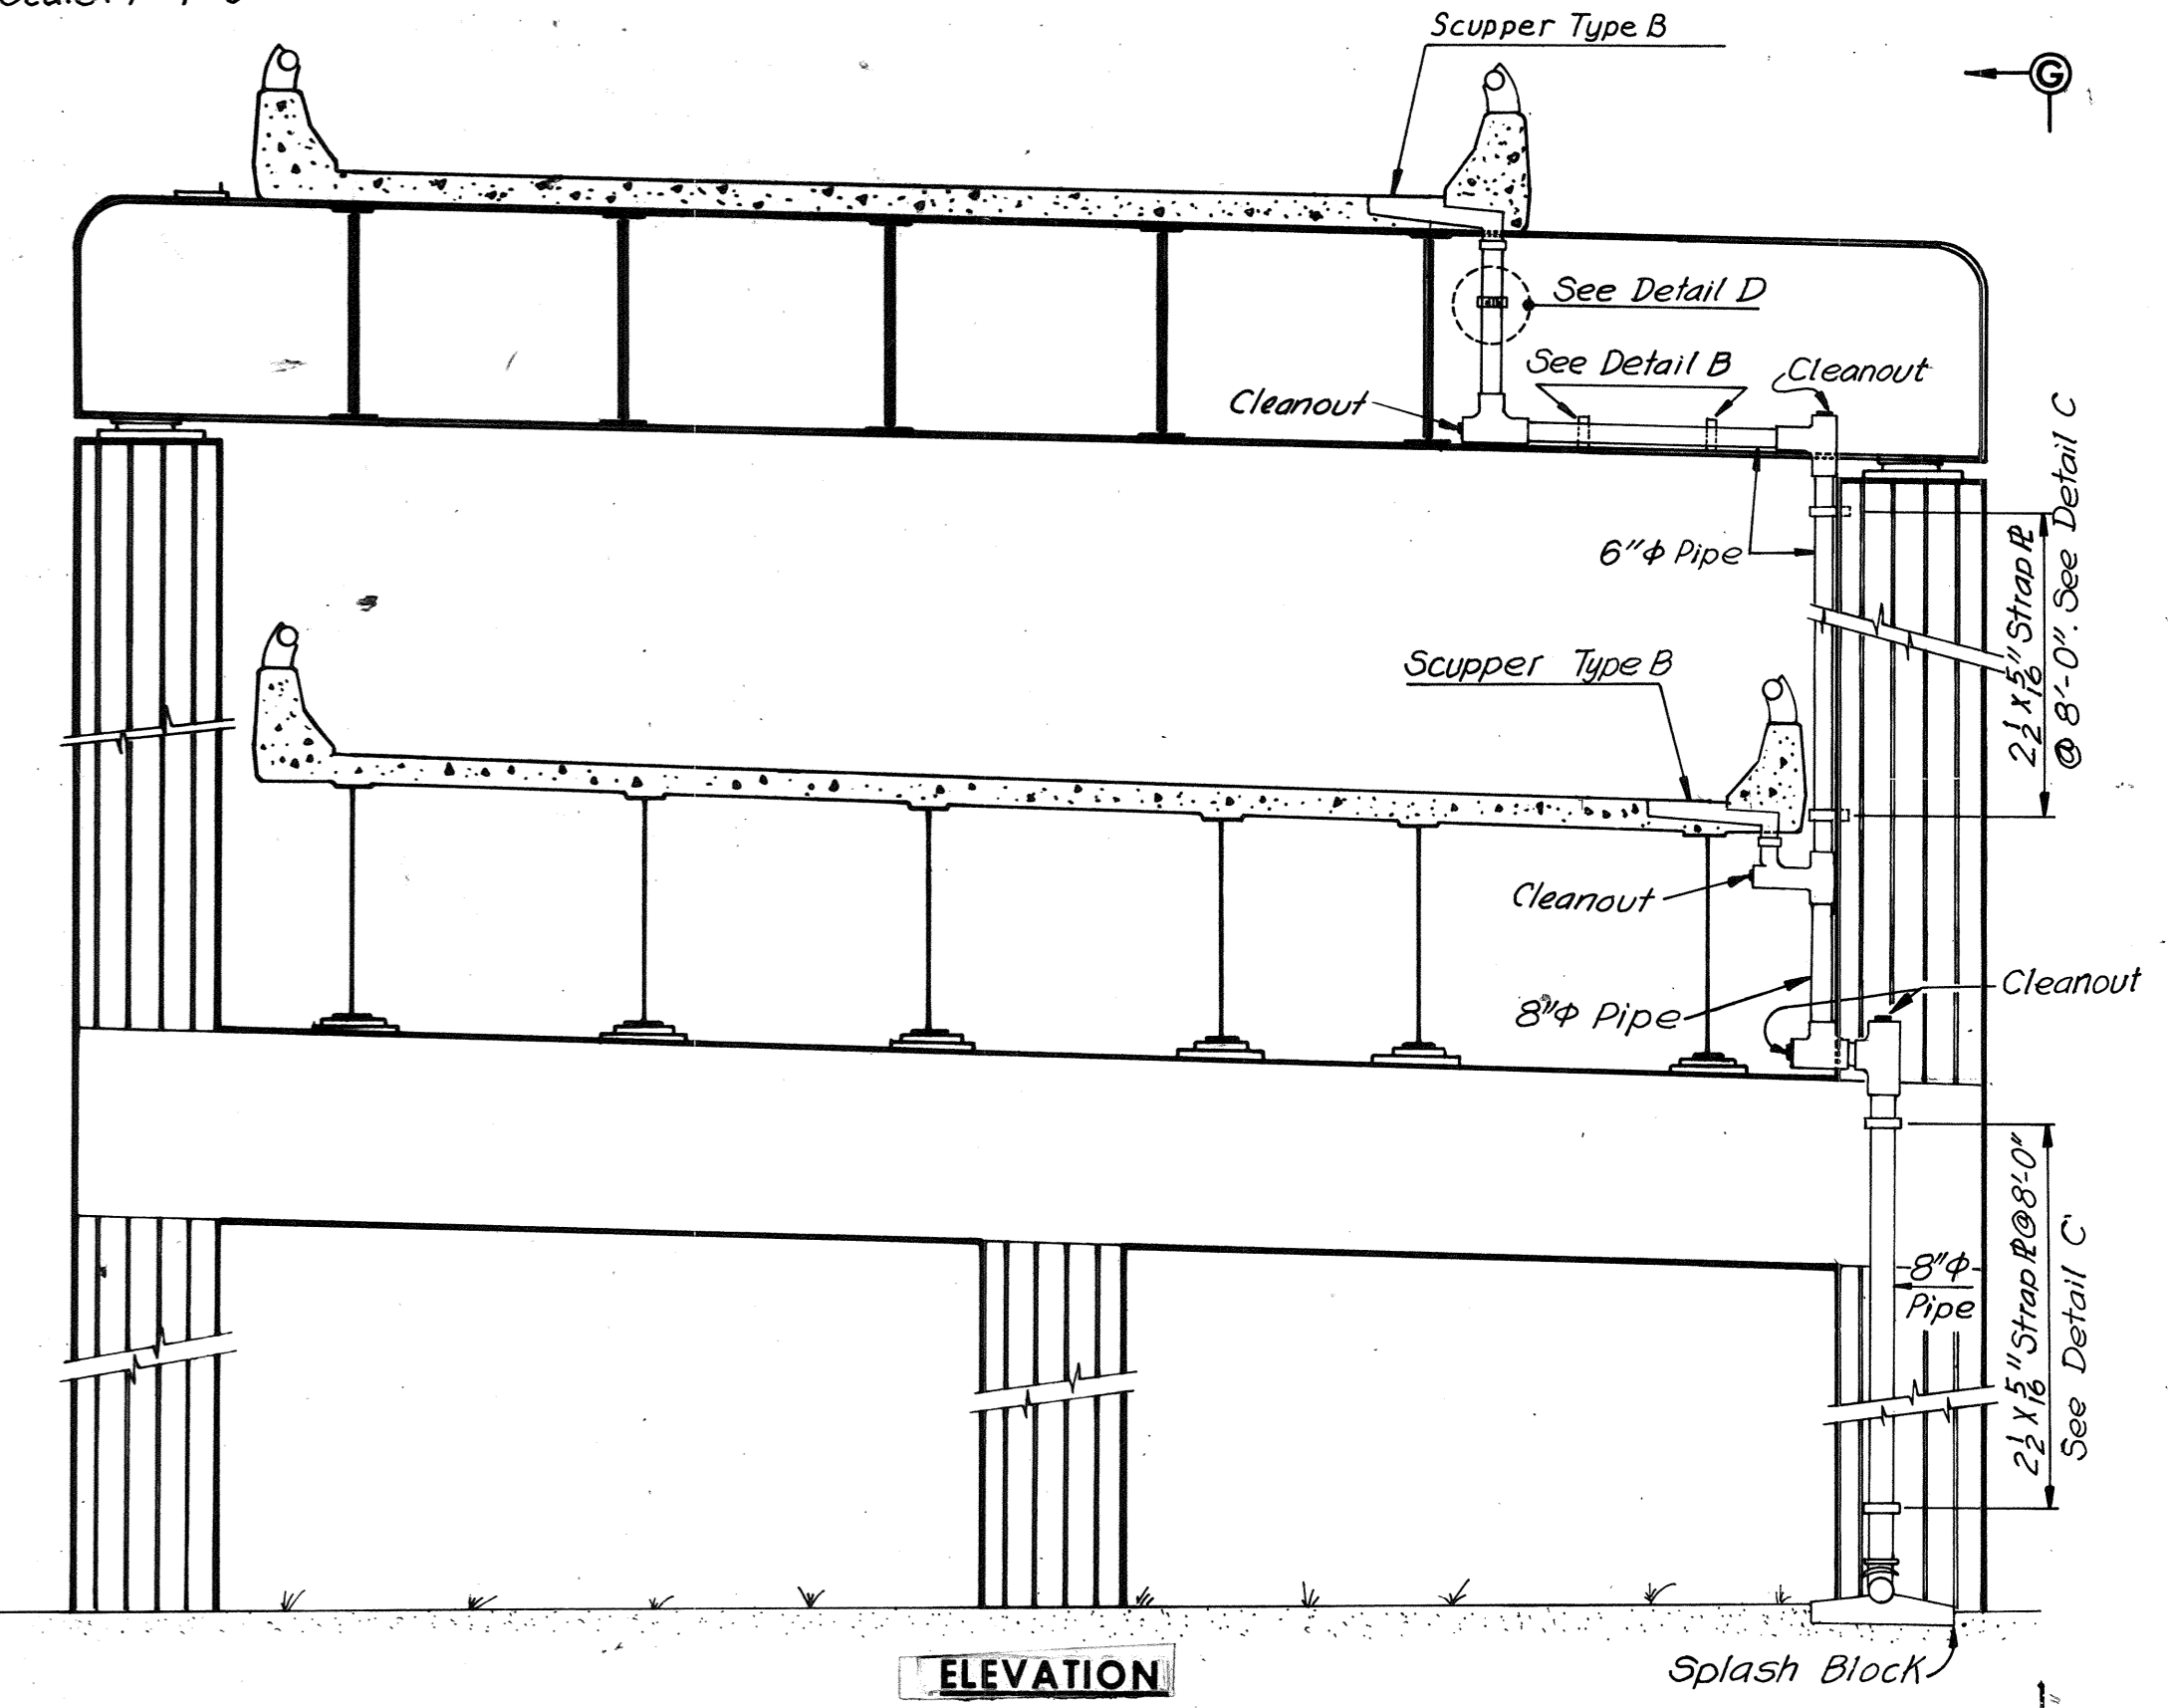

ELEVATION

SUPPORT TYPE 2
Scale: 3/8" = 1'-0"

Note: Where existing scuppers are to be removed, concrete shall be removed 2'-0" minimum from the edges of scuppers.

BY	DATE	REVISION	BY	DATE
BY	10-10-69	Perapet Changed PRMS		4-19-72
CHECKED	G.S.H.			
IN CHARGE				










RICHMOND METROPOLITAN AUTHORITY
RICHMOND EXPRESSWAY SYSTEM
DOWNTOWN EXPRESSWAY

STANDARD DRAINAGE DETAILS



HOWARD, NEEDLES, TAMMEN & BERGENDOFF
consulting engineers
NEW YORK ALEXANDRIA KANSAS CITY

SCALE: As Noted
CONTRACT NO. 11
SHEET NO. 55 OF 6




RICHMOND EXPRESSWAY SYSTEM			
SECTION	PROJECT	SHEET NO.	TOTAL SHEETS
II	DOWNTOWN EXPRESSWAY	97	97

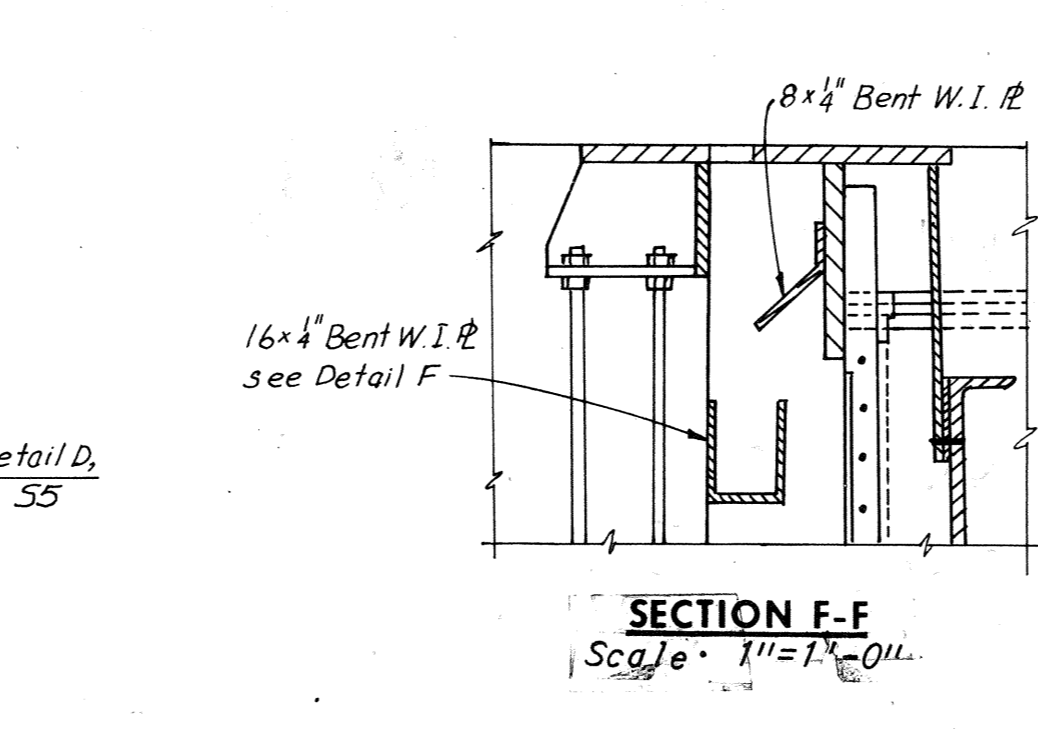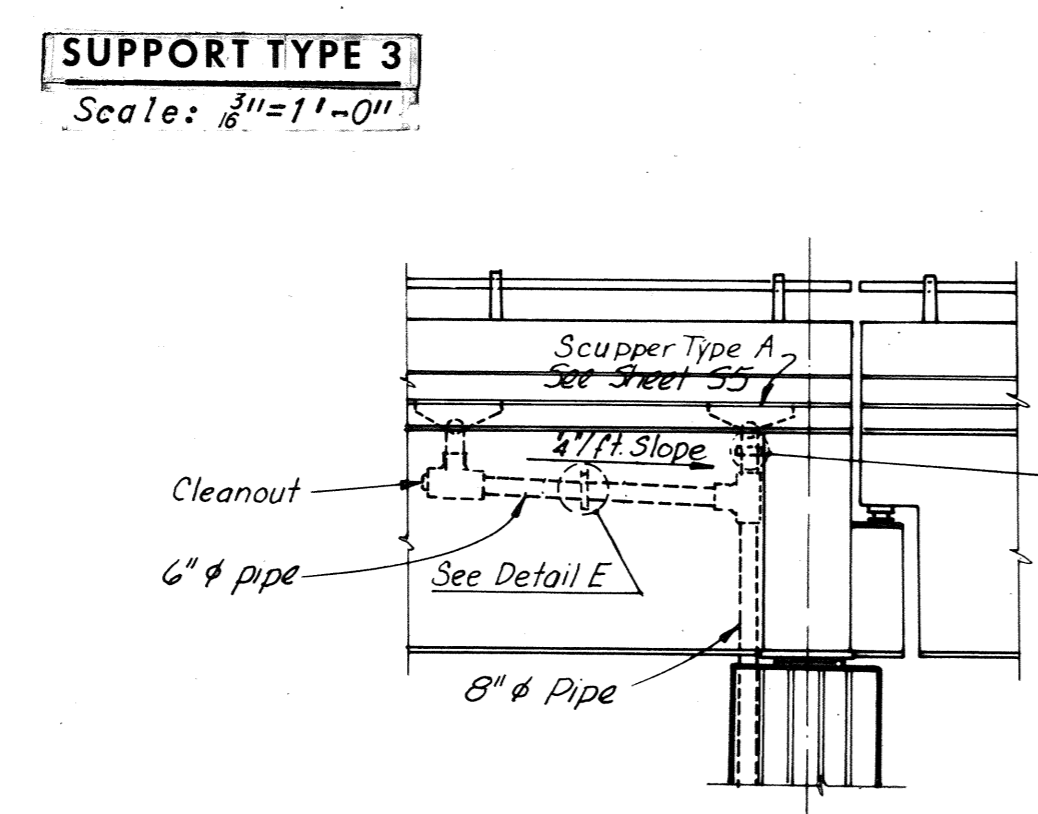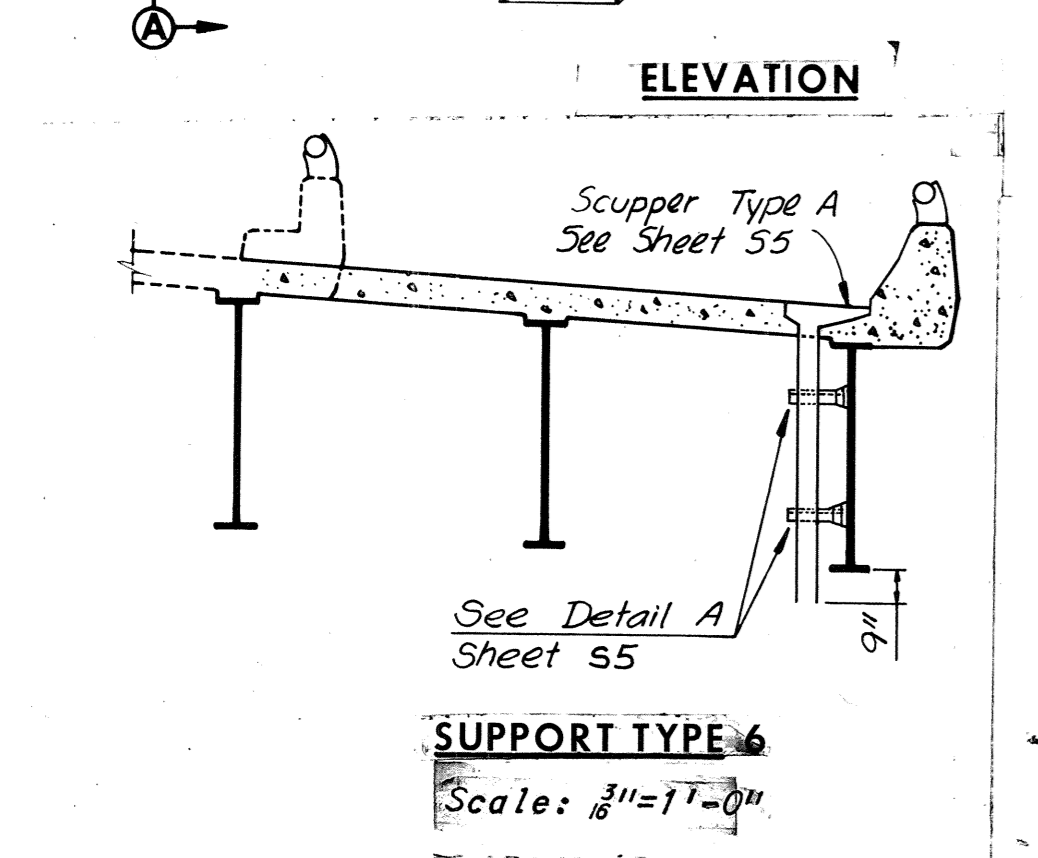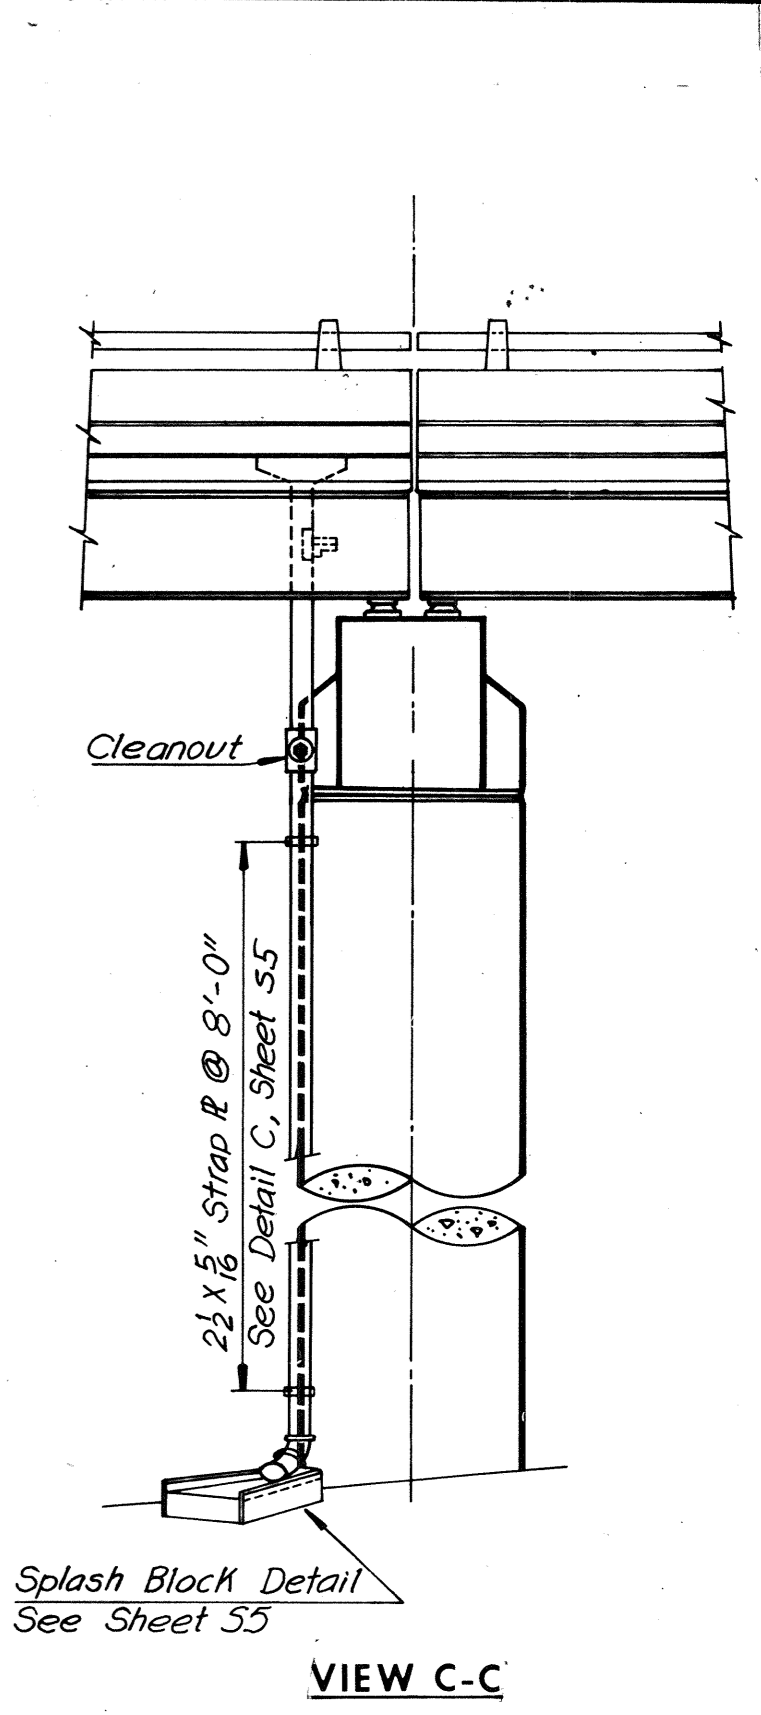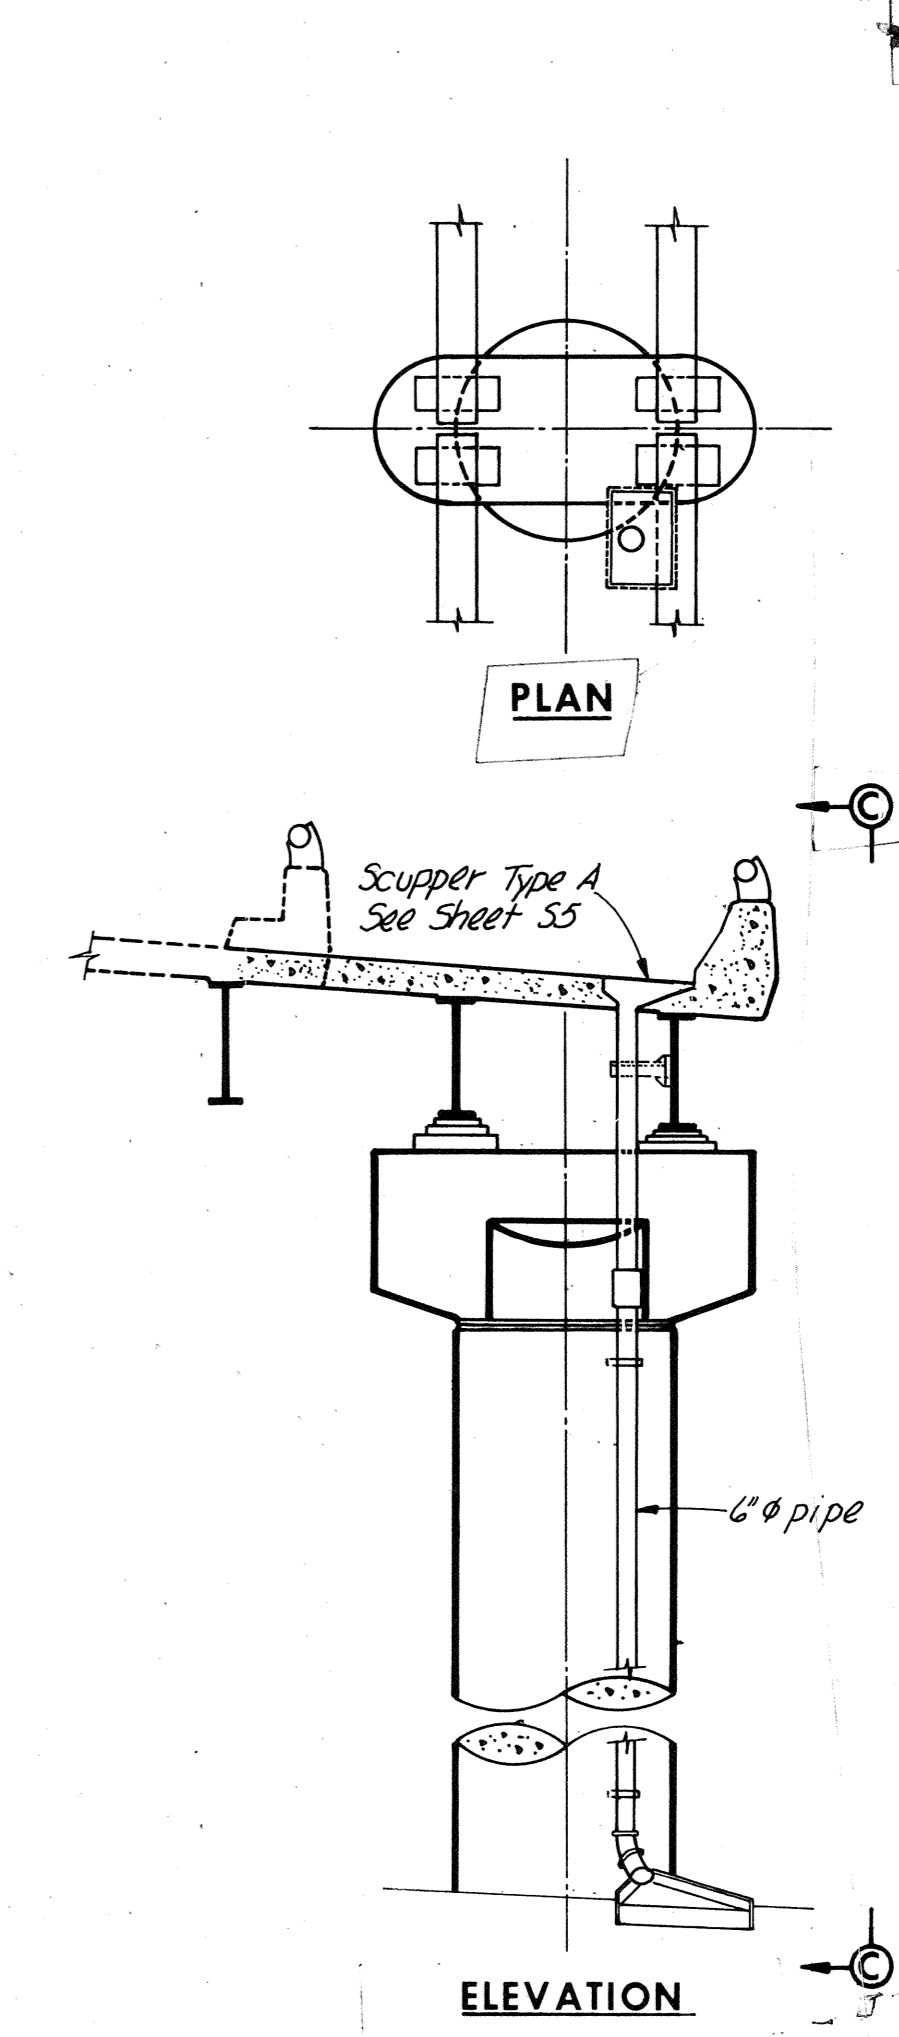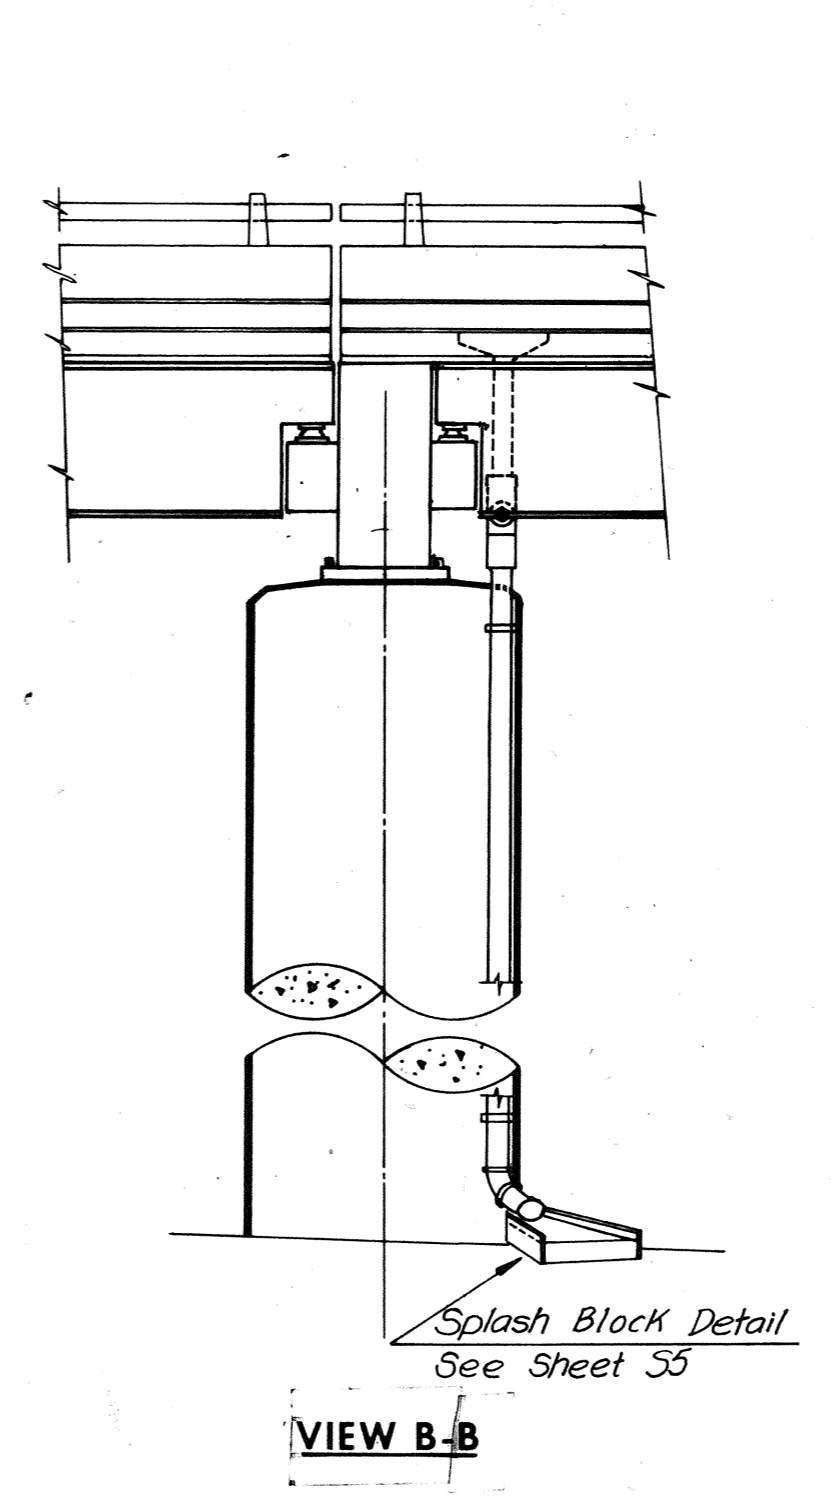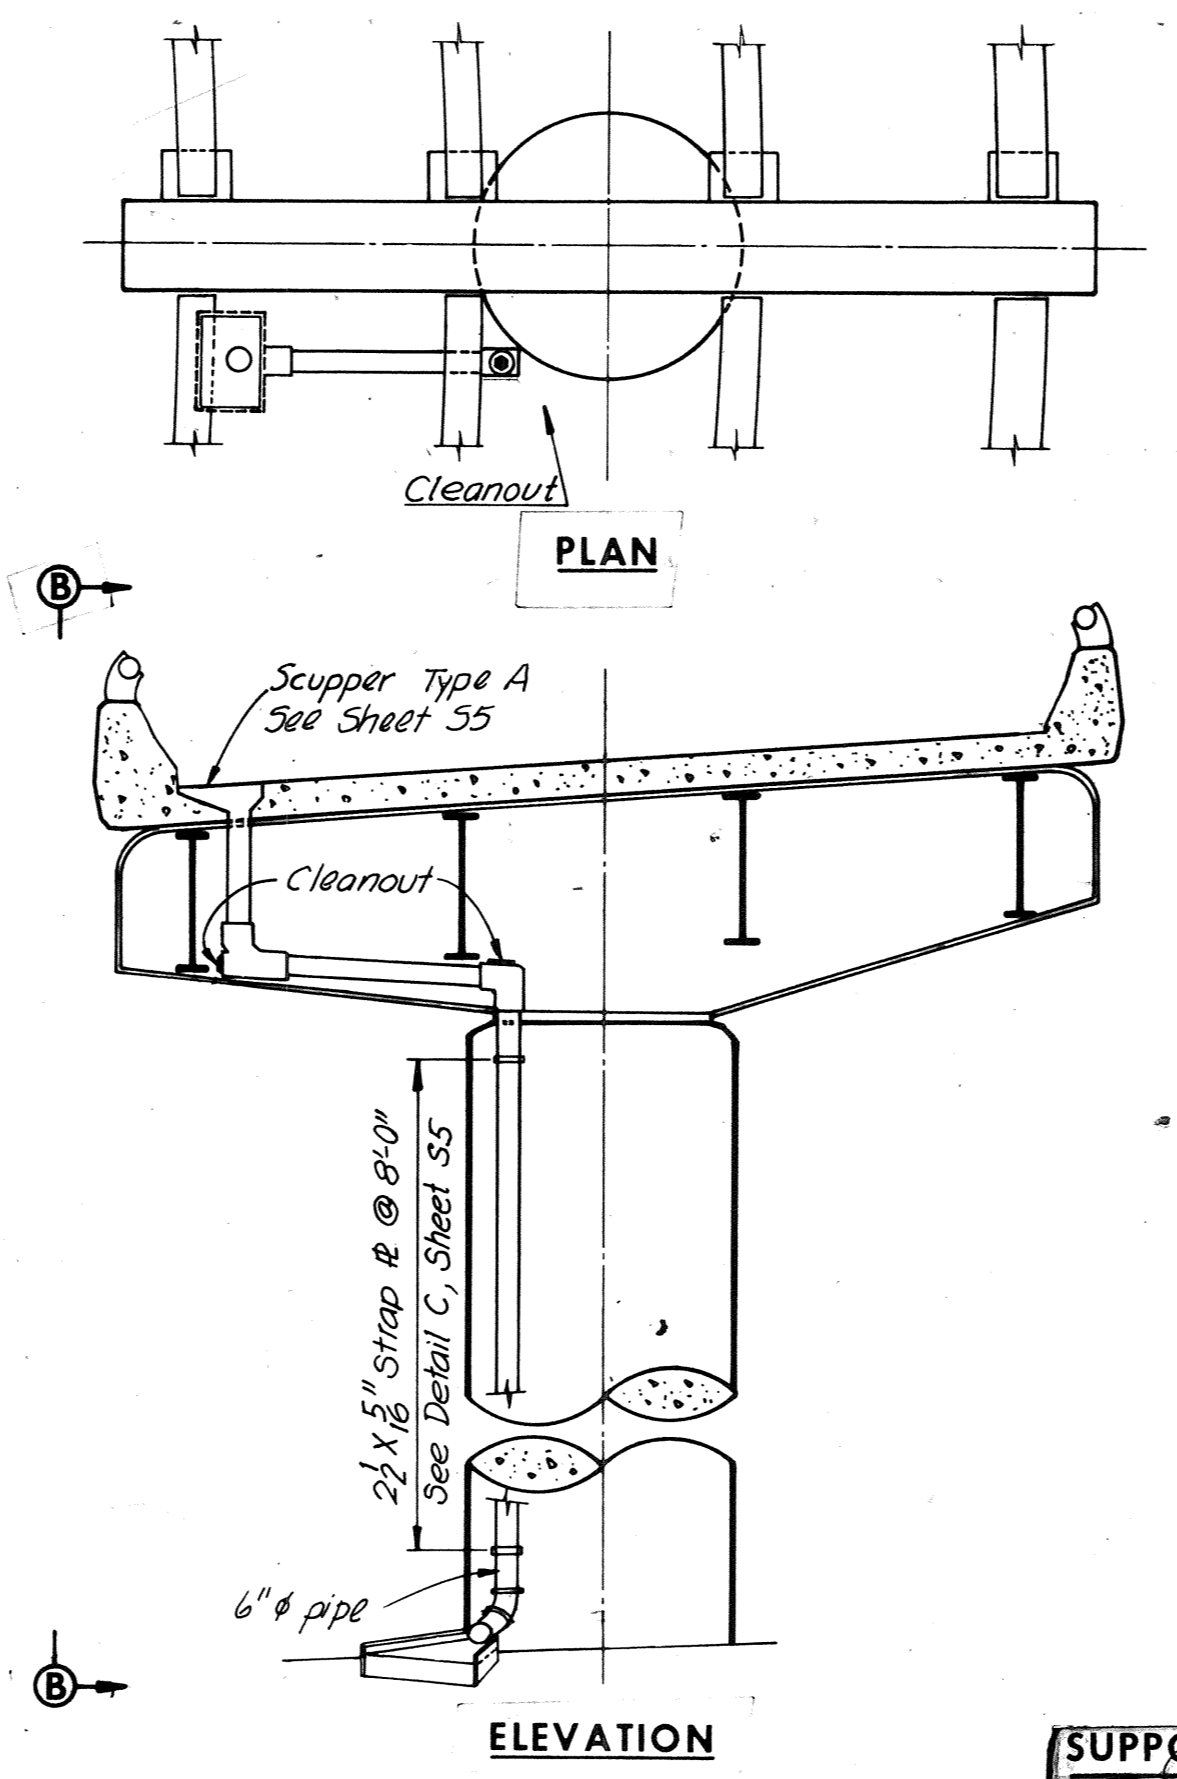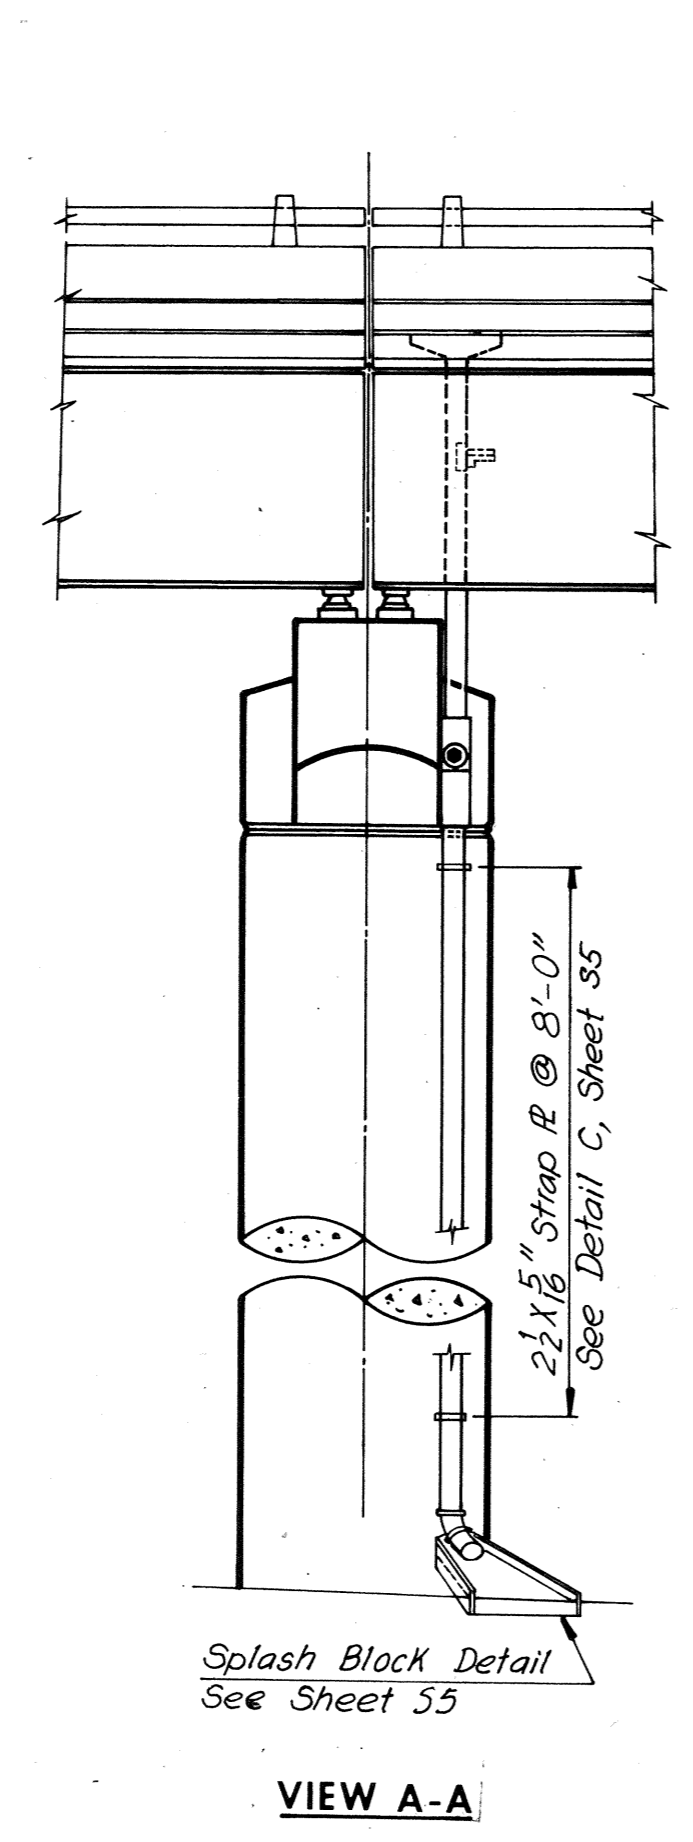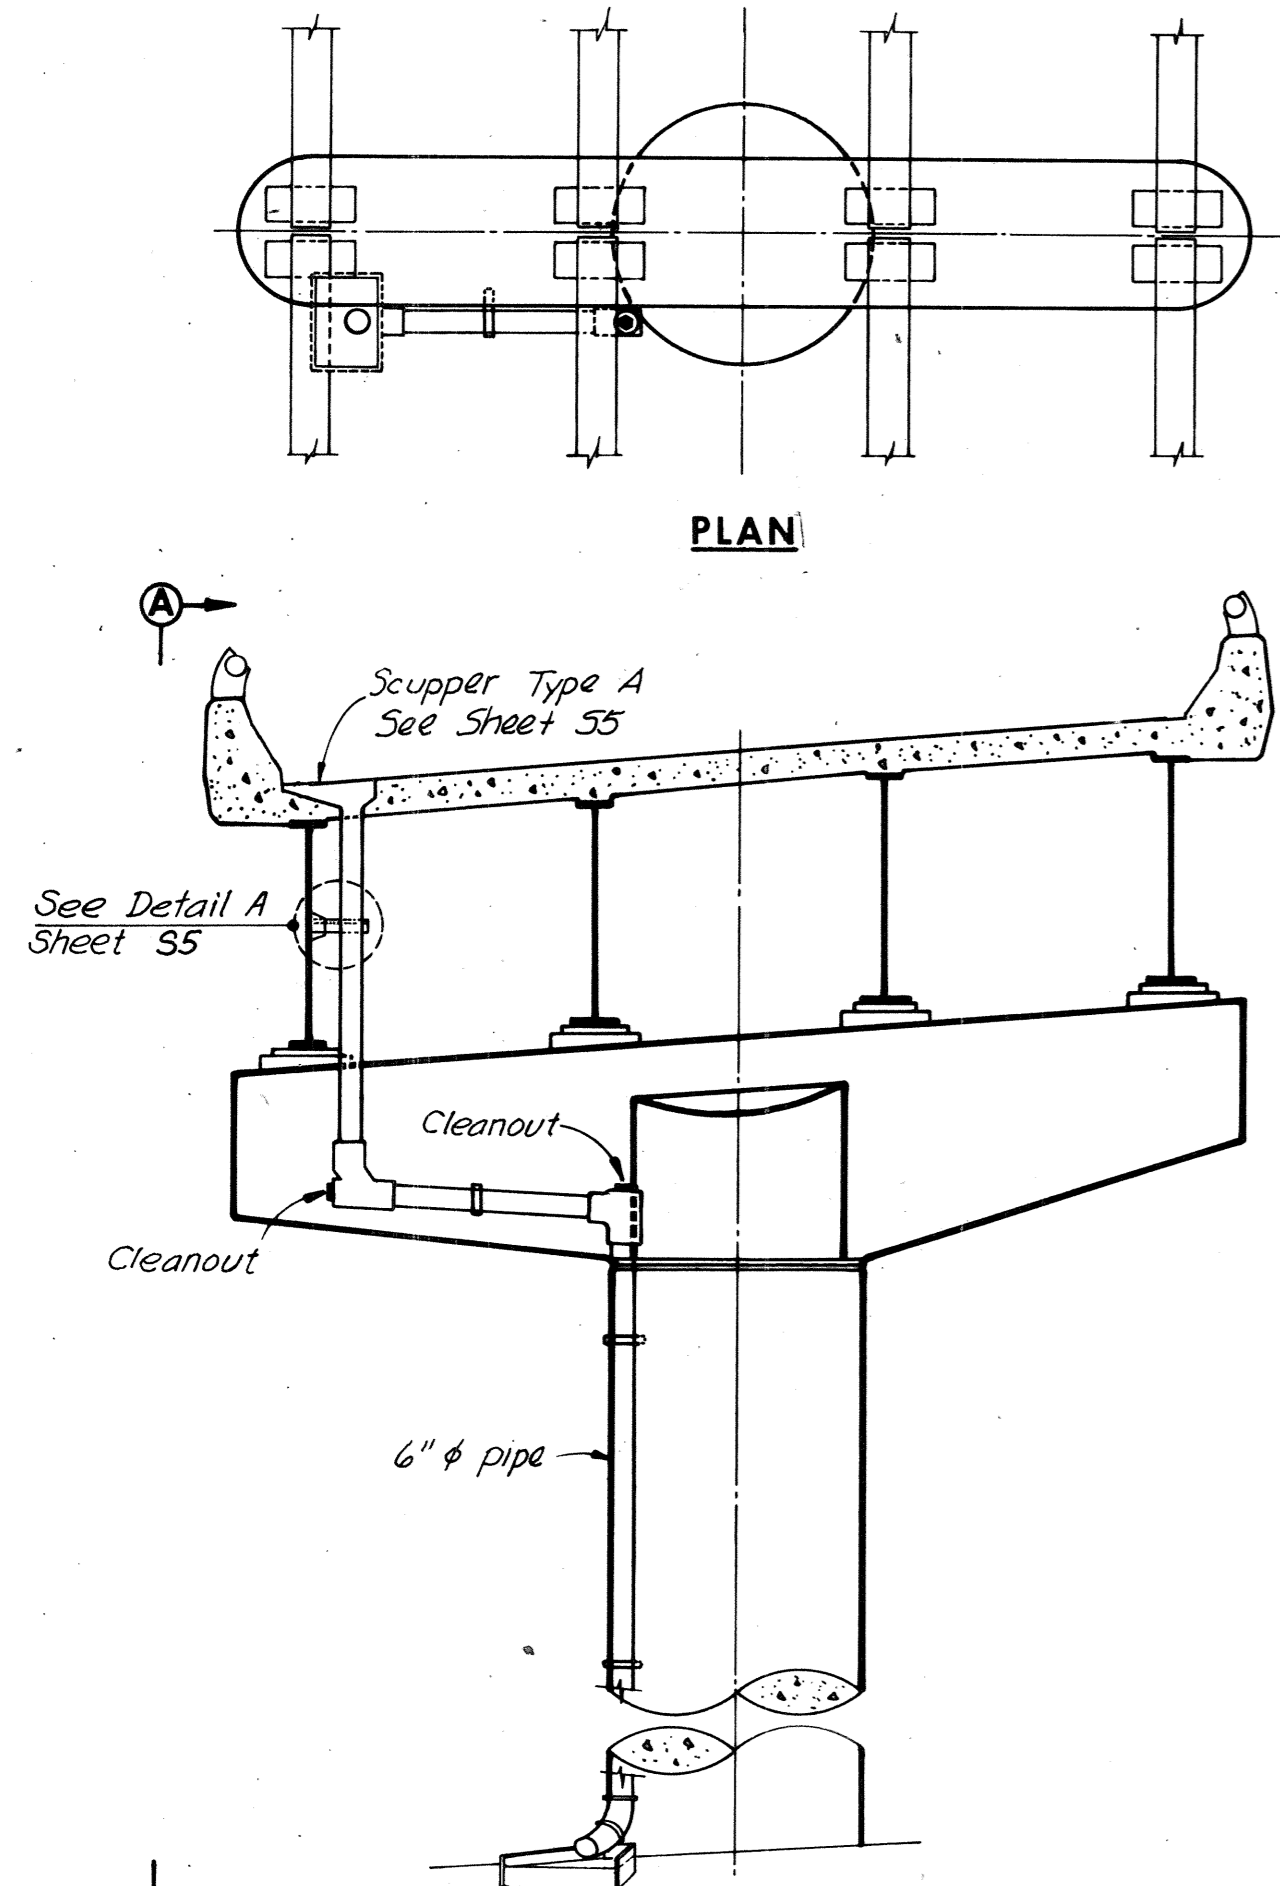



SUPPORT TYPE 4
Scale: 3/8"=1'-0"

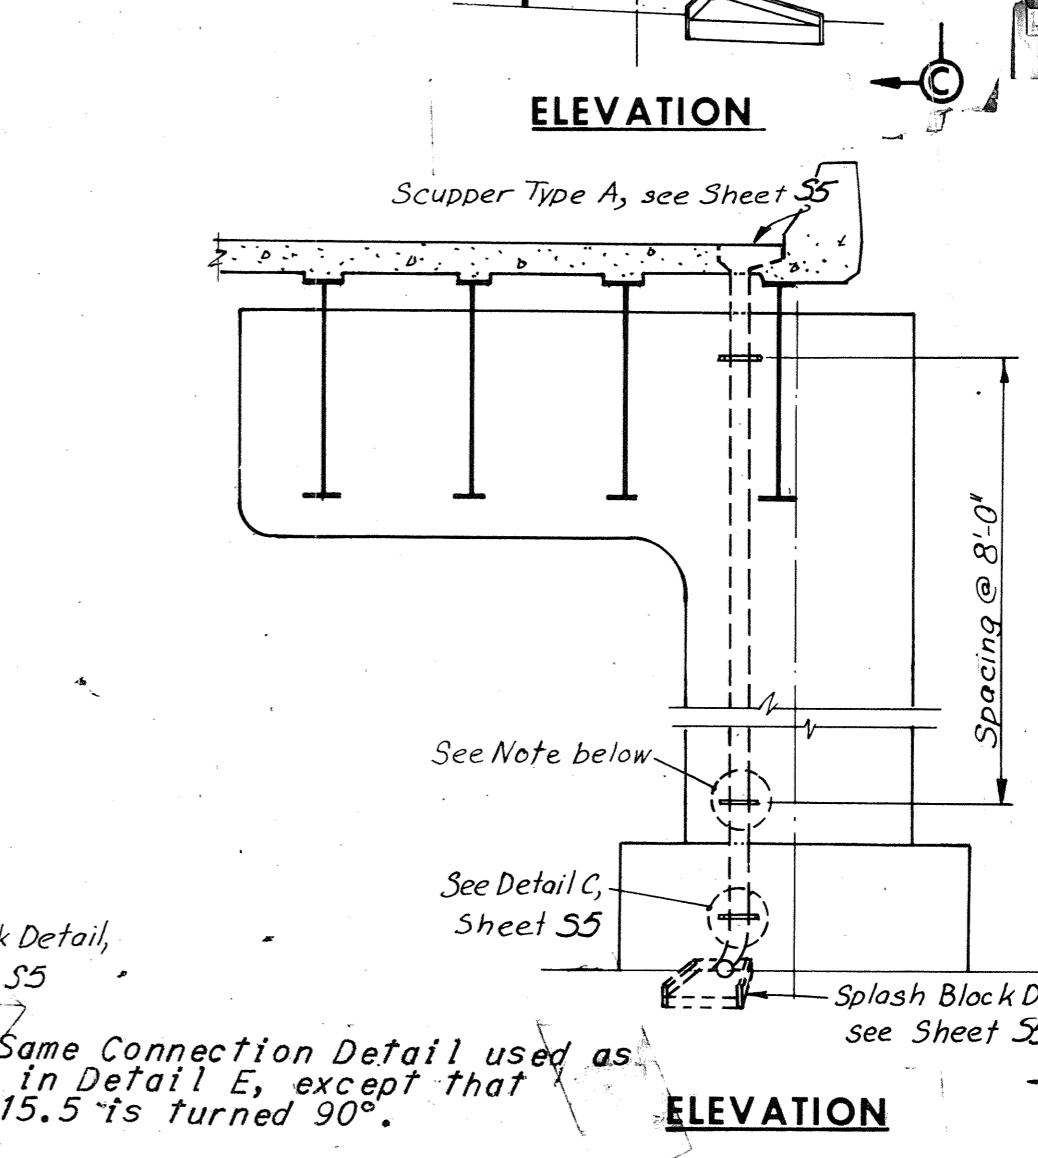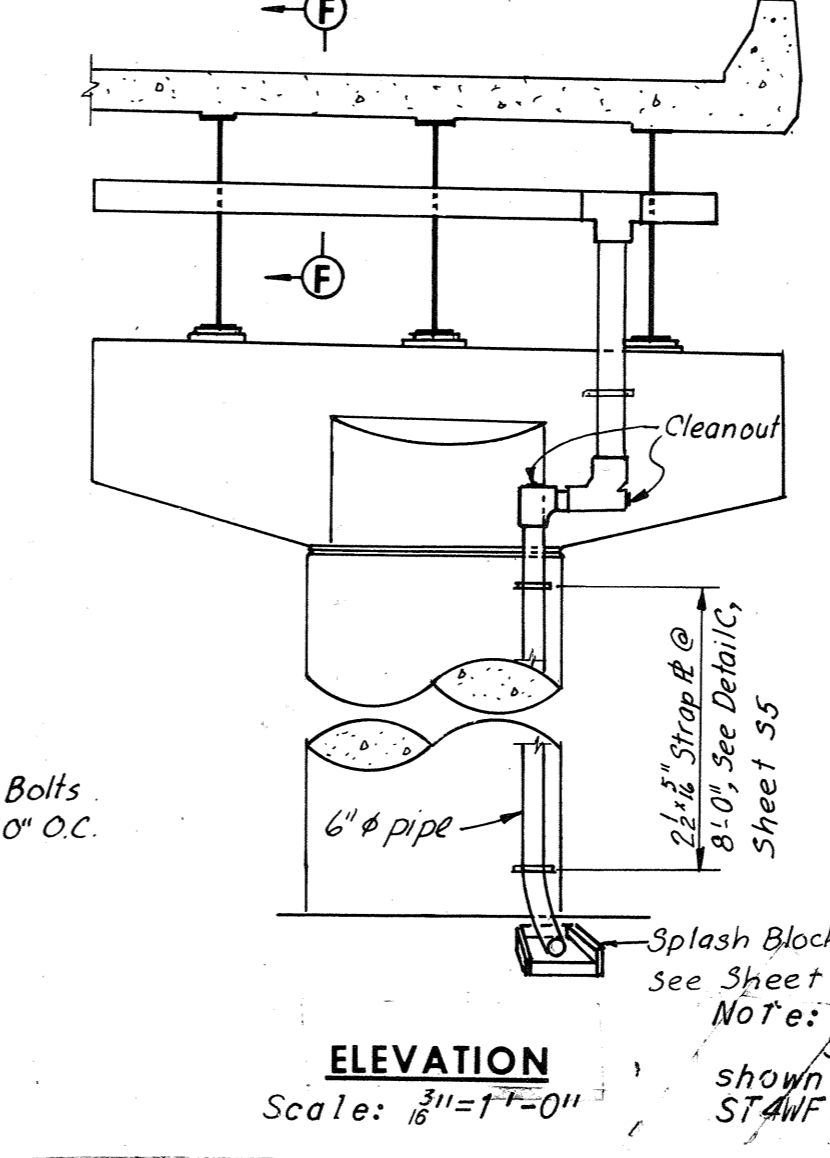


SUPPORT TYPE 5
Scale: 3/8"=1'-0"

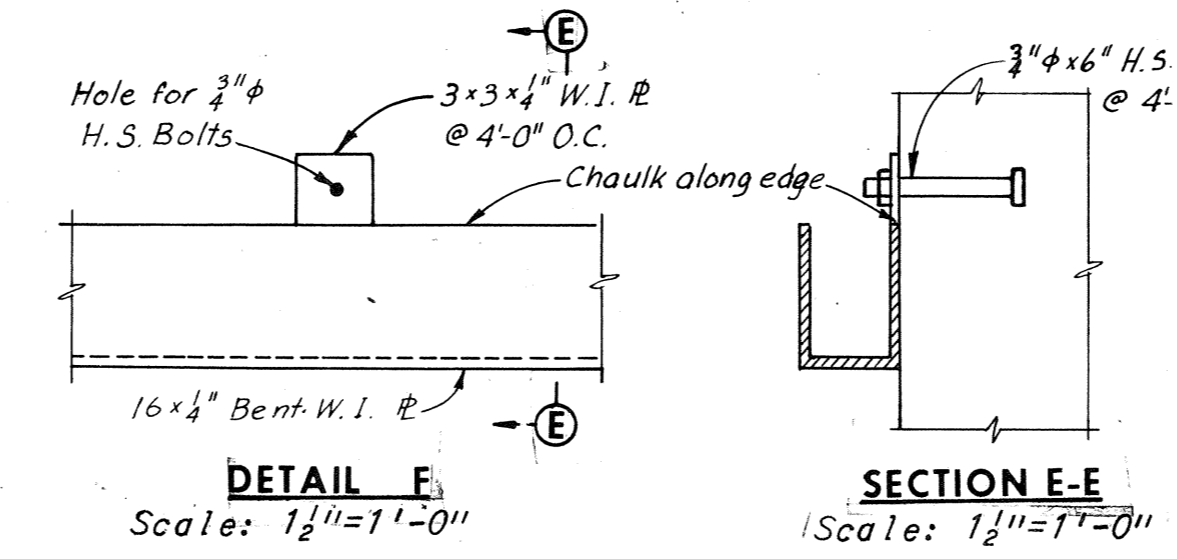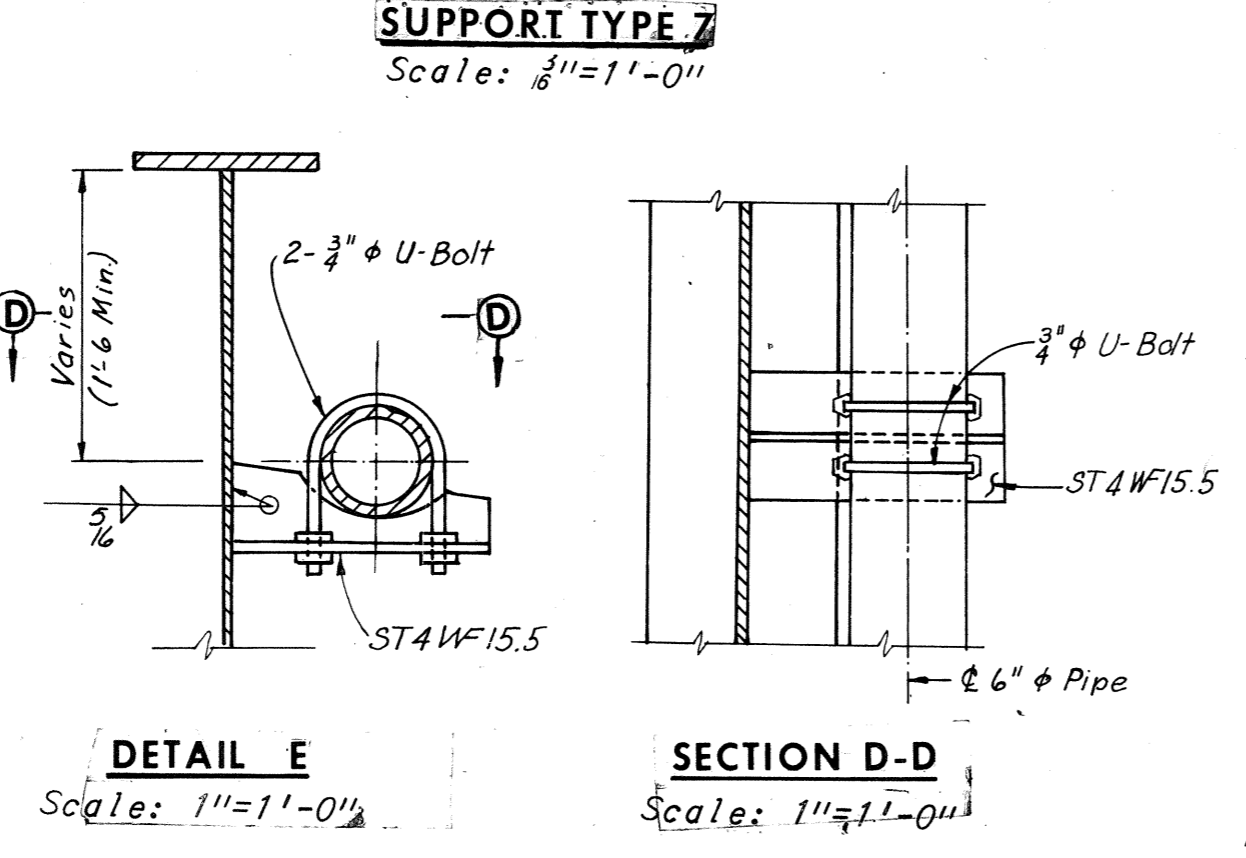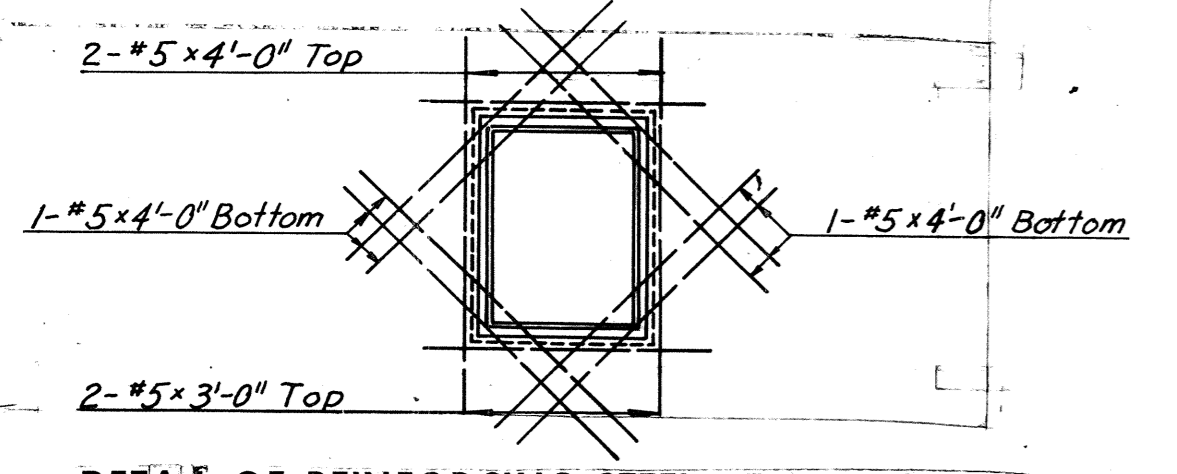

SUPPORT TYPE 6
Scale: 3/8"=1'-0"

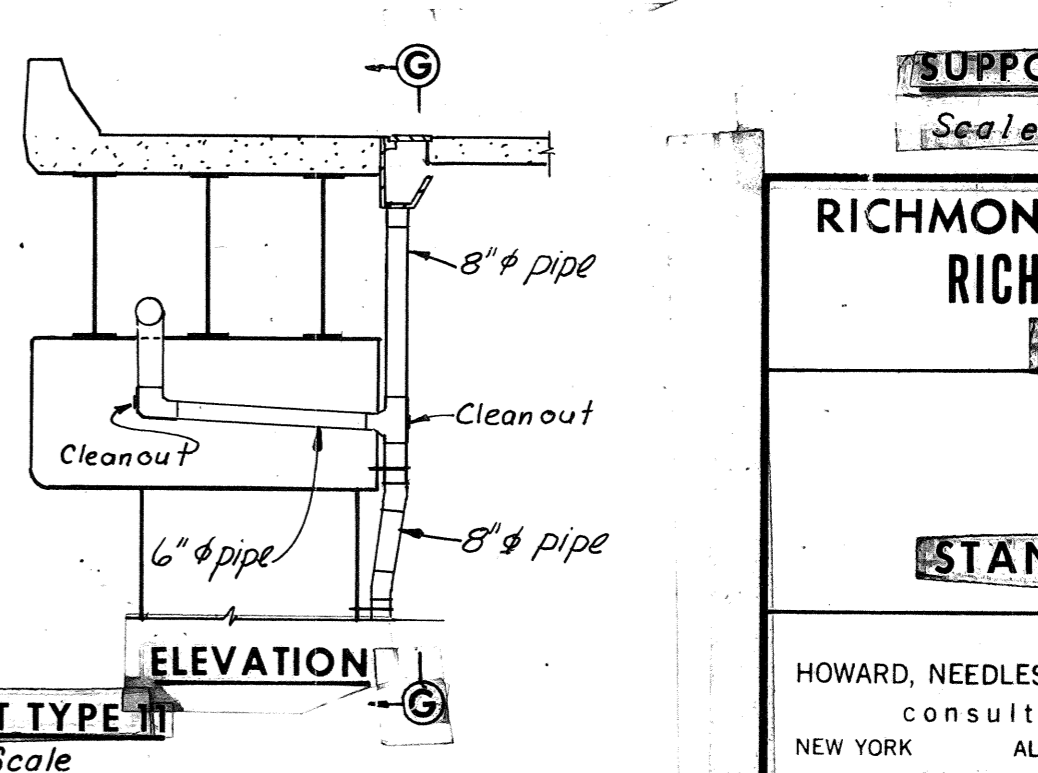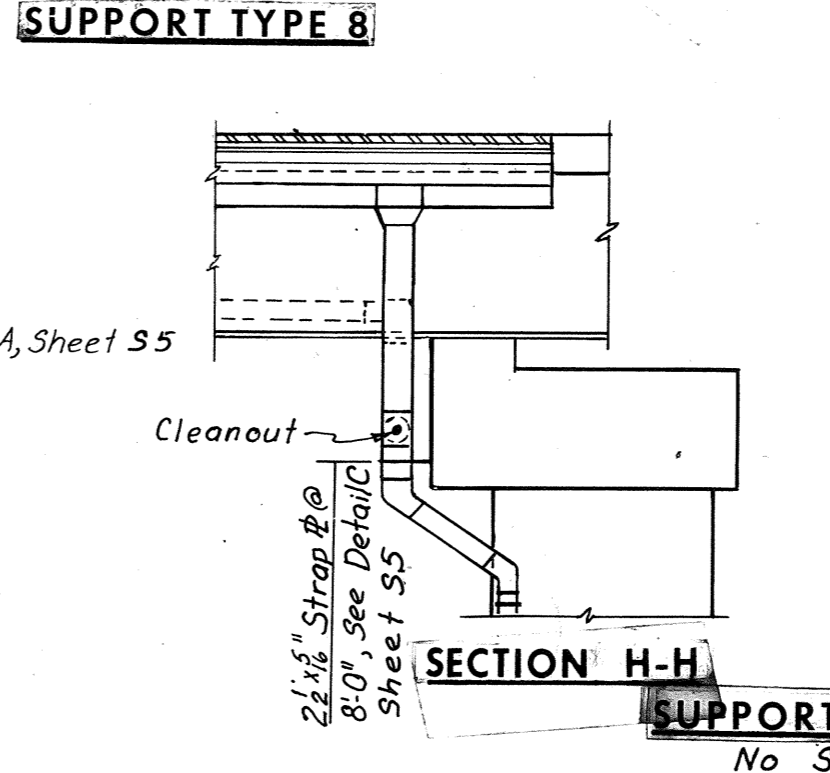

SUPPORT TYPE 7
Scale: 3/8"=1'-0"

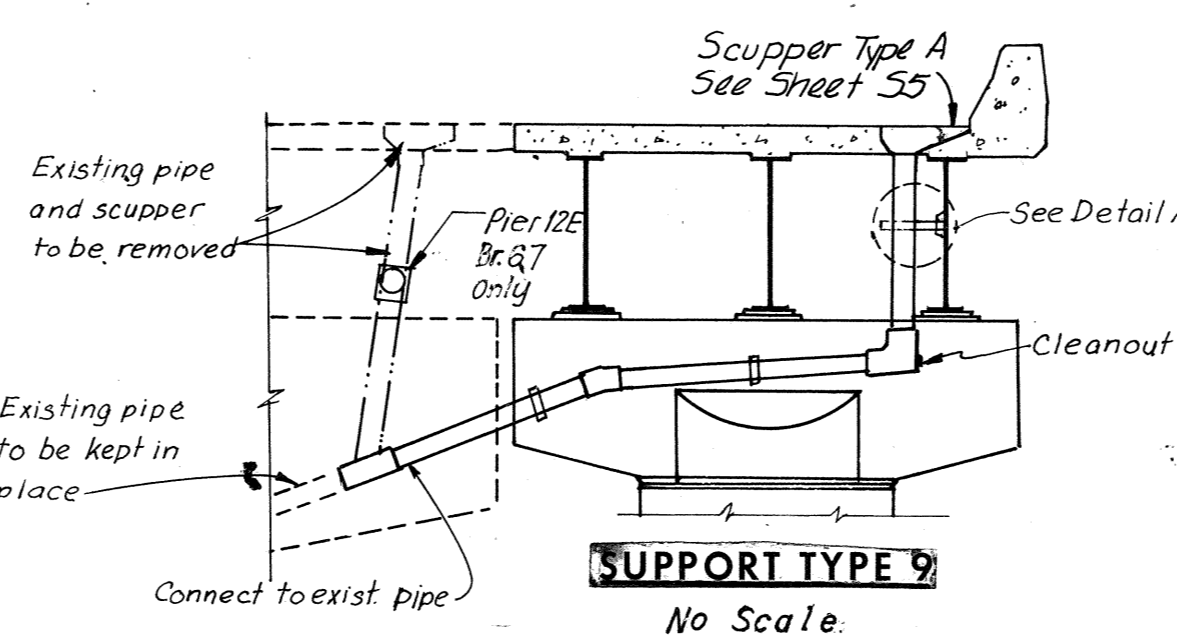

SUPPORT TYPE 8
No Scale

SUPPORT TYPE 9
No Scale

SUPPORT TYPE 10
Scale: 1/2"=1'-0"

RICHMOND METROPOLITAN AUTHORITY
RICHMOND EXPRESSWAY SYSTEM
DOWNTOWN EXPRESSWAY

STANDARD DRAINAGE DETAILS

HOWARD, NEEDLES, TAMMEN & BERGENDOFF
consulting engineers
NEW YORK ALEXANDRIA KANSAS CITY

SCALE: As Noted
CONTRACT NO.: 11
SHEET NO. 56 OF 60

BY	DATE	REVISION	BY	DATE
MADE	S.C.C. 129.69			
CHECKED	B.S.H. 243-69			
IN CHARGE				

Note: Bend bottom and top slab bars at Cast Scuppers where interference occurs.
Weight of Reinforcing Bars at Scupper: 48 lbs.

Note: For Details below top of upper column, see Support Type 2, Sheet 55.