

APPENDIX MR-2018




RECORD DRAWINGS

RMTA SYSTEM MAP AND PIER LOCATION EXHIBIT

RMTA BRIDGES Boulevard, 5, 8N, 9N, 13, 17, 65, 66, 67 & 68

(NOTE: Additional As-built Plans are Available upon Request to the Engineer)

RMTA
System Map

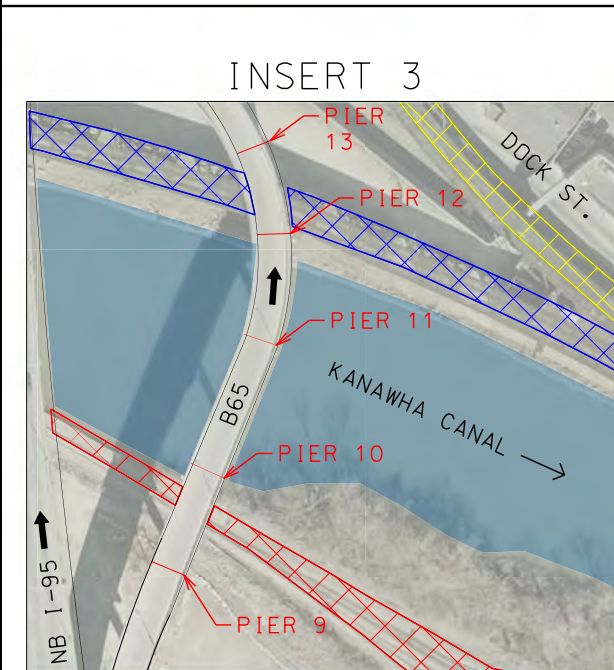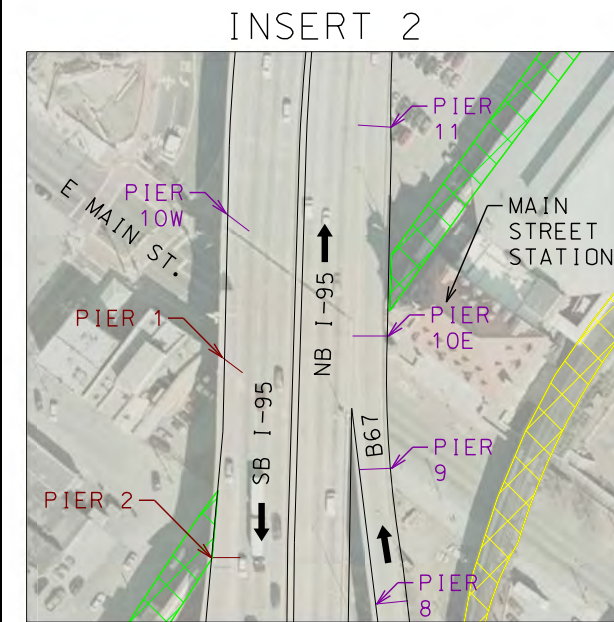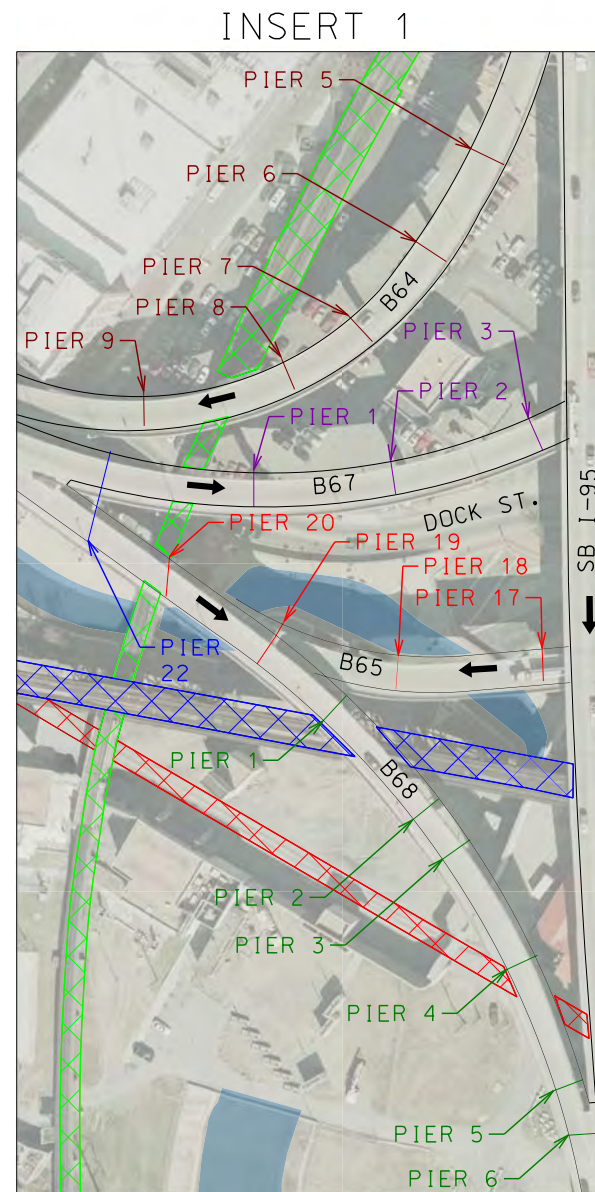

LEGEND:

█	BRIDGE 63
█	BRIDGE 64
█	BRIDGE 65
█	BRIDGE 66
█	BRIDGE 67
█	BRIDGE 68
 	N&S RAILROAD
 	CSX RAILROAD
 	CSX RAILROAD
 	CSX RAILROAD

- NOTES:**
- 1) PIER NUMBERS BASED ON AS-BUILT DRAWINGS FROM CONTRACTS C-10 AND C-11.
 - 2) RAILROAD LIMITS AND PIER LOCATIONS BASED ON AERIAL PHOTOGRAPHY.
 - 3) THIS EXHIBIT IS FOR REFERENCE ONLY. REFER TO AS-BUILT DRAWINGS FOR EXACT PIER LOCATIONS.
 - 4) BRIDGE 63 IS ON BOTTOM, BRIDGE 66 IS ON TOP.

RICHMOND METROPOLITAN TRANSPORTATION AUTHORITY



I-95 RAMPS PIER LOCATION EXHIBIT

2900 S. QUINCY STREET, SUITE 200
ARLINGTON, VIRGINIA
(703) 824-5100


Scale:	Date:	Contract No.:	Sheet:
N.T.S.	MAY 2015	MR-2015	1 OF 1

Boulevard Bridge

(VA State Rte. 161 – Westover Hills Blvd.)

Record Set Plans

RICHMOND EXPRESSWAY SYSTEM			
SECTION	PROJECT	SHEET NO.	TOTAL SHEETS
C-17B	Boulevard Bridge Rehab	35(1)	

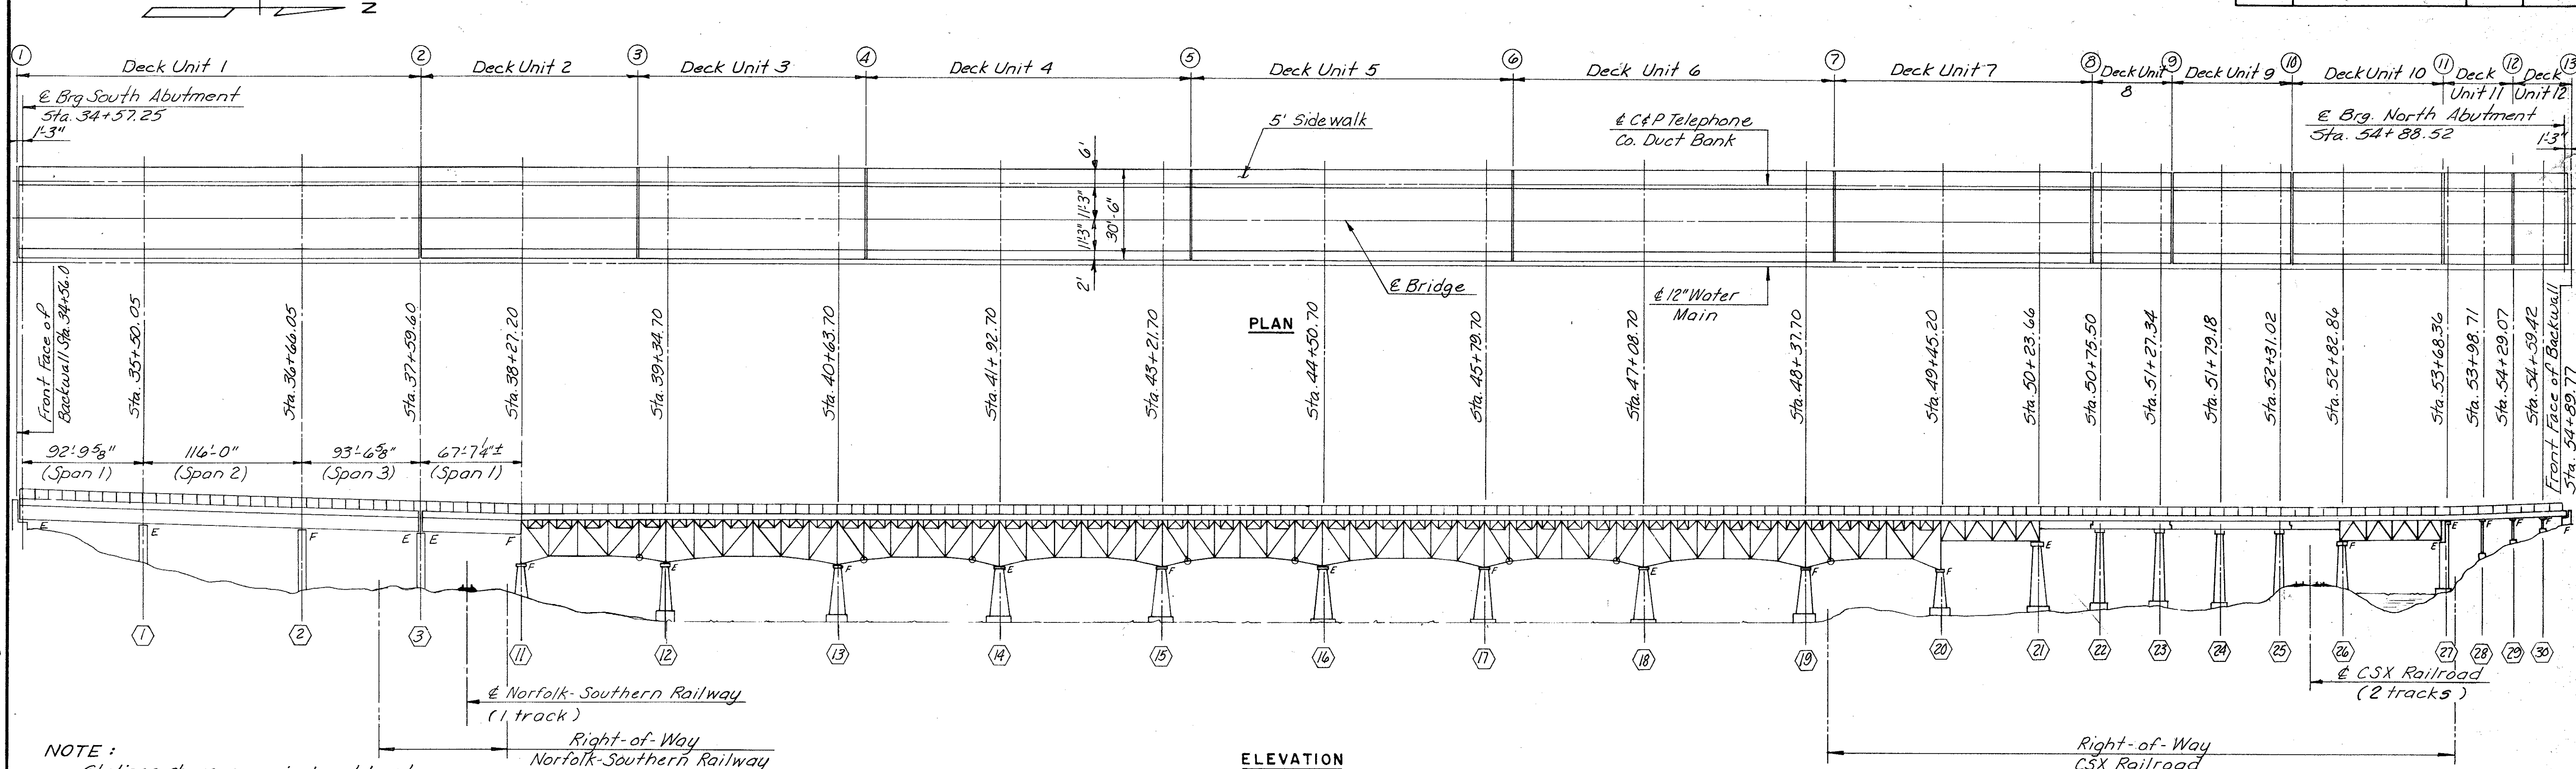

NOTE:
Stations shown approximate and based on surveyed deck joint station. The Contractor is to verify all pertinent dimensions and elevations prior to the fabrication of any structural steel.


ELEVATION

INDEX


- 1 GENERAL PLAN, ELEVATION AND INDEX
- 2 GENERAL NOTES AND QUANTITIES
- 3 GRADING AND SLOPE PROTECTION AT SOUTH ABUTMENT
- 4 NORTH ABUTMENT SLOPE PROTECTION DETAILS
- 5 & 6 SOUTH ABUTMENT DETAILS
- 7 NORTH ABUTMENT DETAILS
- 8 PIER 1
- 9 PIER 2
- 10 PIER 3
- 11-15 GIRDER DETAILS
- 16 TYPICAL CROSS SECTION
- 17 KEY PLAN, LIGHTING LAYOUT PLAN AND CONCRETE PLACEMENT PLAN
- 18-25 DECK UNIT 1 THROUGH 12 REINFORCING PLANS
- 26 SIDEWALK DETAILS (DELETED)
- 27 EXPANSION JOINT DETAILS
- 28 PREFORMED ELASTOMERIC JOINT SEALER DETAILS
- 29 ELASTOMERIC EXPANSION DAM DETAILS
- 30 SIDEWALK RAILING DETAILS
- 31 TRAFFIC RAILING DETAIL
- 32 TELEPHONE CONDUIT SYSTEM
- 33 WATER MAIN INSTALLATION DETAILS
- 34 BRIDGE LIGHTING SYSTEM
- 35 APPROACH SLAB DETAILS
- 36 SOUTH ABUTMENT DRAINAGE APRON REPAIR AND MODIFICATIONS

37 & 38 BAR LIST

LEGEND:
① Joint Number
① Pier Number

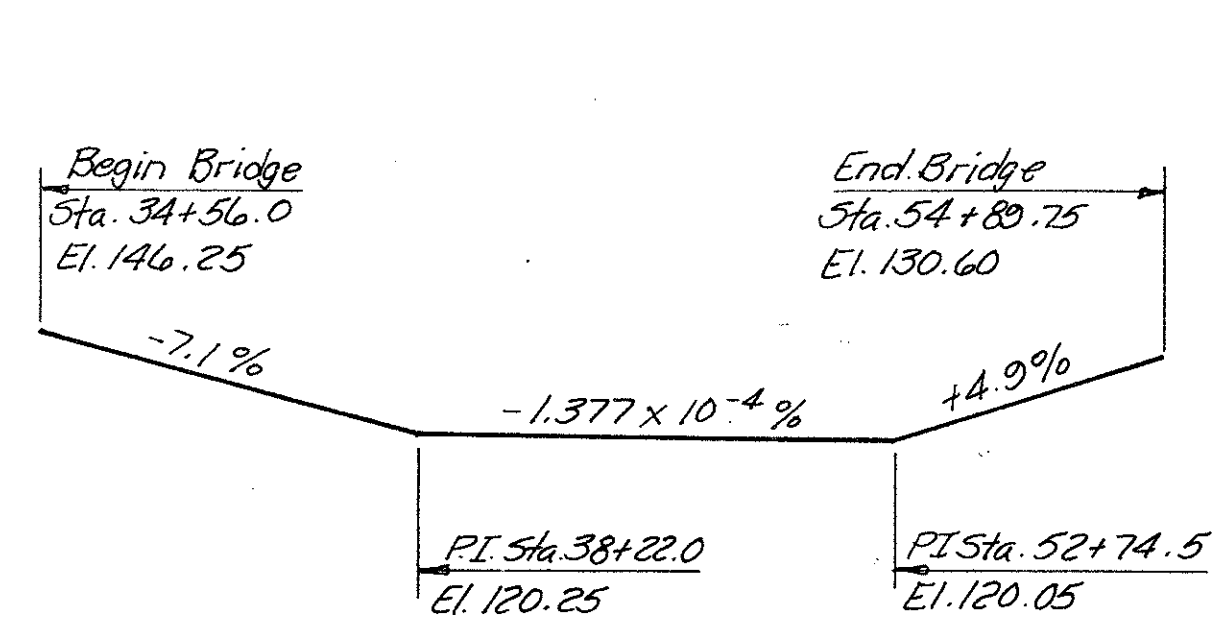


APPROXIMATE EXISTING PROFILE GRADE
Profile grade shown is based on surveyed elevation along the ℓ of the existing bridge. The contractor is to verify all elevations prior to construction.

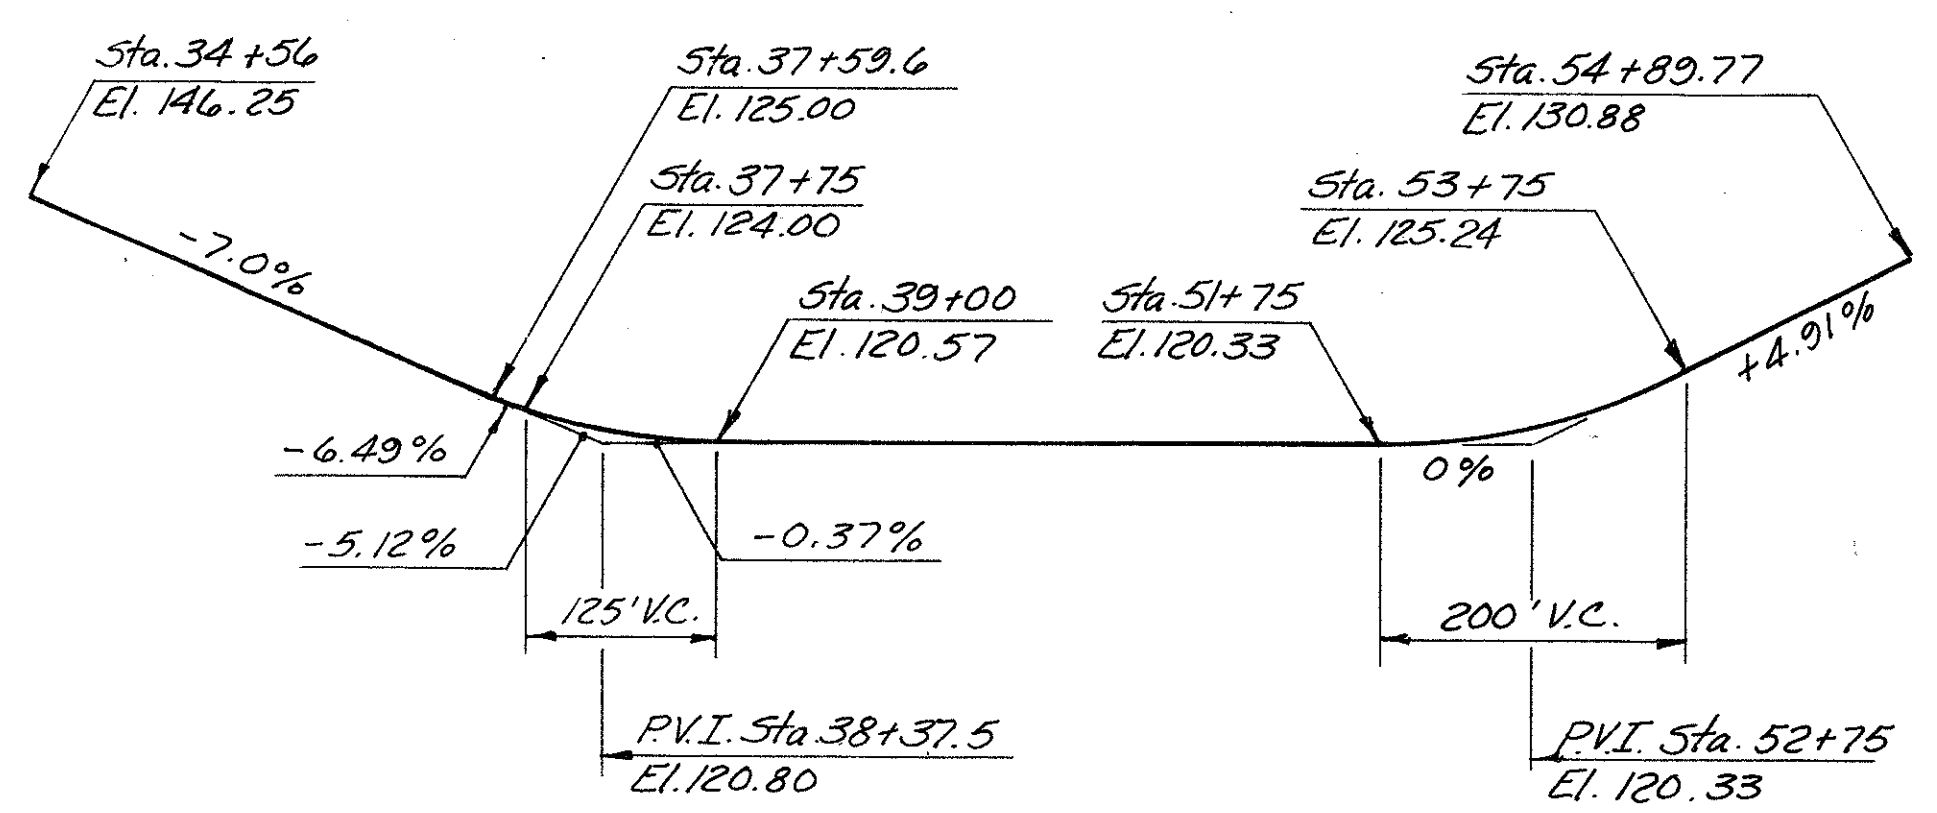

PROPOSED PROFILE GRADE

NOTE:
LOAD RESTRICTIONS ARE CURRENTLY IN EFFECT ON THE EXISTING BRIDGE. CONSTRUCTION EQUIPMENT WEIGHING IN EXCESS OF 8 TONS SHOULD NOT BE PERMITTED ON THE BRIDGE.

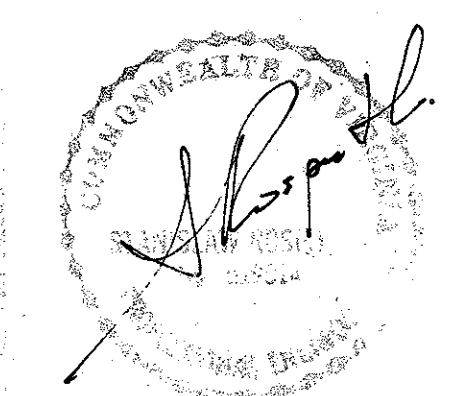

BY	DATE	NO.	REVISION	BY	DATE
MADE	H.H. 2-92				
CHECKED	T.E.M. 3-92				
IN CHARGE					

RECORD DRAWING

**RICHMOND METROPOLITAN AUTHORITY
RICHMOND EXPRESSWAY SYSTEM**


**BOULEVARD BRIDGE REHABILITATION
DECK REPLACEMENT**

**GENERAL PLAN, ELEVATIONS
AND INDEX**


SCALE: No. Scale
CONTRACT NO. C-17B
SHEET NO. 1 OF 38

HOWARD, NEEDLES, TAMMEN & BERGENDOFF
General Consultants


RICHMOND EXPRESSWAY SYSTEM			
SECTION	PROJECT	SHEET NO.	TOTAL SHEETS

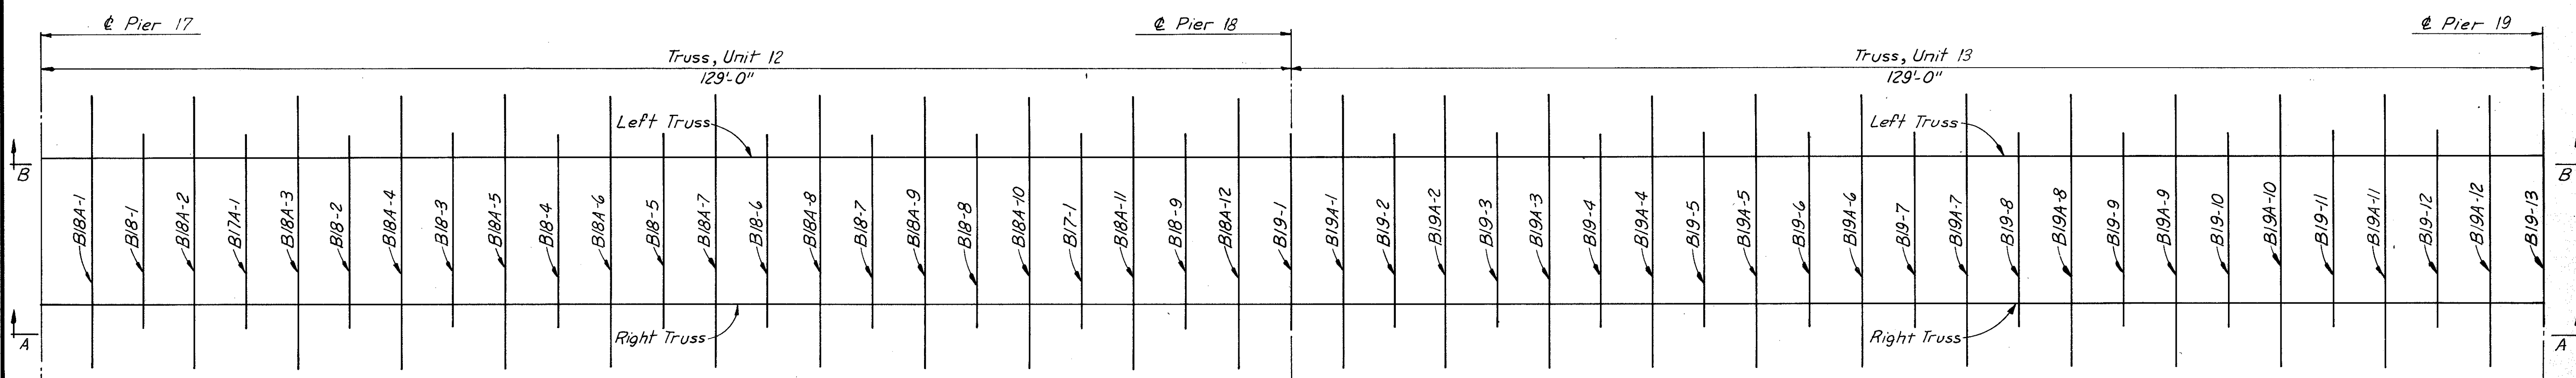


PLAN OF FLOOR BEAMS AND TRUSS

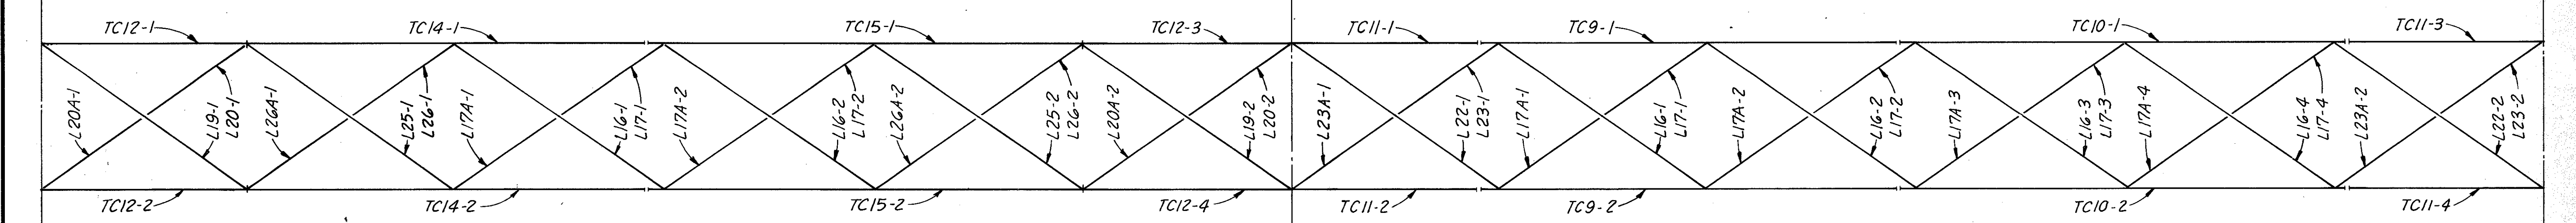

PLAN OF TOP CHORD AND LATERAL BRACING

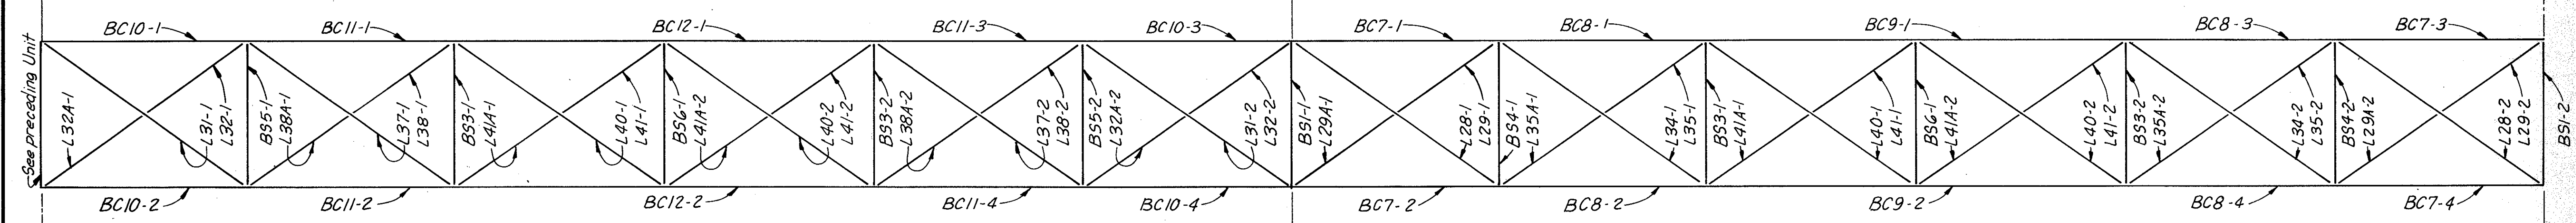

PLAN OF BOTTOM CHORD, DIAPHRAGMS AND LATERAL BRACING

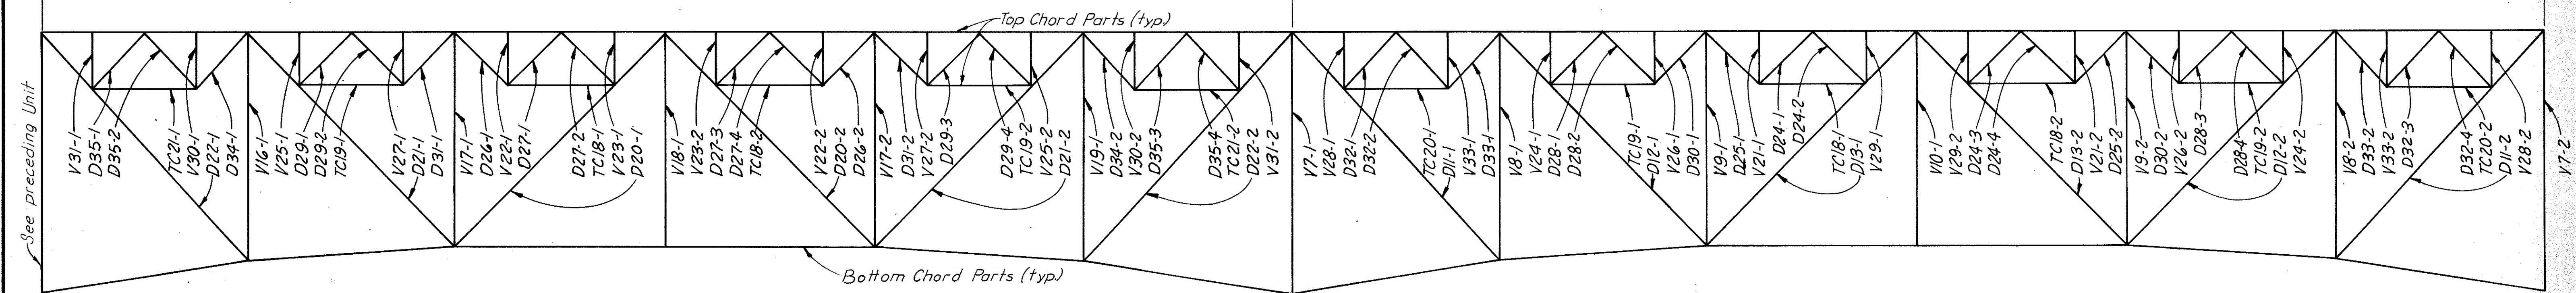

VIEW A-A

Note:
View B-B is similar to View A-A. Parts appearing in the Left Truss (except those shown on the Plans of the Top and Bottom Chords) are indicated, in the table, with an L following the part identification.

Notes:
For Typical Floor Beam Detail, see Layout Units 1 thru 5.
For Typical Diaphragm Details and Elevations, see Layout Unit 14.
For Truss Details see, Typical Truss Detail Sheet.

MADE	BY	DATE			
	T.E.M.	2-72			
CHECKED	H.B.W.	3-72			
IN CHARGE	P.R.V.		NO.	REVISION	BY
					DATE

RICHMOND METROPOLITAN AUTHORITY
RICHMOND EXPRESSWAY SYSTEM

BOULEVARD BRIDGE OVER JAMES RIVER

LAYOUT UNITS 12 & 13


SCALE: No Scale

CONTRACT NO.:


HOWARD, NEEDLES, TAMMEN & BERGENDOFF
General Consultants

SHEET NO. 20 OF


RICHMOND EXPRESSWAY SYSTEM			
SECTION	PROJECT	SHEET NO.	TOTAL SHEETS

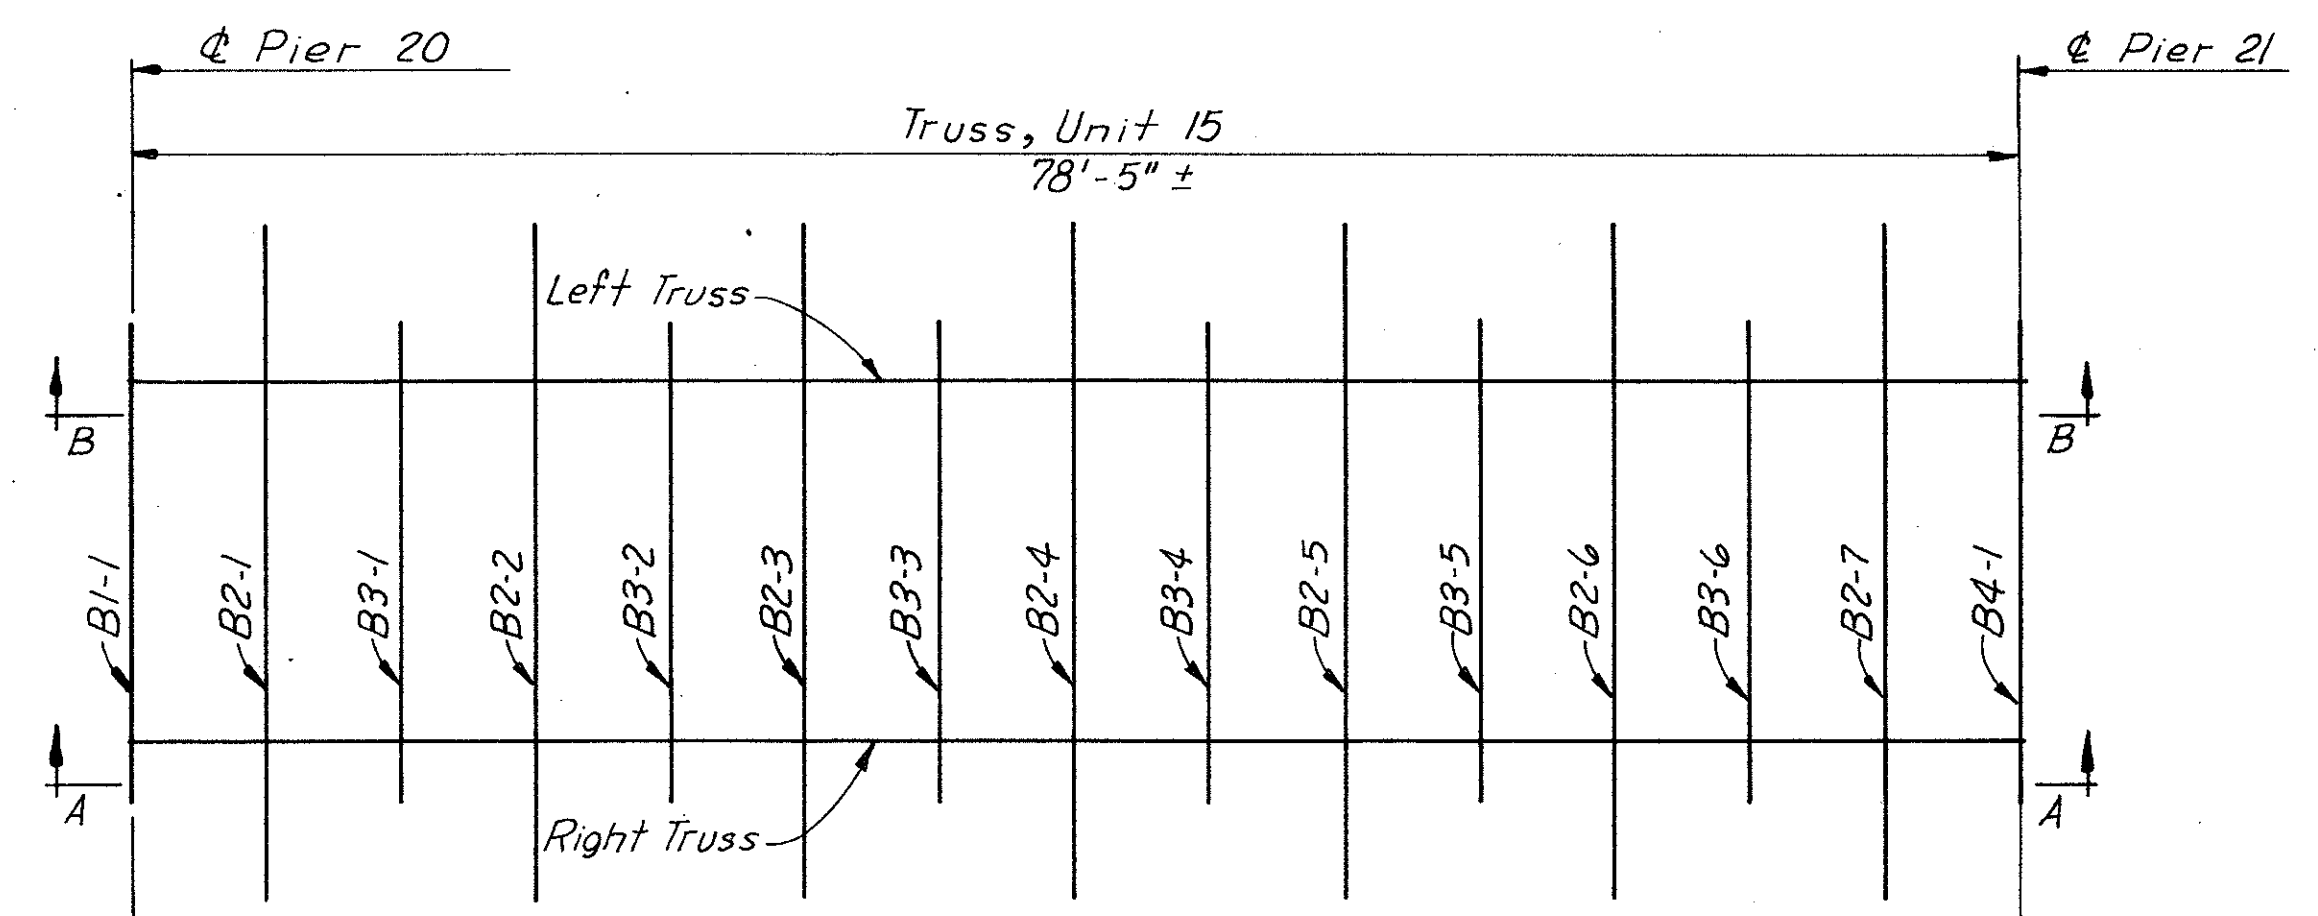


PLAN OF FLOOR BEAMS AND TRUSS

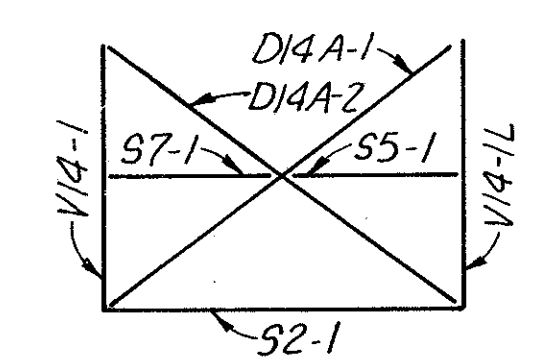


VIEW C-C

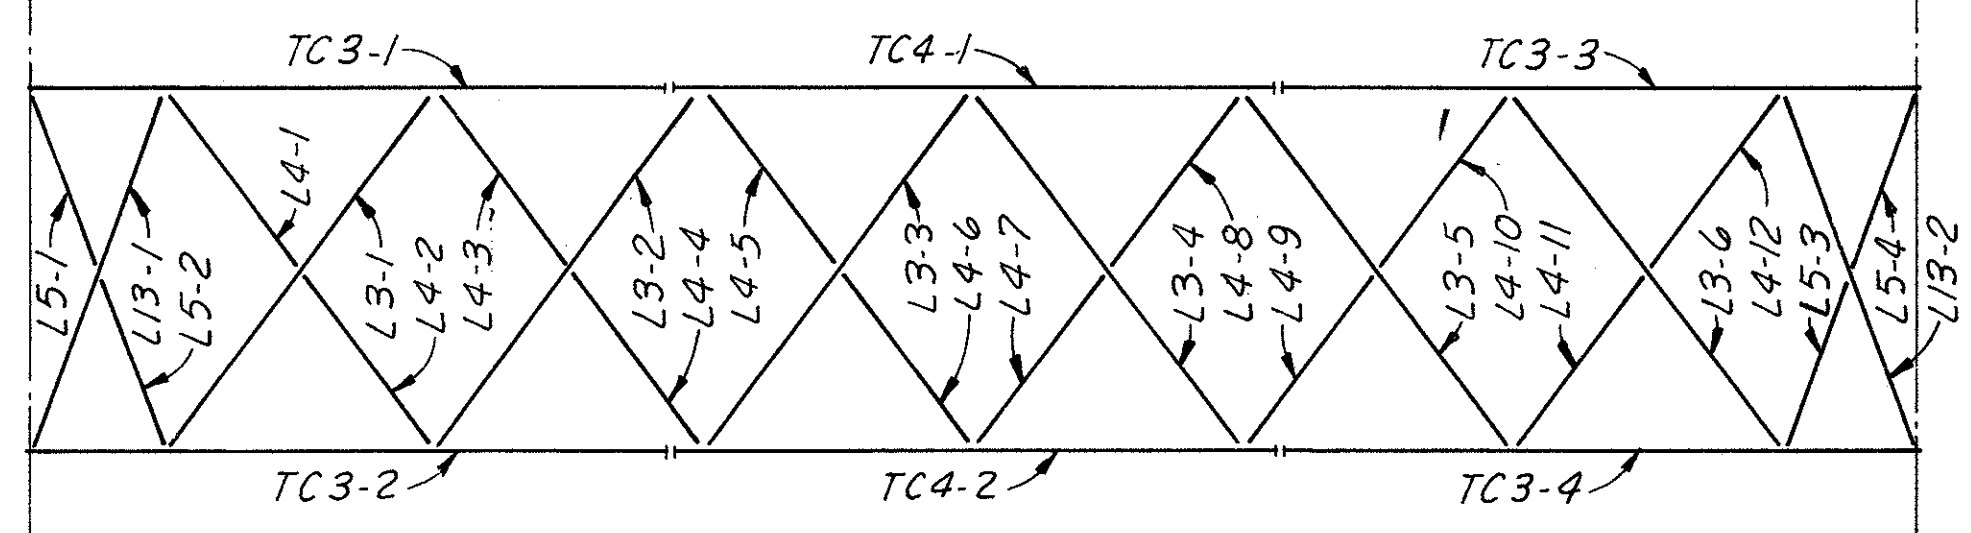


PLAN OF TOP CHORD AND LATERAL BRACING

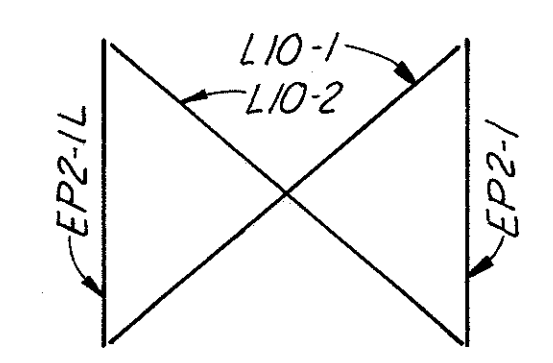


VIEW D-D

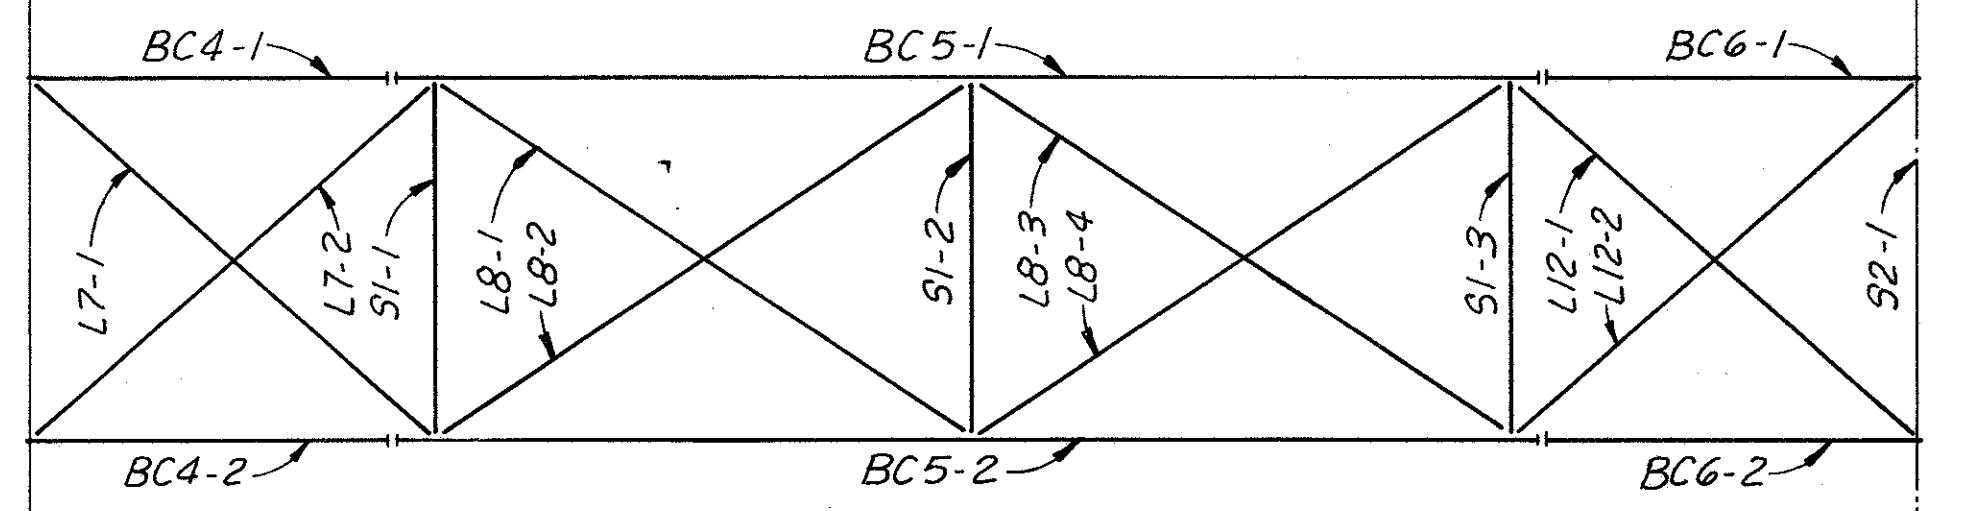


PLAN OF BOTTOM CHORD, DIAPHRAGMS AND LATERAL BRACING

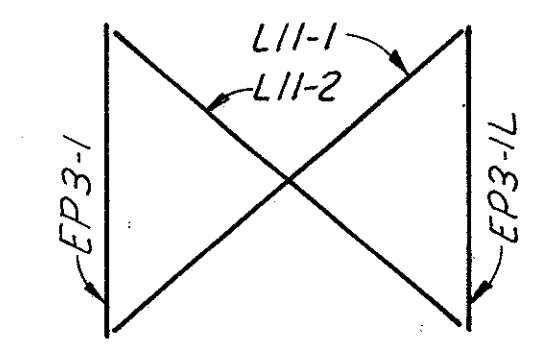


VIEW E-E

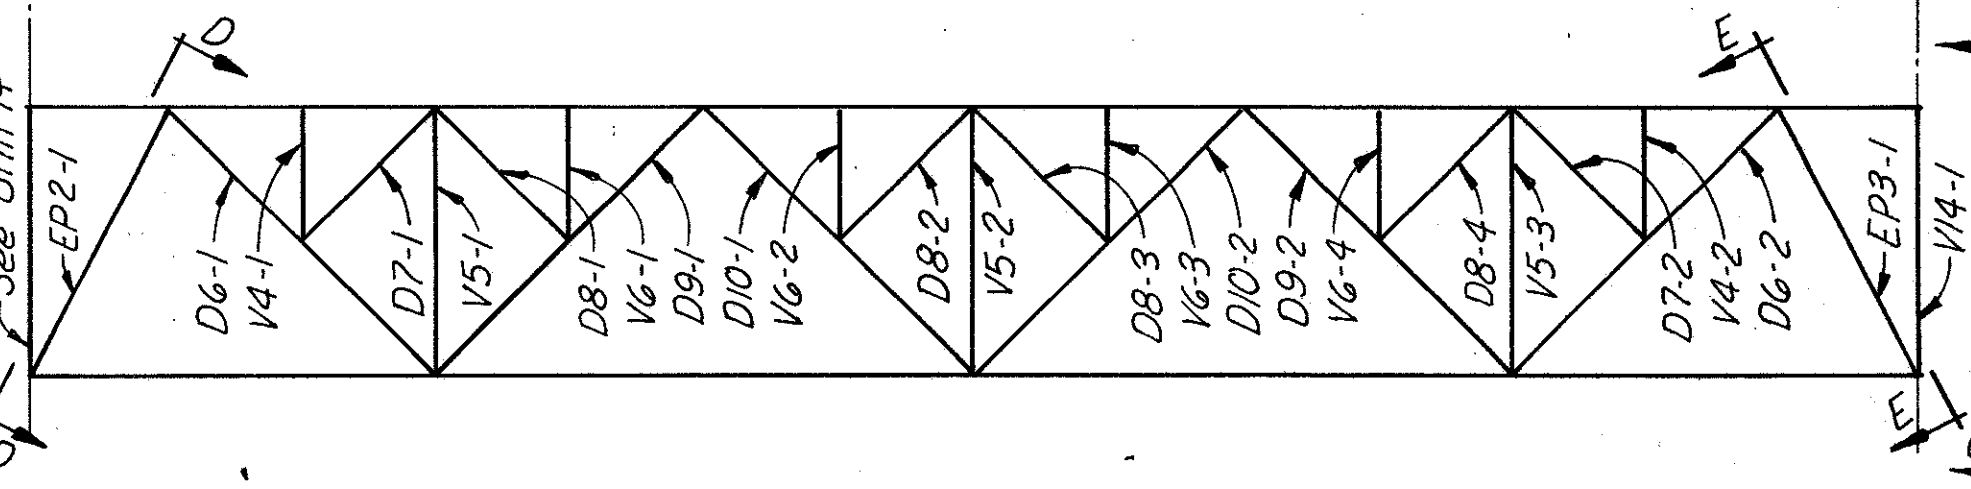

VIEW A-A

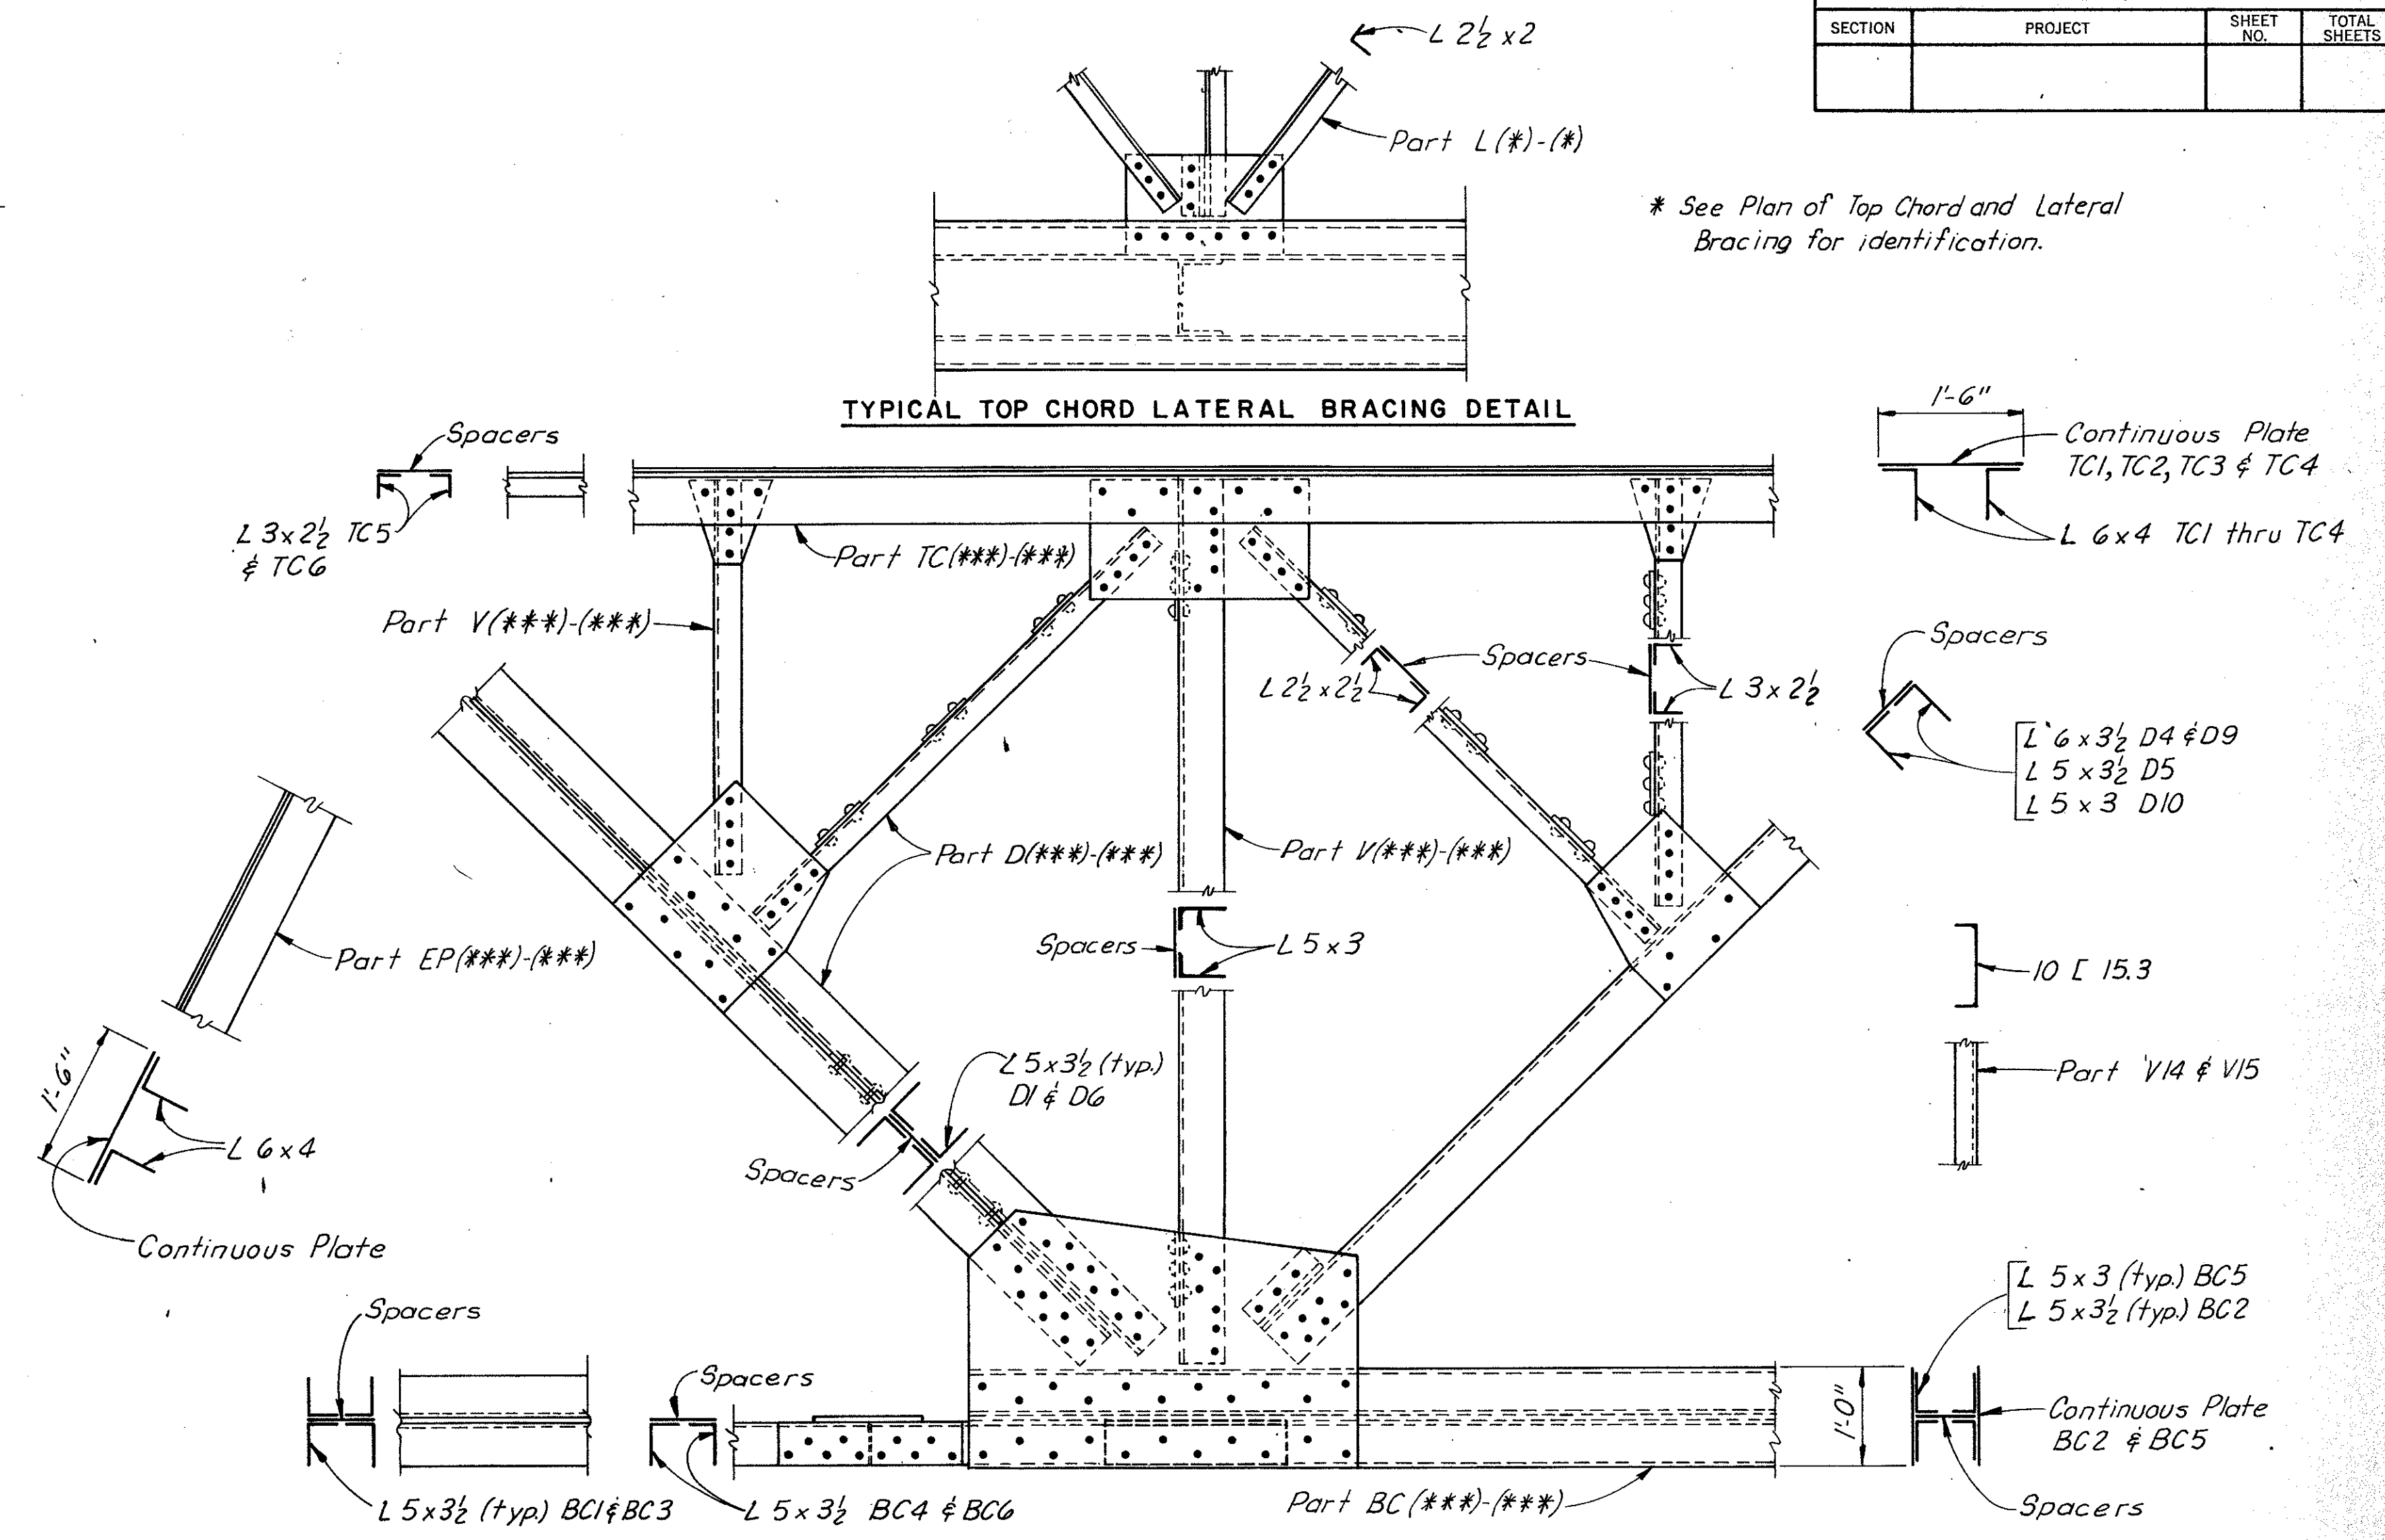

TYPICAL TRUSS DETAIL UNIT 15 AND 21

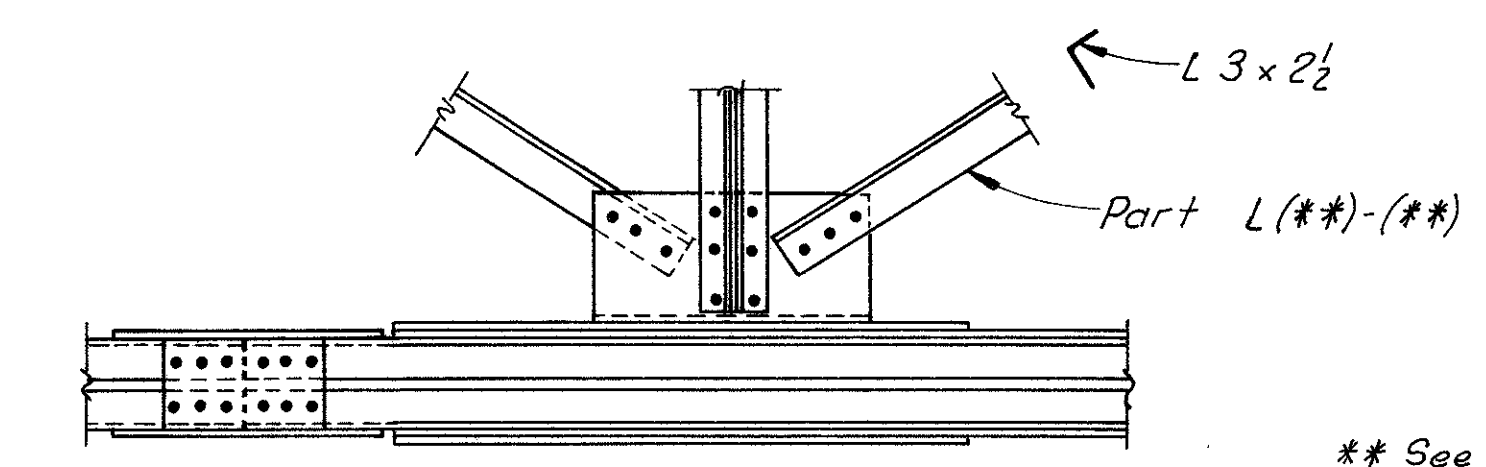

TYPICAL BOTTOM CHORD LATERAL BRACING DETAIL

Note:
View B-B is similar to View A-A. Parts appearing in the Left Truss (except those shown on the Plans of the Top and Bottom Chords) are indicated, in the table, with an L following the part identification.

Notes:
For Typical Floor Beam Detail, see Layout Units 1 thru 5.
For Typical Diaphragm Details see Layout Units 21 thru 23.

BY	DATE				
MADE	T.E.M.	2-72			
CHECKED	H.B.W.	3-72			
IN CHARGE	P.R.V.				

RICHMOND METROPOLITAN AUTHORITY
RICHMOND EXPRESSWAY SYSTEM

BOULEVARD BRIDGE OVER
JAMES RIVER


LAYOUT UNIT 15

SCALE: No Scale

CONTRACT NO. _____

HOWARD, NEEDLES, TAMMEN & BERGENDOFF
General Consultants

SHEET NO. 27 OF _____

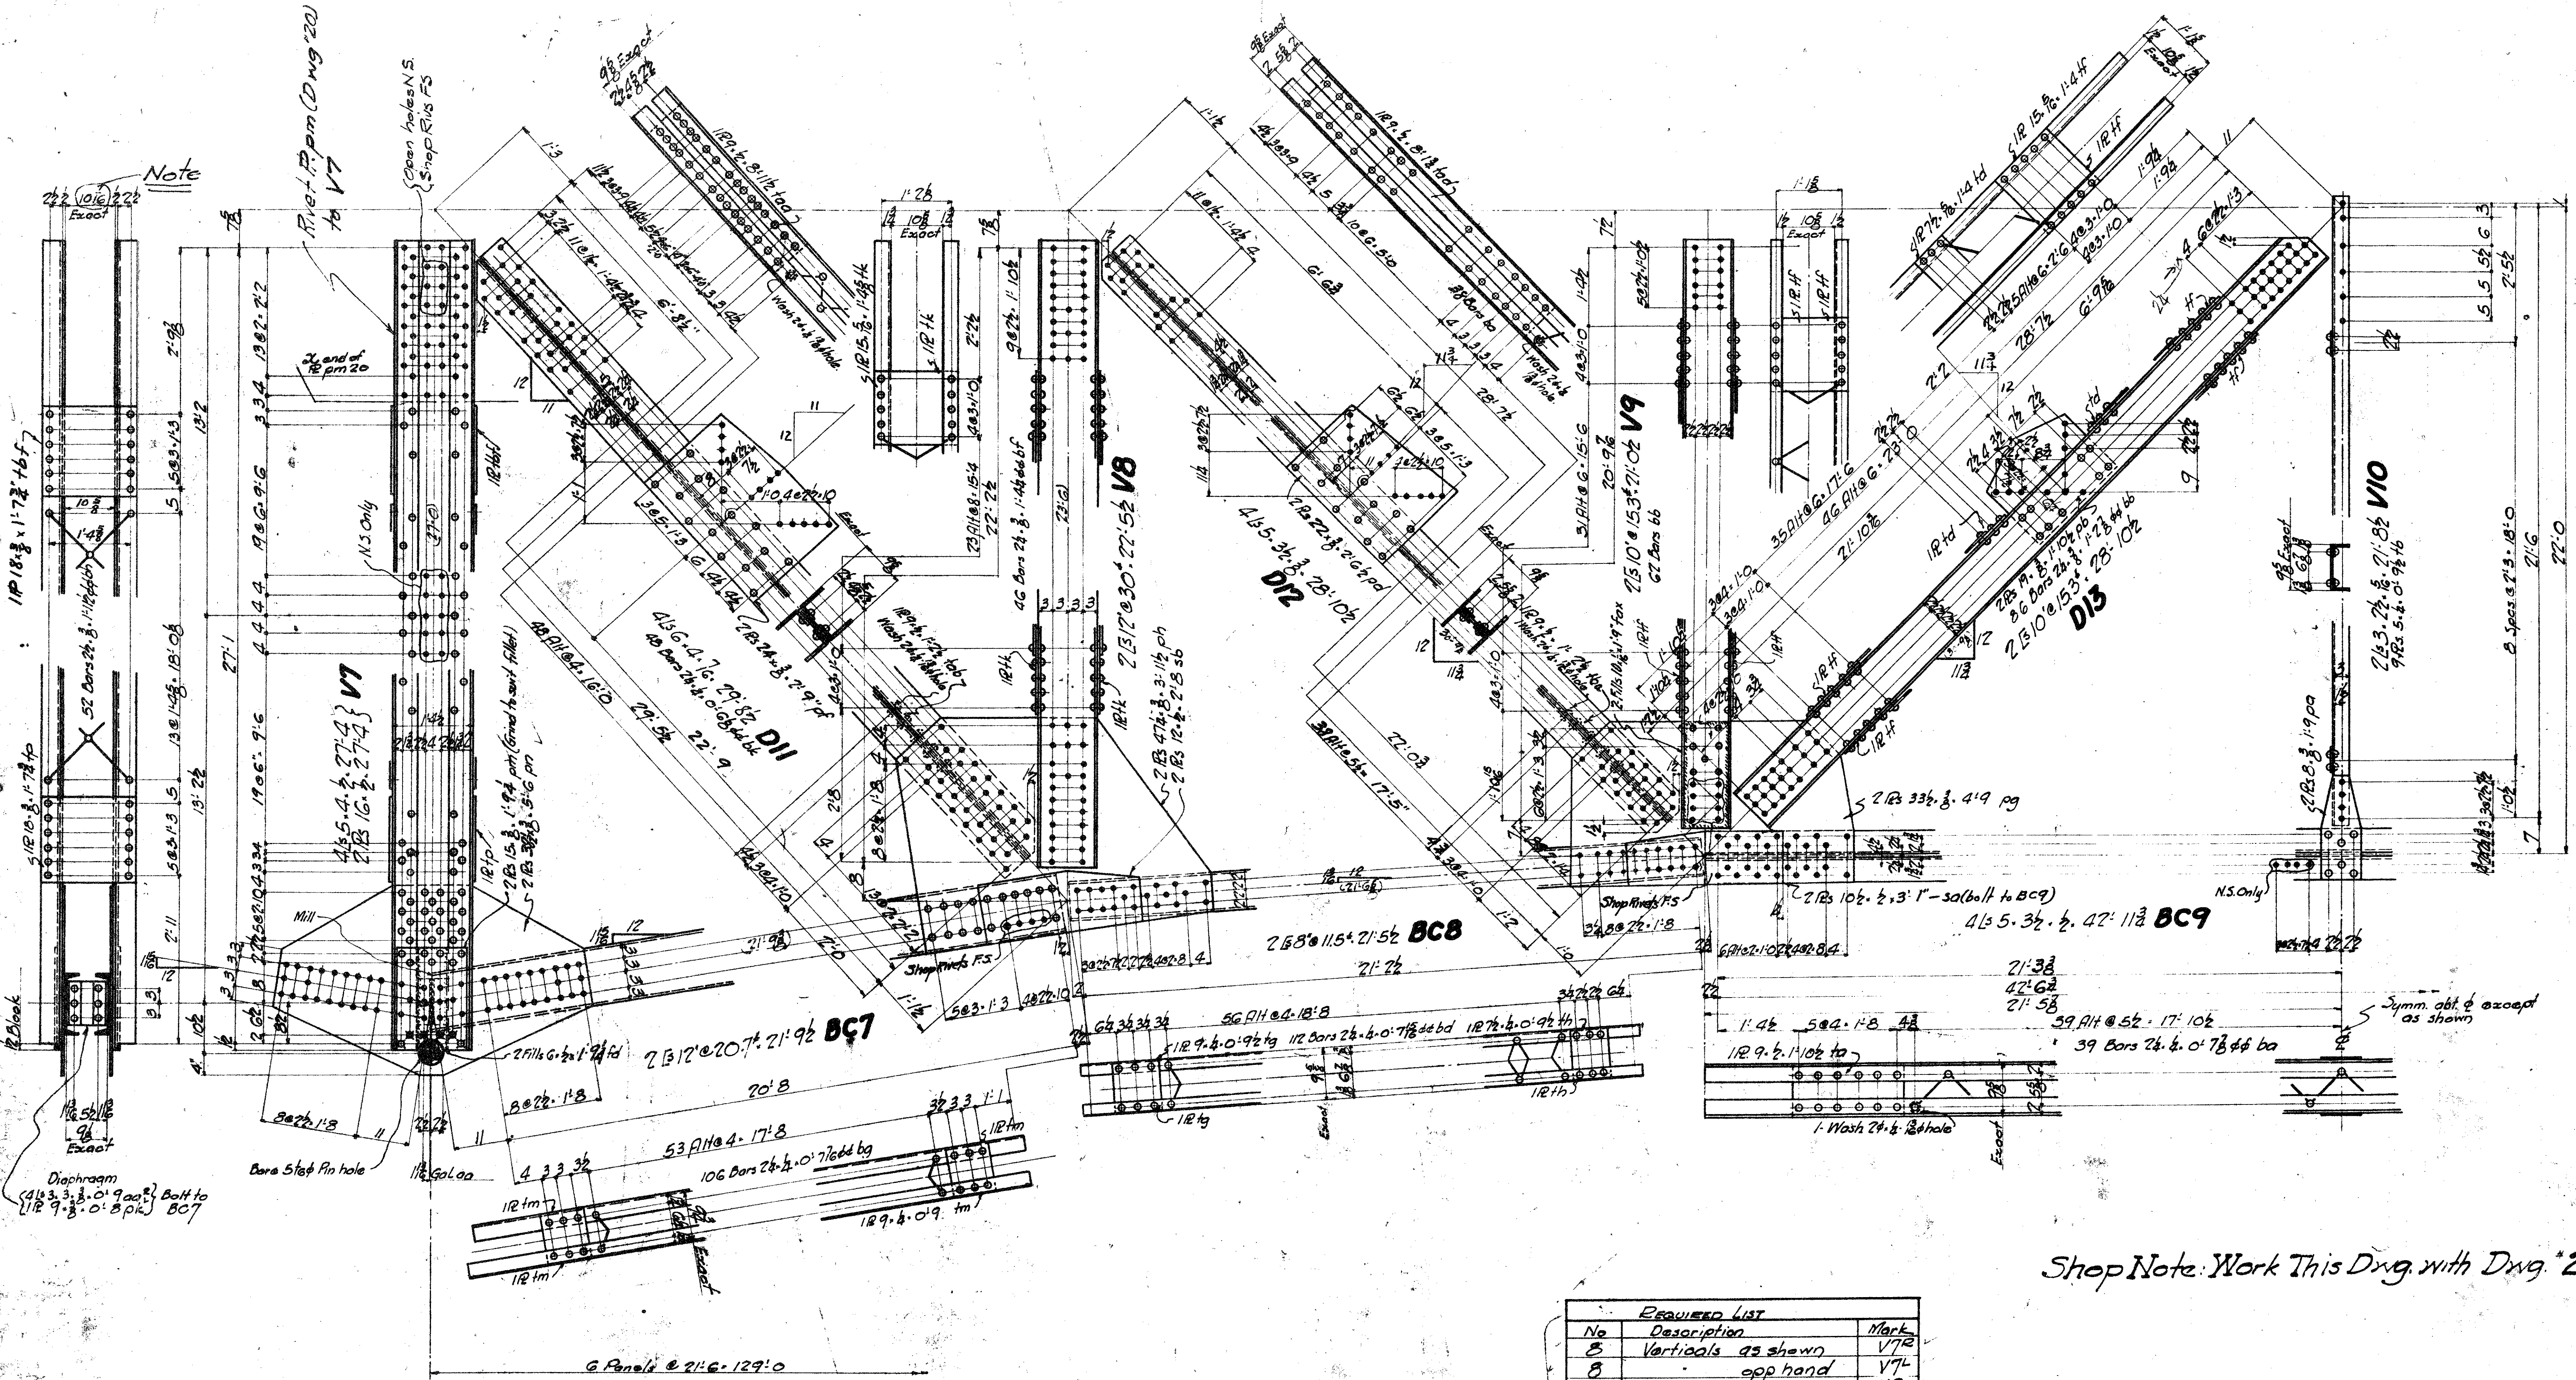

No	Description	Mark
8	Verticals as shown	V7R
8	opp hand	V7L
16		V8
8		V10
16	Diagonals	D11
16		D12
16		D13
8	Bottom Chords as shown	BC7R
8	opp hand	BC7L
8	as shown	BC8R
8	opp hand	BC8L
8	Verticals as shown	V9R
8	opp hand	V9L

GENERAL NOTES:

- Material
- Specifications
- Rivets 3/8"
- Holes 1/8" unless noted
- Reaming
- Shop Paint 1/2 lb Red Lead & Oil
- Field Paint
- Erection
- Field Conn's
- Inspection
- Material on Shop Bills

Atlantic Bridge Co. Dept. 406


CONTRACT V 5585

Details of *Continous Trusses*

For - Bridge over James River
 Location - Richmond, Va.
 Owner - Atlantic Bridge Co.

Virginia Bridge and Iron Co.
 ROANOKE, VA.

Checked by [Signature] 1/15/15
 Made by [Signature] 1/15/15
 In charge of [Signature] 1/15/15
 Revised [Signature] 1/15/15
 Scale 1/4" = 1'-0"

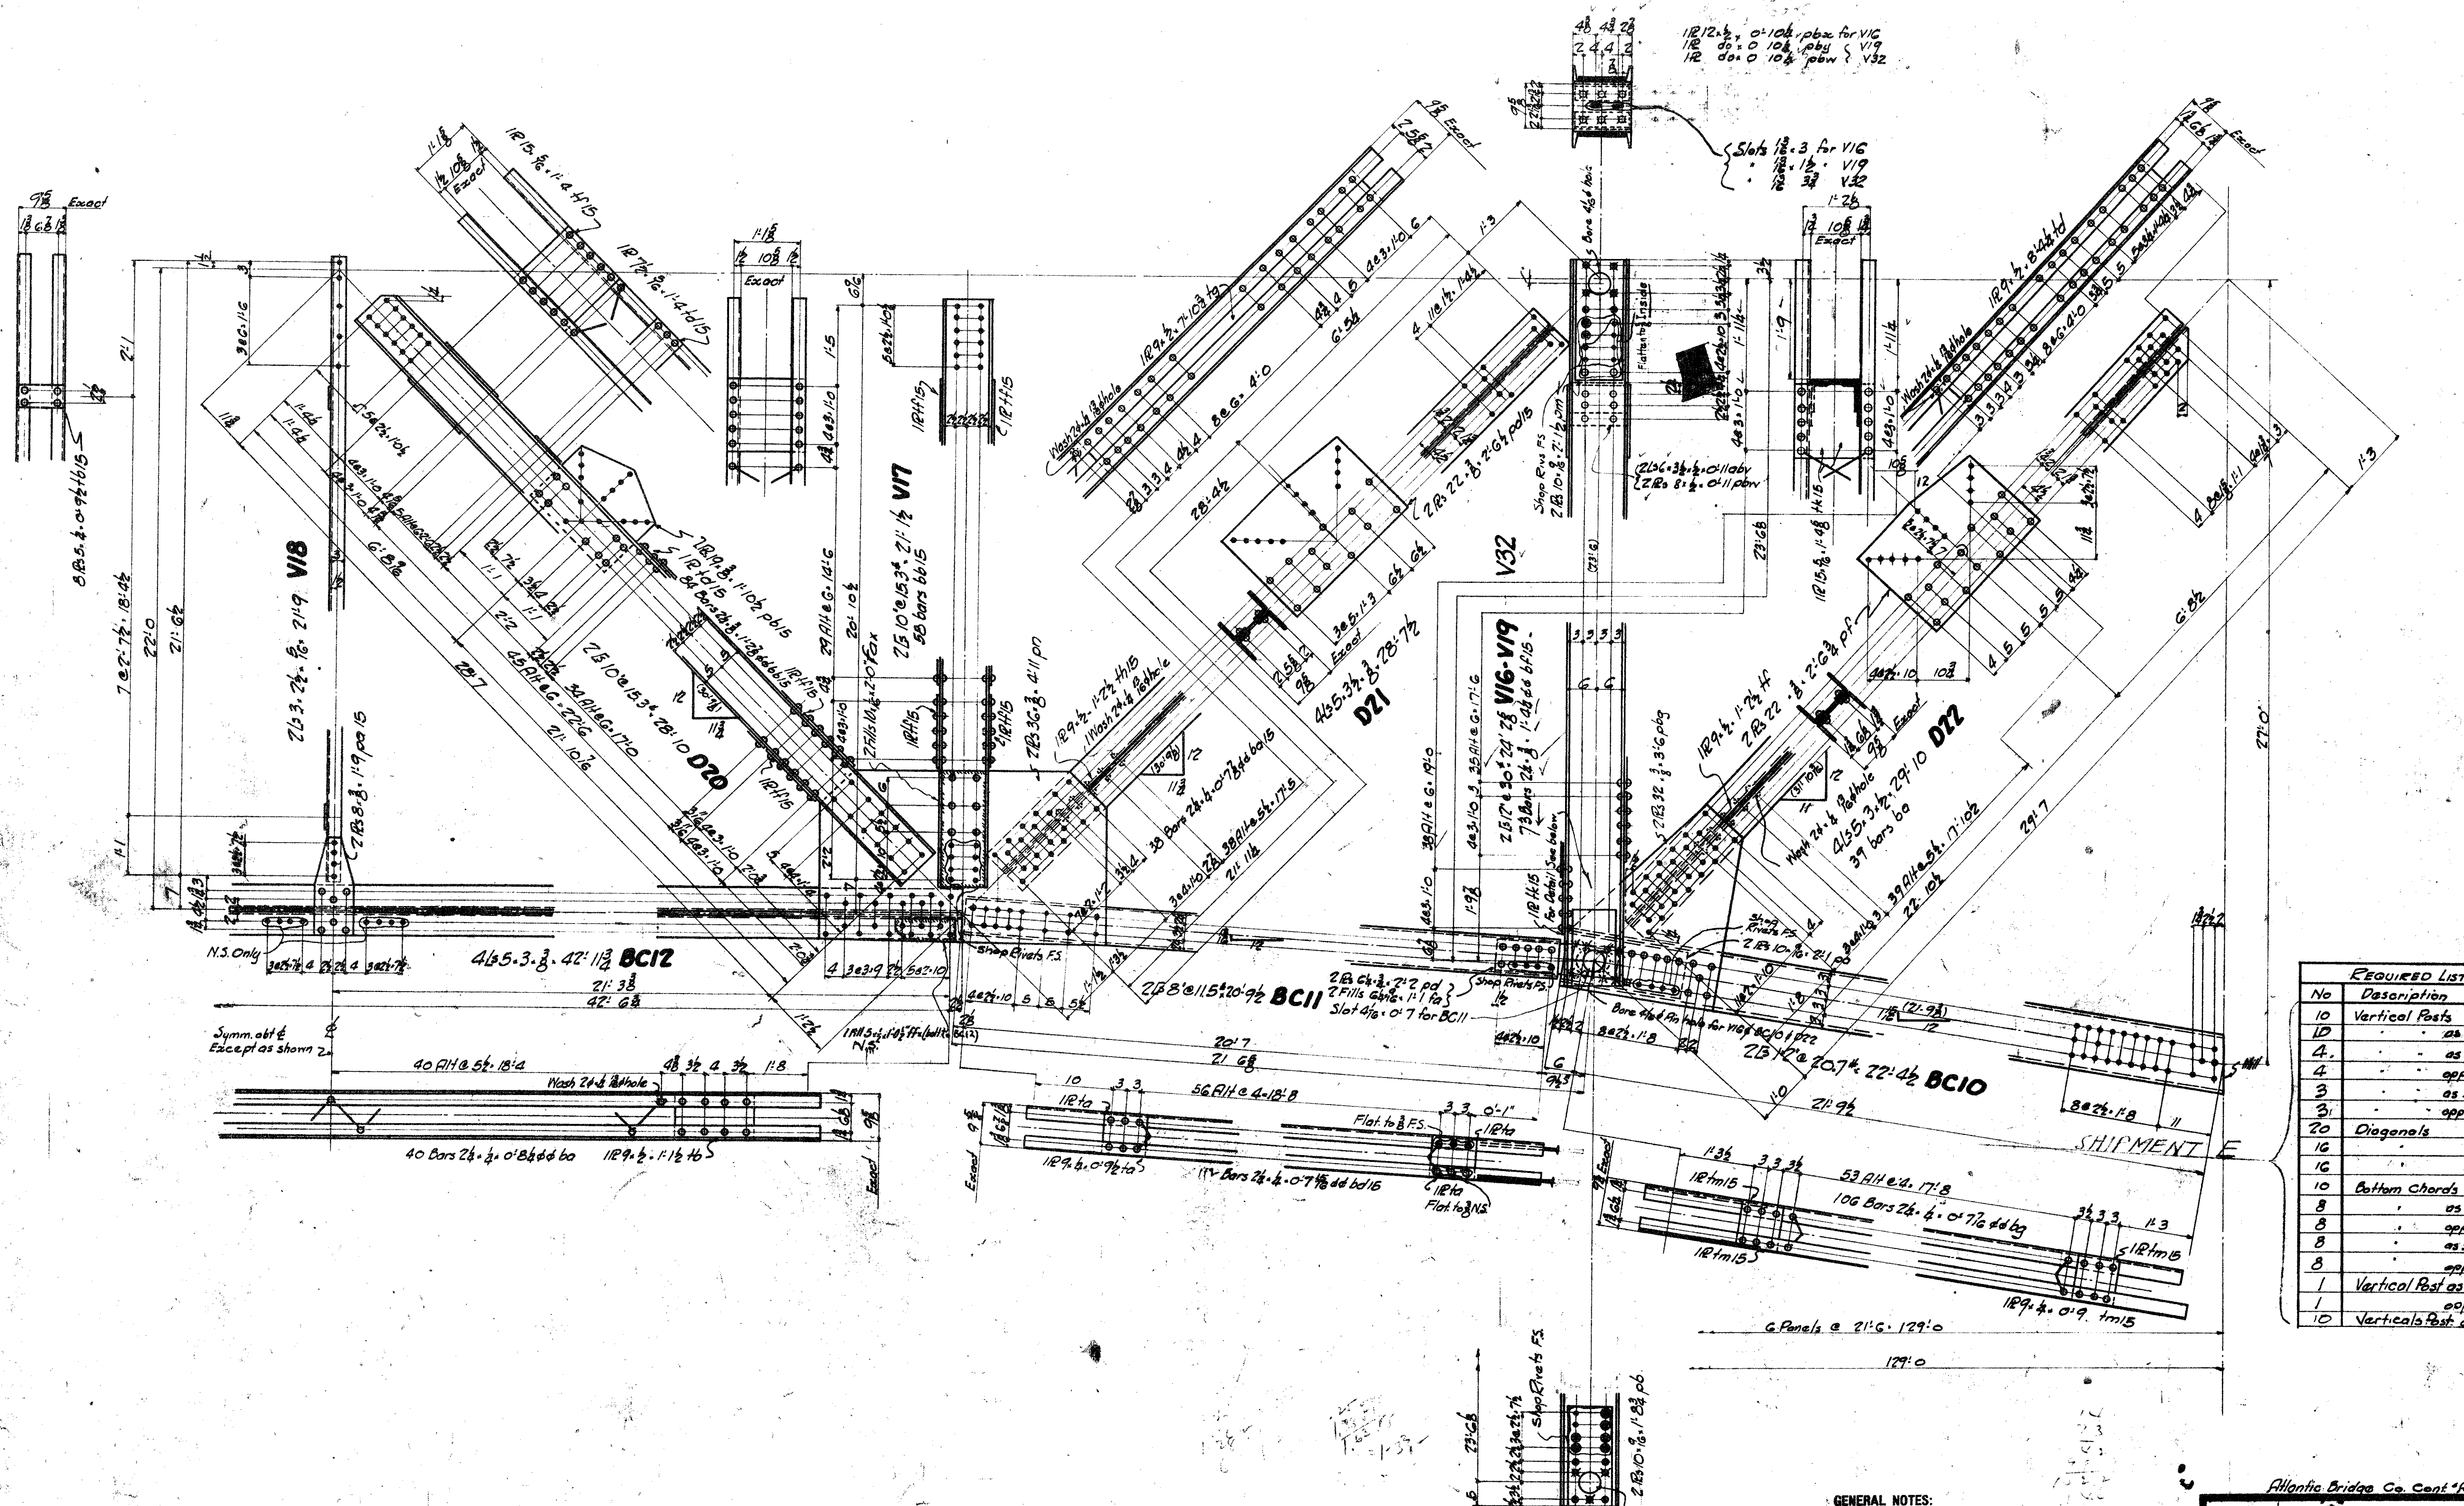

12 1/2 x 3/4 0-104 pbz for V16
 12 1/2 x 3/4 0-104 pbz for V19
 12 1/2 x 3/4 0-104 pbz for V32

Slots 18-3 for V16
 18-12 for V19
 18-37 for V32

REQUIRED LIST		
No	Description	Mark
10	Vertical Posts	V18
10	"	as shown V17R
4	"	as shown V16R
4	"	app hand V16L
3	"	as shown V19R
3	"	app hand V19L
20	Diagonals	D20
16	"	D21
16	"	D22
10	Bottom Chords	BC12
8	"	as shown BC11R
8	"	app hand BC11L
8	"	as shown BC10R
8	"	app hand BC10L
1	Vertical Post as shown	V32R
1	app hand	V32L
10	Verticals Post app hand	V17L

GENERAL NOTES:

Material
 Specifications
 Rivets 3/4
 Holes 1/8 unless noted
 Reaming
 Shop Paint / Oil Red Lead / Oil
 Field Paint
 Erection
 Field Connections
 Inspection

For General Notes See Sheet 1

Atlantic Bridge Co. Cont. #1400

CONTRACT V 5585

Details of Bottom Chord & Web Members for Suspended Trusses
 For Bridge over James River
 Location Richmond, Va.
 Owner Atlantic Bridge Co.


VIRGINIA BRIDGE AND IRON CO.
 ROANOKE, VA.

To be fabricated at Roanoke
 Made by J.M.P.
 In charge of Moore
 Checked by G.I.
 For General Notes See Sheet 1

Scale 1/4" = 1'-0" Sheet No. 16

Detail About Pin hole for V16-V19-V32

Material on Shop Bills 45, 46, 47

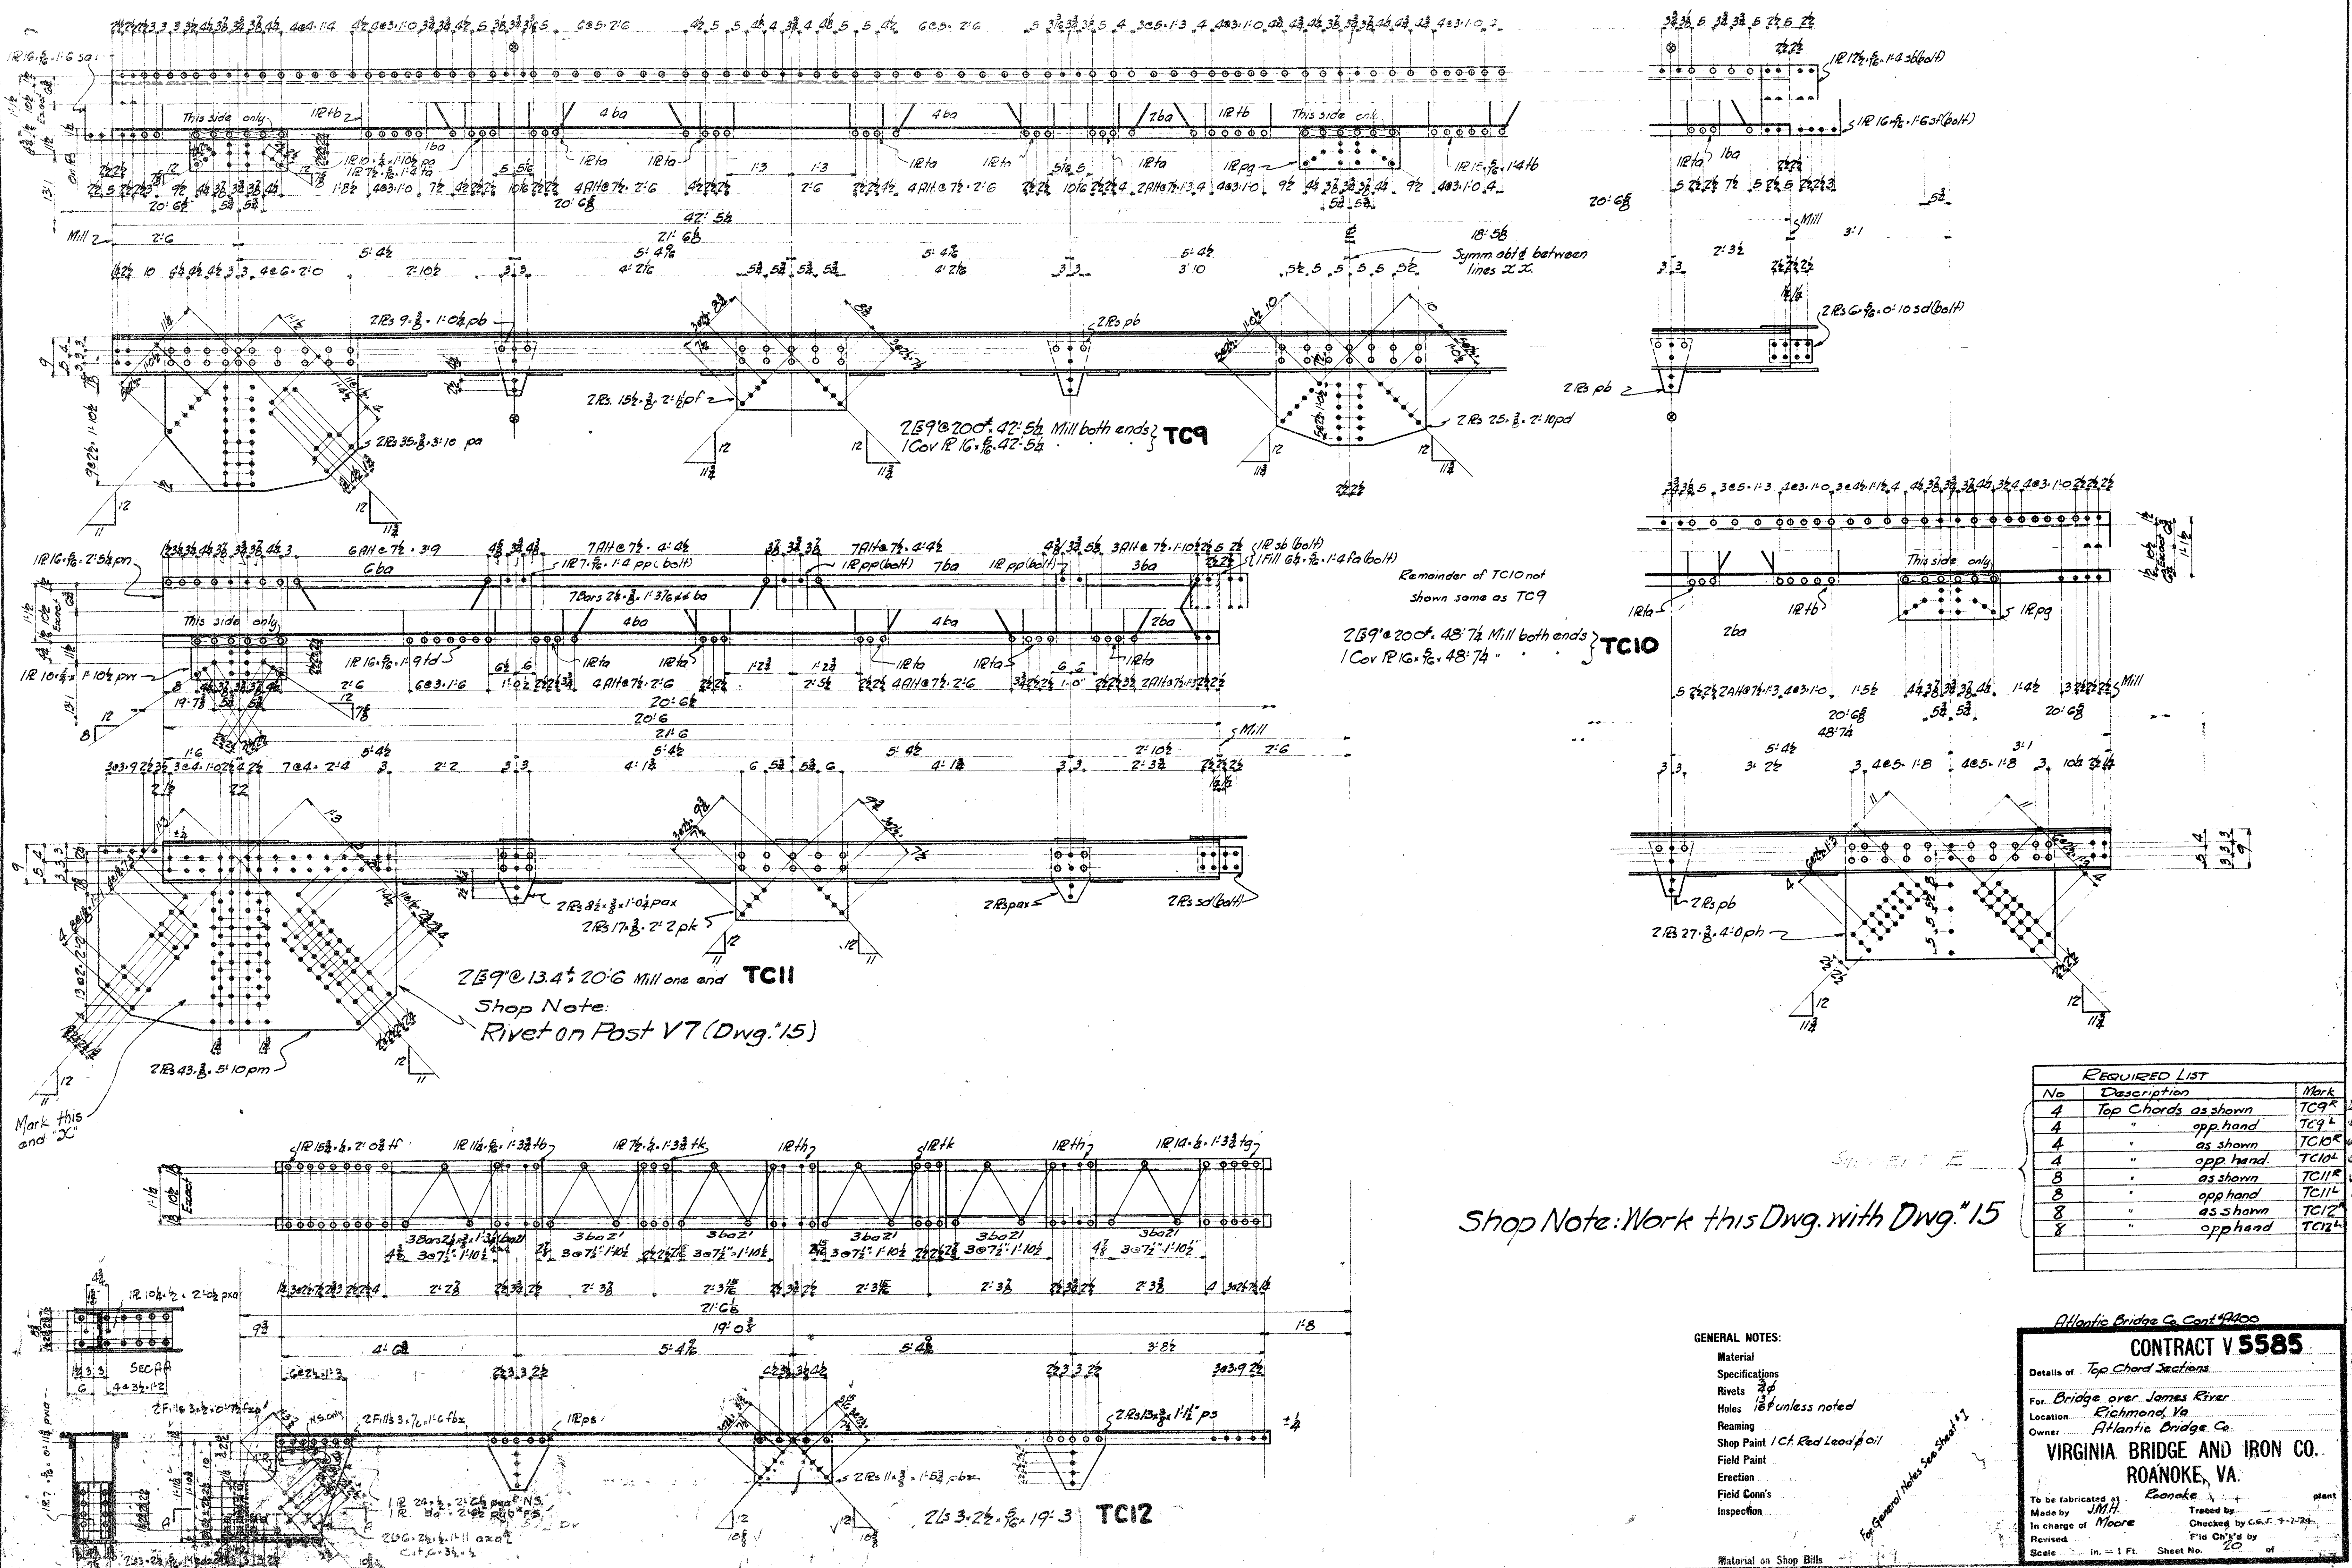

Mark this and '2'

TC11
Shop Note:
Rivet on Post V7 (Dwg. #15)

TC9
TC10
TC10 not shown same as TC9

Shop Note: Work this Dwg. with Dwg. #15

REQUIRED LIST		
No	Description	Mark
4	Top Chords as shown	TC9 ^R
4	" opp hand	TC9 ^L
4	" as shown	TC10 ^R
4	" opp hand	TC10 ^L
8	" as shown	TC11 ^R
8	" opp hand	TC11 ^L
8	" as shown	TC12 ^R
8	" opp hand	TC12 ^L

GENERAL NOTES:

- Material Specifications
- Rivets 3/8"
- Holes 1/8" unless noted
- Reaming
- Shop Paint 1/2" Red Lead paint
- Field Paint
- Erection
- Field Conn's
- Inspection

Atlantic Bridge Co. Cont. 4900

CONTRACT V 5585

Details of Top Chord Sections

For Bridge over James River
Location Richmond, Va.
Owner Atlantic Bridge Co.

VIRGINIA BRIDGE AND IRON CO.
ROANOKE, VA.

To be fabricated at Roanoke plant
Made by J.M.H.
In charge of Moore
Revised
Scale in. = 1 Ft. Sheet No. 20 of

Traced by
Checked by C.G.F. 7-7-24
Field Ch'kd by

For General Notes See Sheet #1

Bridge 5

(Southern Railway Over Powhite Parkway)

Record Set Plans

RICHMOND EXPRESSWAY SYSTEM			
SECTION	PROJECT	SHEET NO.	TOTAL SHEETS
2	POWHITE PARKWAY	132	188

GENERAL NOTES :

SPECIFICATIONS :
 A.R.E.A., current.
 WELDING - 1969 Standard Specifications for welded Highway and Railway Bridges of the American Welding Society.
CONTRACT SPECIAL PROVISIONS
 Specifications and Contract Special Provisions referred to above are necessary to make these plans complete.
LIVE LOAD :
 Cooper's E-80
IMPACT :
 Diesel impact plus rolling effect. Concrete Slab Derailment Impact :
 $LL \times \frac{LL}{DL + LL}$
 Structural Steel Derailment Impact :
 $0.9 \times LL$

DATUM :
 CITY OF RICHMOND
TEMPERATURE :
 The normal temperature referred to on the plan is 68°F. The temperature range for movement is 0°F, to 120°F.

DIMENSIONS :
 All dimensions are measured horizontally and vertically unless otherwise noted.

EXCAVATION :
 Excavation below subgrade and cut slope template shall be classified as Structure Excavation. All excavation above these limits shall be classified as Regular Excavation and is not included in the Structural Quantities.

FOUNDATIONS :
 Footings shall rest on firm material. Foundation material shall be kept dry and special attention is called to Section 401.05 of the General Specifications, and to the Contract Special Provisions, concerning preparation of foundations for footings.

CONCRETE NOTES :
 Concrete in superstructure shall be Class A4 with a maximum slump of 2 1/2 inches. All other concrete shall be Class A3. All exposed edges and corners shall have a 3/4" chamfer or fillet unless otherwise noted. Care in the method of vibration, the use of low-slump concrete, and/or other means shall be employed to prevent downgrade movement of newly placed slab concrete. (When gradient is over 2%).



Finishing concrete surfaces: See the Standard Architectural Detail Sheets and the Contract Special Provisions for types and details.

All reinforcing steel shall conform to A.S.T.M. A615, Grade 40. All reinforcing bar dimensions on the detailed drawings are to centers of bars unless otherwise noted. Clear distance between reinforcing steel and face of concrete shall be as noted on the plans. All bar laps shall be 30 diameters of the smaller diameter bar unless otherwise noted.



STEEL NOTES :
 Structural steel shall conform to A.S.T.M. Specification A36 except as Noted.

All Field connections shall be made with high strength bolts. High strength bolts shall be 3/4" diameter unless otherwise noted and shall conform to A.S.T.M. Specification A-325.

BENCH MARK :
 See Reference Ties and Field Control Data sheet in highway plans.
 F-17 (Copper Weld Rod) Elevation 139.03
 F-20 (Copper Weld Rod) Elevation 145.80

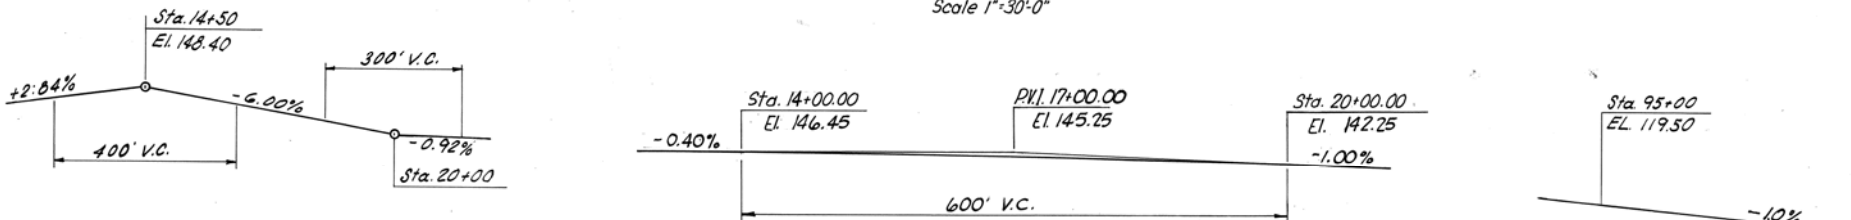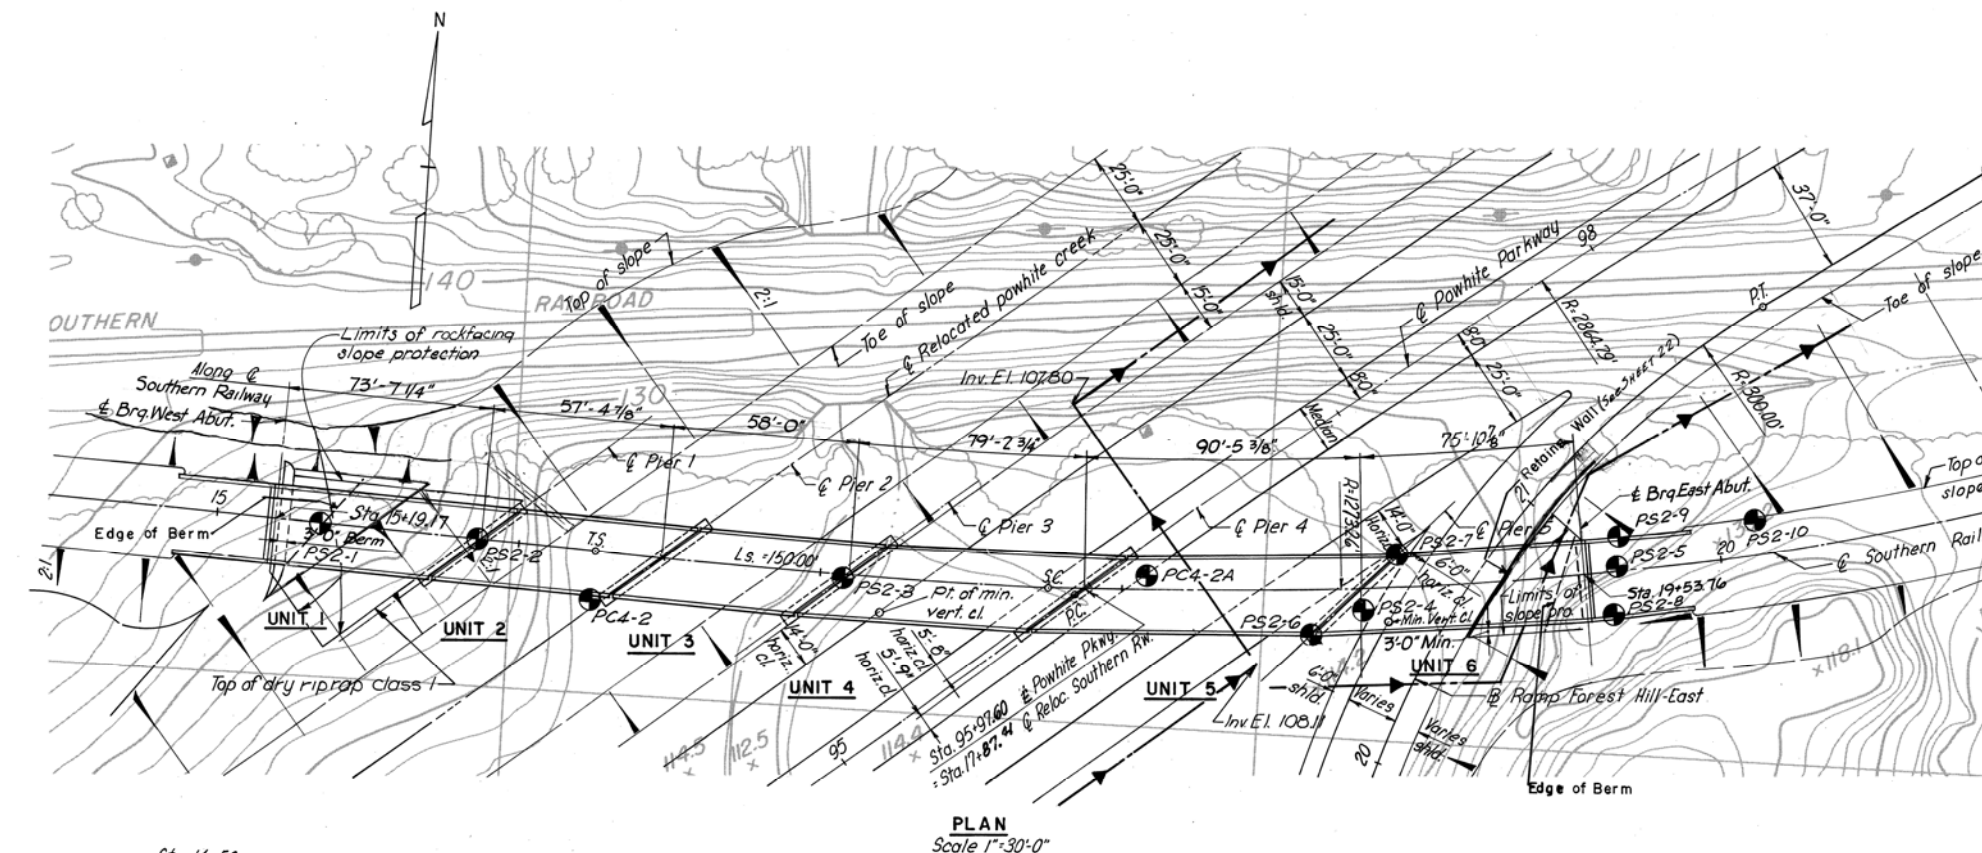

PROFILE GRADE RAMP F-E No Scale
PROFILE GRADE SOUTHERN RAILWAY No Scale
PROFILE GRADE POWHITE PARKWAY No Scale

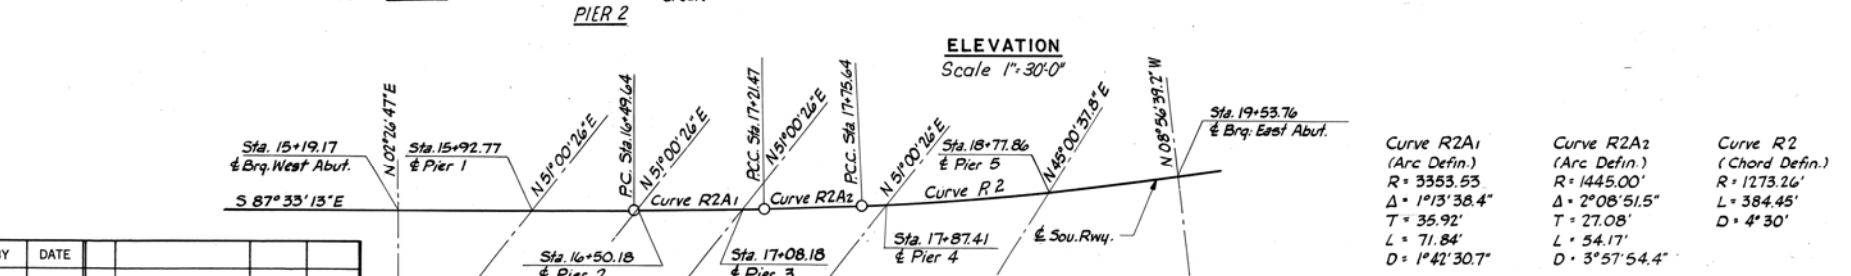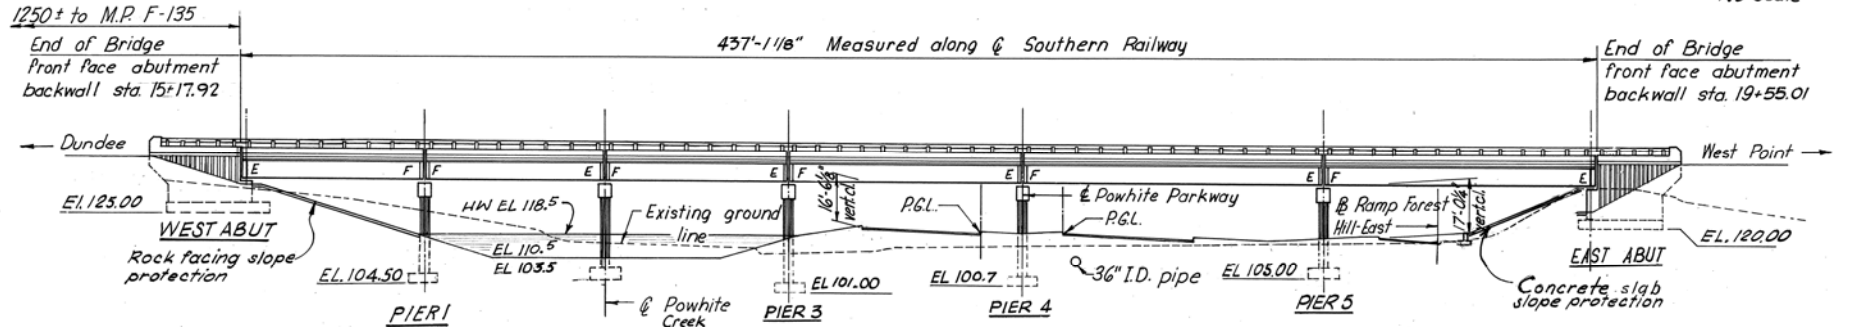

BY	DATE	NO.	REVISION	BY	DATE
MADE	JDB 1-68	2	As Built	JRC	11-72
CHECKED	JGD 2-68	1	Dim. Unit 6 Brq. East	TEM.	6-68
IN CHARGE	JGD				

INDEX	
NO.	DESCRIPTION
1	General Plan and Elevation
2	Quantities and Miscellaneous Det.
3	West Abutment Details
4	West Abutment and Drainage Details
5	East Abutment Details
6	East Abutment Details (1)
7	Pier Details (1)
8	Pier Details (2 & 3)
9	Framing Plan
10	Framing Plan
11	Girder Details
12	Superstructure Details
13	Deck Plans - Units 1 & 2
14	Deck Plans - Units 3 & 4
15	Deck Plans - Unit 5
16	Deck Plans - Unit 6
17	Shoe Details
18	Boring logs
19	Boring logs
20	Standard Aluminum Rail, Det. (1 Rail)
21	Standard Architectural Details.

Note: See sh. 2 for Slab Elevations and Estimated Quantities.

AS BUILT


RICHMOND METROPOLITAN AUTHORITY
 RICHMOND EXPRESSWAY SYSTEM
 POWHITE PARKWAY

SOUTHERN RAILWAY OVER
 POWHITE PARKWAY
 BRIDGE B-05


GENERAL PLAN & ELEVATION

HAYES, SEAY, MATTERN & MATTERN Associate Engineers	SCALE: AS SHOWN
HOWARD, NEEDLES, TAMMEN & BERGENOFF General Consultants	CONTRACT NO. C-2
	SHEET NO. 1 OF 19


GIRDER SUMMARY										
Girder Mark	PLATE A			PLATE B			Dimension			Brg. Stiff.
	Size	Length	Weld A	Size	Length	Weld B	C	D	E	
S1	18"x1 7/8"	16'-9 3/4"	3/8	18"x2 3/4"	51'-0"	1/2	1'-3"	82'-7 7/8"	1'-1 9/16"	8"x1"
S2	18"x1 3/4"	16'-10 5/8"	3/8	18"x2 1/2"	47'-6"	1/2		79'-3 3/8"		
S-3	18"x1 1/2"	15'-1 1/8"	3/8	18"x2 1/4"	47'-6"	3/8		75'-10 5/8"		
S-4	18"x1 1/2"	16'-5 3/8"	3/8	18"x2 3/8"	41'-6"	3/8		72'-5 1/2"		
S5	18"x1 1/4"	14'-9 3/8"	3/8	18"x1 3/4"	41'-6"	3/8		69'-0 3/4"		
S6	18"x1 1/2"	14'-3 3/8"	3/8	18"x1 3/8"	39'-0"	3/8		65'-7 1/8"		
S7	18"x1"	13'-7 3/8"	3/8	18"x1 1/2"	37'-0"	3/8		62'-3 3/8"		
S8	18"x 3/8"	13'-2"	3/8	18"x1 1/2"	34'-6"	3/8	1'-3"	58'-10 3/8"	1'-1 3/8"	8"x1"
S9	18"x 3/8"	14'-0 3/8"	3/8	18"x1 1/8"	29'-0"	3/8	1'-1 3/8"	55'-2 3/8"	1'-1 3/8"	8"x 3/4"
S10-S16	18"x 3/8"	14'-0 1/2"	3/8			3/8	1'-1 3/8"	55'-1 1/2"	1'-1 3/8"	
S17	18"x 3/8"	14'-7"	3/8			3/8	1'-1 3/8"	56'-2 1/4"	1'-1 3/8"	
S18	18"x 3/8"	14'-4 3/8"	3/8			3/8	1'-1 3/8"	55'-8 3/8"	1'-1 3/8"	
S19	18"x 3/8"	14'-4 3/8"	3/8			3/8	1'-1 3/8"	55'-8 3/8"	1'-1 3/8"	
S20	18"x 3/8"	14'-4 3/8"	3/8			3/8	1'-1 3/8"	55'-8 3/8"	1'-1 3/8"	
S21	18"x 3/8"	14'-4 3/8"	3/8			3/8	1'-1 3/8"	55'-8 3/8"	1'-1 3/8"	
S22	18"x 3/8"	14'-4 3/8"	3/8			3/8	1'-1 3/8"	55'-8 3/8"	1'-1 3/8"	
S23	18"x 3/8"	14'-2"	3/8			3/8	1'-1 3/8"	55'-4 3/8"	1'-1 3/8"	
S24	18"x 3/8"	13'-11 3/8"	3/8	18"x1 1/8"	29'-0"	3/8	1'-1 3/8"	55'-0 3/8"	1'-1 3/8"	8"x 3/4"
S25	18"x1 5/8"	16'-3 3/8"	3/8	18"x2 3/8"	47'-0"	1/2	1'-2 3/8"	77'-7 3/8"	1'-2 3/8"	8"x 3/8"
S26	18"x1 5/8"	16'-1 1/2"	3/8	18"x2 3/8"	47'-0"	1/2	1'-2 3/8"	77'-2 3/8"	1'-2 3/8"	8"x 3/8"
S27		15'-11 1/8"	3/8			1/2	1'-2 3/8"	76'-9 3/8"	1'-2 3/8"	
S28		15'-11 1/8"	3/8			1/2	1'-2 3/8"	76'-9 3/8"	1'-2 3/8"	
S29		15'-11 1/8"	3/8			1/2	1'-2 3/8"	76'-9 3/8"	1'-2 3/8"	
S30		15'-11 1/8"	3/8			1/2	1'-2 3/8"	76'-9 3/8"	1'-2 3/8"	
S31		15'-11 1/8"	3/8			1/2	1'-2 3/8"	76'-9 3/8"	1'-2 3/8"	
S32	18"x1 3/8"	15'-5 3/8"	3/8	18"x2 3/8"	47'-0"	1/2	1'-2 3/8"	75'-11 3/8"	1'-2 3/8"	8"x 3/8"
S33	20"x2"	17'-4"	3/8	20"x2 3/8"	54'-0"	1/2	1'-3 3/8"	86'-6 3/8"	1'-1 3/8"	9"x1"
S34		17'-5 3/8"	3/8			1/2	1'-3 3/8"	86'-10 3/8"	1'-1 3/8"	
S35		17'-7 3/8"	3/8			1/2	1'-3 3/8"	87'-2 3/8"	1'-1 3/8"	
S36		18'-0 3/8"	3/8	20"x2 3/8"	54'-0"	1/2	1'-3 3/8"	88'-0"	1'-1 3/8"	9"x1"
S37		16'-11 3/8"	3/8	20"x3"	57'-0"	1/2	1'-3 3/8"	88'-7 3/8"	1'-1 3/8"	
S38		17'-4 3/8"	3/8			1/2	1'-3 3/8"	89'-7 3/8"	1'-1 3/8"	
S39		17'-4 3/8"	3/8			1/2	1'-3 3/8"	89'-9"	1'-1 1/2"	
S40	20"x2"	17'-5 3/8"	3/8	20"x3"	57'-0"	1/2	1'-3 3/8"	89'-10 3/8"	1'-1 3/8"	9"x1"
S41	18"x1 1/8"	14'-2 3/8"	3/8	18"x1 5/8"	36'-6"	1/2	1'-2 3/8"	62'-9 3/8"	1'-3"	8"x1"
S42	18"x1 1/4"	14'-5 3/8"	3/8	18"x1 3/4"	40'-0"	3/8	1'-2 3/8"	66'-8 3/8"	1'-3"	
S43	18"x1 3/8"	14'-8 3/8"	3/8	18"x2"	43'-6"	3/8	1'-2 3/8"	70'-8 3/8"	1'-3"	
S44	18"x1 1/2"	15'-1 3/8"	3/8	18"x2 1/4"	46'-6"	3/8	1'-2 3/8"	74'-8 3/8"	1'-3"	
S45	18"x1 3/4"	16'-7 3/8"	3/8	18"x2 1/2"	47'-6"	1/2	1'-2 3/8"	78'-7 3/8"	1'-3"	
S46	18"x1 3/8"	16'-6 3/8"	3/8	18"x2 3/4"	51'-6"	1/2	1'-2 3/8"	82'-6 3/8"	1'-3"	8"x1"
S47	20"x1 3/8"	17'-7 3/8"	3/8	20"x2 3/4"	53'-6"	1/2	1'-2 3/8"	86'-6 3/8"	1'-3"	9"x1"
S48	20"x2"	17'-10"	3/8	20"x3"	57'-0"	1/2	1'-2 3/8"	90'-6 3/8"	1'-3"	9"x1"

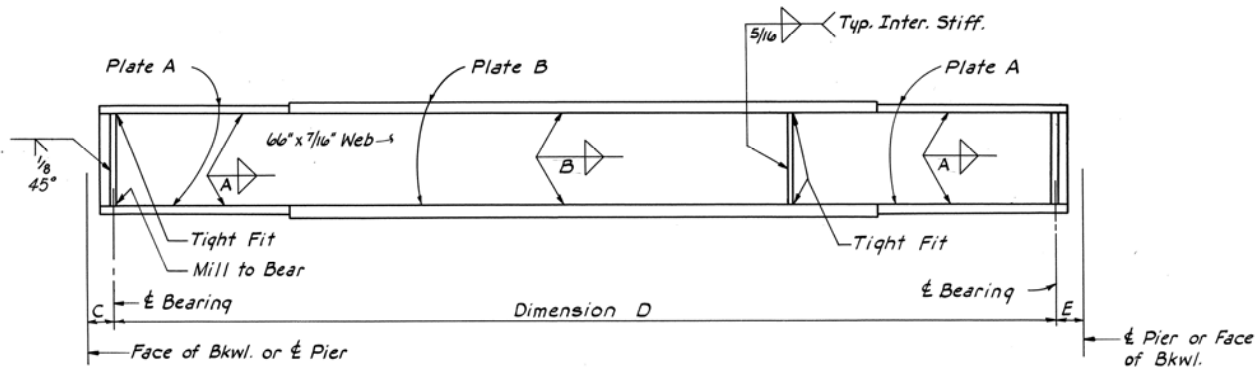

GIRDER DETAIL
No Scale

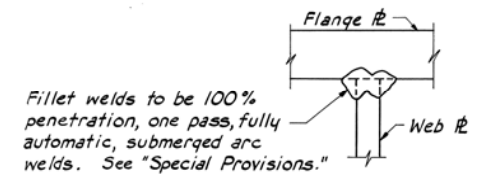

FLANGE PLATE WELDS
No Scale

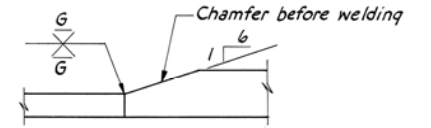


FLANGE THICKNESS TRANSITION
No Scale

DEAD LOAD DEFLECTION SUMMARY

Girder Mark	Total Dead Load Defl. @ E Girder
S1, S2	1/2"
S3	7/16"
S4	3/8"
S5, S6	5/16"
S7, S8	1/4"
S9, S24	3/16"
S25, S32	7/16"
S33, S38	9/16"
S39, S40	5/8"
S41	1/4"
S42	5/16"
S43, S44	3/8"
S45	7/16"
S46	1/2"
S47	9/16"
S48	5/8"

The above deflections are those anticipated to occur in the girder upon placement of the total dead load. The girders shall not be cambered to compensate for this deflection.

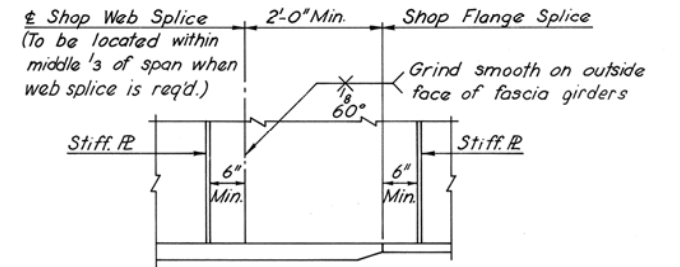

SHOP SPlice DETAILS
Scale: 3/4"=1'-0"

BY	DATE	NO.	REVISION	BY	DATE
MADE	H.B. 1-68	2	As Built	JRC	11-72
CHECKED	THN 2-68	1	Girder Summary	T.E.M.	6-68
IN CHARGE	JGD				

AS BUILT

RICHMOND METROPOLITAN AUTHORITY
RICHMOND EXPRESSWAY SYSTEM
POWHITE PARKWAY

SOUTHERN RAILWAY OVER
POWHITE PARKWAY
BRIDGE B-05



GIRDER DETAILS

HAYES, SEAY, MATTERN & MATTERN
Associate Engineers





HOWARD, NEEDLES, TAMMEN & BERGENDOFF
General Consultants

SCALE: NO SCALE
CONTRACT NO.: 2
SHEET NO. 11 OF 19

RICHMOND EXPRESSWAY SYSTEM			
SECTION	PROJECT	SHEET NO.	TOTAL SHEETS
2	POWHITE PARKWAY	143	188

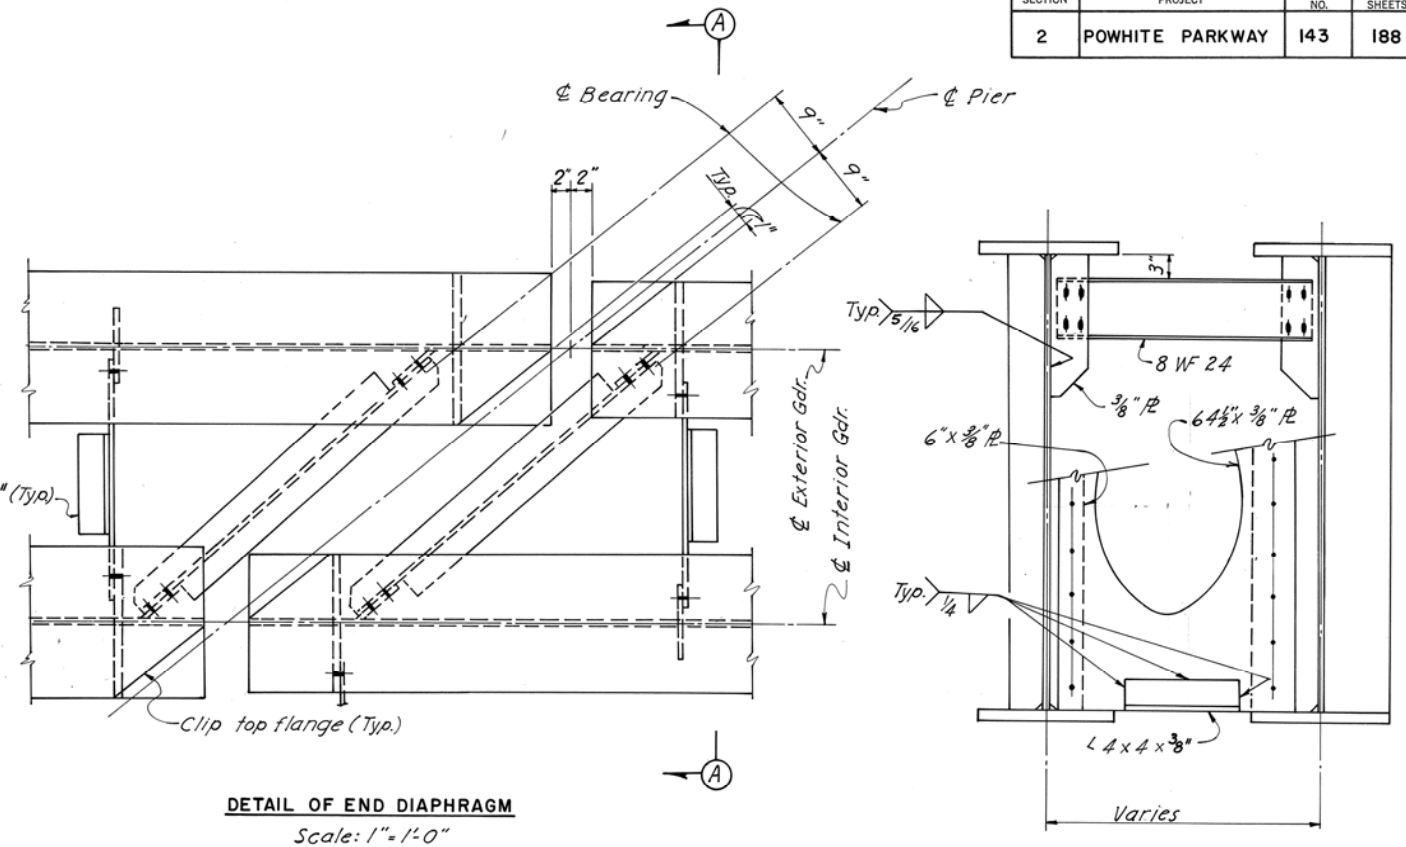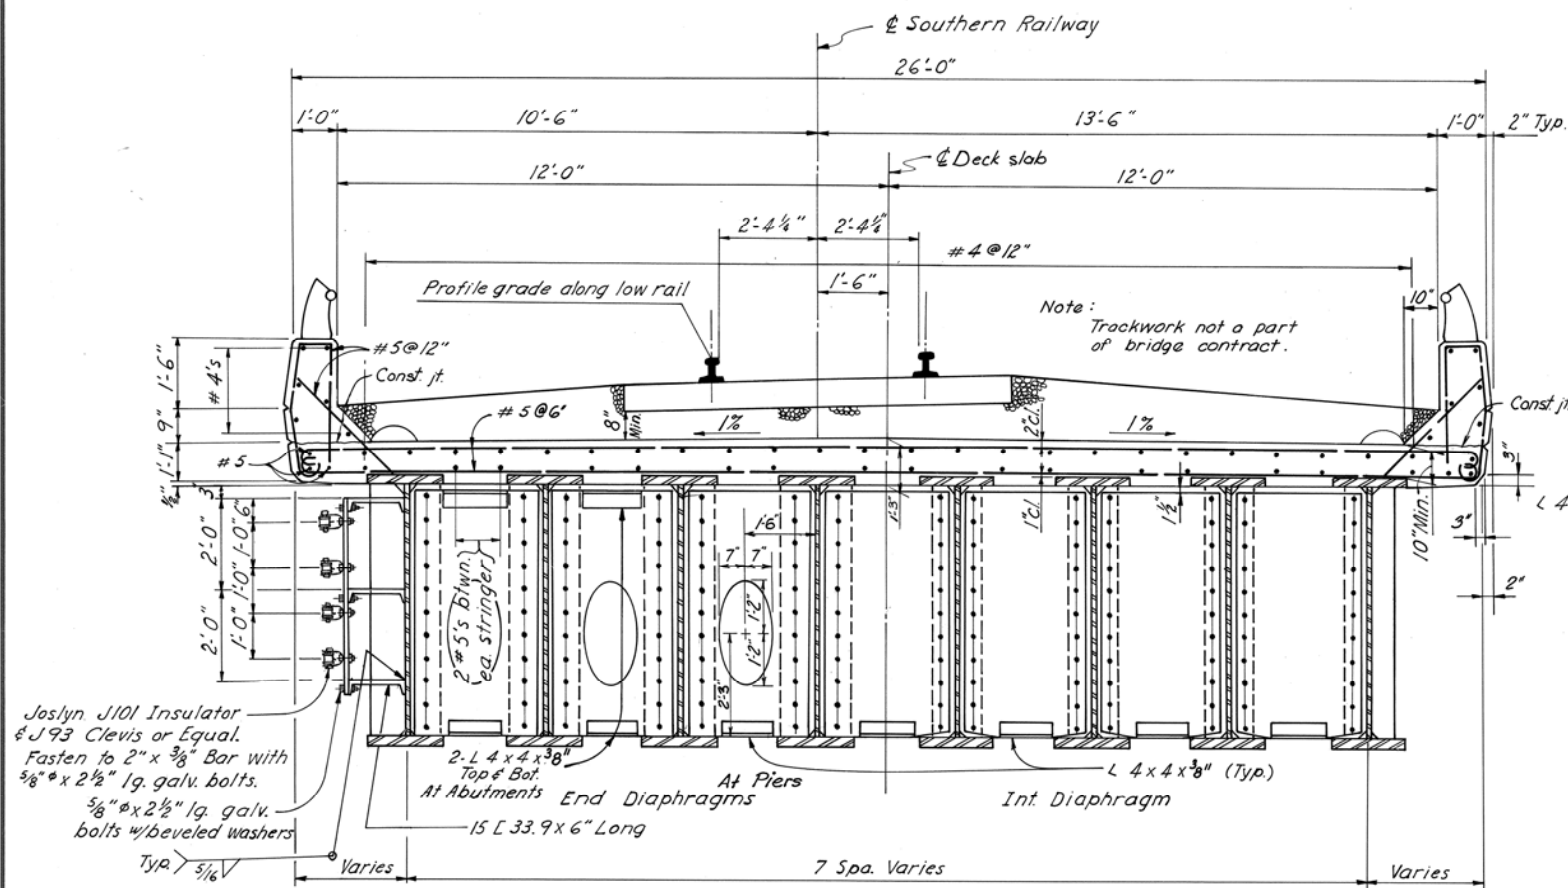

NOTE:
Space racks 20'-0" apart along girders. Fasten high frequency wires to inside of insulators (Max. tension 250 #).

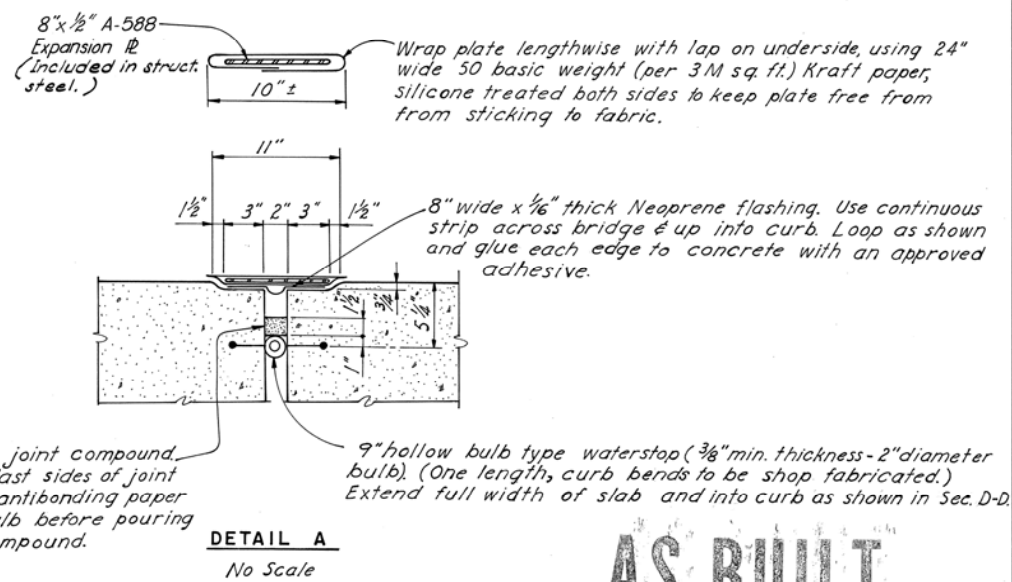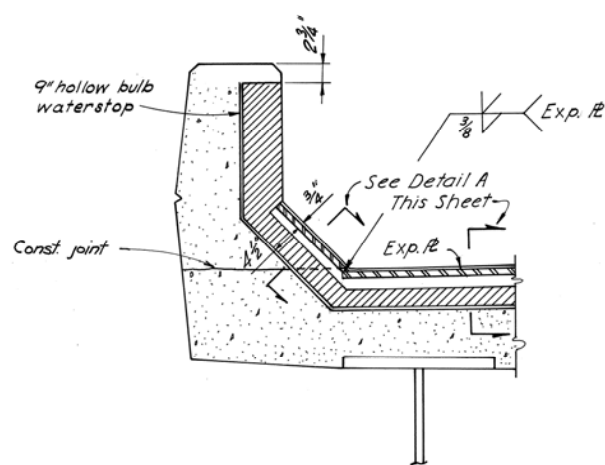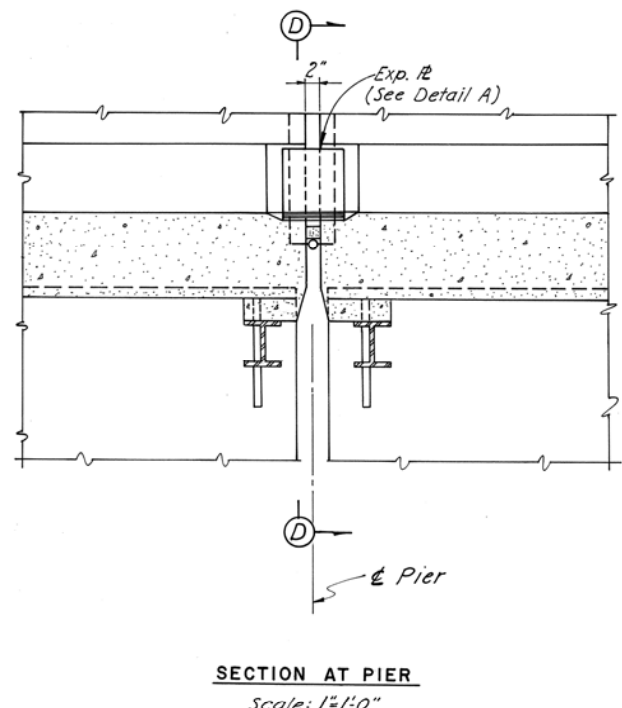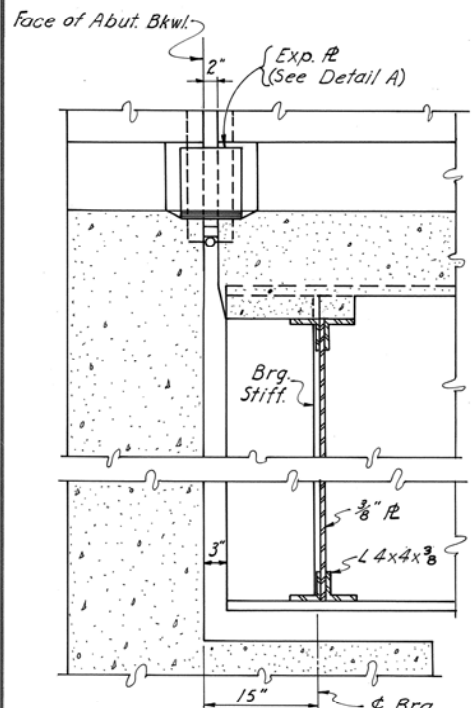

BY	DATE	NO.	REVISION	BY	DATE	
BY	DATE	3	As Built	JRC	11-72	
MADE	HB	1-68	2	General	JGV	10-70
CHECKED	THN	2-68	1	End. diaph & dim.	TEM	6-68
IN CHARGE	JGD					

AS BUILT

RICHMOND METROPOLITAN AUTHORITY
RICHMOND EXPRESSWAY SYSTEM
POWHITE PARKWAY

SOUTHERN RAILWAY OVER
POWHITE PARKWAY
BRIDGE B-05

SUPERSTRUCTURE DETAILS

HAYES, SEAY, MATTERN & MATTERN
Associate Engineers
SCALE: AS SHOWN



HOWARD, NEEDLES, TAMMEN & BERGENDOFF
General Consultants
CONTRACT NO.: 2
SHEET NO. 12 OF 19

Bridge 8

(Powhite Parkway “Rte. 76” Over James River, Kanawha Canal and CSX RR)

Record Set Plans

RICHMOND EXPRESSWAY SYSTEM			
SECTION	PROJECT	SHEET NO.	TOTAL SHEETS
13	WIDENING JAMES RIVER BRIDGE	2	106

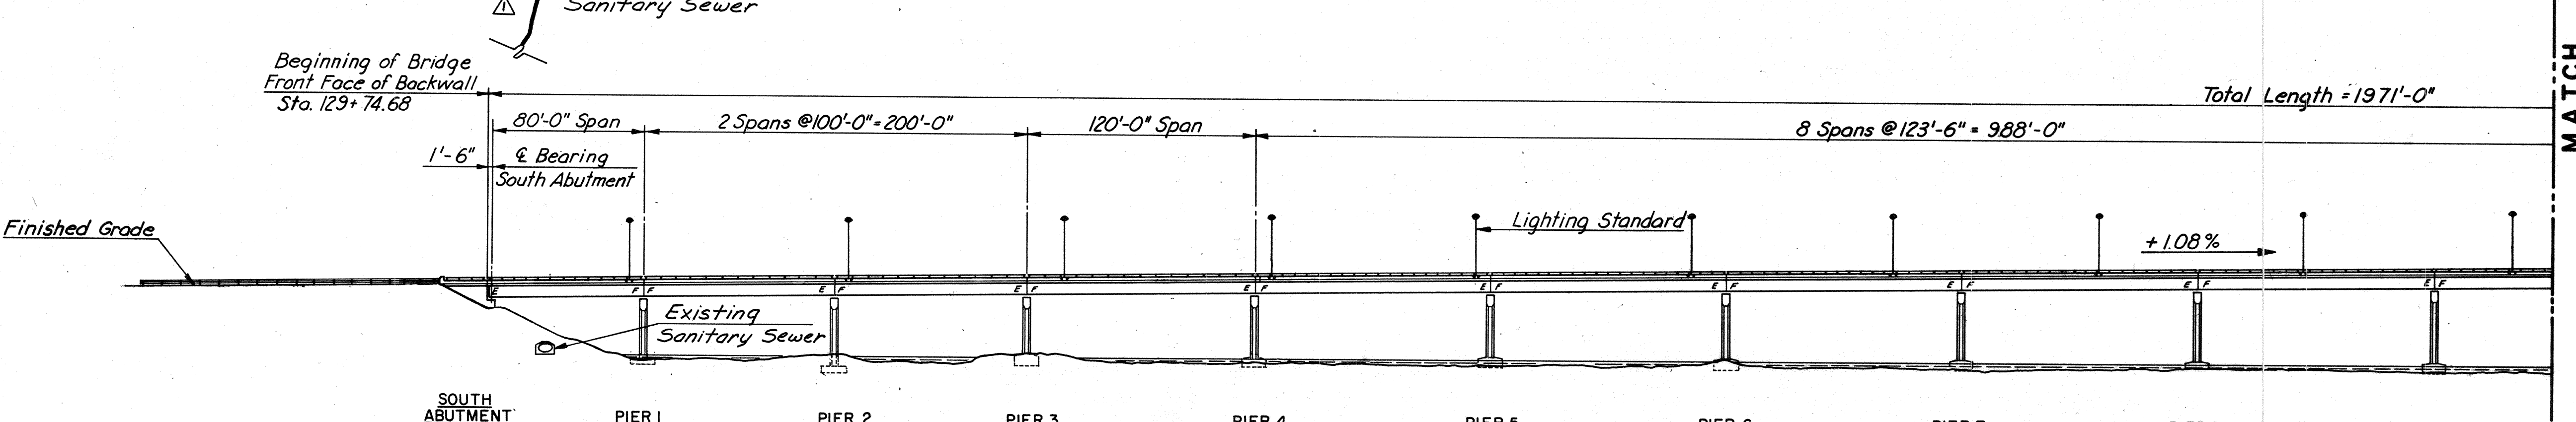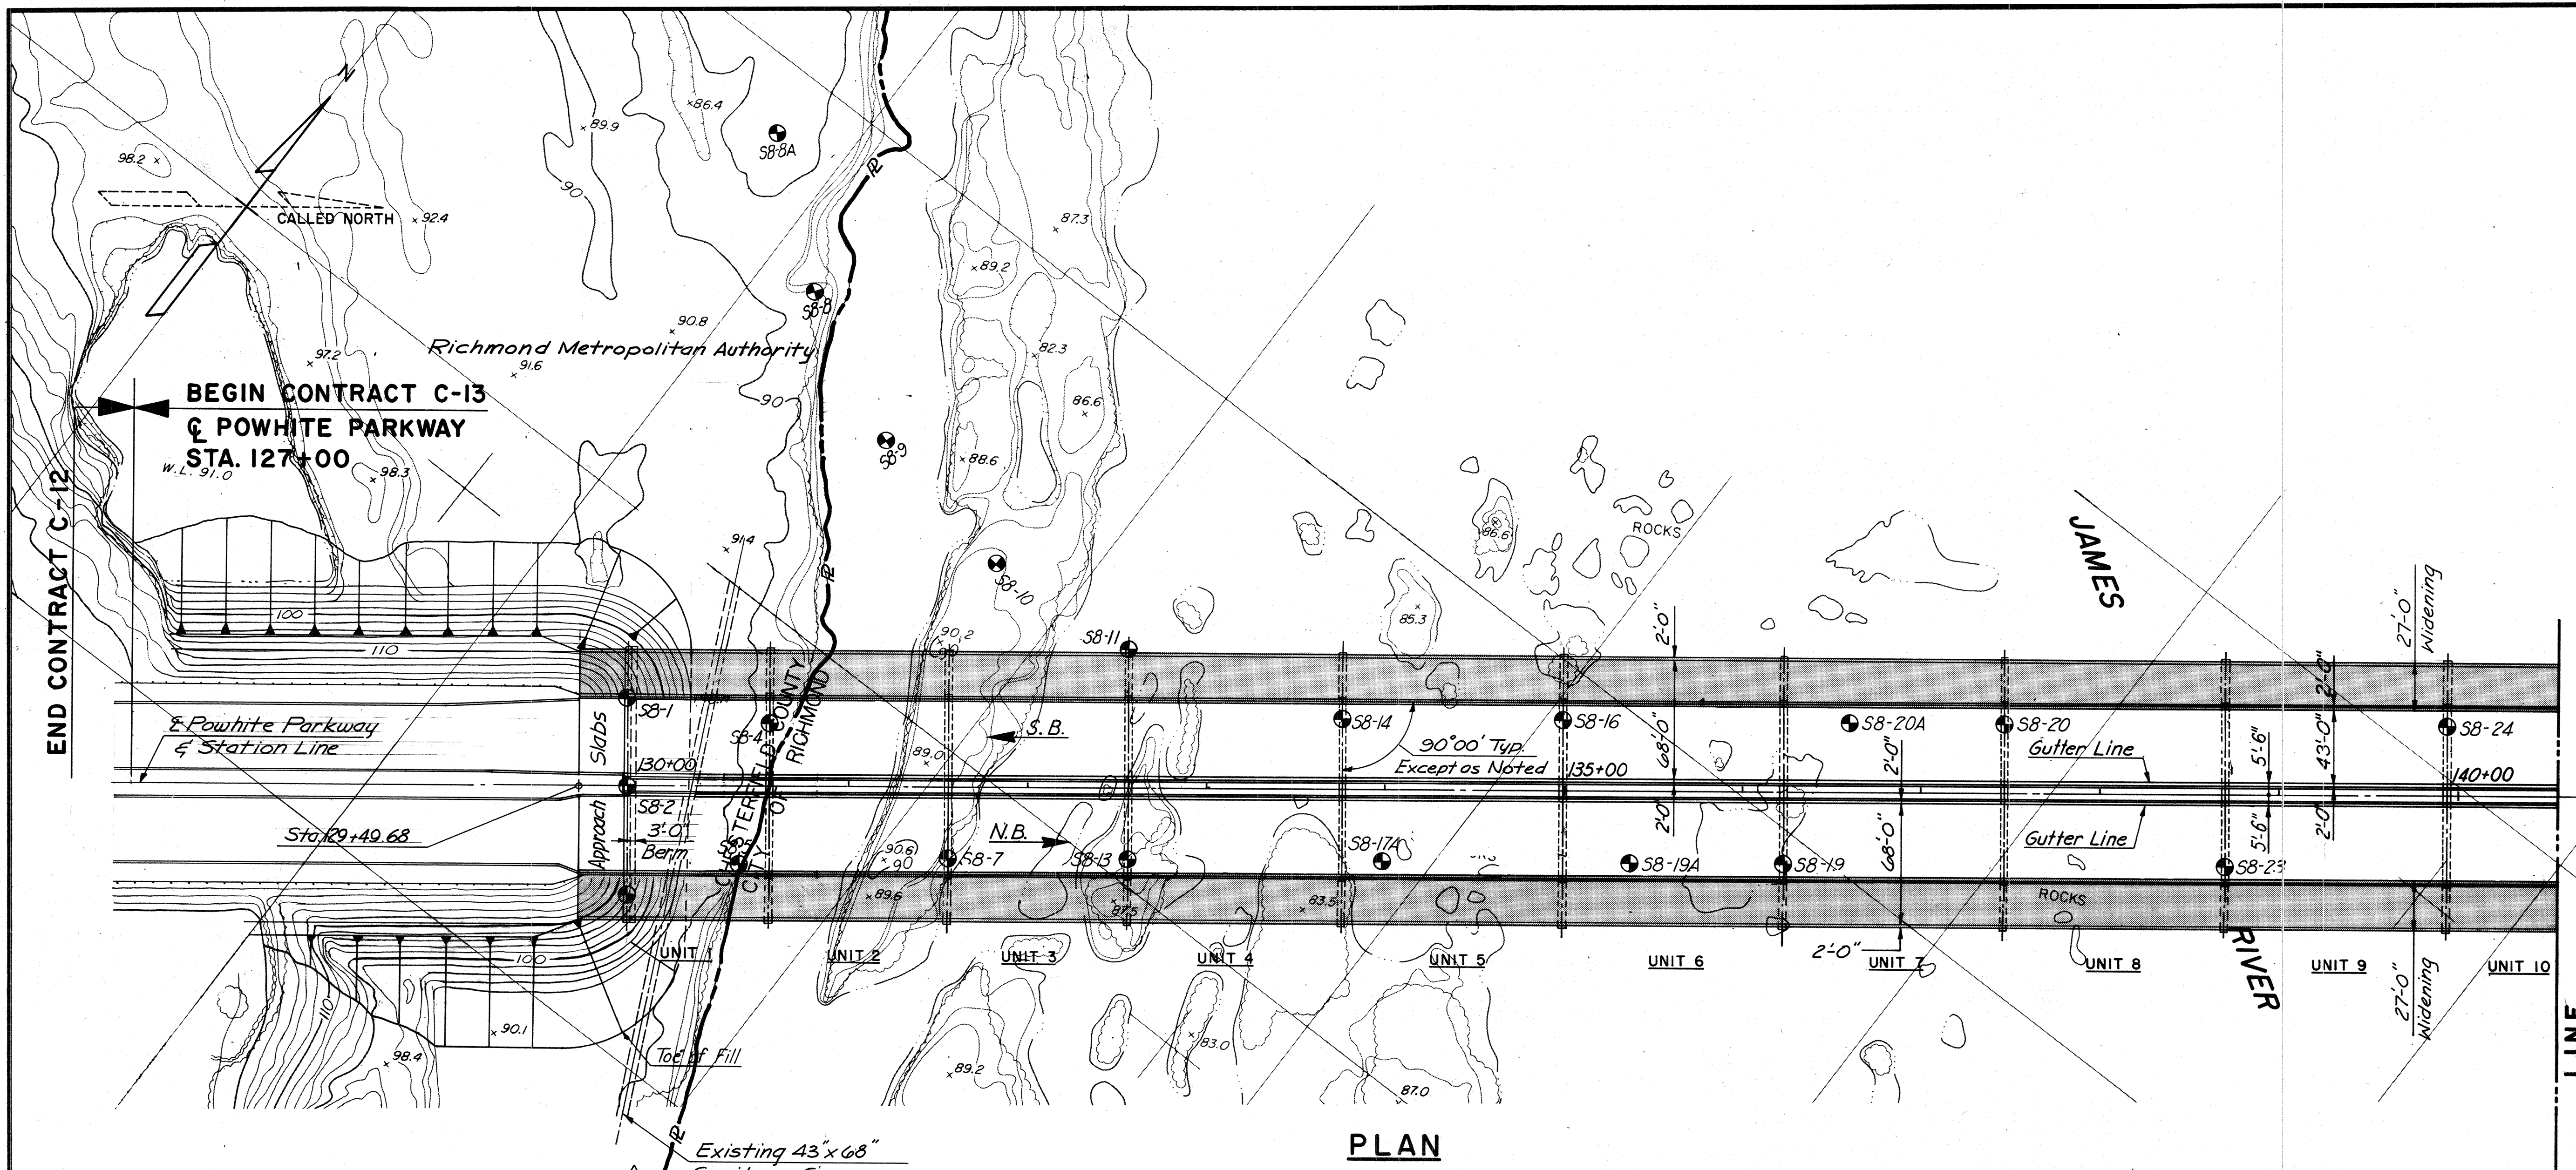

MADE	BY	DATE	NO.	REVISION	BY	DATE
ALC	3-87	As Built	TEM	3-89		
T.F.P.	3-87	Property Line	ALC	4-87		
S.R.						

AS BUILT


**RICHMOND METROPOLITAN AUTHORITY
 RICHMOND EXPRESSWAY SYSTEM**

GENERAL PLAN AND ELEVATION


HOWARD, NEEDLES, TAMMEN & BERGENDOFF
 consulting engineers
 Alexandria, Virginia

SCALE: 1" = 50'
 CONTRACT NO.: C-13
 SHEET NO. 2 OF 106

RICHMOND EXPRESSWAY SYSTEM			
SECTION	PROJECT	SHEET NO.	TOTAL SHEETS
13	WIDENING JAMES RIVER BRIDGE	5	106

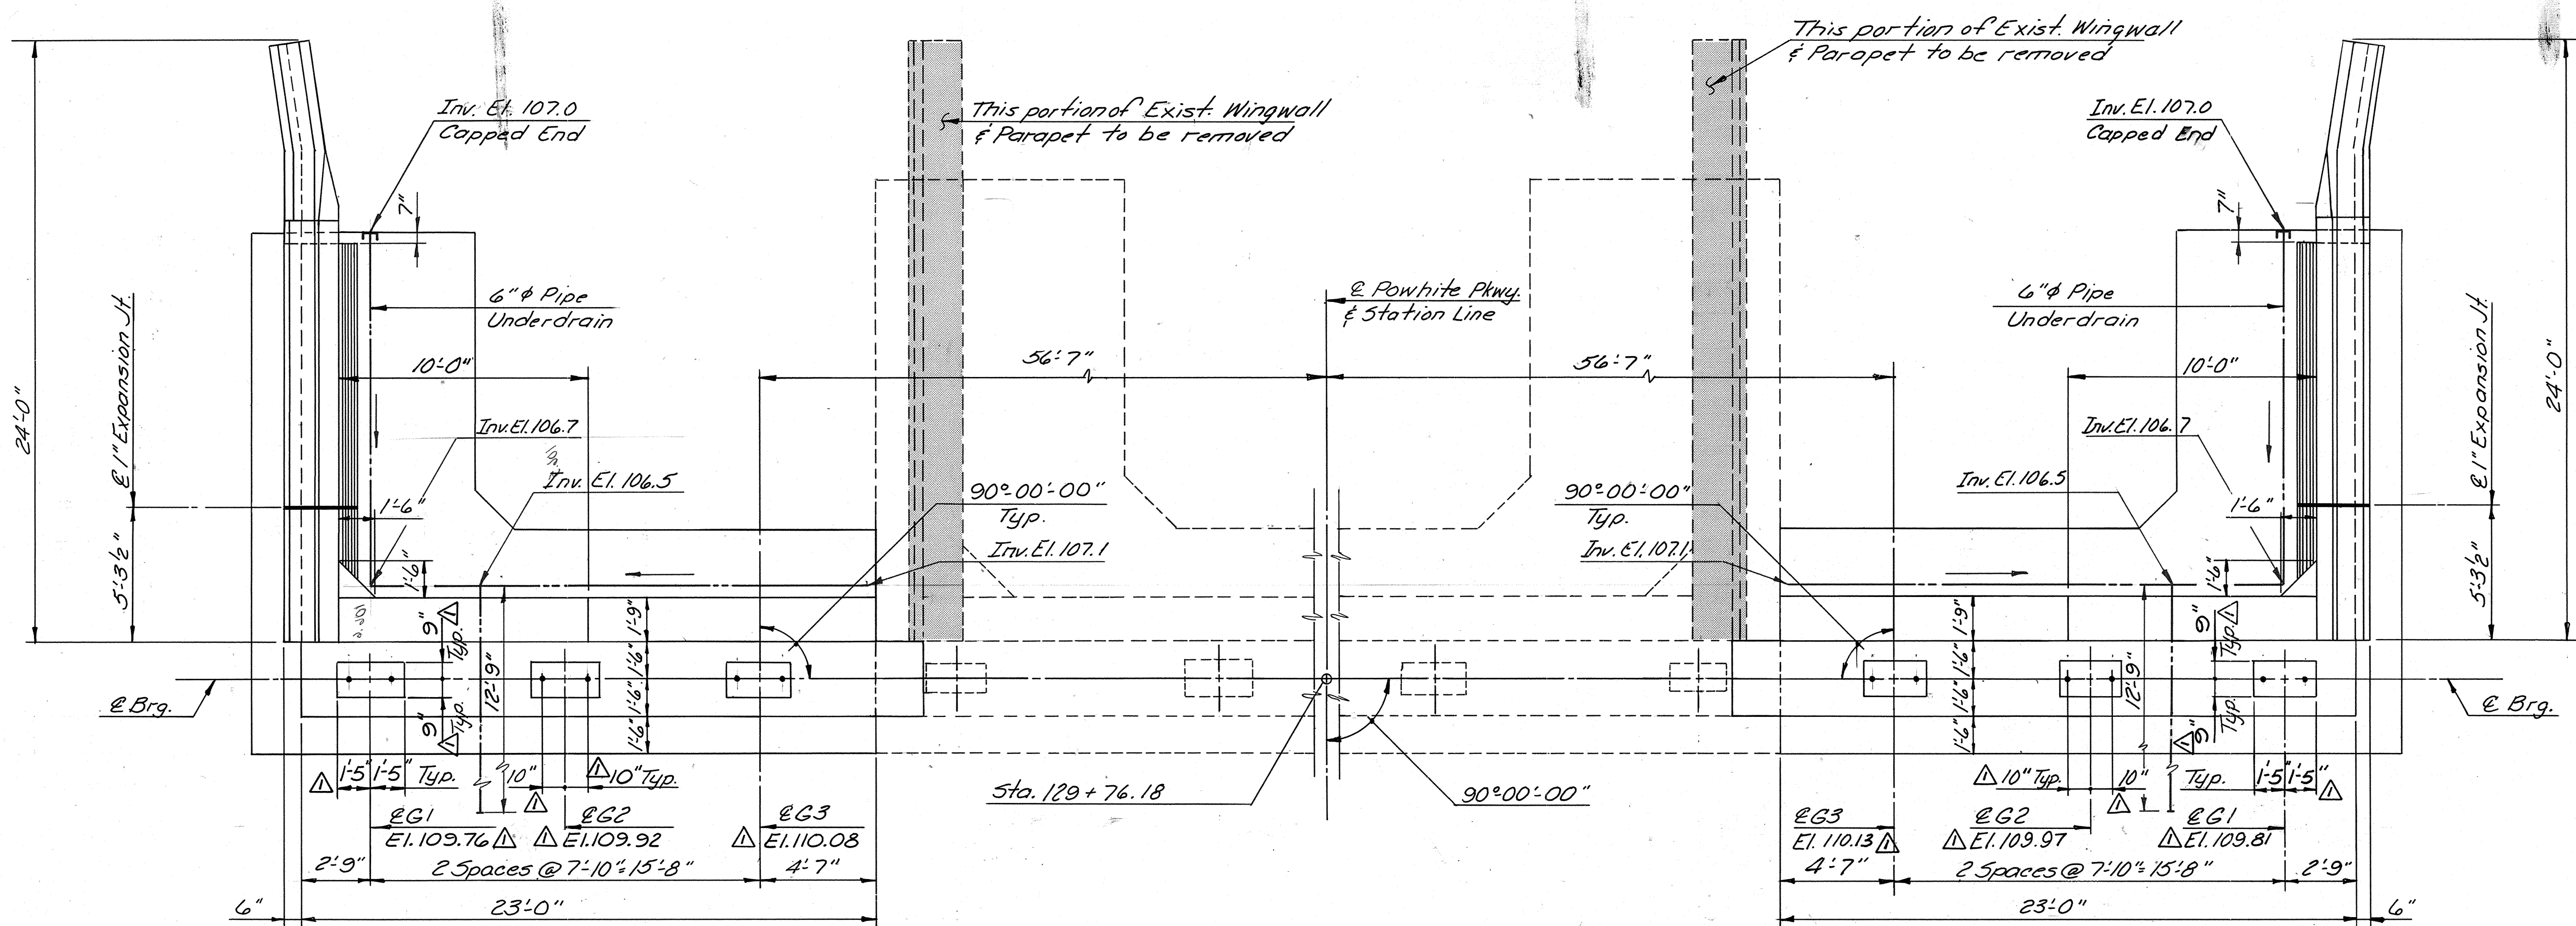


* Field survey elevations.

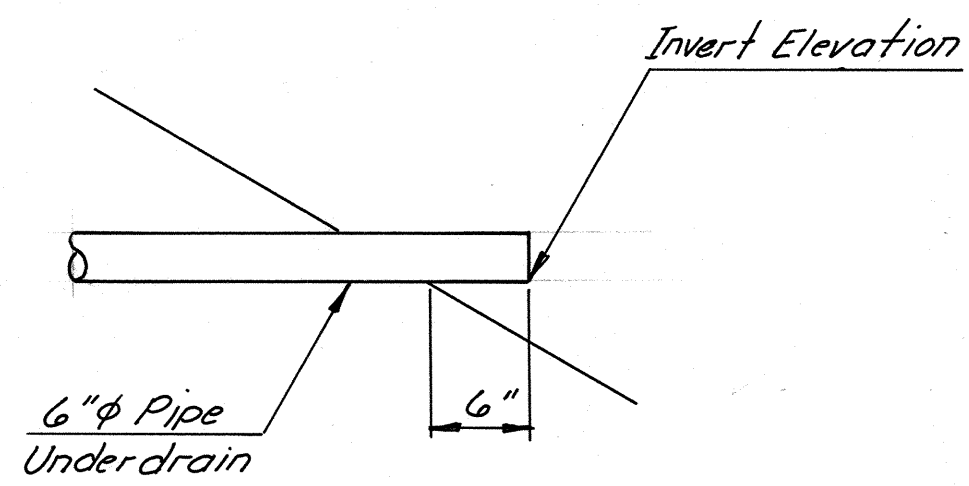

DETAIL "D"
No Scale

LEGEND:
E.F. = Each Face
F.F. = Far Face
N.F. = Near Face

This portion of Exist. Wingwall and Parapet to be removed

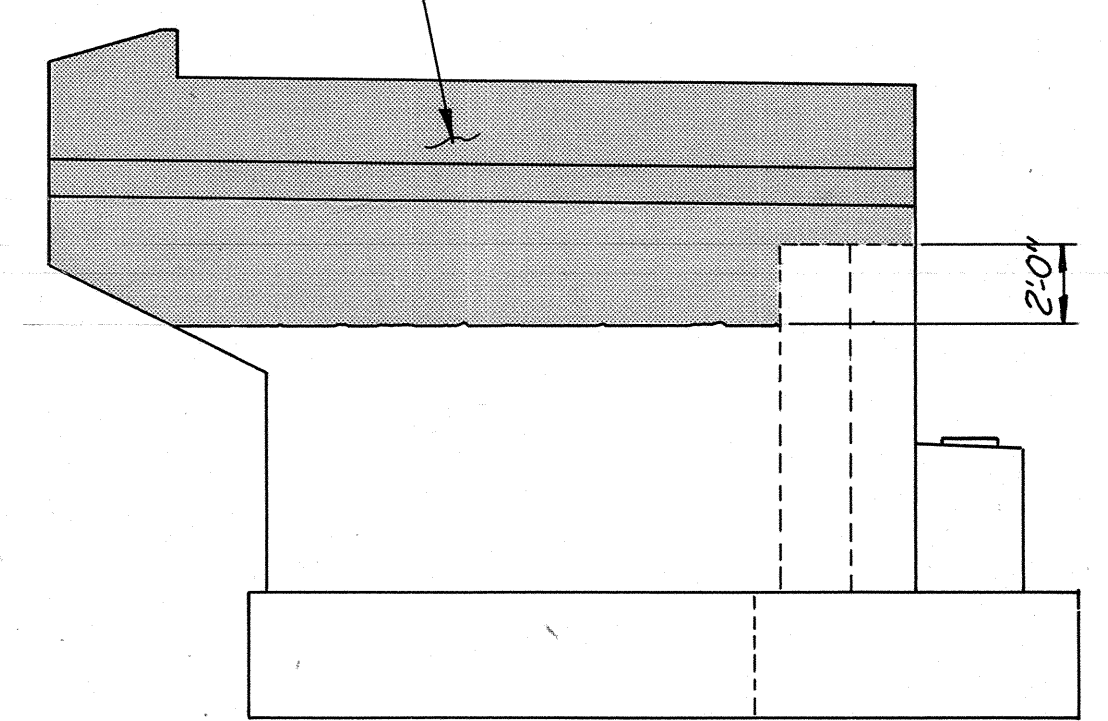


LIMITS OF REMOVAL
No Scale


NOTE:
For Sections A-A, B-B, and C-C see Sheet No. 6

PLAN - NORTHBOUND
Scale: 4"=1'-0"

PLAN - SOUTHBOUND
Scale: 4"=1'-0"

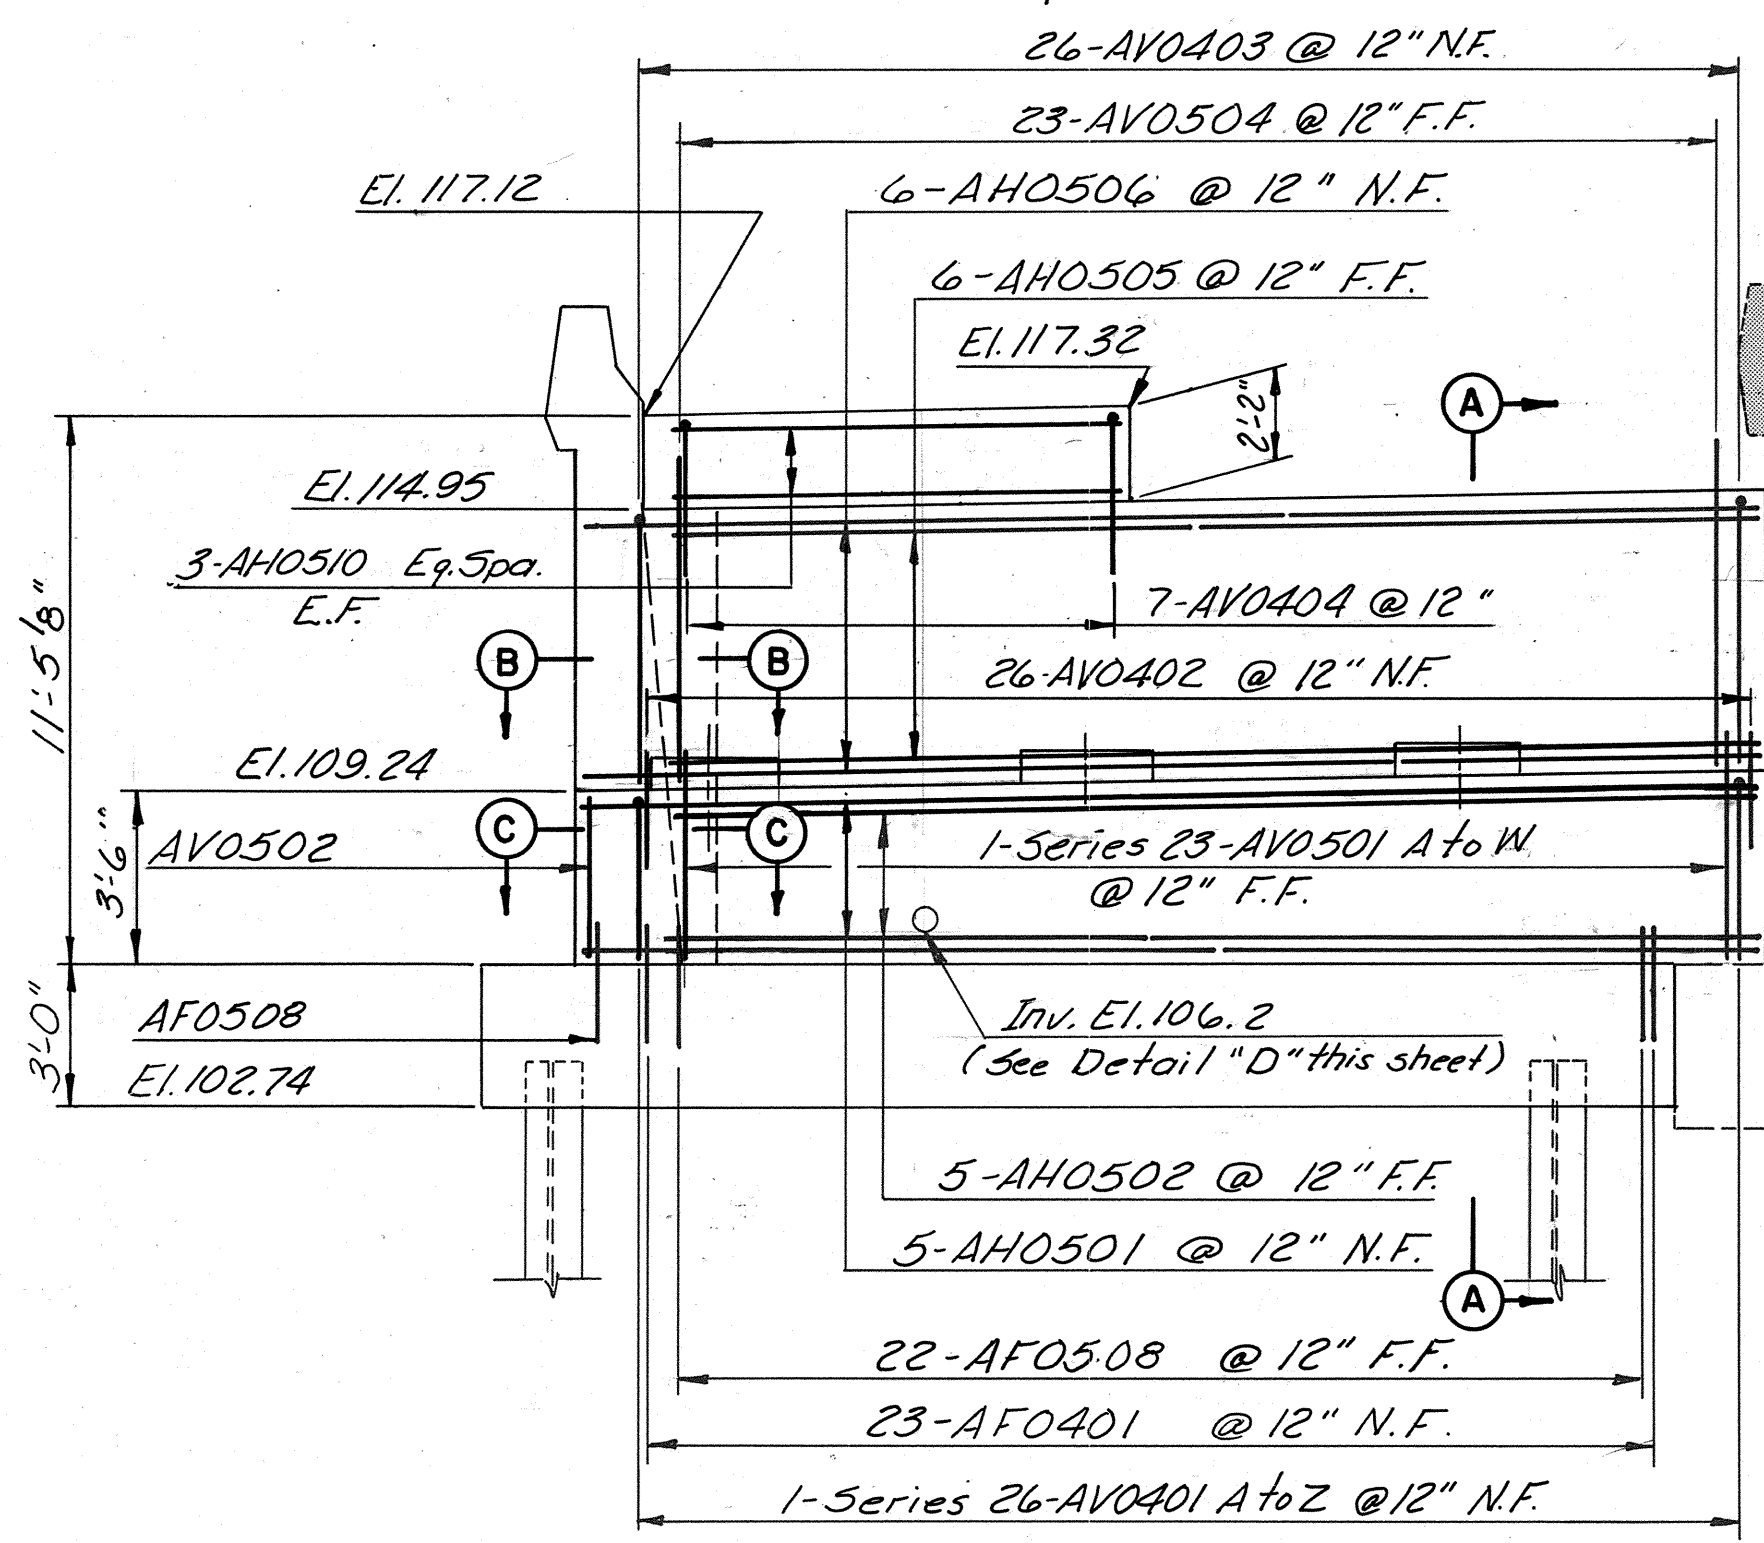

ELEVATION - NORTHBOUND
Scale: 4"=1'-0"

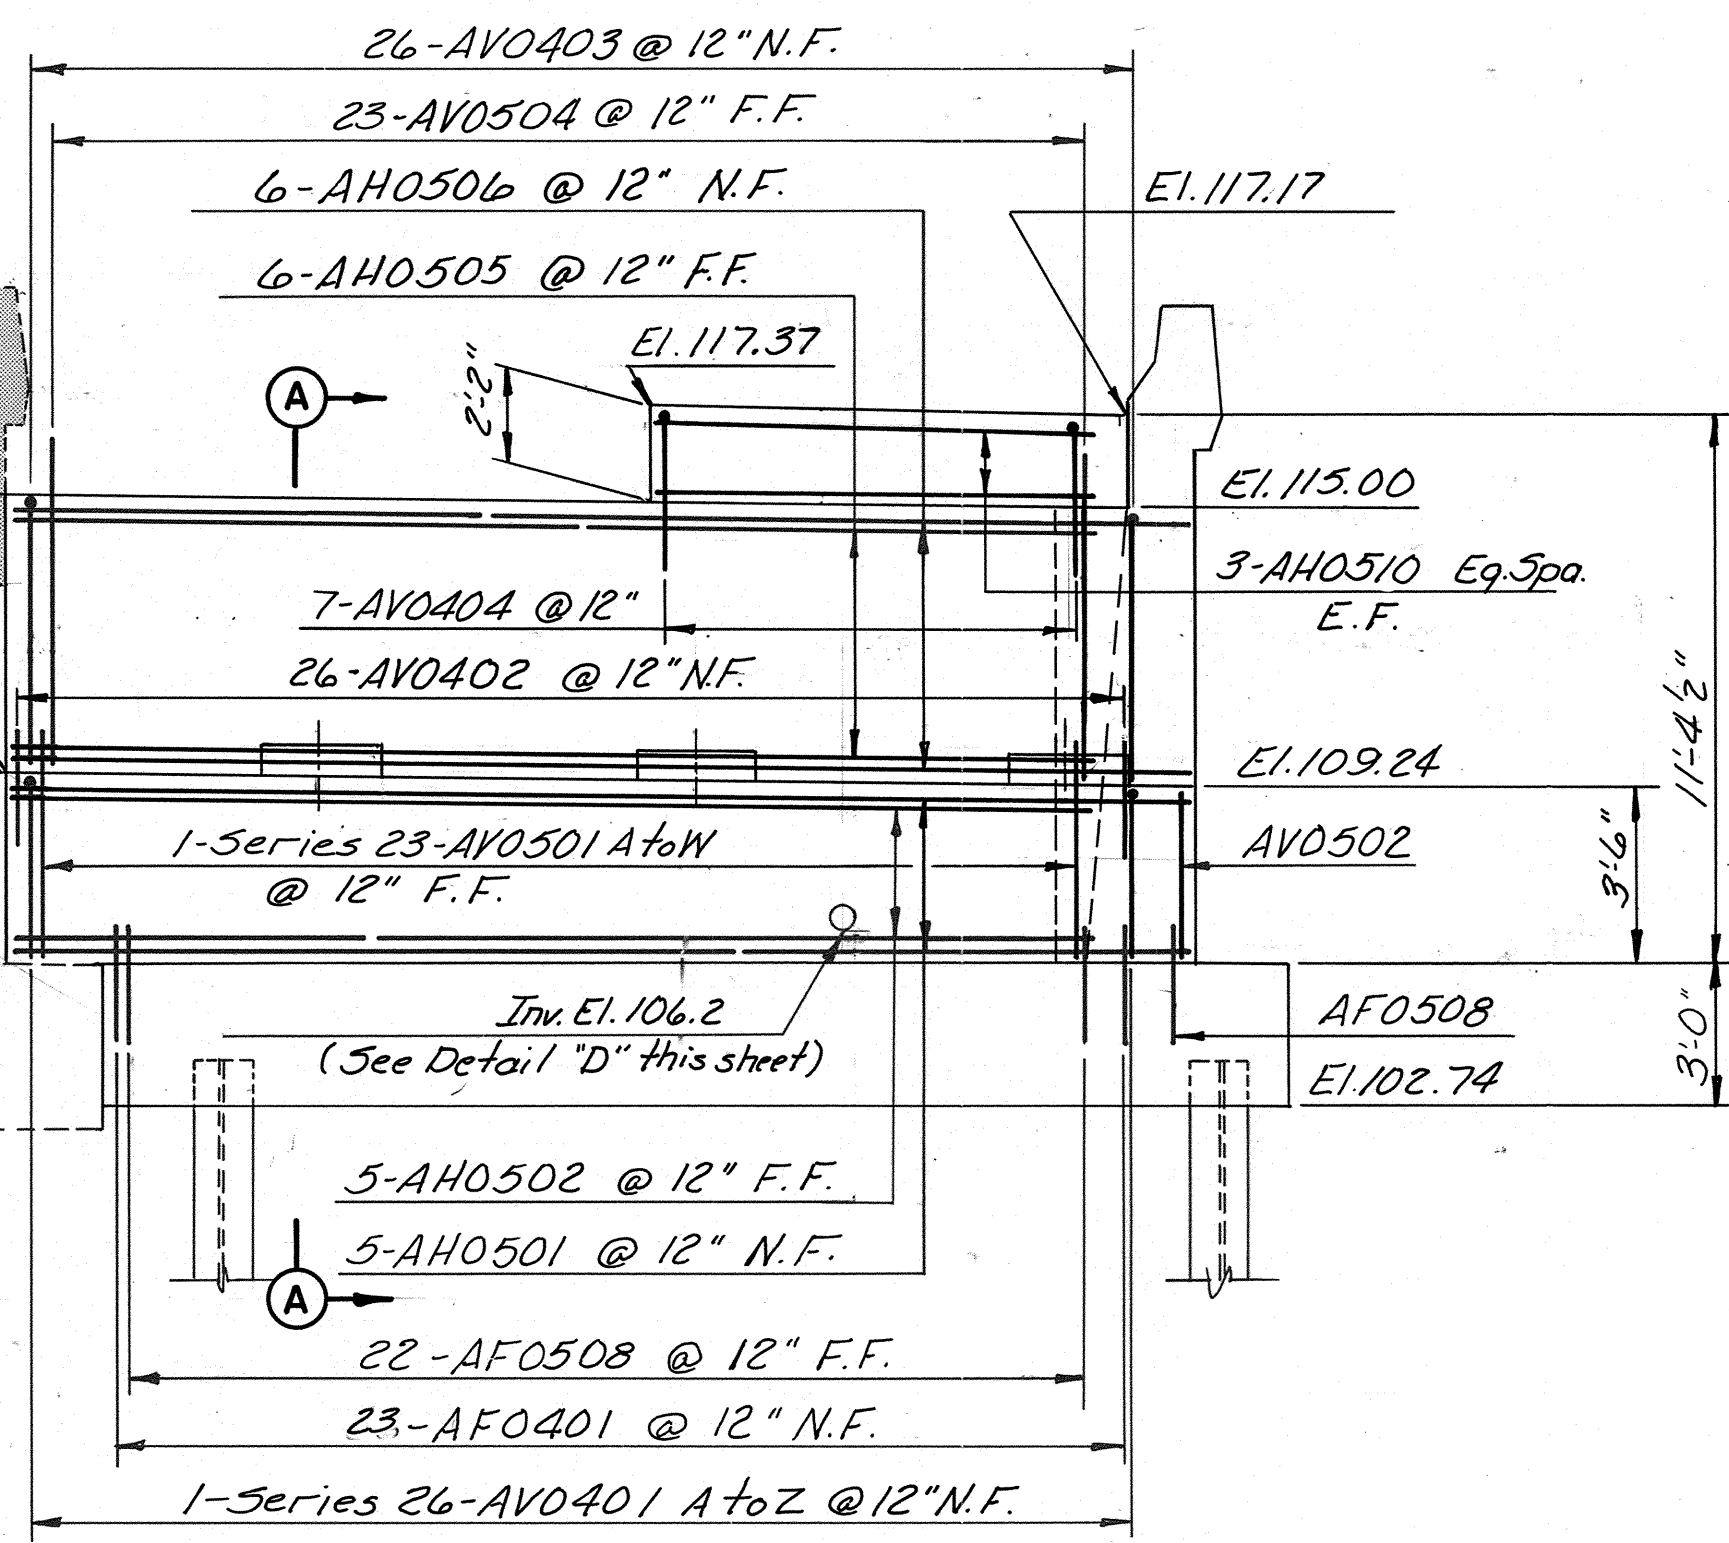

ELEVATION - SOUTHBOUND
Scale: 4"=1'-0"

BY	DATE	REVISION	BY	DATE
MADE	TAL 1-87	As Built	TEM	3-89
CHECKED	T.F.P. 3-87	Rev Anchor Bolt	ALC	6-87
IN CHARGE	S.R.			

AS BUILT

RICHMOND METROPOLITAN AUTHORITY
RICHMOND EXPRESSWAY SYSTEM

SOUTH ABUTMENT PLAN
AND ELEVATION

HOWARD, NEEDLES, TAMMEN & BERGENDOFF
consulting engineers
Alexandria, Virginia

SCALE: AS SHOWN
CONTRACT NO.: C-13
SHEET NO. 5 OF 106

Bridge 9S & 9N

(Northbound & Southbound CSX RR over Northbound Powhite Parkway “Rte. 76”)

Record Set Plans

RICHMOND EXPRESSWAY SYSTEM			
SECTION	PROJECT	SHEET NO.	TOTAL SHEETS
4	BELTLINE EXPRESSWAY	94	155

GENERAL NOTES

STRUCTURE: Dual structures with one welded steel girder span and one rolled beam at each approach. Distance between girders of 18'-4" with 1'-6" min. clear between structures.

CAPACITY: Live Loads - Cooper E-80 with 50% impact

SPECIFICATIONS: GENERAL: Virginia Department of Highway Road and Bridge Specifications 1970 and Contract Special Specifications. DESIGN: A.R.E.A. 1966 for Steel Railway Bridges, for Fixed Spans not exceeding 400 feet in length. WELDING: 1969 Standard Specifications for Welded Highway and Railway Bridges of the American Welding Society.

CONTRACT SPECIAL PROVISIONS: Specifications and Contract Special Provisions referred to above are necessary to make these plans complete.

DATUM: City of Richmond

TEMPERATURE: The normal temperature referred to on the plan is 68°F. The temperature range for movement is 0°F to 120°F.

DIMENSIONS: All dimensions are measured horizontally and vertically unless otherwise noted.

EXCAVATION: Excavation below subgrade and cut slope template shall be classified as Structure Excavation. All excavation above these limits shall be classified as Regular Excavation and is not included in the Structural Quantities.




FOUNDATION: Piles shall be driven to a minimum length corresponding to the approximate tip elevations shown on the Plans but in no case to less than a penetration affording the required safe bearing capacity noted on the Plans.

CONCRETE NOTES: All concrete shall be Class A3. All exposed edges and corners shall have a 3/4" chamfer or fillet unless otherwise noted. Finishing Concrete Surfaces: See The Standard Architectural Detail sheets and the Contract Special Provisions for Types and details.

All reinforcing steel shall conform to A.S.T.M. A615, Grade 40. All reinforcing bar dimensions on the detailed drawings are to centers of bars unless otherwise noted. Clear distance between reinforcing steel and face of concrete shall be as noted on the plans. All bar laps shall be 30 diameters of the smaller bar unless otherwise noted.

STEEL NOTES: Structural steel shall conform to A.S.T.M. Specification A-36 and A-588. All Field Connections shall be made with high strength bolts or rivets. High strength bolts and rivets shall be 1/2" diameter unless otherwise noted and shall conform to A.S.T.M. Specification A-325.

BENCH MARK: A-15 Copperweld rod on bridge on Blue Shingles Road Elev. 204.73.

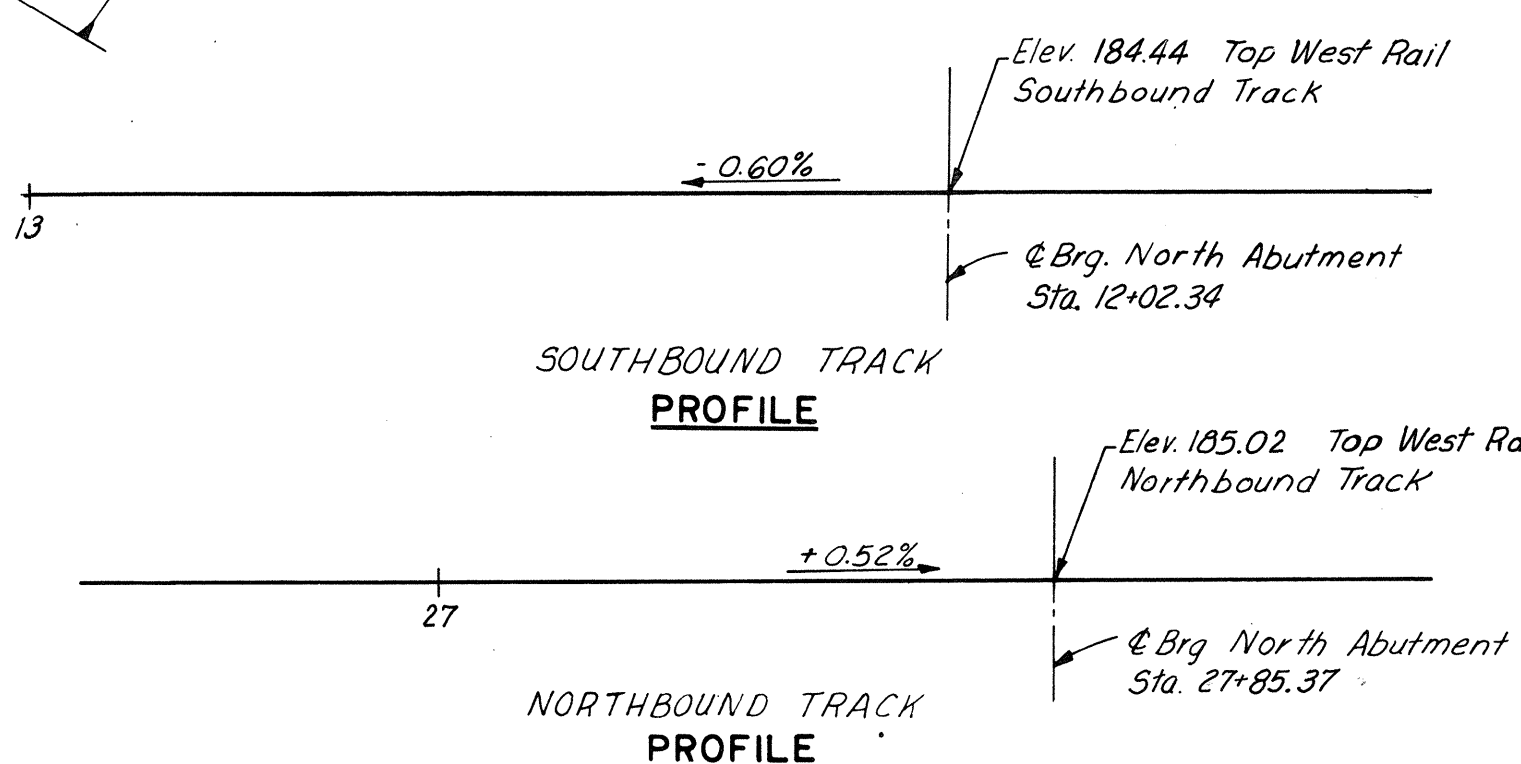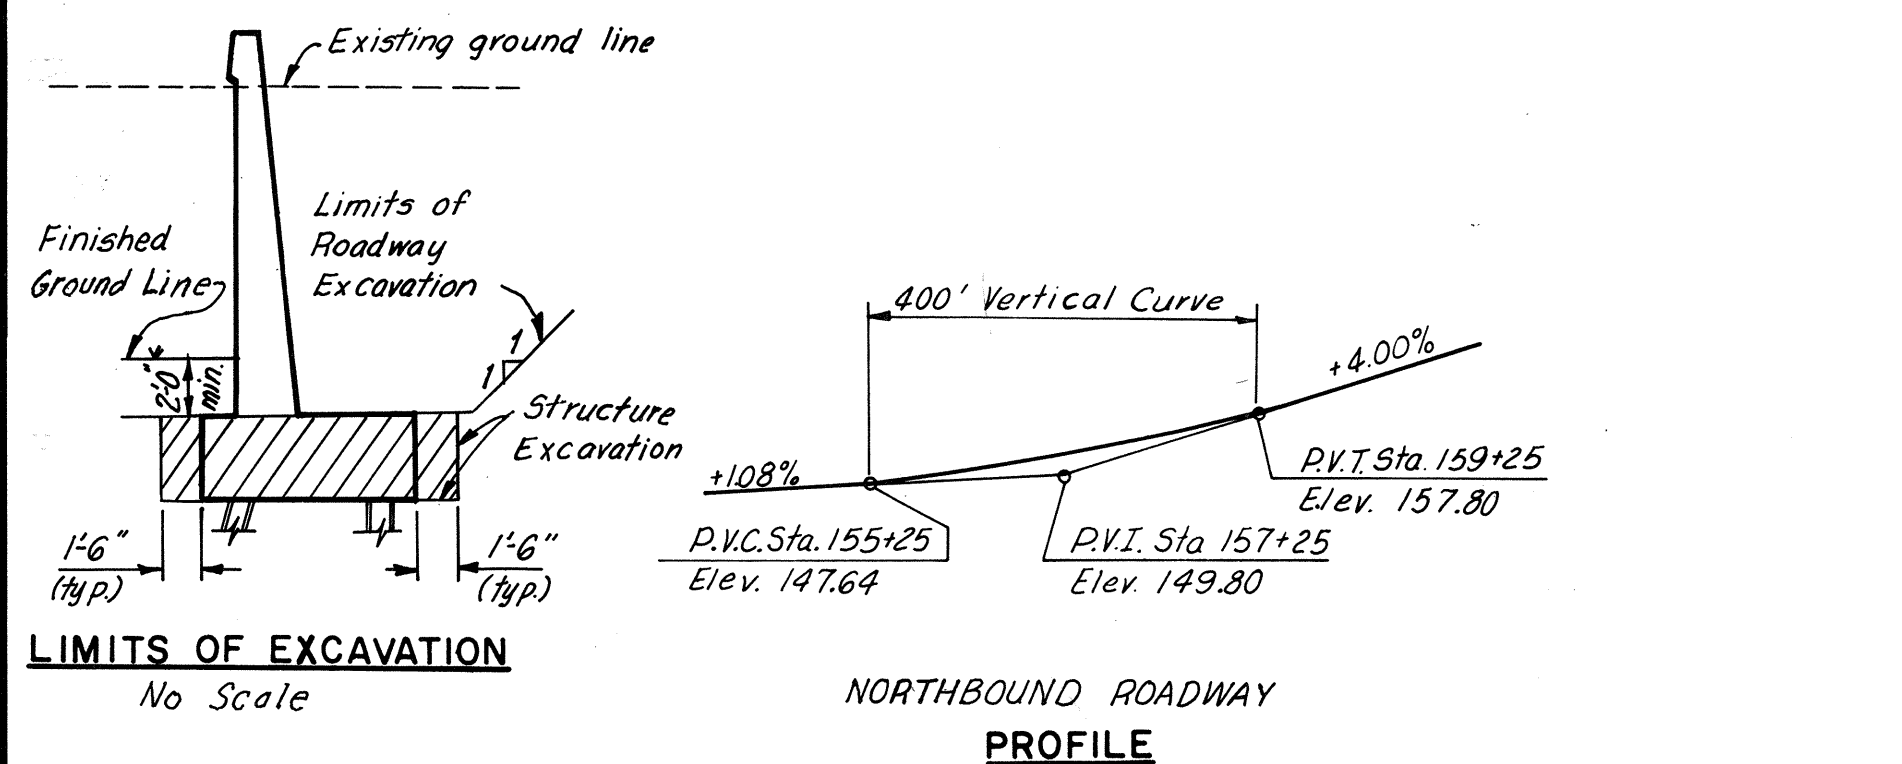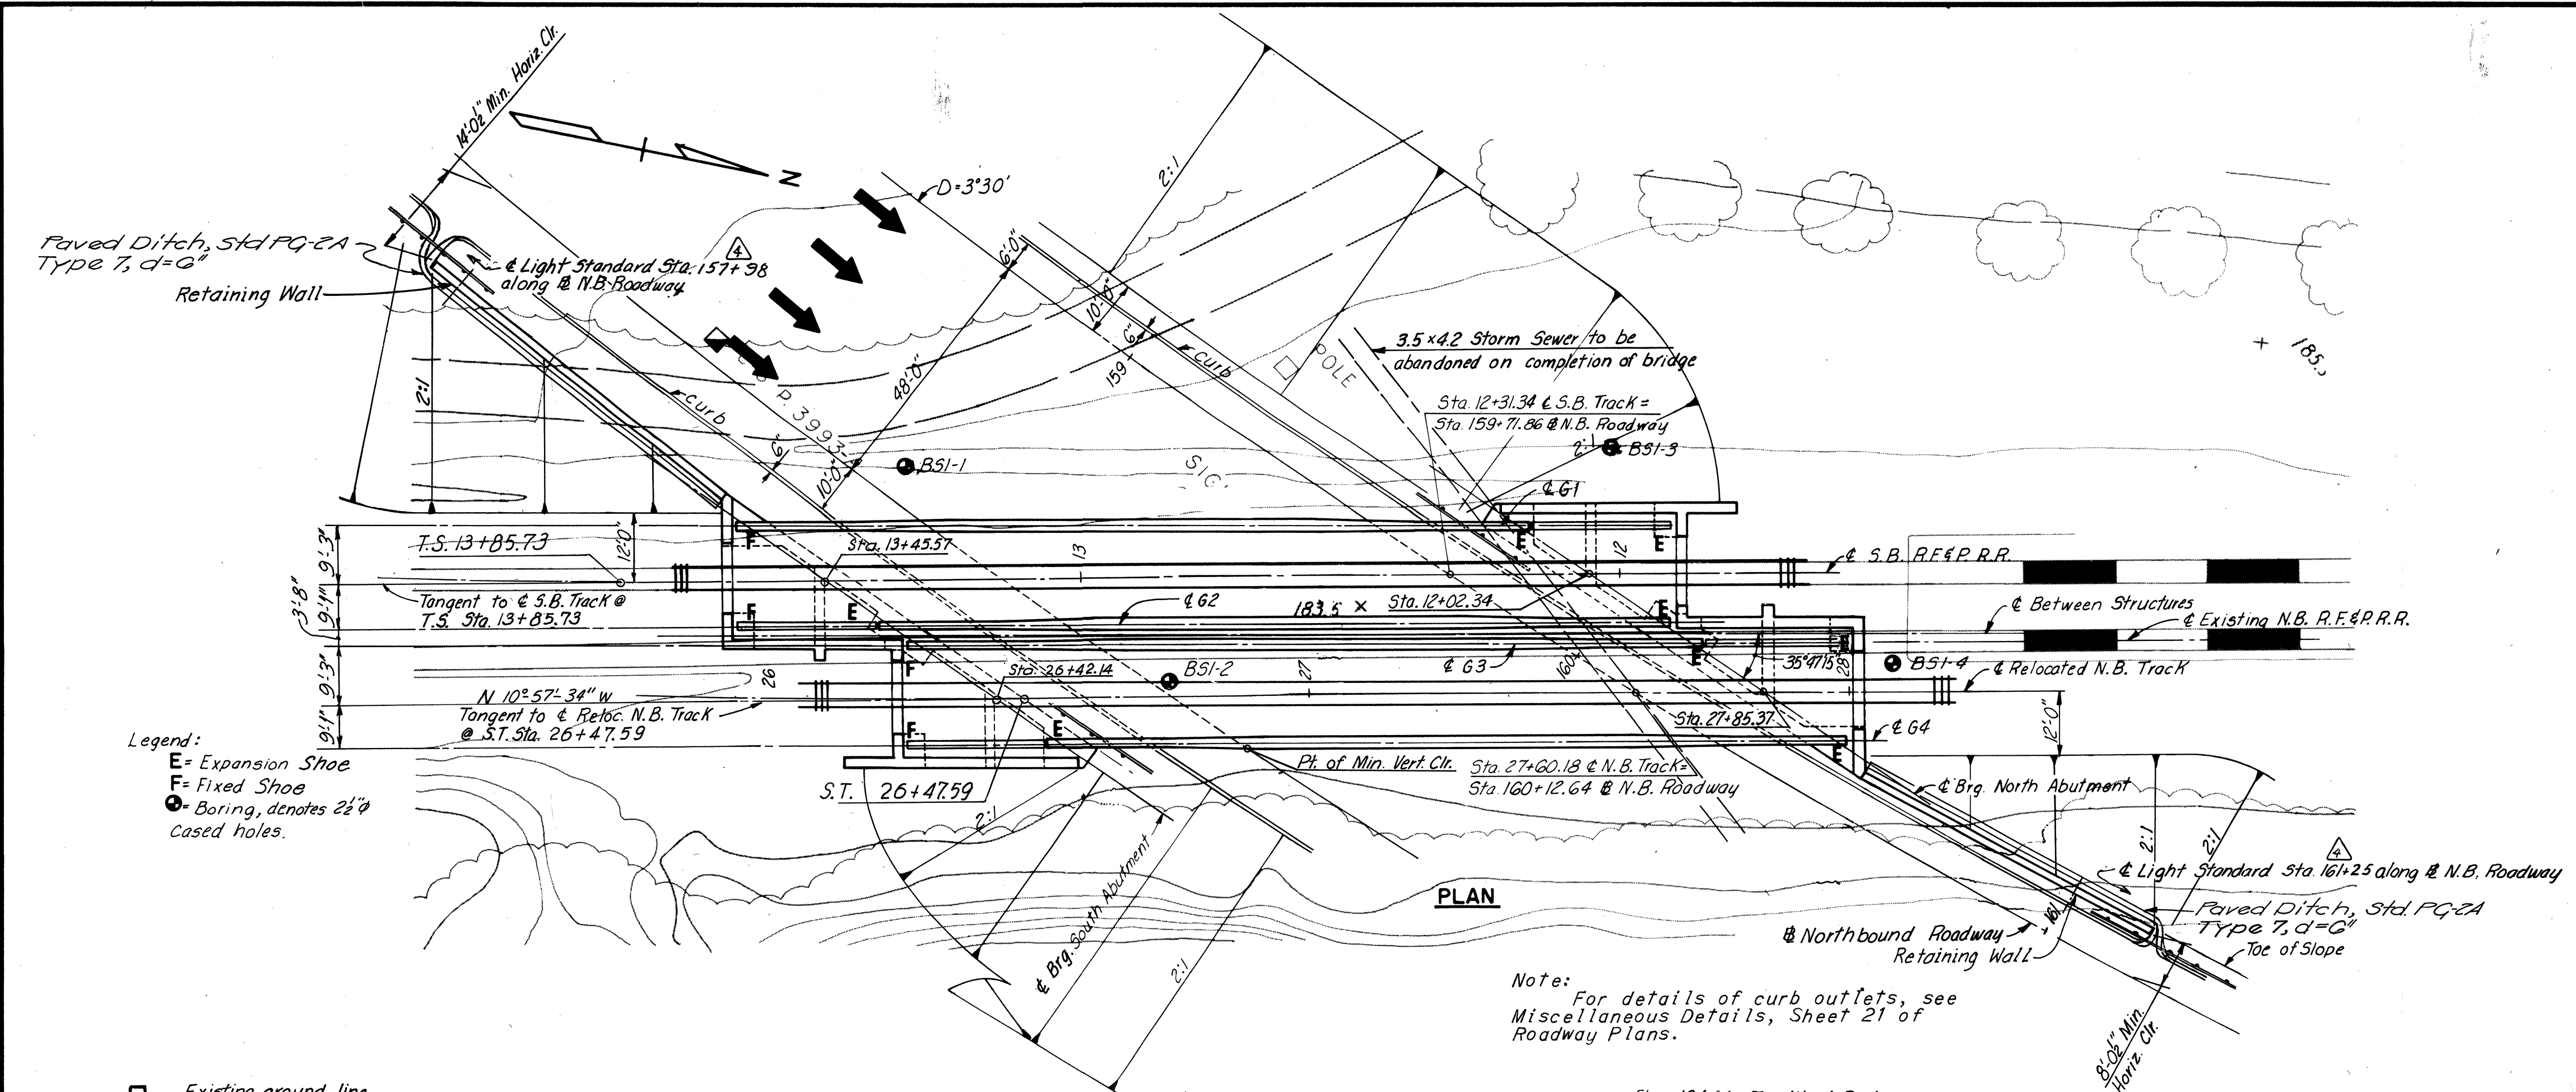

INDEX

Sheet

GENERAL PLAN AND ELEVATION-----1

NORTH ABUTMENT-----2

NORTH ABUTMENT RETAINING WALL-----3

SOUTH ABUTMENT-----4

SOUTH ABUTMENT RETAINING WALL-----5

ABUTMENT DETAILS-----6

FRAMING PLAN-----7

SUPERSTRUCTURE DETAILS-----8

SUPERSTRUCTURE DETAILS-----9

SHOE DETAILS-----10


BORING LOGS-----11

BORING LOGS-----12

STANDARD ELECTRICAL DETAILS-----56

STANDARD ARCHITECTURAL DETAILS - S8 AND S9

BY	DATE	NO.	REVISION	BY	DATE
As Built	JRC	3-73			
Revise Ltg. Std.	JRC	9-71			
Profile Grade	P.S.	4-12-71			
General	J.G.V.	10-70			
General Checking	AMH	5-13-68			

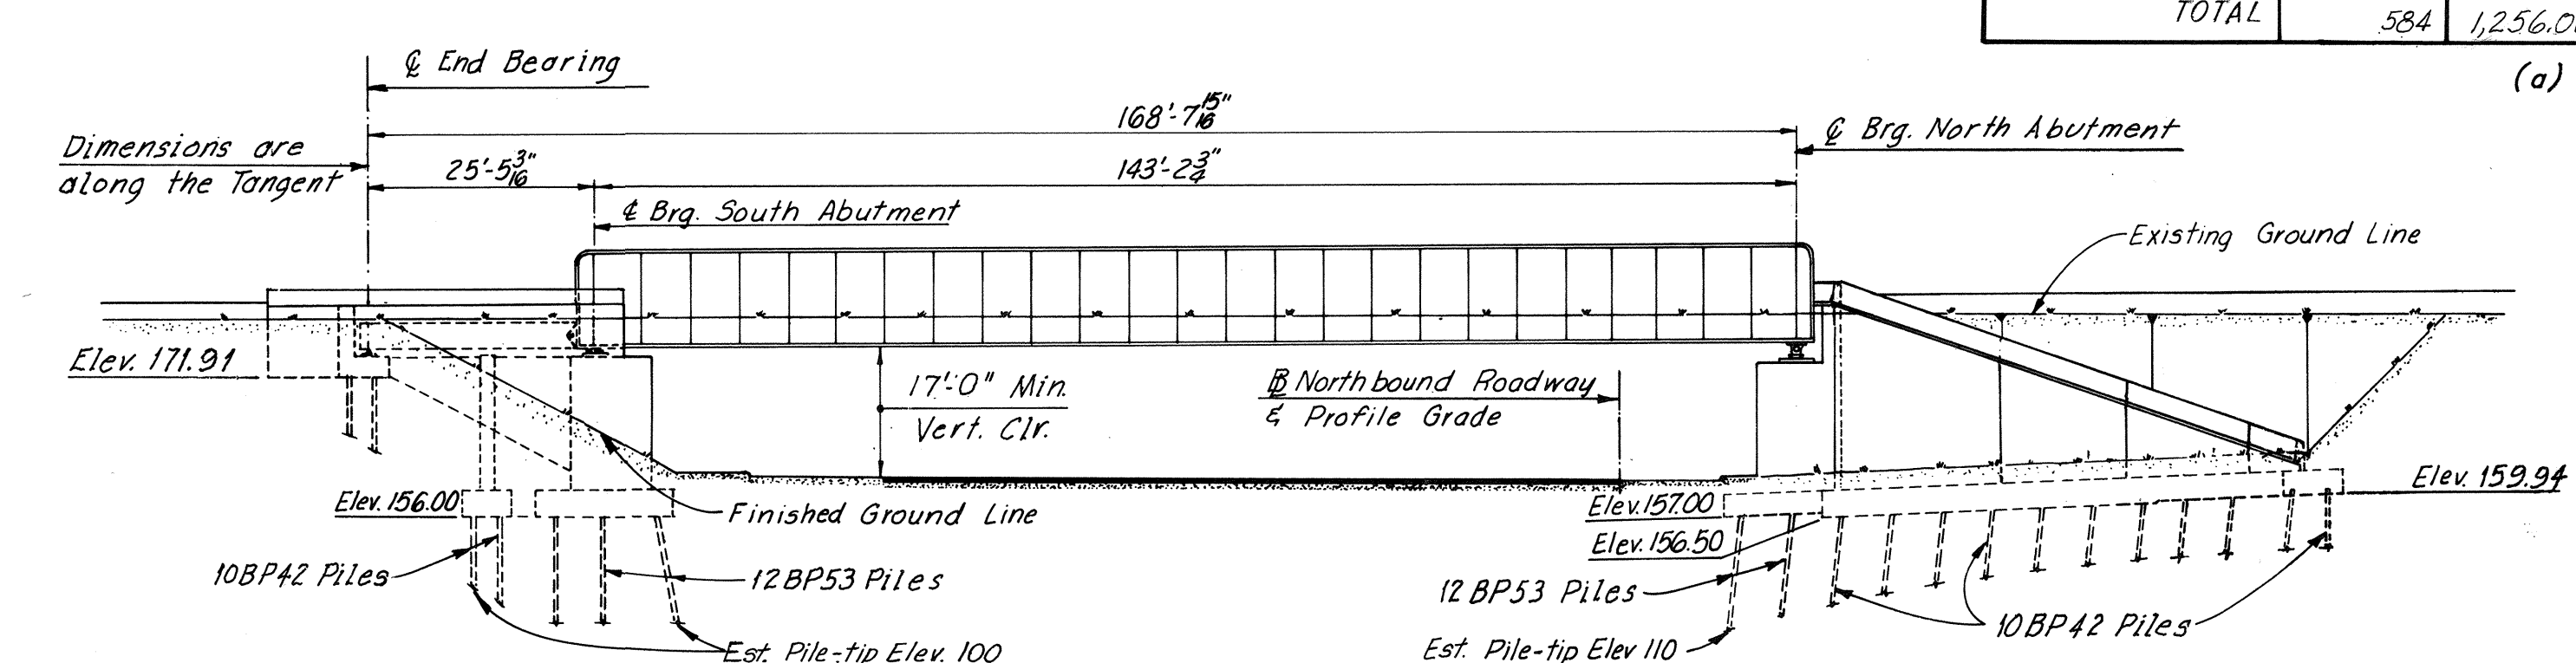

CURVE DATA

Station	Value	Station	Value	Station	Value
T.S.	Sta. 13+85.73	P.I.	Sta. 156+91.30	C.S.	Sta. 23+97.59
S.C.	Sta. 16+41.73	A	37°59'54"	S.T.	Sta. 26+47.59
Ls	256.00'	D	3°30'100"	Ls	250.00'
Os	5'40'14.9"	T	563.64'	Os	4°22'30"
Xc	255.75'	L	1085.66'	Xc	249.85'
Yc	8.45'	R	1637.02'	Yc	6.36'
L.T.	170.75'			L.T.	166.72'
S.T.	85.41'			S.T.	83.38'
L.C.	255.89'			L.C.	249.94'

ESTIMATED QUANTITIES

	Struct. Excav. Cu. Yds.	Concrete (a) Cu. Yds.	Reinf. Steel Lbs.	Struc. Steel (Lbs.) Mild Carbon	High Strength	Porous Backfill Cu. Yds.	Under-drain 6" Dia. Pipe Lin. Ft.	Steel piles 10BP42 Lin. Ft.	Steel piles 12BP53 Lin. Ft.	Asphalt damp-proofing Sq. Yds.	1" Asphalt Plank Sq. Ft.	1/2" Butyl Rubber Water-proofing Square	Bridge Drainage Metalwork Lbs.
Superstructure				855,568.2	280,976.7						7498	75	
North Abutment	286	538.82	65,027			64	129	1,858.4	2,993.0	183			
South Abutment	298	657.26	76,926			75	136	982.8	2,030.4	207			2,691
TOTAL	584	1,256.08	141,953	855,568.2	280,976.7	139	265	2,841.2	5,023.4	390	7498	75	2,691

(a) Class A3



AS BUILT

RICHMOND METROPOLITAN AUTHORITY
RICHMOND EXPRESSWAY SYSTEM
BELTLINE EXPRESSWAY

BRIDGE NO. 9
R.F.&P.R.R. OVER
NORTHBOUND ROADWAY
GENERAL PLAN AND ELEVATION



HOWARD, NEEDLES, TAMMEN & BERGENDOFF consulting engineers
NEW YORK ALEXANDRIA KANSAS CITY

SCALE: 1" = 20' unless noted
CONTRACT NO.: 4
SHEET NO. 1 OF 12

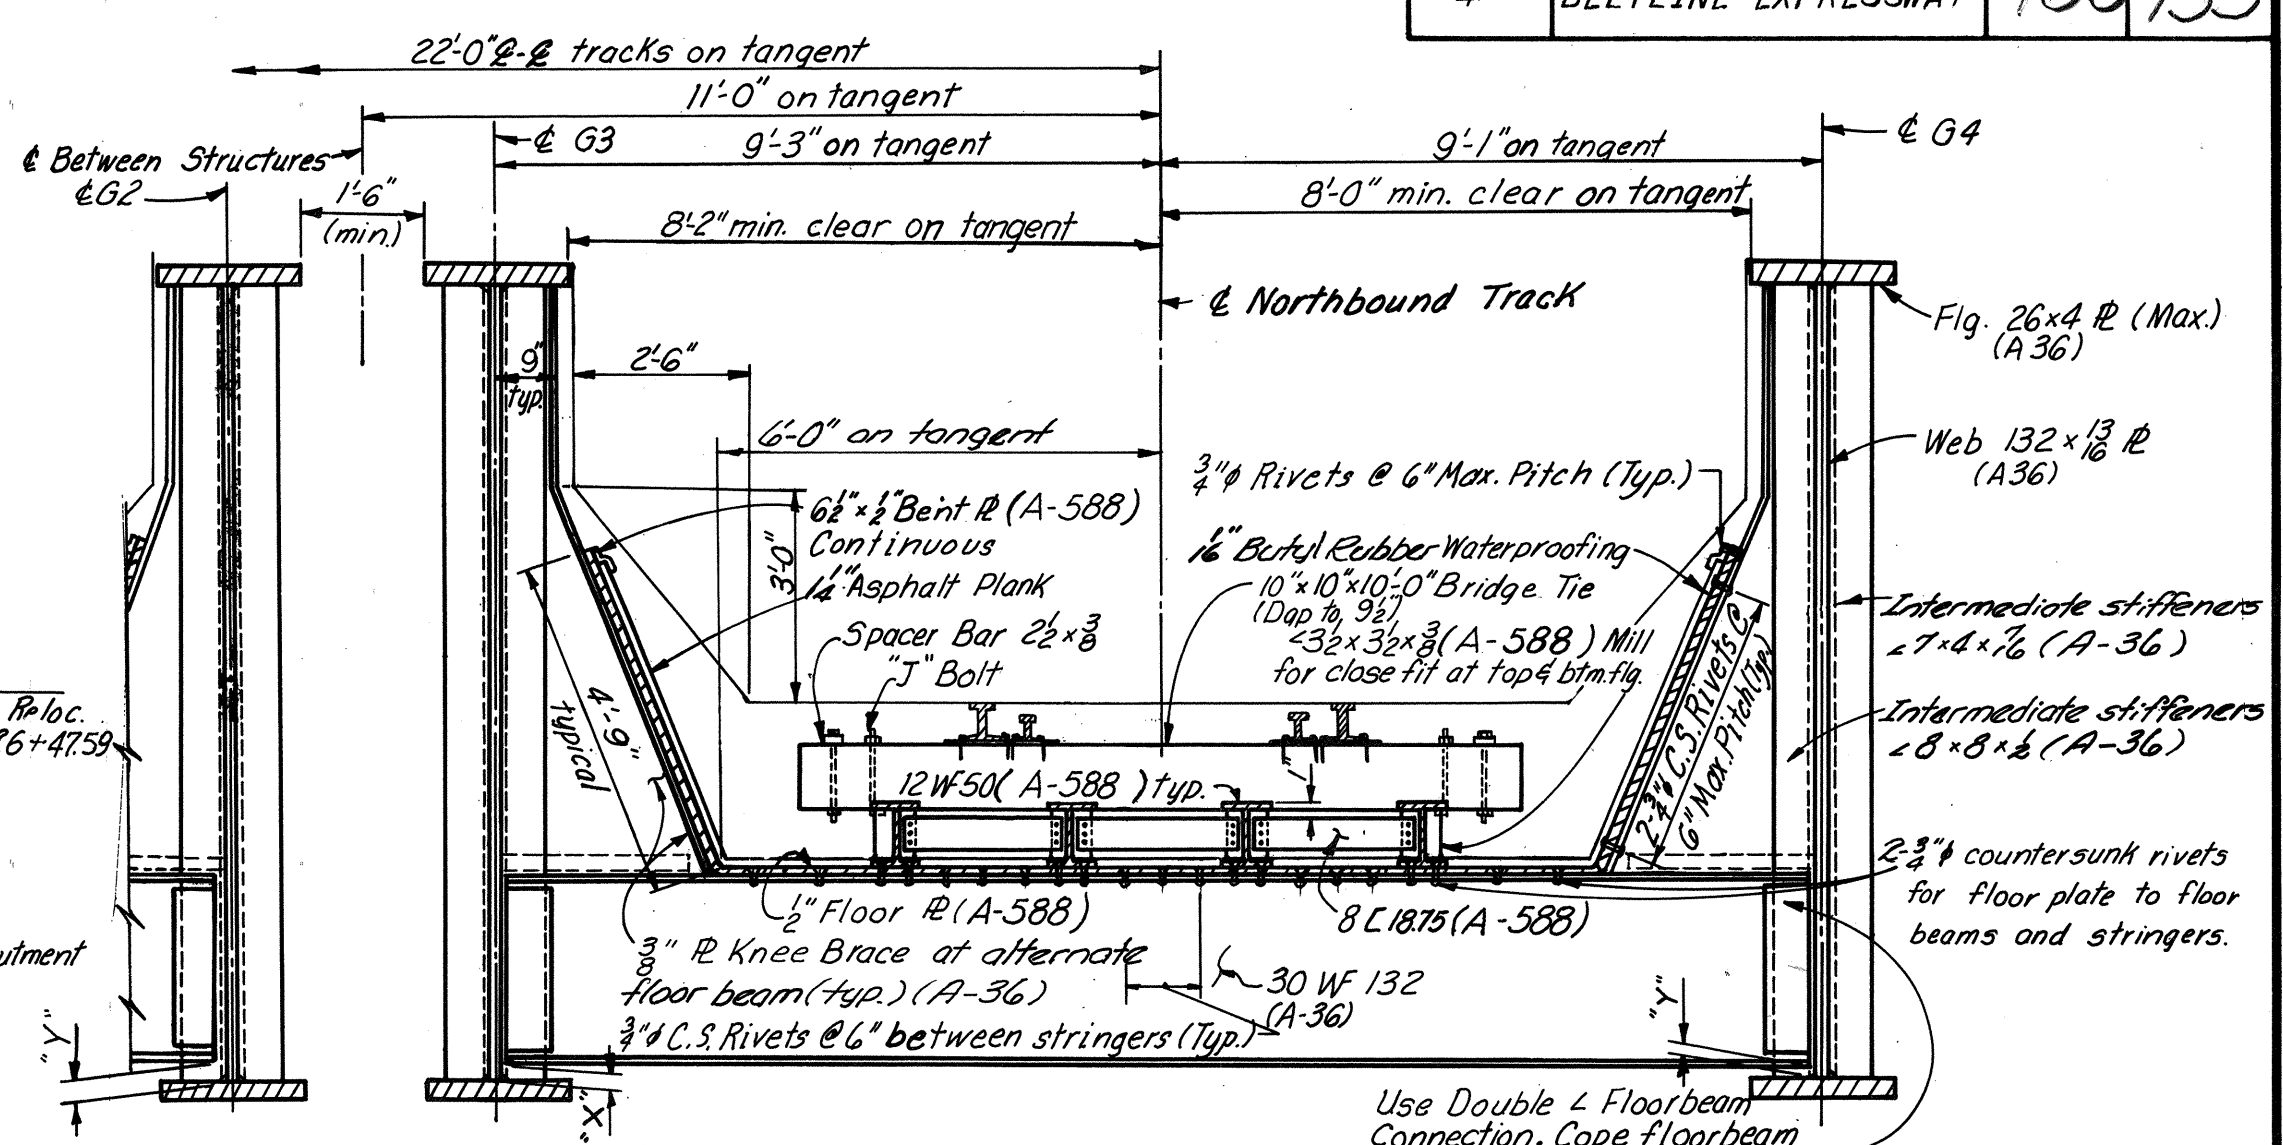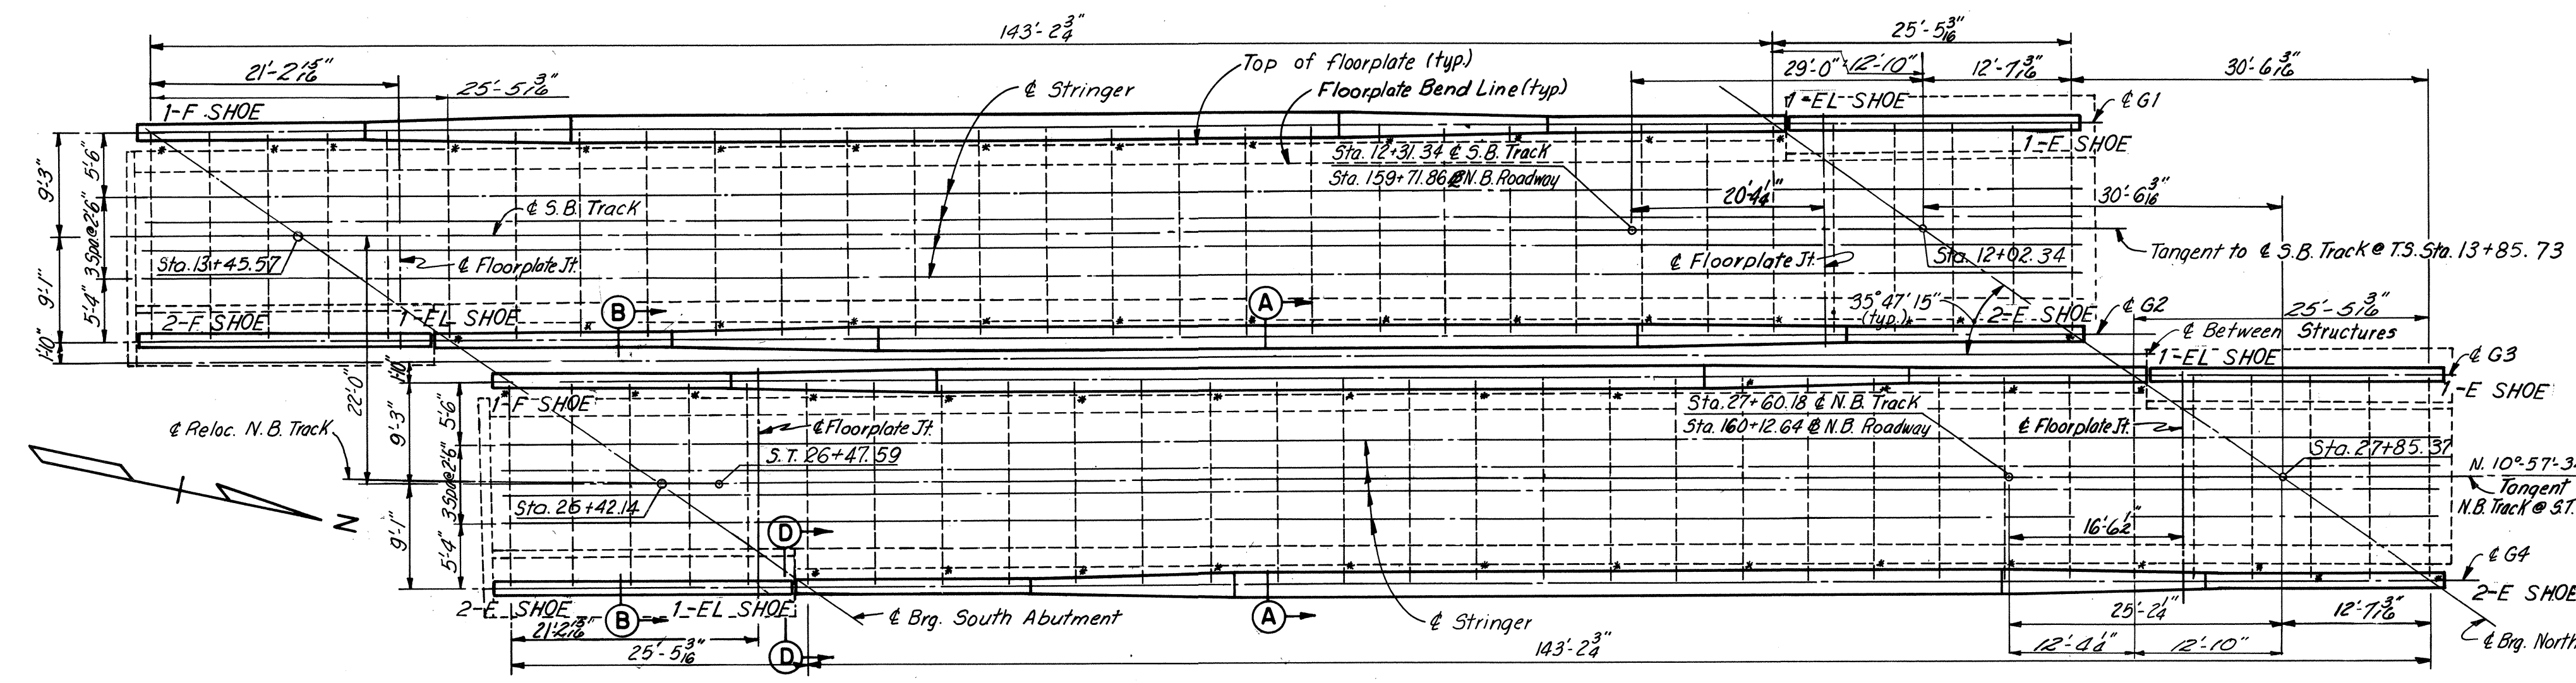

Note: Floorplate connected to stringers by 2 rows of 3/4" Dia. countersunk rivets at 6" maximum pitch.
 All riveted connections shown herein may, at the contractor's option, be replaced by high strength bolt connections.

Note: Ties, track, and fasteners are to be furnished and installed by others.

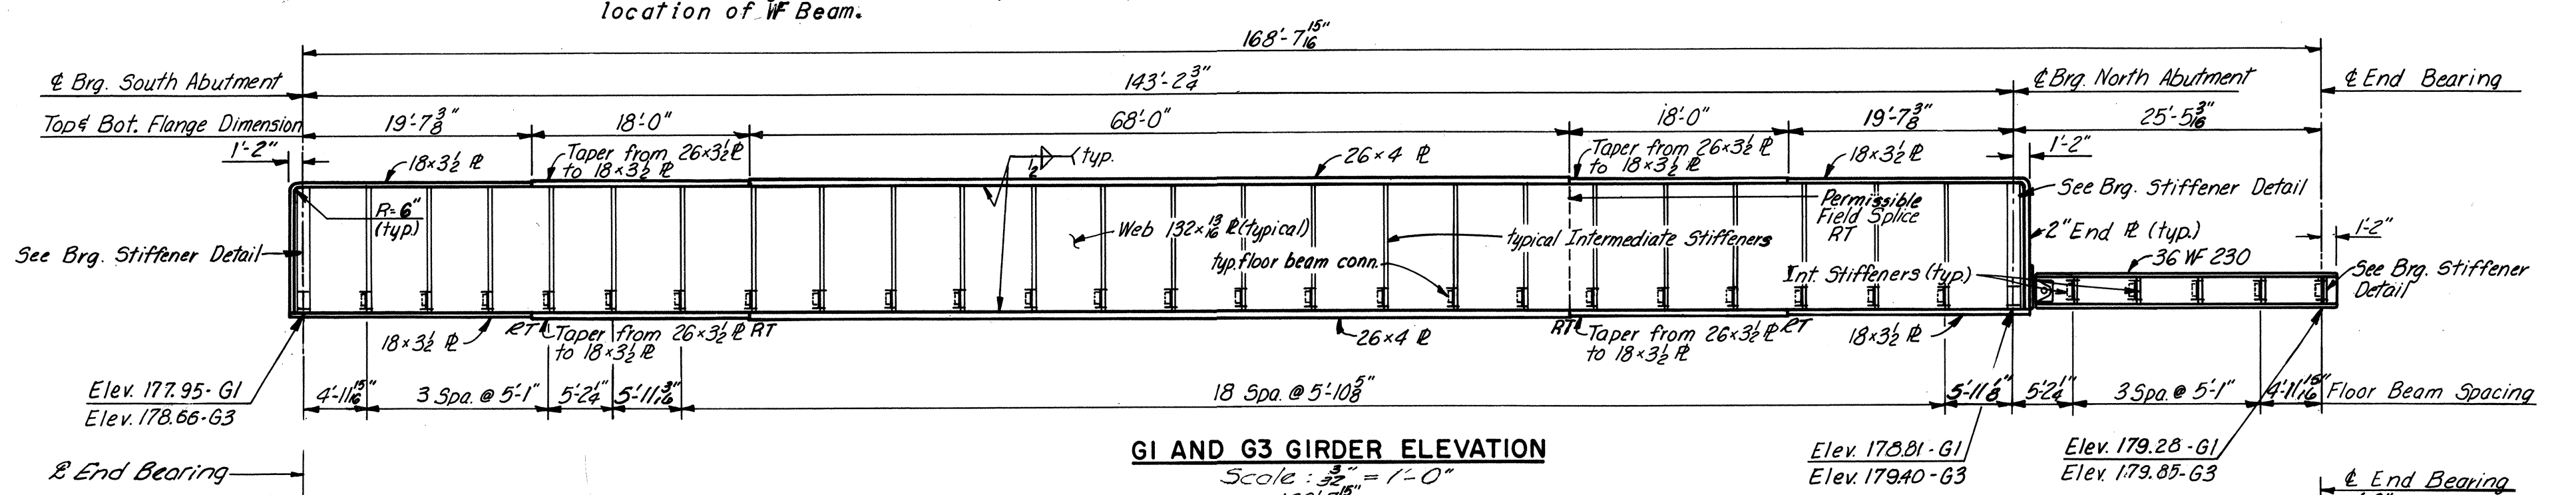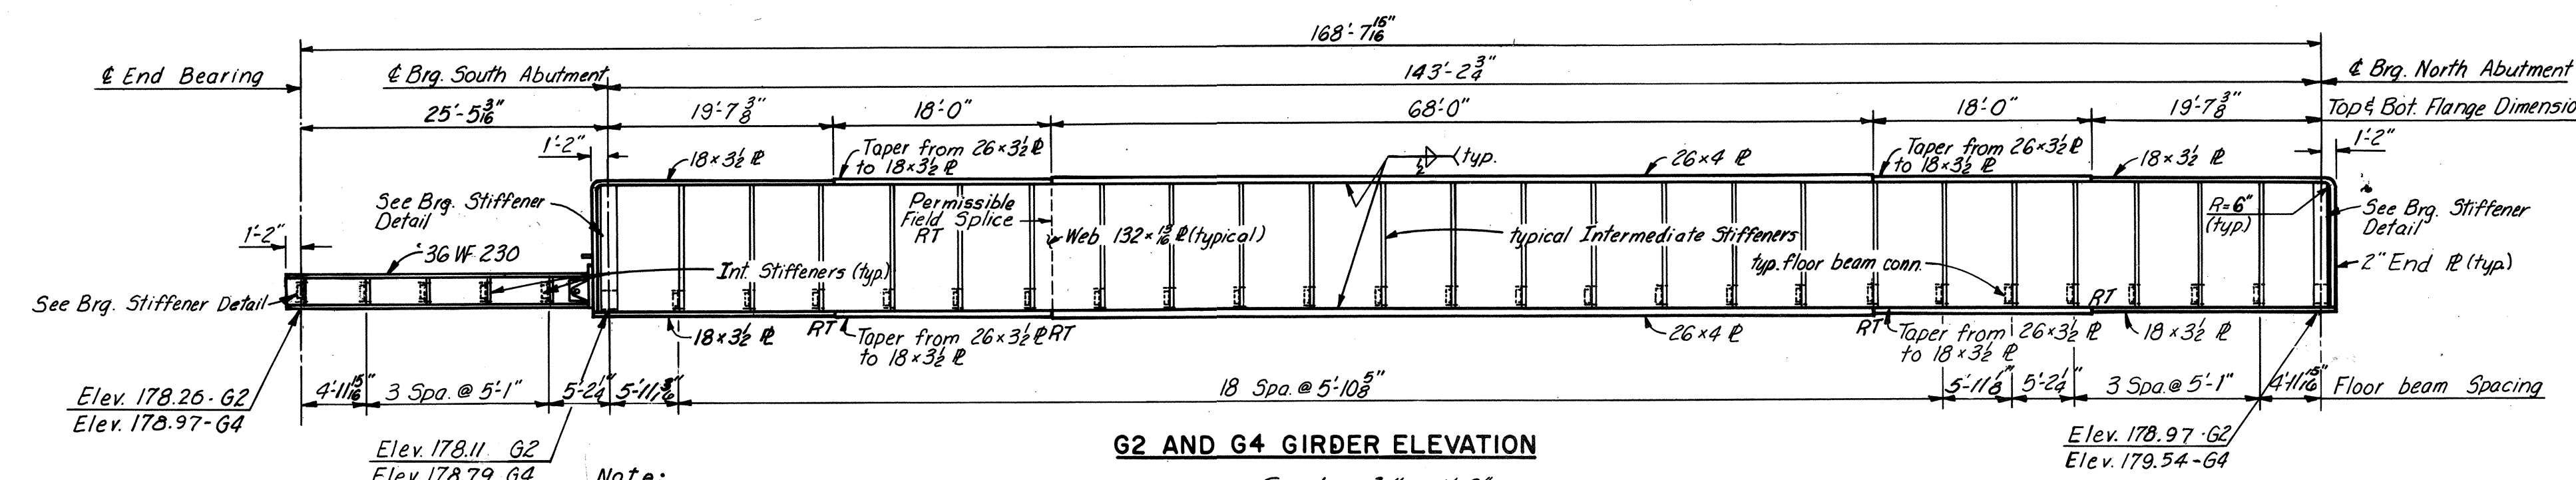

FLOOR BEAM LOCATION TABLE

DISTANCE	SOUTHBOUND TRACK	
	G1	G2
0	2 3/4"	3"
4'-11 1/2"	2 3/4"	3"
10'-0 1/2"	2 3/4"	3"
15'-1 1/2"	2 3/4"	3"
20'-2 1/2"	2 3/4"	3"
25'-5 3/8"	3"	3"
31'-4 3/8"	3"	3"
37'-2 3/8"	3"	3"
43'-1 3/8"	3"	3"
49'-0 3/8"	3"	3"
54'-10 1/8"	3"	3"
60'-9 1/8"	3"	3"
66'-8 1/8"	3"	3"
72'-6 1/8"	3"	3"
78'-5 3/8"	3"	3"
84'-3 3/8"	3"	3"
90'-2 3/8"	3"	3"
96'-1 3/8"	3"	3"
101'-11 1/8"	3"	3"
107'-10 1/8"	3"	3"
113'-9 1/8"	3"	3"
119'-7 1/8"	3"	3"
125'-6 3/8"	3"	3"
131'-4 3/8"	3"	3"
137'-3 3/8"	3"	3"
143'-2 3/8"	3"	3"
148'-5"	3"	2 3/4"
153'-6"	3"	2 3/4"
158'-7"	3"	2 3/4"
163'-8"	3"	2 3/4"
168'-7 1/8"	3"	2 3/4"

FLOOR BEAM LOCATION TABLE

DISTANCE	NORTHBOUND TRACK	
	G3	G4
0	2 9/16"	3 1/8"
4'-11 1/2"	2 9/16"	3 1/8"
10'-0 1/2"	2 9/16"	3 1/8"
15'-1 1/2"	2 9/16"	2 9/16"
20'-2 1/2"	3"	3"
25'-5 3/8"	3"	3"
31'-4 3/8"	3"	3"
37'-3"	3"	3"
43'-1 3/8"	3"	3"
49'-0 1/8"	3"	3"
54'-10 1/8"	3"	3"
60'-9 1/8"	3"	3"
66'-8 1/8"	3"	3"
72'-6 1/8"	3"	3"
78'-5 3/8"	3"	3"
84'-4"	3"	3"
90'-2 3/8"	3"	3"
96'-1 3/8"	3"	3"
101'-11 1/8"	3"	3"
107'-10 1/8"	3"	3"
113'-9 1/8"	3"	3"
119'-7 1/8"	3"	3"
125'-6 3/8"	3"	3"
131'-5"	3"	3"
137'-3 3/8"	3"	3"
143'-2 3/8"	3"	3"
148'-5"	3"	2 3/4"
153'-6"	3"	2 3/4"
158'-7"	3"	2 3/4"
163'-8"	3"	2 3/4"
168'-7 1/8"	3"	2 3/4"

Note: Asphalt plank shall be recessed to receive flange of 12 WF 50 stringers.



RADIOGRAPHIC INSPECTION NOTE:
 An "RT" shown on elevation views indicates radiographic inspection of adjacent flange and web, flange, or web welds in accordance with the Special Provisions.

Note: Welded Girders are to be cambered to compensate for full anticipated dead load, see Sheet 9.

Notes - Southbound Track:
 Distances shown in Floor Beam Table are measured from north to south, starting at the extreme north floor beam.
 Dimensions "X" and "Y" shown in Floor Beam Table for G1 and G2 are measured from top of bottom flange for Plate Girder section and from bottom of WF beam section.

Notes - Northbound Track:
 Distances shown in Floor Beam Table are measured from south to north, starting at the extreme south floor beam.
 Dimensions "X" and "Y" shown in Floor Beam Table for G3 and G4 are measured from top of bottom flange for Plate Girder section and from bottom of WF beam section.

Elevations shown on Girder Elevations are at bottom of bottom flange for Plate Girder section and for WF beam section.

Elevations shown on Girder Elevations are at bottom of bottom flange for Plate Girder section and for WF beam section.

Notes:
 For Shoe Details, see Sheet 10.
 For Dead Load Deflections, see Sheet 9.
 For Superstructure Details, see Sheets 8 and 9.
 For Sections B-B, and D-D, see Sheet 9.

Note:
 One butt welded shop splice will be permitted in each 26"x4" flange plate; details of splice shall be similar to that shown for Field Flange Splice, sheet 8. A maximum of 3 web splices including web splice at "Permissible Field Splice", will be permitted; detail of shop web splice shall be similar to that shown for Field Flange Splice, Sheet 8, except that web opening is not required and web splice shall not be located within 2'-0" of a shop flange splice.

BY	DATE	NO.	REVISION	BY	DATE	
4	As Built	JRC	3-73			
	BY	DATE				
MADE	RLM	12-13-67	2	Profile Grade	ER	4-12-71
CHECKED	JFH	4-9-68	1	General Checking	AMH	5-13-68
IN CHARGE	FKD					

AS BUILT

RICHMOND METROPOLITAN AUTHORITY
RICHMOND EXPRESSWAY SYSTEM
BELTLINE EXPRESSWAY
BRIDGE NO. 9
R.F.&P.R.R. OVER
NORTHBOUND ROADWAY
FRAMING PLAN

HOWARD, NEEDLES, TAMMEN & BERGENDOFF
 consulting engineers
 NEW YORK ALEXANDRIA KANSAS CITY


SCALE: As Noted
 CONTRACT NO. 4
 SHEET NO. 7 OF 12

Bridge 13

(Douglasdale Road Over Beltline Expressway and R.F. & P.R.R.)

Record Set Plans

Note: The 36" Water Main location is approximate. Before beginning construction contractor must locate this main.

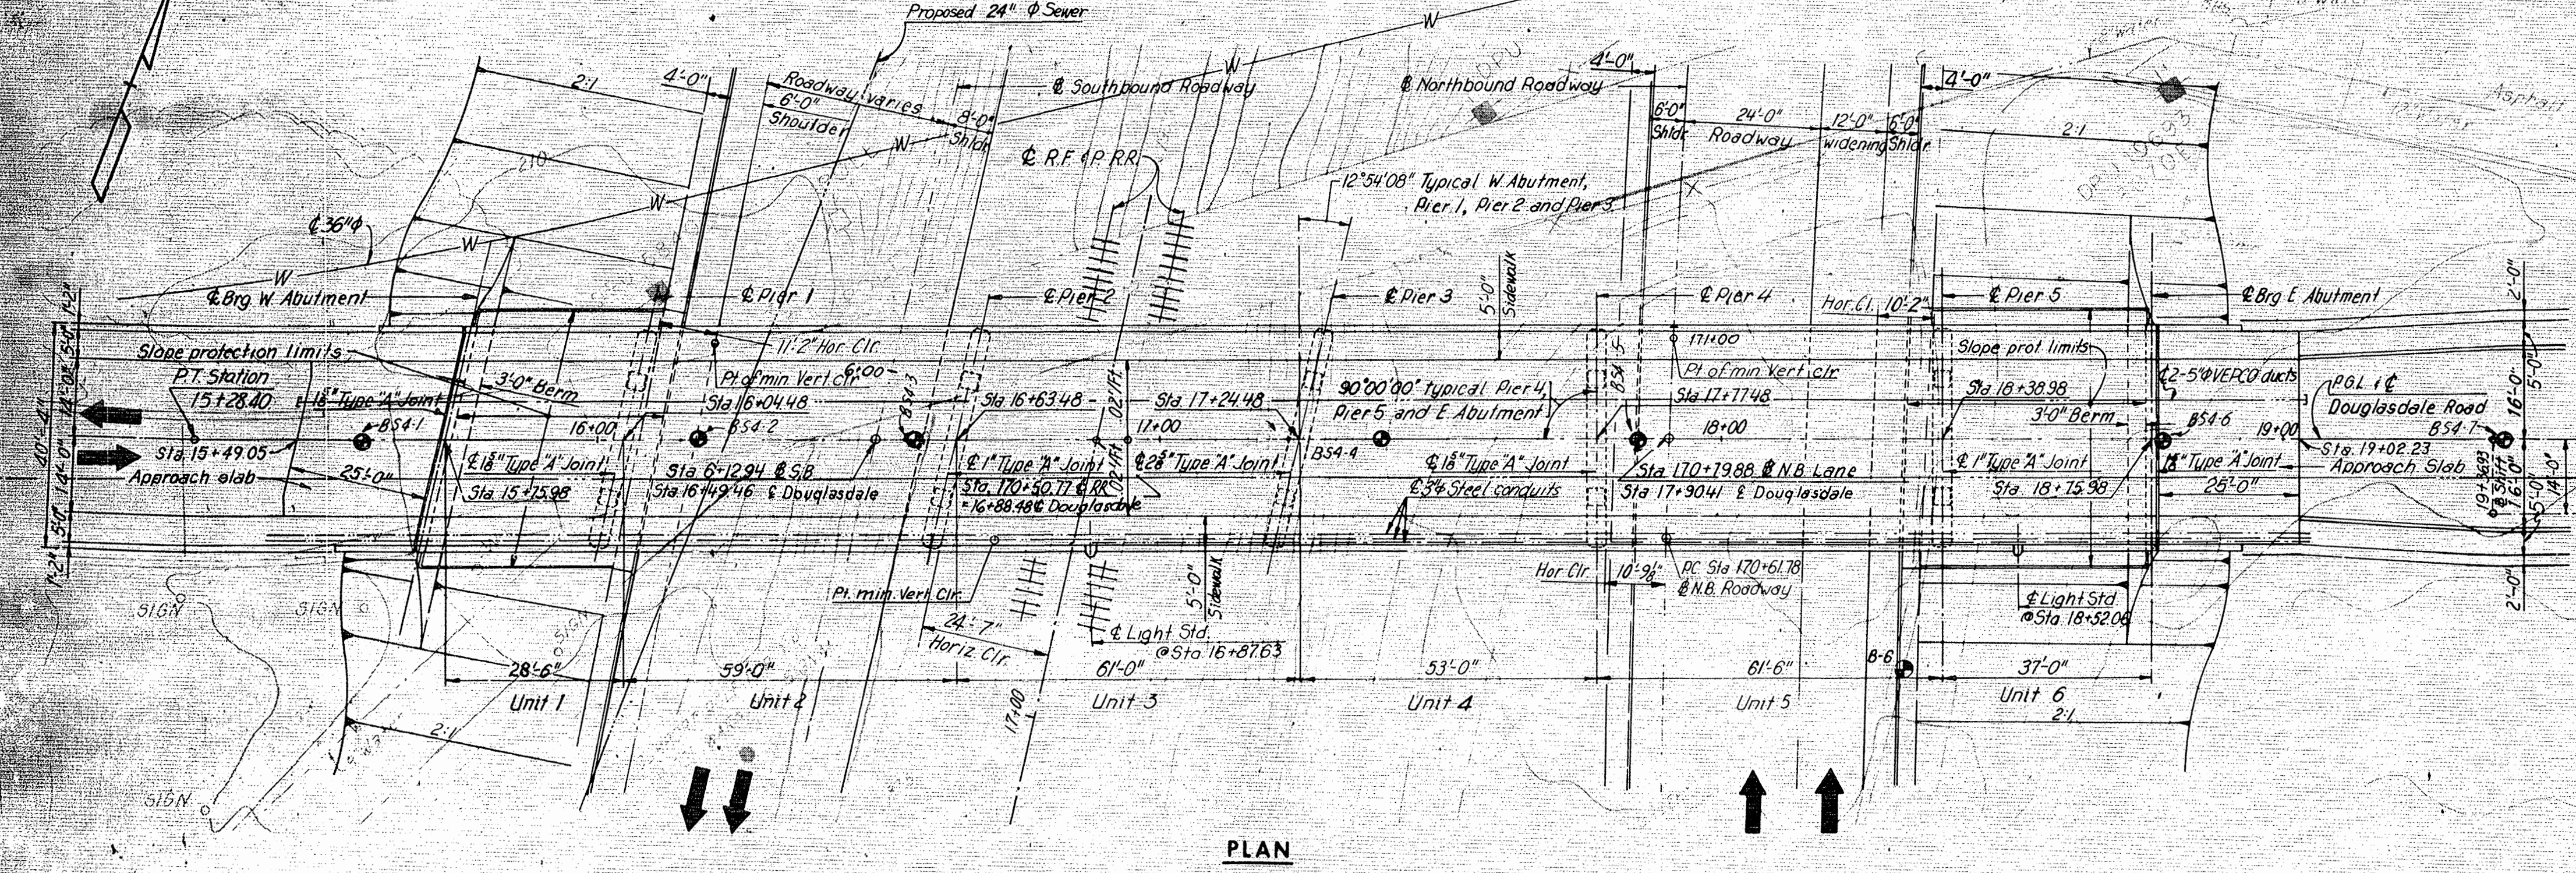

GENERAL NOTES

ROADWAY: One 28'-0" clear roadway. Two 5'-0" sidewalks.

CAPACITY: Dead Load includes 15 lbs. per sq. ft. for future wearing surface. Live Loads - HS20-44 loading.

SPECIFICATIONS:

GENERAL: Virginia Department of Highway Road and Bridge Specifications 1970.

DESIGN: A.A.S.H.O. Standard Specifications for Highway Bridges 1961, modified by Special Design Provisions.

WELDING: 1969 Standard Specifications for Welded Highway and Railway Bridges of the American Welding Society.

CONTRACT SPECIAL PROVISIONS

Specifications and Contract Special Provisions referred to above are necessary to make these plans complete.

DATUM: City of Richmond

TEMPERATURE: The normal temperature referred to on the plan is 68°F. The temperature range for movement is 0°F to 120°F.

DIMENSIONS: All dimensions are measured horizontally and vertically unless otherwise noted.

EXCAVATION: Excavation below subgrade and cut slope template shall be classified as Structure Excavation. All excavation above these limits shall be classified as Regular Excavation and is not included in the Structural Quantities.


FOUNDATIONS: Footings shall rest on firm material. Foundation material shall be dry and special attention is called to Section 401.05 of General Specifications and to the Contract Special Provisions, concerning preparation of foundations for footings.

CONCRETE NOTES:

Concrete in superstructure shall be Class A4. All other concrete shall be Class A3. All exposed edges and corners shall have a 3" chamfer or fillet unless otherwise noted. Care in the method of vibration, the use of low-slump concrete, and/or other means shall be employed to prevent downgrade movement of newly placed slab concrete.

Finishing Concrete Surfaces: See the Standard Architectural Detail Sheets and the Contract Special Provisions for types and details.

All reinforcing steel shall conform to A.S.T.M. A615, Grade 40. All reinforcing bar dimensions on the detail drawings are to centers of bars unless otherwise noted. Clear distance between reinforcing steel and face of concrete shall be as noted on the plans. All bar laps shall be 30 diameters of the smaller diameter bar unless otherwise noted.

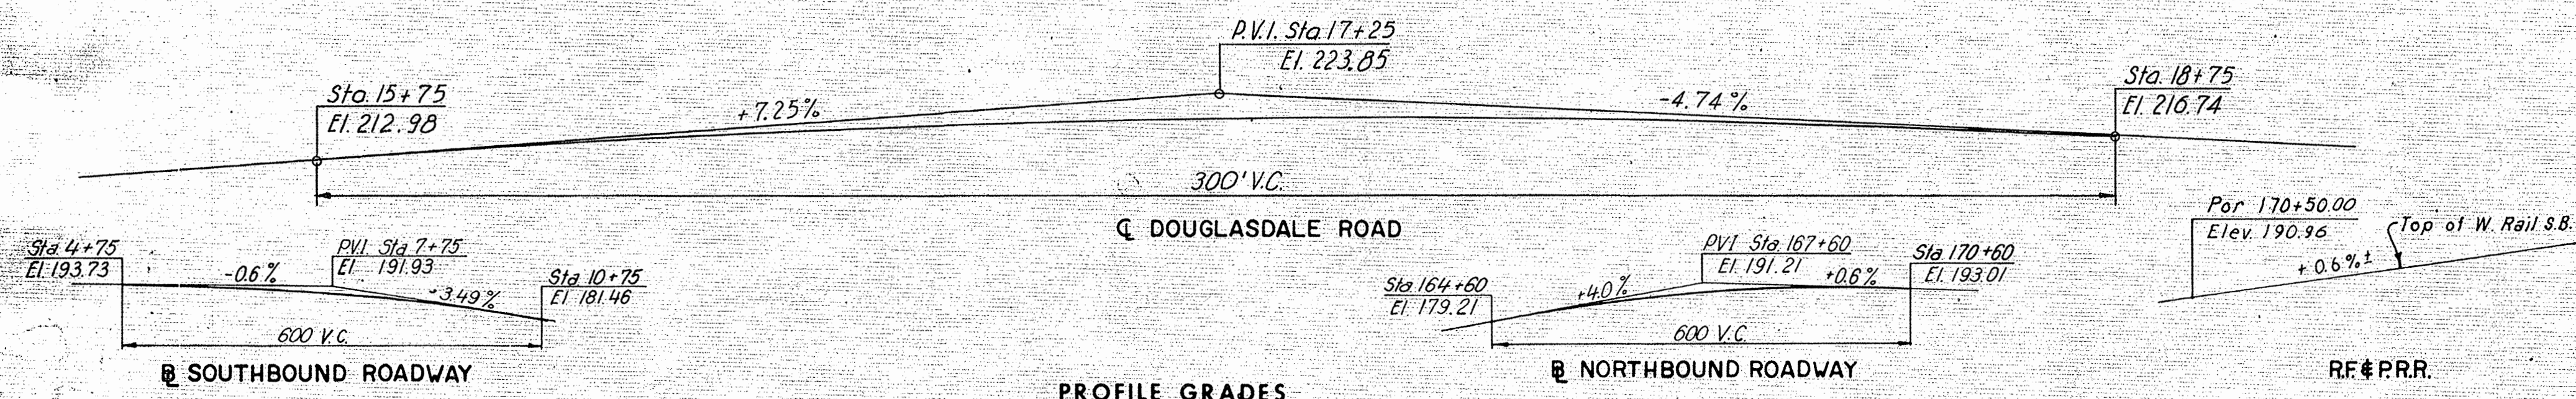


STEEL NOTES:

Structural steel shall conform to A.S.T.M. Specification A36 except as noted. All field connections shall be made with high strength bolts. High strength bolts shall be 1/2" diameter unless otherwise noted and shall conform to A.S.T.M. Specification A 325.

BENCH MARK:

A-16 Copperweld rod N.W. of R.P. Bridge on Douglasdale. Elev. 213.60

Boring, denotes 2 1/2" Cased hole

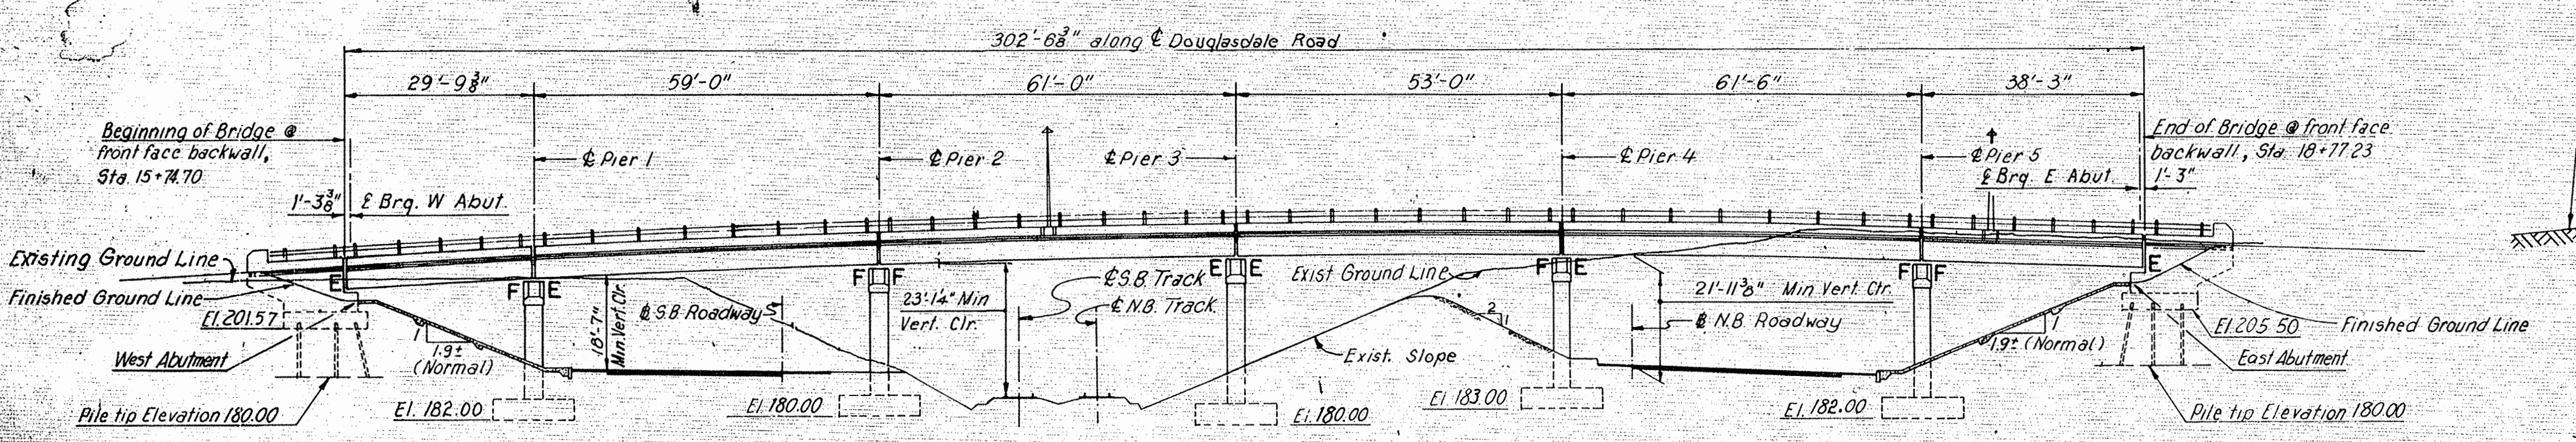

INDEX

1	GENERAL PLAN AND ELEVATION	Sheet
2	WEST ABUTMENT	1
3	EAST ABUTMENT	2
4	PIERS 1, 2 AND 3	3
5	PIERS 4 AND 5	4
6	FRAMING PLAN	5
7	DECK PLAN	6
8	FRAMING DETAILS	7
9	JOINT DETAILS	8
10	APPROACH SLAB AND SLOPE PROTECTION DETAILS	9
11	BORING LOGS	10
12	BORING LOGS	11
13	STANDARD SHOE DETAILS	12
14	STANDARD ALUMINUM RAILING DETAILS	13
15	STANDARD ELECTRICAL DETAILS	14
16	STANDARD ARCHITECTURAL DETAILS	15
17	STANDARD UTILITY SUPPORT DETAILS AT BR. ABUTS.	16
18	STANDARD CONDUIT INSTALLATION DETAILS	17

CURVE DATA

Northbound Roadway

P.I. = Sta. 173+60.82

Δ = 17°47'52"

D = 3°00'00"

Tx = 299.04'

L = 593.26'

R = 1,909.86'

Note: Pile Tip Elevations shown estimated.

(a) Class A3, unless noted

(b) Class A4

* Frame and Cover only.

ELEVATION

	Struct. Excav. Cu. Yds.	Concrete (a) Cu. Yds.	Reinf. Steel lbs.	Str. Stl. Mild Carbon lbs.	Aluminum Railing (2-rails) Lin. Ft.	Porous Backfill Cu. Yds.	Under-drain 6" Dia. Pipe Lin. Ft.	Steel Piles 10" x 42" Lin. Ft.	Con. Slab Sq. Yds.	Asphalt damp proofing Sq. Yds.	Approach Conc. (a) Cu. Yds.	Metal Conduit 2" Dia. Lin. Ft.	Conduit 3" Dia. VEP CO Lin. Ft.	Water Main 8" Dia. Lin. Ft.	*Junction Box Lbs.
Superstructure	—	464.8 (b)	87,170	333,000	650	—	—	—	—	—	—	7,914	704	358	360
West Abutment	130	80.0	13,500	—	—	5.2	50	307	193.3	27	40.4	—	—	—	—
Pier 1	185	65.1	10,220	—	—	—	—	—	—	—	—	—	—	—	—
Pier 2	119	67.5	11,120	—	—	—	—	—	—	—	—	—	—	—	—
Pier 3	204	67.9	11,400	—	—	—	—	—	—	—	—	—	—	—	—
Pier 4	171	66.4	10,740	—	—	—	—	—	—	—	—	—	—	—	—
Pier 5	156	66.6	10,690	—	—	—	—	—	—	—	—	—	—	—	—
East Abutment	126	77.5	13,100	—	—	4.8	49	358	239.7	25	39.4	—	—	—	—
TOTAL	1091	464.8 (b) 491.0	167,940	333,000	650	10	99	665	433	52	79.8	7,914	704	358	360

BY	DATE	3	Profile Grade	P.S.	4-8-71
MADE	JV	3-4-68	2	General	J.G.V. 10-70
CHECKED	MA	3-6-68	1	General Revisions	RLM 5-7-68
IN CHARGE	FKD	NO.	REVISION	BY	DATE

RICHMOND METROPOLITAN AUTHORITY

RICHMOND EXPRESSWAY SYSTEM

BELTLINE EXPRESSWAY

BRIDGE NO. 13

DOUGLASDALE ROAD OVER

BELTLINE EXPRESSWAY AND R.F.&P.R.R.

GENERAL PLAN AND ELEVATION

HOWARD, NEEDLES, TAMMEN & BERGENDOFF
consulting engineers
NEW YORK ALEXANDRIA KANSAS CITY

SCALE 1/8" = 1'-0"


CONTRACT NO. 4

SHEET NO. 1 OF 12

Bridge 17

(Ramp from NB Powhite Parkway “Rte. 76”/NB I-195 Connector over I-195 to Cary Street and Ramp from Northbound I-195 to Floyd Avenue)

Record Set Plans

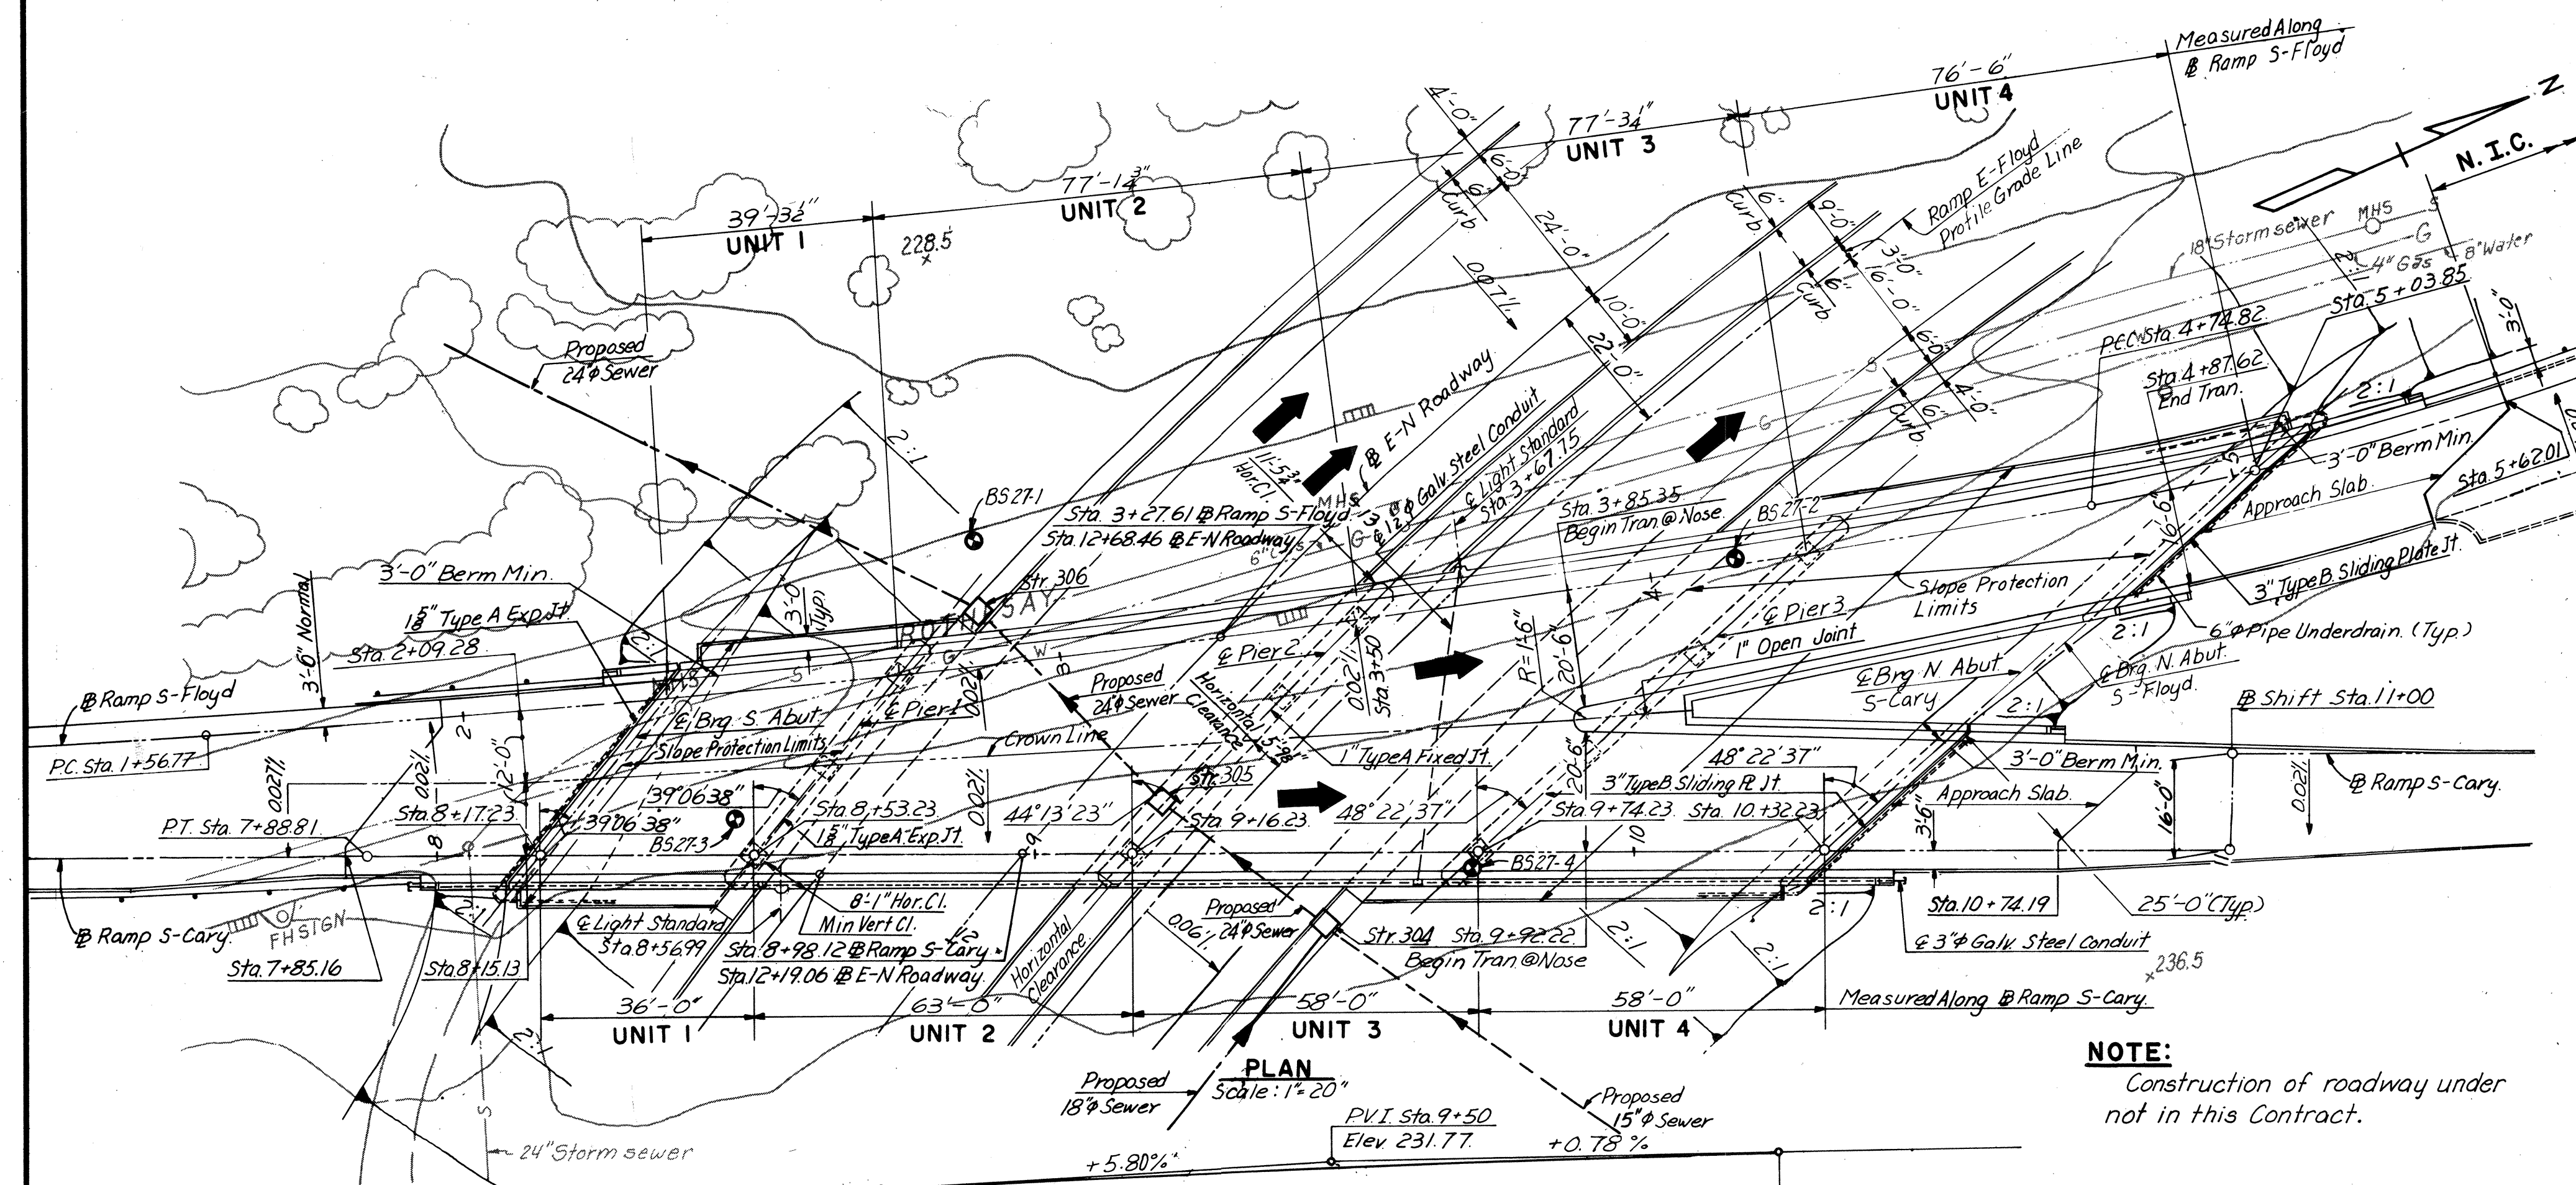

GENERAL NOTES

ROADWAY: Variable width of roadway.

CAPACITY: Dead Load includes 15 lbs. per sq. ft. for future wearing surface.

SPECIFICATIONS:

GENERAL: Virginia Department of Highway Road and Bridge Specifications 1970.
 DESIGN: A.A.S.H.O. Standard Specifications for Highway Bridges 1961, modified by Special Design provisions.
 WELDING: 1969 Standard Specifications for Welded Highway and Railway Bridges of the American Welding Society.

CONTRACT SPECIAL PROVISIONS
 Specifications and Contract Special Provisions referred to above are necessary to make these plans complete.

DATUM: City of Richmond

TEMPERATURE: The normal temperature referred to on the plan is 68°F. The temperature range for movement is 0°F to 120°F.

DIMENSIONS: All dimensions are measured horizontally and vertically unless otherwise noted.

EXCAVATION: Excavation below grade and cut slope template shall be classified as Structure Excavation. All excavation above these limits shall be classified as Regular Excavation and is not included in the Structural Quantities.

FOUNDATIONS: Piles shall be driven to a minimum length corresponding to the approximate tip elevations shown on the Plans but in no case to less than a penetration affording the required safe bearing capacity noted on the Plans.

CONCRETE NOTES: Concrete in superstructure shall be Class A4. All other concrete shall be Class A3. All exposed edges and corners shall have a 3/4" chamfer or fillet unless otherwise noted. Care in the method of vibration, the use of low-slump concrete, and other means shall be employed to prevent downgrade movement of newly placed slab concrete.

STEEL NOTES: All reinforcing steel shall conform to A.S.T.M. A-615, Grade 40. All reinforcing bar dimensions on the detailed drawings are to centers of bars unless otherwise noted. Clear distance between reinforcing steel and face of concrete shall be as noted on the plans. All bar laps shall be 30 diameters of the smaller diameter bar unless otherwise noted.

Structural steel shall conform to A.S.T.M. Specification A36 except as noted. All field connections shall be made with high strength bolts. High strength bolts shall be 3/4" diameter unless otherwise noted and shall conform to A.S.T.M. Specification A-325.


BENCH MARK: A-25 Copperweld rod S. side of Thompson St. and Cary Road. Elev. 236.59.

NOTE:
 Construction of roadway under not in this Contract.



ESTIMATED QUANTITIES

Str. STL. High Strength lbs. A588	Struct. Excav. Cu. Yds.	Concrete (a) Cu. Yds.	Reinf. Steel Lbs.	Str. STL. Mild Carbon Lbs.	Aluminum railing (1-Rail) Lin. Ft.	Porous Backfill Cu. Yds.	Under-6" dia. Pipe Lin. Ft.	Con. Slab Sl. Prot. Sq. Yds.	Asphalt damp-proofing Conc. (a) Cu. Yds.	Approach Slab Conc. (a) Cu. Yds.	Steel Piles 10BPA2 3" Dia. Lin. Ft.	Parapet Juncif. Box Complete Each	Metal Conduit 3" Dia. Lin. Ft.	Metal Conduit 1 1/2" Dia. Lin. Ft.
11,561.2	-	325.98(b)	94,764	342,021.5	687	-	-	-	-	-	-	2	290	56
	179	87.81	26,326	-	-	7	68	-	31	62.91	654.3	-	-	-
	67	67.39	7,653	-	-	-	-	-	-	-	413.4	-	-	-
	90	99.35	12,167	-	-	-	-	-	-	-	432.1	-	-	-
	156	112.88	15,056	-	-	-	-	-	-	-	493.8	-	-	-
	143	79.26	21,016	-	-	5	56	-	25	52.85	621.7	-	-	-
	180	88.22	29,400	-	-	6	80	-	28	73.48	802.1	-	-	-
	815	325.98(b)	206,382	342,021.5	687	18	204	-	84	189.24	3,417.4	2	290	56

Estimated Quantities Notes:
 (a) Class A3, unless noted
 (b) Class A4

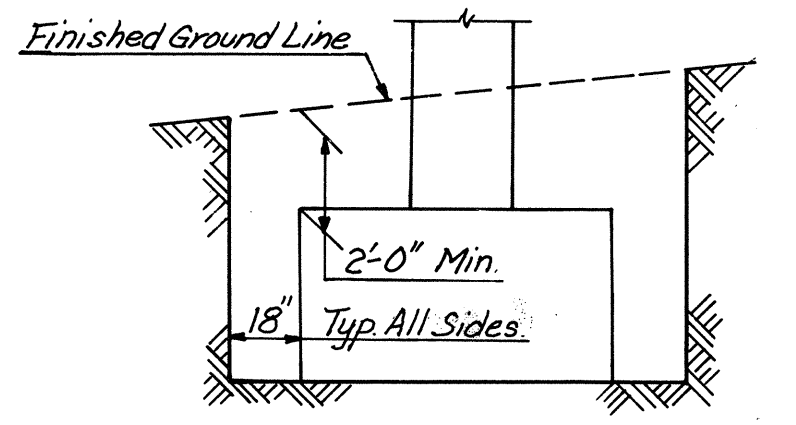

AS BUILT

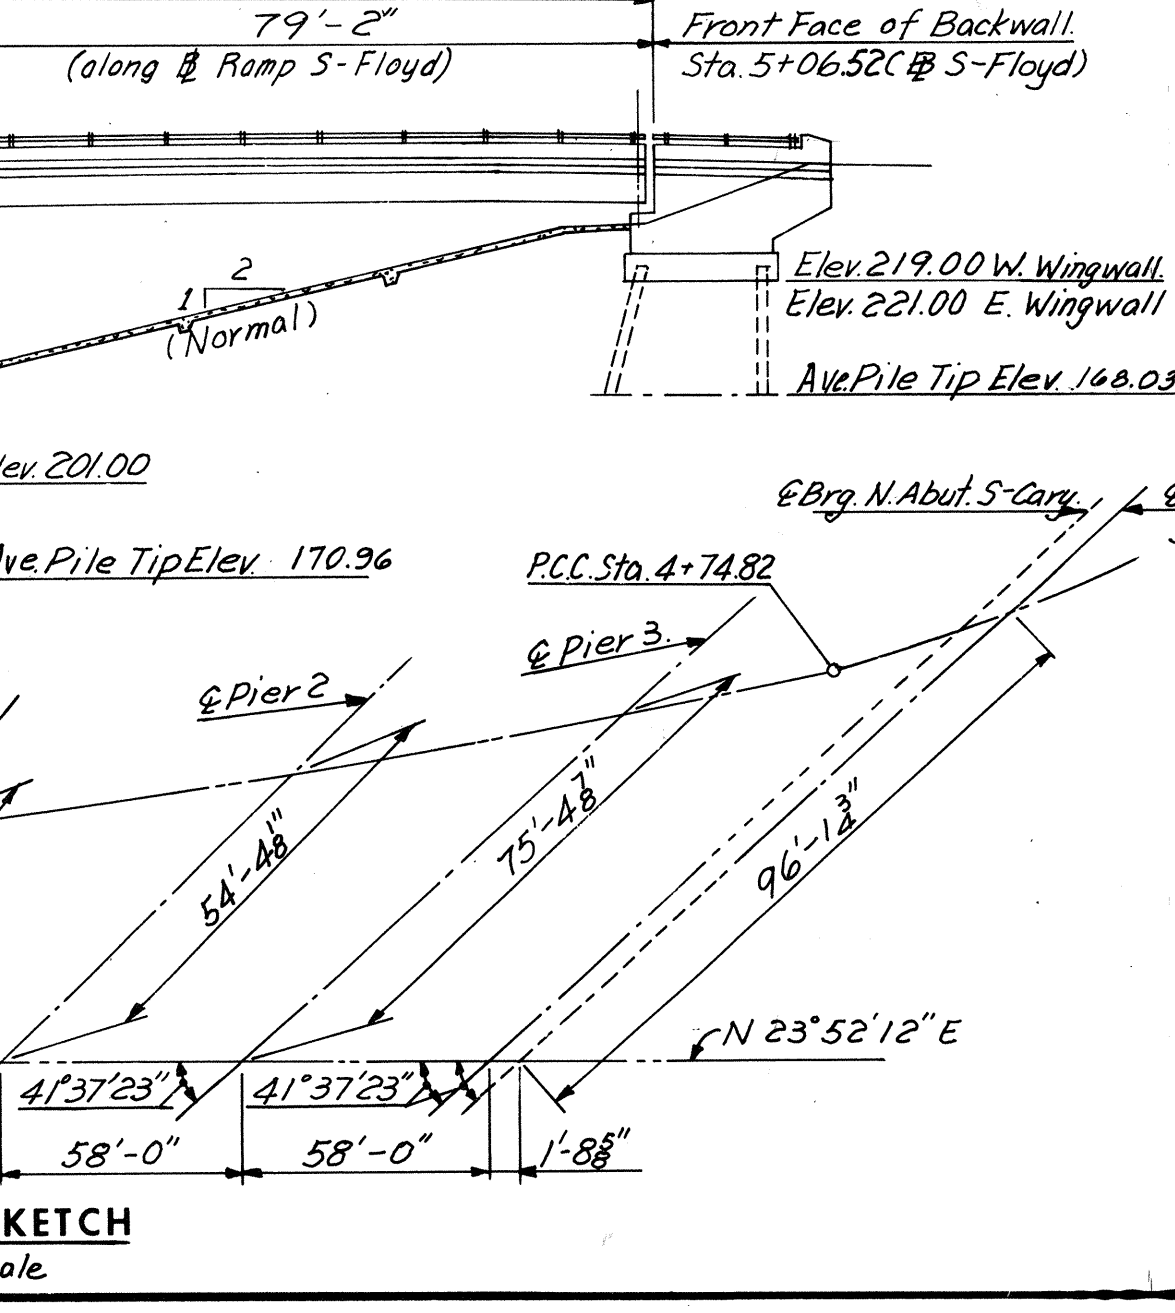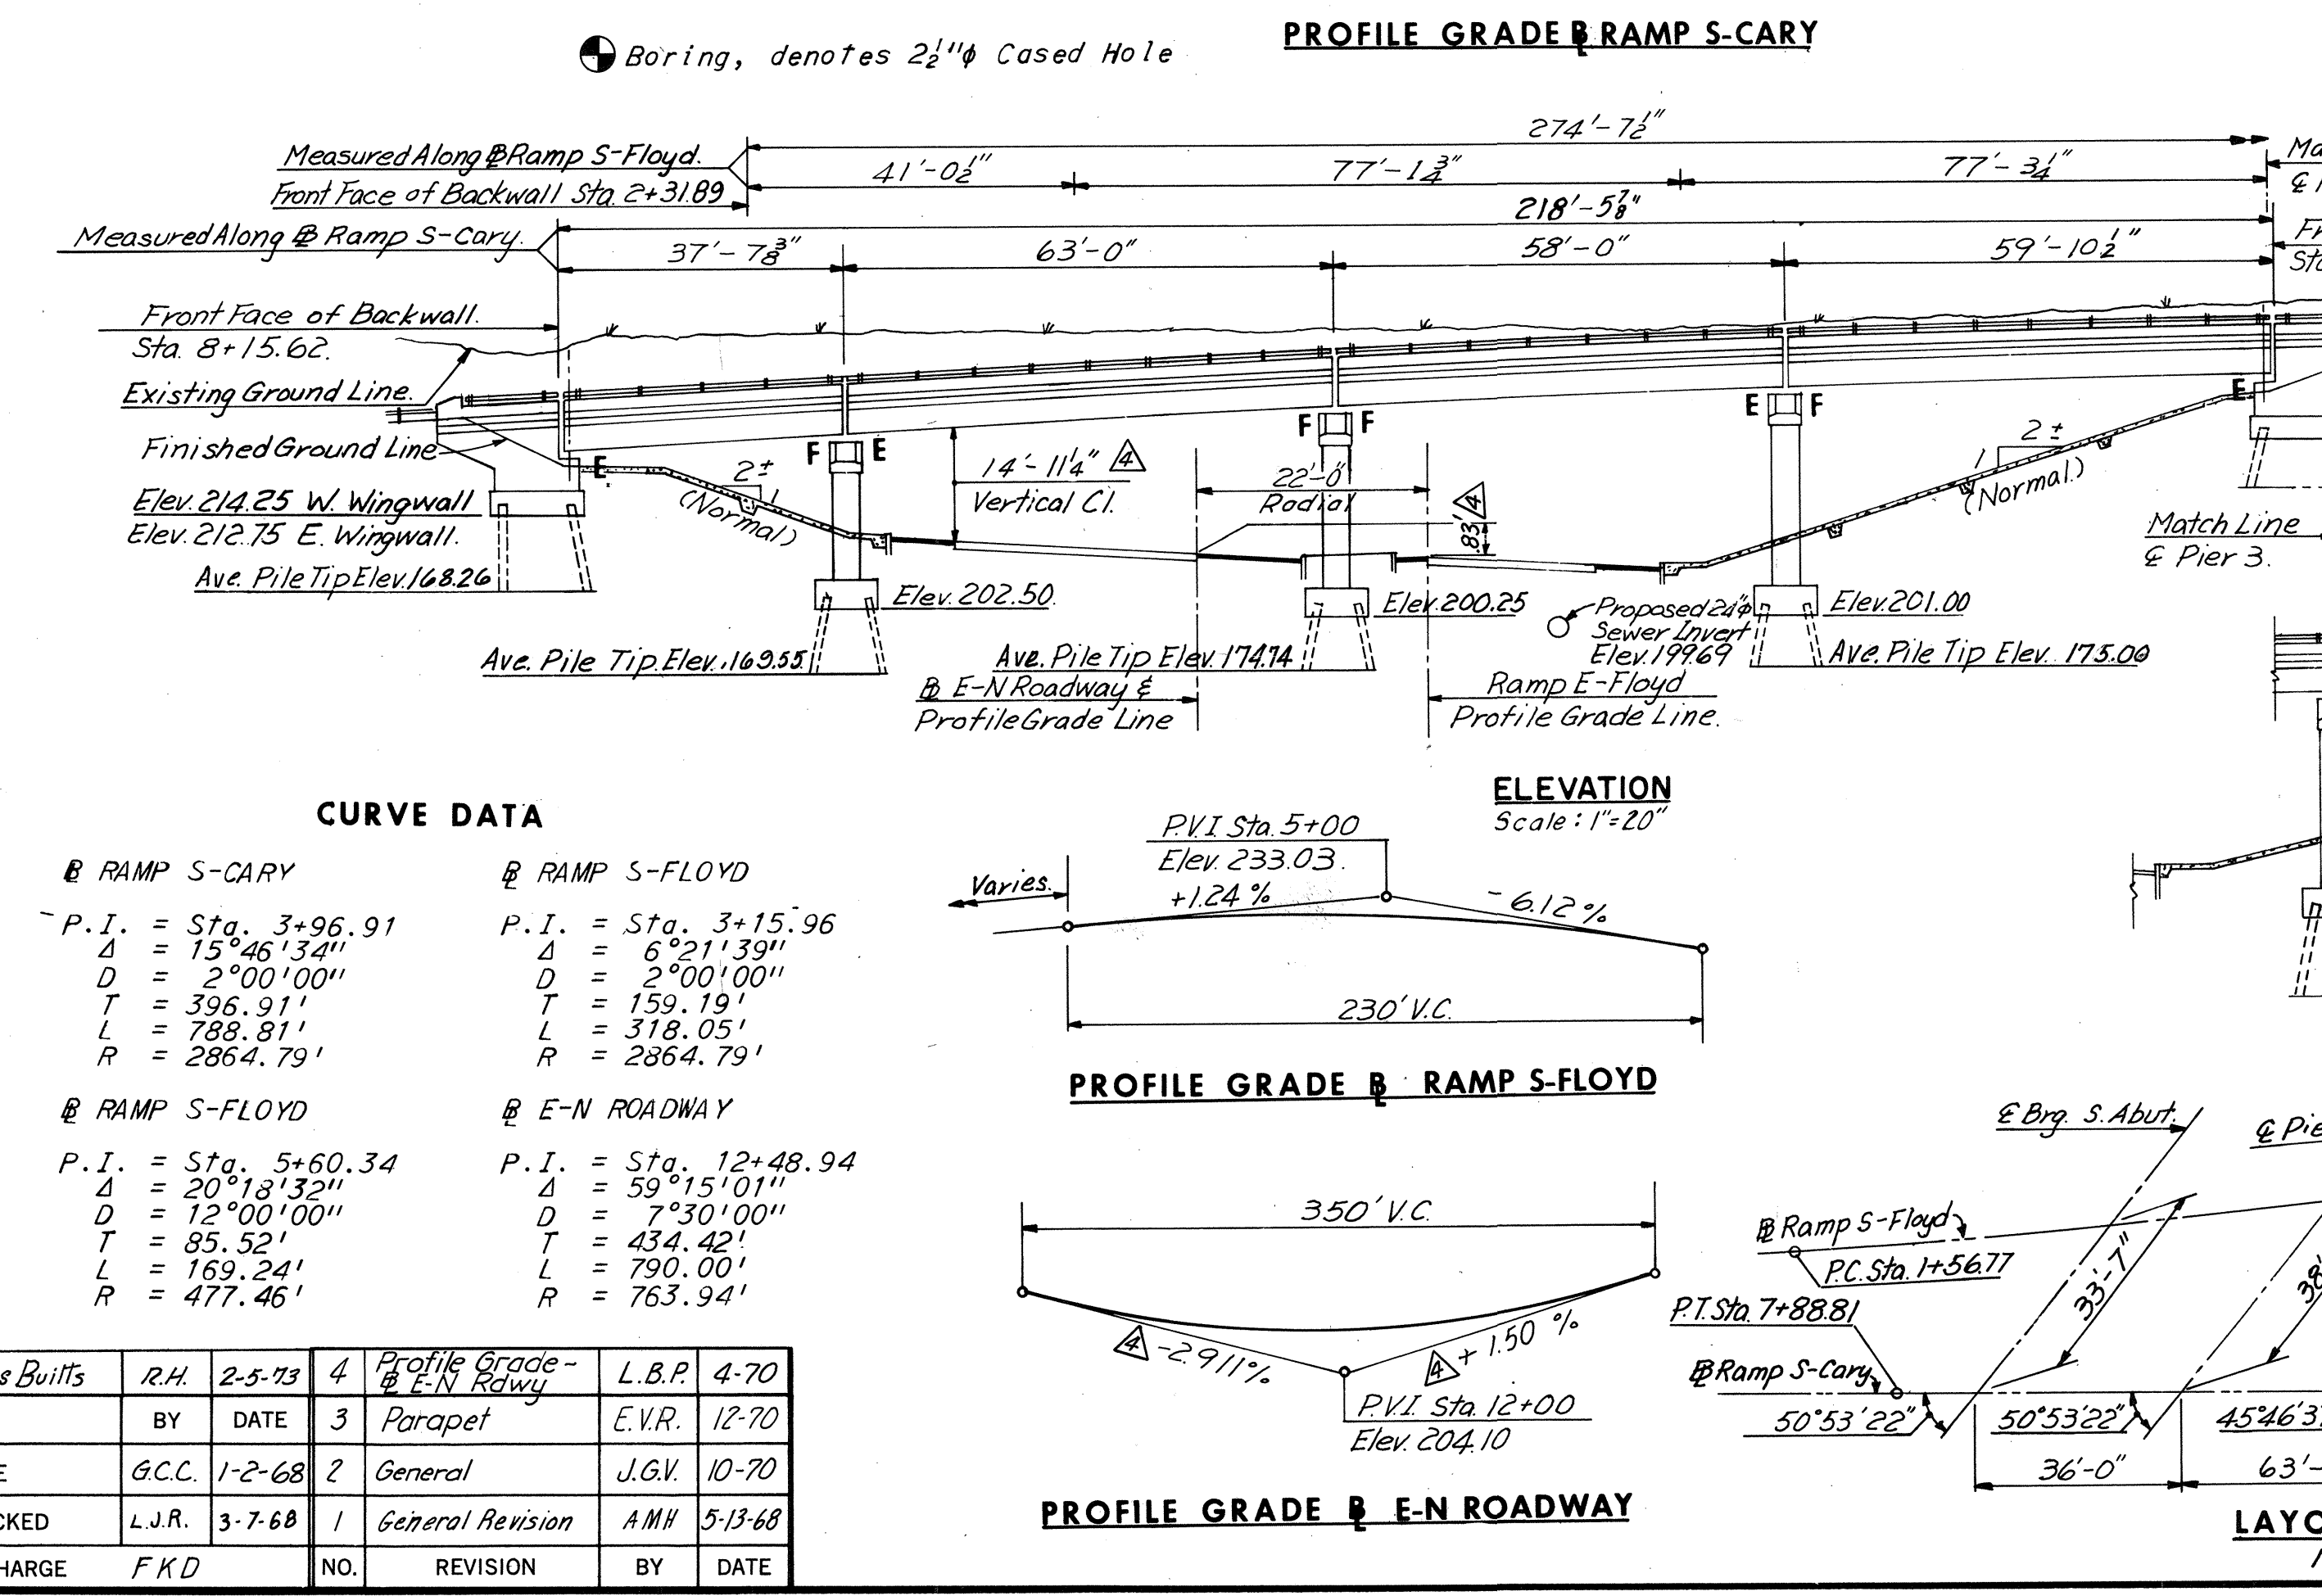

INDEX

GENERAL PLAN AND ELEVATION	Sheet 1
SOUTH ABUTMENT	2
NORTH ABUTMENT S-CARY	3
NORTH ABUTMENT S-FLOYD	4
ABUTMENT DETAILS	5
PIER 1	6
PIERS 2 AND 3	7
FRAMING PLAN	8
DECK PLAN	9
DECK DETAILS	10
JOINT DETAILS	11
JOINT DETAILS	12
APPROACH SLAB AND SLOPE PROTECTION DETAILS	13
BORING LOGS	14
STANDARD SHOE DETAILS	15
STANDARD ALUMINUM RAILING DETAILS	16
STANDARD ELECTRICAL DETAILS	17
STANDARD ARCHITECTURAL DETAILS	18

RICHMOND METROPOLITAN AUTHORITY
RICHMOND EXPRESSWAY SYSTEM
BELTLINE EXPRESSWAY
BRIDGE NO. 17
RAMP S-CARY OVER
EAST-NORTH ROADWAY
GENERAL PLAN AND ELEVATION

HOWARD, NEEDLES, TAMMEN & BERGENDOFF
 consulting engineers
 NEW YORK ALEXANDRIA KANSAS CITY

SCALE: As noted
 CONTRACT NO. 4
 SHEET NO. 1 OF 14


5	As Built	R.H.	2-5-73	4	Profile Grade - E-N Roadway	L.B.P.	4-70
		BY	DATE	3	Parapet	E.V.R.	12-70
MADE	G.C.C.	1-2-68	2	General	J.G.V.	10-70	
CHECKED	L.J.R.	3-7-68	1	General Revision	A.M.H.	5-13-68	
IN CHARGE	F.K.D.			NO.	REVISION	BY	DATE

Bridge 65

(Ramp from Northbound I-95 to Westbound Downtown Expressway “Rte. 195” over NS RR and CSX RR)

Record Set Plans

RICHMOND EXPRESSWAY SYSTEM			
SECTION	PROJECT	SHEET NO.	TOTAL SHEETS
11	DOWNTOWN EXPRESSWAY	26	97

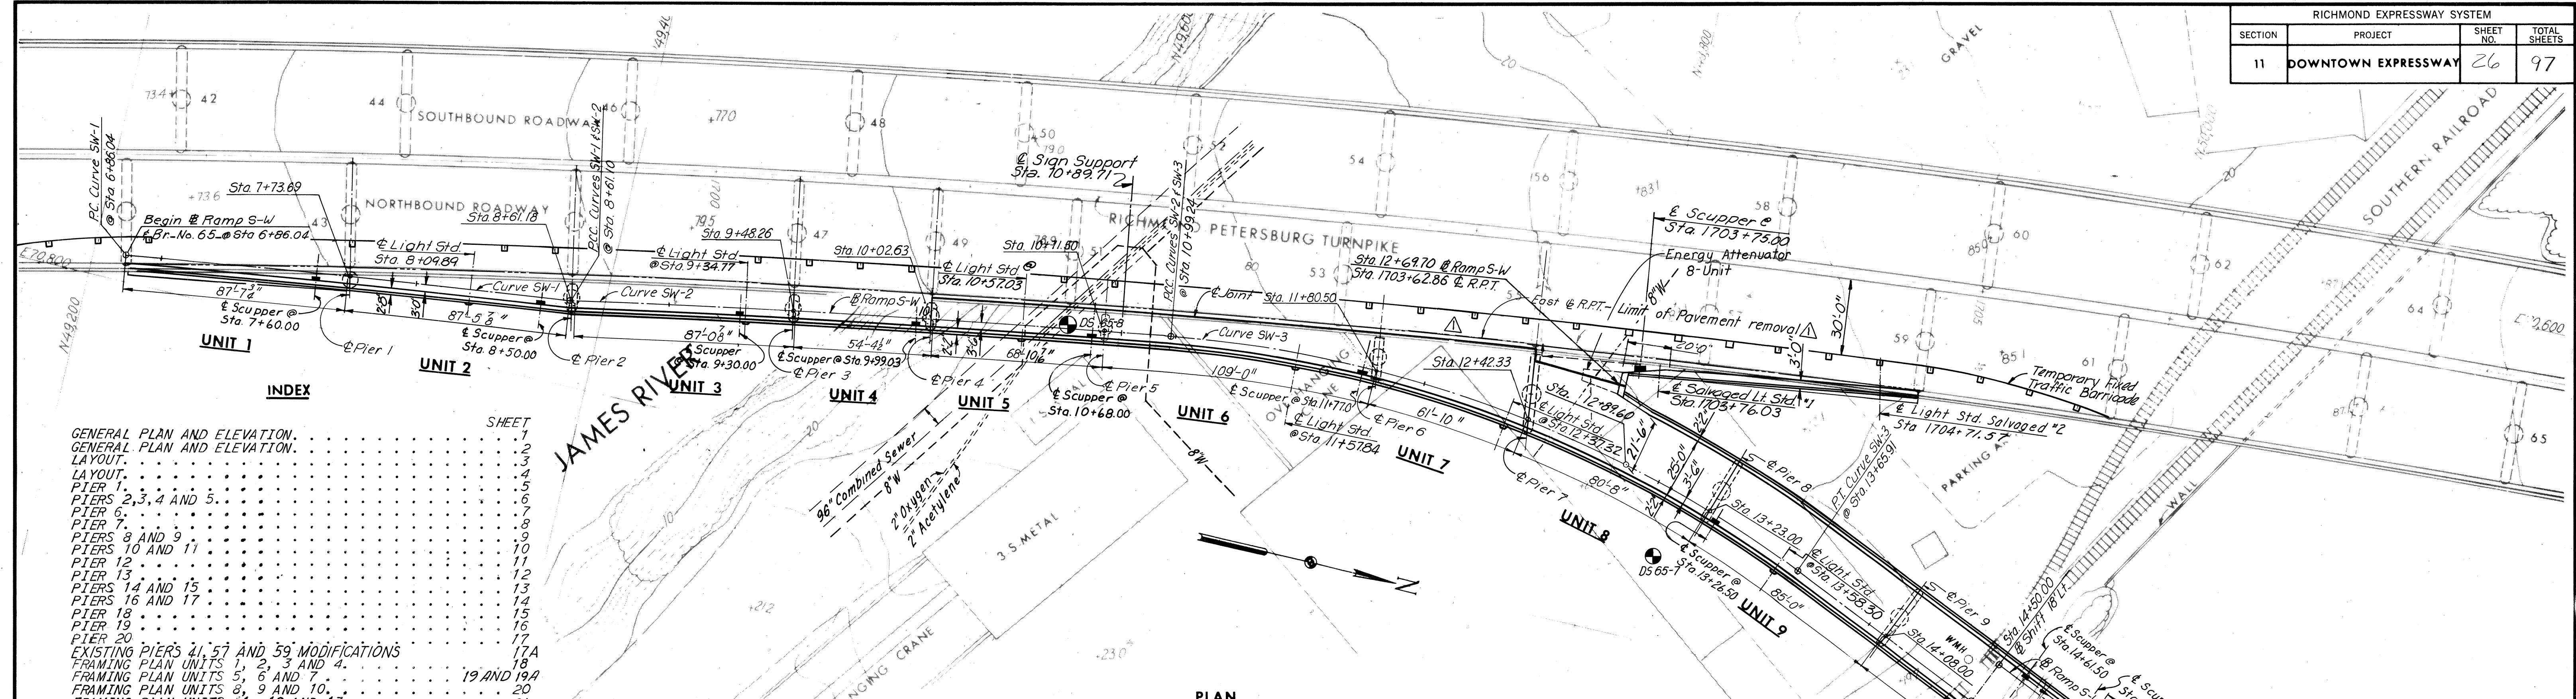


INDEX


GENERAL PLAN AND ELEVATION.	SHEET 1
GENERAL PLAN AND ELEVATION.	2
LAYOUT.	3
LAYOUT.	4
PIER 1.	5
PIERS 2, 3, 4 AND 5.	6
PIER 6.	7
PIERS 8 AND 9.	8
PIERS 10 AND 11.	9
PIER 12.	10
PIER 13.	11
PIERS 14 AND 15.	12
PIERS 16 AND 17.	13
PIER 18.	14
PIER 19.	15
PIER 20.	16
EXISTING PIERS 21, 57 AND 59 MODIFICATIONS.	17A
FRAMING PLAN UNITS 1, 2, 3 AND 4.	18
FRAMING PLAN UNITS 5, 6 AND 7.	19 AND 19A
FRAMING PLAN UNITS 8, 9 AND 10.	20
FRAMING PLAN UNITS 11, 12 AND 13.	21
FRAMING PLAN UNITS 14, 15 AND 16.	22
FRAMING PLAN UNITS 17 AND 18.	23
FRAMING PLAN UNITS 19 AND 20.	24
DECK PLAN UNITS 1, 2, 3 AND 4.	25
DECK PLAN UNITS 5, 6 AND 7.	26
DECK PLAN UNITS 8, 9 AND 10.	27
DECK PLAN UNITS 11, 12 AND 13.	28
DECK PLAN UNITS 14, 15 AND 16.	29
DECK PLAN UNITS 17 AND 18.	30
DECK PLAN UNITS 19 AND 20.	31
SUPERSTRUCTURE DETAILS.	32
FIRE PROTECTION DETAILS (DELETED).	33
JOINT DETAILS.	34 AND 35
BORING LOGS.	36 THRU 38
FRAMING PLAN UNITS 8 AND 8W.	20A

PLAN

PROFILE GRADE DATA

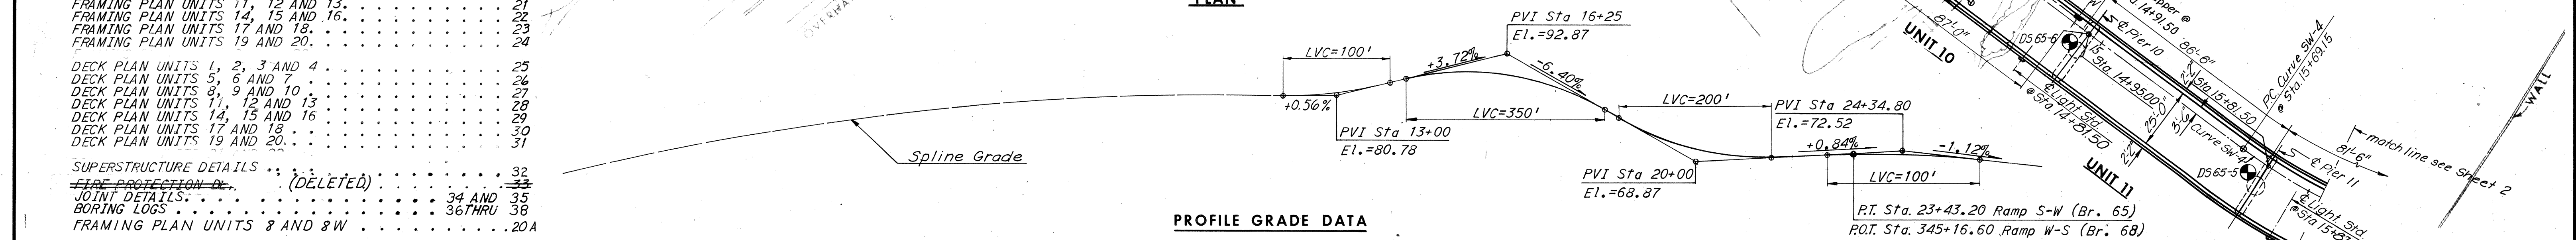


ELEVATION

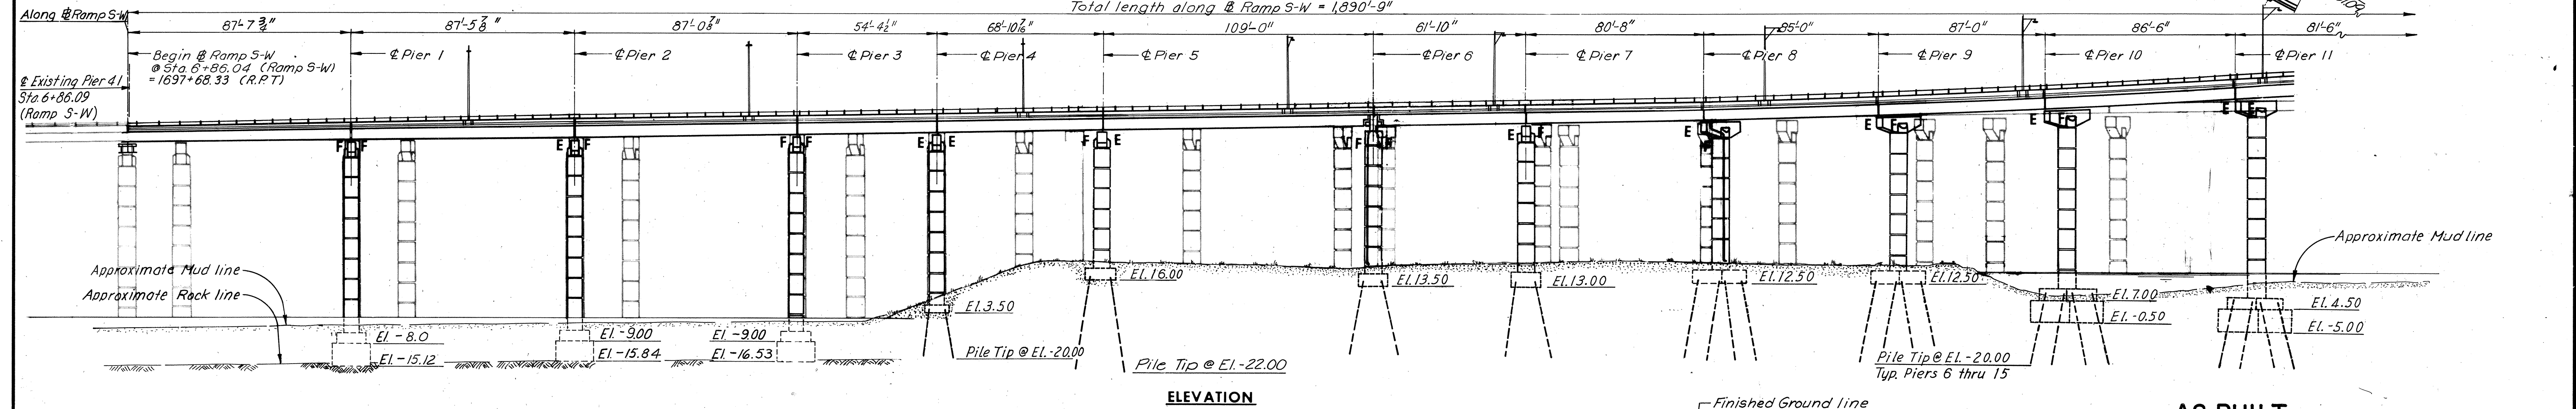

Notes:
 For General Plan and Elevation Units 12 thru 20 see Sheet 2.
 For Layout of Ramp S-W, see Sheets 3 and 4.
 For Estimated Quantities, see Sheet 4.
 For Boring Logs, see Sheets 36 thru 38.
 For General Notes, see Sheet 4.

NO.	REVISION	BY	DATE
1	Sheet 20a Added	TEM	9-9-75
2	Profile Ramp W-S	TEM	9-8-75
3	Limit of pavement removal & Sheet 17A added	ABP	8-25-75

Substructure Note: Footings for Piers 1, 2 and 3 shall be founded on concrete seals socketed 1'-0" into solid rock.

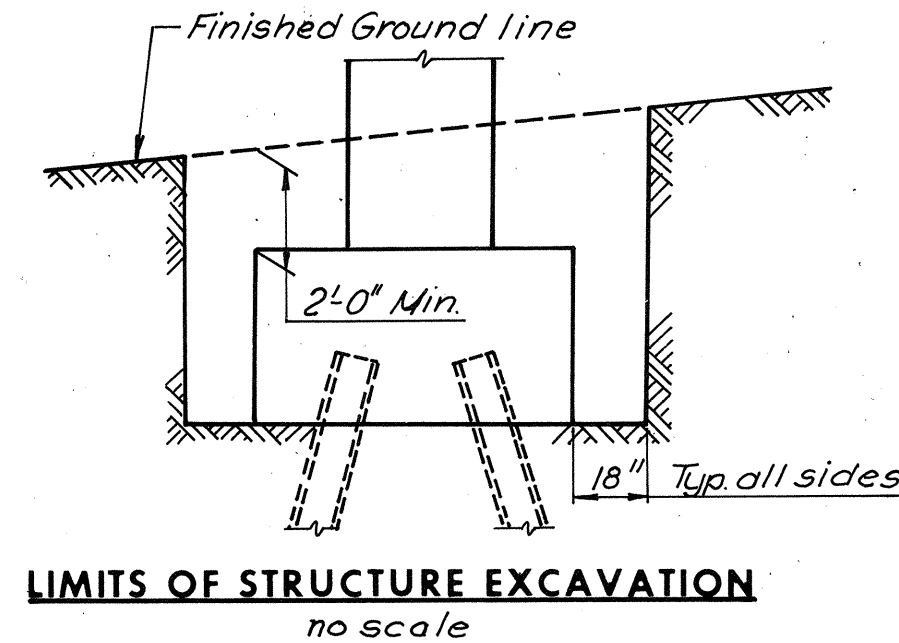

LIMITS OF STRUCTURE EXCAVATION
no scale

AS BUILT



RICHMOND METROPOLITAN AUTHORITY
RICHMOND EXPRESSWAY SYSTEM
DOWNTOWN EXPRESSWAY

BRIDGE NO. 65
RAMP S-W CONNECTION FROM
RICHMOND-PETERSBURG TURNPIKE
GENERAL PLAN AND ELEVATION

HOWARD, NEEDLES, TAMMEN & BERGENDOFF
 consulting engineers
 NEW YORK ALEXANDRIA KANSAS CITY

SCALE: 1"=30'-0"
 CONTRACT NO. 11
 SHEET NO. 1 OF 38

RICHMOND EXPRESSWAY SYSTEM			
SECTION	PROJECT	SHEET NO.	TOTAL SHEETS
11	DOWNTOWN EXPRESSWAY	27	97

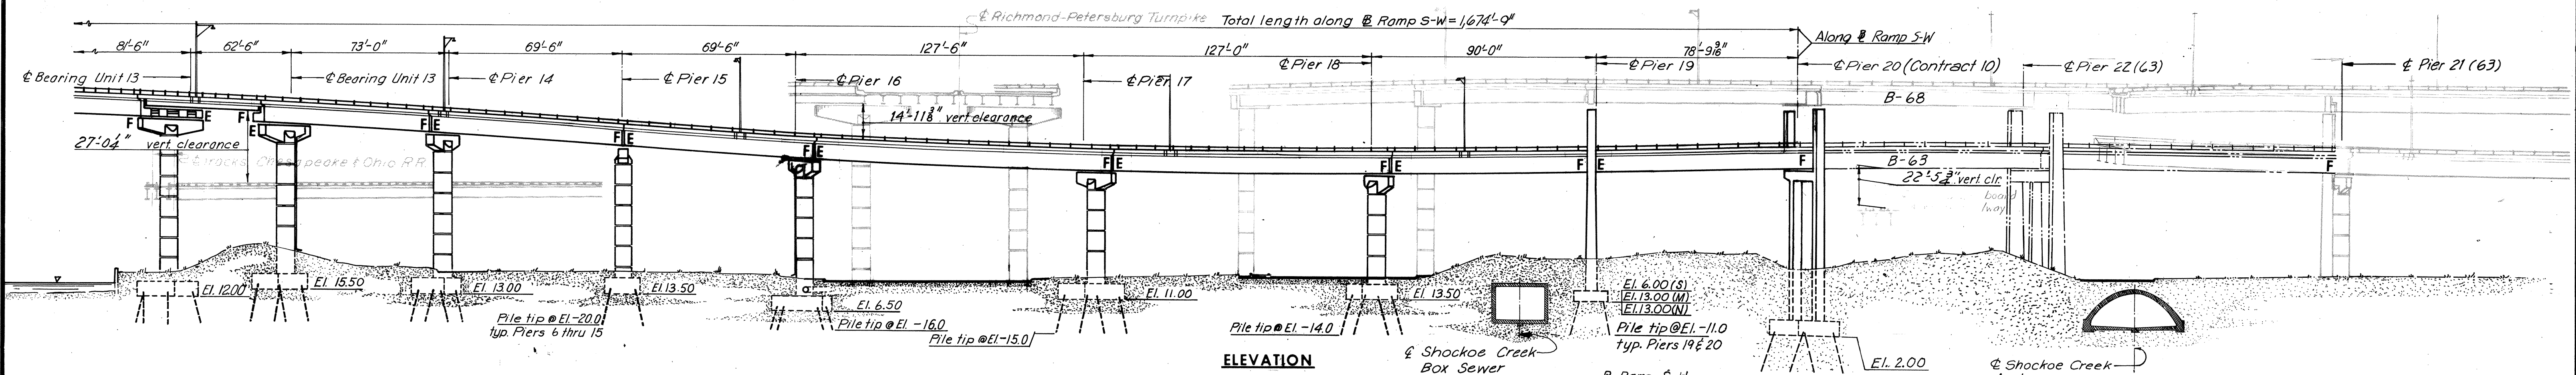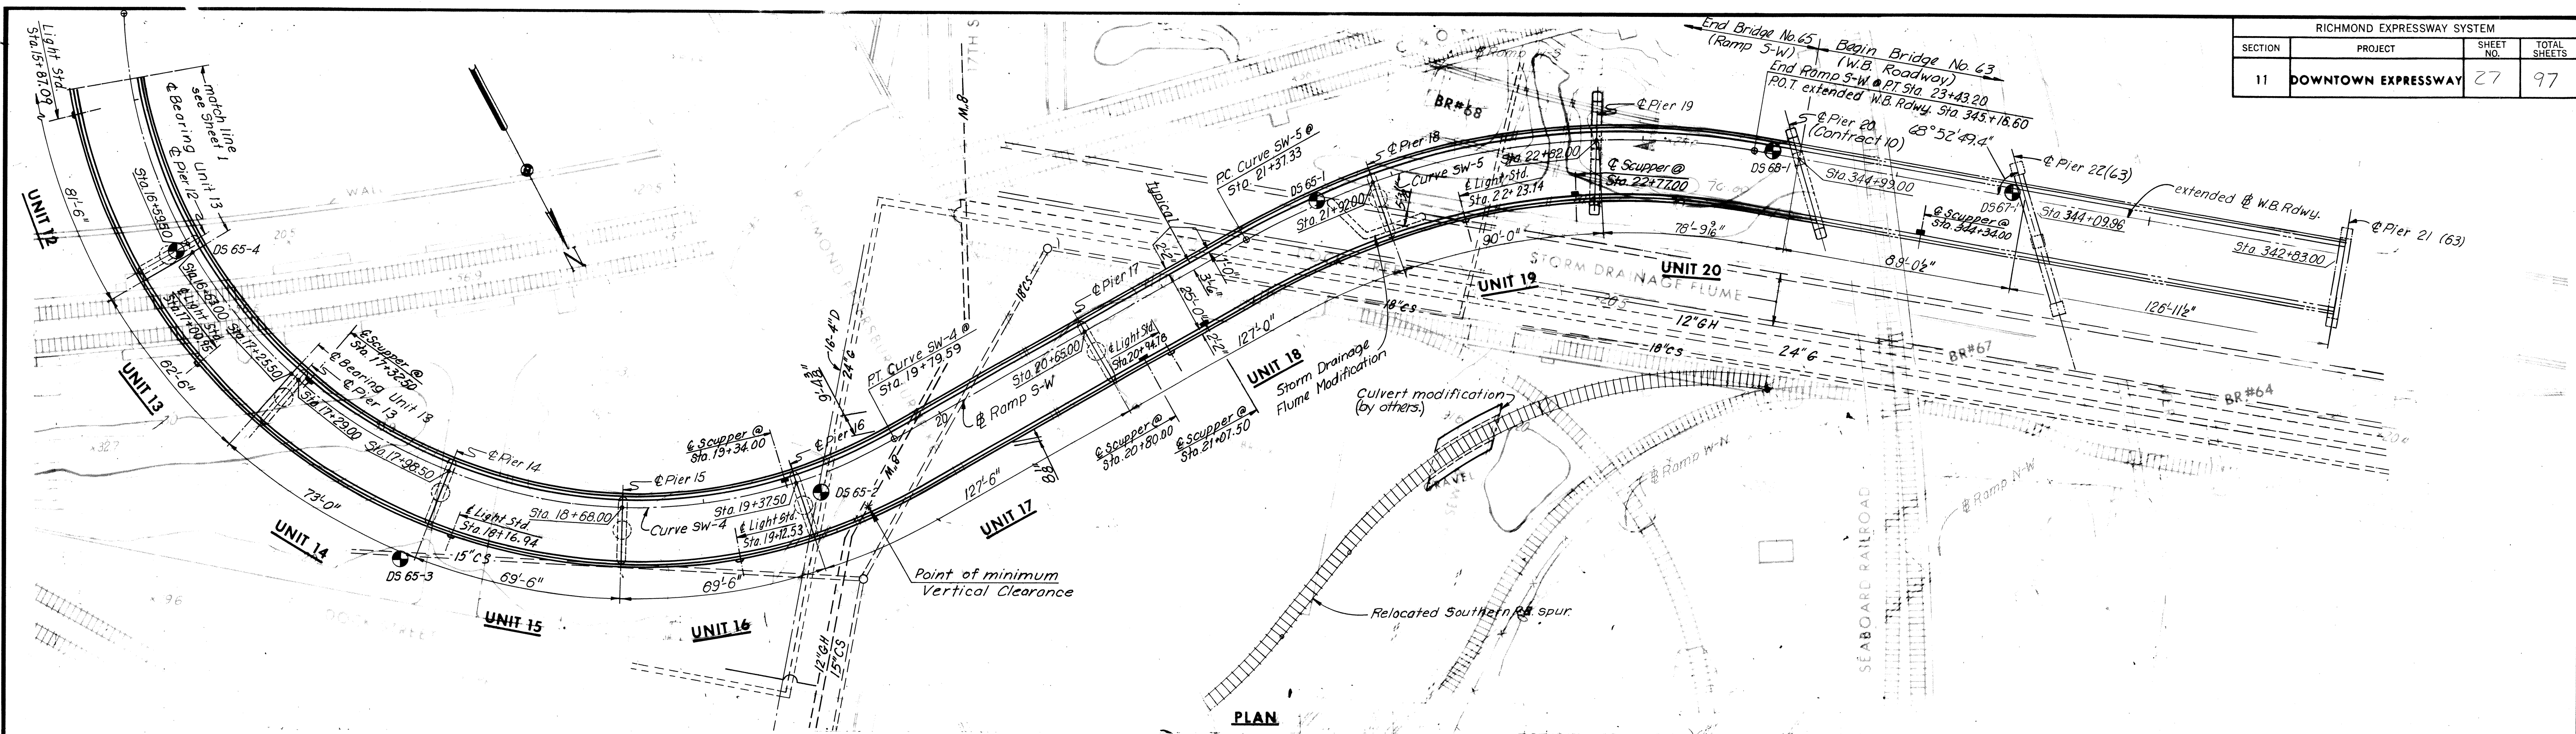

<p>Curve: SW-1</p> <p>P.I. = Sta. 7+73.58</p> <p>Δ = 1°45'10"</p> <p>D = 1°00'</p> <p>T = 87.53'</p> <p>L = 175.05'</p> <p>R = 5,729.58'</p>	<p>Curve: SW-2</p> <p>P.I. = Sta. 9+80.19</p> <p>Δ = 2°24'12"</p> <p>D = 1°00'13"</p> <p>T = 119.09'</p> <p>L = 238.14'</p> <p>R = 5,677.58'</p>	<p>Curve: SW-3</p> <p>P.I. = Sta. 12+36.15</p> <p>Δ = 3°00'00"</p> <p>D = 1°00'</p> <p>T = 136.91'</p> <p>L = 266.67'</p> <p>R = 477.47'</p>
---	---	---

<p>Curve: SW-4</p> <p>P.I. = Sta. 18+95.05</p> <p>Δ = 116°25'03"</p> <p>D = 28°21'51"</p> <p>T = 325.90'</p> <p>L = 410.44'</p> <p>R = 202.00'</p>	<p>Curve: SW-5</p> <p>P.I. = Sta. 22+44.51</p> <p>Δ = 39°19'04"</p> <p>D = 19°05'55"</p> <p>T = 107.17'</p> <p>L = 205.87'</p> <p>R = 300.00'</p>
---	--

Richmond-Petersburg Turnpike	
<p>Curve: R.P.T.-1</p> <p>P.I. = Sta. 1704+68.83</p> <p>Δ = 15°03'56"</p> <p>D = 1°00'</p> <p>T = 757.65'</p> <p>L = 1,506.56'</p> <p>R = 5,729.58'</p>	<p>Curve: R.P.T.-2</p> <p>P.I. = Sta. 1723+07.01</p> <p>Δ = 33°27'07"</p> <p>D = 4°00'</p> <p>T = 430.45'</p> <p>L = 836.30'</p> <p>R = 1,432.39'</p>

Notes:
 For General Plan and Elevation Units 1 thru 11, see Sheet 1.
 For Layout of Ramp S-W, see Sheets 3 and 4.
 For Estimated Quantities, see Sheet 4.
 For Boring Logs, see Sheets 36 thru 38.
 For General Notes, see Sheet 4.

BY	DATE				
MADE	J.V.	4-2-69			
CHECKED	K.C.P.	5-28-69			
IN CHARGE			NO.	REVISION	BY DATE

HORIZONTAL CURVE DATA

AS BUILT

RICHMOND METROPOLITAN AUTHORITY
RICHMOND EXPRESSWAY SYSTEM
DOWNTOWN EXPRESSWAY


BRIDGE NO. 65
RAMP S-W CONNECTION FROM
RICHMOND-PETERSBURG TURNPIKE
GENERAL PLAN AND ELEVATION

HOWARD, NEEDLES, TAMMEN & BERGENDOFF
 consulting engineers
 NEW YORK ALEXANDRIA KANSAS CITY


SCALE: 1"=30'-0"

CONTRACT NO. 11

SHEET NO. 2 OF 38

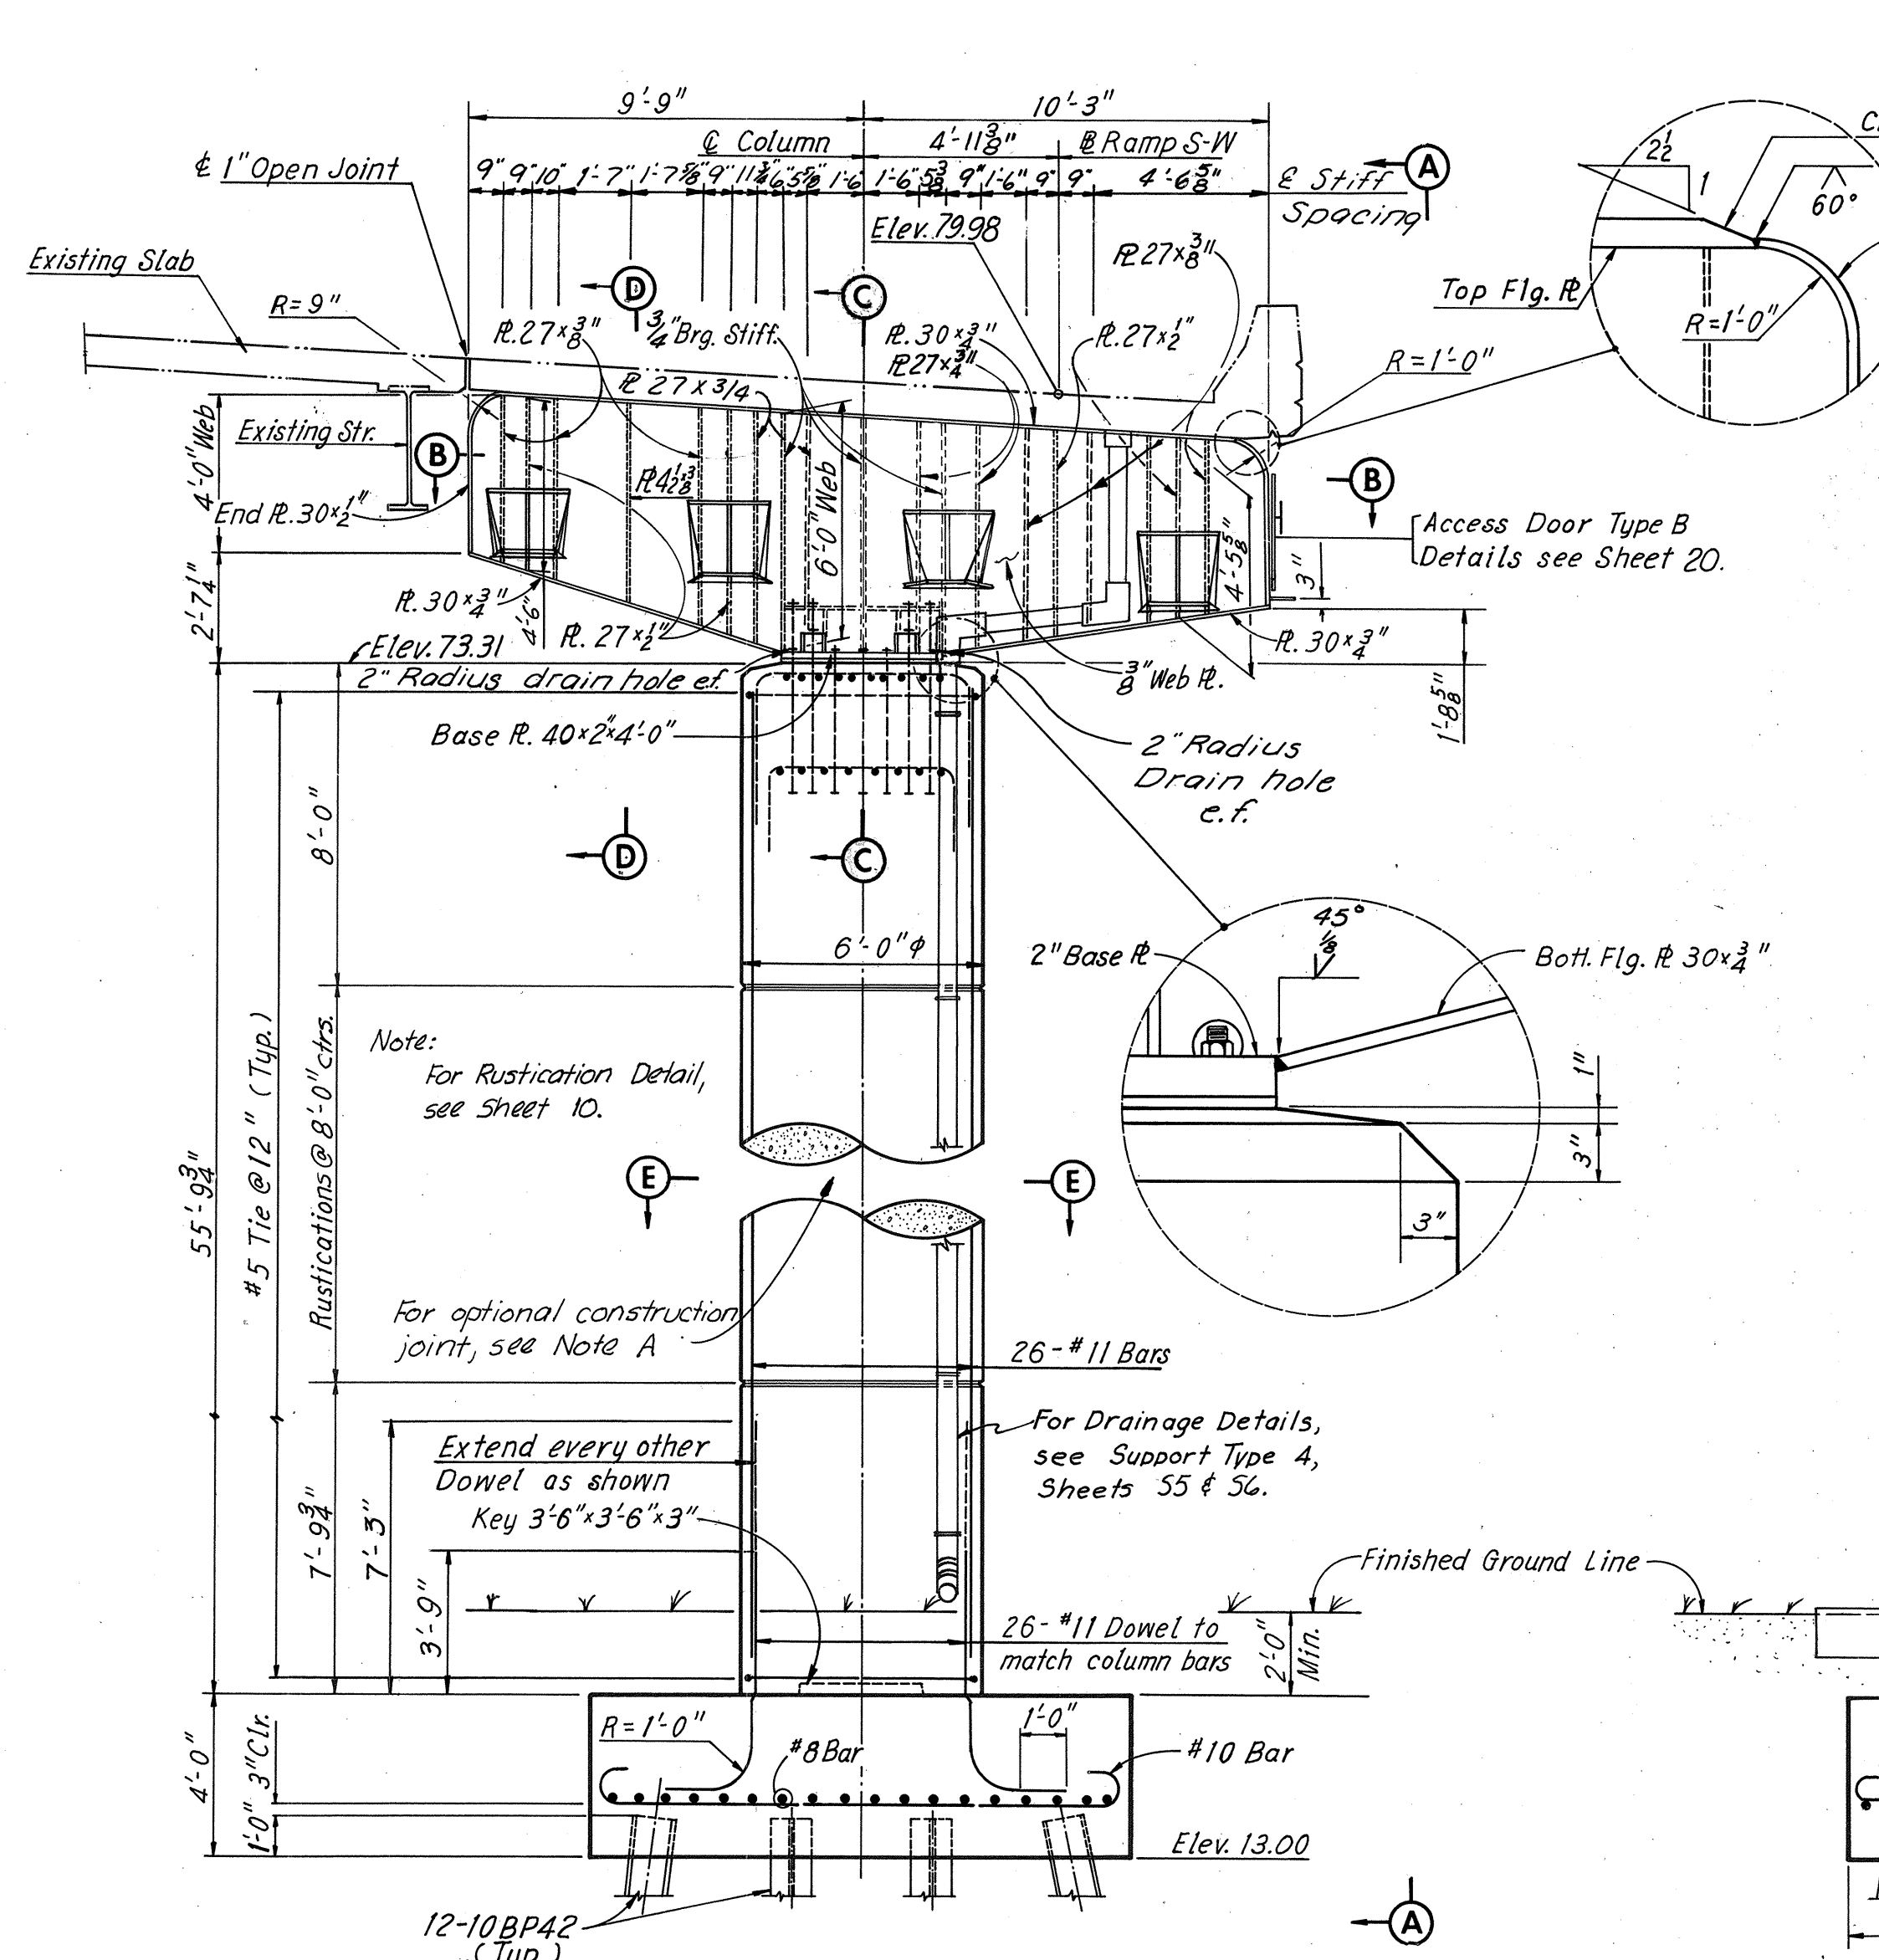


ELEVATION
Scale: 1/4"=1'-0"

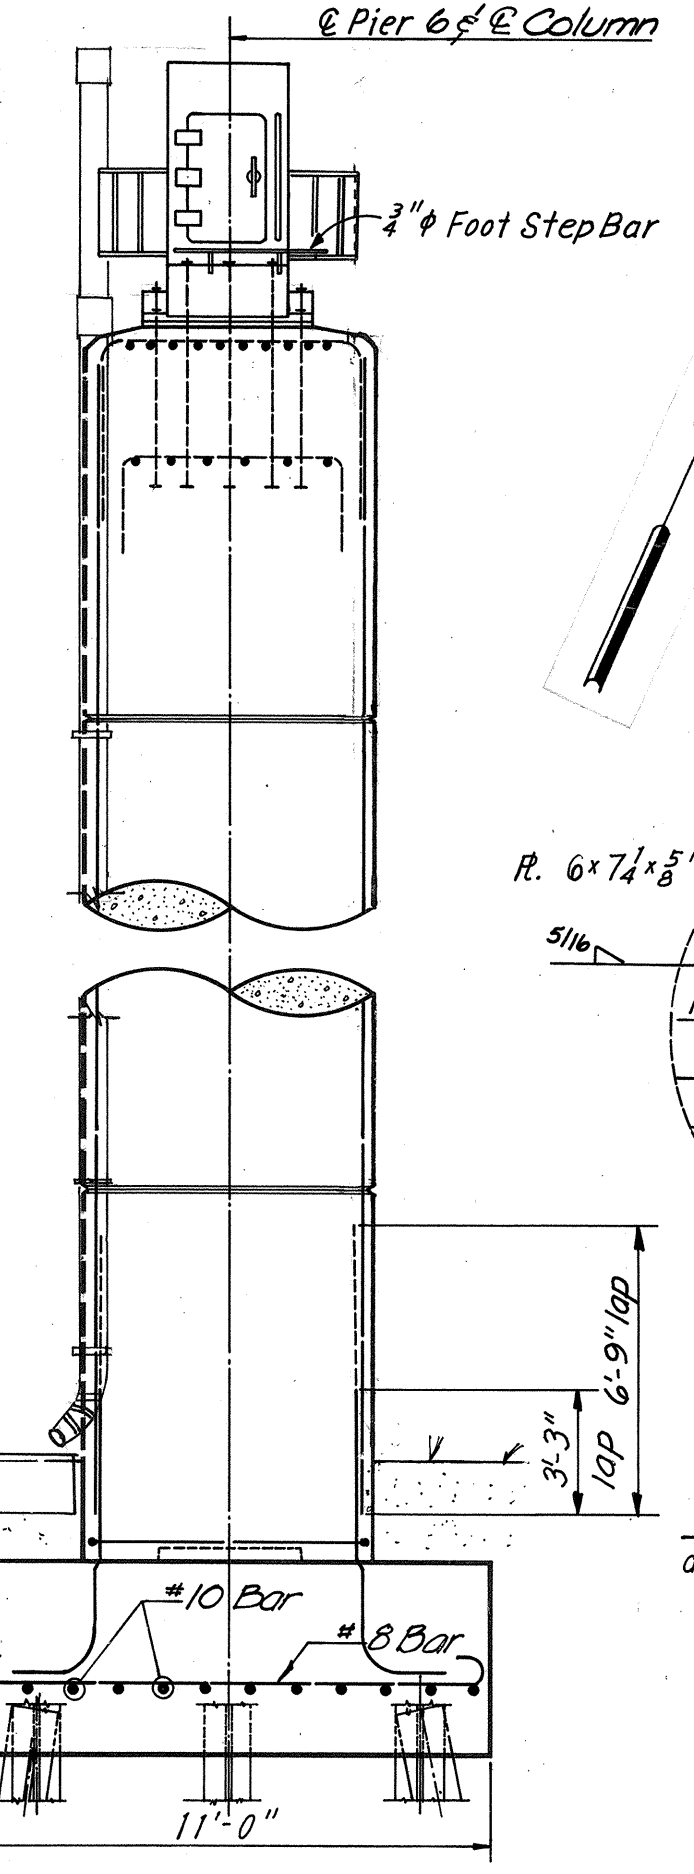


VIEW A-A
Scale: 1/4"=1'-0"

NOTE A
 A construction joint will be permitted at a rustication near mid-height of the column. The column reinforcement may be lap spliced near the construction joint. The lap at the splice shall be a minimum of 3'-6". Splices shall be staggered at least 3'-3" between adjacent bars.

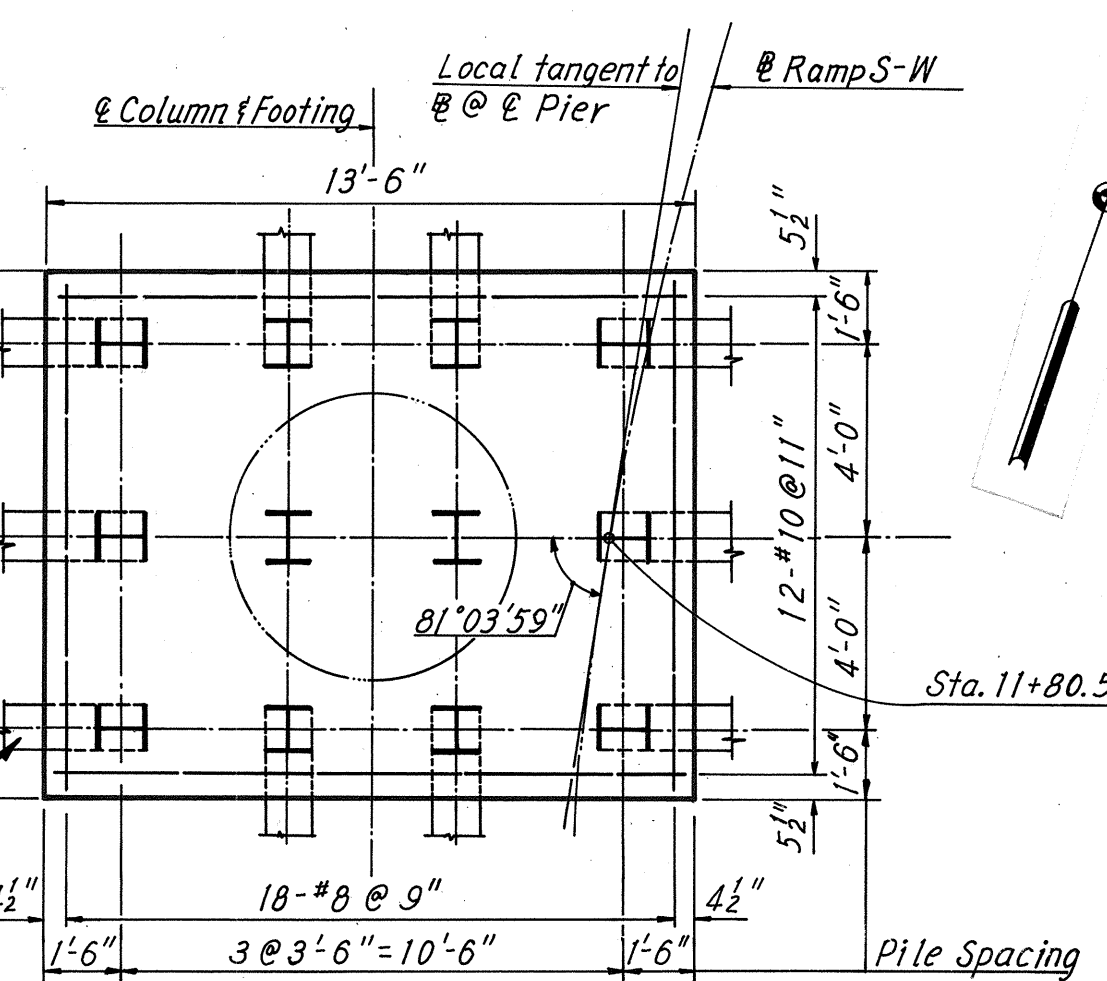

FOOTING PLAN
Scale: 1/4"=1'-0"

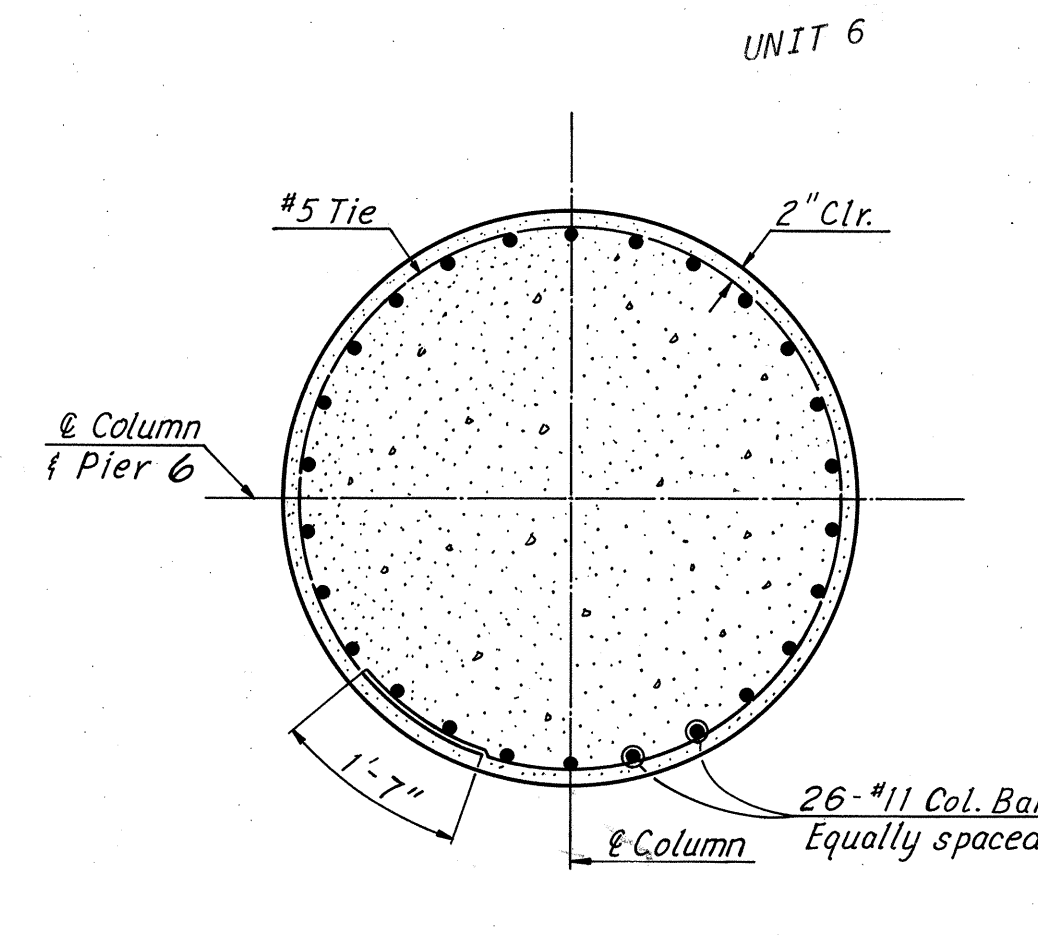


SECTION E-E
Scale: 1/2"=1'-0"


Note: Footing elevations are approximate only and may be varied to suit field conditions as directed by the Engineer. Vertical shaft reinforcement shall not be cut until these elevations are established. Where elevations change more than 2 ft., redesign will be required.

Note: All Structural Steel for Pier 6 shall be A36. Top of cap beam, Pier 6, need not be cambered.


BY	DATE	Shoe Plate Dim. in Detail A	T.E.M.	8-76
MADE	K.C.T. 8-13-69	Pier Cap Dim.	T.E.M.	3-76
CHECKED	J.L.K. 6-25-75	Pad Elev. & Col. Dim.	T.E.M.	9-8-75
IN CHARGE	S.C.C. 5-27-69			

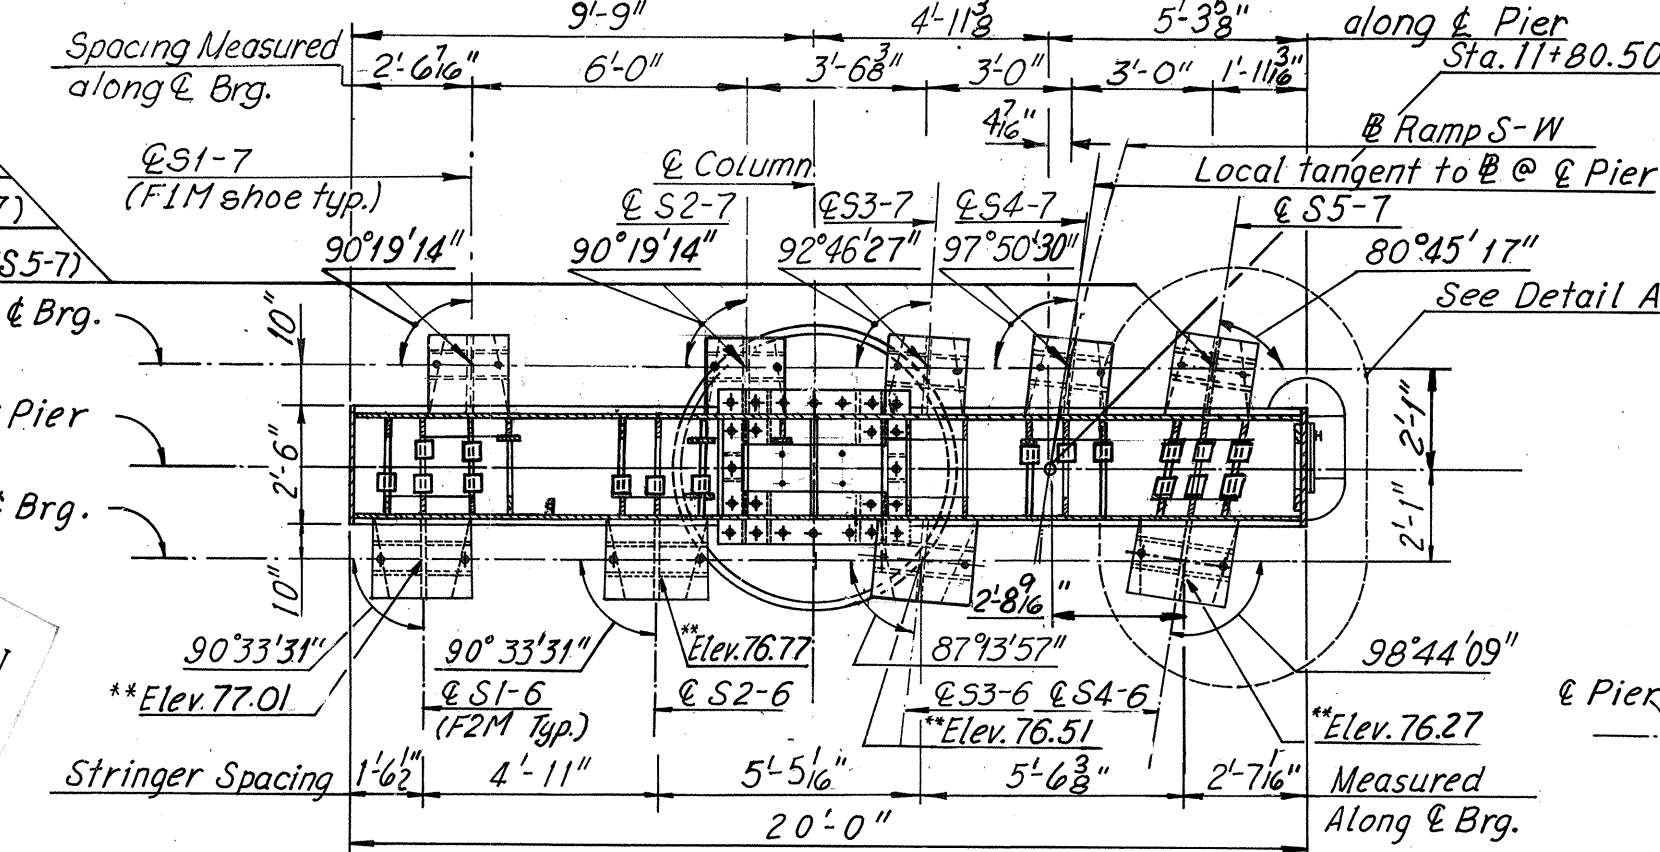


SECTION B-B
Scale: 1/4"=1'-0"

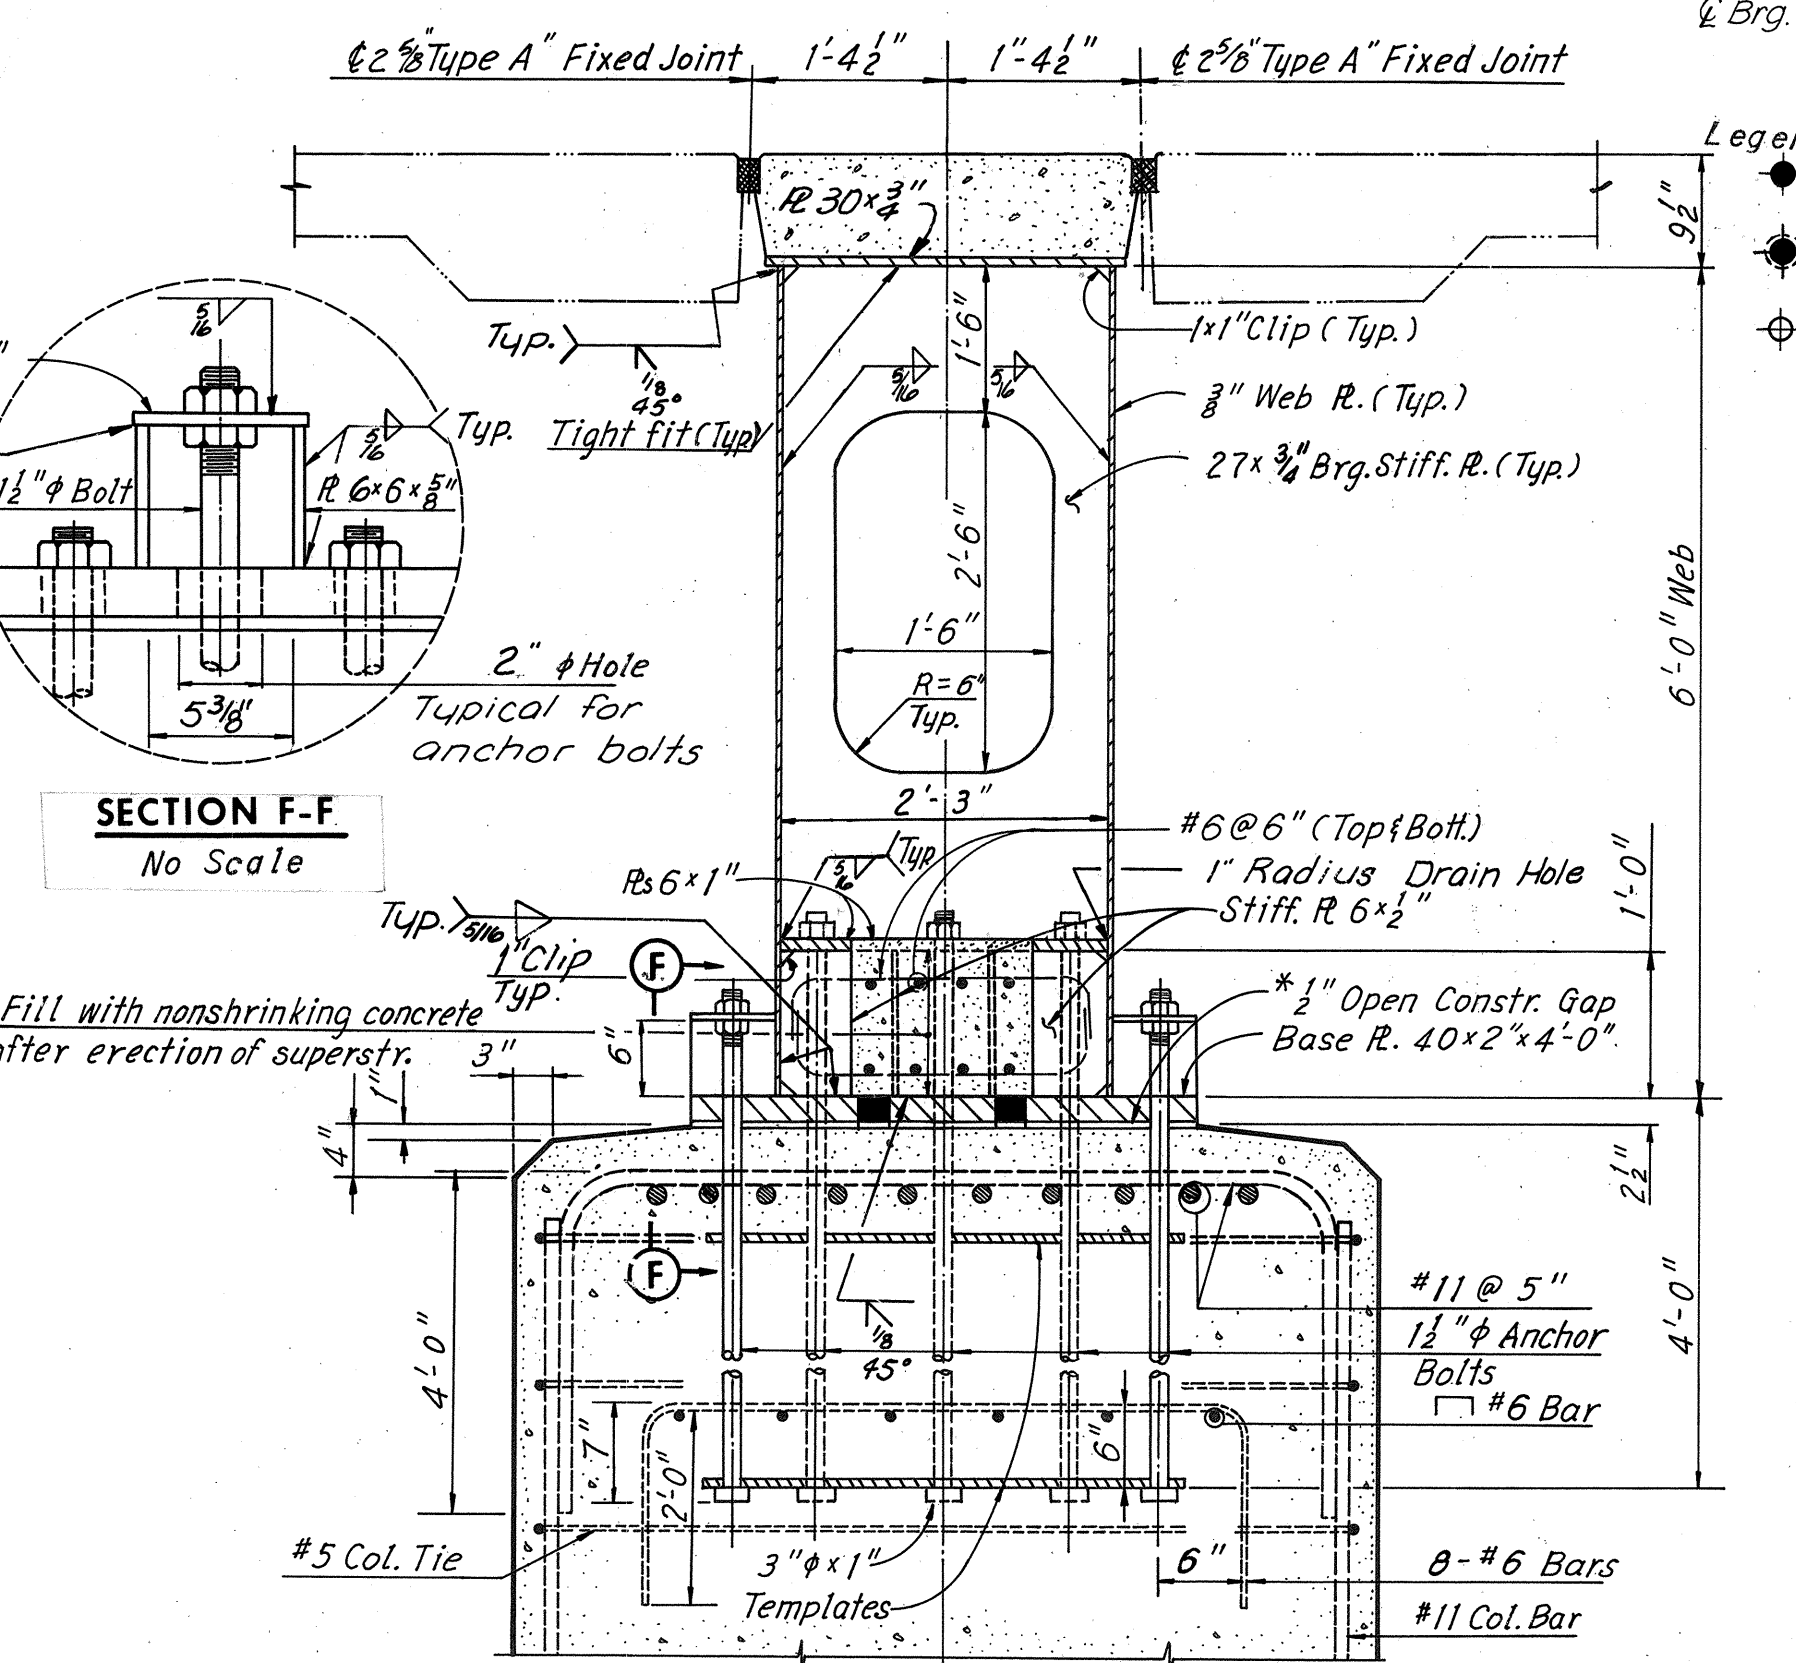


SECTION C-C
Scale: 1/4"=1'-0"

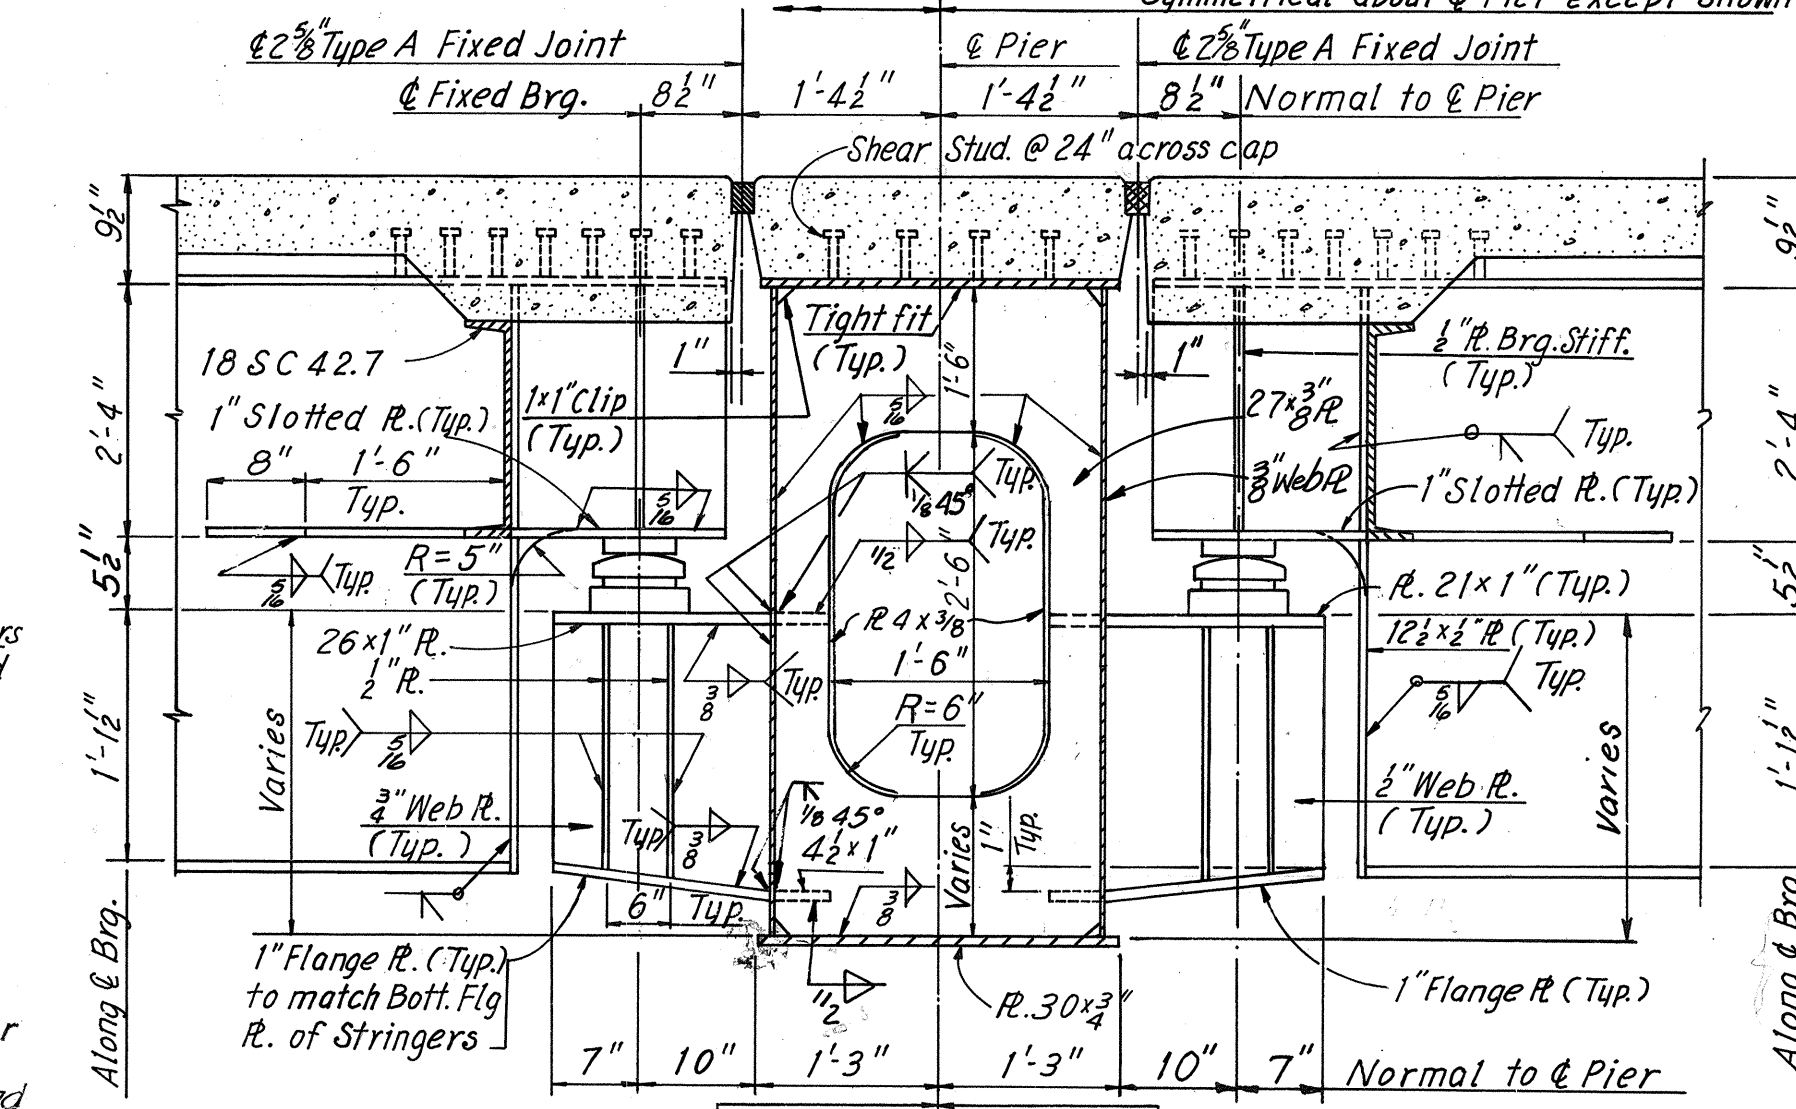

SECTION D-D
Scale: 1/4"=1'-0"

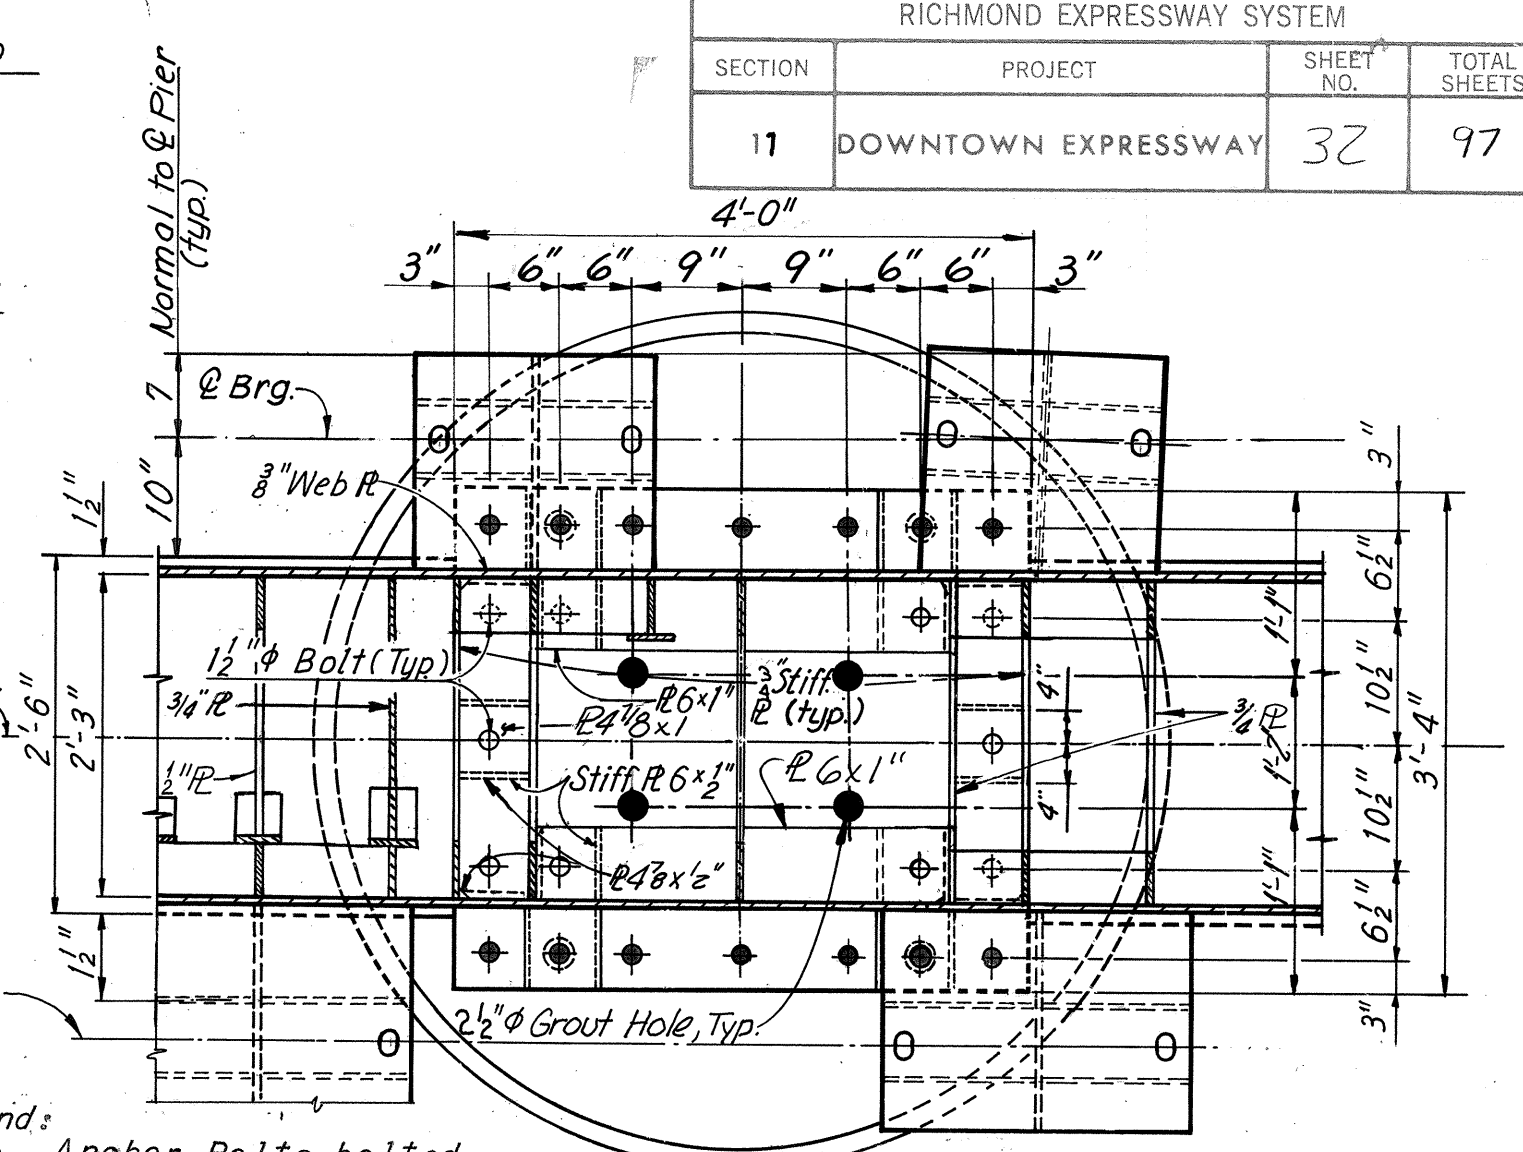

BASE PLATE PLAN
Scale: 1/4"=1'-0"

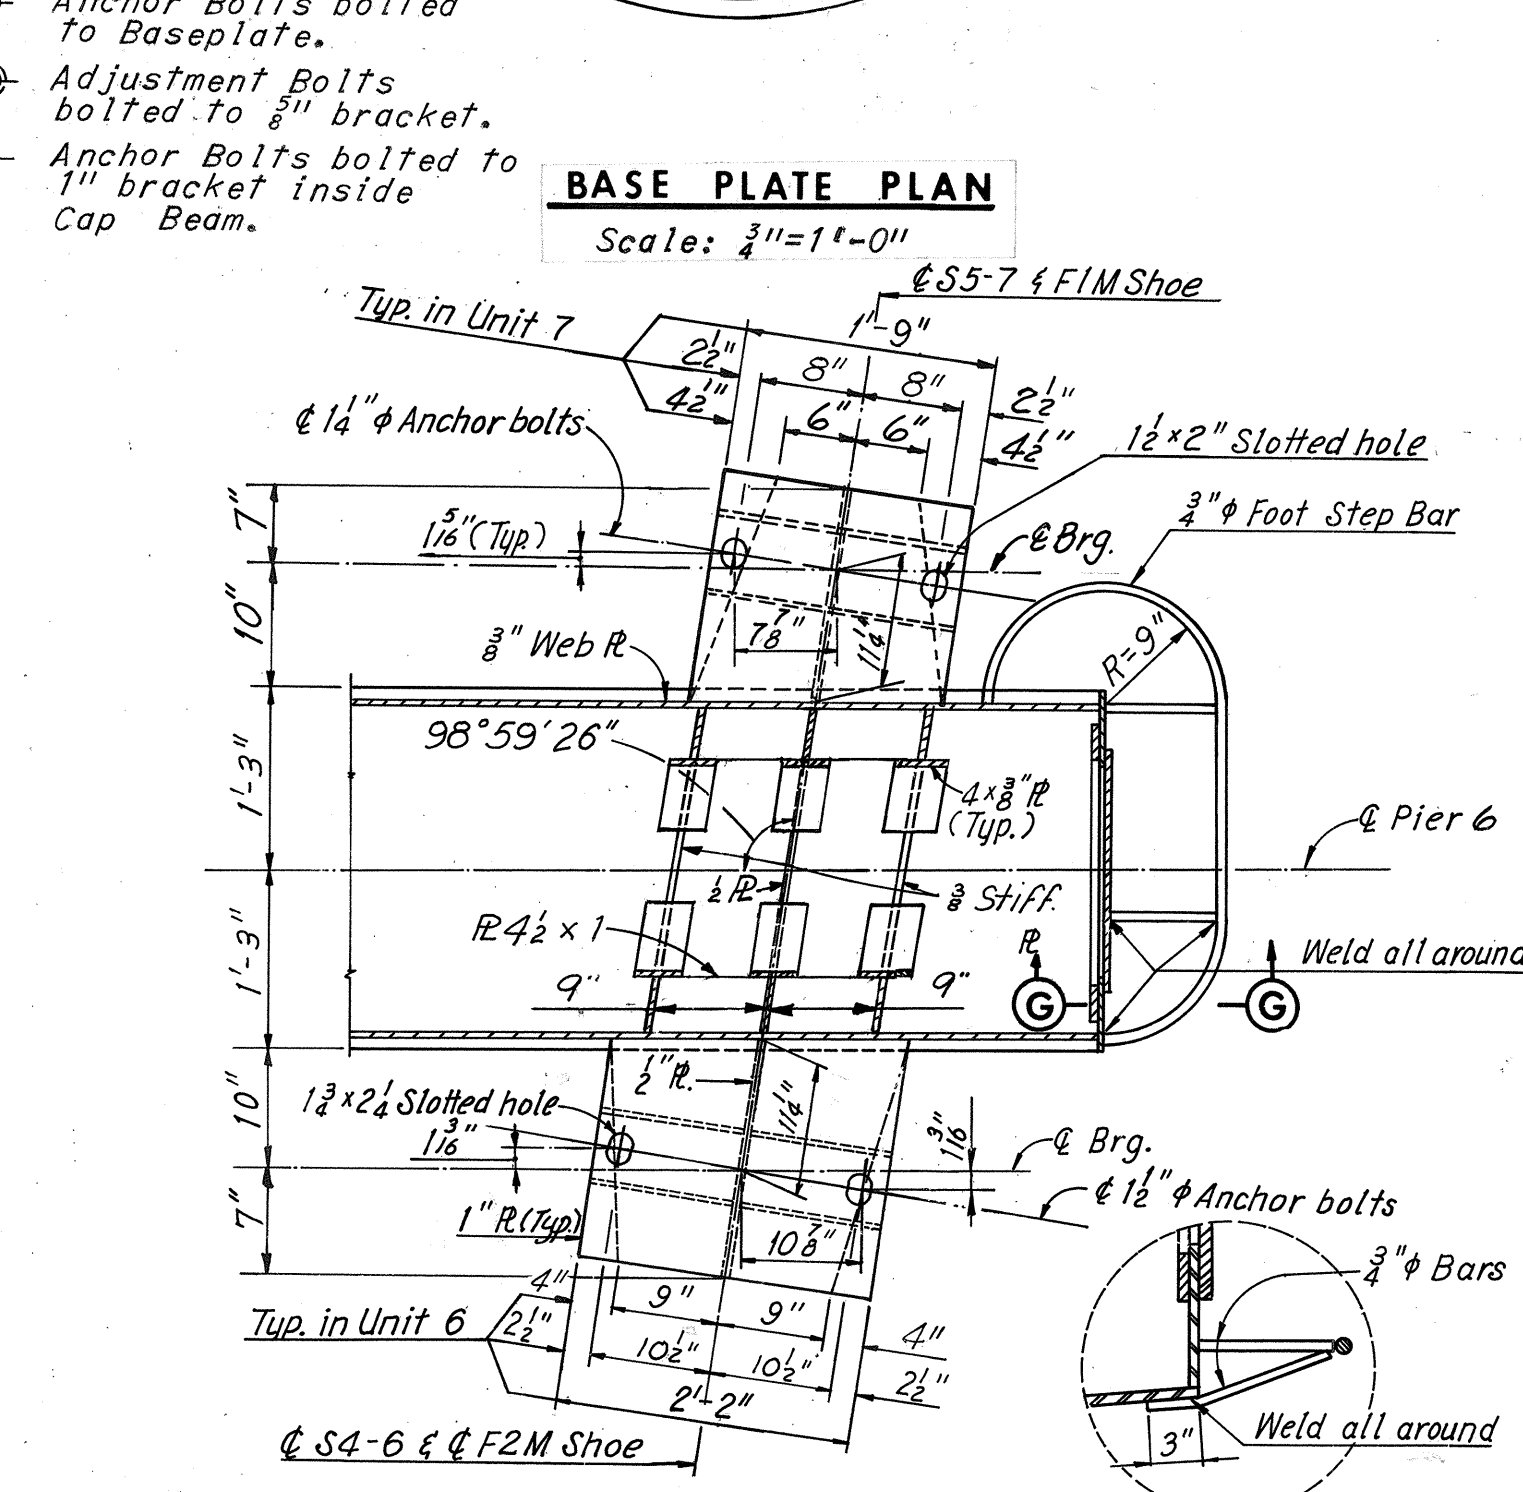

DETAIL A
Scale: 1/4"=1'-0"



SECTION G-G
No Scale

Notes:
 For Joint Details see Sheet 34 and 35.
 For Shear Stud Details see Sheet 20.
 For Shoe Details see Sheet S1 and S2.
 For Bearing Pile Details see Sheet 9.
 Estimated Pile tip Elevation = -20.0
 All piles shall be 10BP42 (Design capacity = 45 tons).
Note:
 All anchor bolts connecting cap beam to column shall be 1/2" in Dia. and each nut shall have washer (not shown on details)

AS BUILT
 RICHMOND METROPOLITAN AUTHORITY
 RICHMOND EXPRESSWAY SYSTEM
 DOWNTOWN EXPRESSWAY
 BRIDGE NO. 65
 RAMP S-W CONNECTION FROM
 RICHMOND-PETERSBURG TURNPIKE
PIER 6


HOWARD, NEEDLES, TAMMEN & BERGENDOFF consulting engineers	SCALE: As Noted
NEW YORK ALEXANDRIA KANSAS CITY	CONTRACT NO. 11
	SHEET NO. 7 OF 38

RICHMOND EXPRESSWAY SYSTEM			
SECTION	PROJECT	SHEET NO.	TOTAL SHEETS
11	DOWNTOWN EXPRESSWAY	45	97

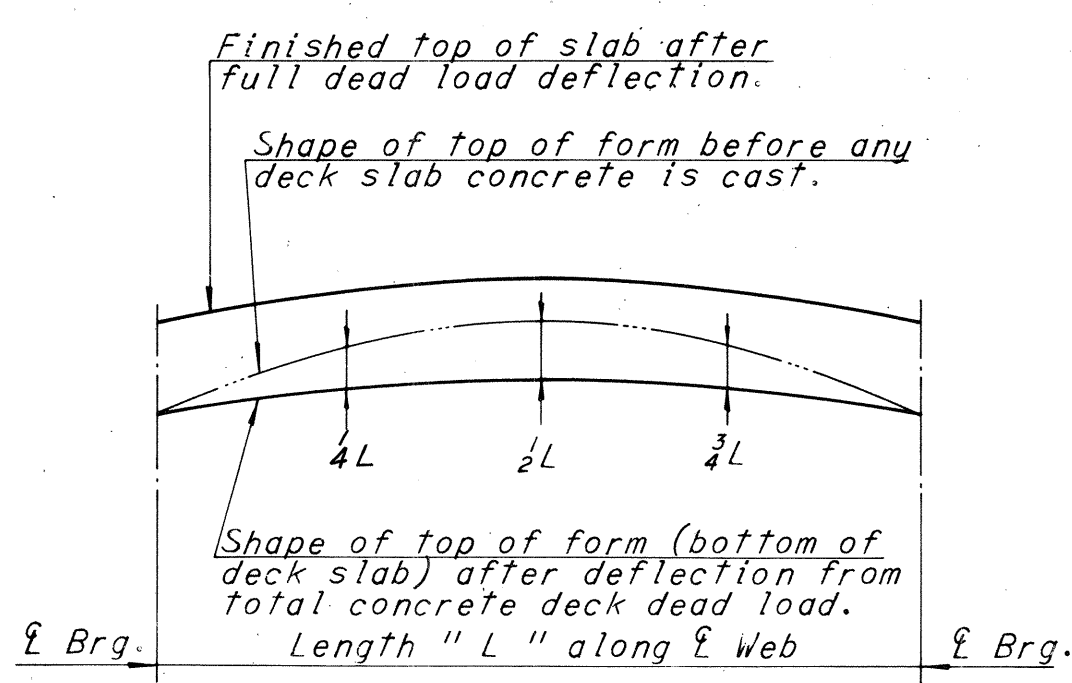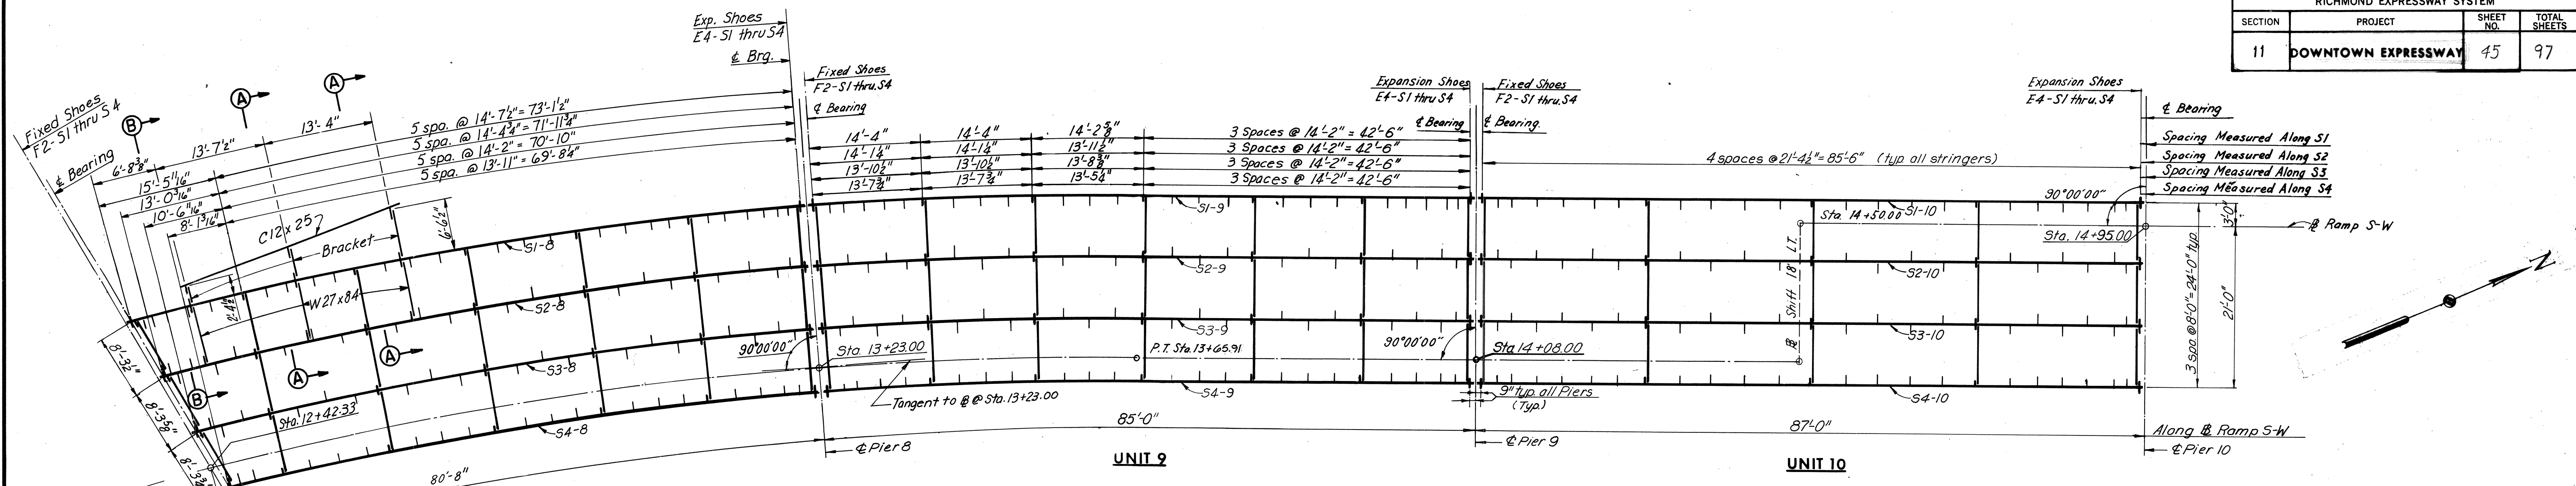

DEAD LOAD DEFLECTION DIAGRAM

NOTE TO CONTRACTOR
Deflections given are those anticipated to occur in the stringer upon placement of the total concrete deck dead load. In practice, the stringers in place are not likely to have the exact camber to compensate for these deflections during construction. The residual amounts shall be provided by adjusting forms to vary the thickness of the concrete haunch between the bottom of the slab and the top of stringer without altering the slab thickness.

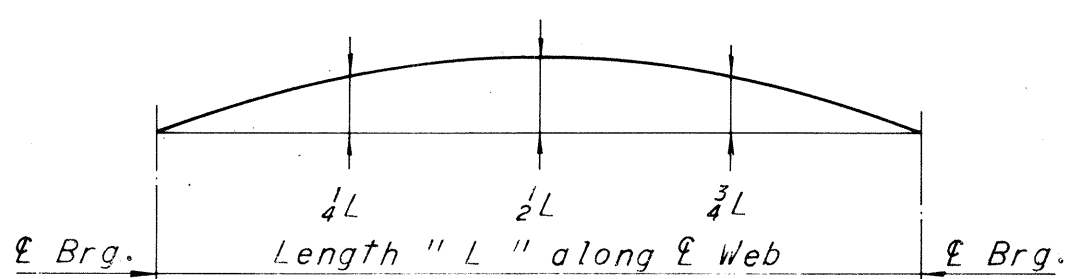


CAMBER DIAGRAM


NOTE TO FABRICATOR
The stringers shall be fabricated with a total camber amounting to the tabulated value. A positive number indicates an upward camber and negative number indicates a downward camber. This will provide approximate compensation for deflection under full dead load and for conformity with finished grade. Dimensions are in inches.

Notes:
Stringers having a total camber of less than 1" are not required to be shop cambered, but should be turned so that any mill tolerance deviation from straightness will be in the direction shown by the Camber Diagram. If stringers are not cambered, distance from top of stringers to top of slab will vary along the stringer in accordance with the offset dimensions shown in the Camber Diagram, and with minimum distance as shown in cross section on sheet 27.

BY	DATE	REVISION	BY	DATE
AMH	1-24-69	Re-design S1-8+52-8	TEM	3-76
AMH	1-24-69	Bracket Unit B	TEM	9-9-75
AMH	1-24-69	Re-design S1-8+52-8	TEM	3-25-75

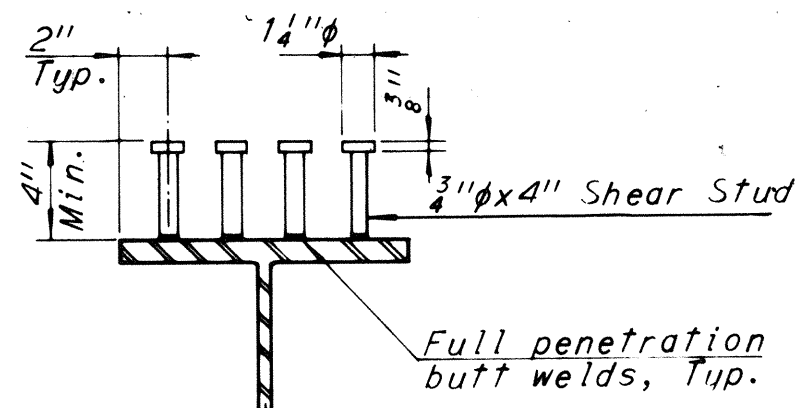


SHEAR STUD DETAIL

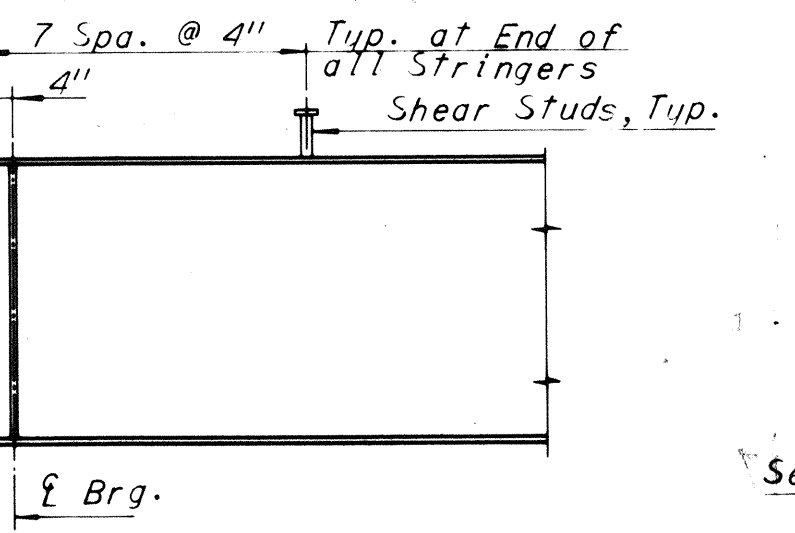


SHEAR STUD NOTE

Contractor may, if he elects, use three 7/8" diameter studs at the same longitudinal spacing in lieu of the four 3/4" diameter studs shown.
Stud rows shall be placed parallel to the main deck reinforcement.

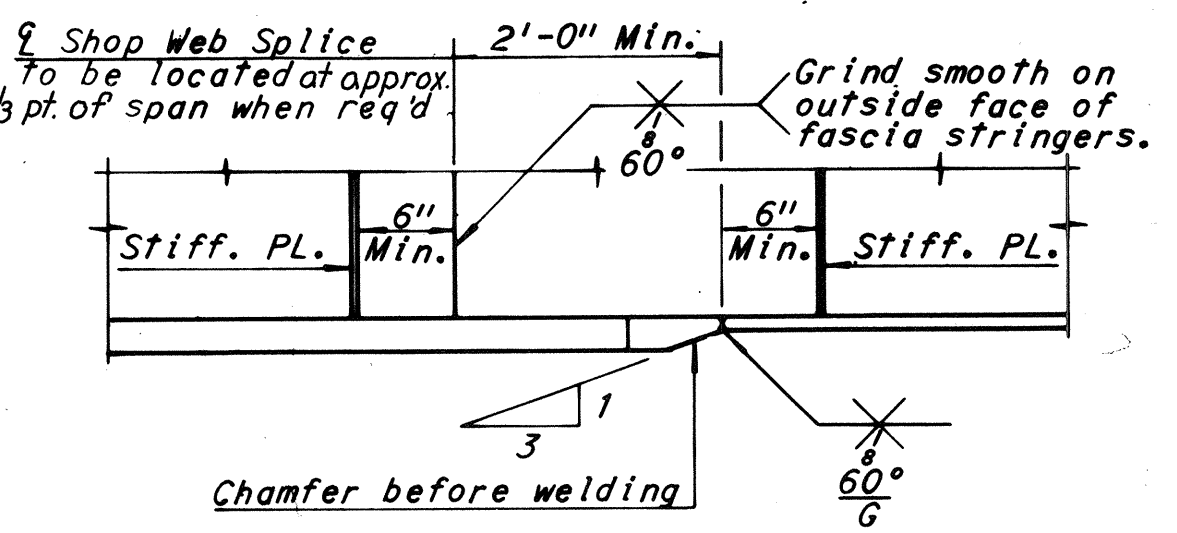


DETAIL "B"


Denotes A572-Grade 50 Steel for thickness of 3/4" and under and A588 Steel for thickness over 3/4".

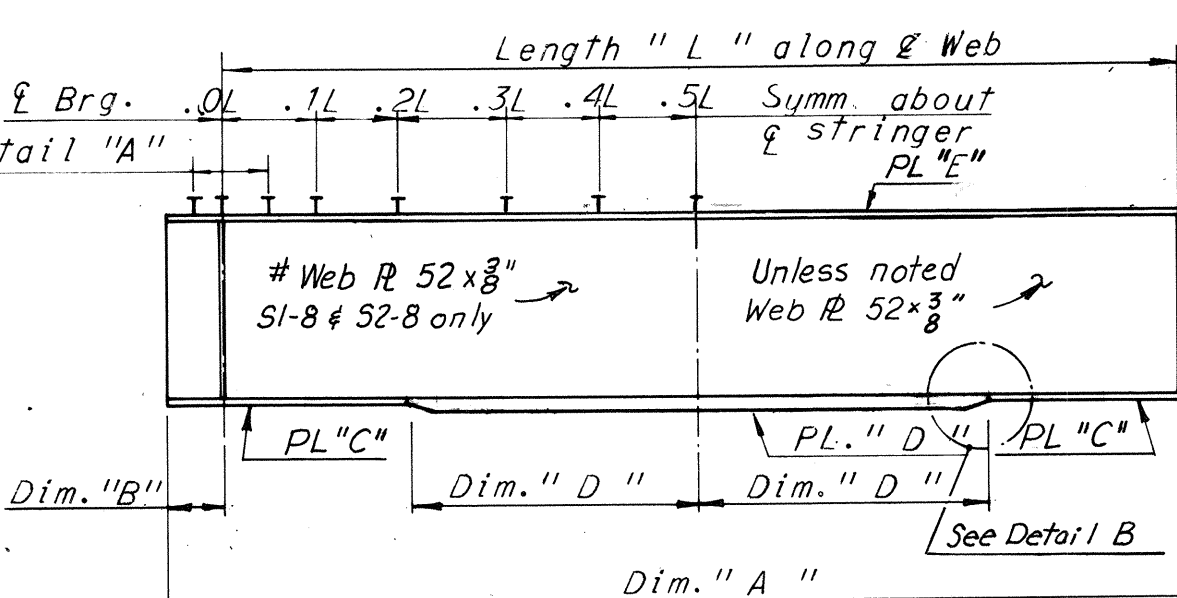

STRINGER ELEVATION

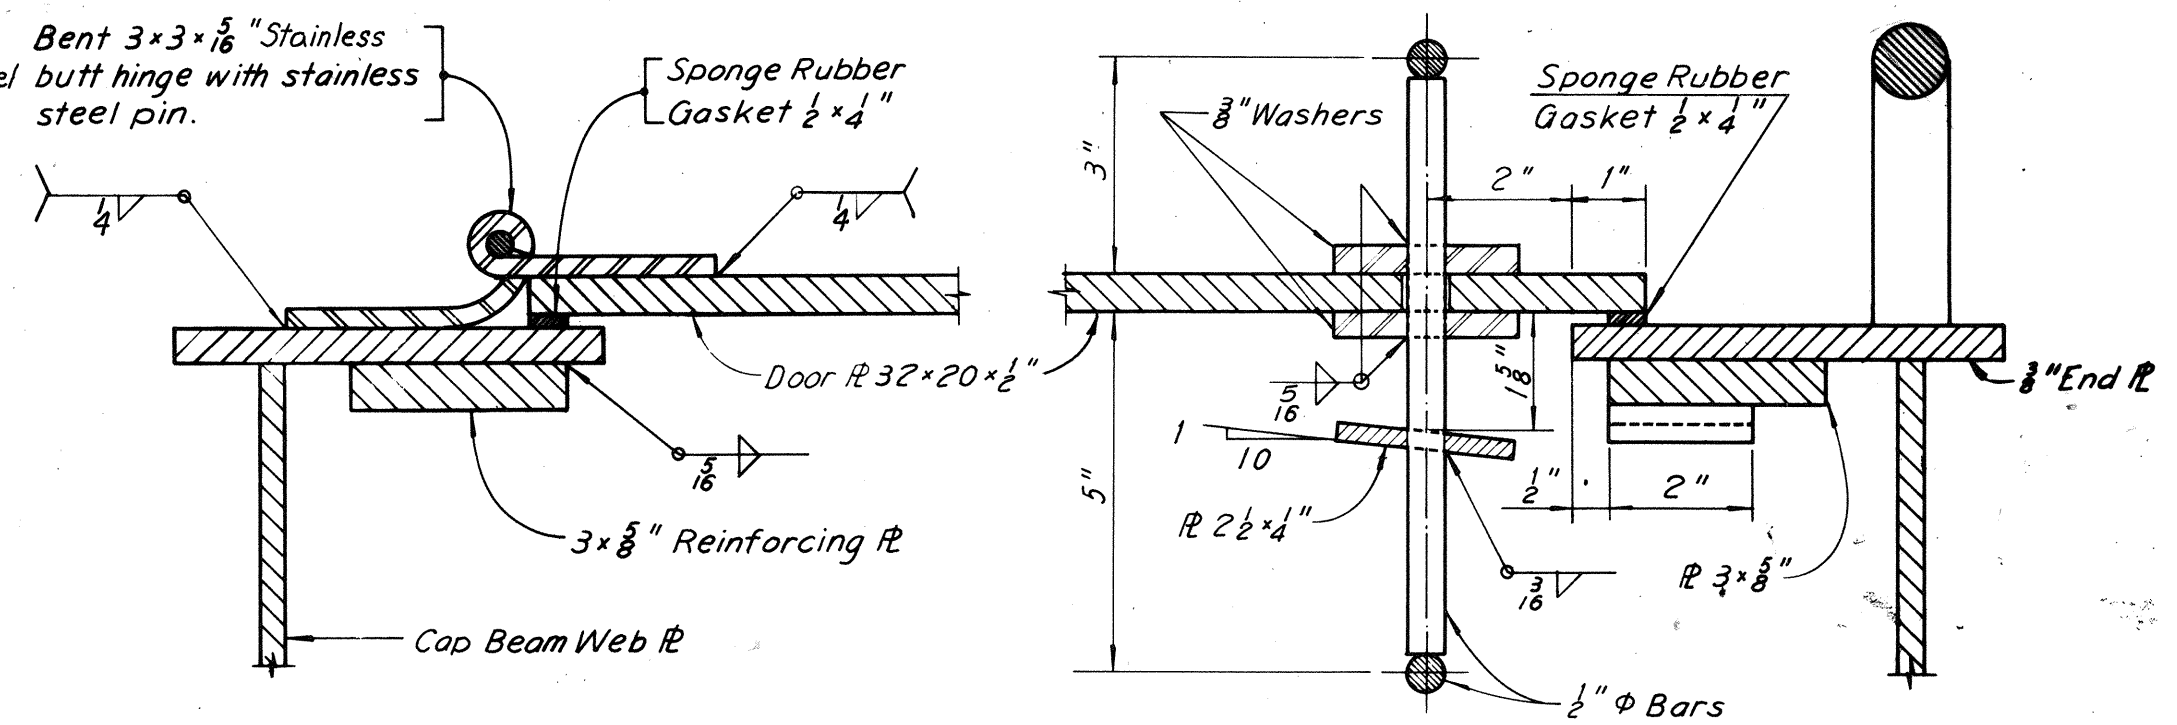

SECTION C-C

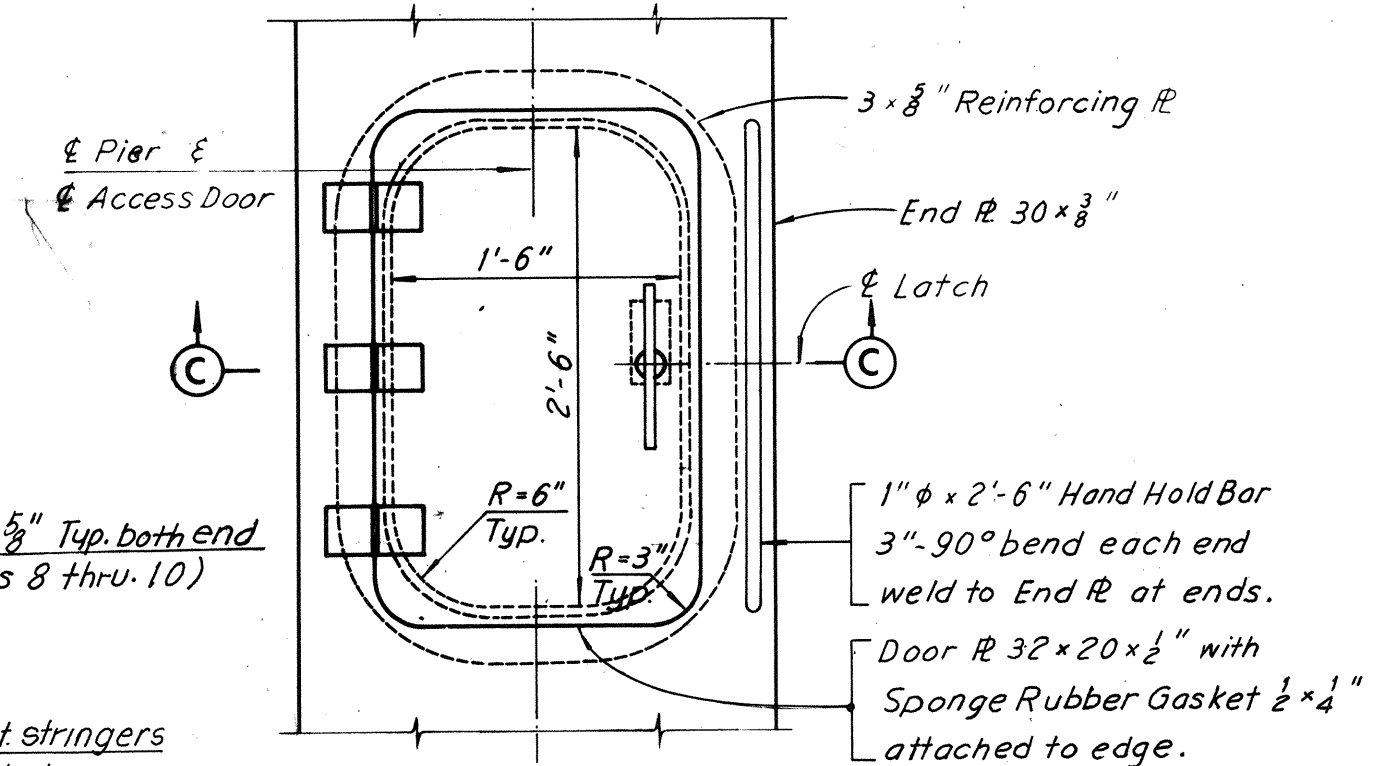

ACCESS DOOR - TYPE B

For the location of Access Door Type-B, see sheet 7.

SHOE SCHEDULE			
EXPANSION SHOES		FIXED SHOES	
TYPE	NO. REQD.	TYPE	NO. REQD.
E	12	F	12

SHOE SCHEDULE

Notes:
All steel shall be A36 steel unless denoted otherwise. Intermediate stiffener plates shall be equally spaced between diaphragms as shown. The first two plates of the ends of stringers shall be one half the normal spacing within the panel. All intermediate stiffeners shall be Pl. 4x3/8". For framing and connecting detail, see sheet 27. For shoe detail, see sheet S1 & S2.

All horizontal dimensions are measured along & Web. For Web to Flange Welds and Longitudinal Stiffener Details, see Sheet 24. For Diaphragm Details, see Sheet 27. For Structural Steel Quantities, see Sheet 4.

For Joint Details, see Sheets 34 and 35. It may be necessary to increase Bearing Stiffener size to accommodate erection of end diaphragms. For Sections A-A and B-B see Sheet 20a.

AS BUILT

RICHMOND METROPOLITAN AUTHORITY
RICHMOND EXPRESSWAY SYSTEM
DOWNTOWN EXPRESSWAY

BRIDGE NO. 65
RAMP S-W CONNECTION FROM
RICHMOND-PETERSBURG TURNPIKE
FRAMING PLAN UNITS 8, 9 AND 10

HOWARD, NEEDLES, TAMMEN & BERGENDOFF
consulting engineers
NEW YORK ALEXANDRIA KANSAS CITY

SCALE: As Noted
CONTRACT NO.: 11
SHEET NO. 20 OF 38




UNIT	STRINGER	Dim. "A"	LENGTH "L"	Dim. "B"	Dim. "D"	PL. "C"	PL. "D"	PL. "E"	MAX. SHEAR STUD SPACING					DEAD LOAD DEFLECTION SCHEDULE			CAMBER SCHEDULE		
									0.0L-0.1L	0.1L-0.2L	0.2L-0.3L	0.3L-0.4L	0.4L-0.5L	1/4L	1/2L	3/4L	1/4L	1/2L	3/4L
8	S1-8	89'-11 3/8"	88'-7 3/8"	8"	26'-6"	#16x1 1/2"	#16x2"	#12x1"	9"	10"	12"	16 1/2"	20"	1 1/4"	1 3/4"	1 1/4"	-3/4"	-1"	-1 1/4"
	S2-8	86'-1 1/8"	84'-11 1/8"	7"	30'-0"	#16x1"	#16x1 1/2"	#12x3/4"	11 1/2"	12 1/2"	15"	18"	21 1/2"	1 3/16"	1 1/16"	1 3/16"	-1 3/4"	-1 1/4"	-1 3/4"
	S3-8	82'-1 1/8"	81'-4 1/8"	7"	24'-0"	16x1 1/2"	16x1 3/4"	12x1 1/2"	12 1/2"	13"	15"	19"	23"	7/8"	1 1/4"	1 1/4"	-1 1/8"	-1 1/2"	-1 1/8"
	S4-8	79'-1 1/8"	77'-9 1/8"	8"	26'-0"	16x 3/4"	16x1 1/8"	12x3/4"	12"	13 1/2"	16"	19"	24"	3/4"	1 1/16"	3/4"	-1 1/4"	-1 5/8"	-1 1/4"
9	S1-9	86'-8 3/8"	85'-4 3/8"	8"	27'-6"	16x1 1/2"	16x2 1/2"	12x3/4"	10"	11"	14"	16 1/2"	21"	1 1/4"	1 3/4"	1 1/4"	1 1/2"	2 1/8"	1 1/2"
	S2-9	85'-10"	84'-8"	7"	28'-0"	16x1 1/2"	16x2"	12x3/4"	11"	12 1/2"	15 1/2"	18"	22"	1"	1 3/8"	1"	1 1/4"	1 1/16"	1 1/4"
	S3-9	85'-1 1/8"	83'-11 1/8"	7"	30'-0"	16x 3/4"	16x1 1/2"	12x3/4"	11 1/2"	13"	16"	19"	23"	1"	1 3/8"	1"	1 3/16"	1 5/8"	1 3/16"
	S4-9	84'-6 3/8"	83'-2 3/8"	8"	28'-0"	16x 3/4"	16x1 1/2"	12x3/4"	11 1/2"	13 1/2"	17"	20 1/2"	24"	1 1/8"	1 5/16"	1 1/8"	1 5/16"	1 9/16"	1 1/8"
10	S1-10	86'-10"	85'-6"	8"	29'-0"	16x 3/4"	16x1 1/2"	12x3/4"	10 1/2"	11 1/2"	15"	18"	23"	1 1/8"	1 9/16"	1 1/8"	1 3/16"	1 5/8"	1 3/16"
	S2-10	86'-8"	85'-6"	7"	29'-0"	16x 3/4"	16x1 1/2"	12x3/4"	11 1/2"	12 1/2"	15 1/2"	18 1/2"	22"	1 1/16"	1 1/2"	1 1/16"	1 9/16"	3 1/2"	2 1/16"
	S3-10	86'-8"	85'-6"	7"	29'-0"	16x 3/4"	16x1 1/2"	12x3/4"	11 1/2"	12 1/2"	15 1/2"	18 1/2"	22"	1 1/16"	1 1/2"	1 1/16"	1 13/16"	3 1/2"	2 13/16"
	S4-10	86'-10"	85'-6"	8"	29'-0"	16x 3/4"	16x1 1/2"	12x3/4"	10 1/2"	11 1/2"	15"	18"	23"	1 1/8"	1 9/16"	1 1/8"	2 3/16"	3 1/2"	2 1/16"

Bridge 66

(Eastbound Downtown Expressway “Rte. 195” over Virginia Street and South 14th Street)

Record Set Plans


RICHMOND EXPRESSWAY SYSTEM			
SECTION	PROJECT	SHEET NO.	TOTAL SHEETS
10	DOWNTOWN EXPRESSWAY	127	265

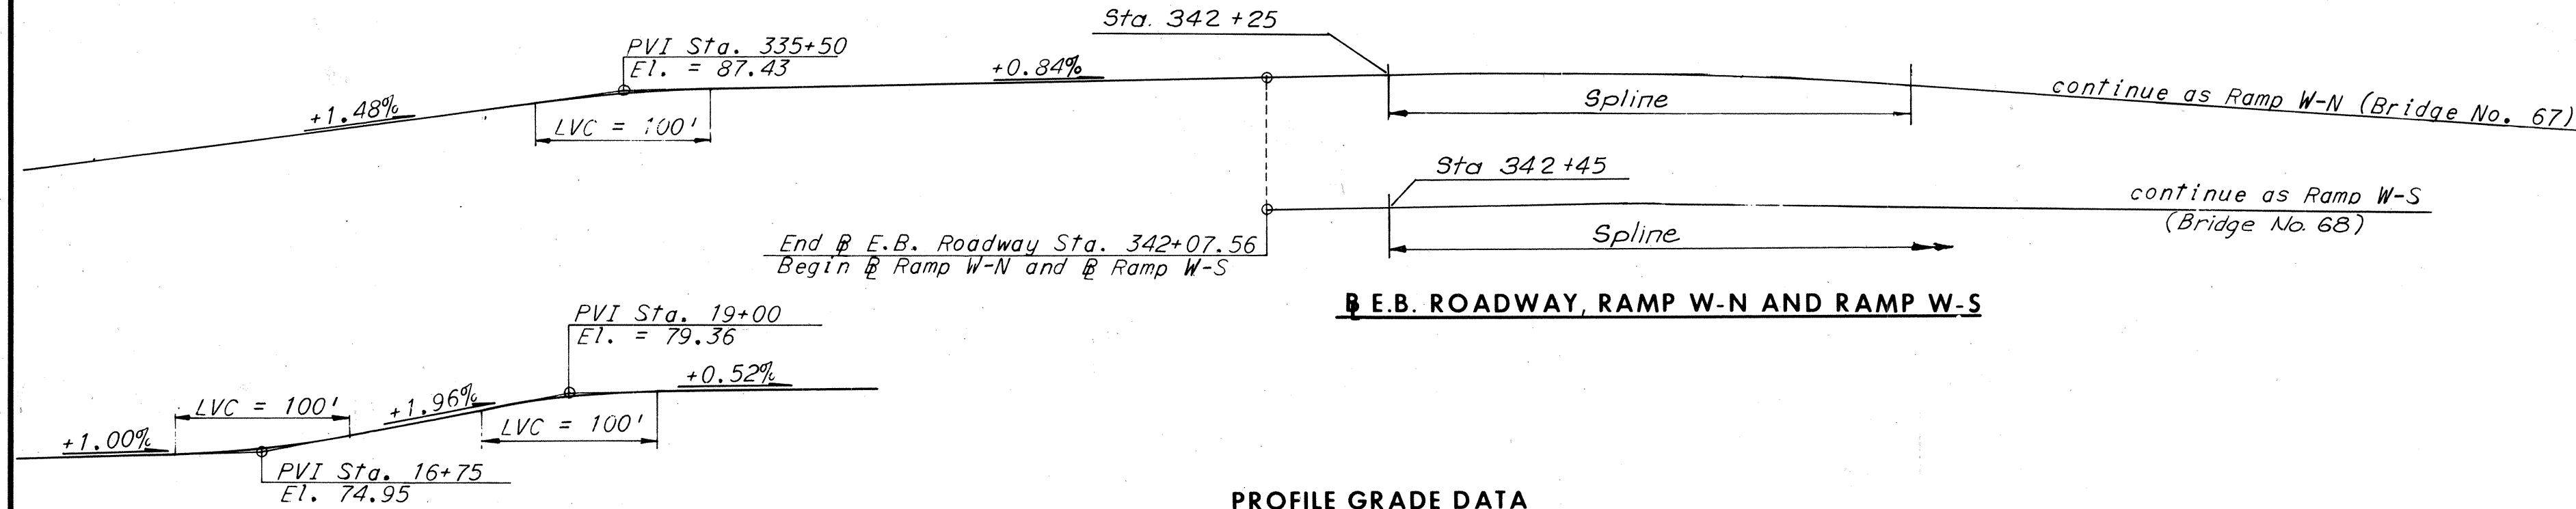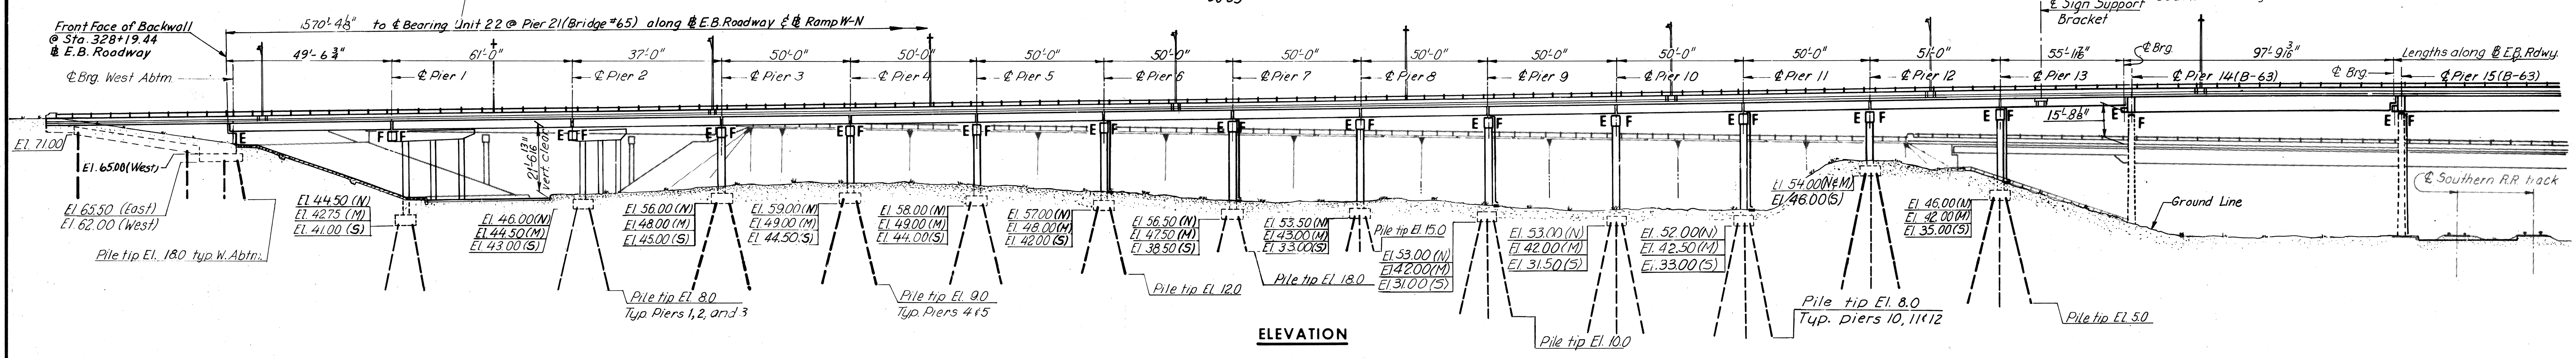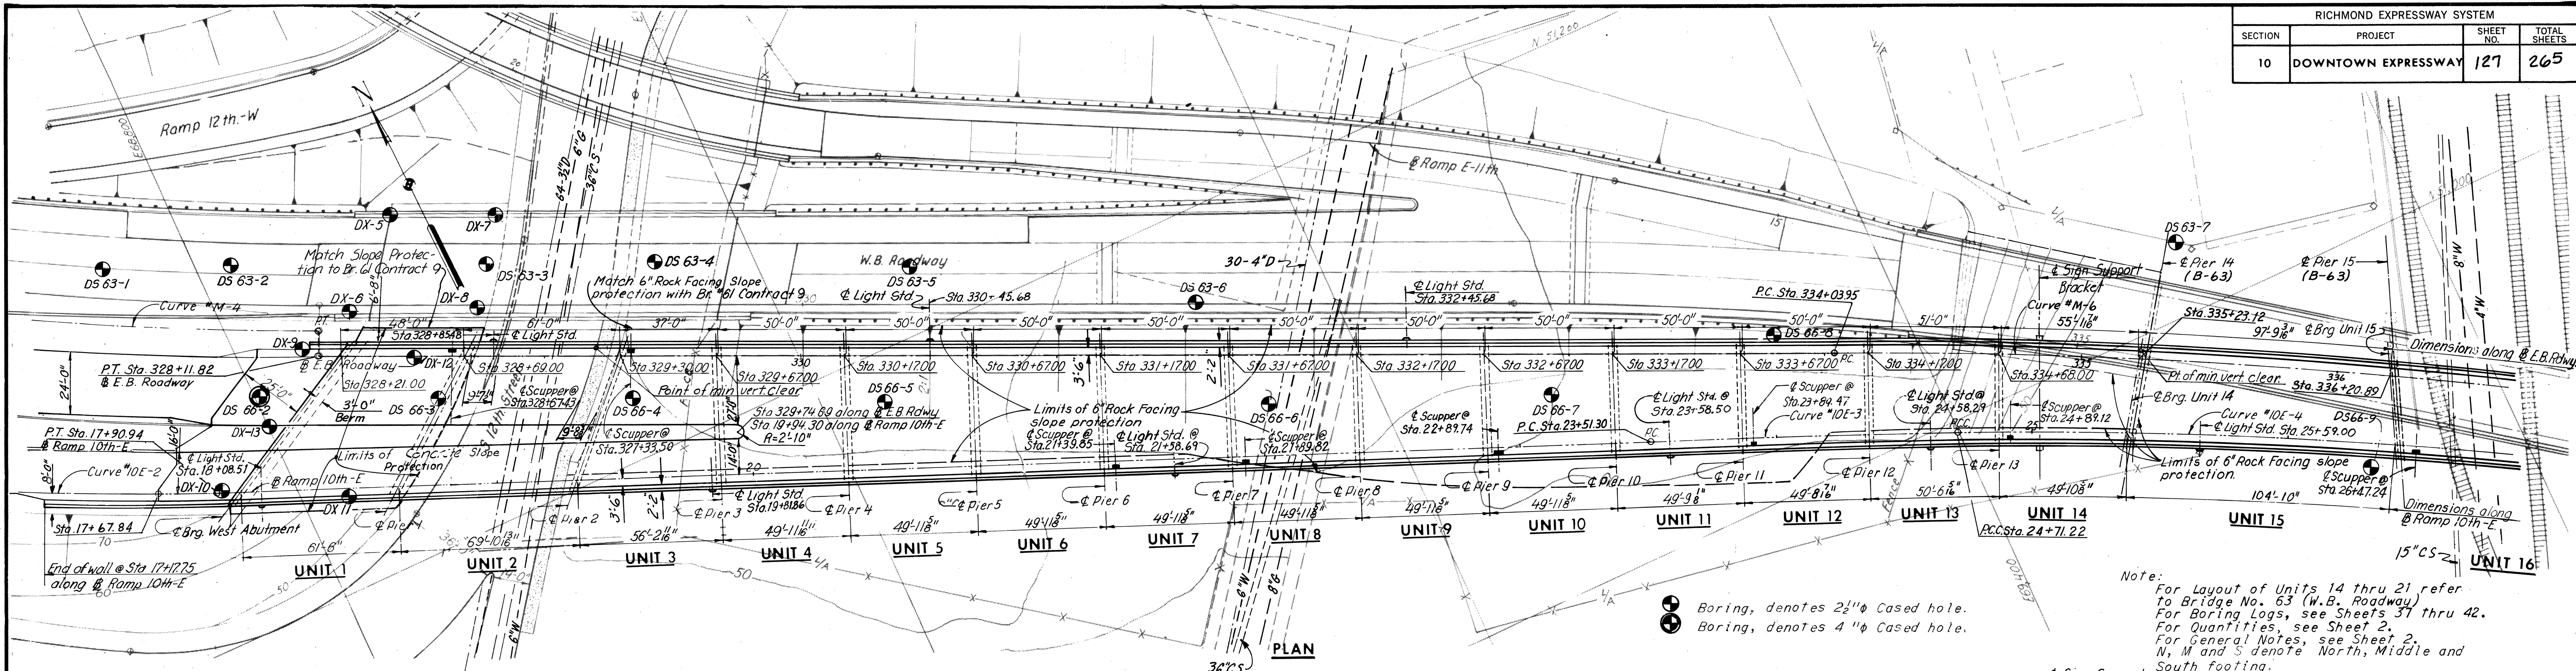

NO.	REVISION	BY	DATE
3	As Built	TEM	8-76
	Sign Support Bracket & Sh. 16A & 20A added	R.B.H.	9-74
	Footing elev. & piles, Piers 8, 9, 10, 11, 12 & 13	R.B.H.	8-74

Downtown Expressway		E.B. Roadway		Ramp W-N	
Curve	M-2	Curve	M-6	Curve	WN-1
P.I.	326+57.21	P.I.	336+40.09	P.I.	345+25.47
Δ	12°25'03"	Δ	11°45'56"	Δ	64°53'49"
D	4°00'	D	2°30'	D	11°27'33"
T	155.83'	T	236.14'	T	317.90'
L	310.44'	L	470.62'	L	566.33'
R	1,432.40'	R	2,291.83'	R	500.00'

INDEX		SHEET	
GENERAL PLAN AND ELEVATION	1	GENERAL PLAN AND ELEVATION	1
WEST ABUTMENT	2	WEST ABUTMENT	2
WEST ABUTMENT RETAINING WALL	3	PIER 1	4
PIER 1	4	PIER 2	5
PIER 2	5	PIERS 3 AND 4	6
PIERS 3 AND 4	6	PIERS 5 AND 6	7
PIERS 5 AND 6	7	PIERS 7 AND 8	8
PIERS 7 AND 8	8	PIERS 9 AND 10	9
PIERS 9 AND 10	9	PIERS 11 AND 12	10
PIERS 11 AND 12	10	PIER 13	11
PIER 13	11	FRAMING PLAN UNITS 1, 2, 3 AND 4	12
FRAMING PLAN UNITS 1, 2, 3 AND 4	12	FRAMING PLAN UNITS 5, 6, 7, 8 AND 9	13
FRAMING PLAN UNITS 5, 6, 7, 8 AND 9	13	FRAMING PLAN UNITS 10, 11, 12, 13 AND 14	14
FRAMING PLAN UNITS 10, 11, 12, 13 AND 14	14	FRAMING PLAN UNITS 15 AND 16	15
FRAMING PLAN UNITS 15 AND 16	15	FRAMING PLAN UNITS 17 AND 18	16
FRAMING PLAN UNITS 17 AND 18	16	FRAMING PLAN UNITS 19 AND 20	17
FRAMING PLAN UNITS 19 AND 20	17	FRAMING PLAN UNITS 21 AND 22	18
FRAMING PLAN UNITS 21 AND 22	18	FRAMING PLAN UNIT 23	19
FRAMING PLAN UNIT 23	19	FRAMING DETAILS PIERS 14, 15 AND 16	20
FRAMING DETAILS PIERS 14, 15 AND 16	20	FRAMING DETAILS PIERS 17, 18, 19 AND 20	21
FRAMING DETAILS PIERS 17, 18, 19 AND 20	21	FRAMING DETAILS PIER 22 (BR 63)	22
FRAMING DETAILS PIER 22 (BR 63)	22	FRAMING DETAILS UNITS 21 AND 22	23
FRAMING DETAILS UNITS 21 AND 22	23	FRAMING DETAILS UNITS 18, 21 AND 22	24
FRAMING DETAILS UNITS 18, 21 AND 22	24	DECK PLAN UNITS 1, 2, 3 AND 4	25
DECK PLAN UNITS 1, 2, 3 AND 4	25	DECK PLAN UNITS 5, 6, 7, 8 AND 9	26
DECK PLAN UNITS 5, 6, 7, 8 AND 9	26	DECK PLAN UNITS 10, 11, 12, 13 AND 14	27
DECK PLAN UNITS 10, 11, 12, 13 AND 14	27	DECK PLAN UNITS 15 AND 16	28
DECK PLAN UNITS 15 AND 16	28	DECK PLAN UNITS 17 AND 18	29
DECK PLAN UNITS 17 AND 18	29	DECK PLAN UNITS 19 AND 20	30
DECK PLAN UNITS 19 AND 20	30	DECK PLAN UNITS 21 AND 22	31
DECK PLAN UNITS 21 AND 22	31	DECK PLAN UNIT 23	32
DECK PLAN UNIT 23	32	JOINT DETAILS	33
JOINT DETAILS	33	APPROACH SLABS AND ROCK FACING SLOPE PROTECTION	34
APPROACH SLABS AND ROCK FACING SLOPE PROTECTION	34	CONCRETE SLAB SLOPE PROTECTION DETAILS	35
CONCRETE SLAB SLOPE PROTECTION DETAILS	35	BORING LOGS	36
BORING LOGS	36	STANDARD DETAILS	37
STANDARD DETAILS	37		38
	38		39
	39		40
	40		41
	41		42
	42		43
	43		44
	44		45
	45		46

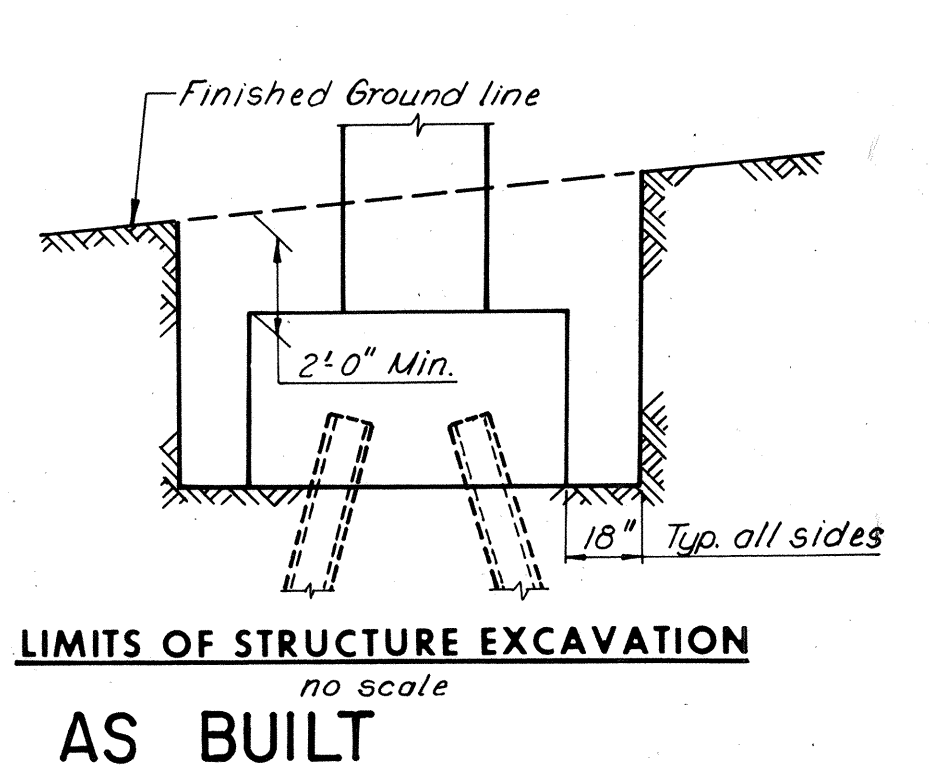


RICHMOND METROPOLITAN AUTHORITY
RICHMOND EXPRESSWAY SYSTEM
DOWNTOWN EXPRESSWAY

BRIDGE NO. 66
EASTBOUND ROADWAY OVER
12TH ST. - R.R. TRACKS AND 16TH ST.
GENERAL PLAN AND ELEVATION

HOWARD, NEEDLES, TAMMEN & BERGENDOFF
 consulting engineers
 NEW YORK ALEXANDRIA KANSAS CITY

SCALE: 1"=30'
 CONTRACT NO. 10
 SHEET NO. 1 OF 46

RICHMOND EXPRESSWAY SYSTEM			
SECTION	PROJECT	SHEET NO.	TOTAL SHEETS
10	DOWNTOWN EXPRESSWAY	128	265

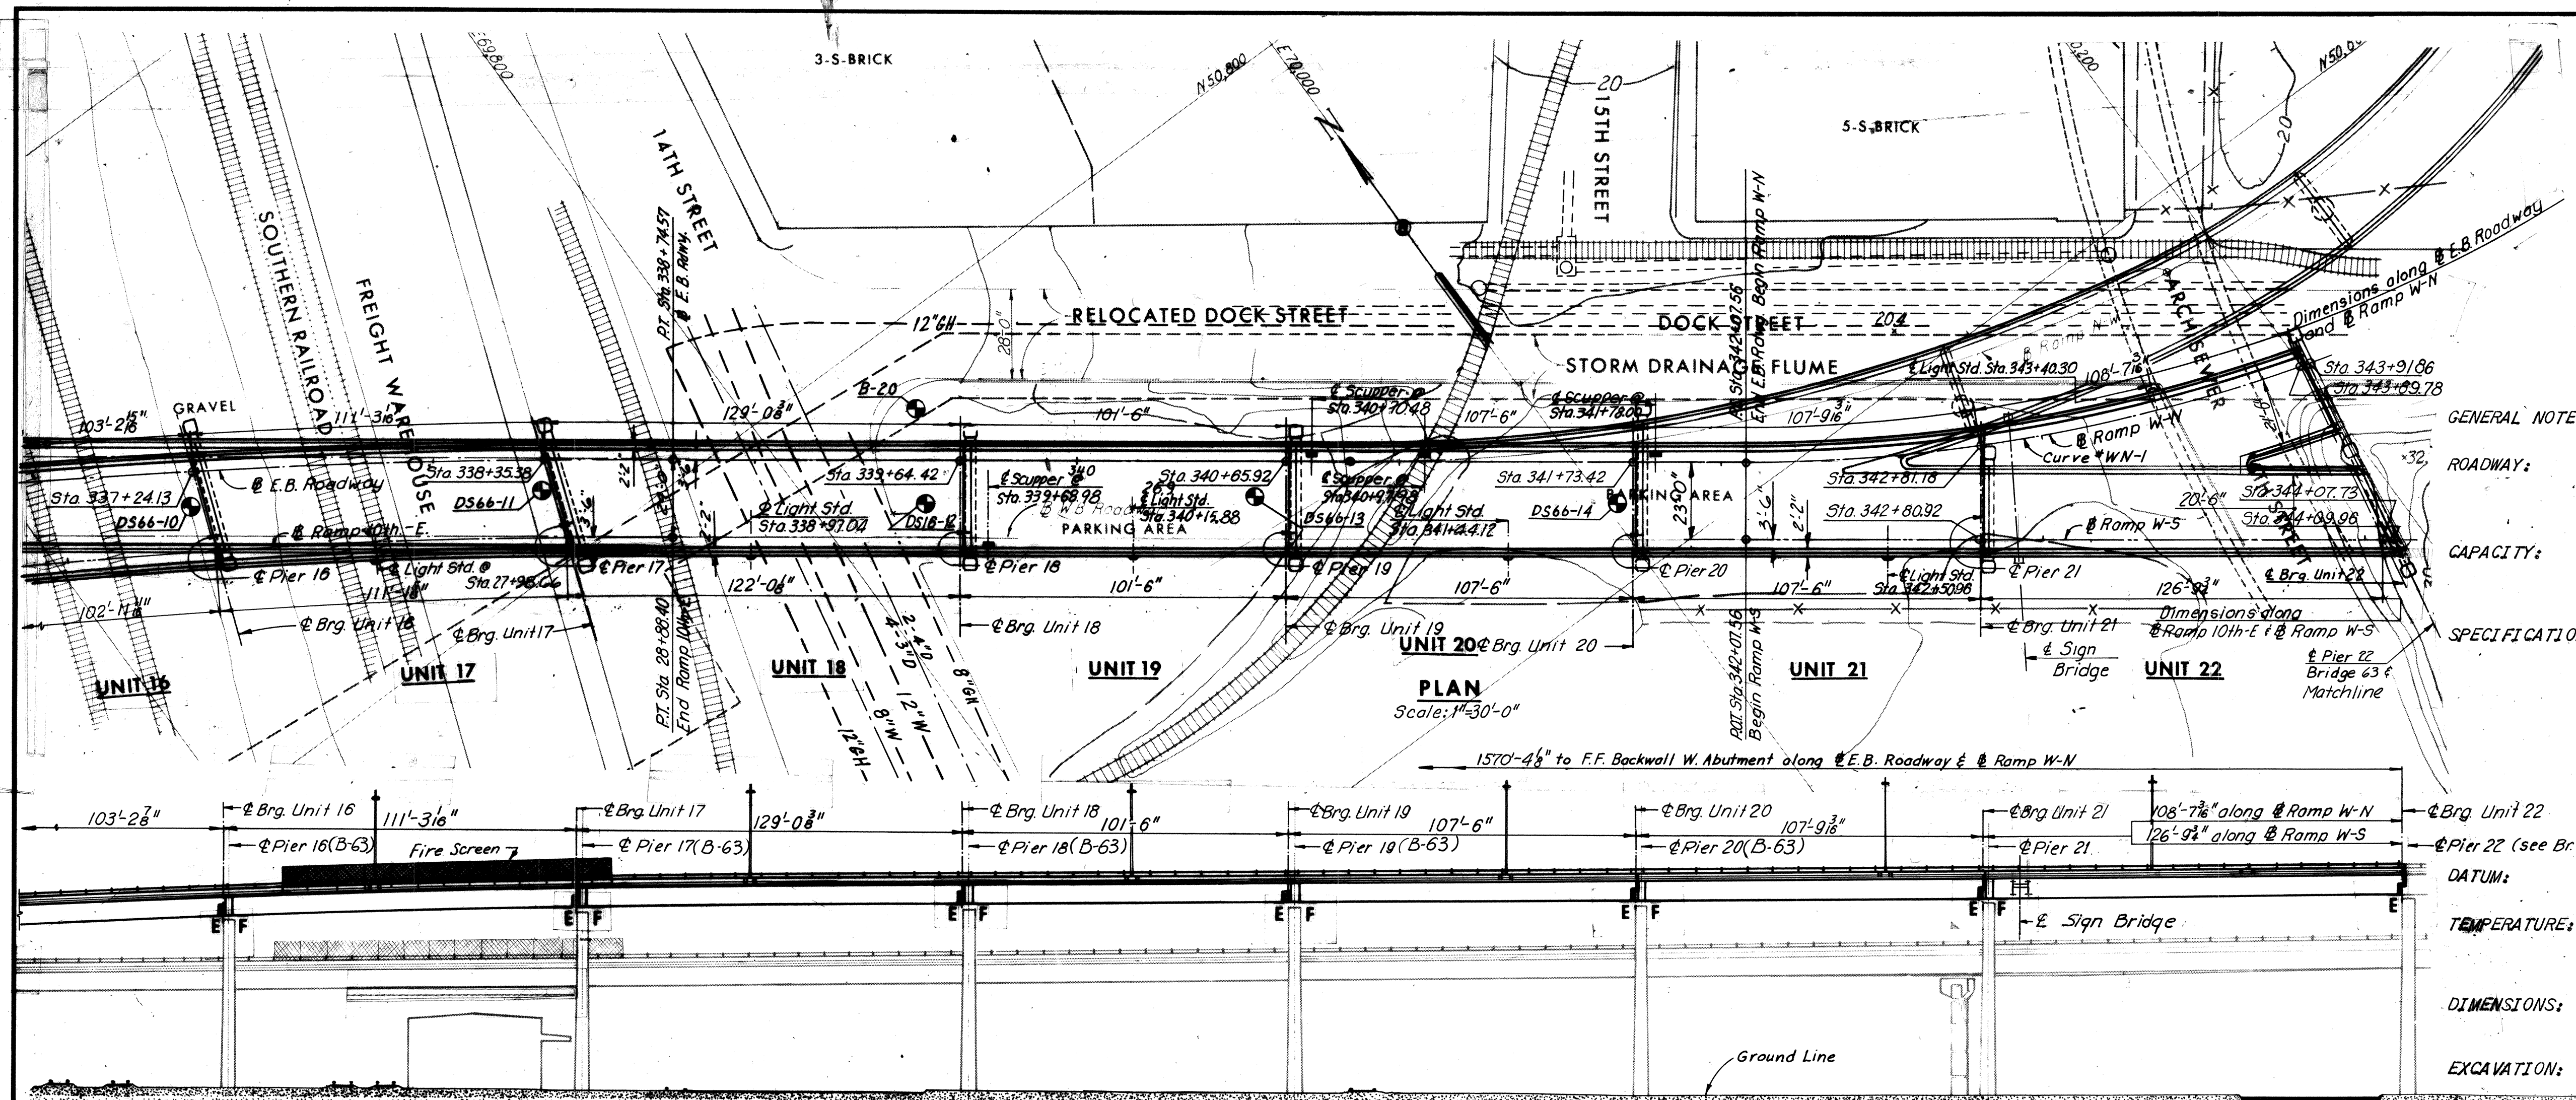

GENERAL NOTES:

ROADWAY: One variable width roadway transitioning from E.B. Roadway Downtown Expressway and Ramp 10th-E into Ramps W-N and W-S (Bridges No. 67 and 68)

CAPACITY: Dead load includes 15 Lbs. per sq. ft. for future wearing surface. Live load, HS 20-44 loading and alternate military loading.

SPECIFICATIONS:

GENERAL: Virginia Department of Highway Road and Bridge Specifications 1970

DESIGN: A.A.S.H.O. Standard Specifications for Highway Bridges 1973 modified by Special Design provisions.

WELDING: 1972 Structural Welding Code of the American Welding Society.

CONTRACT SPECIAL PROVISIONS: Specifications and Contract Special Provisions referred to above are necessary to make these plans complete

DATUM: City of Richmond

TEMPERATURE: The normal temperature referred to in the plans is 60°F. The temperature range for movement is 0°F to 120°F.

DIMENSIONS: All dimensions are measured horizontally and vertically unless otherwise noted.

EXCAVATION: Excavation below subgrade and cut slope template shall be classified as Structure Excavation. All excavation above these limits shall be classified as Regular Excavation and is not included in the Structural Quantities.

FOUNDATIONS: Footings shall rest on firm material. Foundation material shall be dry and special attention is called to Section 401.05 of General Specifications and to the Contract Special Provisions, concerning preparation of foundations for footings.

CONCRETE NOTES: Concrete in superstructure shall be Class A-4. All other concrete shall be Class A-3. All exposed edges and corners shall have a 3/4" chamfer or fillet unless otherwise noted. Care in the method of vibration, the use of low-slump concrete, and or other means shall be employed to prevent downgrade movement of newly placed slab concrete. Finishing Concrete Surfaces: See Standard Architectural Detail Sheets and the Contract Special Provisions for types and details. All reinforcing steel shall be deformed bars conforming to ASTM A615 Grade 40. All reinforcing bar dimensions on the detailed drawings are to centers of bars unless otherwise noted. Clear distance between reinforcing steel and face of concrete shall be as noted on the plans. All bar laps shall be 30 diameters of the smaller diameter bar unless otherwise noted.

STEEL NOTES: Structural steel shall conform to A.S.T.M. Designations A36, A572 - Grade 50 and A588 as noted. See Special Provisions. All field connections shall be made with high strength bolts. High strength bolts shall be 7/8" diameter unless otherwise noted and shall conform to A.S.T.M. Specification A-325.

Notes:
For Vertical and Horizontal Curve Data see Sheet 1.
For Layout of Units 14 thru 22 refer to Bridge No. 63 (Westbound Roadway).



ESTIMATED QUANTITIES

	Structure Excavation Cu. Yds.	Concrete (#) Cu. Yds.	Reinforcing Steel Lbs.	Str. Steel Mild Carbon Lbs.	Str. Steel High Strength Lbs.	Aluminum Railing (1-Rail) Lin. Ft.	Porous Backfill Cu. Yds.	Underdrain 6" Dia. Pipe Lin. Ft.	Steel Piles 10BP42 Lin. Ft.
Superstructure	--	2,237.6	530,060	1,564,700	567,800	3,241	--	--	---
Substructure	1,835	1,256.6	155,030	---	---	84	34	150	9,410
Total	1,835	3,494.2 #	685,890	1,564,700	567,800	3,325	34	150	9,410

	Asphalt Damp-proofing Sq. Yds.	Approach Slab Concrete (#) Cu. Yds.	Fire Screen Lin. Ft.	Approach Slab Reinforcing Steel (Lbs.)	Metal Conduit Lin. Ft.	Concrete Slope Protection Sq. Yds.	Bridge Drainage Metal Work Lbs.	Rock Facing Slope Prot. Sq. Yds.	Energy Attenuator Each
Superstructure	--	--	210	---	2,214	--	11,870	--	1
Substructure	105	91.5	---	23,870	92	559	--	3,320	---
Total	105	91.5 #	210	23,870	2,306	559	11,870	3,320	1

All Concrete for Superstructure shall be Class A4 and for Substructure Class A3.

BY	DATE	REVISION	BY	DATE
MADE	J.V. 1-9-69	Span Fixities & R.R. name added	PRMS	4-19-74
CHECKED	G.C.C. 5-26-69	Sign Bridge added	R.B.H.	9-74
IN CHARGE		3 As Built	TEM	8-76

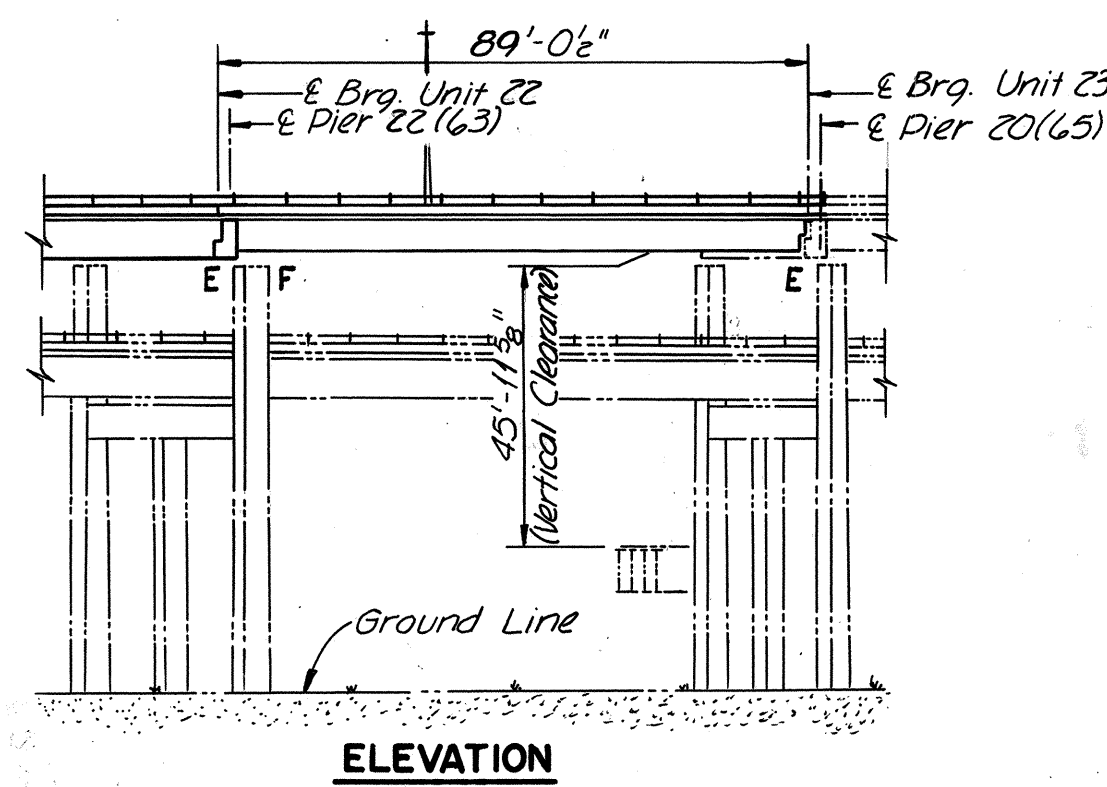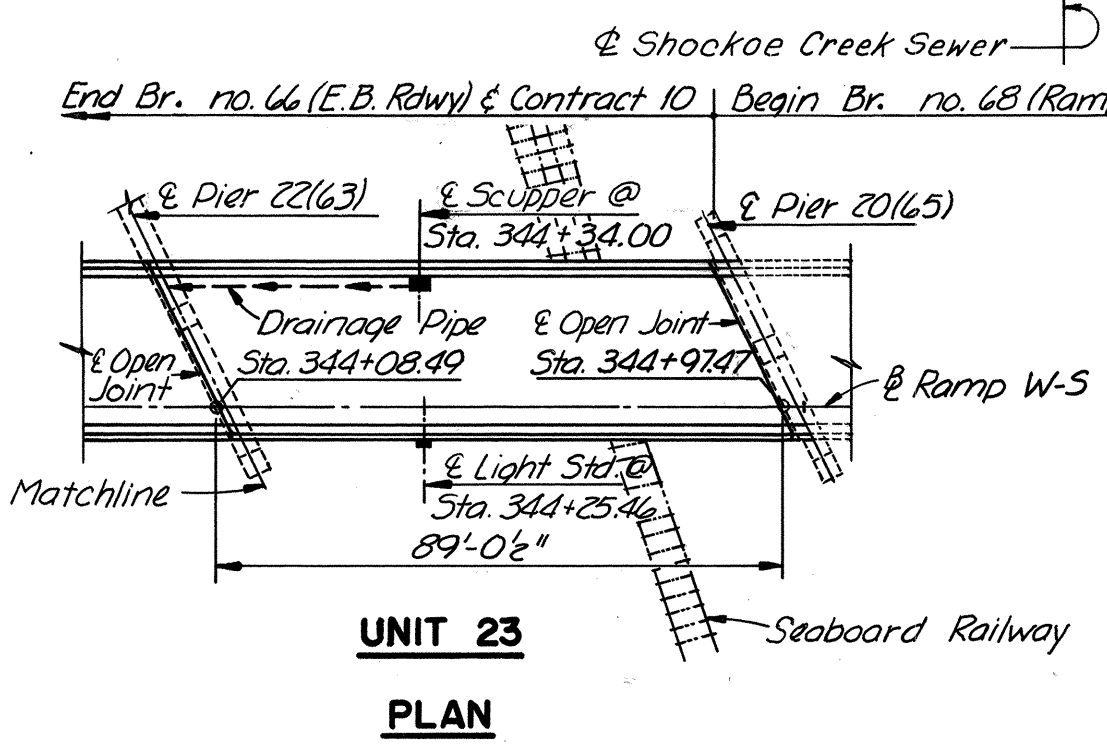

FOUNDATION: Footings shall rest on firm material. Foundation material shall be dry and special attention is called to Section 401.05 of General Specifications and to the Contract Special Provisions, concerning preparation of foundations for footings.

CONCRETE NOTES: Concrete in superstructure shall be Class A-4. All other concrete shall be Class A-3. All exposed edges and corners shall have a 3/4" chamfer or fillet unless otherwise noted. Care in the method of vibration, the use of low-slump concrete, and or other means shall be employed to prevent downgrade movement of newly placed slab concrete. Finishing Concrete Surfaces: See Standard Architectural Detail Sheets and the Contract Special Provisions for types and details. All reinforcing steel shall be deformed bars conforming to ASTM A615 Grade 40. All reinforcing bar dimensions on the detailed drawings are to centers of bars unless otherwise noted. Clear distance between reinforcing steel and face of concrete shall be as noted on the plans. All bar laps shall be 30 diameters of the smaller diameter bar unless otherwise noted.

STEEL NOTES: Structural steel shall conform to A.S.T.M. Designations A36, A572 - Grade 50 and A588 as noted. See Special Provisions. All field connections shall be made with high strength bolts. High strength bolts shall be 7/8" diameter unless otherwise noted and shall conform to A.S.T.M. Specification A-325.




RICHMOND METROPOLITAN AUTHORITY
RICHMOND EXPRESSWAY SYSTEM
DOWNTOWN EXPRESSWAY

BRIDGE NO. 66
EASTBOUND ROADWAY OVER
12TH ST. - R.R. TRACKS AND 16TH ST.
GENERAL PLAN AND ELEVATION

HOWARD, NEEDLES, TAMMEN & BERGENDOFF
consulting engineers
NEW YORK ALEXANDRIA KANSAS CITY

SCALE: As Noted
CONTRACT NO. 10
SHEET NO. 2 of 46

AS BUILT

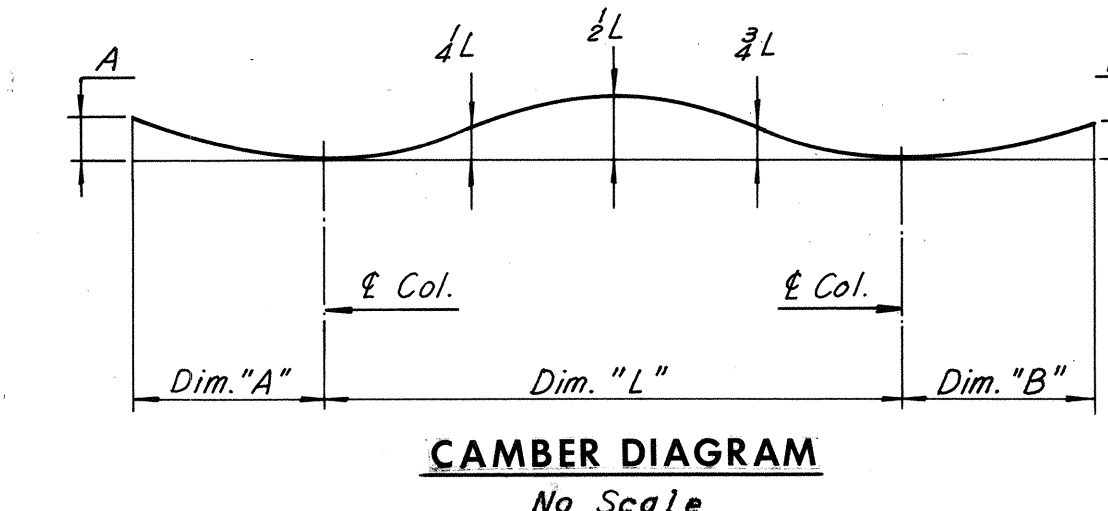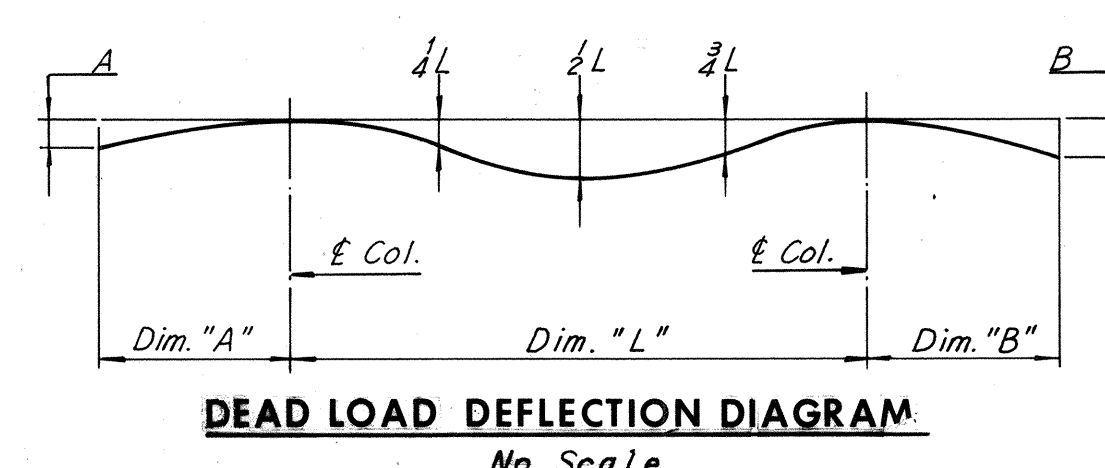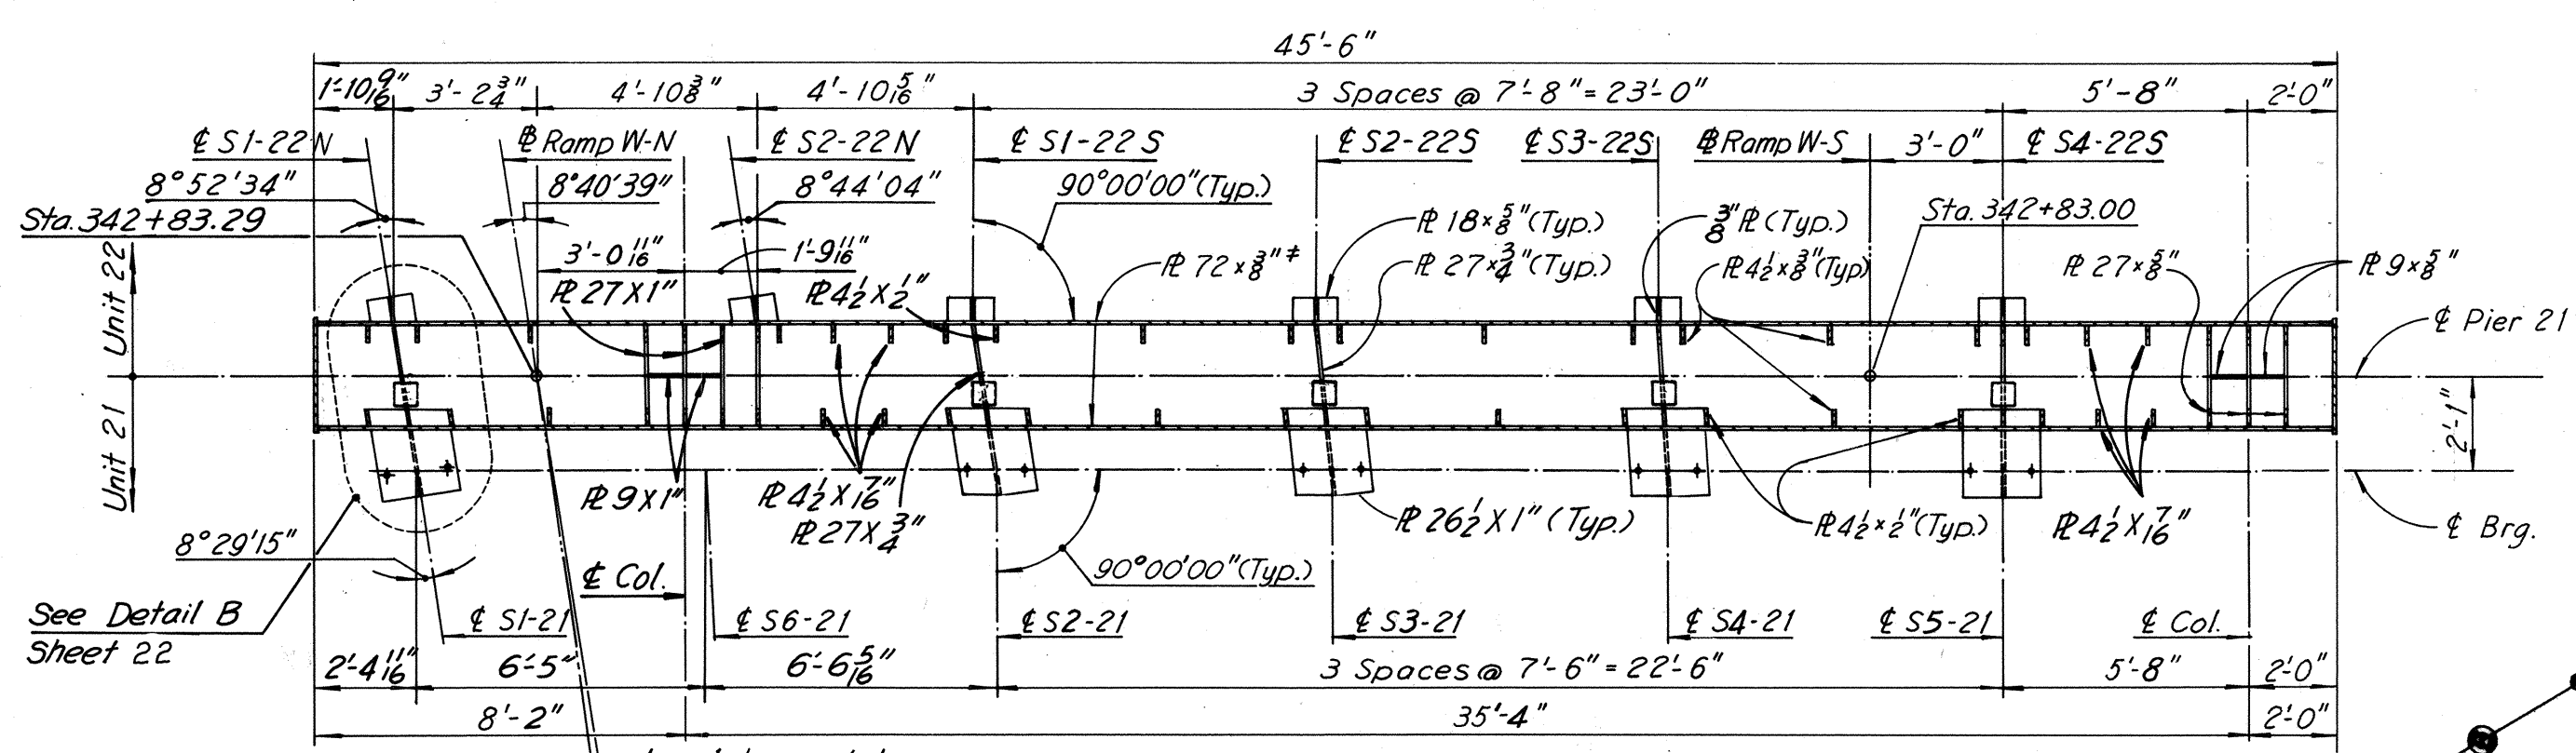

NOTE TO CONTRACTOR
Deflections given are those anticipated to occur in the stringer upon placement of the total concrete deck dead load.

NOTE TO FABRICATOR
The cap beams shall be fabricated with an upward camber amounting to the tabulated value. This will provide approximate compensation for deflection under full dead load and for conformity with finished grade. Dimensions are in inches.









PIER	CAP BEAM SCHEDULE			DEAD LOAD DEFLECTION SCHEDULE				CAMBER SCHEDULE				
	Dim "A"	Dim. "L"	Dim. "B"	Δ	1/4L	1/2L	3/4L	A	1/4L	1/2L	3/4L	B
14	11'-5 1/2"	19'-0"	8'-6 1/2"	0	0	0	0	0	0	0	0	0
15	2'-0"	48'-0"	7'-5"	0	1/8	1/8	4	0	4	8	16	-1/8
16	2'-0"	44'-11"	2'-0"	0	4	8	4	0	5	16	16	0
17	2'-0"	43'-11"	2'-0"	0	4	12	4	0	16	8	16	0
18	2'-0"	41'-6"	2'-0"	0	8	16	8	0	16	4	16	0
19	2'-0"	41'-6"	2'-0"	0	8	16	8	0	16	4	16	0
20	2'-0"	49'-0"	2'-0"	0	16	16	16	0	8	8	8	0
21	8'-2"	35'-4"	2'-0"	-1/16	1/16	8	1/16	0	-1/16	8	8	0

Note: A negative deflection indicates an upward deflection, and a negative camber indicates a downward camber.

Note: Cap beams having a total camber of less than 1" are not required to be shop cambered, but should be turned so that any mill tolerance deviation from straightness will be in the direction shown by the Camber Diagram.

If cap beams are not cambered, distance top of cap beams to top of slab will vary along the cap beams in accordance with the offset dimensions shown in the Camber Diagram and Contractor shall adjust the bearing pads.

Notes:
For Framing Plan Units 21 and 22, see Sheet 20.
For Typical Section through Cap Beam see Sheet 23.
For Deck Plan Units 21 & 22, see Sheet 34.

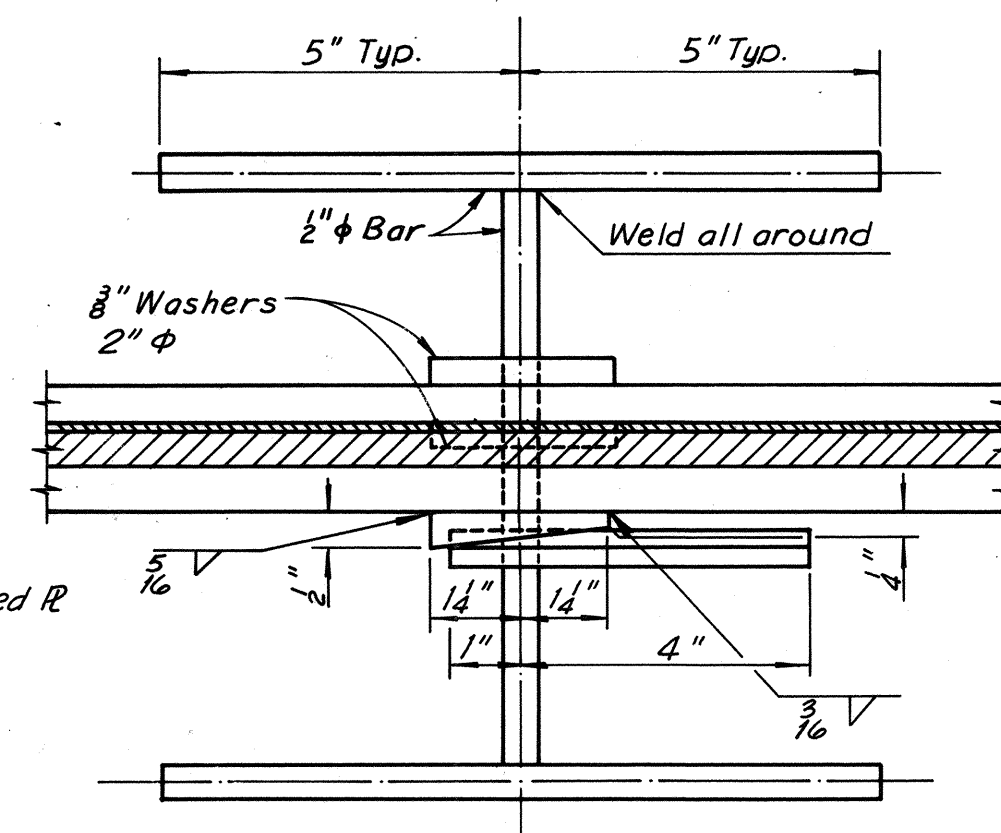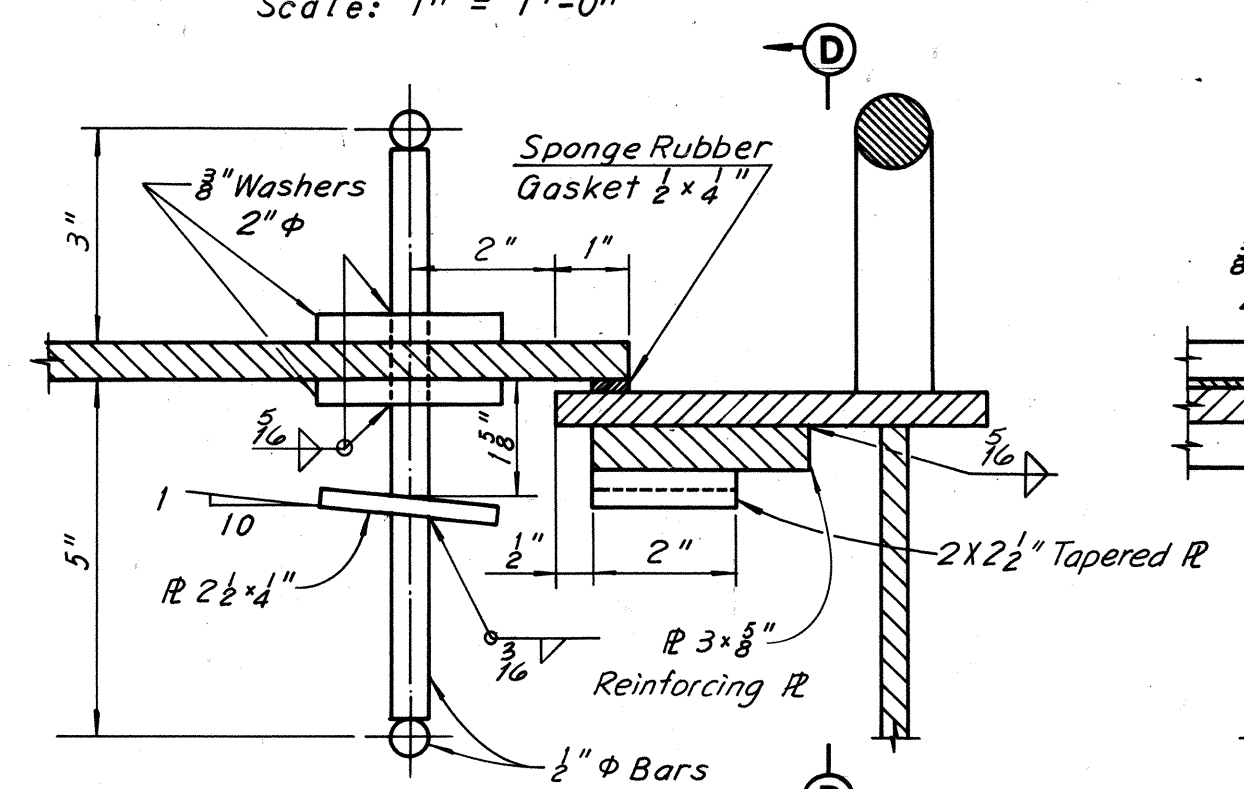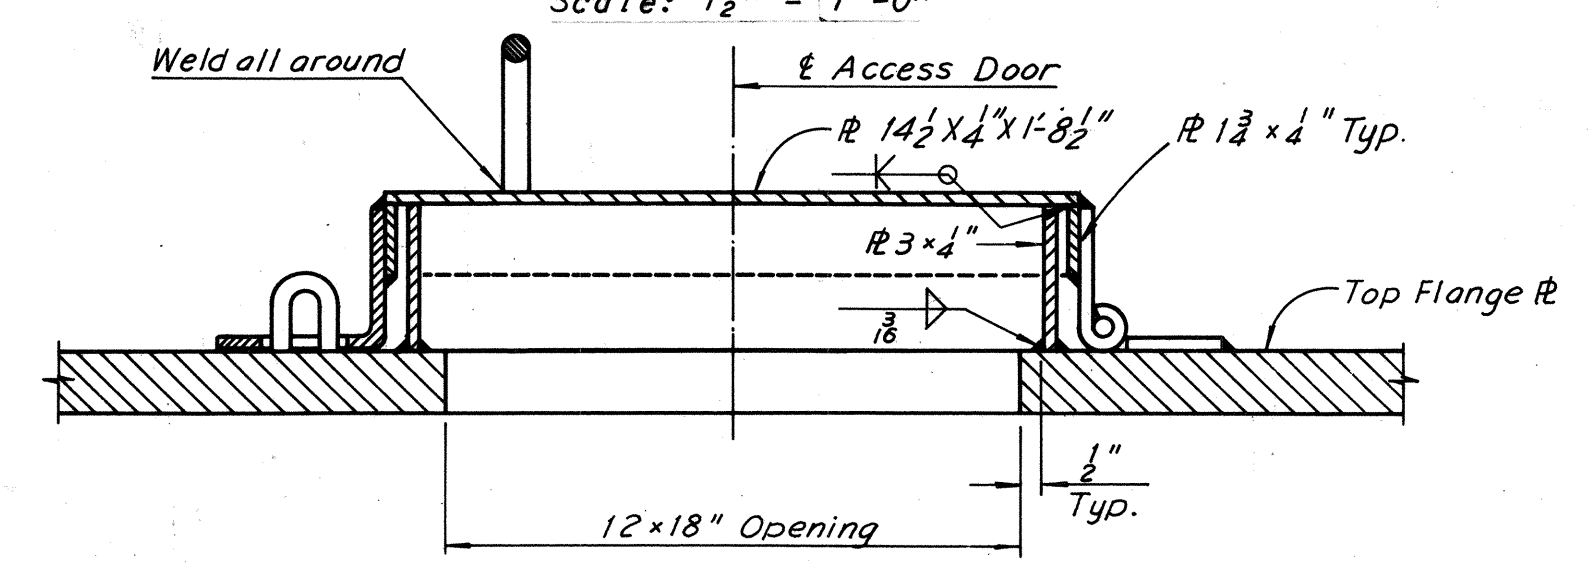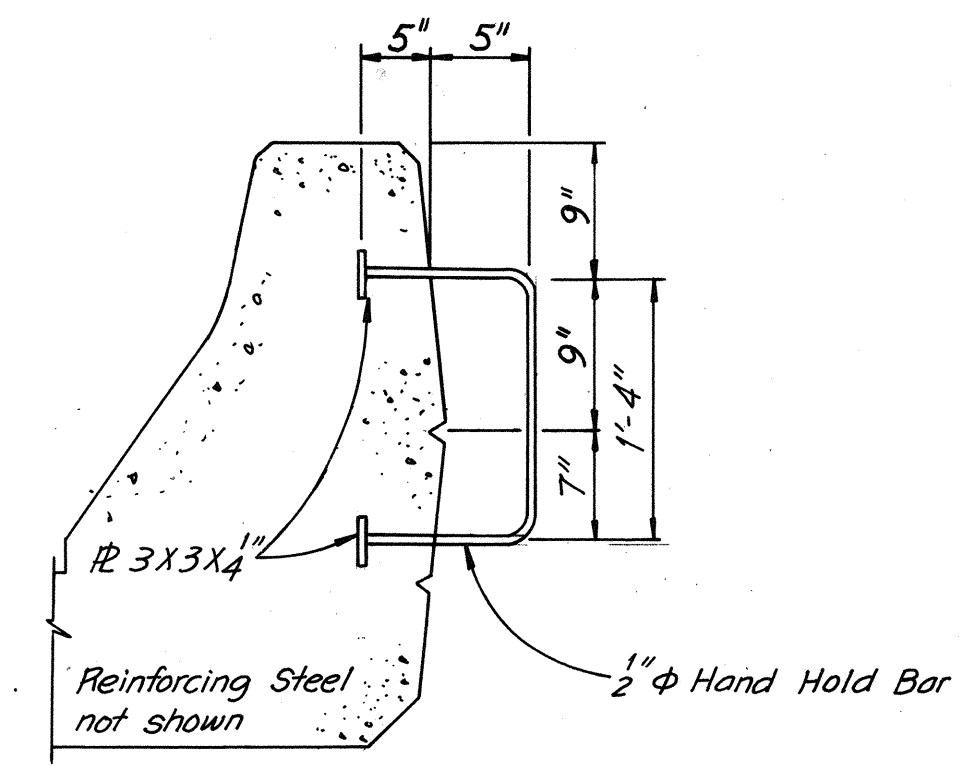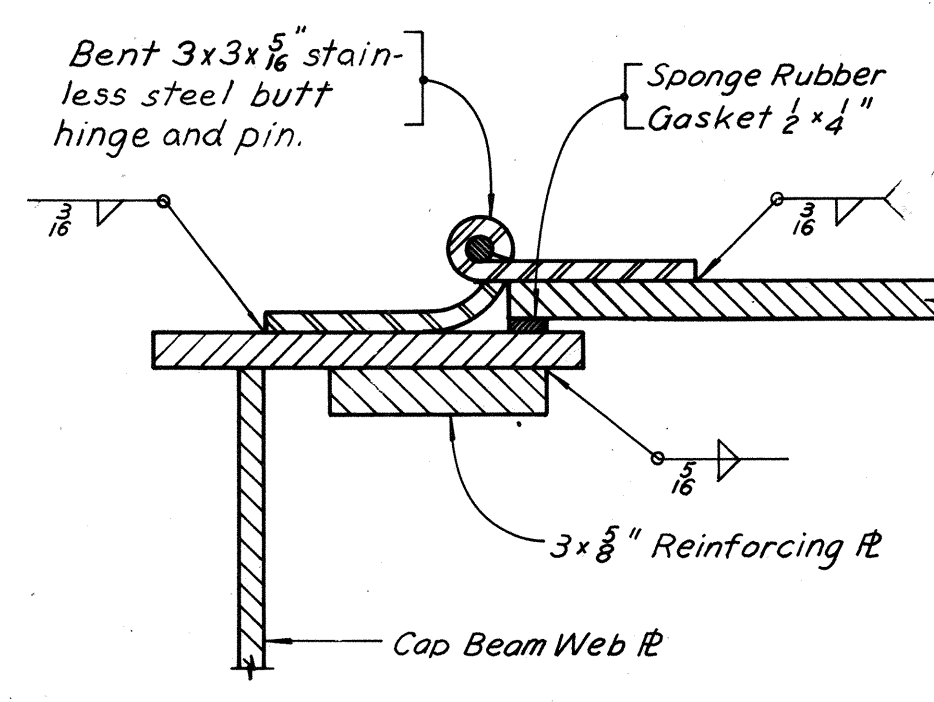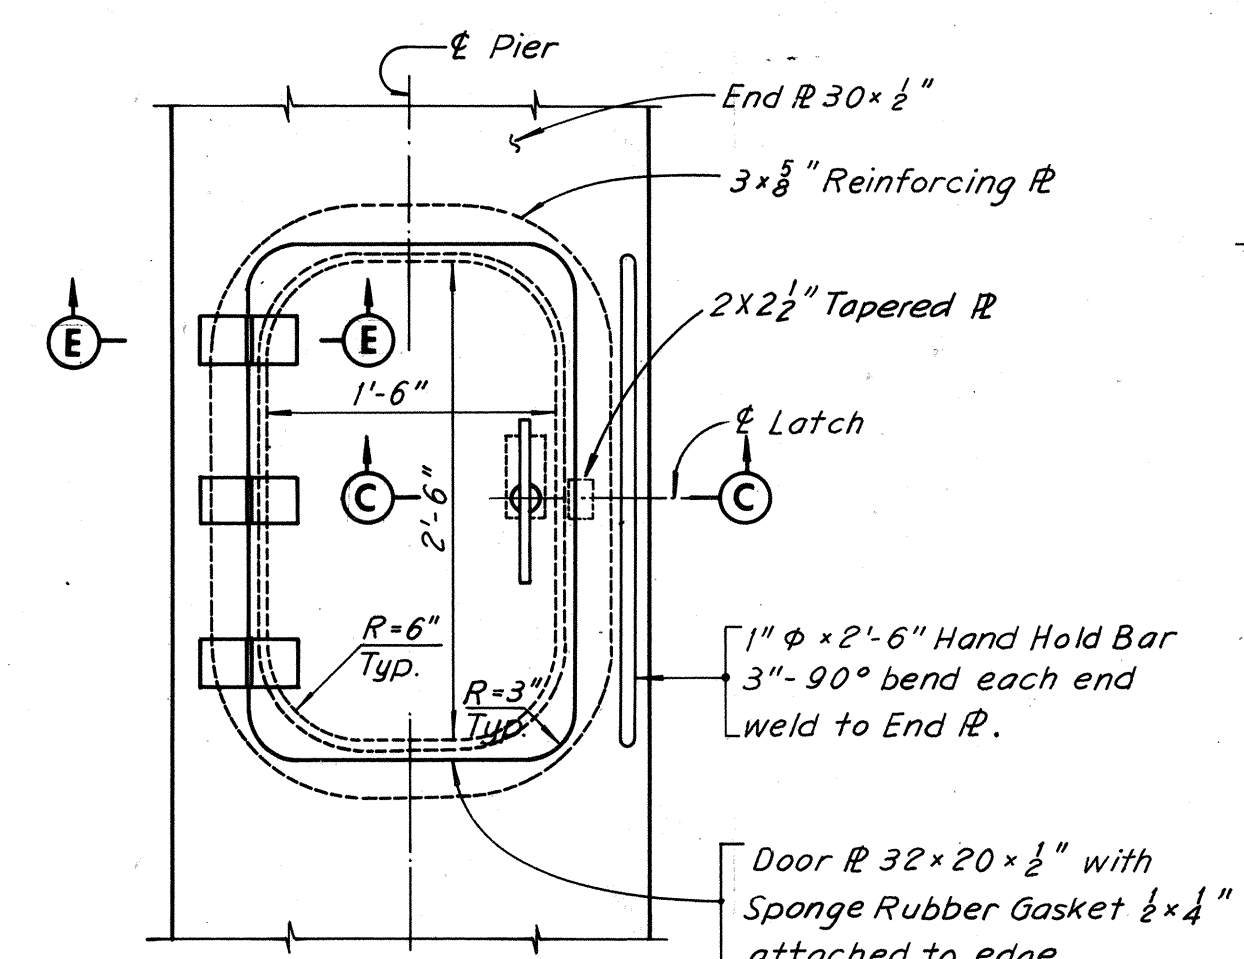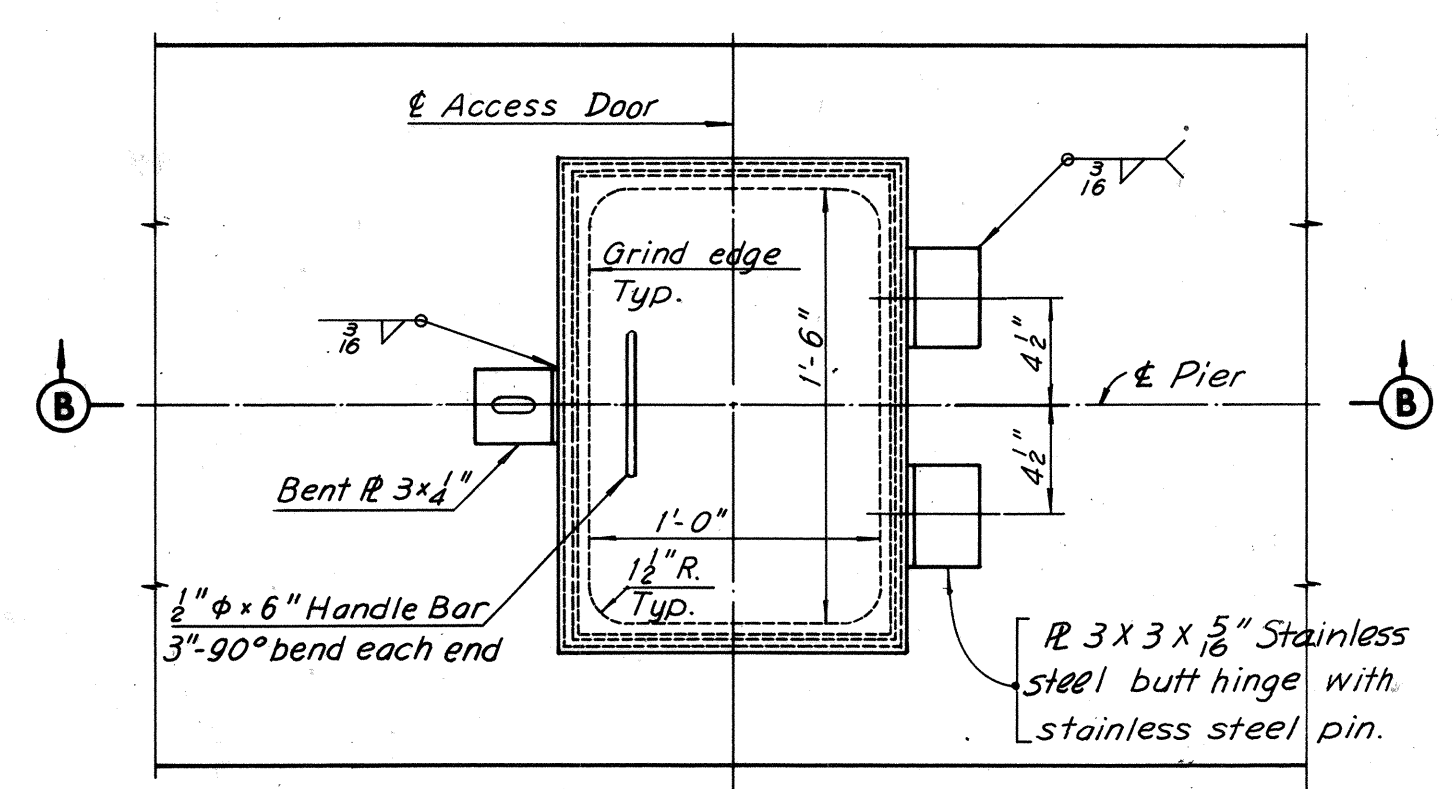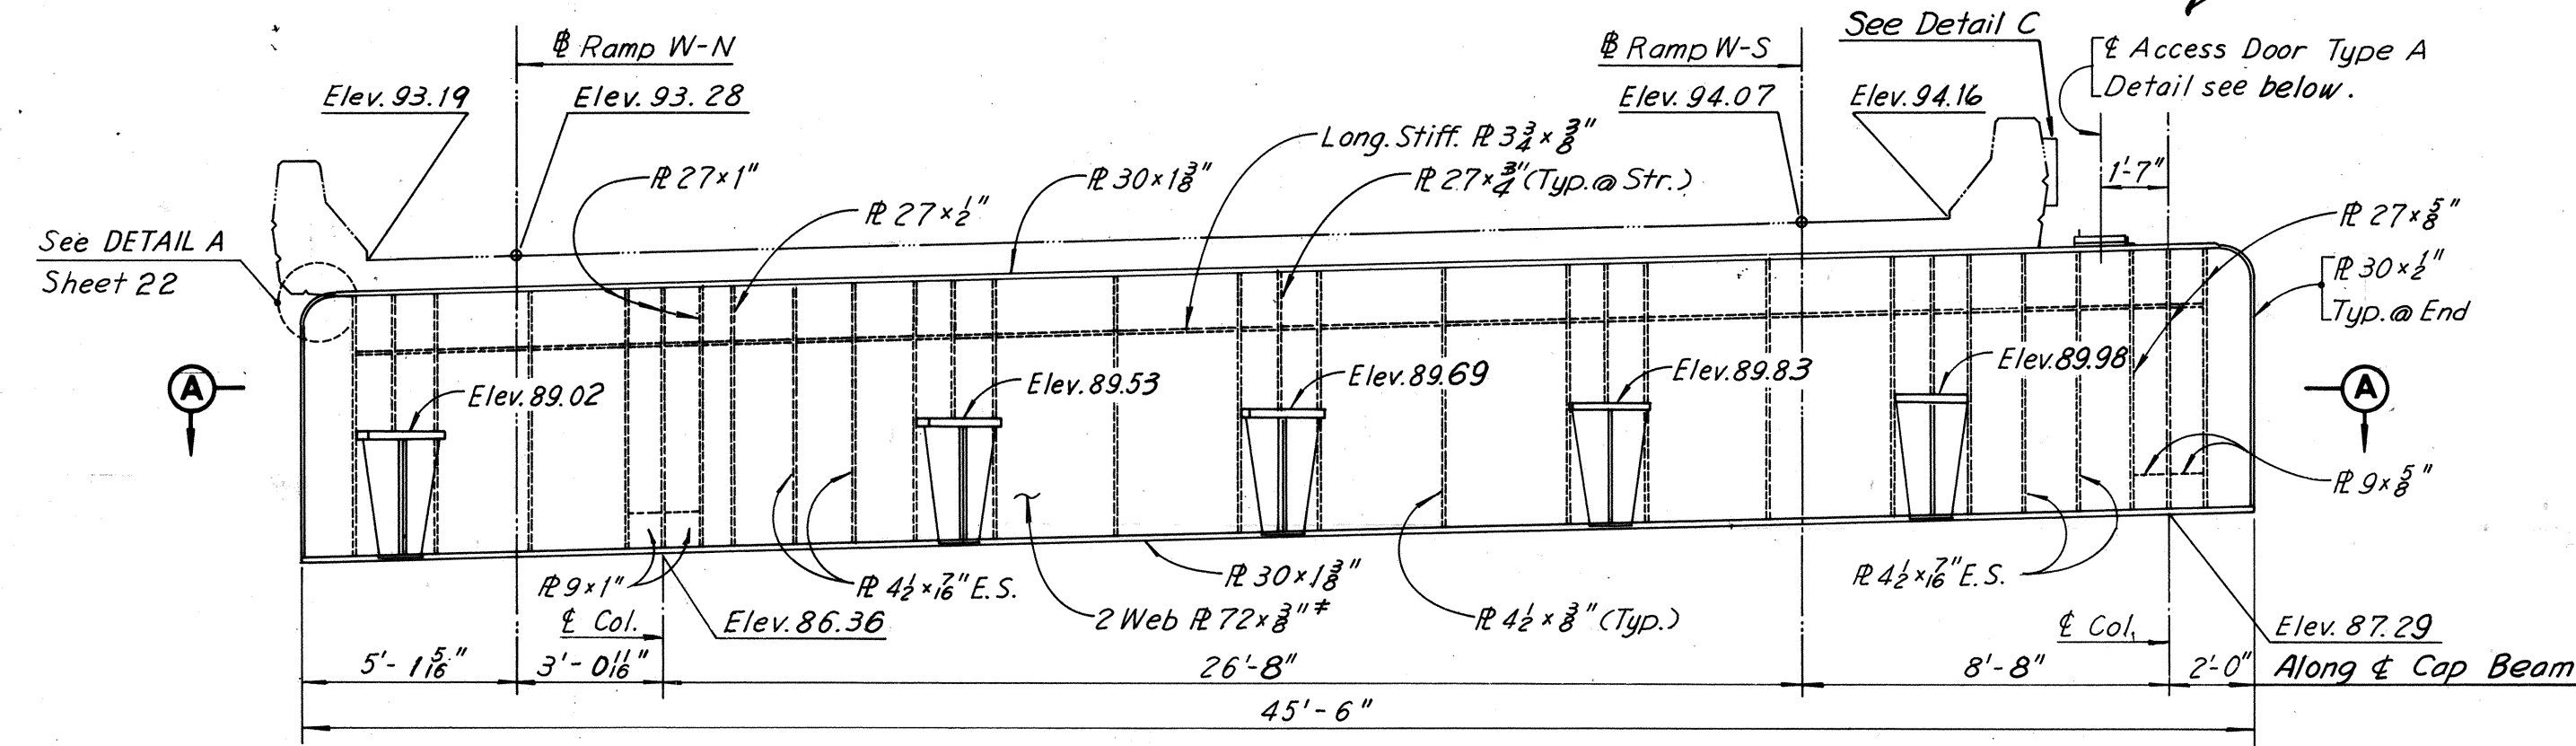

Notes:
All Steel is A36 unless otherwise shown.
Use A572 Grade 50 for thickness of 3/4" and less, and A588 for thickness over 3/4".

RICHMOND METROPOLITAN AUTHORITY
RICHMOND EXPRESSWAY SYSTEM
DOWNTOWN EXPRESSWAY

BRIDGE NO. 66
EASTBOUND ROADWAY OVER
12TH ST. - R.R. TRACKS AND 16TH ST.
FRAMING DETAILS PIER 21

HOWARD, NEEDLES, TAMMEN & BERGENDOFF
consulting engineers
NEW YORK ALEXANDRIA KANSAS CITY

SCALE: As Noted
CONTRACT NO.: 10
SHEET NO. 24 OF 46

BY	DATE	1	Note & Welds Changed	PRMS	4-19-74
MADE	M.H.H.	12-27-68	2	As Built	TEM 8-76
CHECKED	J.D.	5-7-69			
IN CHARGE					


AS BUILT

Bridge 67

(Ramp from Eastbound Downtown Expressway “Rte. 195” to Northbound I-95 over Dock Street, East Cary Street, East Main Street “Rte. 60” and CSX RR)


Record Set Plans

RICHMOND EXPRESSWAY SYSTEM			
SECTION	PROJECT	SHEET NO.	TOTAL SHEETS
10	DOWNTOWN EXPRESSWAY	173	265

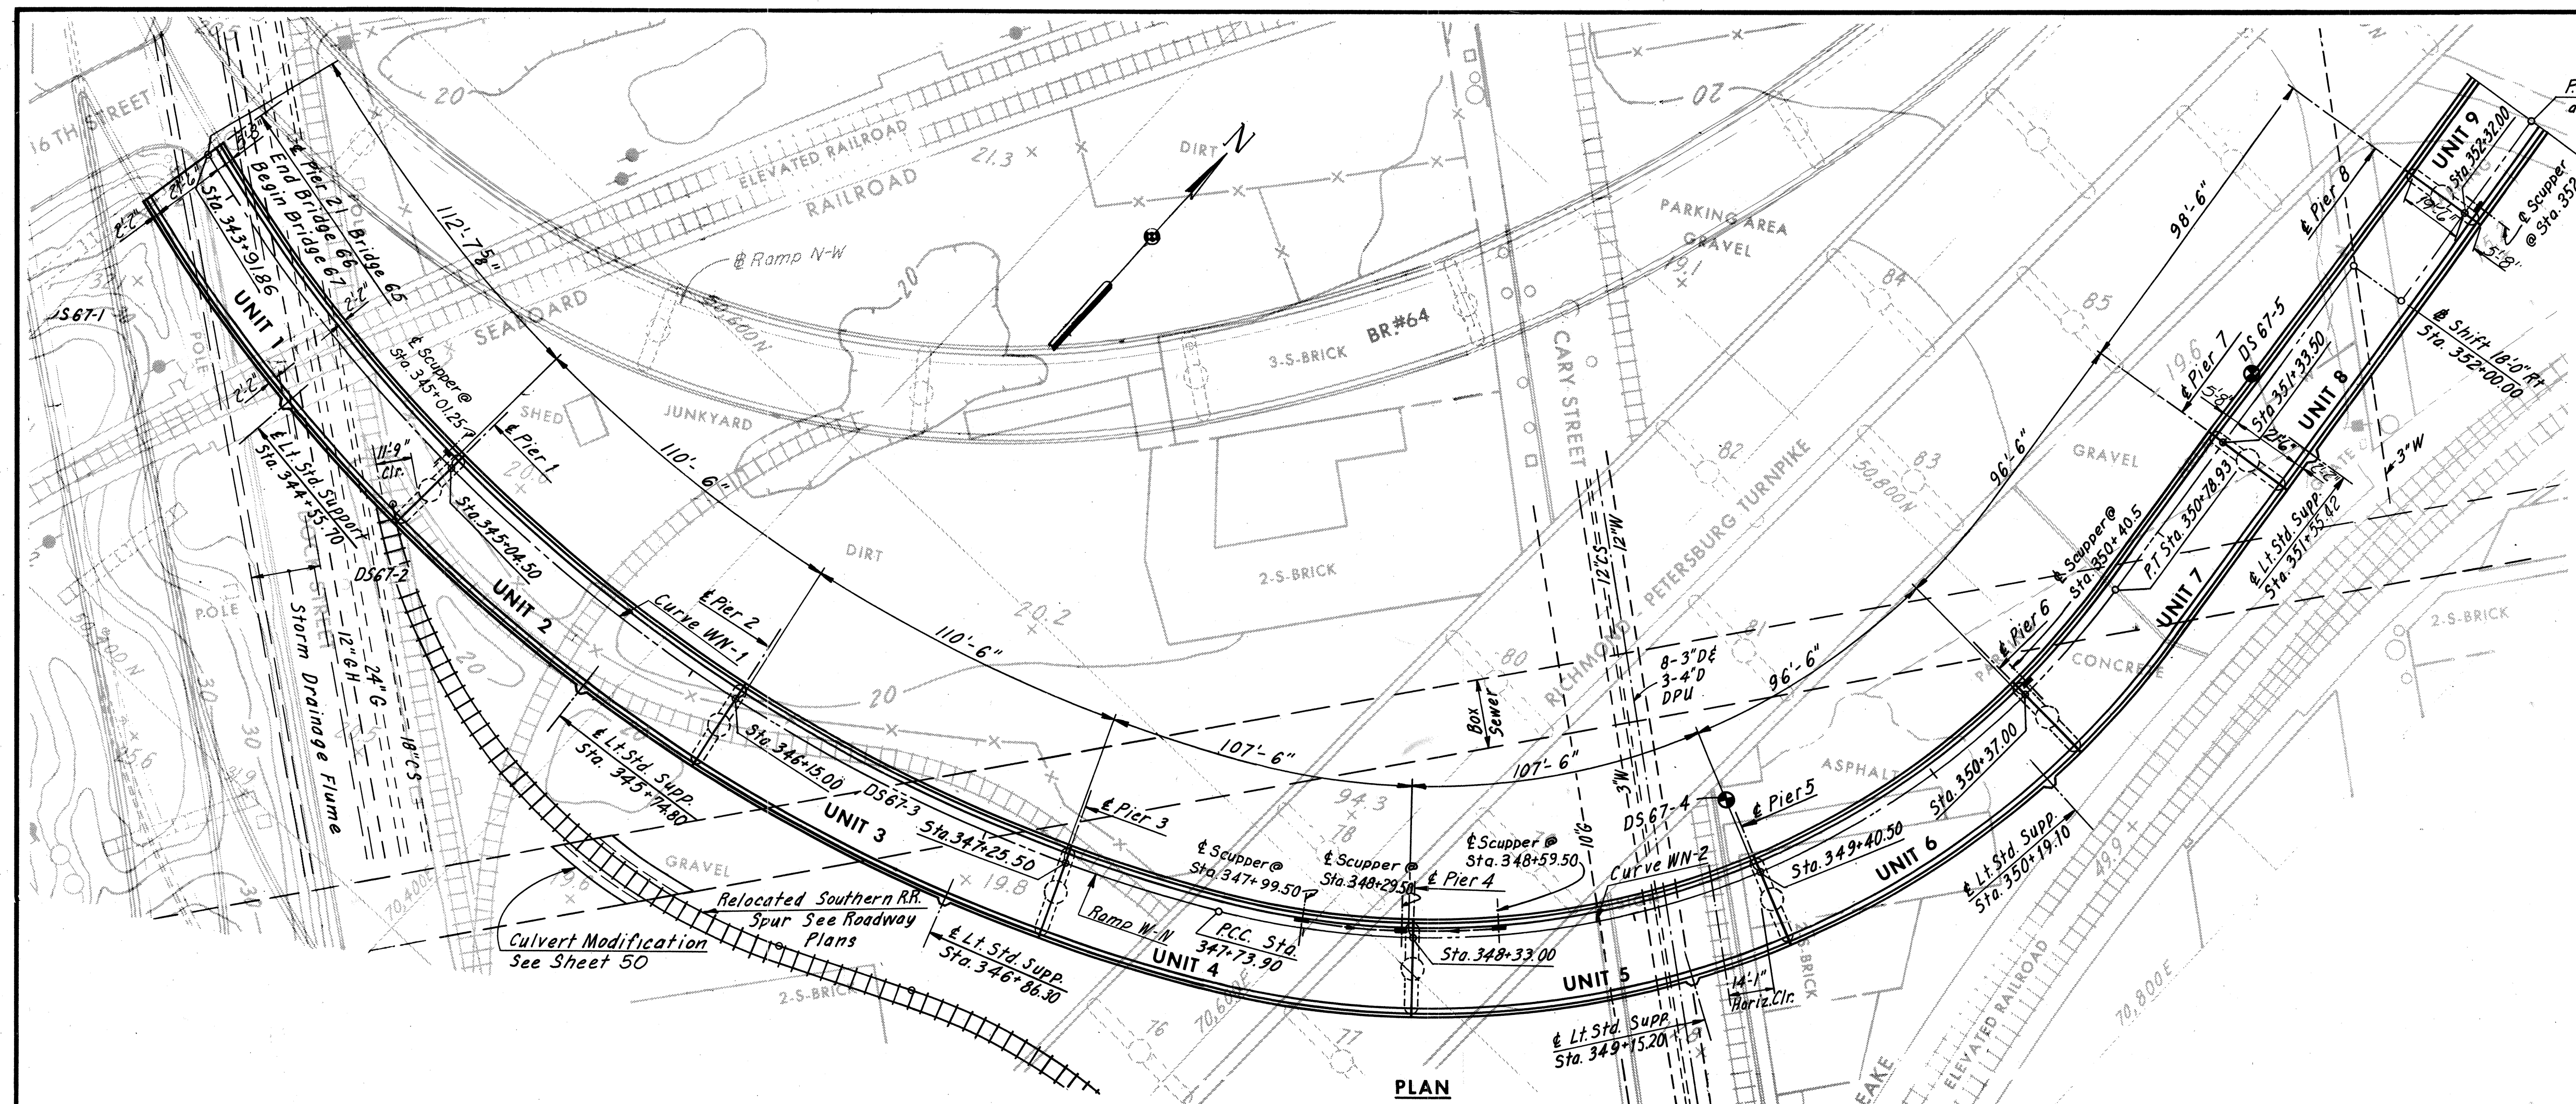

INDEX


GENERAL PLAN AND ELEVATION	1
GENERAL PLAN AND ELEVATION	2
LAYOUT	3
PIERS 1 AND 2	4
PIER 3	5
PIERS 4 AND 5	6
PIER 6	7
PIER 7	8
PIERS 8 AND 9	9
PIER 10E	10
PIERS 11 AND 12E	11
PIER 13E	12
PIERS 10W AND 12W	13
PIERS 13W AND 14	14
NORTH ABUTMENT	15
NORTH ABUTMENT DETAILS	16
NORTH ABUTMENT RETAINING WALL MODIFICATION	17
FRAMING PLAN - UNITS 1 AND 2	18
FRAMING PLAN - UNITS 3 AND 4	19
FRAMING PLAN - UNITS 5 AND 6	20
FRAMING PLAN - UNITS 7 AND 8	21
FRAMING PLAN - UNIT 9 AND FRAMING DETAILS	22
FRAMING PLAN - UNIT 10	23
GIRDER ELEVATIONS - UNIT 10	24
FRAMING PLAN - UNITS 11, 12, 13, 14 AND 15	25
FRAMING PLAN - UNITS 11, 12, 13, 14 AND 15	26
FLOORBEAM 16 AND STEEL COLUMNS	27
DECK PLAN - UNITS 1 AND 2	28
DECK PLAN - UNITS 3 AND 4	29
DECK PLAN - UNITS 5 AND 6	30
DECK PLAN - UNITS 7 AND 8	31
DECK PLAN - UNIT 9 - AND SUPERSTRUCTURE DETAILS	32
DECK PLAN - UNIT 10	33
DECK PLAN - UNITS 11, 12, 13, 14 AND 15	34
STRESS SHEET TRUSS SPAN	35
TOP LATERAL SYSTEM	36
BOTTOM LATERAL SYSTEM	37
TRUSS DETAILS P.P. 0 TO P.P. 6	38
TRUSS DETAILS P.P. 7 TO P.P. 10	39
TRUSS DETAILS P.P. 11 TO P.P. 12	40
FLOORBEAM 0 AND JOINT DETAILS	41
INTERMEDIATE FLOOR BEAMS	42
MISCELLANEOUS DETAILS	43
FLOORBEAM 12 AND JOINT DETAILS	44
DECK PLAN - TRUSS SPAN	45
SHOE DETAILS AND DECK ELEVATIONS	46
JOINT DETAILS	47
SLOPE PROTECTION DETAILS	48 THRU 49
BORING LOGS	50
STANDARD DETAILS	51 THRU 54

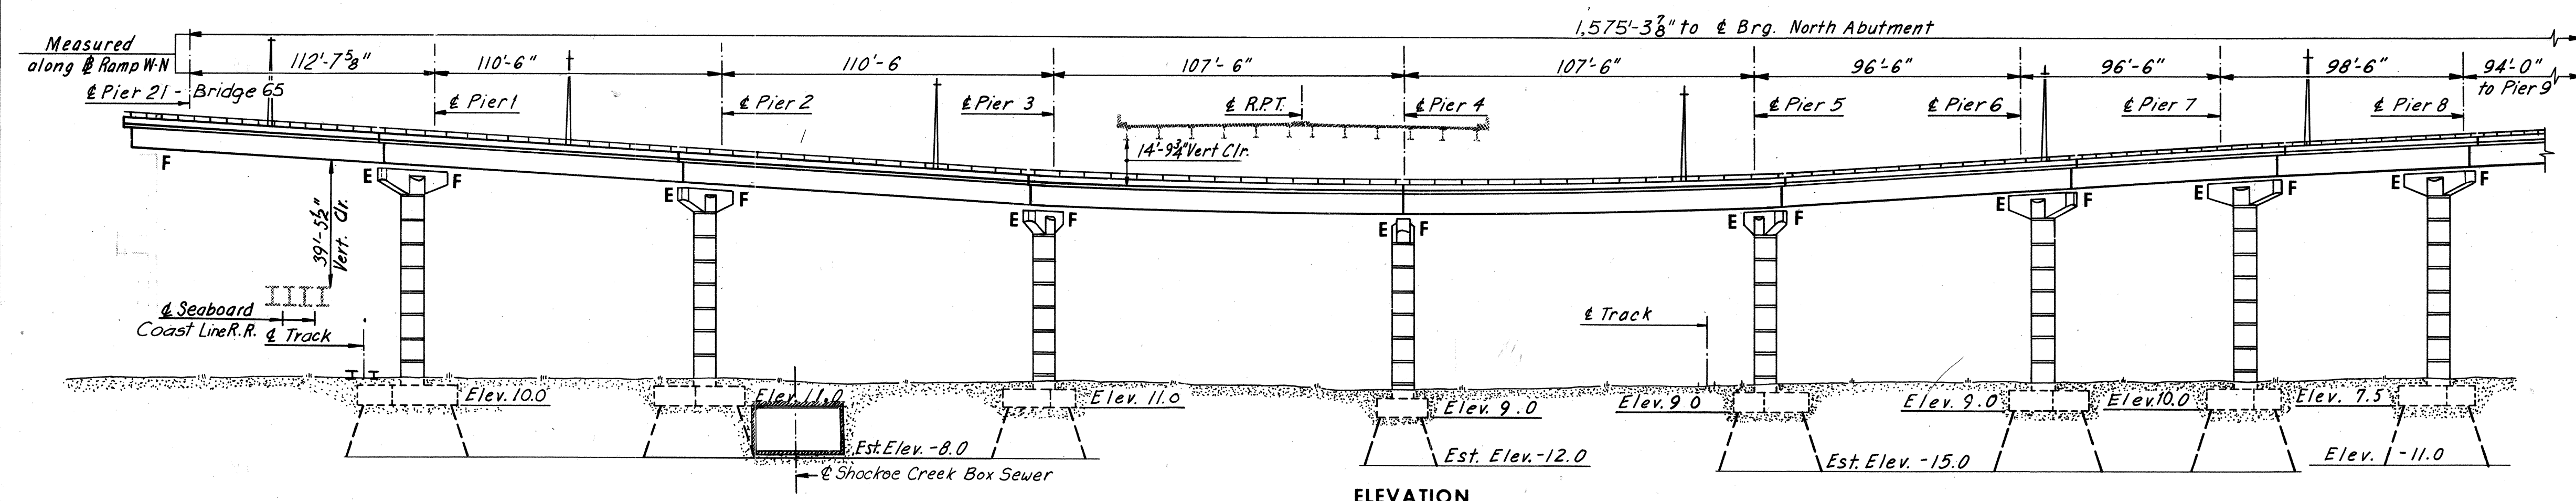

Note:
For General Notes, see Sheet 4.
For Quantity Table, see Sheet 3

CURVE DATA

@ R.P.T.		@ Ramp W-N		@ Ramp N-W	
Curve: R.P.T.-1	Curve: R.P.T.-2	Curve: WN-1	Curve: WN-2	Curve: WN-3	Curve: WN-4
P.I. = Sta. 1704+68.83	P.I. = Sta. 1723+07.01	P.I. = Sta. 345+25.47	P.I. = Sta. 349+47.64	P.I. = Sta. 353+19.15	P.I. = Sta. 13+42.50
Δ = 15°03'56"	Δ = 35°27'40"	Δ = 64°53'49"	Δ = 69°32'15"	Δ = 6°23'54"	Δ = 32°01'34"
D = 1'00'	D = 4'00'	D = 112'7.3"	D = 112'7.3"	D = 6'00'	D = 5'51'36"
T = 757.65'	T = 430.45'	T = 317.90'	T = 173.75'	T = 53.38'	T = 426.01'
L = 1,506.56'	L = 836.30'	L = 566.33'	L = 305.03'	L = 106.64'	L = 829.72'
R = 5,729.58'	R = 1,432.39'	R = 500.00'	R = 255.00'	R = 954.93'	R = 1,484.39'
		Curve: WN-4	Curve: WN-5	Curve: WN-6	
		P.I. = Sta. 355+39.85	P.I. = Sta. 358+17.39	P.I. = Sta. 361+67.68	
		Δ = 5°01'11"	Δ = 13°10'51"	Δ = 19°35'06"	
		D = 1'30'	D = 6'00'	D = 4'09'03"	
		T = 167.43'	T = 110.33'	T = 238.25'	
		L = 334.65'	L = 219.68'	L = 471.85'	
		R = 3,819.72'	R = 954.93'	R = 1,380.39'	

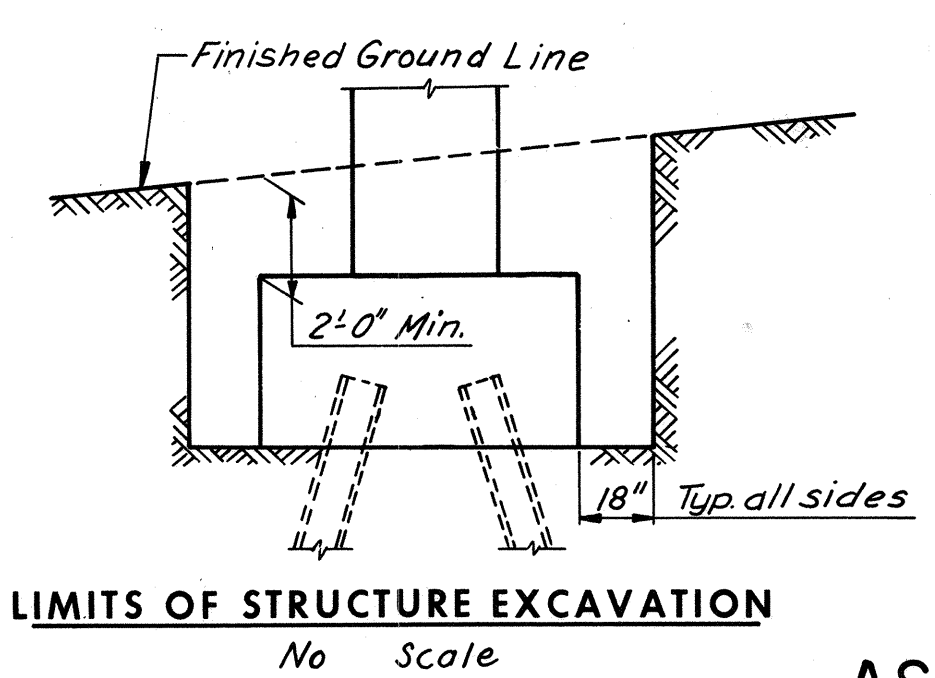

BY	DATE	3	As Built	TEM	6-77
MADE	AMH	3-5-69	Light Sta. Location	JLK	6-6-75
CHECKED	KC T	5-12-69	Sheet 42 & 45 added	L.B.P.	3-5-75
IN CHARGE					

RICHMOND METROPOLITAN AUTHORITY
RICHMOND EXPRESSWAY SYSTEM
DOWNTOWN EXPRESSWAY





BRIDGE NO. 67
RAMP W-N CONNECTION TO
RICHMOND-PETERSBURG TURNPIKE
GENERAL PLAN AND ELEVATION

HOWARD, NEEDLES, TAMMEN & BERGENDOFF
consulting engineers
NEW YORK ALEXANDRIA KANSAS CITY

SCALE: 1" = 30'-0"
CONTRACT NO.: 10
SHEET NO. 1 OF 54

AS BUILT

RICHMOND EXPRESSWAY SYSTEM			
SECTION	PROJECT	SHEET NO.	TOTAL SHEETS
10	DOWNTOWN EXPRESSWAY	174	265

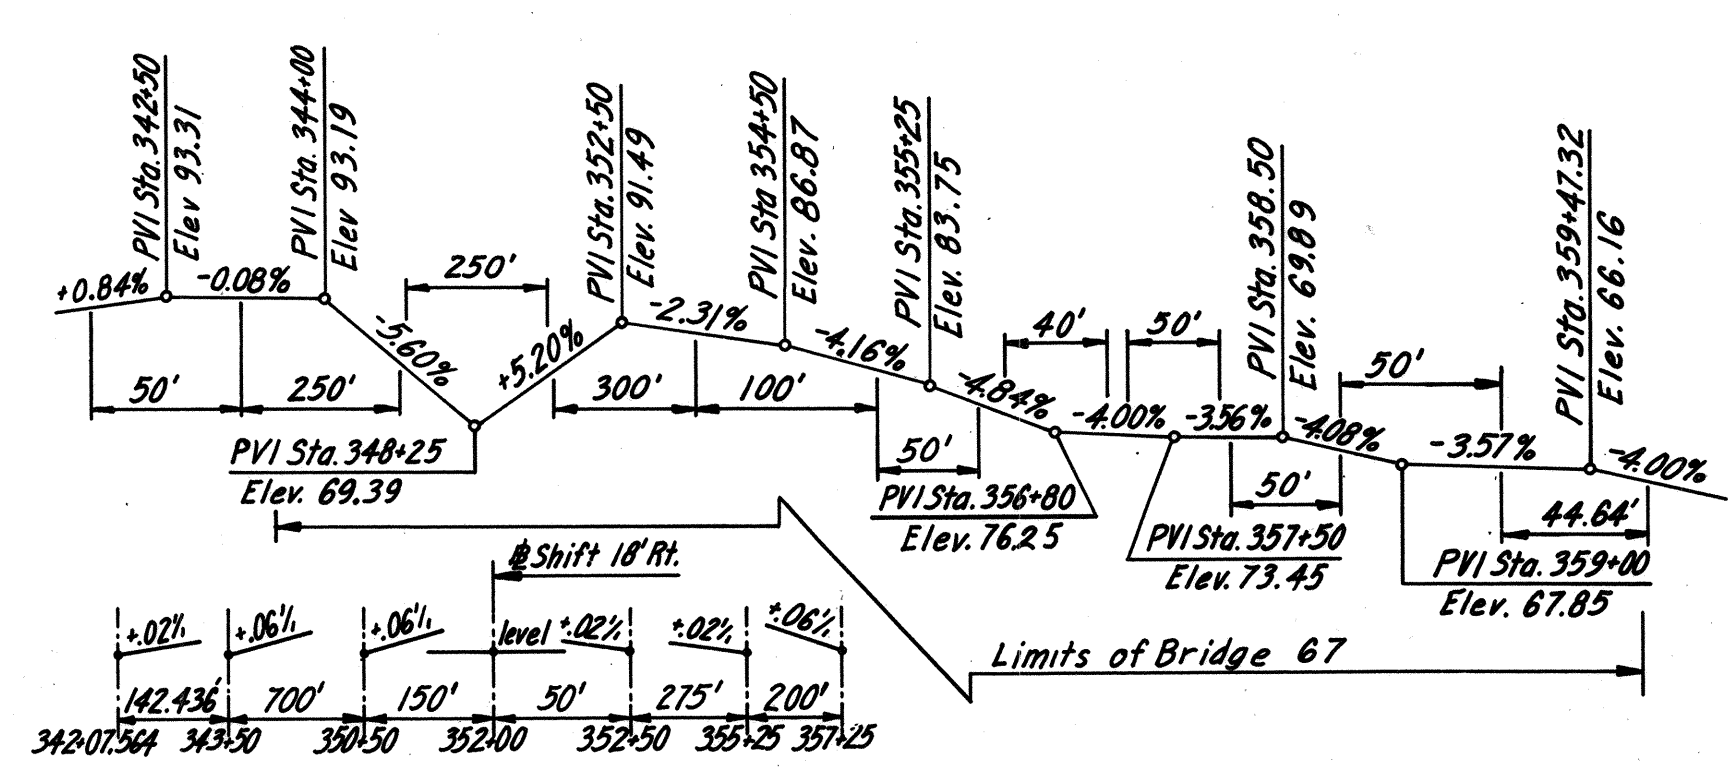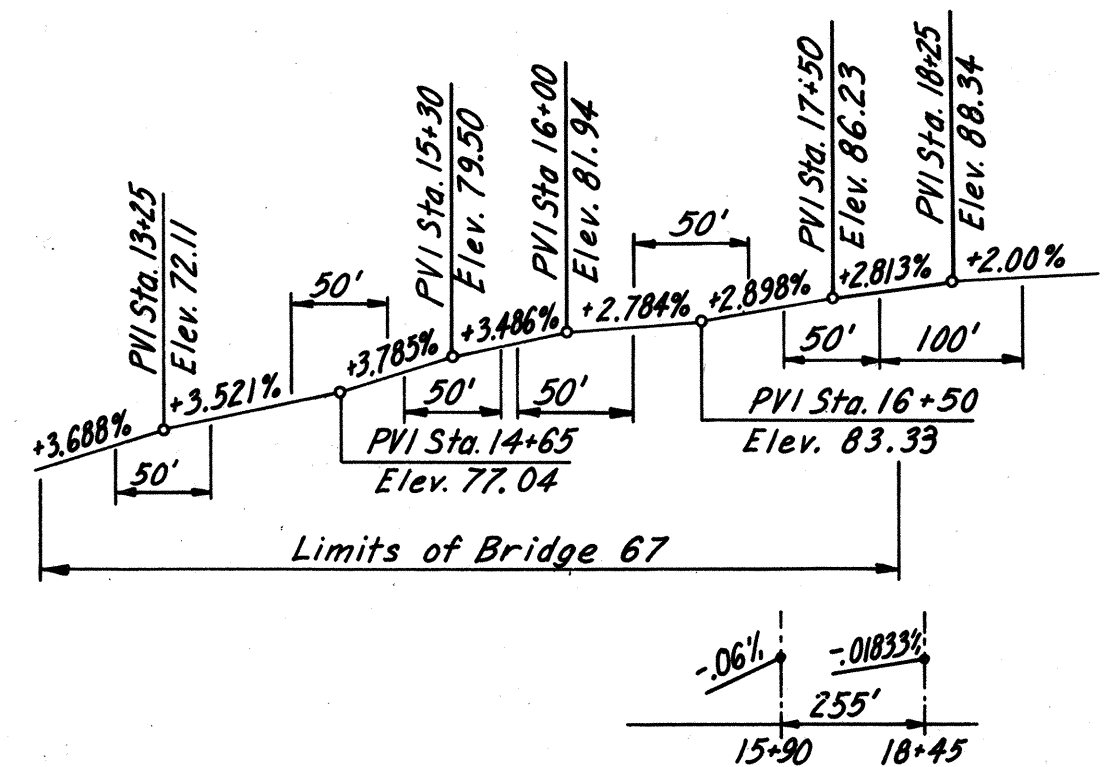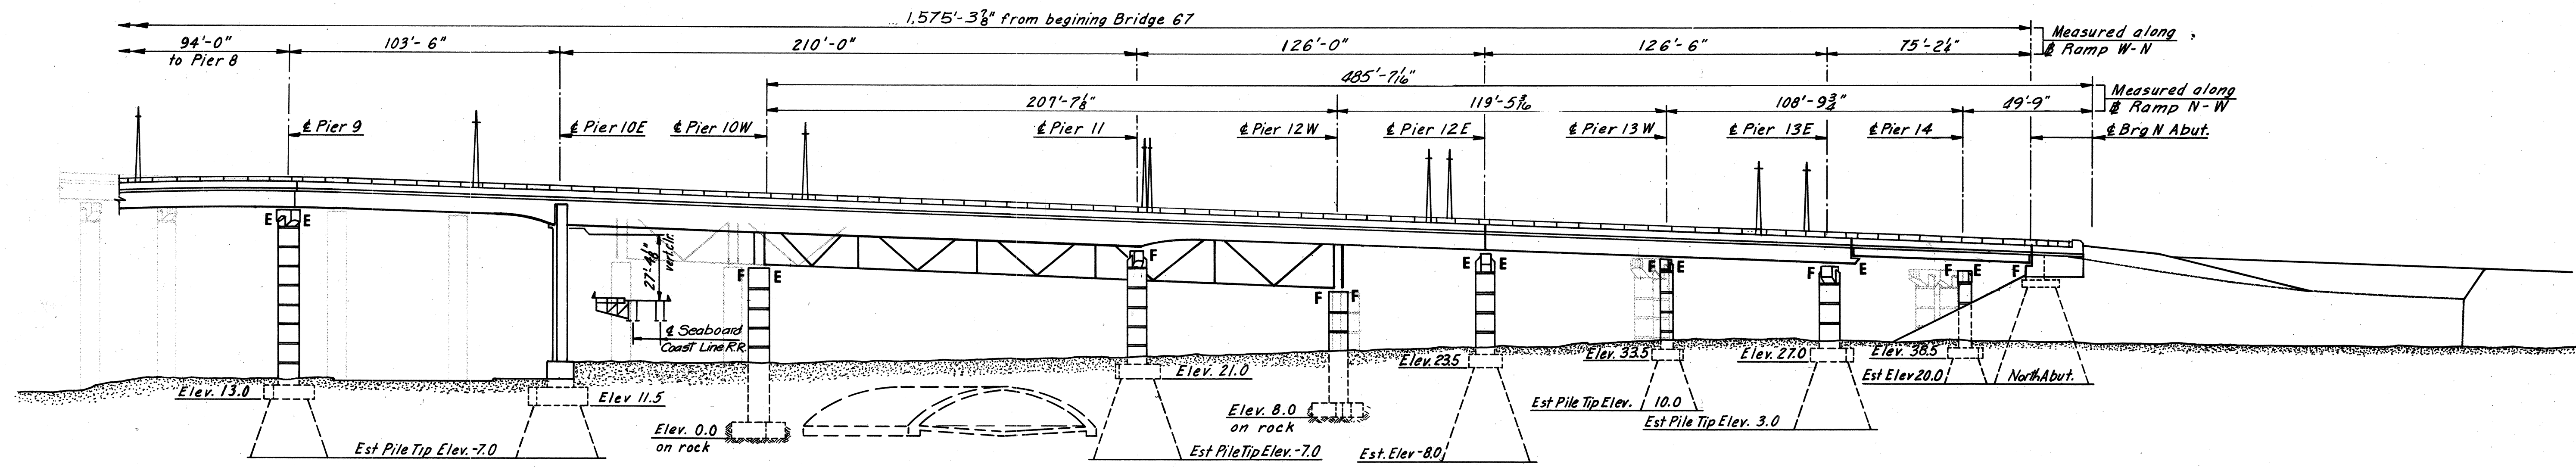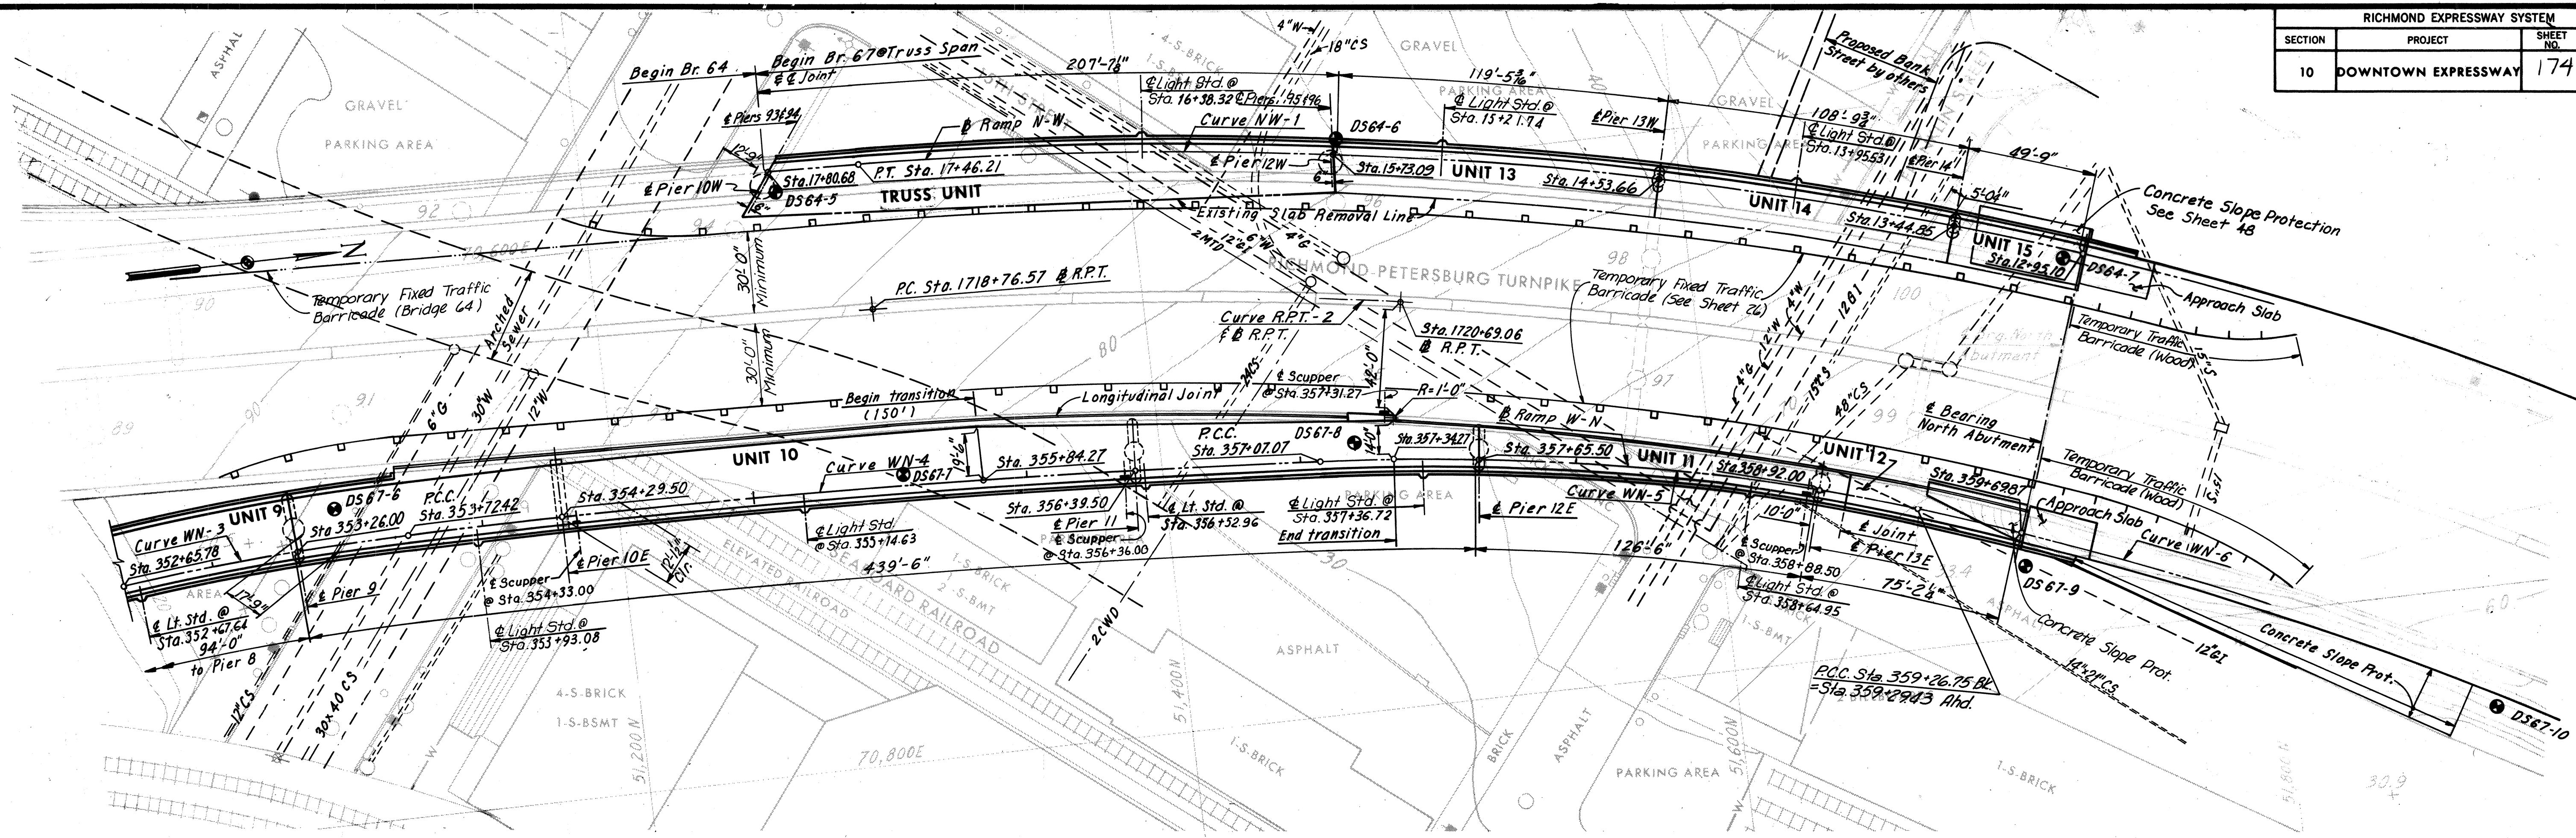

RICHMOND METROPOLITAN AUTHORITY
RICHMOND EXPRESSWAY SYSTEM
DOWNTOWN EXPRESSWAY















BRIDGE NO. 67
RAMP W-N CONNECTION TO
RICHMOND-PETERSBURG TURNPIKE
GENERAL PLAN AND ELEVATION

HOWARD, NEEDLES, TAMMEN & BERGENDOFF
consulting engineers
NEW YORK ALEXANDRIA KANSAS CITY

SCALE: *As Noted*
CONTRACT NO.: 10
SHEET NO. 2 OF 54

BY	DATE	NO.	REVISION	BY	DATE
AMH	12-30-60	2	As Built	TEM	6-77
KCT	5-12-69	1	Revised Plans & Sheet Sta. & Board Length	DWB	1-24-75

RICHMOND EXPRESSWAY SYSTEM			
SECTION	PROJECT	SHEET NO.	TOTAL SHEETS
10	DOWNTOWN EXPRESSWAY	177	265

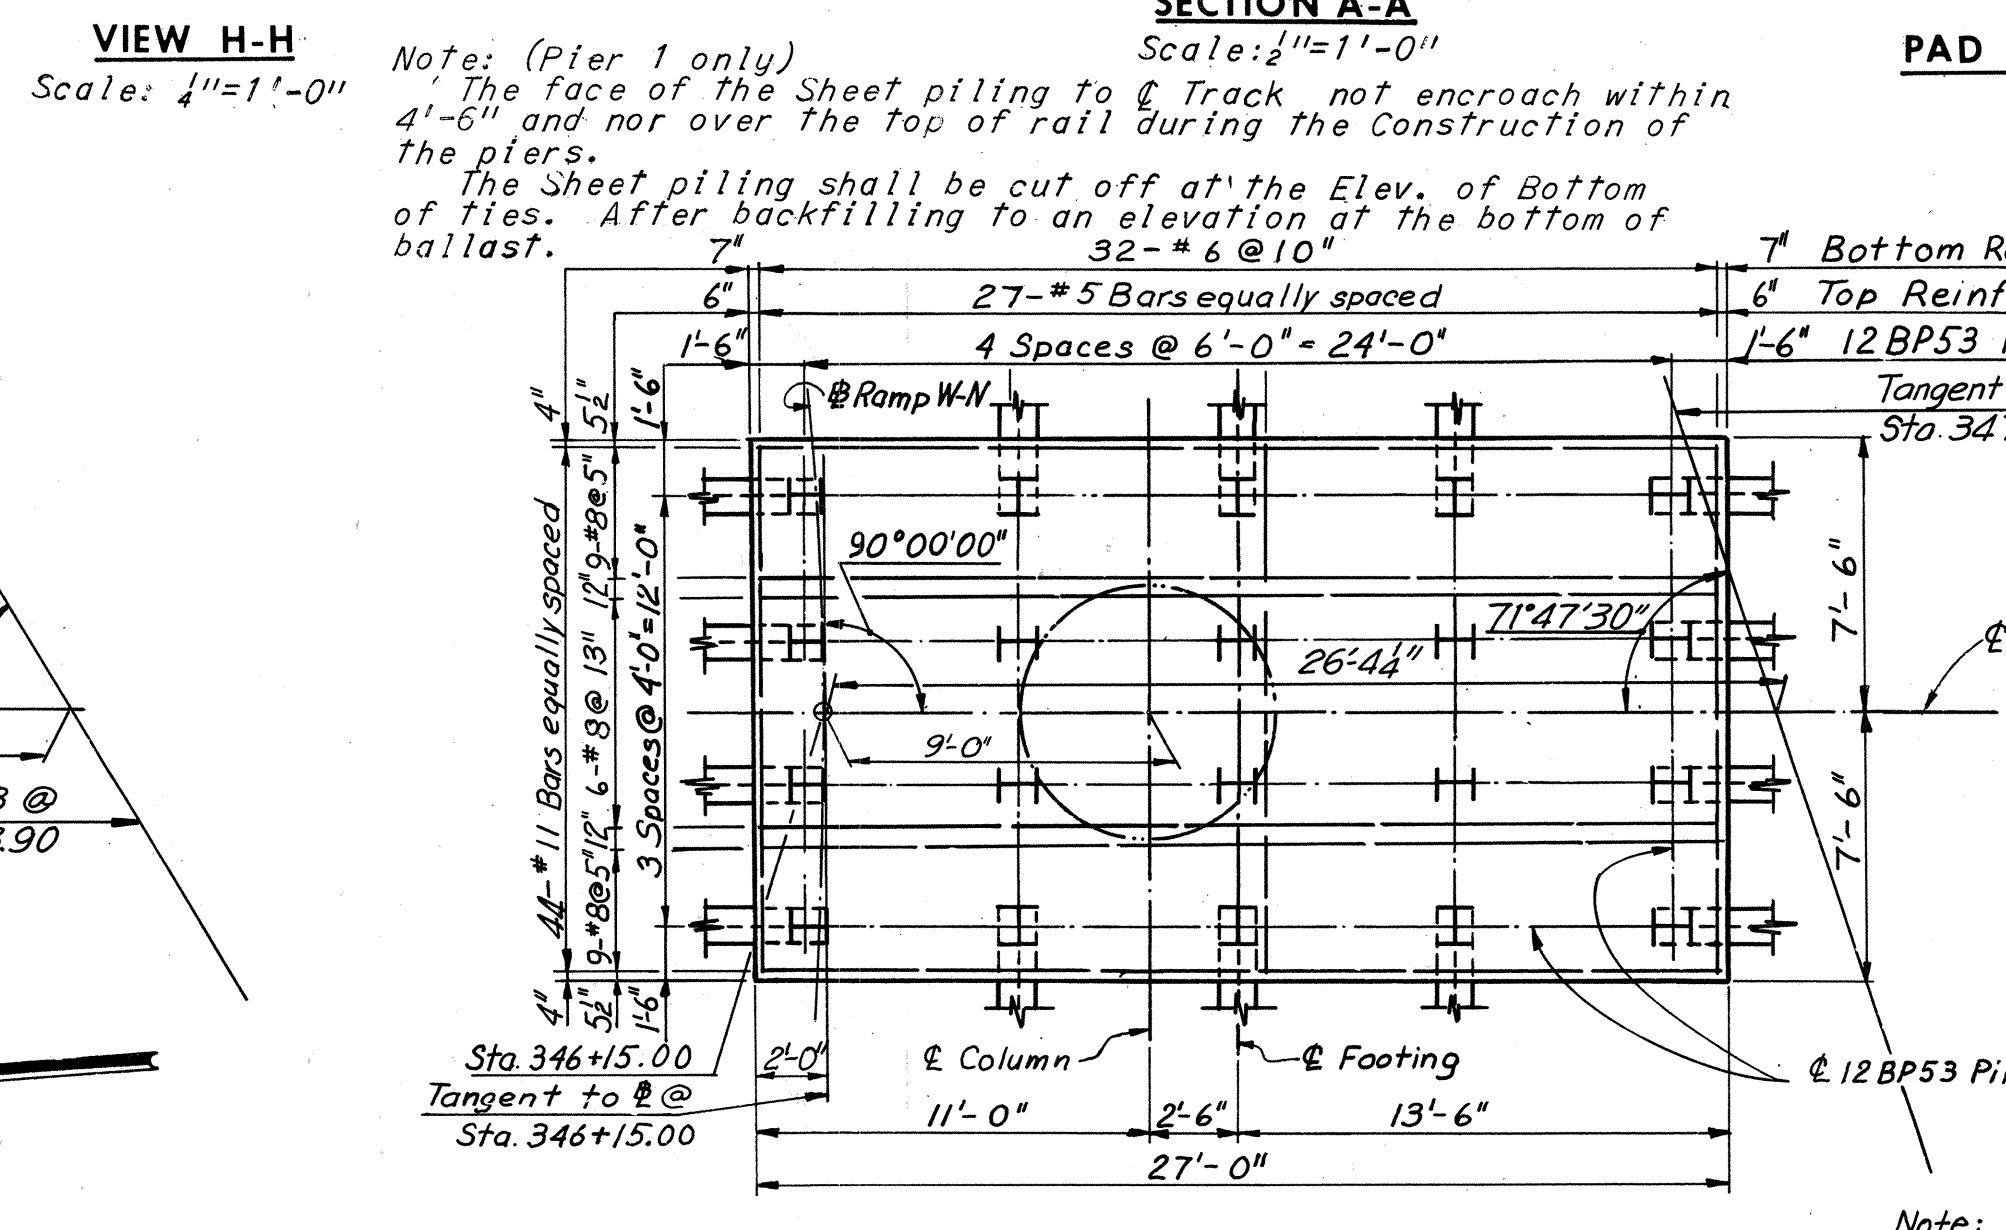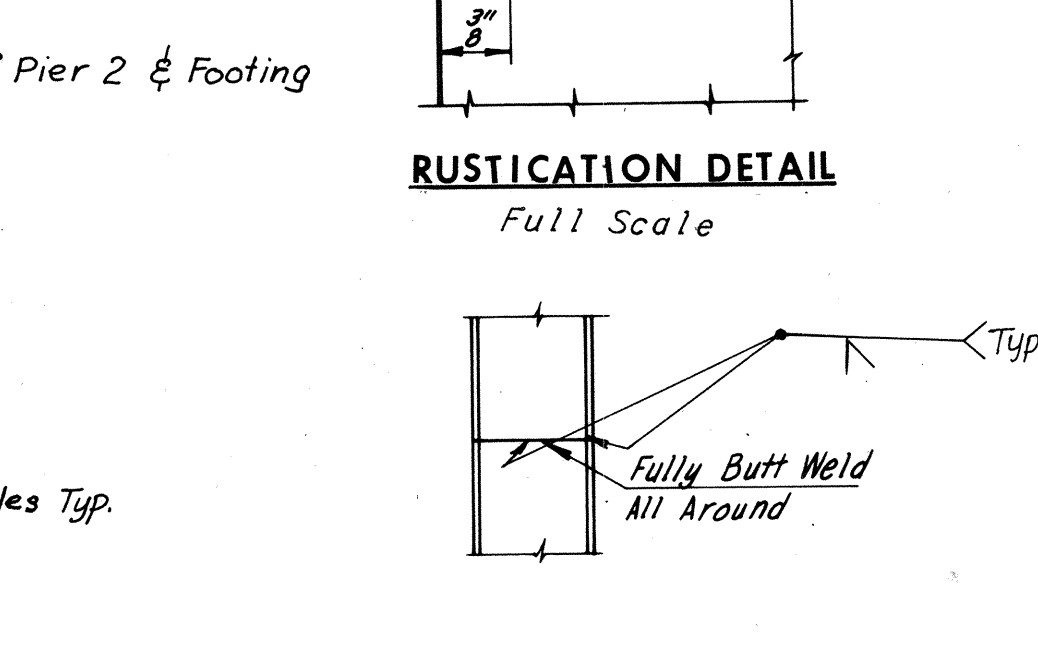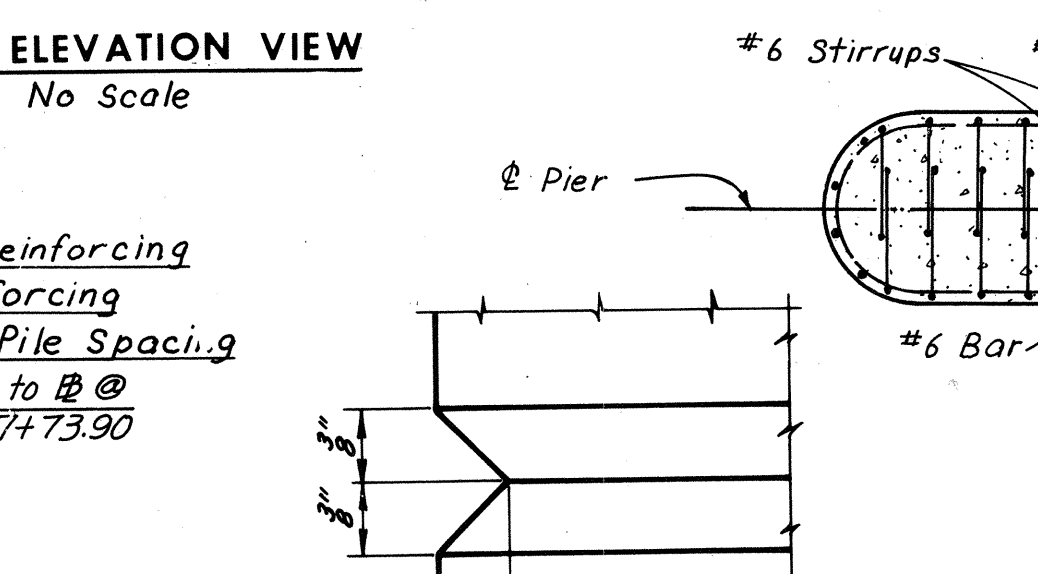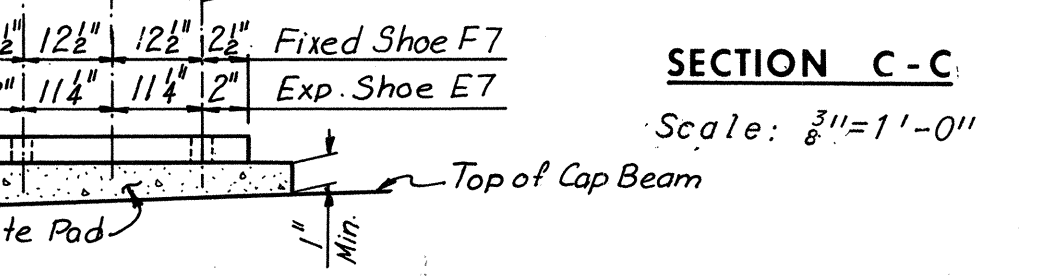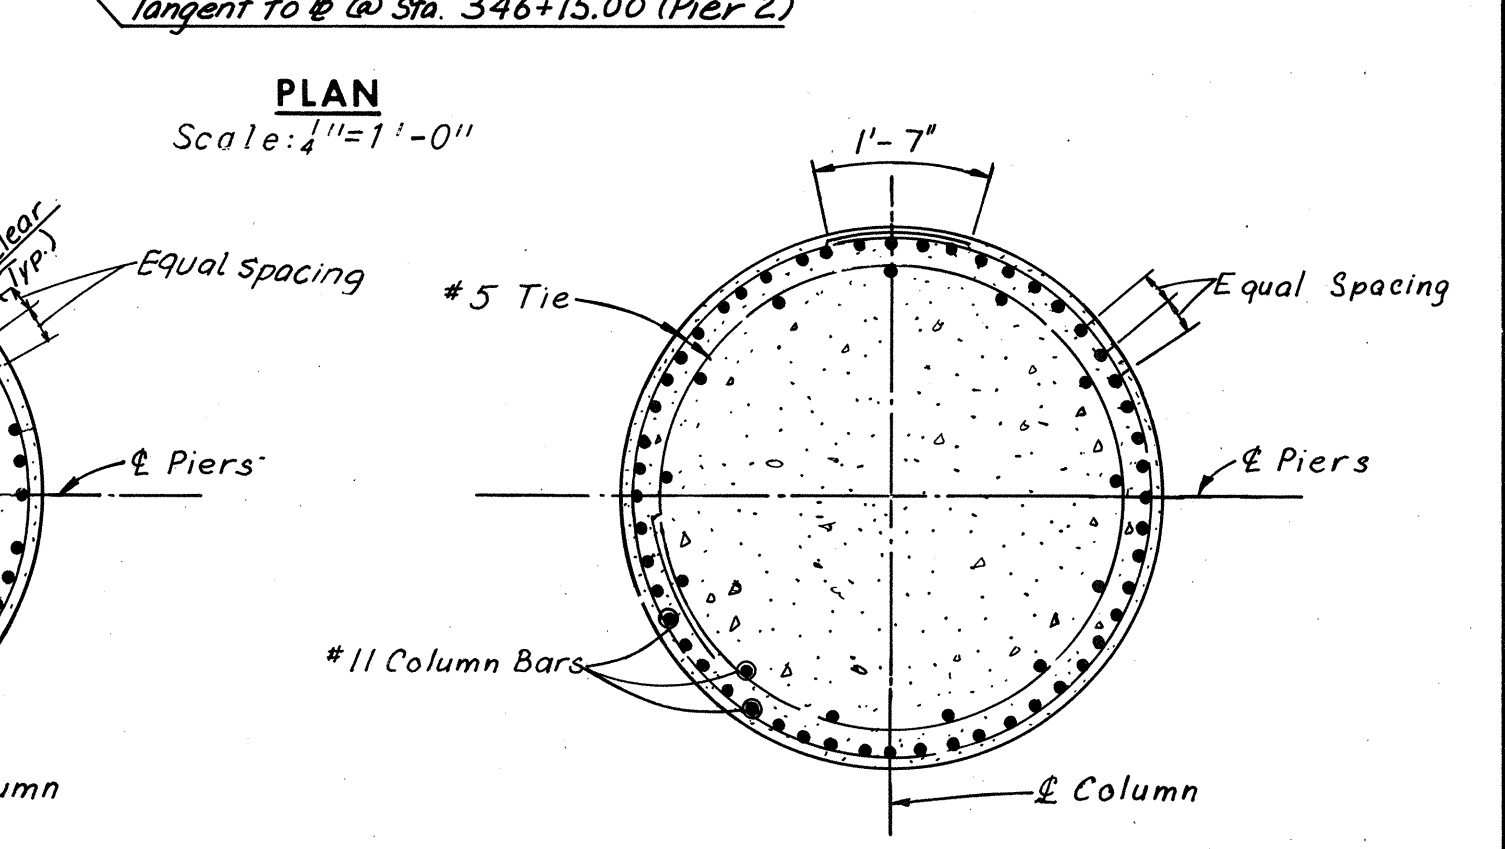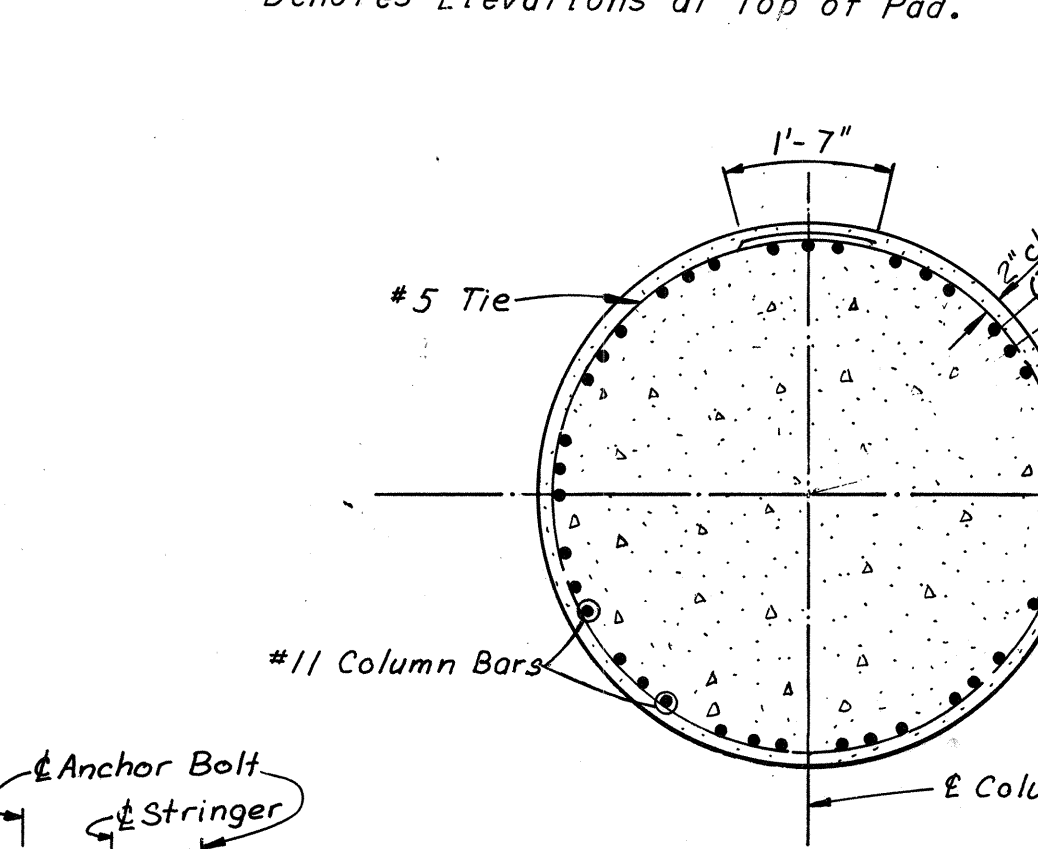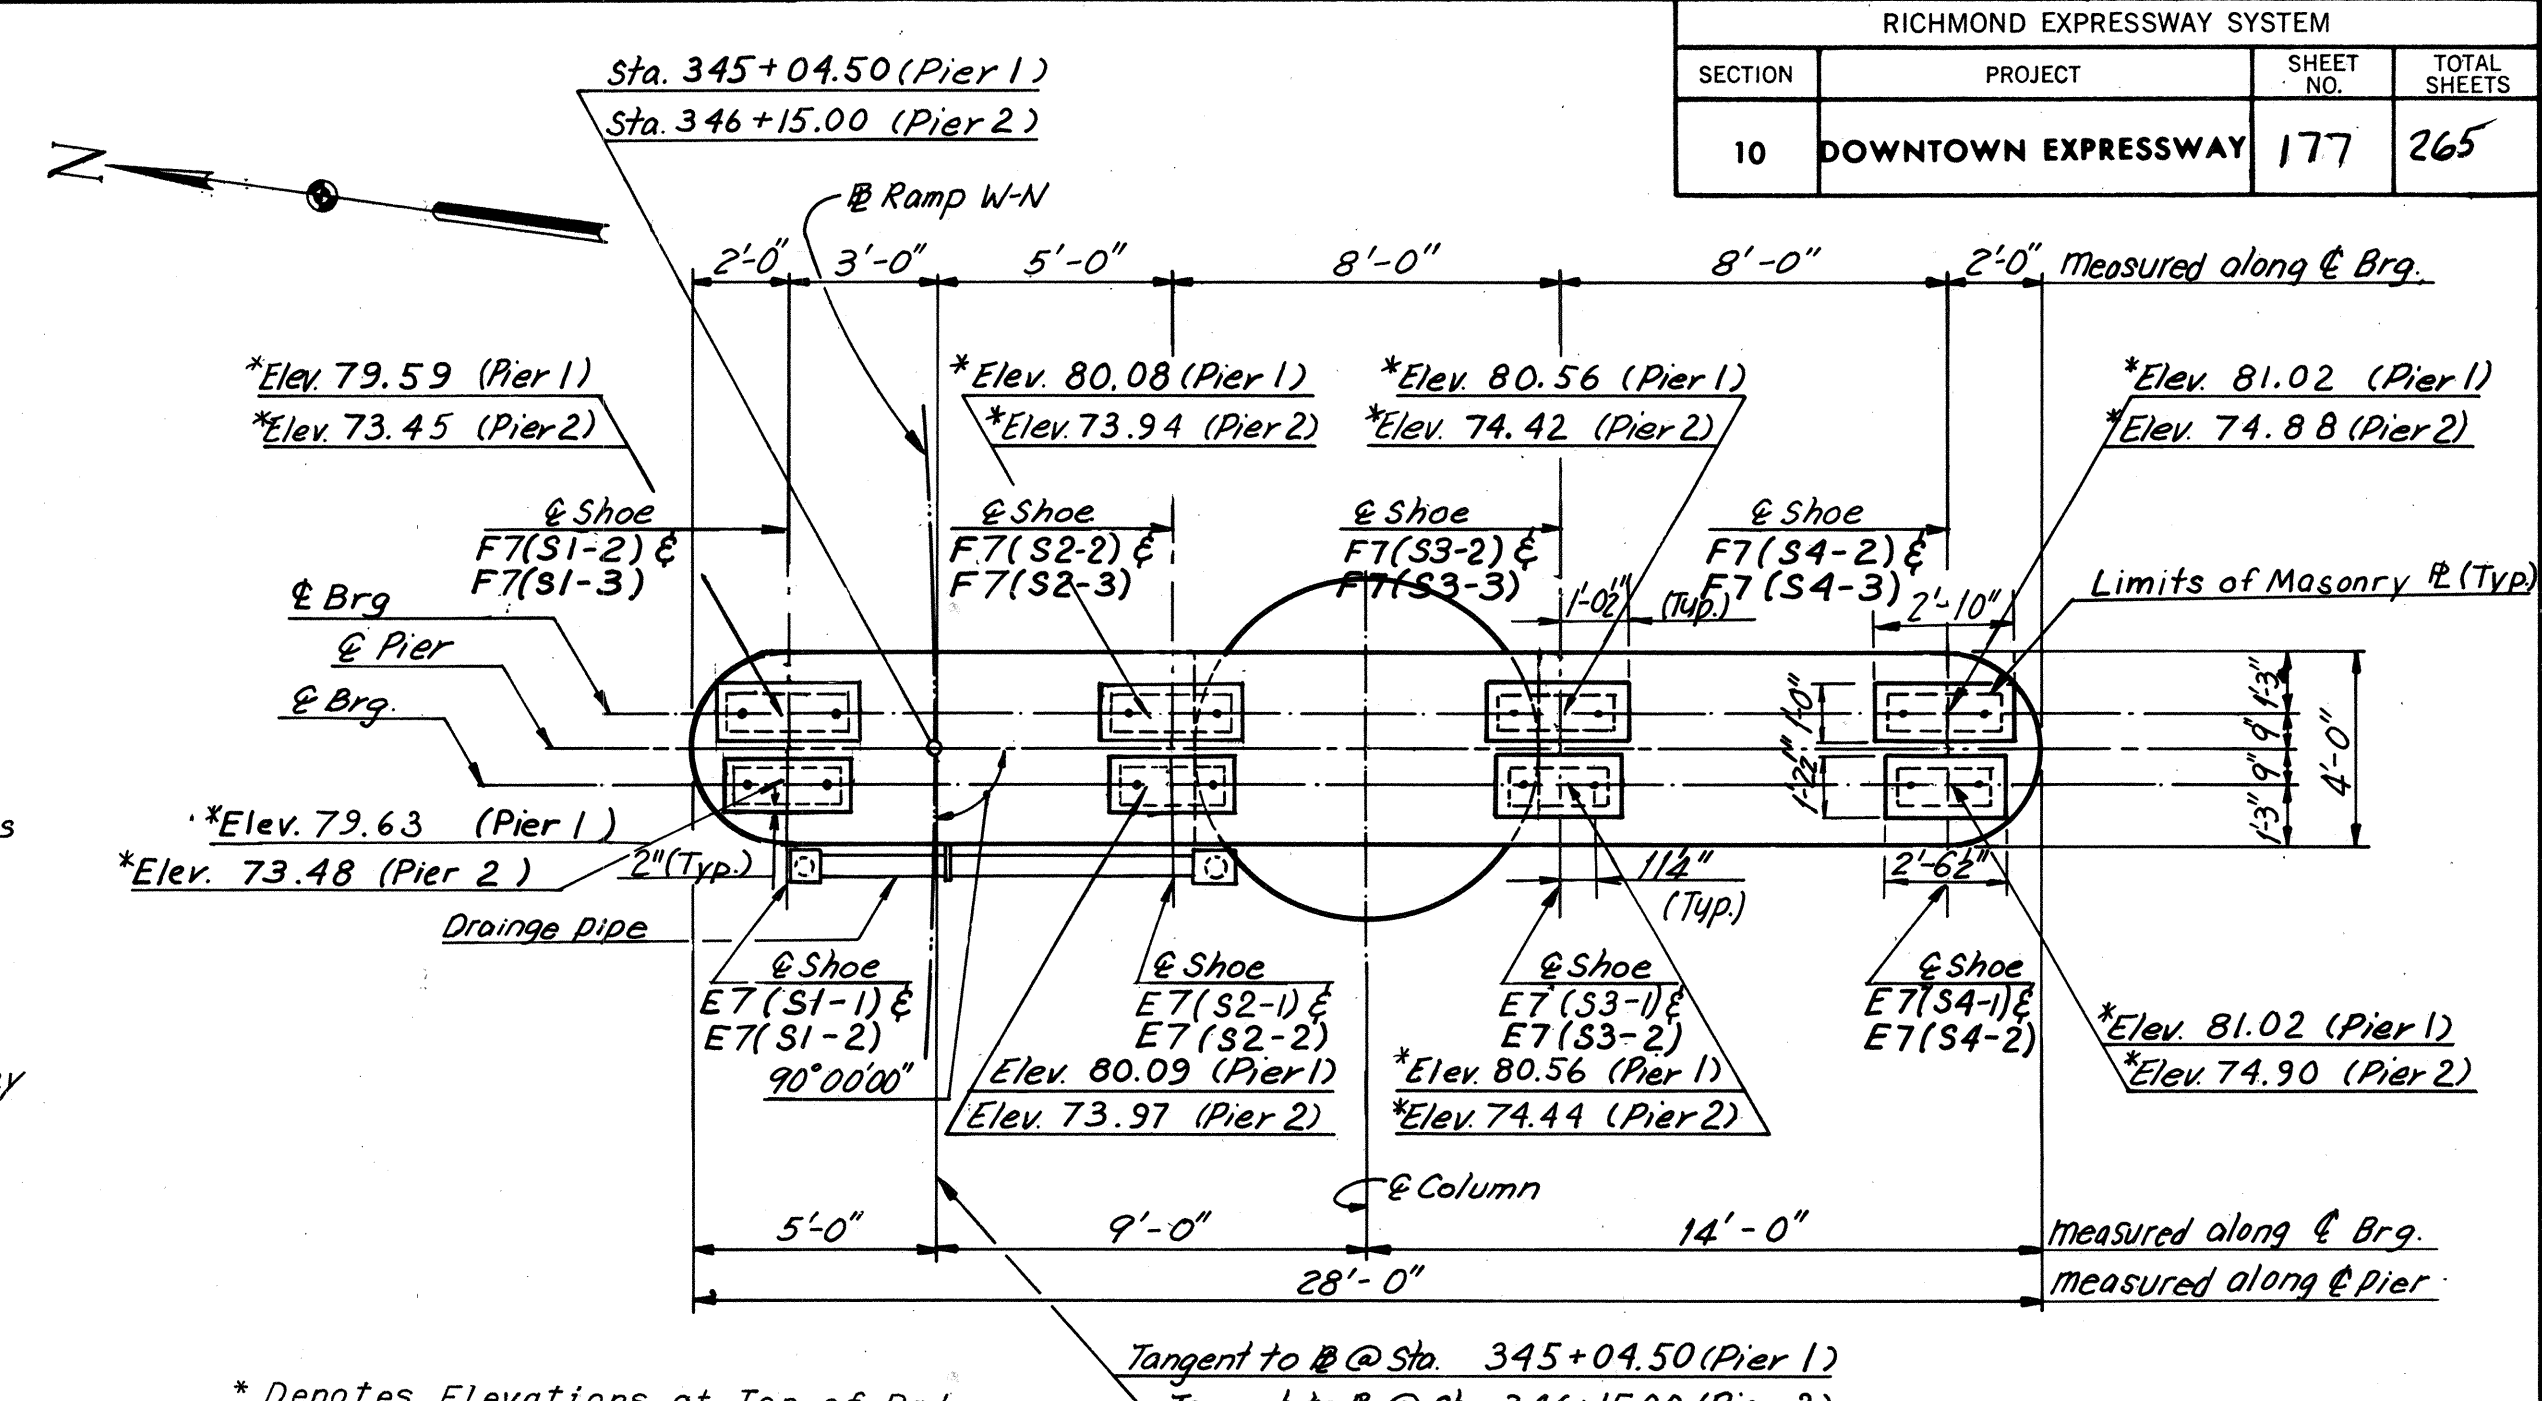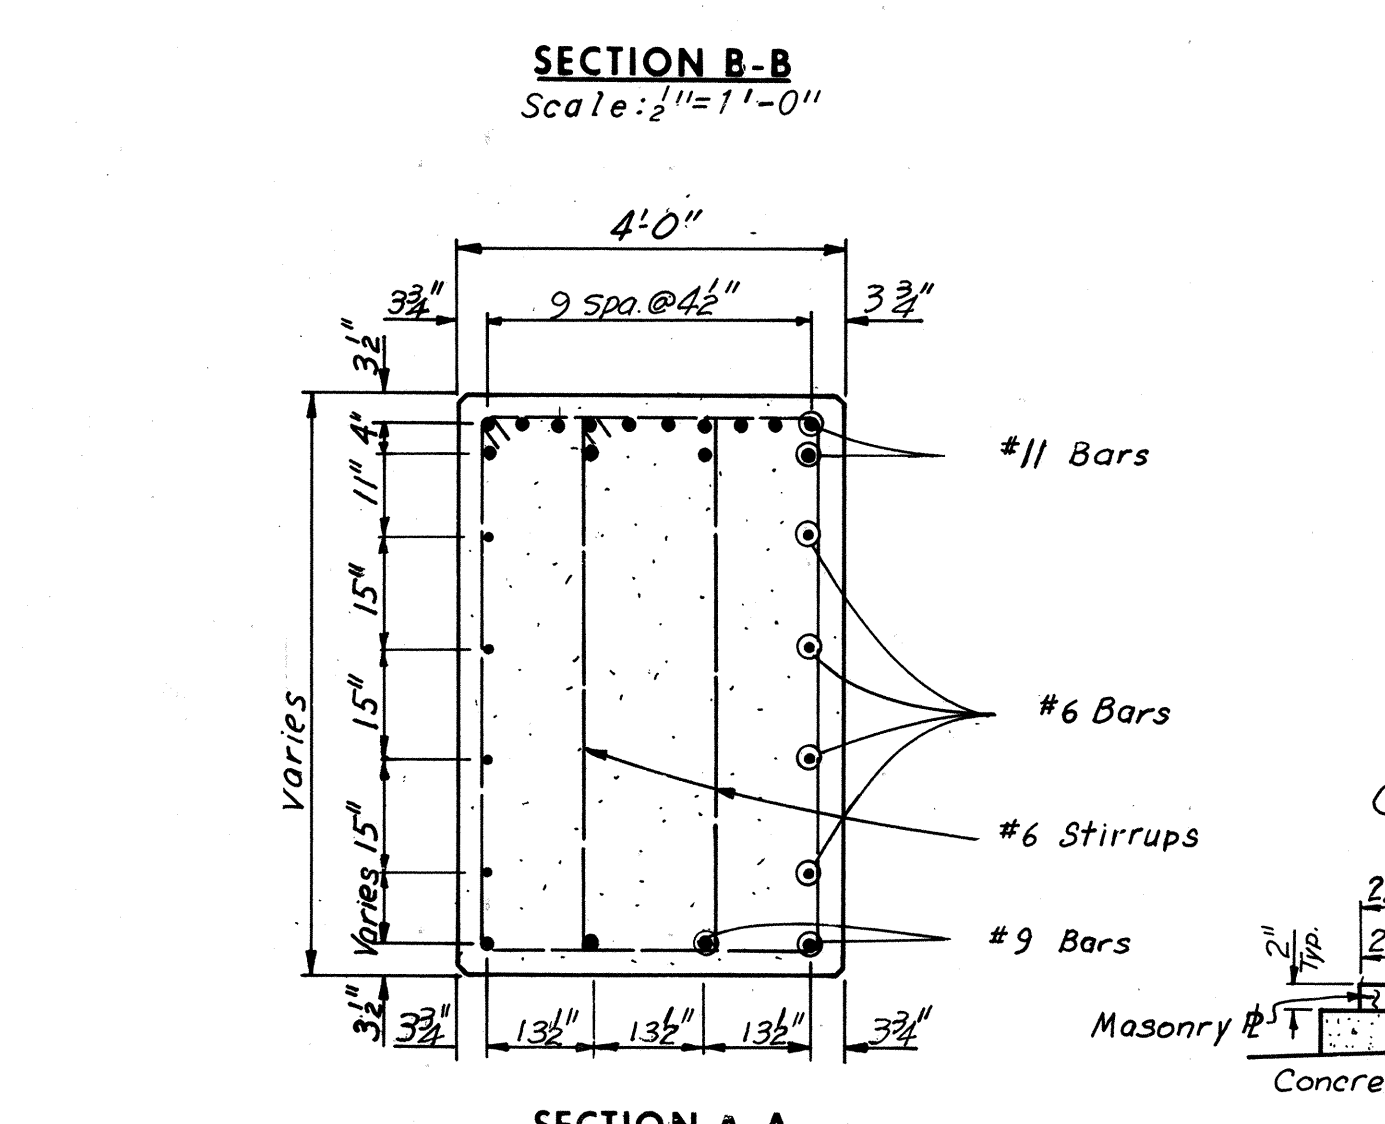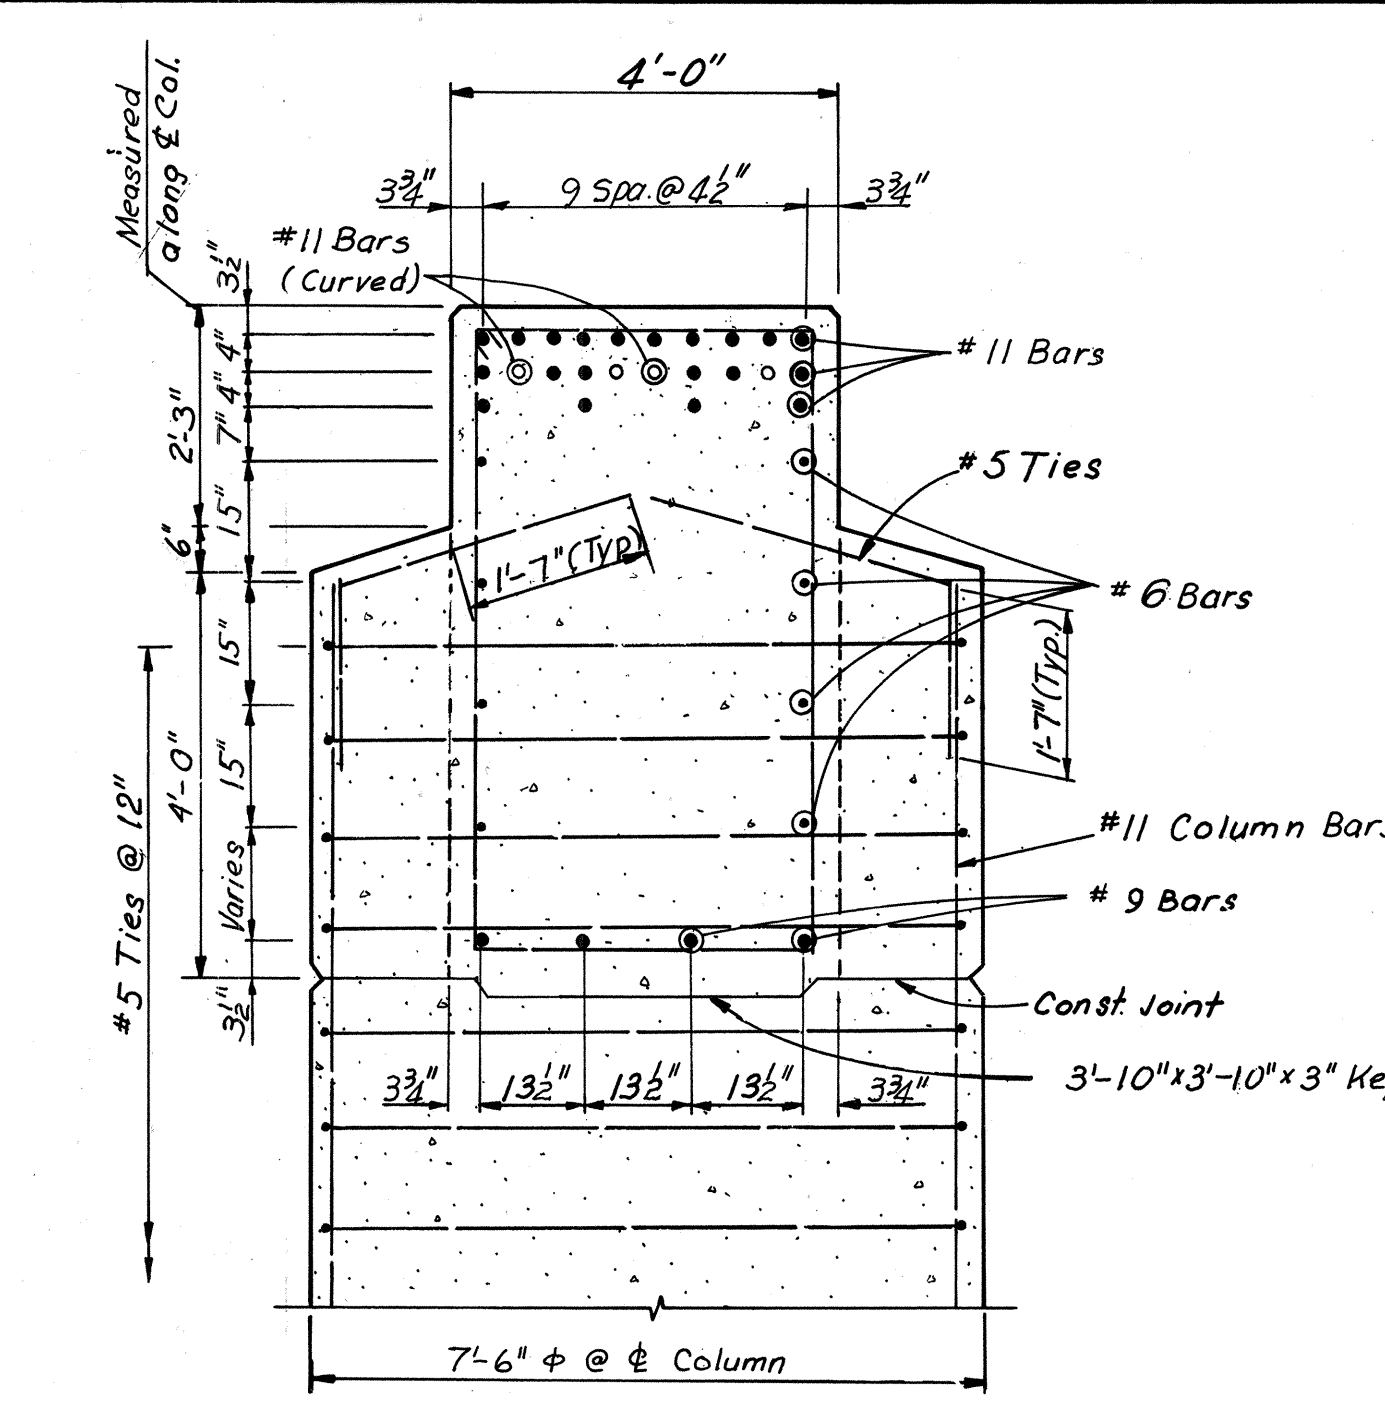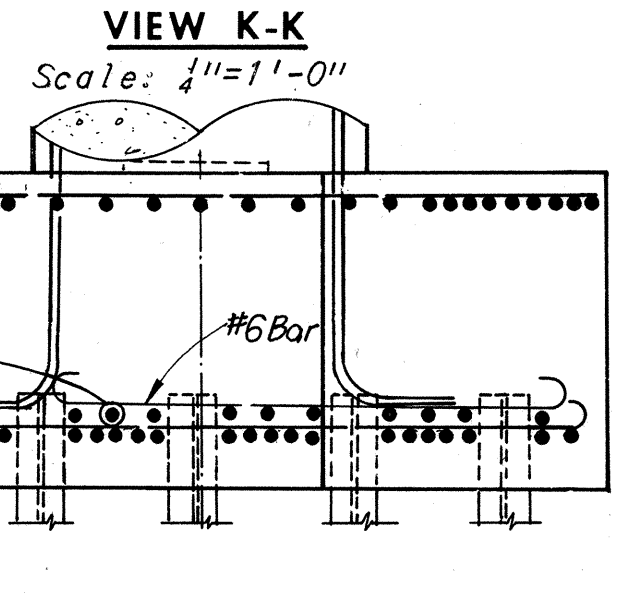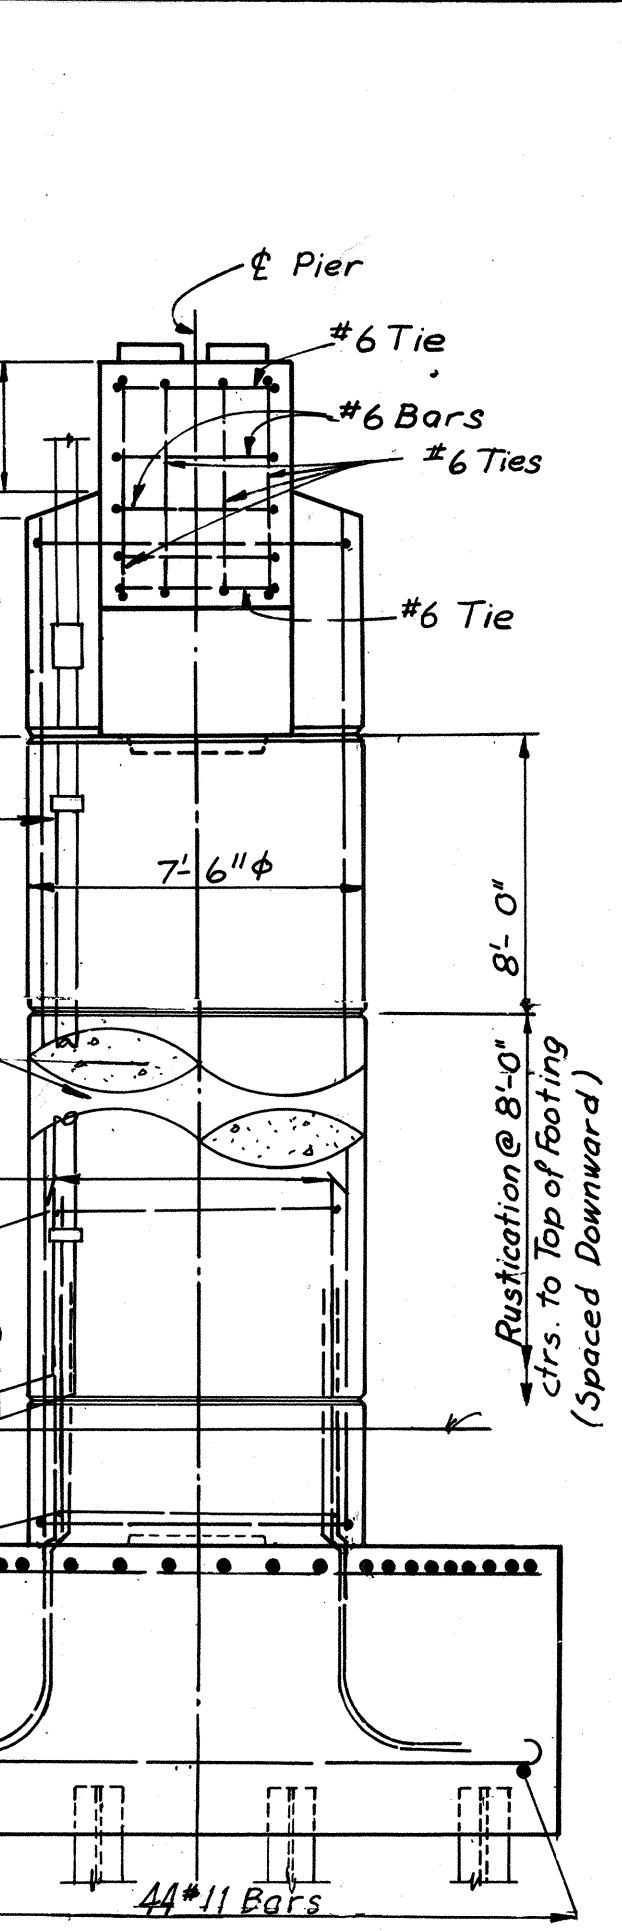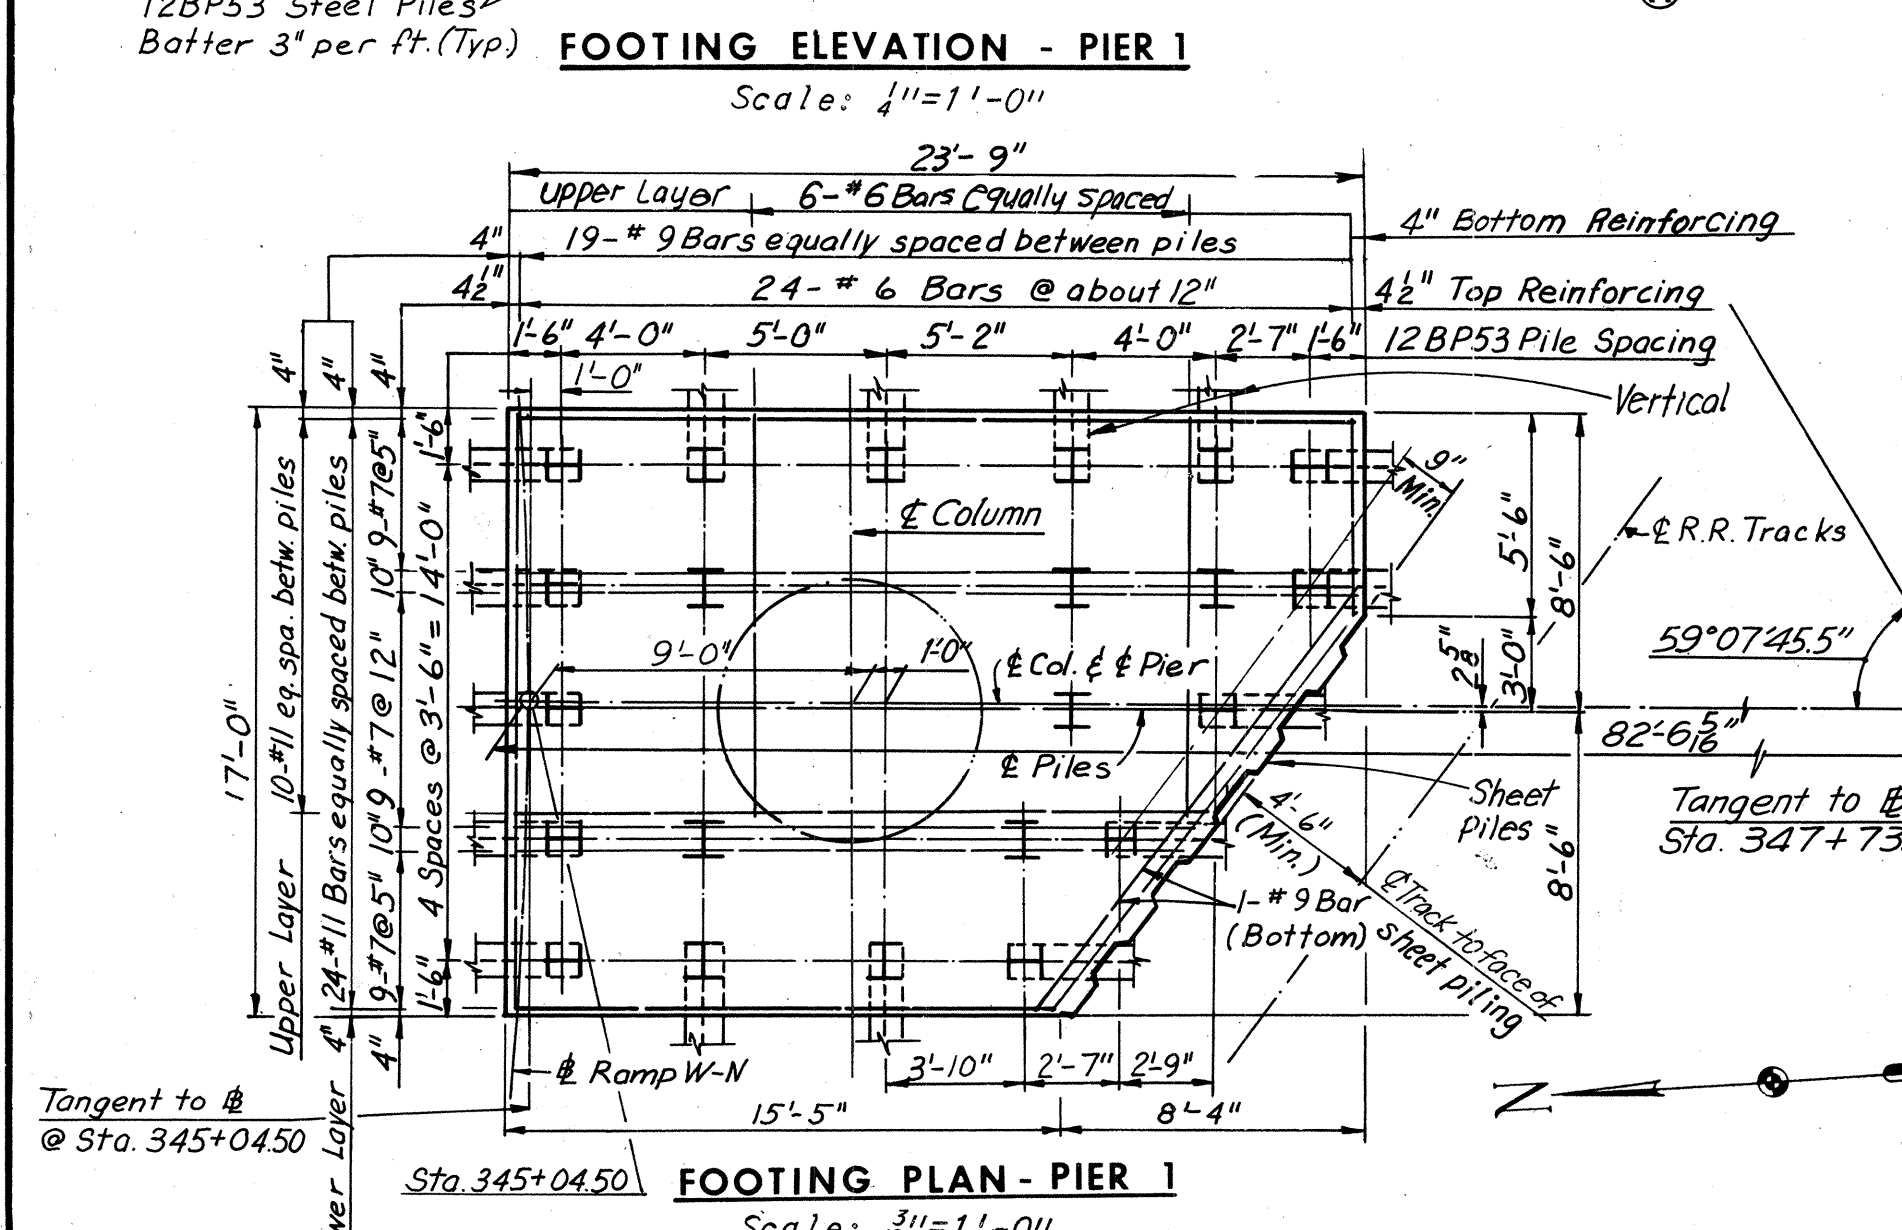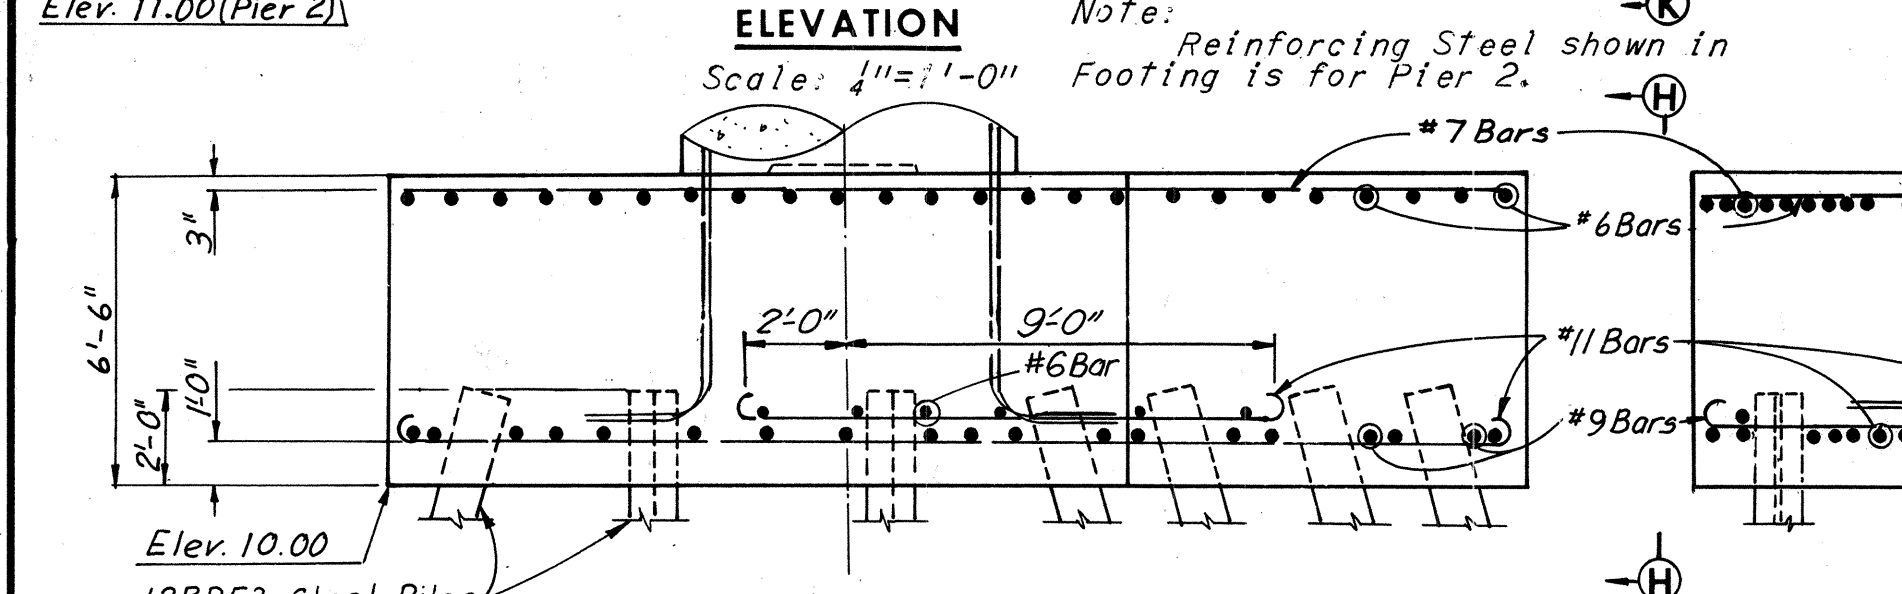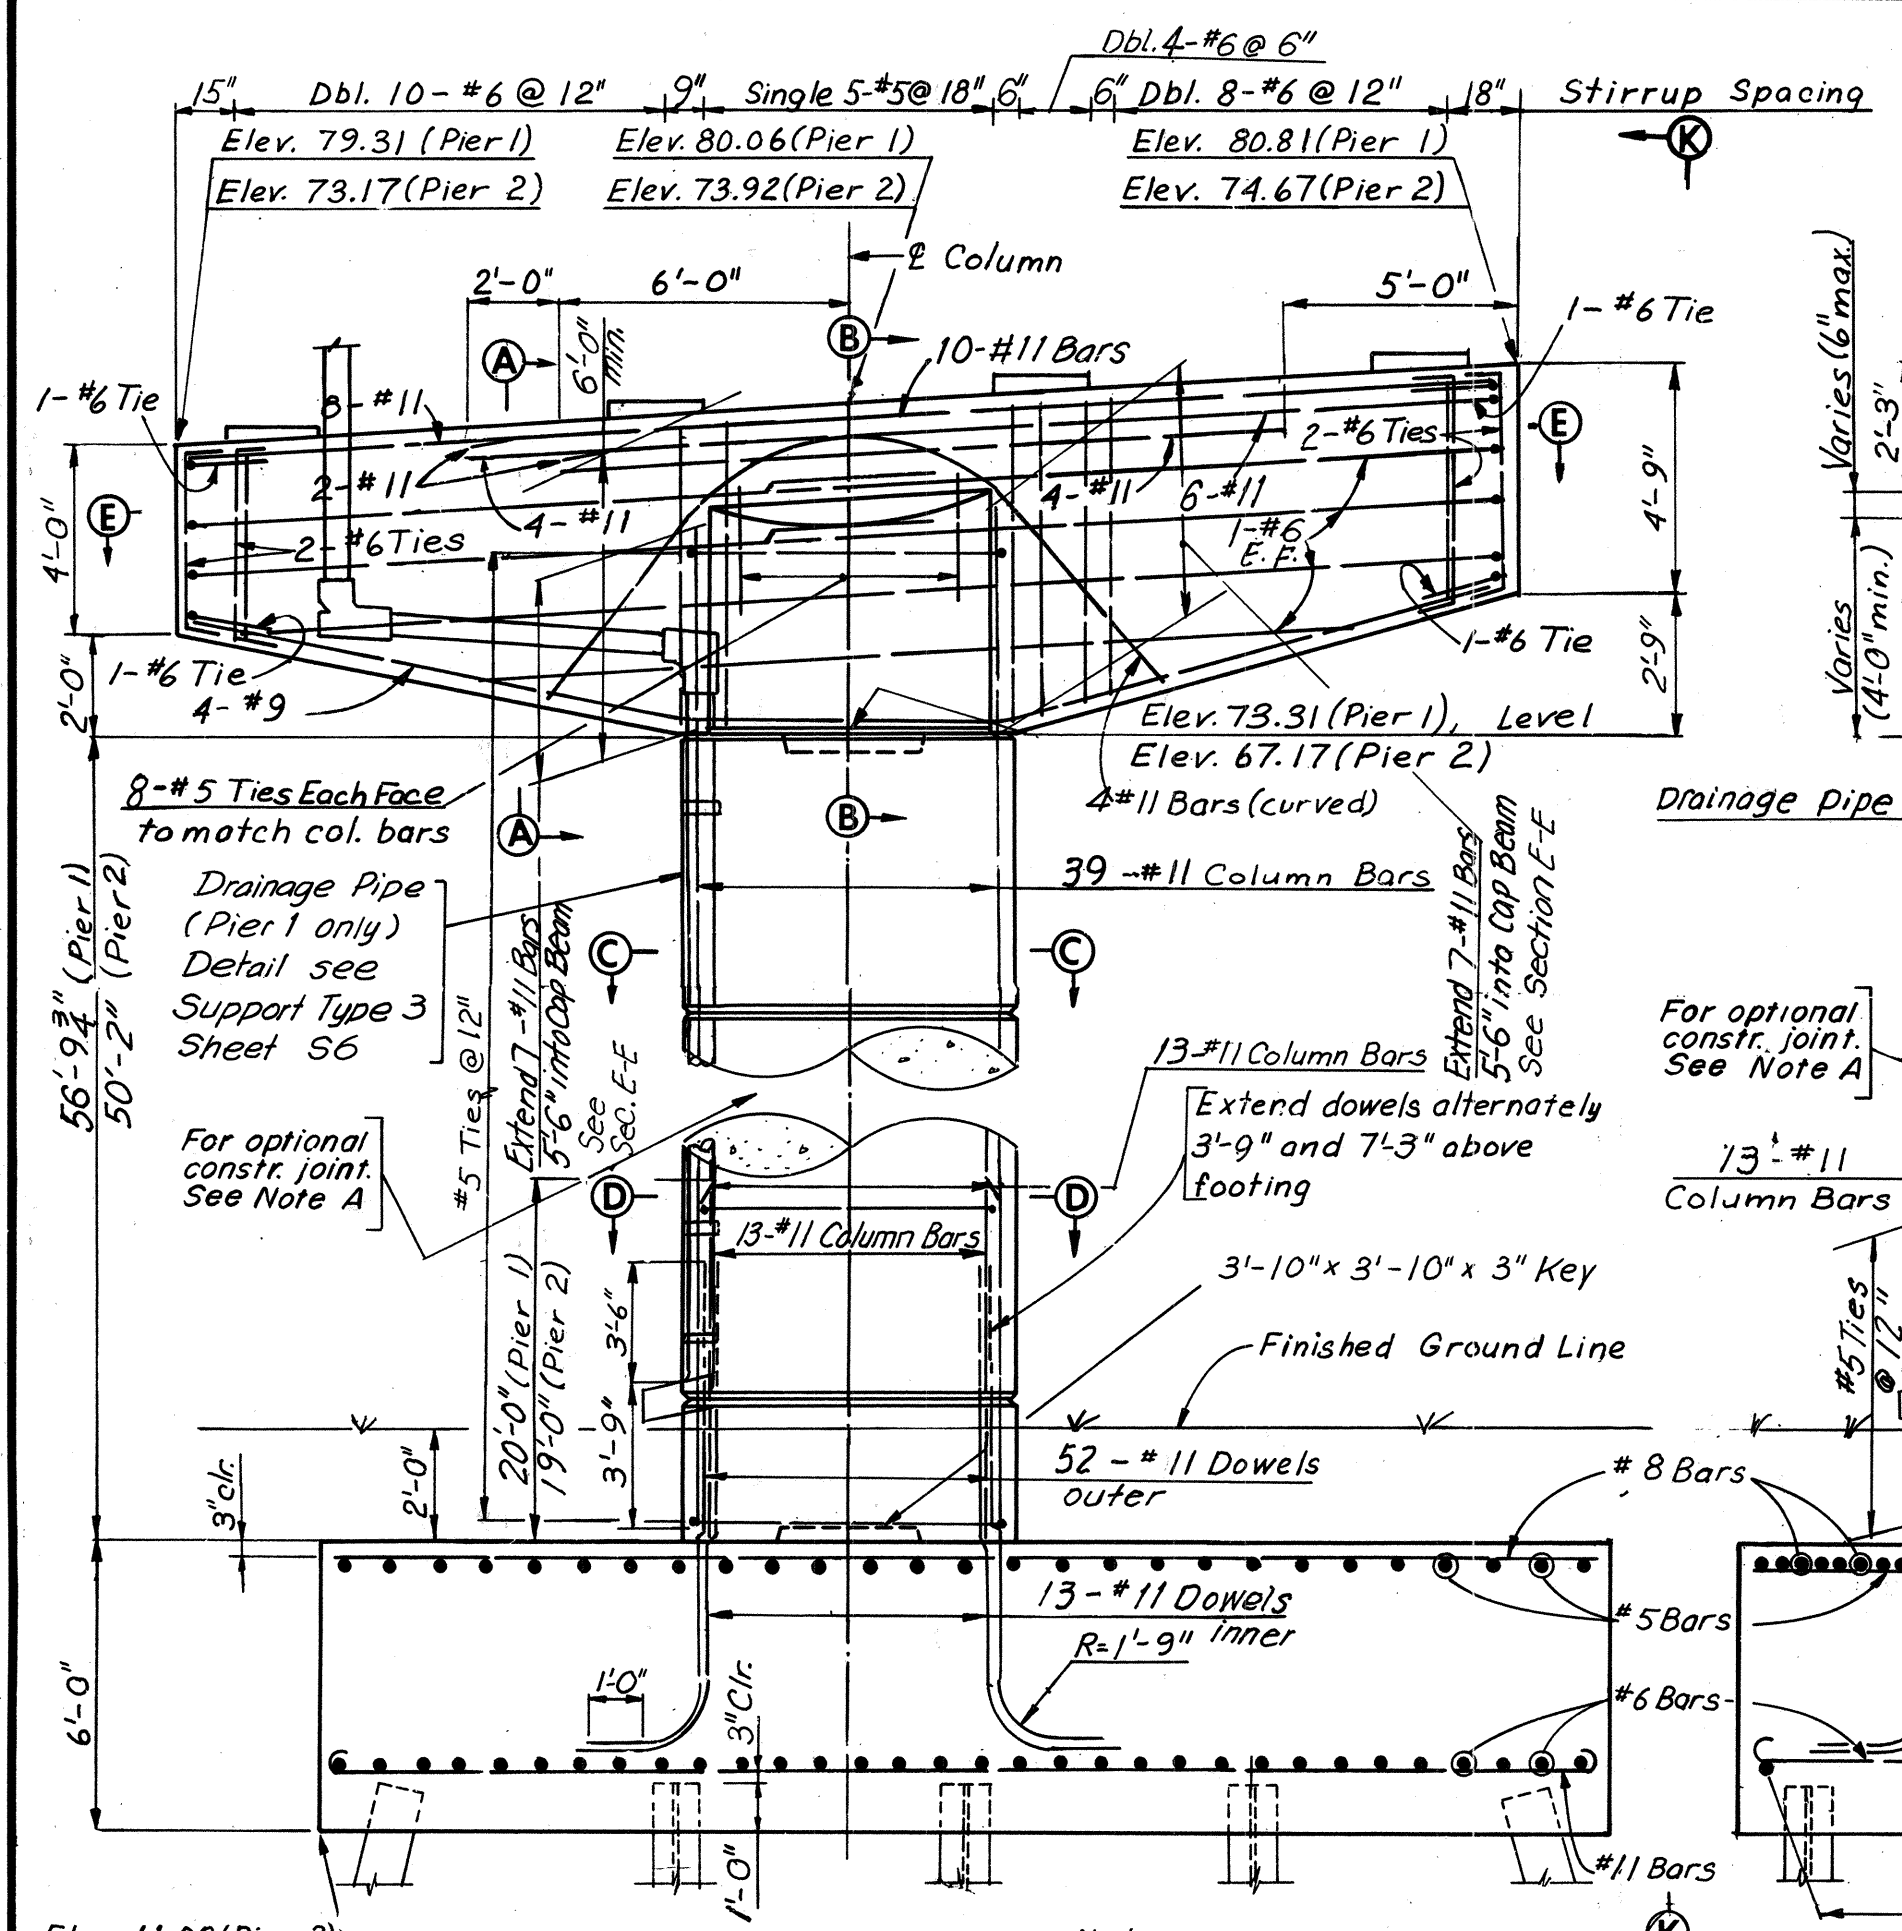

BY	DATE	REVISION	BY	DATE
J.D.	9-16-68			
G.S.H.	4-21-69	1	As Built	TEM 6-77

Note: For 12BP53 Steel Pile Details, see Sheet 6. All piles shall be 12BP53 Steel Piles (Design capacity = 57 tons).
Note: Footing elevations are approximate only and may be varied to suit field conditions as directed by the Engineer. Vertical shaft reinforcement shall not be cut until these elevations are established. Estimated pile tip elevation is 8.00. Where elevations change more than 2 ft., redesign will be required.

RICHMOND METROPOLITAN AUTHORITY
RICHMOND EXPRESSWAY SYSTEM
DOWNTOWN EXPRESSWAY

BRIDGE NO. 67
RAMP W-N CONNECTION TO
RICHMOND-PETERSBURG TURNPIKE
PIERS 1 AND 2

HOWARD, NEEDLES, TAMMEN & BERGENDOFF
consulting engineers
NEW YORK ALEXANDRIA KANSAS CITY

SCALE: As Noted
CONTRACT NO. 10
SHEET NO. 5 OF 54

AS BUILT

FOOTINGS FOR PIERS 1 AND 2 ARE ECCENTRIC AS SHOWN ON FOOTING PLANS ABOVE


Bridge 68

**(Ramp from Eastbound Downtown Expressway “Rte. 195” to Southbound I-95 over East Byrd Street, NS
RR and CSX RR)**

Record Set Plans


RICHMOND EXPRESSWAY SYSTEM			
SECTION	PROJECT	SHEET NO.	TOTAL SHEETS
11	DOWNTOWN EXPRESSWAY	64	97

INDEX	SHEET
GENERAL PLAN AND ELEVATION	1
GENERAL PLAN AND ELEVATION	2
LAYOUT	3
PIERS 1 AND 2	4 AND 4A
PIER 3	5
PIER 4	6
PIER 5	7
PIERS 6 AND 7	8
PIERS 8, 9 AND 10	9
PIERS 11 AND 12	10
PIERS 13 AND 14	11
FRAMING PLAN UNITS 2 AND 3	12
FRAMING PLAN UNITS 4, 5 AND 6	13
FRAMING PLAN UNITS 7, 8, AND 9	14
FRAMING PLAN UNITS 10, 11 AND 12	15
FRAMING PLAN UNITS 13 THRU 18	16 AND 16A
FRAMING DETAILS	17
FRAMING DETAILS 2 AND 3	18
DECK PLAN UNITS 4, 5 AND 6	19
DECK PLAN UNITS 7, 8 AND 9	20
DECK PLAN UNITS 10, 11 AND 12	21
DECK PLAN UNITS 13 THRU 18	22
SUPERSTRUCTURE DETAILS	23
JOINT DETAILS	24
BORING LOGS	25 AND 26
STANDARD SHEETS	27 AND 28
EXISTING PIERS 42 & 44 MODIFICATIONS	51 THRU 56
	11A

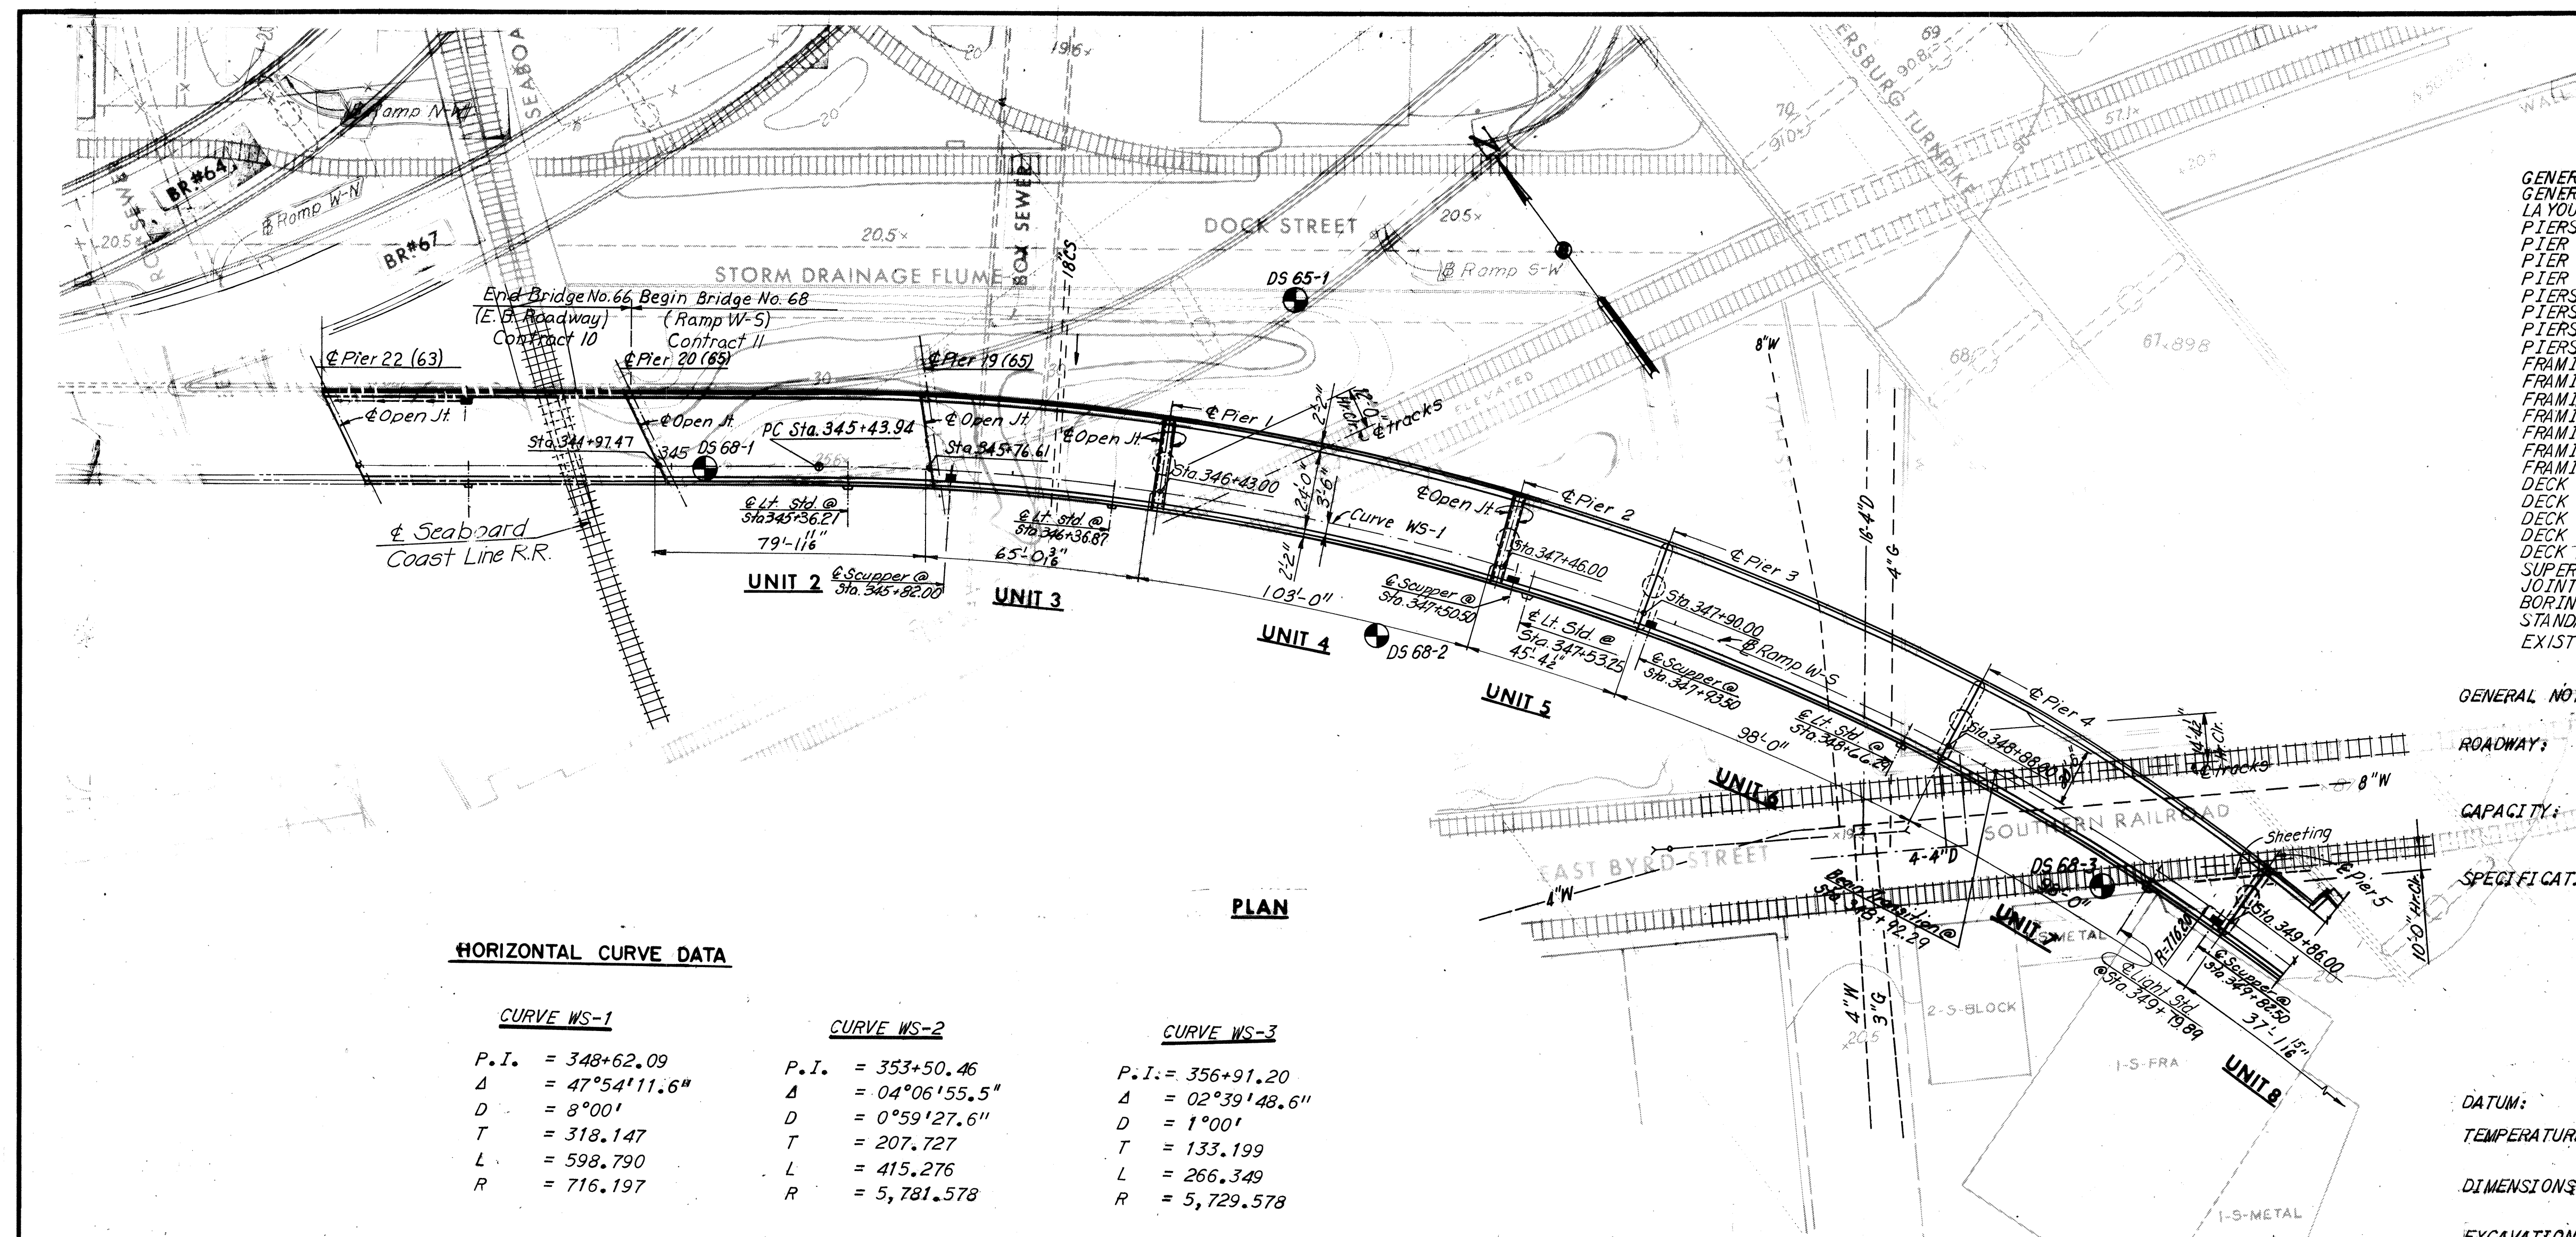

HORIZONTAL CURVE DATA

CURVE WS-1		CURVE WS-2		CURVE WS-3	
P.I.	= 348+62.09	P.I.	= 353+50.46	P.I.	= 356+91.20
Δ	= 47°54'11.6"	Δ	= 04°06'55.5"	Δ	= 02°39'48.6"
D	= 8°00'	D	= 0°59'27.6"	D	= 1°00'
T	= 318.147	T	= 207.727	T	= 133.199
L	= 598.790	L	= 415.276	L	= 266.349
R	= 716.197	R	= 5,781.578	R	= 5,729.578

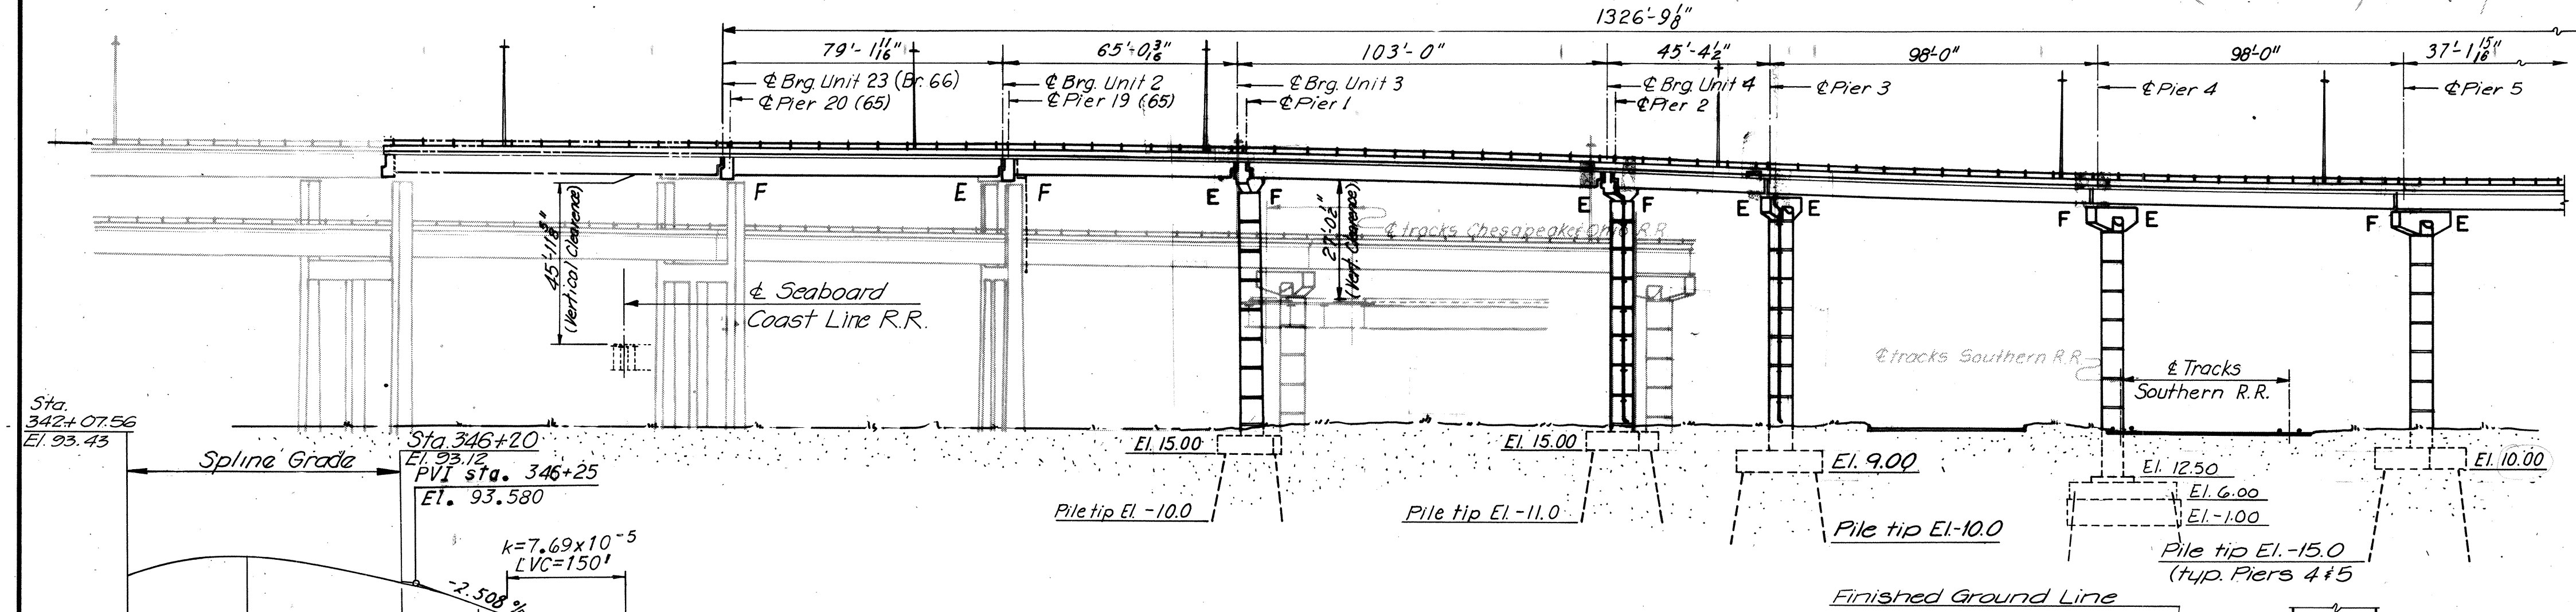

ELEVATION

GENERAL NOTES

ROADWAY: One 24'-0" clear roadway transitioning into a 13'-6" widening of existing Richmond-Petersburg Turnpike.

CAPACITY: Dead load includes 15lbs. per sq.ft. for future wearing surface. Live load HS 20-44 loading and alternate military loading.

SPECIFICATIONS:

GENERAL: Virginia Department of Highway Road and Bridge Specifications 1970.

DESIGN: A.A.S.H.O. Standard Specifications for Highway Bridges 1973, modified by Special Design provisions.

WELDING: 1972 Structural Welding Code of the American Welding Society.

CONTRACT SPECIAL PROVISIONS
Specifications and Contract Special Provisions referred to above are necessary to make these plans complete.

DATUM: City of Richmond

TEMPERATURE: The normal temperature referred to in the plans is 60°F. The temperature range for movement is 0°F to 120°F.

DIMENSIONS: All dimensions are measured horizontally and vertically unless otherwise noted.

EXCAVATION: Excavation below subgrade and cut slope template shall be classified as Regular Excavation. All excavation above these limits shall be classified as Regular Excavation and is not included in the Structural Quantities.

FOUNDATIONS: Footings shall rest on firm material. Foundation material shall be dry and special attention is called to Section 401.05 of General Specifications and to the Contract Special Provisions, concerning preparation of foundations for footings.


CONCRETE NOTES: Concrete in superstructure shall be Class A-4. All other concrete shall be Class A-3. All exposed edges and corners shall have a 3" chamfer or fillet unless otherwise noted. Care in the method of vibration, the use of low-slump concrete, and or other means shall be employed to prevent downgrade movement of newly placed slab concrete. Finishing Concrete Surfaces: See Standard Architectural Detail Sheets and the Contract Special Provisions for types and details. All reinforcing steel shall be deformed bars conforming to ASTM A615 Grade 40. All reinforcing bar dimensions on the detailed drawings are to centers of bars unless otherwise noted. Clear distance between reinforcing steel and face of concrete shall be as noted on the plans. All bar laps shall be 30 diameters of the smaller diameter bar unless otherwise noted.

STEEL NOTES: Structural steel shall conform to A.S.T.M. Designations A36, A572-Grade 50 and A588 as noted. See Special Provisions. All field connections shall be made with high strength bolts. High strength bolts shall be 1" diameter unless otherwise noted and shall conform to A.S.T.M. Specification A-325.

BY	DATE	REVISION	BY	DATE
J.V.	4-2-69	Profile Grade W-5, Index	TEM	8-26-75
G.S.H.	7-16-69	Seaboard Coast Line Added	TEM	6-74

△ PROFILE GRADE ▣ RAMP W-5

LIMITS OF STRUCTURE EXCAVATION

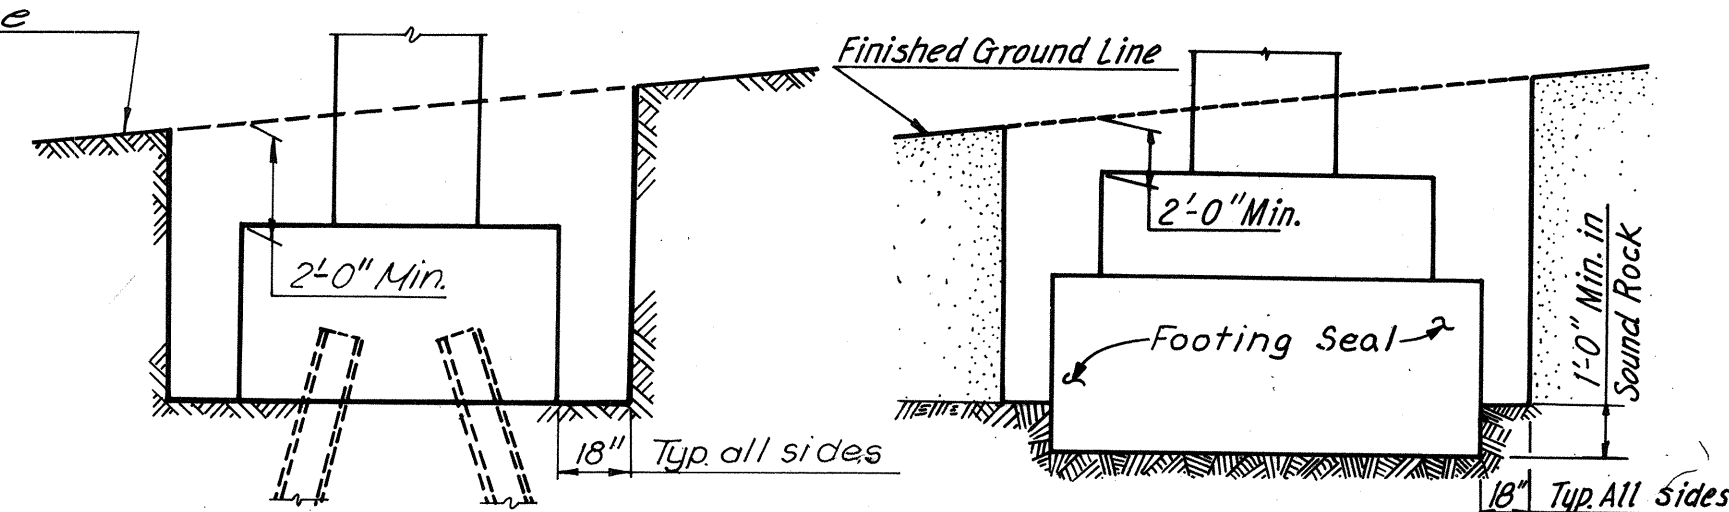

AS BUILT


RICHMOND METROPOLITAN AUTHORITY
RICHMOND EXPRESSWAY SYSTEM
DOWNTOWN EXPRESSWAY

BRIDGE NO. 68
RAMP W-5 CONNECTION TO
RICHMOND-PETERSBURG TURNPIKE
GENERAL PLAN AND ELEVATION


HOWARD, NEEDLES, TAMMEN & BERGENOFF
consulting engineers
NEW YORK ALEXANDRIA KANSAS CITY

SCALE: 1"=30'
CONTRACT NO. 11
SHEET NO. 1 OF 28

RICHMOND EXPRESSWAY SYSTEM			
SECTION	PROJECT	SHEET NO.	TOTAL SHEETS
11	DOWNTOWN EXPRESSWAY	65	97

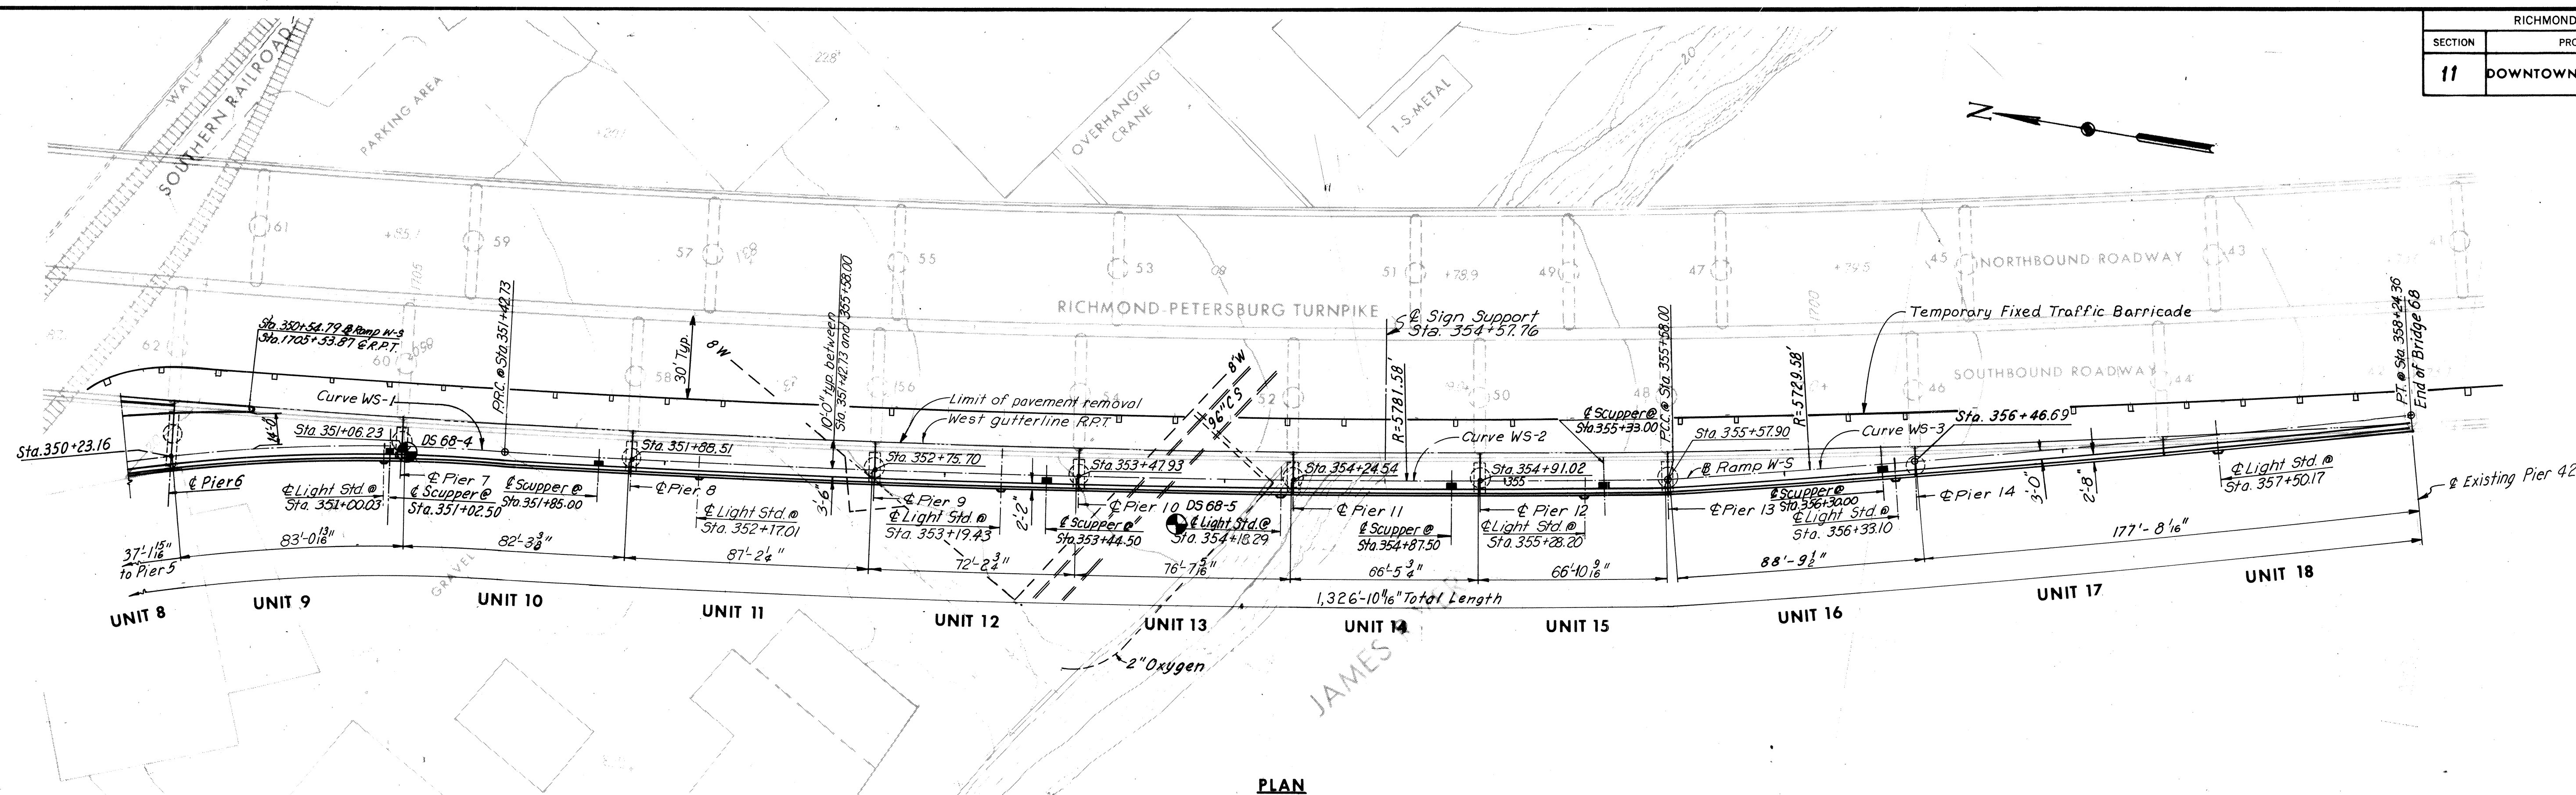

PLAN

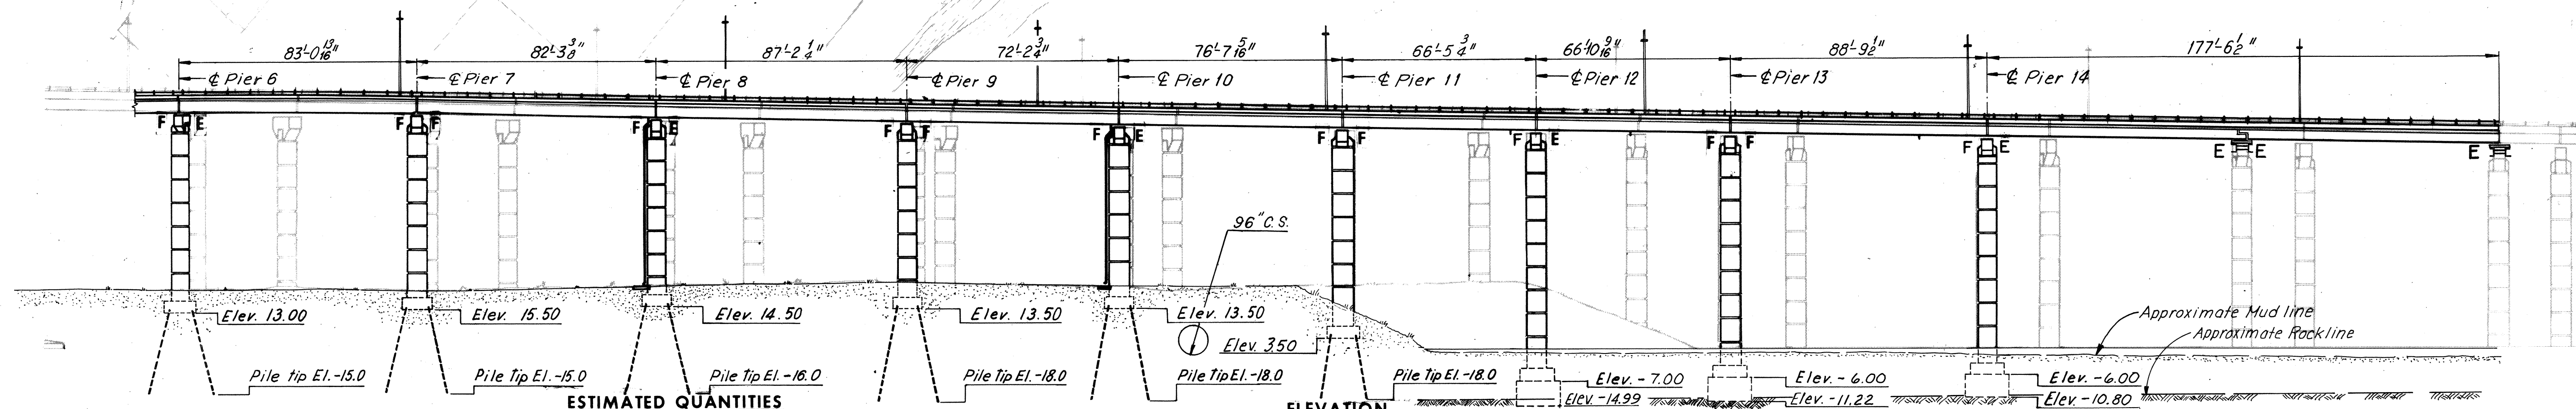

ELEVATION

ESTIMATED QUANTITIES

	Structure Excavation	Concrete	Reinforcing Steel	Str. Steel Mild carbon	Str. Steel High Strength	Aluminum Railing (1-rail)	Steel Piles 10BP42
	Cu. Yds.	Cu. Yds.	Lbs.	Lbs.	Lbs.	Lin. Ft.	Lin. Ft.
Superstructure	----	888.7	215,200	600,400	255,600	1,849	-----
Substructure	1,415*	1,751.0	245,300	31,600	8,400	---	2,630
Total	1,415*	2,639.7	460,500	632,000	264,000	1,849	2,630

	Steel Piles 12BP53	Tremie Concrete Class T3	Sheeting Pier 5	Metal Conduit	Bridge Drainage	Modifications to R.P. Turnpike Bridge	Modifications to Existing Retaining Wall	Temporary Barricade
	Lin. Ft.	Cu. Yds	Lump Sum	Lin. Ft.	metal work Lbs.	Lump Sum	Cu. Yds.	Lin. Ft.
Superstructure	---	---		1,310	11,450	1	50	
Substructure	1,412	173.3	1	---	---	---	---	
Total	1,412	173.3	1	1,310	11,450	1	50	990

* Including 365 Cu. Yds. of "Underwater" Excavation for Piers 12, 13 and 14.
 * All concrete for Superstructure shall be Class A4 and for Substructure Class A3. Concrete for Footing Seals shall be Tremie Concrete, Class T3 and is listed separately.

BY	DATE	REVISION	BY	DATE
MADE	J.V. 4-3-69			
CHECKED	G.S.H. 7-16-69	At Pier 44 # 42	T.E.M. 8-26-75	
IN CHARGE				

AS BUILT


RICHMOND METROPOLITAN AUTHORITY
RICHMOND EXPRESSWAY SYSTEM
DOWNTOWN EXPRESSWAY

BRIDGE NO. 68
RAMP W-S CONNECTION TO
RICHMOND-PETERSBURG TURNPIKE
GENERAL PLAN AND ELEVATION


HOWARD, NEEDLES, TAMMEN & BERGENDOFF
 consulting engineers
 NEW YORK ALEXANDRIA KANSAS CITY

SCALE: 1"=30'
 CONTRACT NO. 11
 SHEET NO. 2 OF 28


RICHMOND EXPRESSWAY SYSTEM			
SECTION	PROJECT	SHEET NO.	TOTAL SHEETS
11	DOWNTOWN EXPRESSWAY	81	97

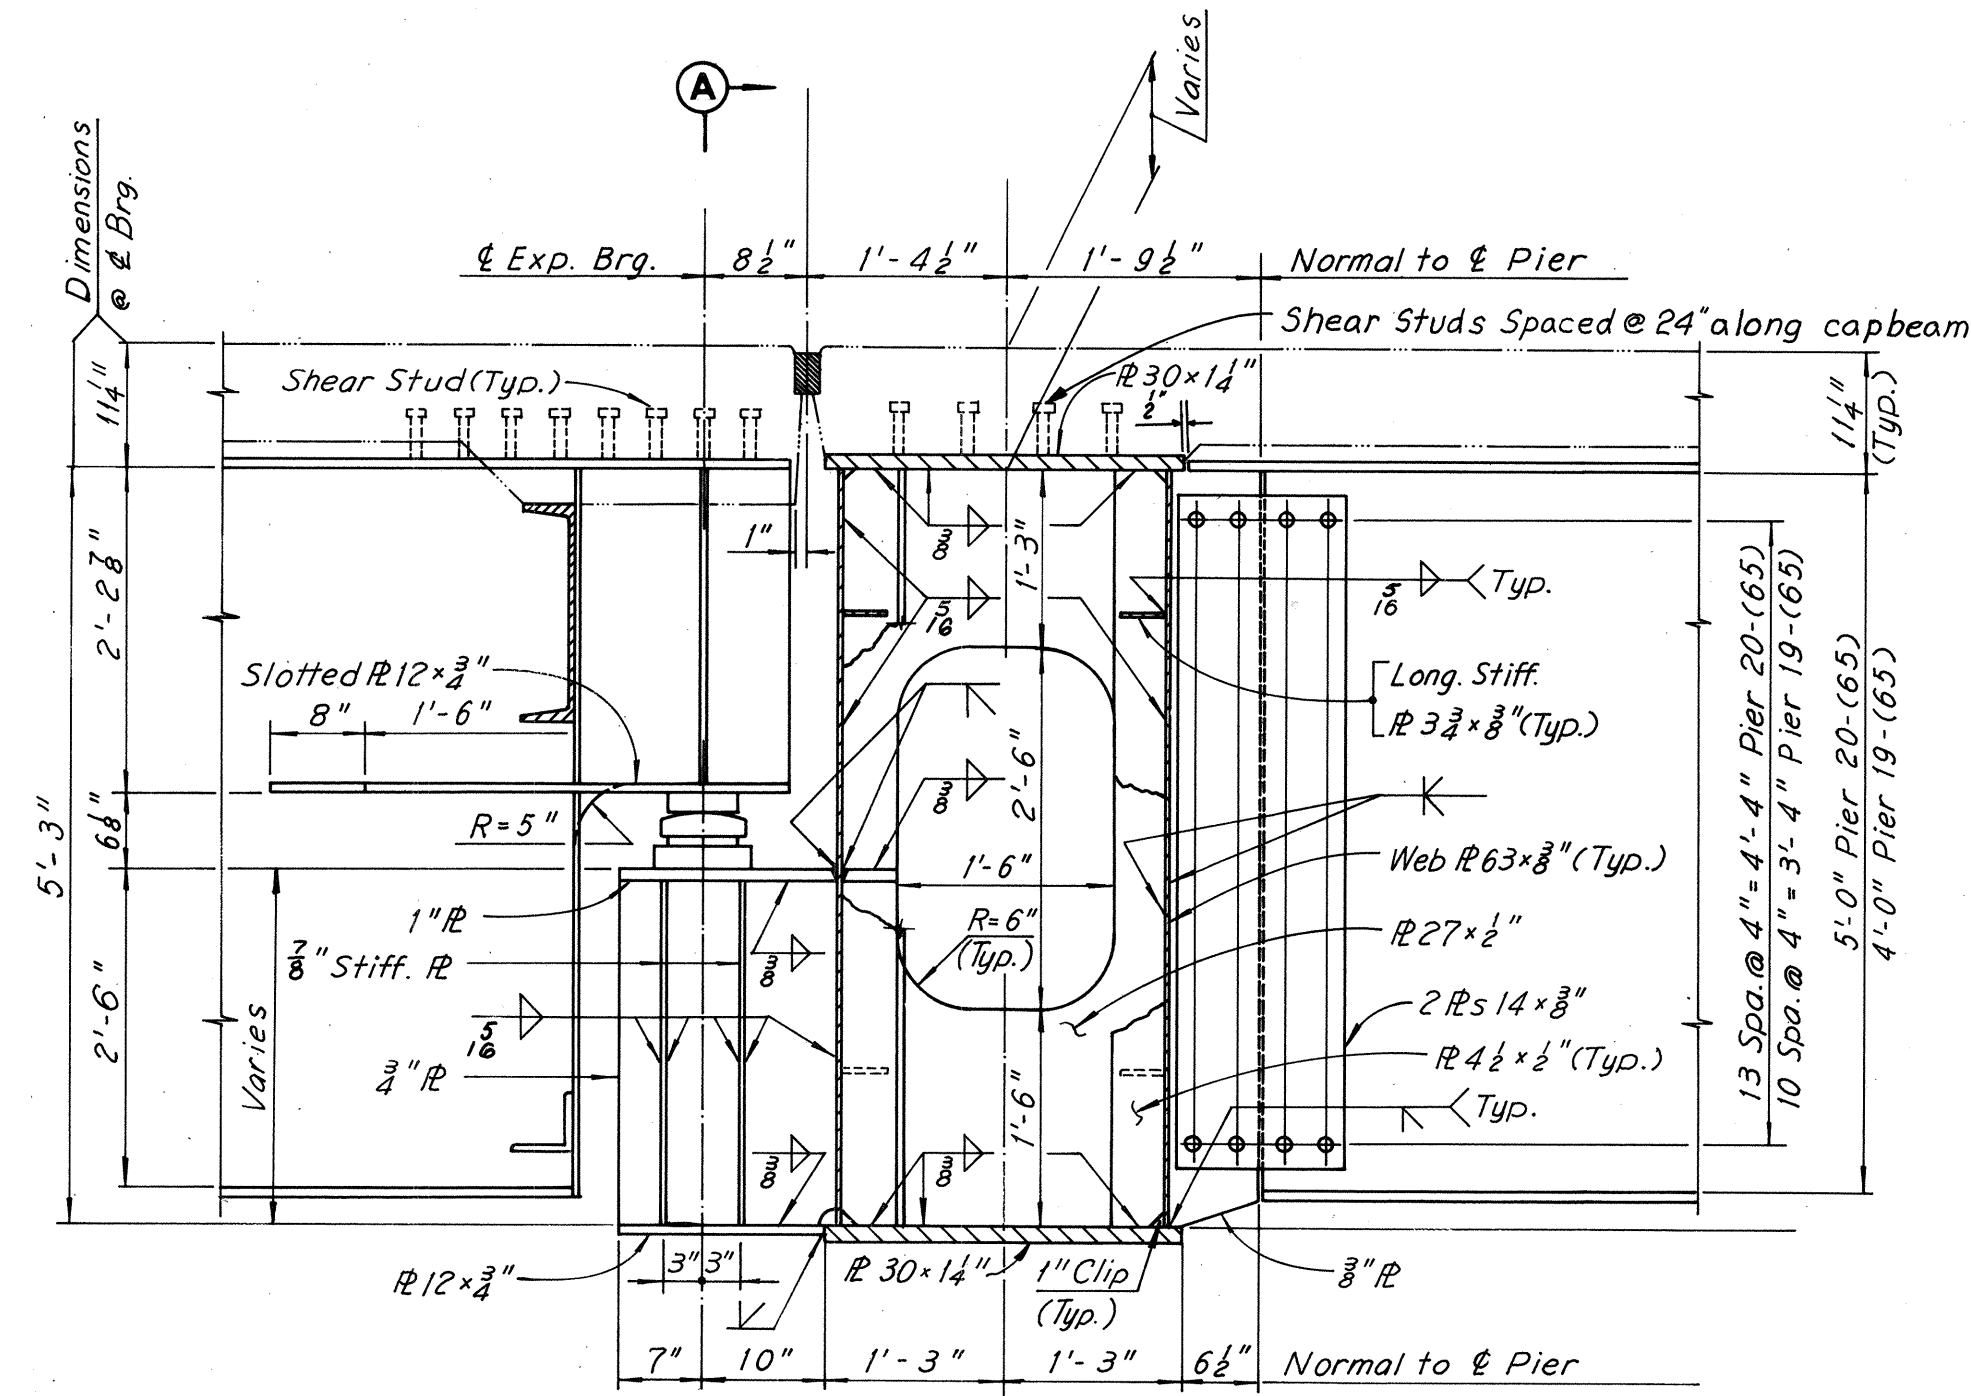

TYPICAL SECTION
Scale: 3/4" = 1'-0"

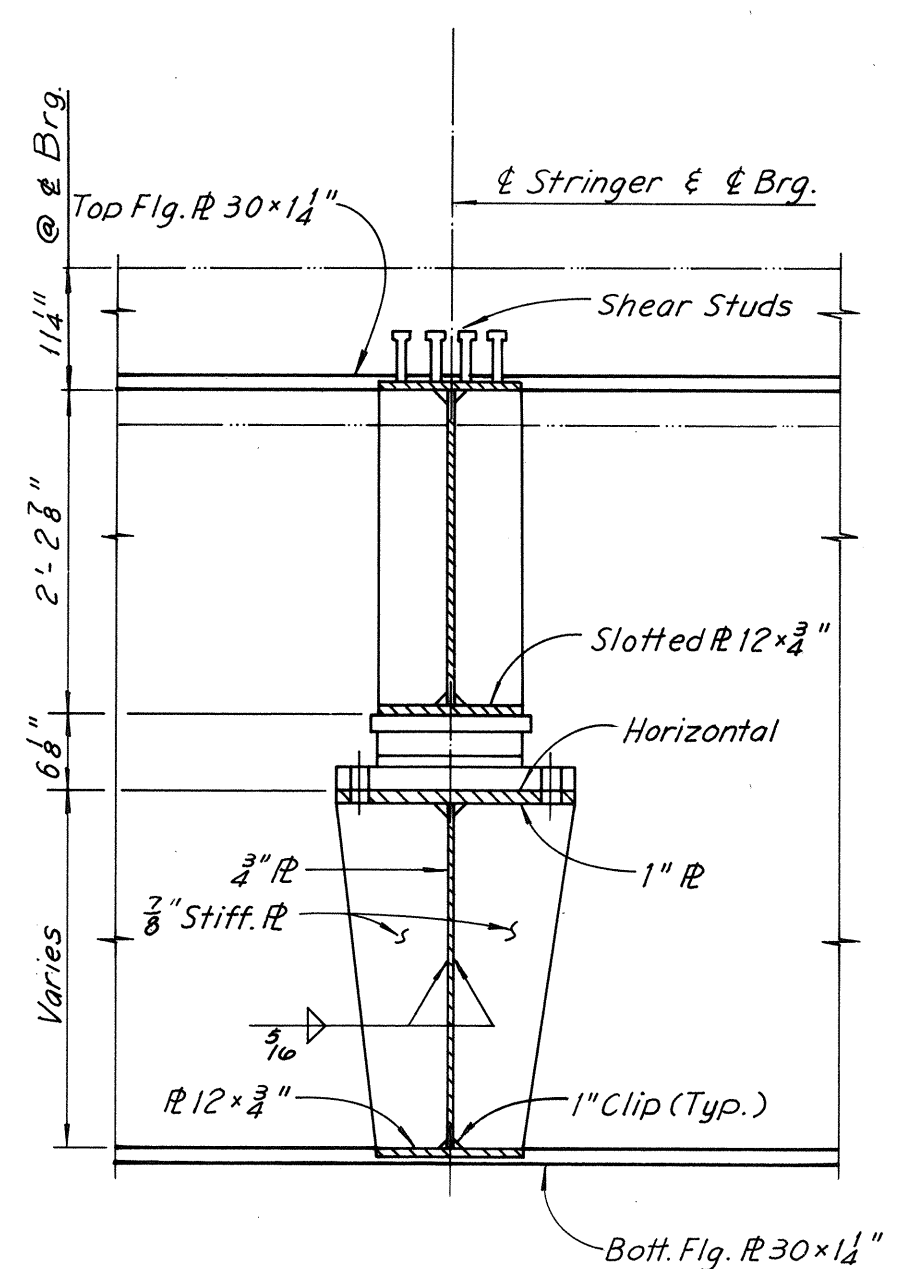


SECTION A-A
Scale: 3/4" = 1'-0"

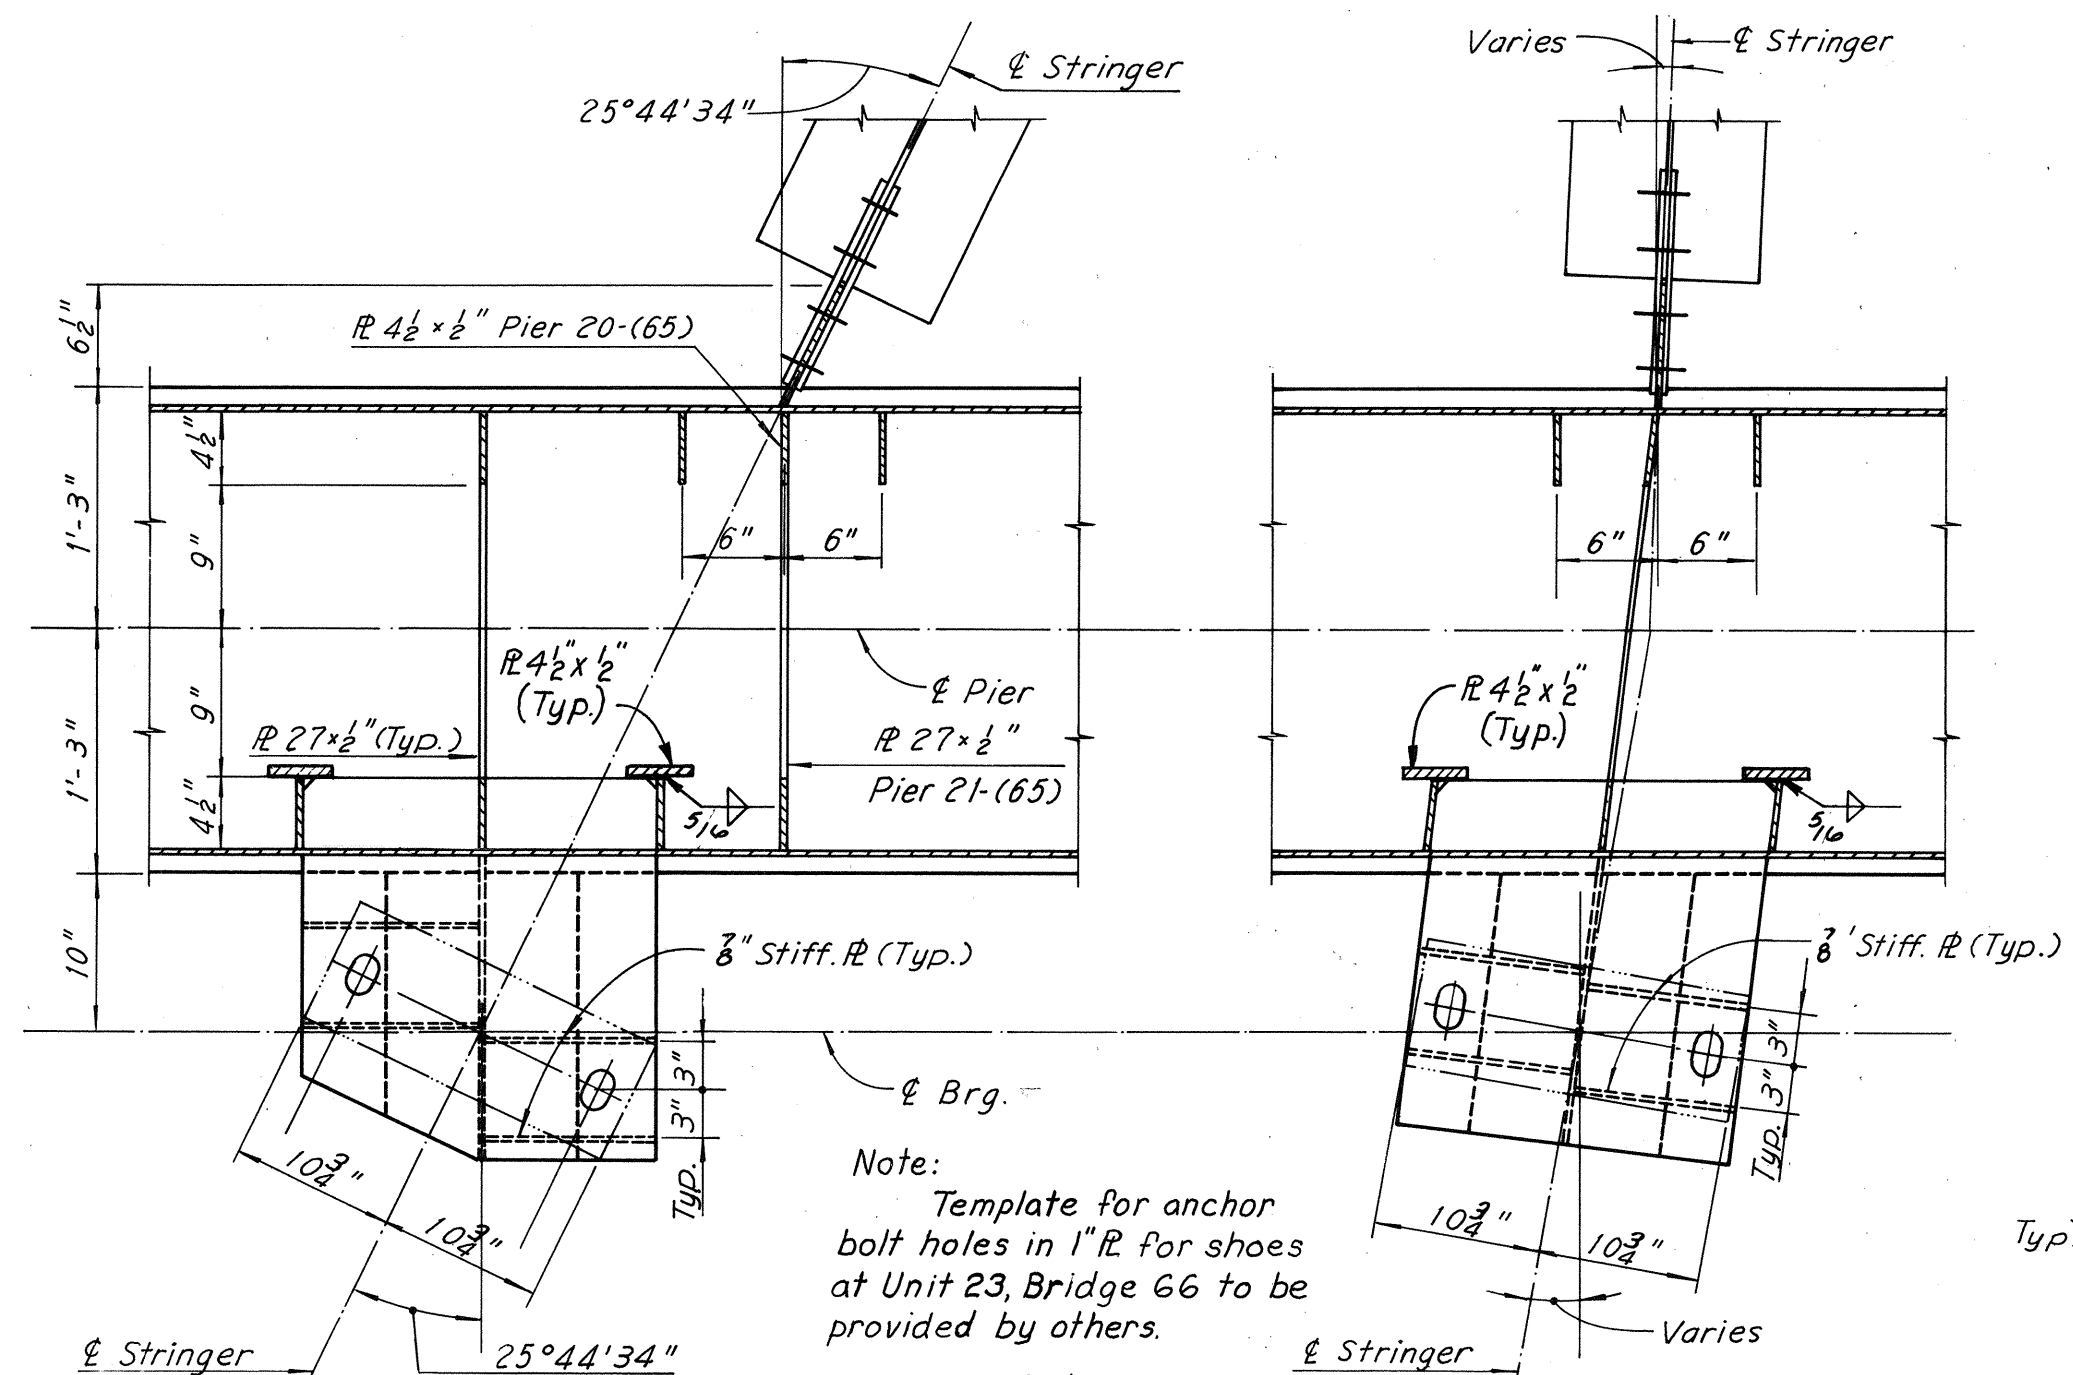


DETAIL A
Scale: 1" = 1'-0"


DETAIL B
Scale: 1" = 1'-0"

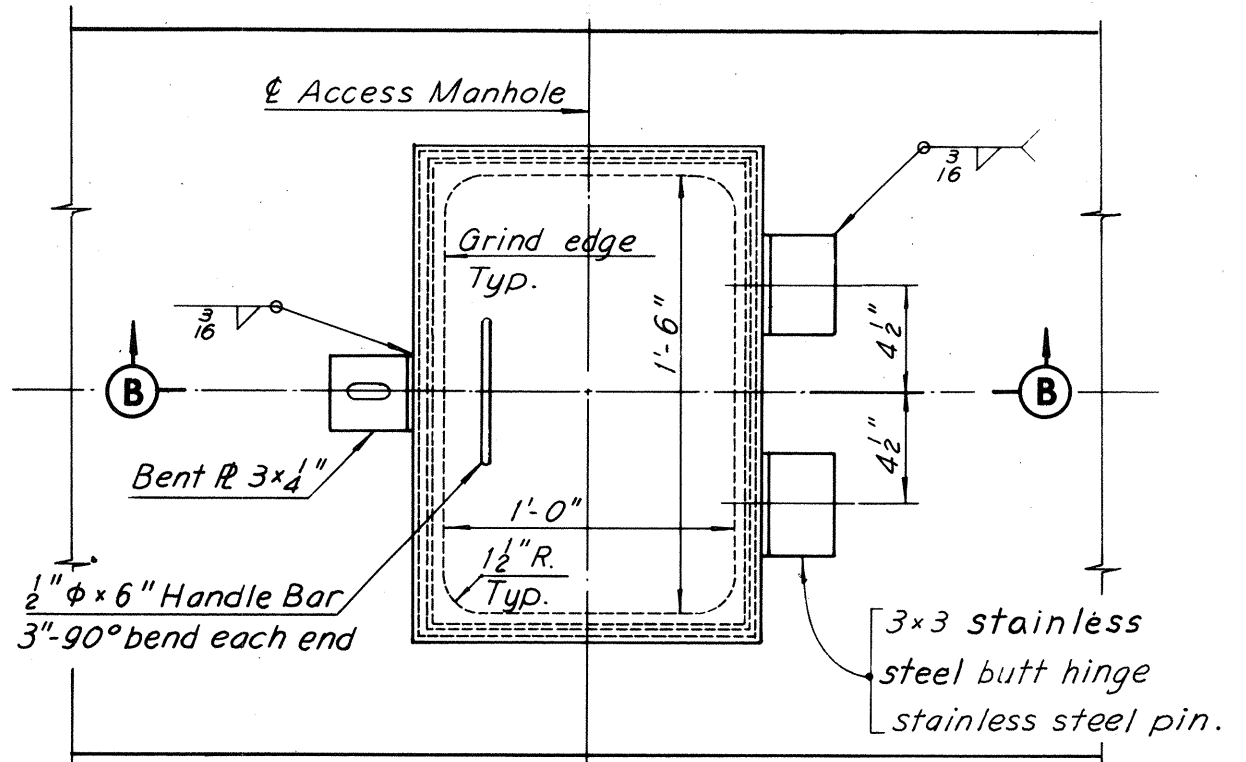


ACCESS DOOR - TYPE A
Scale: 1/2" = 1'-0"

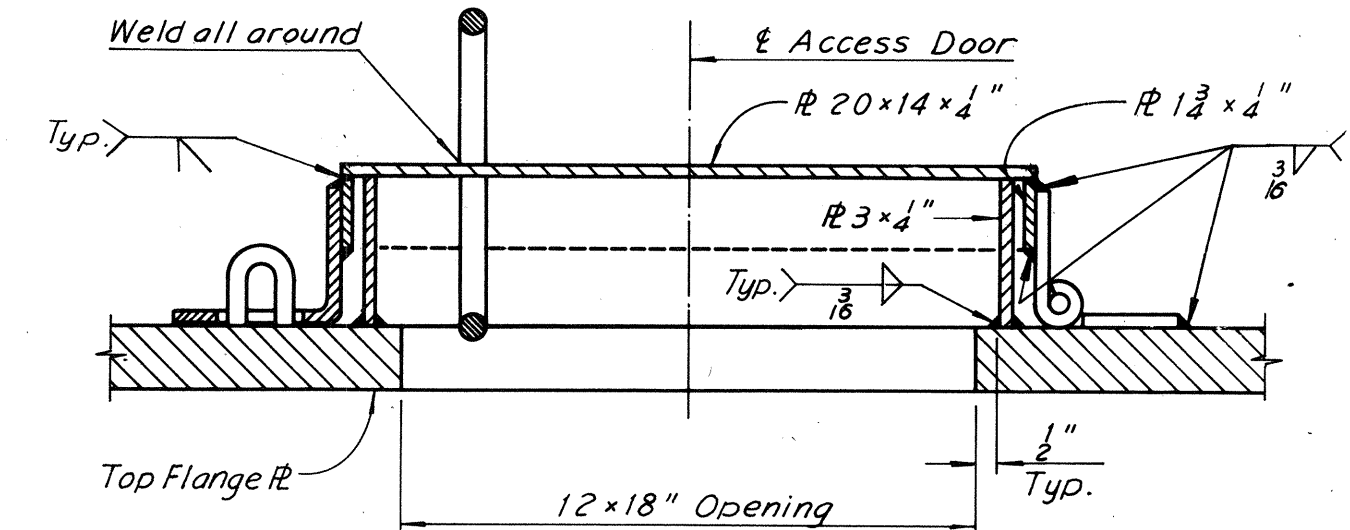


SECTION B-B
No Scale

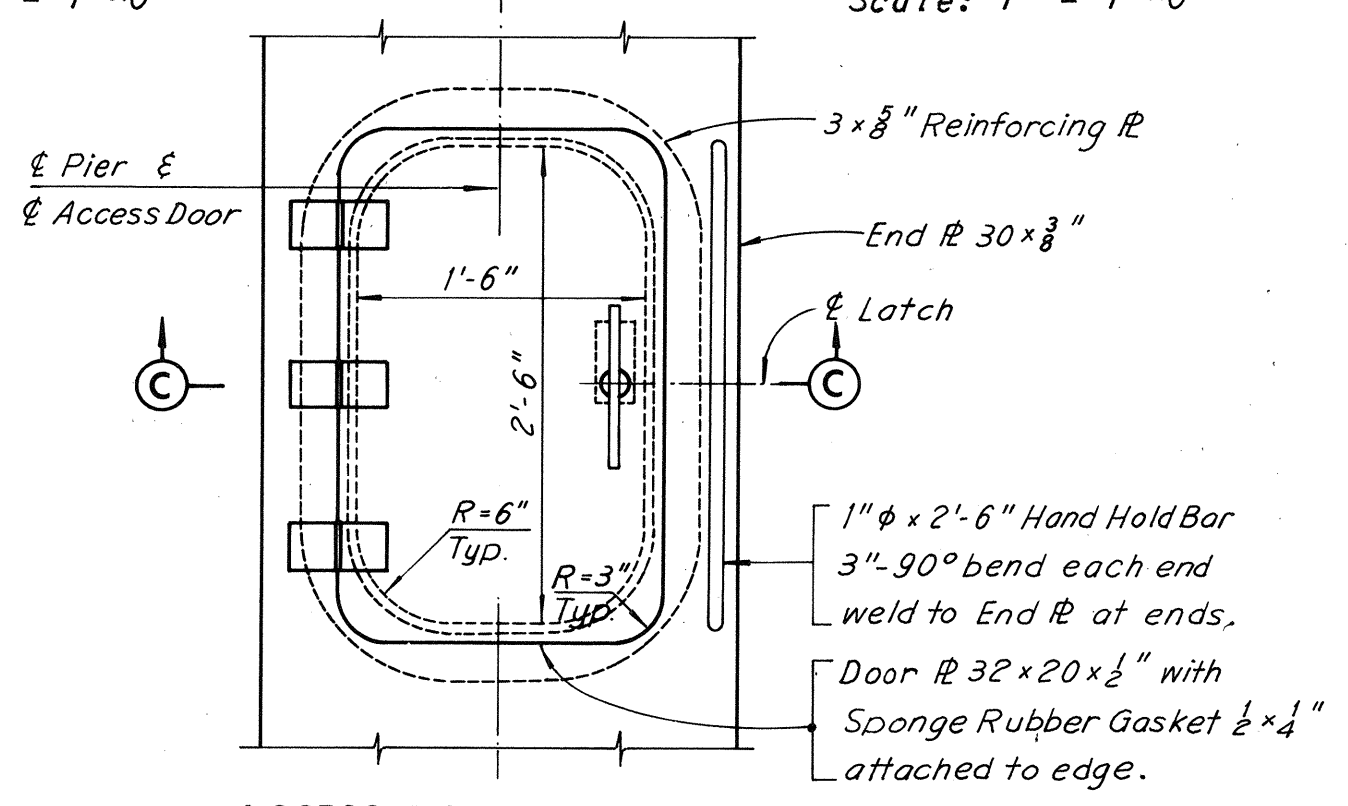

ACCESS DOOR - TYPE B
Scale: 1" = 1'-0"

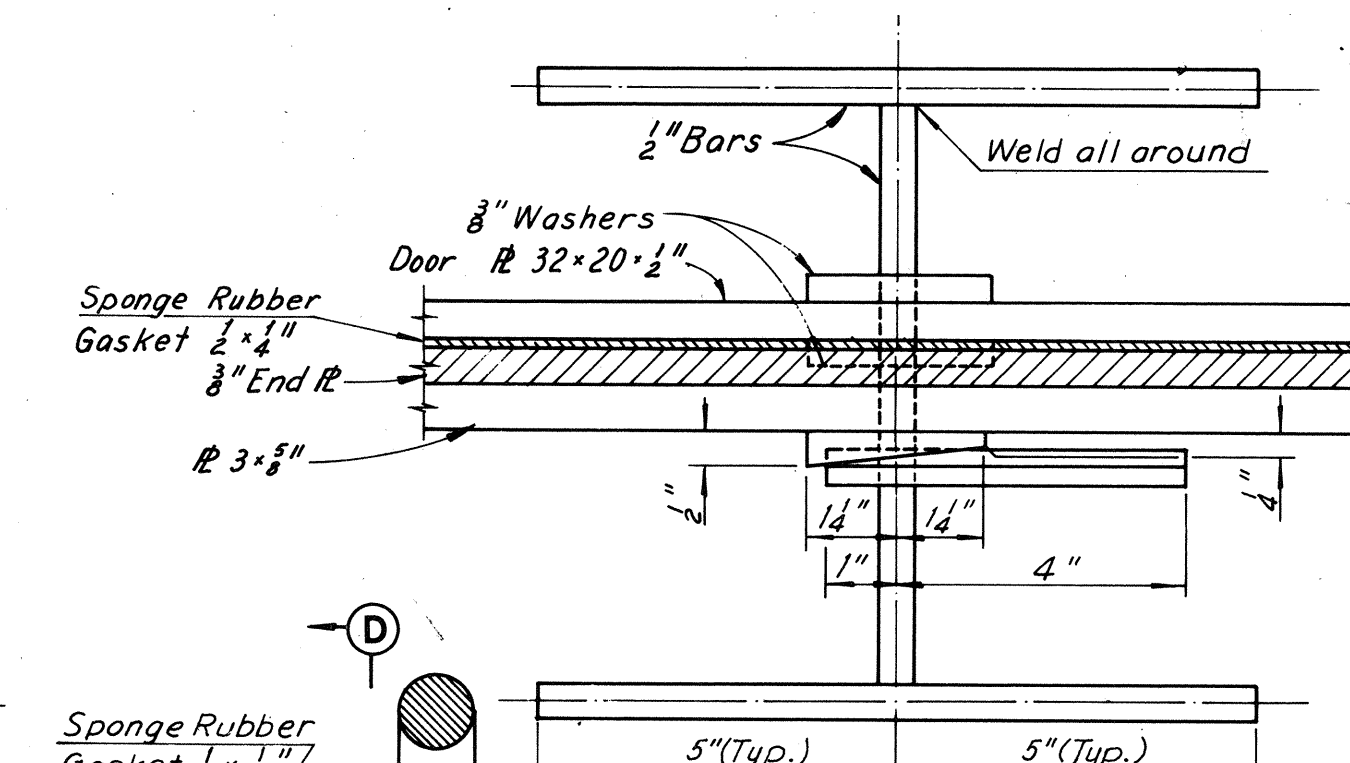

SECTION D-D
No Scale

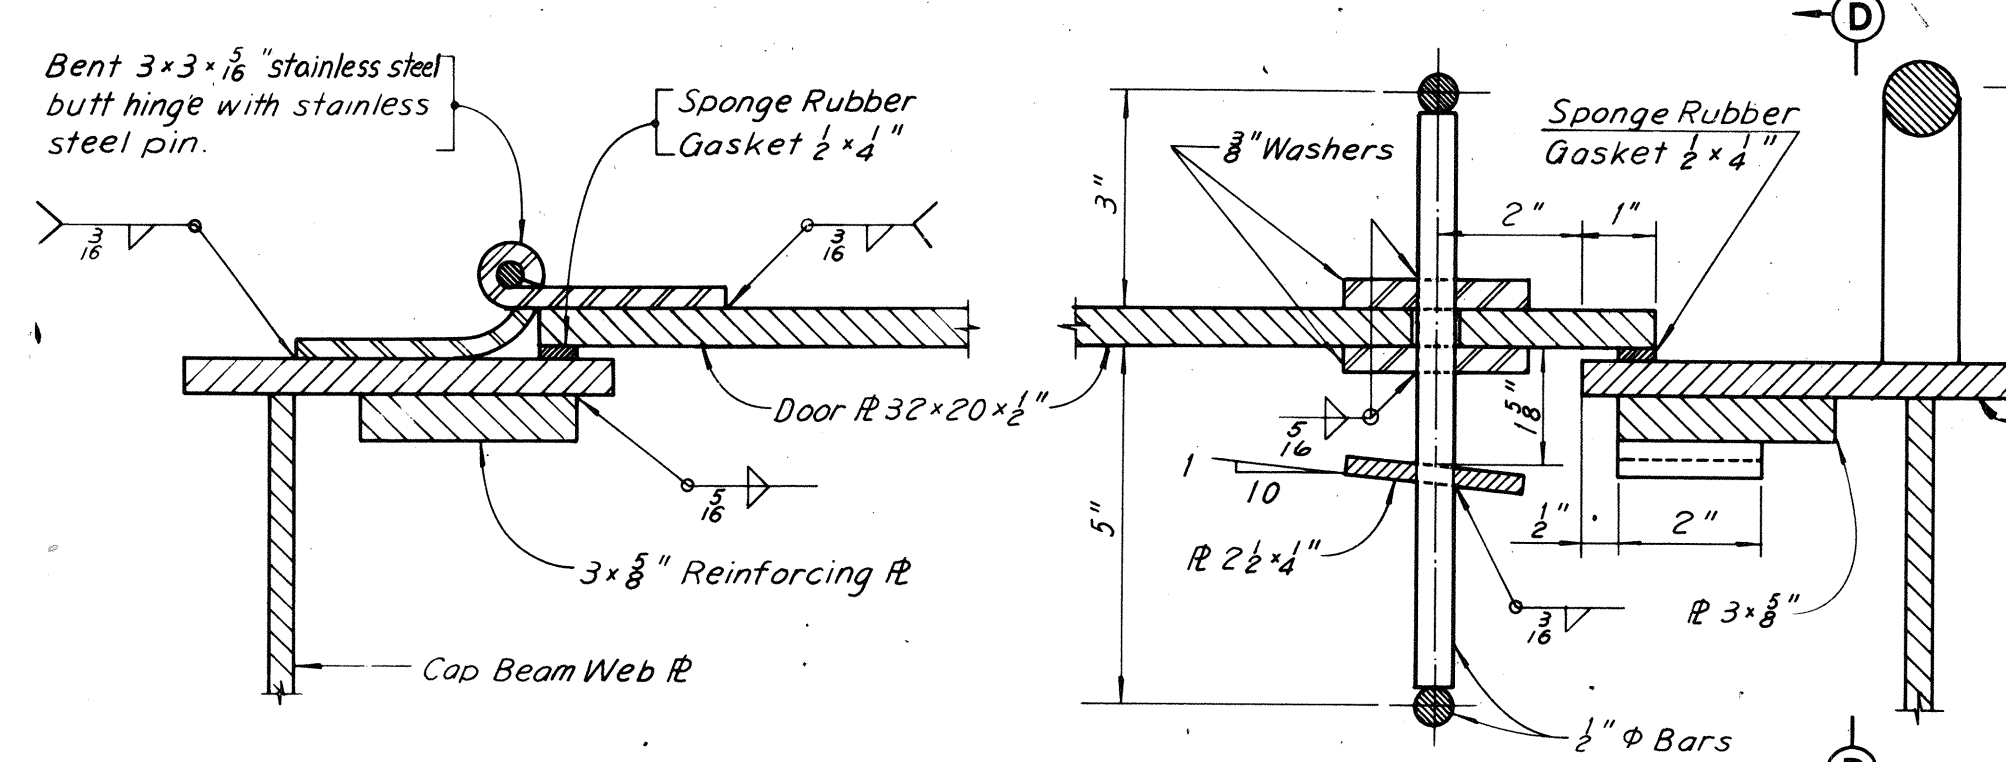

SECTION C-C
No Scale

Notes:
For location of Typical Section, Details A and B, and Access Doors, see Framing Details for Piers 19 and 20, Sheet 17.
For location of Details C and D, see Framing Plan Units 17 and 18, Sheet 16.

BY	DATE	REVISION	BY	DATE
MADE	MHH 1-31-69			
CHECKED	JD 5-2-69	Dim and weld size	TEM	9-30-76
IN CHARGE				

AS BUILT

RICHMOND METROPOLITAN AUTHORITY
RICHMOND EXPRESSWAY SYSTEM
DOWNTOWN EXPRESSWAY

BRIDGE NO. 68
RAMP W-S CONNECTION TO
RICHMOND-PETERSBURG TURNPIKE
FRAMING DETAILS

HOWARD, NEEDLES, TAMMEN & BERGENDOFF
consulting engineers
NEW YORK ALEXANDRIA KANSAS CITY

SCALE: As Noted
CONTRACT NO. 11
SHEET NO. 18 OF 28