

# **APPENDIX MR-2019**

## **RECORD DRAWINGS**

RMTA SYSTEM MAP AND PIER LOCATION EXHIBIT

RMTA BRIDGES Boulevard, 11,63,64, 65, 66, 67 & 68


(NOTE: Additional As-built Plans are Available upon Request to the Engineer)

**RMTA**  
**System Map**

# RICHMOND EXPRESSWAY SYSTEM

Scale: 0 1000 2000 3000ft.

48 - Bridge Number  
 RMTA Facilities Shown in Red

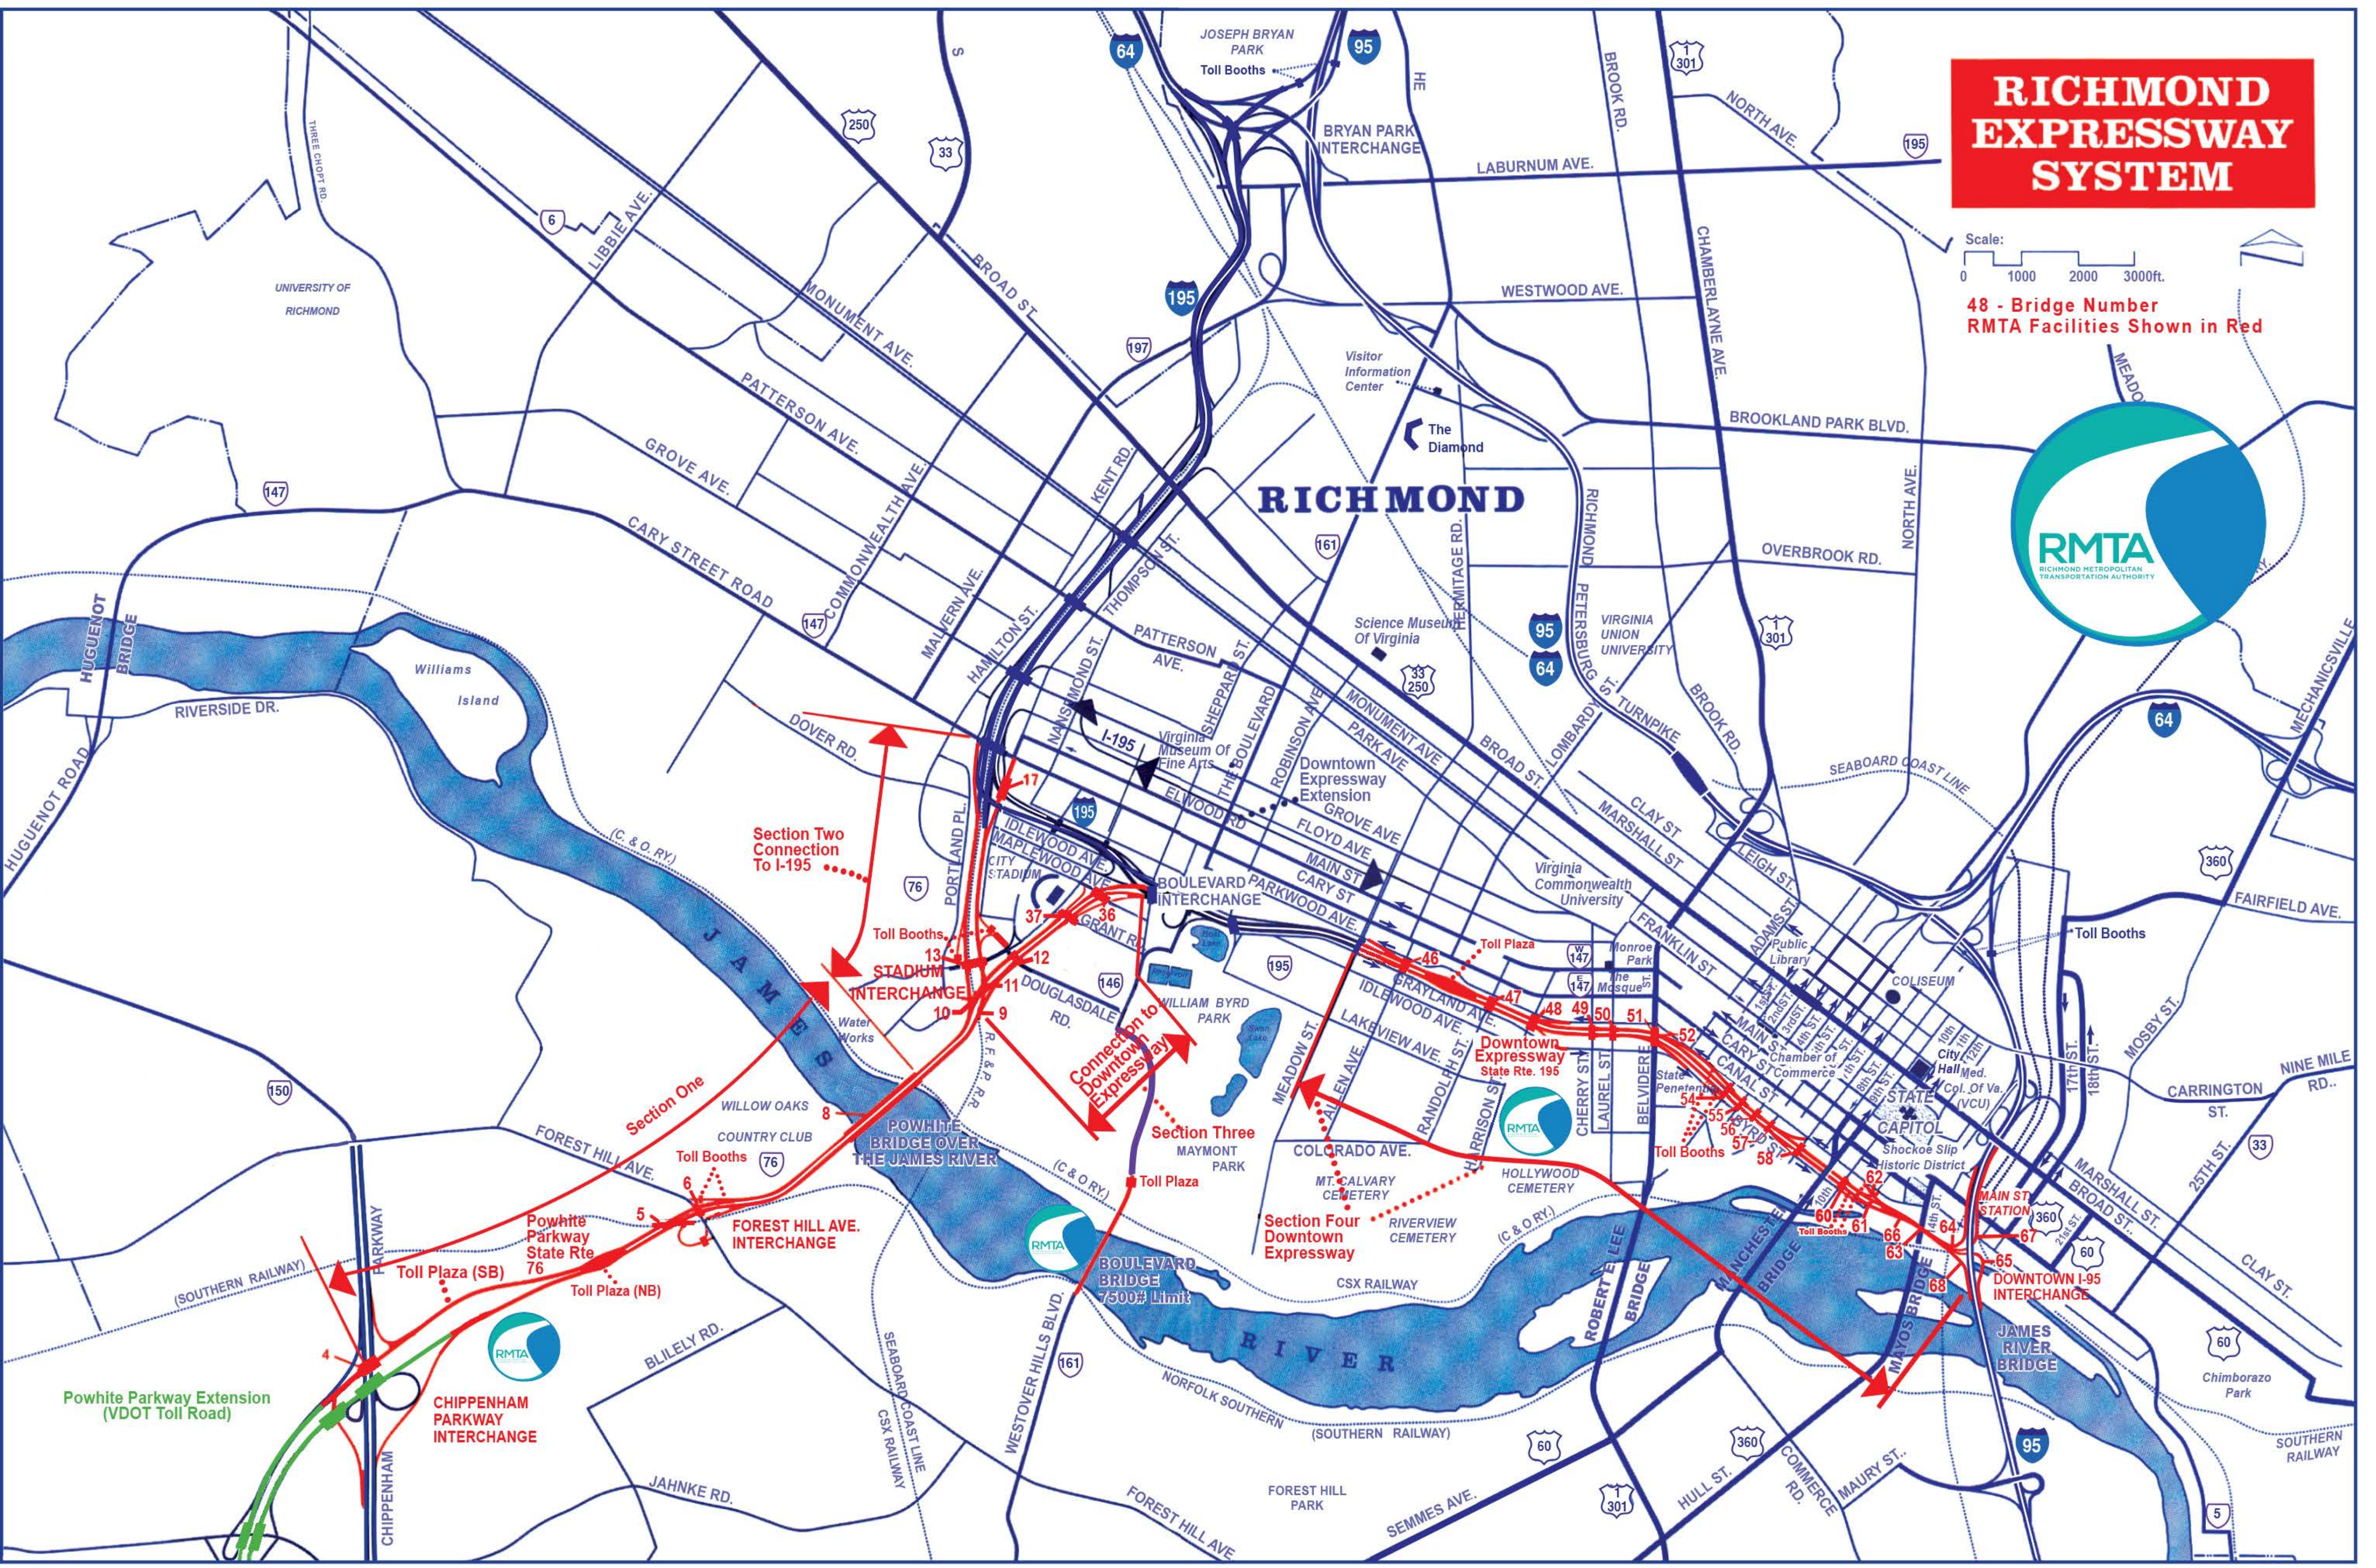

Powhite Parkway Extension (VDOT Toll Road)

CHIPPENHAM PARKWAY INTERCHANGE

POWHITE BRIDGE OVER THE JAMES RIVER

RICHMOND

JAMES RIVER BRIDGE

Downtown Expressway State Rte. 195

Connection to Downtown Expressway

Section Two Connection To I-195




Section One

Section Three

Section Four Downtown Expressway



# **RMATA DTE, I-95 Ramps Pier Location Exhibit**

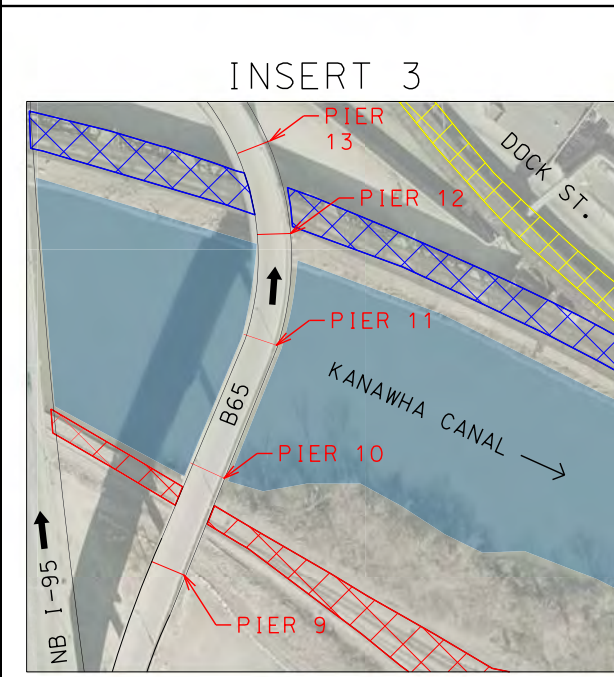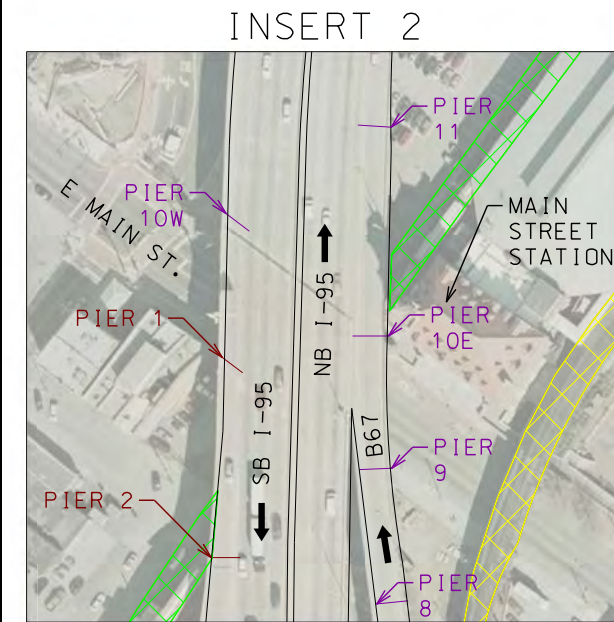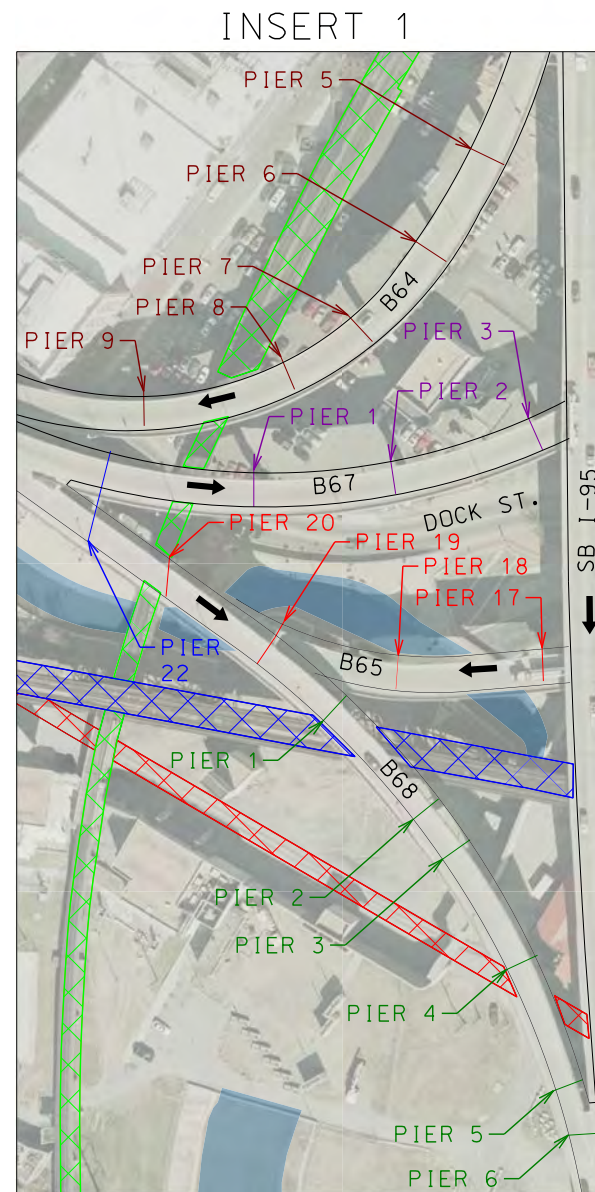

**LEGEND:**

<span style="color: blue;">█</span>	BRIDGE 63
<span style="color: darkred;">█</span>	BRIDGE 64
<span style="color: red;">█</span>	BRIDGE 65
<span style="color: orange;">█</span>	BRIDGE 66
<span style="color: purple;">█</span>	BRIDGE 67
<span style="color: green;">█</span>	BRIDGE 68
<span style="border: 1px dashed red; display: inline-block; width: 10px; height: 10px;"></span>	N&S RAILROAD
<span style="border: 1px dashed green; display: inline-block; width: 10px; height: 10px;"></span>	CSX RAILROAD
<span style="border: 1px dashed blue; display: inline-block; width: 10px; height: 10px;"></span>	CSX RAILROAD
<span style="border: 1px dashed yellow; display: inline-block; width: 10px; height: 10px;"></span>	CSX RAILROAD

- NOTES:**
- 1) PIER NUMBERS BASED ON AS-BUILT DRAWINGS FROM CONTRACTS C-10 AND C-11.
  - 2) RAILROAD LIMITS AND PIER LOCATIONS BASED ON AERIAL PHOTOGRAPHY.
  - 3) THIS EXHIBIT IS FOR REFERENCE ONLY. REFER TO AS-BUILT DRAWINGS FOR EXACT PIER LOCATIONS.
  - 4) BRIDGE 63 IS ON BOTTOM, BRIDGE 66 IS ON TOP.

**RICHMOND METROPOLITAN TRANSPORTATION AUTHORITY**



**I-95 RAMPS PIER LOCATION EXHIBIT**

2900 S. QUINCY STREET, SUITE 200  
ARLINGTON, VIRGINIA  
(703) 824-5100


Scale:	Date:	Contract No.:	Sheet:
N.T.S.	MAY 2015	MR-2015	1 OF 1

# **Boulevard Bridge**

**(VA State Rte. 161 – Westover Hills Blvd.)**

## **Record Set Plans**

RICHMOND EXPRESSWAY SYSTEM			
SECTION	PROJECT	SHEET NO.	TOTAL SHEETS
C-17B	Boulevard Bridge Rehab	35(1)	

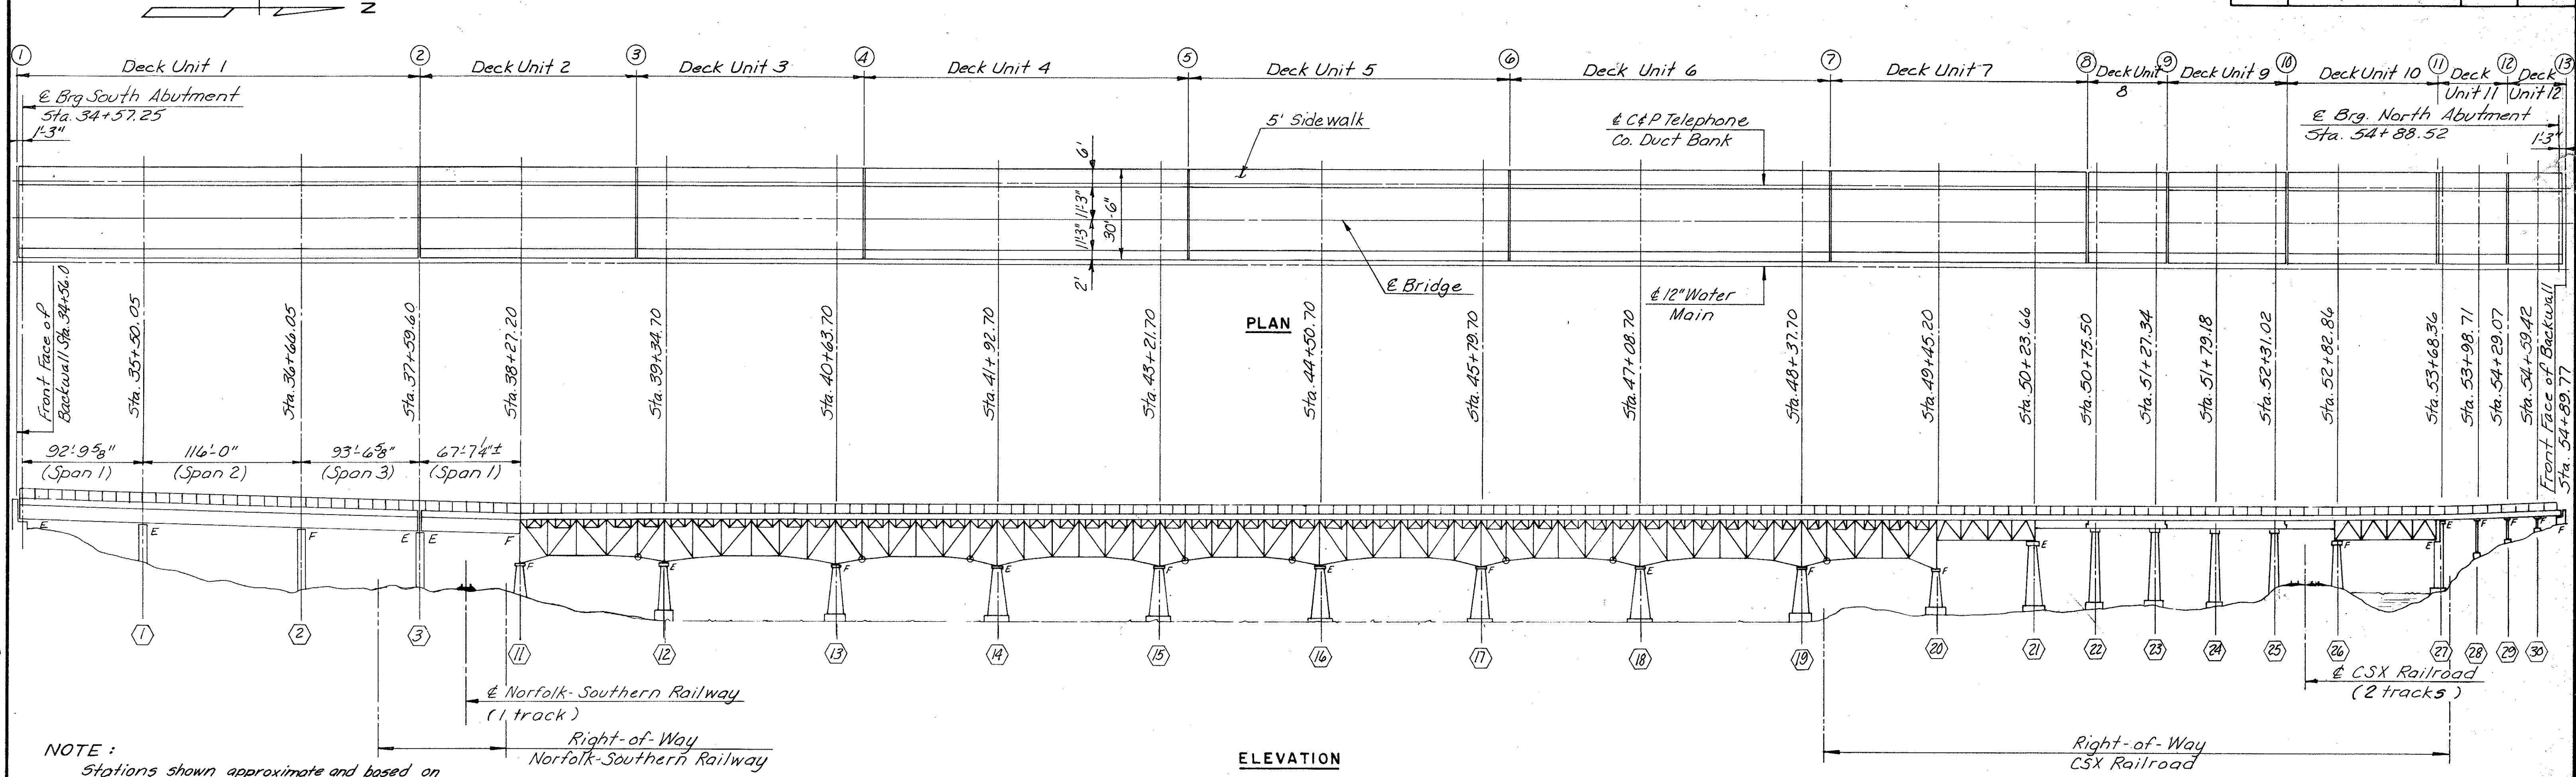


**NOTE:**  
Stations shown approximate and based on surveyed deck joint station. The Contractor is to verify all pertinent dimensions and elevations prior to the fabrication of any structural steel.


**ELEVATION**

- INDEX**
- 1 GENERAL PLAN, ELEVATION AND INDEX
  - 2 GENERAL NOTES AND QUANTITIES
  - 3 GRADING AND SLOPE PROTECTION AT SOUTH ABUTMENT
  - 4 NORTH ABUTMENT SLOPE PROTECTION DETAILS
  - 5 & 6 SOUTH ABUTMENT DETAILS
  - 7 NORTH ABUTMENT DETAILS
  - 8 PIER 1
  - 9 PIER 2
  - 10 PIER 3
  - 11-15 GIRDER DETAILS
  - 16 TYPICAL CROSS SECTION
  - 17 KEY PLAN, LIGHTING LAYOUT PLAN AND CONCRETE PLACEMENT PLAN
  - 18-25 DECK UNIT 1 THROUGH 12 REINFORCING PLANS
  - 26 SIDEWALK DETAILS (DELETED)
  - 27 EXPANSION JOINT DETAILS
  - 28 PREFORMED ELASTOMERIC JOINT SEALER DETAILS
  - 29 ELASTOMERIC EXPANSION DAM DETAILS
  - 30 SIDEWALK RAILING DETAILS
  - 31 TRAFFIC RAILING DETAIL
  - 32 TELEPHONE CONDUIT SYSTEM
  - 33 WATER MAIN INSTALLATION DETAILS
  - 34 BRIDGE LIGHTING SYSTEM
  - 35 APPROACH SLAB DETAILS
  - 36 SOUTH ABUTMENT DRAINAGE APRON REPAIR AND MODIFICATIONS
- 37 & 38 BAR LIST**

**LEGEND:**  
① Joint Number  
① Pier Number

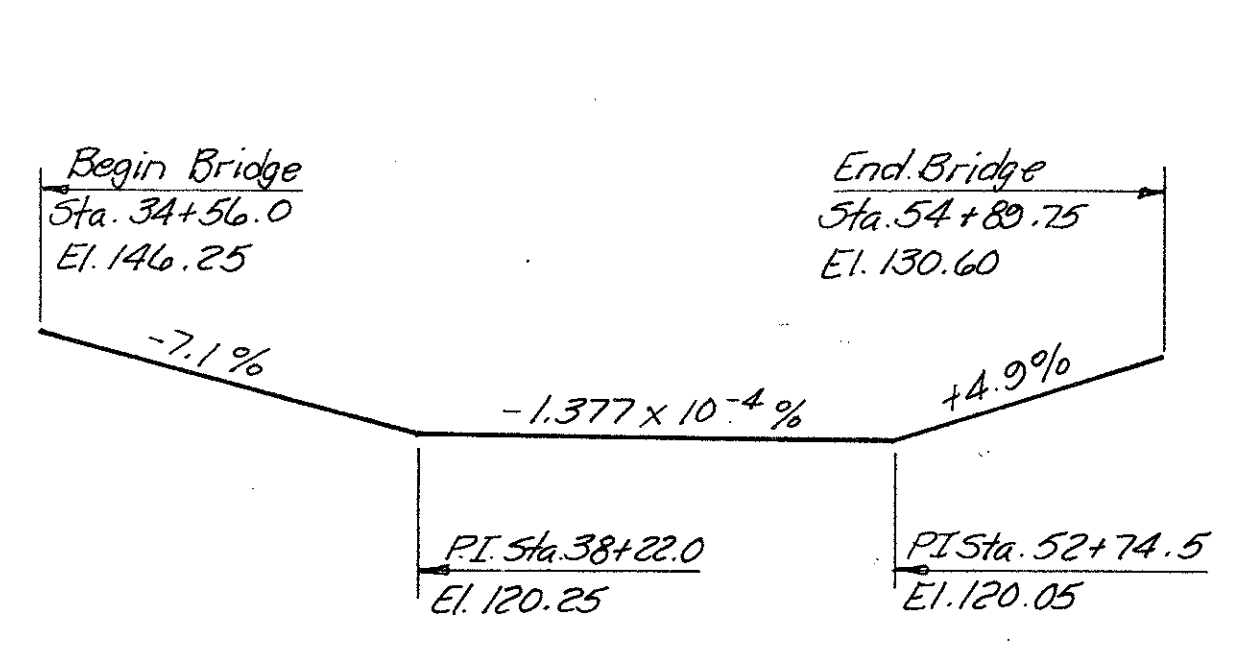


**APPROXIMATE EXISTING PROFILE GRADE**  
Profile grade shown is based on surveyed elevation along the E of the existing bridge. The contractor is to verify all elevations prior to construction.

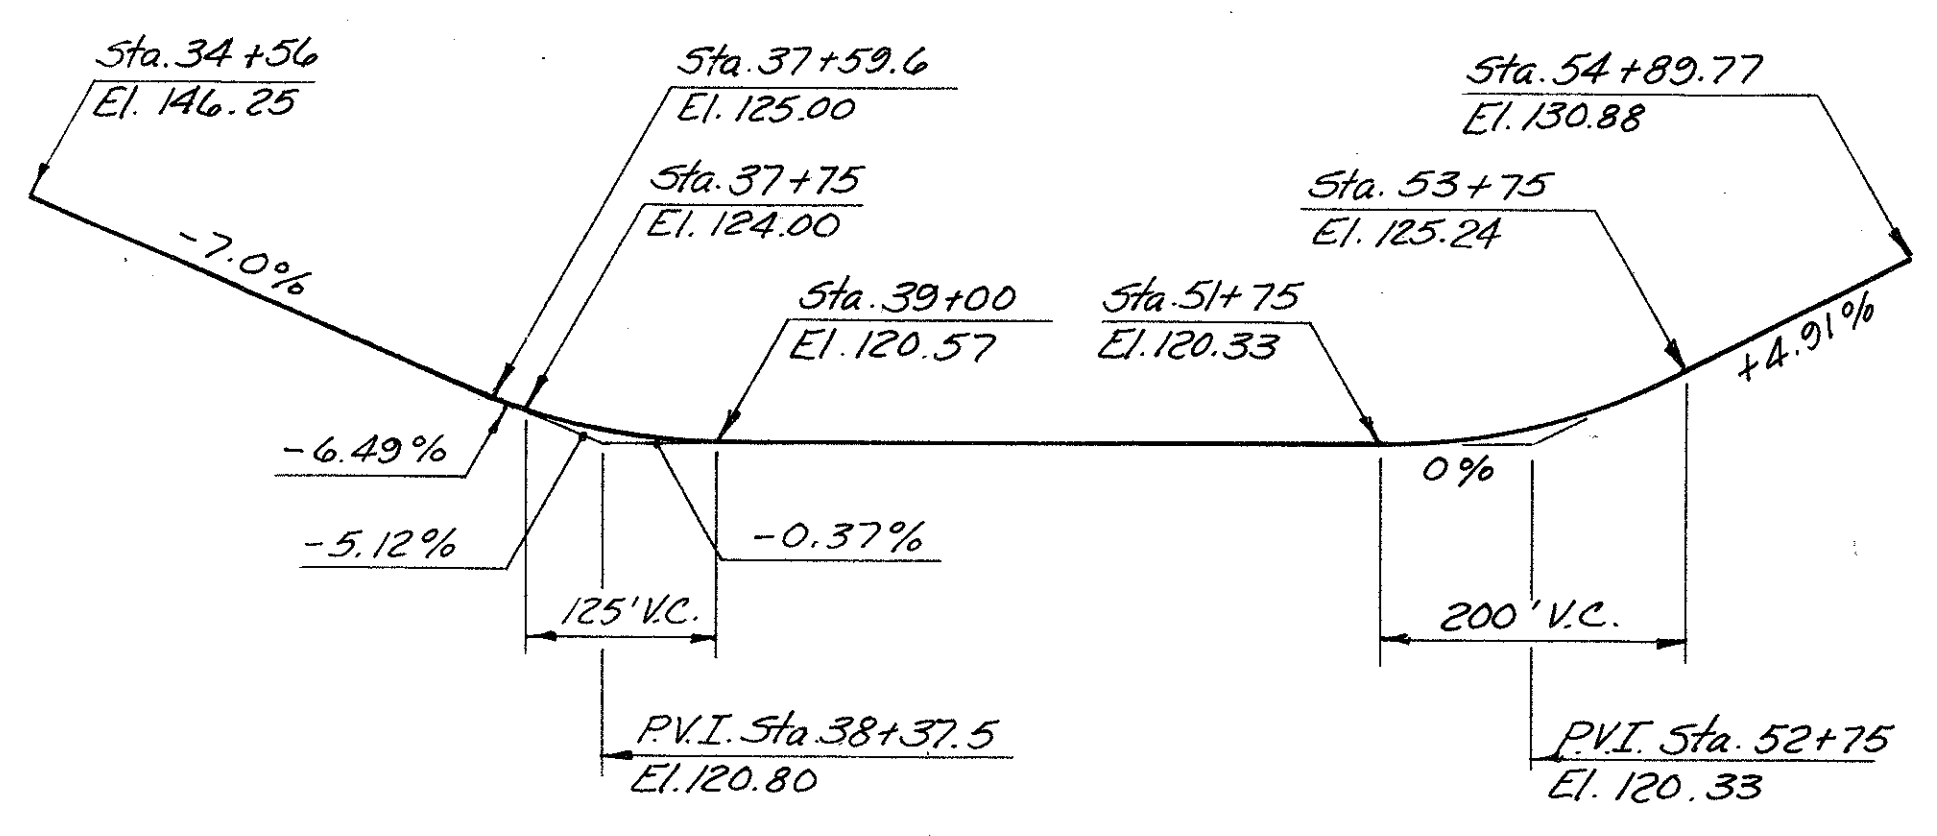

**PROPOSED PROFILE GRADE**

**NOTE:**  
LOAD RESTRICTIONS ARE CURRENTLY IN EFFECT ON THE EXISTING BRIDGE. CONSTRUCTION EQUIPMENT WEIGHING IN EXCESS OF 8 TONS SHOULD NOT BE PERMITTED ON THE BRIDGE.

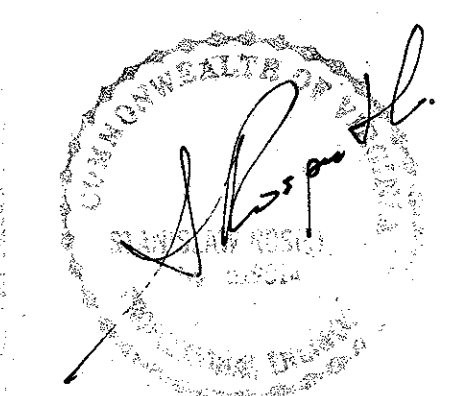

**RECORD DRAWING**

**RICHMOND METROPOLITAN AUTHORITY  
RICHMOND EXPRESSWAY SYSTEM**

**BOULEVARD BRIDGE REHABILITATION  
DECK REPLACEMENT**

**GENERAL PLAN, ELEVATIONS  
AND INDEX**

SCALE: No. Scale  
CONTRACT NO. C-17B  
SHEET NO. 1 OF 38

HOWARD, NEEDLES, TAMMEN & BERGENDOFF  
General Consultants

BY	DATE				
MADE	H.H.	2-92			
CHECKED	T.E.M.	3-92			
IN CHARGE			NO.	REVISION	BY DATE

## **Bridge 11**

**Northbound 76 over Westbound DTE Connector 146**


**Record Set Plans**



RICHMOND EXPRESSWAY SYSTEM			
SECTION	PROJECT	SHEET NO.	TOTAL SHEETS
14	1990-1991 IMPROVEMENTS	16(1)	

**NOTE TO CONTRACTOR**

The contractor's attention is directed to the approximate locations of utilities as shown on the General Plan and Elevation. The contractor shall submit to the engineer for approval, drawings for protection and maintenance of service of utilities, located in the areas adjacent to new footing to be constructed.

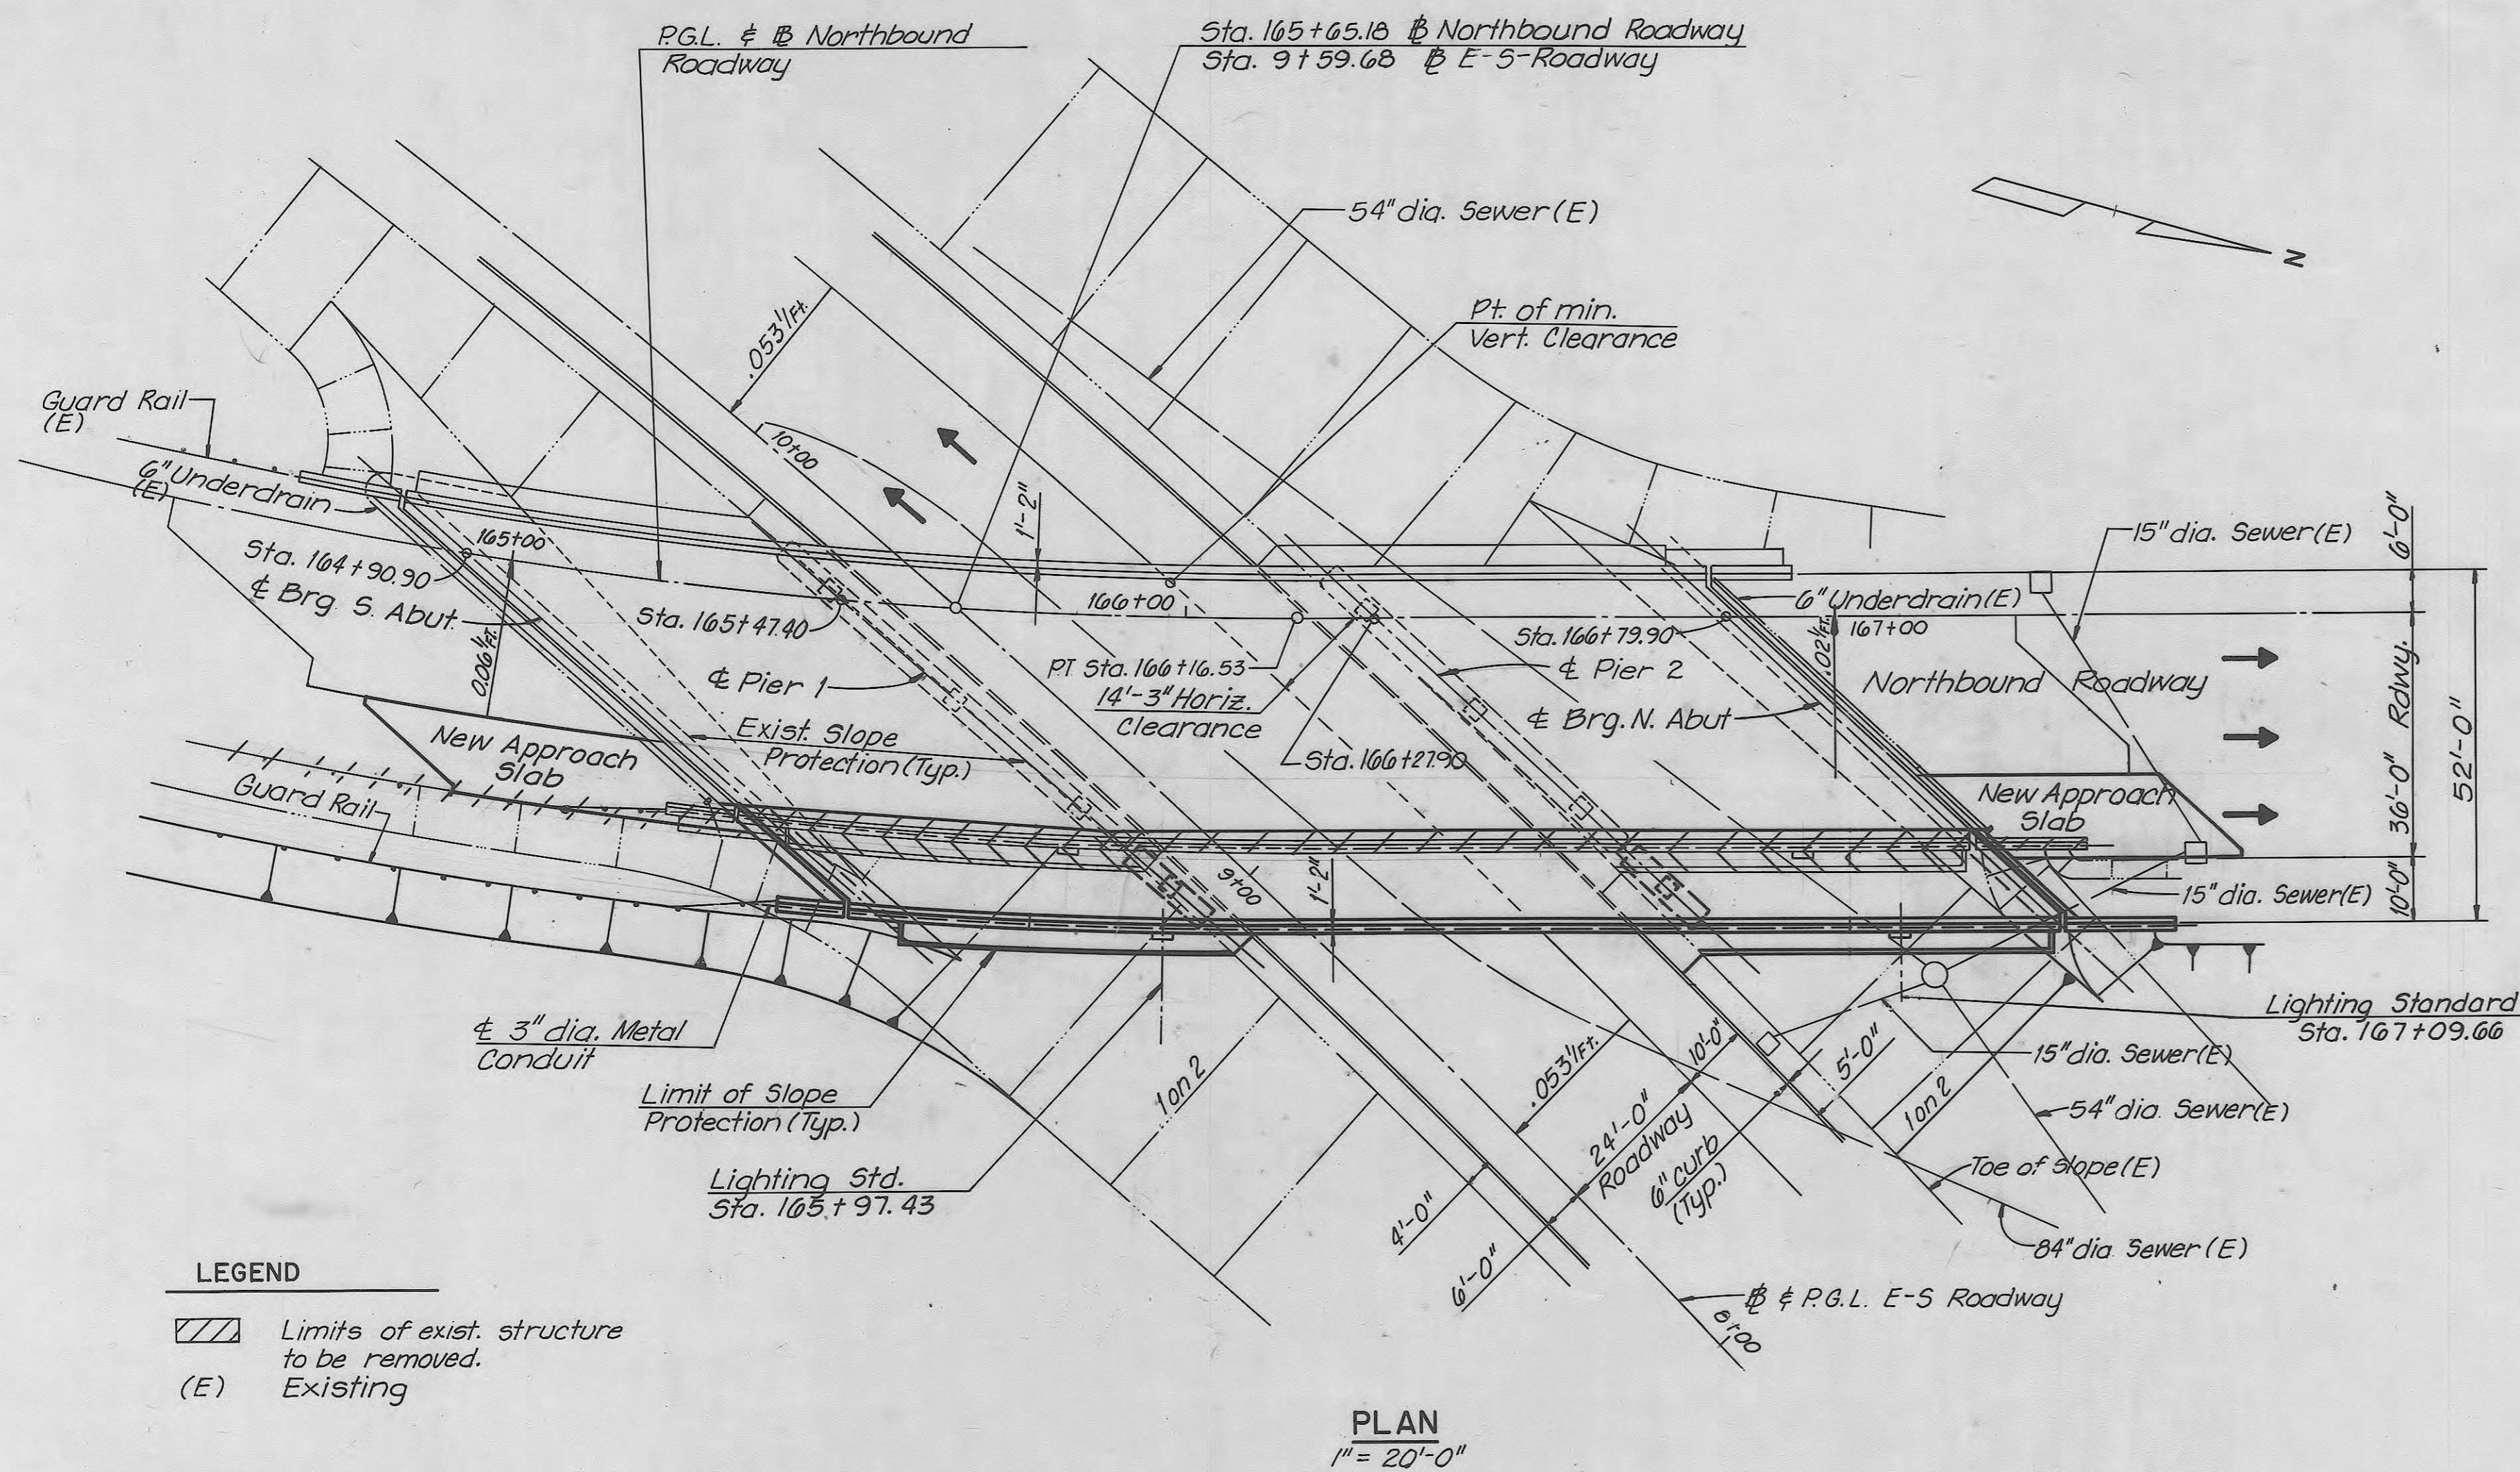



**LEGEND**

- Limits of exist. structure to be removed.
- (E) Existing

**INDEX**

**SHEET NO.**


General Plan and Elevation	1
Quantities and General Notes	2
South Abutment Details	3
North Abutment Details	4
Miscellaneous Abutment Details	5
Flared Terminal Wall Details	6
Piers 1 and 2 Details	7
Framing Plan and Details	8
Deck Plan	9
Typical Section and Details	10
Joint Details	11
Lighting Standards and Electrical Details	12
Miscellaneous Details	13
Approach Slab and Slope Protection Details	14
Bar List - North and South Abutment	15
Bar List - Piers 1 and 2	16
Bar List - Superstructure and Approach Slab	17

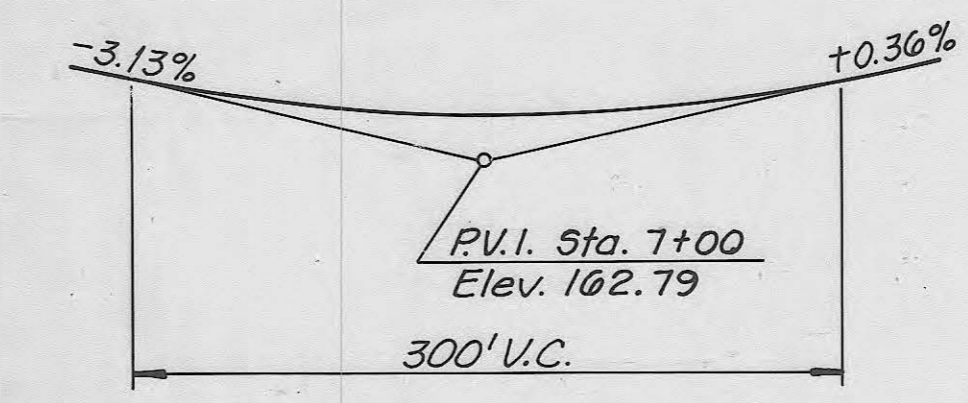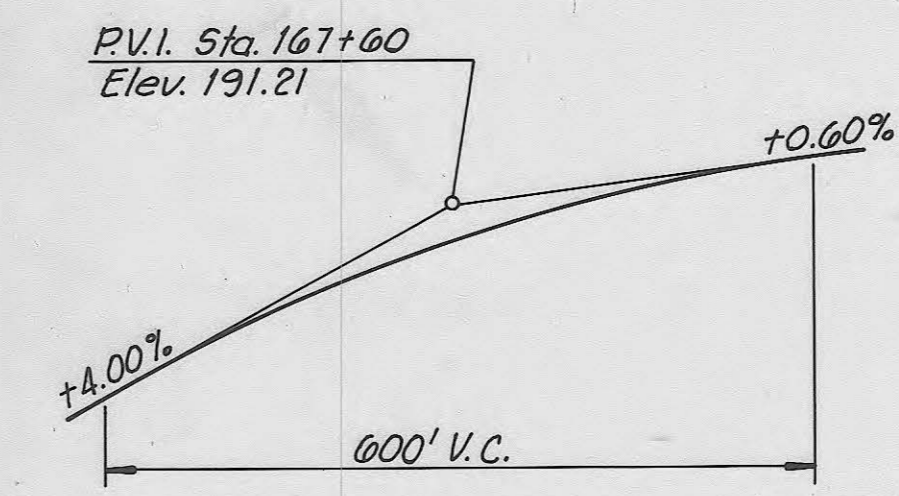

**PROFILE GRADE DATA**  
(Existing)

**HORIZONTAL CURVE DATA**

NORTHBOUND RDWY.	E-S RDWY.
PI. = Sta. 164+19.74	PI. = Sta. 6+43.88
Δ = 30°-14'-26"	Δ = 37°-15'-41"
D = 7°-30'-00"	D = 3°-00'-00"
T = 206.42'	T = 643.88'
L = 403.21'	L = 1242.04'
R = 763.94'	R = 1909.86'

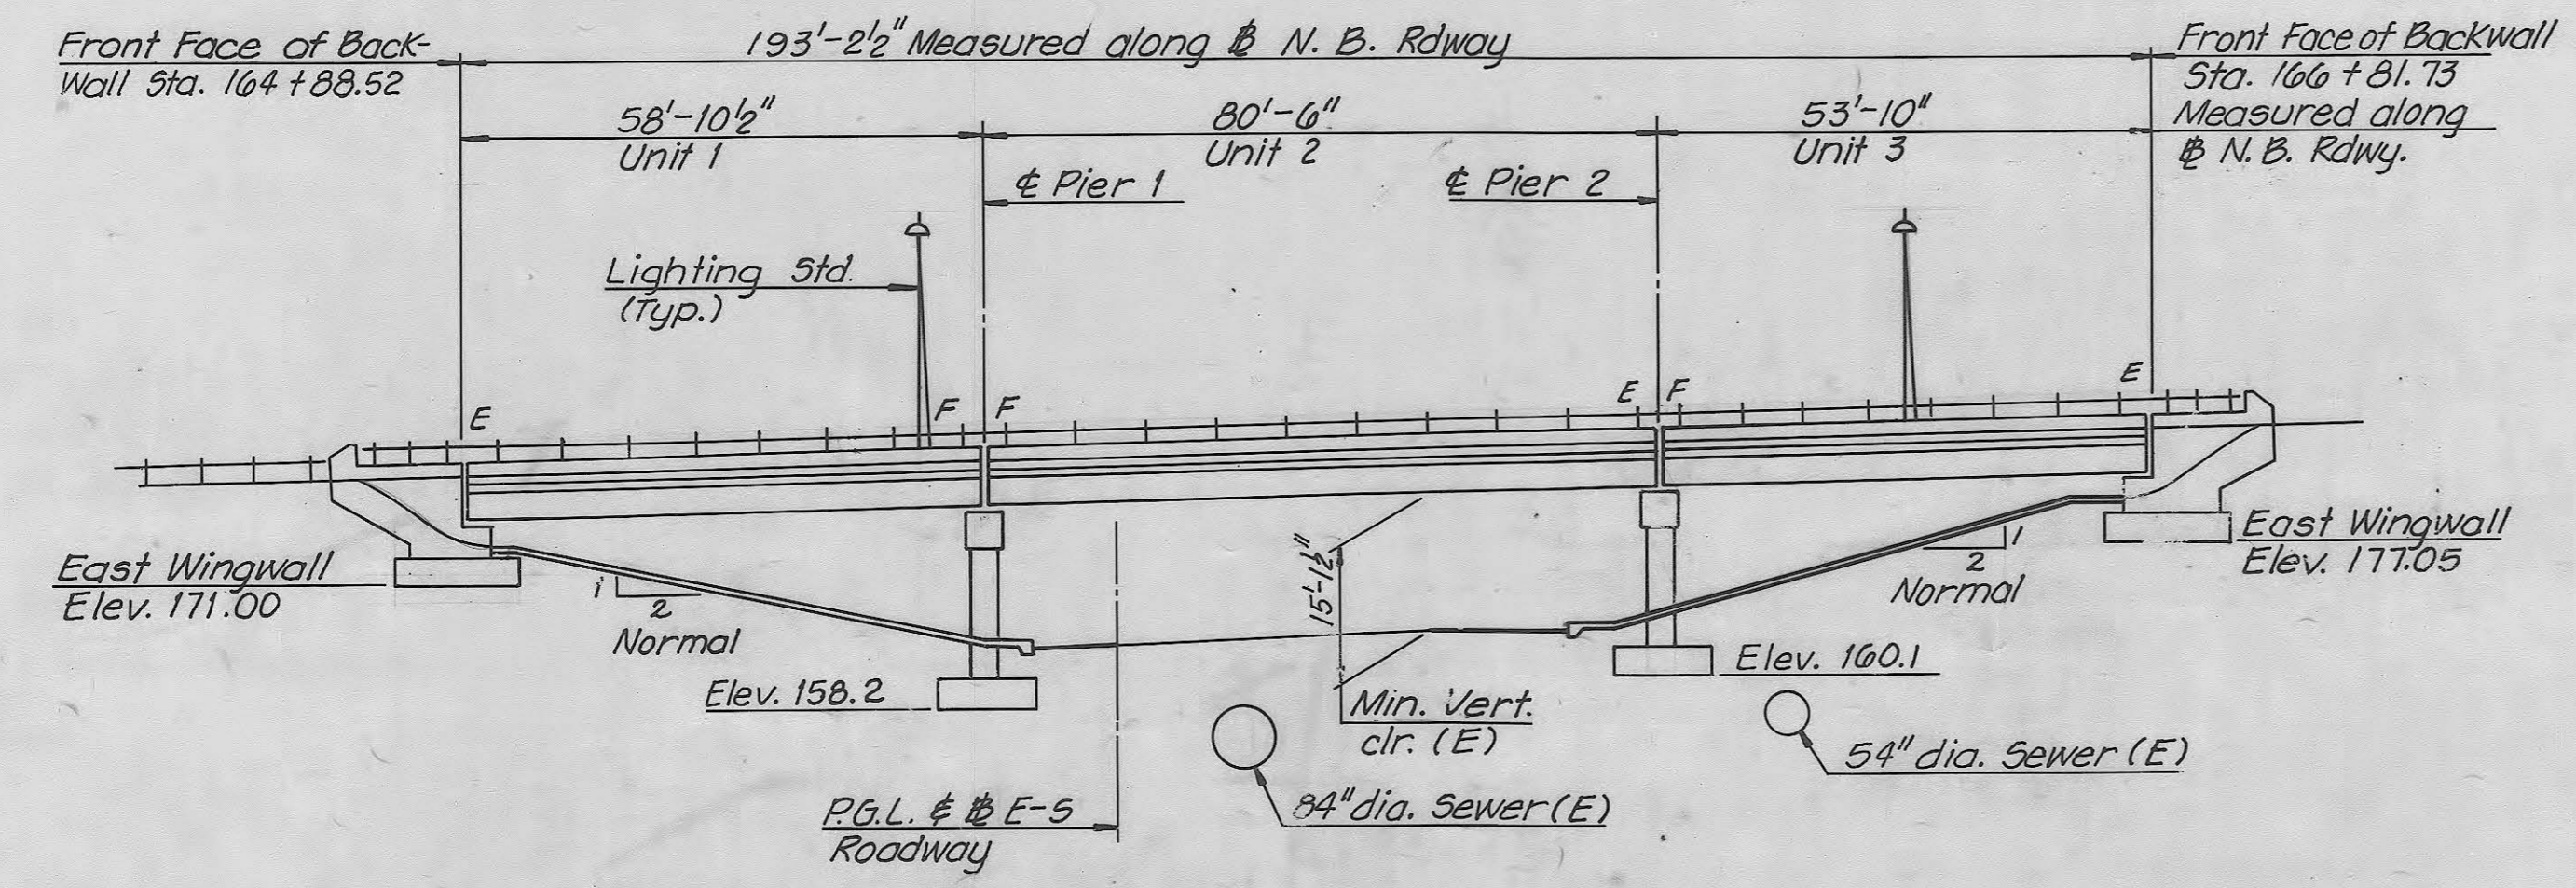

BY	DATE	NO.	REVISION	BY	DATE
MADE	BTG	4/87			
CHECKED	KSH	5/87			
IN CHARGE	S.R.				

**RICHMOND METROPOLITAN AUTHORITY**  
**RICHMOND EXPRESSWAY SYSTEM**  
DOWNTOWN EXPRESSWAY

BRIDGE NO. 11 WIDENING  
NORTHBOUND ROADWAY OVER  
EAST-SOUTH ROADWAY

**GENERAL PLAN & ELEVATION**

HOWARD, NEEDLES, TAMMEN & BERGENDOFF  
consulting engineers  
Alexandria, Virginia





SCALE: AS NOTED  
CONTRACT NO. C-14  
SHEET NO. 1 OF 17

## **Bridge 63**

**(Westbound Downtown Expressway “Rte. 195” over Virginia Street and South 14<sup>th</sup> Street “US Rte. 360”)**

**Record Set Plans**

RICHMOND EXPRESSWAY SYSTEM			
SECTION	PROJECT	SHEET NO.	TOTAL SHEETS
10	DOWNTOWN EXPRESSWAY	70	265

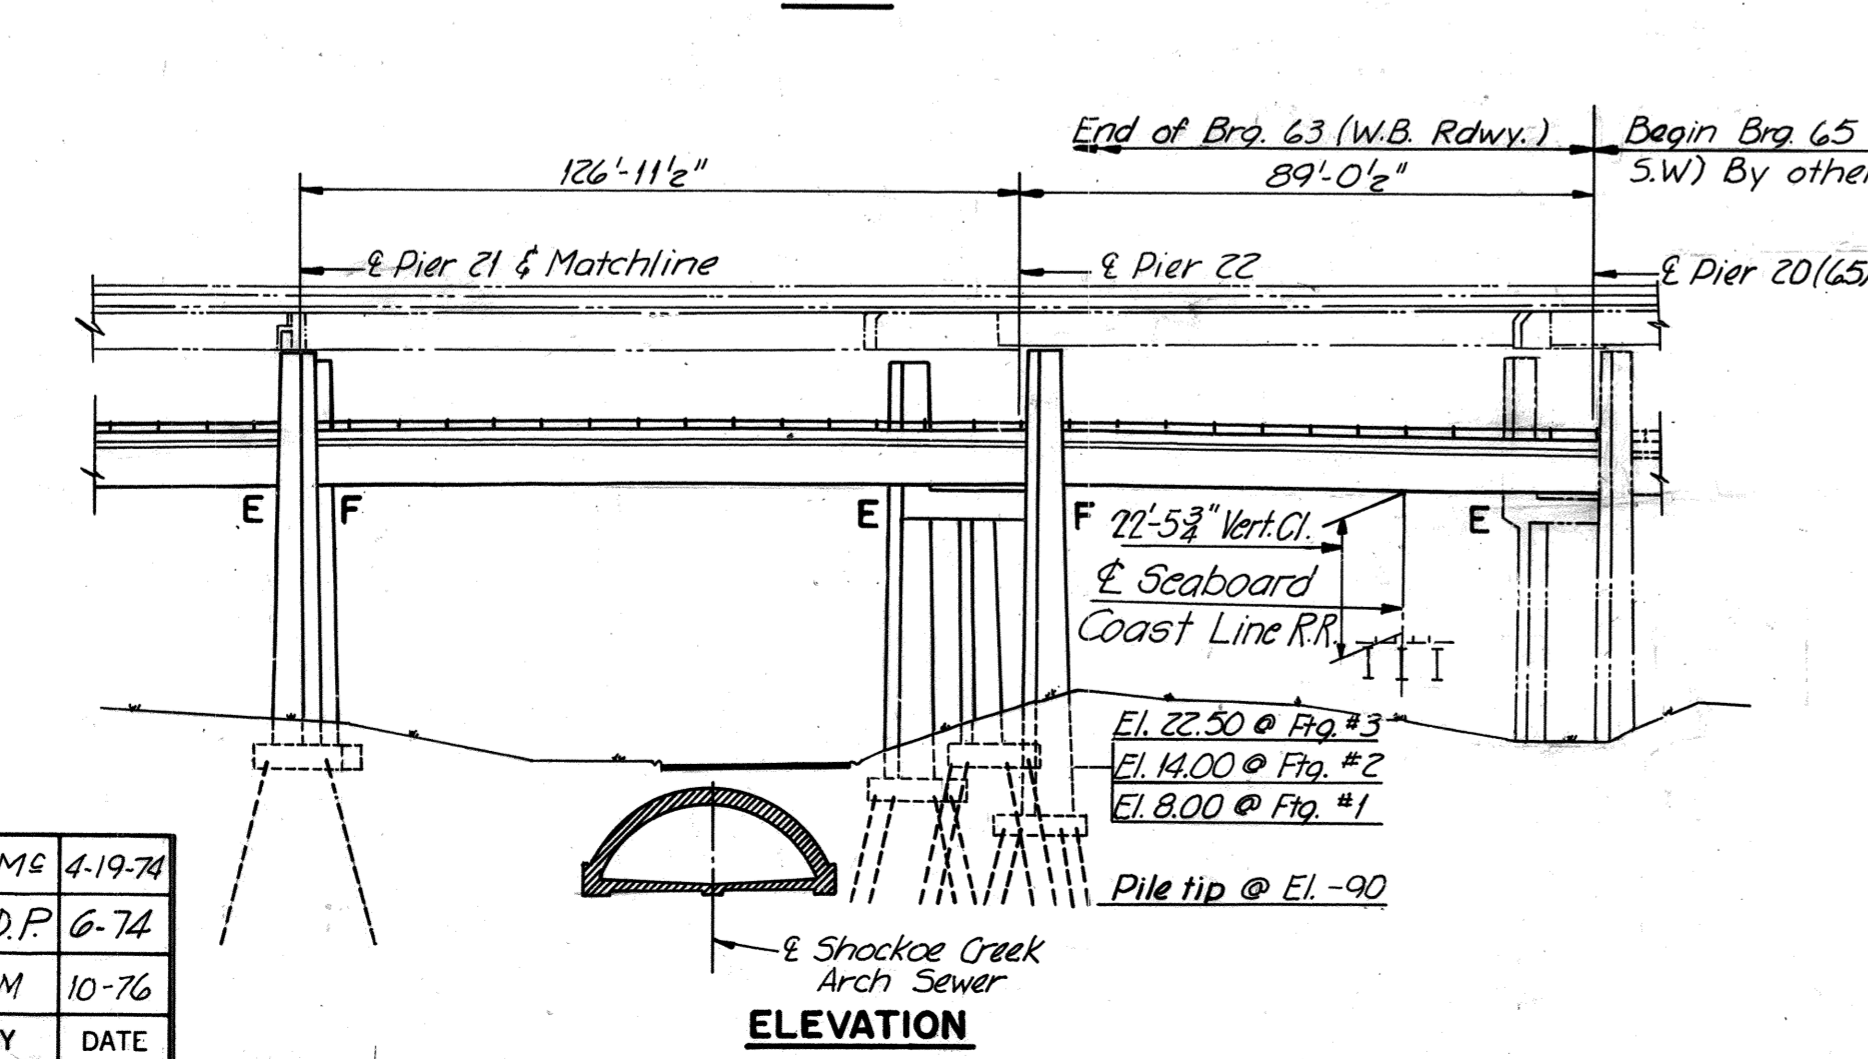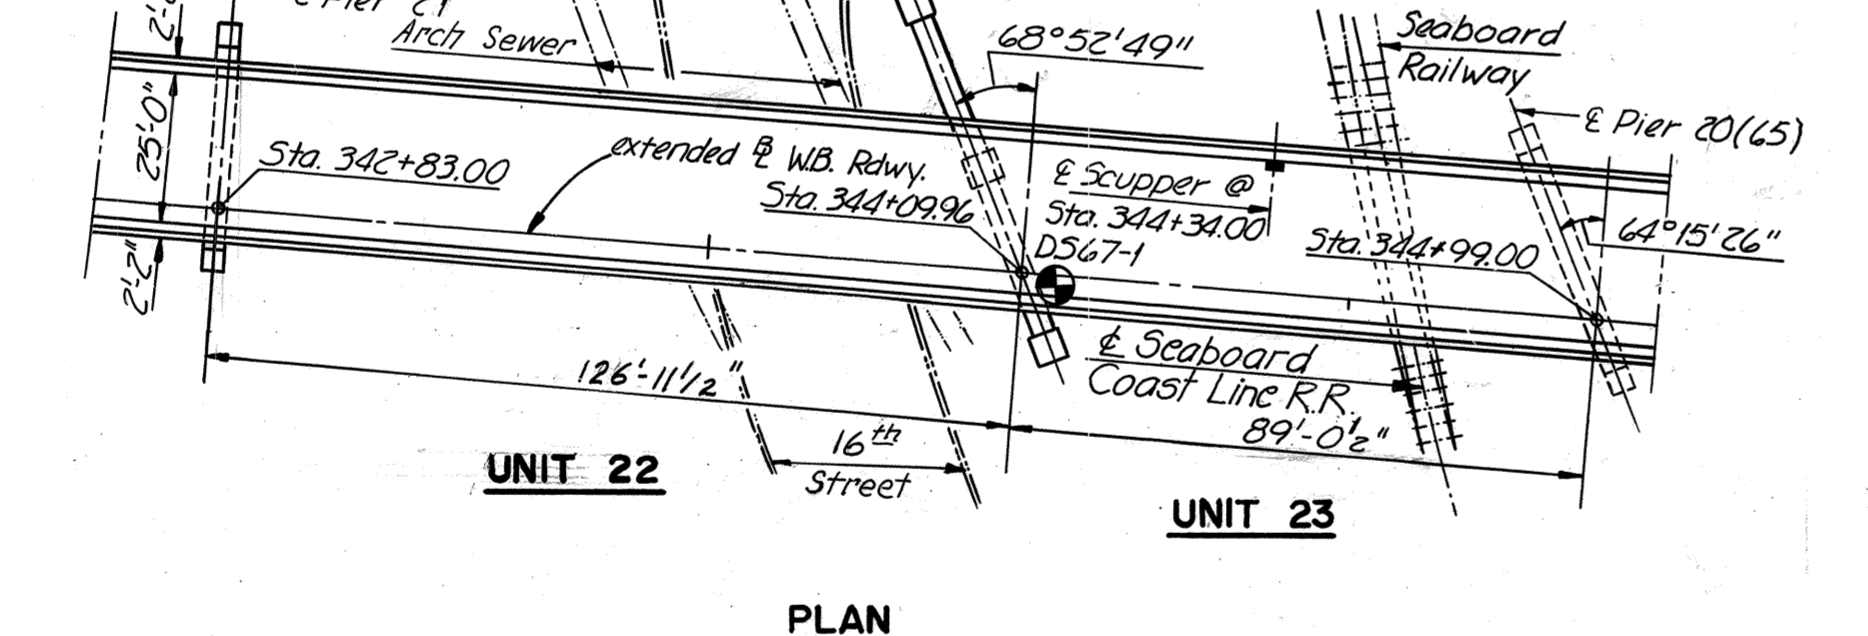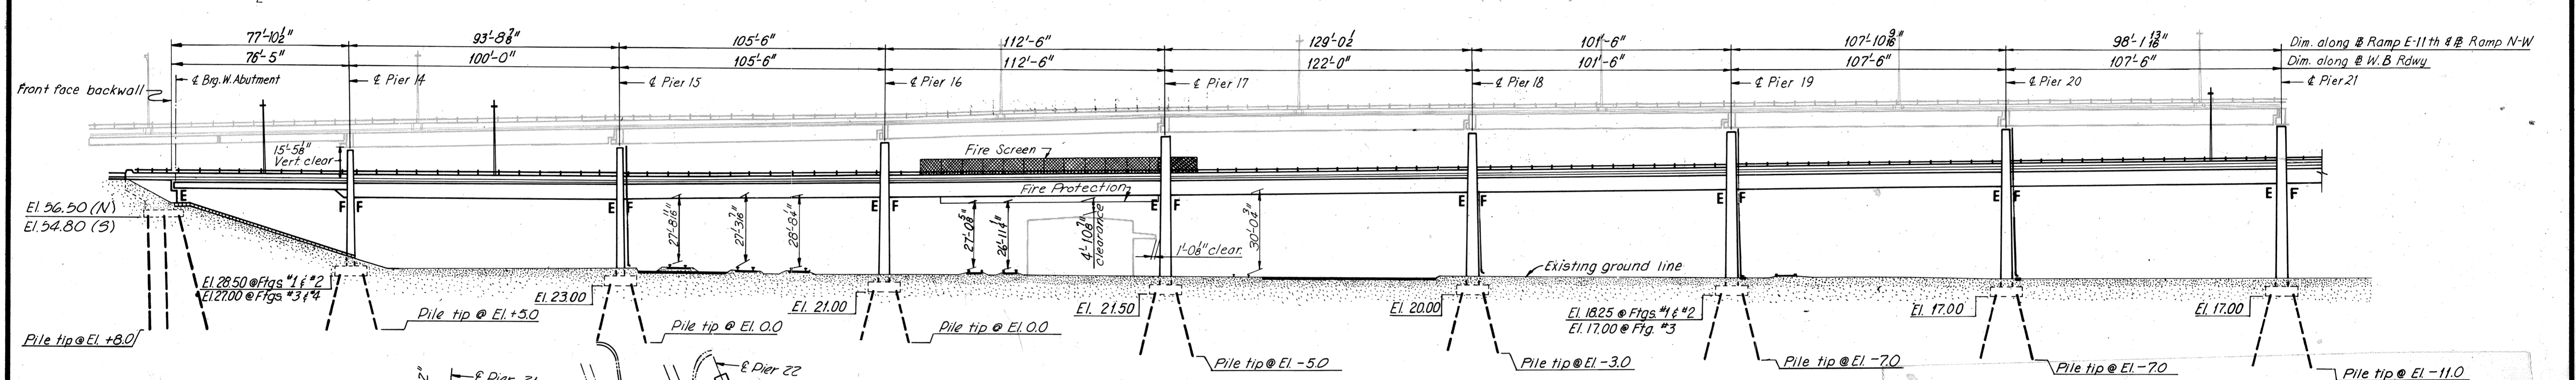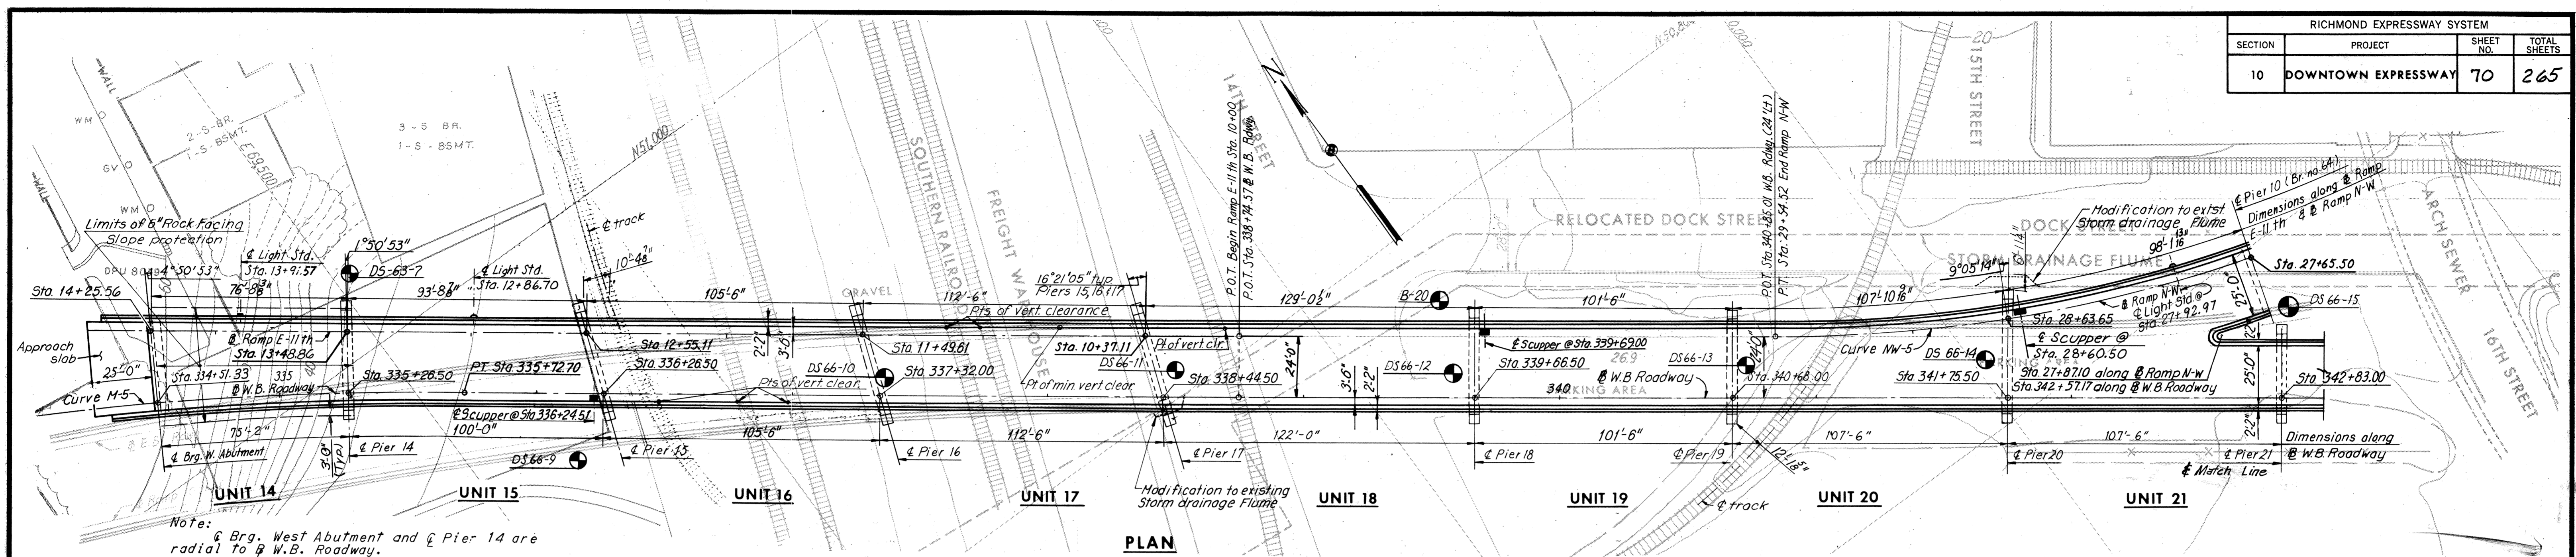

# W.B. Roadway		# Ramp N-W	
Curve: M-5		Curve: NW-5	
P.I. = Sta. 334+26.15		P.I. = Sta. 28+25.38	
Δ = 11°45'56"		Δ = 26°18'00"	
D = 4°00'		D = 10°00'	
T = 147.59'		T = 133.86'	
L = 294.14'		L = 263.00'	
R = 1432.40'		R = 572.96'	

**HORIZONTAL CURVE DATA**

Notes:  
 For Estimated quantities and General Notes see Sheet 2.  
 For Boring Logs see Sheets 26 Thru 29.  
 For Layout of Pier 10(64) see Bridge No. 64 (Ramp N-W) Sheet 3.  
 ⊙ Indicates boring location.  
 Footing numbers (1,2,etc.) on each pier go from North to South.  
 For Profile Grade Data see Sheet 2.

INDEX	SHEET
GENERAL PLAN AND ELEVATION	1
QUANTITIES	2
WEST ABUTMENT	3
WEST ABUTMENT DETAILS	4
PIER 14	5
PIER 15	6
PIER 16	7
PIER 17	8
PIER 18 AND 19	9
PIER 20	10
PIER 21	11
PIER 22	12
FRAMING PLAN UNITS 14, 15 AND 16	13
FRAMING PLAN UNITS 17 AND 18	14
FRAMING PLAN UNITS 19, 20 AND 21	15
FRAMING DETAILS UNITS 20 AND 21	16
FRAMING PLAN UNITS 22 AND 23	17
DECK PLAN UNITS 14, 15 AND 16	18
DECK PLAN UNITS 17, 18 AND 19	19
DECK PLAN UNITS 20 AND 21	20
DECK PLAN UNITS 22 AND 23	21
SUBSTRUCTURE DETAILS	22
FIRE PROTECTION DETAILS	23
JOINT DETAILS	24
APPROACH SLAB AND SLOPE PROTECTION DETAILS	25
BORING LOGS	26 THRU 29
STANDARD SHEETS	31 THRU 37

BY	DATE	Joint Type & Rail-Road Name Added	PRMS	4-19-74
MADE	Y.C.P.	1-9-69	K.D.P.	6-74
CHECKED	J.D.	3-13-69	TEM	10-76
IN CHARGE	FKD			

**RICHMOND METROPOLITAN AUTHORITY**  
**RICHMOND EXPRESSWAY SYSTEM**  
**DOWNTOWN EXPRESSWAY**


**BRIDGE NO. 63**  
**WESTBOUND ROADWAY OVER**  
**12TH ST. - R.R. TRACKS AND 16TH ST.**  
**GENERAL PLAN AND ELEVATION**

HOWARD, NEEDLES, TAMMEN & BERGENDOFF  
 consulting engineers  
 NEW YORK ALEXANDRIA KANSAS CITY

SCALE: 1" = 30'  
 CONTRACT NO.: 10  
 SHEET NO. 1 OF 29


AS BUILT

RICHMOND EXPRESSWAY SYSTEM			
SECTION	PROJECT	SHEET NO.	TOTAL SHEETS
10	DOWNTOWN EXPRESSWAY	87	265

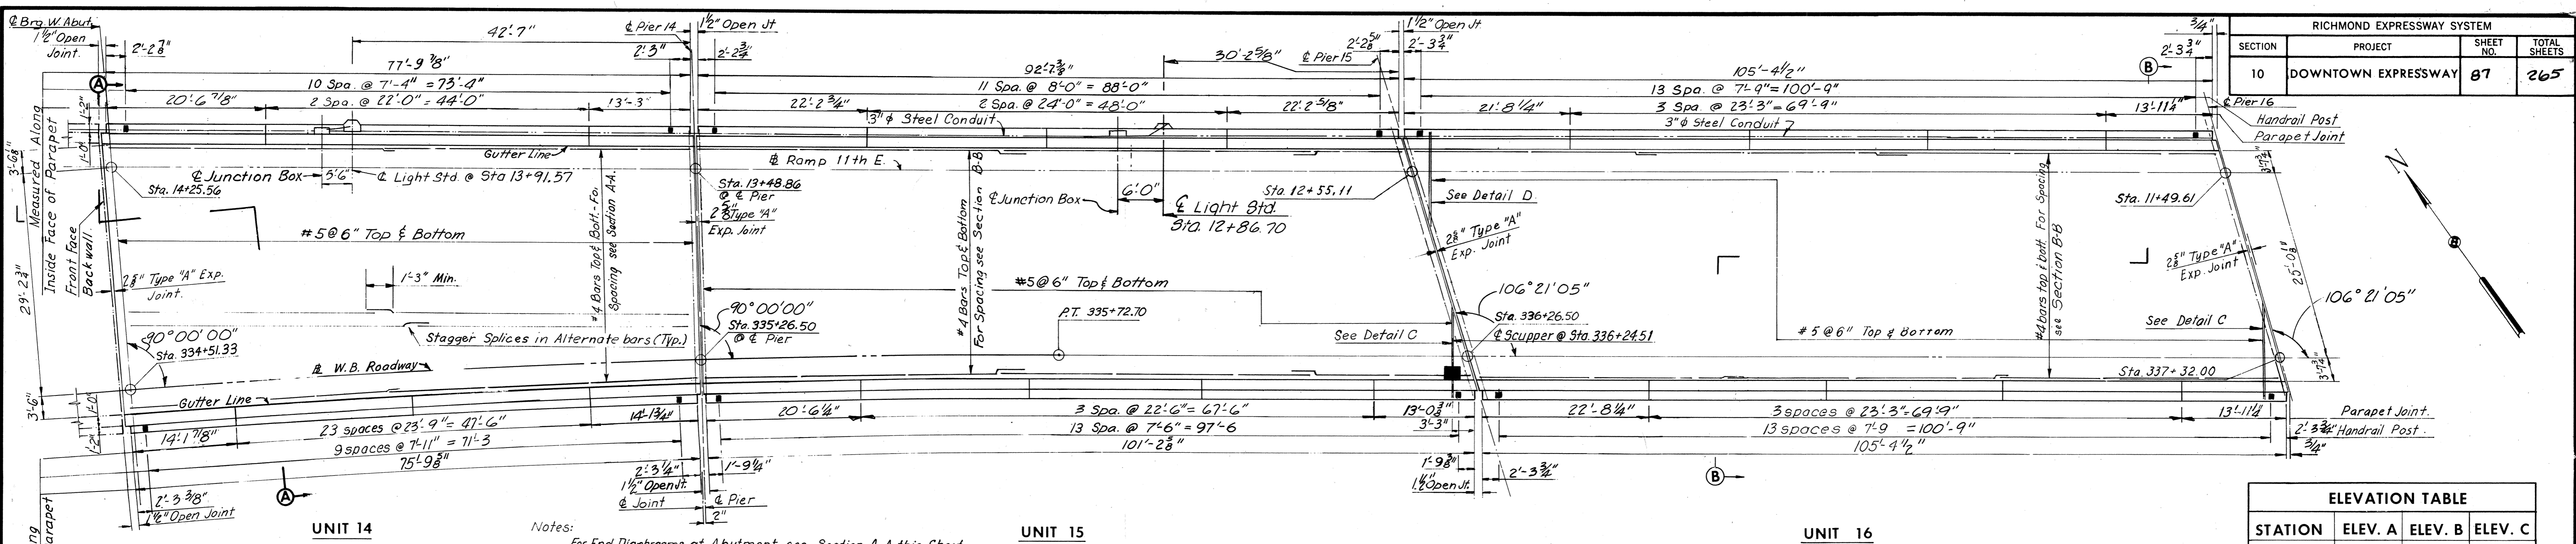


Notes:  
 For End Diaphragms at Abutment, see Section A-A this Sheet.  
 For End Diaphragms at Pier 14, Units 14 & 15, see Section A-A Sheet 14.  
 For End Diaphragms at Pier 15, Units 15 & 16, see Section B-B this Sheet.  
 For End Diaphragms at Pier 16, Unit 16, see Section B-B this Sheet.


ELEVATION TABLE			
STATION	ELEV. A	ELEV. B	ELEV. C
334+50.00	68.13	66.16	65.95
+51.50	68.10	66.13	65.92
+60.00	67.89	65.97	65.76
+70.00	67.65	65.78	65.57
+80.00	67.42	65.58	65.37
+90.00	67.17	65.39	65.18
335+00.00	66.92	65.20	64.99
+10.00	66.67	65.02	64.81
+20.00	66.43	64.85	64.65
+26.50	66.28	64.74	64.55
+30.00	66.20	64.69	64.50
+40.00	65.99	64.55	64.37
+50.00	65.78	64.43	64.26
+60.00	65.61	64.32	64.16
+70.00	65.46	64.23	64.07
+80.00	65.32	64.15	64.00
+90.00	65.20	64.09	63.95
336+00.00	65.09	64.04	63.91
+10.00	65.00	64.01	63.88
+18.58	64.93	---	---
+20.00	64.92	63.99	63.87
+26.50	---	63.99	---
+27.38	---	---	63.87
+30.00	64.86	63.99	63.87
+40.00	64.81	64.00	63.90
+50.00	64.78	64.03	63.94
+60.00	64.76	64.07	63.99
+70.00	64.76	64.13	64.05
+80.00	64.76	64.21	64.13
+90.00	64.81	64.30	64.23
337+00.00	64.85	64.40	64.34
+10.00	64.91	64.51	64.46
+20.00	64.97	64.62	64.58
+24.08	64.96	---	---
+30.00	65.00	64.74	64.71
+32.00	---	64.76	---
+32.88	---	---	64.74
+40.00	65.05	64.85	64.83

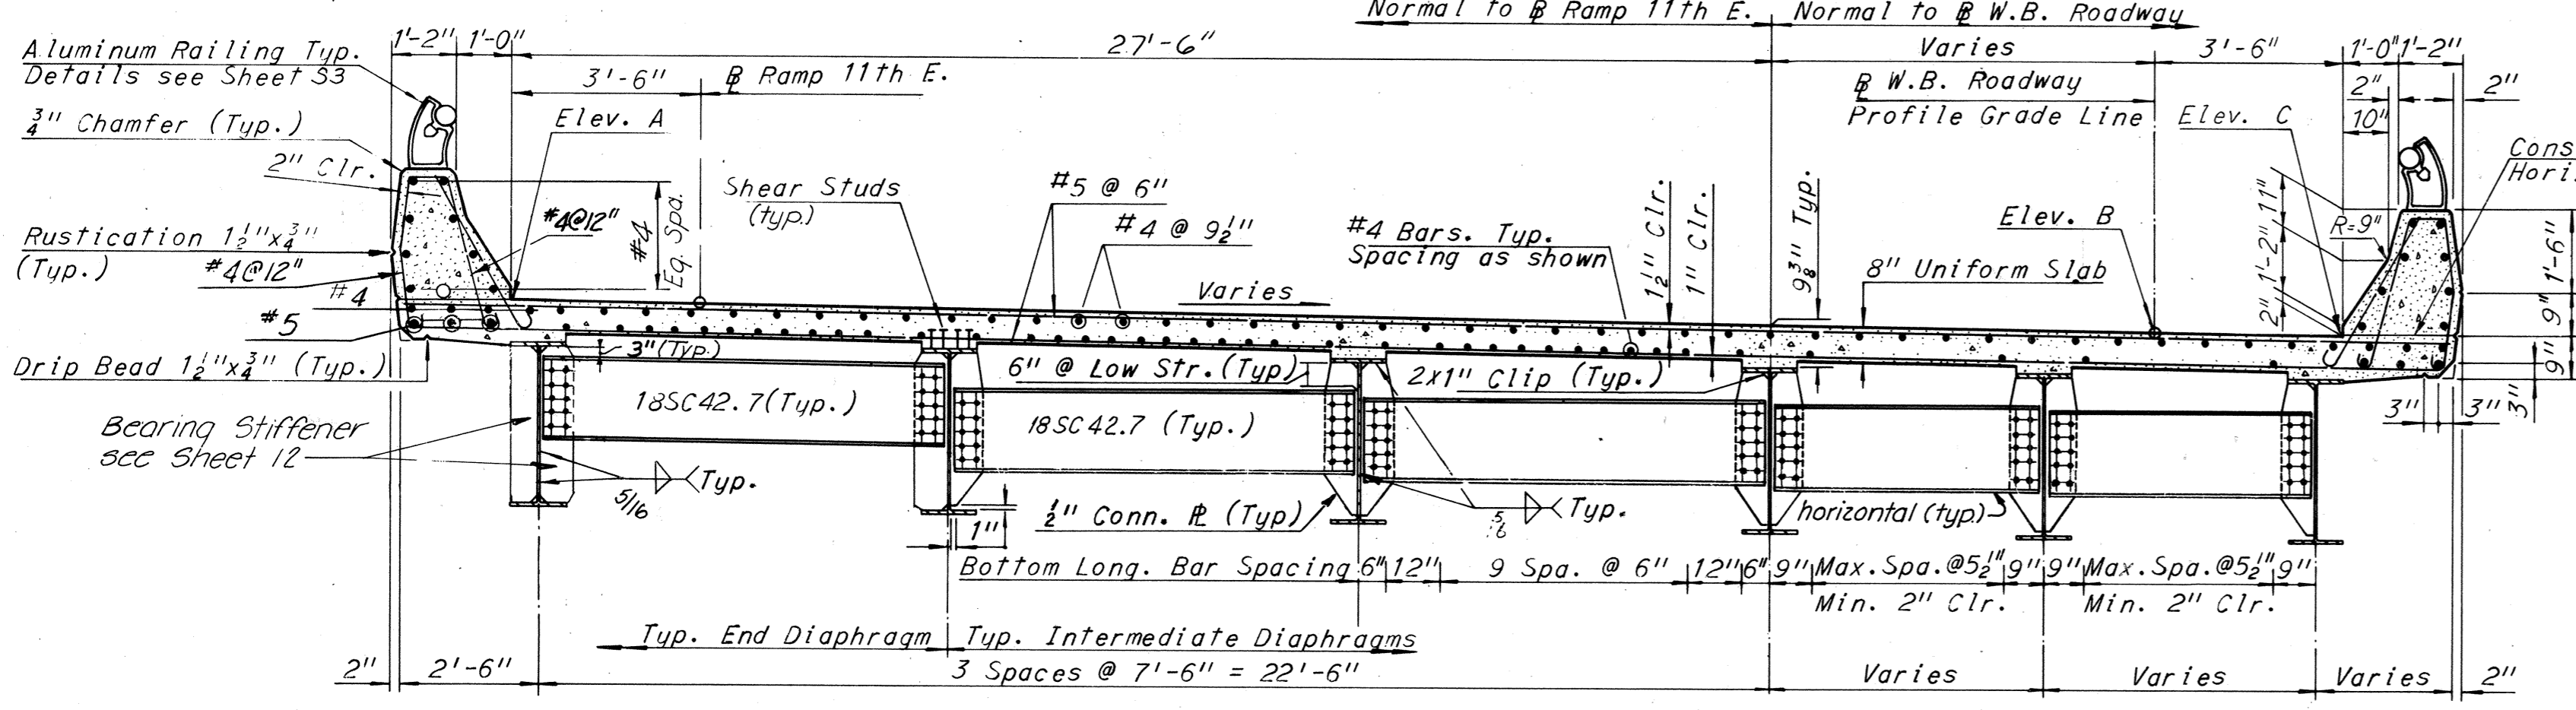


SECTION A-A  
 Scale: 3/8" = 1'-0"

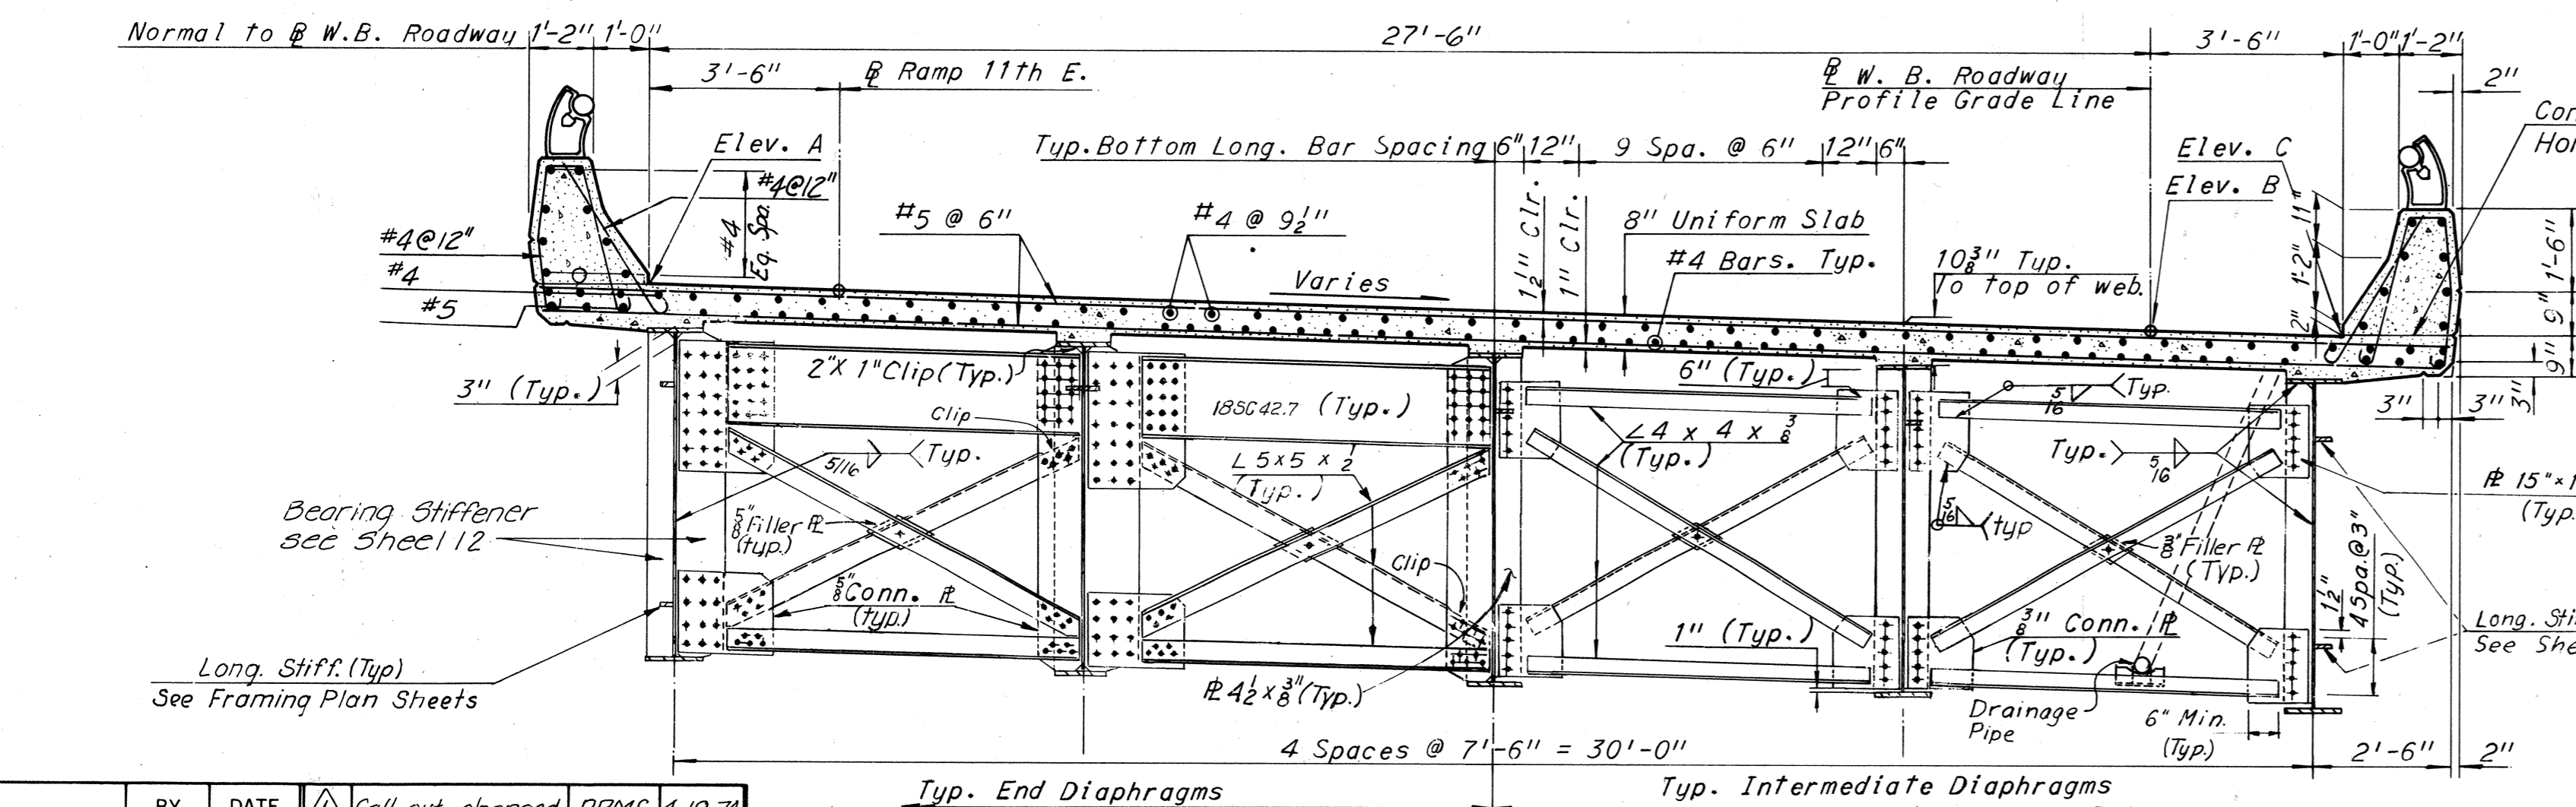

SECTION B-B  
 Scale: 3/8" = 1'-0"

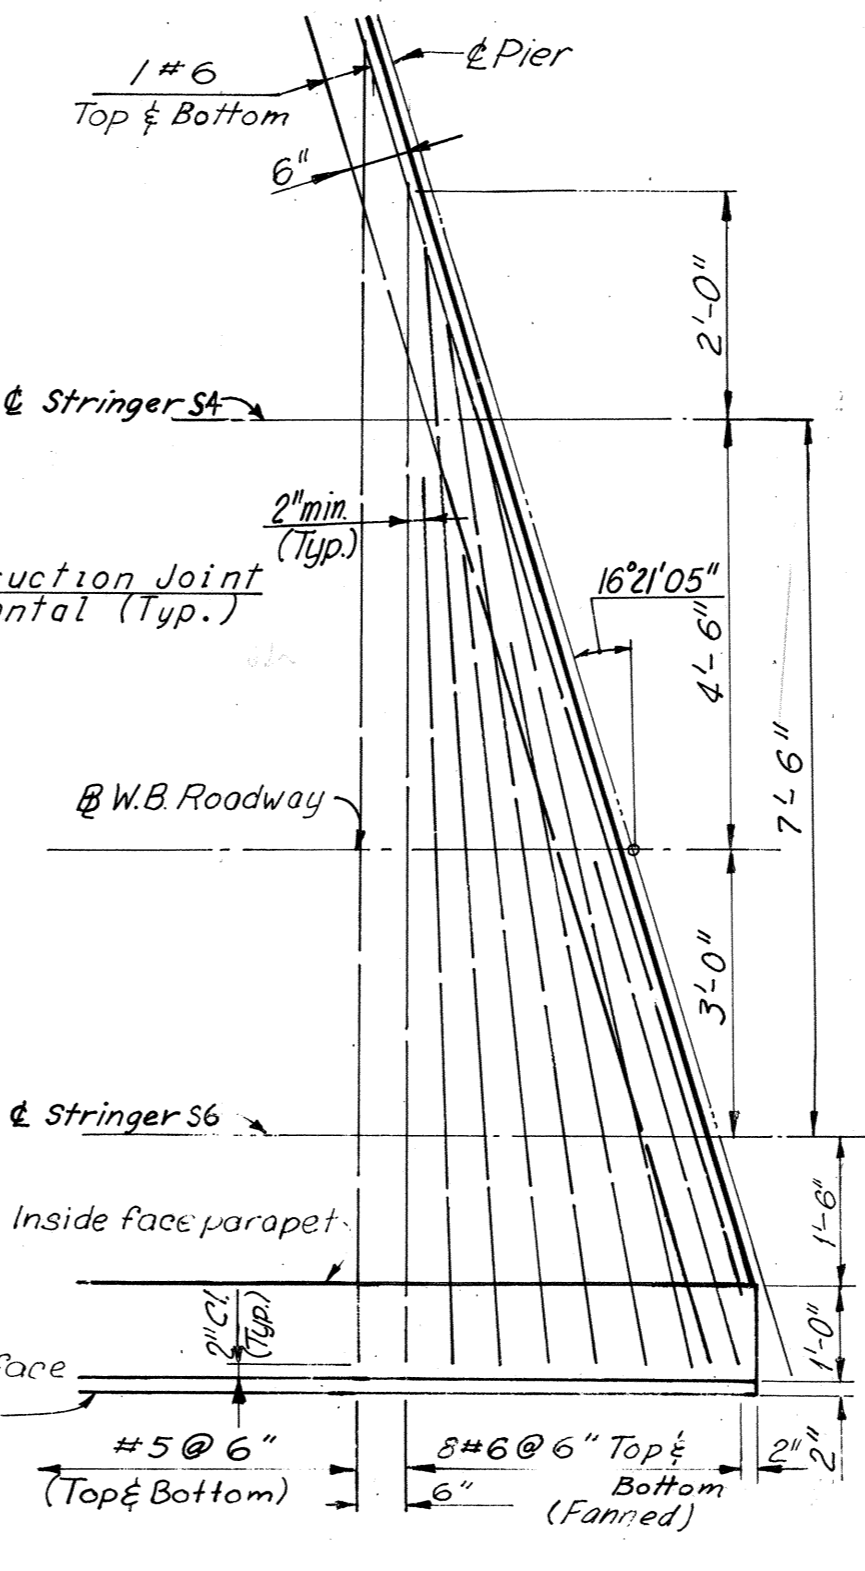

DETAIL C  
 Scale: 1" = 2'-0"

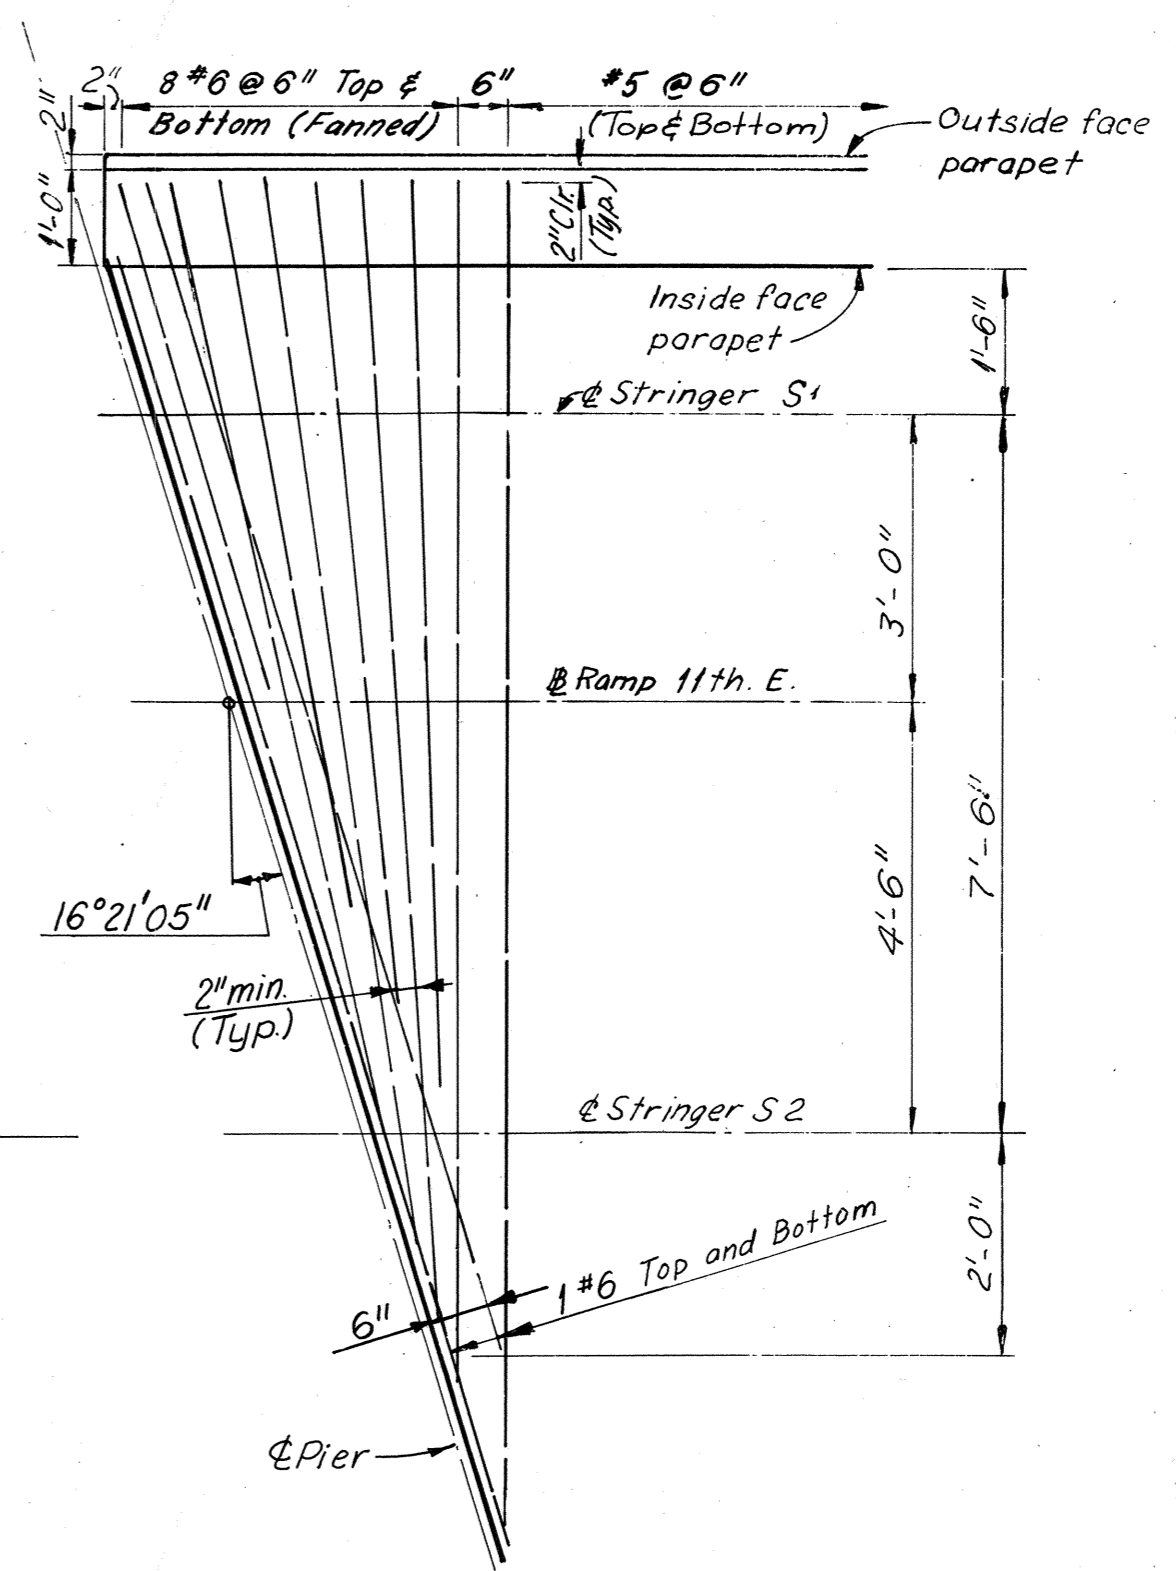

DETAIL D  
 Scale: 1" = 2'-0"

Notes:  
 For Superstructure quantities, see Sheet 2.  
 For Framing plan, see Sheet 13.  
 For Joint details, see Sheet 24.  
 For Railing details, see Sheet 53.  
 For Standard Drainage Details, see Support Type 2 Sheet 55 & 56.

BY	DATE	Call-out changed	PRMS	4-19-78
MADE	SHS	8-2-68	2	As Built
CHECKED	R.C.	10-23-68		
IN CHARGE				
	NO.	REVISION	BY	DATE

**RICHMOND METROPOLITAN AUTHORITY**  
**RICHMOND EXPRESSWAY SYSTEM**  
**DOWNTOWN EXPRESSWAY**

**BRIDGE NO. 63**  
**WESTBOUND ROADWAY OVER**  
**12TH ST. - R.R. TRACKS AND 16TH ST.**  
**DECK PLAN - UNITS 14, 15, AND 16**

HOWARD, NEEDLES, TAMMEN & BERGENDOFF  
 consulting engineers  
 NEW YORK ALEXANDRIA KANSAS CITY

SCALE: \_\_\_\_\_  
 CONTRACT NO. **10**  
 SHEET NO. **18** OF **29**


AS BUILT

## **Bridge 64**

**(Ramp from Southbound I-95 to Westbound Downtown Expressway “Rte. 195” over East Cary Street, Dock Street and CSX RR)**



**Record Set Plans**

RICHMOND EXPRESSWAY SYSTEM			
SECTION	PROJECT	SHEET NO.	TOTAL SHEETS
10	DOWNTOWN EXPRESSWAY	99	265

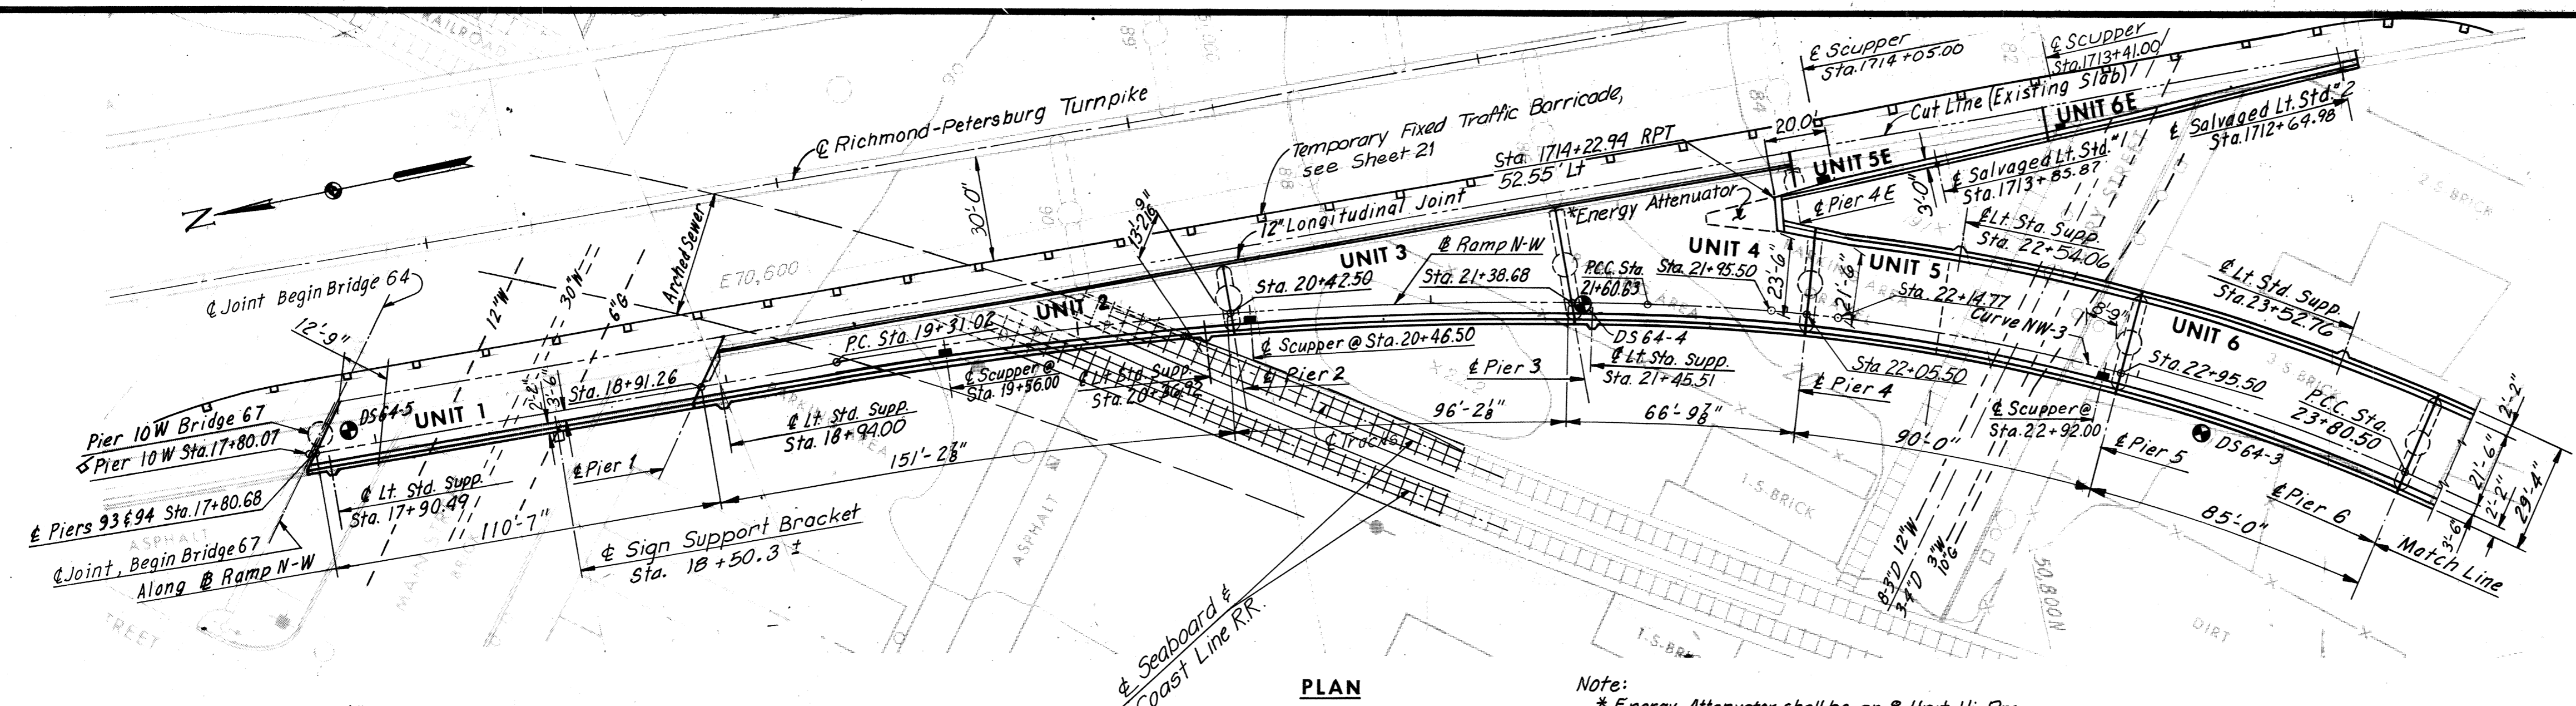


**INDEX**

INDEX	SHEET
GENERAL PLAN AND ELEVATION	1
GENERAL PLAN AND ELEVATION	2
LAYOUT PLAN	3
PIERS 1 AND 2	4
PIERS 3 AND 4E	5
PIER 4	6
PIER 5	7
PIERS 6 AND 7	8
PIER 8	9
PIER 9	10
PIER 10	11
FRAMING PLAN - UNITS 1 AND 2	12
FRAMING PLAN - UNITS 3 AND 4	13
FRAMING PLAN AND DECK PLAN - UNITS 5E AND 6E	14
FRAMING PLAN - UNITS 5 AND 6	15
FRAMING PLAN - UNITS 7 AND 8	16
FRAMING PLAN - UNITS 9 AND 10	17
FRAMING DETAILS	18
DECK PLAN - UNITS 1 AND 2	19
DECK PLAN - UNITS 3 AND 4	20
DECK PLAN - UNITS 5 AND 6	21
DECK PLAN - UNITS 7 AND 8	22
DECK PLAN - UNITS 9 AND 10	23
SUPERSTRUCTURE DETAILS	24
JOINT DETAILS	25
JOINT DETAILS	26
BORING LOGS	27
BORING LOGS	28
STANDARD DETAILS	S1 THRU S7

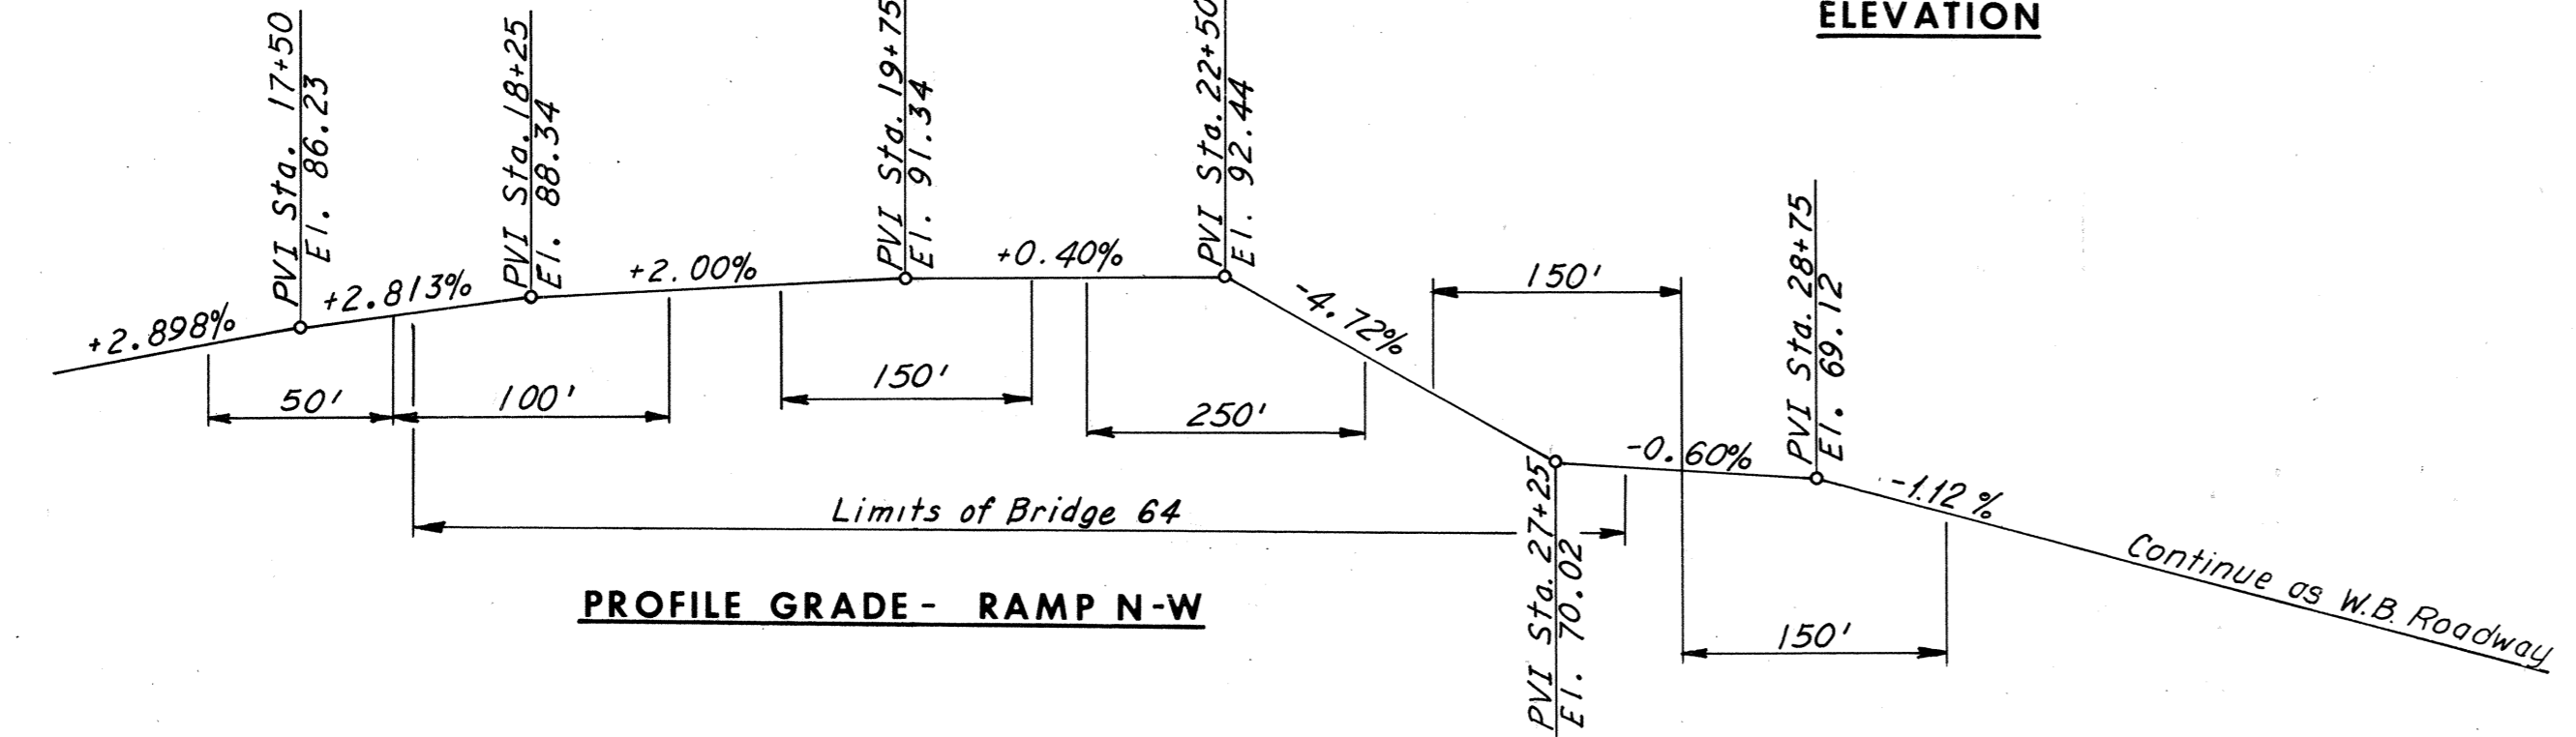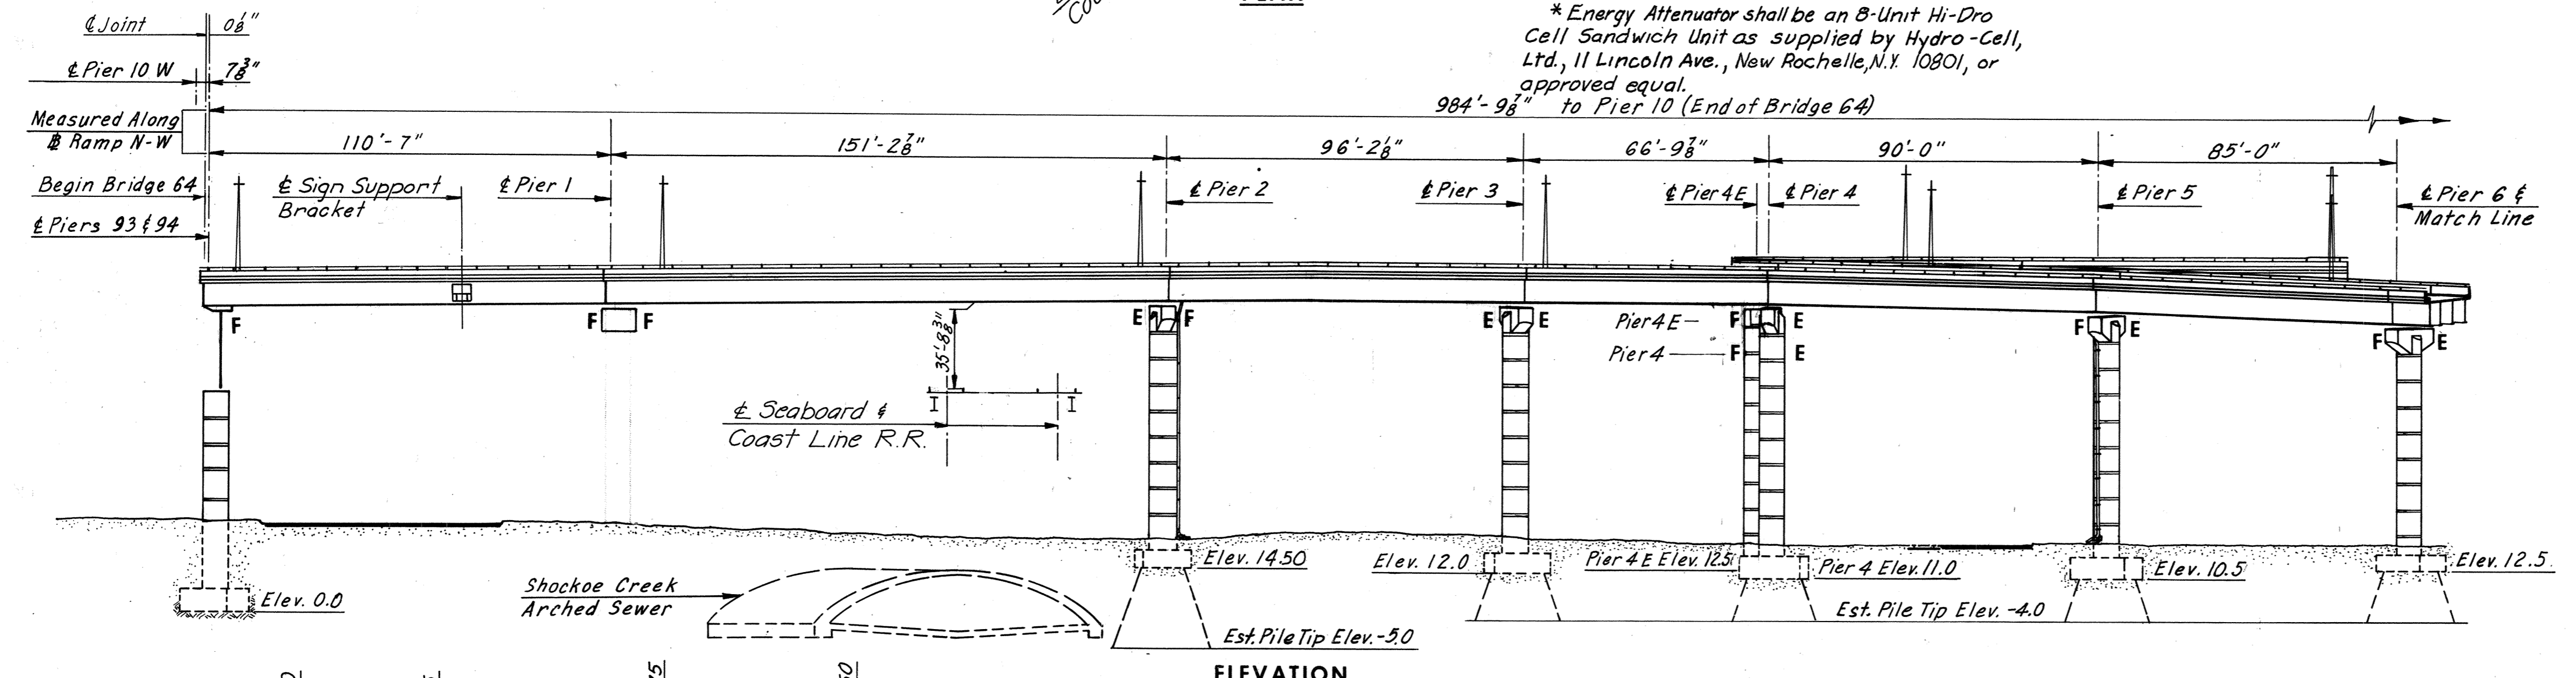

**HORIZONTAL CURVE DATA**

R. P. Turnpike		Ramp N-W	
Curve: R.P.T.-1	Curve: R.P.T.-2	Curve: NW-1	Curve: NW-2
P.I. = Sta. 1704+68.83	P.I. = Sta. 1723+07.01	P.I. = Sta. 13+42.50	P.I. = Sta. 20+46.21
Δ = 15° 03' 56.2"	Δ = 33° 27' 06.8"	Δ = 32° 01' 34"	Δ = 11° 28' 49.9"
D = 17° 00' 00"	D = 4° 00' 00"	D = 3° 51' 35.6"	D = 5° 00'
T = 757.65'	T = 430.45'	T = 426.01'	T = 115.19'
L = 1,506.56'	L = 836.30'	L = 829.72'	L = 229.61'
R = 3,729.58'	R = 1,432.39'	R = 1,484.39'	R = 1,145.92'
Curve: NW-3	Curve: NW-4	Curve: NW-5	
P.I. = Sta. 22+71.93	P.I. = Sta. 25+55.02	P.I. = Sta. 28+25.38	
Δ = 21° 59' 14.9"	Δ = 64° 48' 04"	Δ = 26° 18' 00"	
D = 10° 00' 00"	D = 20° 50' 05.4"	D = 10° 00' 00"	
T = 111.31'	T = 174.52'	T = 133.86'	
L = 219.88'	L = 311.02'	L = 263.00'	
R = 572.96'	R = 275.00'	R = 572.96'	

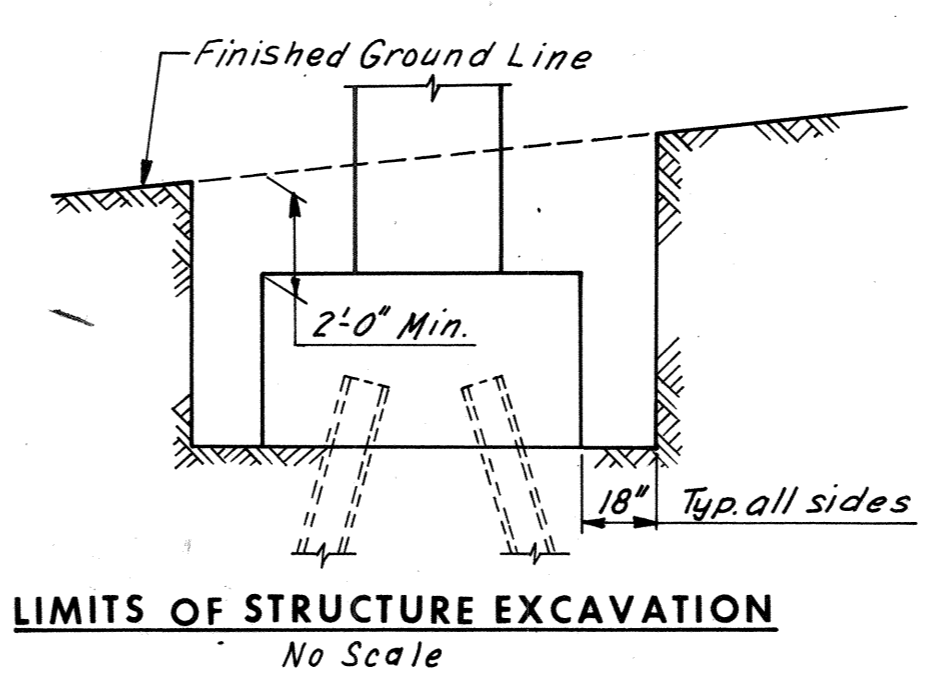

NO.	REVISION	BY	DATE
4	As Built	TEM	6-77
	Seaboard & Coast Line Add. to Plant Et.	K.D.P.	6-74
	Sign Support Bracket & Sheet 12a added	L.B.P.	8-74
	Added Sta.	REG	1-13-75

**RICHMOND METROPOLITAN AUTHORITY**  
**RICHMOND EXPRESSWAY SYSTEM**  
**DOWNTOWN EXPRESSWAY**



**BRIDGE NO. 64**  
**RAMP N-W CONNECTION FROM**  
**RICHMOND-PETERSBURG TURNPIKE**  
**GENERAL PLAN AND ELEVATION**

HOWARD, NEEDLES, TAMMEN & BERGENDOFF  
consulting engineers  
NEW YORK ALEXANDRIA KANSAS CITY

SCALE: 1" = 30'-0"  
CONTRACT NO.: 10  
SHEET NO. 1 OF 28

**AS BUILT**

RICHMOND EXPRESSWAY SYSTEM			
SECTION	PROJECT	SHEET NO.	TOTAL SHEETS
10	DOWNTOWN EXPRESSWAY	100	265

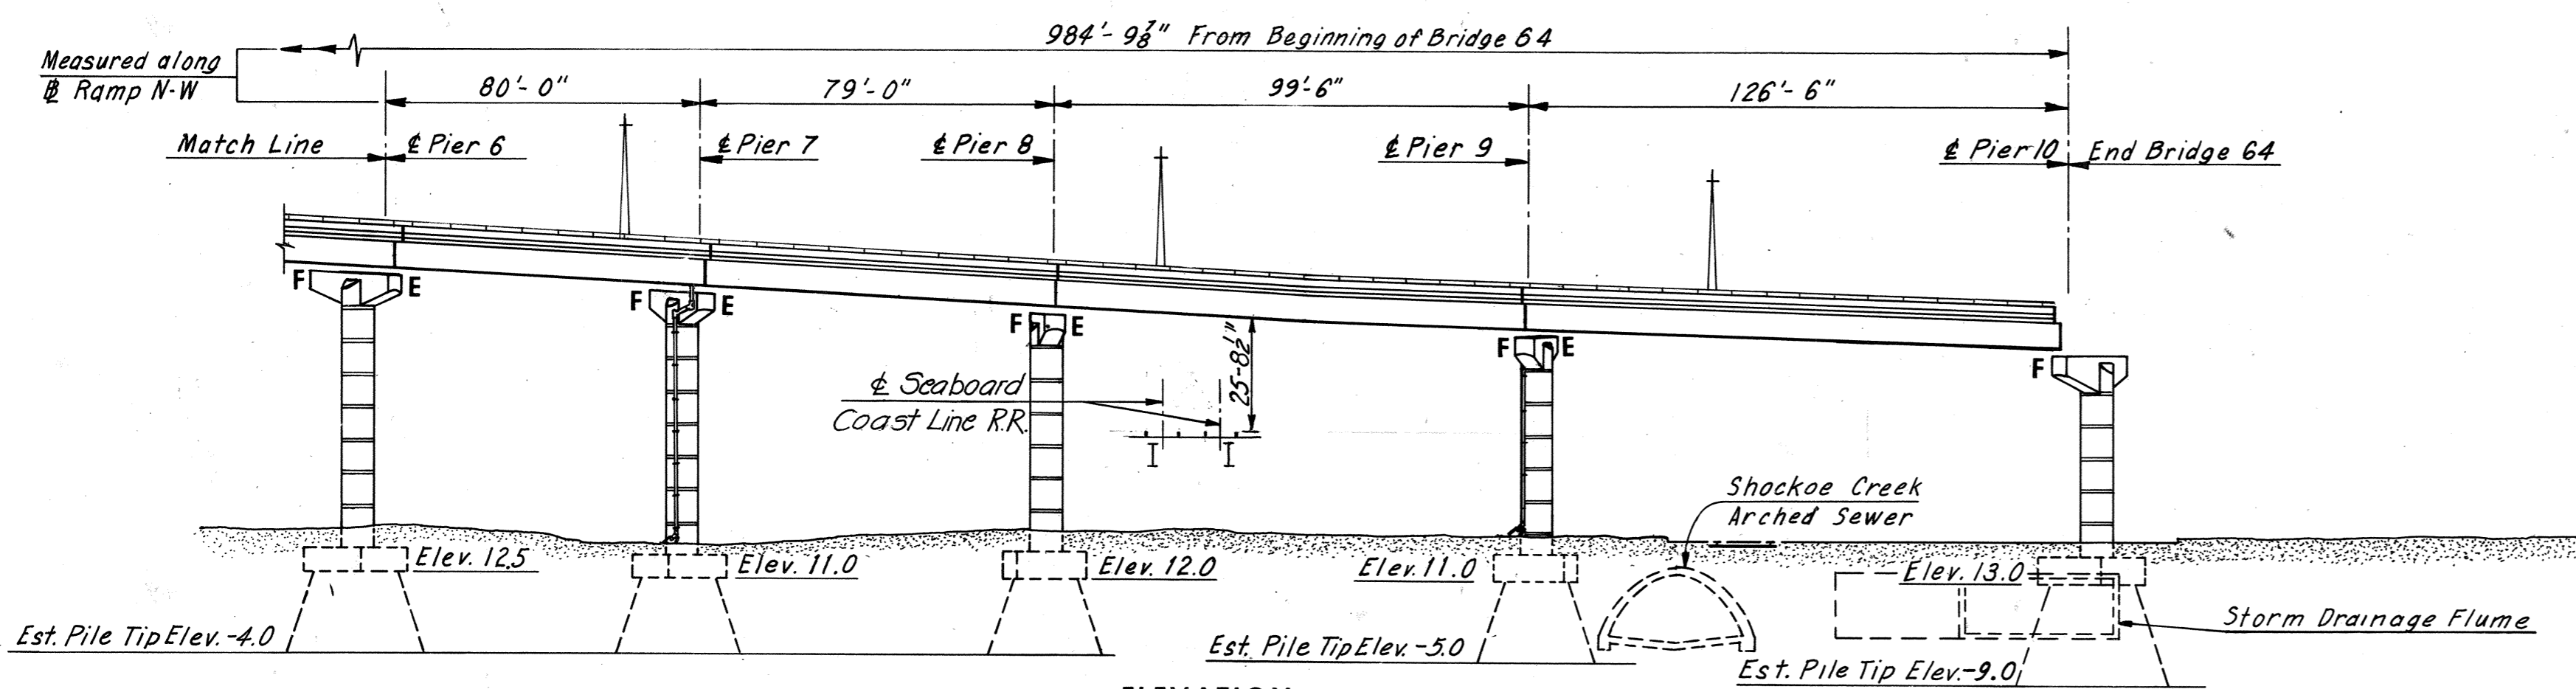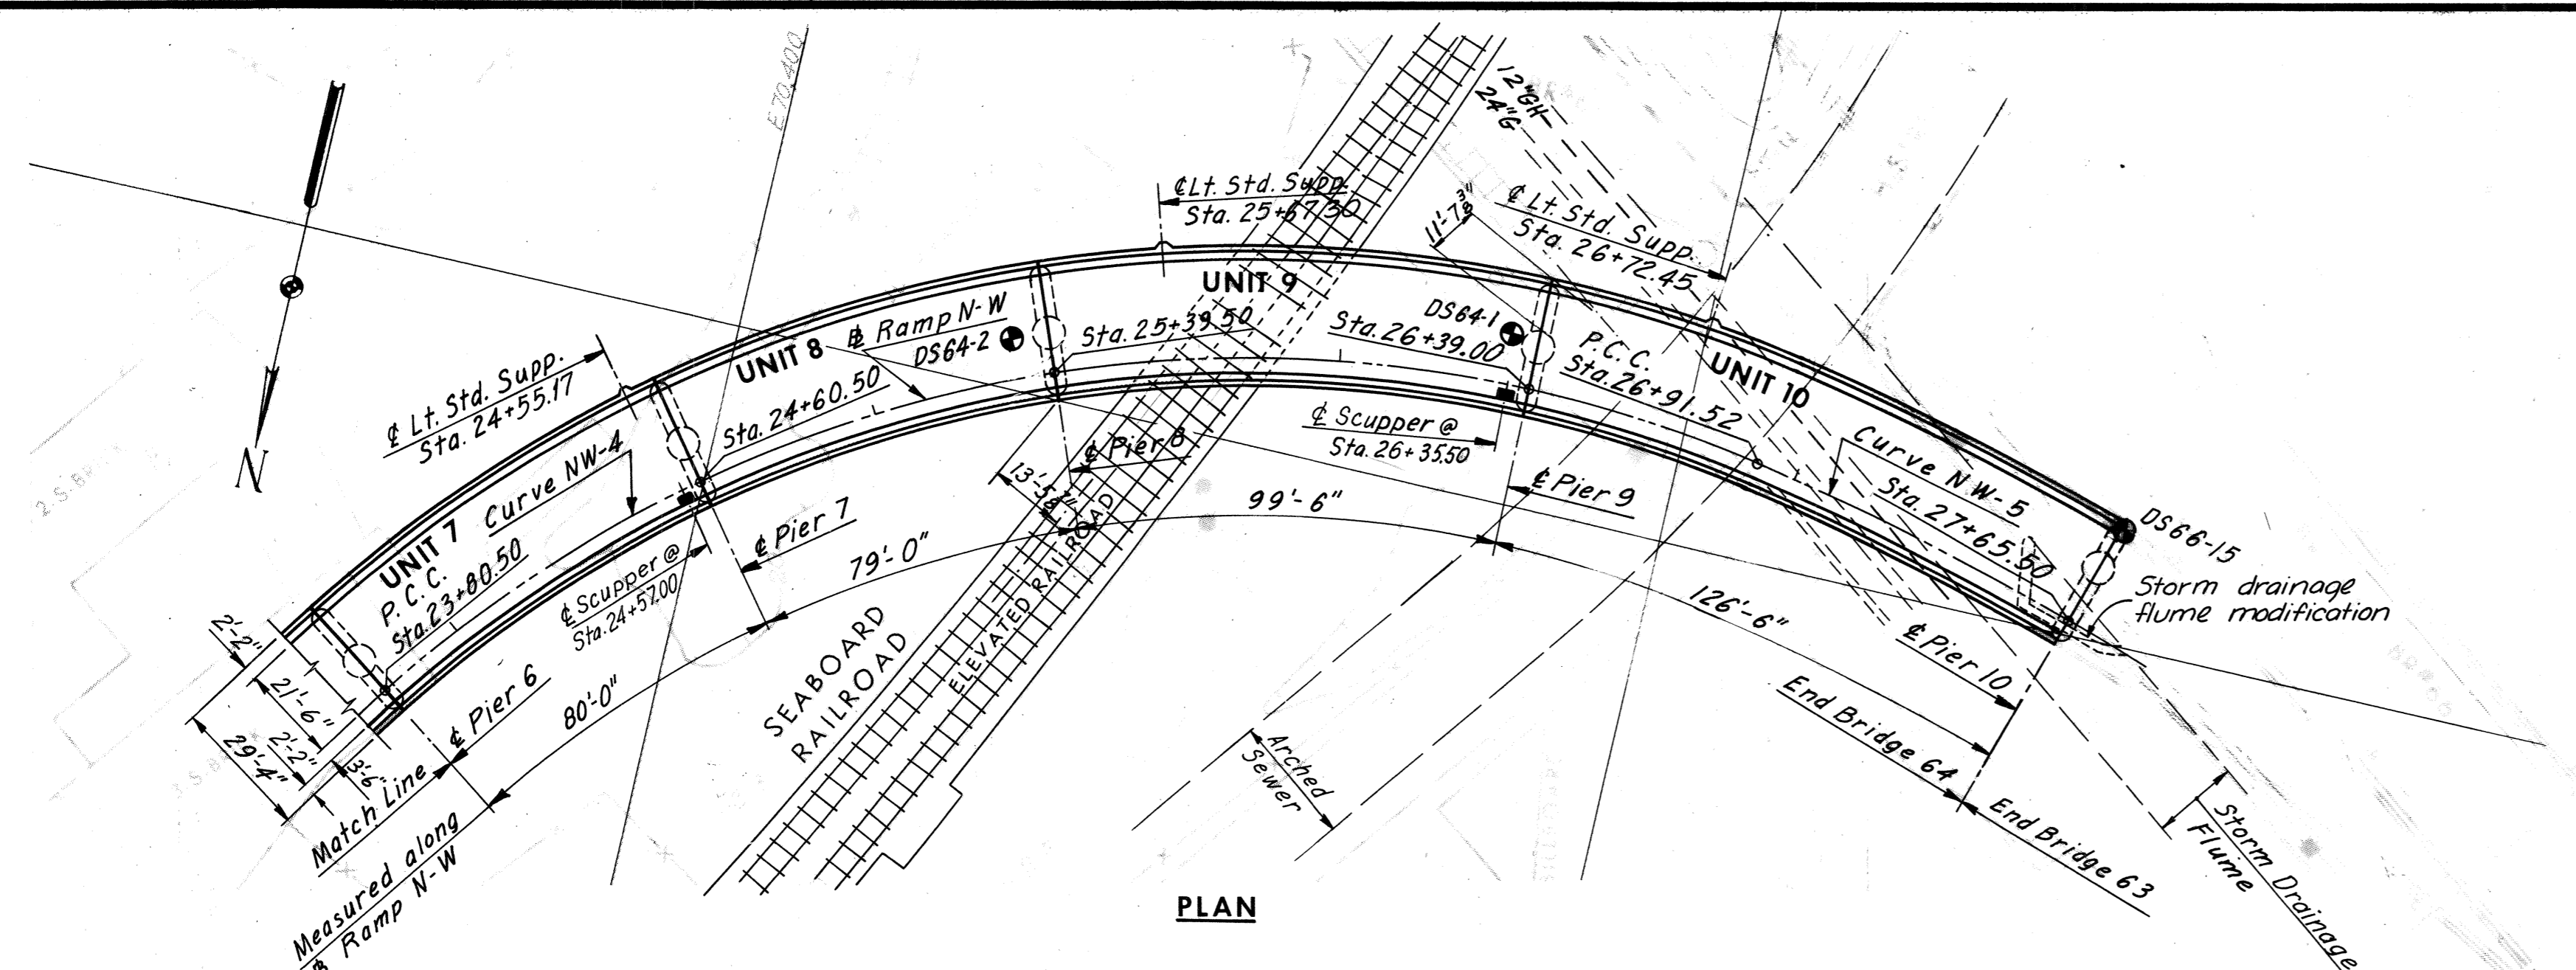

**ESTIMATED QUANTITIES**

	Structure Excavation Cu. Yds.	Concrete (#) Cu. Yds.	Reinforcing Steel Lbs.	Str. Steel Mild Carbon Lbs.	Str. Steel High Strength Lbs.	Aluminum Railing (1-Rail) Lin. Ft.	Steel Piles 10BP42 Lin. Ft.
Superstructure	--	1,023.8	213,790	768,100	413,900	1,600	---
Substructure	1,125	1,484.1	236,580	2,000	---	---	145
Total	1,125	2,507.9	450,370	770,100	413,900	1,600	145

	Steel Piles 12BP53 Lin. Ft.	Sheet Piling Lump Sum	Metal Conduit Lin. Ft.	Energy Attenuator 8-Unit Each	Bridge Drainage Metal Work Lbs.	Modifications to R.P. Turnpike Bridge Lump Sum	Modifications to Storm Drainage Flume Cu. Yds.
Superstructure	---	--	1,075	1	13,030	1	--
Substructure	3,035	1	--	--	--	--	116
Total	3,035	1	1,075	1	13,030	1	116

\* All Concrete for Superstructure shall be Class A4 and for Substructure Class A3.

BY	DATE	Seaboard & Coast Line Add. To Plans	K.D.P.	6-74
MADE	AMH 1-13-69	Str. Steel Quantity	R.B.H.	9-74
CHECKED	GCC 4-28-69	As Built	TEM	6-77
IN CHARGE	NO.	REVISION	BY	DATE

**GENERAL NOTES:**

**ROADWAY:** One variable width roadway transitioning from a widening of Southbound roadway of Richmond-Petersburg Turnpike to a ramp with 25'-0" clear roadway connecting with W.B. Roadway (Br. 63).

**CAPACITY:** Dead load includes 15 lbs. per sq. ft. for future wearing surface. Live load, HS 20-44 loading and alternate military loading.

**SPECIFICATIONS:** GENERAL: Virginia Department of Highway Road and Bridge Specifications 1970.  
DESIGN: A.A.S.H.O. Standard Specifications for Highway Bridges 1973, modified by Special Design provisions.  
WELDING: 1972 Standard Specifications for Welded Highway and Railway Bridges of The American Welding Society.  
CONTRACT SPECIAL PROVISIONS: Specifications and Contract Special Provisions referred to above are necessary to make these plans complete.

**DATUM:** City of Richmond

**TEMPERATURE:** The normal temperature referred to in the plans is 60°F. The temperature range for movement is 0° F. to 120° F.

**DIMENSIONS:** All dimensions are measured horizontally and vertically unless otherwise noted.

**EXCAVATION:** Excavation below subgrade and cut slope template shall be classified as Structure Excavation. All excavation above these limits shall be classified as Regular Excavation and is not included in the Structural Quantities.

**FOUNDATIONS:** Footings shall rest on firm material. Foundation material shall be dry and special attention is called to Section 401.05 of Standard Specifications and to the Contract Special Provisions, concerning preparation of foundations for footings.

**CONCRETE NOTES:** Concrete in superstructure shall be Class A 4. All other concrete shall be Class A 3. All exposed edges and corners shall have a 3" chamfer or fillet unless otherwise noted. Care in the method of vibration, the use of low-slump concrete, and other means shall be employed to prevent downgrade movement of newly placed slab concrete. Finishing Concrete Surfaces: See Standard Architectural Detail Sheets and the Contract Special Provisions for types and details. All reinforcing bar dimensions on the detailed drawings are to centers of bars unless otherwise noted. Clear distance between reinforcing steel and face to concrete shall be as noted on the plans. All bar laps shall be 30 diameters of the smaller diameter bar unless otherwise noted. All reinforcing steel shall conform to ASTM A615 Grade 40.

**STEEL NOTES:** Structural steel shall conform to A.S.T.M. Designations A36, A572 - Grade 50 and A588 as noted. See Special Provisions. All field connections shall be made with high strength bolts. High strength bolts shall be 1/2" diameter unless otherwise noted and shall conform to A.S.T.M. Specification A-325.

Note: For Curve Data and Profile Grade, see Sheet 1. For Layout Plan, see Sheet 3.

AS BUILT

**RICHMOND METROPOLITAN AUTHORITY**  
**RICHMOND EXPRESSWAY SYSTEM**  
**DOWNTOWN EXPRESSWAY**

**BRIDGE NO. 64**  
**RAMP N-W CONNECTION FROM**  
**RICHMOND-PETERSBURG TURNPIKE**  
**GENERAL PLAN AND ELEVATION**

HOWARD, NEEDLES, TAMMEN & BERGENDOFF  
 Consulting Engineers  
 NEW YORK ALEXANDRIA KANSAS CITY

SCALE: 1" = 30'-0"  
 CONTRACT NO. 10  
 SHEET NO. 2 OF 28


## **Bridge 65**

**(Ramp from Northbound I-95 to Westbound Downtown Expressway “Rte. 195” over NS RR and CSX RR)**

**Record Set Plans**



RICHMOND EXPRESSWAY SYSTEM			
SECTION	PROJECT	SHEET NO.	TOTAL SHEETS
11	DOWNTOWN EXPRESSWAY	26	97

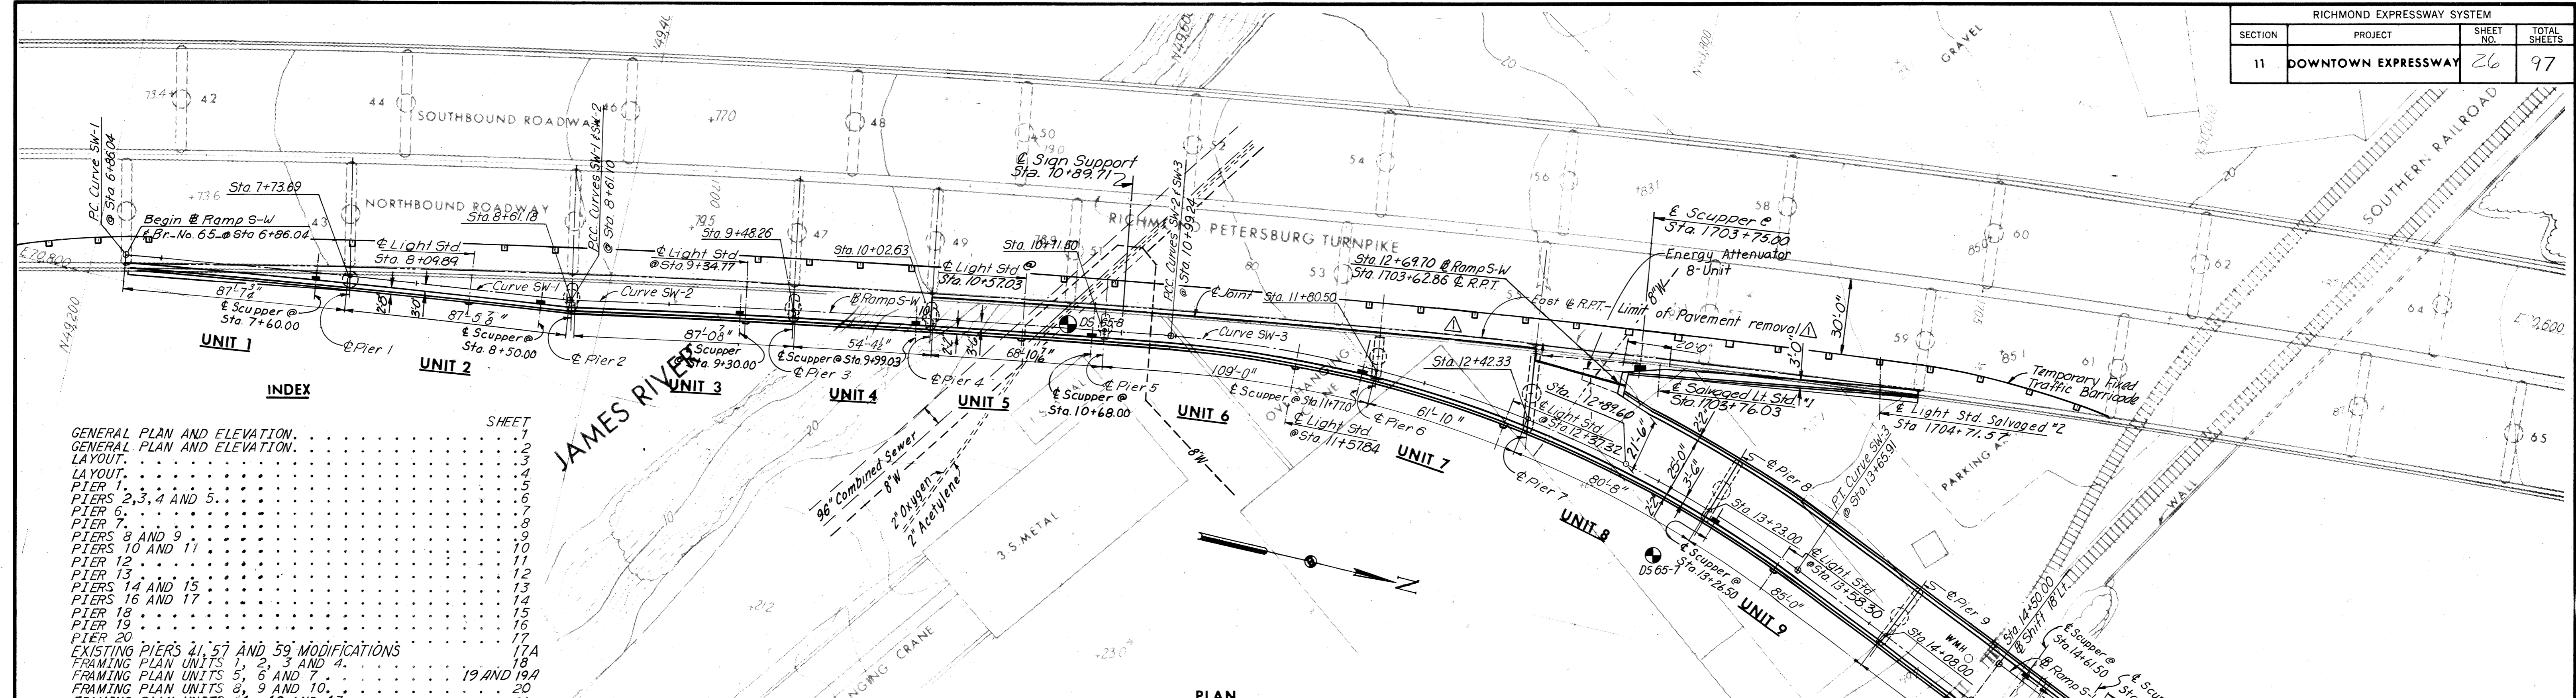


**INDEX**


GENERAL PLAN AND ELEVATION. . . . .	SHEET 1
GENERAL PLAN AND ELEVATION. . . . .	2
LAYOUT. . . . .	3
LAYOUT. . . . .	4
PIER 1. . . . .	5
PIERS 2, 3, 4 AND 5. . . . .	6
PIER 6. . . . .	7
PIERS 8 AND 9. . . . .	8
PIERS 10 AND 11. . . . .	9
PIER 12. . . . .	10
PIER 13. . . . .	11
PIERS 14 AND 15. . . . .	12
PIERS 16 AND 17. . . . .	13
PIER 18. . . . .	14
PIER 19. . . . .	15
PIER 20. . . . .	16
EXISTING PIERS 21, 57 AND 59 MODIFICATIONS. . . . .	17A
FRAMING PLAN UNITS 1, 2, 3 AND 4. . . . .	18
FRAMING PLAN UNITS 5, 6 AND 7. . . . .	19 AND 19A
FRAMING PLAN UNITS 8, 9 AND 10. . . . .	20
FRAMING PLAN UNITS 11, 12 AND 13. . . . .	21
FRAMING PLAN UNITS 14, 15 AND 16. . . . .	22
FRAMING PLAN UNITS 17 AND 18. . . . .	23
FRAMING PLAN UNITS 19 AND 20. . . . .	24
DECK PLAN UNITS 1, 2, 3 AND 4. . . . .	25
DECK PLAN UNITS 5, 6 AND 7. . . . .	26
DECK PLAN UNITS 8, 9 AND 10. . . . .	27
DECK PLAN UNITS 11, 12 AND 13. . . . .	28
DECK PLAN UNITS 14, 15 AND 16. . . . .	29
DECK PLAN UNITS 17 AND 18. . . . .	30
DECK PLAN UNITS 19 AND 20. . . . .	31
SUPERSTRUCTURE DETAILS. . . . .	32
FIRE PROTECTION. . . . . (DELETED)	33
JOINT DETAILS. . . . .	34 AND 35
BORING LOGS. . . . .	36 THRU 38
FRAMING PLAN UNITS 8 AND 8W. . . . .	20A

**PLAN**

**PROFILE GRADE DATA**

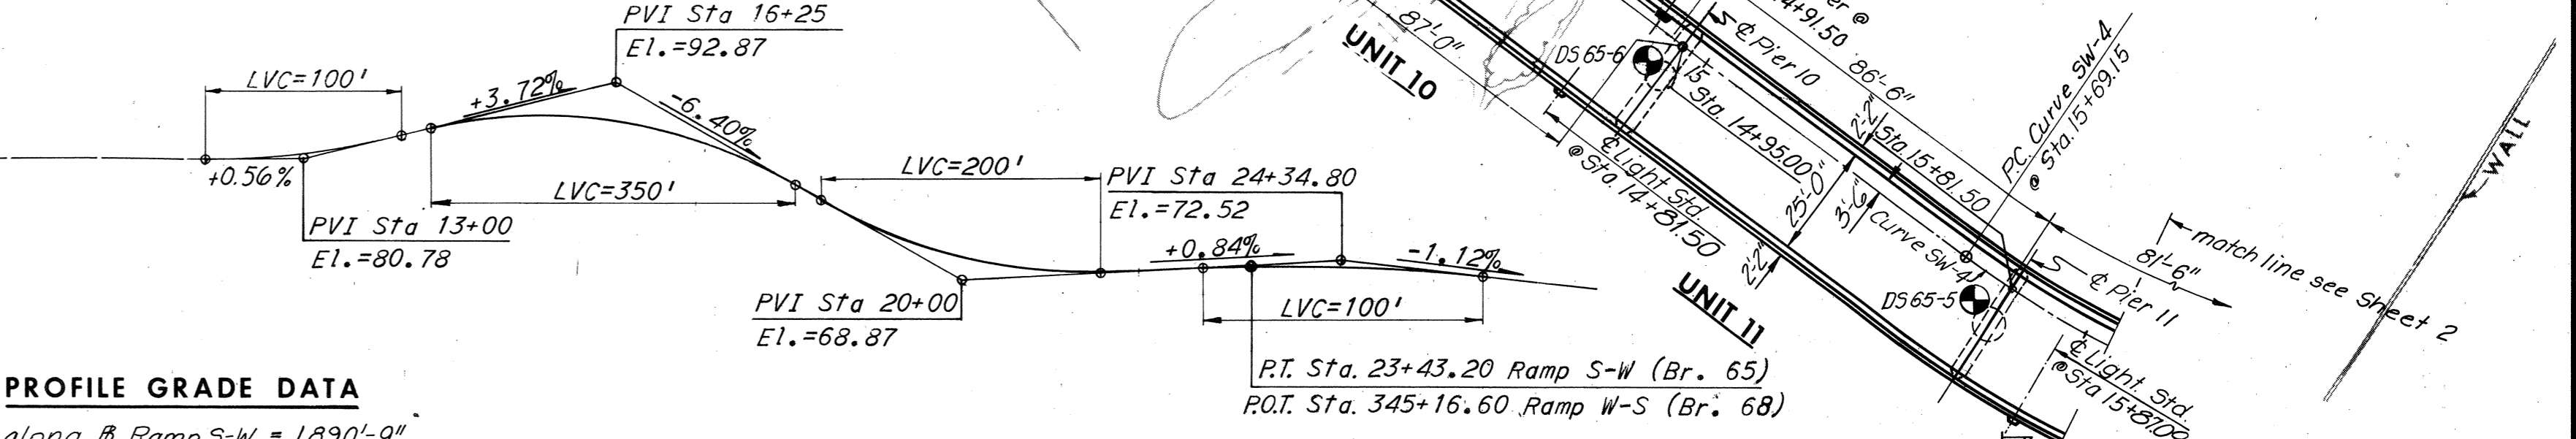


**ELEVATION**

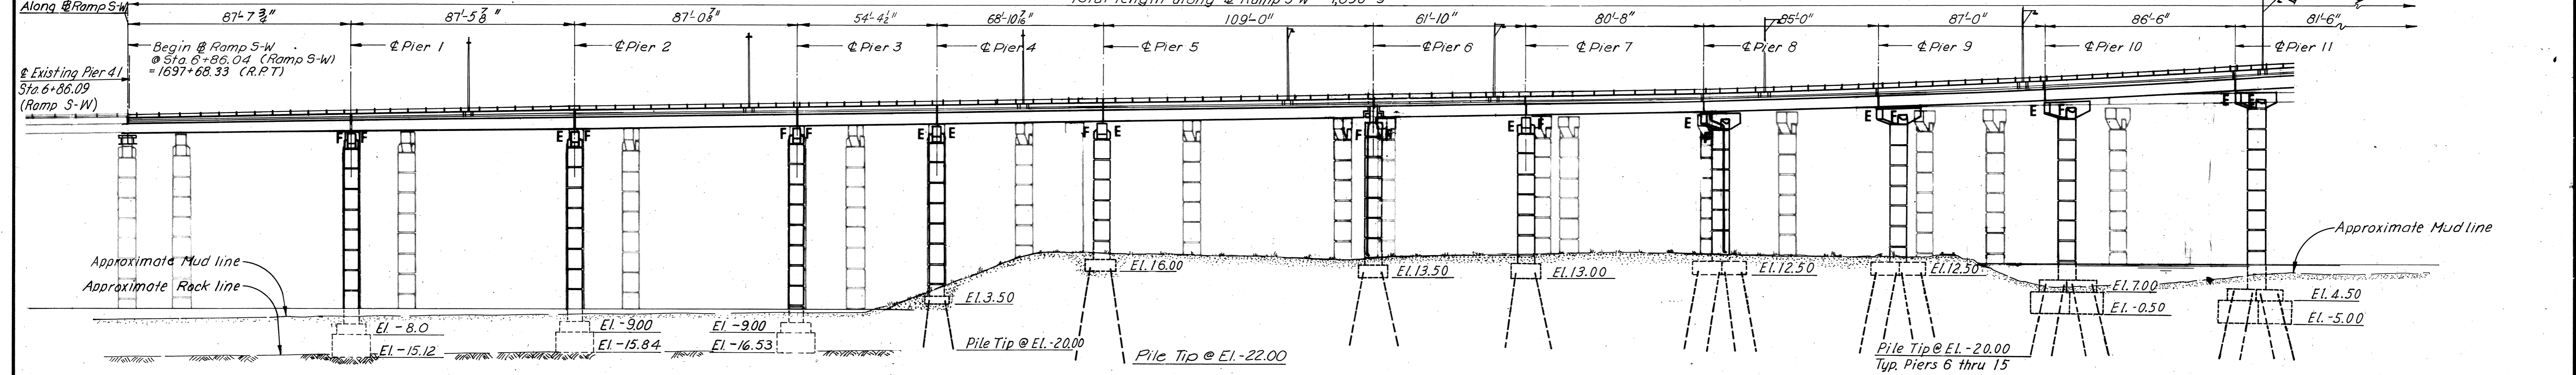

**Notes:**

- For General Plan and Elevation Units 12 thru 20 see Sheet 2.
- For Layout of Ramp S-W, see Sheets 3 and 4.
- For Estimated Quantities, see Sheet 4.
- For Boring Logs, see Sheets 36 thru 38.
- For General Notes, see Sheet 4.

**Substructure Note:** Footings for Piers 1, 2 and 3 shall be founded on concrete seals socketed 1'-0" into solid rock.

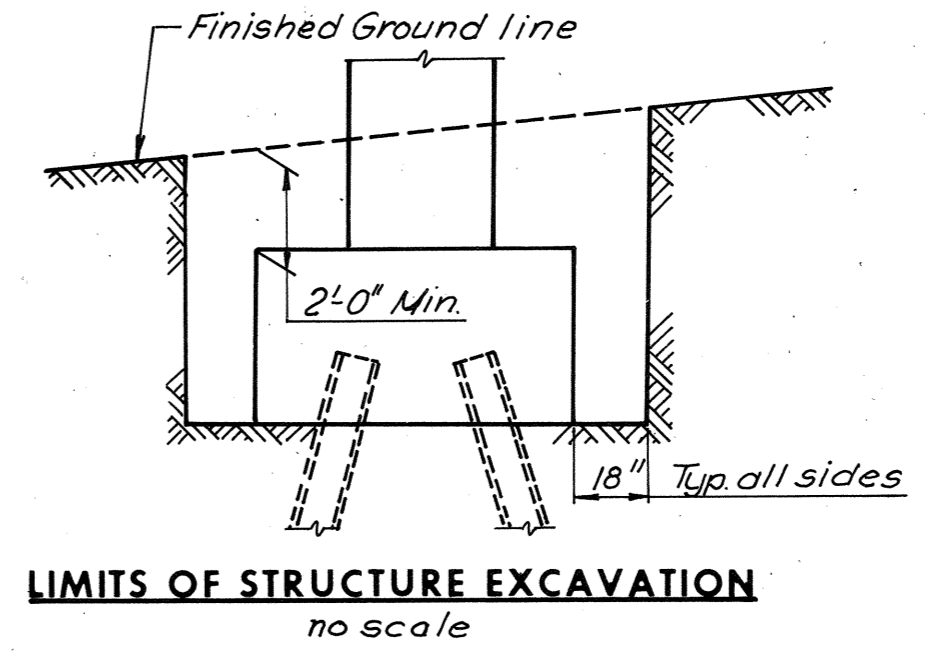

**LIMITS OF STRUCTURE EXCAVATION**  
no scale

NO.	REVISION	BY	DATE
1	Sheet 20a Added	TEM	9-9-75
2	Profile Ramp W-S	TEM	9-8-75
3	Limit of pavement removal & Sheet 17A added	DBP	8-25-75

**AS BUILT**



**RICHMOND METROPOLITAN AUTHORITY**  
**RICHMOND EXPRESSWAY SYSTEM**  
**DOWNTOWN EXPRESSWAY**

**BRIDGE NO. 65**  
**RAMP S-W CONNECTION FROM**  
**RICHMOND-PETERSBURG TURNPIKE**  
**GENERAL PLAN AND ELEVATION**

HOWARD, NEEDLES, TAMMEN & BERGENDOFF  
consulting engineers  
NEW YORK ALEXANDRIA KANSAS CITY

SCALE: 1"=30'-0"  
CONTRACT NO. 11  
SHEET NO. 1 OF 38

RICHMOND EXPRESSWAY SYSTEM			
SECTION	PROJECT	SHEET NO.	TOTAL SHEETS
11	DOWNTOWN EXPRESSWAY	27	97

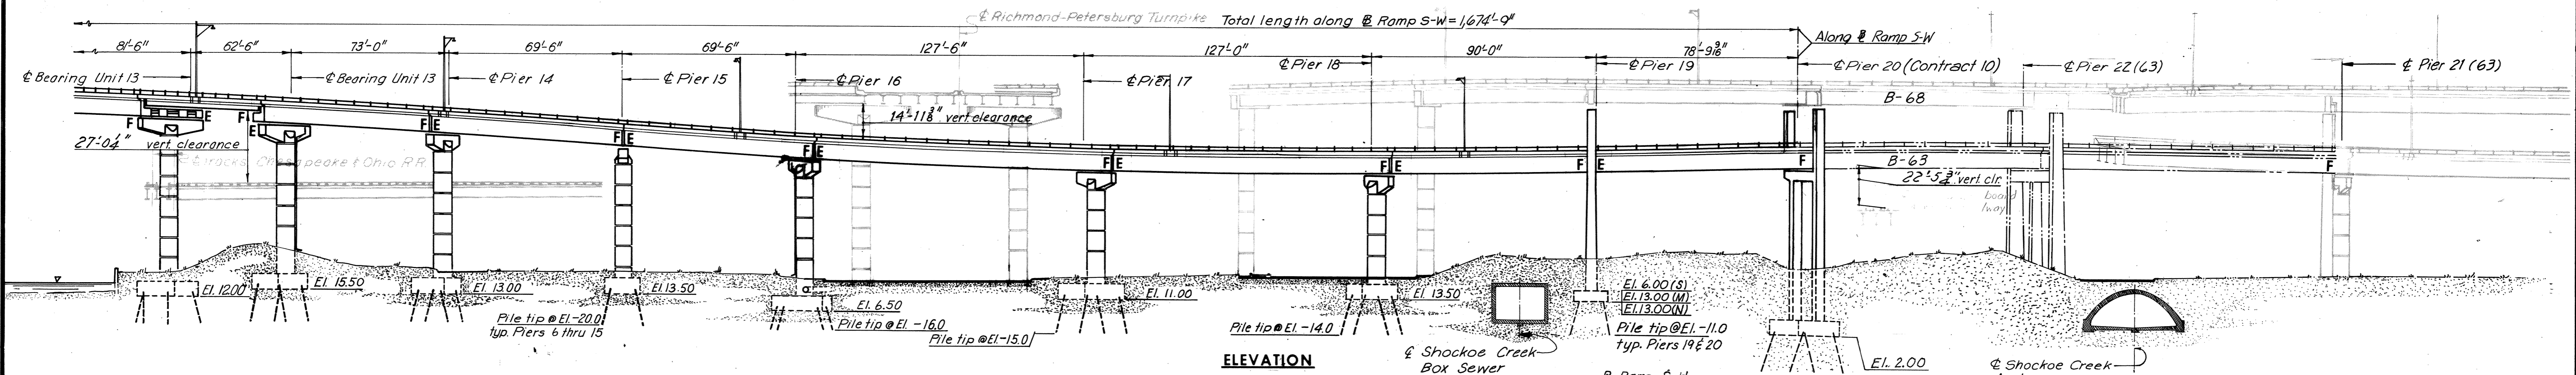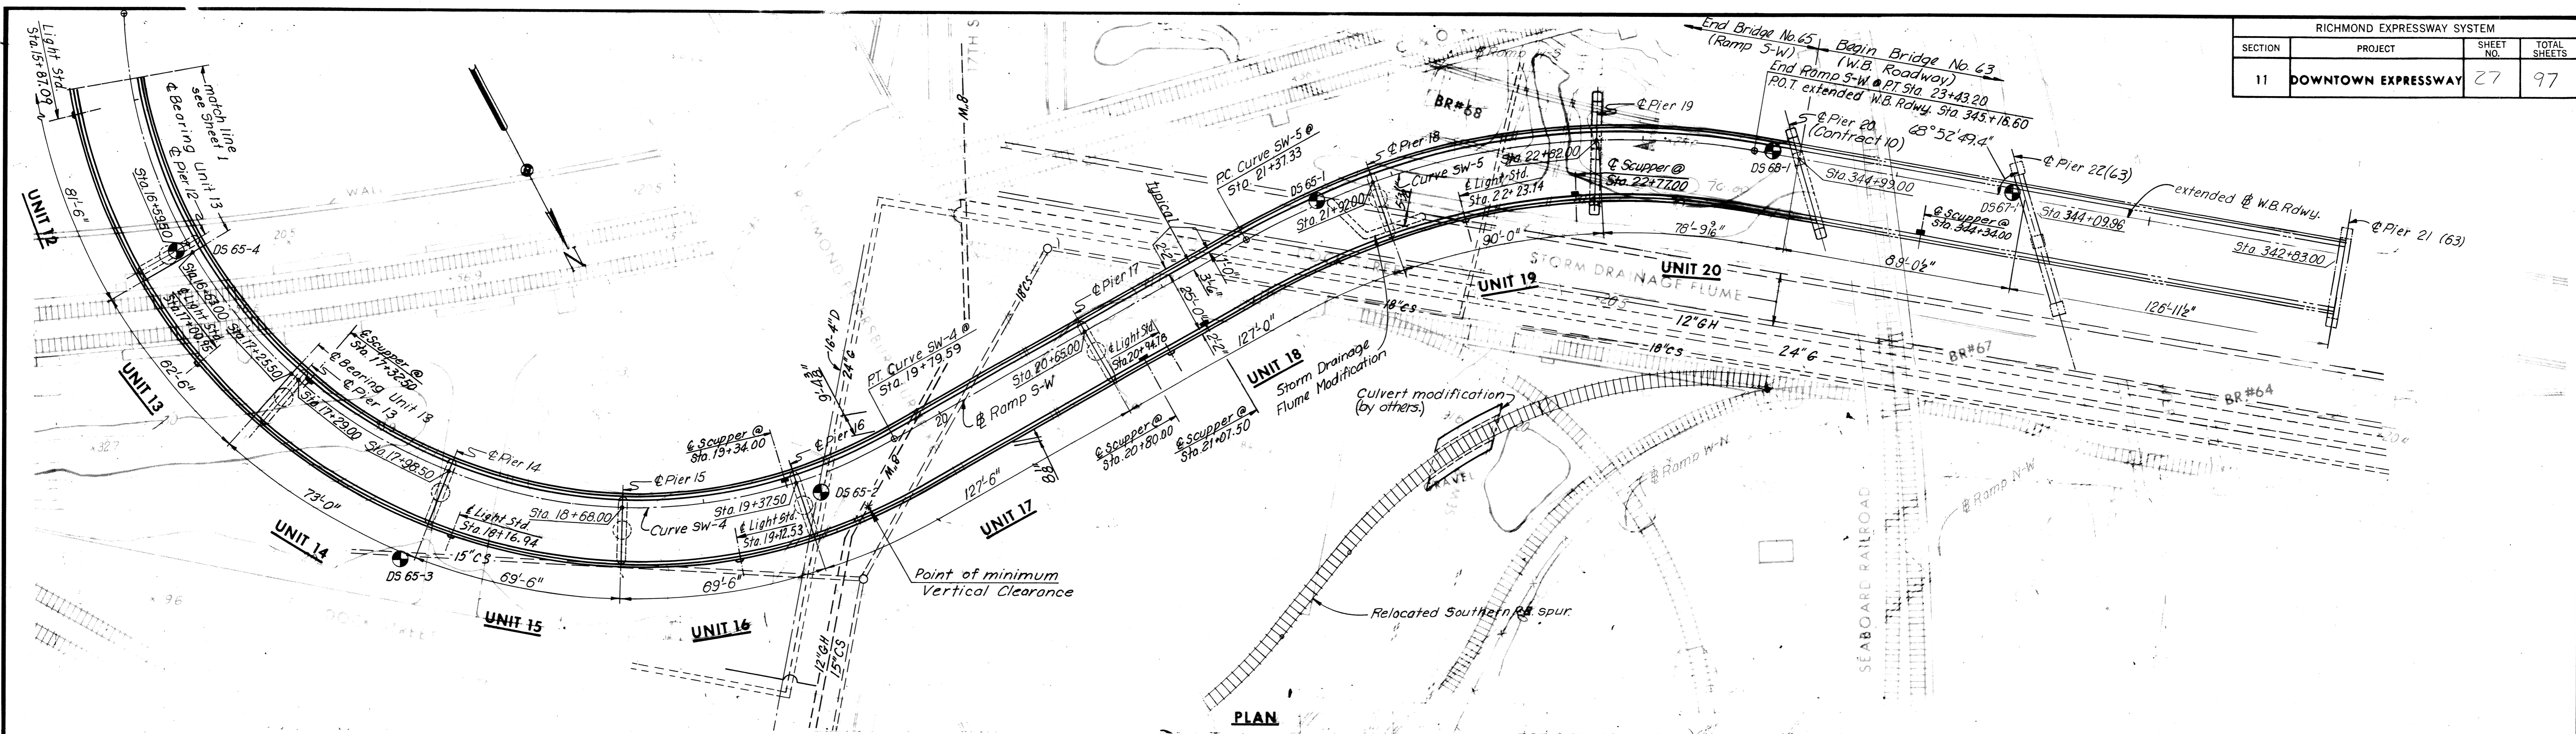

<p><b>Curve: SW-1</b></p> <p>P.I. = Sta. 7+73.58</p> <p>Δ = 1°45'10"</p> <p>D = 1°00'</p> <p>T = 87.53'</p> <p>L = 175.05'</p> <p>R = 5,729.58'</p>	<p><b>Curve: SW-2</b></p> <p>P.I. = Sta. 9+80.19</p> <p>Δ = 2°24'12"</p> <p>D = 1°00'33"</p> <p>T = 119.09'</p> <p>L = 238.14'</p> <p>R = 5,677.58'</p>	<p><b>Curve: SW-3</b></p> <p>P.I. = Sta. 12+36.15</p> <p>Δ = 3°00'00"</p> <p>D = 1°00'</p> <p>T = 136.91'</p> <p>L = 266.67'</p> <p>R = 477.47'</p>
---	---	---

<p><b>Curve: SW-4</b></p> <p>P.I. = Sta. 18+95.05</p> <p>Δ = 116°25'03"</p> <p>D = 28°21'51"</p> <p>T = 325.90'</p> <p>L = 410.44'</p> <p>R = 202.00'</p>	<p><b>Curve: SW-5</b></p> <p>P.I. = Sta. 22+44.51</p> <p>Δ = 39°19'04"</p> <p>D = 19°05'55"</p> <p>T = 107.17'</p> <p>L = 205.87'</p> <p>R = 300.00'</p>
---	--

<b>Richmond-Petersburg Turnpike</b>	
<p><b>Curve: R.P.T.-1</b></p> <p>P.I. = Sta. 1704+68.83</p> <p>Δ = 15°03'56"</p> <p>D = 1°00'</p> <p>T = 757.65'</p> <p>L = 1,506.56'</p> <p>R = 5,729.58'</p>	<p><b>Curve: R.P.T.-2</b></p> <p>P.I. = Sta. 1723+07.01</p> <p>Δ = 33°27'07"</p> <p>D = 4°00'</p> <p>T = 430.45'</p> <p>L = 836.30'</p> <p>R = 1,432.39'</p>

Notes:  
 For General Plan and Elevation Units 1 thru 11, see Sheet 1.  
 For Layout of Ramp S-W, see Sheets 3 and 4.  
 For Estimated Quantities, see Sheet 4.  
 For Boring Logs, see Sheets 36 thru 38.  
 For General Notes, see Sheet 4.

BY	DATE				
MADE	J.V.	4-2-69			
CHECKED	K.C.P.	5-28-69			
IN CHARGE			NO.	REVISION	BY DATE

**HORIZONTAL CURVE DATA**

**AS BUILT**

**RICHMOND METROPOLITAN AUTHORITY**  
**RICHMOND EXPRESSWAY SYSTEM**  
**DOWNTOWN EXPRESSWAY**

**BRIDGE NO. 65**  
**RAMP S-W CONNECTION FROM**  
**RICHMOND-PETERSBURG TURNPIKE**  
**GENERAL PLAN AND ELEVATION**

HOWARD, NEEDLES, TAMMEN & BERGENDOFF consulting engineers  
 NEW YORK ALEXANDRIA KANSAS CITY




SCALE: 1"=30'-0"  
 CONTRACT NO. 11  
 SHEET NO. 2 OF 38

## **Bridge 66**

**(Eastbound Downtown Expressway “Rte. 195” over Virginia Street and South 14<sup>th</sup> Street)**

**Record Set Plans**

RICHMOND EXPRESSWAY SYSTEM			
SECTION	PROJECT	SHEET NO.	TOTAL SHEETS
10	DOWNTOWN EXPRESSWAY	127	265

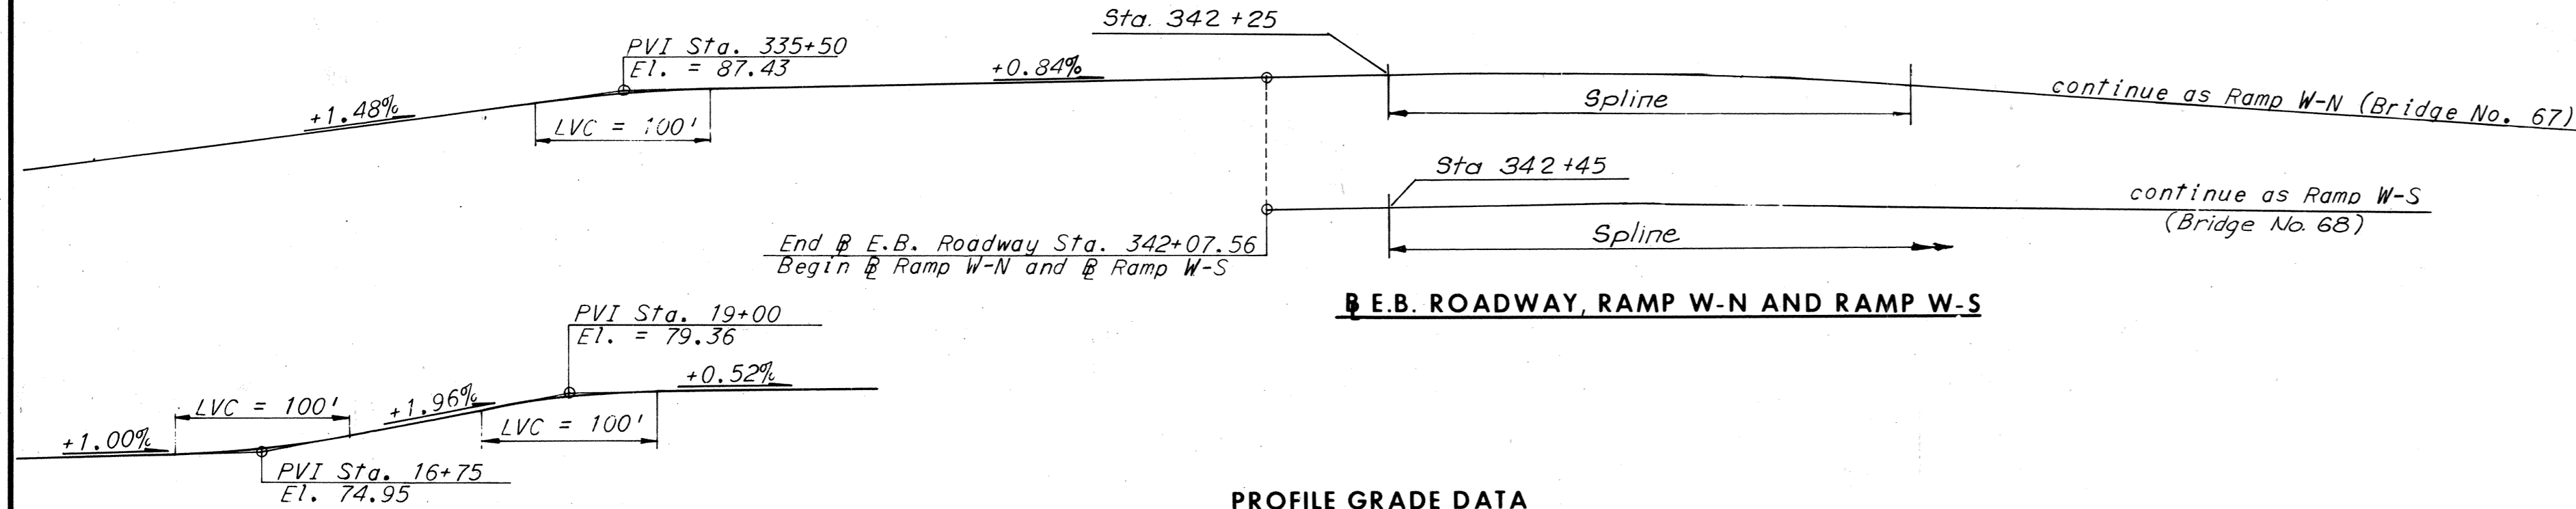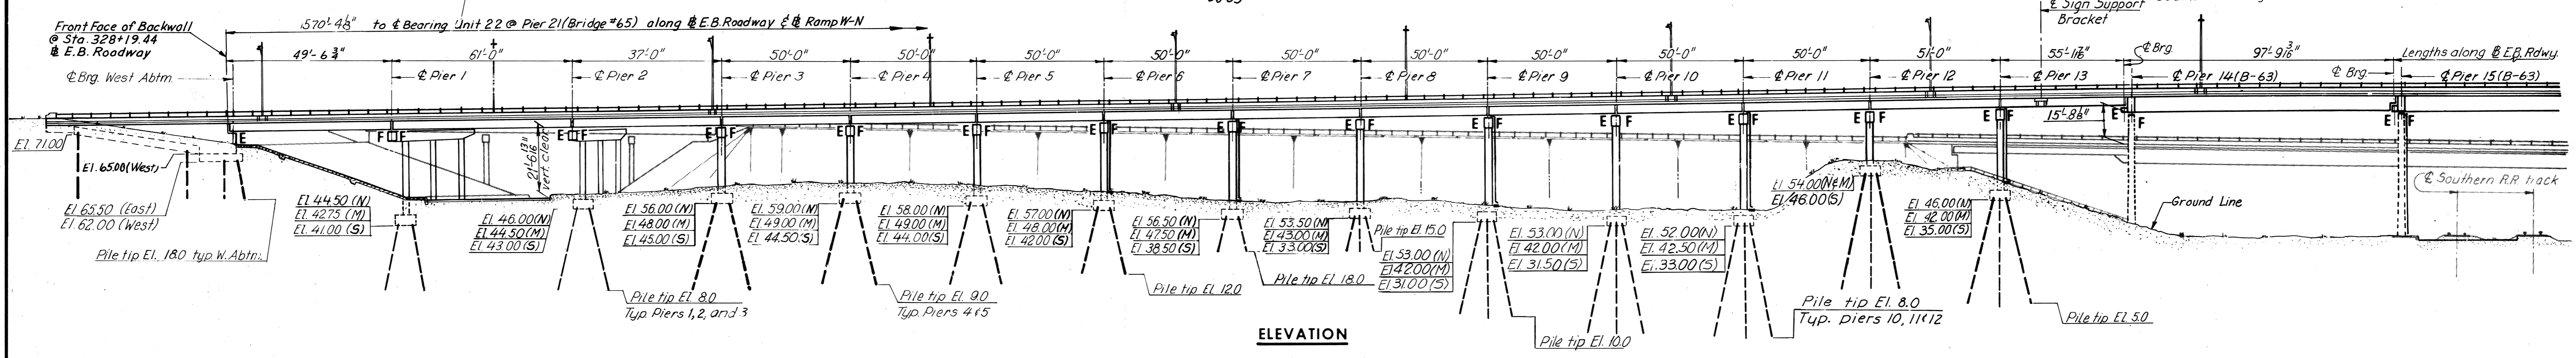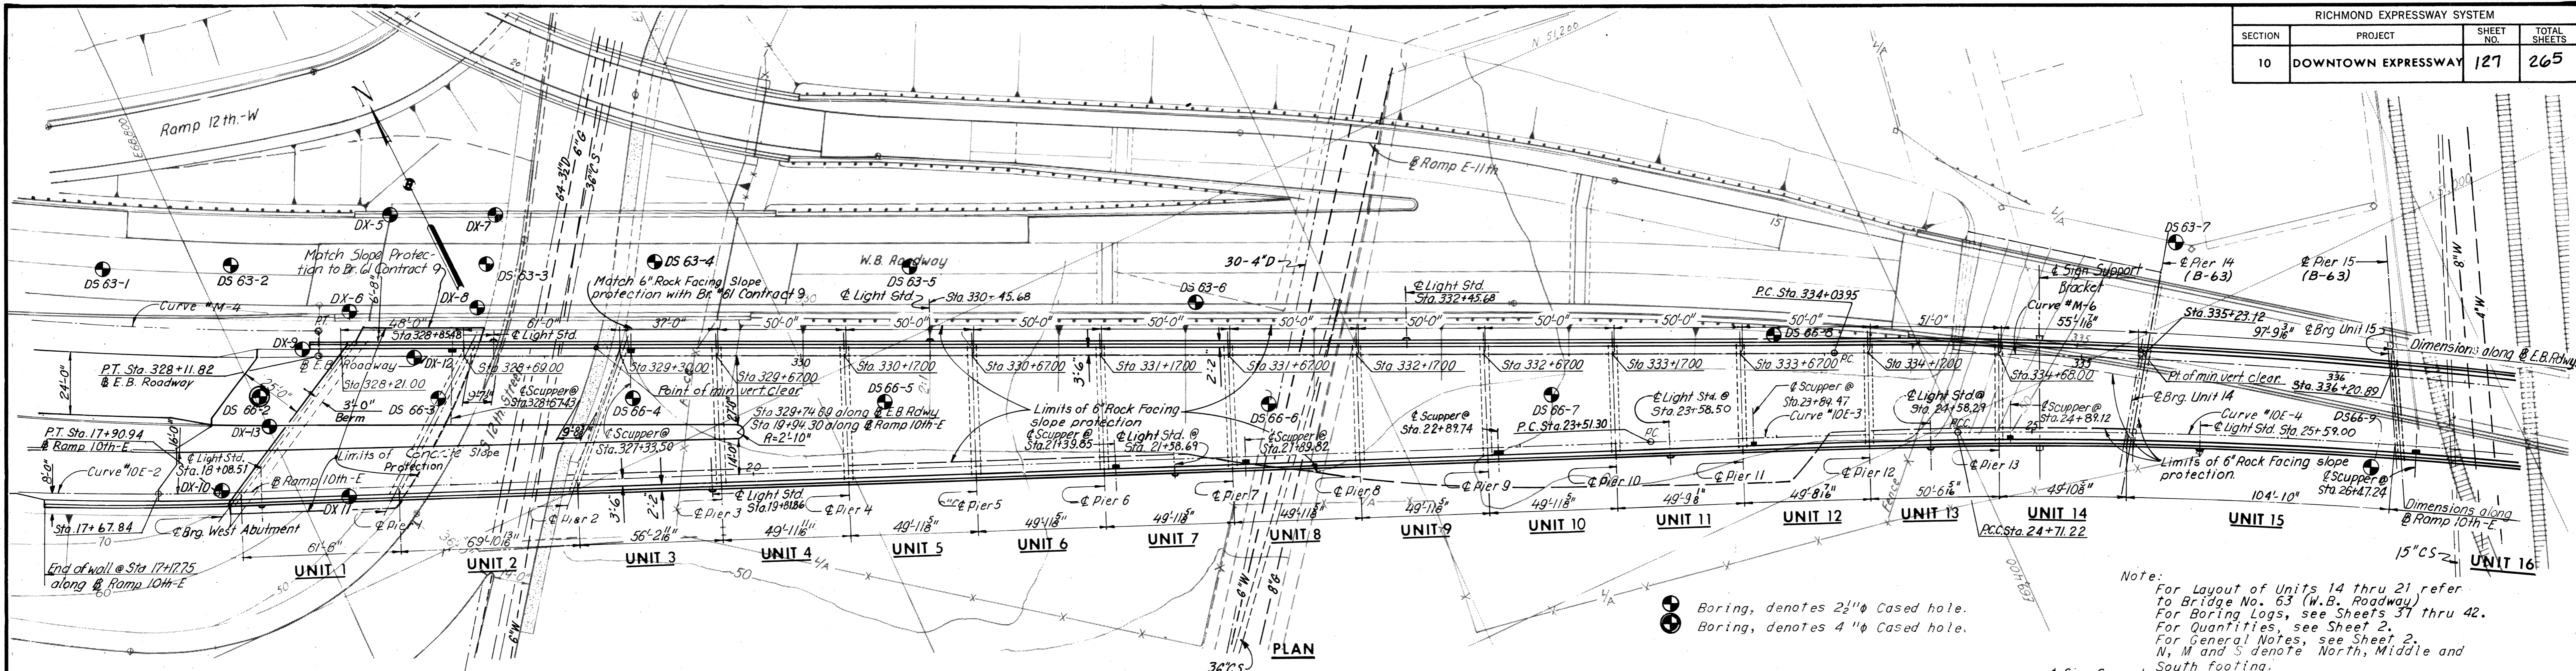


**HORIZONTAL CURVE DATA**

Curve	P.I.	Δ	D	T	L	R
Downtown Expressway Curve M-2	326+57.21	12°25'03"	4'00'	155.83'	310.44'	1,432.40'
E.B. Roadway Curve M-6	336+40.09	11°45'56"	2'30'	236.14'	470.62'	2,291.83'
Ramp W-N Curve W-N-1	345+25.47	6°45'31"	11'27'13"	317.90'	566.33'	500.00'
Ramp 10th-E Curve 10E-2	17+36.87	6°29'42"	6'00'	54.18'	108.25'	954.93'
Ramp 10th-E Curve 10E-3	24+11.27	1°11'57"	1'00'	59.97'	119.93'	5,729.58'
Ramp 10th-E Curve 10E-4	26+80.64	12°30'55"	3'00'	209.42'	417.18'	1,909.86'

**INDEX**

GENERAL PLAN AND ELEVATION	1
GENERAL PLAN AND ELEVATION	2
WEST ABUTMENT	3
WEST ABUTMENT DETAILS	4
WEST ABUTMENT RETAINING WALL	5
PIER 1	6
PIER 2	7
PIERS 3 AND 4	8
PIERS 5 AND 6	9
PIERS 7 AND 8	10
PIERS 9 AND 10	11
PIERS 11 AND 12	12
PIER 13	13
FRAMING PLAN UNITS 1, 2, 3 AND 4	14
FRAMING PLAN UNITS 5, 6, 7, 8 AND 9	15
FRAMING PLAN UNITS 10, 11, 12, 13 AND 14	16
FRAMING PLAN UNITS 15 AND 16	17
FRAMING PLAN UNITS 17 AND 18	18
FRAMING PLAN UNITS 19 AND 20	19
FRAMING PLAN UNITS 21 AND 22	20
FRAMING PLAN UNIT 23	21
FRAMING DETAILS PIERS 14, 15 AND 16	22
FRAMING DETAILS PIERS 17, 18, 19 AND 20	23
FRAMING DETAILS PIER 21	24
FRAMING DETAILS PIER 22 (BR 63)	25
FRAMING DETAILS UNITS 21 AND 22	26
FRAMING DETAILS UNITS 18, 21 AND 22	27
DECK PLAN UNITS 1, 2, 3 AND 4	28
DECK PLAN UNITS 5, 6, 7, 8 AND 9	29
DECK PLAN UNITS 10, 11, 12, 13 AND 14	30
DECK PLAN UNITS 15 AND 16	31
DECK PLAN UNITS 17 AND 18	32
DECK PLAN UNITS 19 AND 20	33
DECK PLAN UNITS 21 AND 22	34
DECK PLAN UNIT 23	35
JOINT DETAILS	36
SUPERSTRUCTURE DETAILS	37 AND 38
APPROACH SLABS AND ROCK FACING SLOPE PROTECTION	39
CONCRETE SLAB SLOPE PROTECTION DETAILS	40
BORING LOGS	41 THRU 46
STANDARD DETAILS	51 THRU 57

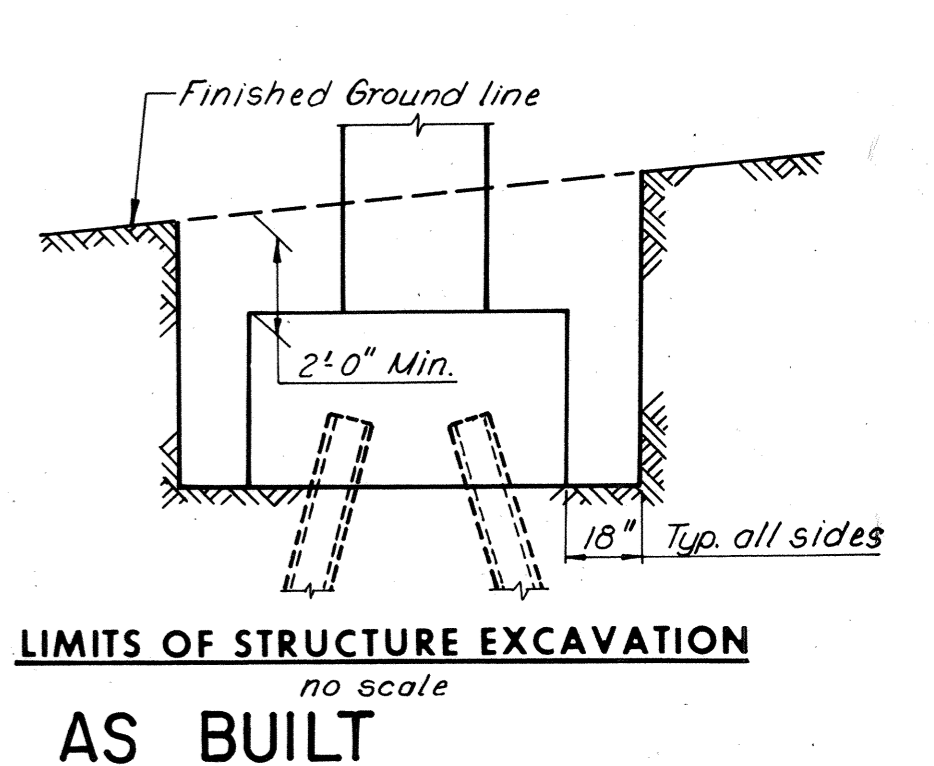

**RICHMOND METROPOLITAN AUTHORITY**  
**RICHMOND EXPRESSWAY SYSTEM**  
**DOWNTOWN EXPRESSWAY**


**BRIDGE NO. 66**  
**EASTBOUND ROADWAY OVER**  
**12TH ST. - R.R. TRACKS AND 16TH ST.**  
**GENERAL PLAN AND ELEVATION**

HOWARD, NEEDLES, TAMMEN & BERGENDOFF  
 consulting engineers  
 NEW YORK ALEXANDRIA KANSAS CITY

SCALE: 1"=30'  
 CONTRACT NO. 10  
 SHEET NO. 1 OF 46

NO.	REVISION	BY	DATE
3	As Built	TEM	8-76
2	Sign Support Bracket & Sh. 16A & 20A added	R.B.H.	9-74
1	Footing elev. & piles, Piers 8, 9, 10, 11, 12 & 13	R.B.H.	8-74

RICHMOND EXPRESSWAY SYSTEM			
SECTION	PROJECT	SHEET NO.	TOTAL SHEETS
10	DOWNTOWN EXPRESSWAY	128	265

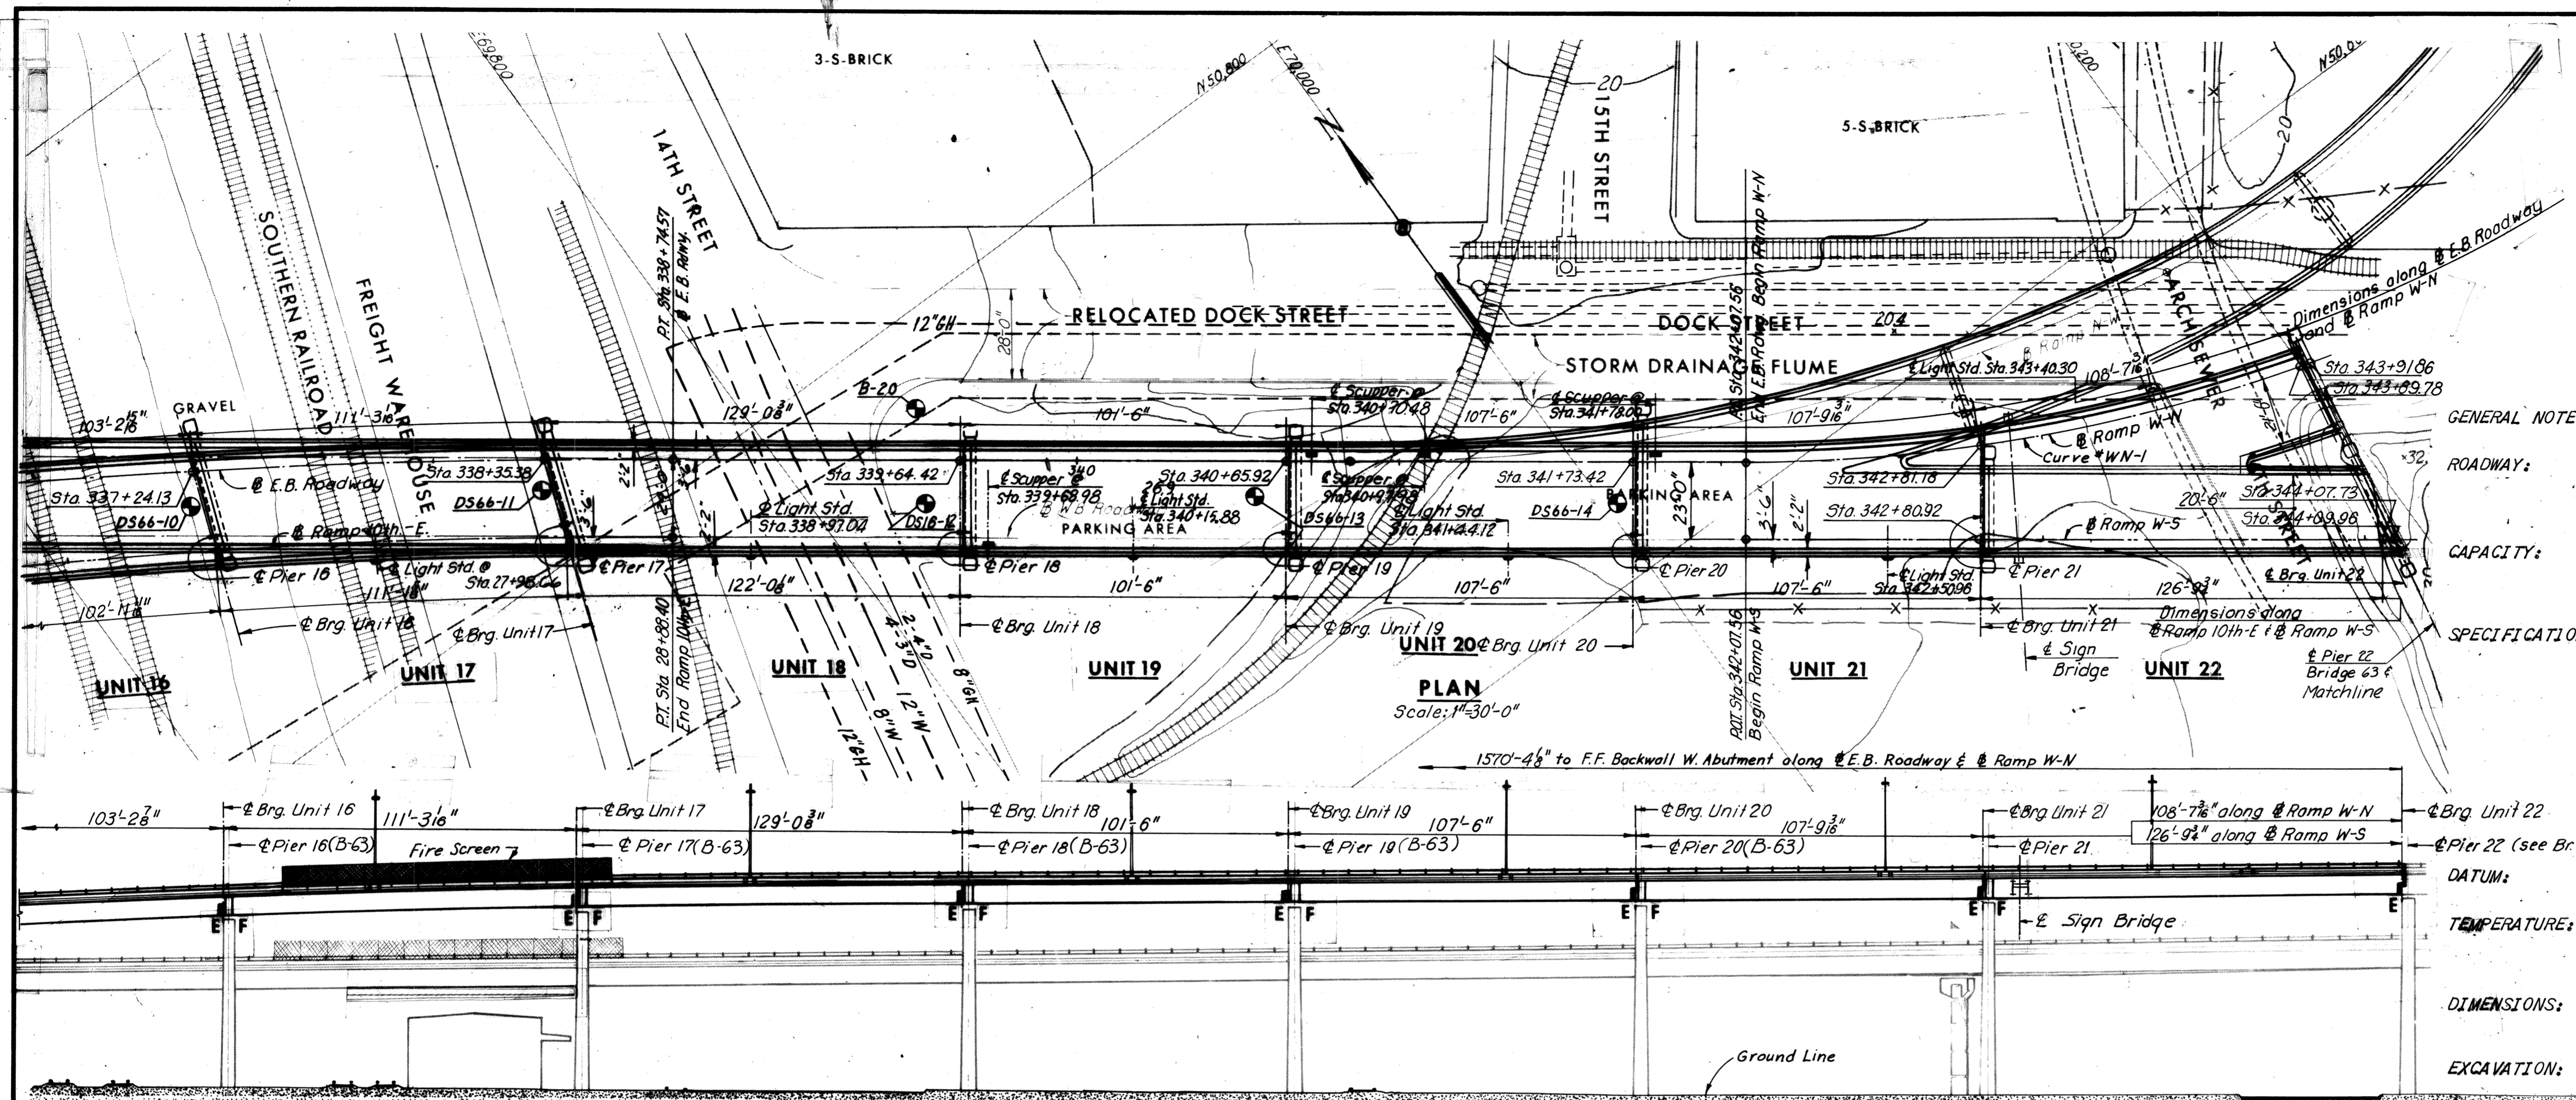

**GENERAL NOTES:**

**ROADWAY:** One variable width roadway transitioning from E.B. Roadway Downtown Expressway and Ramp 10th-E into Ramps W-N and W-S (Bridges No. 67 and 68)

**CAPACITY:** Dead load includes 15 Lbs. per sq. ft. for future wearing surface. Live load, HS 20-44 loading and alternate military loading.

**SPECIFICATIONS:**

**GENERAL:** Virginia Department of Highway Road and Bridge Specifications 1970

**DESIGN:** A.A.S.H.O. Standard Specifications for Highway Bridges 1973 modified by Special Design provisions.

**WELDING:** 1972 Structural Welding Code of the American Welding Society.

**CONTRACT SPECIAL PROVISIONS:** Specifications and Contract Special Provisions referred to above are necessary to make these plans complete

**DATUM:** City of Richmond

**TEMPERATURE:** The normal temperature referred to in the plans is 60°F. The temperature range for movement is 0°F to 120°F.

**DIMENSIONS:** All dimensions are measured horizontally and vertically unless otherwise noted.

**EXCAVATION:** Excavation below subgrade and cut slope template shall be classified as Structure Excavation. All excavation above these limits shall be classified as Regular Excavation and is not included in the Structural Quantities.

**FOUNDATIONS:** Footings shall rest on firm material. Foundation material shall be dry and special attention is called to Section 401.05 of General Specifications and to the Contract Special Provisions, concerning preparation of foundations for footings.

**CONCRETE NOTES:** Concrete in superstructure shall be Class A-4. All other concrete shall be Class A-3. All exposed edges and corners shall have a 3/4" chamfer or fillet unless otherwise noted. Care in the method of vibration, the use of low-slump concrete, and or other means shall be employed to prevent downgrade movement of newly placed slab concrete. Finishing Concrete Surfaces: See Standard Architectural Detail Sheets and the Contract Special Provisions for types and details. All reinforcing steel shall be deformed bars conforming to ASTM A615 Grade 40. All reinforcing bar dimensions on the detailed drawings are to centers of bars unless otherwise noted. Clear distance between reinforcing steel and face of concrete shall be as noted on the plans. All bar laps shall be 30 diameters of the smaller diameter bar unless otherwise noted.

**STEEL NOTES:** Structural steel shall conform to A.S.T.M. Designations A36, A572 - Grade 50 and A588 as noted. See Special Provisions. All field connections shall be made with high strength bolts. High strength bolts shall be 7/8" diameter unless otherwise noted and shall conform to A.S.T.M. Specification A-325.



**Notes:**  
 For Vertical and Horizontal Curve Data see Sheet 1.  
 For Layout of Units 14 thru 22 refer to Bridge No. 63 (Westbound Roadway).

**ESTIMATED QUANTITIES**

	Structure Excavation Cu. Yds.	Concrete (#) Cu. Yds.	Reinforcing Steel Lbs.	Str. Steel Mild Carbon Lbs.	Str. Steel High Strength Lbs.	Aluminum Railing (1-Rail) Lin. Ft.	Porous Backfill Cu. Yds.	Underdrain 6" Dia. Pipe Lin. Ft.	Steel Piles 10BP42 Lin. Ft.
Superstructure	--	2,237.6	530,060	1,564,700	567,800	3,241	--	--	---
Substructure	1,835	1,256.6	155,030	---	---	84	34	150	9,410
Total	1,835	3,494.2 #	685,890	1,564,700	567,800	3,325	34	150	9,410

	Asphalt Damp-proofing Sq. Yds.	Approach Slab Concrete (#) Cu. Yds.	Fire Screen Lin. Ft.	Approach Slab Reinforcing Steel (Lbs.)	Metal Conduit Lin. Ft.	Concrete Slope Protection Sq. Yds.	Bridge Drainage Metal Work Lbs.	Rock Facing Slope Prot. Sq. Yds.	Energy Attenuator Each
Superstructure	--	--	210	---	2,214	--	11,870	--	1
Substructure	105	91.5	---	23,870	92	559	--	3,320	---
Total	105	91.5 #	210	23,870	2,306	559	11,870	3,320	1

# All Concrete for Superstructure shall be Class A4 and for Substructure Class A3.

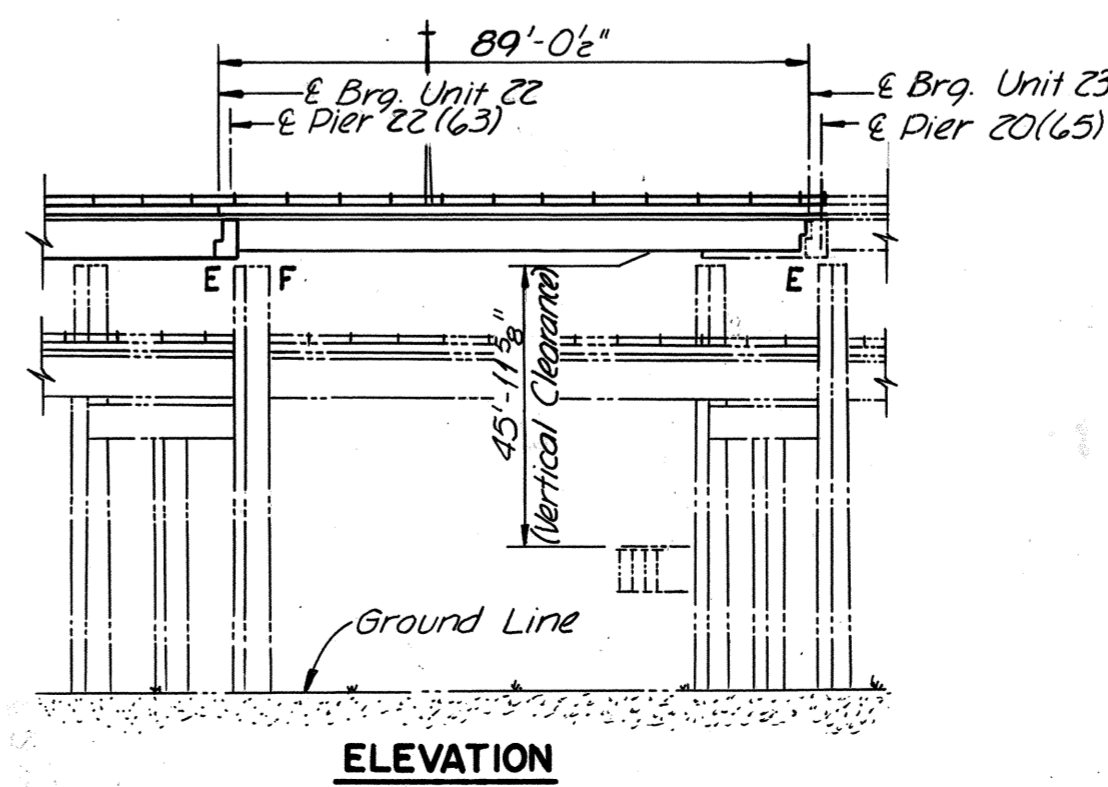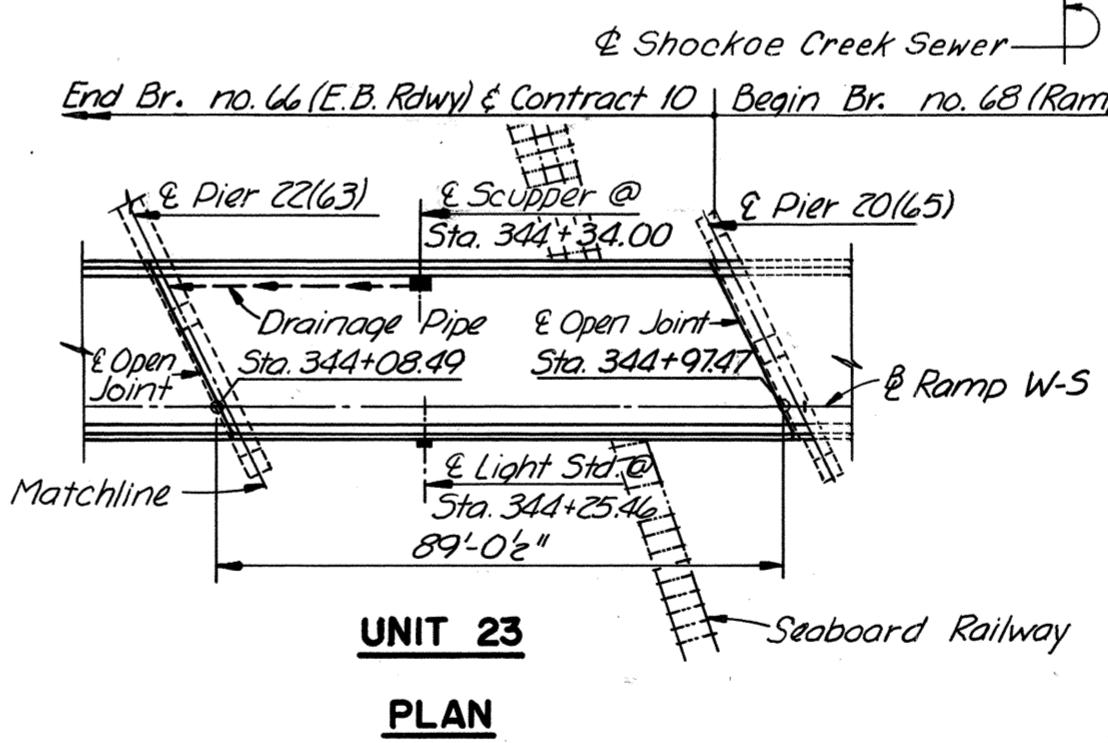

**RICHMOND METROPOLITAN AUTHORITY**  
**RICHMOND EXPRESSWAY SYSTEM**  
**DOWNTOWN EXPRESSWAY**

**BRIDGE NO. 66**  
**EASTBOUND ROADWAY OVER**  
**12TH ST. - R.R. TRACKS AND 16TH ST.**  
**GENERAL PLAN AND ELEVATION**

HOWARD, NEEDLES, TAMMEN & BERGENDOFF  
 consulting engineers  
 NEW YORK ALEXANDRIA KANSAS CITY

SCALE: As Noted  
 CONTRACT NO. 10  
 SHEET NO. 2 of 46

BY	DATE	REVISION	BY	DATE
MADE	J.V. 1-9-69	Span Fixities & R.R. name added	PRMS	4-19-74
CHECKED	G.C.C. 5-26-69	Sign Bridge added	R.B.H.	9-74
IN CHARGE		3 As Built	TEM	8-76


AS BUILT

## **Bridge 67**

**(Ramp from Eastbound Downtown Expressway “Rte. 195” to Northbound I-95 over Dock Street, East Cary Street, East Main Street “Rte. 60” and CSX RR)**


**Record Set Plans**

RICHMOND EXPRESSWAY SYSTEM			
SECTION	PROJECT	SHEET NO.	TOTAL SHEETS
10	DOWNTOWN EXPRESSWAY	173	265

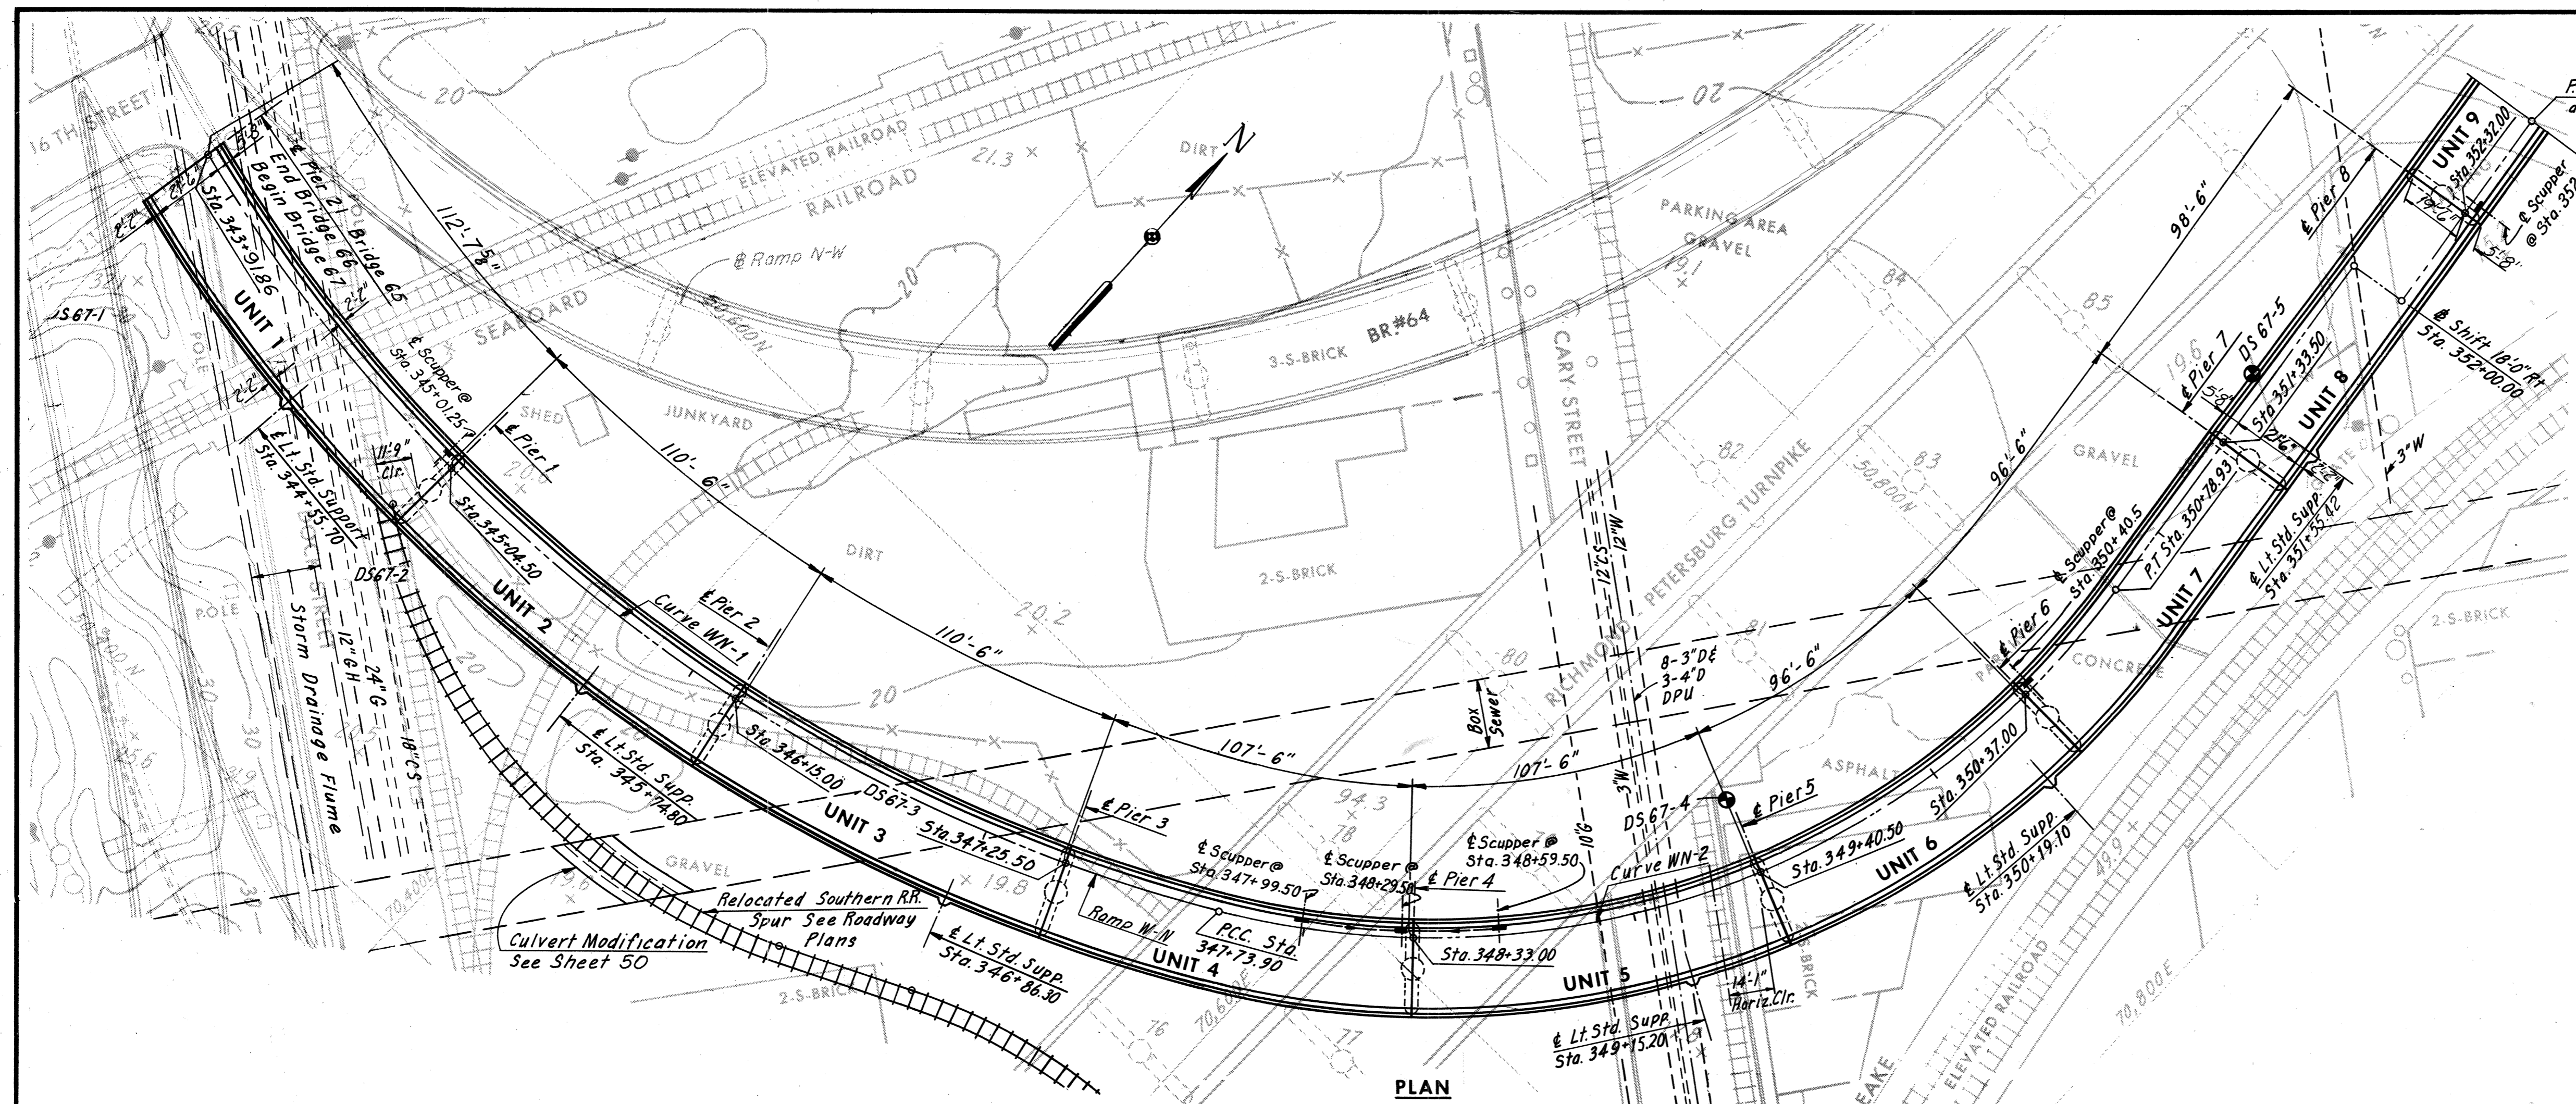

INDEX


GENERAL PLAN AND ELEVATION	1
GENERAL PLAN AND ELEVATION	2
LAYOUT	3
PIERS 1 AND 2	4
PIER 3	5
PIERS 4 AND 5	6
PIER 6	7
PIER 7	8
PIERS 8 AND 9	9
PIER 10E	10
PIERS 11 AND 12E	11
PIER 13E	12
PIERS 10W AND 12W	13
PIERS 13W AND 14	14
NORTH ABUTMENT	15
NORTH ABUTMENT DETAILS	16
NORTH ABUTMENT RETAINING WALL MODIFICATION	17
FRAMING PLAN - UNITS 1 AND 2	18
FRAMING PLAN - UNITS 3 AND 4	19
FRAMING PLAN - UNITS 5 AND 6	20
FRAMING PLAN - UNITS 7 AND 8	21
FRAMING PLAN - UNIT 9 AND FRAMING DETAILS	22
FRAMING PLAN - UNIT 10	23
GIRDER ELEVATIONS - UNIT 10	24
FRAMING PLAN - UNITS 11, 12, 13, 14 AND 15	25
FRAMING PLAN - UNITS 11, 12, 13, 14 AND 15	26
FLOORBEAM 16 AND STEEL COLUMNS	27
DECK PLAN - UNITS 1 AND 2	28
DECK PLAN - UNITS 3 AND 4	29
DECK PLAN - UNITS 5 AND 6	30
DECK PLAN - UNITS 7 AND 8	31
DECK PLAN - UNIT 9 - AND SUPERSTRUCTURE DETAILS	32
DECK PLAN - UNIT 10	33
DECK PLAN - UNITS 11, 12, 13, 14 AND 15	34
STRESS SHEET TRUSS SPAN	35
TOP LATERAL SYSTEM	36
BOTTOM LATERAL SYSTEM	37
TRUSS DETAILS P.P. 0 TO P.P. 6	38
TRUSS DETAILS P.P. 7 TO P.P. 10	39
TRUSS DETAILS P.P. 11 TO P.P. 12	40
FLOORBEAM 0 AND JOINT DETAILS	41
INTERMEDIATE FLOOR BEAMS	42
MISCELLANEOUS DETAILS	43
FLOORBEAM 12 AND JOINT DETAILS	44
DECK PLAN - TRUSS SPAN	45
SHOE DETAILS AND DECK ELEVATIONS	46
JOINT DETAILS	47
SLOPE PROTECTION DETAILS	48 THRU 49
BORING LOGS	50
STANDARD DETAILS	51 THRU 54

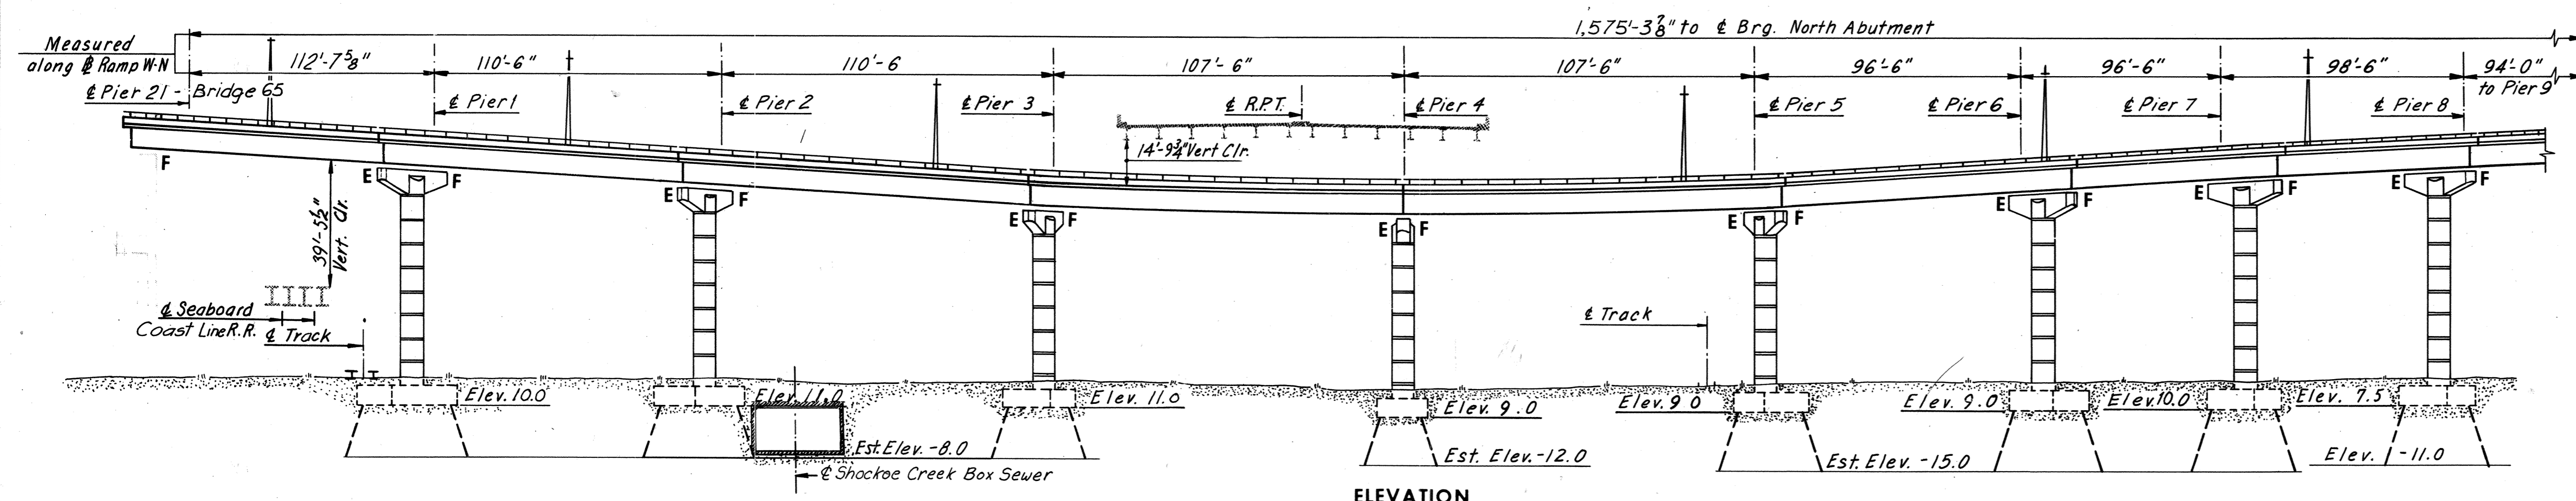

Note:  
For General Notes, see Sheet 4.  
For Quantity Table, see Sheet 3

**CURVE DATA**

<p>Curve: R.P.T.-1 P.I. = Sta. 1704+68.83 Δ = 15°03'56" D = 1'00' T = 757.65' L = 1,506.56' R = 5,729.58'</p>	<p>Curve: R.P.T.-2 P.I. = Sta. 1723+07.01 Δ = 35°27'40" D = 4'00' T = 317.90' L = 836.30' R = 1,432.39'</p>	<p>Curve: WN-1 P.I. = Sta. 345+25.47 Δ = 64°53'49" D = 1'12'13.31" T = 317.90' L = 566.33' R = 500.00'</p>	<p>Curve: WN-2 P.I. = Sta. 349+47.64 Δ = 69°32'15" D = 2'28'10.8" T = 173.75' L = 305.03' R = 255.00'</p>	<p>Curve: WN-3 P.I. = Sta. 353+19.15 Δ = 6°23'54" D = 6'00" T = 53.38' L = 106.64' R = 954.93'</p>	<p>Curve: WN-4 P.I. = Sta. 355+39.85 Δ = 5°01'11" D = 1'30" T = 167.43' L = 334.65' R = 3,819.72'</p>	<p>Curve: WN-5 P.I. = Sta. 358+17.39 Δ = 13°10'51" D = 6'00" T = 110.33' L = 219.68' R = 954.93'</p>	<p>Curve: WN-6 P.I. = Sta. 361+67.68 Δ = 19°35'06" D = 4'09'03" T = 238.25' L = 471.85' R = 1,380.39'</p>	<p>Curve: WN-7 P.I. = Sta. 13+42.50 Δ = 32°01'34" D = 3°51'36" T = 426.01' L = 829.72' R = 1,484.39'</p>
---	---	--	---	--	---	--	---	--

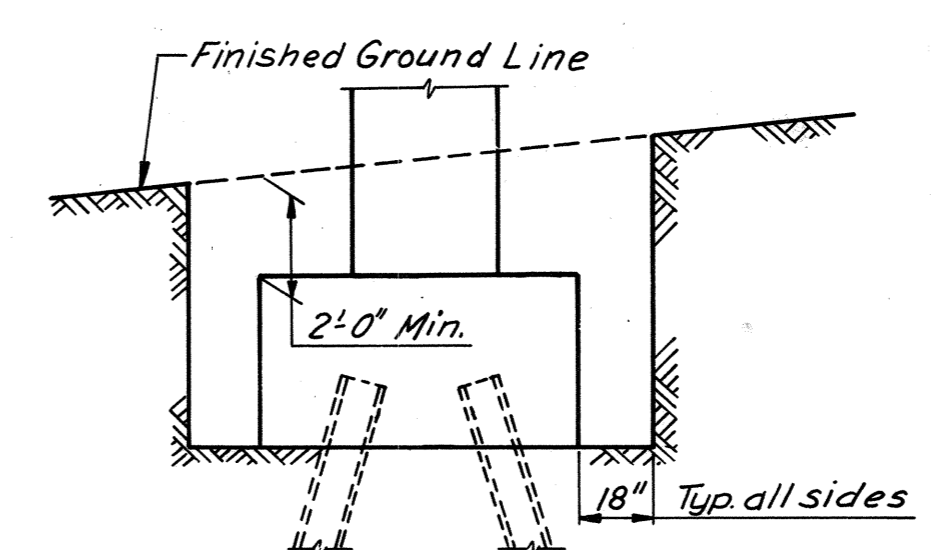

LIMITS OF STRUCTURE EXCAVATION  
No Scale

BY	DATE	3	As Built	TEM	6-77
MADE	AMH	3-5-69	Light Sta. Location	JLK	6-6-75
CHECKED	KC T	5-12-69	Sheet 42 & 45 added	L.B.P.	3-5-75
IN CHARGE					

**RICHMOND METROPOLITAN AUTHORITY**  
**RICHMOND EXPRESSWAY SYSTEM**  
**DOWNTOWN EXPRESSWAY**





BRIDGE NO. 67  
RAMP W-N CONNECTION TO  
RICHMOND-PETERSBURG TURNPIKE  
GENERAL PLAN AND ELEVATION

HOWARD, NEEDLES, TAMMEN & BERGENDOFF  
consulting engineers  
NEW YORK ALEXANDRIA KANSAS CITY

SCALE: 1" = 30'-0"  
CONTRACT NO.: 10  
SHEET NO. 1 OF 54

AS BUILT

RICHMOND EXPRESSWAY SYSTEM			
SECTION	PROJECT	SHEET NO.	TOTAL SHEETS
10	DOWNTOWN EXPRESSWAY	174	265

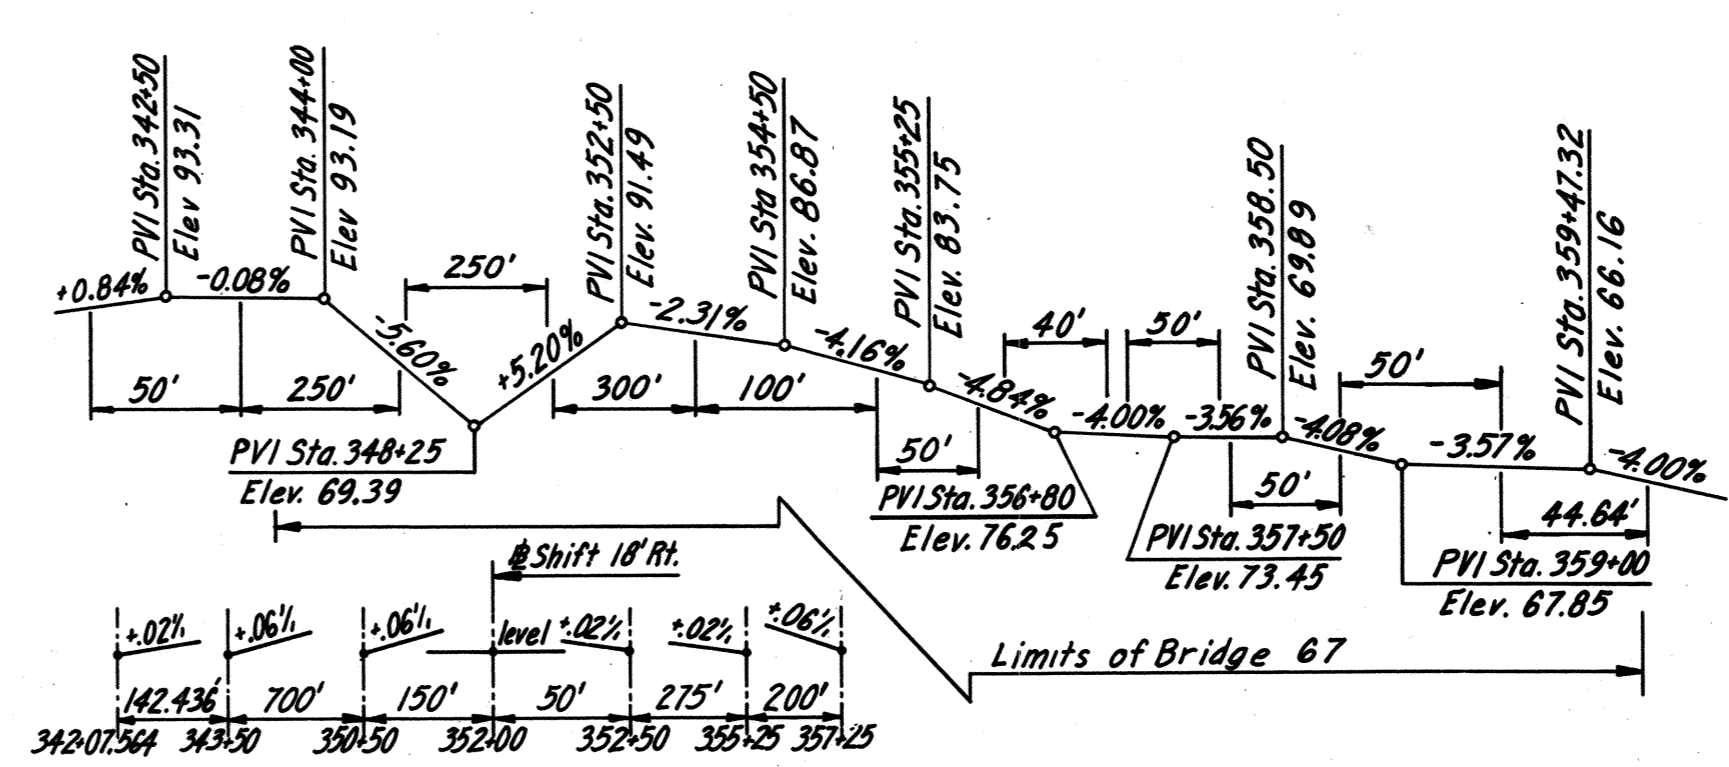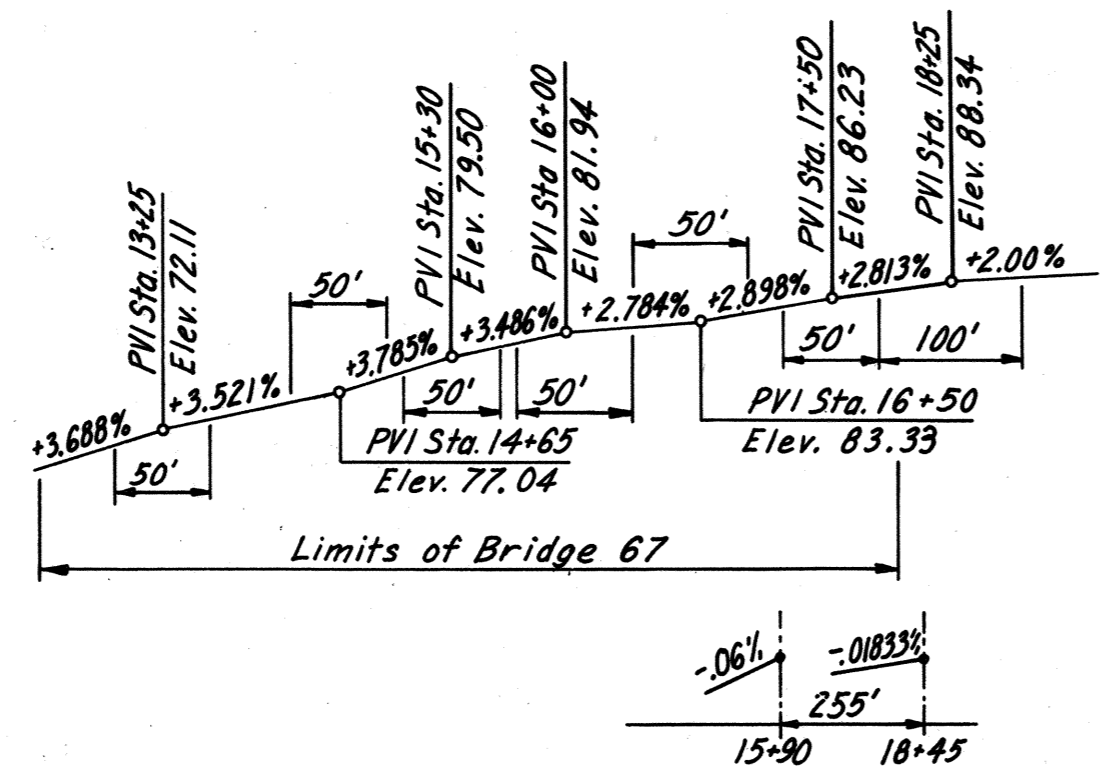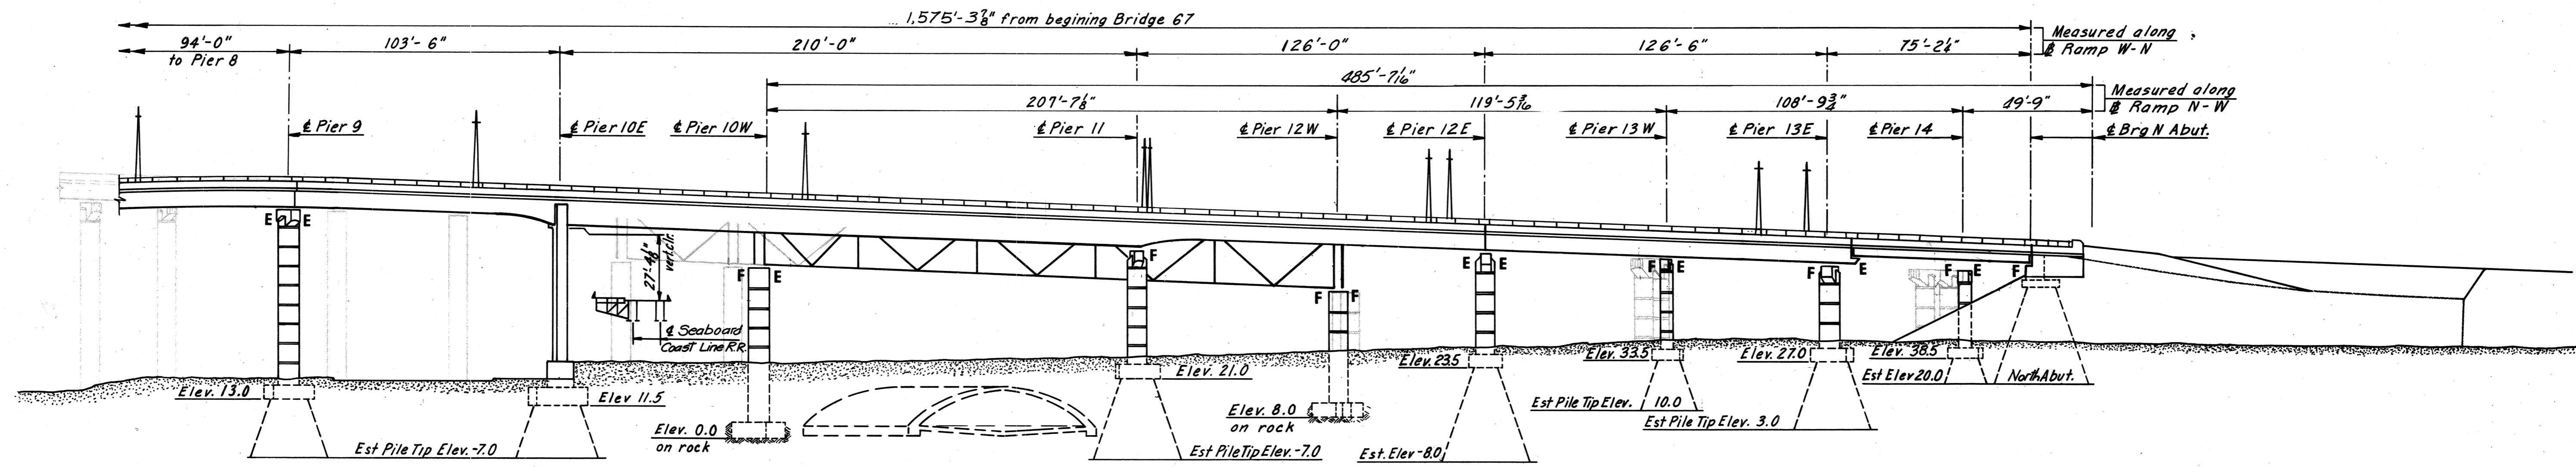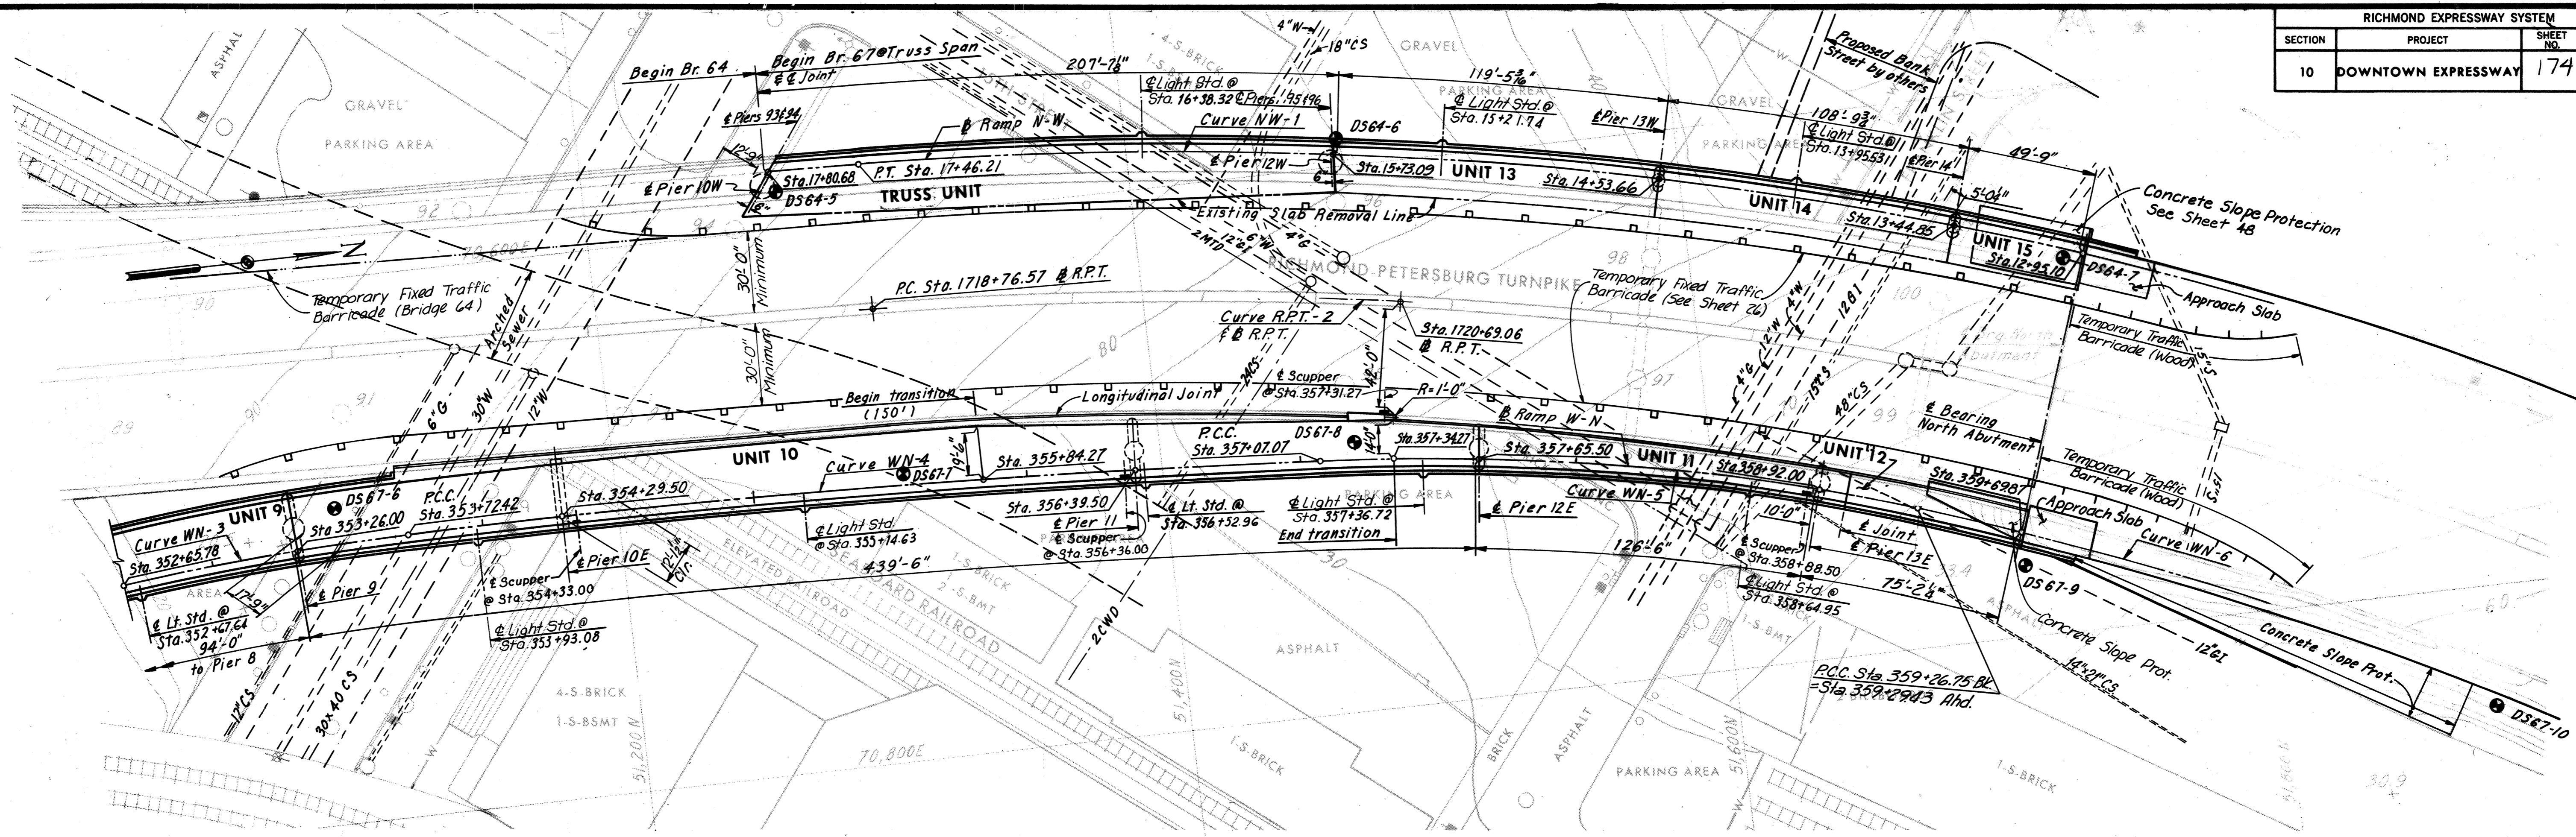

**RICHMOND METROPOLITAN AUTHORITY**  
**RICHMOND EXPRESSWAY SYSTEM**  
**DOWNTOWN EXPRESSWAY**

**BRIDGE NO. 67**  
**RAMP W-N CONNECTION TO**  
**RICHMOND-PETERSBURG TURNPIKE**  
**GENERAL PLAN AND ELEVATION**

HOWARD, NEEDLES, TAMMEN & BERGENDOFF  
consulting engineers  
NEW YORK ALEXANDRIA KANSAS CITY

SCALE: As Noted  
CONTRACT NO.: 10  
SHEET NO. 2 OF 54

BY	DATE	NO.	REVISION	BY	DATE
AMH	12-30-60	2	As Built	TEM	6-77
KCT	5-12-69	1	Revised Plans & Sheet Sta. & Board Length	DWB	1-24-75




## **Bridge 68**

**(Ramp from Eastbound Downtown Expressway “Rte. 195” to Southbound I-95 over East Byrd Street, NS  
RR and CSX RR)**

**Record Set Plans**


RICHMOND EXPRESSWAY SYSTEM			
SECTION	PROJECT	SHEET NO.	TOTAL SHEETS
11	DOWNTOWN EXPRESSWAY	64	97

INDEX		SHEET
GENERAL PLAN AND ELEVATION	.....	1
GENERAL PLAN AND ELEVATION	.....	2
LAYOUT	.....	3
PIERS 1 AND 2	.....	4 AND 4A
PIER 3	.....	5
PIER 4	.....	6
PIER 5	.....	7
PIERS 6 AND 7	.....	8
PIERS 8, 9 AND 10	.....	9
PIERS 11 AND 12	.....	10
PIERS 13 AND 14	.....	11
FRAMING PLAN UNITS 2 AND 3	.....	12
FRAMING PLAN UNITS 4, 5 AND 6	.....	13
FRAMING PLAN UNITS 7, 8, AND 9	.....	14
FRAMING PLAN UNITS 10, 11 AND 12	.....	15
FRAMING PLAN UNITS 13 THRU 18	.....	16 AND 16A
FRAMING DETAILS	.....	17
FRAMING DETAILS 2 AND 3	.....	18
DECK PLAN UNITS 4, 5 AND 6	.....	19
DECK PLAN UNITS 7, 8 AND 9	.....	20
DECK PLAN UNITS 10, 11 AND 12	.....	21
DECK PLAN UNITS 13 THRU 18	.....	22
SUPERSTRUCTURE DETAILS	.....	23
JOINT DETAILS	.....	24
BORING LOGS	.....	25 AND 26
STANDARD SHEETS	.....	27 AND 28
EXISTING PIERS 42 & 44 MODIFICATIONS	.....	51 THRU 56
		11A

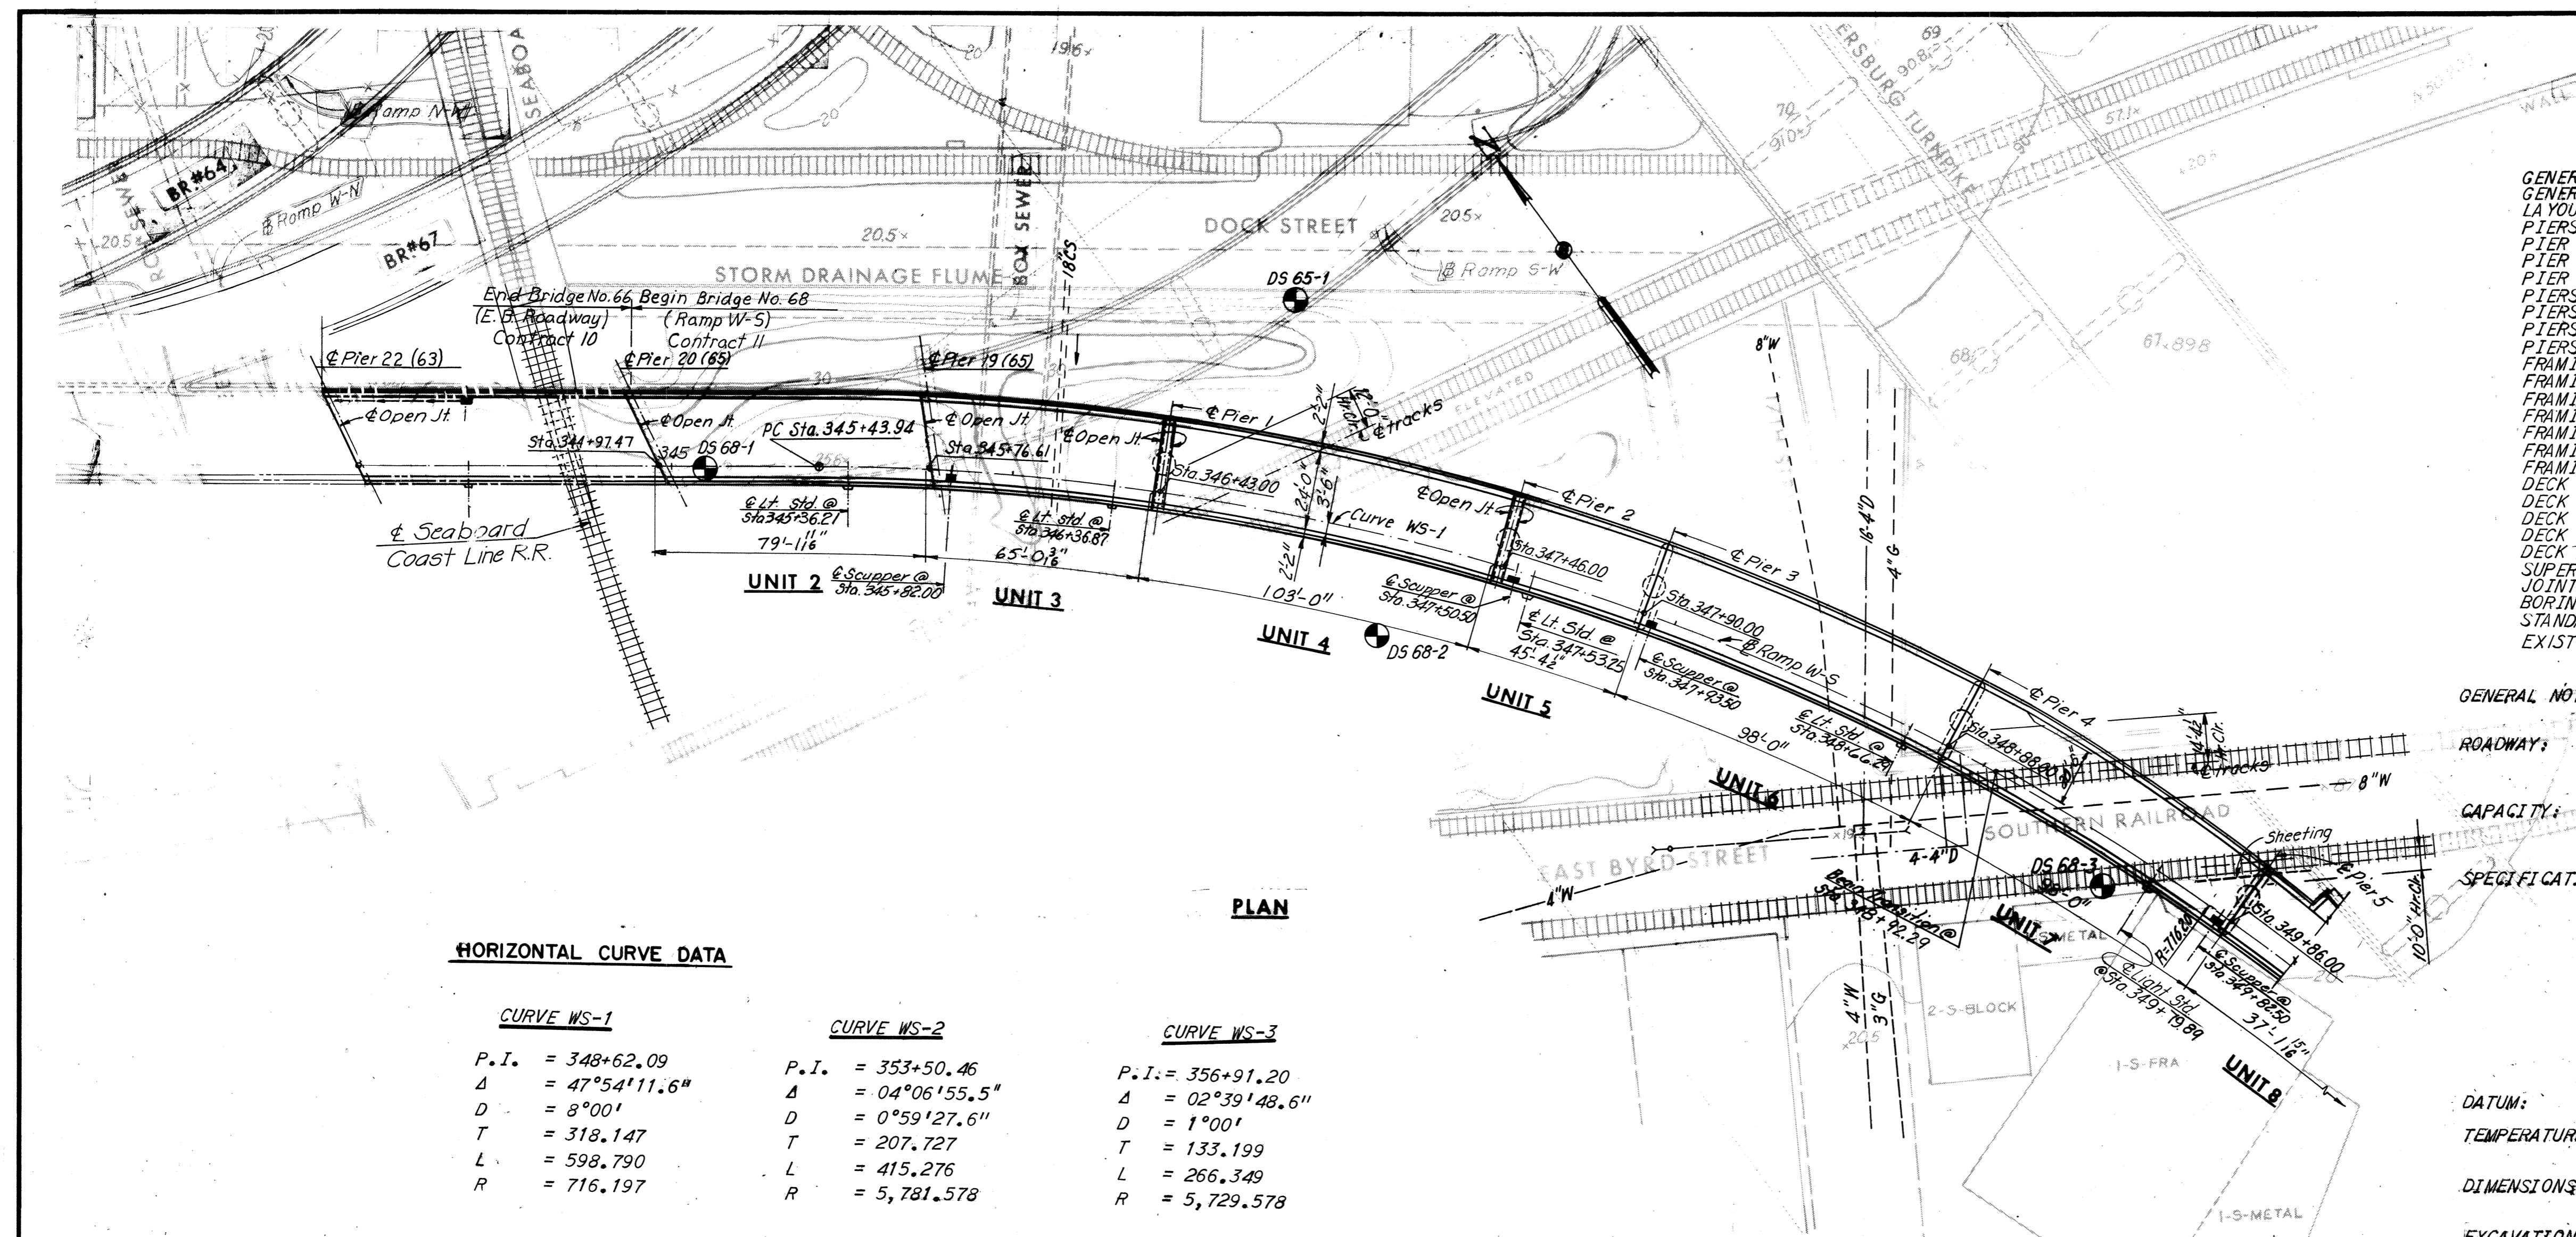

**HORIZONTAL CURVE DATA**

CURVE WS-1		CURVE WS-2		CURVE WS-3	
P.I. = 348+62.09	Δ = 47°54'11.6"	P.I. = 353+50.46	Δ = 04°06'55.5"	P.I. = 356+91.20	Δ = 02°39'48.6"
D = 8°00'	T = 318.147	D = 0°59'27.6"	T = 207.727	D = 1°00'	T = 133.199
L = 598.790	R = 716.197	L = 415.276	R = 5,781.578	L = 266.349	R = 5,729.578

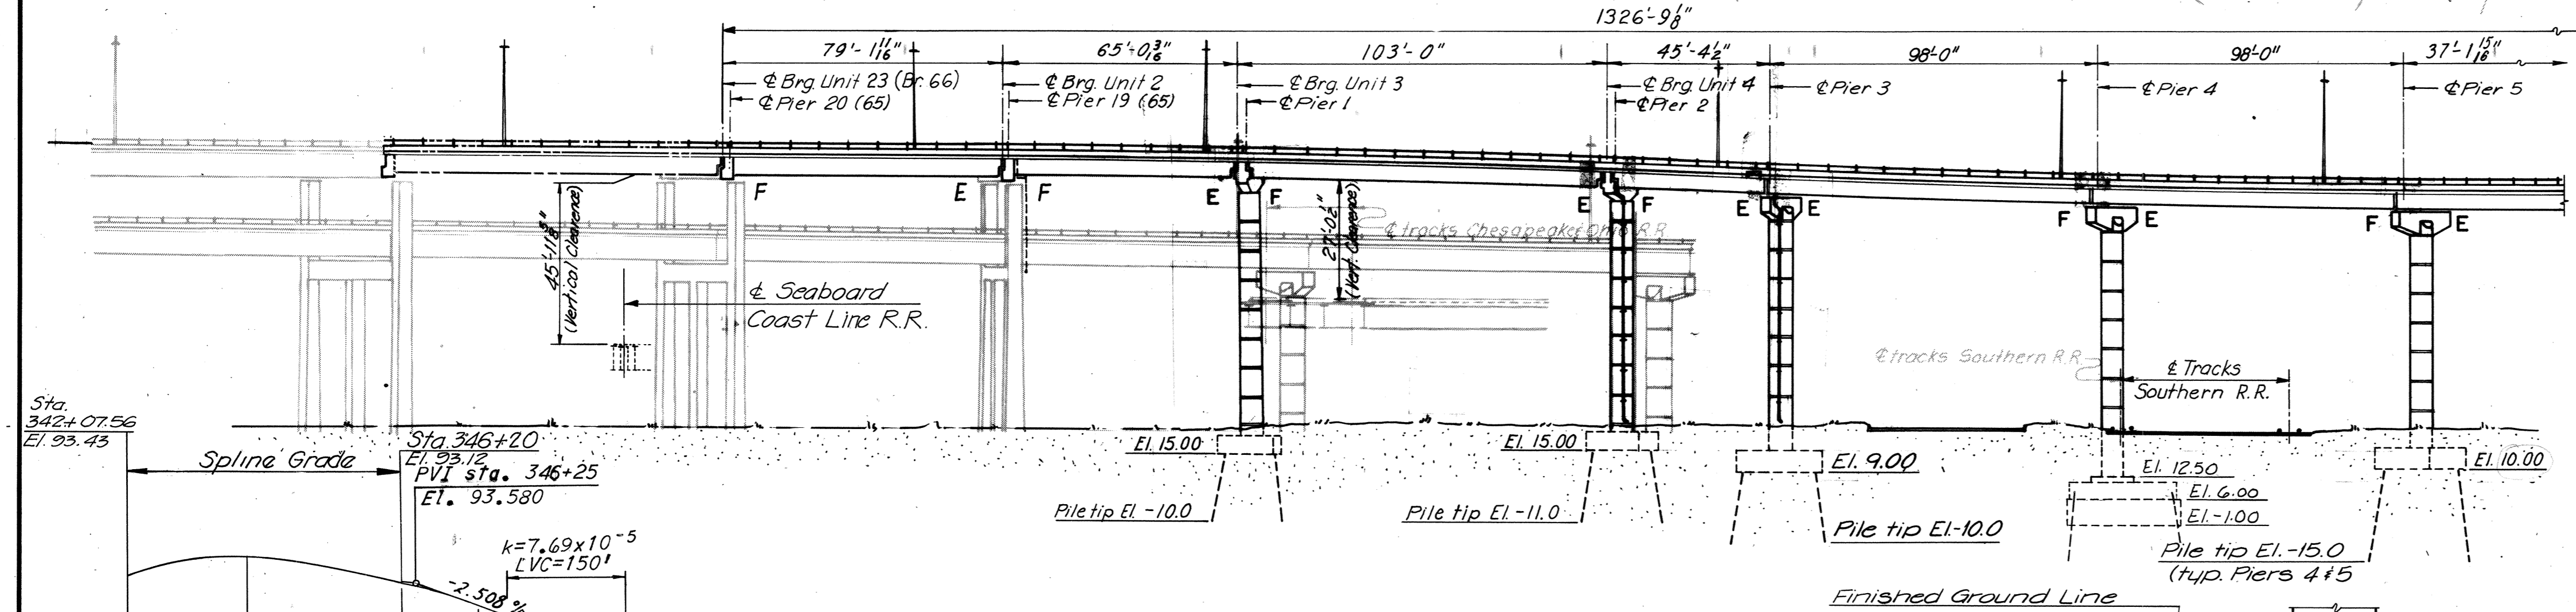

**ELEVATION**

BY	DATE	REVISION	BY	DATE
J.V.	4-2-69	Profile Grade W-S, Index	TEM	8-26-75
G.S.H.	7-16-69	Seaboard Coast Line Added	TEM	6-74

△ PROFILE GRADE    ▣ RAMP W-S

**GENERAL NOTES**

- ROADWAY:** One 24'-0" clear roadway transitioning into a 13'-6" widening of existing Richmond-Petersburg Turnpike.
- CAPACITY:** Dead load includes 15lbs. per sq.ft. for future wearing surface. Live load HS 20-44 loading and alternate military loading.
- SPECIFICATIONS:**
  - GENERAL:** Virginia Department of Highway Road and Bridge Specifications 1970.
  - DESIGN:** A.A.S.H.O. Standard Specifications for Highway Bridges 1973, modified by Special Design provisions.
  - WELDING:** 1972 Structural Welding Code of the American Welding Society.

**CONTRACT SPECIAL PROVISIONS**  
Specifications and Contract Special Provisions referred to above are necessary to make these plans complete.

**DATUM:** City of Richmond

**TEMPERATURE:** The normal temperature referred to in the plans is 60°F. The temperature range for movement is 0°F to 120°F.

**DIMENSIONS:** All dimensions are measured horizontally and vertically unless otherwise noted.

**EXCAVATION:** Excavation below subgrade and cut slope template shall be classified as Regular Excavation. All excavation above these limits shall be classified as Regular Excavation and is not included in the Structural Quantities.

**FOUNDATIONS:** Footings shall rest on firm material. Foundation material shall be dry and special attention is called to Section 401.05 of General Specifications and to the Contract Special Provisions, concerning preparation of foundations for footings.


**CONCRETE NOTES:** Concrete in superstructure shall be Class A-4. All other concrete shall be Class A-3. All exposed edges and corners shall have a 3" chamfer or fillet unless otherwise noted. Care in the method of vibration, the use of low-slump concrete, and or other means shall be employed to prevent downgrade movement of newly placed slab concrete. Finishing Concrete Surfaces: See Standard Architectural Detail Sheets and the Contract Special Provisions for types and details. All reinforcing steel shall be deformed bars conforming to ASTM A615 Grade 40. All reinforcing bar dimensions on the detailed drawings are to centers of bars unless otherwise noted. Clear distance between reinforcing steel and face of concrete shall be as noted on the plans. All bar laps shall be 30 diameters of the smaller diameter bar unless otherwise noted.

**STEEL NOTES:** Structural steel shall conform to A.S.T.M. Designations A36, A572-Grade 50 and A588 as noted. See Special Provisions. All field connections shall be made with high strength bolts. High strength bolts shall be 1" diameter unless otherwise noted and shall conform to A.S.T.M. Specification A-325.

**AS BUILT**  
**RICHMOND METROPOLITAN AUTHORITY**  
**RICHMOND EXPRESSWAY SYSTEM**  
**DOWNTOWN EXPRESSWAY**  
**BRIDGE NO. 68**  
**RAMP W-S CONNECTION TO**  
**RICHMOND-PETERSBURG TURNPIKE**  
**GENERAL PLAN AND ELEVATION**


HOWARD, NEEDLES, TAMMEN & BERGENOFF consulting engineers NEW YORK    ALEXANDRIA    KANSAS CITY	SCALE: 1"=30' CONTRACT NO. 11 SHEET NO. 1 OF 28
--	---

**LIMITS OF STRUCTURE EXCAVATION**

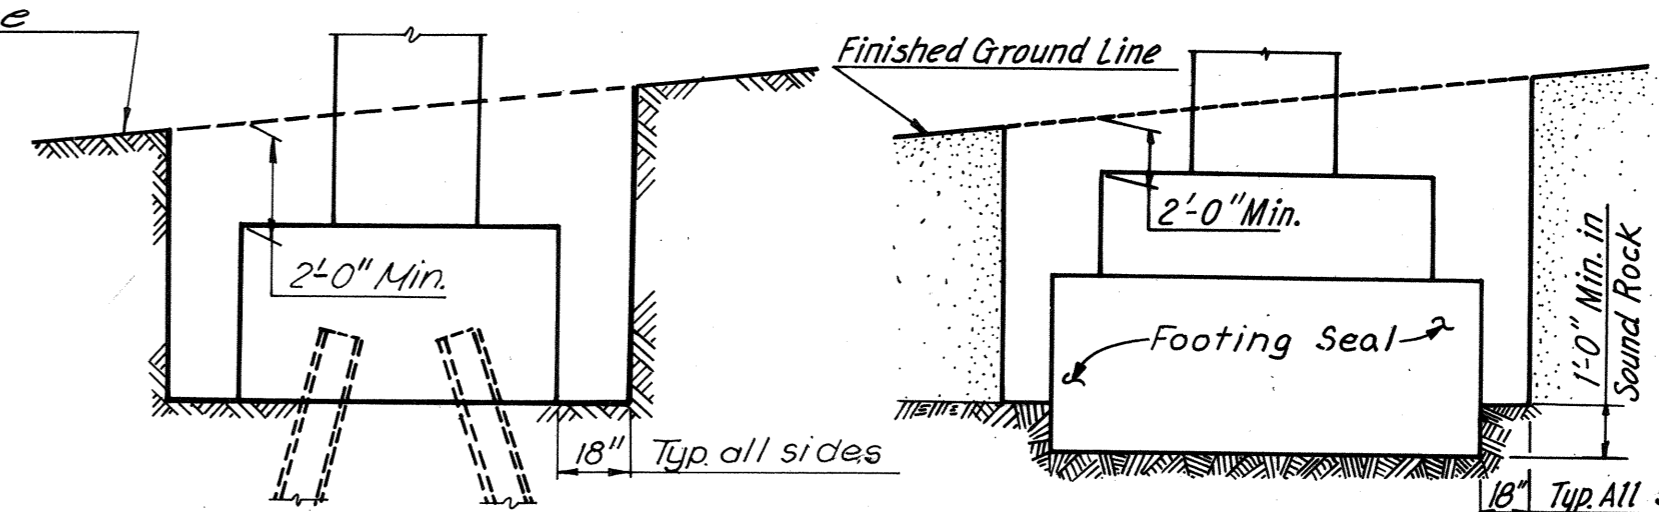


No Scale

RICHMOND EXPRESSWAY SYSTEM			
SECTION	PROJECT	SHEET NO.	TOTAL SHEETS
11	DOWNTOWN EXPRESSWAY	65	97

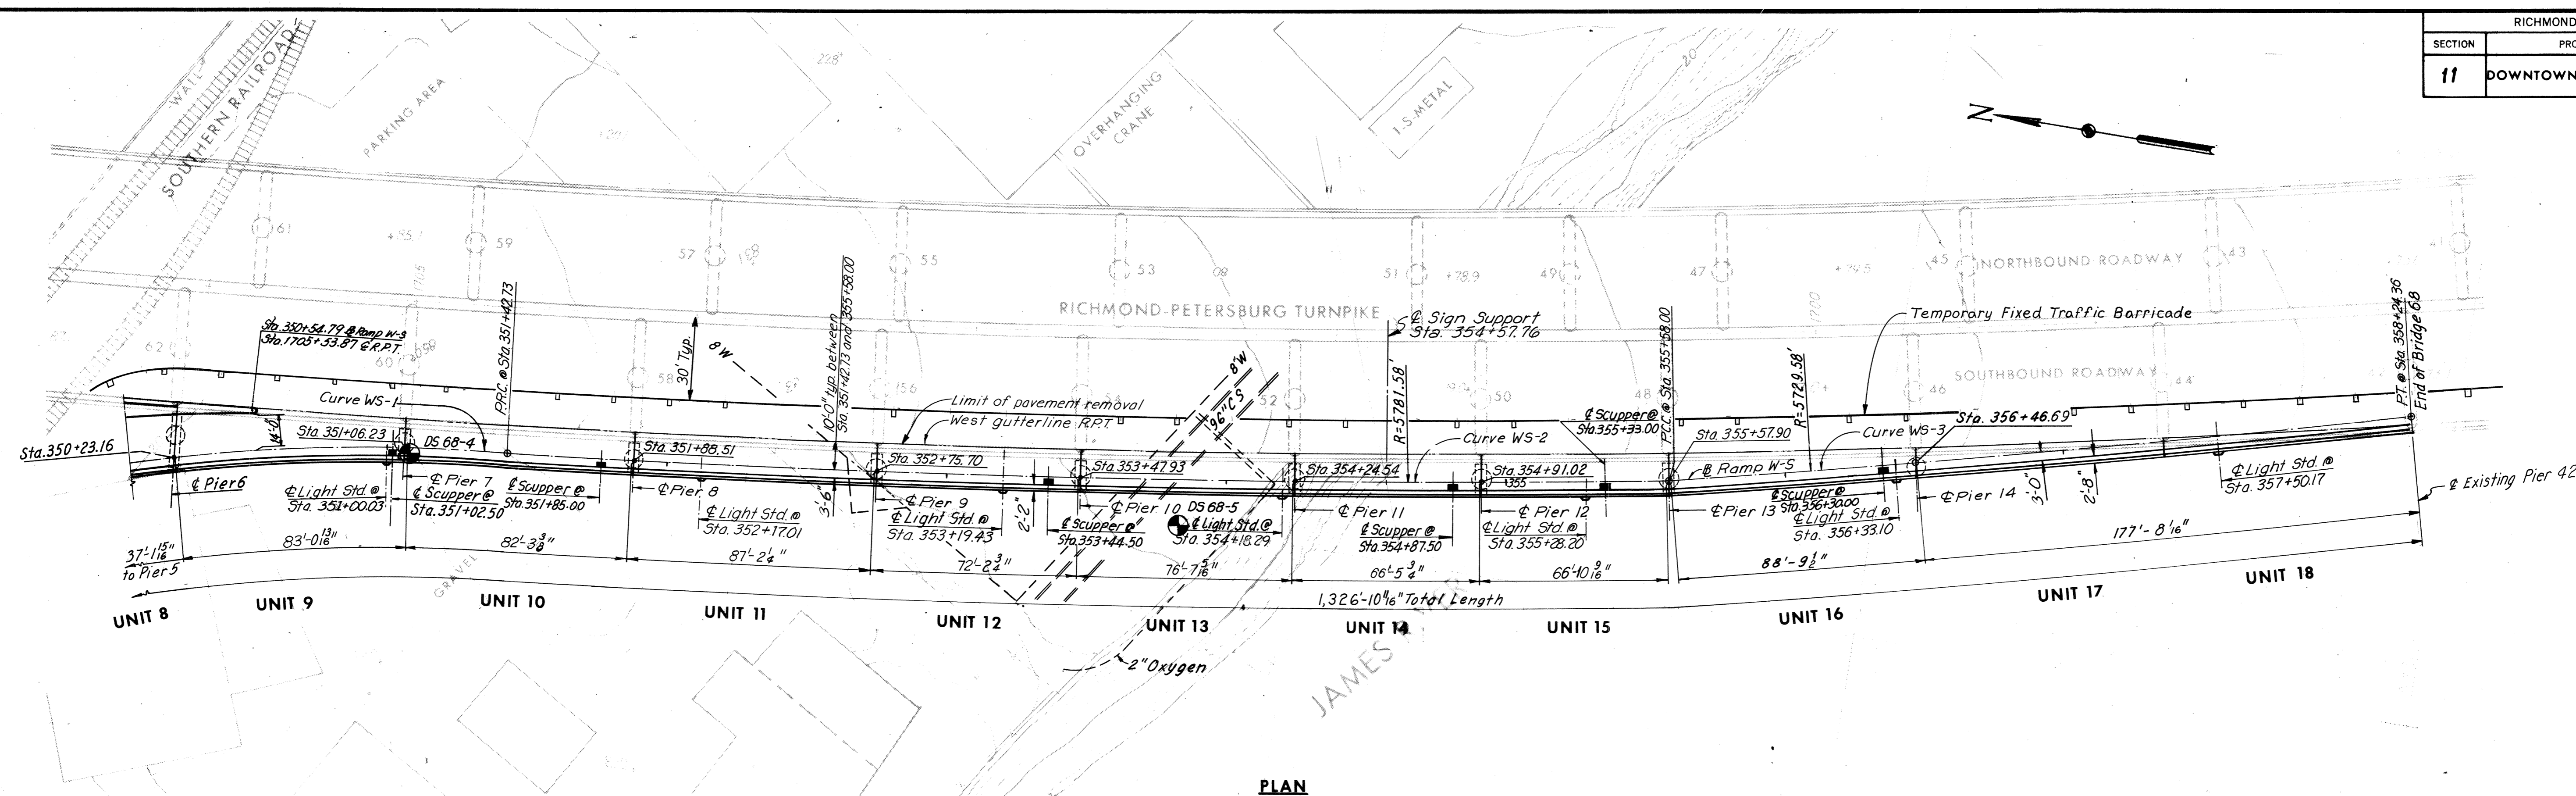

PLAN

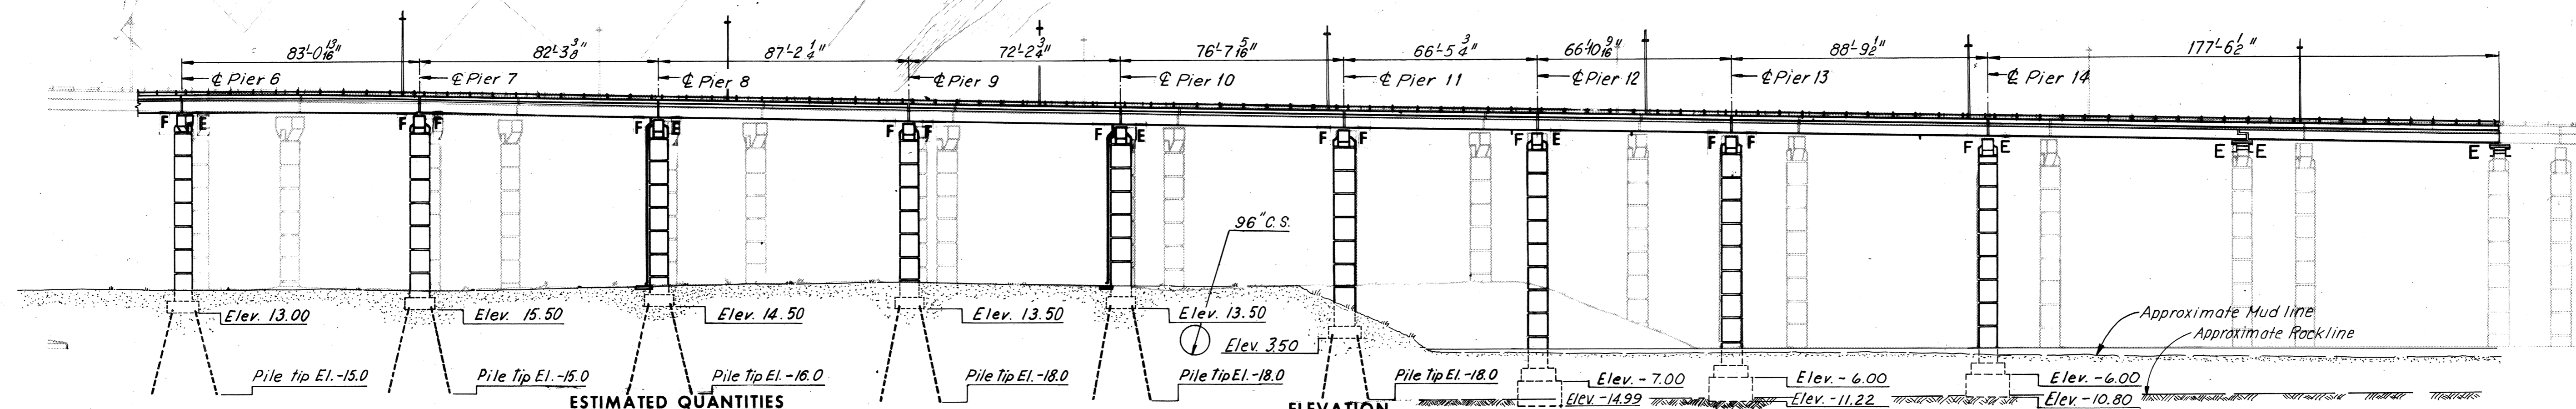

ELEVATION

ESTIMATED QUANTITIES

	Structure Excavation	Concrete	Reinforcing Steel	Str. Steel Mild carbon	Str. Steel High Strength	Aluminum Railing (1-rail)	Steel Piles 10BP42
	Cu. Yds.	Cu. Yds.	Lbs.	Lbs.	Lbs.	Lin. Ft.	Lin. Ft.
Superstructure	----	888.7	215,200	600,400	255,600	1,849	-----
Substructure	1,415*	1,751.0	245,300	31,600	8,400	---	2,630
Total	1,415*	2,639.7	460,500	632,000	264,000	1,849	2,630

	Steel Piles 12BP53	Tremie Concrete Class T3	Sheeting Pier 5	Metal Conduit	Bridge Drainage	Modifications to R.P. Turnpike Bridge	Modifications to Existing Retaining Wall	Temporary Barricade
	Lin. Ft.	Class T3 Cu. Yds	Lump Sum	Lin. Ft.	metal work Lbs.	Lump Sum	Cu. Yds.	Lin. Ft.
Superstructure	---	---		1,310	11,450	1	50	
Substructure	1,412	173.3	1	---	---	---	---	
Total	1,412	173.3	1	1,310	11,450	1	50	990

\* Including 365 Cu. Yds. of "Underwater" Excavation for Piers 12, 13 and 14.  
 \* All concrete for Superstructure shall be Class A4 and for Substructure Class A3. Concrete for Footing Seals shall be Tremie Concrete, Class T3 and is listed separately.

BY	DATE	REVISION	BY	DATE
MADE	J.V. 4-3-69			
CHECKED	G.S.H. 7-16-69	At Pier 44 # 42	T.E.M. 8-26-75	
IN CHARGE				

**AS BUILT**

**RICHMOND METROPOLITAN AUTHORITY**  
**RICHMOND EXPRESSWAY SYSTEM**  
**DOWNTOWN EXPRESSWAY**

**BRIDGE NO. 68**  
**RAMP W-S CONNECTION TO**  
**RICHMOND-PETERSBURG TURNPIKE**  
**GENERAL PLAN AND ELEVATION**

HOWARD, NEEDLES, TAMMEN & BERGENDOFF  
 consulting engineers  
 NEW YORK ALEXANDRIA KANSAS CITY

SCALE: 1"=30'  
 CONTRACT NO. 11  
 SHEET NO. 2 OF 28