

APPENDIX MR-2021

RECORD DRAWINGS

Contract C-10 - Standard Details




Contract C-10 - Bridge Fire Protection Dry Standpipe System

RMTA BRIDGES 8, 13, 17, 47, 62, 63, 64, 66, & 67

(NOTE: Additional sheets of the As-built Plans are Available upon Request to the Engineer)

RMTA
System Map

RM TA DTE, I-95 Ra RM TA DTE, I-95 Ramps Pier Location Exhibit

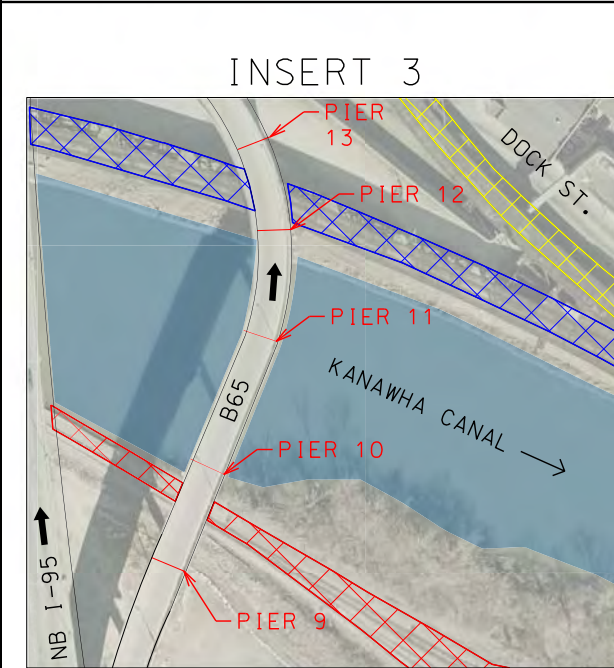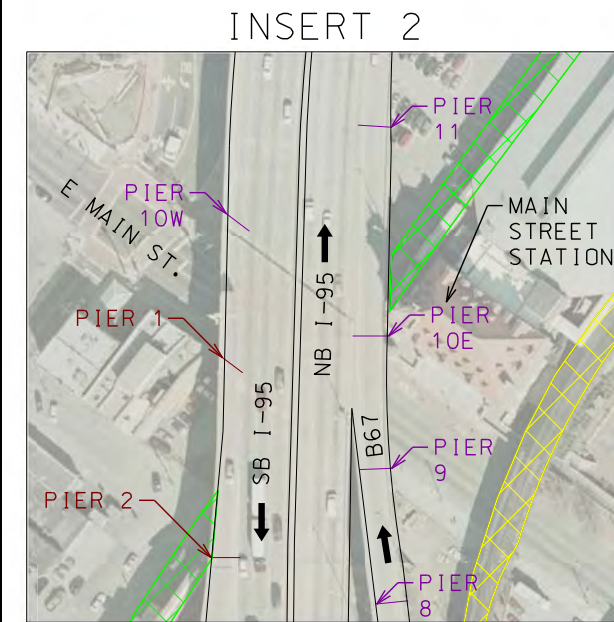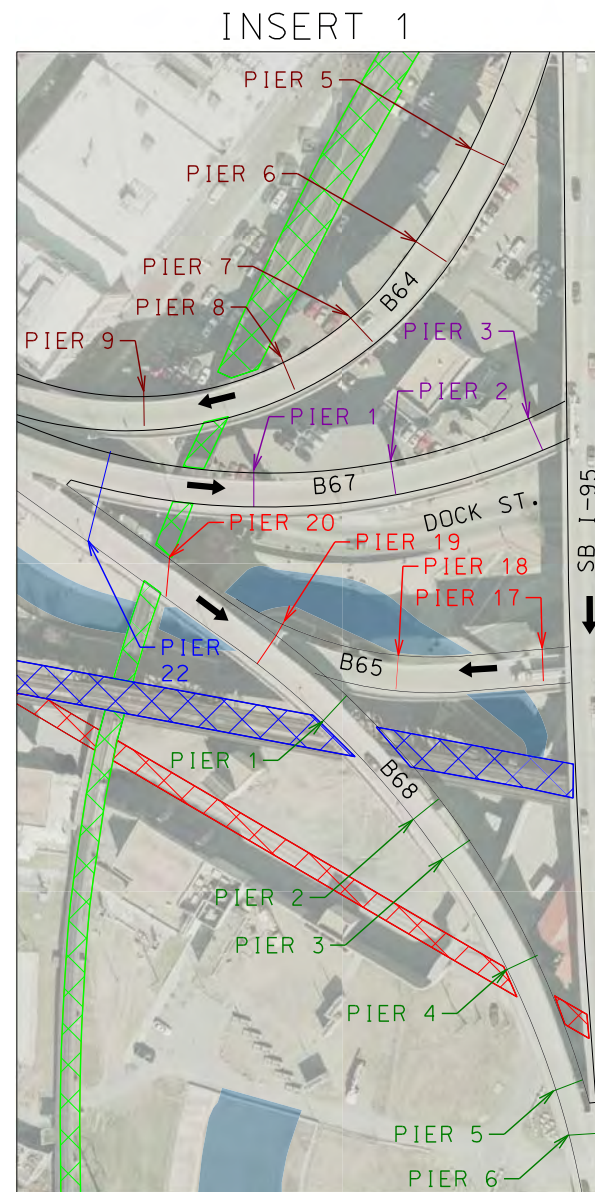

LEGEND:

| | |
|--|--------------|
| | BRIDGE 63 |
| | BRIDGE 64 |
| | BRIDGE 65 |
| | BRIDGE 66 |
| | BRIDGE 67 |
| | BRIDGE 68 |
| | N&S RAILROAD |
| | CSX RAILROAD |
| | CSX RAILROAD |
| | CSX RAILROAD |

- NOTES:**
- 1) PIER NUMBERS BASED ON AS-BUILT DRAWINGS FROM CONTRACTS C-10 AND C-11.
 - 2) RAILROAD LIMITS AND PIER LOCATIONS BASED ON AERIAL PHOTOGRAPHY.
 - 3) THIS EXHIBIT IS FOR REFERENCE ONLY. REFER TO AS-BUILT DRAWINGS FOR EXACT PIER LOCATIONS.
 - 4) BRIDGE 63 IS ON BOTTOM, BRIDGE 66 IS ON TOP.

RICHMOND METROPOLITAN TRANSPORTATION AUTHORITY

HNTB

2900 S. QUINCY STREET, SUITE 200
ARLINGTON, VIRGINIA
(703) 824-6100


I-95 RAMPS PIER LOCATION EXHIBIT

| | | | |
|------------------|-------------------|--------------------------|------------------|
| Scale: N.T.S. | Date: MAY 2015 | Contract No.: MR-2015 | Sheet: 1 OF 1 |
|------------------|-------------------|--------------------------|------------------|


Contract C-10
Standard Details

Record Set Plans


| RICHMOND EXPRESSWAY SYSTEM | | | |
|----------------------------|---------------------|-----------|--------------|
| SECTION | PROJECT | SHEET NO. | TOTAL SHEETS |
| 10 | DOWNTOWN EXPRESSWAY | 259 | 265 |

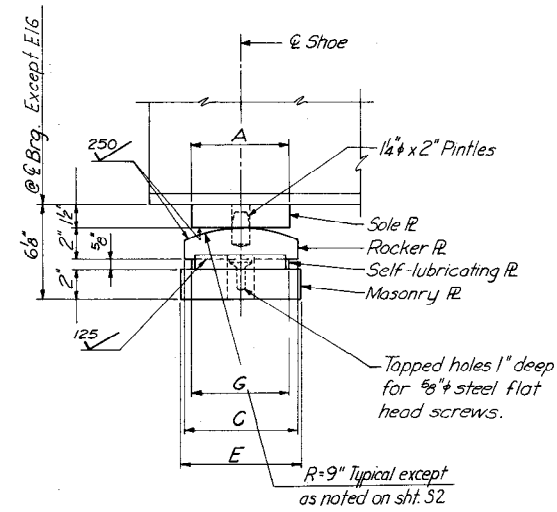


SIDE ELEVATION

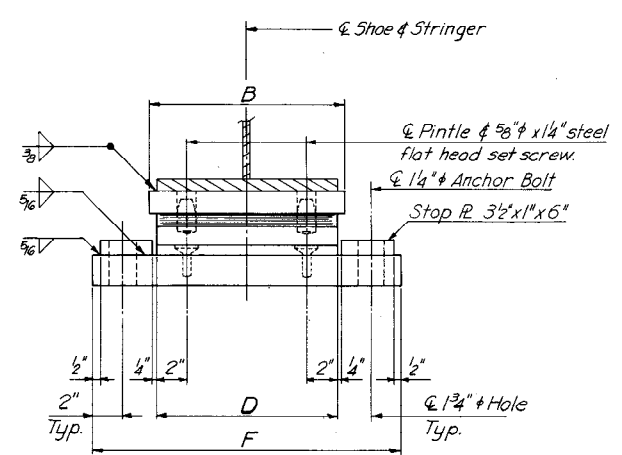


END ELEVATION

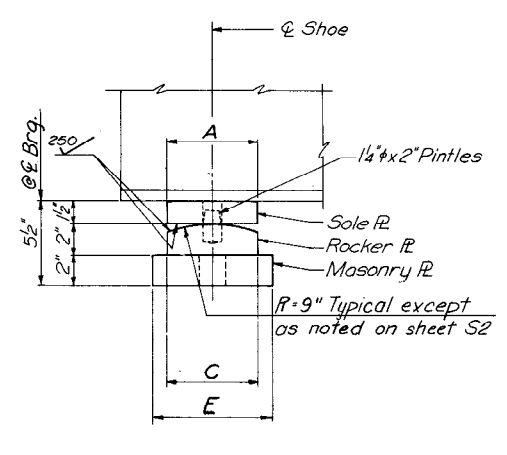

SIDE ELEVATION

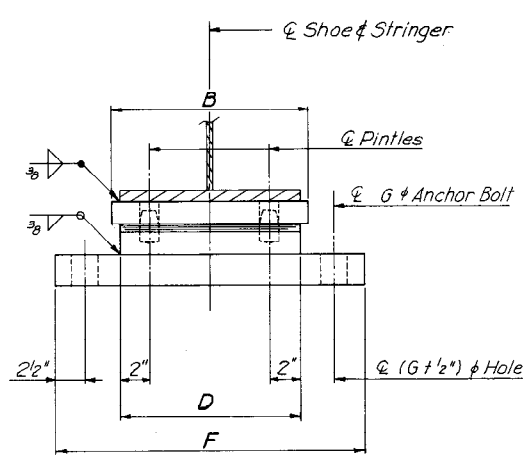



END ELEVATION

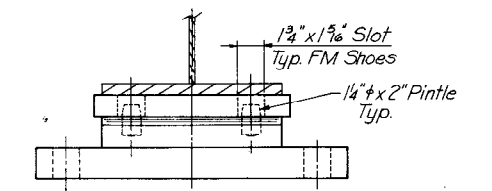

END ELEVATION


Note:
Fixed Modified Shoes some as Fixed Shoes except as shown.

EXPANSION SHOE (Except E16)
No Scale

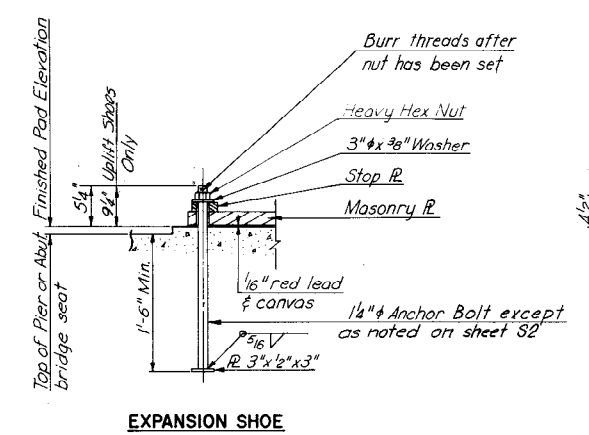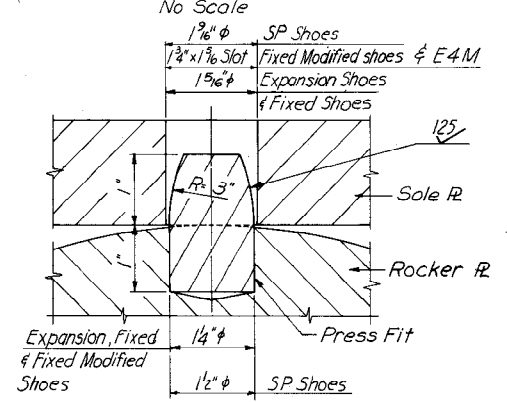


EXPANSION SHOE

FIXED SHOE
No Scale

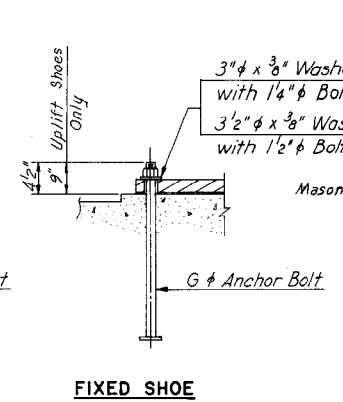


FIXED SHOE

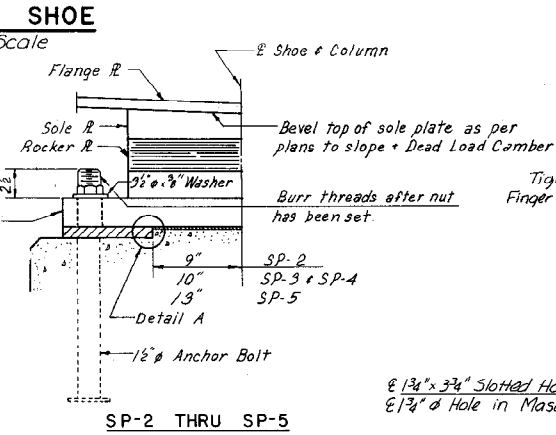

SP-2 THRU SP-5
No Scale


FIXED MODIFIED SHOE
No Scale

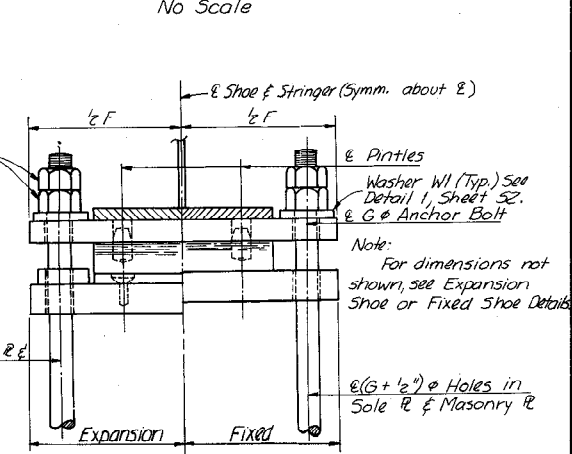


UPLIFT SHOE
No Scale

Note:
For shoe schedules see sheet S2.
For shoe notes, see sheet S2.

MASONRY PLATE DETAIL
E4B4 & F2B4

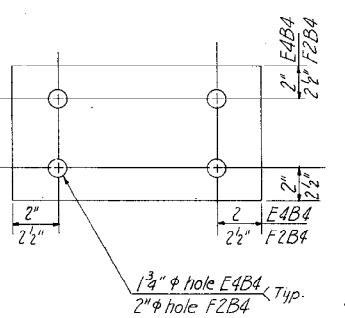


PINTLE DETAIL
Scale: 3/4\"/>

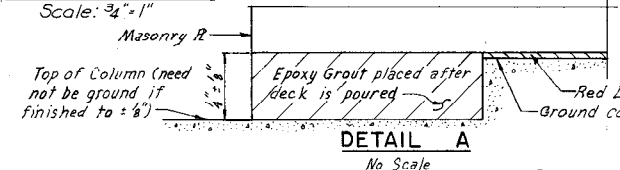

DETAIL A
No Scale


ANCHOR BOLT DETAIL
No Scale

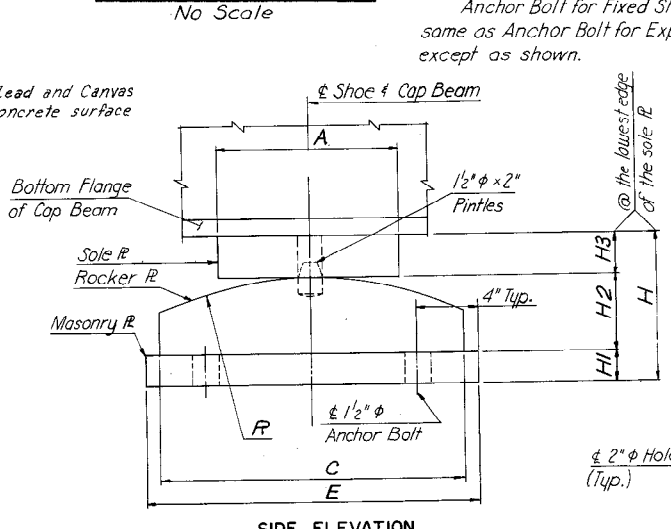

SIDE ELEVATION


Note:
Anchor Bolt for Fixed Shoes & SP Shoes same as Anchor Bolt for Exp. Shoes except as shown.

SP SHOE

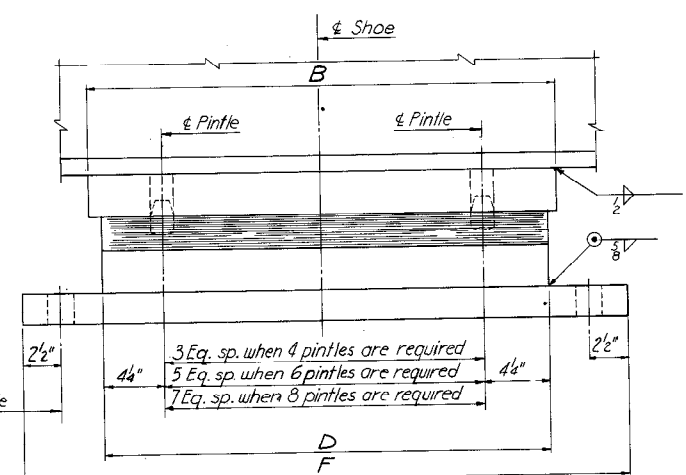

END ELEVATION

AS BUILT

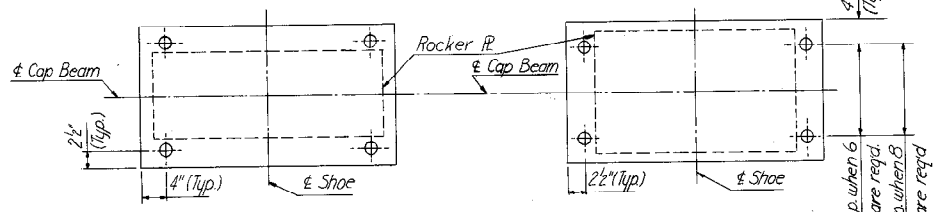

BOLT SETTING FOR SP-2 ONLY

MASONRY PLATE PLAN
SP SHOE

| BY | DATE | REVISION | BY | DATE |
|-------------------|------|----------|----|------|
| Added Uplift Shoe | LRH | 4-19-78 | | |
| Expansion Shoe | MDS | 10-14-74 | | |
| SP-2 thru SP-5 | DMG | 11-14-74 | | |

4 As Built TEM 6-77

RICHMOND METROPOLITAN AUTHORITY
RICHMOND EXPRESSWAY SYSTEM

STANDARD SHOE DETAILS



| | |
|---|---|
| HOWARD, NEEDLES, TAMMEN & BERGENDOFF consulting engineers NEW YORK ALEXANDRIA KANSAS CITY | SCALE: AS NOTED CONTRACT NO. C-10 SHEET NO. 51 OF 7 |
|---|---|

| RICHMOND EXPRESSWAY SYSTEM | | | |
|----------------------------|---------------------|-----------|--------------|
| SECTION | PROJECT | SHEET NO. | TOTAL SHEETS |
| 10 | DOWNTOWN EXPRESSWAY | 260 | 265 |

| EXPANSION SHOE DIMENSIONS | | | | | | | | REMARKS |
|---------------------------|----|-----------|--------|-----------|---------|-----------|--------|------------------------------|
| TYPE | A | B | C | D | E | F | G | |
| E1 | 6" | 1'-1" | 7 1/2" | 1'-0" | 8" | 1'-8 1/2" | 6" | |
| E2 | 6" | 1'-1" | 8 1/2" | 1'-0" | 9" | 1'-8 1/2" | 6 1/2" | |
| E3 | 6" | 1'-1" | 9" | 1'-1" | 9 1/2" | 1'-9 1/2" | 7" | |
| E4 | 6" | 1'-5 1/2" | 8" | 1'-4 1/2" | 8 1/2" | 2'-1" | 6" | |
| E4B4 | 6" | 1'-5 1/2" | 8" | 1'-4 1/2" | 8 1/2" | 2'-1" | 6" | 4 Bolts in Masonry R. |
| E4M | 6" | 1'-5 1/2" | 8" | 1'-4 1/2" | 8 1/2" | 2'-1" | 6" | |
| E5 | 6" | 1'-5 1/2" | 9" | 1'-4 1/2" | 9 1/2" | 2'-1" | 7" | |
| E6 | 6" | 1'-7" | 8" | 1'-6" | 8 1/2" | 2'-2 1/2" | 6" | |
| E7 | 6" | 1'-7" | 9 1/2" | 1'-6" | 10 1/2" | 2'-2 1/2" | 7 1/2" | |
| E8 | 6" | 1'-9" | 9" | 1'-8" | 9 1/2" | 2'-4 1/2" | 6 1/2" | |
| E9 | 6" | 1'-9" | 10" | 1'-8" | 11" | 2'-4 1/2" | 7 1/2" | |
| E12 | 6" | 2'-1" | 9" | 2'-0" | 9 1/2" | 2'-8 1/2" | 6 1/2" | |
| E13 | 6" | 2'-1" | 10" | 2'-0" | 11" | 2'-8 1/2" | 7 1/2" | |
| E14 | 6" | 1'-1" | 9" | 1'-1" | 11" | 1'-9 1/2" | 7" | R=12" |
| E15 | 6" | 1'-5" | 10" | 1'-4" | 11 1/2" | 2'-4 1/2" | 7 1/2" | R=12" |
| E8U | 6" | - | 9" | 1'-8" | 9 1/2" | 2'-4 1/2" | 6 1/2" | Uplift Shoe |
| E9U | 6" | - | 10" | 1'-8" | 11" | 2'-4 1/2" | 7 1/2" | Uplift Shoe |
| E16 | * | * | 8 1/2" | 1'-0" | 9" | 1'-10" | 6 1/2" | *For these dim. See detail A |

| EXPANSION SHOES | | | | | | | | FIXED SHOES | | | | | | | |
|-----------------|-------------|-------------|-------------|-------------|--------------|----------------|-------|-------------|-------------|-------------|-------------|-------------|--------------|---------------|-------|
| TYPE | BRIDGE B-63 | BRIDGE B-64 | BRIDGE B-66 | BRIDGE B-67 | BRIDGE B-654 | BRIDGE B-653 * | TOTAL | TYPE | BRIDGE B-63 | BRIDGE B-64 | BRIDGE B-66 | BRIDGE B-67 | BRIDGE B-654 | BRIDGE B-653* | TOTAL |
| E1 | | | 101 | 4 | 8 | | 113 | F1 | 6 | 4 | 62 | 2 | 20 | | 94 |
| E2 | 6 | 5 | | 8 | 12 | | 31 | F1M | | 2 | 39 | 2 | | | 43 |
| E3 | 4 | 5 | 4 | 4 | | | 17 | F2 | 5 | 8 | | | 4 | | 17 |
| E4 | 5 | | 5 | 3 | | | 13 | F2M | | | | | | | |
| E4B4 | | | | | | | | F2BD | 15 | | | | | | 15 |
| E4M | | 1 | | | | | 1 | F2B4 | | | | | | | |
| E5 | 15 | 16 | 20 | | 4 | | 55 | F3 | | 8 | | | | | 8 |
| E6 | | | 5 | 2 | | | 7 | F4 | 17 | | | | | | 17 |
| E7 | 21 | | 13 | 12 | | | 46 | F4M | 2 | | | 4 | | | 6 |
| E8 | | 4 | | 4 | | | 8 | F4BD | | | | | | | |
| E9 | 1 | | | | | | 1 | FGM | | 3 | | | | | 3 |
| E12 | | 3 | | | | | 3 | F7 | | 4 | | | 12 | | 16 |
| E13 | | 4 | | | | | 4 | F7U | | | | | 12 | | 12 |
| E14 | | | | 4 | | | 4 | F9 | | | | | 3 | | 3 |
| E15 | | | | | 4 | | 4 | F11 | | 4 | | | | | 4 |
| E8U | | | | 4 | | | 4 | F12 | 4 | 4 | | | 8 | | 16 |
| E9U | | | | 8 | | | 8 | F15 | 1 | | | | | | 1 |
| B16 | | 1 | | | | | 1 | | | | | | | | |


| SPECIAL SHOE DIMENSIONS | | | | | | | | | | | | |
|-------------------------|-------|--------|-------|--------|--------|-------|----|--------|--------|---------|-------|-------------------------|
| TYPE | A | B | C | D | E | F | H1 | H2 | H3 | H | R | NO. OF BOLTS OR PINTLES |
| SP-1 | 1'-0" | 1'-11" | 1'-6" | 1'-11" | 1'-8" | 2'-8" | 2" | 4 1/2" | 3" | 9 1/2" | 1'-6" | 4 |
| SP-2 | 1'-0" | 2'-4" | 1'-8" | 2'-4" | 2'-5" | 2'-5" | 2" | 5" | 2 3/4" | 9 3/4" | 1'-6" | 4 |
| SP-3 | 1'-0" | 2'-7" | 1'-8" | 2'-7" | 1'-10" | 3'-4" | 2" | 5" | 2 3/4" | 9 3/4" | 1'-6" | 4 |
| SP-4 | 1'-0" | 2'-7" | 2'-4" | 2'-7" | 2'-6" | 3'-4" | 2" | 6 1/2" | 3 1/2" | 12" | 1'-6" | 6 |
| SP-5 | 1'-6" | 3'-4" | 3'-0" | 3'-4" | 3'-2" | 4'-1" | 2" | 7" | 4 1/2" | 13 1/2" | 3'-0" | 8 |

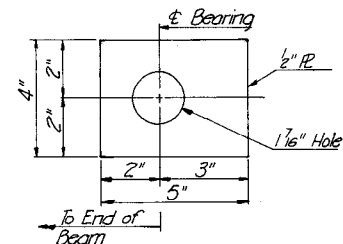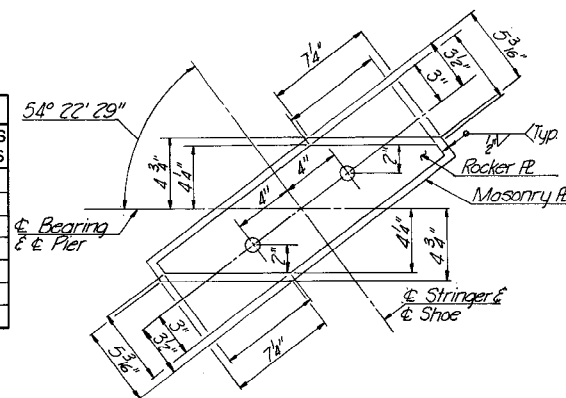


WASHER W-1 DETAIL
Scale: None

* Note: For Shoe Details for Bridge B-653, see sheets 6 & 11 of the detailed drawings for Bridge B-653 (Sheet 232 of 265).

| FIXED SHOE DIMENSIONS | | | | | | | | REMARKS |
|-----------------------|----|-----------|----|-----------|--------|--------|--------|---------|
| TYPE | A | B | C | D | E | F | G | |
| F1 | 6" | 1'-1" | 6" | 1'-0" | 7 1/2" | 1'-9" | 1 1/4" | |
| F1M | 6" | 1'-1" | 6" | 1'-0" | 7 1/2" | 1'-9" | 1 1/4" | |
| F2 | 6" | 1'-5 1/2" | 6" | 1'-4 1/2" | 7" | 2'-2" | 1 1/4" | |
| F2M | 6" | 1'-5 1/2" | 6" | 1'-4 1/2" | 7" | 2'-2" | 1 1/4" | |
| F2BD | 6" | 1'-5 1/2" | 6" | 1'-4 1/2" | 7" | 2'-3" | 1 1/2" | |
| F2B4 | 6" | 1'-5 1/2" | 6" | 1'-4 1/2" | 8" | 2'-2" | 1 1/4" | |
| F3 | 6" | 1'-5 1/2" | 6" | 1'-4 1/2" | 8" | 2'-2" | 1 1/4" | |
| F4 | 6" | 1'-7" | 6" | 1'-6" | 7" | 2'-4" | 1 1/2" | |
| F4M | 6" | 1'-7" | 6" | 1'-6" | 7" | 2'-4" | 1 1/2" | |
| FGM | 6" | 2'-1" | 6" | 1'-8" | 7" | 1'-9" | 1 1/2" | |
| F7 | 6" | 1'-9" | 6" | 1'-8" | 8" | 2'-6" | 1 1/2" | |
| F9 | 6" | 1'-11" | 6" | 1'-10" | 8" | 2'-8" | 1 1/2" | |
| F11 | 6" | 2'-1" | 6" | 2'-0" | 8" | 2'-10" | 1 1/2" | |
| F12 | 6" | 1'-1" | 6" | 1'-1" | 7 1/2" | 1'-10" | 1 1/4" | |
| F15 | 6" | 1'-7" | 6" | 1'-6" | 10" | 2'-4" | 1 1/2" | R=12" |
| F7U | 6" | - | 6" | 1'-8" | 8" | 2'-6" | 1 1/2" | |

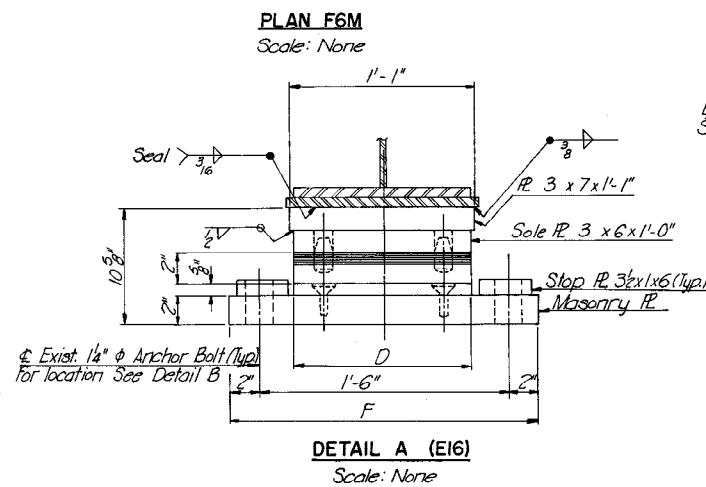

DETAIL A (E16)
Scale: None

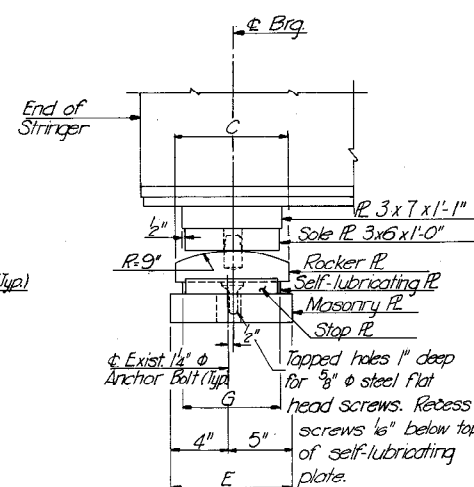

DETAIL B
Scale: None

Shoe Notes:

Material for shoes (exclusive of self-lubricating plates) shall be high strength, low alloy structural steel conforming to ASTM Specification A-588.

Top or masonry plates, bottom of rocker plates and top and bottom of sole plates shall be planed, straightened or otherwise treated to secure true level surfaces.

Contact surfaces noted on the plans with finish symbols shall be finished in accordance with the American Standards Association surface roughness requirement as defined in ASA B461-35, Surface Roughness, Waviness and Lay, Part I.

The plates comprising the expansion shoes shall be set so as to be truly centered under full dead load at a temperature of 60°F.

Concrete pads shall be formed integral with abutment or pier and not less than 1/8" or more than 1/4" above finished elevation. Dress down pads by rubbing, grinding or as otherwise approved by the Engineer, to true level surfaces at the finished elevation.

Anchor bolt assemblies shall conform to A.S.T.M. A-307-66 and shall be hot-dip galvanized conforming to A.S.T.M. A-153-66.

Templates shall be used to accurately set the anchor bolts.

| BY | DATE | REVISION | BY | DATE |
|--------|------|---------------------------------|-----|----------|
| J.G.V. | 1-74 | Shoe Sched Rev. Washer W1 added | PRM | 4-19-74 |
| J.G.V. | 1-74 | Additional Shoe Detail added | MDS | 10-14-74 |
| T.E.M. | 1-74 | Shoe R Size | REJ | 11-12-74 |
| P.R.Y. | | | | |

4 As Built TEM 6-77


RICHMOND METROPOLITAN AUTHORITY
RICHMOND EXPRESSWAY SYSTEM
DOWNTOWN EXPRESSWAY

STANDARD SHOE DETAILS

| | |
|---|--|
| HOWARD, NEEDLES, TAMMEN & BERGENDOFF consulting engineers NEW YORK ALEXANDRIA KANSAS CITY | SCALE: No Scale CONTRACT NO.: 10 SHEET NO. 52 OF 7 |
|---|--|


AS BUILT

| RICHMOND EXPRESSWAY SYSTEM | | | |
|----------------------------|---------------------|-----------|--------------|
| SECTION | PROJECT | SHEET NO. | TOTAL SHEETS |
| | DOWNTOWN EXPRESSWAY | 261 | 265 |

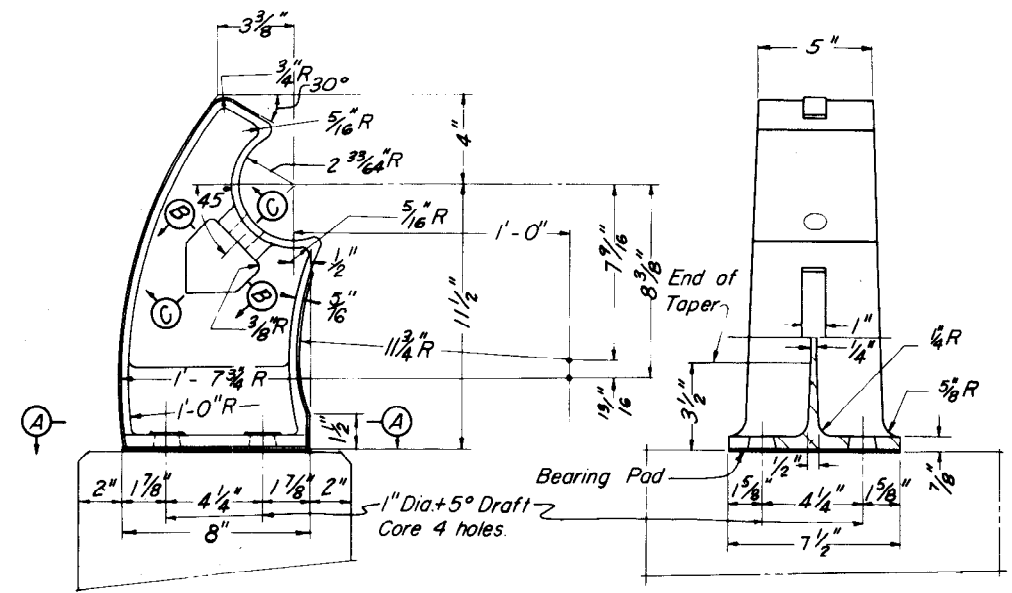


SIDE ELEVATION
Scale: 3"=1'-0"


FRONT ELEVATION
Scale: 3"=1'-0"

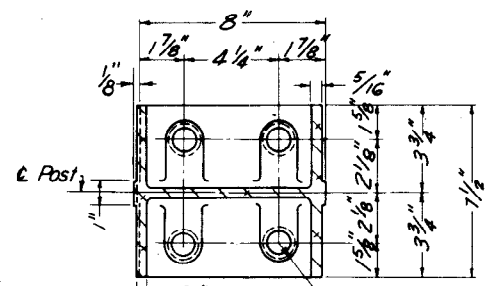


SECTION A-A
Scale: 3"=1'-0"

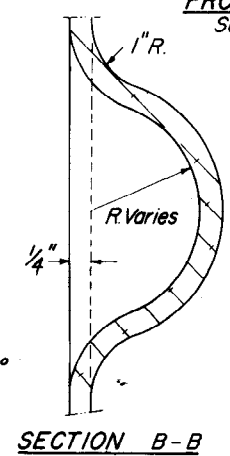

SECTION B-B

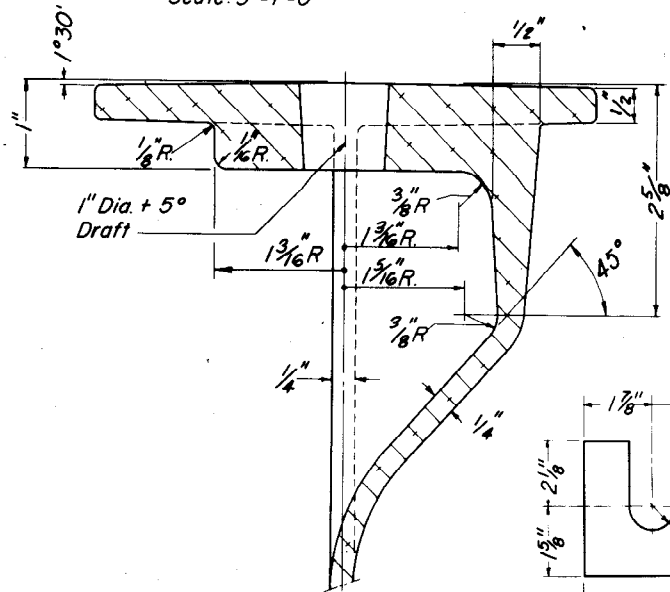


SECTION C-C
Scale: 1"=1"

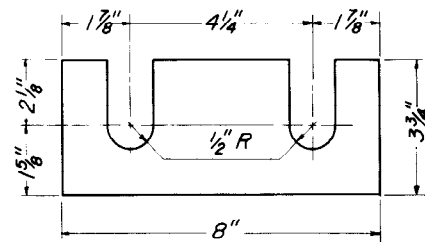

SHIM DETAIL


Shims to be made from 1/8" or 1/4" material. Shims shall not project outside of post base.

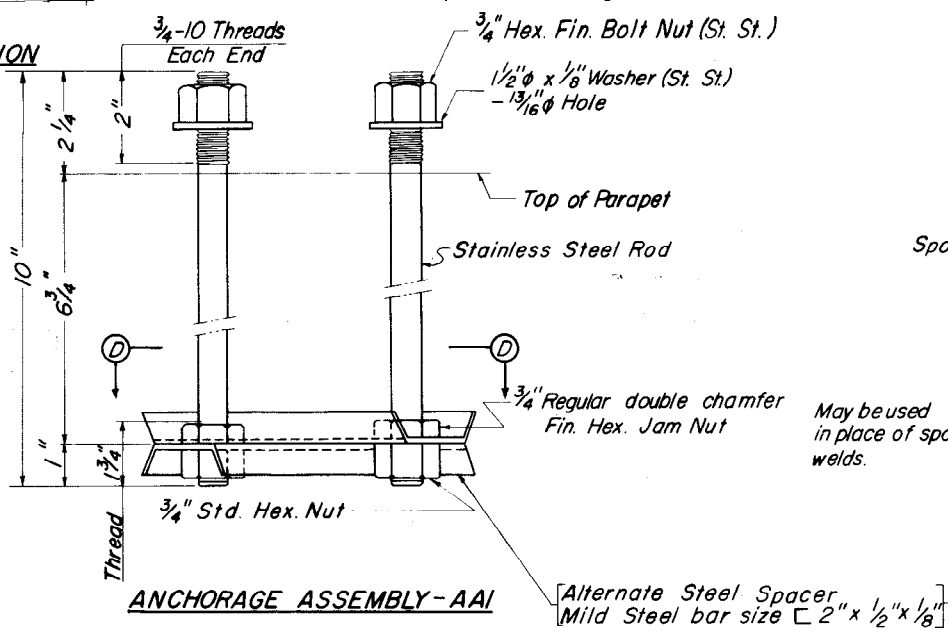


ANCHORAGE ASSEMBLY-AAI

AAI - Steel Spacer - ASTM A425, or A36 (As shown)
Nuts (Top) - ASTM A276, Type 304
Top Washers - Stainless Steel
Rods - ASTM A-276, Type 304 Annealed, Hot-finished
Nuts (Bottom) - ASTM A307
Threads on all rods may be rolled or cut.


NOTES:
Rail to be continuous over a minimum of 3 posts before splicing, unless otherwise shown.
* Post spacing to be measured along inside face of parapet. See plans each bridge.

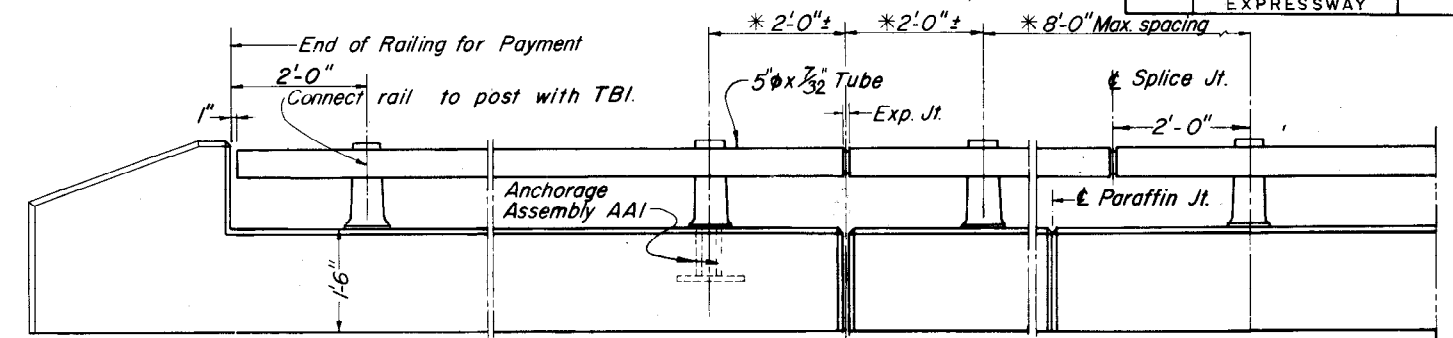

ELEVATION
Scale: 3/4"=1'-0"

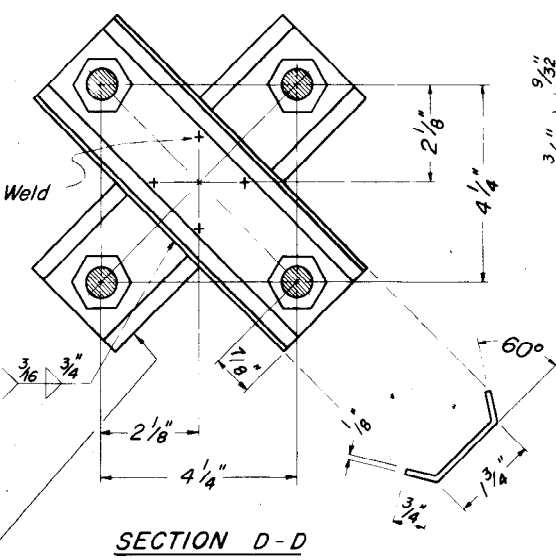


SECTION D-D

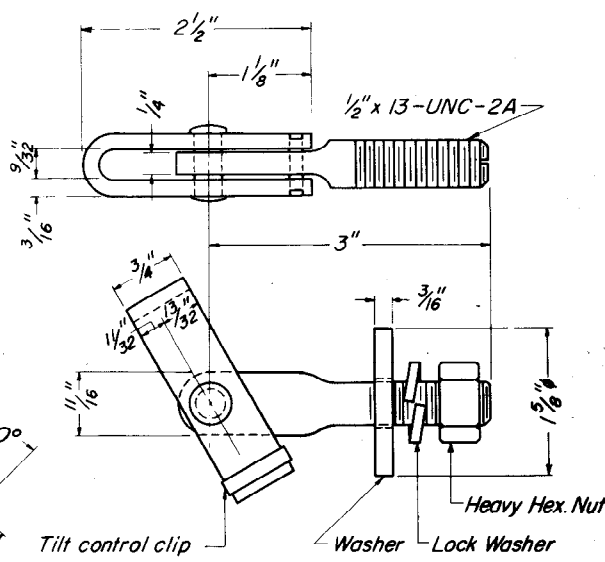


TOGGLE BOLT ASSEMBLY-TBI
TRAFFIC RAIL

Material for toggle bolt assembly TBI shall be carbon or stainless steel having a minimum elongation of 12%. Any non stainless component to be either galvanized to ASTM-A153 or cadmium plated to ASTM-A165, Type NS.
Required minimum tensile load to equal 9000 lbs. when in an open position and tested thru a 1" hole.

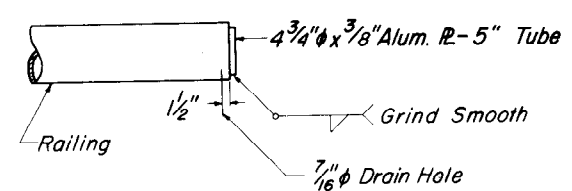

RAIL END CAP

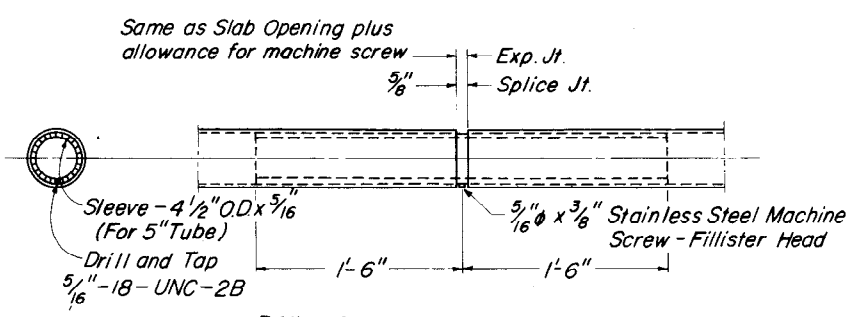

RAIL SPLICE & EXP. JOINT

NOTES:
Posts shall be seated on neoprene bearing pads 1/16" minimum thickness, having a nominal durometer hardness of 70. Pads shall conform to post base dimensions.
Aluminum shims may be used for adjusting post alignment, maximum thickness of shim build-up not to exceed 1/8". Where more tilting of the post is required, the concrete area shall be ground down.
Posts shall be cast aluminum.
Rail members shall be aluminum extruded tube.
Anchor bolts may be set normal to profile grade.
Bi-metallic anchor rods may be used as an alternate for the stainless steel rods. See Special Provisions.

| | | | | | |
|-----------|-----|------|----------|-----|------|
| MADE | BY | DATE | | | |
| CHECKED | ADJ | 0-67 | As Built | TEM | 6-77 |
| IN CHARGE | DRY | | | | |


AS BUILT

RICHMOND METROPOLITAN AUTHORITY
RICHMOND EXPRESSWAY SYSTEM
DOWNTOWN EXPRESSWAY


STANDARD
ALUMINUM RAILING DETAILS
(1 RAIL)

SCALE: AS SHOWN
HOWARD, NEEDLES, TAMMEN & BERGENDOFF
consulting engineers
NEW YORK ALEXANDRIA KANSAS CITY
CONTRACT NO. 10
SHEET NO. S3 OF 7


| RICHMOND EXPRESSWAY SYSTEM | | | |
|----------------------------|---------------------|-----------|--------------|
| SECTION | PROJECT | SHEET NO. | TOTAL SHEETS |
| 10 | DOWNTOWN EXPRESSWAY | 262 | 265 |

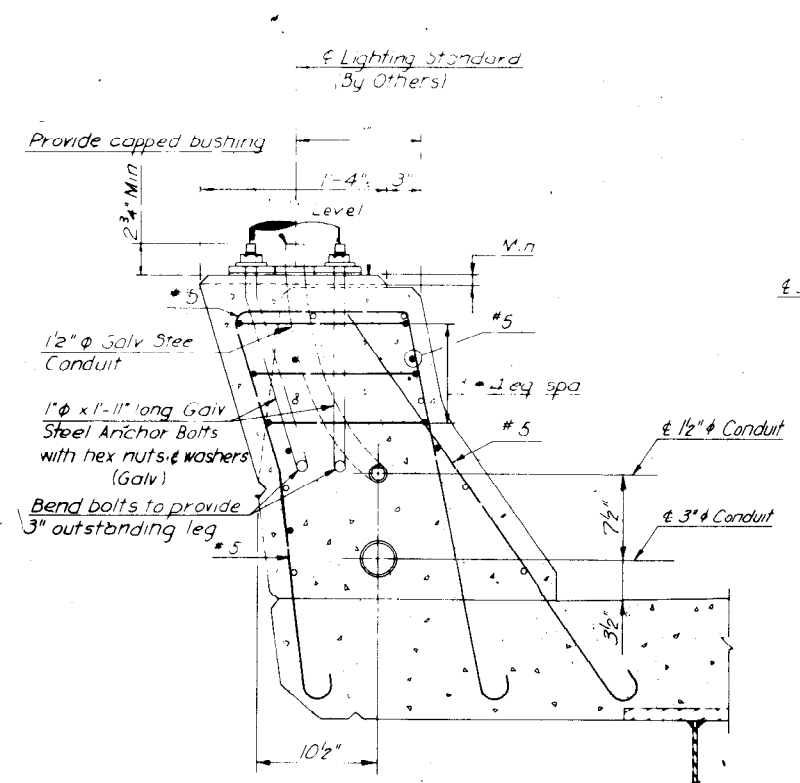


SECTION A-A
Scale 1/2" = 1'-0"

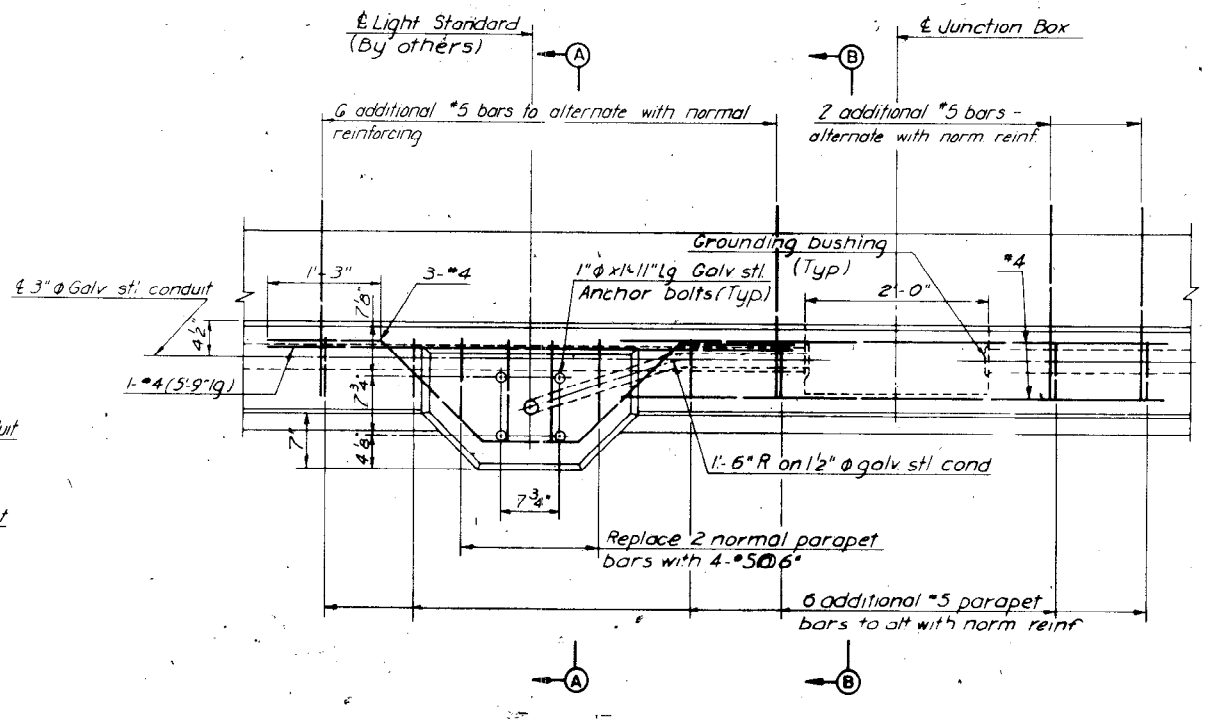


PLAN AT LIGHT STANDARD
Scale 1" = 1'-0"

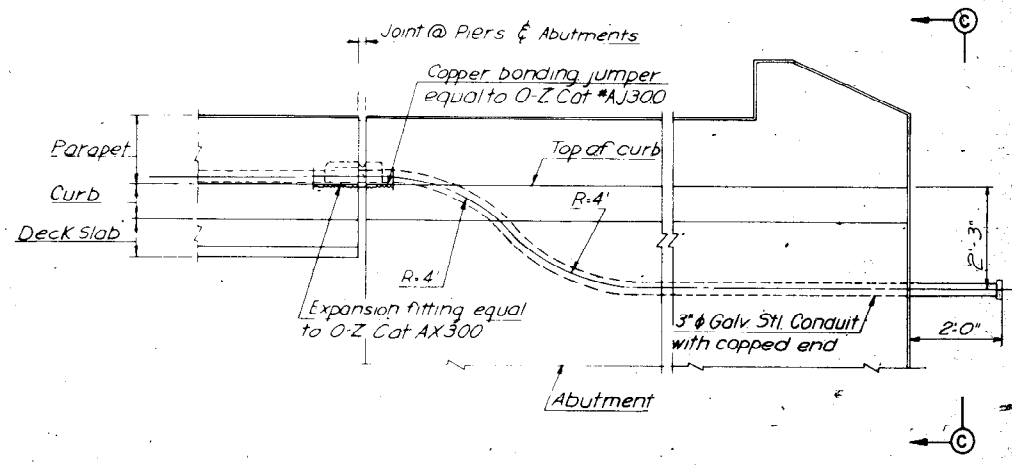


TYPICAL CONDUIT INSTALLATION DETAILS AT DECK JOINTS AND ABUTMENT WINGWALL
No Scale

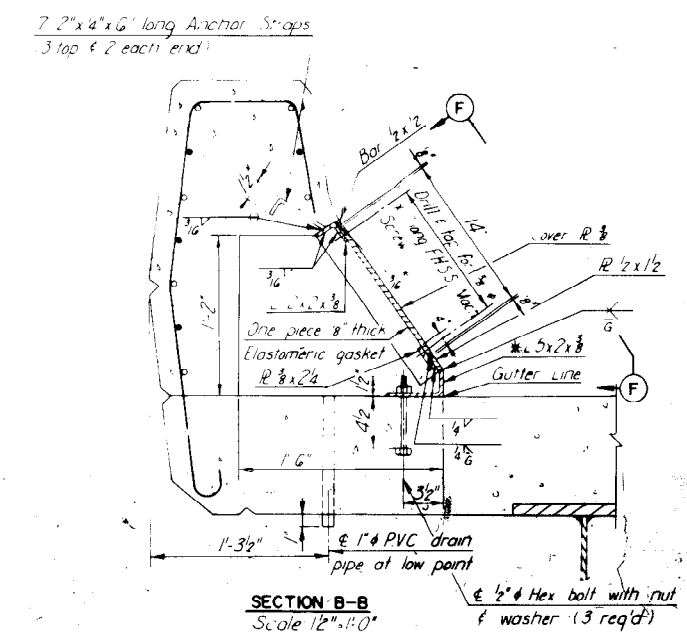


SECTION B-B
Scale 1/2" = 1'-0"

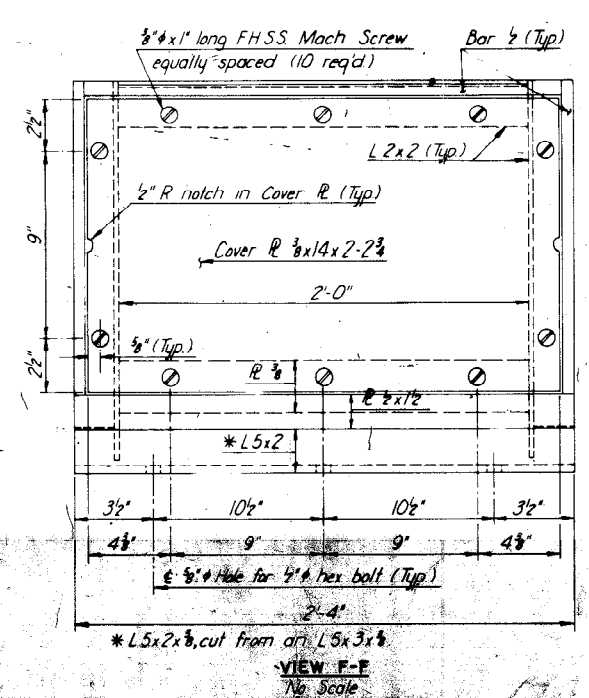

VIEW F-F
No Scale

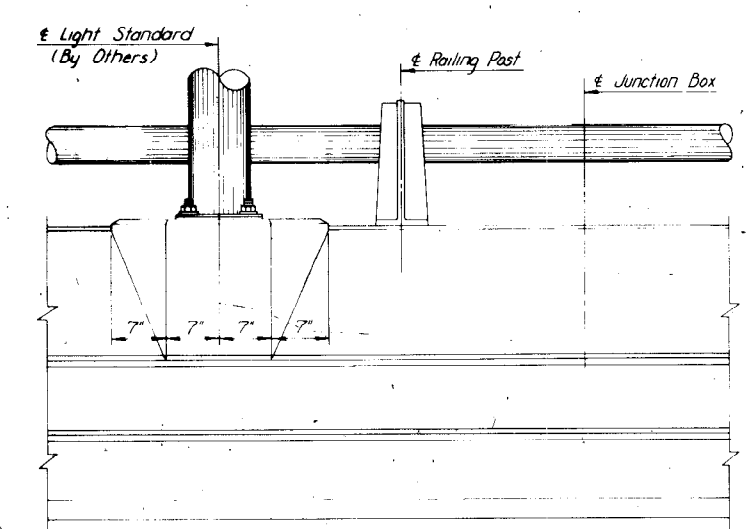

ELEVATION AT LIGHT STANDARD
Scale 1" = 1'-0"

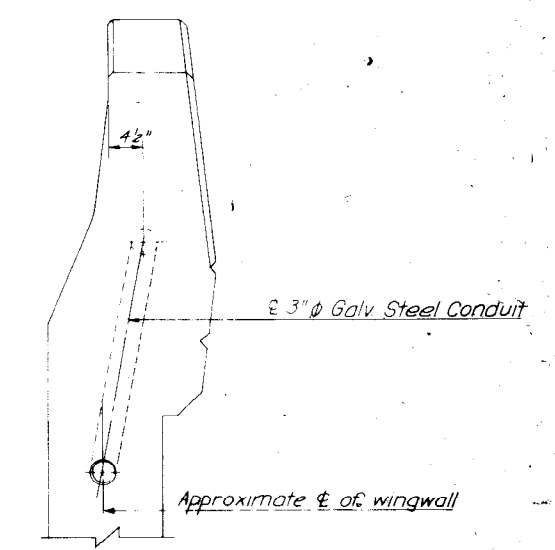

VIEW C-C
No Scale

NOTES:
 All conduits shall be terminated in Junction Boxes with grounding bushings equal to O-Z type 16B.
 Anchor bolt assemblies shall conform to ASTM A307 and shall be hot dip galv after fabrication in accordance with ASTM A153.
 Junction Box and cover shall be hot galvanized after fabrication in accordance with ASTM A123.
 Only additional or replacement reinf. is shown on this sheet for normal reinf. see individual bridge Cross Section and Deck Plan sheets.

| BY | DATE | REVISION | BY | DATE |
|-----------|----------|------------|-----|------|
| MAD | DLA 3-68 | | | |
| CHECKED | PRY 3-68 | 1 As Built | TEM | 6-77 |
| IN CHARGE | PRY | | | |

RICHMOND METROPOLITAN AUTHORITY
RICHMOND EXPRESSWAY SYSTEM
 DOWNTOWN EXPRESSWAY


STANDARD ELECTRICAL DETAILS
(BRIDGES CARRYING EXP SYSTEM)

HOWARD, NEEDLES, TAMMEN & BERGENDOFF
 Consulting Engineers
 NEW YORK ALEXANDRIA KANSAS CITY

SCALE: CONTRACT 10 SHEET

AS BUILT

| RICHMOND EXPRESSWAY SYSTEM | | | |
|----------------------------|---------------------|-----------|--------------|
| SECTION | PROJECT | SHEET NO. | TOTAL SHEETS |
| 10 | DOWNTOWN EXPRESSWAY | 263 A | 265 |

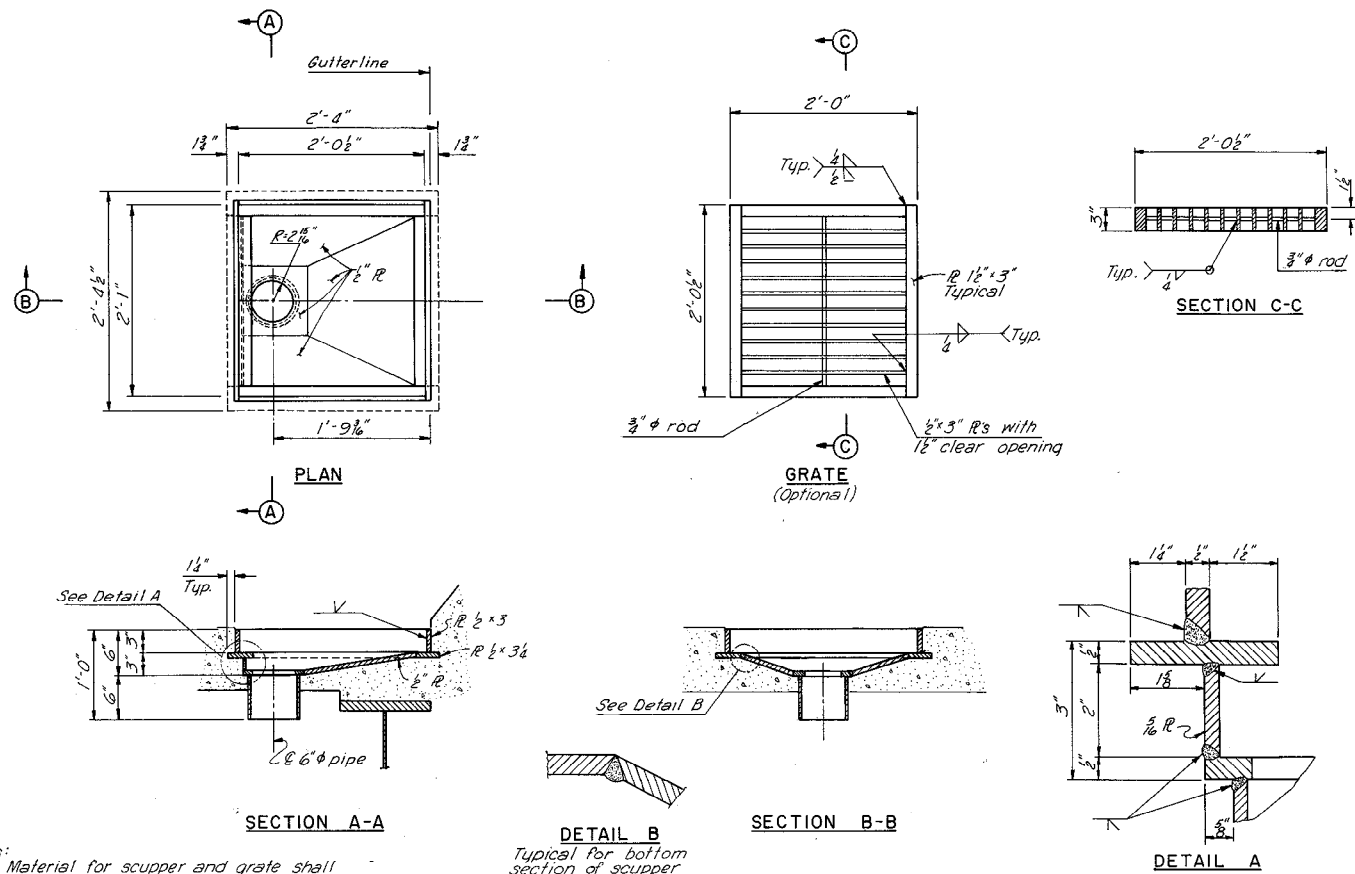

Notes:
 Material for scupper and grate shall be ASTM-A36.
 For additional drainage details sheets 55 and 56.
 Scupper and grate shall be galvanized after fabrication in accordance with ASTM-A123.
 Welded grate shown is optional with cast grate shown on Drawing 35.
 Bends may be substituted for welds where desired.

ALTERNATE TYPE A SCUPPER DETAILS

| | BY | DATE | | | |
|-----------|-----|---------|-----|-----------------|-------------|
| MADE | DWB | 2-28-75 | 2 | As Built | TEM 6-77 |
| CHECKED | MJK | 2-28-75 | 1 | New Sheet Added | DWB 2-28-75 |
| IN CHARGE | | | NO. | REVISION | BY DATE |




AS BUILT

RICHMOND METROPOLITAN AUTHORITY
 RICHMOND EXPRESSWAY SYSTEM




DRAINAGE DETAILS

HOWARD, NEEDLES, TAMMEN & BERGENDOFF
 consulting engineers
 NEW YORK ALEXANDRIA KANSAS CITY


SCALE: _____
 CONTRACT NO. 10
 SHEET NO. S5A OF 7

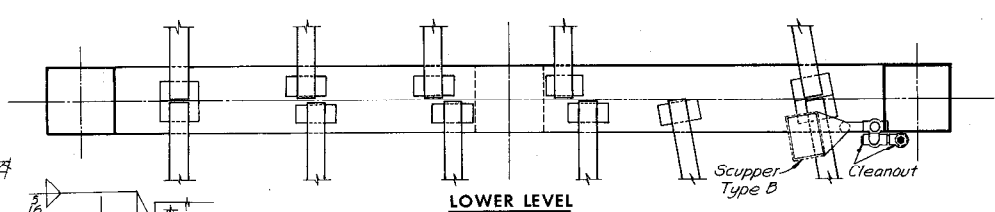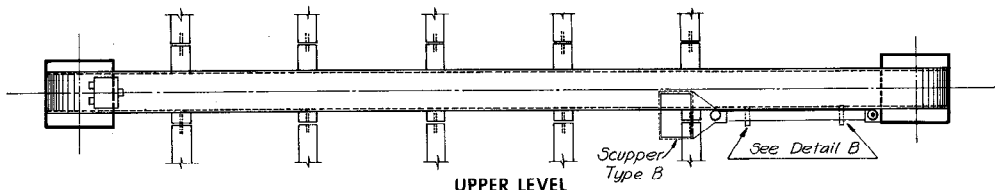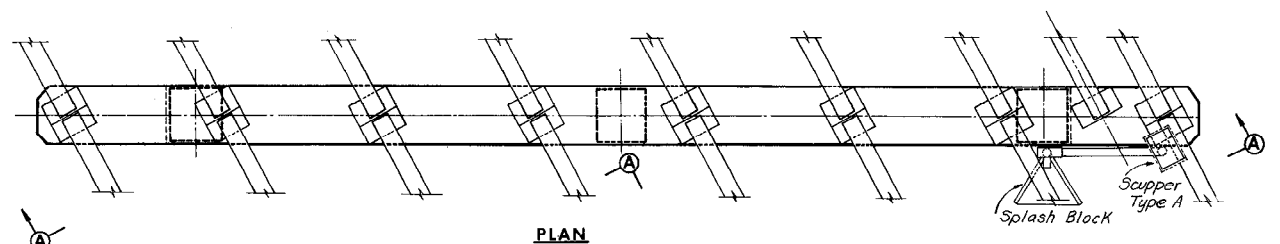


Note: Remove existing scuppers at widening portions. Also remove enough concrete around these scuppers to provide required bond length (about 2'-0").

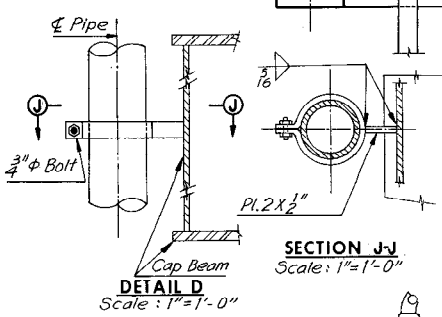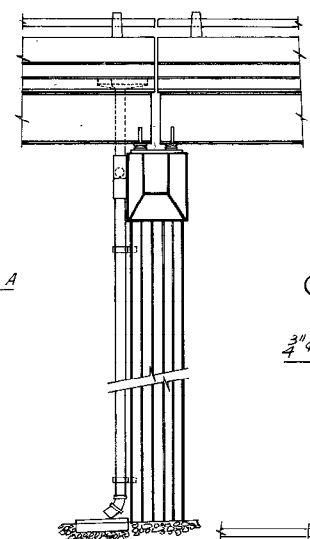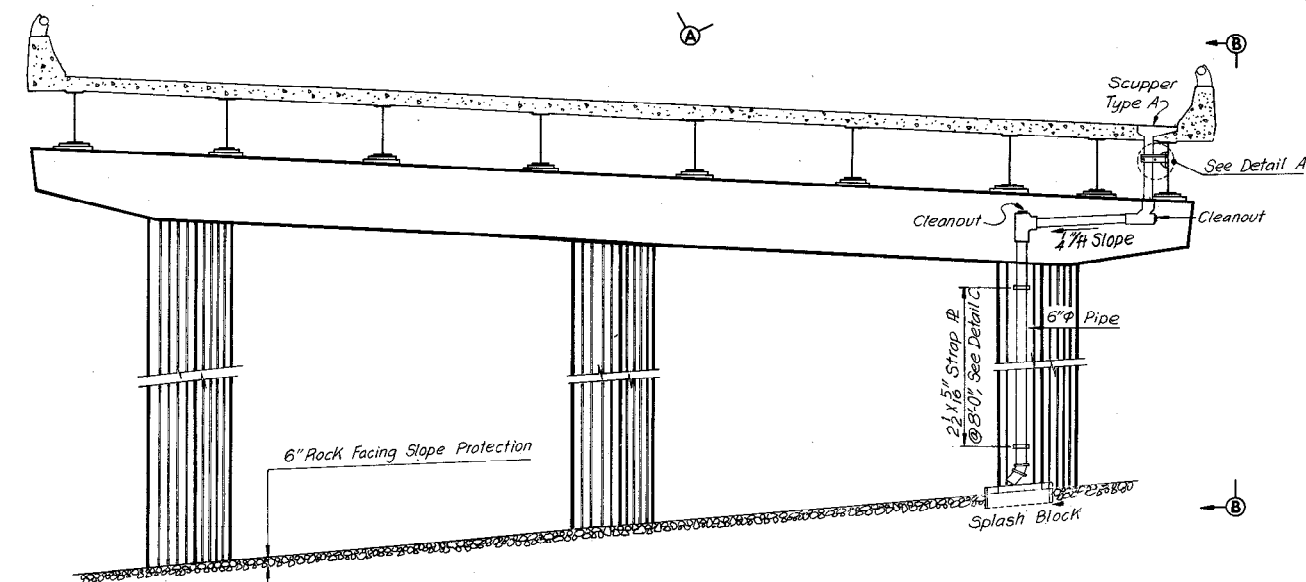






SECTION J-J
Scale: 1" = 1'-0"

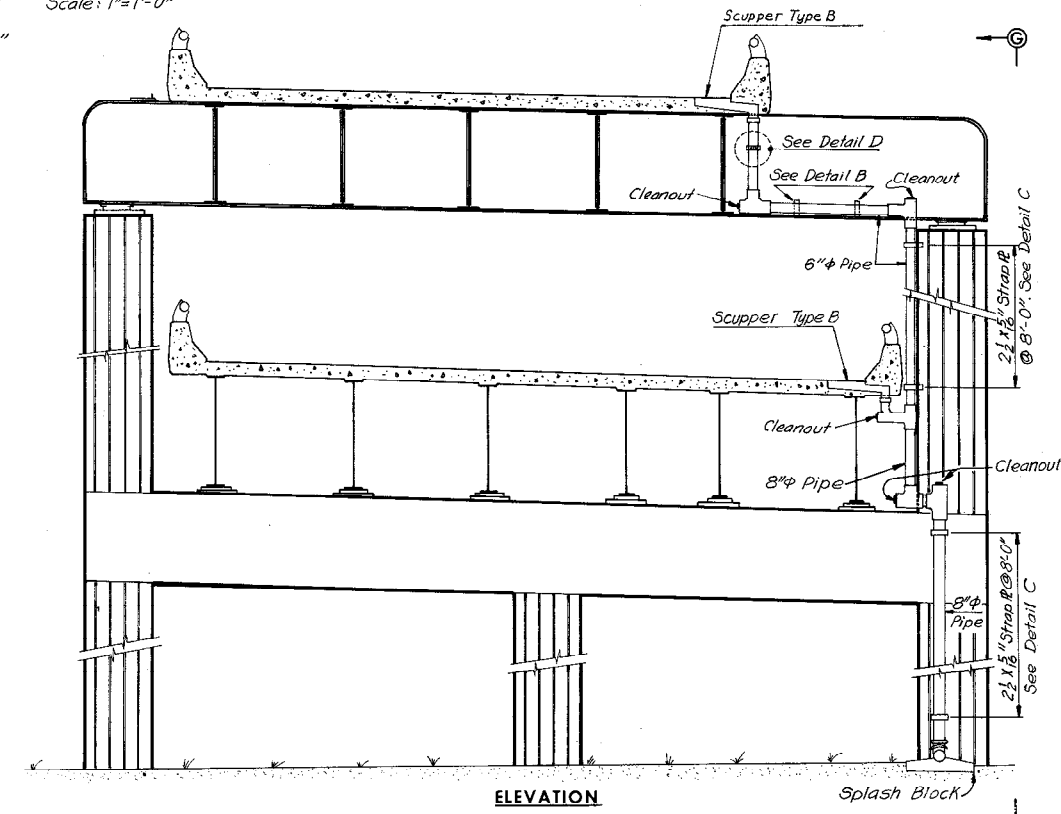




SUPPORT TYPE 2
Scale: 3/8" = 1'-0"

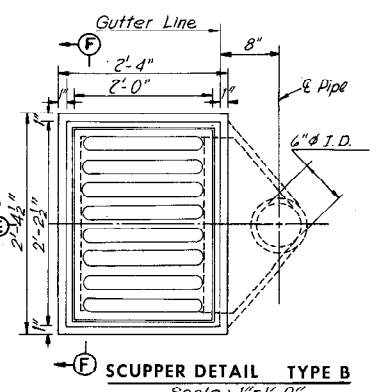

Note: For dimensions not given, see Scupper Detail, Type A.

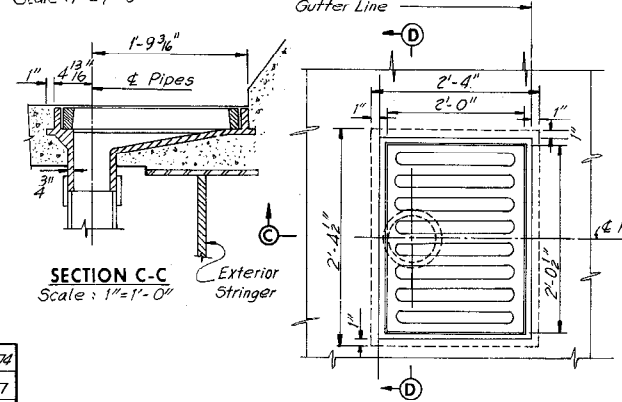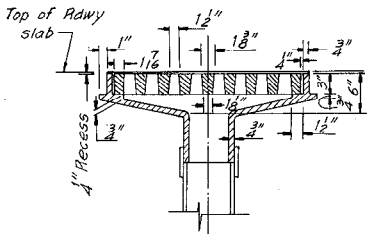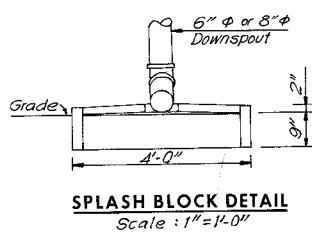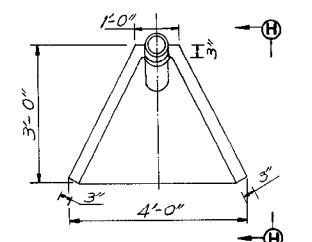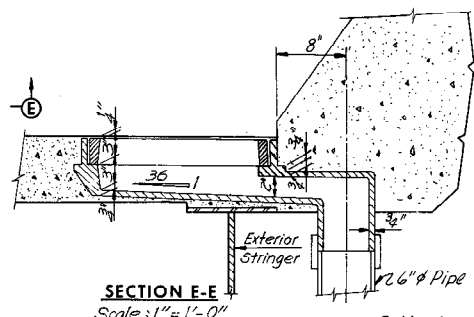

SCUPPER DETAIL TYPE A
Scale: 1" = 1'-0"

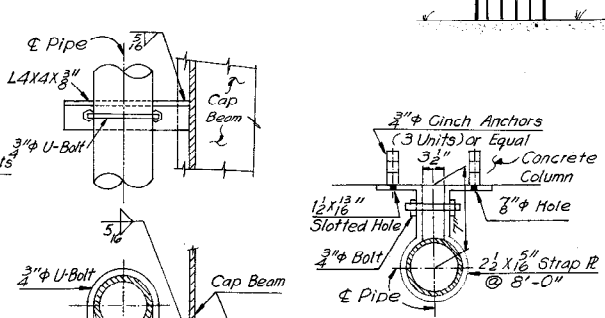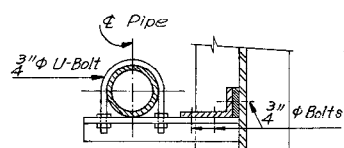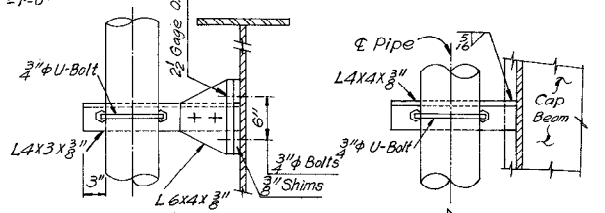

Note: Where existing scuppers are to be removed, concrete shall be removed 2'-0" minimum from the edges of scuppers.

AS BUILT

| | | | | |
|----|------|----------|----|------|
| BY | DATE | REVISION | BY | DATE |
| BY | DATE | REVISION | BY | DATE |
| BY | DATE | REVISION | BY | DATE |


RICHMOND METROPOLITAN AUTHORITY
RICHMOND EXPRESSWAY SYSTEM
DOWNTOWN EXPRESSWAY

STANDARD DRAINAGE DETAILS


HOWARD, NEEDLES, TAMMEN & BERGENDOFF
consulting engineers
NEW YORK ALEXANDRIA KANSAS CITY

SCALE: As Noted
CONTRACT NO.: 10
SHEET NO. 55 OF 7


| RICHMOND EXPRESSWAY SYSTEM | | | |
|----------------------------|---------------------|-----------|--------------|
| SECTION | PROJECT | SHEET NO. | TOTAL SHEETS |
| 10 | DOWNTOWN EXPRESSWAY | 264 | 265 |

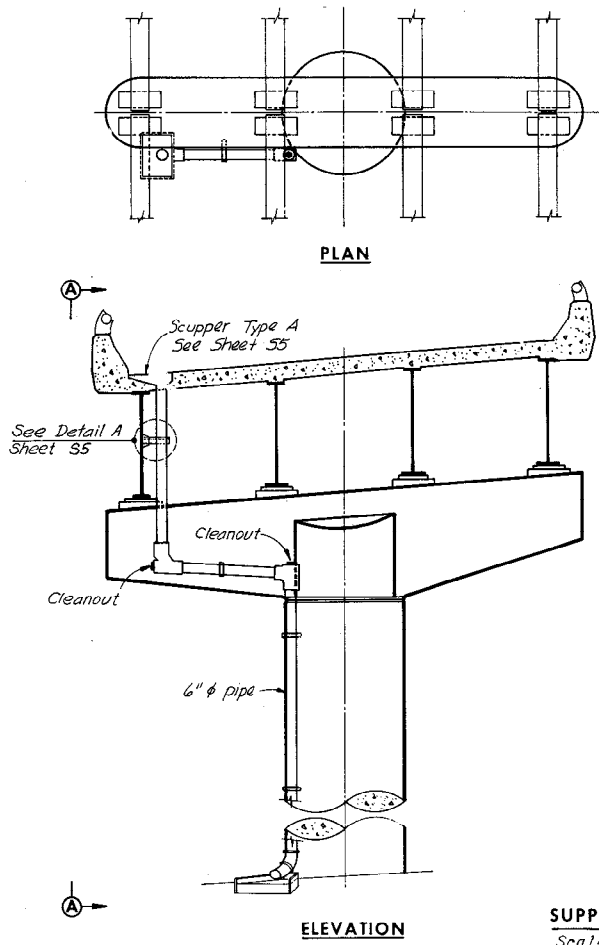


SUPPORT TYPE 3
Scale: 1/8" = 1'-0"

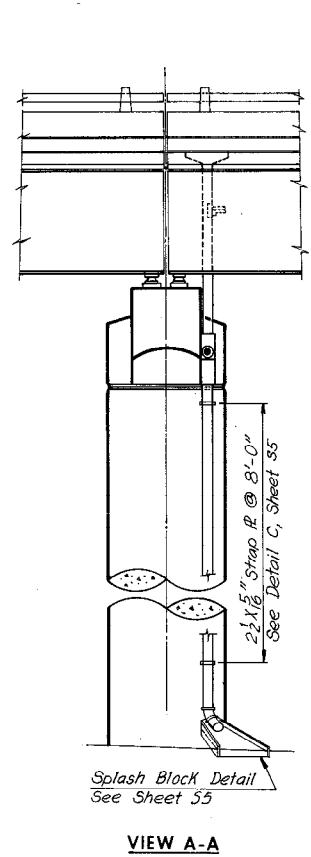


VIEW A-A

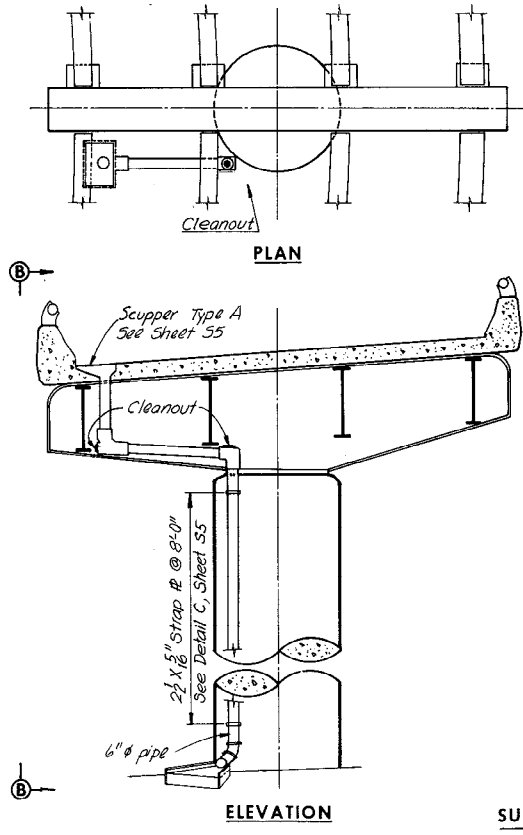


SUPPORT TYPE 4
Scale: 1/8" = 1'-0"

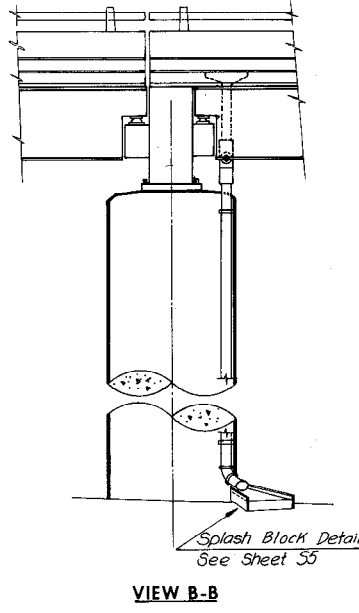


VIEW B-B

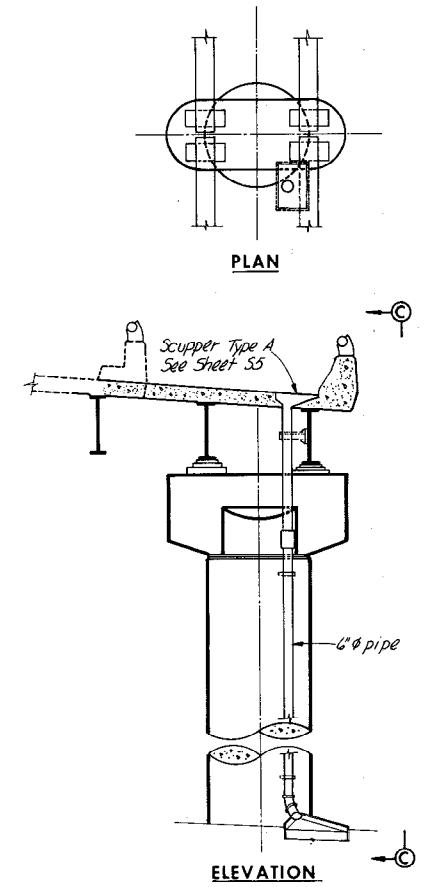


SUPPORT TYPE 5
Scale: 1/8" = 1'-0"

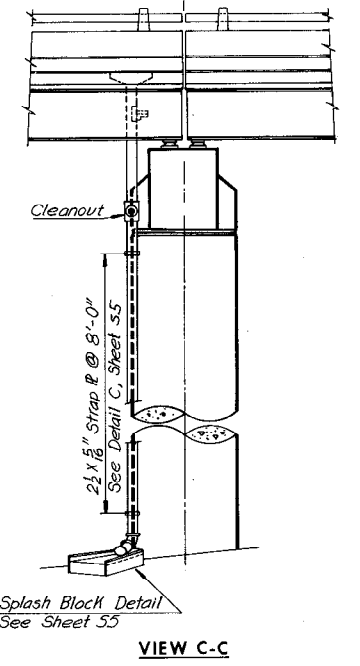


VIEW C-C

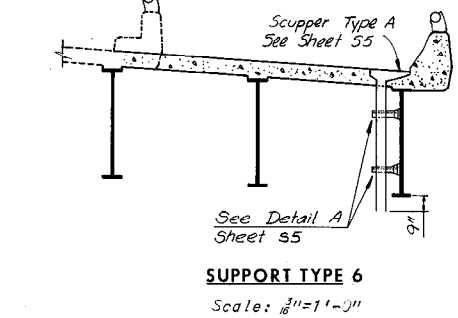


SUPPORT TYPE 6
Scale: 3/16" = 1'-0"

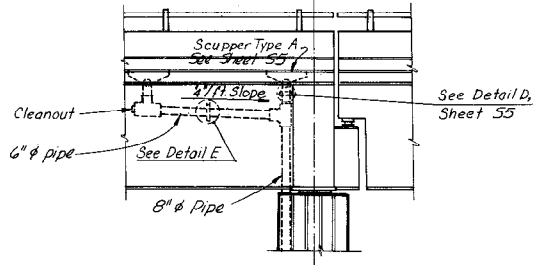


SUPPORT TYPE 7
Scale: 1/8" = 1'-0"

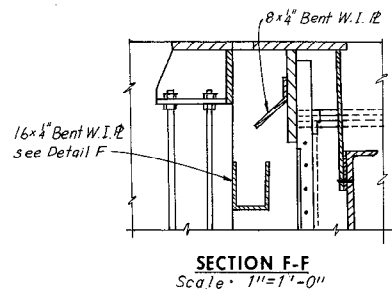


SECTION F-F
Scale: 1" = 1'-0"

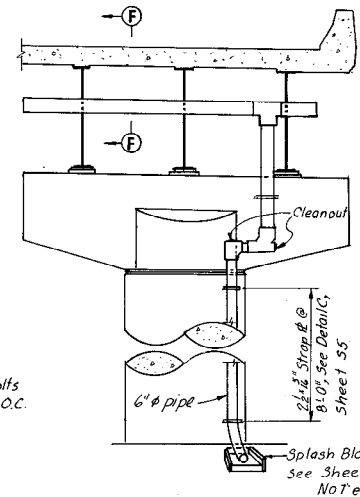


ELEVATION
Scale: 1/8" = 1'-0"

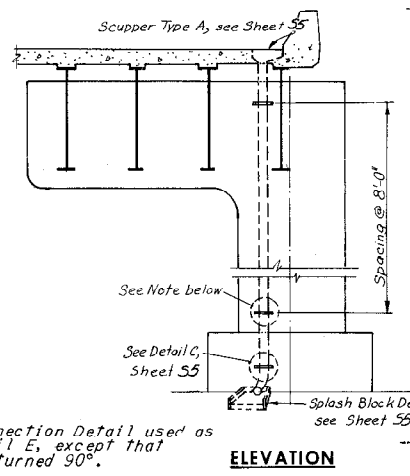

ELEVATION

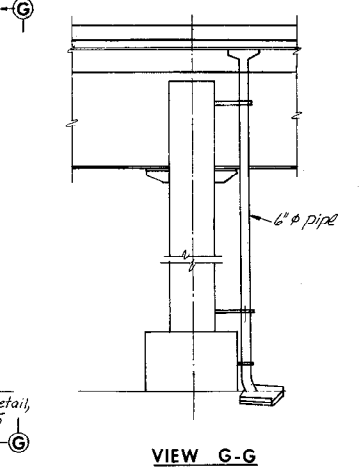


VIEW G-G

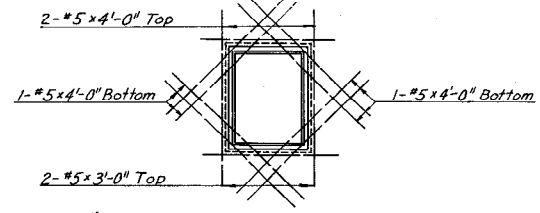


DETAIL OF REINFORCING STEEL AT CAST SCUPPER
No Scale


Note:
Bend bottom and top slab bars at cast scuppers where interference occurs.
Weight of Reinforcing Bars at Scupper: 48 lbs.

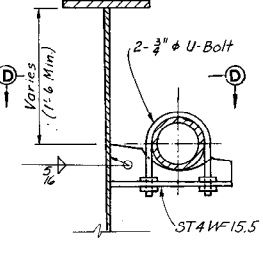


DETAIL E
Scale: 1" = 1'-0"

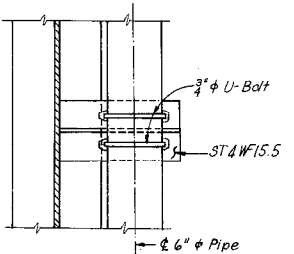


SECTION D-D
Scale: 1" = 1'-0"

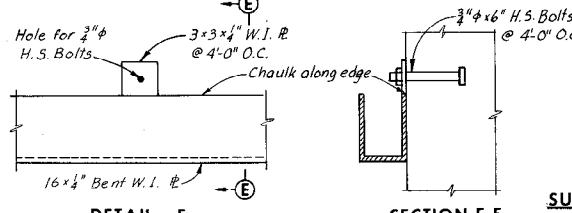


DETAIL F
Scale: 1 1/2" = 1'-0"

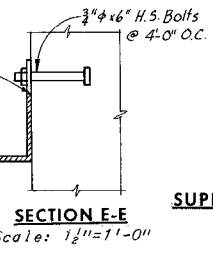


SECTION E-E
Scale: 1 1/2" = 1'-0"

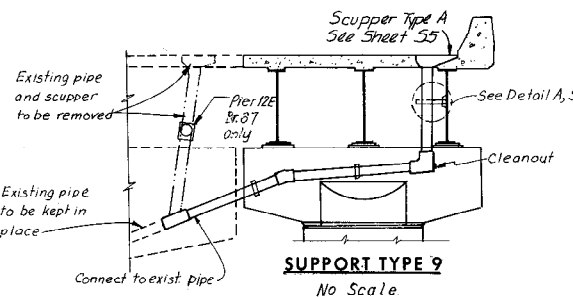

SUPPORT TYPE 9
No Scale

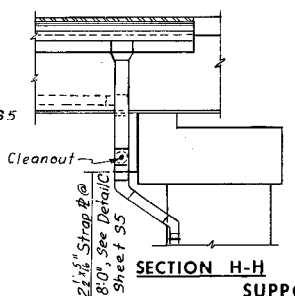

SECTION H-H
SUPPORT TYPE 11
No Scale

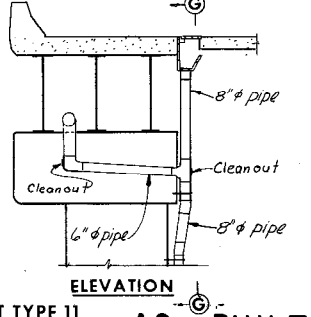

ELEVATION

SUPPORT TYPE 10
Scale: 1/4" = 1'-0"

RICHMOND METROPOLITAN AUTHORITY
RICHMOND EXPRESSWAY SYSTEM
DOWNTOWN EXPRESSWAY

STANDARD DRAINAGE DETAILS

HOWARD, NEEDLES, TAMMEN & BERGENDOFF
consulting engineers
NEW YORK ALEXANDRIA KANSAS CITY



SCALE: As Noted
CONTRACT NO. 10
SHEET NO. 56 OF 77

| BY | DATE | REVISION | BY | DATE |
|-----------|----------------|------------|-----|------|
| MADE | SCC 129.69 | Z As Built | TEM | 6-77 |
| CHECKED | G.S.H. 2/13-69 | | | |
| IN CHARGE | | | | |

AS-BUILT

Contract C-10
Bridge Fire Protection Dry Standpipe System
Record Set Plans

| RICHMOND EXPRESSWAY SYSTEM | | | |
|----------------------------|---------------------|-----------|--------------|
| SECTION | PROJECT | SHEET NO. | TOTAL SHEETS |
| 10 | DOWNTOWN EXPRESSWAY | 265A | |

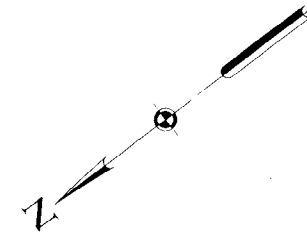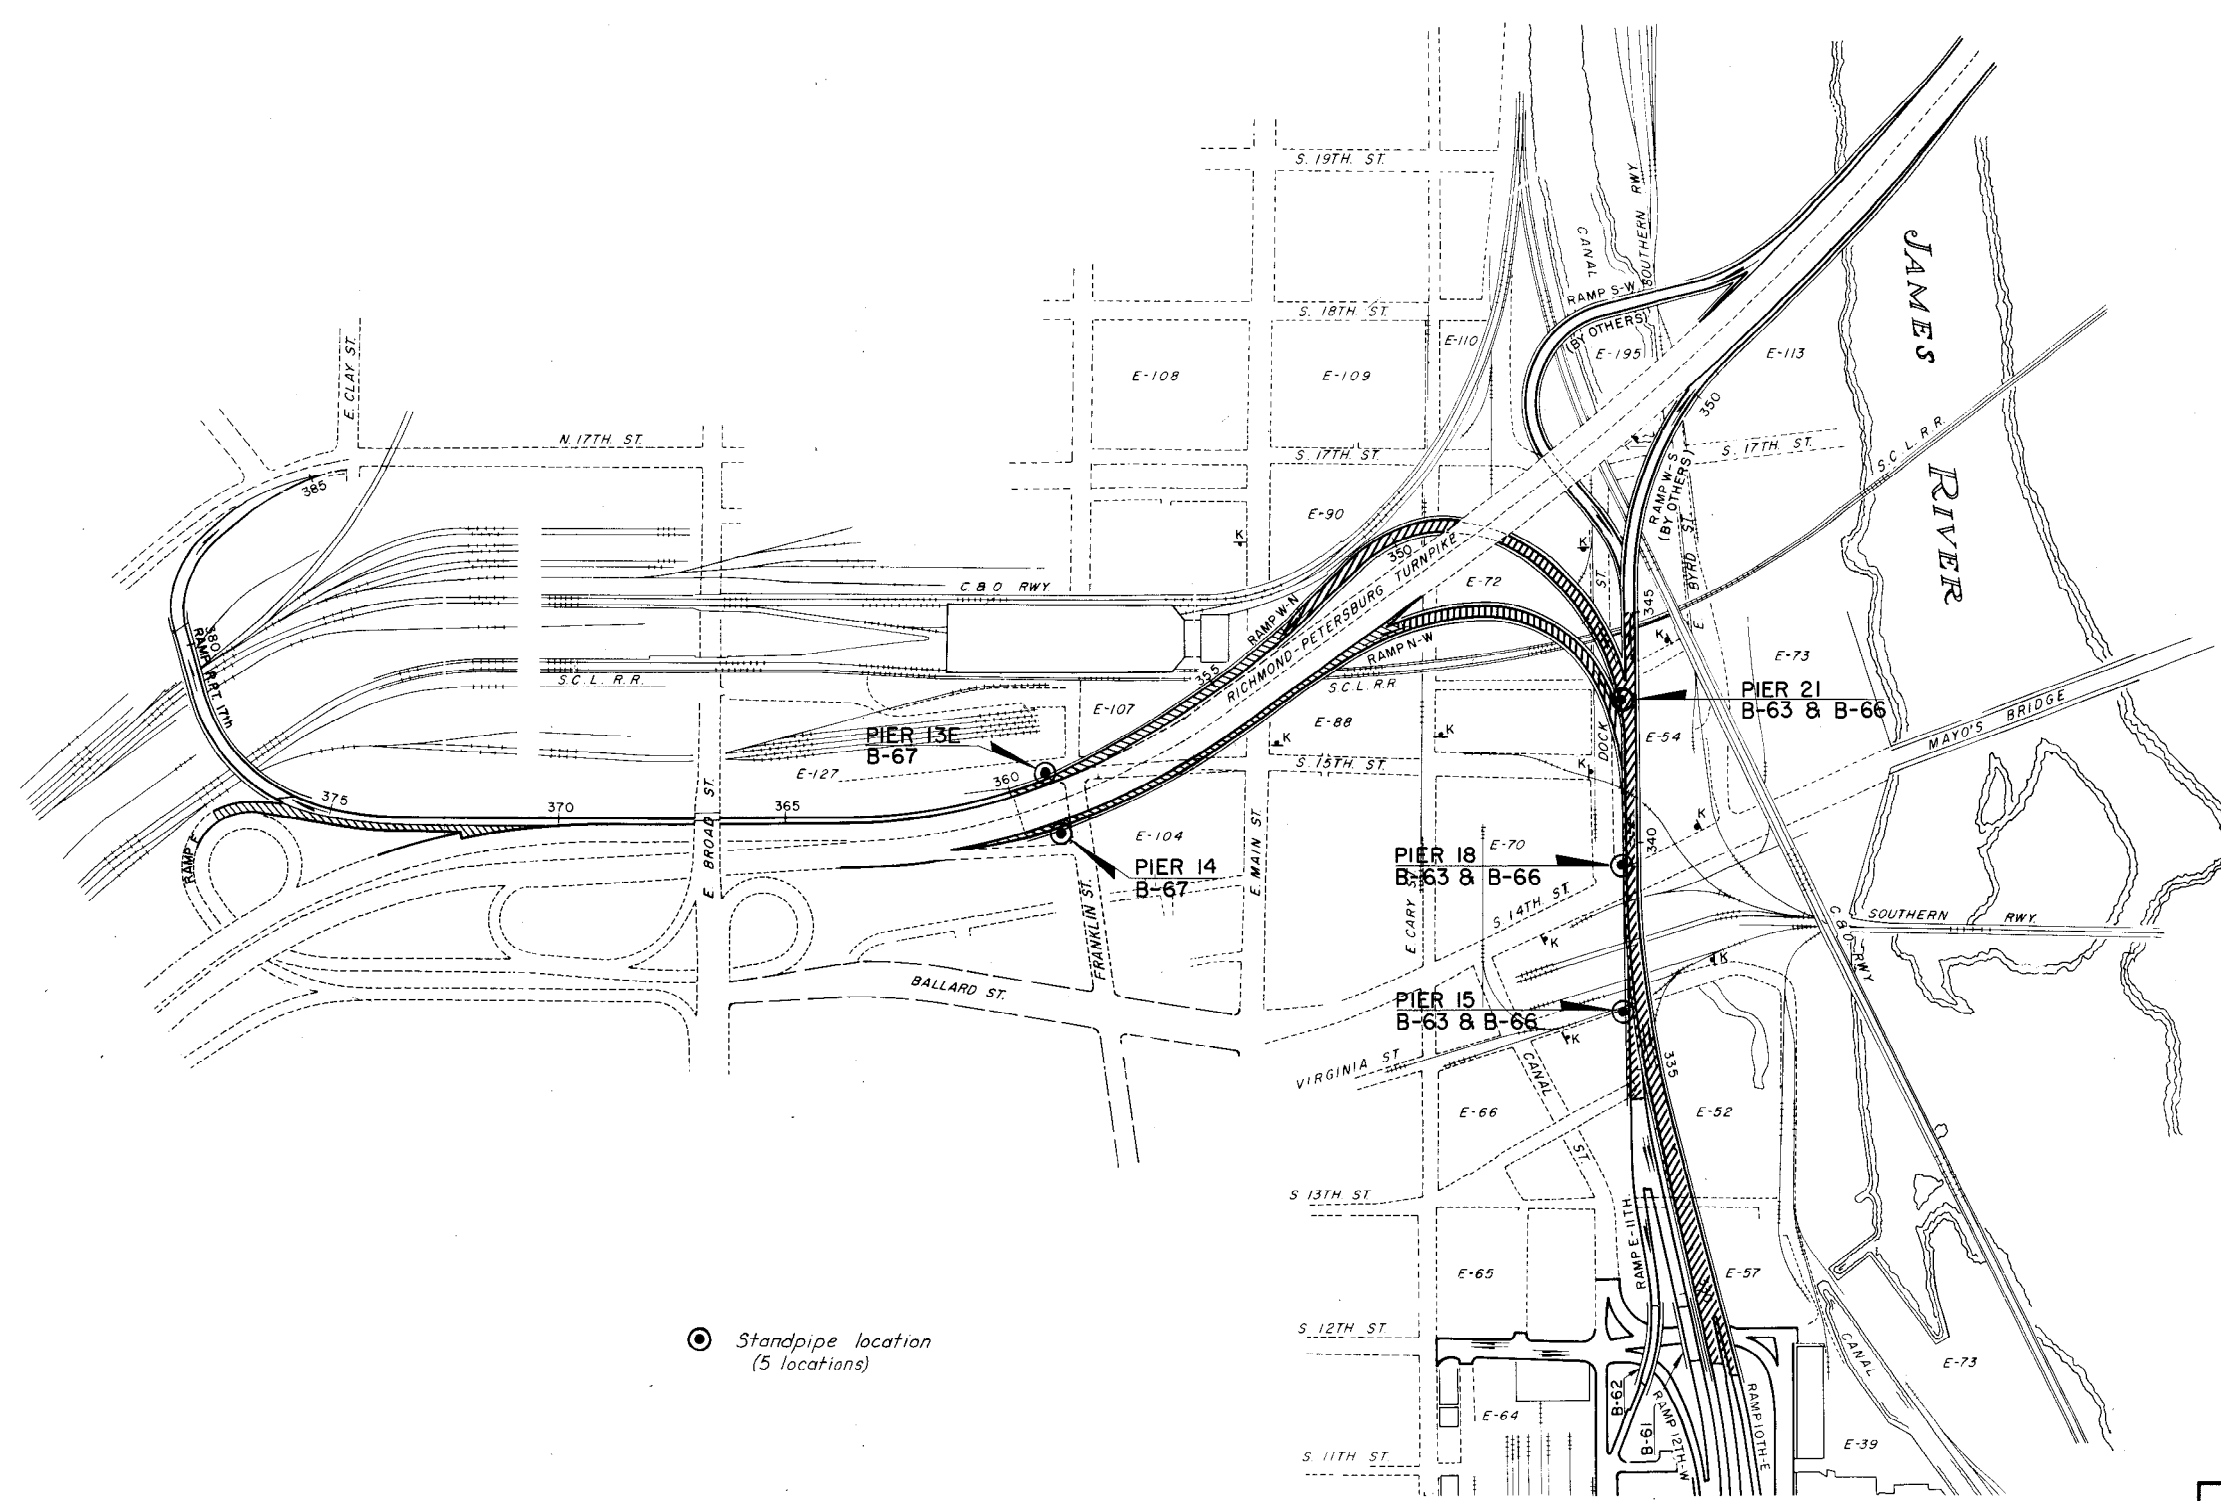

⊙ Standpipe location
(5 locations)

| BY | DATE | | | | |
|-----------|--------|-------|----------|----|------|
| MADE | T.E.M. | 11-75 | | | |
| CHECKED | C.C.J. | 11-75 | | | |
| IN CHARGE | J.P.C. | | | | |
| | | NO. | REVISION | BY | DATE |

RICHMOND METROPOLITAN AUTHORITY
RICHMOND EXPRESSWAY SYSTEM
DOWNTOWN EXPRESSWAY

**BRIDGE FIRE PROTECTION
DRY STANDPIPE SYSTEM**

HOWARD, NEEDLES, TAMMEN & BERGENDOFF
consulting engineers
NEW YORK ALEXANDRIA KANSAS CITY

SCALE: 1"=200'
CONTRACT NO: C-10
SHEET NO. 1 of 5

| RICHMOND EXPRESSWAY SYSTEM | | | |
|----------------------------|---------|-----------|--------------|
| SECTION | PROJECT | SHEET NO. | TOTAL SHEETS |
| | | 265 B | |

GENERAL NOTES FOR DRY STANDPIPE SYSTEM:

- The Standpipe System shall be fabricated from 4 1/2" O.D. Black Steel Pipe and shall conform to ASTM Specification A53-73, Schedule 80, Grade A. All welded joints shall be full penetration butt welds and shall comply with 1973 AWS Specifications.
- All 60° bends shall be cut from 90° bends. All bends shall conform to the specifications for Black Steel Pipe. All bends shall be long radius or full flow type bends.
 - Couplings shall conform to Victaulic Standard Coupling Style 77 with Grade H gasket for steel pipe, or approved equal.
 - Pipe hangers shall be fabricated from Mild Carbon Steel ASTM Specification A36. Bolts shall conform to ASTM Specification A325. Pipe hangers shall be welded per plan details and in accordance with the 1973 AWS Specifications.
- The Standpipe System shall be painted in accordance with the Contract Supplemental Specifications Section 414 Painting of Metal in Structure.

Section 414.02 shall be modified to read;

3rd Coat - The exterior coat shall be DuPont Dulux Metal Protective Patina Green, No. 1025-341, or approved equal. Except as follows, The first 8 feet of pipe at the ground level end shall be painted a reflective Silver-White Alert Series 14-40 as manufactured by Cataphote Division, Ferro Corp., or approved equal.

- As each Dry Standpipe System is completed for operation it shall be tested as a wet system at a minimum of 300 psi static pressure for a period of not less than 30 min. If failure occurs the necessary repairs will be made and the testing procedure shall be repeated until the system as a unit is proven sound to the satisfaction of the engineer. After testing and approval by the engineer each system shall be drained, valves closed, caps and plugs replaced and hand tightened. The sill cock located under the siamese fixture shall be left in an open position and keys turned over to the Chief, Bureau of Fire, City of Richmond.




- Fire Department Connection Fixtures.
 - Each Standpipe System shall have one 4"x2 1/2"x2 1/2" Double Clapper Siamese Connection, at the ground level end, Powhatan Model No. 21-132 "Y" Type cast brass, or approved equal. Branding shall be marked "Standpipe".
 - Each Double Clapper Siamese fixture shall come equipped with a 3/4" sill cock to be located on the underneath side of the fixture, Powhatan Model No. 23-221 cast brass, or approved equal.
 - As noted on the plans, each Standpipe System shall have one or more Roof Manifolds noted as either "Y" Type, two way, 4"x2 1/2"x2 1/2" Powhatan Model No. 20-363 cast brass or approved equal or "90°" Type, two way, 4"x2 1/2"x2 1/2" Powhatan Model No. 20-365 cast brass, or approved equal.
 - Each fixture supplied shall be furnished complete with the necessary caps, plugs and attachment chains.
 - All Fire Department Connections shall be threaded with the City of Richmond Fire Department standard thread.
 - Roof Manifolds shall be supplied with Underwriters Approved Valves Powhatan Model No. 18-157 cast brass, or approved equal.
 - All fire department fixtures and their accessories shall be rated for a minimum working pressure of 300 psi.

| PIER NO. | 4 1/2" O. D. STEEL PIPE | 45° OR 60° ELBOWS | 90° ELBOWS | TEE CONNECTIONS | PIPE HANGERS | COUPLINGS | "Y" TYPE ROOF MANIFOLD | "90°" TYPE ROOF MANIFOLD | DOUBLE CLAPPER SIAMESE | BID QUANTITY |
|--------------|-------------------------|-------------------|------------|-----------------|--------------|-----------|------------------------|--------------------------|------------------------|--------------|
| | L.F. | NO. | NO. | NO. | NO. | NO. | NO. | NO. | NO. | LUMP SUM |
| 15 | 84 | | 3 | 1 | 14 | 2 | 1 | 1 | 1 | |
| 18 | 72 | 2 - 45° | 1 | 1 | 12 | 2 | 1 | 1 | 1 | |
| 21 | 120 | 2 - 45° | 3 | 1 | 20 | 2 | 1 | 1 | 1 | |
| 13E | 36 | 2 - 60° | 1 | | 7 | 2 | 1 | | 1 | |
| 14 | 25 | 2 - 45° | 1 | | 6 | 2 | 1 | | 1 | |
| TOTAL | 337 | 8 | 9 | 3 | 59 | 10 | 5 | 3 | 5 | 1 |

| | | | | | |
|-----------|--------|-------|-----|----------|---------|
| DESIGNED | | | | | |
| DRAWN | T.E.M. | 11-75 | | | |
| CHECKED | C.C.J. | 11-75 | | | |
| IN CHARGE | J.P.F. | | NO. | REVISION | BY DATE |


| | | |
|---|-------------|--------------|
| RICHMOND METROPOLITAN AUTHORITY RICHMOND EXPRESSWAY SYSTEM DOWNTOWN EXPRESSWAY | | |
| BRIDGE FIRE PROTECTION DRY STANDPIPE SYSTEM | | |
| SCALE <i>None</i> | CONTRACT 10 | SHEET 2 OF 5 |
| HOWARD, NEEDLES, TAMMEN & BERGENDOFF CONSULTING ENGINEERS Alexandria, Virginia | | HNTB |

| RICHMOND EXPRESSWAY SYSTEM | | | |
|----------------------------|---------|-----------|--------------|
| SECTION | PROJECT | SHEET NO. | TOTAL SHEETS |
| | | 265 C | |

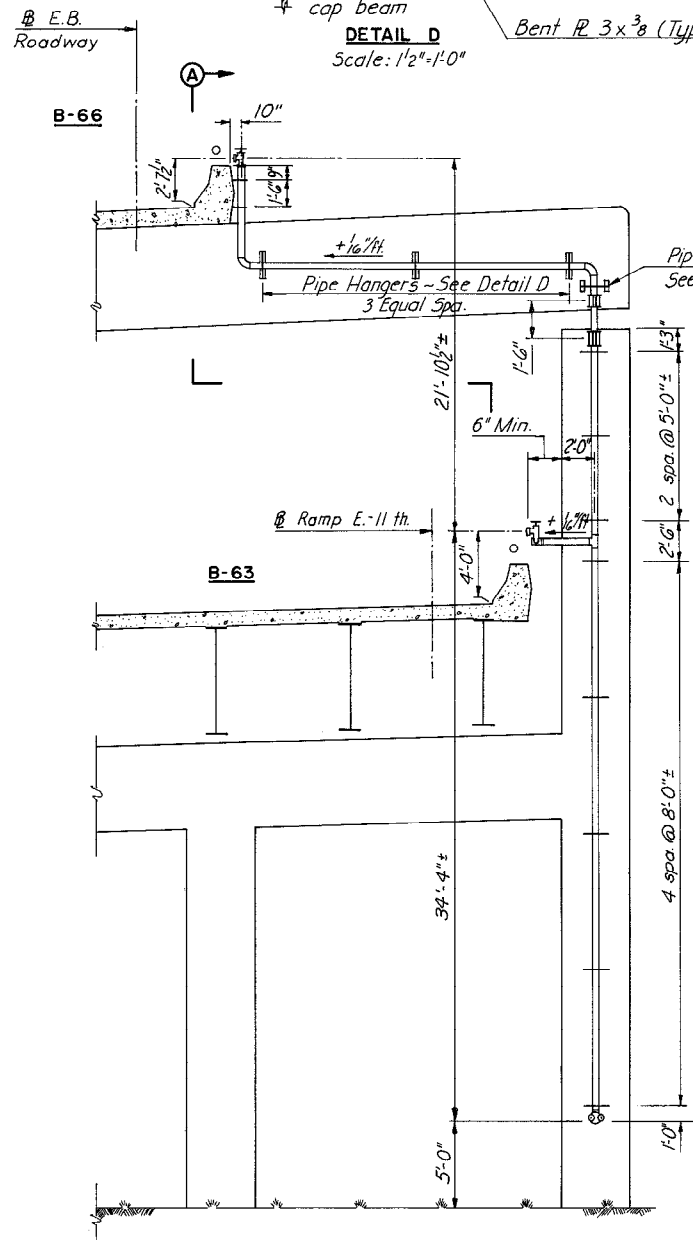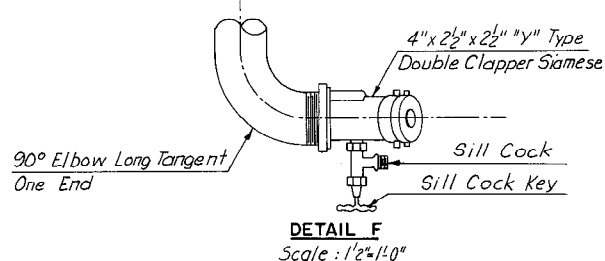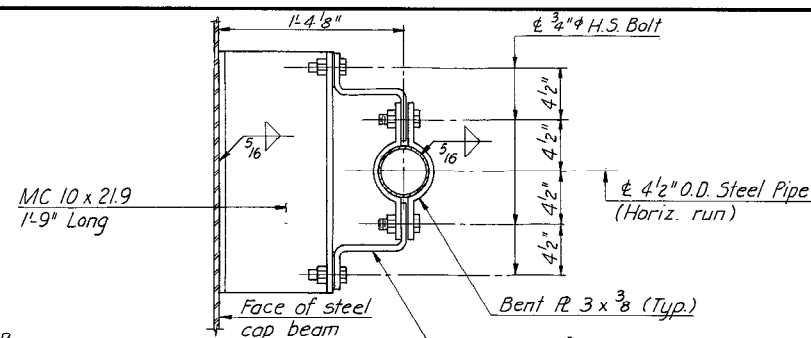


ELEVATION PIER 15
(LOOKING BACK STATION)
Scale: 3/16" = 1'-0"

CROSS-STREETS
VIRGINIA ST. & CANAL ST.

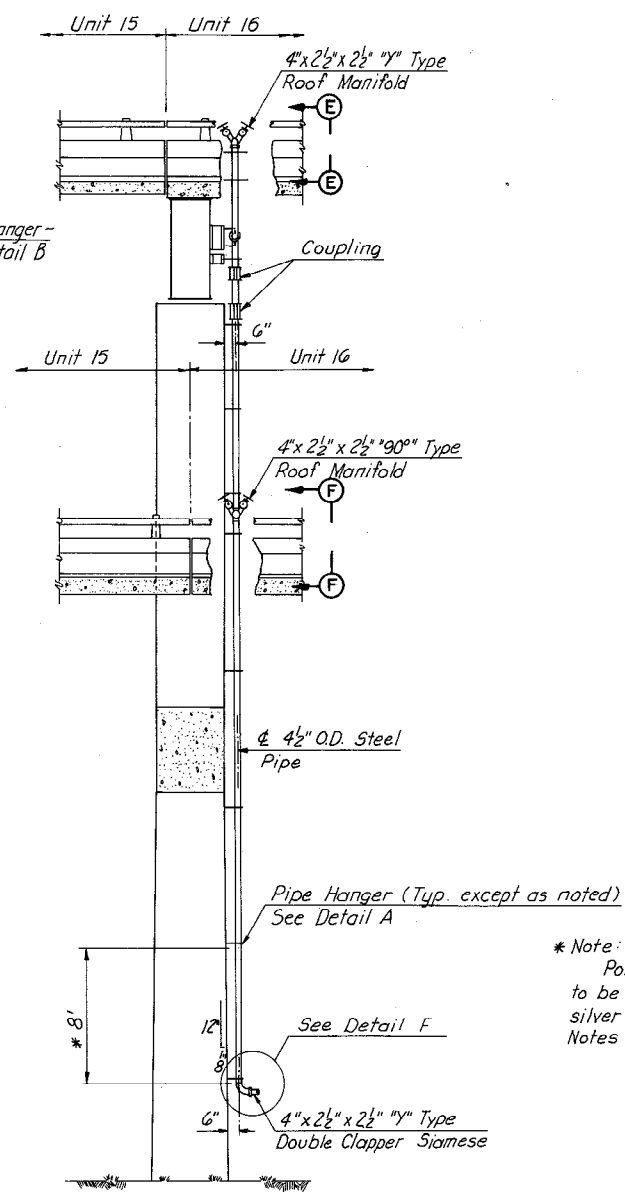

SECTION A-A
Scale: 3/16" = 1'-0"


NOTES:
For General Notes see Sh. 2.
For Details A, B & C, see Sh. 4.

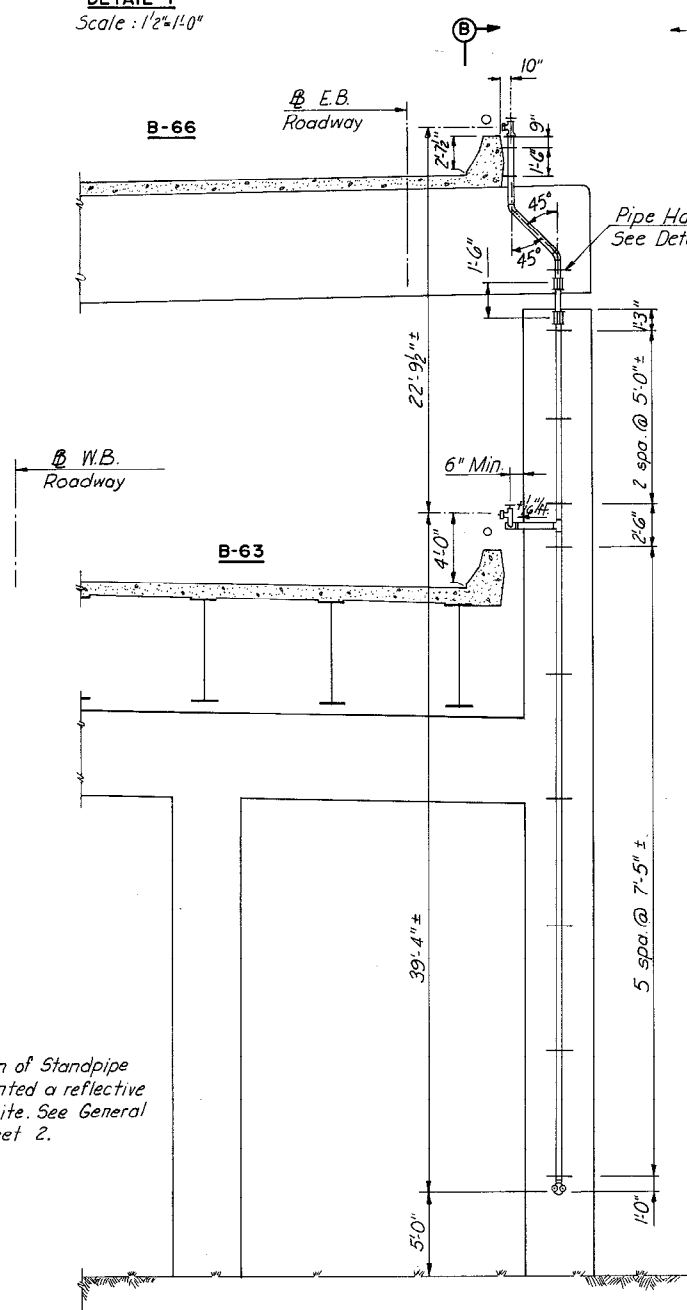

ELEVATION PIER 18
(LOOKING BACK STATION)
Scale: 3/16" = 1'-0"

CROSS-STREETS
14th. & DOCK

NOTE:
For Details and Dimensions
not shown at Pier 18, see Pier 15.

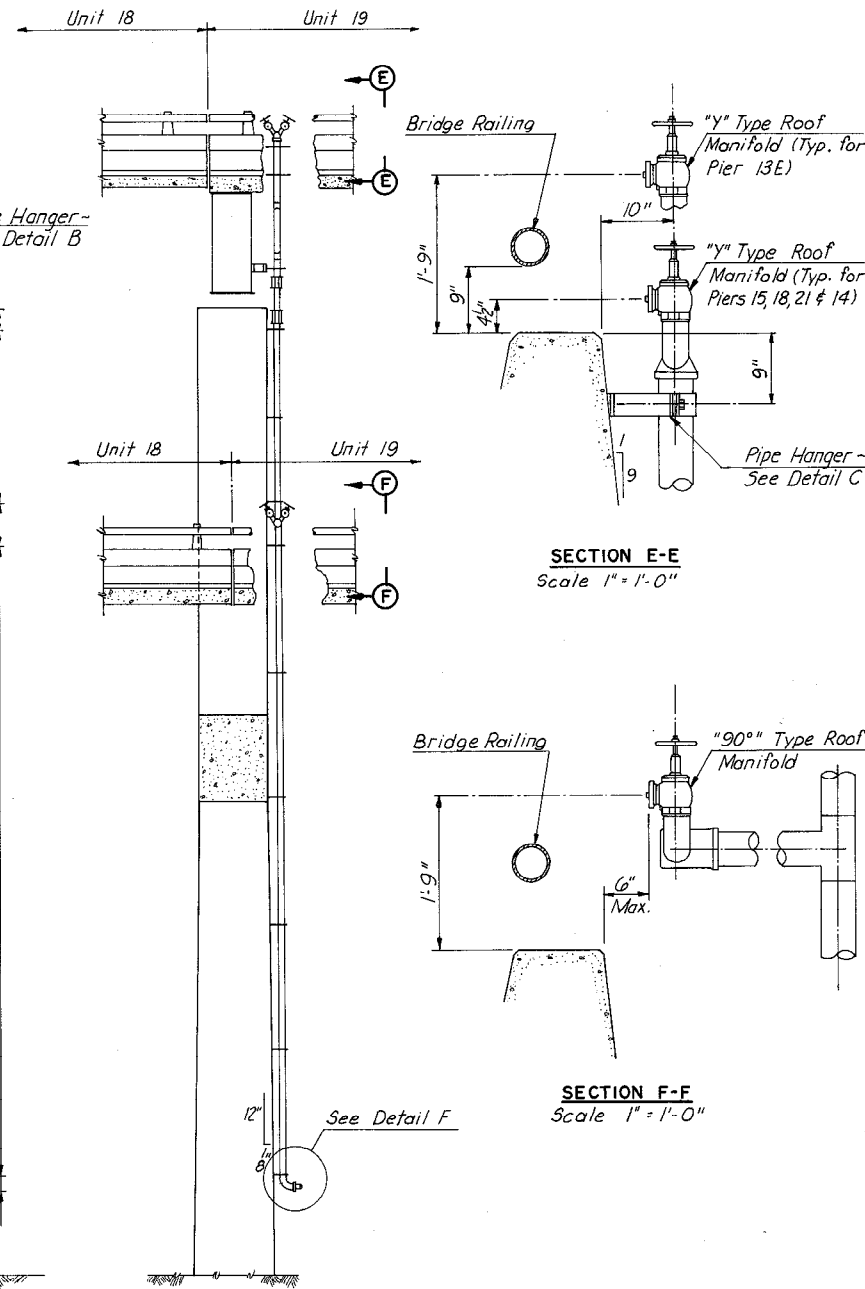

SECTION B-B
Scale: 3/16" = 1'-0"

RICHMOND METROPOLITAN AUTHORITY
RICHMOND EXPRESSWAY SYSTEM
DOWNTOWN EXPRESSWAY

BRIDGE FIRE PROTECTION
DRY STANDPIPE SYSTEM


SCALE *As Shown* CONTRACT 10 SHEET 3 OF 5
DATE

HOWARD, NEEDLES, TAMMEN & BERGENDOFF
CONSULTING ENGINEERS
Alexandria, Virginia

HNTB

| DESIGNED | | | | | |
|-----------|--------|-------|-----|----------|---------|
| DRAWN | T.E.M. | 11-75 | | | |
| CHECKED | CCJ | 11-75 | | | |
| IN CHARGE | J.P.F. | | NO. | REVISION | BY DATE |


| RICHMOND EXPRESSWAY SYSTEM | | | |
|----------------------------|---------|----------|--------------|
| SECTION | PROJECT | SHEET NO | TOTAL SHEETS |
| | | 265 D | |

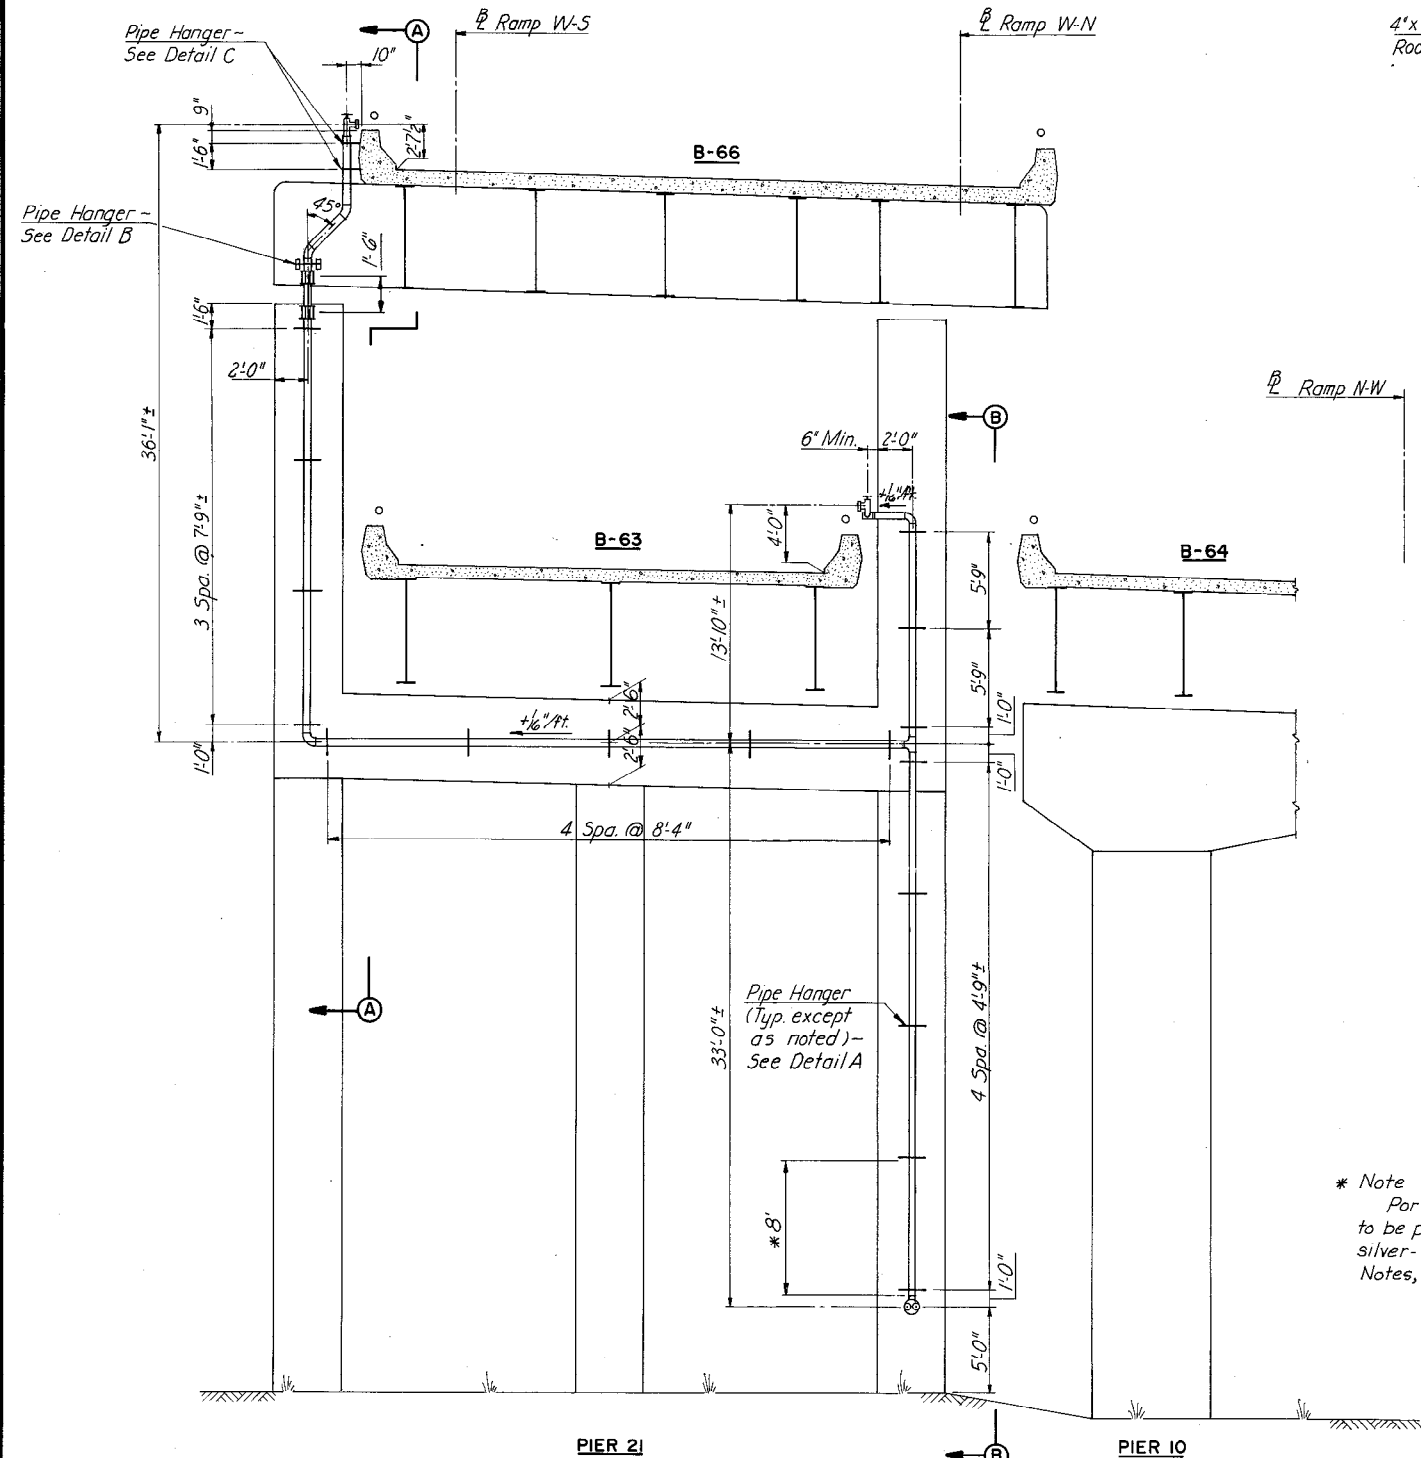

ELEVATION
(LOOKING BACK STATION)
Scale: 3/16"=1'-0"


CROSS-STREETS
S.16 th. ST. & DOCK ST.

* Note
Portion of Standpipe
to be painted a reflective
silver-white. See General
Notes, Sheet 2.

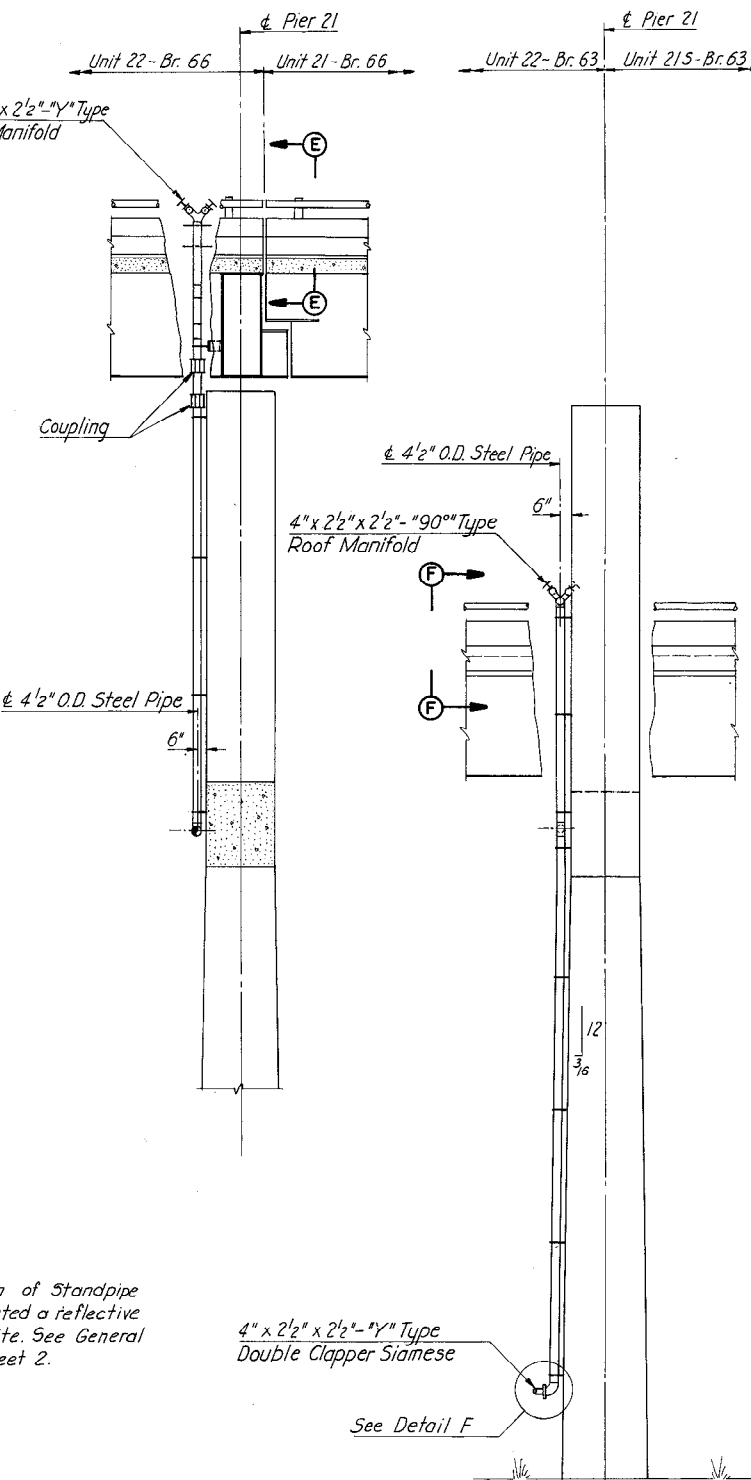


SECTION A-A
Scale: 3/16"=1'-0"


VIEW B-B
Scale: 3/16"=1'-0"

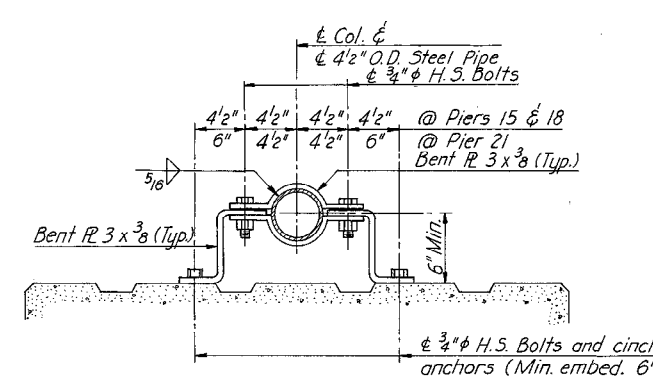

DETAIL A
Scale: 1/2"=1'-0"

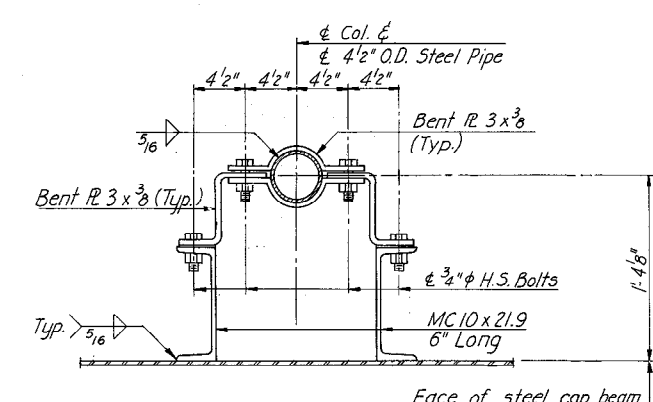

DETAIL B
Scale: 1/2"=1'-0"

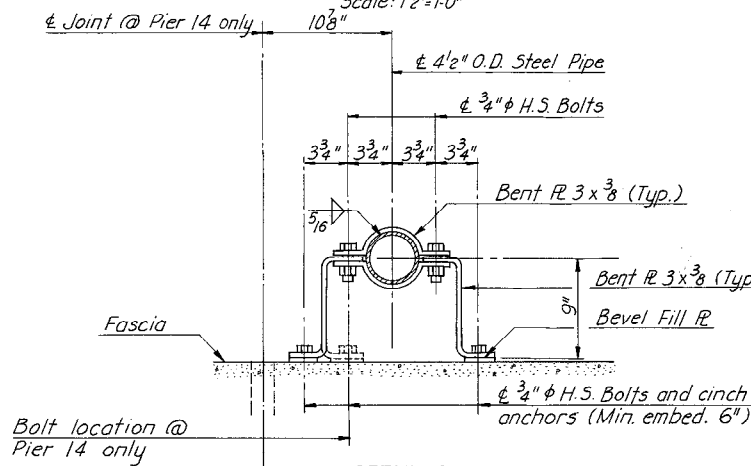

DETAIL C
Scale: 1/2"=1'-0"

NOTES:
For General Notes, see Sh. 2.
For Sections E-E & F-F, see Sh. 3.

| DESIGNED | DRAWN | CHECKED | IN CHARGE | NO. | REVISION | BY | DATE |
|----------|--------------|---------|-----------|-----|----------|----|------|
| | d.B.P. 11-75 | | J.P.F. | | | | |

RICHMOND METROPOLITAN AUTHORITY
RICHMOND EXPRESSWAY SYSTEM
DOWNTOWN EXPRESSWAY


BRIDGE FIRE PROTECTION
DRY STANDPIPE SYSTEM

SCALE: As Shown CONTRACT 10 SHEET 4 OF 5

HOWARD, NEEDLES, TAMMEN & BERGENDOFF
CONSULTING ENGINEERS
Alexandria, Virginia


HNTB

| RICHMOND EXPRESSWAY SYSTEM | | | |
|----------------------------|---------|----------|--------------|
| SECTION | PROJECT | SHEET NO | TOTAL SHEETS |
| | | 265E | |

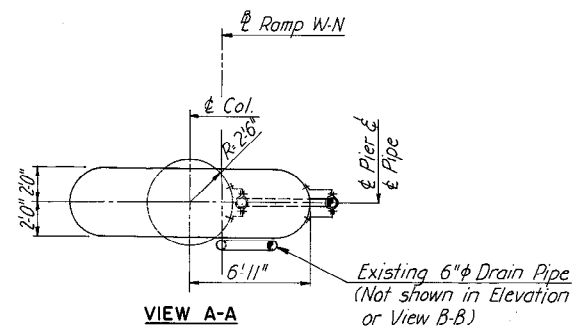


VIEW A-A

Existing 6" ϕ Drain Pipe
(Not shown in Elevation or View B-B)

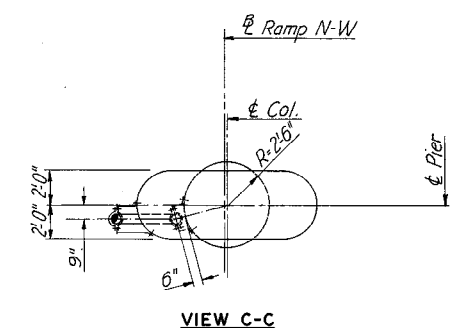


VIEW C-C

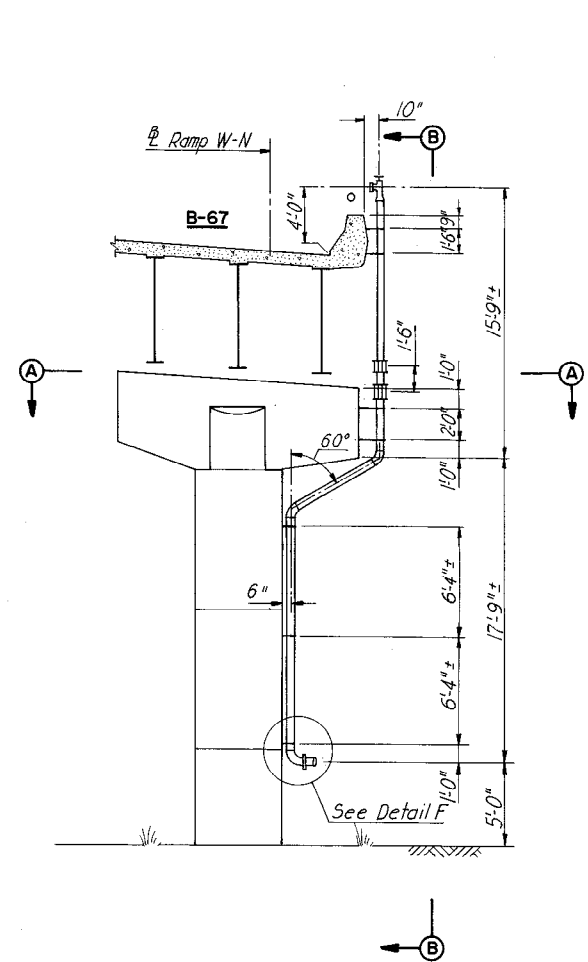

ELEVATION


PIER 13E
Scale: 3/16"=1'-0"

CROSS-STREETS
15th & FRANKLIN ST.

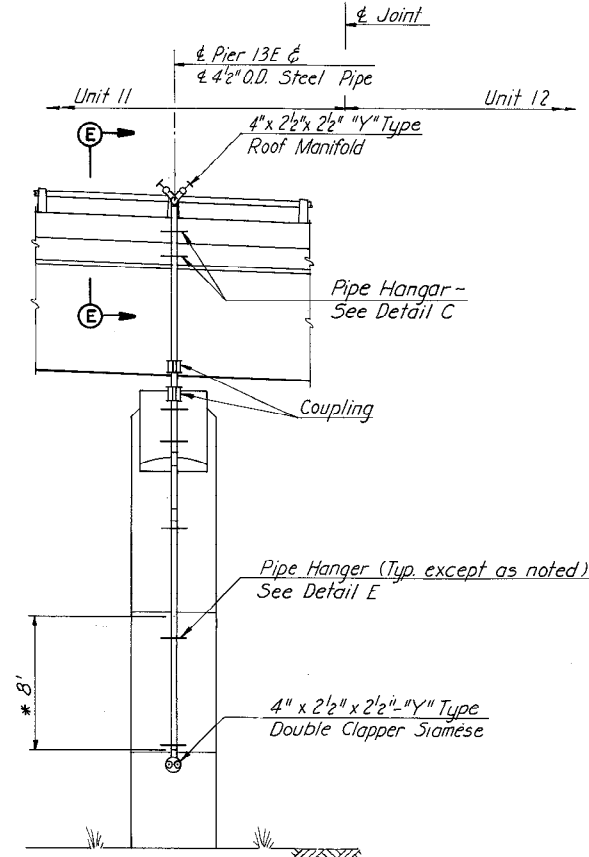

VIEW B-B


* Note
Portion of Standpipe
to be painted a reflective
silver-white. See General
Notes, Sheet 2.

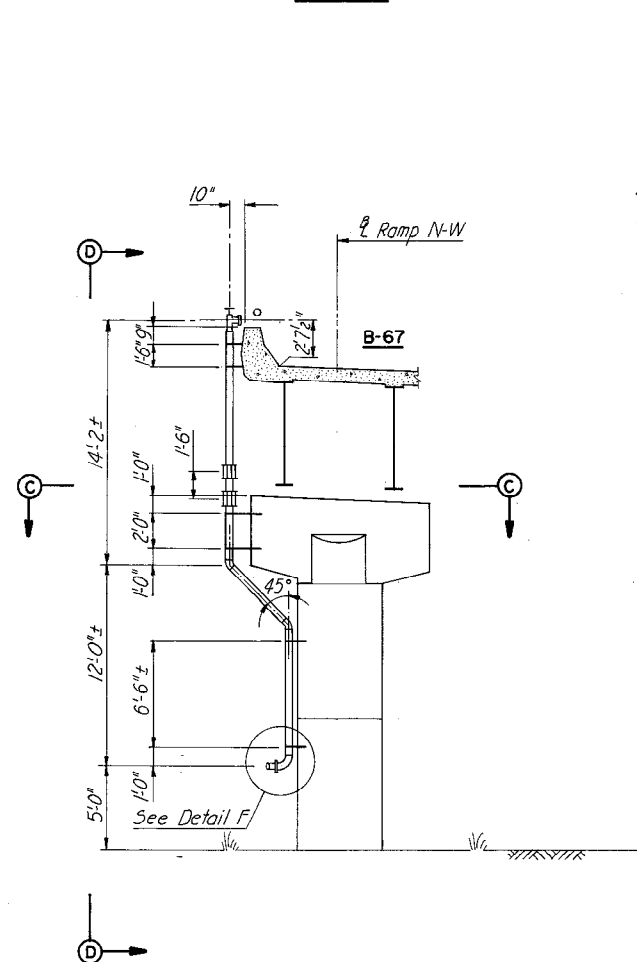

ELEVATION


PIER 14
(LOOKING BACK STATION)
Scale: 3/16"=1'-0"

CROSS-STREETS
15th & FRANKLIN ST.

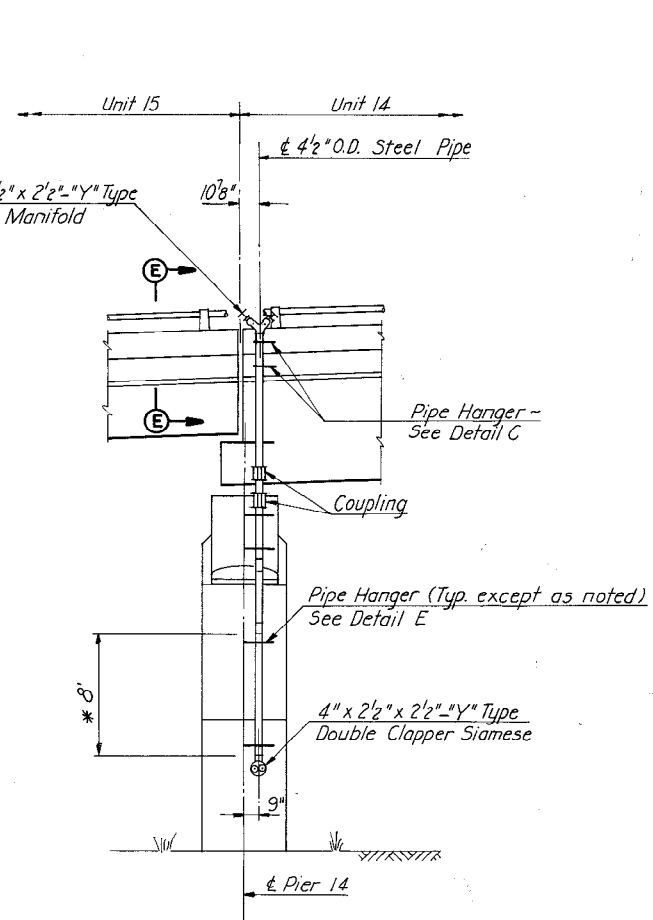

VIEW D-D

NOTES:
For General Notes, see Sh. 2.
For Section E-E & Detail F, see Sh. 3.
For Detail C, see Sh. 4.

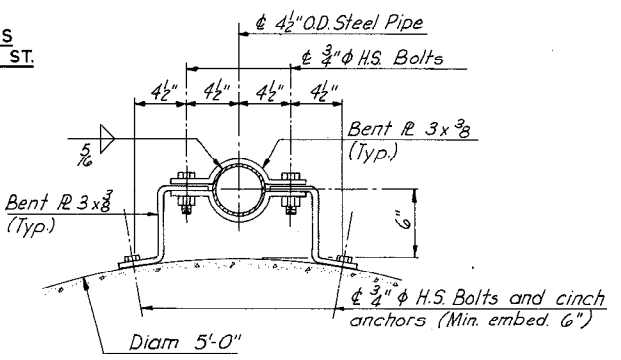

DETAIL E
Scale: 1/2"=1'-0"

| DESIGNED | | | | | |
|-----------|--------|-------|-----|----------|---------|
| DRAWN | d.B.P. | 11-75 | | | |
| CHECKED | G.C.J. | 11-75 | | | |
| IN CHARGE | J.P.F. | | NO. | REVISION | BY DATE |

RICHMOND METROPOLITAN AUTHORITY
RICHMOND EXPRESSWAY SYSTEM
DOWNTOWN EXPRESSWAY

BRIDGE FIRE PROTECTION
DRY STANDPIPE SYSTEM

SCALE *As Shown* CONTRACT 10 SHEET 5 OF 5

HOWARD, NEEDLES, TAMMEN & BERGENOFF
CONSULTING ENGINEERS
Alexandria, Virginia







HNTB

Bridge 8

**(Powhite Parkway - VA State Rte. 76
over James River, Kanawha Canal
and CSX Railroad)**


Record Set Plans

INDEX OF SHEETS

| SHEET NO. | TITLE |
|-----------|--|
| 1 | COVER SHEET |
| 2-3 | GENERAL PLAN AND ELEVATION |
| 4 | BRIDGE LAYOUT, GENERAL NOTES AND ESTIMATE OF QUANTITIES |
| 5 | PROFILES AND PAVEMENT ELEVATIONS |
| 6 | SOUTH ABUTMENT |
| 7 | NORTH ABUTMENT |
| 8 | ABUTMENT DETAILS |
| 9 | PIER 1 |
| 10 | PIER 2 |
| 11 | PIER 3 |
| 12 | (DELETED)  |
| 13 | PIER 4  |
| 14 | (DELETED)  |
| 15 | PIER 5 |
| 16 | PIER 6 |
| 17 | PIER 7 |
| 18 | PIER 8 |
| 19 | PIER 9 |
| 20 | PIER 10 |
| 21 | PIER 11 |
| 22 | PIER 12 |
| 23 | PIER 13 |
| 24 | PIER 14 |
| 25 | PIER 15 |
| 26 | PIER 16 |
| 27 | PIER 17 |
| 28 | FRAMING PLAN - UNITS 1, 2, 3 AND 4 |
| 29 | FRAMING PLAN - UNITS 5 THRU 12  |
| 30 | FRAMING PLAN - UNITS 13, 14 AND 15 |
| 31 | FRAMING PLAN - UNITS 16, 17 AND 18 |
| 32-33 | STRUCTURAL STEEL DETAILS |
| 34 | SHOES |
| 35 | JOINT DETAILS |
| 36 | DRAINAGE SCUPPERS |
| 37 | DECK PLAN - UNITS 1, 2, 3 AND 4 |
| 38 | DECK PLAN - UNITS 5 THRU 12  |
| 39 | DECK PLAN - UNITS 13, 14 AND 15 |
| 40 | DECK PLAN - UNITS 16, 17 AND 18 |
| 41 | DECK DETAILS |
| 42 | ALUMINUM RAILING DETAILS |
| 43 | (DELETED)  |
| 44 | ELECTRICAL DETAILS |
| 45 | APPROACH SLABS |
| 46 | SLOPE PROTECTION |
| 47-53 | BORING LOGS |

RICHMOND METROPOLITAN AUTHORITY
PLAN AND PROFILE OF PROPOSED
RICHMOND EXPRESSWAY SYSTEM
CHESTERFIELD COUNTY
CITY OF RICHMOND
JAMES RIVER BRIDGE

| LIMITED ACCESS HIGHWAY | | | |
|----------------------------|--------------------|-----------|--------------|
| RICHMOND EXPRESSWAY SYSTEM | | | |
| SECTION | PROJECT | SHEET NO. | TOTAL SHEETS |
| 3 | JAMES RIVER BRIDGE | 1 | 53 |

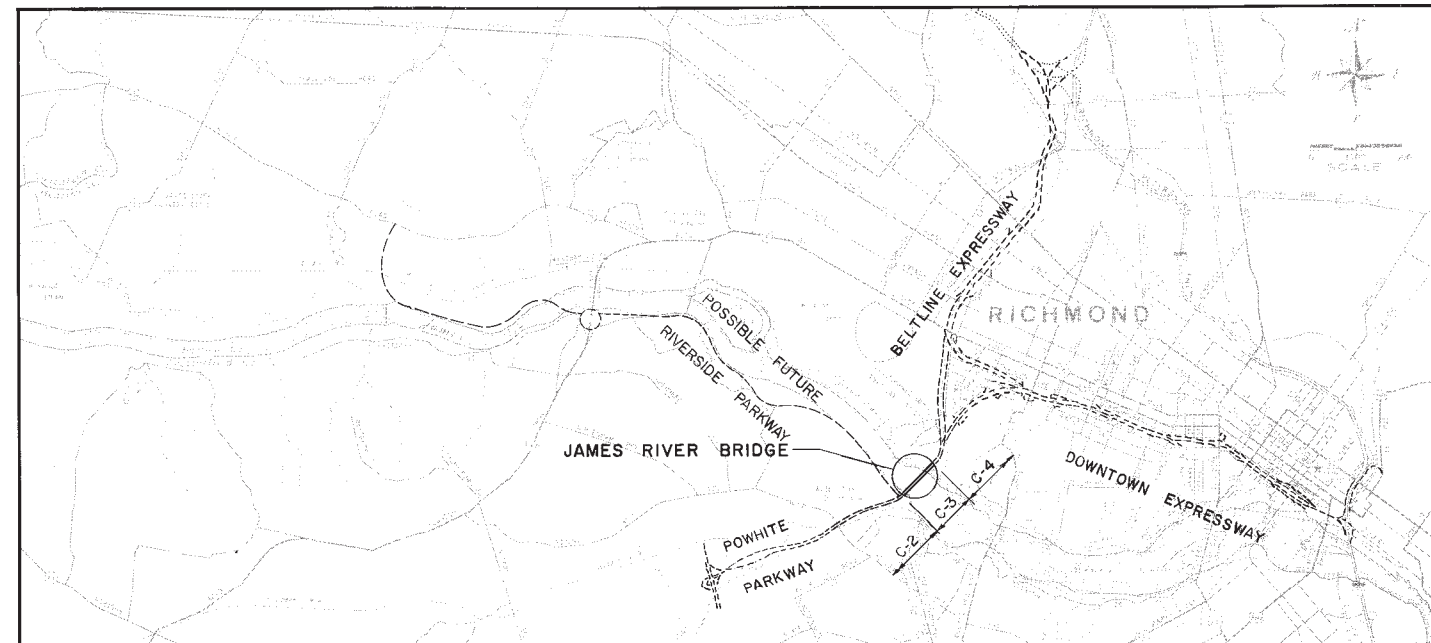

CONTRACT C-3

BRIDGE B-8

| SUBMITTED BY | |
|--------------|---|
| Date | |
| 1-22-71 | <i>John P. Fowler</i> |
| Date | HOWARD, NEEDLES TAMMEN & BERGENDOFF general consultant |


| RECOMMENDED BY | |
|----------------|---|
| Date | |
| 1-23-71 | <i>Chas. A. Jones</i> |
| Date | GENERAL MANAGER, RICHMOND METROPOLITAN AUTHORITY |

| APPROVED BY | |
|-------------|--|
| Date | |
| 1-23-71 | <i>Chas. A. Jones</i> |
| Date | CHAIRMAN, RICHMOND METROPOLITAN AUTHORITY |


| Plans Revised | | | |
|----------------|---------|-----------|------|
| Sheet No. | Date | Sheet No. | Date |
| 1-6,9-16,28,29 | 2-20-71 | | |
| 32-38,41,43,46 | 2-20-71 | | |
| 1,2,3,17,37 | 3-9-71 | | |
| 38,39,40 | 3-9-71 | | |
| 1,4,35,36,44 | 4-5-71 | | |
| 21 | 9-3-71 | | |
| 23 | 4-12-72 | | |
| 45 | 9-12-72 | | |

| CONVENTIONAL SIGNS | |
|------------------------|----------------------------------|
| STATE LINE | LEVEE OR EMBANKMENT |
| COUNTY LINE | BRIDGES |
| CITY, TOWN OR VILLAGE | CULVERTS |
| RIGHT OF WAY LINE | DROP INLET |
| FENCE LINE | TROLLEY POLES |
| UNFENCED PROPERTY LINE | POWER POLES |
| FENCED PROPERTY LINE | TELEPHONE OR TELEGRAPH POLES |
| TRAVELED WAY | MARSH |
| GUARD RAIL | HEDGE |
| RETAINING WALL | WOODS |
| RAILROADS | GROUND ELEVATION |
| BASE OR SURVEY LINE | GRADE ELEVATION |
| | POLES WITHIN CONSTRUCTION LIMITS |

| RICHMOND EXPRESSWAY SYSTEM | | | |
|----------------------------|--------------------|-----------|--------------|
| SECTION | PROJECT | SHEET NO. | TOTAL SHEETS |
| 3 | JAMES RIVER BRIDGE | 2 | 53 |

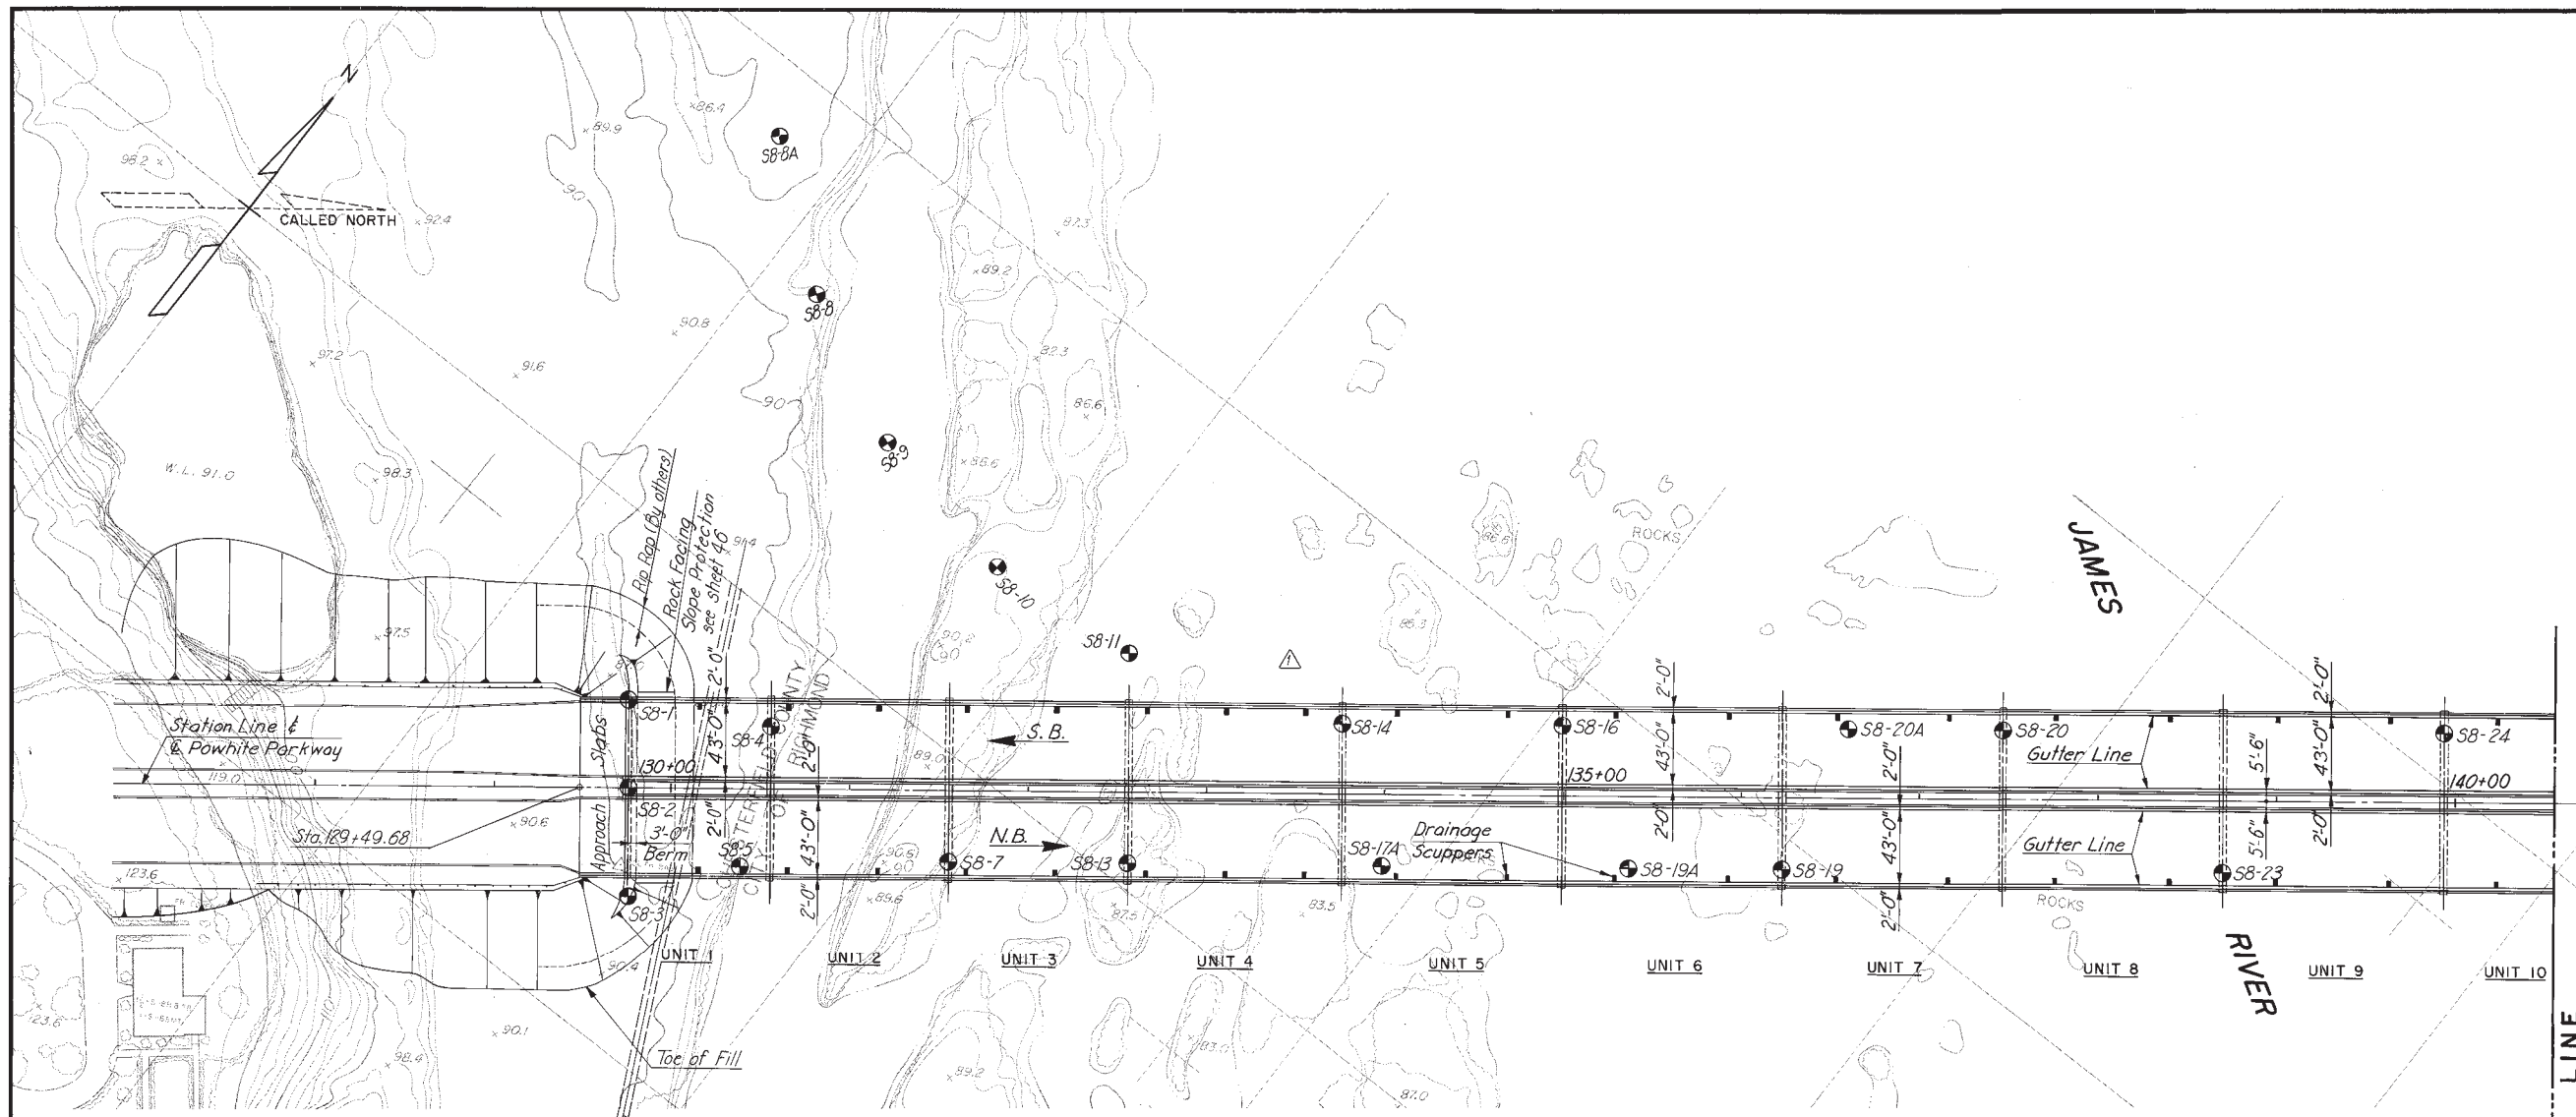

PLAN

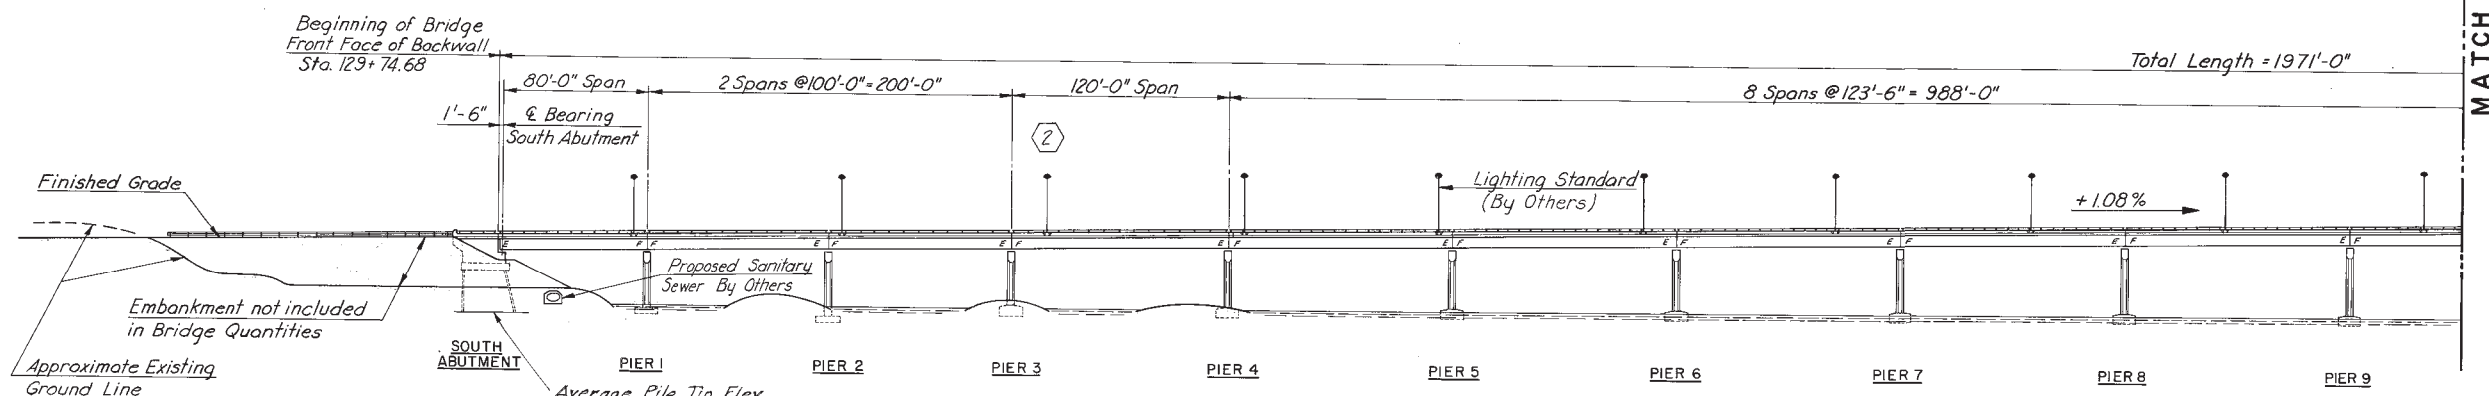

ELEVATION

NOTES:
 For Bridge Layout and General Notes see sheet no. 4.
 For Profiles see sheet no. 5.
 ⊕ Indicates 2^{1/2}" & Cased Hole Boring.

AS BUILT

RICHMOND METROPOLITAN AUTHORITY
 RICHMOND EXPRESSWAY SYSTEM

JAMES RIVER BRIDGE
 GENERAL PLAN AND ELEVATION



HOWARD, NEEDLES, TAMMEN & BERGENDOFF
 consulting engineers
 NEW YORK ALEXANDRIA KANSAS CITY

SCALE: 1" = 50'
 CONTRACT NO.: C-3
 SHEET NO. 2 OF 53

| CURVE NO. | CURVE DATA | | | | SUMMARY | | | | |
|-----------|-------------|-------------|---------|---------|---------|----------------------|-------------------------|-----------------|-----------------|
| | Δ | D | R | T | L | BACK TANGENT BEARING | FORWARD TANGENT BEARING | BEGIN CURVE | END CURVE |
| 1 | 8°00'00" | 10°00'00.0" | 572.96' | 40.06' | 80.00' | S52°46'10.5"W | S60°46'10.5"W | P.C. 10+00.00 | P.C.C. 10+80.00 |
| 2 | 61°13'55.5" | 33°22'40.4" | 310.00' | 183.45' | 231.30' | S60°46'10.5"W | N57°59'54.0"W | P.C. 10+80.00 | P.C.C. 14+11.30 |
| 3 | 30°20'00" | 10°00'00.0" | 572.96' | 153.52' | 300.00' | N57°59'54.0"W | N27°59'54.0"W | P.C.C. 14+11.30 | P.T. 17+11.30 |

| BY | DATE | 3 | AS BUILT | JRC | 12-72 |
|-----------|------|------|----------------------|--------|---------|
| MADE | HBW | 8-67 | Ⓣ Light Std Location | J.G.V. | 3/9/71 |
| CHECKED | FXH | 2-68 | ⚠ Remove Ramp Taper | H.B.W. | 2/20/71 |
| IN CHARGE | FXH | | NO. REVISION | BY | DATE |

| RICHMOND EXPRESSWAY SYSTEM | | | |
|----------------------------|--------------------|-----------|--------------|
| SECTION | PROJECT | SHEET NO. | TOTAL SHEETS |
| 3 | JAMES RIVER BRIDGE | 3 | 53 |

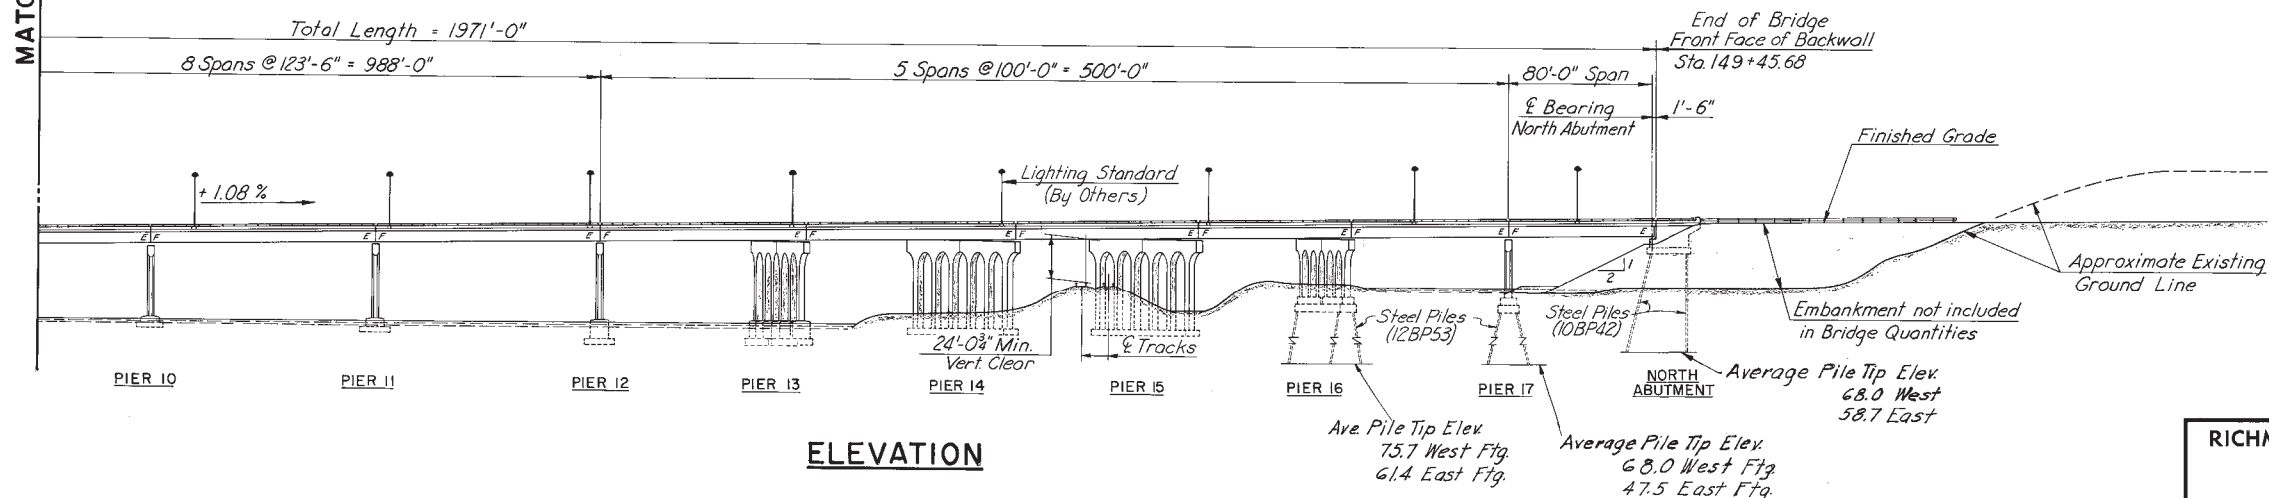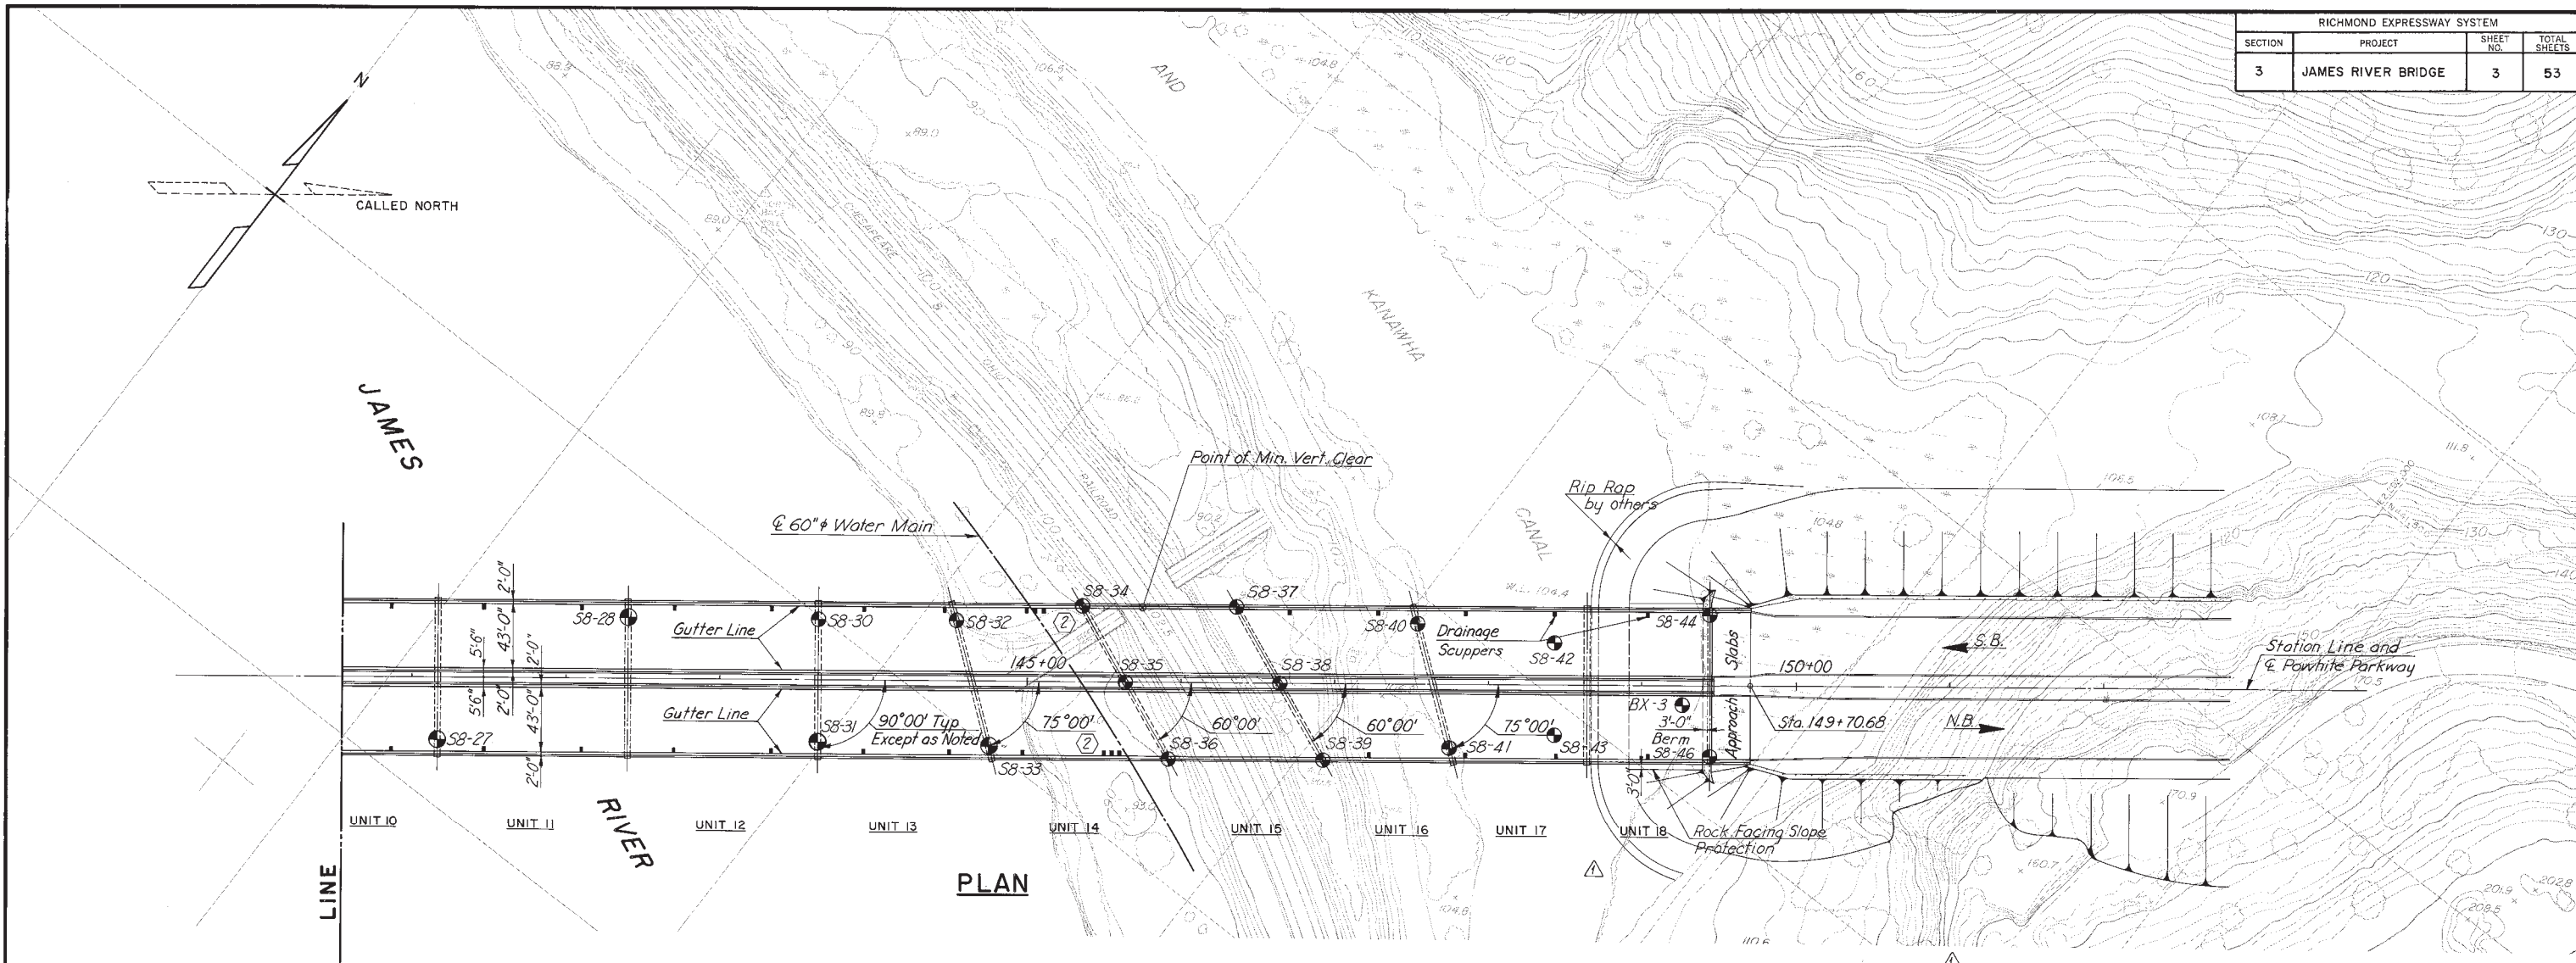

| BY | DATE | NO. | AS BUILT | JRC | DATE |
|-----------|------|------|-------------------------------------|--------|---------|
| BY | DATE | 3 | AS BUILT | JRC | 12-72 |
| MADE | HBW | 8-67 | Ⓞ Scupper Location | J.G.V. | 3/9/71 |
| CHECKED | FXH | 2-68 | ⚠ Elim. Disposal Area Add Foot Path | E.V.R. | 2/20/71 |
| IN CHARGE | FXH | | NO. REVISION | BY | DATE |









AS BUILT

RICHMOND METROPOLITAN AUTHORITY
RICHMOND EXPRESSWAY SYSTEM

JAMES RIVER BRIDGE
GENERAL PLAN AND ELEVATION

HOWARD, NEEDLES, TAMMEN & BERGENDOFF
 consulting engineers
 NEW YORK ALEXANDRIA KANSAS CITY

SCALE: 1" = 50'
 CONTRACT NO.: C-3
 SHEET NO. 3 OF 53

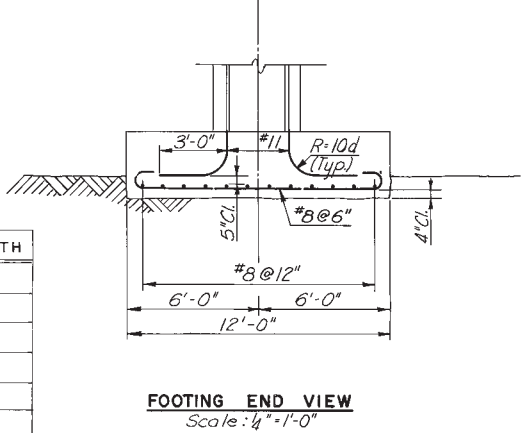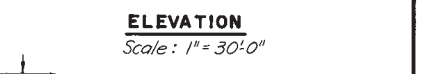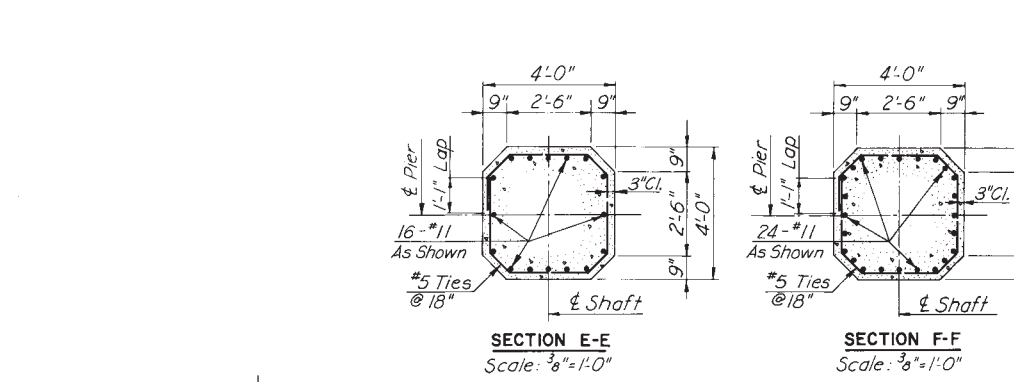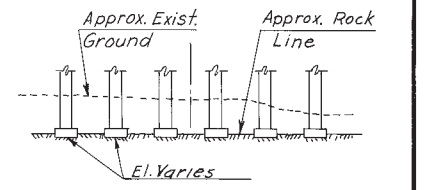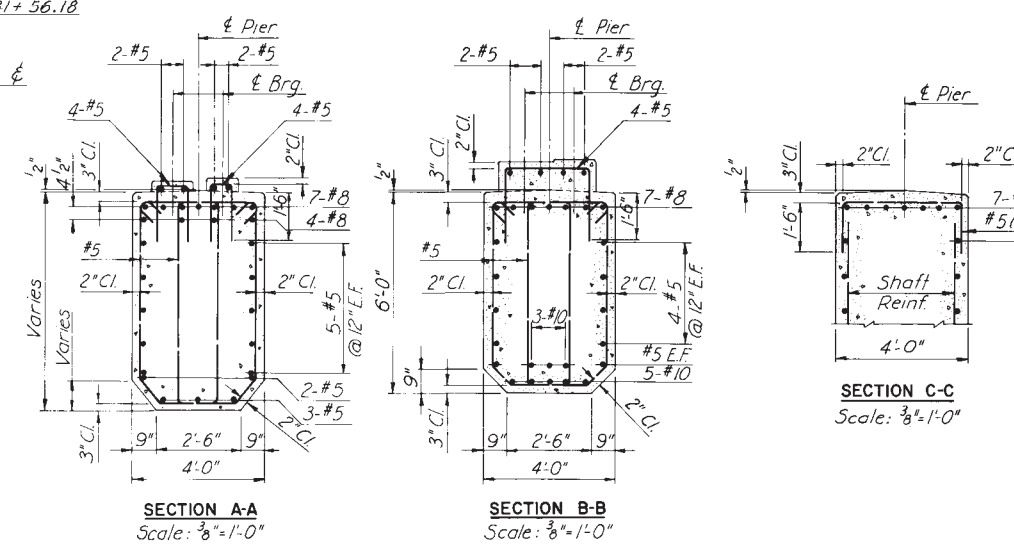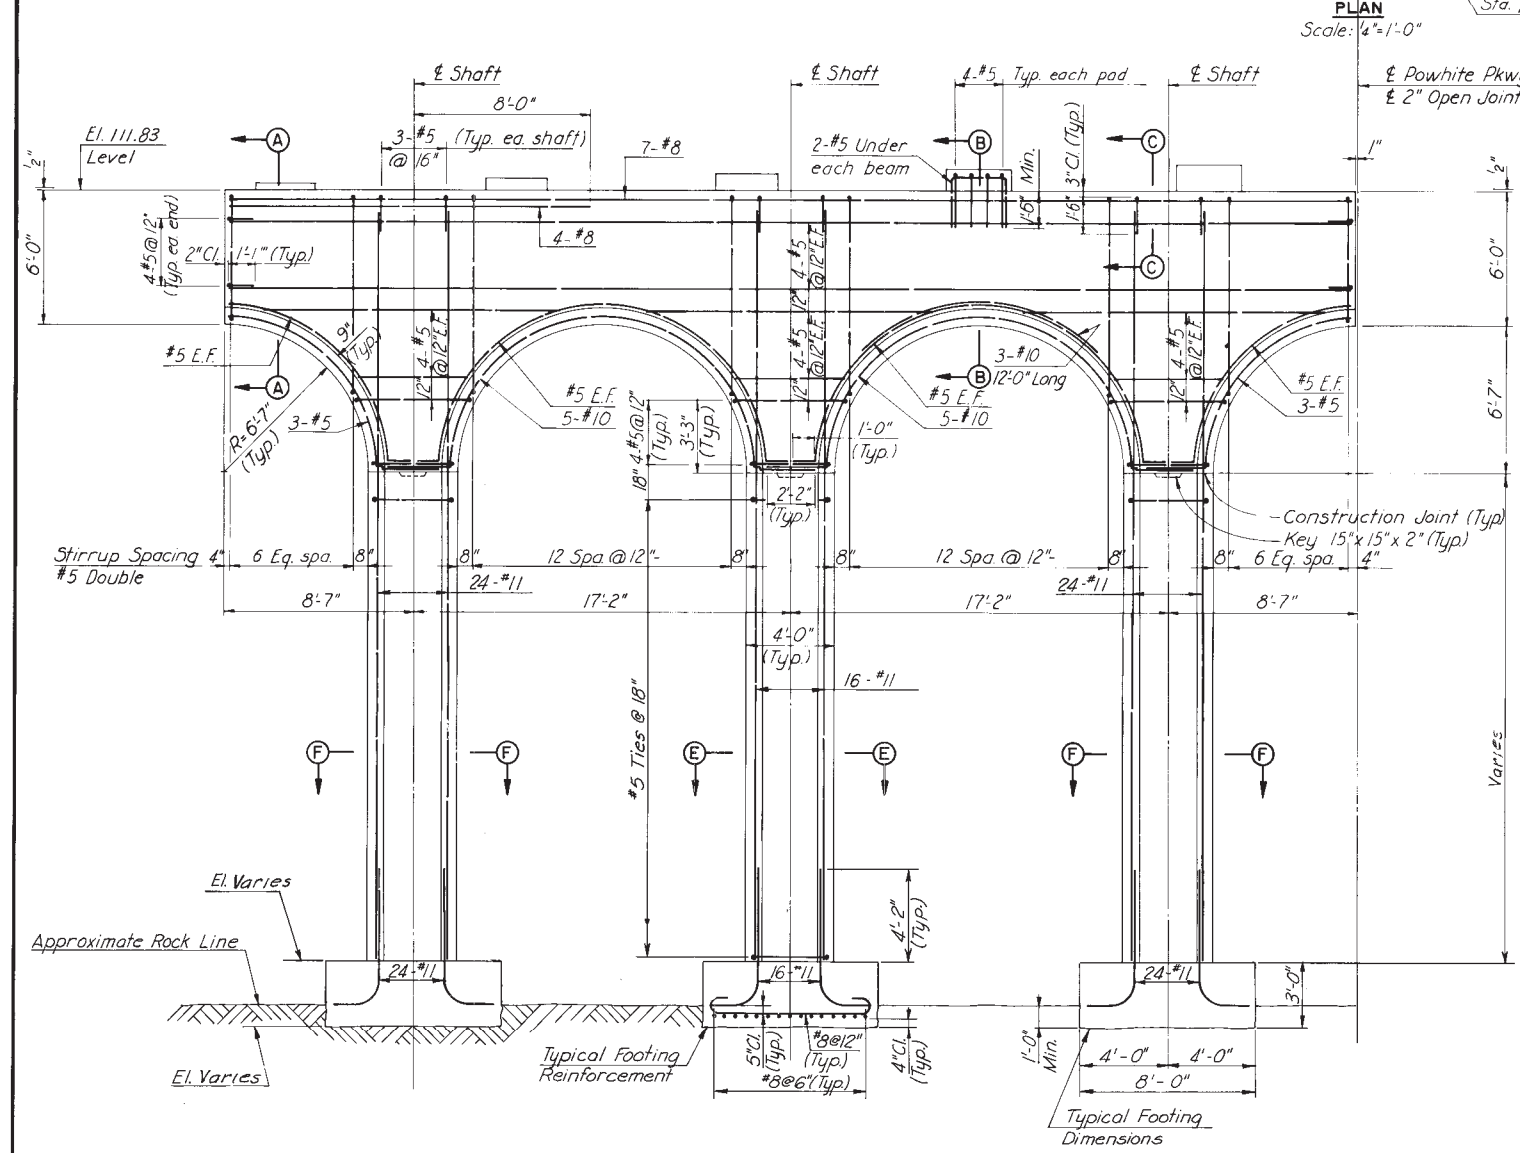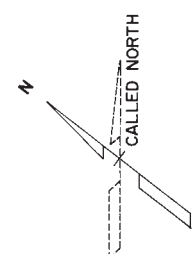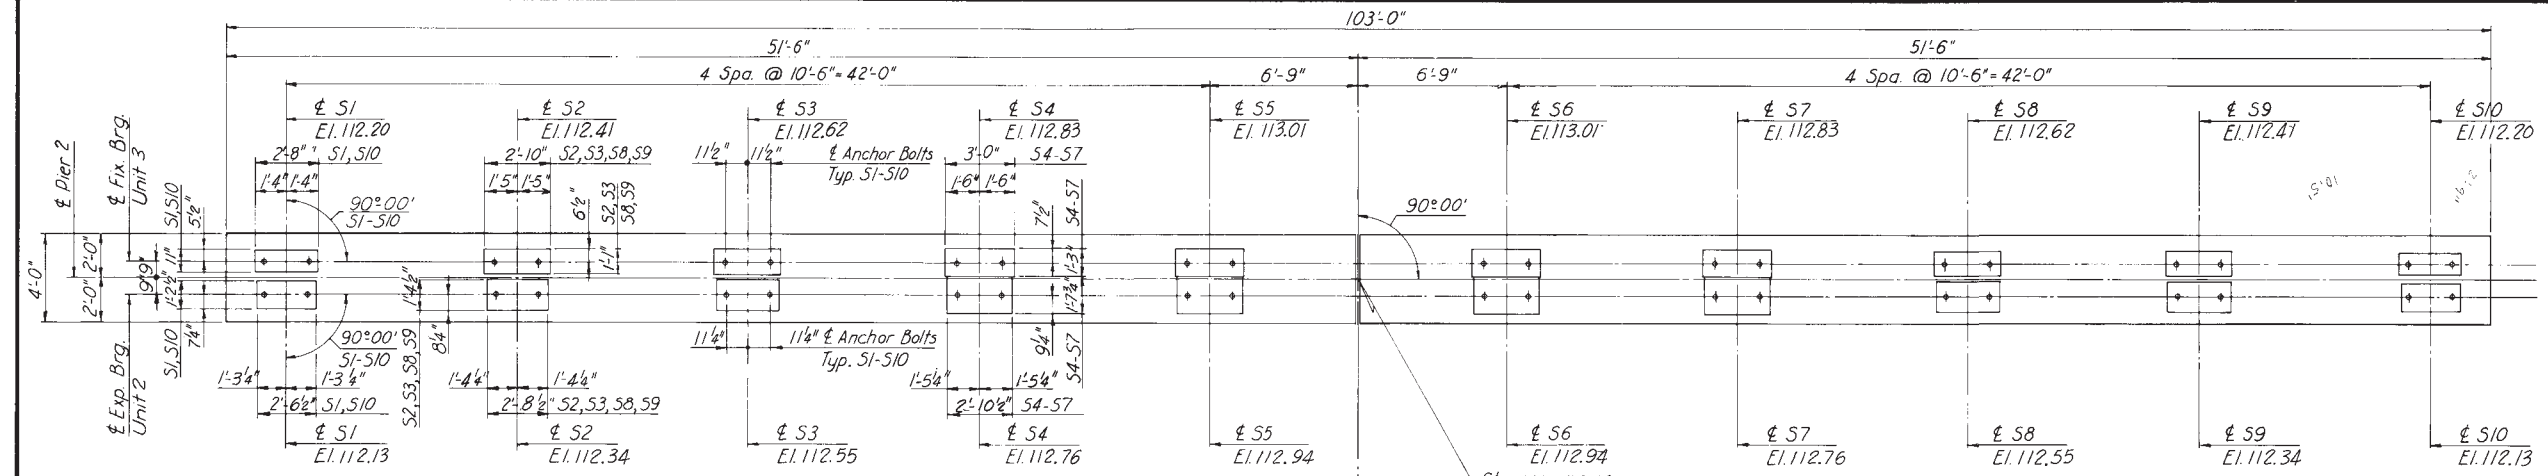

| FOOTING NO. | TOP ELEV. | AVE. BOTTOM ELEV. | STEM LENGTH |
|-------------|-----------|-------------------|-------------|
| 2 LW | 82.81 | 78.95 | 16.44 |
| 2 CW | 84.21 | 80.62 | 15.04 |
| 2 RW | 81.24 | 77.77 | 18.01 |
| 2 LE | 81.81 | 78.30 | 17.44 |
| 2 CE | 81.17 | 77.33 | 18.08 |
| 2 RE | 80.36 | 76.84 | 18.89 |

Note:
Pier symmetrical about & Powhite Pkwy.

NOTES:
Pier foundations are designed for an allowable bearing pressure of 10 Tons/S.F.

| | | | | | |
|-----------|--------|------|---|----------|----------------|
| BY | DATE | | | | |
| MADE | L.B.P. | 7-67 | 2 | AS BUILT | JRC 12-72 |
| CHECKED | FXH | 2-68 | △ | Complete | H.B.W. 2/20/71 |
| IN CHARGE | FXH | | | | |








RICHMOND METROPOLITAN AUTHORITY
RICHMOND EXPRESSWAY SYSTEM

JAMES RIVER BRIDGE
PIER 2

HOWARD, NEEDLES, TAMMEN & BERGENDOFF
consulting engineers
NEW YORK ALEXANDRIA KANSAS CITY

SCALE: AS SHOWN
CONTRACT NO. C-3
SHEET NO. 10 OF 53

| RICHMOND EXPRESSWAY SYSTEM | | | |
|----------------------------|--------------------|-----------|--------------|
| SECTION | PROJECT | SHEET NO. | TOTAL SHEETS |
| 3 | JAMES RIVER BRIDGE | 19 | 53 |

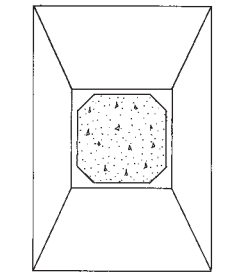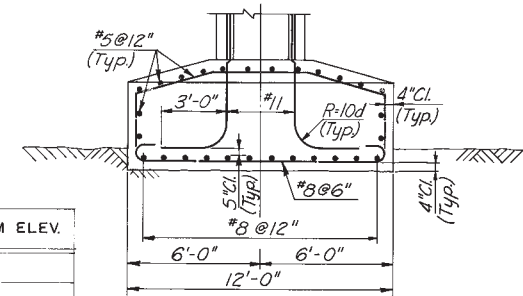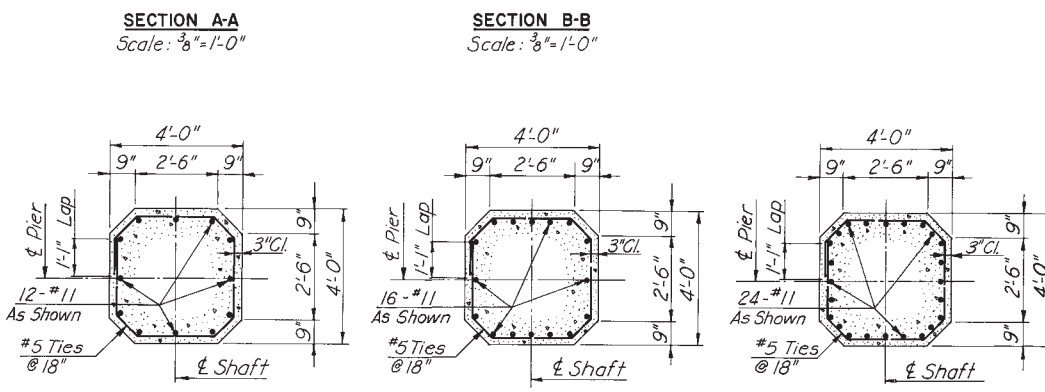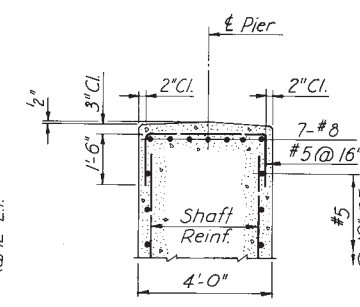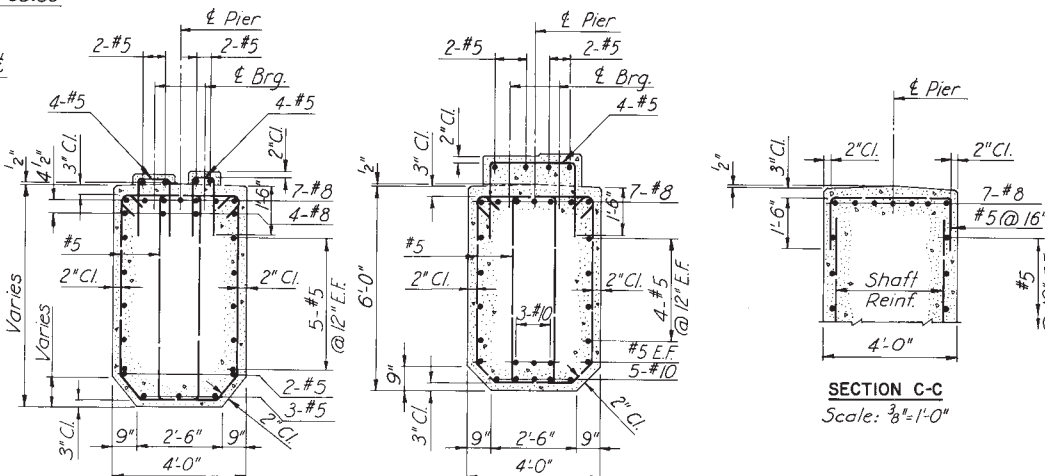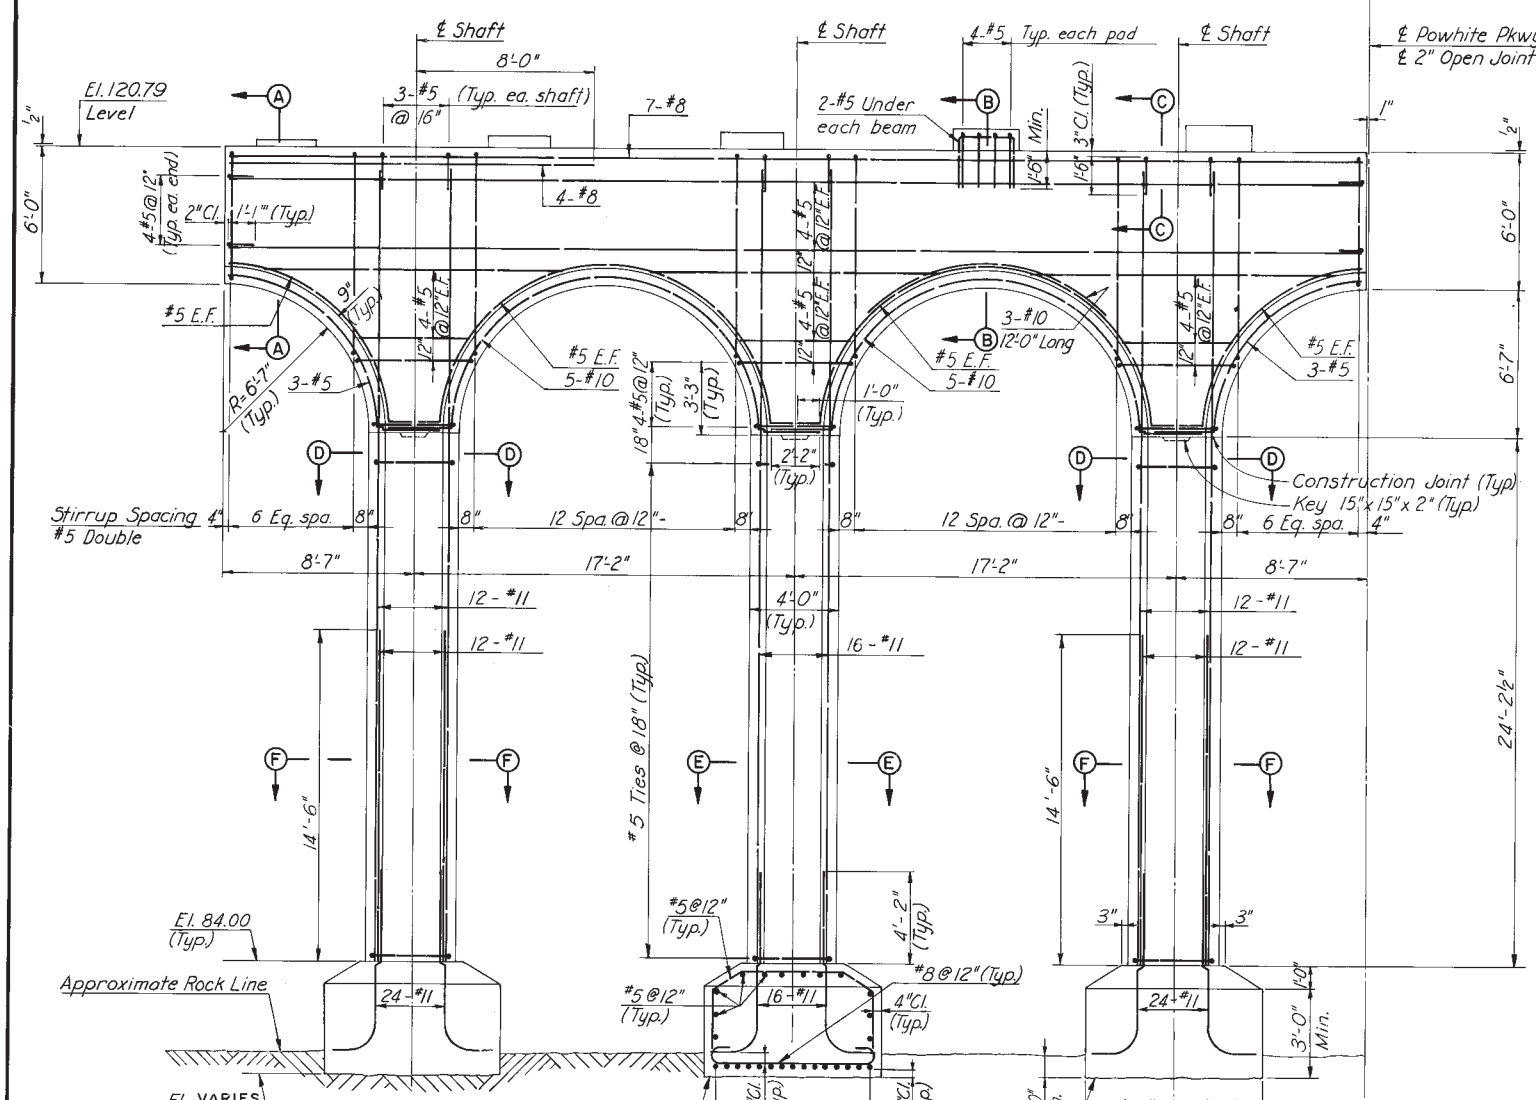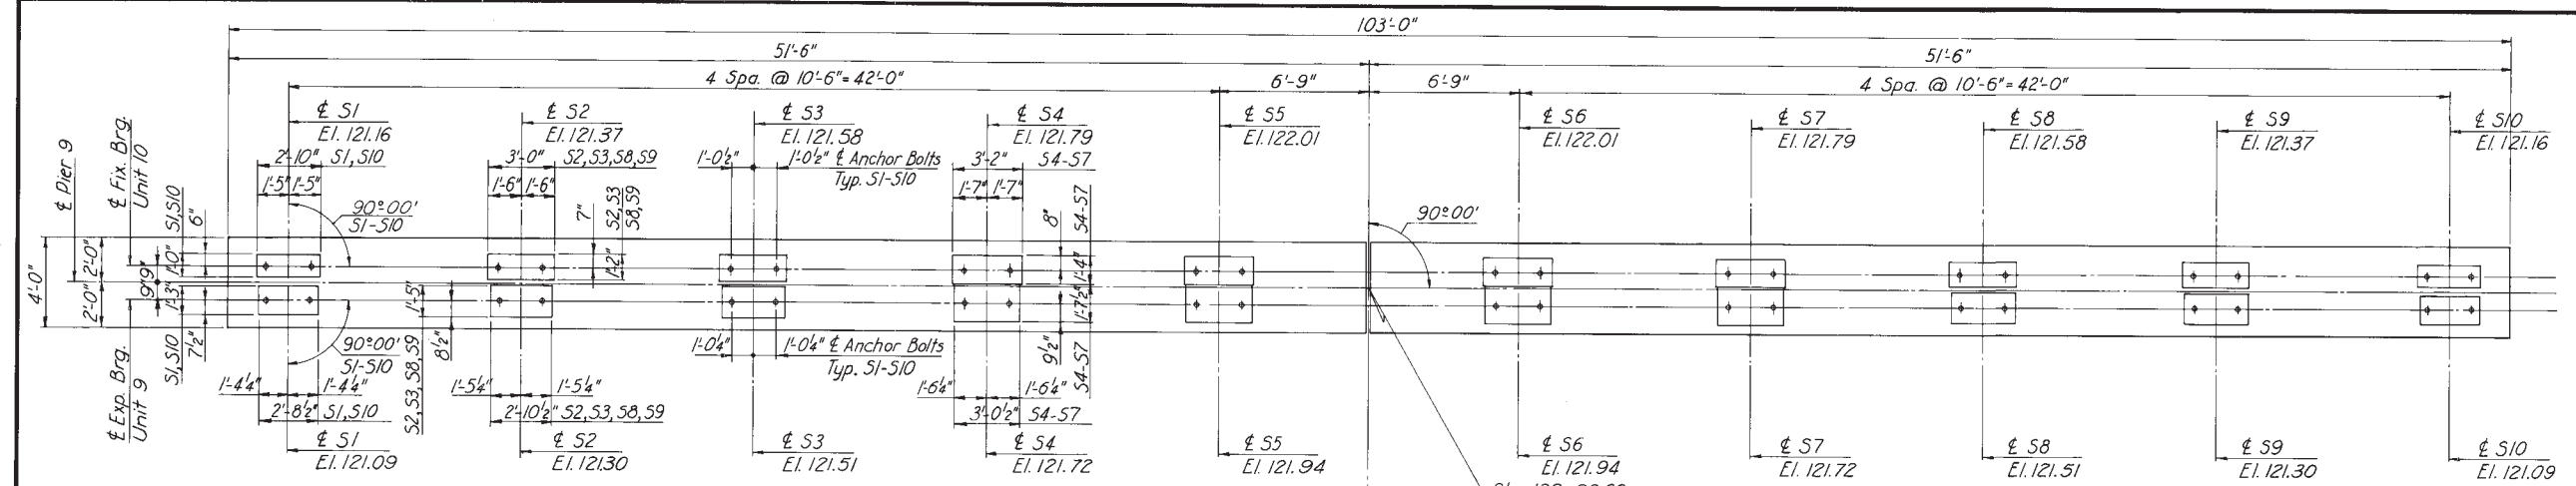

| FOOTING NO. | AVE. BOTTOM ELEV. |
|-------------|-------------------|
| 9 L W | 79.1 |
| 9 C W | 79.3 |
| 9 R W | 79.0 |
| 9 L E | 77.2 |
| 9 C E | 77.7 |
| 9 R E | 78.4 |

Note:
Pier symmetrical about
Powhite Pkwy.

NOTES:
Pier foundations are designed for an allowable bearing pressure of 10 Tons/S.F.

| BY | DATE | NO. | REVISION | BY | DATE |
|-----------|------|------|----------|-----|-------|
| MADE | HBW | 7-67 | | | |
| CHECKED | FXH | 2-68 | AS BUILT | JRC | 12-72 |
| IN CHARGE | FXH | | | | |





RICHMOND METROPOLITAN AUTHORITY
RICHMOND EXPRESSWAY SYSTEM

JAMES RIVER BRIDGE
PIER 9


HOWARD, NEEDLES, TAMMEN & BERGENDOFF
consulting engineers
NEW YORK ALEXANDRIA KANSAS CITY

SCALE: AS SHOWN
CONTRACT NO. C-3
SHEET NO. 19 OF 53

| RICHMOND EXPRESSWAY SYSTEM | | | |
|----------------------------|--------------------|-----------|--------------|
| SECTION | PROJECT | SHEET NO. | TOTAL SHEETS |
| 3 | JAMES RIVER BRIDGE | 20 | 53 |

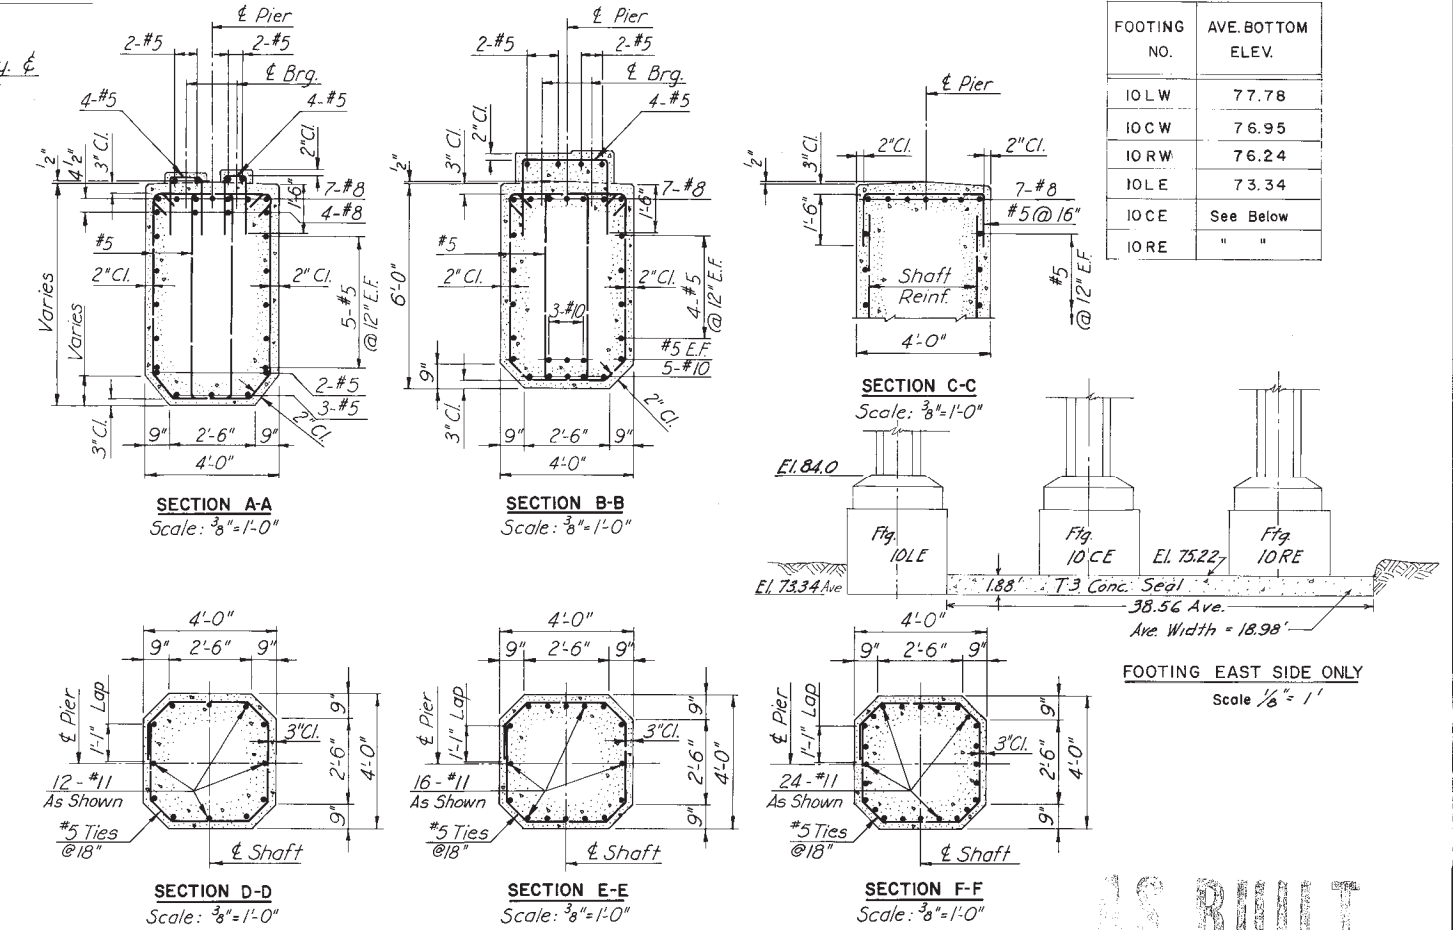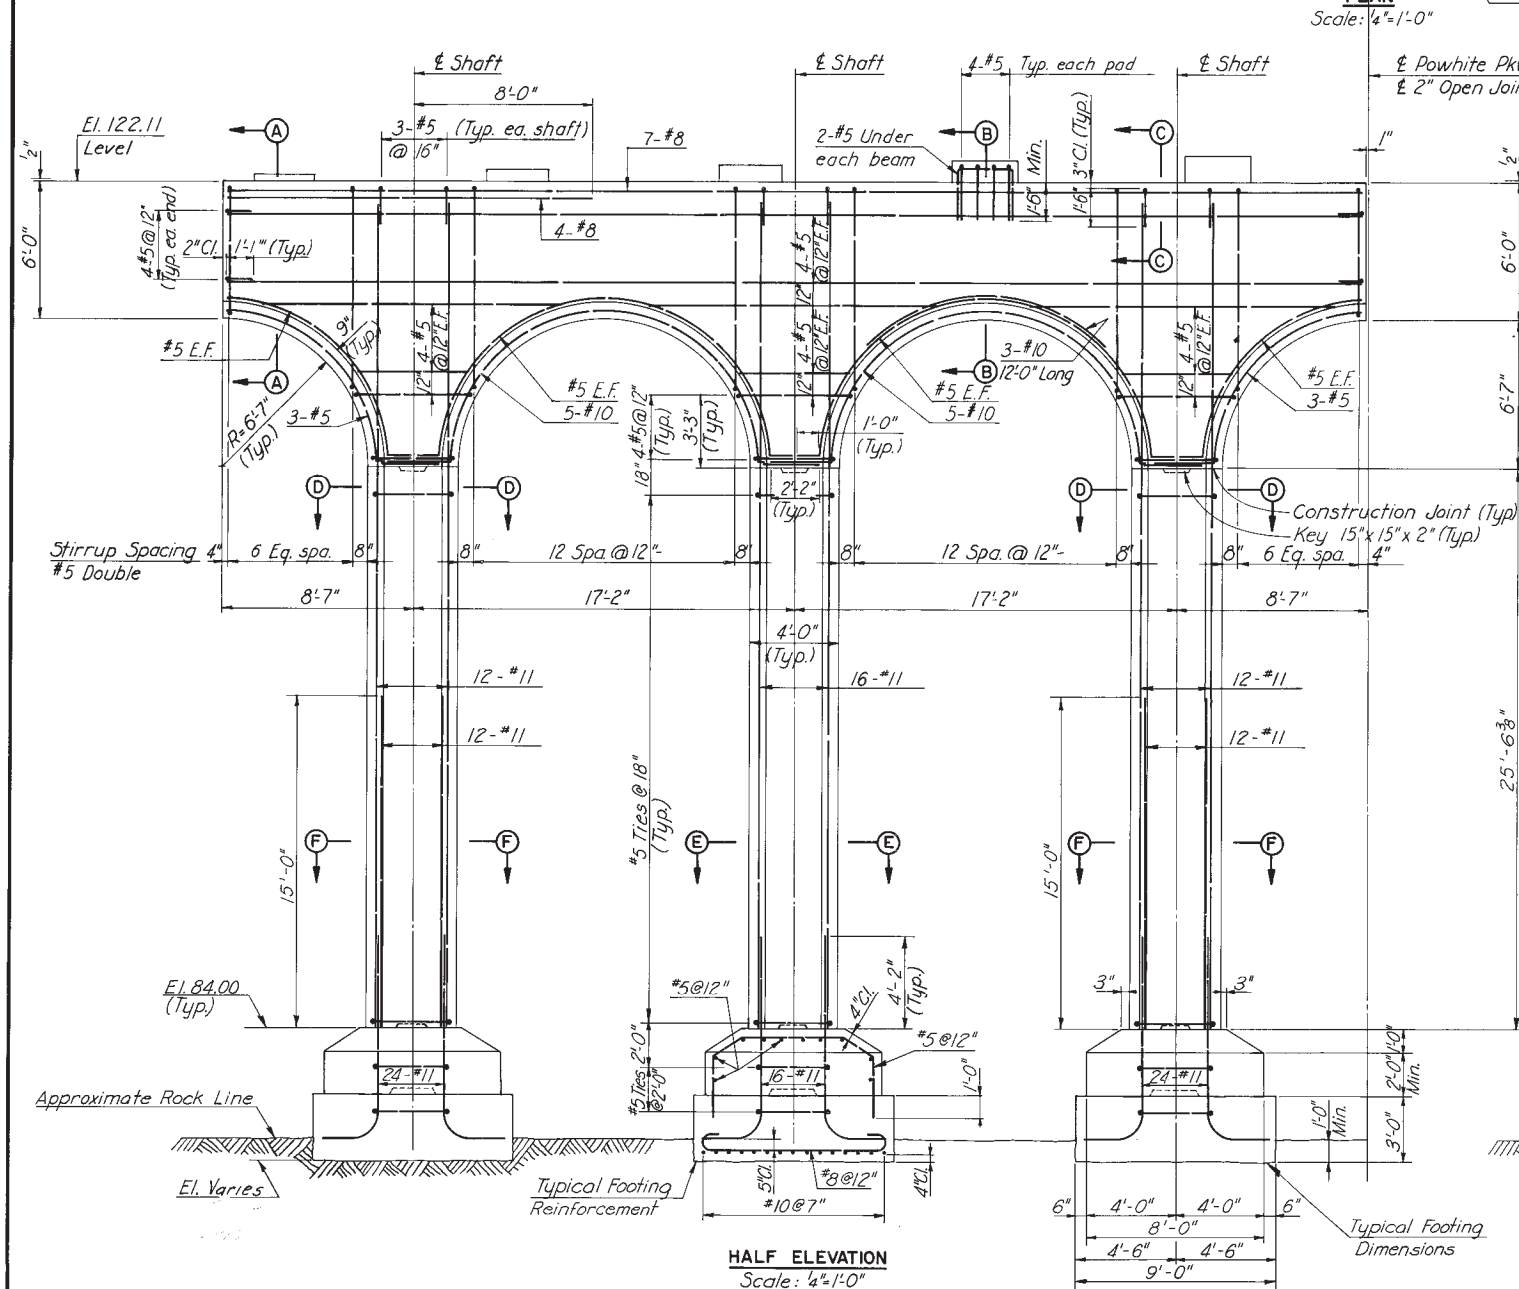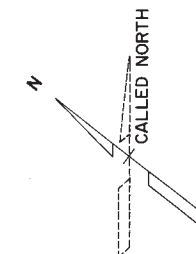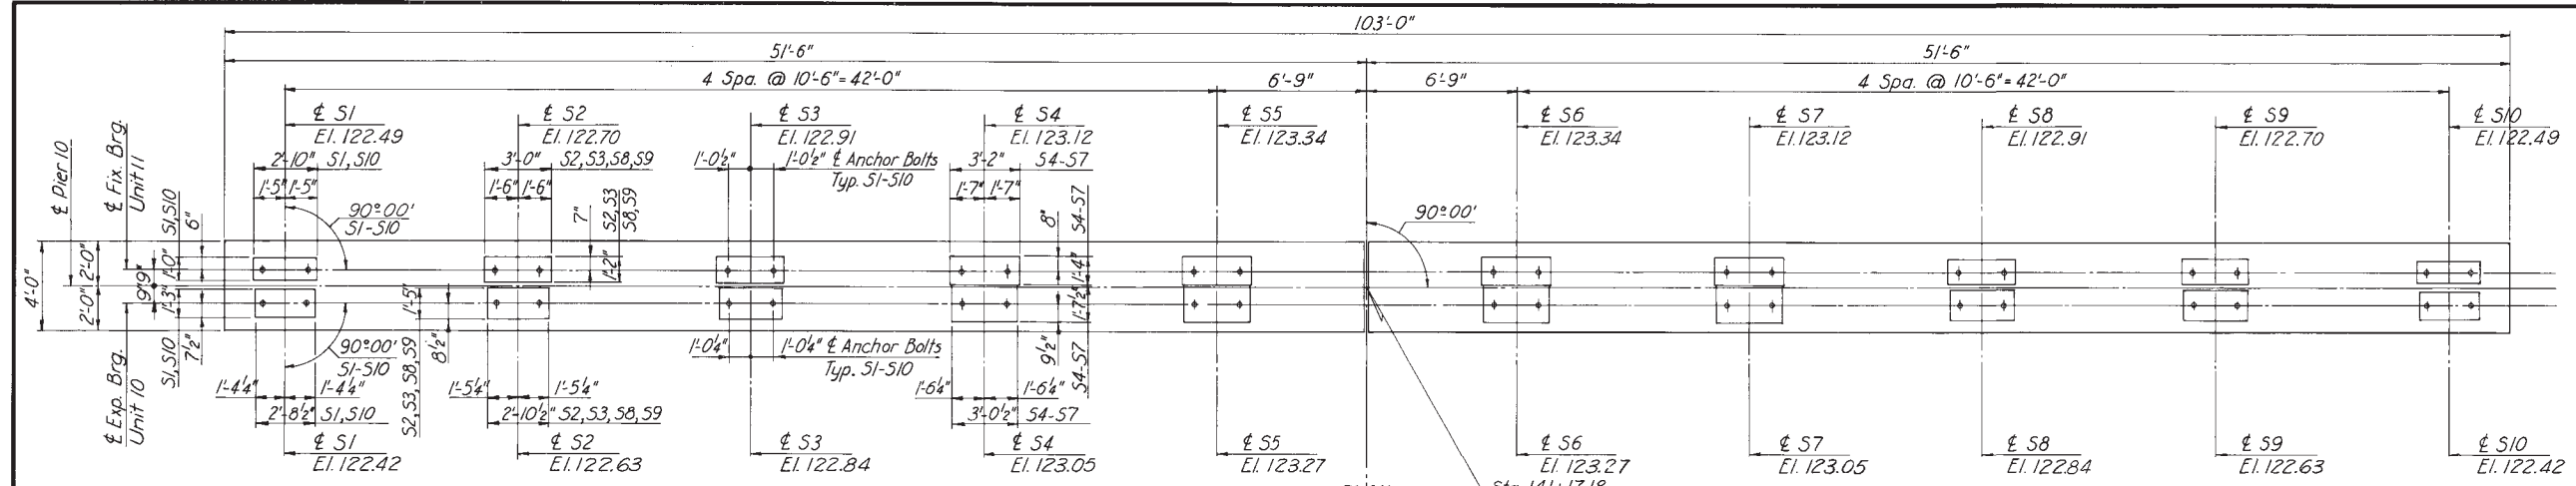

| FOOTING NO. | AVE. BOTTOM ELEV. |
|-------------|-------------------|
| 10LW | 77.78 |
| 10CW | 76.95 |
| 10RW | 76.24 |
| 10LE | 73.34 |
| 10CE | See Below |
| 10RE | " " |

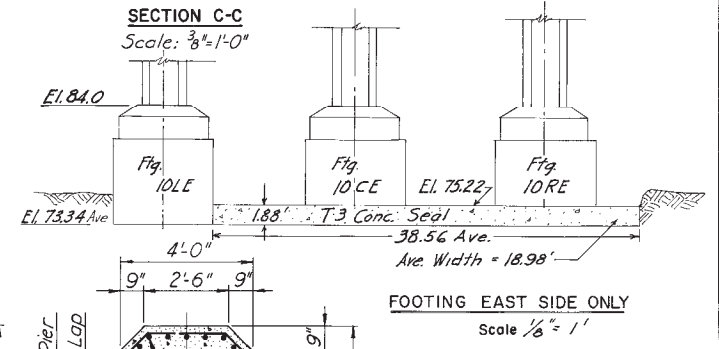

AS BUILT

NOTES:

Pier foundations are designed for an allowable bearing pressure of 5 Tons/S.F.




RICHMOND METROPOLITAN AUTHORITY
RICHMOND EXPRESSWAY SYSTEM

JAMES RIVER BRIDGE
PIER 10

| BY | DATE | NO. | REVISION | BY | DATE |
|-----------|------|------|----------|----------|-----------|
| MADE | HBW | 7-67 | | | |
| CHECKED | FXH | 2-68 | 1 | AS BUILT | JRC 12-72 |
| IN CHARGE | FXH | | | | |

HOWARD, NEEDLES, TAMMEN & BERGENDOFF
consulting engineers
NEW YORK ALEXANDRIA KANSAS CITY

SCALE: AS SHOWN
CONTRACT NO: C-3
SHEET NO. 20 OF 53

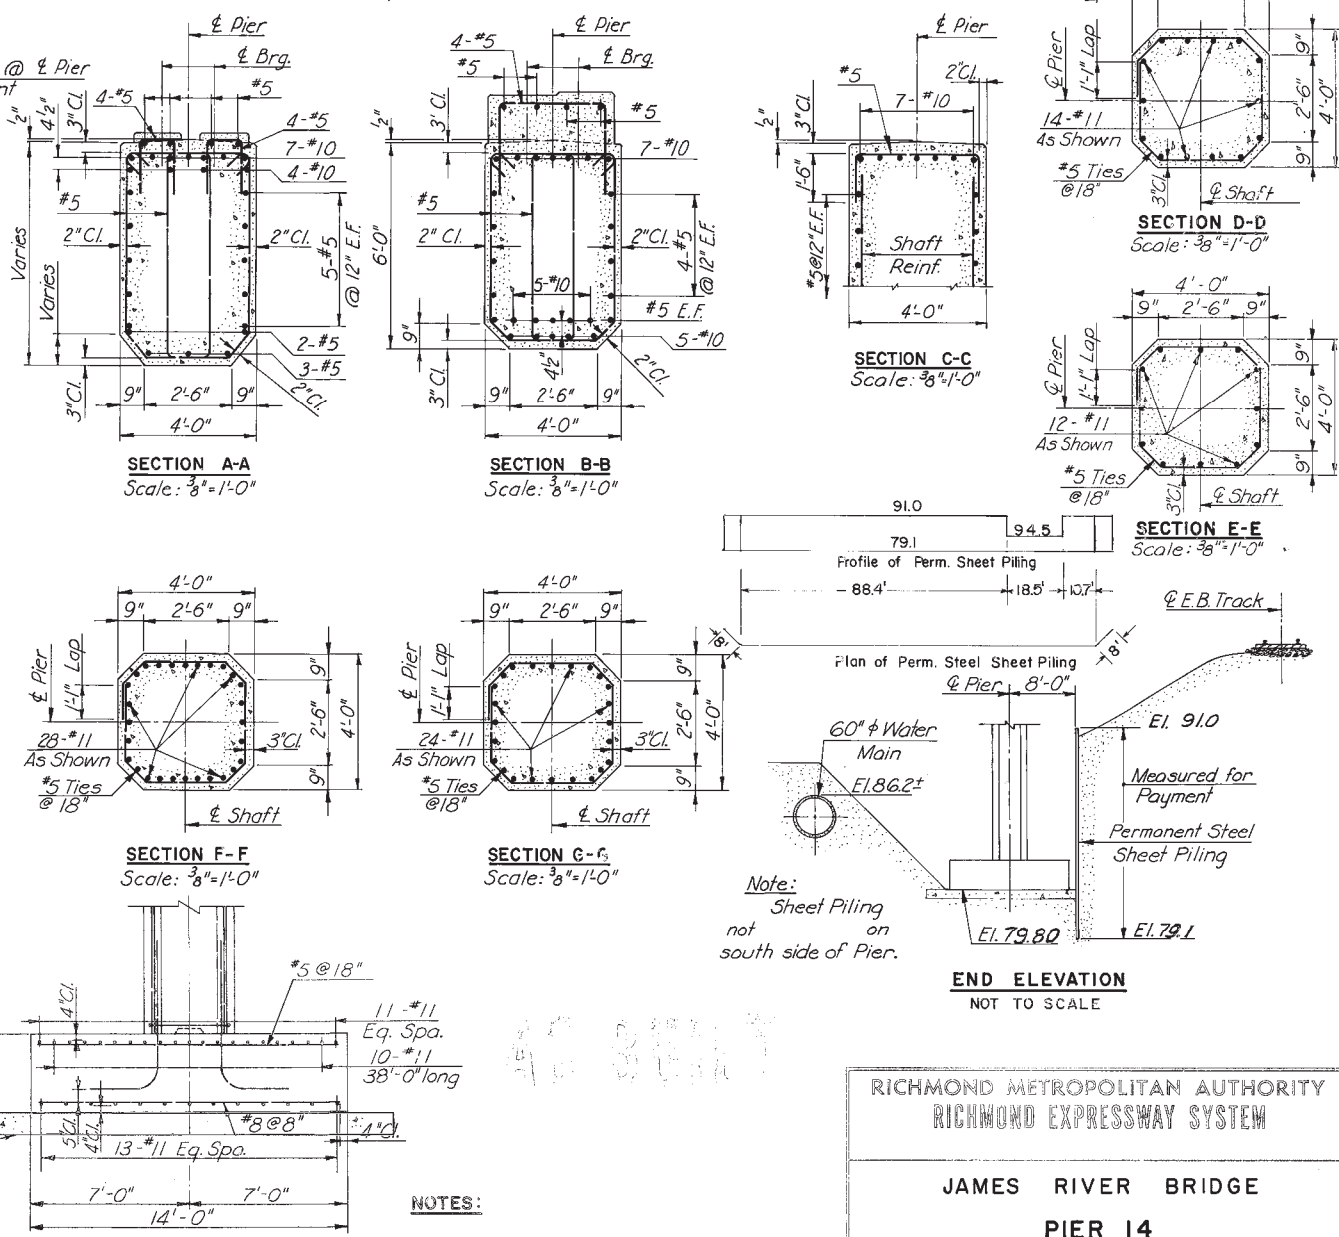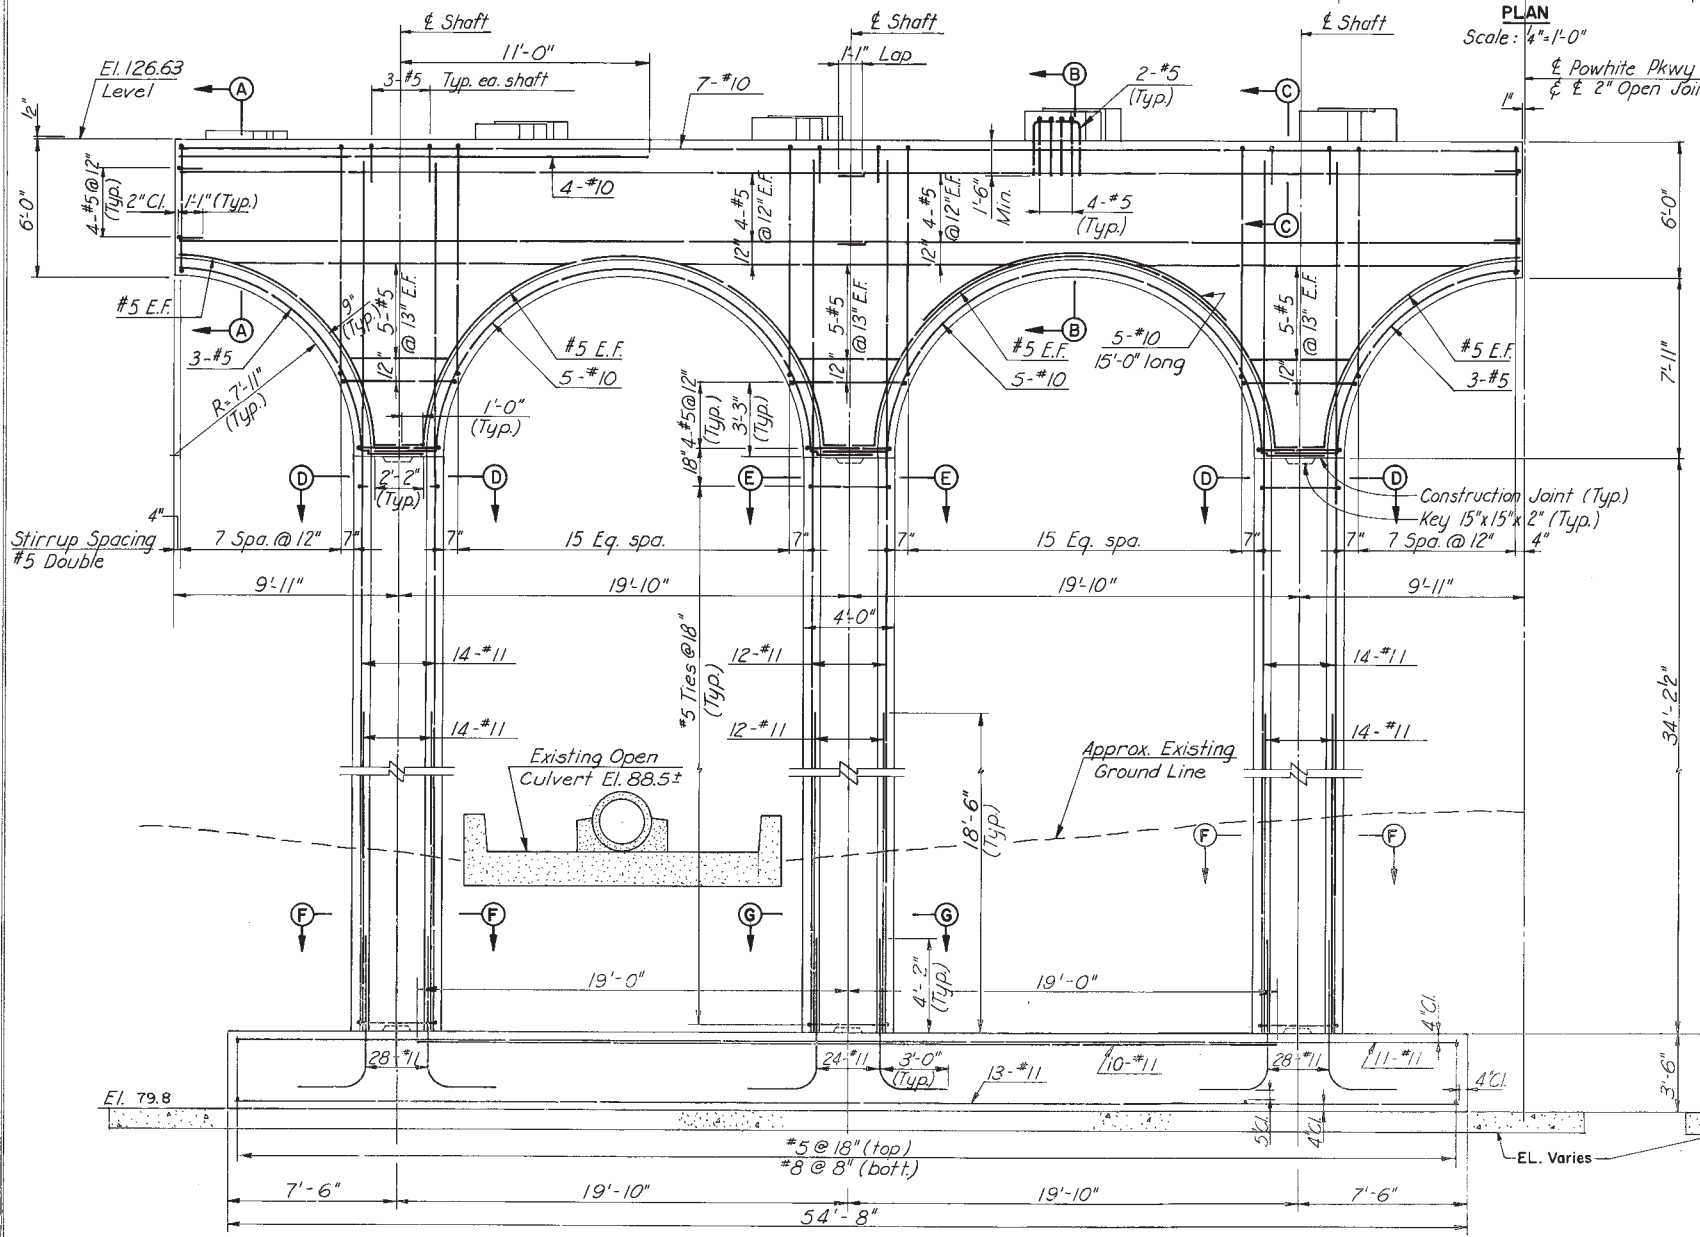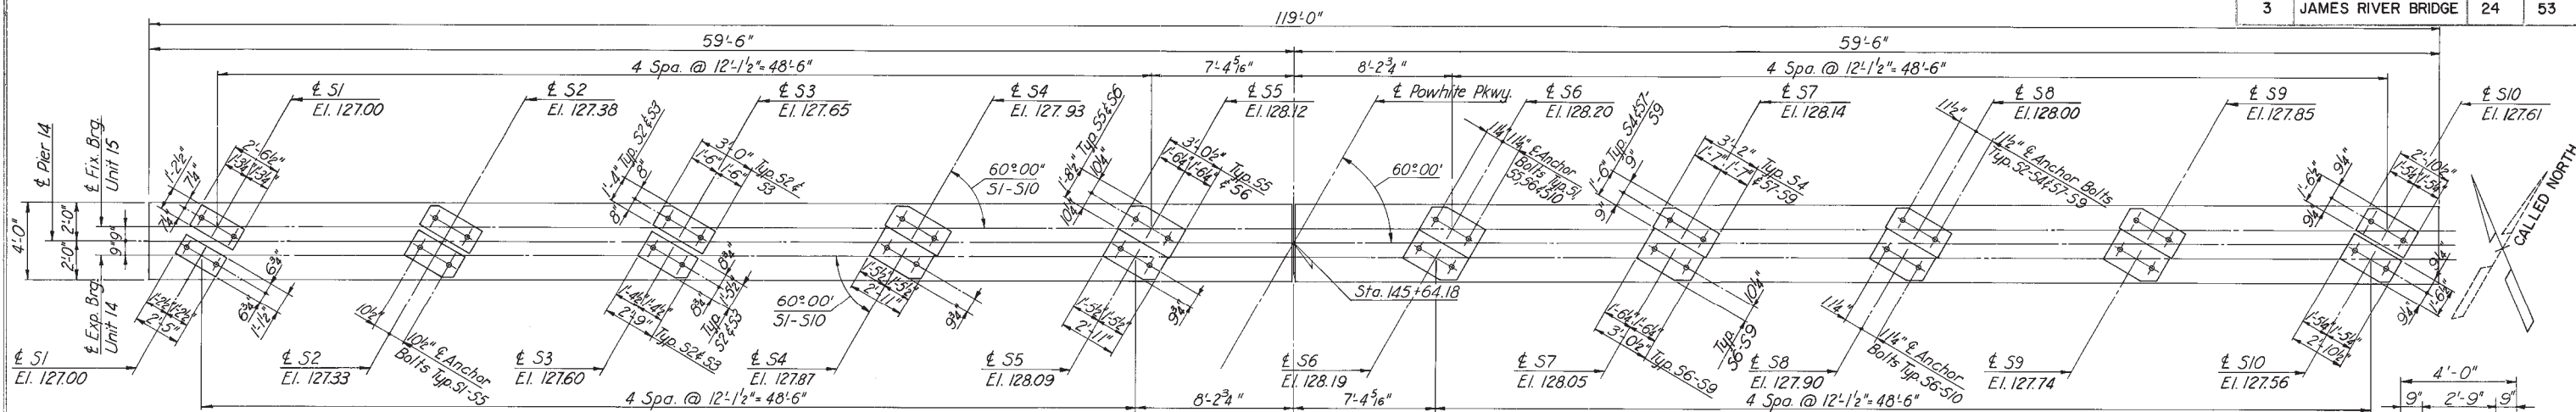


Note:
Sheet Piling
not
on
south side of Pier.

END ELEVATION
NOT TO SCALE

| | | | | | |
|-----------|--------|------|----------|----------|-------|
| BY | DATE | | | | |
| MADE | L.B.P. | 7-67 | | | |
| CHECKED | FX.H. | 3-68 | AS BUILT | JRC | 12-72 |
| IN CHARGE | FX.H. | | NO. | REVISION | BY |

HALF ELEVATION
Scale: 1/4"=1'-0"

Note:
Pier symmetrical about
2' open joint.

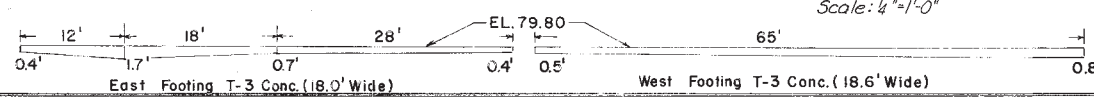

FOOTING END VIEW
Scale: 1/4"=1'-0"

NOTES:







Pier foundations are designed for an allowable bearing pressure of 32 Tons/5.F.

RICHMOND METROPOLITAN AUTHORITY
RICHMOND EXPRESSWAY SYSTEM

**JAMES RIVER BRIDGE
PIER 14**

HOWARD, NEEDLES, TAMM & BERGENDOFF
consulting engineers
NEW YORK ALEXANDRIA KANSAS CITY
SCALE: AS SHOWN
CONTRACT NO. C-3
SHEET NO. 24 OF 53

| RICHMOND EXPRESSWAY SYSTEM | | | |
|----------------------------|--------------------|-----------|--------------|
| SECTION | PROJECT | SHEET NO. | TOTAL SHEETS |
| 3 | JAMES RIVER BRIDGE | 25 | 53 |

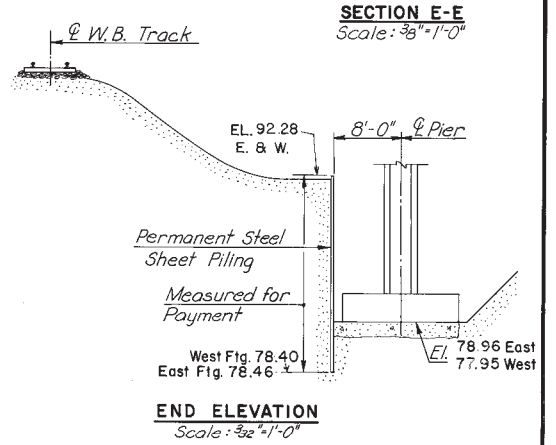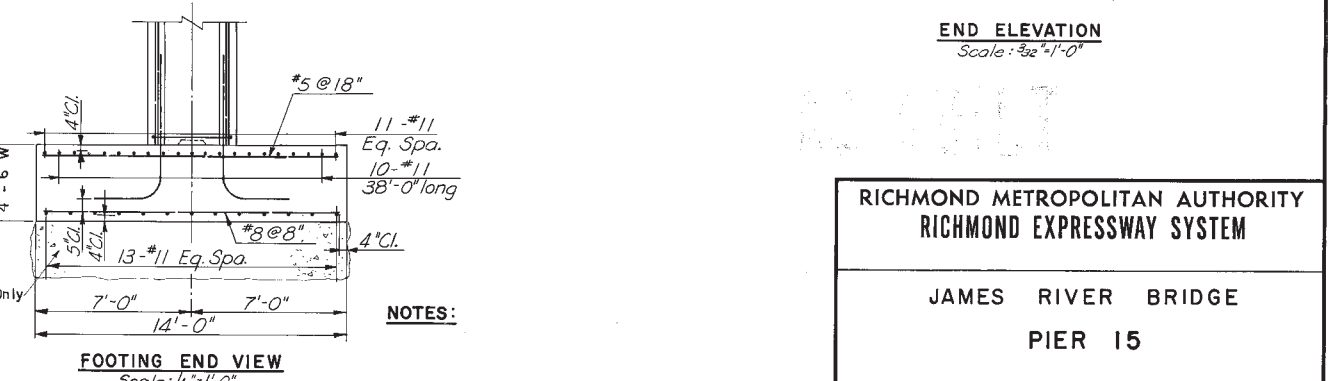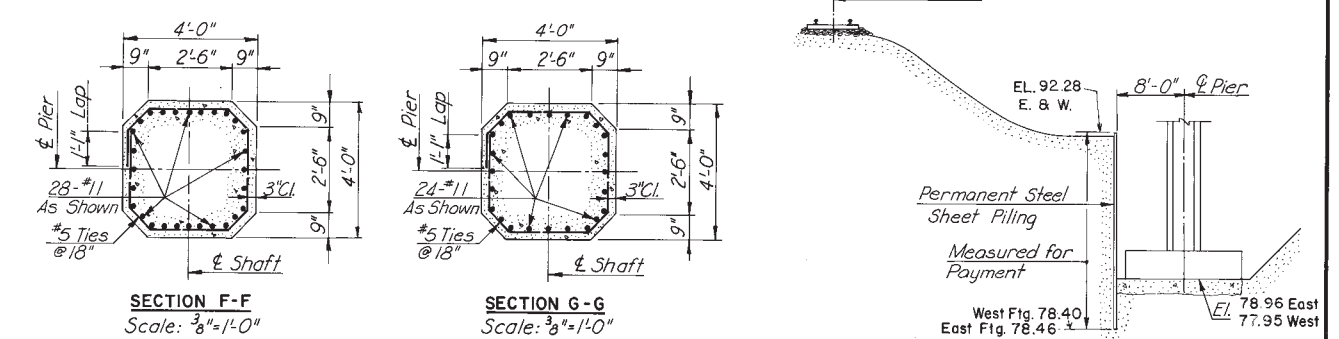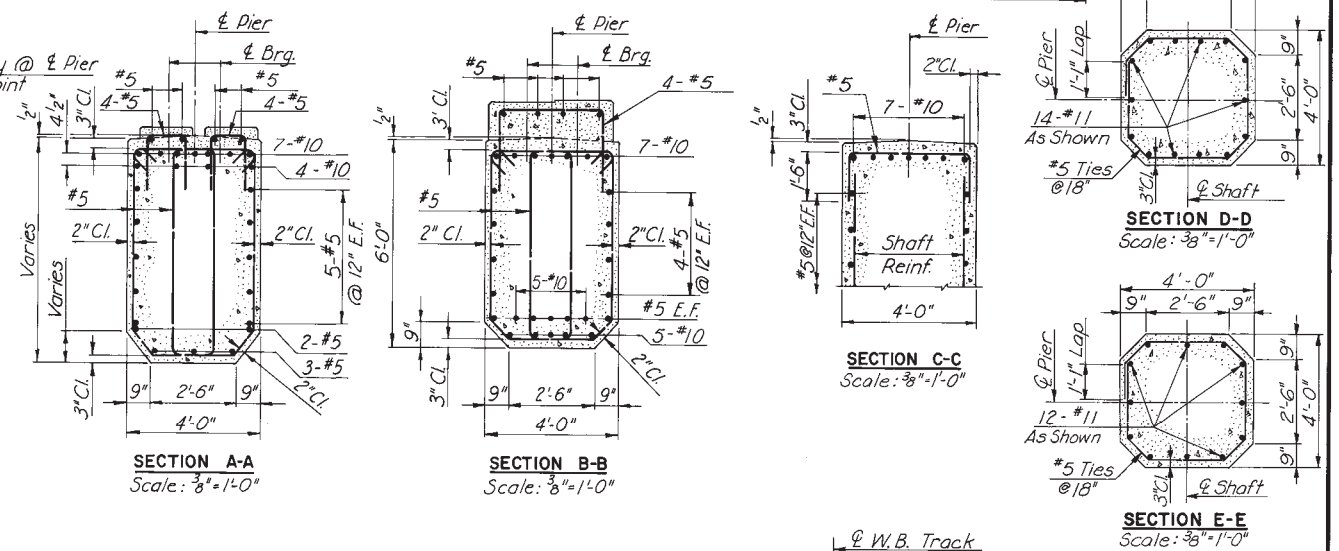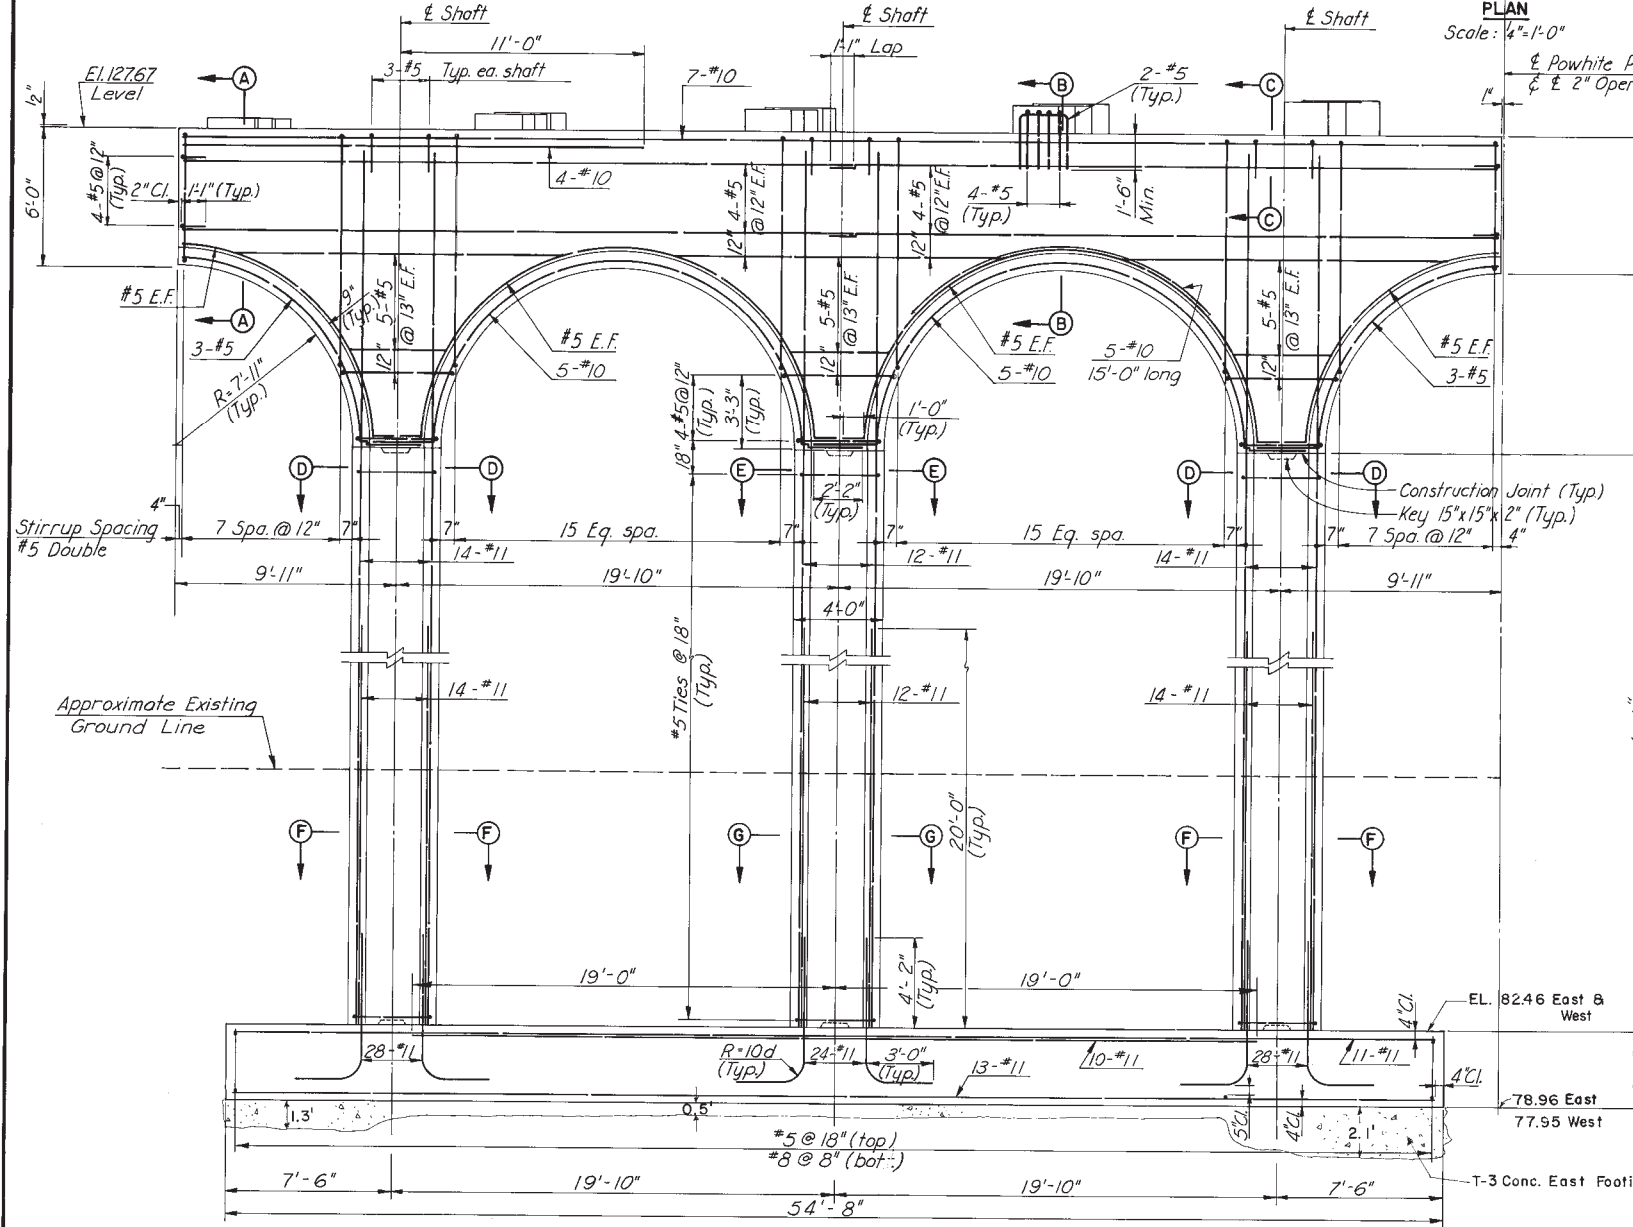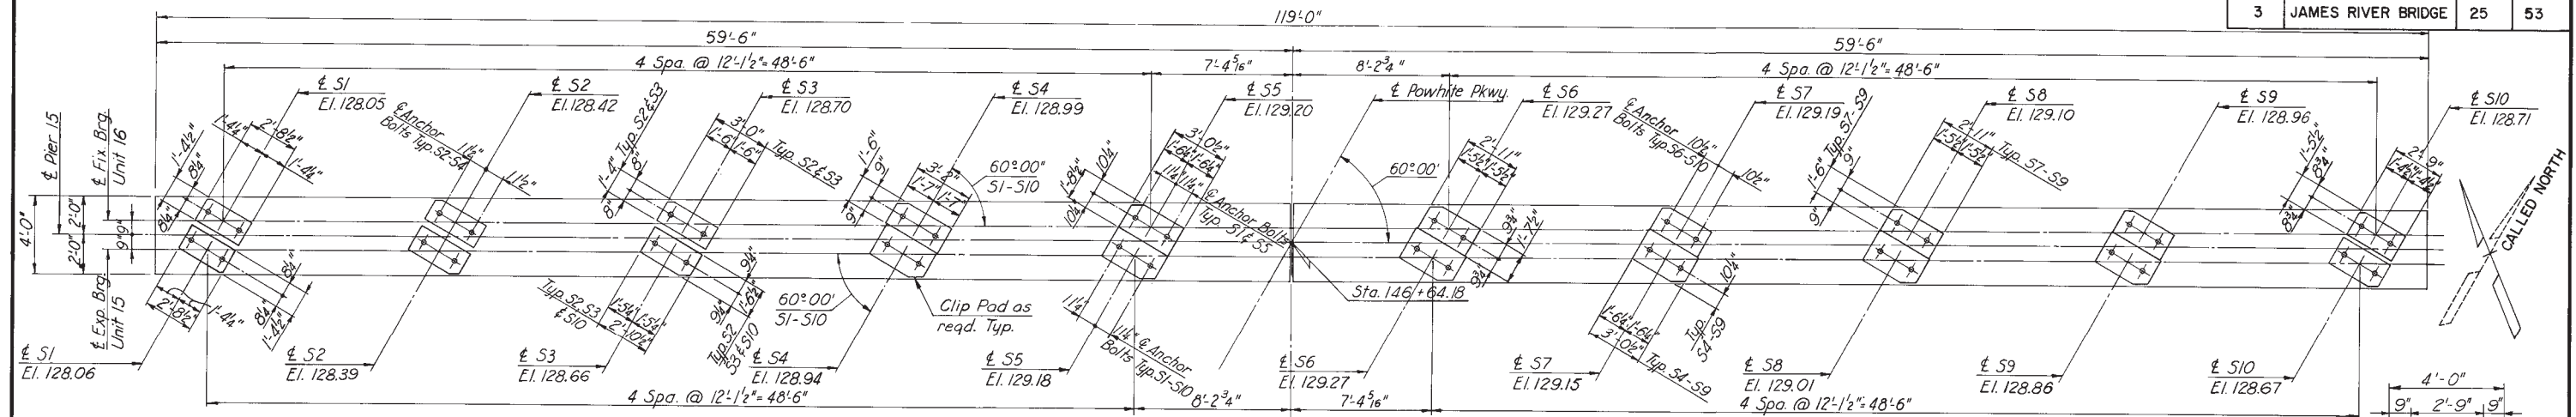

| BY | DATE | | | | |
|-----------|------|------|----------|----------|---------|
| MADE | HBW | 7-67 | | | |
| CHECKED | FXH | 3-68 | AS BUILT | JRC | 12-72 |
| IN CHARGE | FXH | | NO. | REVISION | BY DATE |

HALF ELEVATION
Scale: 1/4"=1'-0"
Note:
Pier symmetrical about
£ 2" open joint.



NOTES:
Pier foundations are designed for an
allowable bearing pressure of 3 1/2 Tons/S.F.

RICHMOND METROPOLITAN AUTHORITY
RICHMOND EXPRESSWAY SYSTEM


JAMES RIVER BRIDGE
PIER 15

HOWARD, NEEDLES, TAMMEN & BERGENDOFF
consulting engineers
NEW YORK ALEXANDRIA KANSAS CITY

SCALE: AS SHOWN
CONTRACT NO: C-3
SHEET NO. 25 OF 53

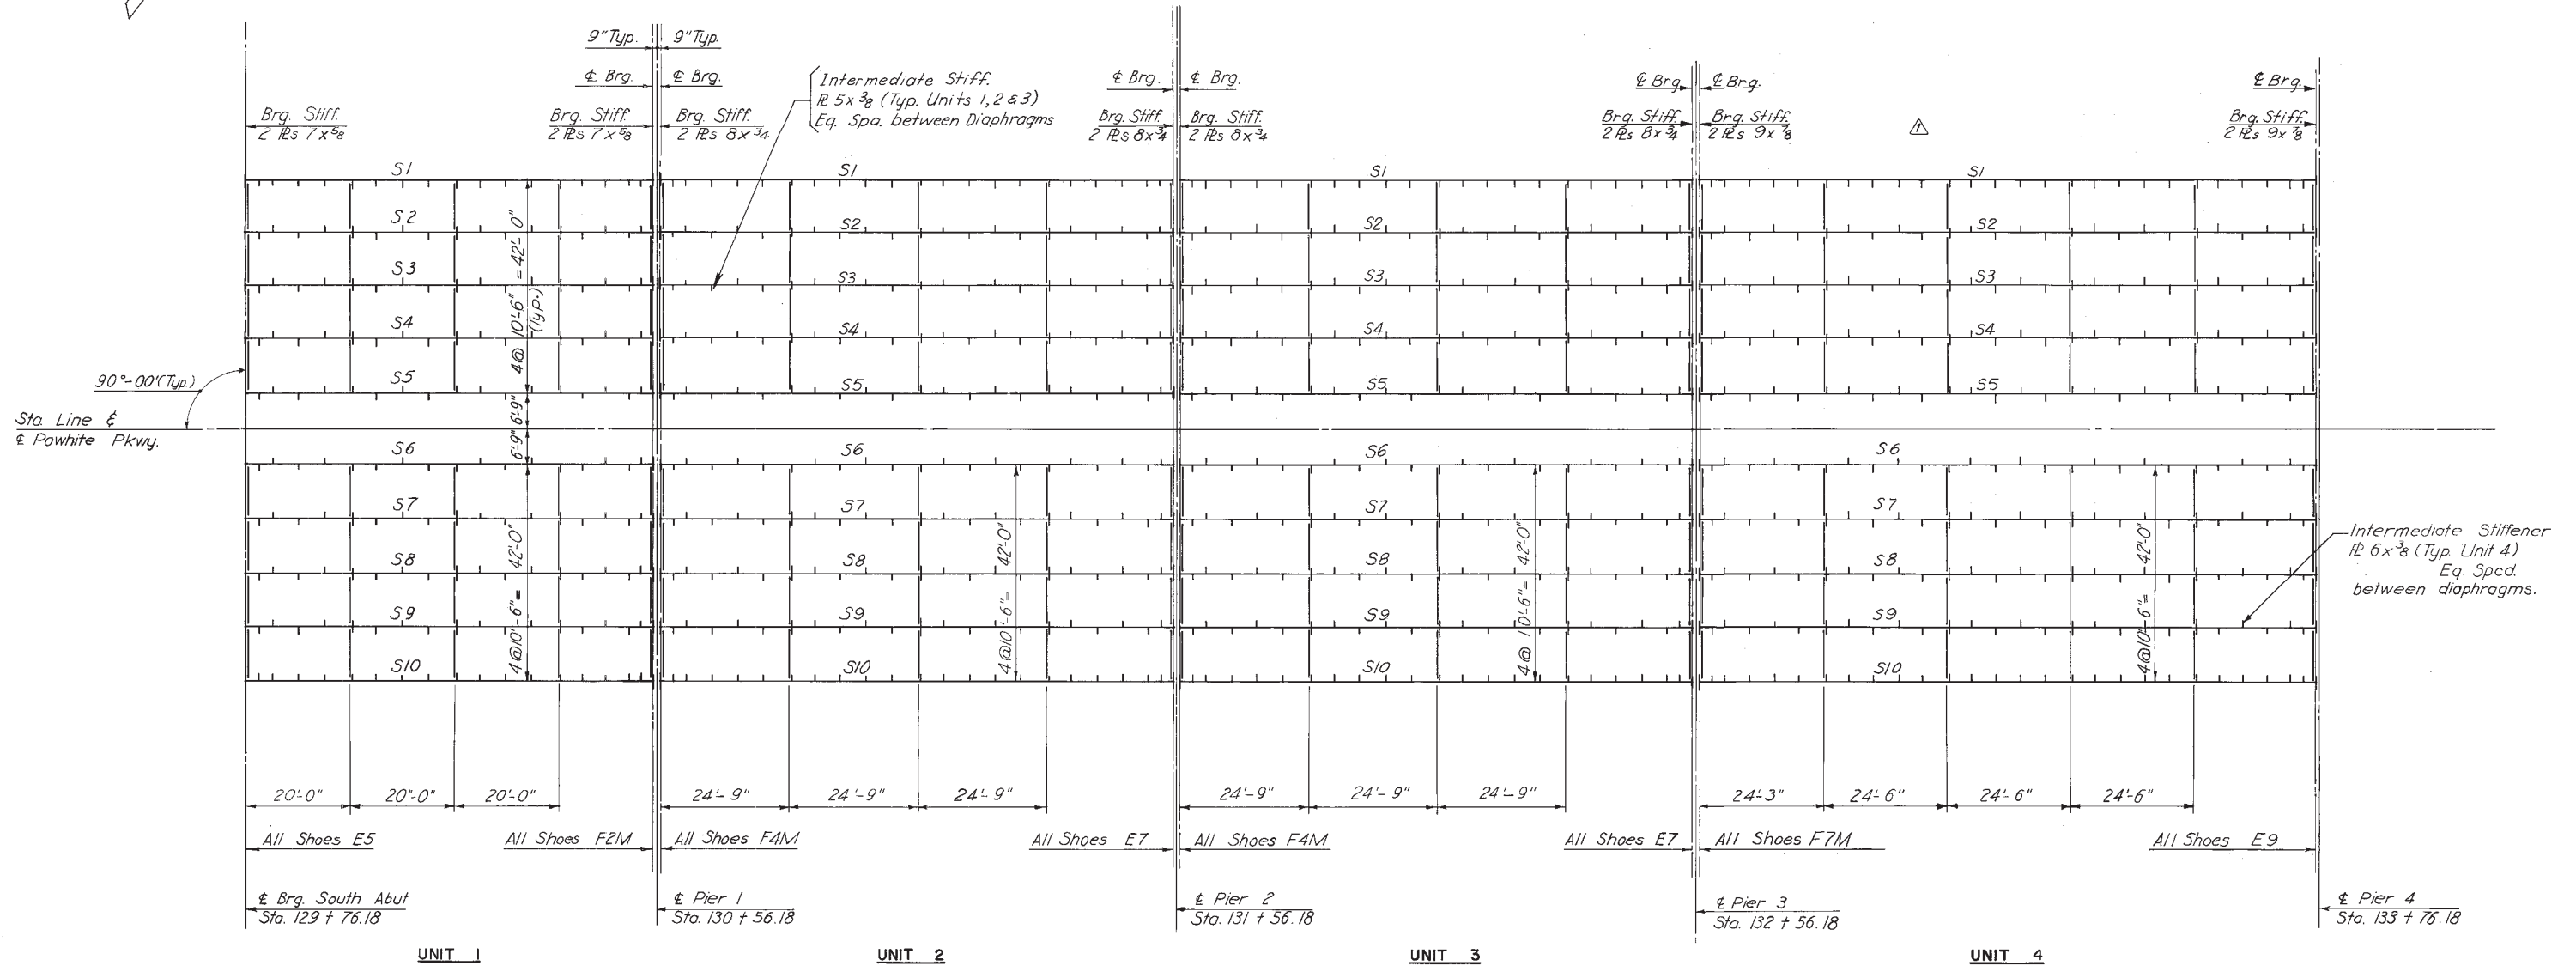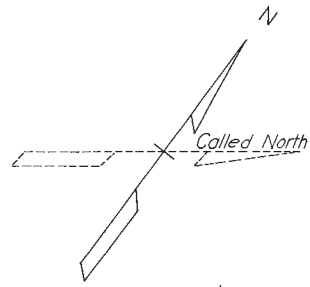

| STRINGER LENGTHS (c to c Bearing) | | | | | |
|-----------------------------------|----------|--------|------|----------|---------|
| Unit | Stringer | Length | Unit | Stringer | Length |
| 1 | S1-S10 | 79'-3" | 3 | S1-S10 | 98'-6" |
| 2 | S1-S10 | 98'-6" | 4 | S1-S10 | 118'-6" |

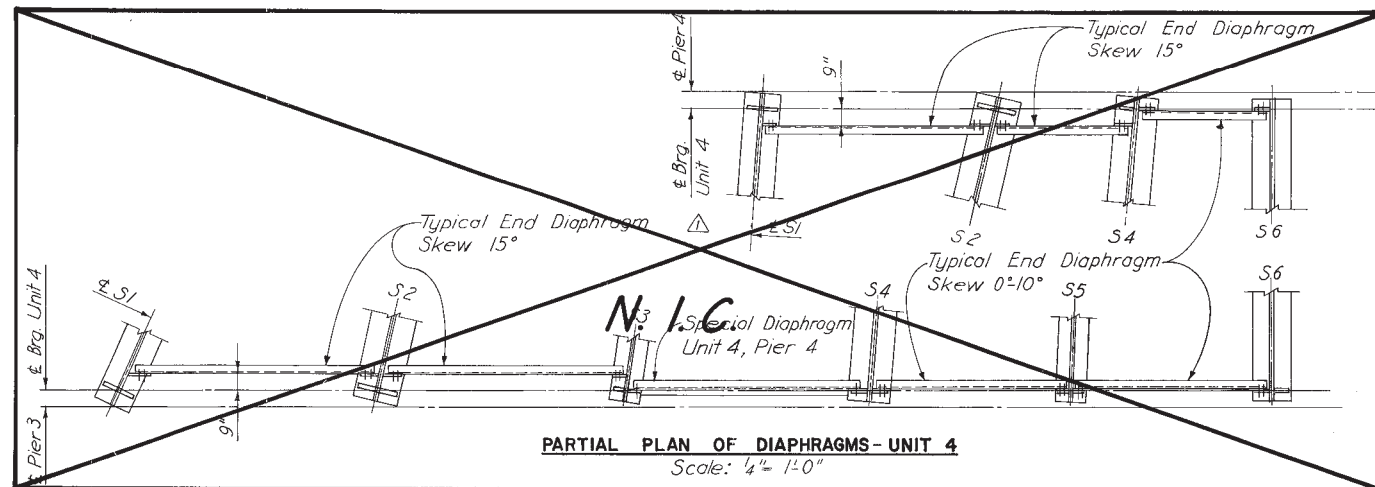

| | | | | | | |
|-----------|-----|------|---|-------------------|--------|---------|
| MADE | EVR | 7-67 | 2 | AS BUILT | JRC | 12-72 |
| CHECKED | FXH | 8-67 | 1 | Remove Ramp Taper | H.B.W. | 2/20/71 |
| IN CHARGE | FXH | | | REVISION | BY | DATE |


RICHMOND METROPOLITAN AUTHORITY
RICHMOND EXPRESSWAY SYSTEM

JAMES RIVER BRIDGE
FRAMING PLAN UNITS 1, 2, 3 & 4


HOWARD, NEEDLES, TAMMEN & BERGENDOFF
consulting engineers
NEW YORK ALEXANDRIA KANSAS CITY

SCALE: 1/4" = 1'-0" (Unless Noted)

CONTRACT NO. C-3
SHEET NO. 28 OF 53

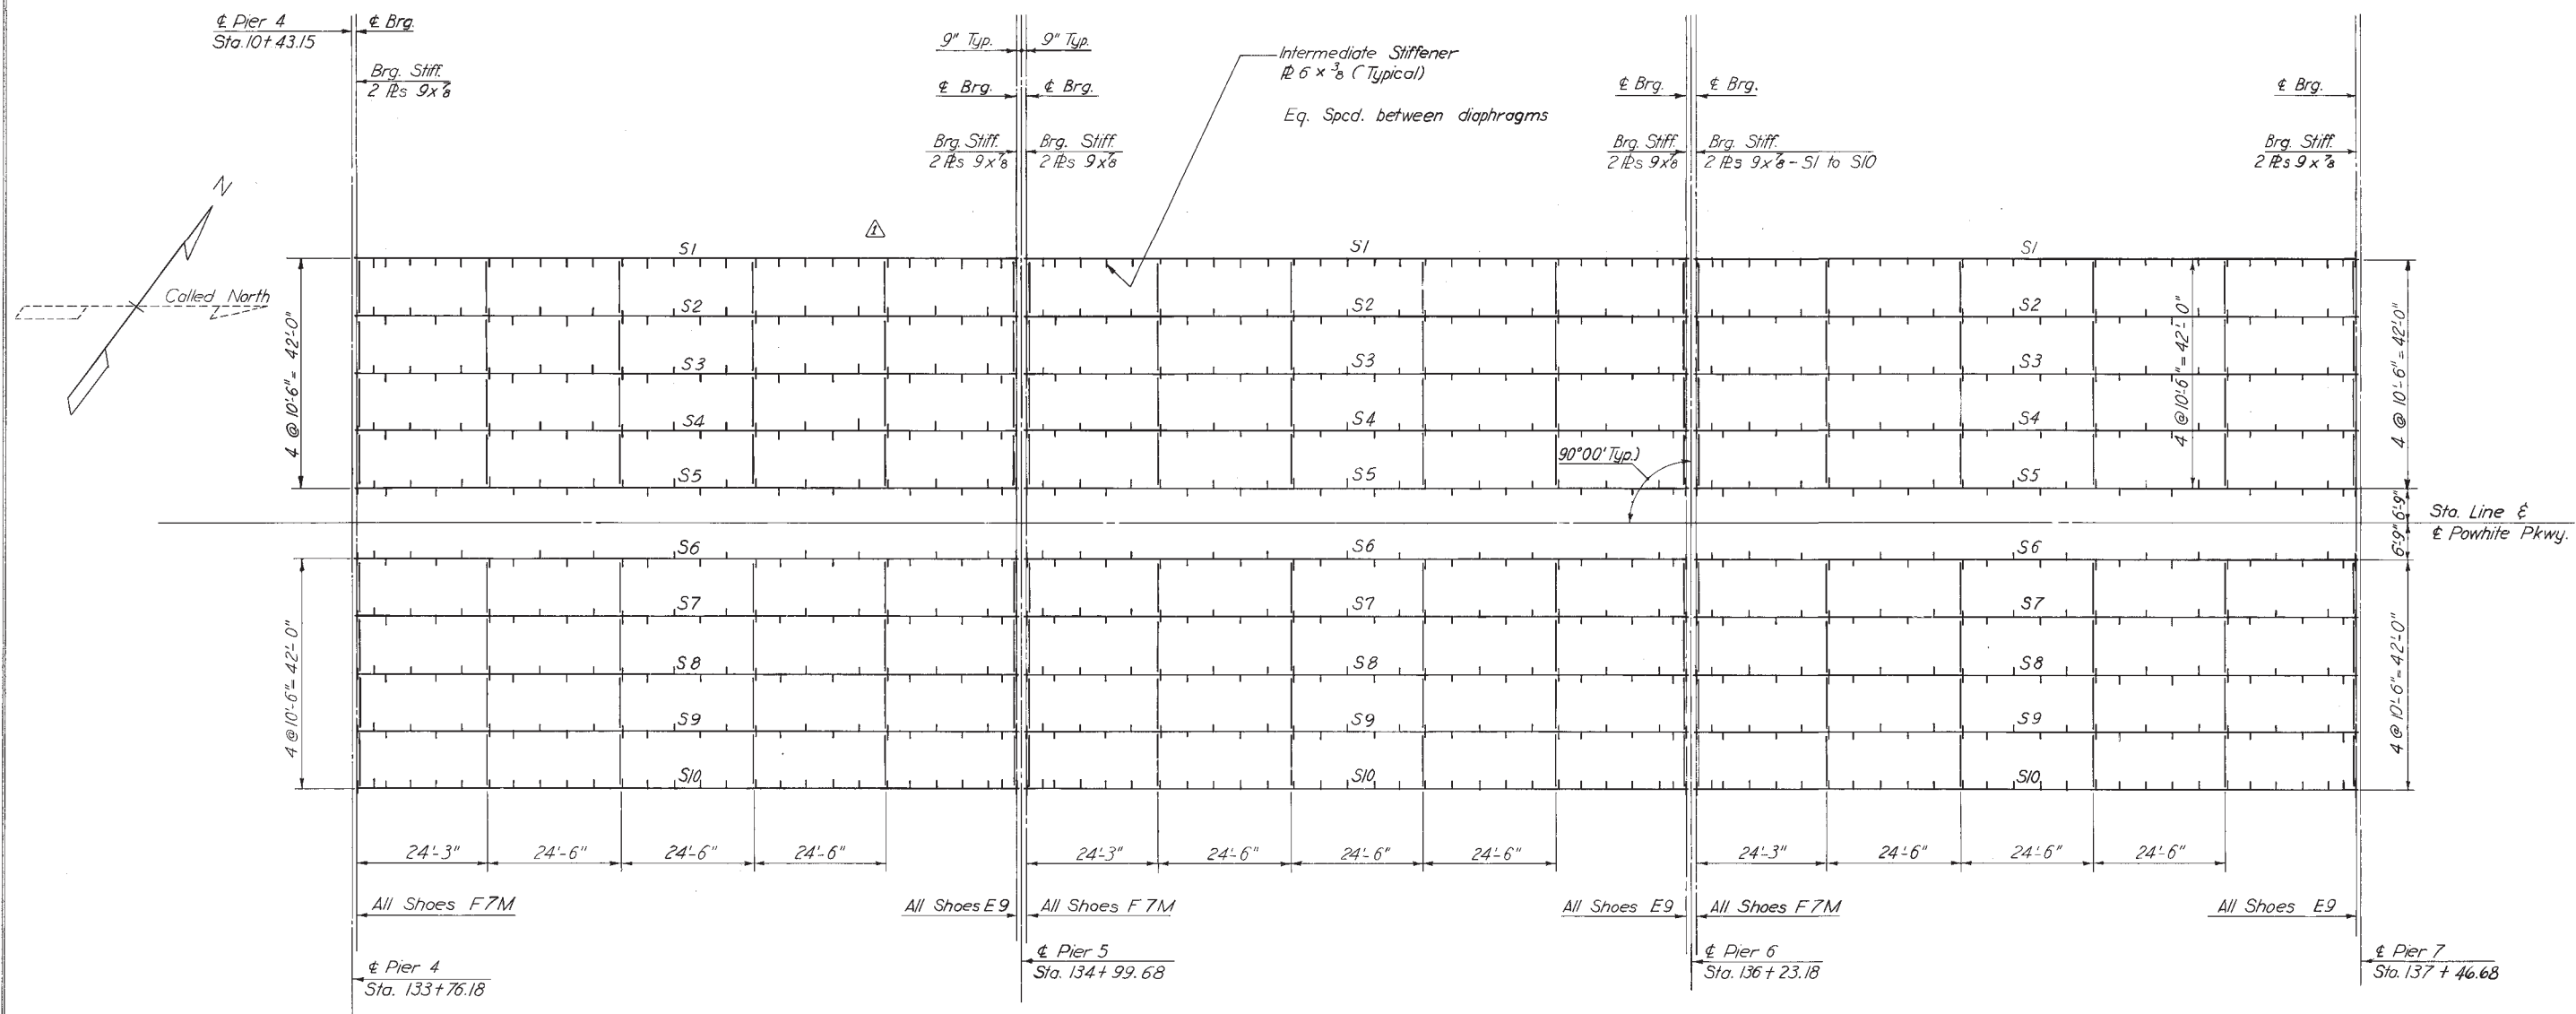

| STRINGER LENGTHS (CC. Bearing) | | |
|--------------------------------|----------|---------|
| Unit | Stringer | Length |
| 5-12 | S1-S10 | 122'-0" |


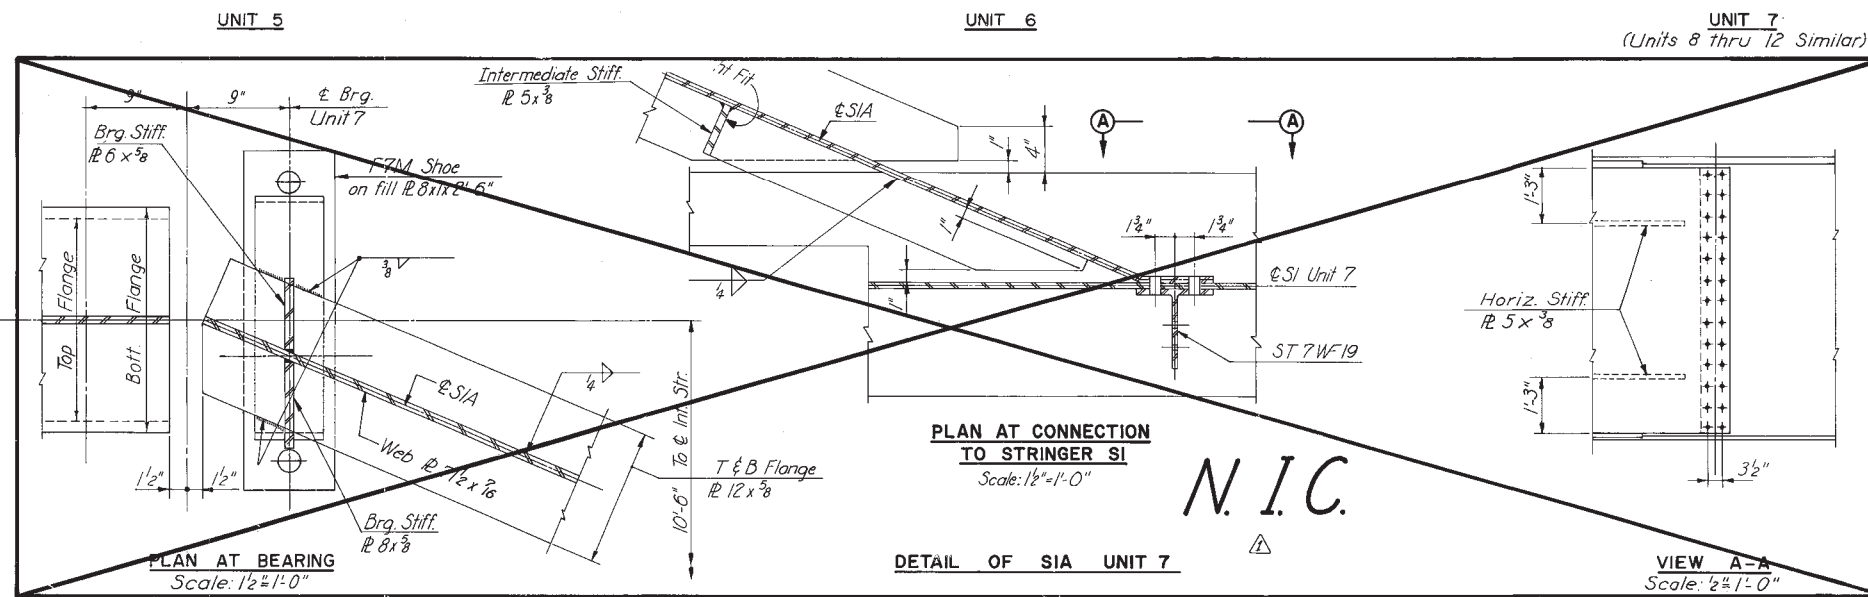


| | | | | | | |
|-----------|-----|------|---|-----------------------|-----|---------|
| MADE | EVR | 7-67 | 2 | AS BUILT | JRC | 12-72 |
| CHECKED | FXH | 8-67 | 1 | Removed Ramp Widening | ER | 2/20/71 |
| IN CHARGE | FXH | | | | | |

RICHMOND METROPOLITAN AUTHORITY
 RICHMOND EXPRESSWAY SYSTEM
JAMES RIVER BRIDGE
FRAMING PLAN UNITS 5 THRU 12

HOWARD, NEEDLES, TAMMEN & BERGENDOFF
 consulting engineers
 NEW YORK ALEXANDRIA KANSAS CITY

SCALE: 1/2" = 1'-0" (Unless Noted)
 CONTRACT NO. C-3
 SHEET NO. 29 OF 53

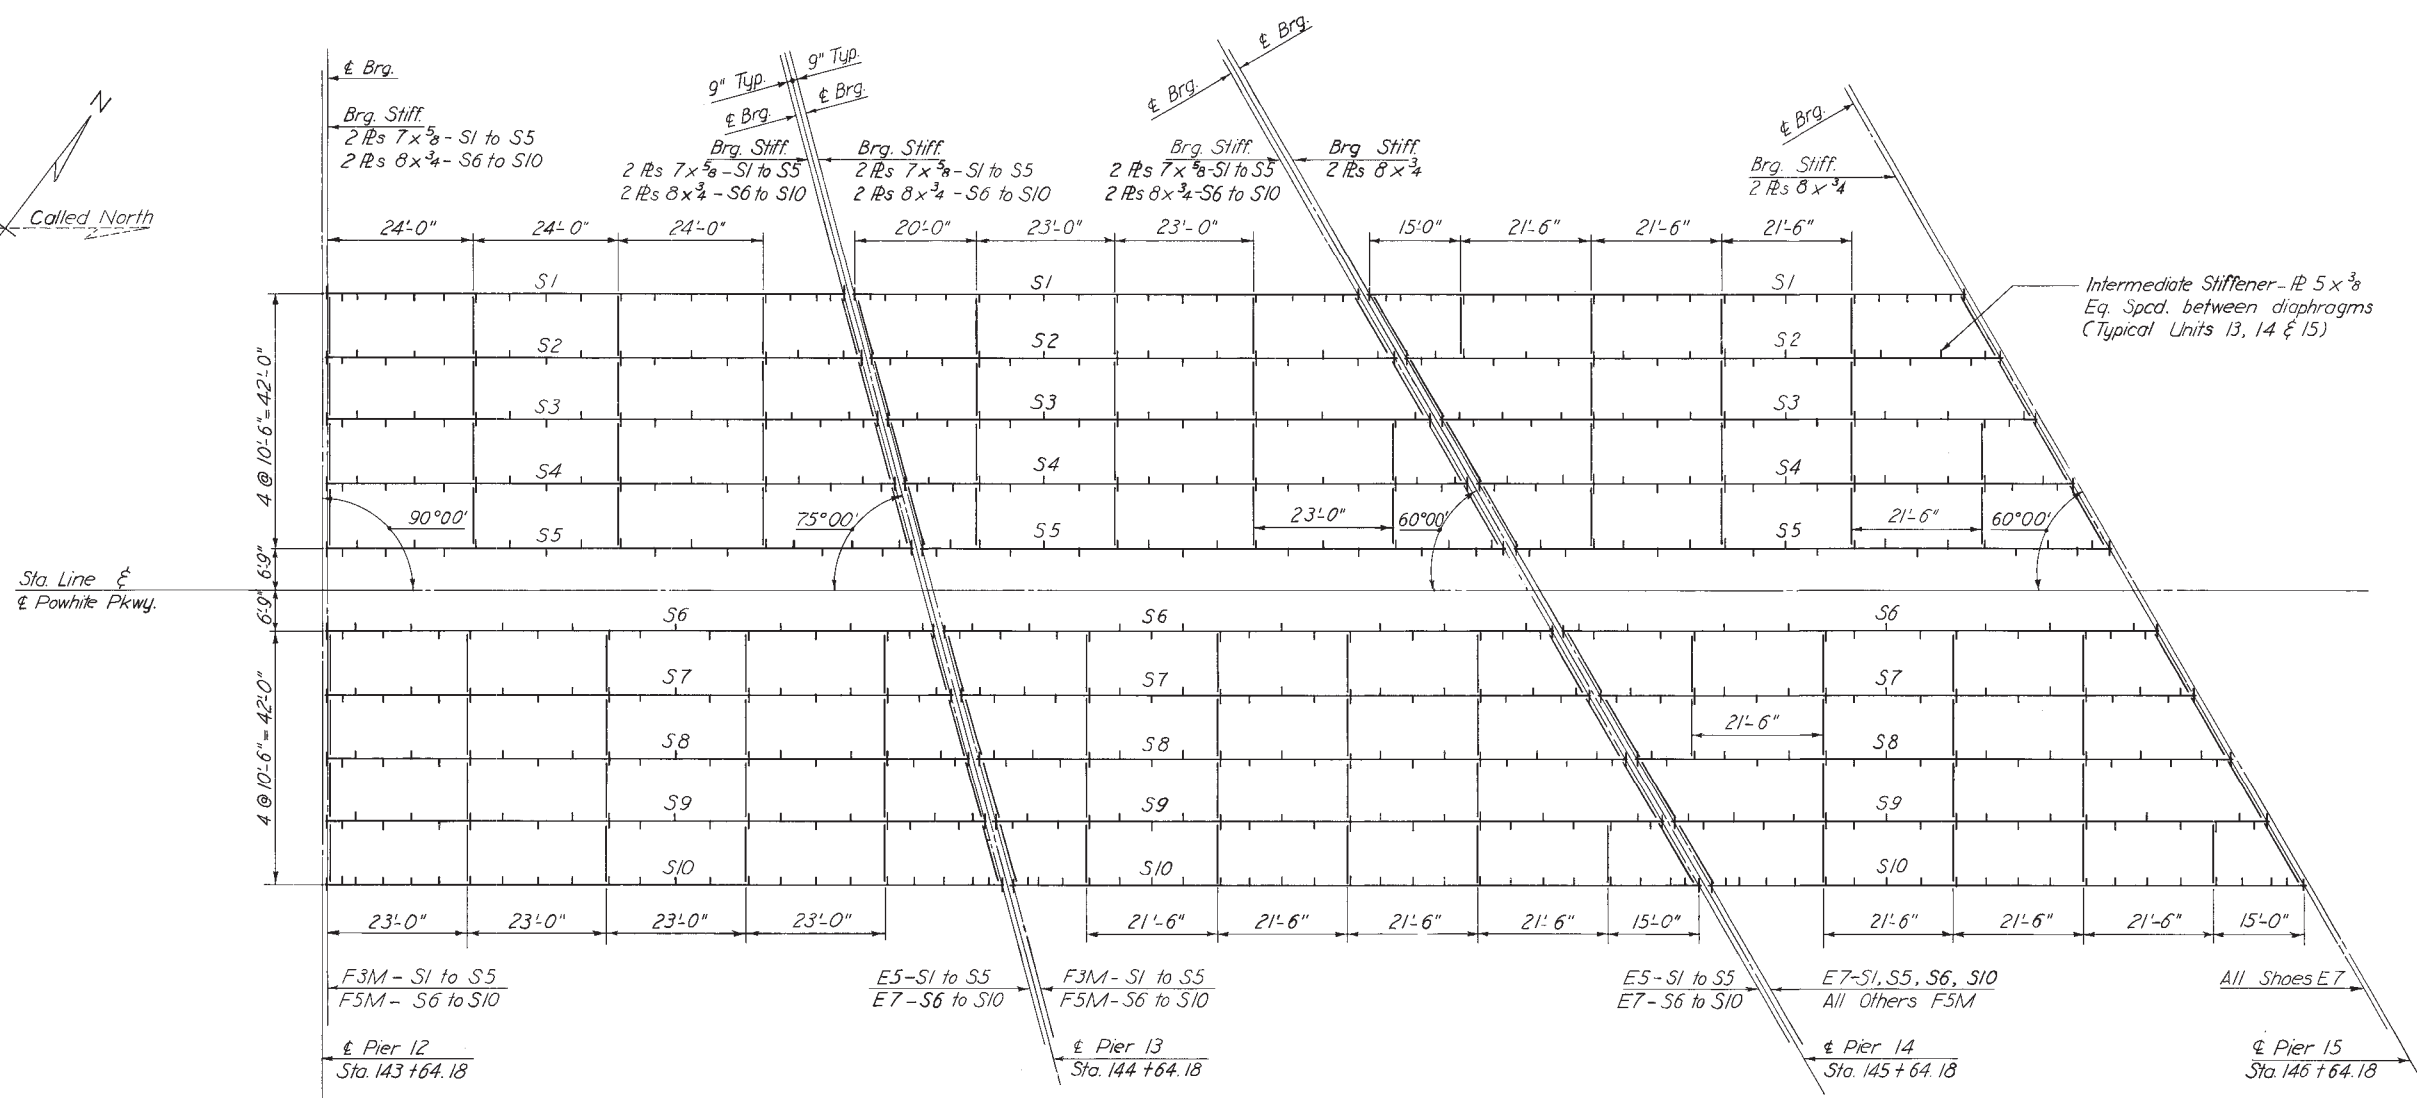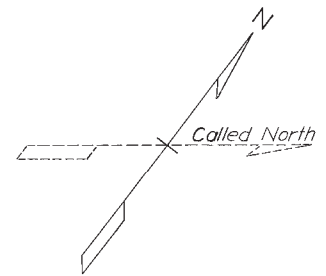

Sta. Line &
Powhite Pkwy.

UNIT 13

UNIT 14

UNIT 15

| STRINGER LENGTHS (c to c Bearing) | | | | | | | | |
|--------------------------------------|----------|---------------------------------------|----------------|----------|--|----------------|----------|--|
| Unit | Stringer | Length | Unit | Stringer | Length | Unit | Stringer | Length |
| 13 | S1 | 85'-4 ¹⁵ / ₁₆ " | 13 (cont'd) | S8 | 105'-10 ⁷ / ₈ " | 14 (cont'd) | S5 | 96'-3 ¹ / ₄ " |
| | S2 | 88'-2 ¹¹ / ₁₆ " | | S9 | 108'-8 ¹¹ / ₁₆ " | | S6 | 100'-5 ³ / ₈ " |
| | S3 | 91'-0 ⁷ / ₁₆ " | | S10 | 111'-6 ⁷ / ₁₆ " | | S7 | 103'-8 ⁵ / ₁₆ " |
| | S4 | 93'-10 ³ / ₁₆ " | 14 | S1 | 83'-3 ⁵ / ₁₆ " | | S8 | 106'-11 ⁵ / ₁₆ " |
| | S5 | 96'-8" | | S2 | 85'-6 ¹ / ₄ " | | S9 | 110'-2 ⁵ / ₁₆ " |
| | S6 | 100'-3 ³ / ₈ " | | S3 | 89'-9 ¹ / ₄ " | | S10 | 113'-5 ⁵ / ₁₆ " |
| | S7 | 103'-1 ¹ / ₈ " | | S4 | 93'-0 ¹ / ₄ " | | S1-S10 | 98'-3 ³ / ₁₆ " |


| | | | | | |
|-----------|-----|------|-----|----------|-----------|
| MADE | BY | DATE | | | |
| | EVR | 7-67 | | | |
| CHECKED | FXH | 8-67 | 1 | AS BUILT | JRC 12-72 |
| IN CHARGE | FXH | | NO. | REVISION | BY DATE |

RICHMOND METROPOLITAN AUTHORITY
RICHMOND EXPRESSWAY SYSTEM

JAMES RIVER BRIDGE
FRAMING PLAN UNITS 13, 14 & 15

HOWARD, NEEDLES, TAMMEN & BERGENDOFF
CONSULTING ENGINEERS
NEW YORK ALEXANDRIA KANSAS CITY

SCALE: 1" = 15'-0"
CONTRACT NO.: C-3
SHEET NO. 30 OF 53

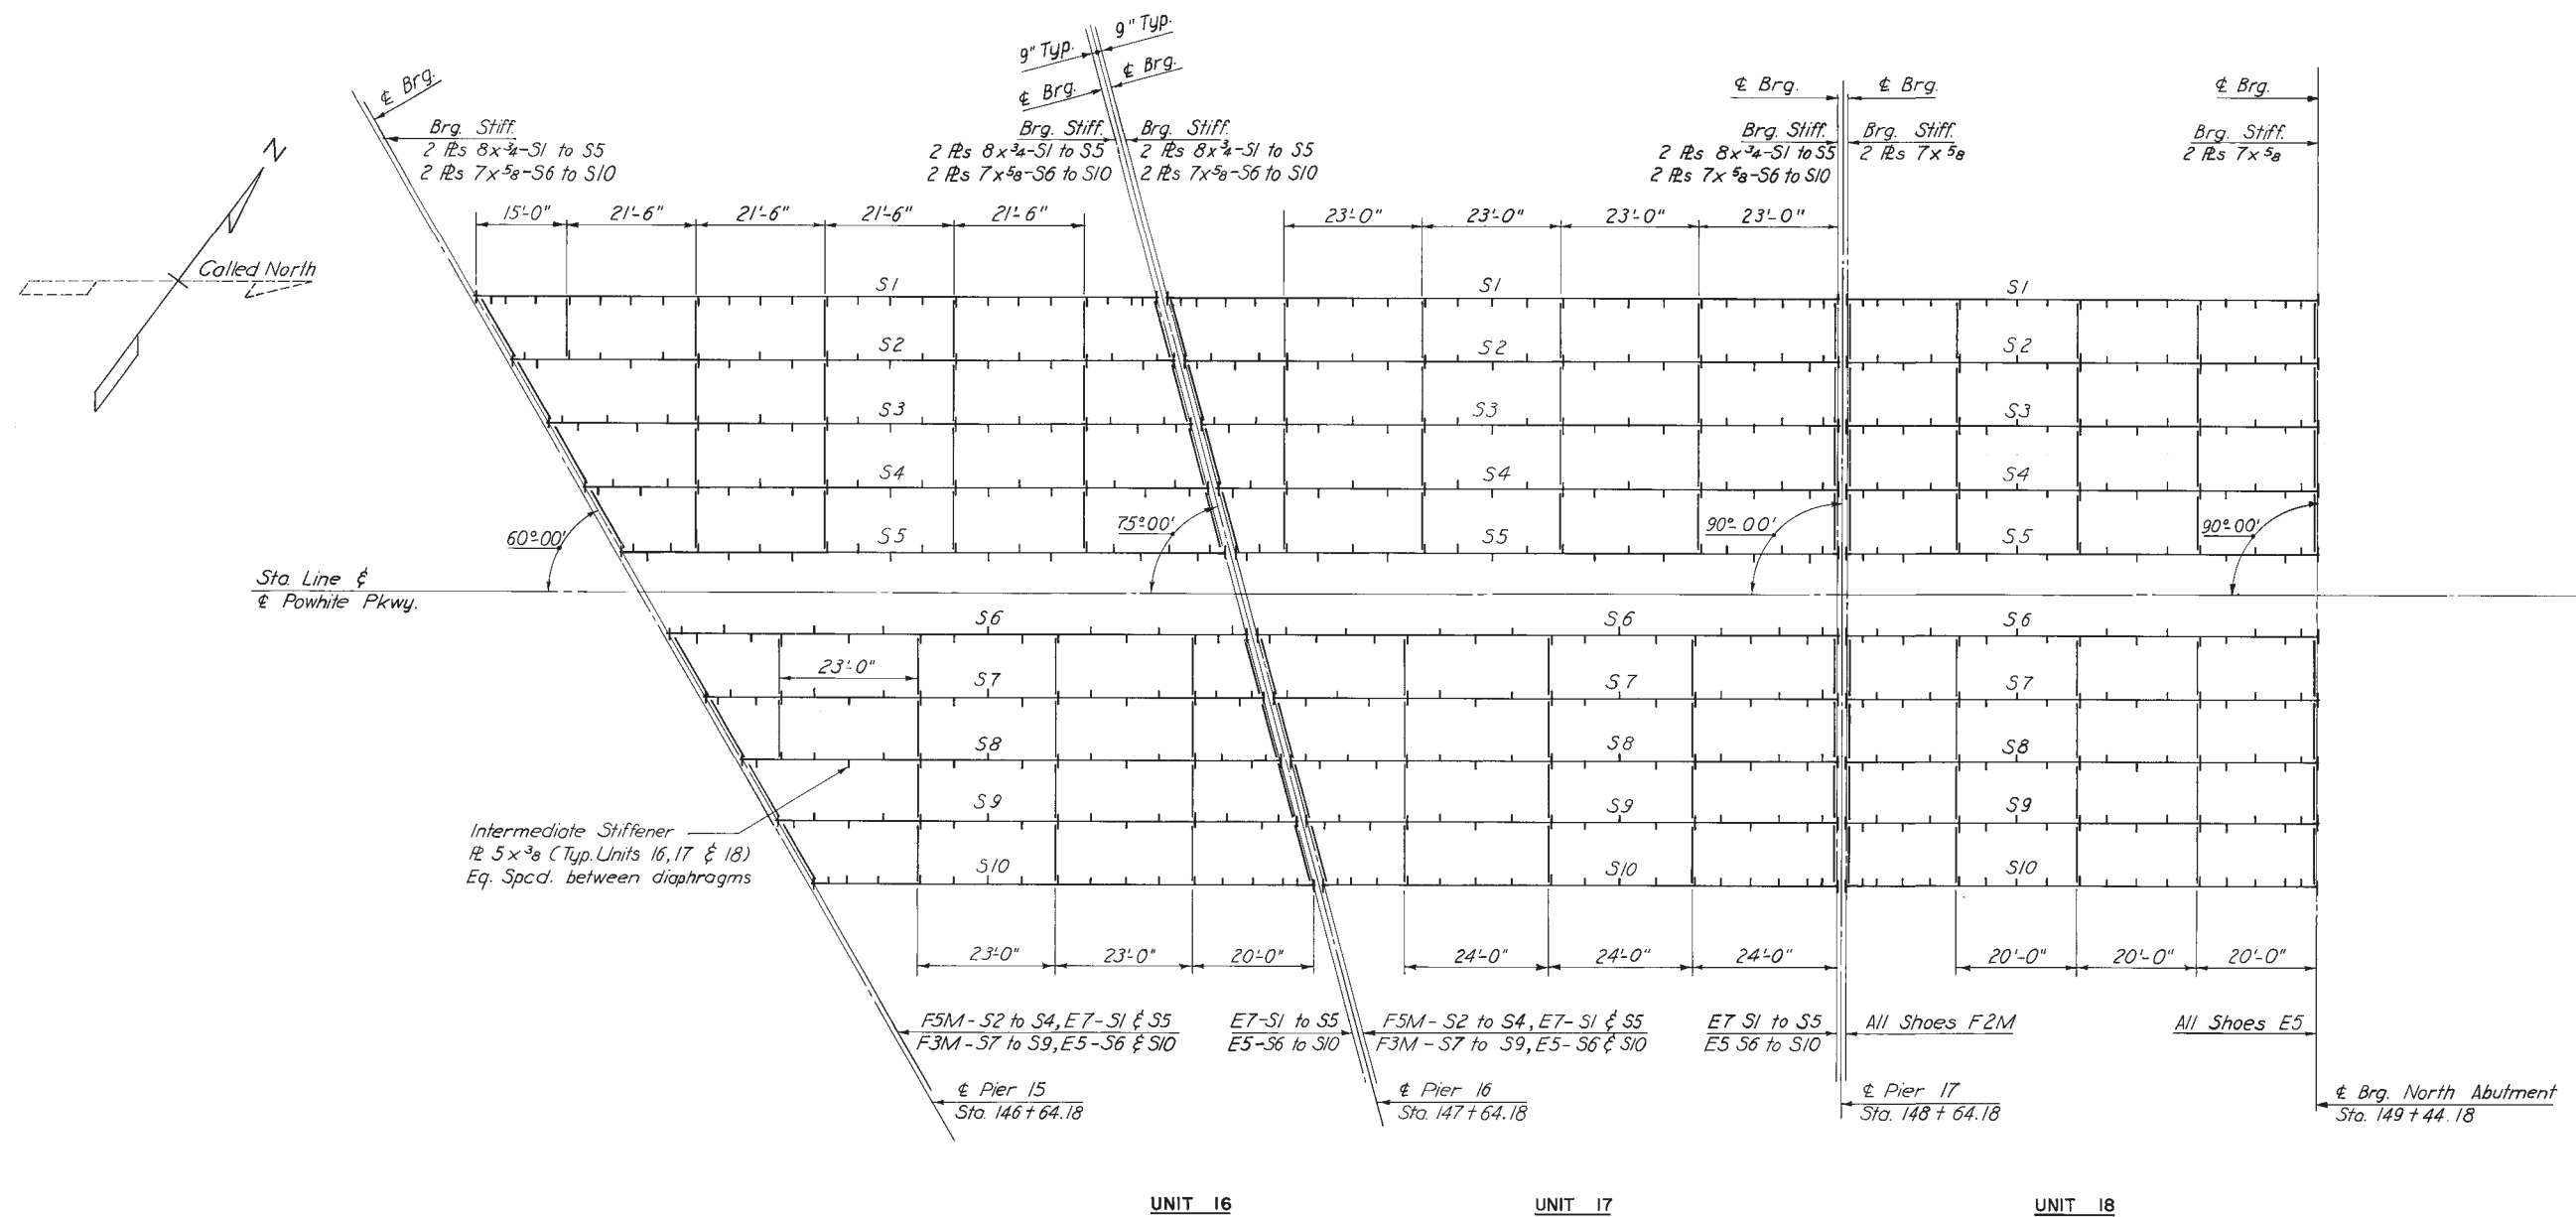

| STRINGER LENGTHS (c to c Bearing) | | | | | | | | |
|--------------------------------------|----------|--|----------------|----------|---------------------------------------|----------------|----------|---------------------------------------|
| Unit | Stringer | Length | Unit | Stringer | Length | Unit | Stringer | Length |
| 16 | S1 | 113'-5 ⁵ / ₁₆ " | 16 (cont'd) | S8 | 89'-9 ¹ / ₄ " | 17 (cont'd) | S5 | 100'-3 ³ / ₈ " |
| | S2 | 110'-2 ⁵ / ₁₆ " | | S9 | 85'-6 ¹ / ₄ " | | S6 | 96'-8" |
| | S3 | 106'-11 ⁵ / ₁₆ " | | S10 | 83'-3 ⁵ / ₁₆ " | | S7 | 93'-10 ³ / ₁₆ " |
| | S4 | 103'-8 ⁵ / ₁₆ " | | S1 | 111'-6 ¹ / ₁₆ " | | S8 | 91'-0 ⁷ / ₁₆ " |
| | S5 | 100'-5 ³ / ₈ " | 17 | S2 | 108'-8 ¹ / ₁₆ " | | S9 | 88'-2 ¹ / ₁₆ " |
| | S6 | 96'-3 ¹ / ₄ " | | S3 | 105'-10 ⁷ / ₈ " | | S10 | 85'-4 ¹⁵ / ₁₆ " |
| | S7 | 93'-0 ⁴ / ₁₆ " | | S4 | 103'-1 ⁸ / ₈ " | | S1-S10 | 79'-3" |

| | | | | | |
|-----------|------|------|-----|----------|-----------|
| BY | DATE | | | | |
| MADE | EVR | 7-67 | | | |
| CHECKED | FXH | 8-67 | 1 | AS BUILT | JRC 12-72 |
| IN CHARGE | FXH | | NO. | REVISION | BY DATE |


RICHMOND METROPOLITAN AUTHORITY
RICHMOND EXPRESSWAY SYSTEM

JAMES RIVER BRIDGE
FRAMING PLAN UNITS 16, 17 & 18


HOWARD, NEEDLES, TAMMEN & BERGENDOFF
consulting engineers
NEW YORK ALEXANDRIA KANSAS CITY

SCALE: 1" = 15'-0"
CONTRACT NO.: C-3
SHEET NO. 31 OF 53


| RICHMOND EXPRESSWAY SYSTEM | | | |
|----------------------------|--------------------|-----------|--------------|
| SECTION | PROJECT | SHEET NO. | TOTAL SHEETS |
| 3 | JAMES RIVER BRIDGE | 32 | 53 |

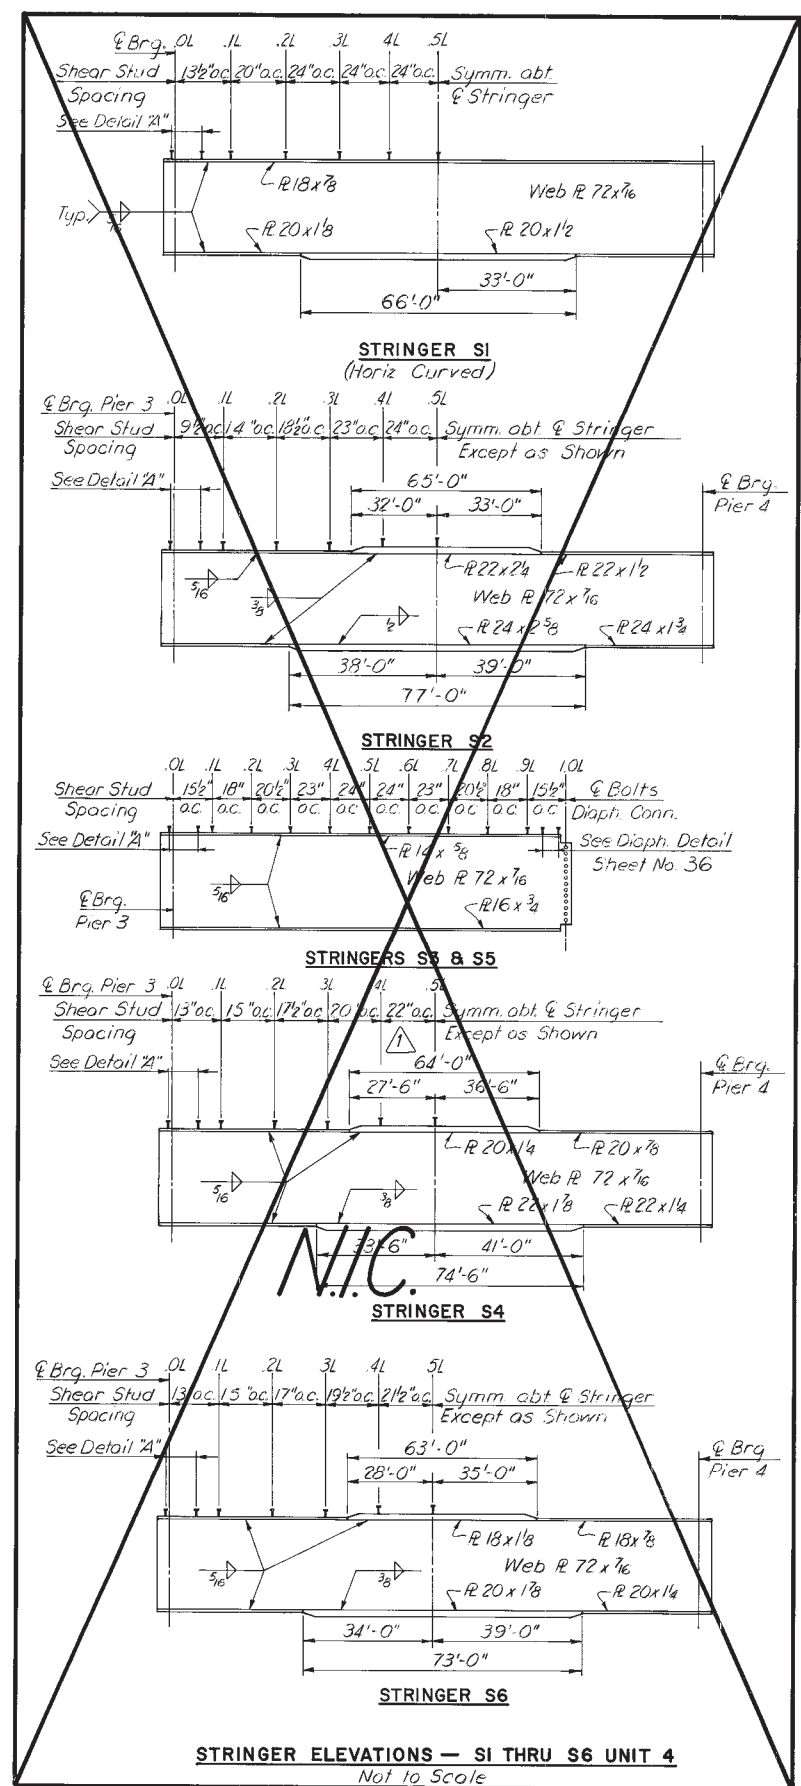

STRINGER ELEVATIONS — SI THRU S6 UNIT 4
Not to Scale

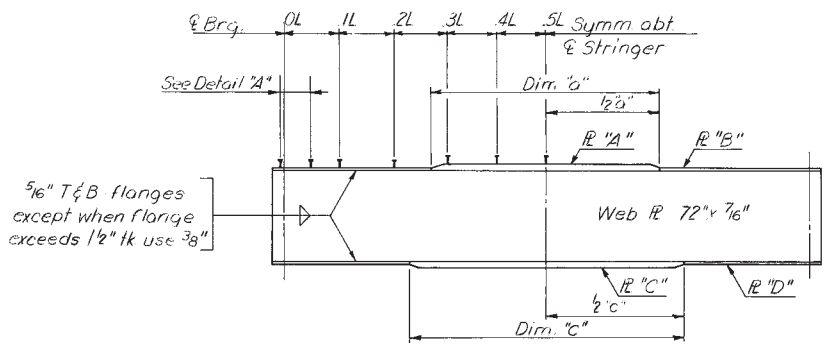


TYPICAL STRINGER ELEVATION
Not to Scale

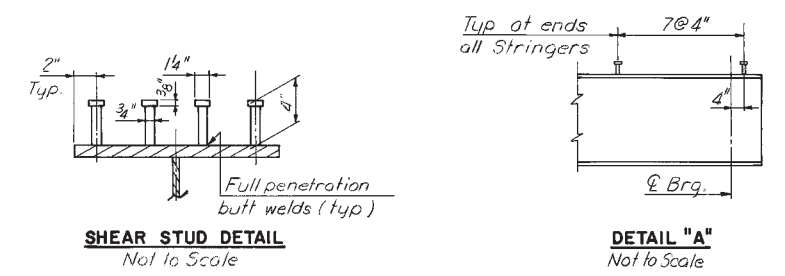

SHEAR STUD DETAIL
Not to Scale

DETAIL "A"
Not to Scale

SHEAR STUD NOTE:
Capacity = 3400 lbs. per stud.
The contractor may, if he elects, use three 7/8" diameter studs at the same longitudinal spacing in lieu of four 3/4" diameter studs shown.
Stud rows shall be placed parallel to the main deck reinforcing.
Shear stud spacing shown is maximum spacing.

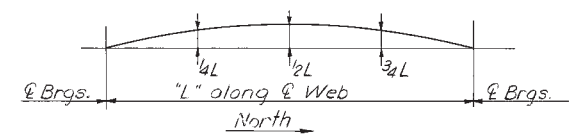

CAMBER DIAGRAM

NOTE TO FABRICATOR:
Stringers fabricated with an upward camber amounting to (see table). This will provide approximate compensation for deflection under full dead load.

| STRINGER SCHEDULE | | | | | | | | | | | | | | | | | | | |
|-------------------|--------------|-----------|----------|---------|-----------|----------|-----------|--------------------|---------|---------|---------|---------|--|--|--|--|--|--|--|
| UNIT | STRINGER | R "A" | Dim. "a" | R "B" | R "C" | Dim. "c" | R "D" | SHEAR STUD SPACING | | | | | | | | | | | |
| | | | | | | | | 0L-1L | 1L-2L | 2L-3L | 3L-4L | 4L-5L | | | | | | | |
| 1 | S5&S6 | 14x 5/8 | F.L. | — | 16x 7/8 | F.L. | — | 12" | 13 1/2" | 15" | 18 1/2" | 20 1/2" | | | | | | | |
| | SI-S4,S7-S10 | 14x 5/8 | F.L. | — | 16x 1 | 40'-6" | 16x 3/4 | 11 1/2" | 13 1/2" | 15 1/2" | 18" | 20" | | | | | | | |
| 2 | S5&S6 | 16x 3/4 | F.L. | — | 18x 1 1/2 | 54'-0" | 18x 7/8 | 13 1/2" | 15 1/2" | 18 1/2" | 24" | 24" | | | | | | | |
| | SI-S4,S7-S10 | 16x 3/4 | F.L. | — | 18x 1 1/2 | 52'-6" | 18x 7/8 | 13 1/2" | 15 1/2" | 18 1/2" | 21 1/2" | 24" | | | | | | | |
| 3 | S5&S6 | 16x 3/4 | F.L. | — | 18x 1 3/8 | 60'-6" | 18x 7/8 | 12" | 14" | 18" | 22" | 24" | | | | | | | |
| | SI-S4,S7-S10 | 16x 3/4 | F.L. | — | 18x 1 1/2 | 56'-6" | 18x 7/8 | 13" | 15" | 17 1/2" | 20 1/2" | 22 1/2" | | | | | | | |
| 4 | SI-S4,S7-S10 | 18x 1 1/2 | 62'-0" | 18x 7/8 | 20x 1 1/8 | 74'-6" | 20x 1 1/4 | 12 1/2" | 14 1/2" | 17 1/2" | 21" | 23" | | | | | | | |
| | S5&S6 | 18x 1 1/2 | 59'-0" | 18x 7/8 | 20x 1 1/8 | 72'-0" | 20x 1 1/4 | 12 1/2" | 14 1/2" | 18 1/2" | 23 1/2" | 24" | | | | | | | |
| 5 | S5&S6 | 18x 1 1/4 | 66'-0" | 18x 7/8 | 20x 2 | 73'-0" | 20x 1 3/8 | 12 1/2" | 14 1/2" | 17 1/2" | 24" | 24" | | | | | | | |
| | SI-S4,S7-S10 | 18x 1 1/4 | 68'-6" | 18x 7/8 | 20x 2 | 75'-6" | 20x 1 3/8 | 12 1/2" | 14 1/2" | 17 1/2" | 21 1/2" | 23 1/2" | | | | | | | |
| 6 | S5&S6 | 18x 1 1/4 | 66'-0" | 18x 7/8 | 20x 2 | 73'-0" | 20x 1 3/8 | 12 1/2" | 14 1/2" | 17 1/2" | 24" | 24" | | | | | | | |
| | SI-S4,S7-S10 | 18x 1 1/4 | 68'-6" | 18x 7/8 | 20x 2 | 75'-6" | 20x 1 3/8 | 12 1/2" | 14 1/2" | 17 1/2" | 21 1/2" | 23 1/2" | | | | | | | |
| 7 Thru 12 | S5&S6 | 18x 1 1/4 | 66'-0" | 18x 7/8 | 20x 2 | 73'-0" | 20x 1 3/8 | 12 1/2" | 14 1/2" | 17 1/2" | 24" | 24" | | | | | | | |
| | SI-S4,S7-S10 | 18x 1 1/4 | 68'-6" | 18x 7/8 | 20x 2 | 75'-6" | 20x 1 3/8 | 12 1/2" | 14 1/2" | 17 1/2" | 21 1/2" | 23 1/2" | | | | | | | |
| 13 | S1 | 14x 5/8 | F.L. | — | 16x 1 1/8 | 51'-0" | 16x 3/4 | 11 1/2" | 13" | 15 1/2" | 18" | 20" | | | | | | | |
| | S2 | 14x 5/8 | F.L. | — | 16x 1 1/4 | 51'-0" | 16x 7/8 | 11 1/2" | 13 1/2" | 15 1/2" | 18" | 20" | | | | | | | |
| 14 | S3 | 14x 5/8 | F.L. | — | 16x 1 3/8 | 55'-6" | 16x 7/8 | 11 1/2" | 13 1/2" | 16 1/2" | 18 1/2" | 20" | | | | | | | |
| | S4 | 14x 5/8 | F.L. | — | 16x 1 1/2 | 55'-6" | 16x 1 | 12" | 13 1/2" | 15 1/2" | 18 1/2" | 20" | | | | | | | |
| 15 | S5 | 14x 5/8 | F.L. | — | 16x 1 1/2 | 57'-0" | 16x 1 | 12" | 14" | 16 1/2" | 21" | 24" | | | | | | | |
| | S6 | 16x 3/4 | F.L. | — | 18x 1 3/8 | 62'-6" | 18x 7/8 | 12" | 14" | 17 1/2" | 22" | 24" | | | | | | | |
| 16 | S7 | 16x 3/4 | F.L. | — | 18x 1 1/2 | 61'-0" | 18x 1 1/8 | 12" | 14" | 16" | 19 1/2" | 21" | | | | | | | |
| | S8 | 16x 1 | 51'-0" | 16x 3/4 | 18x 1 3/4 | 66'-6" | 18x 1 1/8 | 12" | 14" | 17" | 19 1/2" | 21 1/2" | | | | | | | |
| 17 | S9 | 16x 1 | 57'-0" | 16x 3/4 | 18x 1 3/8 | 67'-0" | 18x 1 1/4 | 12" | 14" | 17" | 20" | 22" | | | | | | | |
| | S10 | 16x 1 1/8 | 63'-6" | 16x 3/4 | 18x 1 1/2 | 68'-6" | 18x 1 3/8 | 12 1/2" | 14" | 16 1/2" | 20 1/2" | 22 1/2" | | | | | | | |
| 18 | S1 | 16x 1 1/8 | 63'-6" | 16x 3/4 | 18x 1 1/2 | 68'-6" | 18x 1 3/8 | 12 1/2" | 14" | 16 1/2" | 20 1/2" | 22 1/2" | | | | | | | |
| | S2 | 16x 1 | 57'-0" | 16x 3/4 | 18x 1 1/8 | 67'-0" | 18x 1 1/4 | 12" | 14" | 17" | 20" | 22" | | | | | | | |
| 13 & 14 | S3 | 16x 1 | 51'-0" | 16x 3/4 | 18x 1 3/8 | 66'-6" | 18x 1 1/8 | 12" | 14" | 17" | 19 1/2" | 21 1/2" | | | | | | | |
| | S4 | 16x 7/8 | F.L. | — | 18x 1 1/8 | 61'-0" | 18x 1 1/2 | 12" | 14" | 16" | 19 1/2" | 21" | | | | | | | |
| 13 & 14 | S5 | 16x 3/4 | F.L. | — | 18x 1 1/2 | 62'-6" | 18x 7/8 | 12" | 14" | 17 1/2" | 22" | 24" | | | | | | | |
| | S6 | 14x 3/4 | F.L. | — | 16x 1 1/2 | 57'-0" | 16x 1 | 12" | 14" | 16 1/2" | 21" | 24" | | | | | | | |
| 13 & 14 | S7 | 14x 5/8 | F.L. | — | 16x 1 1/2 | 55'-6" | 16x 1 | 12" | 13 1/2" | 15 1/2" | 18 1/2" | 20" | | | | | | | |
| | S8 | 14x 5/8 | F.L. | — | 16x 1 3/8 | 55'-6" | 16x 7/8 | 11 1/2" | 13 1/2" | 16 1/2" | 18 1/2" | 20" | | | | | | | |
| 13 & 14 | S9 | 14x 3/8 | F.L. | — | 16x 1 1/4 | 51'-0" | 16x 7/8 | 11 1/2" | 13 1/2" | 15 1/2" | 18" | 20" | | | | | | | |
| | S10 | 14x 5/8 | F.L. | — | 16x 1 1/8 | 51'-0" | 16x 3/4 | 11 1/2" | 13" | 15 1/2" | 18" | 20" | | | | | | | |
| 13 & 14 | SI-S4,S7-S10 | 14x 5/8 | F.L. | — | 16x 1 | 40'-6" | 16x 3/4 | 11 1/2" | 13 1/2" | 15 1/2" | 18" | 20" | | | | | | | |
| | S5&S6 | 14x 5/8 | F.L. | — | 16x 7/8 | F.L. | — | 12" | 13 1/2" | 15" | 18 1/2" | 20 1/2" | | | | | | | |

NOTES:
For General Notes see sheet no. 4.
For Joint Details see sheet no. 35.
For Shoe Details see sheet no. 34.
Scupper locations shown on Deck Plans. For Scupper Details see sheet no. 36.
For stringer lengths see Framing Plans.


| CAMBER SCHEDULE | | | | | | | | | | | | |
|-----------------|--------------|----------|--------|----|--------|--------|----|---------|----------|----------|--------|--------|
| UNIT | STRINGER | 4 @ 3/4" | | | 1 1/2" | | | UNIT | STRINGER | 4 @ 3/4" | | |
| | | 3/4" | 1 1/2" | 1" | 3/4" | 1 1/2" | 1" | | | 3/4" | 1 1/2" | |
| 1 | SI-S10 | 3/4" | 1 1/2" | 1" | 3/4" | 1 1/2" | 1" | 13 & 14 | S6 | 1 3/8" | 1 1/2" | 1 1/2" |
| | | 1 1/2" | 1 3/4" | | 1 1/2" | 1 3/4" | | | S7 | 1 1/2" | 2 1/8" | 2 1/8" |
| 2 | SI-S10 | 1 1/2" | 1 3/4" | | 1 1/2" | 1 3/4" | | 15 | S8 | 1 5/8" | 2 1/4" | 2 1/4" |
| | | 1 3/8" | 1 3/4" | | 1 3/8" | 1 3/4" | | | S9 | 1 5/8" | 2 1/4" | 2 1/4" |
| 3 | SI-S10 | 1 3/8" | 1 3/4" | | 1 3/8" | 1 3/4" | | 16 & 17 | S10 | 1 7/8" | 2 1/2" | 2 1/2" |
| | | 1 3/8" | 1 3/4" | | 1 3/8" | 1 3/4" | | | SI-S10 | 1 3/8" | 1 1/2" | 1 1/2" |
| 4 | SI-S10 | 2" | 2 3/4" | | 2" | 2 3/4" | | 18 | S1 | 1 7/8" | 2 1/2" | 2 1/2" |
| | S5&S6 | 2 1/8" | 3" | | 2 1/8" | 3" | | | S2 | 1 3/4" | 2 3/8" | 2 3/8" |
| 5 | SI-S4,S7-S10 | 2 1/8" | 2 3/8" | | 2 1/8" | 2 3/8" | | 16 | S3 | 1 5/8" | 2 1/4" | 2 1/4" |
| | | 2 1/8" | 2 3/8" | | 2 1/8" | 2 3/8" | | | S4 | 1 1/2" | 2 1/8" | 2 1/8" |
| 6 | SI-S4,S7-S10 | 2 1/8" | 2 3/8" | | 2 1/8" | 2 3/8" | | 17 | S5 | 1 3/8" | 1 3/4" | 1 3/4" |
| | | 2 1/8" | 2 3/8" | | 2 1/8" | 2 3/8" | | | S6&S7 | 1 1/4" | 1 3/4" | 1 3/4" |
| 7 Thru 12 | SI-S4,S7-S10 | 2 1/8" | 2 3/8" | | 2 1/8" | 2 3/8" | | 18 | S8 | 1 1/8" | 1 1/2" | 1 1/2" |
| | S5&S6 | 2 1/8" | 3" | | 2 1/8" | 3" | | | S9 | 1" | 1 3/8" | 1 3/8" |
| 13 & 14 | SI | 1" | 1 1/8" | | 1" | 1 1/8" | | 18 | S10 | 1 3/8" | 1 1/2" | 1 1/2" |
| | S2 | 1" | 1 3/8" | | 1" | 1 3/8" | | | SI-S10 | 3/4" | 1" | 1" |
| 13 & 14 | S3 | 1 1/8" | 1 1/2" | | 1 1/8" | 1 1/2" | | | | | | |
| | S4&S5 | 1 1/4" | 1 3/4" | | 1 1/4" | 1 3/4" | | | | | | |

RICHMOND METROPOLITAN AUTHORITY
RICHMOND EXPRESSWAY SYSTEM


JAMES RIVER BRIDGE
STRUCTURAL STEEL DETAILS

HOWARD, NEEDLES, TAMMEN & BERGENDOFF
consulting engineers
NEW YORK ALEXANDRIA KANSAS CITY
SCALE: AS SHOWN
CONTRACT NO. C-3
SHEET NO. 32 OF 53


| | | | | | |
|-----------|----------|-----|-------------------------|--------|---------|
| BY | DATE | | | | |
| MADE | HBW 7-67 | 2 | AS BUILT | JRC | 12-72 |
| CHECKED | FXH 8-67 | 1 | Remove Ramp Toper Strs. | H.B.W. | 2/20/71 |
| IN CHARGE | FXH | NO. | REVISION | BY | DATE |

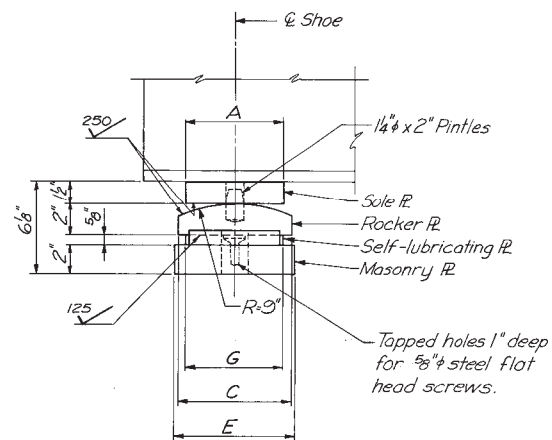


SIDE ELEVATION

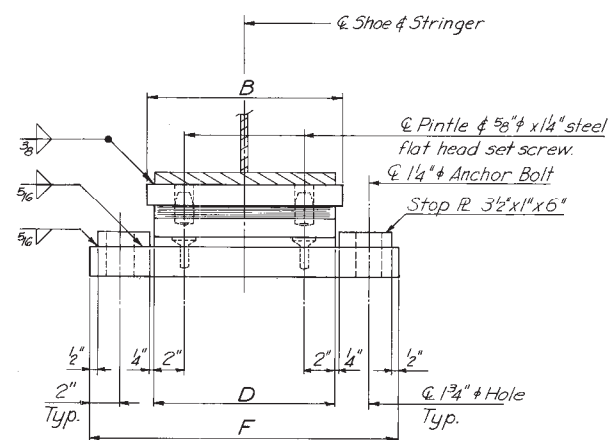

END ELEVATION

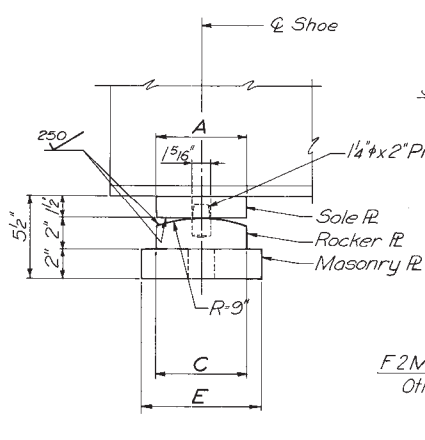


SIDE ELEVATION

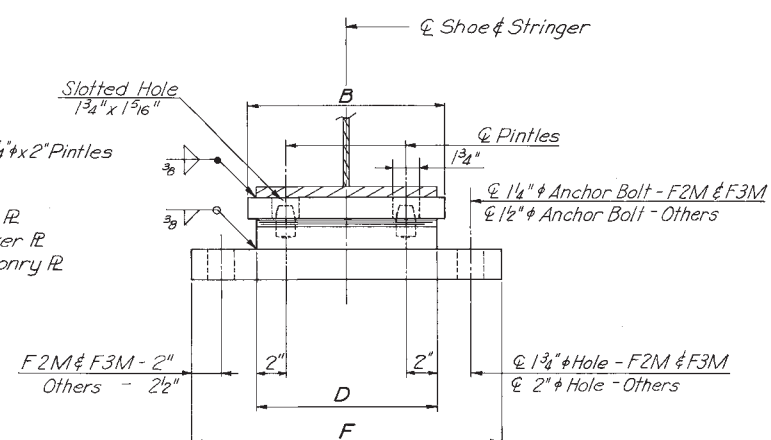


END ELEVATION

EXPANSION SHOE

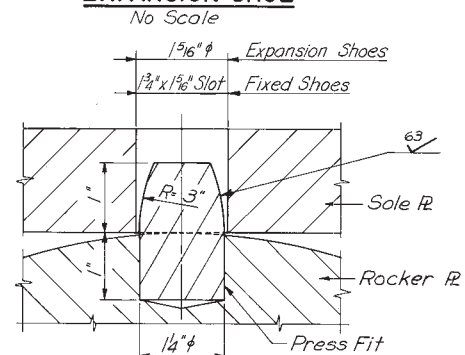

PINTLE DETAIL


Scale: 3/4" = 1"

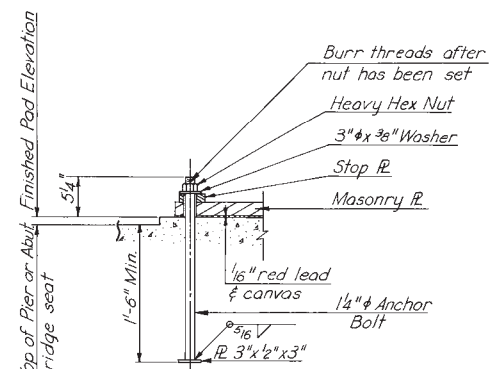

EXPANSION SHOE

ANCHOR BOLT DETAIL

No Scale

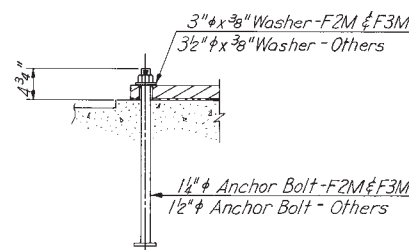

FIXED SHOE

Note:

Anchor Bolt for Fixed Shoes same as Anchor Bolt for Exp. Shoes except as shown.

Shoe Notes:

Top of masonry plates, bottom of rocker plates and top and bottom of sole plates planed, straightened or otherwise treated to secure true level surfaces. Contact surfaces noted on the plans with finish symbols shall be finished in accordance with the American National Standards Institute surface roughness requirement, as defined in ASA B46.1 Surface Roughness, Waviness and Lay, Part I. The plates comprising the expansion shoes shall be set so as to be truly centered under full dead load at a temperature of 68°F. Concrete pads shall be formed integral with abutment or pier and not less than 6" or more than 4" above finished elevation. Dress down pads by rubbing, grinding or as otherwise approved by the Engineer, to true level surfaces at the finished elevation. Anchor bolt assemblies shall conform to A.S.T.M. A-307 and shall be hot-dip galvanized conforming to A.S.T.M. A-153. Templates shall be used to accurately set the anchor bolts. Material for shoes (exclusive of self-lubricating plates) shall be high strength low alloy structural steel conforming to A.S.T.M. Specification A-588. Material for self-lubricating plates shall be Leaded Tin Bronze conforming to A.S.T.M. Specification B22, alloy D modified to the extent that 1.5 to 2.5 percent lead is allowable. Shoes shall be included with structural steel item for payment.

| SHOE DIMENSIONS | | | | | | | | | | | | | | |
|-----------------|----|---------|--------|----------|----------|----------|----------|-------------|----|---------|----|----------|--------|----------|
| EXPANSION SHOES | A | B | C | D | E | F | G | FIXED SHOES | A | B | C | D | E | F |
| | E4 | 6" | 1-5/8" | 8" | 1-4 1/2" | 9 1/2" | 2-1 1/2" | | 6" | F2M | 6" | 1-5/8" | 6" | 1-4 1/2" |
| E5 | 6" | 1-5/8" | 9" | 1-4 1/2" | 9 1/2" | 2-1 1/2" | 7" | F3M | 6" | 1-5/8" | 6" | 1-4 1/2" | 8" | 2-1 1/2" |
| E6 | 6" | 1-7/8" | 8" | 1-6" | 8 1/2" | 2-2 1/2" | 6" | F4M | 6" | 1-7/8" | 6" | 1-6" | 7" | 2-4" |
| E7 | 6" | 1-7/8" | 9 1/2" | 1-6" | 10 1/2" | 2-2 1/2" | 7 1/2" | F5M | 6" | 1-7/8" | 6" | 1-6" | 8" | 2-4" |
| E8 | 6" | 1-9/8" | 9" | 1-9" | 9 1/2" | 2-2 1/2" | 6 1/2" | F6M | 6" | 1-9/8" | 6" | 1-9" | 7 1/2" | 2-6" |
| E9 | 6" | 1-9/8" | 10" | 1-8" | 11" | 2-4 1/2" | 7 1/2" | F7M | 6" | 1-9/8" | 6" | 1-8" | 8" | 2-6" |
| E11 | 6" | 1-11/8" | 10" | 1-10" | 11" | 2-6 1/2" | 7 1/2" | F9M | 6" | 1-11/8" | 6" | 1-10" | 8" | 2-8" |
| E12 | 6" | 2-1/8" | 9" | 2-0" | 9 1/2" | 2-8 1/2" | 6 1/2" | F10M | 6" | 2-1/8" | 6" | 2-0" | 7" | 2-10" |
| E14 | 6" | 2-1/8" | 10" | 2-0" | 11" | 2-8 1/2" | 9 1/2" | | | | | | | |

| | | | | | |
|-----------|------|------|-----|--------------|----------------|
| BY | DATE | | | | |
| MADE | HBW | 5-67 | 2 | AS BUILT | JRC 12-72 |
| CHECKED | FXH | 8-67 | Δ | Delete Shoes | H.B.W. 2/20/77 |
| IN CHARGE | FXH | | NO. | REVISION | BY DATE |


RICHMOND METROPOLITAN AUTHORITY
RICHMOND EXPRESSWAY SYSTEM

JAMES RIVER BRIDGE
SHOES


HOWARD, NEEDLES, TAMMEN & BERGENDOFF
consulting engineers
NEW YORK ALEXANDRIA KANSAS CITY

SCALE: AS SHOWN
CONTRACT NO.: C-3
SHEET NO. 34 OF 53


| RICHMOND EXPRESSWAY SYSTEM | | | |
|----------------------------|--------------------|-----------|--------------|
| SECTION | PROJECT | SHEET NO. | TOTAL SHEETS |
| 3 | JAMES RIVER BRIDGE | 35 | 53 |

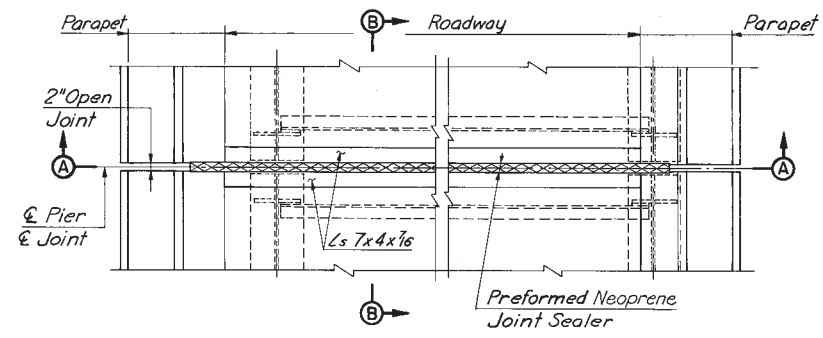


PLAN AT PIER
Scale: 1/2"=1'-0"

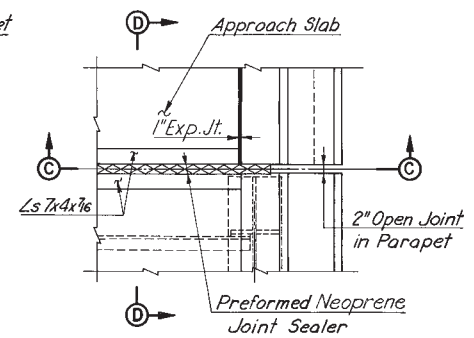


PLAN AT ABUTMENT
Scale: 1/2"=1'-0"

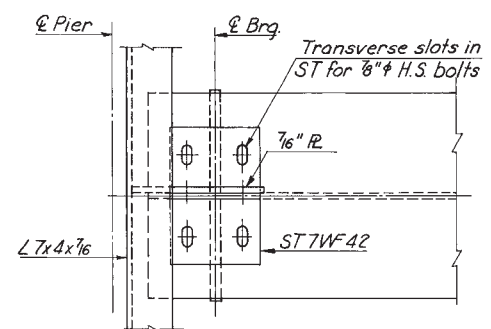


PLAN - 90°

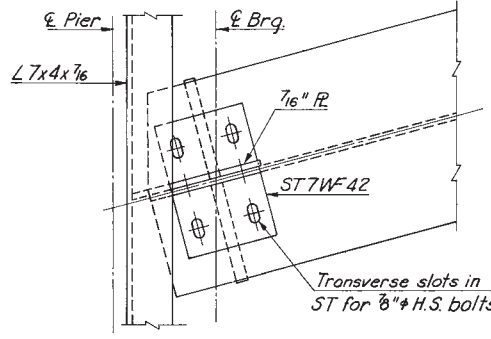


PLAN - SKEW

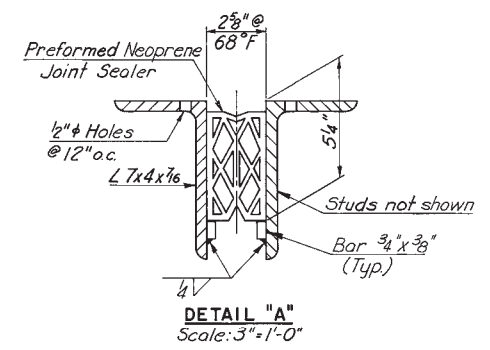


DETAIL "A"
Scale: 3"=1'-0"

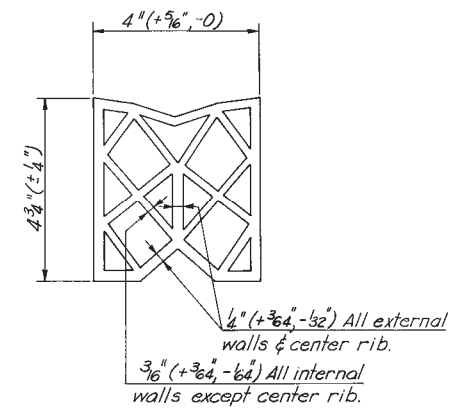


PREFORMED NEOPRENE JOINT SEALER
No Scale

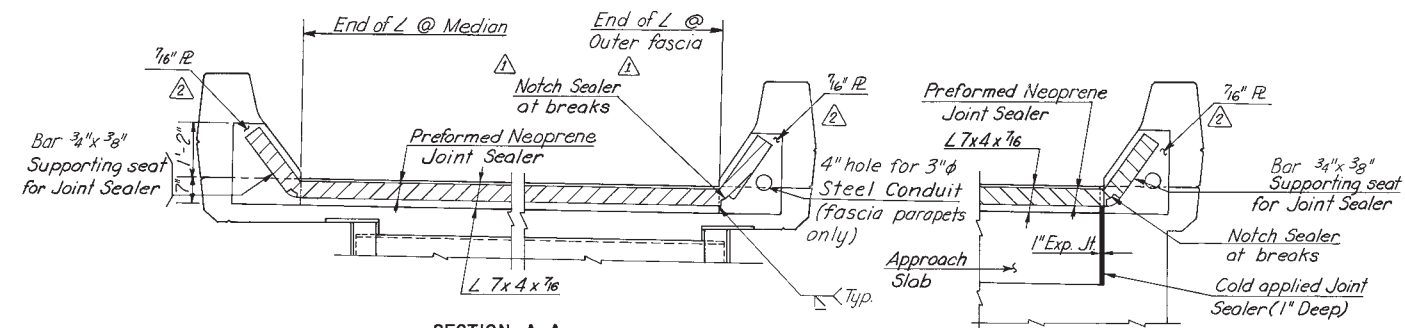


SECTION A-A
Scale: 1/2"=1'-0"

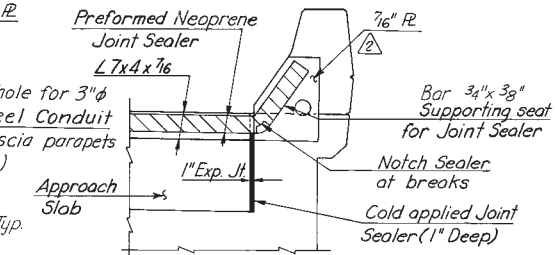


SECTION C-C
Scale: 1/2"=1'-0"

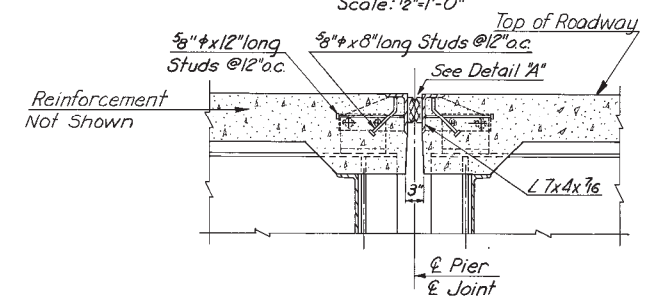


SECTION B-B
Scale: 3/4"=1'-0"

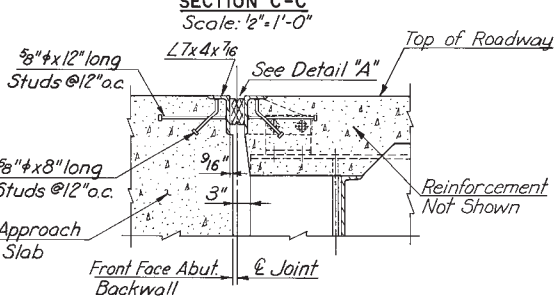

SECTION D-D
Scale: 3/4"=1'-0"

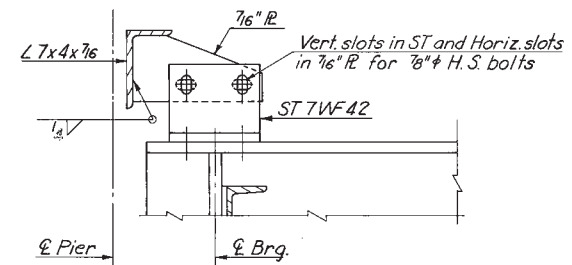

SECTION
ANGLE SUPPORT DETAILS
Scale: 1/2"=1'-0"

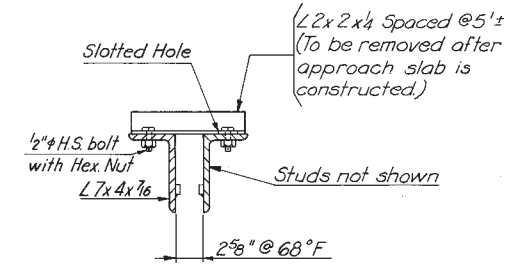

ANGLE SUPPORT AT ABUTMENT JOINTS
Scale: 1/2"=1'-0"

NOTES:

- The size of the joint opening indicated on the plans is for a temperature of 68°F. Actual joint openings take into account the temperature at the time of construction.
- Joint angles set to provide the specified opening after the concrete deck for the unit has been placed to 5 feet from the joint. The concrete deck for a distance of 5 feet on either side of the joint placed and finished after final adjustment and bolting of the joint supports completed.
- Joint openings in the parapet formed and constructed to smooth, straight lines. accurately
- Attachment of the studs to the joint angle made by full penetration butt welds.
- Joint angles, studs and supports furnished and installed under the item "Structural Steel."
- No separate payment made for furnishing and installing preformed neoprene joint sealers, but the cost thereof included in the price bid for "Concrete, Class AA."




RICHMOND METROPOLITAN AUTHORITY
RICHMOND EXPRESSWAY SYSTEM

JAMES RIVER BRIDGE
JOINT DETAILS

HOWARD, NEEDLES, TAMMEN & BERGENDOFF
consulting engineers
NEW YORK ALEXANDRIA KANSAS CITY
SCALE: AS SHOWN
CONTRACT NO.: C-3
SHEET NO. 35 OF 53

| BY | DATE | NO. | REVISION | BY | DATE |
|-----------|------|-------|---------------------|--------|---------|
| AS BUILT | JRC | 12-72 | | | |
| MADE | HBW | 10-67 | Armored Jt. & Notes | S.K.L. | 4/5/71 |
| CHECKED | FXH | 11-67 | Note | ER | 2/20/71 |
| IN CHARGE | FXH | | | | |

| RICHMOND EXPRESSWAY SYSTEM | | | |
|----------------------------|--------------------|-----------|--------------|
| SECTION | PROJECT | SHEET NO. | TOTAL SHEETS |
| 3 | JAMES RIVER BRIDGE | 37 | 53 |

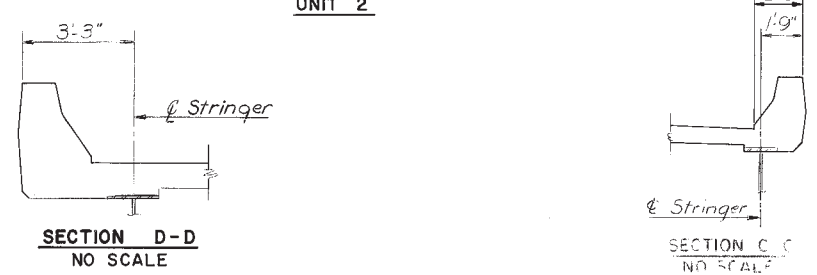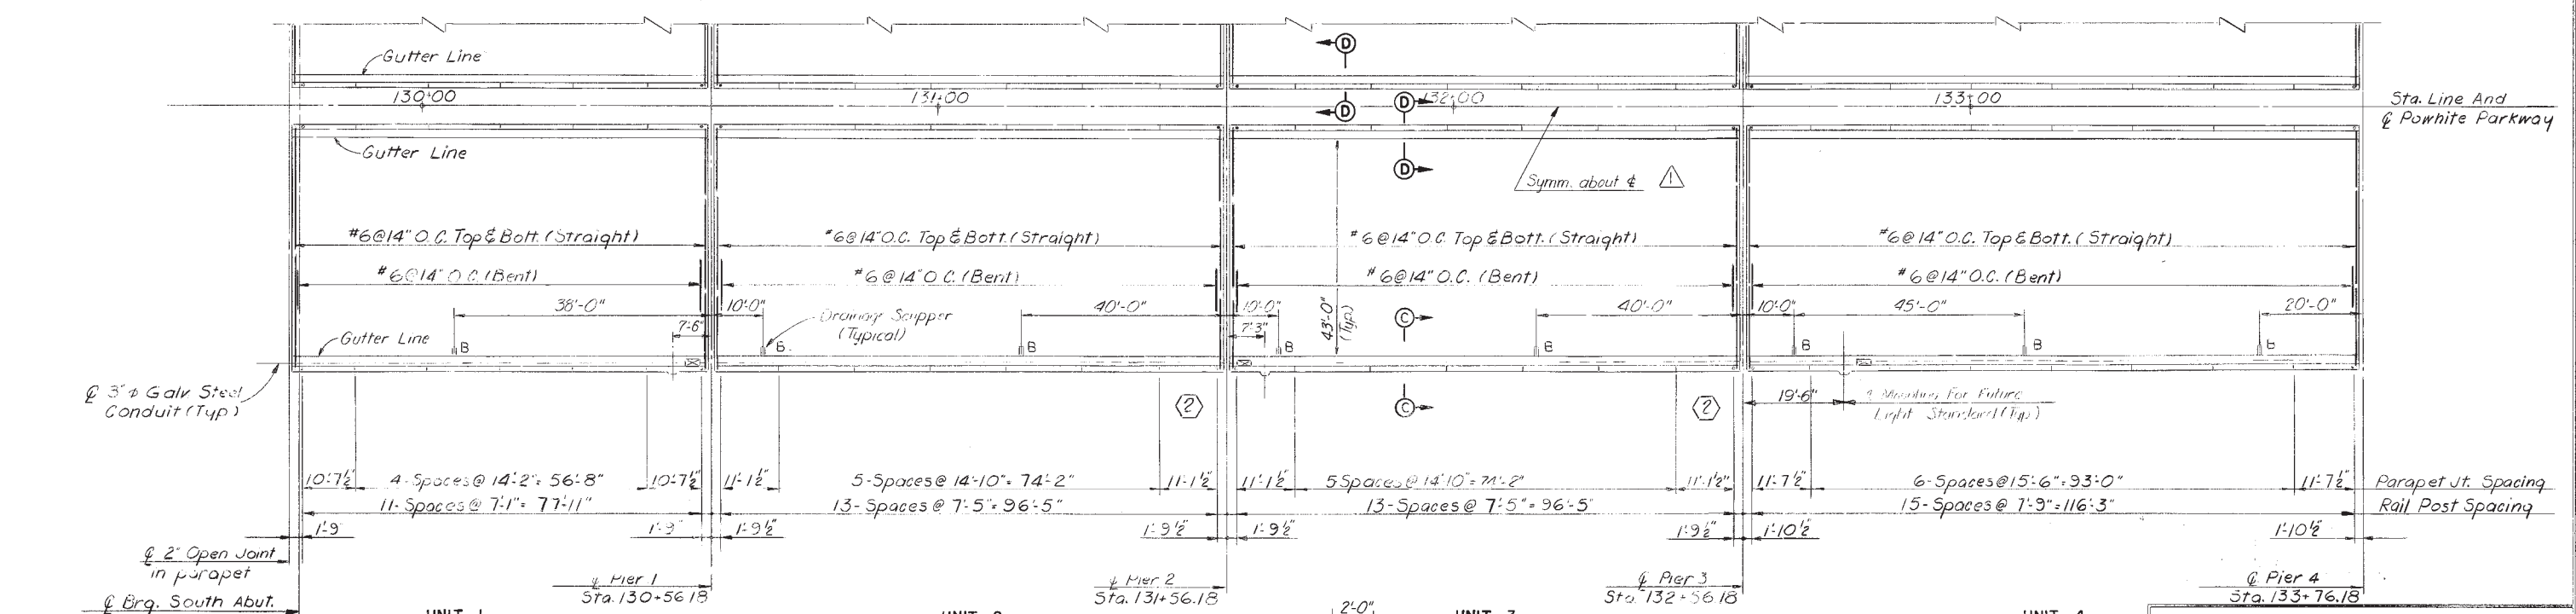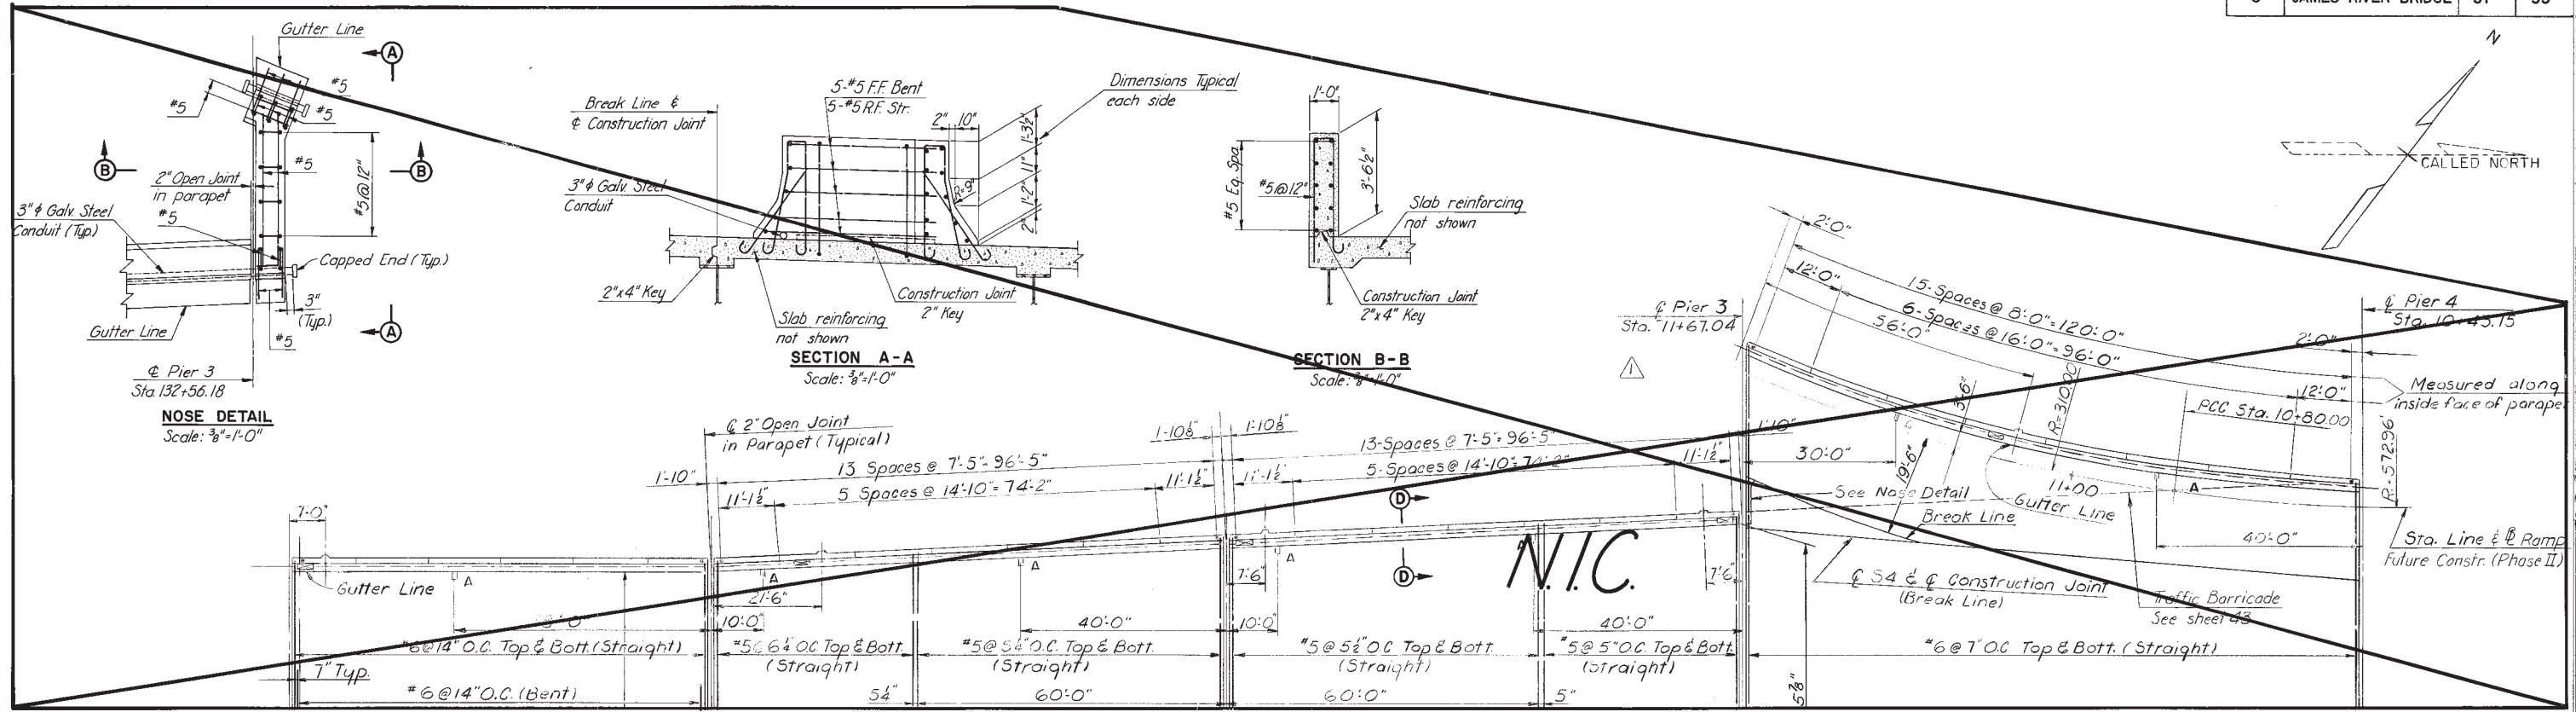

Notes:
 For General Notes see Sheet No. 4.
 For Longitudinal Reinforcement, additional reinforcement at Deck Joints, additional Details and Cross Section see Sheet No. 41.
 For Details of Mounting for Future Lighting Standard see Sheet No. 44.
 For Joint Details see Sheet No. 35.
 For Scupper Details see Sheet No. 36.

RICHMOND METROPOLITAN AUTHORITY
RICHMOND EXPRESSWAY SYSTEM






JAMES RIVER BRIDGE
DECK PLAN - UNITS 1,2,3&4

HOWARD, NEEDLES, TAMMEN & BERGENDOFF
 consulting engineers
 NEW YORK ALEXANDRIA KANSAS CITY

SCALE: 1"=15' UNLESS NOTED
 CONTRACT NO.: C-9
 SHEET NO. 37 OF 53

| BY | DATE | 3 | AS BUILT | JRC | 12-72 |
|-----------|-------------|-----|---------------------|--------|---------|
| MADE | D.E.K. 7-67 | ② | Light Std. Location | J.G.V. | 3/9/71 |
| CHECKED | H.B.W. 9-67 | ⚠ | Remove Ramp Taper | J.G.V. | 2-20-71 |
| IN CHARGE | F.X.H. | NO. | REVISION | BY | DATE |

| RICHMOND EXPRESSWAY SYSTEM | | | |
|----------------------------|--------------------|-----------|--------------|
| SECTION | PROJECT | SHEET NO. | TOTAL SHEETS |
| 3 | JAMES RIVER BRIDGE | 38 | 53 |

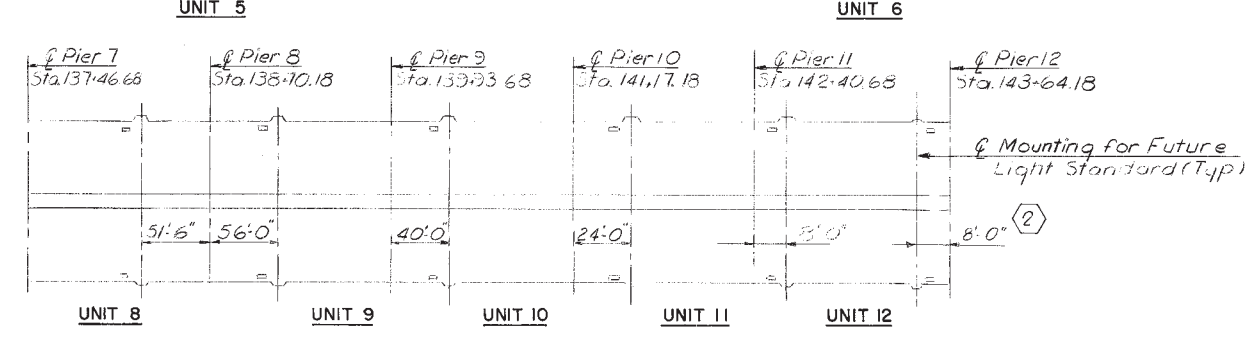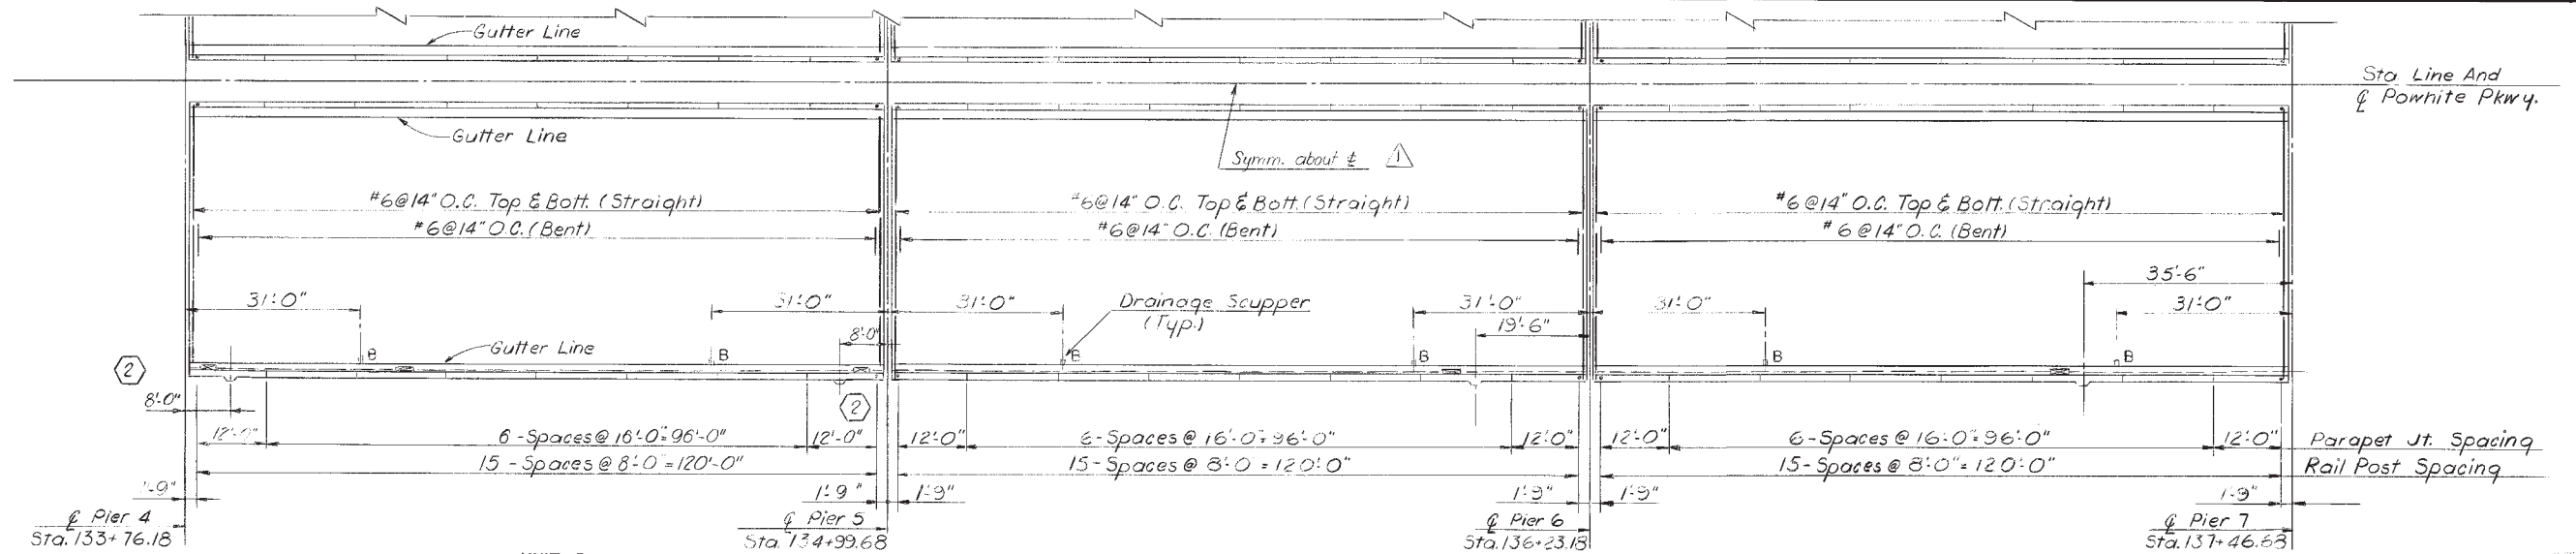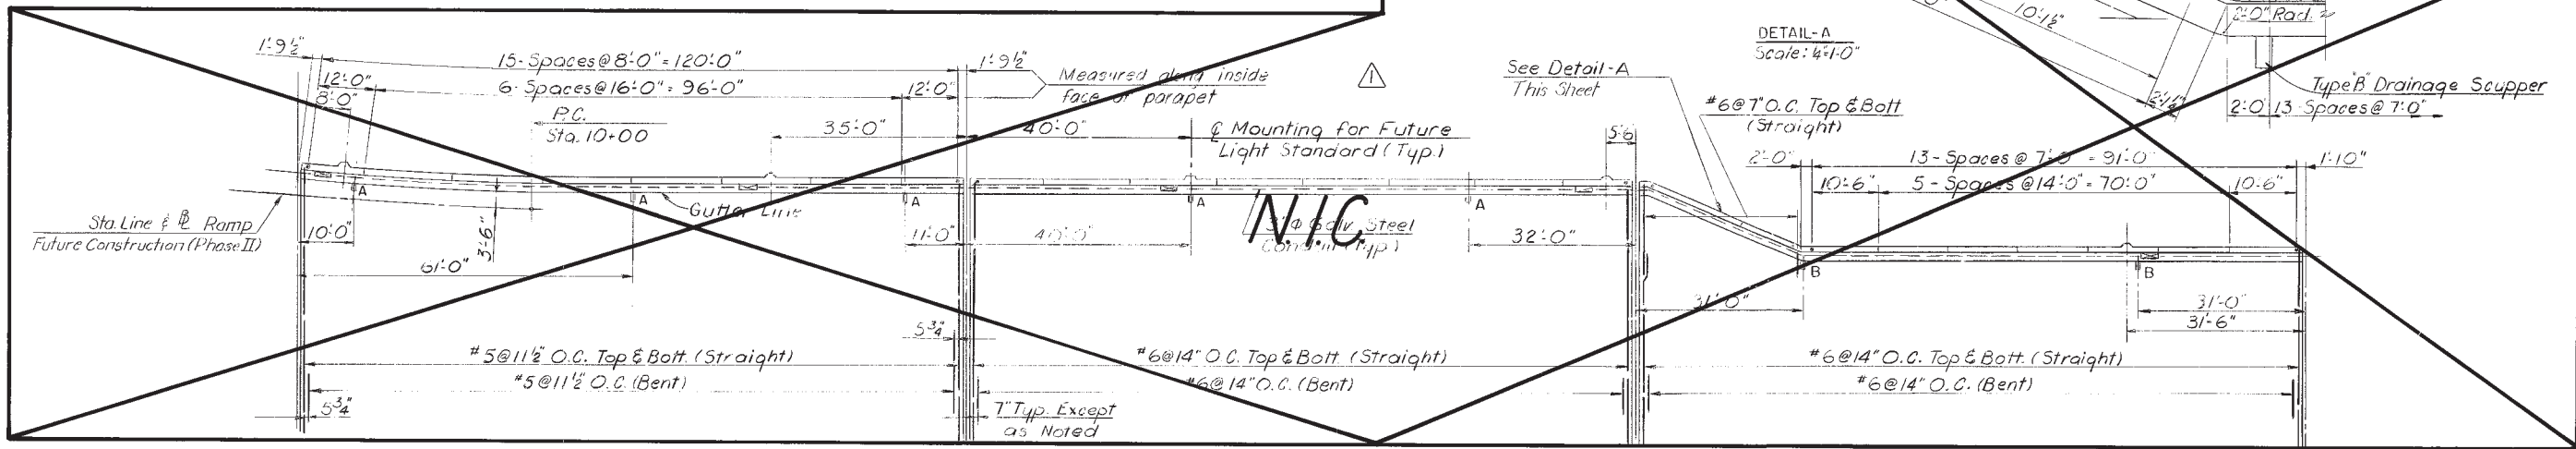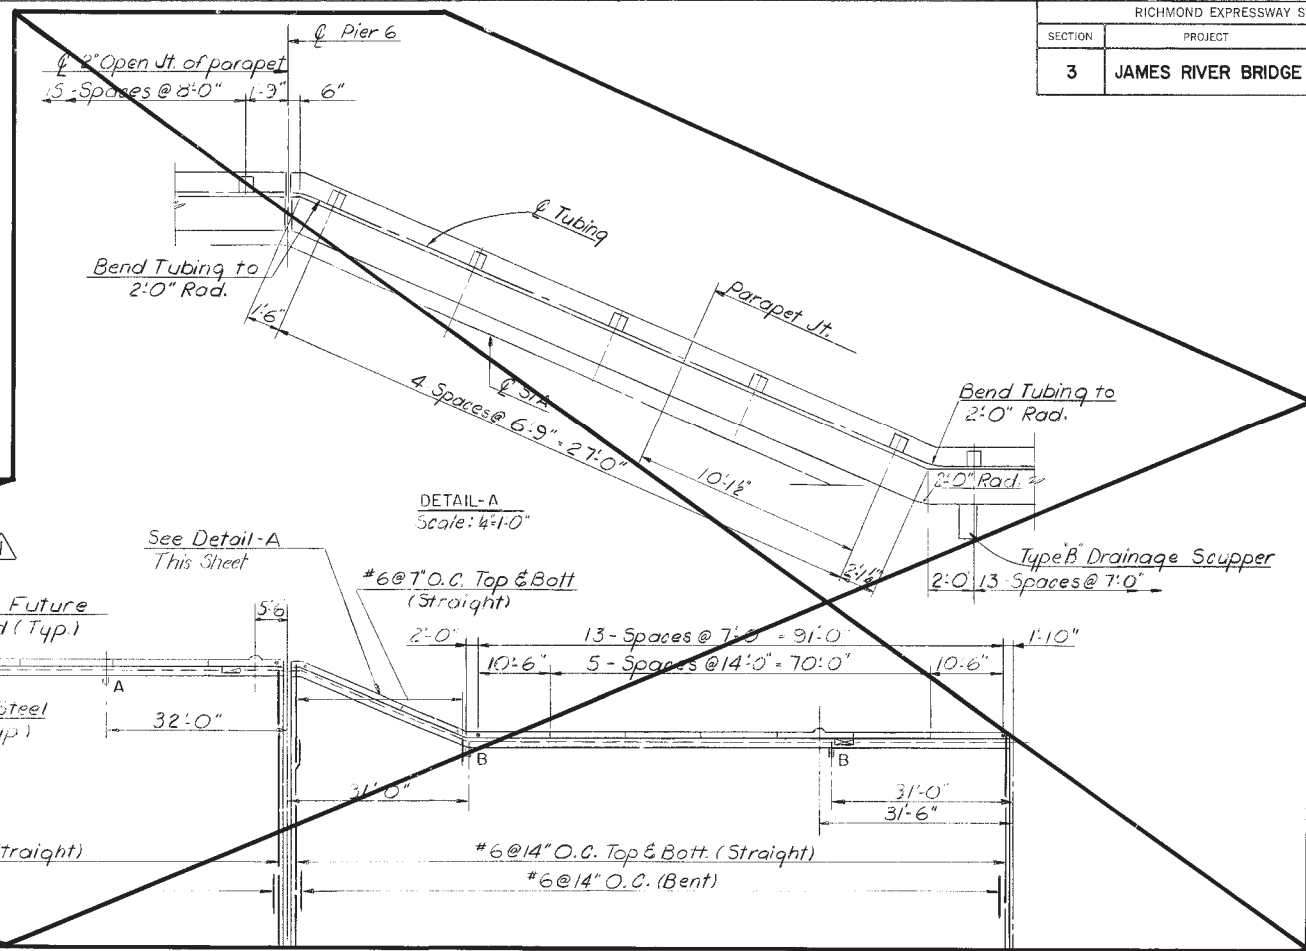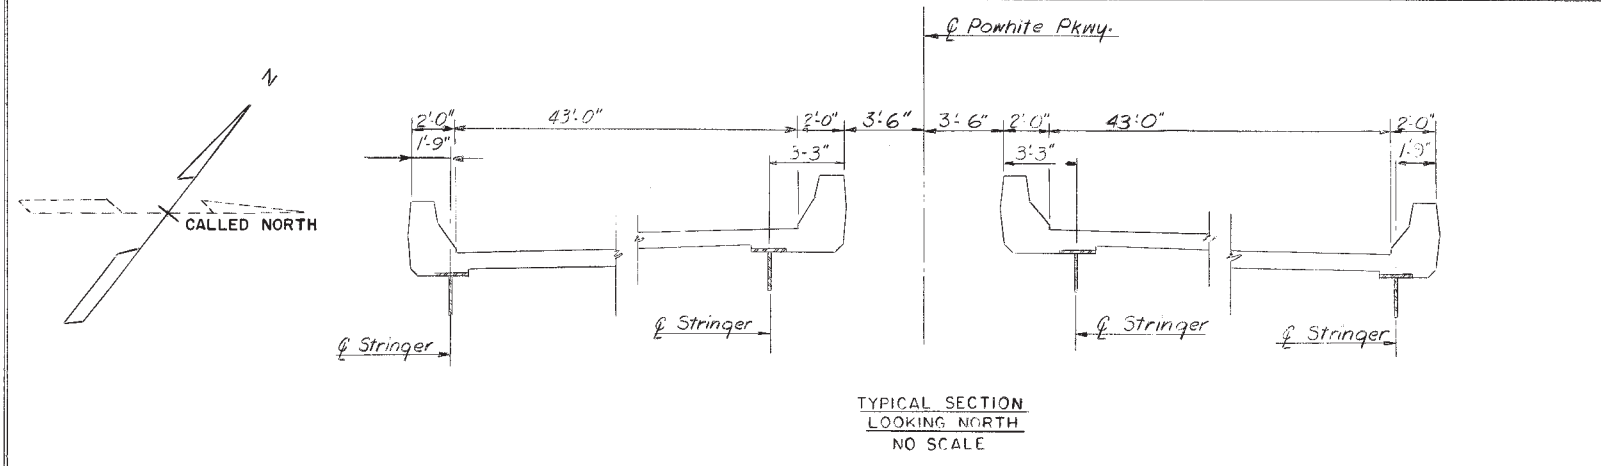

UNIT 7
SCUPPER LOCATIONS AND
REINFORCEMENT FOR UNITS 8
THRU 12 SIMILAR TO UNIT 7

Notes:
For Notes see Sheet No. 37

RICHMOND METROPOLITAN AUTHORITY
RICHMOND EXPRESSWAY SYSTEM


JAMES RIVER BRIDGE
DECK PLAN-UNITS 5 THRU 12

| | | | | | |
|-----------|--------|------|----------------------|--------|---------|
| BY | DATE | 3 | AS BUILT | JRC | 12-72 |
| MADE | D.E.K. | 7-67 | Light Std. Location | J.G.V. | 3/9/77 |
| CHECKED | H.B.W. | 9-67 | Remove Ramp Widening | J.G.V. | 2-20-77 |
| IN CHARGE | F.X.H. | | | | |

HOWARD, NEEDLES, TAMMEN & BERGENDOFF
consulting engineers
NEW YORK ALEXANDRIA KANSAS CITY


SCALE: 1"=15' UNLESS NOTED
CONTRACT NO.: C-3
SHEET NO. 38 OF 53

| RICHMOND EXPRESSWAY SYSTEM | | | |
|----------------------------|--------------------|-----------|--------------|
| SECTION | PROJECT | SHEET NO. | TOTAL SHEETS |
| 3 | JAMES RIVER BRIDGE | 39 | 53 |

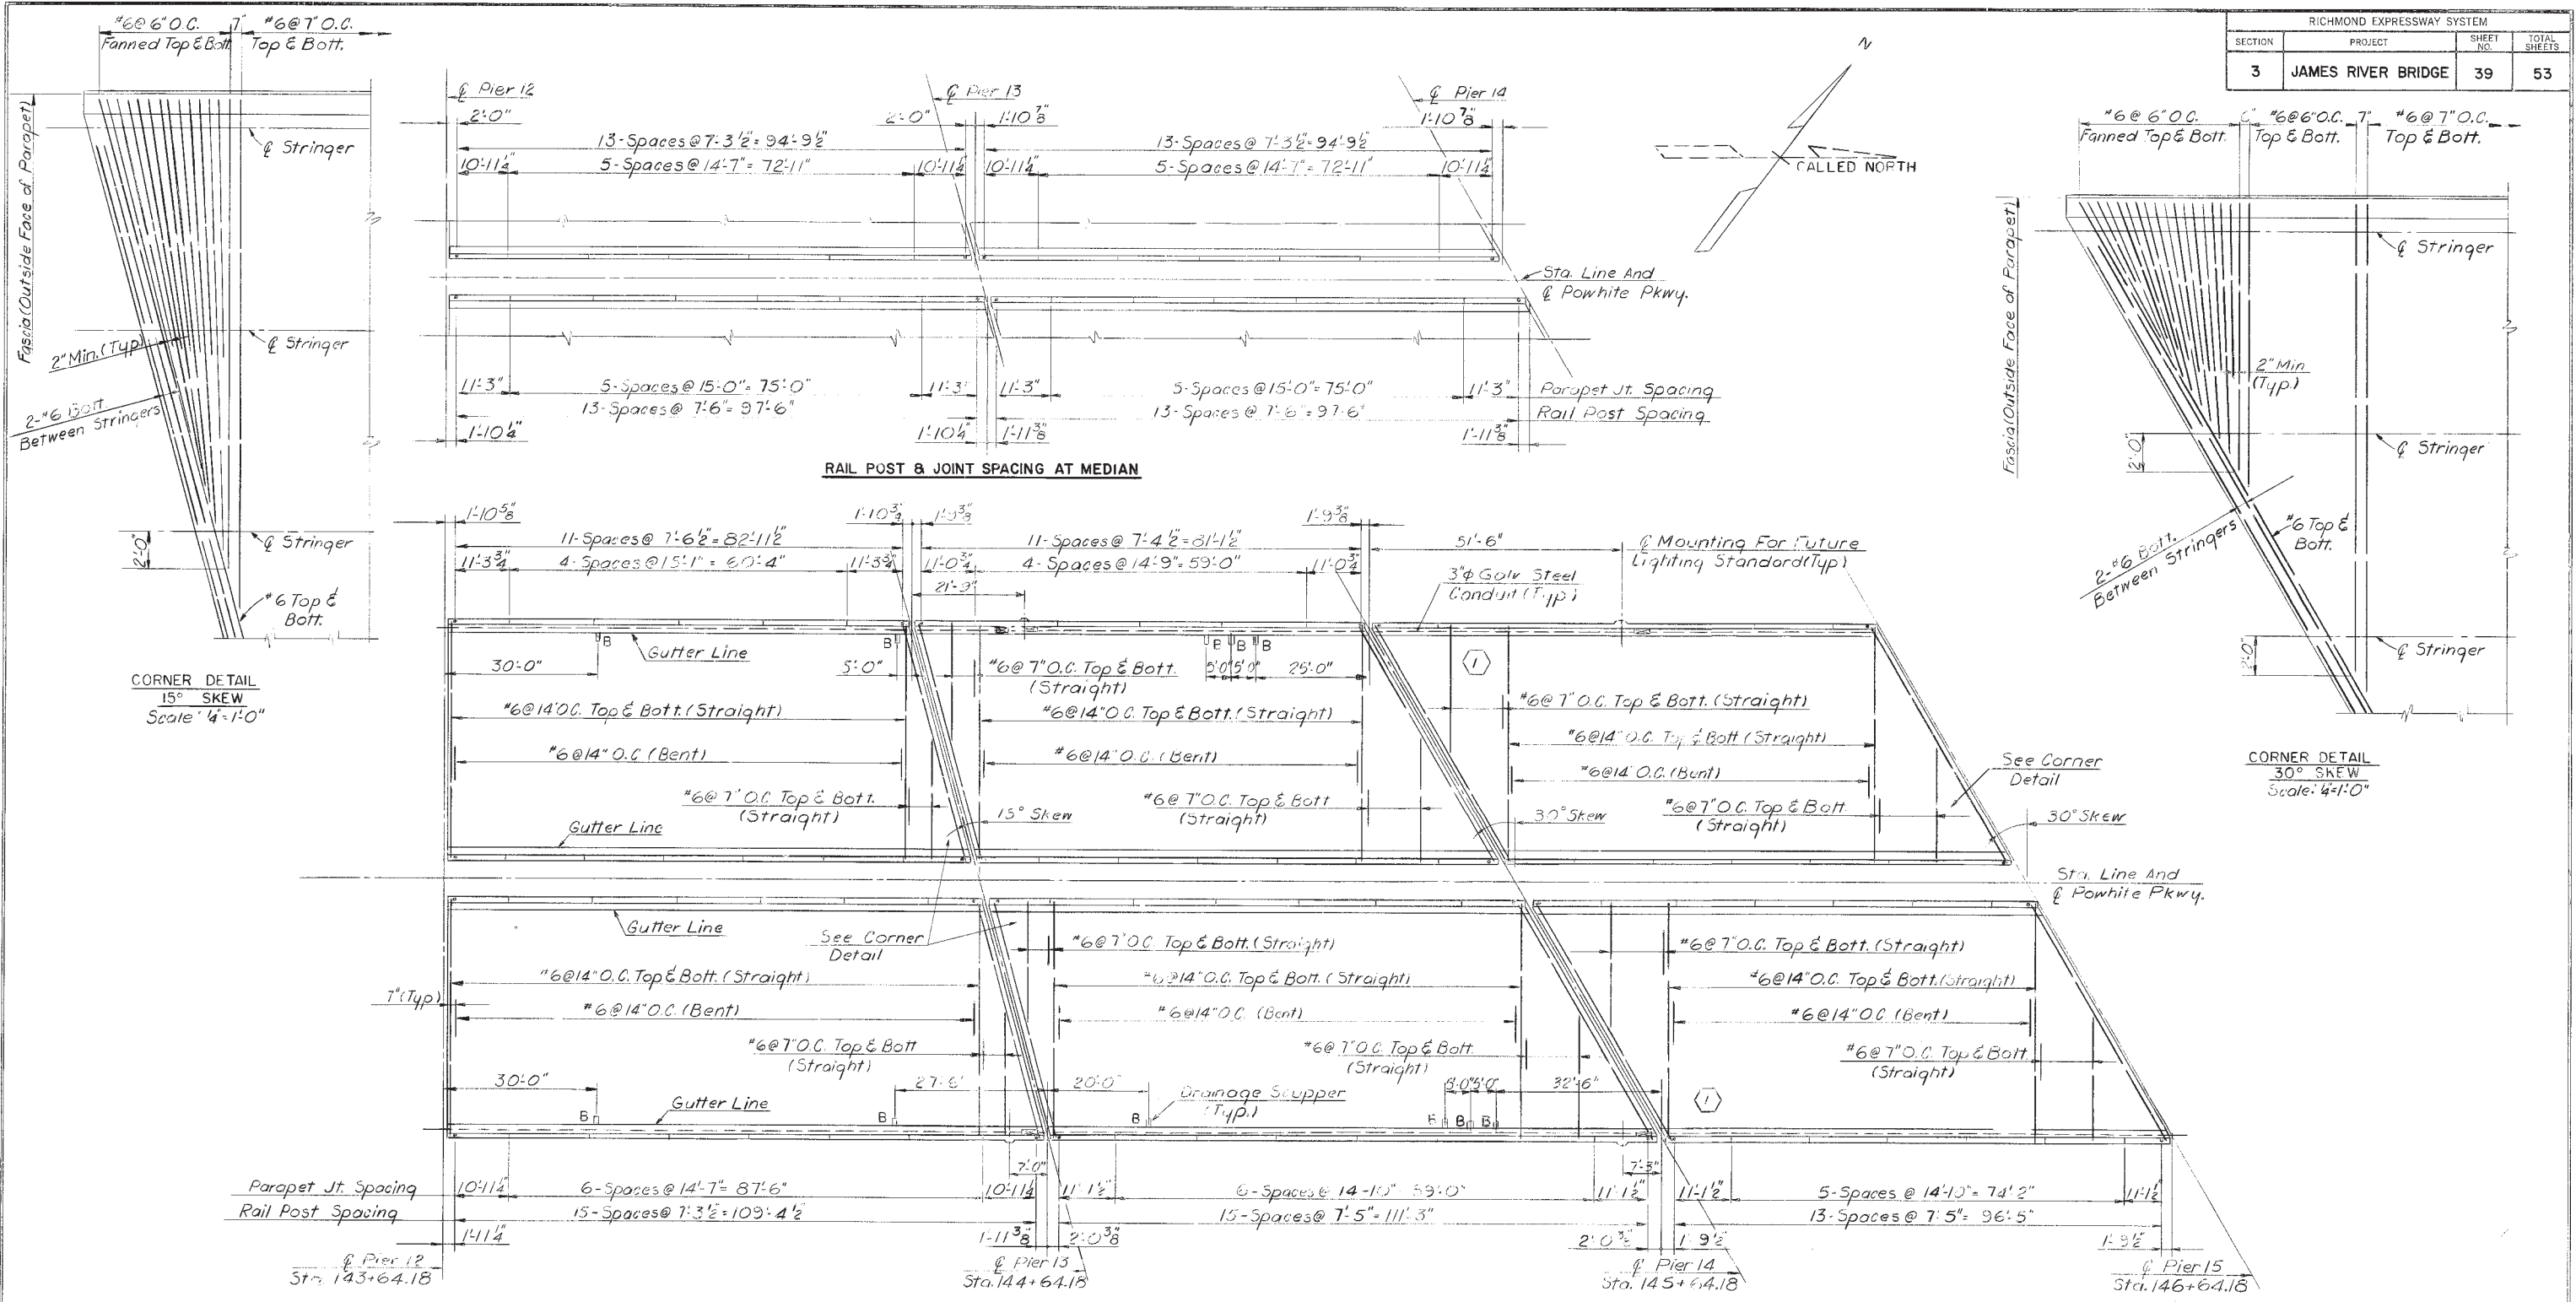

CORNER DETAIL
15° SKEW
Scale: 4"=1'-0"

CORNER DETAIL
30° SKEW
Scale: 4"=1'-0"

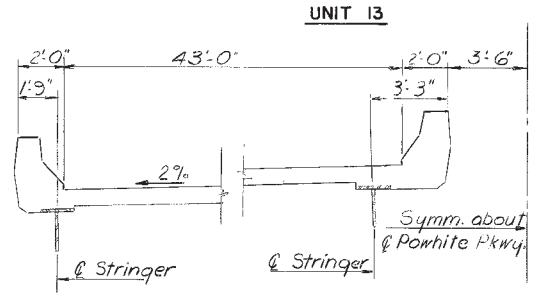

Notes:
For Notes See Sheet No. 37

| BY | DATE | NO. | REVISION | BY | DATE |
|-----------|-------------|-----|-------------------------------|--------|--------|
| MADE | DEK. 7-67 | 2 | AS BUILT | JRC | 12-72 |
| CHECKED | H.B.W. 9-67 | 1 | Light Std. & Scupper Location | J.G.V. | 3/9/71 |
| IN CHARGE | F.X.H. | | | | |




RICHMOND METROPOLITAN AUTHORITY
RICHMOND EXPRESSWAY SYSTEM

JAMES RIVER BRIDGE
DECK PLAN - UNITS 13, 14 & 15

HOWARD, NEEDLES, TAMMEN & BERGENDOFF
consulting engineers
NEW YORK ALEXANDRIA KANSAS CITY






SCALE: 1"=15' UNLESS NOTED
CONTRACT NO. C-3
SHEET NO. 39 OF 53

| RICHMOND EXPRESSWAY SYSTEM | | | |
|----------------------------|--------------------|-----------|--------------|
| SECTION | PROJECT | SHEET NO. | TOTAL SHEETS |
| 3 | JAMES RIVER BRIDGE | 40 | 53 |

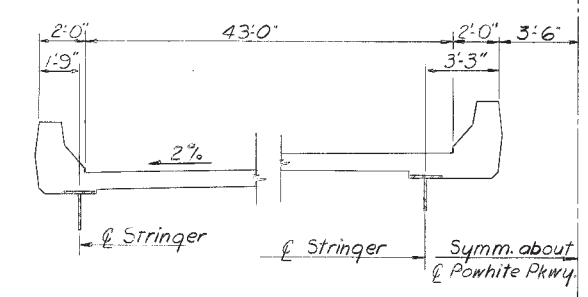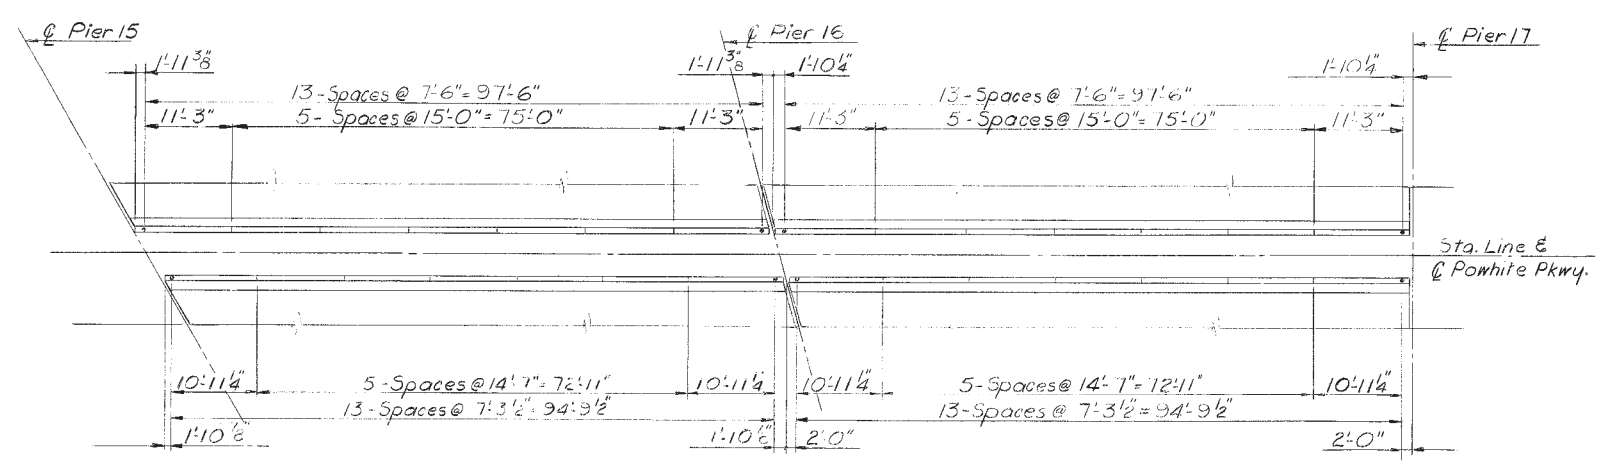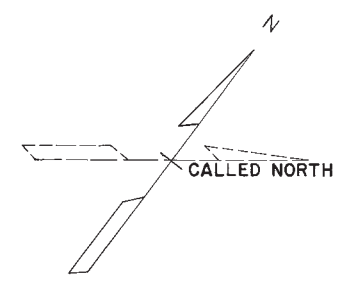

RAIL POST & JOINT SPACING AT MEDIAN

TYPICAL SECTION SCALE: 1/4"=1'-0"

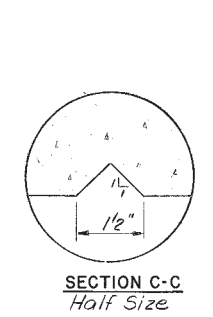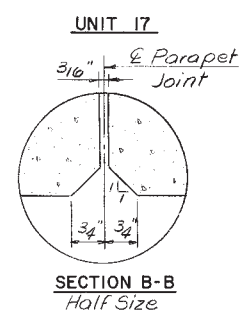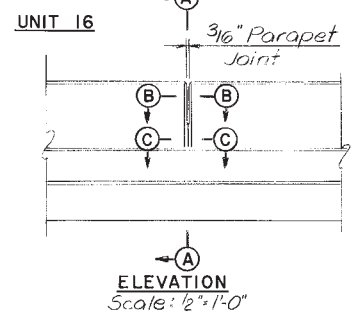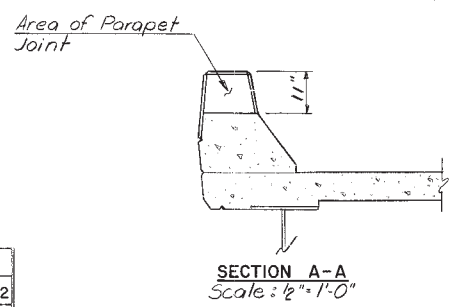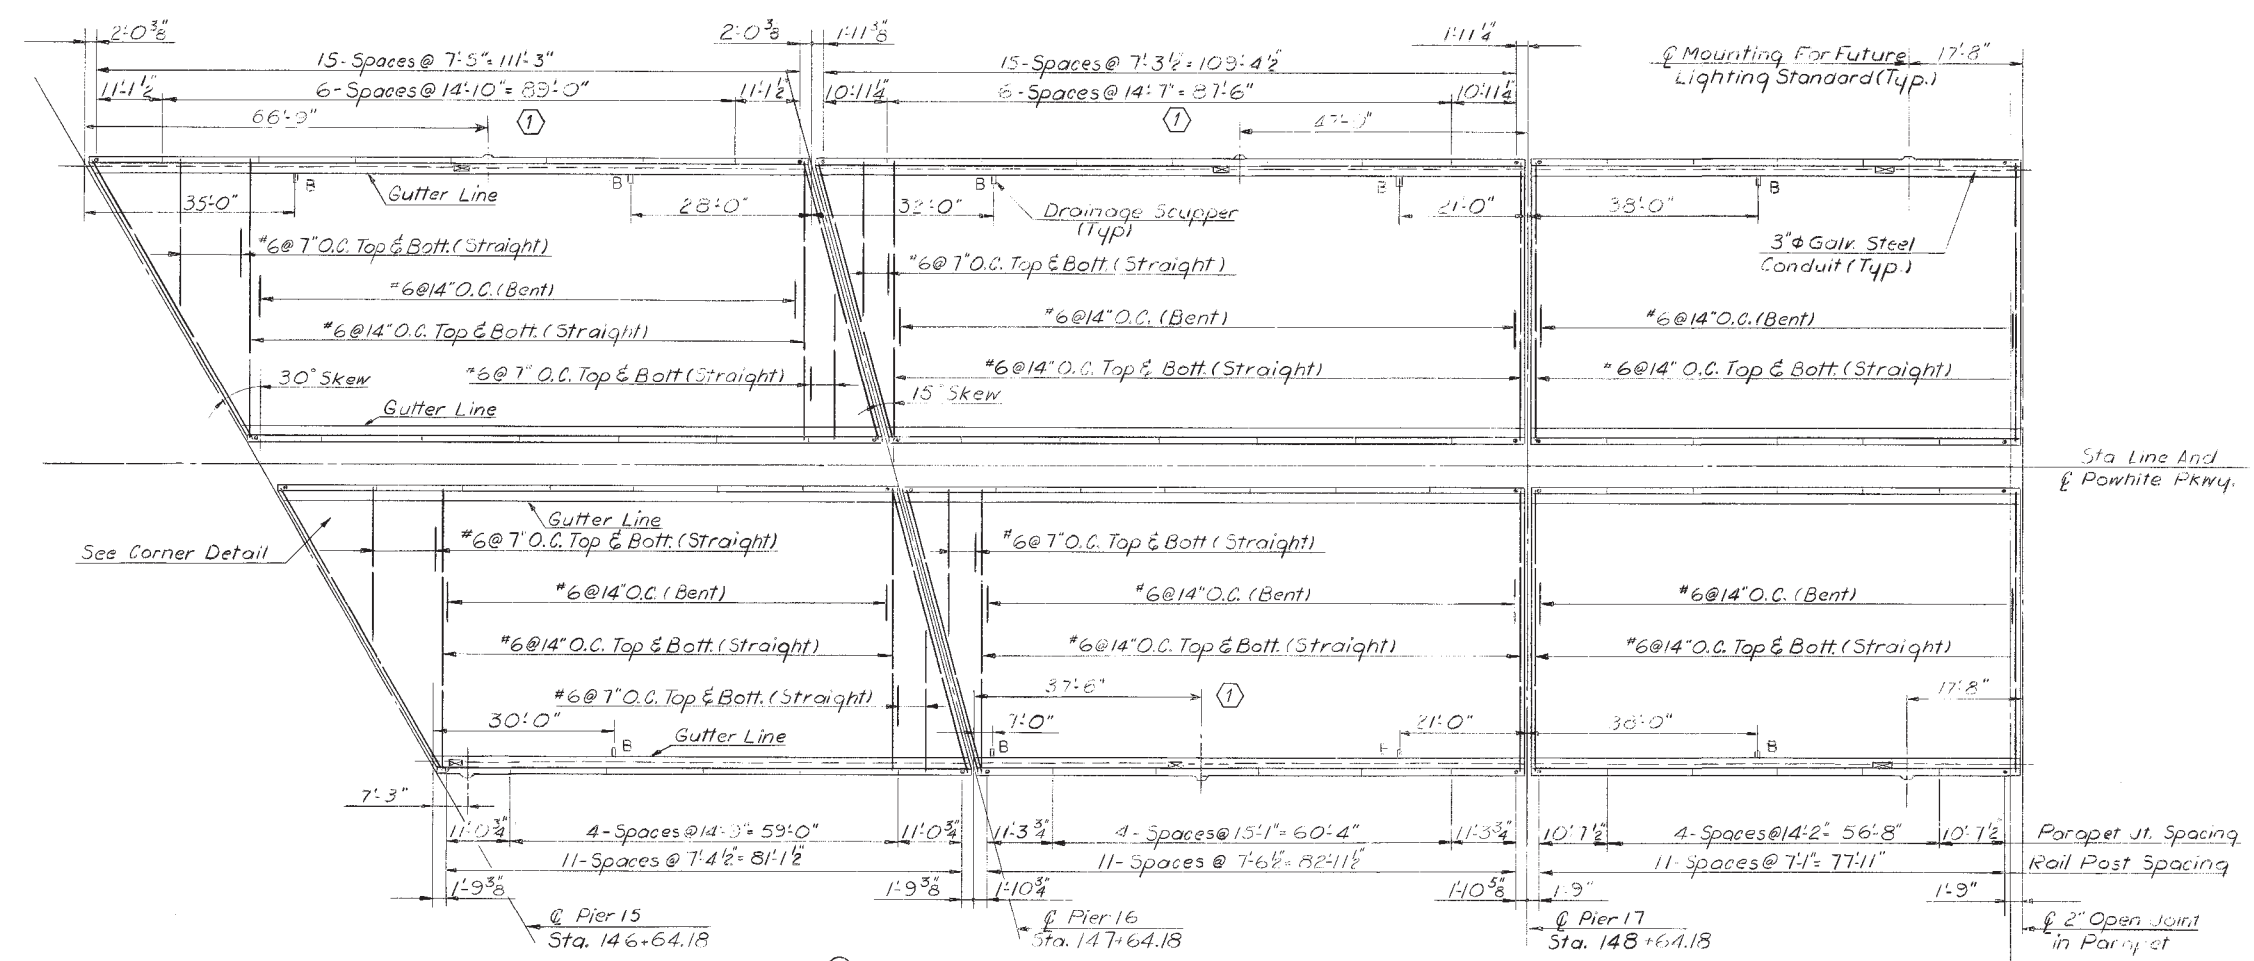

Notes:
For Notes See Sheet No. 37
For Corner Details See Sheet No. 39

Parapet Jt. Spacing
Rail Post Spacing
2" Open Joint in Parapet
Brq North Abut. Sta. 149+44.18

| BY | DATE | REVISION | BY | DATE |
|-----------|-------------|-------------------------|----------|--------|
| MADE | DE.K. 7-67 | 2 AS BUILT | JRC | 12-72 |
| CHECKED | H.B.W. 9-67 | (1) Light Std. Location | H.B.W. | 3/9/77 |
| IN CHARGE | F.X.H. | NO. | REVISION | BY |

RICHMOND METROPOLITAN AUTHORITY
RICHMOND EXPRESSWAY SYSTEM

JAMES RIVER BRIDGE
DECK PLAN - UNITS 16, 17 & 18

HOWARD, NEEDLES, TAMMEN & BERGENDOFF
consulting engineers
NEW YORK ALEXANDRIA KANSAS CITY

SCALE: 1"=15' UNLESS NOTED
CONTRACT NO. C-3
SHEET NO. 40 OF 53

**RICHMOND
METROPOLITAN AUTHORITY**

RICHMOND EXPRESSWAY SYSTEM

PROPOSED WIDENING


JAMES RIVER BRIDGE

LIMITED ACCESS HIGHWAY

| RICHMOND EXPRESSWAY SYSTEM | | | |
|----------------------------|--------------------------------|-----------|--------------|
| SECTION | PROJECT | SHEET NO. | TOTAL SHEETS |
| 13 | WIDENING JAMES RIVER BRIDGE | 1 | 106 |

INDEX OF SHEETS

| SHEET NO. | TITLE |
|-----------|---|
| 1 | COVER SHEET |
| 2-3 | GENERAL PLAN AND ELEVATION |
| 4 | GENERAL NOTES AND ESTIMATED QUANTITIES |
| 5-7 | SOUTH ABUTMENT DETAILS |
| 8-10 | NORTH ABUTMENT DETAILS |
| 11 | FLARED TERMINAL WALL DETAILS |
| 12-28 | PIER DETAILS |
| 29 | MISCELLANEOUS SUBSTRUCTURE DETAILS |
| 30-44 | FRAMING PLANS |
| 45 | STEEL DETAILS |
| 46 | SHOE DETAILS |
| 47 | CAMBER DIAGRAMS AND SCHEDULE |
| 48-49 | DECK SLAB ELEVATIONS |
| 50 | TYPICAL CROSS SECTION AND PARAPET DETAILS |
| 51-65 | DECK PLANS |
| 66-67 | LIGHTING STANDARD AND ELECTRICAL DETAILS |
| 68 | DEAD LOAD DEFLECTION DIAGRAM AND SCHEDULE |
| 69 | JOINT DETAILS |
| 70 | DRAIN ASSEMBLY DETAILS |
| 71 | ALUMINUM RAILING DETAILS |
| 72-89 | BAR LIST |
| 90 | BAR BENDS |
| 91 | SLOPE PROTECTION |
| 92 | APPROACH SLAB DETAILS |
| 93-99 | BORING LOGS |
| 100 | CONSTRUCTION SEQUENCE AND METHOD |
| 101 | MAINTENANCE AND PROTECTION OF TRAFFIC |
| 102 | PARTIAL EMBANKMENT PLAN |
| 103 | TYPICAL ROADWAY SECTION |
| 104-105 | EMBANKMENT CROSS SECTION |
| 106 | EROSION CONTROL |

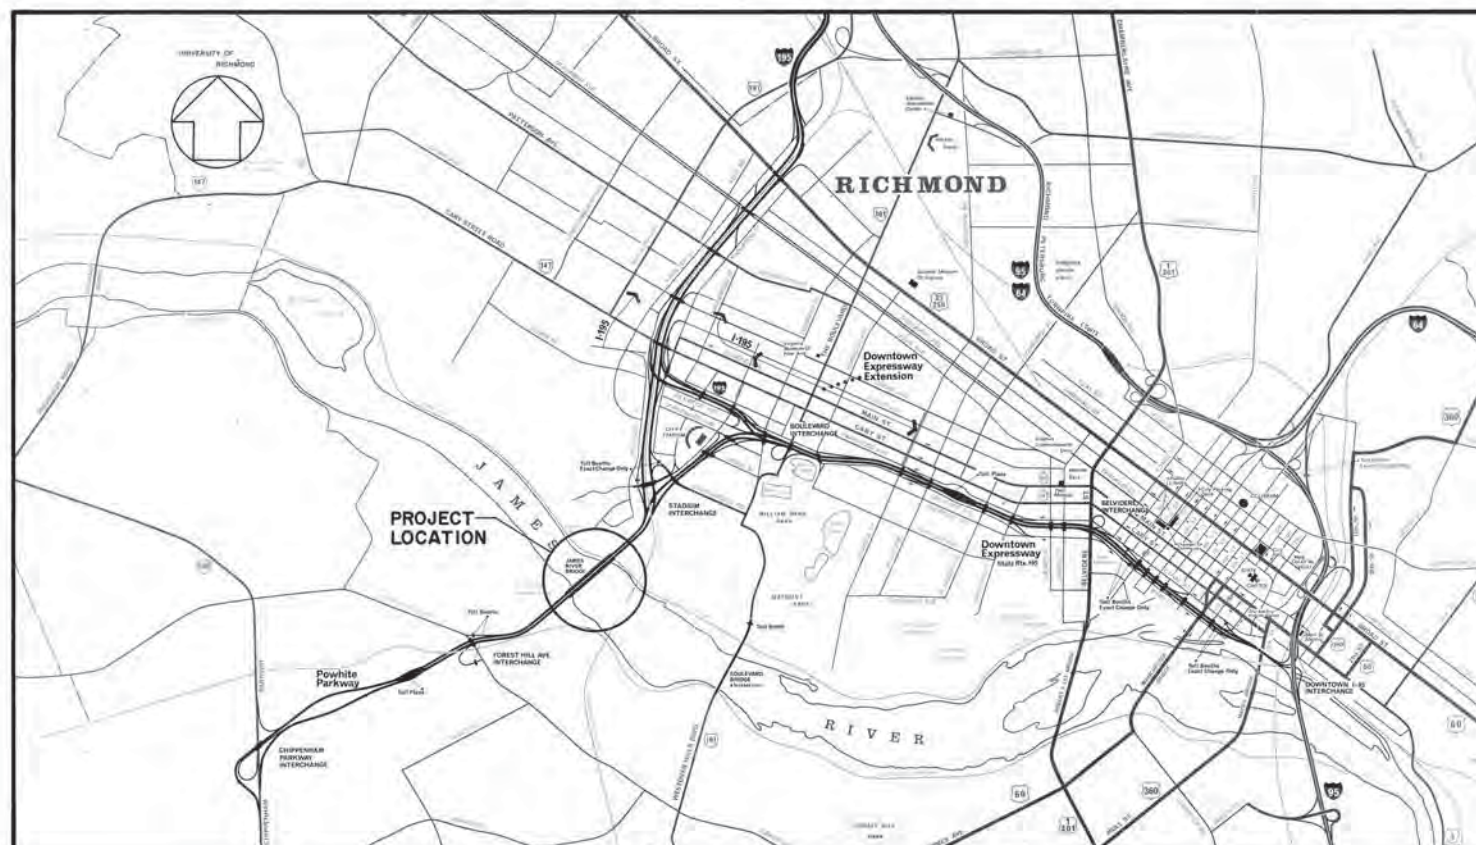

DESIGNED BY

REVISED BY



| SUBMITTED BY | |
|--------------|--|
| Date | |
| 3-14-87 | HOWARD NEEDLES TAMMEN & BERGENDOFF general consultant |

| RECOMMENDED BY | |
|----------------|---|
| Date | |
| 3-29-87 | <i>[Signature]</i> GENERAL MANAGER, RICHMOND METROPOLITAN AUTHORITY |

| APPROVED BY | |
|-------------|---|
| Date | |
| 3-29-87 | CHAIRMAN RICHMOND METROPOLITAN AUTHORITY |

| Plans Revised | | | |
|---------------|------|-----------|------|
| Sheet No. | Date | Sheet No. | Date |
| | | | |
| | | | |
CONVENTIONAL SIGNS

| | |
|------------------------|----------------------------------|
| STATE LINE | LEVEE OR EMBANKMENT |
| COUNTY LINE | BRIDGES |
| CITY, TOWN OR VILLAGE | CULVERTS |
| RIGHT OF WAY LINE | DROP INLET |
| FENCE LINE | TROLLEY POLES |
| UNFENCED PROPERTY LINE | POWER POLES |
| FENCED PROPERTY LINE | TELEPHONE OR TELEGRAPH POLES |
| TRAVELED WAY | MARSH |
| GUARD RAIL | HEDGE |
| RETAINING WALL | WOODS |
| RAILROADS | GROUND ELEVATION |
| BASE OR SURVEY LINE | GRADE ELEVATION |
| | POLES WITHIN CONSTRUCTION LIMITS |

CONTRACT C-13

AS BUILT

| RICHMOND EXPRESSWAY SYSTEM | | | |
|----------------------------|-----------------------------|-----------|--------------|
| SECTION | PROJECT | SHEET NO. | TOTAL SHEETS |
| 13 | WIDENING JAMES RIVER BRIDGE | 2 | 106 |

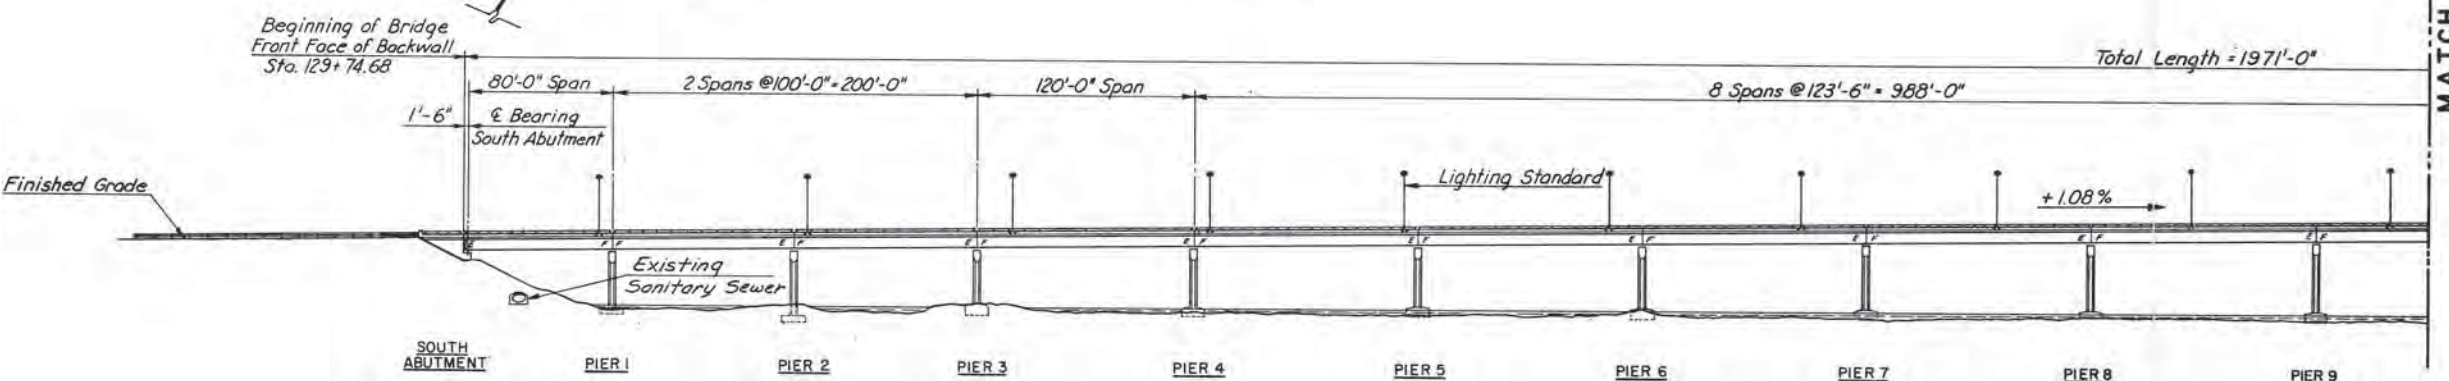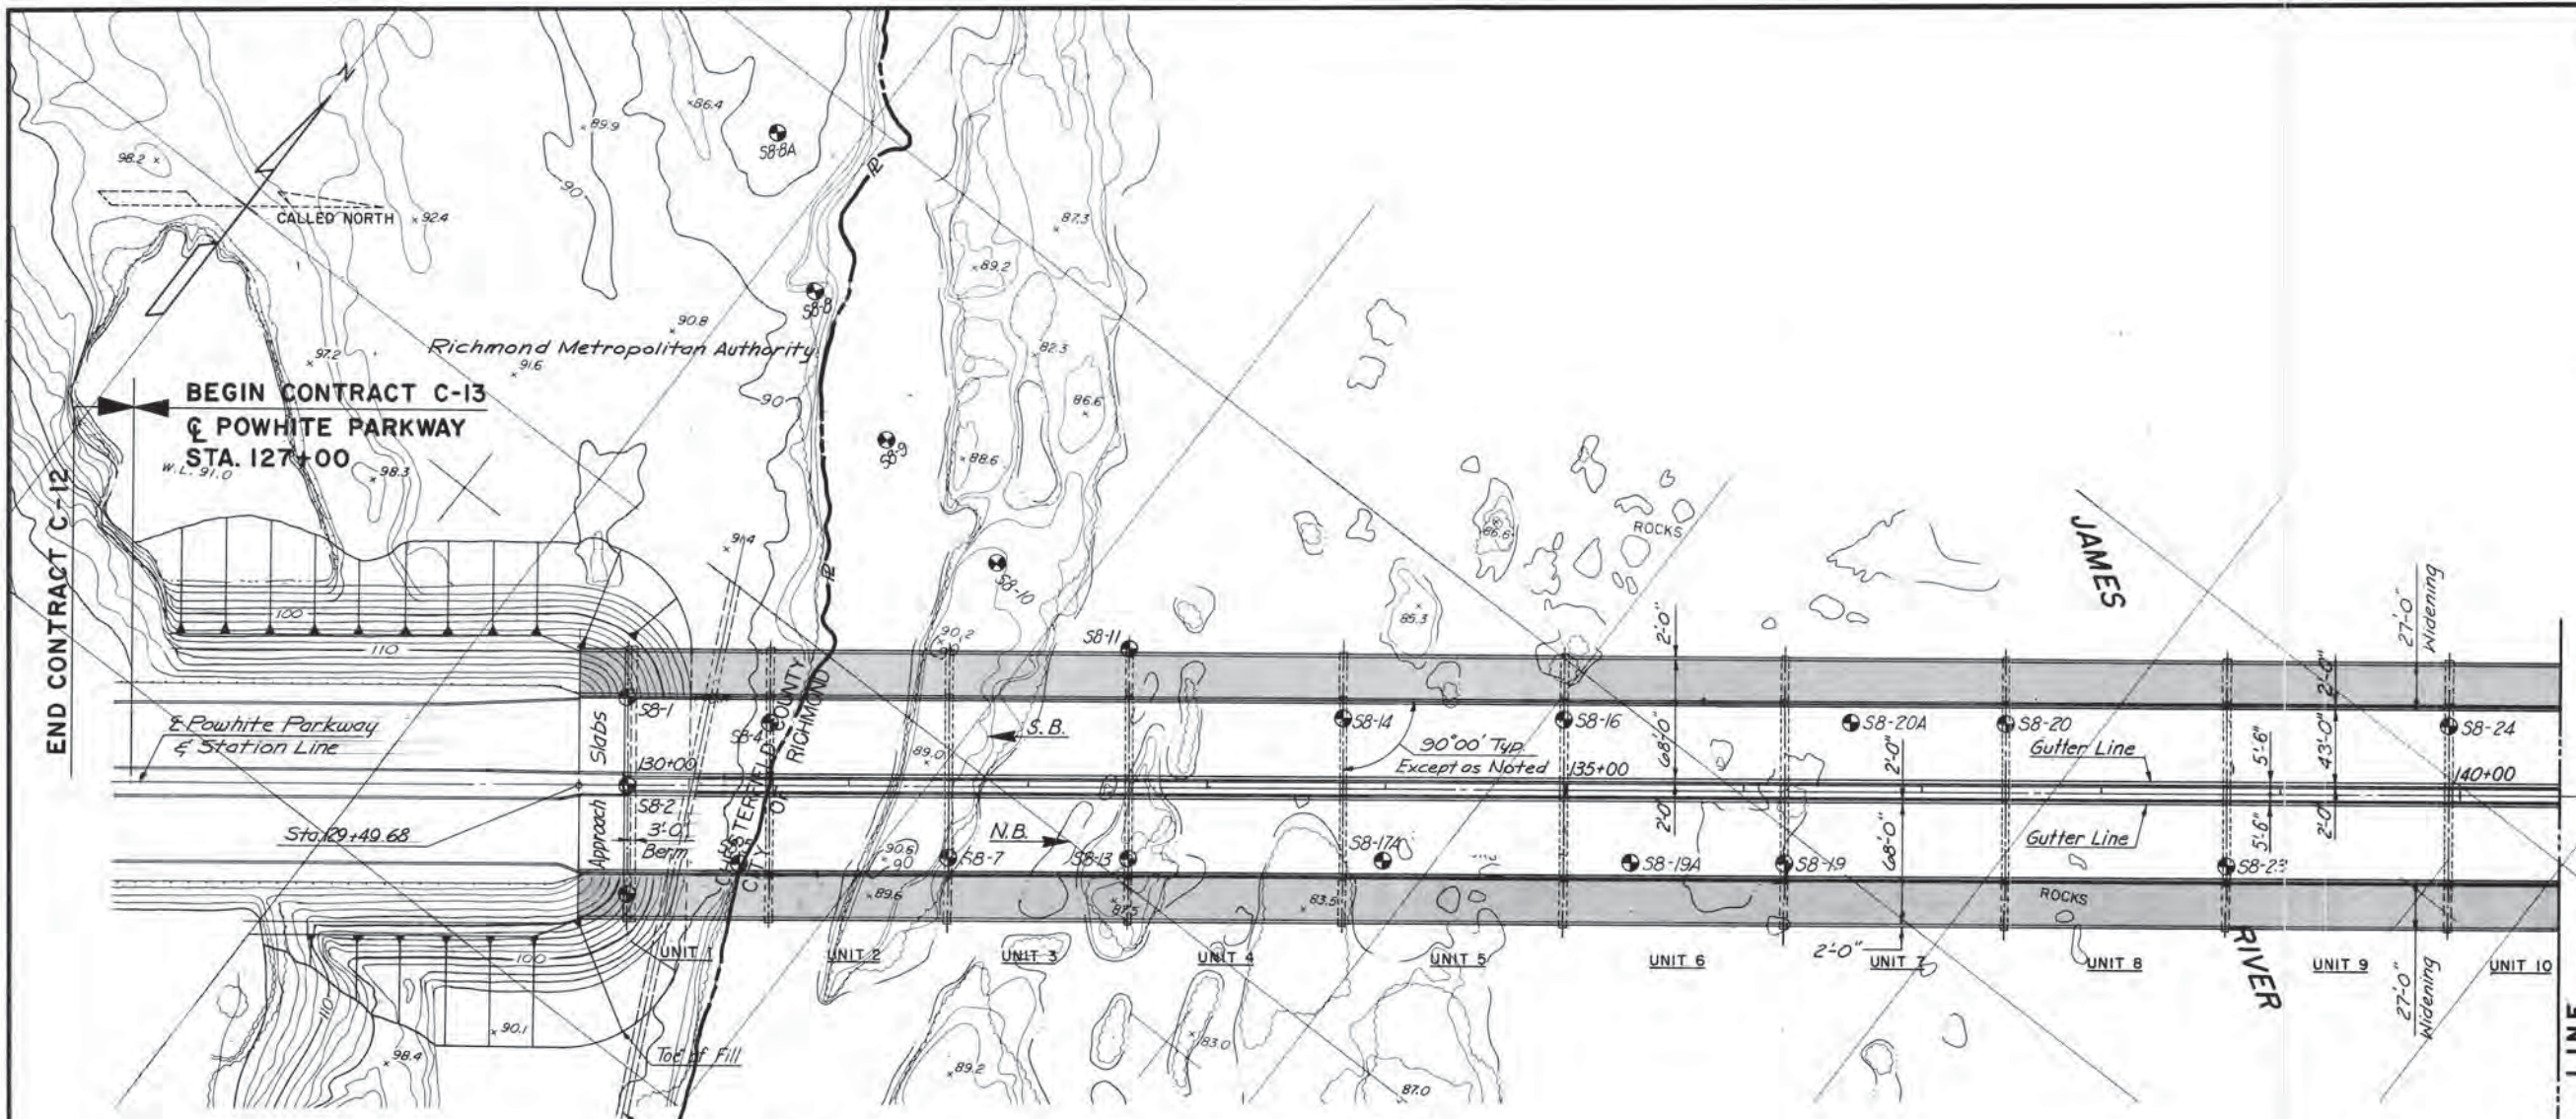

| MADE | BY | DATE | NO. | REVISION | BY | DATE |
|------|------|------|-----|---------------|-----|------|
| ALC | ALC | 3-87 | | As Built | TEM | 3-89 |
| TFP | TFP | 3-87 | | Property Line | ALC | 4-87 |
| S.R. | S.R. | | | | | |

AS BUILT



**RICHMOND METROPOLITAN AUTHORITY
 RICHMOND EXPRESSWAY SYSTEM**

GENERAL PLAN AND ELEVATION

HOWARD, NEEDLES, TAMMEN & BERGENDOFF
 consulting engineers
 Alexandria, Virginia

SCALE: 1" = 50'
 CONTRACT NO.: C-13
 SHEET NO.: 2 OF 106

| RICHMOND EXPRESSWAY SYSTEM | | | |
|----------------------------|-----------------------------|-----------|--------------|
| SECTION | PROJECT | SHEET NO. | TOTAL SHEETS |
| 13 | WIDENING JAMES RIVER BRIDGE | 3 | 106 |

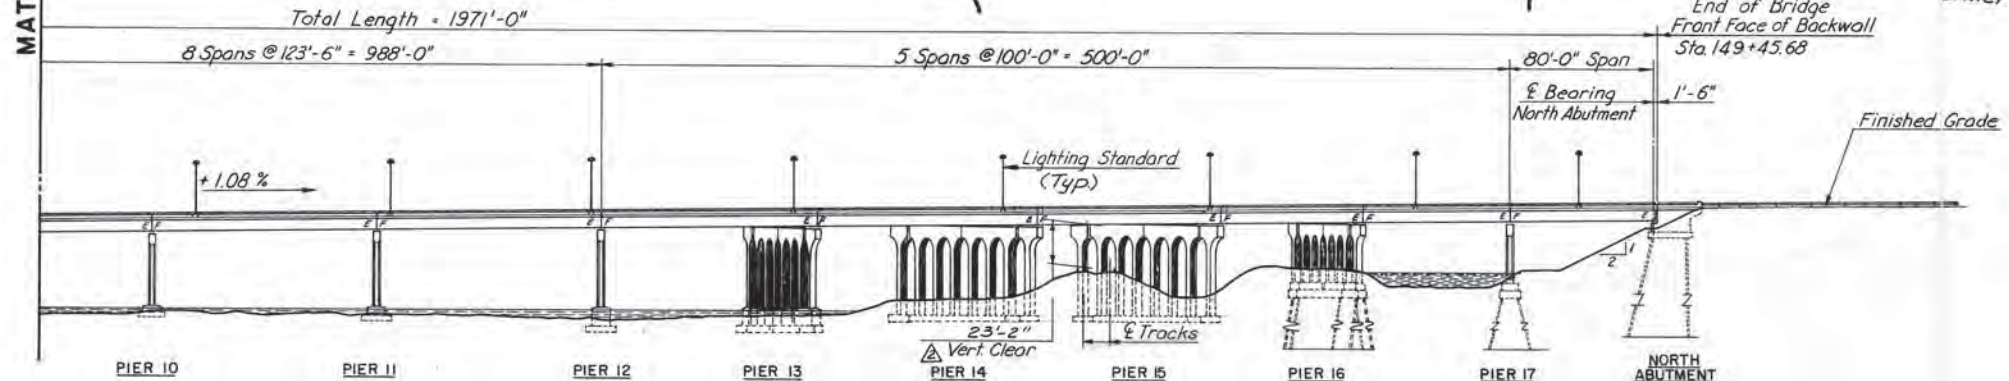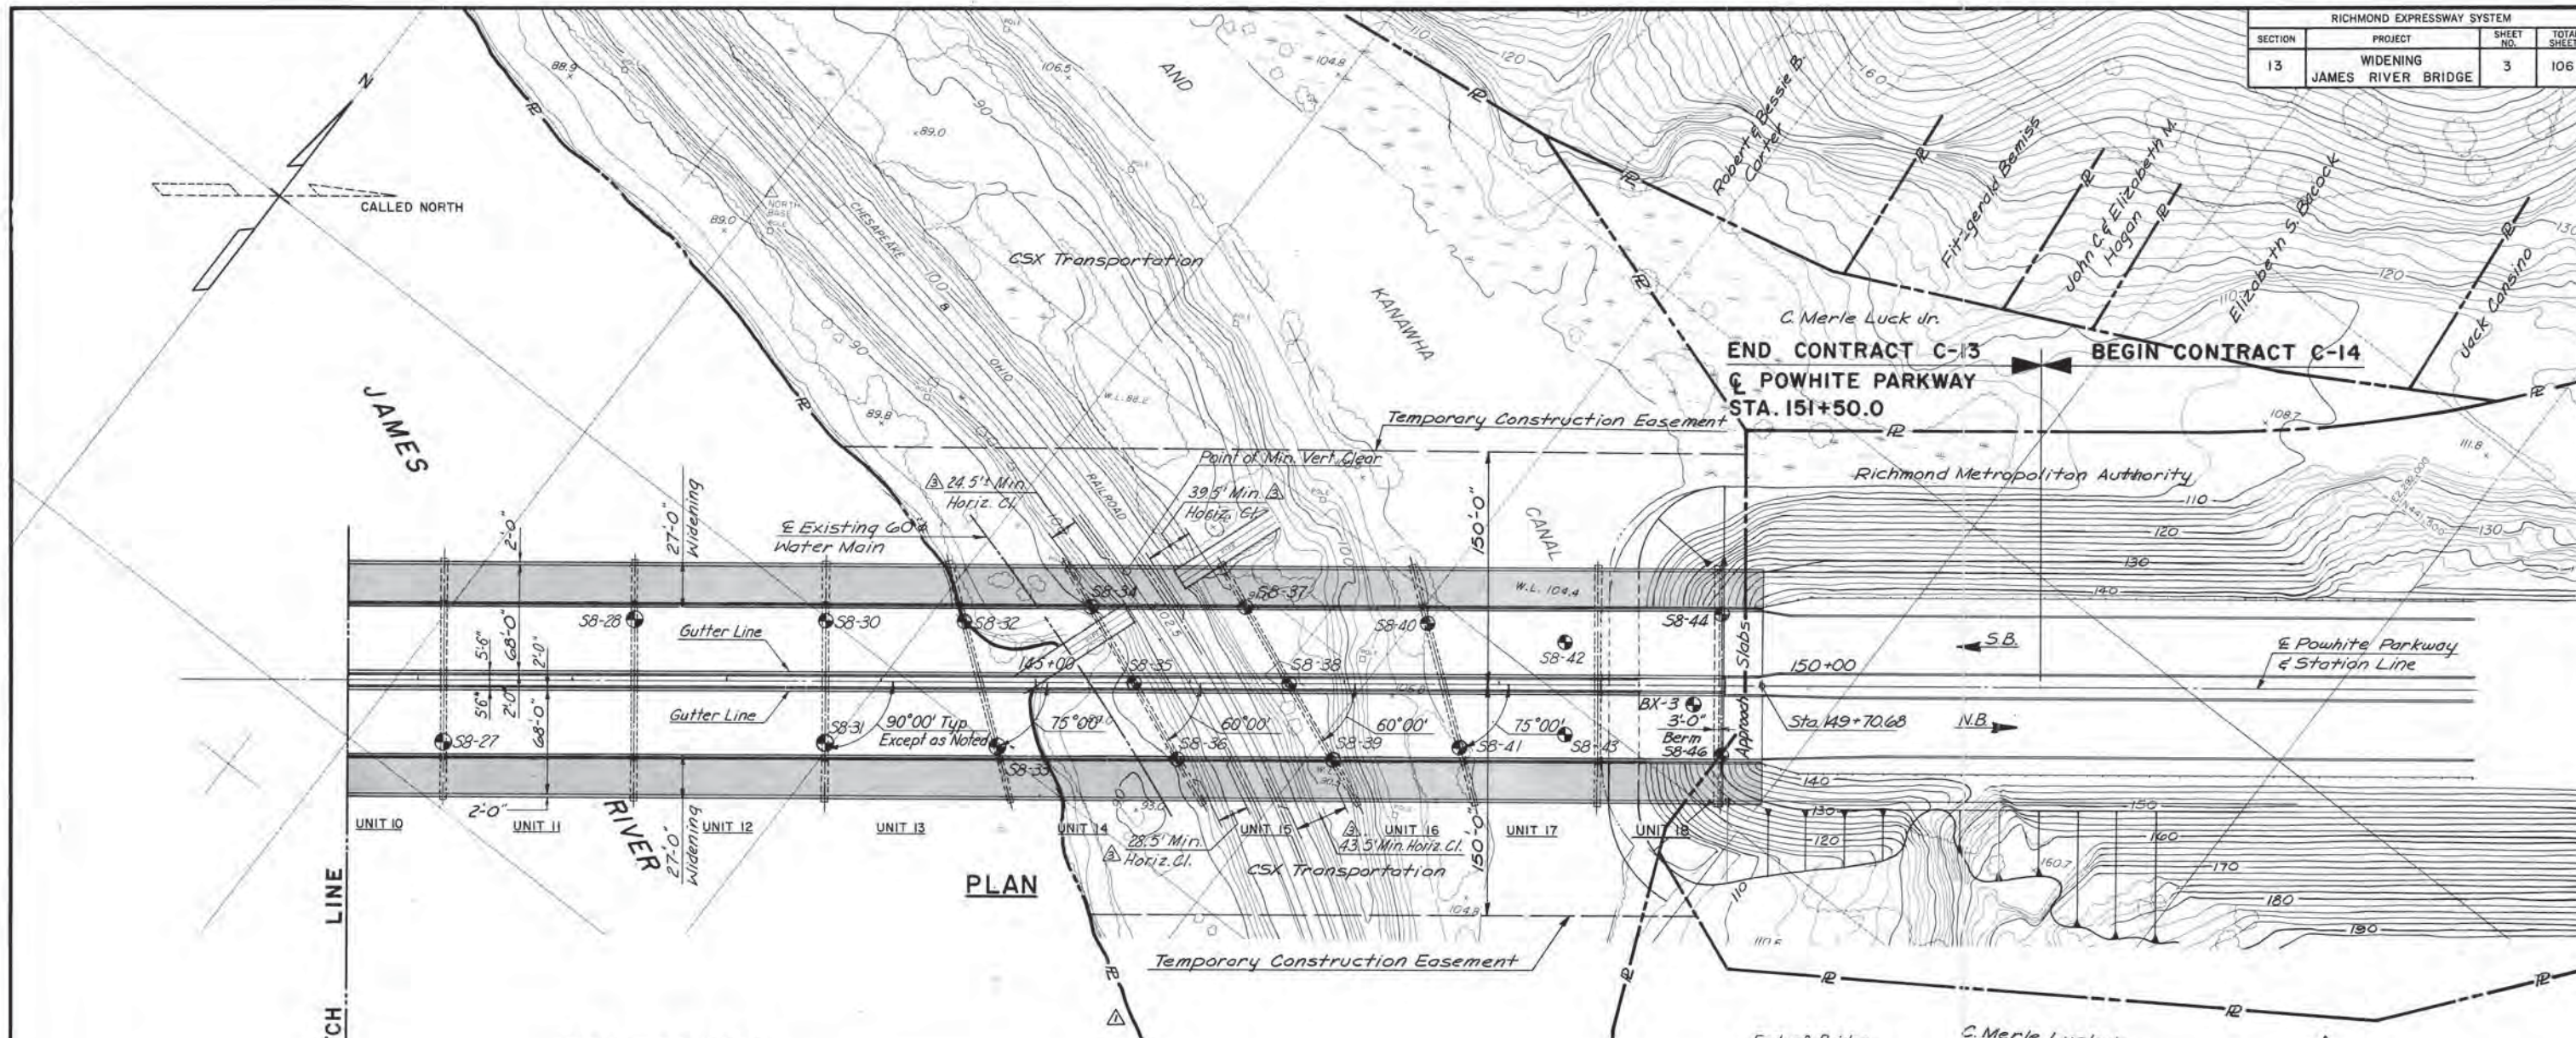

ELEVATION

| As Built TEM 3-89 | | | | | |
|-------------------|------|------------------|----------|------|------|
| BY | DATE | REVISION | BY | DATE | |
| ALC | 3-87 | Added Horiz. Cl. | EJM | 7-87 | |
| | | Vert. Clear | ALC | 5-87 | |
| | | Property Line | ALC | 4-87 | |
| IN CHARGE | S.R. | NO. | REVISION | BY | DATE |

RICHMOND METROPOLITAN AUTHORITY
RICHMOND EXPRESSWAY SYSTEM






GENERAL PLAN AND ELEVATION

HOWARD, NEEDLES, TAMMEN & BERGENDOFF
 consulting engineers
 Alexandria, Virginia

SCALE: 1" = 50'
 CONTRACT NO.: C-13
 SHEET NO. 3 OF 106

AS BUILT

| RICHMOND EXPRESSWAY SYSTEM | | | |
|----------------------------|-----------------------------|-----------|--------------|
| SECTION | PROJECT | SHEET NO. | TOTAL SHEETS |
| 13 | WIDENING JAMES RIVER BRIDGE | 13 | 106 |

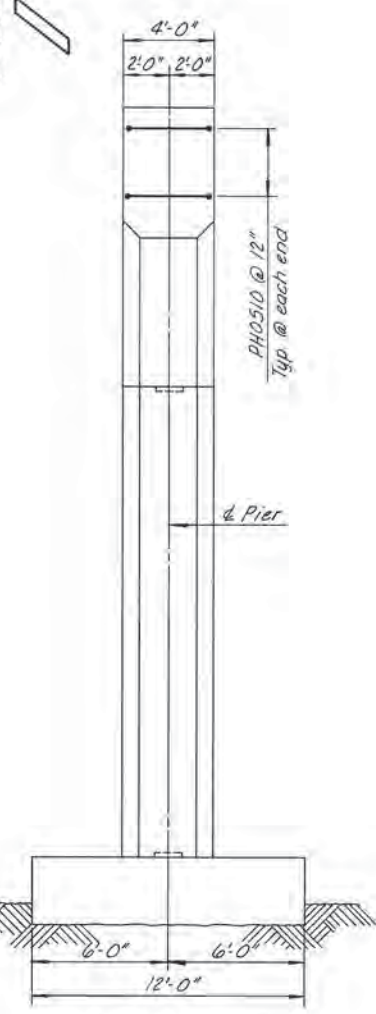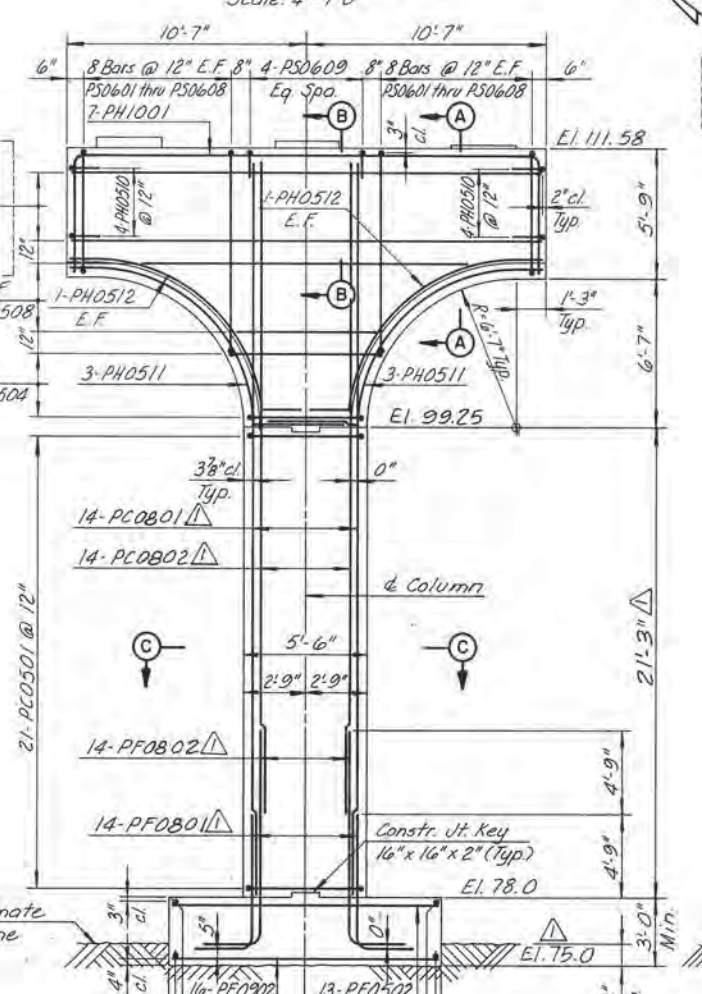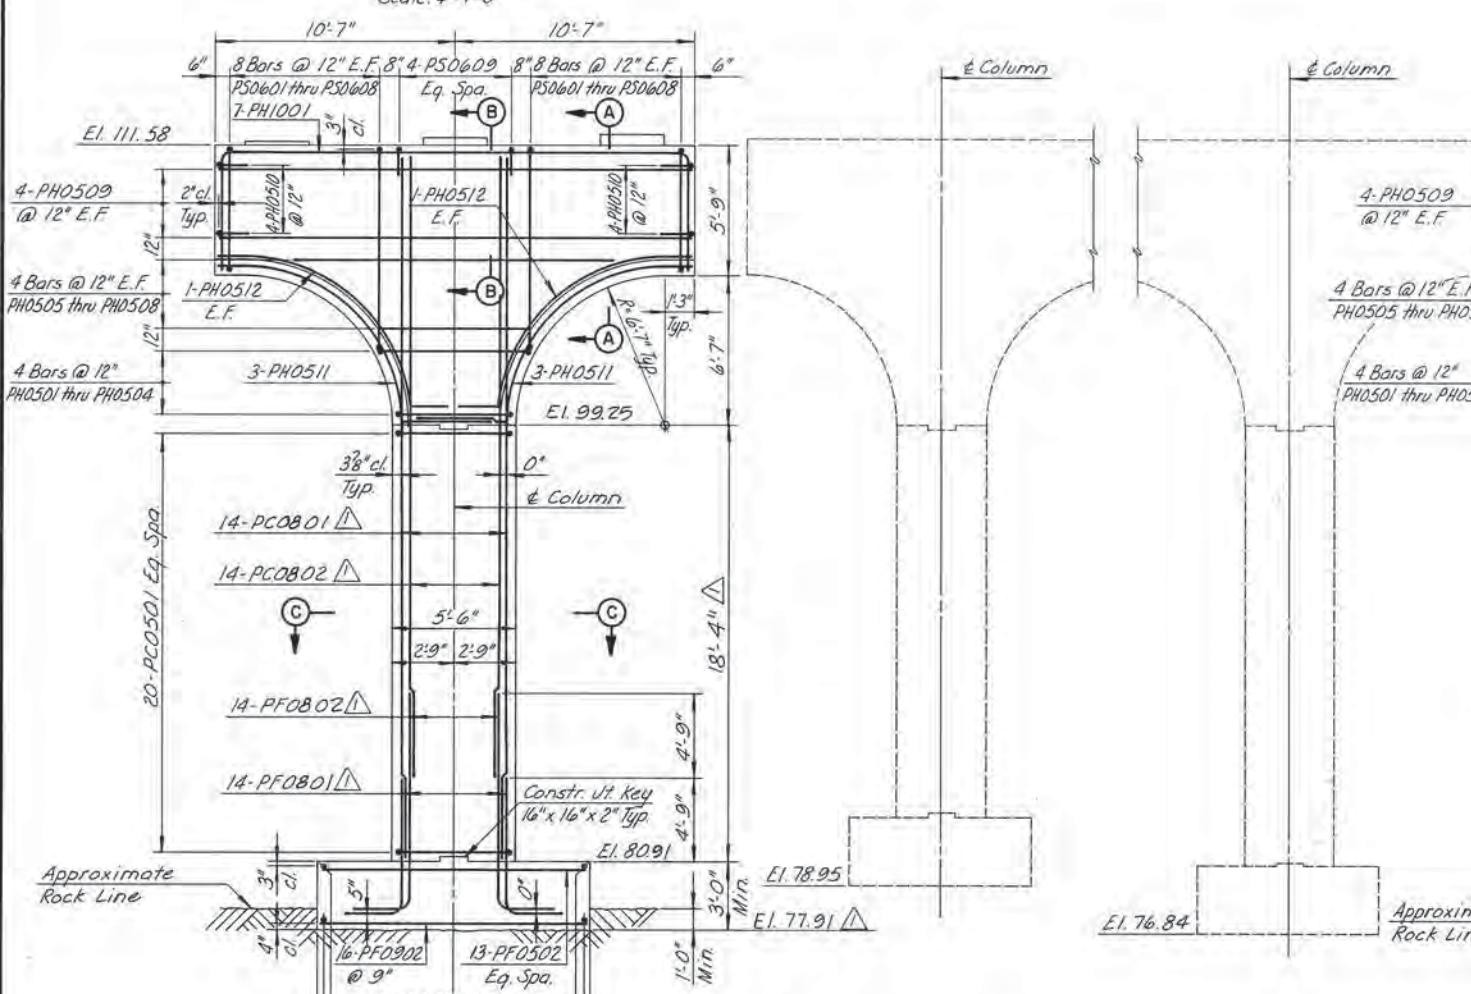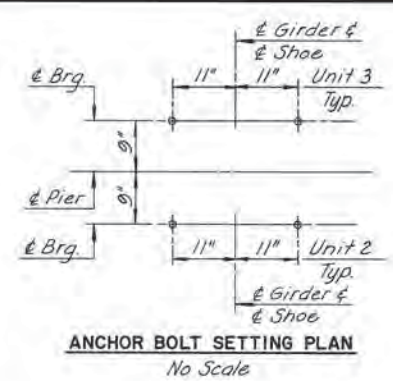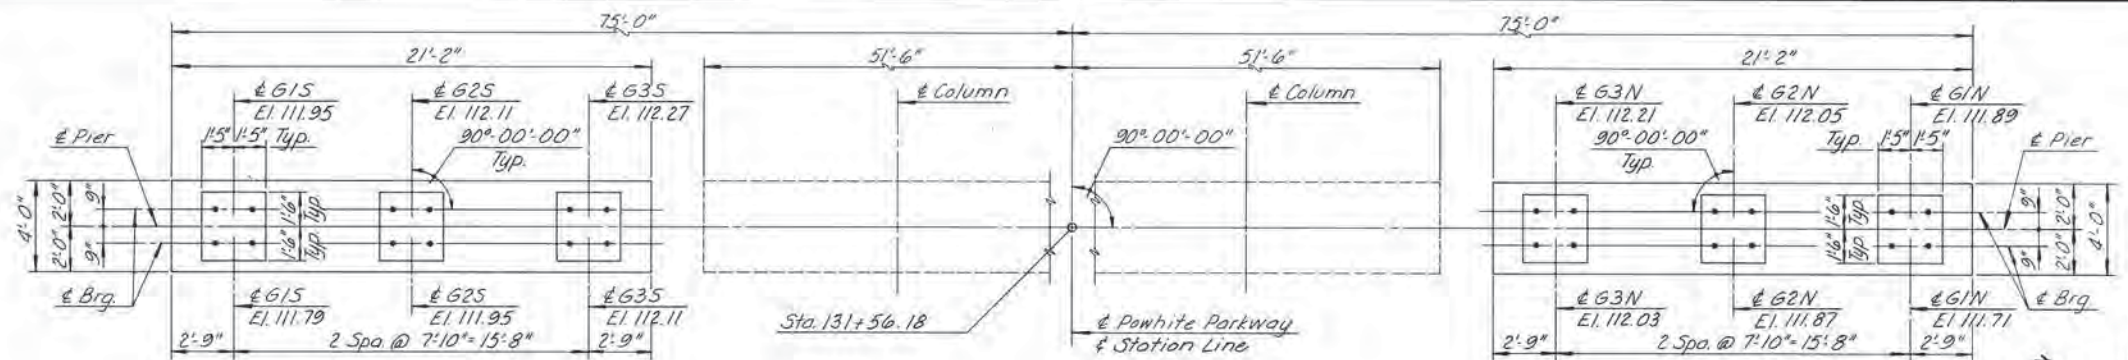

NOTES:
 For Sections A-A, B-B and C-C, see Sheet No. 12
 Maximum Allowable Bearing Pressure 10 tons/s.f.
 Actual Design Bearing Pressure 4.8 tons/s.f.

| BY | DATE | NO. | REVISION | BY | DATE |
|-----------|-------------|----------|----------|------|------|
| MADE | EUM 2-87 | | | | |
| CHECKED | T.F.P. 3-87 | As Built | TEM | 3-89 | |
| IN CHARGE | S.R. | | | | |

**RICHMOND METROPOLITAN AUTHORITY
RICHMOND EXPRESSWAY SYSTEM**






PIER 2 DETAILS

AS BUILT

HOWARD, NEEDLES, TAMMEN & BERGENDOFF
consulting engineers
Alexandria, Virginia

SCALE: AS SHOWN
 CONTRACT NO. C-13
 SHEET NO. 13 OF 106

| RICHMOND EXPRESSWAY SYSTEM | | | |
|----------------------------|-----------------------------|-----------|--------------|
| SECTION | PROJECT | SHEET NO. | TOTAL SHEETS |
| 13 | WIDENING JAMES RIVER BRIDGE | 20 | 106 |

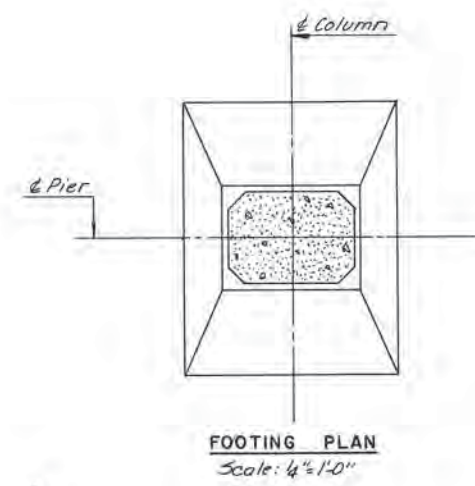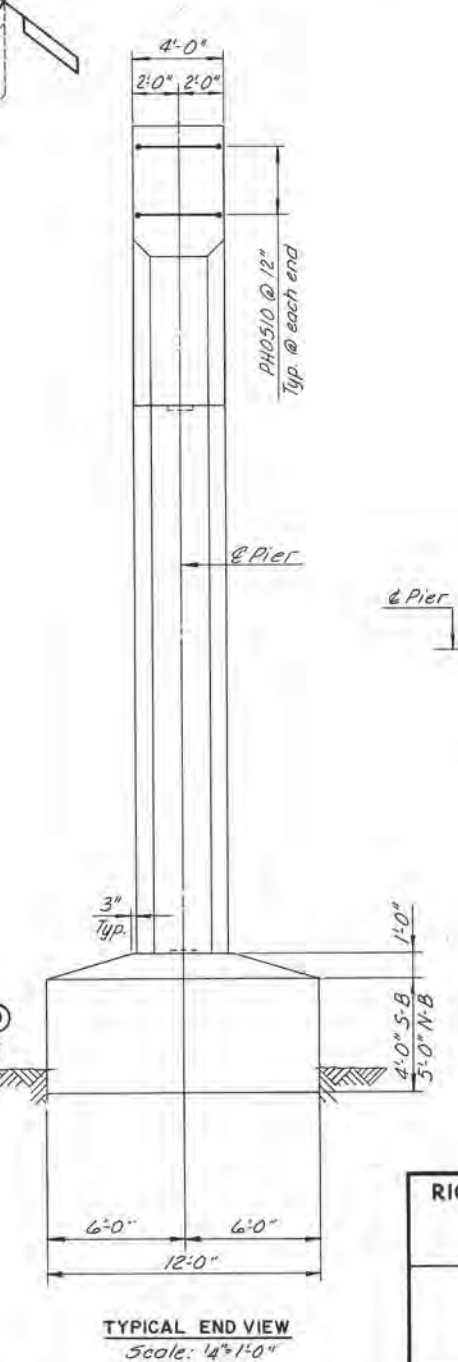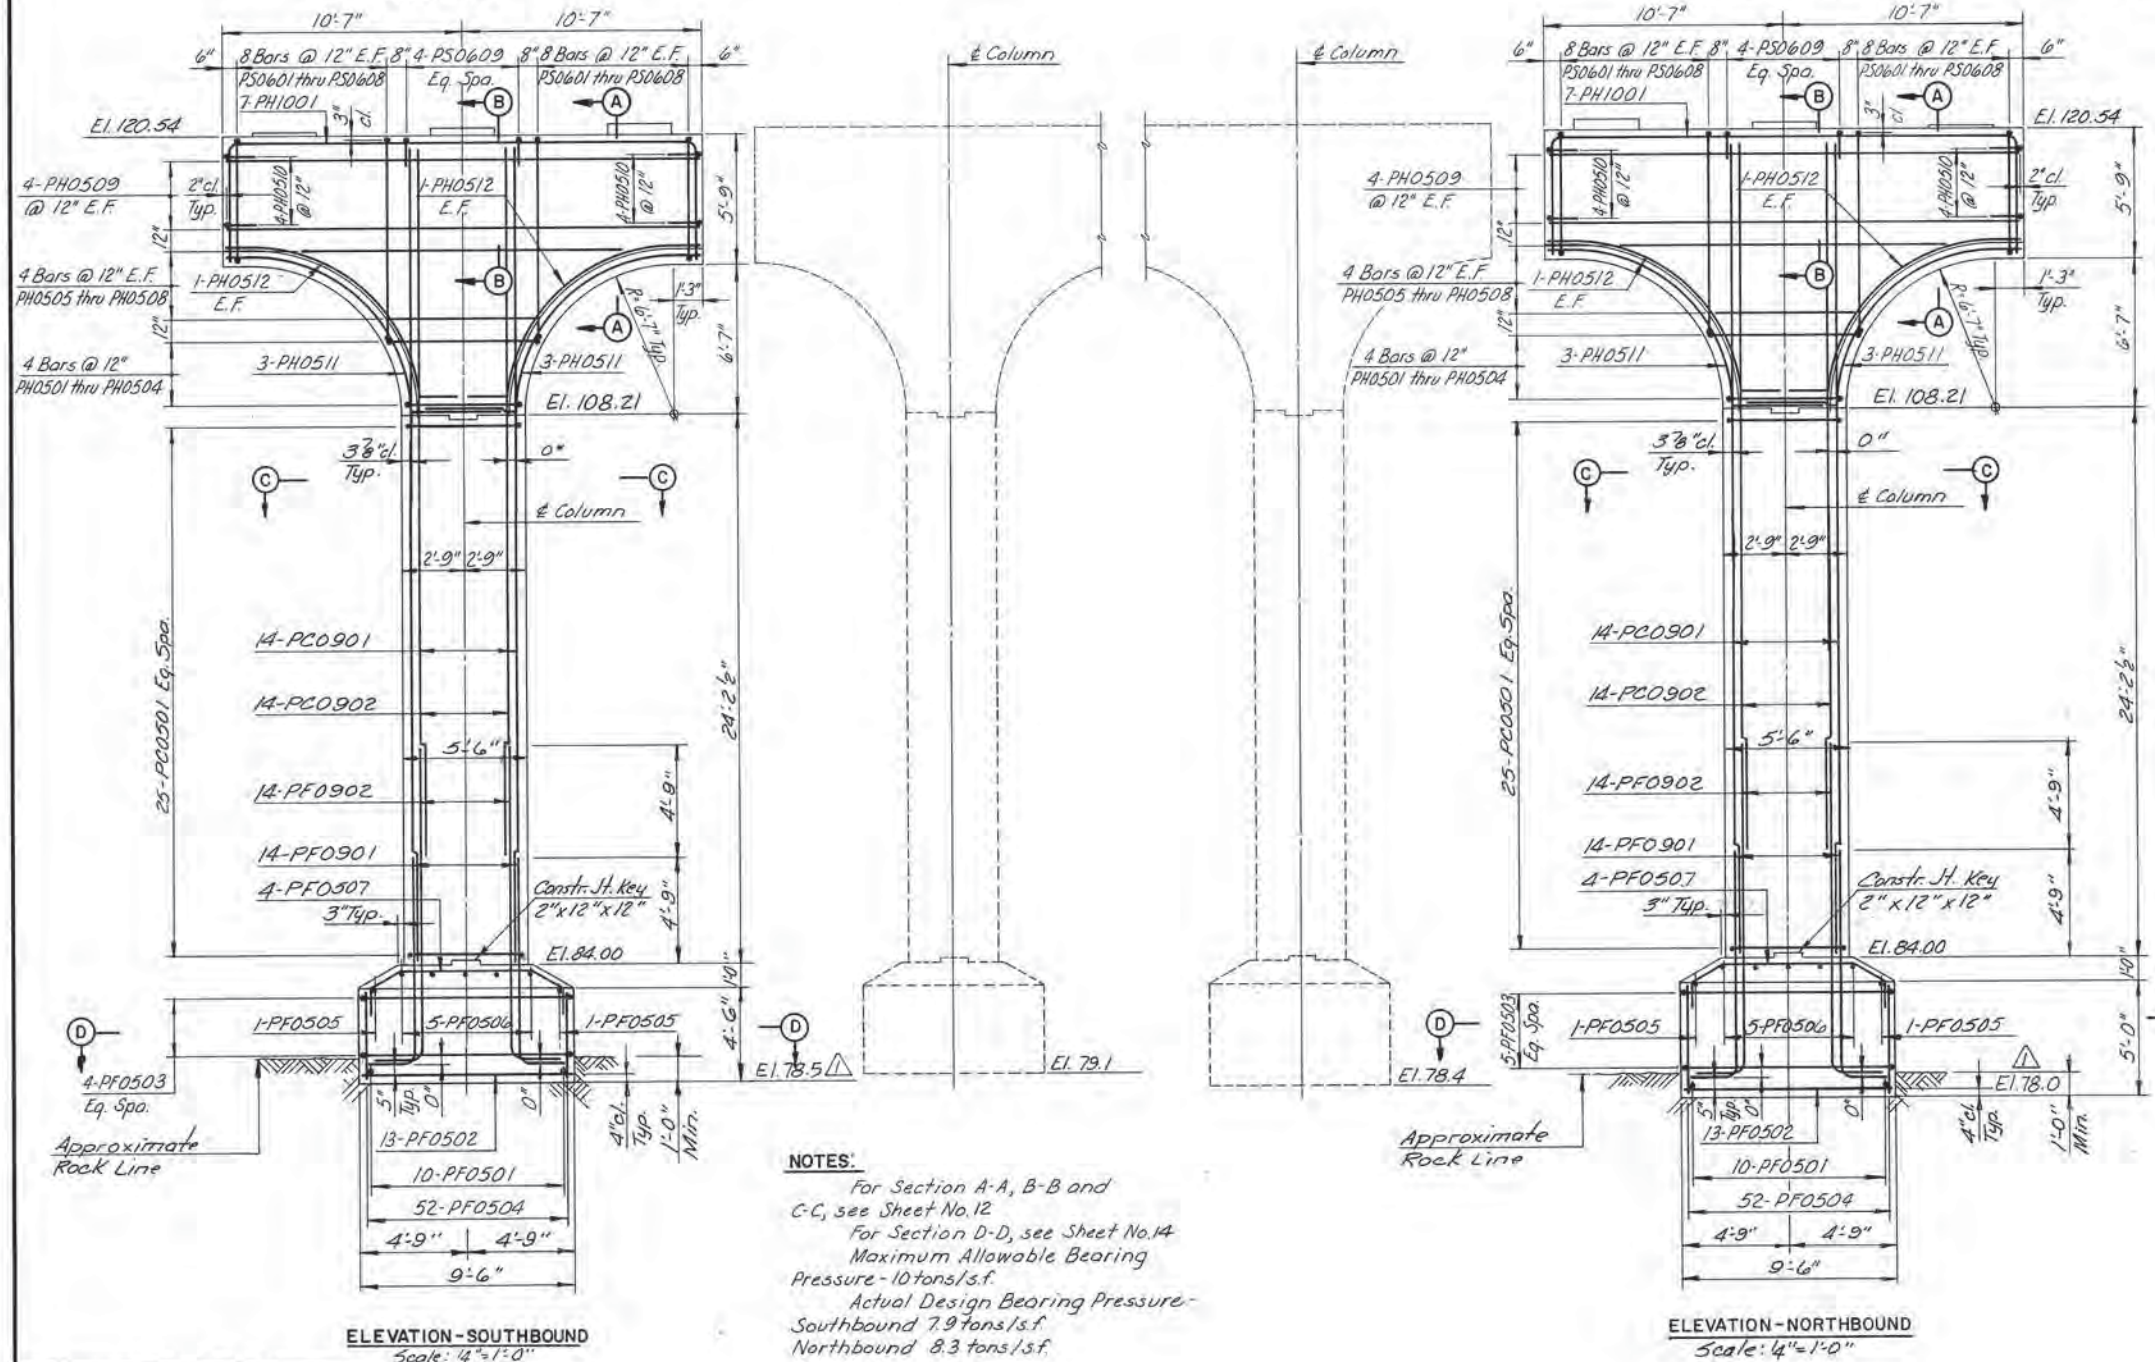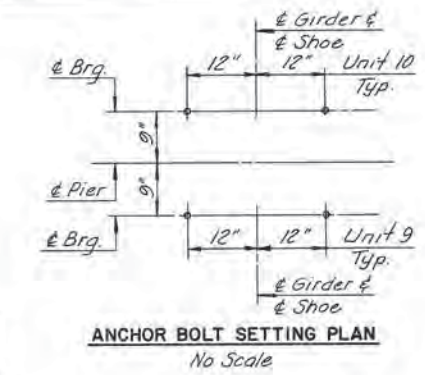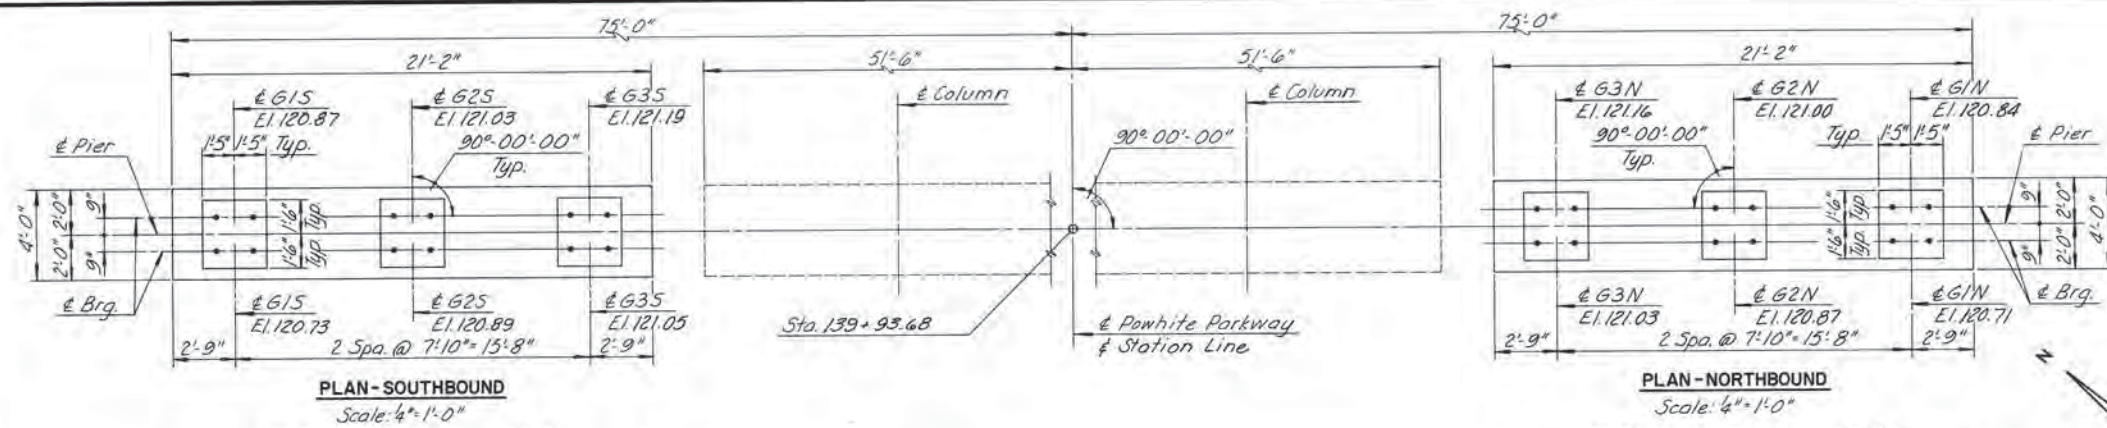

NOTES:
For Section A-A, B-B and C-C, see Sheet No. 12
For Section D-D, see Sheet No. 14
Maximum Allowable Bearing Pressure - 10 tons/s.f.
Actual Design Bearing Pressure -
Southbound 7.9 tons/s.f.
Northbound 8.3 tons/s.f.

| BY | DATE | | | | |
|-----------|--------|------|----------|-----|------|
| MADE | TAL | 3-87 | | | |
| CHECKED | T.F.R. | 3-87 | As Built | TEM | 3-89 |
| IN CHARGE | S.R. | | | | |
| | | | REVISION | BY | DATE |

RICHMOND METROPOLITAN AUTHORITY
RICHMOND EXPRESSWAY SYSTEM


PIER 9 DETAILS

HOWARD, NEEDLES, TAMMEN & BERGENDOFF
consulting engineers
Alexandria, Virginia

SCALE AS SHOWN
CONTRACT NO. C-13
SHEET NO. 20 of 106


AS BUILT

| RICHMOND EXPRESSWAY SYSTEM | | | |
|----------------------------|-----------------------------|-----------|--------------|
| SECTION | PROJECT | SHEET NO. | TOTAL SHEETS |
| 13 | WIDENING JAMES RIVER BRIDGE | 21 | 106 |

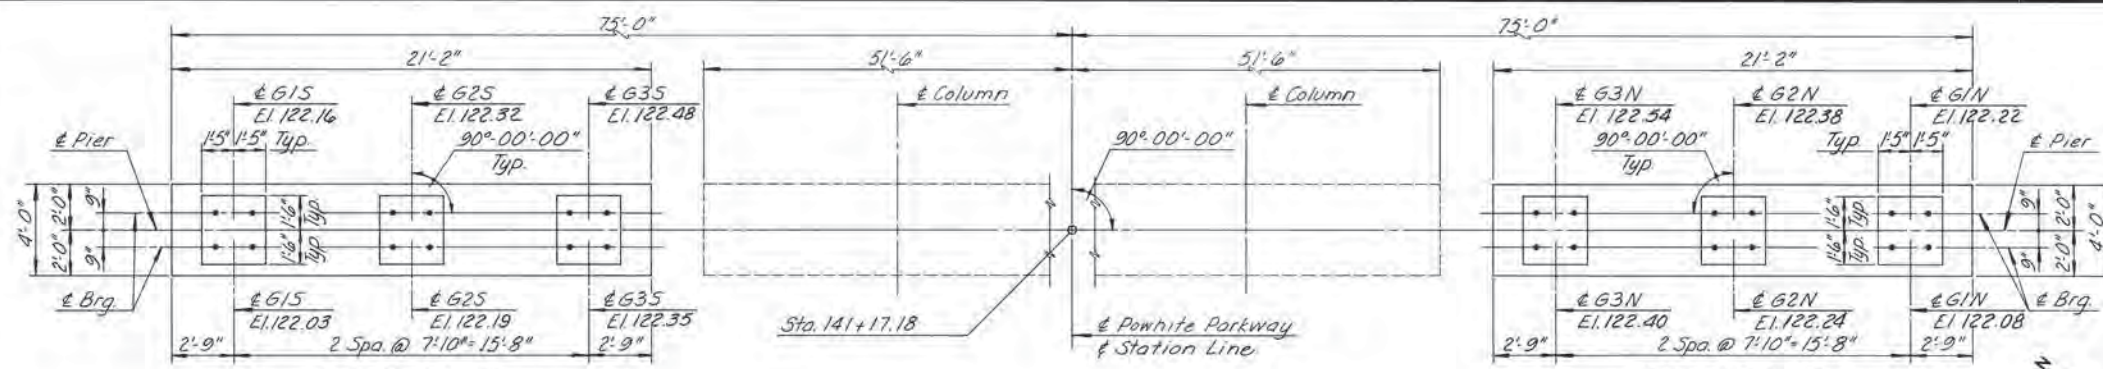


PLAN-SOUTHBOUND
Scale: 1/4"=1'-0"


PLAN-NORTHBOUND
Scale: 1/4"=1'-0"

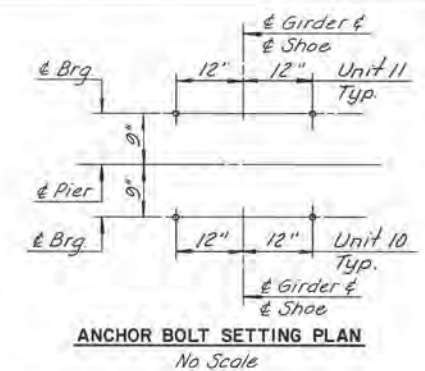


ANCHOR BOLT SETTING PLAN
No Scale

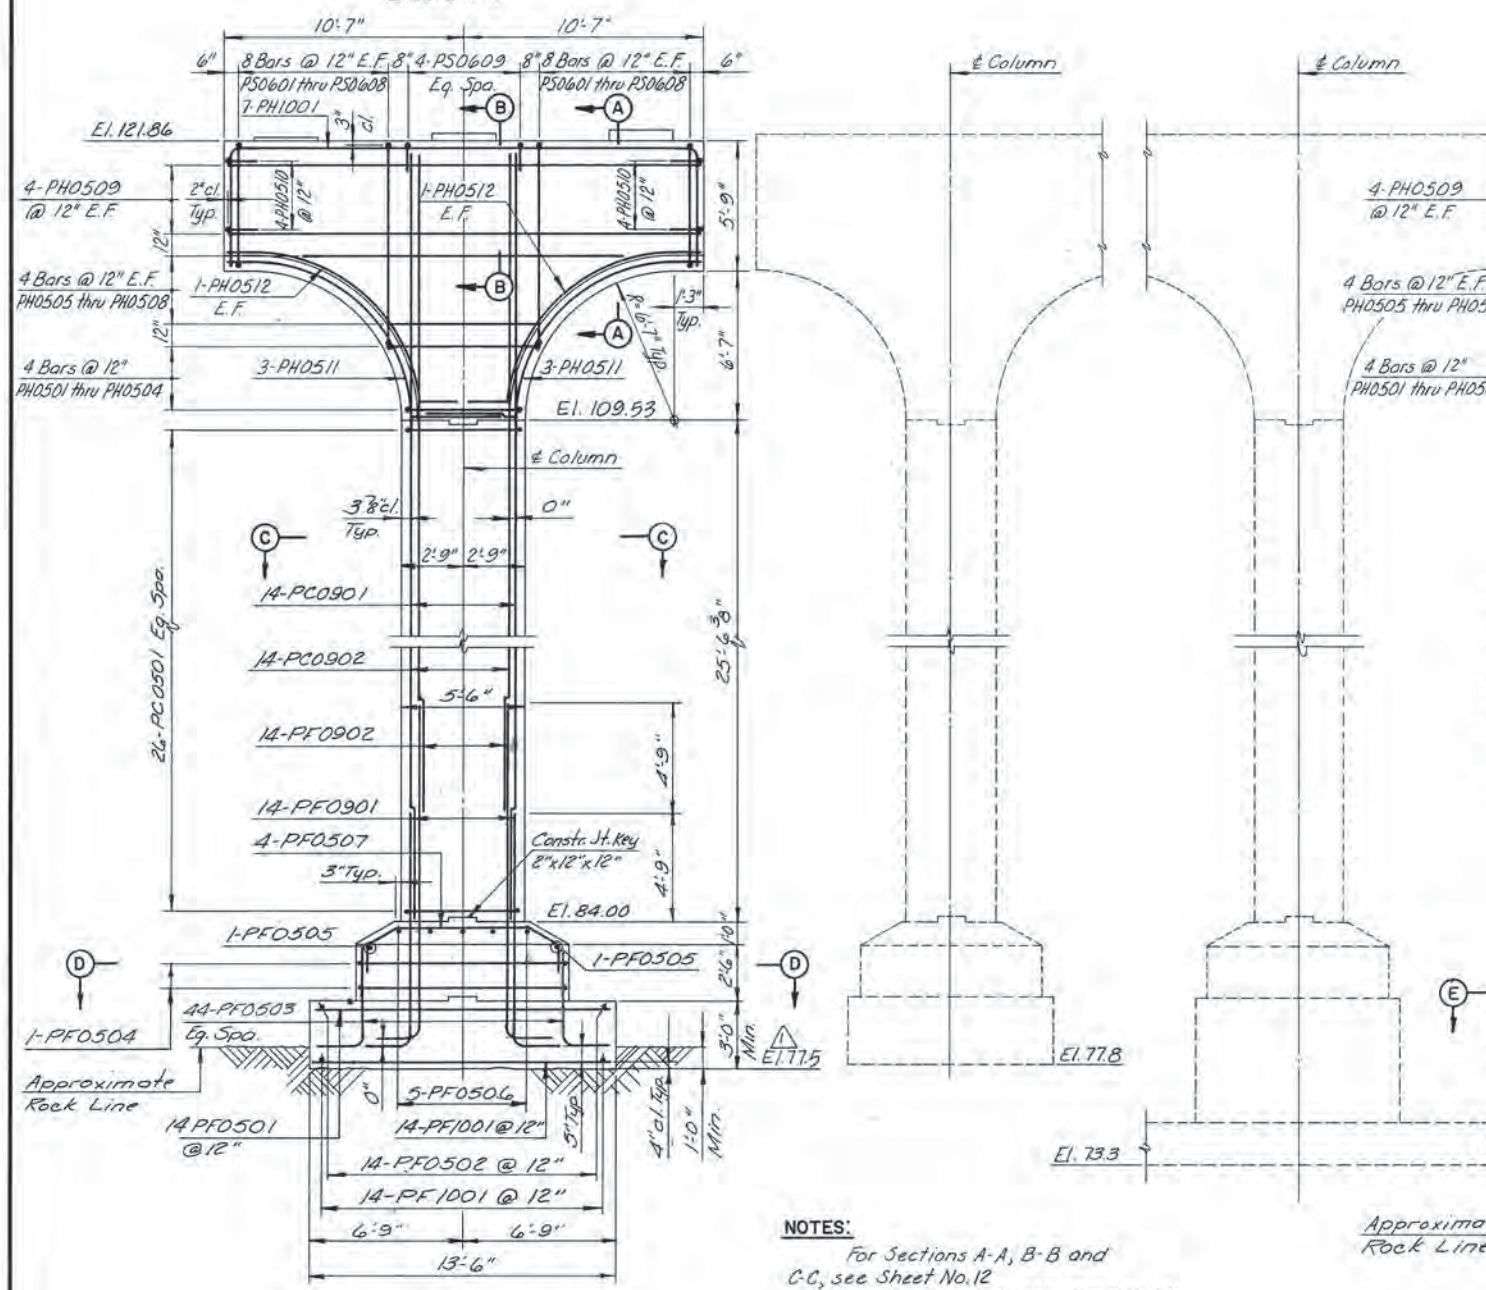


ELEVATION-SOUTHBOUND
Scale: 1/4"=1'-0"

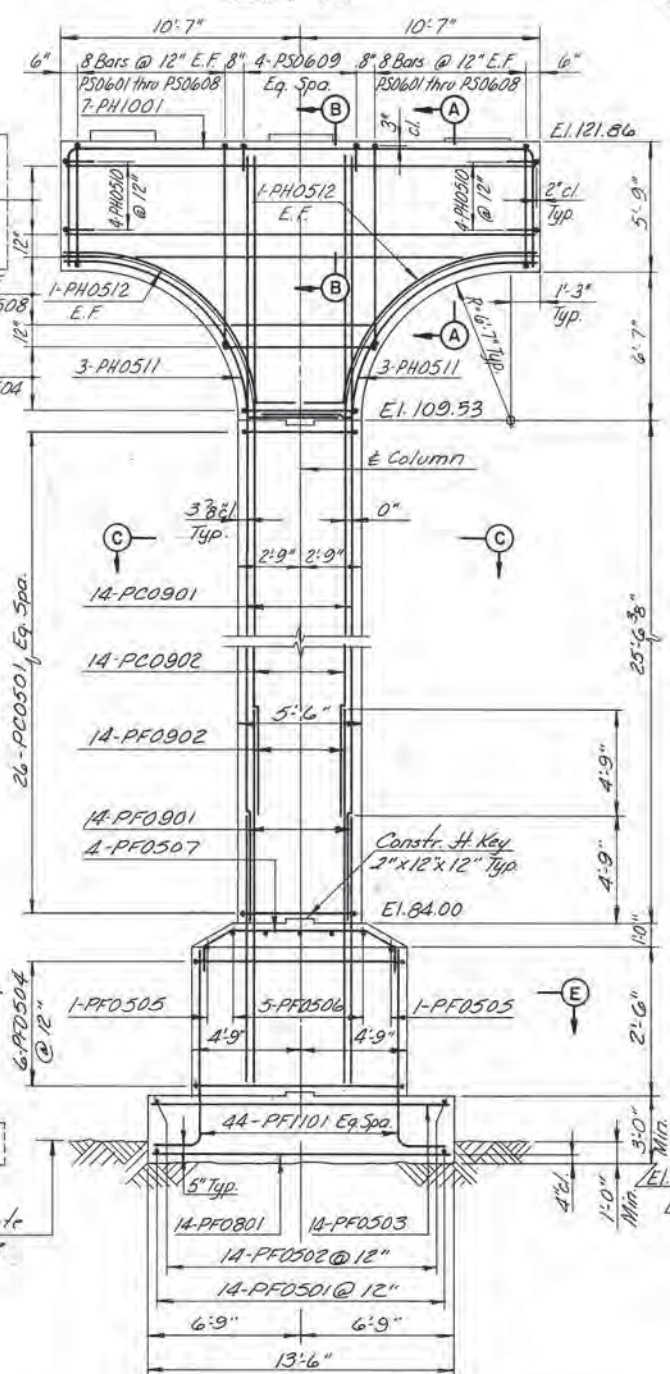

ELEVATION-NORTHBOUND
Scale: 1/4"=1'-0"

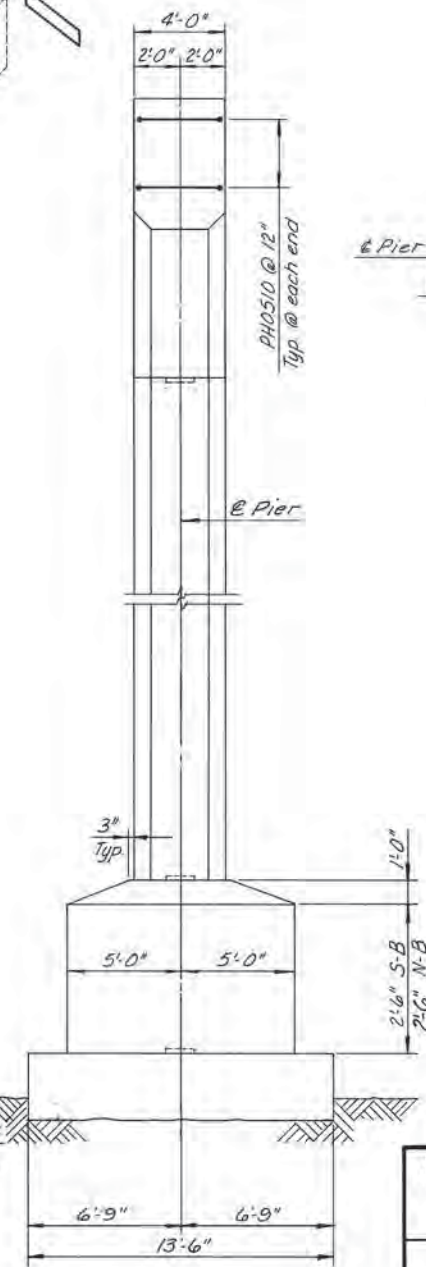

TYPICAL END VIEW
Scale: 1/4"=1'-0"

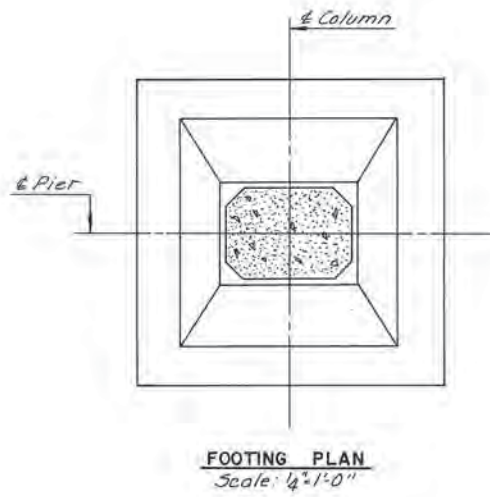

FOOTING PLAN
Scale: 1/4"=1'-0"

NOTES:
 For Sections A-A, B-B and C-C, see Sheet No.12
 For Section D-D, see Sheet No.14
 For Section E-E, see Sheet No.16
 Maximum Allowable Bearing Pressure - 5 tons/s.f.
 Actual Design Bearing Pressure - Southbound 4.5 tons/s.f. Northbound 4.5 tons/s.f.

| BY | DATE | NO. | REVISION | BY | DATE |
|-----------|----------|-----|----------|-----|------|
| MADE | TAL 3-87 | | | | |
| CHECKED | TFP 3-87 | | AS BUILT | TEM | 3-89 |
| IN CHARGE | S.R. | | | | |






RICHMOND METROPOLITAN AUTHORITY
RICHMOND EXPRESSWAY SYSTEM

PIER 10 DETAILS

HOWARD, NEEDLES, TAMMEN & BERGENDOFF
consulting engineers
Alexandria, Virginia
SCALE: AS SHOWN
CONTRACT NO. C-13
SHEET NO. 21 OF 106

AS BUILT

| RICHMOND EXPRESSWAY SYSTEM | | | |
|----------------------------|-----------------------------|-----------|--------------|
| SECTION | PROJECT | SHEET NO. | TOTAL SHEETS |
| 13 | WIDENING JAMES RIVER BRIDGE | 22 | 106 |

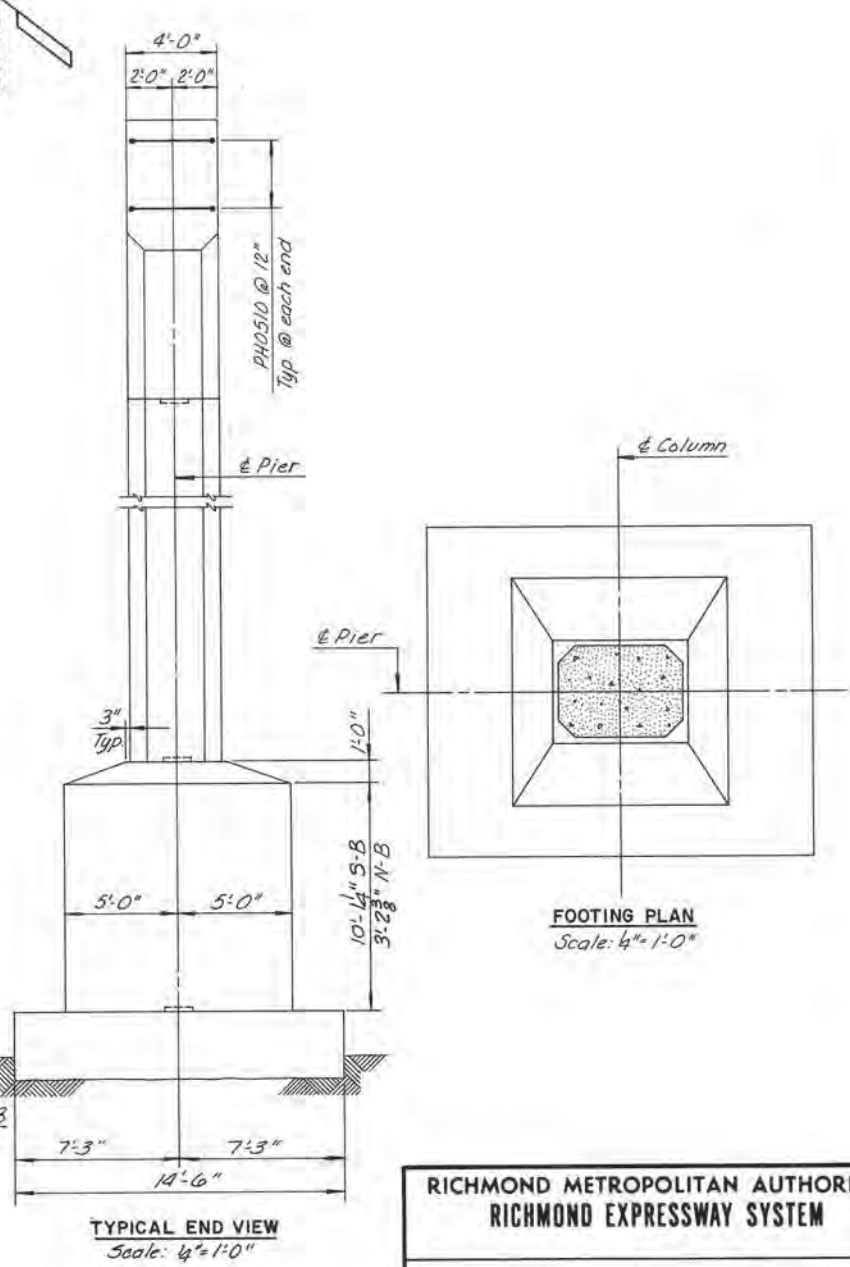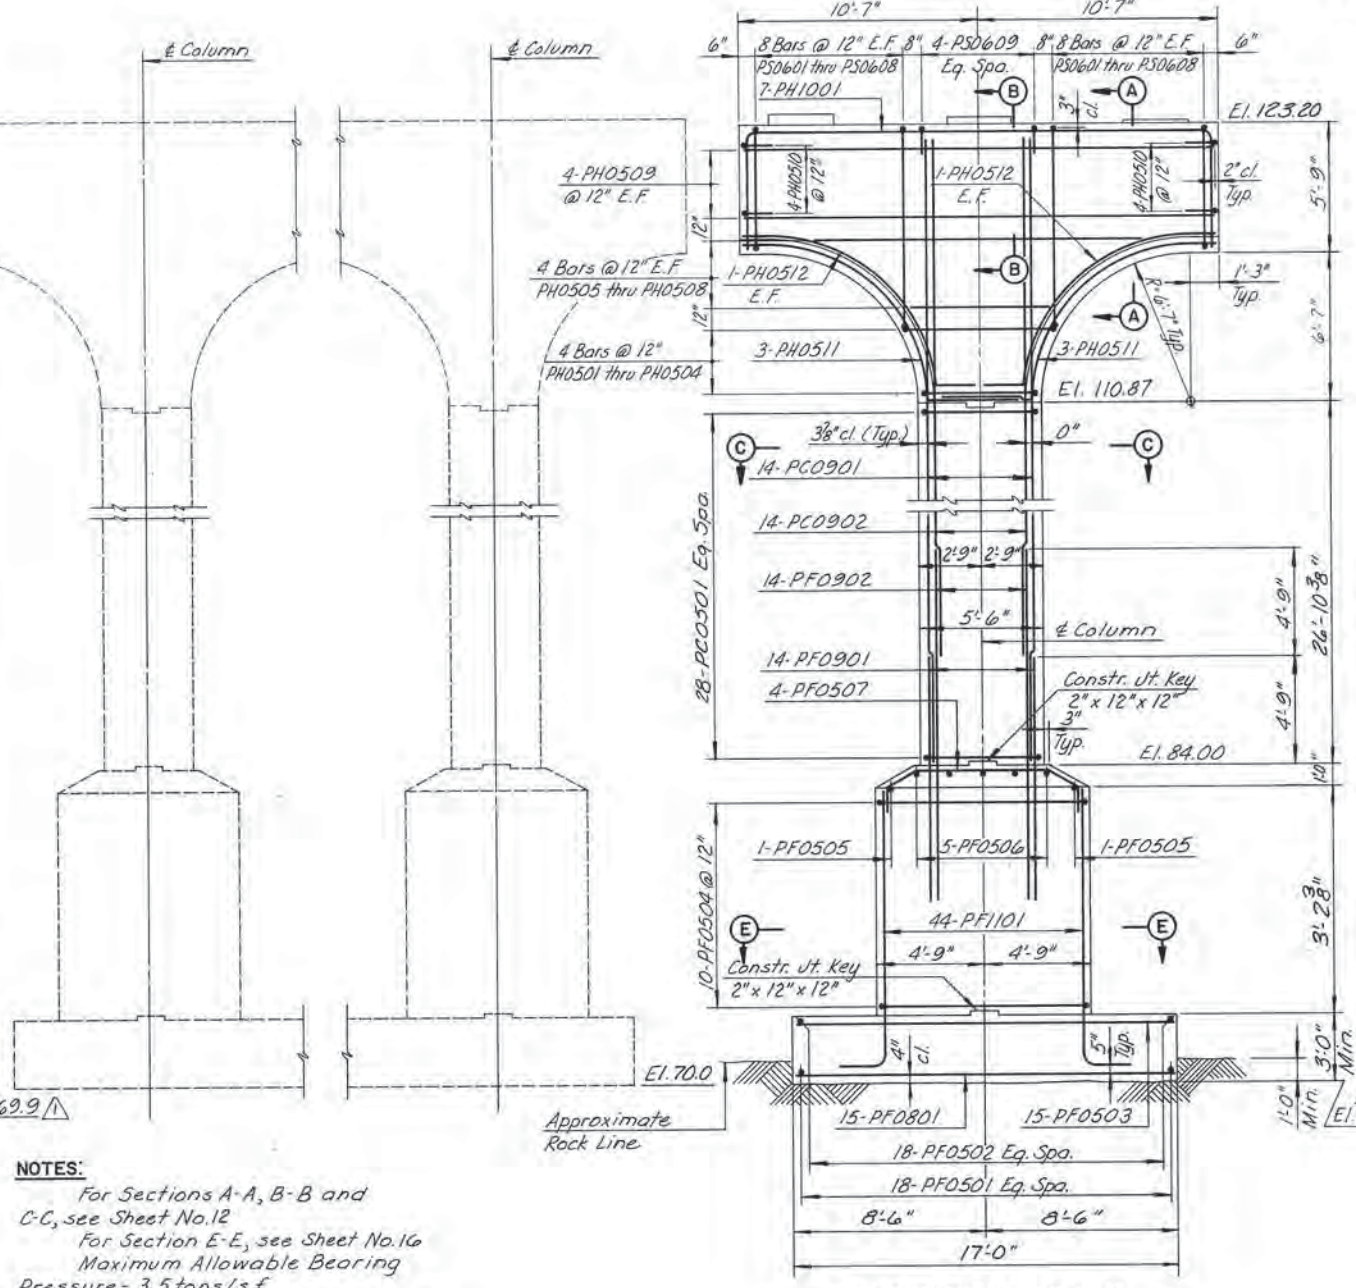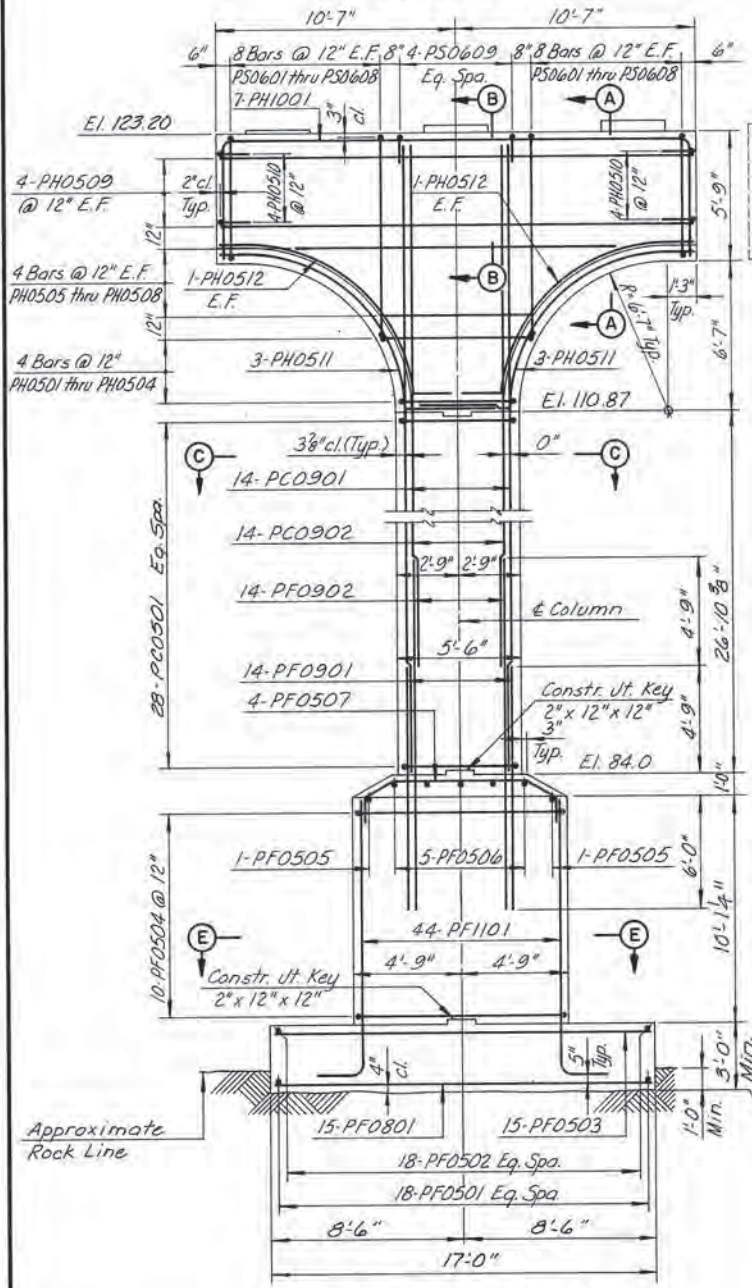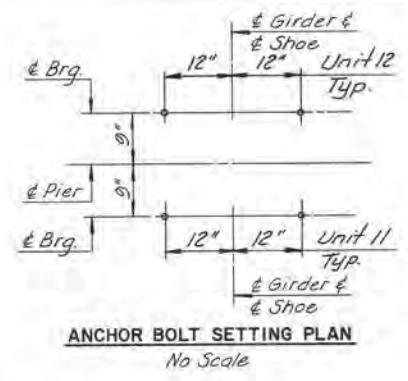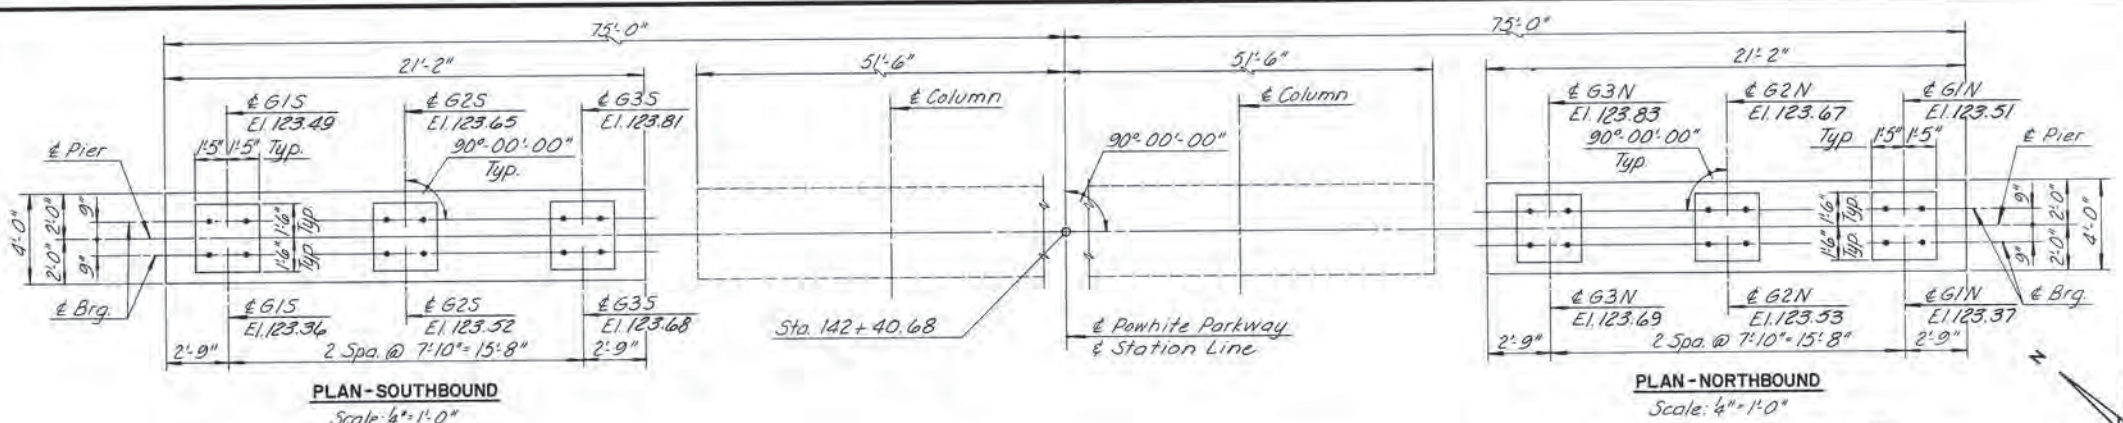

NOTES:
 For Sections A-A, B-B and C-C, see Sheet No. 12
 For Section E-E, see Sheet No. 16
 Maximum Allowable Bearing Pressure - 3.5 tons/s.f.
 Actual Design Bearing Pressure - 3.3 tons/s.f.

| | | | | | |
|-----------|----------|----------|------|------|--|
| BY | DATE | | | | |
| MADE | EJM 3-87 | | | | |
| CHECKED | TRP 3-87 | As Built | TEM | 3-89 | |
| IN CHARGE | S.R. | | | | |
| NO. | REVISION | BY | DATE | | |

RICHMOND METROPOLITAN AUTHORITY
RICHMOND EXPRESSWAY SYSTEM


PIER II DETAILS

HOWARD, NEEDLES, TAMMEN & BERGENDOFF
 consulting engineers
 Alexandria, Virginia


SCALE: AS SHOWN
 CONTRACT NO. C-13
 SHEET NO. 22 OF 106

AS BUILT


| RICHMOND EXPRESSWAY SYSTEM | | | |
|----------------------------|-----------------------------|-----------|--------------|
| SECTION | PROJECT | SHEET NO. | TOTAL SHEETS |
| 13 | WIDENING JAMES RIVER BRIDGE | 25 | 106 |

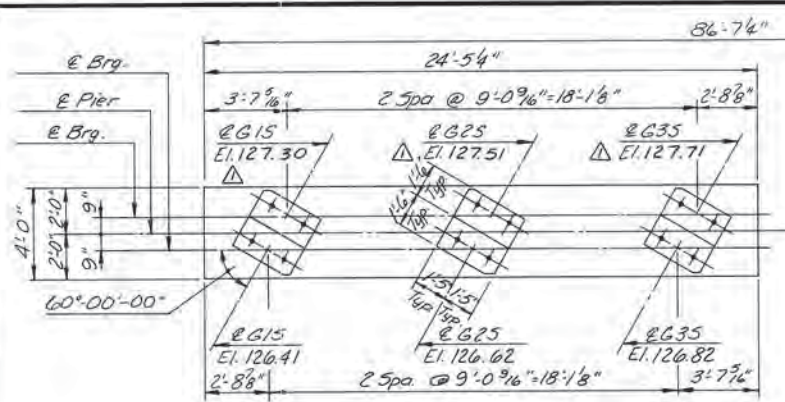


PLAN - SOUTHBOUND
Scale: 4"=1'-0"

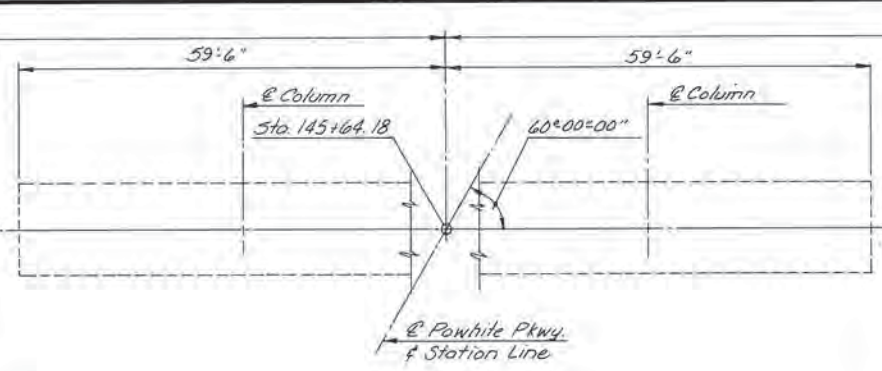


PLAN - NORTHBOUND
Scale: 4"=1'-0"

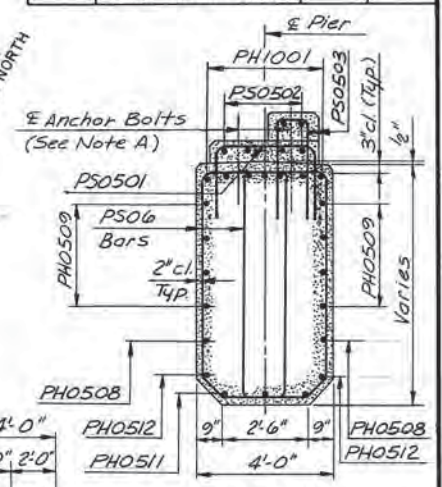


SECTION A-A
Scale: 3/8"=1'-0"

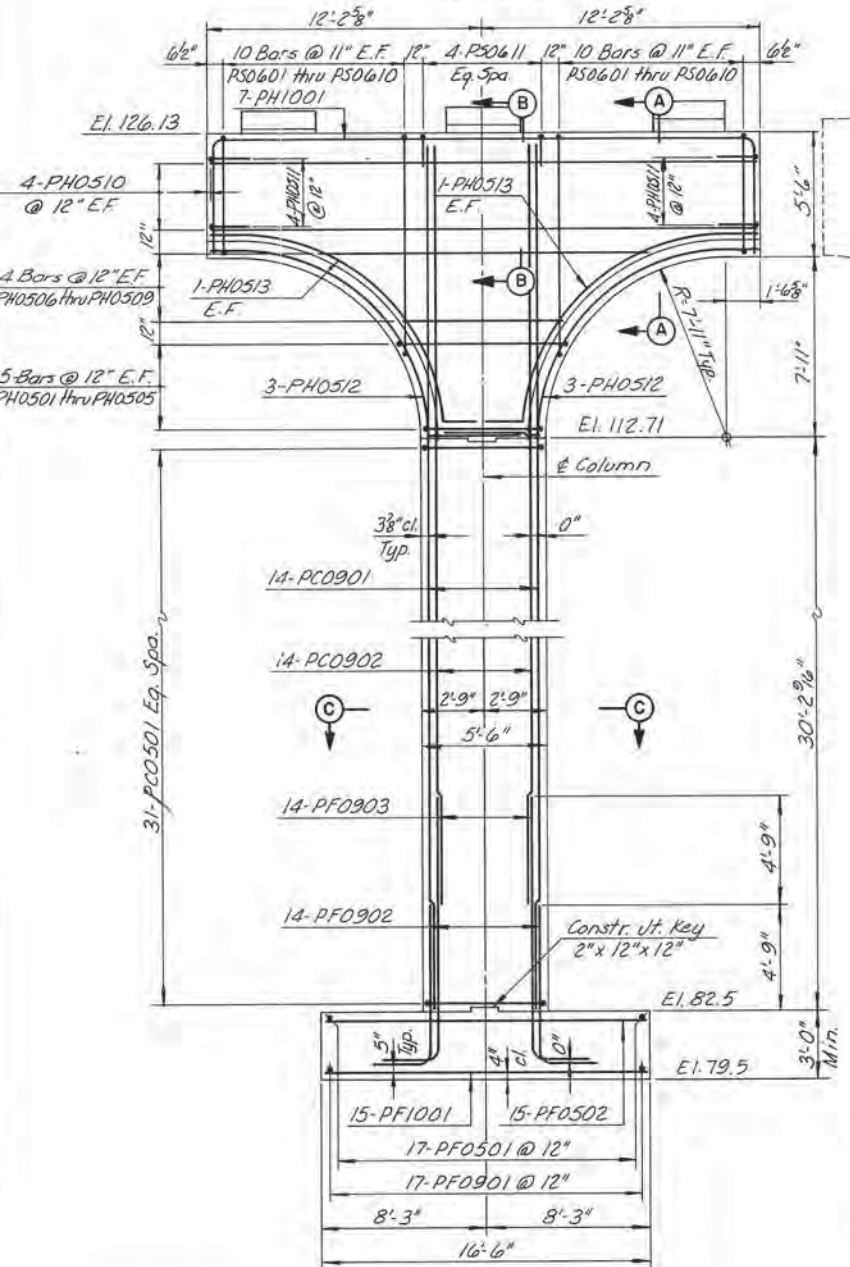

ELEVATION - SOUTHBOUND
Scale: 4"=1'-0"

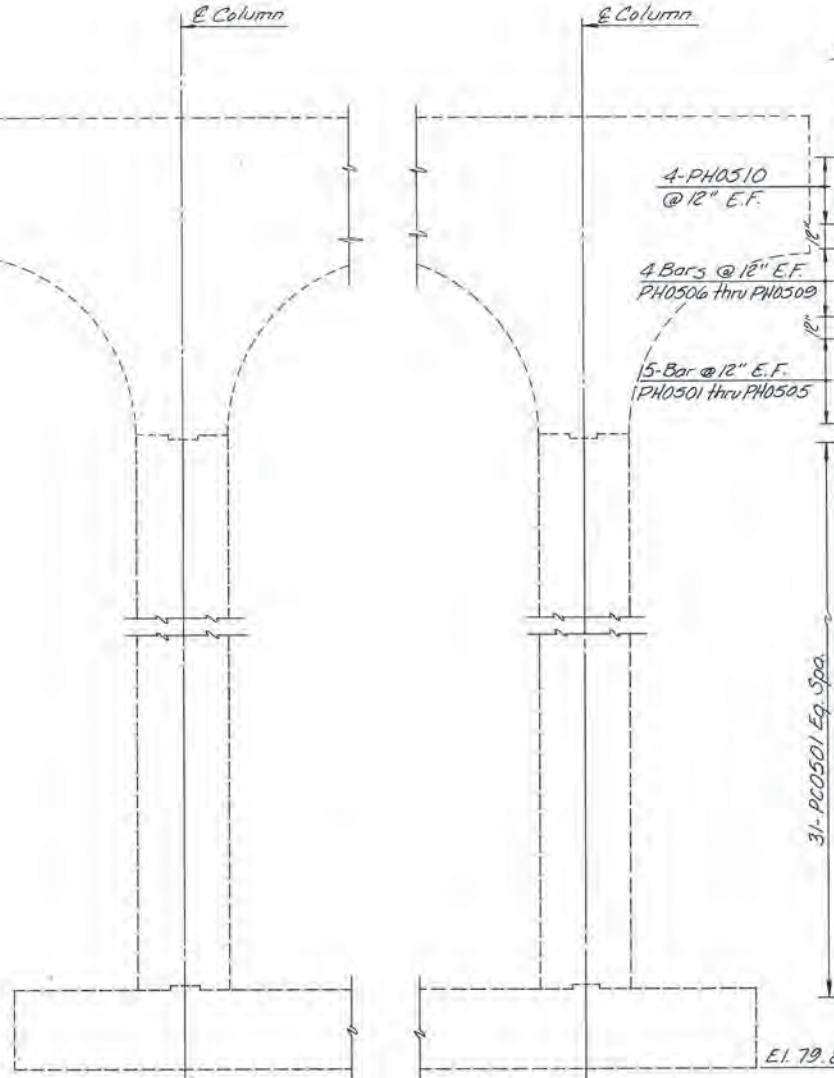

ELEVATION - NORTHBOUND
Scale: 4"=1'-0"

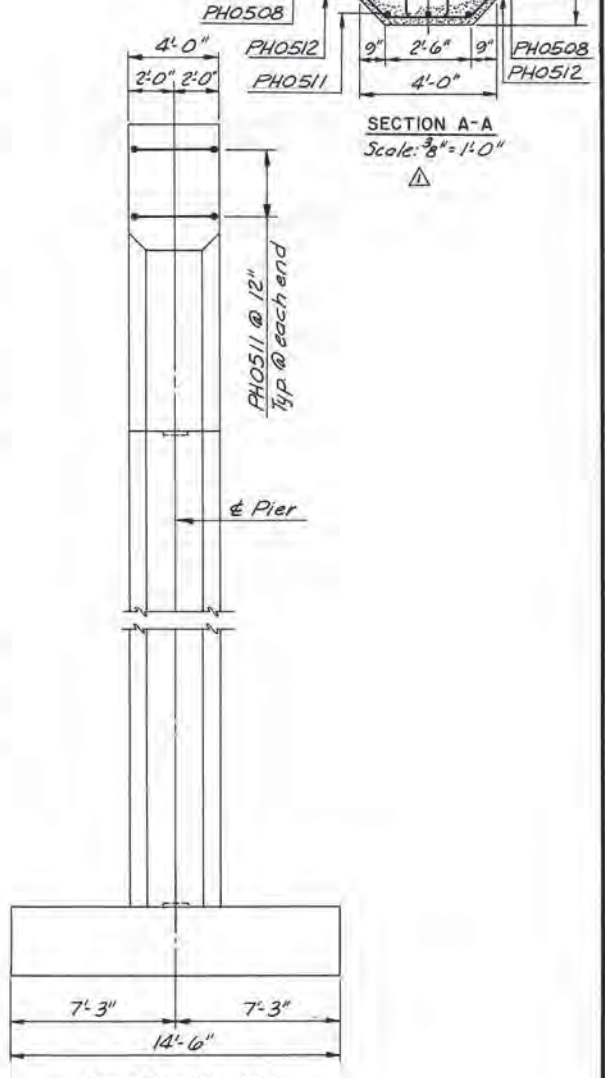

TYPICAL END VIEW
Scale: 4"=1'-0"

NOTES:
 ▲ For Sections B-B and C-C see Sheet No.12
 For Anchor Bolt Setting Plan, see Sheet No.29
 For Steel Sheet Piling requirements, see Sheet No.29
 Maximum Allowable Bearing Pressure - 3.5 tons/s.f.
 Actual Design Bearing Pressure - Southbound - 3.3 tons/s.f.
 Northbound - 3.0 tons/s.f.

NOTE A:
 Pad reinforcing bars are to be spaced to clear Anchor Bolts.

| BY | DATE | REVISION | BY | DATE |
|-----------|----------|---------------------------|-----|------|
| MADE | EUM 2-87 | As Built | TEM | 3-89 |
| CHECKED | TFR 3-87 | EL. Plans Added Sect. A-A | ALC | 5-87 |
| IN CHARGE | S.R. | | | |

AS BUILT


RICHMOND METROPOLITAN AUTHORITY
RICHMOND EXPRESSWAY SYSTEM

PIER 14 DETAILS

HOWARD, NEEDLES, TAMMEN & BERGENOFF
 consulting engineers
 Alexandria, Virginia


SCALE: AS SHOWN
 CONTRACT NO. C-13
 SHEET NO. 25 OF 106

| RICHMOND EXPRESSWAY SYSTEM | | | |
|----------------------------|-----------------------------|-----------|--------------|
| SECTION | PROJECT | SHEET NO. | TOTAL SHEETS |
| 13 | WIDENING JAMES RIVER BRIDGE | 26 | 106 |

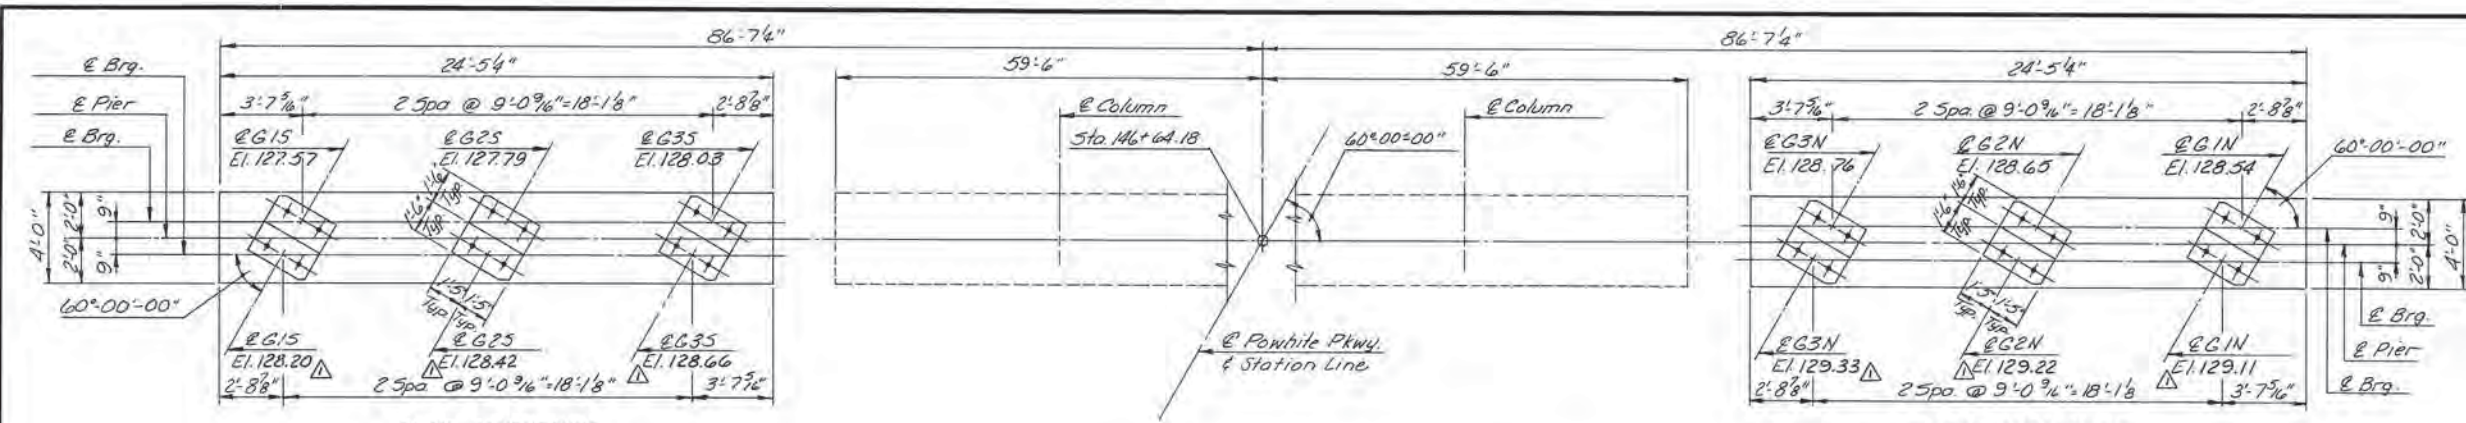


PLAN - SOUTHBOUND
Scale: 4"=10"

PLAN - NORTHBOUND
Scale: 4"=10"


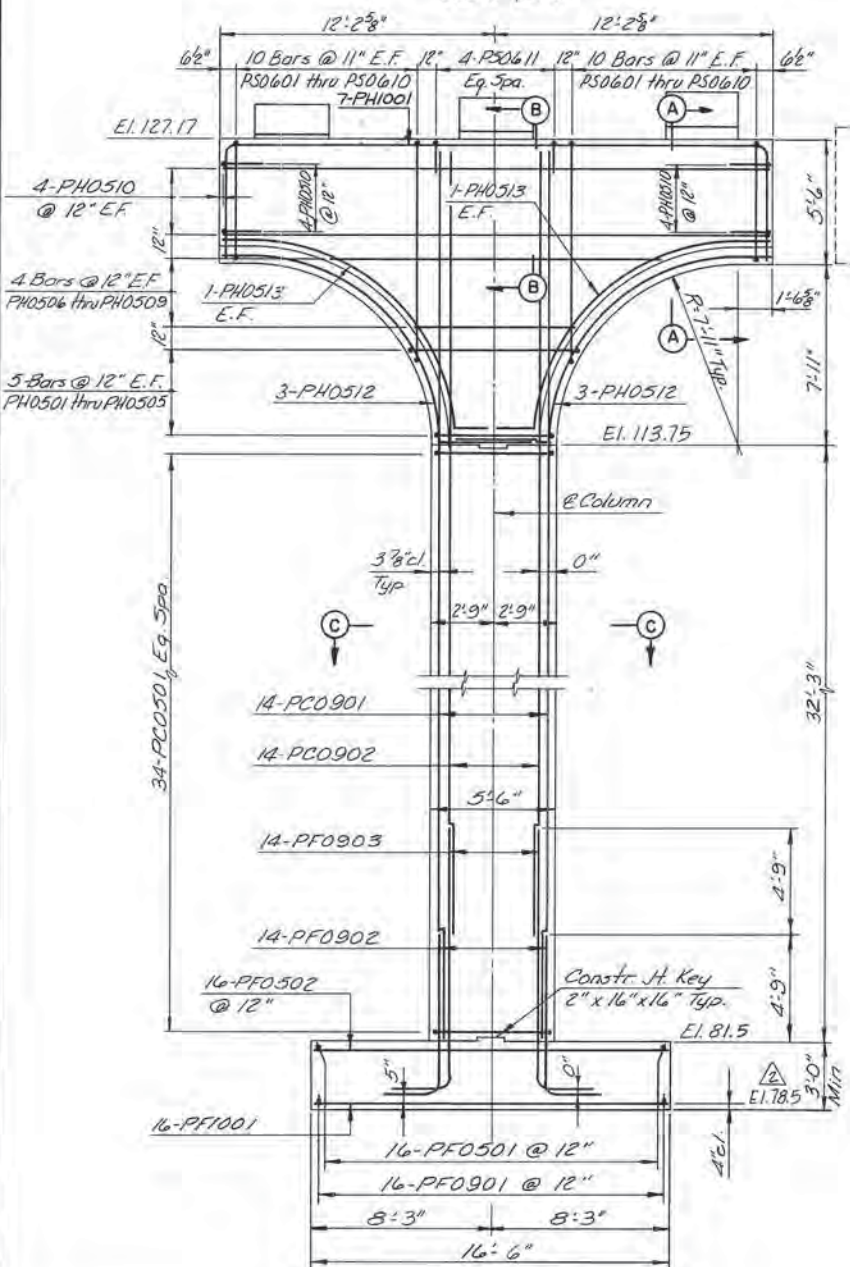


ELEVATION - SOUTHBOUND
Scale: 4"=10"

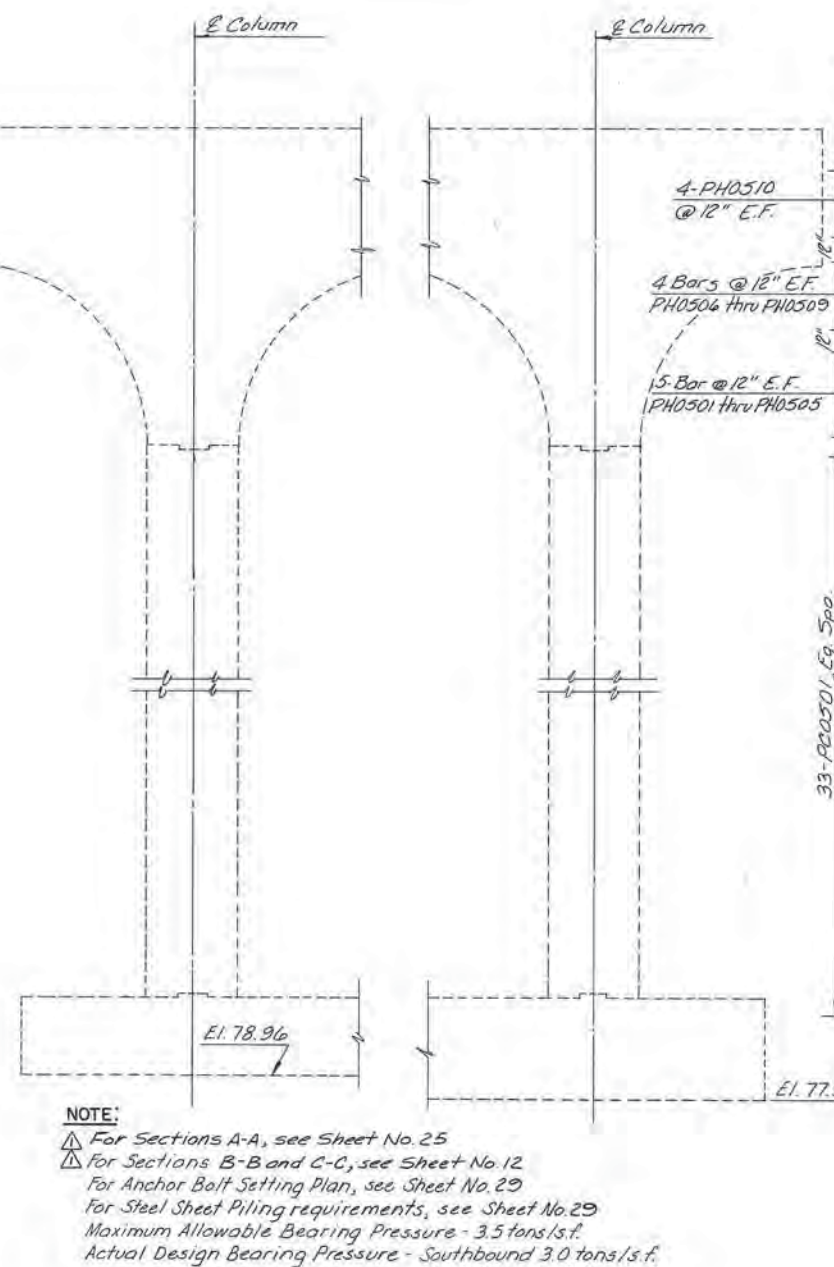

ELEVATION - NORTHBOUND
Scale: 4"=10"

NOTE:
 ▲ For Sections A-A, see Sheet No. 25
 ▲ For Sections B-B and C-C, see Sheet No. 12
 For Anchor Bolt Setting Plan, see Sheet No. 29
 For Steel Sheet Piling requirements, see Sheet No. 29
 Maximum Allowable Bearing Pressure - 3.5 tons/s.f.
 Actual Design Bearing Pressure - Southbound 3.0 tons/s.f.
 Northbound 3.3 tons/s.f.

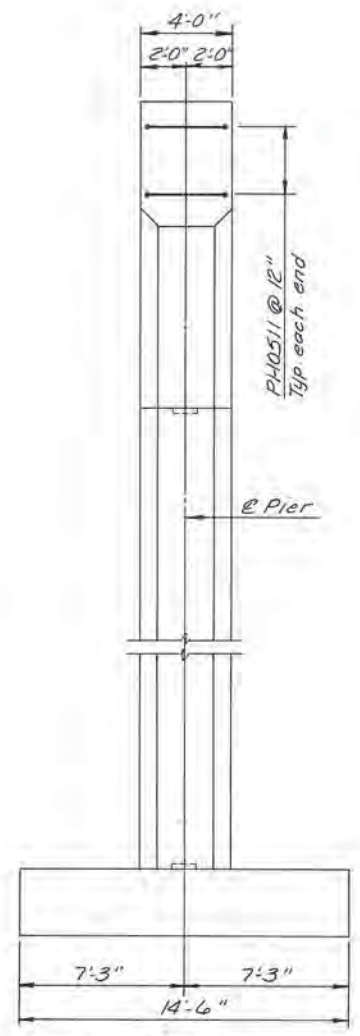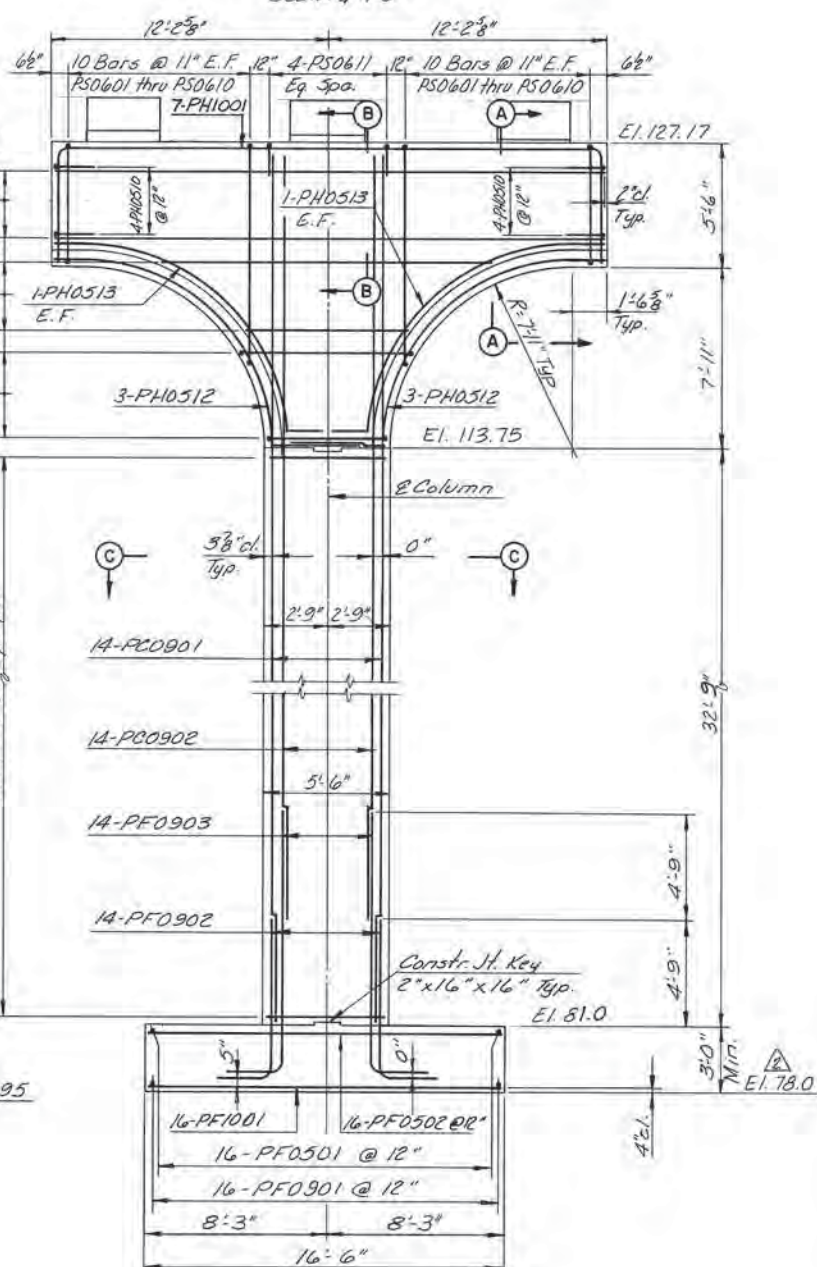

TYPICAL END VIEW
Scale: 4"=10"

RICHMOND METROPOLITAN AUTHORITY
RICHMOND EXPRESSWAY SYSTEM

PIER 15 DETAILS


| MADE | BY | DATE | NO. | REVISION | BY | DATE |
|-------------------|-------------|------|-----|----------|-----|------|
| AS BUILT | TAL. 5-86 | | | | TEM | 3-89 |
| NOTE and EL. PLAN | T.R.F. 3-87 | | | | ALC | 5-87 |

AS BUILT


HOWARD, NEEDLES, TAMMEN & BERGENDOFF
consulting engineers
Alexandria, Virginia

SCALE: AS SHOWN
CONTRACT NO.: C-13
SHEET NO. 26 OF 106

| RICHMOND EXPRESSWAY SYSTEM | | | |
|----------------------------|-----------------------------|-----------|--------------|
| SECTION | PROJECT | SHEET NO. | TOTAL SHEETS |
| 13 | WIDENING JAMES RIVER BRIDGE | 31 | 106 |

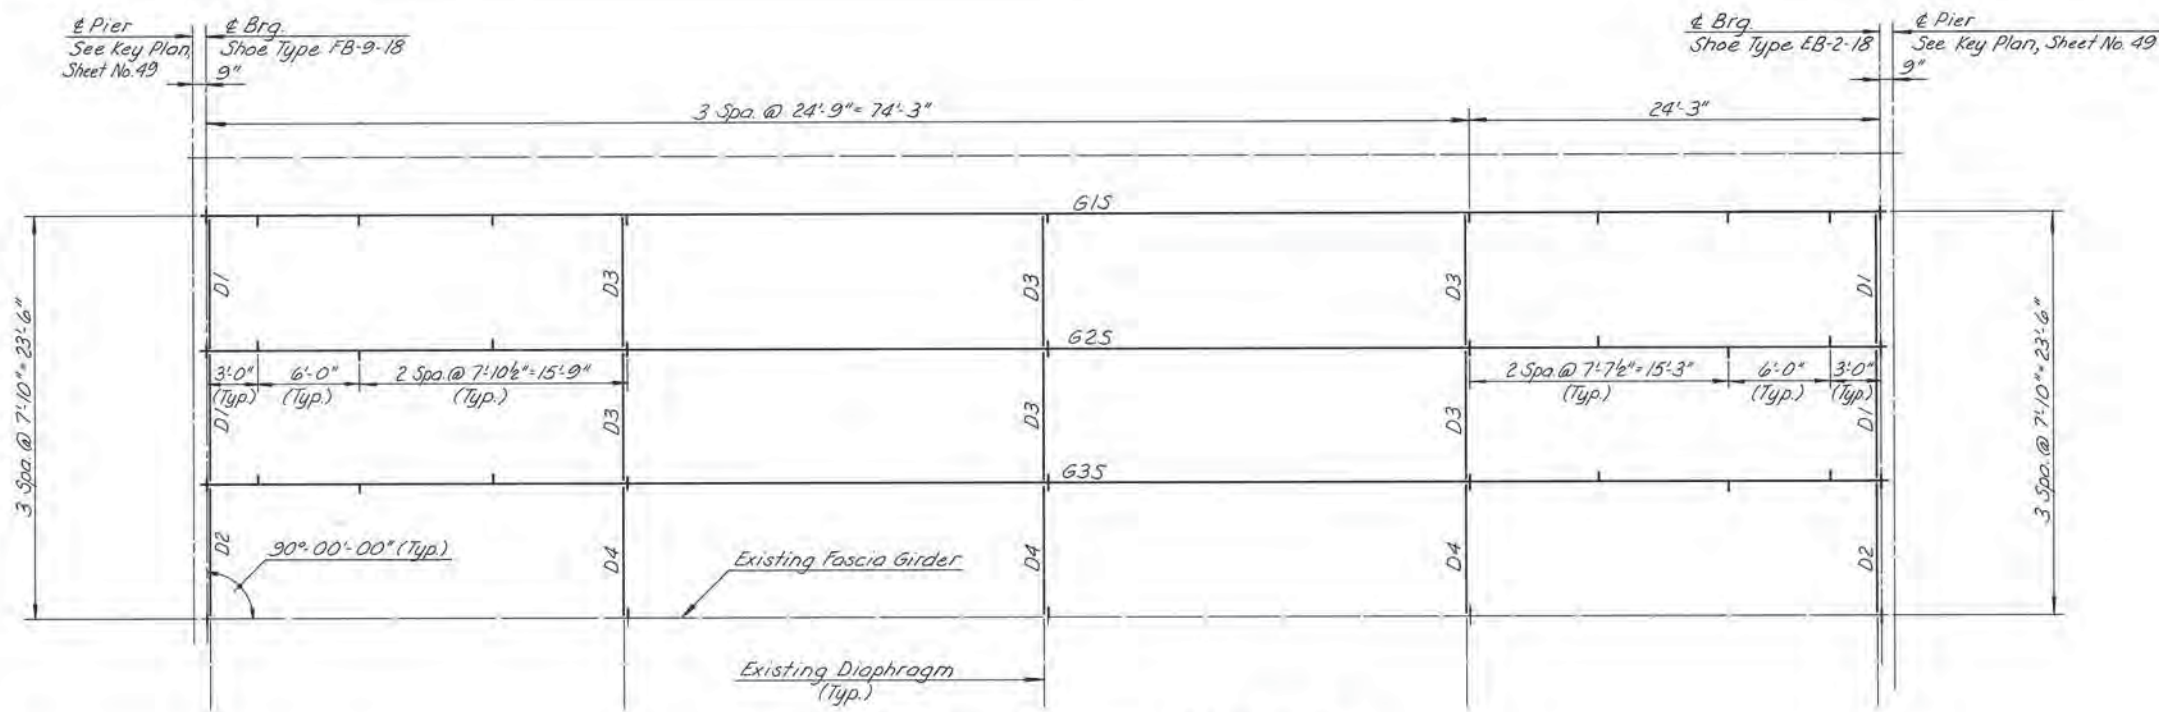

NOTE:
For Steel Details, see Sheet No. 45.

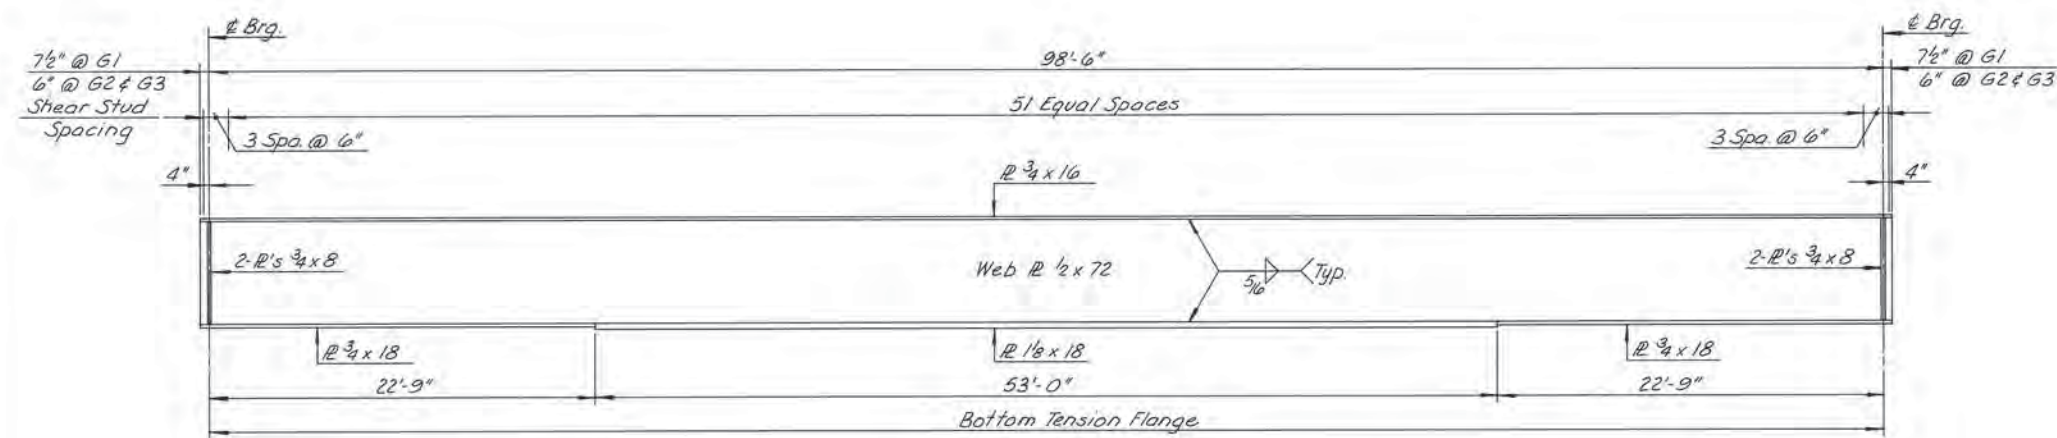

| BY | DATE | | | | |
|-----------|------|------|----------|-----|------|
| MADE | EJM | 1-87 | | | |
| CHECKED | TFP | 3-87 | As Built | TEM | 3-89 |
| IN CHARGE | SR | | | | |

AS BUILT


RICHMOND METROPOLITAN AUTHORITY
RICHMOND EXPRESSWAY SYSTEM

FRAMING PLAN & GIRDER ELEVATION
UNITS 2 & 3 SOUTHBOUND & NORTHBOUND


HOWARD, NEEDLES, TAMMEN & BERGENDOFF
consulting engineers
Alexandria, Virginia

SCALE: AS SHOWN
CONTRACT NO.: C-13
SHEET NO. 31 of 106

| RICHMOND EXPRESSWAY SYSTEM | | | |
|----------------------------|-----------------------------|-----------|--------------|
| SECTION | PROJECT | SHEET NO. | TOTAL SHEETS |
| 13 | WIDENING JAMES RIVER BRIDGE | 38 | 106 |

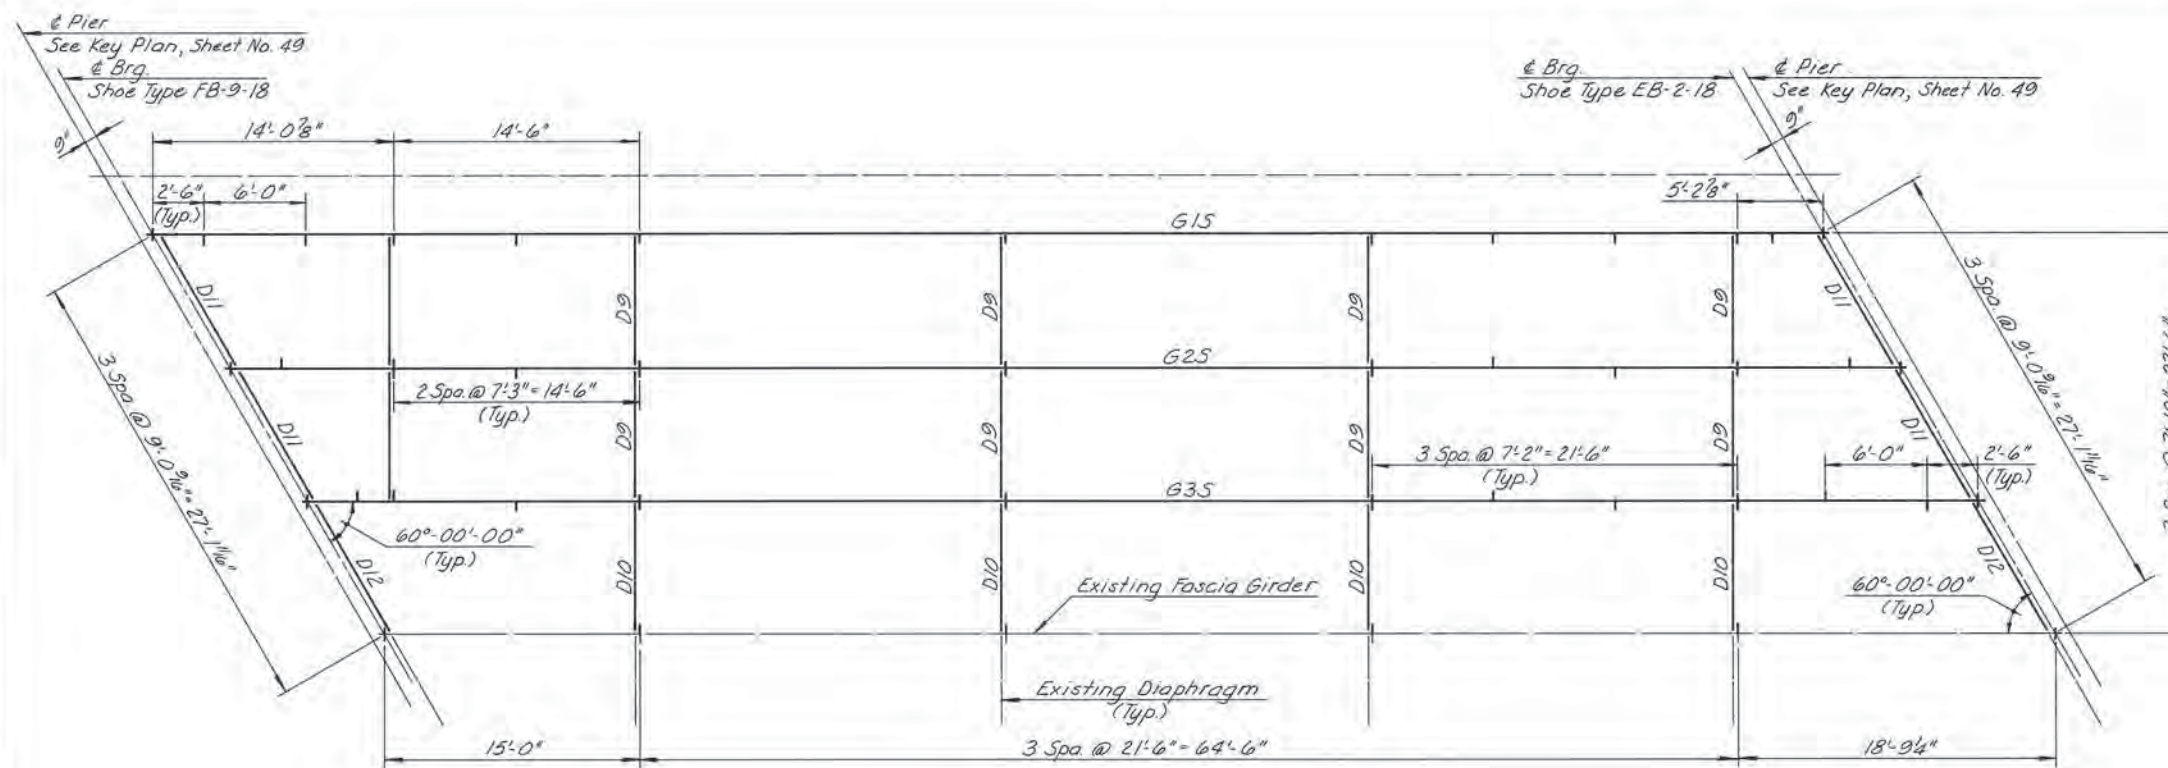


△ FRAMING PLAN-UNIT 15 SOUTHBOUND
Scale: 3/16" = 1'-0"

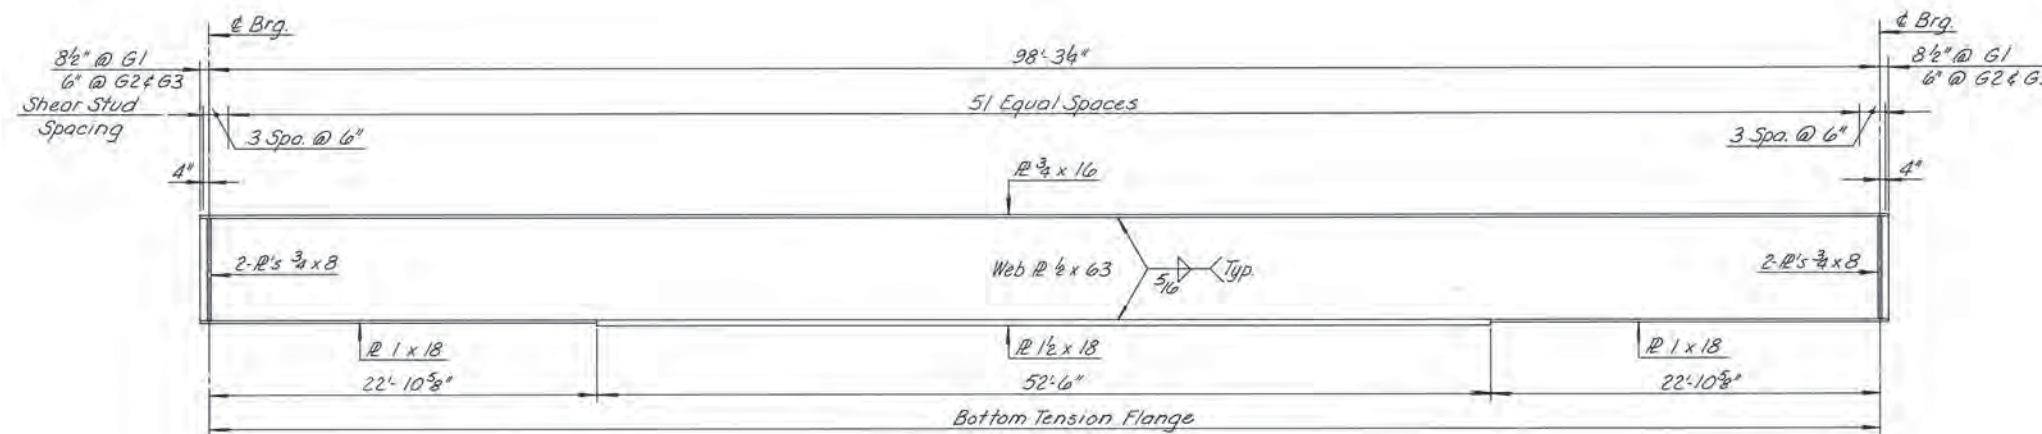


△ GIRDER ELEVATION-UNIT 15 SOUTHBOUND
Scale: 3/16" = 1'-0"

NOTE:
For Section A-A, see Sheet No. 45.
For Diaphragms 11 & 12, see Sheet No. 39.
For Additional Steel Details, see Sheet No. 45.

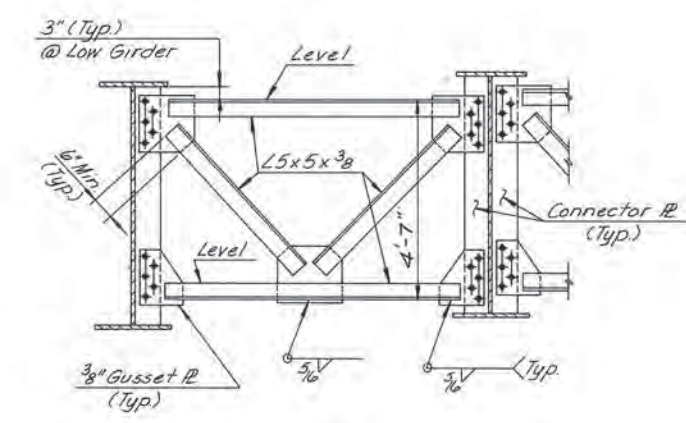

△ INTERMEDIATE DIAPHRAGM D9
Scale: 1/2" = 1'-0"

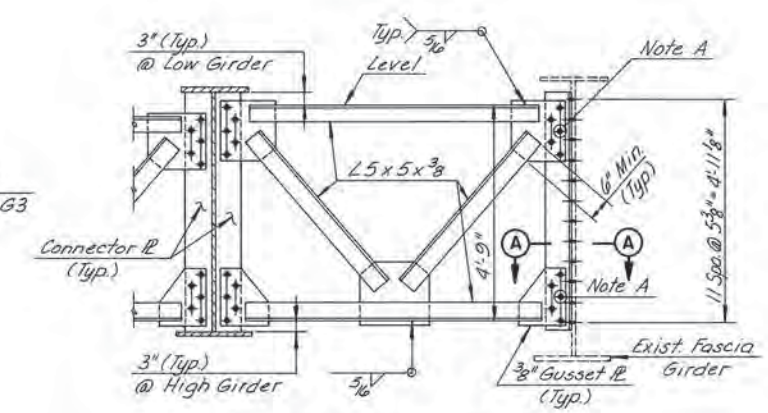

△ INTERMEDIATE DIAPHRAGM D10
Scale: 1/2" = 1'-0"

| MADE | BY | DATE | NO. | REVISION | BY | DATE |
|-----------|-----|------|-----|-------------------------|-----|------|
| MADE | EJM | 1-87 | | As Built | TEM | 3-89 |
| CHECKED | TFP | 3-87 | △ | DIAPHRAGM & GIRDER REV. | EJM | 5-87 |
| IN CHARGE | SR | | | | | |

AS BUILT


**RICHMOND METROPOLITAN AUTHORITY
RICHMOND EXPRESSWAY SYSTEM**

FRAMING PLAN & GIRDER ELEVATION
UNIT 15 SOUTHBOUND

HOWARD, NEEDLES, TAMMEN & BERGENDOFF
consulting engineers
Alexandria, Virginia


SCALE: AS SHOWN
CONTRACT NO.: C-13
SHEET NO. 38 OF 106

| RICHMOND EXPRESSWAY SYSTEM | | | |
|----------------------------|-----------------------------|-----------|--------------|
| SECTION | PROJECT | SHEET NO. | TOTAL SHEETS |
| 13 | WIDENING JAMES RIVER BRIDGE | 39 | 106 |

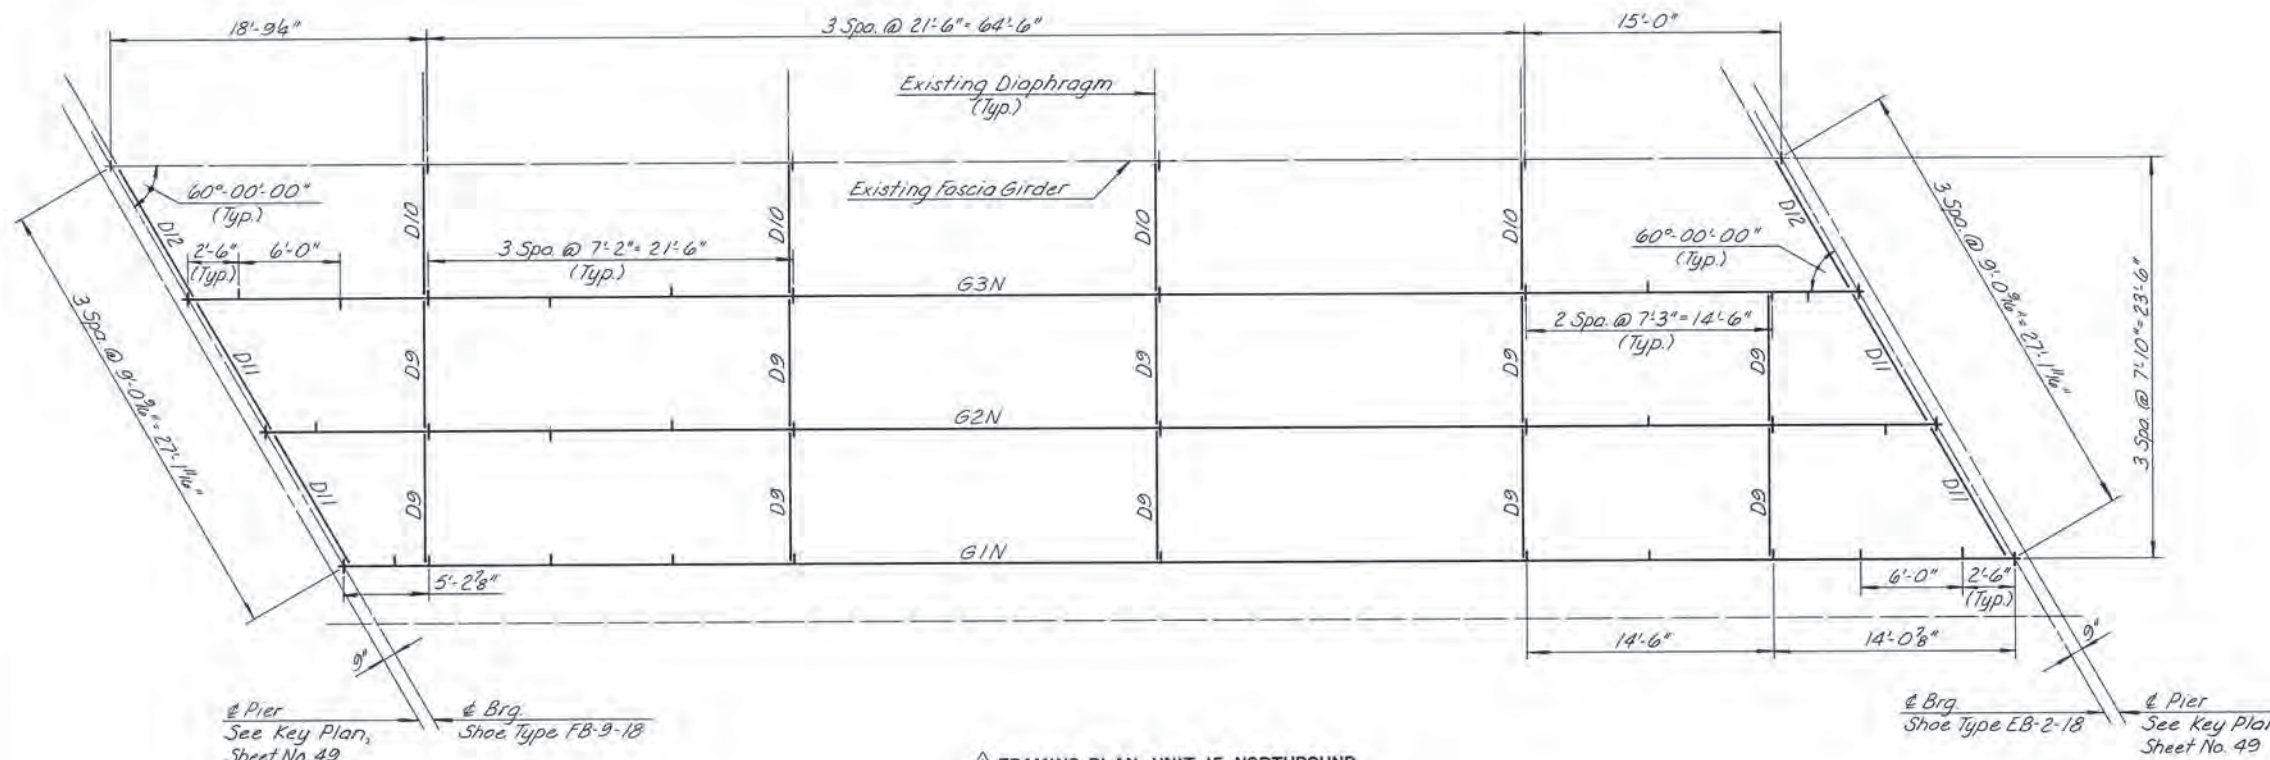


△ FRAMING PLAN - UNIT 15 NORTHBOUND
Scale: 3/16" = 1'-0"


NOTE:
For Steel Details, see Sheet No. 45.

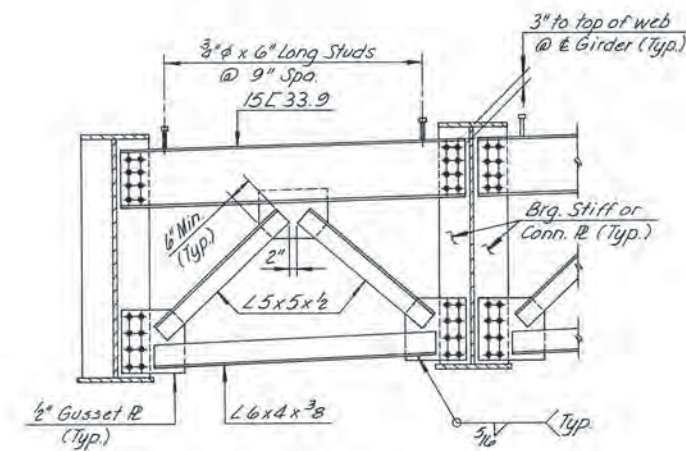

△ END DIAPHRAGM D11
Scale: 1/2" = 1'-0"

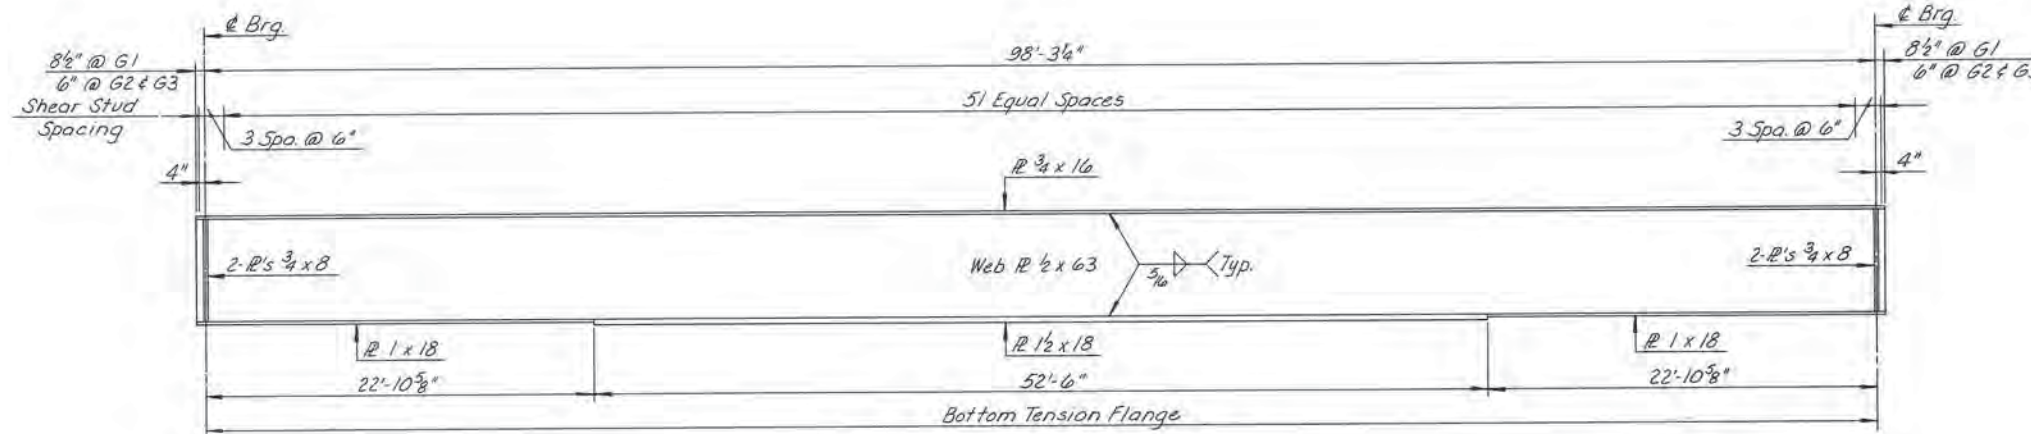

△ GIRDER ELEVATION - UNIT 15 NORTHBOUND
Scale: 3/16" = 1'-0"

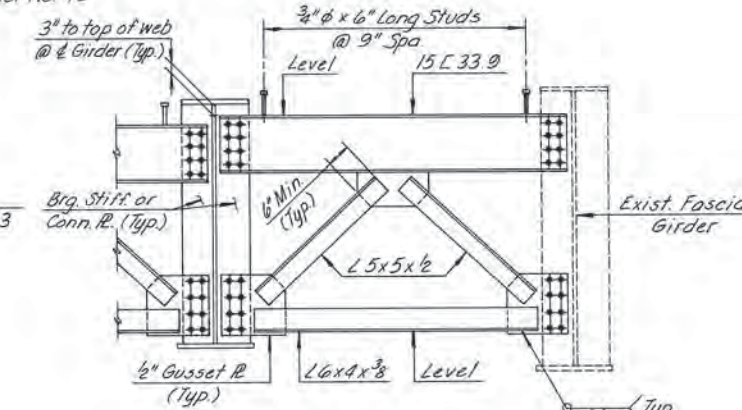

△ END DIAPHRAGM D12
Scale: 1/2" = 1'-0"

| MADE | BY | DATE | NO. | REVISION | BY | DATE |
|------|-----|------|-----|----------------------|-----|------|
| | EJM | 1-87 | | | | |
| | TFP | 3-87 | 1 | Rev. Diaph. & Girder | EJM | 5-87 |
| | JR | | | | | |

AS BUILT


RICHMOND METROPOLITAN AUTHORITY
RICHMOND EXPRESSWAY SYSTEM

FRAMING PLAN & GIRDER ELEVATION
UNIT 15 NORTHBOUND

HOWARD, NEEDLES, TAMMEN & BERGENDOFF
consulting engineers
Alexandria, Virginia


SCALE: AS SHOWN
CONTRACT NO.: C-13
SHEET NO. 39 OF 106

| RICHMOND EXPRESSWAY SYSTEM | | | |
|----------------------------|-----------------------------|-----------|--------------|
| SECTION | PROJECT | SHEET NO. | TOTAL SHEETS |
| 13 | WIDENING JAMES RIVER BRIDGE | 40 | 106 |

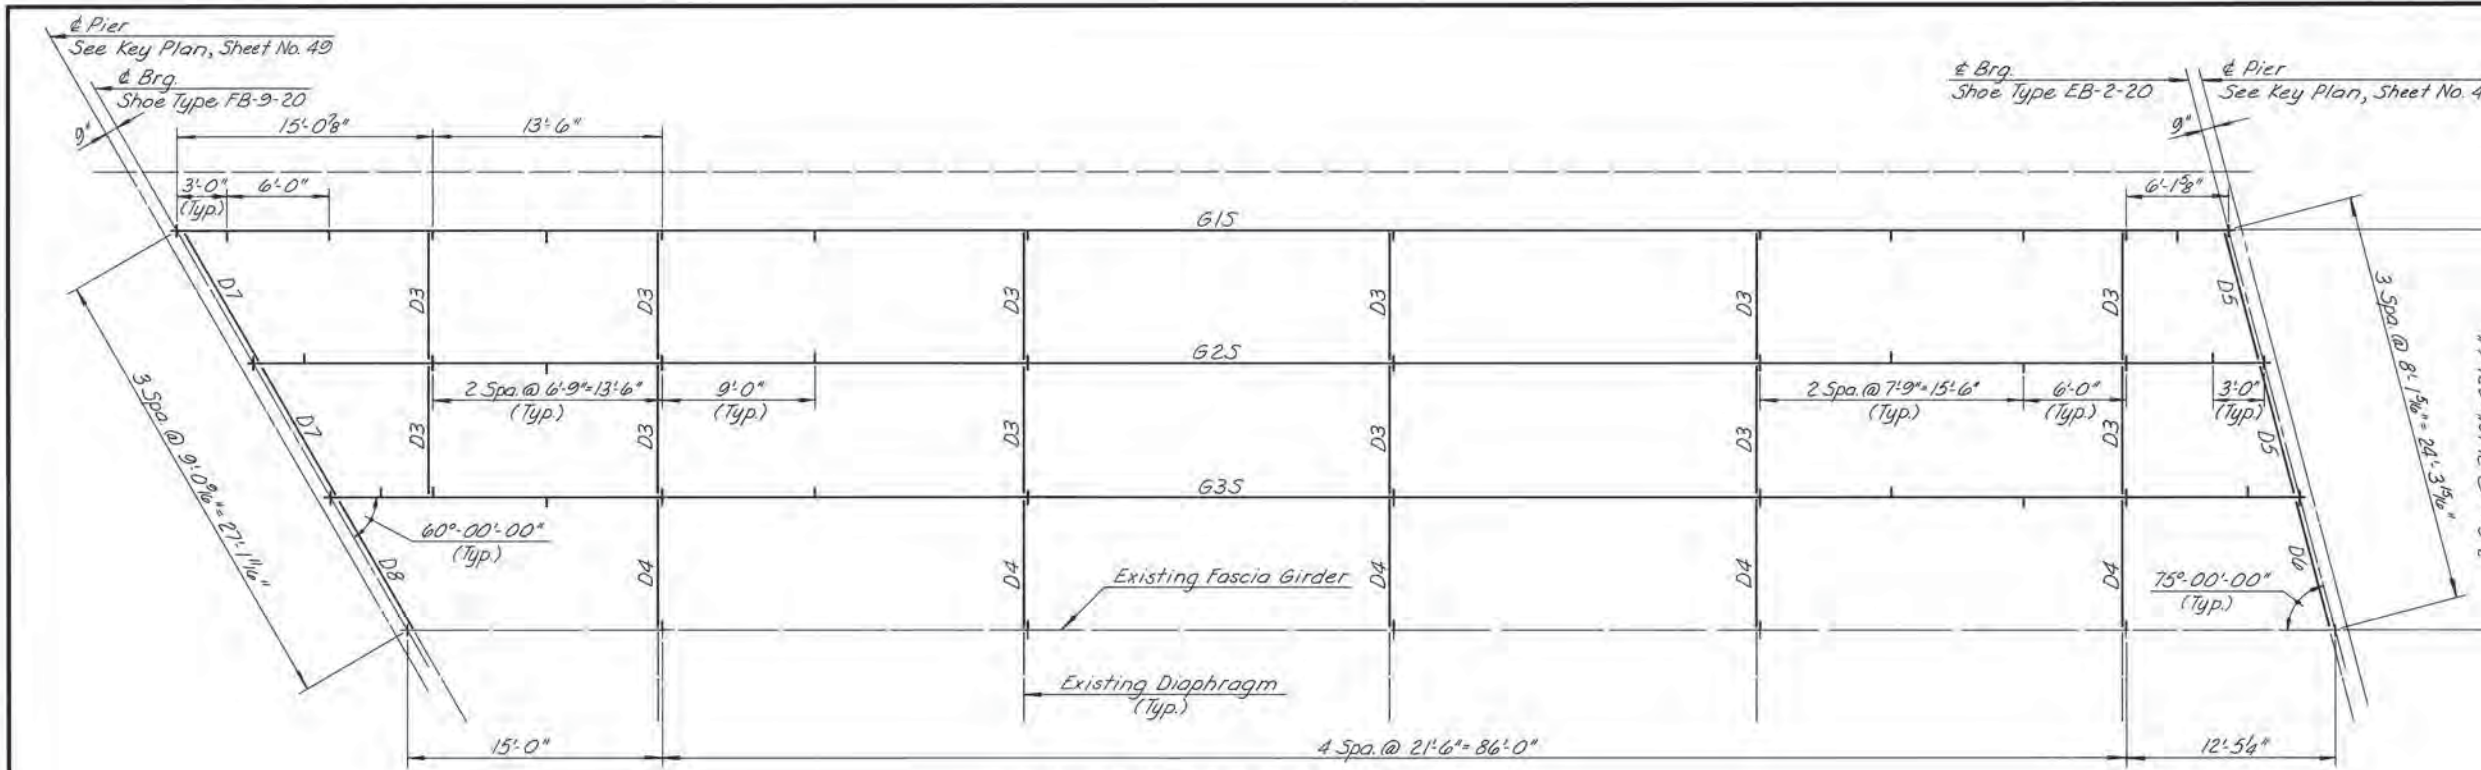

FRAMING PLAN - UNIT 16 SOUTHBOUND
Scale: 3/16" = 1'-0"

NOTE:
For Steel Details, see Sheet No. 45.

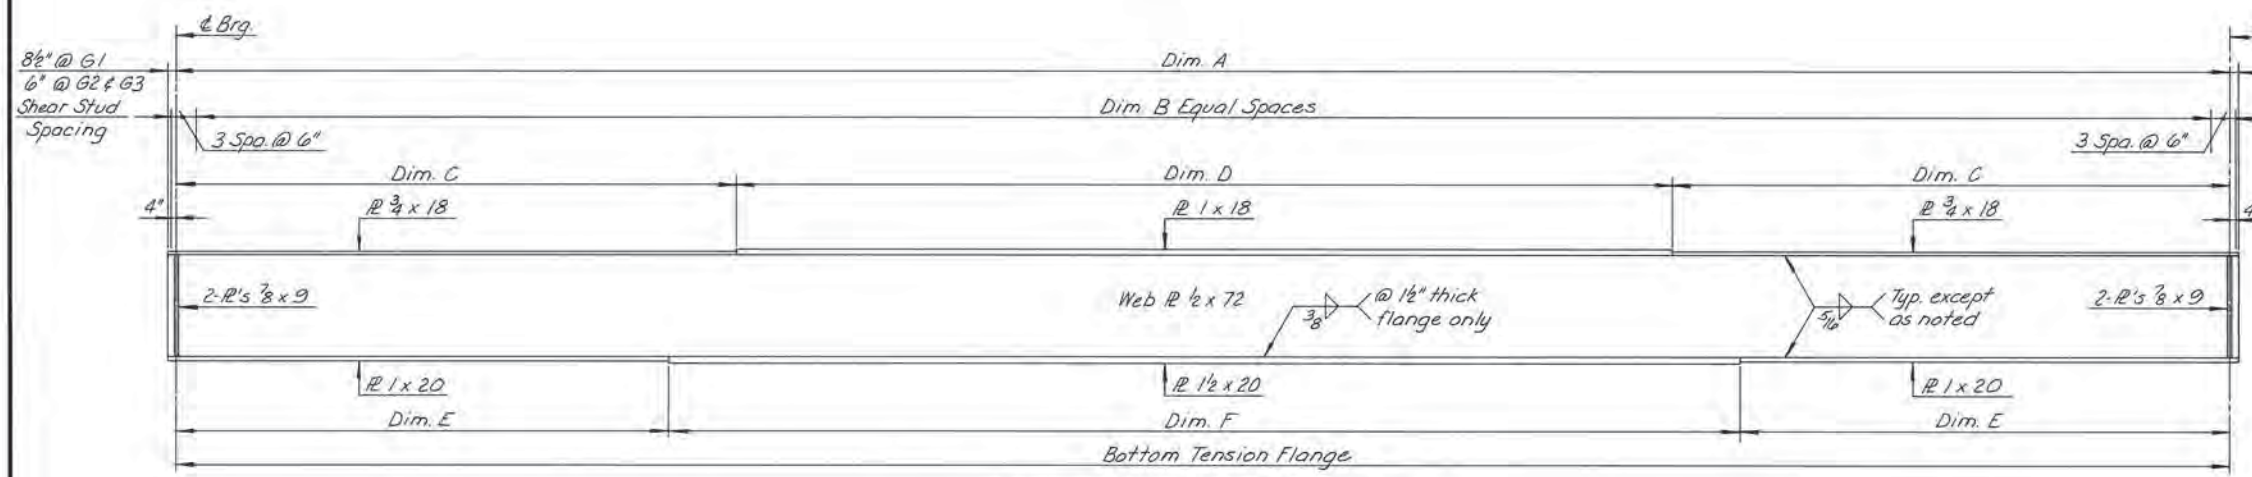

GIRDER ELEVATION - UNIT 16 SOUTHBOUND
Scale: 3/16" = 1'-0"

| GIRDER | DIM. A | DIM. B | DIM. C | DIM. D | DIM. E | DIM. F |
|--------|--------------|--------|--------------|--------|-------------|--------|
| G1 | 120'-8 1/2" | 60 | 32'-10 4" | 55'-0" | 26'-1 4" | 68'-6" |
| G2 | 118'-3 1/2" | 59 | 30'-10 3/4" | 56'-6" | 26'-7 3/4" | 65'-0" |
| G3 | 115'-10 3/8" | 58 | 31'-11 3/16" | 52'-0" | 24'-8 3/16" | 66'-6" |

| BY | DATE | NO. | REVISION | BY | DATE |
|-----------|----------|-----|----------|-----|------|
| MADE | EJM 1-87 | | | | |
| CHECKED | TFP 3-87 | | As Built | TEM | 3-89 |
| IN CHARGE | SR | | | | |


AS BUILT

RICHMOND METROPOLITAN AUTHORITY
RICHMOND EXPRESSWAY SYSTEM

FRAMING PLAN & GIRDER ELEVATION
UNIT 16 SOUTHBOUND


HOWARD, NEEDLES, TAMMEN & BERGENDOFF
consulting engineers
Alexandria, Virginia

SCALE: AS SHOWN
CONTRACT NO. C-13
SHEET NO. 40 of 106

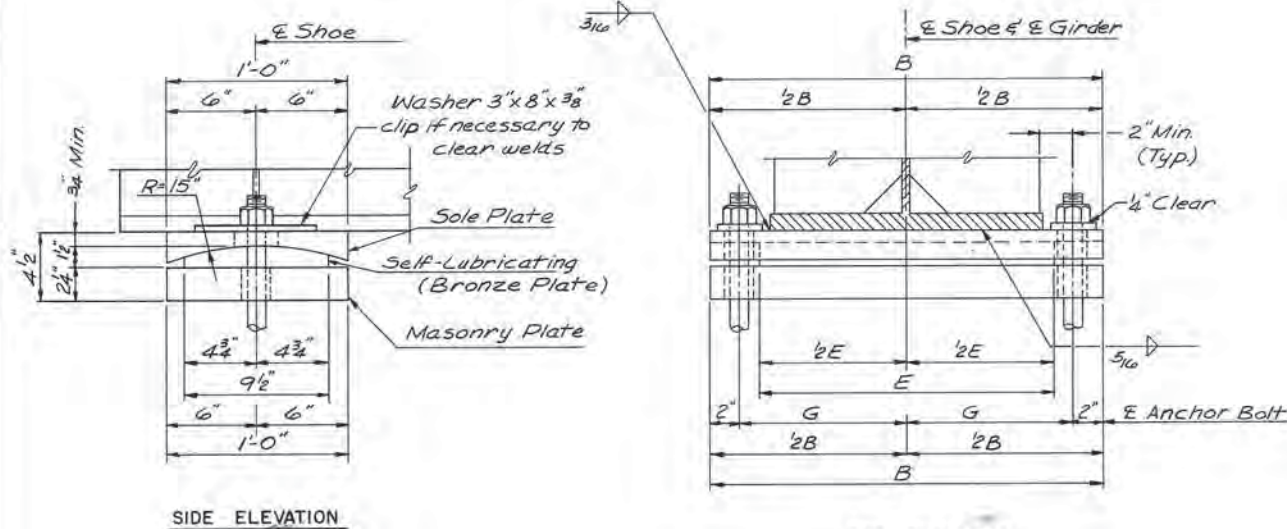


SIDE ELEVATION

END ELEVATION

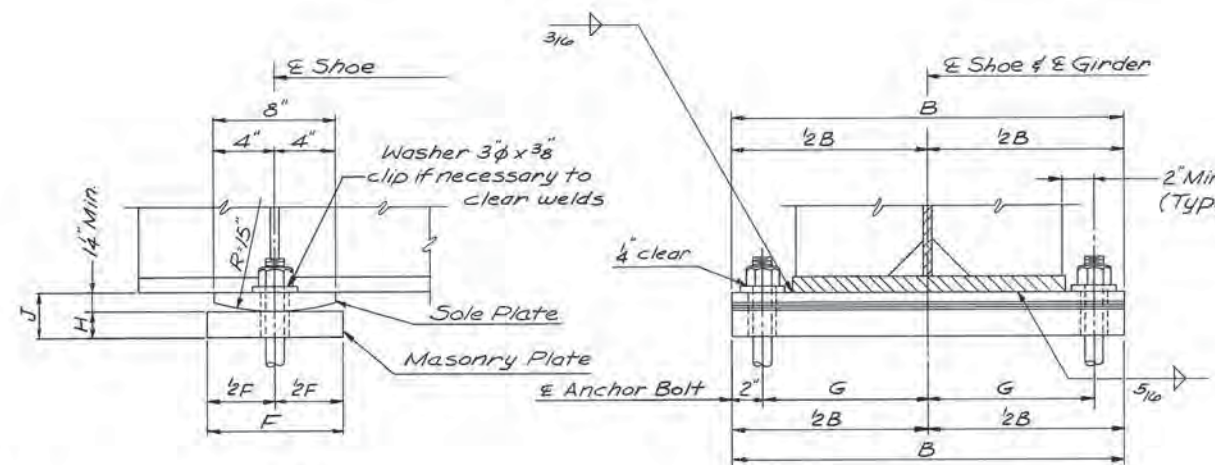


SIDE ELEVATION

END ELEVATION

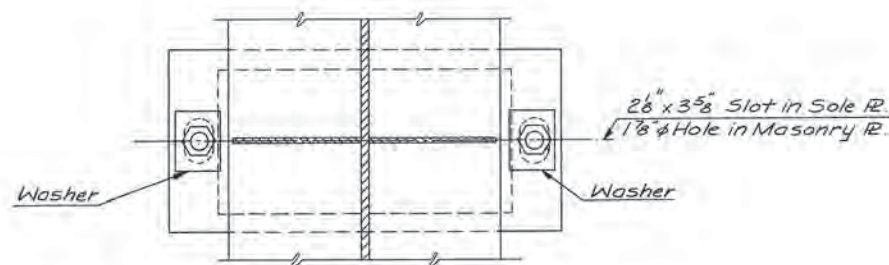

PLAN

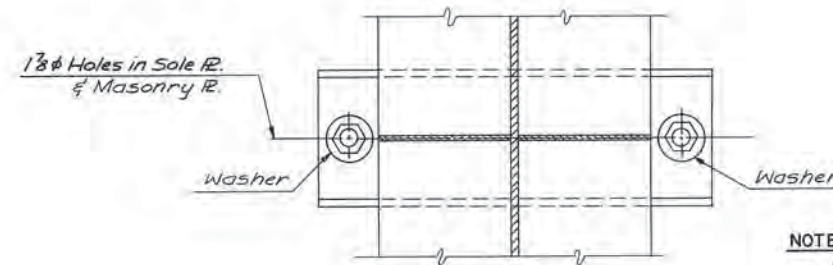


PLAN

EXPANSION SHOE EB-2
No Scale

FIXED SHOE
No Scale

| EXPANSION SHOES | | | | | | | | | | | |
|-----------------|-----------|-------|---|---|---|-----------|---|-------|---|---|-------|
| SHOE TYPE | NO. REQ'D | A | B | C | D | E | F | G | H | J | L |
| EB-2-16 | 24 | 2'-0" | | | | 1'-5 1/2" | | 10" | | | 1'-7" |
| EB-2-18 | 18 | 2'-2" | | | | 1'-7 1/2" | | 11" | | | 1'-7" |
| EB-2-20 | 66 | 2'-4" | | | | 1'-9 1/2" | | 1'-0" | | | 1'-7" |

| FIXED SHOES | | | | | | | | | | | |
|-------------|-----------|-------|---|---|---|---|----|-------|--------|--------|-----------|
| SHOE TYPE | NO. REQ'D | A | B | C | D | E | F | G | H | J | L |
| FB-8-16 | 24 | 2'-0" | | | | | 8" | 10" | 1 1/2" | 2 3/4" | 1'-2" |
| FB-9-18 | 18 | 2'-2" | | | | | 9" | 11" | 1 1/2" | 4 1/2" | 1'-2 1/4" |
| FB-9-20 | 66 | 2'-4" | | | | | 9" | 1'-0" | 1 1/2" | 4 1/2" | 1'-2 1/4" |

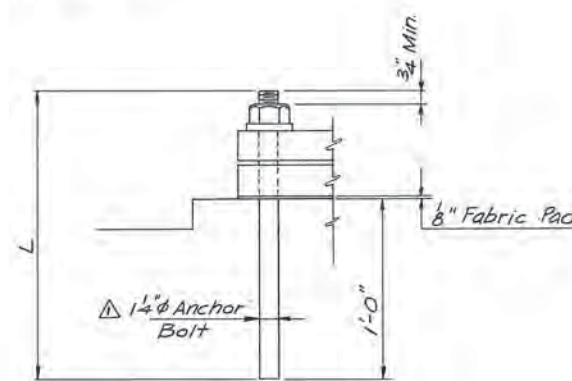

ANCHOR BOLT DETAIL
No Scale

NOTES:

Fill slots and holes in masonry plate around anchor bolts with a nonhardening caulking compound or elastic joint sealer.
For expansion bearing, bevel sole plate to match grade.
Steel in bearing may be ASTM A36, A572, Grade 50, or A588 and shall be painted.
Surface of sole plate and masonry plate in contact with bronze plates shall not be painted, but coated with multipurpose grease before shipment. Prior to assembly in place these surfaces shall be thoroughly coated with additional antioxidant lubricant furnished by the manufacturer.
Radius may be machined to compensate for grade.
Bearing shall be set so that at 68°F, it is at the midpoint of its movement.
For Expansion bearing, 15" Radius tolerances:
Sole Plate -0.0" +0.01"
Bronze Plate -0.01" +0.0"

RICHMOND METROPOLITAN AUTHORITY
RICHMOND EXPRESSWAY SYSTEM

SHOE DETAILS

| | | | | |
|-----------|-------------|------------------|-----|------|
| BY | DATE | | | |
| MADE | ALC 2-87 | As Built | TEM | 3-89 |
| CHECKED | T.F.P. 3-87 | 1/4" Anchor Bolt | ALC | 4-87 |
| IN CHARGE | S.R. | | | |

AS BUILT

HOWARD, NEEDLES, TAMMEN & BERGENDOFF
consulting engineers
Alexandria, Virginia

SCALE: AS SHOWN
CONTRACT NO. C-13
SHEET NO. 46 OF 106


| | STATION | EL. "A" | EL. "B" | | STATION | EL. "A" | EL. "B" | | STATION | EL. "A" | EL. "B" | | STATION | EL. "A" | EL. "B" | | STATION | EL. "A" | EL. "B" | | | | |
|-----------|-----------|---------|---------|----------|-----------|---------|---------|----------|-----------|---------|---------|-----------|-----------|---------|---------|-----------|-----------|---------|---------|-----------|-----------|--------|--------|
| E S. Abut | 129+76.18 | 117.15 | 117.65 | E Pier 3 | 132+56.18 | 120.14 | 120.64 | E Pier 6 | 136+23.18 | 124.10 | 124.60 | E Pier 9 | 139+93.68 | 128.11 | 128.61 | E Pier 12 | 143+64.18 | 132.09 | 132.59 | E Pier 15 | 146+36.18 | 135.04 | 135.54 |
| | 129+83.51 | 117.22 | 117.72 | | 132+68.18 | 120.24 | 120.74 | | 136+35.53 | 124.25 | 124.75 | | 140+06.03 | 128.20 | 128.70 | | 143+72.88 | 132.20 | 132.70 | | 146+47.68 | 135.16 | 135.66 |
| | 129+91.58 | 117.28 | 117.78 | | 132+80.18 | 120.36 | 120.86 | | 136+47.88 | 124.39 | 124.89 | | 140+18.38 | 128.33 | 128.83 | | 143+81.58 | 132.26 | 132.76 | | 146+59.18 | 135.27 | 135.77 |
| | 129+99.66 | 117.38 | 117.88 | | 132+92.18 | 120.52 | 121.02 | | 136+60.23 | 124.53 | 125.03 | | 140+30.73 | 128.48 | 128.98 | | 143+90.28 | 132.36 | 132.86 | | 146+70.68 | 135.34 | 135.84 |
| | 130+07.73 | 117.49 | 117.99 | | 133+04.18 | 120.65 | 121.15 | | 136+72.58 | 124.68 | 125.18 | | 140+43.08 | 128.64 | 129.14 | | 143+98.98 | 132.45 | 132.95 | | 146+82.18 | 135.52 | 136.02 |
| | 130+15.81 | 117.61 | 118.11 | | 133+16.18 | 120.78 | 121.28 | | 136+84.93 | 124.78 | 125.28 | | 140+55.43 | 128.73 | 129.23 | | 144+07.68 | 132.52 | 133.02 | | 146+93.68 | 135.62 | 136.12 |
| | 130+23.88 | 117.68 | 118.18 | | 133+28.18 | 120.93 | 121.43 | | 136+97.28 | 124.92 | 125.42 | | 140+67.78 | 128.90 | 129.40 | | 144+16.38 | 132.63 | 133.13 | | 147+05.18 | 135.77 | 136.27 |
| | 130+31.96 | 117.77 | 118.27 | | 133+40.18 | 121.03 | 121.53 | | 137+09.63 | 125.02 | 125.52 | | 140+80.13 | 129.02 | 129.52 | | 144+25.08 | 132.72 | 133.22 | | 147+16.68 | 135.88 | 136.38 |
| | 130+40.03 | 117.89 | 118.39 | | 133+52.18 | 121.18 | 121.68 | | 137+21.98 | 125.18 | 125.68 | | 140+92.48 | 129.12 | 129.62 | | 144+33.78 | 132.85 | 133.35 | | 147+28.18 | 136.02 | 136.52 |
| | 130+48.11 | 117.97 | 118.47 | | 133+64.18 | 121.28 | 121.78 | | 137+34.33 | 125.30 | 125.80 | | 141+04.83 | 129.16 | 129.76 | | 144+42.48 | 132.96 | 133.46 | | 147+39.68 | 136.17 | 136.67 |
| E Pier 1 | 130+56.18 | 118.05 | 118.55 | E Pier 4 | 133+76.18 | 121.43 | 121.93 | E Pier 7 | 137+46.68 | 125.45 | 125.95 | E Pier 10 | 141+17.18 | 129.41 | 129.91 | E Pier 13 | 144+51.18 | 133.04 | 133.54 | E Pier 16 | 147+51.18 | 136.27 | 136.77 |
| | 130+66.18 | 118.11 | 118.61 | | 133+88.53 | 121.56 | 122.06 | | 137+59.03 | 125.59 | 126.09 | | 141+29.53 | 129.52 | 130.02 | | 144+59.68 | 133.11 | 133.61 | | 147+62.48 | 136.38 | 136.88 |
| | 130+76.18 | 118.24 | 118.74 | | 134+00.88 | 121.69 | 122.19 | | 137+71.38 | 125.70 | 126.20 | | 141+41.88 | 129.63 | 130.13 | | 144+68.18 | 133.20 | 133.70 | | 147+73.78 | 136.50 | 137.00 |
| | 130+86.18 | 118.35 | 118.85 | | 134+13.23 | 121.82 | 122.32 | | 137+83.73 | 125.86 | 126.36 | | 141+54.23 | 129.79 | 130.29 | | 144+76.68 | 133.31 | 133.81 | | 147+85.08 | 136.61 | 137.11 |
| | 130+96.18 | 118.45 | 118.95 | | 134+25.58 | 121.99 | 122.49 | | 137+96.08 | 126.01 | 126.51 | | 141+66.58 | 129.90 | 130.40 | | 144+85.18 | 133.37 | 133.87 | | 147+96.38 | 136.75 | 137.25 |
| | 131+06.18 | 118.56 | 119.06 | | 134+37.93 | 122.15 | 122.65 | | 138+08.43 | 126.15 | 126.65 | | 141+78.93 | 130.03 | 130.53 | | 144+93.68 | 133.45 | 133.95 | | 148+07.68 | 136.87 | 137.37 |
| | 131+16.18 | 118.63 | 119.13 | | 134+50.28 | 122.22 | 122.75 | | 138+20.78 | 126.28 | 126.78 | | 141+91.28 | 130.18 | 130.68 | | 145+02.18 | 133.55 | 134.05 | | 148+18.98 | 137.00 | 137.50 |
| | 131+26.18 | 118.76 | 119.26 | | 134+62.63 | 122.36 | 122.86 | | 138+33.13 | 126.39 | 126.89 | | 142+03.63 | 130.32 | 130.82 | | 145+10.68 | 133.62 | 134.12 | | 148+30.28 | 137.10 | 137.60 |
| | 131+36.18 | 118.89 | 119.39 | | 134+74.98 | 122.52 | 123.02 | | 138+45.48 | 126.52 | 127.02 | | 142+15.98 | 130.45 | 130.95 | | 145+19.18 | 133.72 | 134.22 | | 148+41.58 | 137.25 | 137.75 |
| | 131+46.18 | 119.01 | 119.51 | | 134+87.33 | 122.67 | 123.17 | | 138+57.83 | 126.64 | 127.14 | | 142+28.33 | 130.58 | 131.08 | | 145+27.68 | 133.82 | 134.32 | | 148+52.88 | 137.38 | 137.88 |
| E Pier 2 | 131+56.18 | 119.64 | 119.64 | E Pier 5 | 134+99.68 | 122.80 | 123.30 | E Pier 8 | 138+70.18 | 126.77 | 127.27 | E Pier 11 | 142+40.68 | 130.74 | 131.24 | E Pier 14 | 145+36.18 | 133.89 | 134.39 | E Pier 17 | 148+64.18 | 137.46 | 137.96 |
| | 131+66.18 | 119.22 | 119.72 | | 135+12.03 | 122.91 | 123.41 | | 138+82.53 | 126.89 | 127.39 | | 142+53.03 | 130.87 | 131.37 | | 145+46.18 | 134.02 | 134.52 | | 148+72.26 | 137.51 | 138.01 |
| | 131+76.18 | 119.34 | 119.84 | | 135+24.38 | 123.03 | 123.53 | | 138+94.88 | 127.03 | 127.53 | | 142+65.38 | 131.03 | 131.53 | | 145+56.18 | 134.09 | 134.59 | | 148+80.33 | 137.59 | 138.09 |
| | 131+86.18 | 119.46 | 119.96 | | 135+36.73 | 123.19 | 123.69 | | 139+07.23 | 127.17 | 127.67 | | 142+77.73 | 131.15 | 131.65 | | 145+66.18 | 134.19 | 134.69 | | 148+88.41 | 137.66 | 138.16 |
| | 131+96.18 | 119.54 | 120.04 | | 135+48.08 | 123.31 | 123.81 | | 139+19.58 | 127.30 | 127.80 | | 142+90.08 | 131.27 | 131.77 | | 145+76.18 | 134.31 | 134.81 | | 148+96.48 | 137.74 | 138.24 |
| | 132+06.18 | 119.63 | 120.13 | | 135+61.43 | 123.41 | 123.91 | | 139+31.93 | 127.44 | 127.94 | | 143+02.43 | 131.41 | 131.91 | | 145+86.18 | 134.42 | 134.92 | | 149+04.56 | 137.82 | 138.32 |
| | 132+16.18 | 119.71 | 120.21 | | 135+73.78 | 123.58 | 124.08 | | 139+44.28 | 127.56 | 128.06 | | 143+14.78 | 131.56 | 132.06 | | 145+96.18 | 134.53 | 135.03 | | 149+12.63 | 137.92 | 138.42 |
| | 132+26.18 | 119.83 | 120.33 | | 135+86.13 | 123.71 | 124.21 | | 139+56.63 | 127.72 | 128.22 | | 143+27.13 | 131.69 | 132.19 | | 146+06.18 | 134.63 | 135.13 | | 149+20.71 | 138.00 | 138.50 |
| | 132+36.18 | 119.93 | 120.43 | | 135+98.48 | 123.86 | 124.36 | | 139+68.98 | 127.85 | 128.35 | | 143+39.48 | 131.80 | 132.30 | | 146+16.18 | 134.74 | 135.24 | | 149+28.78 | 138.10 | 138.60 |
| | 132+46.18 | 120.03 | 120.53 | | 136+10.83 | 123.97 | 124.47 | | 139+81.33 | 128.01 | 128.51 | | 143+51.83 | 131.97 | 132.47 | | 146+26.18 | 134.85 | 135.35 | | 149+36.86 | 138.18 | 138.68 |
| E Pier 3 | 132+56.18 | 120.14 | 120.64 | E Pier 6 | 136+23.18 | 124.10 | 124.60 | E Pier 9 | 139+93.68 | 128.11 | 128.61 | E Pier 12 | 143+64.18 | 132.09 | 132.59 | E Pier 15 | 146+36.18 | 135.04 | 135.54 | E N. Abut | 149+44.18 | 138.29 | 138.79 |

NOTES:

Elevations of existing deck are from field survey. Horizontal and vertical dimensions are based on As-Built Plans and included with this Set of plans as Reference Plans. It shall be the Contractor's responsibility to verify all pertinent elevations and dimensions of the existing structure prior to construction and the fabrication of any Structural Steel.

The contractor's attention is directed to the approximate locations of utilities as shown on the General Plan and Elevation.

The contractor shall submit to the engineer for approval, drawings for protection and maintenance of service of utilities, located in the areas adjacent to new footing to be constructed.

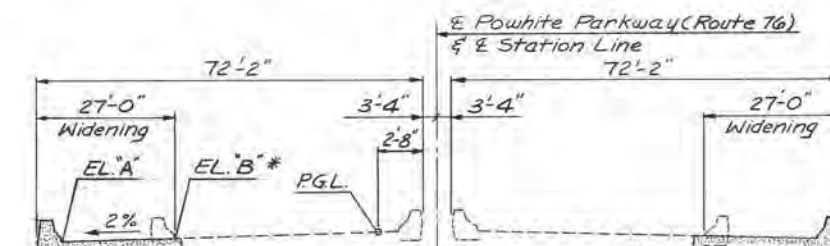

SOUTHBOUND ROADWAY

NORTHBOUND ROADWAY

* Existing deck elevations.

| | | | | | |
|-----------|------|------|----------|----------|------|
| MADE | BY | DATE | | | |
| | ALC | 2-87 | | | |
| CHECKED | TFP | 3-87 | As Built | T&M | 3-89 |
| IN CHARGE | S.R. | | NO | REVISION | BY |
| | | | | | DATE |

RICHMOND METROPOLITAN AUTHORITY
RICHMOND EXPRESSWAY SYSTEM


DECK SLAB ELEVATION
 SOUTHBOUND

HOWARD, NEEDLES, TAMMEN & BERGENDOFF
 consulting engineers
 Alexandria, Virginia

SCALE: NO SCALE
 CONTRACT NO. C-13
 SHEET NO. 48 OF 106

AS BUILT

| | STATION | EL. "C" | EL. "D" | | STATION | EL. "C" | EL. "D" | | STATION | EL. "C" | EL. "D" | | STATION | EL. "C" | EL. "D" | | STATION | EL. "C" | EL. "D" | | | | |
|-----------|-----------|---------|---------|----------|-----------|---------|---------|----------|-----------|---------|---------|-----------|-----------|---------|---------|-----------|-----------|---------|---------|-----------|-----------|--------|--------|
| E S. Abut | 129+76.18 | 117.10 | 117.60 | E Pier 3 | 132+56.18 | 120.12 | 120.62 | E Pier 6 | 136+23.18 | 124.12 | 124.62 | E Pier 9 | 139+93.68 | 128.09 | 128.59 | E Pier 12 | 143+64.18 | 132.10 | 132.60 | E Pier 15 | 146+92.18 | 135.56 | 136.06 |
| | 129+83.51 | 117.19 | 117.69 | | 132+68.18 | 120.24 | 120.74 | | 136+35.53 | 124.27 | 124.77 | | 140+06.03 | 128.25 | 128.75 | | 143+75.48 | 132.21 | 132.71 | | 147+00.68 | 135.66 | 136.16 |
| | 129+91.58 | 117.27 | 117.77 | | 132+80.18 | 120.37 | 120.87 | | 136+47.88 | 124.43 | 124.93 | | 140+18.38 | 128.41 | 128.91 | | 143+86.78 | 132.36 | 132.86 | | 147+09.18 | 135.76 | 136.26 |
| | 129+99.66 | 117.35 | 117.85 | | 132+92.18 | 120.51 | 121.01 | | 136+60.23 | 124.56 | 125.06 | | 140+30.73 | 128.54 | 129.04 | | 143+98.08 | 132.47 | 132.97 | | 147+17.68 | 135.86 | 136.36 |
| | 130+07.73 | 117.43 | 117.93 | | 133+04.18 | 120.61 | 121.11 | | 136+72.58 | 124.73 | 125.23 | | 140+43.08 | 128.69 | 129.19 | | 144+09.38 | 132.58 | 133.08 | | 147+26.18 | 135.97 | 136.47 |
| | 130+15.81 | 117.53 | 118.03 | | 133+16.18 | 120.73 | 121.23 | | 136+84.93 | 124.85 | 125.35 | | 140+55.43 | 128.83 | 129.33 | | 144+20.68 | 132.72 | 133.22 | | 147+34.68 | 136.05 | 136.55 |
| | 130+23.88 | 117.64 | 118.14 | | 133+28.18 | 120.87 | 121.37 | | 136+97.28 | 124.99 | 125.49 | | 140+67.78 | 128.95 | 129.45 | | 144+31.98 | 132.83 | 133.33 | | 147+43.18 | 136.13 | 136.63 |
| | 130+31.96 | 117.68 | 118.18 | | 133+40.18 | 121.01 | 121.51 | | 137+09.63 | 125.09 | 125.59 | | 140+80.13 | 129.06 | 129.56 | | 144+43.28 | 132.94 | 133.44 | | 147+51.68 | 136.24 | 136.74 |
| | 130+40.03 | 117.80 | 118.30 | | 133+52.18 | 121.15 | 121.65 | | 137+21.98 | 125.24 | 125.74 | | 140+92.48 | 129.16 | 129.66 | | 144+54.58 | 133.08 | 133.58 | | 147+60.18 | 136.35 | 136.85 |
| | 130+48.11 | 117.89 | 118.39 | | 133+64.18 | 121.29 | 121.79 | | 137+34.33 | 125.34 | 125.84 | | 141+04.83 | 129.26 | 129.76 | | 144+65.88 | 133.19 | 133.69 | | 147+68.68 | 136.44 | 136.94 |
| E Pier 1 | 130+56.18 | 117.95 | 118.45 | E Pier 4 | 133+76.18 | 121.46 | 121.96 | E Pier 7 | 137+46.68 | 125.45 | 125.95 | E Pier 10 | 141+17.18 | 129.46 | 129.96 | E Pier 13 | 144+77.18 | 133.28 | 133.78 | E Pier 16 | 147+77.10 | 136.54 | 137.04 |
| | 130+66.18 | 118.06 | 118.56 | | 133+88.53 | 121.59 | 122.09 | | 137+59.03 | 125.62 | 126.12 | | 141+29.53 | 129.61 | 130.11 | | 144+88.68 | 133.39 | 133.89 | | 147+85.88 | 136.60 | 137.10 |
| | 130+76.18 | 118.19 | 118.69 | | 134+00.88 | 121.76 | 122.26 | | 137+71.38 | 125.73 | 126.23 | | 141+41.88 | 129.74 | 130.24 | | 145+00.18 | 133.52 | 134.02 | | 147+94.58 | 136.69 | 137.18 |
| | 130+86.18 | 118.29 | 118.79 | | 134+13.23 | 121.85 | 122.35 | | 137+83.73 | 125.89 | 126.39 | | 141+54.23 | 129.88 | 130.38 | | 145+11.68 | 133.63 | 134.13 | | 148+03.28 | 136.79 | 137.29 |
| | 130+96.18 | 118.37 | 118.87 | | 134+25.58 | 122.03 | 122.53 | | 137+96.08 | 126.06 | 126.56 | | 141+66.58 | 130.01 | 130.51 | | 145+23.18 | 133.75 | 134.25 | | 148+11.98 | 137.87 | 137.87 |
| | 131+06.18 | 118.49 | 118.99 | | 134+37.93 | 122.13 | 122.63 | | 138+08.43 | 126.19 | 126.69 | | 141+78.93 | 130.12 | 130.62 | | 145+34.68 | 133.87 | 134.37 | | 148+20.68 | 137.00 | 137.50 |
| | 131+16.18 | 118.60 | 119.10 | | 134+50.28 | 122.23 | 122.73 | | 138+20.78 | 126.32 | 126.82 | | 141+91.28 | 130.24 | 130.74 | | 145+46.18 | 133.99 | 134.49 | | 148+29.38 | 137.07 | 137.57 |
| | 131+26.18 | 118.72 | 119.22 | | 134+62.63 | 122.41 | 122.91 | | 138+33.13 | 126.47 | 126.97 | | 142+03.63 | 130.38 | 130.88 | | 145+57.68 | 134.13 | 134.63 | | 148+38.08 | 137.17 | 137.67 |
| | 131+36.18 | 118.85 | 119.35 | | 134+74.98 | 122.52 | 123.02 | | 138+45.48 | 126.60 | 127.10 | | 142+15.98 | 130.54 | 131.04 | | 145+69.18 | 134.26 | 134.76 | | 148+46.78 | 137.27 | 137.77 |
| | 131+46.18 | 118.94 | 119.44 | | 134+87.33 | 122.65 | 123.15 | | 138+57.83 | 126.70 | 127.20 | | 142+28.33 | 130.64 | 131.14 | | 145+80.68 | 134.37 | 134.87 | | 148+55.48 | 137.35 | 137.85 |
| E Pier 2 | 131+56.18 | 119.06 | 119.56 | E Pier 5 | 134+99.68 | 122.76 | 123.26 | E Pier 8 | 138+70.18 | 126.79 | 127.29 | E Pier 11 | 142+40.68 | 130.75 | 131.25 | E Pier 14 | 145+92.18 | 134.47 | 134.97 | E Pier 17 | 148+64.18 | 137.41 | 137.91 |
| | 131+66.18 | 119.21 | 119.71 | | 135+12.03 | 122.93 | 123.43 | | 138+82.53 | 126.91 | 127.41 | | 142+53.03 | 130.90 | 131.40 | | 146+02.18 | 134.60 | 135.10 | | 148+72.68 | 137.52 | 138.02 |
| | 131+76.18 | 119.27 | 119.77 | | 135+24.38 | 123.06 | 123.56 | | 138+94.88 | 127.09 | 127.59 | | 142+65.38 | 131.01 | 131.51 | | 146+12.18 | 134.71 | 135.21 | | 148+80.33 | 137.58 | 138.08 |
| | 131+86.18 | 119.36 | 119.86 | | 135+36.73 | 123.21 | 123.71 | | 139+07.23 | 127.25 | 127.75 | | 142+77.73 | 131.14 | 131.64 | | 146+22.18 | 134.81 | 135.31 | | 148+88.41 | 137.66 | 138.16 |
| | 131+96.18 | 119.46 | 119.96 | | 135+48.08 | 123.35 | 123.85 | | 139+19.58 | 127.34 | 127.84 | | 142+90.08 | 131.31 | 131.81 | | 146+32.18 | 134.89 | 135.39 | | 148+96.48 | 137.75 | 138.25 |
| | 132+06.18 | 119.58 | 120.08 | | 135+61.43 | 123.52 | 124.02 | | 139+31.93 | 127.50 | 128.00 | | 143+02.43 | 131.44 | 131.94 | | 146+42.18 | 135.02 | 135.52 | | 149+04.56 | 137.82 | 138.32 |
| | 132+16.18 | 119.72 | 120.22 | | 135+73.78 | 123.63 | 124.13 | | 139+44.28 | 127.63 | 128.13 | | 143+14.78 | 131.58 | 132.08 | | 146+52.18 | 135.14 | 135.64 | | 149+12.63 | 137.93 | 138.43 |
| | 132+26.18 | 119.78 | 120.28 | | 135+86.13 | 123.72 | 124.22 | | 139+56.63 | 127.73 | 128.23 | | 143+27.13 | 131.70 | 132.20 | | 146+62.18 | 135.24 | 135.74 | | 149+20.71 | 138.01 | 138.51 |
| | 132+36.18 | 119.87 | 120.37 | | 135+98.48 | 123.90 | 124.40 | | 139+68.98 | 127.88 | 128.38 | | 143+39.48 | 131.83 | 132.33 | | 146+72.18 | 135.36 | 135.86 | | 149+28.78 | 138.10 | 138.60 |
| | 132+46.18 | 119.99 | 120.49 | | 136+10.83 | 123.99 | 124.49 | | 139+81.33 | 127.98 | 128.48 | | 143+51.83 | 131.98 | 132.48 | | 146+82.18 | 135.45 | 135.95 | | 149+36.86 | 138.18 | 138.68 |
| E Pier 3 | 132+56.18 | 120.12 | 120.62 | E Pier 6 | 136+23.18 | 124.12 | 124.62 | E Pier 9 | 139+93.68 | 128.09 | 128.59 | E Pier 12 | 143+64.18 | 132.10 | 132.60 | E Pier 15 | 146+92.18 | 135.56 | 136.06 | E N. Abut | 149+44.18 | 138.27 | 138.77 |

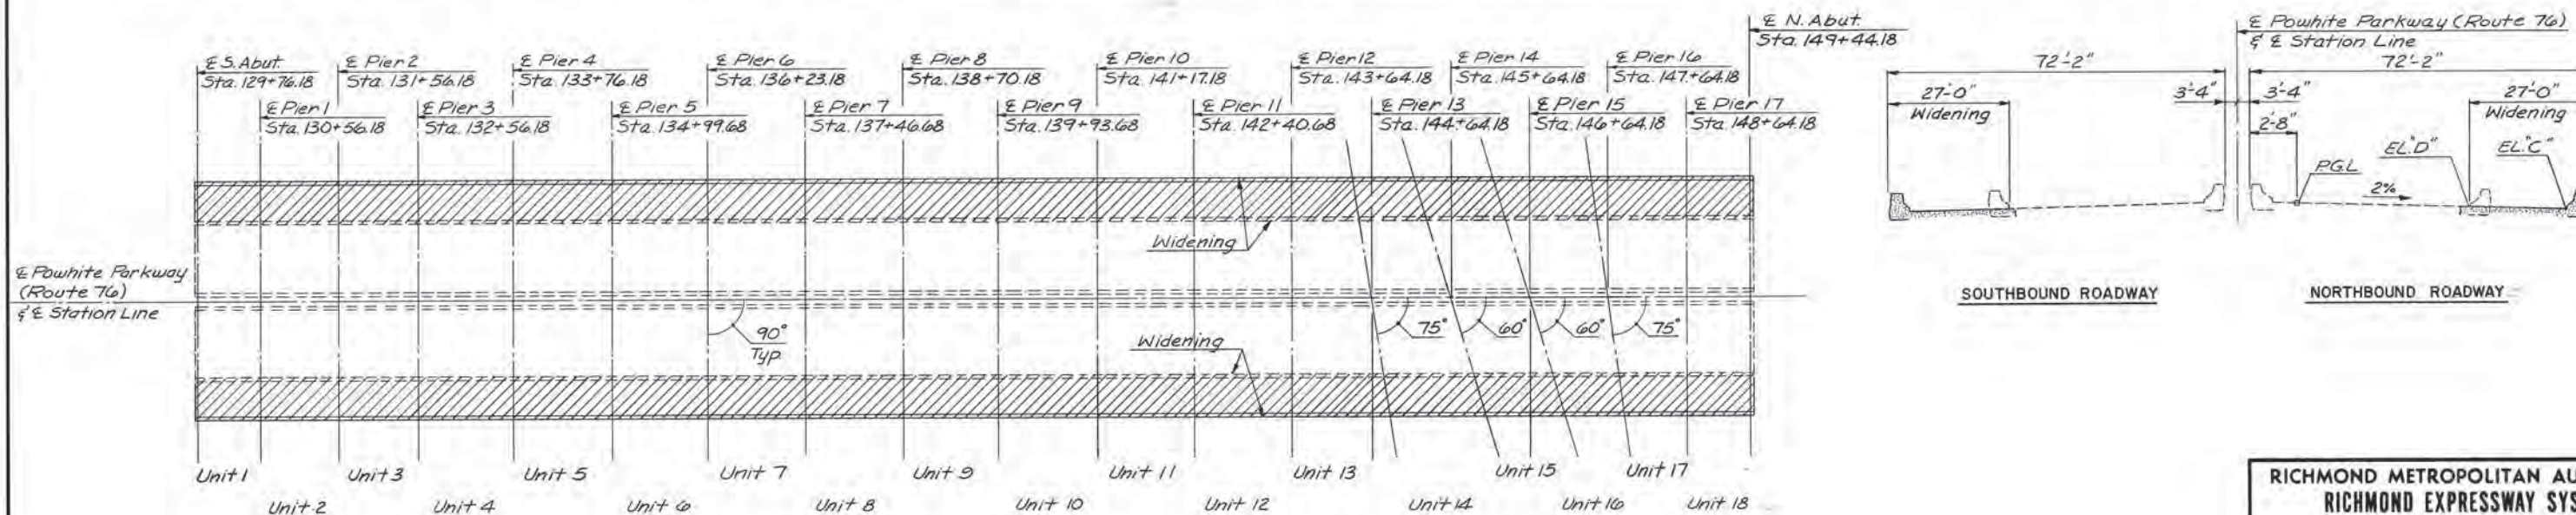

KEY PLAN
No Scale

| | | | | | |
|-----------|----------|------|----------|-----|------|
| BY | DATE | | | | |
| MADE | ALG | 2-87 | | | |
| CHECKED | TEP | 3-87 | As Built | TEM | 3-89 |
| IN CHARGE | S.R. | | | | |
| NO. | REVISION | BY | DATE | | |

RICHMOND METROPOLITAN AUTHORITY
RICHMOND EXPRESSWAY SYSTEM


DECK SLAB ELEVATION
NORTHBOUND

HOWARD, NEEDLES, TAMMEN & BERGENDOFF
consulting engineers
Alexandria, Virginia

SCALE: NO SCALE
CONTRACT NO. C-13
SHEET NO. 49 OF 106

AS BUILT

| RICHMOND EXPRESSWAY SYSTEM | | | |
|----------------------------|-----------------------------|-----------|--------------|
| SECTION | PROJECT | SHEET NO. | TOTAL SHEETS |
| 13 | WIDENING JAMES RIVER BRIDGE | 50 | 106 |

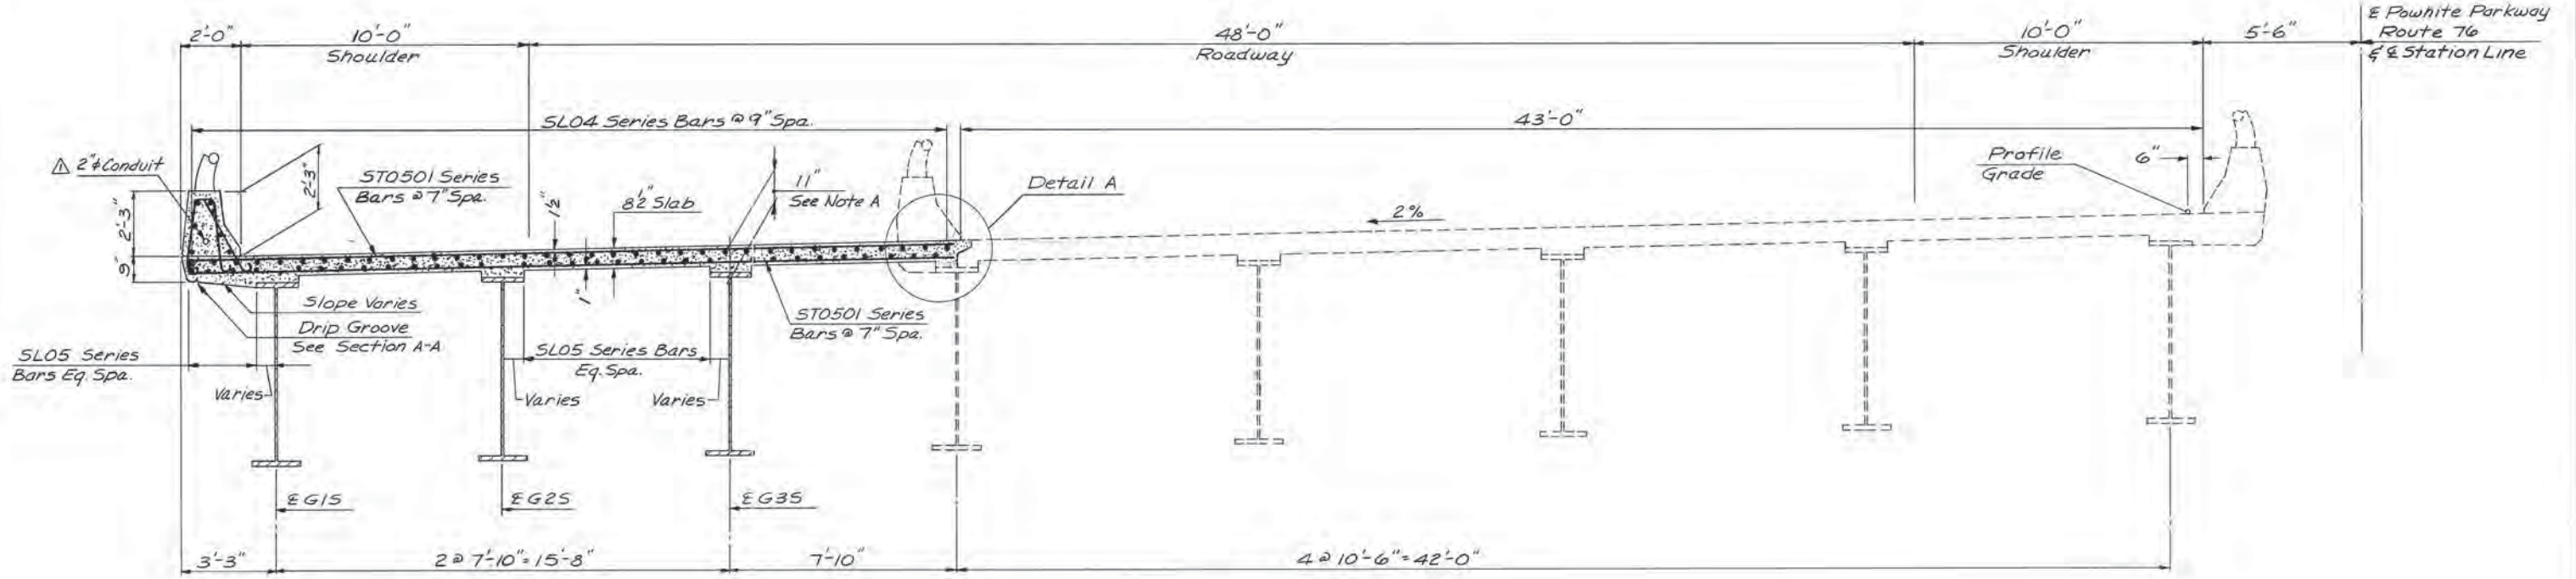

TYPICAL SECTION
(SOUTHBOUND SHOWN)
Scale: 3/8" = 1'-0"

NOTE A:




Dimension shown is measured from top of web to top of slab at the intersection of the centerline of bearing and the centerline of girder. This dimension may be varied between bearings as required to compensate for variations in camber, except that no portion of the girder flange may fall within the slab.

NOTES:


All bevels for concrete on this sheet shall be 3/4". Rounded edges with 1" radius may be used in lieu of bevels along top of parapet. For groove location, see Deck Plan Sheets. Precast Parapet shall not be used on this structure.

Existing No.5 transverse steel top & bottom to remain in place and be cleaned of any concrete


Coat edge of existing slab with Type EP-4 epoxy immediately preceding placement of new concrete (Typ.)

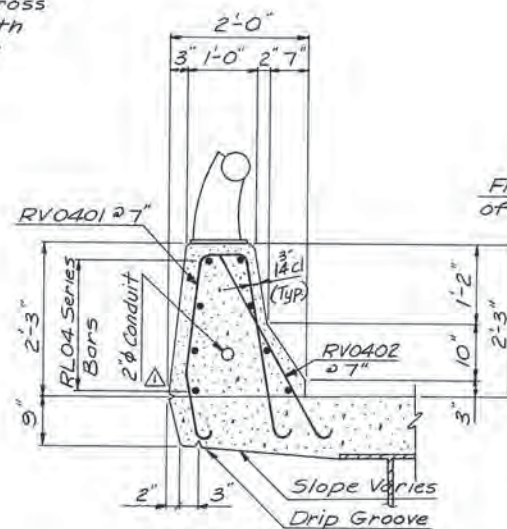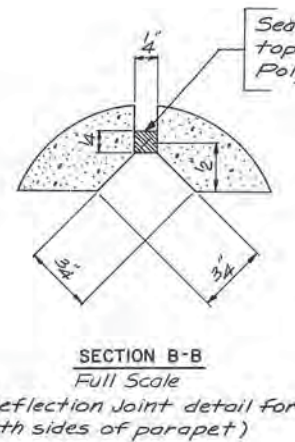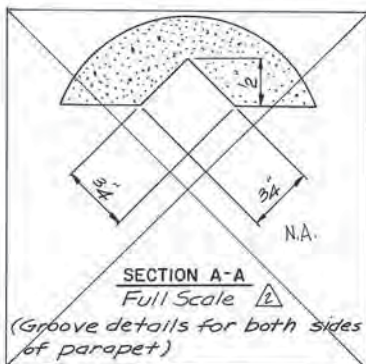


SECTION C-C
Scale: 3/4" = 1'-0"

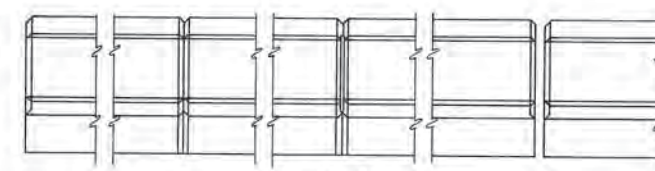

PLAN
Scale: 3/4" = 1'-0"

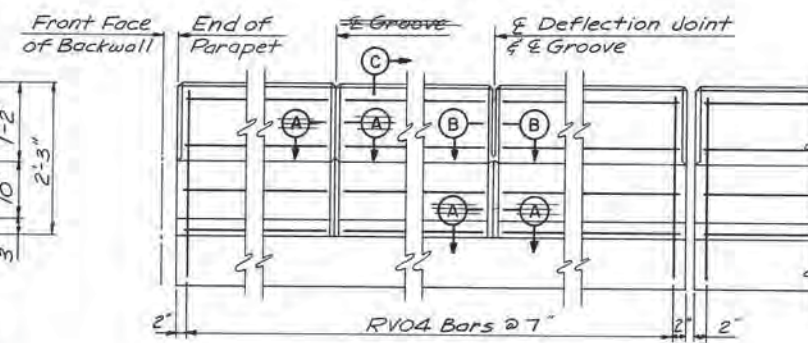

ELEVATION
Scale: 3/4" = 1'-0"

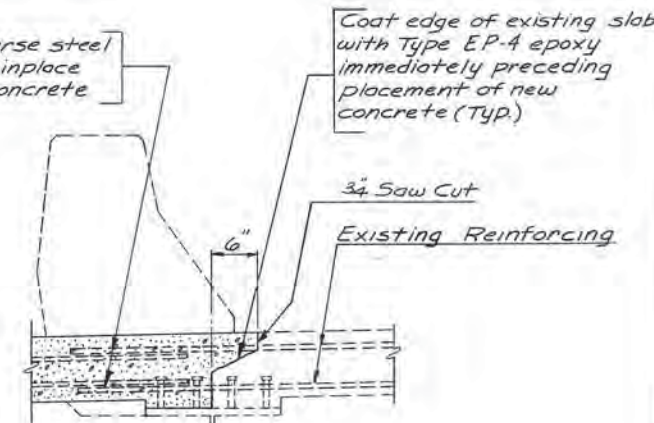

DETAIL A

| BY | DATE | NO. | REVISION | BY | DATE |
|-----------|------------|-----|------------|-----|------|
| MADE | ALC 3-87 | 1 | As Built | TEM | 3-89 |
| CHECKED | T.F.P 3-87 | 2 | 2" Conduit | ALC | 4-87 |
| IN CHARGE | S.R. | | | | |

RICHMOND METROPOLITAN AUTHORITY
RICHMOND EXPRESSWAY SYSTEM


TYPICAL CROSS SECTION
AND PARAPET DETAILS

HOWARD, NEEDLES, TAMMEN & BERGENOFF
consulting engineers
Alexandria, Virginia


SCALE: AS SHOWN
CONTRACT NO.: C-13
SHEET NO. 50 OF 106

AS BUILT


| RICHMOND EXPRESSWAY SYSTEM | | | |
|----------------------------|-----------------------------|-----------|--------------|
| SECTION | PROJECT | SHEET NO. | TOTAL SHEETS |
| 13 | WIDENING JAMES RIVER BRIDGE | 54 | 106 |

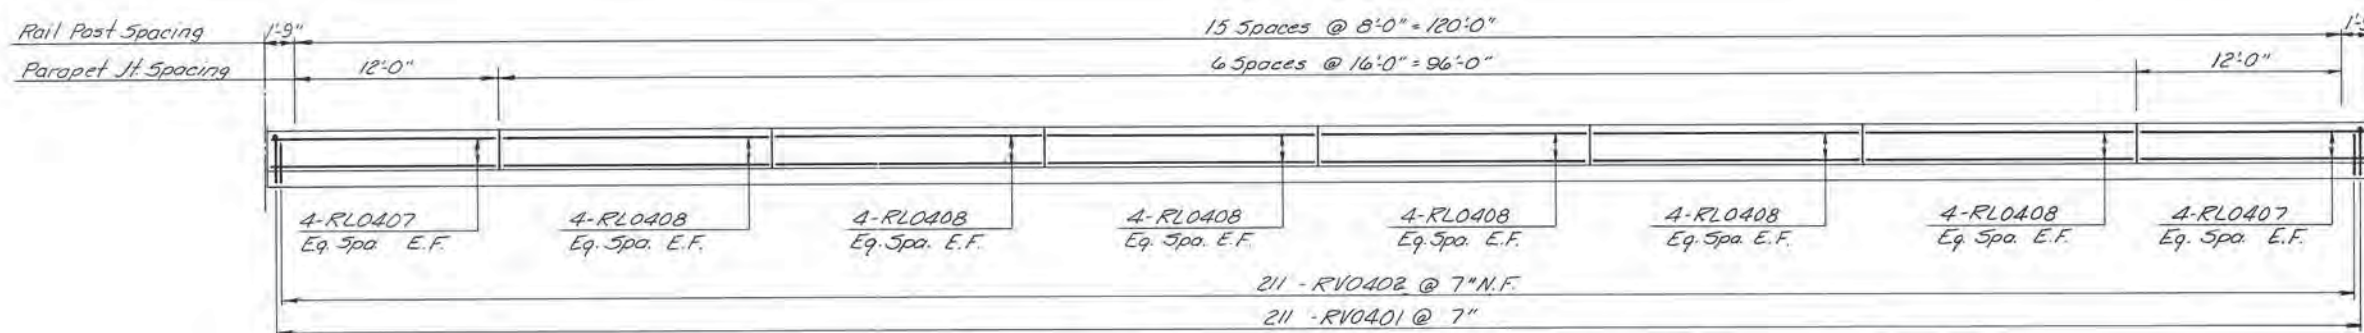

PARAPET ELEVATION - UNITS 5 THRU 12 SOUTHBOUND & NORTHBOUND
(SOUTHBOUND SHOWN)
Scale: 3/8" = 1'-0"

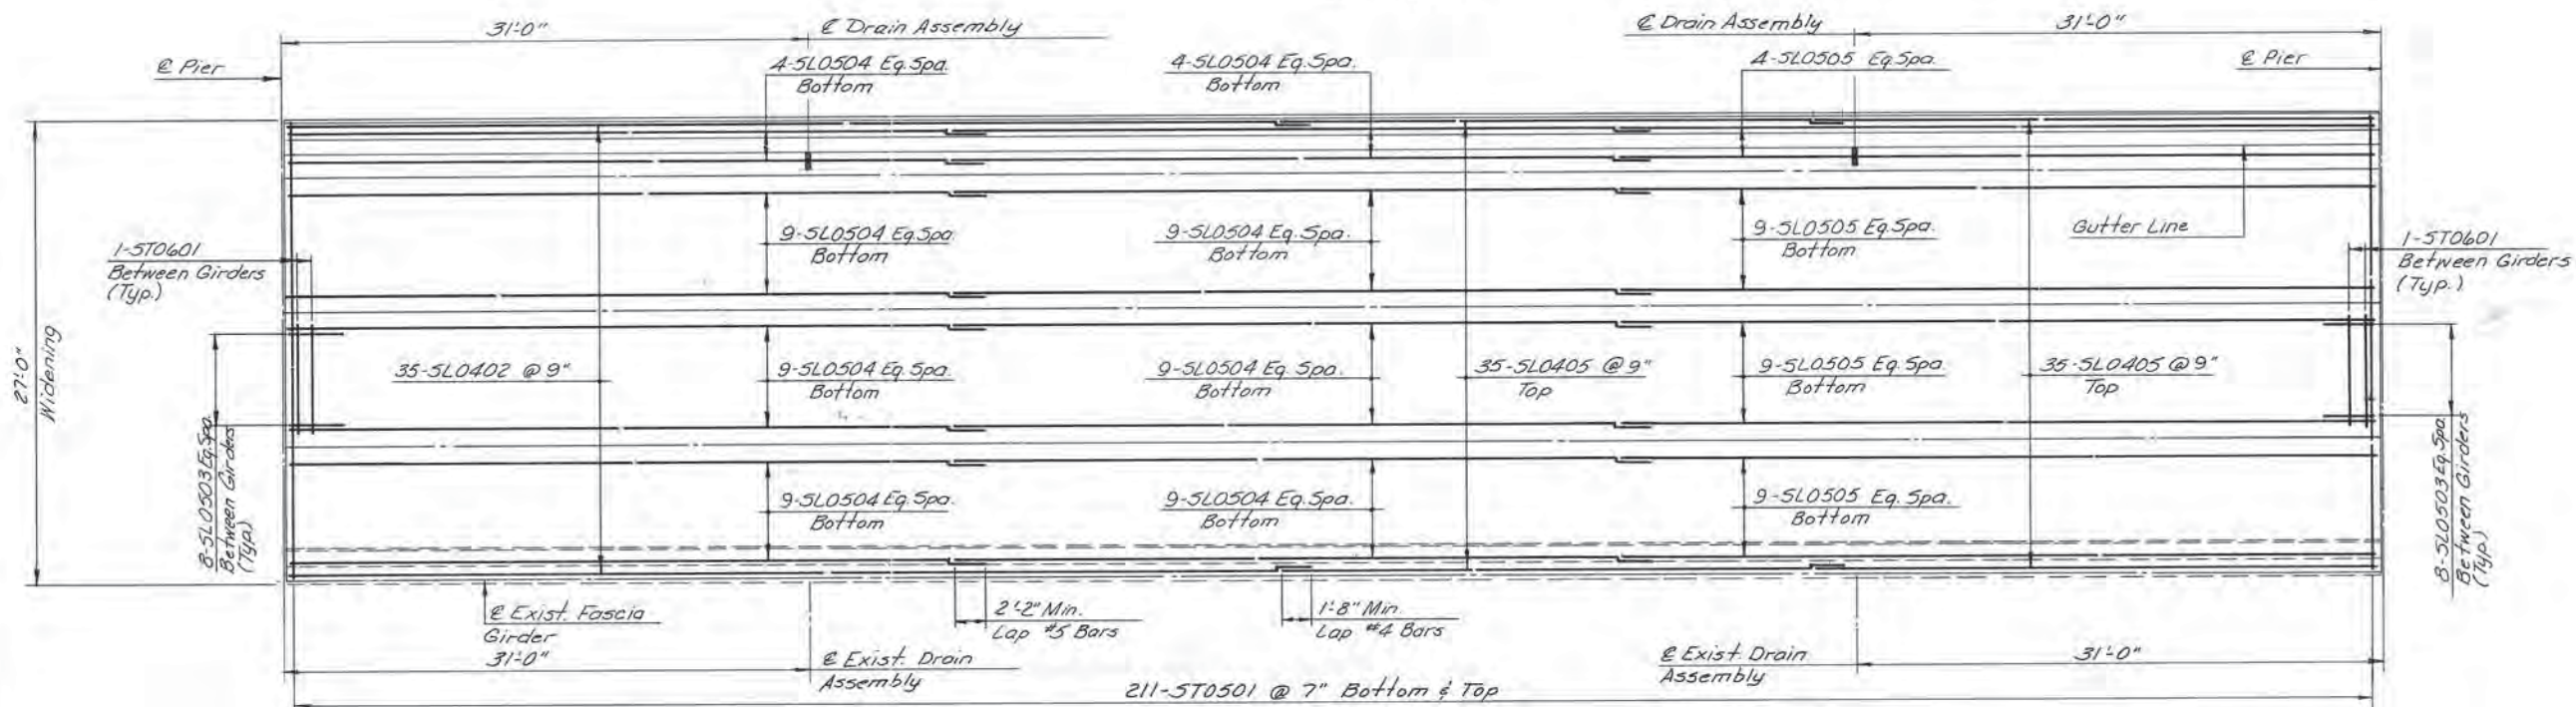

DECK PLAN - UNITS 5 THRU 12 SOUTHBOUND & NORTHBOUND
(SOUTHBOUND SHOWN)
Scale: 3/8" = 1'-0"

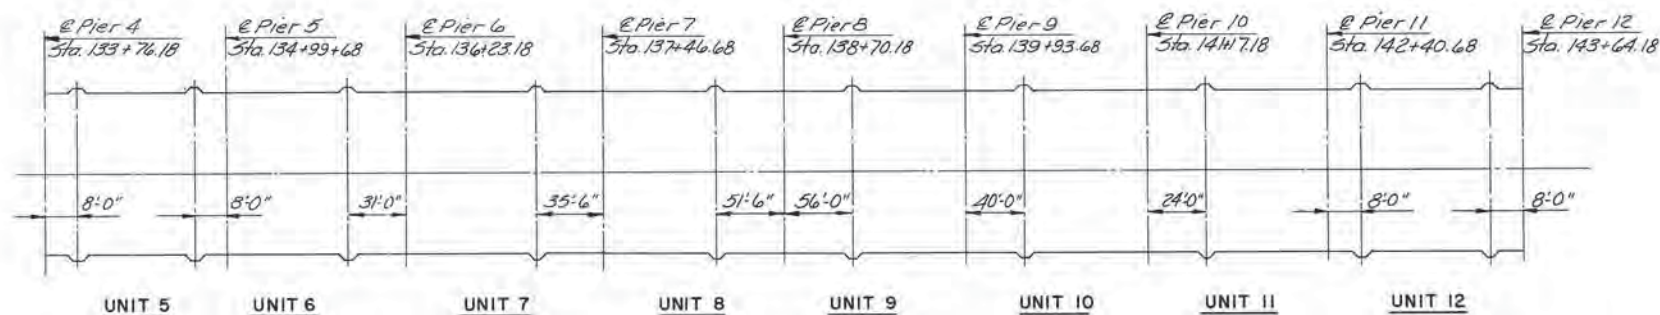

LIGHTING STANDARD LOCATIONS FOR UNITS 5 THRU 12
No Scale

| BY | DATE | | | | |
|-----------|------|------|----------|-----|------|
| MADE | TAL | 3-87 | | | |
| CHECKED | TRP | 3-87 | As Built | TEM | 3-89 |
| IN CHARGE | S.R. | | | | |

AS BUILT


RICHMOND METROPOLITAN AUTHORITY
RICHMOND EXPRESSWAY SYSTEM

DECK PLAN
UNITS 5 THRU 12 SOUTHBOUND & NORTHBOUND


HOWARD, NEEDLES, TAMMEN & BERGENOFF
consulting engineers
Alexandria, Virginia

SCALE: AS SHOWN
CONTRACT NO.: C-13
SHEET NO. 54 OF 106

| RICHMOND EXPRESSWAY SYSTEM | | | |
|----------------------------|--------------------------------|-----------|--------------|
| SECTION | PROJECT | SHEET NO. | TOTAL SHEETS |
| 13 | WIDENING JAMES RIVER BRIDGE | 60 | 106 |

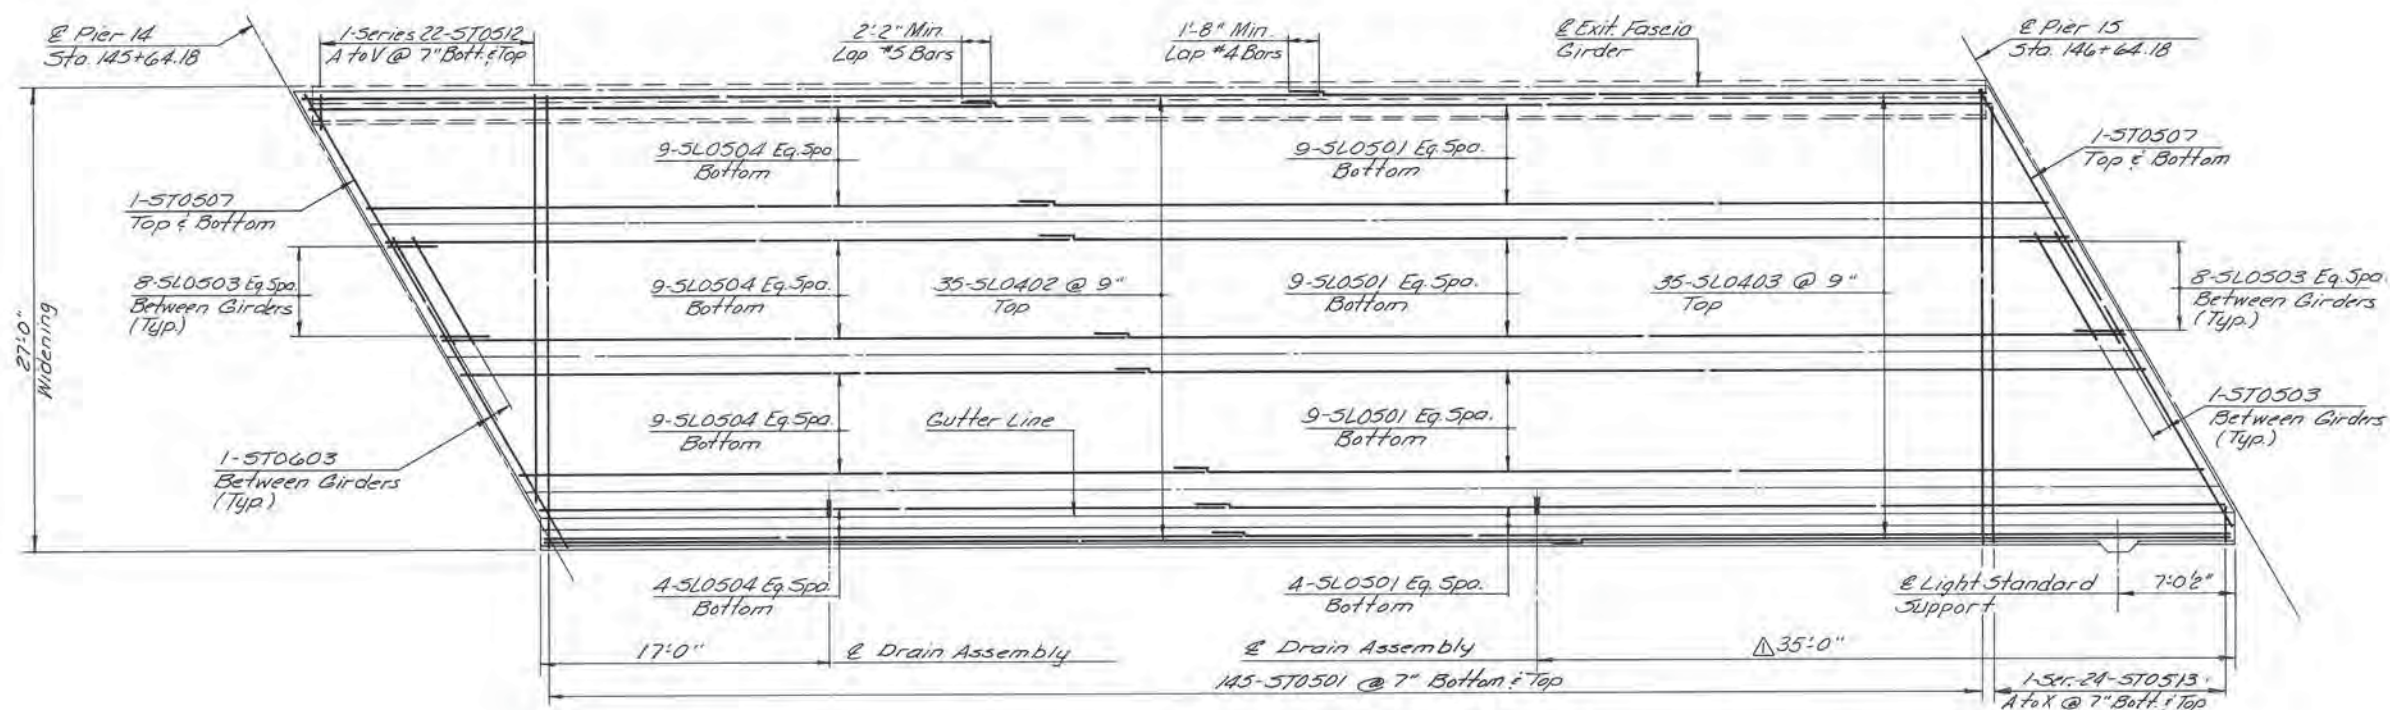

DECK PLAN - UNIT 15 NORTHBOUND
Scale: 3/16" = 1'-0"

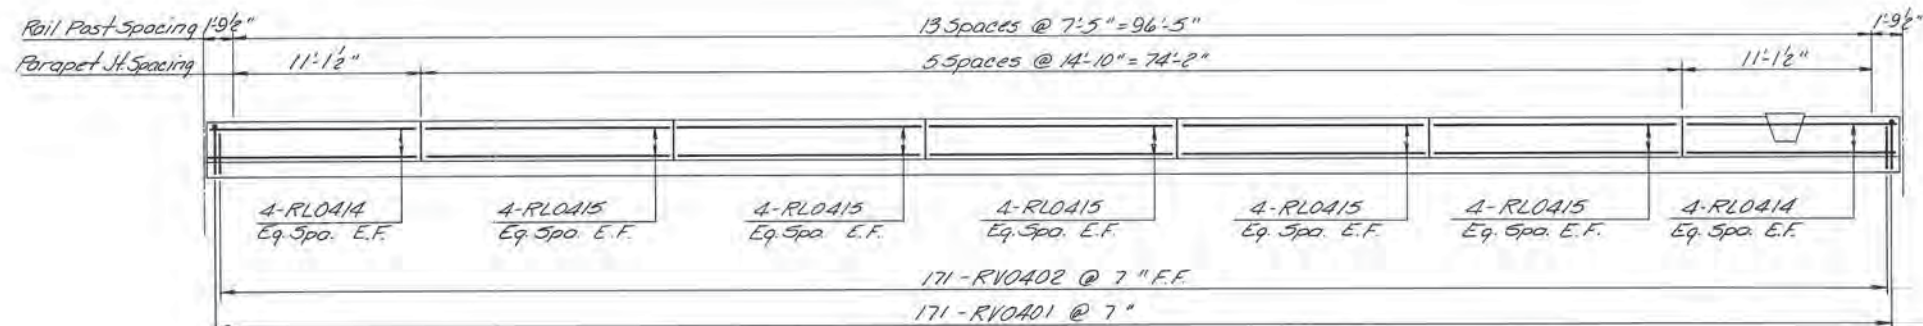

PARAPET ELEVATION - UNIT 15 NORTHBOUND
Scale: 3/16" = 1'-0"

| BY | DATE | NO. | REVISION | BY | DATE |
|-----------|----------|-----|-------------------|-----|------|
| MADE | TAL 3-87 | | As Built | TEM | 3-89 |
| CHECKED | TFP 3-87 | | Rel. Drain Assbly | EJM | 7-87 |
| IN CHARGE | S.R. | | | | |

AS BUILT


RICHMOND METROPOLITAN AUTHORITY
RICHMOND EXPRESSWAY SYSTEM

DECK PLAN - UNIT 15 NORTHBOUND

HOWARD, NEEDLES, TAMMEN & BERGENDOFF
consulting engineers
Alexandria, Virginia


SCALE: AS SHOWN
CONTRACT NO. C-13
SHEET NO. 60 OF 106

| RICHMOND EXPRESSWAY SYSTEM | | | |
|----------------------------|-----------------------------|-----------|--------------|
| SECTION | PROJECT | SHEET NO. | TOTAL SHEETS |
| 13 | WIDENING JAMES RIVER BRIDGE | 61 | 106 |

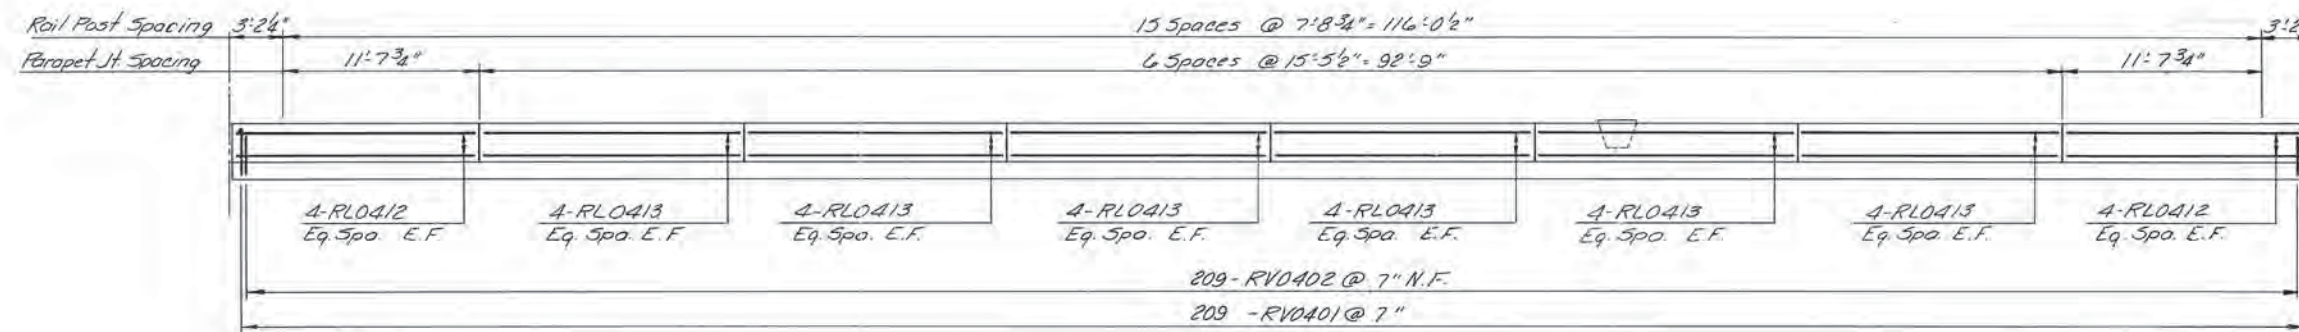

PARAPET ELEVATION - UNIT 16 SOUTHBOUND

Scale: 3/16" = 1'-0"

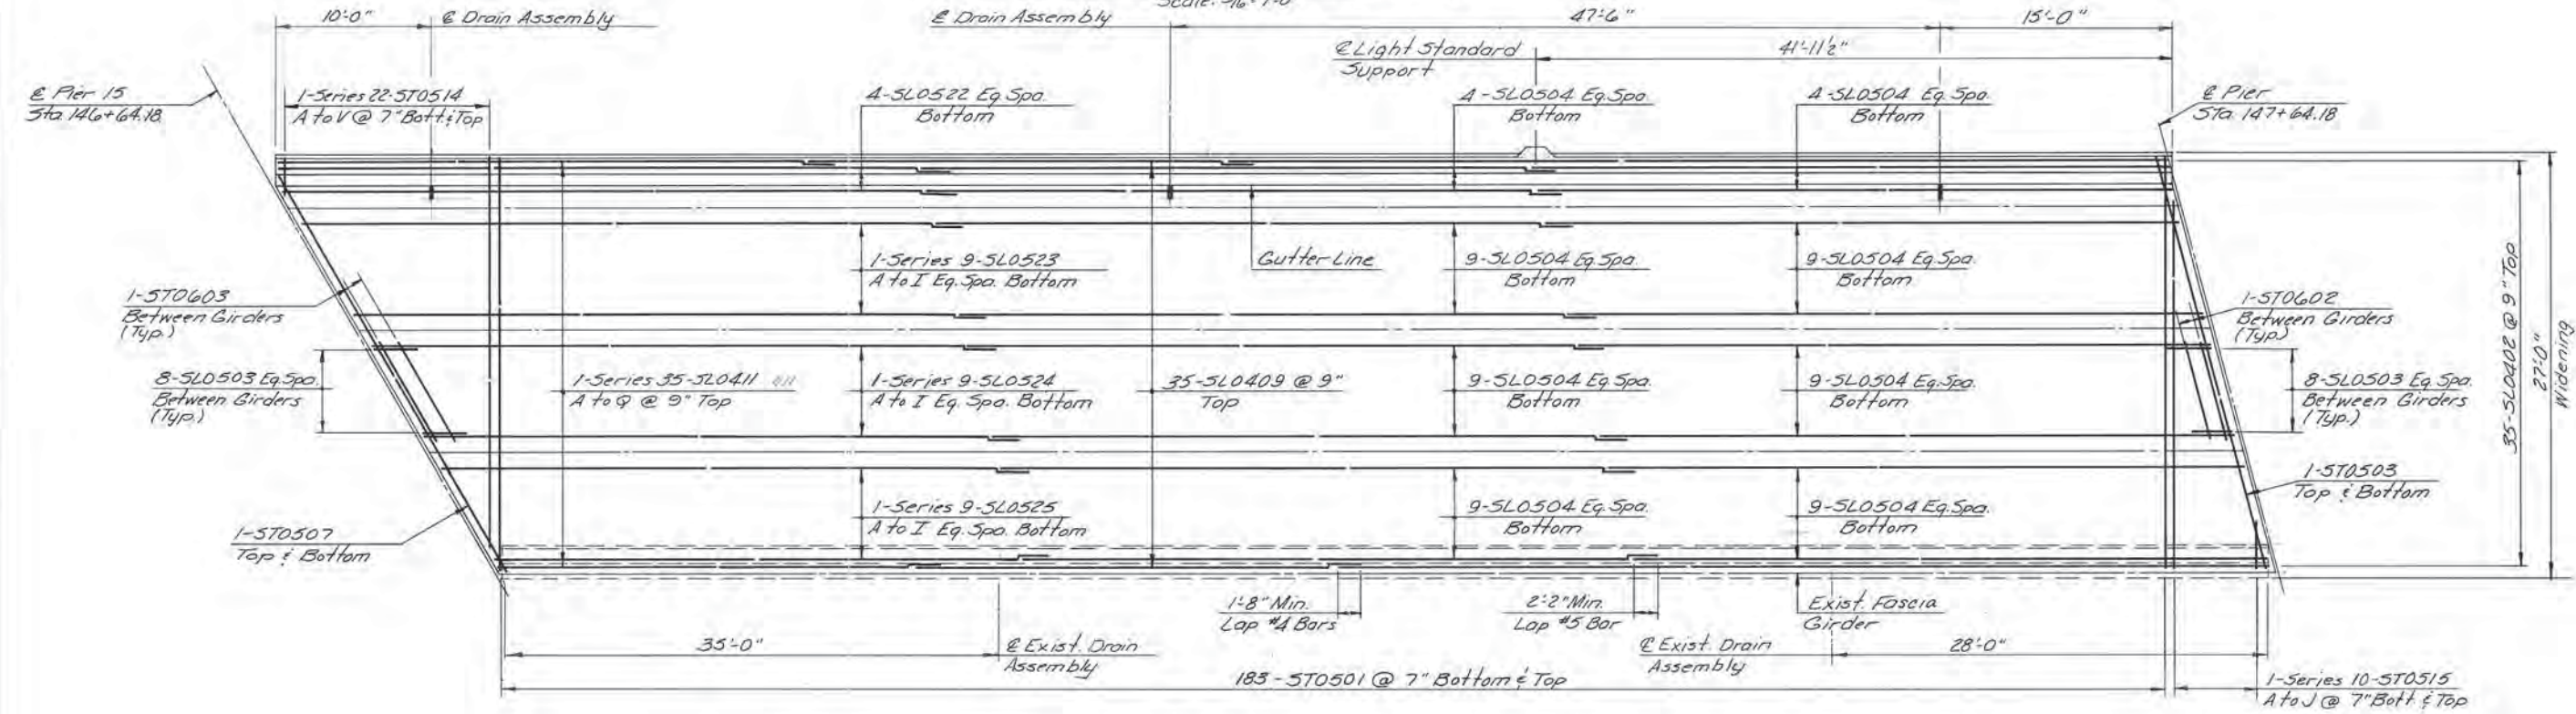

DECK PLAN - UNIT 16 SOUTHBOUND

Scale: 3/16" = 1'-0"

| BY | DATE | NO. | REVISION | BY | DATE |
|-----------|----------|----------|----------|-----|------|
| MADE | TAL 3-87 | | | | |
| CHECKED | TFP 3-87 | As Built | | TEM | 3-89 |
| IN CHARGE | S.R. | | | | |

AS BUILT


RICHMOND METROPOLITAN AUTHORITY
RICHMOND EXPRESSWAY SYSTEM

DECK PLAN - UNIT 16 SOUTHBOUND


HOWARD, NEEDLES, TAMMEN & BERGENDOFF
 consulting engineers
 Alexandria, Virginia

SCALE: AS SHOWN
 CONTRACT NO. C-13
 SHEET NO. 61 OF 106

| RICHMOND EXPRESSWAY SYSTEM | | | |
|----------------------------|-----------------------------|-----------|--------------|
| SECTION | PROJECT | SHEET NO. | TOTAL SHEETS |
| 13 | WIDENING JAMES RIVER BRIDGE | 62 | 106 |

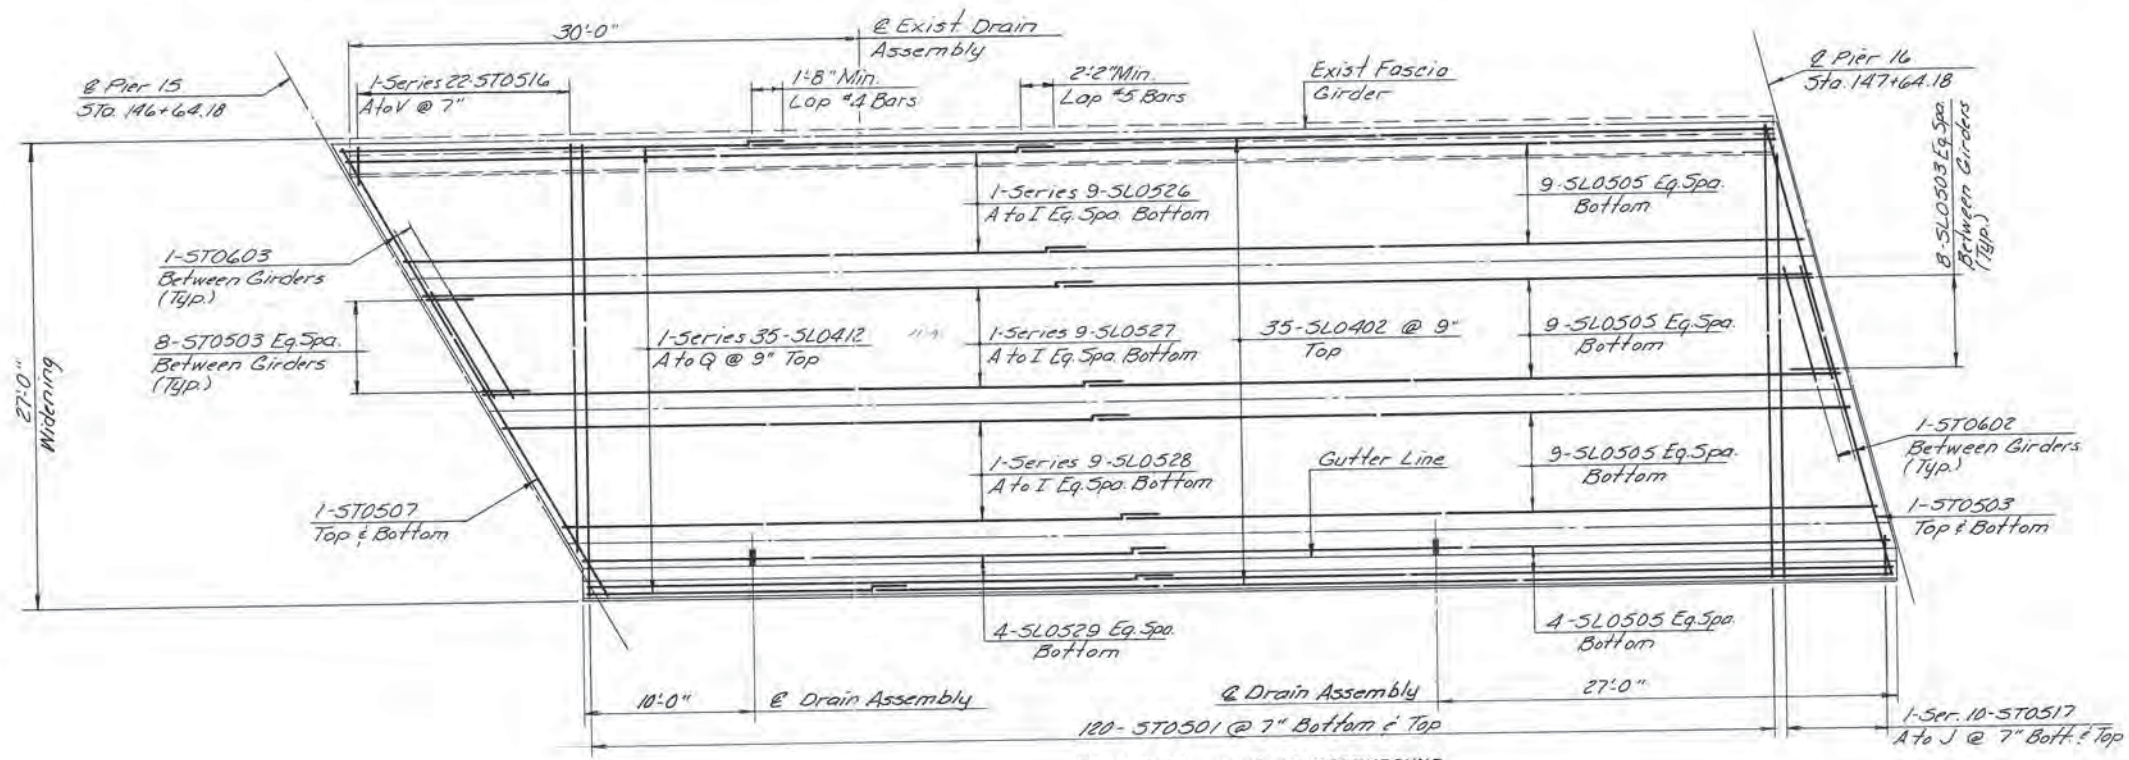

DECK PLAN - UNIT 16 NORTHBOUND
Scale: 3/16" = 1'-0"

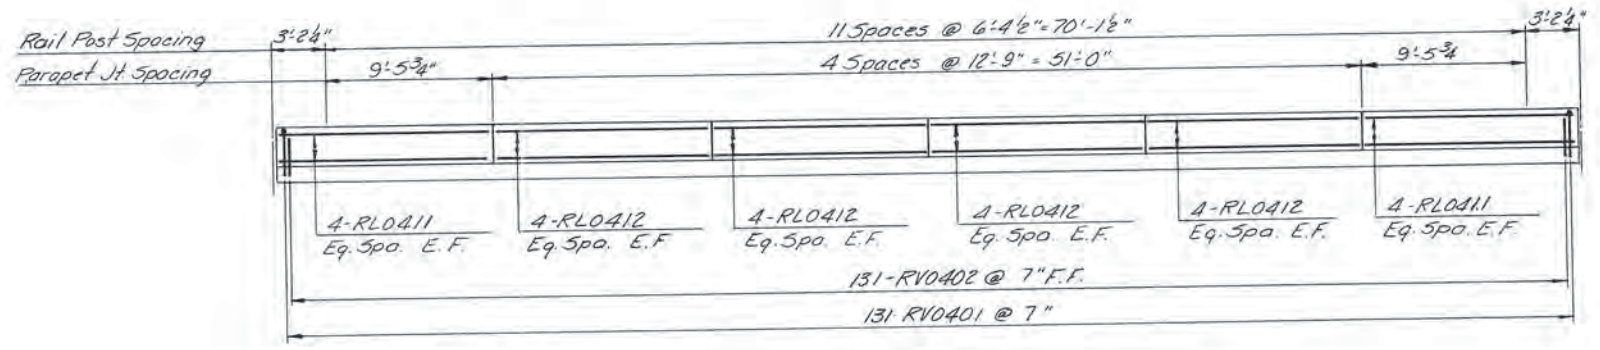

PARAPET ELEVATION - UNIT 16 NORTHBOUND
Scale: 3/16" = 1'-0"

| BY | DATE | NO. | REVISION | BY | DATE |
|-----------|------|------|----------|-----|------|
| MADE | TAL | 3-87 | | | |
| CHECKED | TEP | 3-87 | As Built | TEM | 3-89 |
| IN CHARGE | S.R. | | | | |

AS BUILT











RICHMOND METROPOLITAN AUTHORITY
RICHMOND EXPRESSWAY SYSTEM

DECK PLAN - UNIT 16 NORTHBOUND

HOWARD, NEEDLES, TAMMEN & BERGENDOFF
consulting engineers
Alexandria, Virginia

SCALE: AS SHOWN
CONTRACT NO.: C-13
SHEET NO. 62 OF 106

| RICHMOND EXPRESSWAY SYSTEM | | | |
|----------------------------|-----------------------------|-----------|--------------|
| SECTION | PROJECT | SHEET NO. | TOTAL SHEETS |
| 13 | WIDENING JAMES RIVER BRIDGE | 69 | 106 |

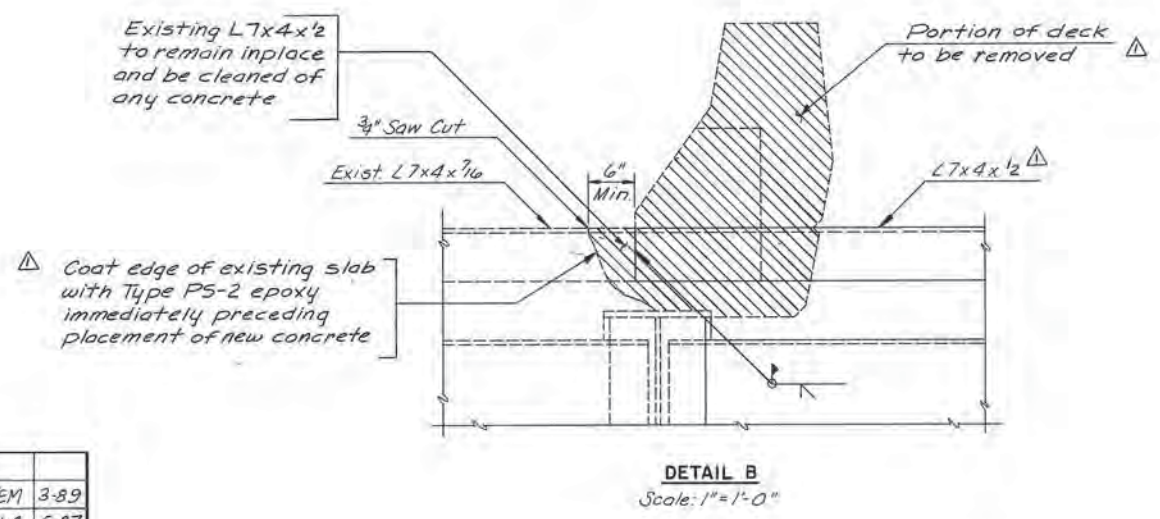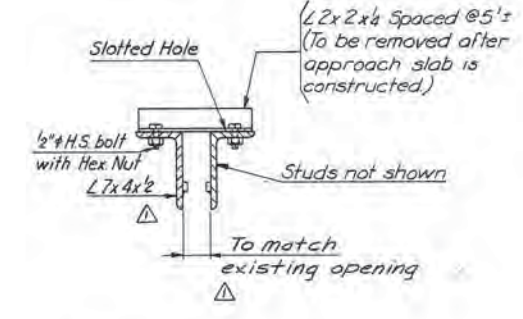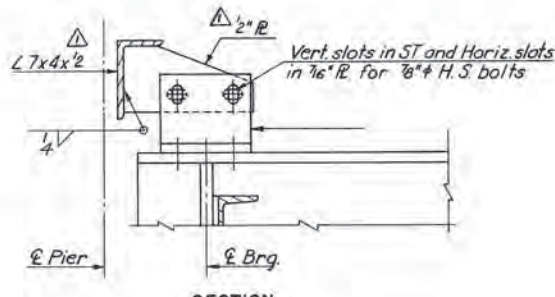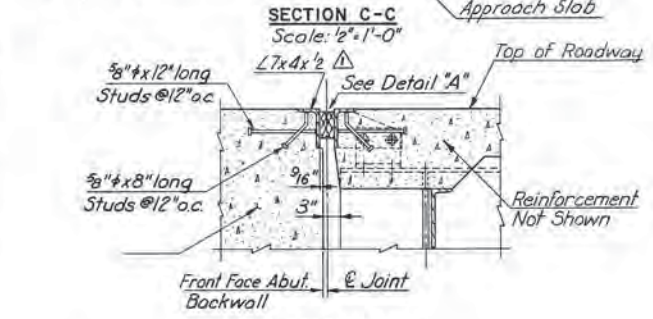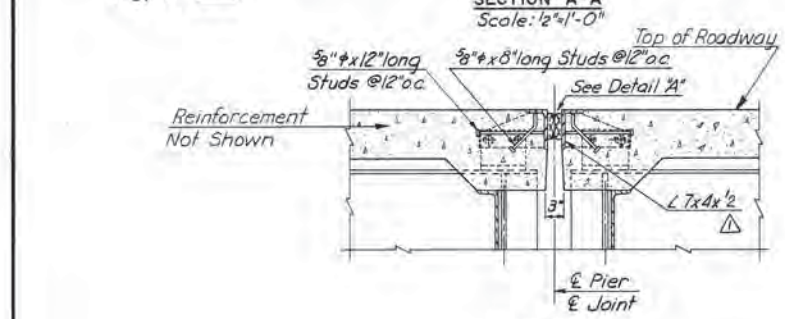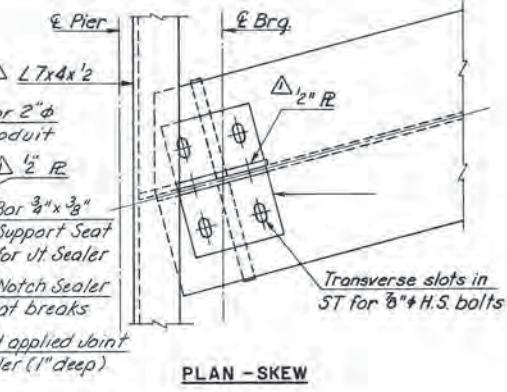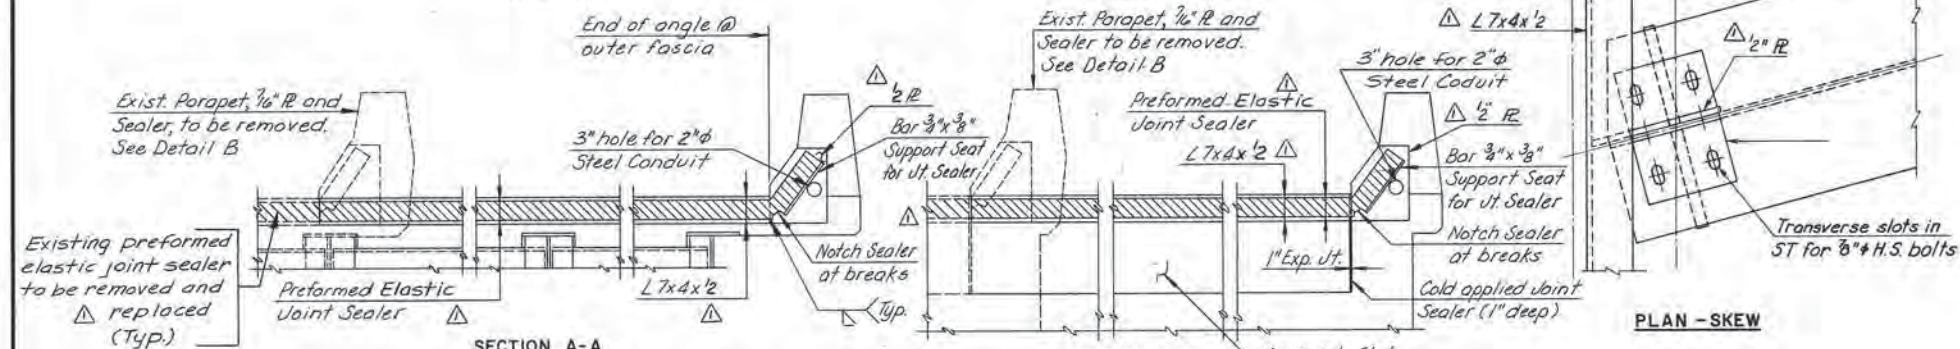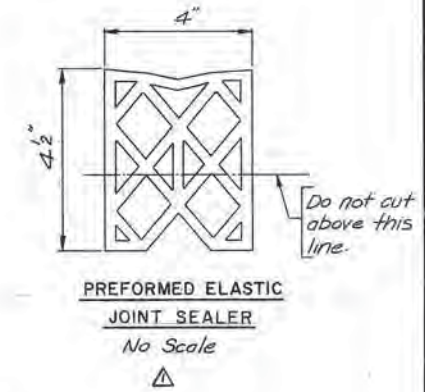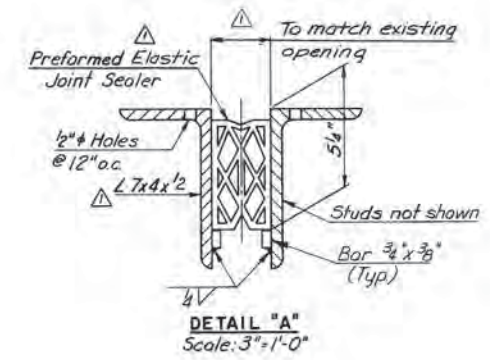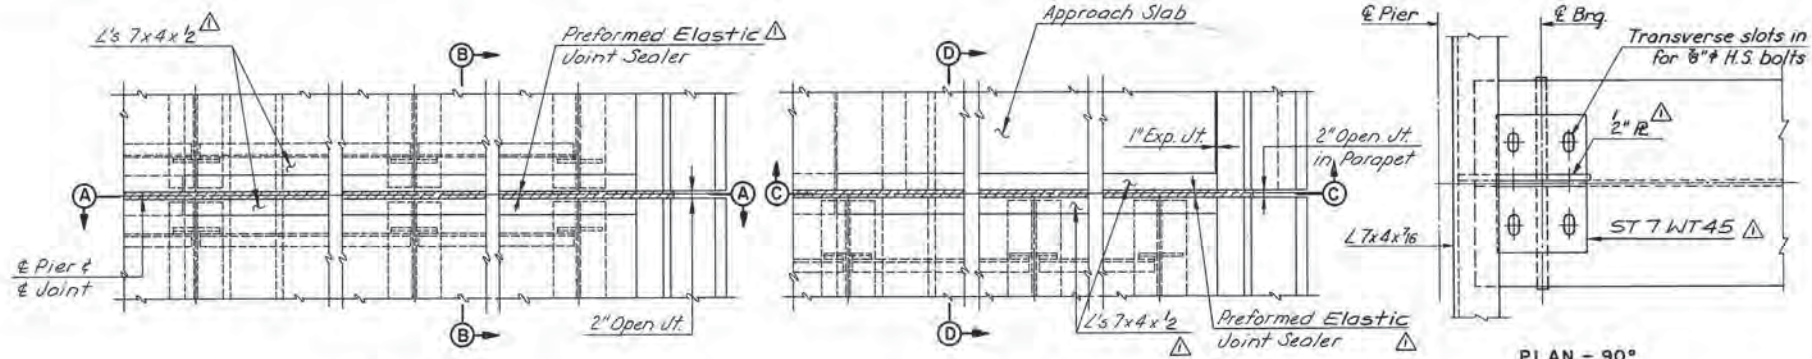

| BY | DATE | | | |
|-----------|----------|-----------|----------|---------|
| MADE | EUM 3-87 | As Built | TEM | 3-89 |
| CHECKED | TFP 3-87 | Revisions | ALC | 5-87 |
| IN CHARGE | SR | NO. | REVISION | BY DATE |

AS BUILT

RICHMOND METROPOLITAN AUTHORITY
RICHMOND EXPRESSWAY SYSTEM

JOINT DETAILS

HOWARD, NEEDLES, TAMMEN & BERGENDOFF
consulting engineers
Alexandria, Virginia

SCALE: AS SHOWN
CONTRACT NO: C-13
SHEET NO 69 OF 106

Bridge 13

**(Douglasdale Road over I-195 Connector / Powhite Parkway - VA State Rte. 76
and CSX Railroad)**

Record Set Plans

| RICHMOND EXPRESSWAY SYSTEM | | | |
|----------------------------|---------------------|-----------|--------------|
| SECTION | PROJECT | SHEET NO. | TOTAL SHEETS |
| 4 | BELTLINE EXPRESSWAY | 118 | 153 |

GENERAL NOTES

ROADWAY: One 28'-0" clear roadway. Two 5'-0" sidewalks.
CAPACITY: Dead Load includes 15 lbs. per sq. ft. for future wearing surface.
 Live Loads - HS20-44 loading.

SPECIFICATIONS:
GENERAL: Virginia Department of Highway Road and Bridge Specifications 1970.
DESIGN: A.A.S.H.O. Standard Specifications for Highway Bridges 1961, modified by Special Design Provisions.
WELDING: 1969 Standard Specifications for Welded Highway and Railway Bridges of the American Welding Society.

CONTRACT SPECIAL PROVISIONS
 Specifications and Contract Special Provisions referred to above are necessary to make these plans complete.

DATUM: City of Richmond
TEMPERATURE: The normal temperature referred to on the plan is 68°F. The temperature range for movement is 0°F to 120°F.

DIMENSIONS: All dimensions are measured horizontally and vertically unless otherwise noted.

EXCAVATION: Excavation below subgrade and cut slope template shall be classified as Structure Excavation. All excavation above these limits shall be classified as Regular Excavation and is not included in the Structural Quantities.

FOUNDATIONS: Footings shall rest on firm material. Foundation material shall be dry and special attention is called to Section 401.05 of General Specifications and to the Contract Special Provisions, concerning preparation of foundations for footings.

CONCRETE NOTES:
 Concrete in superstructure shall be Class A4. All other concrete shall be Class A3. All exposed edges and corners shall have a 1" chamfer or fillet unless otherwise noted. Care in the method of vibration, the use of low-slump concrete, and/or other means shall be employed to prevent downgrade movement of newly placed slab concrete.
 Finishing Concrete Surfaces: See the Standard Architectural Detail Sheets and the Contract Special Provisions for types and details.

All reinforcing steel shall conform to A.S.T.M. A615, Grade 40. All reinforcing bar dimensions on the detailed drawings are to centers of bars unless otherwise noted. Clear distance between reinforcing steel and face of concrete shall be as noted on the plans. All bar laps shall be 30 diameters of the smaller diameter bar unless otherwise noted.

STEEL NOTES:
 Structural steel shall conform to A.S.T.M. Specification A36, except as noted. All field connections shall be made with high strength bolts. High strength bolts shall be 1" diameter unless otherwise noted and shall conform to A.S.T.M. Specification A 325.




BENCH MARK:
 A-16 Copperweld rod N.W. of R.R. Bridge on Douglasdale Road Elev. 213.60

⊙ Boring, denotes 2 1/4" Cased hole

INDEX

| Sheet | Description |
|-------|--|
| 1 | GENERAL PLAN AND ELEVATION |
| 2 | WEST ABUTMENT |
| 3 | EAST ABUTMENT |
| 4 | PIERS 1, 2 AND 3 |
| 5 | PIERS 4 AND 5 |
| 6 | FRAMING PLAN |
| 7 | DECK PLAN |
| 8 | FRAMING DETAILS |
| 9 | JOINT DETAILS |
| 10 | APPROACH SLAB AND SLOPE PROTECTION DETAILS |
| 11 | BORING LOGS |
| 12 | STANDARD SHOE DETAILS |
| 13 | STANDARD ALUMINUM RAILING DETAILS |
| 14 | STANDARD ELECTRICAL DETAILS |
| 15 | STANDARD ARCHITECTURAL DETAILS |
| 16 | STANDARD UTILITY SUPPORT DETAILS AT BR. ABUTS. |
| 17 | STANDARD CONDUIT INSTALLATION DETAILS |

Note: The 36" Water Main location is approximate. Before beginning construction contractor must locate this main.

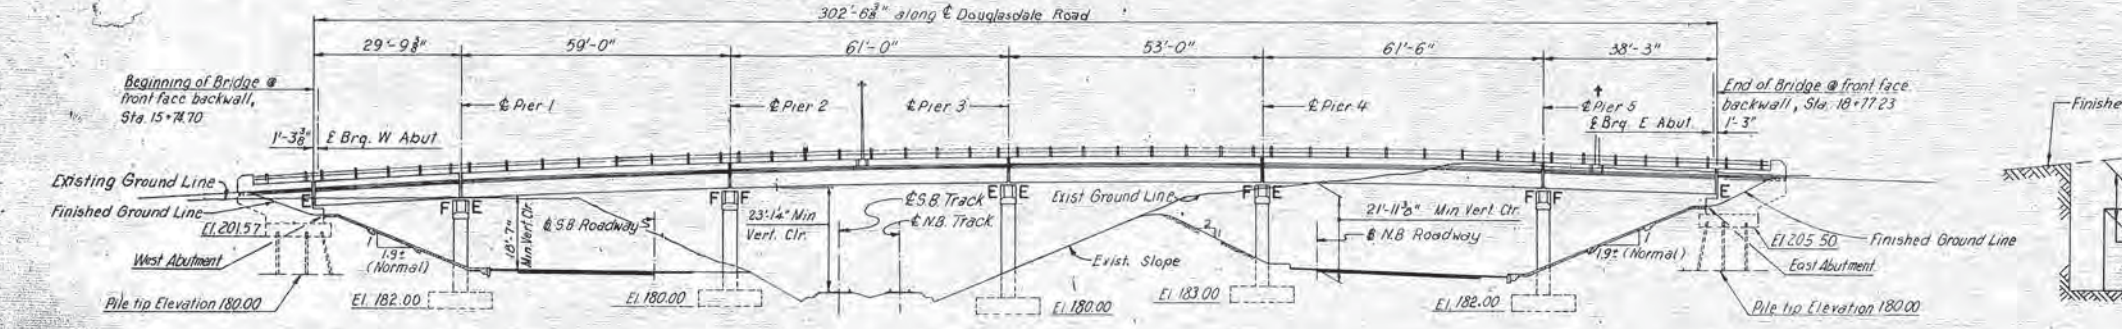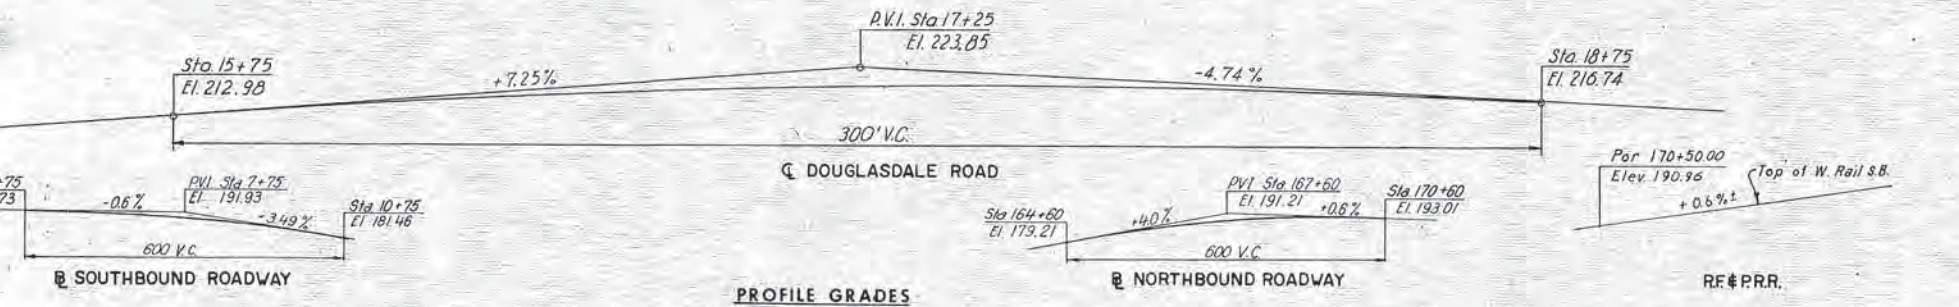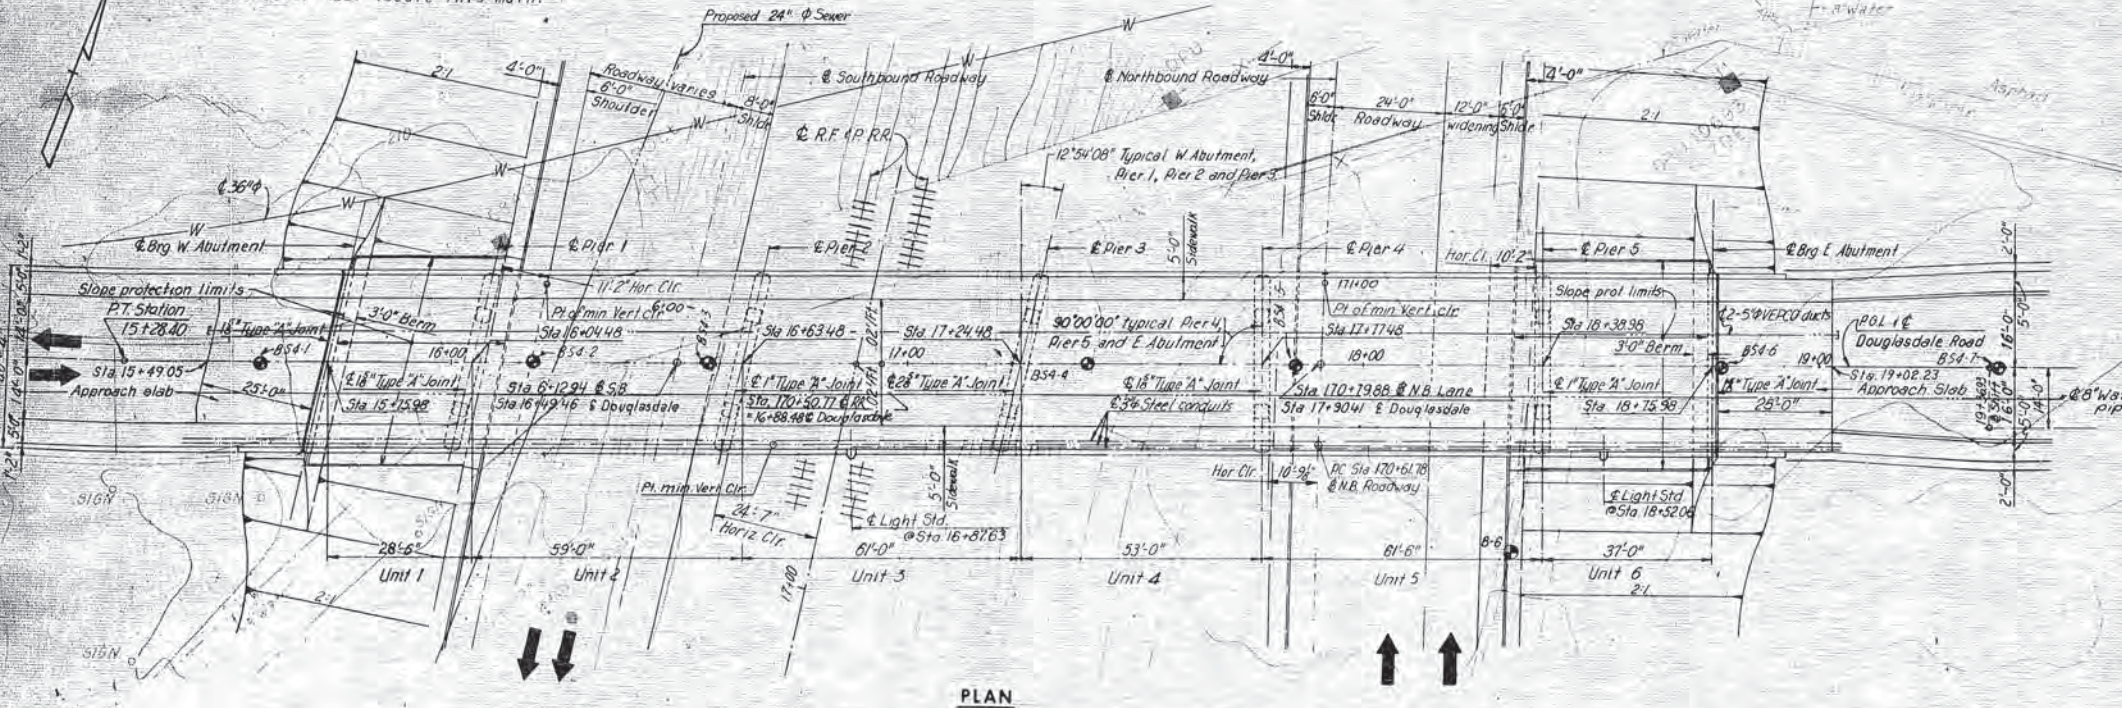

CURVE DATA
 @ Northbound Roadway
 P.I. = Sta. 173+60.82
 Δ = 17°47'52"
 D = 3°00'00"
 T/A = 299.04'
 L = 593.26'
 R = 1,909.86'

Note: Pile Tip Elevations shown estimated.

(a) Class A3, unless noted
 (b) Class A4
 * Frame and Cover only.

ELEVATION

| | Struct. Excav. Cu. Yds. | Concrete (a) Cu. Yds. | Reinf. Steel lbs. | Str. Stl. Mild Corbor. lbs. | Aluminum Railing (2-rails) Lin. Ft. | Porous Backfill Cu. Yds. | Unde-drain Dia. Pipe Lin. Ft. | Steel Piles 100P42 Lin. Ft. | Con. Slab St. Prot. Sq. Yds. | Asphalt amp-proofing Sq. Yds. | Approach Slab Conc. (a) Cu. Yds. | Metal Conduit Lin. Ft. | Conduit 5" Dia VEP-0 Lin. Ft. | Water Main 8" Dia Lin. Ft. | *Junction Box Lbs. |
|----------------|-------------------------|-----------------------|-------------------|-----------------------------|-------------------------------------|--------------------------|-------------------------------|-----------------------------|------------------------------|-------------------------------|----------------------------------|------------------------|-------------------------------|----------------------------|--------------------|
| Superstructure | | 464.8(b) | 87,170 | 333,000 | 650 | | | | | | | 7,914 | 704 | 358 | 360 |
| West Abutment | 130 | 80.0 | 13,500 | | | 5.2 | 50 | 307 | 193.3 | 27 | 40.4 | | | | |
| Pier 1 | 185 | 65.1 | 10,220 | | | | | | | | | | | | |
| Pier 2 | 119 | 67.5 | 11,120 | | | | | | | | | | | | |
| Pier 3 | 204 | 67.9 | 11,400 | | | | | | | | | | | | |
| Pier 4 | 171 | 66.4 | 10,740 | | | | | | | | | | | | |
| Pier 5 | 156 | 66.6 | 10,690 | | | | | | | | | | | | |
| East Abutment | 126 | 77.5 | 13,100 | | | 4.8 | 49 | 358 | 239.7 | 25 | 39.4 | | | | |
| TOTAL | 1091 | 464.8(b) 491.0 | 167,940 | 333,000 | 650 | 10 | 99 | 665 | 433 | 52 | 79.8 | 7,914 | 704 | 358 | 360 |

ESTIMATED QUANTITIES

LIMITS OF EXCAVATION









| MADE | BY | DATE | REVISION | DESCRIPTION | P.S. | DATE |
|-----------|-----|--------|----------|-------------------|--------|--------|
| | JV | 3-4-68 | 2 | General | J.G.V. | 10-70 |
| CHECKED | MAA | 3-6-68 | 1 | General Revisions | RLM | 5-7-68 |
| IN CHARGE | FKD | | | | | |

RICHMOND METROPOLITAN AUTHORITY
RICHMOND EXPRESSWAY SYSTEM
 BELTLINE EXPRESSWAY
 BRIDGE NO. 13
 DOUGLASDALE ROAD OVER
 BELTLINE EXPRESSWAY AND R.F.&P.R.R.
GENERAL PLAN AND ELEVATION

HOWARD, NEEDLES, TAMMEN & BERGENDOFF
 consulting engineers
 NEW YORK ALEXANDRIA KANSAS CITY

SCALE: 1"=50'
 CONTRACT NO. 4
 SHEET NO. 1 OF 12

| RICHMOND EXPRESSWAY SYSTEM | | | |
|----------------------------|---------------------|-----------|--------------|
| SECTION | PROJECT | SHEET NO. | TOTAL SHEETS |
| 4 | BELTLINE EXPRESSWAY | 121 | 155 |

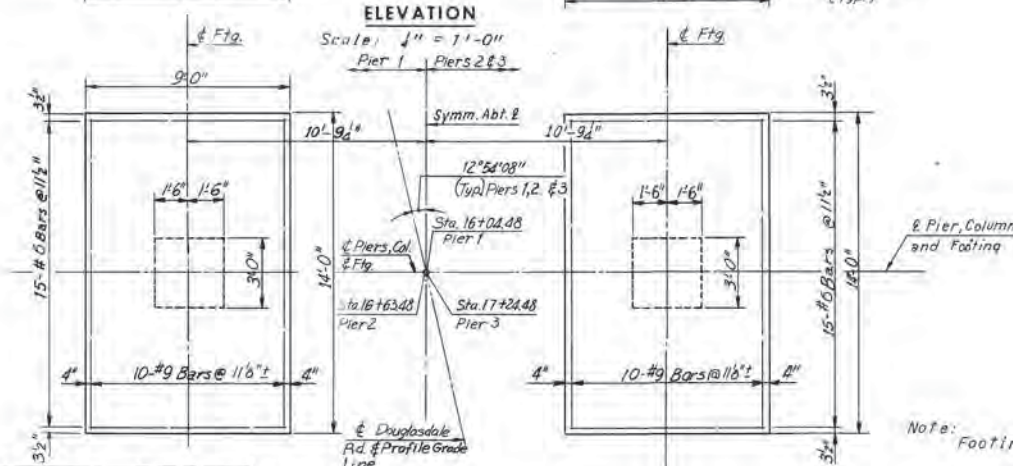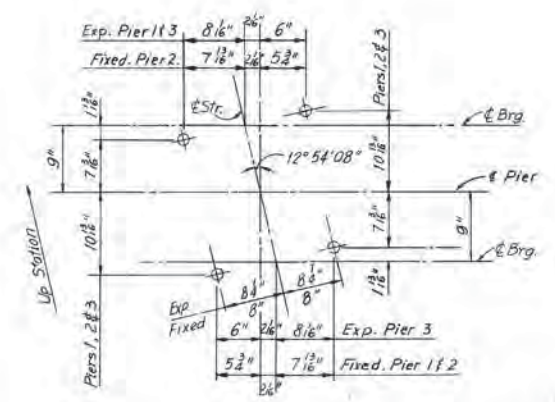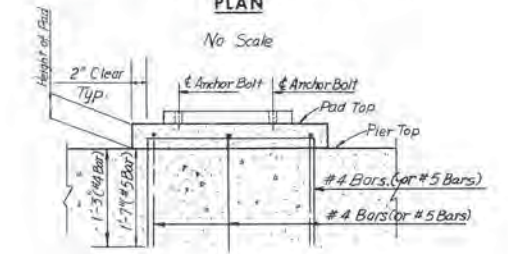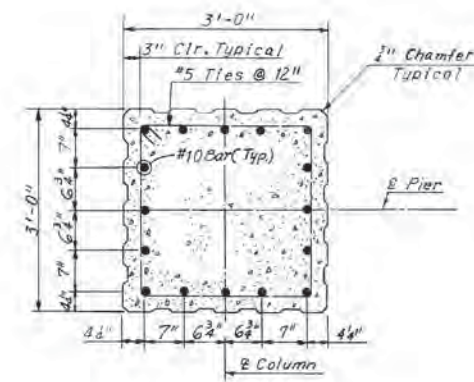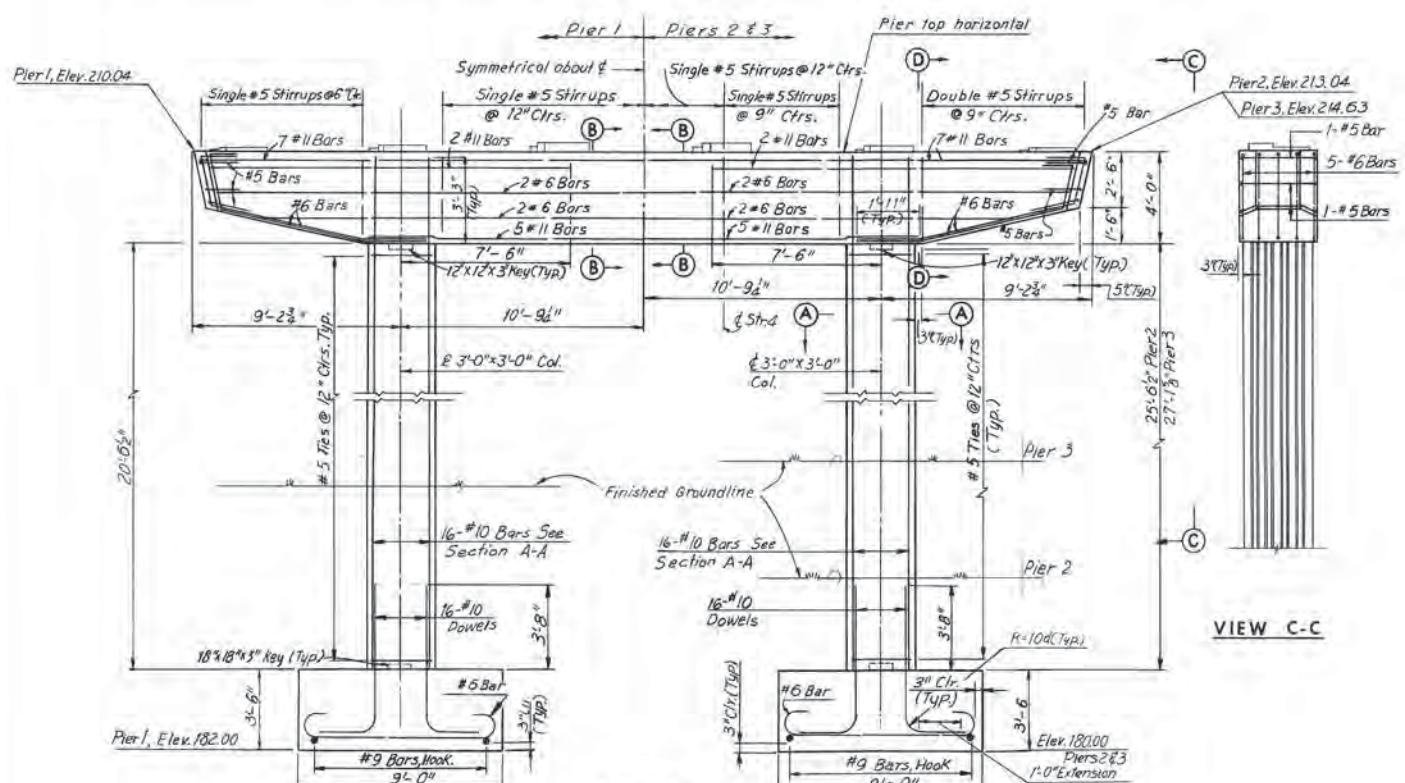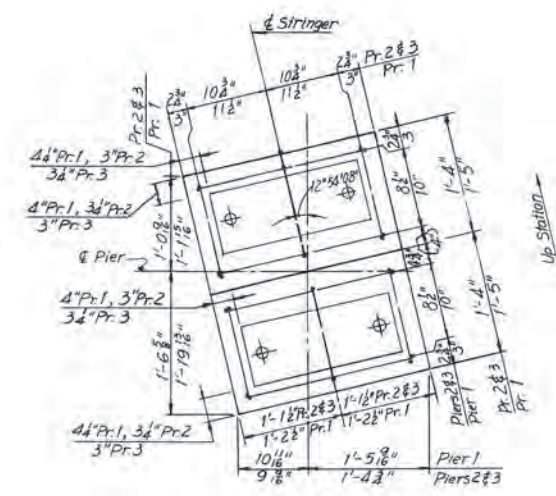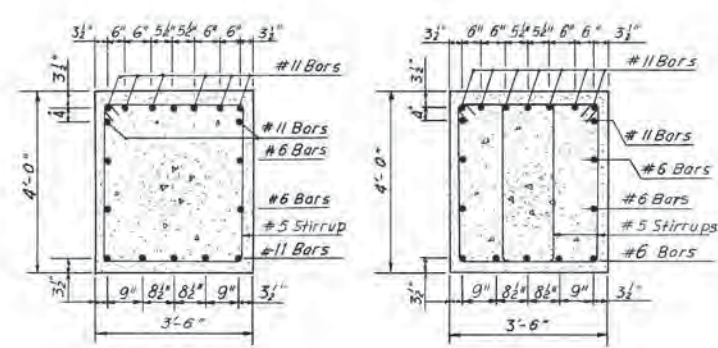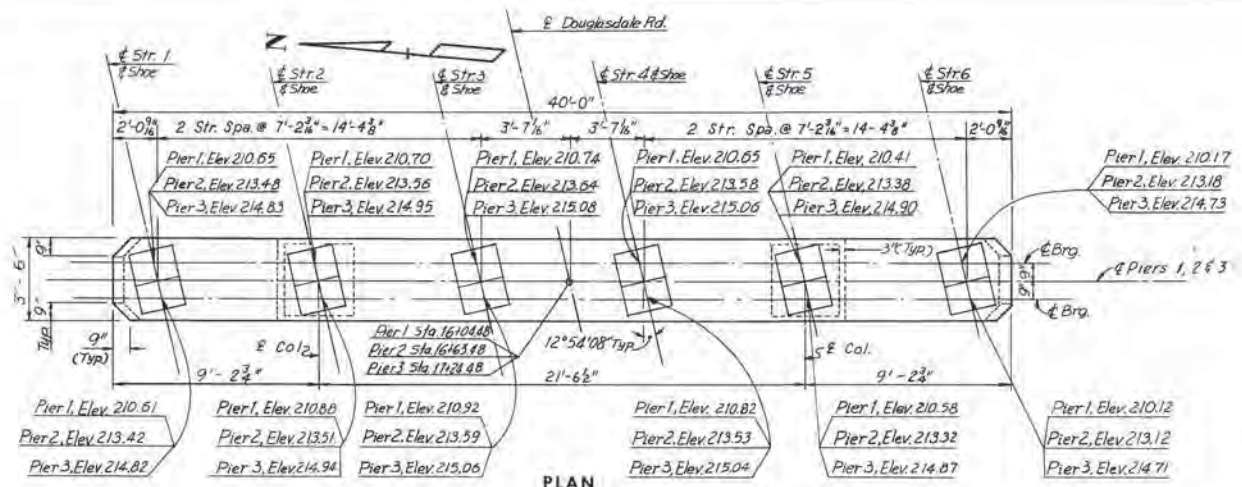

Note:
Pads with heights of 4" or less shall not be reinforced.
Pads with heights between 4" and 6" use #4 bar.
Pads with heights between 6" and 12" use #5 bar.

Note:
For shoe details see Sheet 51.
For Framing Plan see Sheet 5.

Note: Footing elevations are exact.


| BY | DATE | NO. | REVISION | BY | DATE |
|-----------|----------------|-----|---------------|------|--------|
| MADE | M.A.A. 9-29-67 | 2 | As Built | R.H. | 2-2-73 |
| CHECKED | 33W 3-6-69 | 1 | Profile Grade | P.S. | 4-7-71 |
| IN CHARGE | FKD | | | | |

AS BUILT


RICHMOND METROPOLITAN AUTHORITY
RICHMOND EXPRESSWAY SYSTEM
BELTLINE EXPRESSWAY
BRIDGE NO 13
DOUGLASDALE ROAD OVER
BELTLINE EXPRESSWAY AND R.F.&P.R.R.
PIERS 1, 2 AND 3

| | |
|---|--|
| HOWARD, NEEDLES, TAMMEN & BERGENDOFF consulting engineers NEW YORK ALEXANDRIA KANSAS CITY | SCALE: As Noted CONTRACT NO: 4 SHEET NO: 4 OF 12 |
|---|--|


| RICHMOND EXPRESSWAY SYSTEM | | | |
|----------------------------|---------------------|-----------|--------------|
| SECTION | PROJECT | SHEET NO. | TOTAL SHEETS |
| 4 | BELTLINE EXPRESSWAY | 122 | 155 |

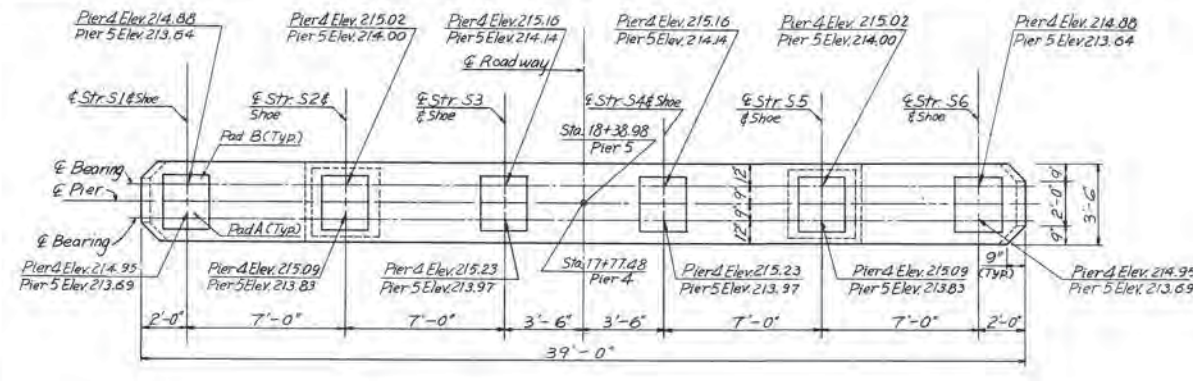


PLAN
Scale: 1/4" = 1'-0"

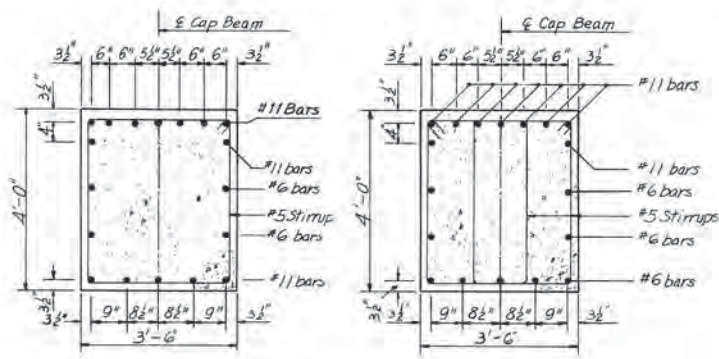


SECTION B-B Scale: 1/4" = 1'-0"
SECTION D-D Scale: 1/4" = 1'-0"

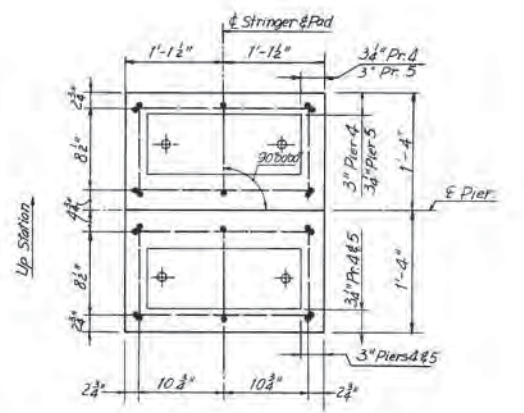


PLAN
No Scale

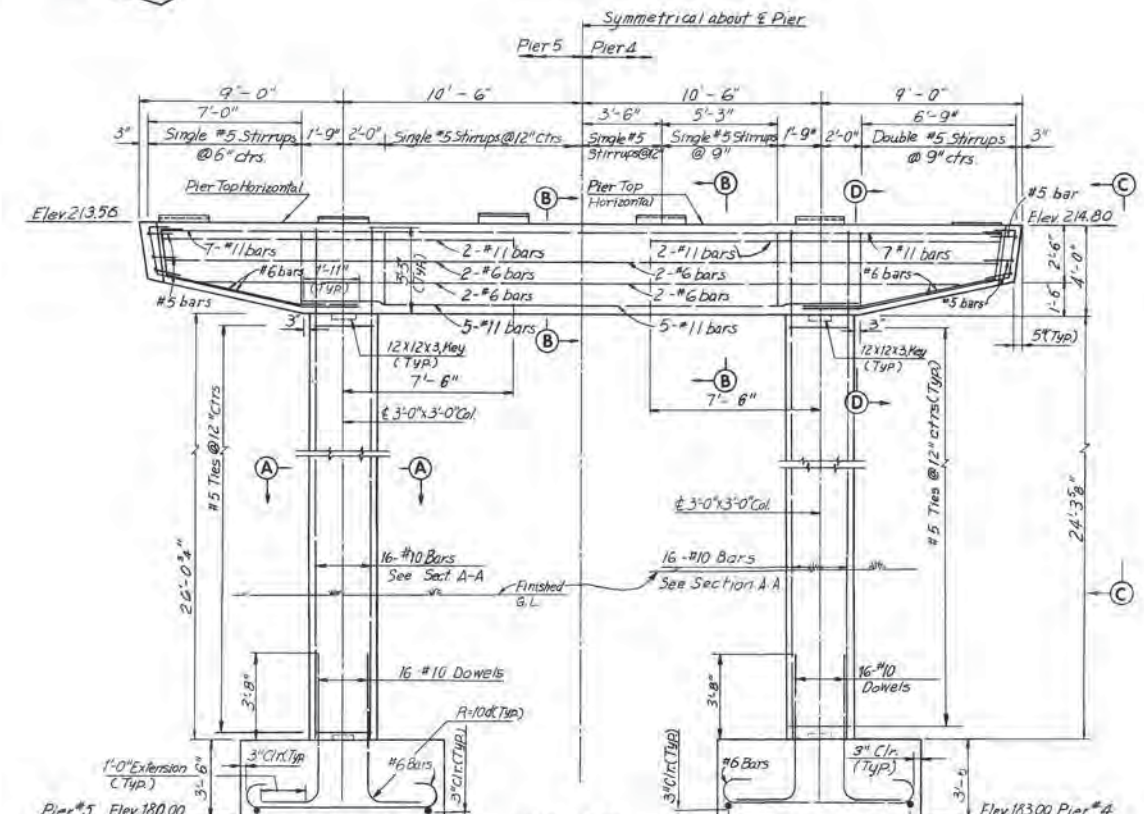

ELEVATION
Scale: 1/4" = 1'-0"

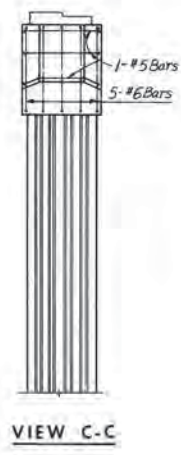


VIEW C-C

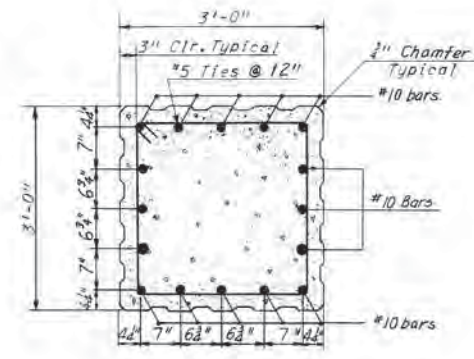


SECTION A-A
Scale: 1/4" = 1'-0"


Note: pads with heights of 4" or less shall not be reinforced.
Pads with heights between 4" and 8" use #4 bar.

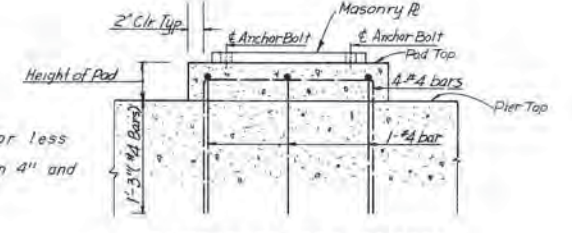

REINFORCED PAD DETAILS
No Scale

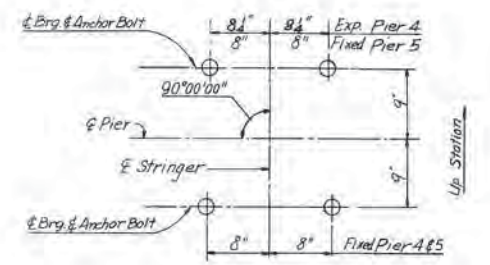

ANCHOR BOLT SETTING PLAN
No Scale

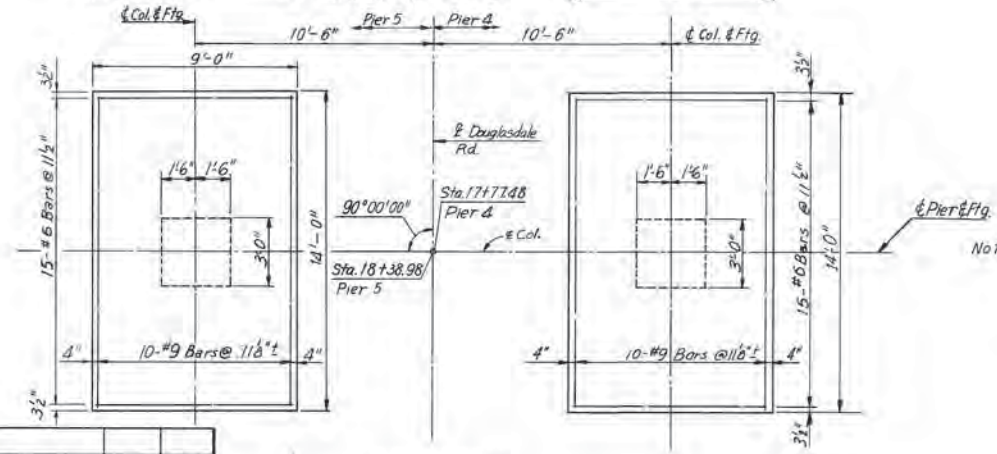

FOOTING PLAN
Scale: 1/4" = 1'-0"

Note: Footing elevations are exact.

AS BUILT


Notes:
For shoe details see Sheet S1.
For Framing Plan see Sheet 6.

| NO. | REVISION | BY | DATE |
|-----|---------------|------|--------|
| 2 | As Built | R.H. | 2-2-73 |
| 1 | Profile Grade | P.S. | 4-7-71 |

RICHMOND METROPOLITAN AUTHORITY
RICHMOND EXPRESSWAY SYSTEM
BELTLINE EXPRESSWAY
BRIDGE NO 13
DOUGLASDALE ROAD OVER
BELTLINE EXPRESSWAY AND R.F.&P.R.
PIERS 4 AND 5

HOWARD, NEEDLES, TAMMEN & BERGENDOFF
consulting engineers
NEW YORK ALEXANDRIA KANSAS CITY


SCALE: As Noted
CONTRACT NO: 4
SHEET NO: 5 OF 12

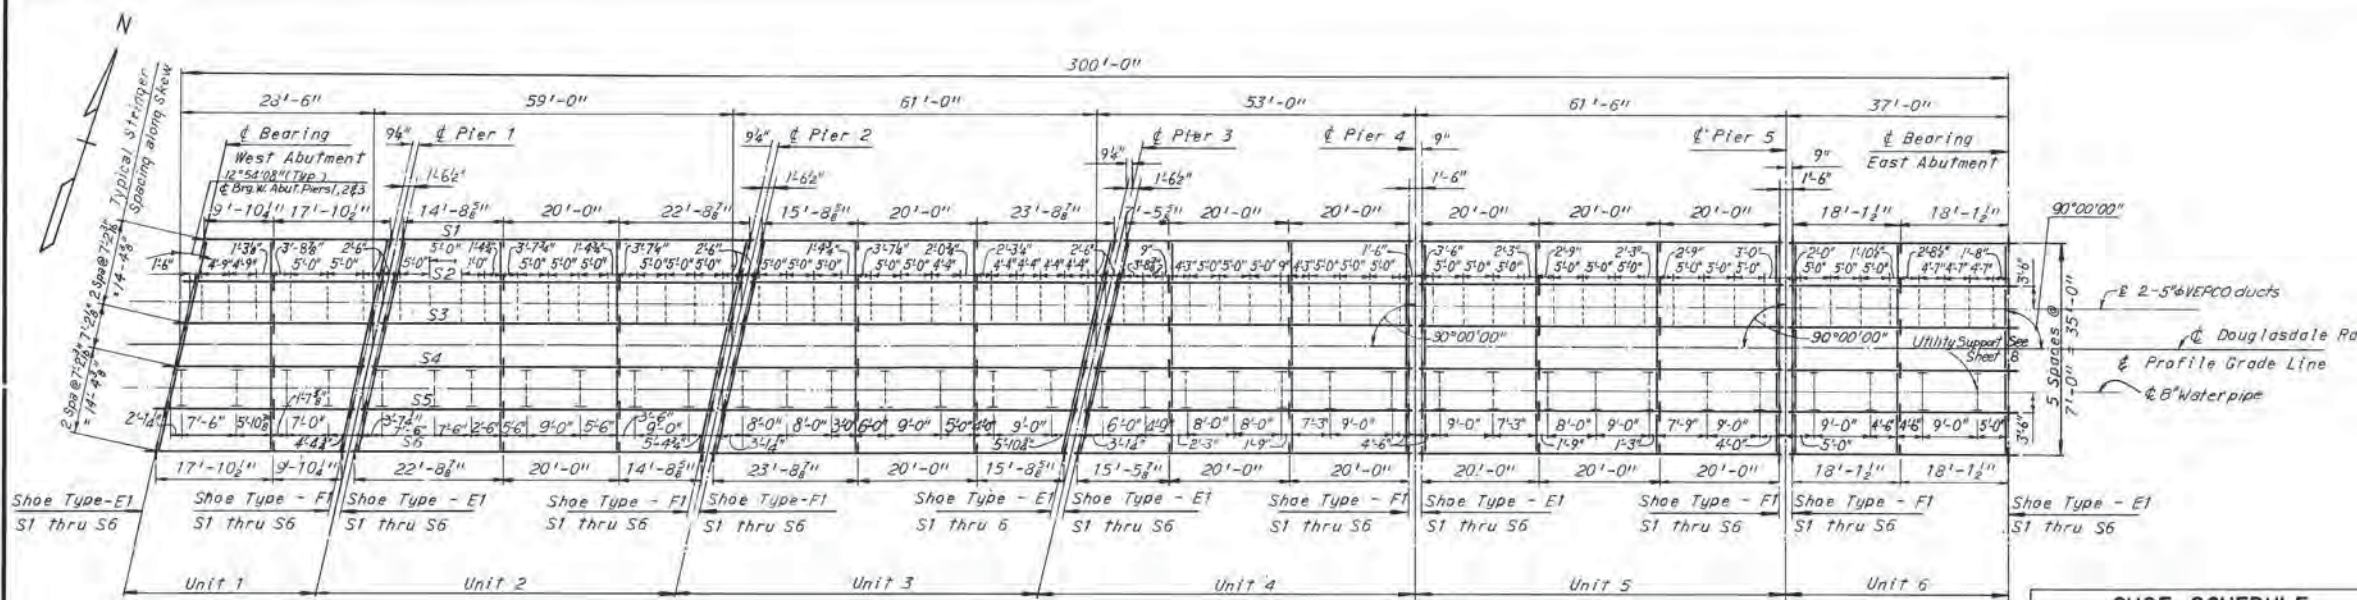

FRAMING PLAN
Scale: 1" = 15'-0"


Notes:
 For Superstructure Quantities see Sheet 1.
 For Framing details see Sheets 7 and 8.
 For details of utility supports see Sheet 8.
 For Joint Details see Sheet 9.
 For standard details of 5" VEPACO ducts see Sheet S11.
 For dimensions, and location of pipe sleeve for 8" Water pipe thru backwall, see Abutment Plans Sheets 2 and 3.
 For additional details of 8" Water Pipe see Sheet S10

| SHOE SCHEDULE | | | |
|-----------------|-----------|-------------|-----------|
| EXPANSION SHOES | | FIXED SHOES | |
| TYPE | NO. REQD. | TYPE | NO. REQD. |
| E1 | 36 | F1 | 36 |

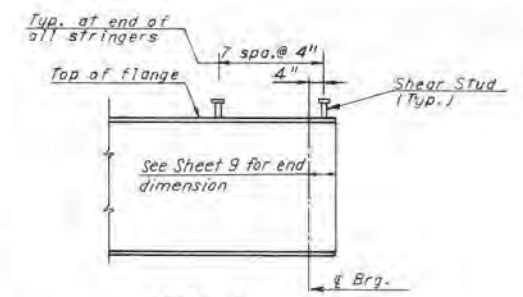

DETAIL A
No Scale


SHEAR STUD NOTE
 Capacity: 3,400 lbs. per stud.
 The contractor may, if he elects, use three 1/2" diameter studs at the same longitudinal spacing in lieu of the four 1/2" diameter studs shown.
 Stud rows shall be placed parallel to the main deck reinforcing.
 Shear stud spacing shown is maximum spacing.

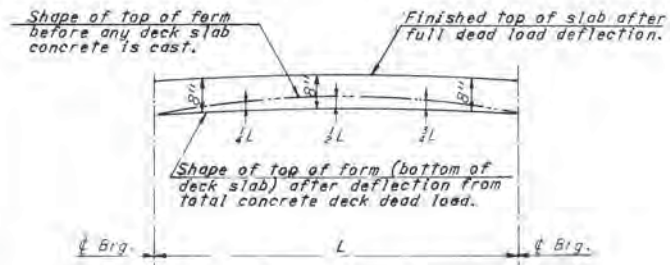


DEAD LOAD DEFLECTION DIAGRAM
No Scale



CAMBER DIAGRAM
No Scale

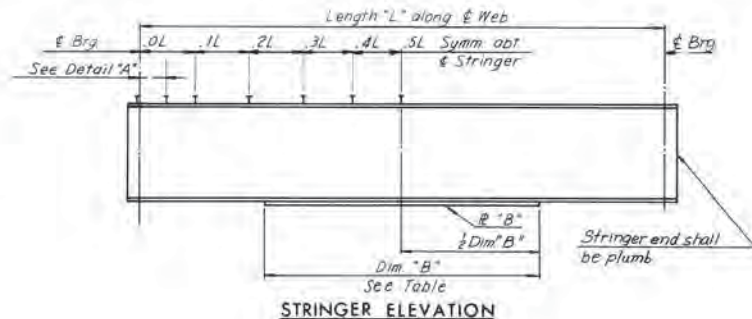

STRINGER ELEVATION

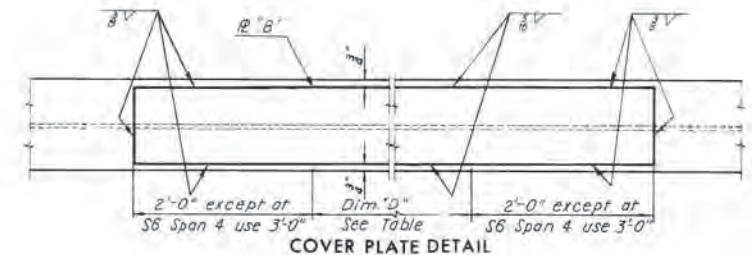


COVER PLATE DETAIL

*...Spacing begins at the termination of 7spacos at 4" ctrs.

| DEAD LOAD DEFLECTION SCHEDULE | | | | | | | | | | | | |
|-------------------------------|--------|------|--------|------|--------|------|--------|------|--------|------|--------|------|
| STRINGER | UNIT 1 | | UNIT 2 | | UNIT 3 | | UNIT 4 | | UNIT 5 | | UNIT 6 | |
| | 1/4L | 1/2L | 1/4L | 1/2L | 1/4L | 1/2L | 1/4L | 1/2L | 1/4L | 1/2L | 1/4L | 1/2L |
| S1 | 1/8" | 1/4" | 5/16" | 1/4" | 1/8" | 1/4" | 1/8" | 1/4" | 1/8" | 1/4" | 1/8" | 1/4" |
| S2 | 1/8" | 1/4" | 9/16" | 1/2" | 1/8" | 1/4" | 1/8" | 1/4" | 1/8" | 1/4" | 1/8" | 1/4" |
| S3 | 1/8" | 1/4" | 3/8" | 1/4" | 1/8" | 1/4" | 1/8" | 1/4" | 1/8" | 1/4" | 1/8" | 1/4" |
| S4 | 1/8" | 1/4" | 1/2" | 1/2" | 1/8" | 1/4" | 1/8" | 1/4" | 1/8" | 1/4" | 1/8" | 1/4" |
| S5 | 1/8" | 1/4" | 1/2" | 1/2" | 1/8" | 1/4" | 1/8" | 1/4" | 1/8" | 1/4" | 1/8" | 1/4" |
| S6 | 1/8" | 1/4" | 1/2" | 1/2" | 1/8" | 1/4" | 1/8" | 1/4" | 1/8" | 1/4" | 1/8" | 1/4" |

| UNIT | STRINGER | LENGTH "L" | STRINGER SIZE | R "B" | DIM. "B" | DIM. "D" | SHEAR STUD SPACING | | | | | CAMBER SCHEDULE | | |
|------|----------|------------|---------------|----------------|----------|----------|--------------------|---------|---------|---------|---------|-----------------|--------|--------|
| | | | | | | | .0L-.1L * | .1L-.2L | .2L-.3L | .3L-.4L | .4L-.5L | 1/4L | 1/2L | 3/4L |
| 1 | S1 & S6 | 27'-8 1/2" | 36 WF 135 | — | — | — | 9 1/2" | 11" | 13 1/2" | 16 1/2" | 22" | 2 1/8" | 2 1/8" | 7 1/8" |
| | S2 & S5 | 27'-8 1/2" | 33 WF 118 | — | — | — | 9 1/2" | 11" | 13 1/2" | 16 1/2" | 22" | 2 1/8" | 2 1/8" | 7 1/8" |
| | S3 & S4 | 27'-8 1/2" | 33 WF 118 | — | — | — | 9 1/2" | 11" | 13 1/2" | 16 1/2" | 22" | 2 1/8" | 2 1/8" | 7 1/8" |
| 2 | S1 & S6 | 57'-5 1/2" | 36 WF 135 | 10 1/2 x 2 1/2 | 43'-2" | 39'-2" | 8" | 9 1/2" | 11 1/2" | 14" | 18 1/2" | 2 3/8" | 3 1/8" | 2 3/8" |
| | S2 & S5 | 57'-5 1/2" | 36 WF 135 | 10 1/2 x 2 1/2 | 43'-2" | 39'-2" | 8" | 9 1/2" | 11 1/2" | 14" | 18 1/2" | 2 3/8" | 3 1/8" | 2 3/8" |
| | S3 & S4 | 57'-5 1/2" | 36 WF 135 | 10 1/2 x 2 1/2 | 43'-2" | 39'-2" | 8" | 9 1/2" | 11 1/2" | 14" | 18 1/2" | 2 3/8" | 3 1/8" | 2 3/8" |
| 3 | S1 & S6 | 59'-5 1/2" | 36 WF 135 | 10 1/2 x 2 1/2 | 44'-8" | 40'-8" | 8" | 9 1/2" | 11 1/2" | 14" | 18 1/2" | 2 3/8" | 3 1/8" | 2 3/8" |
| | S2 & S5 | 59'-5 1/2" | 36 WF 135 | 10 1/2 x 2 1/2 | 44'-8" | 40'-8" | 8" | 9 1/2" | 11 1/2" | 14" | 18 1/2" | 2 3/8" | 3 1/8" | 2 3/8" |
| | S3 & S4 | 59'-5 1/2" | 36 WF 135 | 10 1/2 x 2 1/2 | 44'-8" | 40'-8" | 8" | 9 1/2" | 11 1/2" | 14" | 18 1/2" | 2 3/8" | 3 1/8" | 2 3/8" |
| 4 | S1 | 47'-5 1/2" | 36 WF 135 | 10 1/2 x 2 1/2 | 35'-8" | 31'-8" | 8" | 9" | 11" | 14" | 18 1/2" | 1 1/2" | 1 1/2" | 1 1/2" |
| | S2 | 49'-0 1/2" | 36 WF 135 | 10 1/2 x 2 1/2 | 36'-10" | 32'-10" | 8" | 9" | 11" | 14" | 18 1/2" | 1 1/2" | 1 1/2" | 1 1/2" |
| | S3 | 50'-8 1/2" | 36 WF 135 | 10 1/2 x 2 1/2 | 38'-1" | 34'-1" | 8" | 9" | 11" | 14" | 18 1/2" | 1 1/2" | 1 1/2" | 1 1/2" |
| 5 | S1 & S6 | 60'-0" | 36 WF 135 | 10 1/2 x 2 1/2 | 45'-0" | 41'-0" | 8" | 9 1/2" | 11 1/2" | 14" | 18 1/2" | 2 3/8" | 3 1/8" | 2 3/8" |
| | S2 & S5 | 60'-0" | 36 WF 135 | 10 1/2 x 2 1/2 | 45'-0" | 41'-0" | 8" | 9 1/2" | 11 1/2" | 14" | 18 1/2" | 2 3/8" | 3 1/8" | 2 3/8" |
| | S3 & S4 | 60'-0" | 36 WF 135 | 10 1/2 x 2 1/2 | 45'-0" | 41'-0" | 8" | 9 1/2" | 11 1/2" | 14" | 18 1/2" | 2 3/8" | 3 1/8" | 2 3/8" |
| 6 | S1 & S6 | 36'-3" | 36 WF 135 | — | — | — | 9 1/2" | 11" | 13 1/2" | 16 1/2" | 22" | 2 1/8" | 2 1/8" | 7 1/8" |
| | S2 & S5 | 36'-3" | 33 WF 118 | — | — | — | 9 1/2" | 11" | 13 1/2" | 16 1/2" | 22" | 2 1/8" | 2 1/8" | 7 1/8" |
| | S3 & S4 | 36'-3" | 33 WF 118 | — | — | — | 9 1/2" | 11" | 13 1/2" | 16 1/2" | 22" | 2 1/8" | 2 1/8" | 7 1/8" |

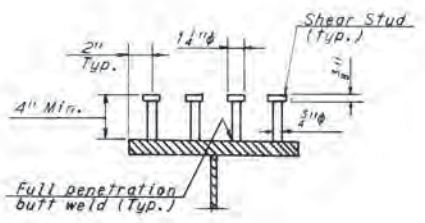

SHEAR STUD DETAIL
No Scale

AS BUILT

RICHMOND METROPOLITAN AUTHORITY
 RICHMOND EXPRESSWAY SYSTEM
 BELTLINE EXPRESSWAY
 BRIDGE NO 13
 DOUGLASDALE ROAD OVER
 BELTLINE EXPRESSWAY AND R.F.&P.R.R.
FRAMING PLAN


HOWARD, NEEDLES, TAMMEN & BERGENDOFF
 consulting engineers
 NEW YORK ALEXANDRIA KANSAS CITY

SCALE: As Noted
 CONTRACT NO.: 4
 SHEET NO.: 6 OF 12

| BY | DATE | NO. | REVISION | BY | DATE |
|----|-------------------|------|----------|----|------|
| 4 | As Built | RH | 2-2-73 | | |
| 3 | Profile Grade | P.S. | 4-7-71 | | |
| 2 | General | | 10-70 | | |
| 1 | General Revisions | M.H. | 3-12-68 | | |

Note: Stringers having a total camber of less than 1" are not required to be shap cambered, but should be turned so that any mill tolerance deviation from straightness will be in the direction shown by the Camber diagram.
 If stringers are not cambered distance top of stringers to top of slab will vary along the stringer in accordance with the offset dimensions shown in the Camber diagram, and with a minimum distance as shown in cross-section on Sheet 7.


| RICHMOND EXPRESSWAY SYSTEM | | | |
|----------------------------|---------------------|-----------|--------------|
| SECTION | PROJECT | SHEET NO. | TOTAL SHEETS |
| 4 | BELTLINE EXPRESSWAY | 124 | 155 |

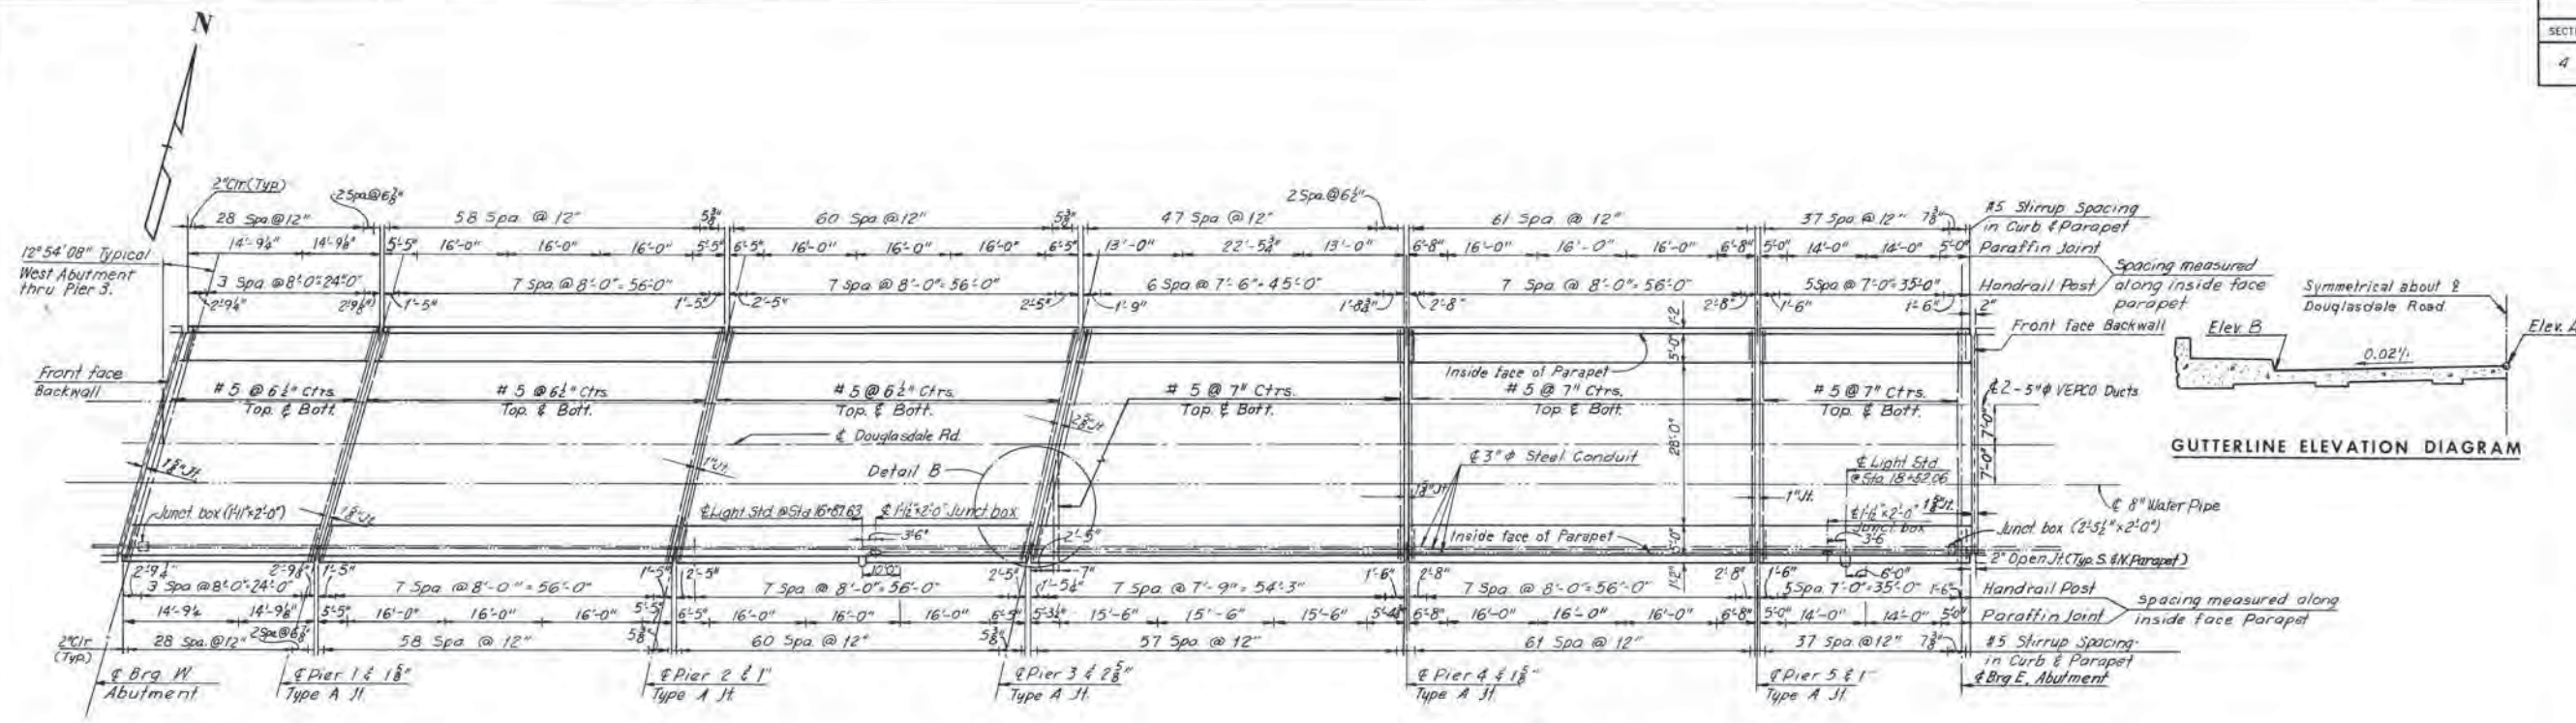


DECK PLAN
Scale: 1/8" = 1'-0"

Note: For reinforcing steel at joints see Sheet 9 joint details.


| TABLE OF ELEVATIONS | | |
|---------------------|---------|---------|
| STATION | ELEV. A | ELEV. B |
| 15+50.00 | 211.17 | 210.89 |
| 60.00 | 211.89 | 211.61 |
| 70.00 | 212.62 | 212.34 |
| 71.49 | — | 212.45 |
| 74.70 | 212.96 | — |
| 77.91 | — | 212.92 |
| 80.00 | 213.34 | 213.06 |
| 90.00 | 214.03 | 213.75 |
| 16+00.00 | 214.67 | 214.39 |
| 01.28 | — | 214.47 |
| 04.48 | 214.95 | — |
| 07.69 | — | 214.86 |
| 10.00 | 215.28 | 215.00 |
| 20.00 | 215.84 | 215.56 |
| 30.00 | 216.37 | 216.09 |
| 40.00 | 216.85 | 216.57 |
| 50.00 | 217.30 | 217.02 |
| 60.00 | 217.70 | 217.42 |
| 60.28 | — | 217.43 |
| 63.48 | 217.83 | — |
| 66.69 | — | 217.67 |
| 70.00 | 218.07 | 217.79 |
| 80.00 | 218.40 | 218.12 |
| 90.00 | 218.68 | 218.40 |
| 17+00.00 | 218.93 | 218.65 |
| 10.00 | 219.13 | 218.85 |
| 20.00 | 219.30 | 219.02 |
| 21.28 | — | 219.03 |
| 24.48 | 219.36 | — |
| 27.69 | — | 219.12 |
| 30.00 | 219.42 | 219.14 |
| 40.00 | 219.51 | 219.23 |
| 50.00 | 219.55 | 219.27 |
| 60.00 | 219.56 | 219.28 |
| 70.00 | 219.52 | 219.24 |
| 77.48 | 219.47 | 219.19 |
| 80.00 | 219.45 | 219.17 |
| 90.00 | 219.33 | 219.05 |
| 18+00.00 | 219.18 | 218.90 |
| 10.00 | 218.99 | 218.71 |
| 20.00 | 218.75 | 218.47 |
| 30.00 | 218.48 | 218.20 |
| 38.98 | 218.20 | 217.92 |
| 40.00 | 218.16 | 217.88 |
| 50.00 | 217.81 | 217.53 |
| 60.00 | 217.42 | 217.14 |
| 70.00 | 216.97 | 216.69 |
| 77.23 | 216.63 | 216.35 |
| 80.00 | 216.50 | 216.22 |
| 90.00 | 216.03 | 215.75 |
| 19+00.00 | 215.55 | 215.27 |

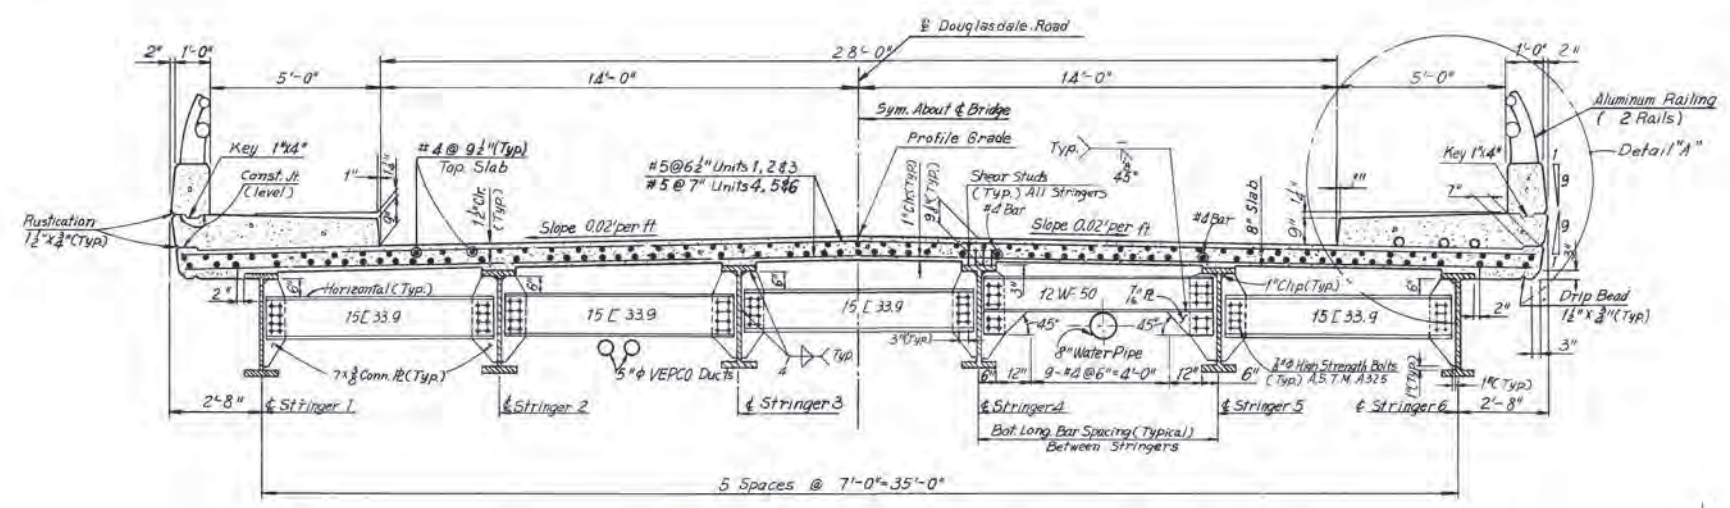

TYPICAL CROSS SECTION INTERMEDIATE DIAPHRAGM
Scale: 3/8" = 1'-0"

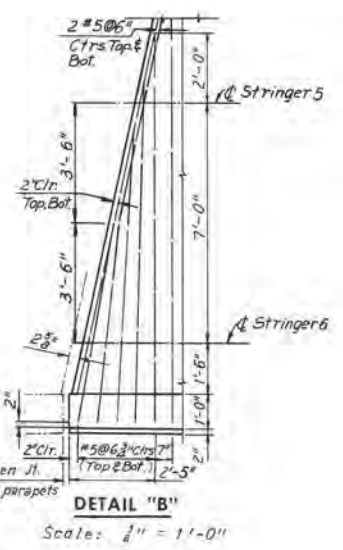

DETAIL "B"
Scale: 1/4" = 1'-0"

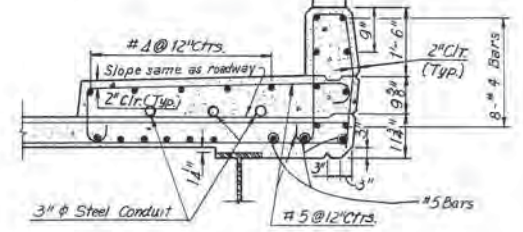

DETAIL "A"
Scale: 1/2" = 1'-0"

Notes:
For Superstructure Quantities see Sheet 1.
For Framing and Utility support details see Sheet 8.
For Joint details see Sheet 9.
For Lighting details see Sheet 5d.
For details of transmission ducts see Sheet 5f.




RICHMOND METROPOLITAN AUTHORITY
RICHMOND EXPRESSWAY SYSTEM
BELTLINE EXPRESSWAY
BRIDGE NO 13
DOUGLASDALE ROAD OVER
BELTLINE EXPRESSWAY AND R.F.&P.R.R.
DECK PLAN

| BY | DATE | NO. | REVISION | R.H. | DATE |
|-----|---------|-----|-------------------|--------|---------|
| AMH | 10-7-67 | 2 | Profile Grade | L.B.P. | 4-6-71 |
| SSN | 2-8-69 | 1 | General Revisions | MHH | 3-12-68 |
| FKD | | | | | |

ASSBUILT

HOWARD, NEEDLES, TAMMEN & BERGENDOFF
consulting engineers
NEW YORK ALEXANDRIA RALEIGH CITY
SCALE: As Noted
CONTRACT NO. 4
SHEET NO. 7 OF 12

| RICHMOND EXPRESSWAY SYSTEM | | | |
|----------------------------|---------------------|-----------|--------------|
| SECTION | PROJECT | SHEET NO. | TOTAL SHEETS |
| A | BELTLINE EXPRESSWAY | 1257 | 1 |

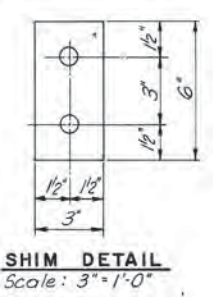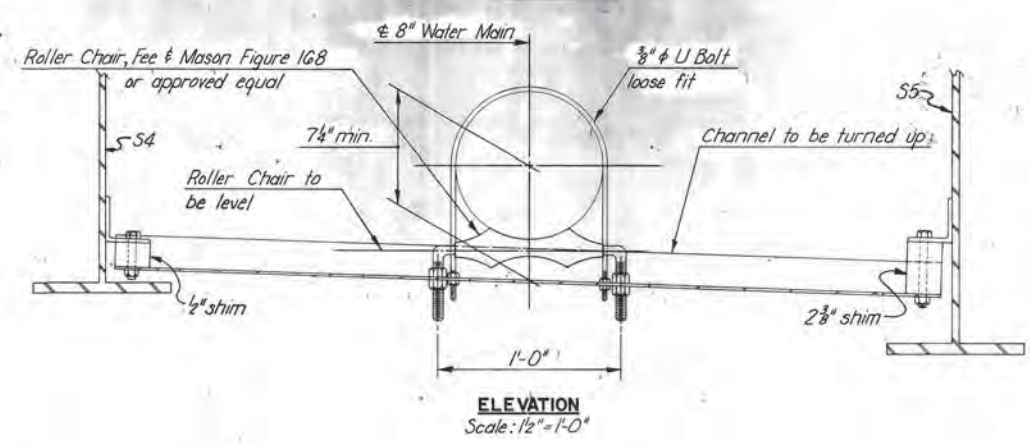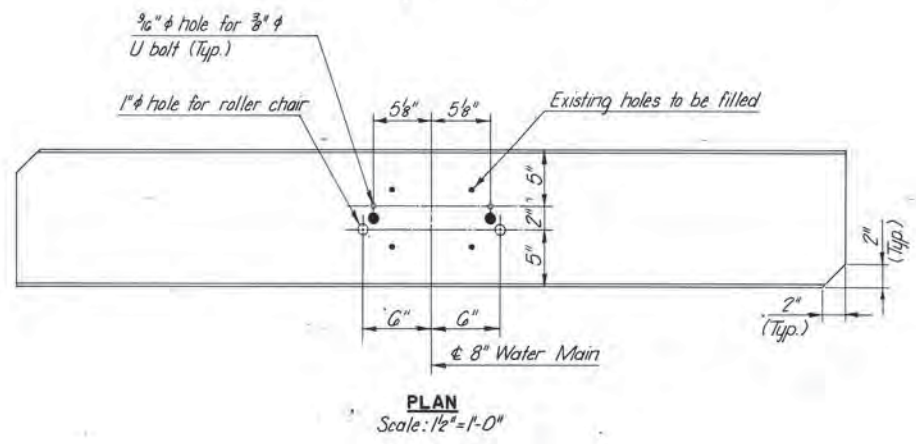


AS BUILT


| | |
|--|--------------------|
| RICHMOND METROPOLITAN AUTHORITY RICHMOND EXPRESSWAY SYSTEM | |
| BRIDGE NO. 13 DOUGLASDALE ROAD OVER BELTLINE EXPRESSWAY AND R.F. & P. R.R. WATER MAIN SUPPORT DIAPHRAGMS UNITS 1 & 6 | |
| SCALE: AS SHOWN | CONTRACT NO. 4 |
| HOWARD, NEEDLES, TAMMEN & BERGENDOFF General Consultants | SHEET NO. 8A OF 12 |

| MADE | BY | DATE | NO. | REVISION | BY | DATE |
|-----------|----|------|-----|----------|----|--------|
| CHECKED | | | 1 | As Built | RH | 2-5-73 |
| IN CHARGE | | | | | | |

| RICHMOND EXPRESSWAY SYSTEM | | | |
|----------------------------|---------------------|-----------|--------------|
| SECTION | PROJECT | SHEET NO. | TOTAL SHEETS |
| 4 | BELTLINE EXPRESSWAY | 125 | 155 |



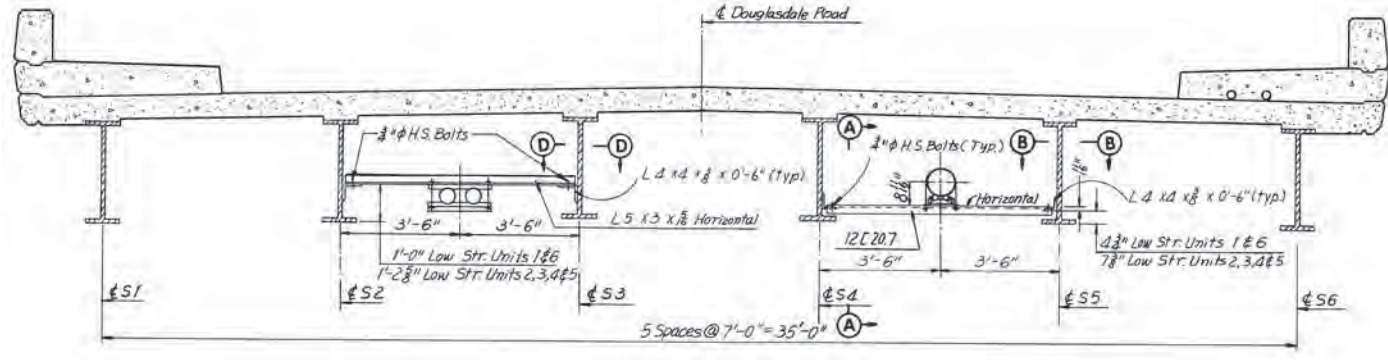


UTILITY SUPPORTS
TYPICAL SECTION BETWEEN DIAPHRAGMS
 Scale: 3/8" = 1'-0"

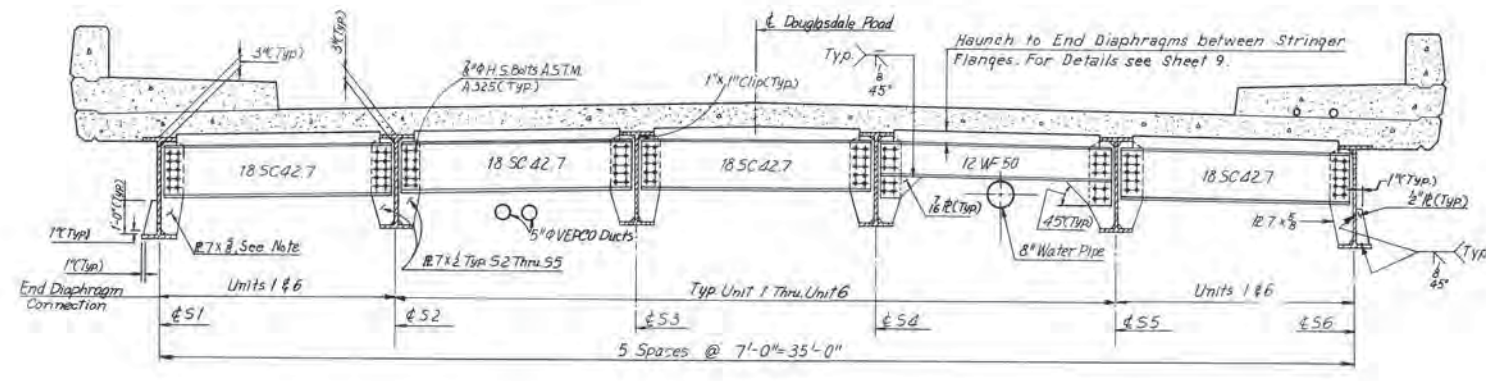


CROSS SECTION
END DIAPHRAGMS
 Scale: 3/8" = 1'-0" Note: For intermediate diaphragms see Sheet 7.


Note: End diaphragms and connections shown above are typical for all units with the following exceptions:
 7"x8" Bearing and connection plates on exterior stringers with 2 rows of 5 bolts as shown for Units 1 and 6, to be replaced by 10"x8" plate with 3 rows of 5 bolts for Units 2 through 5, see Detail A below.

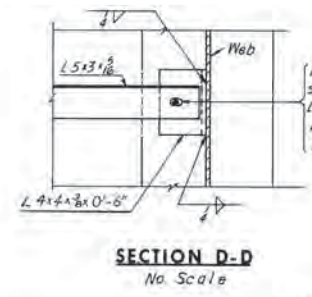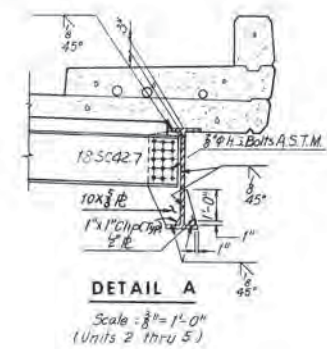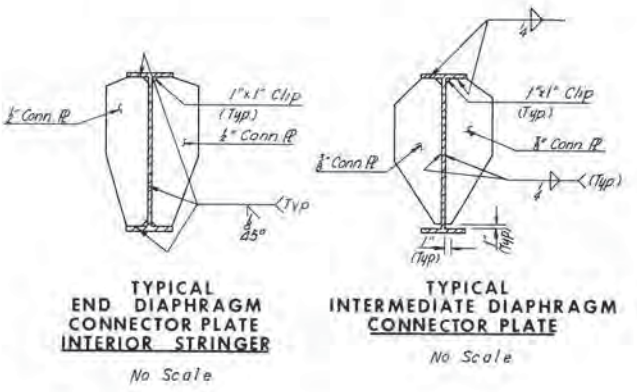


SECTION D-D
 No Scale

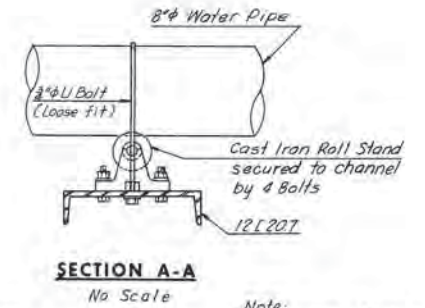

SECTION A-A
 No Scale

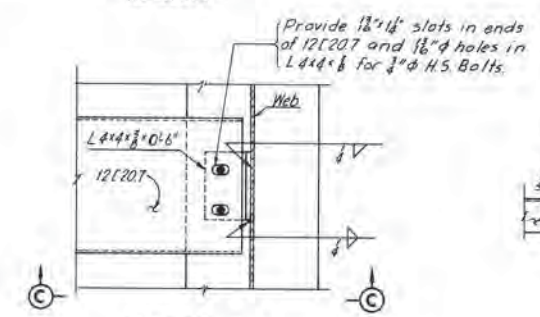


SECTION B-B
 No Scale

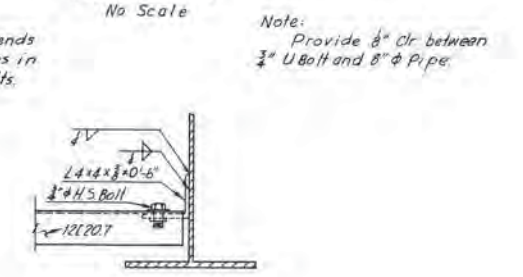

SECTION C-C
 No Scale

Note: For spacing of utility supports see Framing Plan Sheet 6.

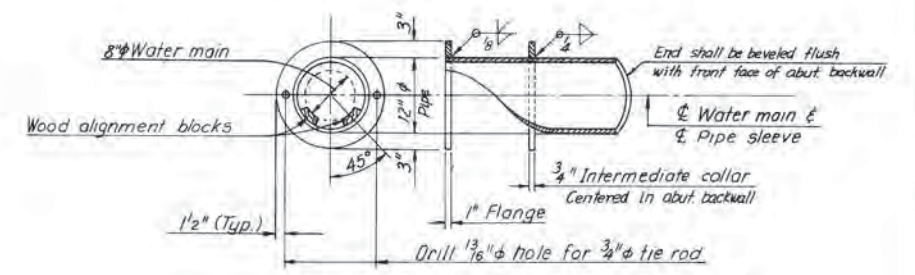

Note: Steel pipe sleeve to be hot-dip galvanized after fabrication in accordance with ASTM A123

PIPE SLEEVE DETAIL FOR WATER MAIN
 No Scale

Note: For location and additional sleeve dimensions of 8\"/>

RICHMOND METROPOLITAN AUTHORITY
RICHMOND EXPRESSWAY SYSTEM
 BELTLINE EXPRESSWAY
 BRIDGE NO 13
 DOUGLASDALE ROAD OVER
 BELTLINE EXPRESSWAY AND R.F.&P.R.
FRAMING DETAILS

AS BUILT


| BY | DATE | NO. | REVISION | BY | DATE |
|-----------|---------------|-----|-------------------|-------|---------|
| MADE | AMH 11-27-67 | 2 | As Built | RH | 2-5-73 |
| CHECKED | S.S.W 2-14-68 | 1 | General Revisions | M.H.H | 3-12-68 |
| IN CHARGE | FKD | NO. | | | |

| | |
|--------------------------------------|-------------------|
| SCALE: | As Noted |
| HOWARD, NEEDLES, TAMMEN & BERGENDOFF | CONTRACT NO. 4 |
| consulting engineers | |
| NEW YORK ALEXANDRIA KANSAS CITY | SHEET NO. 8 OF 12 |

Bridge 17

**(Ramp from NB Powhite Parkway over NB I-195
to Cary Street and to Floyd Ave.)**

Record Set Plans

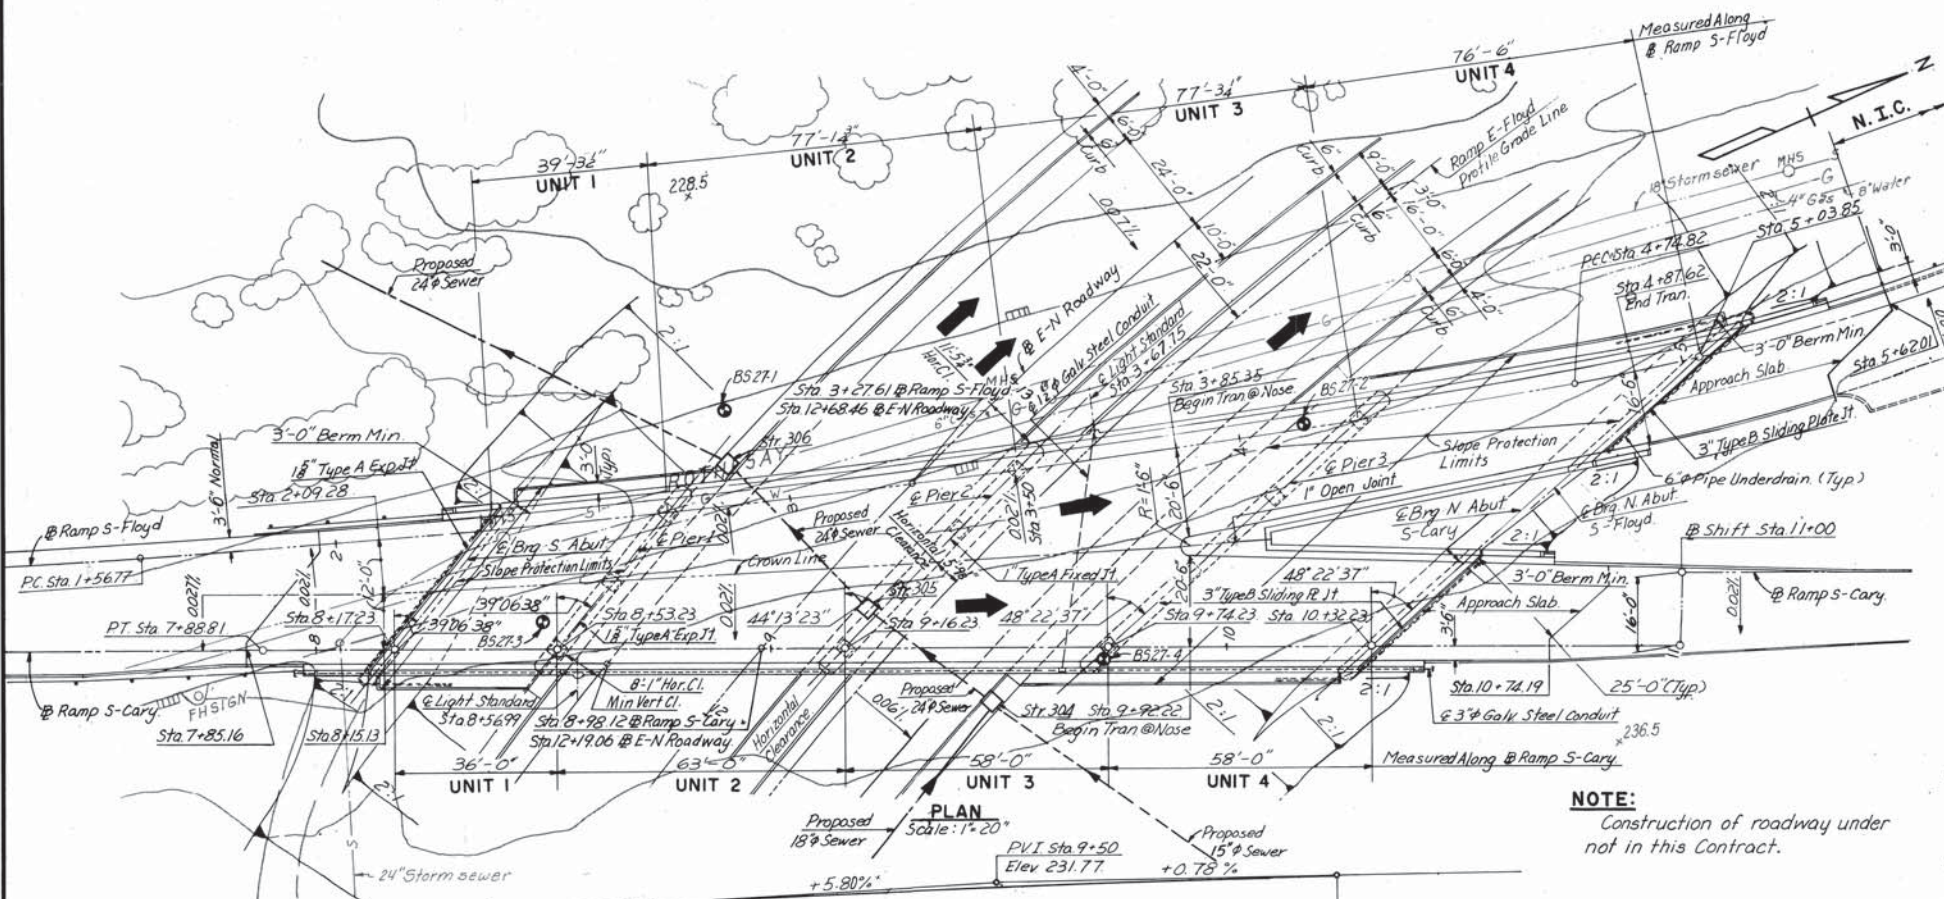

GENERAL NOTES

ROADWAY Variable width of roadway.

CAPACITY: Dead Load includes 15 lbs. per sq. ft. for future wearing surface.

SPECIFICATIONS:

GENERAL: Virginia Department of Highway Road and Bridge Specifications 1970.
DESIGN: A.A.S.H.O. Standard Specifications for Highway Bridges 1961, modified by Special Design provisions.
WELDING: 1969 Standard Specifications for Welded Highway and Railway Bridges of the American Welding Society.

CONTRACT SPECIAL PROVISIONS
 Specifications and Contract Special Provisions referred to above are necessary to make these plans complete.

DATUM: City of Richmond

TEMPERATURE: The normal temperature referred to on the plan is 68°F. The temperature range for movement is 0°F to 120°F.

DIMENSIONS: All dimensions are measured horizontally and vertically unless otherwise noted.

EXCAVATION: Excavation below subgrade and cut slope template shall be classified as Structure Excavation. All excavation above these limits shall be classified as Regular Excavation and is not included in the Structural Quantities.

FOUNDATIONS: Piles shall be driven to a minimum length corresponding to the approximate tip elevations shown on the Plans but in no case to less than a penetration affording the required safe bearing capacity noted on the Plans.

CONCRETE NOTES: Concrete in superstructure shall be Class A4. All other concrete shall be Class A3. All exposed edges and corners shall have a 3/8" chamfer or fillet unless otherwise noted. Care in the method of vibration, the use of low-slump concrete, and or other means shall be employed to prevent downgrade movement of newly placed slab concrete.


STEEL NOTES: All reinforcing steel shall conform to A.S.T.M. A-615, Grade 40. All reinforcing bar dimensions on the detailed drawings are to centers of bars unless otherwise noted. Clear distance between reinforcing steel and face of concrete shall be as noted on the plans. All bar laps shall be 30 diameters of the smaller diameter bar unless otherwise noted.

NOTE: Construction of roadway under not in this Contract.

BENCH MARK: A-25 Copperweld rod S. side of Thompson St. and Cary Road. Elev. 236.59.





| Str. STL. High Strength lbs. A588 | ESTIMATED QUANTITIES | | | | | | | | | | | | | |
|-----------------------------------|-------------------------|-----------------------|-------------------|------------------|------------------------------------|--------------------------|-----------------------------------|------------------------------|--|----------------------------------|-----------------------------|----------------------------------|--------------------------------|------------------------------------|
| | Struct. Excav. Cu. Yds. | Concrete (a) Cu. Yds. | Reinf. Steel Lbs. | Mild Carbon Lbs. | Aluminum Railing (1-Rail) Lin. Ft. | Porous Backfill Cu. Yds. | Under drain 6" Dia. Pipe Lin. Ft. | Con. Slab SI. Prot. Sq. Yds. | Asphalt damp proofing Conc. (a) Sq. Yds. | Approach Slab Conc. (a) Cu. Yds. | Steel Piles 108P42 Lin. Ft. | Parapet Junct. Box Complete Each | Metal Conduit 3" Dia. Lin. Ft. | Metal Conduit 1 1/2" Dia. Lin. Ft. |
| 11,561.2 | Superstructure | 335.98(b) | 94,764 | 342,021.5 | 687 | - | - | - | - | - | 2 | 230 | 56 | |
| | South Abutment | 179 | 87.81 | 26,326 | - | 7 | 68 | - | 31 | 62.91 | 654.3 | - | - | |
| | Pier 1 | 67 | 67.39 | 7,653 | - | - | - | - | - | - | 413.4 | - | - | |
| | Pier 2 | 90 | 99.35 | 12,167 | - | - | - | - | - | - | 432.1 | - | - | |
| | Pier 3 | 156 | 112.88 | 15,056 | - | - | - | - | - | - | 493.8 | - | - | |
| | N-Abut. S-Cary | 143 | 79.26 | 21,016 | - | 5 | 56 | 25 | 52.85 | 621.7 | - | - | - | |
| | N-Abut. S-Floyd | 180 | 88.22 | 29,400 | - | 6 | 80 | 28 | 73.48 | 802.1 | - | - | - | |
| | Total | 815 | 335.98(b) | 206,382 | 342,021.5 | 18 | 204 | 84 | 189.24 | 3,417.4 | 2 | 230 | 56 | |

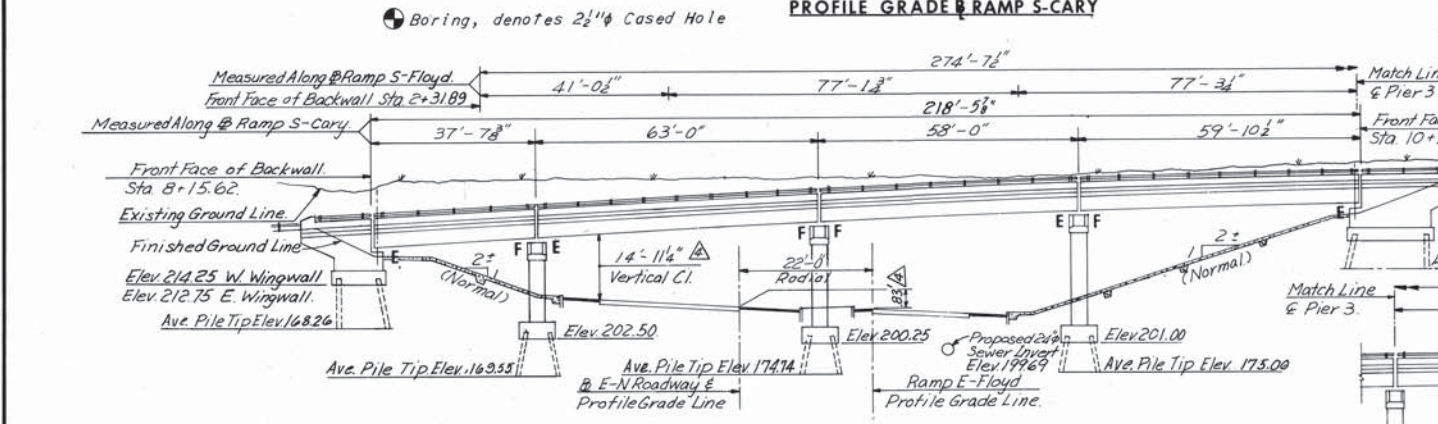

CURVE DATA

| Station | P.I. | Δ | D | T | L | R |
|--------------|---------------|-----------|-----------|---------|---------|----------|
| RAMP S-CARY | Sta. 3+96.91 | 15°46'34" | 2°00'00" | 396.91' | 788.81' | 2864.79' |
| RAMP S-FLOYD | Sta. 5+60.34 | 20°13'32" | 12°00'00" | 85.52' | 169.24' | 477.46' |
| RAMP S-FLOYD | Sta. 12+48.94 | 59°15'01" | 7°30'00" | 434.42' | 790.00' | 763.94' |
| E-N ROADWAY | Sta. 12+48.94 | 59°15'01" | 7°30'00" | 434.42' | 790.00' | 763.94' |


| | | | | | | | |
|---|-----------|--------|--------|-----|-----------------------------|--------|---------|
| 5 | As Built | R.H. | 2-5-73 | 4 | Profile Grade - E-N Roadway | L.B.P. | 4-70 |
| | | BY | DATE | 3 | Parapet | E.V.R. | 12-70 |
| | MADE | G.C.C. | 1-2-68 | 2 | General | J.G.V. | 10-70 |
| | CHECKED | L.J.R. | 3-7-68 | 1 | General Revision | A.M.H. | 5-13-68 |
| | IN CHARGE | F.K.D. | | NO. | REVISION | BY | DATE |

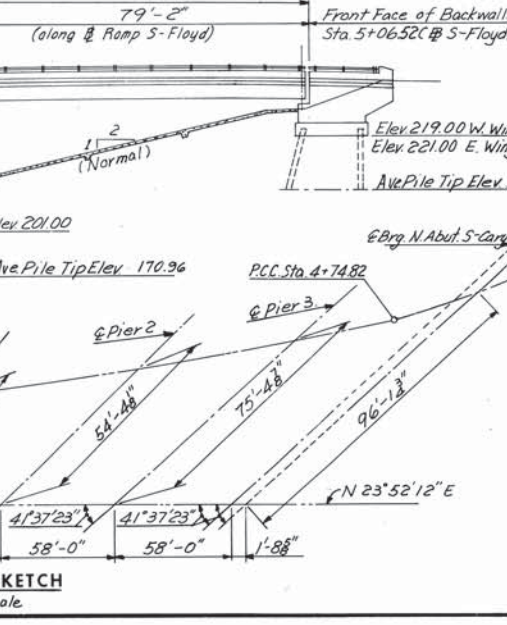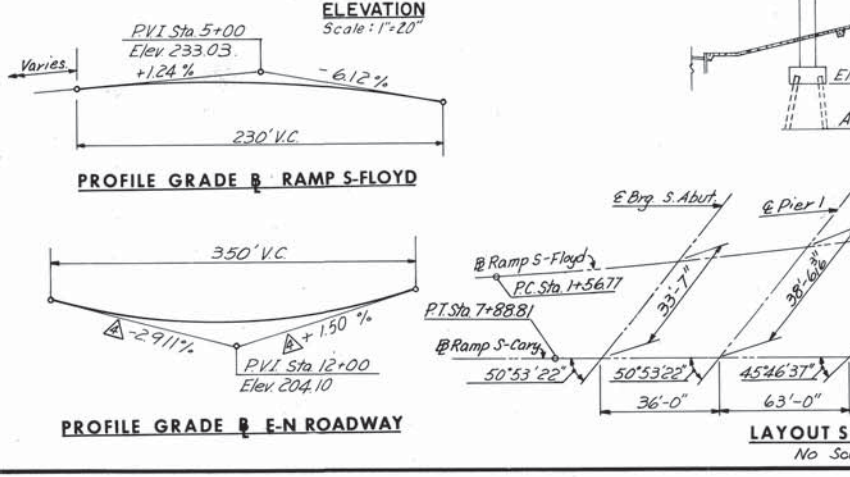

INDEX

| | |
|--|----|
| GENERAL PLAN AND ELEVATION | 1 |
| SOUTH ABUTMENT | 2 |
| NORTH ABUTMENT S-CARY | 3 |
| NORTH ABUTMENT S-FLOYD | 4 |
| ABUTMENT DETAILS | 5 |
| PIER 1 | 6 |
| PIERS 2 AND 3 | 7 |
| FRAMING PLAN | 8 |
| DECK PLAN | 9 |
| DECK DETAILS | 10 |
| JOINT DETAILS | 11 |
| JOINT DETAILS | 12 |
| APPROACH SLAB AND SLOPE PROTECTION DETAILS | 13 |
| BORING LOGS | 14 |
| STANDARD SHOE DETAILS | 15 |
| STANDARD ALUMINUM RAILING DETAILS | 16 |
| STANDARD ELECTRICAL DETAILS | 17 |
| STANDARD ARCHITECTURAL DETAILS | 18 |



AS BUILT

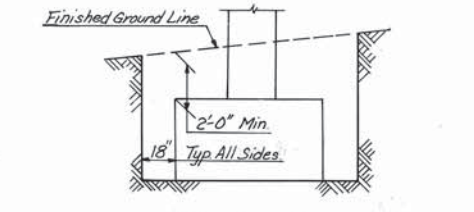

RICHMOND METROPOLITAN AUTHORITY
RICHMOND EXPRESSWAY SYSTEM
BELTLINE EXPRESSWAY
BRIDGE NO. 17
RAMP S-CARY OVER
EAST-NORTH ROADWAY
GENERAL PLAN AND ELEVATION

HOWARD, NEEDLES, TAMMEN & BERGENDOFF
 consulting engineers
 NEW YORK ALEXANDRIA KANSAS CITY

SCALE: As noted
 CONTRACT NO.: 4
 SHEET NO.: 1 OF 14

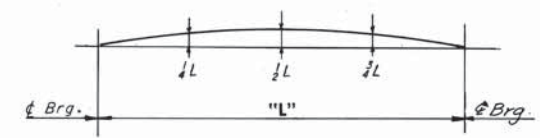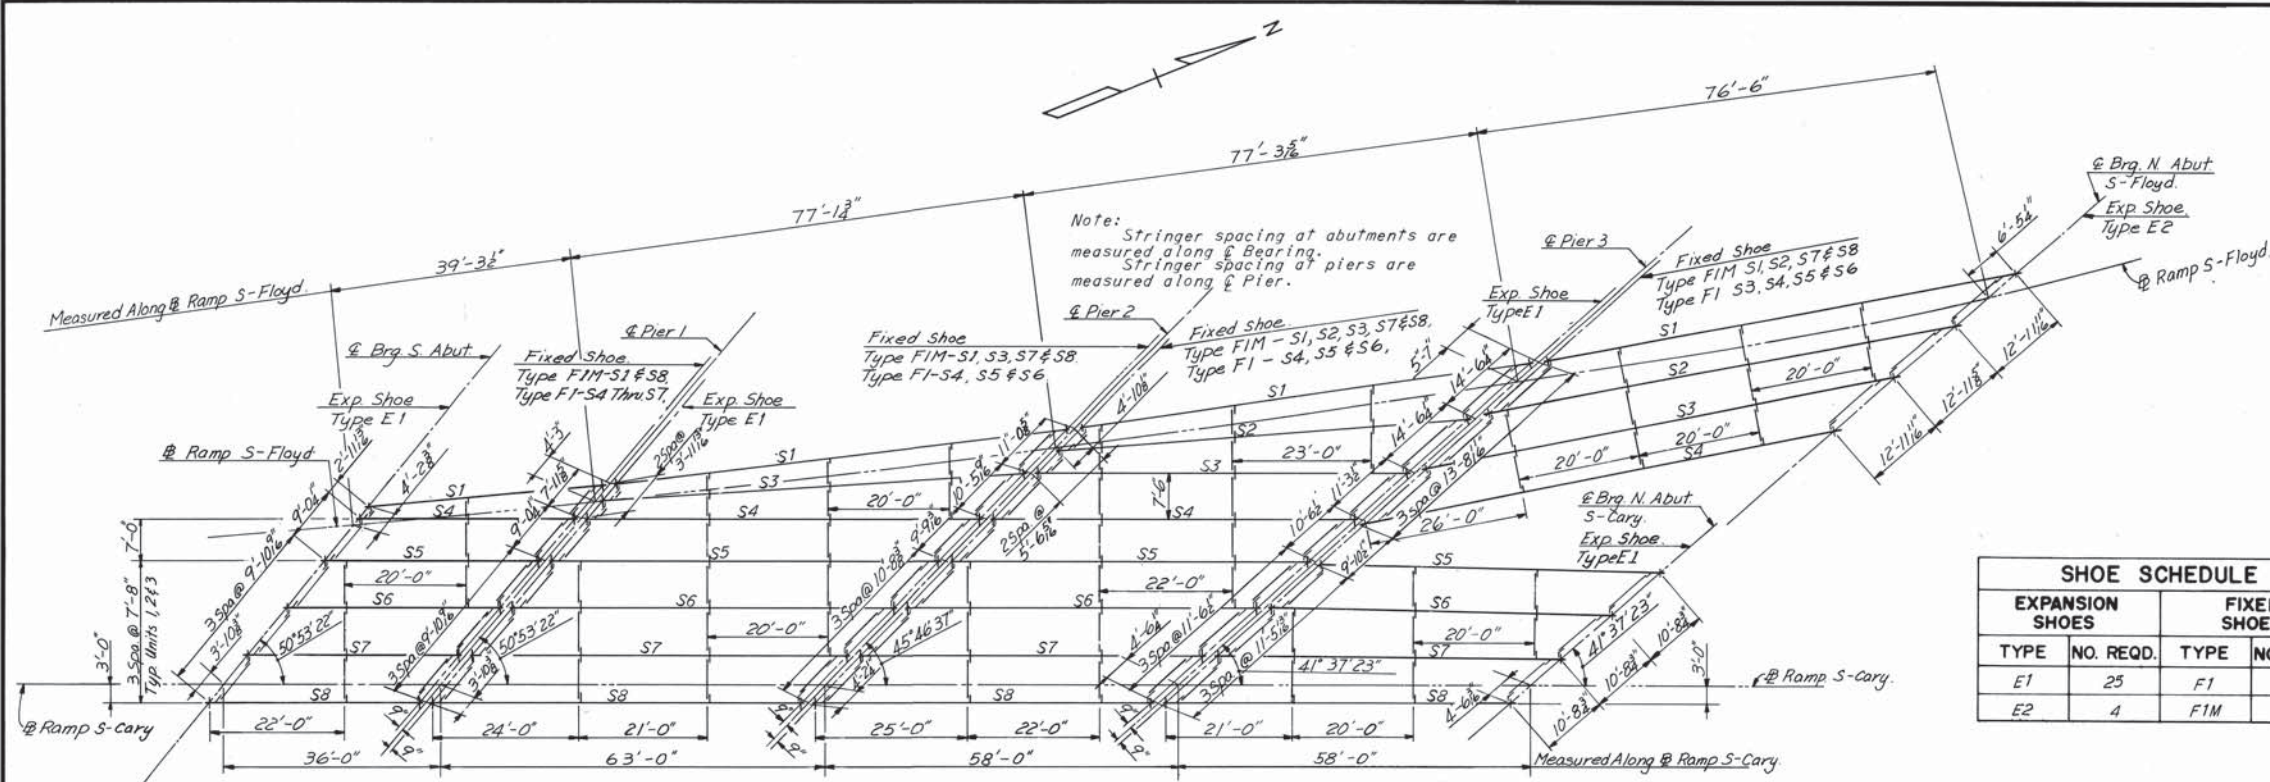


NOTE TO FABRICATOR


Stringers shall be fabricated with an upward camber amounting to the tabulated value. This will provide approximate compensation for deflection under full dead load and for conformity with finished grade. Stringers having a total camber of less than 1" are not required to be shop cambered, but should be turned so that any mill tolerance deviation from straightness will be in the direction shown by the Camber diagram. If stringers are not cambered, distance top of stringers to top of slab will vary along the stringer in accordance with the offset dimensions shown in the Camber diagram, and with a minimum distance as shown in cross-section on Sheet 9.

| SHOE SCHEDULE | | | |
|-----------------|-----------|-------------|-----------|
| EXPANSION SHOES | | FIXED SHOES | |
| TYPE | NO. REQD. | TYPE | NO. REQD. |
| E1 | 25 | F1 | 14 |
| E2 | 4 | F1M | 15 |


AS BUILT

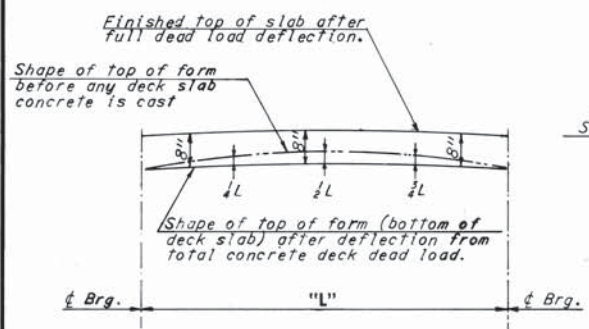


DEAD LOAD DEFLECTION DIAGRAM
No Scale

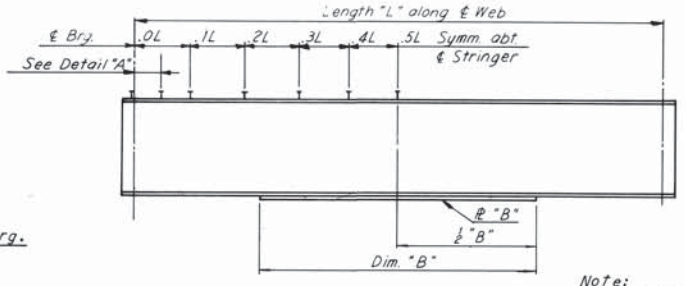


STRINGER ELEVATION

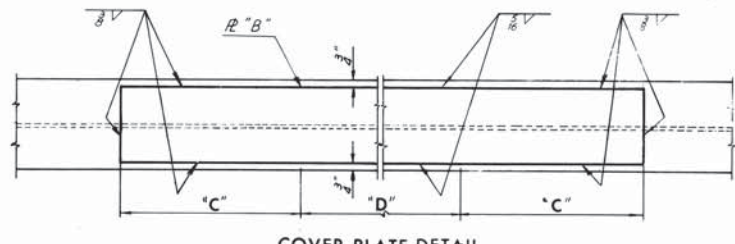

COVER PLATE DETAIL

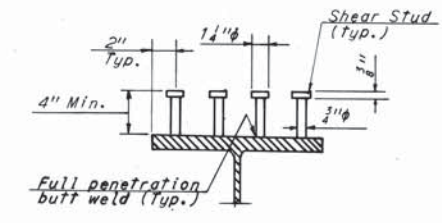

SHEAR STUD DETAIL
No Scale

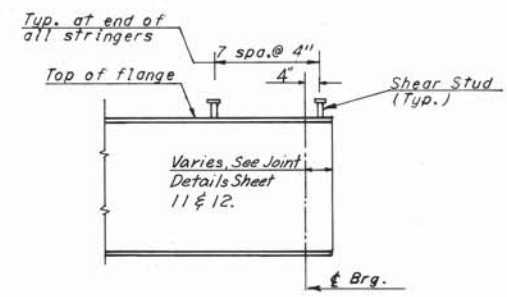

DETAIL A
No Scale

Note: Beam Ends, Bearing Stiffeners and Diaphragm Connections shall be plumb.

SHEAR STUD NOTE

Capacity = 3,400 lbs. per stud. The contractor may, if he elects, use three 1/2" diameter studs at the same longitudinal spacing in lieu of the four 1/2" diameter studs shown. Stud rows shall be placed parallel to the main deck reinforcing. Shear stud spacing shown is maximum spacing.

* Spacing begins at termination of 7 spaces @ 4" as shown in Detail A.
Notes: For Superstructure Structural steel quantities see Sheet 1. For Standard Shoe details see Sheet S1. For Framing details see Sheet 9. For Joint details see Sheets 11 and 12. This sheet must be worked with sheets 2, 3, 4, 6, & 7.

| DEAD LOAD DEFLECTION SCHEDULE | | | | | | | | | | | | |
|-------------------------------|--------|------|------|--------|--------|--------|--------|--------|--------|--------|--------|--------|
| STRINGER | UNIT 1 | | | UNIT 2 | | | UNIT 3 | | | UNIT 4 | | |
| | 1/4L | 1/2L | 3/4L | 1/4L | 1/2L | 3/4L | 1/4L | 1/2L | 3/4L | 1/4L | 1/2L | 3/4L |
| S1 | 1/8" | 1/4" | 3/8" | 1/8" | 1/4" | 1/4" | 1/8" | 1/4" | 1/4" | 1/4" | 3/8" | 1/2" |
| S2 | — | — | — | — | — | — | 7/8" | 1 1/8" | 7/8" | 1 1/4" | 2" | 1 1/4" |
| S3 | — | — | — | 1 1/8" | 1 1/2" | 1 1/8" | 1 1/4" | 1 1/2" | 1 1/4" | 1 1/2" | 2 1/8" | 1 1/8" |
| S4 | 3/8" | 1/2" | 5/8" | 1 1/8" | 1 1/2" | 1 1/8" | 1 1/4" | 1 1/2" | 1 1/4" | 1 1/2" | 2 1/8" | 1 1/8" |
| S5 | 1/2" | 3/4" | 1" | 3/4" | 1 1/8" | 3/4" | 1" | 1 1/8" | 1" | 1 1/4" | 1 1/2" | 1 1/2" |
| S6 | 3/8" | 1/2" | 5/8" | 1 1/8" | 1 1/2" | 1 1/8" | 1 1/4" | 1 1/2" | 1 1/4" | 1 1/2" | 2 1/8" | 1 1/8" |
| S7 | 3/8" | 1/2" | 5/8" | 1 1/8" | 1 1/2" | 1 1/8" | 1 1/4" | 1 1/2" | 1 1/4" | 1 1/2" | 2 1/8" | 1 1/8" |
| S8 | 1/2" | 3/4" | 1" | 3/4" | 1 1/8" | 3/4" | 1" | 1 1/8" | 1" | 1 1/4" | 1 1/2" | 1 1/2" |

NOTE TO CONTRACTOR



Deflections given are those anticipated to occur in the stringer upon placement of the total concrete deck dead load. In practice, the stringers in place are not likely to have the exact camber to compensate for these deflections during construction. The residual amounts shall be provided by adjusting forms to vary the thickness of the concrete haunch between the bottom of the slab and the top of stringer, without altering the slab thickness.

| UNIT | STRINGER | STRINGER LENGTH | STRINGER SIZE | R B | DIM "B" | DIM "C" | DIM "D" | MAX SHEAR STUD SPACING | | | | | CAMBER SCHEDULE | | | |
|------|----------|-----------------|---------------|----------------|------------|---------|---------|------------------------|---------|---------|---------|---------|-----------------|--------|--------|--------|
| | | | | | | | | .0L-.1L* | .1L-.2L | .2L-.3L | .3L-.4L | .4L-.5L | 1/4L | 1/2L | 3/4L | |
| | | | | | | | | | | | | | | | | |
| 1 | S1 | 38'-3 3/8" | 36 WF 135 | — | — | — | — | 15 1/2" | 17" | 20" | 23" | 24" | 1 1/8" | 1 1/4" | 1 1/2" | |
| | S4-S7 | 35'-0 3/8" | 30 WF 99 | — | — | — | — | 7 1/2" | 8 1/2" | 9 1/2" | 11 1/2" | 13 1/2" | 1 1/8" | 1 1/4" | 1 1/2" | |
| | S8 | 35'-0 3/8" | 36 WF 135 | — | — | — | — | 10 1/2" | 11 1/2" | 13" | 15 1/2" | 18 1/2" | 1 1/8" | 1 1/4" | 1 1/2" | |
| | 2 | S1 | 75'-1 7/8" | 36 WF 150 | 10 1/2 x 2 | 57'-0" | 2'-6" | 52'-0" | 11 1/2" | 13" | 15" | 19" | 23 1/2" | 3 3/8" | 5 1/8" | 3 1/2" |
| | | S3 | 70'-1 1/8" | 36 WF 150 | 10 1/2 x 2 | 42'-0" | 2'-0" | 38'-0" | 8" | 9" | 11" | 13" | 15 1/2" | 2 3/8" | 3 3/8" | 2 3/8" |
| | | S4 | 65'-1 3/8" | 36 WF 150 | 10 1/2 x 2 | 48'-0" | 2'-0" | 44'-0" | 8" | 9" | 11" | 13" | 15 1/2" | 2 3/8" | 3 3/8" | 2 3/8" |
| | | S5 | 64'-1 3/8" | 36 WF 150 | 10 1/2 x 2 | 48'-0" | 2'-0" | 44'-0" | 8" | 9" | 11" | 13" | 15 1/2" | 2 3/8" | 3 3/8" | 2 3/8" |
| | | S6 | 62'-11 3/8" | 36 WF 150 | 10 1/2 x 2 | 48'-0" | 2'-0" | 44'-0" | 8" | 9" | 11" | 13" | 15 1/2" | 2 3/8" | 3 3/8" | 2 3/8" |
| S7 | | 61'-8 3/8" | 36 WF 150 | 10 1/2 x 2 | 48'-0" | 2'-0" | 44'-0" | 8" | 9" | 11" | 13" | 15 1/2" | 2 3/8" | 3 3/8" | 2 3/8" | |
| S8 | | 60'-6 3/8" | 36 WF 150 | 10 1/2 x 2 | 44'-0" | 2'-0" | 40'-0" | 9" | 10" | 12" | 14" | 17" | 1 3/8" | 2 3/8" | 1 3/8" | |
| 3 | | S1 | 75'-5 1/8" | 36 WF 150 | 10 1/2 x 1 | 62'-0" | 2'-6" | 57'-0" | 10" | 11 1/2" | 14" | 16 1/2" | 20" | 3 1/2" | 4 3/8" | 3 1/2" |
| | S2 | 68'-1 3/8" | 36 WF 150 | 10 1/2 x 2 | 54'-0" | 2'-6" | 49'-0" | 8 1/2" | 10" | 12" | 14 1/2" | 17 1/2" | 2 3/8" | 3 1/2" | 2 3/8" | |
| | S3 | 61'-0 7/8" | 36 WF 135 | 10 1/2 x 2 | 44'-0" | 2'-0" | 40'-0" | 7" | 8" | 10" | 12" | 14 1/2" | 2" | 2 3/8" | 1 1/2" | |
| | S4 | 59'-11 3/8" | 36 WF 135 | 10 1/2 x 2 | 44'-0" | 2'-0" | 40'-0" | 7" | 8" | 10" | 12" | 14 1/2" | 2" | 2 3/8" | 1 1/2" | |
| | S5 | 58'-10 7/8" | 36 WF 135 | 10 1/2 x 2 | 44'-0" | 2'-0" | 40'-0" | 7" | 8" | 10" | 12" | 14 1/2" | 2" | 2 3/8" | 1 1/2" | |
| | S6 | 57'-8 7/8" | 36 WF 135 | 10 1/2 x 2 | 44'-0" | 2'-0" | 40'-0" | 7" | 8" | 10" | 12" | 14 1/2" | 1 3/8" | 2 3/8" | 1 3/8" | |
| | S7 | 56'-6 7/8" | 36 WF 135 | 10 1/2 x 2 | 44'-0" | 2'-0" | 40'-0" | 7" | 8" | 10" | 12" | 14 1/2" | 1 3/8" | 2 3/8" | 1 3/8" | |
| | S8 | 55'-4 7/8" | 36 WF 150 | — | — | — | — | 9" | 10 1/2" | 12" | 14" | 17" | 1 3/8" | 2 3/8" | 1 3/8" | |
| 4 | S1 | 75'-9 3/4" | 36 WF 160 | 10 1/2 x 1 1/2 | 65'-0" | 3'-0" | 59'-0" | 8 1/2" | 9 1/2" | 12" | 14 1/2" | 18" | 3 3/8" | 4 3/8" | 3 3/8" | |
| | S2 | 76'-4 1/8" | 36 WF 160 | 10 1/2 x 1 1/2 | 65'-0" | 3'-0" | 59'-0" | 7 1/2" | 8 1/2" | 10 1/2" | 13" | 16" | 3 3/8" | 4 3/8" | 3 3/8" | |
| | S3 | 77'-0 3/8" | 36 WF 160 | 10 1/2 x 1 1/2 | 65'-0" | 3'-0" | 59'-0" | 7 1/2" | 8 1/2" | 10 1/2" | 13" | 16" | 3 3/8" | 4 3/8" | 3 3/8" | |
| | S4 | 77'-0 3/8" | 36 WF 160 | 10 1/2 x 1 1/2 | 63'-0" | 3'-0" | 57'-0" | 8 1/2" | 9 1/2" | 12" | 14 1/2" | 18" | 4" | 5 1/8" | 4" | |
| | S5 | 55'-2 3/8" | 36 WF 150 | — | — | — | — | 9" | 10 1/2" | 12" | 14" | 17" | 1 3/8" | 2 3/8" | 1 3/8" | |
| | S6 | 55'-9 3/8" | 36 WF 135 | 10 1/2 x 2 | 44'-0" | 2'-0" | 40'-0" | 7" | 8" | 10" | 12" | 14 1/2" | 1 3/8" | 2 3/8" | 1 3/8" | |
| | S7 | 56'-3 3/8" | 36 WF 135 | 10 1/2 x 2 | 44'-0" | 2'-0" | 40'-0" | 7" | 8" | 10" | 12" | 14 1/2" | 1 3/8" | 2 3/8" | 1 3/8" | |
| | S8 | 56'-10 3/8" | 36 WF 150 | — | — | — | — | 9" | 10 1/2" | 12" | 14" | 17" | 1 3/8" | 2 3/8" | 1 3/8" | |

| | | | | | |
|-----------|--------|---------|----------|------------------|-------------|
| BY | DATE | 3 | As Built | R.H. | 2-5-75 |
| MADE | G.C.C. | 11-3-67 | 2 | General | P.S. 10-70 |
| CHECKED | AMH | 2-26-68 | 1 | General Revision | AMH 5-15-68 |
| IN CHARGE | FKD | | | | |




RICHMOND METROPOLITAN AUTHORITY
RICHMOND EXPRESSWAY SYSTEM
BELTLINE EXPRESSWAY
BRIDGE NO. 17
RAMP S-CARY OVER
EAST-NORTH ROADWAY
FRAMING PLAN

HOWARD, NEEDLES, TAMMEN & BERGENDOFF
consulting engineers
NEW YORK ALEXANDRIA KANSAS CITY
SCALE: As noted
CONTRACT NO. 4
SHEET NO. 8 OF 14

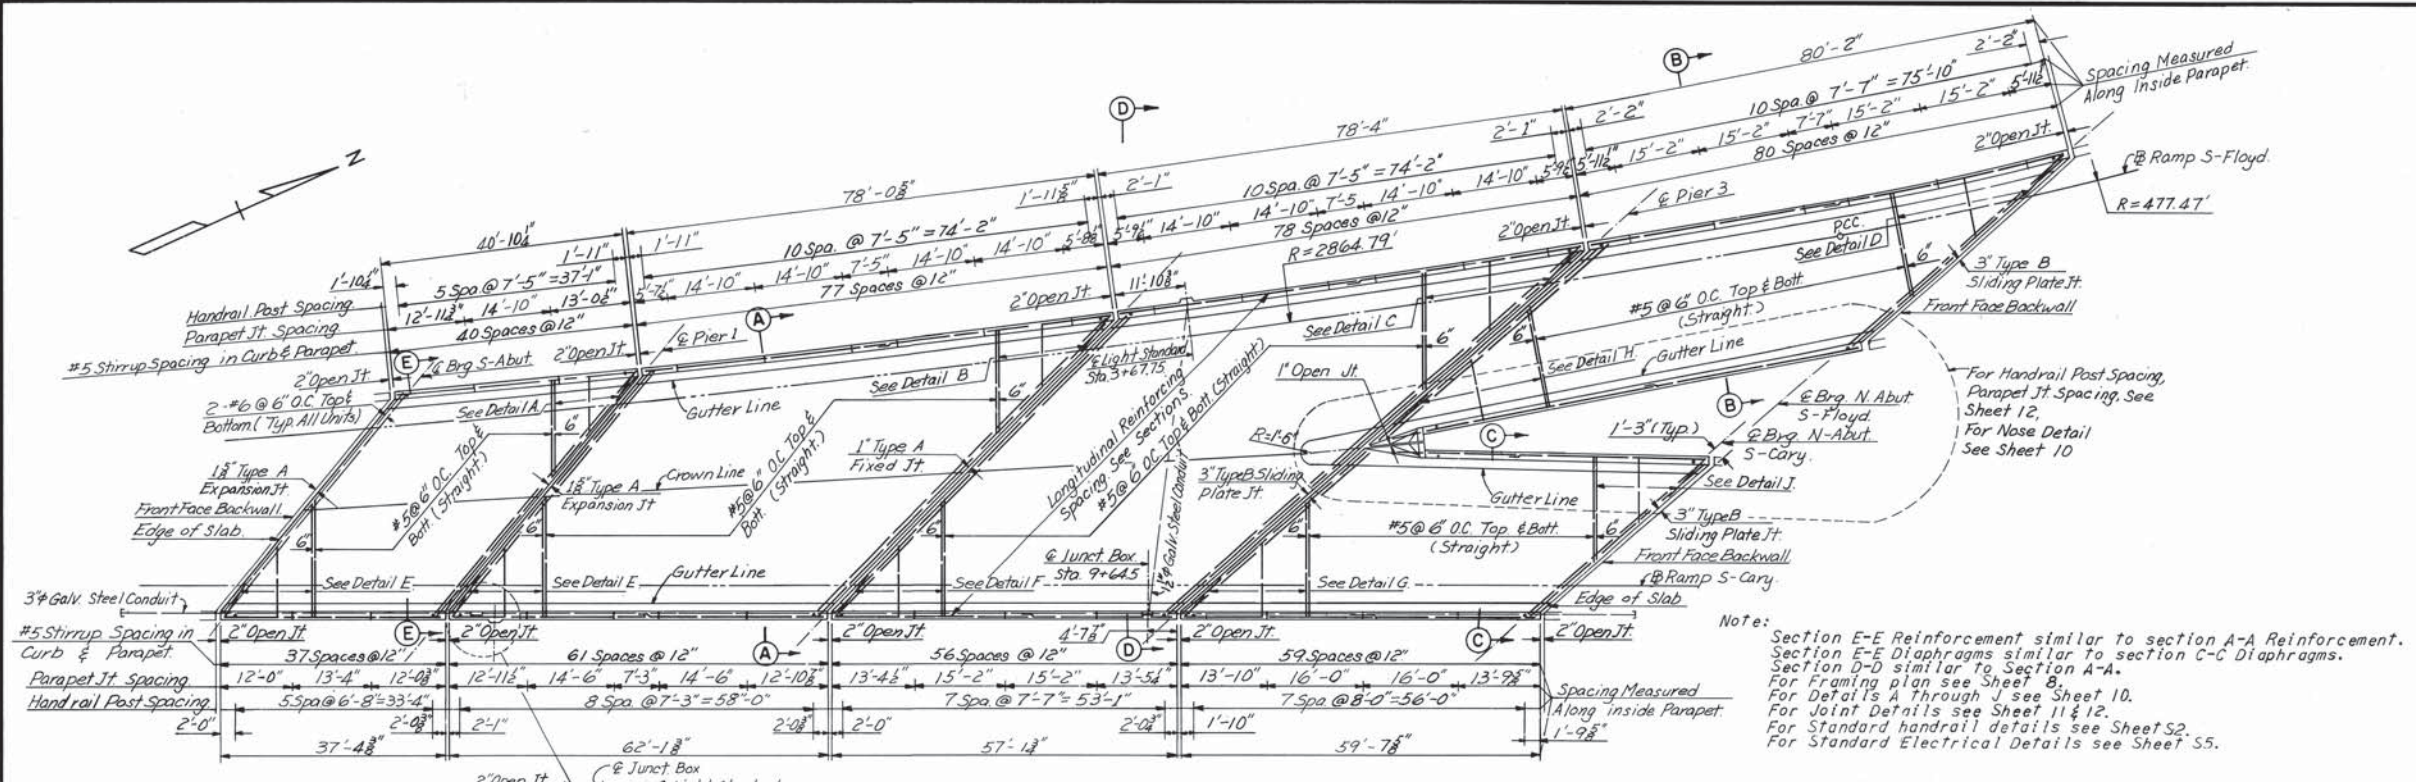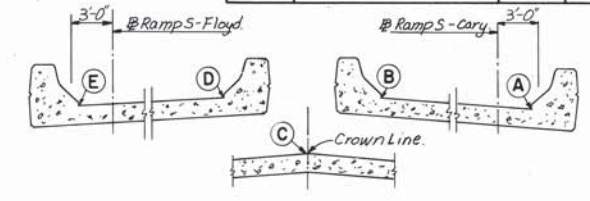

GUTTERLINE ELEVATIONS

| STATION # S-Cary | ELEV. A | ELEV. B | ELEV. C | ELEV. D | ELEV. E | STATION # S-Floyd |
|------------------|---------|---------|---------|---------|---------|-------------------|
| 8+00 | 223.00 | - | 223.31 | - | 223.02 | 1+94.25 |
| 8+10 | 223.58 | - | 223.89 | - | 223.59 | 2+04.18 |
| 8+12.77 | 223.73 | - | - | - | - | - |
| 8+20 | 224.16 | - | 224.48 | - | 224.16 | 2+14.13 |
| 8+30 | 224.74 | - | 225.07 | - | 224.75 | 2+24.10 |
| 8+40 | 225.32 | - | 225.66 | - | 225.33 | 2+34.07 |
| - | - | - | - | - | 225.41 | 2+35.31 |
| 8+50 | 225.90 | - | 226.25 | - | 225.92 | 2+44.03 |
| 8+50.38 | 225.93 | - | - | - | - | - |
| 8+60 | 226.48 | - | 226.84 | - | 226.50 | 2+53.99 |
| 8+70 | 227.06 | - | 227.43 | - | 227.08 | 2+63.95 |
| 8+80 | 227.64 | - | 228.02 | - | 227.66 | 2+73.91 |
| - | - | - | - | - | 227.80 | 2+76.45 |
| 8+90 | 228.18 | - | 228.58 | - | 228.21 | 2+83.86 |
| 9+00 | 228.70 | - | 229.10 | - | 228.72 | 2+93.81 |
| 9+10 | 229.18 | - | 229.59 | - | 229.20 | 3+03.76 |
| 9+12.83 | 229.31 | - | - | - | - | - |
| 9+20 | 229.62 | - | 230.05 | - | 229.65 | 3+13.70 |
| 9+30 | 230.03 | - | 230.47 | - | 230.06 | 3+23.63 |
| 9+40 | 230.41 | - | 230.86 | - | 230.44 | 3+33.57 |
| 9+50 | 230.76 | - | 231.22 | - | 230.78 | 3+43.49 |
| 9+60 | 231.07 | - | 231.55 | - | 231.06 | 3+53.42 |
| - | - | - | - | - | 231.08 | 3+54.53 |
| 9+70 | 231.35 | - | 231.84 | - | 231.24 | 3+63.33 |
| 9+70.29 | 231.36 | - | - | - | - | - |
| 9+80 | 231.60 | - | 232.09 | - | 231.37 | 3+73.25 |
| 9+90 | 231.81 | - | 232.32 | - | 231.47 | 3+83.15 |
| 9+92.22 | - | 232.33 | - | 232.31 | - | 3+85.35 |
| 9+97.17 | - | 232.42 | - | 232.39 | 231.53 | 3+90 |
| - | - | - | - | 232.51 | - | 3+96.70 |
| 10+00 | 231.99 | 232.46 | - | 232.54 | 231.61 | 4+00 |
| 10+10 | 232.13 | 232.60 | - | 232.66 | 231.66 | 4+10 |
| 10+20 | 232.24 | 232.71 | - | 232.74 | 231.68 | 4+20 |
| 10+30 | 232.32 | 232.78 | - | 232.79 | 231.65 | 4+30 |
| 10+30.18 | 232.33 | - | - | - | 231.65 | 4+32.86 |
| 10+40 | 232.40 | 232.86 | - | 232.80 | 231.60 | 4+40 |
| 10+50 | 232.48 | 232.93 | - | 232.78 | 231.52 | 4+50 |
| 10+55.27 | - | 232.96 | - | 232.72 | 231.41 | 4+60 |
| 10+60 | 232.56 | 233.00 | - | 232.64 | 231.27 | 4+70 |
| 10+70 | 232.64 | 233.08 | - | 232.53 | - | 4+77.68 |
| - | - | - | - | 232.48 | 231.10 | 4+80 |
| - | - | - | - | 232.29 | 230.90 | 4+90 |
| - | - | - | - | 232.07 | 230.67 | 5+00 |
| - | - | - | - | 231.80 | 230.41 | 5+10 |
| - | - | - | - | - | 230.31 | 5+13.34 |
| - | - | - | - | 231.51 | 230.12 | 5+20 |
| - | - | - | - | 231.19 | 229.80 | 5+30 |

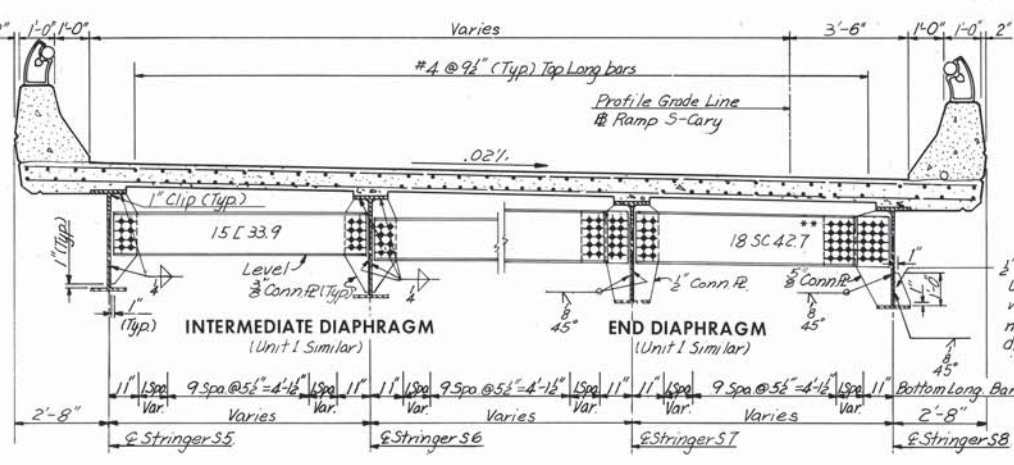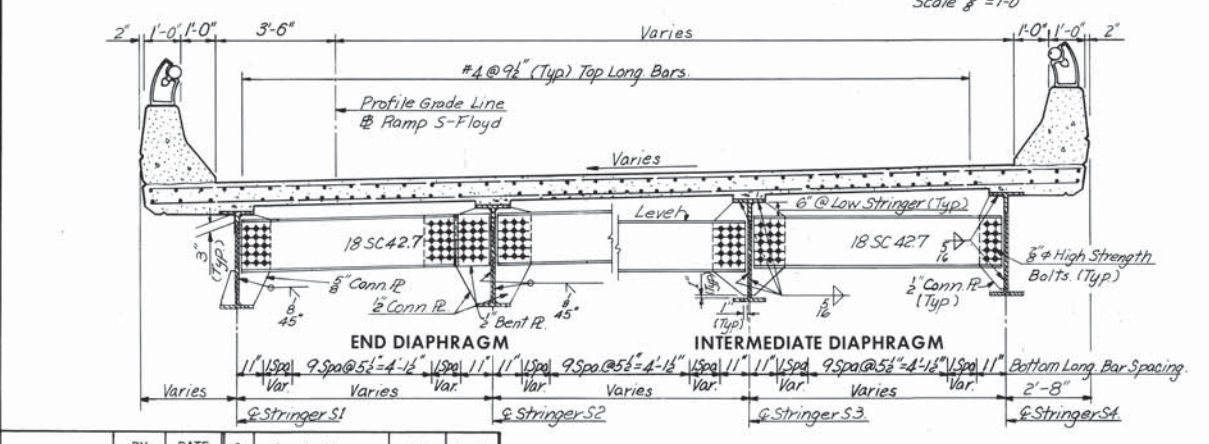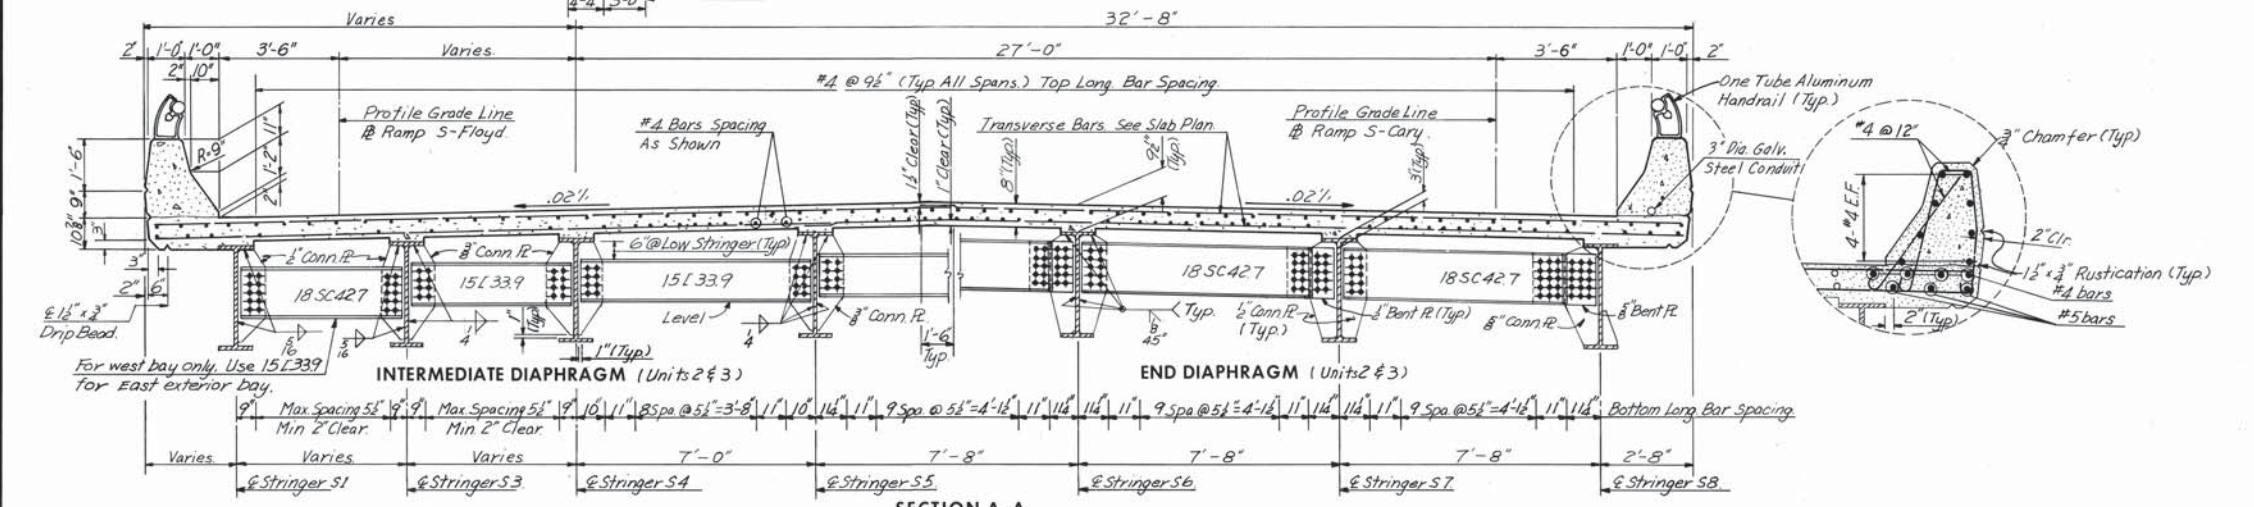


AS BUILT


RICHMOND METROPOLITAN AUTHORITY
RICHMOND EXPRESSWAY SYSTEM
BELTLINE EXPRESSWAY
BRIDGE NO. 17
RAMP S-CARY OVER
EAST-NORTH ROADWAY
DECK PLAN

| BY | DATE | NO. | REVISION | BY | DATE | |
|-----------|--------|----------|----------|------------------|--------|---------|
| MADE | G.C.C. | 11-23-67 | 2 | Parapet | J.G.V. | 12-70 |
| CHECKED | AMH | 2-28-68 | 1 | General Revision | AMH | 5-13-68 |
| IN CHARGE | FKD | | | | | |


| RICHMOND EXPRESSWAY SYSTEM | | | |
|----------------------------|---------------------|-----------|--------------|
| SECTION | PROJECT | SHEET NO. | TOTAL SHEETS |
| 4 | BELTLINE EXPRESSWAY | 139 | 155 |

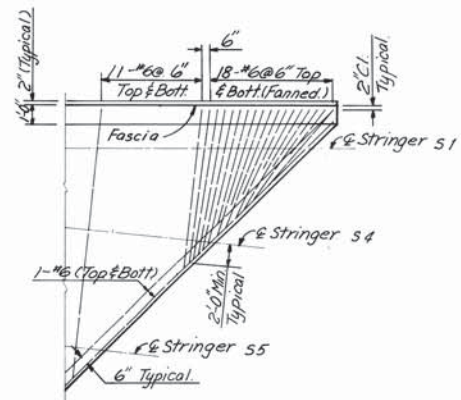


DETAIL A
No Scale

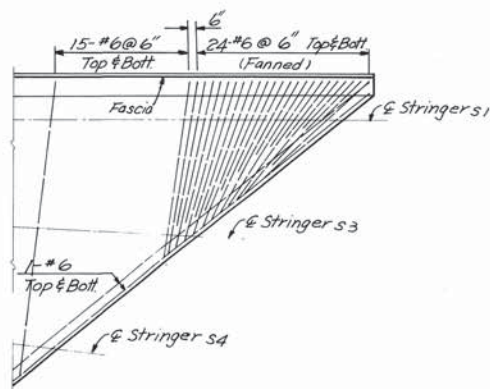


DETAIL B
No Scale

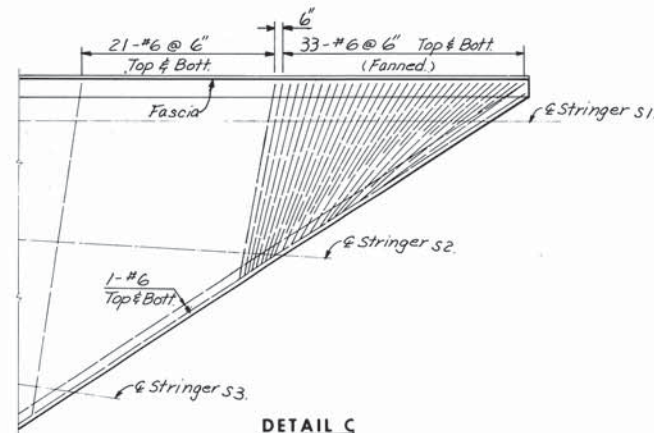


DETAIL C
No Scale

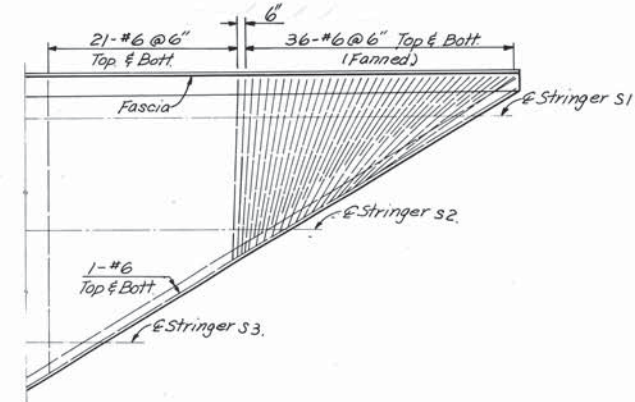


DETAIL D
No Scale

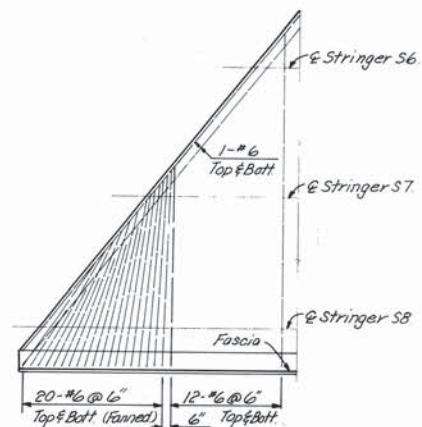


DETAIL E
No Scale

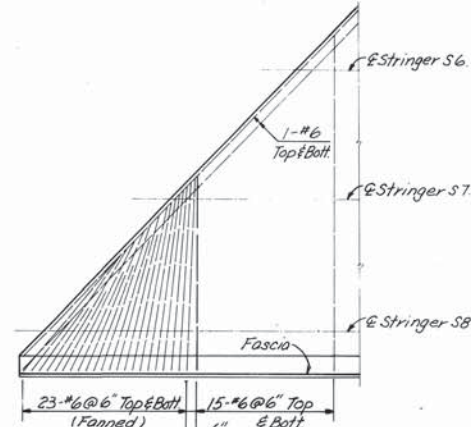


DETAIL F
No Scale

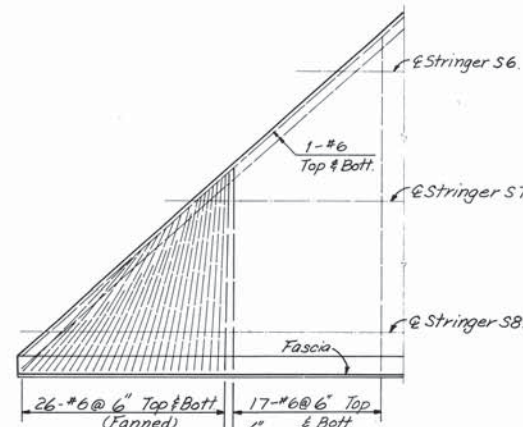


DETAIL G
No Scale

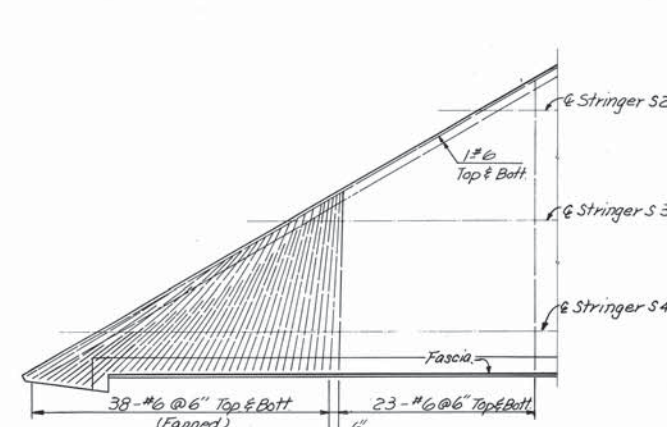


DETAIL H
No Scale

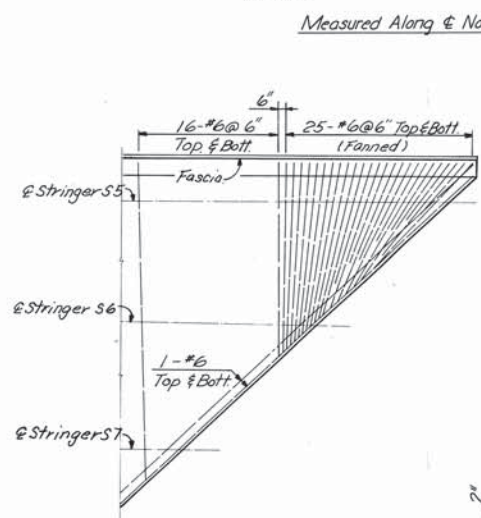


DETAIL J
No Scale

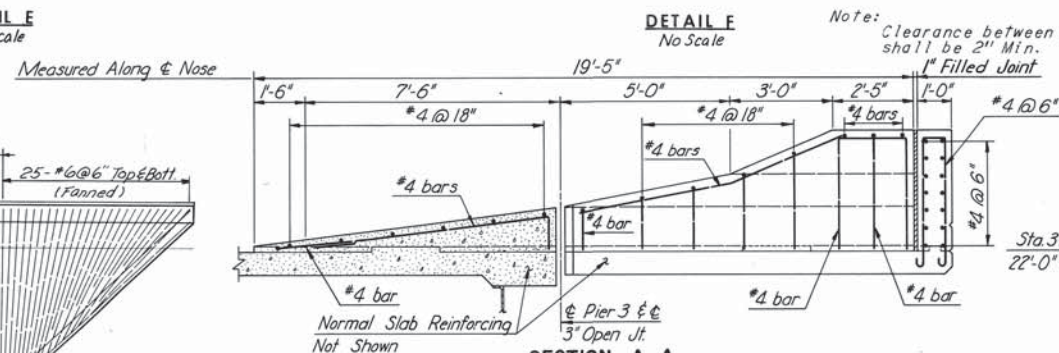


SECTION A-A
Scale: 3/8"=1'-0"

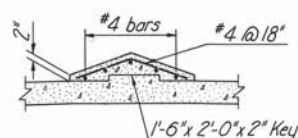

SECTION B-B
Scale: 3/8"=1'-0"

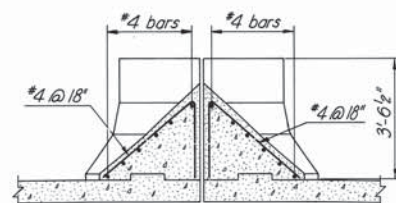

SECTION C-C
Scale: 3/8"=1'-0"

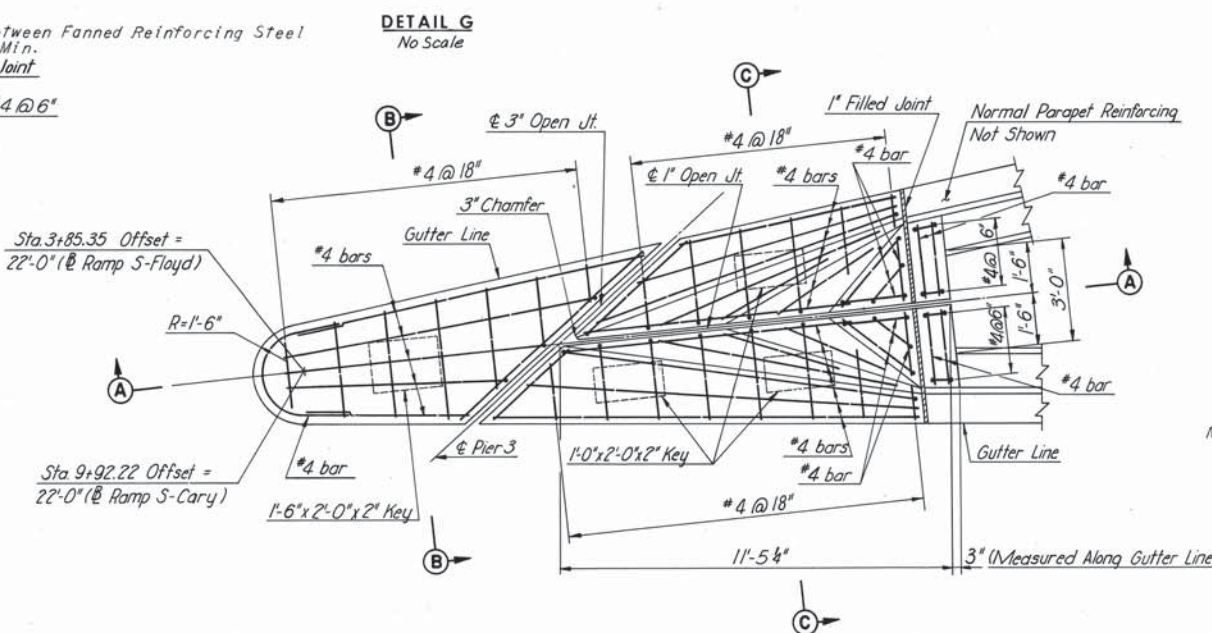

NOSE DETAIL
Scale: 3/8"=1'-0"

AS BUILT













Note:
For Joint details see Sheets 11 and 12
For Deck Plan see Sheet 9.
For Framing Plan see Sheet 8.
For location of Details see Sheet 9.

RICHMOND METROPOLITAN AUTHORITY
RICHMOND EXPRESSWAY SYSTEM
BELTLINE EXPRESSWAY
BRIDGE NO. 17
RAMP S-CARY OVER
EAST-NORTH ROADWAY
DECK DETAILS

HOWARD, NEEDLES, TAMMEN & BERGENDOFF
consulting engineers
NEW YORK ALEXANDRIA KANSAS CITY
SCALE: As noted
CONTRACT NO. 4
SHEET NO. 10 OF 14

| BY | DATE | | | | |
|-----------|--------|----------|----------|------|--------|
| MADE | G.C.C. | 12-15-67 | | | |
| CHECKED | S.S.M. | 3-19-68 | As Built | R.H. | 2-5-73 |
| IN CHARGE | FKD | | | | |
| | NO. | REVISION | BY | DATE | |

| RICHMOND EXPRESSWAY SYSTEM | | | |
|----------------------------|---------------------|-----------|--------------|
| SECTION | PROJECT | SHEET NO. | TOTAL SHEETS |
| 4 | BELTLINE EXPRESSWAY | 140 | 155 |

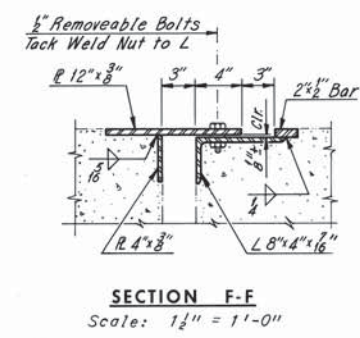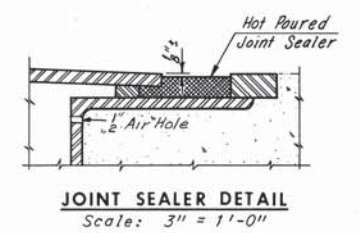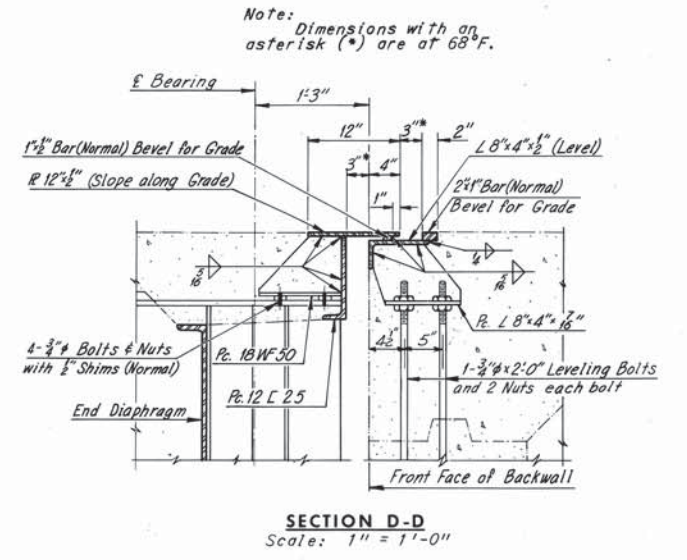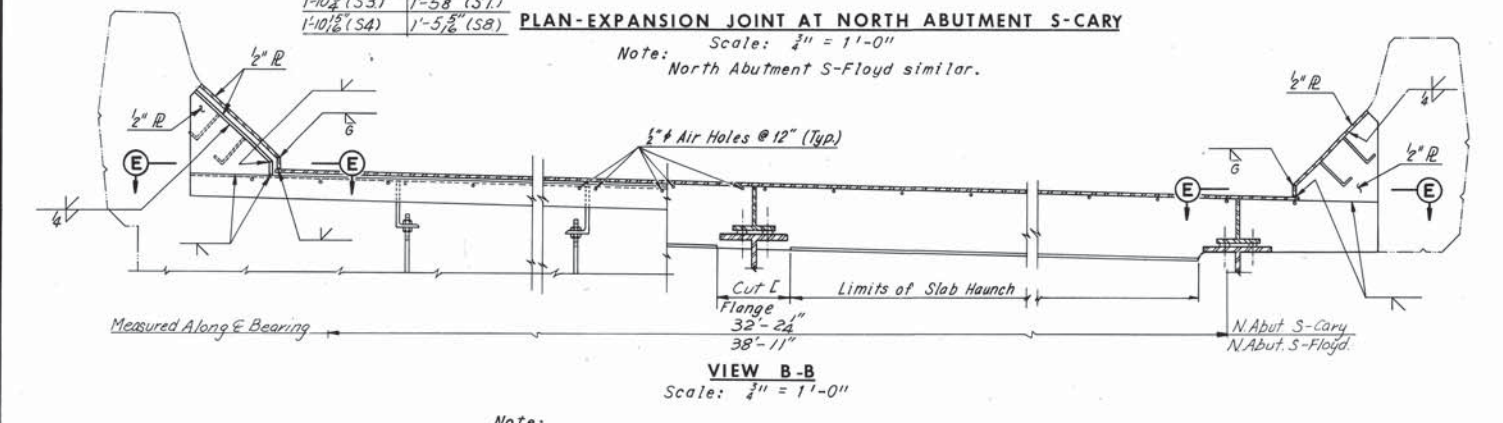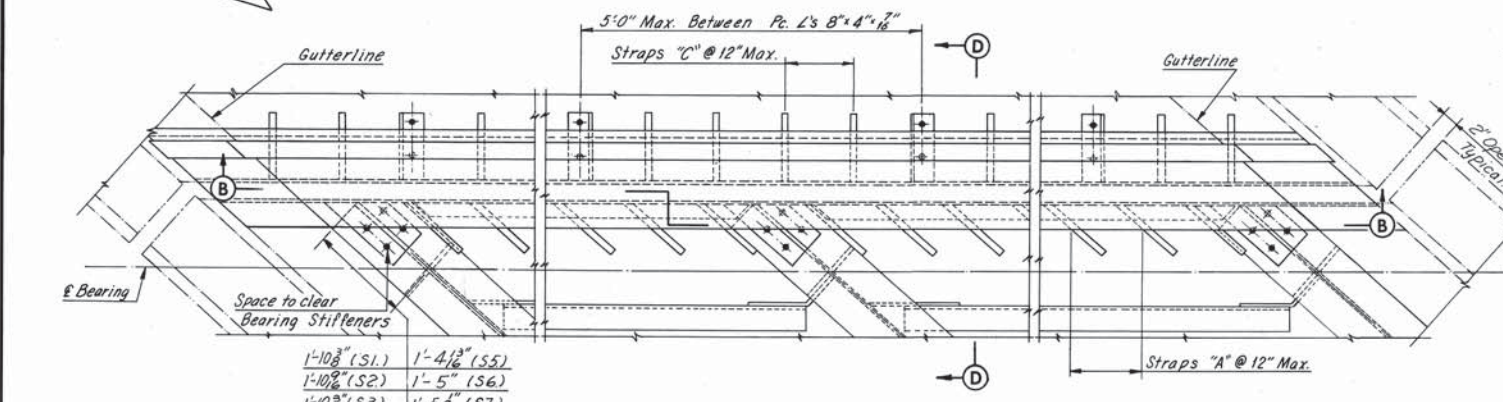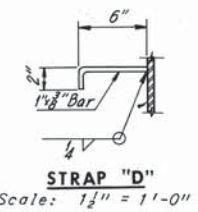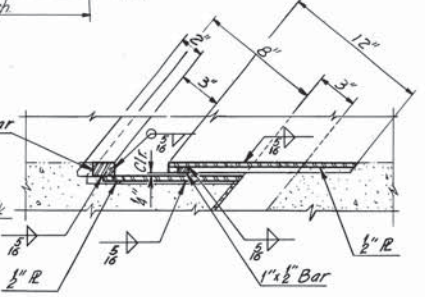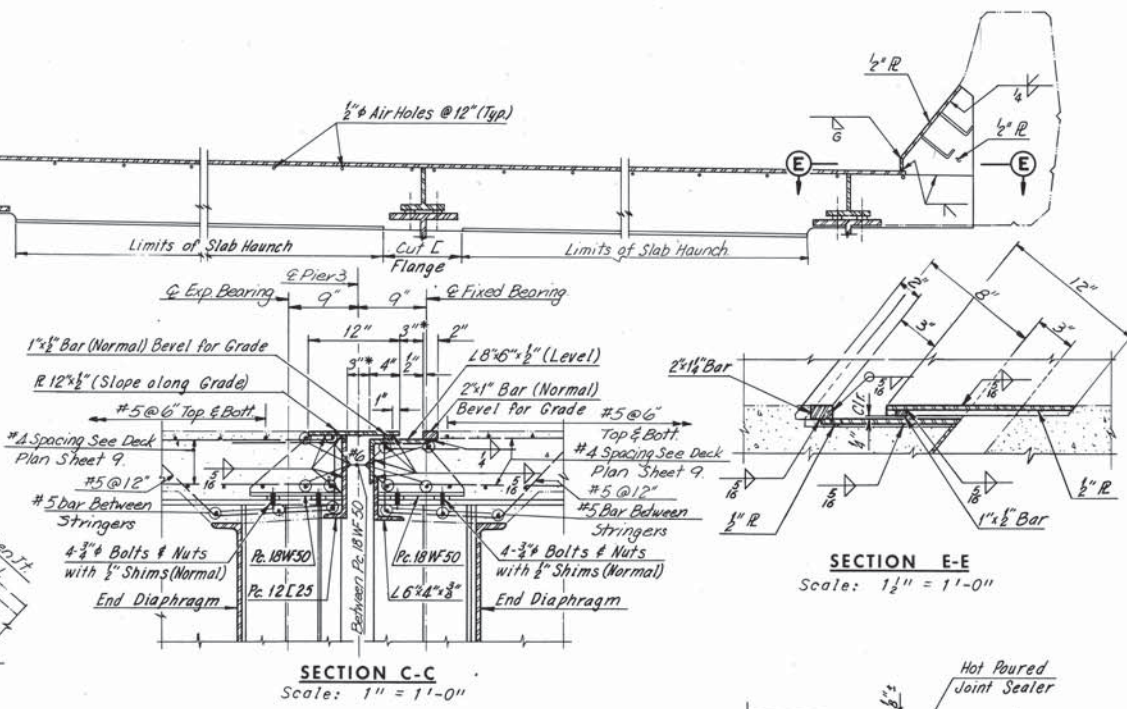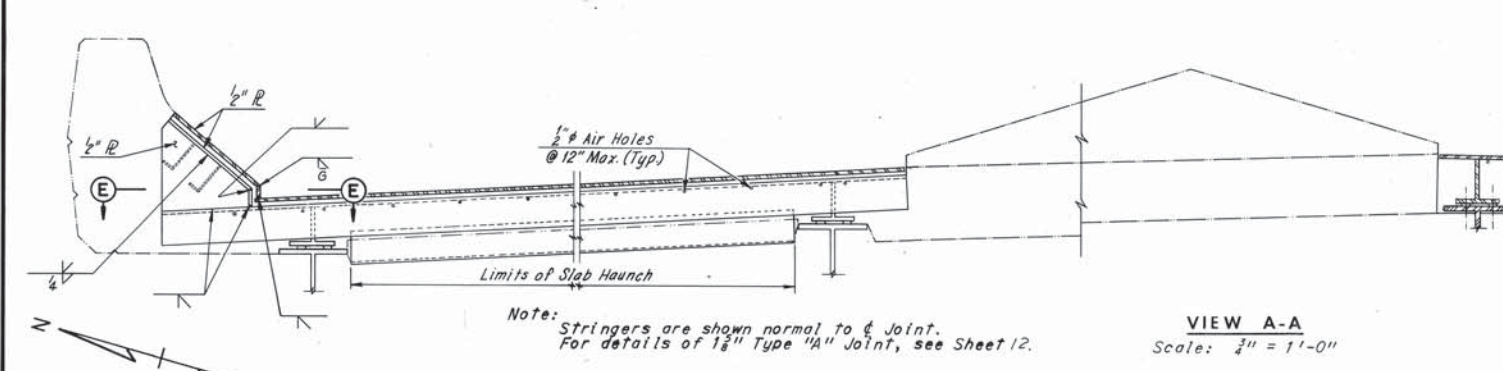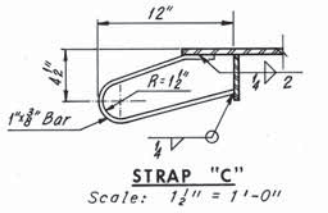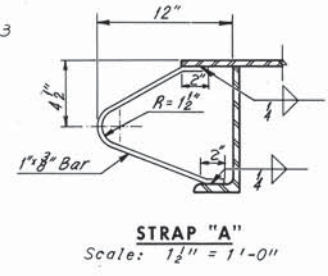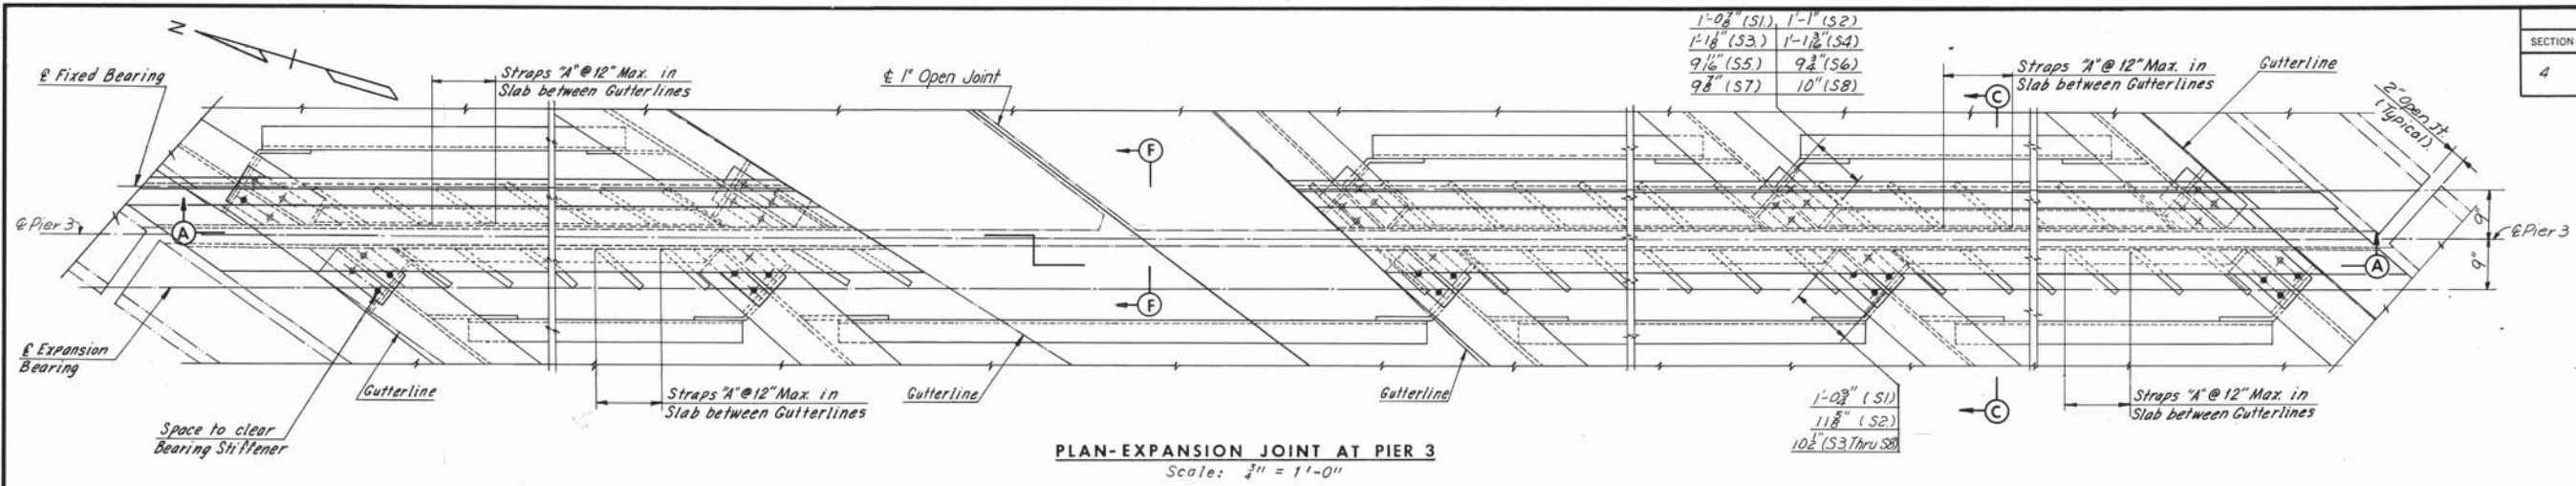

AS BUILT


Note: Work this sheet with Sheets 3, 4, 7, 8 & 9.

RICHMOND METROPOLITAN AUTHORITY
RICHMOND EXPRESSWAY SYSTEM
BELTLINE EXPRESSWAY
 BRIDGE NO. 17
 RAMP S-CARY OVER
 EAST-NORTH ROADWAY
JOINT DETAILS


| BY | DATE | REVISION | BY | DATE |
|-----------|-----------------|----------|----------|-------------|
| MADE | D.E.S. 11-27-67 | 2 | As Built | R.H. 2-5-73 |
| CHECKED | SSW 3-20-68 | 1 | Parapet | J.G.V. 1-71 |
| IN CHARGE | FKD | NO. | REVISION | BY |

HOWARD, NEEDLES, TAMMEN & BERGENDOFF
 consulting engineers
 NEW YORK ALEXANDRIA KANSAS CITY
 SCALE: As noted
 CONTRACT NO. 4
 SHEET NO. 11 OF 14


| RICHMOND EXPRESSWAY SYSTEM | | | |
|----------------------------|---------------------|-----------|--------------|
| SECTION | PROJECT | SHEET NO. | TOTAL SHEETS |
| 4 | BELTLINE EXPRESSWAY | 141 | 155 |

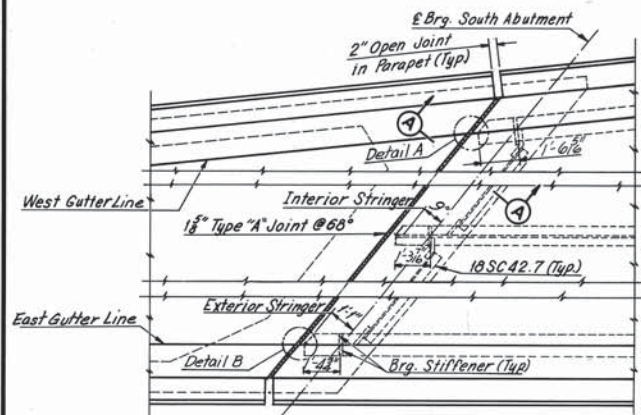


PLAN-JOINT AT SOUTH ABUTMENT
Scale: 1/4" = 1'-0"

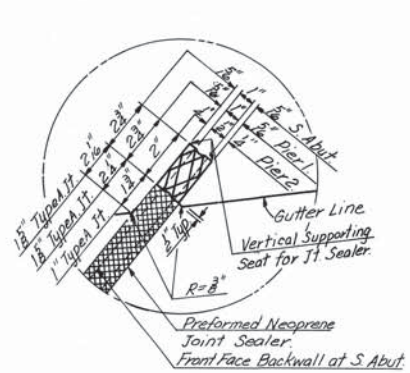


DETAIL A
No Scale

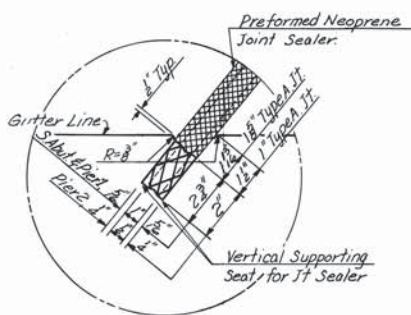


DETAIL B
No Scale

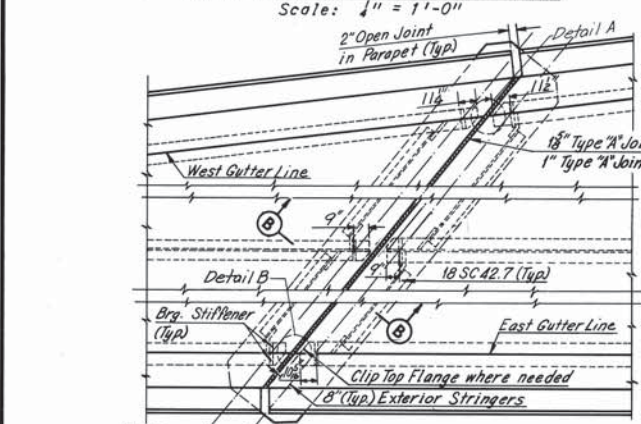

PLAN-JOINT AT PIERS 1 AND 2
Scale: 1/4" = 1'-0"

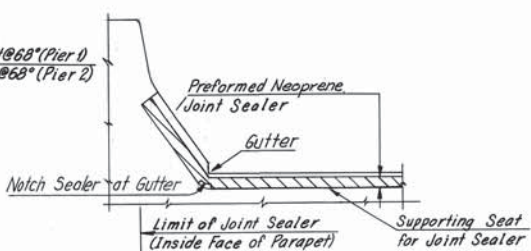


TREATMENT OF TYPE "A" JOINT AT GUTTER

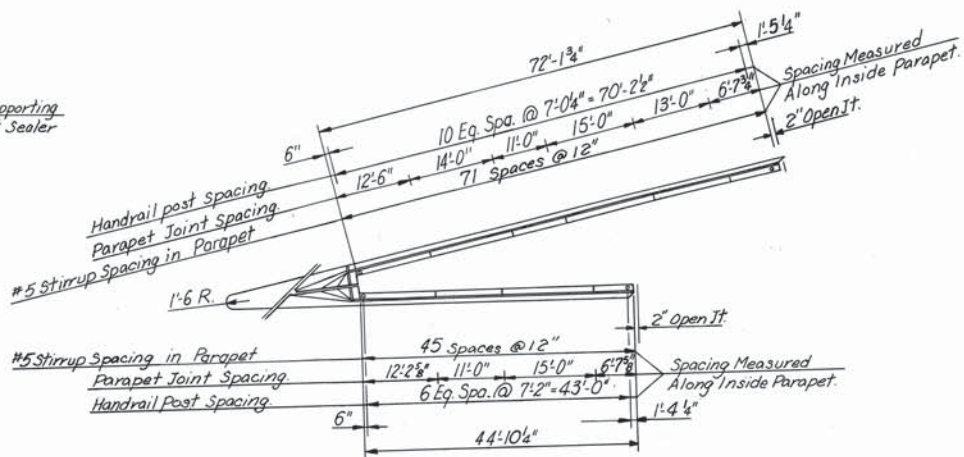


PARAPET DETAIL
Scale: 1" = 15'-0"


Note: For Nose Detail see Sheet 10.

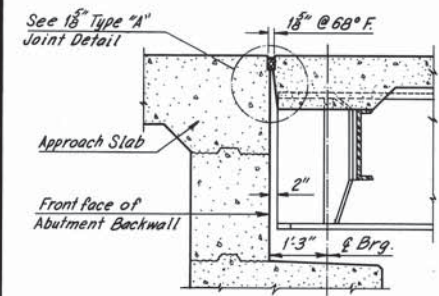


SECTION A-A
Scale: 1/2" = 1'-0"

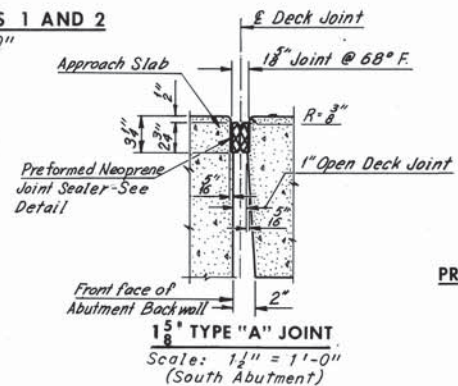


1 5/8" TYPE "A" JOINT
Scale: 1 1/2" = 1'-0"
(South Abutment)

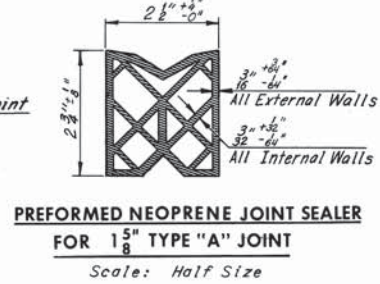


PREFORMED NEOPRENE JOINT SEALER FOR 1 5/8" TYPE "A" JOINT
Scale: Half Size

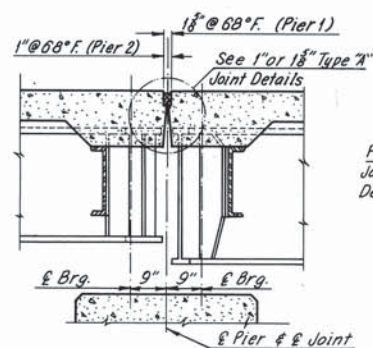


SECTION B-B
Scale: 1/2" = 1'-0"

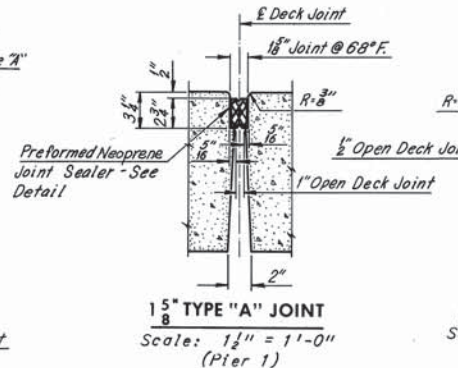


1 5/8" TYPE "A" JOINT
Scale: 1 1/2" = 1'-0"
(Pier 1)

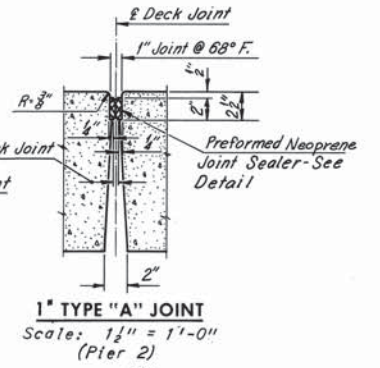

1" TYPE "A" JOINT
Scale: 1 1/2" = 1'-0"
(Pier 2)

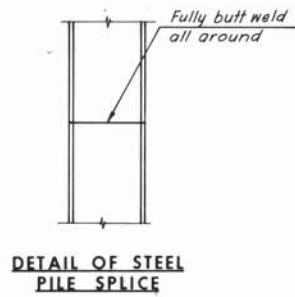

DETAIL OF STEEL PILE SPLICE

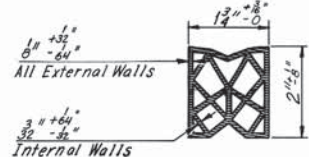

PREFORMED NEOPRENE JOINT SEALER FOR 1" TYPE "A" JOINT
Scale: Half Size

Note: It is absolutely essential that the openings for the preformed neoprene joint sealers be accurately formed and constructed to smooth, straight lines. The size of the opening shall be adjusted to allow for anticipated dead load rotation of the ends of the slab and for the temperature at the time of construction.

AS BUILT

RICHMOND METROPOLITAN AUTHORITY
RICHMOND EXPRESSWAY SYSTEM
BELTLINE EXPRESSWAY

BRIDGE NO. 17
RAMP S-CARY OVER
EAST-NORTH ROADWAY
JOINT DETAILS

| BY | DATE | NO. | REVISION | BY | DATE |
|-----------|--------|---------|----------|---------|-------------|
| AS BUILT | | 3 | | R.H. | 2-5-73 |
| MADE | D.E.S. | 3-21-68 | 2 | Parapet | J.G.V. 1-71 |
| CHECKED | SSW | 3-22-68 | 1 | General | P.S. 10-70 |
| IN CHARGE | FKD | | | | |


| | |
|---|---|
| HOWARD, NEEDLES, TAMMEN & BERGENDOFF consulting engineers NEW YORK ALEXANDRIA KANSAS CITY | SCALE: As noted CONTRACT NO. 4 SHEET NO. 12 OF 14 |
|---|---|

Bridge 47

(Randolph Street over Downtown Expressway - Rte. 195)


Record Set Plans

| RICHMOND EXPRESSWAY SYSTEM | | | |
|----------------------------|---------------------|-----------|--------------|
| SECTION | PROJECT | SHEET NO. | TOTAL SHEETS |
| 8 | DOWNTOWN EXPRESSWAY | 184 | |

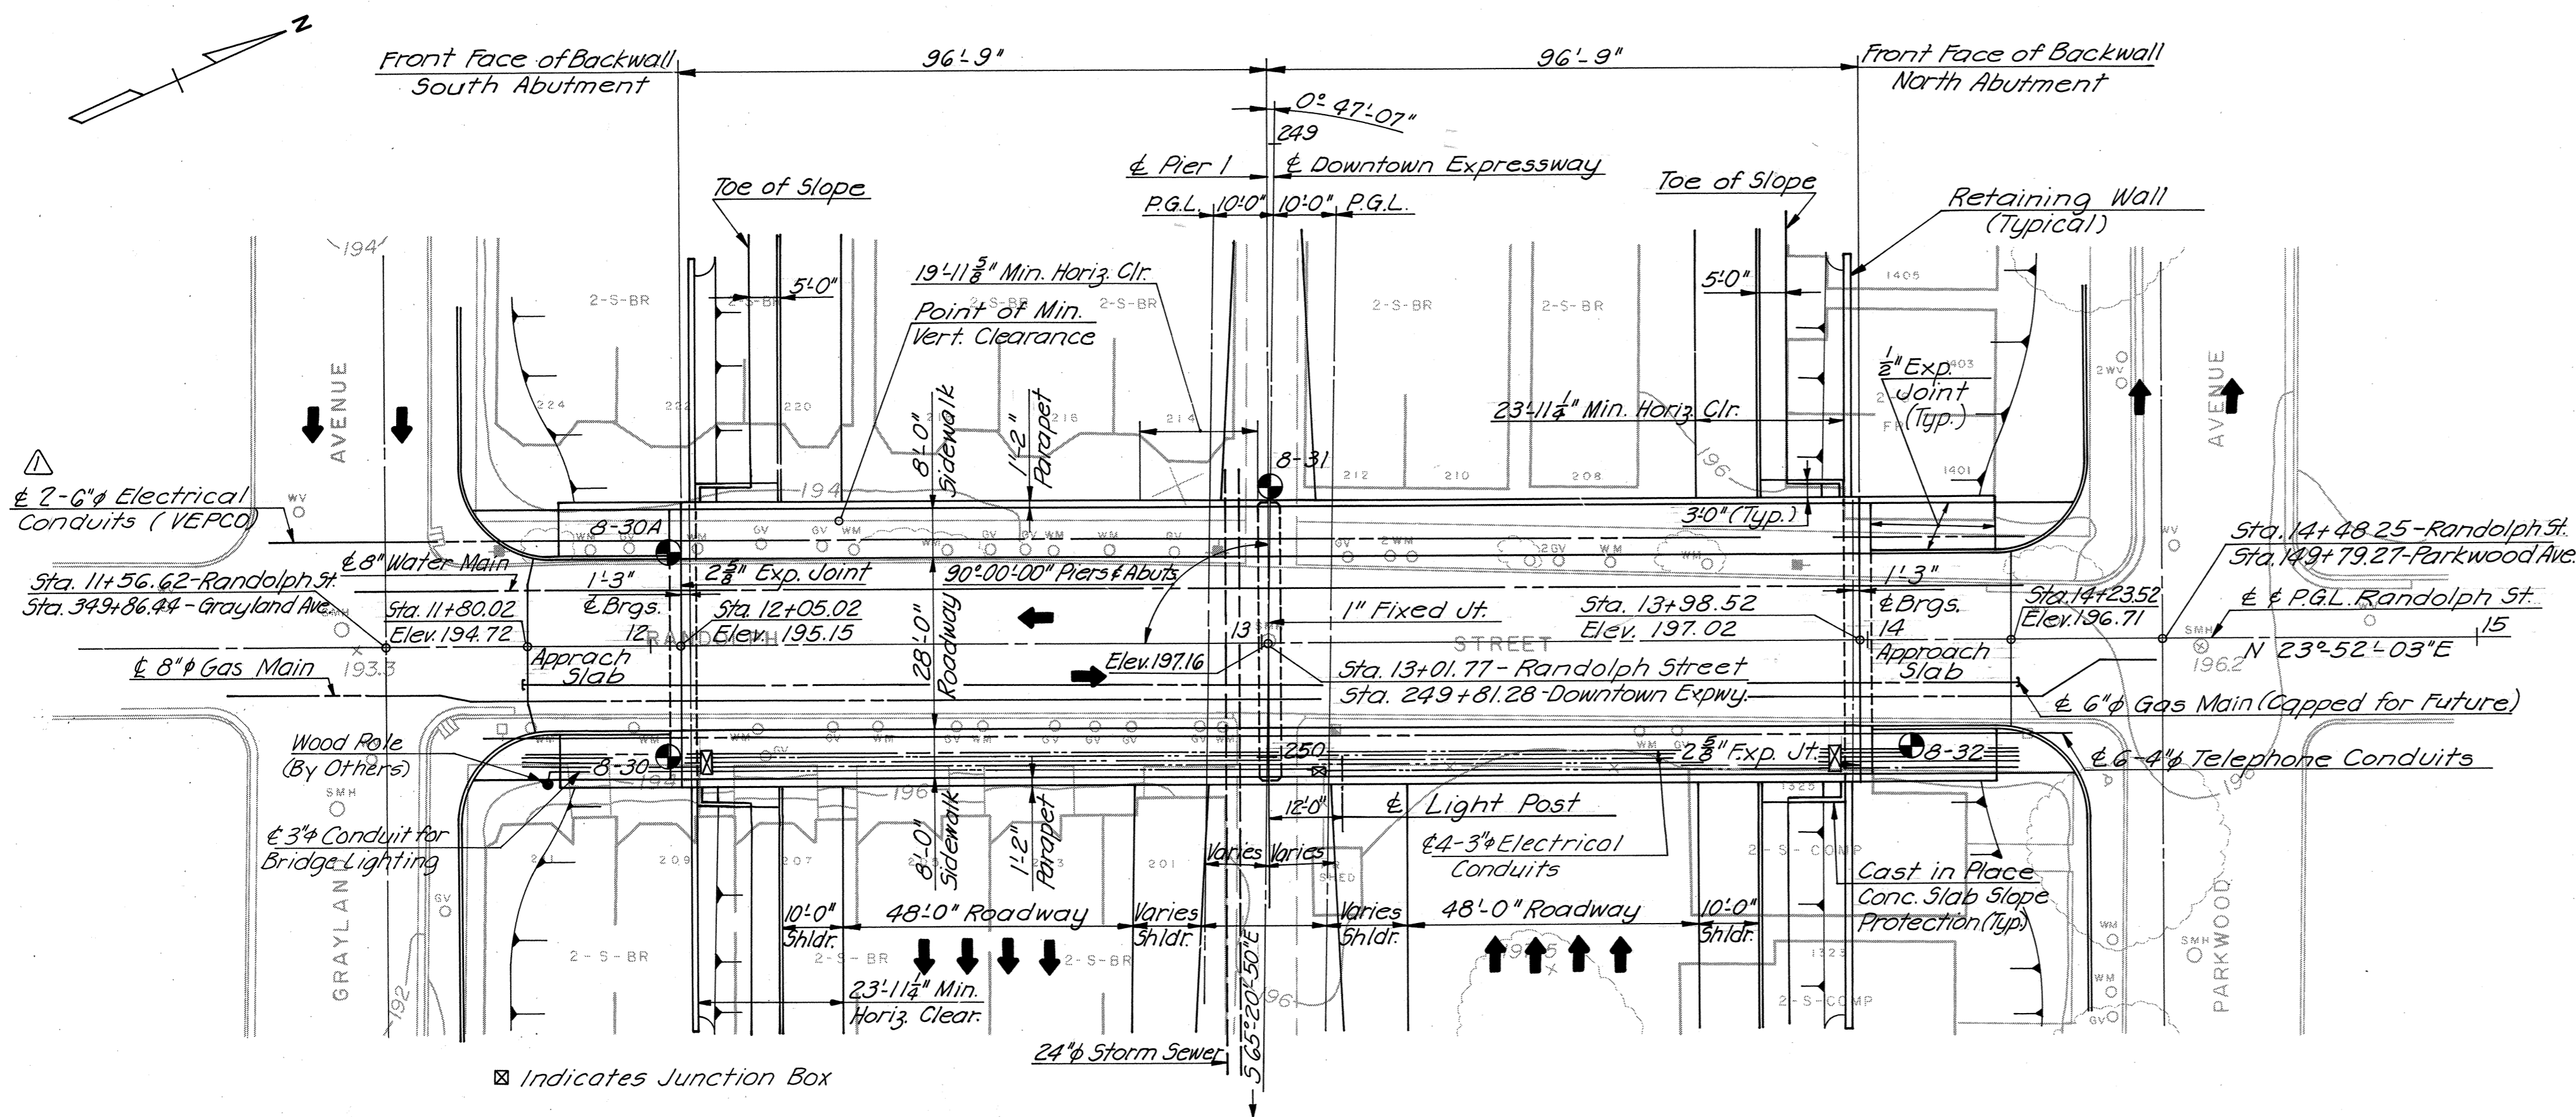


Indicates Junction Box

PLAN

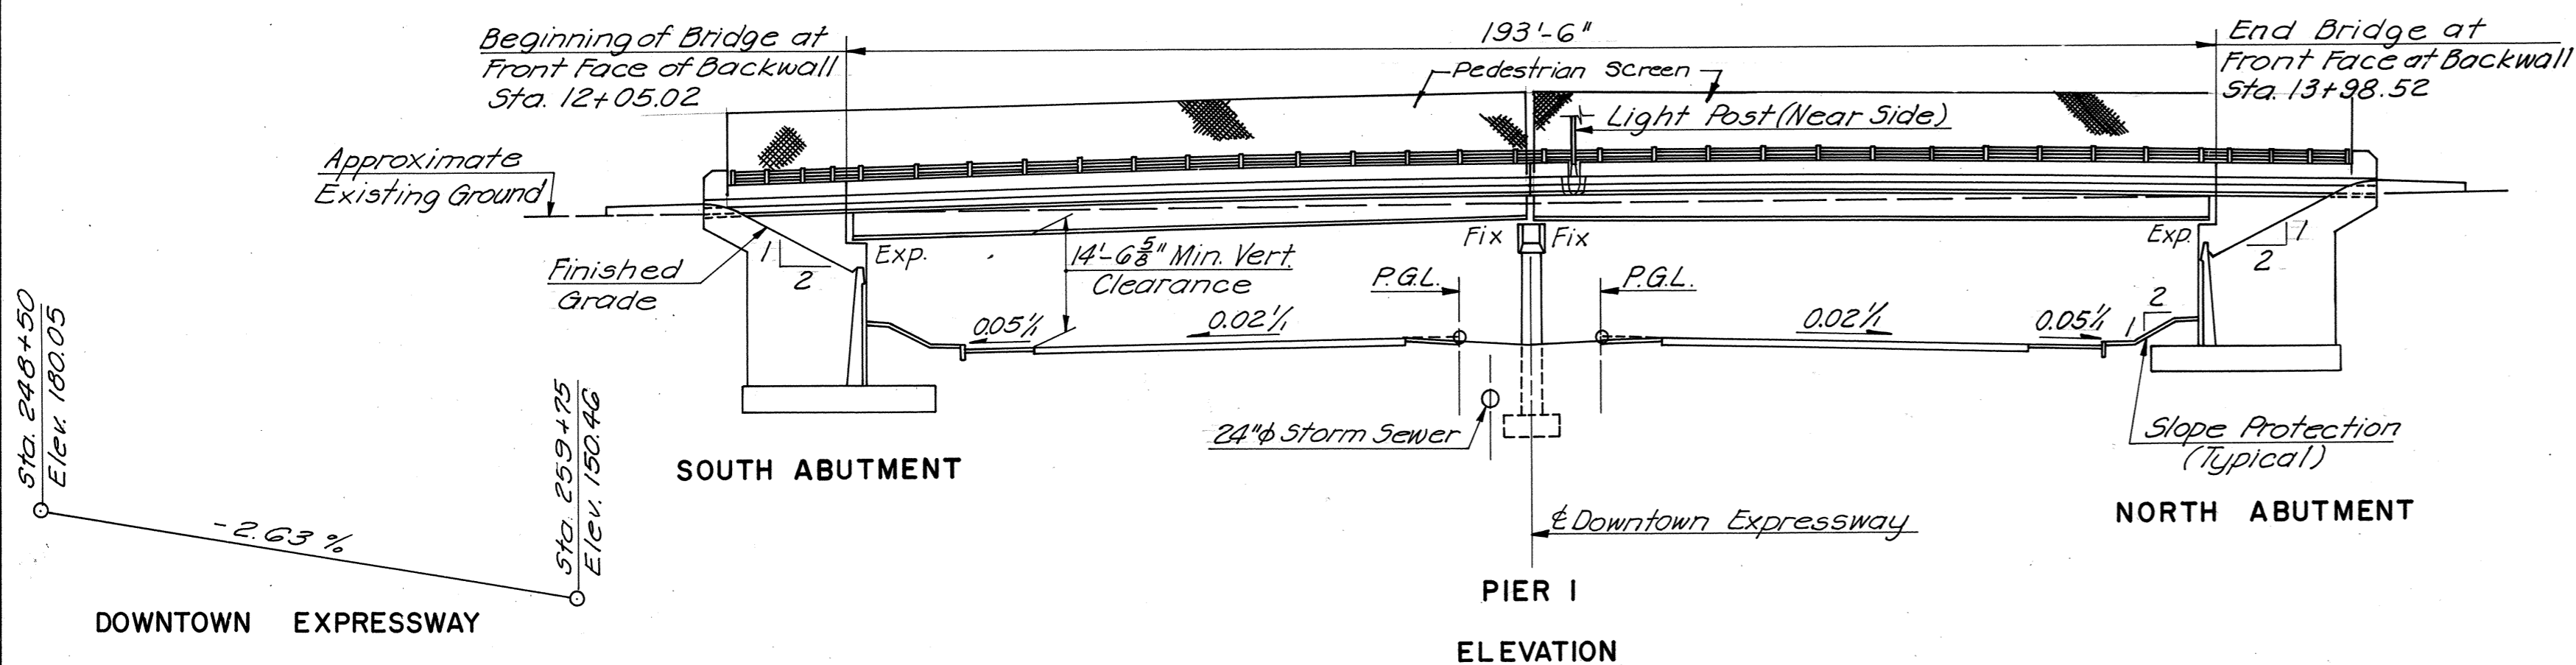

ELEVATION

NOTES:
 Top of Pavement Elevations at ends of deck along P.G.L. are given on plan; Remaining pavement elevations are given on Sheet 10.
 Indicates 2 1/2" Cased Hole Boring.

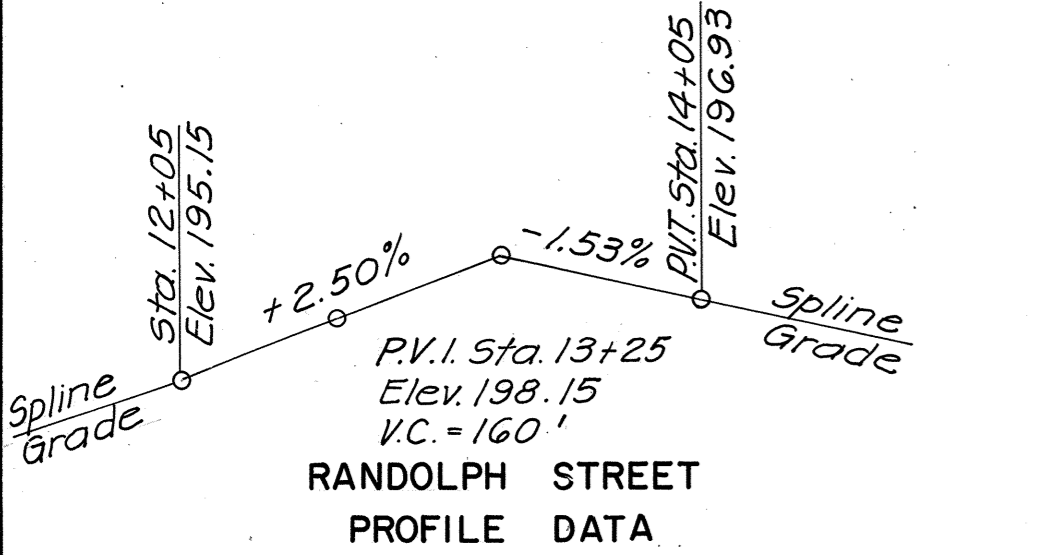

| MADE | BY | DATE | REVISED | BY | DATE |
|-----------|--------|-------|---------------------|--------|----------|
| W.D.U. | W.D.U. | 8-67 | AS BUILT | H.M.W. | |
| CHECKED | W.E.O. | 11-67 | REV. NO. & QUANTITY | D.G.T. | 11/27/74 |
| IN CHARGE | W.E.O. | | NO. REVISION | BY | DATE |

| | ESTIMATED QUANTITIES | | | | | | | | | | | | | | | | | | |
|----------------|----------------------|-------------------|-------------------|-------------------|----------------------|-------------------------|-----------------------------|-----------------------|------------------------|-----------------|---------------|-------------|-------------|---------------|------------------|------------------|----------------|------------------|-------------------|
| | STRUCTURE EXCAVATION | CONCRETE CLASS A4 | CONCRETE CLASS A3 | REINFORCING STEEL | STRUCTURAL STEEL A36 | ALUMINUM BRIDGE RAILING | CONC. SLAB SLOPE PROTECTION | ASPHALT DAMP-PROOFING | 6-INCH PIPE UNDERDRAIN | POROUS BACKFILL | STONE BEDDING | GAS MAIN 8" | GAS MAIN 6" | WATER MAIN 8" | CONDUIT 6" VEPCO | CONDUIT 4" TELE. | PVC CONDUIT 3" | METAL CONDUIT 2" | PEDESTRIAN SCREEN |
| | C.Y. | C.Y. | C.Y. | LBS. | LBS. | L.F. | S.Y. | S.Y. | L.F. | C.Y. | TON | L.F. | L.F. | L.F. | L.F. | L.F. | L.F. | L.F. | L.F. |
| Superstructure | | 365.56 | 516.27 | 70,753 | 334,842.8 | 462 | 82 | 225 | 123 | 87.5 | 52.47 | 245.5 | 245.5 | 247 | 483.1 | 1170 | 1225 | 4 | 462 |
| South Abutment | 1304.9 | | | 36,863 | | | | | | | 23.06 | | | | | | | | |
| Pier I | 315.4 | | 90.36 | 18,495 | | | | | | | | | | | | | | | |
| North Abutment | 950.7 | | 389.44 | 28,117 | | | 82 | 216 | 124 | 67.5 | 38.57 | | | | | | | | 6 |
| Approach Slabs | | | 78.3 | 16,951 | | | | | | | | | | | | | | | |
| Total | 2571 | 365.56 | 1074.37 | 171,179 | 334,842.8 | 462 | 164 | 441 | 247 | 155 | 114.10 | 245.5 | 245.5 | 247 | 483.1 | 1170 | 1225 | 4 | 474 |

GENERAL NOTES:
ROADWAY: One 28'-0" Clear roadway. Two 8'-0" sidewalks.
CAPACITY: Dead Load - Includes 15 lbs. per sq. ft. for future wearing surface.
 Live Loads - HS20-44 loading and B.R.R. modified for military vehicles.

SPECIFICATIONS:
GENERAL - Virginia Department of Highway Road and Bridge Specifications 1970
DESIGN - A.A.S.H.O. Standard Specifications for Highway Bridges, 1961 modified by Special Design Provisions.
WELDING - 1969 Standard Specifications for Welded Highway and Railway Bridges of the American Welding Society.

CONTRACT SPECIAL PROVISIONS:
 Specifications and Contract Special Provisions referred to above are necessary to make these plans complete.

DATUM: CITY OF RICHMOND

TEMPERATURE: The normal temperature referred to on the plan is 60°F. The temperature range for movement is 0°F to 120°F.

DIMENSIONS: All dimensions are measured horizontally and vertically unless otherwise noted.

EXCAVATION: Excavation below subgrade and cut slope template shall be classified as Structure Excavation. All excavation above these limits shall be classified as Regular Excavation and is not included in the Structural Quantities.

FOUNDATIONS: Footings shall rest on firm material. Foundation material shall be kept dry and special attention is called to section 401.05 of the General Specifications, and to the Contract Special Provisions, concerning preparation of foundations for footings.

CONCRETE NOTES:
 Concrete in superstructure shall be Class A4. All other concrete shall be Class A3. All exposed edges and corners shall have a 3/8" chamfer or fillet unless otherwise noted. Care in the method of vibration, the use of low slump concrete and/or other means shall be employed to prevent downgrade movement of newly placed slab concrete. (When gradient is over 2%)
 Finishing concrete surfaces: See the Standard Architectural Detail Sheets and the Contract Special Provisions for types and details.

STEEL NOTES: Structural steel shall conform to A.S.T.M. Specification A36 except as noted.
 All field connections shall be made with high strength bolts. High strength bolts shall be 3/4" diameter unless otherwise noted and shall conform to A.S.T.M. Specification A-325.

BENCH MARK: C-32. Monument located in walk S.W. Corner Idlewood and S. Randolph Sts. Elev. 192.25.

| INDEX | |
|-------|---|
| No. | DESCRIPTION |
| 1 | General Plan and Elevation |
| 2 | South Abutment |
| 3 | North Abutment |
| 4 | Retaining Wall Details-North & South Abut's |
| 5 | Pier Details |
| 6 | Framing Plan |
| 7 | Cross Section and Utility Details |
| 8 | Deck Plan and Joint Details |
| 9 | Approach Slab & Slope Protection Details |
| 10 | Boring Logs |
| 11 | Standard Shoe Details |
| 12 | Standard Aluminum Railing Details |
| 13 | Standard Electrical Details |
| 14 | Standard Architectural Details |
| 15 | Standard Eleaf and Tele. Cond. Details |
| 16 | Standard Utility Support details @ Abutment |

AS BUILT



RICHMOND METROPOLITAN AUTHORITY
 RICHMOND EXPRESSWAY SYSTEM
 DOWNTOWN EXPRESSWAY

STRUCTURE B 47
 RANDOLPH STREET OVER
 DOWNTOWN EXPRESSWAY
GENERAL PLAN AND ELEVATION

AMERICAN ENGINEERS
 Richmond, Virginia
 HOWARD, NEEDLES, TAMMEN & BERGENDOFF
 General Consultants


SCALE: 1" = 20'
 CONTRACT NO.: 8
 SHEET NO. 1 OF 12

| RICHMOND EXPRESSWAY SYSTEM | | | |
|----------------------------|---------------------|-----------|--------------|
| SECTION | PROJECT | SHEET NO. | TOTAL SHEETS |
| 8 | DOWNTOWN EXPRESSWAY | 190 | |

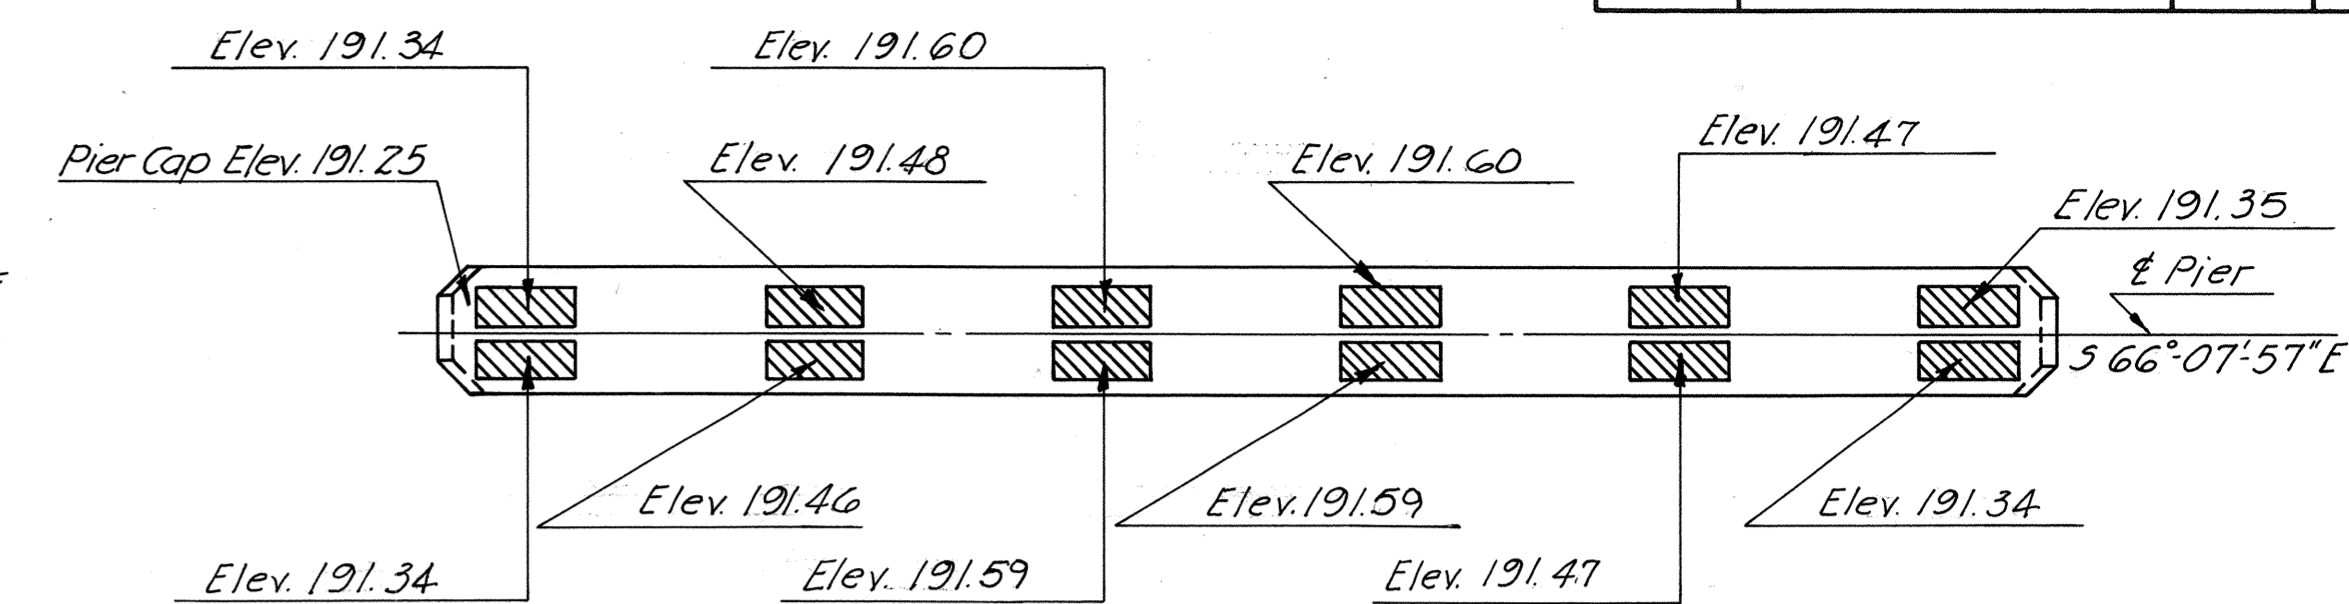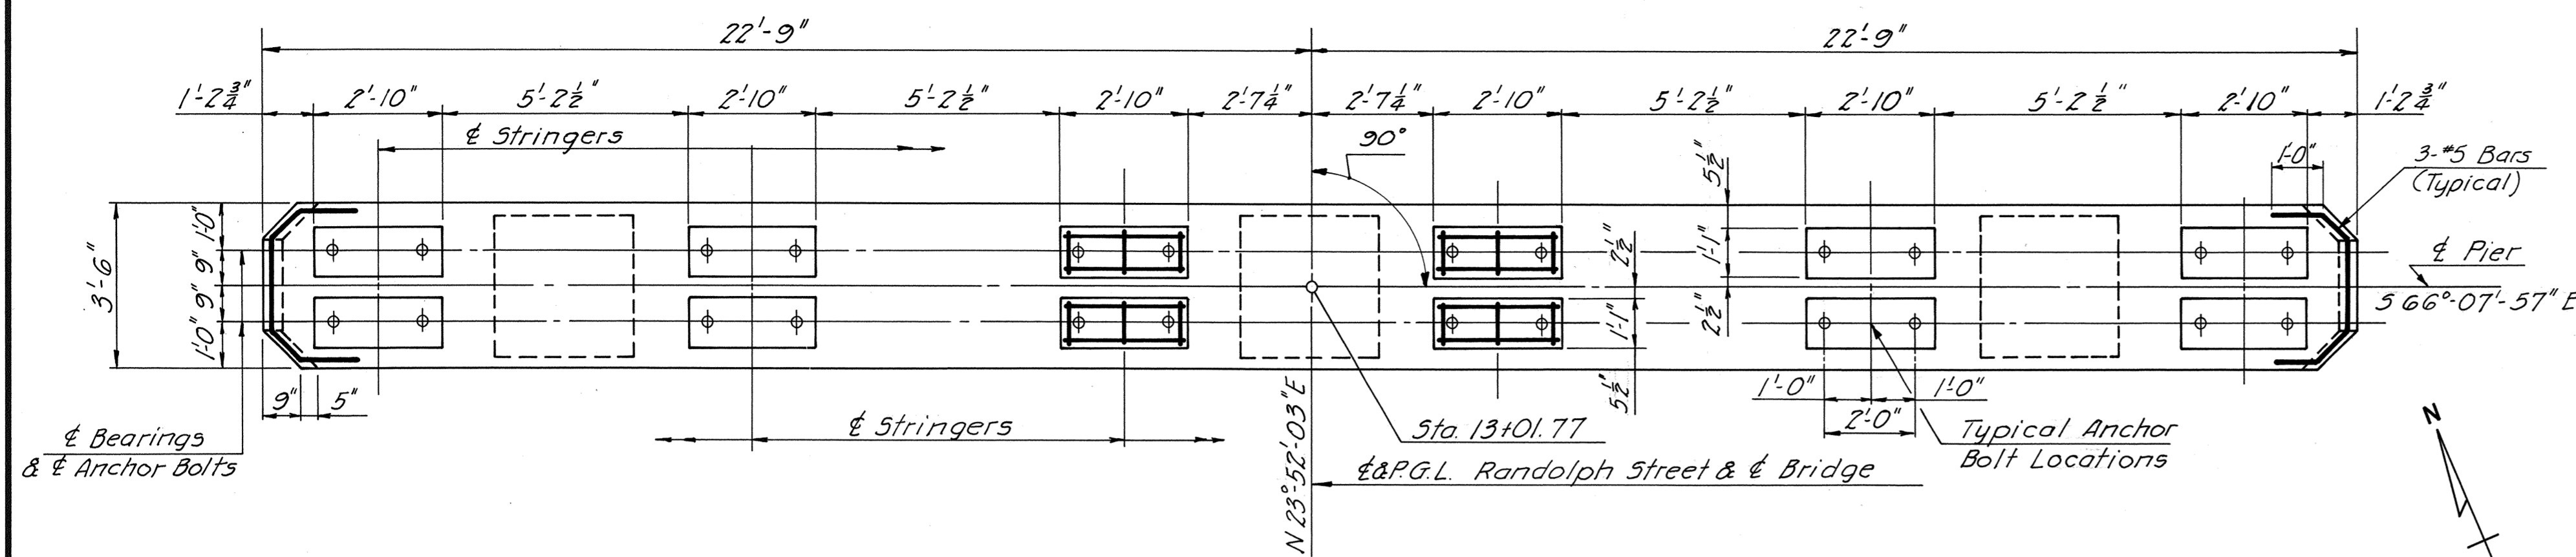


PLAN
Scale: 3/8" = 1'-0"


PAD ELEVATIONS
Scale: 1/8" = 1'-0"

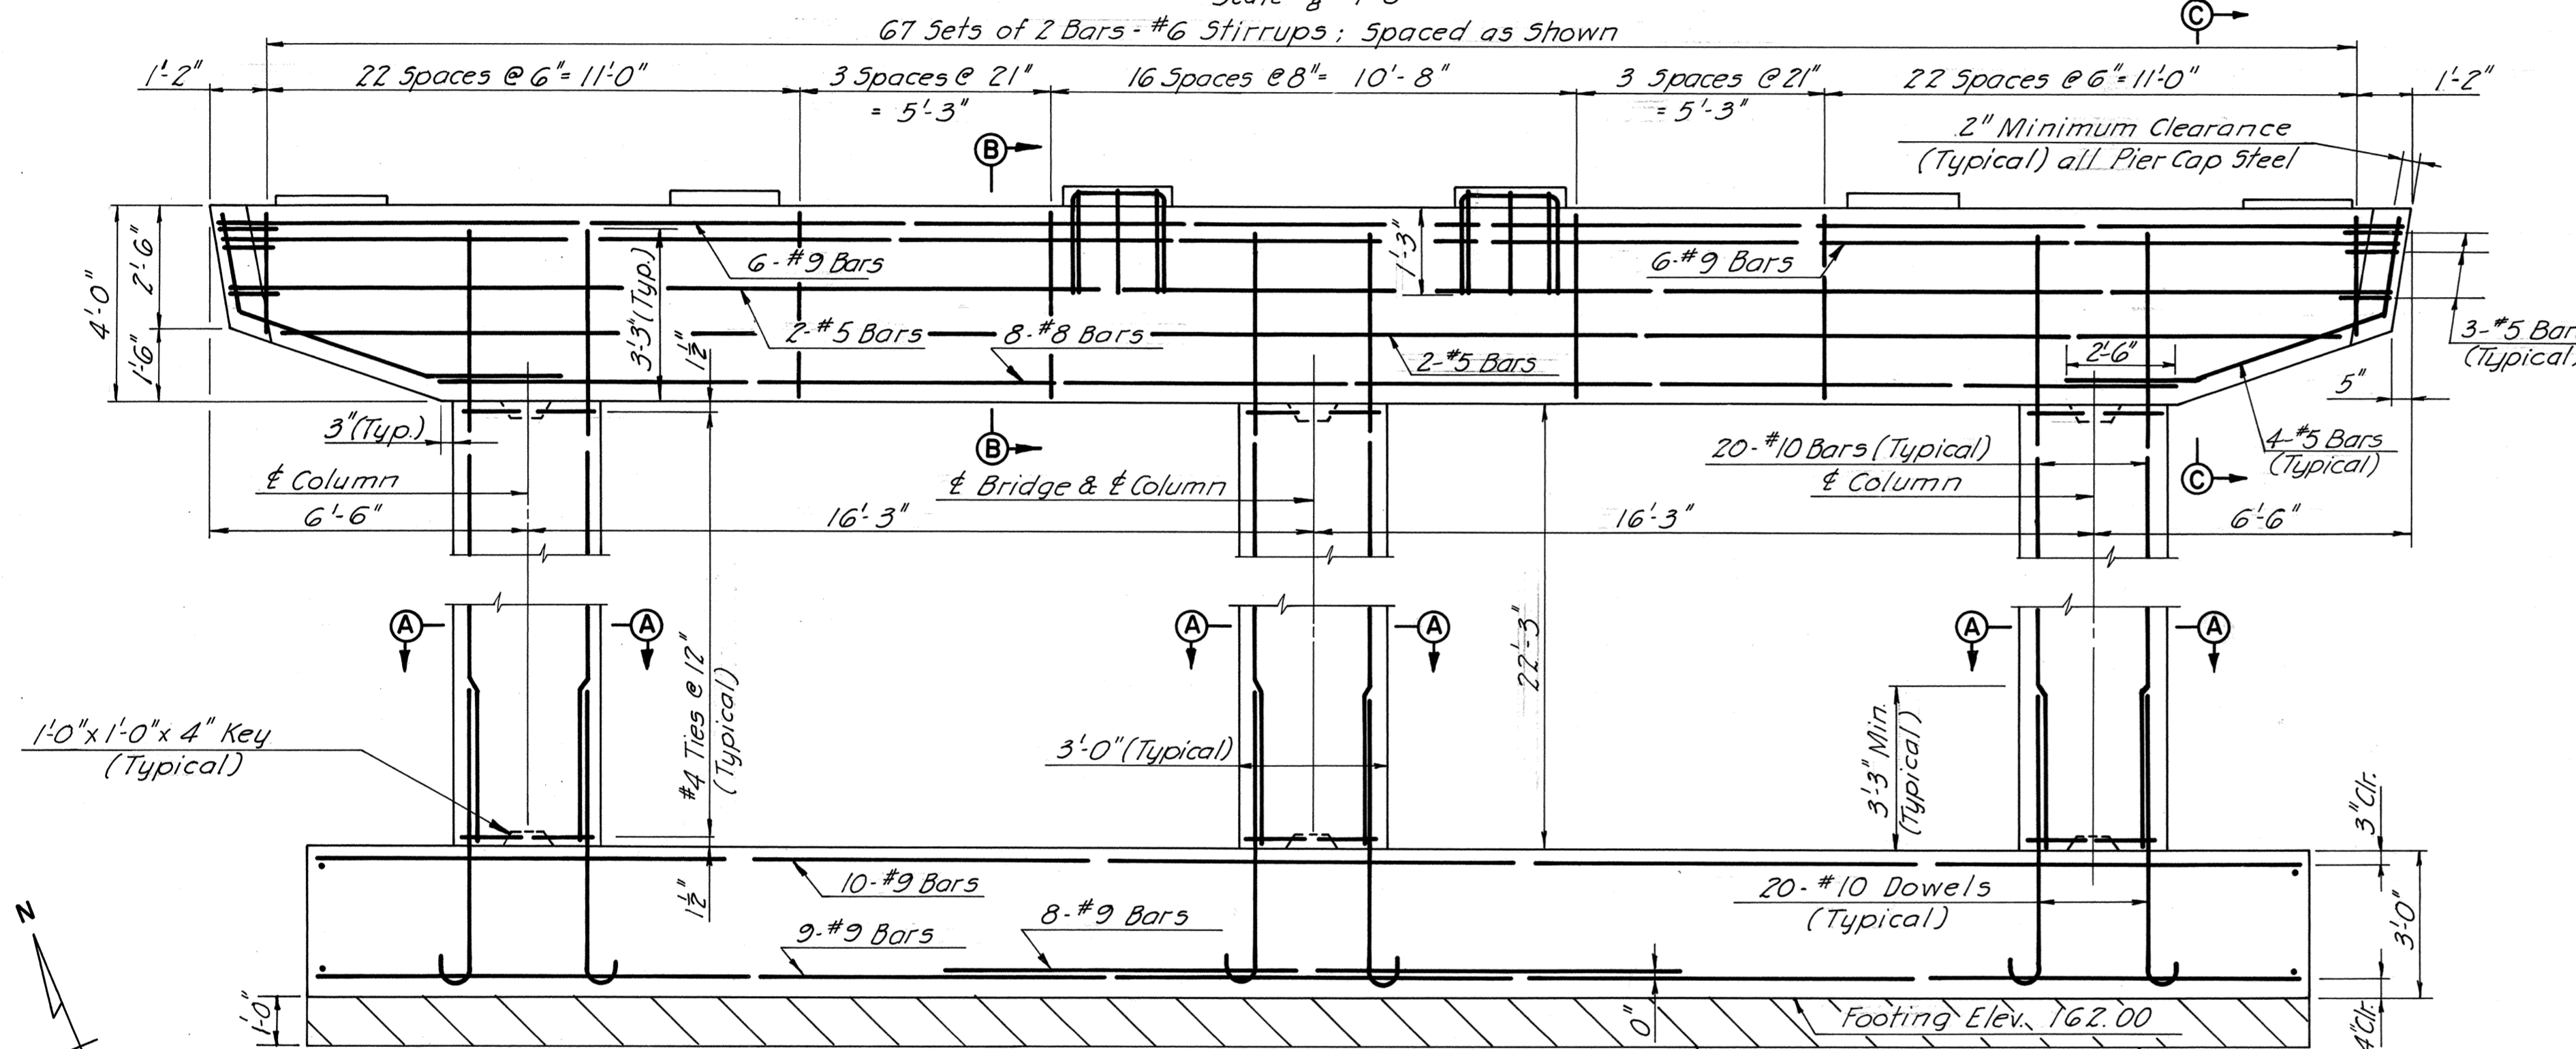


ELEVATION
Scale: 3/8" = 1'-0"

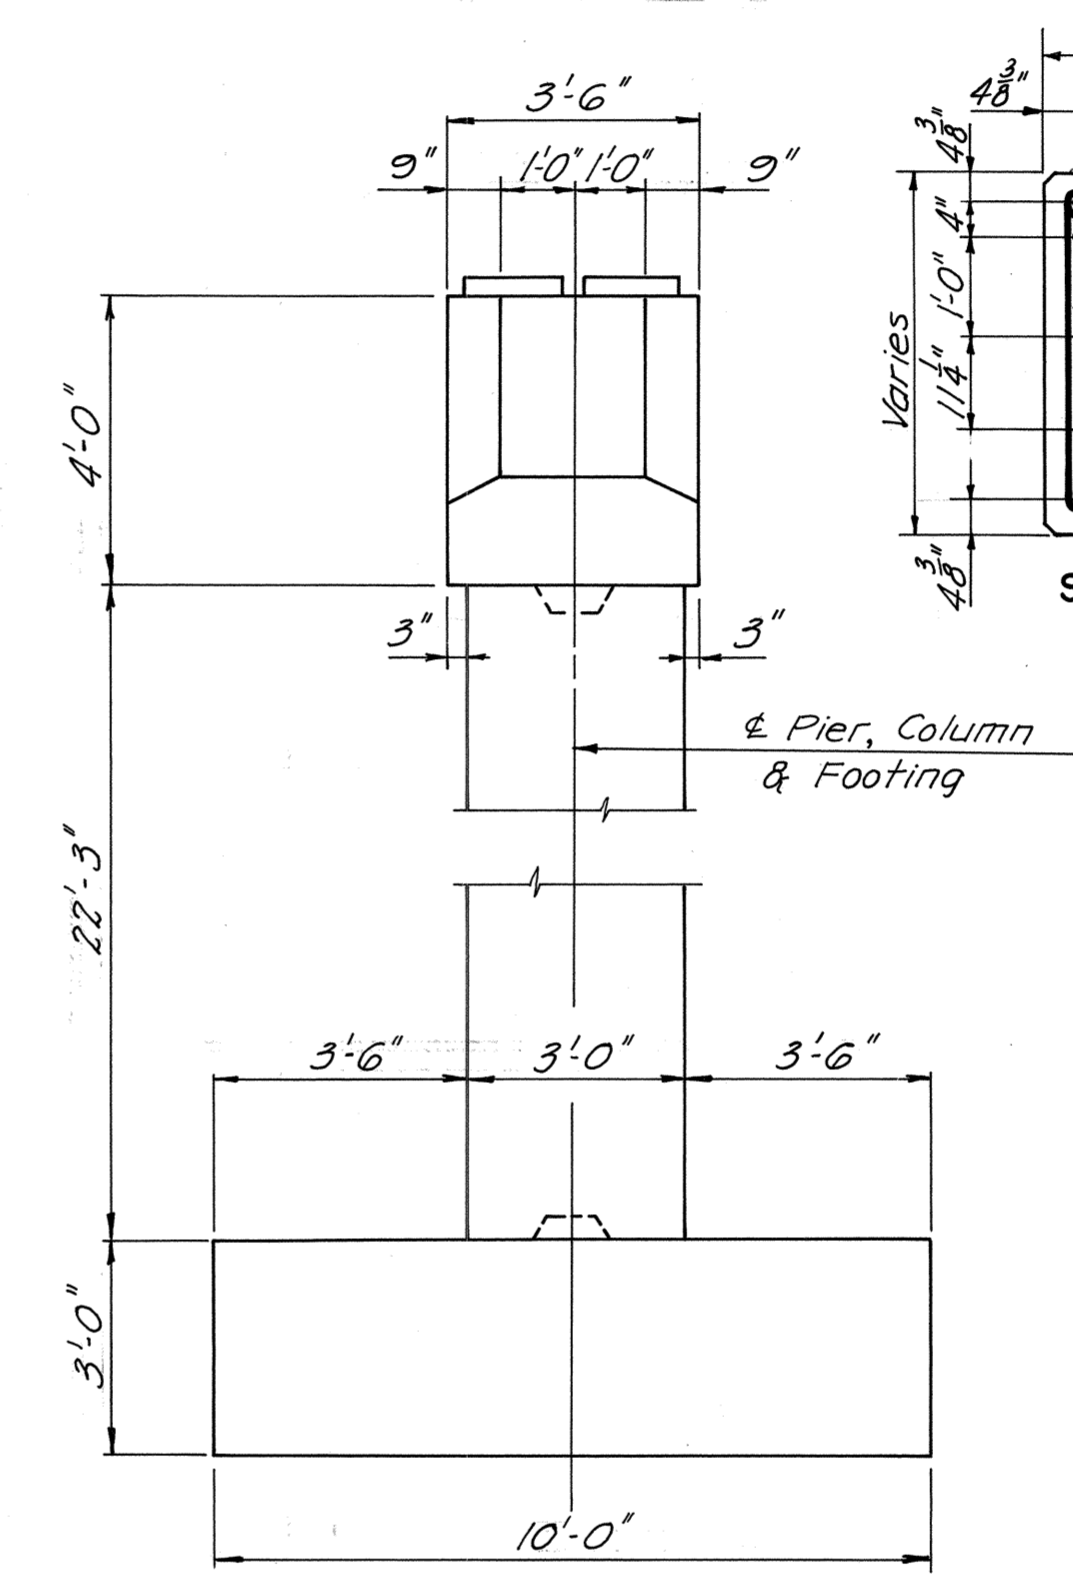


SECTION C-C
Scale: 1/2" = 1'-0"

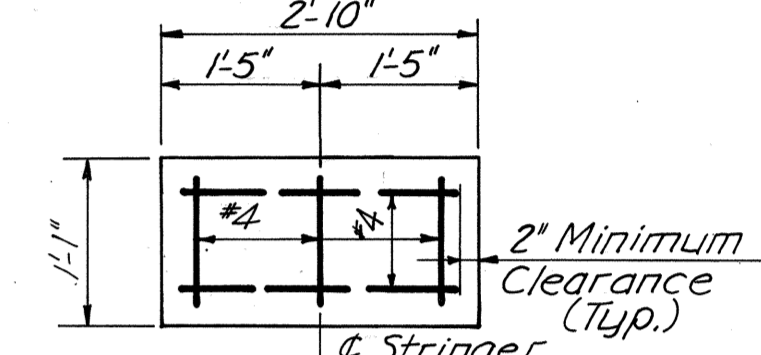


TYPICAL PAD DETAIL
Scale: 3/4" = 1'-0"

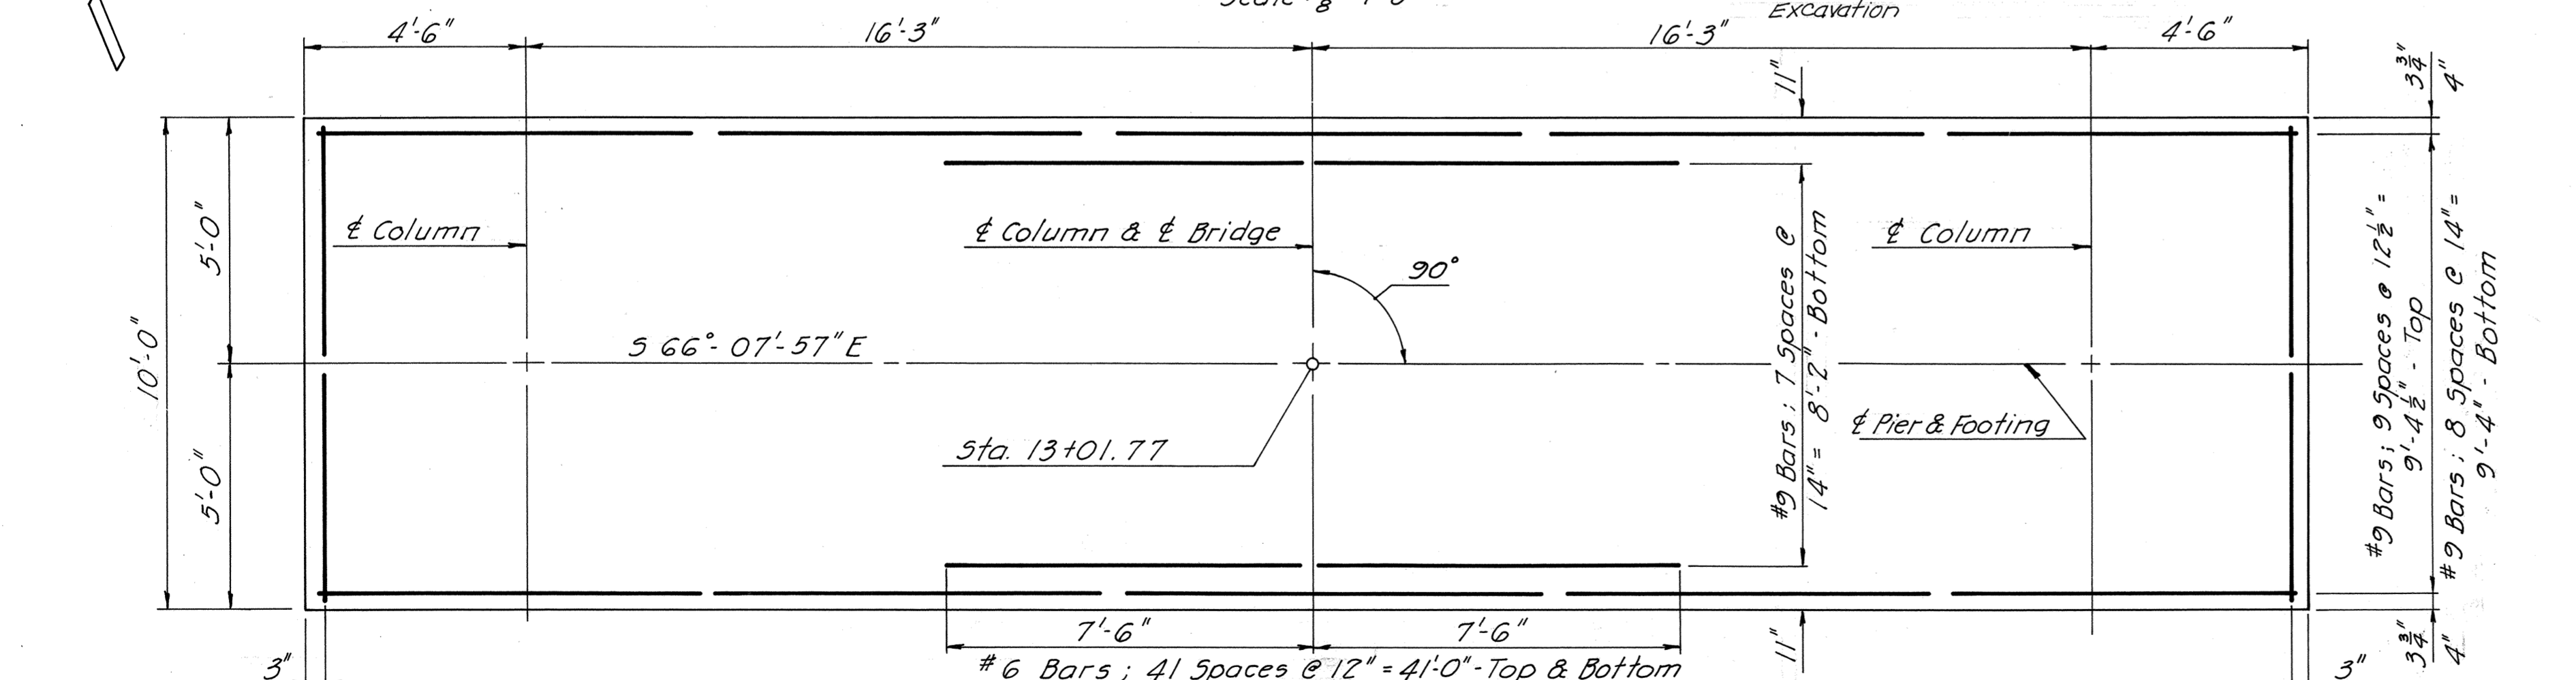

FOOTING PLAN
Scale: 3/8" = 1'-0"

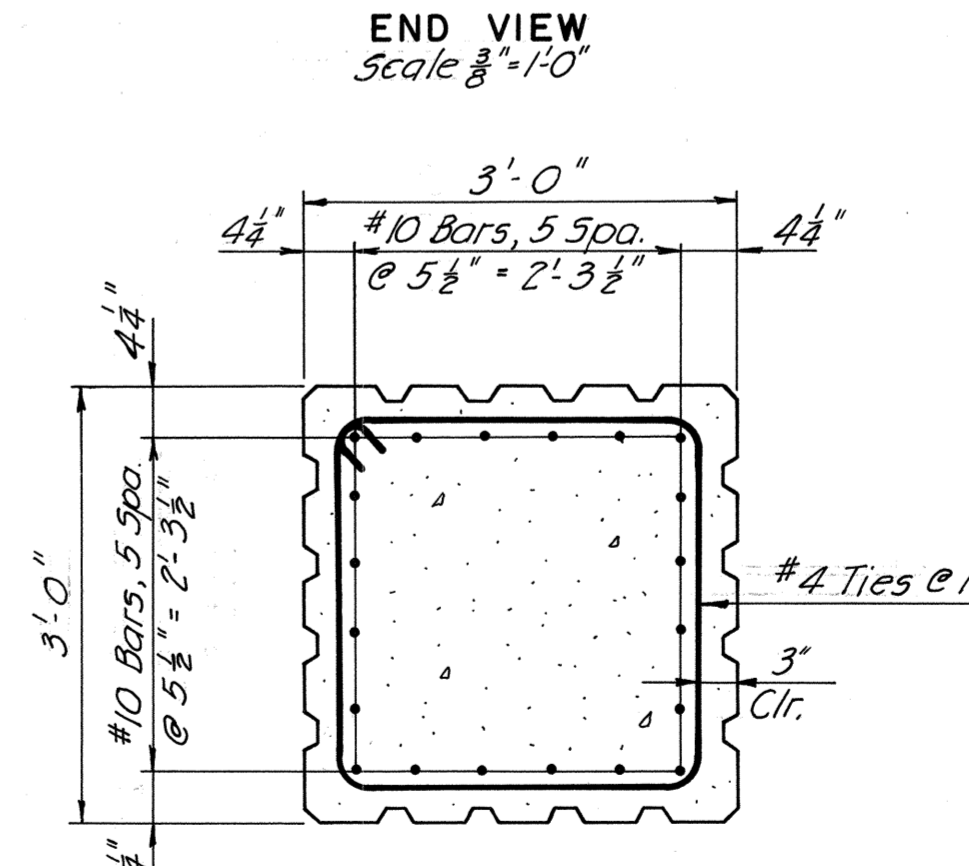

SECTION A-A
Scale: 3/4" = 1'-0"

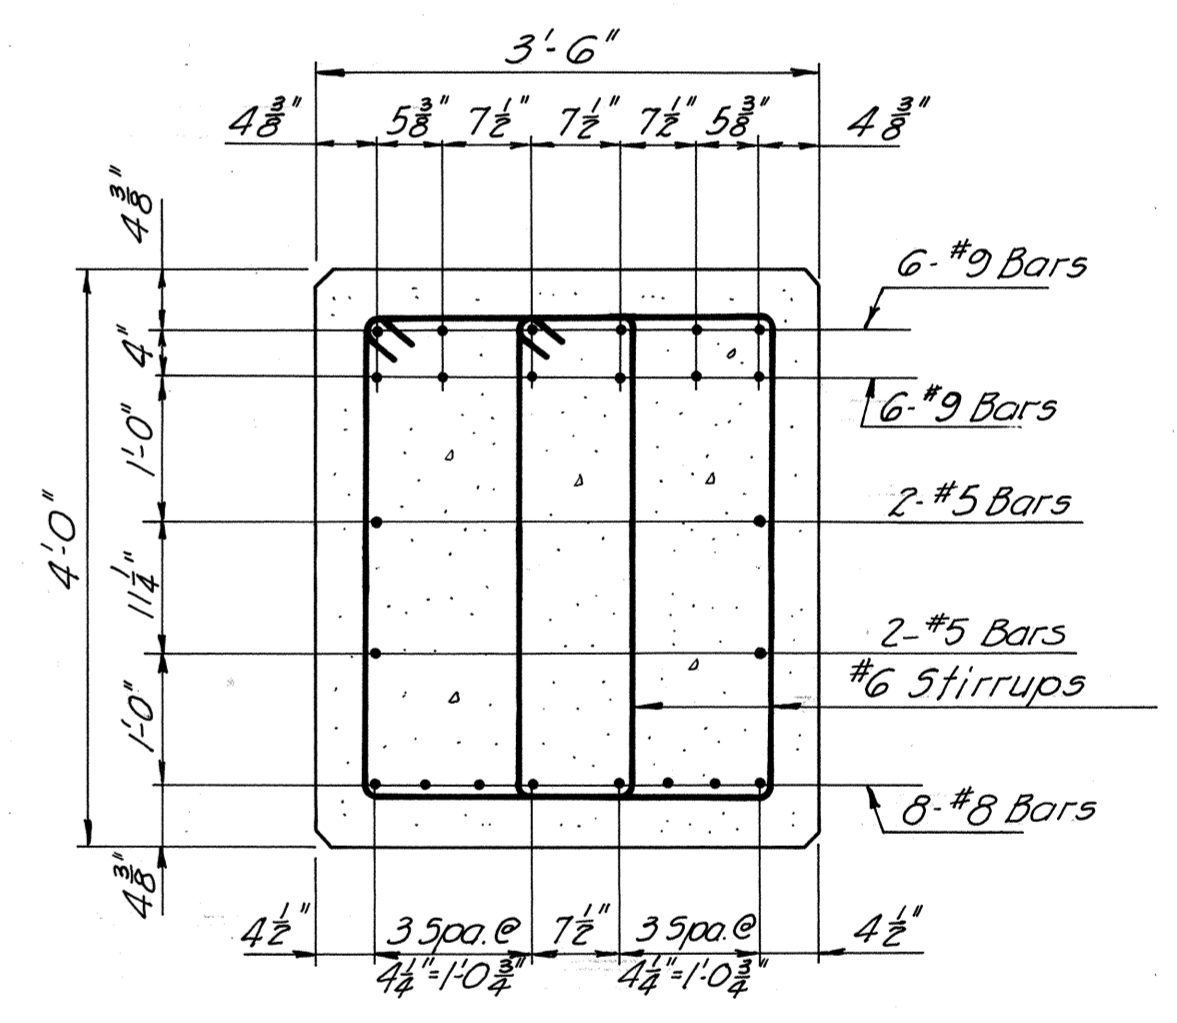

SECTION B-B
Scale: 3/4" = 1'-0"

NOTES:
For Framing Plan Details, see Sheet 8.
For Bearing Details, see Sheet 51.
For General Notes, see Sheet 1.
For Architectural Treatment, see Sheet 57 to 59.

FOUNDATION NOTE:
Foundation Elevations are approximate and may be varied to suit field conditions as directed by the Engineer. Vertical Column reinforcing shall not be cut until these elevations are established.
Where elevations change by more than 2 feet, redesign will be required. Pier Foundation is designed for an allowable Bearing Pressure of 2 1/2 Tons per square foot.

| MADE | BY | DATE | NO. | REVISION | BY | DATE |
|------|--------|------|-----|----------|-----|------|
| | JMS | 9-67 | | | | |
| | WEO | 9-67 | | AS BUILT | HMW | |
| | W.E.O. | | | | | |

AS BUILT


RICHMOND METROPOLITAN AUTHORITY
RICHMOND EXPRESSWAY SYSTEM
DOWNTOWN EXPRESSWAY

STRUCTURE B 47
RANDOLPH STREET OVER
DOWNTOWN EXPRESSWAY

PIER DETAILS

| | |
|---|-------------------|
| AMERICAN ENGINEERS Richmond, Virginia | SCALE: AS NOTED |
| HOWARD, NEEDLES, TAMMEN & BERGENDOFF General Consultants | CONTRACT NO.: 8 |
| | SHEET NO. 7 OF 12 |


| RICHMOND EXPRESSWAY SYSTEM | | | |
|----------------------------|---------------------|-----------|--------------|
| SECTION | PROJECT | SHEET NO. | TOTAL SHEETS |
| 8 | DOWNTOWN EXPRESSWAY | 191 | |

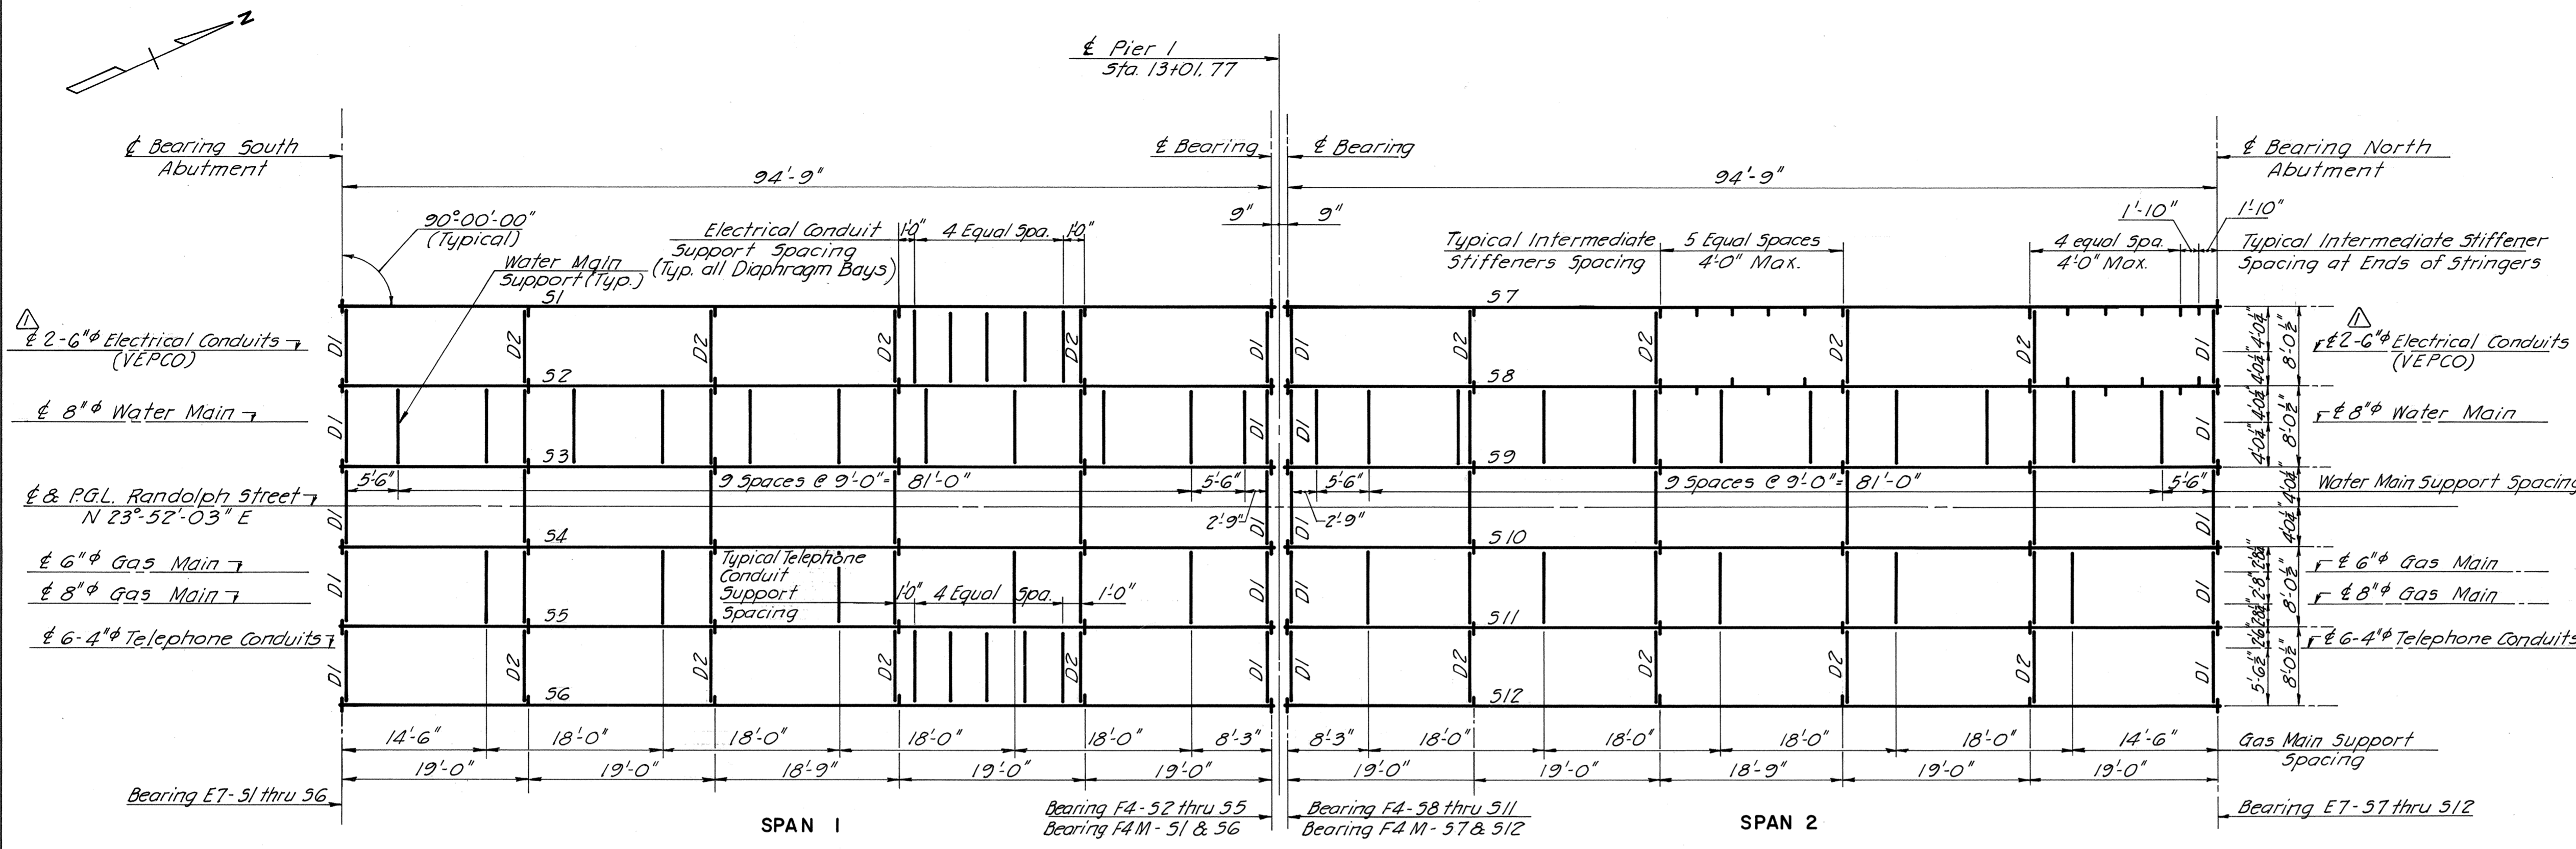


FRAMING PLAN
Scale: 1" = 10'-0"

NOTE:
All intermediate diaphragms are D3 unless otherwise noted. Intermediate stiffeners shall be located on inside face of stringers 51, 56, 57 & 512. They shall be placed on alternate sides along the remaining stringers.


| BEARING TYPE | No. REQUIRED |
|--------------|--------------|
| E7 | 12 |
| F4 | 8 |
| F4 M | 4 |

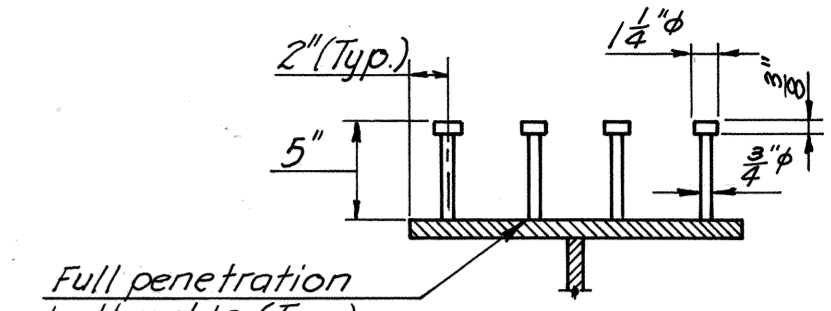

SHEAR STUD DETAIL
Scale: 1/2" = 1'-0"

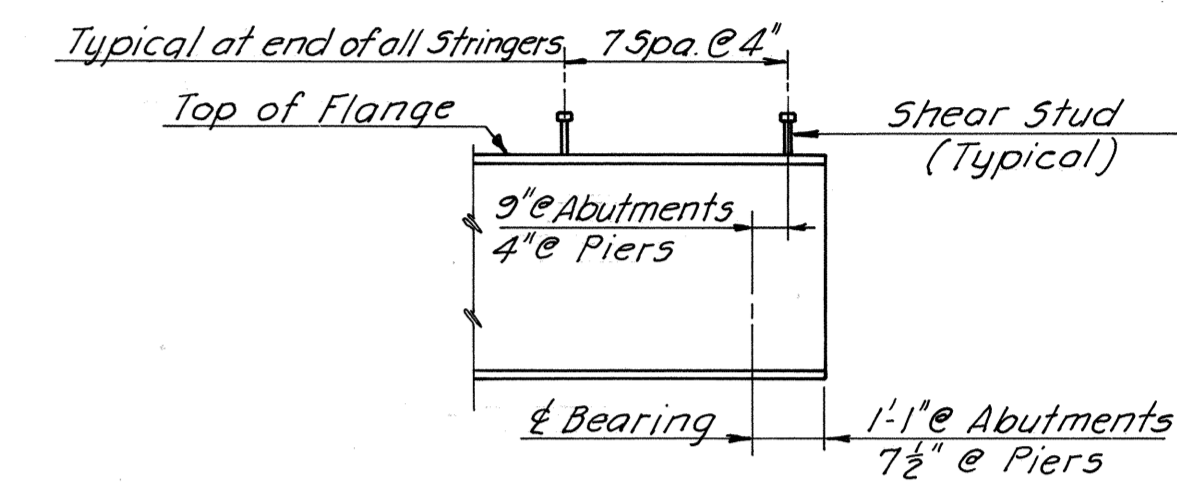


DETAIL "A"
No Scale

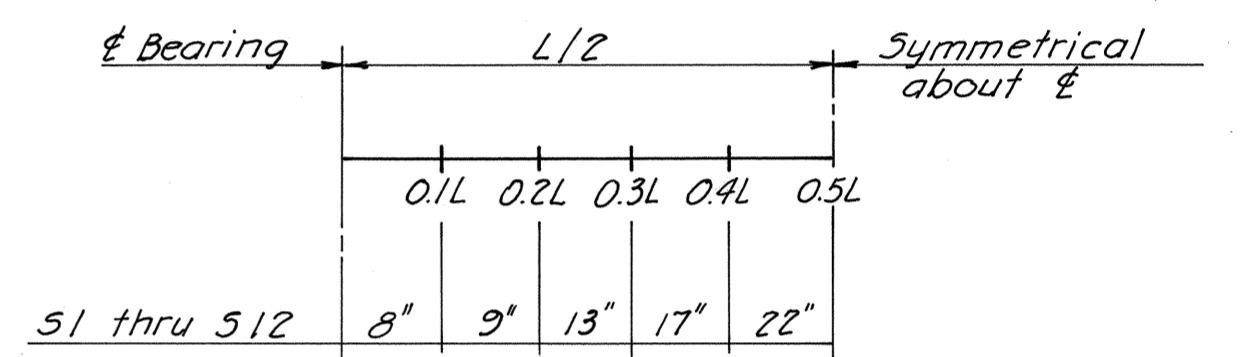

SHEAR STUD SPACING
No Scale


SHEAR STUD NOTES:
Capacity = 3400 lbs. per stud. Three 3/8" studs may be substituted at the same longitudinal spacing as shown for four 1/2" studs. Stud rows to be placed perpendicular to stringer. For end condition, see Detail "A".

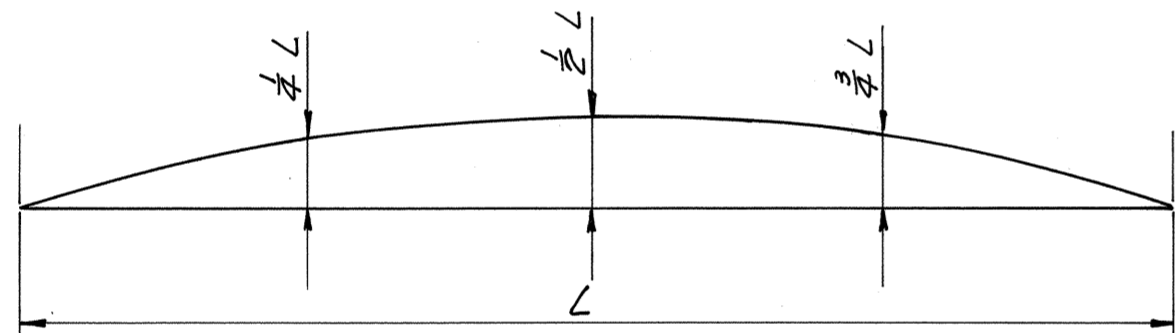

CAMBER DIAGRAM

| STRINGERS | 1/4 L | 1/2 L | 3/4 L |
|-------------|--------|--------|--------|
| 51, 56 | 3" | 4 1/2" | 3 1/2" |
| 52 thru 55 | 2 1/2" | 4 1/8" | 3 1/8" |
| 57, 512 | 4 1/8" | 5 3/8" | 4 1/8" |
| 58 thru 511 | 4 3/8" | 5 3/8" | 4 3/8" |


NOTE TO FABRICATOR:
The above stringers shall be fabricated with an upward camber amounting to (see table). This will provide approximate compensation for deflection under full dead load and for conformity with finished grade.

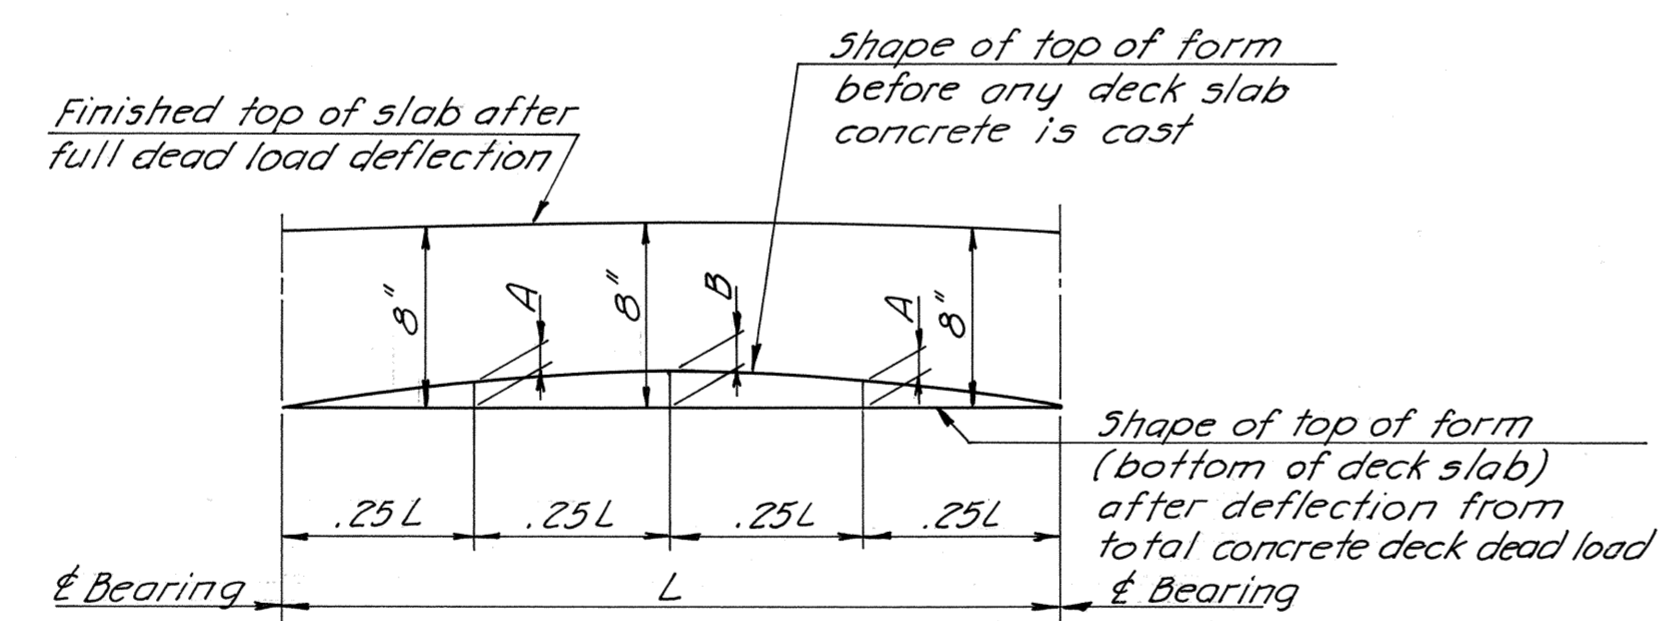

DEAD LOAD DEFLECTION DIAGRAM


| STRINGERS | A | B |
|-------------------------|--------|--------|
| 51, 56, 57, 512 | 1 3/8" | 1 1/2" |
| 52 thru 55, 58 thru 511 | 1 1/4" | 1 3/8" |

NOTE TO CONTRACTOR:
The above deflections are those anticipated to occur in the stringer upon placement of the total concrete deck dead load. In practice the stringers in place, are not likely to have the exact camber to compensate for these deflections during construction. The residual amounts shall be provided for by adjusting forms to vary the thickness of the concrete bolster between the bottom of the slab and the top of the stringer, without alteration of the slab thickness.

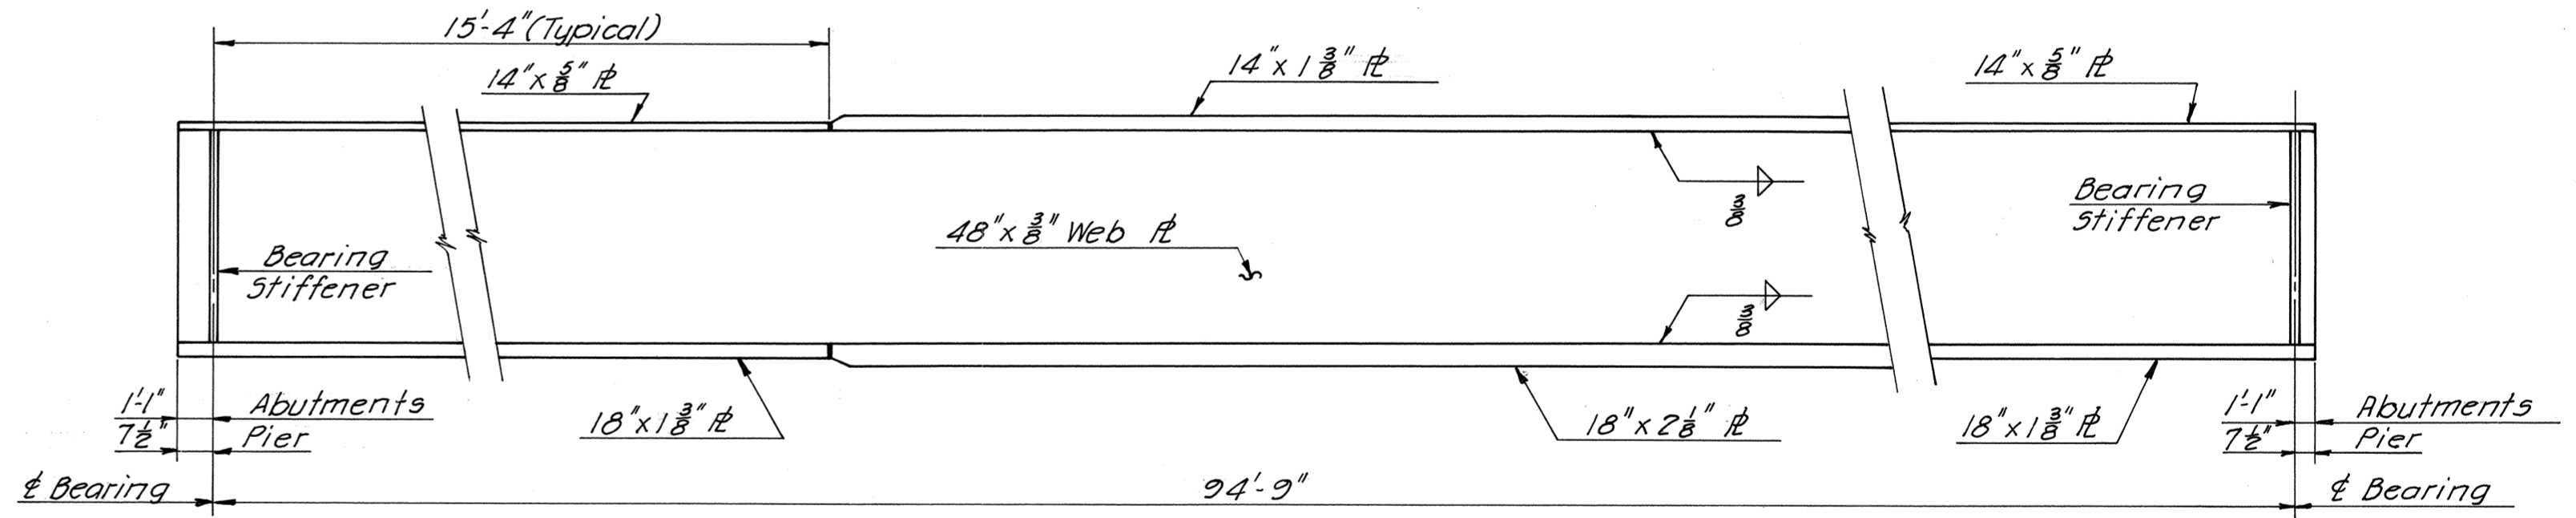


STRINGER DETAILS
No Scale


NOTES:
Structural Steel shall conform to ASTM Specifications A36 (latest revision). For General Notes, see Sheet 1. For Superstructure Cross Section, see Sheet 9. For Diaphragm Details, see Sheet 9. For Utility Support Details, see Sheet 9. For Bearing Shoe Dimensions, see Standard Sheet 51.

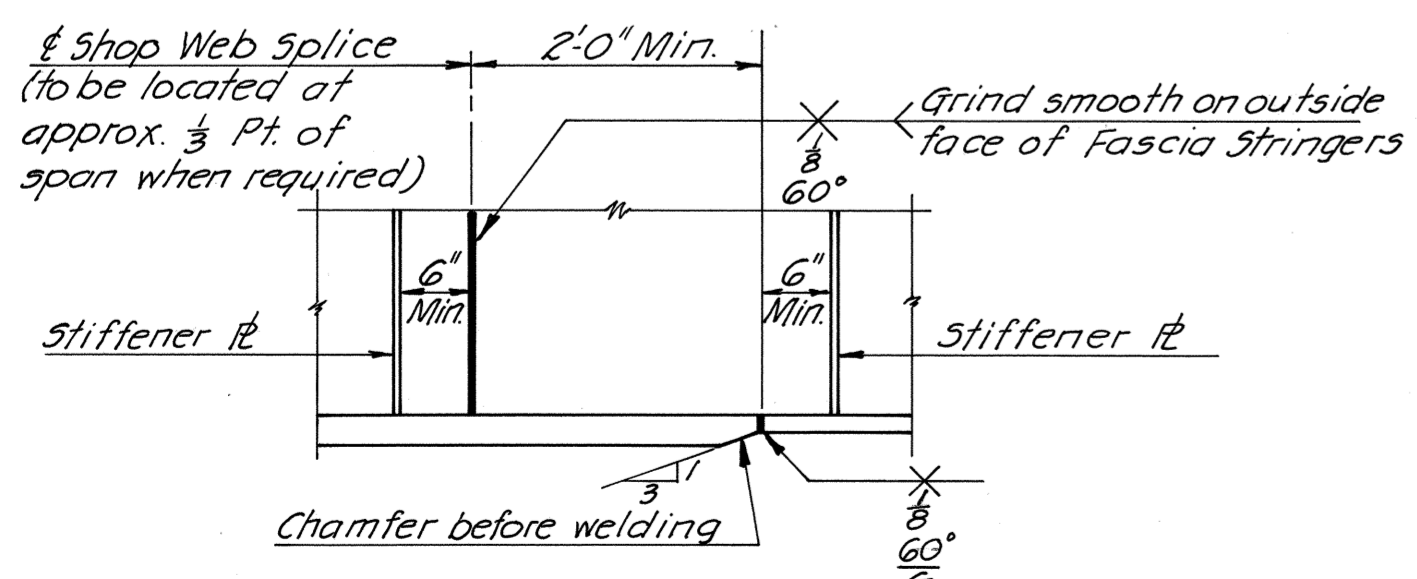

SHOP SPLICE DETAILS
No Scale

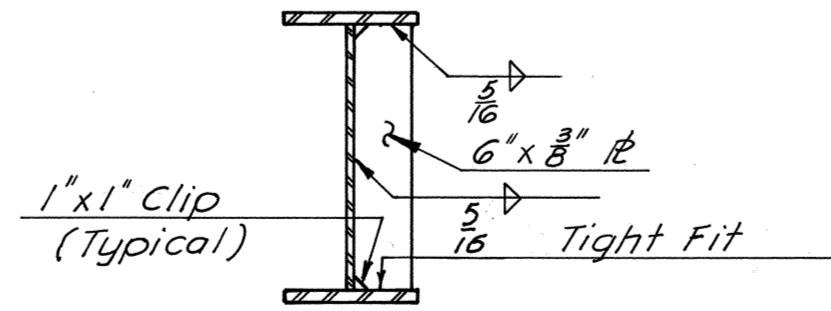

INTERMEDIATE STIFFENER

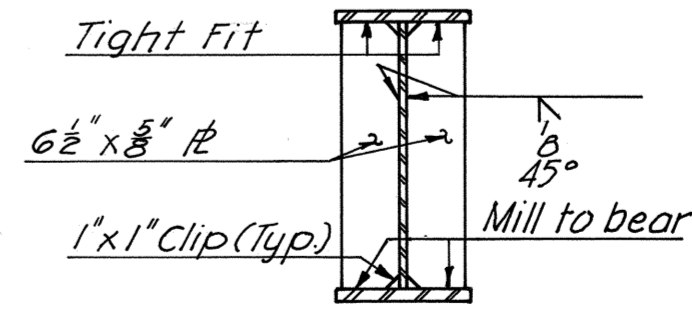

BEARING STIFFENER

STIFFENER DETAILS
No Scale

AS BUILT










| BY | DATE | REVISION | BY | DATE |
|-----------|------|----------|-------------------------|--------------|
| MADE | FBC | 7-67 | | |
| CHECKED | WEO | 9-67 | Rev. No. VEPCO Conduits | DGT 11/27/74 |
| IN CHARGE | WEO | | | |

RICHMOND METROPOLITAN AUTHORITY
RICHMOND EXPRESSWAY SYSTEM
DOWNTOWN EXPRESSWAY
STRUCTURE B 47
RANDOLPH STREET OVER
DOWNTOWN EXPRESSWAY
FRAMING PLAN

AMERICAN ENGINEERS
Richmond, Virginia
HOWARD, NEEDLES, TAMMEN & BERGENDOFF
General Consultants

SCALE: **AS NOTED**
CONTRACT NO.: **8**
SHEET NO. **8** OF **12**

| RICHMOND EXPRESSWAY SYSTEM | | | |
|----------------------------|---------------------|-----------|--------------|
| SECTION | PROJECT | SHEET NO. | TOTAL SHEETS |
| 8 | DOWNTOWN EXPRESSWAY | 193 | |

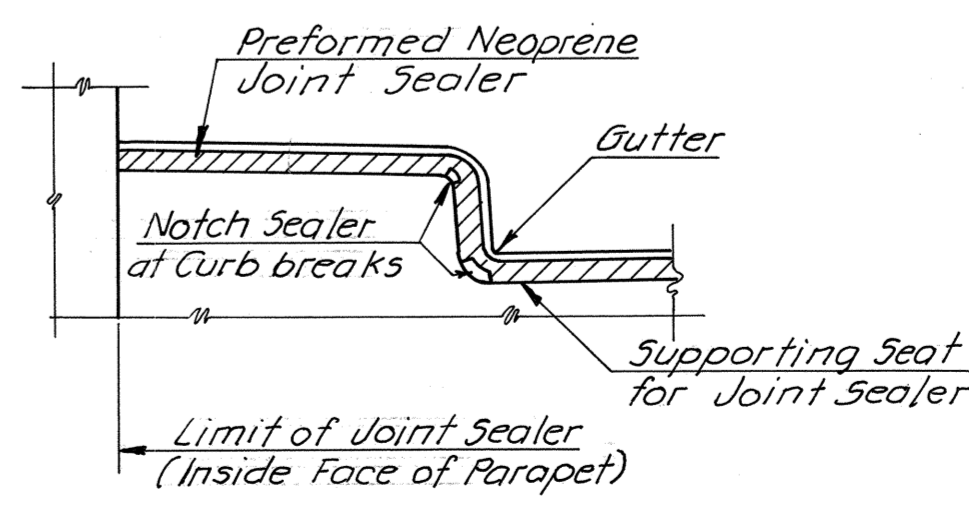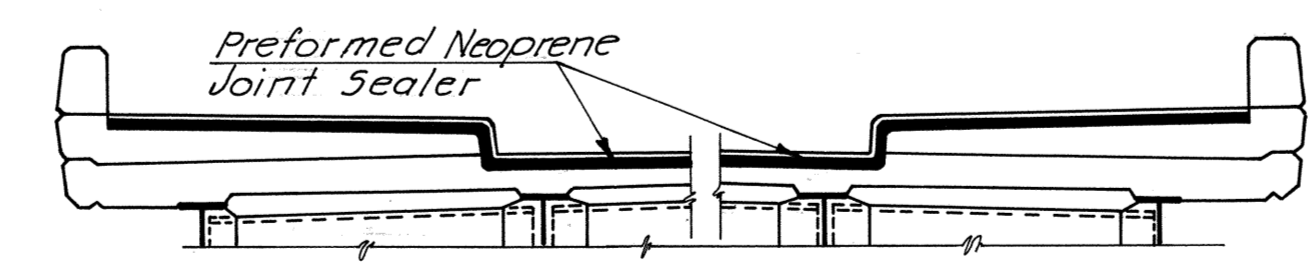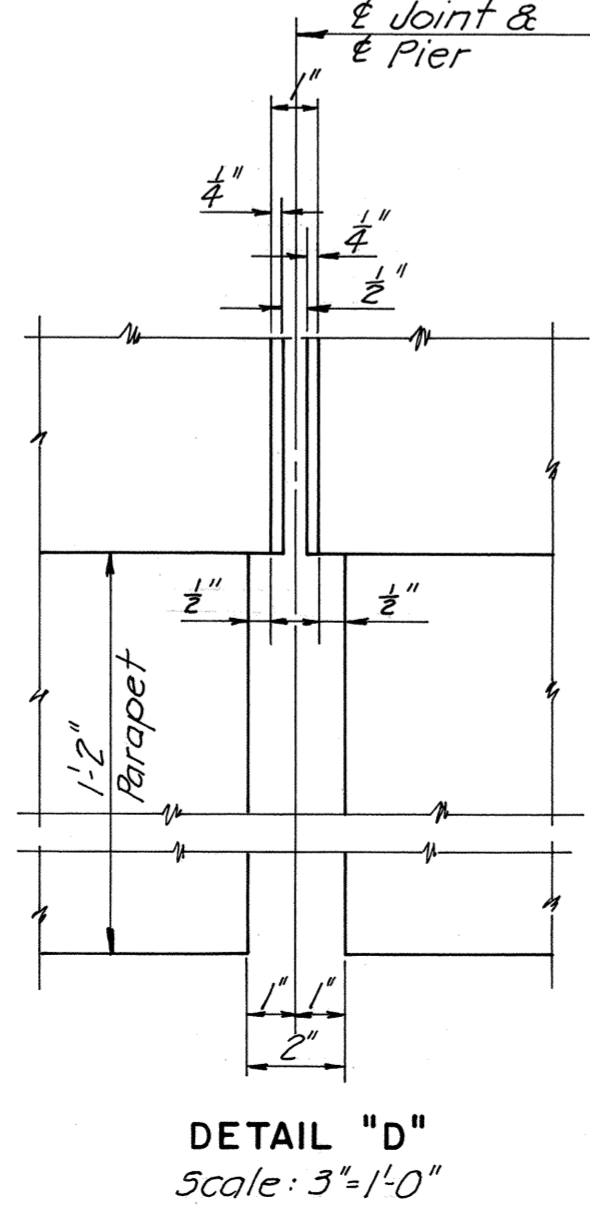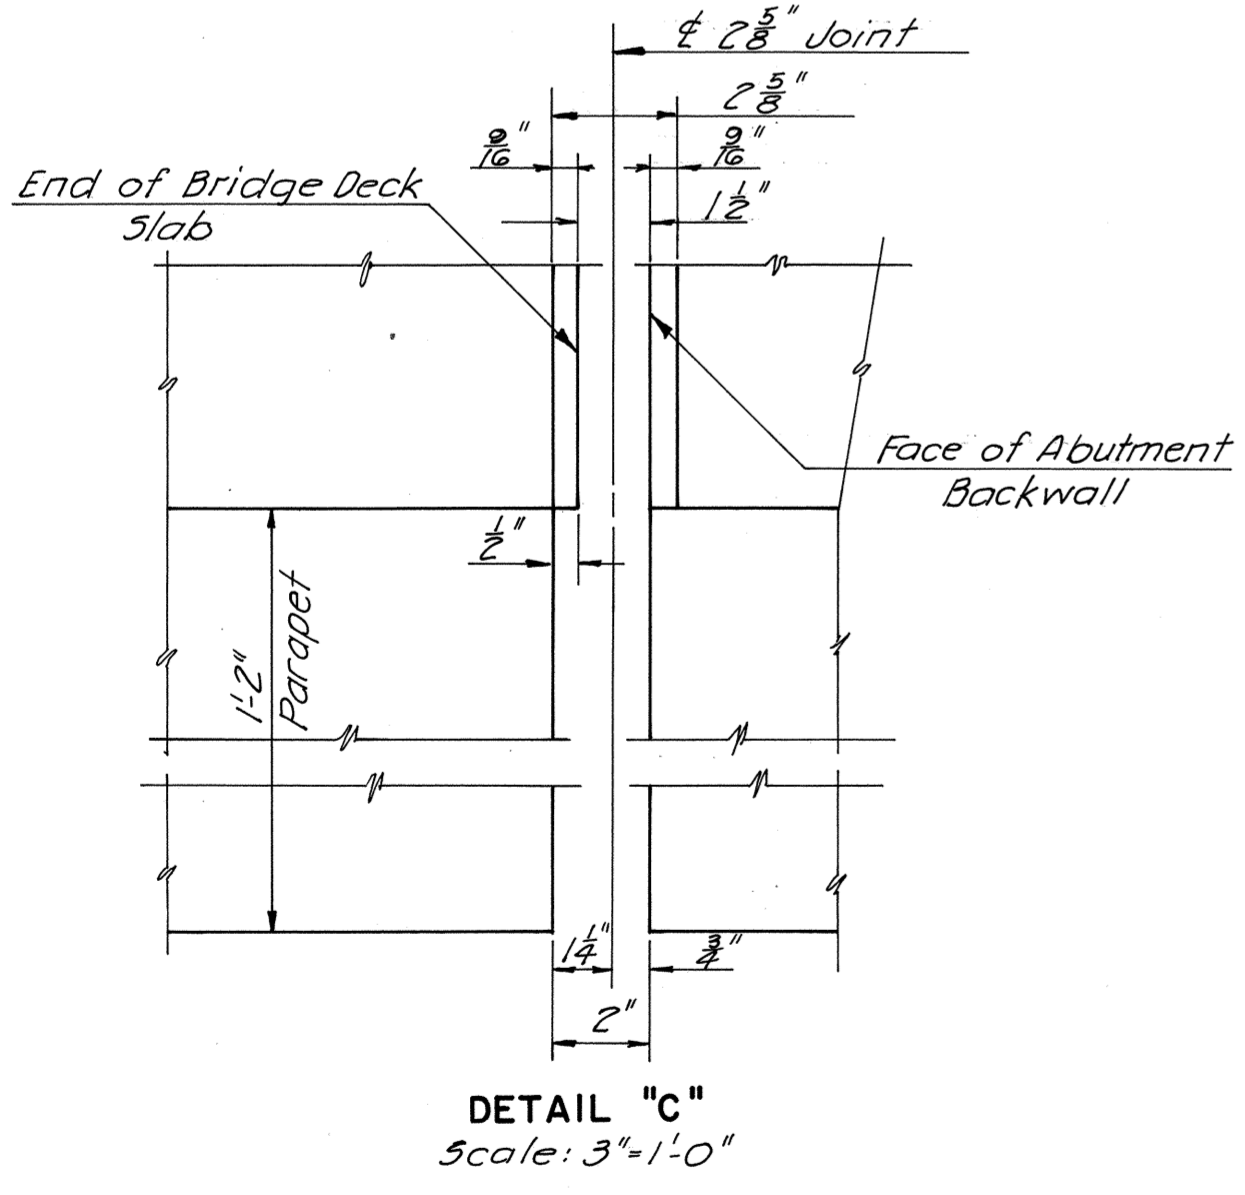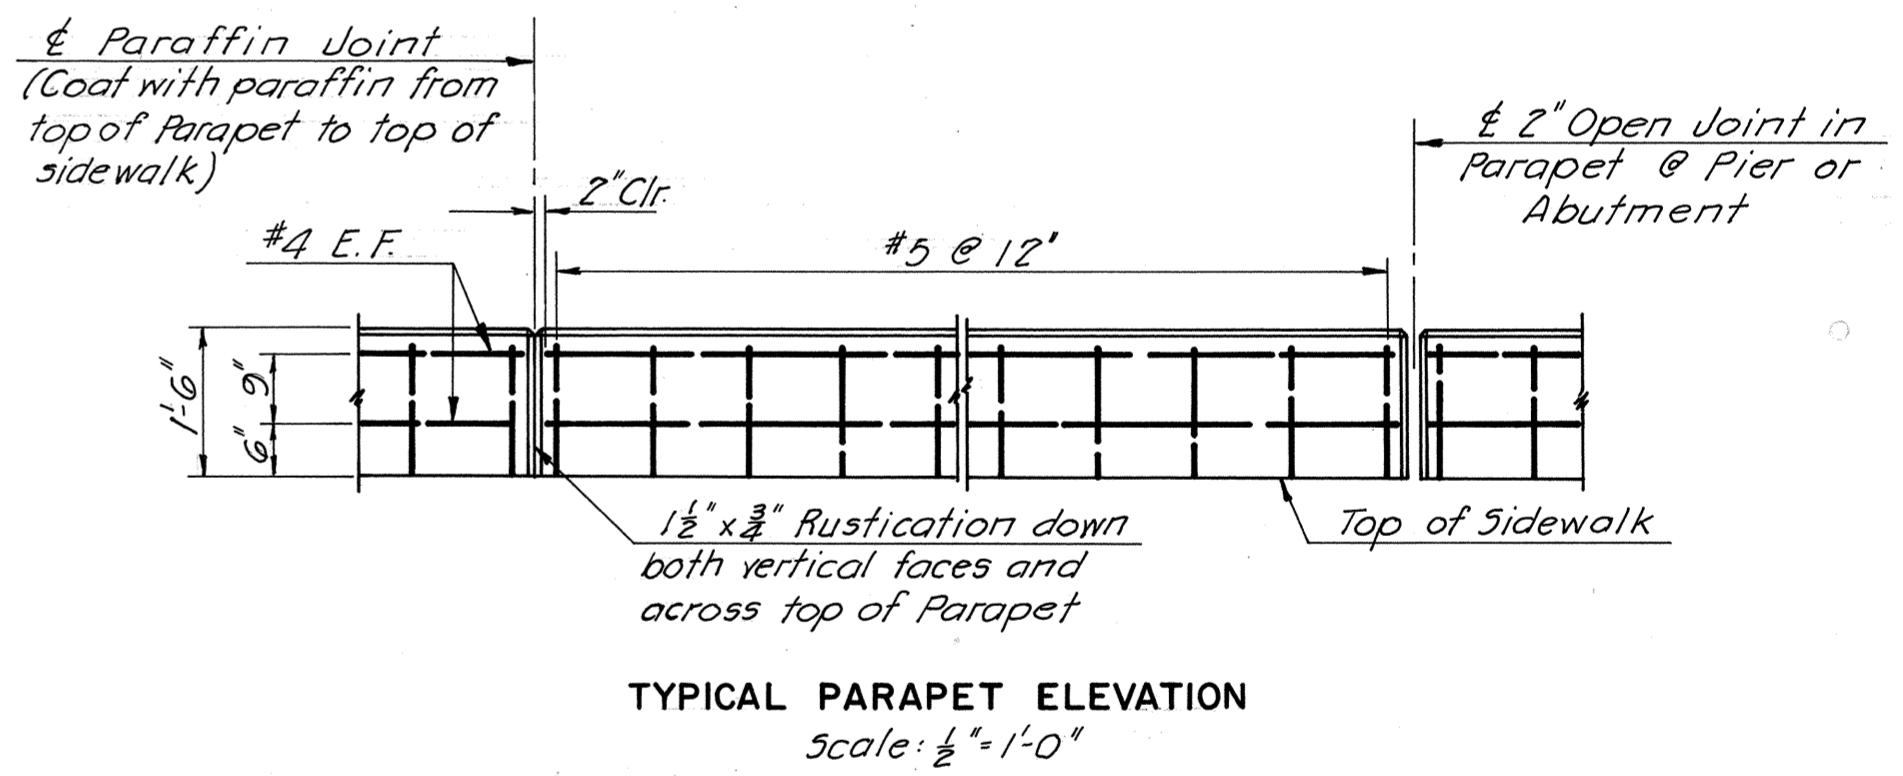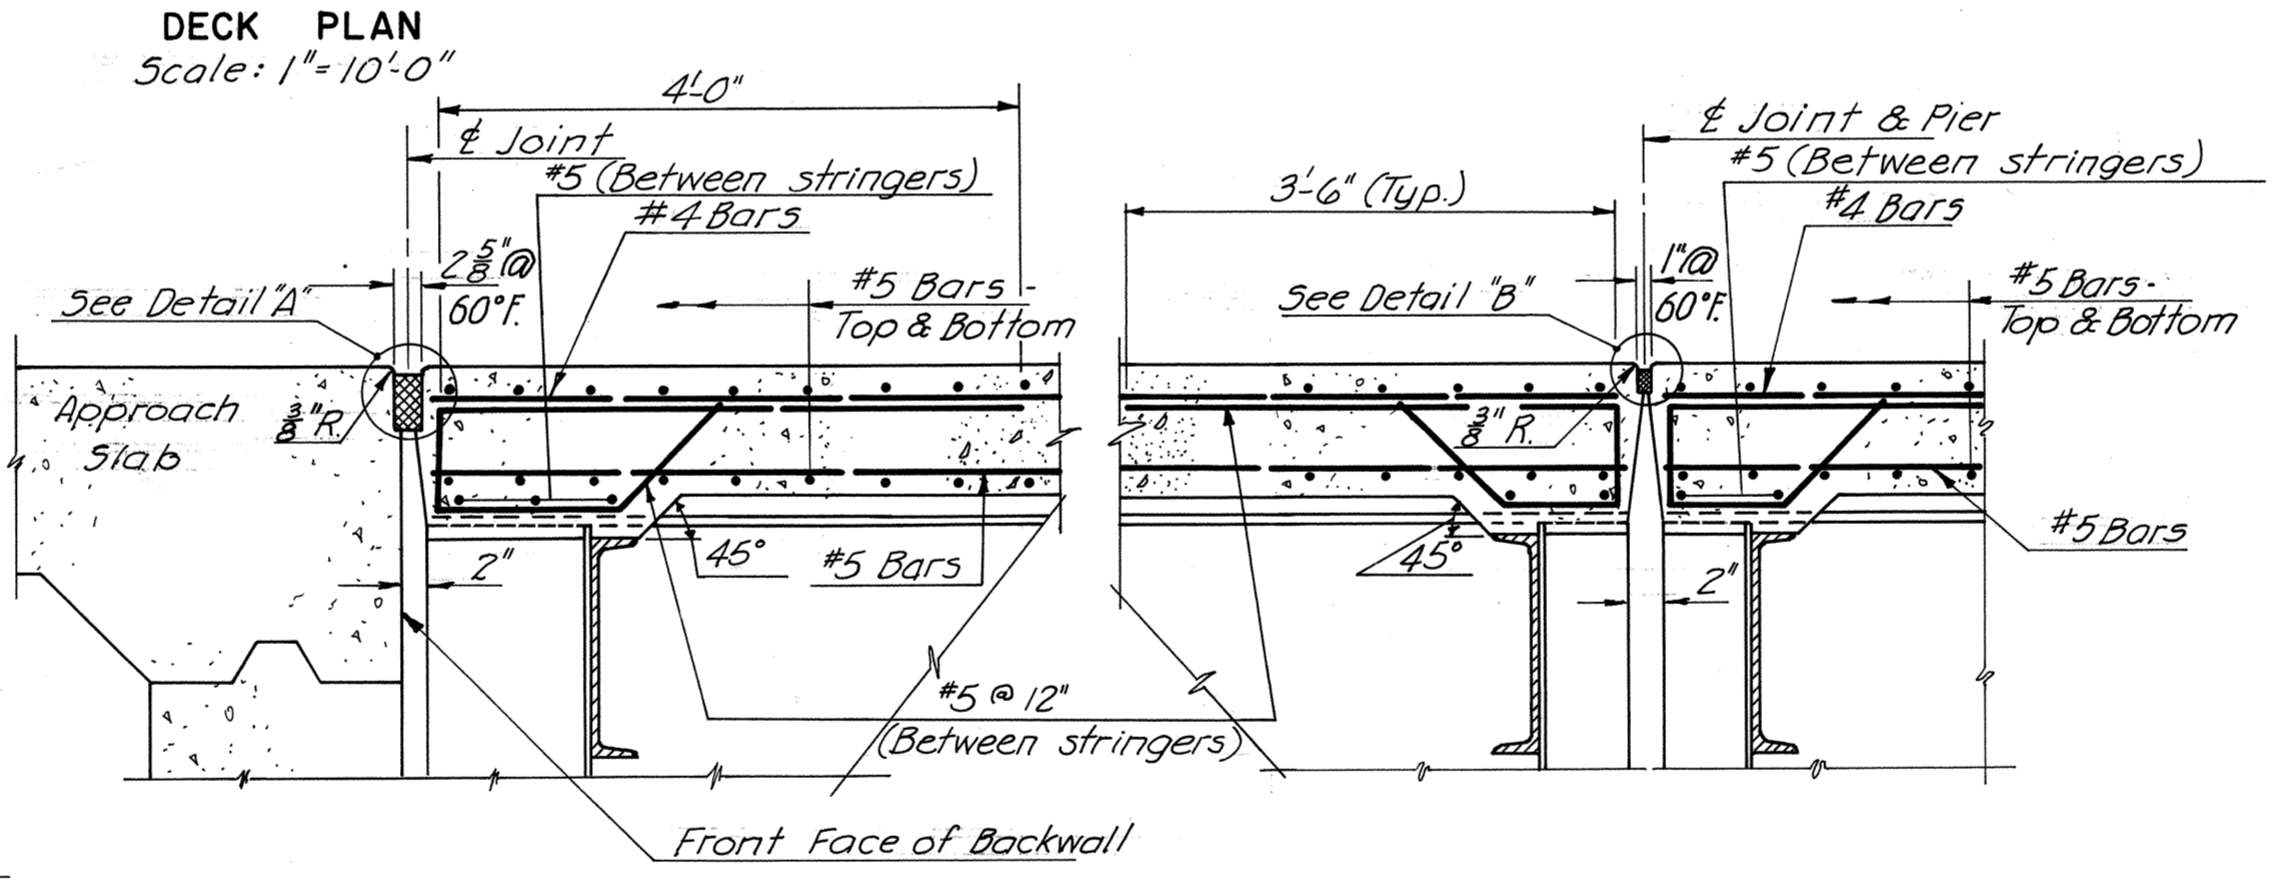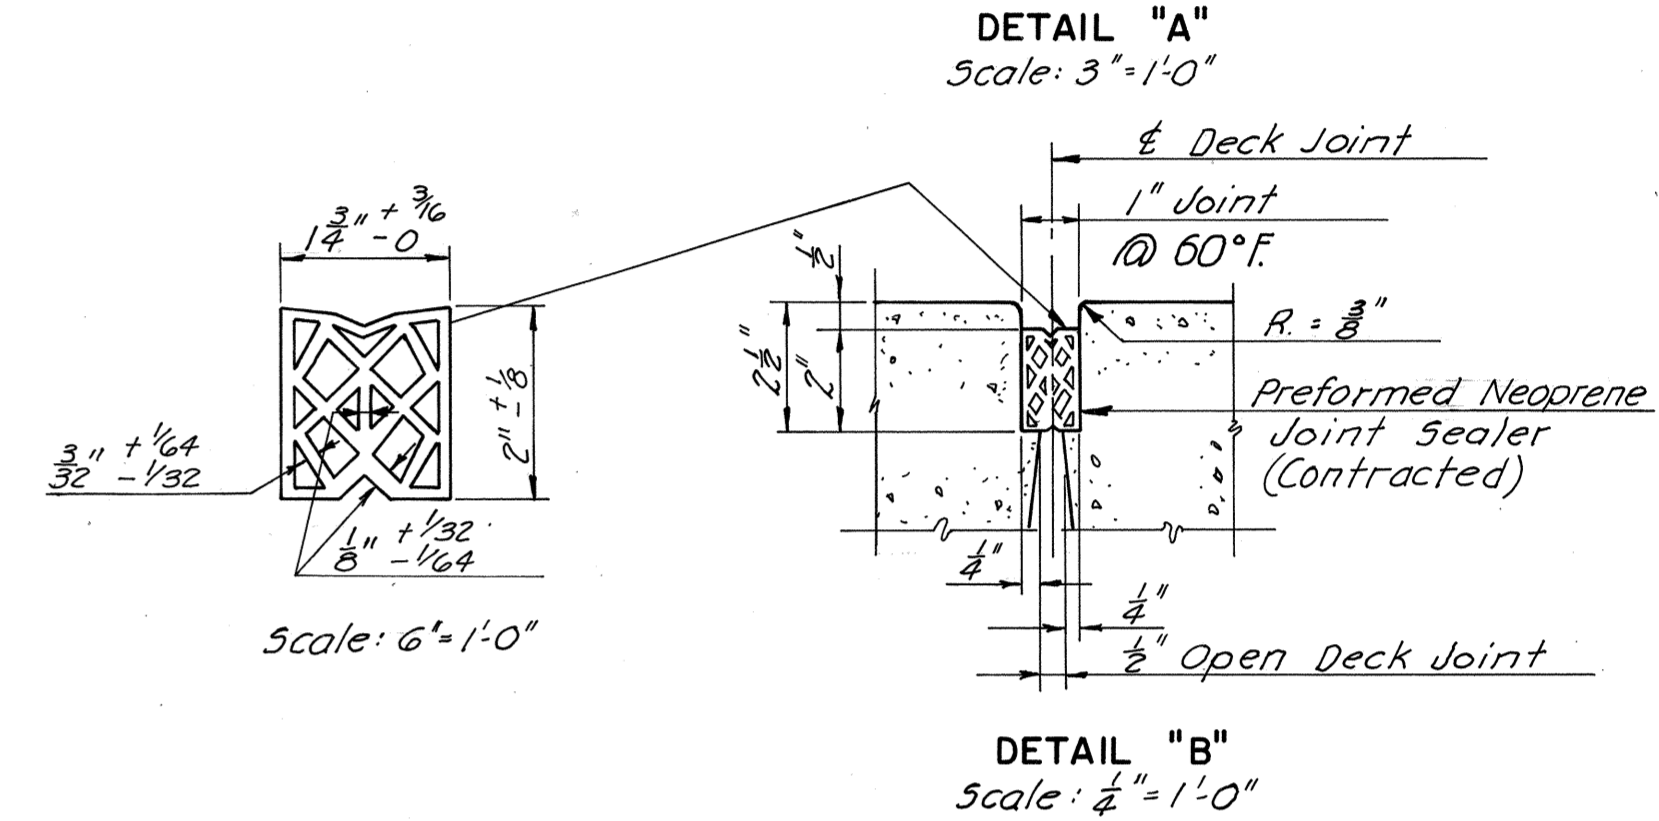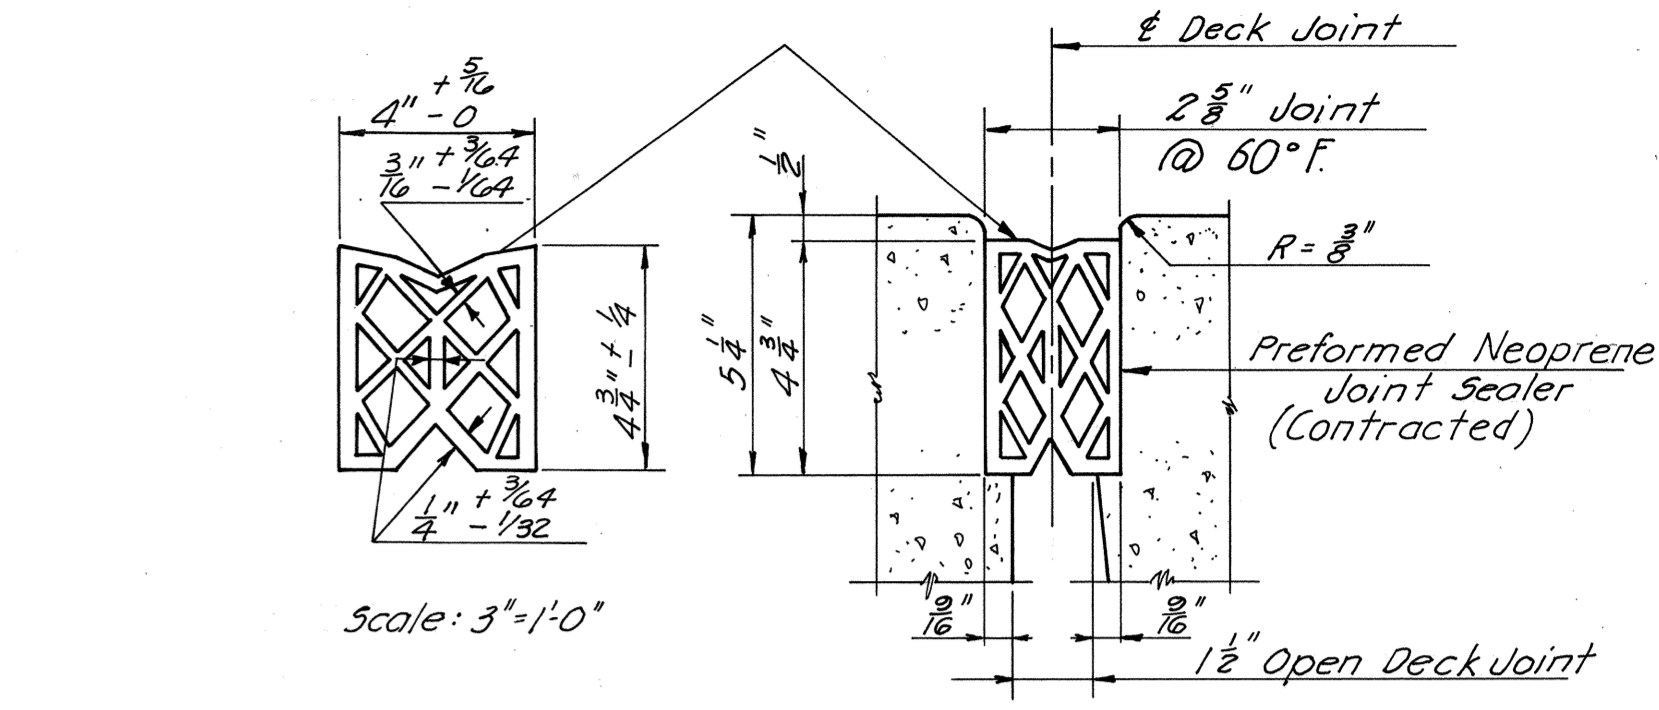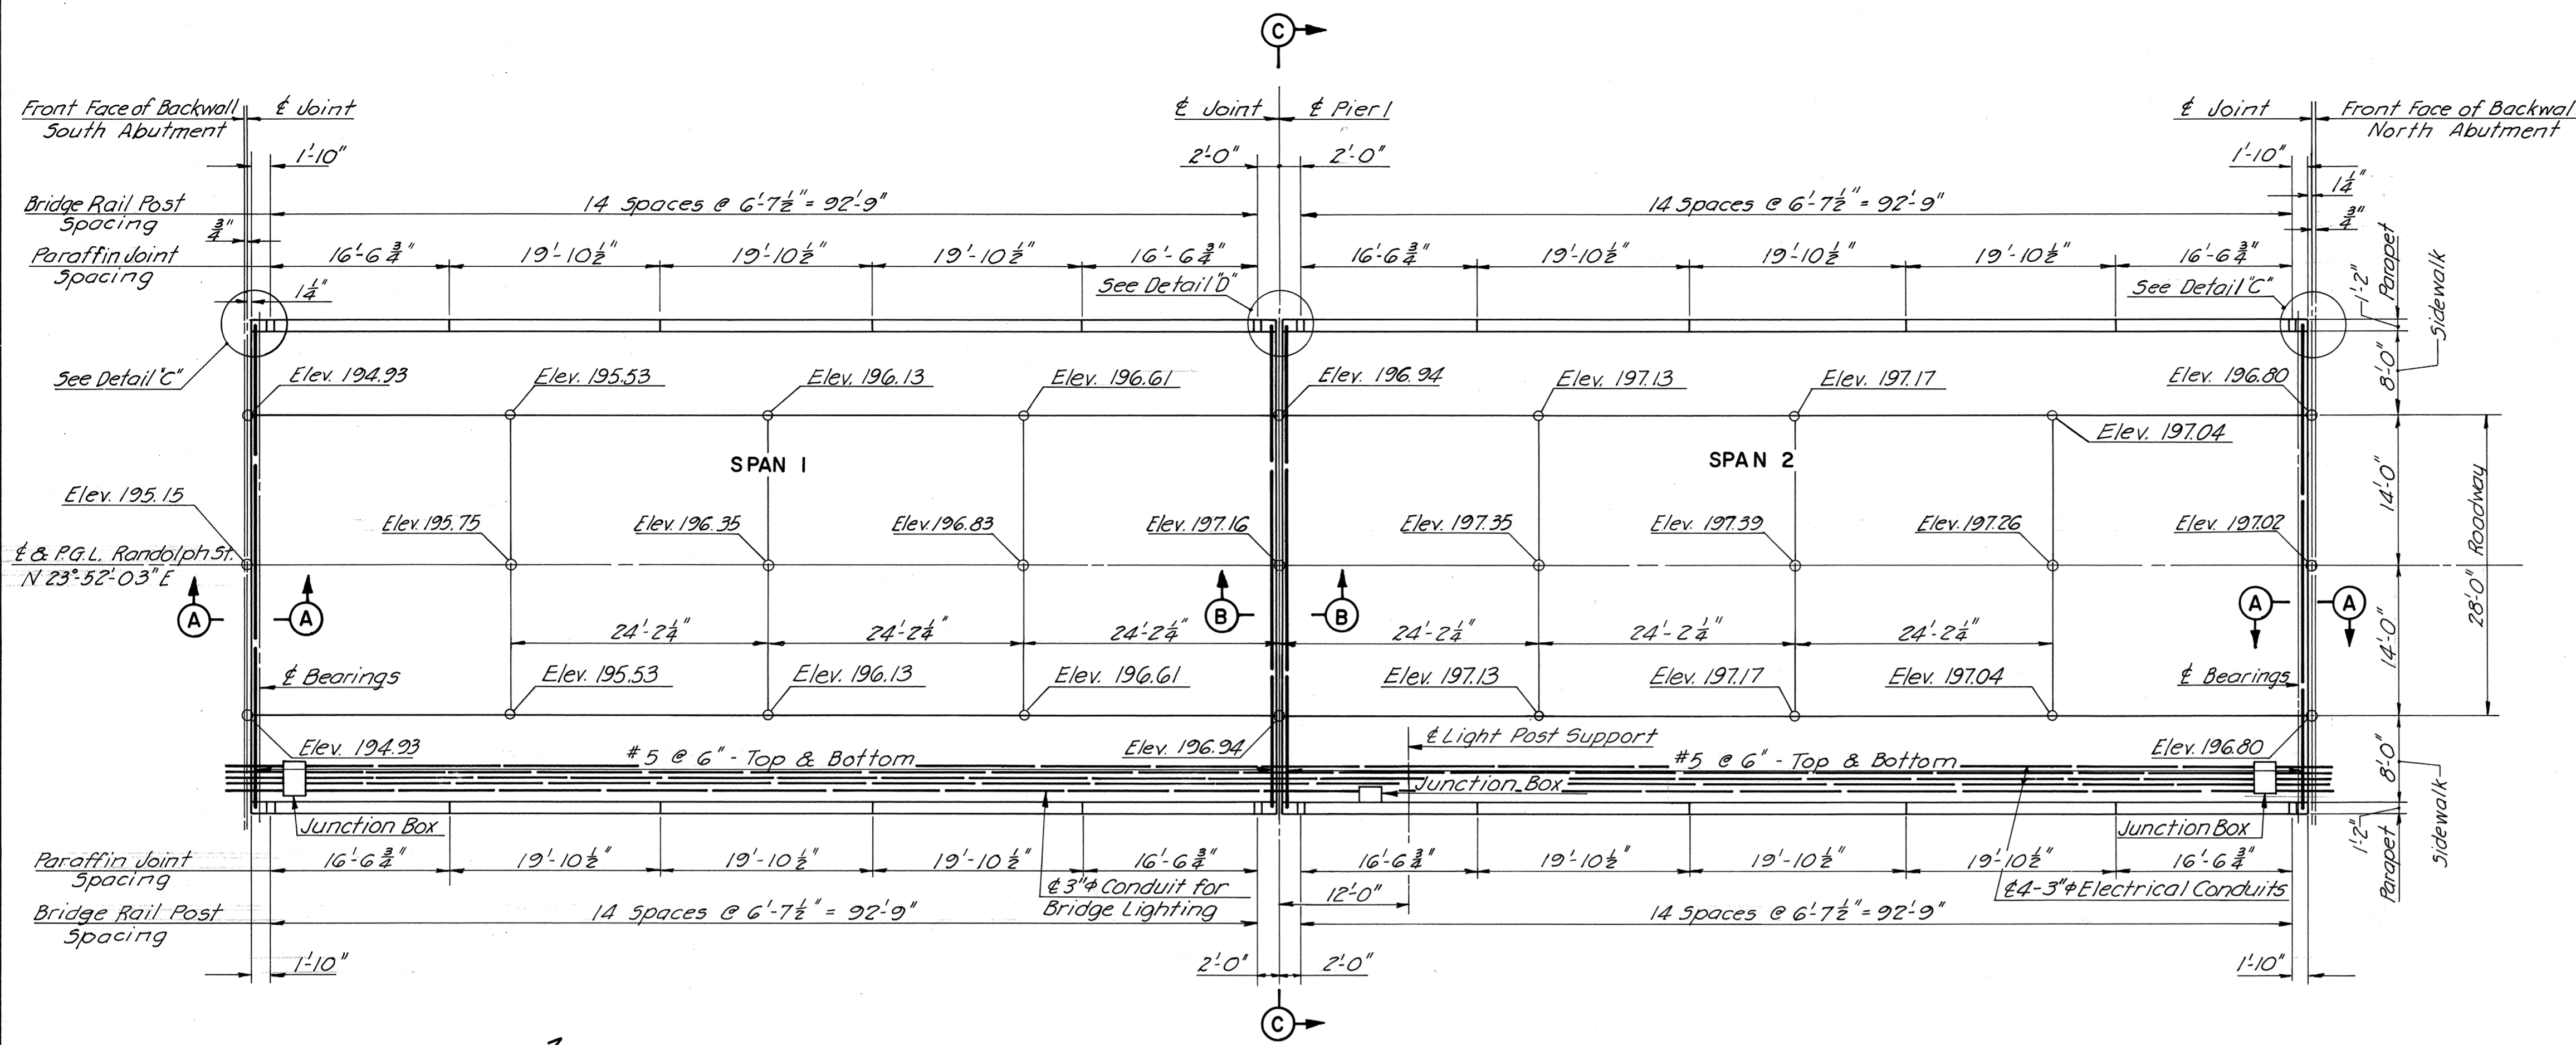

Note to Contractor:
It is absolutely essential that the openings for the preformed neoprene joint sealers be accurately formed and constructed to smooth, straight lines. The size of the opening shall be adjusted to allow for anticipated dead load rotation of the ends of the slab and for the temperature at the time of construction.

NOTES:
For Typical Deck Cross Section, see Sheet 9.
For Railing Details, see Sheet 53.
For General Notes, see Sheet 1.
For Framing Plan, see Sheet 8.
For Light Post Support Details, see Sheet 5A.

| BY | DATE | | | | |
|-----------|--------|------|--|--|--|
| MADE | R.P.R. | 7-67 | | | |
| CHECKED | W.E.O. | 9-67 | | | |
| IN CHARGE | W.E.O. | | | | |

RICHMOND METROPOLITAN AUTHORITY
RICHMOND EXPRESSWAY SYSTEM
DOWNTOWN EXPRESSWAY

STRUCTURE B47
RANDOLPH STREET OVER
DOWNTOWN EXPRESSWAY

DECK PLAN AND JOINT DETAILS





| | |
|---|--------------------|
| AMERICAN ENGINEERS Richmond, Virginia | SCALE: AS NOTED |
| HOWARD, NEEDLES, TAMMEN & BERGENDOFF General Consultants | CONTRACT NO.: 8 |
| | SHEET NO. 10 OF 12 |

AS BUILT

Bridge 62

**(Ramp from WB Downtown Expressway – Rte. 195 to Canal Street
over 12th Street and the Ramp to WB Downtown Expressway)**

Record Set Plans

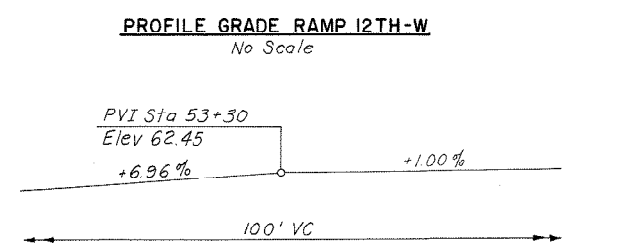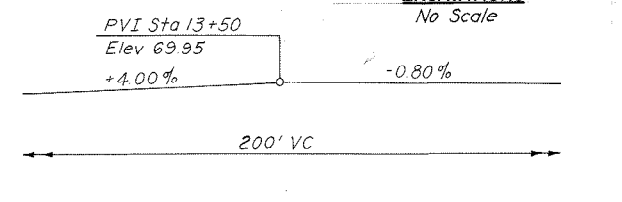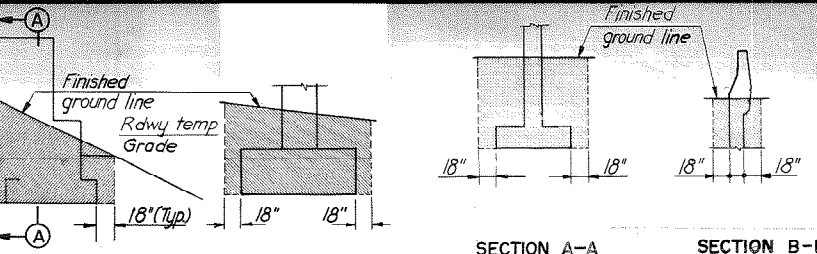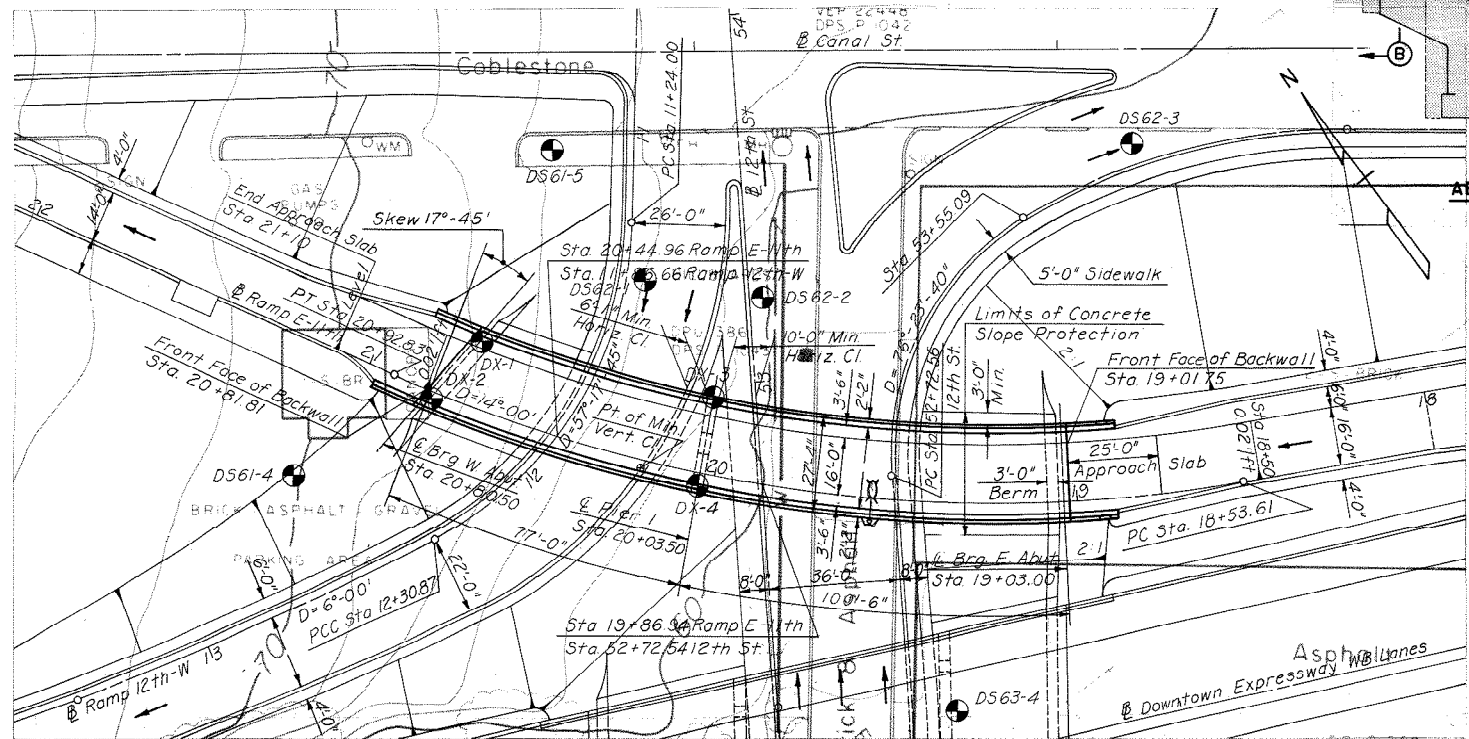

GENERAL NOTES

ROADWAY: One 25'-0" face to face of rail.

CAPACITY: Dead Load-Includes 15 lbs. per sq. ft. for future wearing surface. Live Loads-HS20-44 loading and B.P.R. modified for military vehicles.

SPECIFICATIONS: GENERAL-Virginia Department of Highway Road and Bridge Specifications, 1970. DESIGN-A.A.S.H.O. Standard Specifications for Highway Bridges, 1961, modified by Special Design Provisions. WELDING-1969 Standard Specifications for welded Highway and Railway Bridges of the American Welding Society.

CONTRACT SPECIAL PROVISIONS
Specifications and Contract Special Provisions referred to above are necessary to make these plans complete.

DATUM: CITY OF RICHMOND

TEMPERATURE: The normal temperature referred to on the plan is 60°F. The temperature range for movement is 0°F, to 120°F.

DIMENSIONS: All dimensions are measured horizontally and vertically unless otherwise noted.

EXCAVATION: Excavation below subgrade and cut slope template shall be classified as Structure Excavation. All excavation above these limits shall be classified as Regular Excavation and is not included in the Structural Quantities.


FOUNDATIONS: Footings shall rest on firm material. Foundation material shall be kept dry and special attention is called to Section 401.05 of the General Specifications and to the Contract Special Provisions concerning preparation of foundations for footings.

CONCRETE NOTES: Concrete in superstructure shall be Class A4. All other concrete shall be Class A3. All exposed edges and corners shall have a 1/4" chamfer or fillet unless otherwise noted. Care in the method of vibration, the use of low-slump concrete, and or other means shall be employed to prevent downgrade movement of newly placed slab concrete. (When gradient is over 2%).


Finishing concrete surfaces: See the Standard Architectural Detail Sheets and the Contract Special Provisions for types and details.

STEEL NOTES: Structural steel shall conform to A.S.T.M. Specification A36 except as noted.

All field connections shall be made with high strength bolts. High strength bolts shall be 3/4" diameter unless otherwise noted and shall conform to A.S.T.M. Specification A-325. All shop welded web splices, flange splices and web to flange welds shall be made by the submerged arc process.

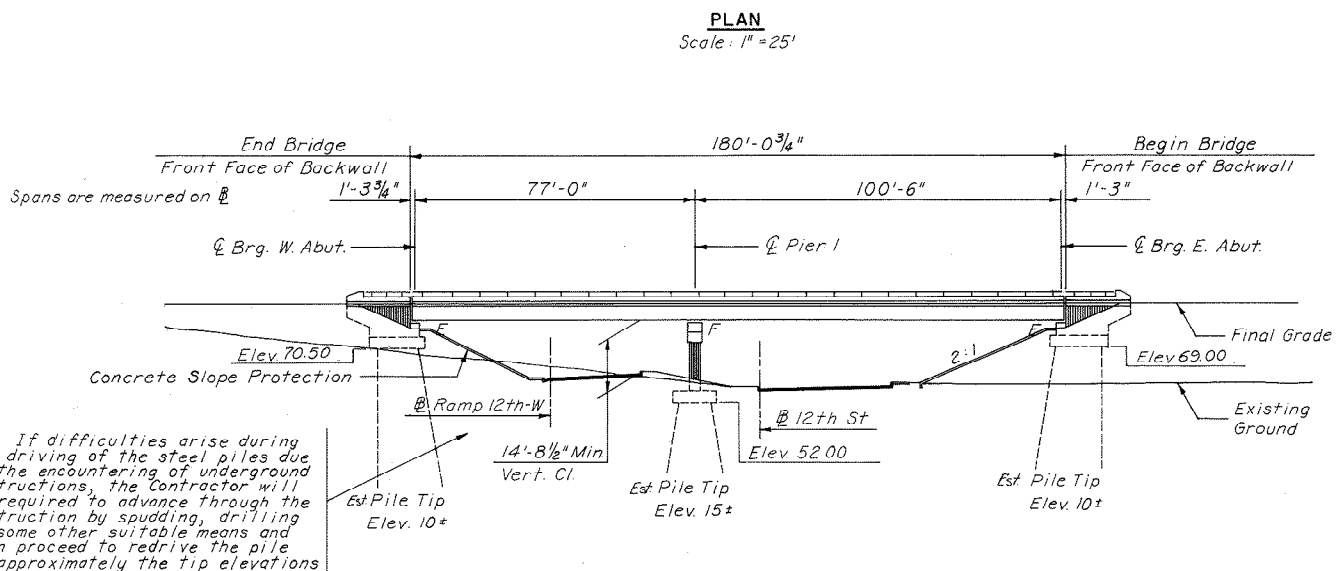

| INDEX OF SHEETS | |
|-----------------|--|
| No. | Title |
| 1 | General Plan and Elevation |
| 2 | West Abutment |
| 3 | East Abutment |
| 4 | Pier 1 |
| 5 | Stringers |
| 6 | Stringer Details |
| 7 | Slab |
| 8 | Joint Details |
| 9 | Approach Slab and Slope Protection Details |
| 10 & 11 | Boring Logs |
| S1 | Standard Shoe Details |
| S2 | Standard Aluminum Railing Details (1 Rail) |
| S5 | Standard Electrical Details (Exp Bridges) |
| S7 | Standard Architectural Details |

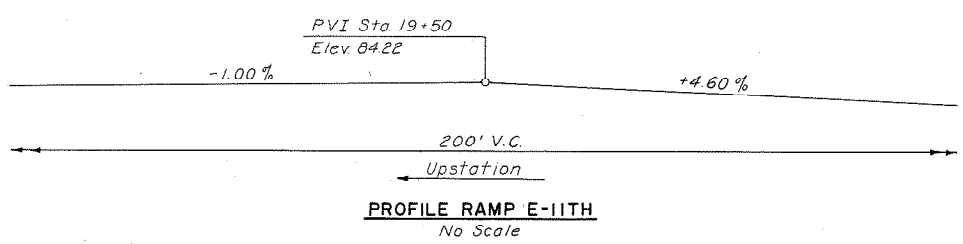

| | ESTIMATE OF QUANTITIES | | | | | | | | | | | | |
|----------------|------------------------|-------------------|-------------------|--------------|-------------------|-----------------------|-------------------------------|-----------------|--------------------|-----------------------|---------------------|--------------------|------------------------|
| | Structure Excavation | Concrete Class A4 | Concrete Class A3 | | Reinforcing Steel | Structural Steel A-36 | Aluminum Br. Railing (1 Rail) | Porous Backfill | Steel Piles 10BP42 | Conc. Slab Slope Prot | Asphalt Dampproof'g | Underdrain 6" Pipe | Material Conduit 3" LF |
| | C.Y. | C.Y. | C.Y. | C.Y. | Lbs. | Lbs. | L.F. | C.Y. | L.F. | S.Y. | S.Y. | L.F. | L.F. |
| Superstructure | | 171.51 | | | 39,055 | 168,253 | 349 | | | | | | 183 |
| West Abutment | 133 | | 18.63 | | 4,298 | | 30 | 5 | 581.3 | 123.25 | 14 | 59 | 23.5 |
| East Abutment | 135 | | 81.50 | | 4,235 | | 30 | 5 | 719.3 | 162.2 | 14 | 55 | 23.5 |
| Pier 1 | 113 | | 71.37 | | 22,443 | | | | 670.1 | | | | |
| Approach Slabs | | | 49.82 | | 11,682 | | | | | | | | |
| Total | 381 | 171.51 | 231.50 | 49.82 | 81,713 | 168,253 | 409 | 10 | 1970.7 | 286.45 | 28 | 114 | 230 |

| BY | DATE | NO. | REVISION | BY | OATE |
|-----------|------|-------|--------------------------|-----|------|
| MADE | JLJ | 11-67 | 2 As Built | TEM | 7-77 |
| CHECKED | LDL | 1-68 | 1 Revised Light Location | TEM | 9-74 |
| IN CHARGE | PRY | | | | |

RICHMOND METROPOLITAN AUTHORITY
RICHMOND EXPRESSWAY SYSTEM
DOWNTOWN EXPRESSWAY


BRIDGE NO. 62
RAMP E-11TH OVER
RAMP 12TH-W AND 12TH ST
GENERAL PLAN AND ELEVATION

SCALE: As Noted
CONTRACT NO.: 9
SHEET NO. 1 OF 11








HOWARD, NEEDLES, TAMMEN & BERGENDOFF
consulting engineers
NEW YORK ALEXANDRIA KANSAS CITY

AS BUILT



| RICHMOND EXPRESSWAY SYSTEM | | | |
|----------------------------|---------------------|-----------|--------------|
| SECTION | PROJECT | SHEET NO. | TOTAL SHEETS |
| 9 | DOWNTOWN EXPRESSWAY | 232 | |

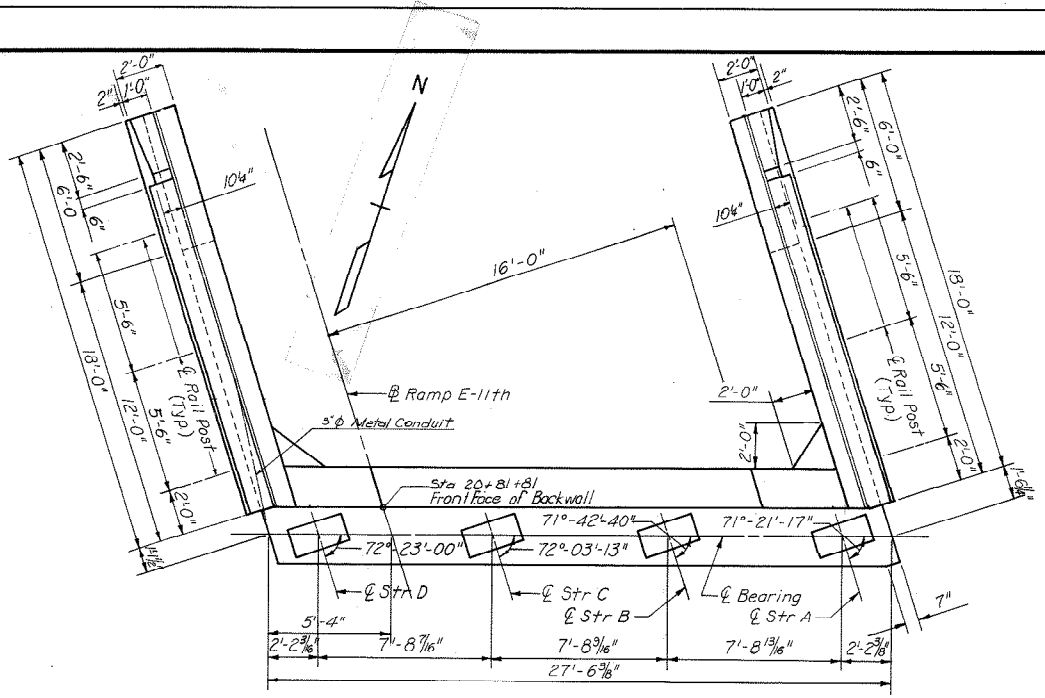

*Place two additional #4 bars at each pad

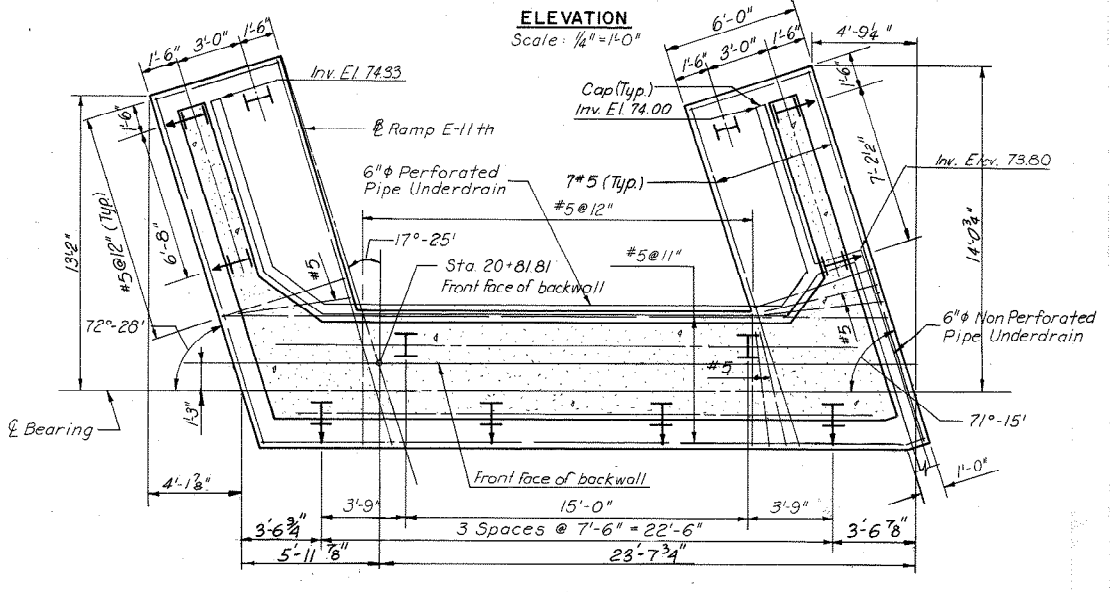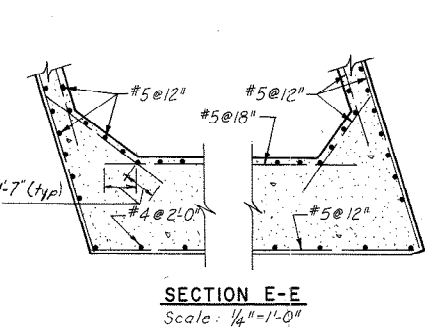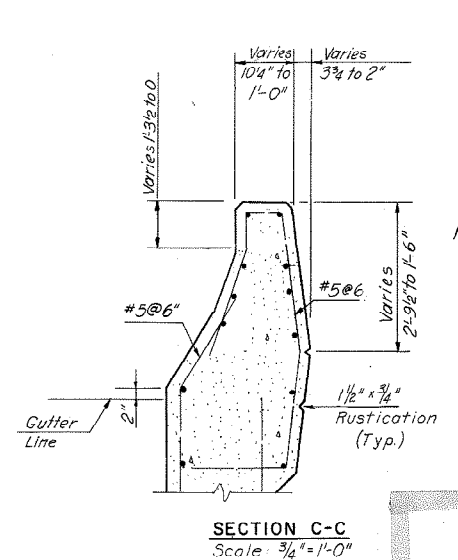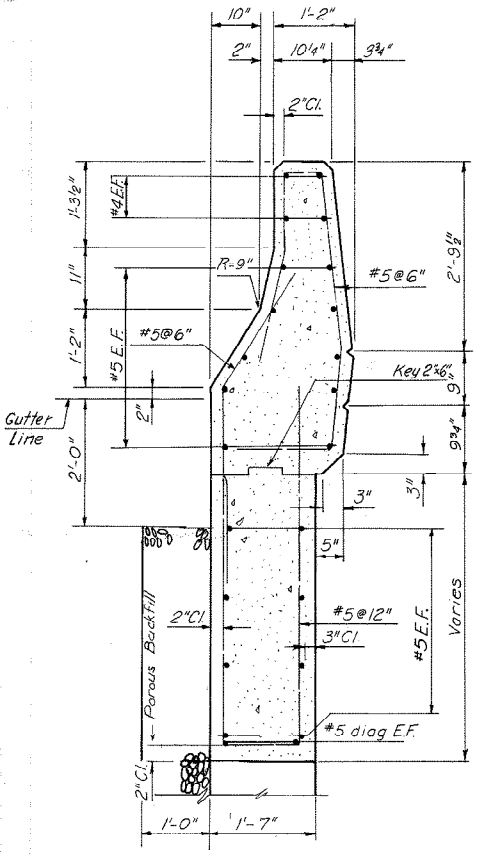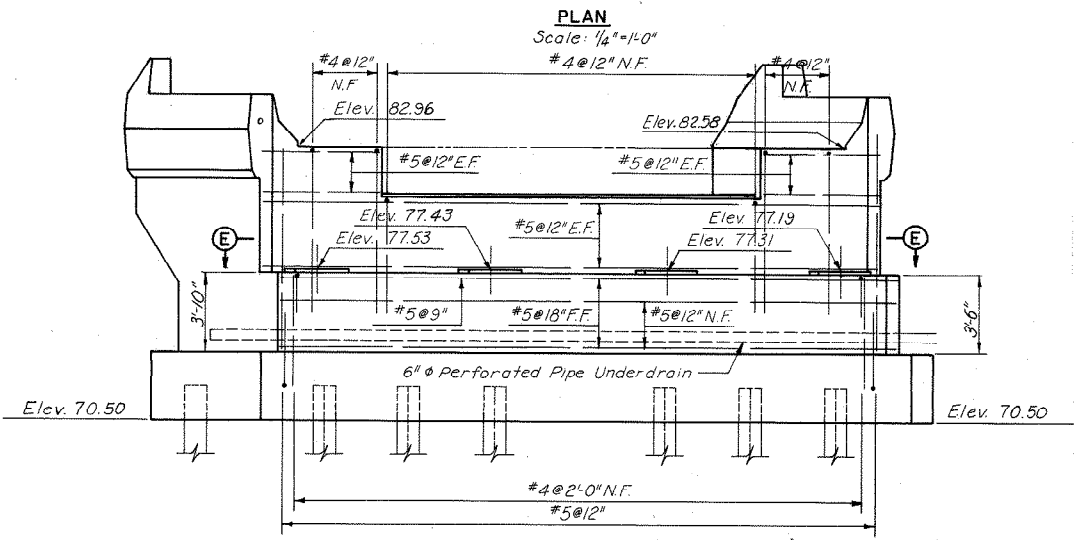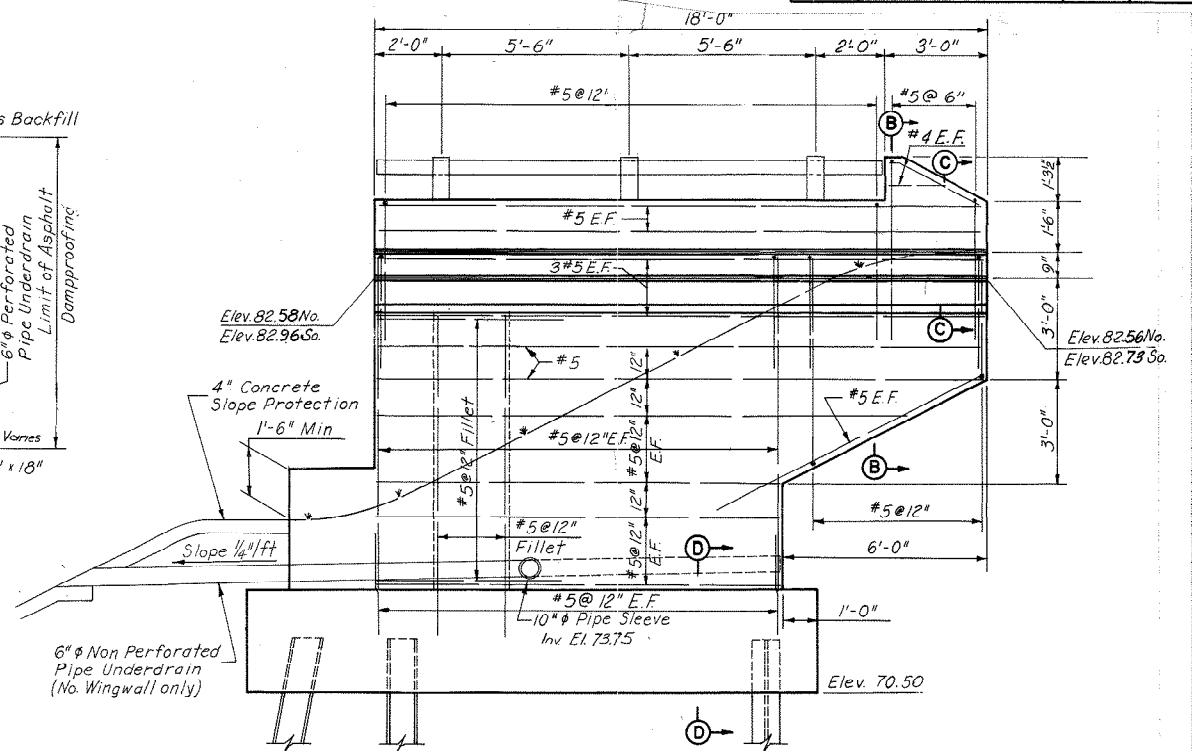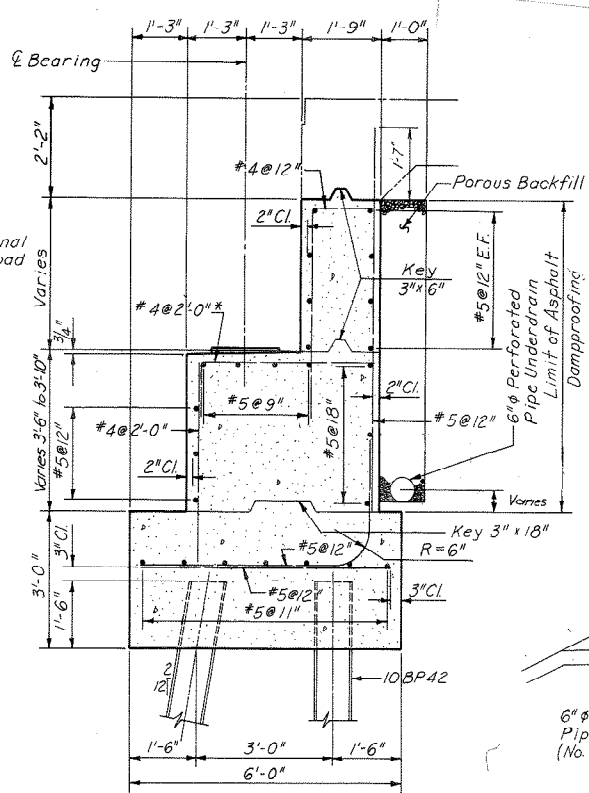

Notes:
Footings should be founded at the elevations shown on the plans unless otherwise directed by the Engineer due to conditions of the site during construction. In such cases, the Engineer will determine the extent of redesign necessary and will advise the Contractor before construction begins.
If difficulties arise during the driving of the steel piles due to the encountering of underground obstructions, the Contractor will be required to advance through the obstruction by spudding, drilling or some other suitable means and then proceed to redrive the pile to approximately the tip elevations given.
All piles shall be 10 BP42 Steel Piles (Design Capacity = 45 tons)

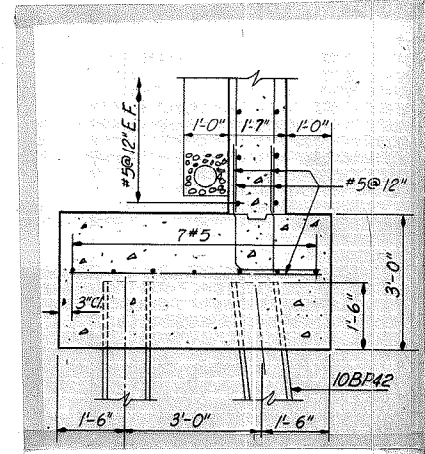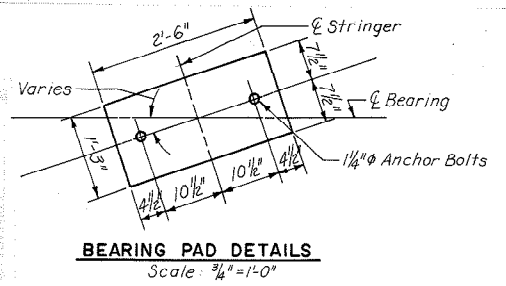

RICHMOND METROPOLITAN AUTHORITY
RICHMOND EXPRESSWAY SYSTEM
DOWNTOWN EXPRESSWAY

BRIDGE NO. 62
RAMP E-11TH OVER RAMP 12TH-W
OVER 12TH ST.

WEST ABUTMENT




HOWARD, NEEDLES, TAMMEN & BERGENDOFF
consulting engineers
NEW YORK ALEXANDRIA KANSAS CITY

SCALE: As Noted
CONTRACT NO.: 9
SHEET NO. 2 OF 11




| BY | DATE | NO. | REVISION | BY | OATE |
|-----------|------|------|----------|----------|----------|
| MADE | JLU | 1-68 | | | |
| CHECKED | LDL | 1-68 | 1 | As Built | TEM 7-77 |
| IN CHARGE | PRY | | | | |

AS BUILT

| RICHMOND EXPRESSWAY SYSTEM | | | |
|----------------------------|---------------------|-----------|--------------|
| SECTION | PROJECT | SHEET NO. | TOTAL SHEETS |
| 9 | DOWNTOWN EXPRESSWAY | 234 | |

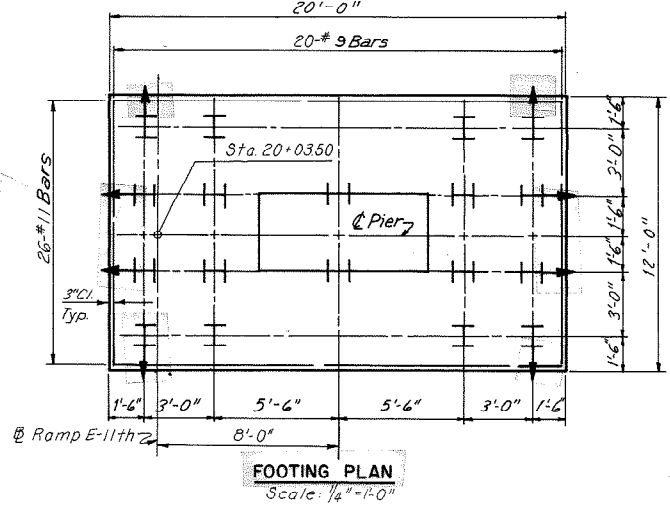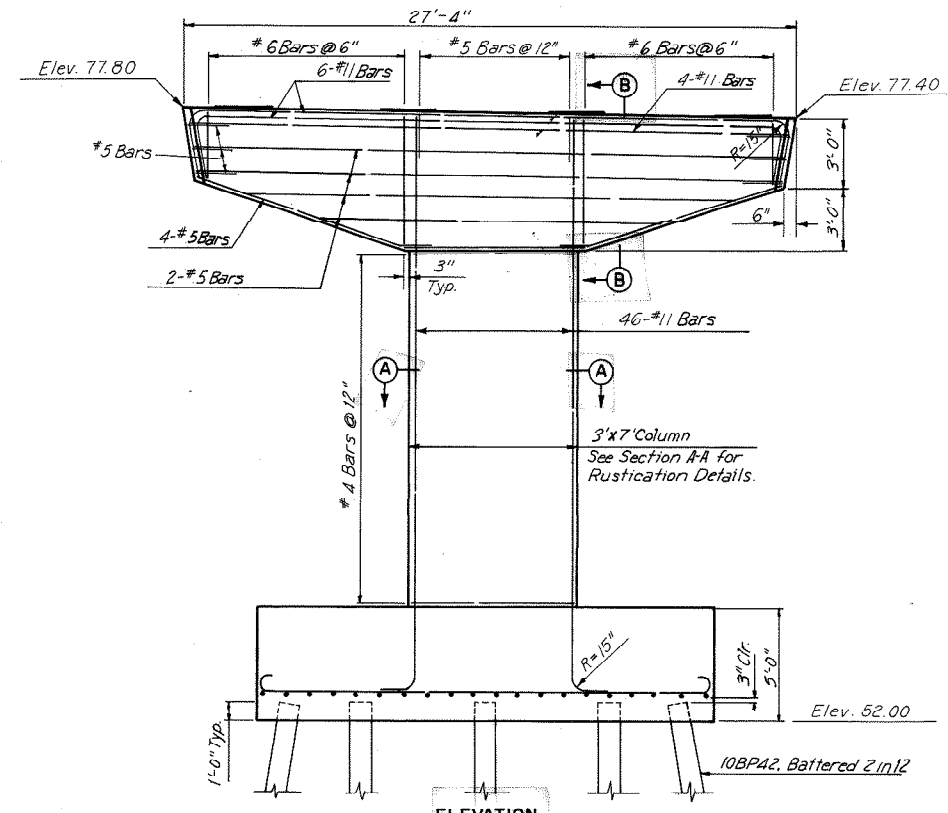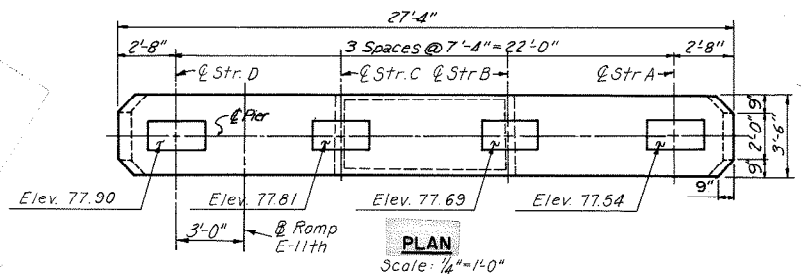

Note: indicates pile battered 2:12 in direction of arrow.

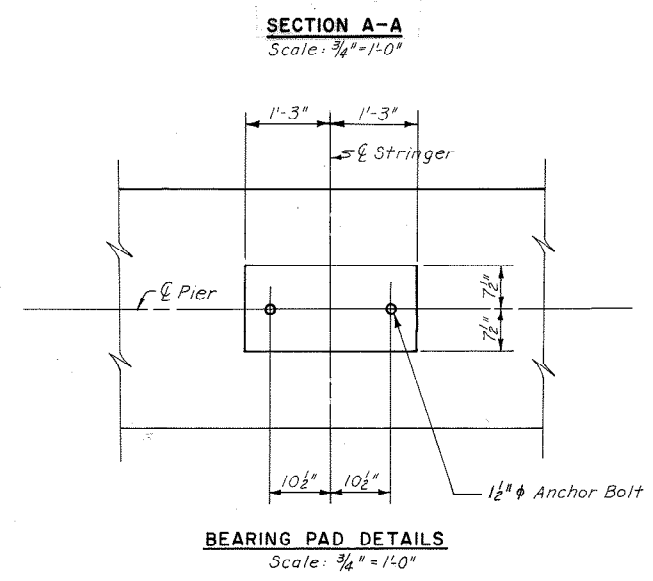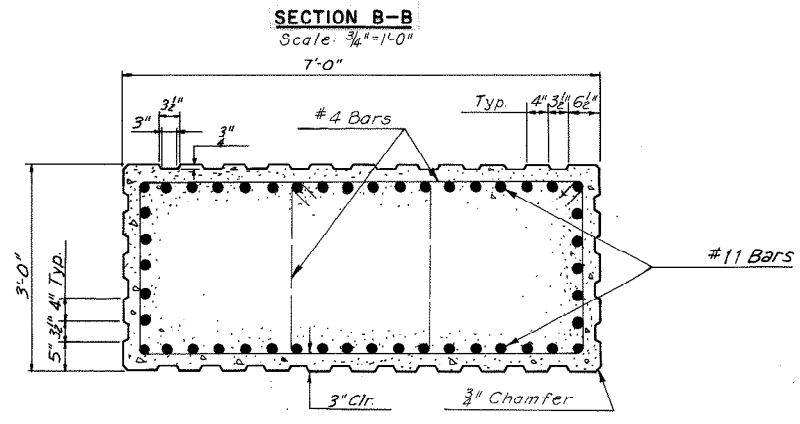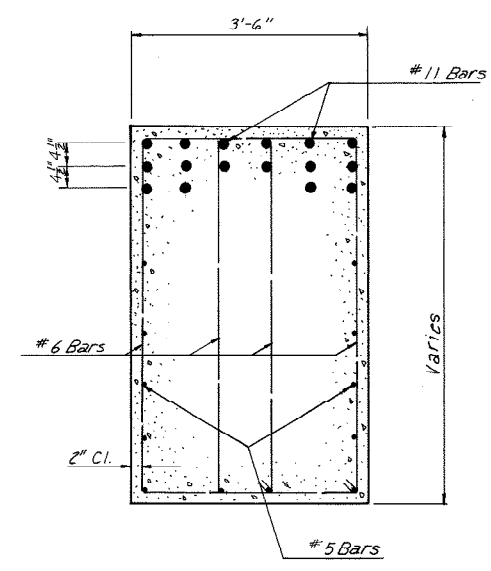

Notes: Footing elevations are approximate only and may be varied to suit field conditions as directed by the Engineer. Vertical shaft reinforcing shall not be cut until these elevations are established. Where elevations change more than 2 ft., redesign will be required. If difficulties arise during the driving of the steel piles due to the encountering of underground obstructions, the Contractor will be required to advance through the obstruction by spudding, drilling or some other suitable means and then proceed to redrive the pile to approximately the tip elevations given.

All piles shall be 10BP42 Steel Piles (Design Capacity = 45 tons)

RICHMOND METROPOLITAN AUTHORITY
RICHMOND EXPRESSWAY SYSTEM
 DOWNTOWN EXPRESSWAY



BRIDGE NO. 62
 RAMP E-11TH OVER RAMP 12TH-W
 OVER 12TH ST.
 PIER I

| | |
|---|--|
| HOWARD, NEEDLES, TAMMEN & BERGENDOFF consulting engineers NEW YORK ALEXANDRIA KANSAS CITY | SCALE: As Noted CONTRACT NO. 9 SHEET NO. 4 OF 11 |
|---|--|

| | | | | | |
|-----------|-----|------|-----|----------|----------|
| MADE | BY | DATE | | | |
| CHECKED | RLJ | 1-68 | 1 | As Built | TEM 7-77 |
| IN CHARGE | FRY | | NO. | REVISION | BY DATE |



AS BUILT

| SHOE SCHEDULE | | | |
|-----------------|-----------|-------------|-----------|
| EXPANSION SHOES | | FIXED SHOES | |
| TYPE | NO. REQD. | TYPE | NO. REQD. |
| E5 | 8 | F3 | 3 |
| | | F14 | 1 |

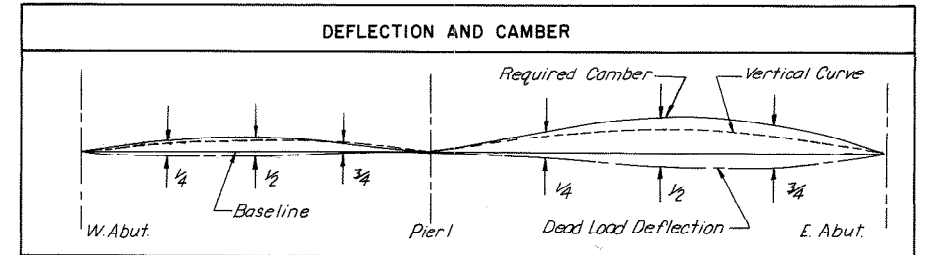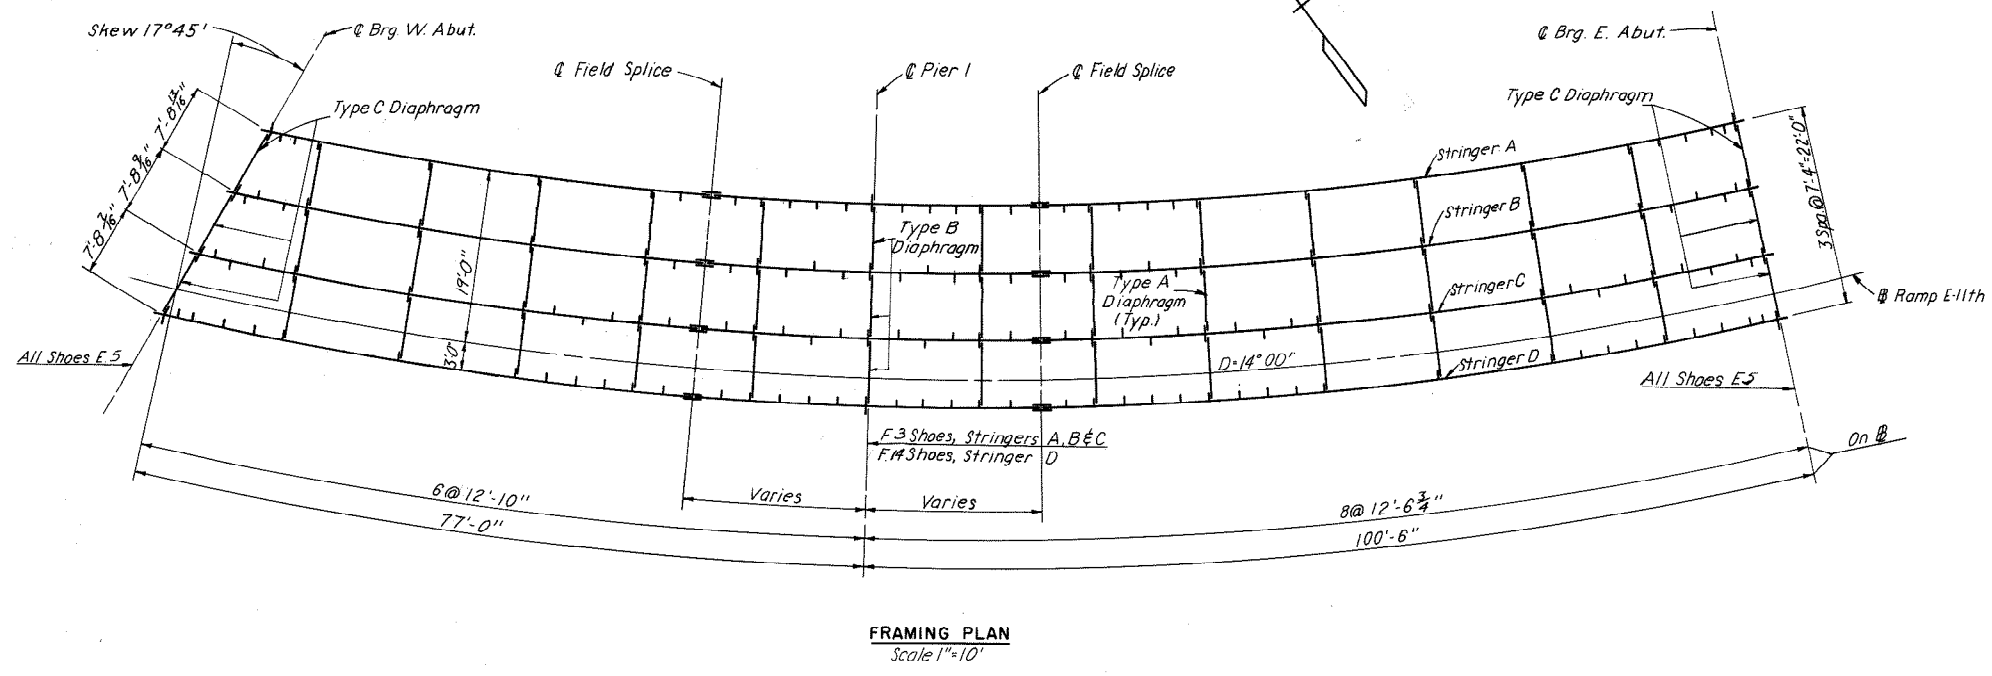

| STRINGER | ITEM | W. ABUT. | 1/4 | 1/2 | 3/4 | PIER I | 1/4 | 1/2 | 3/4 | E. ABUT. |
|----------|------------------|----------|--------|--------|--------|--------|--------|--------|--------|----------|
| A | Steel | 0 | 1/16 | 1/16 | 0 | 0 | 3/16 | 3/8 | 1/4 | 0 |
| | Slab | 0 | 3/16 | 1/8 | 0 | 0 | 5/8 | 1 1/16 | 3/8 | 0 |
| | Curb and Parapet | 0 | 1/16 | 1/16 | -1/16 | 0 | 1/4 | 1/16 | 3/8 | 0 |
| | Vertical Curve | 0 | 15/16 | 15/16 | 13/16 | 0 | 33/16 | 4 1/4 | 33/16 | 0 |
| | Required Camber | 0 | 1 1/2 | 1 3/8 | 1 5/16 | 0 | 4 3/8 | 6 1/8 | 4 1/16 | 0 |
| B | Steel | 0 | 1/16 | 1/16 | 0 | 0 | 1/4 | 3/8 | 1/4 | 0 |
| | Slab | 0 | 3/16 | 1/8 | 0 | 0 | 3/4 | 1 5/16 | 1 1/16 | 0 |
| | Curb and Parapet | 0 | 0 | 0 | 0 | 0 | 0 | 1/16 | 0 | 0 |
| | Vertical Curve | 0 | 15/16 | 15/16 | 13/16 | 0 | 33/16 | 4 1/4 | 33/16 | 0 |
| | Required Camber | 0 | 1 3/16 | 1 3/16 | 1 3/8 | 0 | 4 3/16 | 6 | 4 1/2 | 0 |
| C | Steel | 0 | 1/16 | 1/16 | 0 | 0 | 3/16 | 3/8 | 1/4 | 0 |
| | Slab | 0 | 1/4 | 3/8 | 0 | 0 | 3/4 | 1 5/16 | 1 1/16 | 0 |
| | Curb and Parapet | 0 | 0 | 0 | 0 | 0 | 1/16 | 1/8 | 1/16 | 0 |
| | Vertical Curve | 0 | 15/16 | 1 1/16 | 1 3/16 | 0 | 3 3/16 | 4 1/4 | 3 3/16 | 0 |
| | Required Camber | 0 | 1 1/4 | 1 5/16 | 1 7/16 | 0 | 4 3/16 | 6 1/16 | 4 9/16 | 0 |
| D | Steel | 0 | 1/16 | 1/16 | 0 | 0 | 1/4 | 5/16 | 1/4 | 0 |
| | Slab | 0 | 1/4 | 3/8 | 0 | 0 | 5/8 | 1 1/8 | 7/8 | 0 |
| | Curb and Parapet | 0 | 1/8 | 1/8 | 0 | 0 | 5/16 | 9/16 | 3/16 | 0 |
| | Vertical Curve | 0 | 15/16 | 1 1/16 | 1 7/16 | 0 | 3 3/16 | 4 1/4 | 3 3/16 | 0 |
| | Required Camber | 0 | 1 3/8 | 2 1/16 | 1 7/16 | 0 | 4 3/8 | 6 1/4 | 4 3/4 | 0 |

| Shear Stud Spacing | Area A | | | | | | | | | | Area B | | | | | | | | | | Area A | | | | | | | | | | Stringer | | | | | | | | | | | | |
|---|
| | 00L-01L | 01L-02L | 02L-03L | 03L-04L | 04L-05L | 05L-06L | 06L-07L | 07L-08L | 08L-09L | 09L-10L | 00L-01L | 01L-02L | 02L-03L | 03L-04L | 04L-05L | 05L-06L | 06L-07L | 07L-08L | 08L-09L | 09L-10L | 00L-01L | 01L-02L | 02L-03L | 03L-04L | 04L-05L | 05L-06L | 06L-07L | 07L-08L | 08L-09L | 09L-10L | | | | | | | | | | | | | |
| 10" | 13" | 17" | 24" | 21" | 15" | 12" | 15" | 13" | 12" | 12" | 13" | 10" | 12" | 17" | 24" | 24" | 17" | 12" | 9" | 10" | 13" | 17" | 21" | 24" | 18" | 14" | 18" | 24" | 24" | 18" | 14" | 10" | Stringer A | | | | | | | | | | |
| 10" | 13" | 17" | 21" | 24" | 18" | 14" | 18" | 16" | 15" | 15" | 16" | 12" | 14" | 18" | 24" | 24" | 18" | 14" | 10" | 10" | 12" | 16" | 20" | 21" | 16" | 12" | 15" | 24" | 24" | 18" | 14" | 10" | Stringer B | | | | | | | | | | |
| 10" | 12" | 16" | 20" | 21" | 16" | 12" | 15" | 13" | 13" | 13" | 15" | 11" | 14" | 18" | 24" | 22" | 17" | 12" | 9" | 8" | 10" | 14" | 20" | 18" | 12" | 10" | 12" | 14" | 20" | 20" | 14" | 9" | 7" | Stringer C | | | | | | | | | |
| 8" | 10" | 14" | 20" | 18" | 12" | 10" | 12" | 10" | 9" | 9" | 9" | 7" | 10" | 14" | 20" | 20" | 14" | 9" | 7" | | | | | | | | | | | | | | | | Stringer D | | | | | | | | |
| Top Flange | | R 12x 1/2 x 41'-3 1/8" | | | | | | | | | | R 12x 1/2 x 40'-0" | | | | | | | | | | R 12x 1/2 x 19'-10" | | | | | | | | | | Stringer A | | | | | | | | | | | |
| | | R 12x 1/2 x 45'-0 3/8" | | | | | | | | | | R 12x 1/2 x 21'-0" | | | | | | | | | | R 12x 1/2 x 40'-0" | | | | | | | | | | Stringer B | | | | | | | | | | | |
| | | R 12x 1/2 x 46'-9 3/16" | | | | | | | | | | R 12x 1/2 x 20'-0" | | | | | | | | | | R 12x 1/2 x 45'-0" | | | | | | | | | | Stringer C | | | | | | | | | | | |
| | | R 12x 1/2 x 48'-6 3/16" | | | | | | | | | | R 12x 1/2 x 21'-0" | | | | | | | | | | R 12x 1/2 x 44'-0" | | | | | | | | | | Stringer D | | | | | | | | | | | |
| Bottom Flange | | R 16x 1 1/4 x 51'-3 1/8" | | | | | | | | | | R 16x 1 1/4 x 25'-0" | | | | | | | | | | R 16x 1 1/4 x 45'-0" | | | | | | | | | | Stringer A | | | | | | | | | | | |
| | | R 16x 1 1/4 x 55'-0 3/8" | | | | | | | | | | R 16x 1 1/4 x 27'-0" | | | | | | | | | | R 16x 1 1/4 x 45'-0" | | | | | | | | | | Stringer B | | | | | | | | | | | |
| | | R 16x 1 1/4 x 56'-9 3/16" | | | | | | | | | | R 16x 1 1/4 x 27'-0" | | | | | | | | | | R 16x 1 1/4 x 47'-0" | | | | | | | | | | Stringer C | | | | | | | | | | | |
| | | R 16x 1 1/4 x 58'-6 3/16" | | | | | | | | | | R 16x 1 1/4 x 22'-0" | | | | | | | | | | R 16x 1 1/4 x 55'-0" | | | | | | | | | | Stringer D | | | | | | | | | | | |
| Intermediate Stiffener Spacing | | 3 Spa ① No Stiffeners | | | | | | | | | | 4 Eq. Spa ② 4 Eq. Spa | | | | | | | | | | 4 Eq. Spa ② 4 Eq. Spa | | | | | | | | | | No Stiffeners | | | | | | | | | | 5 Spa ① | Stringer A |
| | | 4 Spa ① No Stiffeners | | | | | | | | | | 1 Eq. Spa ② 4 Eq. Spa | | | | | | | | | | 1 Eq. Spa ② 4 Eq. Spa | | | | | | | | | | No Stiffeners | | | | | | | | | | 5 Spa ① | Stringer B |
| | | 4 Spa ① No Stiffeners | | | | | | | | | | 4 Eq. Spa ② 4 Eq. Spa | | | | | | | | | | 4 Eq. Spa ② 4 Eq. Spa | | | | | | | | | | 4 Eq. Spa | | | | | | | | | | 5 Spa ① | Stringer C |
| | | 5 Spa ① No Stiffeners | | | | | | | | | | 4 Eq. Spa ② 4 Eq. Spa | | | | | | | | | | 4 Eq. Spa ② 4 Eq. Spa | | | | | | | | | | 4 Eq. Spa | | | | | | | | | | 5 Spa ① | Stringer D |
| Diaphragm Spacing | | 6'-1 1/8" | | | | | | | | | | 5 Spa @ obt. 12'-2 3/8" = 61'-2 3/8" | | | | | | | | | | 8 Spa @ obt. 11'-11 3/4" = 95'-10" | | | | | | | | | | Stringer A | | | | | | | | | | | |
| | | 8'-8 1/8" | | | | | | | | | | 5 Spa @ obt. 12'-5 3/8" = 82'-4 1/8" | | | | | | | | | | 8 Spa @ obt. 12'-2 3/8" = 97'-7 3/8" | | | | | | | | | | Stringer B | | | | | | | | | | | |
| | | 11'-3 1/8" | | | | | | | | | | 5 Spa @ obt. 12'-0 3/8" = 63'-5 7/8" | | | | | | | | | | 8 Spa @ obt. 12'-5 3/8" = 99'-5 3/8" | | | | | | | | | | Stringer C | | | | | | | | | | | |
| | | 13'-10 1/8" | | | | | | | | | | 5 Spa @ obt. 12'-1 1/8" = 64'-7 3/8" | | | | | | | | | | 8 Spa @ obt. 12'-7 3/8" = 101'-2 1/8" | | | | | | | | | | Stringer D | | | | | | | | | | | |
| Spans | | 67'-3 1/8" | | | | | | | | | | 95'-10" | | | | | | | | | | 97'-7 3/8" | | | | | | | | | | Stringer A | | | | | | | | | | | |
| | | 71'-0 3/8" | | | | | | | | | | 97'-7 3/8" | | | | | | | | | | 97'-7 3/8" | | | | | | | | | | Stringer B | | | | | | | | | | | |
| | | 74'-9 3/16" | | | | | | | | | | 97'-5 1/4" | | | | | | | | | | 97'-5 1/4" | | | | | | | | | | Stringer C | | | | | | | | | | | |
| | | 78'-6 5/16" | | | | | | | | | | 101'-2 1/8" | | | | | | | | | | 101'-2 1/8" | | | | | | | | | | Stringer D | | | | | | | | | | | |

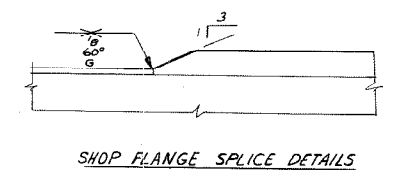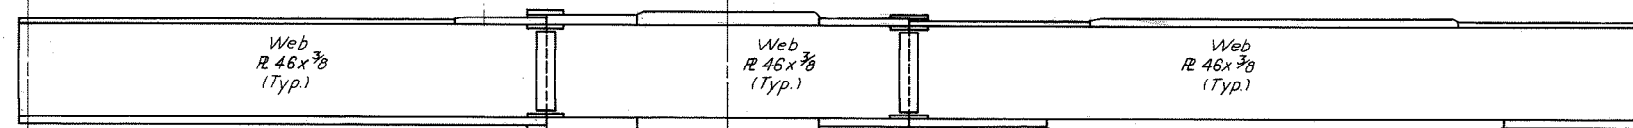

- ① The first two spaces of the ends of the stringers shall be one-half of the remaining spaces.
- ② Stiffeners shall be relocated as required to clear web splice plates.
- ③ See Shear Stud Details At End Bearings.

RICHMOND METROPOLITAN AUTHORITY
RICHMOND EXPRESSWAY SYSTEM
 DOWNTOWN EXPRESSWAY

BRIDGE NO. 62
 RAMP E-11TH OVER RAMP 12TH-W
 OVER 12TH ST.

STRINGERS


HOWARD, NEEDLES, TAMMEN & BERGENDOFF
 consulting engineers
 NEW YORK ALEXANDRIA KANSAS CITY

SCALE: As Noted
 CONTRACT NO.: 9
 SHEET NO. 5 OF 11




| | | | | |
|-----------|------|-------|--------------|----------|
| BY | DATE | | | |
| MADE | RDR | 12-67 | | |
| CHECKED | JLJ | 1-68 | 1 As Built | TEM 7-77 |
| IN CHARGE | PRY | | NO. REVISION | BY DATE |

AS BUILT

| RICHMOND EXPRESSWAY SYSTEM | | | |
|----------------------------|---------------------|-----------|--------------|
| SECTION | PROJECT | SHEET NO. | TOTAL SHEETS |
| 9 | DOWNTOWN EXPRESSWAY | 237 | |

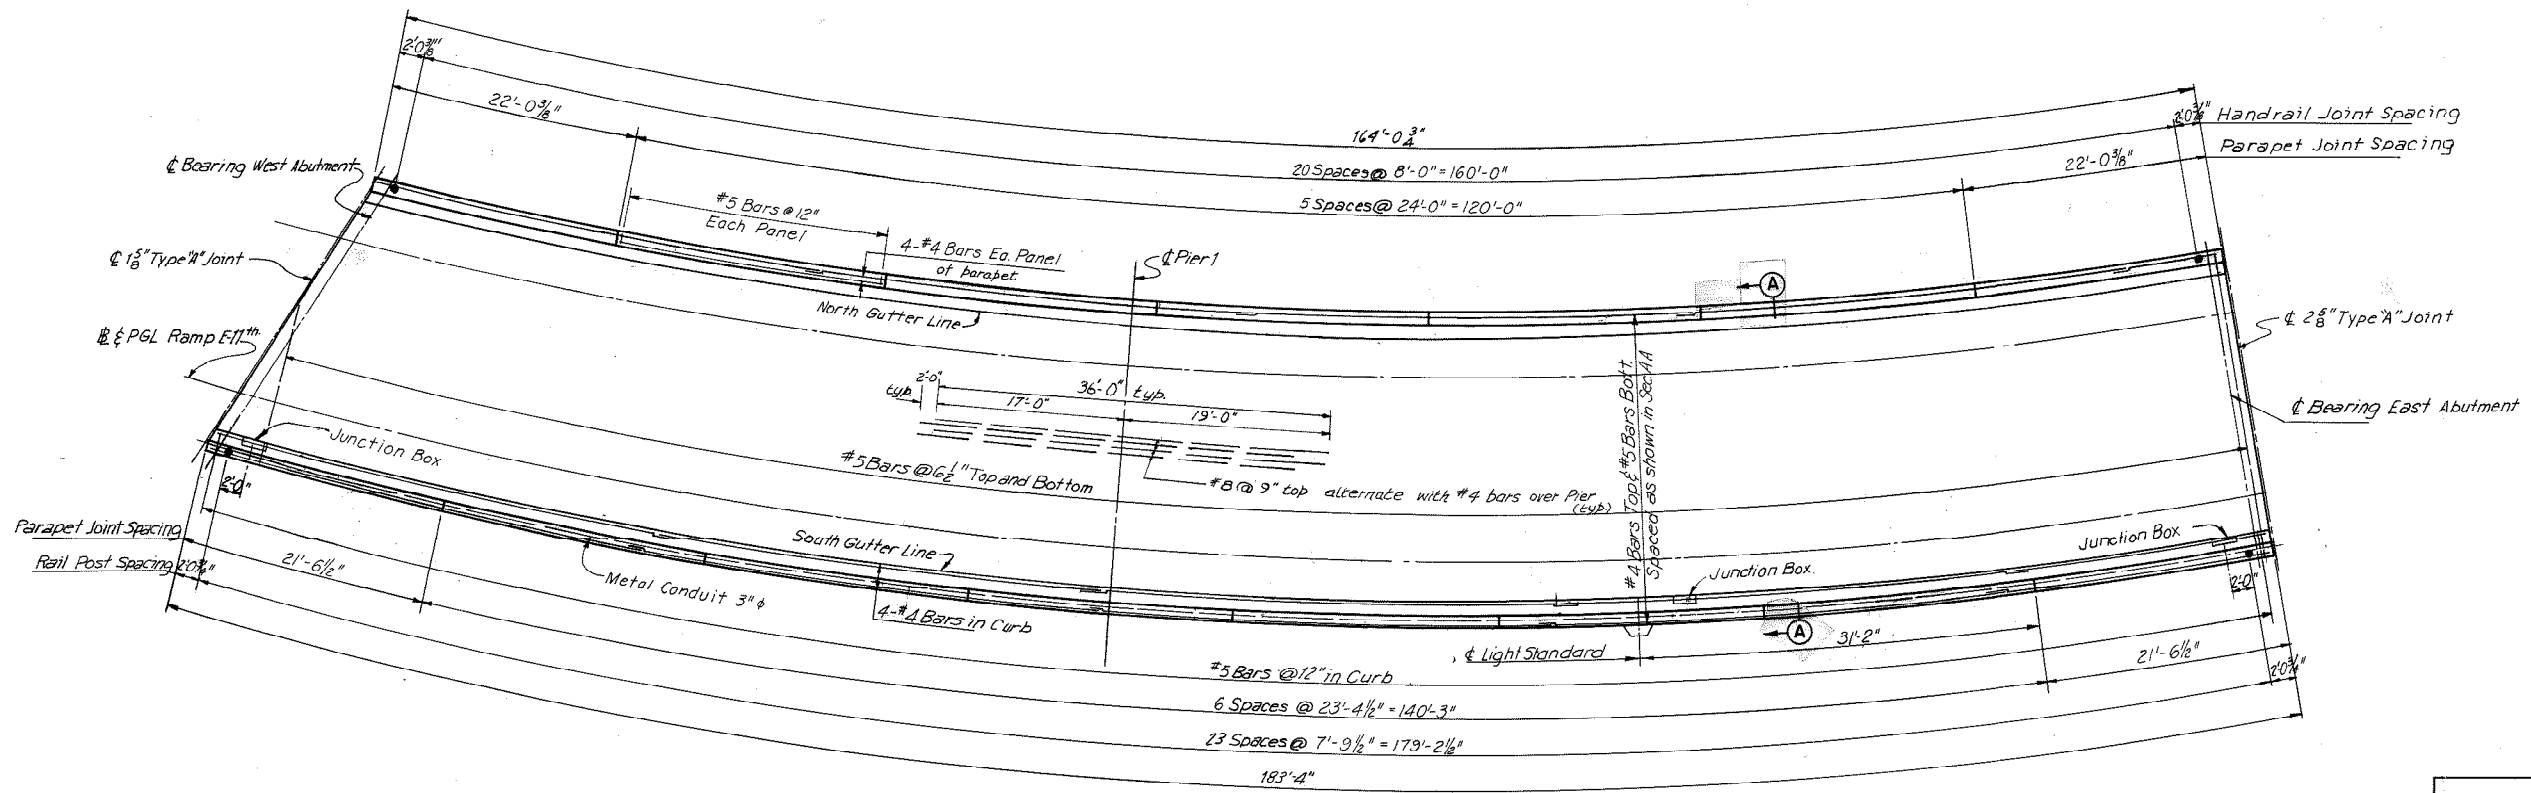

| LOCATION | N. GUTTER | BASE LINE | S. GUTTER |
|----------------|-----------|-----------|-----------|
| CL. JT.W. ABUT | 82.58 | 82.90 | 82.96 |
| 1/4 POINT | 82.76 | 83.10 | 83.16 |
| 1/2 POINT | 82.92 | 83.29 | 83.35 |
| 3/4 POINT | 83.00 | 83.39 | 83.45 |
| CL. PIER 1 | 82.99 | 83.38 | 83.45 |
| 1/4 POINT | 82.83 | 83.22 | 83.29 |
| 1/2 POINT | 82.48 | 82.87 | 82.94 |
| 3/4 POINT | 81.95 | 82.34 | 82.41 |
| CL. JT.E. ABUT | 81.23 | 81.63 | 81.70 |

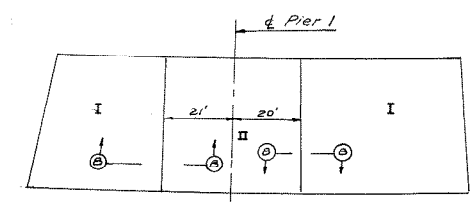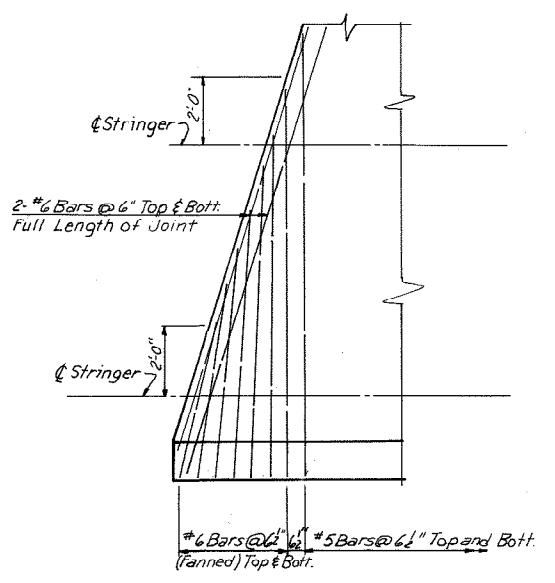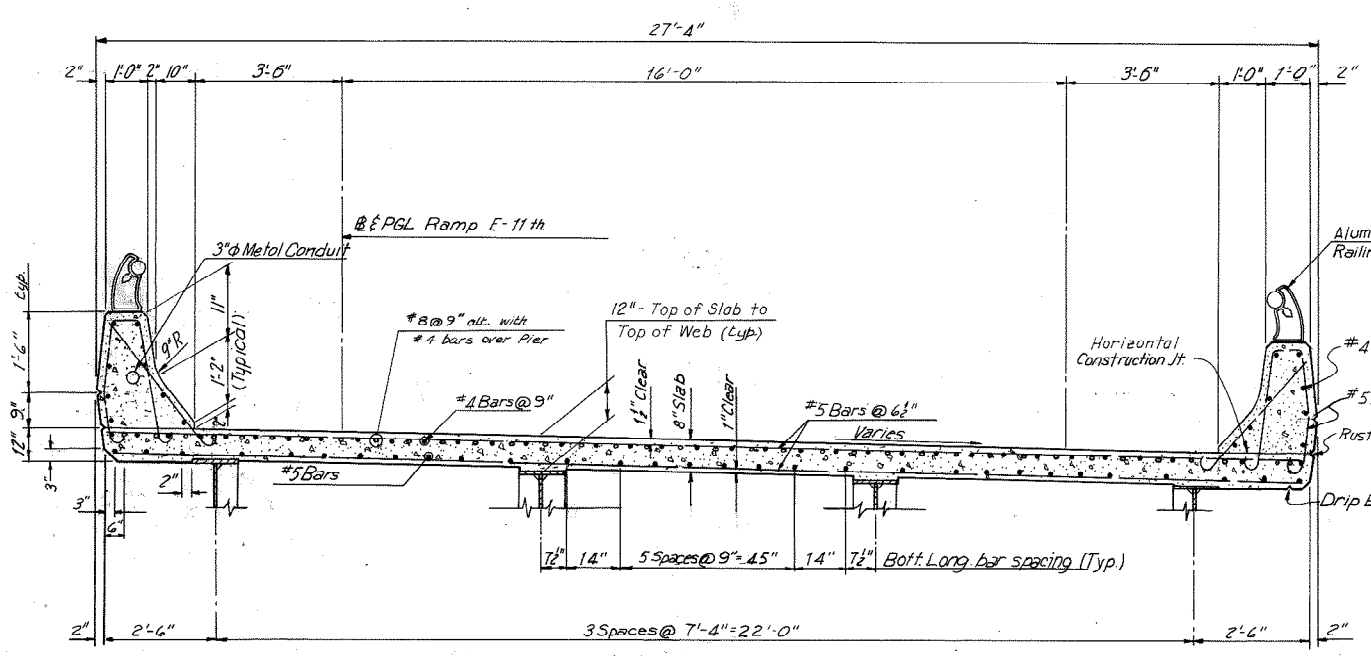

OPTIONAL DECK POURING SEQUENCE
 no scale
 I indicates first pour
 II indicates second pour
 Note:
 Deck poured in one pour.

| BY | DATE | NO. | REVISION | BY | DATE |
|-----------|------|----------|----------|------------------------------|----------|
| MADE | PP | 12-20-47 | 2 | As Built | TEM 7-77 |
| CHECKED | JLJ | 12-22-67 | 1 | Revised Light Std. Locations | TEM 9-74 |
| IN CHARGE | PRY | | | | |

SECTION A-A
 Scale: 1/2"=1'-0"

SECTION B-B
 no scale

RICHMOND METROPOLITAN AUTHORITY
RICHMOND EXPRESSWAY SYSTEM
 DOWNTOWN EXPRESSWAY

BRIDGE NO. 62
 RAMP E-11TH OVER RAMP 12TH-W
 OVER 12TH ST.


SLAB

HOWARD, NEEDLES, TAMMEN & BERGENDOFF
 consulting engineers
 NEW YORK ALEXANDRIA KANSAS CITY


SCALE: As Noted
 CONTRACT NO.: 9
 SHEET NO. 7 OF 11

AS BUILT


| RICHMOND EXPRESSWAY SYSTEM | | | |
|----------------------------|---------------------|-----------|--------------|
| SECTION | PROJECT | SHEET NO. | TOTAL SHEETS |
| 9 | DOWNTOWN EXPRESSWAY | 238 | |

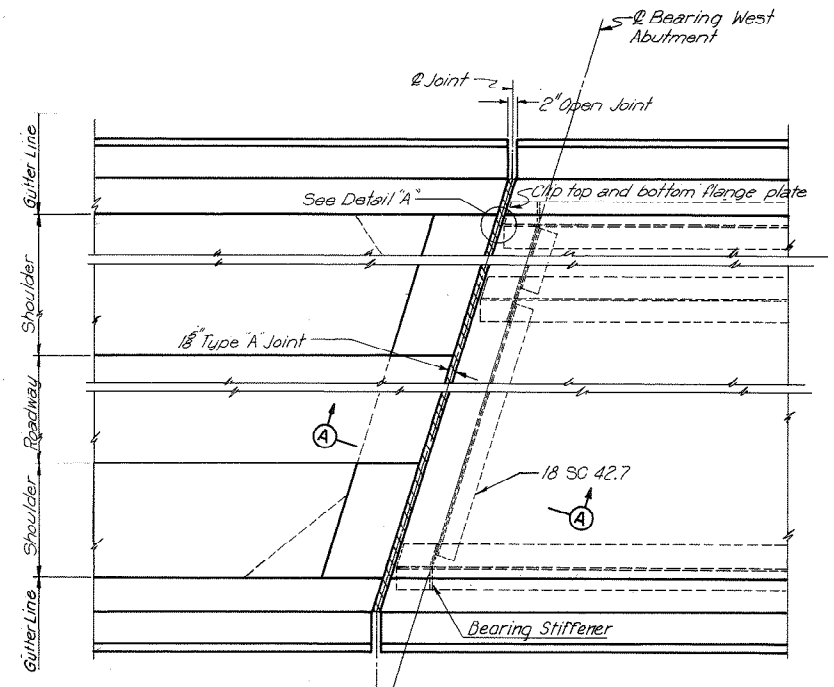


PLAN-JOINT AT WEST ABUTMENT
No Scale

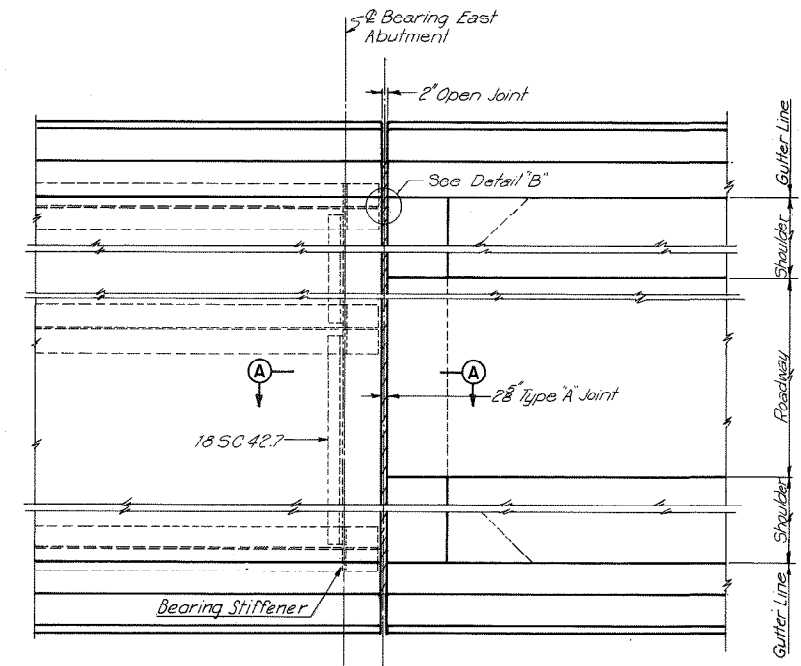


PLAN-JOINT AT EAST ABUTMENT
No Scale

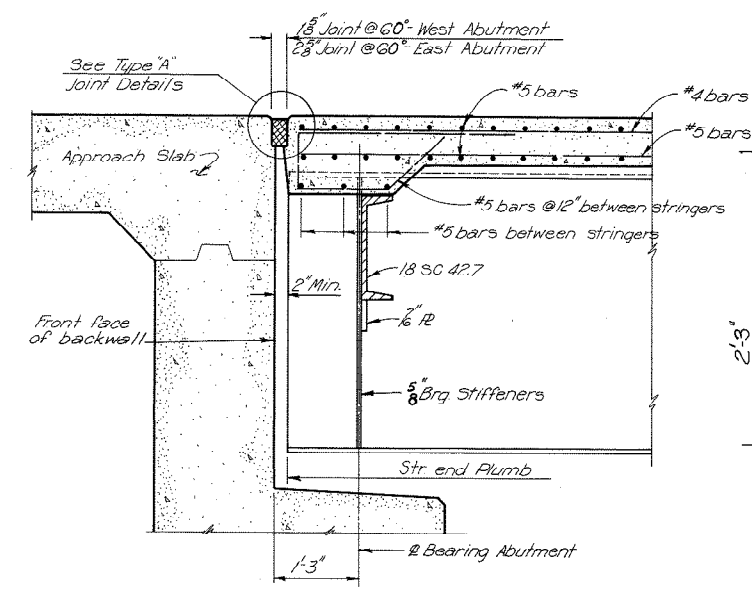


SECTION A-A
Scale: 3/4\"/>

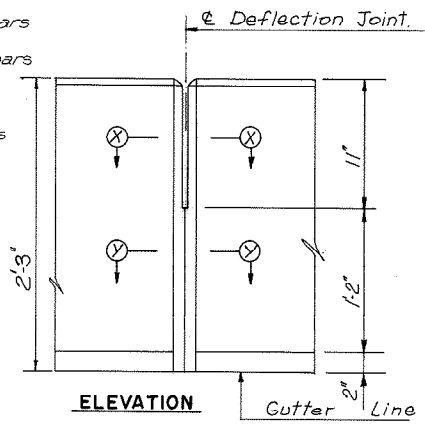


ELEVATION

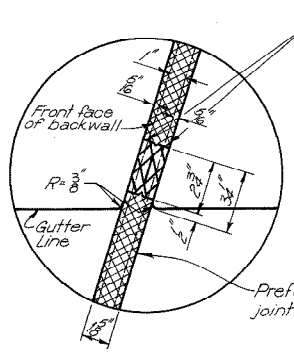


DETAIL "A"
No Scale

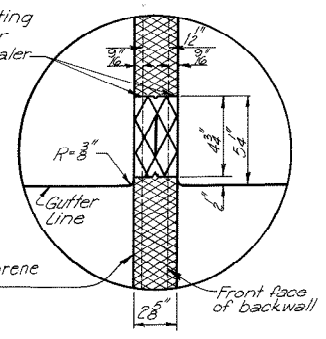


DETAIL "B"
No Scale

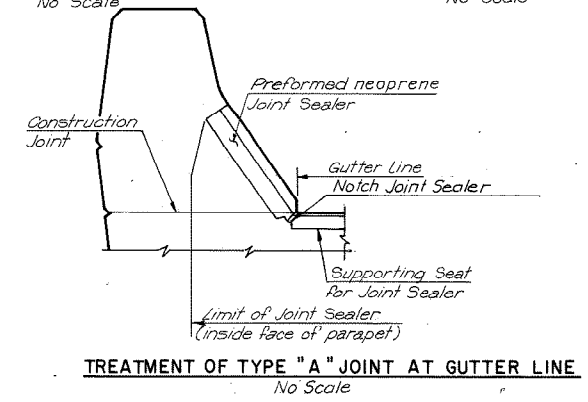

TREATMENT OF TYPE "A" JOINT AT GUTTER LINE
No Scale

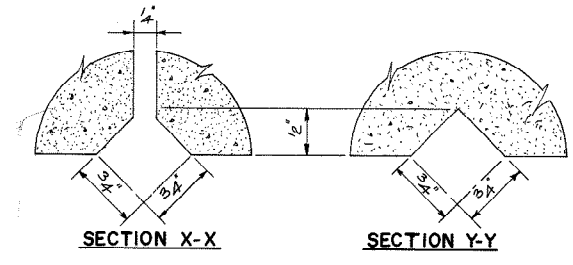

PARAPET DEFLECTION JOINT DETAILS
Note: Groove details are for both sides of parapet.

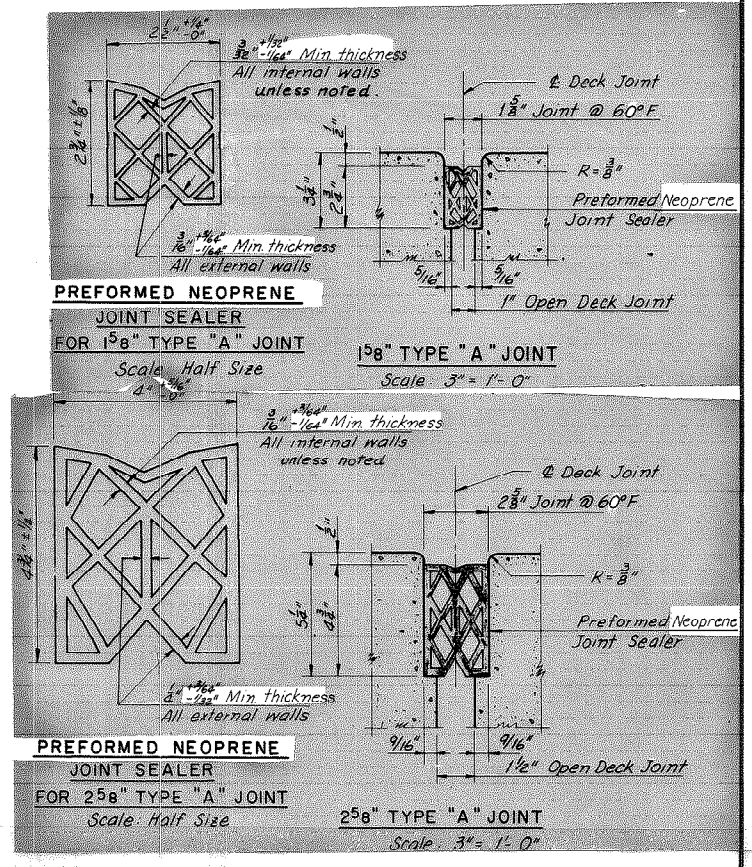

NOTE TO CONTRACTOR:
It is absolutely essential that the openings for the preformed neoprene joint sealers be accurately formed and constructed to smooth, straight lines. The size of the opening shall be adjusted to allow for anticipated dead load rotation of the ends of the slab and for the temperature at the time of construction.

| BY | DATE | NO. | REVISION | BY | DATE |
|-----------|----------|-----|---------------------|--------|------|
| MADE | LDL 1-68 | 2 | As Built | TEM | 7-77 |
| CHECKED | JLJ 1-68 | 1 | PARAPET JOINT ADDED | T.E.M. | 7-74 |
| IN CHARGE | PRX | | | | |

RICHMOND METROPOLITAN AUTHORITY
RICHMOND EXPRESSWAY SYSTEM
DOWNTOWN EXPRESSWAY

BRIDGE NO. 62
RAMP E-11TH OVER RAMP I2TH-W
OVER I2TH ST.


JOINT DETAILS

SCALE: As Shown
CONTRACT NO. 9
SHEET NO. 8 OF 11

HOWARD, NEEDLES, TAMMEN & BERGENDOFF
consulting engineers
NEW YORK ALEXANDRIA KANSAS CITY

AS BUILT

| RICHMOND EXPRESSWAY SYSTEM | | | |
|----------------------------|------------------------|-----------|--------------|
| SECTION | PROJECT | SHEET NO. | TOTAL SHEETS |
| C-15 | 1990-1991 IMPROVEMENTS | 6(1) | |

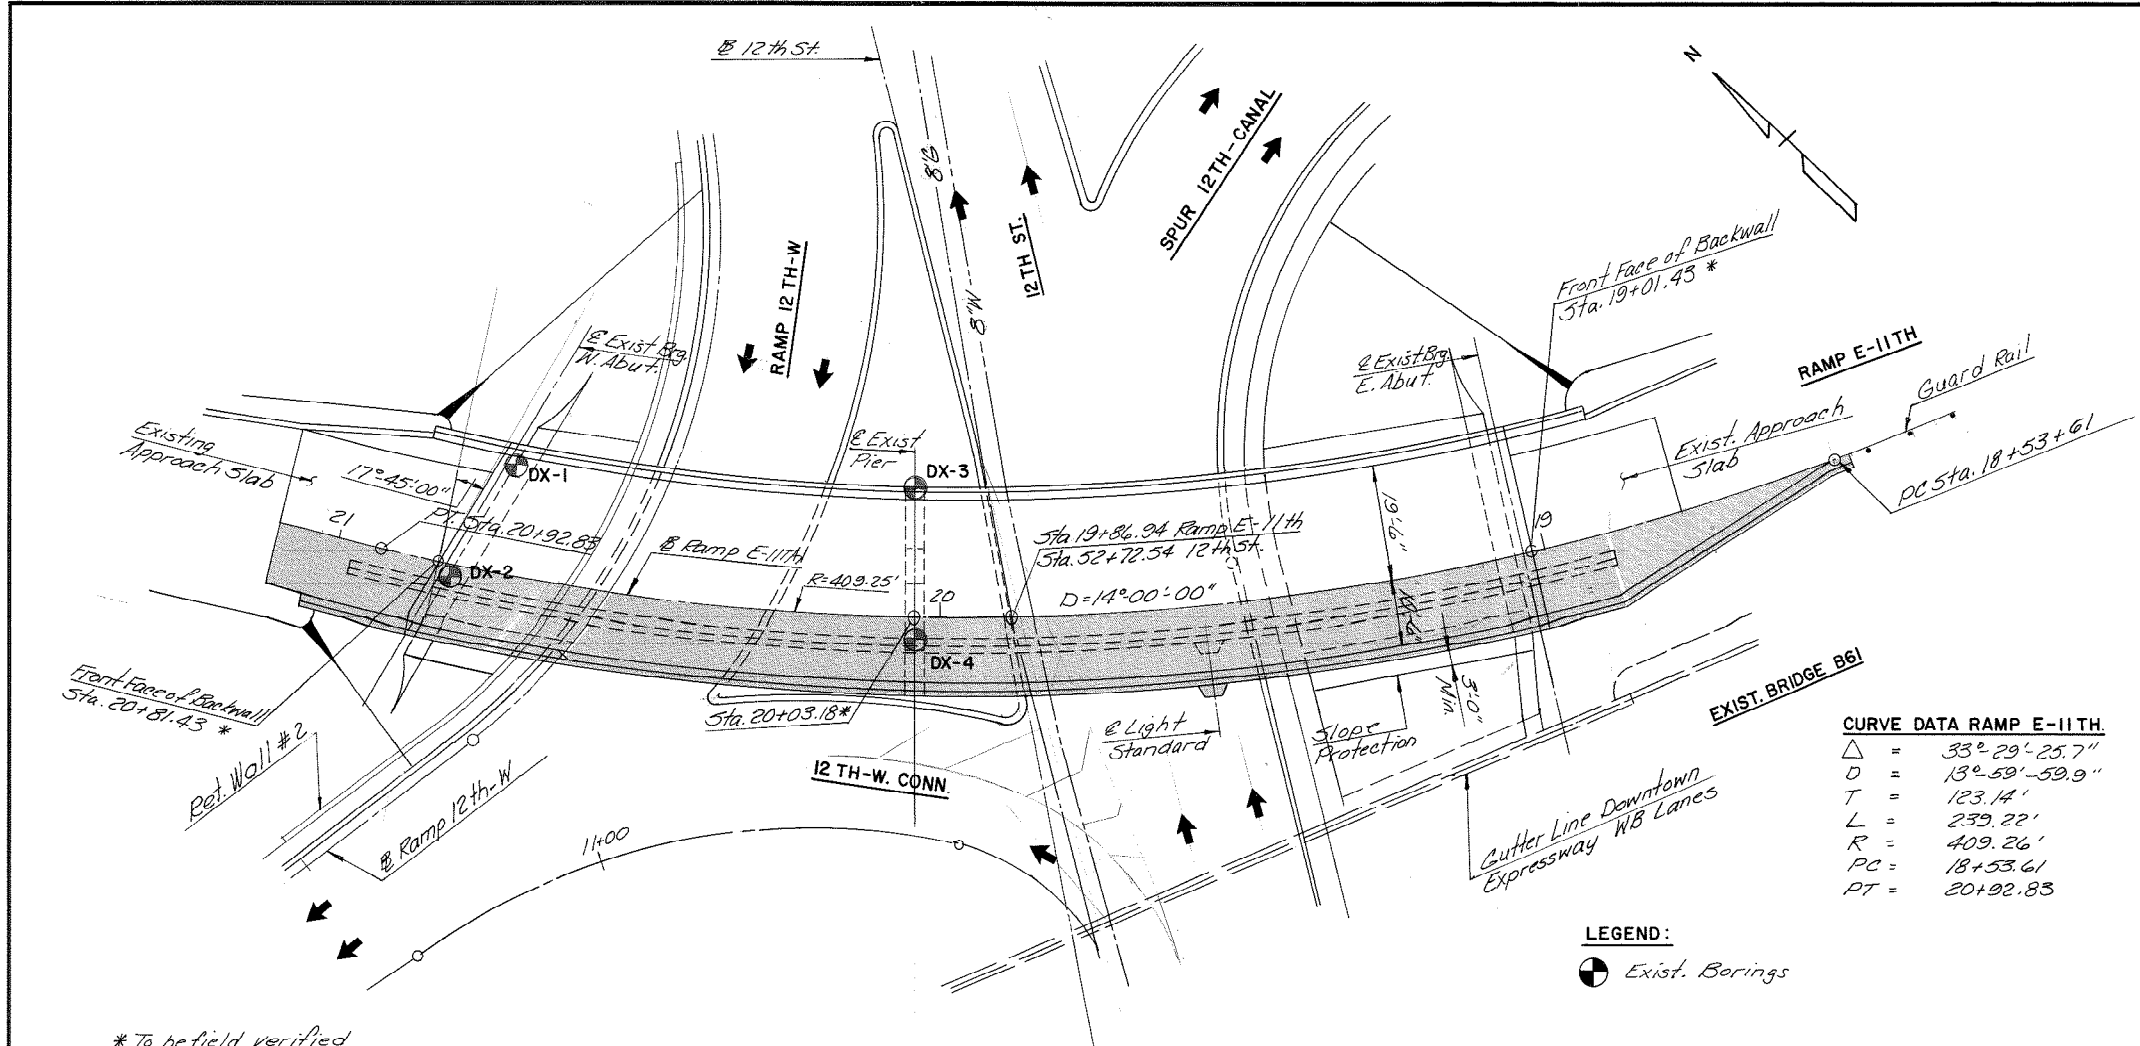


GENERAL NOTES:

- WIDTH: WIDENING OF 7'-0" TO THE SOUTH OF THE EXISTING STRUCTURE.
 - SPAN LAYOUT: 100.5'-77" CONTINUOUS STEEL PLATE GIRDER SPANS.
 - CAPACITY: HS20-44 LOADING AND ALTERNATE MILITARY LOADING. DESIGN LOADING INCLUDES 15 PSF FOR FUTURE WEARING SURFACE AND 20 PSF ALLOWANCE FOR CONSTRUCTION TOLERANCES AND CONSTRUCTION METHODS.
 - SPECIFICATIONS:
 - CONSTRUCTION: VIRGINIA DEPARTMENT OF TRANSPORTATION ROAD AND BRIDGE SPECIFICATIONS, 1987.
 - DESIGN: AASHTO STANDARD SPECIFICATIONS FOR HIGHWAY BRIDGES, 1989, INCLUDING INTERIM SPECIFICATIONS, 1990 AND VDOT MODIFICATIONS.
 - STANDARDS: VIRGINIA DEPARTMENT OF TRANSPORTATION ROAD AND BRIDGE STANDARDS, 1989.
- ALL DIMENSIONS ARE MEASURED HORIZONTALLY AND VERTICALLY UNLESS OTHERWISE SPECIFIED.
- THESE PLANS ARE INCOMPLETE UNLESS ACCOMPANIED BY THE SUPPLEMENTAL SPECIFICATIONS AND SPECIAL PROVISIONS INCLUDED IN THE CONTRACT DOCUMENTS.
- THE USE OF STAY-IN-PLACE FORMS WILL NOT BE PERMITTED.
- ALL STRUCTURAL STEEL SHALL BE ASTM A36, EXCEPT AS NOTED.
- CONCRETE IN SUPERSTRUCTURE SHALL BE CLASS A4. ALL OTHER CONCRETE SHALL BE CLASS A3.
- DEFORMED REINFORCING BARS SHALL CONFORM TO ASTM A615, GRADE 60. ALL REINFORCING BAR DIMENSIONS ON THE DETAILED DRAWINGS ARE TO CENTERS OF BARS EXCEPT WHERE OTHERWISE NOTED AND ARE SUBJECT TO FABRICATION AND CONSTRUCTION TOLERANCES.
- H-PILES HAVE A DESIGN CAPACITY OF 45 TONS PER PILE, AND SHALL BE DRIVEN TO REFUSAL.
- PRIOR TO THE COMMENCEMENT OF ANY WORK THE CONTRACTOR SHALL FIELD VERIFY ALL DIMENSIONS AND ELEVATIONS OF THE EXISTING STRUCTURE AND REPORT TO THE ENGINEER ANY DISCREPANCIES BETWEEN FIELD MEASUREMENTS AND MEASUREMENT SHOWN ON THE CONTRACT PLANS.
- THE CONTRACTOR SHALL COORDINATE CONSTRUCTION OF RETAINING WALL NO. 2 WITH THE BRIDGE B62 CONTRACTOR.


CURVE DATA RAMP E-11TH

| | | |
|----|---|---------------|
| Δ | = | 33° 29' 25.7" |
| D | = | 13° 59' 59.9" |
| T | = | 123.14' |
| L | = | 239.22' |
| R | = | 409.26' |
| PC | = | 18+53.61 |
| PT | = | 20+92.83 |


PLAN
Scale: 1"=15'

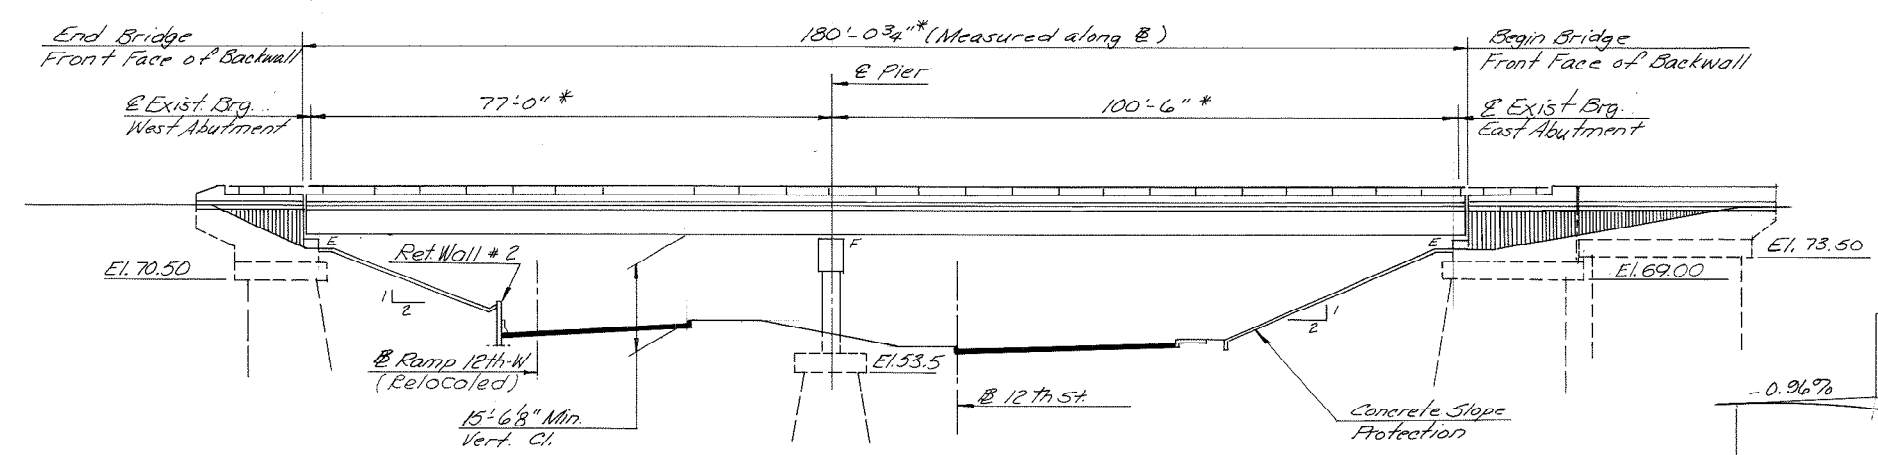


ELEVATION
Scale: 1"=15'

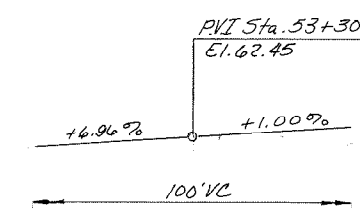

PROFILE GRADE 12TH ST.
No Scale

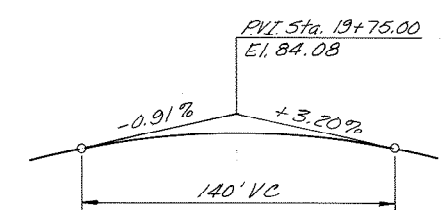

PROFILE GRADE RAMP E-11 TH.
(WIDENING)
No Scale

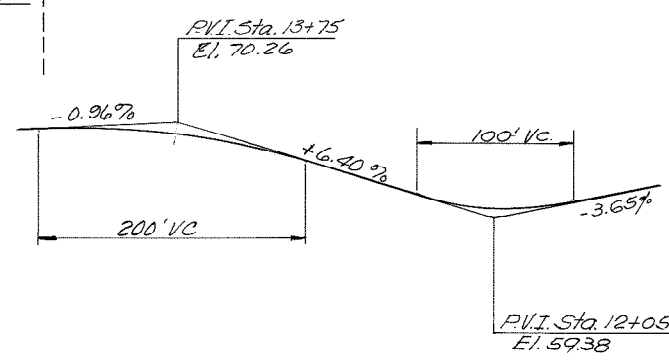

PROFILE GRADE RAMP 12TH-W
(RELOCATED)
No Scale

AS BUILT

| BY | DATE | | | | |
|-----------|----------|-------|------|--|--|
| MADE | TAL | 12/90 | | | |
| CHECKED | BS | 12/90 | | | |
| IN CHARGE | SR | | | | |
| NO. | REVISION | BY | DATE | | |

RICHMOND METROPOLITAN AUTHORITY
RICHMOND EXPRESSWAY SYSTEM

BRIDGE NO. 62 WIDENING
RAMP E-11TH OVER
RAMP 12TH-W AND 12TH ST.
PLAN AND ELEVATION

SCALE: As Shown

HOWARD, NEEDLES, TAMMEN & BERGENDOFF
consulting engineers
Alexandria, Virginia


CONTRACT NO. C-15
SHEET NO. 1 OF 31

14-237-21-02

| ESTIMATE OF QUANTITIES | | | | | | | | | | | | | | | | | | | | |
|------------------------|----------------------|-----------------|--------------------------------|----------------------------------|----------------------------------|-------------------|--------------------------------|-------------------------------|------------------|------------------------------|-----------------|-------------------------|--------------------------------------|-------------------------|--------------------------------|---------------------------------------|---------------|---|-----|--|
| | STRUCTURE EXCAVATION | STEEL PILES 10" | CONCRETE CLASS A3 SUBSTRUCTURE | CONCRETE CLASS A4 SUPERSTRUCTURE | CONCRETE CLASS A4 APPROACH SLABS | REINFORCING STEEL | EPOXY COATED REINFORCING STEEL | STRUCTURAL STEEL PLATE GIRDER | CONCRETE PARAPET | 4" CONCRETE SLOPE PROTECTION | POROUS BACKFILL | 6" DIA. PIPE UNDERDRAIN | REMOVE PORTION OF EXISTING STRUCTURE | EXPANSION JOINT REMOVAL | LATEX PORTLAND CEMENT CONCRETE | PREFORMED ELASTOMERIC 2" JOINT SEALER | DAMP PROOFING | REMOVE & RESET EXIT ALUMINUM BRIDGE RAILING (1" RAIL) | | |
| | C.Y. ⊗ | L.F. | C.Y. | C.Y. | C.Y. | LBS. ⊗ | LBS. ⊗ | LBS. * | L.F. ⊗ | S.Y. ⊗ | C.Y. | L.F. | L.S. ** | L.F. | C.Y. | L.F. ⊗ | S.Y. | L.F. | | |
| SUPERSTRUCTURE | | | | 60.2 | | | 16,593 | 65,960 | 185 | | | | | 58 | 9.4 | 71 | | | 188 | |
| WEST ABUT. | 46 | 455 | 26.5 | | | 2,783 | | | 18 | 75 | 5 | 20 | | | | | | 11 | 15 | |
| EAST ABUT. | 141 | 970 | 66.6 | | | 6,180 | | | 58 | 42 | 13 | 60 | | | | | | 38 | 11 | |
| PIER | 51 | 335 | 24.3 | | | 2,952 | | | | | | | | | | | | | | |
| APPROACH SLAB | | | | | 12.7 | 3,757 | | | | | | | | | | | | | | |
| TOTALS | 238 | 1760 | 117.4 | 60.2 | 12.7 | 15,444 | 16,593 | 65,960 | 261 | 117 | 18 | 80 | 1 | 58 | 9.4 | 71 | 49 | | 214 | |

⊗ Denotes item to be paid for on basis of plan quantities in accordance with current VDOT Road & Bridge Specifications.
 * Lump Sum - Includes 350lbs. for bearings.
 ** Includes Removal of Concrete Slope Protection at West Abutment.

| INDEX | |
|------------------------|--|
| SHT. NO. | TITLE |
| 1 | General Plan and Elevation |
| 2 | Footing Layout Plan & Estimate of Quantities |
| 3 | East Abutment |
| 4 | East Abutment Details |
| 5 | East Abutment Wingwall |
| 6 | West Abutment |
| 7 | West Abutment Details |
| 8 | Pier |
| 9 | Framing Plan and Girder Elevation |
| 10 | Diaphragm Details & Field Splice Details |
| 11 | Deck Plan and Typical Section |
| 12 | Parapet Elevation & Details |
| 13 | Joint Details |
| 14 | Approach Slab & Slope Protection Details |
| 15 | Shoe Details |
| 16 | Standard Aluminum Railing Details |
| 17 | Standard Electrical Details |
| 18, 19 | Bar Lists |
| 20 | Bar Bends |
| 21 of 31 thru 31 of 31 | Bridge 862 Ramp E-11th As Built (For Reference Only) |

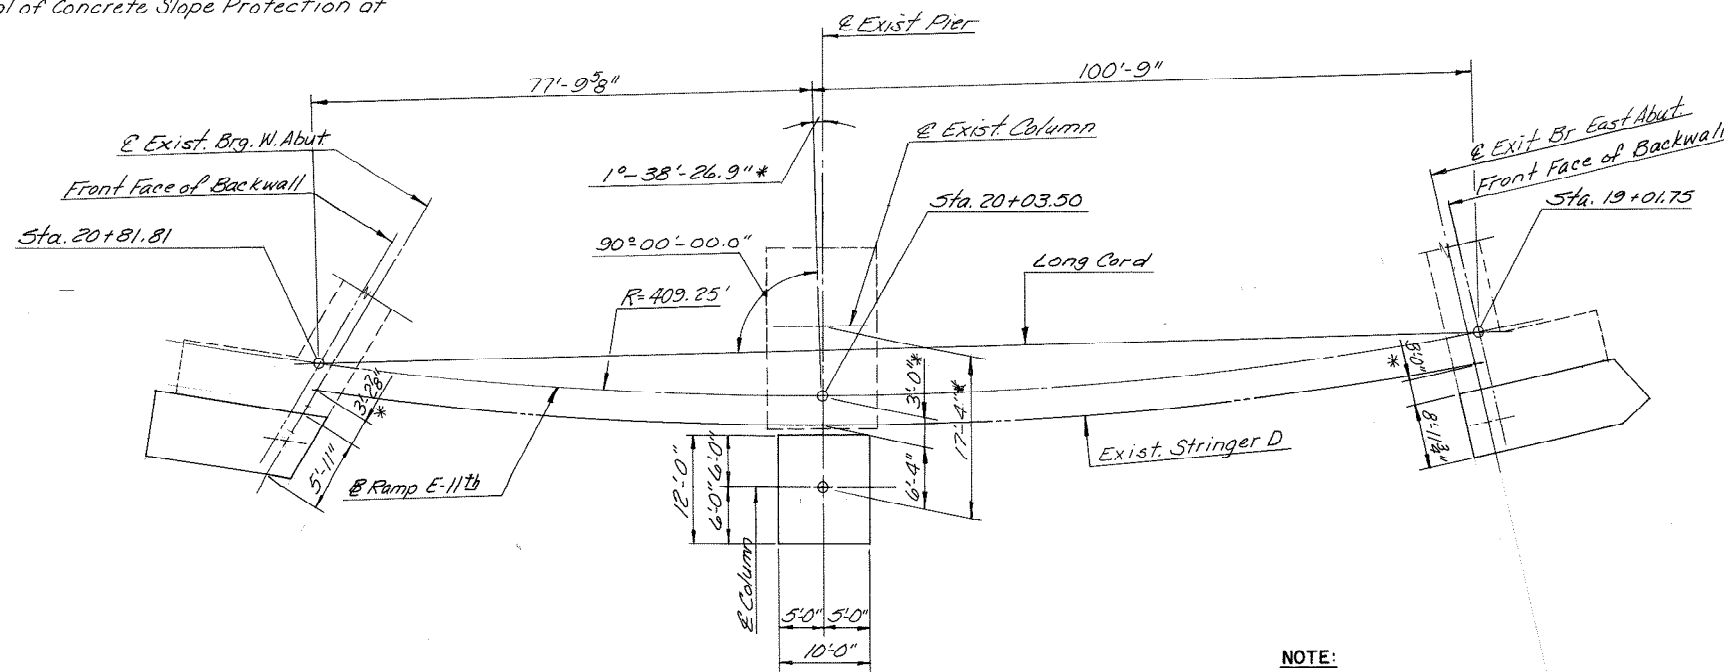

FOOTING LAYOUT
No Scale

NOTE:
The footing layout plan shall be used only for the purpose of locating the footing of Abutments and Pier.
* - Dimensions to be field verified.

| | | | | | |
|-----------|----------|-------|------|--|--|
| BY | DATE | | | | |
| MADE | TAL | 12/90 | | | |
| CHECKED | BS | 12/90 | | | |
| IN CHARGE | SR | | | | |
| NO. | REVISION | BY | DATE | | |


RICHMOND METROPOLITAN AUTHORITY
RICHMOND EXPRESSWAY SYSTEM

BRIDGE NO. 62 WIDENING
RAMP E-11TH OVER
RAMP 12TH-W AND 12TH ST.
ESTIMATE OF QUANTITIES AND
FOOTING LAYOUT PLAN


SCALE: As Shown
HOWARD, NEEDLES, TAMMEN & BERGENDOFF
consulting engineers
Alexandria, Virginia
CONTRACT NO.: C-15
SHEET NO. 2 OF 31

AS BUILT


| RICHMOND EXPRESSWAY SYSTEM | | | |
|----------------------------|------------------------|-----------|--------------|
| SECTION | PROJECT | SHEET NO. | TOTAL SHEETS |
| C-15 | 1990-1991 IMPROVEMENTS | 6(7) | |

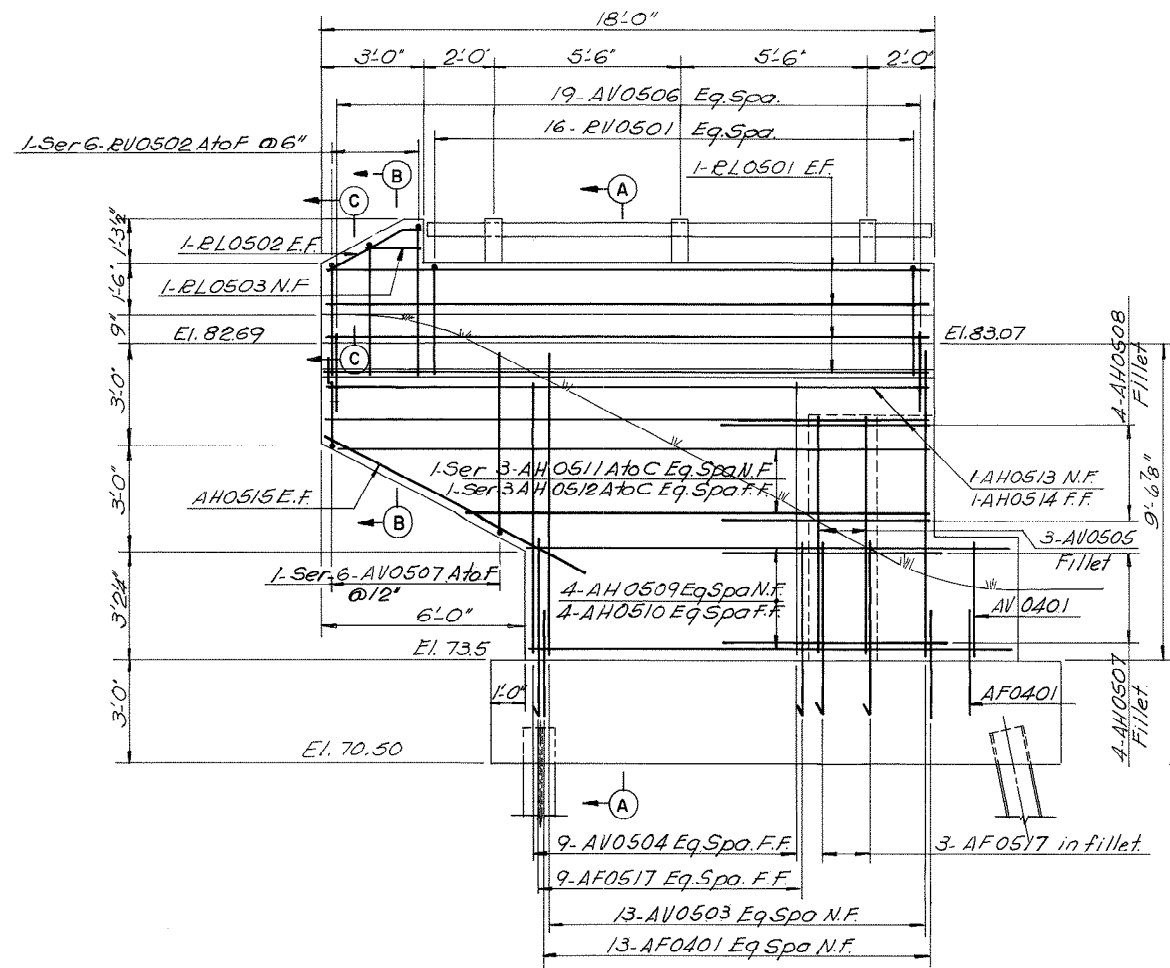


WINGWALL ELEVATION
Scale: 3/8"=1'-0"

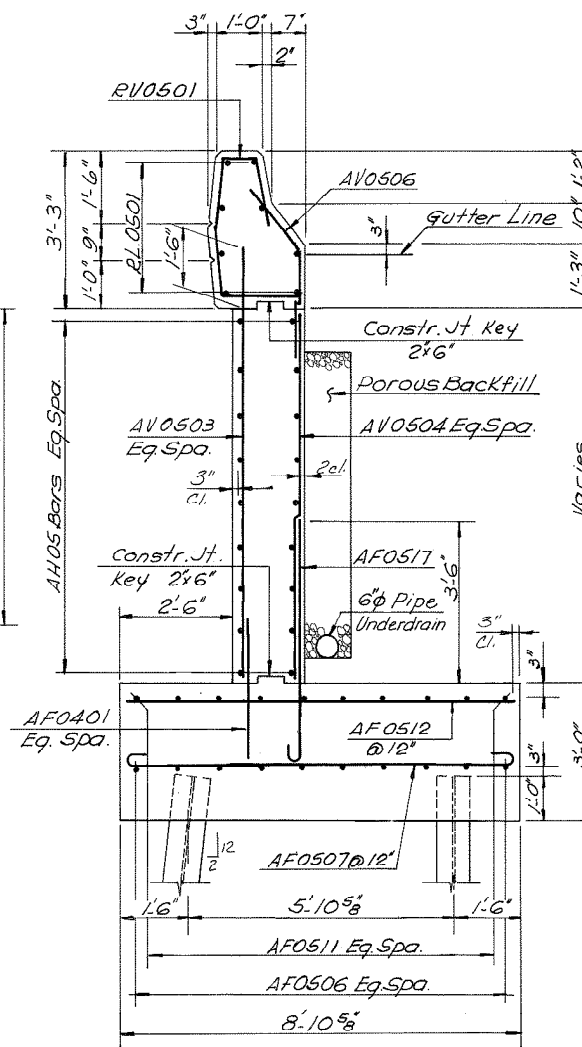



SECTION A-A
Scale: 1/2"=1'-0"

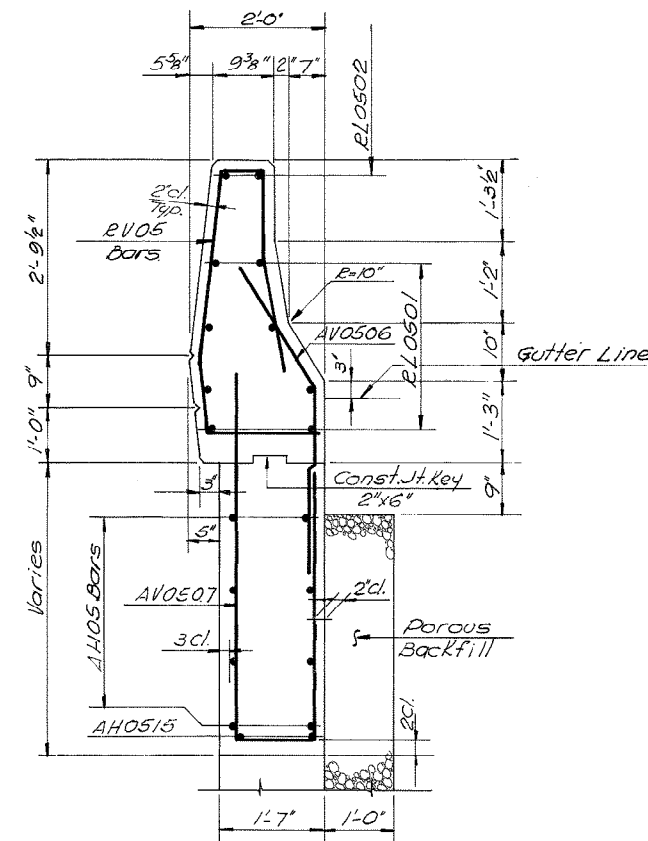

SECTION B-B
Scale: 3/4"=1'-0"

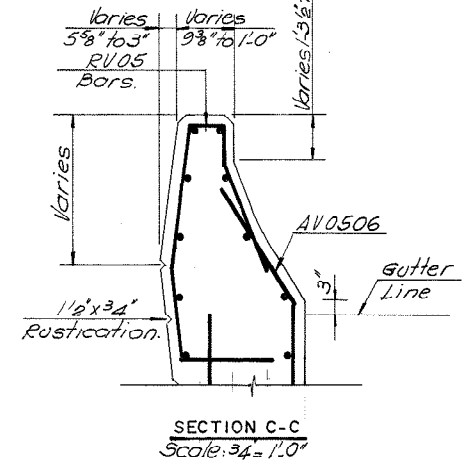


SECTION C-C
Scale: 3/4"=1'-0"

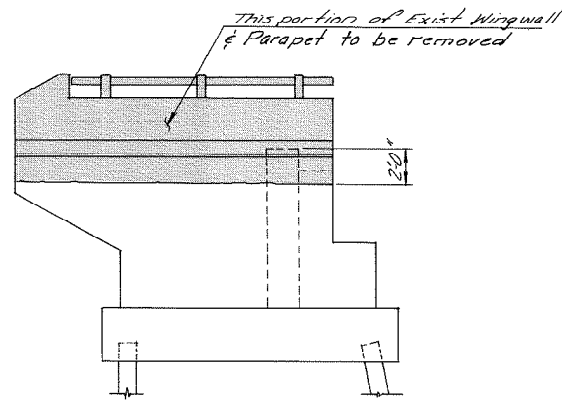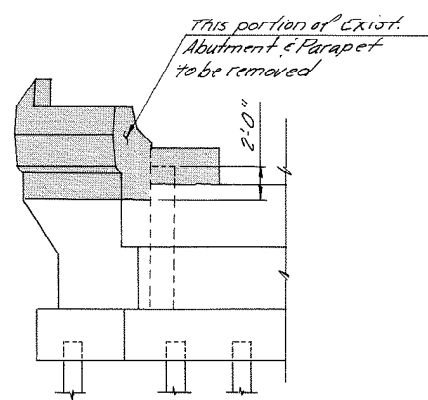

LIMITS OF REMOVAL
No Scale

LEGEND:

- EF = Each Face
- N.F. = Near Face
- FF. = Far Face

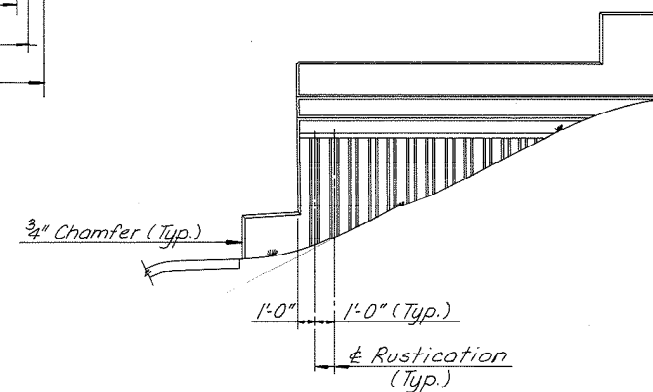

ARCHITECTURAL TREATMENT DETAILS
No Scale

CONCRETE FINISH NOTES:

All exposed edges and corners having an internal angle of 90° or less shall have a 3/4" chamfer or fillet unless otherwise noted.

TYPICAL RUSTICATION DETAIL

Scale: 3"=1'-0"

NOTE:

Rustications on abutment shall extend a minimum of 2'-0" below the finished ground line.

| BY | DATE | | | | |
|-----------|----------|-------|------|--|--|
| MADE | TAL | 12/90 | | | |
| CHECKED | BS | 1/91 | | | |
| IN CHARGE | SR | | | | |
| NO. | REVISION | BY | DATE | | |

RICHMOND METROPOLITAN AUTHORITY
RICHMOND EXPRESSWAY SYSTEM


BRIDGE NO. 62 WIDENING
RAMP E-11TH OVER
RAMP 12TH-W AND 12TH ST.
WEST ABUTMENT DETAIL

HOWARD, NEEDLES, TAMMEN & BERGENDOFF
consulting engineers
Alexandria, Virginia

SCALE: As Shown
CONTRACT NO.: C-15
SHEET NO. 7 OF 31


AS BUILT

| RICHMOND EXPRESSWAY SYSTEM | | | |
|----------------------------|------------------------|-----------|--------------|
| SECTION | PROJECT | SHEET NO. | TOTAL SHEETS |
| C-15 | 1990-1991 IMPROVEMENTS | 6(8) | |

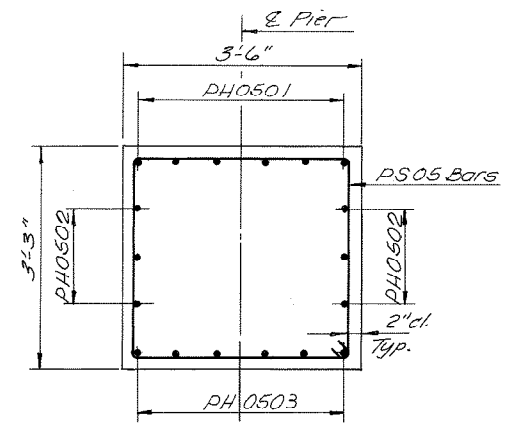


SECTION A-A
Scale: 3/4" = 1'-0"

* Anchor Bolt spacing to be furnished by manufacturer of Type PB Shoes.

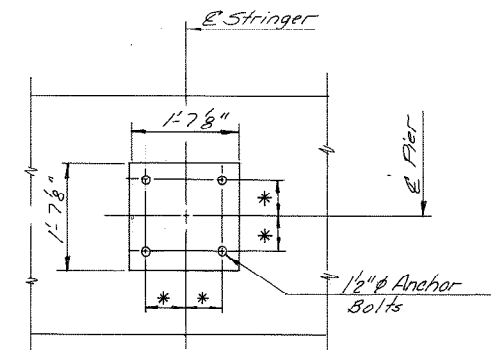


BEARING PAD DETAIL
Scale: 3/4" = 1'-0"

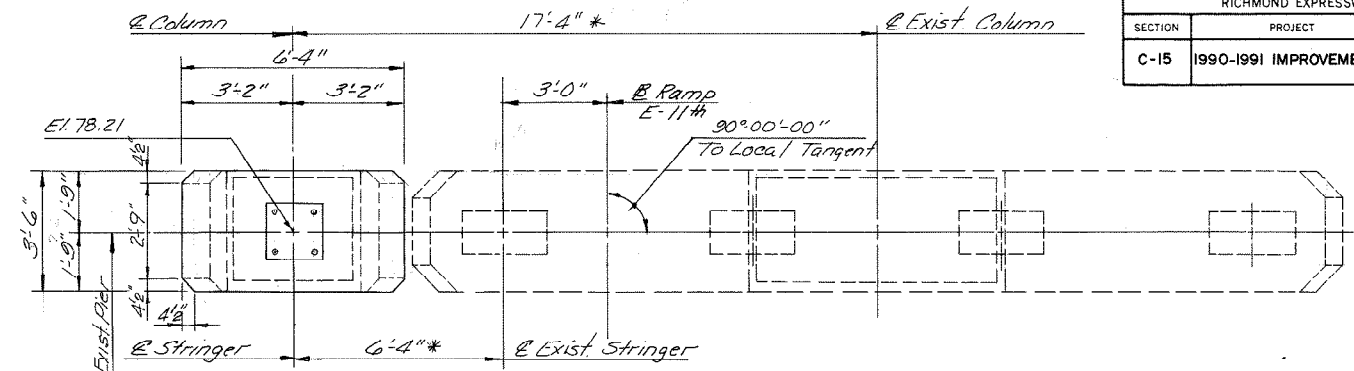


PLAN
Scale: 3/8" = 1'-0"


* Dimension to be field verified

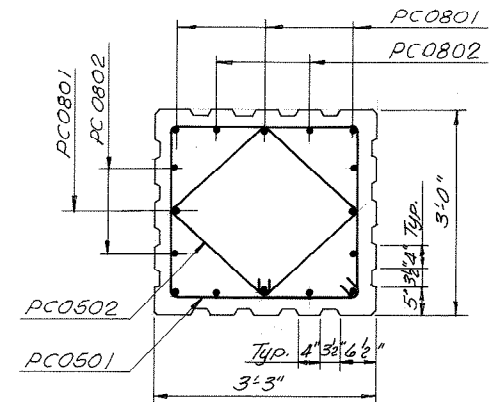


SECTION B-B
Scale: 3/4" = 1'-0"

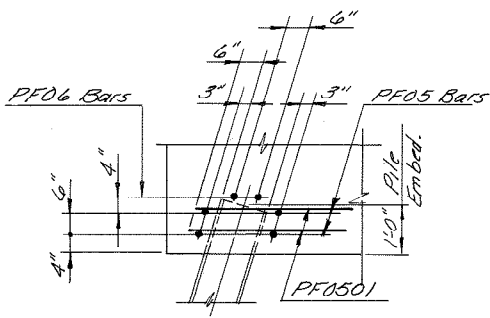


PILE REINFORCING DETAIL
Scale: 1/2" = 1'-0"

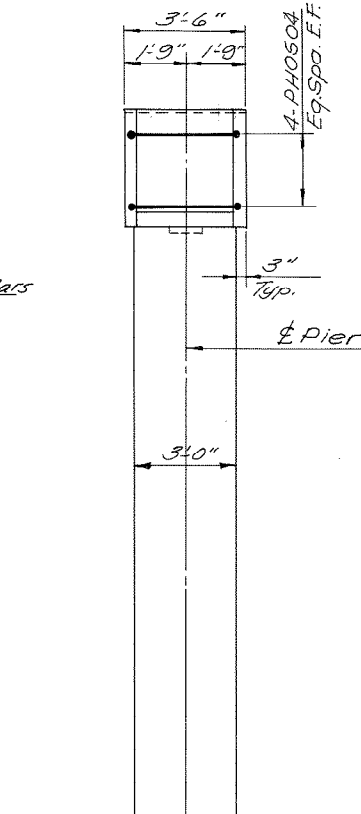

END VIEW
Scale: 3/8" = 1'-0"

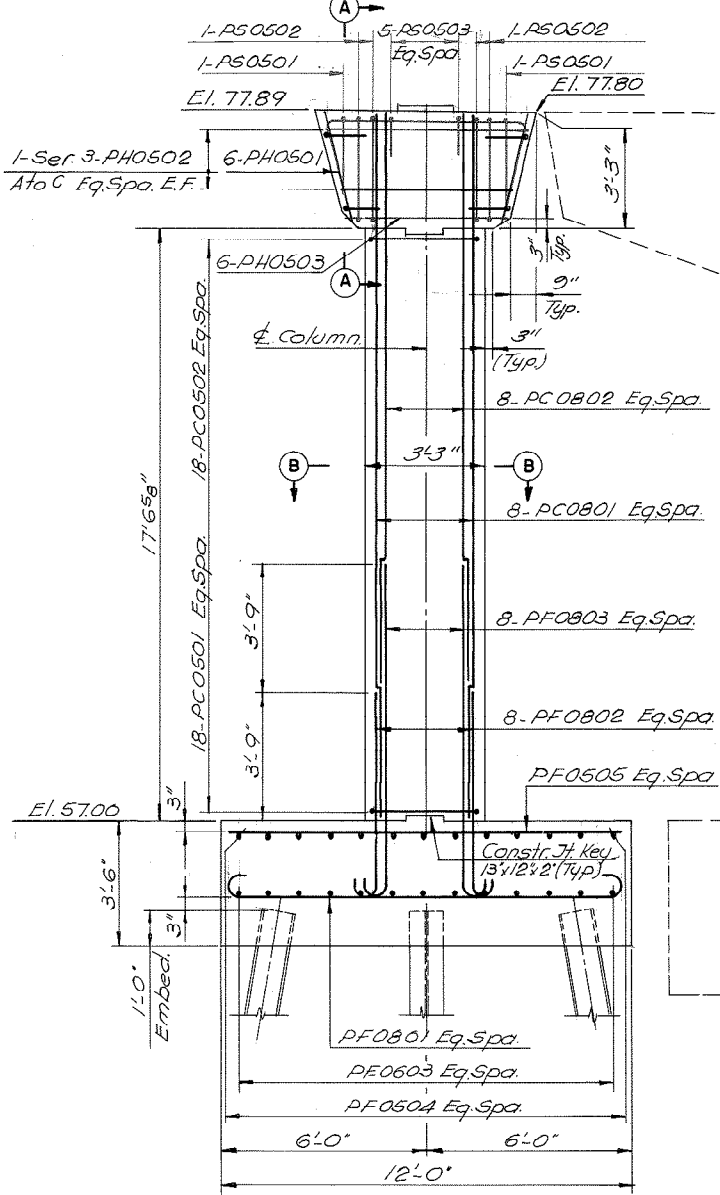

ELEVATION
Scale: 3/8" = 1'-0"

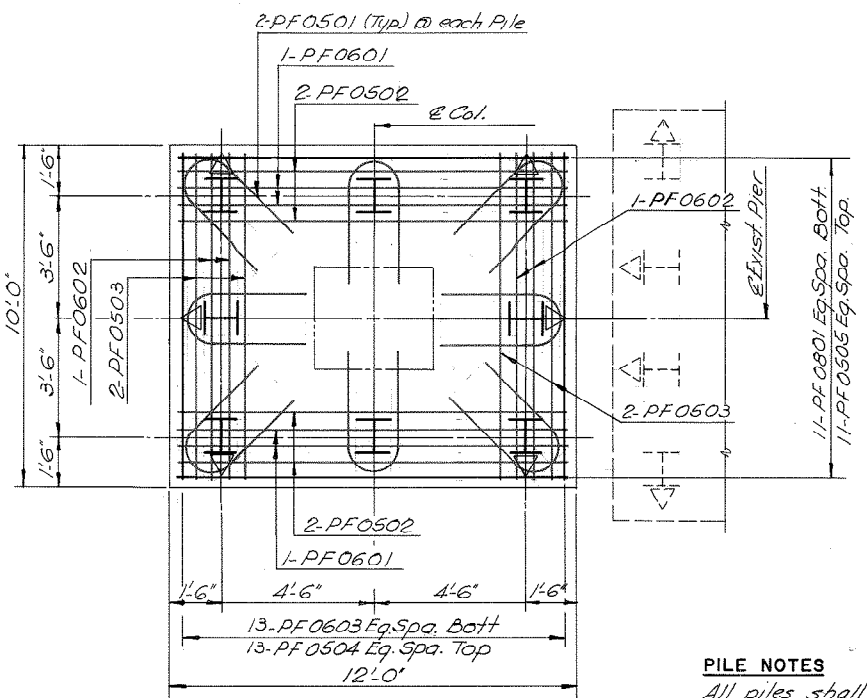

FOOTING PLAN
Scale: 3/8" = 1'-0"

PILE NOTES

- All piles shall be HP10 x 42.
- ⊥ Indicates Vertical Piles.
- ↘ Indicates Piles battered 2:12 in the direction of the arrow.
- ⊥ Indicates Exist Vertical Piles
- ↘ Indicates Exist Piles battered 2:12 in the direction of the arrow.

| BY | DATE | NO. | REVISION | BY | DATE |
|-----------|------|-------|----------|----|------|
| MADE | TAL | 12/90 | | | |
| CHECKED | BS | 12/90 | | | |
| IN CHARGE | SR | | | | |

RICHMOND METROPOLITAN AUTHORITY
RICHMOND EXPRESSWAY SYSTEM



BRIDGE NO. 62 WIDENING
RAMP E-11TH OVER
RAMP 12TH-W AND 12TH ST.
PIER

HOWARD, NEEDLES, TAMMEN & BERGENDOFF
consulting engineers
Alexandria, Virginia

SCALE: As Shown
CONTRACT NO.: C-15
SHEET NO. 8 OF 31

AS BUILT


| RICHMOND EXPRESSWAY SYSTEM | | | |
|----------------------------|------------------------|-----------|--------------|
| SECTION | PROJECT | SHEET NO. | TOTAL SHEETS |
| C-15 | 1990-1991 IMPROVEMENTS | 6(9) | |

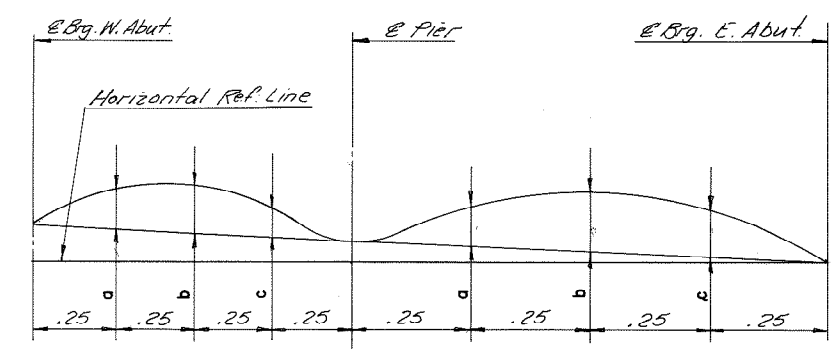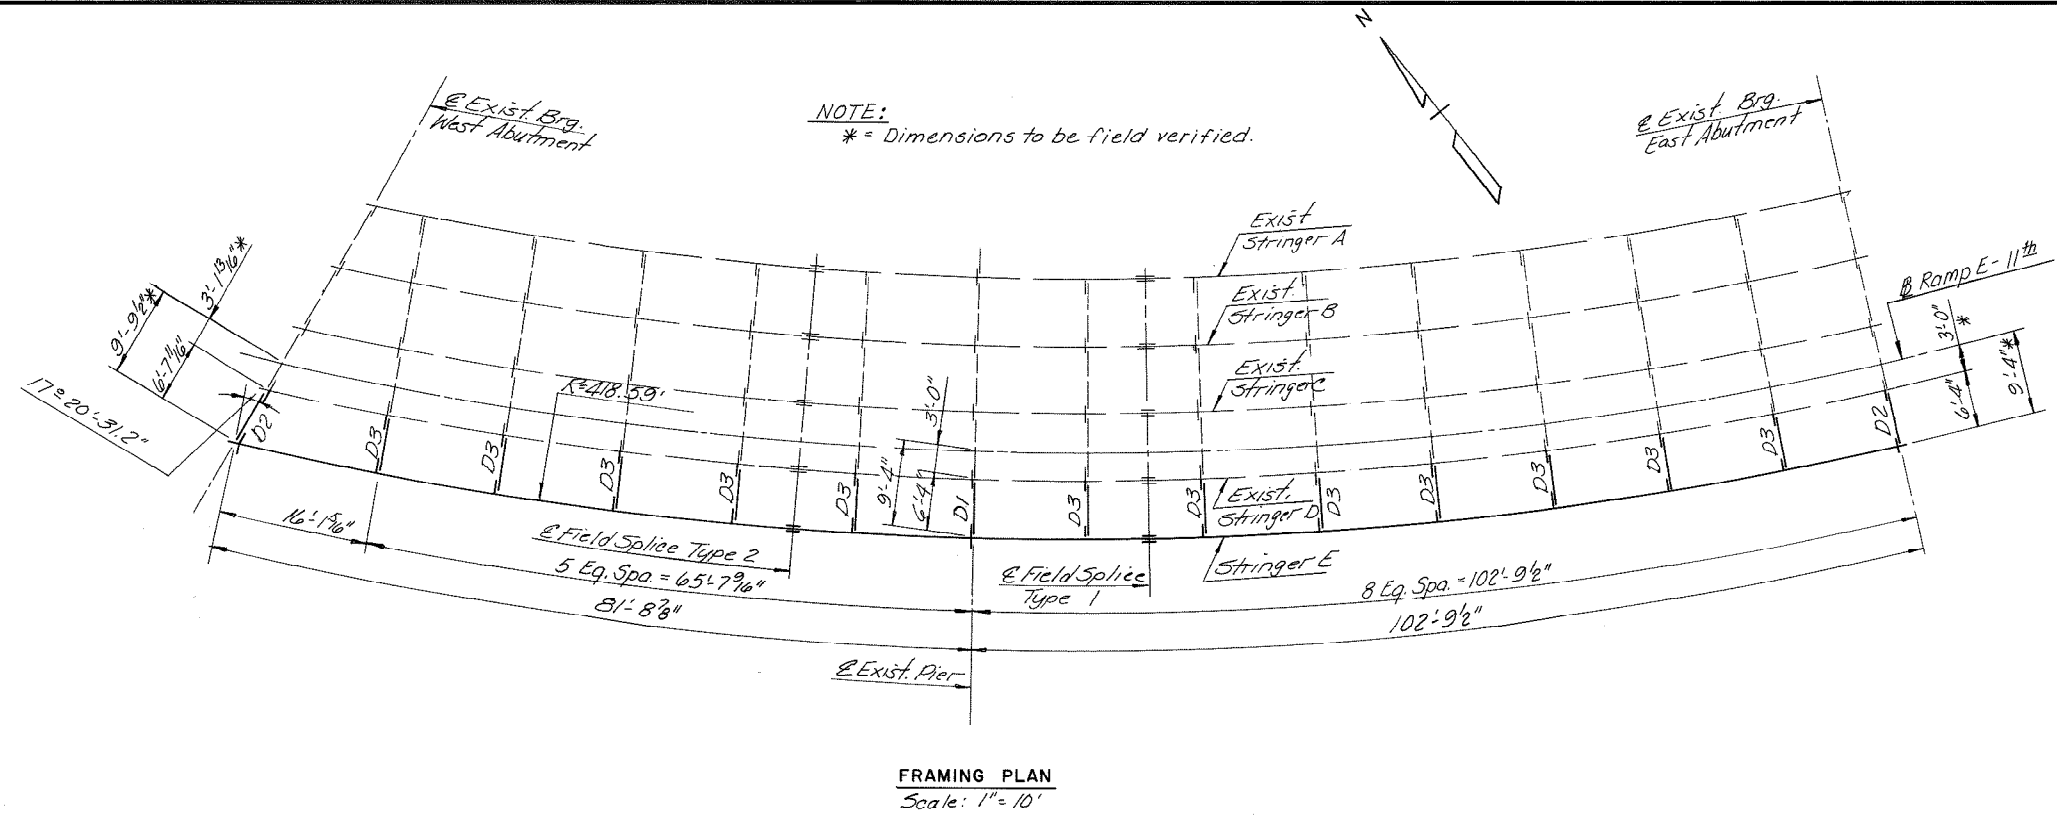



| CAMBER SCHEDULE - STRINGER E | | | | | | | | | |
|------------------------------|--------|--------|----------|---------|------|---------|---------|---------|--------|
| ITEM | W.ABUT | a | b | c | PIER | a | b | c | E.ABUT |
| Δ_s | — | 1/4" | 1/4" | -1/4" | — | 1/4" | 3/8" | 5/16" | — |
| Δ_b | — | 1/4" | 3/16" | 1/16" | — | 1/2" | 1/4" | 7/8" | — |
| Δ_c | — | 1/16" | 3/16" | 1/16" | — | 3/16" | 5/16" | 1/4" | — |
| VC | — | 3/4" | 1/2" | 1 7/16" | — | 3 7/16" | 4 7/16" | 3 5/16" | — |
| Total | — | 1 1/8" | 1 15/16" | 1 9/16" | — | 4 1/4" | 6 3/16" | 4 3/4" | — |

Δ_s Camber due to dead load of steel.
 Δ_b Camber due to dead load of deck slab and bolster and 20 p.s.f. allowance for construction methods and construction tolerance.
 Δ_c Camber due to dead load of parapets.
 VC Camber due to roadway vertical curve.
 Dimensions are in inches.

NOTE TO FABRICATOR
 The girders shall be fabricated with an upward camber amounting to the sum of $\Delta_s + \Delta_b + \Delta_c + VC$. This will provide approximate compensation for deflection under full dead load for conformity with the finished grade.

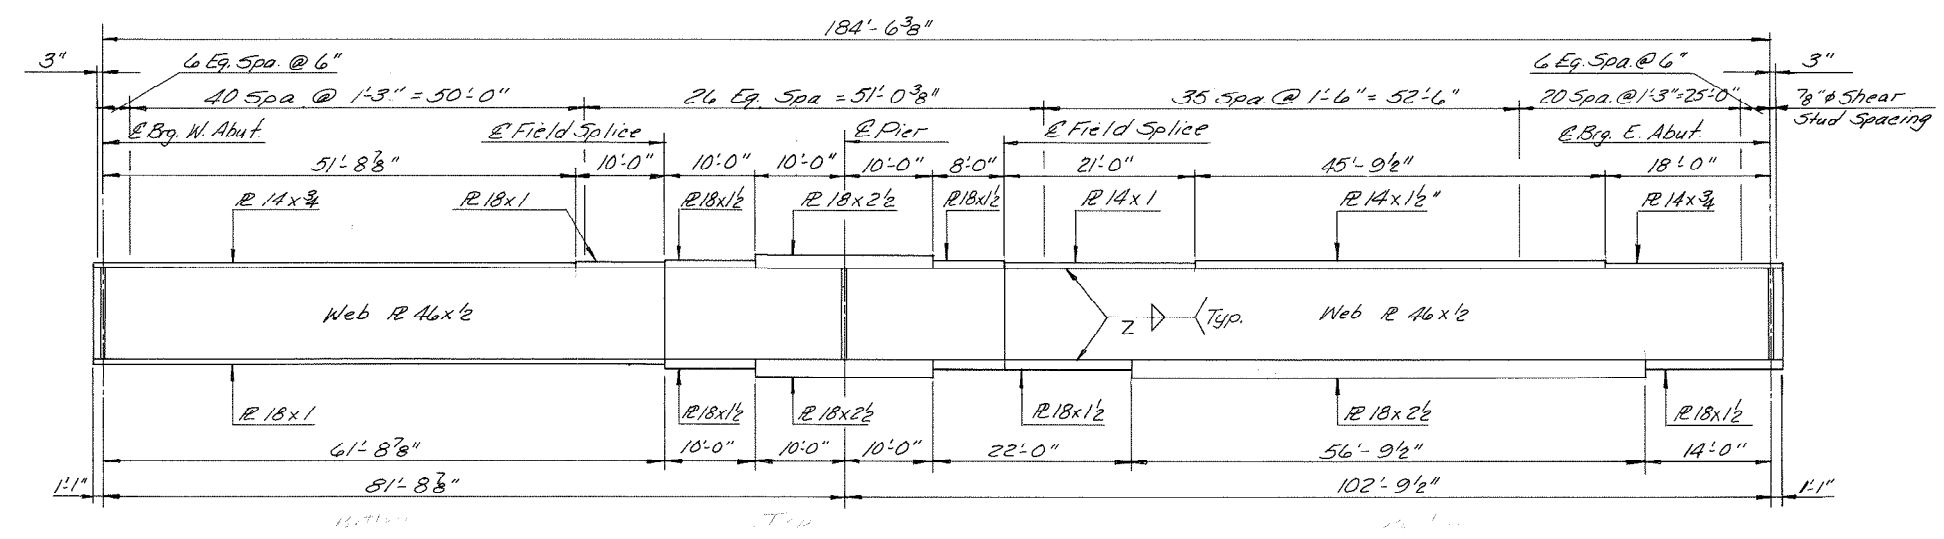

| FLANGE THICKNESS | Z |
|------------------|------|
| 3/4" to 1 1/2" | 5/16 |
| 1 3/8" to 2" | 3/8 |

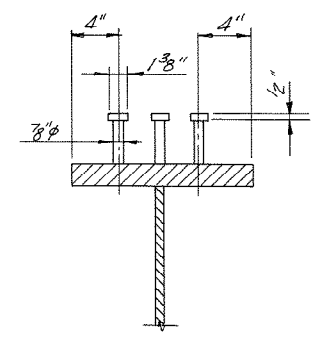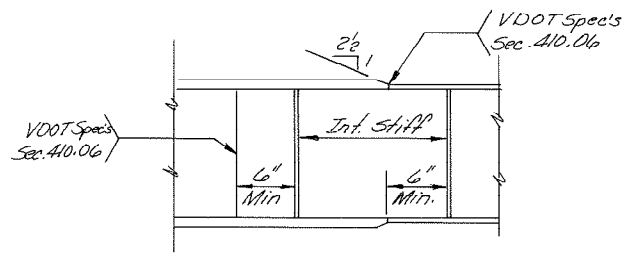

| BY | DATE | NO. | REVISION | BY | DATE |
|-----------|------|-------|----------|----|------|
| MADE | TAL | 12/90 | | | |
| CHECKED | BS | | | | |
| IN CHARGE | SR | | | | |

RICHMOND METROPOLITAN AUTHORITY
RICHMOND EXPRESSWAY SYSTEM


BRIDGE NO. 62 WIDENING
 RAMP E-11TH OVER
 RAMP 12TH-W AND 12TH ST.

FRAMING PLAN AND GIRDER ELEVATION


HOWARD, NEEDLES, TAMMEN & BERGENDOFF
 consulting engineers
 Alexandria, Virginia

SCALE: As Shown
 CONTRACT NO. C-15
 SHEET NO. 9 OF 31


AS BUILT

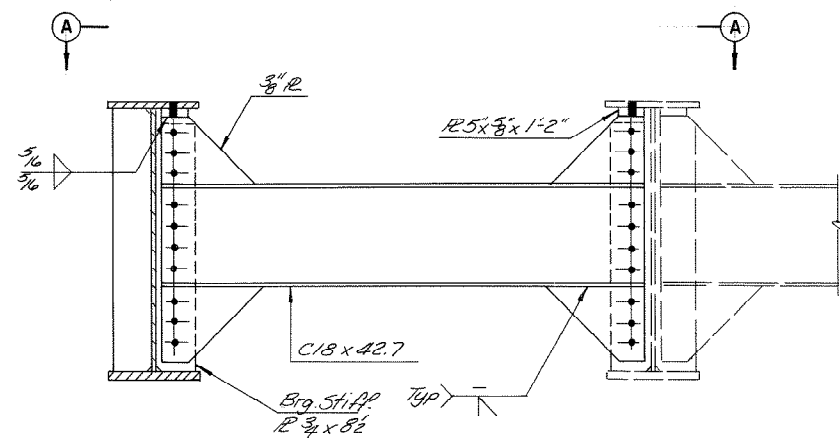


DIAPHRAGM D1
Scale: 3/4" = 1'-0"

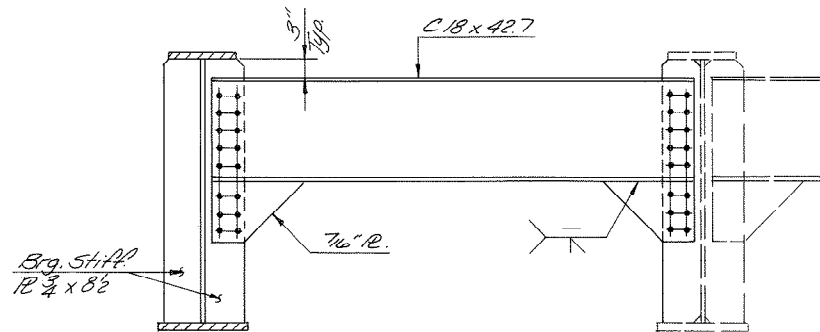


DIAPHRAGM D2
Scale: 3/4" = 1'-0"

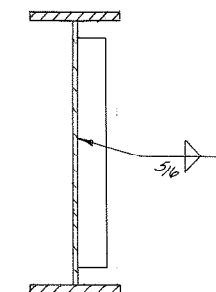


INTERMEDIATE DIAPHRAGM CONNECTOR DETAIL
Scale: 3/4" = 1'-0"

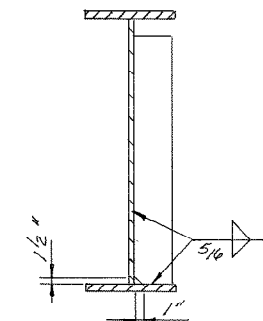


BEARING STIFFENER DETAIL AT PIER
Scale: 3/4" = 1'-0"

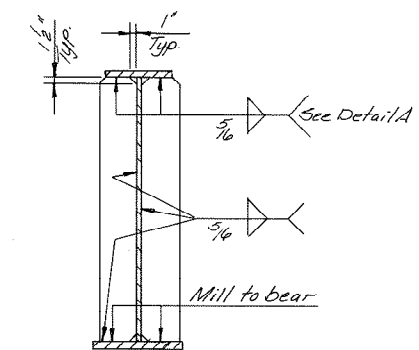


BEARING STIFFENER DETAIL
Scale: 3/4" = 1'-0"

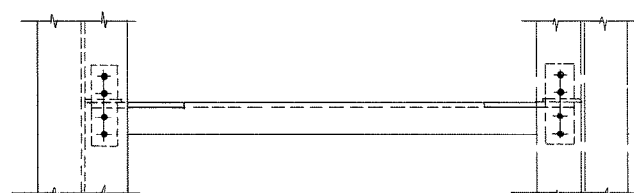


VIEW A-A
Scale: 3/4" = 1'-0"

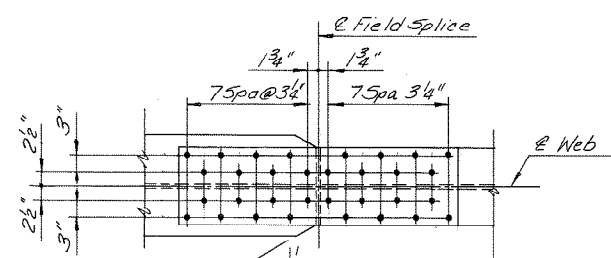


18"x1 1/2" TO 14"x1" FLANGE SPLICE DETAIL

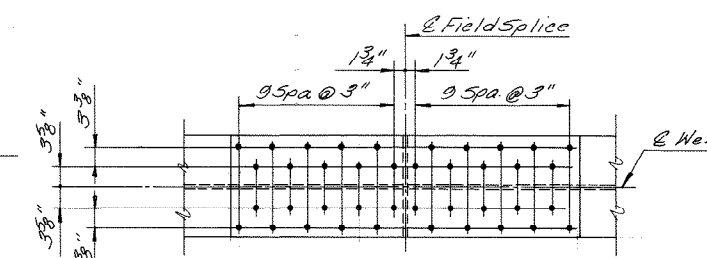


18"x1 1/2" TO 18"x1" FLANGE SPLICE DETAIL
Scale: 3/4" = 1'-0"

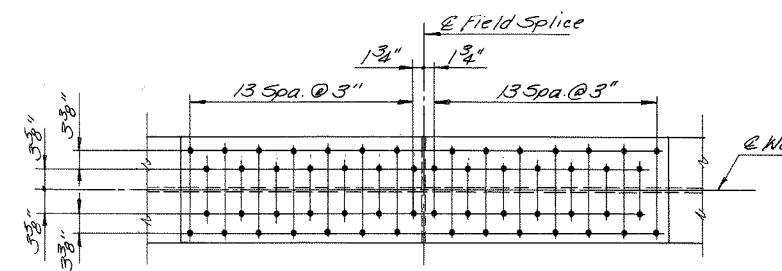


18"x1 1/2" TO 18"x1 1/2" FLANGE SPLICE DETAIL
Scale: 3/4" = 1'-0"

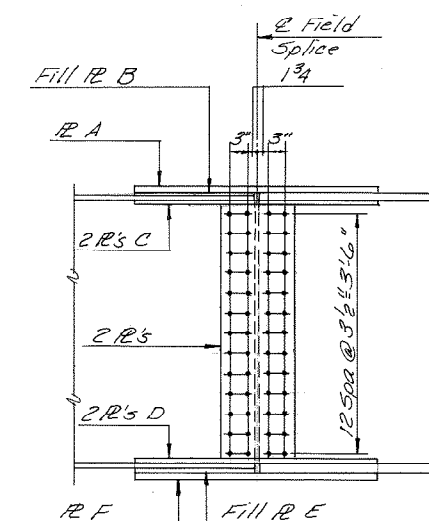


ELEVATION
Scale: 3/4" = 1'-0"

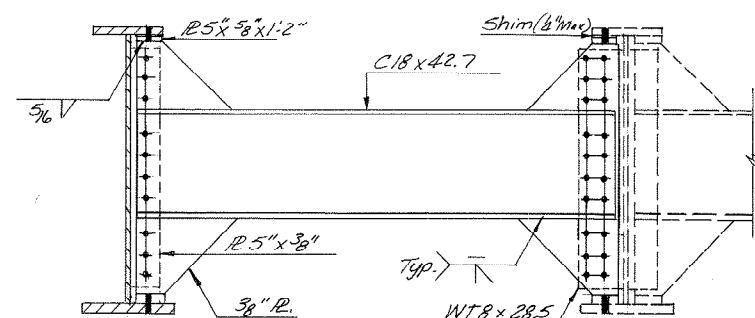

DIAPHRAGM D3
Scale: 3/4" = 1'-0"

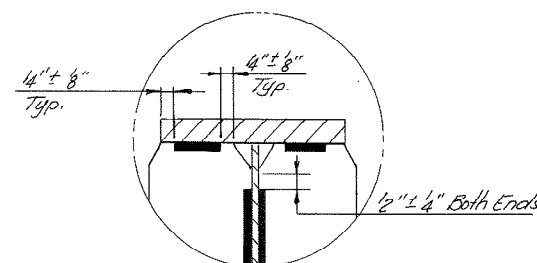

DETAIL A
No Scale

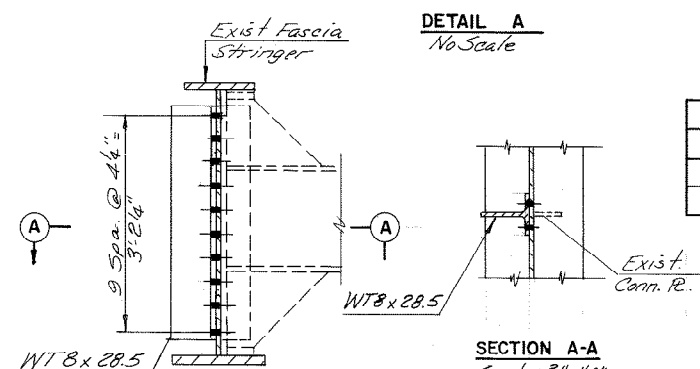

TYPICAL DIAPHRAGM CONNECTION TO EXIST. FASCIA STRINGER
Scale: 3/4" = 1'-0"

| FIELD SPLICE DETAILS | | | | | | |
|----------------------|------------------------|------------------------|---------------------------|-----------------------|------------------------|----------------------|
| TYPE | R A | FILL R B | R C | R D | FILL R E | R F |
| 1 | 3/4" x 18" x 5'-1" | 1/2" x 18" x 2'-6 3/8" | 3/8" x 8 1/2" x 5'-1" | 3/8" x 8 1/2" x 5'-1" | 1/2" x 18" x 2'-6 3/8" | 3/4" x 18" x 5'-1" |
| 2 | 3/4" x 14" x 4'-1 1/2" | 1/2" x 14" x 2'-1 1/8" | 3/8" x 6 1/2" x 4'-1 1/2" | 1/2" x 8 1/2" x 7'-1" | | 1 1/8" x 18" x 7'-1" |



| | | | | | |
|-----------|-----|-------|-----|----------|---------|
| MADE | TAL | 12/90 | | | |
| CHECKED | BS | 12/90 | | | |
| IN CHARGE | SR | | NO. | REVISION | BY DATE |

RICHMOND METROPOLITAN AUTHORITY
RICHMOND EXPRESSWAY SYSTEM

BRIDGE NO. 62 WIDENING
RAMP E-11TH OVER
RAMP 12TH-W AND 12TH ST.
DIAPHRAGM DETAILS AND
FIELD SPLICE DETAIL


SCALE: As Shown
HOWARD, NEEDLES, TAMMEN & BERGENDOFF
consulting engineers
Alexandria, Virginia
CONTRACT NO. C-15
SHEET NO. 10 OF 31

AS BUILT

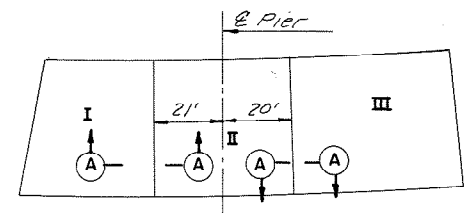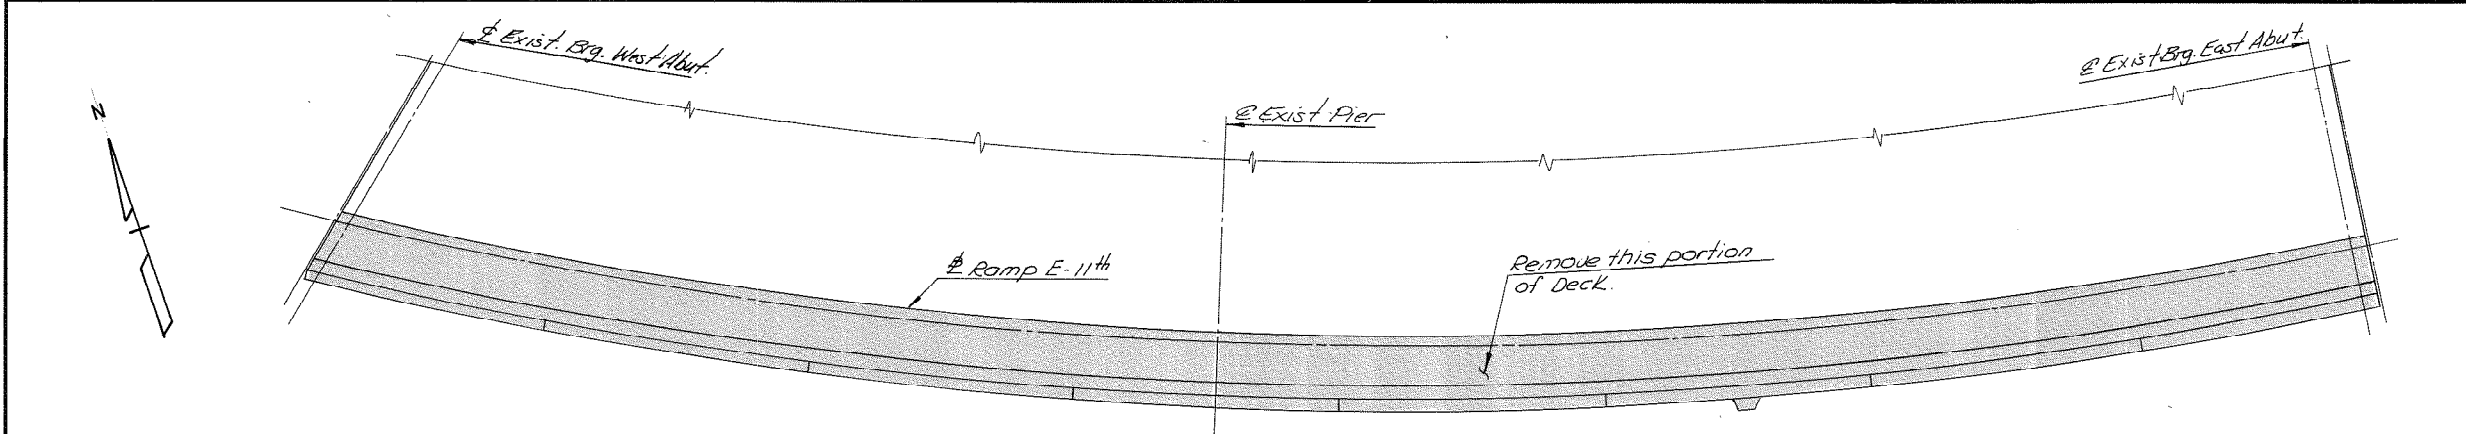


DECK POURING SEQUENCE
No Scale

NOTE:
The numbers shown indicate the order of concrete placement in deck sections.

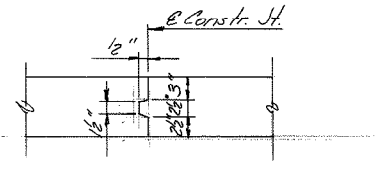


SECTION A-A
No Scale

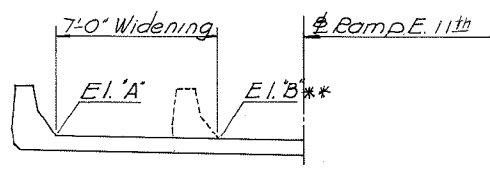

DECK REMOVAL
Scale: 1/8" = 1'-0"


NOTE:
After removing the existing portion of concrete as shown, remove the longitudinal bars in that area. The existing transverse bars should be thoroughly cleaned and incorporated in the finished structure.

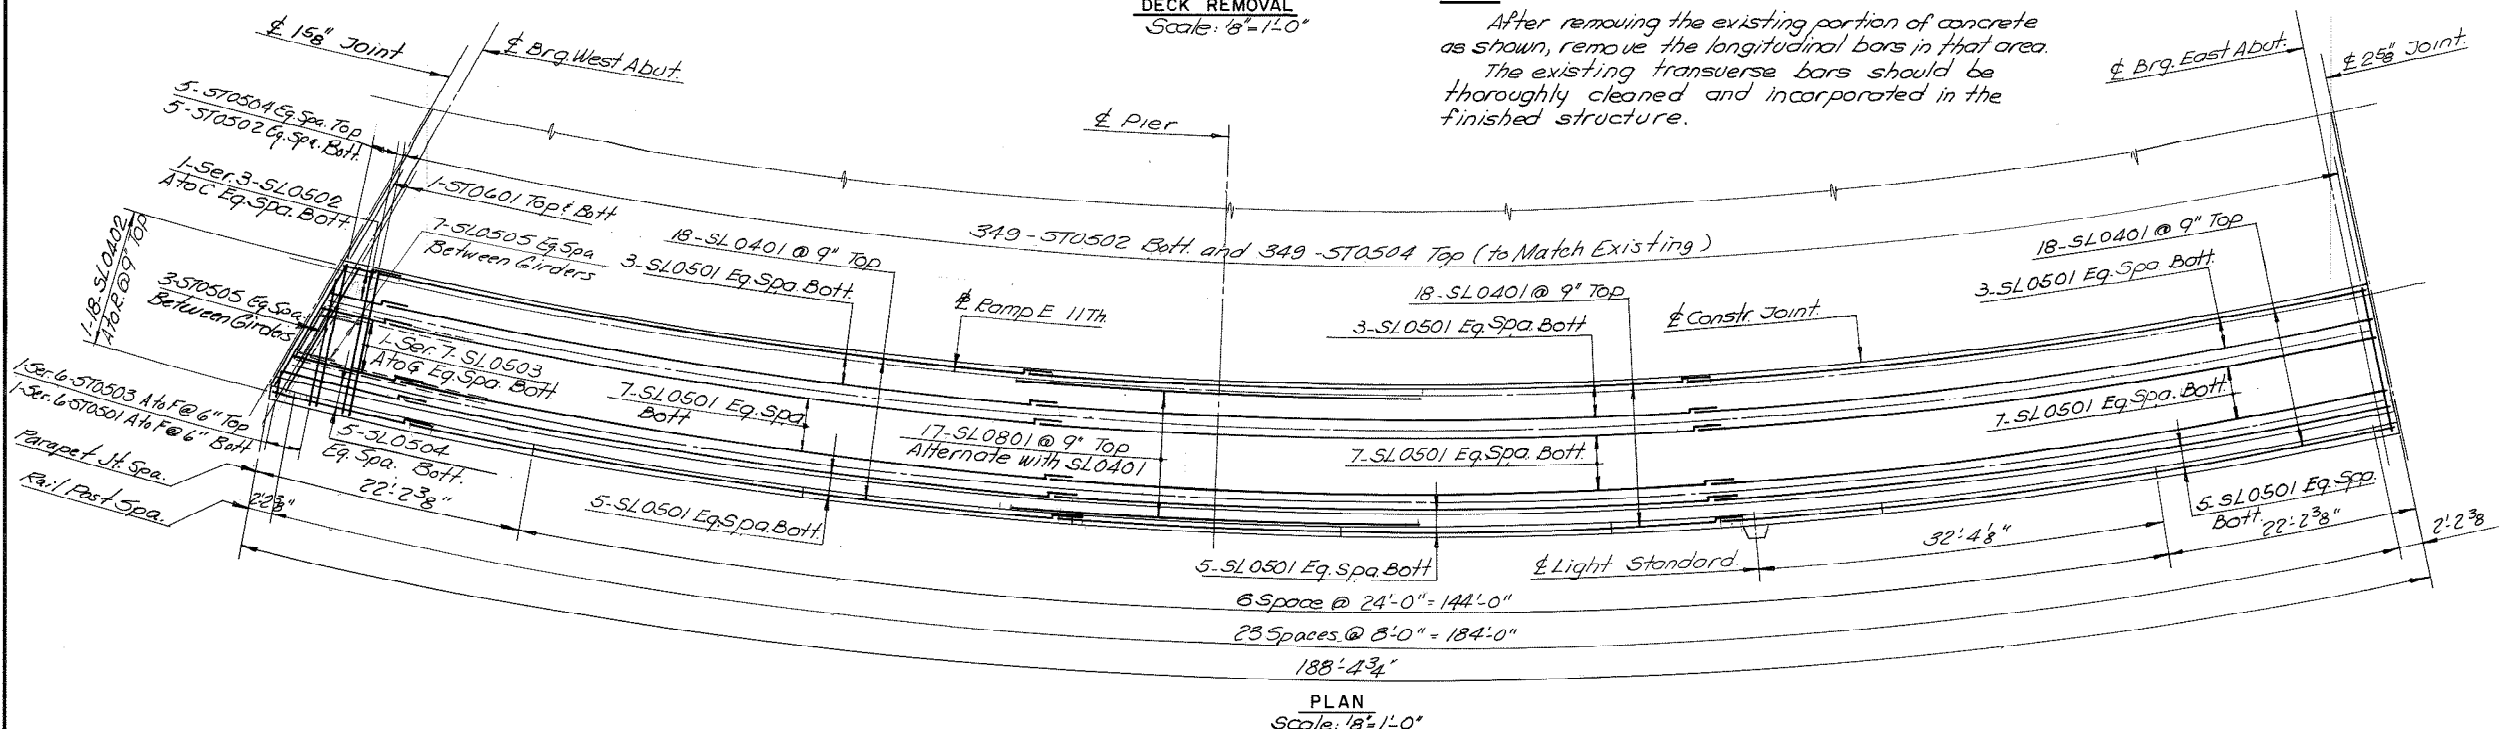

| DECK SLAB ELEVATIONS | | |
|----------------------|---------|------------|
| STATION | EI. "A" | EI. "B" ** |
| ± Jt. W. Abut. | 83.38 | 83.19 |
| 1/4 pt. | 83.54 | 83.30 |
| 1/2 pt. | 83.71 | 83.47 |
| 3/4 pt. | 83.80 | 83.55 |
| ± Pier | 83.79 | 83.64 |
| 1/4 pt. | 83.61 | 83.40 |
| 1/2 pt. | 83.26 | 83.03 |
| 3/4 pt. | 82.71 | 82.52 |
| ± Jt. E. Abut. | 81.28 | 81.86 |

** Existing deck elevations
Above elevations are to top of overlay


NOTE:
Elevations of existing deck are from field survey. Horizontal and vertical dimensions are based on As-Built Plans and included with this set of plans as Reference Plans. It shall be the Contractor's responsibility to verify all pertinent elevations and dimensions of the existing structure prior to construction and the fabrication of any structural steel.

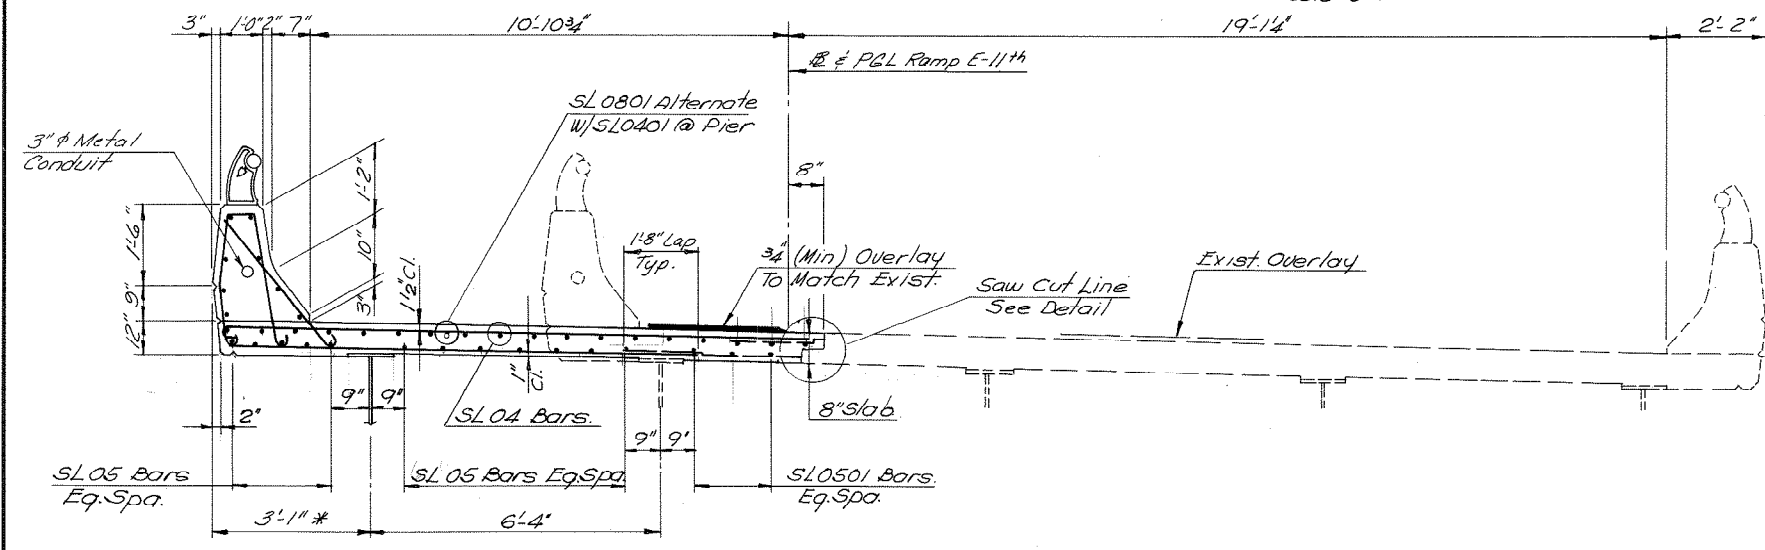

TYPICAL SECTION
Scale: 1/2" = 1'-0"

* Dimensions to be field verified.

Coat-Edge of exist. Slab with Type PS-2 epoxy immediately preceding placement of new concrete

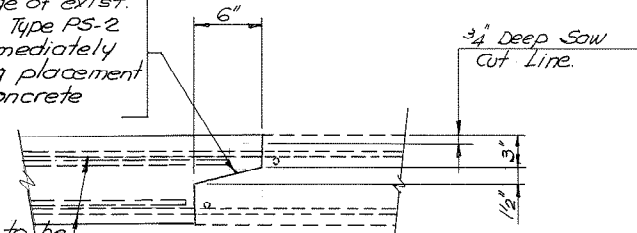

SAW CUT LINE DETAIL
Scale: 1/2" = 1'-0"

AS BUILT

| | | | | | |
|-----------|----------|-------|------|--|--|
| BY | DATE | | | | |
| MADE | TAL | 12/90 | | | |
| CHECKED | BS | 12/90 | | | |
| IN CHARGE | SR | | | | |
| NO. | REVISION | BY | DATE | | |

RICHMOND METROPOLITAN AUTHORITY
RICHMOND EXPRESSWAY SYSTEM

BRIDGE NO. 62 WIDENING
RAMP E-11TH OVER
RAMP 12TH-W AND 12TH ST.


DECK PLAN AND TYPICAL SECTION

SCALE: As Shown


HOWARD, NEEDLES, TAMMEN & BERGENDOFF
consulting engineers
Alexandria, Virginia

CONTRACT NO.: C-15
SHEET NO. 11 OF 31

| RICHMOND EXPRESSWAY SYSTEM | | | |
|----------------------------|------------------------|-----------|--------------|
| SECTION | PROJECT | SHEET NO. | TOTAL SHEETS |
| C-15 | 1990-1991 IMPROVEMENTS | 6(12) | |

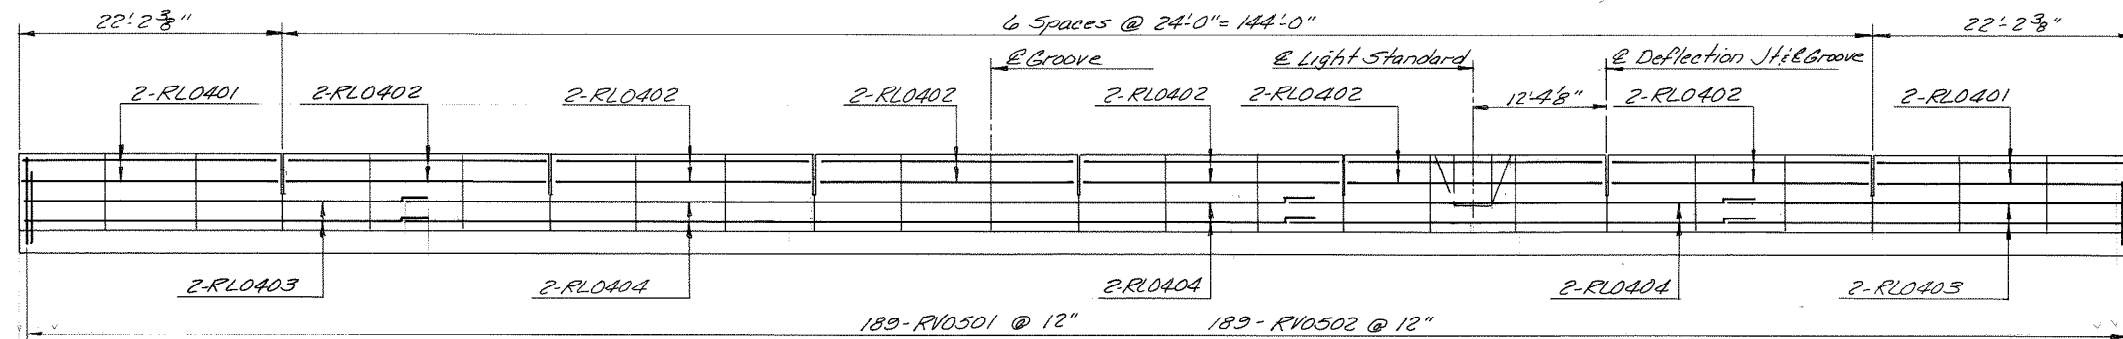

PARAPET ELEVATION
No Scale

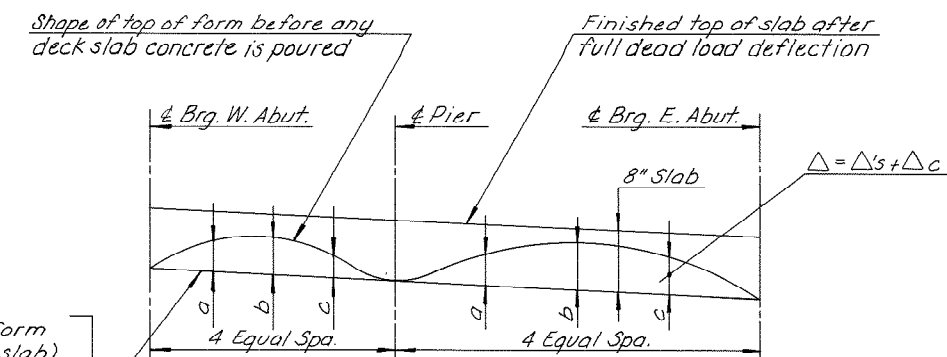


DEAD LOAD DEFLECTION DIAGRAM
No Scale

Shape of top of form (bottom of deck slab) after deflection from total dead load added after erection of structural steel.


| DEFLECTION SCHEDULE | | | | | | | | | | |
|---------------------|------|--------|------|------|------|------|------|------|------|--------|
| STRINGER | ITEM | W.ABUT | a | b | c | PIER | a | b | c | E.ABUT |
| EXIST. D | Δ's | — | 0.21 | 0.15 | 0.05 | — | 0.59 | 1.07 | 0.88 | — |
| | Δc | — | 0.05 | 0.05 | 0.01 | — | 0.14 | 0.25 | 0.19 | — |
| | Δ | — | 0.26 | 0.20 | 0.06 | — | 0.73 | 1.32 | 1.07 | — |

| DEFLECTION SCHEDULE | | | | | | | | | | |
|---------------------|------|--------|------|------|------|------|------|------|------|--------|
| STRINGER | ITEM | W.ABUT | a | b | c | PIER | a | b | c | E.ABUT |
| E | Δ's | — | 0.23 | 0.19 | 0.03 | — | 0.54 | 1.05 | 0.89 | — |
| | Δc | — | 0.06 | 0.06 | 0.01 | — | 0.16 | 0.30 | 0.23 | — |
| | Δ | — | 0.29 | 0.25 | 0.04 | — | 0.70 | 1.35 | 1.12 | — |


Δ's Deflection of girder from dead load of concrete deck slab and bolster and 20 psf. allowance for construction tolerance and construction methods.
 Δc Deflection of girder from dead load (e.g. parapet) added after deck slab is cast.
 Dimensions are in inches.

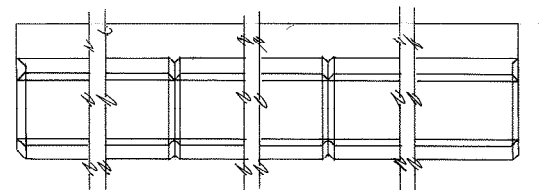

PLAN

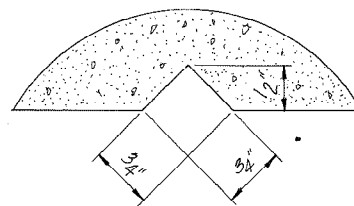


SECTION A-A
Full Scale
(Groove details for both sides of parapet.)

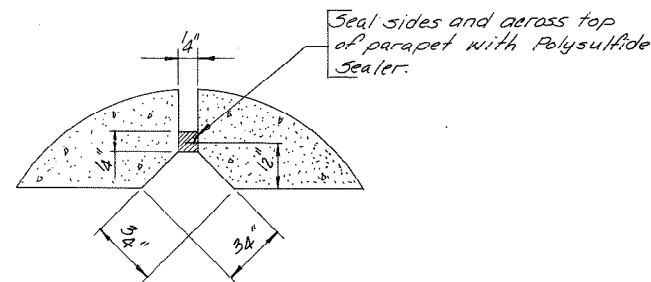


SECTION B-B
Full Scale
(Deflection Joint detail for both sides of parapet.)

Seal sides and across top of parapet with Polysulfide Sealer.

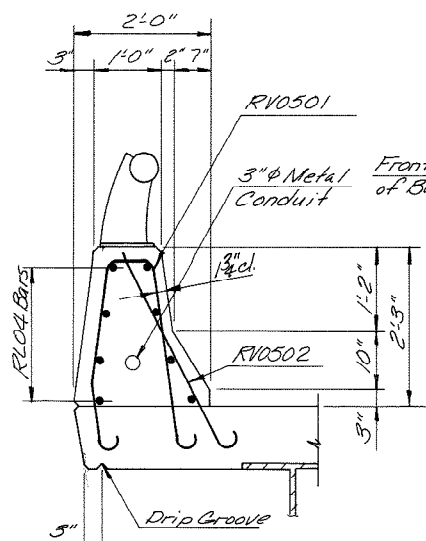

SECTION C-C

PARAPET DETAIL
Scale: 3/4" = 1'-0"

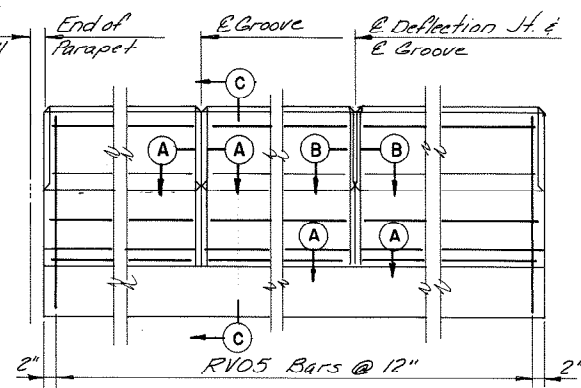

ELEVATION

| NO. | BY | DATE | NO. | REVISION | BY | DATE |
|-----------|-----|-------|-----|----------|----|------|
| MADE | TAL | 12/90 | | | | |
| CHECKED | BS | 12/90 | | | | |
| IN CHARGE | SR | | | | | |

RICHMOND METROPOLITAN AUTHORITY
RICHMOND EXPRESSWAY SYSTEM


BRIDGE NO. 62 WIDENING
 RAMP E-11TH OVER
 RAMP 12TH-W AND 12TH ST.
PARAPET ELEVATION AND DETAILS

HOWARD, NEEDLES, TAMMEN & BERGENDOFF
 consulting engineers
 Alexandria, Virginia

SCALE: As Shown
 CONTRACT NO.: C-15
 SHEET NO. 12 OF 31


AS BUILT

| RICHMOND EXPRESSWAY SYSTEM | | | |
|----------------------------|------------------------|-----------|--------------|
| SECTION | PROJECT | SHEET NO. | TOTAL SHEETS |
| C-15 | 1990-1991 IMPROVEMENTS | 6(13) | |

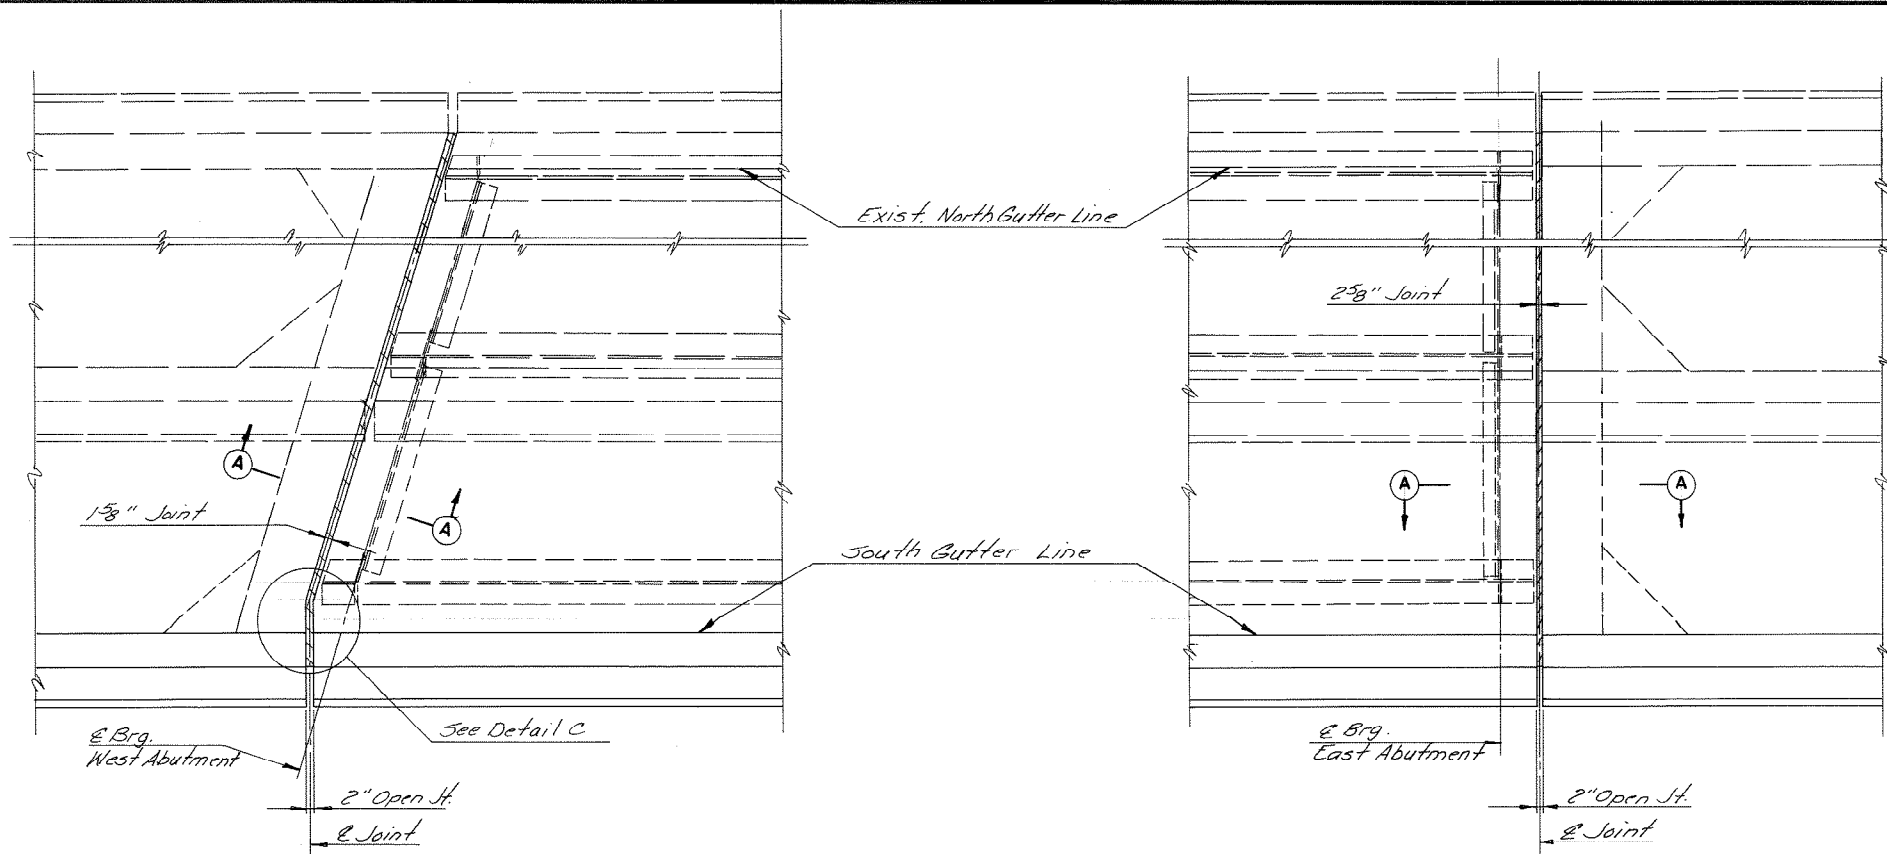


PLAN-JOINT AT WEST ABUTMENT
No Scale


PLAN-JOINT AT EAST ABUTMENT
No Scale

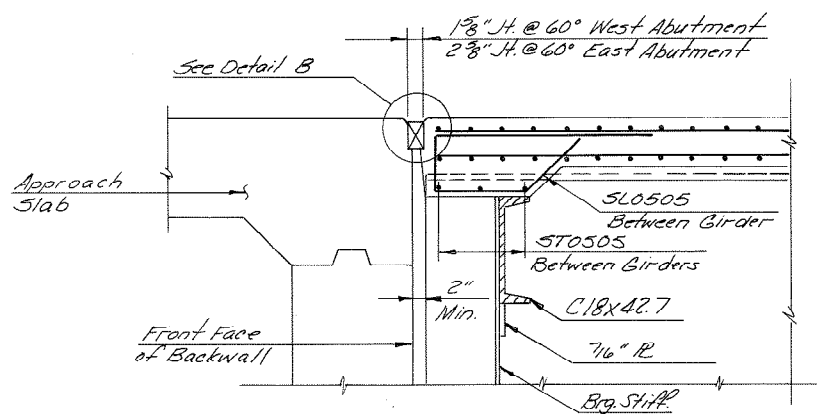

SECTION A-A
Scale: 3/4" = 1'-0"

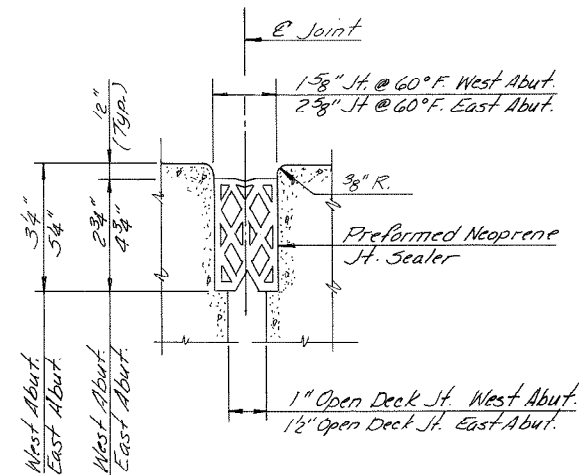


DETAIL B
No Scale

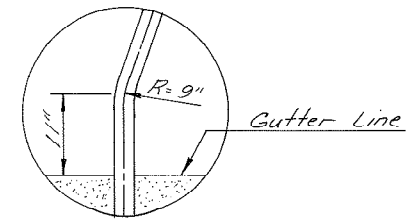


DETAIL C
Scale: 1" = 1'-0"

NOTE:
Existing preformed joint sealer at each Abutment to be completely removed. New continuous joint sealer shall be installed from gutter to gutter and up faces of parapet as shown. In damaged areas, joint edges on existing deck slab (R=3/8") shall be repaired.

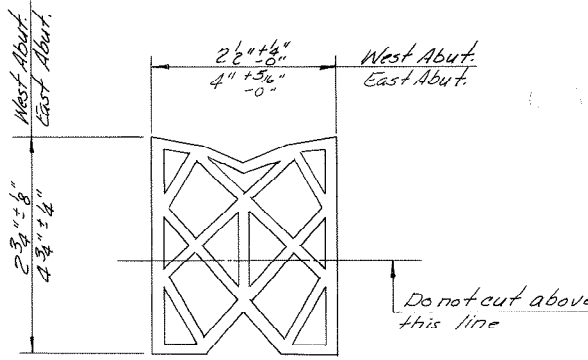

PREFORMED NEOPRENE JOINT SEALER
No Scale

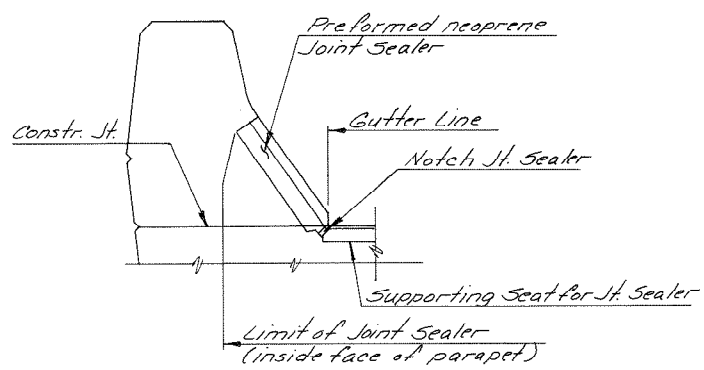

TREATMENT OF JOINT AT GUTTER LINE
No Scale

AS BUILT


| BY | DATE | NO. | REVISION | BY | DATE |
|-----------|------|-------|----------|----|------|
| MADE | TAL | 12/90 | | | |
| CHECKED | BS | 12/90 | | | |
| IN CHARGE | SR | | | | |

RICHMOND METROPOLITAN AUTHORITY
RICHMOND EXPRESSWAY SYSTEM


BRIDGE NO. 62 WIDENING
RAMP E-11TH OVER
RAMP 12TH-W AND 12TH ST.
JOINT DETAILS

SCALE: As Shown
HOWARD, NEEDLES, TAMMEN & BERGENDOFF
consulting engineers
Alexandria, Virginia
CONTRACT NO. C-15
SHEET NO. 13 OF 31

| RICHMOND EXPRESSWAY SYSTEM | | | |
|----------------------------|------------------------|-----------|--------------|
| SECTION | PROJECT | SHEET NO. | TOTAL SHEETS |
| C-15 | 1990-1991 IMPROVEMENTS | 6(15) | |

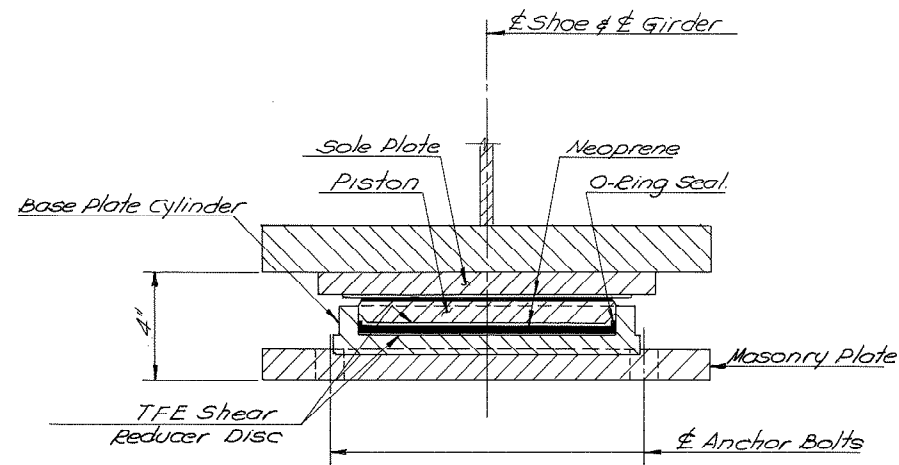

TYPICAL SECTION

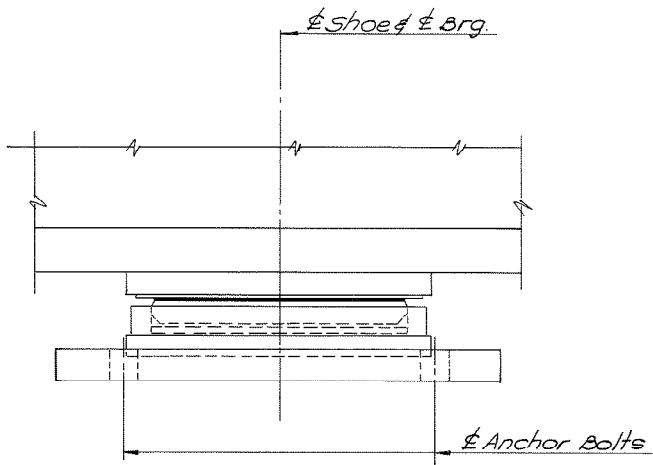


SIDE ELEVATION


EXPANSION SHOE TYPE PB-1
Scale: 3/4"=1'-0"

| SHOE TYPE | LOCATION | DESIGN LOAD |
|-----------|----------|-------------|
| PB-1 | E. Abut. | 80 |
| PB-2 | Pier | 210 |
| PB-1 | W. Abut. | 110 |

NOTE:
 Pad elevations have been set using dimensions shown. Revision to pad elevations may be required based on depth of shoe as furnished by the Fabricator for each location.
 The guide key shall be designed for a lateral force of 15% of the Design Load.
 Total temperature movement equals 1 inch either direction.
 The permissible rotation shall not be less than 2 degrees.
 Structural steel in bearing shall be ASTM A36.

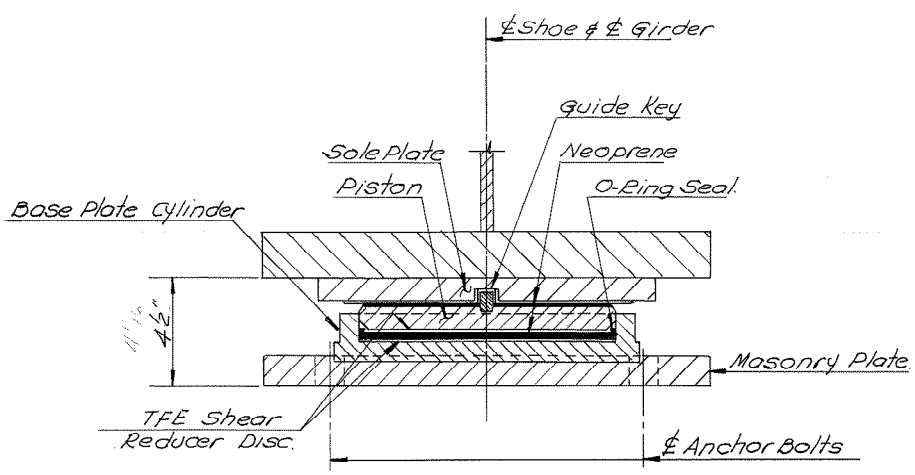

TYPICAL SECTION

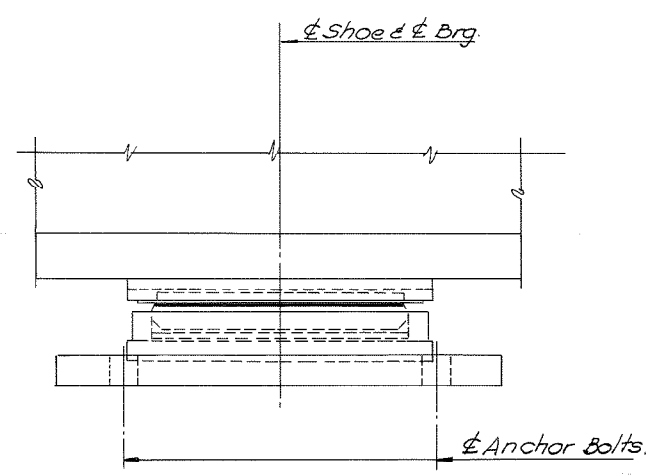

SIDE ELEVATION

FIXED SHOE TYPE PB-2
Scale: 3/4"=1'-0"

| BY | DATE | NO. | REVISION | BY | DATE |
|-----------|------|-------|----------|----|------|
| MADE | TAL | 12/90 | | | |
| CHECKED | BJS | 12/90 | | | |
| IN CHARGE | SR | | | | |

AS BUILT

RICHMOND METROPOLITAN AUTHORITY
RICHMOND EXPRESSWAY SYSTEM

BRIDGE NO. 62 WIDENING
 RAMP E-11TH OVER
 RAMP 12TH-W AND 12TH ST.
SHOE DETAILS

HOWARD, NEEDLES, TAMMEN & BERGENDOFF
 consulting engineers
 Alexandria, Virginia





SCALE: As Shown
 CONTRACT NO.: C-15
 SHEET NO. 15 OF 31

Bridge 63

**(Westbound Downtown Expressway - Rte. 195 over Virginia Street,
South 14th Street - US Rte. 360 and CSX Railroad)**

Record Set Plans

| RICHMOND EXPRESSWAY SYSTEM | | | |
|----------------------------|---------------------|-----------|--------------|
| SECTION | PROJECT | SHEET NO. | TOTAL SHEETS |
| 10 | DOWNTOWN EXPRESSWAY | 70 | 265 |

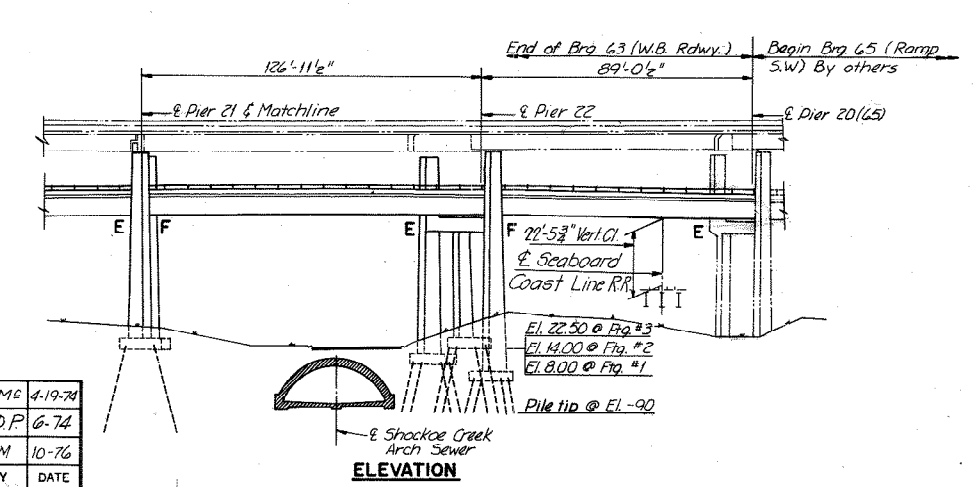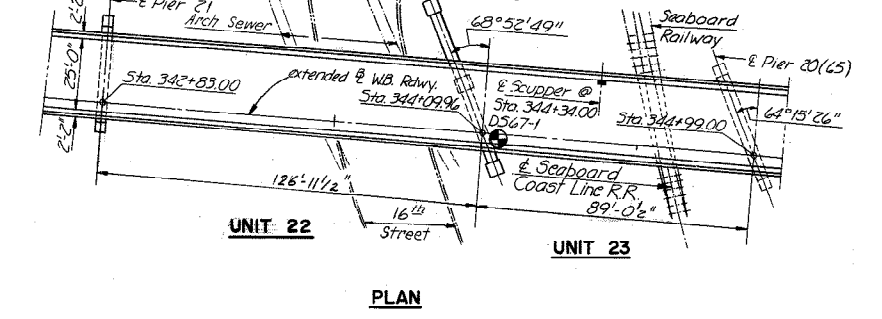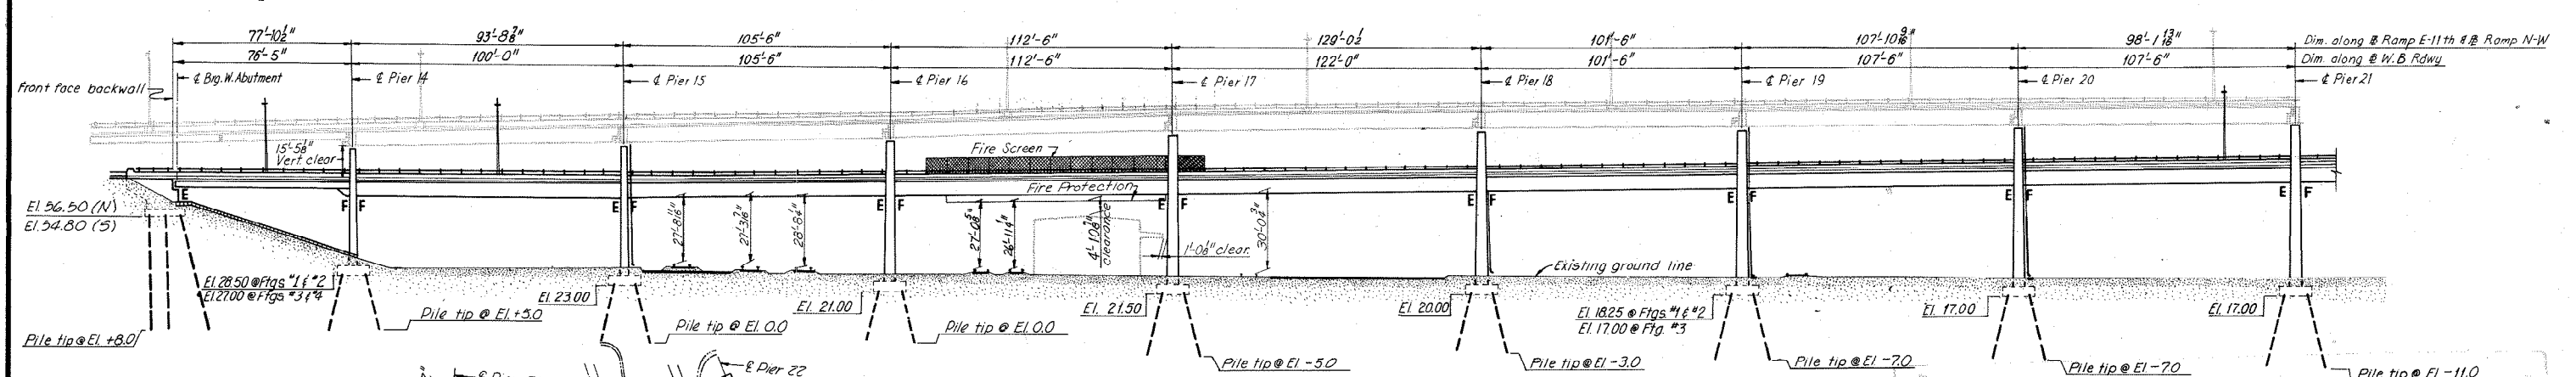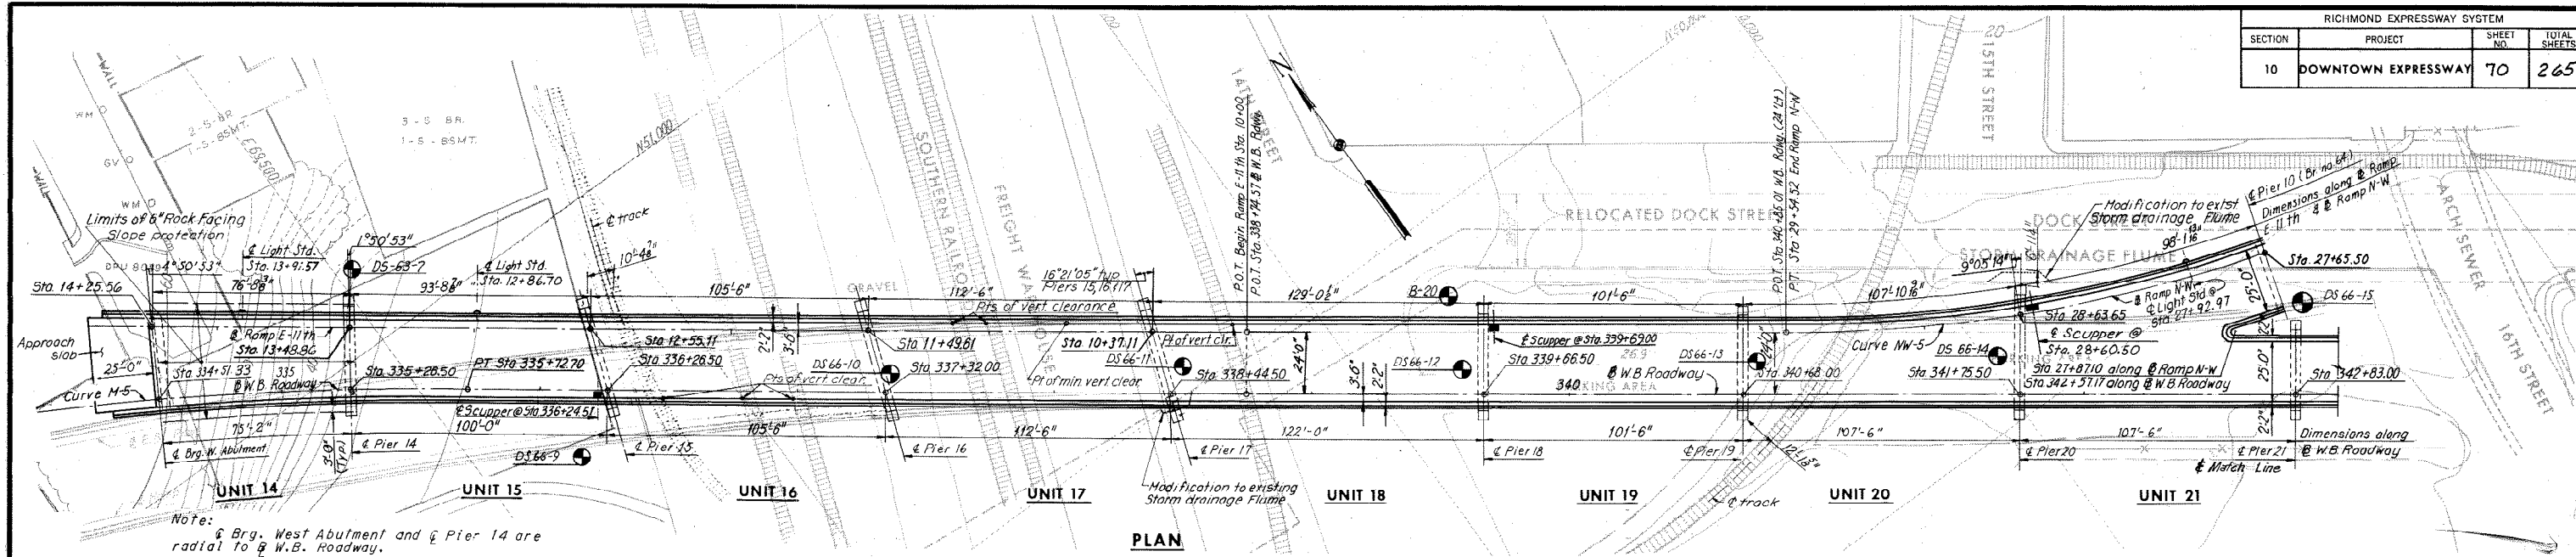

| # W.B. Roadway | | # Ramp N-W | |
|-----------------------|--|----------------------|--|
| Curve: M-5 | | Curve NW-5 | |
| P.I. = Sta. 334+26.15 | | P.I. = Sta. 28+25.38 | |
| Δ = 11°45'15" | | Δ = 26°18'00" | |
| D = 4°00' | | D = 10°00' | |
| T = 147.59' | | T = 133.86' | |
| L = 294.14' | | L = 263.00' | |
| R = 1432.40' | | R = 572.96' | |

HORIZONTAL CURVE DATA

Notes:
 For Estimated quantities and General Notes see Sheet 2.
 For Boring Logs see Sheets 26 thru 29.
 For Layout of Pier 10(64) see Bridge No. 64 (Ramp N-W) Sheet 3.
 ● Indicates boring location.
 Footing numbers (1, 2, etc.) on each pier go from North to South.
 For Profile Grade Data see Sheet 2.

| INDEX | SHEET |
|---|------------|
| GENERAL PLAN AND ELEVATION | 1 |
| QUANTITIES | 2 |
| WEST ABUTMENT | 3 |
| WEST ABUTMENT DETAILS | 4 |
| PIER 14 | 5 |
| PIER 15 | 6 |
| PIER 16 | 7 |
| PIER 17 | 8 |
| PIERS 18 AND 19 | 9 |
| PIER 20 | 10 |
| PIER 21 | 11 |
| PIER 22 | 12 |
| FRAMING PLAN UNITS 14, 15 AND 16 | 13 |
| FRAMING PLAN UNITS 17 AND 18 | 14 |
| FRAMING PLAN UNITS 19, 20 AND 21 | 15 |
| FRAMING DETAILS UNITS 20 AND 21 | 16 |
| FRAMING PLAN UNITS 22 AND 23 | 17 |
| DECK PLAN UNITS 14, 15 AND 16 | 18 |
| DECK PLAN UNITS 17 AND 18 | 19 |
| DECK PLAN UNITS 19, 20 AND 21 | 20 |
| DECK PLAN UNITS 22 AND 23 | 21 |
| SUPERSTRUCTURE DETAILS | 22 |
| FIRE PROTECTION DETAILS | 23 |
| JOINT DETAILS | 24 |
| APPROACH SLABS AND SLOPE PROTECTION DETAILS | 25 |
| BORING LOGS | 26 THRU 29 |
| STANDARD SHEETS | 31 THRU 37 |

| BY | DATE | Joint Type & Rail-Road Name Added | PRM | DATE |
|-----------|---------------|------------------------------------|--------|-------|
| MADE | Y.C.P. 1-9-69 | Seaboard Coast Line Added to Elev. | K.D.P. | 6-74 |
| CHECKED | J.D. 3-13-69 | As Built | TEM | 10-76 |
| IN CHARGE | FRD | | | |

RICHMOND METROPOLITAN AUTHORITY
RICHMOND EXPRESSWAY SYSTEM
DOWNTOWN EXPRESSWAY


BRIDGE NO. 63
WESTBOUND ROADWAY OVER
12TH ST. - R.R. TRACKS AND 16TH ST.
GENERAL PLAN AND ELEVATION

HOWARD, NEEDLES, TAMMEN & BERGENDOFF
 consulting engineers
 NEW YORK ALEXANDRIA KANSAS CITY






SCALE: 1" = 30'
 CONTRACT NO. 10
 SHEET NO. 1 OF 29

AS BUILT

| RICHMOND EXPRESSWAY SYSTEM | | | |
|----------------------------|---------------------|-----------|--------------|
| SECTION | PROJECT | SHEET NO. | TOTAL SHEETS |
| 10 | DOWNTOWN EXPRESSWAY | 78 | 265 |

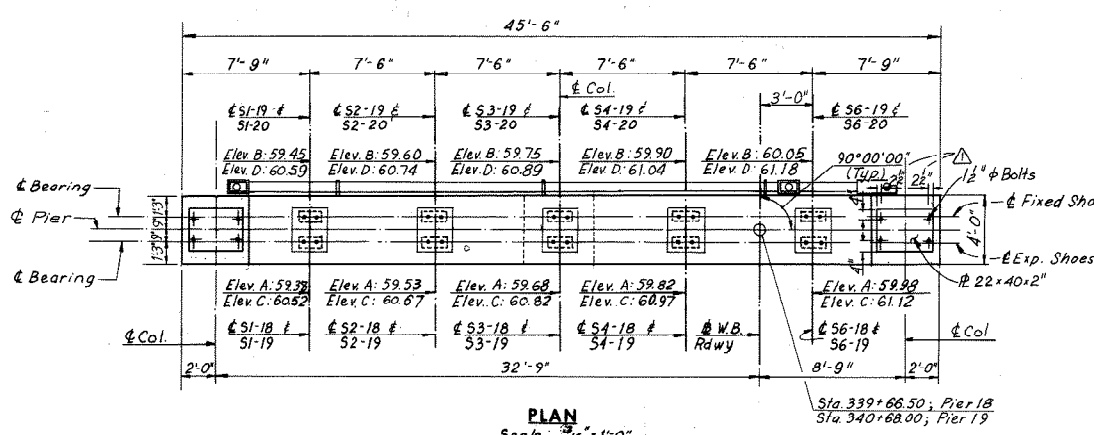


Note:
Elevations given in plan are elevations of Top of Pad and at Bearing.
Elevation A refers to Brq. Unit 18 @ Pier 18
Elevation B refers to Brq. Unit 19 @ Pier 18
Elevation C refers to Brq. Unit 19 @ Pier 19
Elevation D refers to Brq. Unit 20 @ Pier 19

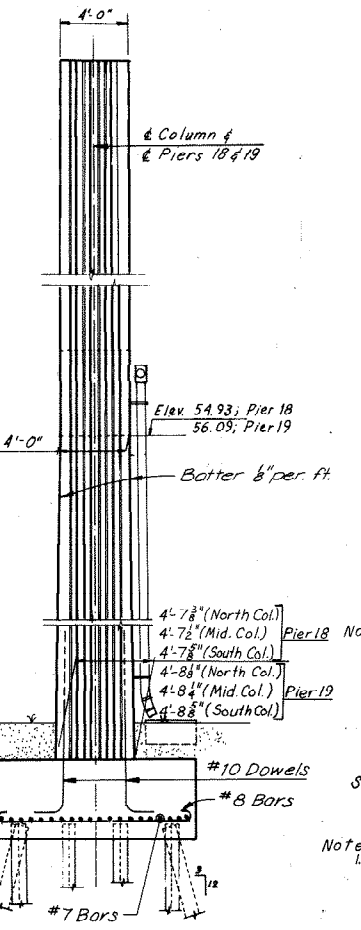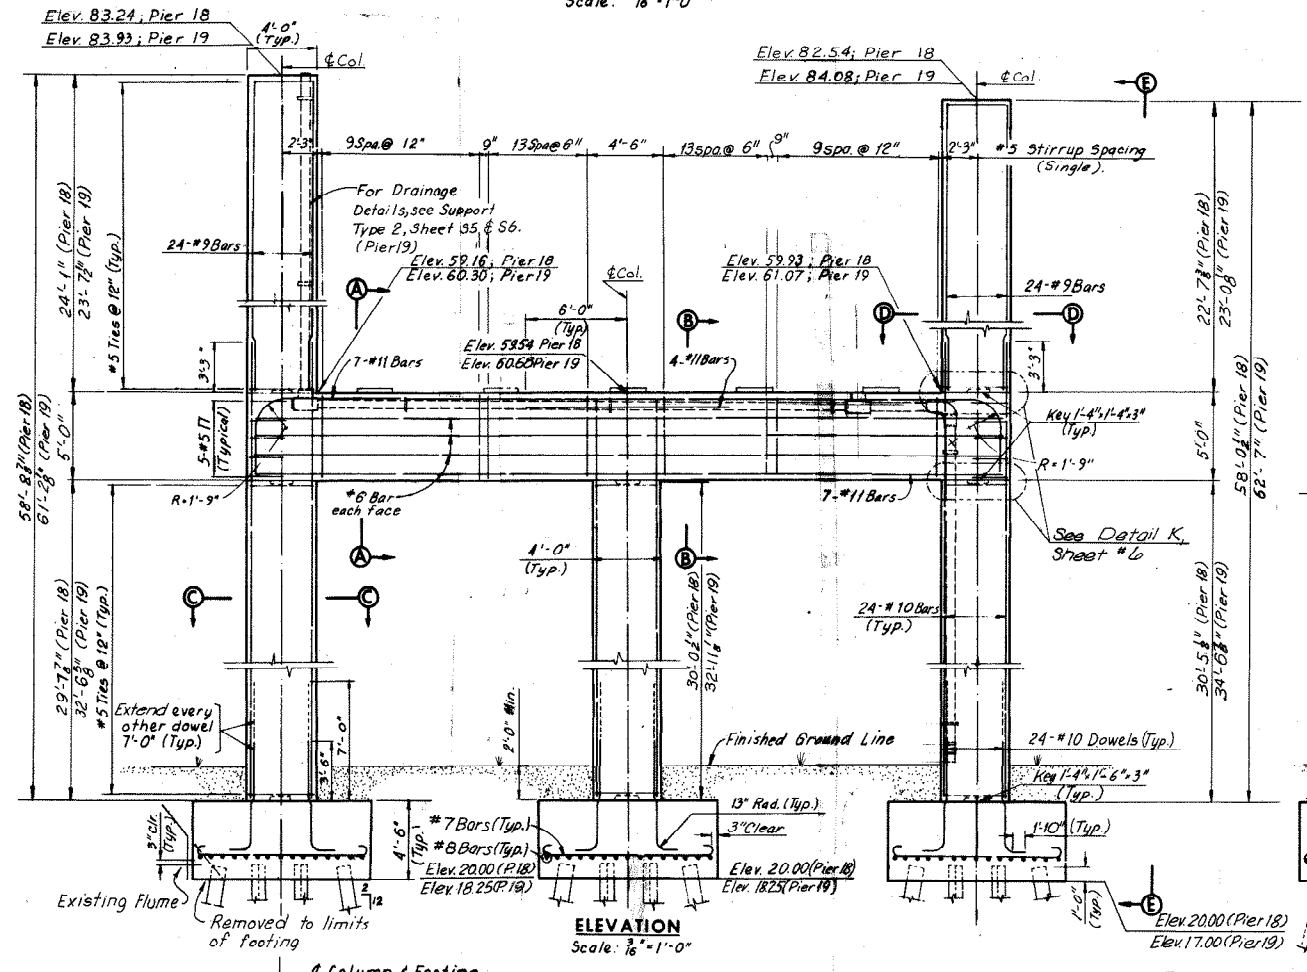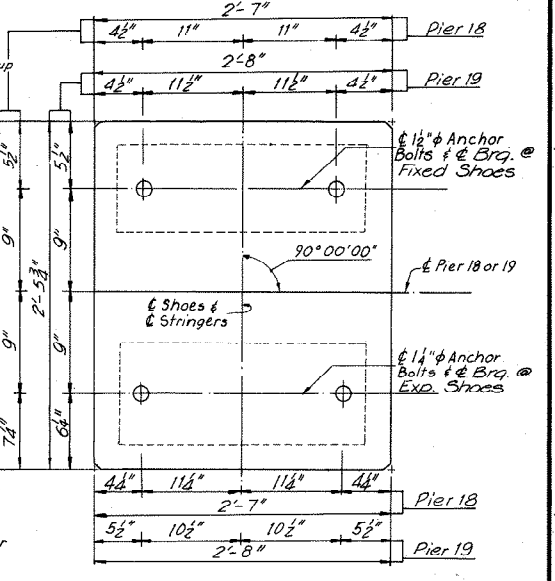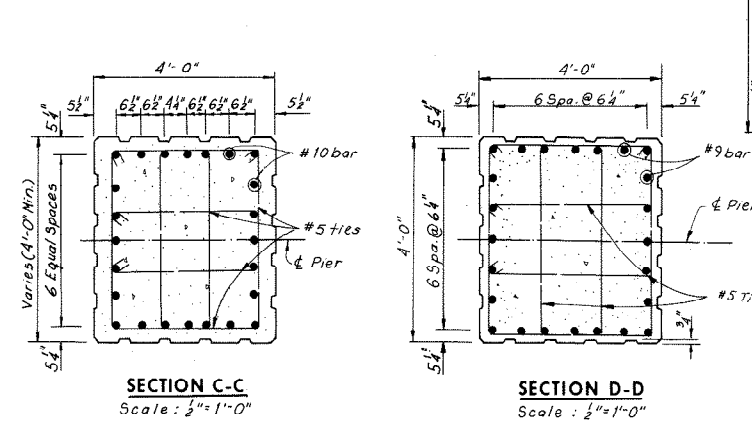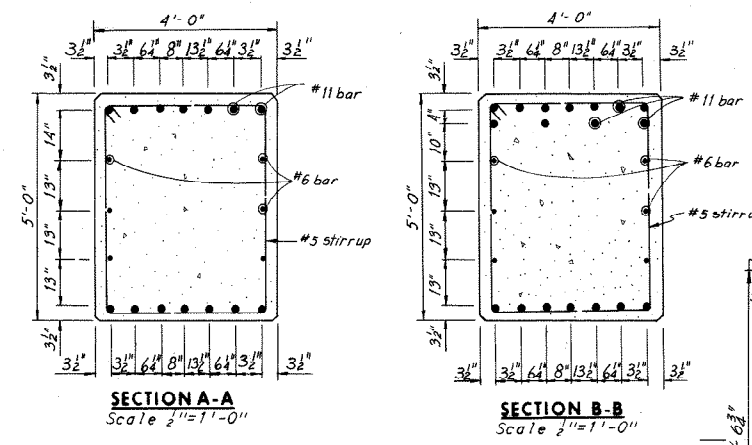

Note:
All piles shall be 10BP42 Steel Piles (Design capacity = 45 tons).
Batter piles 3" or 2" per foot where shown.
For Shoe Details, see Sheets S1 and S2.
For Steel Pile Details, see Sheet 11.
Estimated Pile Tip elevations: -7.0 @ Pier 18, -7.0 @ Pier 19.
For architectural treatment of columns, see Sheet S7.

Note:
1) Footing elevations are approximate only and may be varied to suit field conditions as directed by the Engineer. Vertical shaft reinforcing shall not be cut until these elevations are established. Where elevations change more than 2 ft. redesign will be required.
2) Flume modification at Pier 18 only.

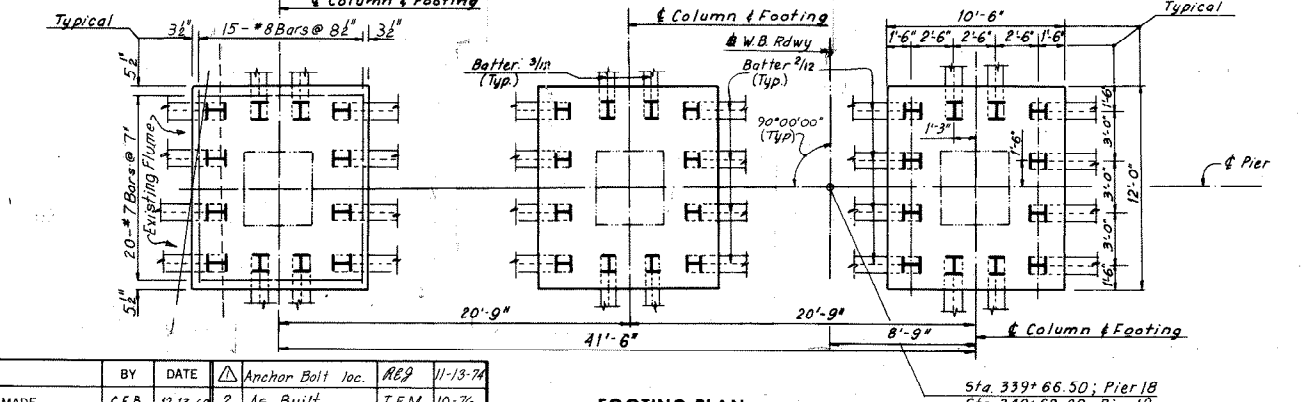

Note:
Dimensions given in Footing Plan are measured at bottom of Footing.

| BY | DATE | Anchor Bolt Loc. | REVISION | BY | DATE |
|-----------|-----------------|------------------|----------|-----|-------|
| MADE | C.E.B. 12-13-68 | 2 As Built | | TEM | 10-76 |
| CHECKED | PTA 01-24-69 | | | | |
| IN CHARGE | | | | | |

RICHMOND METROPOLITAN AUTHORITY
RICHMOND EXPRESSWAY SYSTEM
DOWNTOWN EXPRESSWAY



BRIDGE NO. 63
WESTBOUND ROADWAY OVER
12TH ST. - R.R. TRACKS AND 16TH ST.
PIERS 18 AND 19

HOWARD, NEEDLES, TAMMEN & BERGENDOFF
consulting engineers
NEW YORK ALEXANDRIA KANSAS CITY

SCALE: As Noted
CONTRACT NO.: 10
SHEET NO. 9 OF 29

AS BUILT


| RICHMOND EXPRESSWAY SYSTEM | | | |
|----------------------------|---------------------|-----------|--------------|
| SECTION | PROJECT | SHEET NO. | TOTAL SHEETS |
| 10 | DOWNTOWN EXPRESSWAY | 84 | 265 |

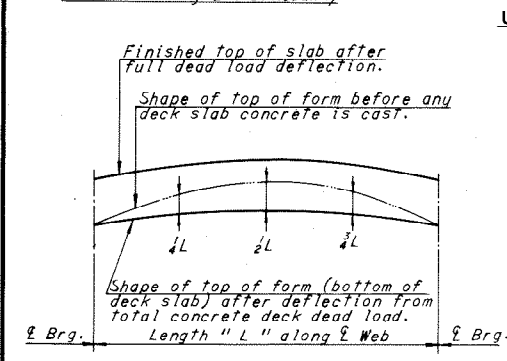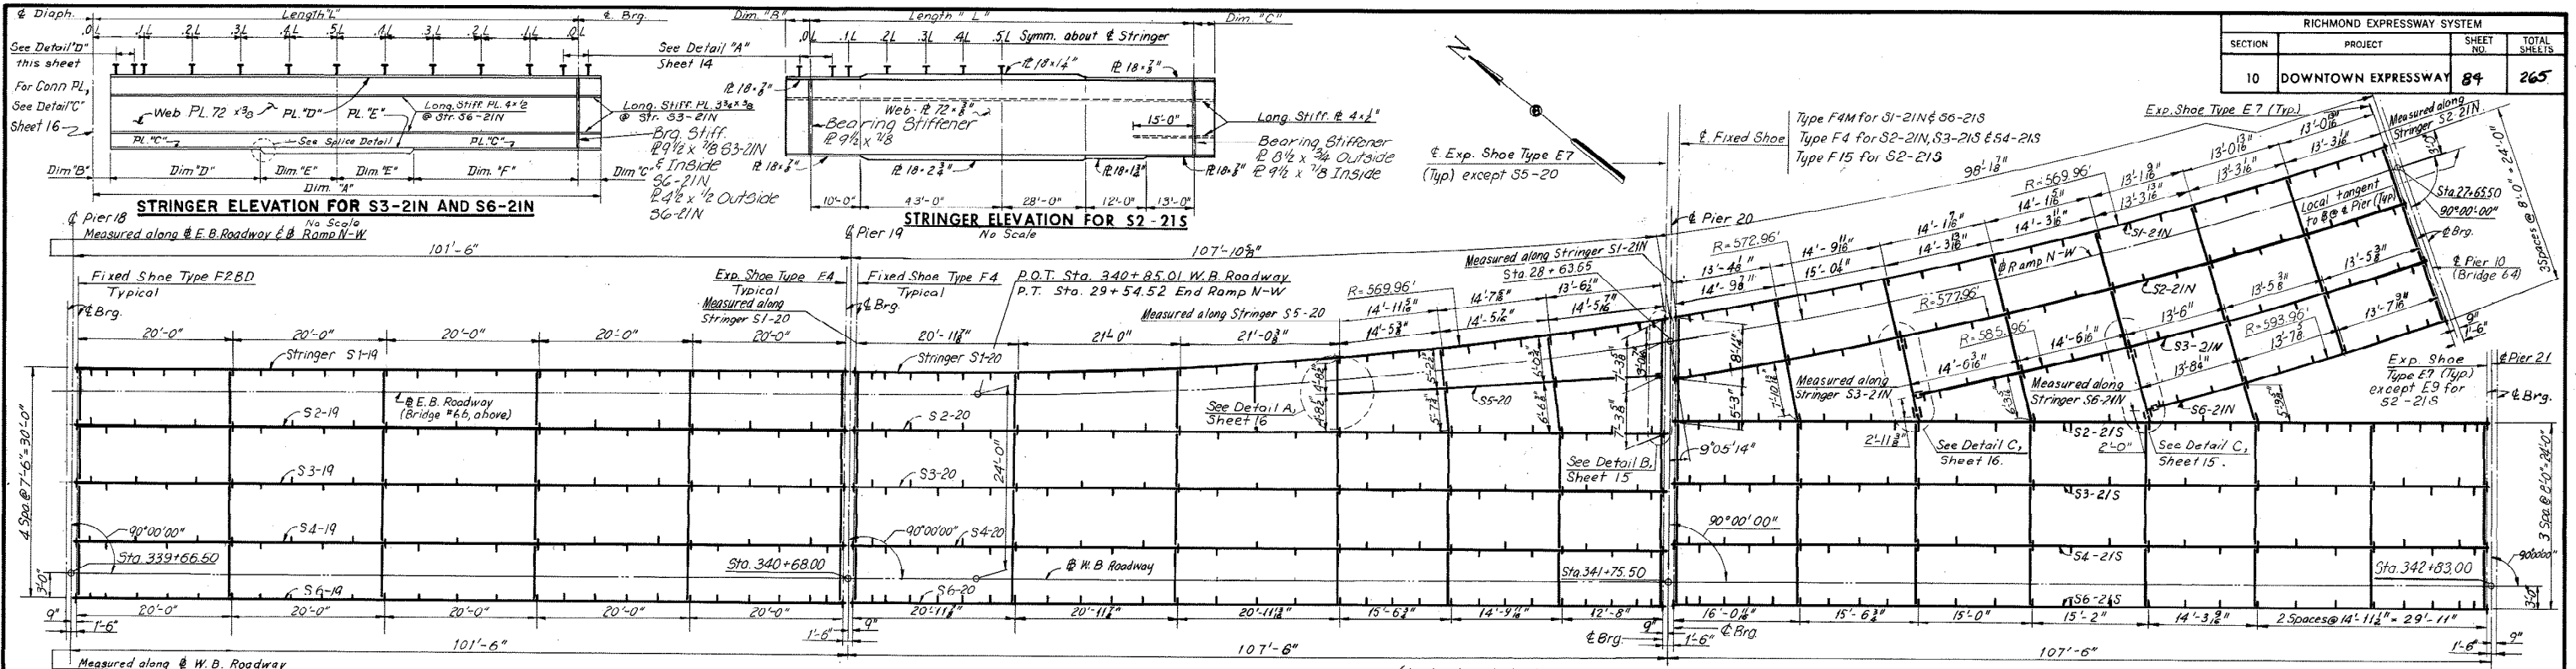

DEAD LOAD DEFLECTION DIAGRAM

NOTE TO CONTRACTOR


Deflections given are those anticipated to occur in the stringer upon placement of the total concrete deck dead load. In practice, the stringers in place are not likely to have the exact camber to compensate for these deflections during construction. The residual amounts shall be provided by adjusting forms to vary the thickness of the concrete haunch between the bottom of the slab and the top of stringer without altering the slab thickness.

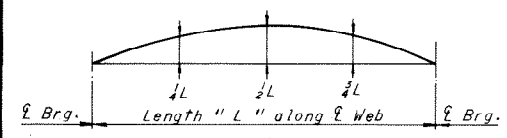


CAMBER DIAGRAM

NOTE TO FABRICATOR

The stringers shall be fabricated with an upward camber amounting to the tabulated value. This will provide approximate compensation conformity with finished grade. Dimensions are in inches. (-) Sign in camber denotes downward camber.

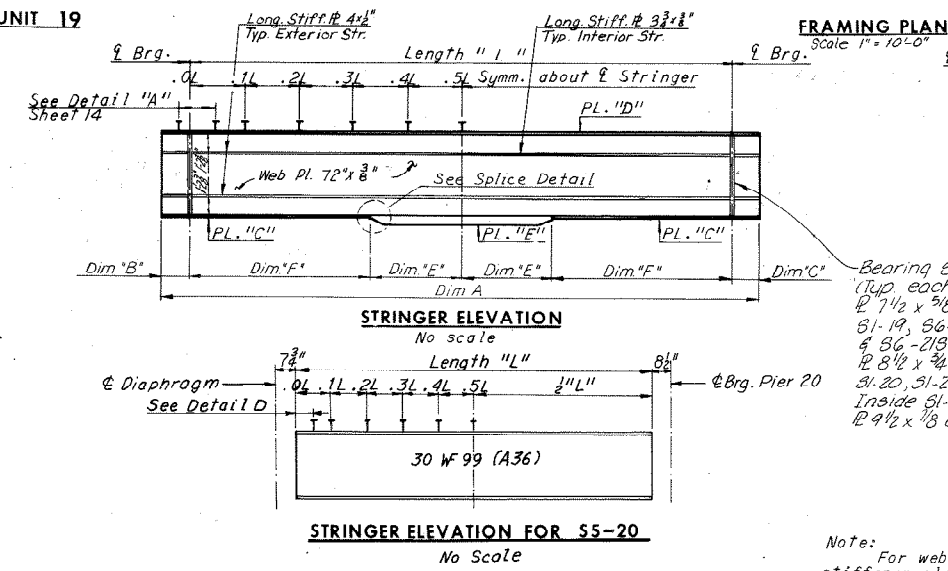


| UNIT | STRINGER | Dim. "A" | LENGTH "L" | Dim. "B" | Dim. "C" | Dim. "D" | Dim. "E" | Dim. "F" | PL. "C" | PL. "D" | PL. "E" | MAX. SHEAR STUD SPACING | | | | | DEAD LOAD DEFLECTION SCHEDULE | | | CAMBER SCHEDULE | | | | | | | |
|------|----------|-------------|-------------|----------|----------|----------|----------|------------|---------|---------------------|---------|-------------------------|-----------|-----------|-----------|-----------|-------------------------------|--------|--------|-----------------|--------|--------|--------|--------|--------|--------|--------|
| | | | | | | | | | | | | 0.0L-0.1L | 0.1L-0.2L | 0.2L-0.3L | 0.3L-0.4L | 0.4L-0.5L | 1/4 | 1/2 | 3/4 | 1/4 | 1/2 | 3/4 | | | | | |
| 19 | S1-19 | 101'-4" | 100'-0" | 8" | 8" | -- | 25'-0" | 25'-0" | 15x3" | 15x3" | 15x14" | 14 1/2" | 17" | 20" | 24" | 24" | 1 1/8" | 1 3/8" | 1 1/8" | 1 1/8" | 1 3/8" | 1 1/8" | 1 1/8" | 1 1/8" | 1 1/8" | 1 1/8" | |
| | S2-19 | 101'-2" | 100'-0" | 7" | 7" | -- | 24'-0" | 26'-0" | 15x3" | 15x3" | 15x14" | 16" | 18" | 21" | 24" | 24" | 1 1/8" | 1 3/8" | 1 1/8" | 1 1/8" | 1 3/8" | 1 1/8" | 1 1/8" | 1 1/8" | 1 1/8" | 1 1/8" | |
| | S3-19 | 101'-2" | 100'-0" | 7" | 7" | -- | 24'-0" | 26'-0" | 15x3" | 15x3" | 15x14" | 16" | 18" | 21" | 24" | 24" | 1 1/8" | 1 3/8" | 1 1/8" | 1 1/8" | 1 3/8" | 1 1/8" | 1 1/8" | 1 1/8" | 1 1/8" | 1 1/8" | 1 1/8" |
| | S4-19 | 101'-2" | 100'-0" | 7" | 7" | -- | 24'-0" | 26'-0" | 15x3" | 15x3" | 15x14" | 16" | 18" | 21" | 24" | 24" | 1 1/8" | 1 3/8" | 1 1/8" | 1 1/8" | 1 3/8" | 1 1/8" | 1 1/8" | 1 1/8" | 1 1/8" | 1 1/8" | 1 1/8" |
| | S6-19 | 101'-4" | 100'-0" | 8" | 8" | -- | 25'-0" | 25'-0" | 15x3" | 15x3" | 15x14" | 14 1/2" | 17" | 20" | 24" | 24" | 1 1/8" | 1 3/8" | 1 1/8" | 1 1/8" | 1 3/8" | 1 1/8" | 1 1/8" | 1 1/8" | 1 1/8" | 1 1/8" | 1 1/8" |
| 20 | S1-20 | 107'-8 3/8" | 106'-4 1/2" | 8" | 8 1/2" | -- | 34'-0" | 19'-2 1/2" | 18x3" | 18x3" | 18x13" | 12" | 13 1/2" | 17 1/2" | 21 1/2" | 24" | 1 1/8" | 1 1/8" | 1 1/8" | 1 1/8" | 1 1/8" | 1 1/8" | 1 1/8" | 1 1/8" | 1 1/8" | 1 1/8" | 1 1/8" |
| | S2-20 | 107'-2" | 106'-0" | 7" | 7" | -- | 29'-6" | 23'-6" | 15x3" | 15x3" | 15x13" | 15 1/2" | 18" | 21" | 24" | 24" | 1 1/8" | 1 3/8" | 1 1/8" | 1 1/8" | 1 3/8" | 1 1/8" | 1 1/8" | 1 1/8" | 1 1/8" | 1 1/8" | |
| | S3-20 | 107'-2" | 106'-0" | 7" | 7" | -- | 29'-6" | 23'-6" | 15x3" | 15x3" | 15x13" | 15 1/2" | 18" | 21" | 24" | 24" | 1 1/8" | 1 3/8" | 1 1/8" | 1 1/8" | 1 3/8" | 1 1/8" | 1 1/8" | 1 1/8" | 1 1/8" | 1 1/8" | |
| | S4-20 | 107'-2" | 106'-0" | 7" | 7" | -- | 29'-6" | 23'-6" | 15x3" | 15x3" | 15x13" | 15 1/2" | 18" | 21" | 24" | 24" | 1 1/8" | 1 3/8" | 1 1/8" | 1 1/8" | 1 3/8" | 1 1/8" | 1 1/8" | 1 1/8" | 1 1/8" | 1 1/8" | |
| | S5-20 | -- | 41'-9 1/2" | -- | -- | -- | -- | -- | -- | Stringer Size 30W99 | 9" | 10" | 11" | 13" | 15" | 15" | 4" | 4" | 4" | 4" | 4" | 4" | 4" | 4" | 4" | 4" | 4" |
| 21 | S2-21S | 107'-4" | 106'-0" | 8" | 8" | -- | 28'-0" | 25'-0" | 15x3" | 15x3" | 15x14" | 14 1/2" | 17" | 20" | 24" | 24" | 1 1/8" | 1 3/8" | 1 1/8" | 1 1/8" | 1 3/8" | 1 1/8" | 1 1/8" | 1 1/8" | 1 1/8" | 1 1/8" | |
| | S3-21S | 107'-2" | 106'-0" | 7" | 7" | -- | 28'-6" | 24'-6" | 15x3" | 15x3" | 15x14" | 15 1/2" | 17" | 20" | 22 1/2" | 24" | 1 1/8" | 1 3/8" | 1 1/8" | 1 1/8" | 1 3/8" | 1 1/8" | 1 1/8" | 1 1/8" | 1 1/8" | 1 1/8" | |
| | S4-21S | 107'-2" | 106'-0" | 7" | 7" | -- | 28'-6" | 24'-6" | 15x3" | 15x3" | 15x14" | 15 1/2" | 17" | 20" | 22 1/2" | 24" | 1 1/8" | 1 3/8" | 1 1/8" | 1 1/8" | 1 3/8" | 1 1/8" | 1 1/8" | 1 1/8" | 1 1/8" | 1 1/8" | |
| | S6-21S | 107'-4" | 106'-0" | 8" | 8" | -- | 28'-6" | 24'-6" | 15x3" | 15x3" | 15x14" | 14 1/2" | 17" | 20" | 24" | 24" | 1 1/8" | 1 3/8" | 1 1/8" | 1 1/8" | 1 3/8" | 1 1/8" | 1 1/8" | 1 1/8" | 1 1/8" | 1 1/8" | |
| | S2-21N | 99'-5 1/2" | 98'-3 3/8" | 7 1/2" | 7 1/2" | -- | 34'-0" | 15'-1 1/8" | 18x3" | 18x3" | 18x13" | 12 1/2" | 14" | 17 1/2" | 24" | 24" | 1 1/8" | 1 1/8" | 1 1/8" | 1 1/8" | 1 1/8" | 1 1/8" | 1 1/8" | 1 1/8" | 1 1/8" | 1 1/8" | 1 1/8" |

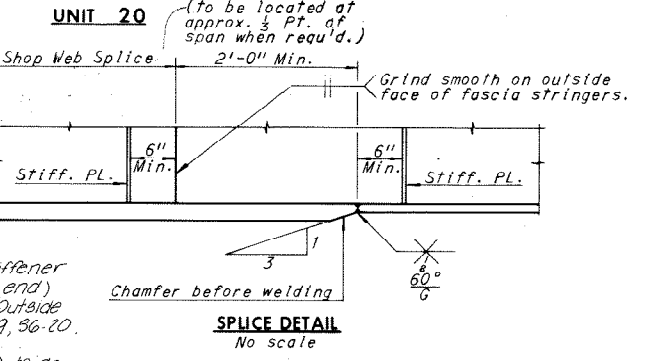

SPICE DETAIL

Note: All Steel shall be A36 unless otherwise shown. Exterior Stringer Longitudinal Stiffeners shall be located on the exterior face of the stringer. Intermediate stiffener pls. 4 1/2" x 3" shall be equally spaced between diaphragms as shown. The first two stiffener spaces at the ends of stringers shall be one-half the normal spacing within the panel.

| SHOE SCHEDULE | | | |
|-----------------|-----------|-------------|-----------|
| EXPANSION SHOES | | FIXED SHOES | |
| TYPE | NO. REQD. | TYPE | NO. REQD. |
| E4 | 5 | F2BD | 5 |
| E7 | 12 | F4 | 8 |
| E9 | 1 | F15 | 1 |

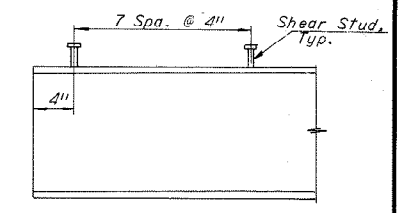

DETAIL D

Note: It may be necessary to increase Bearing Stiffener size to accommodate erection of end diaphragms.

Notes:
For Shoe details, see Sheets S1-S2
For Diaphragm details, see Sheet 20
For Superstructure steel quantities, see Sheet 2
For additional framing details, see Sheet 16
For joint details, see Sheet 24
For Shear stud detail see Sheet 14.

AS BUILT

RICHMOND METROPOLITAN AUTHORITY
RICHMOND EXPRESSWAY SYSTEM
DOWNTOWN EXPRESSWAY

BRIDGE NO. 63
WESTBOUND ROADWAY OVER
12TH ST. - R.R. TRACKS AND 16TH ST.
FRAMING PLAN—UNITS 19, 20 AND 21




| BY | DATE | Note Added | PRMS | 4-19-74 | | |
|-----------|------|------------|------|----------|-----|-------|
| MADE | GSH | 07-31-68 | 2 | As Built | TEM | 10-76 |
| CHECKED | PTA | 10-23-68 | | | | |
| IN CHARGE | | | NO. | REVISION | BY | DATE |

HOWARD, NEEDLES, TAMMEN & BERGENDOFF
consulting engineers
NEW YORK ALEXANDRIA KANSAS CITY

SCALE: As Noted
CONTRACT NO. 10
SHEET NO. 15 OF 29

* Spacing begins at termination of B spaces @ 4".

| RICHMOND EXPRESSWAY SYSTEM | | | |
|----------------------------|---------------------|-----------|--------------|
| SECTION | PROJECT | SHEET NO. | TOTAL SHEETS |
| 10 | DOWNTOWN EXPRESSWAY | 85 | 265 |

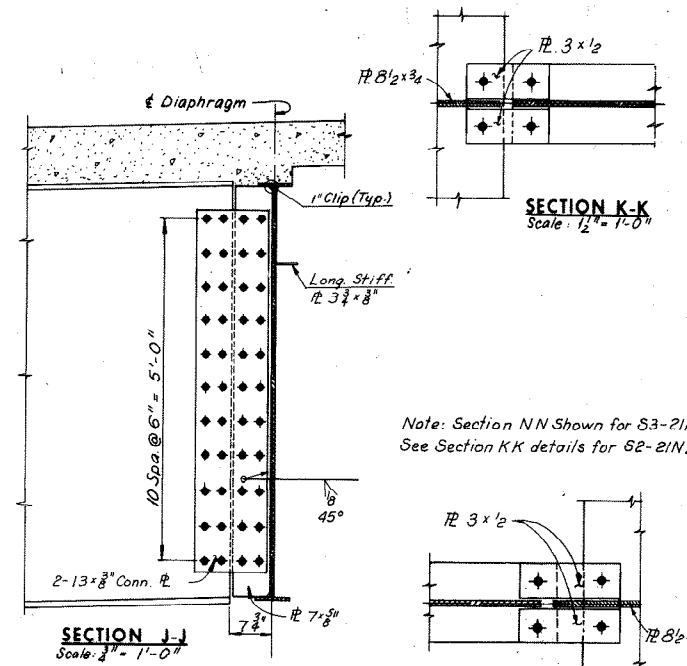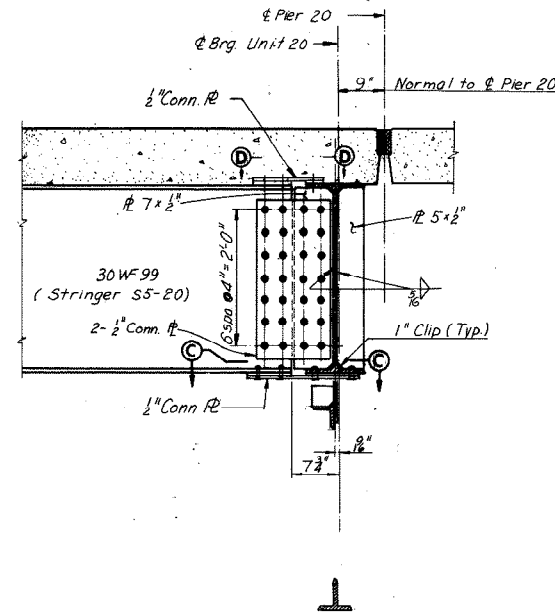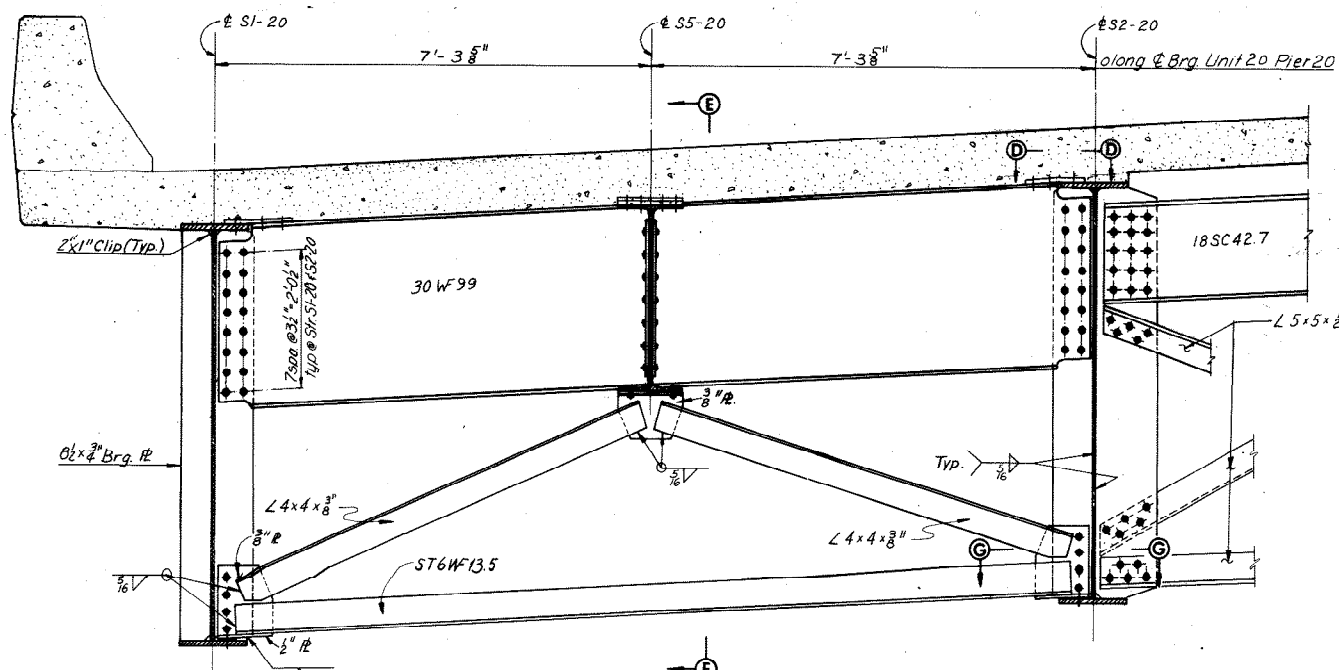




Note: Section NN Shown for S3-21N. See Section KK details for S2-21N.

DETAIL B
Scale: 3/4" = 1'-0"
Looking East

SECTION E-E
Scale: 3/4" = 1'-0"

SECTION J-J
Scale: 3/4" = 1'-0"

SECTION N-N
Scale: 1/2" = 1'-0"

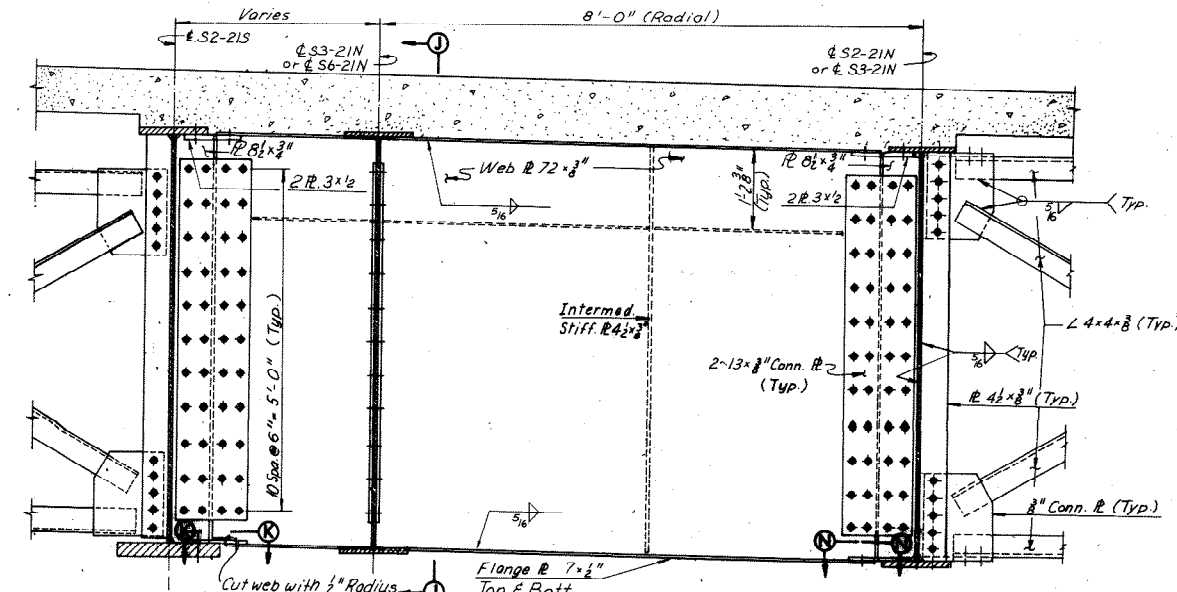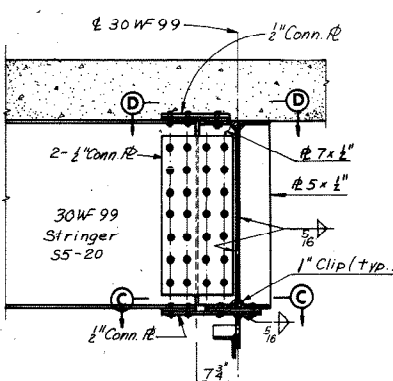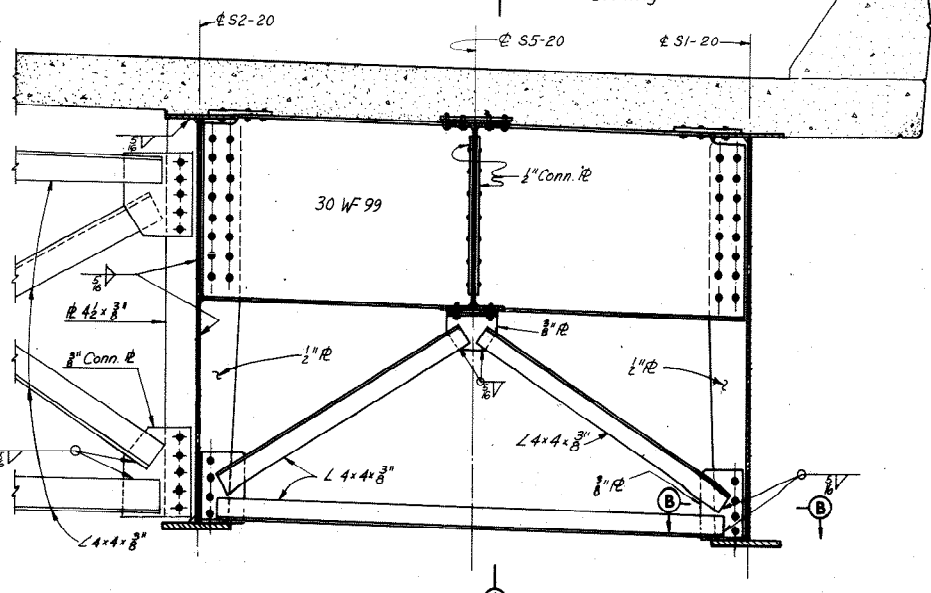


DETAIL A
Scale: 3/4" = 1'-0"
Looking West


SECTION A-A
Scale: 3/4" = 1'-0"

DETAIL C
Scale: 3/4" = 1'-0"
Looking West


Note: For location of Details A, B and C, see Framing Plan Units 20 and 21, Sheet 15. All steel shall be A36 unless otherwise shown.

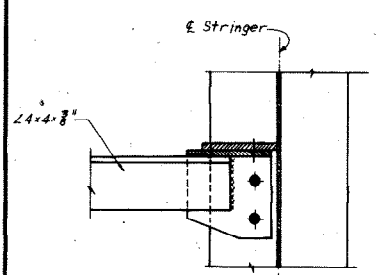


SECTION B-B
Scale: 1/2" = 1'-0"

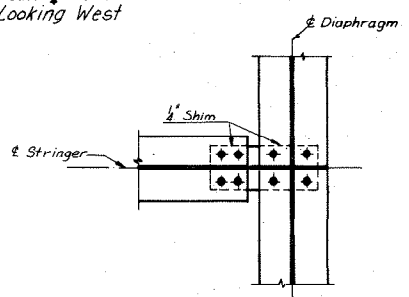

SECTION C-C
Scale: 3/4" = 1'-0"

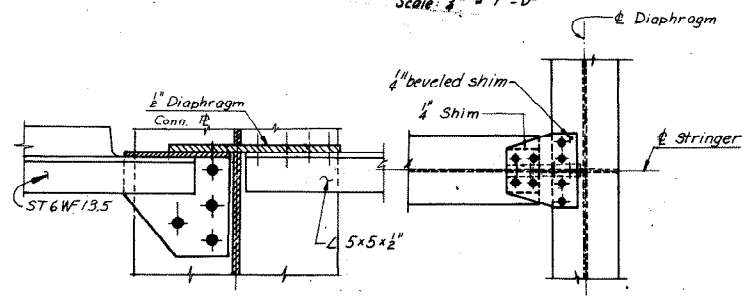

SECTION G-G
Scale: 1/2" = 1'-0"

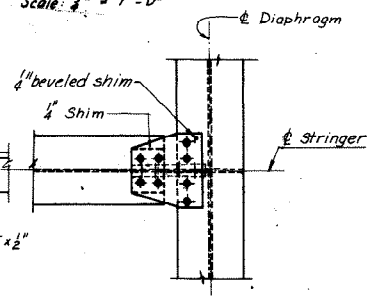

SECTION D-D
Scale: 3/4" = 1'-0"

Section H-H similar

| BY | DATE | NO. | REVISION | BY | DATE |
|-----------|---------------|-----|----------|-----|-------|
| MADE | J.D. 12-18-68 | | | | |
| CHECKED | PTA 1-29-69 | 1 | As Built | TEM | 10-76 |
| IN CHARGE | | | | | |

RICHMOND METROPOLITAN AUTHORITY
RICHMOND EXPRESSWAY SYSTEM
DOWNTOWN EXPRESSWAY

BRIDGE NO. 63
WESTBOUND ROADWAY OVER
12TH ST. - R.R. TRACKS AND 16TH ST.
FRAMING DETAILS
UNITS 20 AND 21

SCALE: As Noted

HOWARD, NEEDLES, TAMMEN & BERGENDOFF
consulting engineers
NEW YORK ALEXANDRIA KANSAS CITY


CONTRACT NO. 10
SHEET NO. 16 OF 29

AS BUILT


| RICHMOND EXPRESSWAY SYSTEM | | | |
|----------------------------|---------------------|-----------|--------------|
| SECTION | PROJECT | SHEET NO. | TOTAL SHEETS |
| 10 | DOWNTOWN EXPRESSWAY | 89 | 265 |

Notes:
 For End Diaphragms at Pier 18, Unit 19, see Section A-A, Sheet 19.
 For End Diaphragms at Pier 19, Units 19 & 20, see Section A-A, Sheet 19.
 For End Diaphragms at Pier 20, Units 20 & 21, see Section A-A, Sheet 19.
 and For Detail "C" see Sheet 16.
 For End Diaphragms at Pier 10, Unit 21N and Pier 21, Unit 21S, see Section C-C this Sheet.


Note: Transverse dotted lines in Units 20 and 21 represent interior diaphragm at left end of stringers S5-20, S3-21N and S6-21N.
 For location of diaphragms see Sheet 14.

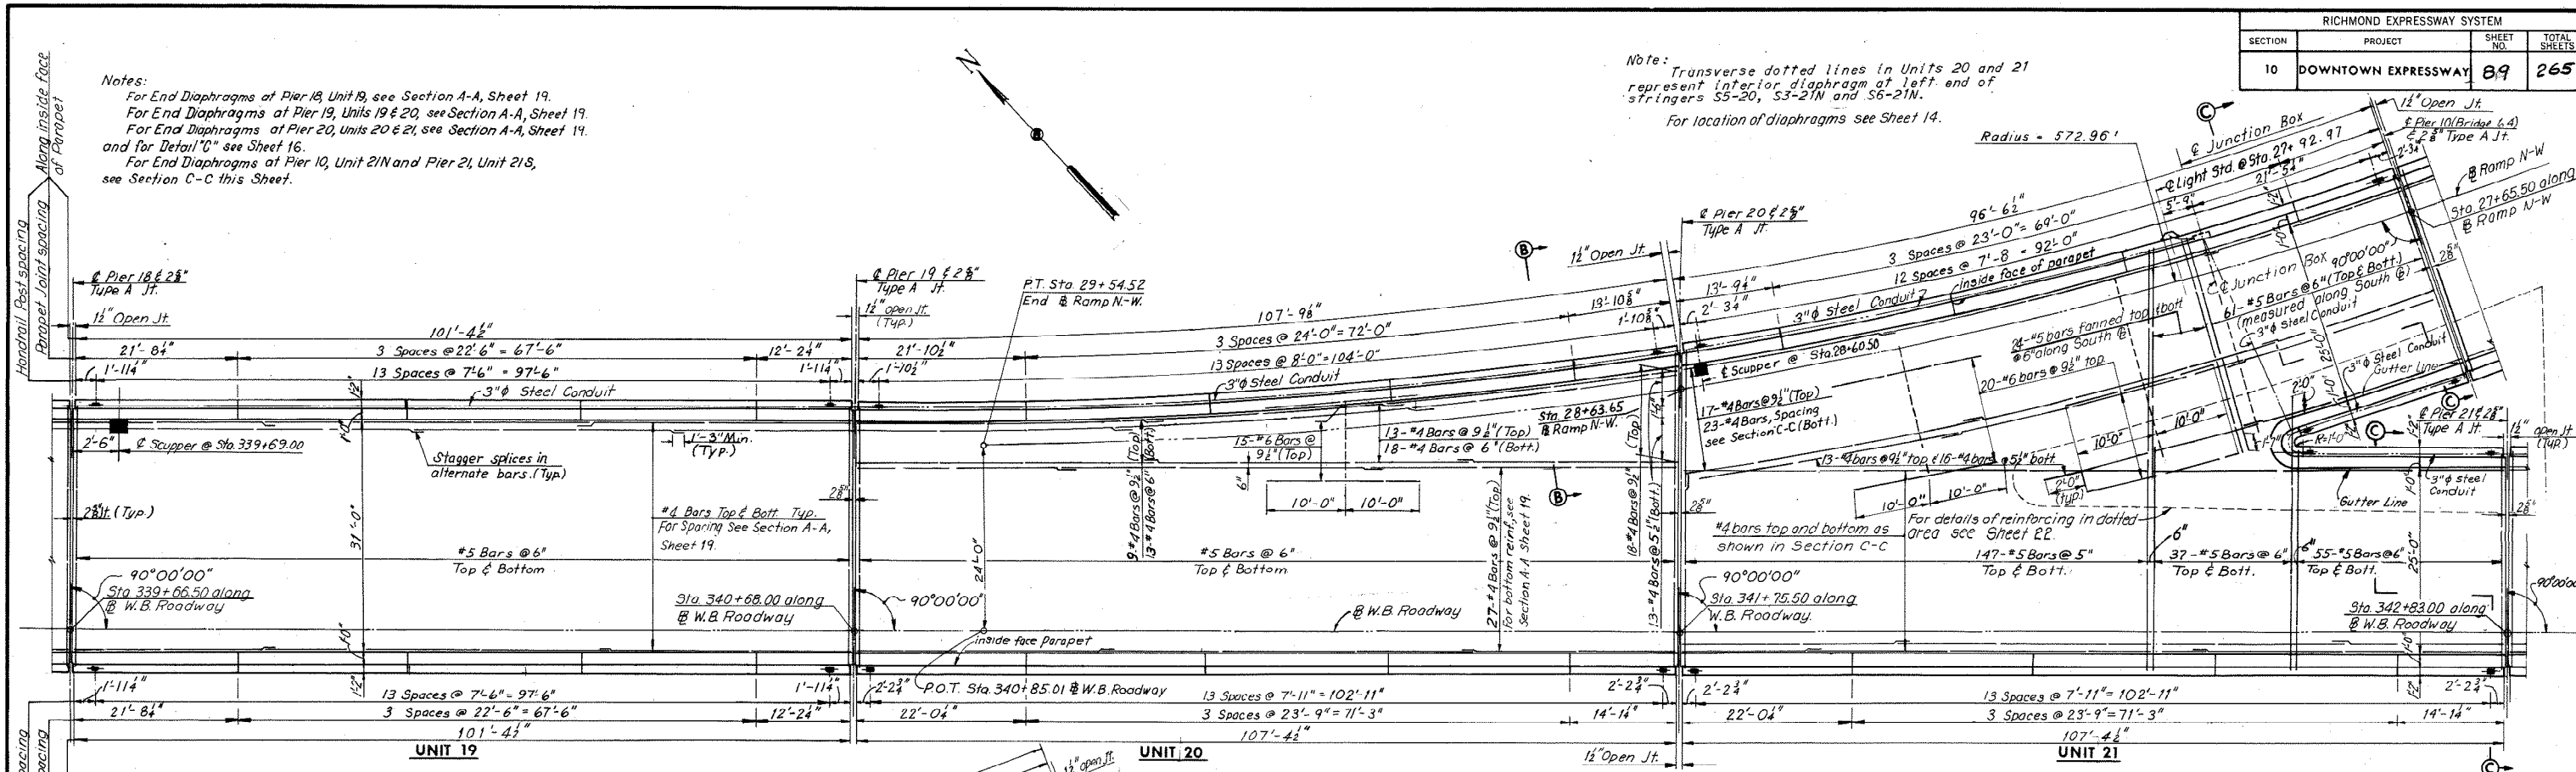


DECK PLAN
 Scale 1/4" = 1'-0"

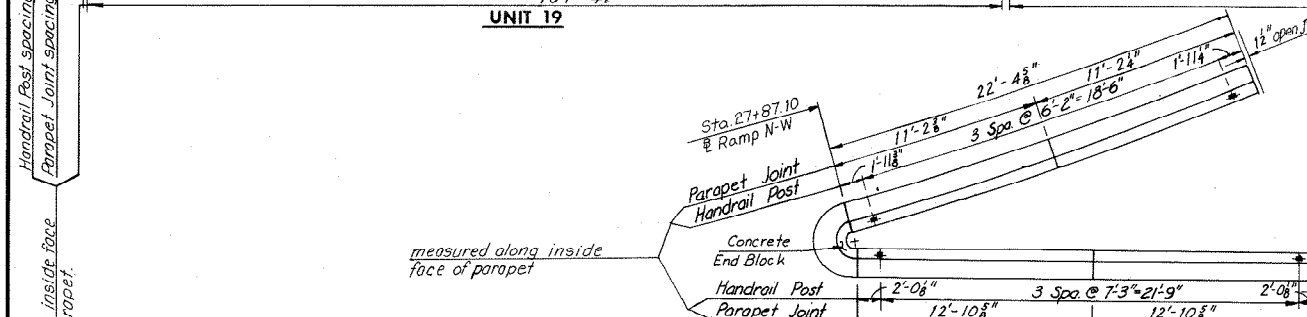

CURB AND PARAPET DETAIL
 No Scale

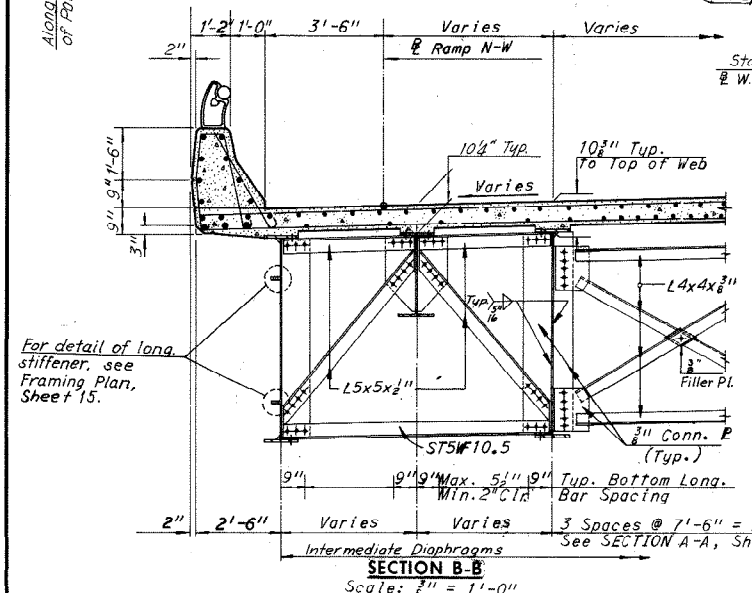

SECTION B-B
 Scale: 3/8" = 1'-0"

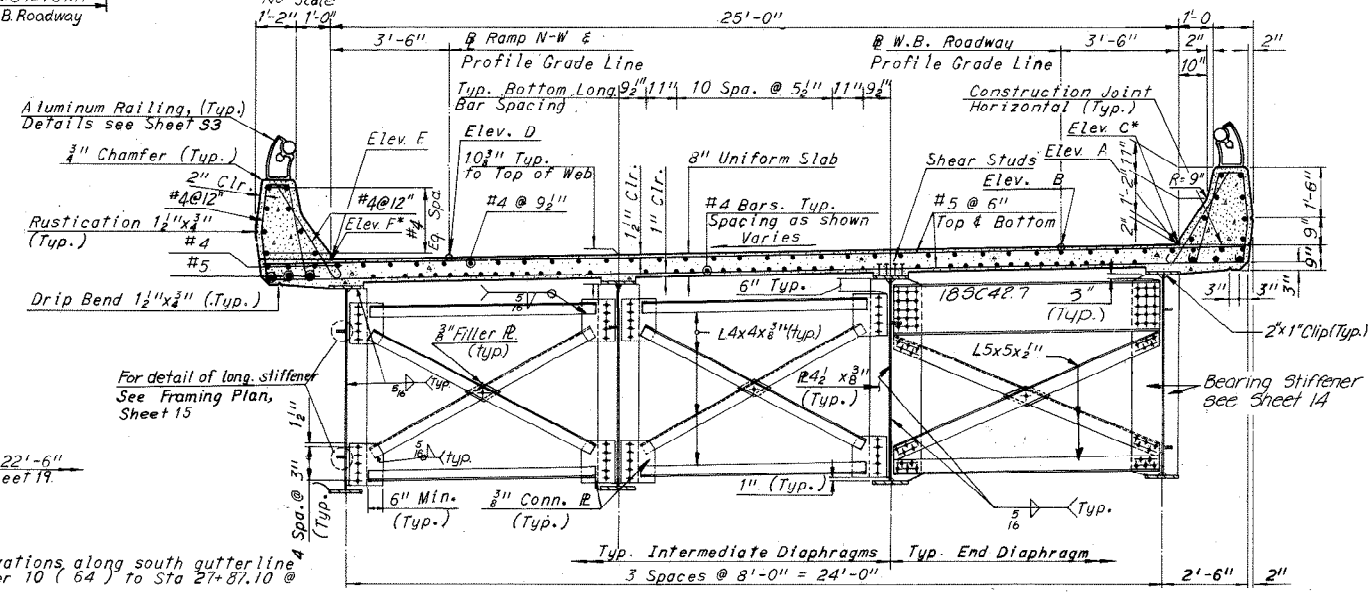

SECTION C-C
 Scale: 3/8" = 1'-0"

Notes:
 For Superstructure quantities, see Sheet 2.
 For Framing plan, see Sheet 15.
 For Joint details, see Sheet 24.
 For Railing details, see Sheet 53.
 For Standard Drainage Details, see Sheet 55 & 56.
 Support Type 2 for Units 19 and 21.

Note: Intermediate Diaphragms shown in Section C-C can only be used where stringers are straight. For Intermediate Diaphragm Details for curved stringers, see Sheet 19.

| STATION @ W.B. | ELEVATION TABLE | | | | |
|----------------|-----------------|---------|---------|---------|---------|
| | ELEV. A | ELEV. B | ELEV. F | ELEV. D | ELEV. E |
| 339+66.50 | 67.46 | 67.39 | — | 66.91 | 66.84 |
| +70.00 | 67.49 | 67.42 | — | 66.94 | 66.87 |
| +80.00 | 67.61 | 67.54 | — | 67.06 | 66.99 |
| +90.00 | 67.72 | 67.65 | — | 67.17 | 67.10 |
| 340+00.00 | 67.83 | 67.76 | — | 67.28 | 67.21 |
| +10.00 | 67.94 | 67.87 | — | 67.39 | 67.32 |
| +20.00 | 68.05 | 67.98 | — | 67.50 | 67.43 |
| +30.00 | 68.17 | 68.10 | — | 67.62 | 67.55 |
| +40.00 | 68.28 | 68.21 | — | 67.73 | 67.66 |
| +50.00 | 68.39 | 68.32 | — | 67.84 | 67.77 |
| +60.00 | 68.50 | 68.43 | — | 67.95 | 67.88 |
| +68.00 | 68.59 | 68.52 | — | 68.04 | 67.97 |
| +70.00 | 68.61 | 68.54 | — | 68.06 | 67.99 |
| +80.00 | 68.73 | 68.66 | — | 68.18 | 68.11 |
| +85.01 | 68.78 | 68.71 | — | 68.23 | 68.16 |
| +90.00 | 68.84 | 68.77 | — | — | — |
| 341+00.00 | 68.95 | 68.88 | — | — | — |
| +10.00 | 69.06 | 68.99 | — | — | — |
| +20.00 | 69.18 | 69.11 | — | — | — |
| +30.00 | 69.29 | 69.22 | — | — | — |
| +40.00 | 69.40 | 69.33 | — | — | — |
| +50.00 | 69.51 | 69.44 | — | — | — |
| +60.00 | 69.62 | 69.55 | — | — | — |
| +70.00 | 69.73 | 69.66 | — | — | — |
| +75.50 | 69.80 | 69.73 | — | — | — |
| +80.00 | 69.85 | 69.78 | — | — | — |
| +90.00 | 69.96 | 69.89 | — | — | — |
| 342+00.00 | 70.07 | 70.00 | — | — | — |
| +10.00 | 70.18 | 70.11 | — | — | — |
| +20.00 | 70.29 | 70.22 | — | — | — |
| +30.00 | 70.41 | 70.34 | — | — | — |
| +40.00 | 70.52 | 70.45 | — | — | — |
| +50.00 | 70.63 | 70.56 | — | — | — |
| +57.17 | 70.71 | 70.64 | 70.21 | — | — |
| +60.00 | 70.74 | 70.67 | 70.24 | — | — |
| +70.00 | 70.85 | 70.78 | 70.35 | — | — |
| +80.00 | 70.97 | 70.90 | 70.47 | — | — |
| 342+83.00 | 71.00 | 70.93 | 70.50 | — | — |

| STATION @ Ramp N-W | ELEVATION TABLE | | |
|--------------------|-----------------|---------|---------|
| | ELEV. D | ELEV. E | ELEV. C |
| 29+54.52 | 68.23 | — | — |
| +50.00 | 68.28 | 68.21 | — |
| +40.00 | 68.39 | 68.32 | — |
| +30.00 | 68.50 | 68.43 | — |
| +20.00 | 68.60 | 68.53 | — |
| +10.00 | 68.70 | 68.63 | — |
| 29+00.00 | 68.80 | 68.73 | — |
| 28+90.00 | 68.89 | 68.82 | — |
| +80.00 | 68.98 | 68.91 | — |
| +70.00 | 69.07 | 69.00 | — |
| +63.65 | 69.12 | — | — |
| +63.17 | — | 69.05 | — |
| +60.00 | 69.15 | 69.08 | — |
| +50.00 | 69.23 | 69.16 | — |
| +40.00 | 69.30 | 69.23 | — |
| +30.00 | 69.37 | 69.30 | — |
| +20.00 | 69.44 | 69.37 | — |
| +10.00 | 69.51 | 69.44 | — |
| 28+00.00 | 69.57 | 69.50 | — |
| 27+90.00 | 69.64 | 69.56 | — |
| 27+87.10 | 69.67 | 69.58 | 70.21 |
| +80.00 | 69.74 | 69.64 | 70.34 |
| +70.00 | 69.87 | 69.76 | 70.56 |
| 27+65.50 | 69.94 | 69.87 | 70.66 |










AS BUILT
 RICHMOND METROPOLITAN AUTHORITY
 RICHMOND EXPRESSWAY SYSTEM
 DOWNTOWN EXPRESSWAY
 BRIDGE NO. 63
 WESTBOUND ROADWAY OVER
 12TH ST. - R.R. TRACKS AND 16TH ST.
 DECK PLAN - UNITS 19, 20 AND 21

| BY | DATE | NO. | REVISION | BY | DATE |
|-----------|------|----------|----------|-----|-------|
| MADE | GSH | 7-29-68 | | | |
| CHECKED | KCT | 10-18-68 | As Built | TEM | 10-76 |
| IN CHARGE | | | | | |

Note: Elev. C* are elevations along south gutterline of Ramp N-W from Pier 10 (64) to Sta 27+87.10 @ ctr. of Nose.
 Elev. F* are elevations along north gutterline of W.B. Roadway between Sta. 342+57.17 @ ctr. of Nose and Sta. 342+83.00 @ Pier 21.

HOWARD, NEELES, TAMMEN & BERGENDOFF
 consulting engineers
 NEW YORK ALEXANDRIA KANSAS CITY
 SCALE: As Noted
 CONTRACT NO. 10
 SHEET NO. 20 OF 29


| RICHMOND EXPRESSWAY SYSTEM | | | |
|----------------------------|---------------------|-----------|--------------|
| SECTION | PROJECT | SHEET NO. | TOTAL SHEETS |
| 10 | DOWNTOWN EXPRESSWAY | 93 | 265 |

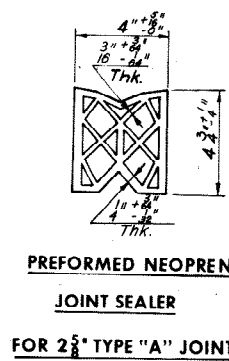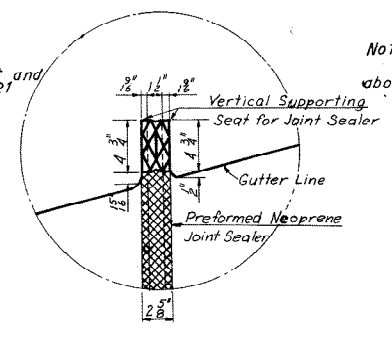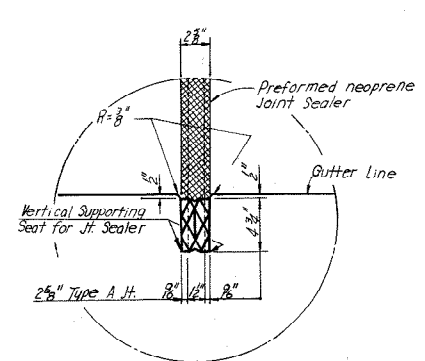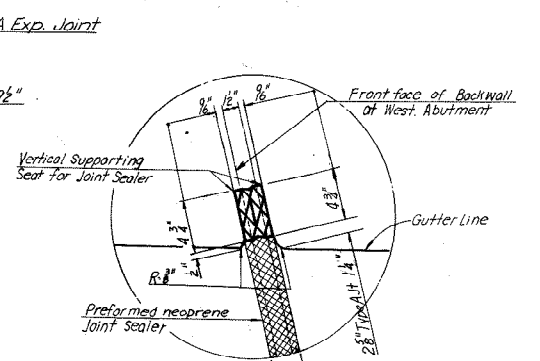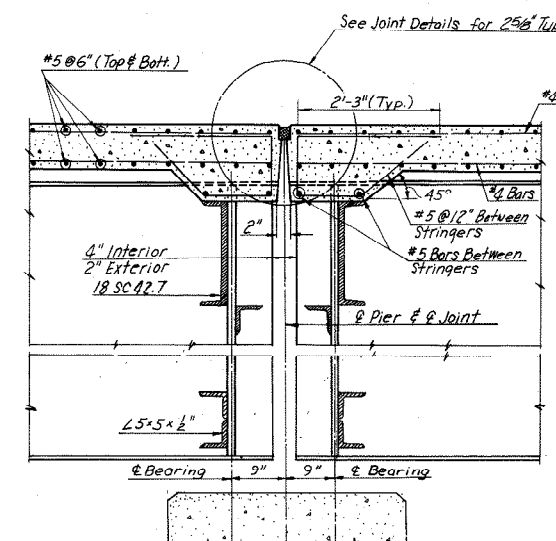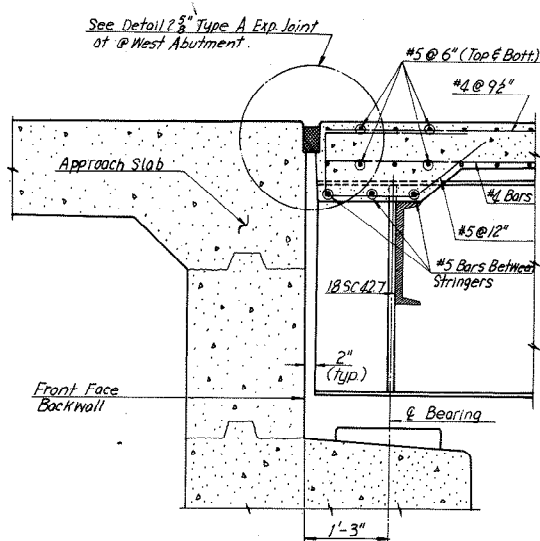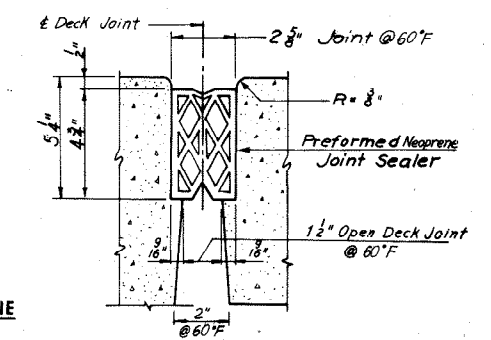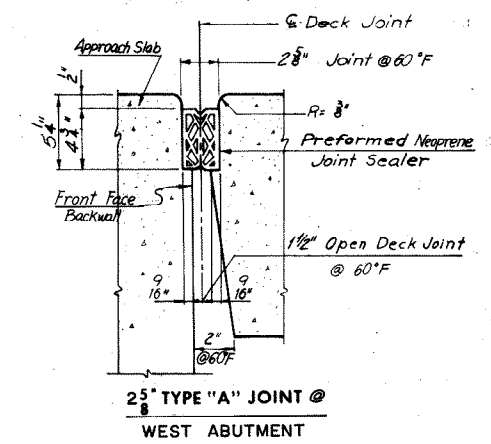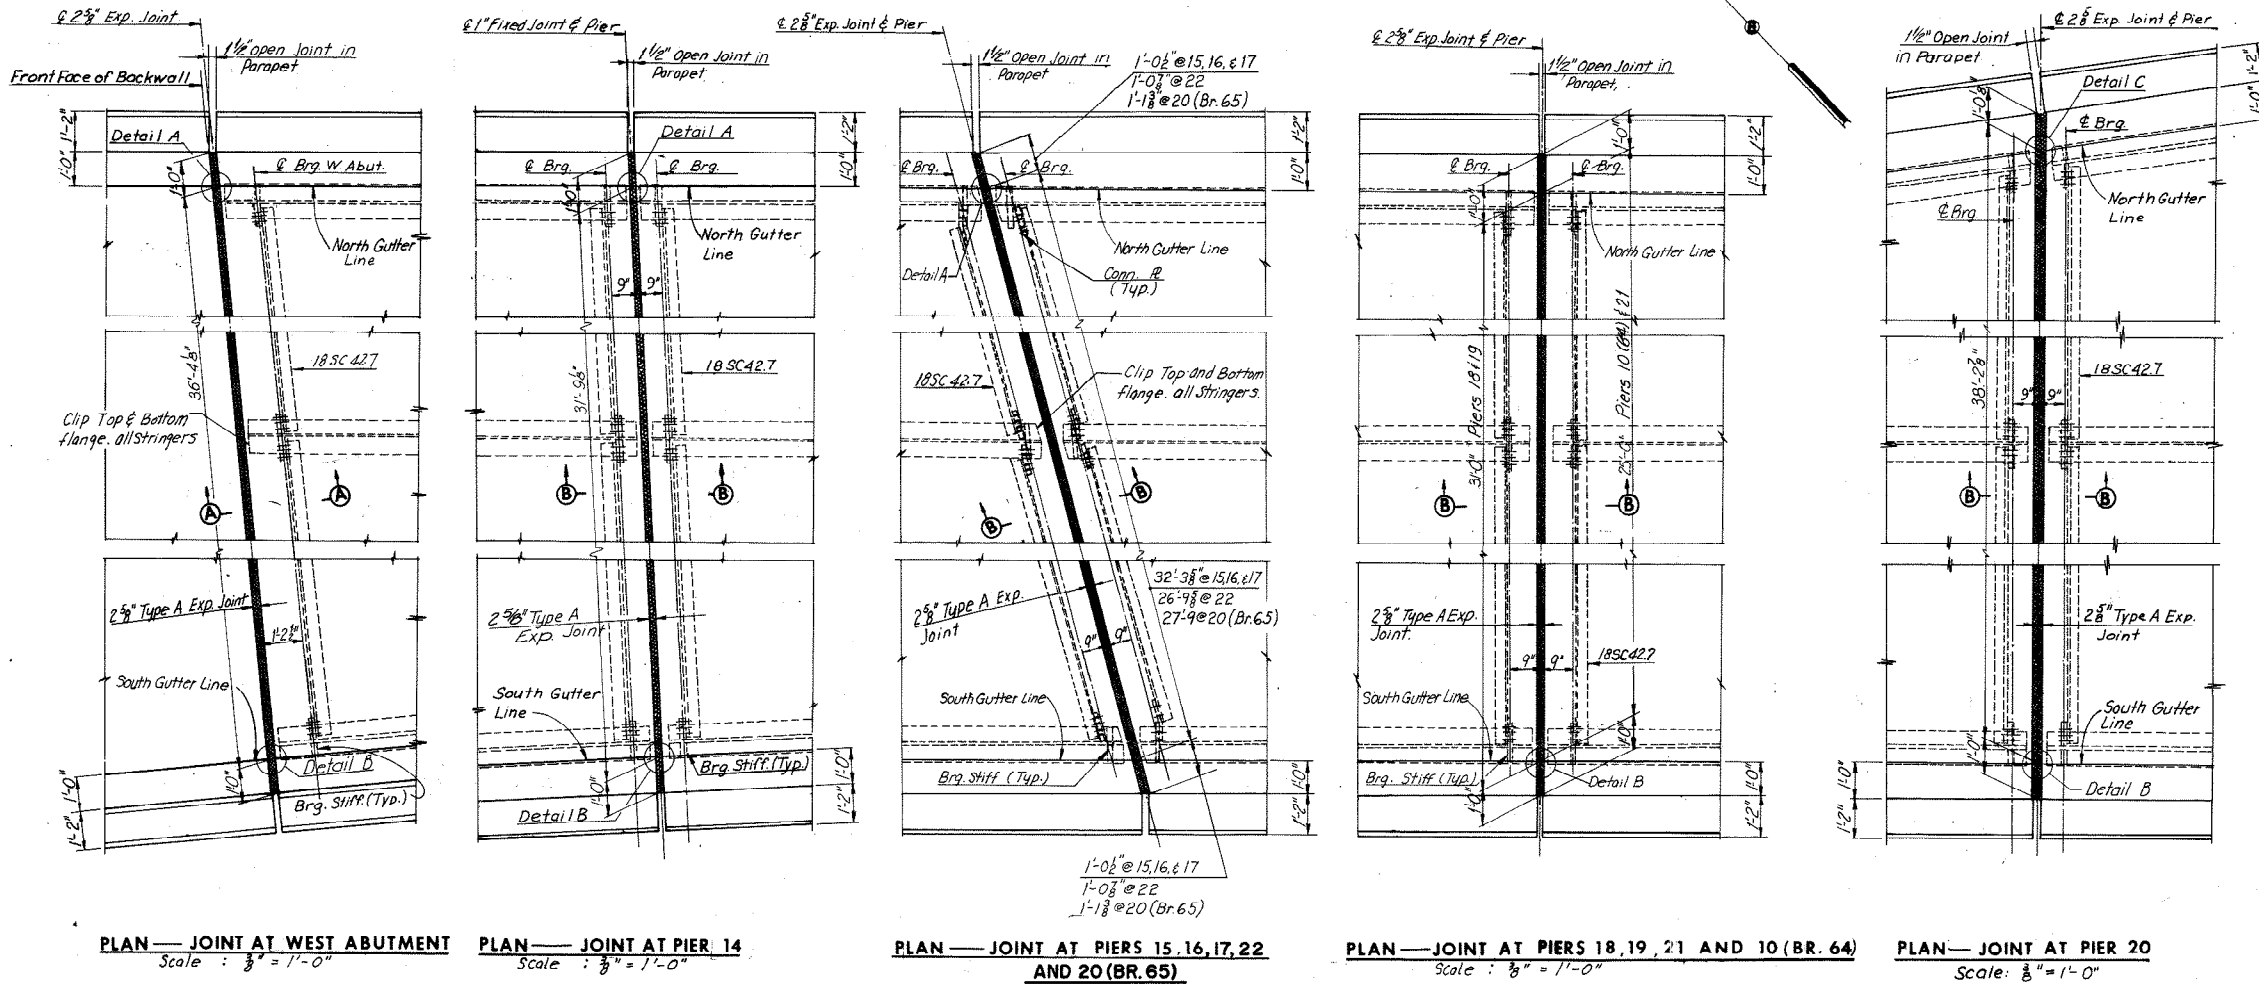

EXPANSION JOINTS
No Scale

Note: All horizontal dimensions shown above are normal to ϵ joint.

Note: It is absolutely essential that the openings for the preformed neoprene joint sealers be accurately formed and constructed to smooth, straight lines. The size of opening shall be adjusted to allow for anticipated dead load rotation of the ends of the slab and for the temperature at the time of construction.

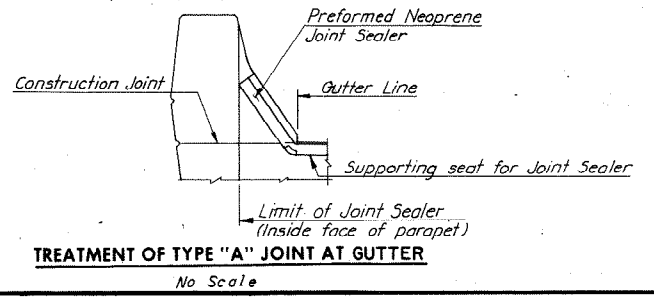

RICHMOND METROPOLITAN AUTHORITY
RICHMOND EXPRESSWAY SYSTEM
DOWNTOWN EXPRESSWAY

BRIDGE NO. 63
WESTBOUND ROADWAY OVER
12TH ST. - R.R. TRACKS AND 16TH ST.
JOINT DETAILS

HOWARD, NEEDLES, TAMMEN & BERGENDOFF
consulting engineers
NEW YORK ALEXANDRIA KANSAS CITY

SCALE: As Noted
CONTRACT NO. 10
SHEET NO. 24 OF 29

| BY | DATE | NO. | REVISION | BY | DATE |
|-----------|---------------|-----|----------|-----|-------|
| MADE | GSH 10-1-68 | | | | |
| CHECKED | J.D. 11-19-68 | 1 | As Built | TEM | 10-76 |
| IN CHARGE | | | | | |

AS BUILT


Bridge 64

**(Ramp From SB I-95 to Eastbound Downtown Expressway - Rte. 195
Over East Cary Street, Dock Street, and CSX Railroad)**

Record Set Plans



| RICHMOND EXPRESSWAY SYSTEM | | | |
|----------------------------|---------------------|-----------|--------------|
| SECTION | PROJECT | SHEET NO. | TOTAL SHEETS |
| 10 | DOWNTOWN EXPRESSWAY | 99 | 265 |

| INDEX | SHEET |
|--|------------|
| GENERAL PLAN AND ELEVATION | 1 |
| GENERAL PLAN AND ELEVATION | 2 |
| LAYOUT PLAN | 3 |
| PIERS 1 AND 2 | 4 |
| PIERS 3 AND 4E | 5 |
| PIER 4 | 6 |
| PIER 5 | 7 |
| PIERS 6 AND 7 | 8 |
| PIER 8 | 9 |
| PIER 9 | 10 |
| PIER 10 | 11 |
| FRAMING PLAN - UNITS 1 AND 2 | 12 & 12a |
| FRAMING PLAN - UNITS 3 AND 4 | 13 |
| FRAMING PLAN AND DECK PLAN - UNITS 5E AND 6E | 14 |
| FRAMING PLAN - UNITS 5 AND 6 | 15 |
| FRAMING PLAN - UNITS 7 AND 8 | 16 |
| FRAMING PLAN - UNITS 9 AND 10 | 17 |
| FRAMING DETAILS | 18 |
| DECK PLAN - UNITS 1 AND 2 | 19 |
| DECK PLAN - UNITS 3 AND 4 | 20 |
| DECK PLAN - UNITS 5 AND 6 | 21 |
| DECK PLAN - UNITS 7 AND 8 | 22 |
| DECK PLAN - UNITS 9 AND 10 | 23 |
| SUPERSTRUCTURE DETAILS | 24 |
| JOINT DETAILS | 25 |
| JOINT DETAILS | 26 |
| BORING LOGS | 27 |
| BORING LOGS | 28 |
| STANDARD DETAILS | S1 THRU S7 |

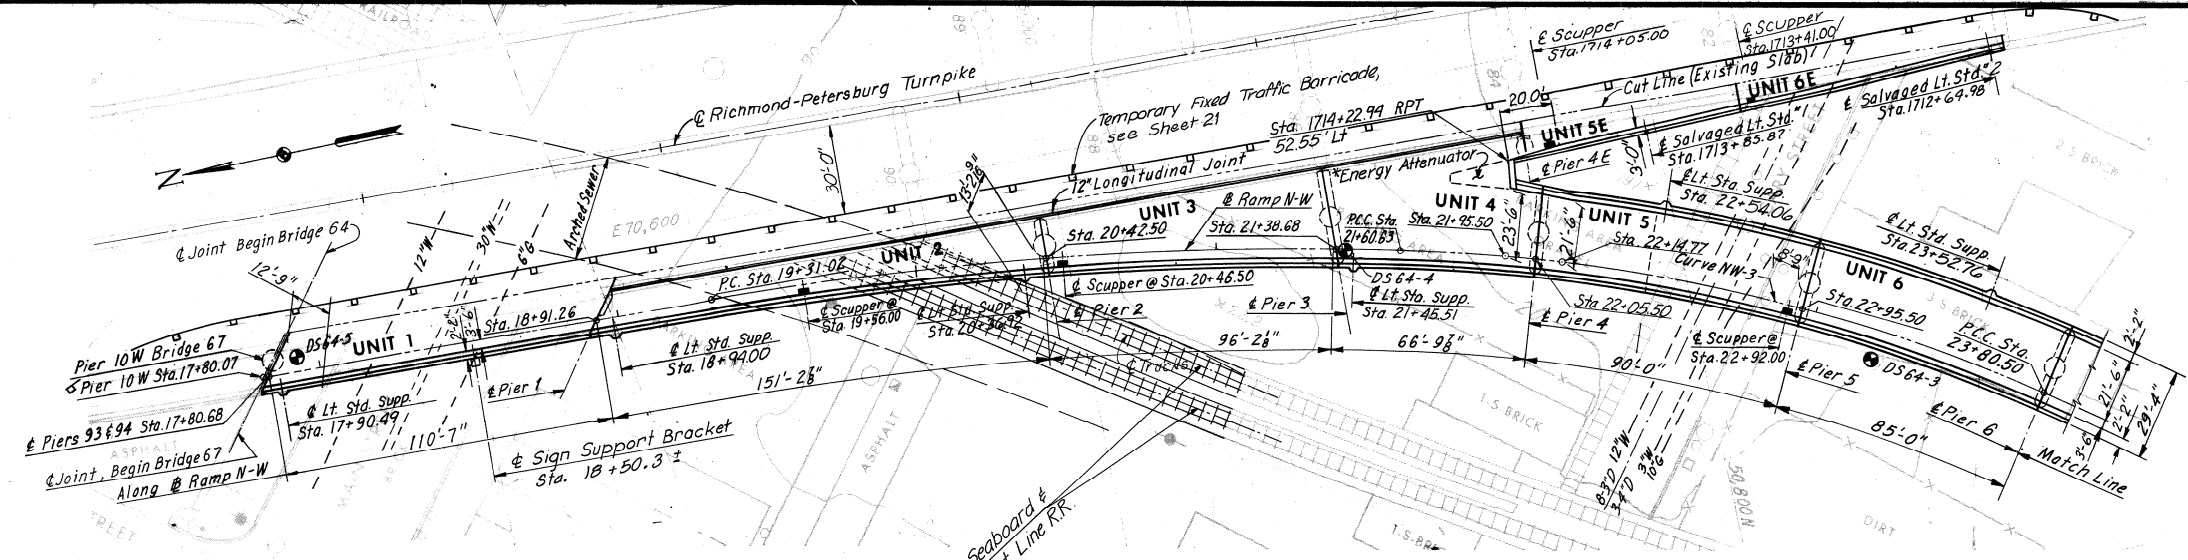


Note:
 * Energy Attenuator shall be an 8-Unit Hi-Dro Cell Sandwich Unit as supplied by Hydro-Cell, Ltd., 11 Lincoln Ave., New Rochelle, N.Y. 10801, or approved equal.
 984'-9 1/2" to Pier 10 (End of Bridge 64)

Note:
 For General Notes, see Sheet 2.
 For Quantity Table, see Sheet 2.

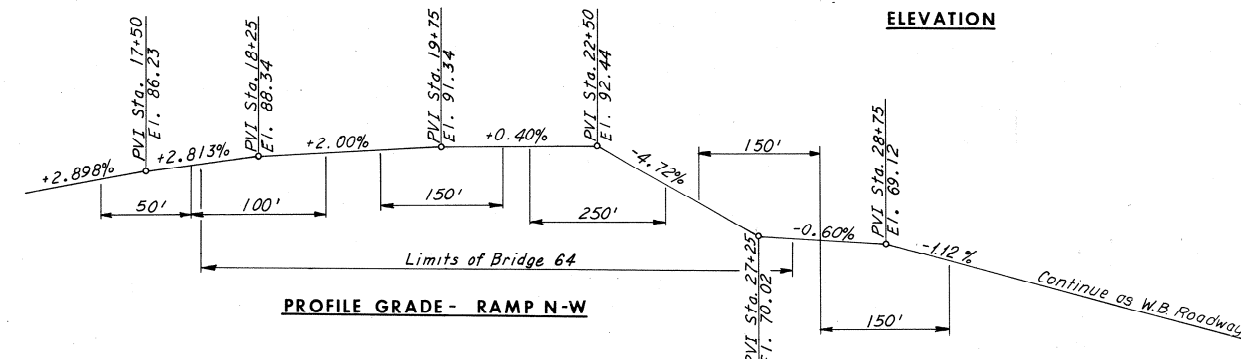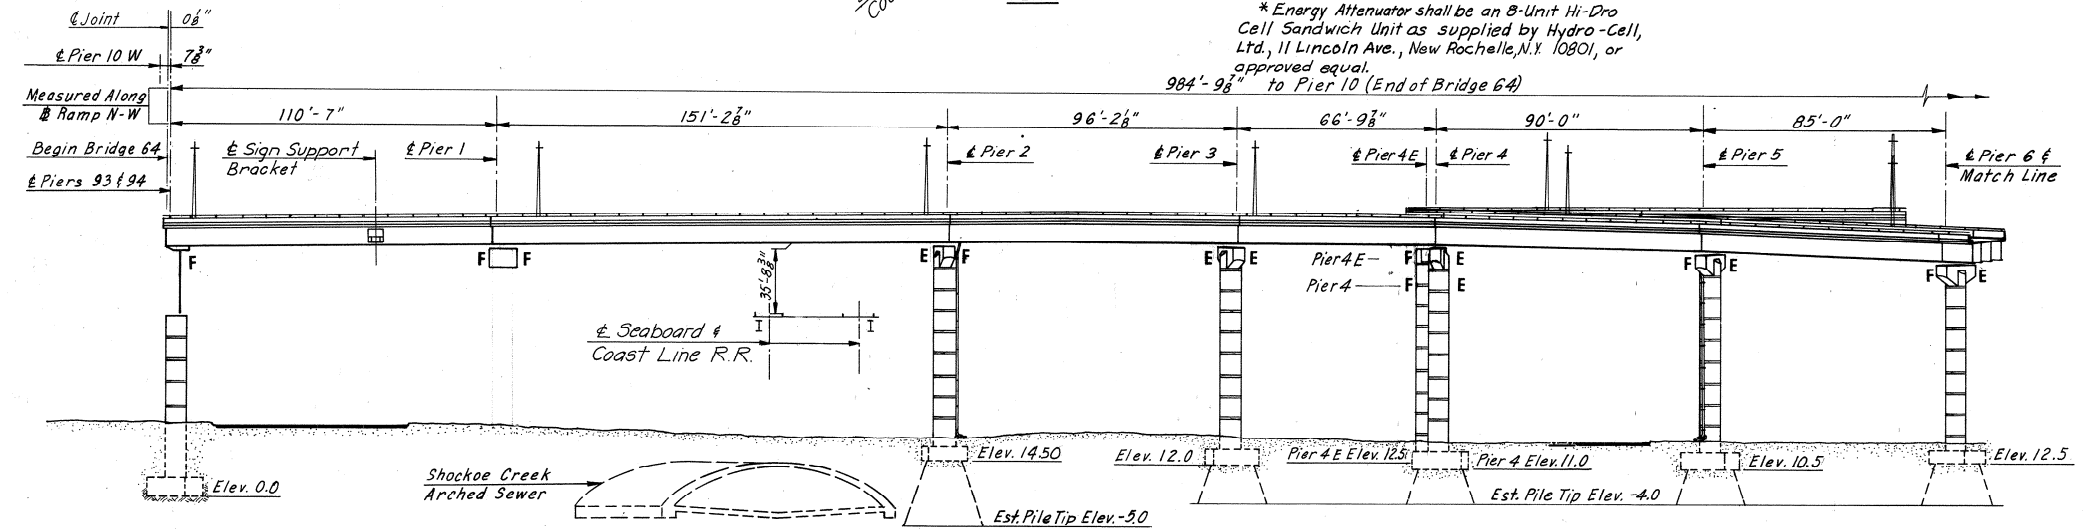

HORIZONTAL CURVE DATA

| R. P. Turnpike | | R. Ramp N-W | | Curve: NW-1 | | Curve: NW-2 | | Curve: NW-3 | |
|------------------------|------------------------|----------------------|----------------------|----------------------|----------------------|----------------------|--|-------------|--|
| Curve: R.P.T.-1 | Curve: R.P.T.-2 | Curve: NW-1 | Curve: NW-2 | Curve: NW-3 | Curve: NW-4 | Curve: NW-5 | | | |
| P.I. = Sta. 1704+68.83 | P.I. = Sta. 1723+07.01 | P.I. = Sta. 13+42.50 | P.I. = Sta. 20+46.21 | P.I. = Sta. 22+71.93 | P.I. = Sta. 25+55.02 | P.I. = Sta. 28+25.38 | | | |
| Δ = 15° 03' 56.2" | Δ = 35° 27' 06.8" | Δ = 32° 07' 32" | Δ = 11° 28' 49.9" | Δ = 21° 59' 14.3" | Δ = 64° 48' 04" | Δ = 26° 18' 00" | | | |
| D = 1° 00' 00" | D = 49° 00' 00" | D = 3° 51' 35.6" | D = 5° 00' 00" | D = 10° 00' 00" | D = 20° 50' 05.4" | D = 10° 00' 00" | | | |
| T = 757.65' | T = 430.45' | T = 426.01' | T = 115.19' | T = 111.31' | T = 174.52' | T = 133.86' | | | |
| L = 1,506.56' | L = 836.30' | L = 829.72' | L = 229.61' | L = 219.88' | L = 311.02' | L = 263.00' | | | |
| R = 5,729.58' | R = 1,432.39' | R = 1,484.39' | R = 1,145.92' | R = 572.96' | R = 275.00' | R = 572.96' | | | |

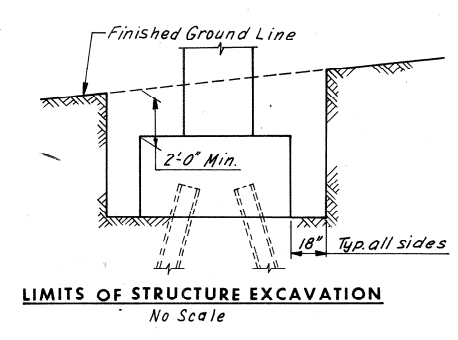

| NO. | REVISION | BY | DATE |
|-----|--|--------|---------|
| 4 | As Built | TEM | 6-77 |
| | Seaboard & Coast Line Add'l to Plan E1 | K.D.P. | 6-74 |
| | Sign Support Bracket | L.B.P. | 8-74 |
| | Sheet 12a added | | |
| | Added Sta. | REG | 1-13-75 |

RICHMOND METROPOLITAN AUTHORITY
RICHMOND EXPRESSWAY SYSTEM
DOWNTOWN EXPRESSWAY



BRIDGE NO. 64
RAMP N-W CONNECTION FROM
RICHMOND-PETERSBURG TURNPIKE
GENERAL PLAN AND ELEVATION

HOWARD, NEEDLES, TAMMEN & BERGENDOFF
 consulting engineers
 NEW YORK ALEXANDRIA KANSAS CITY

SCALE: 1" = 30'-0"
 CONTRACT NO.: 10
 SHEET NO. 1 OF 28

AS BUILT

| RICHMOND EXPRESSWAY SYSTEM | | | |
|----------------------------|---------------------|-----------|--------------|
| SECTION | PROJECT | SHEET NO. | TOTAL SHEETS |
| 10 | DOWNTOWN EXPRESSWAY | 100 | 265 |

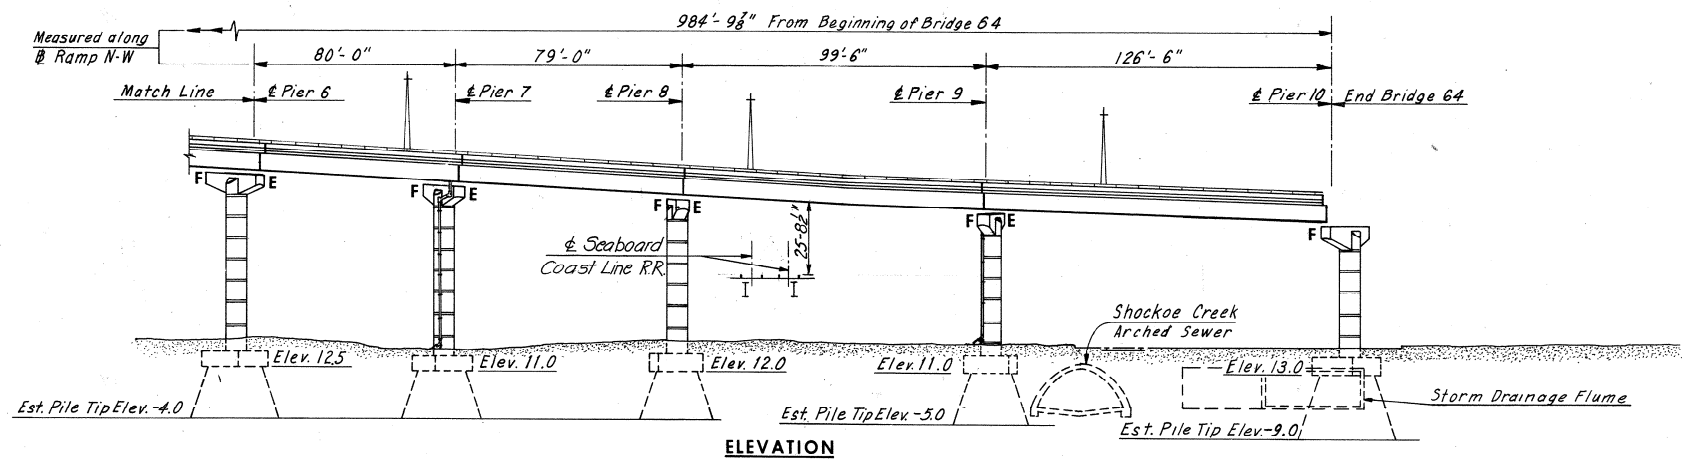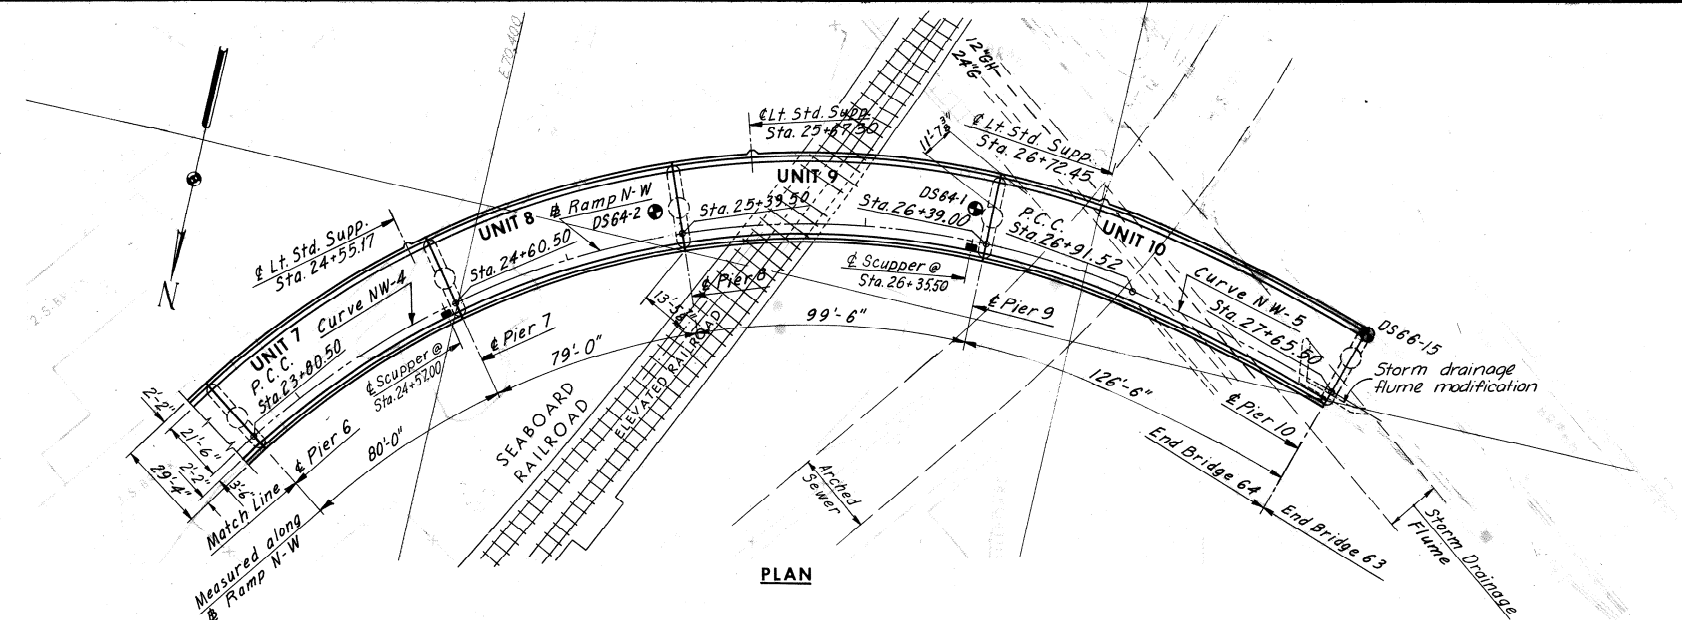

ESTIMATED QUANTITIES

| | Structure Excavation Cu. Yds. | Concrete (#) Cu. Yds. | Reinforcing Steel Lbs. | Str. Steel Mild Carbon Lbs. | Str. Steel High Strength Lbs. | Aluminum Railing (1-Rail) Lin. Ft. | Steel Piles 10BP42 Lin. Ft. |
|----------------|----------------------------------|--------------------------|---------------------------|--------------------------------|----------------------------------|---------------------------------------|--------------------------------|
| Superstructure | -- | 1,023.8 | 213,790 | 768,100 | 413,900 | 1,600 | --- |
| Substructure | 1,125 | 1,484.1 | 236,580 | 2,000 | --- | --- | 145 |
| Total | 1,125 | 2,507.9 | 450,370 | 770,100 | 413,900 | 1,600 | 145 |

| | Steel Piles 12BP53 Lin. Ft. | Sheet Piling Lump Sum | Metal Conduit Lin. Ft. | Energy Attenuator B-Unit Each | Bridge Drainage Metal Work Lbs. | Modifications to R.P. Turnpike Bridge Lump Sum | Modifications to Storm Drainage Flume Cu. Yds. |
|----------------|--------------------------------|--------------------------|---------------------------|----------------------------------|------------------------------------|---|---|
| Superstructure | --- | -- | 1,075 | 1 | 13,030 | 1 | -- |
| Substructure | 3,035 | 1 | -- | -- | -- | -- | 116 |
| Total | 3,035 | 1 | 1,075 | 1 | 13,030 | 1 | 116 |

* All Concrete for Superstructure shall be Class A4 and for Substructure Class A3.

| BY | DATE | REVISION | BY | DATE |
|-----------|-------------|----------|----------|----------|
| MADE | AMH 1-13-69 | | KDP | 6-74 |
| CHECKED | GCC 4-28-69 | 3 | R.B.H. | 9-74 |
| IN CHARGE | | | As Built | TEM 6-77 |

GENERAL NOTES:

ROADWAY: One variable width roadway transitioning from a widening of Southbound roadway of Richmond-Petersburg Turnpike to a ramp with 25'-0" clear roadway connecting with W.B. Roadway (Br. 63).

CAPACITY: Dead load includes 15 lbs. per sq. ft. for future wearing surface. Live load, HS 20-44 loading and alternate military loading.

SPECIFICATIONS: GENERAL: Virginia Department of Highway Road and Bridge Specifications 1970.
DESIGN: A.S.H.O. Standard Specifications for Highway Bridges 1973, modified by Special Design provisions.
WELDING: 1972 Standard Specifications for Welded Highway and Railway Bridges of the American Welding Society.
CONTRACT SPECIAL PROVISIONS: Specifications and Contract Special Provisions referred to above are necessary to make these plans complete.

DATUM:

City of Richmond

TEMPERATURE:

The normal temperature referred to in the plans is 60°F. The temperature range for movement is 0°F. to 120°F.

DIMENSIONS:

All dimensions are measured horizontally and vertically unless otherwise noted.

EXCAVATION:

Excavation below subgrade and cut slope template shall be classified as Structure Excavation. All excavation above these limits shall be classified as Regular Excavation and is not included in the Structural Quantities.

FOUNDATIONS:

Footings shall rest on firm material. Foundation material shall be dry and special attention is called to Section 401.05 of Standard Specifications and to the Contract Special Provisions, concerning preparation of foundations for footings.

CONCRETE NOTES:

Concrete in superstructure shall be Class A 4. All other concrete shall be Class A 3. All exposed edges and corners shall have a 1/4" chamfer or fillet unless otherwise noted. Care in the method of vibration, the use of low-slump concrete, and other means shall be employed to prevent downgrade movement of newly placed slab concrete. Finishing Concrete Surfaces: See Standard Architectural Detail Sheets and the Contract Special Provisions for types and details. All reinforcing bar dimensions on the detailed drawings are to centers of bars unless otherwise noted. Clear distance between reinforcing steel and face to concrete shall be as noted on the plans. All bar laps shall be 30 diameters of the smaller diameter bar unless otherwise noted. All reinforcing steel shall conform to ASTM A615 Grade 40.

STEEL NOTES:

Structural steel shall conform to A.S.T.M. Designations A36, A572 - Grade 50 and A588 as noted. See Special Provisions. All field connections shall be made with high strength bolts. High strength bolts shall be 1/2" diameter unless otherwise noted and shall conform to A.S.T.M. Specification A-325.

Note: For Curve Data and Profile Grade, see Sheet 1.
For Layout Plan, see Sheet 3.












**RICHMOND METROPOLITAN AUTHORITY
RICHMOND EXPRESSWAY SYSTEM
DOWNTOWN EXPRESSWAY**

**BRIDGE NO. 64
RAMP N-W CONNECTION FROM
RICHMOND-PETERSBURG TURNPIKE
GENERAL PLAN AND ELEVATION**

| | |
|---|--|
| HOWARD, NEEDLES, TAMMEN & BERGENDOFF consulting engineers NEW YORK ALEXANDRIA KANSAS CITY | SCALE: 1" = 30'-0" CONTRACT NO. 10 SHEET NO. 2 OF 28 |
|---|--|





AS BUILT

| RICHMOND EXPRESSWAY SYSTEM | | | |
|----------------------------|---------------------|-----------|--------------|
| SECTION | PROJECT | SHEET NO. | TOTAL SHEETS |
| 10 | DOWNTOWN EXPRESSWAY | 102 | 265 |

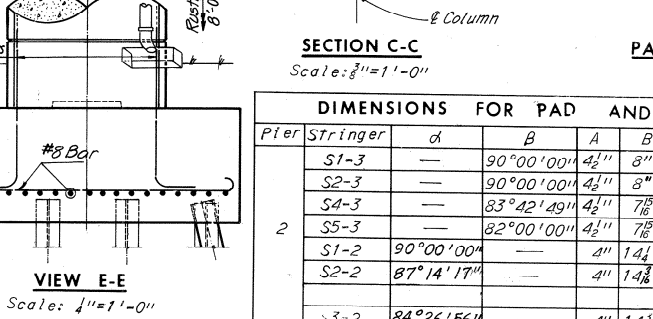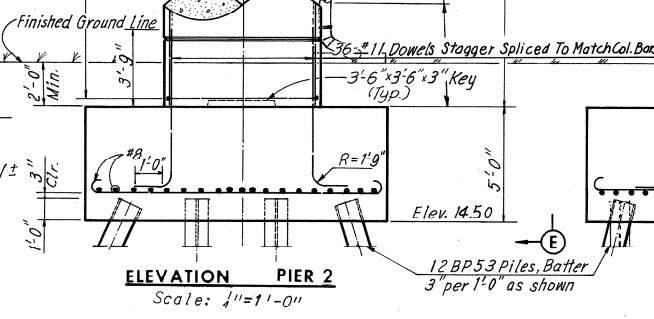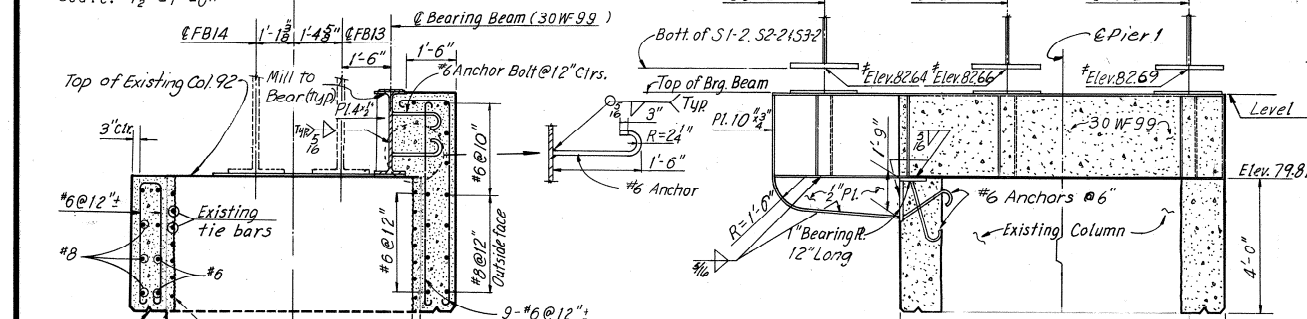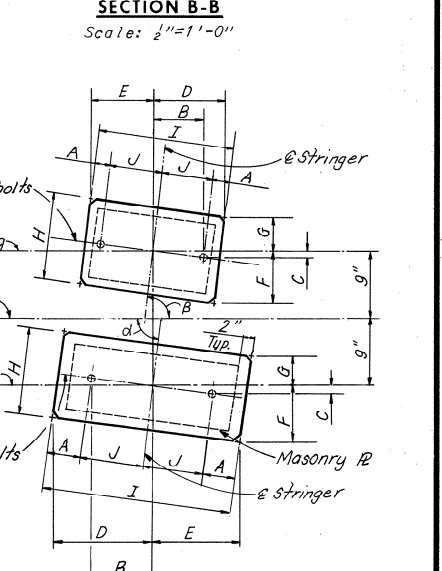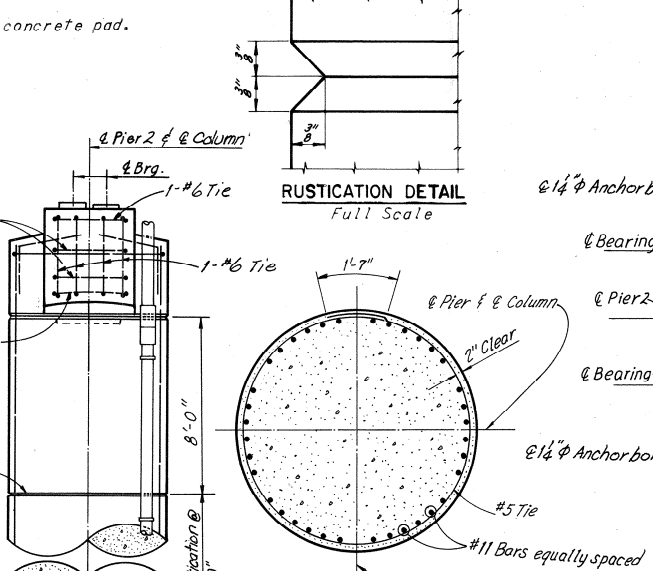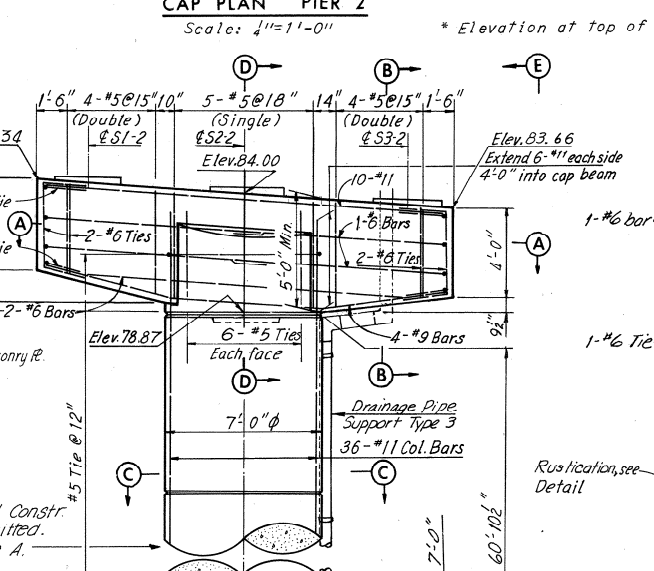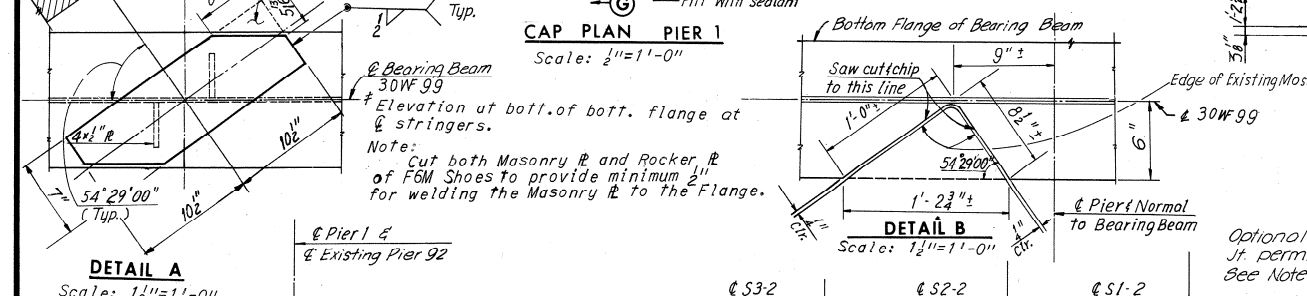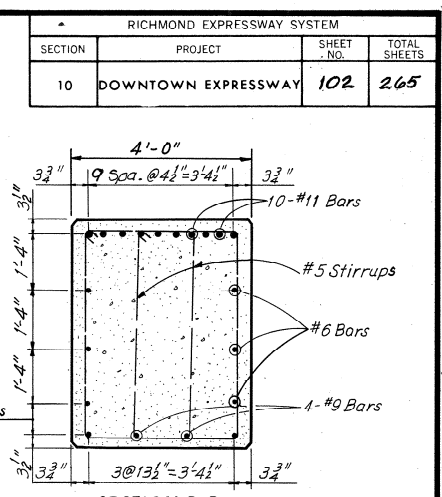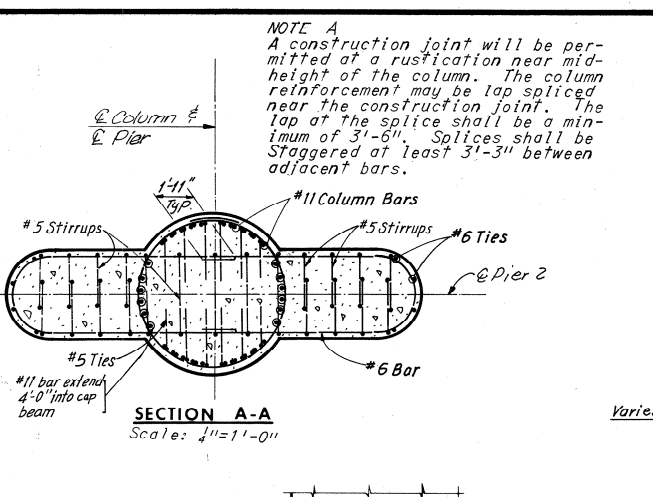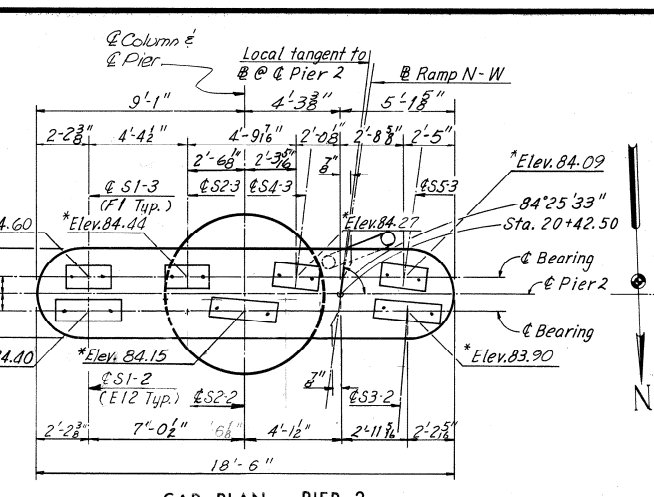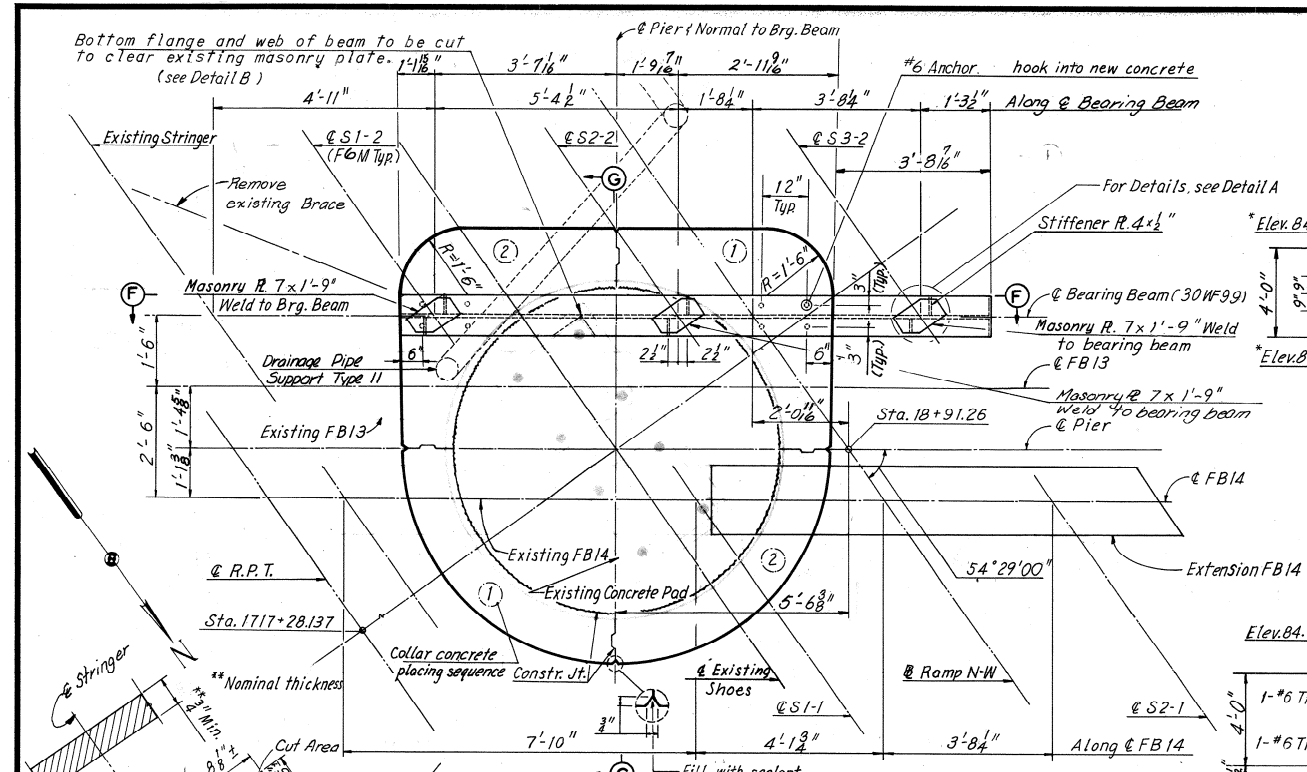

DIMENSIONS FOR PAD AND ANCHOR BOLT SETTING PLAN

| Pier | Stringer | a | B | A | B | C | D | E | F | G | H | I | J |
|------|-----------|-----------|-----------|---------|---------|---------|---------|---------|--------|---------|---------|---------|---------|
| 1 | S1-3 | — | 90°00'00" | 4 1/2" | 8" | 0 | 12 1/2" | 12 1/2" | 5 1/2" | 5 1/2" | 11 1/2" | 25" | 8" |
| | S2-3 | — | 90°00'00" | 4 1/2" | 8" | 0 | 12 1/2" | 12 1/2" | 5 1/2" | 5 1/2" | 11 1/2" | 25" | 8" |
| | S4-3 | — | 83°42'49" | 4 1/2" | 7 1/8" | 8" | 13 1/2" | 11 1/2" | 7" | 4 1/2" | 11 1/2" | 25" | 8" |
| 2 | S5-3 | — | 82°00'00" | 4 1/2" | 7 1/8" | 1 1/8" | 13 1/2" | 11 1/2" | 7 1/8" | 4" | 11 1/2" | 25" | 8" |
| | S1-2 | 90°00'00" | — | 4" | 14 1/2" | 0 | 18 1/2" | 18 1/2" | 6 1/2" | 6 1/2" | 13 1/2" | 36 1/2" | 14 1/2" |
| | S2-2 | 87°14'17" | — | 4" | 14 1/2" | 0 | 18 1/2" | 17 1/8" | 6 1/2" | 6" | 13 1/2" | 36 1/2" | 14 1/2" |
| S3-2 | 84°26'56" | — | 4" | 14 1/2" | 1 1/8" | 18 1/2" | 17 1/8" | 8 1/2" | 5 1/4" | 13 1/2" | 36 1/2" | 14 1/2" | |

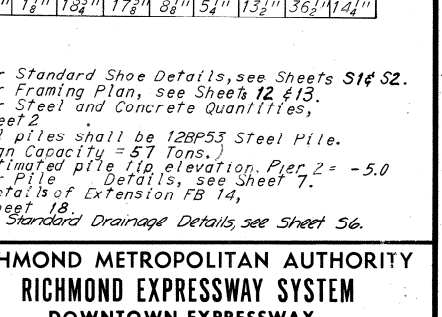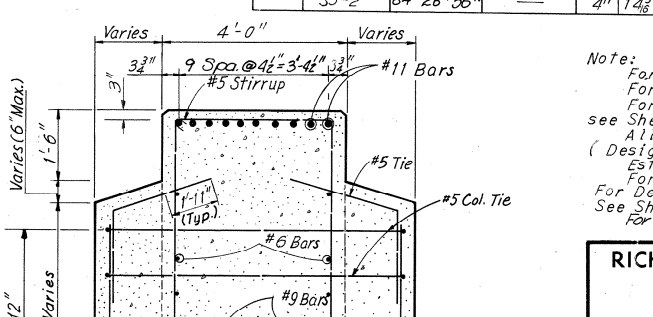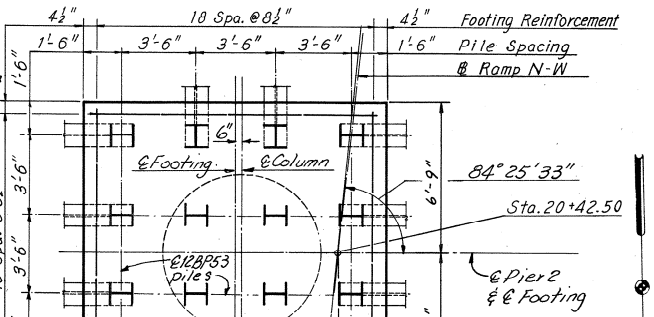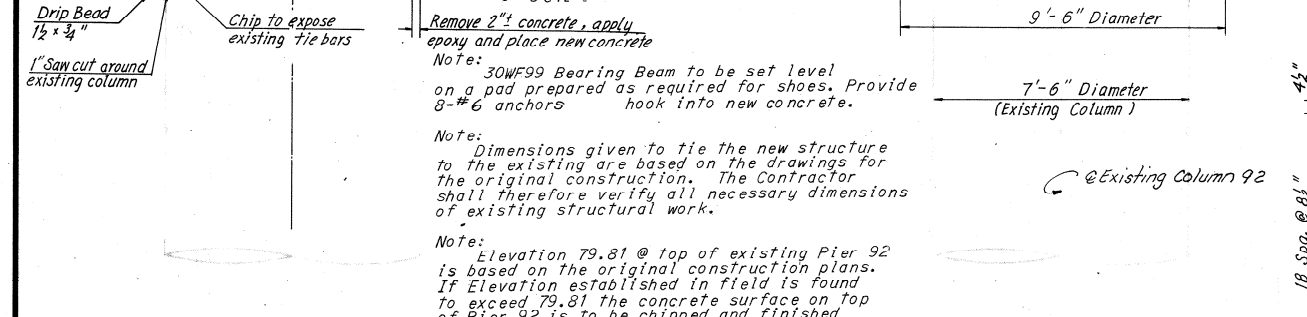

4 As Built

| BY | DATE | ANGLE OF BEAM | REF | 1-6-75 |
|-----------|----------------|-------------------|-----|----------|
| MADE | K.C.T. 3-16-69 | Number of Girders | REF | 12-30-74 |
| CHECKED | Y.C.P. 4-24-69 | Note Change | TEM | 5-74 |
| IN CHARGE | | NO. REVISION | BY | DATE |

FOOTING FOR PIER 2 IS ECCENTRIC AS SHOWN ON FOOTING PLAN

Note to Fabricator:
All Structural Steel for Pier 1 shall be A-36. Fabricate top of cap beam flat.

AS BUILT

RICHMOND METROPOLITAN AUTHORITY
RICHMOND EXPRESSWAY SYSTEM
DOWNTOWN EXPRESSWAY

BRIDGE NO. 64
RAMP N-W CONNECTION FROM
RICHMOND-PETERSBURG TURNPIKE

PIERS 1 AND 2

HOWARD, NEEDLES, TAMMEN & BERGENDOFF
consulting engineers
NEW YORK ALEXANDRIA KANSAS CITY

SCALE: As Noted
CONTRACT NO. 10
SHEET NO. 4 OF 28

NOTE A
A construction joint will be permitted at a rustication near mid-height of the column. The column reinforcement may be lap spliced near the construction joint. The lap at the splice shall be a minimum of 3'-6". Splices shall be staggered at least 3'-3" between adjacent bars.

Note: Cut both Masonry R and Rocker R of FGM Shoes to provide minimum 2" for welding the Masonry R to the Flange.


Note: 30WF99 Bearing Beam to be set level on a pad prepared as required for shoes. Provide 8-#6 anchors hook into new concrete.

Note: Dimensions given to tie the new structure to the existing are based on the drawings for the original construction. The Contractor shall therefore verify all necessary dimensions of existing structural work.


Note: Elevation 79.81 @ top of existing Pier 92 is based on the original construction plans. If Elevation established in field is found to exceed 79.81 the concrete surface on top of Pier 92 is to be chipped and finished as required for shoes. If below, the difference is to be added to the nominal thickness of bearing plates under the shoes. All elevations of existing steel structures are to be verified in field by contractor.

Note: Footing elevations are approximate only and may be varied to suit field conditions as directed by the Engineer. Vertical shaft reinforcing shall not be cut until these elevations are established. Where elevations change more than 2 ft., redesign will be required.


| RICHMOND EXPRESSWAY SYSTEM | | | |
|----------------------------|---------------------|-----------|--------------|
| SECTION | PROJECT | SHEET NO. | TOTAL SHEETS |
| 10 | DOWNTOWN EXPRESSWAY | 110 | 265 |

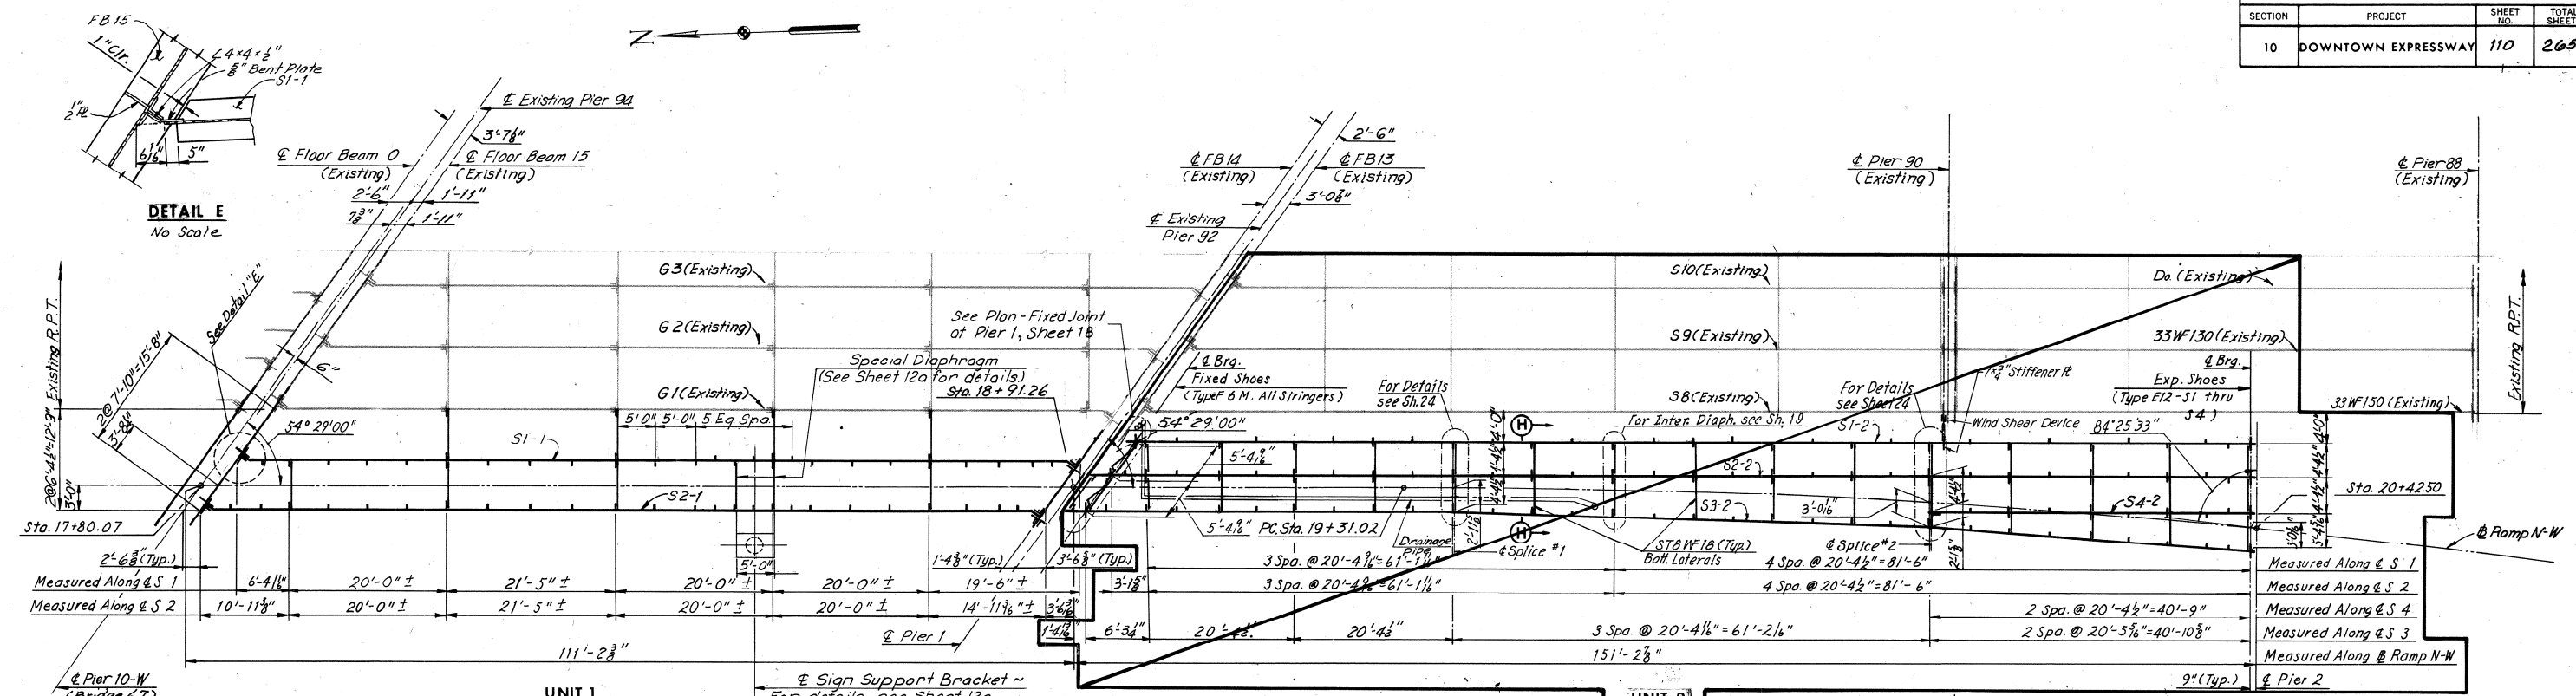

DETAIL E
No Scale

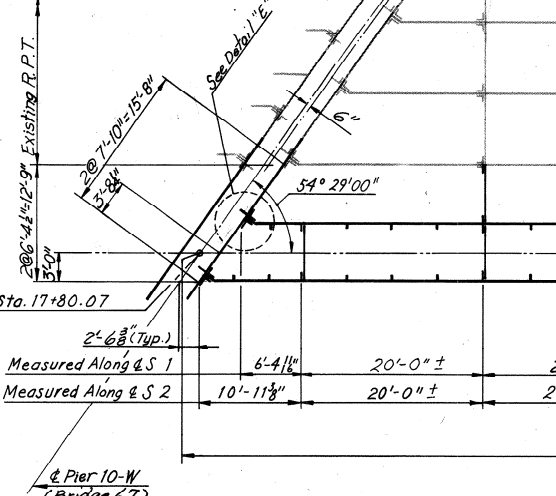

STRINGER ELEVATION
UNIT 1
No Scale

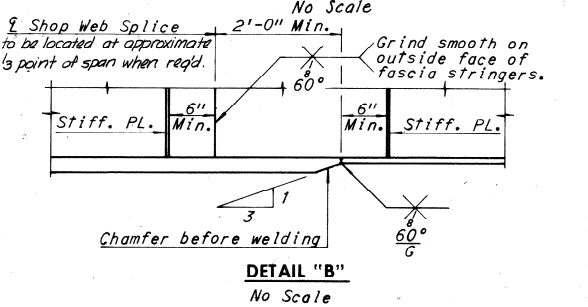


DETAIL "B"
No Scale

UNIT 1

Note: Dimensions shown on the plans for existing structural metal work are in accordance with drawings prepared for the original construction. The Contractor shall verify all necessary dimensions of existing structural metalwork prior to fabrication of new metalwork. New Diaphragms are to match Existing Diaphragms, in Unit 1.


FRAMING PLAN
Scale: 1"=10'-0"

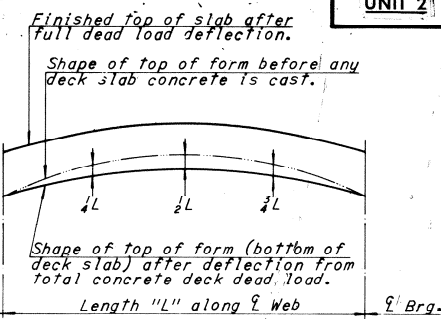

DEAD LOAD DEFLECTION DIAGRAM

NOTE TO CONTRACTOR

Deflections given are those anticipated to occur in the stringer upon placement of the total concrete deck dead load. In practice, the stringers in place are not likely to have the exact camber to compensate for these deflections during construction. The residual amounts shall be provided by adjusting forms to vary the thickness of the concrete haunch between the bottom of the slab and the top of stringer without altering the slab thickness.

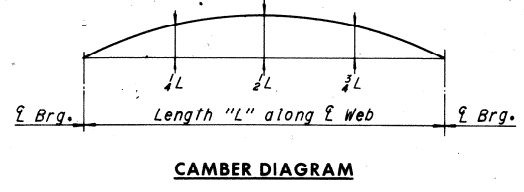

CAMBER DIAGRAM

NOTE TO FABRICATOR

The stringers shall be fabricated with an upward camber amounting to the tabulated value. This will provide approximate compensation for deflection under full dead load and for conformity with finished grade. Note: Stringers having a total camber of less than 1" are not required to be shop cambered, but should be turned so that any mill tolerance deviation from straightness will be in the direction shown by the Camber Diagram. If stringers are not cambered distance top of stringers to top of slab will vary along the stringer in accordance with the offset dimensions shown in the Camber Diagram, and with minimum distance as shown in Cross-Section on Sheet 19.

Except as shown otherwise. Note: Intermediate stiffener R.s 4x4 1/2 shall be equally spaced between diaphragms as shown. The first two stiffeners spaced at the ends of stringers shall be one-half normal spacing within the panel. It may be necessary to increase Bearing Stiffener size to accommodate erection of end diaphragm.

Note: For Deck Plan, see Sheet 19. For Joint Details, see Sheets 18 & 25. For Joint Details of Pier 10W, see Sheet 42, Bridge 67. For Standard Shoe Details, see Sheet 51. For Details of FB 14 and FB 15, see Sheet 18. See Sheet 4 for special modifications of masonry plate, F6M @ Pier 1. For Section H-H, see Sheet 19. For Horizontal Stiffener Detail and Flange to Web Welds, see Sheet 15.

| SHOE SCHEDULE | | | |
|----------------|-----------|------------|-----------|
| EXPANSION SHOE | | FIXED SHOE | |
| TYPE | NO. REQD. | TYPE | NO. REQD. |
| E 12 | 4 | F 6 M | 3 |

| UNIT | STRINGER | Dim. "A" | LENGTH | Dim. "B" | Dim. "C" | Dim. "D" | Dim. "E" | Dim. "F" | Dim. "G" | PL "C" | PL "D" | PL "F" | PL "G" | MAX. SHEAR STUD SPACING | | | | | CAMBER SCHEDULE | | | | | | |
|------|----------|-------------|-------------|------------|------------|------------|------------|----------|-------------|-----------|-----------|-----------|-----------|-------------------------|-----------|-----------|-----------|-----------|-----------------|---------|---------|---------|---------|---------|---------|
| | | | | | | | | | | | | | | 0.0L-0.1L | 0.1L-0.2L | 0.2L-0.3L | 0.3L-0.4L | 0.4L-0.5L | 1/4L | 1/2L | 3/4L | | | | |
| 1 | S1-1 | 106'-3 3/8" | 105'5 3/8" | 23'-0 1/2" | 23'-0" | 29'-8 3/4" | 23'-0 1/2" | 23'-0" | 29'-8 3/4" | 18x7 1/2" | 18x1 1/2" | 18x7 1/2" | 18x1 1/2" | — | — | — | — | — | — | 7/8" | 1 1/4" | 7/8" | 2 3/16" | 2 1/8" | 2 1/8" |
| | S2-1 | 106'-3 3/8" | 105'-5 7/8" | 23'-0 1/2" | 23'-0" | 29'-8 3/4" | 23'-0 1/2" | 23'-0" | 29'-8 3/4" | 18x7 1/2" | 18x1 1/2" | 18x7 1/2" | 18x1 1/2" | — | — | — | — | — | — | 7/8" | 1 1/4" | 7/8" | 2 3/16" | 3" | 2 3/16" |
| 2 | S1-2 | 143'-9 1/2" | 142'-7 1/4" | 19'-0" | 19'-7 1/4" | 52'-0" | — | — | 71'-3 1/2" | 24x1 1/2" | 24x2 1/2" | — | 18x1" | 24" | 24" | 24" | 24" | 24" | 24" | 1 3/16" | 2 9/16" | 1 3/16" | 4 3/8" | 6 3/16" | 4 1/4" |
| | S2-2 | 149'-2 5/8" | 145'-9 3/8" | 20'-0" | 20'-9 3/8" | 52'-6" | — | — | 72'-10 1/2" | 24x1 1/2" | 24x2 1/2" | — | 18x1" | 24" | 24" | 24" | 24" | 24" | 24" | 1 3/16" | 2 9/16" | 1 3/16" | 4 3/8" | 6 3/16" | 4 1/4" |
| | S3-2 | 152'-6 1/2" | 149'-0 1/2" | 20'-0" | 22'-0 1/2" | 53'-6" | — | — | 74'-0 1/2" | 24x1 1/2" | 24x2 1/2" | — | 18x1" | 24" | 24" | 24" | 24" | 24" | 24" | 2 1/4" | 3 1/8" | 2 1/4" | 6 1/8" | 8 1/16" | 6 1/8" |
| | S4-2 | 141'-4" | 141'-4" | — | — | 20'-4 1/2" | — | — | 20'-4 1/2" | — | 12x3 1/2" | — | 12x3 1/2" | 24" | 24" | 24" | 24" | 24" | 24" | 0 | 1 1/16" | 0 | 4 1/16" | 1 1/16" | 1 1/16" |

Note: * Spacing begins at termination of 6 spaces @ 4". All steel shall be A36 unless otherwise shown.

Note: For revisions to Unit 2, see Sheet 12a.

| MADE | BY | DATE | NO. | REVISION | BY | DATE |
|--------|---------|------|--|----------|---------|------|
| Y.C.P. | 2-11-69 | 1 | As Built | TEM | 6-77 | |
| SCC | 4-24-69 | 2 | Pier Angle Chg. | REB | 1-13-75 | |
| | | 3 | Note changed, added | PRMS | 4-19-74 | |
| | | 4 | Sign Support Bracket & Inter Diaph. Spc. added | L.N.B. | 9-9-74 | |
| | | 5 | Unit 2 Deleted | L.N.B. | 10-1-74 | |


RICHMOND METROPOLITAN AUTHORITY
RICHMOND EXPRESSWAY SYSTEM
DOWNTOWN EXPRESSWAY

BRIDGE NO. 64
RAMP N-W CONNECTION FROM
RICHMOND-PETERSBURG TURNPIKE
FRAMING PLAN- UNITS 1


HOWARD, NEEDLES, TAMMEN & BERGENDOFF
consulting engineers
NEW YORK ALEXANDRIA KANSAS CITY

SCALE: As Noted
CONTRACT NO.: 10
SHEET NO. 12 OF 28


AS BUILT

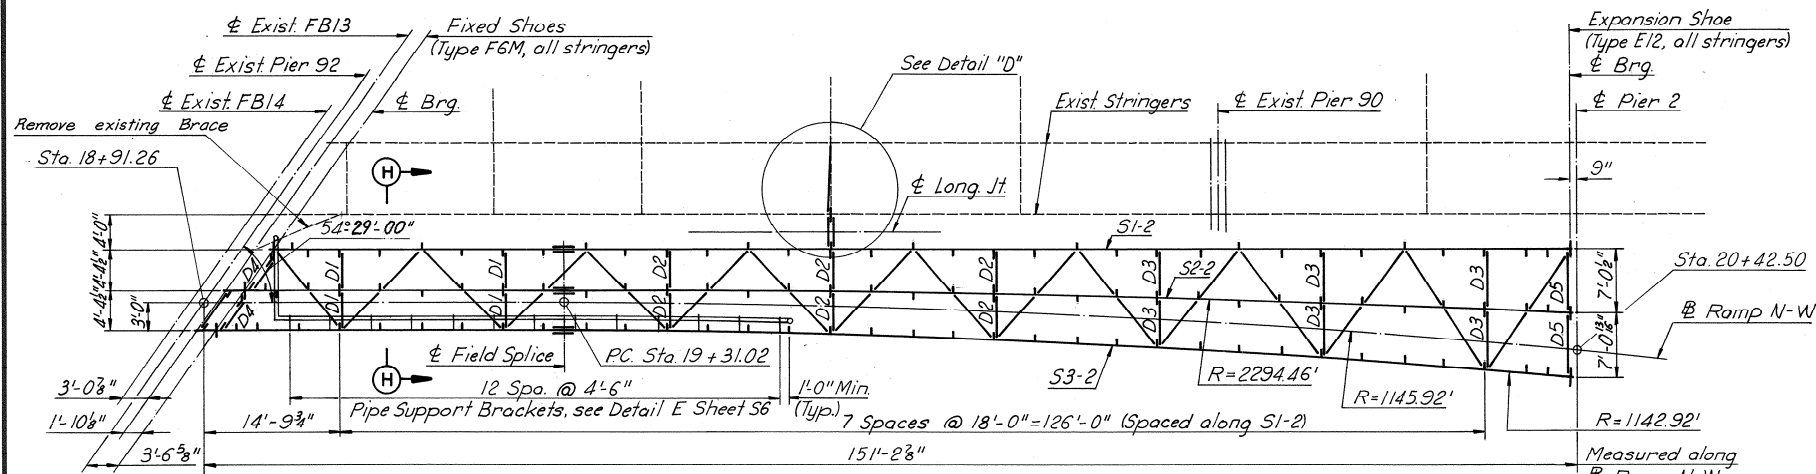


FRAMING PLAN
Scale: 1"=10'-0"

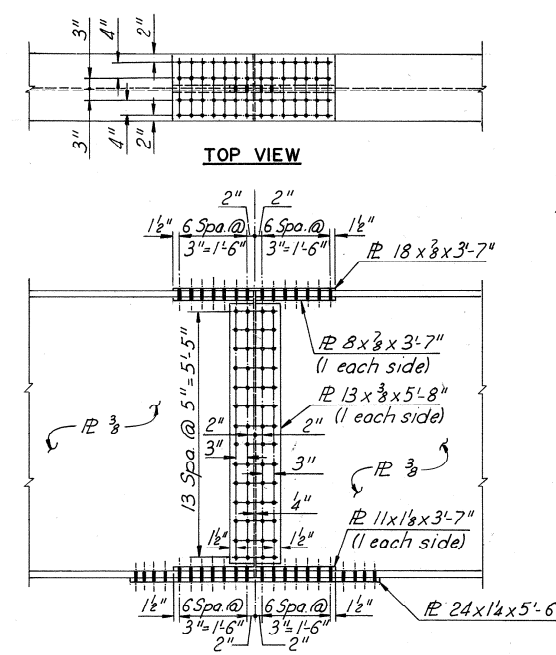

ELEVATION

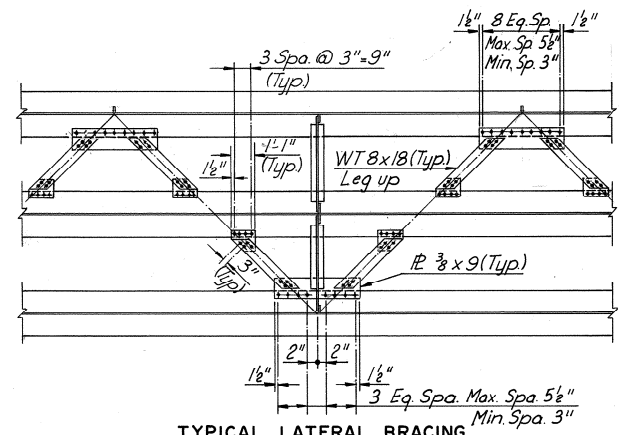


TYPICAL LATERAL BRACING
Scale: 1/4"=1'-0"

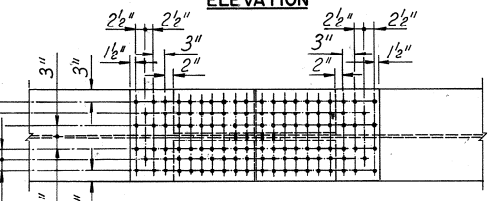


BOTTOM VIEW

DETAIL "C"
Scale: 1/2"=1'-0"

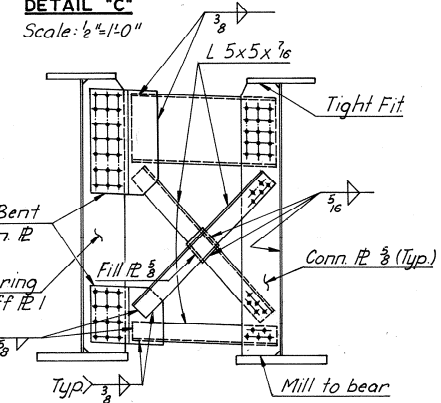


DIAPHRAGM D4
Scale: 1/2"=1'-0"

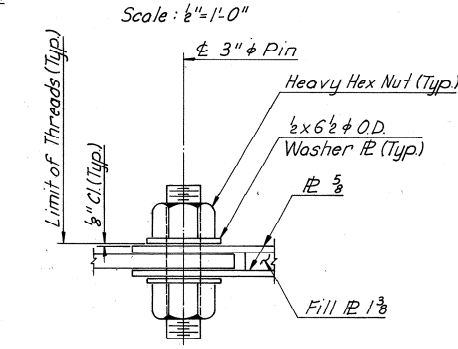

DETAIL "E"
Scale: 1/2"=1'-0"


NOTE: Spot weld nut to pin upon completion of assembly.

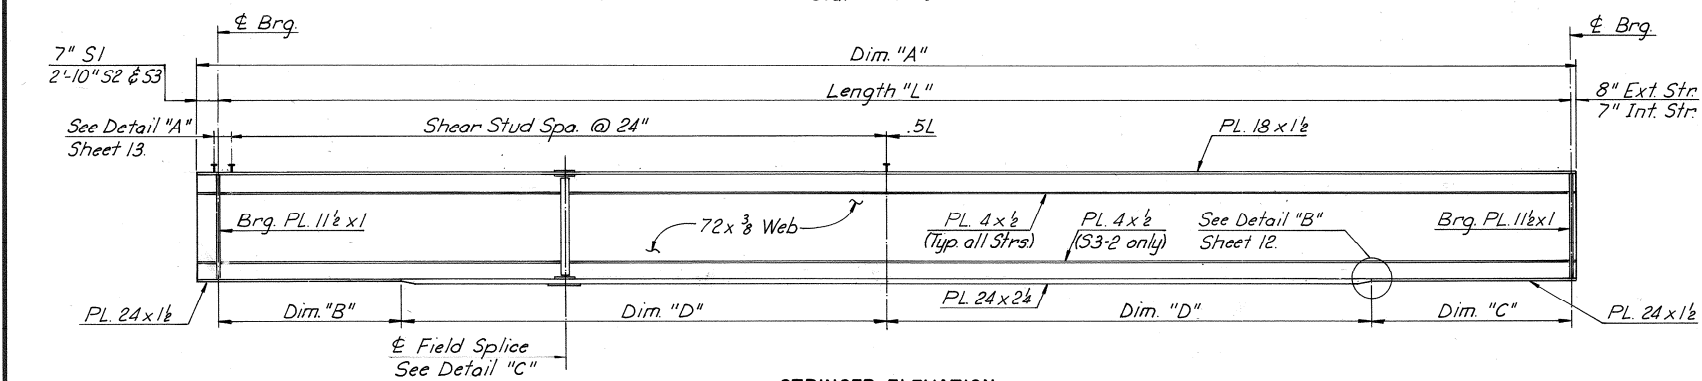


STRINGER ELEVATION
Scale: None

| STRINGER SCHEDULE | | | | | DEAD LOAD DEFLECTION SCHEDULE | | | | | | CAMBER SCHEDULE | | | |
|-------------------|-------------|-------------|----------|------------|-------------------------------|---------|--------|--------------|--------|--------|-----------------|--------|--------|--------|
| STRINGER | LENGTH "L" | DIM. "A" | DIM. "B" | DIM. "C" | DUE TO CONCRETE | | | DUE TO STEEL | | | | | | |
| | | | | | 1/4L | 1/2L | 3/4L | 1/4L | 1/2L | 3/4L | 1/4L | 1/2L | 3/4L | |
| S1-2 | 142'-7 1/8" | 143'-9 3/8" | 19'-0" | 19'-7 1/8" | 52'-0" | 1 3/8" | 1 7/8" | 1 3/8" | 3/4" | 1 1/8" | 3/8" | 3 3/8" | 4 3/8" | 3 3/8" |
| S2-2 | 145'-9 3/8" | 149'-2 3/8" | 20'-0" | 20'-9 3/8" | 52'-6" | 1 9/16" | 2 1/4" | 1 5/8" | 3/8" | 1 3/8" | 5/8" | 4 3/8" | 6 1/4" | 4 3/8" |
| S3-2 | 149'-1" | 152'-6 1/8" | 20'-0" | 22'-1" | 53'-6" | 1 3/8" | 2 1/2" | 1 3/8" | 1 5/8" | 1 1/4" | 5/8" | 5 1/8" | 7 1/8" | 5 1/8" |


These holes to be shop sub-punched. Ream and connect in field after full dead load deflection has occurred.

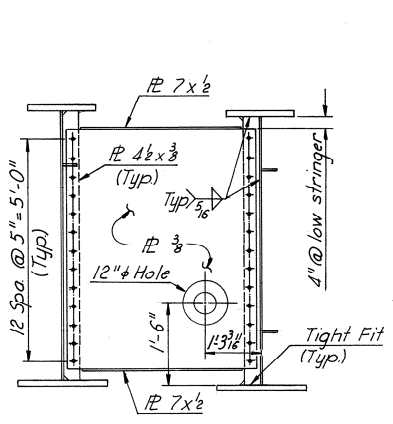


DIAPHRAGM D1
Scale: 1/2"=1'-0"

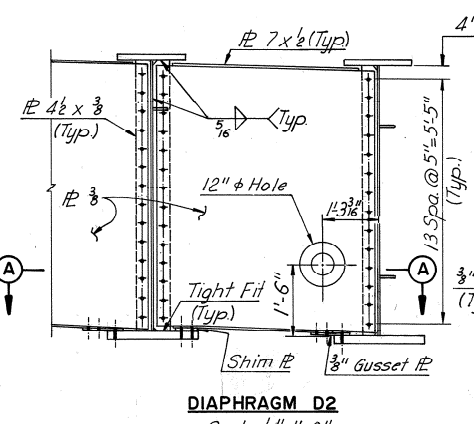


DIAPHRAGM D2
Scale: 1/2"=1'-0"

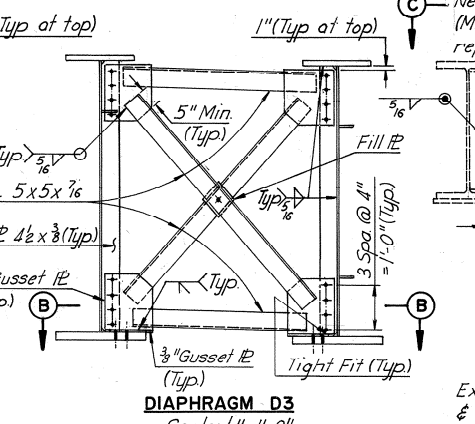


DIAPHRAGM D3
Scale: 1/2"=1'-0"

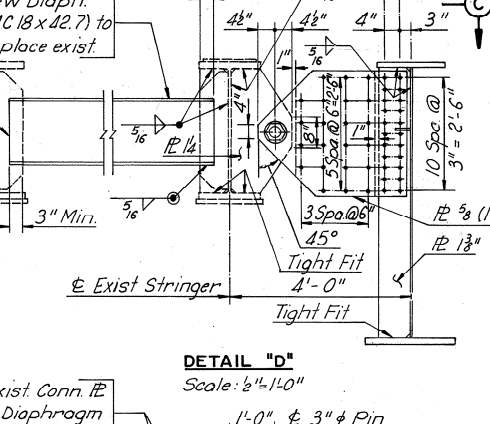


DETAIL "D"
Scale: 1/2"=1'-0"

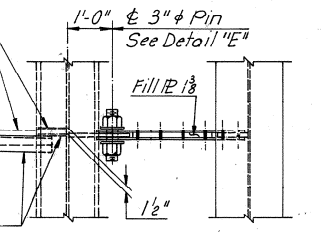

VIEW C-C
Scale: 1/2"=1'-0"

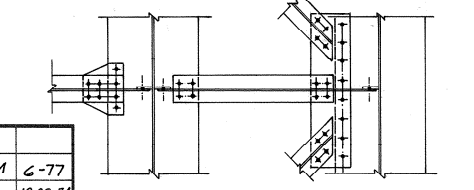

SECTION A-A
Scale: 1/2"=1'-0"

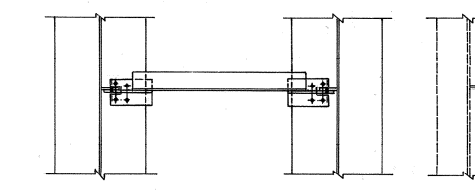

SECTION B-B
Scale: 1/2"=1'-0"

- NOTE:**
1. For Diaphragm D5 use type shown as end diaphragm section B-B, Sheet 20.
 2. For notes not shown, see Sheet 12.
 3. For Section H-H see Sheet 19.


| | | | | | |
|-----------|----------------|-----|-----------------------------|-----|----------|
| DESIGNED | | 3 | As Built | TEM | 6-77 |
| DRAWN | N.L.B. 10-7-74 | 1 | Remove Brace & change angle | NLB | 12-30-74 |
| CHECKED | R.B.H. 11-4-74 | 1 | New Sheet Added | NLB | 10-7-74 |
| IN CHARGE | PRY | NO. | REVISION | BY | DATE |

AS BUILT

RICHMOND METROPOLITAN AUTHORITY
RICHMOND EXPRESSWAY SYSTEM
DOWNTOWN EXPRESSWAY


BRIDGE NO. 64
RAMP N-W CONNECTION FROM
RICHMOND-PETERSBURG TURNPIKE
FRAMING PLAN-UNIT 2

| RICHMOND EXPRESSWAY SYSTEM | | | |
|----------------------------|---------------------|-----------|--------------|
| SECTION | PROJECT | SHEET NO. | TOTAL SHEETS |
| 10. | DOWNTOWN EXPRESSWAY | 116 | 265 |

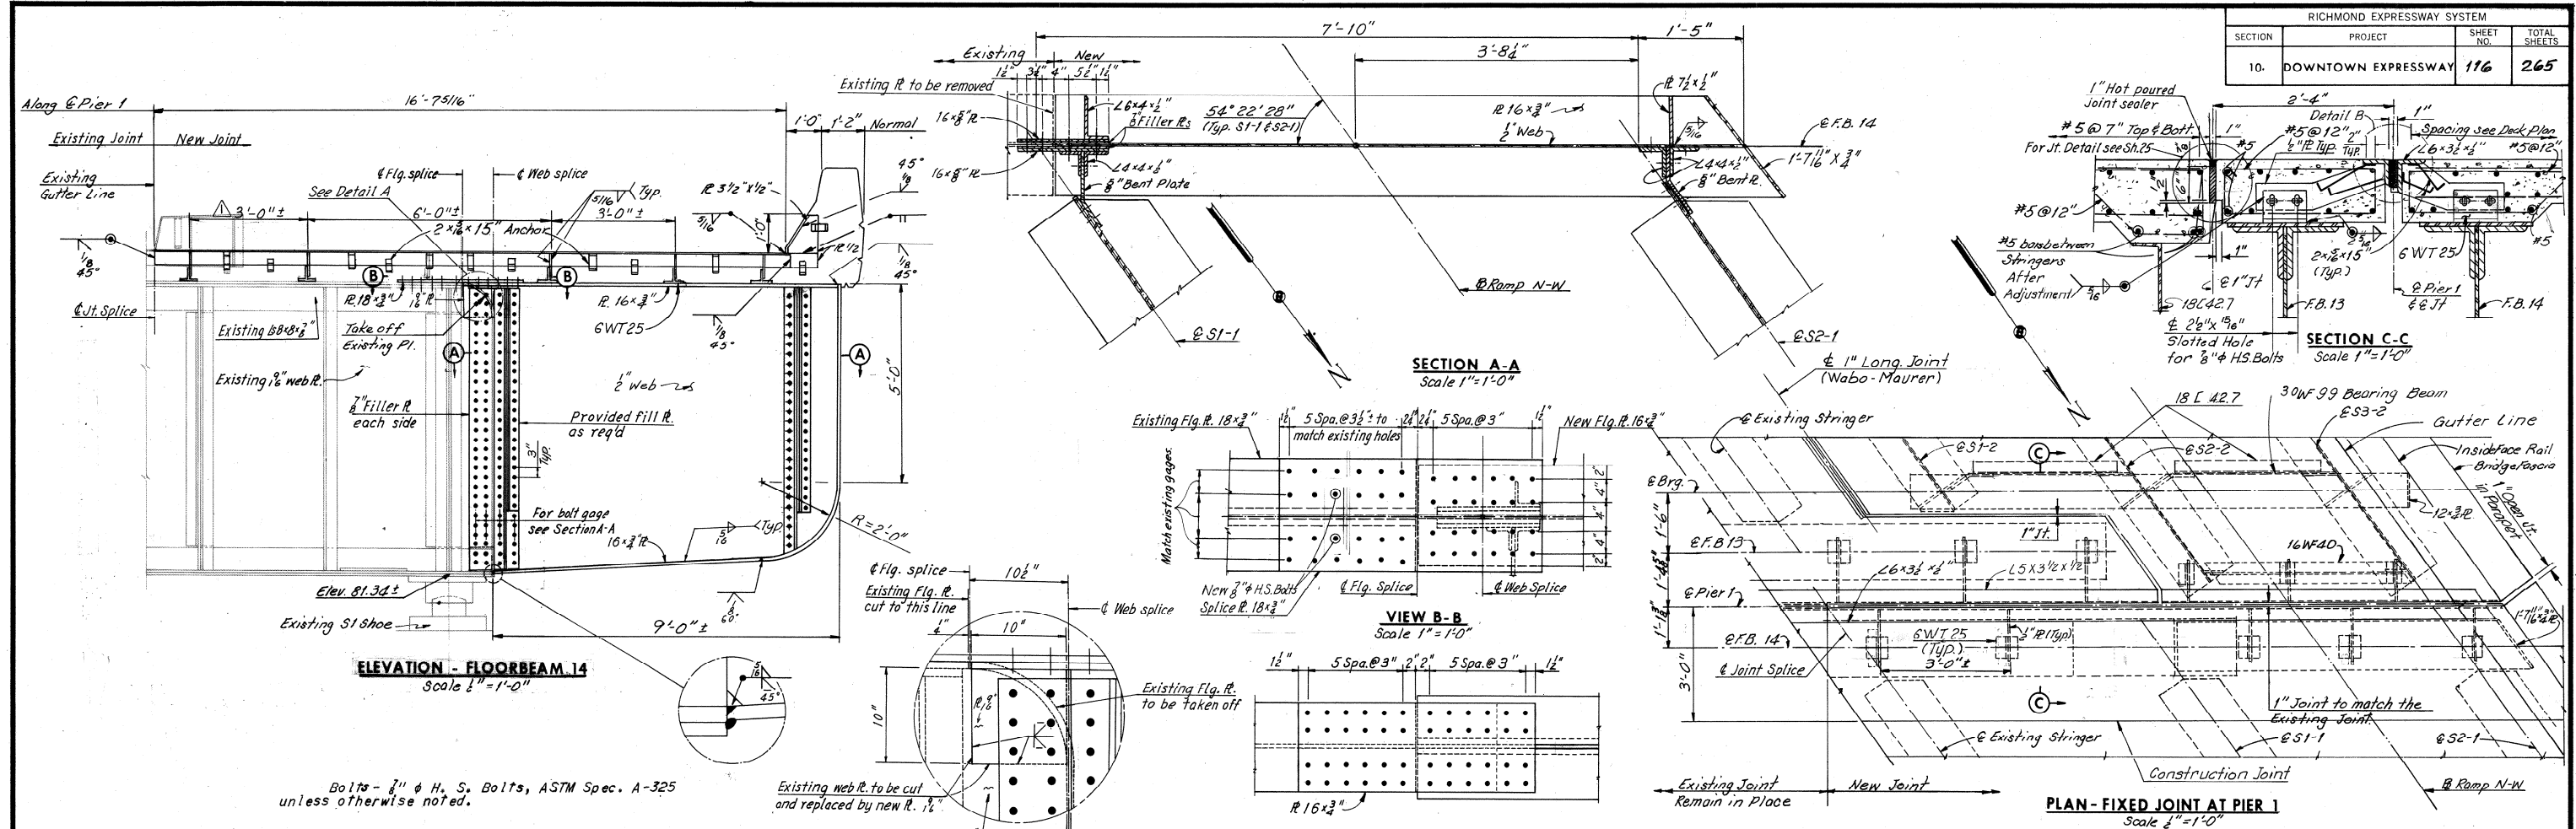

Bolts - 7/8" ϕ H. S. Bolts, ASTM Spec. A-325 unless otherwise noted.

Note: 1" Joint at pier 1 is to match the existing joint. The Contractor shall verify the location of joint.

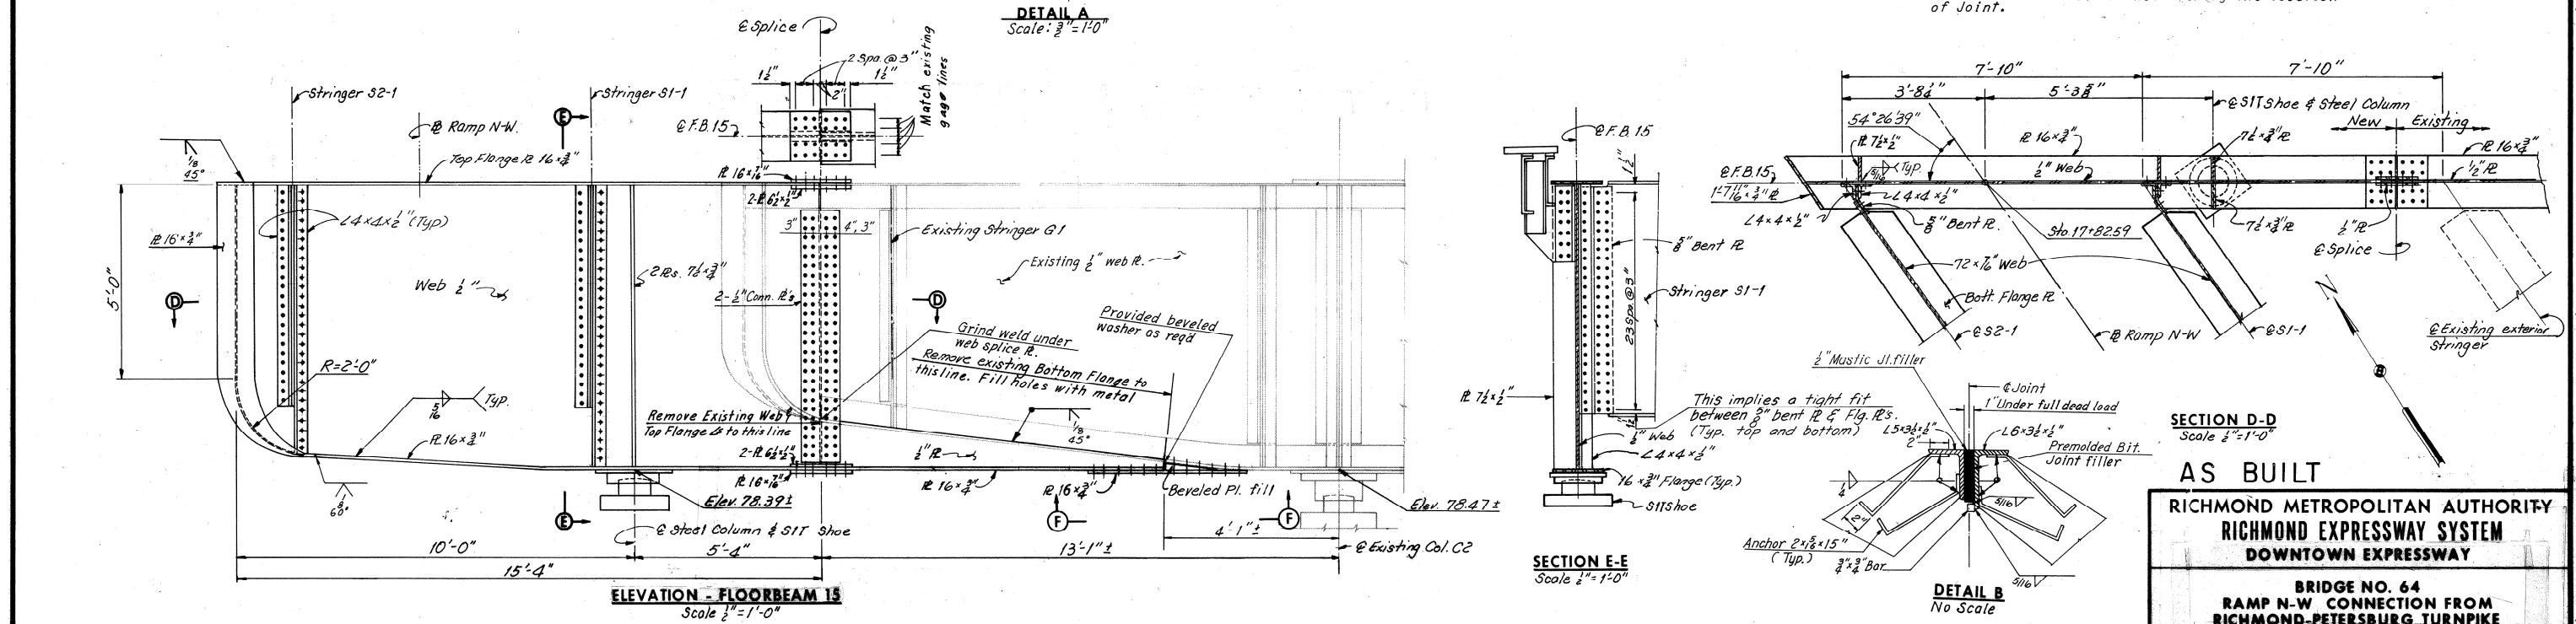

Note: Dimensions shown on the plans for existing structural metalwork are in accordance with drawings prepared for the original construction. The Contractor shall verify all necessary dimensions of existing structural metalwork prior to fabrication of new metalwork.

Note: For Joint Details at F.B. 15, see Sheet 42 Bridge 67. For Framing plan, see Sheet 12. For Steel Column Details, see Sheet 28 Bridge 67. For SIT Shoe Details, see Sheet 47 Bridge 67. All Elevations are to be verified by the Contractor.

| BY | DATE | Z | As Built | TEM | G-77 |
|-----------|--------|---------|-------------------------------------|-----|----------|
| MADE | G.C.C. | 3-13-69 | Unit 2 End Dept. Pier 1 revised | LBP | 10-31-74 |
| CHECKED | Y.C.P. | 4-25-69 | 1.32x32x6 3/4 post changed to 6WT25 | | |
| IN CHARGE | | | | | |

AS BUILT

RICHMOND METROPOLITAN AUTHORITY
RICHMOND EXPRESSWAY SYSTEM
DOWNTOWN EXPRESSWAY

BRIDGE NO. 64
RAMP N-W CONNECTION FROM
RICHMOND-PETERSBURG TURNPIKE

FRAMING DETAILS


HOWARD, NEEDLES, TAMMEN & BERGENDOFF
 consulting engineers
 NEW YORK ALEXANDRIA KANSAS CITY

SCALE: As Noted
 CONTRACT NO. 10
 SHEET NO. 18 OF 28


| RICHMOND EXPRESSWAY SYSTEM | | | |
|----------------------------|---------------------|-----------|--------------|
| SECTION | PROJECT | SHEET NO. | TOTAL SHEETS |
| 10 | DOWNTOWN EXPRESSWAY | 124 | 265 |

NOTES FOR FILLED JOINTS:

Joints shall be free of cracked and spalled areas and their faces shall be free of all foreign matter, curing compound, oils, greases and dirt. All faces must be sandblasted or brushed with a mechanical rotary wire brush. Just prior to sealing, the joint shall be blown out with oil-free and water-free compressed air.

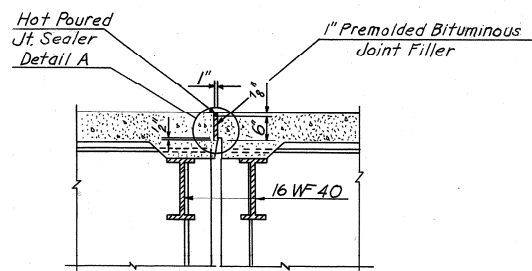


TYPICAL SECTION THRU 1" FIXED JOINT
Scale: 1/2" = 1'-0"

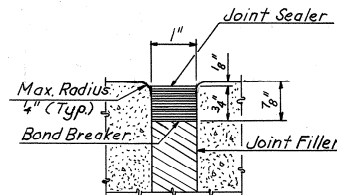

DETAIL A
No Scale

Note: Joint filler material and copper flashing to be included in price bid for Superstr. Concrete

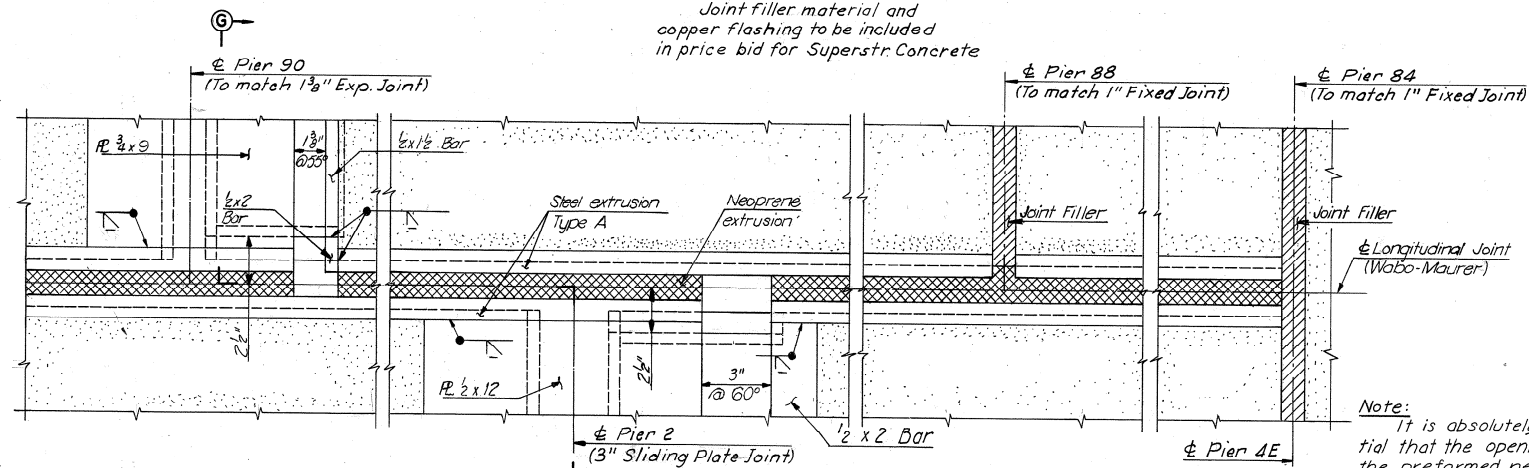

PLAN - LONGITUDINAL JOINT
Scale: 3" = 1'-0"


NOTE: For Plan of Pier 3 & existing Pier 86, see Sheet 25.

Note: It is absolutely essential that the openings for the preformed neoprene joint sealers be accurately formed and constructed to smooth, straight lines. The size of opening shall be adjusted to allow for anticipated dead load rotation of the ends of the slab and for the temperature of the time of construction.


NOTES FOR WABO-MAURER JOINT:

Do not use steel extrusions as screed support. Steel extrusion shall conform to ASTM A36. Structural steel shall conform to ASTM A588. Steel assembly shall be shop welded to convenient lengths and butt welded in the field to desired length. Joint shall conform to grade of deck slab. Steel assembly shall be sandblasted in the shop prior to painting. Steel assembly shall receive one shop coat of epoxy zinc paint.

Neoprene extrusion shall be roughened with a wire brush before bonding to steel extrusion with Bon Lastic Adhesive. Groove in steel extrusion to be blown out with oil-free and water-free compressed air prior to installation of Neoprene extrusion. The Wabo-Maurer joint assembly shall be installed in accordance with manufacturer's recommended construction methods.

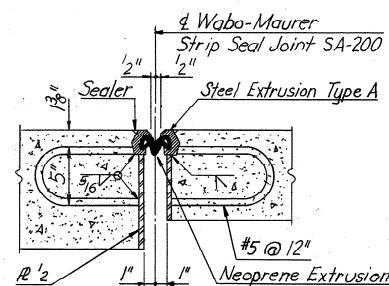


TYPICAL SECTION THRU WABO-MAURER JOINT
Scale: 1 1/2" = 1'-0"

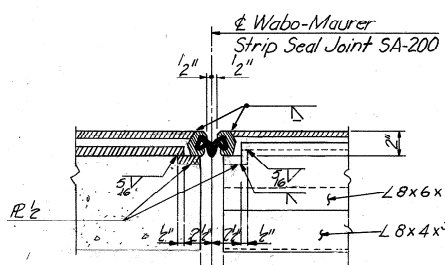

SECTION G-G
Scale: 1 1/2" = 1'-0"


NOTE: Steel extrusion of Wabo-Maurer Joint to rest & slide on #2. For location of Sect. G-G, see Plan-Long. Joint above & Detail L. Sheet 25.

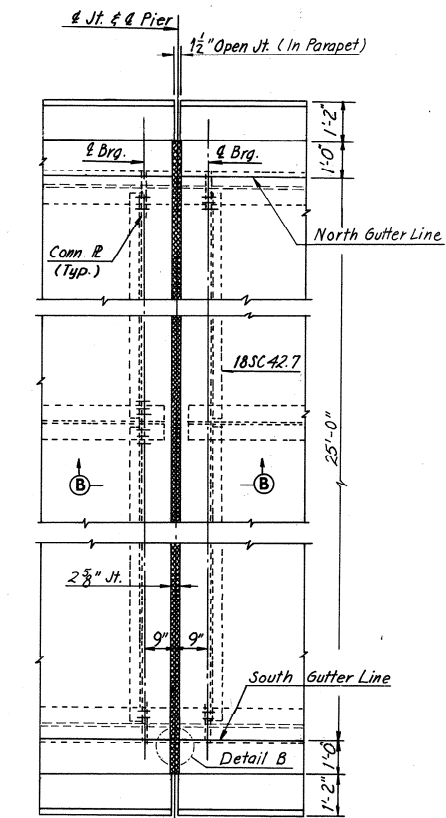

PLAN - JOINT AT PIERS 4, 5, 6, 7, 8 AND 9
Scale: 3/8" = 1'-0"


PLAN - JOINT AT PIER 4E
Scale: 3/8" = 1'-0"

PLAN - JOINT AT EXISTING PIER 82
Scale: 3/8" = 1'-0"

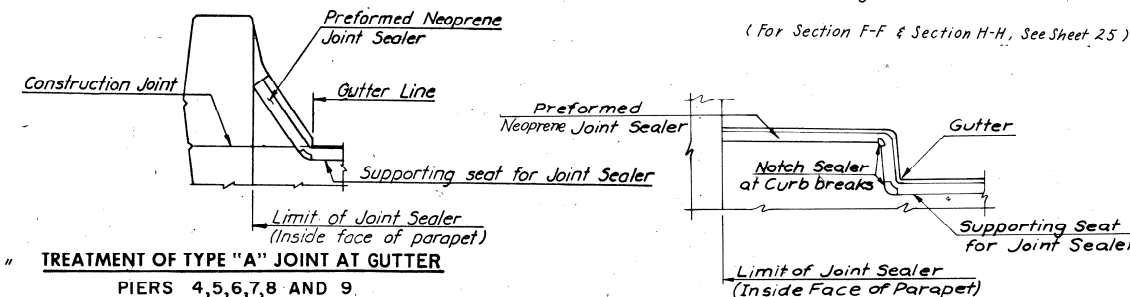


TREATMENT OF TYPE "A" JOINT AT GUTTER
PIERS 4, 5, 6, 7, 8 AND 9
No Scale


TREATMENT OF TYPE "A" JOINT AT CURB
PIER 4E
No Scale

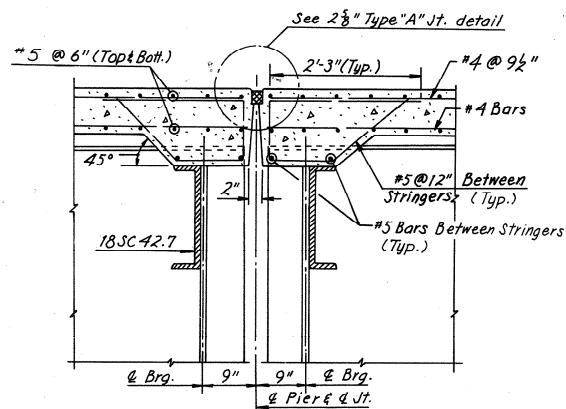


SECTION B-B
Scale: 3/4" = 1'-0"

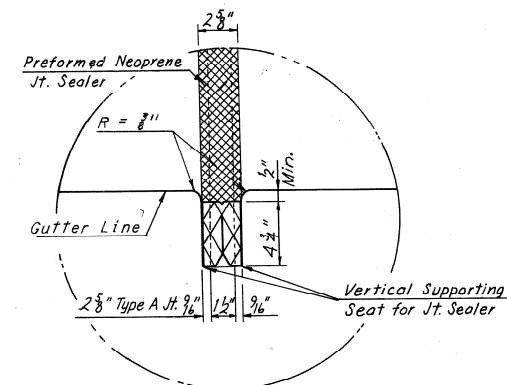

DETAIL B
No Scale


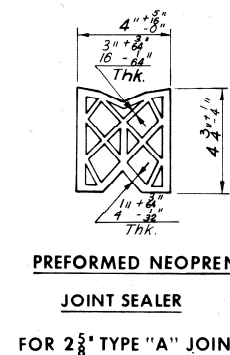


PREFORMED NEOPRENE JOINT SEALER FOR 2 1/2" TYPE "A" JOINT

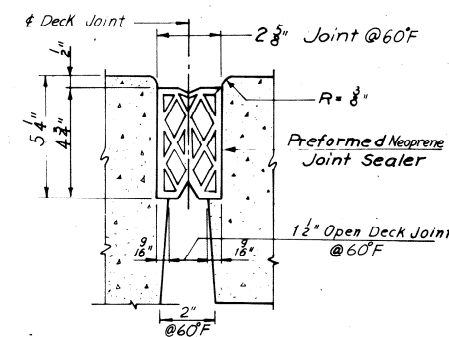

2 1/2" TYPE "A" JOINT

EXPANSION JOINT DETAILS

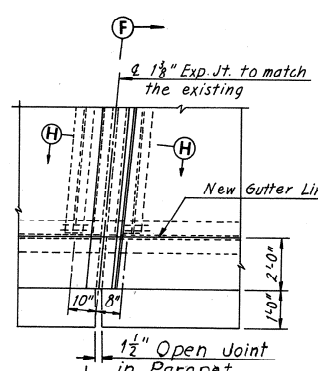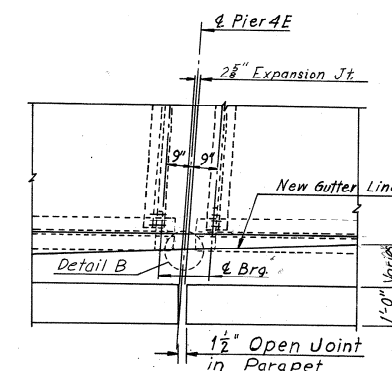

PLAN - JOINT AT EXISTING PIER 82
Scale: 3/8" = 1'-0"

(For Section F-F & Section H-H, See Sheet 25)

**RICHMOND METROPOLITAN AUTHORITY
RICHMOND EXPRESSWAY SYSTEM
DOWNTOWN EXPRESSWAY**

**BRIDGE NO. 64
RAMP N-W CONNECTION FROM
RICHMOND-PETERSBURG TURNPIKE
JOINT DETAILS**

HOWARD, NEEDLES, TAMMEN & BERGENDOFF
consulting engineers
NEW YORK ALEXANDRIA KANSAS CITY

SCALE: As Noted
CONTRACT NO. 10
SHEET NO. 26 OF 28

AS BUILT




| BY | DATE | Z | As Built | TEM | G-77 |
|-----------|--------|---------|--|--------|----------|
| MADE | Y.C.P. | 3-18-69 | Notes Typ Sect thru Joint at A, Typ Sect thru Wabo-Maurer joint Sect G-G add | E.J.M. | 10-31-77 |
| CHECKED | G.C.C. | 4-21-69 | | | |
| IN CHARGE | | | | | |

Bridge 66

**(Eastbound Downtown Expressway - Rte. 195
Over Virginia Street, South 14th Street, South 12th and CSX Railroad)**

Record Set Plans

| RICHMOND EXPRESSWAY SYSTEM | | | |
|----------------------------|---------------------|-----------|--------------|
| SECTION | PROJECT | SHEET NO. | TOTAL SHEETS |
| 10 | DOWNTOWN EXPRESSWAY | 127 | 265 |

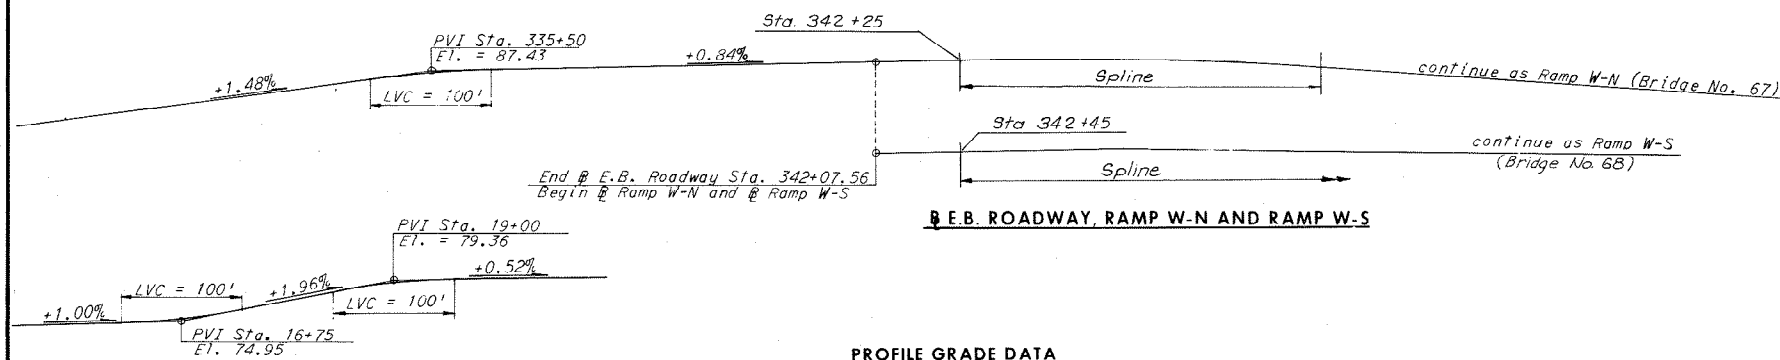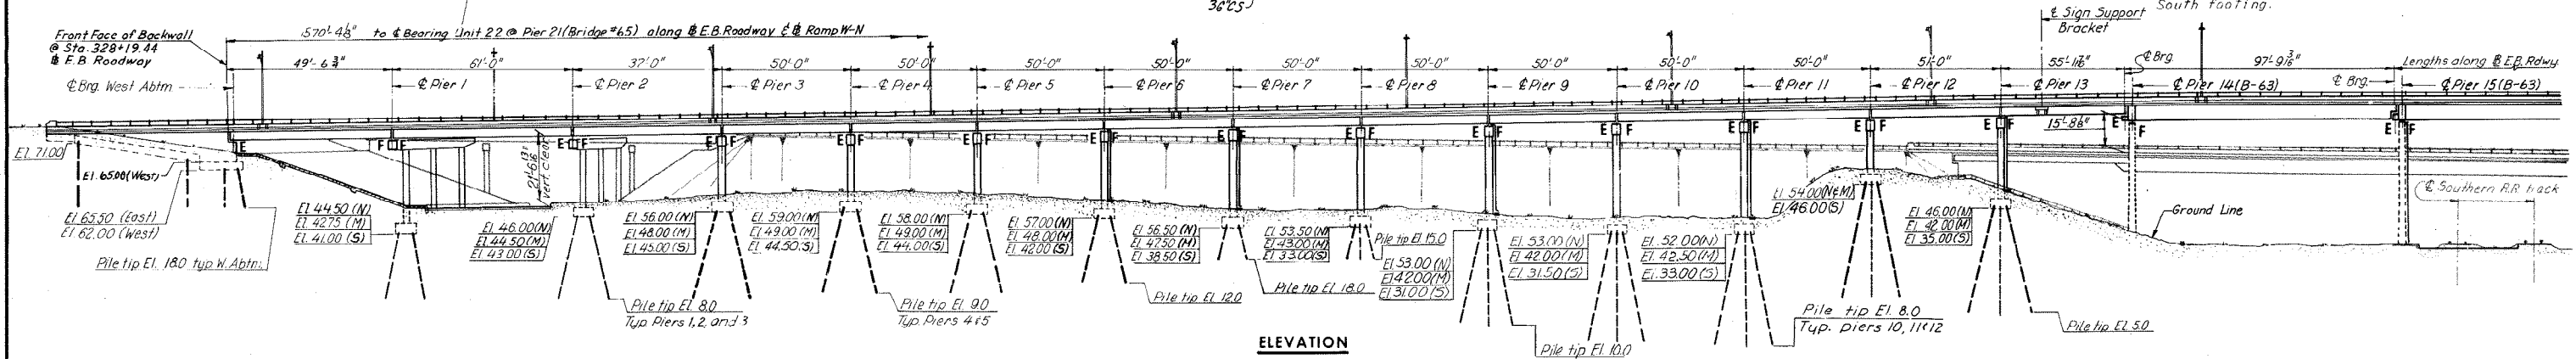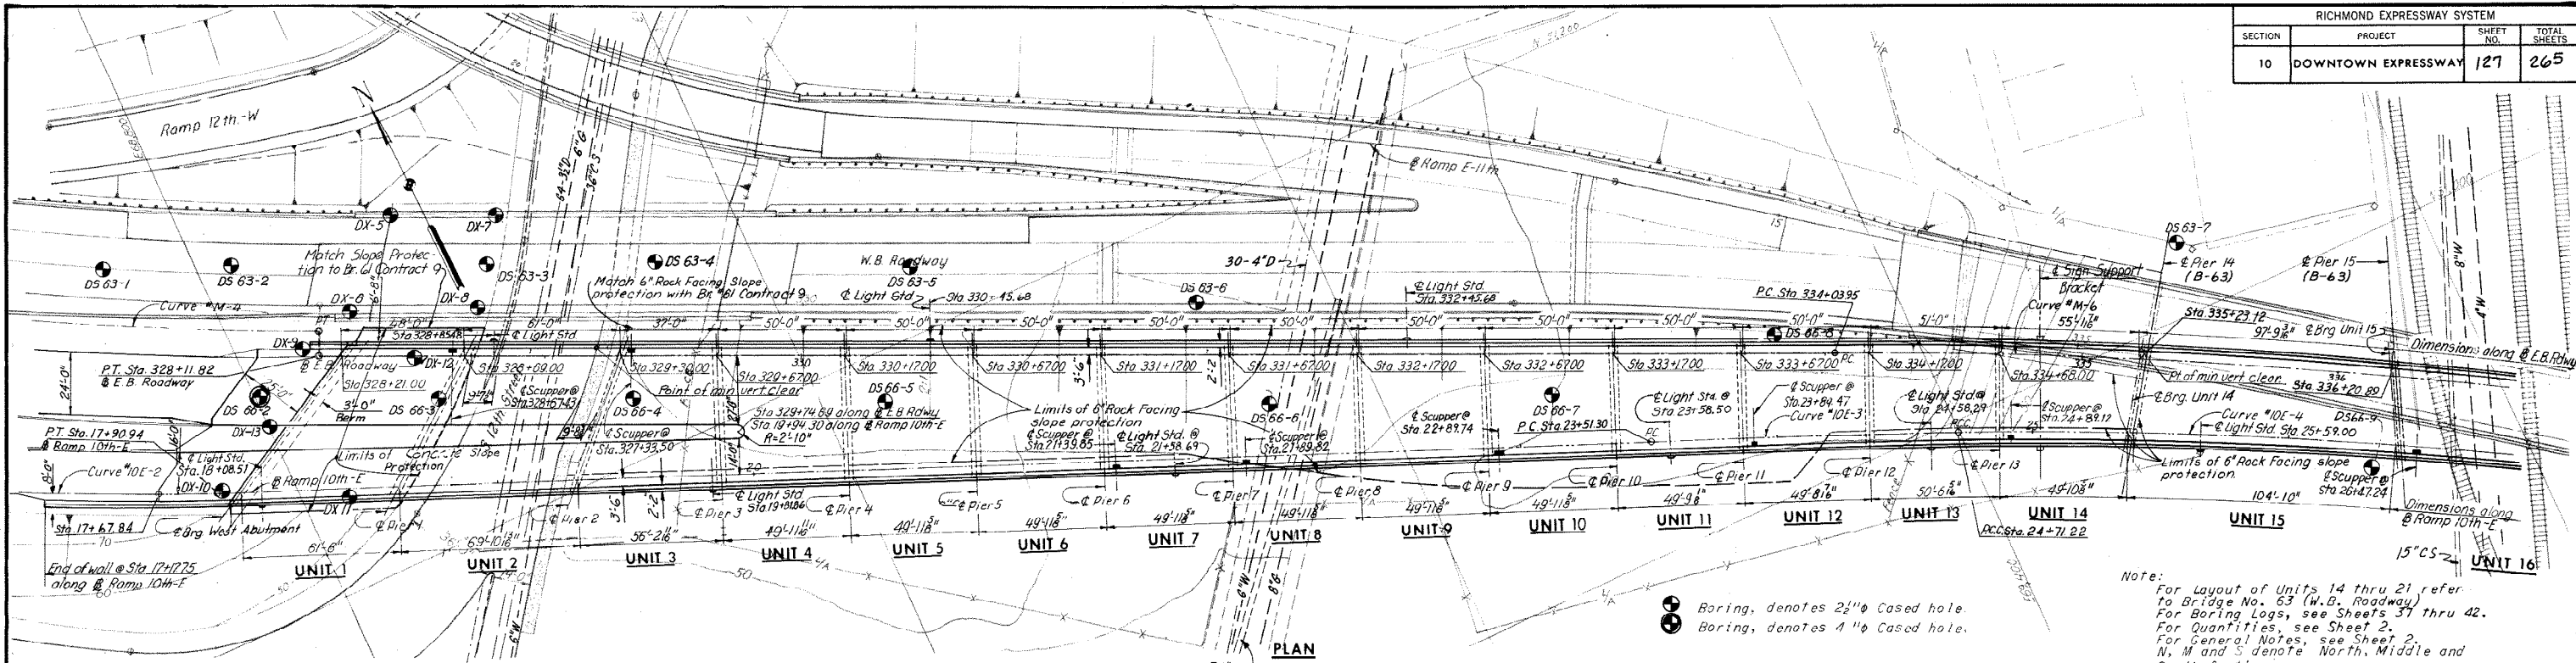

| REVISIONS | |
|-----------|--|
| NO. | REVISION |
| 3 | As Built |
| 2 | Sign Support Bracket & Sh. 16A & 20A added |
| 1 | Footing elev. & piles, Piers 8, 9, 10, 11, 12 & 13 |

| BY | DATE | BY | DATE |
|--------|---------|--------|------|
| J.V. | 9-12-68 | R.B.H. | 9-74 |
| G.C.C. | 5-26-69 | R.B.H. | 8-74 |

| HORIZONTAL CURVE DATA | | |
|-------------------------------|---|------------------------|
| Curve | P.I. | Curve |
| Downtown Expressway Curve M-4 | P.I. = 326+57.21 Δ = 12°25'03" D = 4'00" T = 155.83' L = 310.44' R = 1,432.40' | E.B. Roadway Curve M-6 |
| Ramp 10th-E Curve 10E-2 | P.I. = 17+35.87 Δ = 6°29'42" D = 6'00" T = 54.18' L = 108.25' R = 954.93' | Ramp W-N Curve WN-1 |
| | | Ramp W-S Curve WS-1 |

| INDEX | SHEET |
|---|------------|
| GENERAL PLAN AND ELEVATION | 1 |
| GENERAL PLAN AND ELEVATION | 2 |
| WEST ABUTMENT | 3 |
| WEST ABUTMENT DETAILS | 4 |
| WEST ABUTMENT RETAINING WALL | 5 |
| PIER 1 | 6 |
| PIER 2 | 7 |
| PIERS 3 AND 4 | 8 |
| PIERS 5 AND 6 | 9 |
| PIERS 7 AND 8 | 10 |
| PIERS 9 AND 10 | 11 |
| PIERS 11 AND 12 | 12 |
| PIER 13 | 13 |
| FRAMING PLAN UNITS 1, 2, 3 AND 4 | 14 |
| FRAMING PLAN UNITS 5, 6, 7, 8 AND 9 | 15 |
| FRAMING PLAN UNITS 10, 11, 12, 13 AND 14 | 16 |
| FRAMING PLAN UNITS 15 AND 16 | 17 |
| FRAMING PLAN UNITS 17 AND 18 | 18 |
| FRAMING PLAN UNITS 19 AND 20 | 19 |
| FRAMING PLAN UNITS 21 AND 22 | 20 |
| FRAMING PLAN UNIT 23 | 21 |
| FRAMING DETAILS PIERS 14, 15 AND 16 | 22 |
| FRAMING DETAILS PIERS 17, 18, 19 AND 20 | 23 |
| FRAMING DETAILS PIER 21 | 24 |
| FRAMING DETAILS PIER 22 (BR 63) | 25 |
| FRAMING DETAILS UNITS 21 AND 22 | 26 |
| FRAMING DETAILS UNITS 18, 21 AND 22 | 27 |
| DECK PLAN UNITS 1, 2, 3 AND 4 | 28 |
| DECK PLAN UNITS 5, 6, 7, 8 AND 9 | 29 |
| DECK PLAN UNITS 10, 11, 12, 13 AND 14 | 30 |
| DECK PLAN UNITS 15 AND 16 | 31 |
| DECK PLAN UNITS 17 AND 18 | 32 |
| DECK PLAN UNITS 19 AND 20 | 33 |
| DECK PLAN UNITS 21 AND 22 | 34 |
| DECK PLAN UNIT 23 | 35 |
| SUBSTRUCTURE DETAILS | 36 |
| JOINT DETAILS | 37 AND 38 |
| APPROACH SLABS AND ROCK FACING SLOPE PROTECTION | 39 |
| CONCRETE SLAB SLOPE PROTECTION DETAILS | 40 |
| BORING LOGS | 41 THRU 46 |
| STANDARD DETAILS | 47 THRU 57 |

LIMITS OF STRUCTURE EXCAVATION AS BUILT

2'0" Min.
18" Top all sides


**RICHMOND METROPOLITAN AUTHORITY
RICHMOND EXPRESSWAY SYSTEM
DOWNTOWN EXPRESSWAY**

**BRIDGE NO. 66
EASTBOUND ROADWAY OVER
12TH ST. - R.R. TRACKS AND 16TH ST.
GENERAL PLAN AND ELEVATION**

HOWARD, NEEDLES, TAMMEN & BERGENDOFF
consulting engineers
NEW YORK ALEXANDRIA KANSAS CITY

SCALE: 1"=30'
CONTRACT NO: 10
SHEET NO. 1 OF 46

| RICHMOND EXPRESSWAY SYSTEM | | | |
|----------------------------|---------------------|-----------|--------------|
| SECTION | PROJECT | SHEET NO. | TOTAL SHEETS |
| 10 | DOWNTOWN EXPRESSWAY | 128 | 265 |

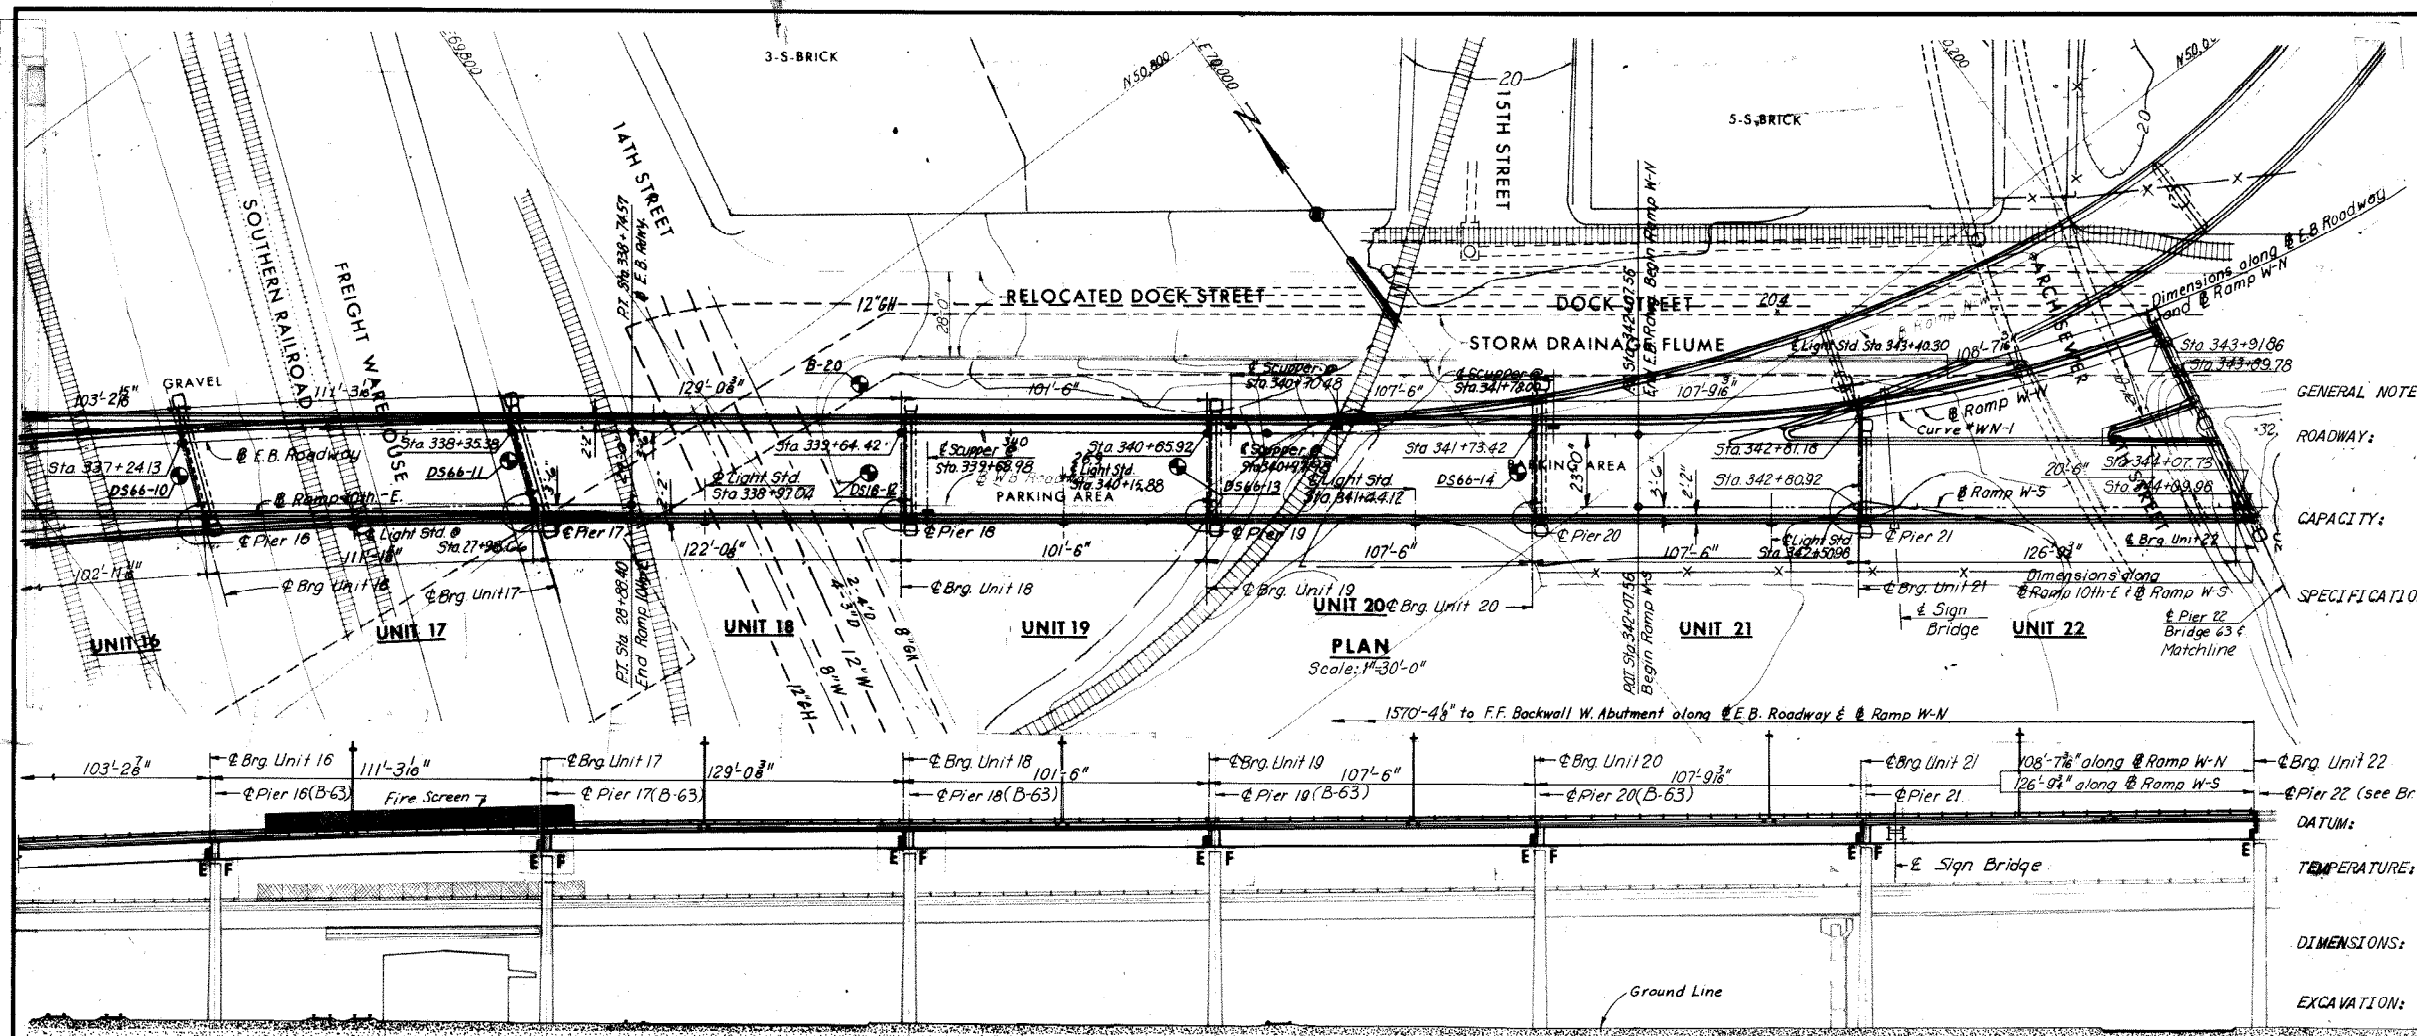

GENERAL NOTES:

ROADWAY: One variable width roadway transitioning from E.B. Roadway Downtown Expressway and Ramp 10th-E into Ramps W-N and W-S (Bridges No. 67 and 68)

CAPACITY: Dead load includes 15 Lbs. per sq. ft. for future wearing surface. Live load, HS 20-44 loading and alternate military loading.

SPECIFICATIONS:

GENERAL: Virginia Department of Highway Road and Bridge Specifications 1970

DESIGN: A.A.S.H.O. Standard Specifications for Highway Bridges 1973 modified by Special Design provisions.

WELDING: 1942 Structural Welding Code of the American Welding Society

CONTRACT SPECIAL PROVISIONS
Specifications and Contract Special Provisions referred to above are necessary to make these plans complete

DATUM: City of Richmond

TEMPERATURE: The normal temperature referred to in the plans is 60°F. The temperature range for movement is 0°F to 120°F.

DIMENSIONS: All dimensions are measured horizontally and vertically unless otherwise noted.


EXCAVATION: Excavation below subgrade and cut slope template shall be classified as Structure Excavation. All excavation above these limits shall be classified as Regular Excavation and is not included in the Structural Quantities.

FOUNDATIONS: Footings shall rest on firm material. Foundation material shall be dry and special attention is called to Section 401.05 of General Specifications and to the Contract Special Provisions, concerning preparation of foundations for footings.

CONCRETE NOTES: Concrete in superstructure shall be Class A-4. All other concrete shall be Class A-3. All exposed edges and corners shall have a 3" chamfer or fillet unless otherwise noted. Care in the method of vibration, the use of low-slump concrete, and or other means shall be employed to prevent downgrade movement of newly placed slab concrete. Finishing Concrete Surfaces: See Standard Architectural Detail Sheets and the Contract Special Provisions for types and details. All reinforcing steel shall be deformed bars conforming to ASTM A615 Grade 40. All reinforcing bar dimensions on the detailed drawings are to centers of bars unless otherwise noted. Clear distance between reinforcing steel and face of concrete shall be as noted on the plans. All bar laps shall be 30 diameters of the smaller diameter bar unless otherwise noted.

STEEL NOTES: Structural steel shall conform to A.S.T.M. Designations A36, A572 - Grade 50 and A588 as noted. See Special Provisions. All field connections shall be made with high strength bolts. High strength bolts shall be 8" diameter unless otherwise noted and shall conform to A.S.T.M. Specification A-325.

ELEVATION
Scale: 1"=30'-0"

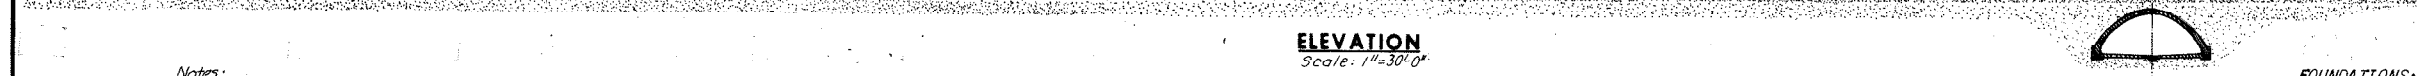



Notes:
For Vertical and Horizontal Curve Data see Sheet 1.
For Layout of Units 14 thru 22 refer to Bridge No. 63 (Westbound Roadway).

ESTIMATED QUANTITIES

| | Structure Excavation | Concrete (cu. Yds.) | Reinforcing Steel (Lbs.) | Str. Steel Mild Carbon (Lbs.) | Str. Steel High Strength (Lbs.) | Aluminum Railing (1-Rail) (Lin. Ft.) | Porous Backfill (Cu. Yds.) | Underdrain 6" Dia. Pipe (Lin. Ft.) | Steel Piles 10BP42 (Lin. Ft.) |
|----------------|----------------------|---------------------|--------------------------|-------------------------------|---------------------------------|--------------------------------------|----------------------------|------------------------------------|-------------------------------|
| Superstructure | -- | 2,237.6 | 530,860 | 1,564,700 | 567,800 | 3,241 | -- | -- | --- |
| Substructure | 1,835 | 1,256.6 | 155,030 | --- | --- | 84 | 34 | 150 | 9,410 |
| Total | 1,835 | 3,494.2 † | 685,890 | 1,564,700 | 567,800 | 3,325 | 34 | 150 | 9,410 |

| | Asphalt Damp-proofing (Sq. Yds.) | Approach Slab Concrete (cu. Yds.) | Fire Screen (Lin. Ft.) | Approach Slab Reinforcing Steel (Lbs.) | Metal Conduit (Lin. Ft.) | Concrete Slope Protection (Sq. Yds.) | Bridge Drainage Metal Work (Lbs.) | Rock Facing Slope Prot. (Sq. Yds.) | Energy Attenuator B-Unit Each |
|----------------|----------------------------------|-----------------------------------|------------------------|--|--------------------------|--------------------------------------|-----------------------------------|------------------------------------|-------------------------------|
| Superstructure | -- | -- | 210 | --- | 2,214 | --- | 11,870 | -- | 1 |
| Substructure | 105 | 91.5 | --- | 23,870 | 92 | 559 | --- | 3,320 | --- |
| Total | 105 | 91.5 † | 210 | 23,870 | 2,306 | 559 | 11,870 | 3,320 | 1 |

† All Concrete for Superstructure shall be Class A4 and for Substructure Class A3.

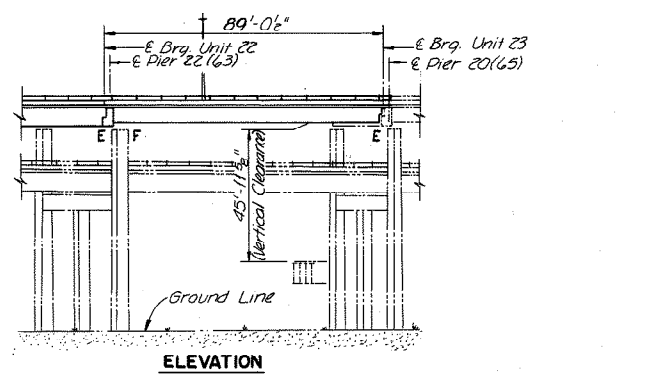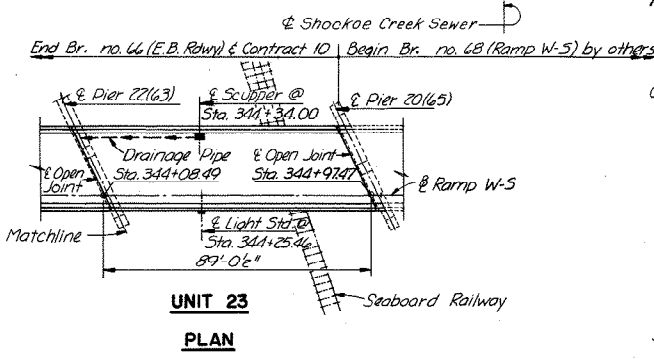

RICHMOND METROPOLITAN AUTHORITY
RICHMOND EXPRESSWAY SYSTEM
DOWNTOWN EXPRESSWAY







BRIDGE NO. 66
EASTBOUND ROADWAY OVER
12TH ST. - R.R. TRACKS AND 16TH ST.
GENERAL PLAN AND ELEVATION

HOWARD, NEEDLES, TAMMEN & BERGENDOFF
consulting engineers
NEW YORK ALEXANDRIA KANSAS CITY

SCALE: As Noted
CONTRACT NO: 10
SHEET NO. 2 OF 46

| BY | DATE | REVISION | BY | DATE |
|-----------|----------------|----------|-----|------|
| MADE | J.V. 1-9-69 | As Built | TEM | 8-76 |
| CHECKED | G.C.C. 5-26-69 | As Built | TEM | 8-76 |
| IN CHARGE | | | | |


AS BUILT

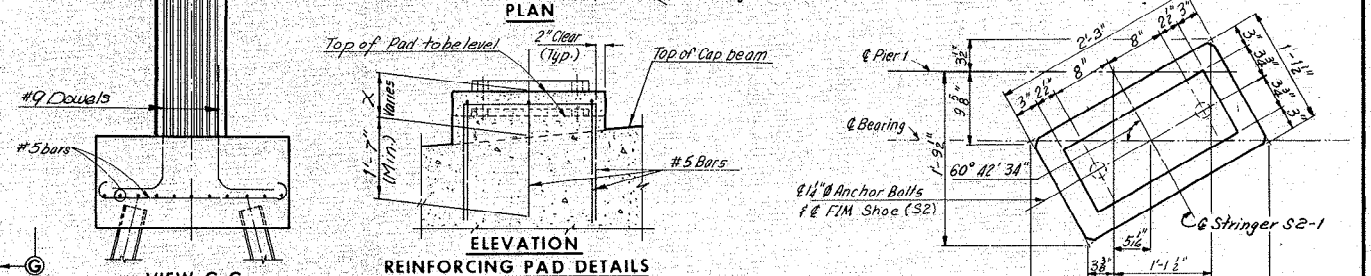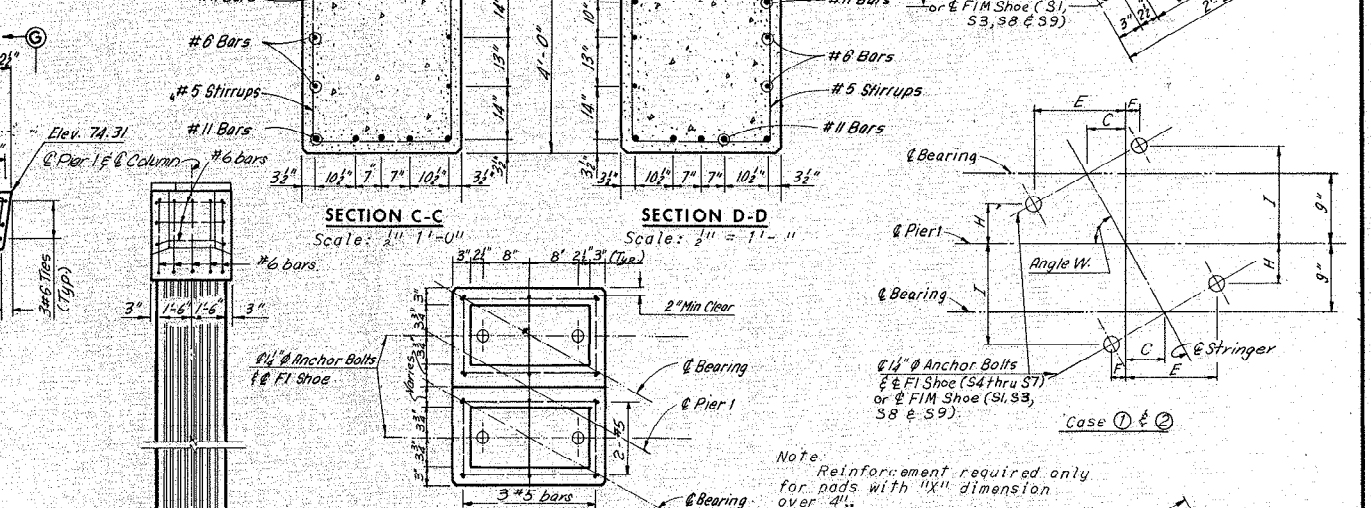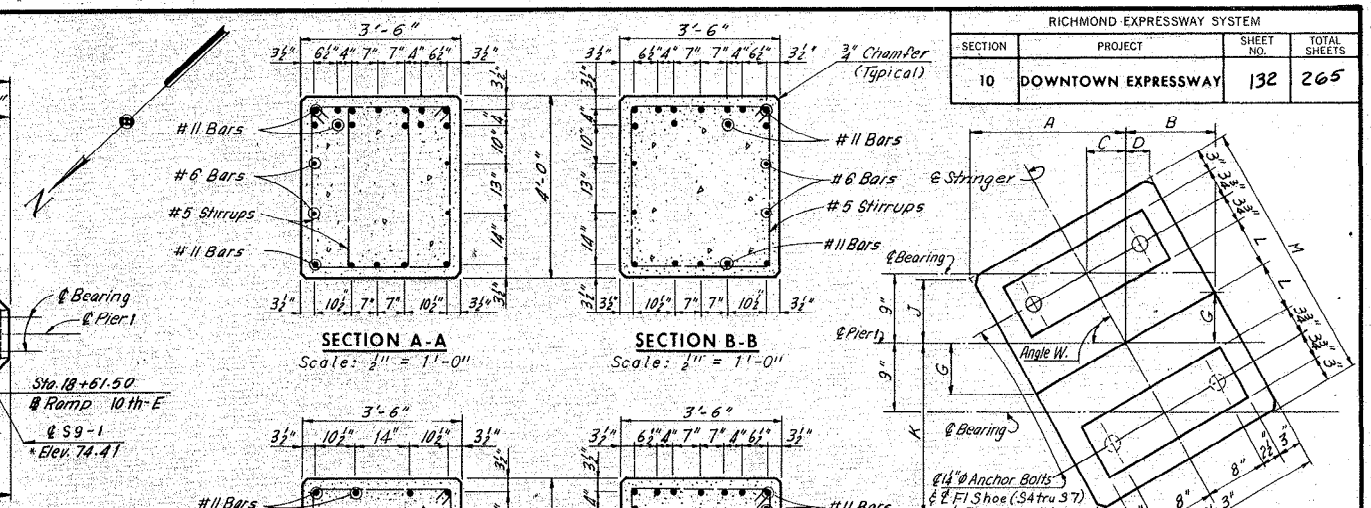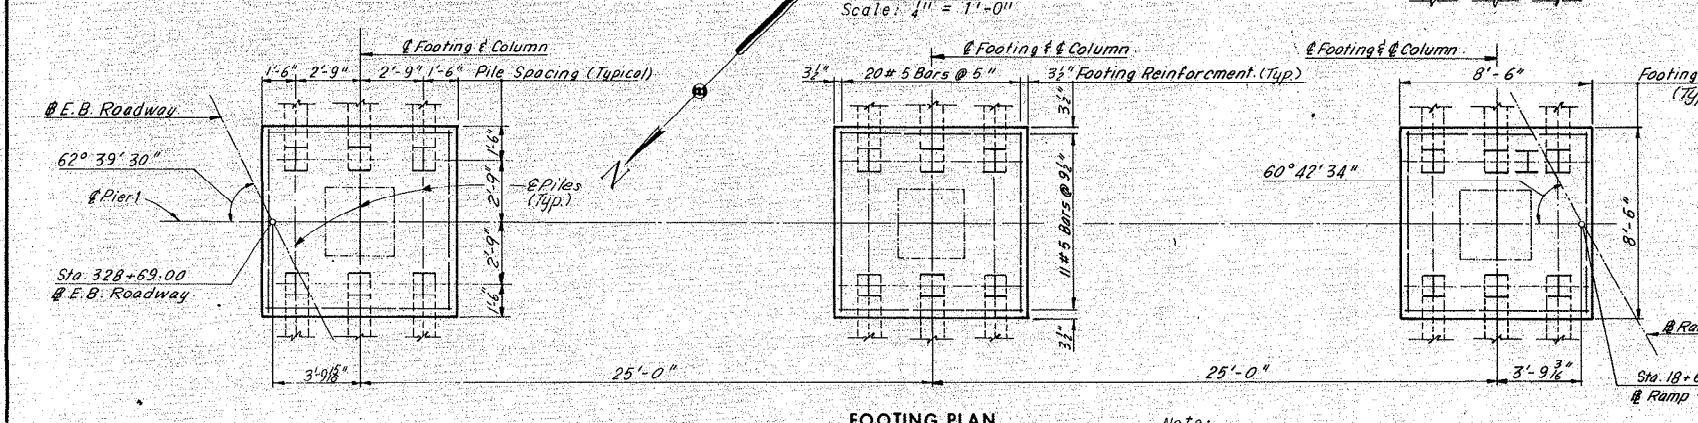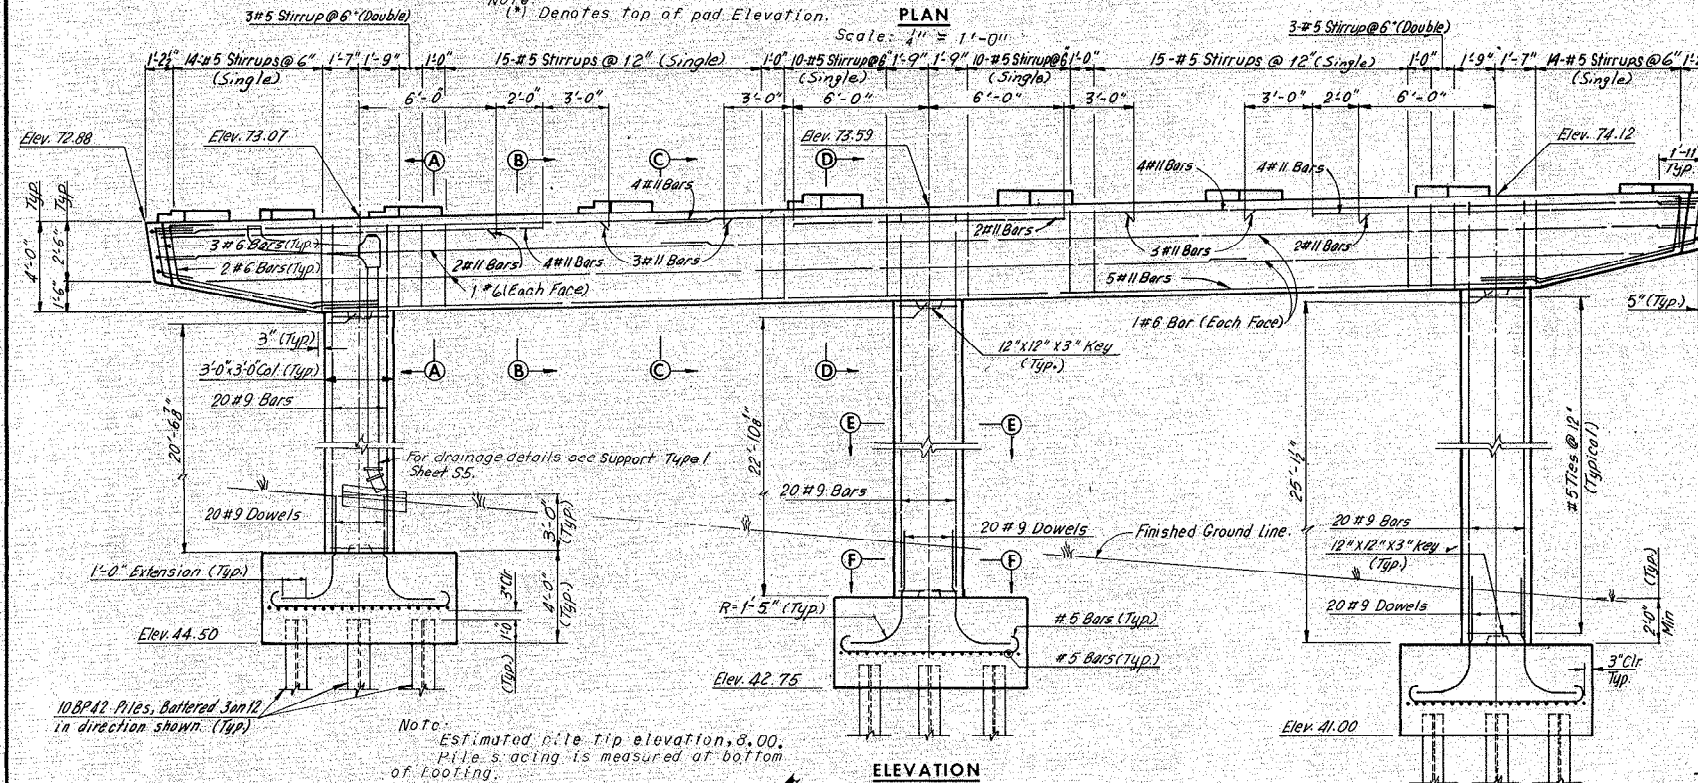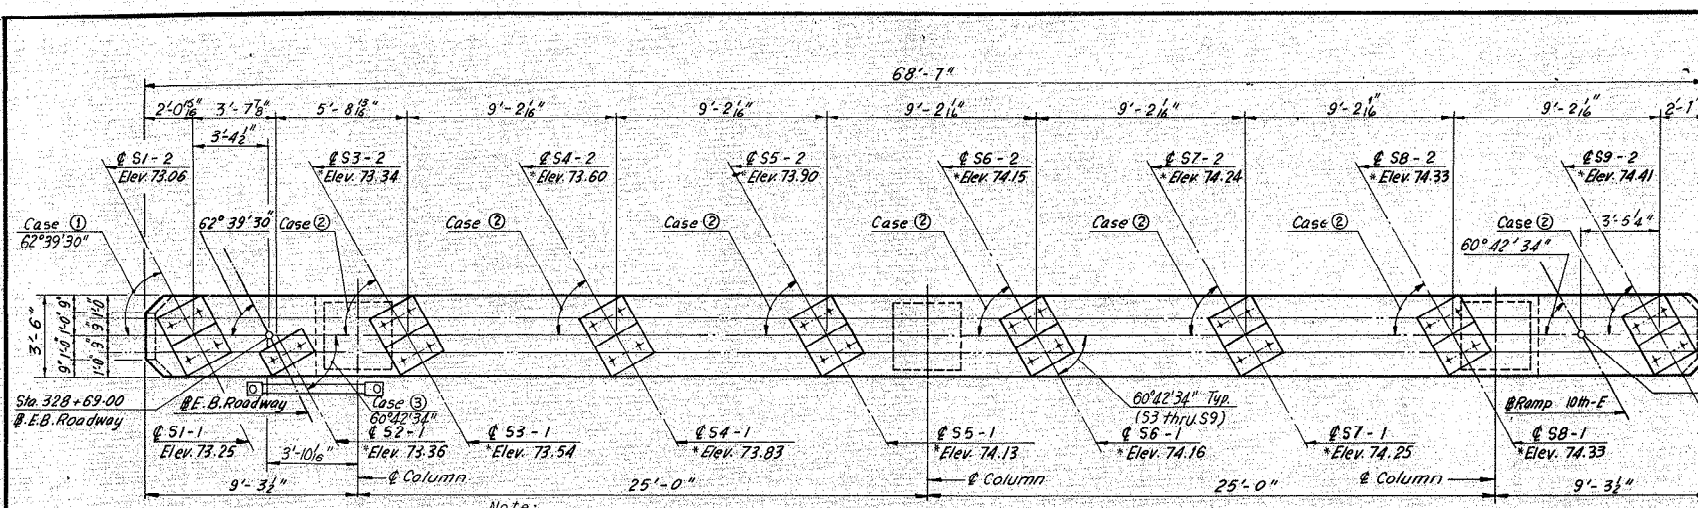

ANCHOR BOLT SETTING PLAN DIMENSIONS

| Case | Angle W | A | B | C | D | E | F | G | H | I | J | K | L | M |
|------|-------------|--------|--------|-------|-------|--------|-------|-------|-------|--------|-------|-------|-------|--------|
| 1 | 62° 39' 30" | 19 1/2 | 12 | 4 1/2 | 4 1/2 | 11 1/2 | 2 1/2 | 6 1/2 | 5 1/2 | 12 1/2 | 8 1/2 | 2 1/2 | 6 1/2 | 33 1/2 |
| 2 | 60° 42' 34" | 20 1/2 | 11 1/2 | 5 1/2 | 3 1/2 | 12 1/2 | 1 1/2 | 6 1/2 | 5 1/2 | 12 1/2 | 8 1/2 | 2 1/2 | 6 1/2 | 34 1/2 |

Dimensions are in inches.

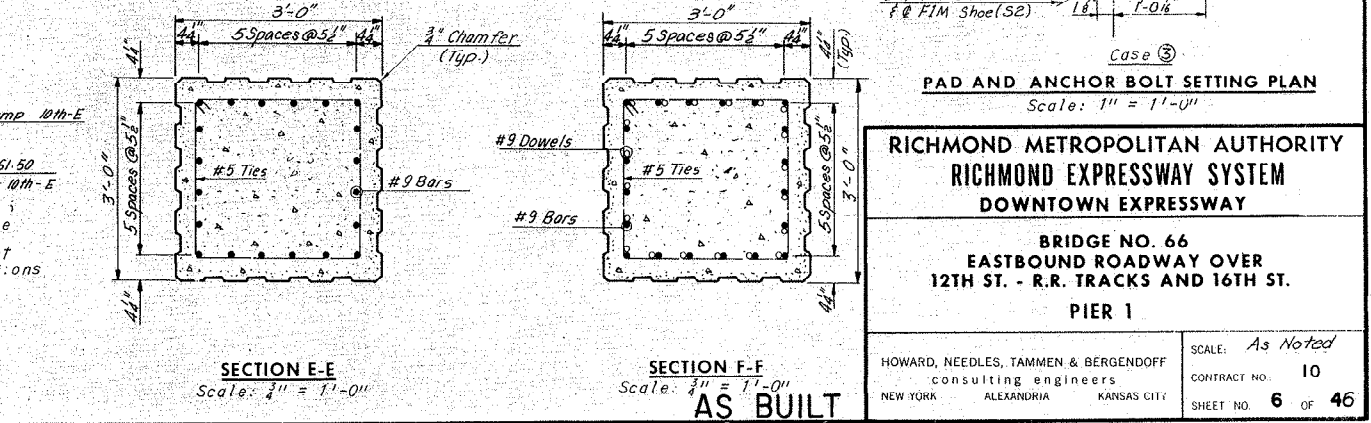

Note: Estimated pile tip elevation, 8.00. Pile spacing is measured at bottom of footing.

Note: For architectural treatment of columns, see Sheet 37.

Note: Footing elevations are approximate only and may be varied to suit field conditions as directed by the Engineer. Vertical shaft reinforcing shall not be cut until these elevations are established. Where elevations change more than 2 ft., redesign will be required.

Note: All piles shall be 10BP42 Steel Piles (Design capacity = 45 tons). Buffer all piles 3" per foot where shown. For Standard Shoe details, see Sheets 31 and 32. For Framing Plan, see Sheet 14. For Steel Pile Details, See Sheet 11.

| BY | DATE | NO. | REVISION | BY | DATE |
|-----------|---------|---------|------------|-----|-------|
| MAR | 7-31-68 | 2 | As Built | TEM | 8-76 |
| CHECKED | RLM | 8-15-68 | Dimensions | RWZ | 10-74 |
| IN CHARGE | | | | | |

RICHMOND METROPOLITAN AUTHORITY
 RICHMOND EXPRESSWAY SYSTEM
 DOWNTOWN EXPRESSWAY


BRIDGE NO. 66
 EASTBOUND ROADWAY OVER
 12TH ST. - R.R. TRACKS AND 16TH ST.

PIER 1

HOWARD, NEEDLES, TAMMEN & BERGENDOFF
 consulting engineers
 NEW YORK ALEXANDRIA KANSAS CITY

SCALE: As Noted
 CONTRACT NO. 10
 SHEET NO. 6 OF 46


AS BUILT

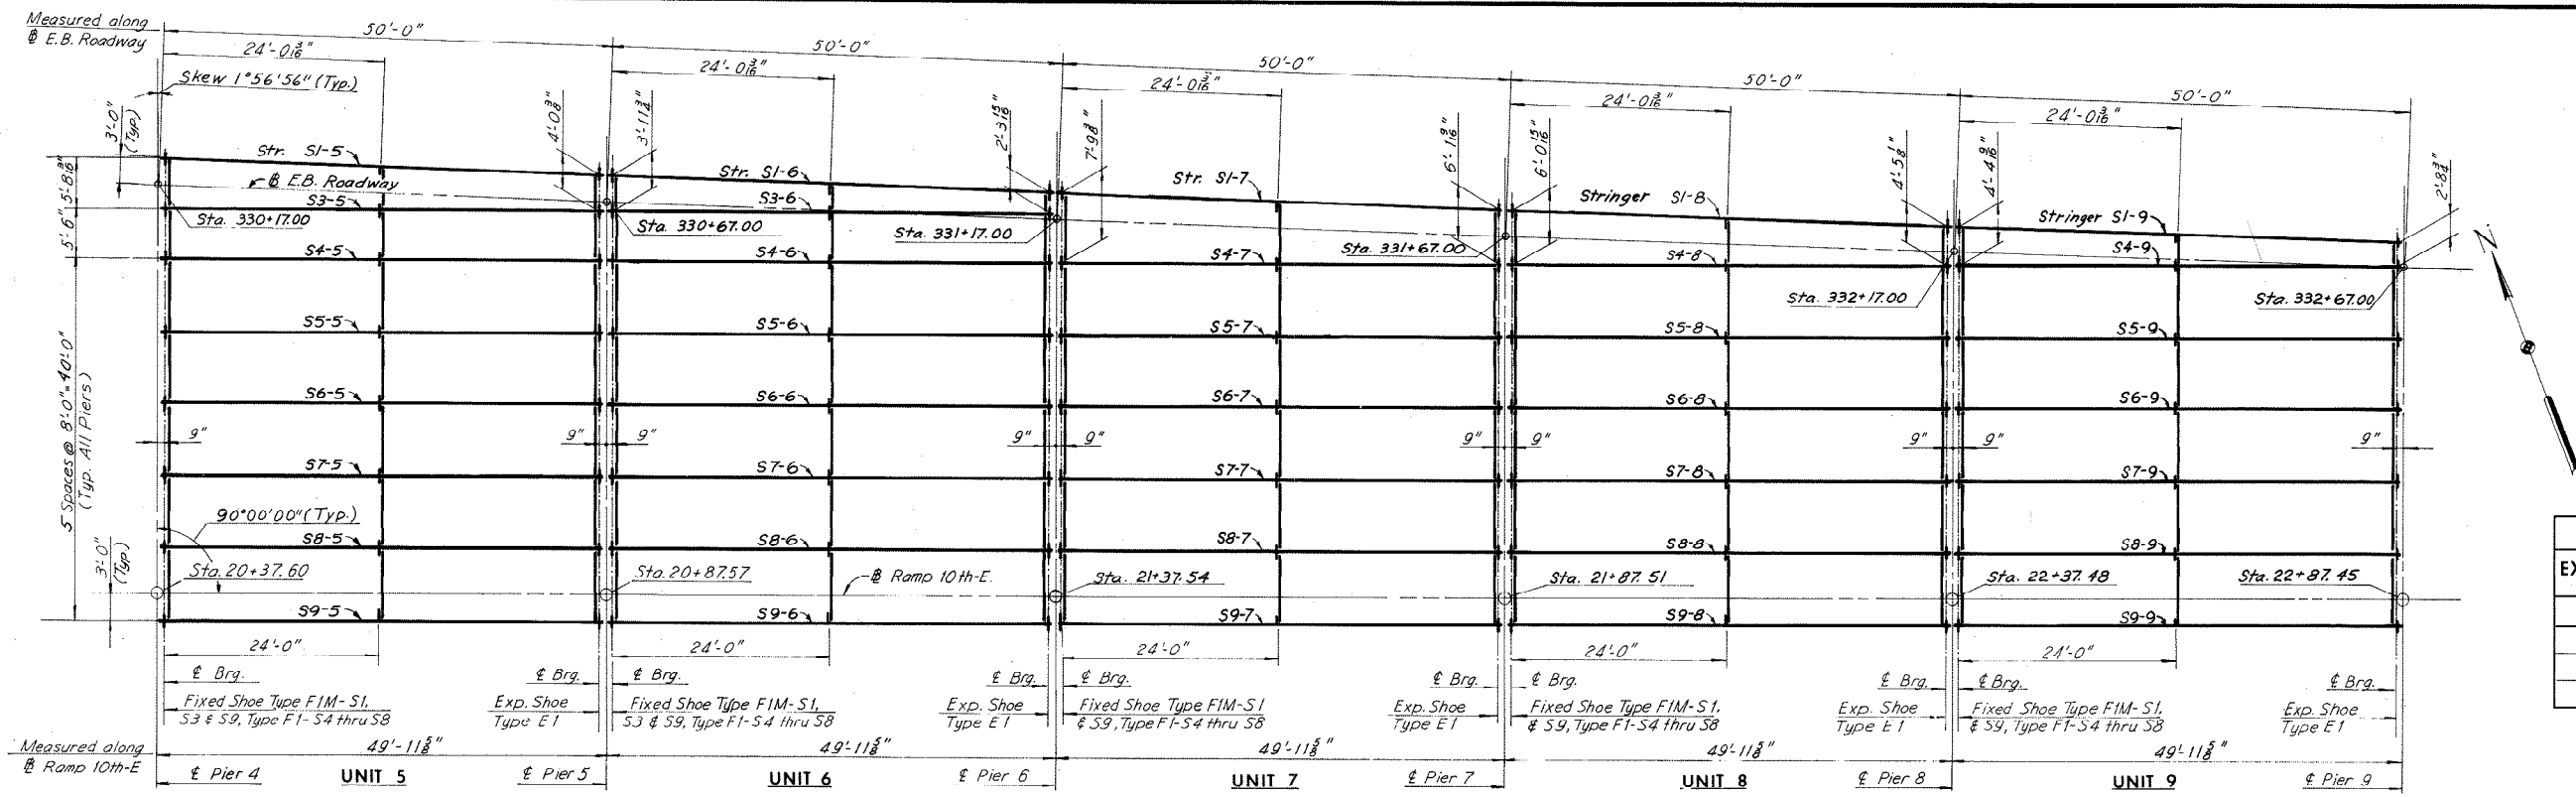


| SHOE SCHEDULE | | | |
|-----------------|-----------|-------------|-----------|
| EXPANSION SHOES | | FIXED SHOES | |
| TYPE | NO. REQD. | TYPE | NO. REQD. |
| F1 | 31 | F1 | 25 |
| | | F1M | 12 |

FRAMING PLAN
Scale: 1" = 10'-0"


| UNIT | STRINGER | STRINGER SIZE | STRINGER SCHEDULE | | | | | DEAD LOAD DEFLECTION SCHEDULE | | | | | CAMBER SCHEDULE | | | | |
|------|----------|---------------|-------------------|------------|------------|----------|----------|-------------------------------|-------------------------|-----------|-----------|-----------|-----------------|-----------|------|------|------|
| | | | Dim. "A" | LENGTH | Dim. "B" | Dim. "C" | Dim. "D" | PL. "D" | MAX. SHEAR STUD SPACING | | | | | 1/4L | 1/2L | 3/4L | |
| | | | | " | " | " | " | " | | 0.0L-0.1L | 0.1L-0.2L | 0.2L-0.3L | 0.3L-0.4L | 0.4L-0.5L | | | |
| 5 | S1-5 | 30 W 108 | 49'-10" | 48'-6" | 8" | 8" | 0 | 0 | 11" | 11 1/2" | 13 1/2" | 16 1/2" | 20 1/2" | 1/4" | 1/2" | 3/4" | |
| | S3-5 | 30 W 108 | 49'-7 3/4" | 48'-5 1/2" | 7" | 7" | 0 | 0 | 10" | 11 1/2" | 13" | 15 1/2" | 19" | 1/4" | 1/2" | 3/4" | |
| | S4-5 | 30 W 99 | 49'-7 3/4" | 48'-5 1/2" | 7" | 7" | 18'-0" | 9x3/4" | 8" | 9" | 11" | 12 1/2" | 15" | 1/4" | 1/2" | 3/4" | |
| | S5-5 | 30 W 108 | 49'-7 3/4" | 48'-5 1/2" | 7" | 7" | 18'-6" | 9x3/4" | 7" | 7 1/2" | 9 1/2" | 11" | 13" | 1/4" | 1/2" | 3/4" | |
| | S6-5 | 30 W 108 | 49'-7 3/4" | 48'-5 1/2" | 7" | 7" | 18'-6" | 9x3/4" | 7" | 7 1/2" | 9 1/2" | 11" | 13" | 1/4" | 1/2" | 3/4" | |
| | S7-5 | 30 W 108 | 49'-7 3/4" | 48'-5 1/2" | 7" | 7" | 18'-6" | 9x3/4" | 7" | 7 1/2" | 9 1/2" | 11" | 13" | 1/4" | 1/2" | 3/4" | |
| | S8-5 | 30 W 108 | 49'-7 3/4" | 48'-5 1/2" | 7" | 7" | 18'-6" | 9x3/4" | 7" | 7 1/2" | 9 1/2" | 11" | 13" | 1/4" | 1/2" | 3/4" | |
| | S9-5 | 30 W 108 | 49'-9 3/8" | 48'-5 1/2" | 8" | 8" | 19'-0" | 9x3/4" | 7 1/2" | 8" | 9 1/2" | 11 1/2" | 14" | 1/4" | 1/2" | 3/4" | |
| | 6 | S1-6 | 30 W 99 | 49'-10" | 48'-6" | 8" | 8" | 0 | 0 | 13 1/2" | 15" | 18" | 22" | 21" | 1/4" | 1/2" | 3/4" |
| S3-6 | | 30 W 99 | 49'-7 3/4" | 48'-5 1/2" | 7" | 7" | 0 | 0 | 11 1/2" | 12 1/2" | 14 1/2" | 17 1/2" | 21 1/2" | 1/4" | 1/2" | 3/4" | |
| S4-6 | | 30 W 99 | 49'-7 3/4" | 48'-5 1/2" | 7" | 7" | 18'-0" | 9x3/4" | 8" | 9" | 11" | 12 1/2" | 15" | 1/4" | 1/2" | 3/4" | |
| S5-6 | | 30 W 108 | 49'-7 3/4" | 48'-5 1/2" | 7" | 7" | 18'-6" | 9x3/4" | 7" | 7 1/2" | 9 1/2" | 11" | 13" | 1/4" | 1/2" | 3/4" | |
| S6-6 | | 30 W 108 | 49'-7 3/4" | 48'-5 1/2" | 7" | 7" | 18'-6" | 9x3/4" | 7" | 7 1/2" | 9 1/2" | 11" | 13" | 1/4" | 1/2" | 3/4" | |
| S7-6 | | 30 W 108 | 49'-7 3/4" | 48'-5 1/2" | 7" | 7" | 18'-6" | 9x3/4" | 7" | 7 1/2" | 9 1/2" | 11" | 13" | 1/4" | 1/2" | 3/4" | |
| S8-6 | | 30 W 108 | 49'-7 3/4" | 48'-5 1/2" | 7" | 7" | 18'-6" | 9x3/4" | 7" | 7 1/2" | 9 1/2" | 11" | 13" | 1/4" | 1/2" | 3/4" | |
| S9-6 | | 30 W 108 | 49'-9 3/8" | 48'-5 1/2" | 8" | 8" | 19'-0" | 9x3/4" | 7 1/2" | 8" | 9 1/2" | 11 1/2" | 14" | 1/4" | 1/2" | 3/4" | |
| 7 | | S1-7 | 30 W 108 | 49'-10" | 48'-6" | 8" | 8" | 17'-6" | 9x3/4" | 8" | 8 1/2" | 10 1/2" | 12 1/2" | 15 1/2" | 1/4" | 1/2" | 3/4" |
| | S4-7 | 30 W 108 | 49'-7 3/4" | 48'-5 1/2" | 7" | 7" | 18'-6" | 9x3/4" | 7" | 7 1/2" | 9 1/2" | 11" | 13" | 1/4" | 1/2" | 3/4" | |
| | S5-7 | 30 W 108 | 49'-7 3/4" | 48'-5 1/2" | 7" | 7" | 18'-6" | 9x3/4" | 7" | 7 1/2" | 9 1/2" | 11" | 13" | 1/4" | 1/2" | 3/4" | |
| | S6-7 | 30 W 108 | 49'-7 3/4" | 48'-5 1/2" | 7" | 7" | 18'-6" | 9x3/4" | 7" | 7 1/2" | 9 1/2" | 11" | 13" | 1/4" | 1/2" | 3/4" | |
| | S7-7 | 30 W 108 | 49'-7 3/4" | 48'-5 1/2" | 7" | 7" | 18'-6" | 9x3/4" | 7" | 7 1/2" | 9 1/2" | 11" | 13" | 1/4" | 1/2" | 3/4" | |
| | S8-7 | 30 W 108 | 49'-7 3/4" | 48'-5 1/2" | 7" | 7" | 18'-6" | 9x3/4" | 7" | 7 1/2" | 9 1/2" | 11" | 13" | 1/4" | 1/2" | 3/4" | |
| | S9-7 | 30 W 108 | 49'-9 3/8" | 48'-5 1/2" | 8" | 8" | 19'-0" | 9x3/4" | 7 1/2" | 8" | 9 1/2" | 11 1/2" | 14" | 1/4" | 1/2" | 3/4" | |
| | 8 | S1-8 | 30 W 108 | 49'-10" | 48'-6" | 8" | 8" | 17'-6" | 9x3/4" | 9 1/2" | 10 1/2" | 13" | 15 1/2" | 19 1/2" | 1/4" | 1/2" | 3/4" |
| | | S4-8 | 30 W 108 | 49'-7 3/4" | 48'-5 1/2" | 7" | 7" | 18'-6" | 9x3/4" | 8" | 8 1/2" | 11" | 13" | 15 1/2" | 1/4" | 1/2" | 3/4" |
| S5-8 | | 30 W 108 | 49'-7 3/4" | 48'-5 1/2" | 7" | 7" | 18'-6" | 9x3/4" | 7" | 7 1/2" | 9 1/2" | 11" | 13 1/2" | 1/4" | 1/2" | 3/4" | |
| S6-8 | | 30 W 108 | 49'-7 3/4" | 48'-5 1/2" | 7" | 7" | 18'-6" | 9x3/4" | 7" | 7 1/2" | 9 1/2" | 11" | 13 1/2" | 1/4" | 1/2" | 3/4" | |
| S7-8 | | 30 W 108 | 49'-7 3/4" | 48'-5 1/2" | 7" | 7" | 18'-6" | 9x3/4" | 7" | 7 1/2" | 9 1/2" | 11" | 13 1/2" | 1/4" | 1/2" | 3/4" | |
| S8-8 | | 30 W 108 | 49'-7 3/4" | 48'-5 1/2" | 7" | 7" | 18'-6" | 9x3/4" | 7" | 7 1/2" | 9 1/2" | 11" | 13 1/2" | 1/4" | 1/2" | 3/4" | |
| S9-8 | | 30 W 108 | 49'-9 3/8" | 48'-5 1/2" | 8" | 8" | 19'-6" | 9x3/4" | 7" | 7 1/2" | 10" | 12" | 14 1/2" | 1/4" | 1/2" | 3/4" | |
| 9 | | S1-9 | 30 W 99 | 49'-10" | 48'-6" | 8" | 8" | 0 | 0 | 14" | 15" | 18" | 22" | 24" | 1/4" | 1/2" | 3/4" |
| | | S4-9 | 30 W 99 | 49'-7 3/4" | 48'-5 1/2" | 7" | 7" | 17'-0" | 9x3/4" | 9" | 10" | 12" | 14" | 17" | 1/4" | 1/2" | 3/4" |
| | S5-9 | 30 W 108 | 49'-7 3/4" | 48'-5 1/2" | 7" | 7" | 18'-6" | 9x3/4" | 7" | 7 1/2" | 9 1/2" | 11" | 13" | 1/4" | 1/2" | 3/4" | |
| | S6-9 | 30 W 108 | 49'-7 3/4" | 48'-5 1/2" | 7" | 7" | 18'-6" | 9x3/4" | 7" | 7 1/2" | 9 1/2" | 11" | 13" | 1/4" | 1/2" | 3/4" | |
| | S7-9 | 30 W 108 | 49'-7 3/4" | 48'-5 1/2" | 7" | 7" | 18'-6" | 9x3/4" | 7" | 7 1/2" | 9 1/2" | 11" | 13" | 1/4" | 1/2" | 3/4" | |
| | S8-9 | 30 W 108 | 49'-7 3/4" | 48'-5 1/2" | 7" | 7" | 18'-6" | 9x3/4" | 7" | 7 1/2" | 9 1/2" | 11" | 13" | 1/4" | 1/2" | 3/4" | |
| | S9-9 | 30 W 108 | 49'-9 3/8" | 48'-5 1/2" | 8" | 8" | 19'-0" | 9x3/4" | 7 1/2" | 8" | 9 1/2" | 11 1/2" | 14" | 1/4" | 1/2" | 3/4" | |

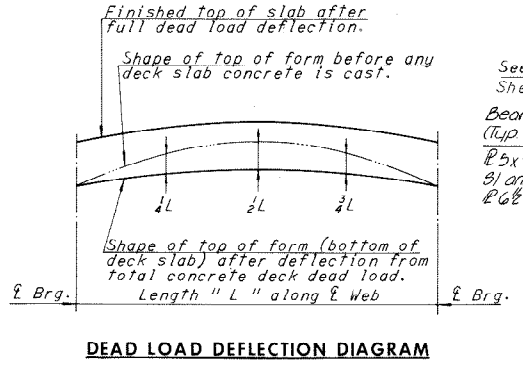

NOTE TO CONTRACTOR
Deflections given are those anticipated to occur in the stringer upon placement of the total concrete deck dead load. In practice, the stringers in place are not likely to have the exact camber to compensate for these deflections during construction. The residual amounts shall be provided by adjusting forms to vary the thickness of the concrete haunch between the bottom of the slab and the top of stringer without altering the slab thickness.

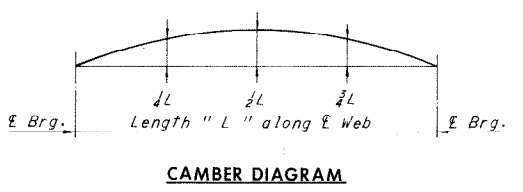

NOTE TO FABRICATOR
The stringers shall be fabricated with an upward camber amounting to the tabulated value. This will provide approximate compensation for deflection under full dead load and for conformity with finished grade. Dimensions are in inches.

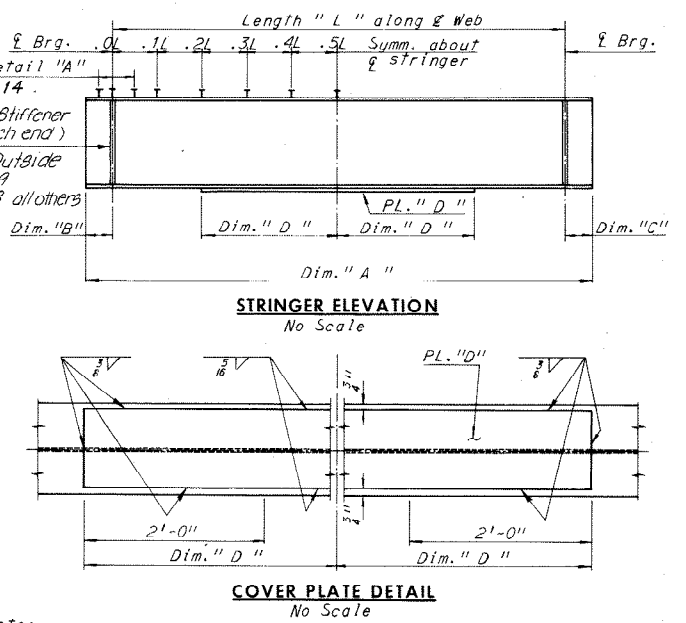

Note: Stringers having a total camber of less than 1" are not required to be shop cambered, but should be turned so that any mill tolerance deviation from straightness will be in the direction shown by the Camber Diagram. If stringers are not cambered, distance top of stringers to top of slab will vary along the stringer in accordance with the offset dimensions shown in the Camber Diagram, and with minimum distance as shown in cross-section on Sheet 29.

* Spacing begins at termination of b spaces @ 4".
Note: All steel shall be A36 unless denoted otherwise.

Notes:
For Diaphragm and Connection Details, see Sheet 29.
For Joint Details, see Sheet 37.
For Shoe Details, see Sheets 51 and 52.
For Shear Stud Details, see Sheet 14.
For angles between & Piers and Stringers, see Sheets 8, 9, 10 & 11.
For Superstructure steel quantities, see Sheet 2.

| | | | | | |
|-----------|------|---------|-----|----------|---------|
| BY | DATE | | | | |
| MADE | SHS | 8-2-68 | | | |
| CHECKED | JD | 10-2-68 | 1 | As Built | TEM 8-7 |
| IN CHARGE | | | NO. | REVISION | BY |

RICHMOND METROPOLITAN AUTHORITY
RICHMOND EXPRESSWAY SYSTEM
DOWNTOWN EXPRESSWAY


BRIDGE NO. 66
EASTBOUND ROADWAY OVER
12TH ST. - R.R. TRACKS AND 16TH ST.
FRAMING PLAN-UNITS 5,6,7,8,AND 9

HOWARD, NEEDLES, TAMMEN & BERGENDOFF
consulting engineers
NEW YORK ALEXANDRIA KANSAS CITY

SCALE: 1"=10' Unless as shown
CONTRACT NO. 10
SHEET NO. 15 OF 46

AS BUILT

Note: Dimensions shown at piers are between extended centerlines of stringers.

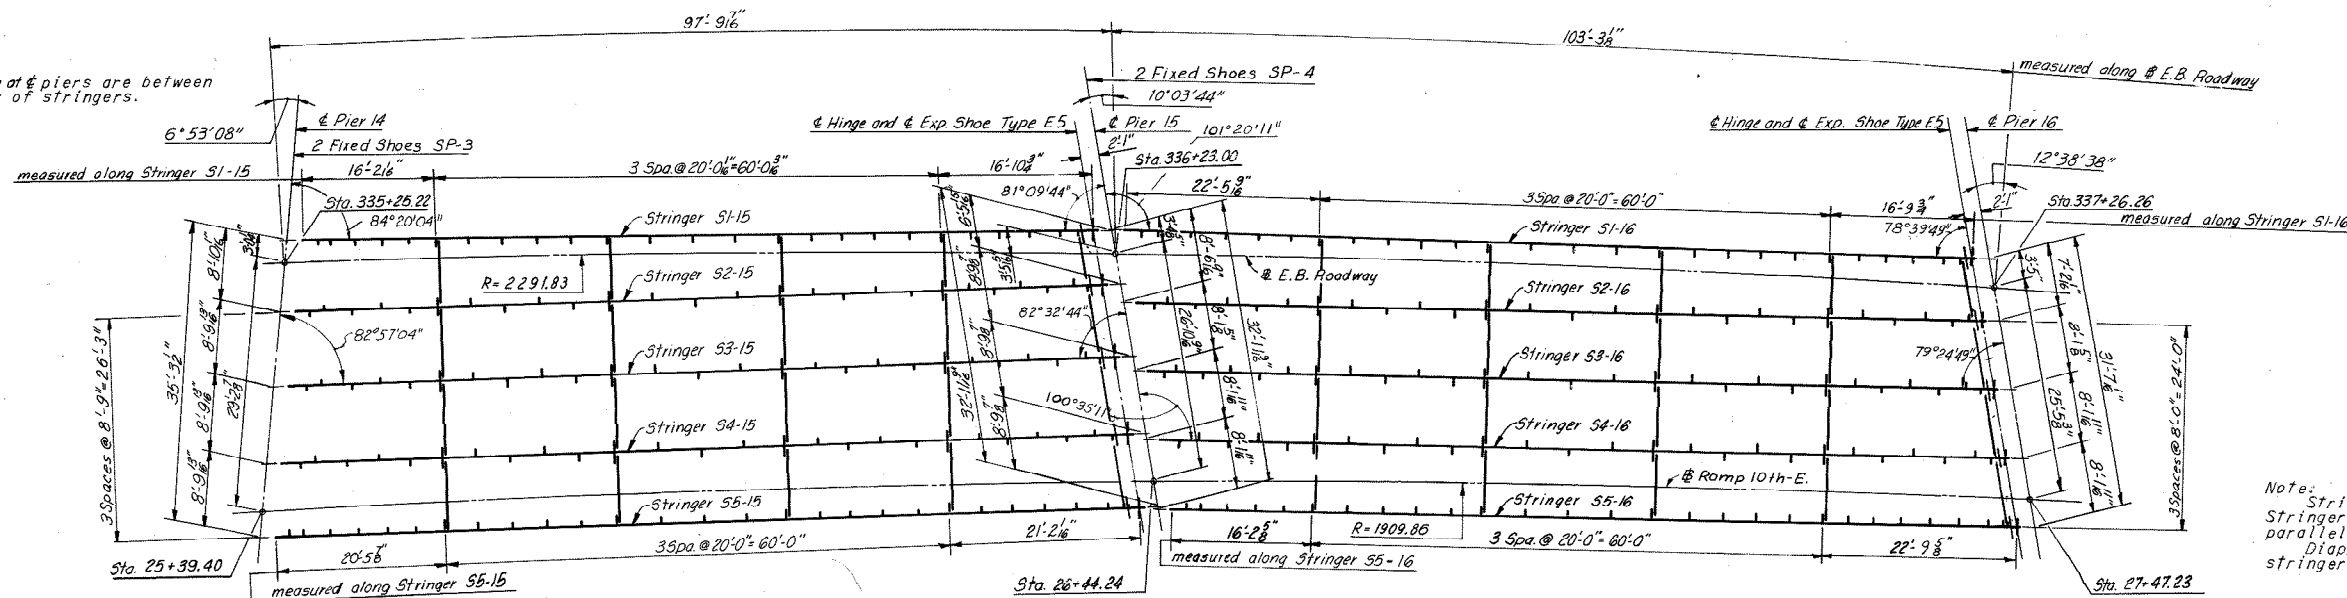


Note: Stringers S2-15 thru S5-15 and Stringers S2-16 thru S5-16 are parallel. Diaphragm spacing is shown along stringer length "L".

UNIT 15

UNIT 16


FRAMING PLAN

Scale: 1/32" = 1'-0"

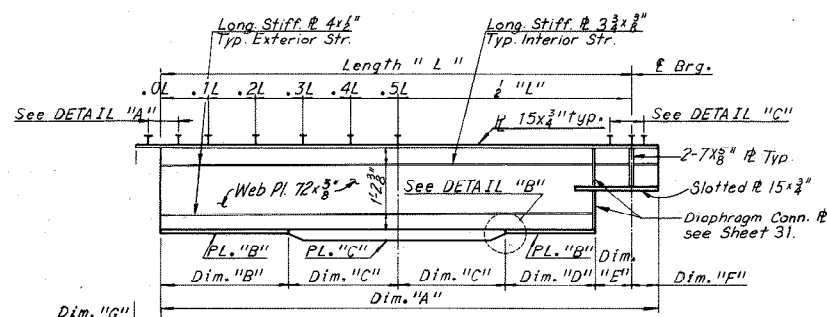


STRINGER ELEVATION

No Scale

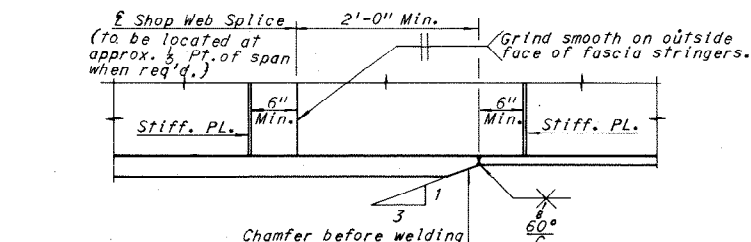

DETAIL "B"


No Scale

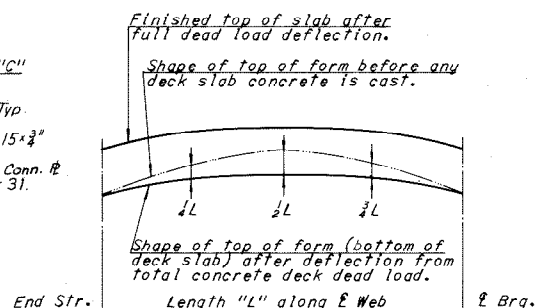

DEAD LOAD DEFLECTION DIAGRAM

NOTE TO CONTRACTOR


Deflections given are those anticipated to occur in the stringer upon placement of the total concrete deck dead load. In practice, the stringers in place are not likely to have the exact camber to compensate for these deflections during construction. The residual amounts shall be provided by adjusting forms to vary the thickness of the concrete haunch between the bottom of the slab and the top of stringer without altering the slab thickness.

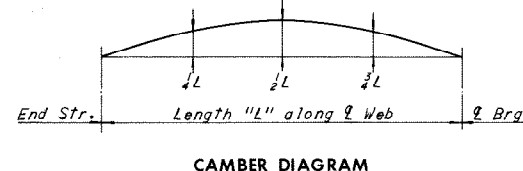

CAMBER DIAGRAM

NOTE TO FABRICATOR

The stringers shall be fabricated with an upward camber amounting to the tabulated value. This will provide approximate compensation for deflection under full dead load and for conformity with finished grade. Dimensions are in inches. Stringers having a total camber of less than 1" are not required to be shop cambered, but should be turned so that any mill tolerance deviation from straightness will be in the direction shown by the Camber Diagram. If stringers are not cambered, distance top of stringers to top of slab will vary along the stringer in accordance with the offset dimensions shown in the Camber Diagram, and with minimum distance as shown in cross-section on Sheet 31.

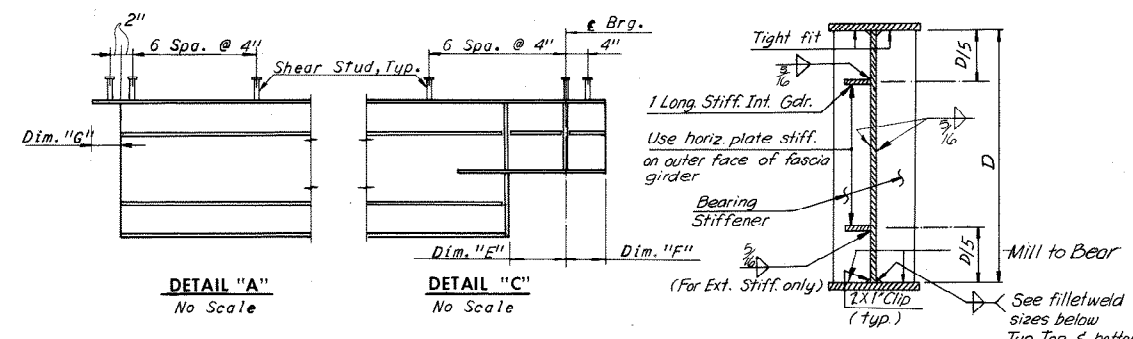

DETAIL "A"

No Scale

DETAIL "C"

No Scale

| SHOE SCHEDULE | | | |
|---------------|-----------|-----------------|-----------|
| FIXED SHOES | | EXPANSION SHOES | |
| TYPE | NO. REQD. | TYPE | NO. REQD. |
| SP-3 | 2 | E5 | 10 |
| SP-4 | 2 | | |

WEB TO FLANGE WELDS AND LONGITUDINAL STIFFENER WELD DETAILS

No Scale

Note: Web to flange weld size shall be determined by flange thickness as follows:

To 1/2" 3/8" weld
over 1/2" to 2 1/2" 5/8" weld

Notes:
For Superstructure steel quantities, see Sheet 2.
For Joint Details, see Sheet 38.
For Shoe Details, see Sheets 31 and 32.
For Diaphragm Details, see Sheet 31.
For Framing Details, see Sheet 22.
For Shear Stud Details, see Sheet 14.
For Angles between Piers and Stringers see Sheet 22.

| UNIT | STRINGER | Dim. "A" | LENGTH | Dim. "B" | Dim. "C" | Dim. "D" | Dim. "E" | Dim. "F" | Dim. "G" | PL. "B" | PL. "C" | MAX. SHEAR STUD SPACING | | | | | DEAD LOAD DEFLECTION SCHEDULE | | | CAMBER SCHEDULE | | | | | | | | | |
|------|----------|-------------|-------------|------------|----------|------------|----------|----------|----------|-----------|-----------|-------------------------|-----------|-----------|-----------|-----------|-------------------------------|--------|--------|-----------------|--------|--------|--------|--------|--------|--------|--------|--------|--------|
| | | | | | | | | | | | | 0.0L-0.1L | 0.1L-0.2L | 0.2L-0.3L | 0.3L-0.4L | 0.4L-0.5L | 1/4L | 1/2L | 3/4L | 1/4L | 1/2L | 3/4L | | | | | | | |
| | | | | | | | | | | | | 1/4L | 1/2L | 3/4L | 1/4L | 1/2L | 3/4L | | | | | | | | | | | | |
| 15 | S1-15 | 93'-8 1/2" | 93'-1" | 23'-3 1/2" | 23'-3" | 22'-5 3/4" | 10 1/2" | 7 1/2" | 6 3/4" | 15x2 1/2" | 15x1 1/2" | 13 1/2" | 15 1/2" | 19" | 24" | 24" | 1 1/8" | 1 1/8" | 1 1/8" | 1 1/8" | 1 1/8" | 1 1/8" | 1 1/8" | 1 1/8" | 1 1/8" | 1 1/8" | 1 1/8" | | |
| | S2-15 | 95'-6 3/4" | 94'-11 1/2" | 24'-5 1/2" | 23'-0" | 23'-7 1/2" | 10 1/2" | 7 1/2" | 6 3/4" | 15x2 1/2" | 15x1 1/2" | 14" | 16" | 18 1/2" | 21 1/2" | 23 1/2" | 1 1/8" | 1 1/8" | 1 1/8" | 1 1/8" | 1 1/8" | 1 1/8" | 1 1/8" | 1 1/8" | 1 1/8" | 1 1/8" | 1 1/8" | | |
| | S3-15 | 97'-9 3/4" | 97'-2 1/2" | 22'-1 1/2" | 26'-6" | 21'-3 3/4" | 10 1/2" | 7 1/2" | 6 3/4" | 15x2 1/2" | 15x1 1/2" | 14" | 16" | 19" | 21" | 22 1/2" | 1 1/8" | 1 1/8" | 1 1/8" | 1 1/8" | 1 1/8" | 1 1/8" | 1 1/8" | 1 1/8" | 1 1/8" | 1 1/8" | 1 1/8" | 1 1/8" | |
| | S4-15 | 100'-0 3/4" | 99'-5 1/2" | 24'-2 3/4" | 25'-6" | 23'-4 1/2" | 10 1/2" | 7 1/2" | 6 3/4" | 15x2 1/2" | 15x1 1/2" | 14" | 16" | 18 1/2" | 21" | 23" | 1 1/8" | 1 1/8" | 1 1/8" | 1 1/8" | 1 1/8" | 1 1/8" | 1 1/8" | 1 1/8" | 1 1/8" | 1 1/8" | 1 1/8" | 1 1/8" | |
| | S5-15 | 102'-3" | 101'-7 1/2" | 24'-4" | 26'-6" | 23'-5 1/2" | 10 1/2" | 7 1/2" | 6 3/4" | 15x2 1/2" | 15x1 1/2" | 13 1/2" | 15 1/2" | 18 1/2" | 23" | 24" | 1 1/8" | 1 1/8" | 1 1/8" | 1 1/8" | 1 1/8" | 1 1/8" | 1 1/8" | 1 1/8" | 1 1/8" | 1 1/8" | 1 1/8" | 1 1/8" | |
| 16 | S1-16 | 99'-10 3/4" | 99'-3 3/4" | 23'-7 3/4" | 26'-0" | 22'-9 1/2" | 10 1/2" | 7 1/2" | 6 3/4" | 15x2 1/2" | 15x1 1/2" | 14" | 16" | 19" | 24" | 24" | 1 1/8" | 1 1/8" | 1 1/8" | 1 1/8" | 1 1/8" | 1 1/8" | 1 1/8" | 1 1/8" | 1 1/8" | 1 1/8" | 1 1/8" | 1 1/8" | |
| | S2-16 | 99'-7 3/4" | 99'-0 1/2" | 24'-6 1/2" | 25'-0" | 23'-7 3/4" | 10 1/2" | 7 1/2" | 6 3/4" | 15x2 1/2" | 15x1 1/2" | 15" | 17" | 19 1/2" | 22 1/2" | 24" | 1 1/8" | 1 1/8" | 1 1/8" | 1 1/8" | 1 1/8" | 1 1/8" | 1 1/8" | 1 1/8" | 1 1/8" | 1 1/8" | 1 1/8" | 1 1/8" | |
| | S3-16 | 99'-7 3/4" | 99'-0 1/2" | 24'-0 1/2" | 25'-6" | 23'-1 1/2" | 10 1/2" | 7 1/2" | 6 3/4" | 15x2 1/2" | 15x1 1/2" | 15" | 17" | 19 1/2" | 22 1/2" | 24" | 1 1/8" | 1 1/8" | 1 1/8" | 1 1/8" | 1 1/8" | 1 1/8" | 1 1/8" | 1 1/8" | 1 1/8" | 1 1/8" | 1 1/8" | 1 1/8" | 1 1/8" |
| | S4-16 | 99'-7 3/4" | 99'-0 1/2" | 24'-0 1/2" | 25'-6" | 23'-1 1/2" | 10 1/2" | 7 1/2" | 6 3/4" | 15x2 1/2" | 15x1 1/2" | 15" | 17" | 19 1/2" | 22 1/2" | 24" | 1 1/8" | 1 1/8" | 1 1/8" | 1 1/8" | 1 1/8" | 1 1/8" | 1 1/8" | 1 1/8" | 1 1/8" | 1 1/8" | 1 1/8" | 1 1/8" | 1 1/8" |
| | S5-16 | 99'-7 3/4" | 99'-0 1/2" | 24'-0 1/2" | 25'-6" | 23'-1 1/2" | 10 1/2" | 7 1/2" | 6 3/4" | 15x2 1/2" | 15x1 1/2" | 14" | 16 1/2" | 19 1/2" | 24" | 24" | 1 1/8" | 1 1/8" | 1 1/8" | 1 1/8" | 1 1/8" | 1 1/8" | 1 1/8" | 1 1/8" | 1 1/8" | 1 1/8" | 1 1/8" | 1 1/8" | 1 1/8" |

Note All structural steel in Units 15 and 16 is A36.

* Spacing begins at termination of 6 spaces @ 4"

Longitudinal stiffeners shall be located on the exterior face of the exterior Stringers.

Intermediate stiffener Pls. 4 1/2 x 3/8" shall be equally spaced between diaphragms as shown. The first two stiffener spaces at the ends of stringers shall be one-half the normal spacing within the panel.

| | | | | | |
|-----------|------|---------|----------|-----|------|
| BY | DATE | | | | |
| MADE | RLM | 7-31-68 | | | |
| CHECKED | PTA | 11-4-68 | As Built | TEM | 8-76 |
| IN CHARGE | | | | | |

AS BUILT

RICHMOND METROPOLITAN AUTHORITY
RICHMOND EXPRESSWAY SYSTEM
DOWNTOWN EXPRESSWAY

BRIDGE NO. 66
EASTBOUND ROADWAY OVER
12TH ST. - R.R. TRACKS AND 16TH ST.

FRAMING PLAN - UNITS 15 AND 16


HOWARD, NEEDLES, TAMMEN & BERGENDOFF
consulting engineers
NEW YORK ALEXANDRIA KANSAS CITY

SCALE: As Noted
CONTRACT NO.: 10
SHEET NO.: 17 OF 46

| RICHMOND EXPRESSWAY SYSTEM | | | |
|----------------------------|---------------------|-----------|--------------|
| SECTION | PROJECT | SHEET NO. | TOTAL SHEETS |
| 10 | DOWNTOWN EXPRESSWAY | 144 | 265 |

Note: Stringers S2-17 thru S5-17 and Stringers S1-18 thru S5-18 are parallel. Diaphragm spacing is shown along stringer length "L".

Dimensions shown at Piers are between extended center lines of stringers.

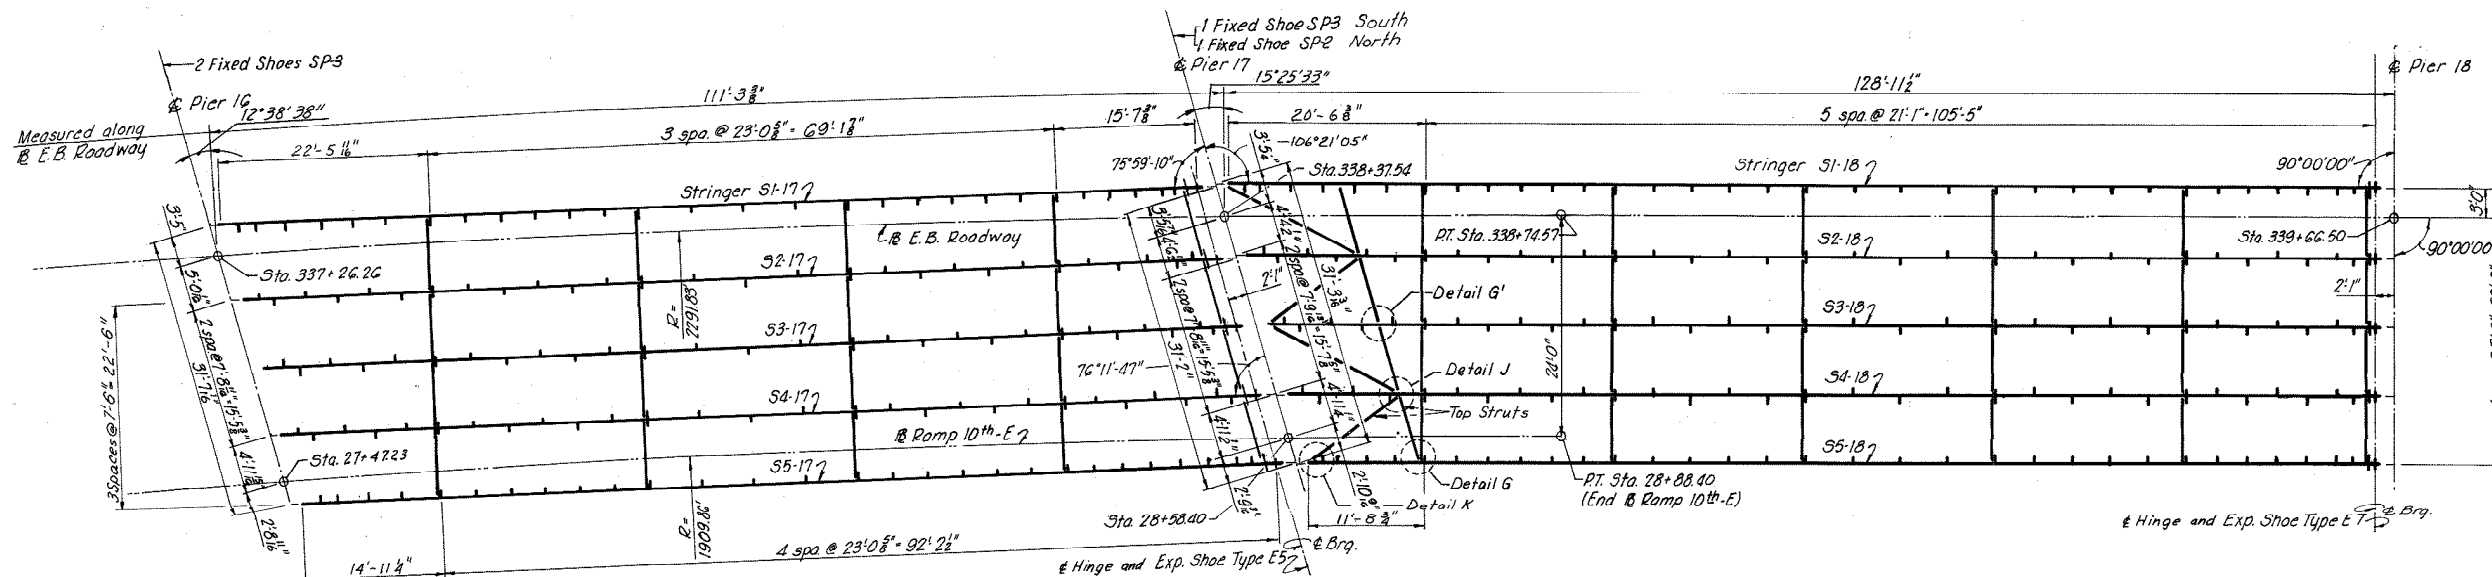


UNIT 17

UNIT 18


FRAMING PLAN

Scale: 1"=10'-0"


Note: For web to flange weld sizes and longitudinal stiffener plate details see Sheet 17.

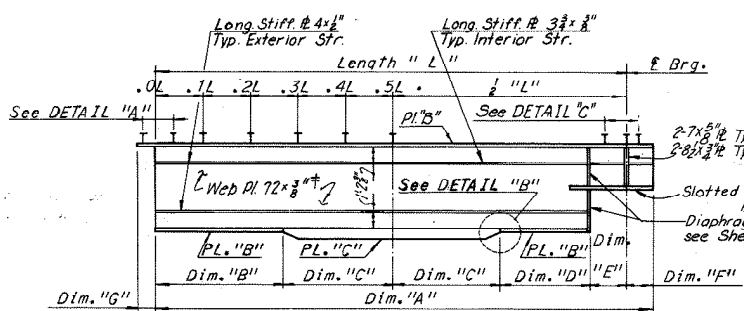

STRINGER ELEVATION
No Scale

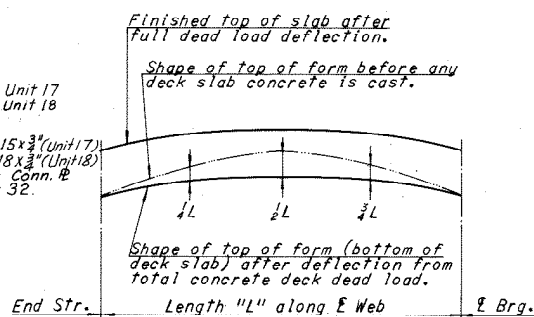

DEAD LOAD DEFLECTION DIAGRAM

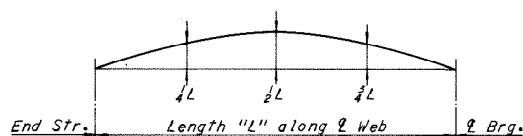


CAMBER DIAGRAM

NOTE TO FABRICATOR

The stringers shall be fabricated with an upward camber amounting to the tabulated value. This will provide approximate compensation for deflection under full dead load and for conformity with finished grade. Dimensions are in inches. Stringers having a total camber of less than 1" are not required to be shop cambered, but should be turned so that any mill tolerance deviation from straightness will be in the direction shown by the Camber Diagram. If stringers are not cambered, distance top of stringers to top of slab will vary along the stringer in accordance with the offset dimensions shown in the Camber Diagram, and with minimum distance as shown in cross-section on Sheet 32.

NOTE TO CONTRACTOR

Deflections given are those anticipated to occur in the stringer upon placement of the total concrete deck dead load. In practice, the stringers in place are not likely to have the exact camber to compensate for these deflections during construction. The residual amounts shall be provided by adjusting forms to vary the thickness of the concrete haunch between the bottom of the slab and the top of stringer without altering the slab thickness.

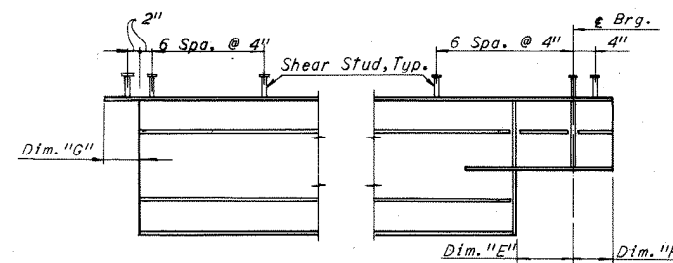

DETAIL "A"
No Scale

DETAIL "C"
No Scale

| SHOE SCHEDULE | | | |
|-----------------|-----------|-------------|-----------|
| EXPANSION SHOES | | FIXED SHOES | |
| TYPE | NO. REQD. | TYPE | NO. REQD. |
| E5 | 5 | SP-2 | 1 |
| E7 | 5 | SP-3 | 3 |

Note: Longitudinal stiffeners shall be located on the exterior face of the exterior stringers. Intermediate stiffener PIs, 4x3/4" shall be equally spaced between diaphragms as shown. The first two stiffener spaces at the ends of stringers shall be one-half the normal spacing within the panel. All steel shall be A36 unless otherwise noted.

Notes: For Framing Details, see Sheet 22 and 23. For Joint Details, see Sheet 38. For Shoe Details, see Sheets S1, S2. For Diaphragm Details, see Sheet 32. For Superstructure steel quantities, see Sheet 2. For Details G, G', J and K, see Sheet 27. For Shear Stud Details, see Sheet 14. For Angles between Piers and Stringers, see Sheets 22 & 23.

| UNIT | STRINGER | STRINGER SCHEDULE | | | | | | | | | | DEAD LOAD DEFLECTION SCHEDULE | | | | | CAMBER SCHEDULE | | | | | |
|------|----------|-------------------|--------------|-------------|----------|------------|----------|----------|----------|-----------|-------------|-------------------------------|-----------|-----------|-----------|-----------|-----------------|--------|--------|--------|--------|--------|
| | | Dim. "A" | LENGTH "L" | Dim. "B" | Dim. "C" | Dim. "D" | Dim. "E" | Dim. "F" | Dim. "G" | PL. "B" | PL. "C" | 0.0L-0.1L | 0.1L-0.2L | 0.2L-0.3L | 0.3L-0.4L | 0.4L-0.5L | 1/4L | 1/2L | 3/4L | | | |
| | | 107'-10 3/4" | 107'-2 3/4" | 26'-7 1/2" | 27'-0" | 25'-9 1/4" | 10 3/4" | 7 1/4" | 6 3/4" | * 15x3/4" | * 15x1 1/4" | | | | | | | | | | | |
| 17 | S1-17 | 107'-10 3/4" | 107'-2 3/4" | 26'-7 1/2" | 27'-0" | 25'-9 1/4" | 10 3/4" | 7 1/4" | 6 3/4" | * 15x3/4" | * 15x1 1/4" | 13 1/2" | 15 1/2" | 18 1/2" | 23" | 24" | 1 3/8" | 2 1/4" | 1 3/8" | 2" | 2 3/8" | 2 1/4" |
| | S2-17 | 107'-9" | 107'-1 1/4" | 28'-6 3/4" | 25'-0" | 27'-8 3/4" | 10 3/4" | 7 1/4" | 6 3/4" | * 15x3/4" | * 15x1 1/4" | 14 1/2" | 17" | 19 1/2" | 22" | 24" | 1 3/8" | 2 1/4" | 1 3/8" | 1 1/8" | 2 3/8" | 1 3/8" |
| | S3-17 | 107'-9" | 107'-1 1/4" | 28'-6 3/4" | 25'-0" | 27'-8 3/4" | 10 3/4" | 7 1/4" | 6 3/4" | * 15x3/4" | * 15x1 1/4" | 14 1/2" | 17" | 19 1/2" | 22" | 24" | 1 3/8" | 2 1/4" | 1 3/8" | 1 1/2" | 2 1/8" | 1 3/8" |
| | S4-17 | 107'-9" | 107'-1 1/4" | 28'-6 3/4" | 25'-0" | 27'-8 3/4" | 10 3/4" | 7 1/4" | 6 3/4" | * 15x3/4" | * 15x1 1/4" | 14 1/2" | 17" | 19 1/2" | 22" | 24" | 1 3/8" | 2 1/4" | 1 3/8" | 1 5/8" | 1 5/8" | 1 1/2" |
| | S5-17 | 107'-9" | 107'-1 1/4" | 28'-0 3/4" | 25'-6" | 27'-2 3/4" | 10 3/4" | 7 1/4" | 6 3/4" | * 15x3/4" | * 15x1 1/4" | 14" | 16" | 19" | 24" | 24" | 1 3/8" | 2 3/8" | 1 3/8" | 1" | 1 1/8" | 3/4" |
| 18 | S1-18 | 126'-6 3/4" | 125'-11 1/2" | 30'-11 1/2" | 32'-0" | 30'-1 1/2" | 10" | 7" | 6 3/4" | * 18x3/4" | * 18x1 1/4" | 14" | 16 1/2" | 19 1/2" | 24" | 24" | 2 1/8" | 3 3/8" | 2 1/8" | 2 3/8" | 4 1/8" | 2 3/8" |
| | S2-18 | 124'-4" | 123'-9" | 34'-10 1/2" | 27'-0" | 34'-0 1/2" | 10" | 7" | 6 3/4" | * 18x3/4" | * 18x1 1/4" | 16" | 18 1/2" | 21 1/2" | 24" | 24" | 2 1/8" | 2 3/8" | 2 1/8" | 2 1/8" | 3 3/8" | 2 3/8" |
| | S3-18 | 122'-1 9/16" | 121'-6 3/8" | 36'-3 3/8" | 24'-6" | 35'-5 1/4" | 10" | 7" | 6 3/4" | * 18x3/4" | * 18x1 1/4" | 16" | 18 1/2" | 21 1/2" | 23 1/2" | 24" | 2" | 2 1/4" | 2" | 2 3/8" | 3 3/8" | 2 3/8" |
| | S4-18 | 119'-11 3/4" | 119'-4 3/4" | 37'-0 3/4" | 21'-6" | 36'-2 3/4" | 10" | 7" | 6 3/4" | * 18x3/4" | * 18x1 1/4" | 16" | 18 1/2" | 21 1/2" | 23 1/2" | 24" | 1 3/8" | 2 3/8" | 1 3/8" | 2 3/8" | 3 3/8" | 2 3/8" |
| | S5-18 | 117'-8 1/2" | 117'-1 1/2" | 37'-0 1/2" | 21'-6" | 36'-2 3/4" | 10" | 7" | 6 3/4" | * 18x3/4" | * 18x1 1/4" | 14 1/2" | 17" | 20" | 24" | 24" | 1 3/8" | 2 3/8" | 1 3/8" | 2 1/4" | 3 3/8" | 2 3/8" |

*Spacing begins at termination of 6 spaces @ 4".

† Denotes A572-Grade 50 steel for thickness of 3/4" and under and A500 steel for thickness over 3/4".

| BY | DATE | REVISION | BY | DATE |
|-----------|-------------|-----------------|-----|----------|
| MADE | FKD 8-20-68 | 2 As Built | TEM | 8-76 |
| CHECKED | PTA 4-25-69 | 1 Pier 17 Shoes | DWS | 11-14-74 |
| IN CHARGE | | | | |


AS BUILT

RICHMOND METROPOLITAN AUTHORITY
RICHMOND EXPRESSWAY SYSTEM
DOWNTOWN EXPRESSWAY

BRIDGE NO. 66
 EASTBOUND ROADWAY OVER
 12TH ST. - R.R. TRACKS AND 16TH ST.
FRAMING PLAN - UNITS 17 AND 18

SCALE: As Noted
 HOWARD, NEEDLES, TAMMEN & BERGENDOFF
 consulting engineers
 NEW YORK ALEXANDRIA KANSAS CITY
 CONTRACT NO. 10
 SHEET NO. 18 OF 46


| RICHMOND EXPRESSWAY SYSTEM | | | |
|----------------------------|---------------------|-----------|--------------|
| SECTION | PROJECT | SHEET NO. | TOTAL SHEETS |
| 10 | DOWNTOWN EXPRESSWAY | 145 | 265 |

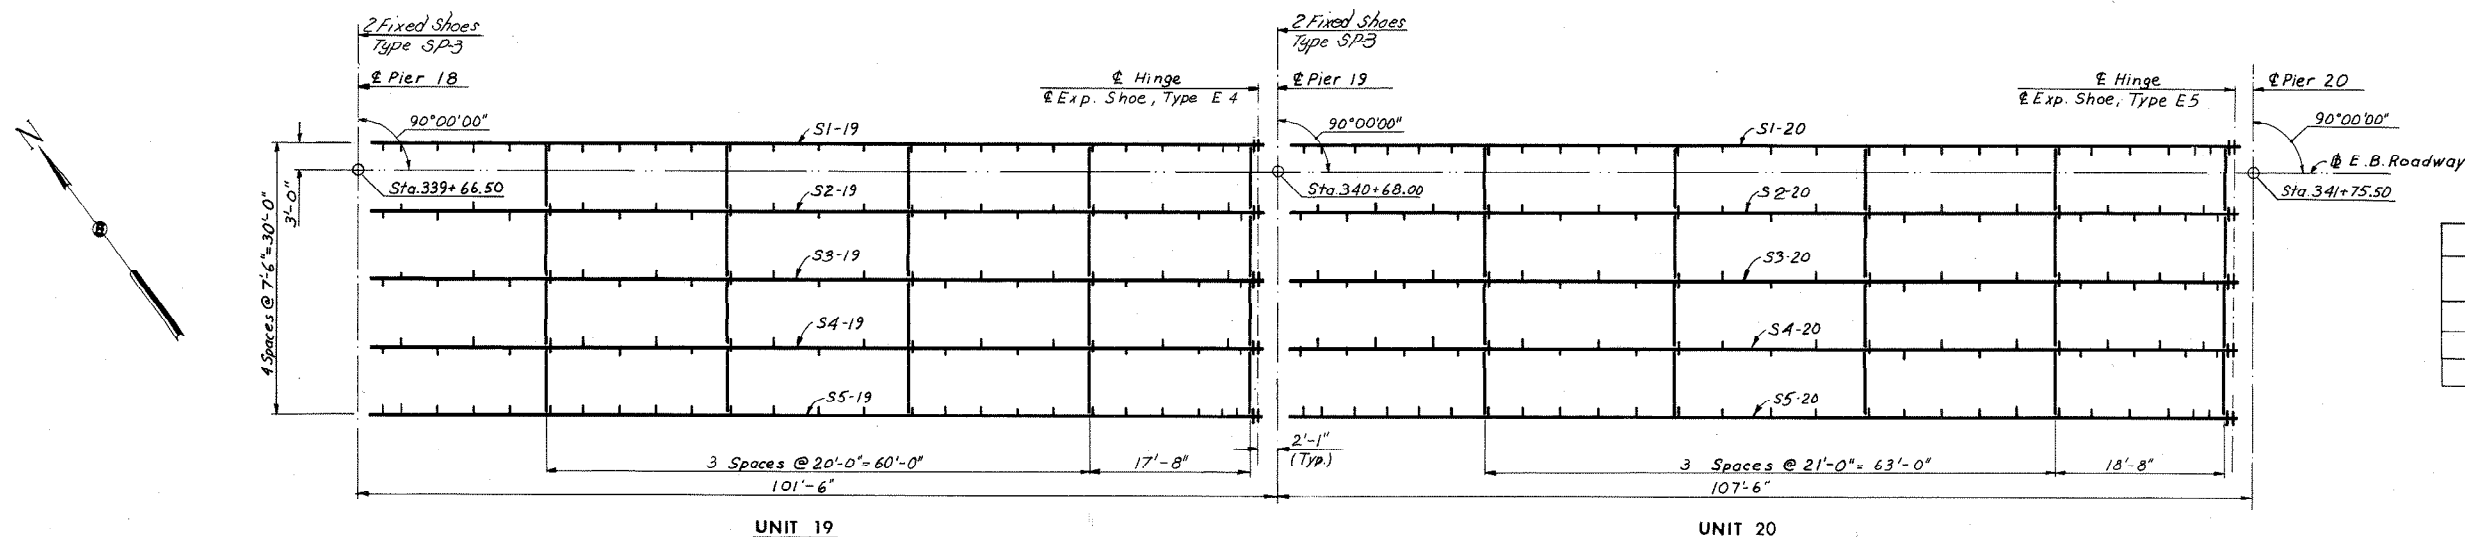


| SHOE SCHEDULE | | | |
|-----------------|-----------|-------------|-----------|
| EXPANSION SHOES | | FIXED SHOES | |
| TYPE | NO. REQD. | TYPE | NO. REQD. |
| E4 | 5 | SP-3 | 4 |
| E5 | 5 | | |

FRAMING PLAN
Scale: 1"=10'-0"

Note: For web to flange weld sizes and Longitudinal Stiffener Plate details see Sheet 17.

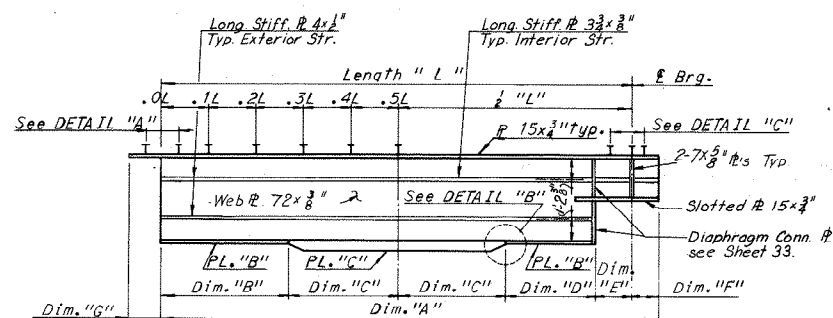


STRINGER ELEVATION
No Scale

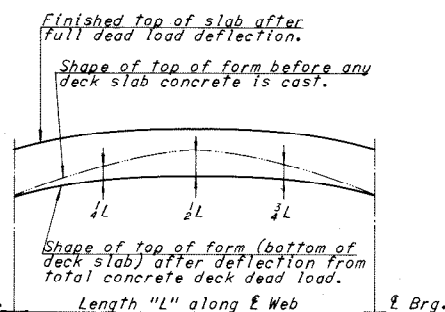

DEAD LOAD DEFLECTION DIAGRAM

NOTE TO CONTRACTOR


Deflections given are those anticipated to occur in the stringer upon placement of the total concrete deck dead load. In practice, the stringers in place are not likely to have the exact camber to compensate for these deflections during construction. The residual amounts shall be provided by adjusting forms to vary the thickness of the concrete haunch between the bottom of the slab and the top of stringer without altering the slab thickness.

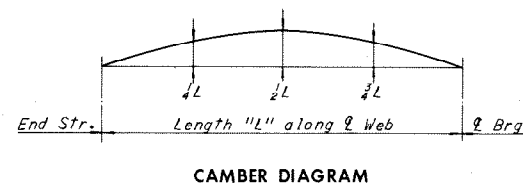

CAMBER DIAGRAM

NOTE TO FABRICATOR


The stringers shall be fabricated with an upward camber amounting to the Tabulated value. This will provide approximate compensation for deflection under full dead load and for conformity with finished grade. Dimensions are in inches. Stringers having a total camber of less than 1" are not required to be shop cambered, but should be turned so that any mill tolerance deviation from straightness will be in the direction shown by the Camber Diagram. If stringers are not cambered, distance top of stringers to top of slab will vary along the stringer in accordance with the offset dimensions shown in the Camber Diagram, and with minimum distance as shown in cross-section on Sheet 33.

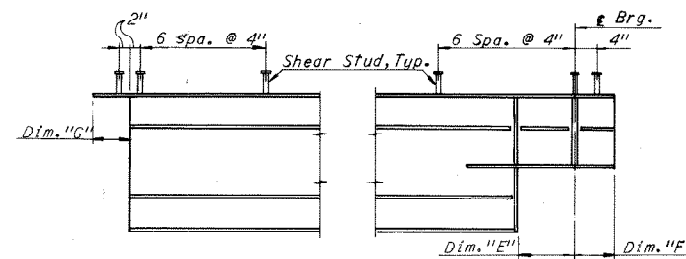

DETAIL "A"
No Scale

DETAIL "C"
No Scale

Note: Longitudinal stiffeners shall be located on the exterior face of the exterior Stringers. Intermediate stiffener Pls. 4 1/2 x 3/8" shall be equally spaced between diaphragms as shown. The first two stiffener spaces at the end of stringers shall be one-half the normal spacing within the panel.

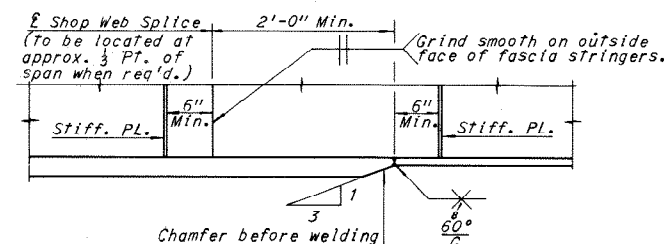

DETAIL "B"
No Scale

Notes: For Superstructure steel quantities, see Sheet 2. For Diaphragm Details, see Sheet 33. For Shoe Details, see Sheets S1/S2. For Joint Details, see Sheet 38. For Framing Details, see Sheet 23. For Shear Stud Details, see Sheet 14. For Angles between Piers and Stringers, see Sheet 23.

| UNIT | STRINGER | Dim. "A" | LENGTH "L" | Dim. "B" | Dim. "C" | Dim. "D" | Dim. "E" | Dim. "F" | Dim. "G" | PL. "B" | PL. "C" | MAX. SHEAR STUD SPACING | | | | | DEAD LOAD DEFLECTION SCHEDULE | | | CAMBER SCHEDULE | | |
|------|----------|-------------|-------------|------------|----------|-------------|----------|----------|----------|---------|-----------|-------------------------|-----------|------------|------------|------------|-------------------------------|-------------|--------|-----------------|--------|--------|
| | | | | | | | | | | | | 0.0L-0.1L | 0.1L-0.2L | 0.2L-0.3L | 0.3L-0.4L | 0.4L-0.5L | 1/4L | 1/2L | 3/4L | 1/4L | 1/2L | 3/4L |
| | | | | | | | | | | | | 19 | S1-19 | 98'-2 1/2" | 97'-7 1/4" | 23'-9 5/8" | 25'-0" | 22'-11 5/8" | 10" | 7" | 6 1/2" | 15x8" |
| 19 | S2-19 | 98'-2 1/2" | 97'-7 1/4" | 24'-9 5/8" | 24'-0" | 23'-11 5/8" | 10" | 7" | 6 1/2" | 15x8" | 15x1 1/4" | 16" | 18" | 21" | 24" | 24" | 1" | 1 1/8" | 1" | 1 1/4" | 1 1/2" | 1 1/4" |
| 19 | S3-19 | 98'-2 1/2" | 97'-7 1/4" | 24'-9 5/8" | 24'-0" | 23'-11 5/8" | 10" | 7" | 6 1/2" | 15x8" | 15x1 1/4" | 16" | 18" | 21" | 24" | 24" | 1" | 1 1/8" | 1" | 1 1/4" | 1 1/2" | 1 1/4" |
| 19 | S4-19 | 98'-2 1/2" | 97'-7 1/4" | 24'-9 5/8" | 24'-0" | 23'-11 5/8" | 10" | 7" | 6 1/2" | 15x8" | 15x1 1/4" | 16" | 18" | 21" | 24" | 24" | 1" | 1 1/8" | 1" | 1 1/4" | 1 1/2" | 1 1/4" |
| 19 | S5-19 | 98'-2 1/2" | 97'-7 1/4" | 23'-9 5/8" | 25'-0" | 22'-11 5/8" | 10" | 7" | 6 1/2" | 15x8" | 15x1 1/4" | 14 1/2" | 17" | 20" | 24" | 24" | 1" | 1 1/8" | 1" | 1 1/4" | 1 1/2" | 1 1/4" |
| 20 | S1-20 | 104'-2 1/2" | 103'-7 1/4" | 24'-3 5/8" | 27'-6" | 23'-5 5/8" | 10" | 7" | 6 1/2" | 15x8" | 15x1 1/2" | 14 1/2" | 17" | 20" | 24" | 24" | 1 1/8" | 1 1/8" | 1 1/8" | 1 1/8" | 2 1/8" | 1 1/8" |
| 20 | S2-20 | 104'-2 1/2" | 103'-7 1/4" | 22'-3 5/8" | 29'-6" | 21'-5 5/8" | 10" | 7" | 6 1/2" | 15x8" | 15x1 1/2" | 15 1/2" | 18" | 21" | 24" | 24" | 1 1/8" | 1 1/8" | 1 1/8" | 1 1/8" | 2 1/8" | 1 1/8" |
| 20 | S3-20 | 104'-2 1/2" | 103'-7 1/4" | 22'-3 5/8" | 29'-6" | 21'-5 5/8" | 10" | 7" | 6 1/2" | 15x8" | 15x1 1/2" | 15 1/2" | 18" | 21" | 24" | 24" | 1 1/8" | 1 1/8" | 1 1/8" | 1 1/8" | 2 1/8" | 1 1/8" |
| 20 | S4-20 | 104'-2 1/2" | 103'-7 1/4" | 22'-3 5/8" | 29'-6" | 21'-5 5/8" | 10" | 7" | 6 1/2" | 15x8" | 15x1 1/2" | 15 1/2" | 18" | 21" | 24" | 24" | 1 1/8" | 1 1/8" | 1 1/8" | 1 1/8" | 2 1/8" | 1 1/8" |
| 20 | S5-20 | 104'-2 1/2" | 103'-7 1/4" | 24'-3 5/8" | 27'-6" | 23'-5 5/8" | 10" | 7" | 6 1/2" | 15x8" | 15x1 1/2" | 14 1/2" | 17" | 20" | 24" | 24" | 1 1/8" | 1 1/8" | 1 1/8" | 1 1/8" | 2 1/8" | 1 1/8" |

* Spacing begins at termination of 6 spaces @ 4"

Note: All structural steel in Units 19 and 20 is A36.

| | | | | | |
|-----------|------|---------|----------|-----|------|
| MADE | J.D. | 8-6-68 | | | |
| CHECKED | PTA | 11-4-68 | As Built | TEM | 8-76 |
| IN CHARGE | | | | | |











RICHMOND METROPOLITAN AUTHORITY
RICHMOND EXPRESSWAY SYSTEM
DOWNTOWN EXPRESSWAY

BRIDGE NO. 66
EASTBOUND ROADWAY OVER
12TH ST. - R.R. TRACKS AND 16TH ST.
FRAMING PLAN - UNITS 19 AND 20

| | | | |
|---|-----------------|------------------|--------------------|
| HOWARD, NEEDLES, TAMMEN & BERGENDOFF consulting engineers NEW YORK ALEXANDRIA KANSAS CITY | SCALE: As Noted | CONTRACT NO.: 10 | SHEET NO. 19 OF 46 |
|---|-----------------|------------------|--------------------|

AS BUILT

| RICHMOND EXPRESSWAY SYSTEM | | | |
|----------------------------|---------------------|-----------|--------------|
| SECTION | PROJECT | SHEET NO. | TOTAL SHEETS |
| 10 | DOWNTOWN EXPRESSWAY | 148 | 265 |

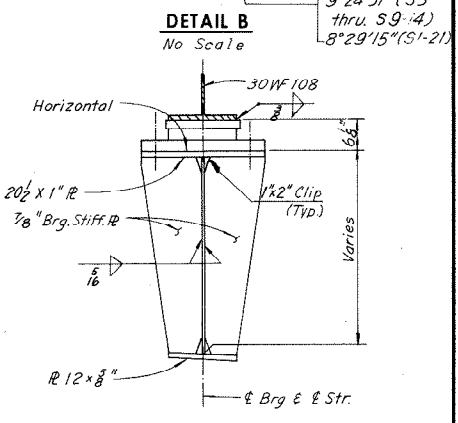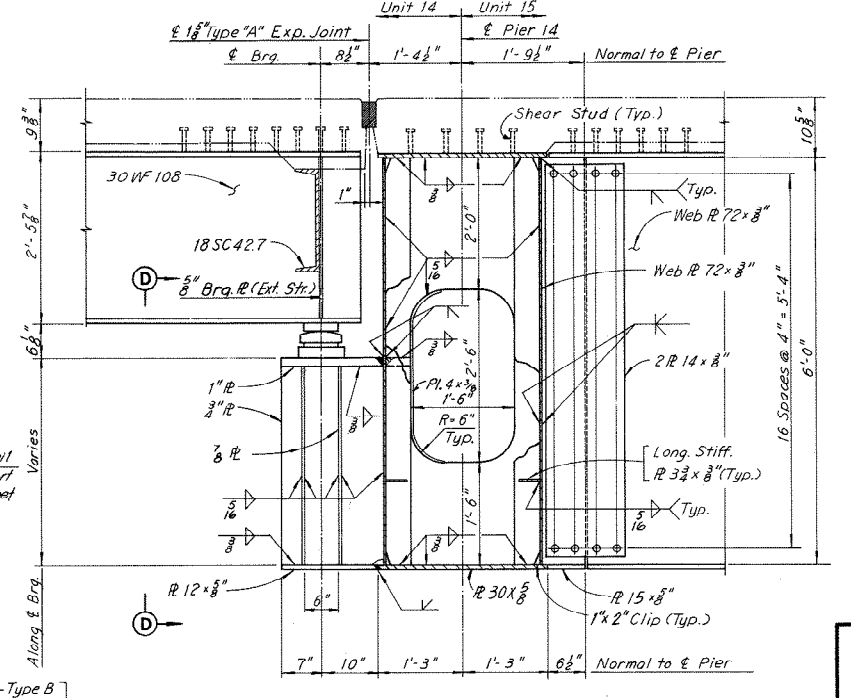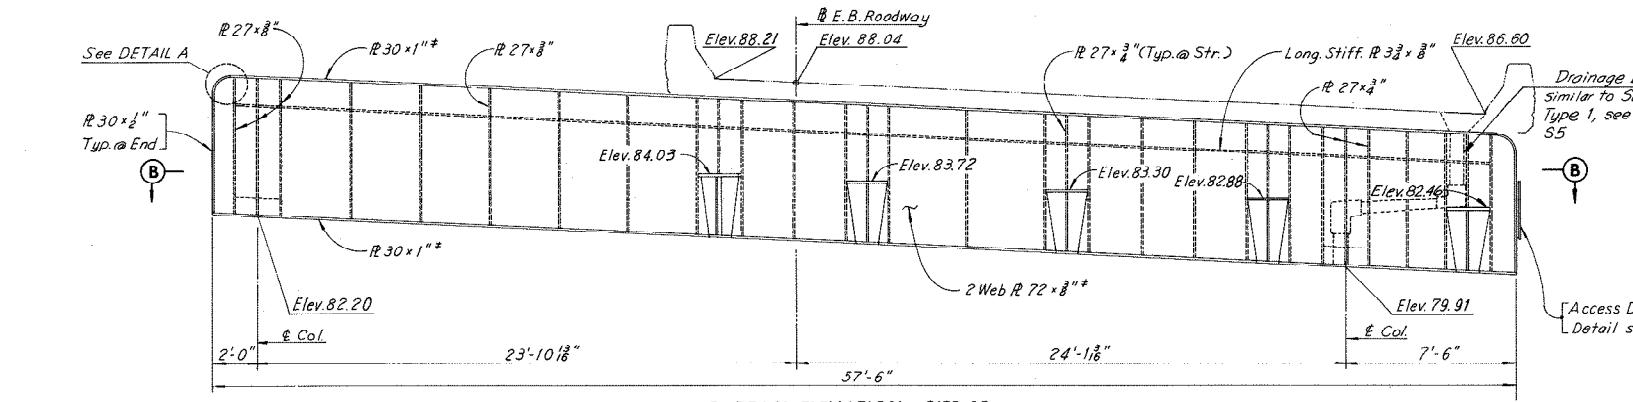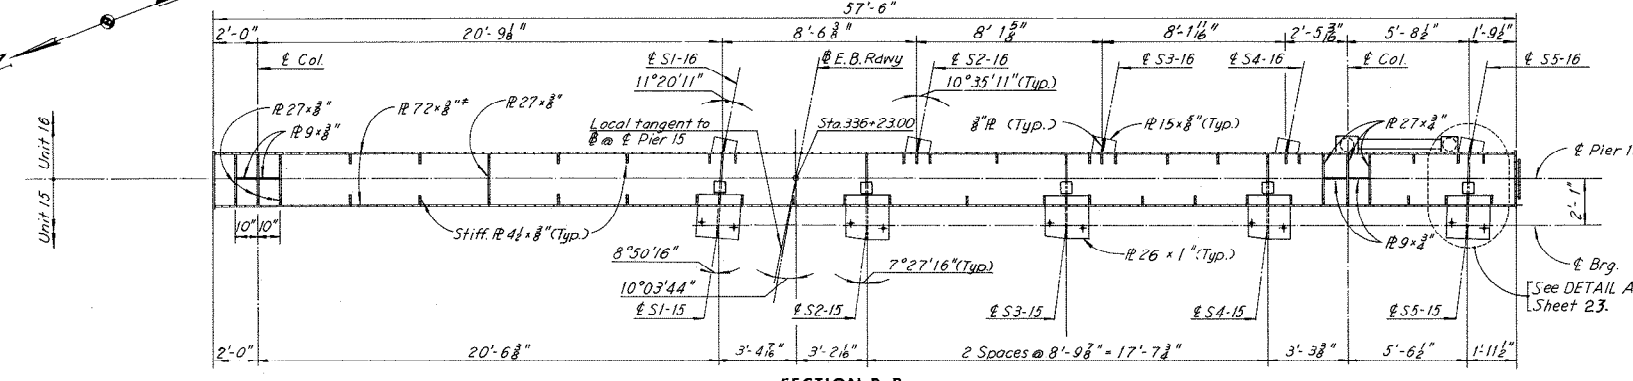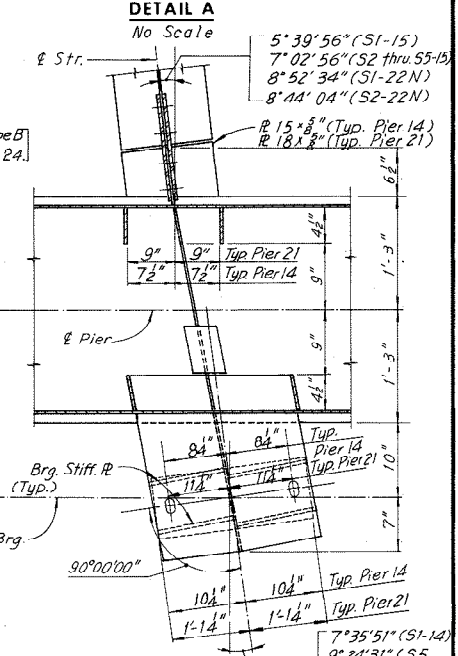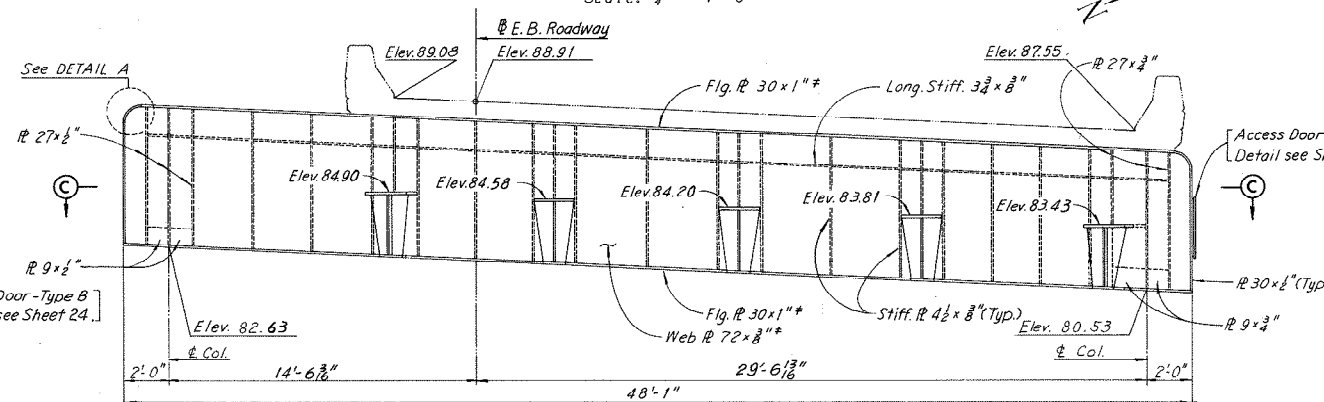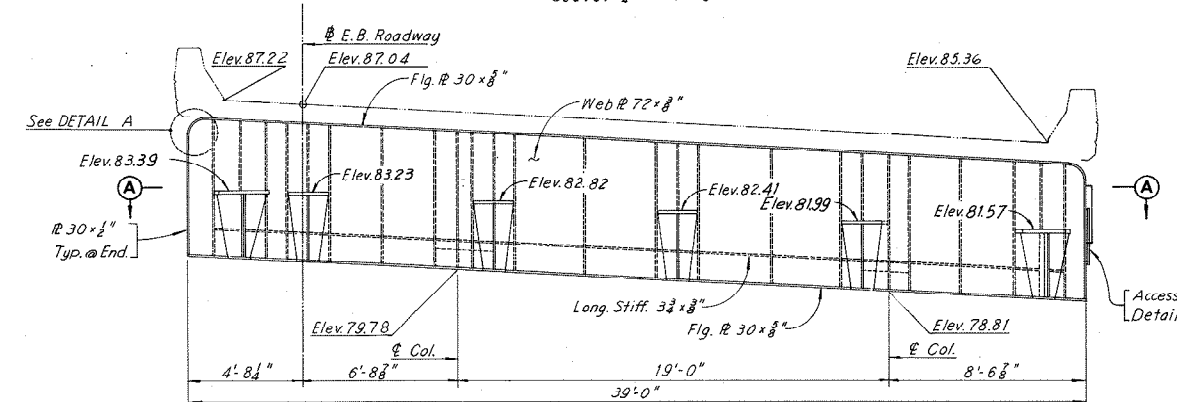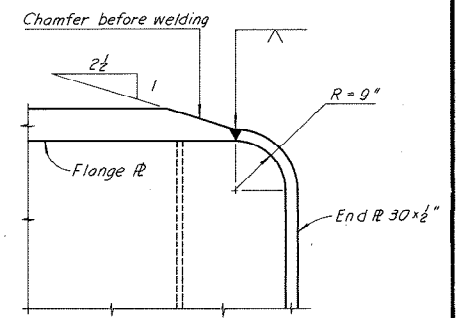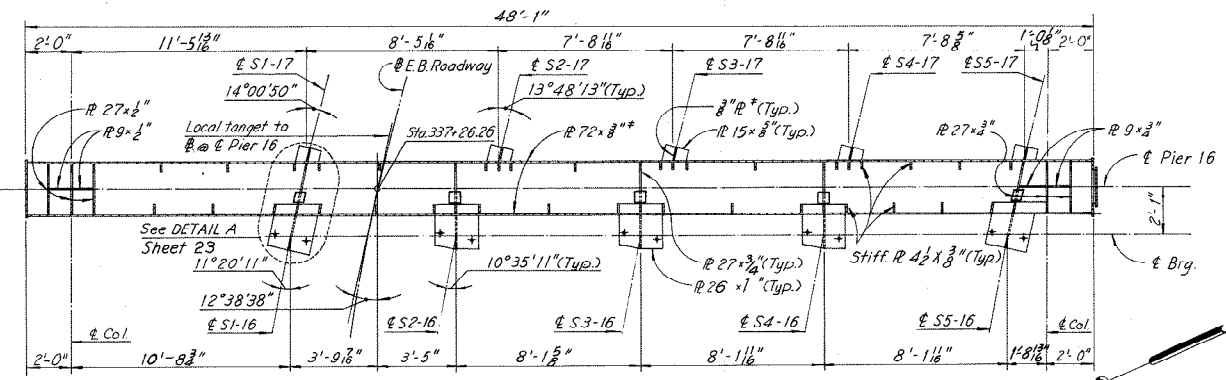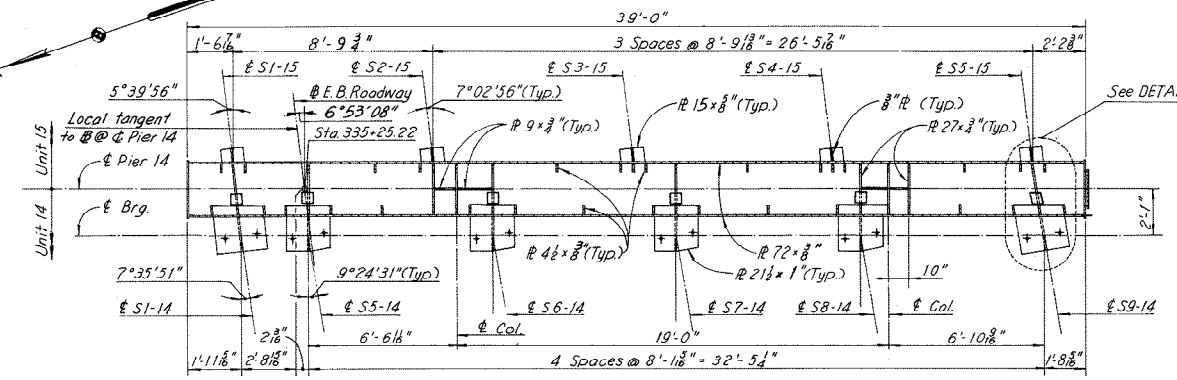

Notes:
For Framing Plans see: Sheet 16 for Unit 14, Sheet 17 for Units 15 & 16, Sheet 18 for Unit 17.
For Deck Plans see: Sheet 30 for Unit 14, Sheet 31 for Units 15 & 16, Sheet 32 for Unit 17.

| NO. | REVISION | BY | DATE |
|-----|--------------|------|---------|
| 1 | Note changed | PRMS | 4-19-74 |
| 2 | As Built | TEM | 8-74 |
| 3 | | | |
| 4 | | | |

Note:
All steel shall be A36 unless denoted otherwise.
* Denotes A572-Grade 50 steel for thickness of 3/4" and under and A588 steel for thickness over 3/4".
Provide Drain Holes at lower end of cap beam.
All elevations shown are final elevations.

Note:
Shear studs are placed in rows, with four shear studs in each row. Rows are spaced at 2d" centers within limits of concrete deck.

AS BUILT


RICHMOND METROPOLITAN AUTHORITY
RICHMOND EXPRESSWAY SYSTEM
DOWNTOWN EXPRESSWAY

BRIDGE NO. 66
EASTBOUND ROADWAY OVER
12TH ST. - R.R. TRACKS AND 16TH ST.
FRAMING DETAILS
PIERS 14, 15 AND 16


HOWARD, NEEDLES, TAMMEN & BERGENDOFF
consulting engineers
NEW YORK ALEXANDRIA KANSAS CITY

SCALE: As Noted
CONTRACT NO. 10
SHEET NO. 22 OF 46


| RICHMOND EXPRESSWAY SYSTEM | | | |
|----------------------------|---------------------|-----------|--------------|
| SECTION | PROJECT | SHEET NO. | TOTAL SHEETS |
| 10 | DOWNTOWN EXPRESSWAY | 149 | 265 |

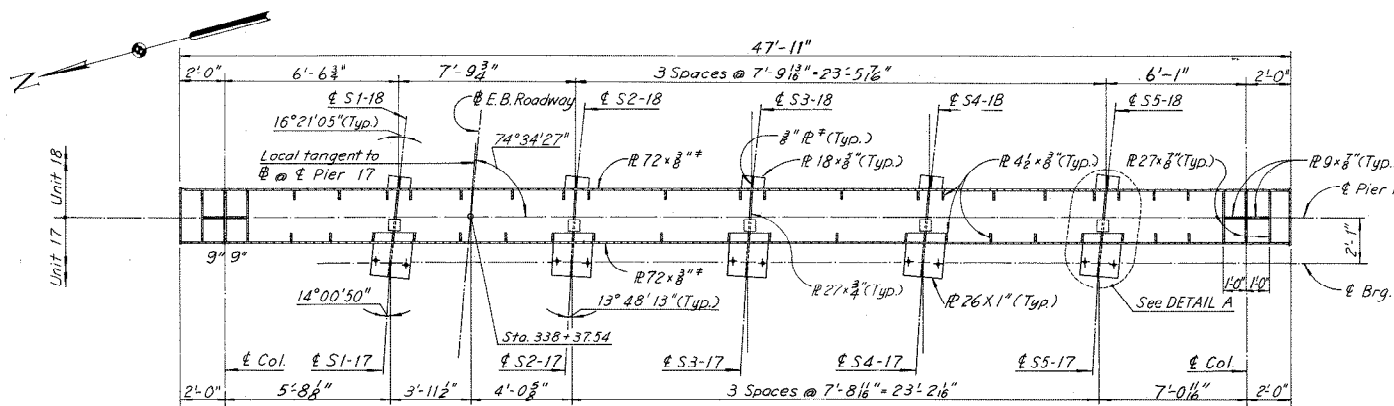


SECTION A-A
Scale: 1/4" = 1'-0"

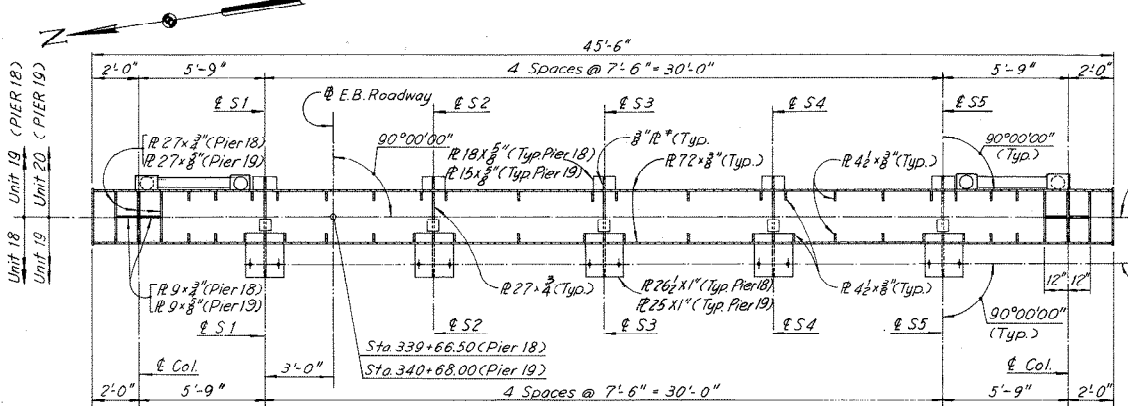


SECTION B-B
Scale: 1/4" = 1'-0"

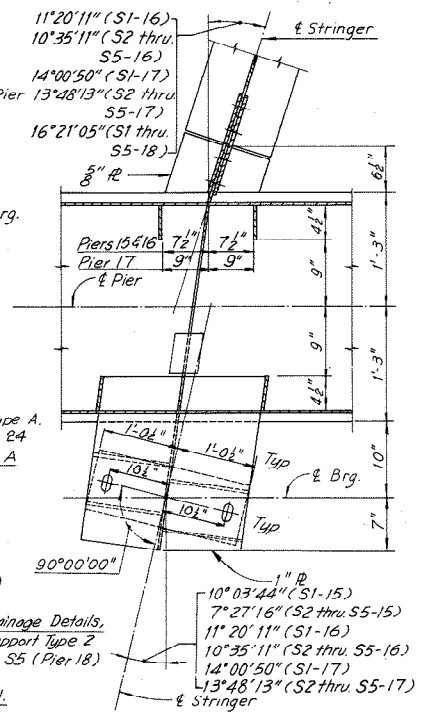


DETAIL A
No Scale

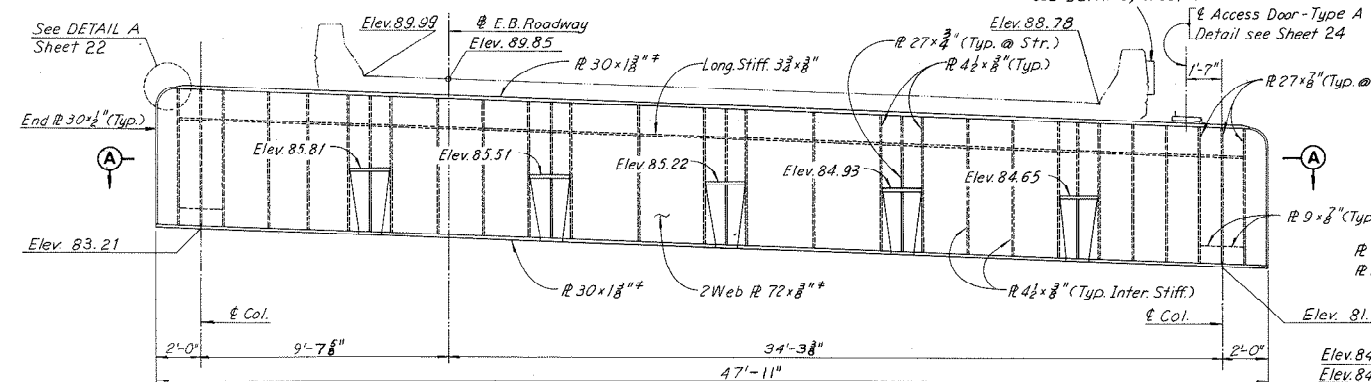


CAP BEAM ELEVATION - PIER 17
Scale: 1/4" = 1'-0"

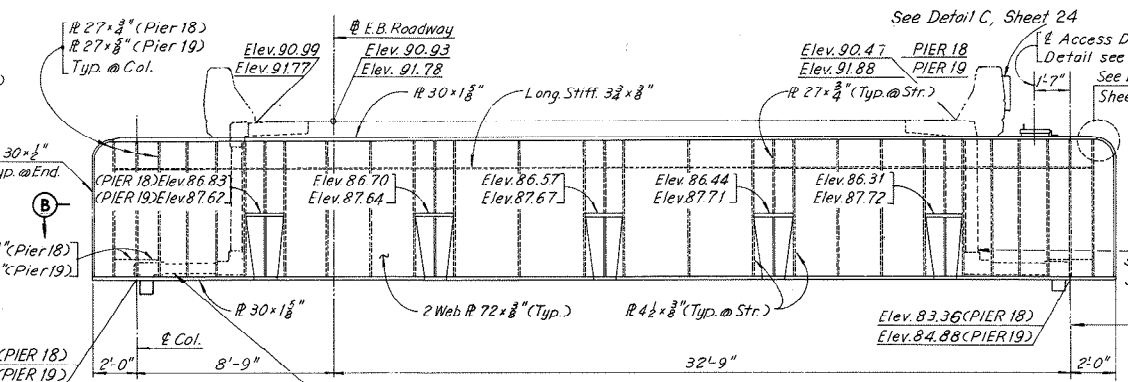


CAP BEAM ELEVATION - PIERS 18 AND 19
Scale: 1/4" = 1'-0"

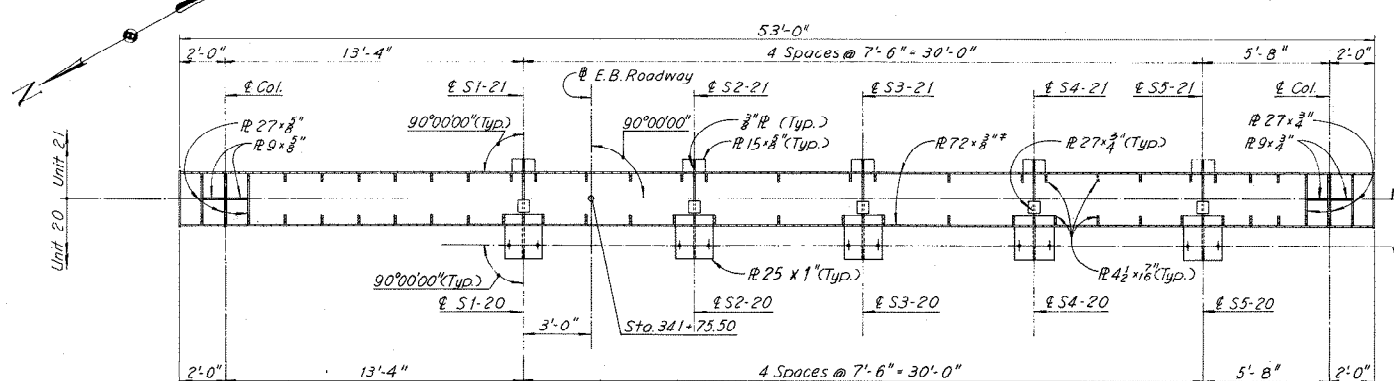


SECTION C-C
Scale: 1/4" = 1'-0"

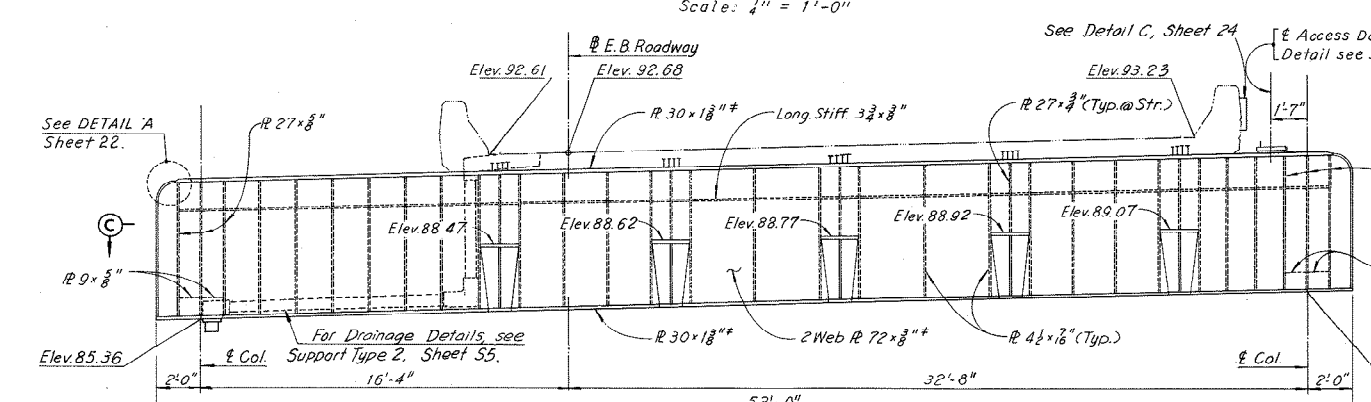

CAP BEAM ELEVATION - PIER 20
Scale: 1/4" = 1'-0"

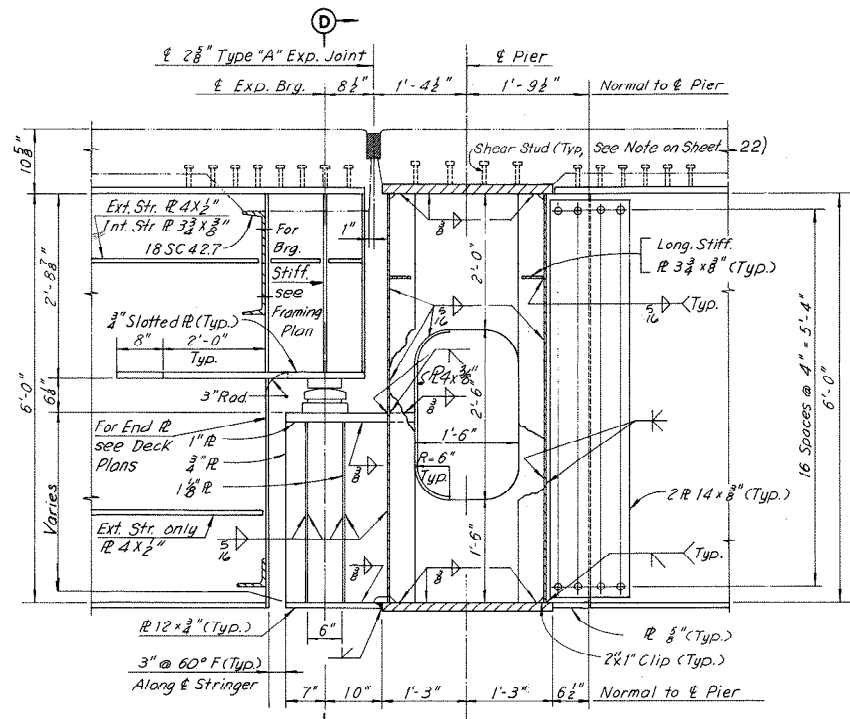

TYPICAL SECTION
Scale: 3/8" = 1'-0"

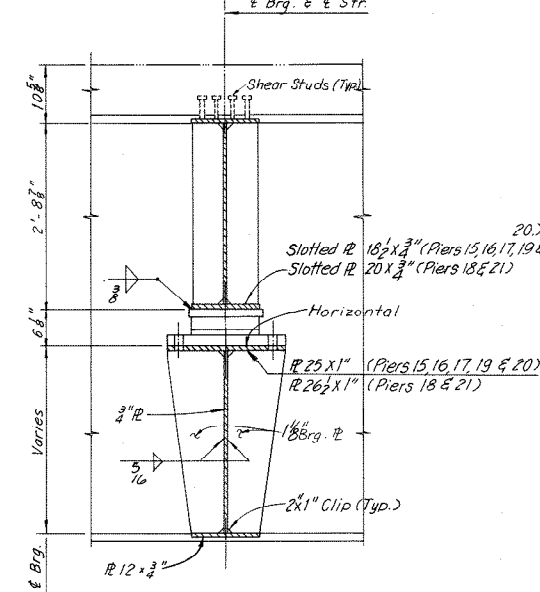

SECTION D-D
Scale: 3/8" = 1'-0"

Notes:
For Framing Plans see:
Sheet 18 for Units 17 & 18.
Sheet 19 for Units 19 & 20.
Sheet 20 for Units 21 & 22.
For Deck Plans see:
Sheet 32 for Units 17 & 18.
Sheet 33 for Units 19 & 20.
Sheet 34 for Units 21 & 22.

Note:
All steel shall be A36 unless denoted otherwise.
* Denotes A572-Grade 50 steel for thickness of 3/4" and under and A588 steel for thickness over 3/4".
Provide Drain Holes at lower end of cap beam.
All elevations shown are final elevations.

| BY | DATE | REVISION | BY | DATE |
|-----------|-----------------|----------|-----|------|
| MADE | M.H.H. 12-17-68 | | | |
| CHECKED | J.D. 1-29-69 | As Built | TEM | B-7C |
| IN CHARGE | | | | |

RICHMOND METROPOLITAN AUTHORITY
RICHMOND EXPRESSWAY SYSTEM
DOWNTOWN EXPRESSWAY





















BRIDGE NO. 66
EASTBOUND ROADWAY OVER
12TH ST. - R.R. TRACKS AND 16TH ST.
FRAMING DETAILS
PIERS 17, 18, 19 AND 20

HOWARD, NEEDLES, TAMMEN & BERGENDOFF
consulting engineers
NEW YORK ALEXANDRIA KANSAS CITY

SCALE: As Noted
CONTRACT NO. 10
SHEET NO. 23 OF 46

AS BUILT

| RICHMOND EXPRESSWAY SYSTEM | | | |
|----------------------------|---------------------|-----------|--------------|
| SECTION | PROJECT | SHEET NO. | TOTAL SHEETS |
| 10 | DOWNTOWN EXPRESSWAY | 153 | 265 |

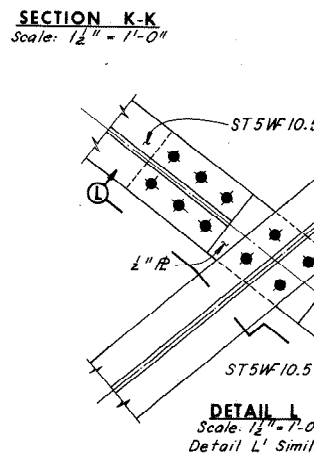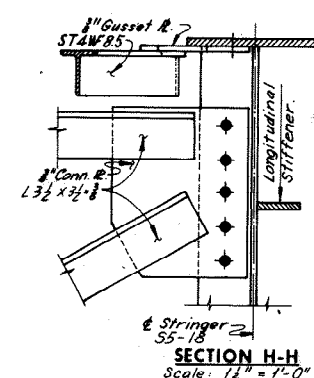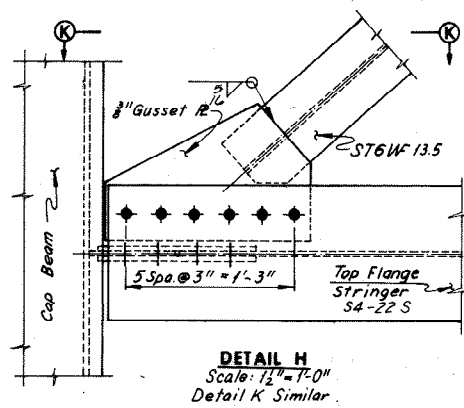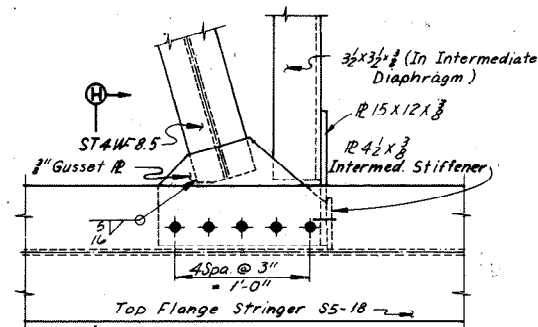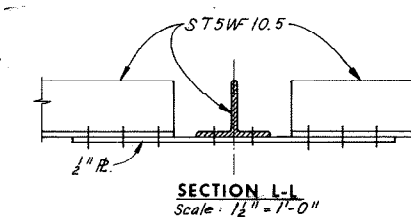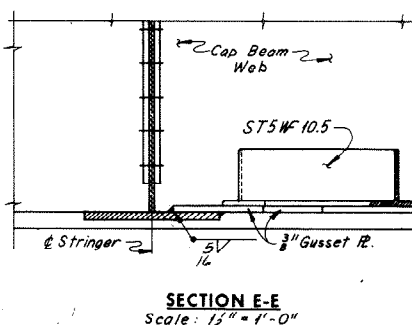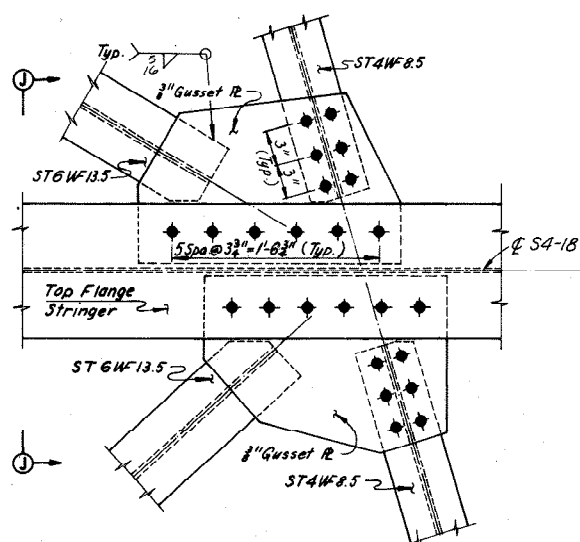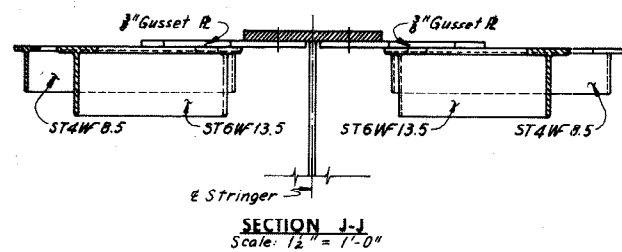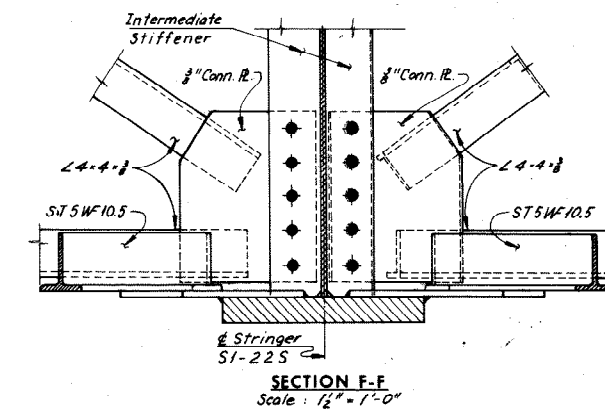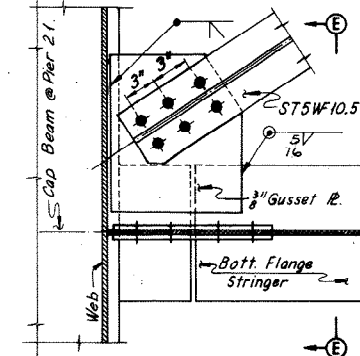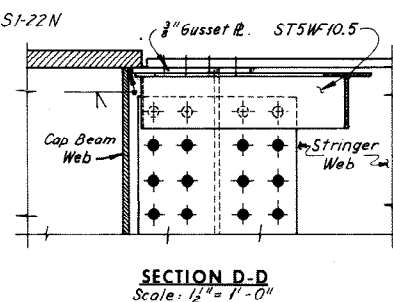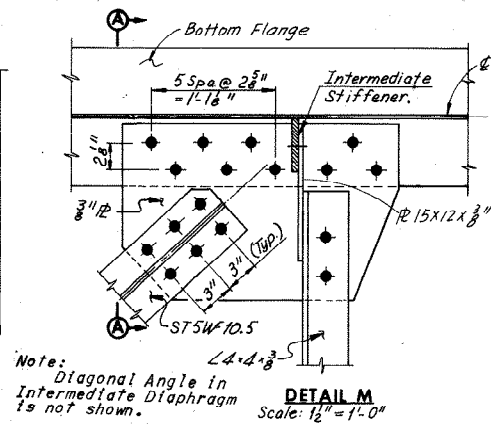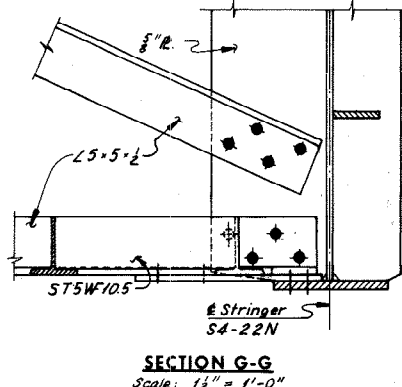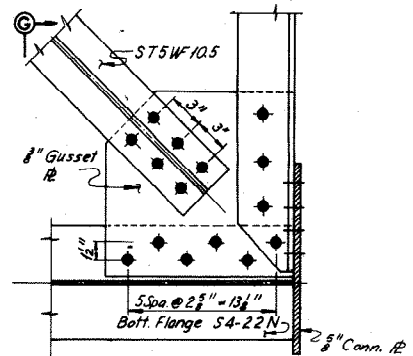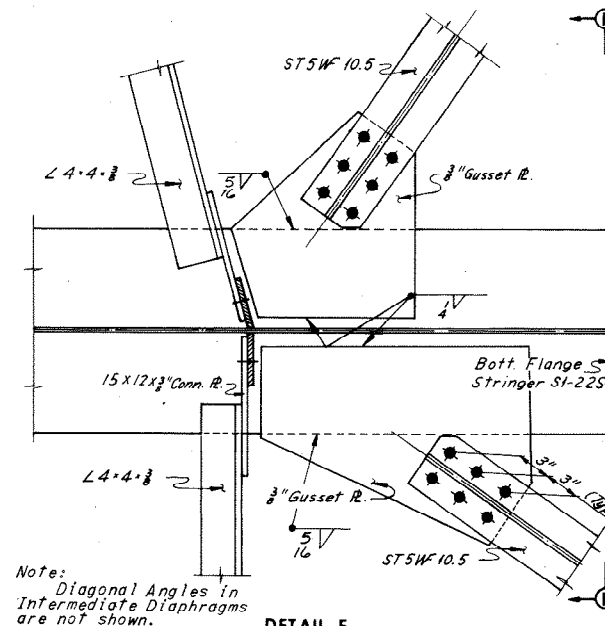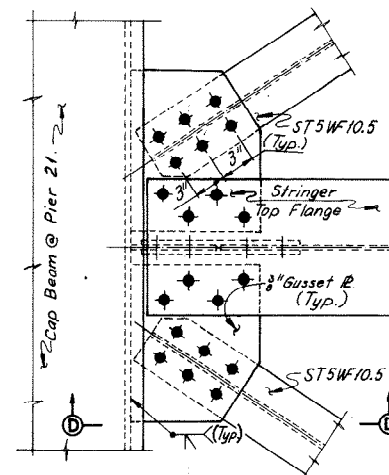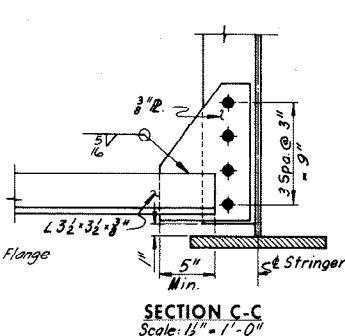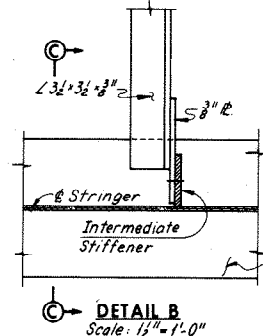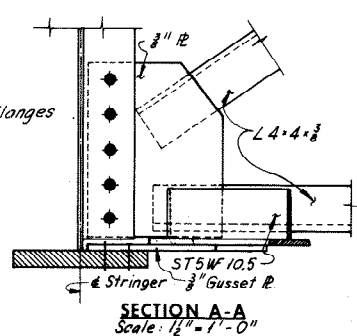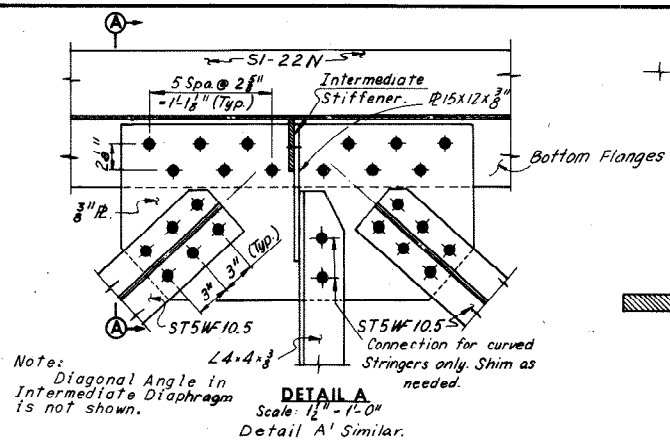

Note: For location of Details A, A', B, C, D, E, F, H, J, L, L' and M, see Sheet 20. For location of Details G, G', J and K, see Sheet 18.

| BY | DATE | NO. | REVISION | BY | DATE |
|-----------|--------------|-----|----------|-----|------|
| MADE | PTA 12-14-68 | | | | |
| CHECKED | AMH 2-10-69 | 1 | As Built | TEM | 8-76 |
| IN CHARGE | | | | | |

RICHMOND METROPOLITAN AUTHORITY
RICHMOND EXPRESSWAY SYSTEM
DOWNTOWN EXPRESSWAY


BRIDGE NO. 66
 EASTBOUND ROADWAY OVER
 12TH ST., R.R. TRACKS AND 16TH ST.
FRAMING DETAILS
UNITS 18, 21 AND 22

HOWARD, NEEDLES, TAMMEN & BERGENDOFF
 consulting engineers
 NEW YORK ALEXANDRIA KANSAS CITY



SCALE: As Noted
 CONTRACT NO. 10
 SHEET NO. 27 OF 46

AS BUILT

| RICHMOND EXPRESSWAY SYSTEM | | | |
|----------------------------|---------------------|-----------|--------------|
| SECTION | PROJECT | SHEET NO. | TOTAL SHEETS |
| 10 | DOWNTOWN EXPRESSWAY | 154 | 265 |

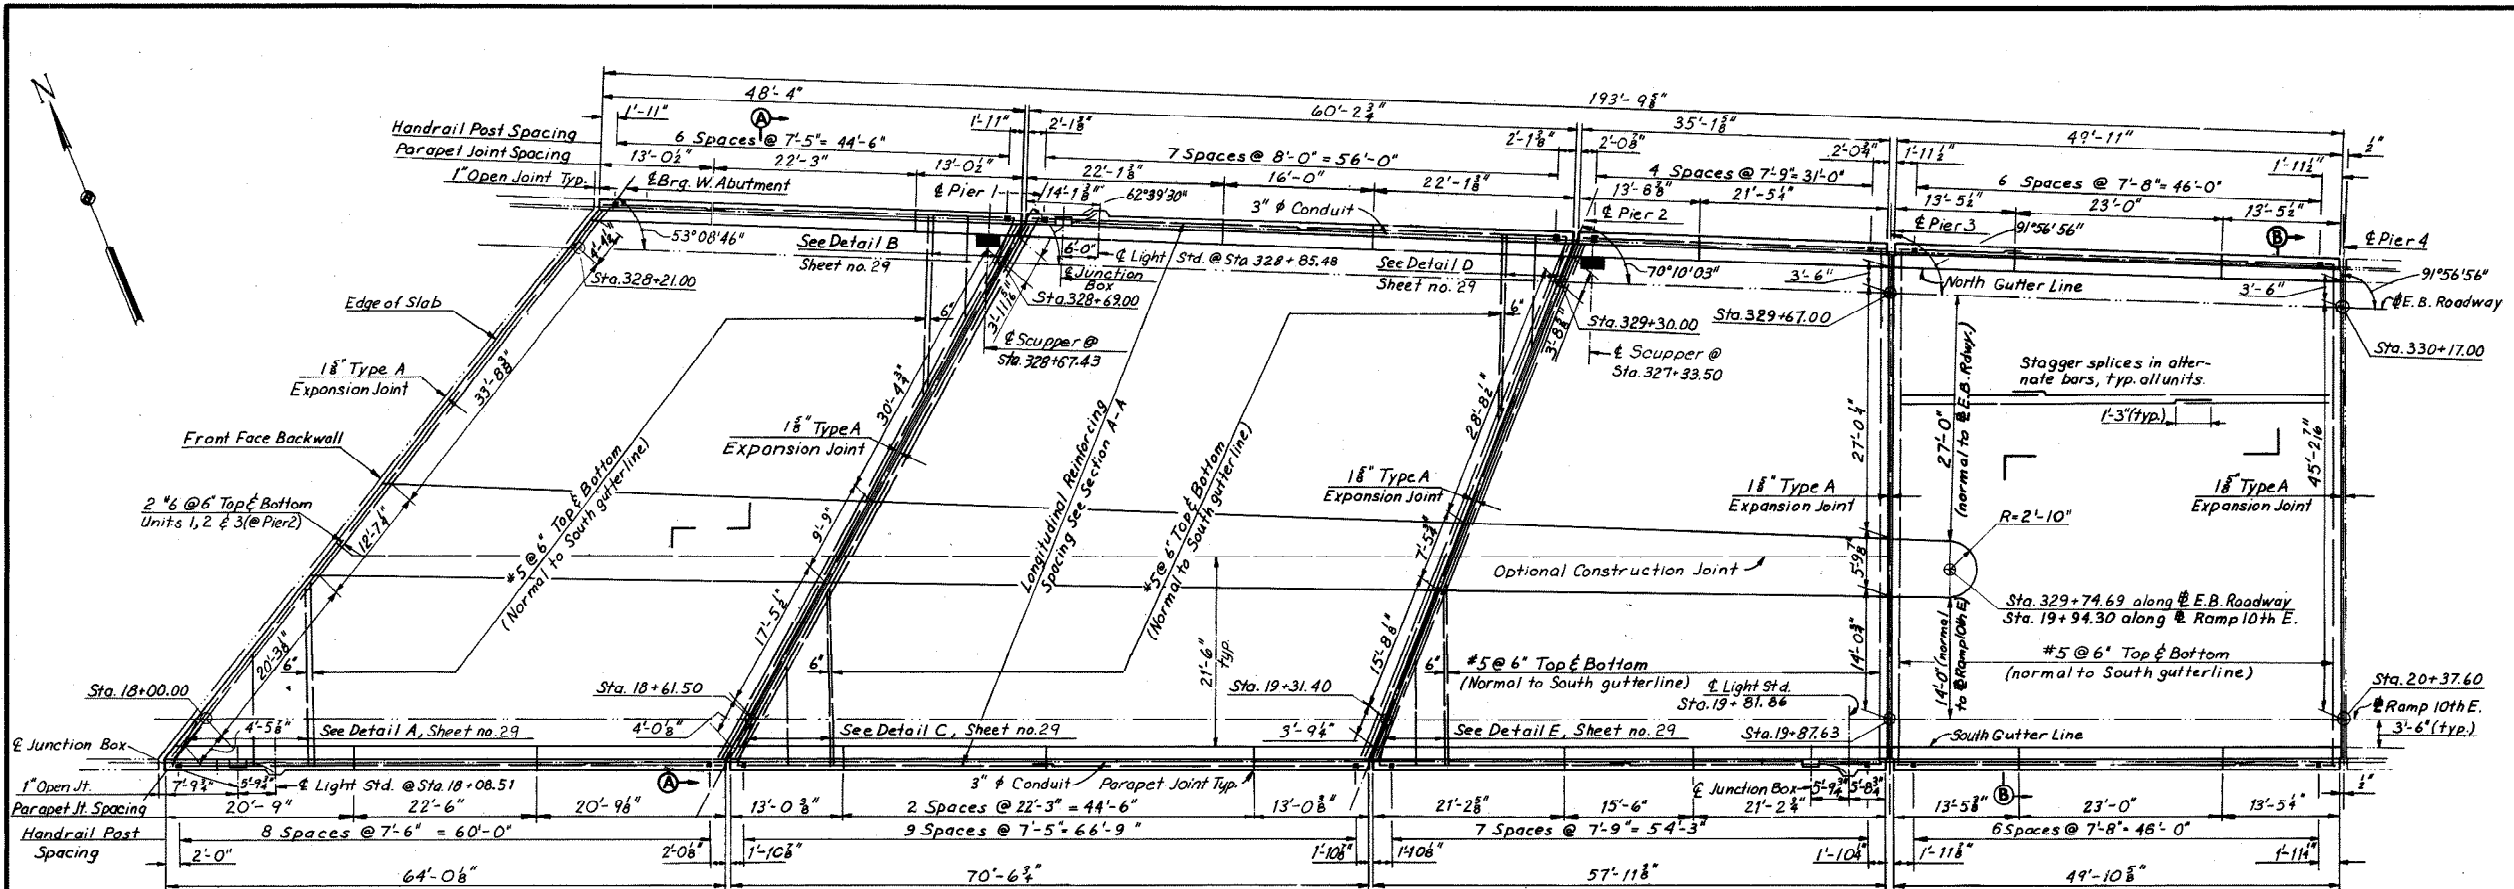

| ELEVATION TABLE | | | | | |
|-----------------|---------|---------|---------|---------|-------|
| STATION | ELEV. A | ELEV. B | ELEV. C | ELEV. E | ELEV. |
| 328+00.00 | 76.13 | 76.33 | 77.81 | — | — |
| +00.00 | — | — | 77.81 | — | — |
| +10.00 | 76.29 | 76.48 | 77.91 | — | — |
| +20.00 | 76.44 | 76.63 | 78.00 | — | — |
| +21.00 | — | — | 76.64 | — | — |
| +23.62 | 76.50 | — | — | — | — |
| +30.00 | 76.61 | 76.77 | 78.10 | — | — |
| +40.00 | 76.76 | 76.92 | 78.19 | — | — |
| +50.00 | 76.91 | 77.07 | 78.28 | — | — |
| +55.04 | — | — | 78.33 | — | — |
| +60.00 | 77.07 | 77.22 | 78.38 | — | — |
| +69.00 | — | — | 77.35 | — | — |
| +70.00 | 77.22 | 77.37 | 78.47 | — | — |
| +70.81 | 77.25 | — | — | — | — |
| +80.00 | 77.38 | 77.51 | 78.57 | — | — |
| +90.00 | 77.53 | 77.66 | 78.66 | — | — |
| 329+00.00 | 77.68 | 77.81 | 78.75 | — | — |
| +10.00 | 77.84 | 77.96 | 78.85 | — | — |
| +20.00 | 77.99 | 78.11 | 78.94 | — | — |
| +20.26 | — | — | 78.95 | — | — |
| +30.00 | 78.16 | 78.25 | 79.04 | — | — |
| +31.26 | 78.17 | — | — | — | — |
| +40.00 | 78.31 | 78.40 | 79.13 | — | — |
| +50.00 | 78.46 | 78.55 | 79.22 | — | — |
| +60.00 | 78.62 | 78.70 | 79.32 | — | — |
| +66.88 | 78.73 | — | — | — | — |
| +67.00 | — | — | 78.80 | — | — |
| +67.92 | — | — | 79.39 | — | — |
| +70.00 | 78.77 | 78.85 | 79.41 | — | — |
| +80.00 | 78.93 | 78.99 | — | 79.88 | 79.94 |
| +90.00 | 79.08 | 79.14 | — | 79.93 | 79.99 |
| 330+00.00 | 79.23 | 79.29 | — | 79.98 | 80.03 |
| +10.00 | 79.39 | 79.44 | — | 80.03 | 80.08 |
| +16.88 | 79.51 | — | — | — | — |
| +17.00 | — | — | 79.54 | — | — |
| +18.54 | — | — | — | — | 80.08 |
| +18.64 | — | — | — | — | 80.12 |
| +20.00 | 79.54 | 79.59 | — | 80.08 | 80.13 |

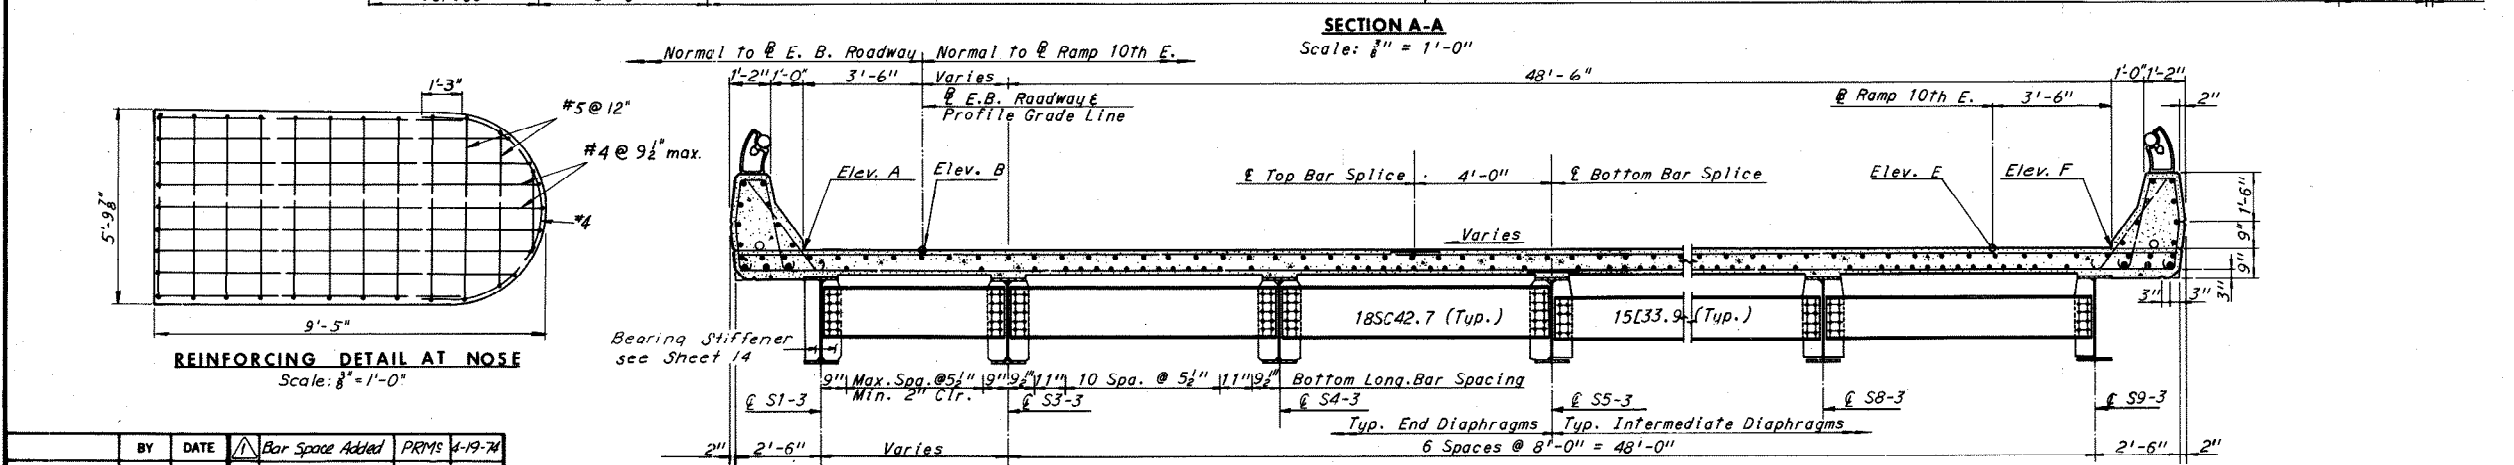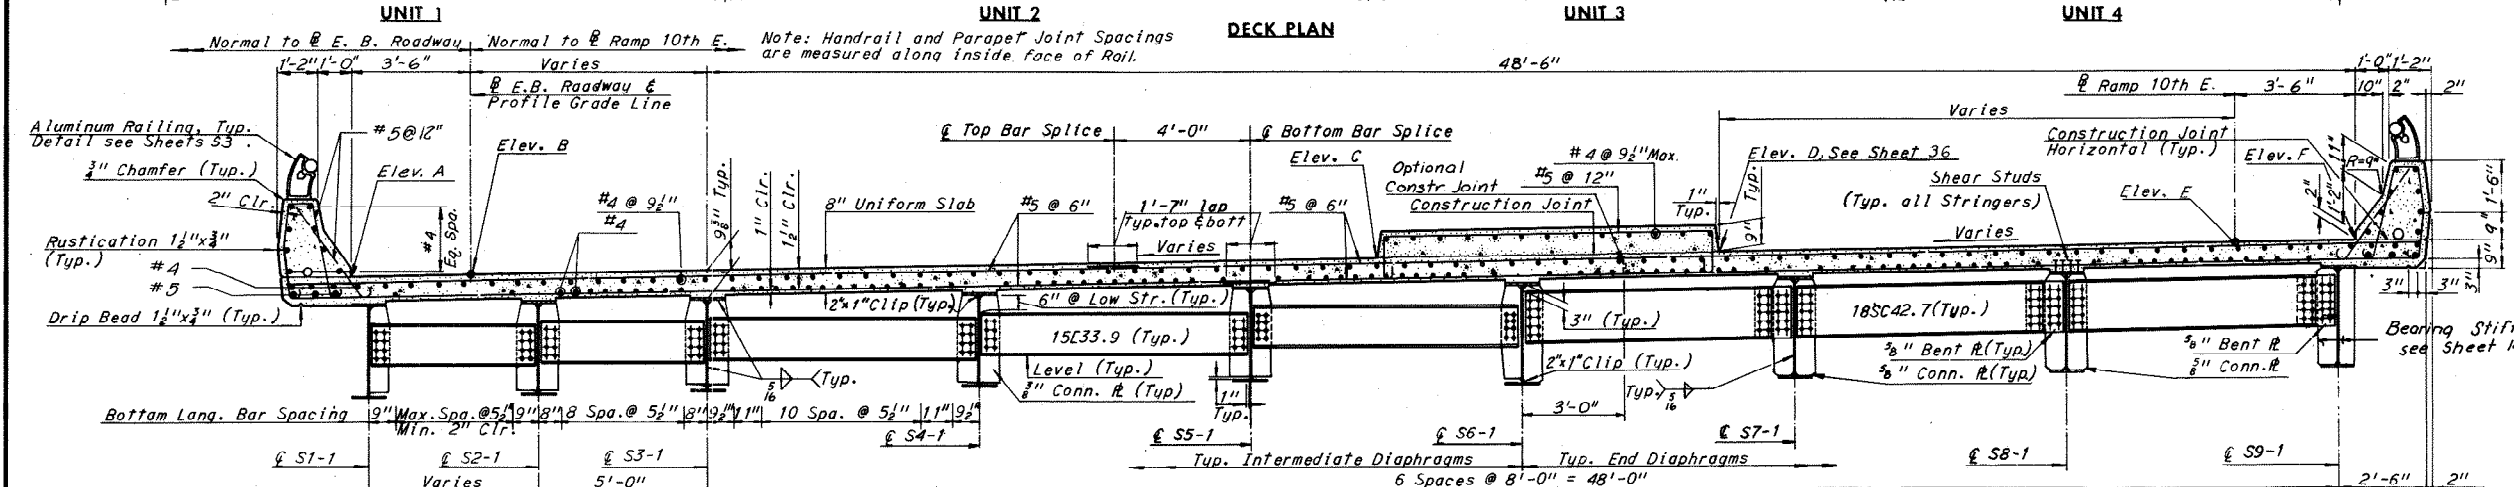

Note: For Elevations along @ Ramp 10th East, see Sheet 33.

Notes:
 For Joint Details, see Sheet 37
 For Framing Plan, see Sheet 14.
 For Handrail Details, see Sheet S3
 For Superstructure quantities, see Sheet 2.
 For Details A, B, C, D and E, see Sheet 29
 For Standard Drainage Details, see Support Type 1, Sheet S5 & S6.

| BY | DATE | Bar Space Added | PRMS | 4-19-74 |
|-----------|------|-----------------|------------|-------------|
| MADE | J.D. | 8-6-68 | 2 As Built | T.E.M. 8-76 |
| CHECKED | J.V. | 10/23/68 | | |
| IN CHARGE | | | | |

RICHMOND METROPOLITAN AUTHORITY
RICHMOND EXPRESSWAY SYSTEM
DOWNTOWN EXPRESSWAY




BRIDGE NO. 66
EASTBOUND ROADWAY OVER
12TH ST. - R.R. TRACKS AND 16TH ST.
DECK PLAN - UNITS 1,2,3 AND 4

HOWARD, NEEDLES, TAMMEN & BERGENDOFF
 consulting engineers
 NEW YORK ALEXANDRIA KANSAS CITY

SCALE: 1/2" = 1'-0" Unless shown
 CONTRACT NO. 10
 SHEET NO. 26 OF 46

AS BUILT

| RICHMOND EXPRESSWAY SYSTEM | | | |
|----------------------------|---------------------|-----------|--------------|
| SECTION | PROJECT | SHEET NO. | TOTAL SHEETS |
| 10 | DOWNTOWN EXPRESSWAY | 157 | 265 |

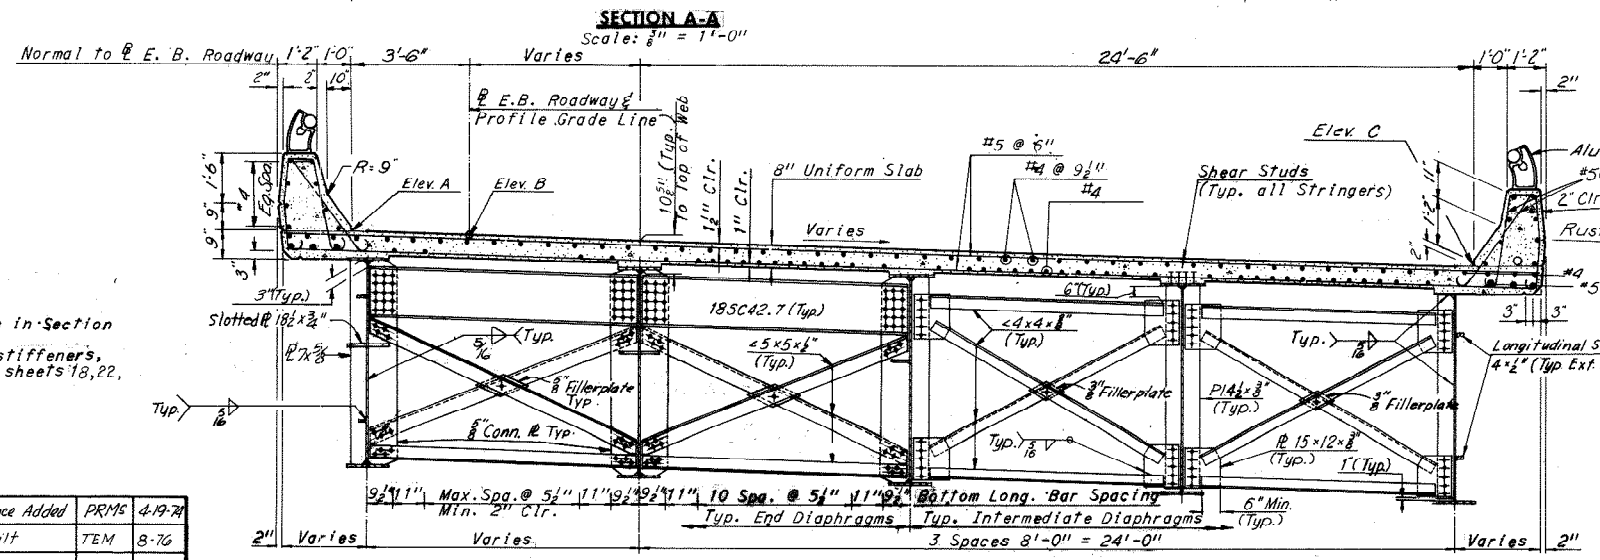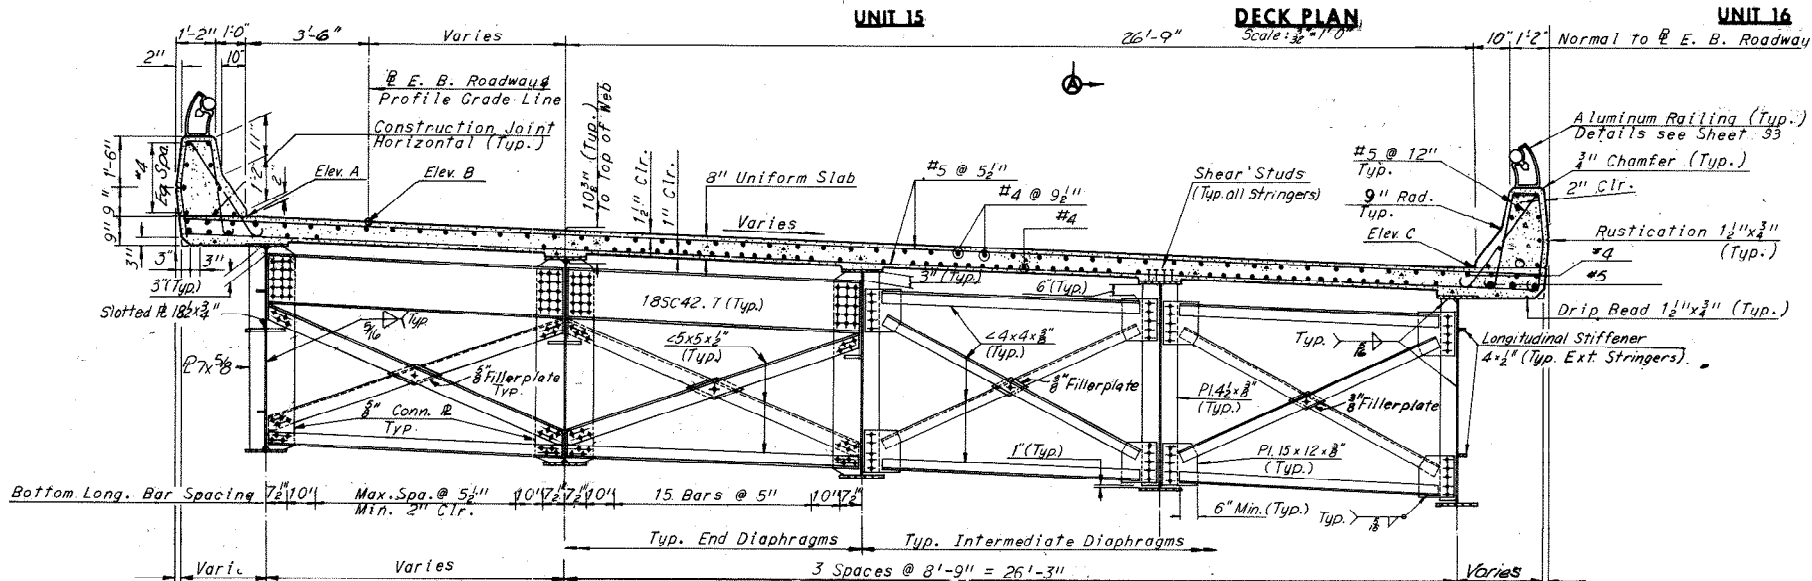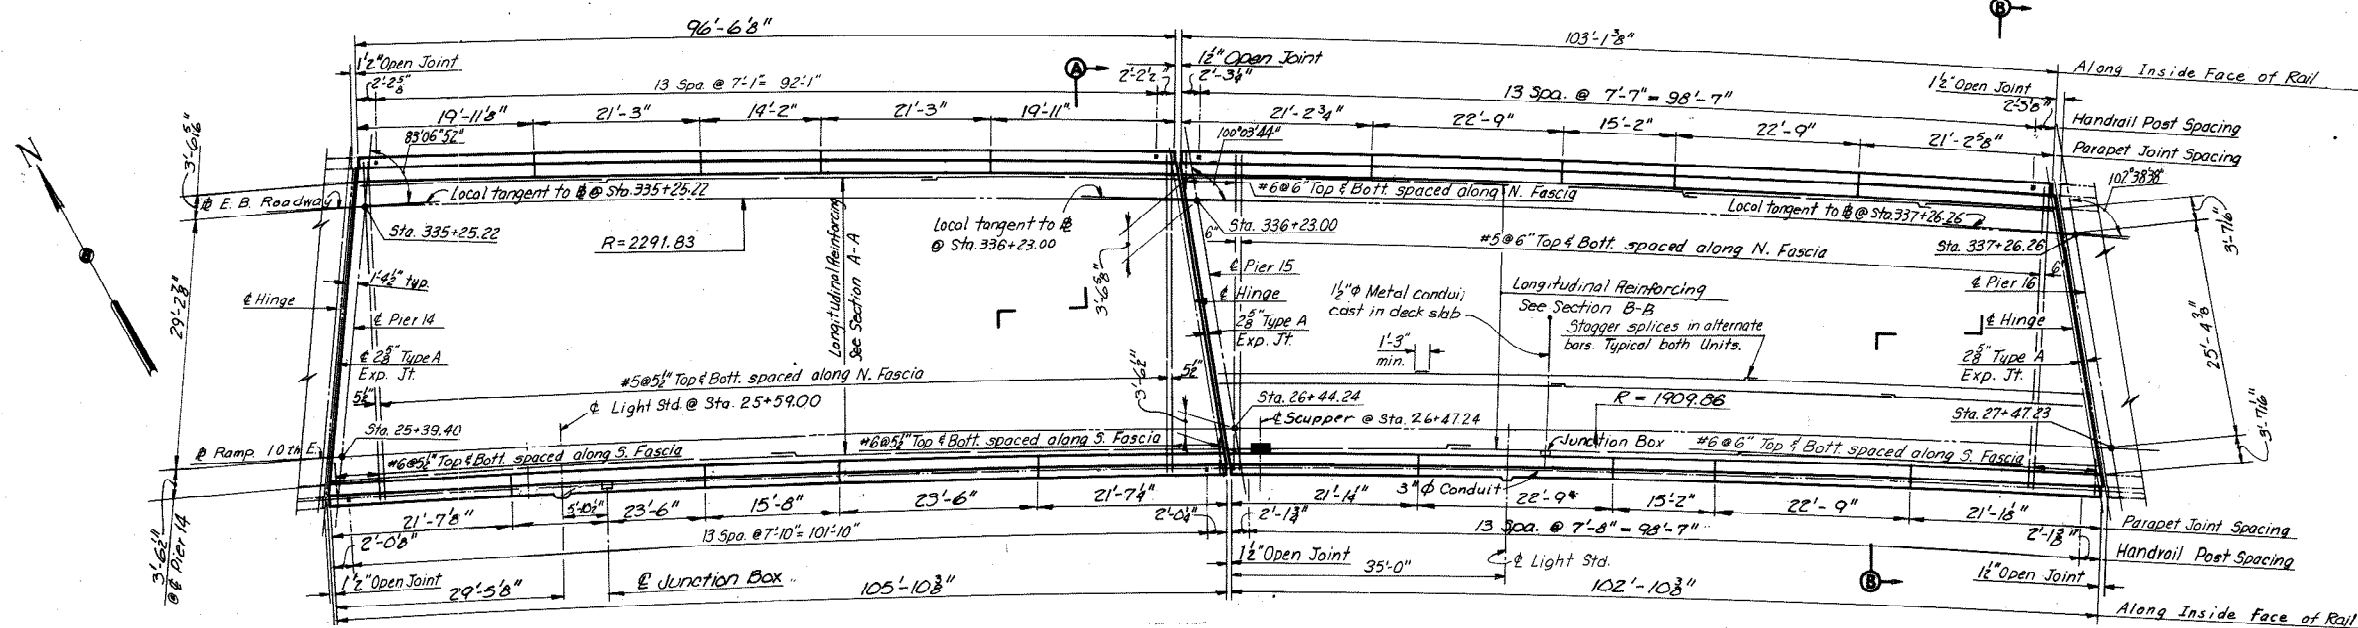

| ELEVATION TABLE | | | |
|-----------------|---------|---------|---------|
| STATION | ELEV. A | ELEV. B | ELEV. C |
| 335+10.00 | 87.01 | 86.84 | 85.20 |
| +20.00 | 87.15 | 86.97 | 85.35 |
| +21.29 | — | — | 85.36 |
| +25.22 | 87.22 | — | — |
| +30.00 | 87.18 | 87.11 | 85.50 |
| +40.00 | 87.40 | 87.23 | 85.64 |
| +50.00 | 87.53 | 87.35 | 85.76 |
| +60.00 | 87.63 | 87.46 | 85.89 |
| +70.00 | 87.74 | 87.57 | 86.01 |
| +80.00 | 87.85 | 87.67 | 86.11 |
| +90.00 | 87.93 | 87.76 | 86.23 |
| 336+00.00 | 88.02 | 87.85 | 86.33 |
| +10.00 | 88.10 | 87.93 | 86.42 |
| +20.00 | 88.19 | 88.02 | 86.52 |
| +22.38 | 88.21 | — | — |
| +23.00 | — | 88.04 | — |
| +28.25 | — | — | 86.60 |
| +30.00 | 88.27 | 88.10 | 86.61 |
| +40.00 | 88.36 | 88.19 | 86.70 |
| +50.00 | 88.44 | 88.27 | 86.80 |
| +60.00 | 88.52 | 88.35 | 86.89 |
| +70.00 | 88.61 | 88.44 | 86.98 |
| +80.00 | 88.69 | 88.52 | 87.08 |
| +90.00 | 88.78 | 88.61 | 87.17 |
| 337+00.00 | 88.86 | 88.69 | 87.26 |
| +10.00 | 88.94 | 88.77 | 87.35 |
| +20.00 | 89.03 | 88.86 | 87.44 |
| +25.48 | 89.08 | — | — |
| +26.26 | — | 88.91 | — |
| +30.00 | 89.11 | 88.94 | 87.53 |
| +32.60 | — | — | 87.55 |
| 337+40.00 | 89.20 | 89.03 | 87.62 |

Notes:
 For details not shown in Section B-B, see Section A-A.
 For details of brg. stiffeners, long. stiffeners, see sheets 18, 22, and 23.

Notes:
 For Joint Details, see Sheet 38.
 For Framing Plan, see Sheet 17.
 For Handrail Details, see Sheet 53.
 For Superstructure quantities, see Sheet 2.
 For Standard Drainage Details, see Support Type 2 Sheet 55/56.

| BY | DATE | Bar Space Added | PRMS | 4-19-74 | | |
|-----------|------|-----------------|------|----------|-----|------|
| MADE | RLM | 8-6-68 | 2 | As Built | TEM | 8-76 |
| CHECKED | SCC | 10-27-68 | | | | |
| IN CHARGE | | | | | | |

RICHMOND METROPOLITAN AUTHORITY
RICHMOND EXPRESSWAY SYSTEM
DOWNTOWN EXPRESSWAY


BRIDGE NO. 66
EASTBOUND ROADWAY OVER
12TH ST. - R.R. TRACKS AND 16TH ST.
DECK PLAN - UNITS 15 AND 16

HOWARD, NEEDLES, TAMMEN & BERGENDOFF
 consulting engineers
 NEW YORK ALEXANDRIA KANSAS CITY



SCALE: As Noted
 CONTRACT NO. 10
 SHEET NO. 31 OF 46

AS BUILT

| RICHMOND EXPRESSWAY SYSTEM | | | |
|----------------------------|---------------------|-----------|--------------|
| SECTION | PROJECT | SHEET NO. | TOTAL SHEETS |
| 10 | DOWNTOWN EXPRESSWAY | 158 | 265 |

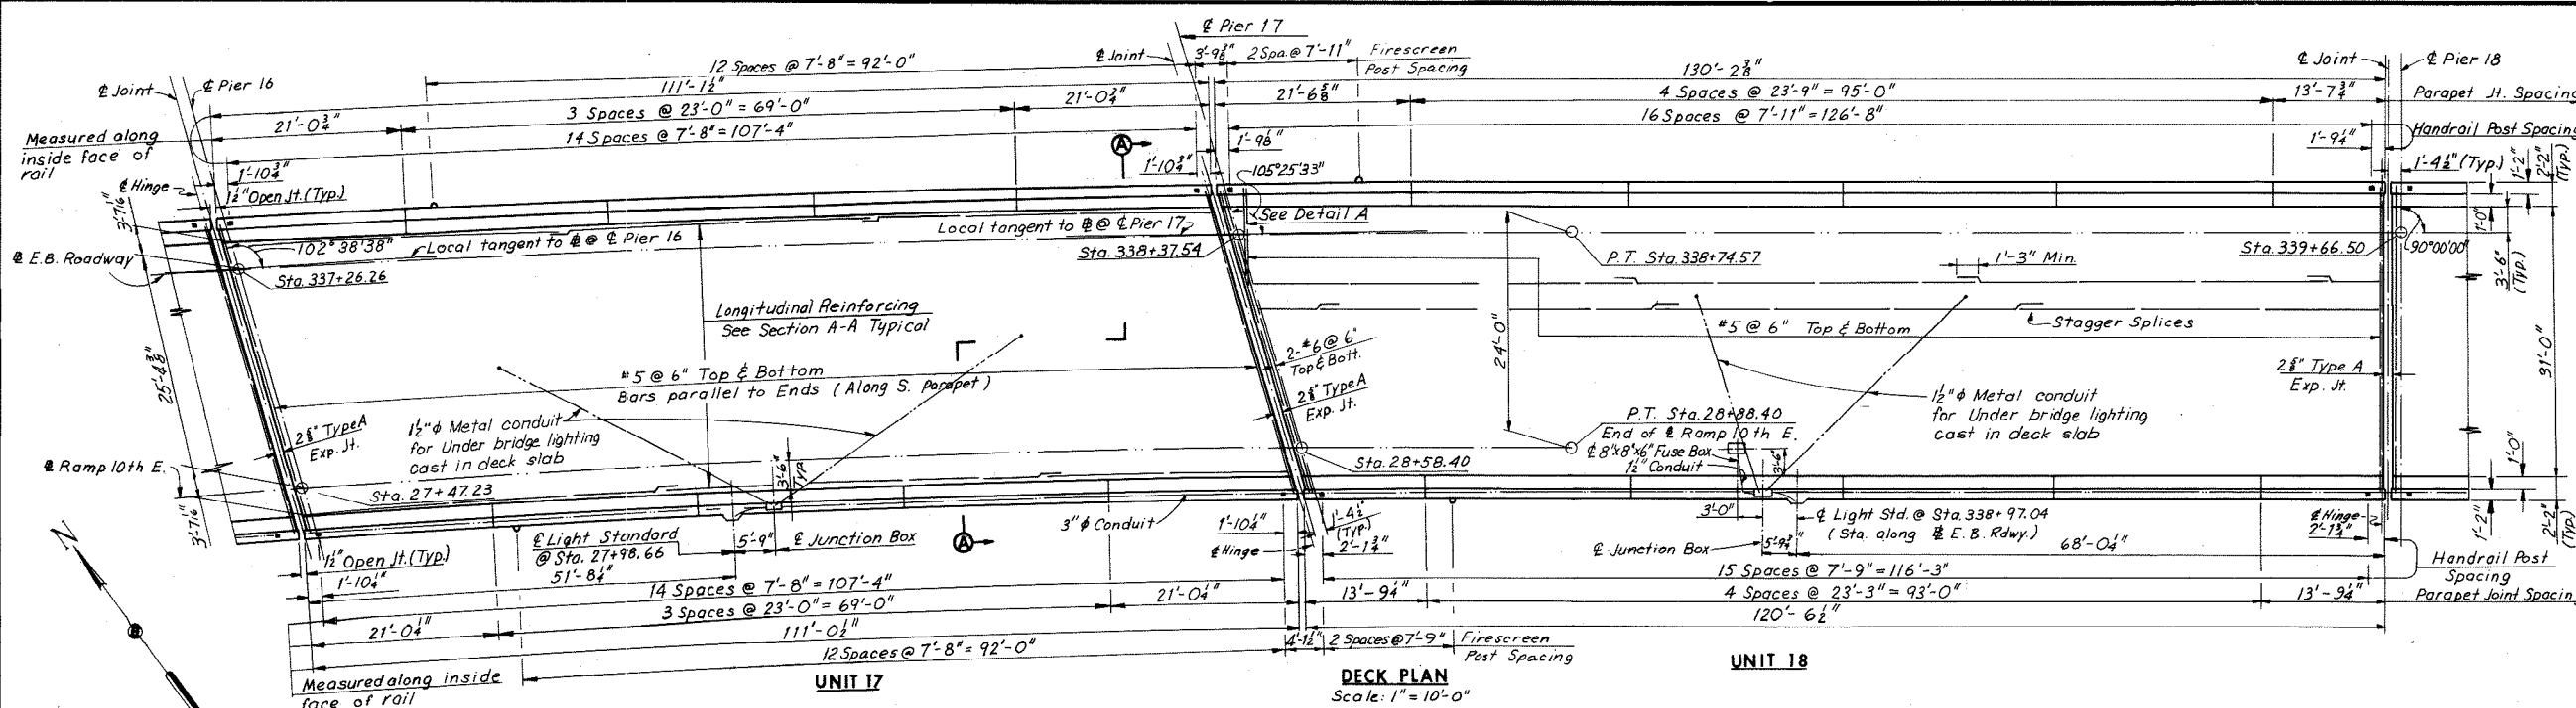

| ELEVATION TABLE | | | |
|-----------------|---------|---------|---------|
| STATION | ELEV. A | ELEV. B | ELEV. C |
| 337+20.00 | 89.03 | 88.86 | 87.44 |
| +25.48 | 89.08 | -- | -- |
| +26.26 | -- | 88.91 | -- |
| +30.00 | 89.11 | 88.94 | 87.53 |
| +32.60 | -- | -- | 87.55 |
| +40.00 | 89.20 | 89.03 | 87.62 |
| +50.00 | 89.28 | 89.11 | 87.71 |
| +60.00 | 89.36 | 89.19 | 87.80 |
| +70.00 | 89.45 | 89.28 | 87.89 |
| +80.00 | 89.53 | 89.36 | 87.98 |
| +90.00 | 89.62 | 89.45 | 88.07 |
| 338+00.00 | 89.70 | 89.53 | 88.18 |
| +10.00 | 89.78 | 89.61 | 88.30 |
| +20.00 | 89.86 | 89.70 | 88.43 |
| +30.00 | 89.93 | 89.78 | 88.51 |
| +36.58 | 89.99 | -- | -- |
| +37.54 | -- | 89.85 | -- |
| +40.00 | 90.01 | 89.87 | 88.71 |
| +45.13 | -- | -- | 88.78 |
| +50.00 | 90.09 | 89.95 | 88.85 |
| +60.00 | 90.17 | 90.03 | 88.99 |
| +70.00 | 90.25 | 90.12 | 89.13 |
| +80.00 | 90.32 | 90.20 | 89.26 |
| +90.00 | 90.40 | 90.29 | 89.40 |
| 339+00.00 | 90.48 | 90.37 | 89.54 |
| +10.00 | 90.55 | 90.45 | 89.69 |
| +20.00 | 90.63 | 90.54 | 89.83 |
| +30.00 | 90.70 | 90.62 | 89.96 |
| +40.00 | 90.78 | 90.71 | 90.10 |
| +50.00 | 90.86 | 90.79 | 90.24 |
| +60.00 | 90.94 | 90.87 | 90.38 |
| +66.50 | 90.99 | 90.93 | 90.47 |
| +70.00 | 91.02 | 90.96 | 90.52 |

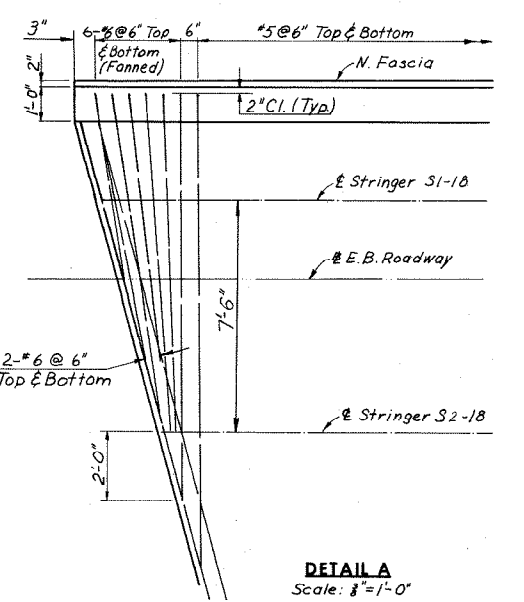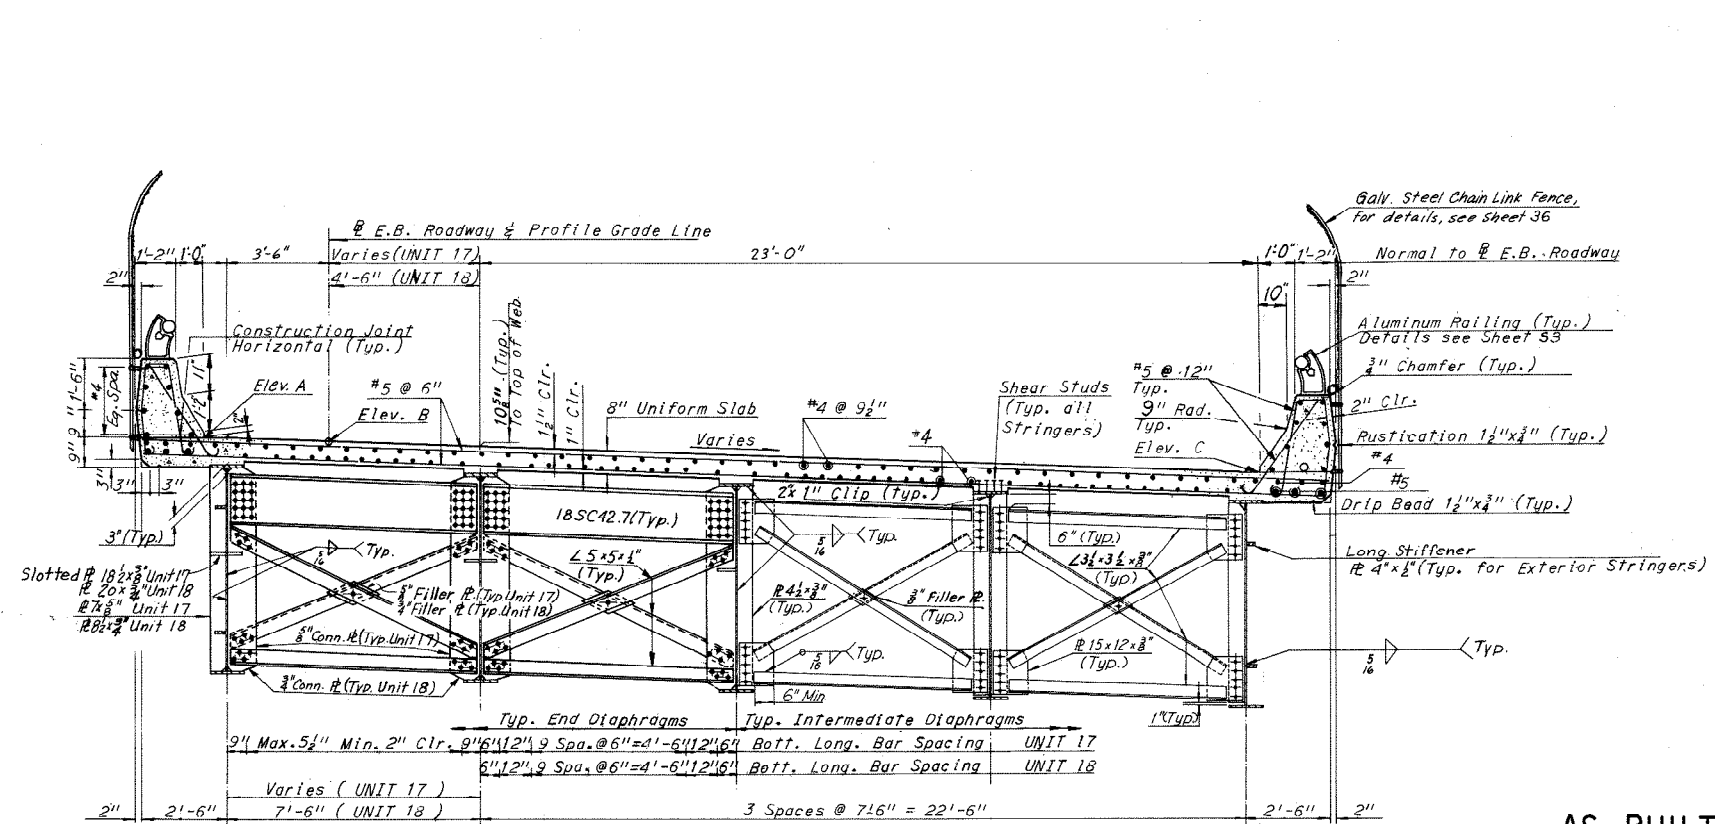

SECTION A-A
Scale: 3/8" = 1'-0"

AS BUILT

Notes:
For Joint Details, see Sheet 38.
For Framing Plan, see Sheet 18.
For Handrail Details, see Sheet 53.
For Superstructure quantities, see Sheet 2.

| BY | DATE | NO. | REVISION | BY | DATE |
|-----------|---------------|-----|----------|-----|------|
| MADE | J.D. 8-9-68 | | | | |
| CHECKED | R.C. 10-18-68 | 1 | As Built | TEM | 8-70 |
| IN CHARGE | | | | | |

RICHMOND METROPOLITAN AUTHORITY
RICHMOND EXPRESSWAY SYSTEM
DOWNTOWN EXPRESSWAY


BRIDGE NO. 66
EASTBOUND ROADWAY OVER
12TH ST. - R.R. TRACKS AND 16TH ST.
DECK PLAN - UNITS 17 AND 18

HOWARD, NEEDLES, TAMMEN & BERGENDOFF
consulting engineers
NEW YORK ALEXANDRIA KANSAS CITY


SCALE:
CONTRACT NO. 10
SHEET NO. 32 OF 46

| RICHMOND EXPRESSWAY SYSTEM | | | |
|----------------------------|---------------------|-----------|--------------|
| SECTION | PROJECT | SHEET NO. | TOTAL SHEETS |
| 10 | DOWNTOWN EXPRESSWAY | 159 | 265 |


| ELEVATION TABLE | | | |
|-----------------|---------|---------|---------|
| STATION | ELEV. A | ELEV. B | ELEV. C |
| 339+60.00 | 90.94 | 90.87 | 90.38 |
| +66.50 | 90.99 | 90.93 | 90.47 |
| +70.00 | 91.02 | 90.96 | 90.52 |
| +80.00 | 91.09 | 91.04 | 90.65 |
| +90.00 | 91.17 | 91.13 | 90.79 |
| 340+00.00 | 91.24 | 91.21 | 90.94 |
| +10.00 | 91.32 | 91.29 | 91.08 |
| +20.00 | 91.40 | 91.38 | 91.22 |
| +30.00 | 91.47 | 91.46 | 91.35 |
| +40.00 | 91.55 | 91.55 | 91.49 |
| +50.00 | 91.63 | 91.63 | 91.63 |
| +60.00 | 91.71 | 91.71 | 91.77 |
| +68.00 | 91.77 | 91.78 | 91.88 |
| +70.00 | 91.79 | 91.80 | 91.91 |
| +80.00 | 91.86 | 91.88 | 92.04 |
| +90.00 | 91.94 | 91.97 | 92.18 |
| 341+00.00 | 92.02 | 92.05 | 92.32 |
| +10.00 | 92.09 | 92.13 | 92.47 |
| +20.00 | 92.17 | 92.22 | 92.61 |
| +30.00 | 92.24 | 92.30 | 92.74 |
| +40.00 | 92.32 | 92.39 | 92.87 |
| +50.00 | 92.40 | 92.47 | 92.99 |
| +60.00 | 92.49 | 92.55 | 93.09 |
| +70.00 | 92.57 | 92.64 | 93.19 |
| +75.50 | 92.61 | 92.68 | 93.23 |
| +80.00 | 92.65 | 92.72 | 93.27 |

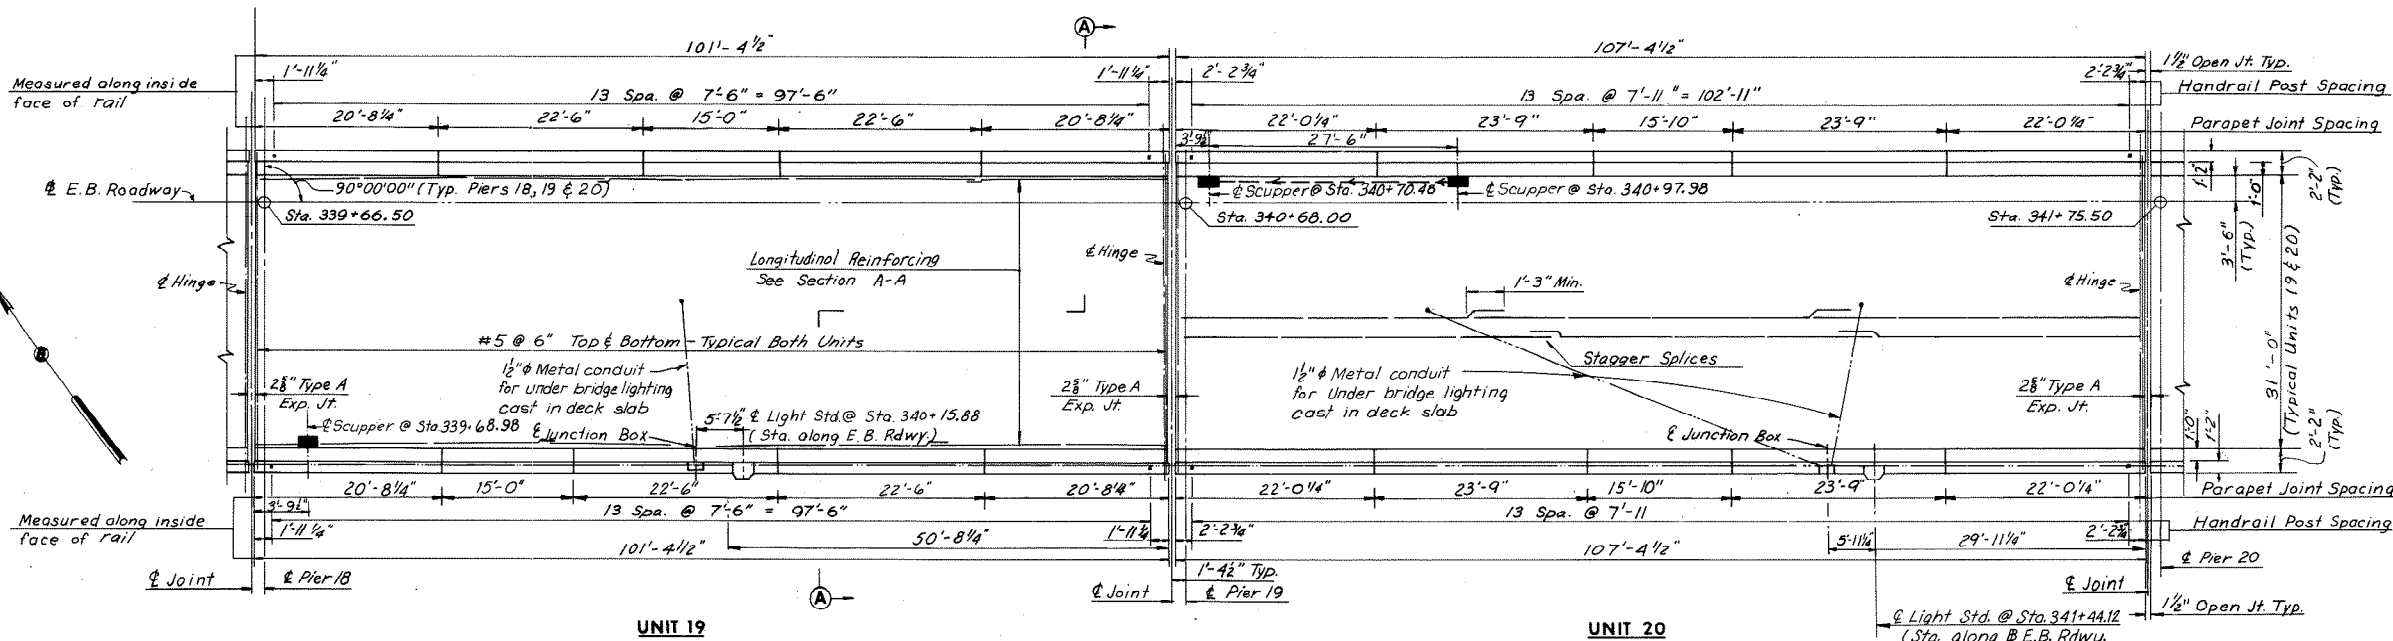


Note: For Standard Drainage details for Unit 19 See Support Type 2 Sheet 55 and for Unit 20 Support Type 7 Sheet 56.

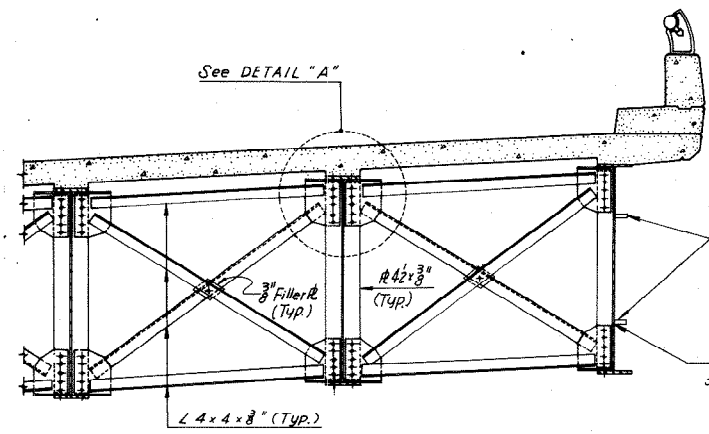


INTERMEDIATE DIAPHRAGM Scale: 3/8" = 1'-0"

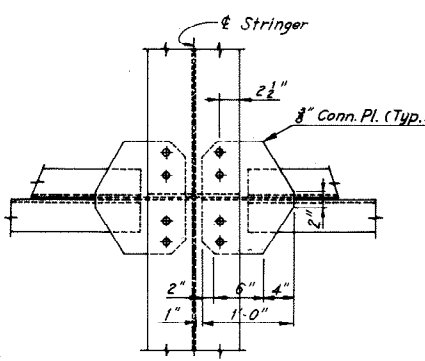

VIEW B-B Scale: 1" = 1'-0"

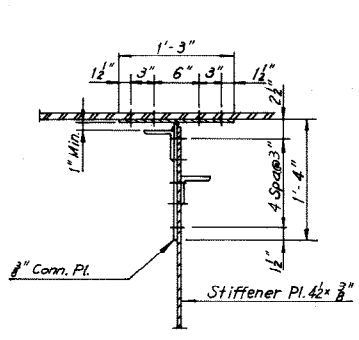


SECTION D-D Scale: -

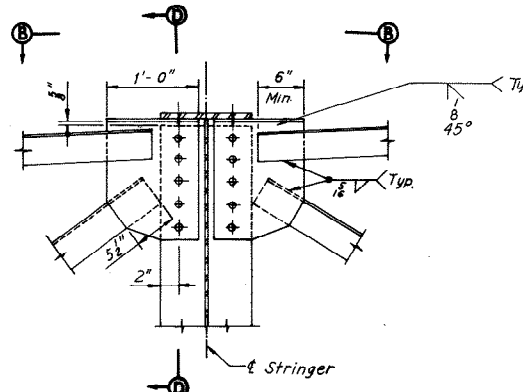

DETAIL A Scale: 1" = 1'-0"

Note: Intermediate Diaphragm Details belong to Units 21 and 22, see Sheet 34

Note: For details of brg. stiffeners, see sheets 19 & 23

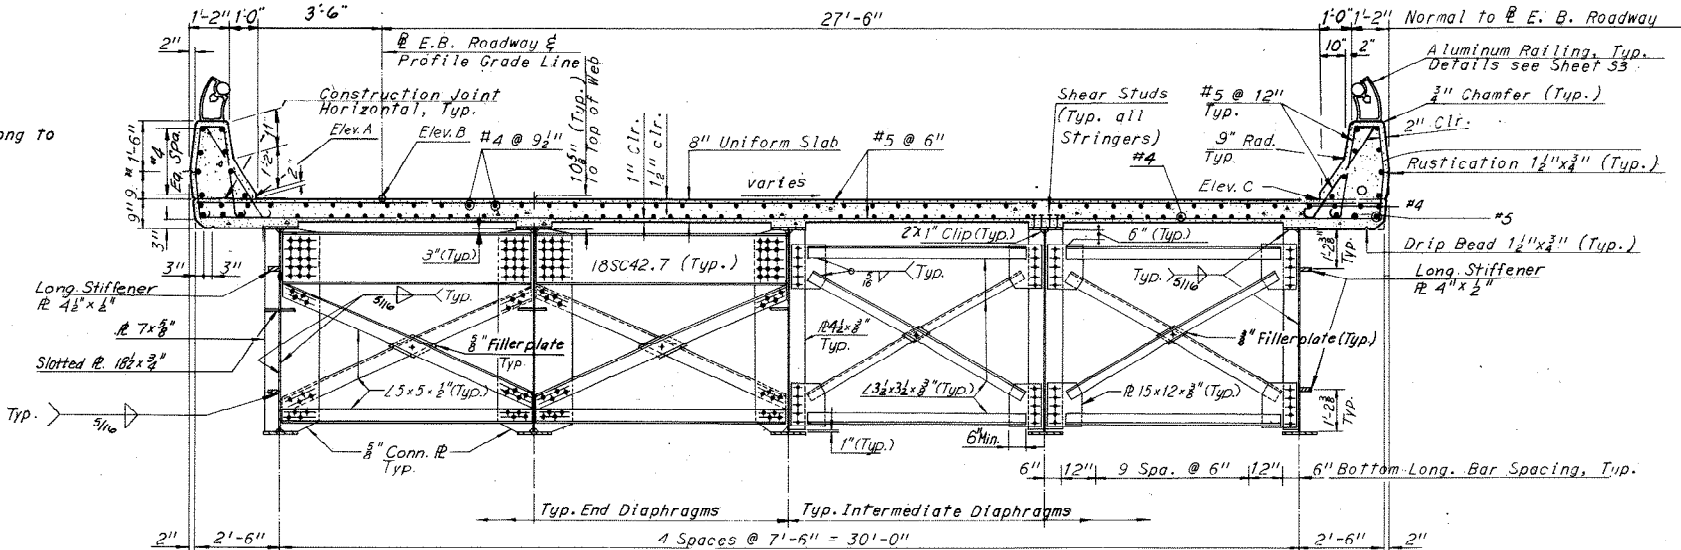

SECTION A-A Scale: 3/8" = 1'-0"

Notes: For Joint Details, see Sheet 38 For Framing Plan, see Sheet 19 For Handrail Details, see Sheet 53 For Superstructure quantities, see Sheet 2.

RICHMOND METROPOLITAN AUTHORITY
RICHMOND EXPRESSWAY SYSTEM
DOWNTOWN EXPRESSWAY

BRIDGE NO. 66
EASTBOUND ROADWAY OVER
12TH ST. - R.R. TRACKS AND 16TH ST.
DECK PLAN-UNITS 19 AND 20









HOWARD, NEEDLES, TAMMEN & BERGENDOFF
consulting engineers
NEW YORK ALEXANDRIA KANSAS CITY

SCALE: As Noted
CONTRACT NO.: 10
SHEET NO. 33 OF 46

| MADE | BY | DATE | NO. | REVISION | BY | DATE |
|-----------|------|----------|-----|----------|-----|------|
| | SHS | 8-2-68 | | | | |
| CHECKED | R.C. | 10-18-68 | 1 | As Built | TEM | 8-76 |
| IN CHARGE | | | | | | |

AS BUILT

| RICHMOND EXPRESSWAY SYSTEM | | | |
|----------------------------|---------------------|-----------|--------------|
| SECTION | PROJECT | SHEET NO. | TOTAL SHEETS |
| 10 | DOWNTOWN EXPRESSWAY | 163 | 265 |

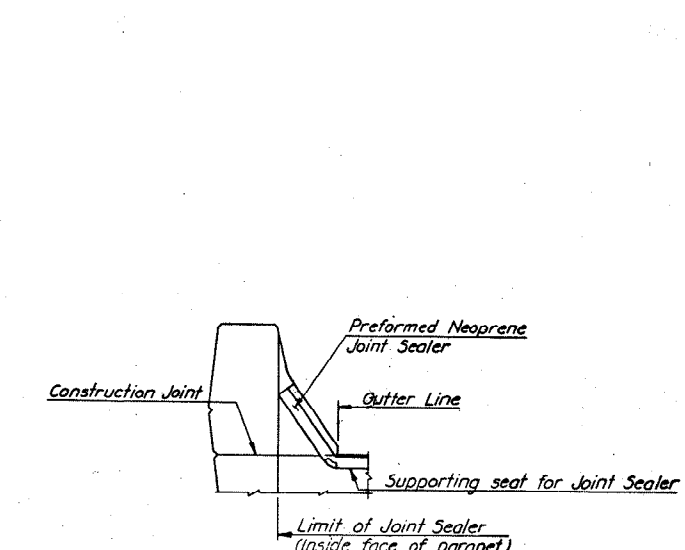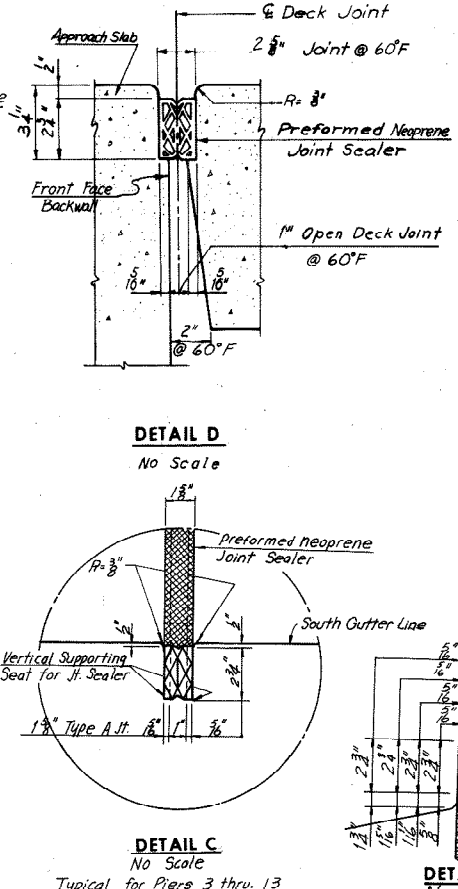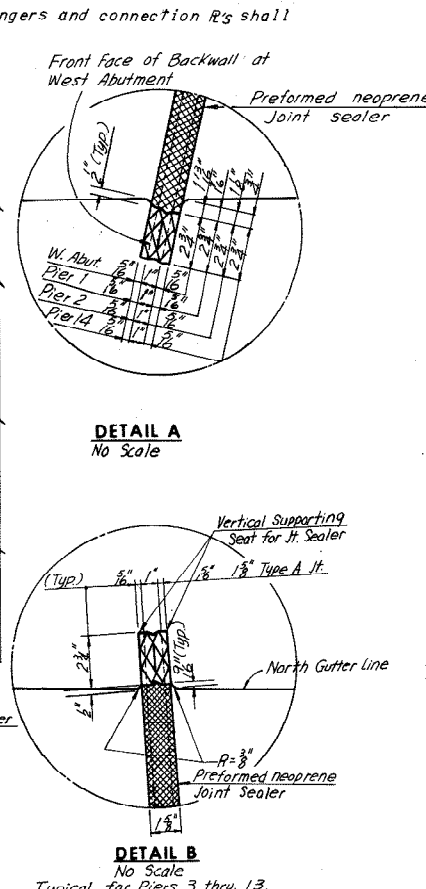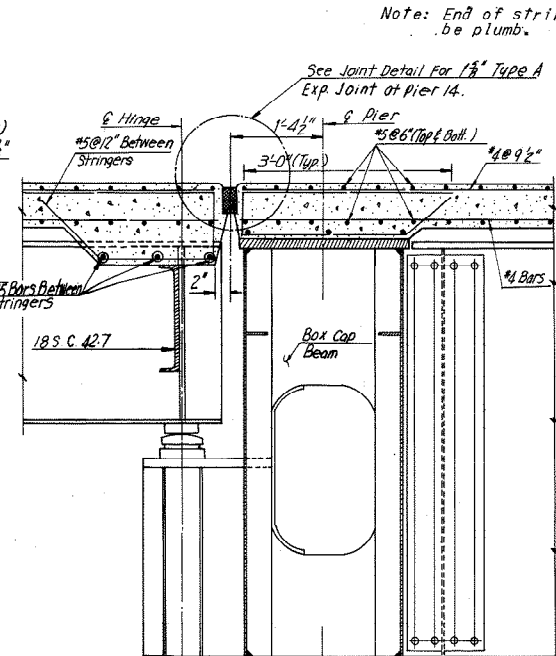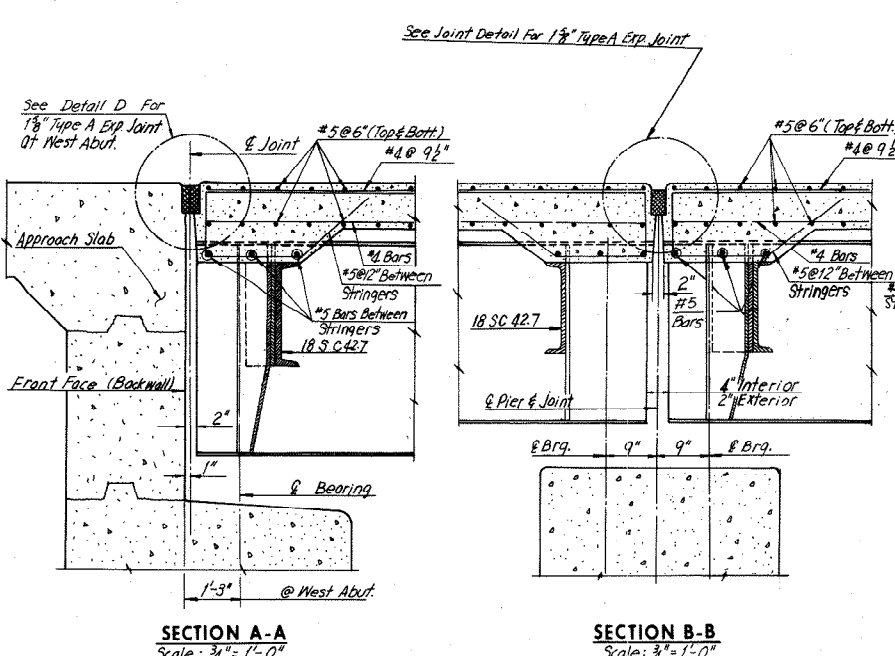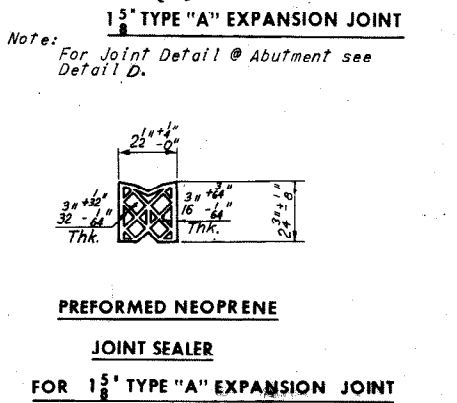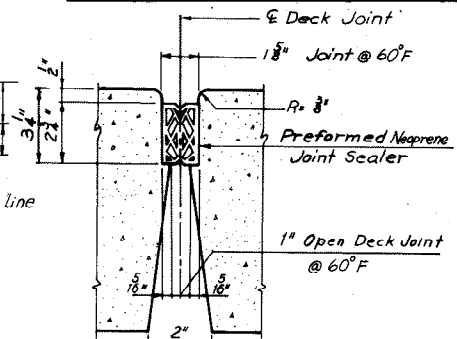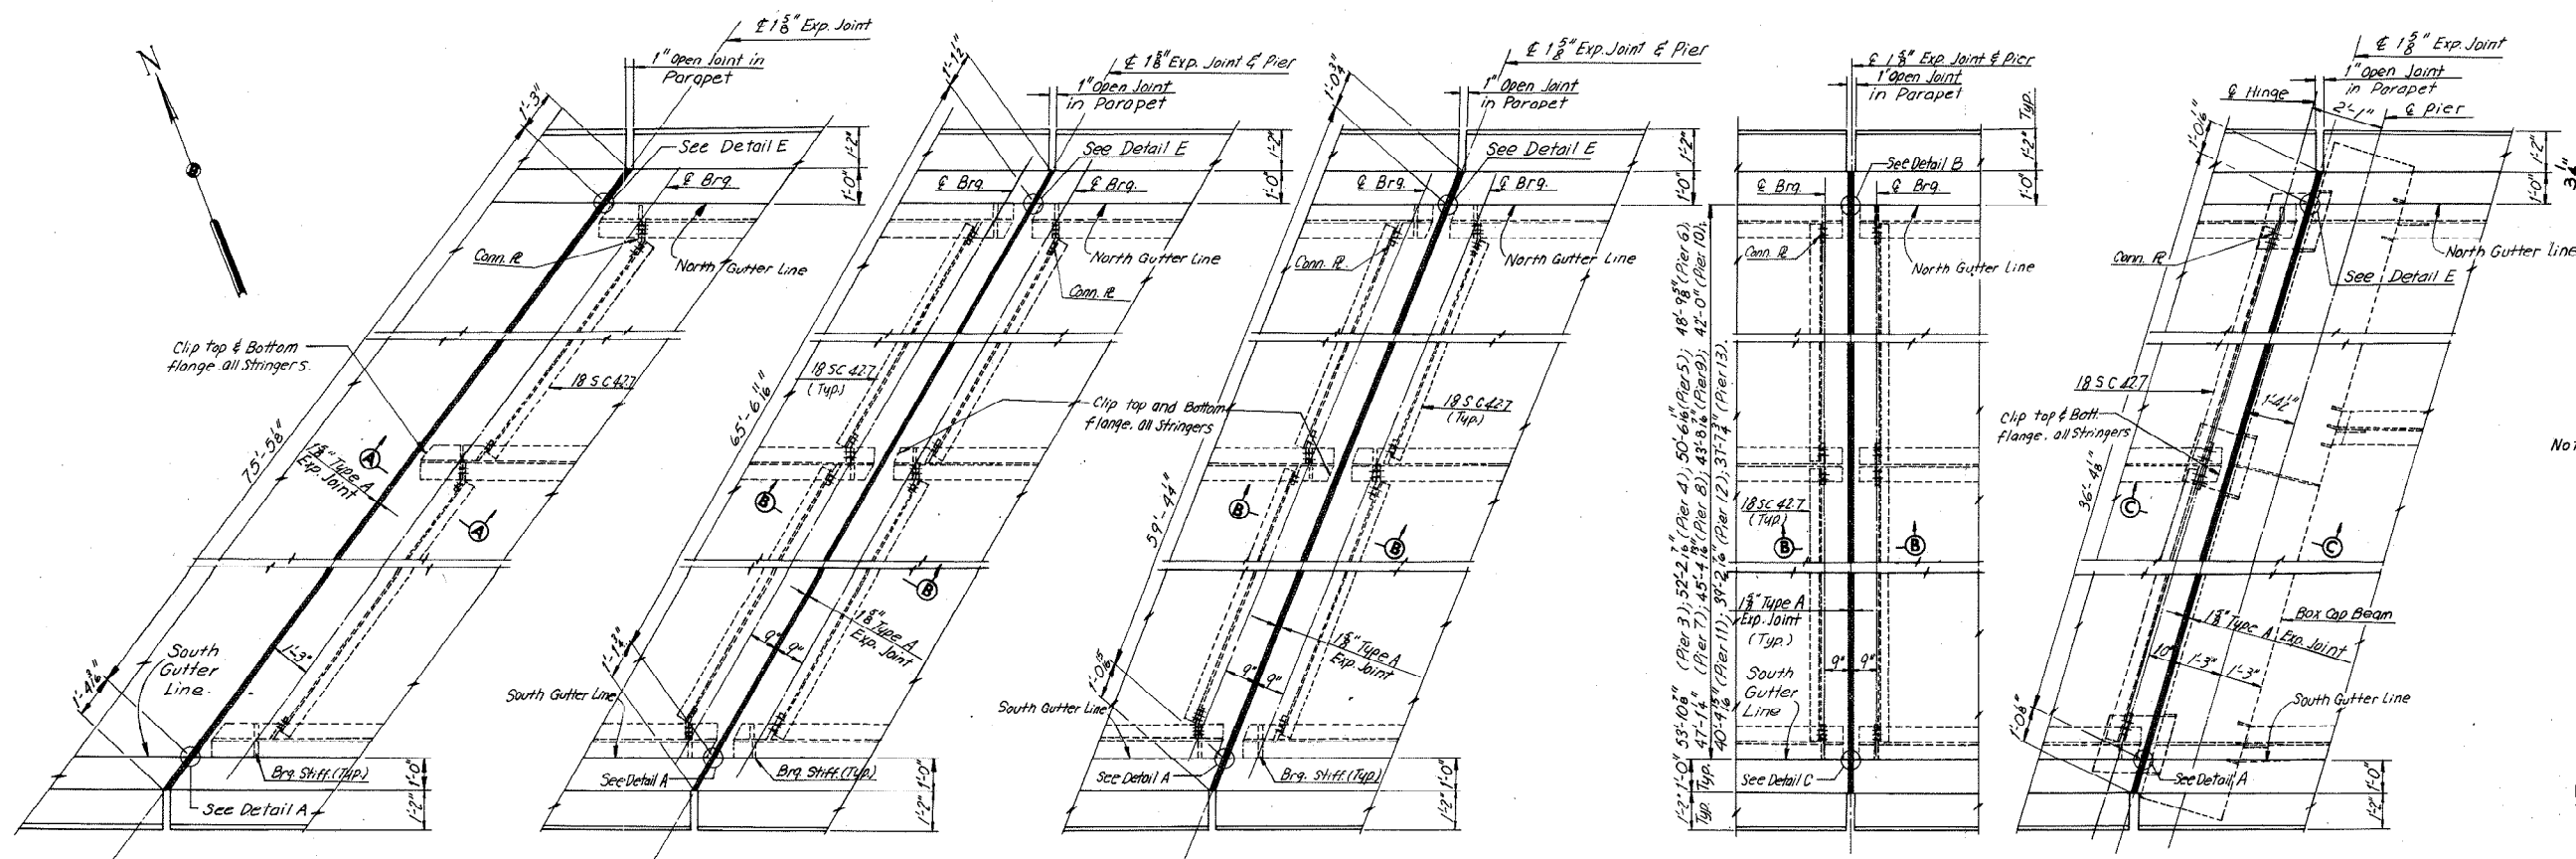

Note: All horizontal dimensions of Sections shown above are normal to \perp joint and pier.

Note: For details of bearing stiffeners, see Deck Plan Sheets 28, 29, & 30.

Note: It is absolutely essential that the openings for the preformed neoprene joint sealers be accurately formed and constructed to smooth, straight lines. The size of opening shall be adjusted to allow for anticipated dead load rotation of the ends of the slab and for the temperature at the time of construction.

| BY | DATE | NO. | REVISION | BY | DATE |
|-----------|-----------------|-----|----------|-----|------|
| MADE | G.S.H. 10/10/69 | | | | |
| CHECKED | C.F.B. 2-5-69 | 1 | As Built | TEM | 8-76 |
| IN CHARGE | | | | | |

RICHMOND METROPOLITAN AUTHORITY
RICHMOND EXPRESSWAY SYSTEM
DOWNTOWN EXPRESSWAY


BRIDGE NO. 66
 EASTBOUND ROADWAY ON
 12TH ST. - R.R. TRACKS AND 161

JOINT DETAILS


HOWARD, NEEDLES, TAMMEN & BERGENDOFF
 consulting engineers
 NEW YORK ALEXANDRIA KANSAS CITY

SCALE: As Noted
 CONTRACT NO. 10
 SHEET NO. 37 OF 46


| RICHMOND EXPRESSWAY SYSTEM | | | |
|----------------------------|---------------------|-----------|--------------|
| SECTION | PROJECT | SHEET NO. | TOTAL SHEETS |
| 10 | DOWNTOWN EXPRESSWAY | 164 | 265 |

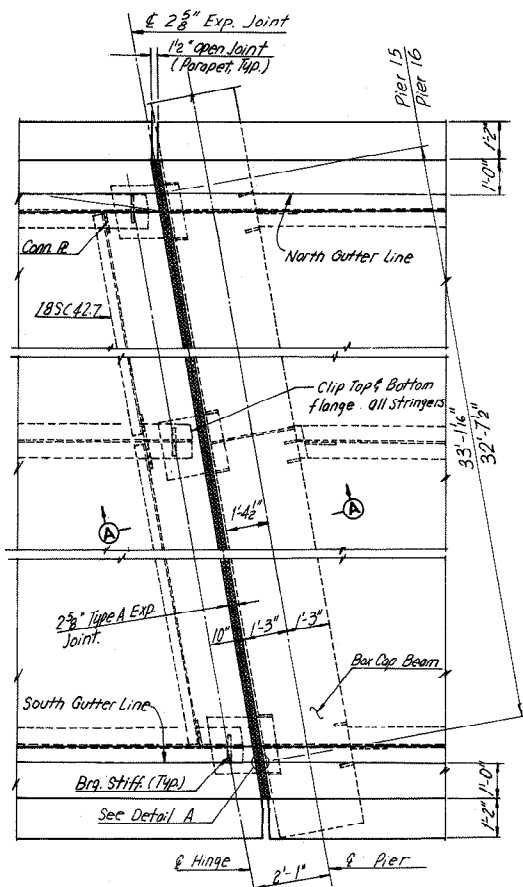


PLAN — JOINT AT PIERS 15 AND 16
Scale 3/8" = 1'-0"

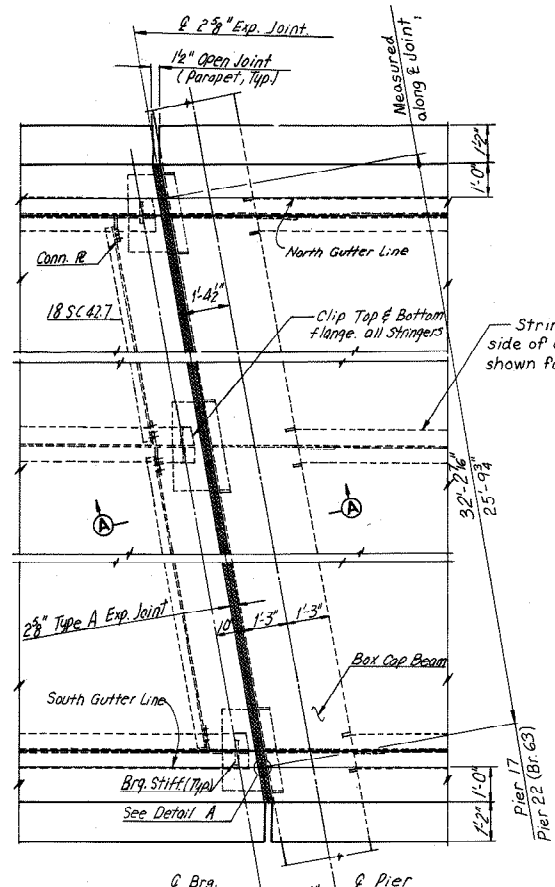


PLAN — JOINT AT PIER 17 AND PIER 22 (BR. 63)
Scale 3/8" = 1'-0"

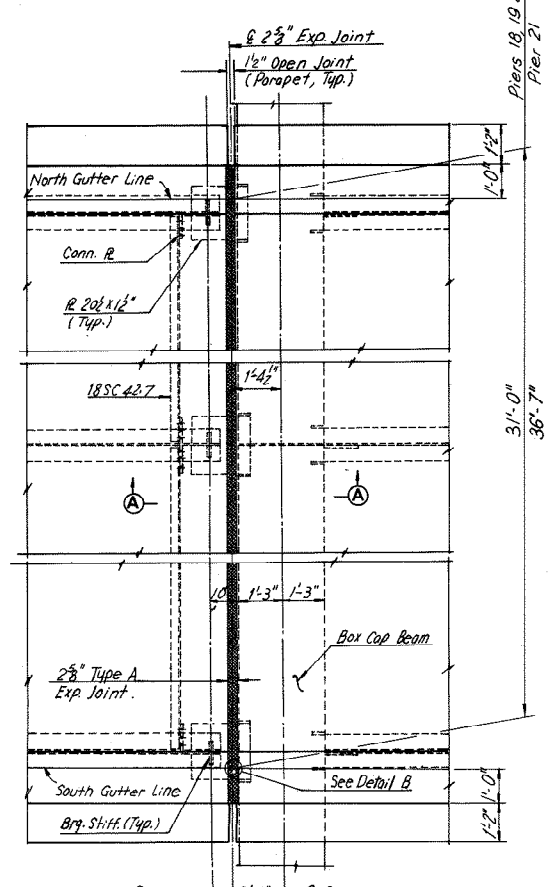

PLAN — JOINT AT PIERS 18, 19, 20 AND 21 (BRIDGE 63)
Scale 3/8" = 1'-0"

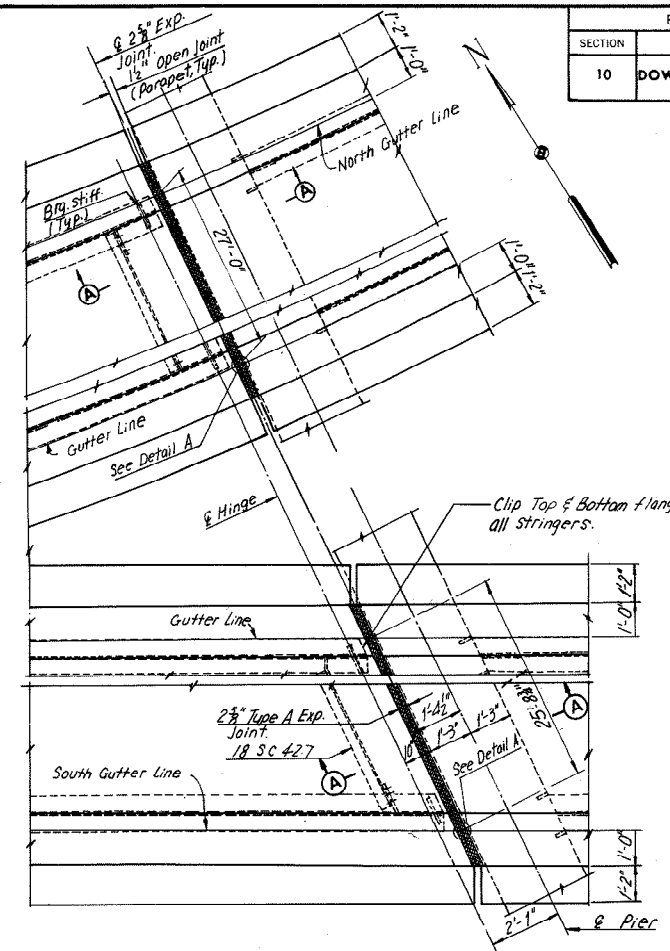


PLAN — JOINT AT PIER 22 (BRIDGE 63)
Scale 3/8" = 1'-0"

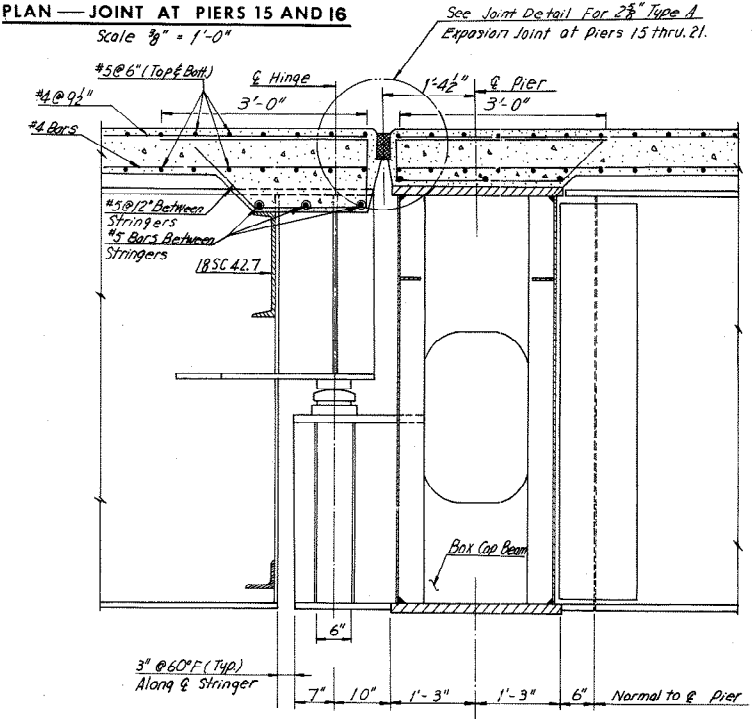

SECTION A-A
Scale 3/4" = 1'-0"


Note: All horizontal dimensions of Section shown above are normal to ϕ joint and pier.

Note: End of stringers and connection R's shall be plumb.

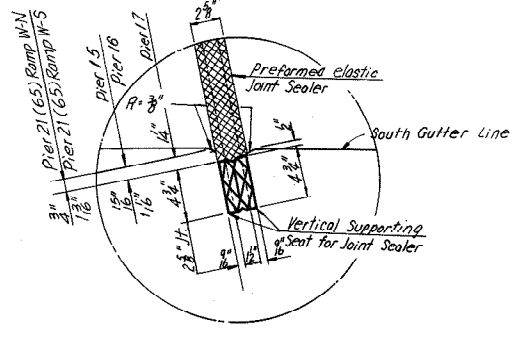


DETAIL A
No Scale

Typical for Piers 15 thru 17 & Pier 21 (Br. 63)

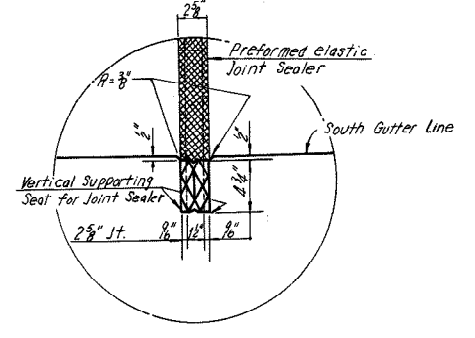


DETAIL B
No Scale

Typical for Piers 18 thru 20 & Pier 21 (Br. 63)

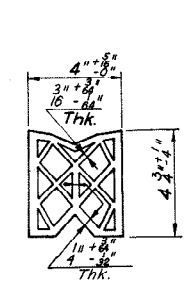

PREFORMED NEOPRENE JOINT SEALER
FOR 2 1/2" TYPE "A" EXPANSION JOINT
No Scale

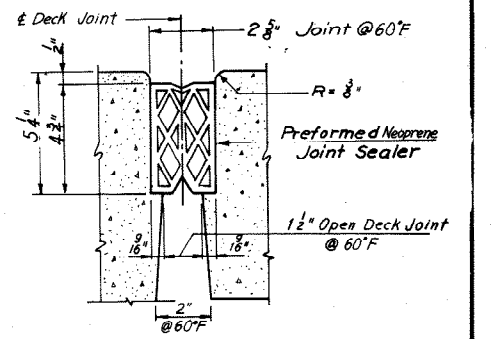


2 1/2" TYPE "A" EXPANSION JOINT
No Scale

Note: All horizontal dimensions shown above are normal to ϕ joint.

Note: For details of bearing stiffeners, see Framing Plan Sheets 17 thru 21.

Note: It is absolutely essential that the openings for the preformed neoprene joint sealers be accurately formed and constructed to smooth, straight lines. The size of opening shall be adjusted to allow for anticipated dead load rotation of ends of the slab and for the temperature at the time of construction.

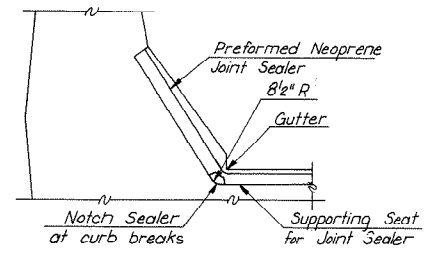

TREATMENT OF TYPE "A" JOINT AT CURB
No Scale

| BY | DATE | | | | |
|-----------|--------|---------|-----|----------|----------|
| MADE | G.S.H. | 10-5-68 | | | |
| CHECKED | C.F.B. | 2-5-69 | 1 | As Built | TEM 8-76 |
| IN CHARGE | | | NO. | REVISION | BY DATE |

RICHMOND METROPOLITAN AUTHORITY
RICHMOND EXPRESSWAY SYSTEM
 DOWNTOWN EXPRESSWAY

BRIDGE NO. 66
 EASTBOUND ROADWAY OVER
 12TH ST. - R.R. TRACKS AND 16TH ST.

JOINT DETAILS

SCALE: As Noted

HOWARD, NEEDLES, TAMMEN & BERGENDOFF
 consulting engineers
 NEW YORK ALEXANDRIA KANSAS CITY

CONTRACT NO. 10
 SHEET NO. 38 OF 46


AS BUILT

Bridge 67

**(Ramp from Eastbound Downtown Expressway - Rte. 195
to Northbound I-95 Over Dock Street, East Cary Street, East Main Street and CSX Railroad)**


Record Set Plans

| RICHMOND EXPRESSWAY SYSTEM | | | |
|----------------------------|---------------------|-----------|--------------|
| SECTION | PROJECT | SHEET NO. | TOTAL SHEETS |
| 10 | DOWNTOWN EXPRESSWAY | 173 | 265 |

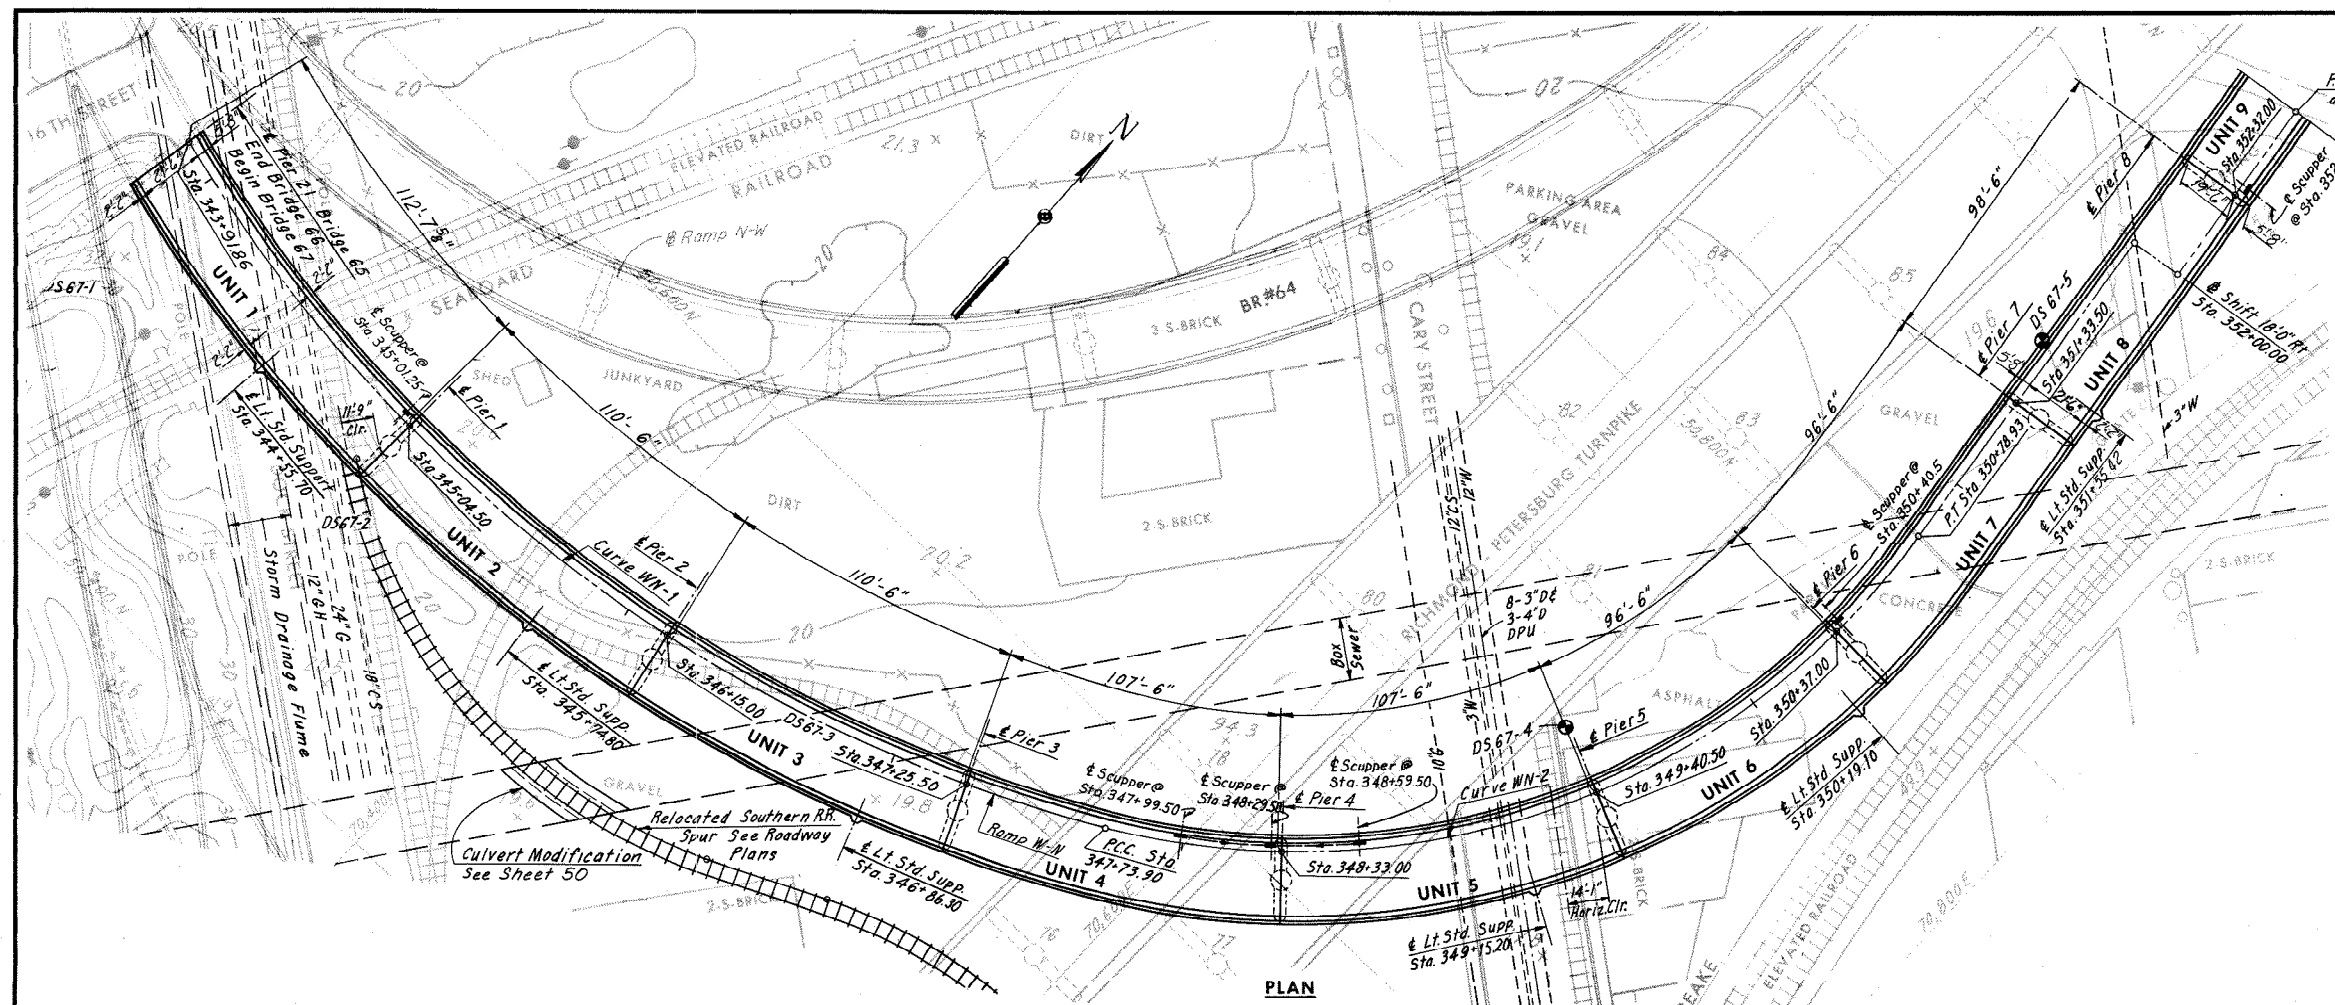

INDEX


| | |
|---|------------|
| GENERAL PLAN AND ELEVATION | 1 |
| GENERAL PLAN AND ELEVATION LAYOUT | 2 |
| LAYOUT | 3 |
| PIERS 1 AND 2 | 4 |
| PIER 3 | 5 |
| PIERS 4 AND 5 | 6 |
| PIER 6 | 7 |
| PIER 7 | 8 |
| PIERS 8 AND 9 | 9 |
| PIER 10 | 10 |
| PIERS 11 AND 12E | 11 |
| PIER 13E | 12 |
| PIERS 10A AND 12W | 13 |
| PIERS 13W AND 14 | 14 |
| NORTH ABUTMENT | 15 |
| NORTH ABUTMENT DETAILS | 16 |
| NORTH ABUTMENT RETAINING WALL MODIFICATION | 17 |
| FRAMING PLAN - UNITS 1 AND 2 | 18 |
| FRAMING PLAN - UNITS 3 AND 4 | 19 |
| FRAMING PLAN - UNITS 5 AND 6 | 20 |
| FRAMING PLAN - UNITS 7 AND 8 | 21 |
| FRAMING PLAN - UNIT 9 AND FRAMING DETAILS | 22 |
| FRAMING PLAN - UNIT 10 | 23 |
| GIRDER ELEVATIONS - UNIT 10 | 24 |
| FRAMING PLAN - UNITS 11, 12, 13, 14 AND 15 | 25 |
| FRAMING PLAN - UNITS 11, 12, 13, 14 AND 15 | 26 |
| FLOORBEAM 16 AND STEEL COLUMNS | 27 |
| DECK PLAN - UNITS 1 AND 2 | 28 |
| DECK PLAN - UNITS 3 AND 4 | 29 |
| DECK PLAN - UNITS 5 AND 6 | 30 |
| DECK PLAN - UNITS 7 AND 8 | 31 |
| DECK PLAN - UNIT 9 - AND SUPERSTRUCTURE DETAILS | 32 |
| DECK PLAN - UNIT 10 | 33 |
| DECK PLAN - UNITS 11, 12, 13, 14 AND 15 | 34 |
| STRESS SHEET TRUSS SPAN | 35 |
| TOP LATERAL SYSTEM | 36 |
| BOTTOM LATERAL SYSTEM | 37 |
| TRUSS DETAILS P.P. 0 TO P.P. 6 | 38 |
| TRUSS DETAILS P.P. 7 TO P.P. 10 | 39 |
| TRUSS DETAILS P.P. 11 TO P.P. 12 | 40 |
| FLOORBEAM 0 AND JOINT DETAILS | 41 |
| INTERMEDIATE FLOOR BEAMS | 42 |
| MISCELLANEOUS DETAILS | 43 |
| FLOORBEAM 12 AND JOINT DETAILS | 44 |
| DECK PLAN - TRUSS SPAN | 45 |
| SHOE DETAILS AND DECK ELEVATIONS | 46 |
| JOINT DETAILS | 47 |
| SLOPE PROTECTION DETAILS | 48 THRU 49 |
| BORING LOGS | 50 |
| STANDARD DETAILS | 51 THRU 54 |

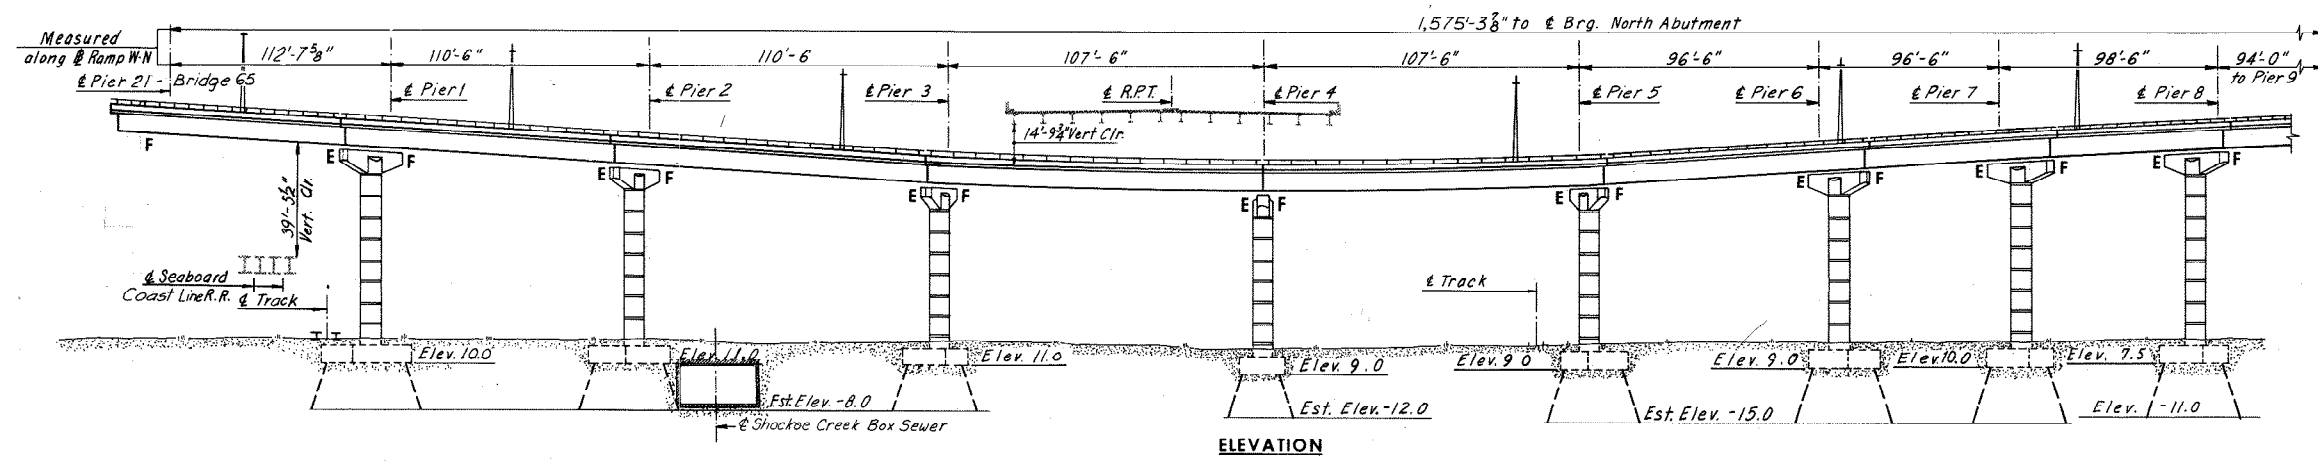

Note:
For General Notes, see Sheet 4.
For Quantity Table, see Sheet 3

CURVE DATA

| @ R.P.T. | | @ Ramp W-N | | @ Ramp N-W | |
|------------------------|------------------------|-----------------------|-----------------------|-----------------------|----------------------|
| Curve: R.P.T.-1 | Curve: R.P.T.-2 | Curve: WN-1 | Curve: WN-2 | Curve: WN-3 | Curve: WN-4 |
| P.I. = Sta. 1704+68.83 | P.I. = Sta. 1723+07.01 | P.I. = Sta. 345+25.47 | P.I. = Sta. 349+47.64 | P.I. = Sta. 353+19.15 | P.I. = Sta. 13+42.50 |
| A = 15°03'56" | A = 33°27'10" | A = 64°53'49" | A = 68°32'15" | A = 6°23'54" | A = 32°01'34" |
| D = 1°00' | D = 4°06' | D = 11°27'33" | D = 12°28'08" | D = 6°00' | D = 5°51'36" |
| T = 757.65' | T = 430.45' | T = 317.90' | T = 173.75' | T = 53.38' | T = 426.01' |
| L = 1,506.56' | L = 836.30' | L = 566.33' | L = 305.63' | L = 106.64' | L = 829.72' |
| R = 5,729.58' | R = 1,432.39' | R = 500.00' | R = 255.00' | R = 954.93' | R = 1,484.39' |
| | | Curve: WN-4 | Curve: WN-5 | Curve: WN-6 | |
| | | P.I. = Sta. 355+39.85 | P.I. = Sta. 358+17.39 | P.I. = Sta. 361+67.68 | |
| | | A = 5°01'11" | A = 13°10'51" | A = 19°35'06" | |
| | | D = 6°00' | D = 6°00' | D = 4°09'03" | |
| | | T = 167.43' | T = 110.33' | T = 238.25' | |
| | | L = 334.65' | L = 219.68' | L = 471.85' | |
| | | R = 3,819.72' | R = 954.93' | R = 1,380.39' | |

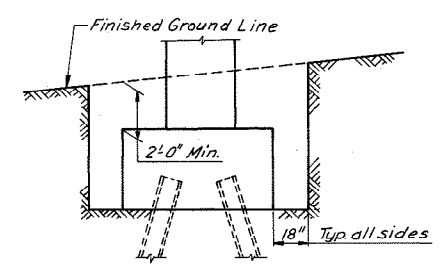

LIMITS OF STRUCTURE EXCAVATION
No Scale

RICHMOND METROPOLITAN AUTHORITY
RICHMOND EXPRESSWAY SYSTEM
DOWNTOWN EXPRESSWAY

BRIDGE NO. 67
RAMP W-N CONNECTION TO
RICHMOND-PETERSBURG TURNPIKE
GENERAL PLAN AND ELEVATION


HOWARD, NEEDLES, TAMMEN & BERGENDOFF
consulting engineers
NEW YORK ALEXANDRIA KANSAS CITY

SCALE: 1" = 30'-0"
CONTRACT NO.: 10
SHEET NO. 1 OF 54


AS BUILT

| BY | DATE | 3 | As Built | TEM | 6-77 |
|-----------|------|---------|----------------------------|--------|--------|
| MADE | AMH | 3-5-69 | Light Site Location Unit 9 | JLK | 6-6-75 |
| CHECKED | KCT | 5-12-69 | Sheets 42 & 45 added | L.B.P. | 3-5-75 |
| IN CHARGE | | | REVISION | BY | DATE |


| RICHMOND EXPRESSWAY SYSTEM | | | |
|----------------------------|---------------------|-----------|--------------|
| SECTION | PROJECT | SHEET NO. | TOTAL SHEETS |
| 10 | DOWNTOWN EXPRESSWAY | 174 | 265 |

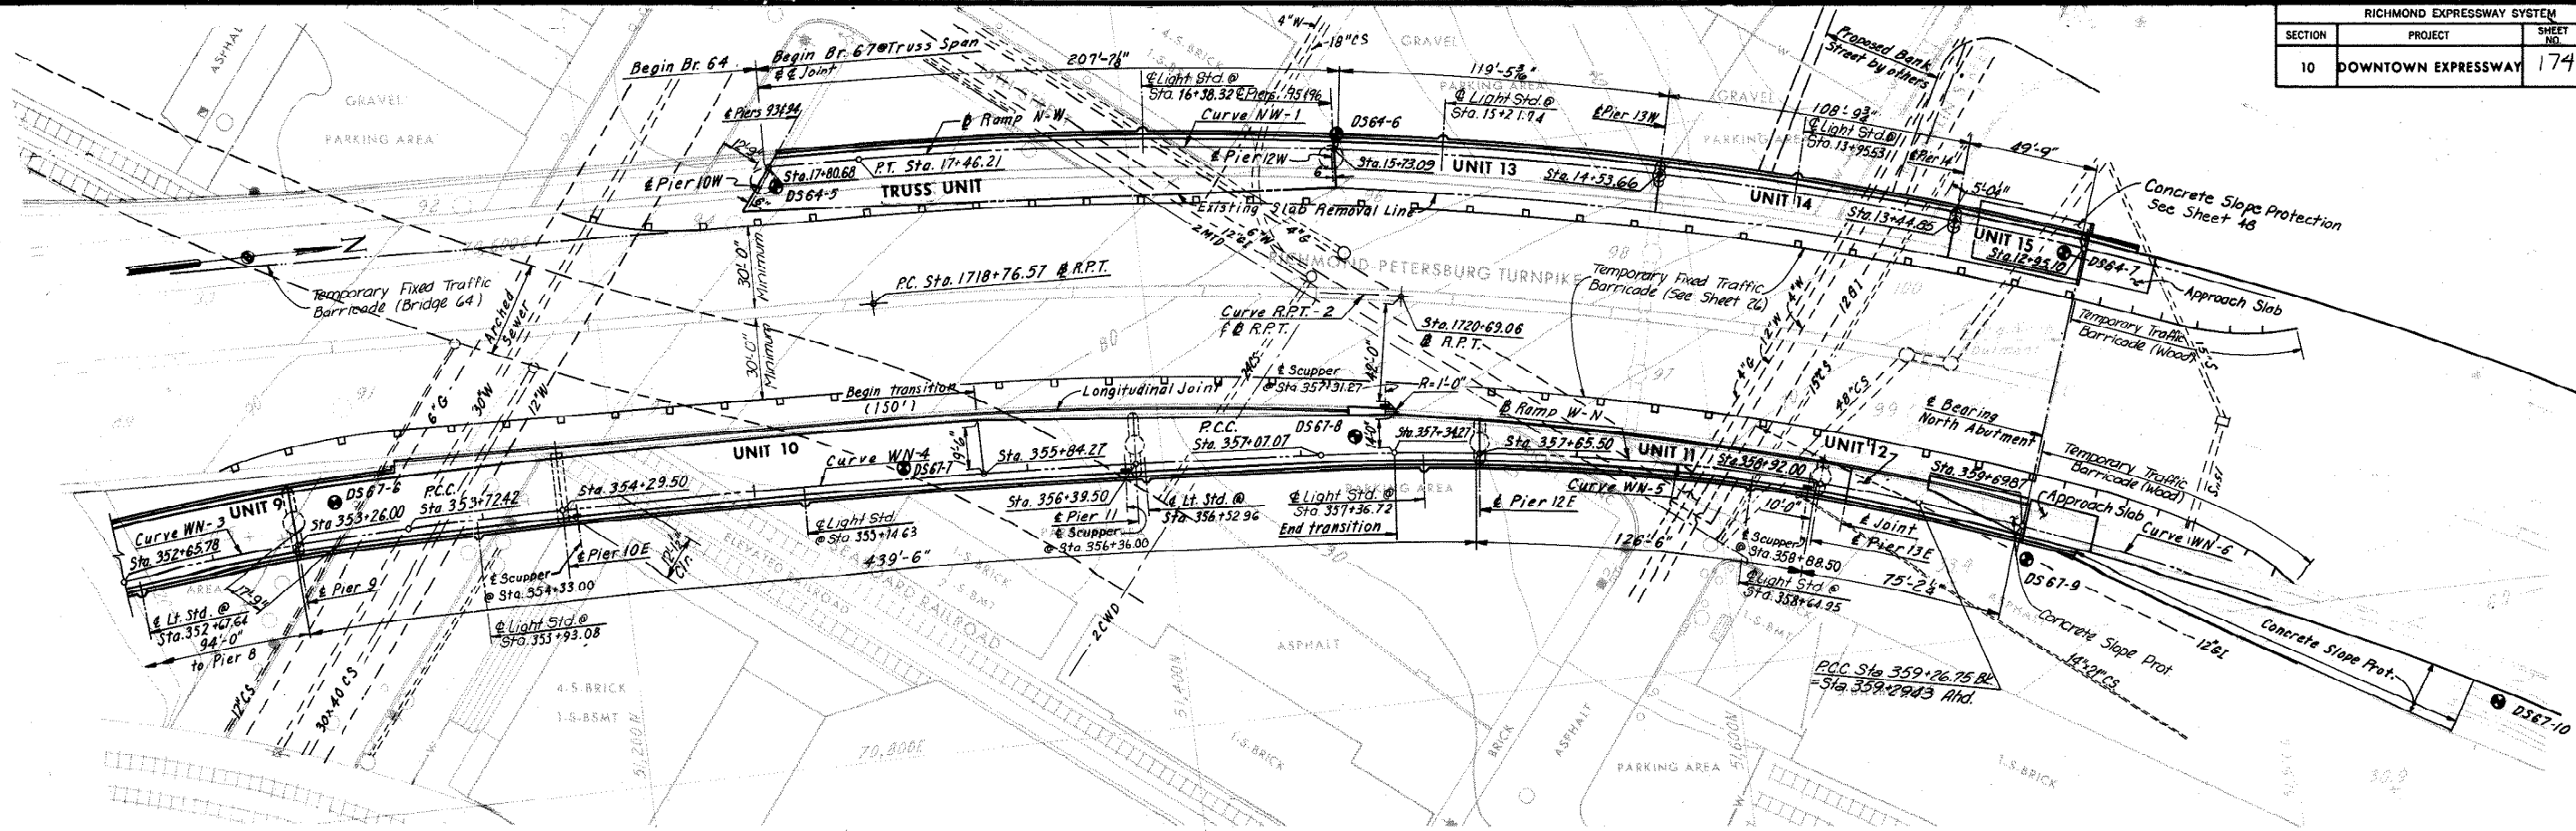


PLAN
Scale: 1" = 30'-0"

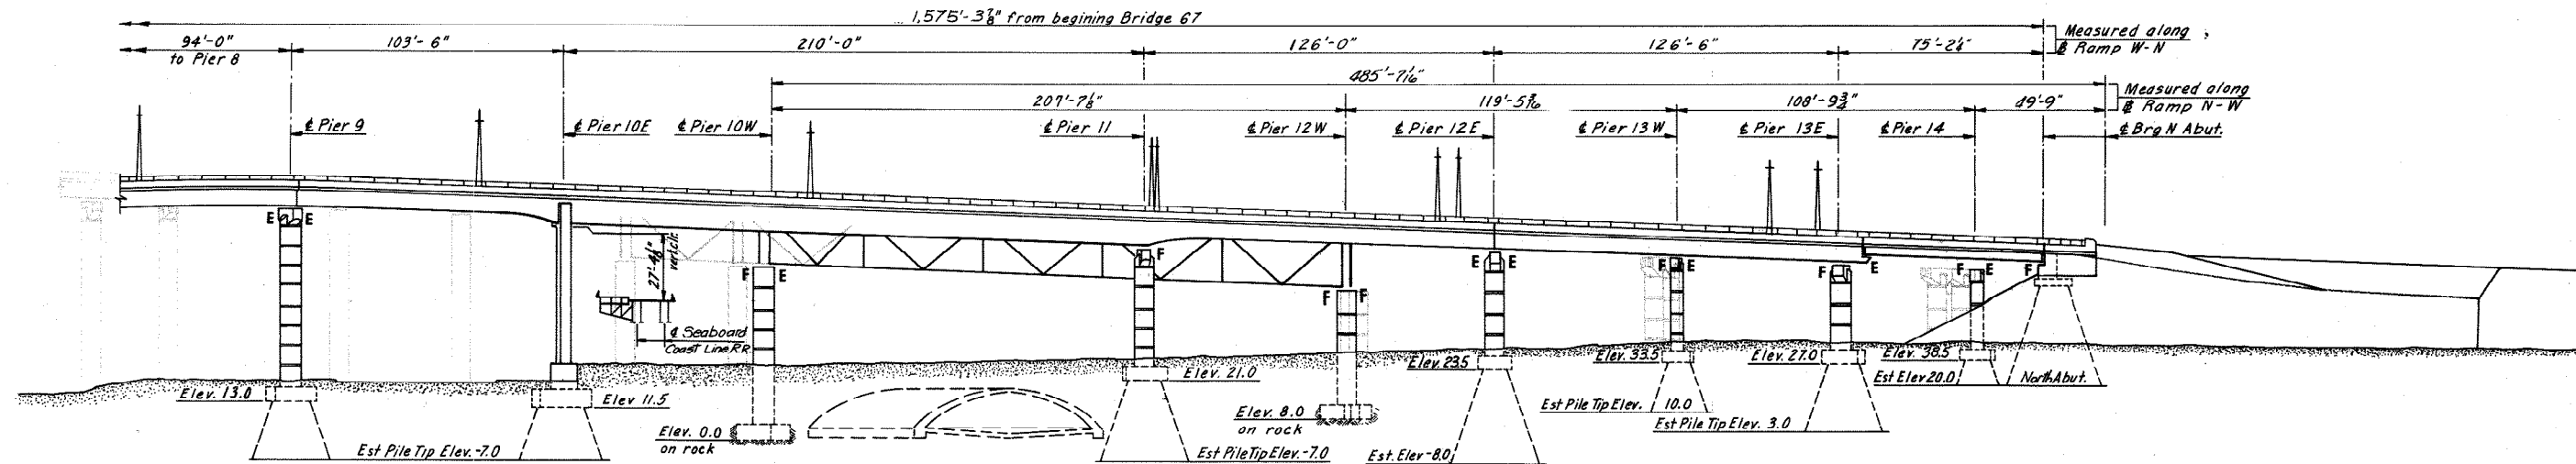

ELEVATION
Scale: 1" = 30'-0"

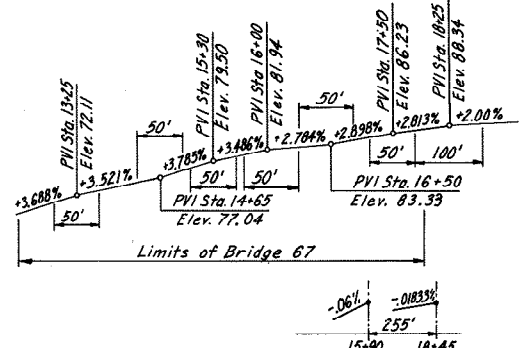

PROFILE GRADE CROSS SLOPE - RAMP N-W

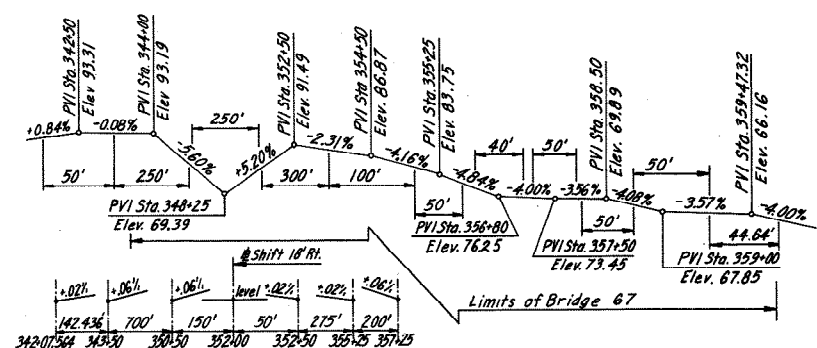

PROFILE GRADE AND CROSS SLOPE - RAMP W-N

AS BUILT

| BY | DATE | REVISION | BY | DATE |
|-----|----------|--|-----|---------|
| AMH | 12-30-68 | 2 As Built | JEM | 6-77 |
| KCT | 5-12-69 | Revised Plans to Meet Sta. & Span Length | DWB | 1-28-75 |


RICHMOND METROPOLITAN AUTHORITY
RICHMOND EXPRESSWAY SYSTEM
DOWNTOWN EXPRESSWAY

BRIDGE NO. 67
RAMP W-N CONNECTION TO
RICHMOND-PETERSBURG TURNPIKE
GENERAL PLAN AND ELEVATION


HOWARD, NEEDLES, TAMMEN & BERGENDOFF
 consulting engineers
 NEW YORK ALEXANDRIA KANSAS CITY

SCALE: As Noted
 CONTRACT NO. 10
 SHEET NO. 2 OF 54


Note: All Steel shall be A36 except otherwise shown.
 Pile Tip Elev. -7.00
 batter exterior piles 2" per foot in direction shown.
 All piles shall be 12BP53 Steel Piles (Design Cap.=57 Tons).

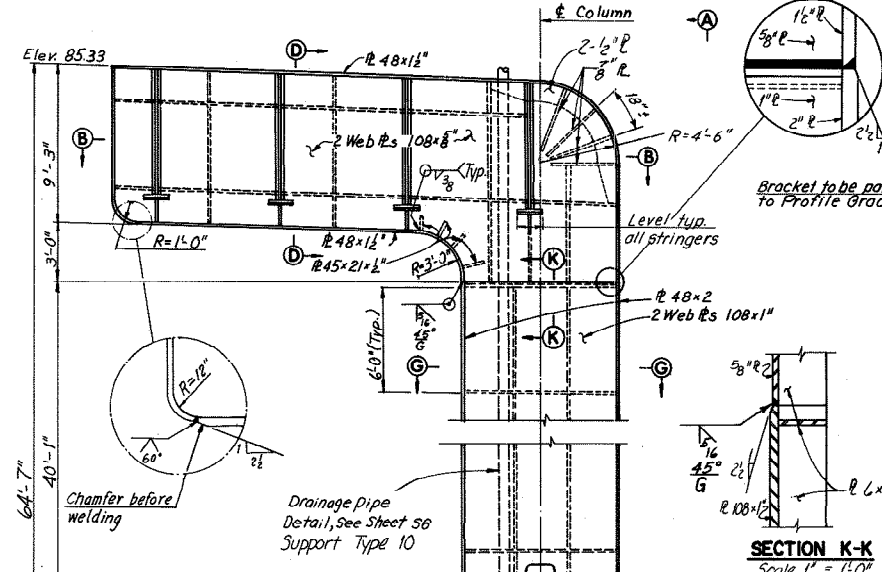

SECTION K-K
 Scale: 1" = 1'-0"

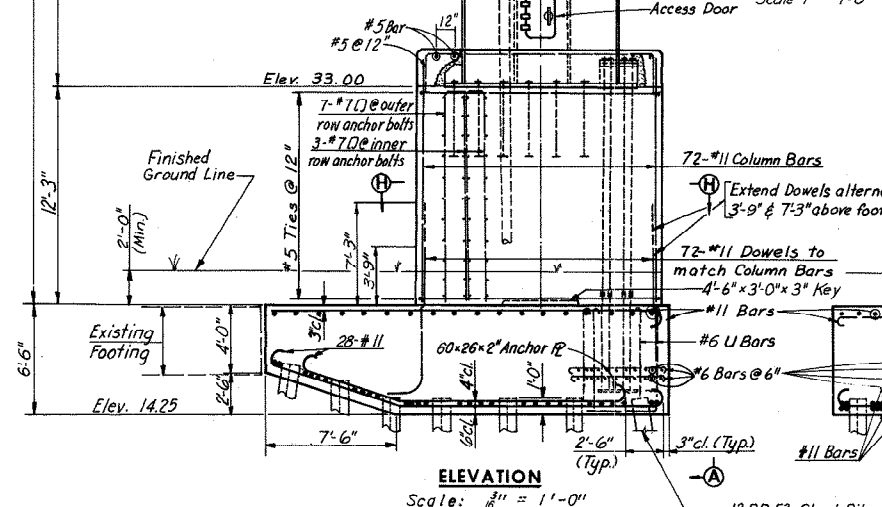


ELEVATION
 Scale: 3/8" = 1'-0"

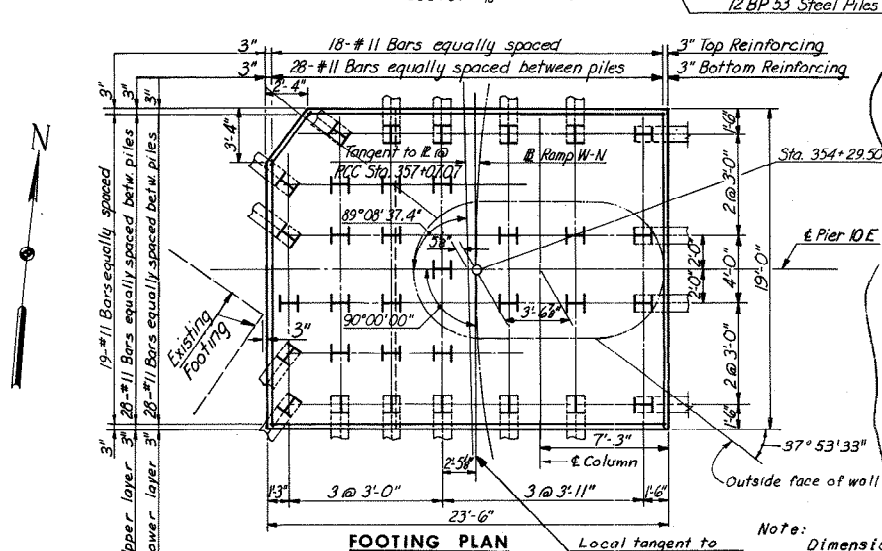

FOOTING PLAN
 Scale: 3/8" = 1'-0"


FOOTING FOR PIER 10E IS ECCENTRIC AS SHOWN ON FOOTING PLAN

Note: Concrete under column. Base plate shall be prepared as given in standard shoe details. Base plate shall be set on a thin layer of dry cement powder to provide a uniform bearing.

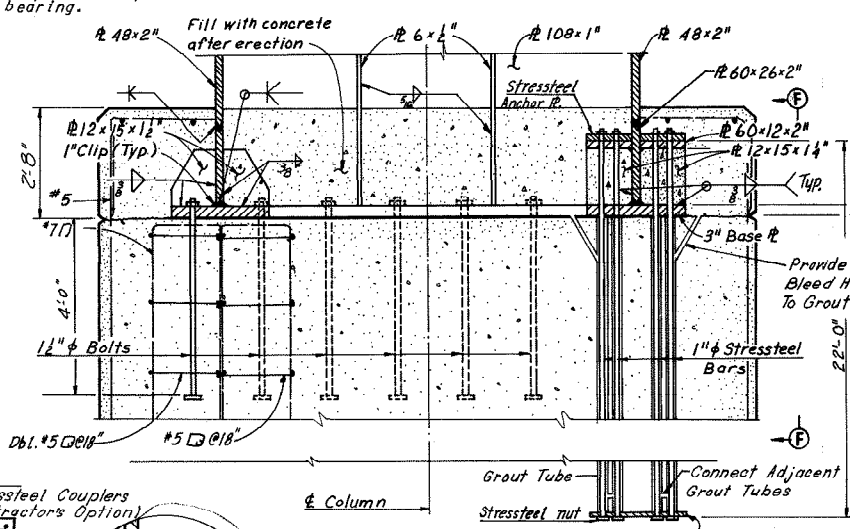


SECTION B-B
 Scale: 3/8" = 1'-0"

Not Revised See Shop Drawing

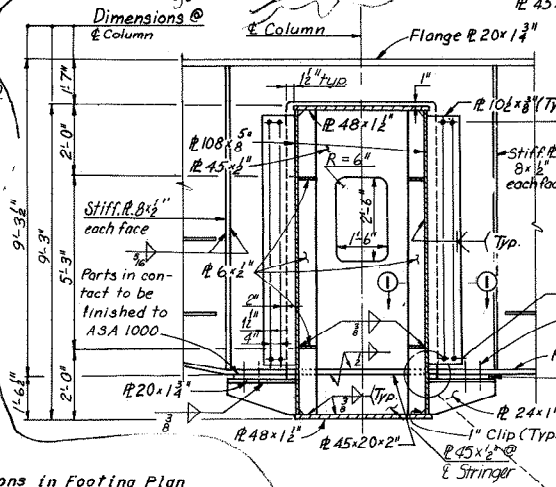


SECTION D-D
 Scale: 3/8" = 1'-0"


Note: Dimensions in Footing Plan are measured at bottom of Footing.
 Note: Footing elevations are approximate only and may be varied to suit field conditions as directed by the Engineer. Vertical shaft reinforcing shall not be cut until these elevations are established. Where elevations change more than 2 ft., redesign will be required.

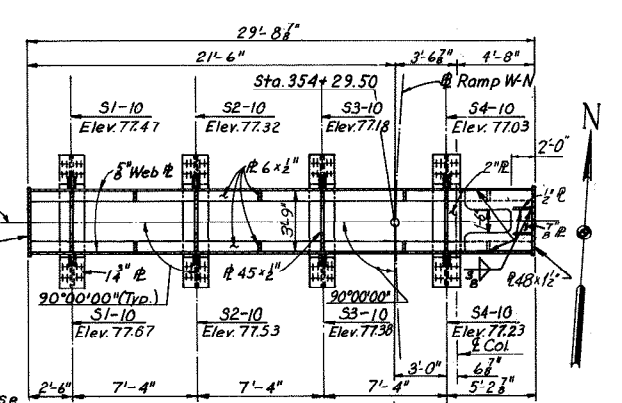


SECTION C-C
 Scale: 3/8" = 1'-0"

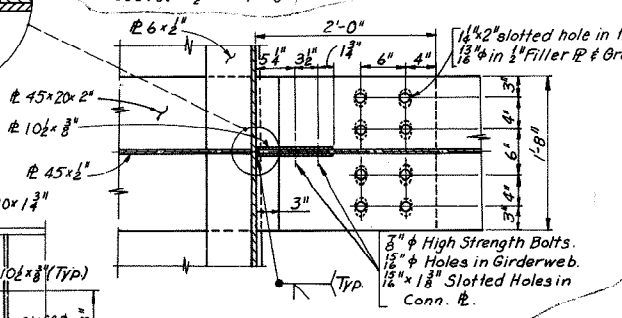


SECTION I-I
 Scale: 1" = 1'-0"

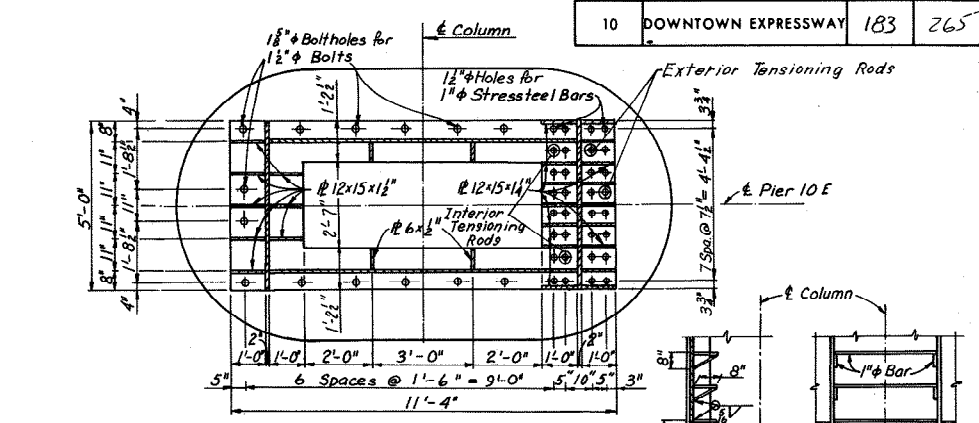


PLAN OF COLUMN BASE PLATE
 Scale: 3/8" = 1'-0"

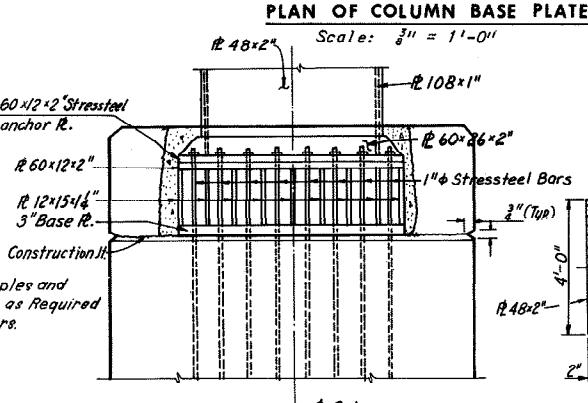

VIEW F-F
 Scale: 2" = 1'-0"

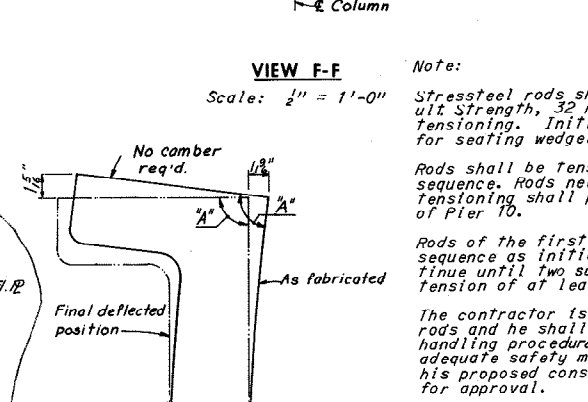

CAMBERING OF COLUMN
 No Scale

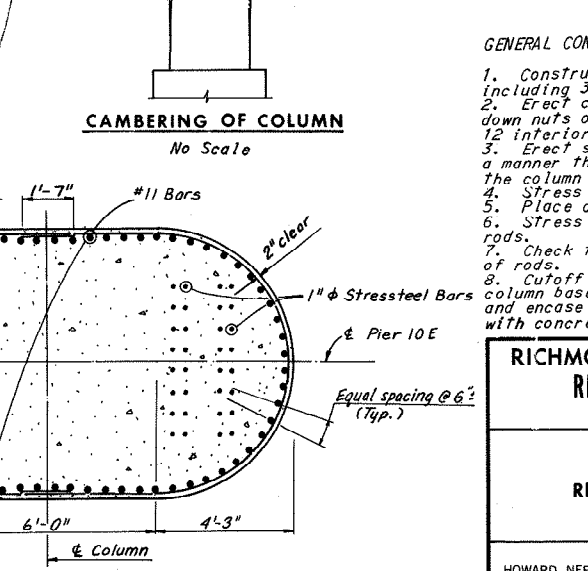

SECTION H-H
 Scale: 3/8" = 1'-0"

Note: Stress steel rods shall be 1" Special Grade, 160 ksi. min. ult. Strength, 32 rods red'd. Rods to be grouted after tensioning. Initial Jacking Force Required = 88" for seating wedge.
 Rods shall be tensioned as outlined in the construction sequence. Rods need not be tensioned in pairs, however, tensioning shall proceed outward from the centerline of Pier 10.
 Rods of the first group shall be checked in the same sequence as initial tensioning, checking shall continue until two successive 1" rods checked have a tension of at least 80%.
 The contractor is cautioned against nicking the stress rods and he shall follow the manufacturers recommended handling procedures. The contractor shall provide adequate safety measures. The contractor shall submit his proposed construction procedures to the engineer for approval.

- GENERAL CONSTRUCTION SEQUENCE:
1. Construct footing and pedestal including 32-1/4" stress steel bars.
 2. Erect column and capbeam. Tighten down nuts on 1/2" anchor bolts. Stress 12 interior tensioning rods.
 3. Erect structural steel superstructure in such a manner that load eccentricity on the column is kept at a minimum.
 4. Stress 12 exterior tensioning rods.
 5. Place concrete deck.
 6. Stress remaining 8 tensioning rods.
 7. Check tension on initial group of rods.
 8. Cutoff rod extension. Fill column base with concrete, grout and encase base and anchorage with concrete.

RICHMOND METROPOLITAN AUTHORITY
 RICHMOND EXPRESSWAY SYSTEM
 DOWNTOWN EXPRESSWAY

BRIDGE NO. 67
 RAMP W-N CONNECTION TO
 RICHMOND-PETERSBURG TURNPIKE
 PIER 10E














HOWARD, NEEDLES, TAMMEN & BERGENDOFF
 consulting engineers
 NEW YORK ALEXANDRIA KANSAS CITY

| | | | | | |
|-----------|------|---------|---------------------------|--------|---------|
| BY | DATE | 3 | As Built | TEM | 6-77 |
| MADE | J.D. | 3-11-69 | Fig. Plan & Elev. changed | d.B.P. | 723-75 |
| CHECKED | PTA | 4-24-69 | Changed Dim. Section | REB | 1-24-75 |
| IN CHARGE | NO. | | REVISION | BY | DATE |

SCALE: As Noted
 CONTRACT NO.: 10
 SHEET NO. 11 OF 54

AS BUILT

| RICHMOND EXPRESSWAY SYSTEM | | | |
|----------------------------|---------------------|-----------|--------------|
| SECTION | PROJECT | SHEET NO. | TOTAL SHEETS |
| 10 | DOWNTOWN EXPRESSWAY | 184 | 265 |

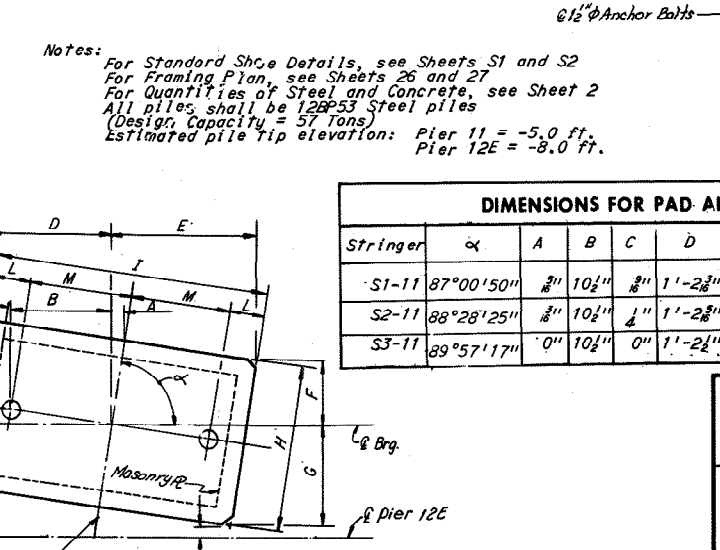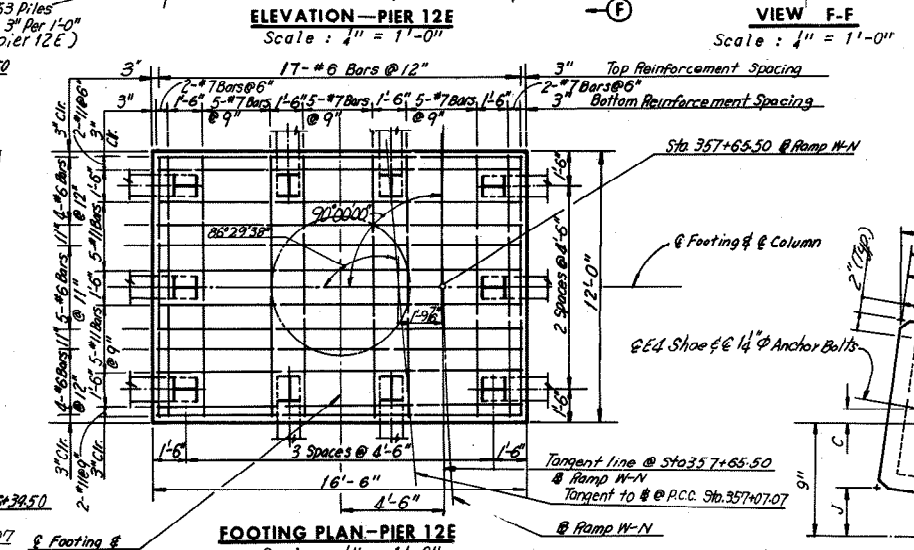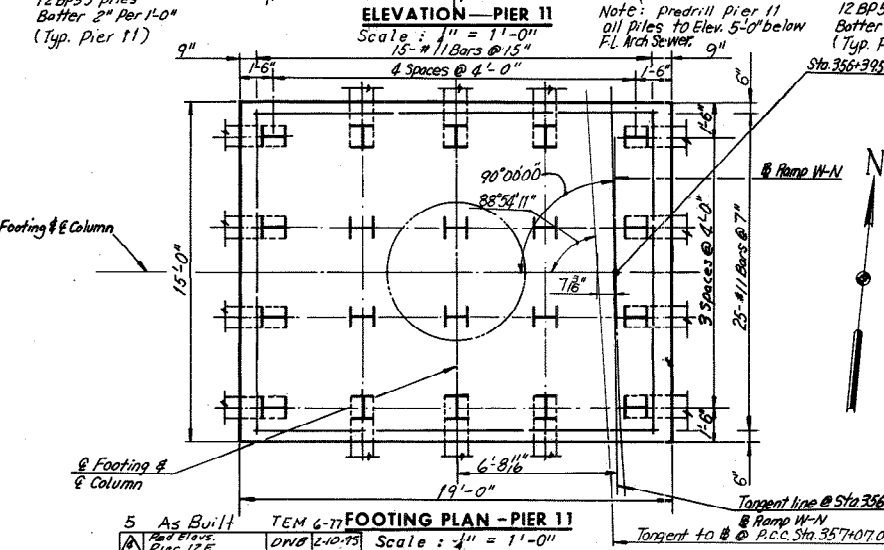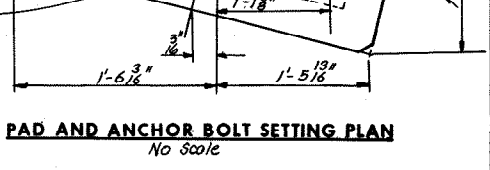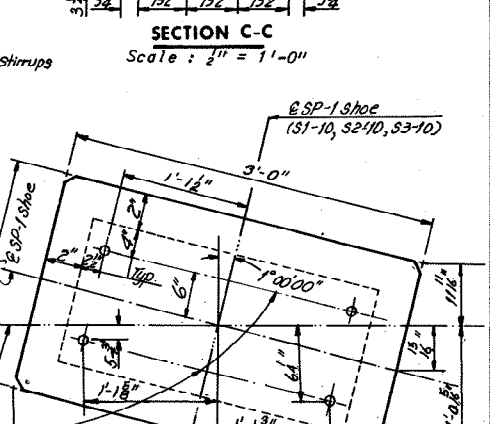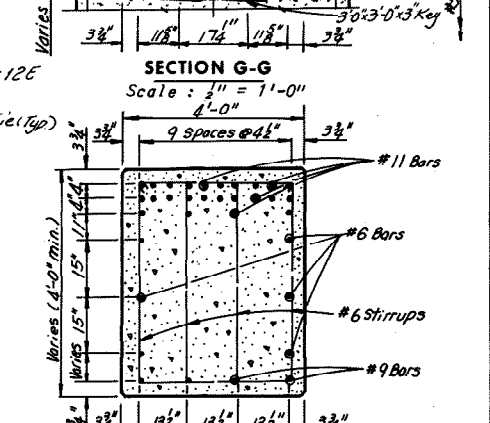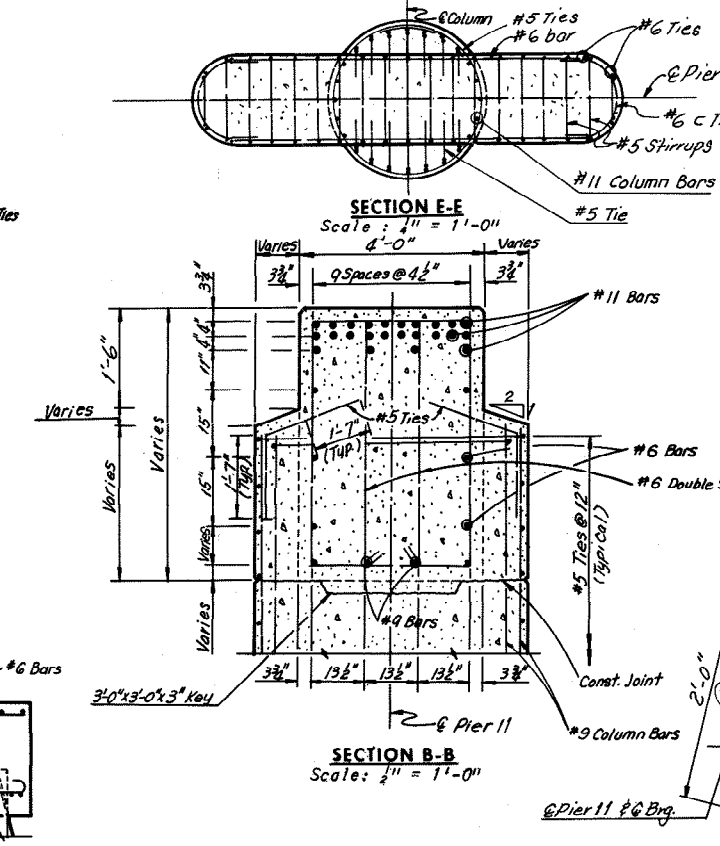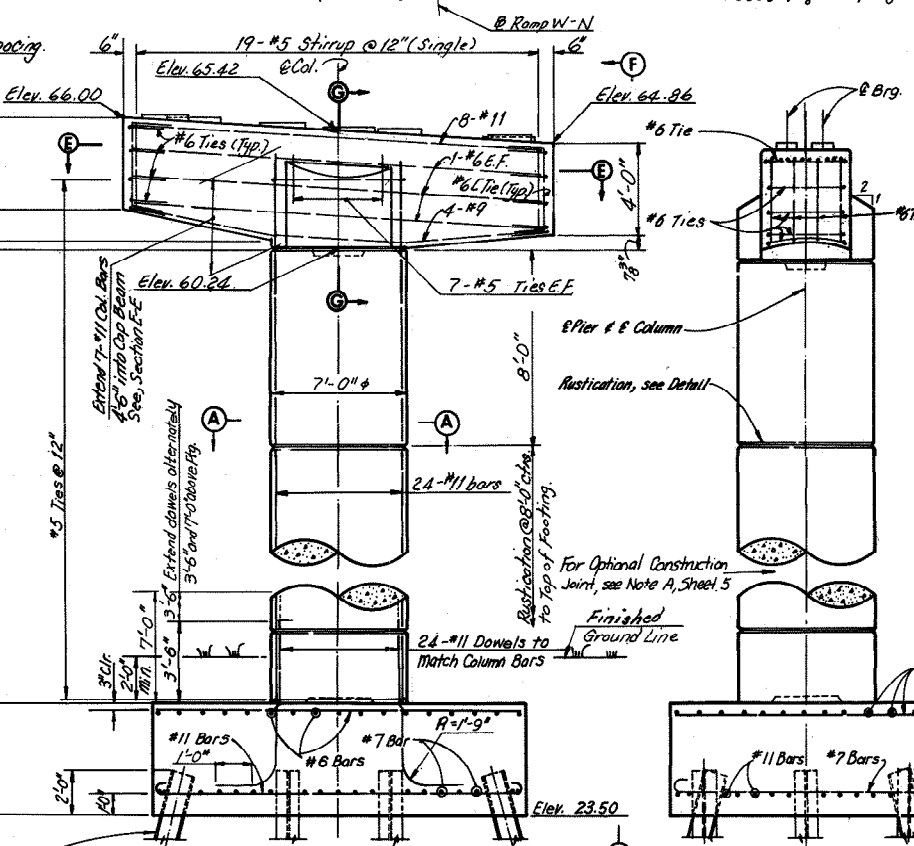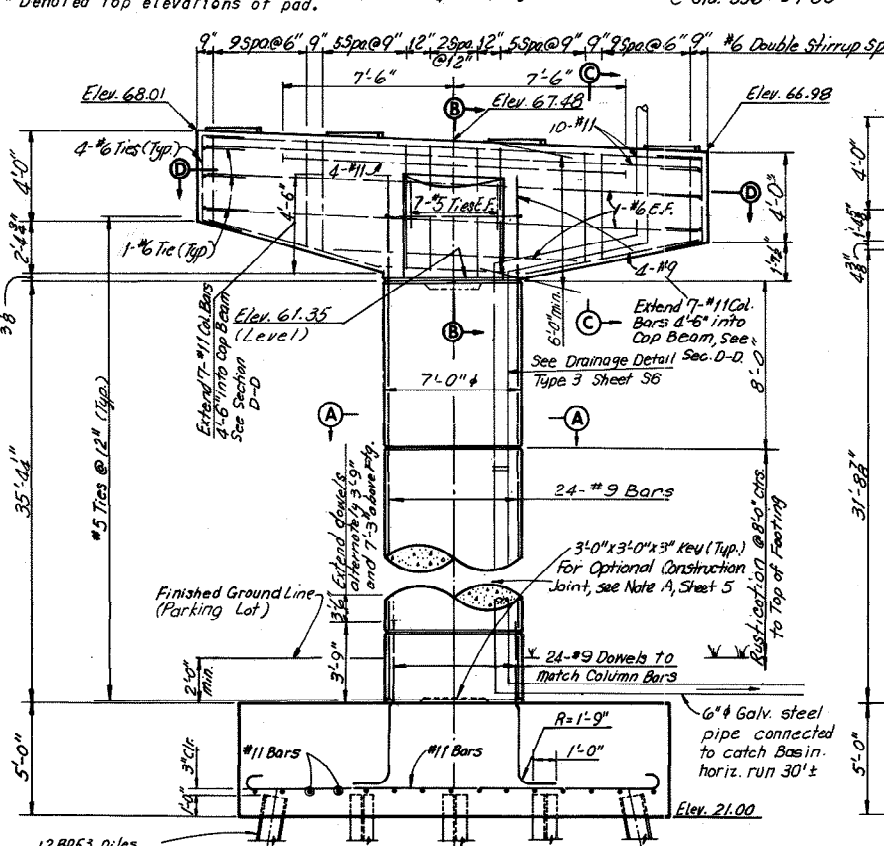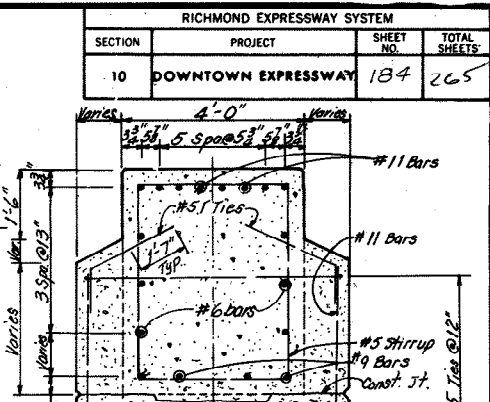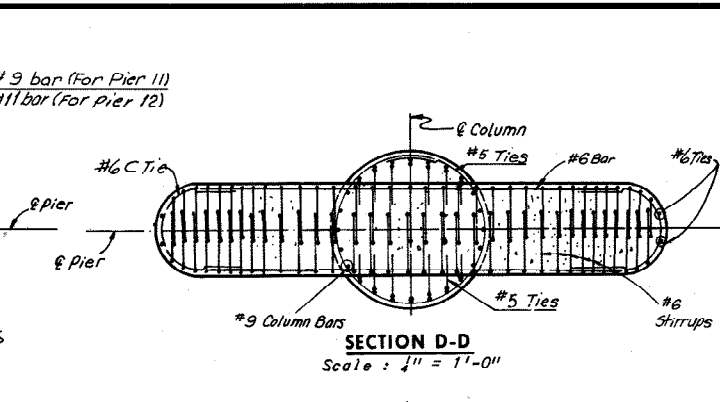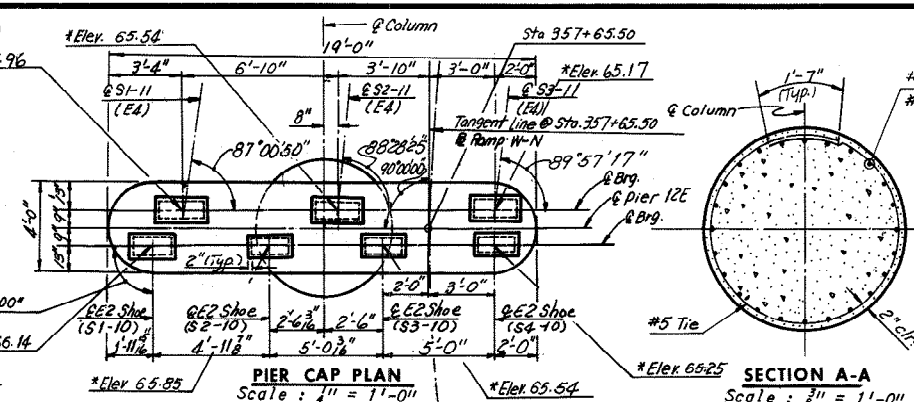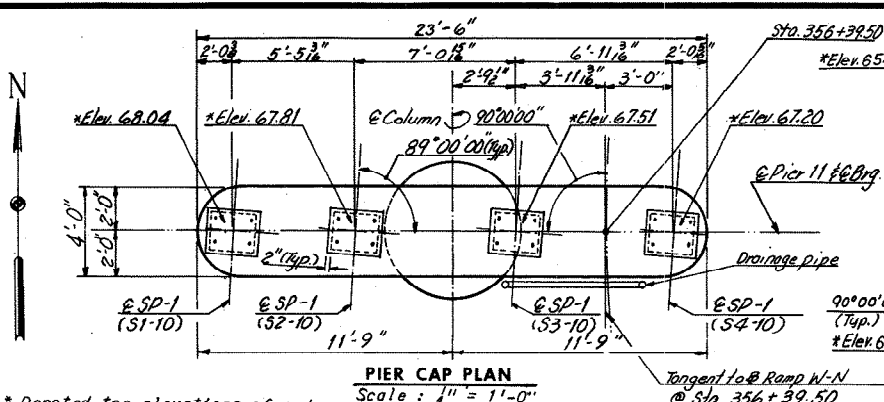

| DIMENSIONS FOR PAD AND ANCHOR BOLT SETTING PLAN | | | | | | | | | | | | | | |
|---|------------|----|---------|----|-----------|-----------|--------|--------|-----------|-------|--------|--------|----|---------|
| Stringer | α | A | B | C | D | E | F | G | H | I | J | K | L | M |
| S1-11 | 87°00'150" | 3" | 10 1/2" | 3" | 1'-2 3/4" | 1'-2 3/4" | 5 1/2" | 7" | 1'-0 1/2" | 2'-5" | 3 1/2" | 2" | 4" | 10 1/2" |
| S2-11 | 88°28'25" | 3" | 10 1/2" | 4" | 1'-2 3/4" | 1'-2 3/4" | 5 1/2" | 6 1/2" | 1'-0 1/2" | 2'-5" | 3 1/2" | 2 3/4" | 4" | 10 1/2" |
| S3-11 | 89°57'17" | 0" | 10 1/2" | 0" | 1'-2 3/4" | 1'-2 3/4" | 6 1/2" | 6 1/2" | 1'-0 1/2" | 2'-5" | 2 3/4" | 2 3/4" | 4" | 10 1/2" |

| BY | DATE | Notes Added | LRH | 4-19-74 | |
|-----------|--------|-------------|--------------------|---------|----------|
| MADE | G.S.H. | 3-10-69 | Column size | T.E.M. | 9-10-74 |
| CHECKED | PTA | 5-7-69 | SP-1 size chg. | R.P. | 11-13-74 |
| IN CHARGE | | | Pier cap dim. chg. | | |

| NO. | REVISION | BY | DATE |
|-----|----------|----|------|
| 1 | As Built | | |

RICHMOND METROPOLITAN AUTHORITY
RICHMOND EXPRESSWAY SYSTEM
DOWNTOWN EXPRESSWAY

BRIDGE NO. 67
 RAMP W-N CONNECTION TO
 RICHMOND-PETERSBURG TURNPIKE
 PIERS 11 AND 12E







HOWARD, NEEDLES, TAMMEN & BERGENDOFF
 consulting engineers
 NEW YORK ALEXANDRIA KANSAS CITY

SCALE: As Noted
 CONTRACT NO.: 10
 SHEET NO. 12 of 54

AS BUILT

| SHOE SCHEDULE | | | |
|----------------|-----------------|-----|-----|
| EXP. SHOE TYPE | FIXED SHOE TYPE | NO. | NO. |
| E2 | SP-1 | 8 | 4 |

| RICHMOND EXPRESSWAY SYSTEM | | | |
|----------------------------|---------------------|-----------|--------------|
| SECTION | PROJECT | SHEET NO. | TOTAL SHEETS |
| 10 | DOWNTOWN EXPRESSWAY | 196 | 265 |

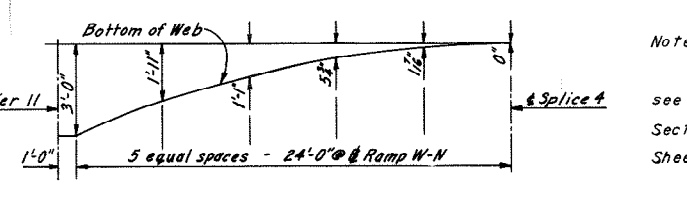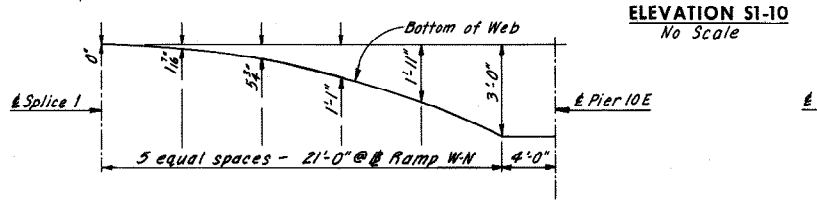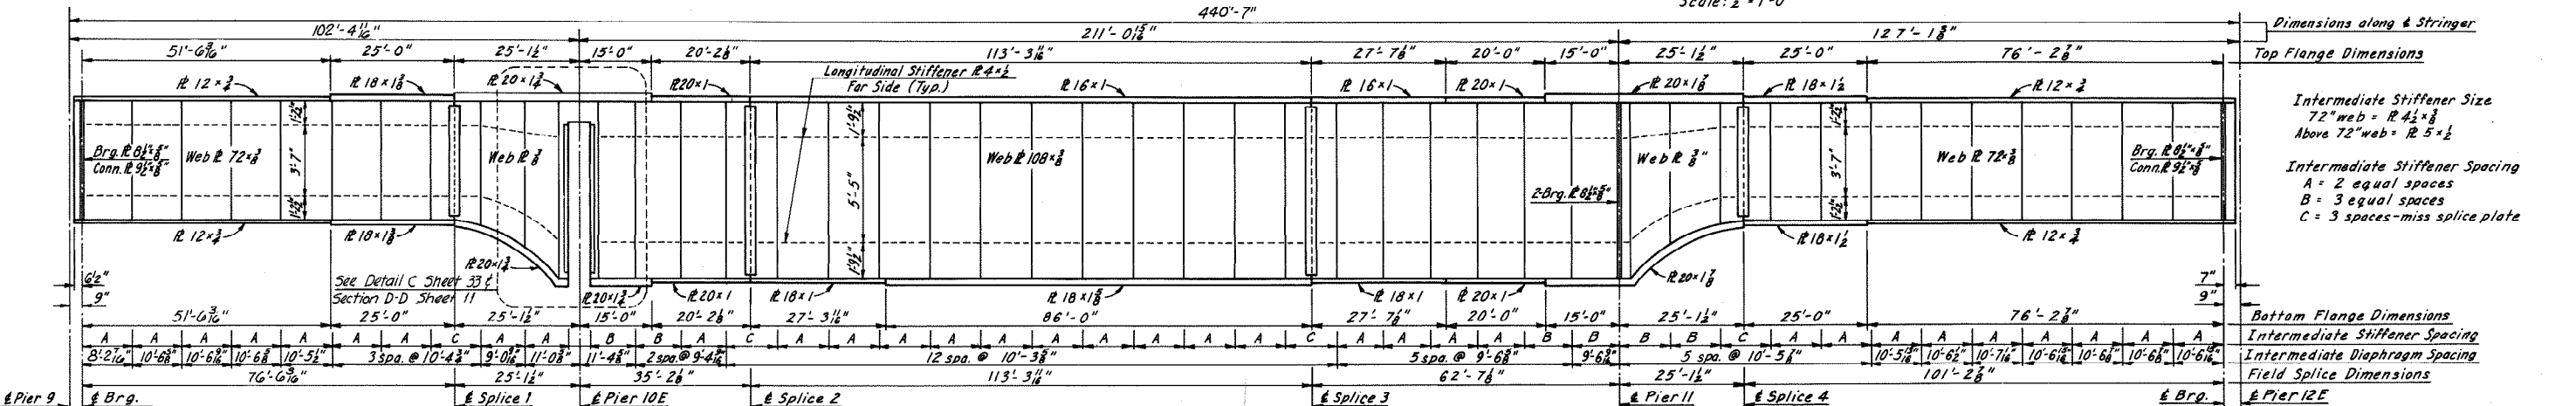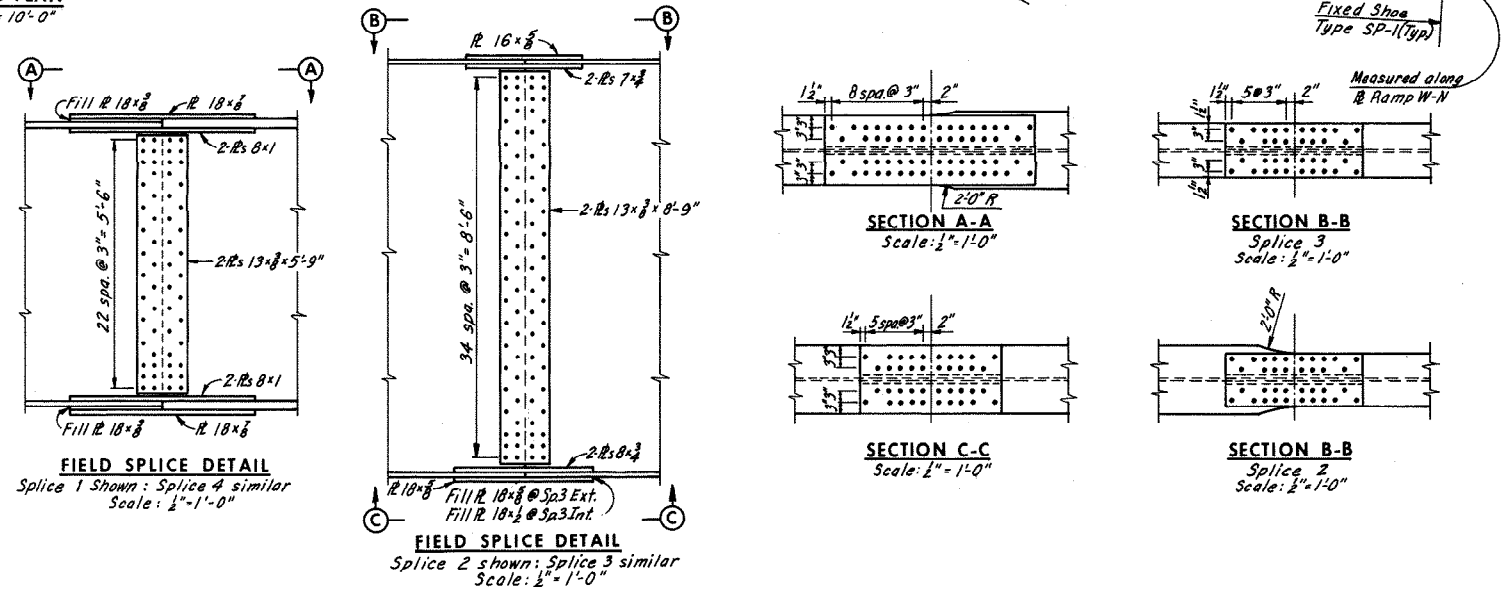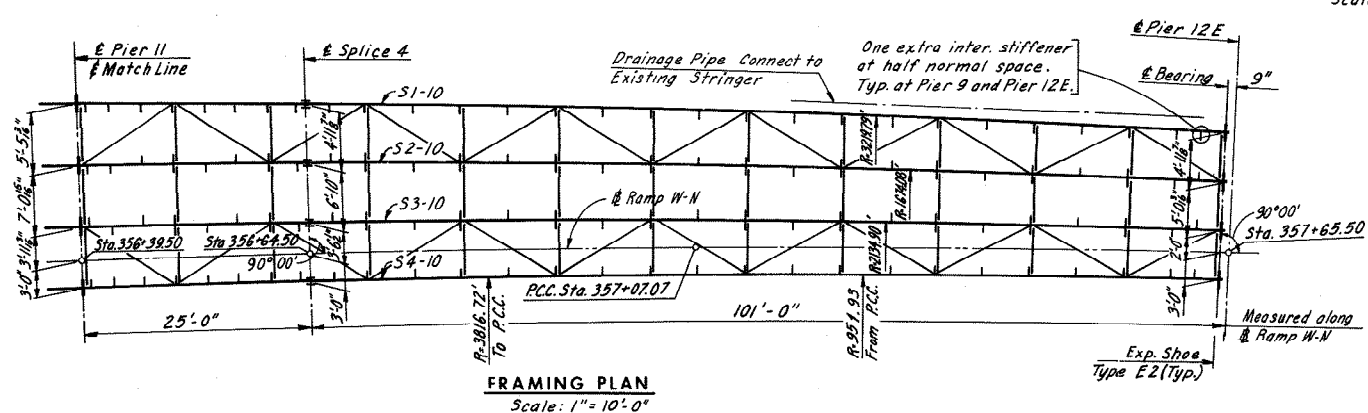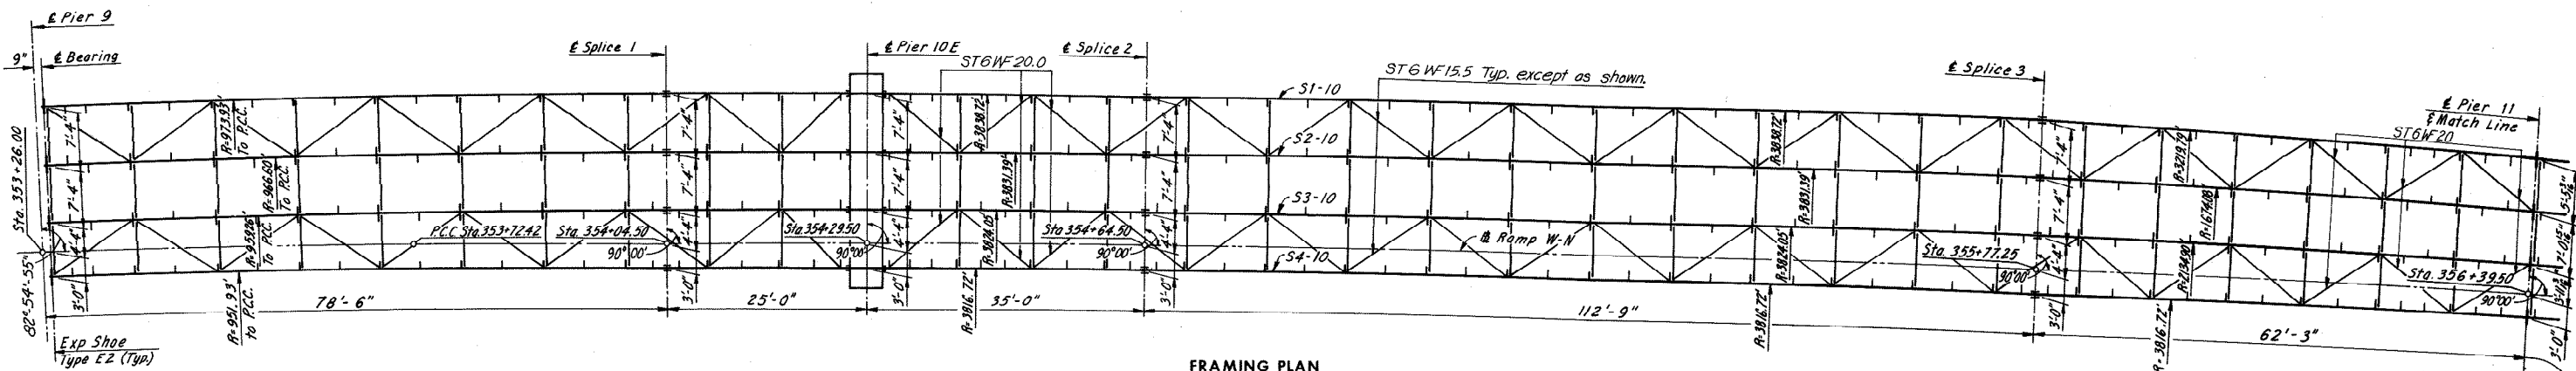

Notes:
 For Deck Plan, see Sheet 34.
 For Shoe Details, see Sheet S2.
 For Details of Intermediate Diaphragms, see Sheet 23.
 For Details of End Diaphragms, see Section D-D Sheet 33.
 For Details of Lateral Bracing, see Sheet 23.
 All steel is A36 unless otherwise noted.
 For Joint Details, see Sheet 49.
 For Web to Flange Weld, see Note, Sheet 20.


RICHMOND METROPOLITAN AUTHORITY
RICHMOND EXPRESSWAY SYSTEM
DOWNTOWN EXPRESSWAY
 BRIDGE NO. 67
 RAMP W-N CONNECTION TO
 RICHMOND-PETERSBURG TURNPIKE
FRAMING PLAN - UNIT 10

| BY | DATE | Note Added | LRH | 4-19-74 |
|-----------|------|------------|-----|----------|
| MADE | AMH | 2-28-69 | 2 | As Built |
| CHECKED | JD | 4-26-69 | | |
| IN CHARGE | | | | |

| | |
|---------------|----------|
| SCALE: | As Noted |
| CONTRACT NO.: | 10 |
| SHEET NO.: | 24 of 54 |

AS BUILT

| RICHMOND EXPRESSWAY SYSTEM | | | |
|----------------------------|---------------------|-----------|--------------|
| SECTION | PROJECT | SHEET NO. | TOTAL SHEETS |
| 10 | DOWNTOWN EXPRESSWAY | 198 | 265 |


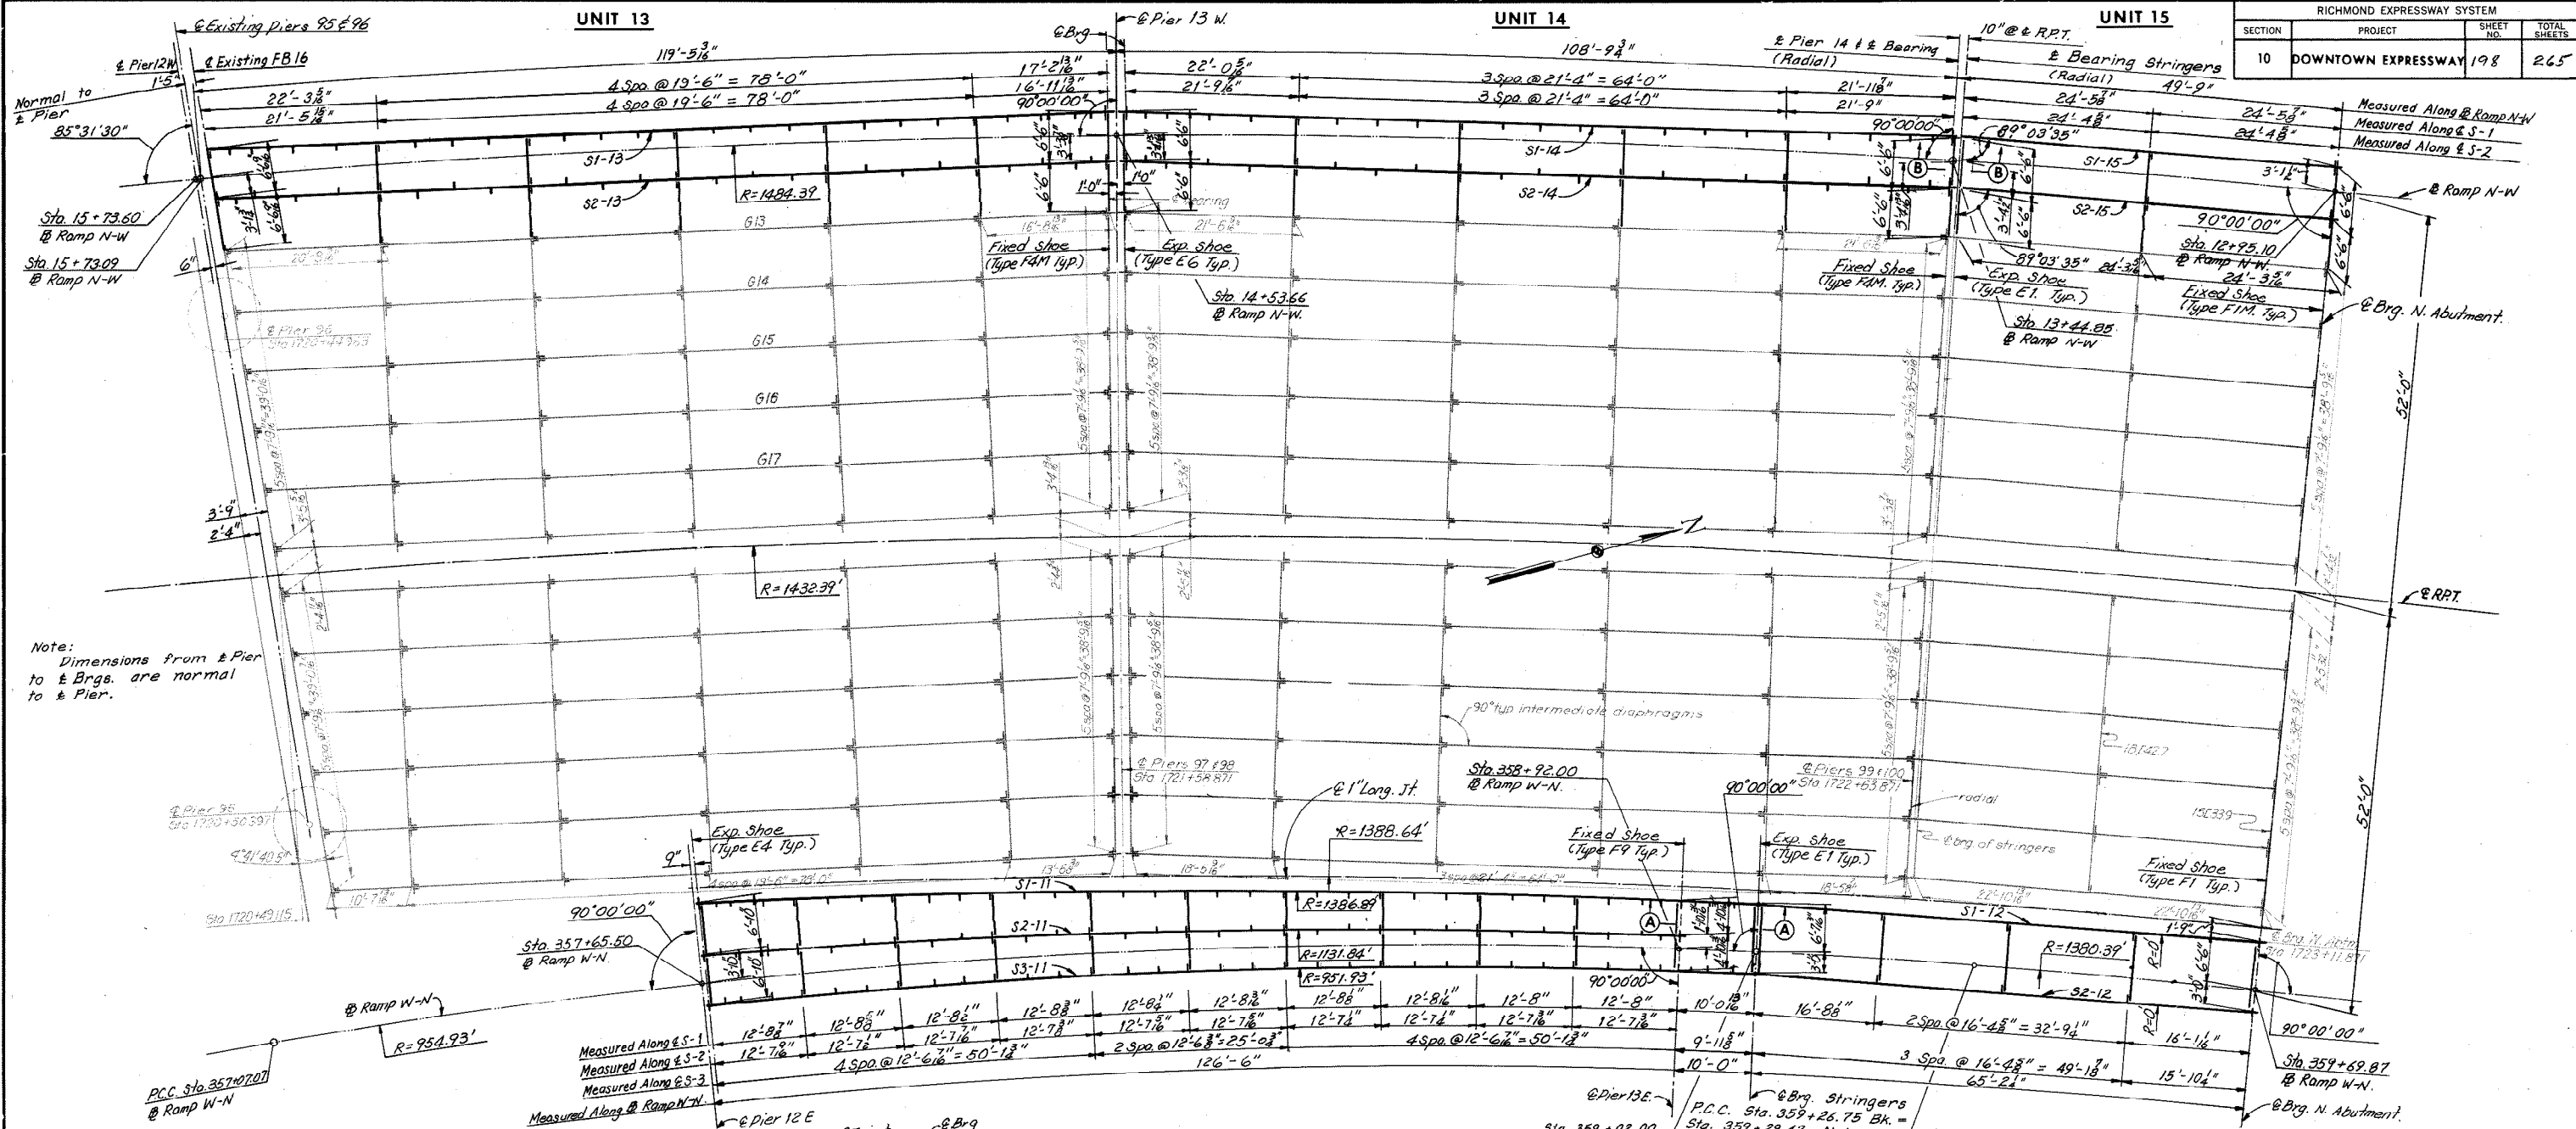


Note:
Dimensions from & Pier
to & Brgs. are normal
to & Pier.

Note:
For Stringer Elevation, see Sheet 27.
For Stringer Schedule, see Sheet 27.
For Camber Schedule, see Sheet 27.
For FB 16 Details, see Sheet 28.
For Deck Plan, see Sheet 33.
For Shoe Details, see Sheets S1&S2.

Note:
Dimensions shown on the plans for existing structural metalwork are in accordance with drawings prepared for the original construction. The Contractor shall verify all necessary dimensions of existing structural metalwork prior to fabrication of new metalwork.
New Diaphragms are to match Existing Diaphragms, in Units 13, 14 and 15.

| | | | | |
|-----------|---------|----------|-----|----------|
| BY | DATE | REVISION | BY | DATE |
| K.C.T. | 2-24-69 | As Built | TEM | 6-77 |
| CHECKED | K.C.T. | 3 | NO. | REVISION |
| IN CHARGE | | | | |

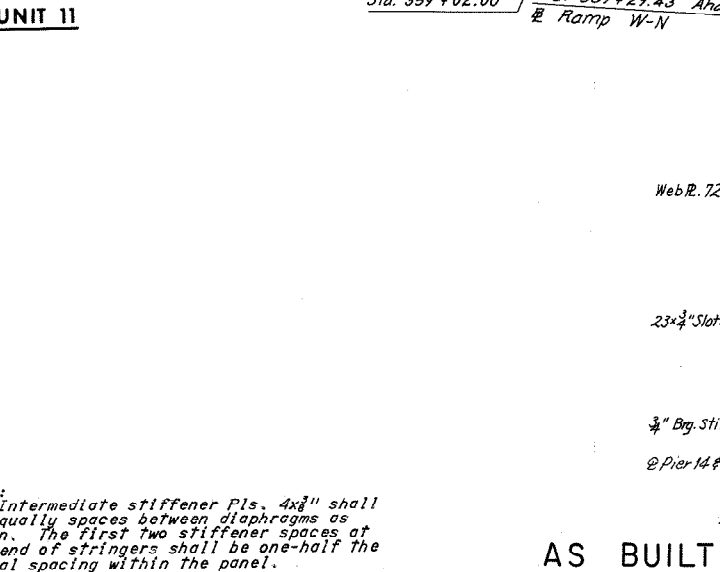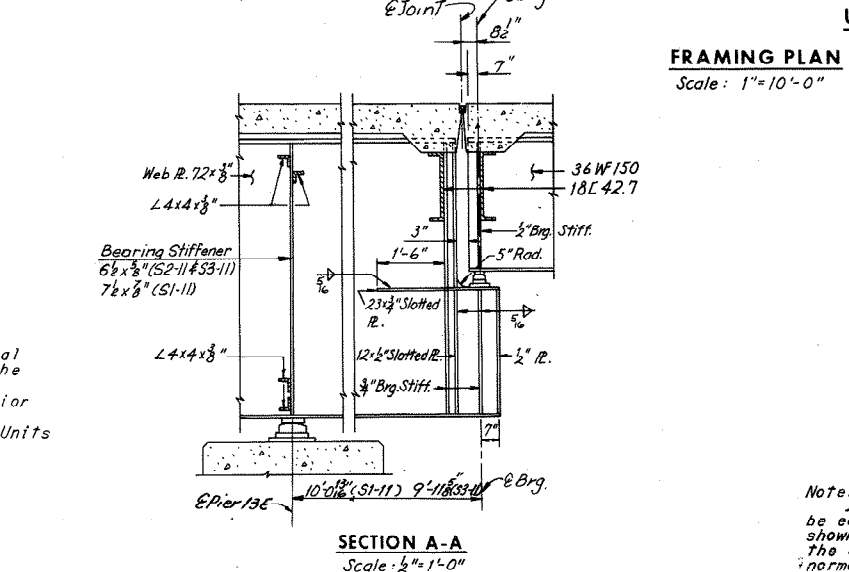

Note:
Intermediate stiffener Pls. 4x3" shall be equally spaced between diaphragms as shown. The first two stiffener spaces at the end of stringers shall be one-half the normal spacing within the panel.

| SHOE SCHEDULE | | | |
|---------------|-----------|-----------------|-----------|
| FIXED SHOES | | EXPANSION SHOES | |
| TYPE | NO. REQD. | TYPE | NO. REQD. |
| F1 | 2 | E1 | 4 |
| F1M | 2 | E4 | 3 |
| F4M | 4 | E6 | 2 |
| F9 | 3 | | |

RICHMOND METROPOLITAN AUTHORITY
RICHMOND EXPRESSWAY SYSTEM
DOWNTOWN EXPRESSWAY

BRIDGE NO. 67
RAMP W-N CONNECTION TO
RICHMOND-PETERSBURG TURNPIKE
FRAMING PLAN - UNITS 11, 12, 13, 14 AND 15


HOWARD, NEEDLES, TAMMEN & BERGENDOFF
consulting engineers
NEW YORK ALEXANDRIA KANSAS CITY

SCALE: As Noted
CONTRACT NO. 10
SHEET NO. 26 OF 54


AS BUILT

SECTION B-B
Scale: 1/2" = 1'-0"

| RICHMOND EXPRESSWAY SYSTEM | | | |
|----------------------------|---------------------|-----------|--------------|
| SECTION | PROJECT | SHEET NO. | TOTAL SHEETS |
| 10 | DOWNTOWN EXPRESSWAY | 199 | 265 |

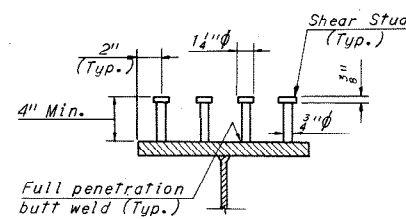

SHEAR STUD DETAIL
No Scale

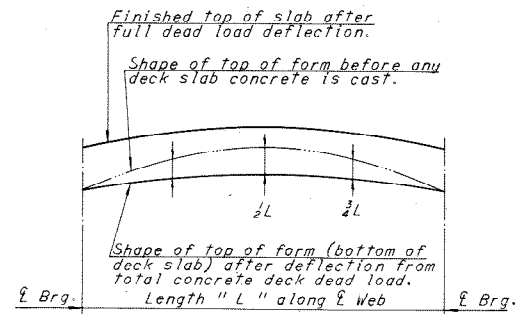


DEAD LOAD DEFLECTION DIAGRAM

NOTE TO CONTRACTOR

Deflections given are those anticipated to occur in the stringer upon placement of the total concrete deck dead load. In practice, the stringers in place are not likely to have the exact camber to compensate for these deflections during construction. The residual amounts shall be provided by adjusting forms to vary the thickness of the concrete haunch between the bottom of the slab and the top of stringer without altering the slab thickness.

SHEAR STUD NOTE

Capacity = 3,400 lbs. per stud. The Contractor may, if he elects, use three 1/2" diameter studs at the same longitudinal spacing in lieu of the four 3/4" diameter studs shown. Stud rows shall be placed parallel to the main deck reinforcing. Shear stud spacing shown is maximum spacing.

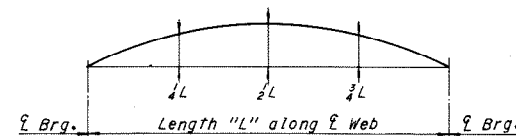


CAMBER DIAGRAM


NOTE TO FABRICATOR

The stringers shall be fabricated with an upward camber amounting to the tabulated value. This will provide approximate compensation for deflection under full dead load and for conformity with finished grade.


Note: Stringers having a total camber of less than 1" are not required to be shop cambered, but should be turned so that any mill tolerance deviation from straightness will be in the direction shown by the Camber Diagram. If stringers are not cambered, distance top of stringers to top of slab will vary along the stringer in accordance with the offset dimensions shown in the Camber Diagram, and with minimum distance as shown in Cross-Section on Sheet 35.

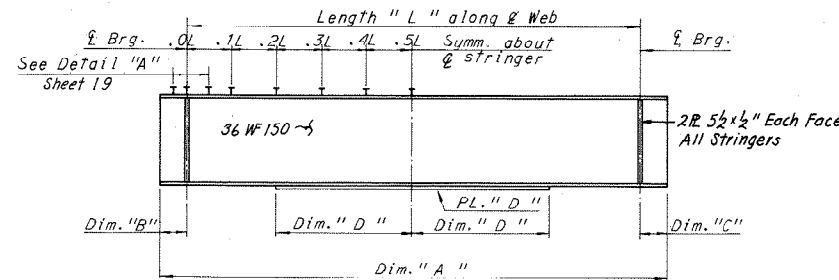


STRINGER ELEVATION
No Scale
(Unit 12 & 15)

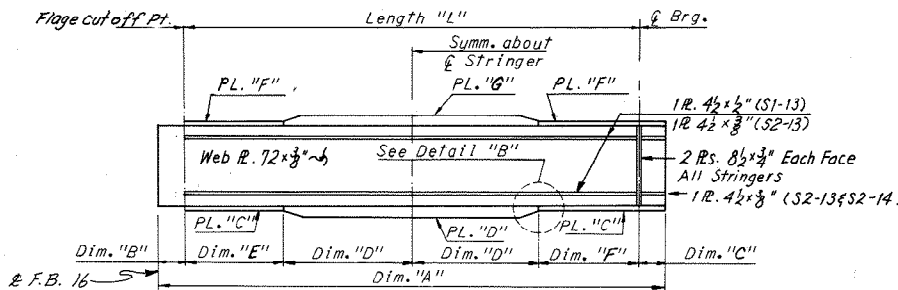


STRINGER ELEVATION
No Scale
(Unit 13)

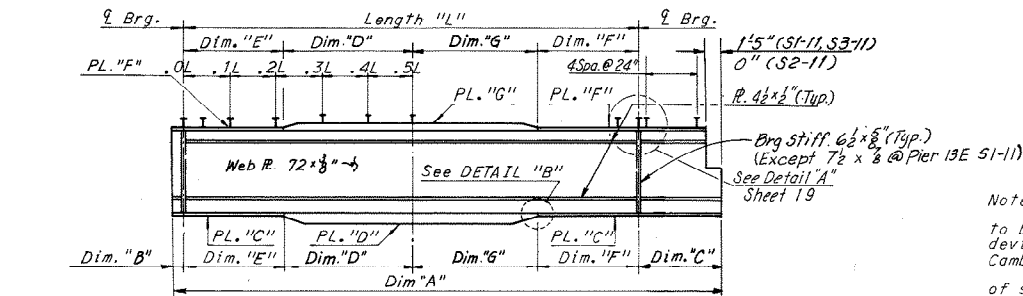

STRINGER ELEVATION
No Scale
(Unit 11)

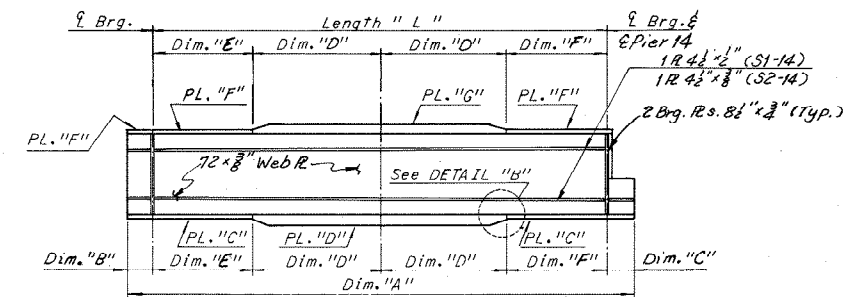


STRINGER ELEVATION
No Scale
(Unit 14)

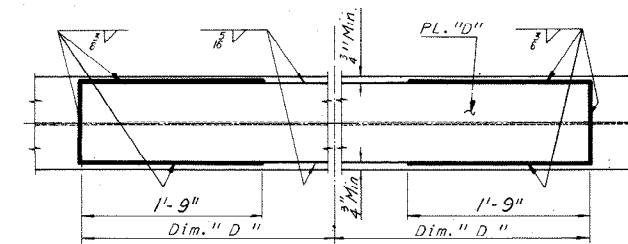

COVER PLATE DETAIL
No Scale

Note: Stringers having a total camber of less than 1" are not required to be shop cambered, but should be turned so that any mill tolerance deviation from straightness will be in the direction shown by the Camber Diagram. If stringers are not cambered, distance top of stringers to top of slab will vary along the stringer in accordance with the offset dimensions shown in the Camber Diagram, and with minimum distance as shown in cross-section on Sheet 35.

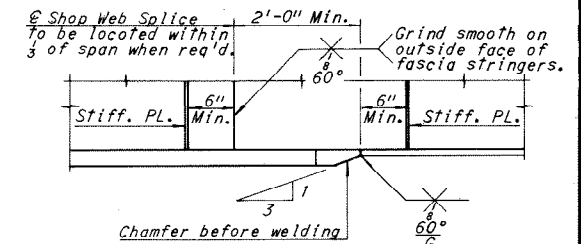

DETAIL "B"
No Scale
NOTE: Web to flange weld size see sheet 20.

| UNIT | STRINGER | Dim. "A" | LENGTH "L" | Dim. "B" | Dim. "C" | Dim. "D" | Dim. "E" | Dim. "F" | Dim. "G" | PL. "C" | PL. "D" | PL. "F" | PL. "G" | MAX. SHEAR STUD SPACING | | | | | DEAD LOAD DEFLECTION SCHEDULE | | | CAMBER SCHEDULE | | | |
|------|----------|--------------|-------------|----------|------------|----------|------------|------------|----------|-------------|---------------|-------------|-------------|-------------------------|-----------|-----------|-----------|-----------|-------------------------------|--------|--------|-----------------|--------|--------|--------|
| | | | | | | | | | | | | | | 0.0L-0.1L* | 0.1L-0.2L | 0.2L-0.3L | 0.3L-0.4L | 0.4L-0.5L | 1/4L | 1/2L | 3/4L | 1/4L | 1/2L | 3/4L | |
| 11 | S1-11 | 133'-1 1/2" | 126'-11" | 7" | 10'-7 1/2" | 38'-0" | 25'-5 1/2" | 25'-5 1/2" | 38'-0" | 16'-1 1/2" | 18 x 2" | 12 x 1" | 16 x 1" | 17" | 19" | 24" | 24" | 24" | 24" | 1 1/2" | 1 1/2" | 1 1/2" | 2 3/4" | 3 3/4" | 2 3/4" |
| | S2-11 | 127'-3 3/8" | 126'-1 3/8" | 7" | 7" | 31'-6" | 31'-6 1/8" | 31'-6 1/8" | 31'-6" | 14 x 1 1/2" | 16 x 2" | 12 x 1" | 12 x 1" | 18" | 20 1/2" | 24" | 24" | 24" | 24" | 1 1/2" | 2 3/4" | 1 1/2" | 2 1/2" | 4" | 3 3/4" |
| | S3-11 | 136'-5 1/2" | 125'-4 1/2" | 7" | 10'-6 5/8" | 37'-8" | 25'-0 1/2" | 18'-6 1/2" | 44'-2" | 14 x 1" | 14 x 2" | 12 x 1 1/2" | 12 x 1 1/2" | 22" | 24" | 24" | 24" | 24" | 24" | 1 3/4" | 2 1/2" | 1 1/2" | 2 3/8" | 4" | 2 1/2" |
| 12 | S1-12 | 66'-9 1/2" | 65'-6 1/2" | 7" | 8" | 24'-0" | - | - | - | 36 W 150 | 10 1/2 x 3/8" | - | - | 8" | 9" | 11" | 12 1/2" | 15" | 15" | 1 3/4" | 1 1/2" | 1 1/2" | 1 1/2" | 1 1/2" | 1 1/2" |
| | S3-12 | 66'-5 1/2" | 65'-0 1/2" | 7" | 10" | 23'-9" | - | - | - | 36 W 150 | 10 1/2 x 3/8" | - | - | 10" | 11" | 14 1/2" | 17 1/2" | 24" | 24" | 1 3/4" | 1 1/2" | 1 1/2" | 1 1/2" | 1 1/2" | 1 1/2" |
| 13 | S1-13 | 118'-4 3/8" | 116'-2 3/8" | 11" | 10 1/2" | 37'-0" | 21'-3 3/8" | 21'-3 3/8" | - | 18 x 1" | 18 x 1 1/2" | 18 x 1" | 18 x 1 1/2" | - | - | - | - | - | - | 1 3/4" | 1 3/4" | 1 3/4" | 1 3/4" | 2 3/4" | 1 3/4" |
| | S2-13 | 117'-4 1/4" | 115'-6 3/4" | 11" | 10 1/2" | 36'-0" | 21'-9 3/8" | 21'-9 3/8" | - | 18 x 1" | 18 x 1 1/2" | 18 x 1" | 18 x 1 1/2" | - | - | - | - | - | - | 1 3/4" | 1 3/4" | 1 3/4" | 1 3/4" | 2 3/4" | 1 3/4" |
| 14 | S1-14 | 110'-4 1/2" | 108'-0 3/4" | 10 1/2" | 11'-5 3/8" | 35'-0" | 19'-0 1/2" | 19'-0 1/2" | - | 18 x 1" | 18 x 1 1/2" | 18 x 1" | 18 x 1 1/2" | - | - | - | - | - | - | 1 1/2" | 1 3/8" | 1 1/2" | 1 3/4" | 1 3/4" | 1 1/2" |
| | S2-14 | 109'-10 3/8" | 107'-6 1/2" | 10 1/2" | 11'-5 3/8" | 35'-0" | 18'-9 1/2" | 18'-9 1/2" | - | 18 x 1" | 18 x 1 1/2" | 18 x 1" | 18 x 1 1/2" | - | - | - | - | - | - | 1 1/2" | 1 3/8" | 1 1/2" | 1 3/4" | 1 3/4" | 1 1/2" |
| 15 | S1-15 | 50'-1 1/4" | 48'-11 3/4" | 3 1/2" | 10" | - | - | - | - | 36 W 150 | - | - | - | - | - | - | - | - | - | 1 1/2" | 1 1/2" | 1 1/2" | 1 1/2" | 1 1/2" | 1 1/2" |
| | S2-15 | 49'-8 1/4" | 48'-9 3/8" | 3 1/2" | 8" | - | - | - | - | 36 W 150 | - | - | - | - | - | - | - | - | - | 1 1/2" | 1 1/2" | 1 1/2" | 1 1/2" | 1 1/2" | 1 1/2" |

* Spacing begins at termination of 6 spaces @ 4".

NOTE: All steel shall be A36 unless otherwise shown. Longitudinal stiffeners of exterior stringer shall be located on the exterior face of the stringer.

| | | | | |
|-----------|----------------|------------|-----|------|
| BY | DATE | REVISION | BY | DATE |
| MADE | K.C.P. 2-26-69 | 2 As Built | TEM | 6-77 |
| CHECKED | K.C.T. 4-28-69 | | | |
| IN CHARGE | | | | |

RICHMOND METROPOLITAN AUTHORITY
RICHMOND EXPRESSWAY SYSTEM
DOWNTOWN EXPRESSWAY

BRIDGE NO. 67
RAMP W-N CONNECTION TO
RICHMOND-PETERSBURG TURNPIKE
FRAMING PLAN - UNITS 11,12,13,14 AND 15


| | |
|---|--|
| HOWARD, NEEDLES, TAMMEN & BERGENDOFF consulting engineers NEW YORK ALEXANDRIA KANSAS CITY | SCALE: No Scale CONTRACT NO. 10 SHEET NO. 27 OF 54 |
|---|--|

AS BUILT


| RICHMOND EXPRESSWAY SYSTEM | | | |
|----------------------------|---------------------|-----------|--------------|
| SECTION | PROJECT | SHEET NO. | TOTAL SHEETS |
| 10 | DOWNTOWN EXPRESSWAY | 205 | 265 |

| ELEVATION TABLE | | | |
|-----------------|--------|--------|--------|
| STATION | ELEV A | ELEV B | ELEV C |
| 352+30.00 | 88.57 | 88.33 | 88.29 |
| 32.00 | 88.63 | 88.37 | 88.33 |
| 40.00 | 88.83 | 88.52 | 88.46 |
| 50.00 | 89.06 | 88.67 | 88.60 |
| 60.00 | 89.20 | 88.81 | 88.74 |
| 70.00 | 89.30 | 88.91 | 88.84 |
| 80.00 | 89.39 | 89.00 | 88.93 |
| 90.00 | 89.44 | 89.05 | 88.98 |
| 353+00.00 | 89.47 | 89.08 | 89.01 |
| 10.00 | 89.48 | 89.09 | 89.02 |
| 20.00 | 89.46 | 89.07 | 89.00 |
| 26.00 | 89.44 | 89.05 | 88.98 |
| 30.00 | 89.42 | 89.03 | 88.96 |


Note: Connect Lighting Conduit in existing structure with Junction Box at nose of new part of structure.

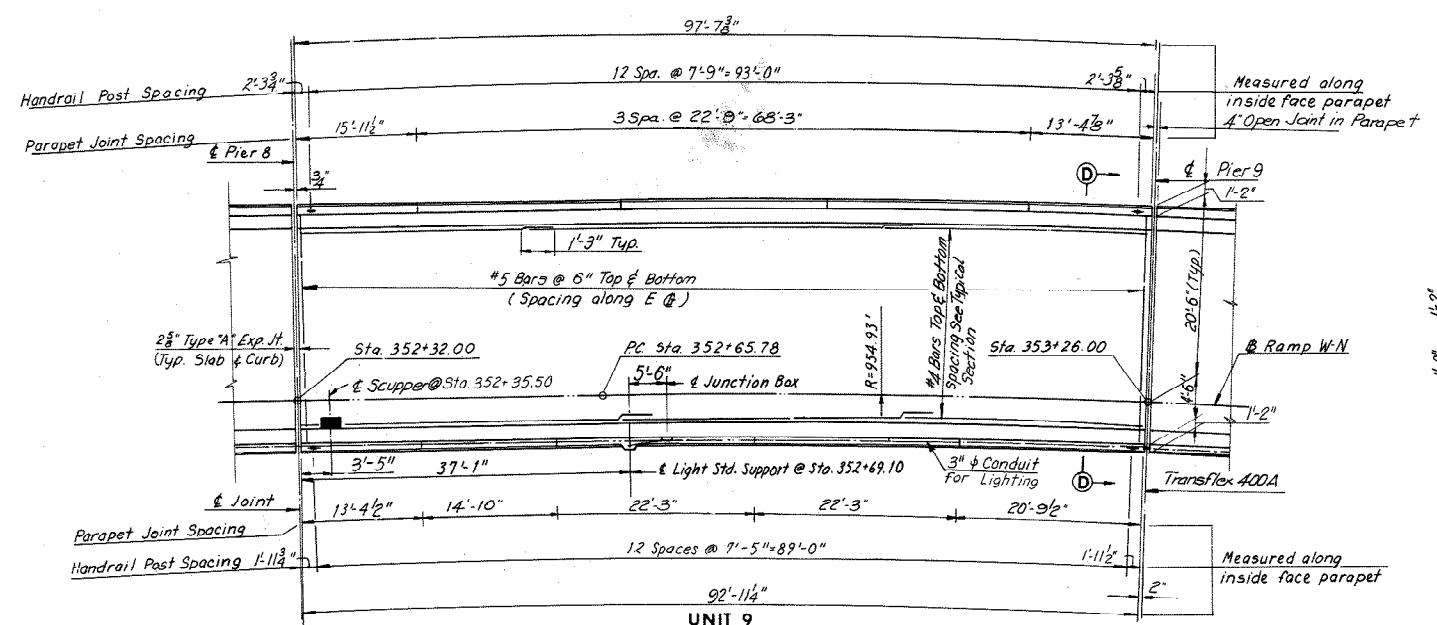


UNIT 9
DECK PLAN
Scale: 1" = 10'-0"

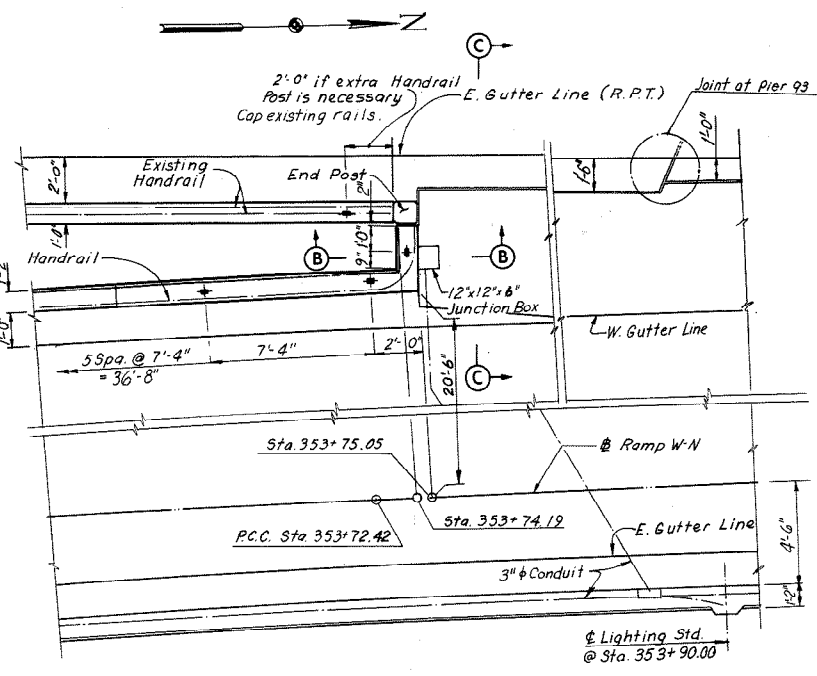


DETAIL B
Scale: 1/4" = 1'-0"

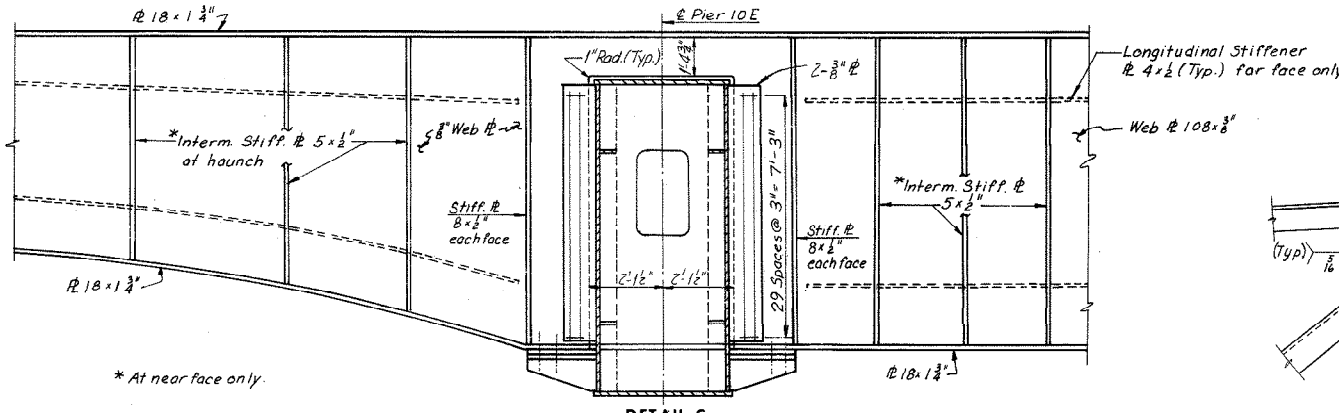


DETAIL C
Scale: 3/8" = 1'-0"

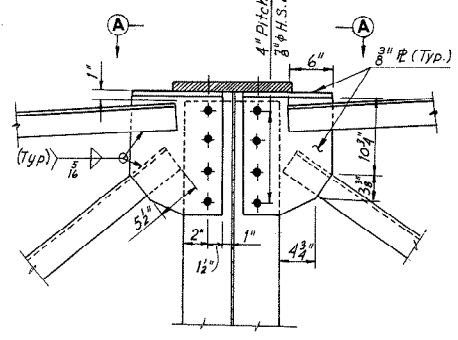


DETAIL A
Scale: 1" = 1'-0"

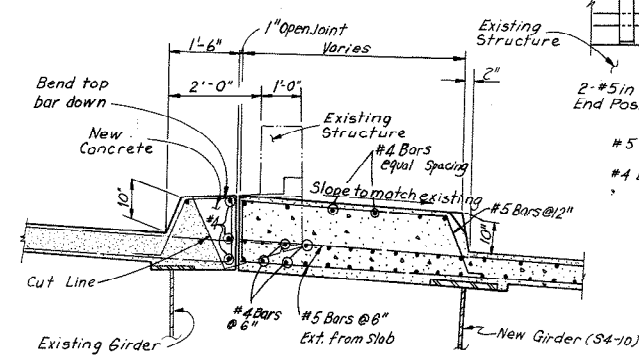


SECTION C-C
Scale: 1/2" = 1'-0"

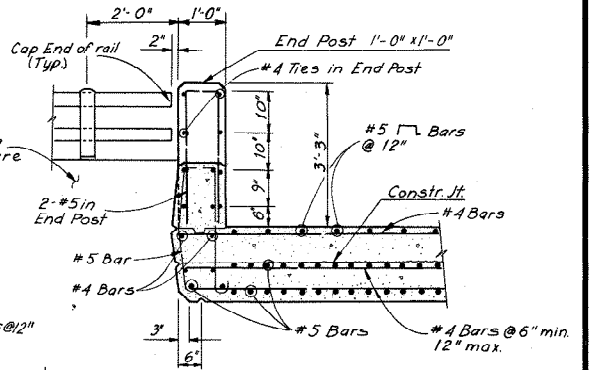

SECTION B-B
Scale: 1/2" = 1'-0"

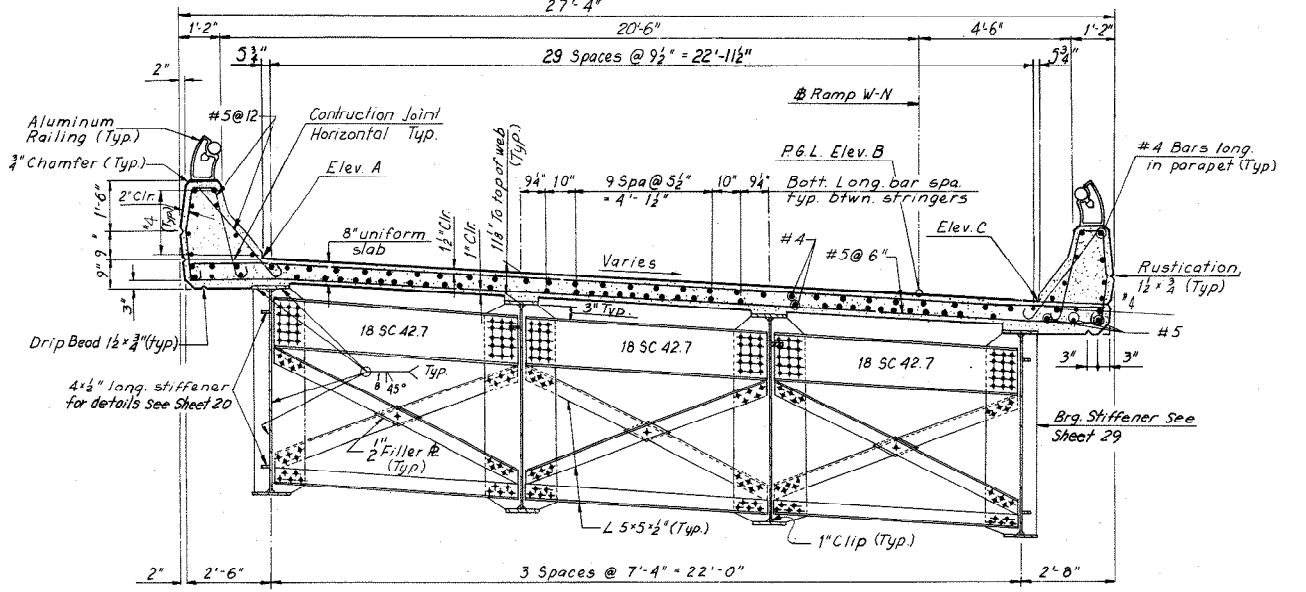


SECTION D-D - END DIAPHRAGM
Scale: 3/8" = 1'-0"

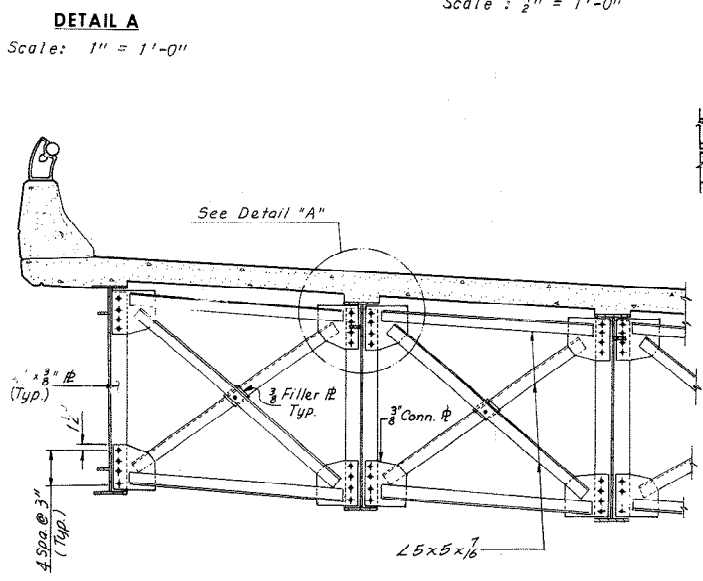

INTERMEDIATE DIAPHRAGM-UNIT 9
Scale: 3/8" = 1'-0"

AS BUILT

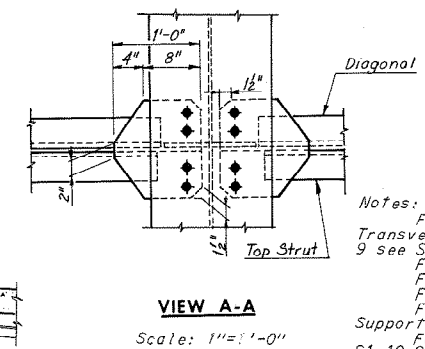

VIEW A-A
Scale: 1" = 1'-0"

Notes:
For Intermediate Diaphragm and Transverse Stiffener Spacing for Unit 9 see Sheet 23.
For Handrail Details see Sheet S3.
For Lighting Details see Sheet S4.
For Location of Detail B see Sheet 34.
For Standard Drainage Details see Support Type 3 Sheet S6.
For Location of Detail C see Stringer S1-10 Sheet 24.
For Typical Parapet Detail, see Sheet 29.

RICHMOND METROPOLITAN AUTHORITY
RICHMOND EXPRESSWAY SYSTEM
DOWNTOWN EXPRESSWAY

BRIDGE NO. 67
RAMP W-N CONNECTION TO
RICHMOND-PETERSBURG TURNPIKE
DECK PLAN AND SUPERSTRUCTURE DETAILS
UNIT 9




HOWARD, NEEDLES, TAMMEN & BERGENDOFF
consulting engineers
NEW YORK ALEXANDRIA KANSAS CITY
SCALE: As Noted
CONTRACT NO.: 10
SHEET NO. 33 OF 54

| BY | DATE | REVISION | BY | DATE |
|-----------|----------------|--|-----|---------|
| MADE | C.E.B. 3-7-69 | 2 As Built | TEM | G-77 |
| CHECKED | A.M.H. 4-21-69 | 1 Revised 2 size, Intermediate Post Wall | RKF | 1-24-75 |
| IN CHARGE | | | | |

Unit 9 shown, Unit 10, Diaphragm similar

| RICHMOND EXPRESSWAY SYSTEM | | | |
|----------------------------|---------------------|-----------|--------------|
| SECTION | PROJECT | SHEET NO. | TOTAL SHEETS |
| 10 | DOWNTOWN EXPRESSWAY | 206 | 265 |

| ELEVATION TABLE | | | |
|-----------------|---------|---------|---------|
| STATION | ELEV. A | ELEV. B | ELEV. C |
| 353+26.00 | 88.98 | 89.05 | 89.43 |
| +30.00 | 88.96 | 89.03 | 89.41 |
| +40.00 | 88.89 | 88.96 | 89.34 |
| +50.00 | 88.80 | 88.87 | 89.25 |
| +60.00 | 88.68 | 88.75 | 89.13 |
| +70.00 | 88.54 | 88.61 | 88.99 |
| +80.00 | 88.37 | 88.44 | 88.82 |
| +90.00 | 88.17 | 88.24 | 88.62 |
| 354+00.00 | 87.90 | 88.03 | 88.41 |
| +10.00 | 87.72 | 87.79 | 88.17 |
| +20.00 | 87.46 | 87.53 | 87.91 |
| +29.50 | 87.19 | 87.26 | 87.64 |
| +30.00 | 87.17 | 87.24 | 87.62 |
| +40.00 | 86.88 | 86.95 | 87.33 |
| +50.00 | 86.57 | 86.64 | 87.02 |
| +60.00 | 86.24 | 86.31 | 86.69 |
| +70.00 | 85.89 | 85.96 | 86.34 |
| +80.00 | 85.52 | 85.59 | 85.97 |
| +90.00 | 85.13 | 85.20 | 85.58 |
| 355+00.00 | 84.72 | 84.79 | 85.17 |
| +10.00 | 84.30 | 84.37 | 84.75 |
| +20.00 | 83.86 | 83.93 | 84.33 |
| +30.00 | 83.41 | 83.48 | 83.90 |
| +40.00 | 82.94 | 83.02 | 83.46 |
| +50.00 | 82.45 | 82.54 | 83.02 |
| +60.00 | 81.97 | 82.06 | 82.57 |
| +70.00 | 81.48 | 81.57 | 82.12 |
| +80.00 | 80.99 | 81.09 | 81.68 |
| +90.00 | 80.49 | 80.61 | 81.23 |
| 356+00.00 | 80.00 | 80.12 | 80.77 |
| +10.00 | 79.51 | 79.64 | 80.31 |
| +20.00 | 79.02 | 79.15 | 79.85 |
| +30.00 | 78.53 | 78.67 | 79.39 |
| +39.50 | 78.06 | 78.21 | 78.95 |
| +40.00 | 78.04 | 78.19 | 78.92 |
| +50.00 | 77.55 | 77.70 | 78.46 |
| +60.00 | 77.06 | 77.22 | 77.99 |
| +70.00 | 76.58 | 76.74 | 77.53 |
| +80.00 | 76.11 | 76.29 | 77.10 |
| +90.00 | 75.67 | 75.86 | 76.68 |
| 357+00.00 | 75.25 | 75.45 | 76.28 |
| +10.00 | 74.85 | 75.05 | 75.88 |
| +20.00 | 74.44 | 74.65 | 75.48 |
| +30.00 | 74.04 | 74.25 | 75.09 |
| +40.00 | 73.65 | 73.86 | — |
| +50.00 | 73.27 | 73.48 | — |
| +60.00 | 72.89 | 73.10 | — |
| +65.50 | 72.69 | 72.90 | — |

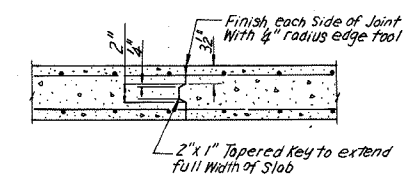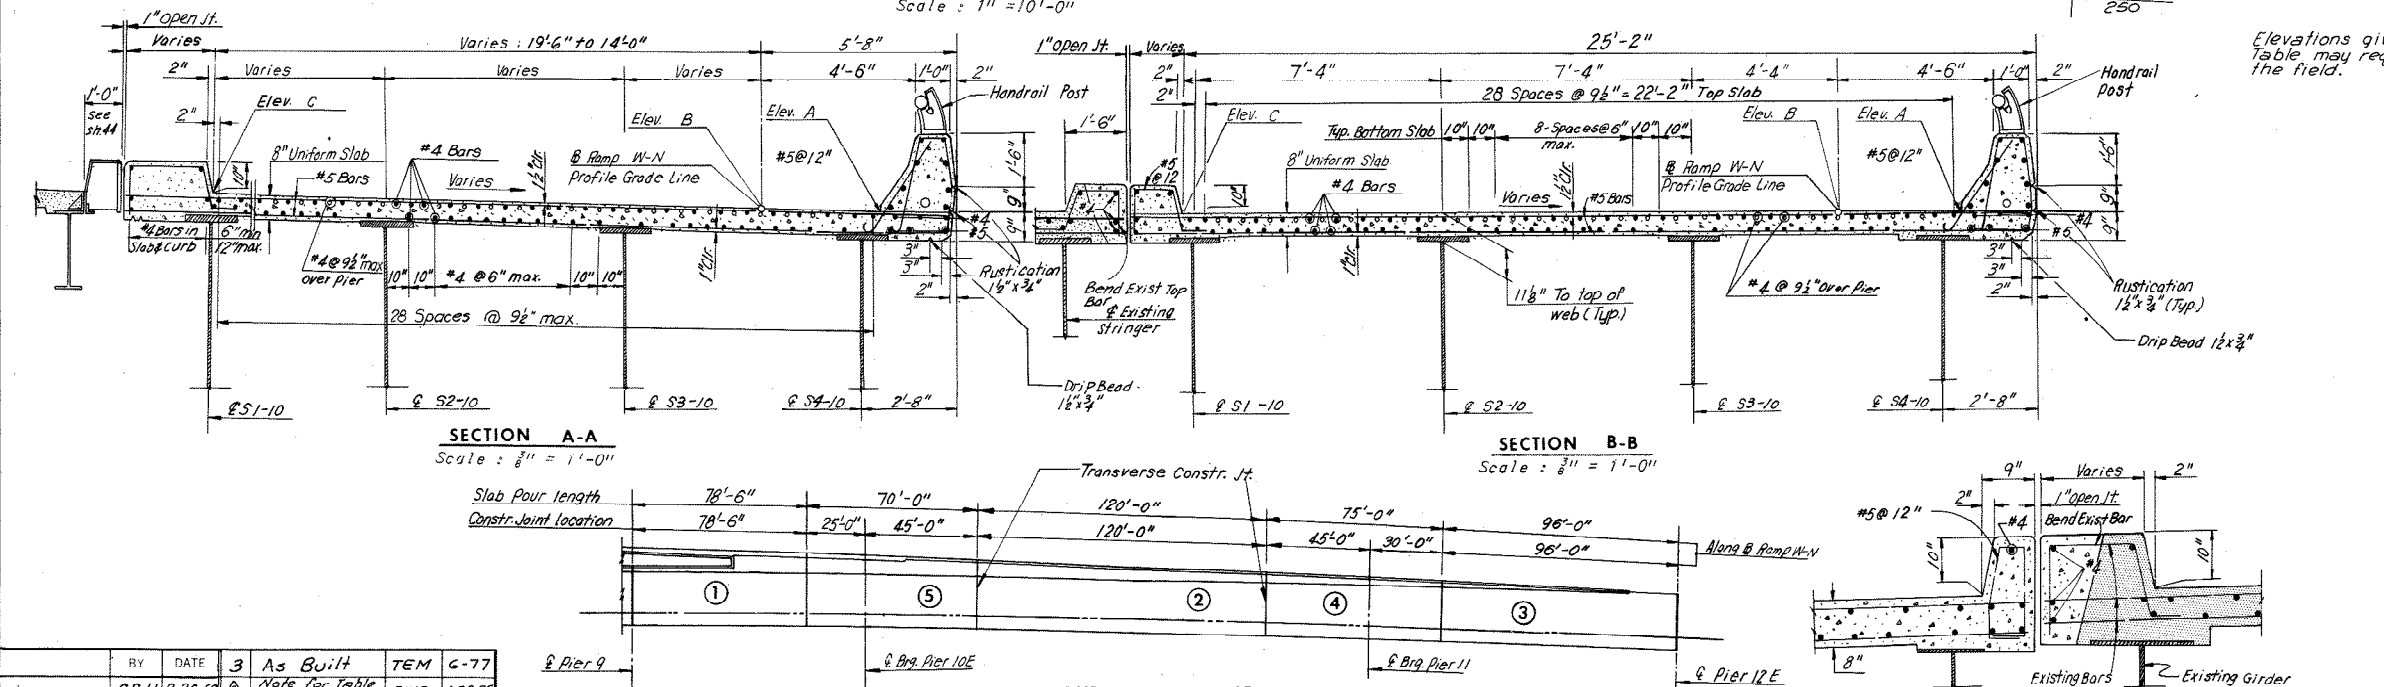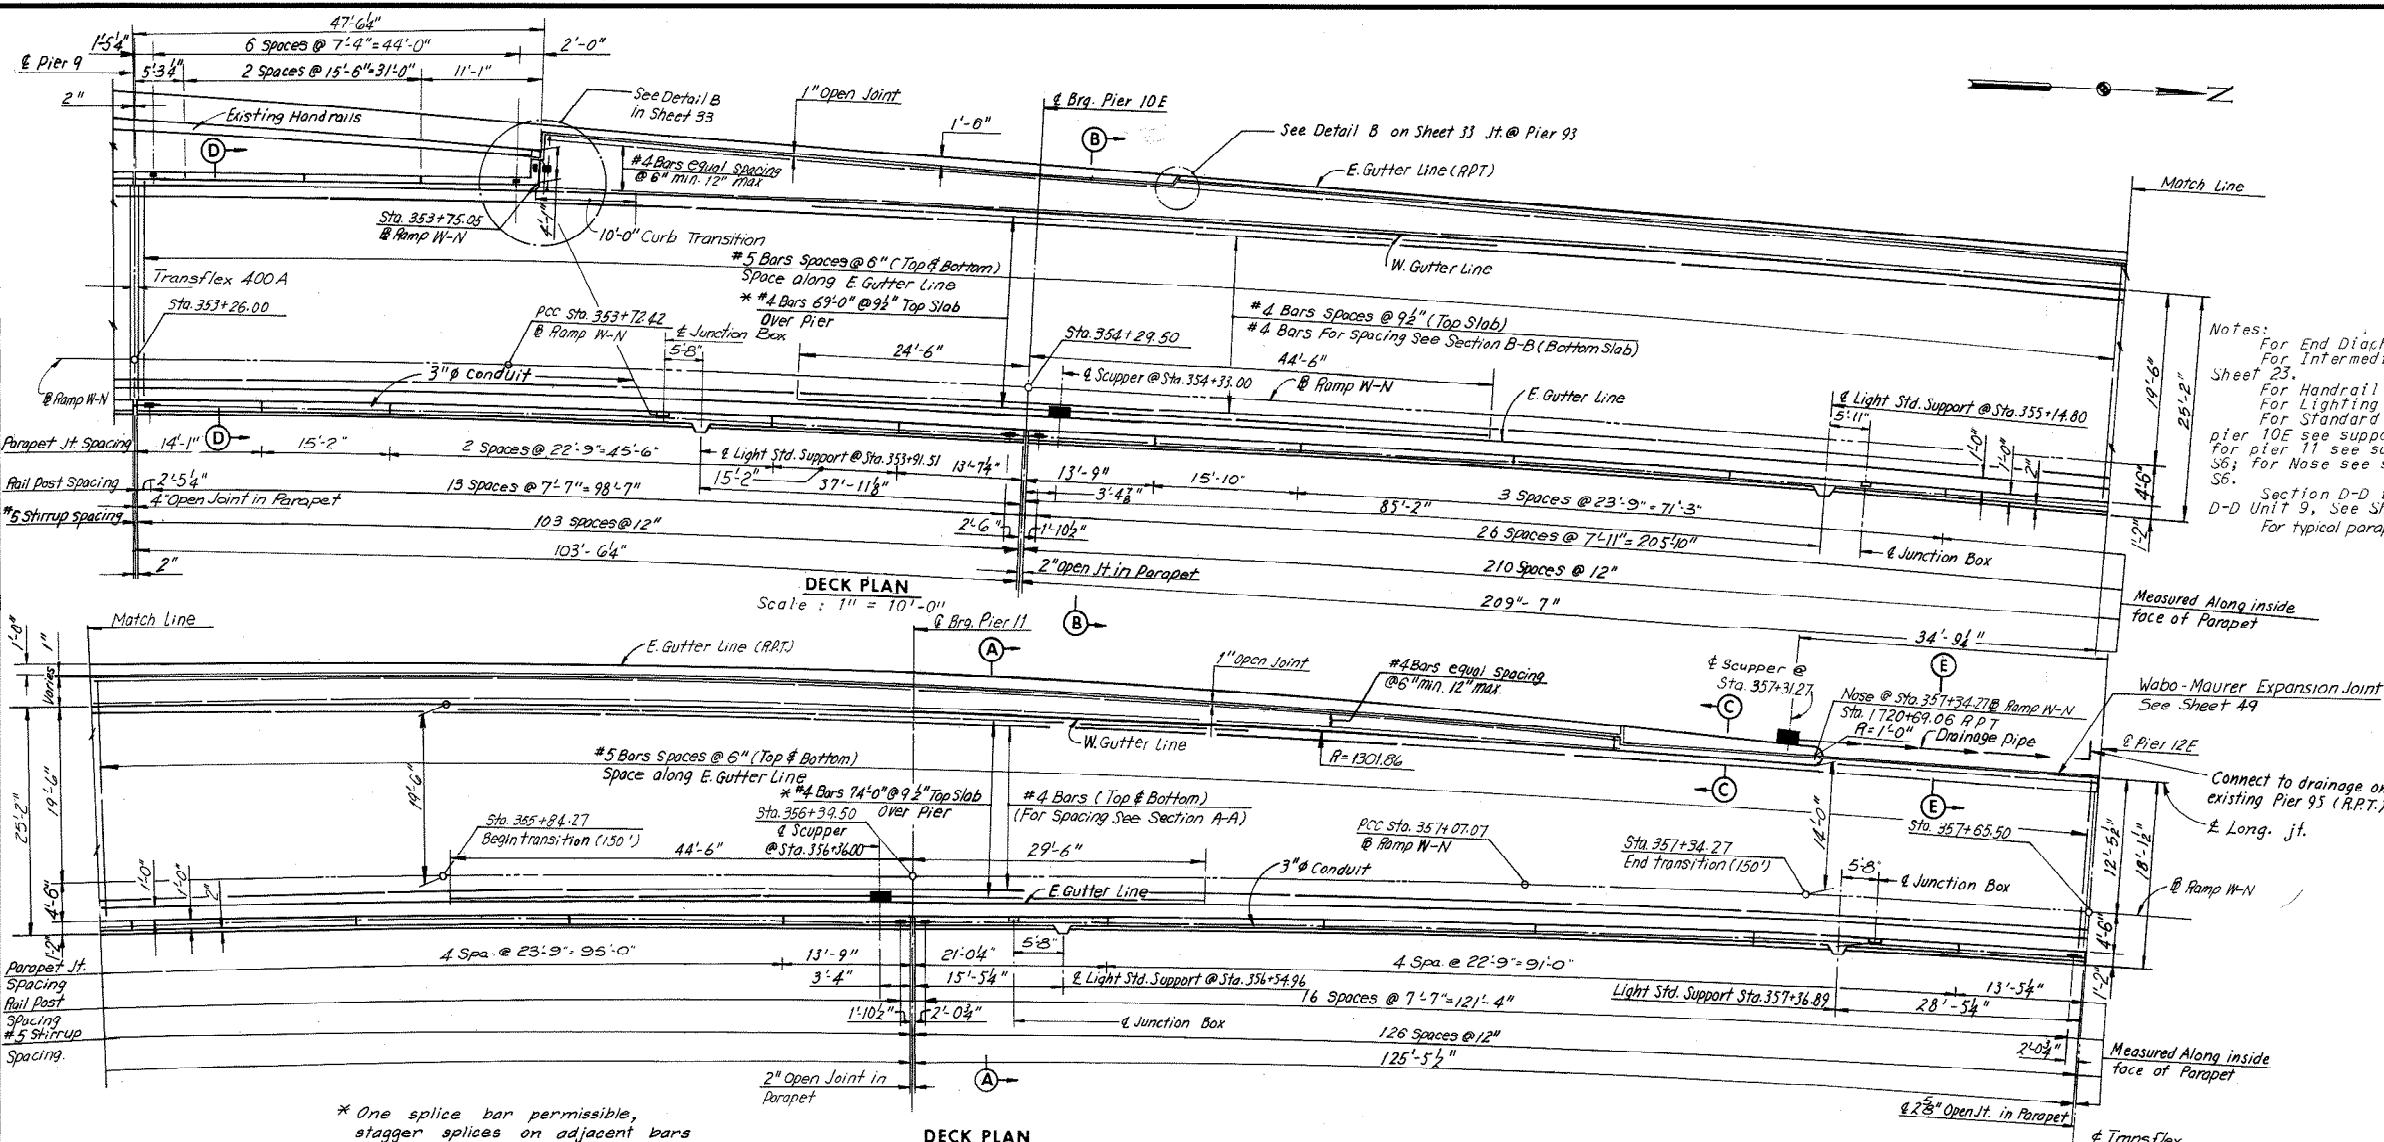

Elevations given in the Elevation table may require adjustment in the field.

| RY | DATE | 3 | As Built | TEM | G-77 |
|-----------|----------------|---|--------------------------------------|-----|---------|
| MADE | G.S.H. 2-26-69 | 1 | Note for table of elevations | DWB | 1-28-75 |
| CHECKED | AMH 4-23-69 | 1 | Rev. length of bars, Rev. Road width | KY | 1-24-75 |
| IN CHARGE | | | | | |

RICHMOND METROPOLITAN AUTHORITY
RICHMOND EXPRESSWAY SYSTEM
DOWNTOWN EXPRESSWAY

BRIDGE NO. 67
RAMP W-N CONNECTION TO
RICHMOND-PETERSBURG TURNPIKE


DECK PLAN — UNIT 10

HOWARD, NEEDLES, TAMMEN & BERGENDOFF
consulting engineers
NEW YORK ALEXANDRIA KANSAS CITY

SCALE: As Noted
CONTRACT NO.: 10
SHEET NO. 34 OF 54

AS BUILT

| RICHMOND EXPRESSWAY SYSTEM | | | |
|----------------------------|---------------------|-----------|--------------|
| SECTION | PROJECT | SHEET NO. | TOTAL SHEETS |
| 10 | DOWNTOWN EXPRESSWAY | 207 | 265 |

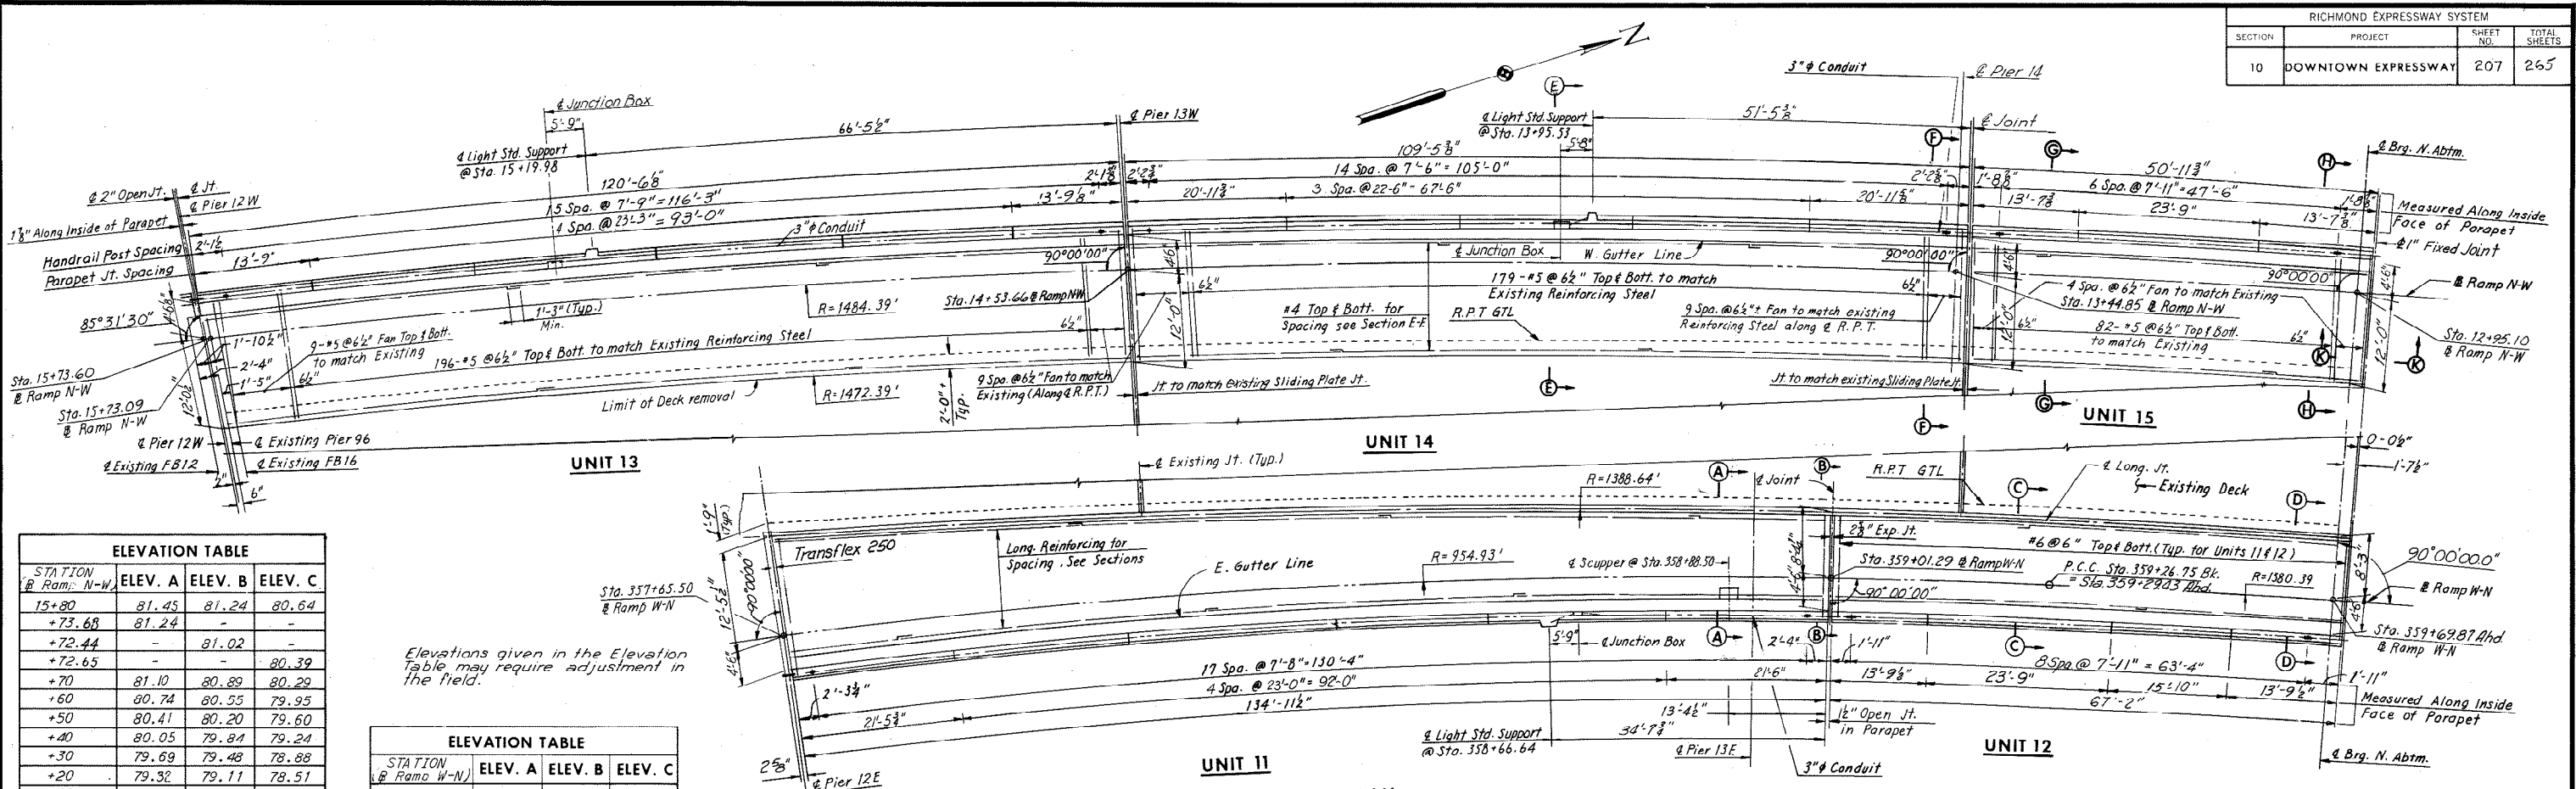


| ELEVATION TABLE | | | |
|--------------------|---------|---------|---------|
| STATION @ Ramp N-W | ELEV. A | ELEV. B | ELEV. C |
| 15+80 | 81.45 | 81.24 | 80.64 |
| +73.68 | | | |
| +72.44 | | 81.02 | |
| +72.65 | | | 80.39 |
| +70 | 81.10 | 80.89 | 80.29 |
| +60 | 80.74 | 80.55 | 79.95 |
| +50 | 80.41 | 80.20 | 79.60 |
| +40 | 80.05 | 79.84 | 79.24 |
| +30 | 79.69 | 79.48 | 78.88 |
| +20 | 79.32 | 79.11 | 78.51 |
| +10 | 78.95 | 78.74 | 78.14 |
| 15+00 | 78.57 | 78.36 | 77.76 |
| 14+90 | 78.20 | 77.99 | 77.39 |
| +80 | 77.82 | 77.61 | 77.01 |
| +70 | 77.45 | 77.24 | 76.64 |
| +60 | 77.08 | 76.87 | 76.27 |
| +53.40 | 76.85 | 76.64 | 76.04 |
| +50 | 76.72 | 76.51 | 75.91 |
| +40 | 76.37 | 76.15 | 75.56 |
| +30 | 76.02 | 75.81 | 75.21 |
| +20 | 75.67 | 75.46 | 74.86 |
| +10 | 75.31 | 75.10 | 74.50 |
| 14+00 | 74.96 | 74.75 | 74.15 |
| 13+90 | 74.61 | 74.40 | 73.80 |
| +80 | 74.26 | 74.05 | 73.45 |
| +70 | 73.91 | 73.70 | 73.10 |
| +60 | 73.55 | 73.34 | 72.74 |
| +50 | 73.20 | 72.99 | 72.39 |
| +44.61 | 73.01 | 72.80 | 72.20 |
| +40 | 72.85 | 72.64 | 72.04 |
| +30 | 72.49 | 72.28 | 71.68 |
| +20 | 72.13 | 71.92 | 71.32 |
| +10 | 71.77 | 71.56 | 70.96 |
| 13+00 | 71.40 | 71.19 | 70.59 |
| 12+92.81 | 71.12 | 70.91 | 70.31 |


| ELEVATION TABLE | | | |
|--------------------|---------|---------|---------|
| STATION @ Ramp W-N | ELEV. A | ELEV. B | ELEV. C |
| 357+60 | 72.89 | 73.10 | 74.28 |
| +65.50 | 72.69 | 72.90 | 73.65 |
| +70 | 72.53 | 72.74 | 73.48 |
| +80 | 72.17 | 72.38 | 73.09 |
| +90 | 71.82 | 72.03 | 72.70 |
| 358+00 | 71.46 | 71.67 | 72.32 |
| +10 | 71.10 | 71.31 | 71.94 |
| +20 | 70.75 | 70.96 | 71.56 |
| +30 | 70.39 | 70.60 | 71.19 |
| +40 | 70.02 | 70.23 | 70.80 |
| +50 | 69.65 | 69.86 | 70.41 |
| +60 | 69.26 | 69.47 | 70.01 |
| +70 | 68.86 | 69.07 | 69.60 |
| +80 | 68.46 | 68.67 | 69.18 |
| +90 | 68.06 | 68.27 | 68.78 |
| +92 | 67.98 | 68.19 | 68.70 |
| 359+00 | 67.67 | 67.88 | 68.38 |
| +02.00 | 67.60 | 67.81 | 68.31 |
| +10 | 67.24 | 67.50 | 68.00 |
| +20 | 66.93 | 67.14 | 67.63 |
| +30 | 66.57 | 66.78 | 67.27 |
| +40 | 66.20 | 66.41 | 66.91 |
| +50 | 65.82 | 66.03 | 66.53 |
| +60 | 65.44 | 65.65 | 66.14 |
| +69.39 | 65.06 | 65.27 | 65.78 |
| +70 | 65.04 | 65.25 | 65.75 |

Elevations given in the Elevation Table may require adjustment in the field.


Note:
For Sections E-E, F-F, G-G and H-H, see Sheet 47.
For Framing Plan, see Sheet 26.
For Joint Details, see Sheet 48 and 49.
Elevation C is to be confirmed by Contractor.
For Handrail Details, see Sheet 33.
For Typical Parapet Details, see Sheet 23.

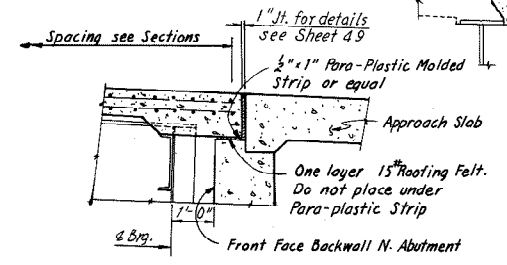


SECTION K-K
Scale 1/2" = 1'-0"

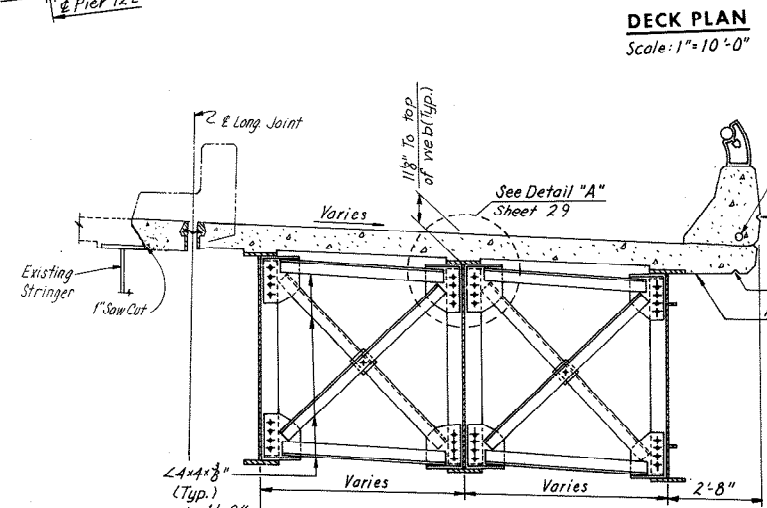


SECTION A-A
Scale 3/8" = 1'-0"

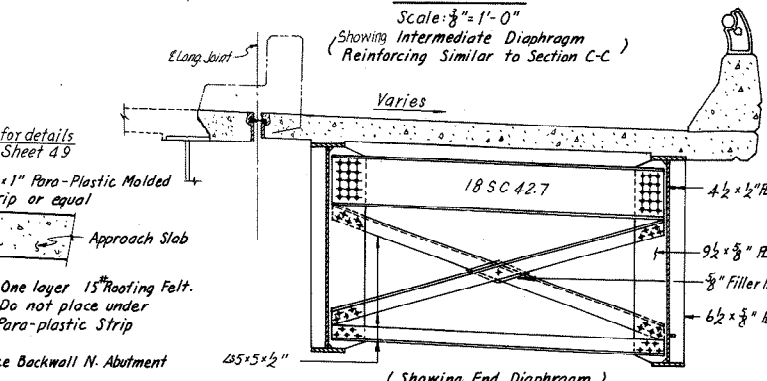


SECTION B-B
Scale 3/8" = 1'-0"

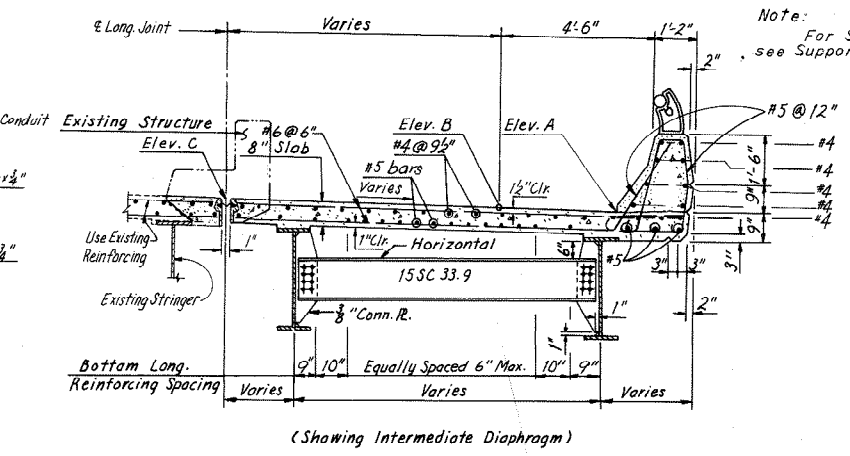

SECTION C-C
Scale 3/8" = 1'-0"

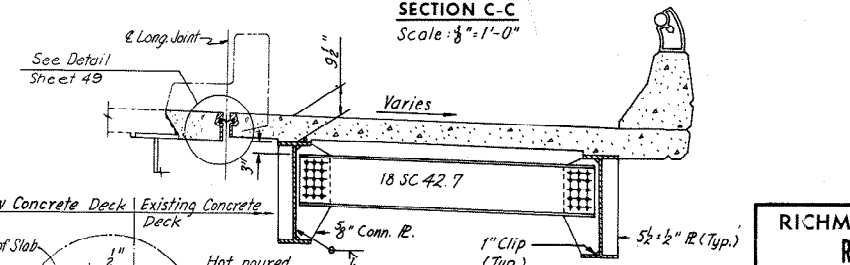

SECTION D-D
Scale 3/8" = 1'-0"

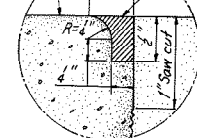

DETAIL C
Full Scale

NOTE:
For the proposed joint details between the existing and the new slab, see Detail C.

Note:
For Standard Drainage Details for Unit 11, see Support Type 3 Sheet 36.

RICHMOND METROPOLITAN AUTHORITY
RICHMOND EXPRESSWAY SYSTEM
DOWNTOWN EXPRESSWAY

BRIDGE NO. 67
RAMP W-N CONNECTION TO
RICHMOND-PETERSBURG TURNPIKE
DECK PLAN-UNITS 11, 12, 13, 14 AND 15

HOWARD, NEEDLES, TAMMEN & BERGENDOFF
consulting engineers
NEW YORK ALEXANDRIA KANSAS CITY

| BY | DATE | 3 | As Built | TEM | G-77 |
|-----------|--------|---------|------------------------------|-----|---------|
| MADE | Y.C.P. | 2-27-69 | Note For Table of Elevations | DWB | 1-28-75 |
| CHECKED | K.C.T. | 5-1-69 | Piers & Abutment Sta. Change | DWB | 1-17-75 |
| IN CHARGE | | | | | |

AS BUILT

SCALE: As Noted
CONTRACT NO: 10
SHEET NO 35 OF 54

